



TEST HOLE LOCATIONS				
POINT	NORTH	EAST	REMARKS	COVER
TH-1	558,450.2	1,344,707.6	SHC	NA
TH-2	558,450.7	1,344,714.5	WHC	NA
TH-3	558,454.7	1,344,744.2	34" ELEC.	2.50'
TH-3A	558,455.1	1,344,744.5	2" GAS	3.02'
TH-4	558,452.9	1,344,746.7	WHC	NA
TH-4A	558,341.0	1,344,762.9	WHC	3.83'
TH-5	558,454.6	1,344,756.0	SHC	NA

SURVEY CONTROL TABLE			
POINT	NORTHING	EASTING	ELEVATION
1	558,402.89	1,344,986.28	397.85
2	558,289.06	1,344,766.83	403.09
3	558,506.85	1,344,572.76	404.86
4	558,588.31	1,344,808.80	401.65
5	558,899.36	1,344,805.45	0.00
6	558,455.32	1,344,791.3	399.97
35FI	557,787.38	1,345,217.31	400.49 HO CO 35FI
35FA	559,266.12	1,344,682.70	410.40 HO CO 35FA

PROJECT LOCATION

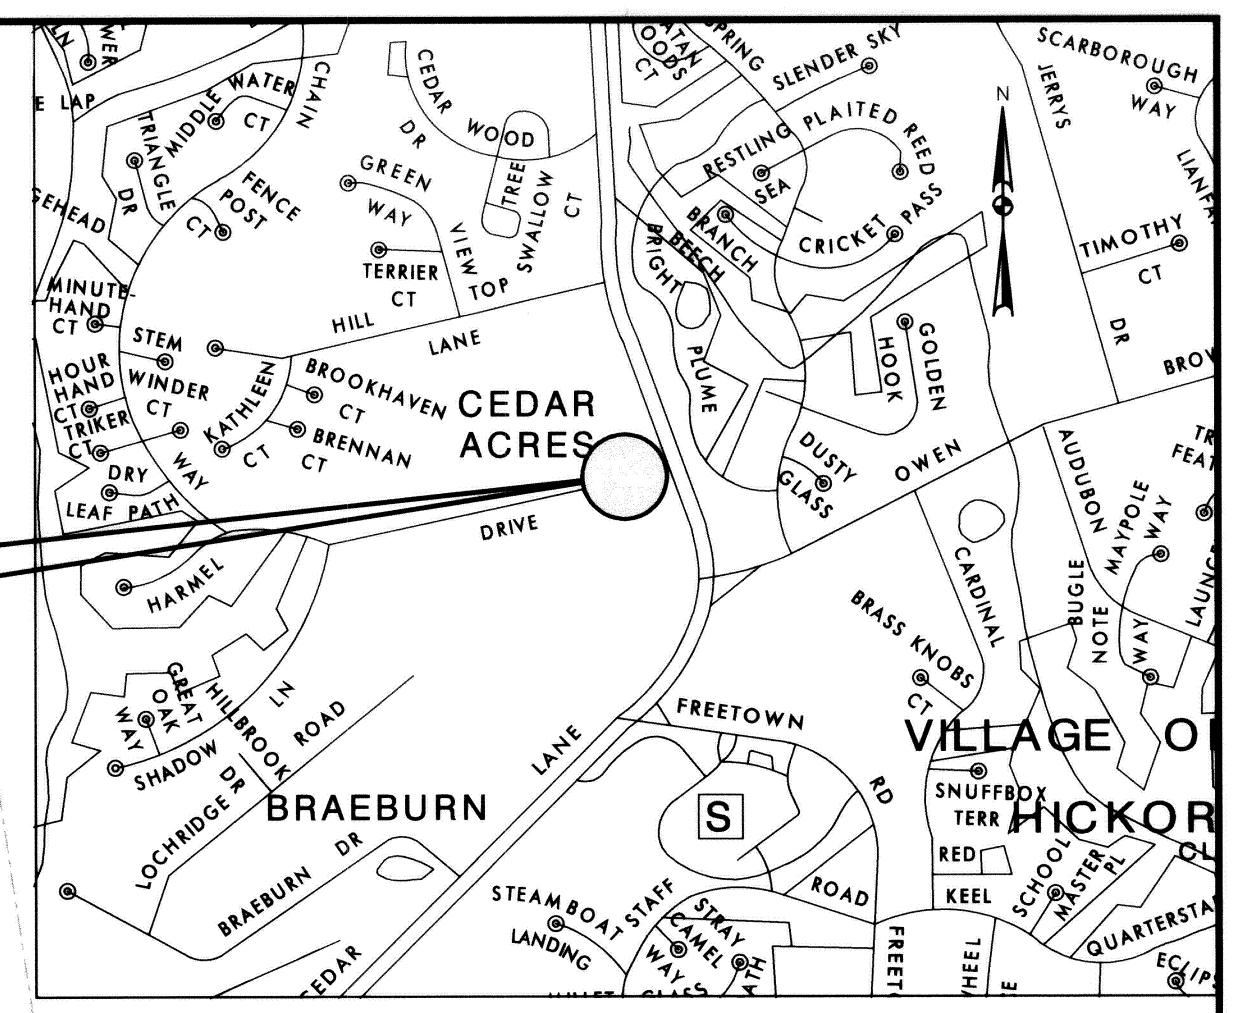

- NOTES:
- PLACE 15' OF SILT FENCE AT 35' INTERVALS AS STORM DRAIN CONSTRUCTION PROGRESSES.
 - ALL EXCAVATED MATERIAL FROM TRENCH SHALL BE PLACED ON THE UPHILL SIDE.
 - DRIVEWAYS TO BE REPAIRED AFTER STORM DRAIN INSTALLATION IN ACCORDANCE WITH HOWARD COUNTY PAVING SECTION P-2.
 - WEEP HOLES WILL BE PROVIDED IN THE INLETS TO ALLOW GROUNDWATER TO DRAIN INTO THE STORM DRAIN SYSTEM.
 - THE STORM DRAIN TRENCH SHALL BE BACKFILLED PER HOWARD COUNTY STANDARD DETAIL G-2.01.
 - 4-INCH PVC STUB OUTS (CAPPED) WILL BE INSTALLED FOR FUTURE CONNECTIONS BY OTHERS. TWO STUB OUTS WILL BE PROVIDED FOR I-2 AND I-4.
 - GRADE TO DRAIN AREA IN THE VICINITY OF INLETS I-1, I-2, I-3 AND I-4 AS NECESSARY. TOP ELEVATIONS FOR INLETS ARE FOR THROAT OPENINGS, ADD 10' (±) FOR THE TOP OF SLAB ELEVATIONS.
 - CHANGE IN THE AREA OF FOREST CONSERVATION EASEMENT IS +54.0 SF.
 - SURVEY SHOWN ON THIS PLAN WAS PERFORMED BY URS IN OCTOBER 2004.
 - HORIZONTAL CONTROL: COORDINATES SHOWN HEREON ARE BASED ON THE MARYLAND STATE REFERENCE SYSTEM (83/91) AS PROJECTED BY HOWARD COUNTY GEODETIC CONTROL SYSTEMS NO 35FI AND 35FA.
 - VERTICAL CONTROL: LOCATION AND ELEVATION OF BENCHMARKS SHOWN ON THIS PLAN ARE BASED ON NAVD '88.

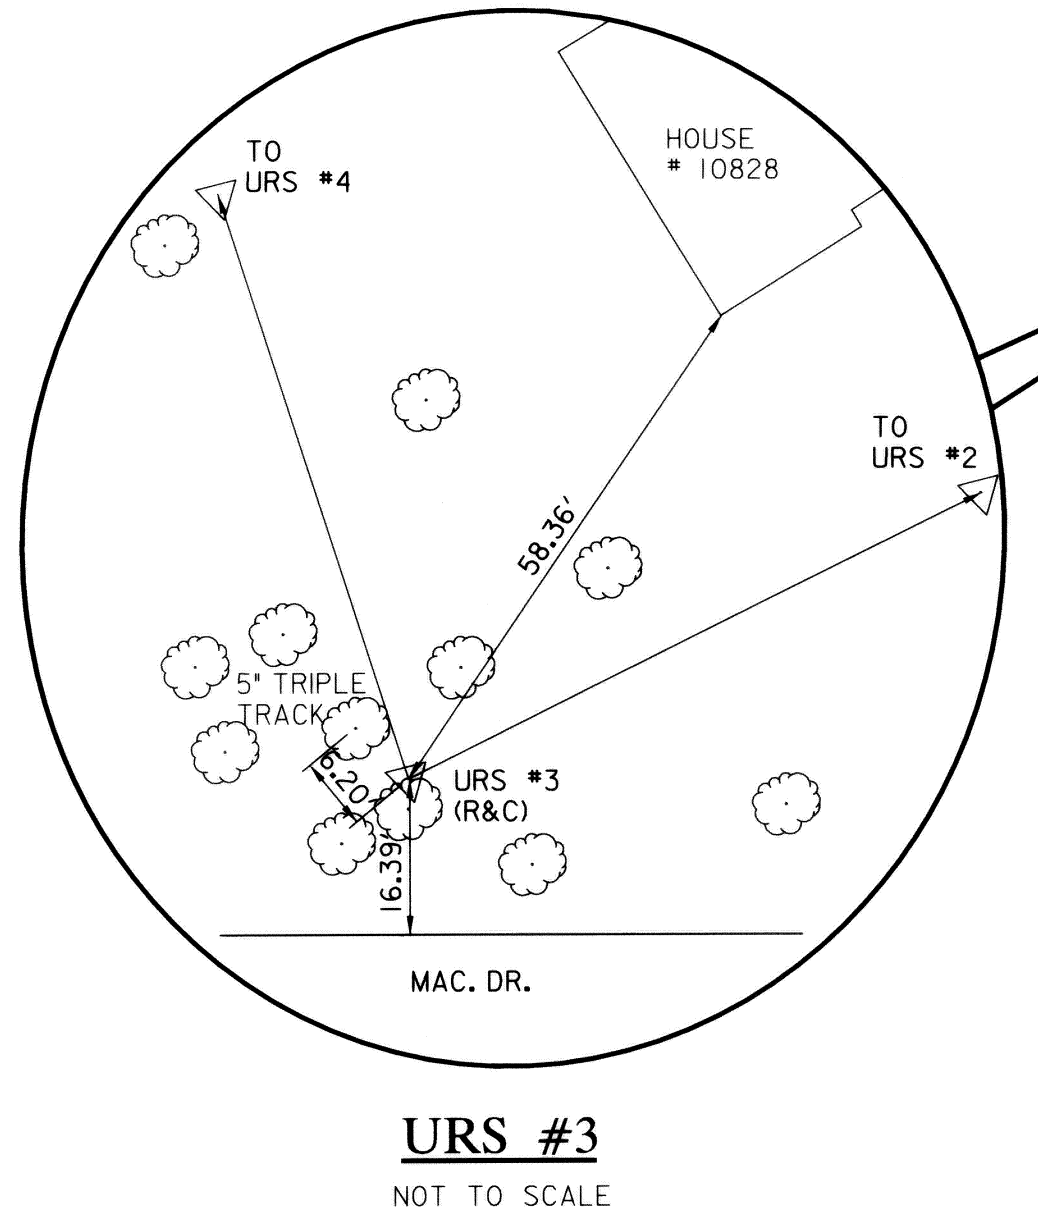


URS #3
NOT TO SCALE

REVIEWED FOR HOWARD SOIL CONSERVATION DISTRICT AND MEETS TECHNICAL REQUIREMENTS.

Jim M... 11/19/05
U.S. NATURAL RESOURCES CONSERVATION SERVICE DATE


THIS DEVELOPMENT IS APPROVED FOR EROSION AND SEDIMENT CONTROL BY HOWARD SOIL CONSERVATION DISTRICT.

Jim R. ... 11/17/05
HOWARD SOIL CONSERVATION DISTRICT DATE

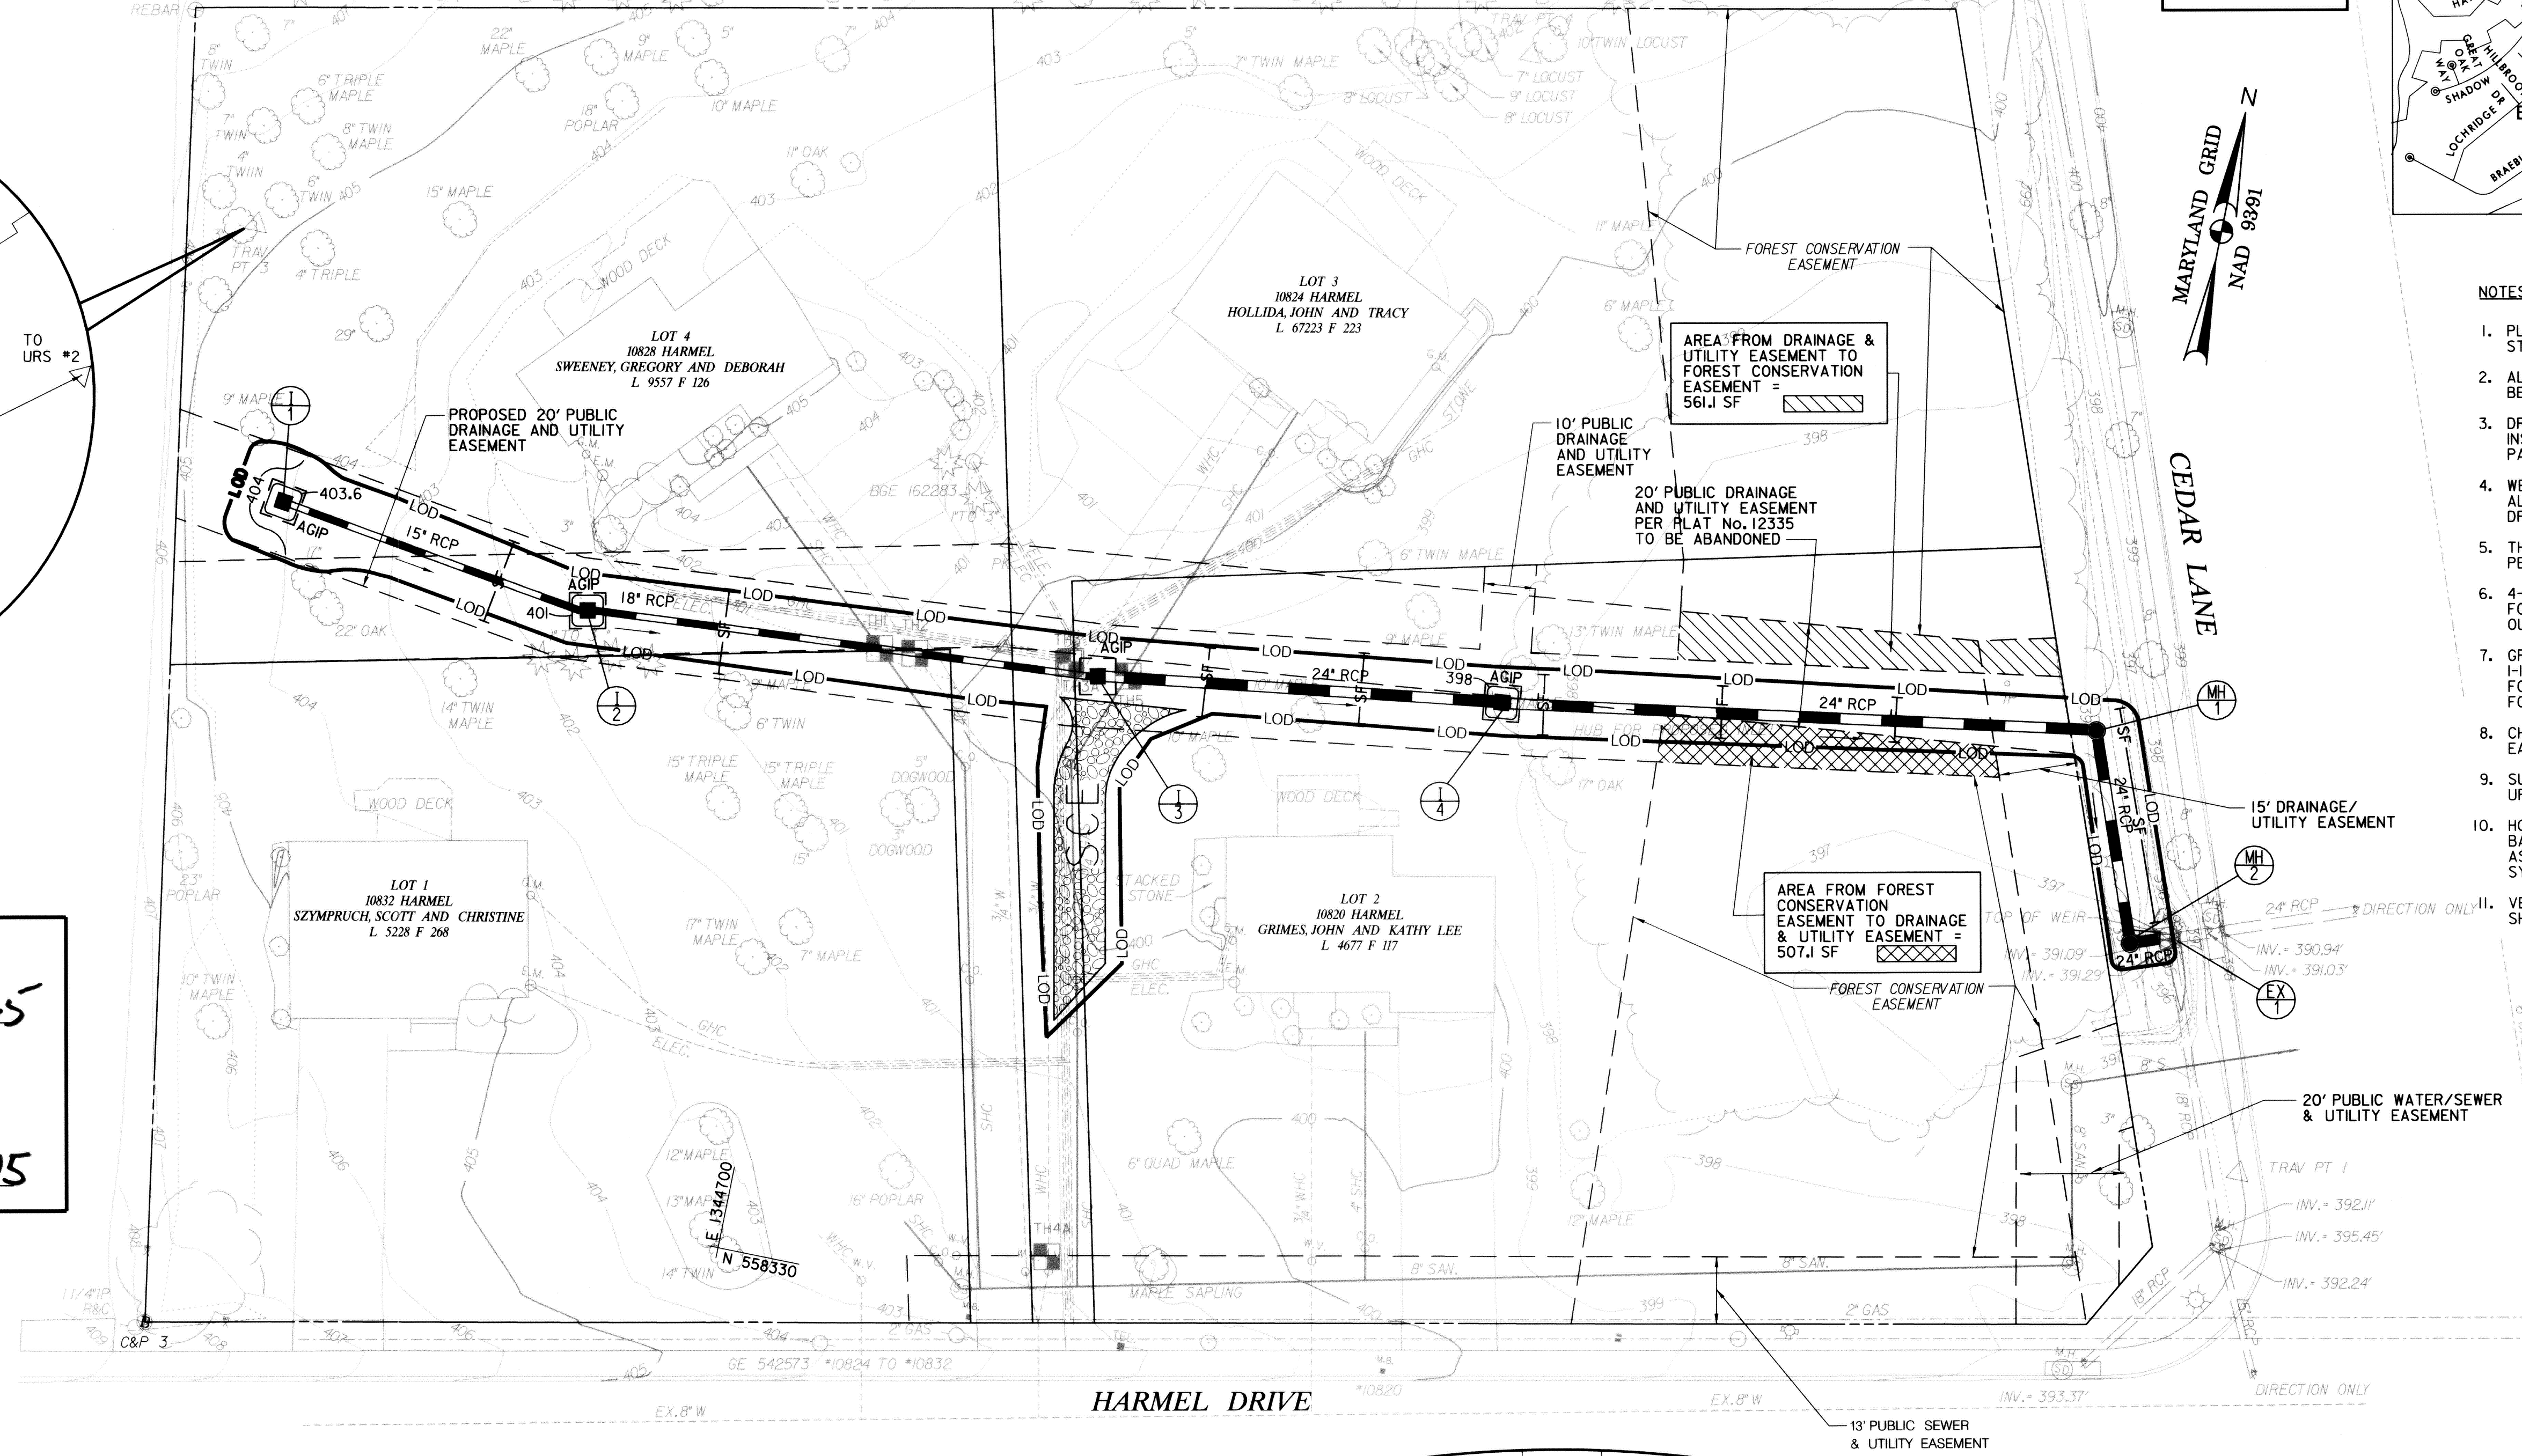

STORM DRAIN STRUCTURE SCHEDULE					
STRUCTURE NO.	WORK POINT* NORTH	EAST	INVERT IN / OUT	TOP ELEV.	REMARK
I-1	558,455.08	1,344,588.58	- / 399.10	403.6	TYPE 'S' INLET (SD 4.22)
I-2	558,446.17	1,344,650.66	397.92/394.30	401.0	TYPE 'S' INLET (SD 4.22)
I-3	558,453.34	1,344,750.22	393.80/393.30	399.1	TYPE 'S' INLET (SD 4.22)
I-4	558,463.99	1,344,828.14	392.92/392.82	397.7	TYPE 'S' INLET (SD 4.22)
MH-1	558,481.65	1,344,942.27	391.98/391.88	396.9	STD. MH (G 5.12)
MH-2	558,442.49	1,344,956.89	391.50/391.30	397.1	STD. MH (G 5.12)


* WORK POINT IS LOCATED AT THE CENTER OF RESPECTIVE STRUCTURE

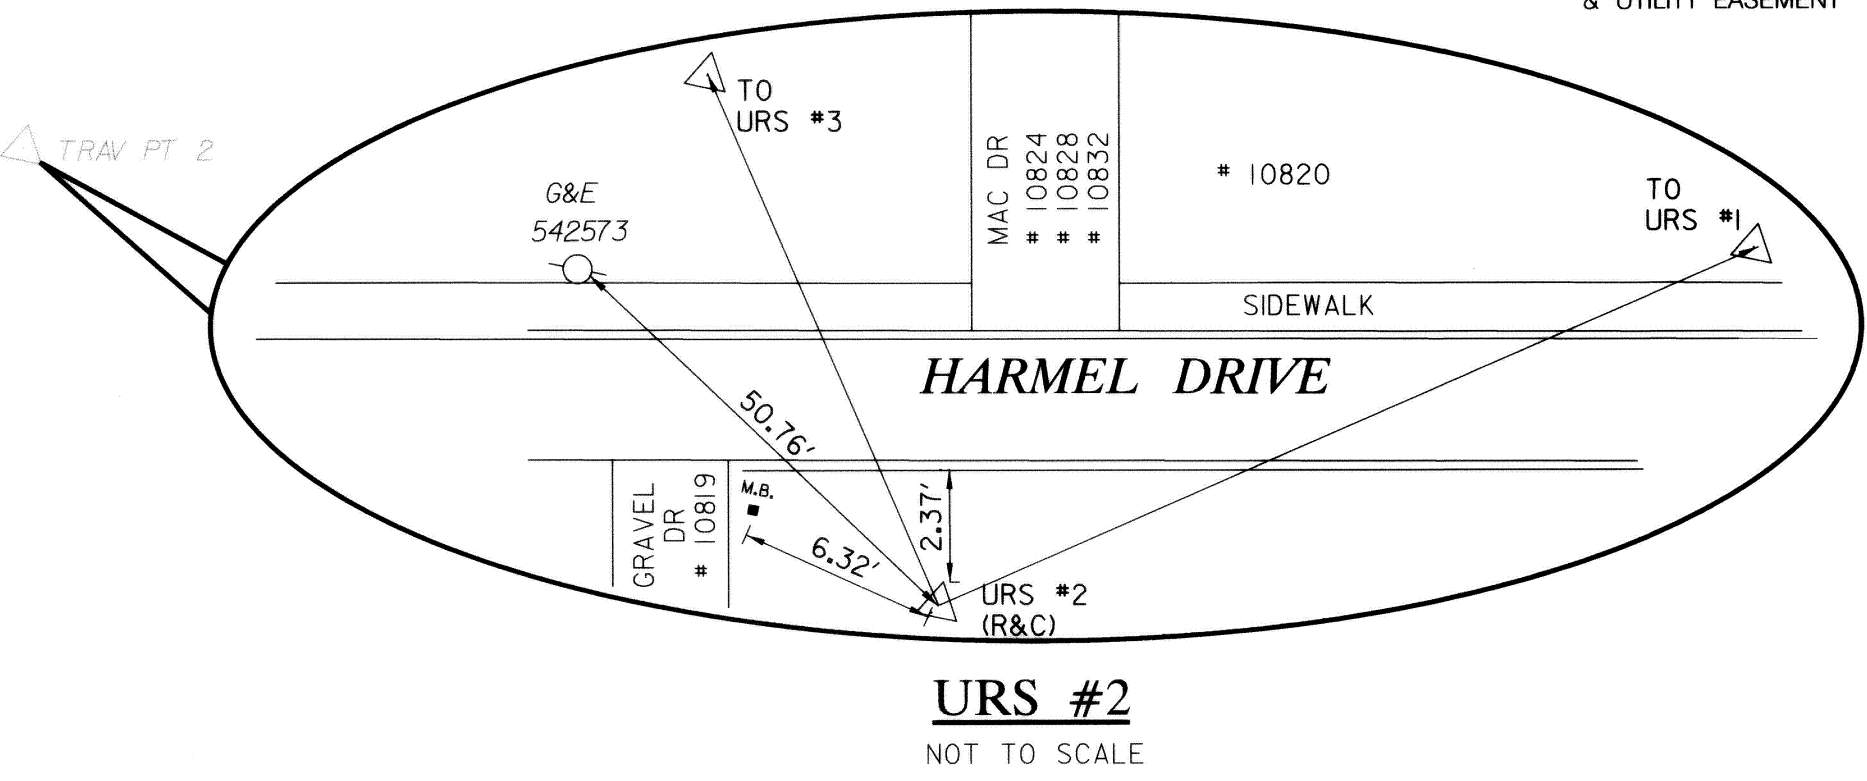

URS #2
NOT TO SCALE

- LEGEND
- SF — SILT FENCE
 - AGIP — AGIP (AT GRADE INLET PROTECTION)
 - LOD — LIMIT OF DISTURBANCE
 - SC — STABILIZED CONSTRUCTION ENTRANCE
 - — — — — EXISTING UTILITY EASEMENTS
 - — — — — PROPERTY LINE
 - TH# — TEST HOLE LOCATION
 - 400 — EXISTING CONTOURS
 - 400 — PROPOSED CONTOURS

MISS UTILITY
CONTRACTOR TO NOTIFY MISS UTILITY AT (800) 257-7777 AT LEAST TWO (2) DAYS PRIOR TO ANY EXCAVATION

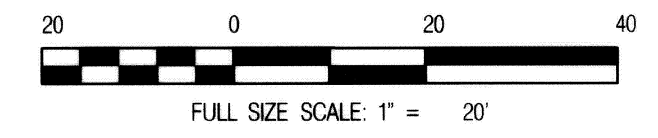

DEPARTMENT OF PUBLIC WORKS
HOWARD COUNTY, MARYLAND


John ... 11/11/05
DIRECTOR OF PUBLIC WORKS DATE

Steve ... 11/11/05
CHIEF, TRANSPORTATION AND SPECIAL PROJECTS DIVISION DATE

Paul ... 11/14/05
CHIEF, BUREAU OF ENGINEERING DATE

Willie ... 11-4-05
CHIEF, BUREAU OF HIGHWAYS DATE

PREPARED BY
URS
4 NORTH PARK DRIVE
HUNT VALLEY, MARYLAND
TEL: (410) 785-7220

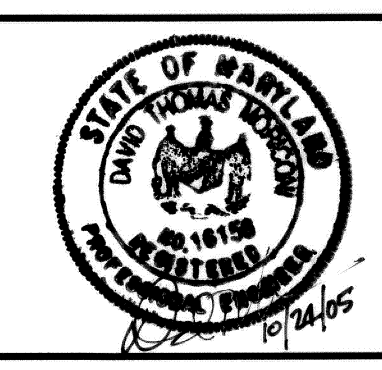

DES: BNL					
DRN: EGB					
CHK: DTM					
DATE: 9/05					
BY NO.		REVISION		DATE	

EROSION & SEDIMENT CONTROL
AND
GRADING & DRAINAGE PLAN

SCALE MAP NO. 41 BLOCK NO. 1

SCALE AS SHOWN


SHEET 1 OF 3

HOWARD COUNTY, MARYLAND

10/24/2005 3:28:55 PM love


STORM DRAIN STRUCTURE SCHEDULE					
STRUCTURE NO.	WORK POINT*		INVERT IN / OUT	TOP ELEV.	REMARK
	NORTH	EAST			
I-1	558,455.08	1,344,588.58	- / 399.10	403.6	TYPE 'S' INLET (SD 4.22)
I-2	558,446.17	1,344,650.66	397.92/394.30	401.0	TYPE 'S' INLET (SD 4.22)
I-3	558,453.34	1,344,750.22	393.80/393.30	399.1	TYPE 'S' INLET (SD 4.22)
I-4	558,463.99	1,344,828.14	392.92/392.82	397.7	TYPE 'S' INLET (SD 4.22)
MH-1	558,481.65	1,344,942.27	391.98/391.88	396.9	STD. MH (G 5.12)
MH-2	558,442.49	1,344,956.89	391.50/391.30	397.1	STD. MH (G 5.12)

* WORK POINT IS LOCATED AT THE CENTER OF RESPECTIVE STRUCTURE

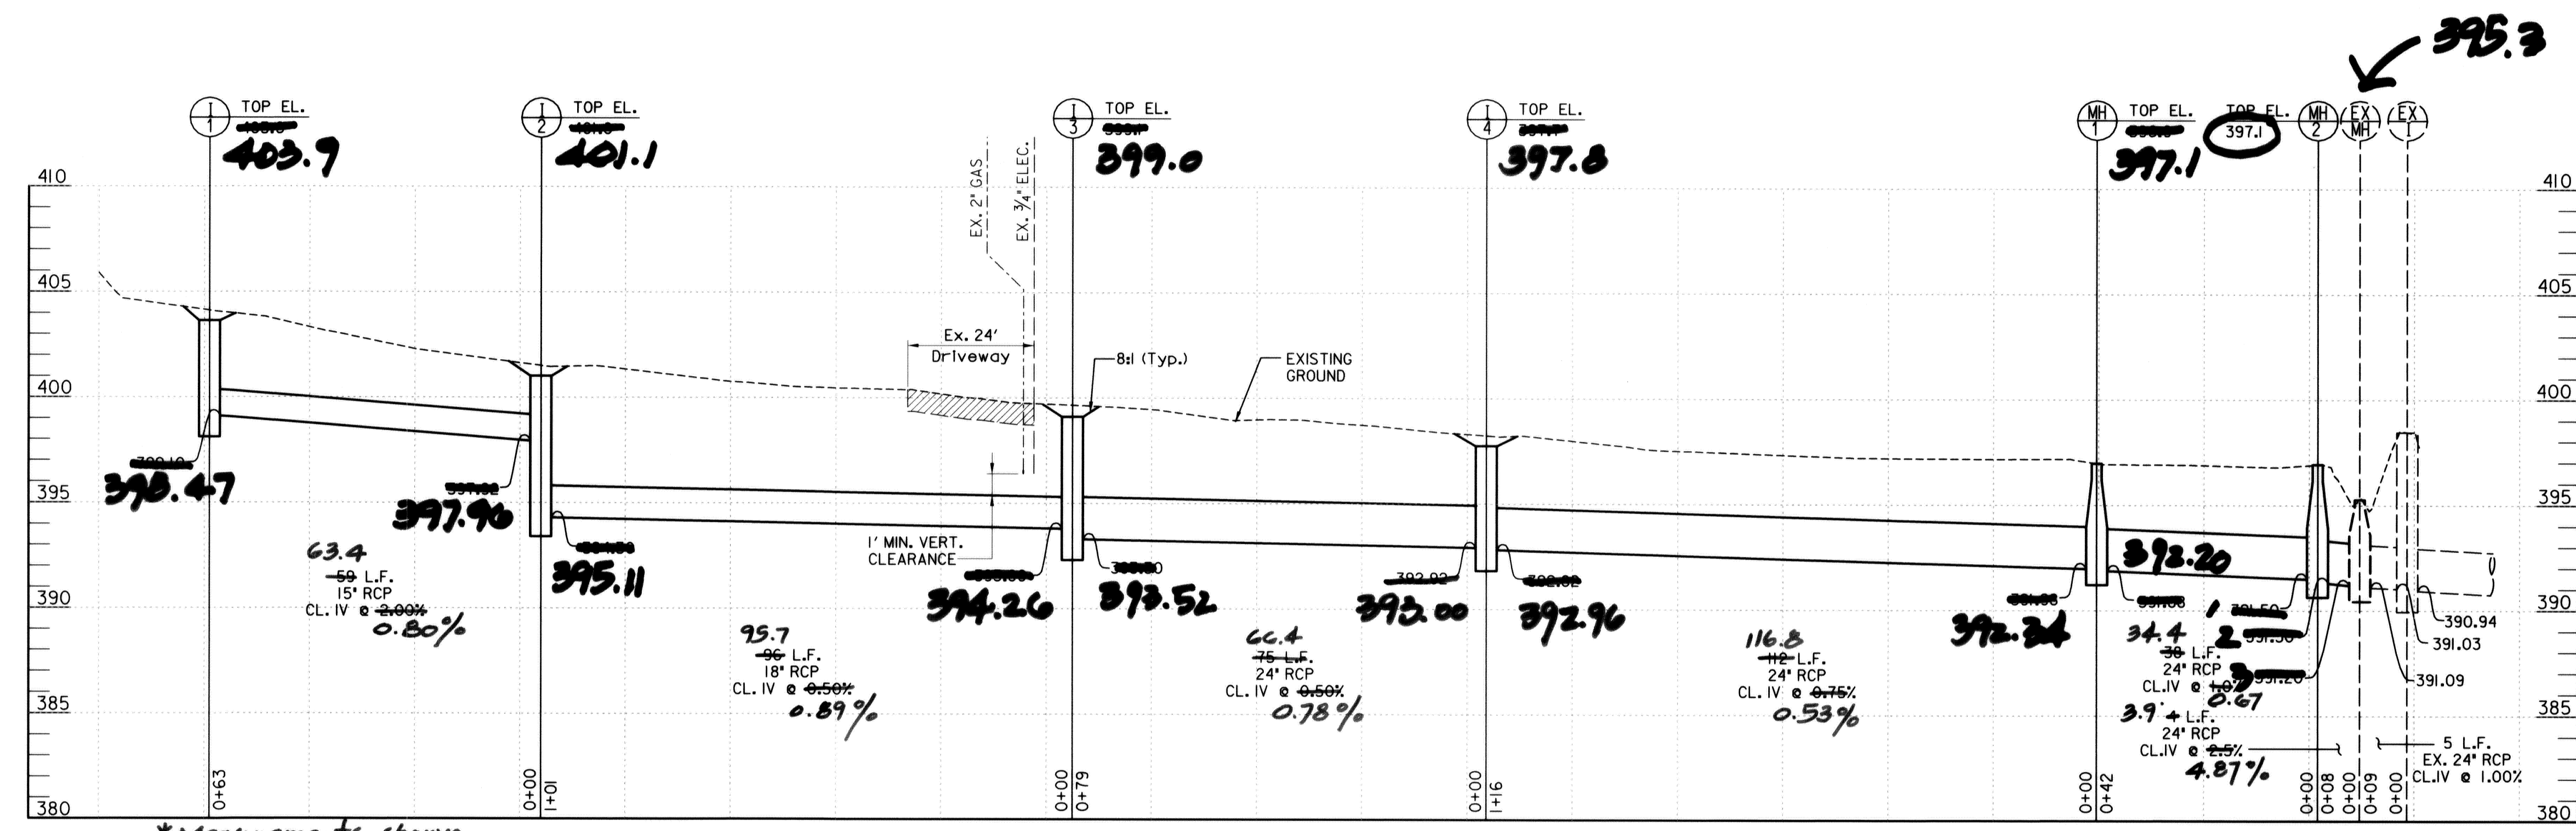

* Measurements shown are end of pipe to end of pipe

- 1) 391.97
- 2) 391.78
- 3) 391.59

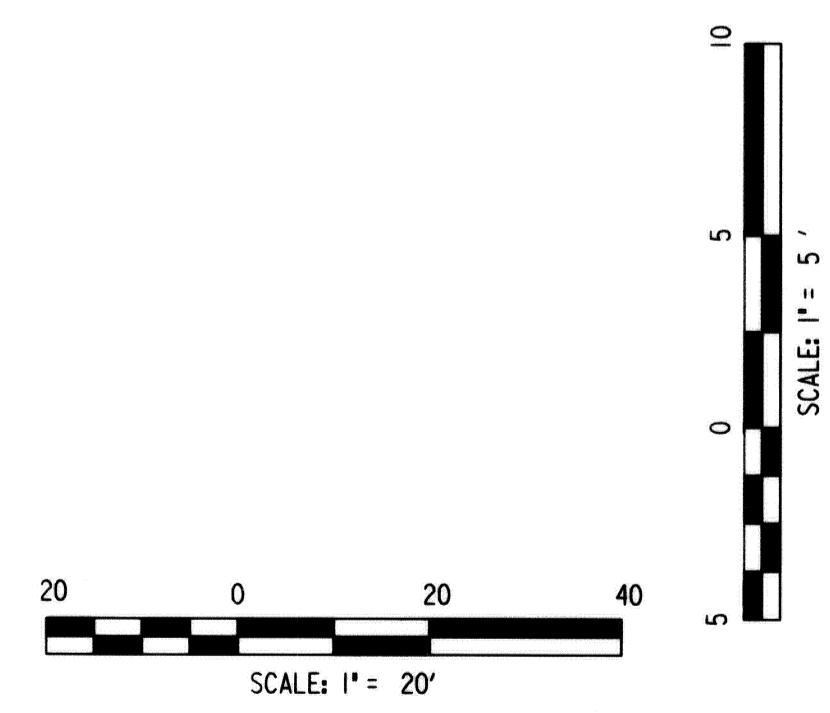

As built shown 1.4.07
D. Miller

<p>DEPARTMENT OF PUBLIC WORKS HOWARD COUNTY, MARYLAND</p> <p><i>John O'Hara</i> 11/4/05 DIRECTOR OF PUBLIC WORKS DATE</p> <p><i>Steve Shanahan</i> 11/1/05 CHIEF, TRANSPORTATION AND SPECIAL PROJECTS DIVISION DATE</p>	<p>PREPARED BY</p> <p>URS 4 NORTH PARK DRIVE HUNT VALLEY, MARYLAND TEL: (410) 785-7220</p>		<p>DES: BNL</p> <p>DRN: EGB</p> <p>CHK: DTM</p> <p>DATE: 9/05</p>	<p>BY NO. _____</p> <p>REVISION _____</p> <p>DATE _____</p>	<p>PIPE PROFILE</p> <p>SCALE MAP NO. 41 BLOCK NO. 1</p>	<p>HARREL DRIVE DRAINAGE IMPROVEMENTS</p> <p>HOWARD COUNTY, MARYLAND</p>	<p>SCALE AS SHOWN</p> <p>SHEET 2 OF 3</p>
--	---	--	---	---	--	---	---

PERMANENT SEEDING NOTES

APPLY TO GRADED OR CLEARED AREAS NOT SUBJECT TO IMMEDIATE FURTHER DISTURBANCE WHERE A PERMANENT LONG-LIVED VEGETATIVE COVER IS NEEDED.

SEEDBED PREPARATION: LOOSEN UPPER 3 INCHES OF SOIL BY RAKING, DISCING, OR OTHER ACCEPTABLE MEANS BEFORE SEEDING. IF NOT PREVIOUSLY LOOSENED.

SOIL AMENDMENTS: IN LIEU OF SOIL TEST RECOMMENDATIONS, USE ONE OF THE FOLLOWING SCHEDULES:

1) PREFERRED - APPLY 2 TONS PER ACRE DOLOMITIC LIMESTONE (92 LBS. PER 1,000 SQUARE FEET) AND 600 LBS. PER ACRE 10-10-10 FERTILIZER (14 LBS. PER 1,000 SQUARE FEET) BEFORE SEEDING. HARROW OR DISC INTO UPPER 3 INCHES OF SOIL AT TIME OF SEEDING. APPLY 400 LBS. PER ACRE 30-0-0 UREA/FORM FERTILIZER (19 LBS. PER 1,000 SQUARE FEET).

2) ACCEPTABLE - APPLY 2 TONS PER ACRE DOLOMITIC LIMESTONE (92 LBS. PER 1,000 SQUARE FEET) AND 1,000 LBS. PER ACRE 10-10-10 FERTILIZER (23 LBS. PER 1,000 SQUARE FEET) BEFORE SEEDING. HARROW OR DISC INTO UPPER 3 INCHES OF SOIL.

SEEDING: FOR THE PERIOD MARCH 1 THROUGH APRIL 30 AND FROM AUGUST 1 THROUGH OCTOBER 15, SEED WITH 60 LBS. PER ACRE (1.4 LBS. PER 1,000 SQUARE FEET) OF KENTUCKY 31 TALL FESCUE. FOR THE PERIOD MAY 1 THROUGH JULY 31, SEED WITH 60 LBS. PER ACRE OF KENTUCKY 31 TALL FESCUE PER ACRE AND 2 LBS. PER ACRE (0.05 LBS. PER 1,000 SQUARE FEET) OF WEEPING LOVEGRASS. DURING THE PERIOD OCTOBER 16 THROUGH FEBRUARY 28, PROTECT SITE BY ONE OF THE FOLLOWING OPTIONS:

1) 2 TONS PER ACRE OF WELL-ANCHORED MULCH STRAW AND SEED AS SOON AS POSSIBLE IN THE SPRING.

2) USE SOD.

3) SEED WITH 60 LBS. PER ACRE KENTUCKY 31 TALL FESCUE AND MULCH WITH 2 TONS PER ACRE WELL ANCHORED STRAW.

MULCHING: APPLY 1 1/2 TO 2 TONS PER ACRE (70 TO 90 LBS. PER 1,000 SQUARE FEET) OF UNROTTED SMALL GRAIN STRAW IMMEDIATELY AFTER SEEDING. ANCHOR MULCH IMMEDIATELY AFTER APPLICATION USING MULCH ANCHORING TOOL OR 218 GALLONS PER ACRE (15 GALLONS PER 1,000 SQUARE FEET) OF EMULSIFIED ASPHALT ON FLAT AREAS ON SLOPES, 8 FEET OR HIGHER, USE 347 GALLONS PER ACRE (8 GALLONS PER 1,000 SQUARE FEET) FOR ANCHORING.

MAINTENANCE: INSPECT ALL SEEDED AREAS AND MAKE NEEDED REPAIRS, REPLACEMENTS, AND RESEEDINGS.

TEMPORARY SEEDING NOTES

APPLY TO GRADED OR CLEARED AREAS LIKELY TO BE REDISTRIBUTED WHERE A SHORT-TERM VEGETATIVE COVER IS NEEDED.

SEEDBED PREPARATION: LOOSEN UPPER 3 INCHES OF SOIL BY RAKING, DISCING, OR OTHER ACCEPTABLE MEANS BEFORE SEEDING.

SOIL AMENDMENTS: APPLY 600 LBS. PER ACRE 10-10-10 FERTILIZER (14 LBS. PER 1,000 SQUARE FEET).

SEEDING: FOR PERIODS MARCH 1 THROUGH APRIL 30 AND FROM AUGUST 15 THROUGH NOVEMBER 15, SEED WITH 2 1/2 BUSHELS PER ACRE OF ANNUAL RYE (3.2 LBS. PER 1,000 SQUARE FEET). FOR THE PERIOD MAY 1 THROUGH AUGUST 14, SEED WITH 3 LBS. PER ACRE OF WEEPING LOVEGRASS (0.07 LBS. PER 1,000 SQUARE FEET). FOR THE PERIOD NOVEMBER 16 THROUGH FEBRUARY 28, PROTECT SITE BY APPLYING 2 TONS PER ACRE OF WELL ANCHORED STRAW MULCH AND SEED AS SOON AS POSSIBLE IN THE SPRING OR USE SOD.

MULCHING: APPLY 1 1/2 TO 2 TONS PER ACRE (70 TO 90 LBS. PER 1,000 SQUARE FEET) OF UNROTTED SMALL GRAIN STRAW IMMEDIATELY AFTER SEEDING. ANCHOR MULCH IMMEDIATELY AFTER APPLICATION USING MULCH ANCHORING TOOL OR 218 GALLONS PER ACRE (15 GALLONS PER 1,000 SQUARE FEET) OF EMULSIFIED ASPHALT ON FLAT AREAS ON SLOPES, 8 FEET OR HIGHER, USE 347 GALLONS PER ACRE (8 GALLONS PER 1,000 SQUARE FEET) FOR ANCHORING. REFER TO THE 1994 MARYLAND STANDARDS AND SPECIFICATIONS FOR SOIL EROSION AND SEDIMENT CONTROL FOR RATE AND METHODS NOT COVERED.

SEQUENCE OF CONSTRUCTION

- OBTAIN THE GRADING PERMIT PRIOR TO CONSTRUCTION. (1 DAY)
- INSTALL THE PERIMETER SEDIMENT CONTROL MEASURES INCLUDING SILT FENCE, SUPER SILT FENCE, EARTH DIKE, AND STABILIZED CONSTRUCTION ENTRANCE AS SHOWN ON PLAN. (3 DAYS)
- CLEAR AND GRUB THE SITE AS NEEDED. (2 DAYS)
- INSTALL NEW STORM DRAINS BEGINNING DOWNSTREAM TO UPSTREAM BACKFILL AND STABILIZE AS WORK PROGRESSES.
- STABILIZE THE DISTURBED AREAS WITH TOPSOIL, PERMANENT SEEDING AND MULCHING AS NEEDED. (2 DAYS)
- CONTRACTOR SHALL CLEAN ALL PIPES INSTALLED AS PART OF THIS PROJECT AFTER ALL UPSTREAM AREAS HAVE BEEN STABILIZED.
- UPON THE HOWARD CO. INSPECTOR'S APPROVAL, REMOVE ALL EROSION AND SEDIMENT CONTROL DEVICES AND STABILIZE THE REMAINING AREAS WITH PERMANENT SEEDING. (15 DAYS)

NOTE: THE TIME LINE EXCLUDES WEATHER RELATED DELAYS.

STANDARD SEDIMENT CONTROL NOTES

1. A MINIMUM OF 48 HOURS NOTICE MUST BE GIVEN TO THE HOWARD COUNTY DEPARTMENT OF INSPECTIONS, LICENSES AND PERMITS, SEDIMENT CONTROL DIVISION PRIOR TO THE START OF ANY CONSTRUCTION (410-313-1855).

2. ALL VEGETATIVE AND STRUCTURAL PRACTICES ARE TO BE INSTALLED ACCORDING TO THE PROVISIONS OF THIS PLAN AND ARE TO BE IN CONFORMANCE WITH THE 1994 MARYLAND STANDARDS AND SPECIFICATIONS FOR SOIL EROSION AND SEDIMENT CONTROL AND REVISIONS THERETO.

3. FOLLOWING INITIAL SOIL DISTURBANCE OR REDISTURBANCE, PERMANENT OR TEMPORARY STABILIZATION SHALL BE COMPLETED WITHIN:

A) 7 CALENDAR DAYS FOR ALL PERIMETER SEDIMENT CONTROL STRUCTURES, DIKES, PERIMETER SLOPES, AND ALL SLOPES STEEPER THAN 3:1.

B) 14 DAYS AS TO ALL OTHER DISTURBED OR GRADED AREAS ON THE PROJECT SITE.

4. ALL SEDIMENT TRAPS/BASINS SHOWN MUST BE FENCED AND WARNING SIGNS POSTED AROUND THE PERIMETER IN ACCORDANCE WITH VOLUME 1, CHAPTER 7, OF THE HOWARD COUNTY DESIGN MANUAL, STORM DRAINAGE.

5. ALL DISTURBED AREAS MUST BE STABILIZED WITHIN THE TIME PERIOD SPECIFIED ABOVE IN ACCORDANCE WITH THE 1994 MARYLAND STANDARDS AND SPECIFICATIONS FOR SOIL EROSION AND SEDIMENT CONTROL. TEMPORARY STABILIZATION WITH MULCH ALONE SHALL ONLY BE DONE WHEN RECOMMENDED SEEDING DATES DO NOT ALLOW FOR PROPER GERMINATION AND ESTABLISHMENT OF GRASSES.

6. ALL SEDIMENT CONTROL STRUCTURES ARE TO REMAIN IN PLACE AND ARE TO BE MAINTAINED IN OPERATIVE CONDITION UNTIL PERMISSION FOR THEIR REMOVAL HAS BEEN OBTAINED FROM THE HOWARD COUNTY SEDIMENT CONTROL INSPECTOR.

7. SITE ANALYSIS:

TOTAL SITE AREA - 2.15 ACRES
 AREA DISTURBED - 0.18 ACRES
 AREAS TO BE ROOFED OR PAVED - 0 ACRES
 AREA TO BE VEGETATIVELY STABILIZED - 0.05 ACRES
 TOTAL CUT - 325 C.Y.
 TOTAL FILL - 0 C.Y.
 OFF-SITE WASTE SITE - HOWARD COUNTY LANDFILL
 OFF-SITE BORROW SITE - APPROVED SITE

8. ANY SEDIMENT CONTROL PRACTICE WHICH IS DISTURBED BY GRADING ACTIVITY FOR PLACEMENT OF UTILITIES MUST BE REPAIRED ON THE SAME DAY OF DISTURBANCE.

9. ADDITIONAL SEDIMENT CONTROLS MUST BE PROVIDED, IF DEEMED NECESSARY BY THE HOWARD COUNTY SEDIMENT CONTROL INSPECTOR.

10. ON ALL SITES WITH DISTURBED AREAS IN EXCESS OF 2 ACRES, APPROVAL OF THE INSPECTION AGENCY SHALL BE REQUESTED UPON COMPLETION OF INSTALLATION OF PERIMETER EROSION AND SEDIMENT CONTROLS, BUT BEFORE PROCEEDING WITH ANY OTHER EARTH DISTURBANCE OR GRADING, OTHER BUILDING OR GRADING INSPECTION APPROVALS MAY NOT BE AUTHORIZED UNTIL THIS INITIAL APPROVAL BY THE INSPECTION AGENCY IS MADE.

11. TRENCHES FOR THE CONSTRUCTION OF UTILITIES IS LIMITED TO THREE PIPE LENGTHS OR THAT WHICH SHALL BE BACKFILLED AND STABILIZED WITHIN ONE WORKING DAY, WHICHEVER IS SHORTER.

12. SITE GRADING WILL BEGIN ONLY AFTER ALL PERIMETER SEDIMENT CONTROL MEASURES HAVE BEEN INSTALLED AND ARE IN A FUNCTIONING CONDITION.

13. SEDIMENT WILL BE REMOVED FROM TRAPS WHEN ITS DEPTH REACHES CLEAN OUT ELEVATION SHOWN ON THE PLANS.

14. CUT AND FILL QUANTITIES PROVIDED UNDER SITE ANALYSIS DO NOT REPRESENT BID QUANTITIES. THESE QUANTITIES DO NOT DISTINGUISH BETWEEN TOPSOIL, STRUCTURAL FILL OR EMBANKMENT MATERIAL, NOR DO THEY REFLECT CONSIDERATION OF UNDERCUTTING OR REMOVAL OF UNSUITABLE MATERIAL. THE CONTRACTOR SHALL FAMILIARIZE HIMSELF WITH SITE CONDITIONS WHICH MAY AFFECT THE WORK.

15. CONSTRUCTION WITHIN, ALONG OR ACROSS STREAM CHANNELS SHALL, AS A MINIMUM CONFORM TO CRITERIA DESCRIBED UNDER "MARYLAND'S GUIDELINES TO WATERWAY CONSTRUCTION".

EROSION CONTROL MATTING

Construction Specifications

- Key-in the matting by placing the top ends of the matting in a narrow trench, 6" in depth. Backfill the trench and tamp firmly to conform to the channel cross-section. Secure with a row of staples about 4" down slope from the trench. Spacing between staples is 6".
- Staple the 4" overlap in the channel center using an 18" spacing between staples.
- Before stapling the outer edges of the matting, make sure the matting is smooth and in firm contact with the soil.
- Staples shall be placed 2' apart with 4 rows for each strip, 2 outer rows, and 2 alternating rows down the center.
- Where one roll of matting ends and another begins, the end of the top strip shall overlap the upper end of the lower strip by 4", shiplap fashion. Reinforce the overlap with a double row of staples spaced 6" apart in a staggered pattern on either side.
- The discharge end of the matting liner should be similarly secured with 2 double rows of staples.

Note: If flow will enter from the edge of the matting then the area effected by the flow must be keyed-in.

U.S. DEPARTMENT OF AGRICULTURE SOIL CONSERVATION SERVICE	PAGE G - 22 - 2A	MARYLAND DEPARTMENT OF ENVIRONMENT WATER MANAGEMENT ADMINISTRATION
---	---------------------	---


REVIEWED FOR HOWARD SOIL CONSERVATION DISTRICT AND MEETS TECHNICAL REQUIREMENTS.

Jim Morgan 11/17/05
 U.S. NATURAL RESOURCES CONSERVATION SERVICE DATE

THIS DEVELOPMENT IS APPROVED FOR EROSION AND SEDIMENT CONTROL BY HOWARD SOIL CONSERVATION DISTRICT.

John R. Robinson 11/17/05
 HOWARD SOIL CONSERVATION DISTRICT DATE


DETAIL 24 - STABILIZED CONSTRUCTION ENTRANCE

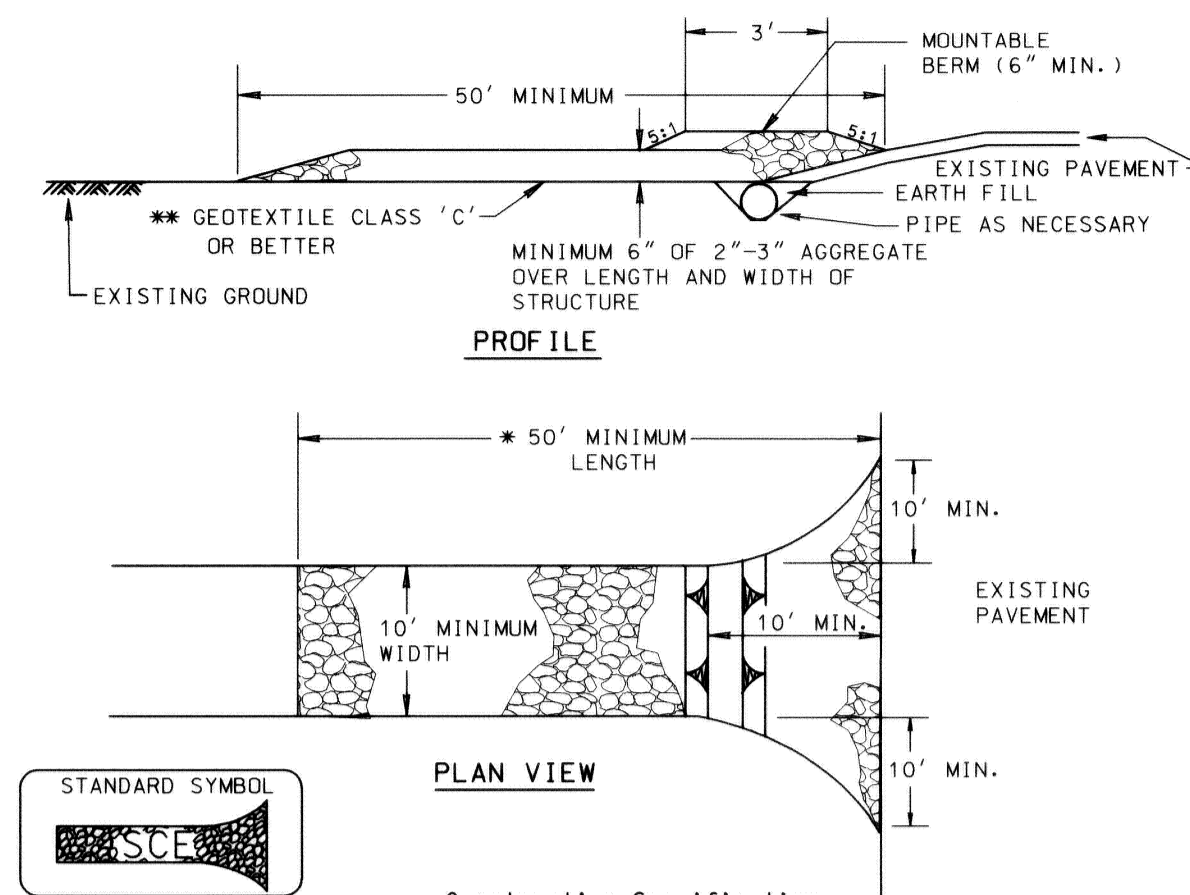

- Length - minimum of 50' (#30' for single residence lot).
- Width - 10' minimum, should be flared at the existing road to provide a turning radius.
- Geotextile fabric (filter cloth) shall be placed over the existing ground prior to placing stone. The plan approval authority may not require single family residences to use geotextile.
- Stone - crushed aggregate (2" to 3") or reclaimed or recycled concrete equivalent shall be placed at least 6" deep over the length and width of the entrance.
- Surface Water - all surface water flowing to or diverted toward construction entrances shall be piped through the entrance, maintaining positive drainage. Pipe installed through the stabilized construction entrance shall be protected with a mountable berm with 5:1 slopes and a minimum of 6" of stone over the pipe. Pipe has to be sized according to the drainage. When the SCE is located at a high spot and has no drainage to convey a pipe will not be necessary. Pipe should be sized according to the amount of runoff to be conveyed. A 6" minimum will be required.
- Location - A stabilized construction entrance shall be located at every point where construction traffic enters or leaves a construction site. Vehicles leaving the site must travel over the entire length of the stabilized construction entrance.


U.S. DEPARTMENT OF AGRICULTURE SOIL CONSERVATION SERVICE	PAGE F - 17 - 3	MARYLAND DEPARTMENT OF ENVIRONMENT WATER MANAGEMENT ADMINISTRATION
---	--------------------	---

DETAIL 30 - EROSION CONTROL MATTING

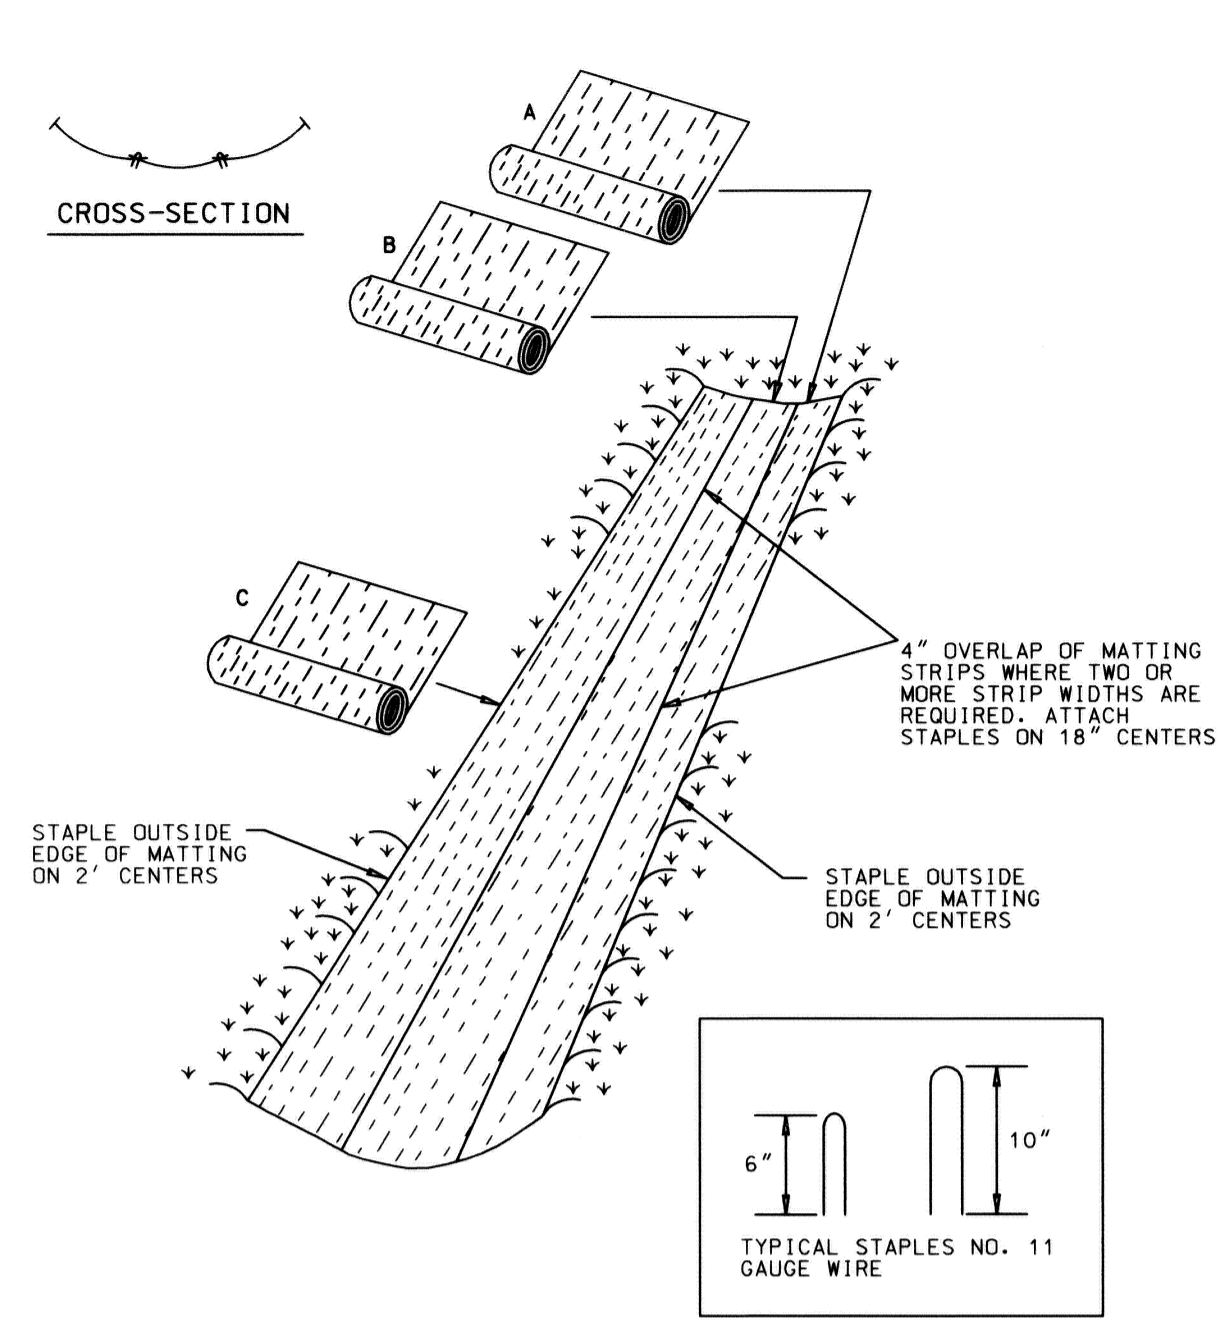

U.S. DEPARTMENT OF AGRICULTURE SOIL CONSERVATION SERVICE	PAGE G - 22 - 2	MARYLAND DEPARTMENT OF ENVIRONMENT WATER MANAGEMENT ADMINISTRATION
---	--------------------	---


DETAIL 33 - SUPER SILT FENCE

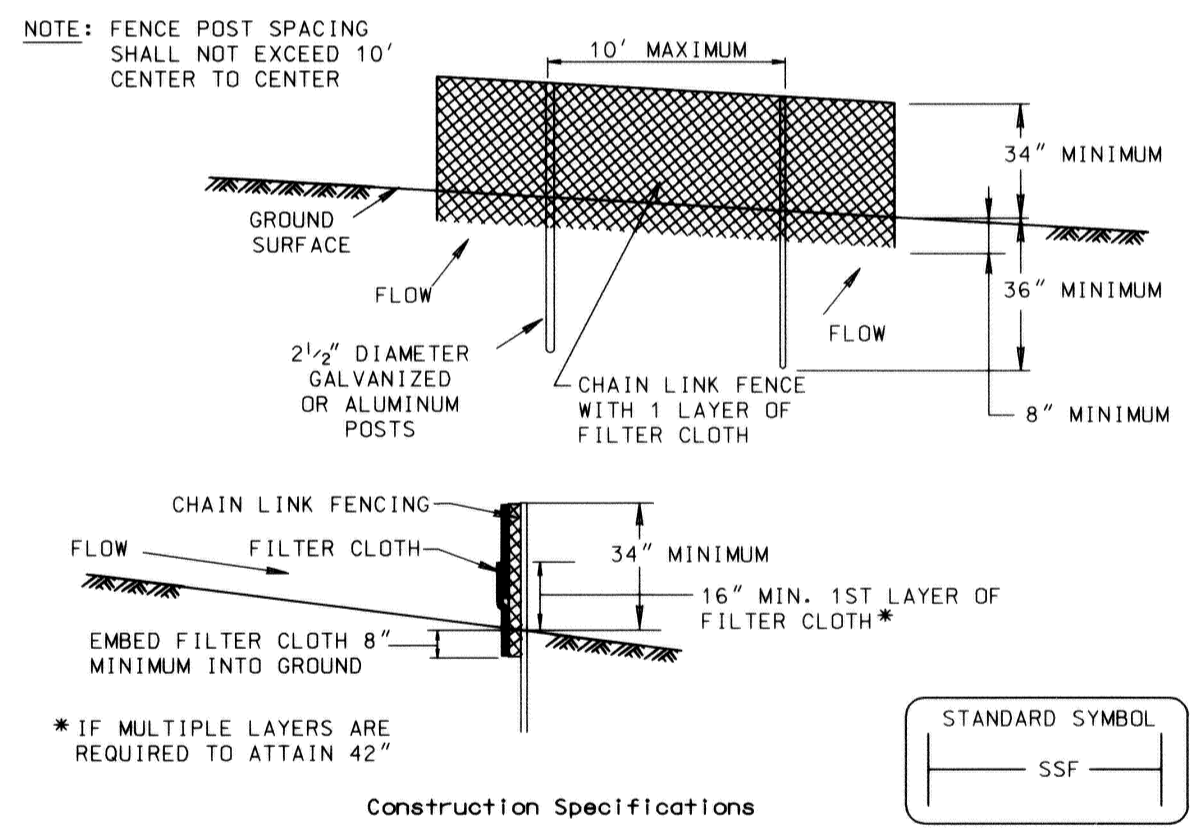

- Fencing shall be 42" in height and constructed in accordance with the latest Maryland State Highway Details for Chain Link Fencing. The specification for a 6' fence shall be used, substituting 42" fabric and 6' length posts.
- Chain link fence shall be fastened securely to the fence posts with wire ties. The lower tension wire, brace and truss rods, drive anchors and post caps are not required except on the ends of the fence.
- Filter cloth shall be fastened securely to the chain link fence with ties spaced every 24" at the top and mid section.
- Filter cloth shall be embedded a minimum of 8" into the ground.
- When two sections of filter cloth adjoin each other, they shall be overlapped by 6" and folded.
- Maintenance shall be performed as needed and silt buildups removed when "bulges" develop in the silt fence, or when silt reaches 50% of fence height.
- Filter cloth shall be fastened securely to each fence post with wire ties or staples at top and mid section and shall meet the following requirements for Geotextile Class F:

U.S. DEPARTMENT OF AGRICULTURE SOIL CONSERVATION SERVICE	PAGE H - 26 - 3	MARYLAND DEPARTMENT OF ENVIRONMENT WATER MANAGEMENT ADMINISTRATION
---	--------------------	---

DETAIL 22 - SILT FENCE

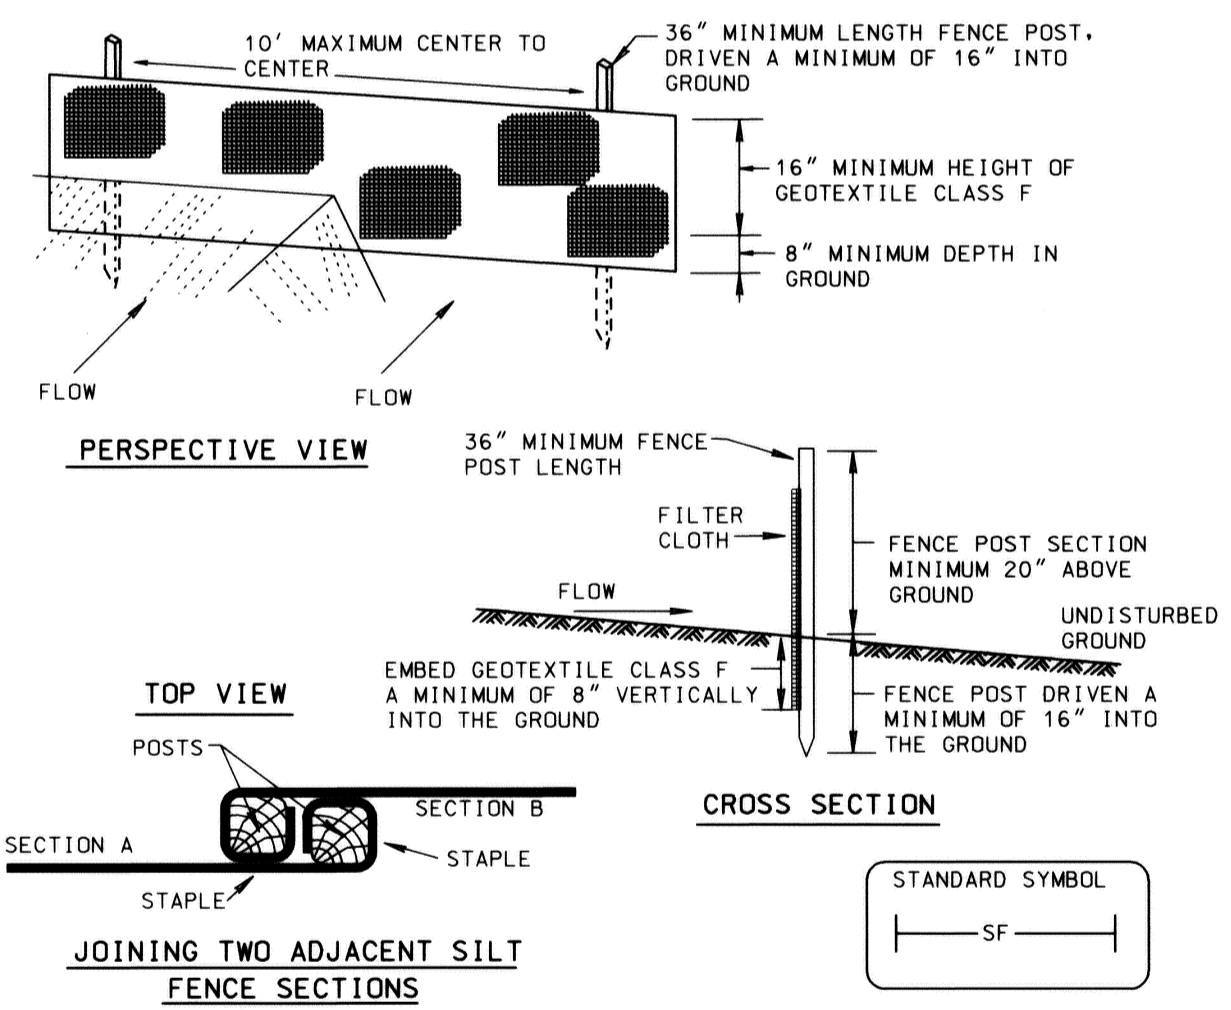

- Fence posts shall be a minimum of 36" long driven 16" minimum into the ground. Wood posts shall be 1 1/2" x 1 1/2" square (minimum) cut, or 1 3/4" diameter (minimum) round and shall be of sound quality hardwood. Steel posts will be standard T or U section weighting not less than 1.00 pound per linear foot.
- Geotextile shall be fastened securely to each fence post with wire ties or staples at top and mid-section and shall meet the following requirements for Geotextile Class F:

U.S. DEPARTMENT OF AGRICULTURE SOIL CONSERVATION SERVICE	PAGE E - 15 - 3	MARYLAND DEPARTMENT OF ENVIRONMENT WATER MANAGEMENT ADMINISTRATION
---	--------------------	---

DEPARTMENT OF PUBLIC WORKS
 HOWARD COUNTY, MARYLAND

Steve Shuman 11/10/05
 CHIEF, TRANSPORTATION AND SPECIAL PROJECTS DIVISION DATE

Willie Z. Smith 11-4-05
 CHIEF, BUREAU OF HIGHWAYS DATE

PREPARED BY
URS
 4 NORTH PARK DRIVE
 HUNT VALLEY, MARYLAND
 TEL: (410) 785-7220



DES: BNL				
DRN: EGB				
CHK: DTM				
DATE: 9/05	BY NO.	REVISION	DATE	

EROSION & SEDIMENT CONTROL NOTES & DETAILS

SCALE MAP NO. 41 BLOCK NO. 1

HARMEI DRIVE DRAINAGE IMPROVEMENTS

HOWARD COUNTY, MARYLAND

SCALE
 N.T.S.

SHEET
 3 OF 3