

Howard County, Maryland - Department of Public Works

McKENZIE ROAD ROADWAY AND STORMDRAIN IMPROVEMENTS


CAPITAL PROJECT NO. J-4164-10

INDEX OF SHEETS


1. TITLE SHEET
2. TYPICAL SECTIONS AND DETAILS
3. SPEED TABLE
4. GEOMETRIC LAYOUT SHEET GS-1
5. GEOMETRIC LAYOUT SHEET GS-2
6. CURB GEOMETRY SHEET
7. PLAN SHEET PS-1
8. PLAN SHEET PS-2
9. PLAN SHEET PS-3
10. PLAN SHEET PS-4
11. PROFILE SHEET
12. EROSION AND SEDIMENT CONTROL GENERAL NOTES 1
13. EROSION AND SEDIMENT CONTROL GENERAL NOTES 2
14. EROSION AND SEDIMENT CONTROL PLAN SHEET EP-1
15. EROSION AND SEDIMENT CONTROL PLAN SHEET EP-2
16. EROSION AND SEDIMENT CONTROL PLAN SHEET EP-3
17. EROSION AND SEDIMENT CONTROL PLAN SHEET EP-4
18. STORMDRAIN PROFILE PP-1
19. STORMDRAIN PROFILE PP-2
20. MINI-ROUNDBOUT MARKING AND SIGNING PLAN
21. TRAFFIC CONTROL GENERAL NOTES AND SIGN LEGEND
22. TRAFFIC CONTROL PLAN SHEET TP-1: STAGE 1
23. TRAFFIC CONTROL PLAN SHEET TP-2: STAGE 2
24. TRAFFIC CONTROL PLAN SHEET TP-3: (THORNBROOK ROAD INTERSECTION)

NOTE:

EROSION AND SEDIMENT CONTROL WILL BE STRICTLY ENFORCED

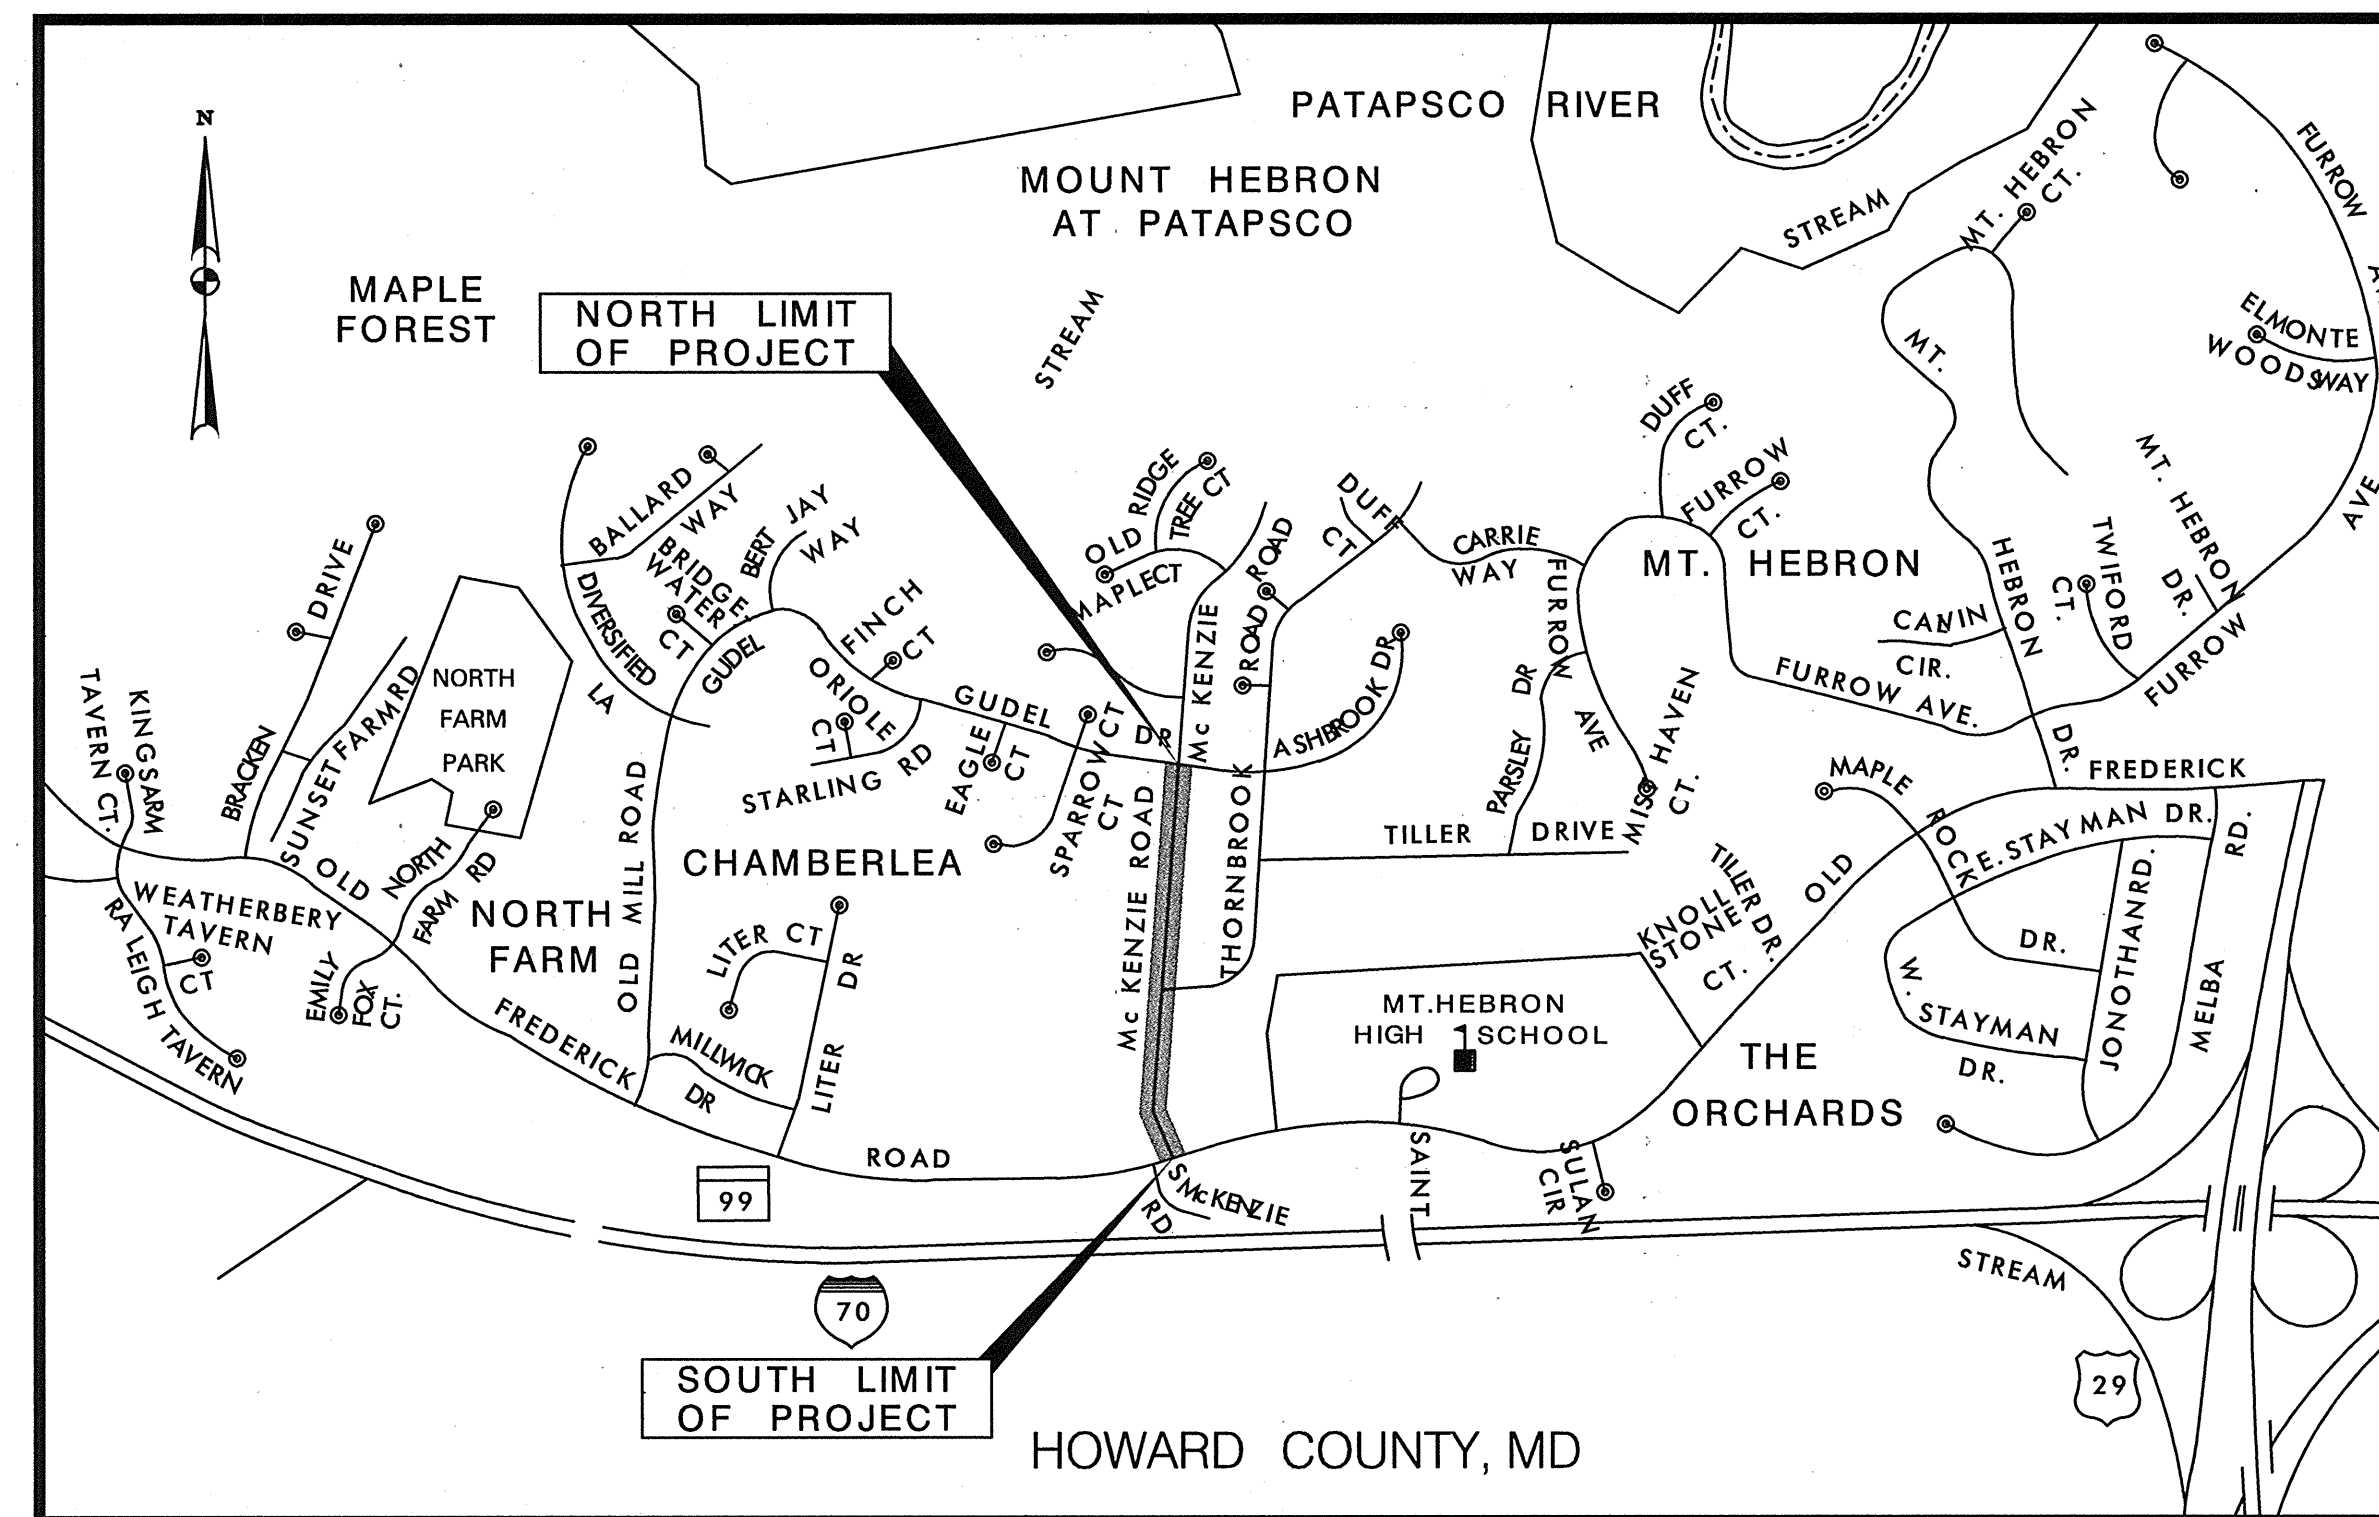

PROJECT LENGTH: 0.40 MILES

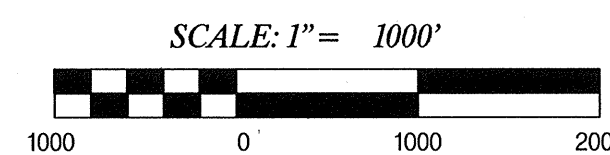

CONVENTIONAL SIGNS


PROPOSED MEDIAN BARRIER		PROPOSED CULVERT	
ELECTRICAL HAND BOX - SIGNALS		EXISTING CULVERT	
BURIED UTILITY LINES & NO. OF CABLES		EXISTING DROP INLET	
STATE, COUNTY OR CITY LINES		UTILITY POLE	
PROPOSED TRAFFIC BARRIER		MARSH	
EXISTING TRAFFIC BARRIER		HEDGE	
FENCE LINE		GROUND ELEVATION	
RIGHT OF WAY LINE		GRADE ELEVATION	
EXISTING ROADWAY		CUT LIMIT	
RAILROAD		FILL LIMIT	
BASE OR SURVEY LINE			
FIRE HYDRANT			

GENERAL NOTES

1. ALL STATIONING AND DIMENSIONING ARE TO BE FIELD VERIFIED BY THE CONTRACTOR.
2. APPROXIMATE LOCATIONS OF EXISTING UTILITIES ARE SHOWN. THE CONTRACTOR SHALL TAKE ALL NECESSARY PRECAUTIONS TO PROTECT EXISTING UTILITIES AND TO MAINTAIN UNINTERRUPTED SERVICE. ANY DAMAGE INCURRED SHALL BE REPAIRED IMMEDIATELY TO THE SATISFACTION OF THE HOWARD COUNTY ENGINEER BY THE CONTRACTOR AND AT THE CONTRACTOR'S EXPENSE. CONTRACTOR SHALL NOTIFY THE FOLLOWING UTILITIES OR AGENCIES AT LEAST FIVE WORKING DAYS BEFORE STARTING WORK SHOWN ON THESE PLANS:
 - MISS UTILITY 1-800-257-7777
 - CONSTRUCTION INSPECTION DIVISION, HOWARD COUNTY 410-313-1880
 - STATE HIGHWAY ADMINISTRATION DISTRICT 7- 301-624-8100
 - BALTIMORE GAS & ELECTRIC COMPANY - UNDERGROUND ELECTRIC 410-855-6958
 - BALTIMORE GAS & ELECTRIC COMPANY - GAS ENGINEERING AND CONSTRUCTION 410-291-5834
 - DISTRIBUTION CUSTOMER SERVICE 685-0123
 - ENGINEERING DAMAGE CONTROL 234-5621
 - BELL ATLANTIC TELEPHONE 1-800-870-0000
 - AMERICAN TELEPHONE & TELEGRAPH CABLE LOCATION DIVISION 393-3553
 - COLONIAL PIPELINE COMPANY 781-4641
 - BUREAU OF UTILITIES, HOWARD COUNTY 410-313-4900
 - COMCAST CABLE 888-793-1800
3. THE CONTRACTOR SHALL CONTACT THE HOWARD COUNTY CONSTRUCTION INSPECTION DIVISION OF ENGINEERING FOR VERIFICATION AND/OR INFORMATION REGARDING:
 - A. EXISTING/PROPOSED RIGHT-OF-WAY
 - B. UTILITY RELOCATION
 - C. MAINTENANCE OF TRAFFIC DURING CONSTRUCTION
 - D. EROSION/SEDIMENT CONTROL CERTIFICATION AND PERMIT
 - E. HORIZONTAL/VERTICAL CONTROL
 - F. GRADING PERMIT
4. PLACE REGULATION "ROAD WORK" AND WARNING SIGNS AS REQUIRED TO COMPLY WITH THE MANUAL ON UNIFORM TRAFFIC CONTROL DEVICES (MUTCD) FOR HIGHWAY CONSTRUCTION AND MAINTENANCE OPERATIONS AT LIMIT OF WORK ALONG COUNTY ROADWAYS. COMPLY WITH HOWARD COUNTY STANDARD SPECIFICATIONS AND DETAILS.
5. ALL GRADING SHALL BE LIMITED TO EXISTING R.O.W. AND EASEMENTS INCLUDING SIDE SLOPES AND STABILIZATION. FOLLOWING INITIAL SOIL DISTURBANCE OR REDISTURBANCE, PERMANENT OR TEMPORARY STABILIZATION SHALL BE COMPLETED IN ACCORDANCE WITH THE SEDIMENT CONTROL NOTES AND DETAILS.
6. FOR DETAILS NOT SHOWN ON THESE DRAWINGS, AND FOR MATERIALS AND CONSTRUCTION METHODS, THE CONTRACTOR SHALL ABIDE BY THE HOWARD COUNTY STANDARDS AND SPECIFICATIONS, THE PROJECT INVITATION FOR BID BOOKLET, THE SPECIAL PROVISIONS AND THE MARYLAND STATE HIGHWAY ADMINISTRATION'S "BOOK OF STANDARDS FOR HIGHWAY AND INCIDENTAL STRUCTURES" AND "STANDARD SPECIFICATIONS FOR CONSTRUCTION AND MATERIALS." IN THE EVENT OF ANY DISCREPANCY BETWEEN THESE SOURCES, THE SPECIAL PROVISIONS SHALL GOVERN.
7. ALL CONSTRUCTION SHALL BE IN ACCORDANCE WITH THE LATEST STANDARDS AND SPECIFICATIONS OF HOWARD COUNTY PLUS MD SHA STANDARDS AND SPECIFICATIONS.
8. STAGING AND STOCKPILE AREA WILL BE DETERMINED BY CONTRACTOR, AND AS APPROVED BY THE RESIDENT ENGINEER.
9. COORDINATES SHOWN HEREON ARE BASED ON MARYLAND STATE REFERENCE SYSTEM NAD 83' AS PROJECTED BY HOWARD COUNTY GEODETIC CONTROL STATION NO. 17EA AND NO. 17EB.
10. HORIZONTAL SITE CONTROL IS NAD88 , VERTICAL SITE CONTROL IS NGVD29.
11. SITE SURVEY WAS PERFORMED BY URS ON OCTOBER 1999.


REGISTERED PROFESSIONAL ENGINEER
STATE OF MARYLAND
JAMES M. PAVAN
9/16/03

DEPARTMENT OF PUBLIC WORKS HOWARD COUNTY, MARYLAND 		RJM ENGINEERING, INC. CONSULTING ENGINEERS COLUMBIA, MARYLAND <small>TEL: 410-730-1001 FAX: 410-730-5403</small>	DES: DRN: CHK: DATE:	TITLE SHEET	McKENZIE ROAD ROADWAY AND STORMDRAIN IMPROVEMENTS HOWARD COUNTY, MARYLAND CAPITAL PROJECT NO. J-4164-10	SCALE AS SHOWN SHEET 1 OF 24
			BY NO. REVISION DATE	NO. DATE: 9/03		

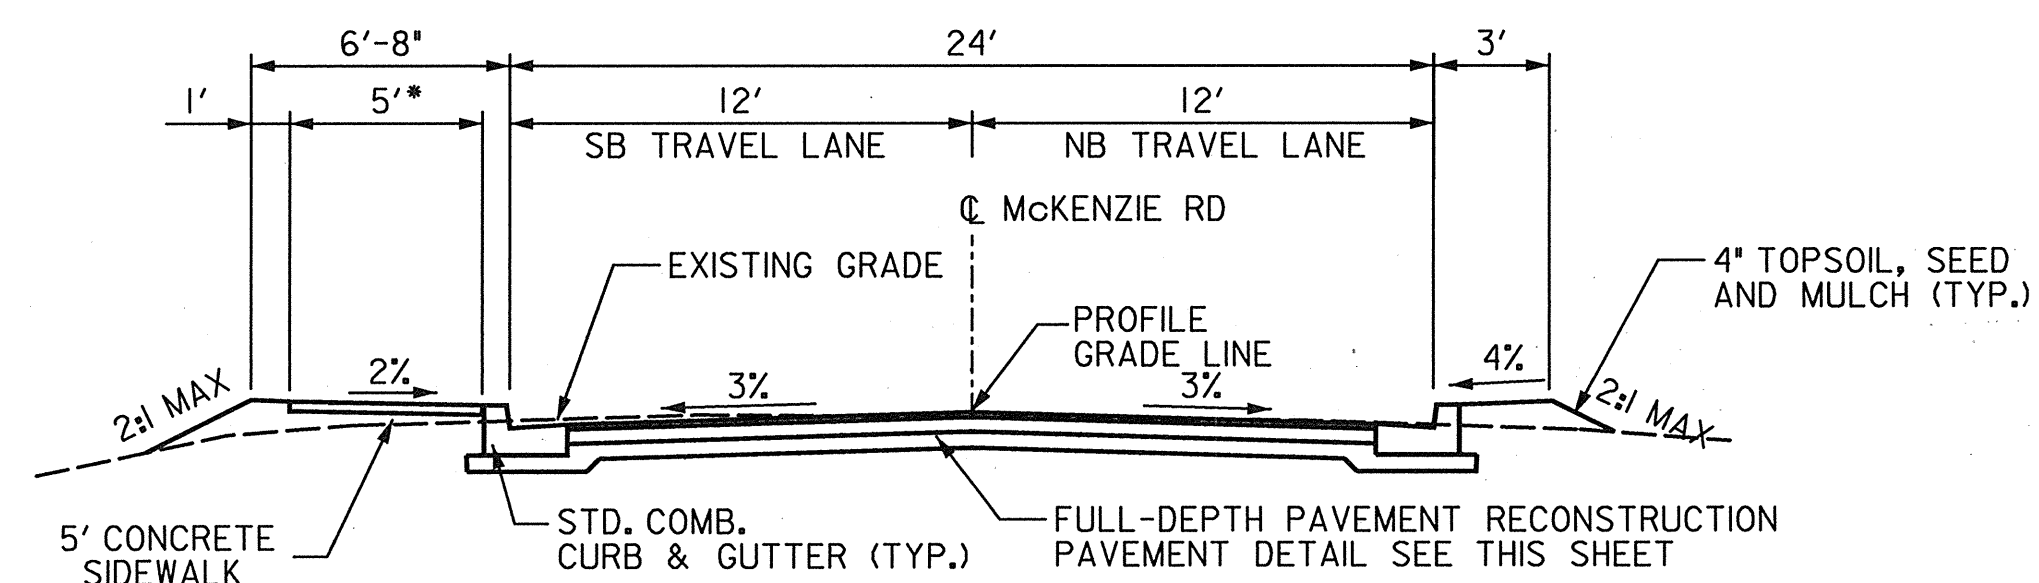


TYPICAL SECTION

STA. 100+85.00 TO 109+6.10
 * STA. 109+6.10 TO 109+27.22;
 TRANSITION FROM 5' TO 4' SIDEWALK AND
 TRANSITION FROM 0' TO 2'-4" OPEN SPACE

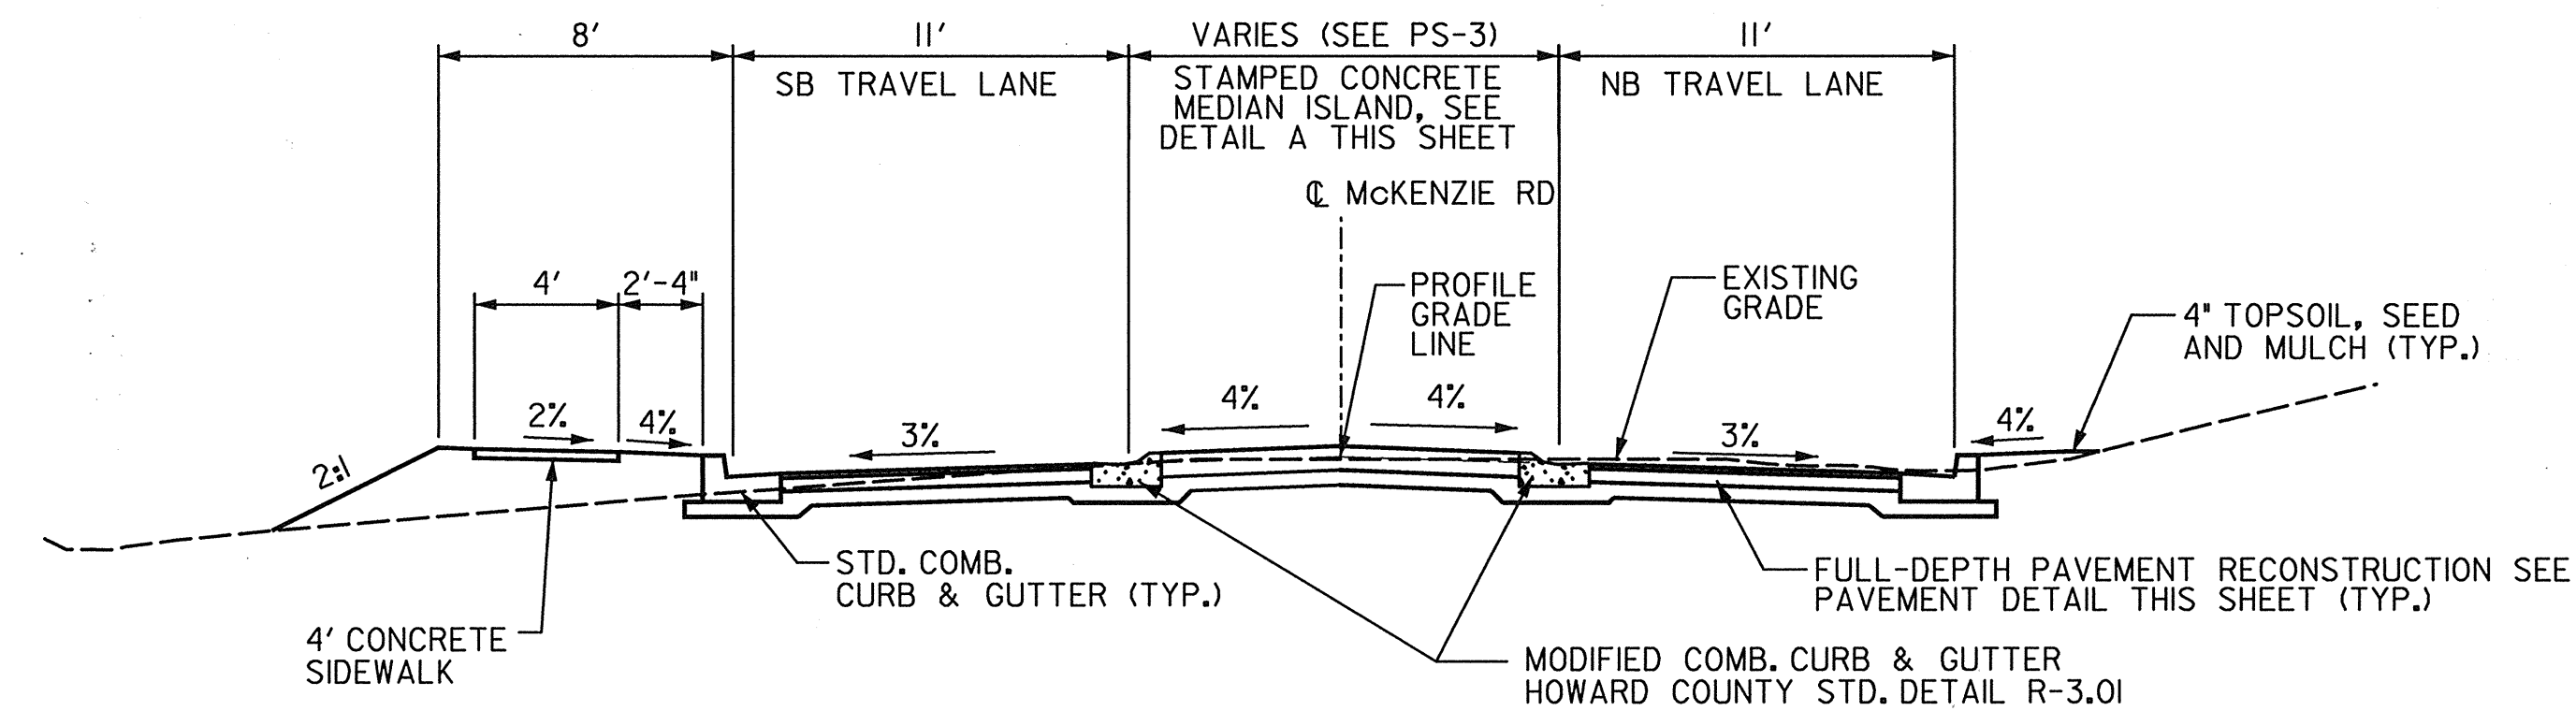


TYPICAL SECTION - MEDIAN ISLAND AT STA. 116+00

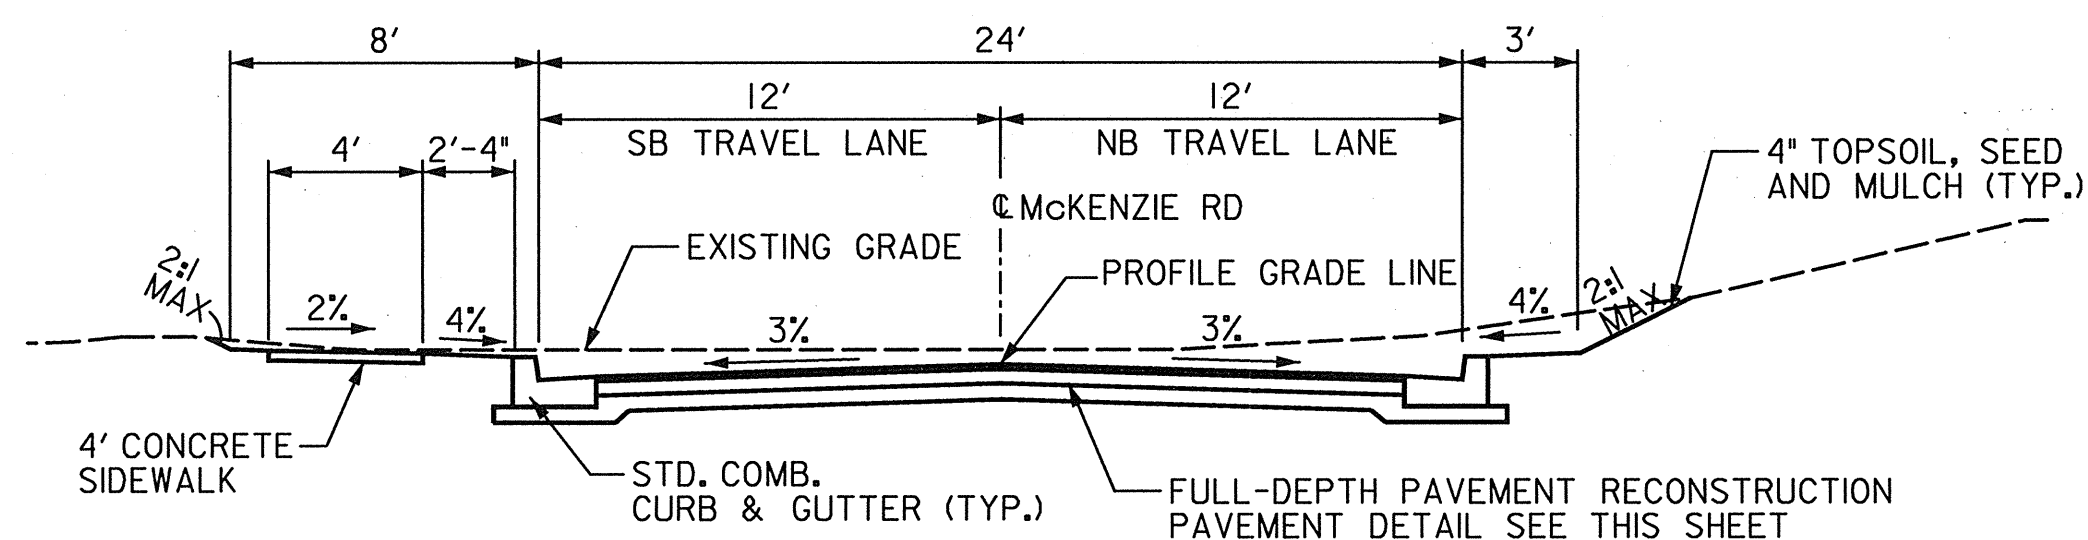


TYPICAL SECTION

STA. 109+27.22 TO 115+54.38
 STA. 116+41.27 TO 120+56.02

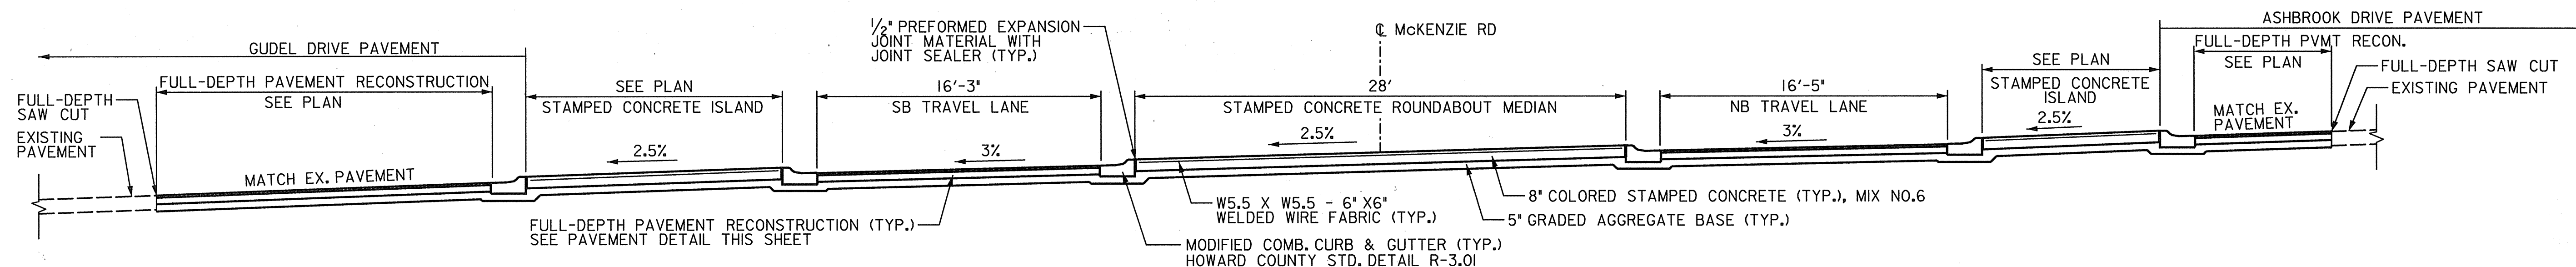


CROSS SECTION THROUGH ROUNDABOUT AT ASHBROOK INTERSECTION

STA. 121+30.85

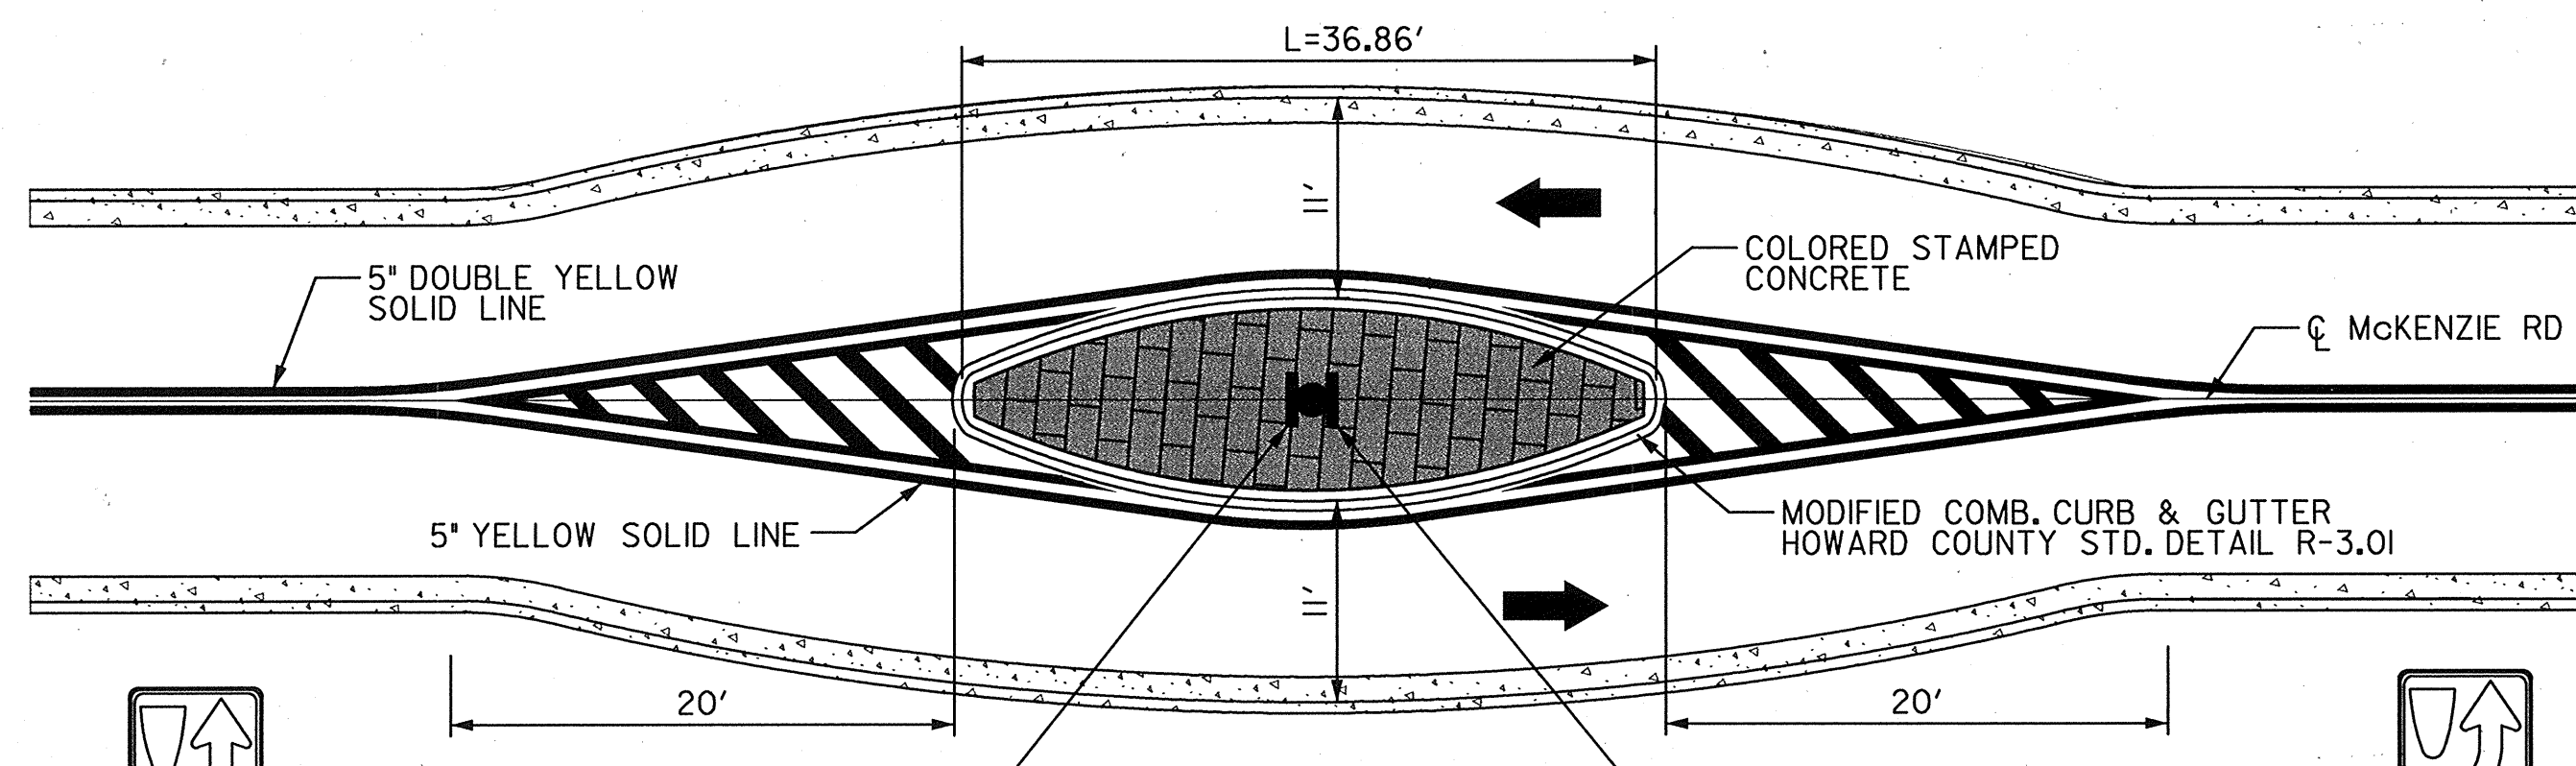

DETAIL A: MEDIAN @ STA. 116+00

NOT TO SCALE

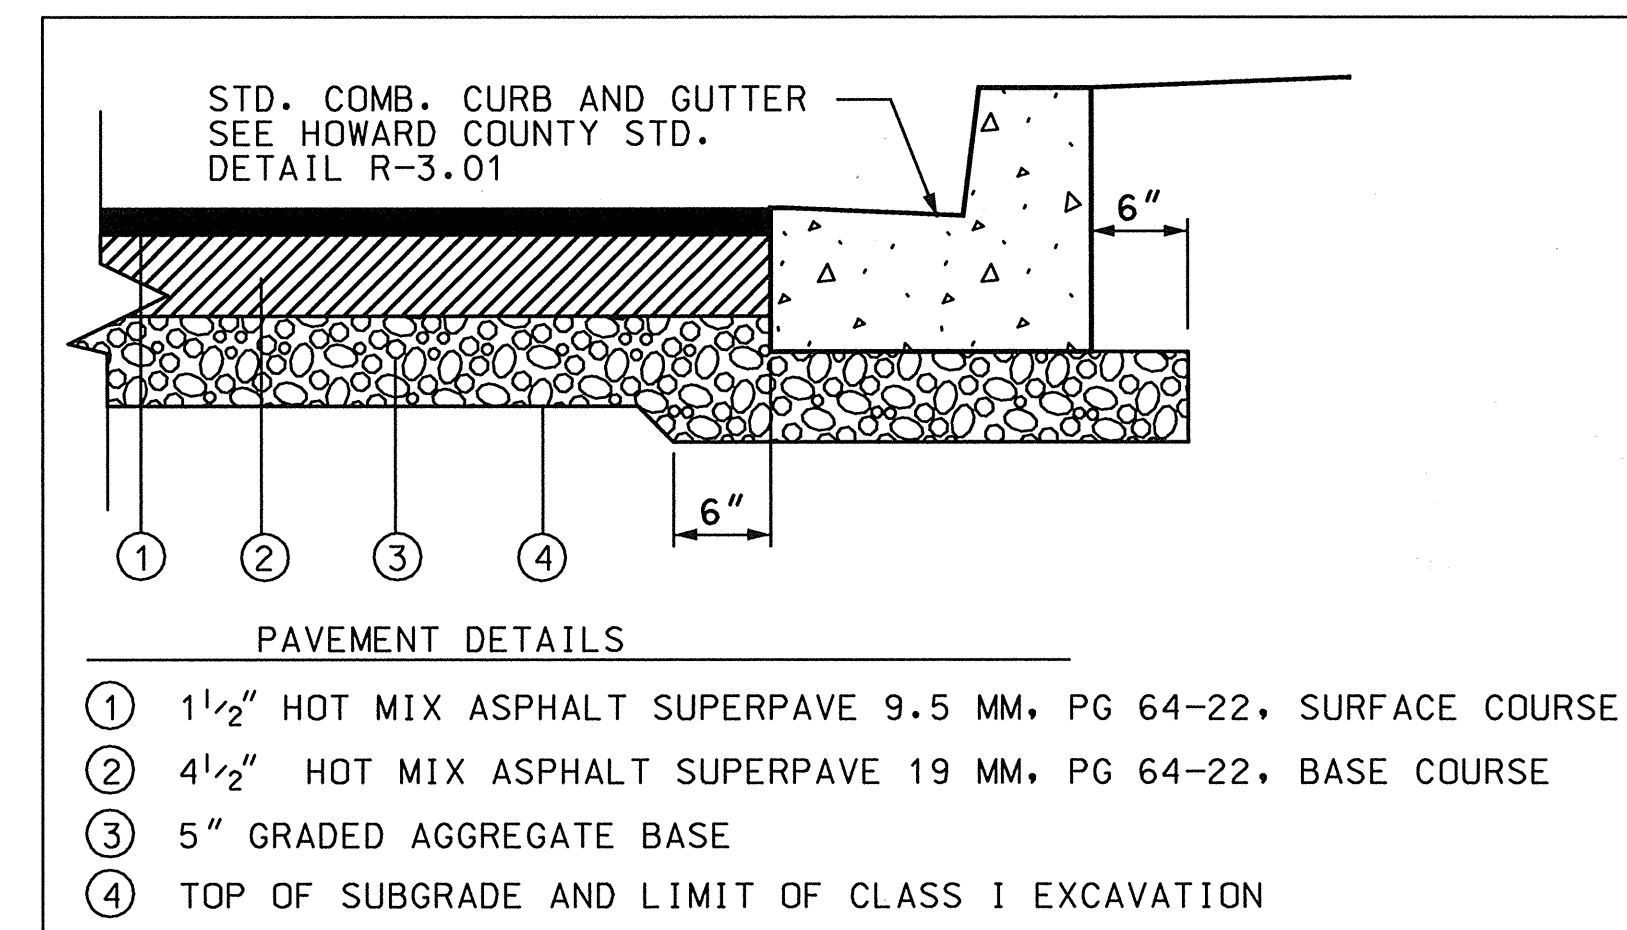

PAVEMENT DETAIL

NTS

- PAVEMENT DETAILS
- ① 1 1/2" HOT MIX ASPHALT SUPERPAVE 9.5 MM, PG 64-22, SURFACE COURSE
 - ② 4 1/2" HOT MIX ASPHALT SUPERPAVE 19 MM, PG 64-22, BASE COURSE
 - ③ 5" GRADED AGGREGATE BASE
 - ④ TOP OF SUBGRADE AND LIMIT OF CLASS I EXCAVATION




DEPARTMENT OF PUBLIC WORKS
 HOWARD COUNTY, MARYLAND

[Signature] 9/22/03
 CHIEF, BUREAU OF ENGINEERING

[Signature] 9/22/03
 CHIEF, TRANSPORTATION AND SPECIAL PROJECTS DIVISION

[Signature] 9-24-03
 CHIEF, BUREAU OF HIGHWAYS

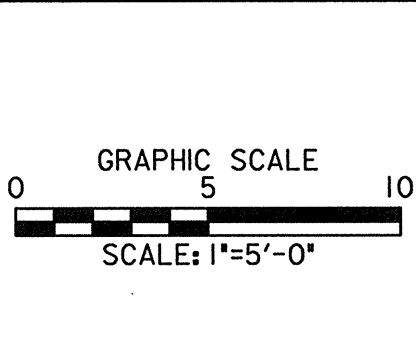

URS
 HUNT VALLEY, MARYLAND

RJM
 RJM ENGINEERING, INC.
 CONSULTING ENGINEERS
 COLUMBIA, MARYLAND

TEL: (410) 730-1001 FAX: (410) 730-5403

DES:					
DRN:					
CHK:					
DATE:	BY	NO.	REVISION	DATE	

TYPICAL SECTIONS AND DETAILS SHEET


NO.: _____ DATE: 9/03

McKENZIE ROAD ROADWAY AND STORMDRAIN IMPROVEMENTS


HOWARD COUNTY, MARYLAND
 CAPITAL PROJECT NO. J-4164-10

SCALE AS SHOWN

SHEET 2 OF 24

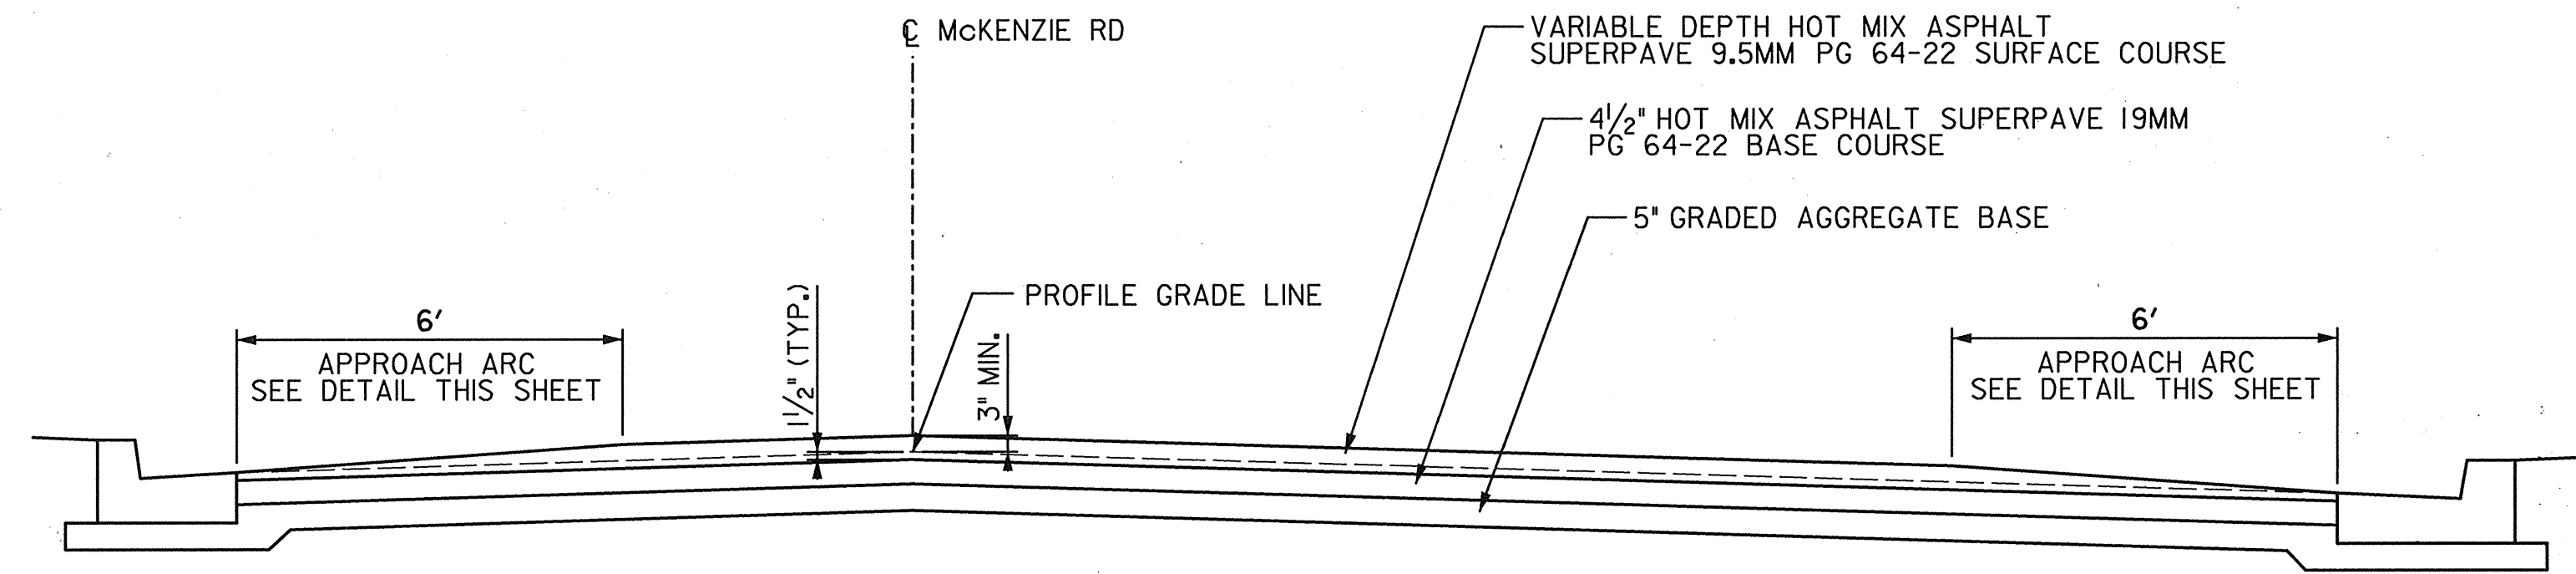


TYPICAL SECTION - SPEED TABLE

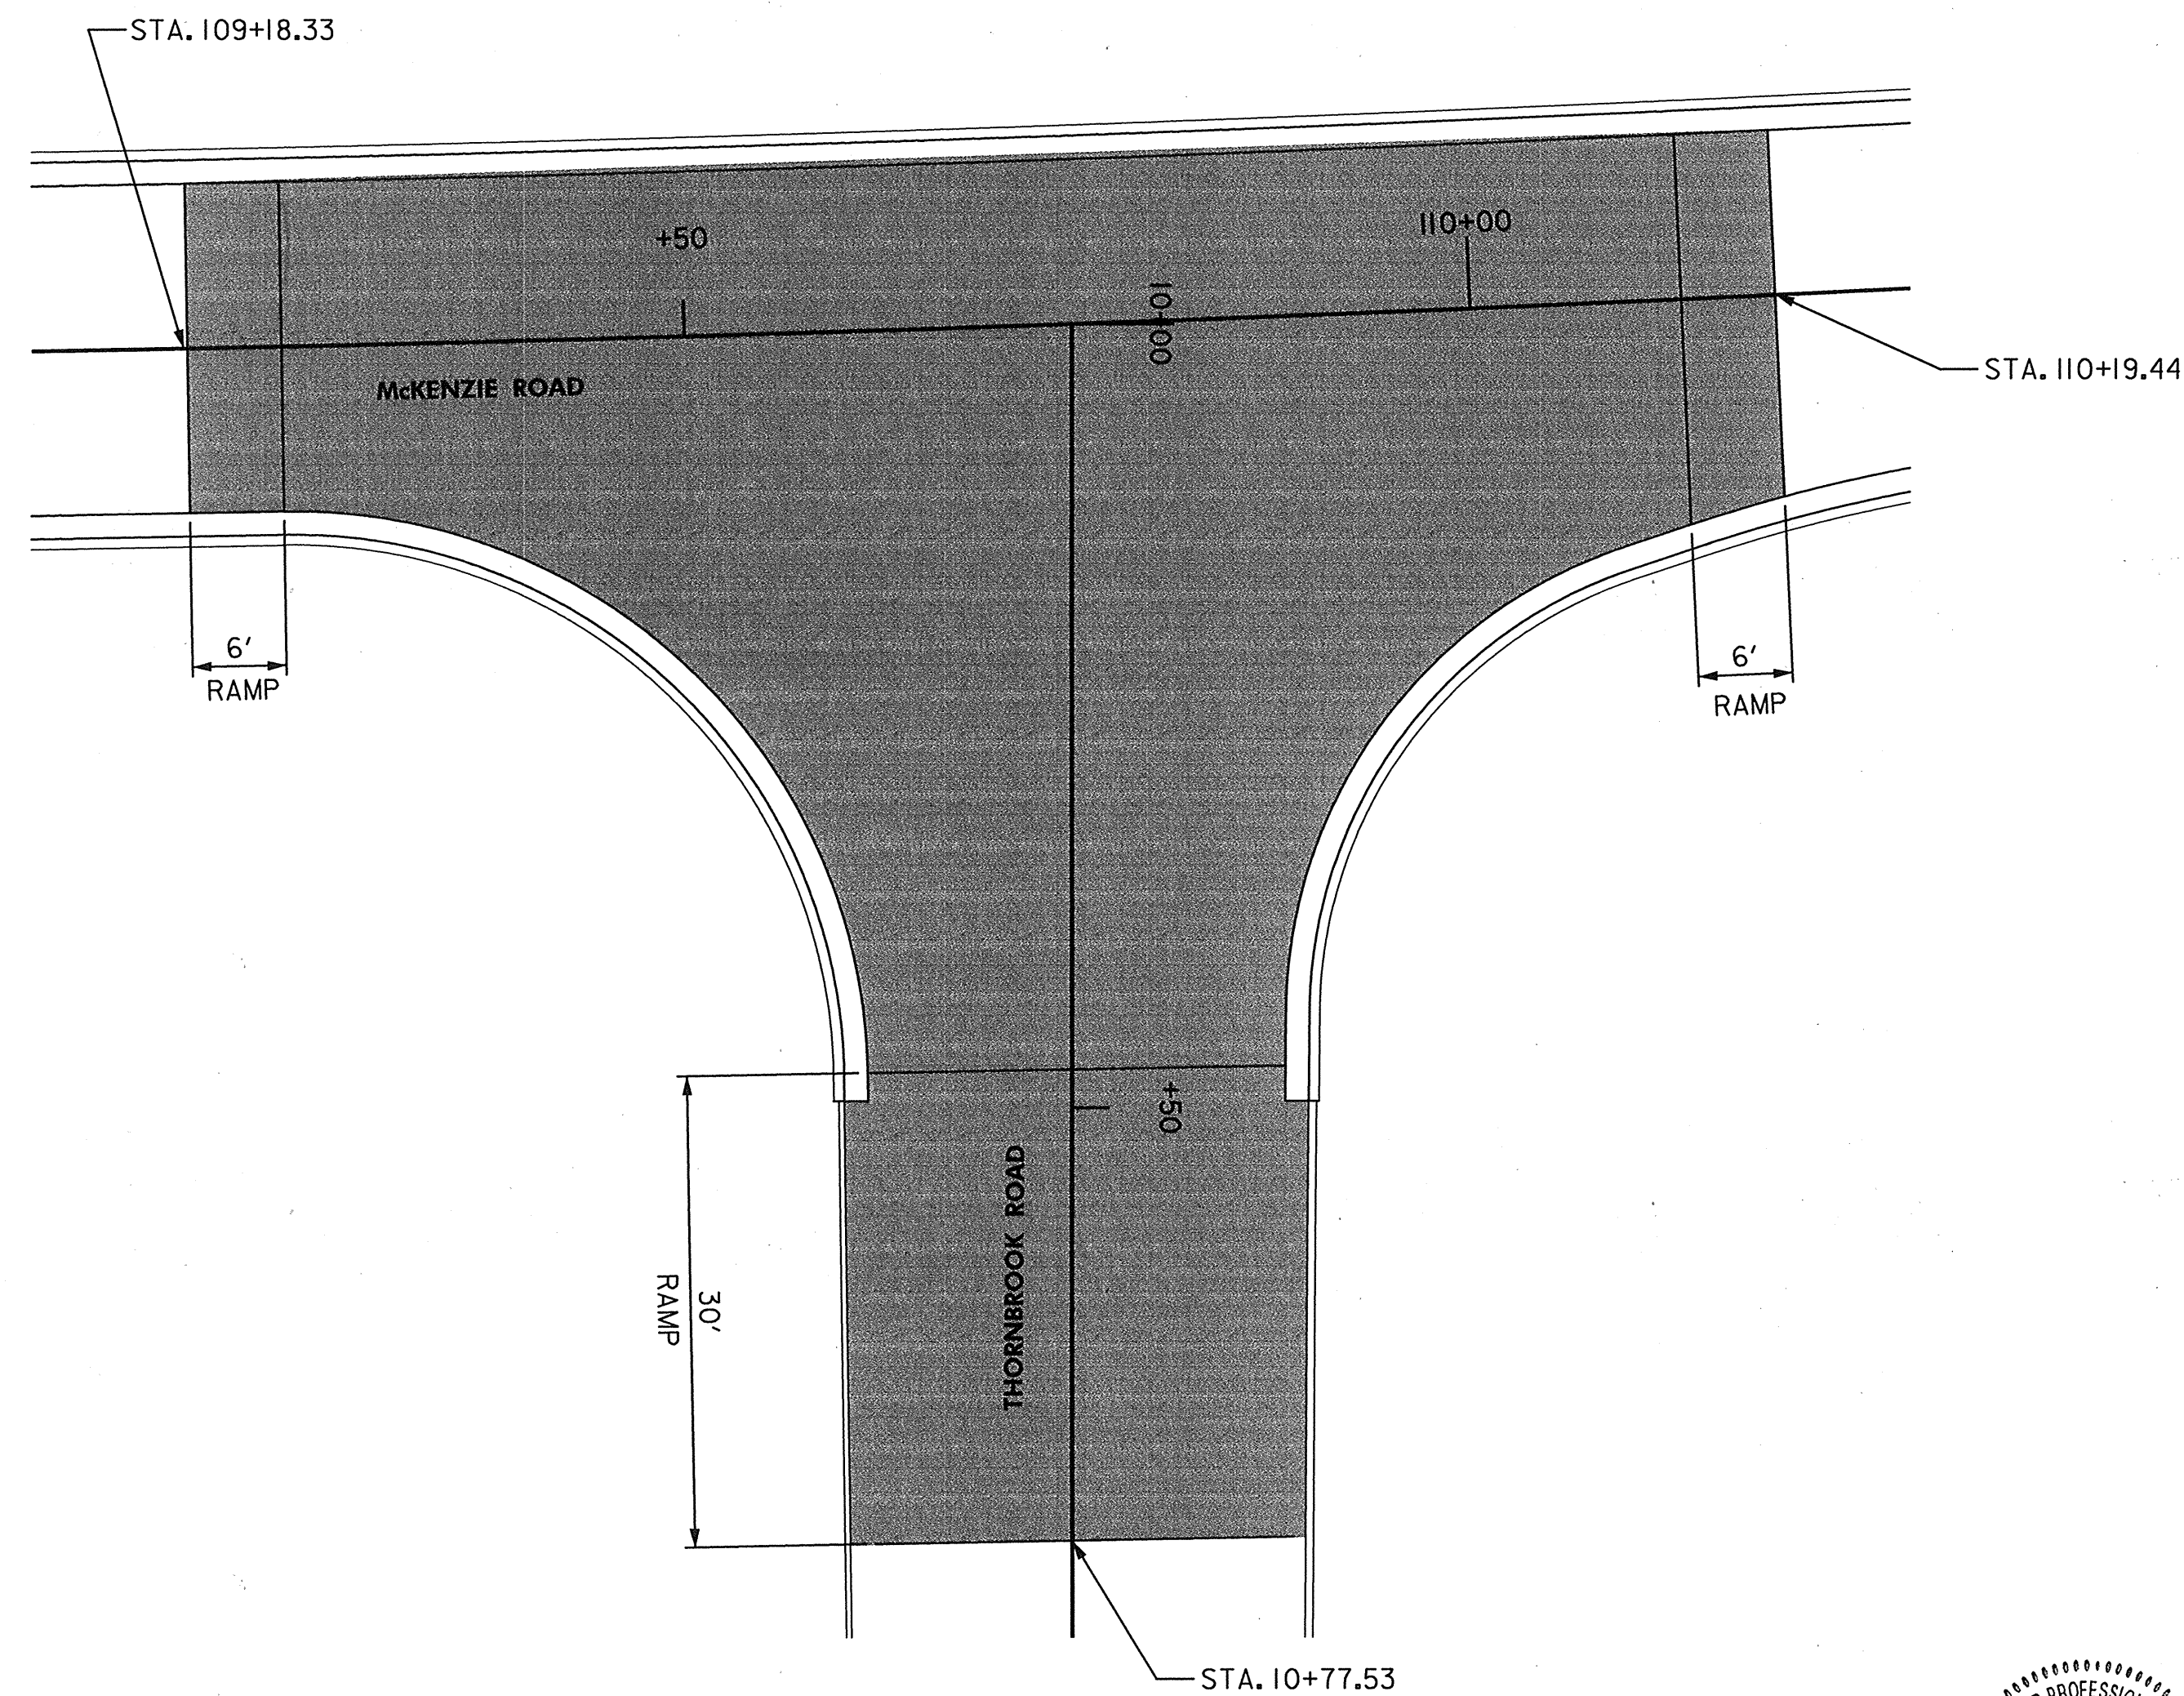

**THREE LEGGED SPEED TABLE LOCATIONS
(INTERSECTION OF McKENZIE ROAD AND THORNBROOK ROAD)**


SCALE: NOT TO SCALE

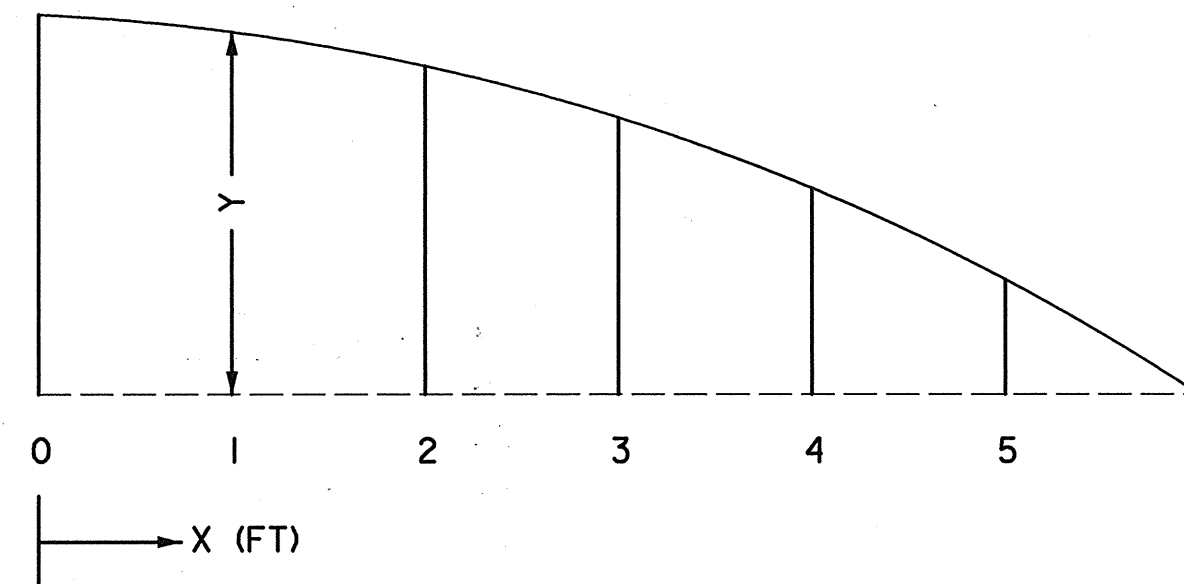

APPROACH ARC DETAIL

NOT TO SCALE

X (FT)	Y (FT)	Y (IN)
0	0.25	3.0
1	0.243	2.92
2	0.222	2.64
3	0.188	2.25
4	0.139	1.67
5	0.077	0.92
6	0	0

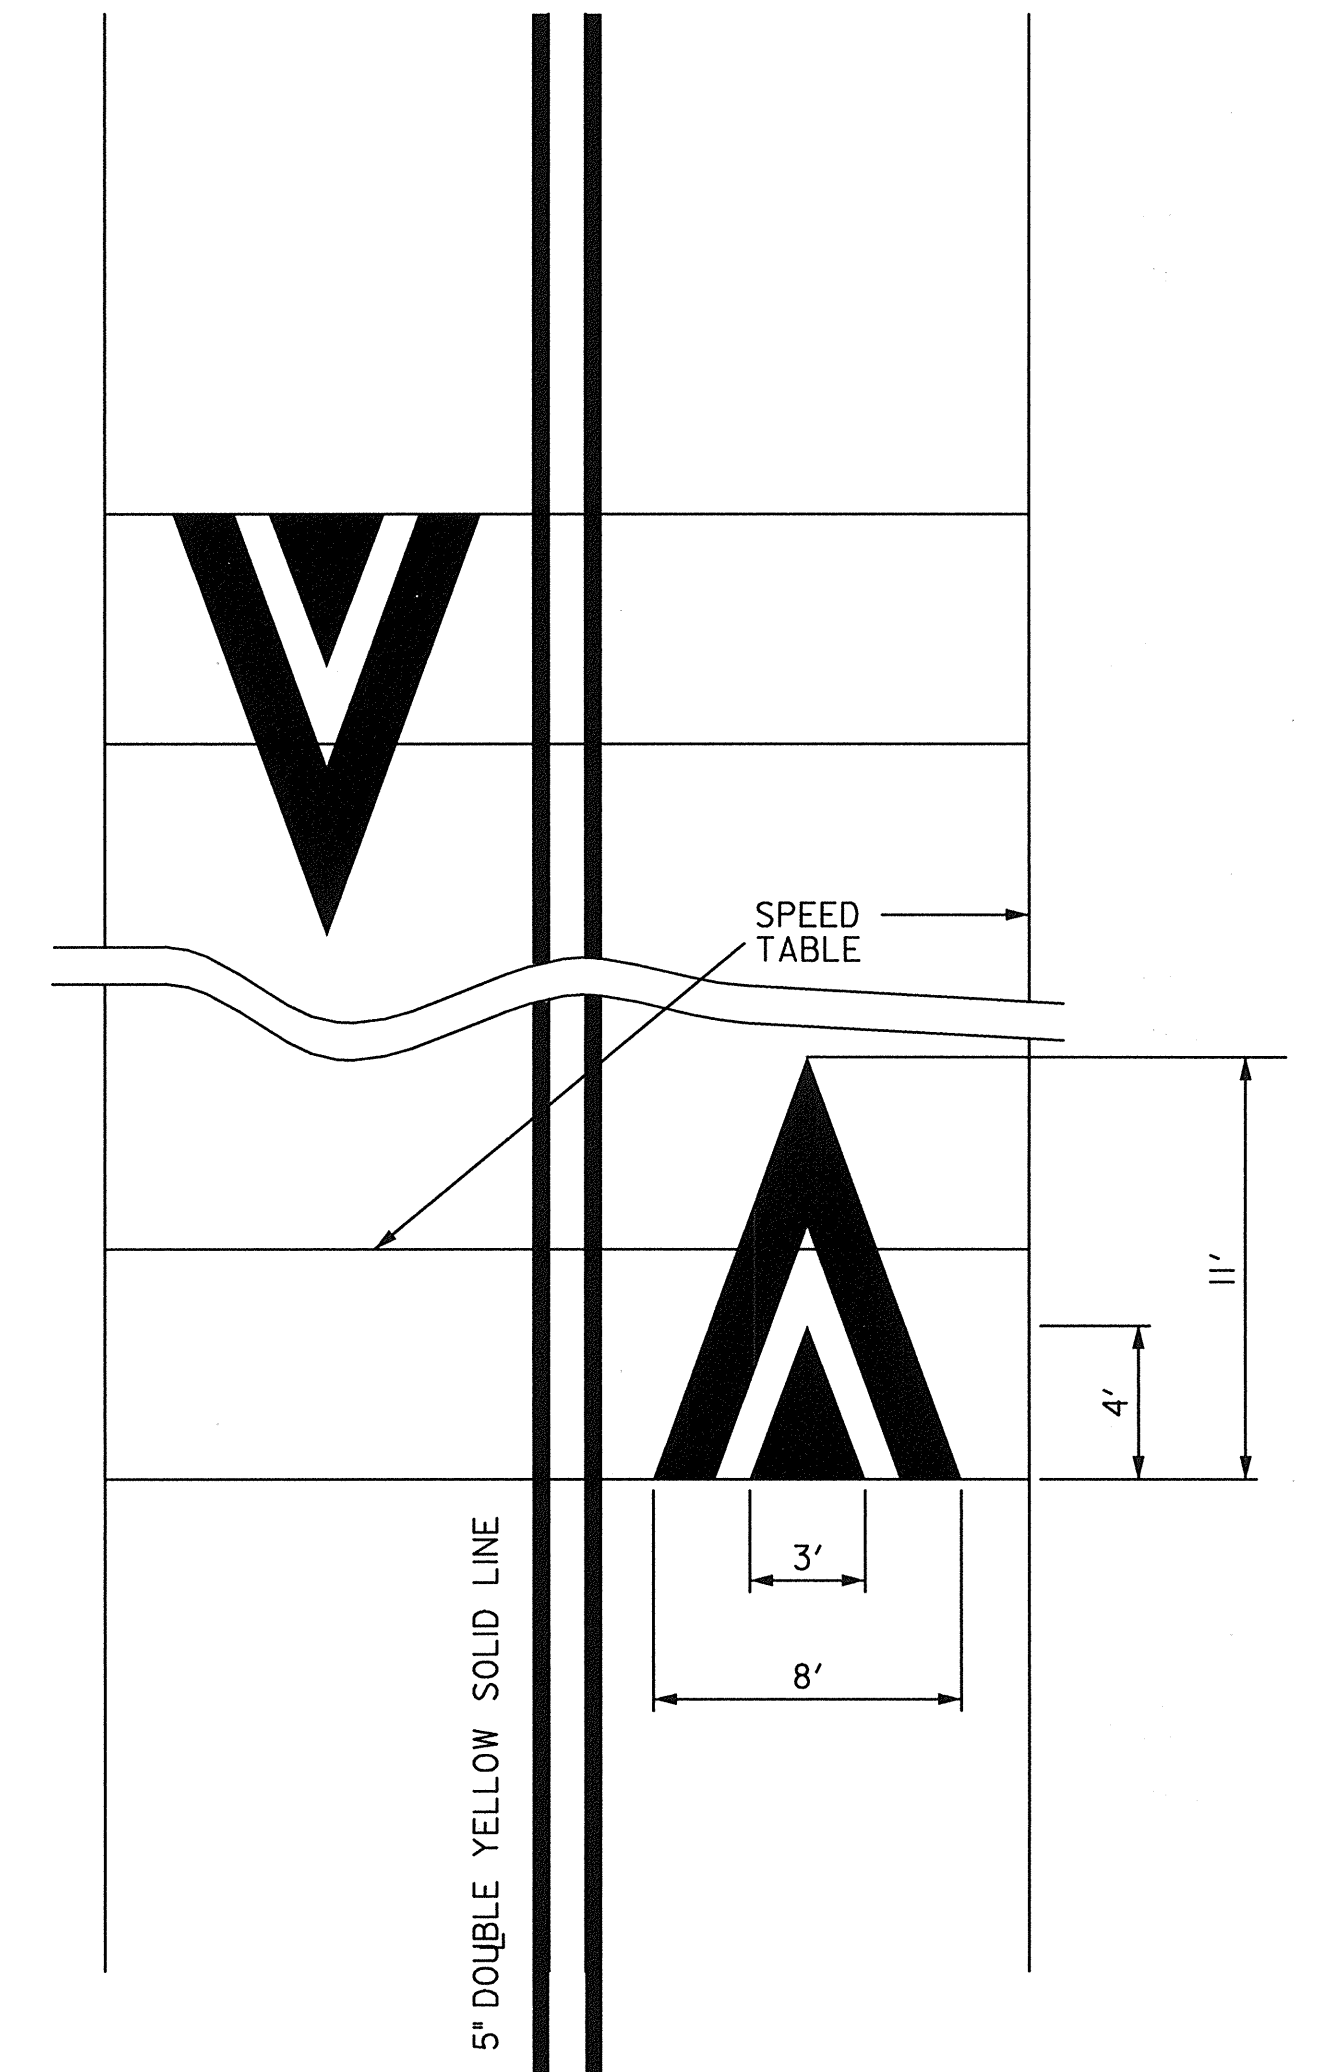

TYPICAL MARKING DETAIL

NOT TO SCALE




DEPARTMENT OF PUBLIC WORKS
HOWARD COUNTY, MARYLAND

John J. ... 9/22/03
CHIEF, BUREAU OF ENGINEERING

Fuellyn E. ... 9/22/03
CHIEF, TRANSPORTATION AND SPECIAL PROJECTS DIVISION

William J. ... 9-24-03
CHIEF, BUREAU OF HIGHWAYS

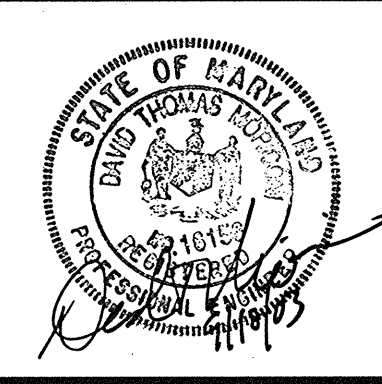

URS
HUNT VALLEY, MARYLAND

RJM
RJM ENGINEERING, INC.
CONSULTING ENGINEERS
COLUMBIA, MARYLAND

DES:				
DRN:				
CHK:				
DATE:	BY	NO.	REVISION	DATE

SPEED TABLE

NO.: _____ DATE: 9/03


**McKENZIE ROAD ROADWAY
AND STORMDRAIN IMPROVEMENTS**

HOWARD COUNTY, MARYLAND
CAPITAL PROJECT NO. J-4164-10


SCALE AS SHOWN

SHEET 3 OF 24


LIMIT OF WORK
CONT. NO. J-4164-10
McKENZIE ROAD
STA. 100+27.26

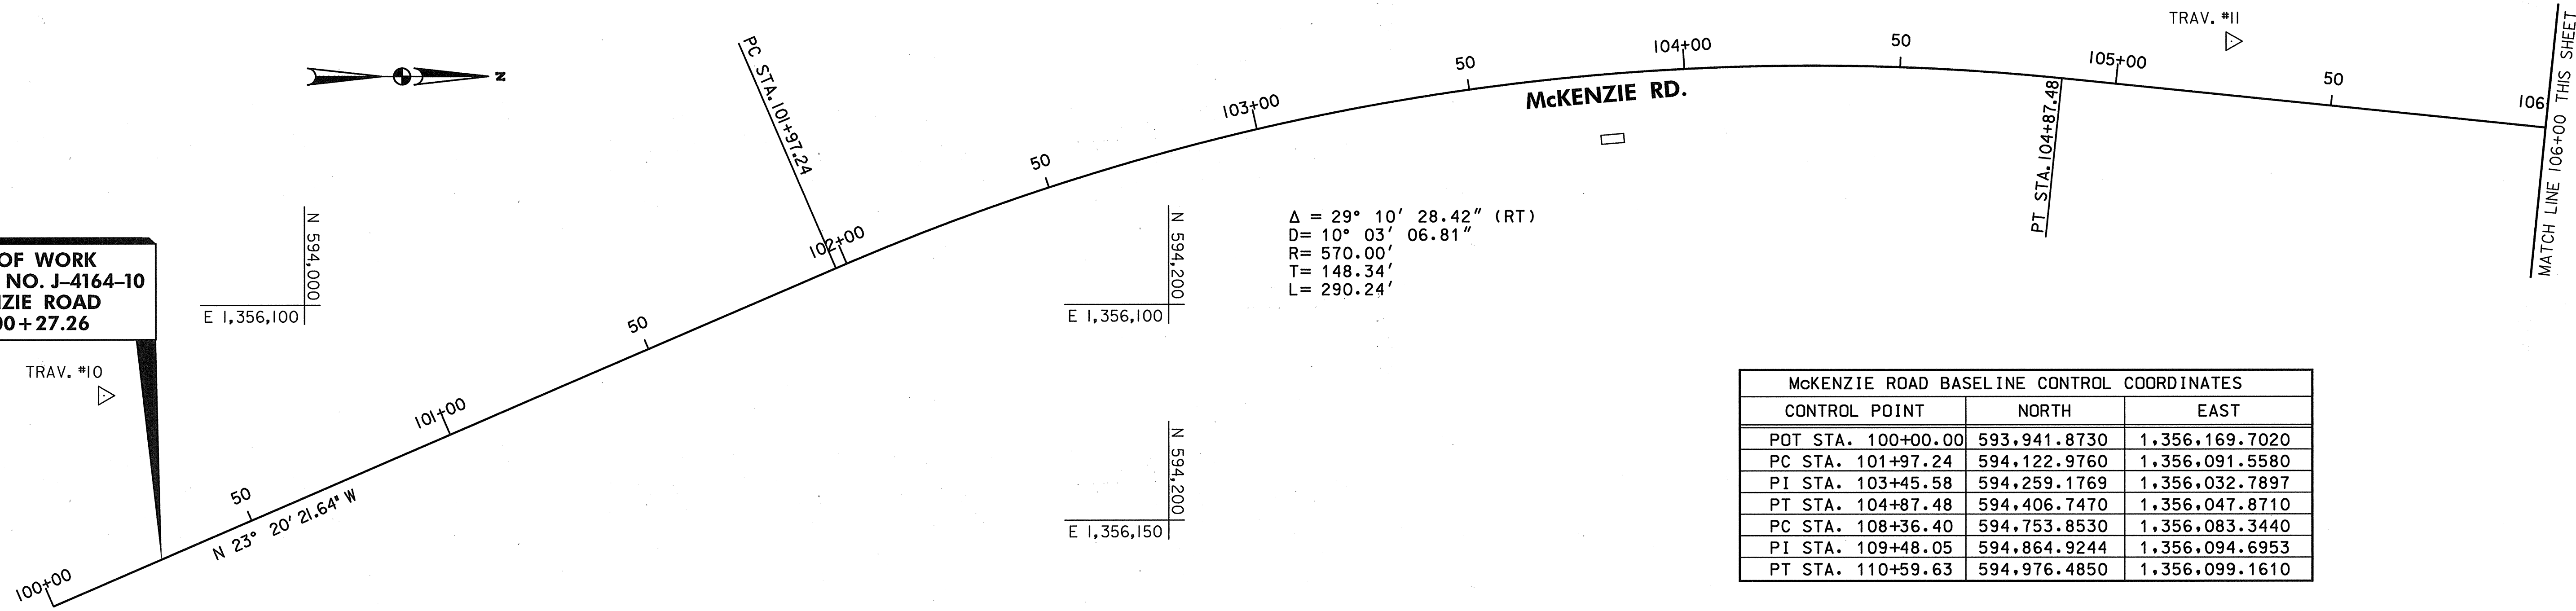


McKENZIE ROAD BASELINE CONTROL COORDINATES		
CONTROL POINT	NORTH	EAST
POT STA. 100+00.00	593,941.8730	1,356,169.7020
PC STA. 101+97.24	594,122.9760	1,356,091.5580
PI STA. 103+45.58	594,259.1769	1,356,032.7897
PT STA. 104+87.48	594,406.7470	1,356,047.8710
PC STA. 108+36.40	594,753.8530	1,356,083.3440
PI STA. 109+48.05	594,864.9244	1,356,094.6953
PT STA. 110+59.63	594,976.4850	1,356,099.1610

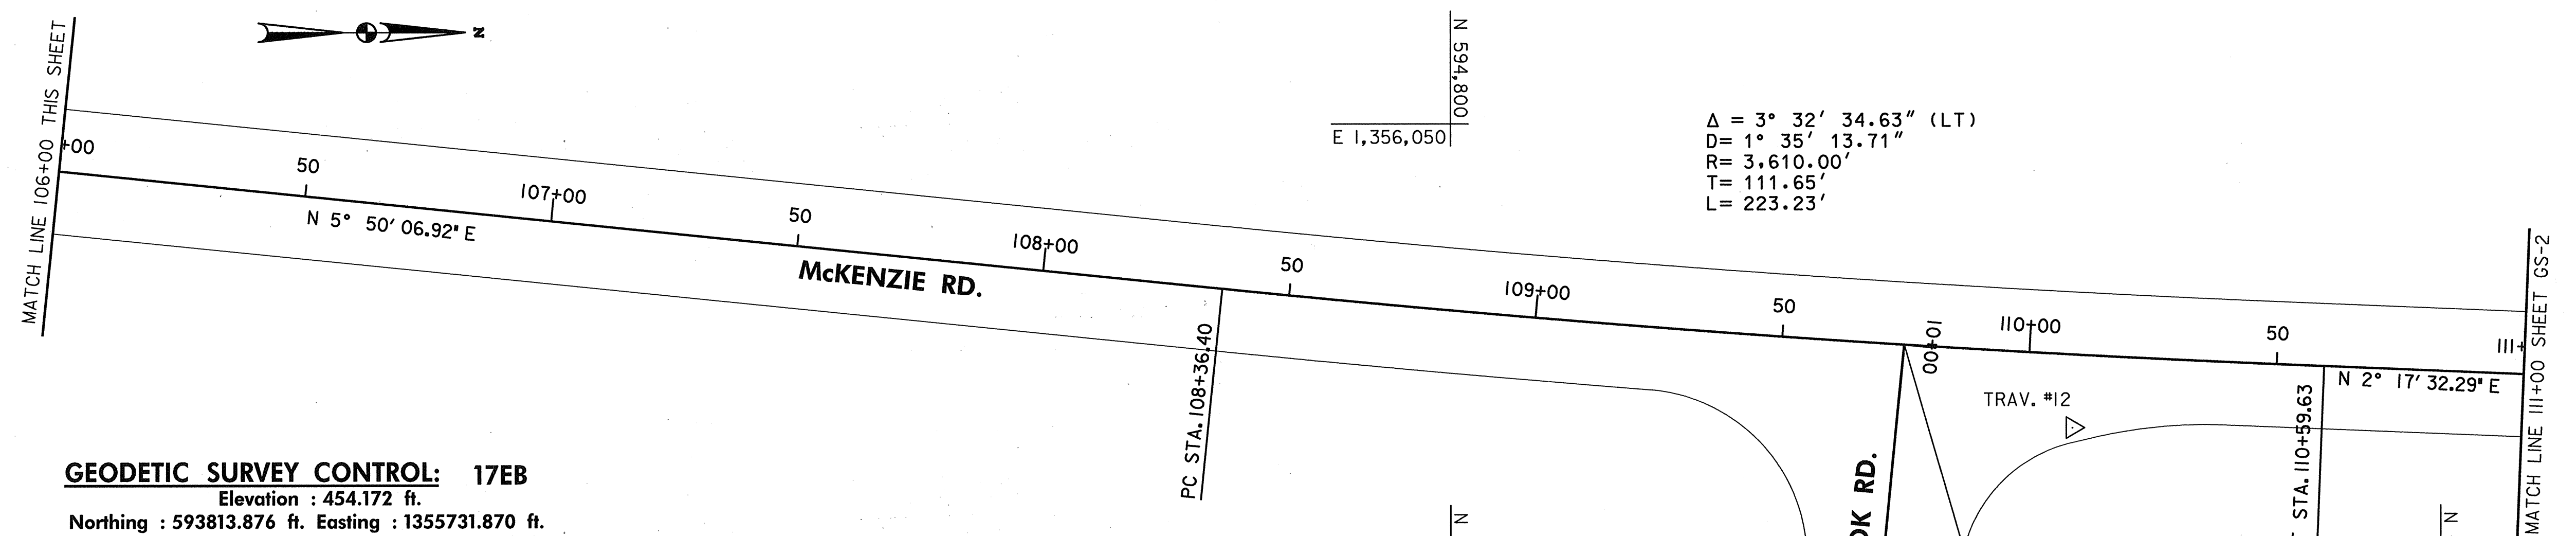


GEODETIC SURVEY CONTROL: 17EA
 Elevation : 479.462 ft.
 Northing : 594357.618 ft. Easting : 1357519.371 ft.

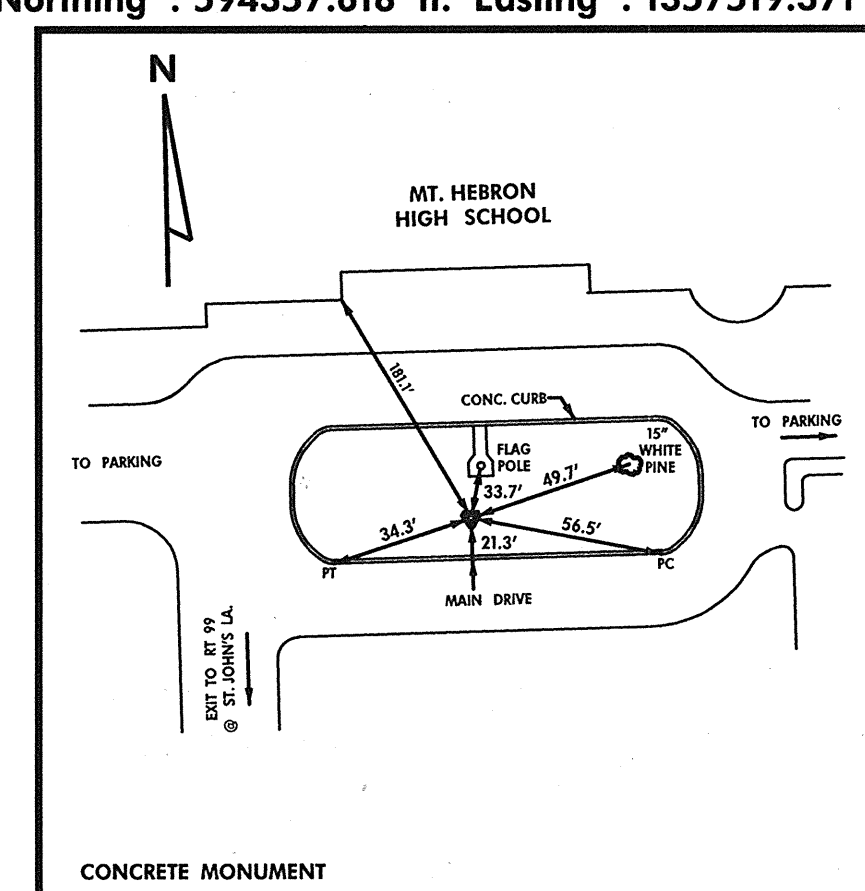

GEODETIC SURVEY CONTROL: 17EB
 Elevation : 454.172 ft.
 Northing : 593813.876 ft. Easting : 1355731.870 ft.

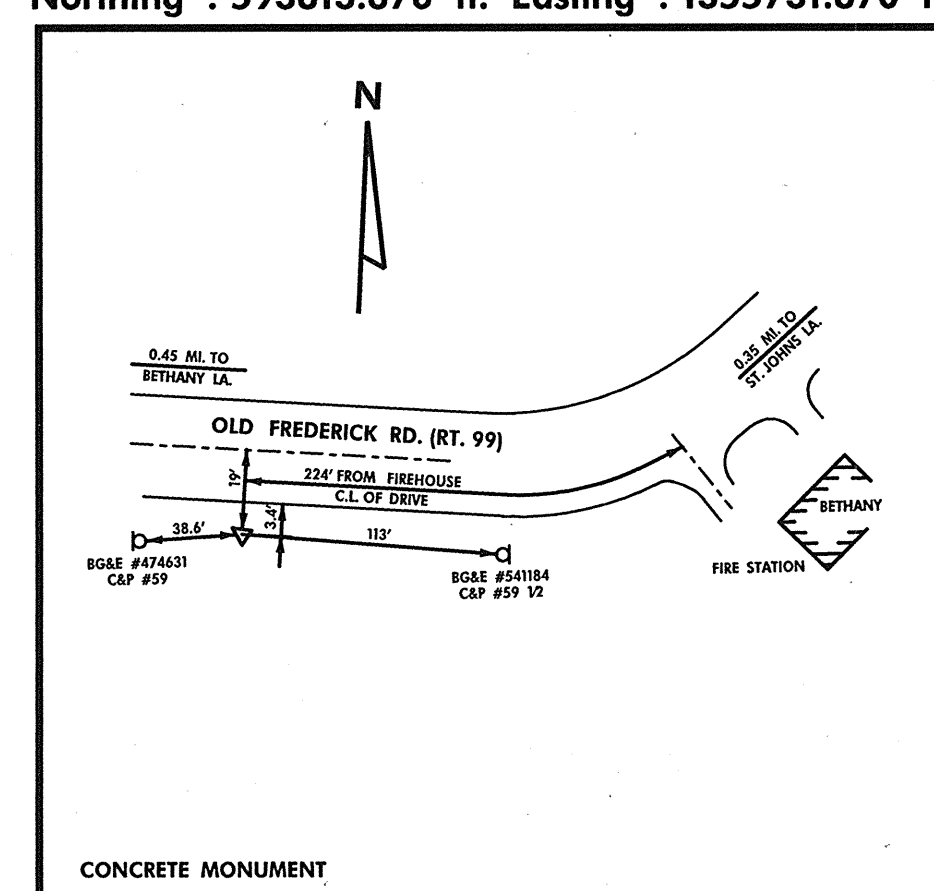


CONTROL POINTS		
CONTROL POINT	NORTH	EAST
TRAV 10	593,953.5717	1,356,120.9294
TRAV 11	594,445.9143	1,356,039.3153
TRAV 12	594,925.5961	1,356,111.5476
TRAV 13	595,317.6345	1,356,107.0275
TRAV 14	595,661.7865	1,356,146.0366
TRAV 15	596,041.1278	1,356,212.9679

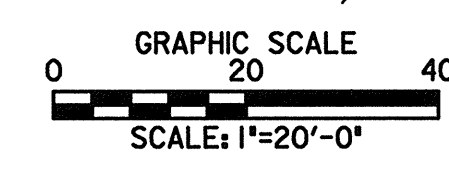

THORNBROOK ROAD BASELINE CONTROL COORDINATES		
CONTROL POINT	NORTH	EAST
POT STA. 10+00.00	594,891.6298	1,356,094.7628
POT STA. 11+12.80	594,880.6093	1,356,207.0269

DEPARTMENT OF PUBLIC WORKS
 HOWARD COUNTY, MARYLAND
 [Signatures and Dates]
 CHIEF, BUREAU OF ENGINEERING
 CHIEF, BUREAU OF HIGHWAYS
 CHIEF, TRANSPORTATION AND SPECIAL PROJECTS DIVISION

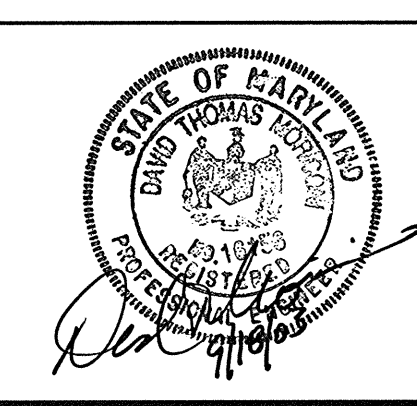


URS
 HUNT VALLEY, MARYLAND
RJM
 RJM ENGINEERING, INC.
 CONSULTING ENGINEERS
 COLUMBIA, MARYLAND
 TEL: 410/730-1001 FAX: 410/730-5403

DES:				
DRN:				
CHK:				
DATE:	BY	NO.	REVISION	DATE


GEOMETRIC LAYOUT
SHEET GS-1
 NO.: _____ DATE: 9/03

McKENZIE ROAD ROADWAY
AND STORMDRAIN IMPROVEMENTS
 HOWARD COUNTY, MARYLAND
 CAPITAL PROJECT NO. J-4164-10

SCALE AS SHOWN
 SHEET 4 OF 24

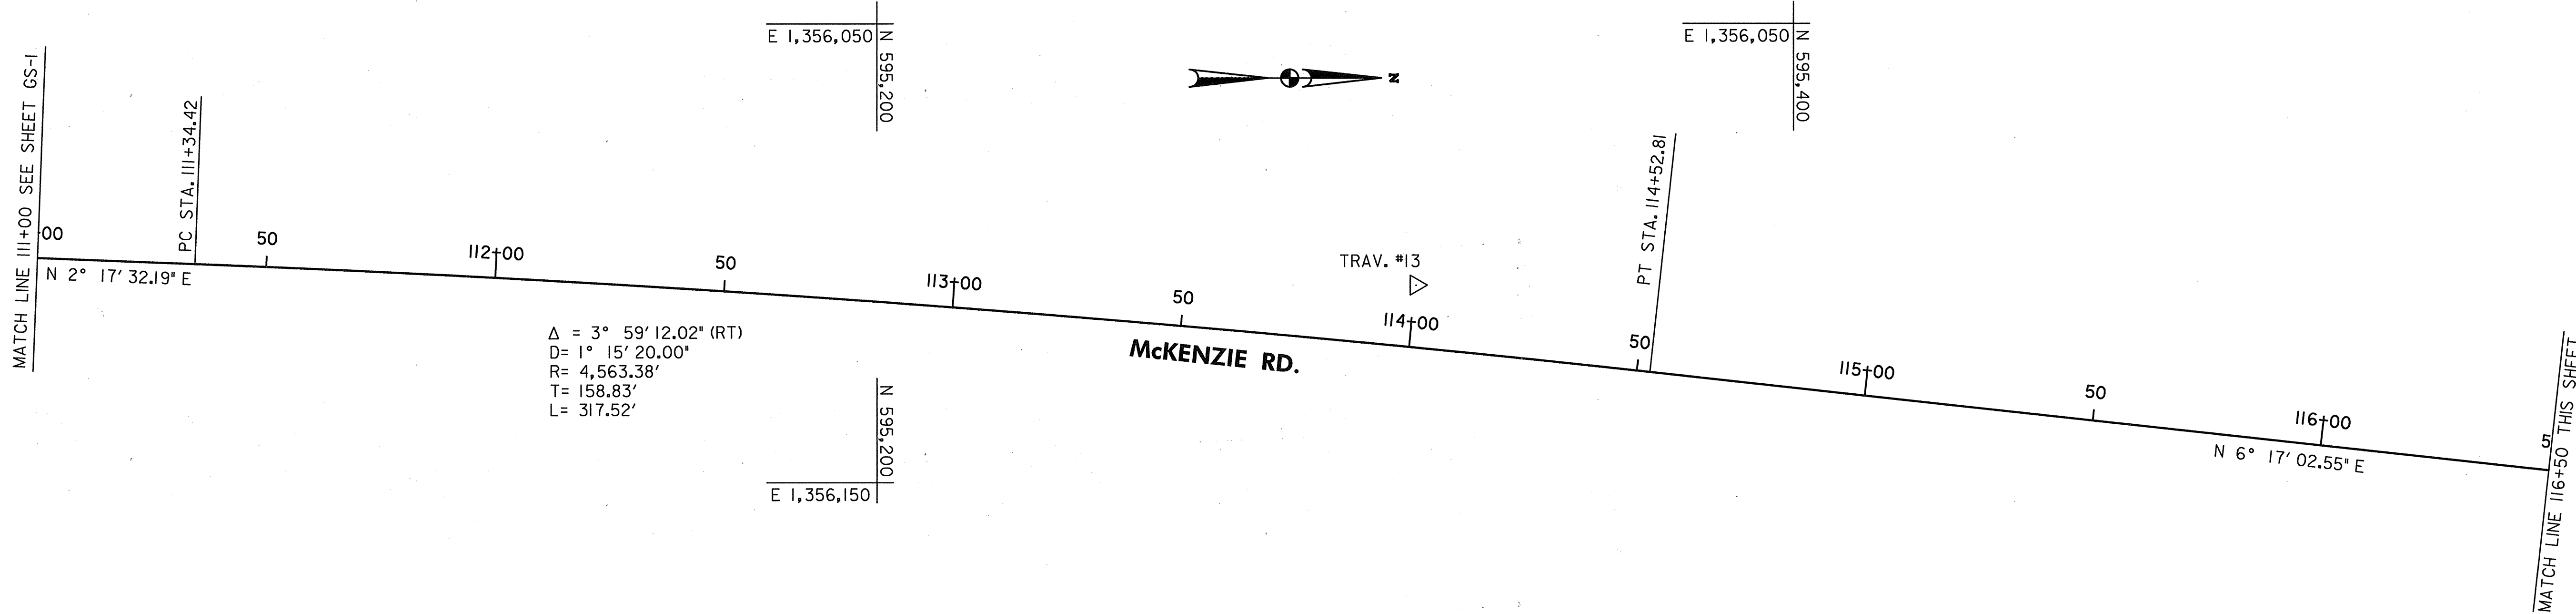

$\Delta = 3^\circ 59' 12.02''$ (RT)
 $D = 1^\circ 15' 20.00''$
 $R = 4,563.38'$
 $T = 158.83'$
 $L = 317.52'$

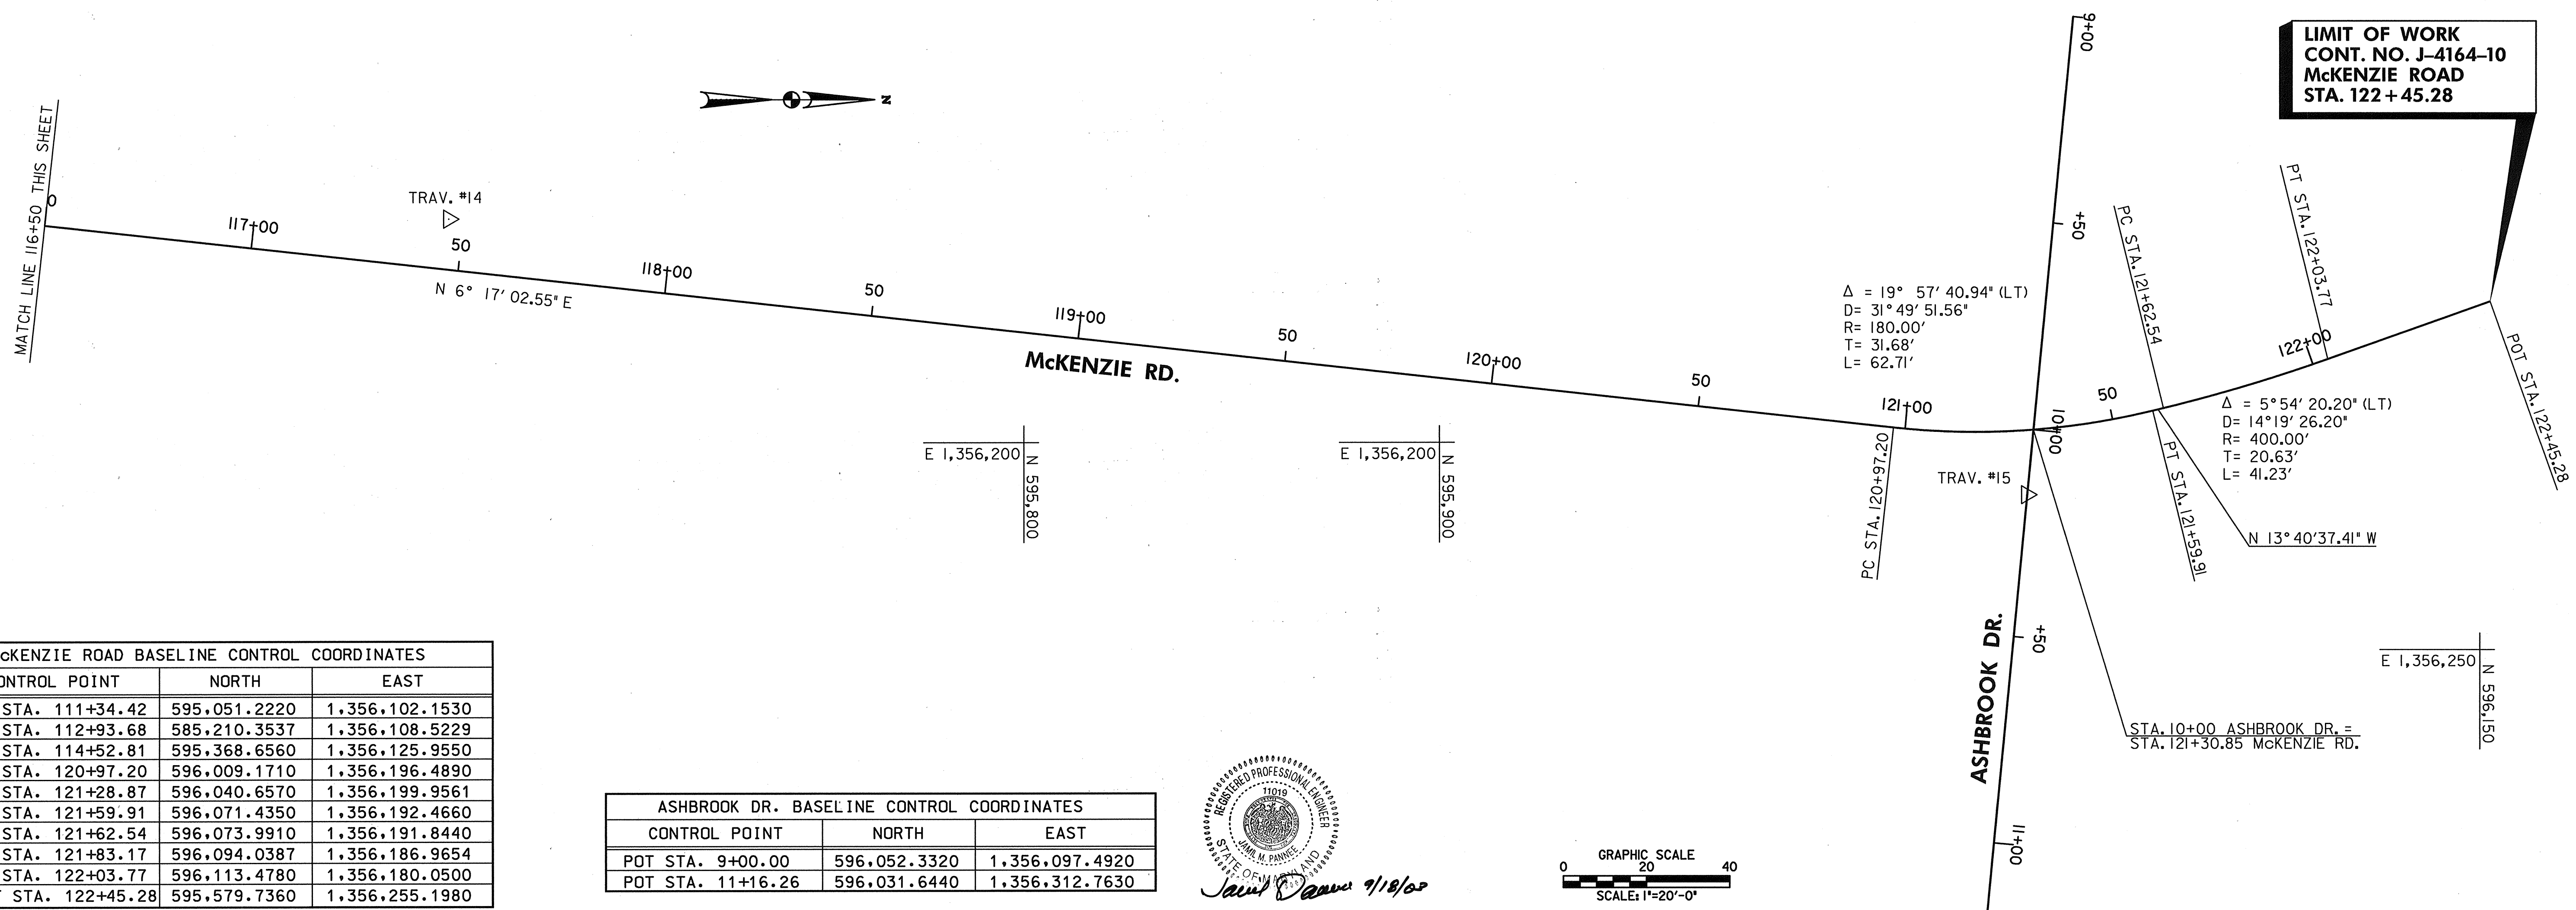

**LIMIT OF WORK
CONT. NO. J-4164-10
McKENZIE ROAD
STA. 122 + 45.28**


$\Delta = 19^\circ 57' 40.94''$ (LT)
 $D = 31^\circ 49' 51.56''$
 $R = 180.00'$
 $T = 31.68'$
 $L = 62.71'$

$\Delta = 5^\circ 54' 20.20''$ (LT)
 $D = 14^\circ 19' 26.20''$
 $R = 400.00'$
 $T = 20.63'$
 $L = 41.23'$

McKENZIE ROAD BASELINE CONTROL COORDINATES		
CONTROL POINT	NORTH	EAST
PC STA. 111+34.42	595,051.2220	1,356,102.1530
PI STA. 112+93.68	585,210.3537	1,356,108.5229
PT STA. 114+52.81	595,368.6560	1,356,125.9550
PC STA. 120+97.20	596,009.1710	1,356,196.4890
PI STA. 121+28.87	596,040.6570	1,356,199.9561
PT STA. 121+59.91	596,071.4350	1,356,192.4660
PC STA. 121+62.54	596,073.9910	1,356,191.8440
PI STA. 121+83.17	596,094.0387	1,356,186.9654
PT STA. 122+03.77	596,113.4780	1,356,180.0500
POT STA. 122+45.28	595,579.7360	1,356,255.1980

ASHBROOK DR. BASELINE CONTROL COORDINATES		
CONTROL POINT	NORTH	EAST
POT STA. 9+00.00	596,052.3320	1,356,097.4920
POT STA. 11+16.26	596,031.6440	1,356,312.7630


James M. Pannell
 9/18/03

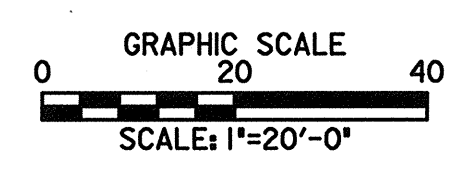

DEPARTMENT OF PUBLIC WORKS
 HOWARD COUNTY, MARYLAND

 CHIEF, BUREAU OF PUBLIC WORKS

 CHIEF, TRANSPORTATION AND SPECIAL PROJECTS DIVISION

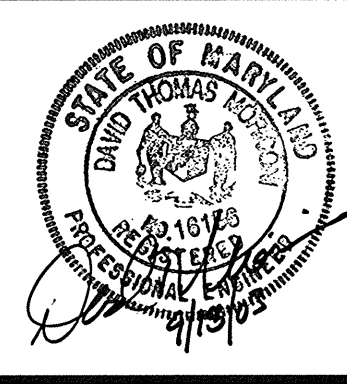

HUNT VALLEY, MARYLAND



RJM ENGINEERING, INC.
 CONSULTING ENGINEERS
 COLUMBIA, MARYLAND

DES:			
DRN:			
CHK:			
DATE:	BY	NO.	REVISION

**GEOMETRIC LAYOUT
SHEET GS-2**
 NO.: _____ DATE: 9/03

**McKENZIE ROAD ROADWAY
AND STORMDRAIN IMPROVEMENTS**
 HOWARD COUNTY, MARYLAND
 CAPITAL PROJECT NO. J-4164-10

SCALE AS SHOWN
 SHEET 5 OF 24

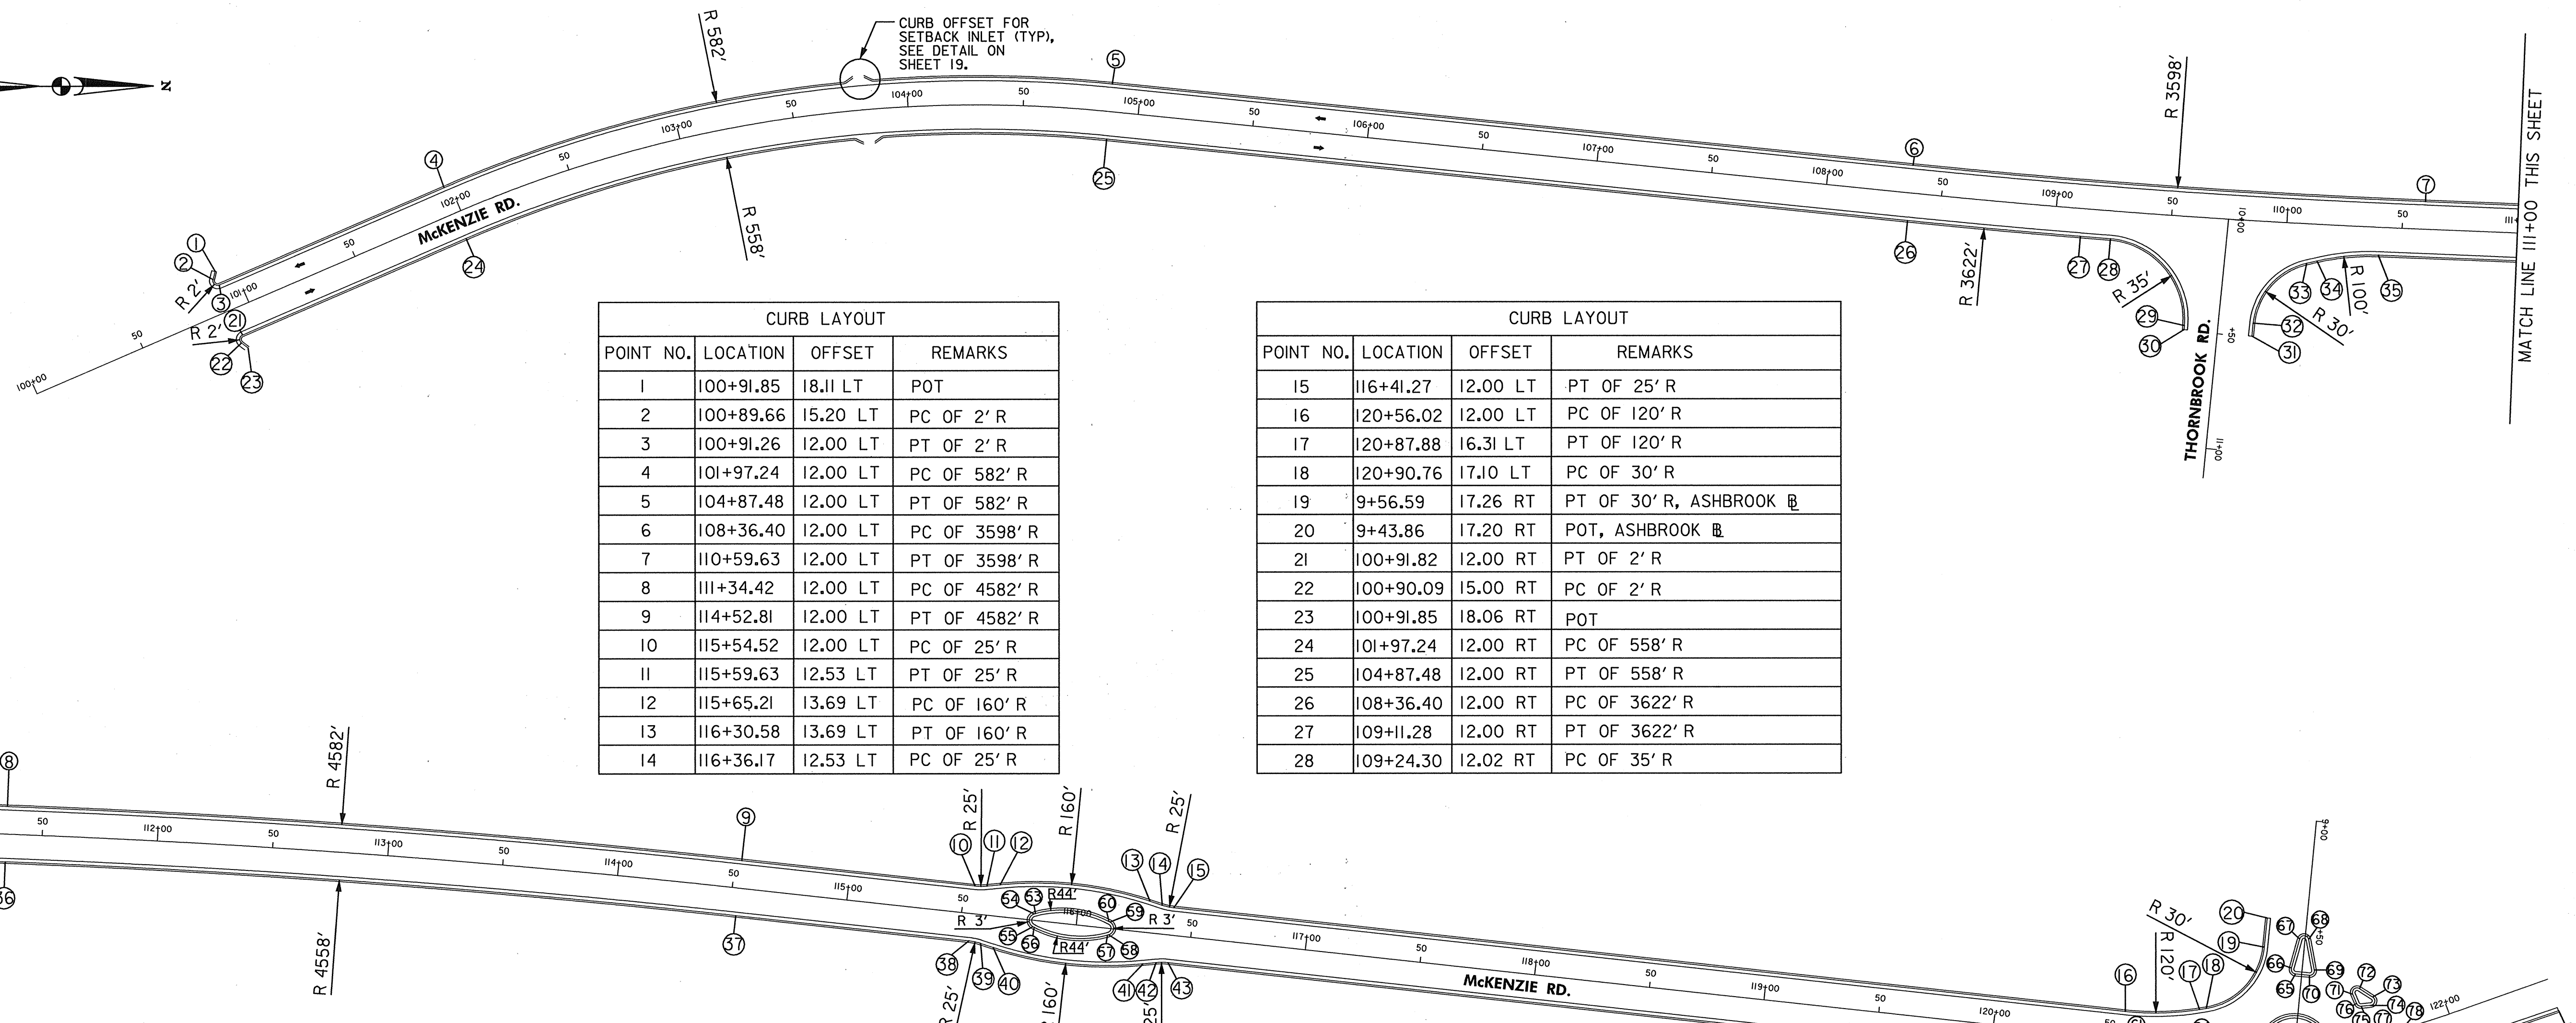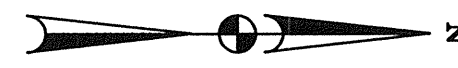

CURB LAYOUT			
POINT NO.	LOCATION	OFFSET	REMARKS
1	100+91.85	18.11 LT	POT
2	100+89.66	15.20 LT	PC OF 2' R
3	100+91.26	12.00 LT	PT OF 2' R
4	101+97.24	12.00 LT	PC OF 582' R
5	104+87.48	12.00 LT	PT OF 582' R
6	108+36.40	12.00 LT	PC OF 3598' R
7	110+59.63	12.00 LT	PT OF 3598' R
8	111+34.42	12.00 LT	PC OF 4582' R
9	114+52.81	12.00 LT	PT OF 4582' R
10	115+54.52	12.00 LT	PC OF 25' R
11	115+59.63	12.53 LT	PT OF 25' R
12	115+65.21	13.69 LT	PC OF 160' R
13	116+30.58	13.69 LT	PT OF 160' R
14	116+36.17	12.53 LT	PC OF 25' R

CURB LAYOUT			
POINT NO.	LOCATION	OFFSET	REMARKS
15	116+41.27	12.00 LT	PT OF 25' R
16	120+56.02	12.00 LT	PC OF 120' R
17	120+87.88	16.31 LT	PT OF 120' R
18	120+90.76	17.10 LT	PC OF 30' R
19	9+56.59	17.26 RT	PT OF 30' R, ASHBROOK DR
20	9+43.86	17.20 RT	POT, ASHBROOK DR
21	100+91.82	12.00 RT	PT OF 2' R
22	100+90.09	15.00 RT	PC OF 2' R
23	100+91.85	18.06 RT	POT
24	101+97.24	12.00 RT	PC OF 558' R
25	104+87.48	12.00 RT	PT OF 558' R
26	108+36.40	12.00 RT	PC OF 3622' R
27	109+11.28	12.00 RT	PT OF 3622' R
28	109+24.30	12.02 RT	PC OF 35' R


MATCH LINE 111+00 THIS SHEET

MATCH LINE 111+00 THIS SHEET

CURB LAYOUT			
POINT NO.	LOCATION	OFFSET	REMARKS
29	10+47.81	14.51 RT	PT OF 35' R, THORNBROOK RD
30	10+49.57	14.51 RT	POT, THORNBROOK RD
31	10+49.57	15.05 LT	POT, THORNBROOK RD
32	10+43.91	15.09 LT	PC OF 30' R, THORNBROOK RD
33	110+9.45	17.12 RT	PT OF 30' R
34	110+13.90	15.83 RT	PC OF 100' R
35	110+40.13	12.05 RT	PT OF 100' R
36	111+34.42	12.00 RT	PC OF 4558' R
37	114+52.81	12.00 RT	PT OF 4558' R
38	115+54.52	12.00 RT	PC OF 25' R
39	115+59.63	12.53 RT	PT OF 25' R
40	115+65.21	13.69 RT	PC OF 160' R
41	116+30.58	13.69 RT	PT OF 160' R
42	116+36.17	12.53 RT	PC OF 25' R
43	116+41.27	12.00 RT	PT OF 25' R
44	120+75.44	12.00 RT	PC OF 40' R
45	10+53.62	15.97 RT	PT OF 40' R, ASHBROOK DR
46	10+54.38	15.96 RT	POT, ASHBROOK DR
47	10+54.38	14.07 LT	POT, ASHBROOK DR
48	10+52.92	14.05 LT	PC OF 45' R, ASHBROOK DR
49	121+58.25	22.97 RT	PT OF 45' R
50	121+88.03	15.60 RT	PC OF 100' R

CURB LAYOUT			
POINT NO.	LOCATION	OFFSET	REMARKS
51	122+4.11	14.07 RT	PT OF 100' R
52	122+45.28	14.54 RT	POT
53	115+81.91	3.00 LT	PT OF 44' R
54	115+81.38	2.79 LT	PC OF 3' R
55	115+81.38	2.79 LT	PT OF 3' R
56	115+81.91	3.00 RT	PC OF 44' R
57	116+13.89	3.00 RT	PT OF 44' R
58	116+14.42	2.79 RT	PC OF 3' R
59	116+14.42	2.79 RT	PT OF 3' R
60	116+13.89	3.00 RT	PC OF 44' R
61	120+65.64	2.00 LT	PC OF 2' R
62	120+65.64	2.00 RT	PT OF 2' R
63	120+96.69	2.00 RT	PC OF 2' R
64	120+96.69	2.00 LT	PT OF 2' R
65	9+66.88	2.65 RT	PC OF 2' R, ASHBROOK DR
66	9+64.53	4.62 RT	PT OF 2' R, ASHBROOK DR
67	9+51.61	2.32 RT	PC OF 2' R, ASHBROOK DR
68	9+51.41	1.57 LT	PT OF 2' R, ASHBROOK DR
69	9+64.32	5.28 LT	PC OF 2' R, ASHBROOK DR
70	9+66.88	3.36 LT	PT OF 2' R, ASHBROOK DR
71	121+61.35	20.06 LT	PC OF 2' R

CURB LAYOUT			
POINT NO.	LOCATION	OFFSET	REMARKS
72	121+64.91	21.74 LT	PT OF 2' R
73	121+69.76	16.78 LT	PC OF 2' R
74	121+67.88	13.45 LT	PT OF 2' R
75	121+63.73	14.09 LT	PC OF 2' R
76	121+62.02	15.77 LT	PT OF 2' R
77	121+66.60	1.49 LT	PC OF 2' R
78	121+78.06	0.54 RT	PT OF 2' R
79	121+78.12	4.46 RT	PC OF 2' R
80	121+66.74	7.21 RT	PT OF 2' R
81	121+64.28	5.27 RT	PC OF 2' R
82	121+64.28	0.48 RT	PT OF 2' R
83	10+33.26	0.49 RT	PC OF 2' R, ASHBROOK DR
84	10+35.41	1.51 LT	PT OF 2' R, ASHBROOK DR
85	10+44.16	0.81 LT	PC OF 2' R, ASHBROOK DR
86	10+44.38	3.15 RT	PT OF 2' R, ASHBROOK DR
87	10+35.63	4.83 RT	PC OF 2' R, ASHBROOK DR
88	10+33.26	2.87 RT	PT OF 2' R, ASHBROOK DR

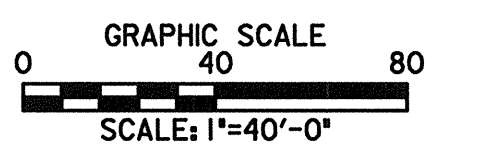


DEPARTMENT OF PUBLIC WORKS
HOWARD COUNTY, MARYLAND

James M. Cannon 9/22/03
DATE

Richard J. Sporn 9/22/03
DATE

Elizabeth E. Jones 9/22/03
DATE

William F. Anderson 9-24-03
DATE

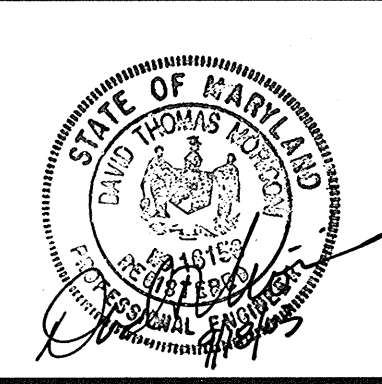

URS
HUNT VALLEY, MARYLAND

RJM
RJM ENGINEERING, INC.
CONSULTING ENGINEERS
COLUMBIA, MARYLAND

TELE: (410) 730-1001 FAX: (410) 730-5403

DES:				
DRN:				
CHK:				
DATE:	BY	NO.	REVISION	DATE

CURB GEOMETRY SHEET

NO.: _____ DATE: 9/03

McKENZIE ROAD ROADWAY AND STORMDRAIN IMPROVEMENTS

HOWARD COUNTY, MARYLAND
CAPITAL PROJECT NO. J-4164-10

SCALE AS SHOWN

SHEET 6 OF 24

RELOCATE EX. MAILBOX (SEE DETAIL A THIS SHEET)	
STATION	OFFSET
103+26	15.83' LT
104+70	13.02' LT
105+12	11.72' RT

RECONSTRUCT CONCRETE DRIVEWAY	
STATION	QUANTITY (SY)
102+95.67 LT	35.23
104+89.34 LT	18.18

RECONSTRUCT ASPHALT DRIVEWAY	
STATION	QUANTITY (SY)
102+79.12 RT	27.73
103+16.20 RT	25.52
104+39.69 RT	22.16
104+98.17 RT	9.42

ROTATE SANITARY MANHOLE	
STATION	OFFSET
105+64	12' LT

CONSTRUCT STD. COMB. CURB AND GUTTER		
FROM STATION	TO STATION	QUANTITY (LF)
100+91.85 LT	106+00 LT	515
100+91.85 RT	106+00 RT	515


RELOCATE EXISTING SIGN	
STATION	OFFSET
103+20.16	17.79 LT
104+66.84	13.59 LT
104+75.70	12.34 RT

ADJUST COVER ON MANHOLE	
STATION	OFFSET
103+61	15.2' LT

REMOVE HEDGES		
FROM STATION	TO STATION	QUANTITY (LF)
103+72 LT	106+00 LT	228'



CLEAN EXISTING PIPE CULVERT		
STATION	SIZE/TYPE	QUANTITY (LF)
103+60 LT	24" CMP	17'

CONSTRUCT 4" CONCRETE SIDEWALK		
FROM STATION	TO STATION	QUANTITY (SF)
100+90 LT	106+00 LT	2398

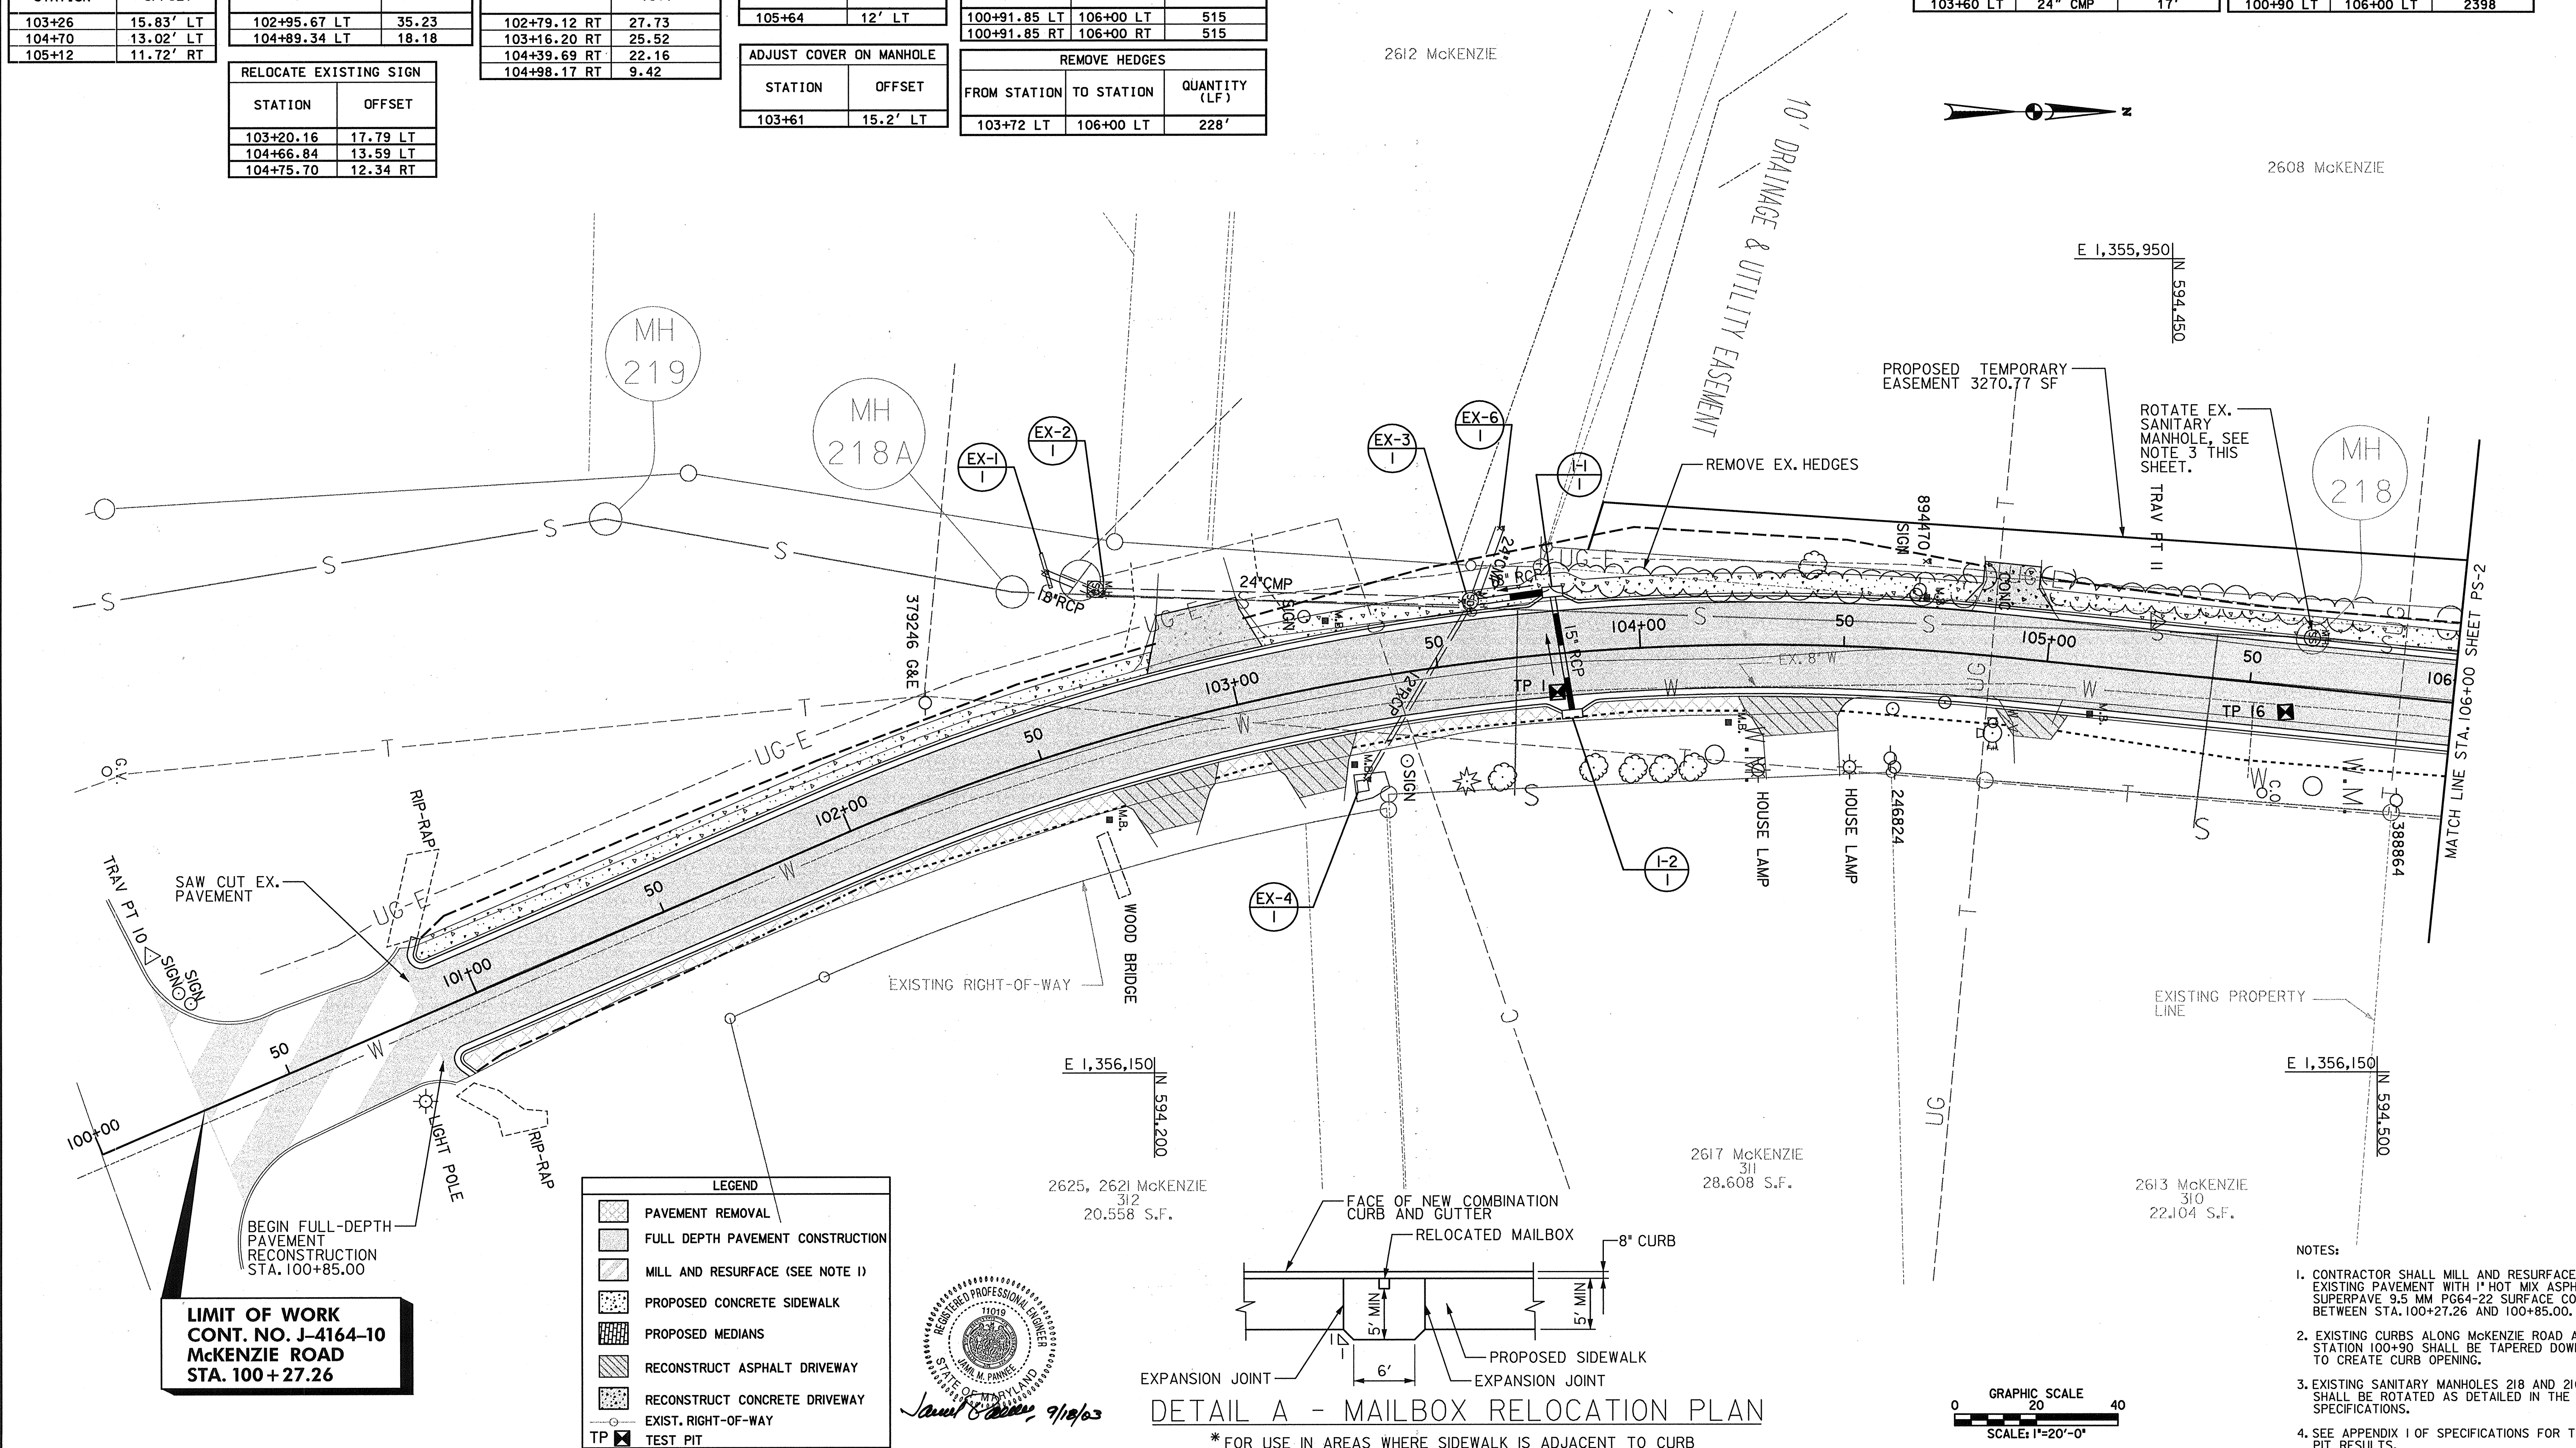


LIMIT OF WORK
CONT. NO. J-4164-10
McKENZIE ROAD
STA. 100+27.26

LEGEND	
[Pattern]	PAVEMENT REMOVAL
[Pattern]	FULL DEPTH PAVEMENT CONSTRUCTION
[Pattern]	MILL AND RESURFACE (SEE NOTE 1)
[Pattern]	PROPOSED CONCRETE SIDEWALK
[Pattern]	PROPOSED MEDIANS
[Pattern]	RECONSTRUCT ASPHALT DRIVEWAY
[Pattern]	RECONSTRUCT CONCRETE DRIVEWAY
[Pattern]	EXIST. RIGHT-OF-WAY
[Symbol]	TP TEST PIT

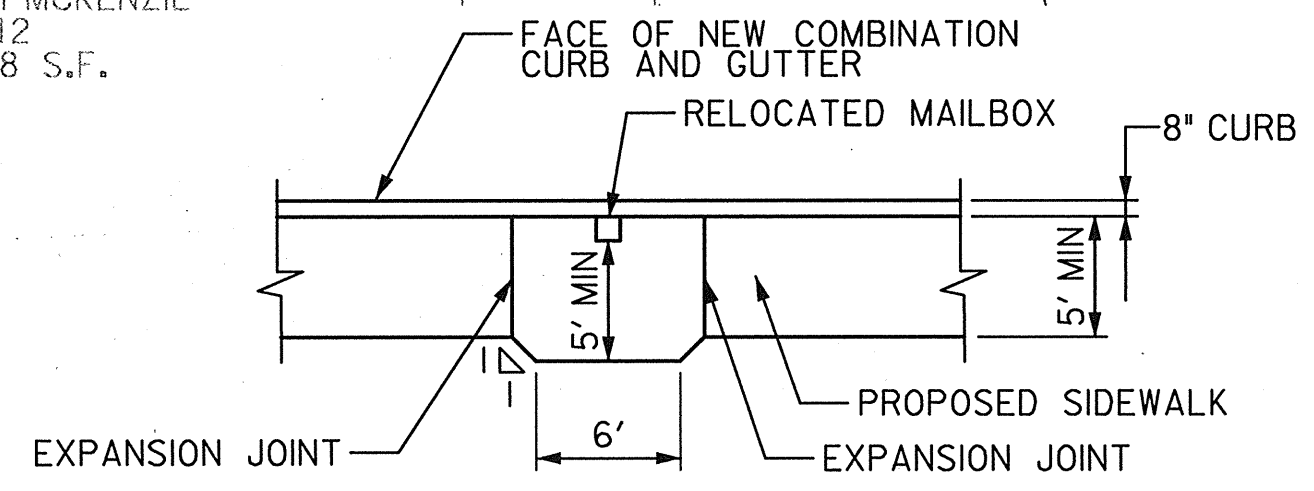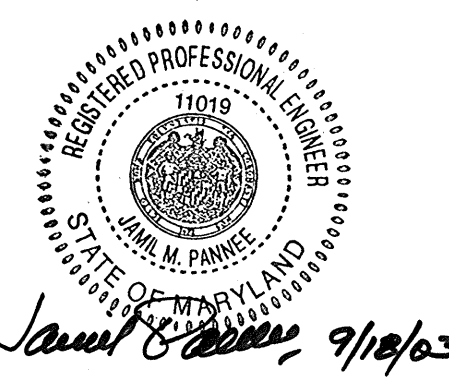

DETAIL A - MAILBOX RELOCATION PLAN
* FOR USE IN AREAS WHERE SIDEWALK IS ADJACENT TO CURB

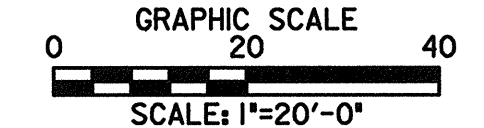


- NOTES:
- CONTRACTOR SHALL MILL AND RESURFACE 1" EXISTING PAVEMENT WITH 1" HOT MIX ASPHALT SUPERPAVE 9.5 MM PG64-22 SURFACE COURSE BETWEEN STA. 100+27.26 AND 100+85.00.
 - EXISTING CURBS ALONG MCKENZIE ROAD AT STATION 100+90 SHALL BE TAPERED DOWN TO CREATE CURB OPENING.
 - EXISTING SANITARY MANHOLES 218 AND 216 SHALL BE ROTATED AS DETAILED IN THE SPECIFICATIONS.
 - SEE APPENDIX I OF SPECIFICATIONS FOR TEST PIT RESULTS.

DEPARTMENT OF PUBLIC WORKS
HOWARD COUNTY, MARYLAND

Janet L. ... 9/22/03
CHIEF, BUREAU OF ENGINEERING

William J. ... 9-24-03
CHIEF, BUREAU OF HIGHWAYS

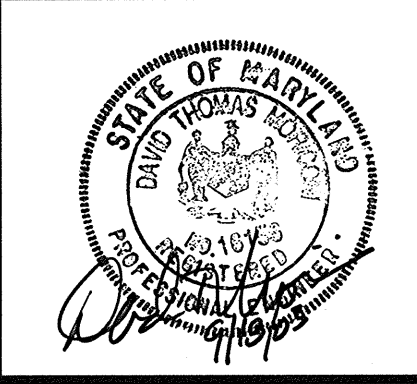

URS
HUNT VALLEY, MARYLAND

RJM
RJM ENGINEERING, INC.
CONSULTING ENGINEERS
COLUMBIA, MARYLAND

TEL: (410) 730-1000 FAX: (410) 730-5403

DES:				
DRN:				
CHK:				
DATE:	BY	NO.	REVISION	DATE

PLAN SHEET PS-1

NO.: _____ DATE: 9/03

McKENZIE ROAD ROADWAY AND STORMDRAIN IMPROVEMENTS

HOWARD COUNTY, MARYLAND
CAPITAL PROJECT NO. J-4164-10

SCALE AS SHOWN
SHEET 7 OF 24

RELOCATE EX. MAILBOX	
STATION	OFFSET
106+35	10.50' RT
107+39	11.57' RT
108+70	12.38' LT
109+12	14.17' LT
110+21	12.22' RT
110+23	12.68' LT

CONSTRUCT STD. COMB. CURB AND GUTTER		
FROM STATION	TO STATION	QUANTITY (LF)
106+00 LT	111+00 LT	500.0
106+00 RT	109+59 RT	381.0
109+88 RT	111+00 RT	134.0

ADJUST COVER ON MANHOLE	
STATION	OFFSET
109+67	16.82' LT

CONSTRUCT CONCRETE DRIVEWAY	
STATION	QUANTITY (SY)
107+46 LT	18.93
108+54 LT	25.97
109+35 LT	14.90
110+53 LT	17.35

REMOVE FENCE			
FROM STATION	TO STATION	OFFSET	QUANTITY (LF)
107+51 LT	107+56 LT	193' LT	93

CONSTRUCT ASPHALT DRIVEWAY	
STATION	QUANTITY (SY)
106+59 RT	12.58
107+57 RT	15.73



CONSTRUCT 4" CONCRETE SIDEWALK		
FROM STATION	TO STATION	QUANTITY (SF)
106+00 LT	111+00 LT	2027

REMOVE EXISTING INLET		
STATION	OFFSET	QUANTITY (EA)
110+2.1	15.5' RT	1


REMOVE EXISTING MANHOLE		
STATION	OFFSET	QUANTITY (EA)
109+30.8	14.7' RT	1

REMOVE EXISTING CURB AND GUTTER		
FROM STATION	TO STATION	QUANTITY (LF)
109+34.50 RT	10+49.57 RT	46.8
(@ MCKENZIE)	(@ THORNBROOK)	
10+49.57 LT	110+19.40 RT	54.7
(@ THORNBROOK)	(@ MCKENZIE)	

REMOVAL OF EXISTING PIPE CULVERTS			
FROM STATION	TO STATION	SIZE/TYPE	QUANTITY (LF)
107+70 RT	107+69 LT	12" CMP	36
108+49 RT	109+27 RT	18" CMP	80
109+34 RT	110+01 RT	UNKNOWN	67

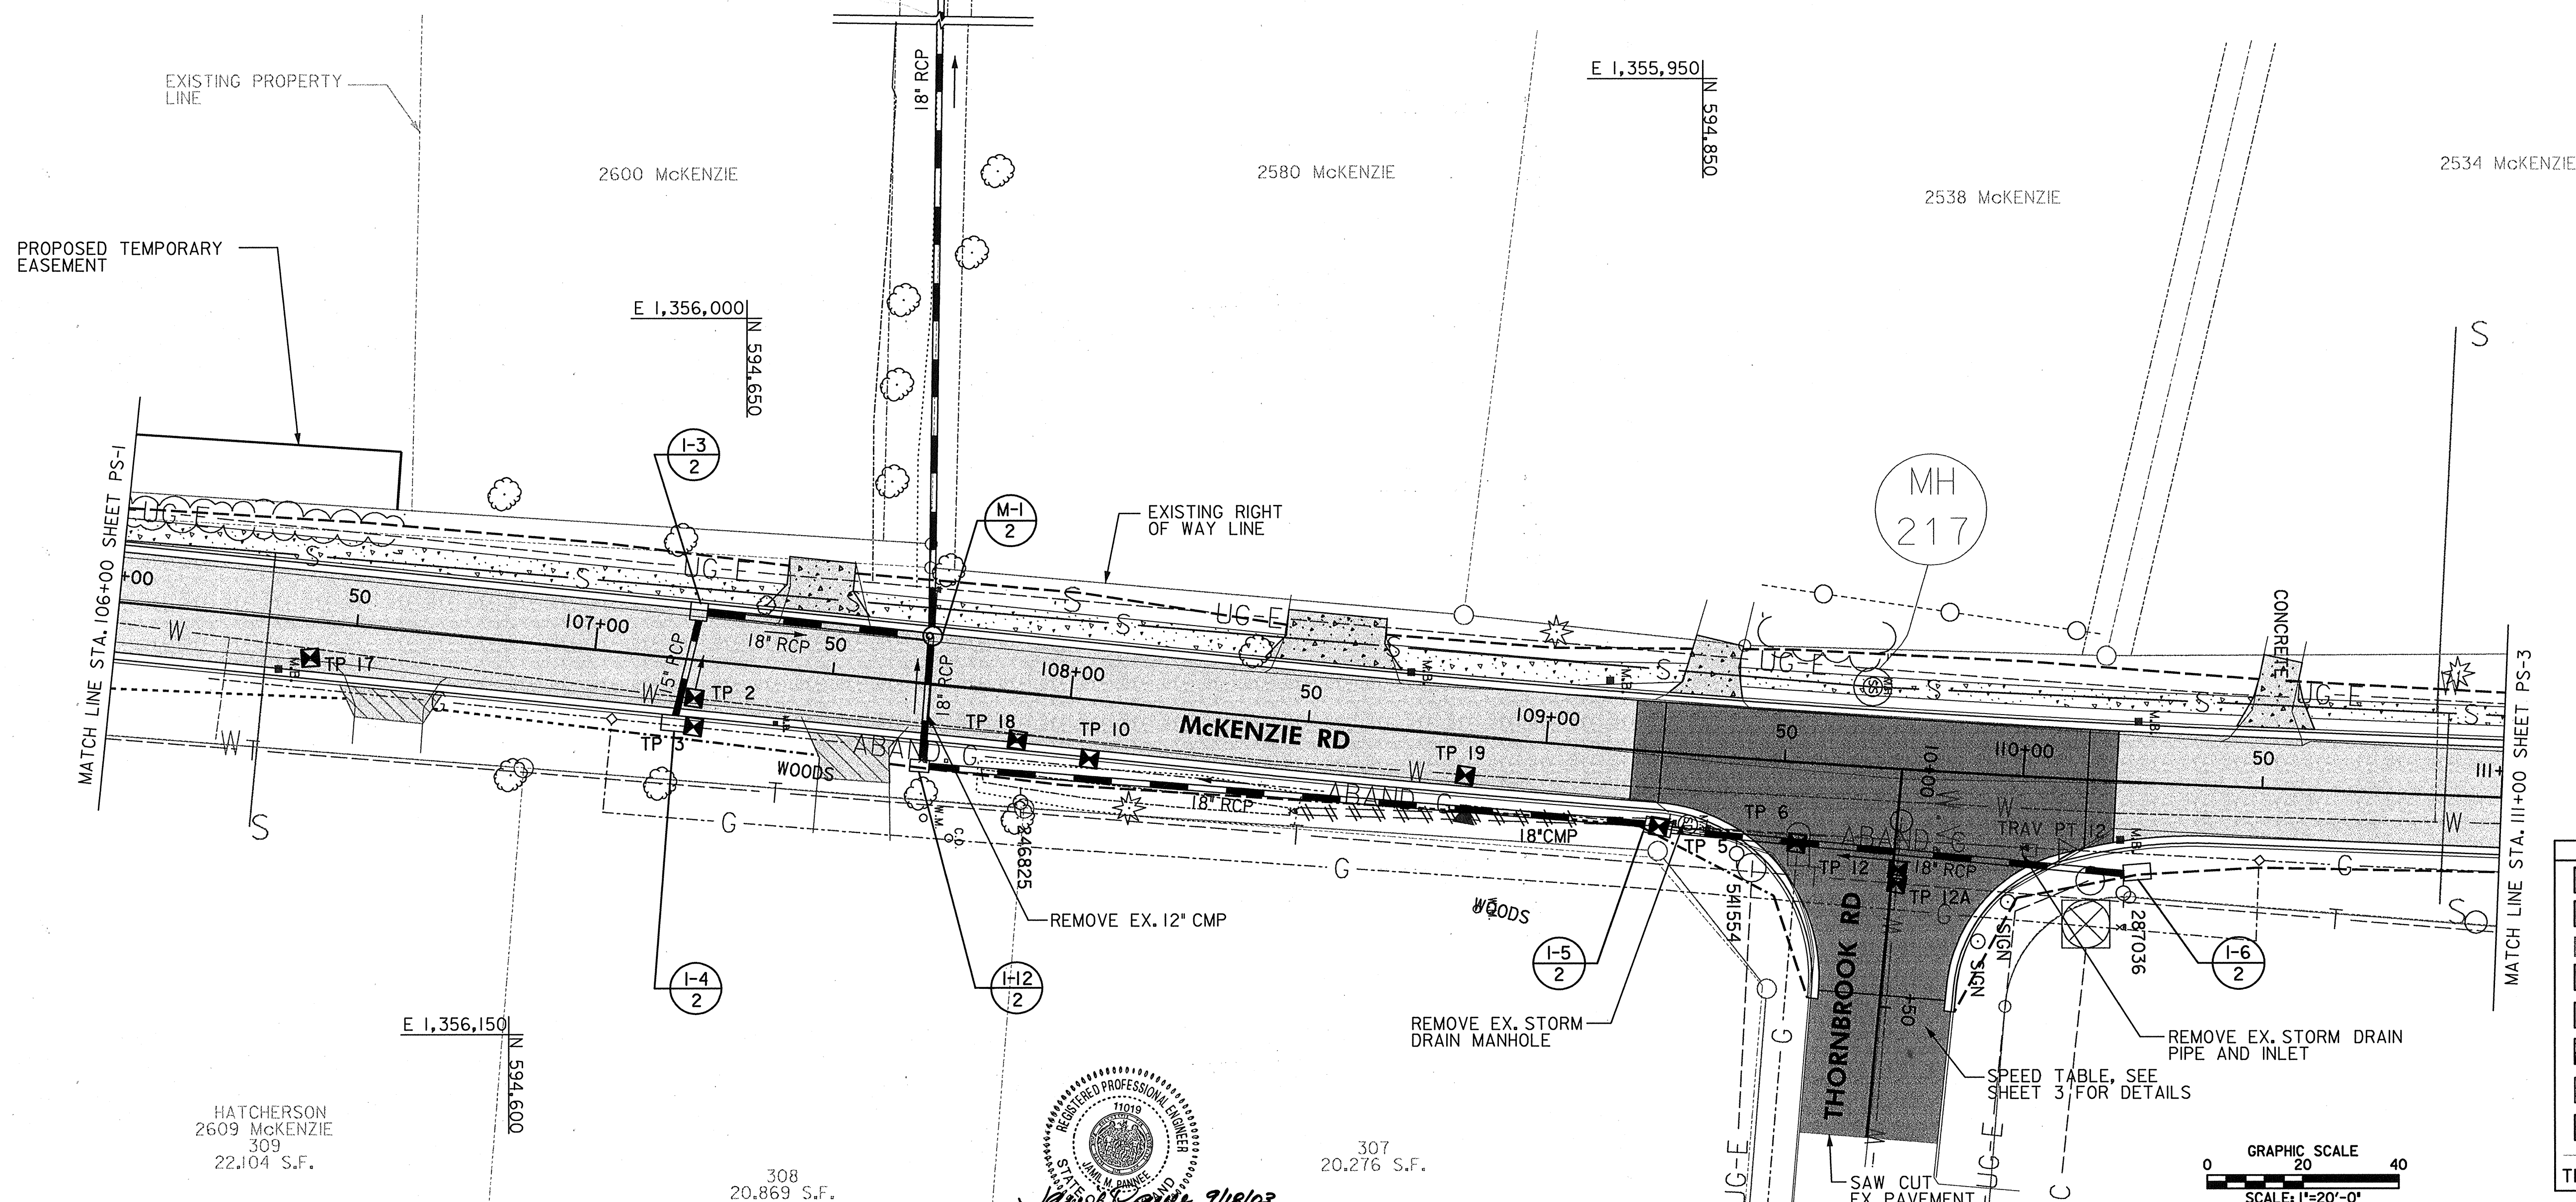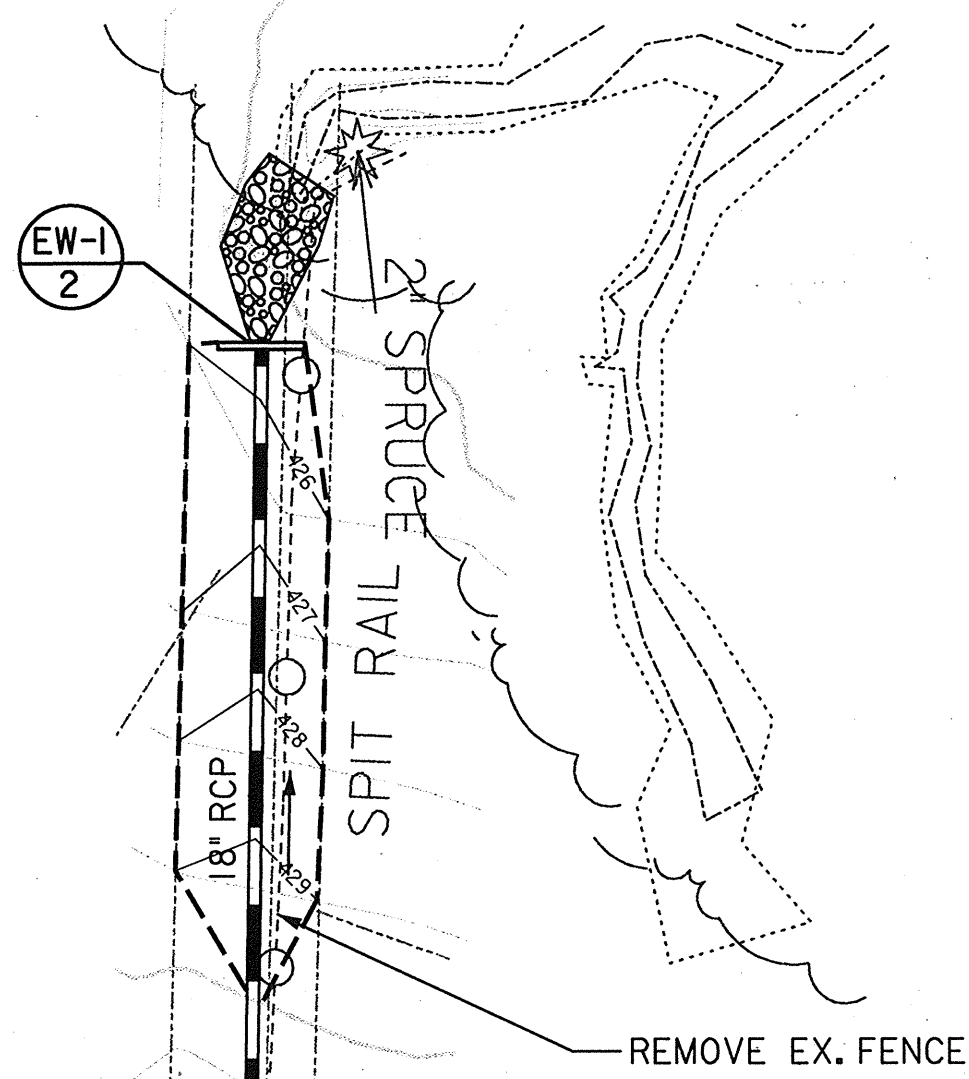


LEGEND	
[Symbol]	PAVEMENT REMOVAL
[Symbol]	FULL DEPTH PAVEMENT CONSTRUCTION
[Symbol]	SPEED TABLE
[Symbol]	MILL AND RESURFACE
[Symbol]	PROPOSED CONCRETE SIDEWALK
[Symbol]	PROPOSED MEDIANS
[Symbol]	RECONSTRUCT ASPHALT DRIVEWAY
[Symbol]	RECONSTRUCT CONCRETE DRIVEWAY
[Symbol]	EXIST. RIGHT-OF-WAY
[Symbol]	TP TEST PIT

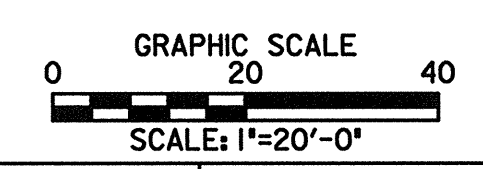

HATCHELSON
2609 MCKENZIE
309
22,104 S.F.

308
20,869 S.F.

307
20,276 S.F.

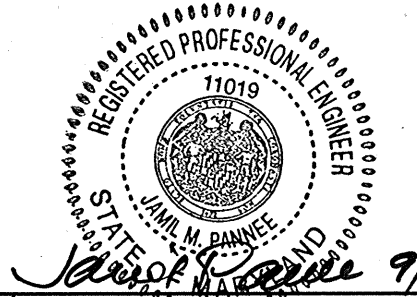

DEPARTMENT OF PUBLIC WORKS
HOWARD COUNTY, MARYLAND

Jan P. ... 9/22/03
CHIEF, BUREAU OF ENGINEERING

William J. ... 9-24-03
CHIEF, BUREAU OF HIGHWAYS



URS
HUNT VALLEY, MARYLAND

ijm
RJM ENGINEERING, INC.
CONSULTING ENGINEERS
COLUMBIA, MARYLAND

TELE: 410-730-1001 FAX: 410-730-5403

DES:					
DRN:					
CHK:					
DATE:	BY	NO.	REVISION	DATE	

PLAN SHEET PS-2

NO.: _____ DATE: 9/03

MCKENZIE ROAD ROADWAY AND STORMDRAIN IMPROVEMENTS

HOWARD COUNTY, MARYLAND
CAPITAL PROJECT NO. J-4164-10

SCALE AS SHOWN

SHEET 8 OF 24

RELOCATE EX. MAILBOX	
STATION	OFFSET
111+51.0	10.8' LT
111+84.5	9.85' LT
112+46.5	12.5' LT
113+79.2	17.4' LT
114+29.0	17.0' LT
115+19.1	19.0' LT
115+52.6	17.9' LT
112+48.9	11.7' RT
113+9.2	12.0' RT
116+35.1	12.6' RT

CONSTRUCT STD. COMB. CURB & GUTTER		
FROM STATION	TO STATION	QUANTITY (LF)
111+00 RT	117+00 RT	601
111+00 LT	117+00 LT	601

CONSTRUCT 4" CONCRETE SIDEWALK		
FROM STATION	TO STATION	QUANTITY (SF)
111+00 LT	117+00 LT	2062

CONSTRUCT ASPHALT DRIVEWAY		CONSTRUCT CONCRETE DRIVEWAY	
STATION	QUANTITY (SY)	STATION	QUANTITY (SY)
112+31 RT	20.0	111+69.7 LT	16.8
113+27 RT	10.0	112+58.8 LT	18.7
114+23 RT	16.8	113+87.4 LT	19.6
115+11 RT	18.6	114+36.8 LT	20.8
116+51 RT	11.6	115+30.6 LT	24.1
		115+62.4 LT	18.9

ADJUST COVER ON MANHOLE	
STATION	OFFSET
111+8.4	17' LT

ROTATE SANITARY MANHOLE	
STATION	OFFSET
113+54	12' LT


CONSTRUCT MODIFIED COMB. CURB & GUTTER		
FROM STATION	TO STATION	QUANTITY (LF)
115+79.5	116+16.3	82.1

CONSTRUCT COLORED STAMPED CONCRETE *		
FROM STATION	TO STATION	QUANTITY (SF)
115+80.5	116+15.3	256.0


* SEE DETAIL ON SHEET 2

REMOVAL OF EXISTING INLET		
STATION	OFFSET	QUANTITY (EA)
115+48.0	18.7' LT	1
115+51.8	20.7' RT	1
115+70.8	20.2' LT	1

REMOVAL OF EXISTING PIPE CULVERTS			
FROM STATION	TO STATION	SIZE/TYPE	QUANTITY (LF)
113+77.7 LT	113+95.7 LT	15" CMP	19.5
114+28.4 LT	114+46.3 LT	15" CMP	20.0
115+8.4 LT	115+46.3 LT	15" CMP	39.9
115+48.3 LT	115+50.3 RT	12" CMP	29.5
115+45.7 LT	115+47.5 LT	UNKNOWN	26.7
115+49.2 LT	115+70.3 LT	15" CMP	21.2

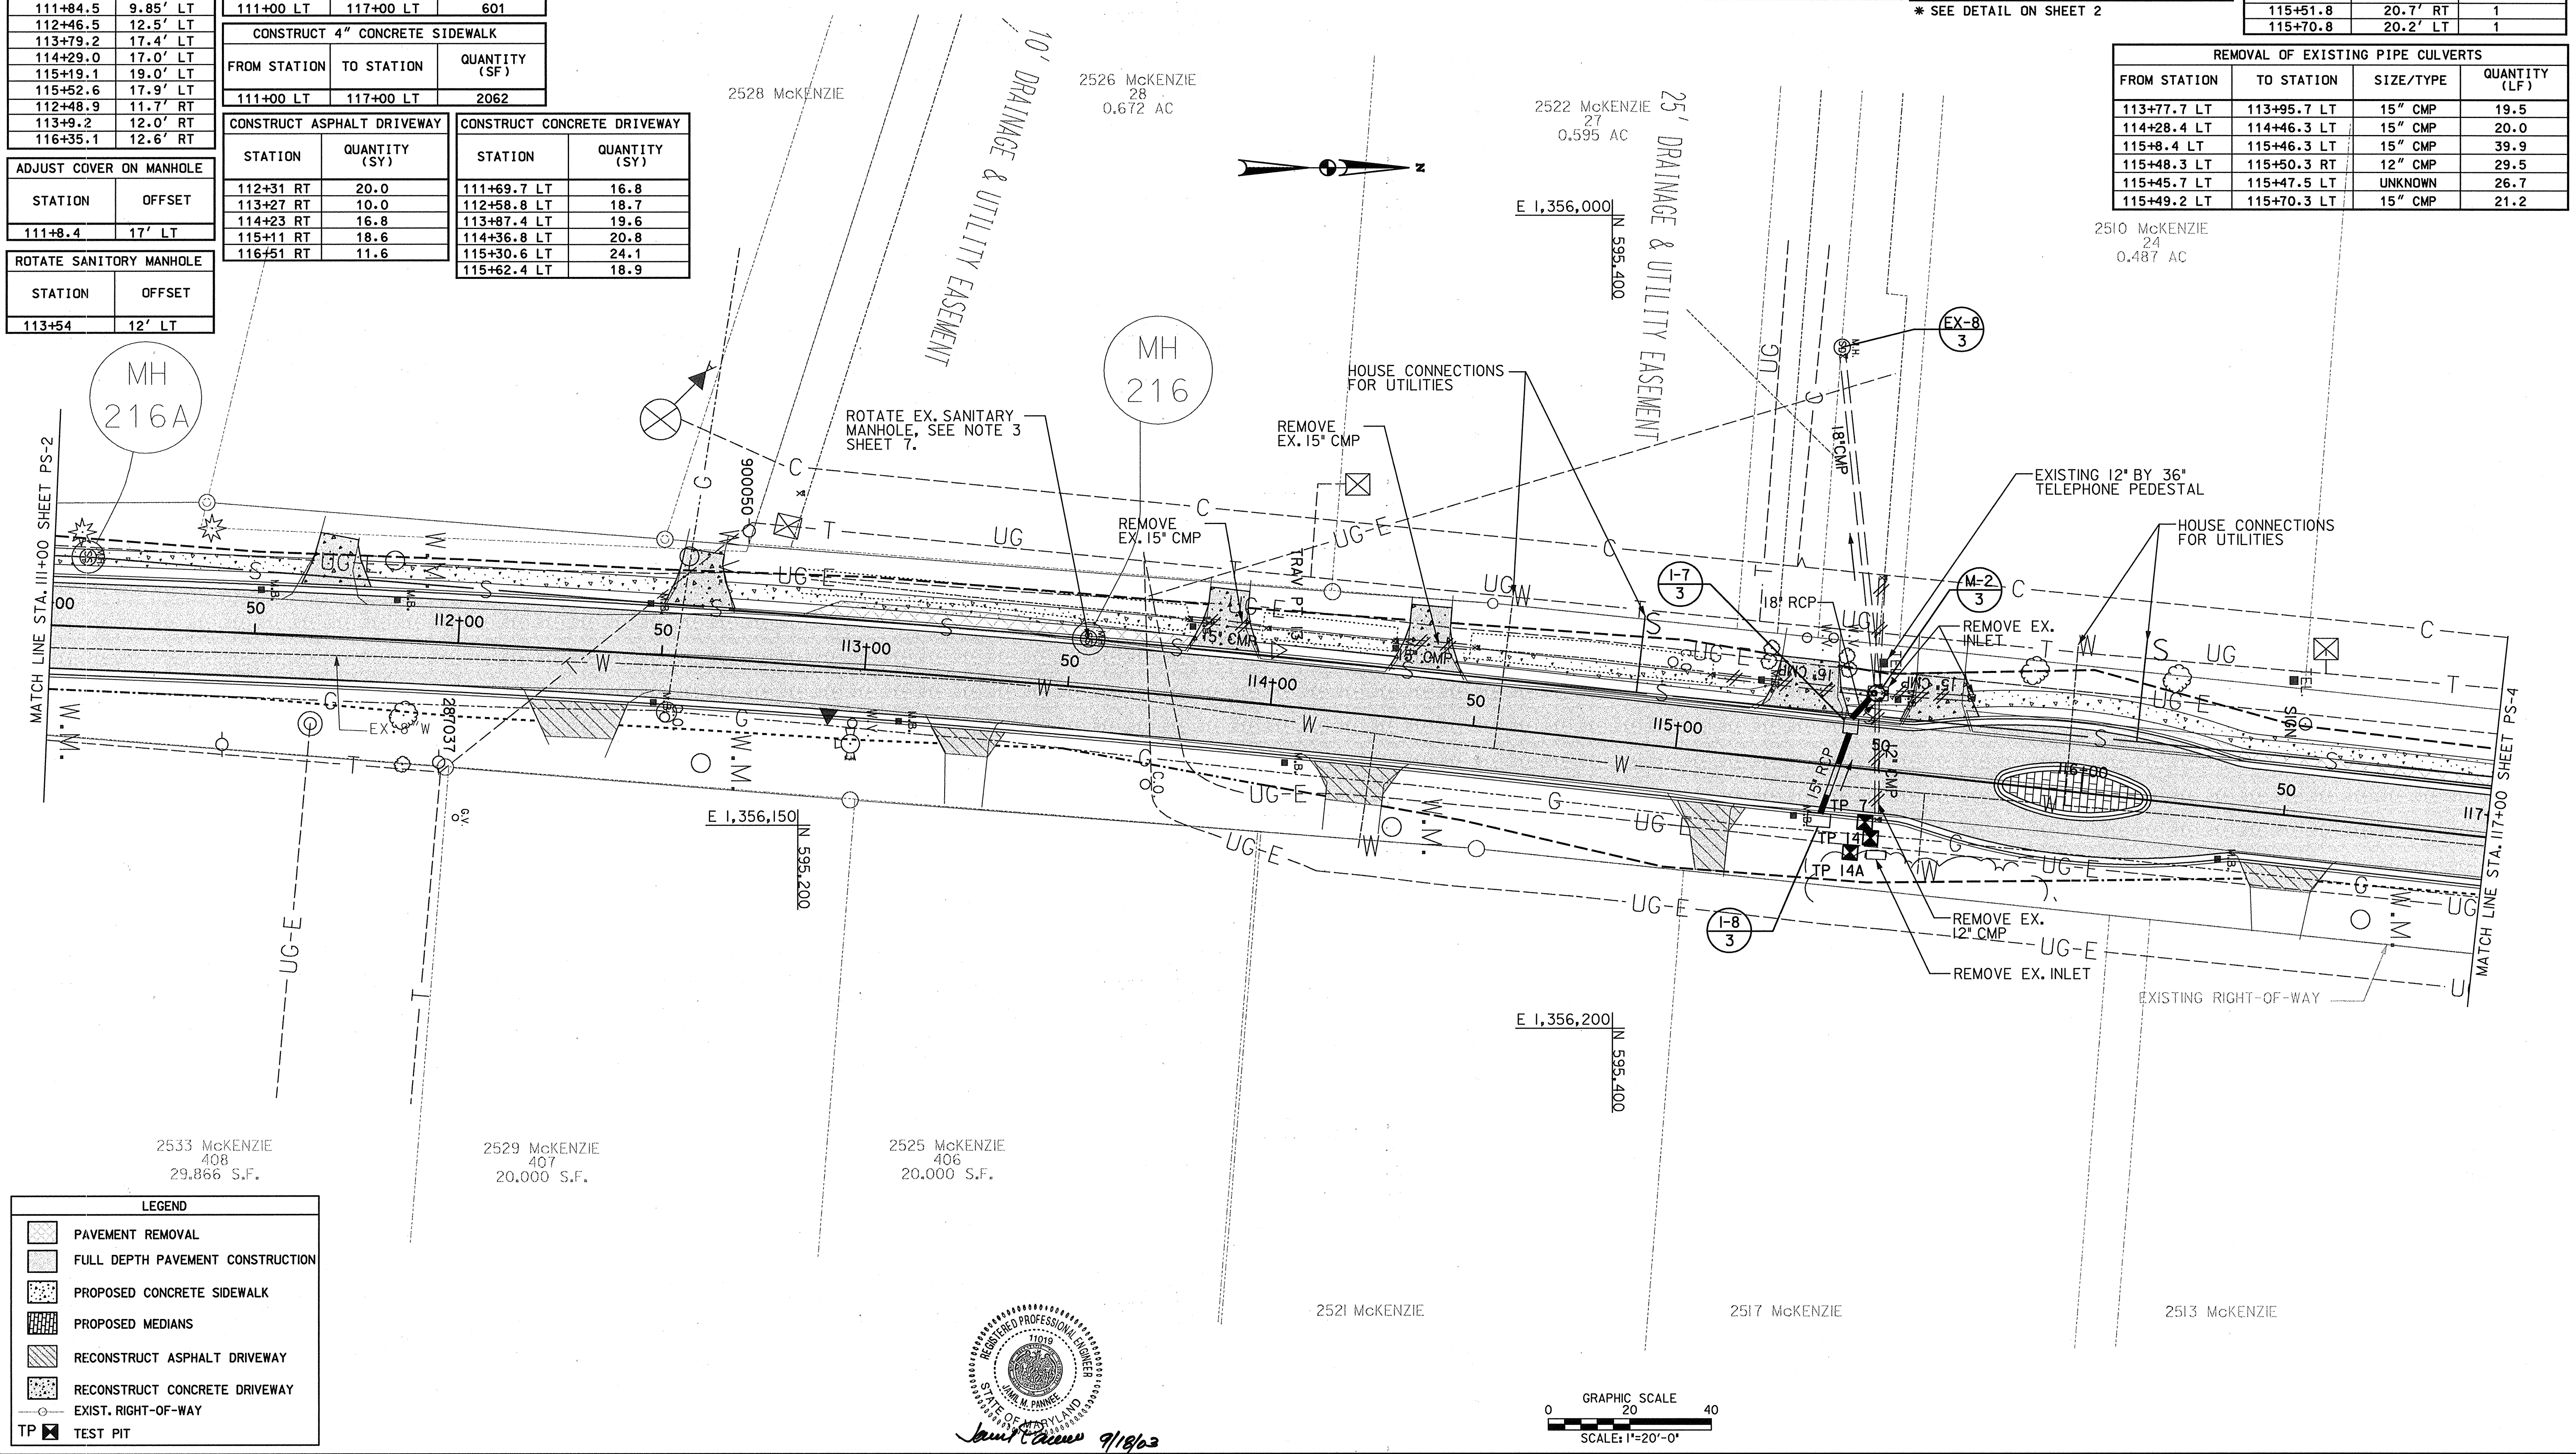

LEGEND	
[Symbol]	PAVEMENT REMOVAL
[Symbol]	FULL DEPTH PAVEMENT CONSTRUCTION
[Symbol]	PROPOSED CONCRETE SIDEWALK
[Symbol]	PROPOSED MEDIANS
[Symbol]	RECONSTRUCT ASPHALT DRIVEWAY
[Symbol]	RECONSTRUCT CONCRETE DRIVEWAY
[Symbol]	EXIST. RIGHT-OF-WAY
[Symbol]	TEST PIT

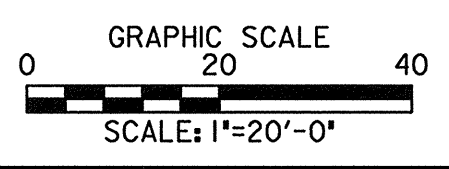

DEPARTMENT OF PUBLIC WORKS HOWARD COUNTY, MARYLAND <i>James M. Panne</i> 9/22/03 CHIEF, BUREAU OF ENGINEERING <i>Evelyn E. Jones</i> 9/22/03 CHIEF, TRANSPORTATION AND SPECIAL PROJECTS DIVISION		HUNT VALLEY, MARYLAND	RJM ENGINEERING, INC. CONSULTING ENGINEERS COLUMBIA, MARYLAND TEL: 410/730-1001 FAX: 410/730-5403	DES:				McKENZIE ROAD ROADWAY AND STORMDRAIN IMPROVEMENTS HOWARD COUNTY, MARYLAND CAPITAL PROJECT NO. J-4164-10	SCALE AS SHOWN SHEET 9 OF 24
				DRN:					
				CHK:					
				DATE:	BY	NO.	REVISION	DATE	NO.: 9/03

RELOCATE EX. MAILBOX	
STATION	OFFSET
117+49	20.4' LT
117+54	20.2' LT
117+75	19.3' LT
117+82	18.6' LT
119+56	14.8' LT
120+54	19.8' LT
117+85	12.3' RT
118+93	10.3' RT
119+93	12.7' RT

CONSTRUCT STD. COMB. CURB AND GUTTER		
FROM STATION	TO STATION	QUANTITY (LF)
117+00 LT (McKENZIE)	9+43.86 RT (ASHBROOK)	443
117+00 RT (McKENZIE)	10+54.38 RT (ASHBROOK)	438
10+54.38 LT (ASHBROOK)	122+45.28 RT (McKENZIE)	136

CONSTRUCT ASPHALT DRIVEWAY		
STATION	QUANTITY (SY)	
117+63 RT	12.00	
117+64 LT	20.35	
118+74 RT	11.54	
119+79 RT	21.60	

CONSTRUCT MODIFIED COMB. CURB AND GUTTER			
FROM STATION	TO STATION	QUANTITY (LF)	
120+64	120+98	69	
121+16	121+46	95	
121+61	121+72	28	
121+66	121+80	41	
9+50	9+67	45	
10+33	10+46	33	

CONSTRUCT COLORED STAMPED CONCRETE			
FROM STATION	TO STATION	QUANTITY (SF)	
121+17	121+45	615.7	
121+62	121+71	24.5	
121+67	121+79	55.4	
9+51	9+66	70.5	
10+34	10+45	30.9	

REMOVAL OF EXISTING PIPE CULVERTS				
FROM STATION	TO STATION	SIZE/TYPE	QUANTITY (LF)	
118+59.3 LT	118+79.0 LT	12" CMP	19.7	
119+55.4 LT	119+75.2 LT	12" CMP	19.8	
120+63 RT	120+63 LT	15" CMP	38.0	

REMOVAL OF EXISTING INLET		
STATION	OFFSET	QUANTITY (EA)
120+63	23.4' LT	1

REMOVE EXISTING CURB AND GUTTER		
FROM STATION	TO STATION	QUANTITY (SY)
120+96 RT	10+54 RT	41.1
120+83 LT	9+44 RT	62.6
10+54 LT	121+81 RT	72.0

RELOCATE EXISTING SIGN	
STATION	OFFSET
121+4.6	27.5' LT

CONSTRUCT 4" CONCRETE SIDEWALK *		
FROM STATION	TO STATION	QUANTITY (SF)
117+00 LT (McKENZIE)	9+56.58 RT (ASHBROOK)	1400
SIDEWALK EXTENSION		2400

CONSTRUCT CONCRETE DRIVEWAY	
STATION	QUANTITY (SY)
117+29 LT	26.52
118+69 LT	18.93
119+65 LT	20.72


ADJUST COVER ON MANHOLE	
STATION	OFFSET
117+54	16' LT
121+30	2' RT

* SIDEWALK RAMPS WILL BE INCIDENTAL TO SIDEWALK.

2494 McKENZIE
20
0.501 AC



LANTZ
2490 McKENZIE
19
0.5074 AC

2486 McKENZIE
18
0.557 AC

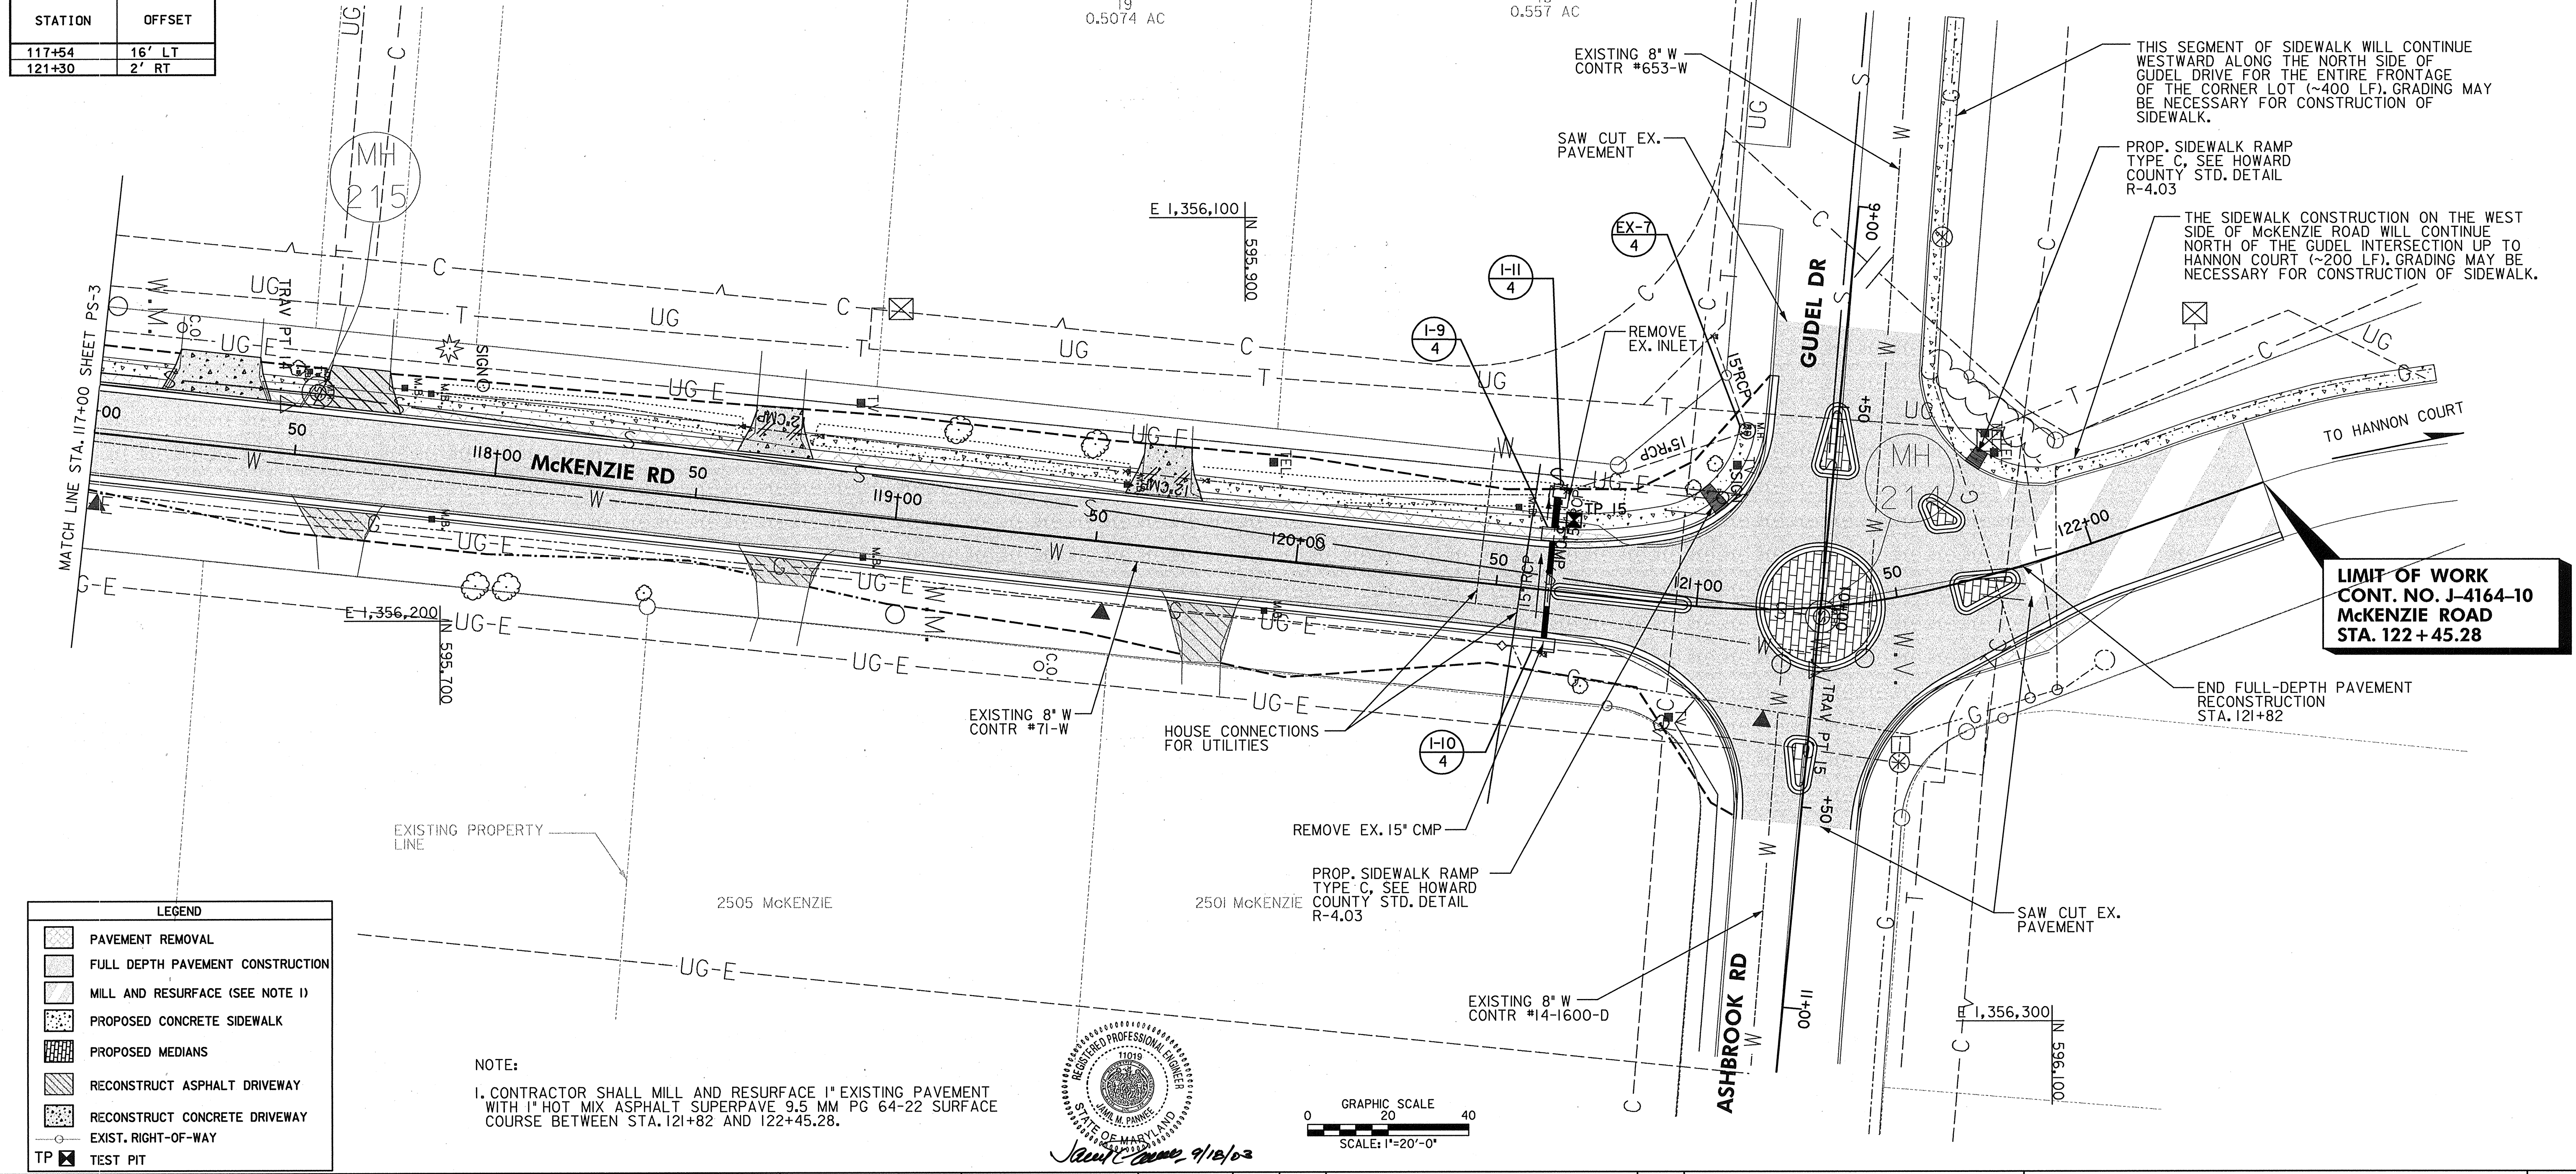

LEGEND	
[Symbol]	PAVEMENT REMOVAL
[Symbol]	FULL DEPTH PAVEMENT CONSTRUCTION
[Symbol]	MILL AND RESURFACE (SEE NOTE 1)
[Symbol]	PROPOSED CONCRETE SIDEWALK
[Symbol]	PROPOSED MEDIANS
[Symbol]	RECONSTRUCT ASPHALT DRIVEWAY
[Symbol]	RECONSTRUCT CONCRETE DRIVEWAY
[Symbol]	EXIST. RIGHT-OF-WAY
[Symbol]	TP [Symbol] TEST PIT

NOTE:
1. CONTRACTOR SHALL MILL AND RESURFACE 1" EXISTING PAVEMENT WITH 1" HOT MIX ASPHALT SUPERPAVE 9.5 MM PG 64-22 SURFACE COURSE BETWEEN STA. 121+82 AND 122+45.28.

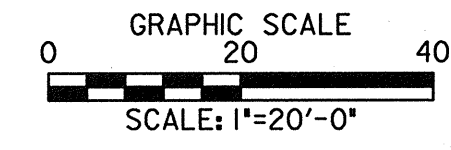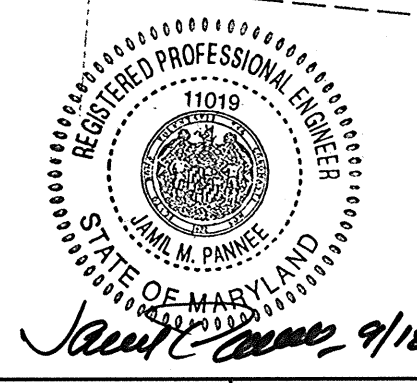


DEPARTMENT OF PUBLIC WORKS
HOWARD COUNTY, MARYLAND

Jan 4, 2005 9/22/05
DATE DATE

9/22/05 9-24-05
DATE DATE

CHEF, TRANSPORTATION AND SPECIAL PROJECTS DIVISION
CHEF, BUREAU OF HIGHWAYS

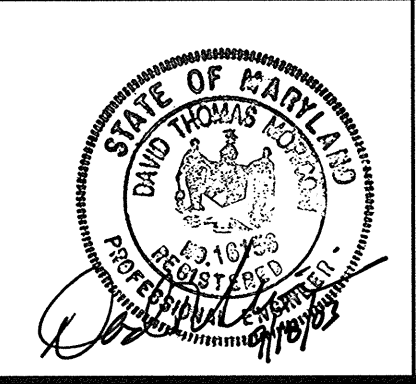

URS
HUNT VALLEY, MARYLAND

ijm
RJM ENGINEERING, INC.
CONSULTING ENGINEERS
COLUMBIA, MARYLAND

TELE: (410) 730-1001 FAX: (410) 730-5403

DES:				
DRN:				
CHK:				
DATE:	BY	NO.	REVISION	DATE


PLAN SHEET PS-4

NO.: _____ DATE: 9/03


McKENZIE ROAD ROADWAY AND STORMDRAIN IMPROVEMENTS

HOWARD COUNTY, MARYLAND
CAPITAL PROJECT NO. J-4164-10

SCALE AS SHOWN
SHEET 10 OF 24


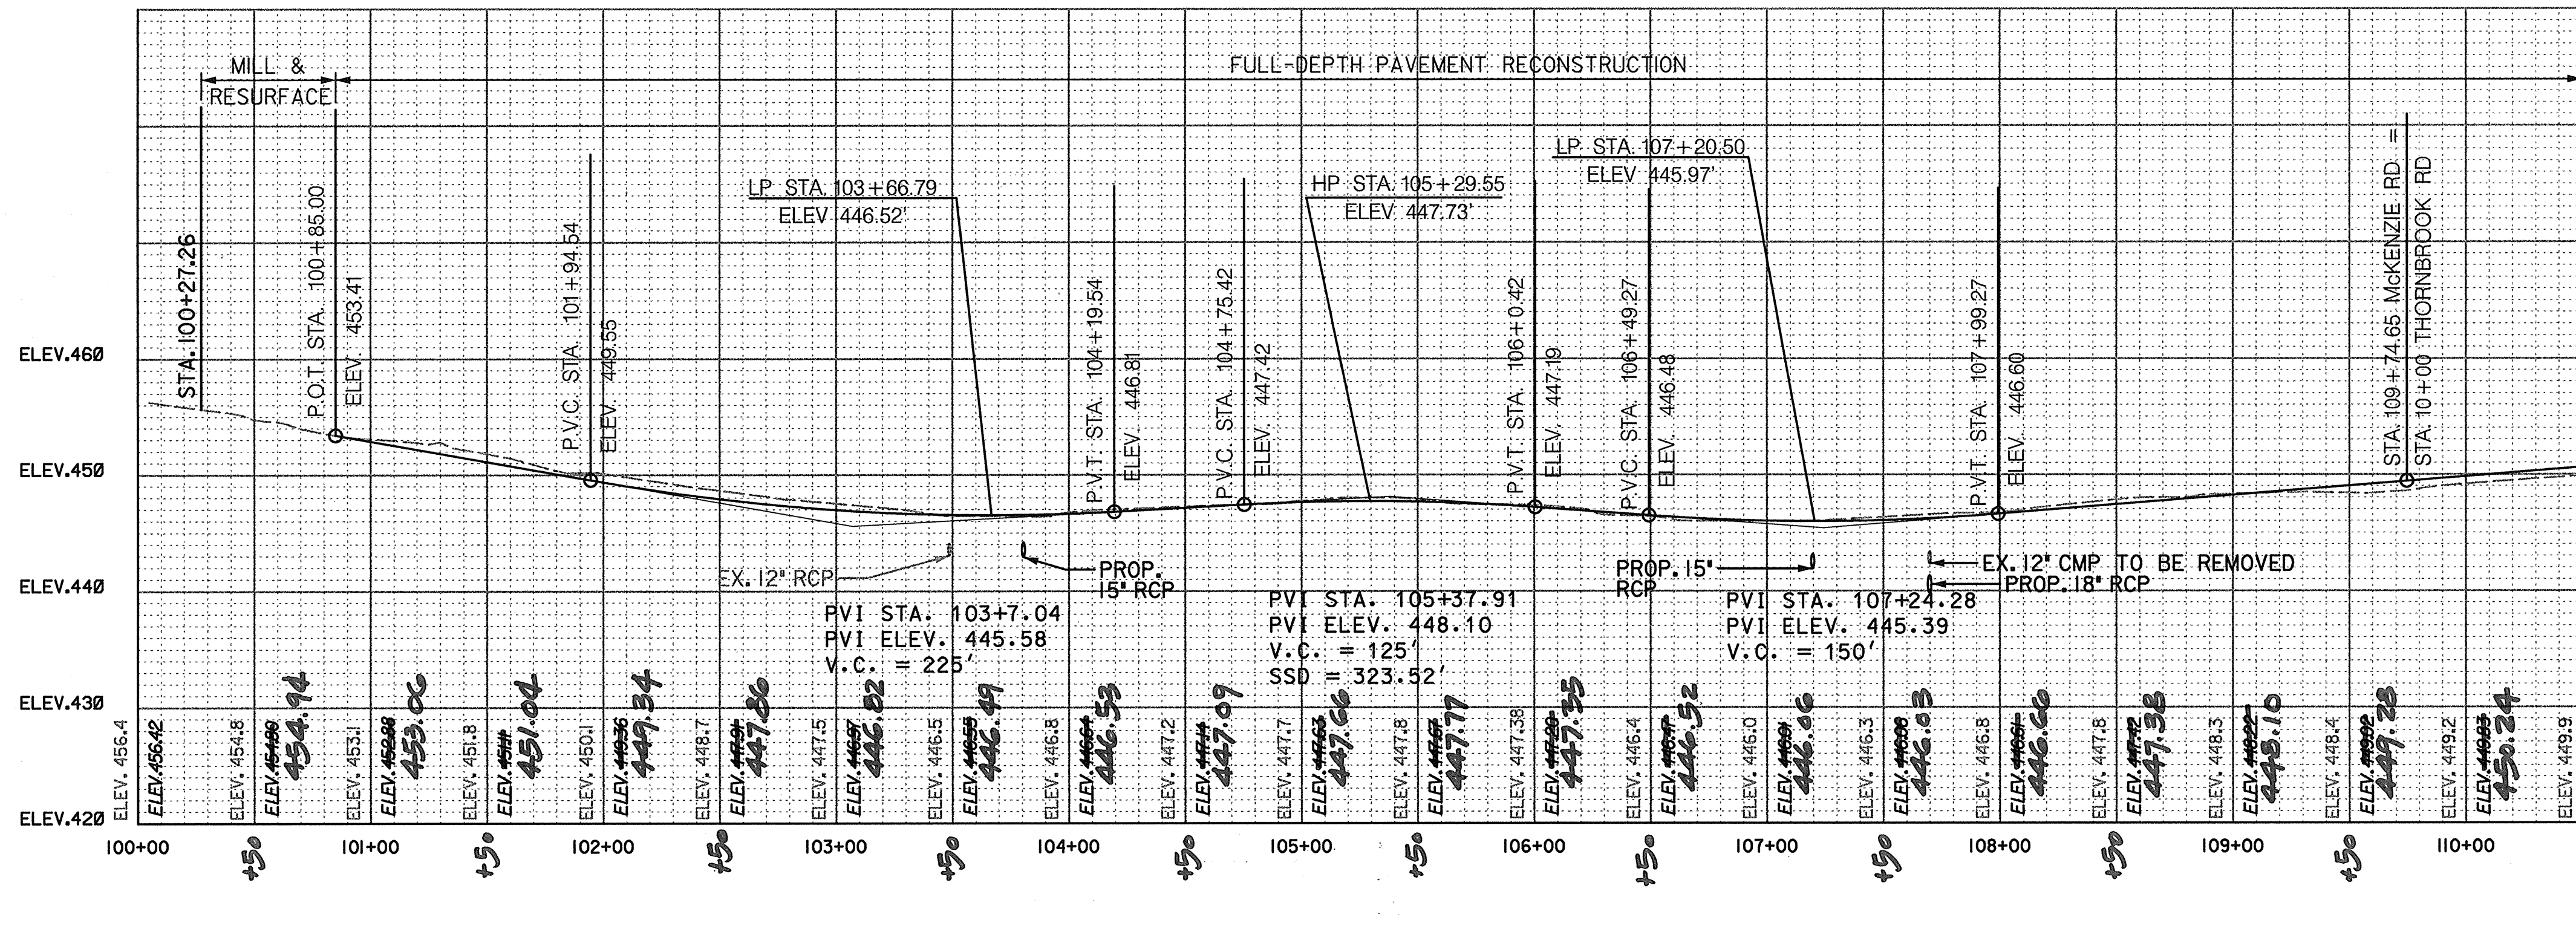


MATCH LINE THIS SHEET

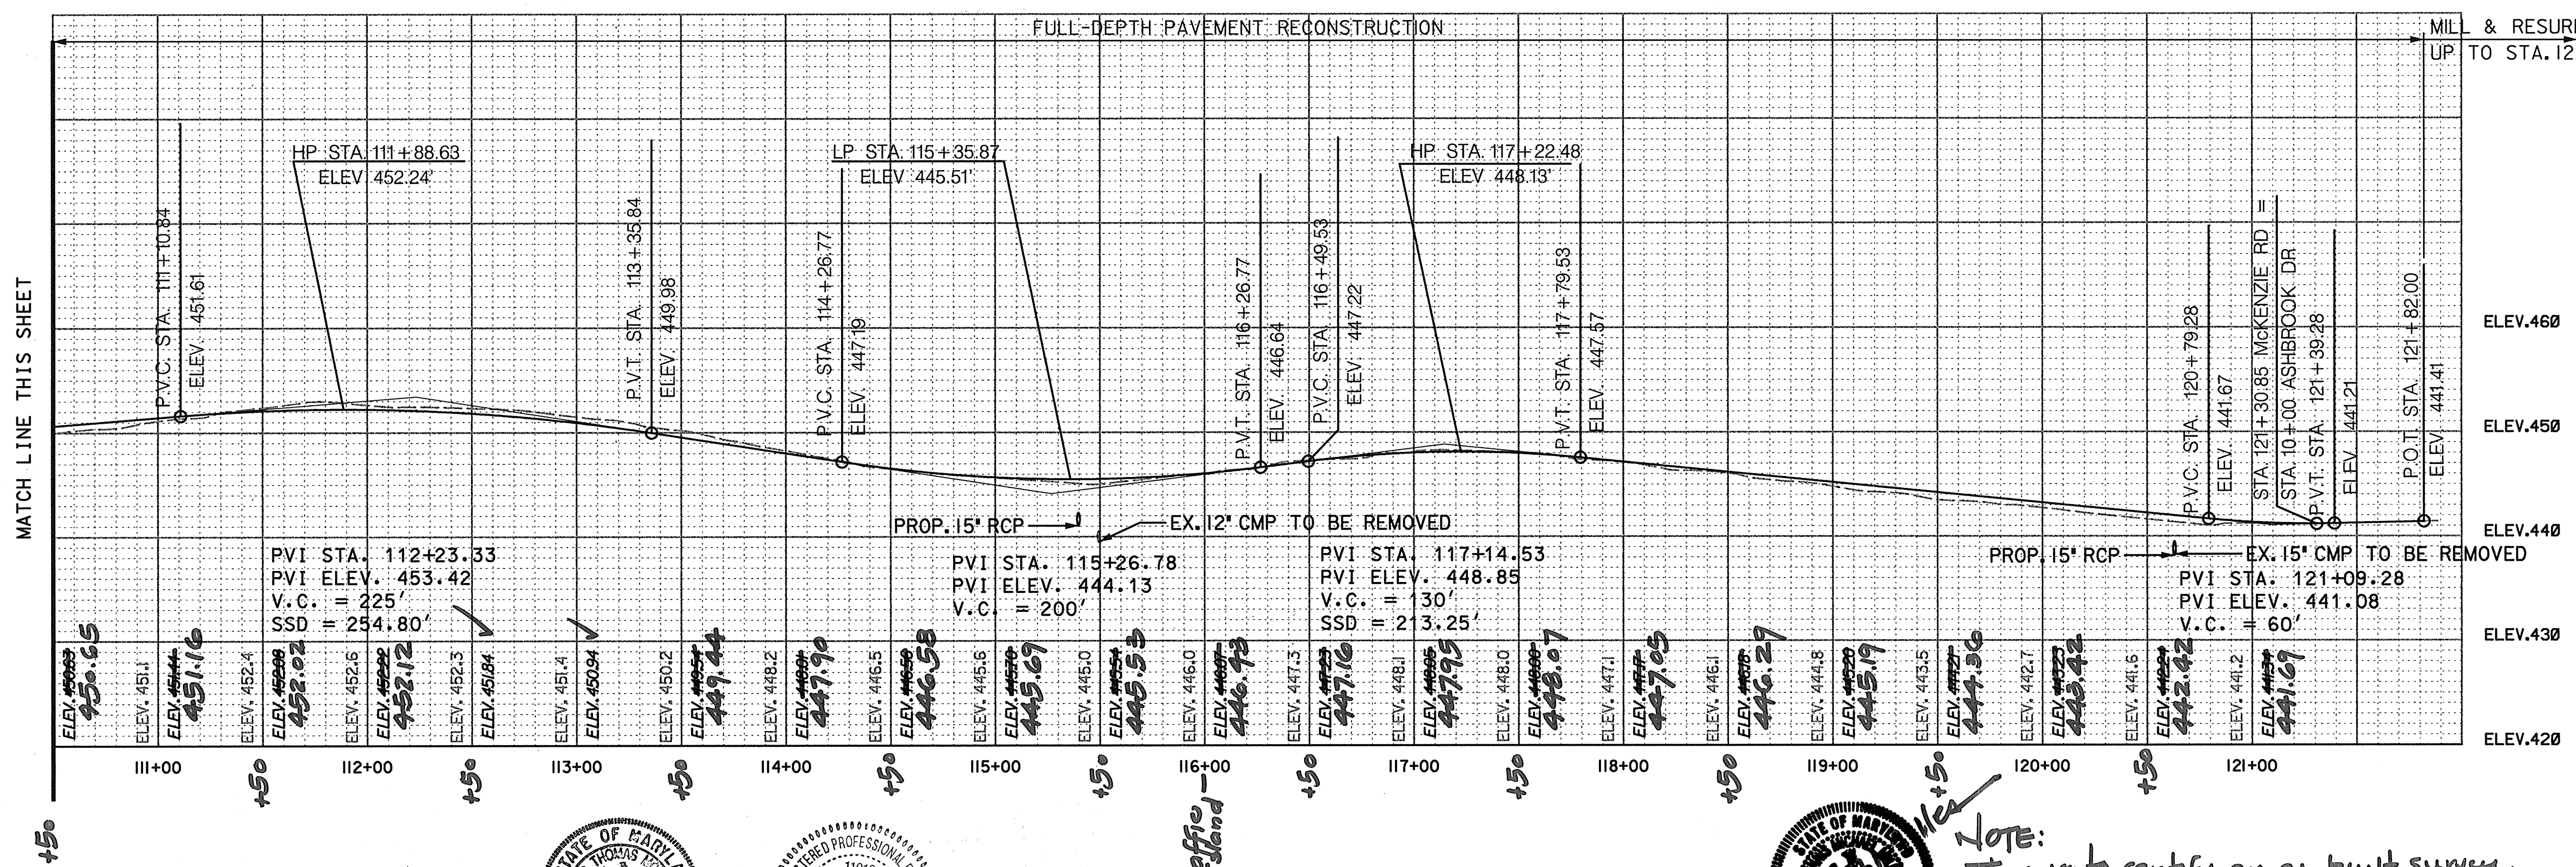

MATCH LINE THIS SHEET

MILL & RESURFACE UP TO STA. 122+45.28

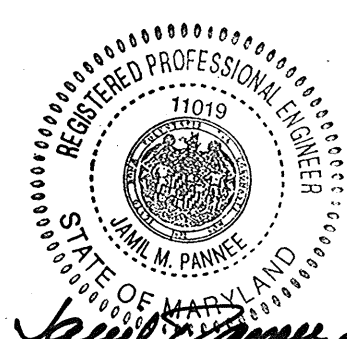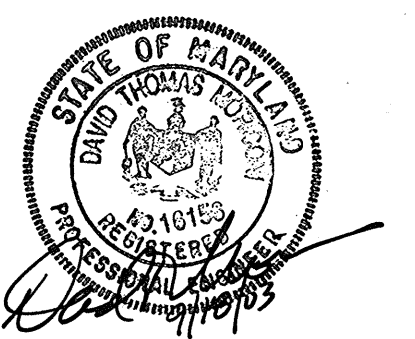


NOTE:
This is to certify an as-built survey of the centerline profile was made in November 2004
* As-built remarks are shown in red!

DEPARTMENT OF PUBLIC WORKS
HOWARD COUNTY, MARYLAND

[Signature] 9/22/03
DATE

[Signature] 9/22/03
DATE

CHIEF, TRANSPORTATION AND SPECIAL PROJECTS DIVISION

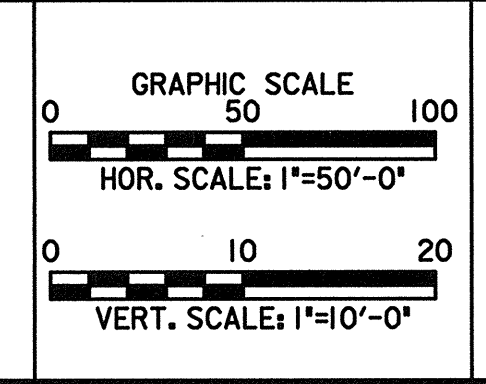

URS
HUNT VALLEY, MARYLAND

RJM
RJM ENGINEERING, INC.
CONSULTING ENGINEERS
COLUMBIA, MARYLAND

TEL: (410) 730-1000 FAX: (410) 730-5403

DES:					
DRN:					
CHK:					
DATE:	BY	NO.	REVISION	DATE	

PROFILE SHEET

NO.: _____ DATE: 9/03

McKENZIE ROAD ROADWAY AND STORMDRAIN IMPROVEMENTS

HOWARD COUNTY, MARYLAND
CAPITAL PROJECT NO. J-4164-10

SCALE AS SHOWN
SHEET 11 OF 24

Pipe Conduits

All pipes shall be circular in cross section.

Corrugated Metal Pipe

All of the following criteria shall apply for corrugated metal pipe:

1. Materials - (Steel Pipe) - This pipe and its appurtenances shall be galvanized and conform to the requirements of AASHTO Specifications M-36 and M-218. It shall be fully bituminous coated and shall conform to the requirements of AASHTO Specification M-190 Type A with watertight coupling bands or flanges. Any bituminous coating damaged or otherwise removed shall be replaced with cold applied bituminous coating compound.

Materials - (Polymer Coated Steel Pipe) - Steel pipes with polymeric coatings shall have a minimum coating thickness of 0.01 inch (10 mil) on both sides of the pipe. This pipe and its appurtenances shall conform to the requirements of AASHTO Specifications M-245 and M-246 with watertight coupling bands or flanges.

Materials - (Aluminum Coated Steel Pipe) - This pipe and its appurtenances shall conform to the requirements of AASHTO Specification M-274 with watertight coupling bands or flanges. Aluminum coated steel pipe when used with flowable fill shall be fully bituminous coated per requirements of AASHTO Specification M-190 Type A. Any aluminum coating damaged or otherwise removed shall be replaced with cold applied bituminous coating compound. Aluminum surfaces that are to be in contact with concrete shall be painted with one coat of zinc chromate primer.

Materials - (Aluminum Pipe) - This pipe and its appurtenances shall conform to the requirements of AASHTO Specification M-196 or M-211 with watertight coupling bands or flanges. Aluminum pipe, when used with flowable fill, shall be fully bituminous coated per requirements of AASHTO Specification M-190 Type A. Aluminum surfaces that are to be in contact with concrete shall be painted with one coat of zinc chromate primer. Hot-dip galvanized bolts may be used for connection. The pH of the surrounding soils shall be between 4 and 5.

2. Coupling bands, anti-seep collars, and sections, etc. must be composed of the same material as the pipe. Metals must be insulated from dissimilar materials with use of rubber or plastic insulating materials at least 24 mils in thickness.

3. Connections - All connections with pipes must be completely watertight. The drain pipe or barrel connection to the riser shall be welded all around when the pipe and riser are metal. Anti-seep collars shall be connected to the pipe in such a manner as to be completely watertight. Anti-seep collars are not considered to be watertight.

All connections shall use a rubber or neoprene gasket when joining pipe sections. The end of each pipe shall be provided an adequate number of corrugations to accommodate the band width. The following type connections are acceptable for pipes less than 24 inches in diameter: flanges on both ends of the pipe with a circular gasket, pre-punched to the flange bolt circle sandwiched between adjacent flanges; a 12-inch wide standard lap-type band with 12-inch wide by 3/8-inch thick closed cell circular neoprene gasket; and a 12-inch wide hugger-type band with O-ring gaskets having a minimum diameter of 1/2-inch greater than the corrugation depth. Pipes 24 inches in diameter and larger shall be connected by a 24-inch long annular corrugated band using a minimum of four (4) rods and lugs, two on each connecting pipe end. A 24-inch wide by 3/8-inch thick closed cell circular neoprene gasket will be installed with 12 inches on the end of each pipe. Flanged joints with gaskets are also acceptable.

Helically corrugated pipe shall have either continuously welded seams or have lock seams with internal caulking or a neoprene bead.

4. Bedding - The pipe shall be firmly and uniformly bedded throughout its entire length. Where rock is soft, spongy or other unstable soils encountered, all such material shall be removed and replaced with suitable earth compacted to provide adequate support.

5. Backfilling shall conform to "Structure Backfill."

6. Other details (anti-seep collars, valves, etc.) shall be as shown on the drawings.

Reinforced Concrete Pipe

All of the following criteria shall apply for reinforced concrete pipe:

1. Materials - Reinforced concrete pipe shall have bell and spigot joints with rubber gaskets and shall equal or exceed ASTM C 361.

2. Bedding - All reinforced concrete pipe conduits shall be laid in a concrete bedding for their entire length. This bedding shall consist of high strength concrete placed under the pipe and up the sides of the pipe at least 50 percent of its outside diameter with a minimum thickness of 6 inches, or as shown on the drawings.

3. Laying Pipe: Bell and spigot pipe shall be placed with the bell and upstream. Joints shall be made in accordance with recommendations of the manufacturer of the material. After the joints are sealed for the entire line, the bedding shall be placed so that all spaces under the pipe are filled. Care shall be exercised to prevent any deviation from the original line and grade of the pipe. The first joint must be located within 2 feet from the riser.

4. Backfilling shall conform to "Structure Backfill."

5. Other details (anti-seep collars, valves, etc.) shall be as shown on the drawings.

Polyvinyl Chloride (PVC) Pipe

All of the following criteria shall apply for polyvinyl chloride (PVC) pipe:

1. Materials - PVC pipe shall be PVC-1120 or PVC-1220 conforming to ASTM D 1785 or ASTM D 2241.

2. Joints and connections to anti-seep collars shall be completely watertight.

3. Bedding - The pipe shall be firmly and uniformly bedded throughout its entire length. Where rock is soft, spongy or other unstable soils encountered, all such material shall be removed and replaced with suitable earth compacted to provide adequate support.

4. Backfilling shall conform to "Structure Backfill."

5. Other details (anti-seep collars, valves, etc.) shall be as shown on the drawings.

Concrete

Concrete shall meet the requirements of Maryland Department of Transportation, State Highway Administration Standard Specifications for Construction and Materials, Section 414, Mix No. 4.

Rock Riprap

Rock riprap shall meet the requirements of Maryland Department of Transportation, State Highway Administration Standard Specifications for Construction and Materials, Section 901.

Filter cloth shall be placed under all riprap and shall meet the requirements of Maryland Department of Transportation, State Highway Administration Standard Specifications for Construction and Materials, Section 921.09, Class C.

Care of Water During Construction

All work on permanent structures shall be carried out in areas free from water. The Contractor shall construct and maintain all temporary dikes, levees, cofferdams, drainage channels, and stream diversions necessary to protect the areas to be occupied by the permanent works. The Contractor shall also furnish, install, operate, and maintain all necessary pumping and other equipment required for removal of water from various parts of the work and for maintaining the excavations, foundation, and other parts of the work free from water as required or directed by the Engineer for constructing each part of the work. After having served their purpose, all temporary protective measures shall be removed or leveled and graded to the extent required to prevent obstruction in any degree whatsoever of the flow of water to the spillway or outlet and so as not to interfere in any way with the operation or maintenance of the structure. Stream diversions shall be maintained until the full flow can be passed through the permanent structure. The removal of water from the required excavation and the foundation shall be accomplished in a manner and to the extent that will maintain stability of the excavated slopes and bottom of required excavations and will allow satisfactory performance of all construction operations during the placing and compacting of material in required excavations, the water level at the locations being refilled shall be maintained below the bottom of the excavation at such locations which may require draining the water pumps from which the water shall be pumped.

Stabilization

All borrow areas shall be graded to provide proper drainage and left in a slightly condition. All exposed surfaces of the embankment, spillway, spoil, and borrow areas, berms shall be stabilized by seeding, mulching, fertilizing and mulching in accordance with the Maryland Soil Conservation Service standards and Specifications for Critical Area Planting (MD-542) or as shown on the accompanying drawings.

Erosion and Sediment Control

Construction operations will be carried out in such a manner that erosion will be controlled and water and soil pollution minimized. State and local laws concerning pollution abatement will be followed. Construction plans shall detail erosion and sediment control measures.

PERMANENT SEEDING NOTES

Apply to graded or cleared areas not subject to immediate further disturbance where a permanent long-lived vegetative cover is needed.

Seeded preparation: loosen upper 3 inches of soil by raking, disking, or other acceptable means before seeding. If not previously loosened.

Soil amendments: In lieu of soil test recommendations, use one of the following schedules:

- 1) Preferred - apply 2 tons per acre dolomite limestone (92 lbs. per 1,000 square feet) and 800 lbs. per acre 10-10-10 fertilizer (14 lbs. per 1,000 square feet) before seeding. Harrow or disc into upper 3 inches of soil immediately before seeding, apply 400 lbs. per acre 30-0-0 urea-form fertilizer (14 lbs. per 1,000 square feet).
- 2) Acceptable - apply 2 tons per acre dolomite limestone (92 lbs. per 1,000 square feet) and 1,000 lbs. per acre 10-10-10 fertilizer (23 lbs. per 1,000 square feet) before seeding. Harrow or disc into upper 3 inches of soil.

Seeding: For the period March 1 through April 30 and from August 1 through October 15, seed with 50 lbs. per acre Kentucky 31 tall fescue (14 lbs. per acre Kentucky 31 tall fescue) and 100 lbs. per acre timothy (14 lbs. per acre Kentucky 31 tall fescue) and 100 lbs. per acre timothy. For the period May 1 through July 31, seed with 60 lbs. per acre Kentucky 31 tall fescue (14 lbs. per acre Kentucky 31 tall fescue) and 100 lbs. per acre timothy (14 lbs. per acre Kentucky 31 tall fescue) and 100 lbs. per acre timothy. During the period October 16 through February 28, protect site by one of the following options:

- 1) 2 tons per acre of well-anchored mulch straw and seed as soon as possible in the spring.
- 2) Use sod.
- 3) Seed with 60 lbs. per acre Kentucky 31 tall fescue and mulch with 2 tons per acre well anchored straw.

Mulching: Apply 12% to 2 tons per acre (70 to 90 lbs. per 1,000 square feet) of unrotted straw immediately after seeding. Anchor mulch immediately after application using mulch anchoring tool or 18 gallons per acre (8 gallons per 1,000 square feet) of emulsified asphalt on flat areas, on slopes, 8 feet or higher, use 347 gallons per acre (8 gallons per 1,000 square feet) for anchoring.

Maintenance: inspect all seeded areas and make needed repairs, replacements, and reseeding.

TEMPORARY SEEDING NOTES

Apply to graded or cleared areas likely to be redistributed where a short-term vegetative cover is needed.

Seeded preparation: loosen upper 3 inches of soil by raking, disking, or other acceptable means before seeding.

Soil amendments: apply 600 lbs. per acre 10-10-10 fertilizer (14 lbs. per 1,000 square feet).

Seeding: For the period March 1 through April 30 and from August 1 through November 15, seed with 50 lbs. per acre of annual ryegrass (14 lbs. per 1,000 square feet), for the period May 1 through August 14, seed with 2 lbs. per acre of weeping lovegrass (0.07 lbs. per 1,000 square feet) and 100 lbs. per acre timothy (14 lbs. per 1,000 square feet) or for the period November 16 through February 28, protect site by applying 2 tons per acre of well anchored straw mulch and seed as soon as possible in the spring or use sod.

Mulching: Apply 12% to 2 tons per acre (70 to 90 lbs. per 1,000 square feet) of unrotted straw immediately after seeding. Anchor mulch immediately after application using mulch anchoring tool or 18 gallons per acre (8 gallons per 1,000 square feet) of emulsified asphalt on flat areas, on slopes, 8 feet or higher, use 347 gallons per acre (8 gallons per 1,000 square feet) for anchoring.

Refer to the 1994 Maryland standards and specifications for soil erosion and sediment control for rate and methods not covered.

STANDARD SEDIMENT CONTROL NOTES

1. A minimum of 48 hours notice must be given to the Howard County Department of Inspections, Licenses and Permits, sediment control division prior to the start of any construction (15-1955).
2. All vegetative and structural practices are to be installed according to the provisions of this plan and are to be in conformance with the 1994 Maryland standards and specifications for soil erosion and sediment control and revisions thereto.
3. Following initial soil disturbance or redistribution, permanent or temporary stabilization shall be completed within:
 - a) 7 calendar days for all perimeter sediment control structures, dikes, perimeter slopes, and all slopes steeper than 3:1.
 - b) 14 days as to all other disturbed or graded areas on the project site.
4. All sediment traps/basins shown must be fenced and warning signs posted around the perimeter in accordance with Volume 1, Chapter 1, of the Howard County design manual, storm drainage.
5. All disturbed areas must be stabilized within the time period specified above in accordance with the 1994 Maryland standards and specifications for soil erosion and sediment control for permanent seeding, sod, temporary seeding, and mulching (section 9); temporary stabilization with mulch alone shall only be done when recommended seeding rates do not allow for proper germination and establishment of grasses.
6. All sediment control structures are to remain in place and are to be maintained in operative condition until permission for their removal has been obtained from the Howard County sediment control inspector.
7. Site analysis:
 - Area disturbed - 2.25 acres
 - Areas to be seeded or paved - 1.64 acres
 - Area to be vegetatively stabilized - 0.61 acres
 - Total cut - 850 cubic yards
 - Total fill - 1240 cubic yards
 - Off-site waste site - Howard County landfill
 - Off-site borrow site - approved site with current and active grading permit
8. Any sediment control practice which is disturbed by grading activity for placement of utilities must be repaired on the same day of disturbance.
9. Additional sediment controls must be provided, if deemed necessary by the Howard County sediment control inspector.
10. On all sites with disturbed areas in excess of 2 acres, approval of the inspection agency shall be requested upon completion of installation of perimeter erosion and sediment controls, but before proceeding with any other earth disturbance or grading. Other building or grading inspection approvals may not be authorized until this initial approval by the inspection agency is made.
11. Trenches for the construction of utilities is limited to three pipe lengths or that which shall be backfilled and stabilized within one working day, whichever is shorter.
12. Site grading will begin only after all perimeter sediment control measures have been installed and are in a functioning condition.
13. Sediment will be removed from traps when its depth reaches clean out elevation shown on the plans.
14. Cut and fill quantities provided under site analysis do not include bid quantities. These quantities do not distinguish between topsoil, structural fill or embankment material, nor do they reflect consideration of undercutting or removal of unsuitable material. The contractor shall familiarize himself with site conditions which may affect the work.

DEVELOPER'S CERTIFICATION

"I/WE CERTIFY THAT ALL DEVELOPMENT AND CONSTRUCTION WILL BE DONE ACCORDING TO THIS PLAN, AND THAT ANY RESPONSIBLE PERSONNEL INVOLVED IN THE CONSTRUCTION PROJECT WILL HAVE A CERTIFICATE OF ATTENDANCE AT A DEPARTMENT OF THE ENVIRONMENT APPROVED TRAINING PROGRAM FOR THE CONTROL OF SEDIMENT AND EROSION BEFORE BEGINNING THE PROJECT. I ALSO AUTHORIZE PERIODIC ON-SITE INSPECTION BY THE HOWARD SOIL CONSERVATION DISTRICT"

Jay Sternby Acting Chief DATE 9/26/03
SIGNATURE OF DEVELOPMENT

ENGINEER'S CERTIFICATION

"I CERTIFY THAT THIS PLAN FOR EROSION AND SEDIMENT CONTROL REPRESENTS A PRACTICAL AND WORKABLE PLAN BASED ON MY PERSONAL KNOWLEDGE OF THE SITE CONDITIONS AND THAT IT WAS PREPARED IN ACCORDANCE WITH THE REQUIREMENTS OF THE HOWARD SOIL CONSERVATION DISTRICT."

James C. Newell DATE 9/25/03
RJM ENGINEERING, INC
5525 TWIN KNOLLS ROAD
SUITE 332
COLUMBIA, MD 21045
(410)730-1001

REVIEWED FOR HOWARD SOIL CONSERVATION DISTRICT AND MEETS TECHNICAL REQUIREMENTS

Jim Myers 9/29/03
U.S. NATURAL RESOURCES CONSERVATION SERVICE DATE

THIS DEVELOPMENT IS APPROVED FOR EROSION AND SEDIMENT CONTROL BY HOWARD SOIL CONSERVATION DISTRICT.

Wally Lee 9/29/03
HOWARD SOIL CONSERVATION DISTRICT DATE

DEPARTMENT OF PUBLIC WORKS
HOWARD COUNTY, MARYLAND

Jim J. Clark 9/25/03 DATE
CHIEF, BUREAU OF ENGINEERING
Ernie E. Jones 9/25/03 DATE
CHIEF, TRANSPORTATION AND SPECIAL PROJECTS DIVISION
William J. Mahala 9-26-03 DATE
CHIEF, BUREAU OF HIGHWAYS

URS

HUNT VALLEY, MARYLAND

RJM

RJM ENGINEERING, INC.
CONSULTING ENGINEERS
COLUMBIA, MARYLAND

TELE: (410)730-1001 FAX: (410)730-5403


DES:					
DRN:					
CHK:					
DATE:	BY	NO.	REVISION	DATE	











EROSION AND SEDIMENT CONTROL GENERAL NOTES 1

MCKENZIE ROAD ROADWAY AND STORMDRAIN IMPROVEMENTS

HOWARD COUNTY, MARYLAND
CAPITAL PROJECT NO. J-4164-10

SCALE AS SHOWN
SHEET 120F24

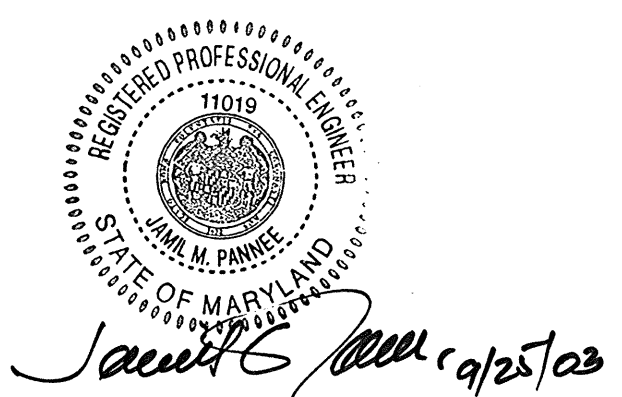

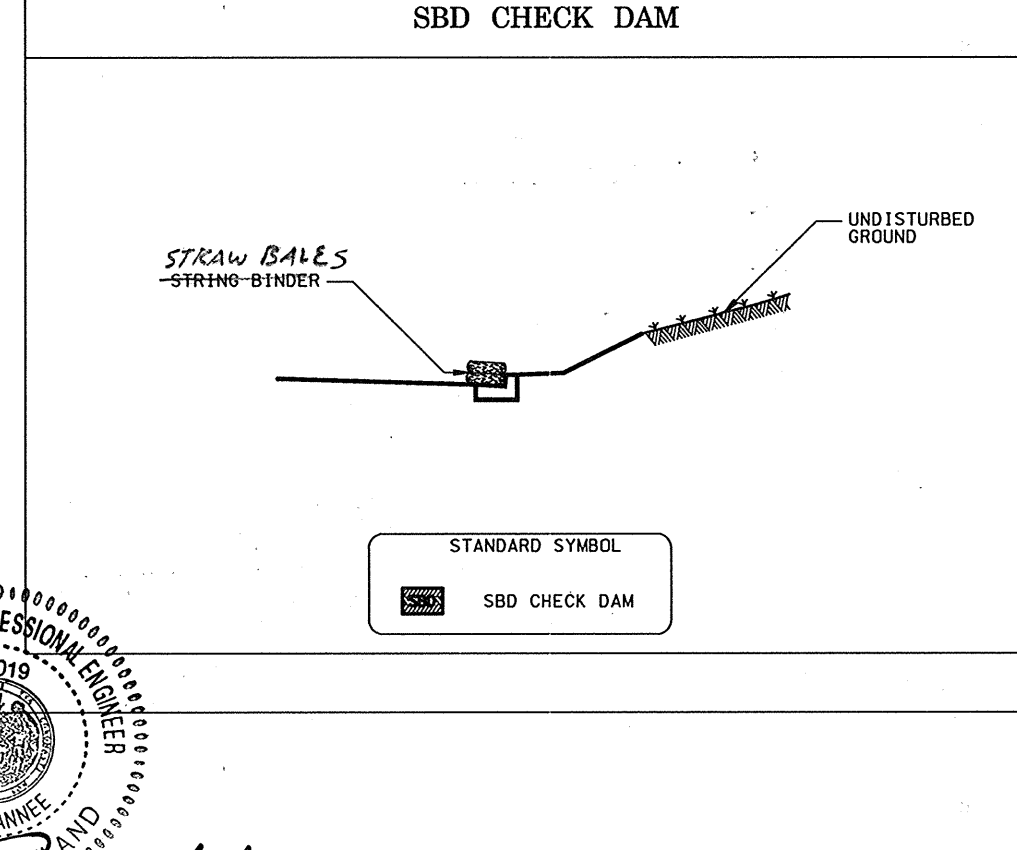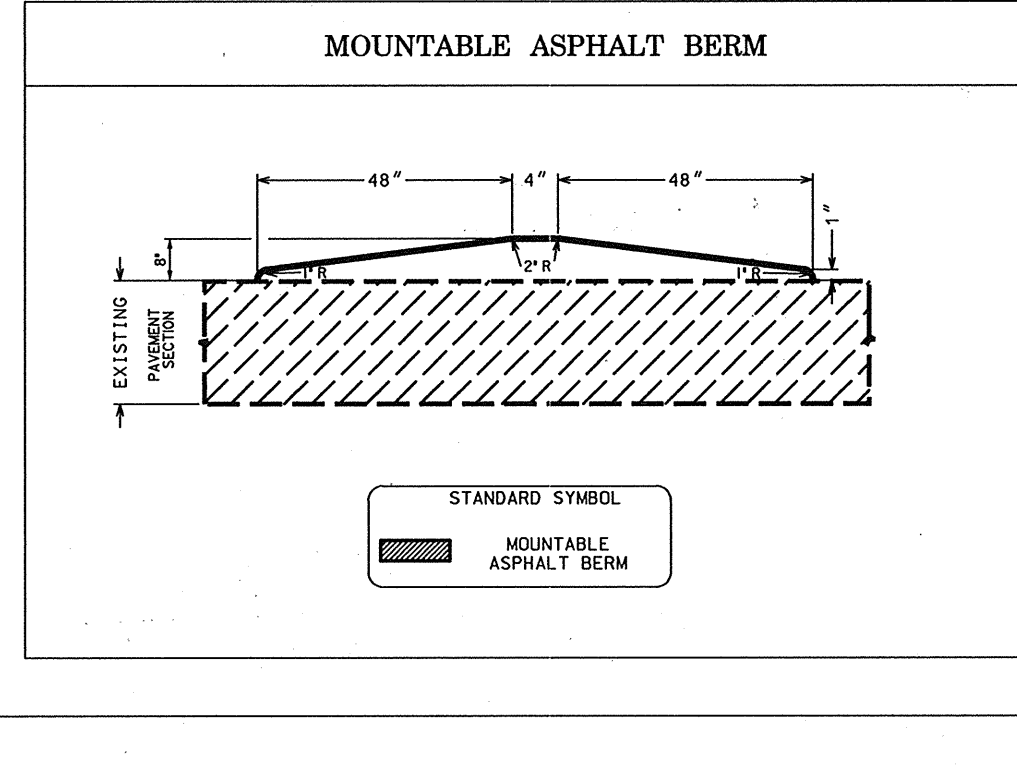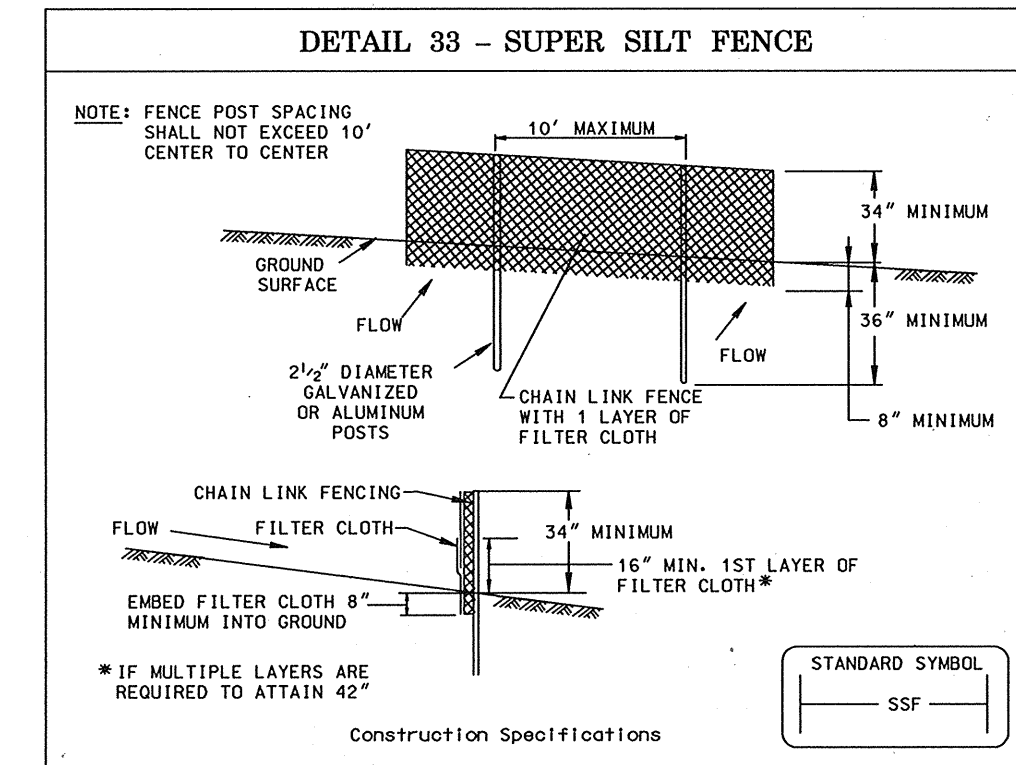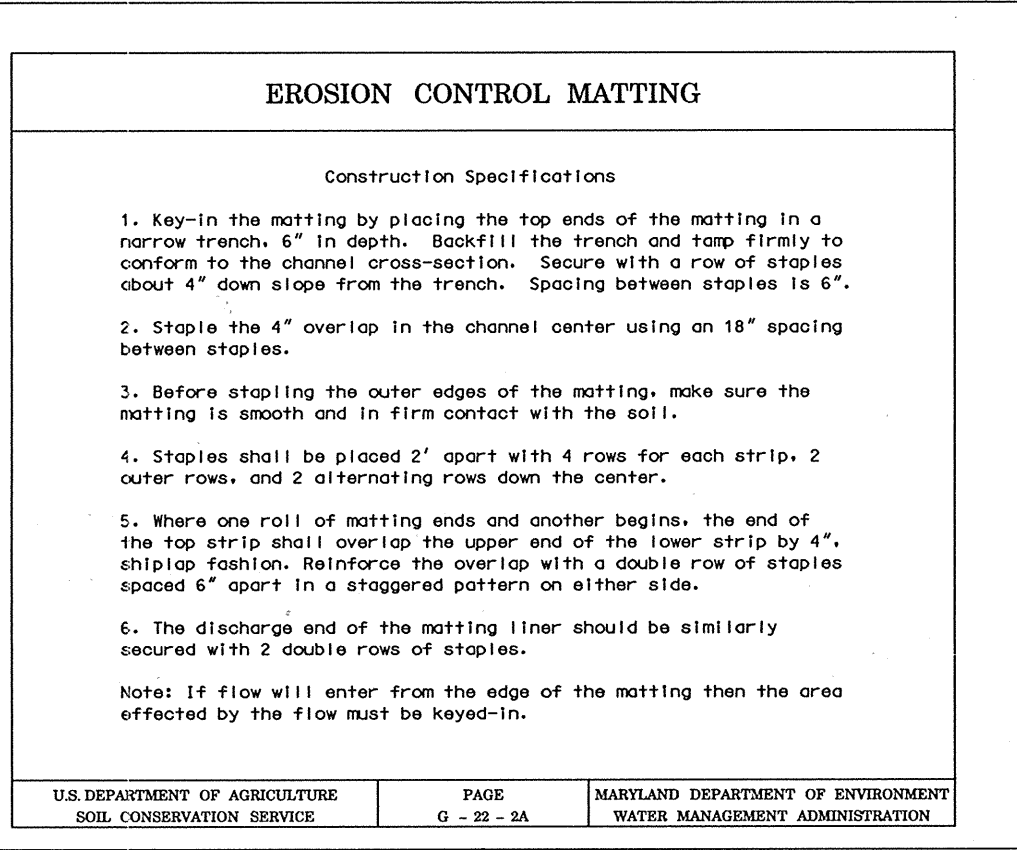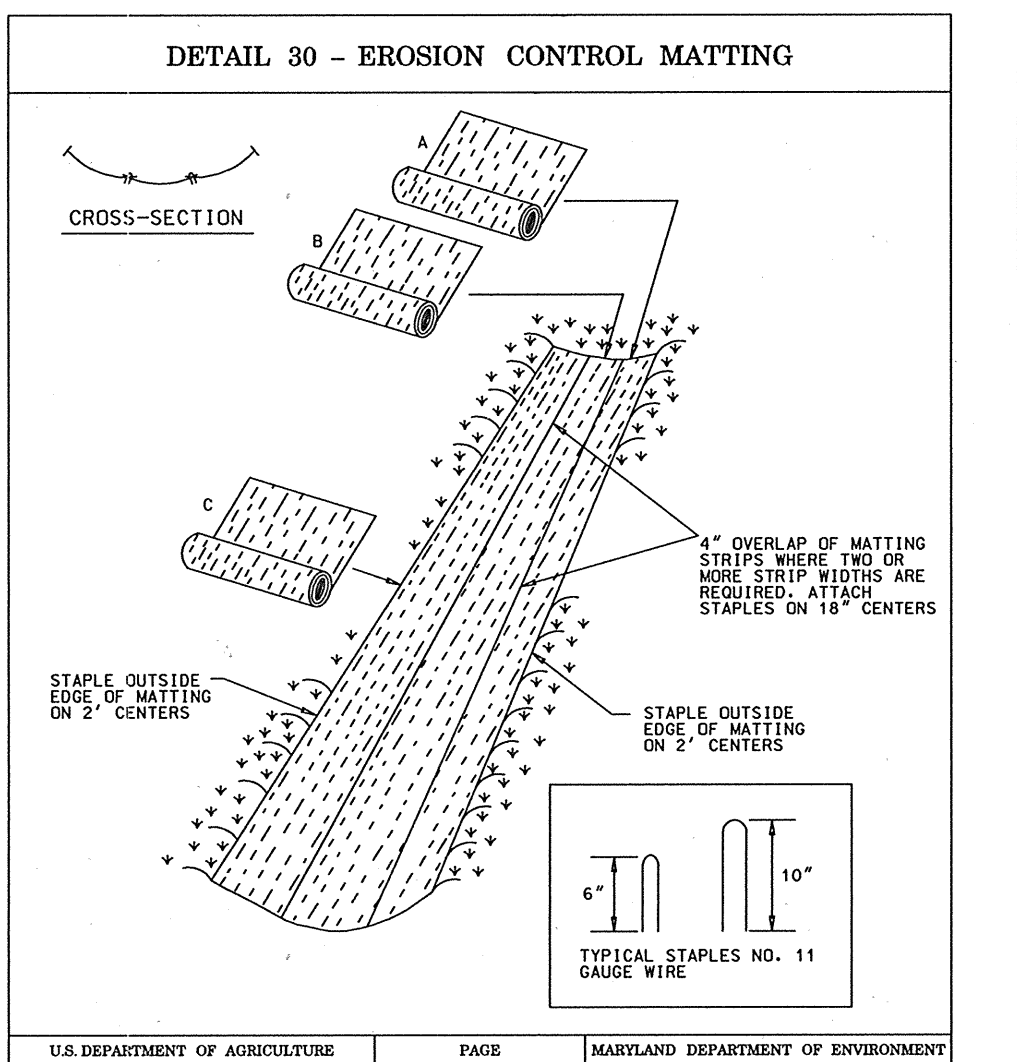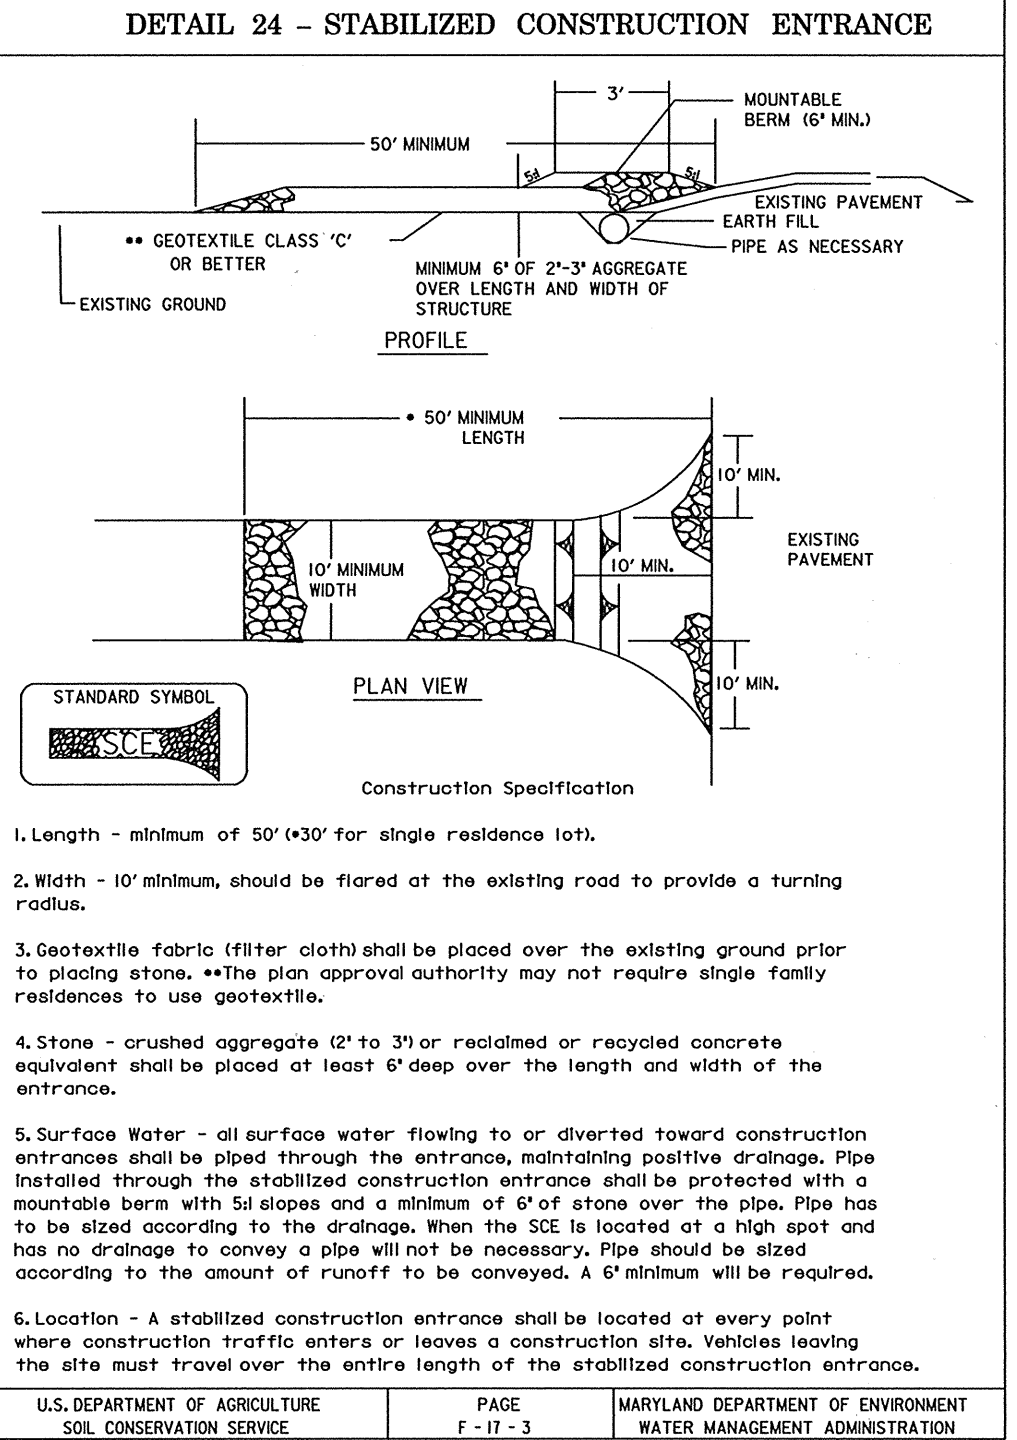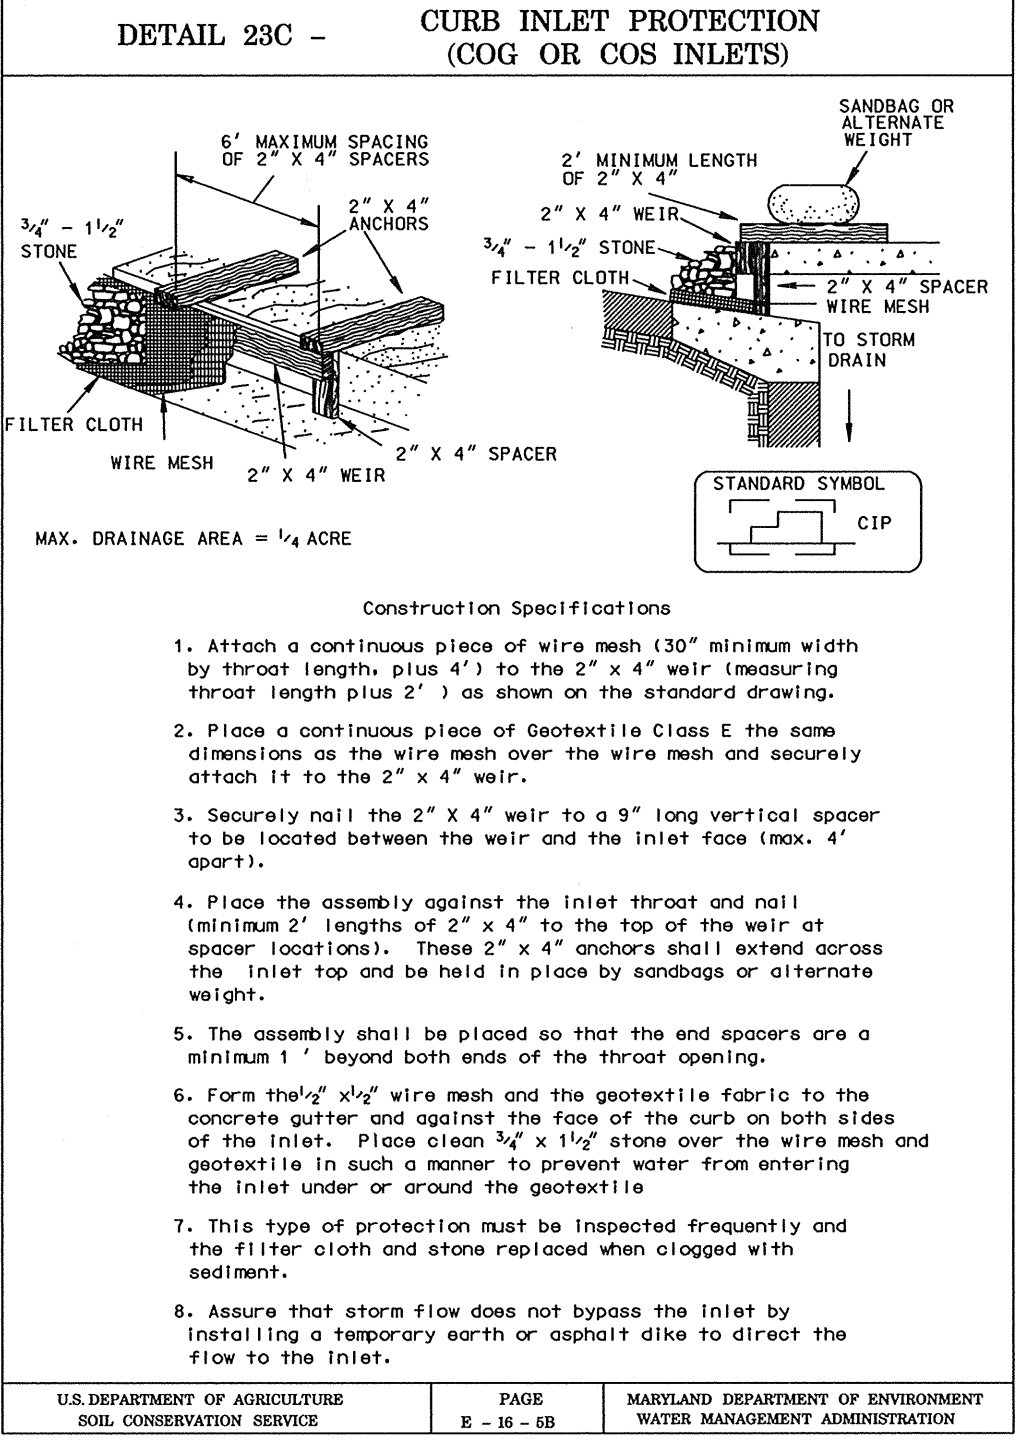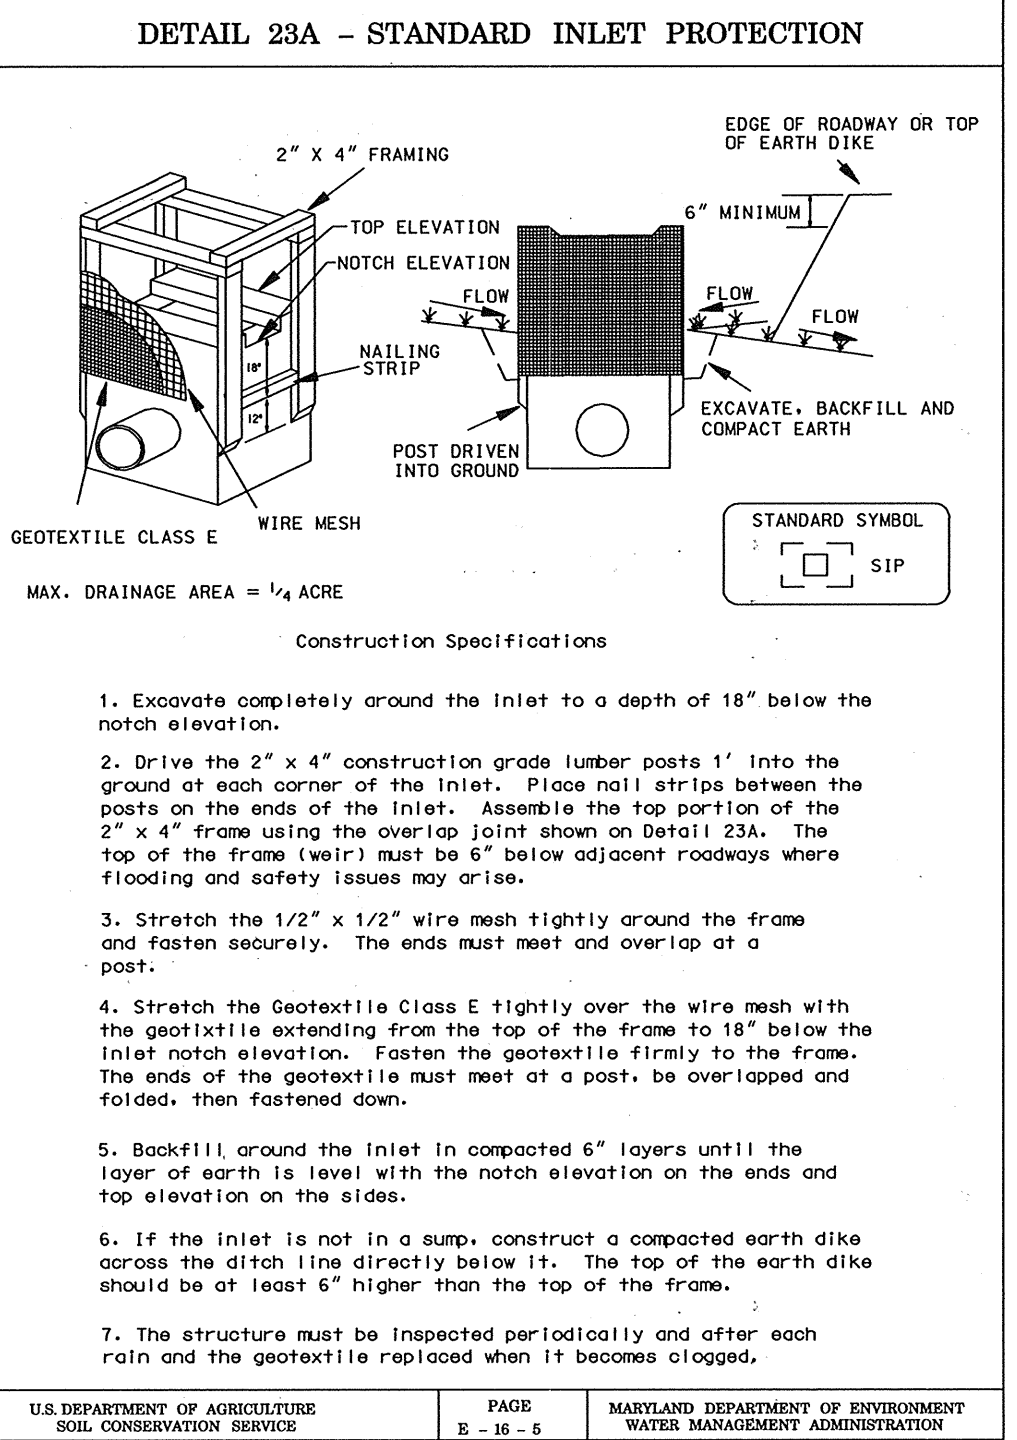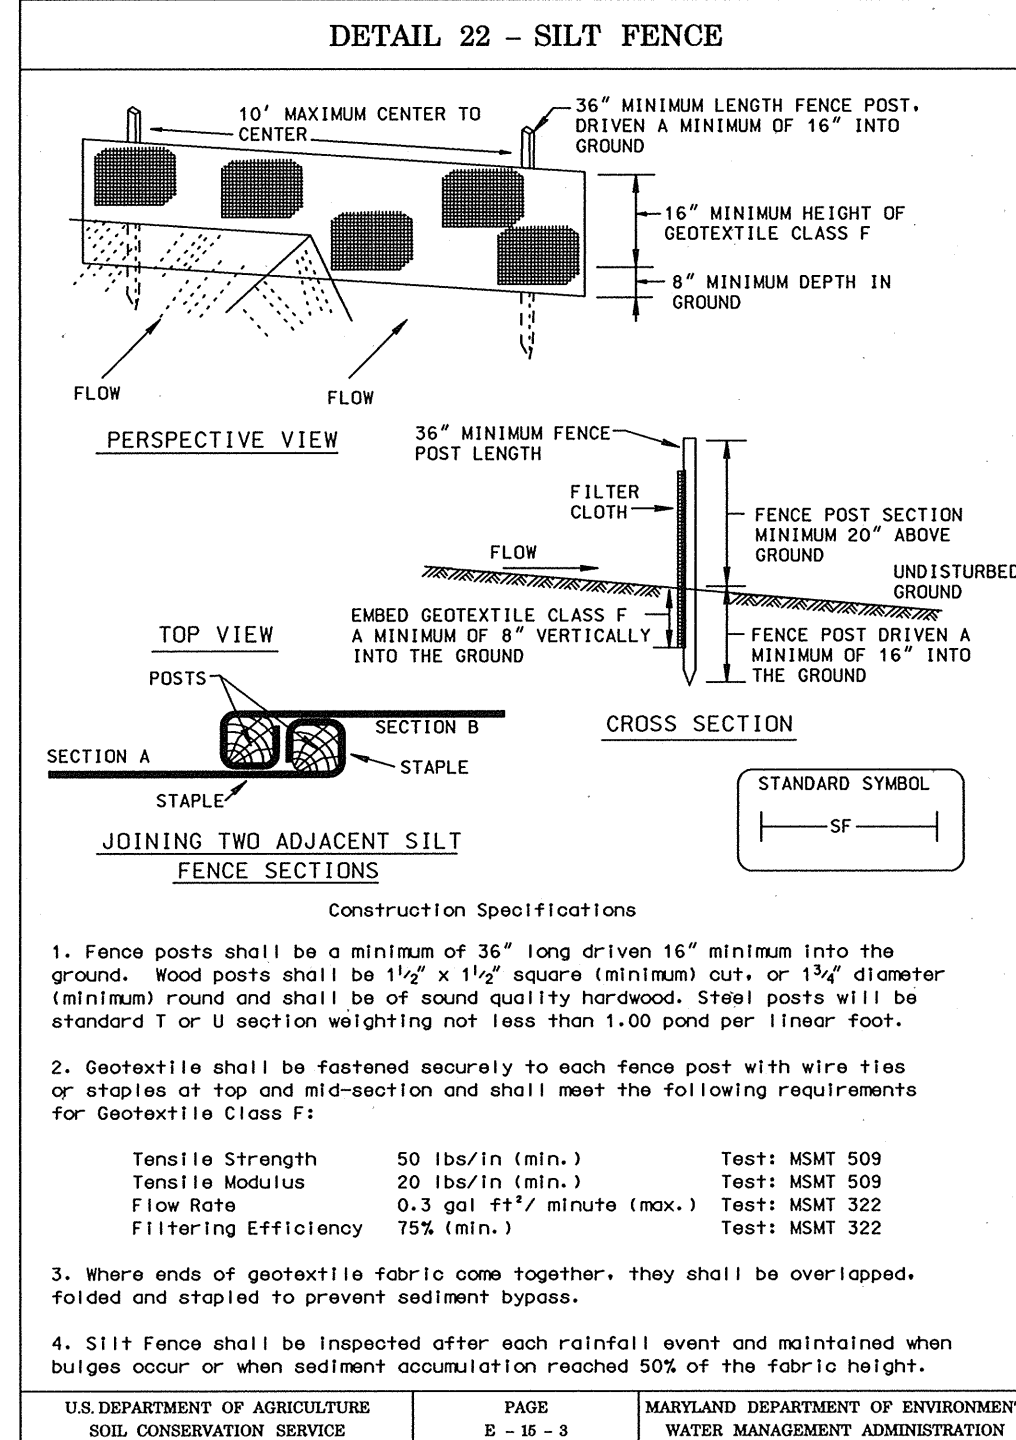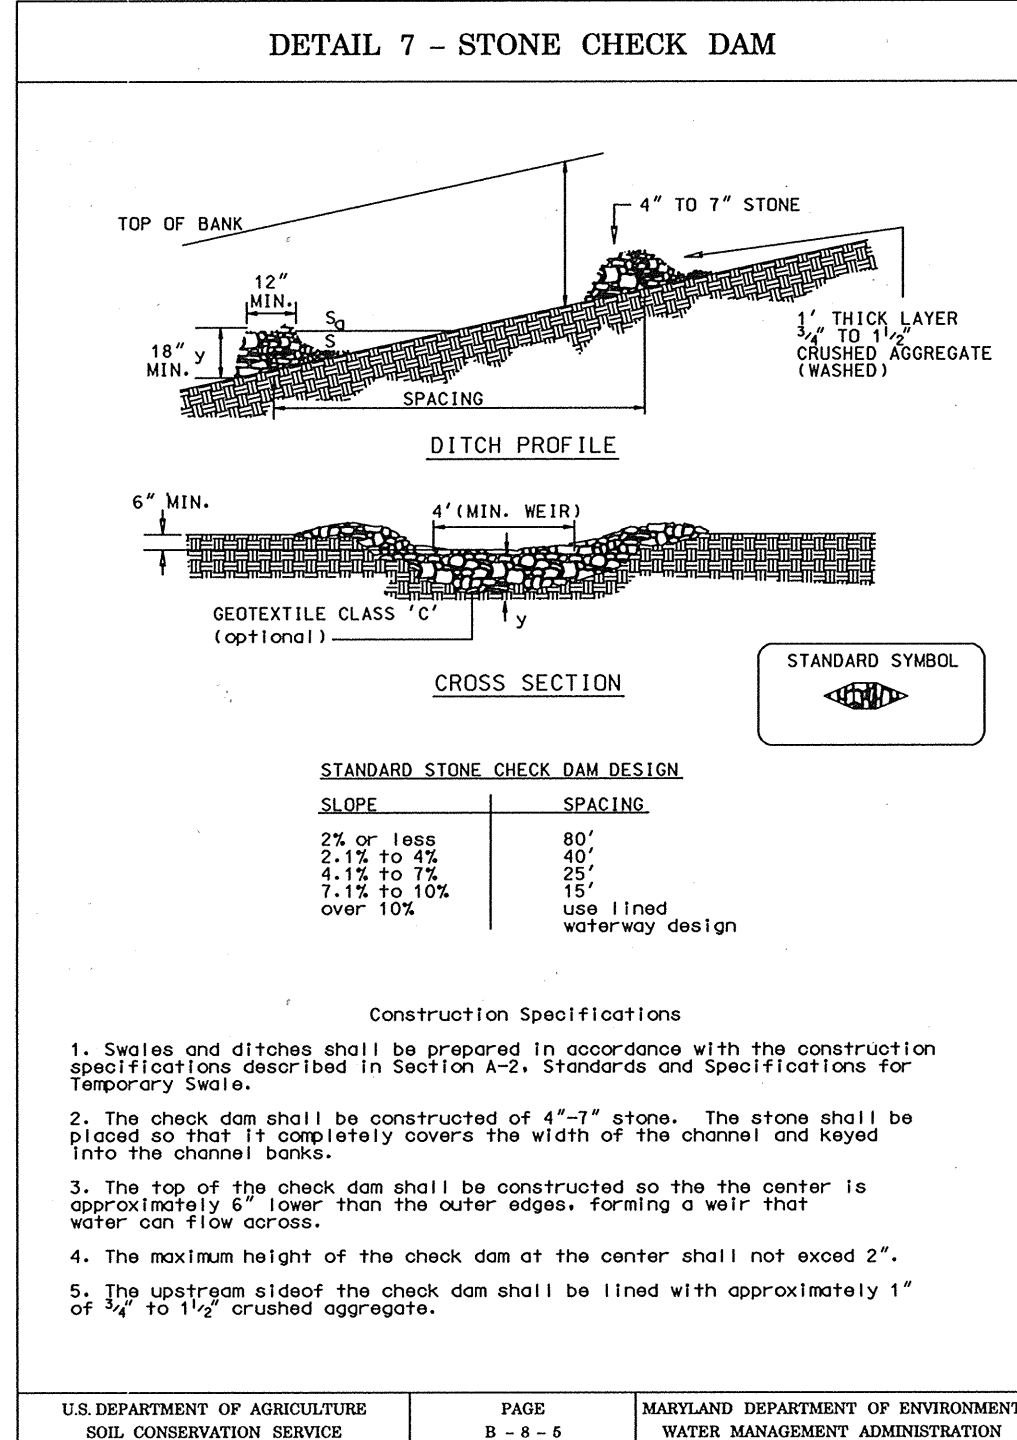

SEQUENCE OF CONSTRUCTION EROSION AND SEDIMENT CONTROL

DURATION (DAYS)	STEP ACTION
--	1. THE CONTRACTOR SHALL OBTAIN A GRADING PERMIT BEFORE ANY TYPE OF CONSTRUCTION IS TO START.
--	2. THE CONTRACTOR SHALL NOTIFY THE HOWARD COUNTY DEPARTMENT OF PUBLIC WORKS AT LEAST SEVEN (7) DAYS PRIOR TO INITIATION OF THE PROJECT AND FIVE (5) DAYS AFTER WORK ENDS.
--	3. UTILITIES AND STORM DRAINS SHOWN ON THE EROSION AND SEDIMENT CONTROL PLANS ARE FOR THE GUIDANCE OF THE CONTRACTOR ONLY. ALL UTILITIES SHALL BE CONSTRUCTED AS SHOWN ON THE ROADWAY PLANS.
--	4. MAINTAIN ALL SEDIMENT CONTROL PRACTICES ACCORDING TO THE MARYLAND 1994 STANDARDS AND COUNTY REGULATIONS UNTIL THE ENTIRE SITE IS STABILIZED.
--	5. THE EROSION AND SEDIMENT CONTROL MEASURES MUST BE IN PLACE AND FUNCTIONING PRIOR TO THE CLEARING, CLEAR AND GRUB FOR EROSION AND SEDIMENT CONTROL MEASURES OR DEVICES ONLY.
15	6. INSTALL PERIMETER CONTROLS AS REQUIRED FOR CONSTRUCTION.
60	7. GRADE ALL DISTURBED SLOPES TO DRAIN AS INDICATED ON THE PLANS. CONSTRUCT STORM DRAINS AS SHOWN. INSTALL INLET PROTECTION AS REQUIRED.
120	8. CONSTRUCT PAVEMENT, CURBS AND GUTTERS, SIDEWALKS, TRAFFIC CIRCLES AS SHOWN. CONSTRUCT ONLY THOSE AREAS THAT CAN BE STABILIZED IN THE SAME WORKING DAY. INSTALL STRAW BALE DIKE CHECK DAMS AS REQUIRED.
10	9. PLACE TOPSOIL, SEED AND MULCH ON ALL UNPAVED AREAS CONSTRUCTED AS DIRECTED BY THE ENGINEER. INSTALL EROSION CONTROL MATTING AS SHOWN.
--	10. SEDIMENT CONTROL DEVICES ARE TO REMAIN IN PLACE UNTIL ALL DISTURBED AREAS ARE STABILIZED WITH GROWTH AND HOWARD COUNTY DEPARTMENT OF PUBLIC WORKS APPROVES THEIR REMOVAL.
--	11. REMOVE EROSION AND SEDIMENT CONTROL DEVICES. STABILIZE ALL REMAINING DISTURBED AREAS.

AS-BUILT CERTIFICATION

I HEREBY CERTIFY THAT THE FACILITY SHOWN ON THIS PLAN WAS CONSTRUCTED AS SHOWN ON THE "AS-BUILT" PLANS AND MEETS THE APPROVED PLANS AND SPECIFICATIONS.

PE NO. _____
DATE _____

CERTIFY MEANS TO STATE OR DECLARE A PROFESSIONAL OPINION BASED UPON ONSITE INSPECTIONS AND MATERIAL TESTS WHICH ARE CONDUCTED DURING CONSTRUCTION. THE ONSITE INSPECTIONS AND MATERIAL TESTS ARE THOSE INSPECTIONS AND TESTS DEEMED SUFFICIENT AND APPROPRIATE BY DOMESTICALLY ACCEPTED ENGINEERING STANDARDS. DOES NOT MEAN OR IMPLY A GUARANTEE BY THE ENGINEER NOR DOES AN ENGINEER'S CERTIFICATION RELIEVE ANY OTHER PARTY FROM MEETING REQUIREMENTS IMPOSED BY CONTRACT, EMPLOYMENT, OR OTHER MEANS, INCLUDING MEETING COMMONLY ACCEPTED INDUSTRY PRACTICES.

BY THE ENGINEER:

I CERTIFY THAT THIS PLAN FOR EROSION AND SEDIMENT CONTROL REPRESENTS A PRACTICAL AND WORKABLE PLAN BASED ON MY PERSONAL KNOWLEDGE OF THE SITE CONDITIONS. THIS PLAN WAS PREPARED IN ACCORDANCE WITH THE REQUIREMENTS OF THE HOWARD SOIL CONSERVATION DISTRICT.

ENGINEER _____ DATE _____
Janet P. Owen 9/15/03

THESE PLANS HAVE BEEN REVIEWED FOR THE HOWARD SOIL CONSERVATION DISTRICT AND MEET THE TECHNICAL REQUIREMENTS FOR SOIL EROSION AND SEDIMENT CONTROL.

Jim Myers, Esq. 9/29/03
NATURAL RESOURCES CONSERVATION SERVICE DATE

THESE PLANS FOR SOIL EROSION AND SEDIMENT CONTROL MEET THE REQUIREMENTS OF THE HOWARD SOIL CONSERVATION DISTRICT.

John S. ... 9/29/03
HOWARD SOIL CONSERVATION DISTRICT DATE

DEPARTMENT OF PUBLIC WORKS
HOWARD COUNTY, MARYLAND

Janet P. Owen 9/22/03
CHIEF, BUREAU OF ENGINEERING DATE

William J. ... 9-24-03
CHIEF, BUREAU OF HIGHWAYS DATE

URS
HUNT VALLEY, MARYLAND

RJM ENGINEERING, INC.
CONSULTING ENGINEERS
COLUMBIA, MARYLAND

STATE OF MARYLAND
DAVID THOMAS FORD
COMMISSIONER OF PUBLIC WORKS
9/18/03

DES:	DRN:	CHK:	DATE:	BY:	NO.:	REVISION:	DATE:


EROSION AND SEDIMENT CONTROL
GENERAL NOTES 2

NO.: _____ DATE: 9/03

McKENZIE ROAD ROADWAY AND STORMDRAIN IMPROVEMENTS

HOWARD COUNTY, MARYLAND
CAPITAL PROJECT NO. J-4164-10

SCALE AS SHOWN
SHEET 13 OF 24

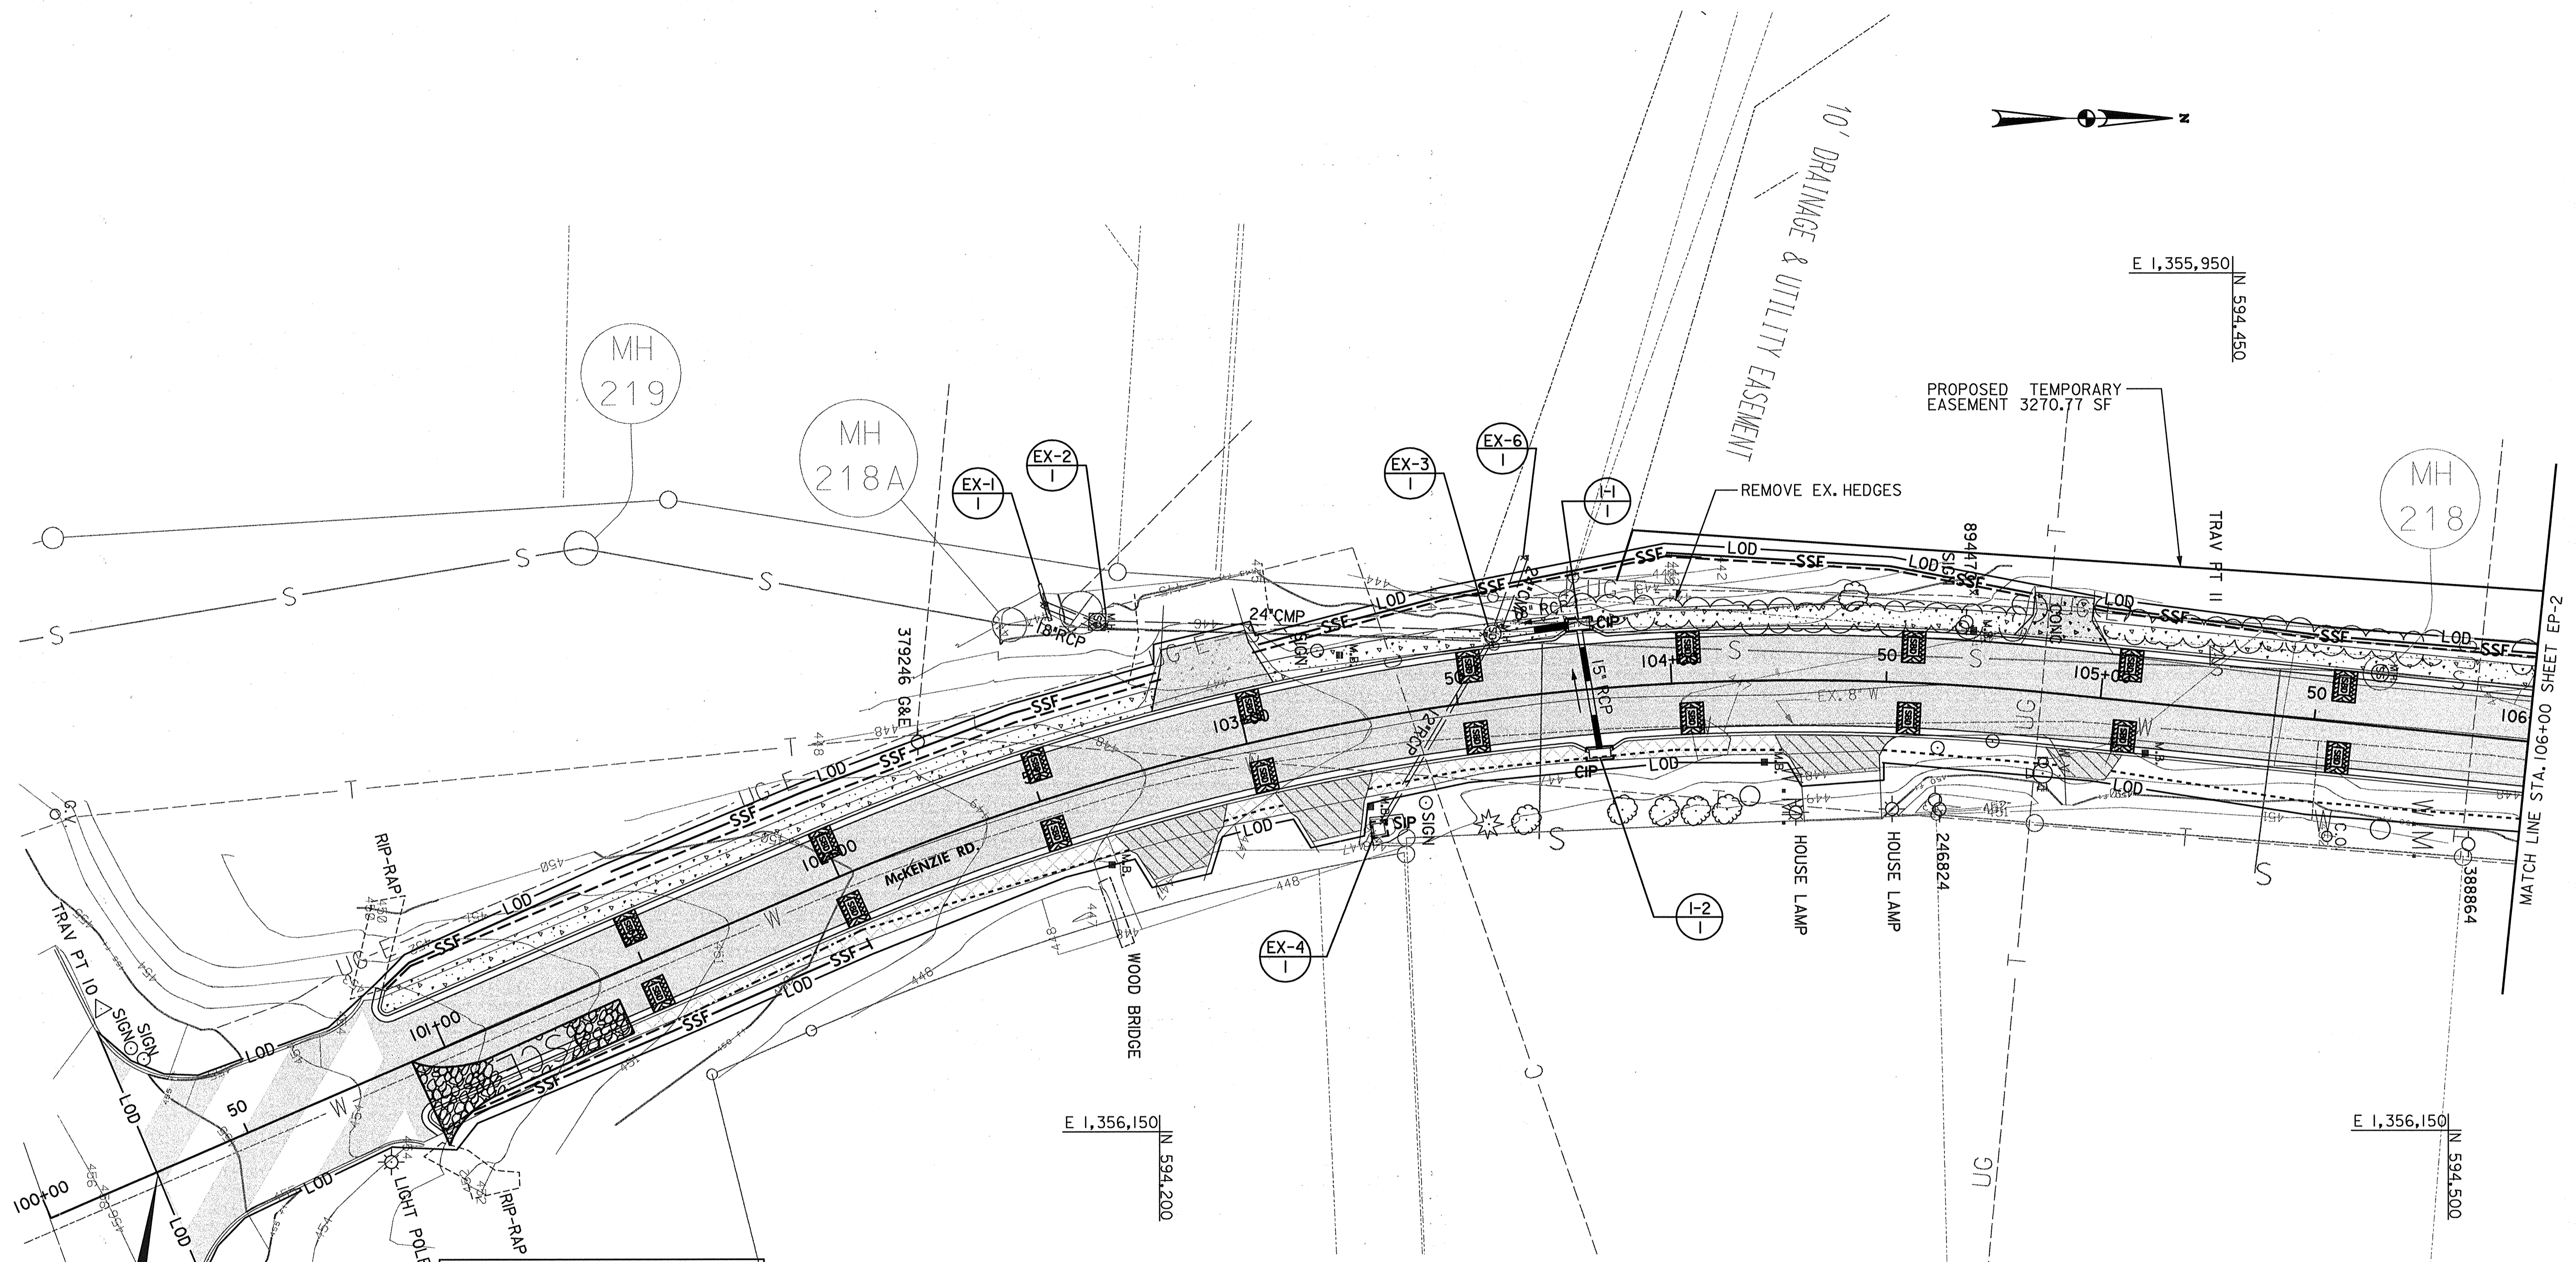

LIMIT OF WORK
CONT. NO. J-4164-10
McKENZIE ROAD
STA. 100+27.26


LEGEND

[Pattern]	PAVEMENT REMOVAL
[Pattern]	FULL DEPTH PAVEMENT CONSTRUCTION
[Pattern]	MILL AND RESURFACE
[Pattern]	PROPOSED CONCRETE SIDEWALK
[Pattern]	PROPOSED MEDIANS
[Pattern]	RECONSTRUCT ASPHALT DRIVEWAY
[Pattern]	RECONSTRUCT CONCRETE DRIVEWAY
[Pattern]	EXIST. RIGHT-OF-WAY

ITEM DESCRIPTION	QUANTITY
STABILIZED CONSTRUCTION ENTRANCE	50 TON
SUPER SILT FENCE	665 LF
SBD CHECK DAM	18 EA
CURB INLET PROTECTION (CIP)	2 EA
STANDARD INLET PROTECTION (SIP)	1 EA

NOTES:

1. ALL EROSION AND SEDIMENT CONTROL DEVICES SHALL BE PLACED WITHIN THE RIGHT OF WAY OR EASEMENT. THE LINES FOR SSF AND LOD ARE IN THE SAME LOCATION, HOWEVER, THEY ARE SEPARATED ON THE PLAN FOR CLARITY.
2. SBD CHECK DAMS SHALL BE PLACED PERPENDICULAR TO THE CURBS, SPACED AT APPROXIMATELY 50' AS DIRECTED BY THE ENGINEER.

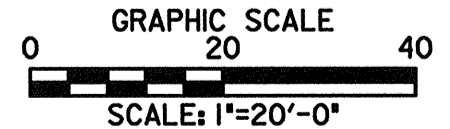


DEPARTMENT OF PUBLIC WORKS
 HOWARD COUNTY, MARYLAND

[Signature] 9/22/03
 CHIEF, TRANSPORTATION AND SPECIAL PROJECTS DIVISION

[Signature] 9/22/05
 CHIEF, BUREAU OF ENGINEERING

[Signature] 9-24-03
 CHIEF, BUREAU OF HIGHWAYS

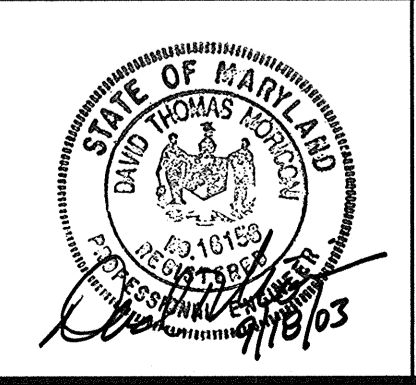

URS
 HUNT VALLEY, MARYLAND

RJM
 RJM ENGINEERING, INC.
 CONSULTING ENGINEERS
 COLUMBIA, MARYLAND

TELE: (410) 730-1001 FAX: (410) 730-5403

DES:			
DRN:			
CHK:			
DATE:	BY	NO.	REVISION

EROSION AND SEDIMENT CONTROL PLAN SHEET EP-1

NO.: _____ DATE: 9/03

McKENZIE ROAD ROADWAY AND STORMDRAIN IMPROVEMENTS

HOWARD COUNTY, MARYLAND
 CAPITAL PROJECT NO. J-4164-10


SCALE AS SHOWN
 SHEET 14 OF 24

ITEM DESCRIPTION	QUANTITY
STABILIZED CONSTRUCTION ENTRANCE •	50 TON
SUPER SILT FENCE	970 LF
SBD CHECK DAM	18 EA
CLASS I RIPRAP	66 SF
STONE CHECK DAM	1 EA
CURB INLET PROTECTION (CIP)	1 EA
STANDARD INLET PROTECTION (SIP)	3 EA
EROSION CONTROL MATTING	225 SY


• QUANTITY FOR ONE STABILIZED CONSTRUCTION ENTRANCE NOT SHOWN HAS BEEN PROVIDED AND SHALL BE PLACED AS DETERMINED BY THE INSPECTOR.

NOTE:

SBD CHECK DAMS SHALL BE PLACED PERPENDICULAR TO THE CURBS, SPACED AT APPROXIMATELY 50' AS DIRECTED BY THE ENGINEER.

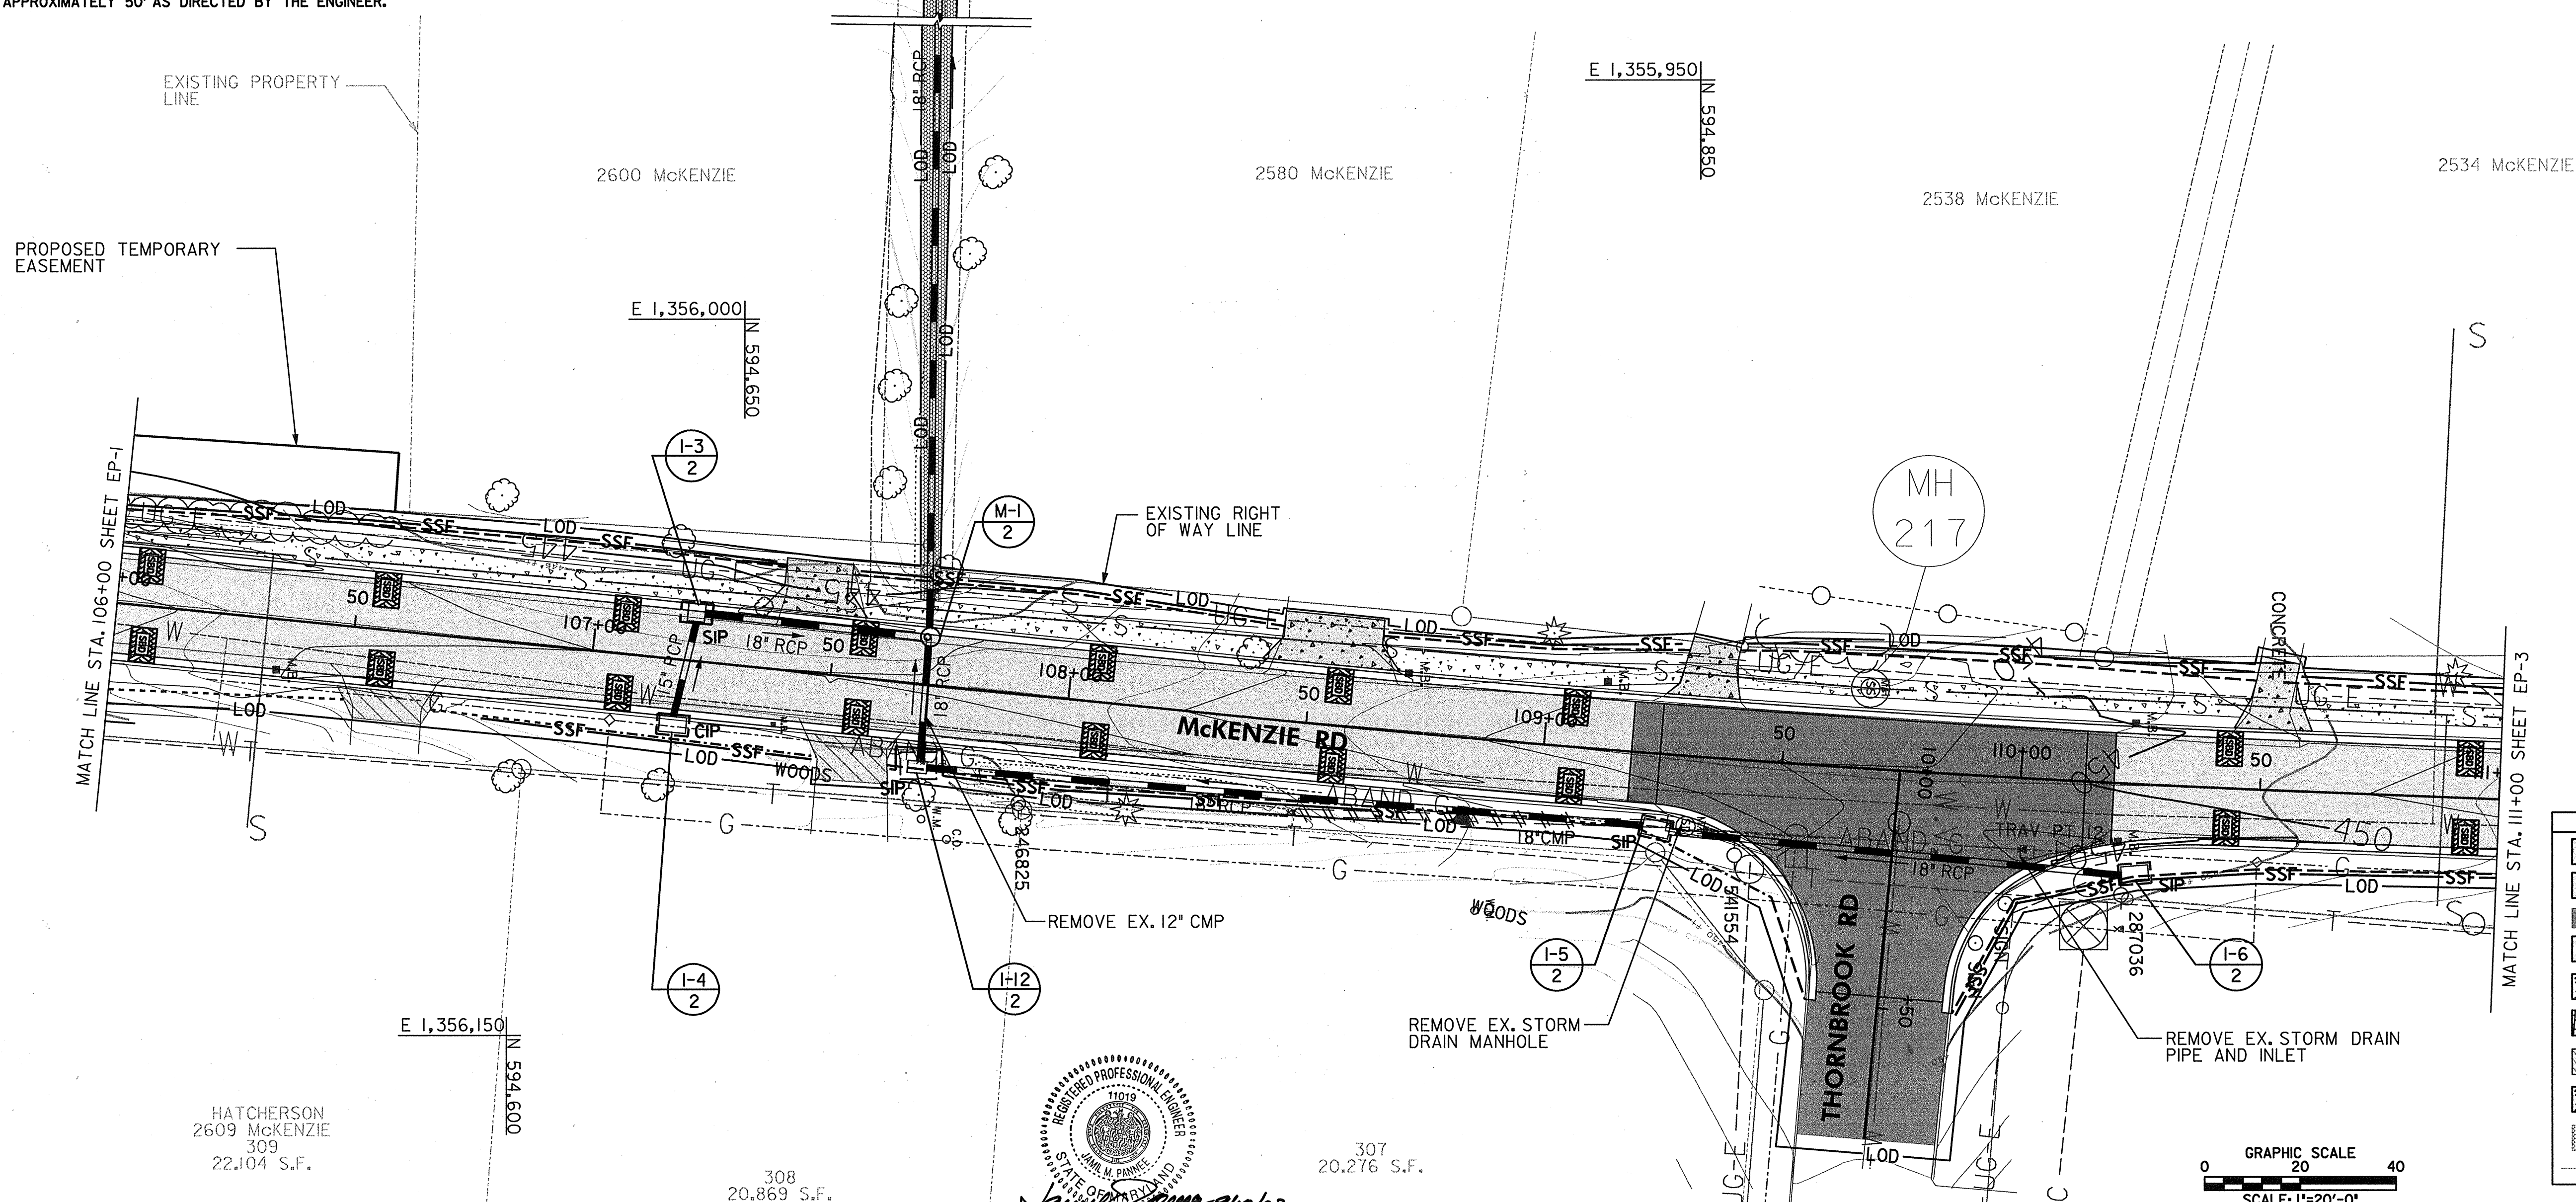

LEGEND	
[Symbol]	PAVEMENT REMOVAL
[Symbol]	FULL DEPTH PAVEMENT CONSTRUCTION
[Symbol]	SPEED TABLE
[Symbol]	MILL AND RESURFACE
[Symbol]	PROPOSED CONCRETE SIDEWALK
[Symbol]	PROPOSED MEDIANS
[Symbol]	RECONSTRUCT ASPHALT DRIVEWAY
[Symbol]	RECONSTRUCT CONCRETE DRIVEWAY
[Symbol]	INSTALL EROSION CONTROL MATTING
[Symbol]	EXIST. RIGHT-OF-WAY

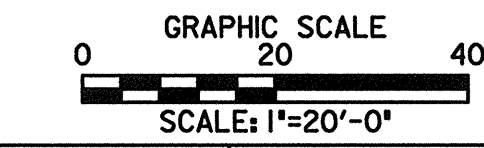


DEPARTMENT OF PUBLIC WORKS
HOWARD COUNTY, MARYLAND

James J. Blair 9/29/03
CHIEF, BUREAU OF ENGINEERING

William J. Jones 9/22/03
CHIEF, TRANSPORTATION AND SPECIAL PROJECTS DIVISION

William J. Jones 9/24/03
CHIEF, BUREAU OF HIGHWAYS

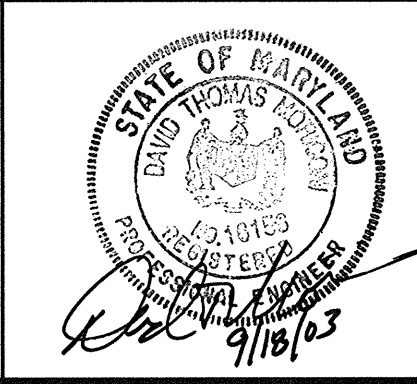

URS
HUNT VALLEY, MARYLAND

RJM
RJM ENGINEERING, INC.
CONSULTING ENGINEERS
COLUMBIA, MARYLAND

TELE: (410) 730-1001 FAX: (410) 730-5403

DES:				
DRN:				
CHK:				
DATE:	BY	NO.	REVISION	DATE

EROSION AND SEDIMENT CONTROL PLAN SHEET EP-2

NO.: _____ DATE: 9/03

McKENZIE ROAD ROADWAY AND STORMDRAIN IMPROVEMENTS

HOWARD COUNTY, MARYLAND
CAPITAL PROJECT NO. J-4164-10


SCALE AS SHOWN
SHEET 15 OF 24

ITEM DESCRIPTION	QUANTITY
STABILIZED CONSTRUCTION ENTRANCE *	50 TON
SUPER SILT FENCE	600 LF
SBD CHECK DAM	24 EA
CURB INLET PROTECTION (CIP)	1 EA
STANDARD INLET PROTECTION (SIP)	1 EA

* QUANTITY FOR ONE STABILIZED CONSTRUCTION ENTRANCE NOT SHOWN HAS BEEN PROVIDED AND SHALL BE PLACED AS DETERMINED BY THE INSPECTOR.


NOTE:

SBD CHECK DAMS SHALL BE PLACED PERPENDICULAR TO THE CURB, SPACED AT APPROXIMATELY 50' AS DIRECTED BY THE ENGINEER.

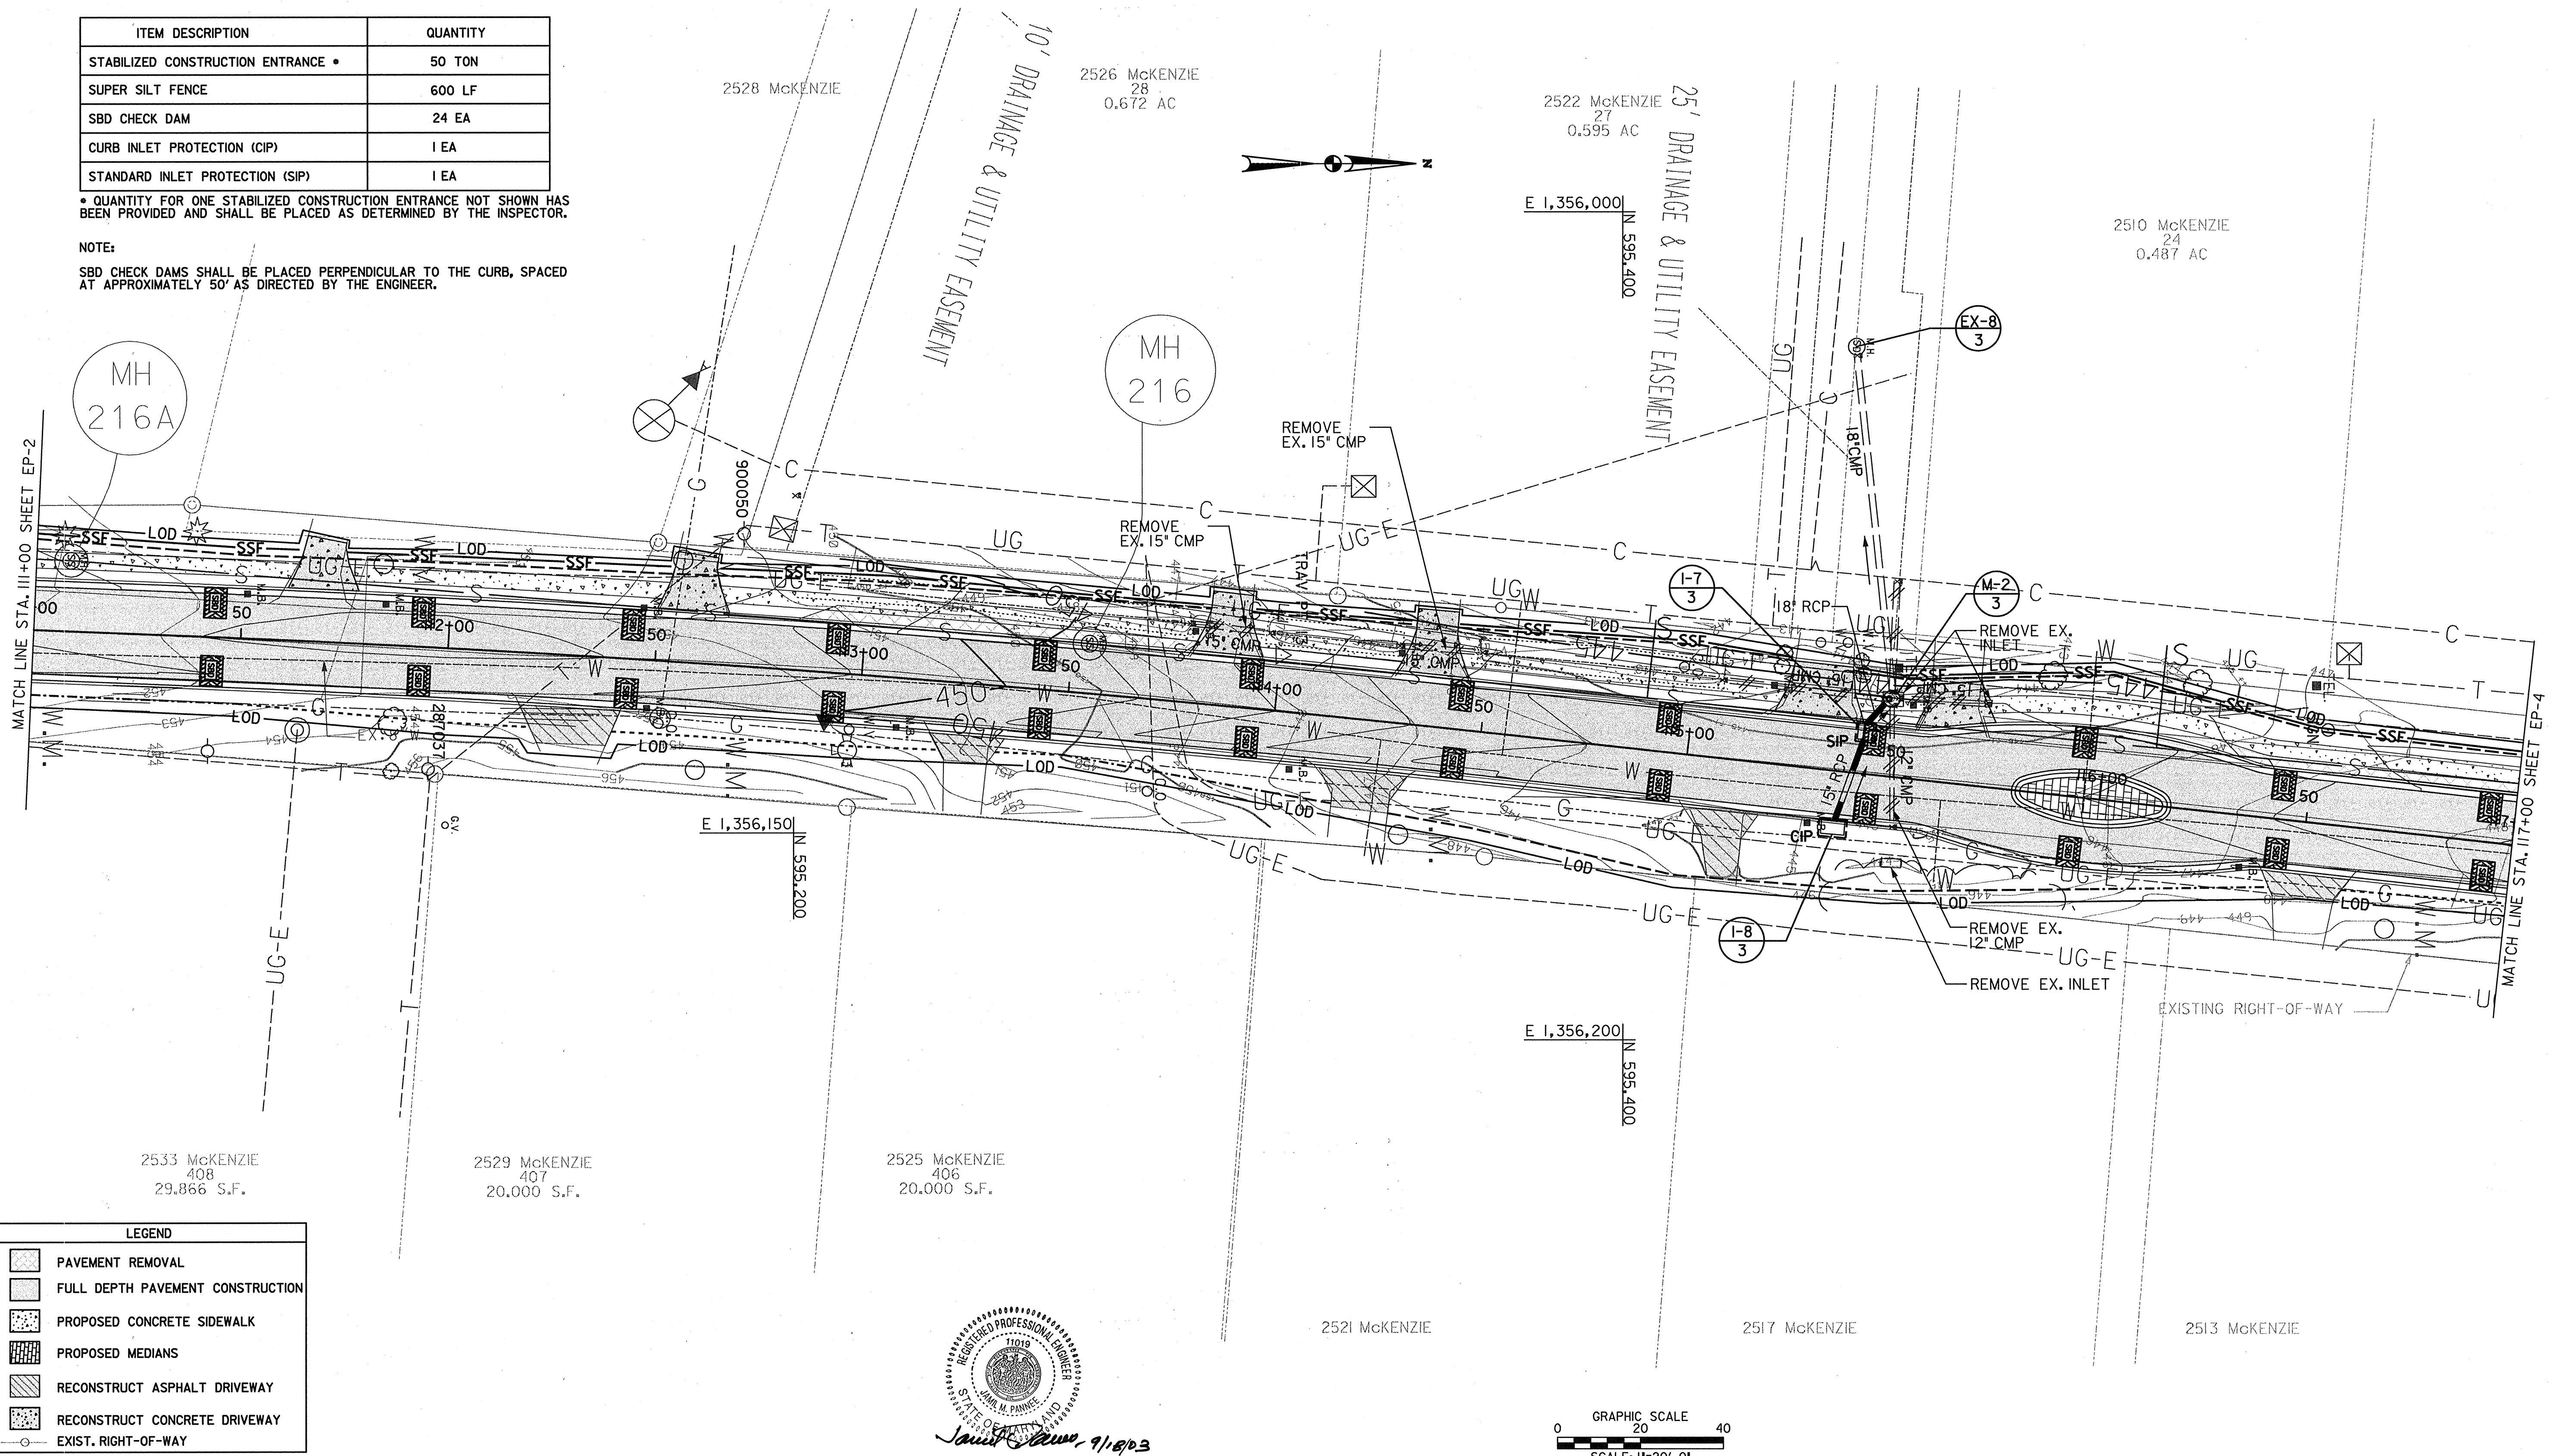



LEGEND	
[Symbol]	PAVEMENT REMOVAL
[Symbol]	FULL DEPTH PAVEMENT CONSTRUCTION
[Symbol]	PROPOSED CONCRETE SIDEWALK
[Symbol]	PROPOSED MEDIANS
[Symbol]	RECONSTRUCT ASPHALT DRIVEWAY
[Symbol]	RECONSTRUCT CONCRETE DRIVEWAY
[Symbol]	EXIST. RIGHT-OF-WAY

Professional Engineer Seal for James J. Law, No. 91803, State of Maryland, dated 9/18/03.

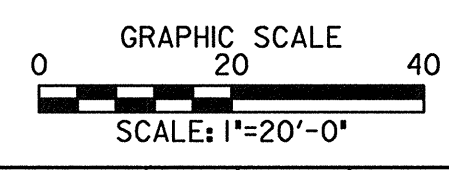

DEPARTMENT OF PUBLIC WORKS HOWARD COUNTY, MARYLAND <i>James J. Law</i> 9/18/03 CHIEF, TRANSPORTATION AND SPECIAL PROJECTS DIVISION	STATE OF MARYLAND DIVISION OF PUBLIC WORKS <i>William J. Johnson</i> 9/24/03 CHIEF, BUREAU OF HIGHWAYS	URS HUNT VALLEY, MARYLAND	RJM ENGINEERING, INC. CONSULTING ENGINEERS COLUMBIA, MARYLAND TEL: 410-730-1001 FAX: 410-730-5403	DES:				EROSION AND SEDIMENT CONTROL PLAN SHEET EP-3	McKENZIE ROAD ROADWAY AND STORMDRAIN IMPROVEMENTS HOWARD COUNTY, MARYLAND CAPITAL PROJECT NO. J-4164-10	SCALE AS SHOWN SHEET 16 OF 24
				DRN:						
CHK:				DATE:	BY	NO.	REVISION			

ITEM DESCRIPTION	QUANTITY
STABILIZED CONSTRUCTION ENTRANCE	50 TON
SUPER SILT FENCE	425 LF
SBD CHECK DAM	16 EA
ASPHALT BERM	64 LF
CURB INLET PROTECTION (CIP)	2 EA
STANDARD INLET PROTECTION (SIP)	1 EA

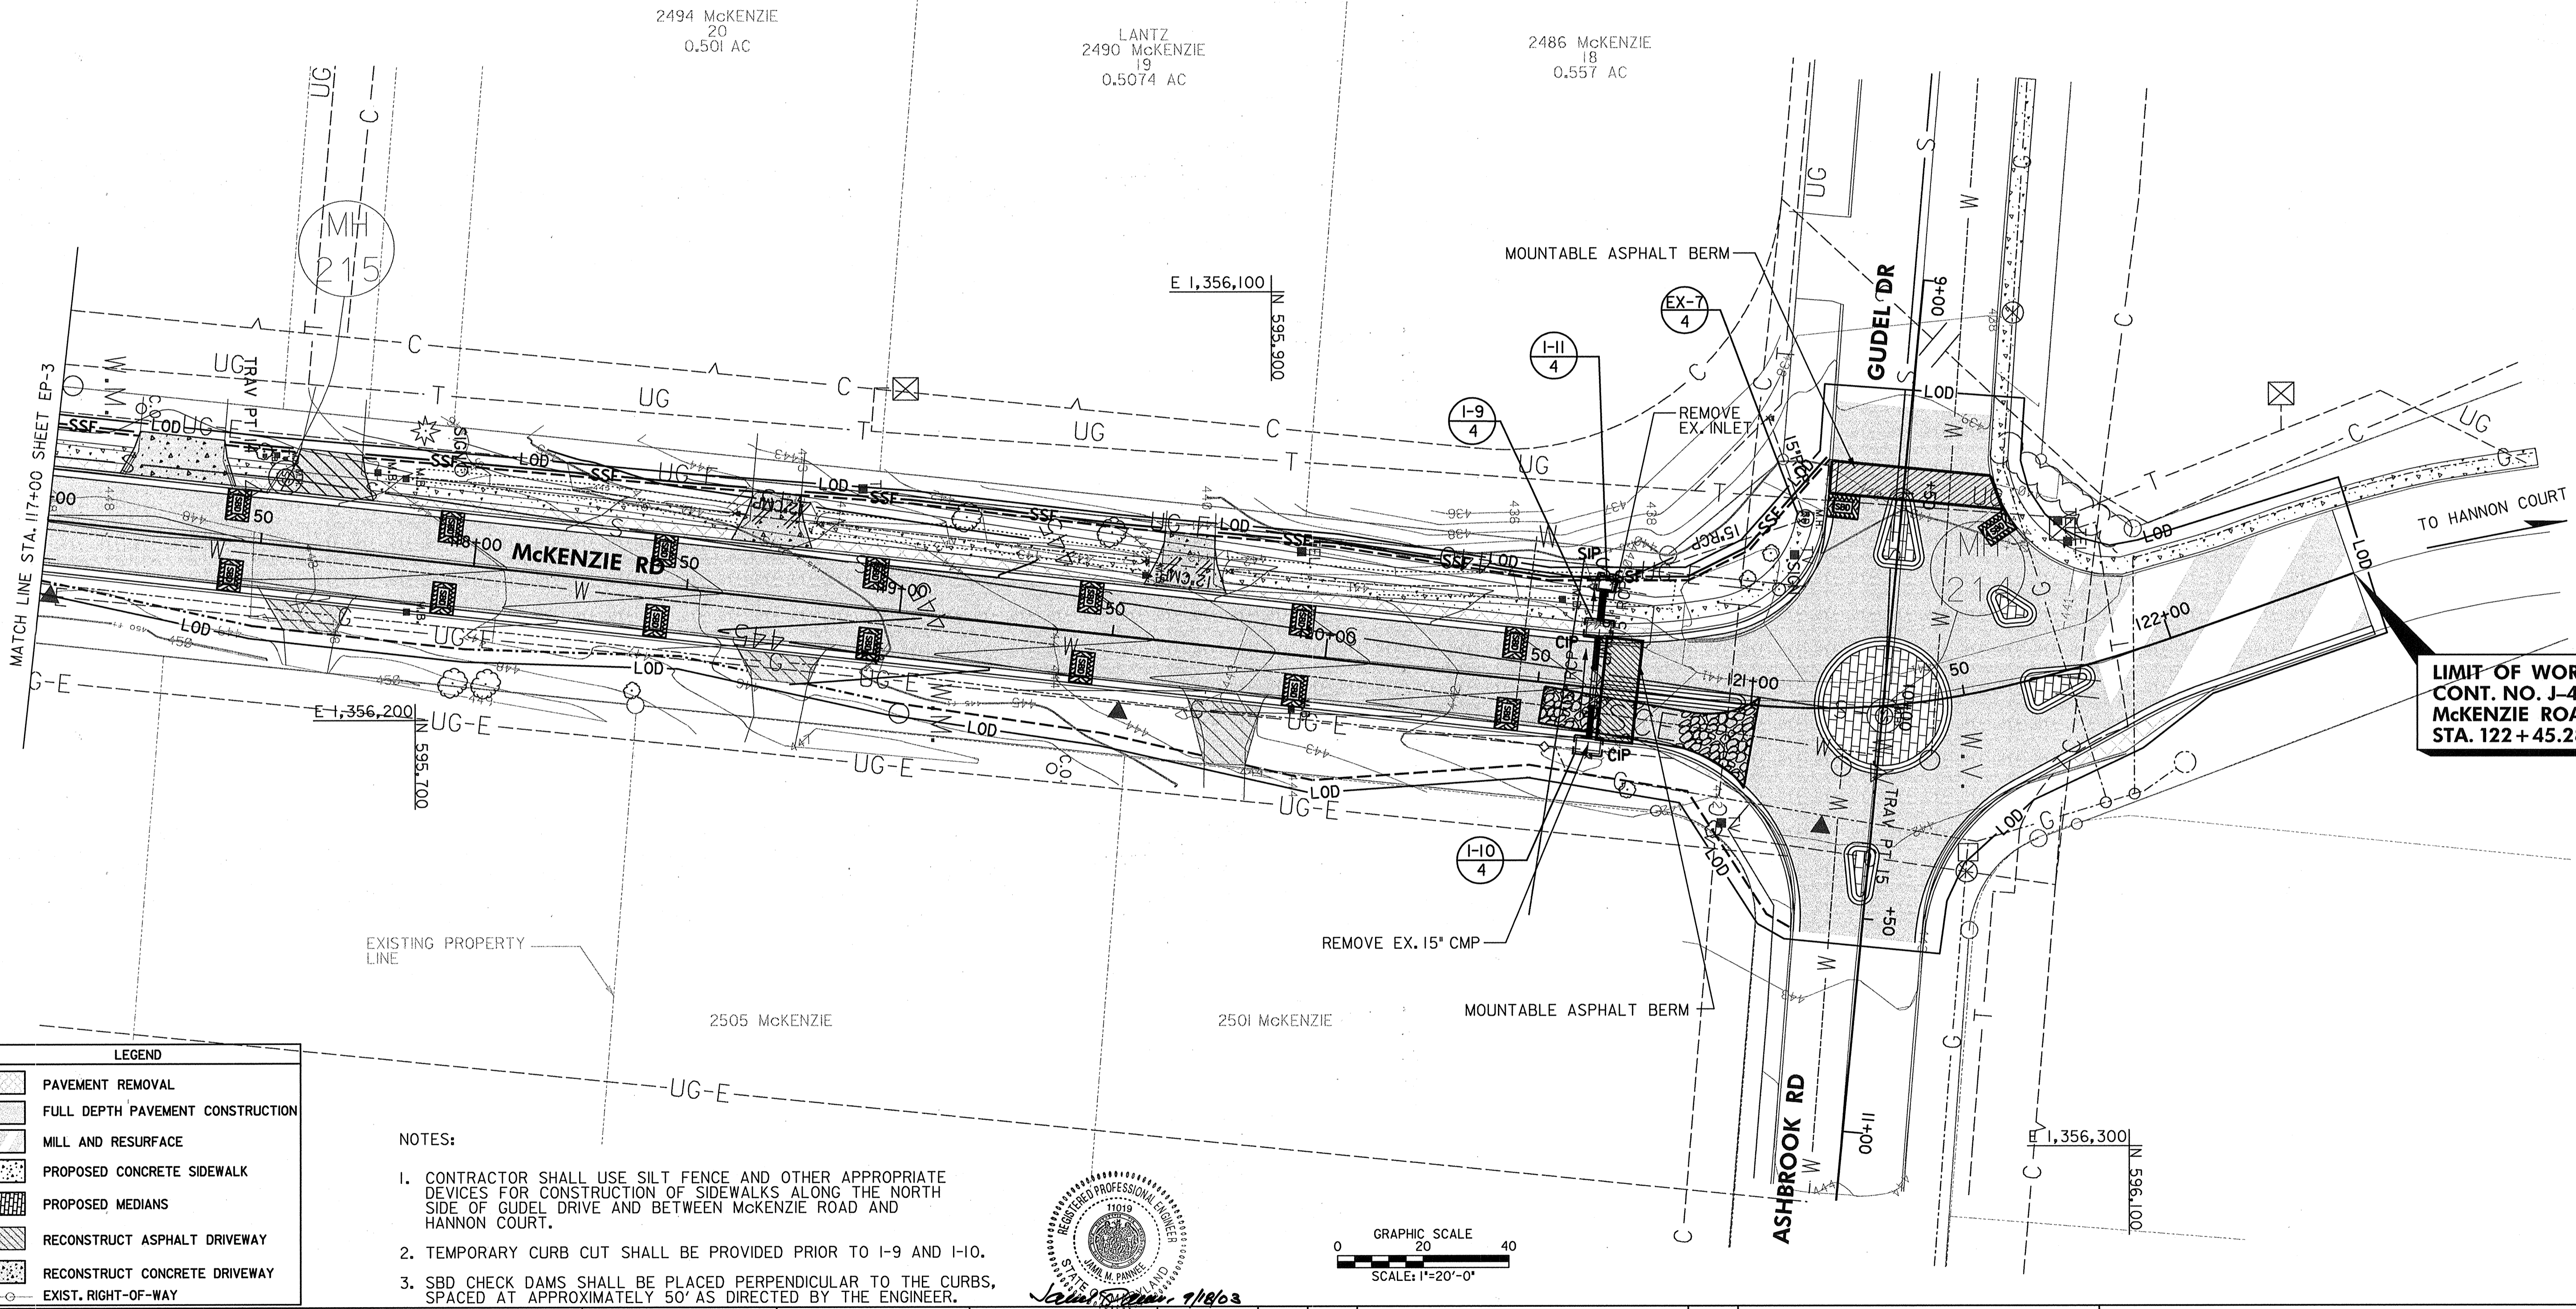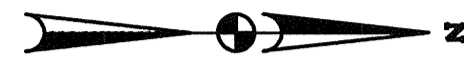


LIMIT OF WORK
CONT. NO. J-4164-10
McKENZIE ROAD
STA. 122+45.28

LEGEND

[Pattern]	PAVEMENT REMOVAL
[Pattern]	FULL DEPTH PAVEMENT CONSTRUCTION
[Pattern]	MILL AND RESURFACE
[Pattern]	PROPOSED CONCRETE SIDEWALK
[Pattern]	PROPOSED MEDIANS
[Pattern]	RECONSTRUCT ASPHALT DRIVEWAY
[Pattern]	RECONSTRUCT CONCRETE DRIVEWAY
[Pattern]	EXIST. RIGHT-OF-WAY

- NOTES:**
- CONTRACTOR SHALL USE SILT FENCE AND OTHER APPROPRIATE DEVICES FOR CONSTRUCTION OF SIDEWALKS ALONG THE NORTH SIDE OF GUDEL DRIVE AND BETWEEN McKENZIE ROAD AND HANNON COURT.
 - TEMPORARY CURB CUT SHALL BE PROVIDED PRIOR TO I-9 AND I-10.
 - SBD CHECK DAMS SHALL BE PLACED PERPENDICULAR TO THE CURBS, SPACED AT APPROXIMATELY 50' AS DIRECTED BY THE ENGINEER.

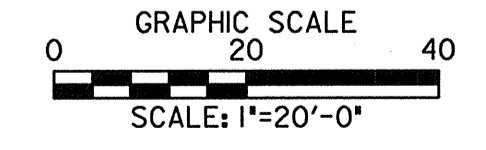

DEPARTMENT OF PUBLIC WORKS
 HOWARD COUNTY, MARYLAND

[Signature] 9/22/03
 CHIEF, BUREAU OF ENGINEERING

[Signature] 9/22/03
 CHIEF, TRANSPORTATION AND SPECIAL PROJECTS DIVISION



URS
 HUNT VALLEY, MARYLAND

RJM
 RJM ENGINEERING, INC.
 CONSULTING ENGINEERS
 COLUMBIA, MARYLAND

DES:	DRN:	CHK:	DATE:	BY	NO.	REVISION	DATE


EROSION AND SEDIMENT CONTROL PLAN SHEET EP-4

NO.: _____ DATE: 9/03


McKENZIE ROAD ROADWAY AND STORMDRAIN IMPROVEMENTS

HOWARD COUNTY, MARYLAND
 CAPITAL PROJECT NO. J-4164-10


SCALE AS SHOWN
 SHEET 17 OF 24

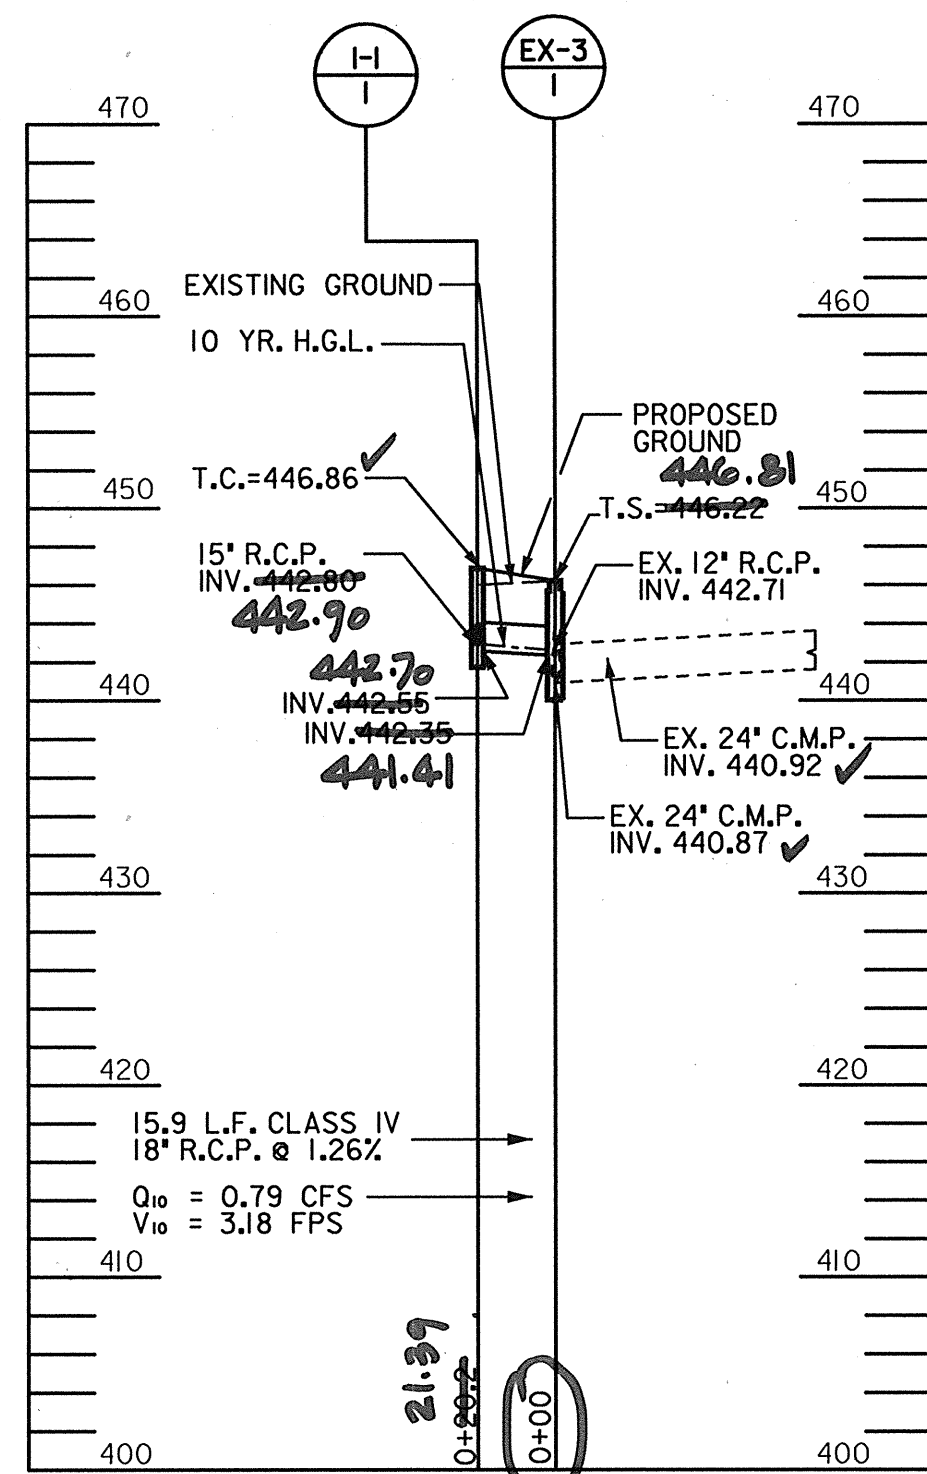


STA. 103+59.96 LT

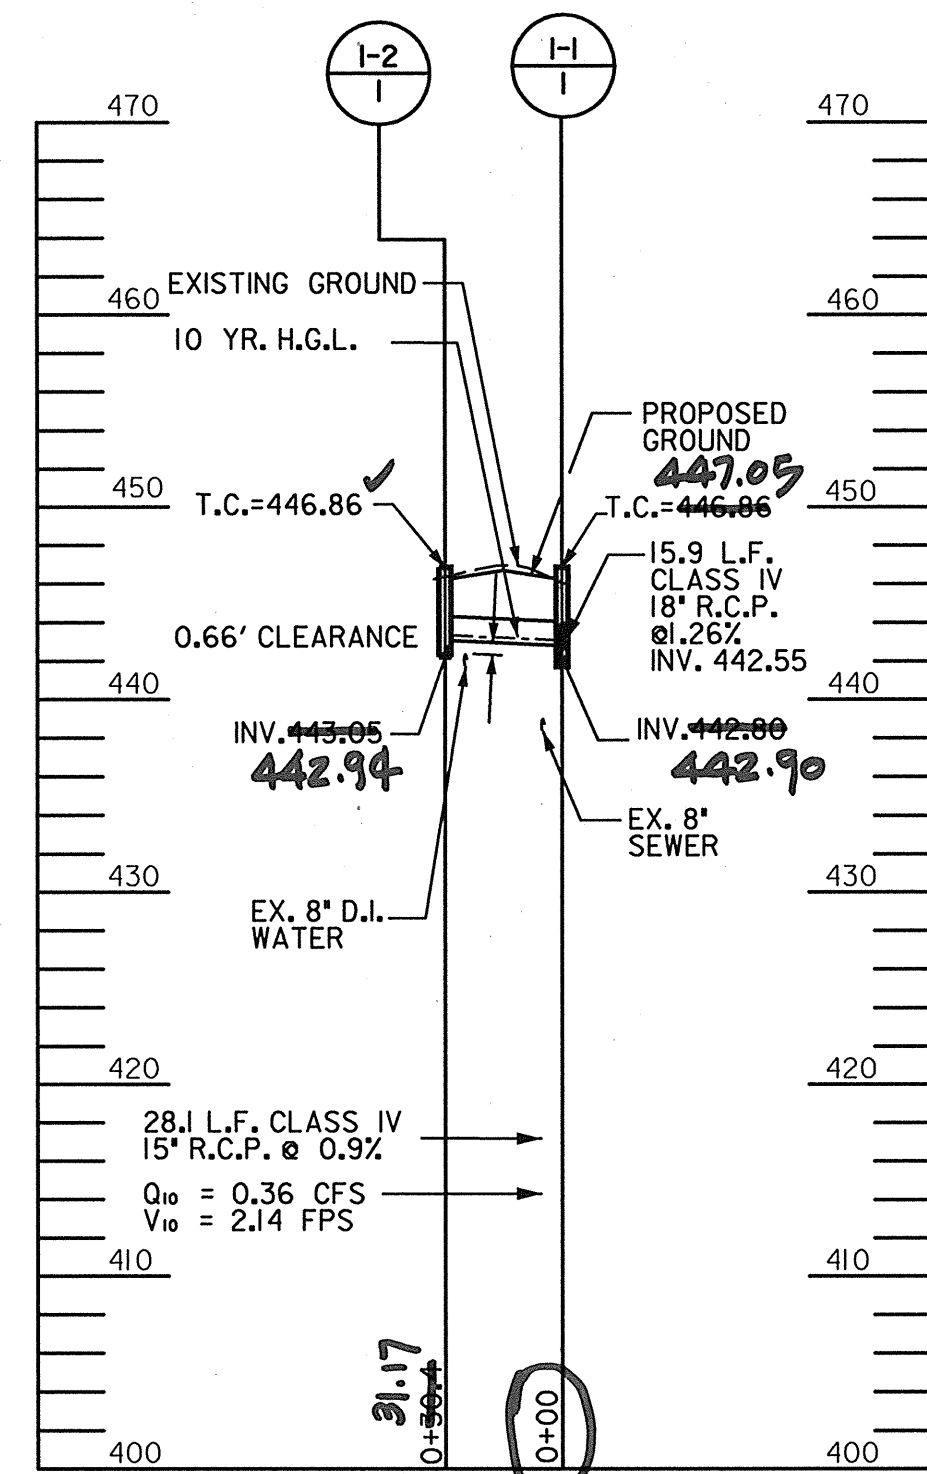


STA. 103+79.52 LT

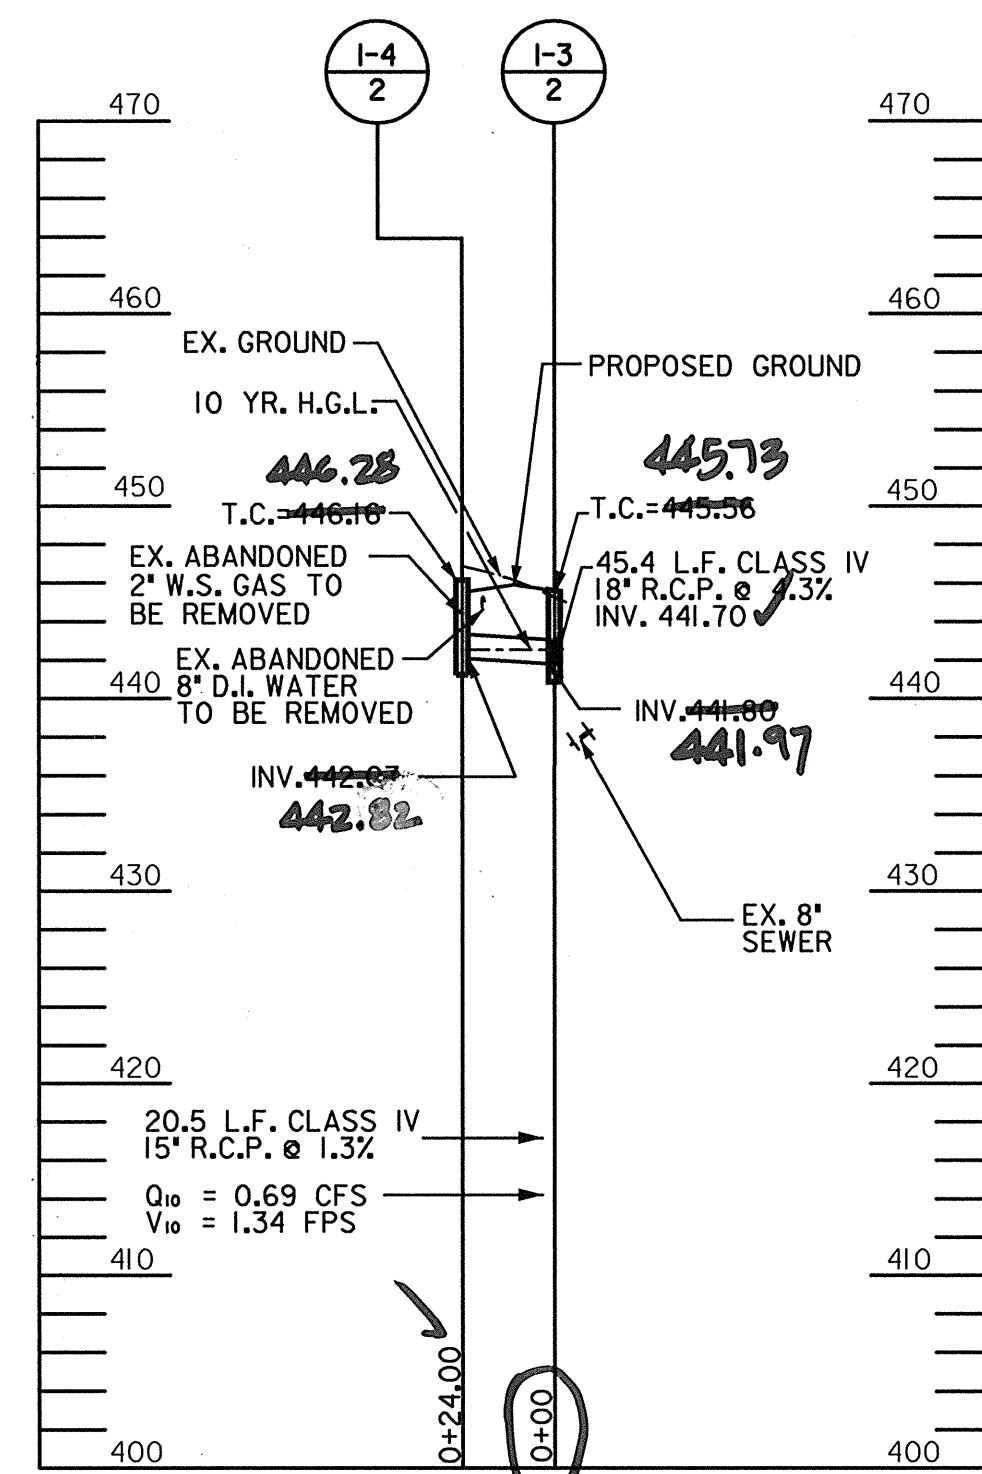


STA. 107+20.87 LT

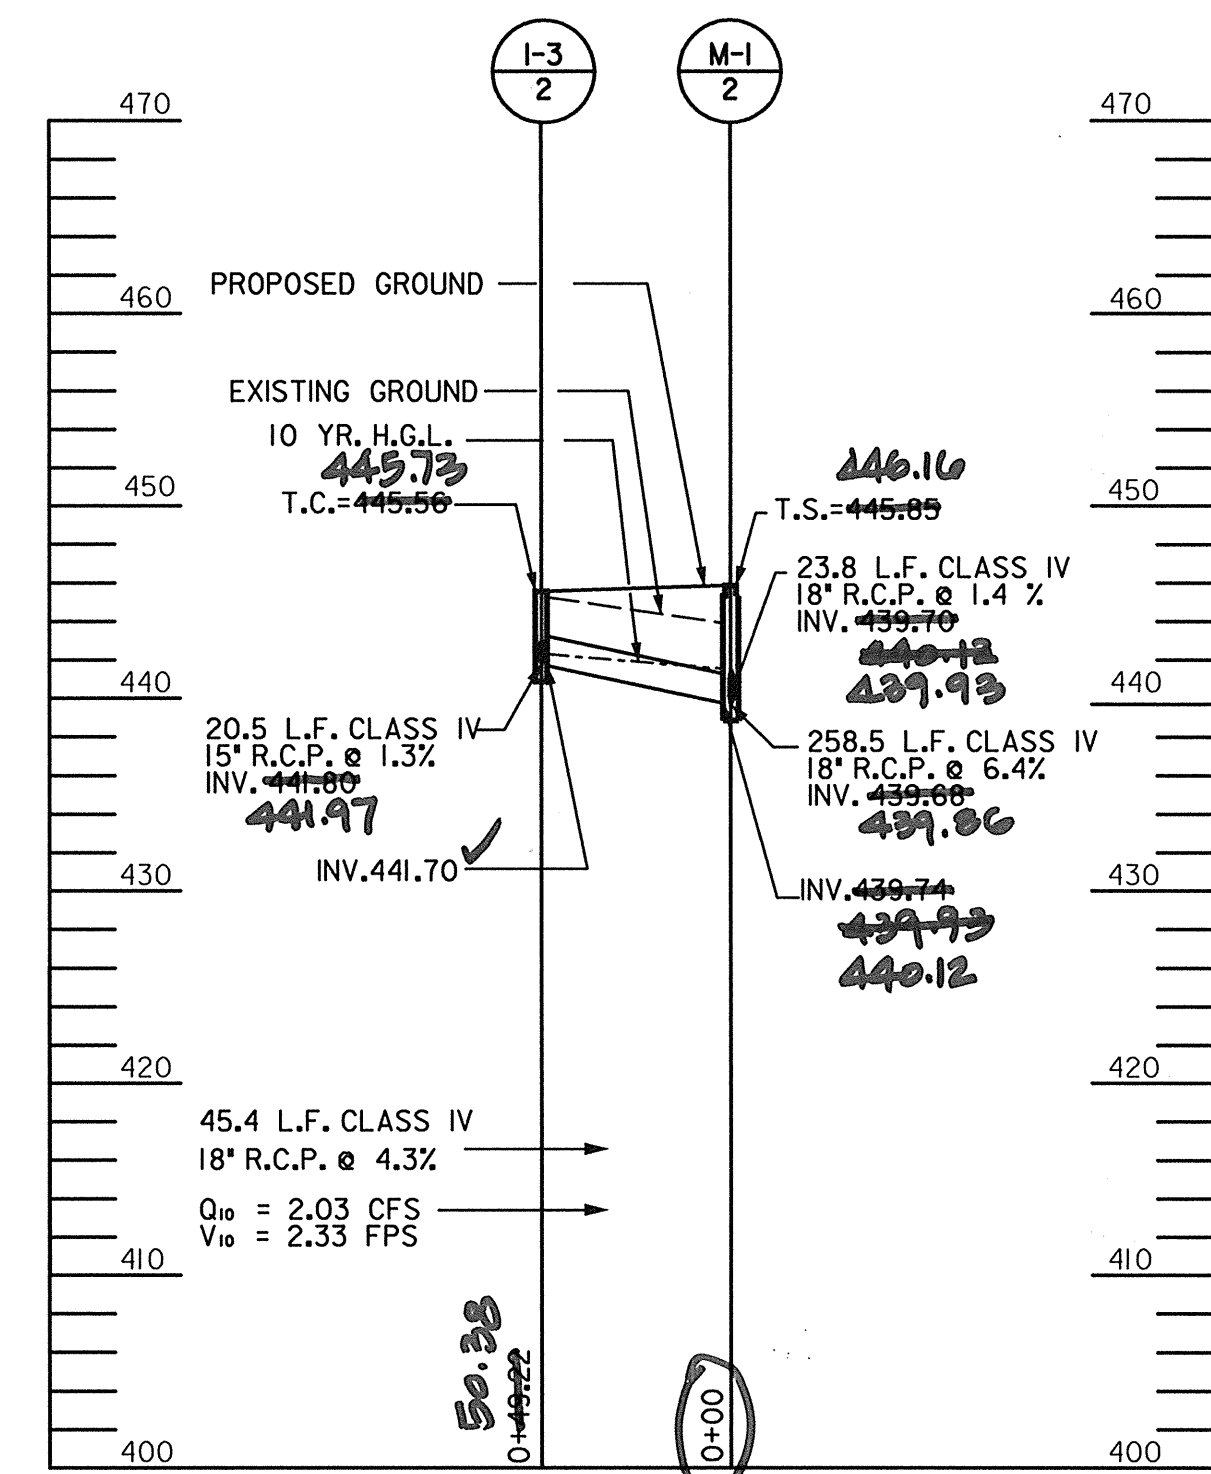


STA. 107+69.53 LT

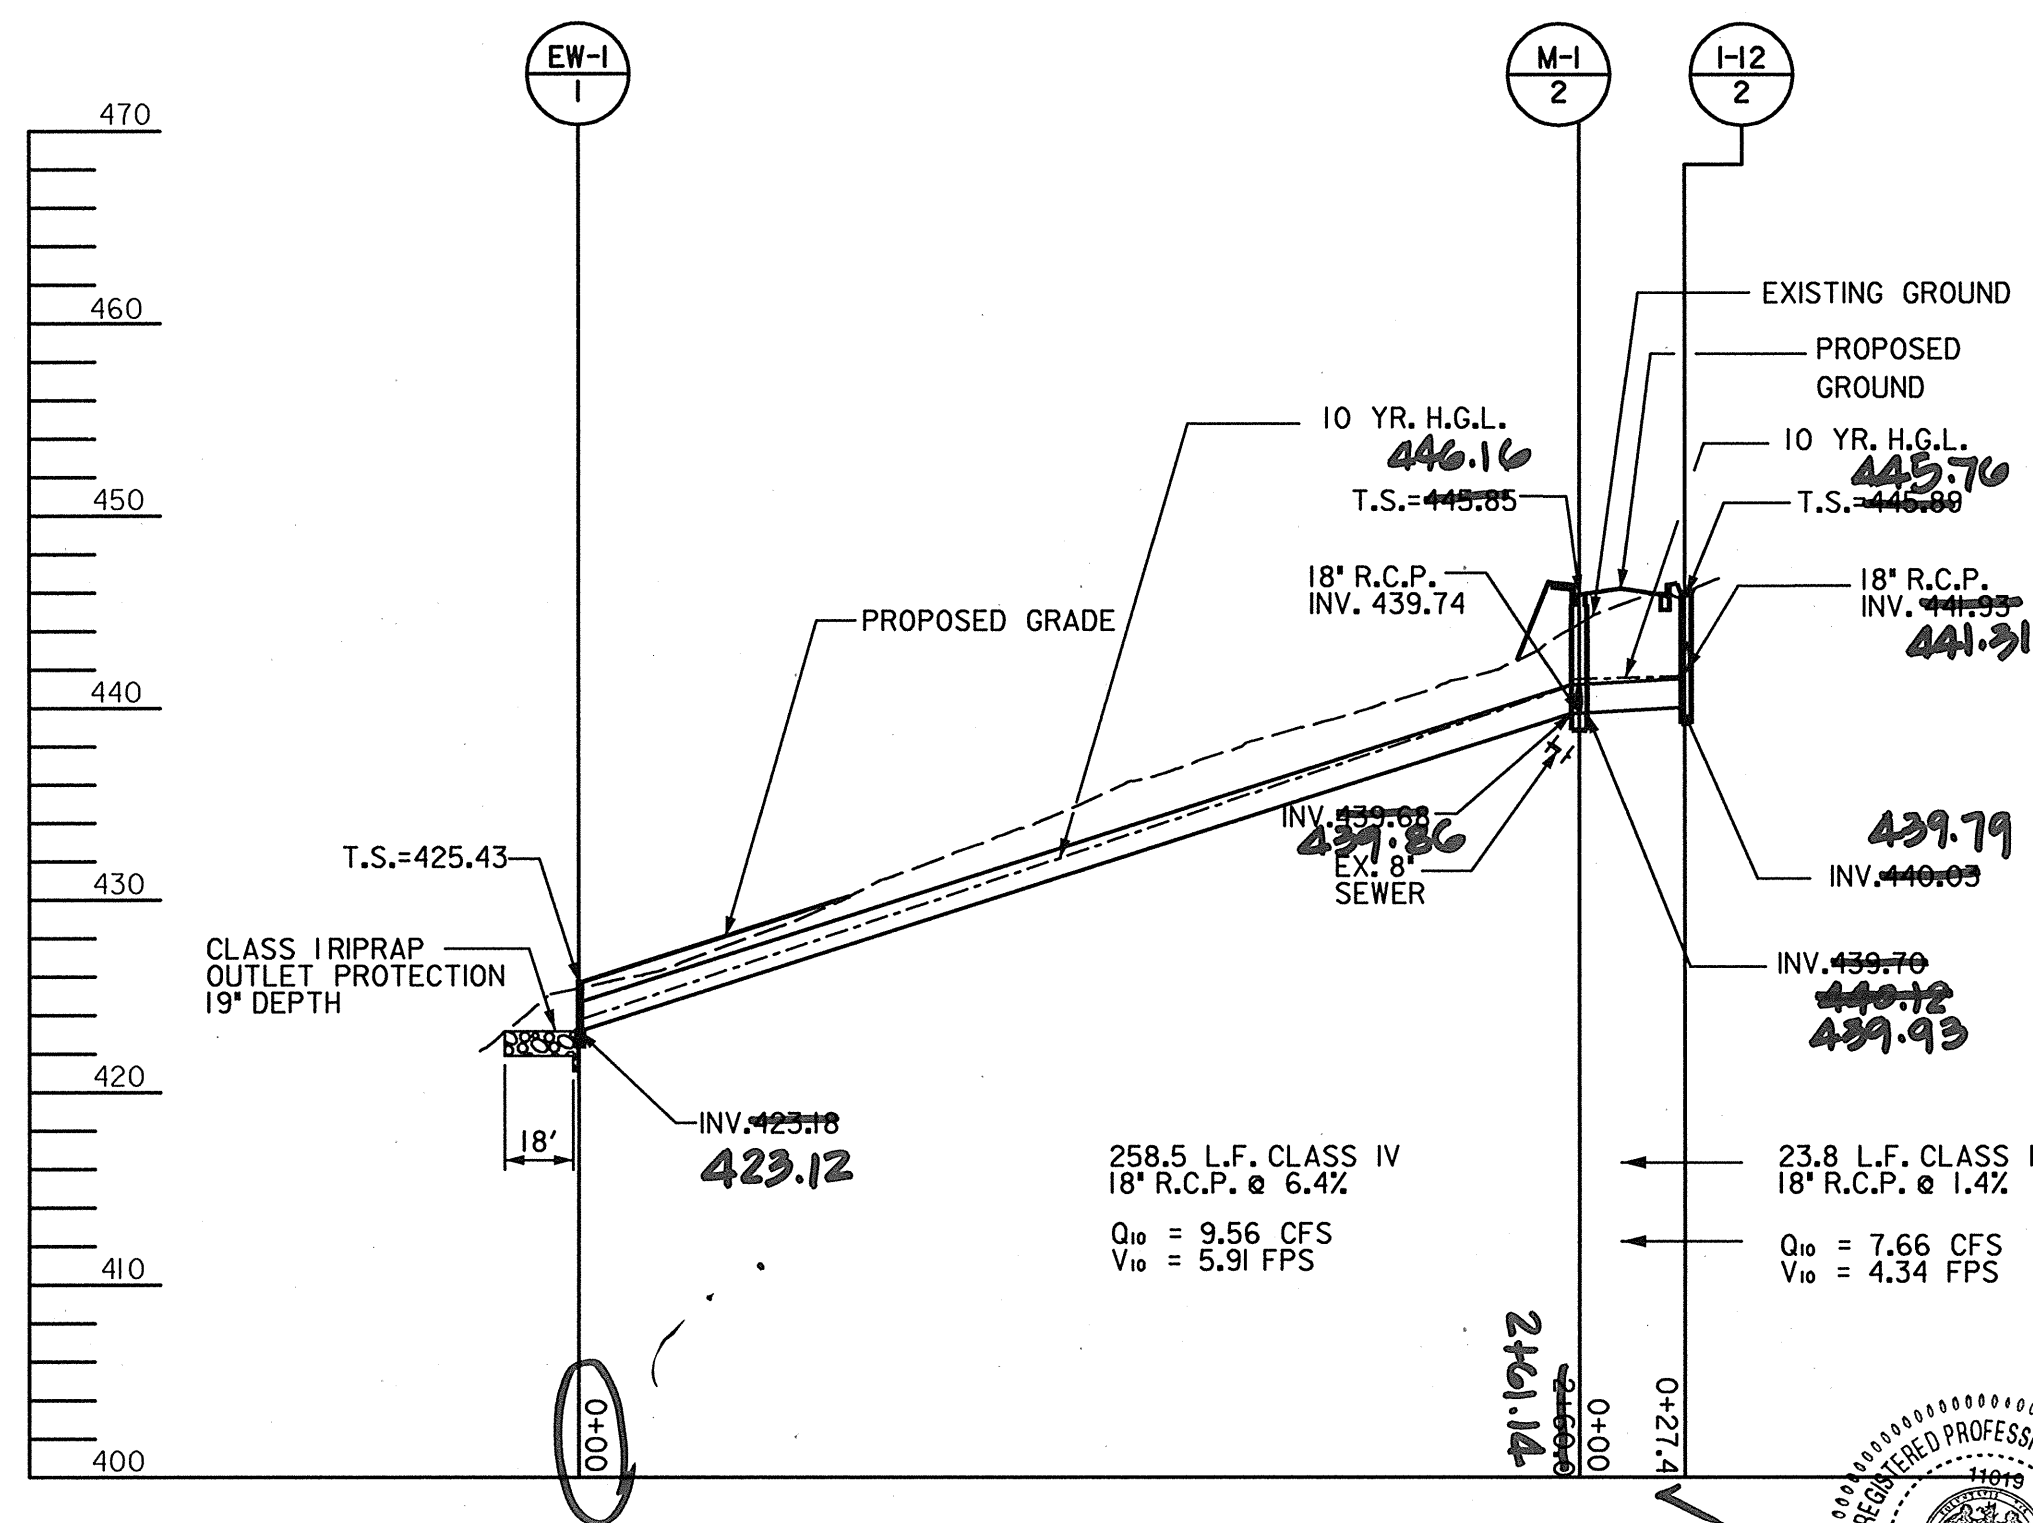

STA. 107+43.63 LT

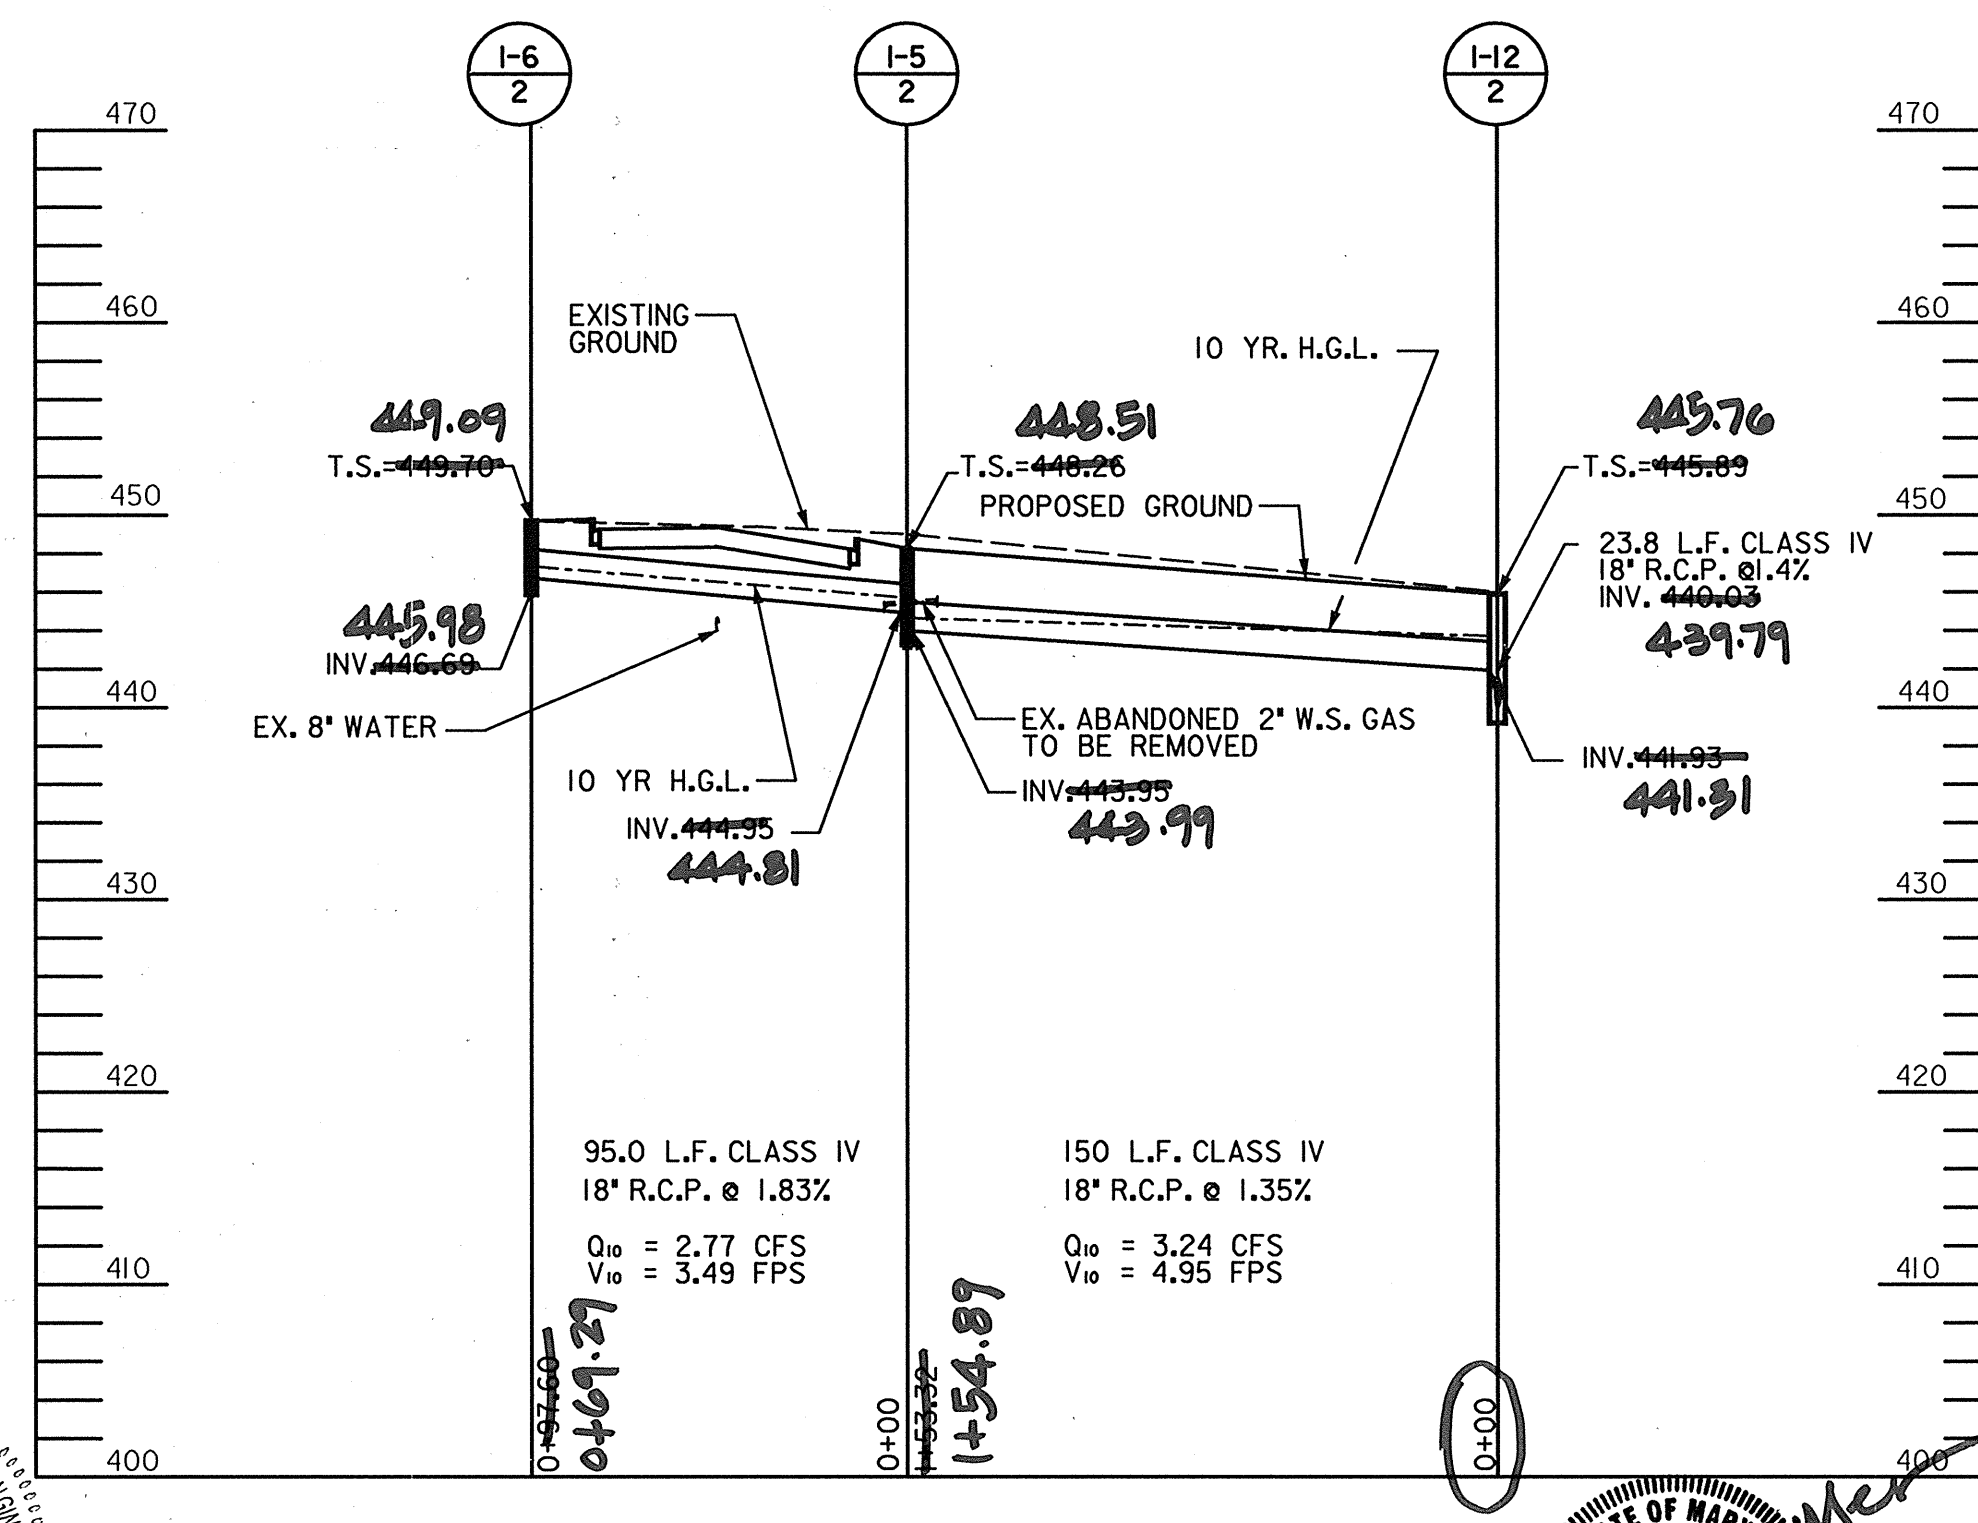

STA. 107+70.36 RT

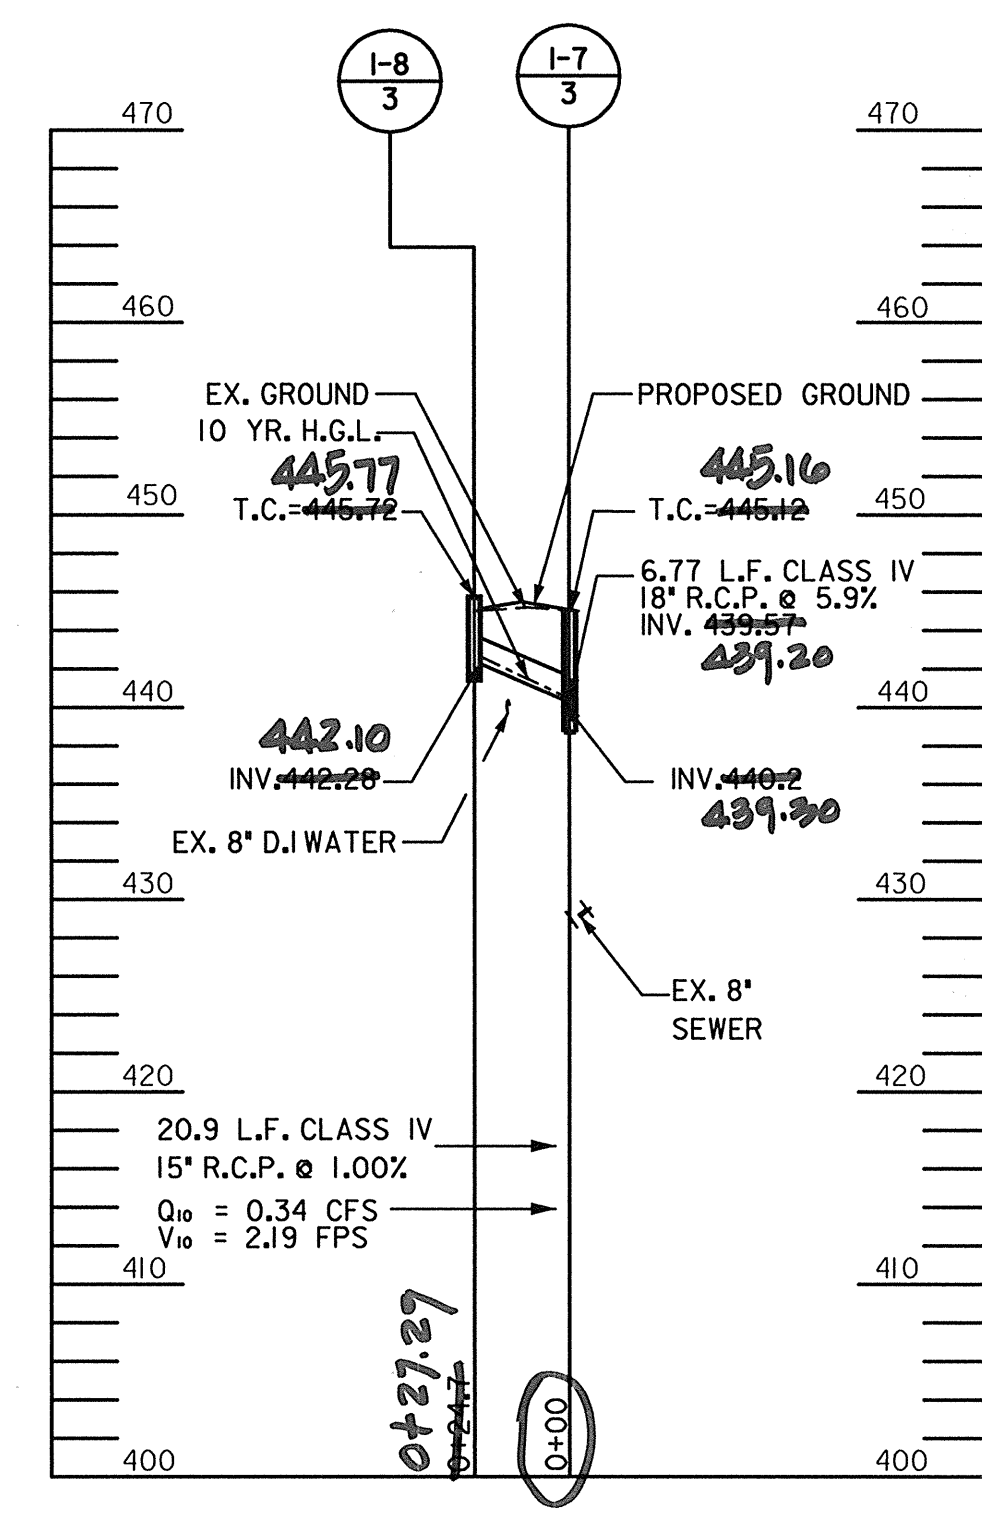


STA. 115+41.97 LT



Note: This is to certify an as-built survey of storm drain structures and inverts was made in November 2004. *As-built remarks are shown in red!

DEPARTMENT OF PUBLIC WORKS
 HOWARD COUNTY, MARYLAND
 DATE: 9/25/03
 DATE: 9-26-03

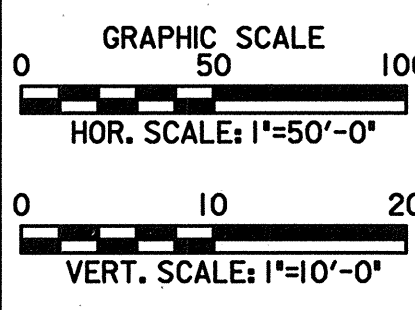


URS
 HUNT VALLEY, MARYLAND

RJM ENGINEERING, INC.
 CONSULTING ENGINEERS
 COLUMBIA, MARYLAND

DES:				
DRN:				
CHK:				
DATE:	BY	NO.	REVISION	DATE

STORMDRAIN PROFILE
 PP-1
 NO.: _____ DATE: 9/03

MCKENZIE ROAD ROADWAY
 AND STORMDRAIN IMPROVEMENTS
 HOWARD COUNTY, MARYLAND
 CAPITAL PROJECT NO. J-4164-10
 SCALE AS SHOWN
 SHEET 18 OF 24

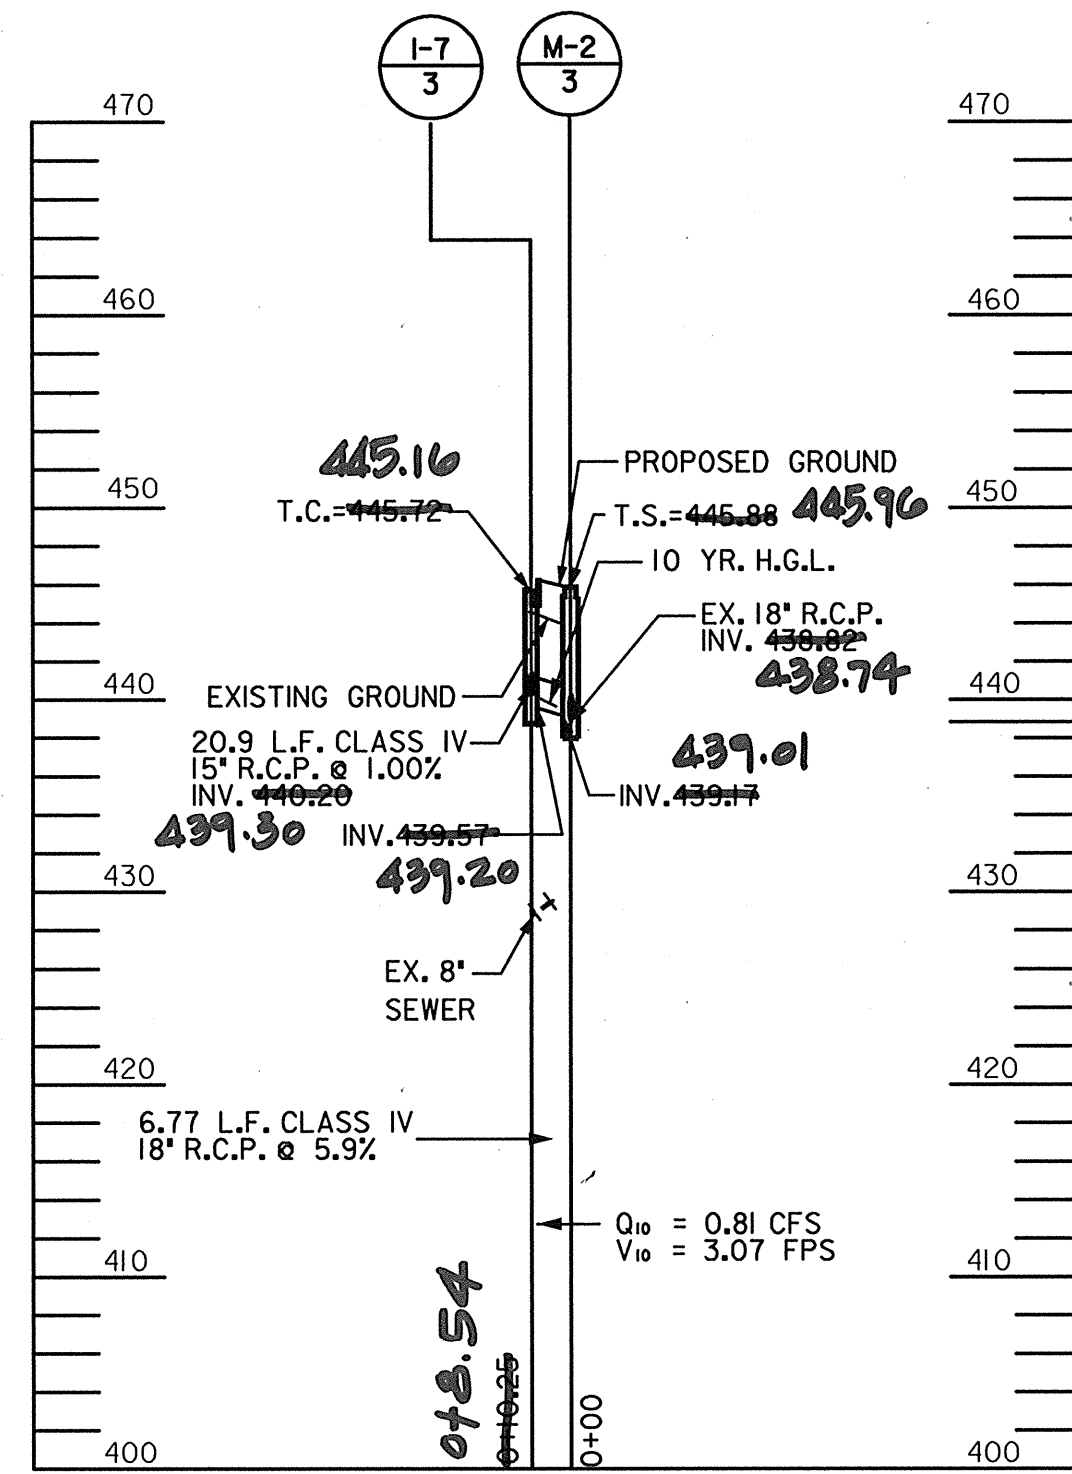


STA. 115+47.53 LT

PIPE SCHEDULE


PIPE SCHEDULE				
FROM	TO	SIZE	TYPE	LENGTH
I-1	EX-3	18"	RCP, CL 4	15.9'
I-2	I-1	15"	RCP, CL 4	28.1'
I-4	I-3	15"	RCP, CL 4	20.5'
I-3	M-1	18"	RCP, CL 4	45.4'
M-1	EW-1	18"	RCP, CL 4	258.5'
I-6	I-5	18"	RCP, CL 4	95'
I-5	I-12	18"	RCP, CL 4	150'
I-12	M-1	18"	RCP, CL 4	23.8'
I-8	I-7	15"	RCP, CL 4	20.9'
I-7	M-2	18"	RCP, CL 4	6.77'
I-10	I-9	15"	RCP, CL 4	24.2'
I-9	I-11	15"	RCP, CL 4	7.6'

DRAINAGE STRUCTURE SCHEDULE				
STRUCTURE NO.	STATION	OFFSET	TYPE	REF.
I-1	103+80	16' LT.	STD. 'A-5' INLET (SETBACK INLET)	SD-4.01, DETAIL THIS SHEET
I-2	103+79	16' RT.	STD. 'A-5' INLET (SETBACK INLET)	SD-4.01, DETAIL THIS SHEET
I-3	107+21	10' LT.	STD. WR INLET	SD-4.37
I-4	107+22	12' RT.	STD. 'A-10' INLET	SD-4.02
I-5	109+25	14' RT.	STD. WR INLET	SD-4.37
I-6	110+24	17' RT.	STD. OPEN END GRATE INLET	SD-4.36
I-12	107+70	17' RT.	STD. TYPE 'E' INLET	SD-4.21
M-1	107+69	15' LT.	STD. 48" DIA. MANHOLE	G-5.12
EW-1	107+51	209' LT.	STD. TYPE 'C' ENDWALL	SD-5.51
I-7	115+42	10' LT.	STD. WR INLET	SD-4.37
I-8	115+39	12' RT.	STD. 'A-5' INLET	SD-4.01
I-9	120+63	12' LT.	STD. 'A-10' INLET	SD-4.02
I-10	120+63	12' RT.	STD. 'A-10' INLET	SD-4.02
I-11	120+63	25' LT.	STD. 'S' INLET	SD-4.22
M-2	115+47	19' LT.	STD. 48" DIA. MANHOLE	G-5.12

NOTE: THE OFFSET TO THE DRAINAGE STRUCTURES IS MEASURED TO THE FACE OF THE CURB (WHERE APPLICABLE), OR TO THE CENTER OF THE STRUCTURES.

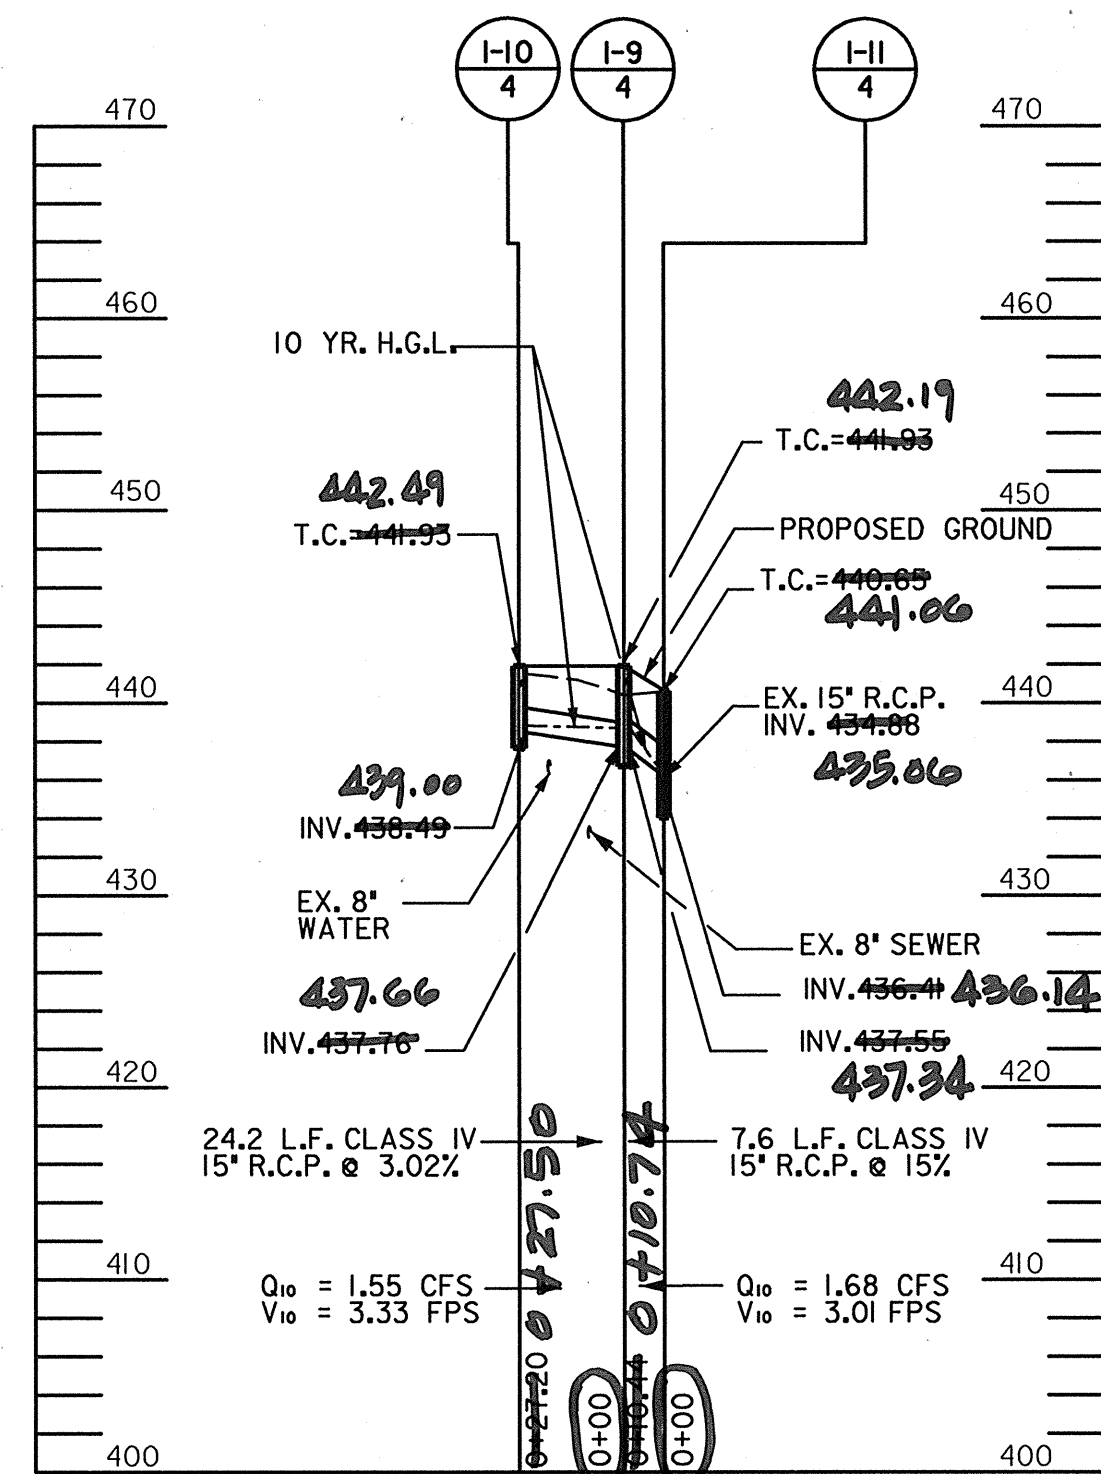

STA. 120+63.19 LT

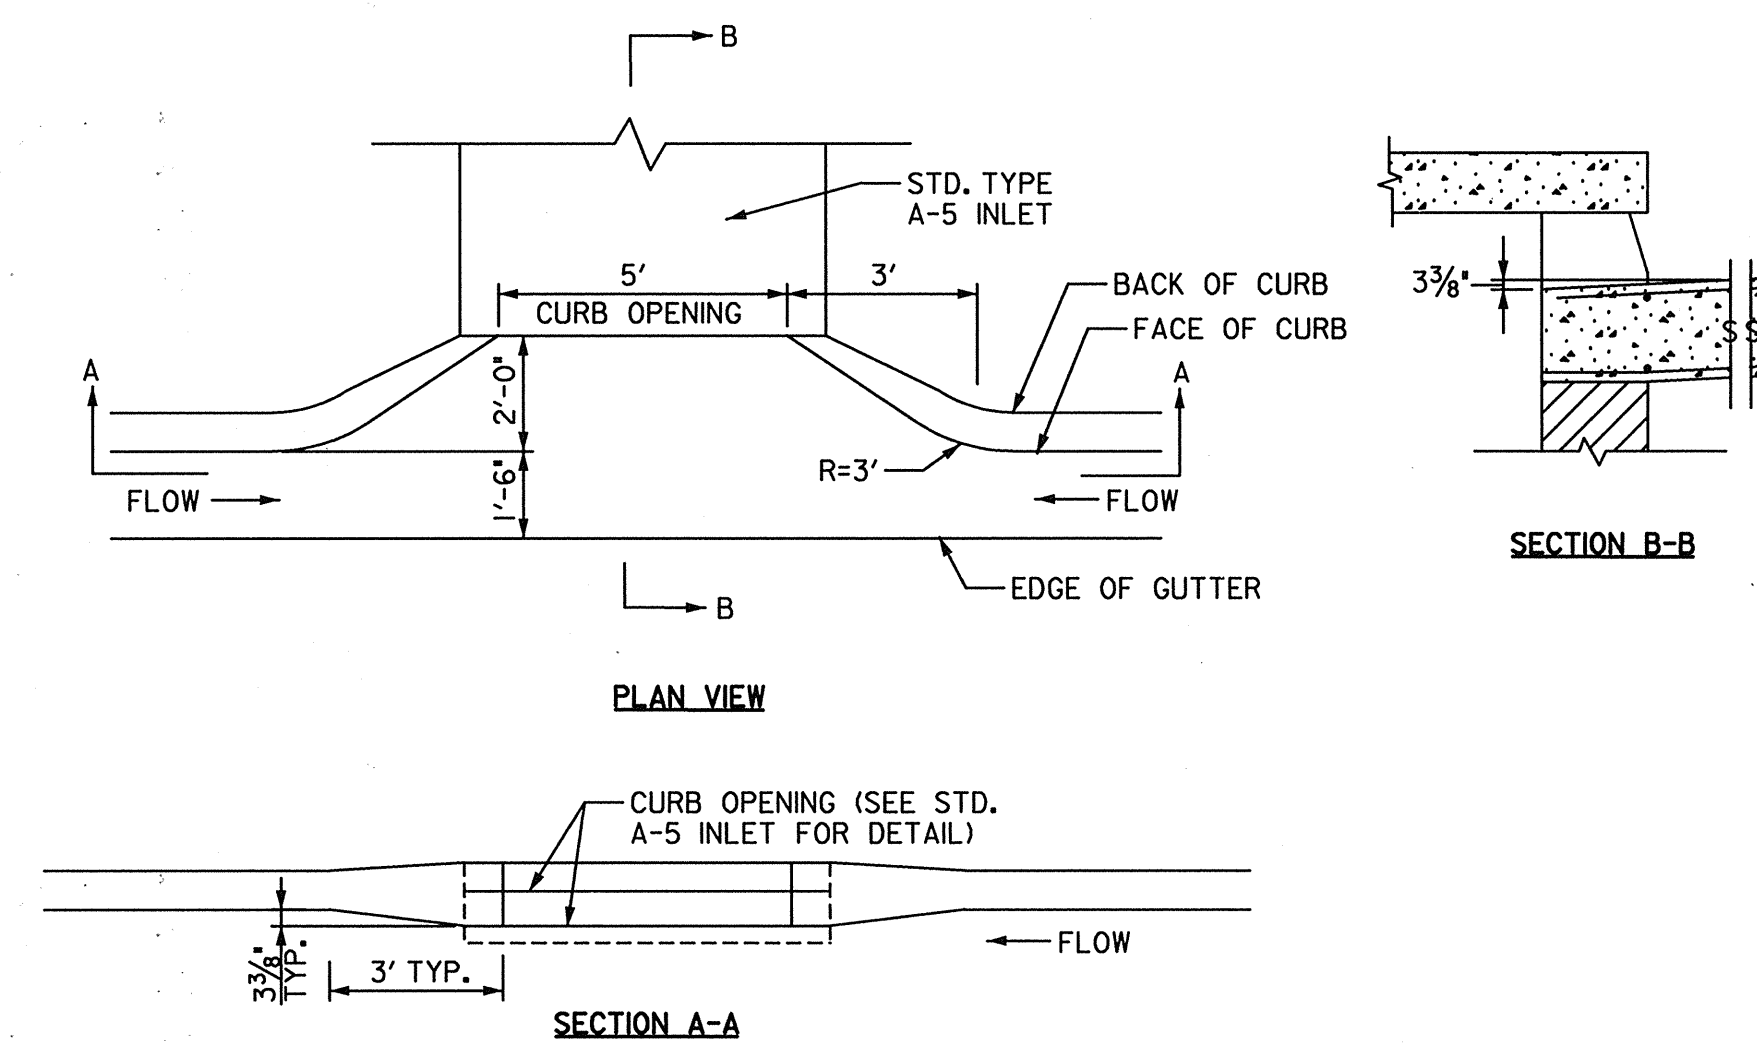

DETAIL - CURB OFFSET AND MODIFIED SETBACK TYPE A-5 INLET

SCALE: N.T.S.





9/25/03



Note: This is to certify an as-built survey of storm drain structures and inverts was made in November 2004. * As-built remarks are shown in red!


DEPARTMENT OF PUBLIC WORKS HOWARD COUNTY, MARYLAND <i>[Signature]</i> 9/25/03 CHIEF, BUREAU OF ENGINEERING	GRAPHIC SCALE 0 50 100 HOR. SCALE: 1"=50'-0" 0 10 20 VERT. SCALE: 1"=10'-0"	URS HUNT VALLEY, MARYLAND	RJM RJM ENGINEERING, INC. CONSULTING ENGINEERS COLUMBIA, MARYLAND TEL: 410/730-1001 FAX: 410/730-5403	DES:		STORMDRAIN PROFILE PP-2	McKENZIE ROAD ROADWAY AND STORMDRAIN IMPROVEMENTS	SCALE AS SHOWN
				DRN:				
DEPARTMENT OF PUBLIC WORKS CHIEF, TRANSPORTATION AND SPECIAL PROJECTS DIVISION <i>[Signature]</i> 9/25/03				CHK:		HOWARD COUNTY, MARYLAND CAPITAL PROJECT NO. J-4164-10	NO.: _____ DATE: 9/03	
DEPARTMENT OF PUBLIC WORKS CHIEF, BUREAU OF HIGHWAYS <i>[Signature]</i> 9/26/03				DATE:				

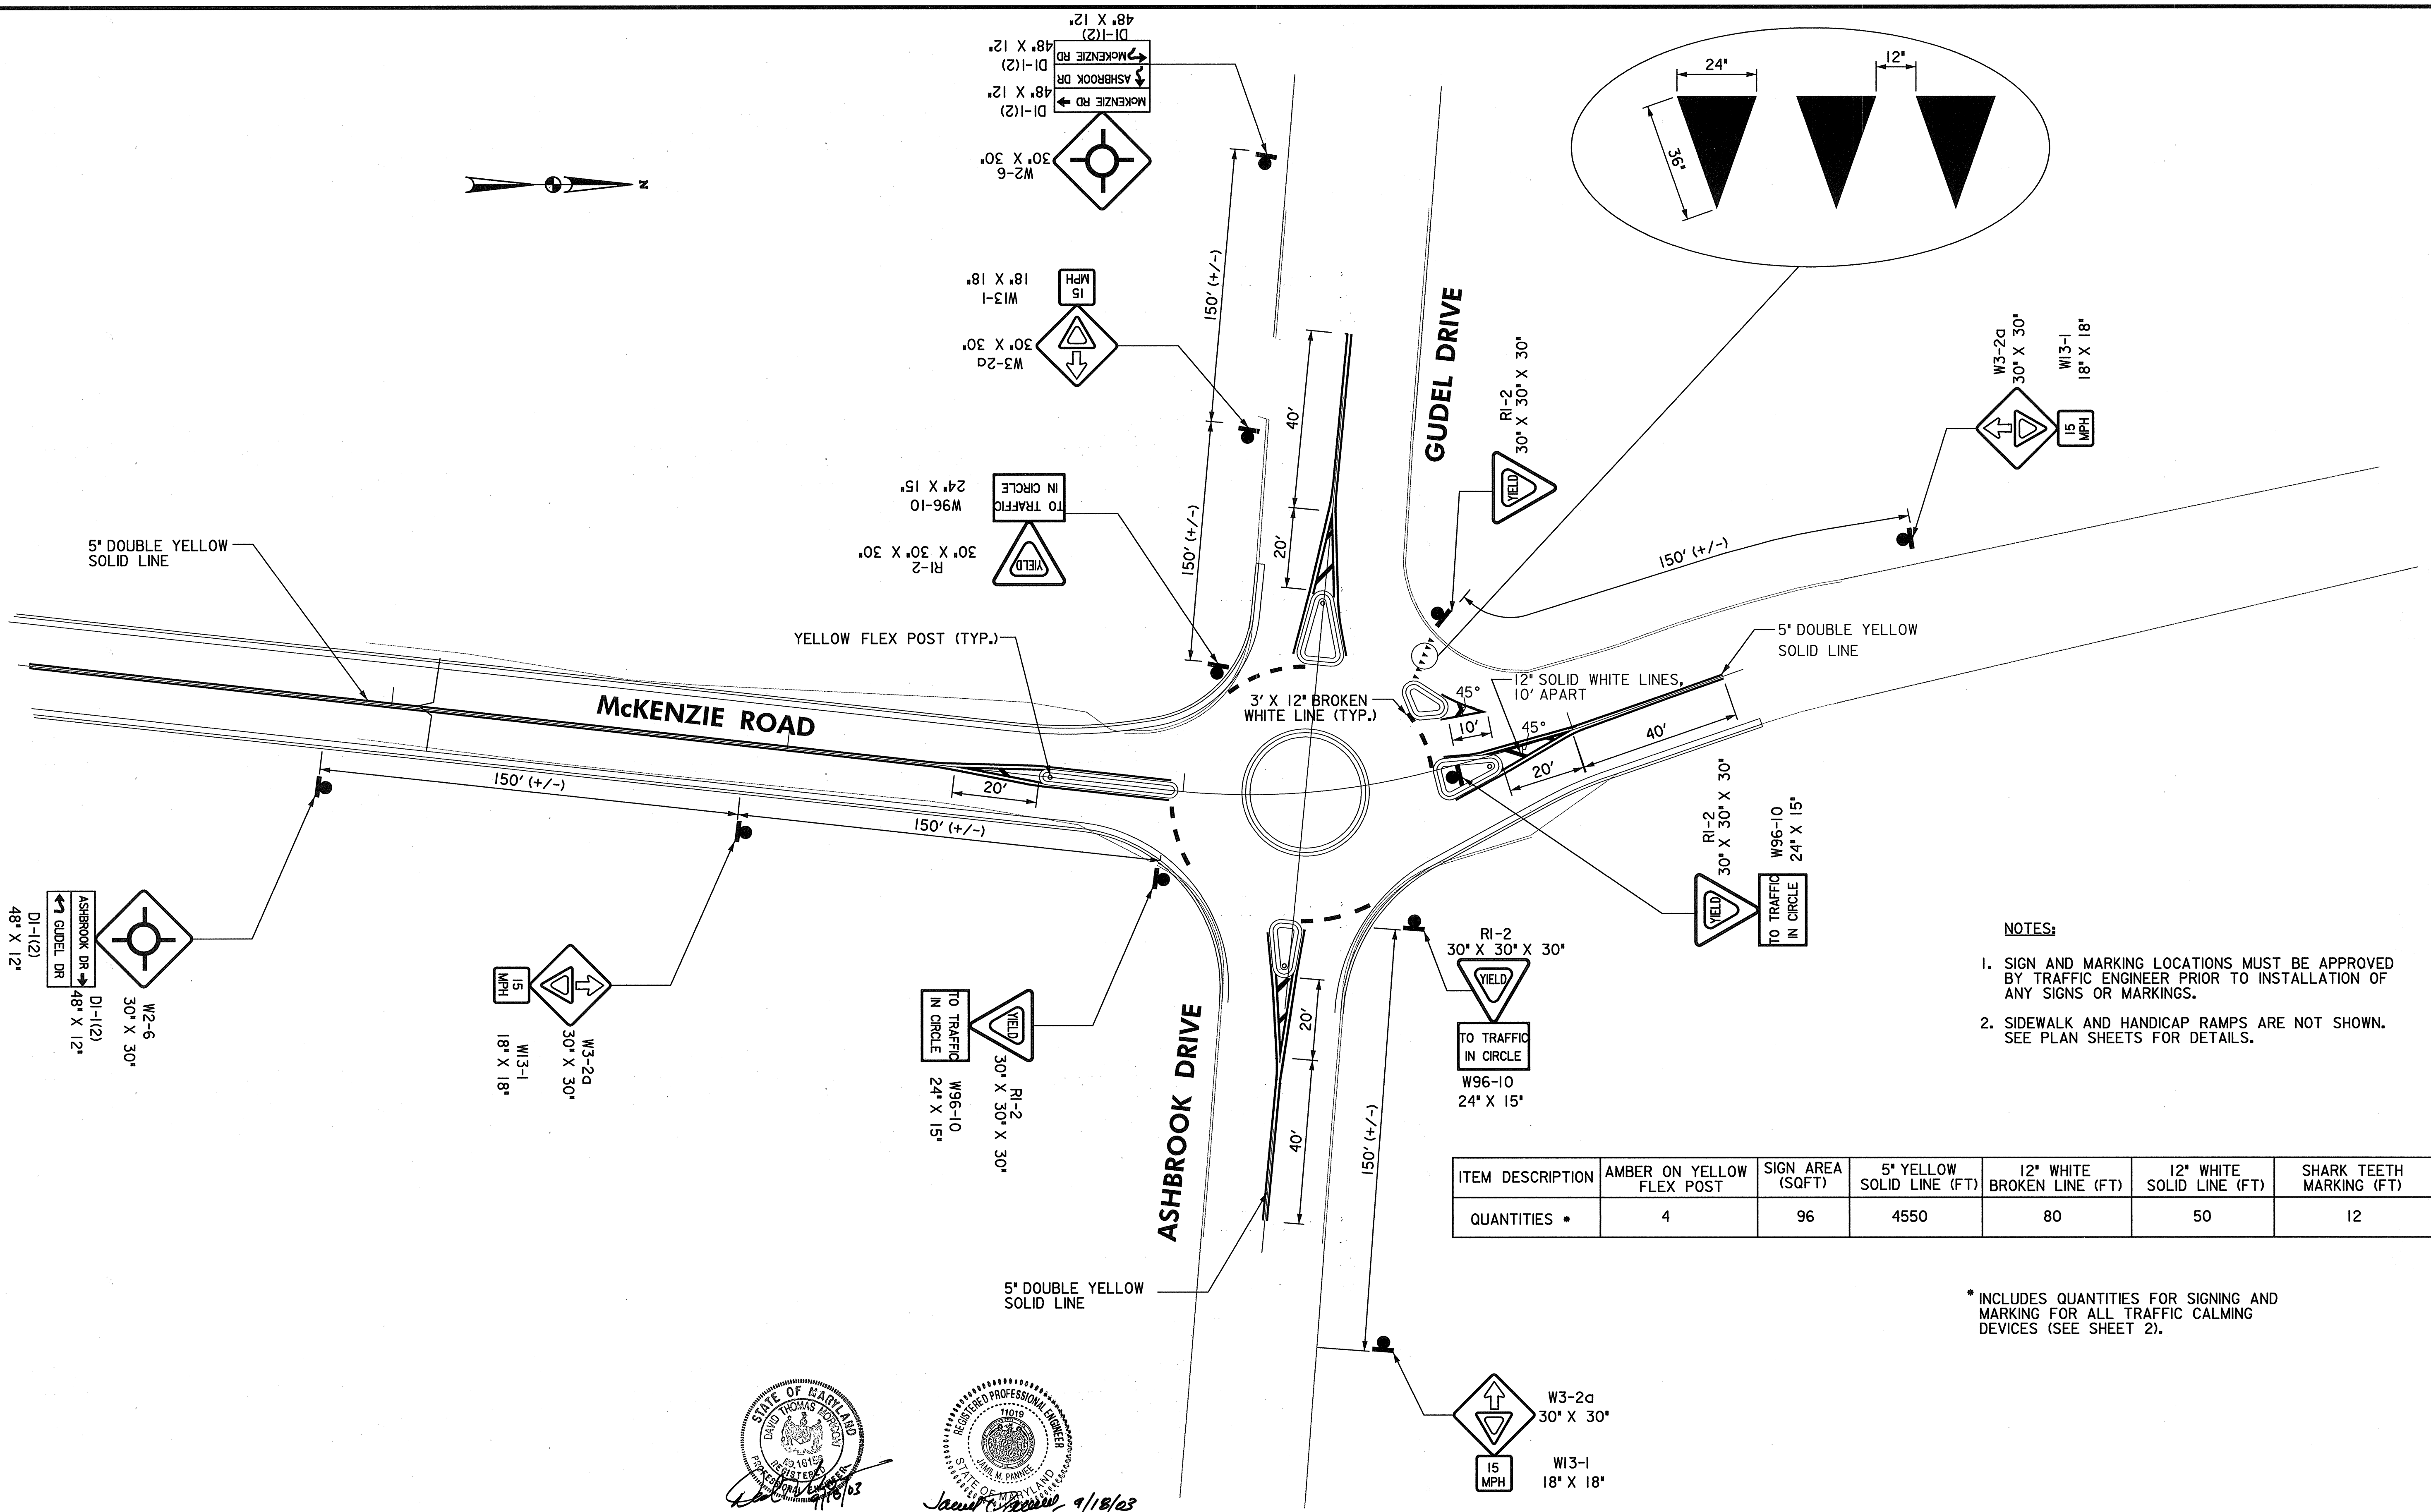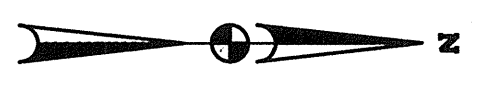

- NOTES:**
- SIGN AND MARKING LOCATIONS MUST BE APPROVED BY TRAFFIC ENGINEER PRIOR TO INSTALLATION OF ANY SIGNS OR MARKINGS.
 - SIDEWALK AND HANDICAP RAMPS ARE NOT SHOWN. SEE PLAN SHEETS FOR DETAILS.

ITEM DESCRIPTION	AMBER ON YELLOW FLEX POST	SIGN AREA (SQFT)	5' YELLOW SOLID LINE (FT)	12' WHITE BROKEN LINE (FT)	12' WHITE SOLID LINE (FT)	SHARK TEETH MARKING (FT)
QUANTITIES *	4	96	4550	80	50	12

* INCLUDES QUANTITIES FOR SIGNING AND MARKING FOR ALL TRAFFIC CALMING DEVICES (SEE SHEET 2).

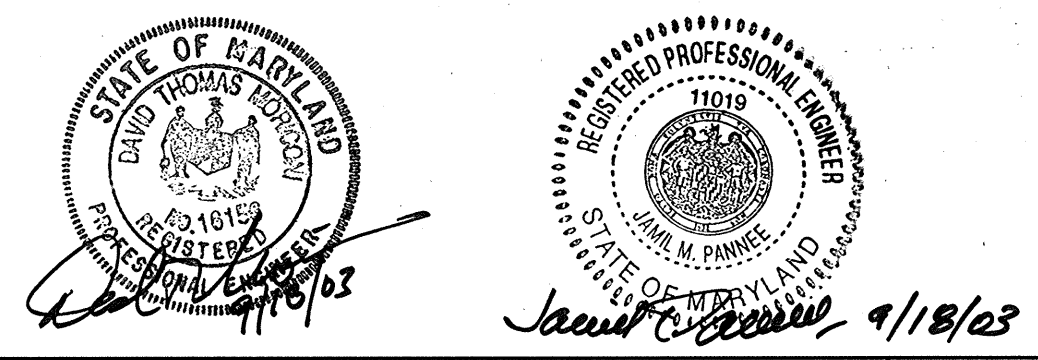

DEPARTMENT OF PUBLIC WORKS
HOWARD COUNTY, MARYLAND

Jan P. ... 9/29/03
DATE

David Thomas DeWitt 2/22/03
DATE


Evelyn E. ... 9/22/03
DATE

William J. Mahler 9-24-03
DATE

CHIEF, TRANSPORTATION AND SPECIAL PROJECTS DIVISION

CHIEF, BUREAU OF ENGINEERING

CHIEF, BUREAU OF HIGHWAYS

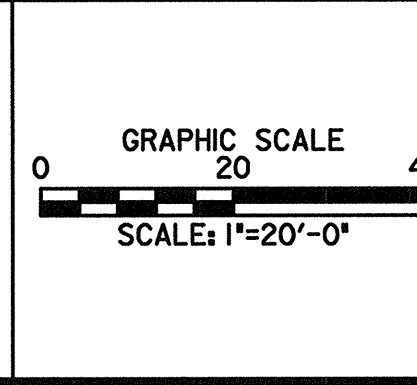

URS
HUNT VALLEY, MARYLAND

RJM
RJM ENGINEERING, INC.
CONSULTING ENGINEERS
COLUMBIA, MARYLAND

TELE: (410) 730-1001 FAX: (410) 730-5403

DES:			
DRN:			
CHK:			
DATE:	BY	NO.	REVISION

MINI- ROUNDABOUT MARKING AND SIGNING PLAN AT ASHBROOK DRIVE

NO.: _____ DATE: 9/03

McKENZIE ROAD ROADWAY AND STORMDRAIN IMPROVEMENTS












HOWARD COUNTY, MARYLAND
CAPITAL PROJECT NO. J-4164-10

SCALE AS SHOWN


SHEET 200F24

GENERAL NOTES


- ALL STANDARD REGULATORY AND WARNING SIGNS USED FOR MAINTENANCE OF TRAFFIC SHALL BE IN ACCORDANCE WITH LATEST APPROVED EDITIONS OF THE 'MANUAL ON UNIFORM TRAFFIC CONTROL DEVICES', THE MARYLAND DEPARTMENT OF TRANSPORTATION STATE HIGHWAY ADMINISTRATION (SHA) 'STANDARD SIGN BOOK', AND THE HOWARD COUNTY 'STANDARD SPECIFICATIONS AND DETAILS FOR CONSTRUCTION'. THE MARYLAND STATE HIGHWAY ADMINISTRATION'S TEMPORARY TRAFFIC CONTROL REFERENCE MANUAL STANDARDS SHALL BE USED WHEN REFERENCED. IT SHALL BE THE RESPONSIBILITY OF THE CONTRACTOR TO PROCURE AND UTILIZE THE LATEST EDITION AND SUPPLEMENTS OF EACH OF THE PUBLICATIONS.
- DURING CONSTRUCTION OF STAGE I AND 2, ACCESS TO MCKENZIE ROAD FOR LOCAL TRAFFIC SHALL BE PROVIDED.
- ALL EXISTING SIGNS IN CONFLICT WITH THE PROPOSED MAINTENANCE OF TRAFFIC SCHEME SHALL BE COVERED. AFTER EACH STAGE OF WORK IS COMPLETE, THE CONTRACTOR SHALL UNCOVER EXISTING SIGNS AS SOON AS POSSIBLE OR AS DIRECTED BY THE ENGINEER TO IMPROVE OVERALL PROJECT SAFETY. NO SECTION OF ROADWAY SHALL BE OPEN TO TRAFFIC UNTIL ALL EXISTING SIGNS AND PERMANENT MARKINGS ARE RESTORED.
- ALL WORK ZONE SIGNS SHALL BE FIELD LOCATED AND APPROVED BY TRAFFIC ENGINEER PRIOR TO INSTALLATION OF ANY SIGNS.
- DETOUR PLAN FOR STAGE I IS IN EFFECT DURING WORK HOURS. AFTER EACH WORK DAY, ALL DETOUR SIGNS SHALL BE REMOVED, COVERED, OR TURNED AWAY FROM INCOMING TRAFFIC.
- ALL EXISTING TRAFFIC SIGNAL SUPPORT STRUCTURES AND SIGNS SHALL BE MAINTAINED DURING CONSTRUCTION.
- ALL PLASTIC DRUMS SHALL BE WEIGHTED WITH SAND BAGS OR OTHER APPROVED MATERIALS TO WITHSTAND WIND LOADS.
- CONTRACTOR SHALL MONITOR ALL TRAFFIC CONTROL DEVICES (DRUMS, SIGNS, ETC.) 24 HOURS A DAY AND 7 DAYS A WEEK AND IMMEDIATELY CORRECT ANY DAMAGE DUE TO TRAFFIC OR WEATHER RELATED CONDITIONS. THE CONTRACTOR WILL NEED A CERTIFIED TRAFFIC CONTROL MANAGER FOR THE PROJECT.

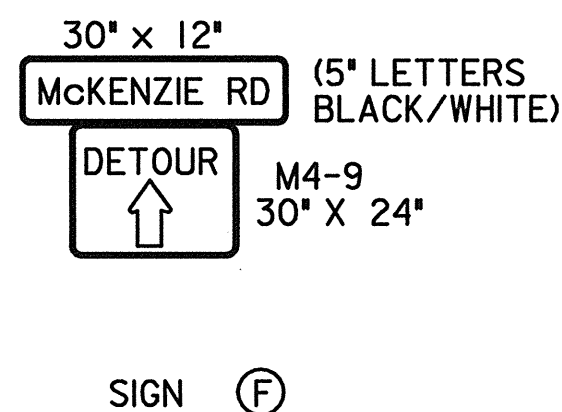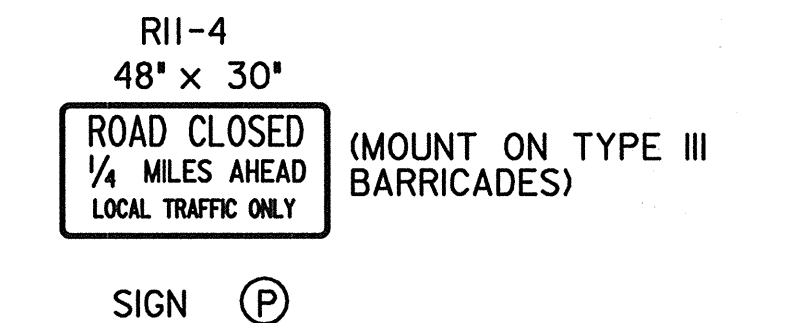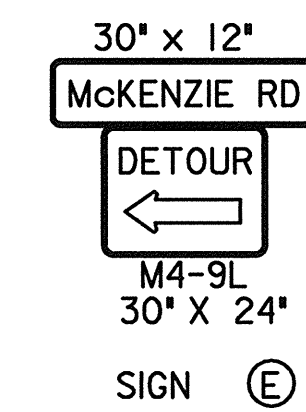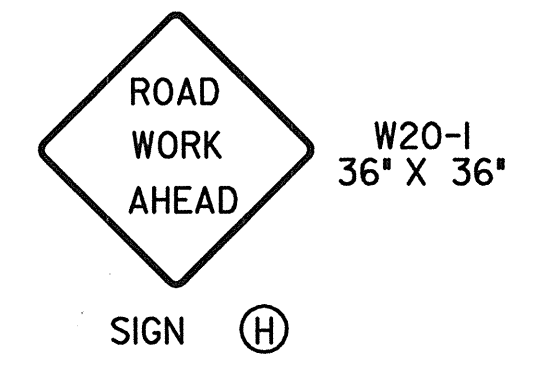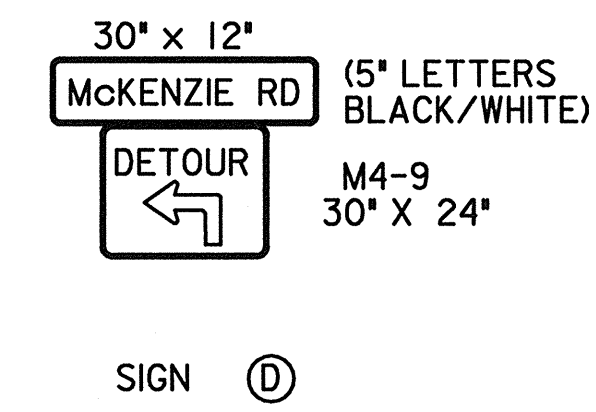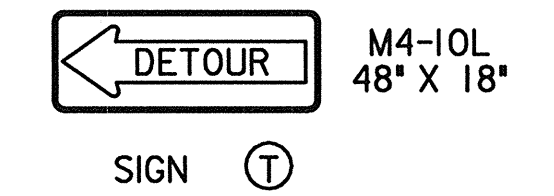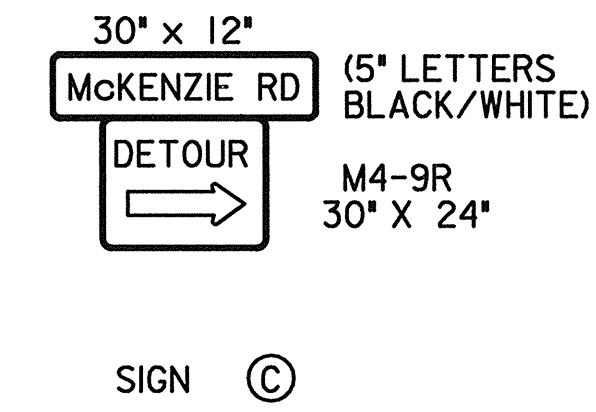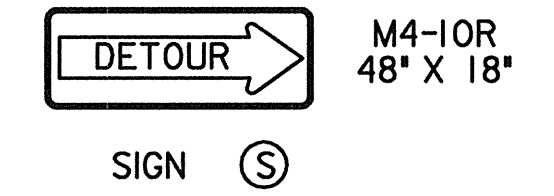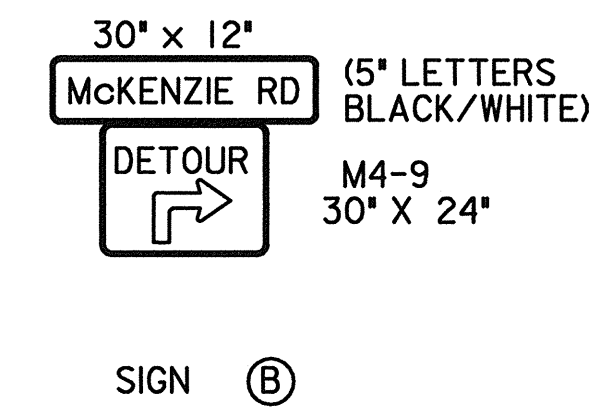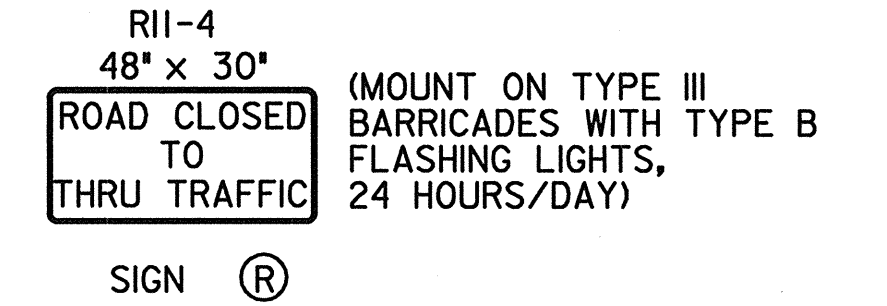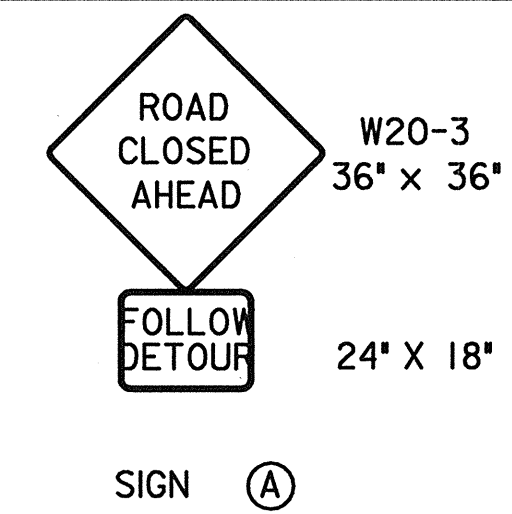

BLACK/YELLOW NOTICE 48" X 12", 7" LETTERS
 MCKENZIE ROAD 6" LETTERS
 BLACK/WHITE CLOSED 48" X 30", 8" LETTERS
 AT ROUTE 99 6" LETTERS
 BLACK/ORANGE DETOUR AHEAD 48" X 12", 6" LETTERS

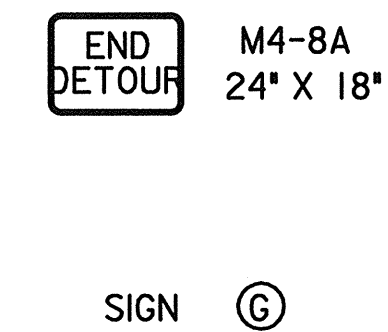

SIGN LEGEND
SCALE: N.T.S.

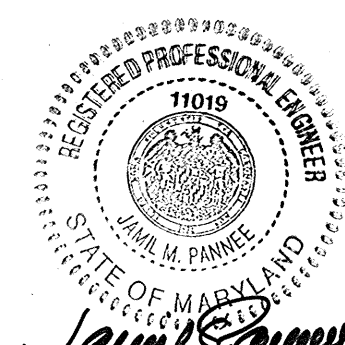


James J. Jones, 9/18/03

DEPARTMENT OF PUBLIC WORKS
HOWARD COUNTY, MARYLAND

James J. Jones 9/29/03
CHIEF, BUREAU OF ENGINEERING

William J. Johnson 9-29-03
CHIEF, BUREAU OF HIGHWAYS

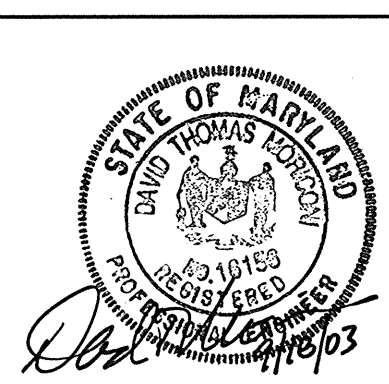

URS
HUNT VALLEY, MARYLAND

RJM
RJM ENGINEERING, INC.
CONSULTING ENGINEERS
COLUMBIA, MARYLAND

TELE: 410-730-1000 FAX: 410-730-5403

DES:				
DRN:				
CHK:				
DATE:	BY	NO.	REVISION	DATE

**TRAFFIC CONTROL
GENERAL NOTES
AND SIGN LEGEND**

NO.: _____ DATE: 9/03


**MCKENZIE ROAD ROADWAY
AND STORMDRAIN IMPROVEMENTS**

HOWARD COUNTY, MARYLAND
CAPITAL PROJECT NO. J-4164-10

SCALE AS SHOWN
SHEET 210F24

MOUNT HEBRON

AT PATAPSCO

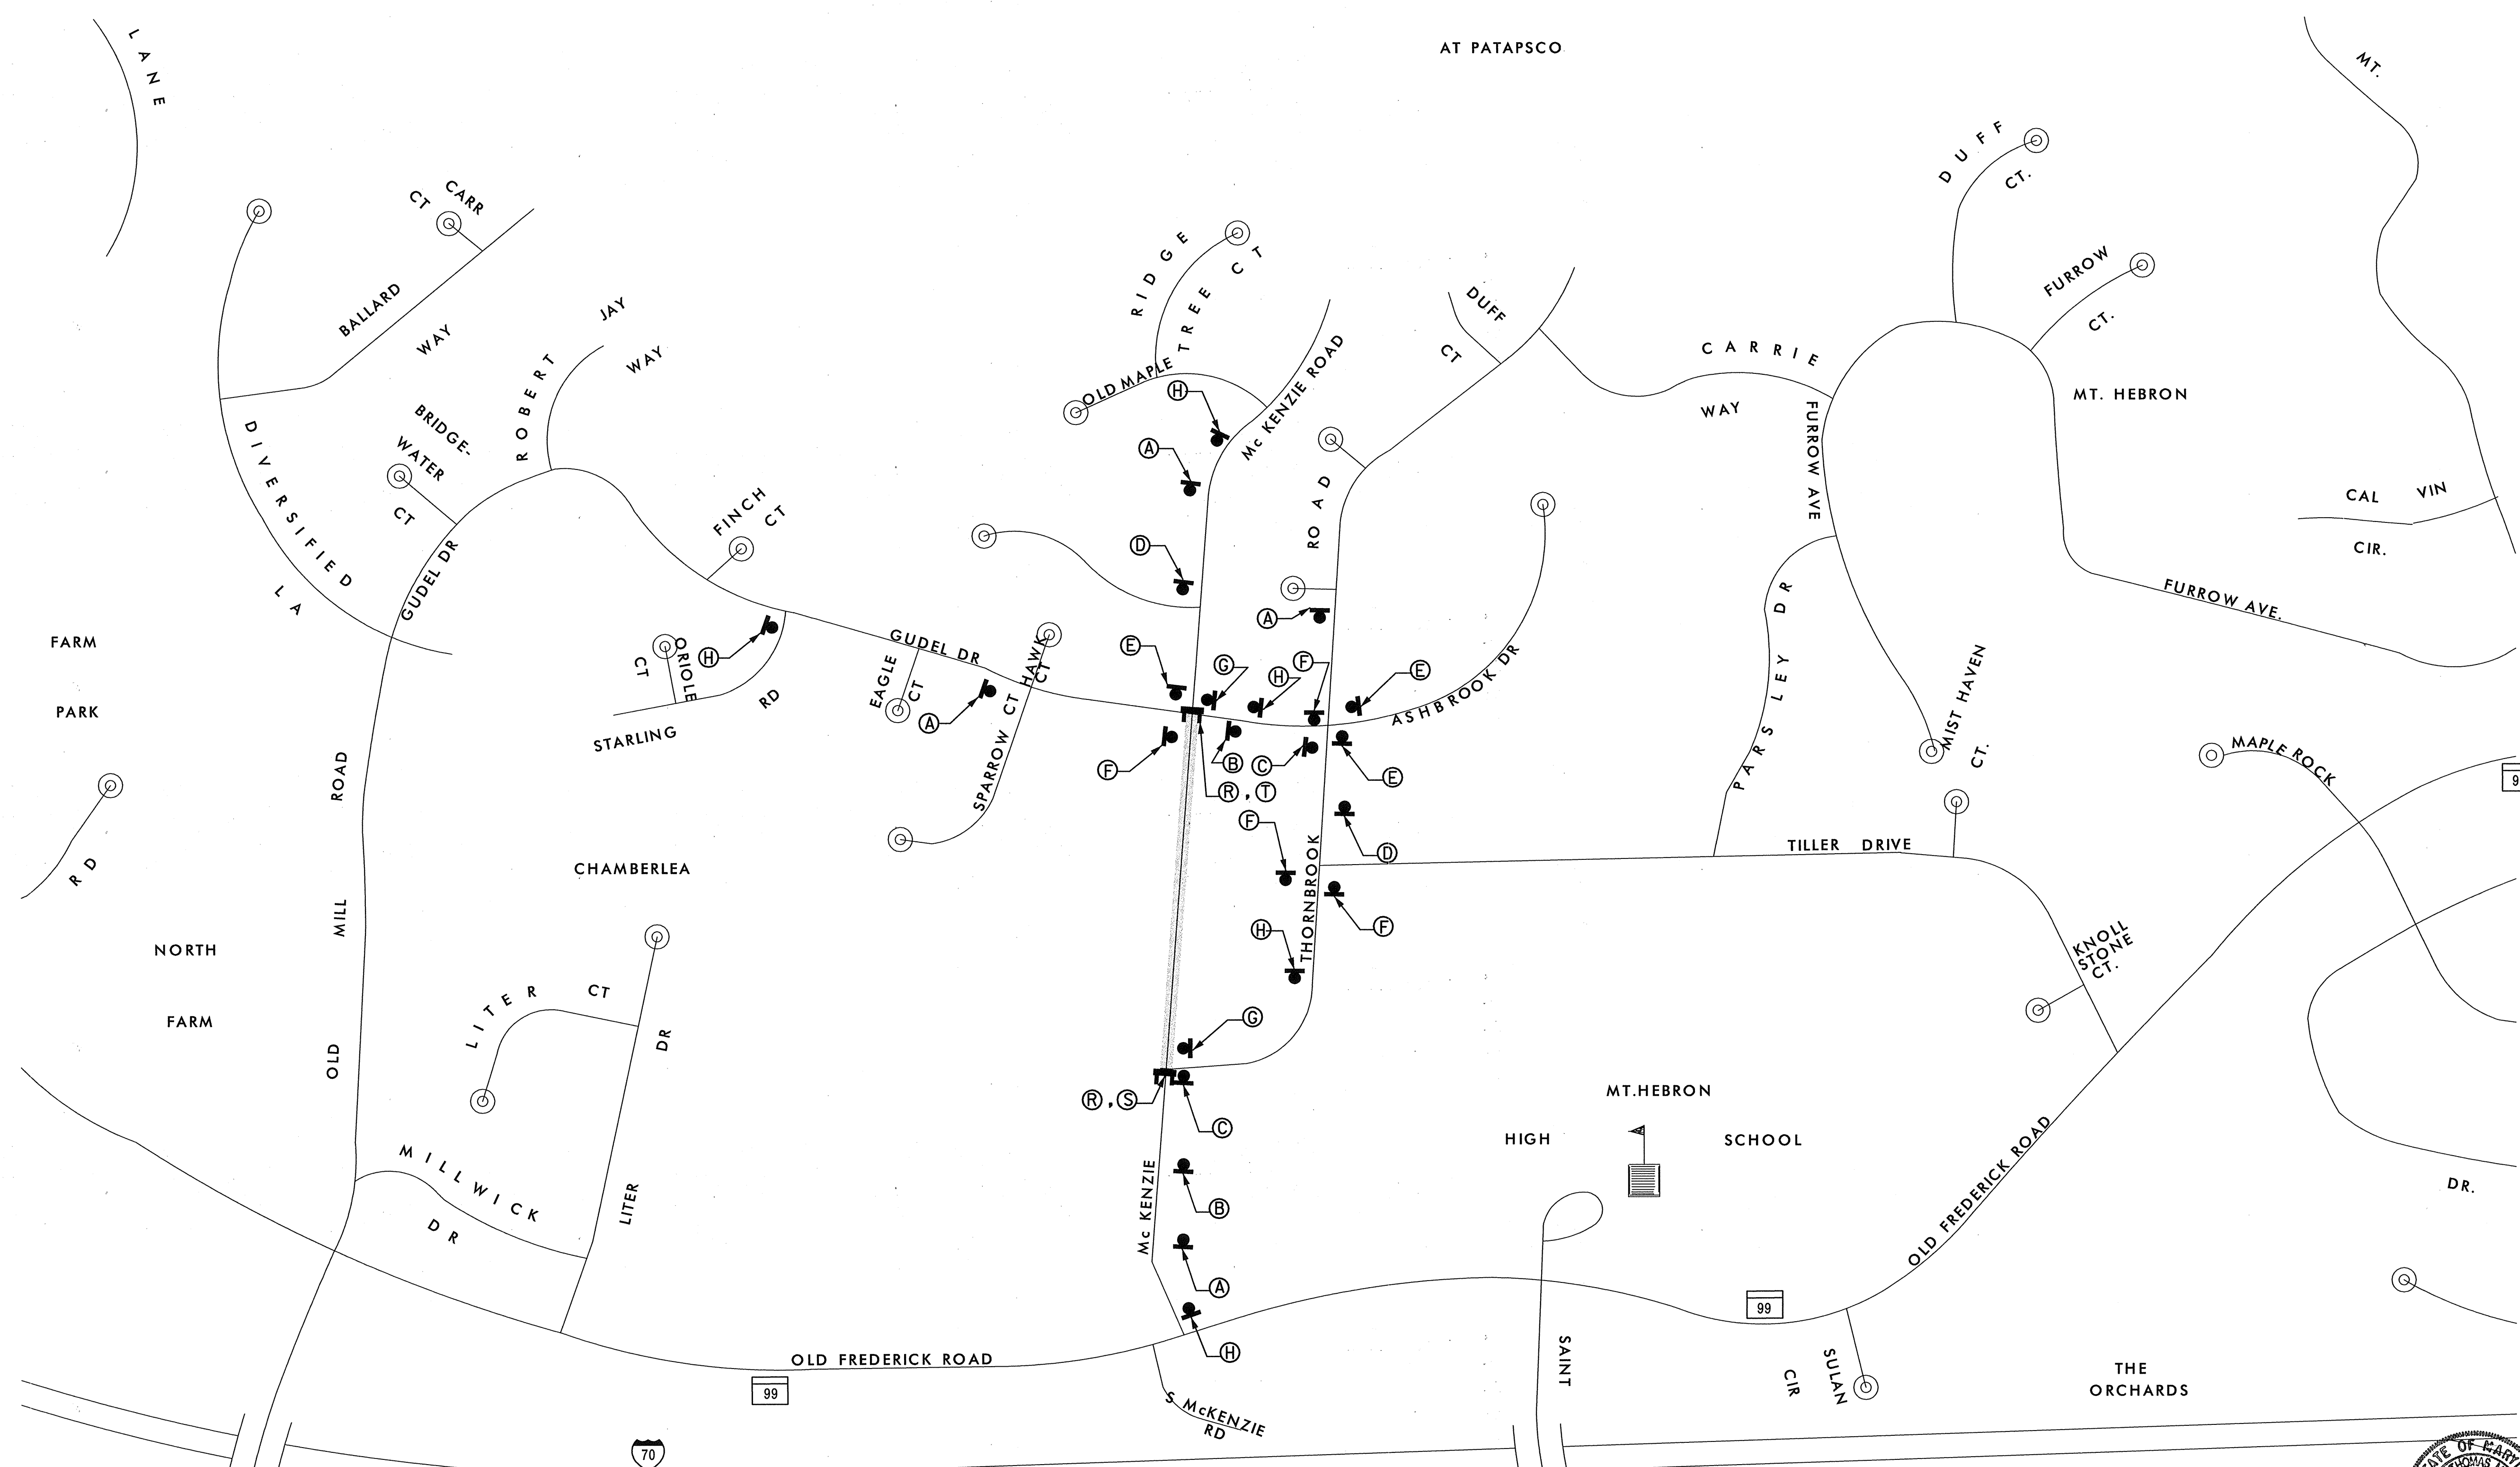


NOTES:

1. CONSTRUCT PAVEMENT, CURB AND GUTTER, SIDEWALK, AND DRAINAGE STRUCTURES FROM STATION 109+97 TO STATION 121+20 ON MCKENZIE ROAD WITH THIS ROAD CLOSURE SETUP. PERFORM PAVEMENT RECONSTRUCTION, MILL AND RESURFACE, AND CONSTRUCT THE FOUR ISLANDS AND THE ROUNDABOUT NORTH OF STATION 121+20 UNDER FLAGGER OPERATION.
2. SEE TRAFFIC CONTROL PLAN SHEET TP-3 FOR DETAILED CONSTRUCTION SEQUENCE AT THORNBROOK ROAD.
3. THIS TRAFFIC CONTROL SET UP IS ONLY FOR WORKING HOURS BETWEEN 9 AM AND 4 PM. CONTRACTOR SHALL OPEN ROADS TO TRAFFIC DURING NON-WORKING HOURS.

SIGNS AREA (SQFT)	226
TYPE III BARRICADE (EA)	4
TRAFFIC DRUMS (EA)	8

TRAFFIC CONTROL - LEGEND	
	PROPOSED CONSTRUCTION

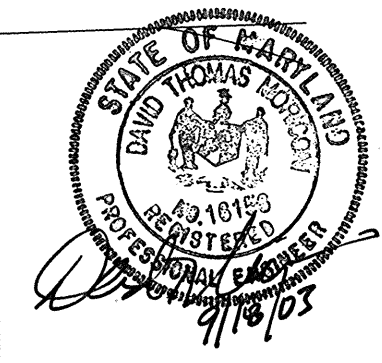

STAGE 1

DEPARTMENT OF PUBLIC WORKS
HOWARD COUNTY, MARYLAND

Jan P. Chu 9/22/03
DATE
CHIEF, TRANSPORTATION AND SPECIAL PROJECTS DIVISION

Paul J. Sisson 9/22/03
DATE
CHIEF, BUREAU OF ENGINEERING

William J. Malachuk 9/22/03
DATE
CHIEF, BUREAU OF HIGHWAYS

GRAPHIC SCALE
0 300 600
SCALE: 1"=300'

URS
HUNT VALLEY, MARYLAND

RJM
RJM ENGINEERING, INC.
CONSULTING ENGINEERS
COLUMBIA, MARYLAND

TELE: (410) 730-1001 FAX: (410) 730-5403

DES:				
DRN:				
CHK:				
DATE:	BY	NO.	REVISION	DATE


TRAFFIC CONTROL PLAN SHEET TP-1

NO.: _____ DATE: 9/03

MCKENZIE ROAD ROADWAY AND STORMDRAIN IMPROVEMENTS

HOWARD COUNTY, MARYLAND
CAPITAL PROJECT NO. J-4164-10

SCALE AS SHOWN
SHEET 220F24

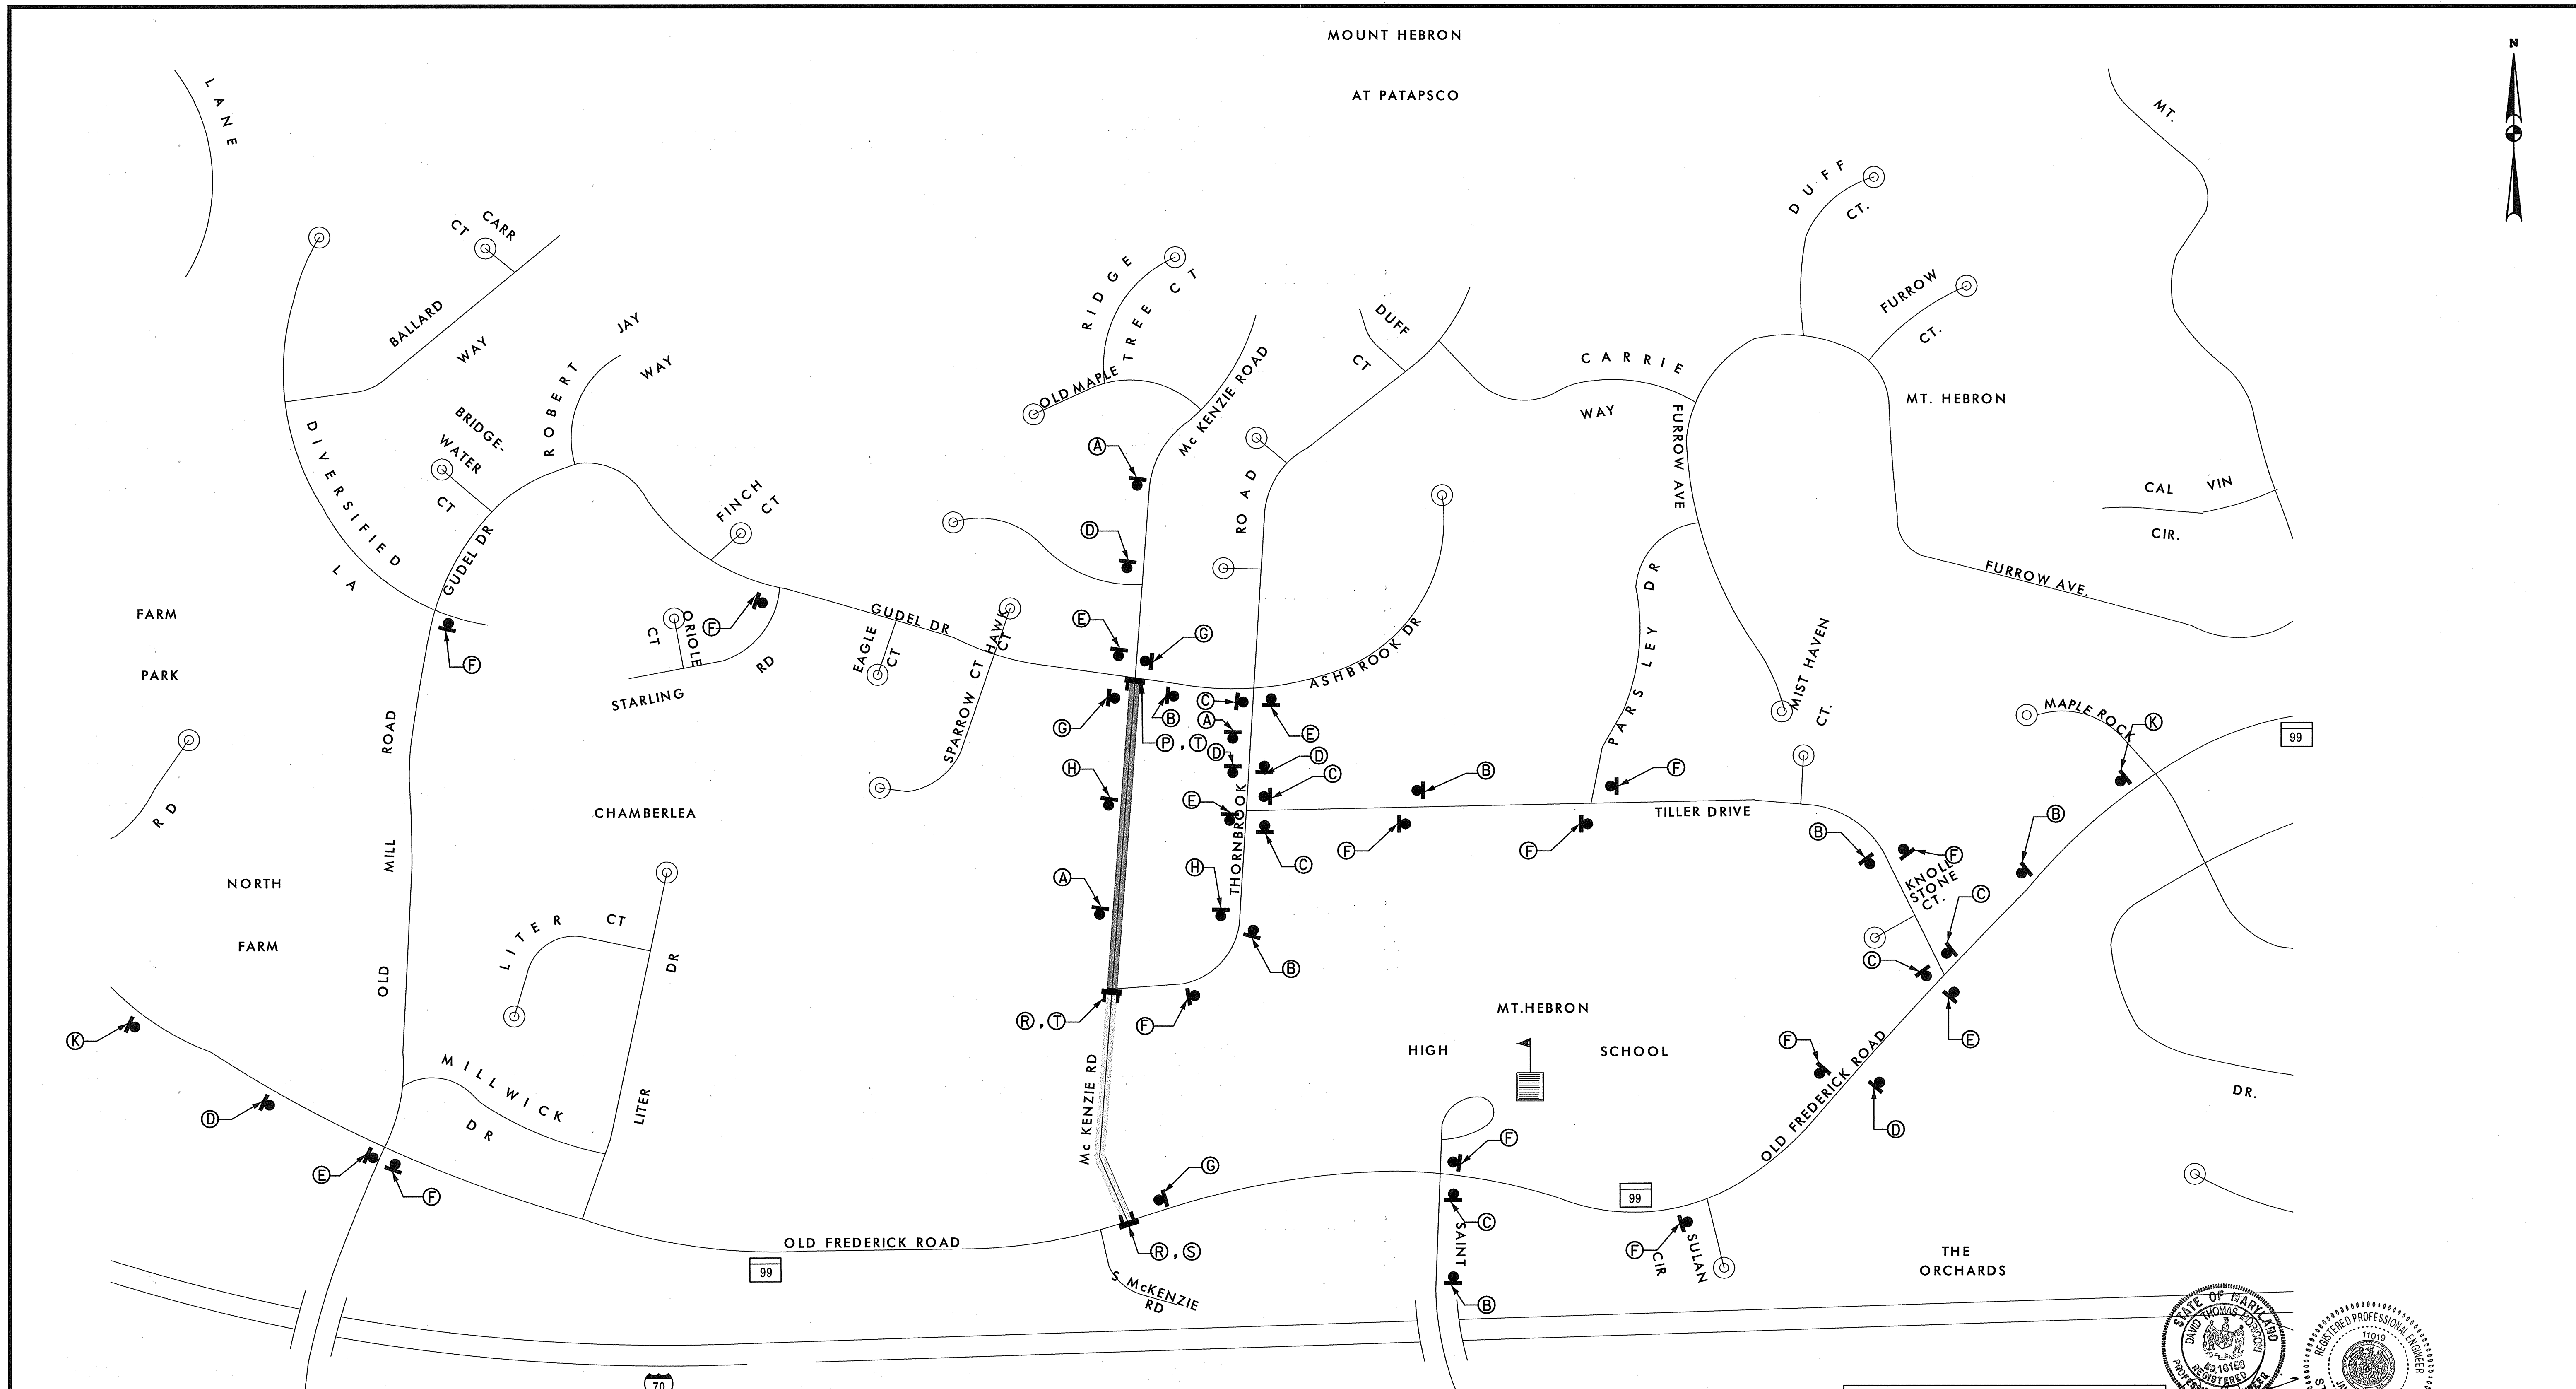


NOTES:

1. CONSTRUCT PAVEMENT, CURB AND GUTTER, SIDEWALK, AND DRAINAGE STRUCTURES FROM STATION 100+27 TO STATION 109+73 ON MCKENZIE ROAD DURING THIS STAGE.
2. SEE TRAFFIC CONTROL PLAN SHEET TP-3 FOR DETAILED CONSTRUCTION SEQUENCE AT THORNBROOK ROAD.

SIGNS AREA (SQFT)	423
TYPE III BARRICADE (EA)	5
TRAFFIC DRUMS (EA)	10

TRAFFIC CONTROL - LEGEND	
	COMPLETED CONSTRUCTION
	PROPOSED CONSTRUCTION

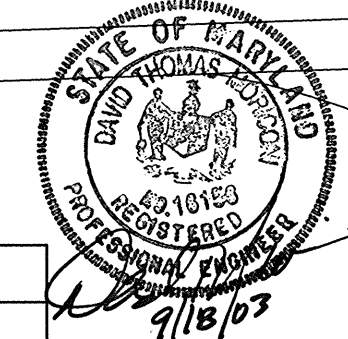

Signature 9/18/03

STAGE 2

DEPARTMENT OF PUBLIC WORKS
HOWARD COUNTY, MARYLAND

Jan 9, 03 9/22/03
DATE

Michelle J. Smith 9/24/03
DATE

CHIEF, TRANSPORTATION AND SPECIAL PROJECTS DIVISION

GRAPHIC SCALE
0 300 600
SCALE: 1"=300'

URS
HUNT VALLEY, MARYLAND

RJM
RJM ENGINEERING, INC.
CONSULTING ENGINEERS
COLUMBIA, MARYLAND

DES:				
DRN:				
CHK:				
DATE:	BY	NO.	REVISION	DATE

TRAFFIC CONTROL PLAN SHEET TP-2

NO.: _____ DATE: 9/03

McKENZIE ROAD ROADWAY AND STORMDRAIN IMPROVEMENTS

HOWARD COUNTY, MARYLAND
CAPITAL PROJECT NO. J-4164-10



SCALE AS SHOWN
SHEET 230F24

TRAFFIC CONTROL - LEGEND

S
MAX
O O O O

PLASTIC DRUM SPACING EQUALS TO 10 FEET UNLESS NOTED OTHERWISE OR AS DIRECTED BY THE ENGINEER.

PROPOSED CONSTRUCTION

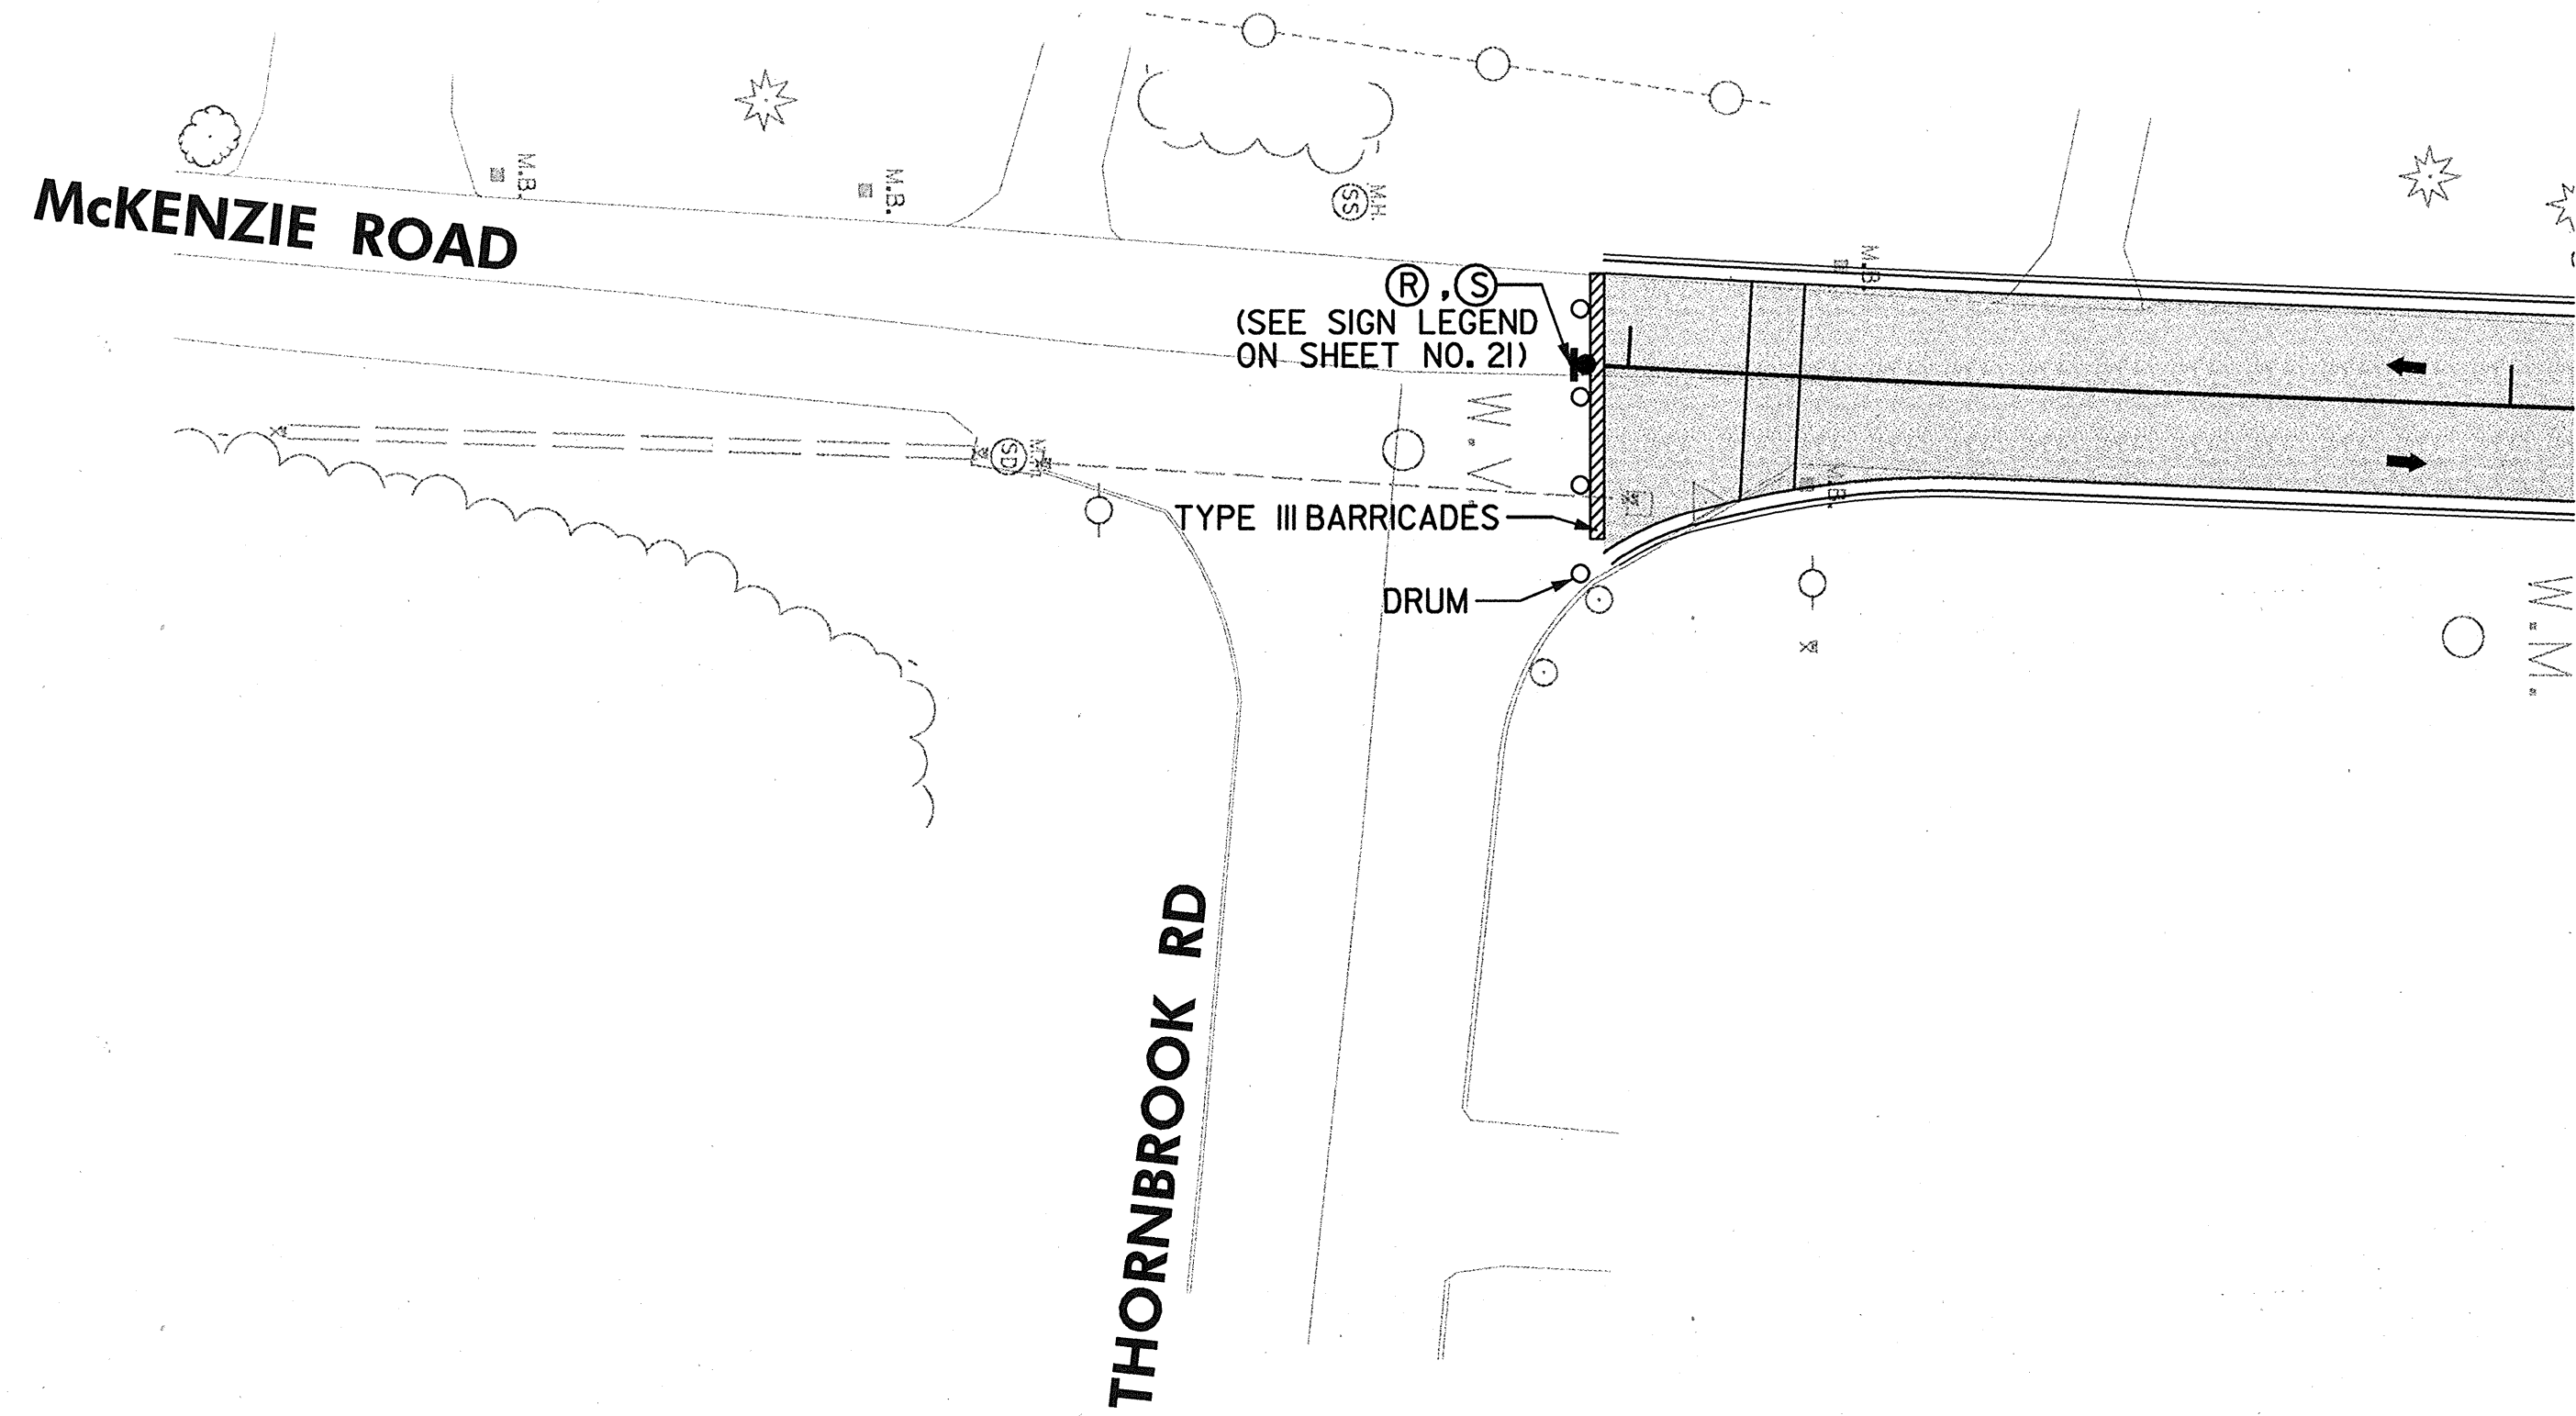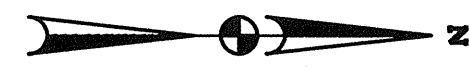

STAGE 1

NOTES:

1. CONSTRUCT PAVEMENT, CURB AND GUTTER, SIDEWALK AND DRAINAGE STRUCTURES FROM STA. 109+97 TO STA. 121+20 ON MCKENZIE ROAD.
2. SEE TRAFFIC CONTROL PLAN SHEET TP-1 FOR SIGNS AND LOCATIONS. SEE ALSO THE GENERAL NOTES ON SHEET NO. 21.
3. USE FLAGGER OPERATION FOR CONSTRUCTION OF THE AREA BETWEEN STA. 109+73 AND 109+97.



TRAFFIC CONTROL - LEGEND

S
MAX
O O O O

PLASTIC DRUM SPACING EQUALS TO 10 FEET UNLESS NOTED OTHERWISE OR AS DIRECTED BY THE ENGINEER.

COMPLETED CONSTRUCTION

PROPOSED CONSTRUCTION

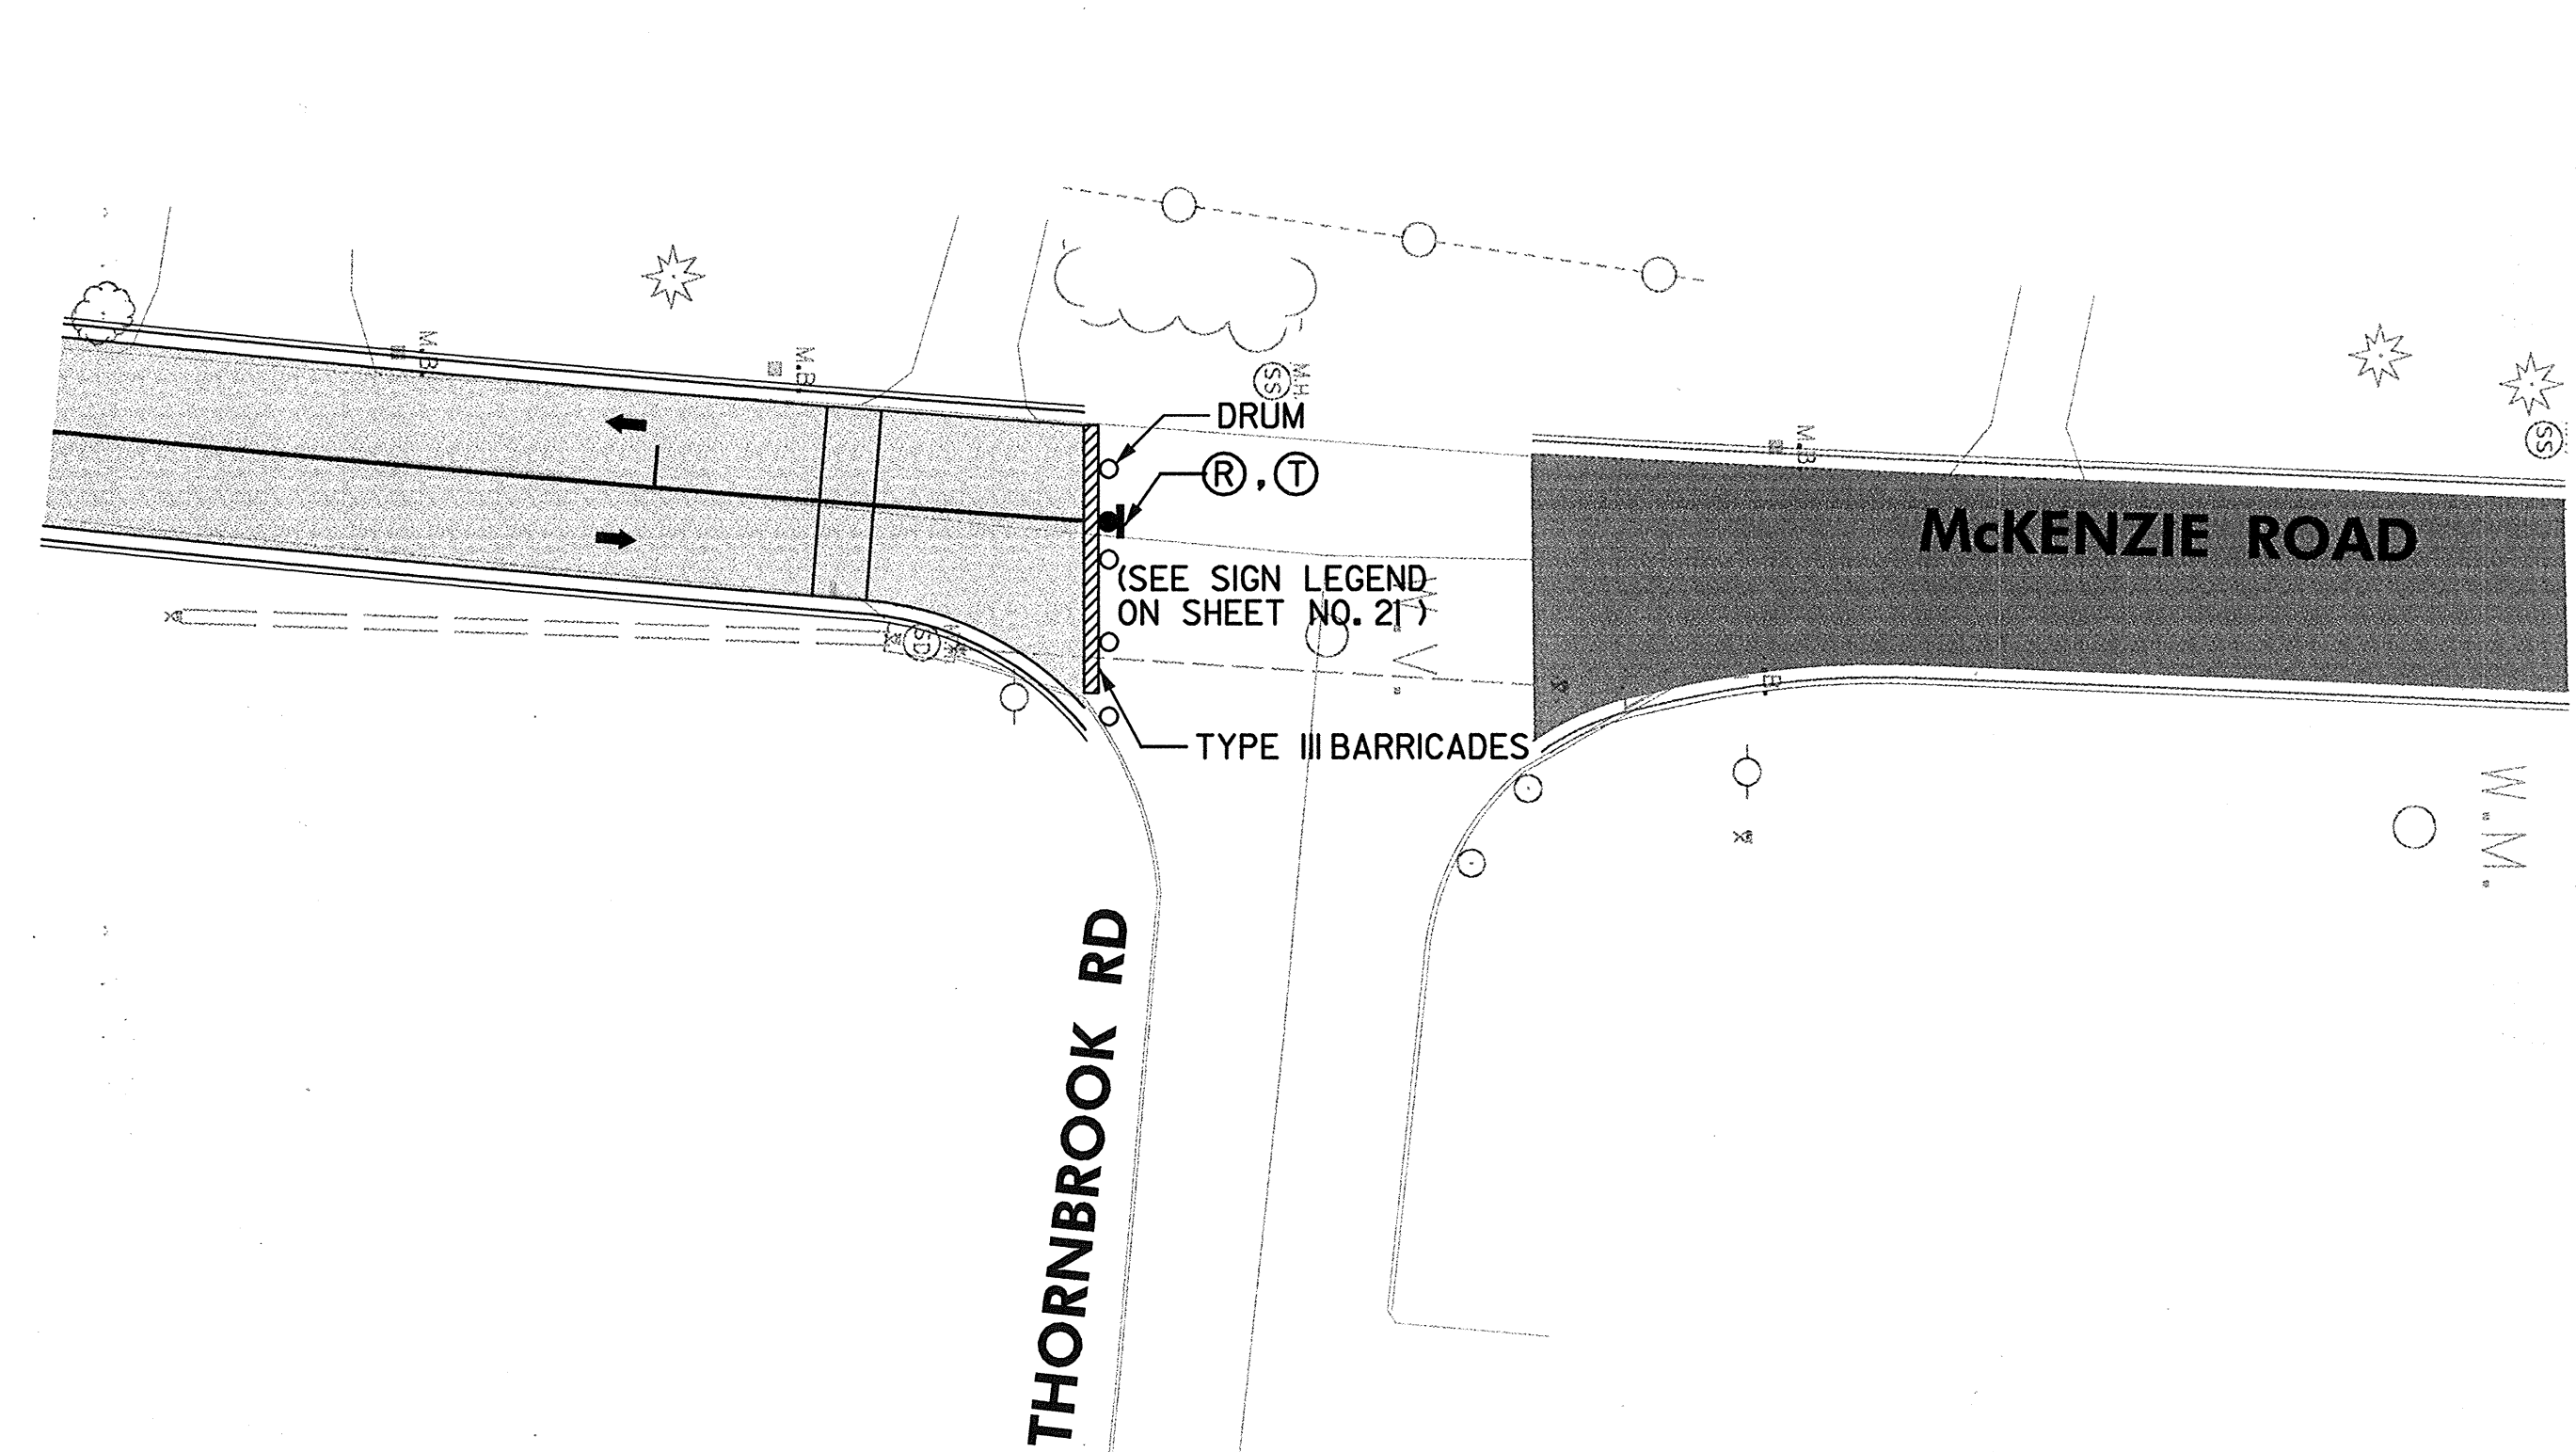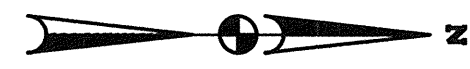

STAGE 2

NOTES:

1. CONSTRUCT PAVEMENT, CURB AND GUTTER, SIDEWALK AND DRAINAGE STRUCTURES FROM STA. 100+23 TO STA. 109+73 ON MCKENZIE ROAD.
2. SEE TRAFFIC CONTROL PLAN SHEET TP-2 FOR SIGNS AND LOCATIONS. SEE ALSO THE GENERAL NOTES ON SHEET NO. 21.



DEPARTMENT OF PUBLIC WORKS
HOWARD COUNTY, MARYLAND

Jan J. [Signature] 9/29/03
DATE

Richard [Signature] 9/22/03
DATE

Evellen E. [Signature] 9/22/03
DATE

William J. [Signature] 9-24-03
DATE

GRAPHIC SCALE
0 20 40
SCALE: 1"=20'-0"

URS
HUNT VALLEY, MARYLAND

RJM
RJM ENGINEERING, INC.
CONSULTING ENGINEERS
COLUMBIA, MARYLAND
TEL: 410-730-1001 FAX: 410-730-5403

DES:					
DRN:					
CHK:					
DATE:	BY	NO.	REVISION	DATE	

TRAFFIC CONTROL
PLAN SHEET 3

NO.: _____ DATE: 9/03

**MCKENZIE ROAD ROADWAY
AND STORMDRAIN IMPROVEMENTS**

HOWARD COUNTY, MARYLAND
CAPITAL PROJECT NO. J-4164-10

SCALE
AS
SHOWN

SHEET
240F24