

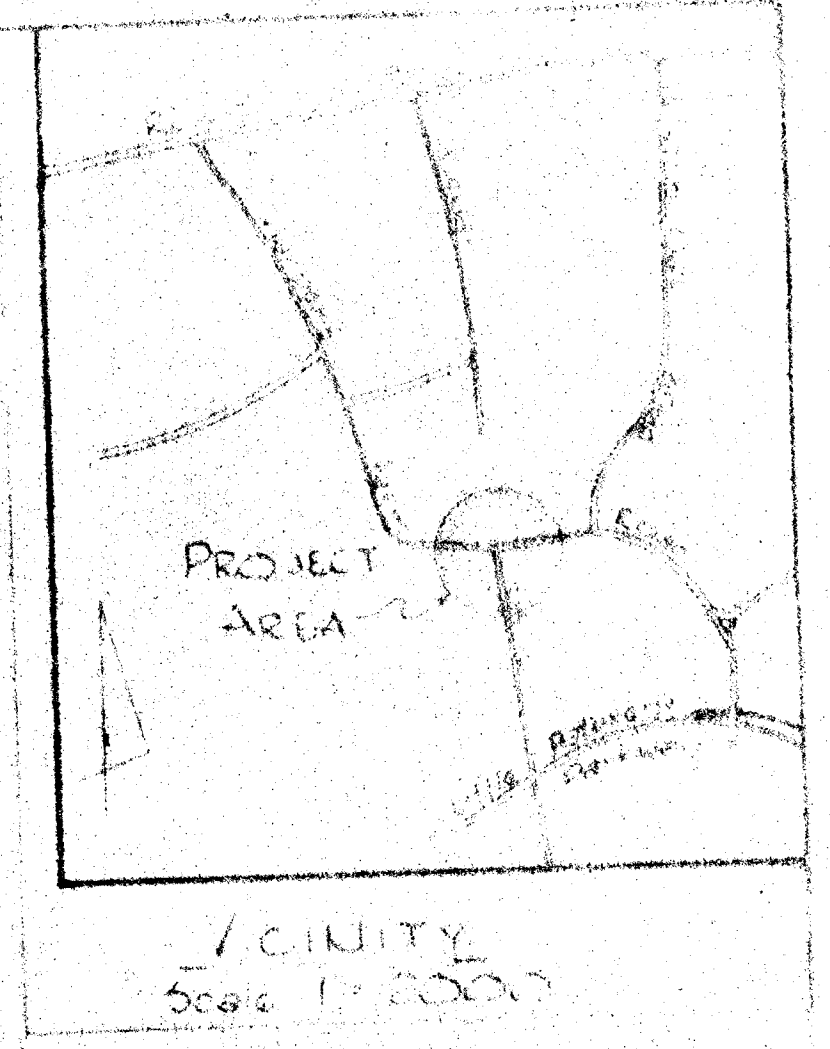


PHASE & SEQUENCE DIAGRAM	TRAFFIC SIGNAL HEADS			
	2	1, 5	3, 4	6, 7
	(K)	(R)	(R)	(R)
PHASE 1 CLEAR	(A)	(A)	(R)	(R)
PHASE 2	(G)	(G)	(G)	(R)
PHASE 2 CLEAR	(A)	(A)	(A)	(R)
PHASE 3	(R)	(R)	(R)	(G)
PHASE 3 CLEAR	(R)	(R)	(R)	(A)
FLASH PHASE	F/A	F/A	F/A	F/R

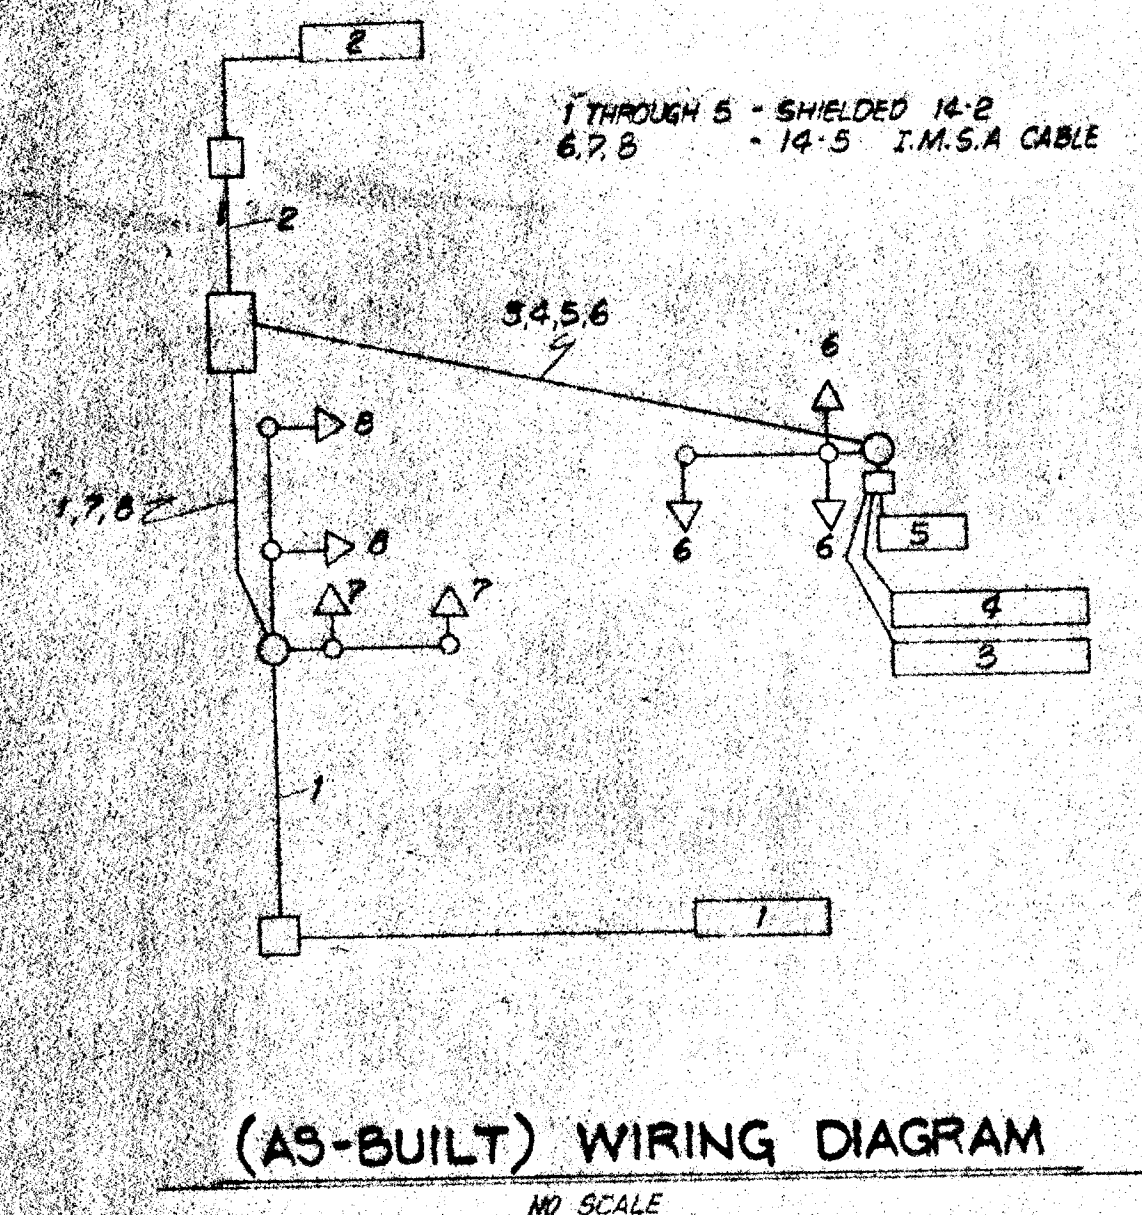

- SYMBOLS**
- Signal Head
 - Vehicular Lane Detectors
 - ⊞ Hand Box
 - ⊙ Meter
 - ⊞ Signal Cabinet
 - Street Light (Proposed)
 - ⊞ Street Light (existing)

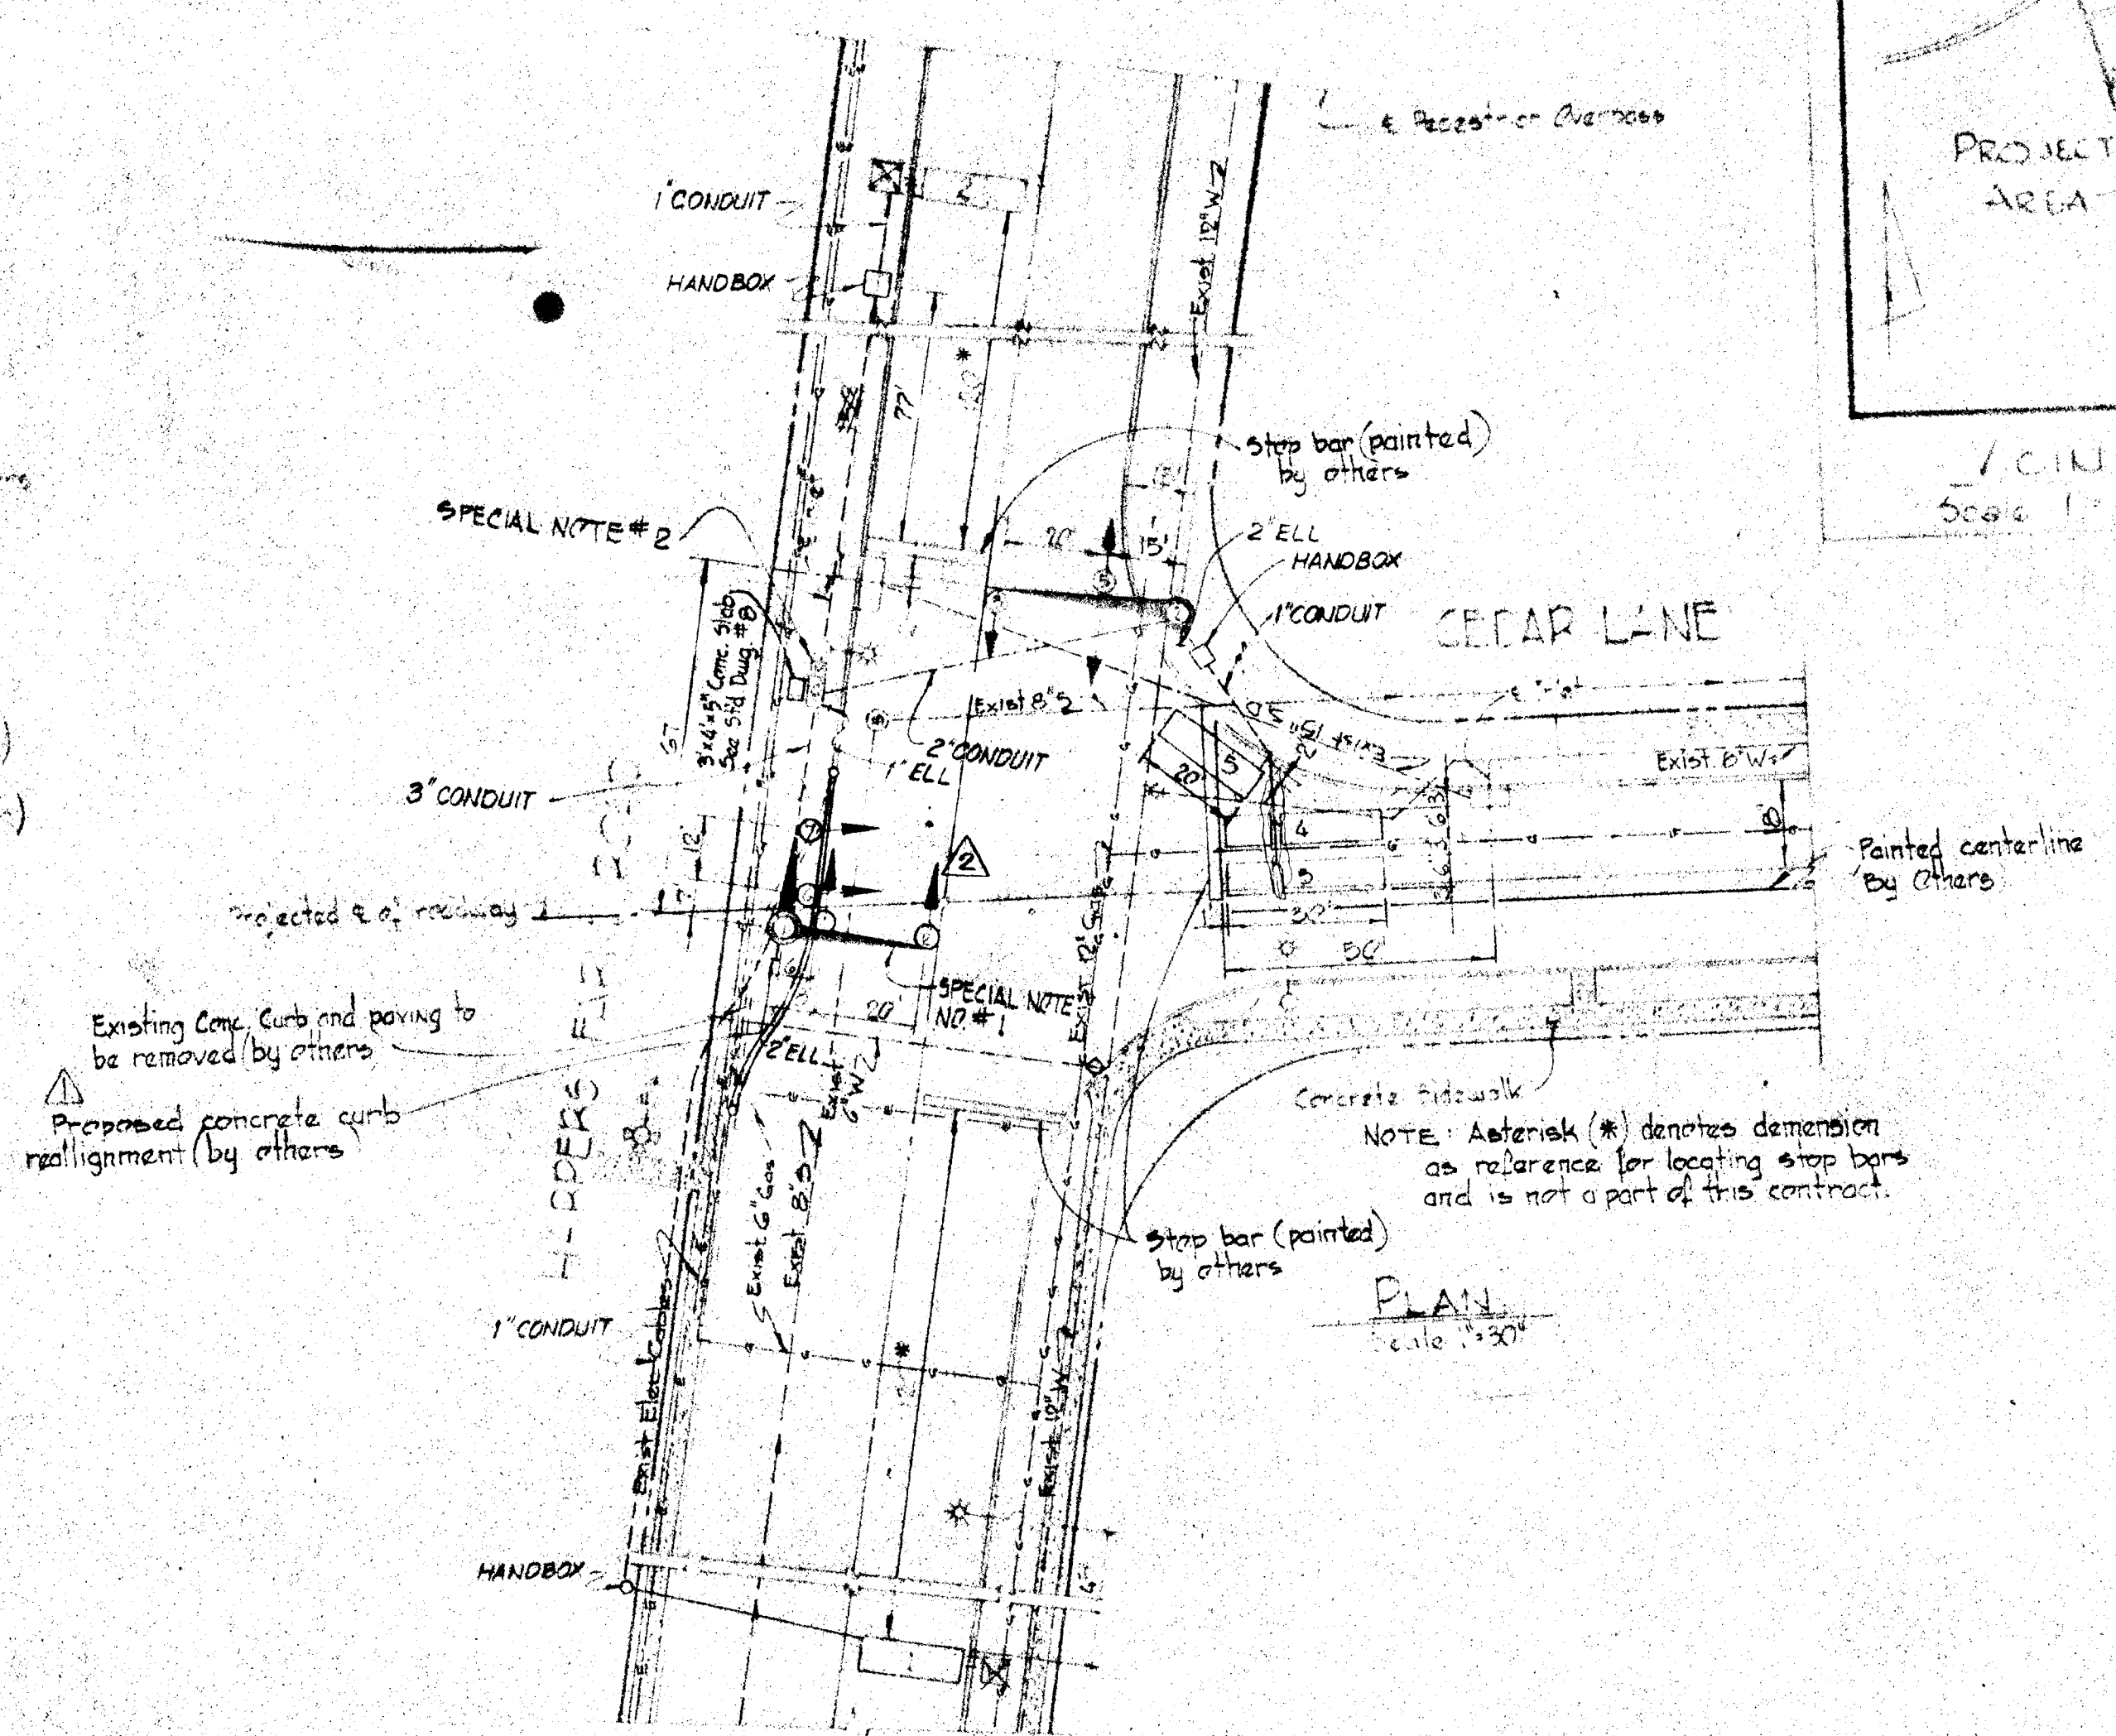

EXISTING EQUIPMENT LIST
SEE PAGE 9-II OF SPECIFICATIONS FOR MAKE/MODEL

- A. CONTROLLER**
- 1 Fully actuated four (4) phase solid state signal controller compatible to three (3) vehicle phases fully actuated plus all red pedestrian phase actuated.
 - 2 Nameplate and recall for each phase.
 - 3 Standard Police Panel (see General Specifications) without manual override.
 - 4 All red clearance interval for each phase.
 - 5 Conflict monitor with solid state signal leading switches.
 - 6 Two (2) Loop detector amplifiers (standard).
 - 7 Minimum acceptable adjustment range:
 - a) Major / Minor street initial period and unit extension 2" - 200"
 - b) Major / Minor street extension 1" - 200"
 - c) Vehicle clearance interval and all red clearance interval as required.
 - 8 Phase insulated control cabinet large enough to accommodate the ultimate 3 phase and pedestrian phase.
 - 9 Control cabinet to be painted bronze.
 - 10 Two Loop detector amplifiers with adjustable delayed timer.

C. SIGNAL HEADS

- 1 A" signal heads shall have 12" red, 6" amber and 6" green lens face with standard for warning.

D. POLES - MAST ARM

- | No. (SEE PLAN) | Description |
|----------------|---|
| 1 | Twin arm support with 90° angle at separation with 28" span supporting an ultimate 3 signal heads and the 16" span supporting 2 signal heads. |
| 2 | 3' span supports 3 signal heads. |
- Pole Finish - Manufacturer's recommended finish for the pole and the mast arm.
- Pole Design - Style and appearance equivalent to UNION METAL DESIGN B0300.

E. SPECIAL NOTE #1

Signal heads shall be mounted on a maximum clearance of 16' above the roadway surface to allow maximum visibility from beyond intersection.

F. SPECIAL NOTE #2

In accordance with the B44-E requirements, a fringed steel (12ga.) or aluminum (10ga.) enclosure with loop shall be provided for vandal protection.

GENERAL NOTES

1. The Contractor shall not be responsible for highway markings.
2. The timing of the Traffic Signal System shall be furnished by the Traffic Engineer (Reference 4.03 g, General Specifications).
3. The Contractor shall comply with the General Specifications for Installation of and Equipment for Traffic Signals prepared by Howard County Dept. of Public Works, Bureau of Engineering, Division of Traffic Engineering, Oct. 1974 and Feb. 1976.
4. The Contractor shall locate all underground utilities prior to construction, as required.
5. All disturbed areas shall be seeded and mulched.

LEFT-TURN EQUIPMENT

- G. SIGNAL HEADS - STD. CAP VISORS**
Remove existing signal head #2, and replace with 5' head COMBINATION No. (see plan)
Traffic Signal #2
Size of indication
12" Red
12" Amber, 12" Amber Arrow
12" Green, 12" Green Arrow
- H. CONTROLLER MODIFICATIONS**
Phase module(s), Solid State load switch(es)

FOR ECONOLITE EMC 4000 S/N 472 P/N 314056100 PROGRAM 31454

3/24/81 LEFT TURN PHASES	
Rev. Date	Revision Description
	RELOCATED CONCRETE CURBS
	CHIEF, DIV. RDS., BRIDGES, & ST. DRNG.
	CHIEF, DIV. TRAFFIC ENGINEERING
	CHIEF, DIV. DEPT. OF ENGINEERING
	DEPT. OF PUBLIC WORKS

HOWARD COUNTY DEPARTMENT OF PUBLIC WORKS
BUREAU OF ENGINEERING
CAPITAL PROJECT T-1-7012
TRAFFIC SIGNAL MODIFICATION PLAN
AND EQUIPMENT LIST
CAPITAL IMPROVEMENT PROJECT T-1-7012
HARBERS FARM ROAD AT CEDAR LANE

Scale as Noted
Date: 3/24/81
Drawn: EAC
Checked: JIK & EAC

AS-BUILT JUNE 6, 1979

C744B201

PHASE AND SEQUENCE DIAGRAM	TRAFFIC SIGNAL HEADS				
	1	2,6	3,4,5	7,8	
	← G	G	R	R	
	G	G	G	R	
	R	R	R	G	
FLASH (F/)	F/A	1/A	F/A	F/R	

* F/ — FLASH FREE MOVEMENT
 --- YIELD PRIOR TO MOVEMENT

GENERAL NOTES

- Pole # 1 & 2 are to be installed in place of the existing luminaire supports numbered 431 & 426.
- The contractor is not responsible for providing highway markings.
- The timing of the signal system shall be furnished by the Traffic Engineer (ref 10.03 general specification).
- The contractor shall conduct all backfill and cleanup operations as noted in the specifications (ref 22-07 & 22-08) or as directed by the Traffic Engineer.
- The contractor shall comply with all provisions contained within the General Specifications for Installation and Equipment of Traffic Signals for Howard County Department of Public Works, October 1974 and rev. Feb. 1976.
- The existing luminaires shall be removed by the Baltimore Gas & Electric Co. Arrangement for removal shall be the responsibility of Howard County. The existing poles shall be removed by the contractor and returned to a location specified by the Traffic Engineer.
- The contractor shall, after furnishing and installing the two (2) 250 watt Hg luminaires, notify the Baltimore Gas & Electric Co., Mr. Walter W. Kimmel 265-7500, to have the luminaires energized.
- The two (2) luminaires shall not be supplied by the metered power source for the traffic signal system.

EXISTING EQUIPMENT LIST

SEE PAGE 2-100 OF SPECIFICATIONS FOR MAKE/MODEL

A. CONTROLLER

- Fully actuated two (2) phase solid state controller expandable to three (3) phase fully actuated with all red pedestrian phase push button actuated.
 - All red clearance interval for phase A & phase B.
 - Memory and recall for each phase.
 - Conflict monitor with solid state signal loading switches.
 - Standard police panel (ref 29.35 general specifications) without manual override feature.
 - Two (2) loop detector amplifiers.
 - Minimum acceptable adjustment range:
 - Major & minor street initial period and unit extension 2-30
 - Major & minor street extension 10-60
 - Vehicle clearance interval & all red clearance interval up to 10
- Base mounted control cabinet large enough to accommodate the ultimate three (3) phases. The cabinet shall be finished bronze.

B. DETECTORS - VEHICLE LOOP

Location in accordance	Phase	Detector N° (see plan)	Dimensions
A		2/3	6' x 18'
B		1	6' x 12'

C. SIGNAL HEADS STANDARD CAP VISORS

N° (see plan)	Size of indication
Traffic } 1,2,3,4,5,6	12" red, 8" amber, 8" green
signals } 7,8	12" red, 8" amber, 8" green

D. POLES

N° (see plan)	Description
1	Combination monolover with two (2) arms 28 ft. / 18 ft. with 100° angle of separation & luminaire support. 28 ft. arm supports 4-12" signal heads. 18 ft. arm supports 1-12" signal head.
2	Combination monolover with one (1) arm 28 ft. luminaire support. 28 ft. arm supports 3-12" signal heads.


Pole Finish - Zinc chromate prime coat with exterior bronze finish to be applied in the field.

Note - The luminaire for poles 1 & 2 shall be 250 watt mercury vapor. The contractor shall furnish and install the two (2) luminaires & all related hardware. The luminaires & hardware provided shall be consistent with standard B.G.E. specifications and the following:

- It shall be for use with 250 watt Hg Vapor lamp.
- It shall have long stem cut-off with Type 3 distribution with clear lamp.
- It shall be equipped with 120-240V regulated out-put ballast connected for 120 v operation with locking type receptacle for photo electric controls.
- It shall have a 2" slip fitter mounting and bronze exterior finish.

SYMBOLS

○	Signal Head
□	Vehicle Loop Detector
⊞	Hand Box (Junction Box)
⊞	Meter Box
⊞	Control Cabinet
⊞	Proposed Steel Pole

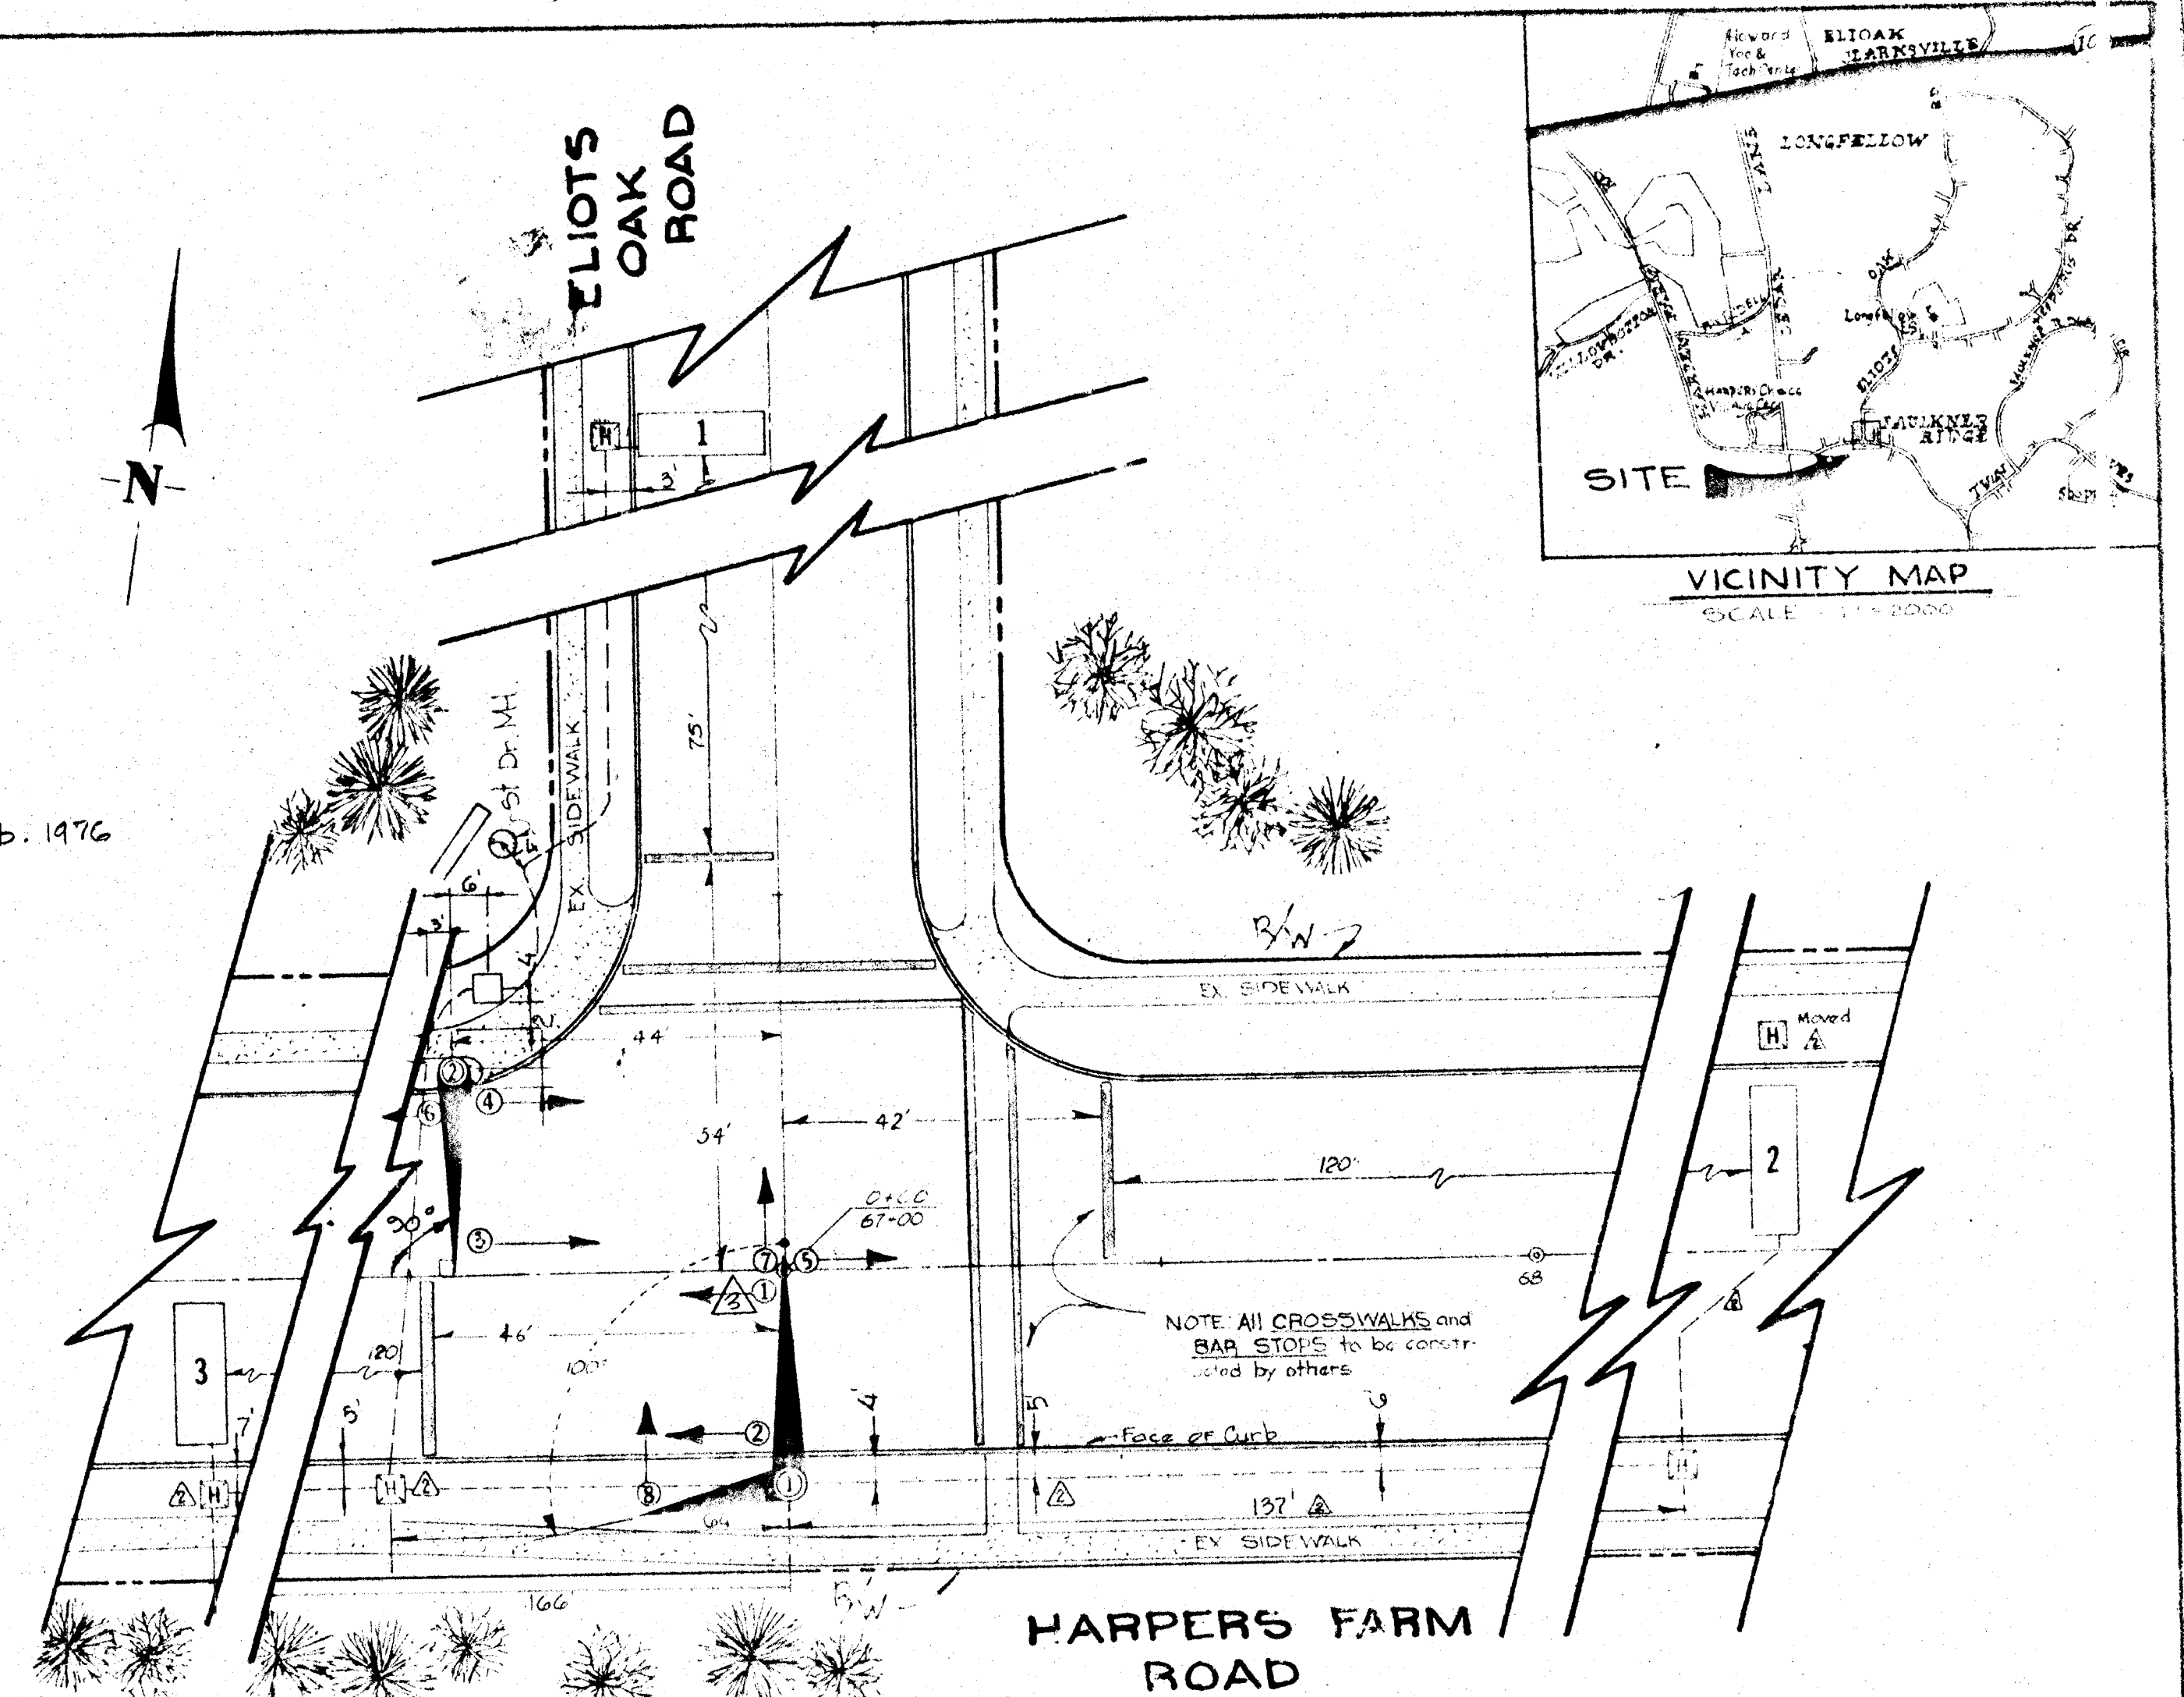

PLAN

SCALE: 1"=20'

A. LEFT TURN PHASE EQUIPMENT

E. SIGNAL HEADS STANDARD CAP VISORS
 Remove existing signal head #1 and replace with 5 hand combination No. (see plan).
 Size of indication:
 Traffic } 1 12" Red, 12" amber, 12" amber arrow
 Signal } 1 12" Green Arrow, 12" Green

F. CONTROLLER - MODIFICATIONS
 Phase modules FOR ECONOLITE DI3200 S/N 0613
 Solid state load switch(s) COMPATIBLE WITH ECONOLITE DI3200 S/N 0613

REV. NO.	DESCRIPTION	D. T.E.
A	Left Turn Phases	3/14/81
B	As Built	3-1-76
C	Clear General Note # 7 & 8	3-1-76

TRAFFIC SIGNAL CONSTRUCTION PLAN AND EQUIPMENT LIST
 HOWARD COUNTY MARYLAND
 CAPITAL PROJECT T-1-7012

PROJECT AREA
 HARPER'S FARM ROAD AT ELIOTS OAK ROAD

SCALE AS SHOWN
 DATE 3/1/81
 SHEET 10/1

CHIEF DIV. OF TRAFFIC EN.

C-7443702