


REVISION #3 BY:
BOLLMAN CONSULTING
2350 RINA ROAD, SUITE 200
ANNAPOLIS, MD 21401
410-224-7590

NO. REVISIONS	DATE	BY
2	03-03-05	KD
3	05-18-03	PM

THIS SEAL FOR REVISION NO. 1 ONLY
REVISION NO. 1 BY: CENTURY ENGINEERING
No. 2
32 WEST ROAD
TOWSON, MD. 21284
410-823-8070

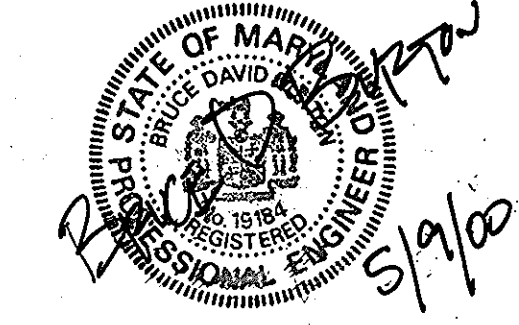

PROFESSIONAL CERTIFICATION: I hereby certify that these documents were prepared or approved by me, and that I am a duly licensed Professional Engineer under the laws of the State of Maryland.
License No. 21876, Expiration Date: 8/19/2016

- NOTES:
- For street tree locations, see sheets 16 & 17.
 - All street trees and/or street signs shall be located 5 feet minimum from proposed drainage and utility structures.
 - There shall be a minimum of 20 feet between street lights and street signs.
 - For storm drain profiles refer to sheet 4 of 18.
 - All future driveway crossings within the Public R/W shall be approved at the time of Building Permit.
 - For Traffic Control Sign Location Table, see sh. 3 of 18.
 - See Sh. 2 of 18 for Guilford Road Improvement Plan and Profile.

PAVING LEGEND:
P-5 Paving Section (Guilford Rd. Improvements) (Howard County)
P-2 Paving Section (Walter Scott Way) (Howard County)


SECTION NUMBER	ROAD AND STREET CLASSIFICATION	PAVEMENT MATERIALS	GRAVEL BASE ALTERNATES
P-5	COMMERCIAL-INDUSTRIAL ZONES MAJOR COLLECTOR ALL ZONES MINOR ARTERIAL	FULL DEPTH BIT. CONC. ALTERNATE 1 1/2" BIT. CONC. SURFACE 4 1/2" BIT. CONC. BASE 5" BIT. CONC. BASE	1 1/2" BIT. CONC. SURFACE 4 1/2" BIT. CONC. BASE 5" BIT. CONC. BASE 5" CRUSHED AGGREGATE BASE (TAB)

HOWARD COUNTY, MARYLAND
DEPARTMENT OF PUBLIC WORKS
Approved: [Signature] & [Signature]
Chief, [Title] & [Title]
Date: [Date]

APPROVED: Department of Planning & Zoning
Cindy Hamlett 7/18/00
Chief, Division of Land Development


APPROVED: Department of Public Works for Storm Drainage Systems and Roads
[Signature] 6/26/00
Chief, Development Engineering Division

APPROVED: Department of Public Works for Storm Drainage Systems and Roads
[Signature] 5-26-00
Chief, Bureau of Highways

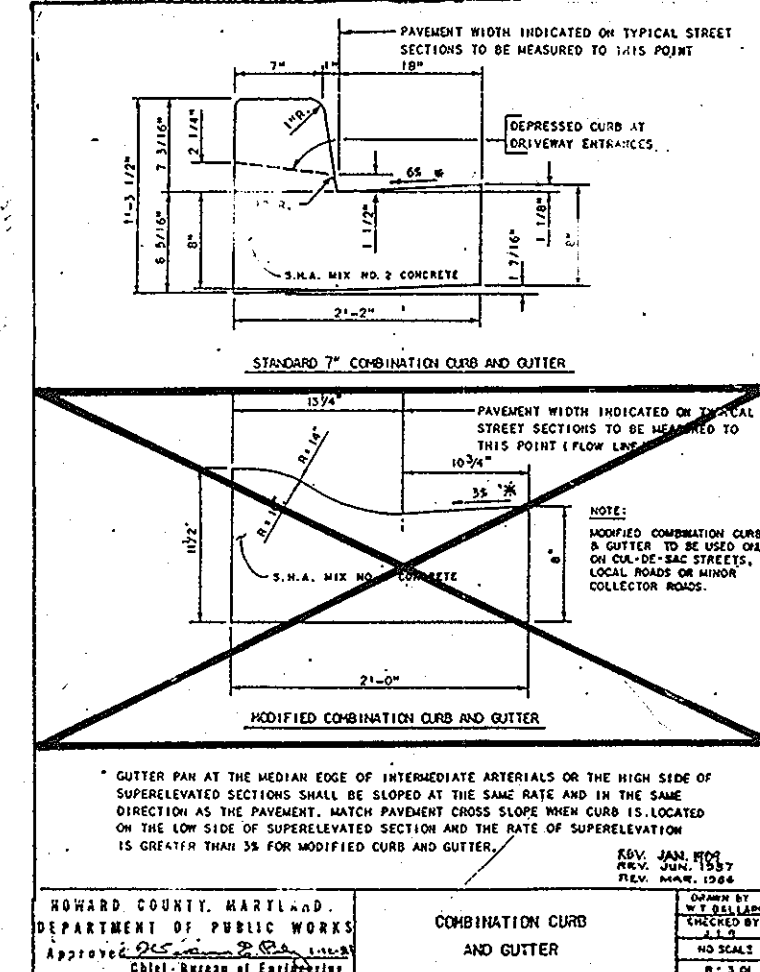



LDE, INC.
9250 Rumsey Road, Suite 106, Columbia, MD. 21045
(410) 715-1070 (301) 596-3424 (410) 715-9540 (Fax)

DESIGNED	S.D.H.	Plan & Profile Guilford Road	SCALE	1"=5' V. 1"=50' H.
DRAWN	S.M.C.	Scott Farm	DRAWING	2 of 20
CHECKED	B.D.B.	Lots 29 to 42 and Open Space Lots 27, 28, 43 & 44 Tax Map No. 35 - P/O Parcels 354 5th Election District Howard County, Maryland	JOB NO.	98-009
DATE	11/99	Owner/Developer: Scarlet Wilkinson & Earl Omer 6799 Guilford Road Clarksville, Maryland 21029 Tel: 410-531-2826 or 410-987-0497	FILE NO.	F-00-73

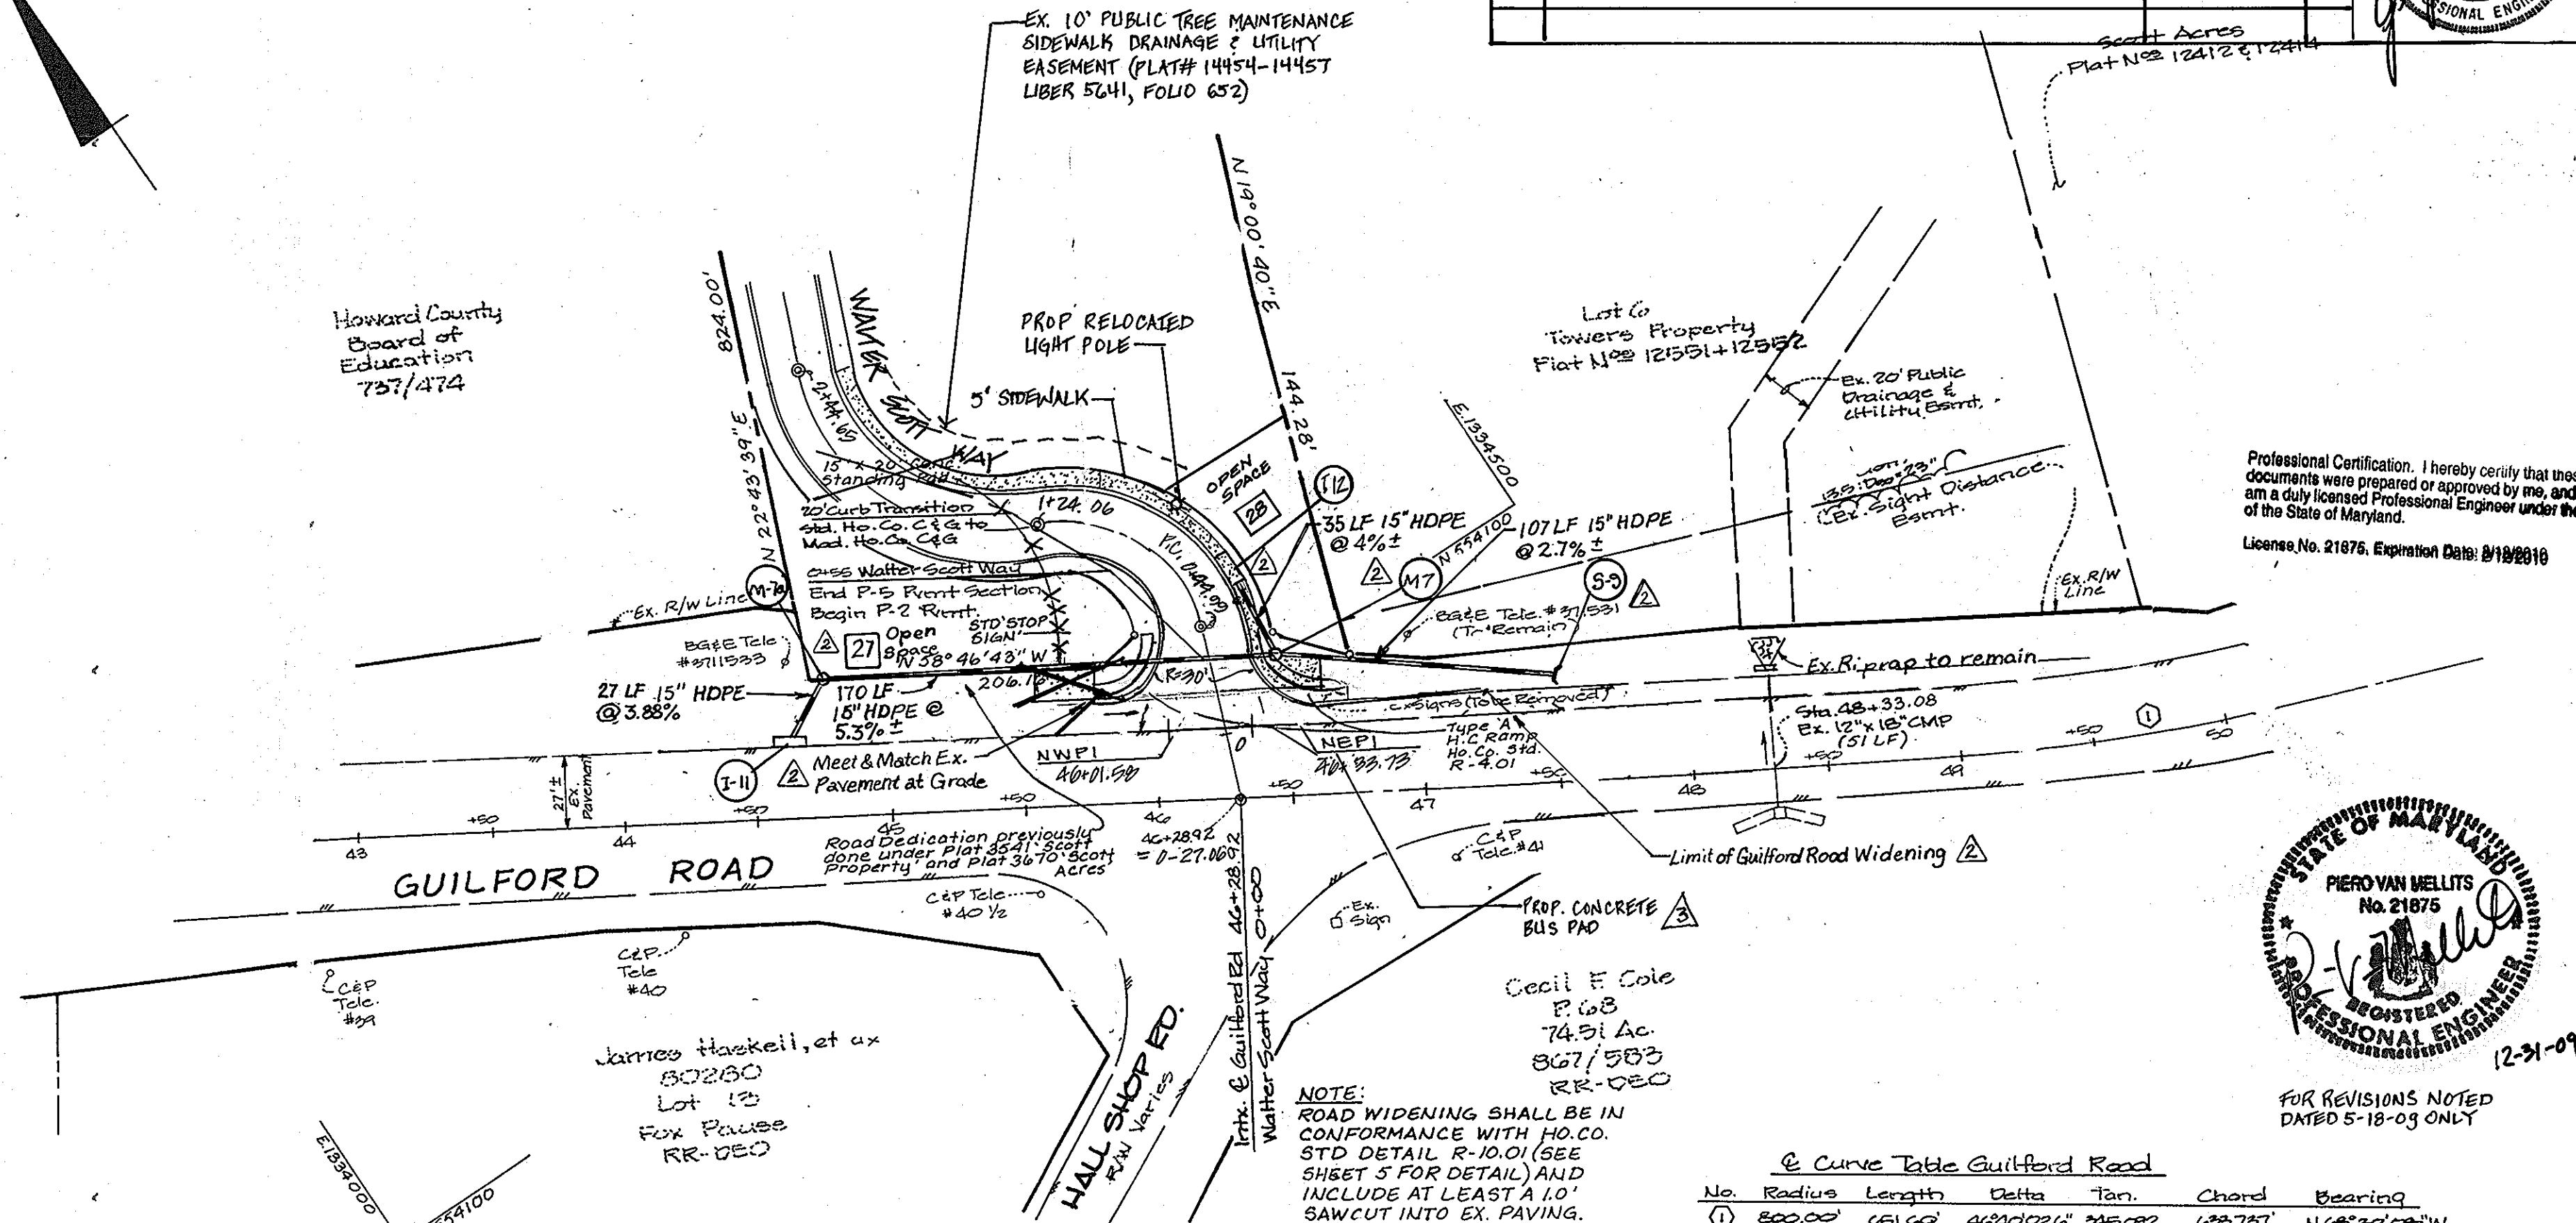

Curve Table Guilford Road

No.	Radius	Length	Delta	Tan	Chord	Bearing
1	800.00'	451.00'	44°20'00"	245.00'	694.78'	N 68°30'00" W

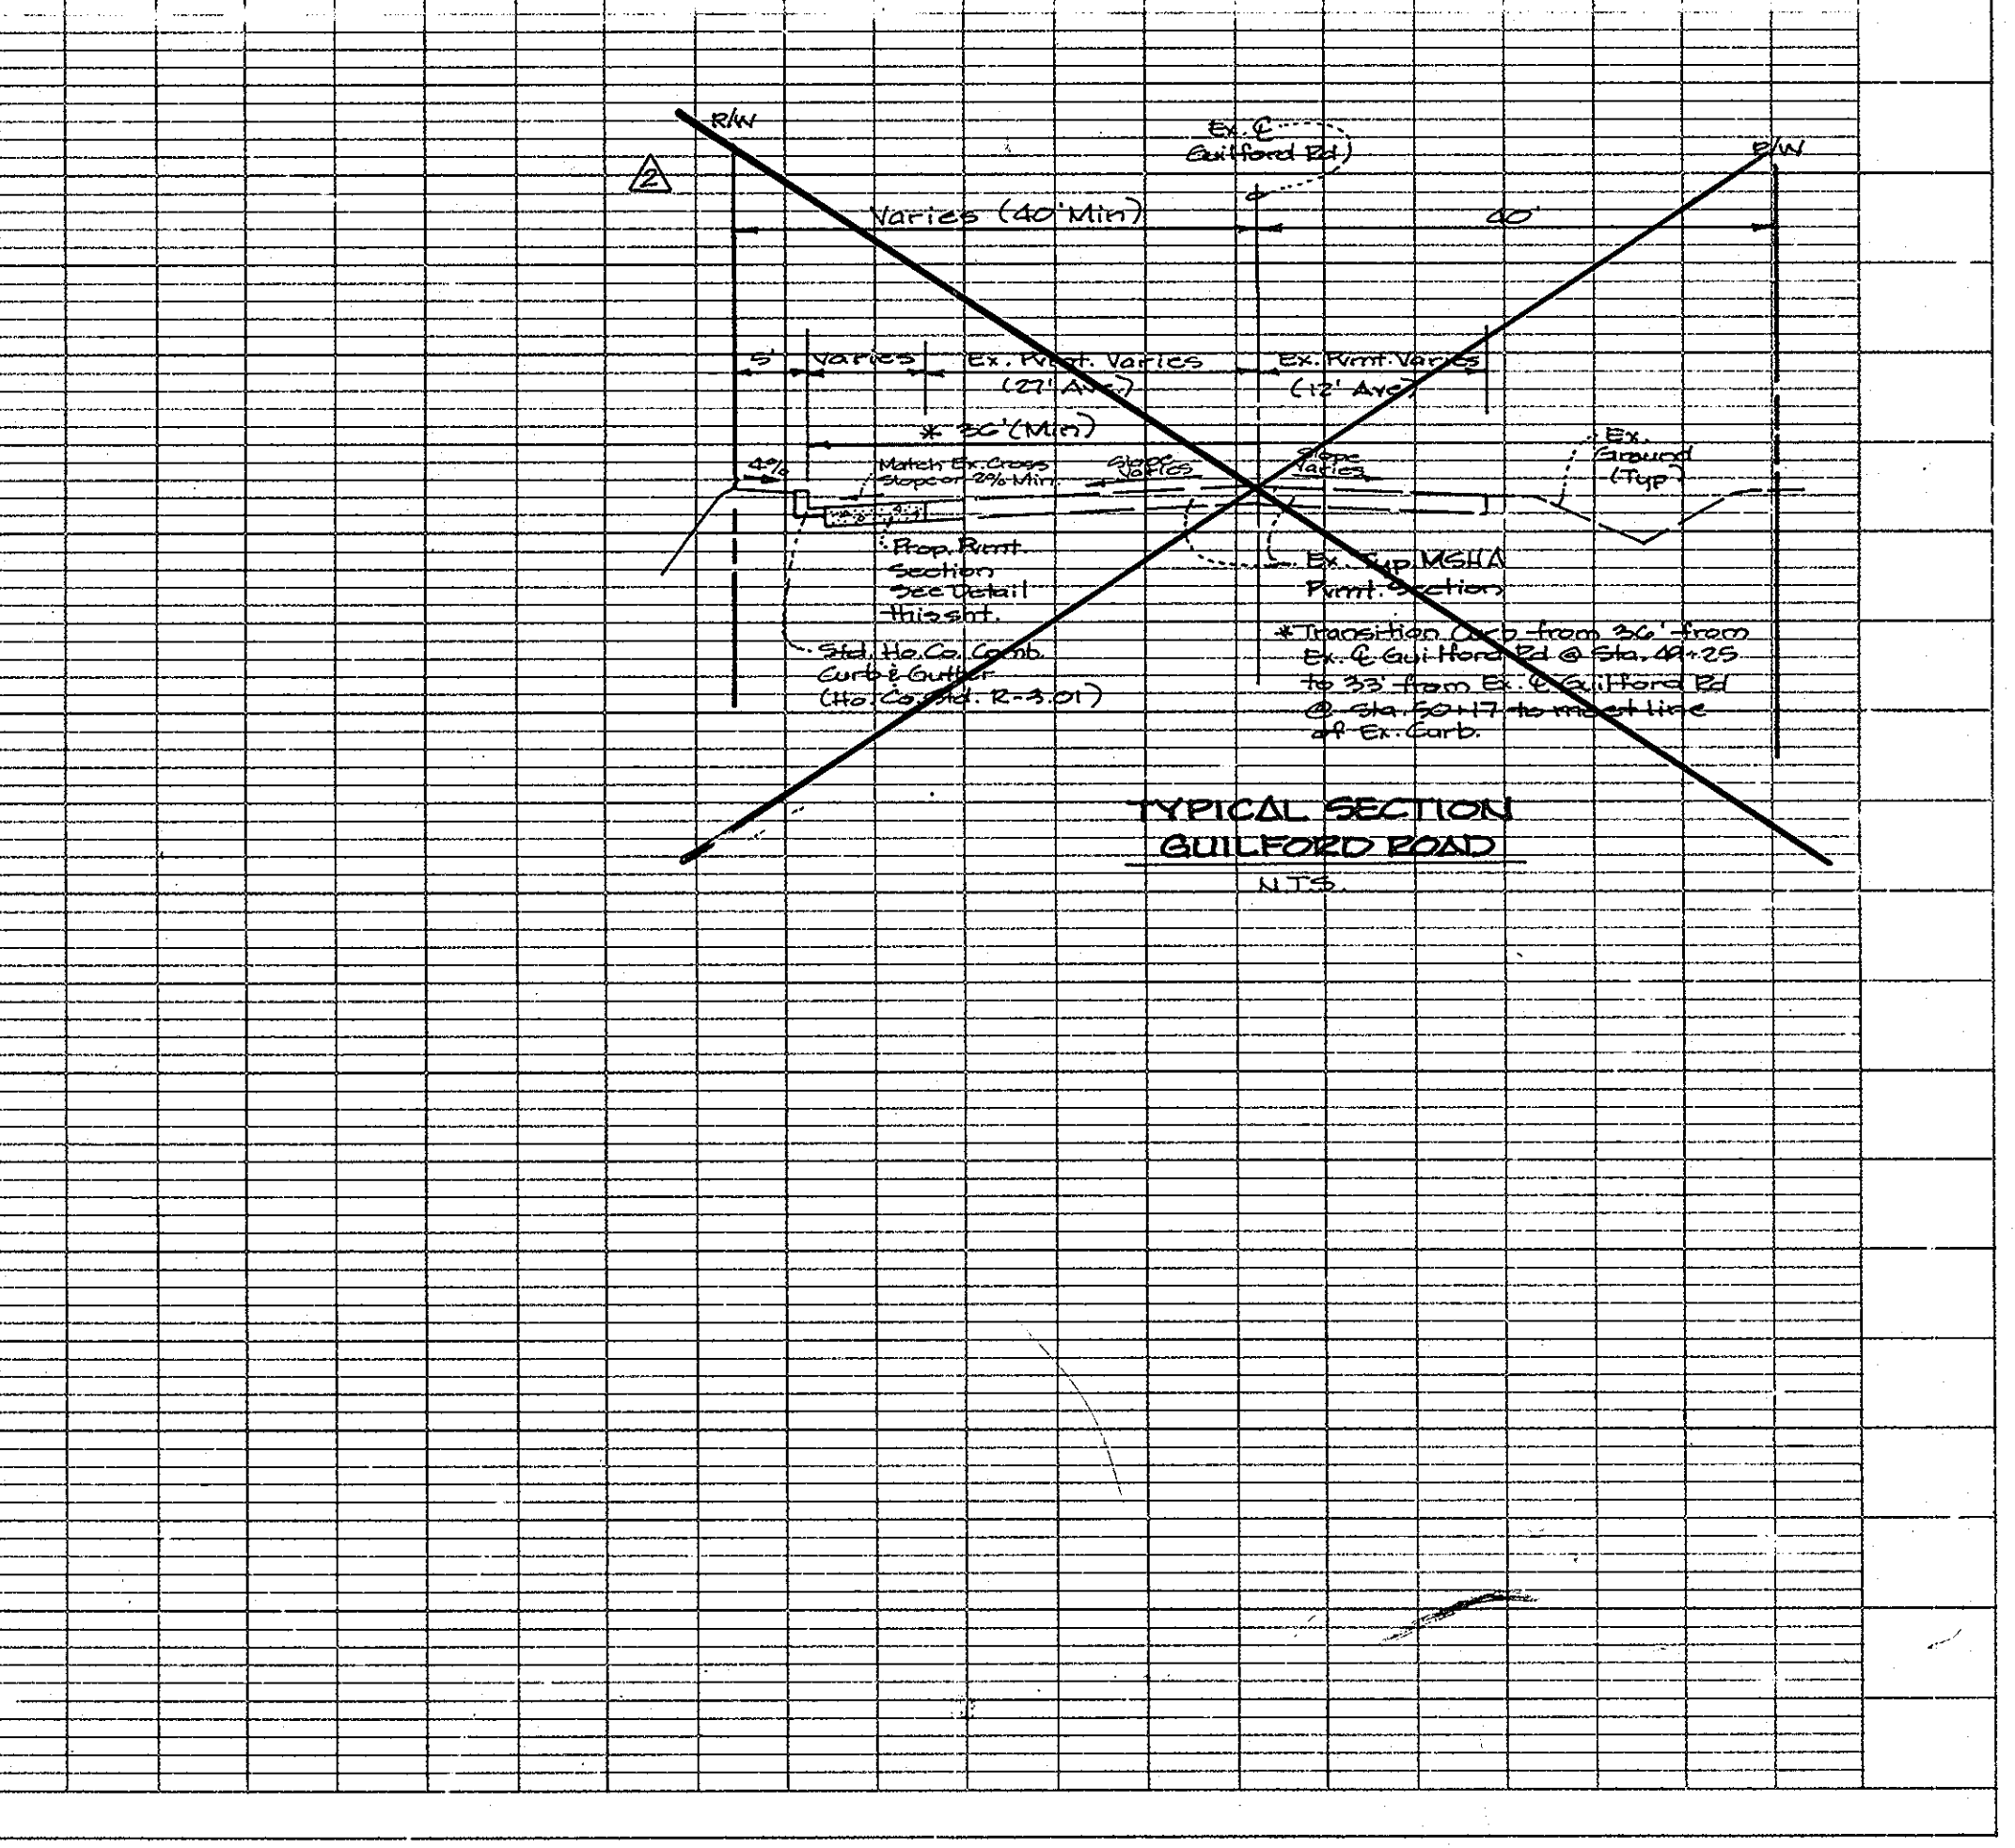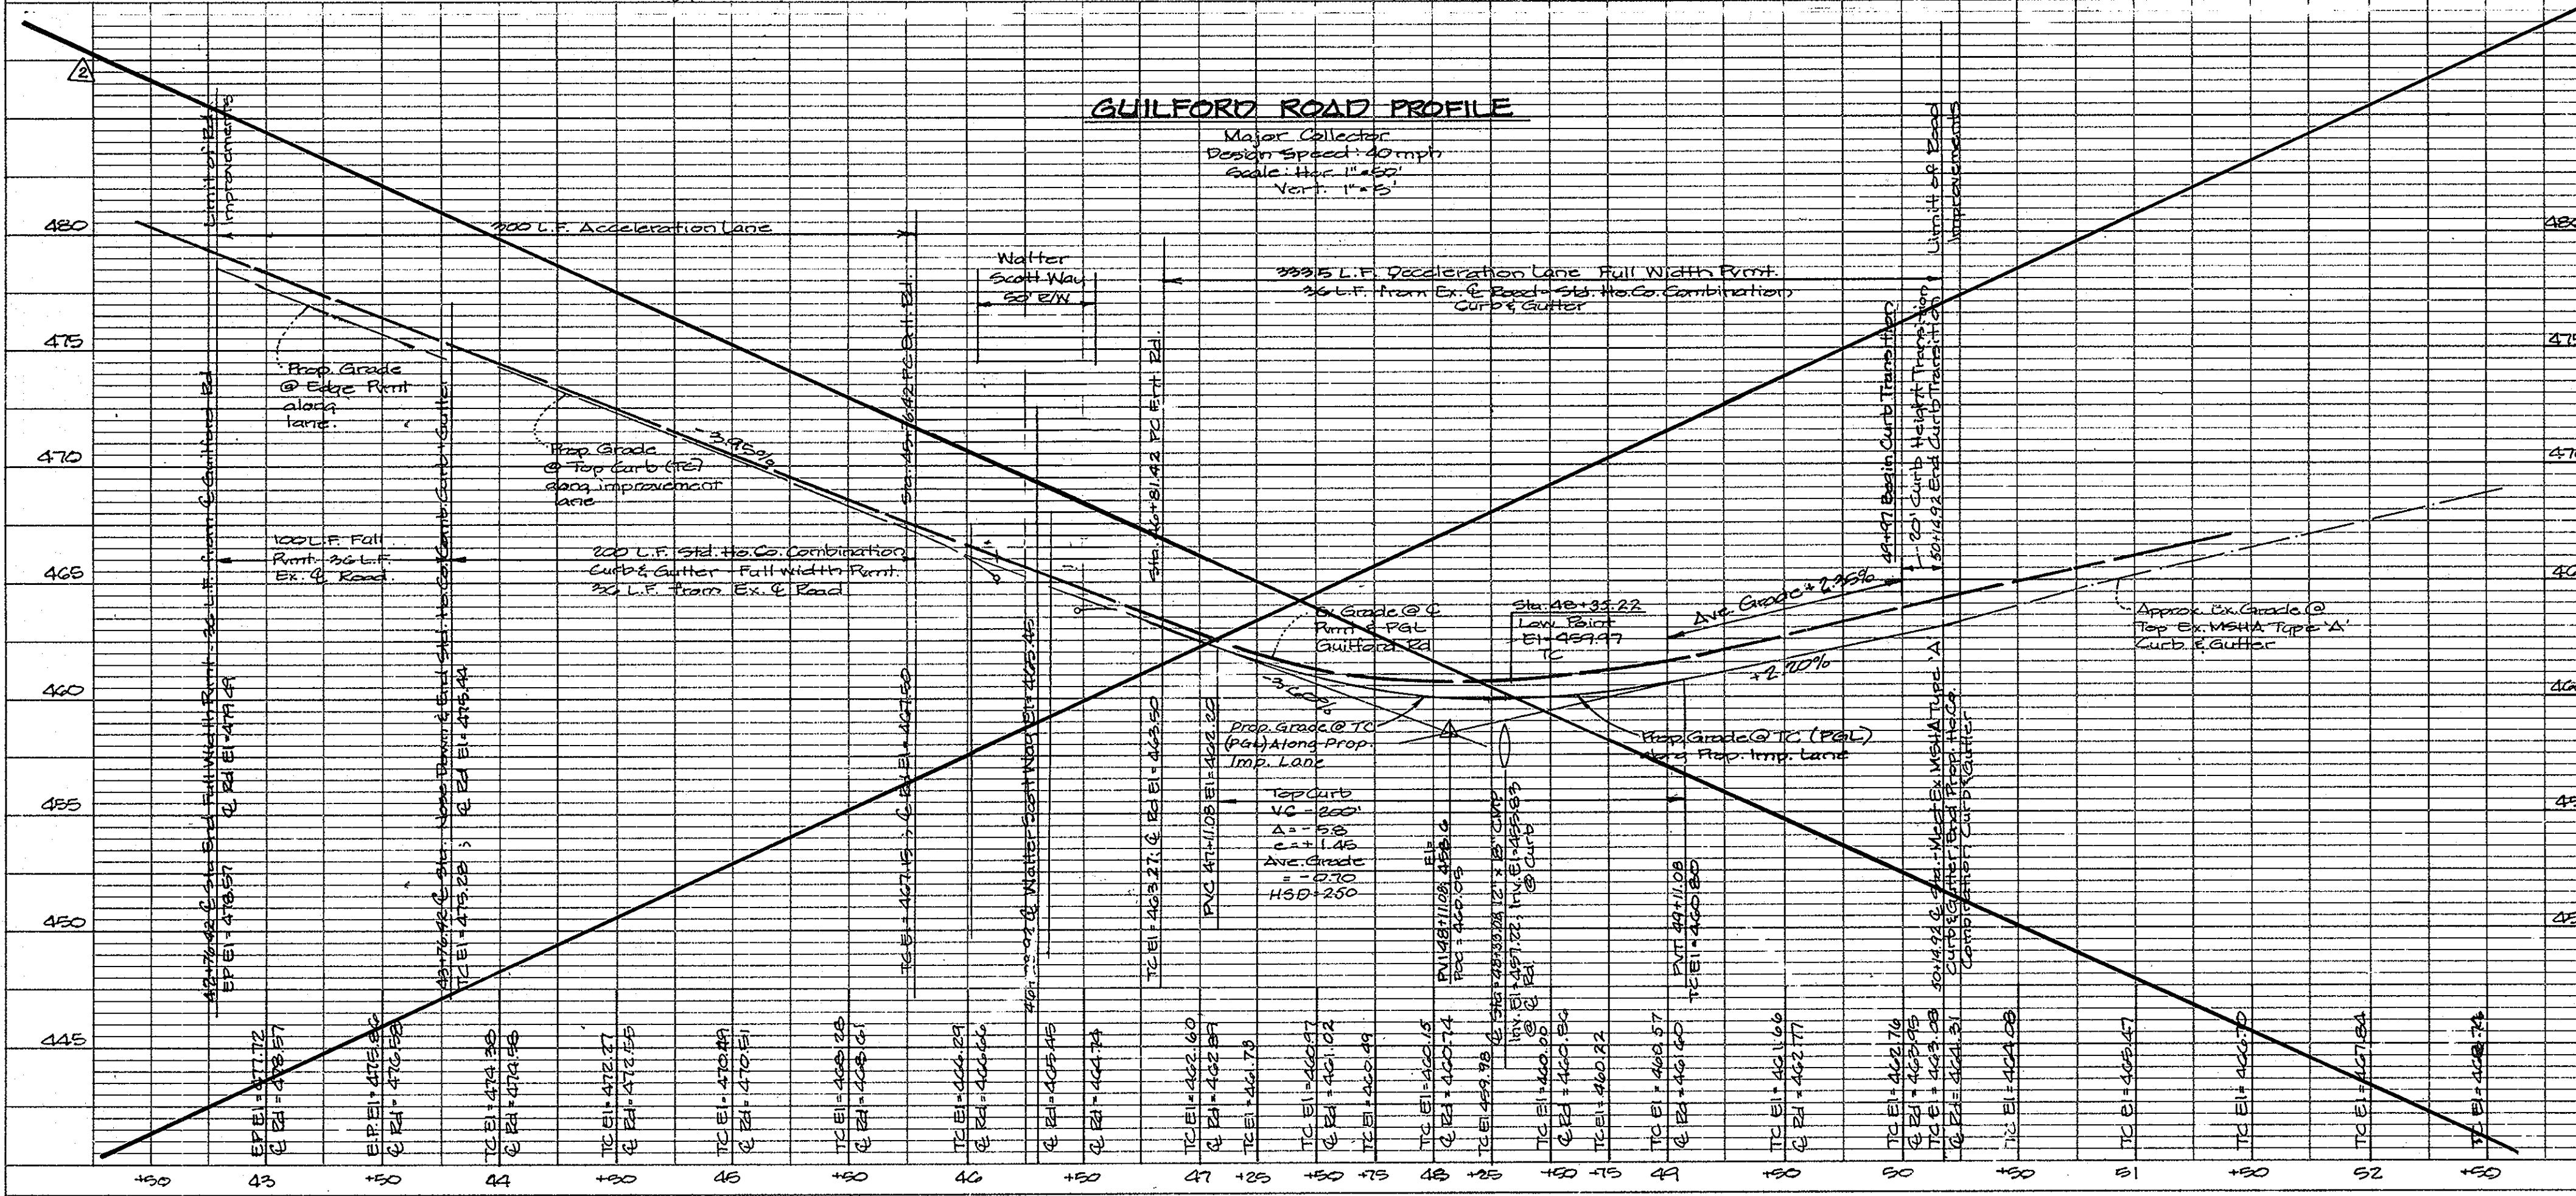

COORDINATE DATA

STATION	NORTHING	EASTING
0+44.00 PC	554127.06	1334378.14
0+44.16 PK	554127.06	1334378.14
0+44.32 PT	554127.06	1334378.14
0+44.48 PT	554127.06	1334378.14
0+50.00 PC	554127.06	1334378.14

STREET LIGHT TABLE

Street Name	Symbol	Station	Offset	Lamp Type	Fixture Type	Pole Type
Walter Scott Way	☼	0+51	4' Right	250w HPS Vapor	Point Mounted (Curtain Mounted)	Black Fiberglass - 12' Arm
Walter Scott Way	☼	2+20	12' Right	100w HPS Vapor	Post - Top	Black Fiberglass Embedded - 14' Pole
Walter Scott Way	☼	4+03	15' Left	100w HPS Vapor	Post - Top	Black Fiberglass Embedded - 14' Pole
Walter Scott Way	☼	7+20	0' (Median)	100w HPS Vapor	Post - Top	Black Fiberglass Embedded - 14' Pole
Walter Scott Way	☼	11+86	15' Left	100w HPS Vapor	Post - Top	Black Fiberglass Embedded - 14' Pole
Walter Scott Way	☼	11+10	15' Left	100w HPS Vapor	Post - Top	Black Fiberglass Embedded - 14' Pole
Walter Scott Way	☼	13+91	11' Right	100w HPS Vapor	Post - Top	Black Fiberglass Embedded - 14' Pole

CURVE DATA TABLE

Name & Station	Radius	Delta	Length	Tangent	Chord Bearing & Dist.
Walter Scott Way 0+44.00 - 0+44.00	150.00'	33.69°	10.00'	10.00'	N 0° 00' 00" E 10.00'
Walter Scott Way 0+44.00 - 0+44.00	150.00'	33.69°	10.00'	10.00'	N 0° 00' 00" E 10.00'
Howard County Board of Education
7/27/99

Professional Certification. I hereby certify that these documents were prepared or approved by me, and that I am a duly licensed Professional Engineer under the laws of the State of Maryland.
License No. 21875, Expiration Date: 2/12/2010

BY NO REVISIONS


NO	DATE	DESCRIPTION
1	9-9-05	Revised Lot Layout, Numbering, DRL's and Storm Drain, Revised Title Block, Sheet No., and Deleted Lighting Info.
2	5-18-09	REVISED THE TIE-POINTS INCLUDING BALLAD LOCATIONS AND BUSSES INCLUDING ADDED COMMUNITY MAILBOXES AND SPEED LIMIT SIGNS, REVISED LOCATIONS OF CONCRETE BUS PAD, AND REMOVED ON-STREET PARKING.

APPROVED: Department of Planning & Zoning
Cindy Hamota 7/13/00
Chief, Division of Land Development

APPROVED: Department of Public Works for Storm Drainage Systems and Roads
Andrew M. Dwyer 5-26-00
Chief, Bureau of Highways

Professional Engineer Seal: PERO VON MELLITS No. 21875

PLAN
1" = 50'

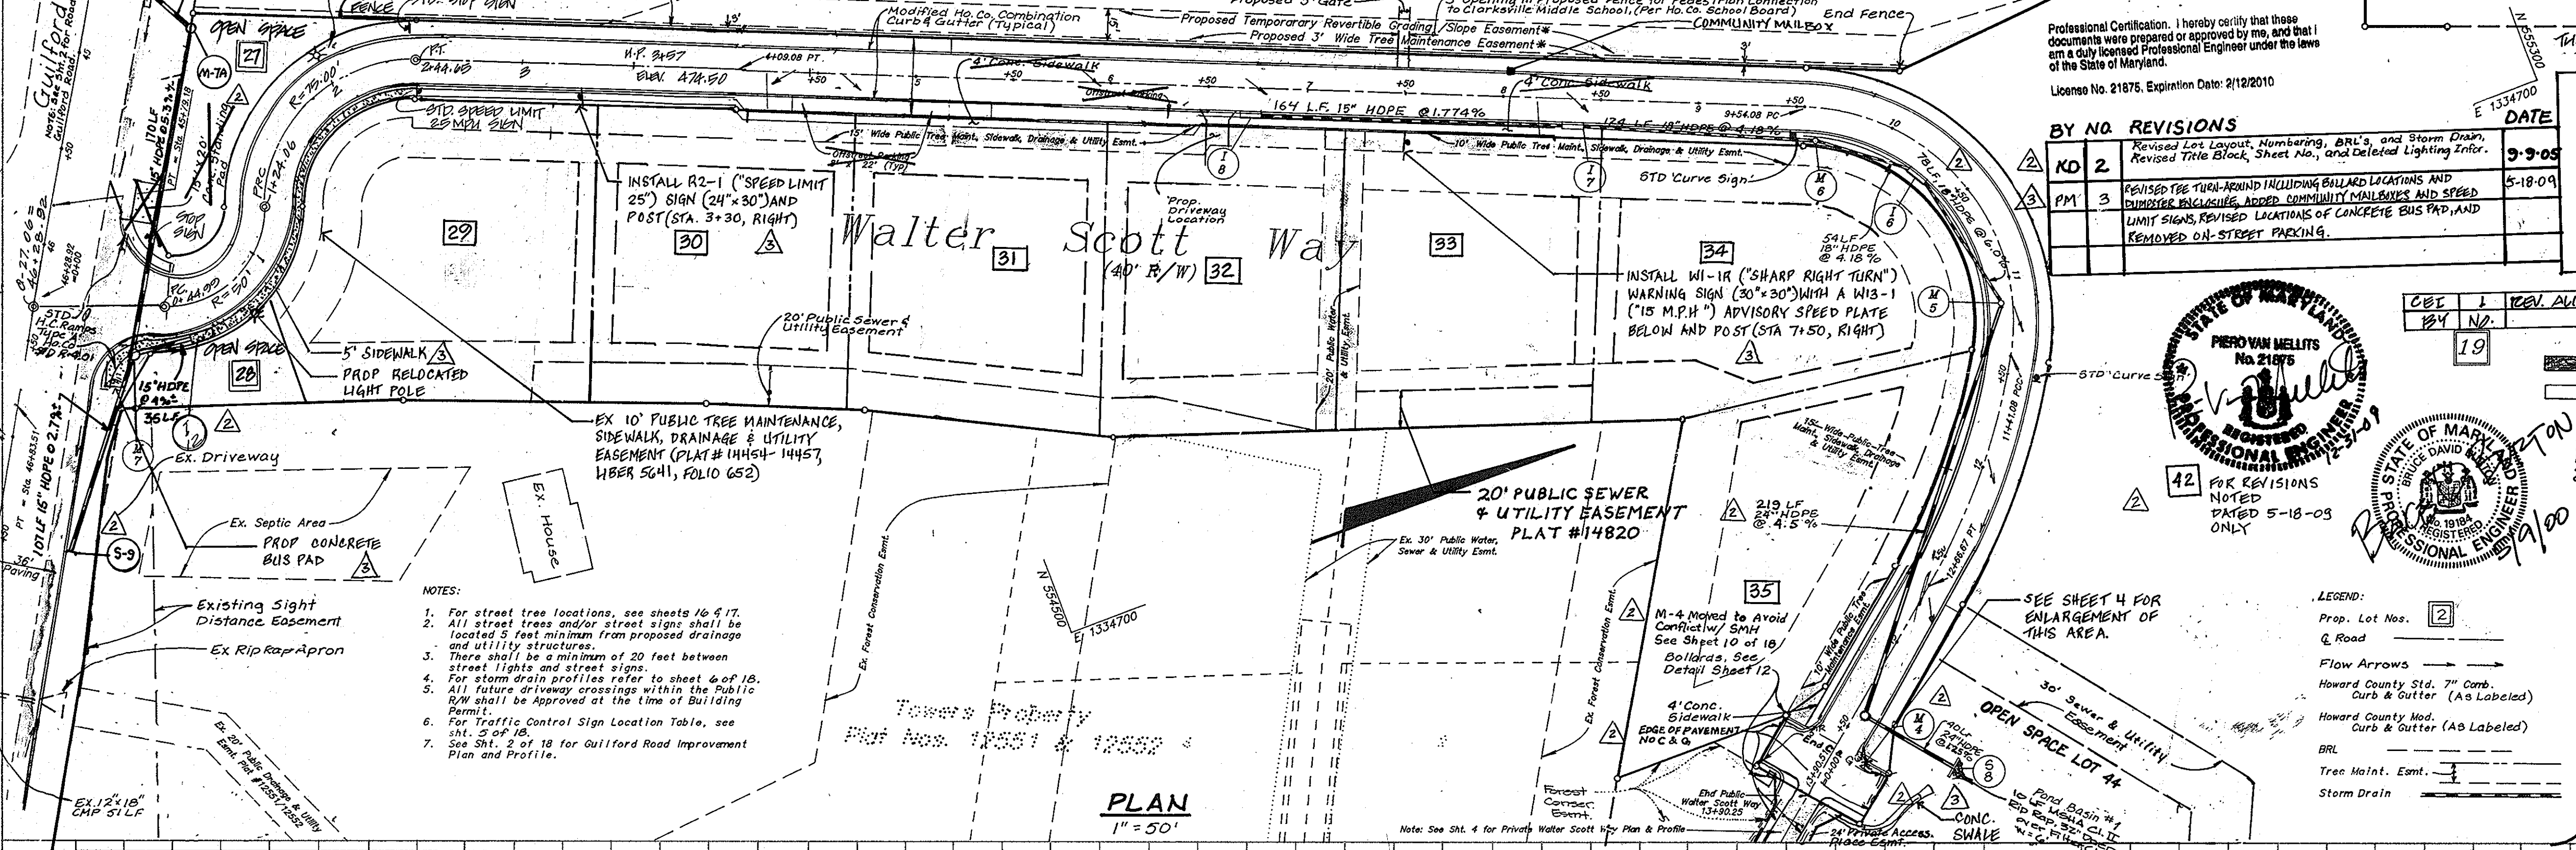

- NOTES:**
- For street tree locations, see sheets 10 & 17.
 - All street trees and/or street signs shall be located 5 feet minimum from proposed drainage and utility structures.
 - There shall be a minimum of 20 feet between street lights and street signs.
 - For storm drain profiles refer to sheet 4 of 18.
 - All future driveway crossings within the Public R/W shall be approved at the time of Building Permit.
 - For Traffic Control Sign Location Table, see Sht. 2 of 18.
 - See Sht. 2 of 18 for Guilford Road Improvement Plan and Profile.

PAVING LEGEND:
P-5 Paving Section (Guilford Rd. Improvements) (Howard County)
P-2 Paving Section (Walter Scott Way) (Howard County)

REVISION 19
REV. ALIGNMENT 50.0+00 TO STA. 400+00 @ 10/10/01


LEGEND:
Prop. Lot Nos.
Q Road
Flow Arrows
Howard County Std. 7" Comb. Curb & Gutter (As Labeled)
Howard County Mod. Curb & Gutter (As Labeled)
BRL
Tree Maint. Emt.
Storm Drain

LDE, INC.
9250 Ramsey Road, Suite 106, Columbia, MD. 21045
(410) 715-1070 (301) 596-3424 (410) 715-9540 (Fax)

Plan & Profile
Walter Scott Way 0+00 thru 13+90.51
Scott Farm
Lots 29 to 42 and Open Space Lots 27, 28, 43 & 44

Scale: 1" = 5' H
1" = 50' V
Drawing: 3 of 20
Job No.: 98009
File No.: F-00-73





PROFILE
1" = 5' V
1" = 50' H

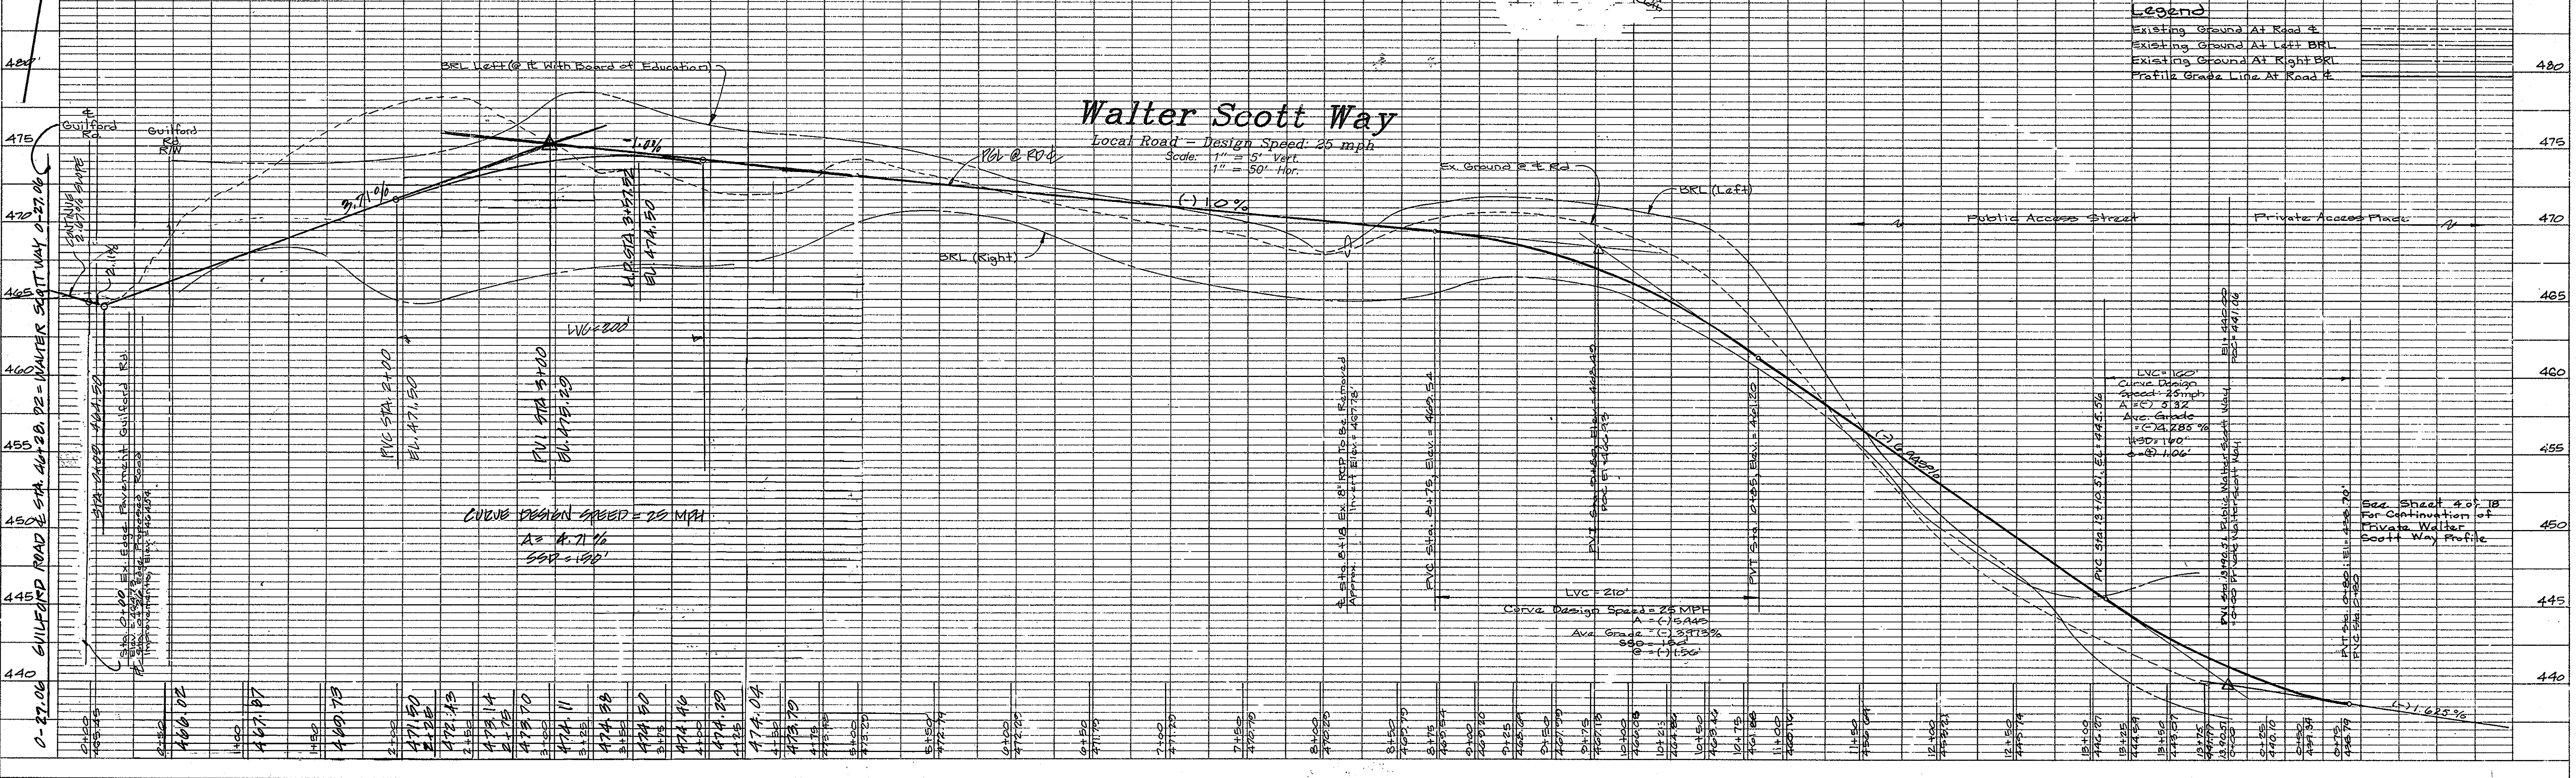

HIGHWAY FEDERAL AID SHEET
PLATE 1-SINGLE PLAN AND PROFILE-FULL LINE
NATIONAL PRIORITY
PRINTED IN U.S.A.

F-00-73
REVISION #3 BY:
BOWMAN CONSULTING
2350 RIVA ROAD, SUITE 200
ANNAPOLIS, MD 21401
410-224-7590

NAME AND STATION	RADIUS	DELTA	LENGTH	TANGENT	CHORD BEARING AND DISTANCE
Walter Scott Way 0+00.00 - 1+16.00	42.00'	109°38'31"	80.37'	59.59'	N 65°25'51" E 68.66'
Walter Scott Way 2+67.42 - 3+06.32	92.00'	24°13'40"	38.90'	19.75'	N 01°30'14" W 38.61'
Walter Scott Way 3+06.32 - 5+51.85	129.00'	109°02'54"	245.52'	181.01'	N 40°54'23" E 210.10'

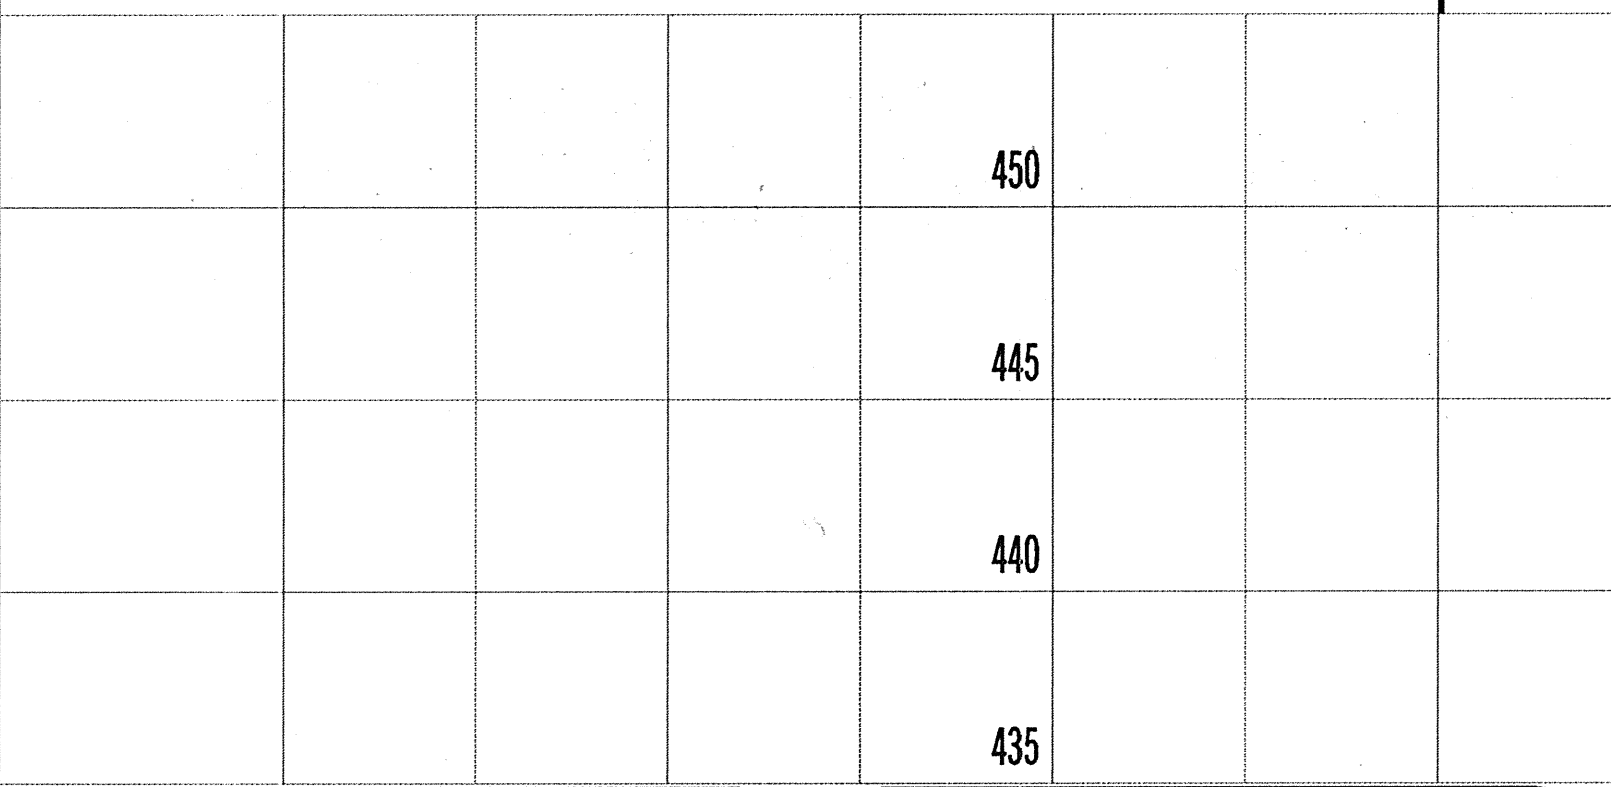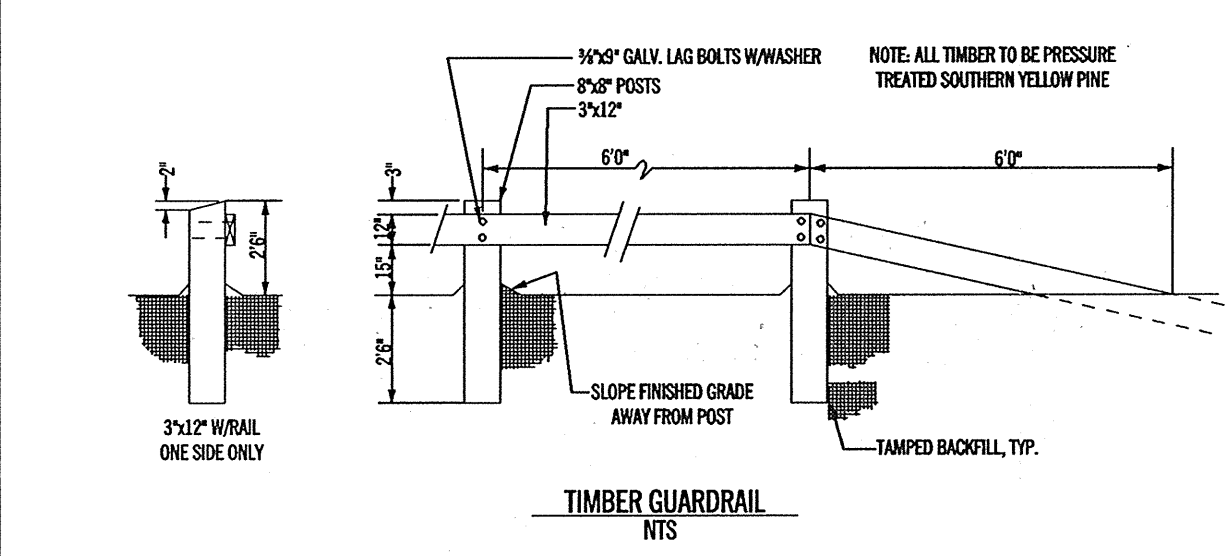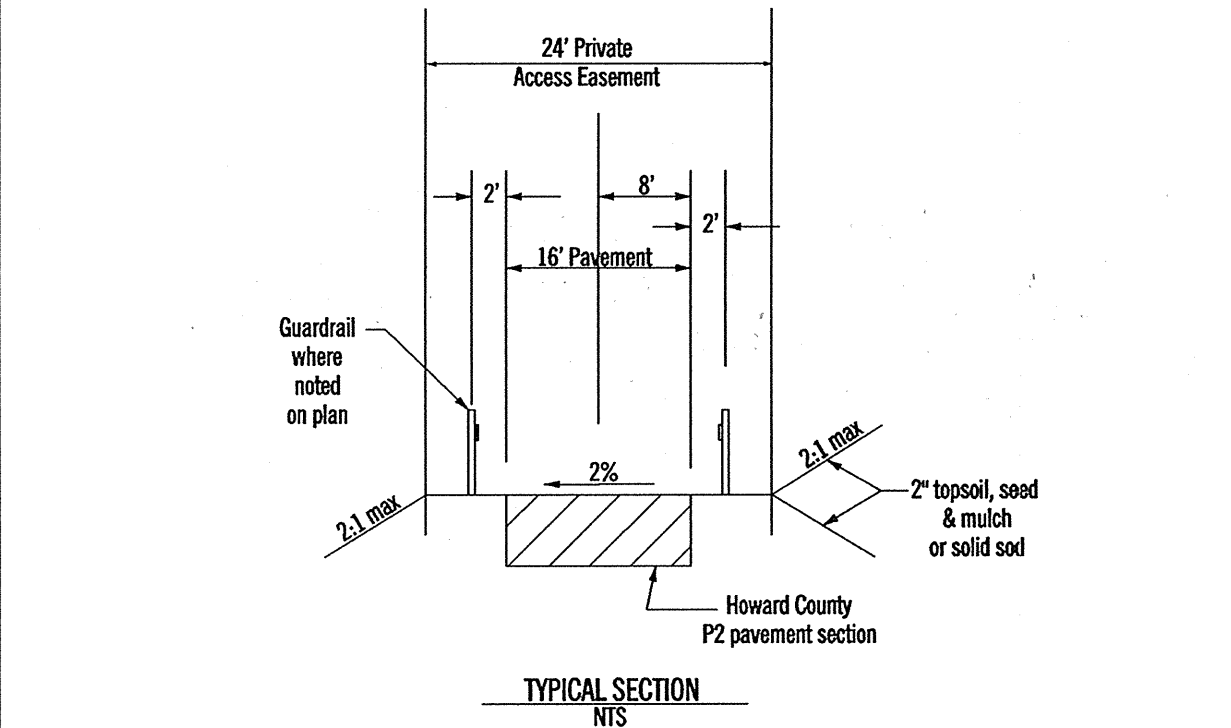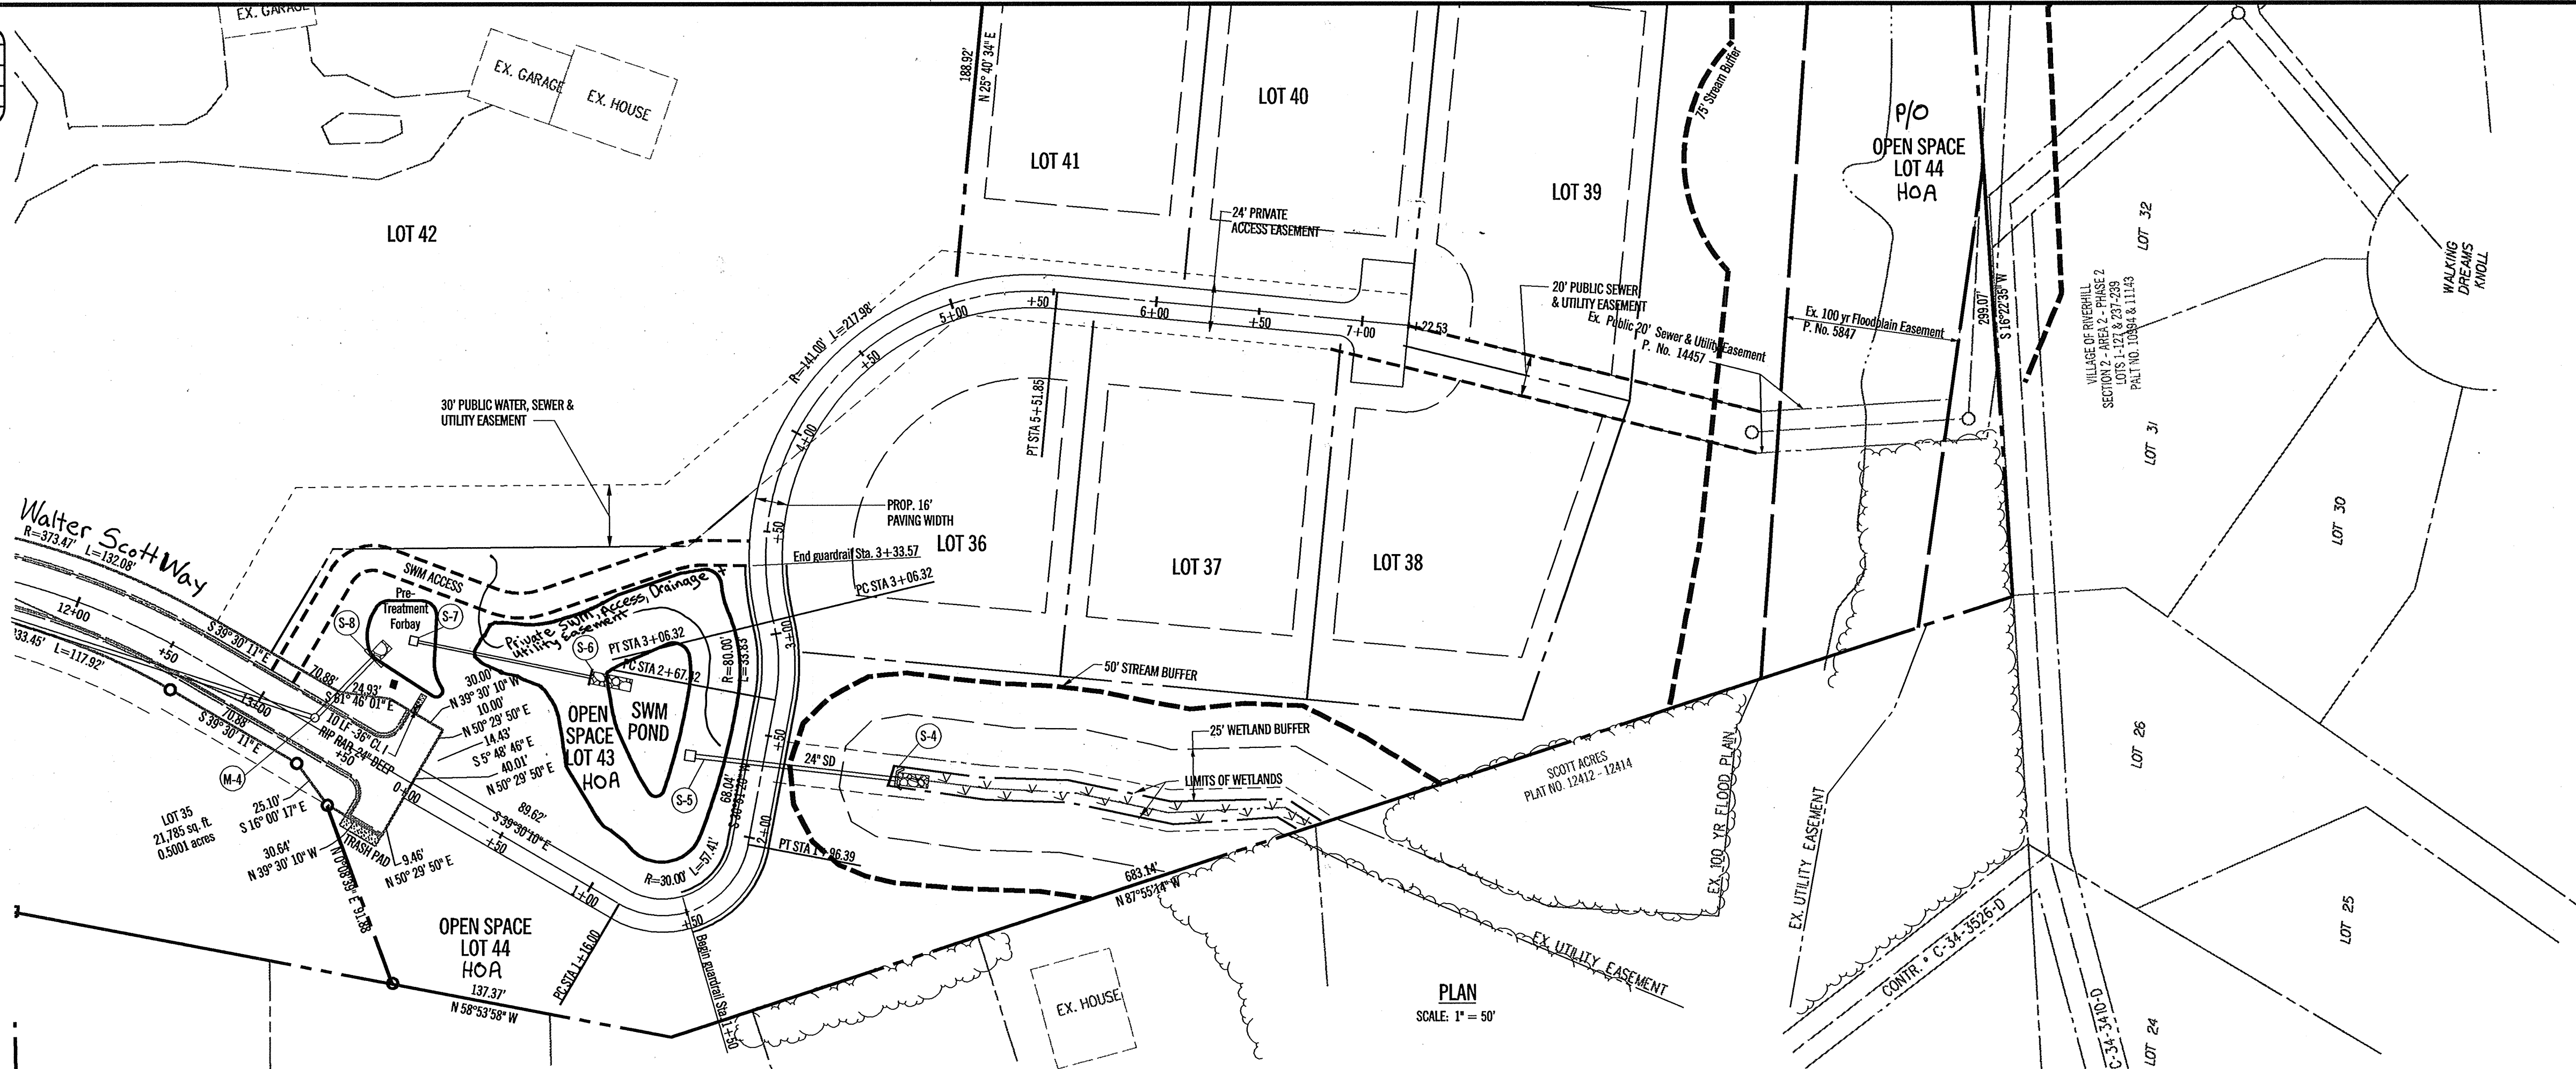

ENGINEER'S CERTIFICATE
I certify that this plan for road construction and sediment control represents a practical and verifiable plan based on the personal knowledge of the site conditions. This plan was prepared in accordance with the requirements of the Howard Soil Conservation District. I have verified the design and the requirements of the Howard Soil Conservation District. I have verified the design and the requirements of the Howard Soil Conservation District. I have verified the design and the requirements of the Howard Soil Conservation District.

Chad Sten 9-9-05
SIGNATURE OF ENGINEER Date

DEVELOPER'S CERTIFICATE
I hereby certify that all construction and/or installation will be done according to these plans, and that any responsibility incurred in the construction project will be the responsibility of the contractor. I have verified the design and the requirements of the Howard Soil Conservation District. I have verified the design and the requirements of the Howard Soil Conservation District. I have verified the design and the requirements of the Howard Soil Conservation District.

Scarlett Hill 9/5/05
SIGNATURE OF ENGINEER Date

APPROVED: DEPARTMENT OF PLANNING AND ZONING
William J. Mahan 10/16/05
CHIEF, DEVELOPMENT ENGINEERING DIVISION Date

Cindy Hammett 10/20/05
CHIEF, DIVISION OF LAND DEVELOPMENT Date

William J. Mahan 10-14-05
CHIEF, BUREAU OF HIGHWAYS Date

THESE PLANS HAVE BEEN REVIEWED FOR THE HOWARD SOIL CONSERVATION DISTRICT AND MEET THE TECHNICAL REQUIREMENTS FOR SMALL POND CONSTRUCTION, SOIL EROSION, AND SEDIMENT CONTROL.

NATURAL RESOURCE CONSERVATION SERVICE
Date

THESE PLANS FOR SMALL POND CONSTRUCTION, SOIL EROSION, AND SEDIMENT CONTROL MEET THE REQUIREMENTS OF THE HOWARD COUNTY SOIL CONSERVATION DISTRICT.

HOWARD SOIL CONSERVATION DISTRICT
Date

No.	REVISION	DATE	BY
1	Shows realignment of private road & resubdivision of lots. Added trash pad, rip rap channel, Revised SWM Pond 1 & storm drain layout. Revised title block & added purpose statement.	09-09-05	KD

ENGINEERS • PLANNERS • SCIENTISTS • SURVEYORS
GREENHORNE & O'MARA, INC.
200 HARRY S TRUMAN PKWY., SUITE 200 ANNAPOLIS, MARYLAND 21401
(410) 266-0066





Greenbelt, MD - Annapolis, MD - Atlanta, GA - Fairfax, VA - Fredericksburg, VA - Mechanicsburg, PA
Raleigh, NC - Rockville, MD - Tampa, FL - West Palm Beach, FL

PLAN AND PROFILE
REVISED FINAL ROAD CONSTRUCTION PLAN
SCOTT FARM
LOTS 29-42 and Open Space Lots 27, 28, 43 & 44
TAX MAP NO. 35 P/O PARCEL 354

5th ELECTION DISTRICT
HOWARD COUNTY, MARYLAND

CVF DESIGN	AS SHOWN
LMM DRAWN	4 OF 20
CRK CHECKED	SHEET
OCT, '04 DATE	F - 00 - 73 FILE No.
PROJ No.	


FOO-73 *SUBSTITUTE SHEET

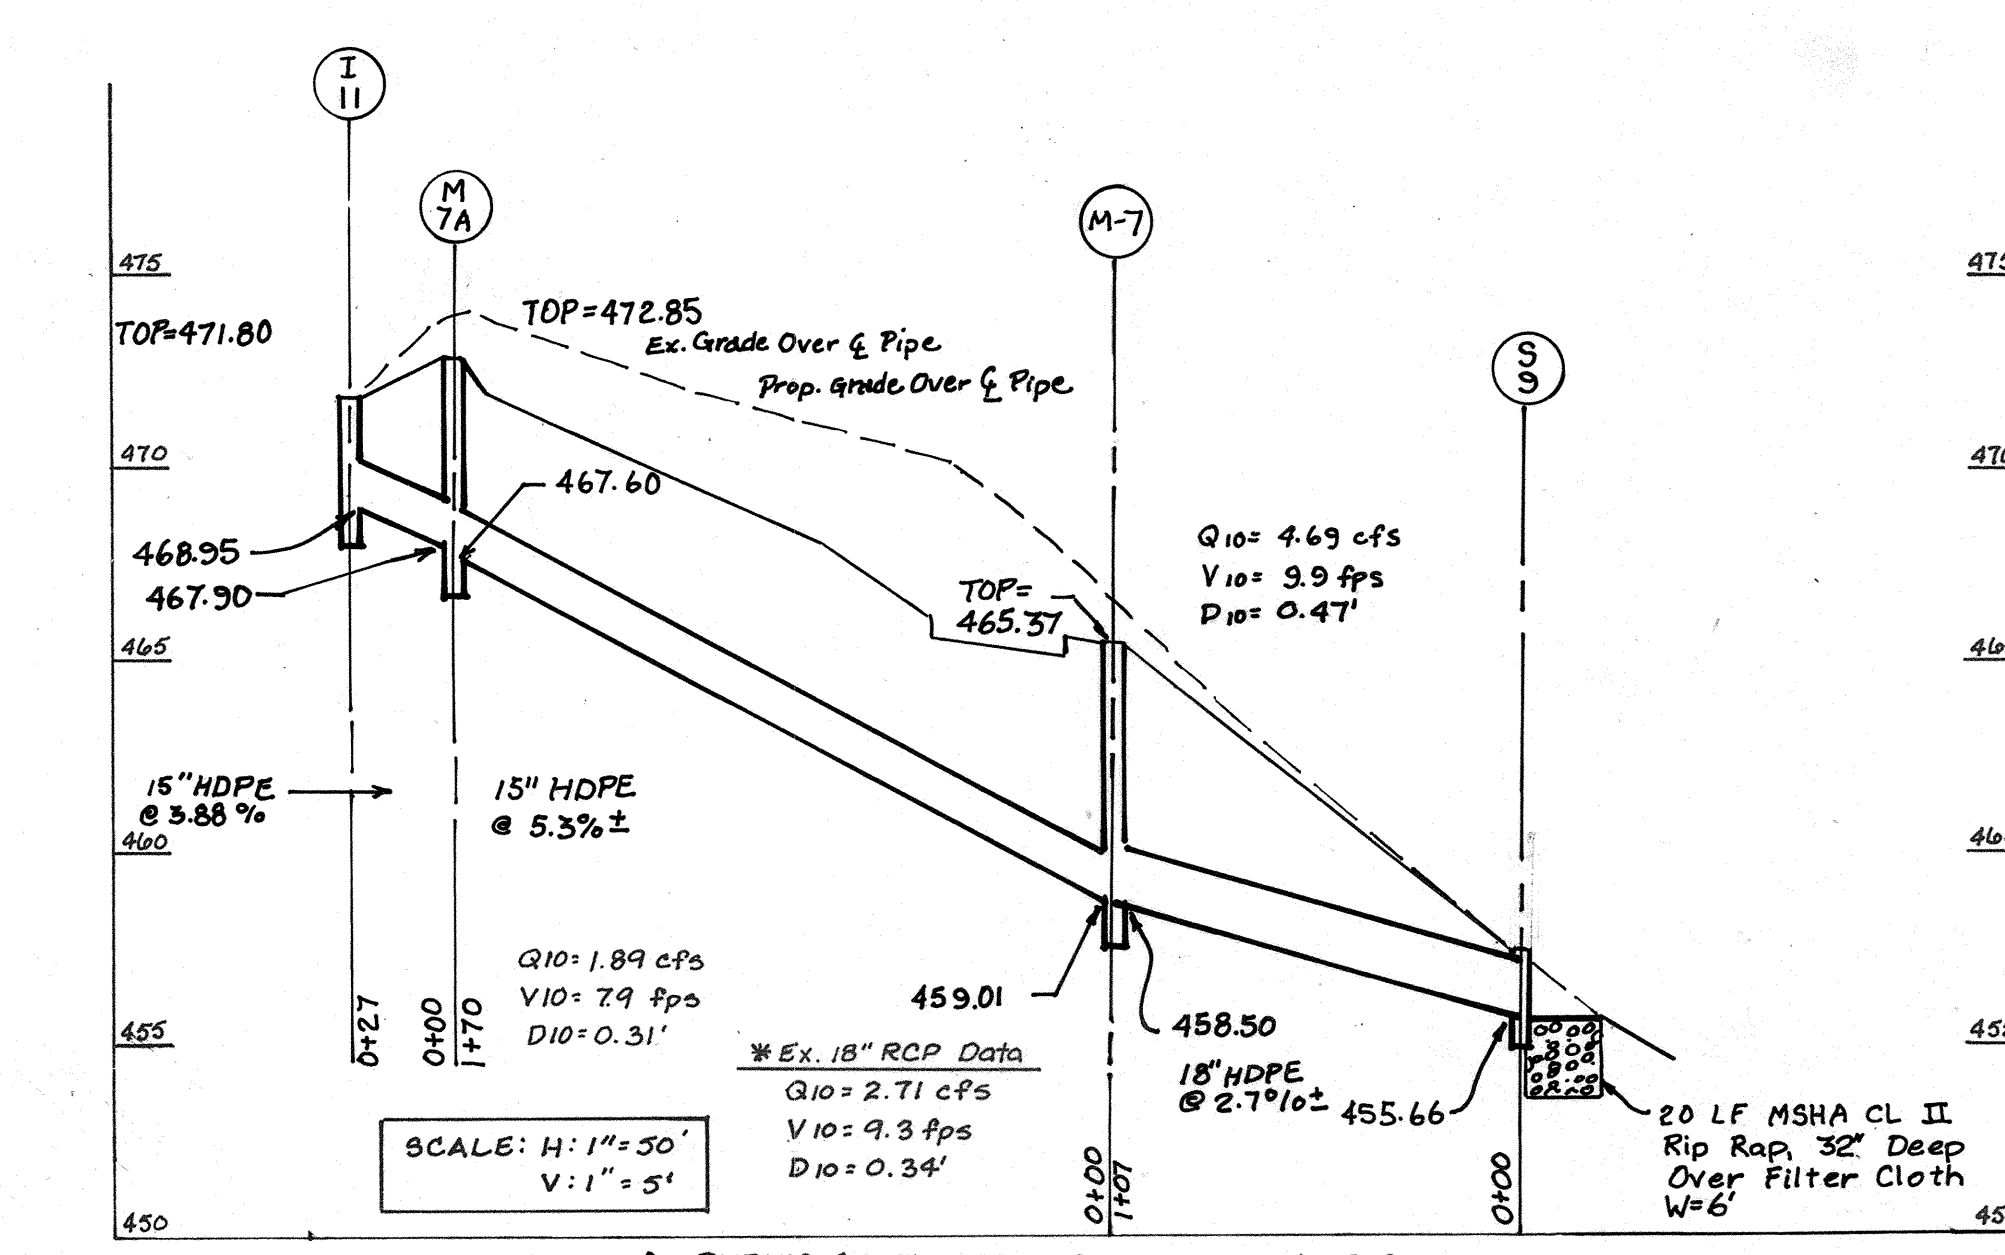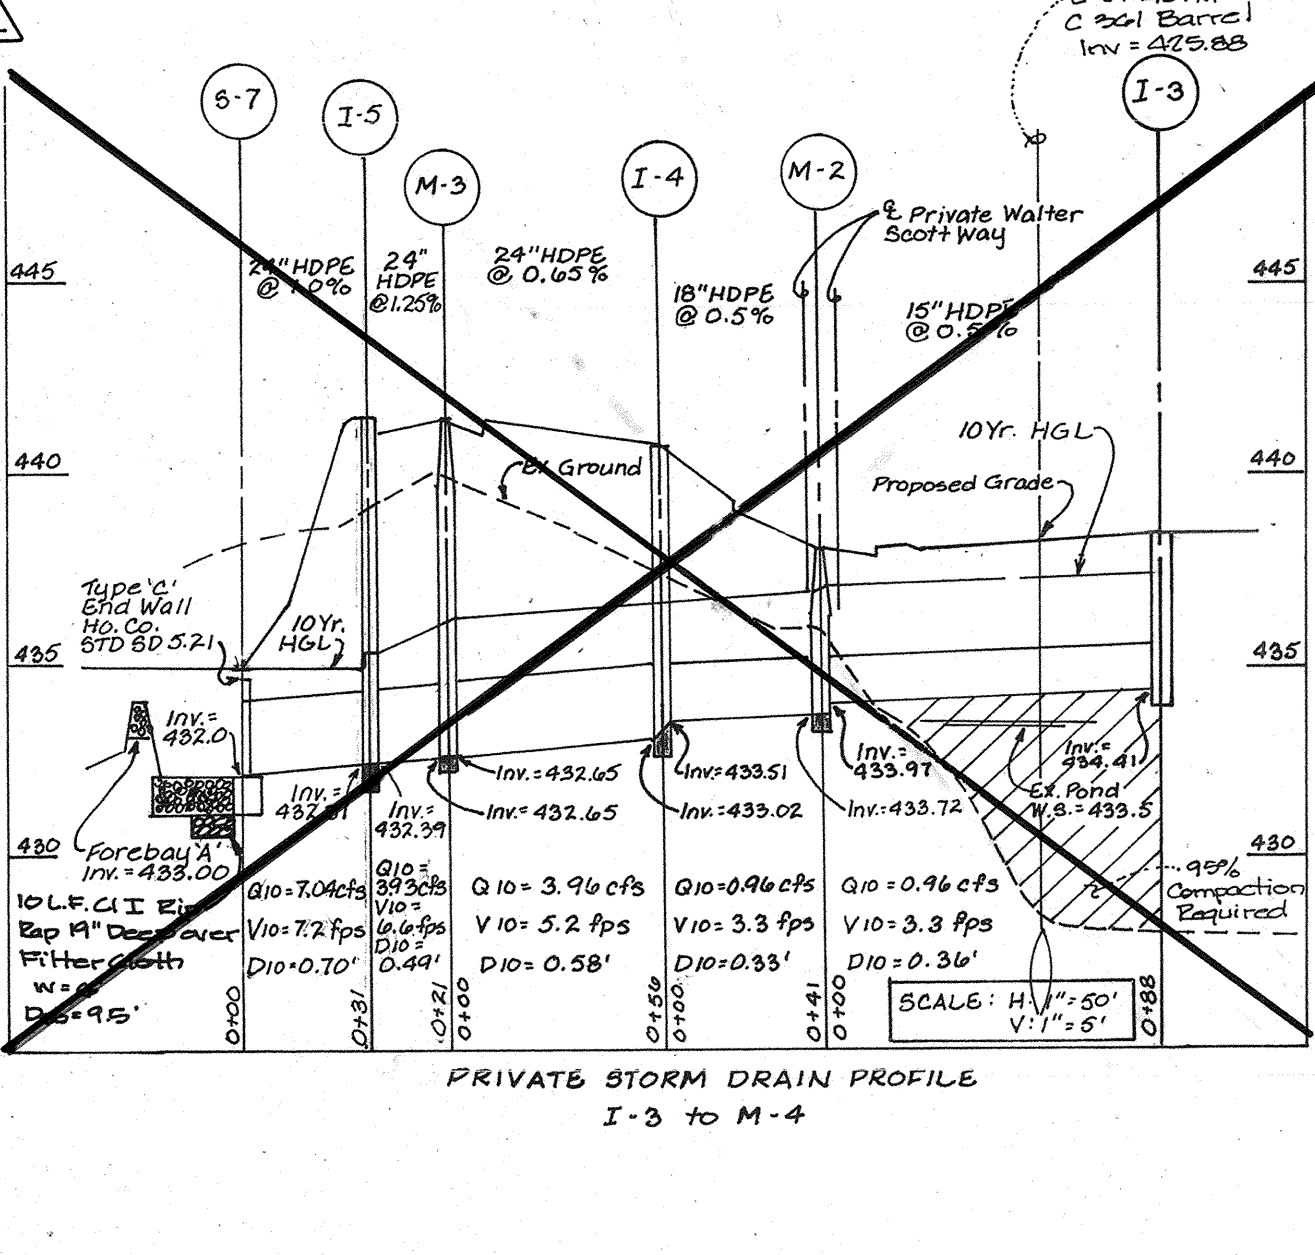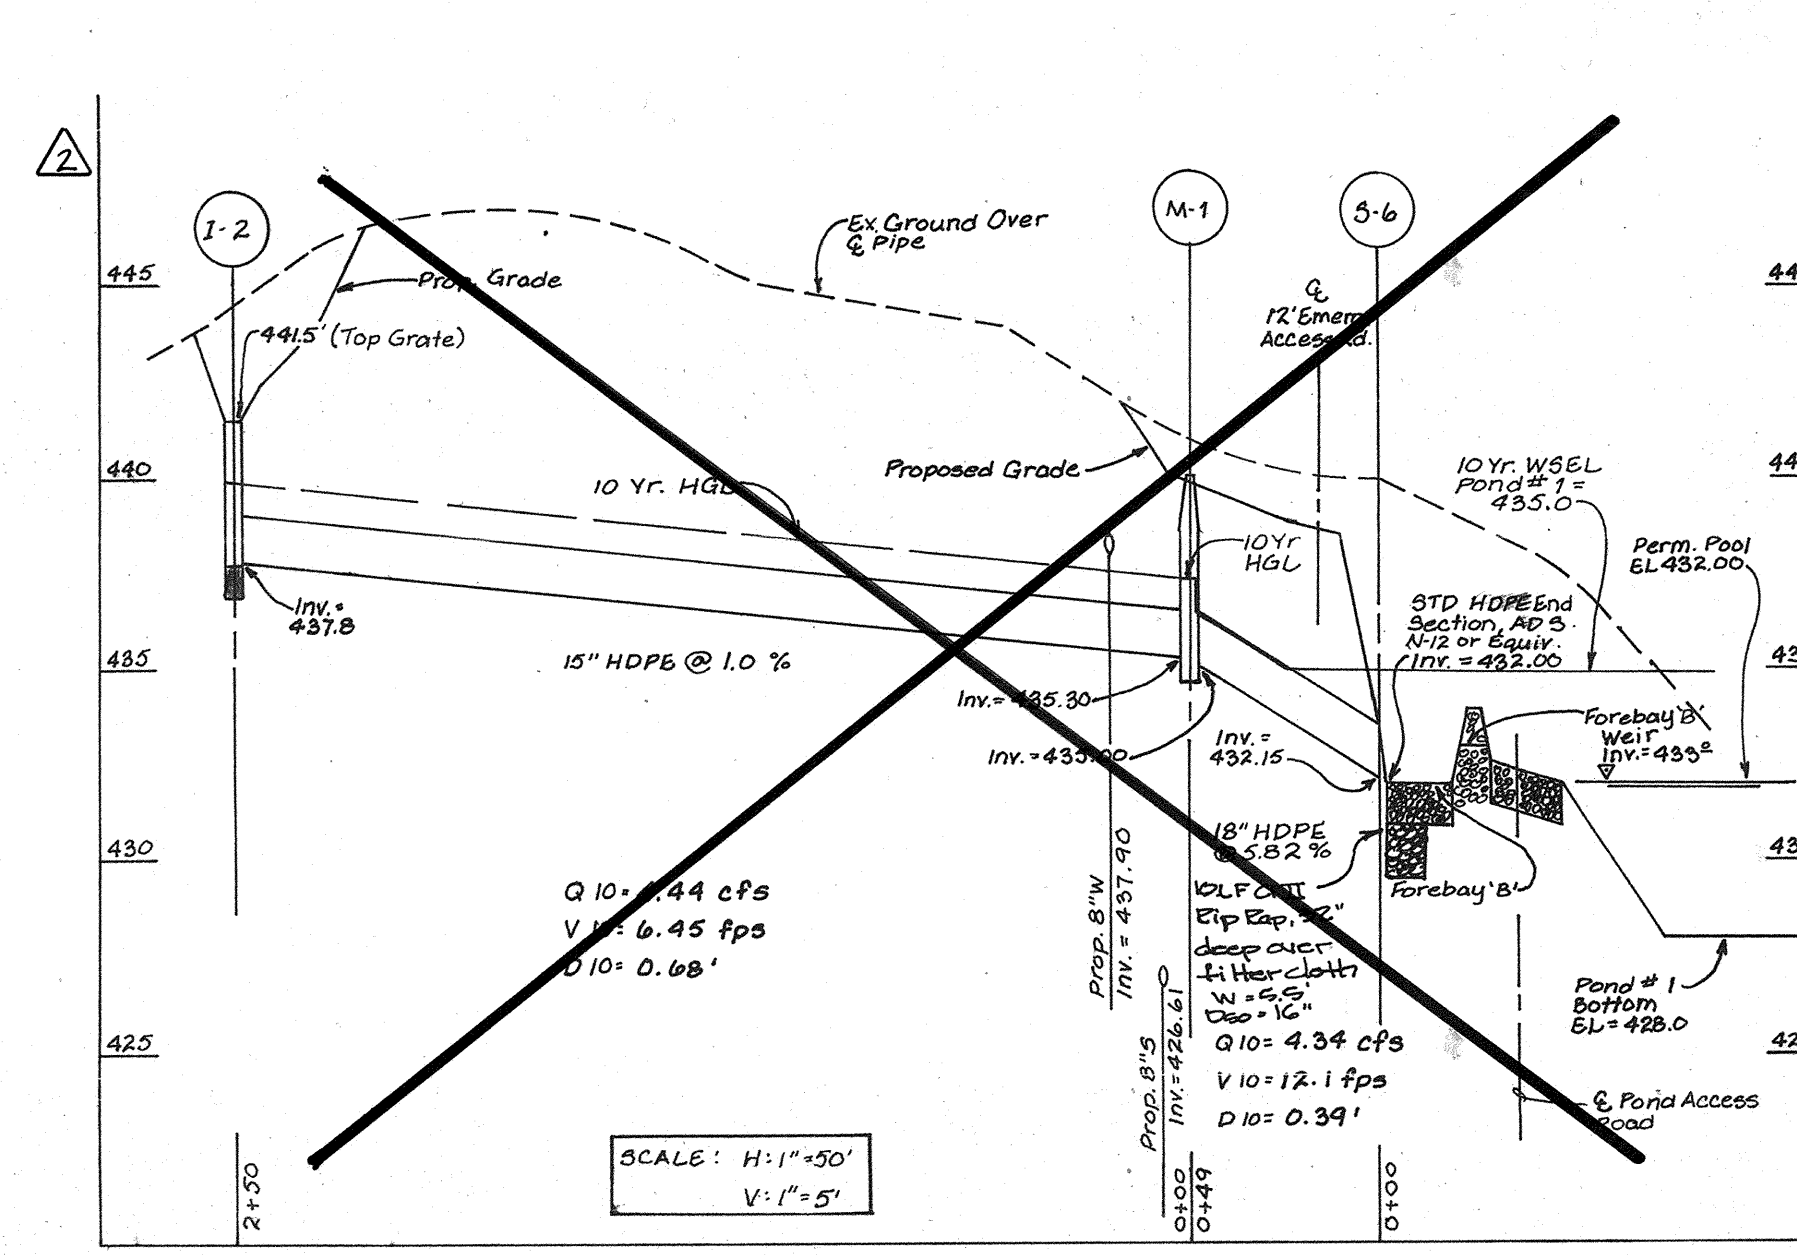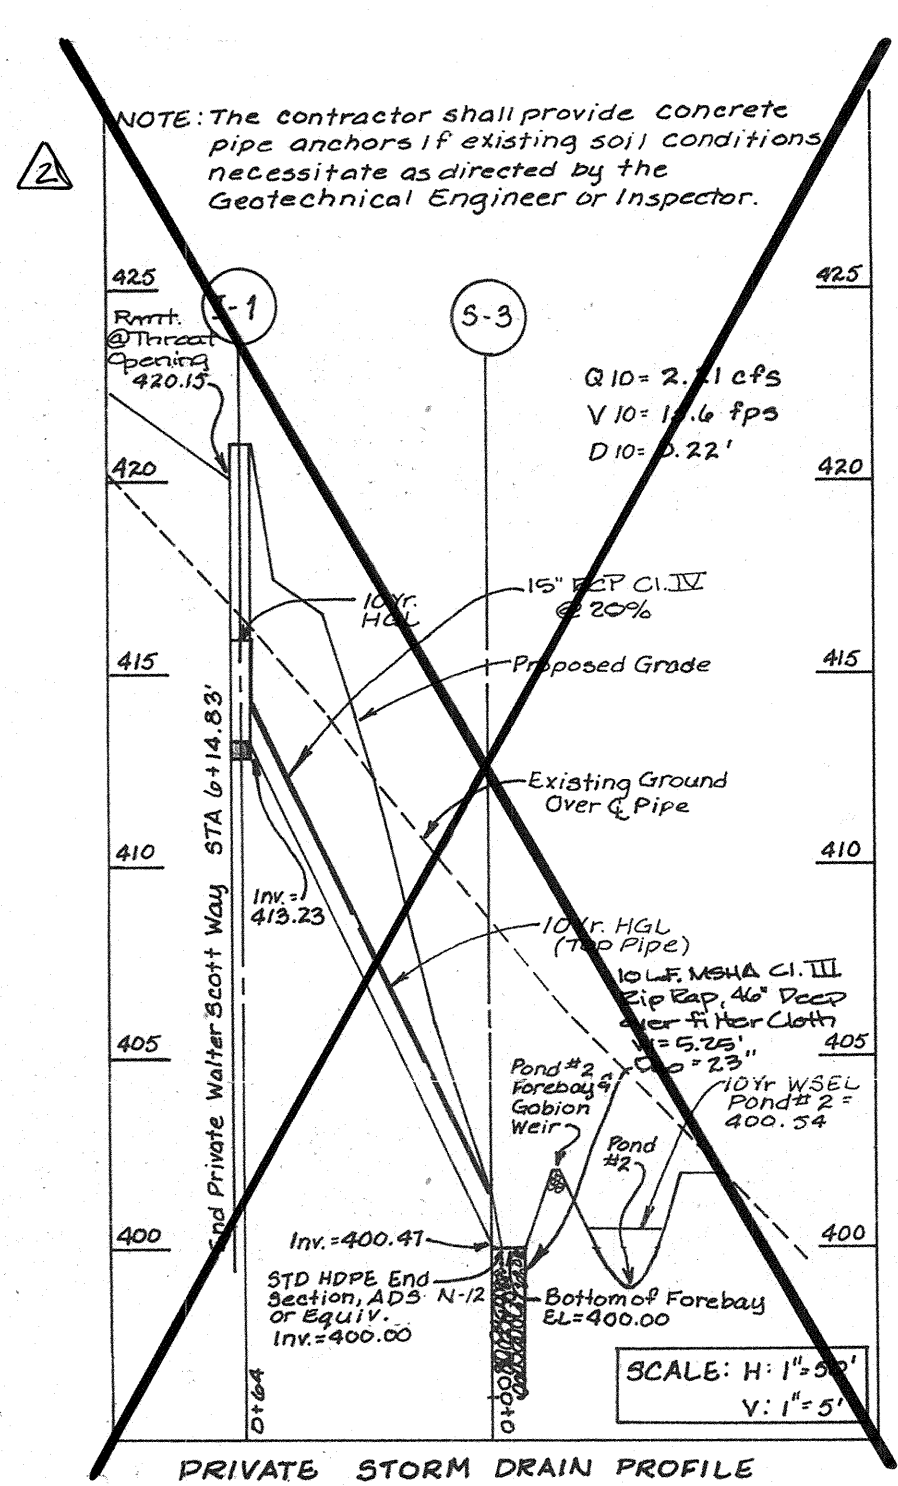

STORM DRAIN STRUCTURE SCHEDULE

Structure #	Type	Inv. In	Inv. Out	Upper	Lower	Detail	Location*	Remarks
I-6	A-10 Inlet	454.00	453.50	465.52	465.05	SD 4.02	Sta. 10425.25, 12.67' R	Public Walter Scott Way
I-7	A-10 Inlet	461.73	461.48	470.45	470.10	SD 4.02	Sta. 8436.25, 12.52' R	Public Walter Scott Way
I-8	A-10 Inlet	-	464.64	472.59	472.09	SD 4.02	Sta. 6472.25, 12.52' R	Public Walter Scott Way
I-11	K Inlet	-	468.95	471.80	471.80	SD 4.12	Sta. 44465.9, 36' L	Guilford Road (SD 4.13)
I-12	A-10 Inlet	-	460.03	466.31	466.31	SD 4.12	Sta. 0462.55, 17.25' L	Guilford Road
M-4	Std. Manhole	437.5	434.70	444.4	444.4	G 5.12	Sta. 13412.6, 17' L	Public Walter Scott Way
M-5	Std. Manhole	447.50	447.5	460.4	460.4	G 5.12	Sta. 11402.63, 6' R	Public Walter Scott Way
M-6	Std. Manhole	456.50	456.50	467.73	467.73	G 5.12	Sta. 9464.25, 11' L	Public Walter Scott Way
M-7	Std. Manhole	459.01/458.64	458.50	465.37	465.37	G 5.12	Sta. 46476.42' L	Guilford Road
M-7a	Junction Box	467.30	467.60	472.85	472.85	G 5.12	Sta. 44475.7, 54.7' L	Guilford Road (SD 4.14)
S-4	Type 'C' Endwall	422.00	424.75	424.75	SD 5.21	Sta. 24409.4, 61.15' R	Private Walter Scott Way	
S-5	Pond Riser	425.50	425.50	432.50	-	Sta. 2434.57, 26.62' L	Private Walter Scott Way	
S-6	Type 'C' Endwall	424.00	424.00	428.75	SD 5.21	Sta. 24629.5, 50.85' L	Private Walter Scott Way	
S-7	Type 'C' Inlet	434.00	434.00	437.93	SD 4.11	Sta. 13499.6, 60.5' L	Public Walter Scott Way	
S-8	Type 'C' Endwall	434.2	434.2	436.95	SD 5.21	Sta. 13436.9, 42.9' L	Public Walter Scott Way	
S-9	Type 'C' Endwall	455.66	455.66	457.16	SD 5.21	Sta. 41403.50, 40.4' L	Guilford Road	

Note: All hydraulic gradient lines are at or below ground of pipe and, therefore, not shown per Howard County design requirements.

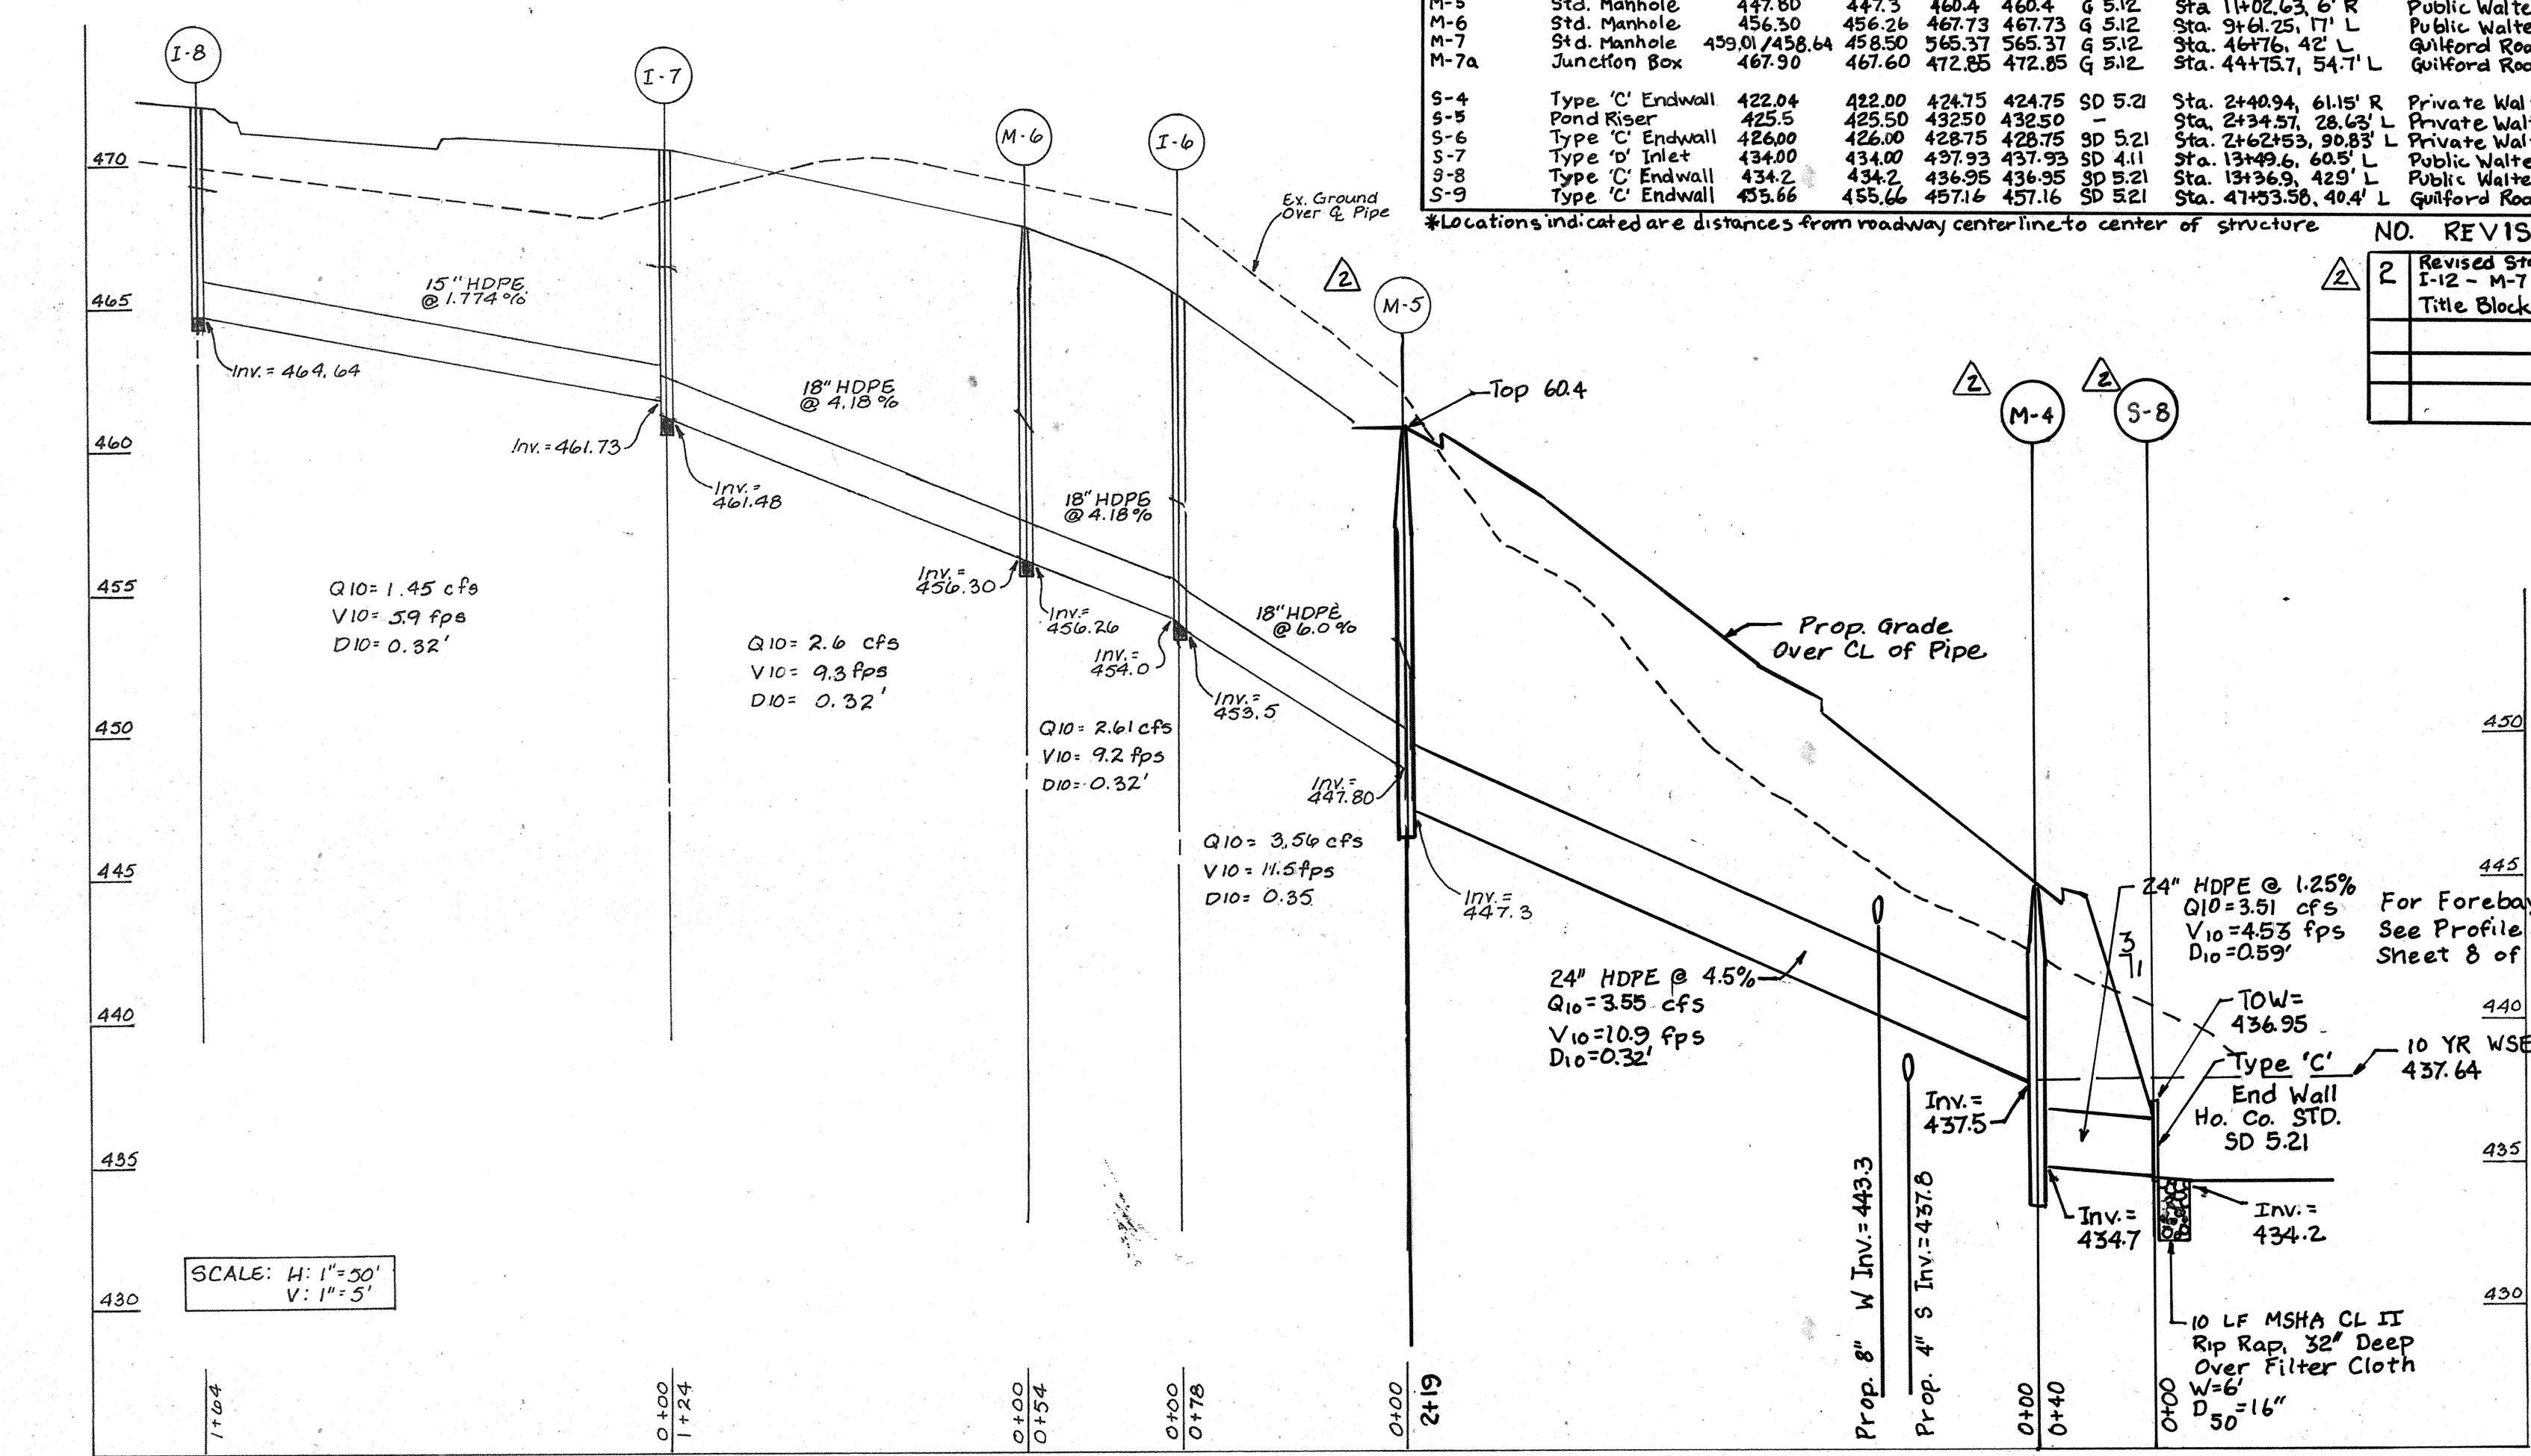

STORM DRAIN STRUCTURE SCHEDULE

Structure No.	Type	Inv. In	Inv. Out	Upper	Lower	Detail	Location*	Remarks
I-1	A-10 Inlet	-	413.23	421.25	421.25	SD 4.02	Sta. 6+14.83, 23.6' Left	Private Walter Scott Way
I-2	Y Inlet	-	437.80	441.60	441.6	SD 4.14	N 555161.25E 1335265.19	Private Structure
I-3	A-10 Inlet	-	434.41	438.52	438.52	SD 4.41	Sta. 1+79.05, 7.52' Left	Private Walter Scott Way
I-4	A-10 Inlet	433.51	433.02	440.12	440.02	SD 4.02	Sta. 0+46, 7.52' Left	Private Walter Scott Way
I-5	A-10 Inlet	432.39	432.31	440.88	440.32	SD 4.02	Sta. 13+80, 30.73' Left	Private Walter Scott Way
I-6	A-10 Inlet	436.90	435.5	465.52	465.05	SD 4.02	Sta. 10+25.25, 13.07' Right	Public Walter Scott Way
I-7	A-10 Inlet	461.73	461.48	470.45	470.10	SD 4.02	Sta. 8+36.25, 12.52' Right	Public Walter Scott Way
I-8	A-10 Inlet	-	464.64	472.53	472.09	SD 4.02	Sta. 6+72.25, 12.52' Right	Public Walter Scott Way
I-9	A-10 Inlet	455.78/453.74	455.64	459.97	459.97	SD 4.02	Sta. 48+30.79, 36' Left	Guilford Road
I-10	A-10 Inlet	455.45	455.38	459.85	459.71	SD 4.14	Sta. 47+83.0, 36' Left	Guilford Road
I-11	A-10 Inlet	-	466.00	471.89	471.52	SD 4.12	Sta. 44+65.9, 36' Left	Guilford Road
I-12	A-10 Inlet	466.95	466.95	472.85	472.85	SD 4.02	Sta. 0+62.55, 17.25' L	Public Walter Scott Way
M-1	A-10 Inlet	466.95	466.95	471.73	471.73	SD 4.02	Sta. 2+82.25, 12.52' Right	Public Walter Scott Way
M-2	Std. Manhole	435.30	435.00	439.80	439.80	G 5.12	Sta. 3+32.02, 21.97' Left	Private Walter Scott Way
M-3	Std. Manhole	433.97	433.72	438.67	438.67	G 5.12	Sta. 0+68.0, 3' Right	Private Walter Scott Way
M-3	Std. Manhole	432.65	432.65	441.7	441.33	G 5.12	Sta. 13+80, 10' Left	Private Walter Scott Way
M-4	Std. Manhole	434.30	434.20	438.8	443.8	G 5.12	Sta. 13+41.26, 17' Left	Public Walter Scott Way
M-5	Std. Manhole	447.80	447.30	459.42	459.42	G 5.12	Sta. 11+13.25, 6' Right	Public Walter Scott Way
M-6	Std. Manhole	456.30	456.30	467.73	467.73	G 5.12	Sta. 9+61.25, 17' Right	Public Walter Scott Way
M-7	Std. Manhole	459.14/488.85	458.85	464.10	464.10	G 5.12	Sta. 46+76, 42' Left	Guilford Road
M-7	Std. Manhole	466.30	466.95	466.77	466.77	G 5.12	Sta. 48+30.79, 36' Left	Public Walter Scott Way
S-1	Type 'C' Endwall	397.03	394.00	396.75	396.75	SD 5.21	N 554959.07E 1335245.16	
S-2	Pond #2 Riser	395.00	395.00	401.33	401.33	-	N 554961.80E 1335250.84	See Detail Sheet 8
S-3	HDPE End Sec.	400.47	400.00	401.72	401.72	-	N 554810.84E 1335510.84	See Manufacturer's Specs
S-4	Type 'C' Endwall	422.04	422.00	424.75	424.75	SD 5.21	N 554745.45E 1335129.37	
S-5	Pond #1 Riser	427.00	427.00	436.33	436.33	-	N 554813.97E 1334996.37	See Detail Sheet 8
S-6	HDPE End Sec.	432.15	432.00	433.65	433.65	-	Sta. 2+96.0, 35' Left	See Manufacturer's Specs
S-7	Type 'C' Endwall	432.01	432.00	434.75	434.75	SD 5.21	Sta. 13+46.00, 60' Left	Public Walter Scott Way
S-8	Type 'C' Endwall	432.07	432.00	434.75	434.75	SD 5.21	Sta. 13+41.26, 57' Left	Public Walter Scott Way
S-9	HDPE End Sec.	453.29	453.00	454.50	454.50	-	Sta. 48+30.79, 35' Left	Guilford Road

*Locations indicated are distances from roadway centerline to center of structure or center coordinate.

APPROVED: DEPARTMENT OF PLANNING AND ZONING
 [Signature] 6/26/00
 [Signature] 7/12/00
 [Signature] 5-26-00

THESE PLANS HAVE BEEN REVIEWED FOR THE HOWARD SOIL CONSERVATION DISTRICT AND MEET THE TECHNICAL REQUIREMENTS FOR SMALL POND CONSTRUCTION, SOIL EROSION AND SEDIMENT CONTROL.
 [Signature] 5/18/00
 [Signature] 5/10/00

ENGINEER'S CERTIFICATE
 I certify that this plan for pond construction...
 [Signature] 5/10/00

DEVELOPER'S CERTIFICATE
 I/We certify that all development and/or construction will be done according to these plans...
 [Signature] 11-17-00

STATE OF MARYLAND PROFESSIONAL ENGINEER
 [Signature] 5/9/00

REVISION NO. 1 BY:
 CENTURY ENGINEERING INC.
 32 WEST ROAD
 TOWSON, MD 21284 (410) 823-8070
 THIS SEAL FOR REVISION NO. 1 ONLY

NO.	REVISION	DATE
1	REVISED TO ELIMINATE I-13 M-6	6-19-01

LDE, INC.
 9250 Rumsey Road, Suite 106, Columbia, MD. 21045
 (410) 715-1070 (301) 596-3424 (410) 715-9540 (Fax)



DESIGNED BY: S.D.H.
 DRAWN BY: CADD STB
 CHECKED BY: B.D.B.
 DATE: 11/99

Storm Drain Profiles
Scott Farm
 Lots 29-42 and Open Space Lots 27, 28, 43 & 44

Tax Map No. 35 - P/O Parcel 354
 5th Election District - Howard County, Maryland
 Previous Submittals: F79-104, F84-144, F87-160, S97-23, BA91-848, S95-10, F98-29, P98-13 & S98-04

Owner/Developer: Scarlet Wilkinson & Earl Omer
 6799 Guilford Road, Carverville Maryland 21088
 (410) 331-3828 or (410) 847-0497

SCALE: 1" = 50' H, 1" = 5' V.
 DRAWING: 6 of 20
 JOB NO.: 98009
 FILE NO.: F-00-73

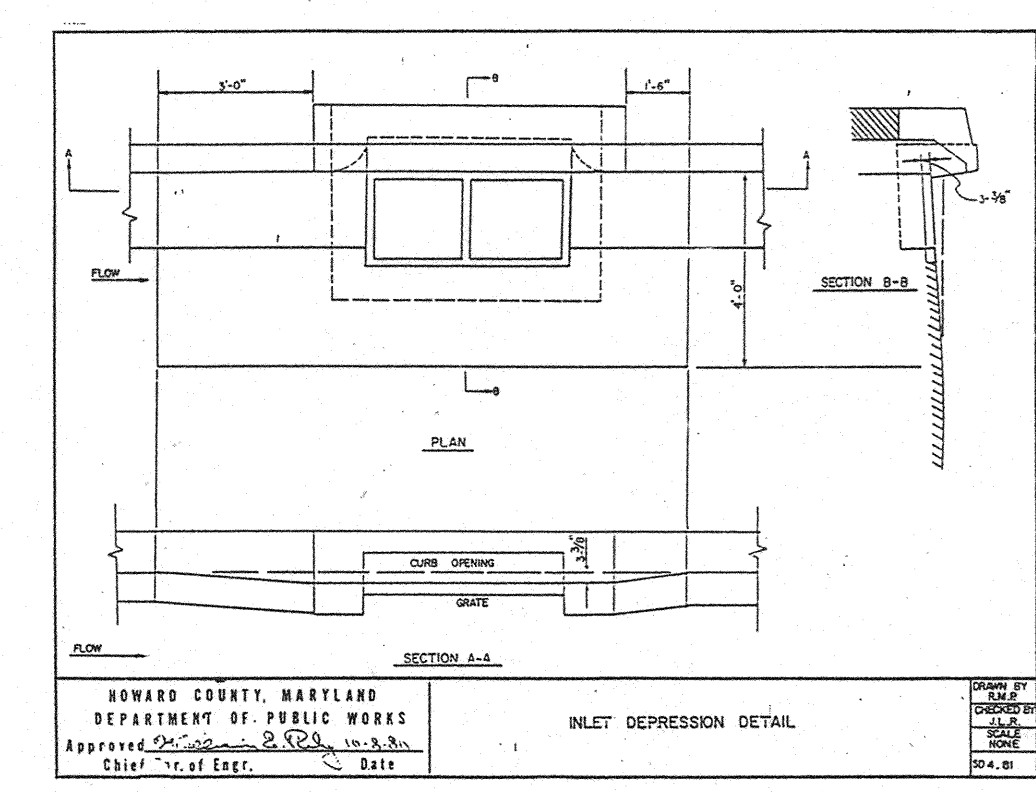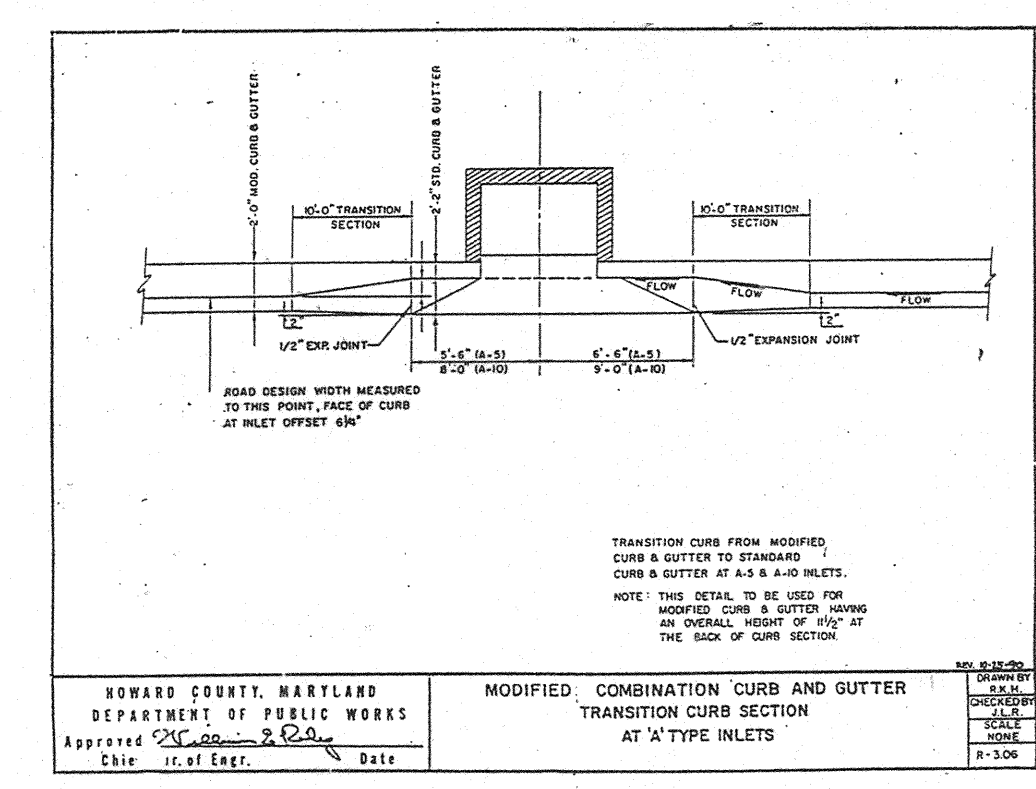

PIPE SCHEDULE

SIZE	CLASS	TOTAL LENGTH*
15"	HDPE Smooth Interior	59D LF
18"	HDPE Smooth Interior	256 LF
24"	HDPE Smooth Interior	259 LF
24"	CCP, CI, IV	90 LF

*The total length of pipe does not take into account the slope of the pipe. This total is for linear feet only.

POND CONSTRUCTION SPECIFICATIONS

These specifications are appropriate to all ponds within the scope of the Standard for practice MD-378. All references to ASTM and AASHTO specifications apply to the most recent version.

SITE PREPARATION

Areas designated for borrow areas, embankment and structural works shall be cleared, grubbed, and stripped of topsoil. All trees, vegetation, roots, and other objectionable material shall be removed. Channel banks and sharp breaks shall be sloped to no steeper than 1:1.

Areas to be covered by the reservoir will be cleared of all trees, brush, logs, fences, rubbish, and other objectionable material or less otherwise designated on the plans. Trees, brush and stumps shall be cut approximately level to the ground surface. For dry stormwater management ponds, a minimum of a 50 foot radius around the inlet structure shall be cleared.

All cleared and grubbed material shall be disposed of outside and below the limits of the dam and reservoir as directed by the owner or his representative. When specified, a sufficient quantity of topsoil will be stockpiled in a suitable location for use on the embankment and other designated areas.

EARTH FILL

Material - The fill material shall be taken from approved designated borrow areas. It shall be free of roots, stumps, wood, rubbish, stones greater than 6", frozen or other objectionable materials. Fill material for the center of the embankment and cut off trench shall conform to Unified Soil Classification GC, SC, CH, or CL. Consideration may be given to the use of other materials in the embankment if design and construction are supervised by a geotechnical engineer.

Placement - Areas on which fill is to be placed shall be scarified prior to the placement of fill. Fill materials shall be placed in maximum 8 inch thick (before compaction) layers which are to be continuous over the entire length of fill. The most permeable borrow material shall be placed in the downstream portions of the embankment. The principal spillway must be installed concurrently with fill placement and not excavated into the embankment.

Compaction - The movement of the hauling and spreading equipment over the fill shall be controlled so that the entire surface of each lift is compacted. Each lift shall be compacted by the use of a sheepfoot, rubber tired, or vibratory roller. Fill material shall contain sufficient moisture such that the fill material will be compacted to the maximum dry density. The fill material shall contain sufficient moisture so that if formed into a ball it will not crumble yet not be so wet that water can be squeezed out.

Where a minimum required density is specified, it shall not be less than 95% of maximum dry density with a moisture content within +/- 2% of the optimum. Each layer of fill shall be compacted to obtain that density, and is to be certified by the Engineer at the time of construction. All compaction is to be determined by AASHTO Method T-99.

Cut off Trench - The cutoff trench shall be excavated into impervious material along or parallel to the centerline of the embankment as shown on the plans. The bottom width of the trench shall be governed by the equipment used for excavation, with the minimum width being four feet. The depth shall be at least four feet below existing grade or as shown on the plans. The side slopes of the trench shall be 1 to 1 of flatter. The backfill shall be compacted with construction equipment, rollers, or hand tampers to assure maximum density and minimum permeability.

STRUCTURAL BACKFILL

Backfill adjacent to pipes or structures shall be of the type and quality conforming to that specified for the adjoining fill material. The fill shall be placed in horizontal layers not to exceed four inches in thickness and compacted by hand tampers or other manually directed equipment. The contractor shall also furnish, install, operate and maintain all necessary pumping and other equipment required for removal of water from the various parts of the work and for maintaining the excavations, foundation, and other parts of the work free from water as required or directed by the engineer for construction of each part of the work. After having served their purpose, all temporary protective works shall be removed or leveled and graded to the extent required to prevent obstruction in any degree whatsoever of the flow of water to the spillway or outlet works and so as not to interfere with the removal of water from the required excavation and the foundation shall be accomplished in a manner and to the extent that will maintain stability of the excavated slopes and bottom required excavations and will allow satisfactory performance of all construction operations. During the placing and compacting of material in required excavations, the water level at the locations being refilled shall be maintained below the bottom of the excavation at such locations which may require draining the water to surps from which the water shall be pumped.

PIPE CONDUITS

All pipes shall be circular in cross section.

CORRUGATED METAL PIPE - All of the following criteria shall apply for corrugated metal pipe:

1. Materials - (Steel Pipe) - This pipe and its appurtenances shall be galvanized and fully bituminous coated and shall conform to the requirements of AASHTO Specification M-190 Type A with watertight coupling bands. Any bituminous coating damaged or otherwise removed shall be replaced with cold applied bituminous coating compound. Steel pipes with polymeric coatings have a minimum coating thickness of 0.01 inch (10 mil) on both sides of the pipe. The following coating or an approved equal may be used: Hexon, Plast-Cote, Blac-Klad, air Beth Co-Lay. Coated corrugated steel pipe shall meet the requirements of AASHTO M-245 and M-246.

Materials - (Aluminum Coated Steel Pipe) - This pipe and its appurtenances shall conform to the requirements of AASHTO Specification M-274 with watertight coupling bands or flanges. Any aluminum coating damaged or otherwise removed shall be replaced with cold applied bituminous coating compound.

Materials - (Aluminum Pipe) - This pipe and its appurtenances shall conform to the requirements of AASHTO Specification M-190 or M-274 with watertight coupling bands or flanges. Aluminum surfaces that are to be in contact with concrete shall be painted with one coat of zinc chromate primer. Hot dip galvanized bolts may be used for connections. The pH of the surrounding soils shall be between 4 and 9.

2. Coupling bands, anti-seep collars, and sections, etc., must be composed of the same material as the pipe. Metals must be insulated from dissimilar materials with use of rubber or plastic insulating materials at least 24 mils in thickness.

3. Connections - All connections with pipes must be completely watertight. The drain or barrel connection to the riser shall be welded all around when the pipe and riser are metal. Anti-seep collars shall be connected to the pipe in such a manner as to be completely watertight. Dimple bands are not considered to be watertight.

All connections shall use a rubber or neoprene gasket when joining pipe sections. The end of each pipe shall be re-rolled an adequate number of corrugations to accommodate the band width. The following type connections are acceptable for pipes less than 24" in diameter: Flanges on both ends of the pipe, a 12 inch wide standard lap type band with 12" wide by 3/8" thick closed cell circular neoprene gasket; and a 12 inch wide huggar type band with O-ring gaskets having a minimum diameter of 1/2 inch greater than the corrugated depth. Pipes 24" in diameter and larger shall be connected by a 24" long annular corrugated band using rods and lugs. A 12" wide by 3/8" thick closed cell circular neoprene gasket will be installed on the end of the pipe for a total of 24".

Helically corrugated pipe shall have either continuously welded seams or have lock seams with internal caulking or a neoprene bead.

4. Bedding - The pipe shall be firmly and uniformly bedded throughout its entire length. Where rock or soft, spongy or other unstable fill is encountered, all such material shall be removed and replaced with suitable earth compacted to provide adequate support.

5. Backfilling shall conform to "Structure Backfill."

6. Other details (anti-seep collars, valves, etc.) shall be as shown on the drawings.

REINFORCED CONCRETE PIPE - All of the following criteria shall apply for reinforced concrete pipe:

1. Materials - Reinforced concrete pipe shall have bell and spigot joints with rubber gaskets and shall equal or exceed ASTM Designation C-361.

2. Bedding - All reinforced concrete pipe conduits shall be laid in a concrete bedding for their entire length. This bedding shall consist of high slump concrete placed under the pipe and up the sides of the pipe at least 10% of its outside diameter with a minimum thickness of 3 inches, or as shown on the drawings.

3. Laying pipe - Bell and spigot pipe shall be placed with the bell end upstream. Joints shall be made in accordance with recommendations of the manufacturer of the material. After the joints are sealed for the entire line, the bedding shall be placed so that all spaces under the pipe are filled. Care shall be exercised to prevent any deviation from the original line and grade of the pipe. The first joint must be located within 2 feet from the riser.

4. Backfilling shall conform to "Structure Backfill."

5. Other details (anti-seep collars, valves, etc.) shall be as shown on the drawings.

POLYVINYL CHLORIDE (PVC) PIPE - All of the following criteria shall apply for polyvinyl chloride (PVC) pipe:

1. Materials - PVC pipe shall be PVC-1120 or PVC-1220 conforming to ASTM D-1785 or ASTM D-2241.

2. Joints and connections to anti-seep collars shall be completely watertight.

3. Bedding - The pipe shall be firmly and uniformly bedded throughout its entire length. Where rock or soft, spongy or other unstable fill is encountered, all such material shall be removed and replaced with suitable earth compacted to provide adequate support.

4. Backfilling shall conform to "Structure Backfill."

5. Other details (anti-seep collars, valves, etc.) shall be as shown on the drawings.

CONCRETE

Concrete shall meet the requirements of Maryland Department of Transportation, State Highway Administration Standard Specifications for Construction and Materials, Section 908, Mix No. 3.

ROCK RIPRAP

Rock riprap shall meet the requirements of Maryland Department of Transportation, State Highway Administration Standard Specifications for Construction and Materials, Section 905.

The riprap shall be placed to the required thickness in one operation. The rock shall be delivered and placed in a manner that will place the riprap in place shall be reasonably homogeneous with the larger rocks uniformly distributed and firmly in contact one to another with the smaller rocks filling the voids between the larger rocks. Filter cloth shall be placed under all riprap and shall meet the requirements of Maryland Department of Transportation, State Highway Administration Standard Specifications for Construction and Materials, Section 919.12.

CARE OF WATER DURING CONSTRUCTION

All work on permanent structures shall be carried out in areas free from water. The contractor shall construct and maintain all temporary dikes, levees, cofferdams, drainage channels, and stream diversions necessary to protect the areas to be occupied by the permanent works. The contractor shall also furnish, install, operate and maintain all necessary pumping and other equipment required for removal of water from the various parts of the work and for maintaining the excavations, foundation, and other parts of the work free from water as required or directed by the engineer for construction of each part of the work. After having served their purpose, all temporary protective works shall be removed or leveled and graded to the extent required to prevent obstruction in any degree whatsoever of the flow of water to the spillway or outlet works and so as not to interfere with the removal of water from the required excavation and the foundation shall be accomplished in a manner and to the extent that will maintain stability of the excavated slopes and bottom required excavations and will allow satisfactory performance of all construction operations. During the placing and compacting of material in required excavations, the water level at the locations being refilled shall be maintained below the bottom of the excavation at such locations which may require draining the water to surps from which the water shall be pumped.

STABILIZATION

All borrow areas shall be graded to provide proper drainage and left in a slightly condition. All exposed surfaces of the embankment, spillway, spoil and borrow areas, and berms shall be stabilized by seeding, liming, fertilizing and mulching in accordance with the Maryland Soil Conservation Service Standards and Specifications for Critical Area Planting (MD-342) or as shown on the accompanying drawings.

EROSION AND SEDIMENT CONTROL

Construction operations will be carried out in such a manner that erosion will be controlled and water and air pollution minimized. State and local laws concerning pollution abatement will be followed. Construction plans shall detail erosion and sediment control measures to be employed during the construction process.

GEOTECHNICAL RECOMMENDATIONS

EVALUATIONS AND RECOMMENDATIONS

Given the presence of groundwater at or above the proposed bottom of pond elevations (Bottoms B.4, B.4, B.7, B.8, B.9) stormwater management practices via infiltration are not recommended. Consideration should be given to the design of wet ponds.

It is understood that the existing pond (1) is located on the east side of the site and that the proposed pond (2) is located on the west side of the site. The proposed pond (2) is located on the west side of the site and is to be constructed on the existing pond (1) site. The proposed pond (2) is located on the west side of the site and is to be constructed on the existing pond (1) site. The proposed pond (2) is located on the west side of the site and is to be constructed on the existing pond (1) site.


EMBANKMENT AND CUT-OFF TRENCH CONSTRUCTION

The site should be stripped of topsoil and any other unsuitable materials from the embankment or structure areas in accordance with Soil Conservation Guidelines. After stripping operations have been completed, the exposed subgrade materials should be protected with a bonded dump truck or similar equipment in the presence of a geotechnical engineer or his representative. For areas that are not accessible to a dump truck, the exposed materials should be covered and tested by a geotechnical engineer or his representative utilizing a Dynamic Cone Penetrometer. Any excessively soft or loose materials identified by probing or penetrometer testing should be excavated to suitable firm soil, and then graded re-established by backfilling with suitable soil.


Based on the groundwater levels identified in the borings, dewatering of excavations should be anticipated in accordance with the Geotechnical Engineer's report. The contractor shall place and compact of fill for the embankment and cut off trench. In accordance with Maryland Soil Conservation Specification 378, consideration shall be given to the center of embankment and cut off trench shall conform to Unified Soil Classification GC, SC, CH, or CL. Consideration may be given to the use of other materials in the embankment if design and construction are supervised by a geotechnical engineer. It is our professional opinion that in addition to the soil materials described above in the geotechnical report, the use of plastic sheeting (if a material can be utilized for the center of the embankment and core trench. These soil materials are identified on the site plan. It is our professional opinion that these materials are suitable for use in the embankment and core trench. These soil materials are identified on the site plan. It is our professional opinion that these materials are suitable for use in the embankment and core trench. These soil materials are identified on the site plan.

QUALIFICATIONS

These recommendations are based upon generally accepted principles of geotechnical engineering. These recommendations are intended for the use of designer for planning this project. HSEA is not responsible for any other use. Inherent in these recommendations is the assumption that work will be done under the supervision of a registered professional engineer specializing in geotechnical engineering. The engineer for this project was based upon the information from the borings and the association of various subsurface conditions between the borings whereas, in reality, sharp changes may occur. If any conditions are encountered in the field which do not conform to the conditions assumed herein, these recommendations should be reviewed and revised as necessary.






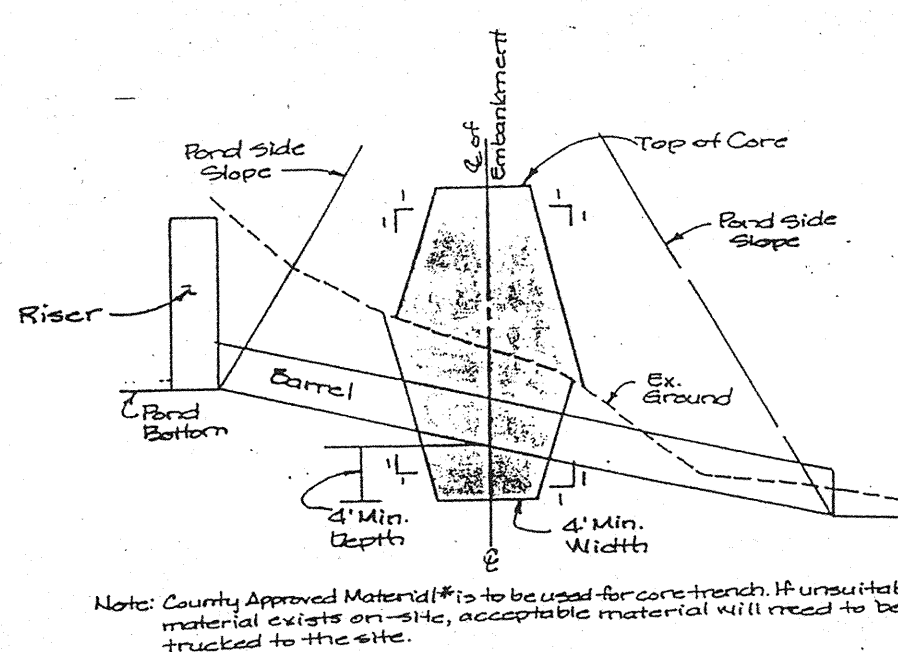


Core Trench Section
No Scale

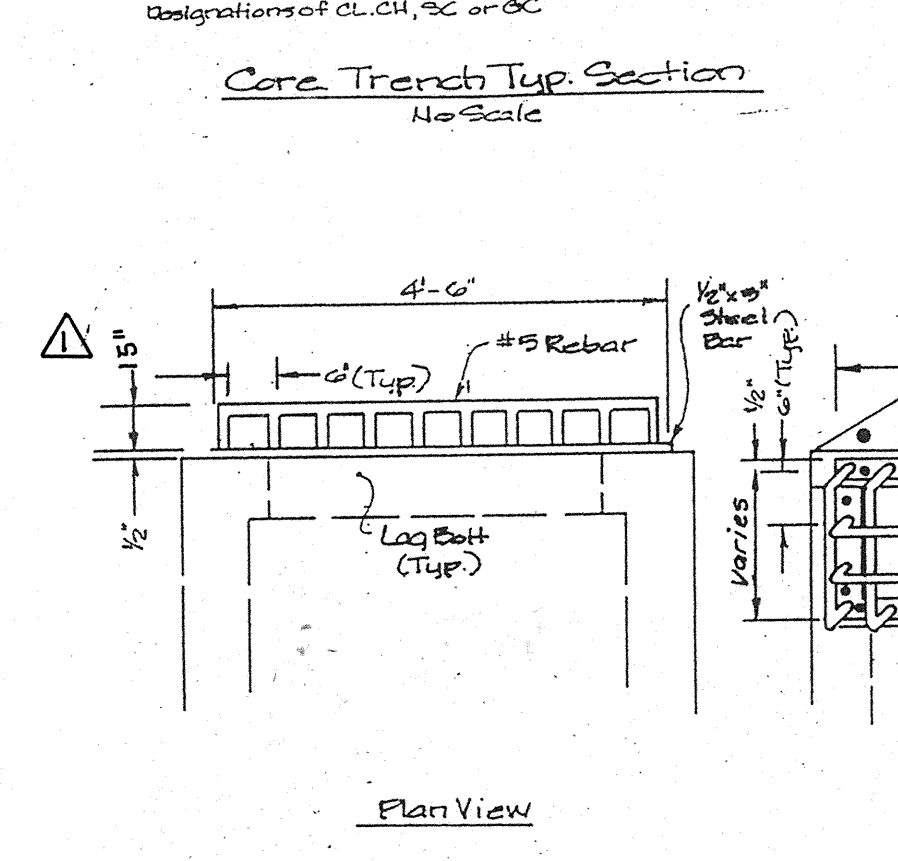


Trash Rack Details (2 Required)
Scale: 1/2" = 1'

Notes: 1. The steel used in the trash rack shall be galvanized and painted battleship grey after fabrication. 2. The 1/2" x 3/8" steel bar to be welded to the face of the structure. 3. All bolts used to fasten trash rack to the riser structure shall be galvanized.

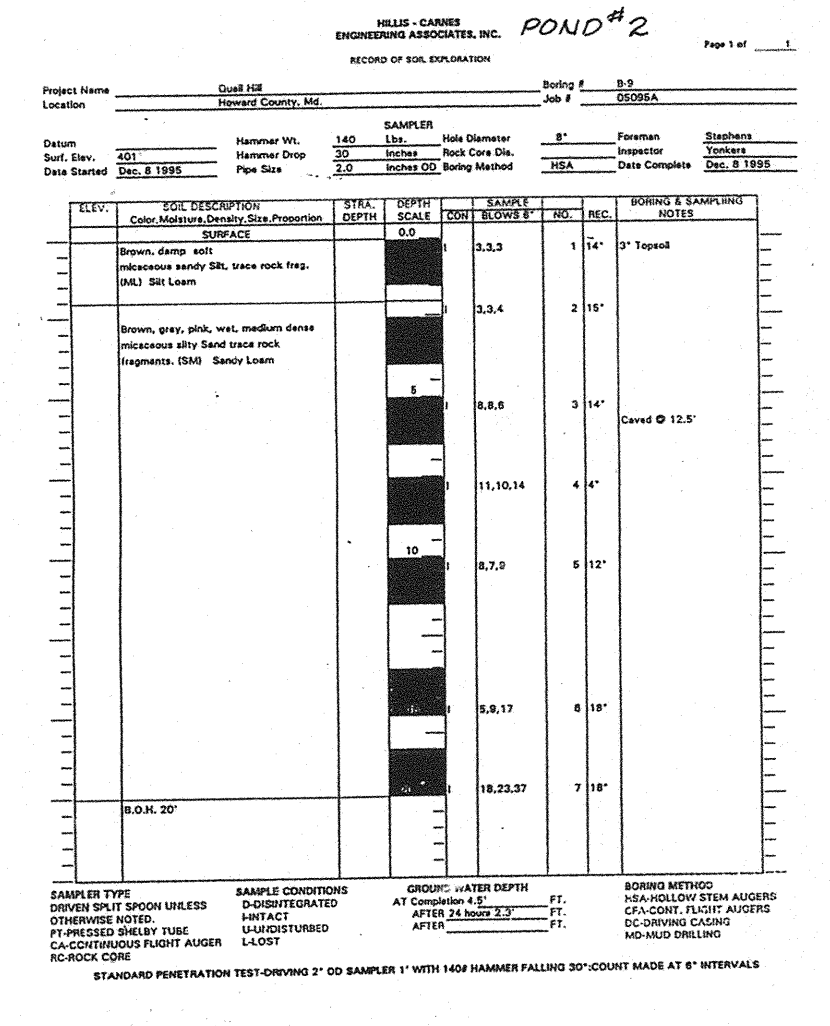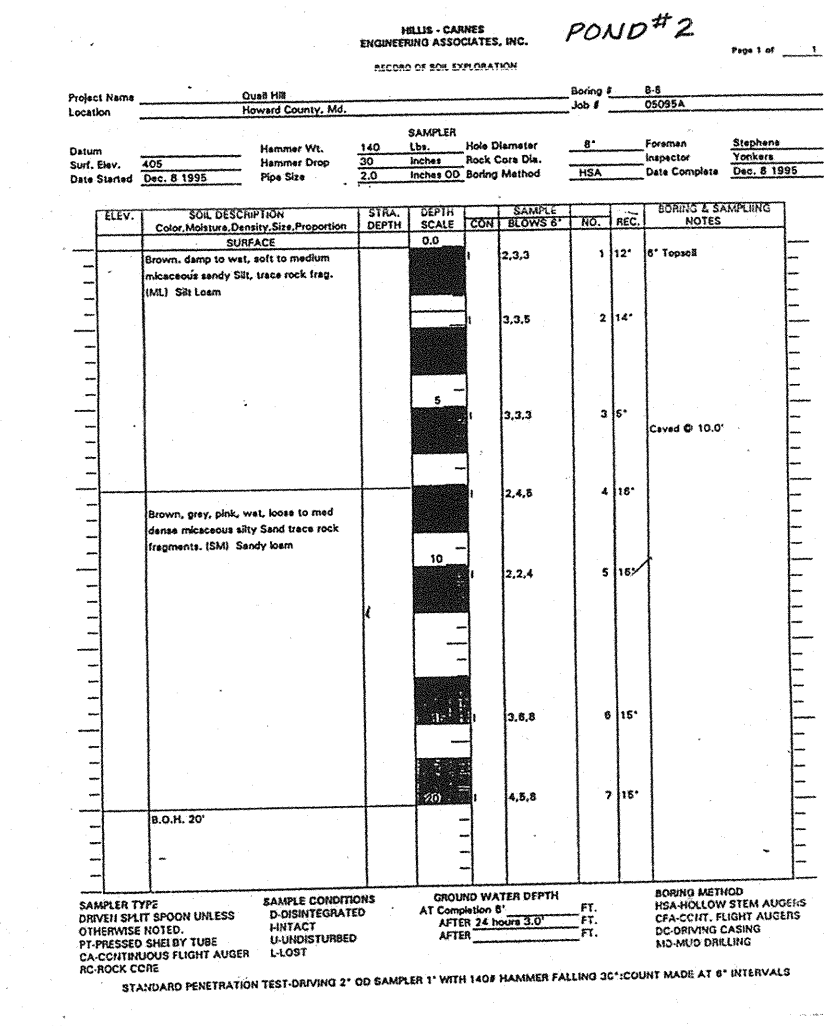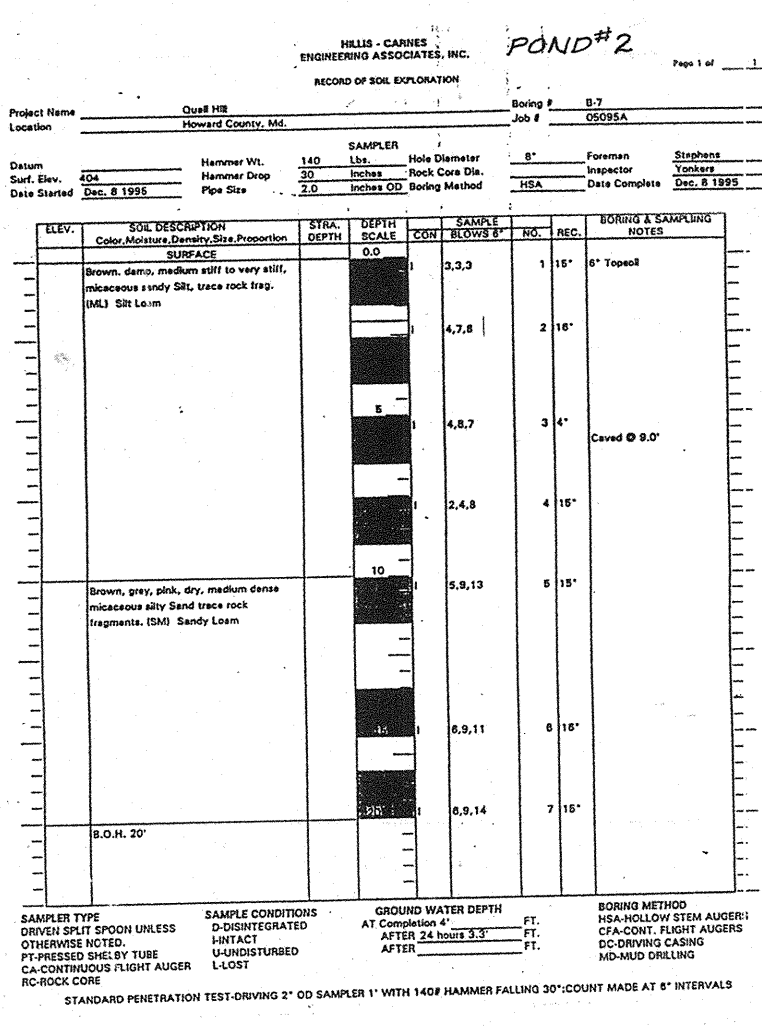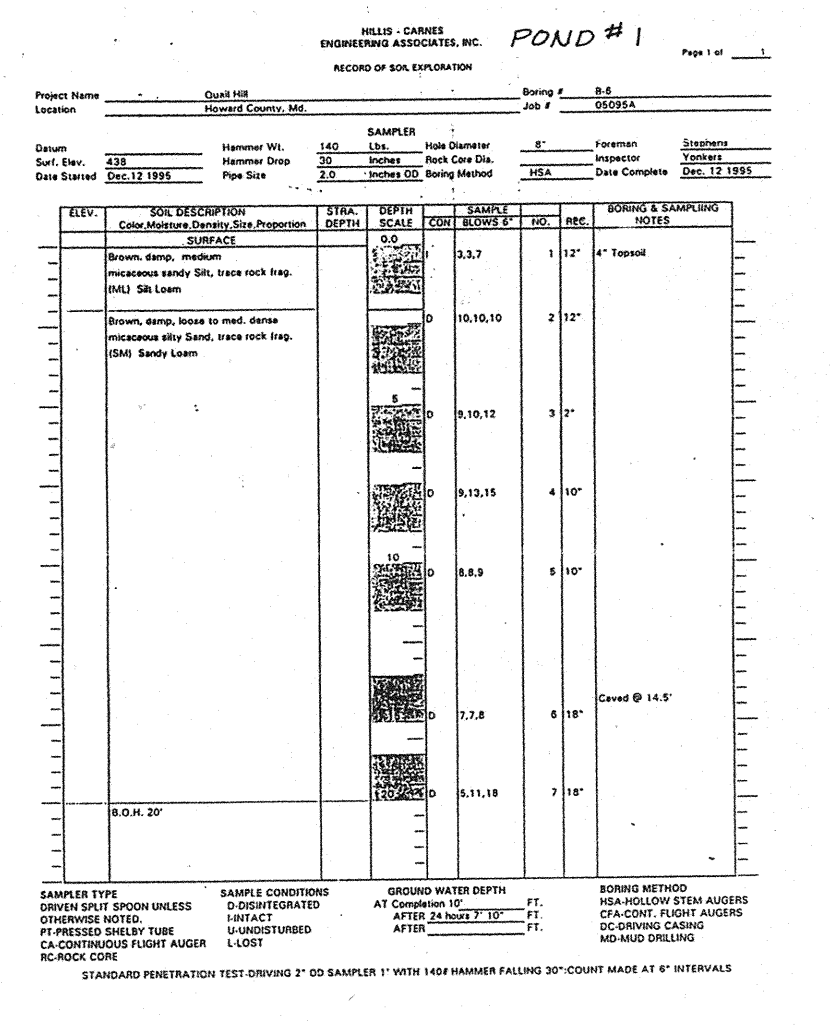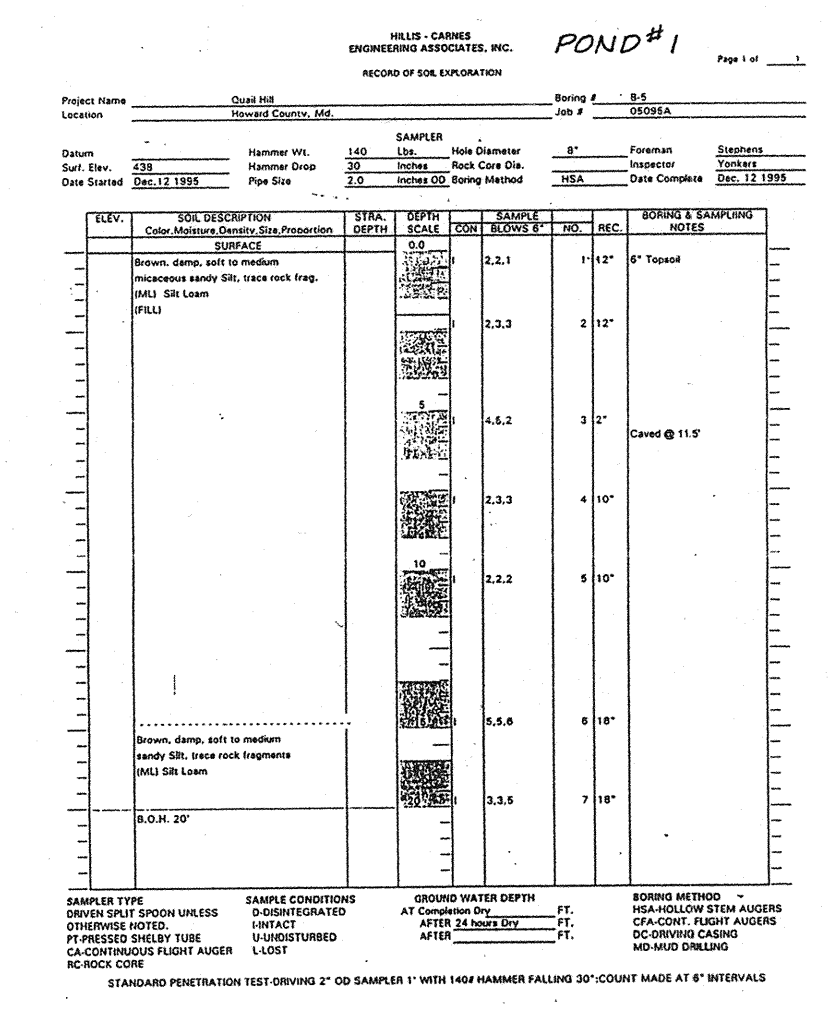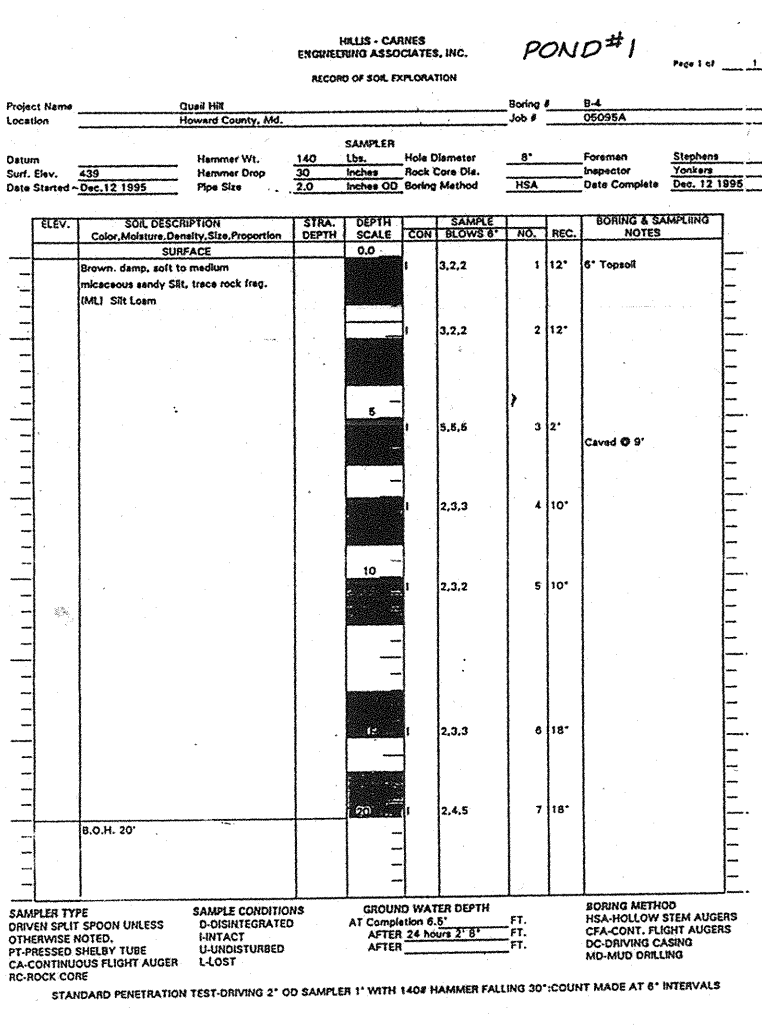


TYPICAL FOREBAY DETAILS (N.T.S.)

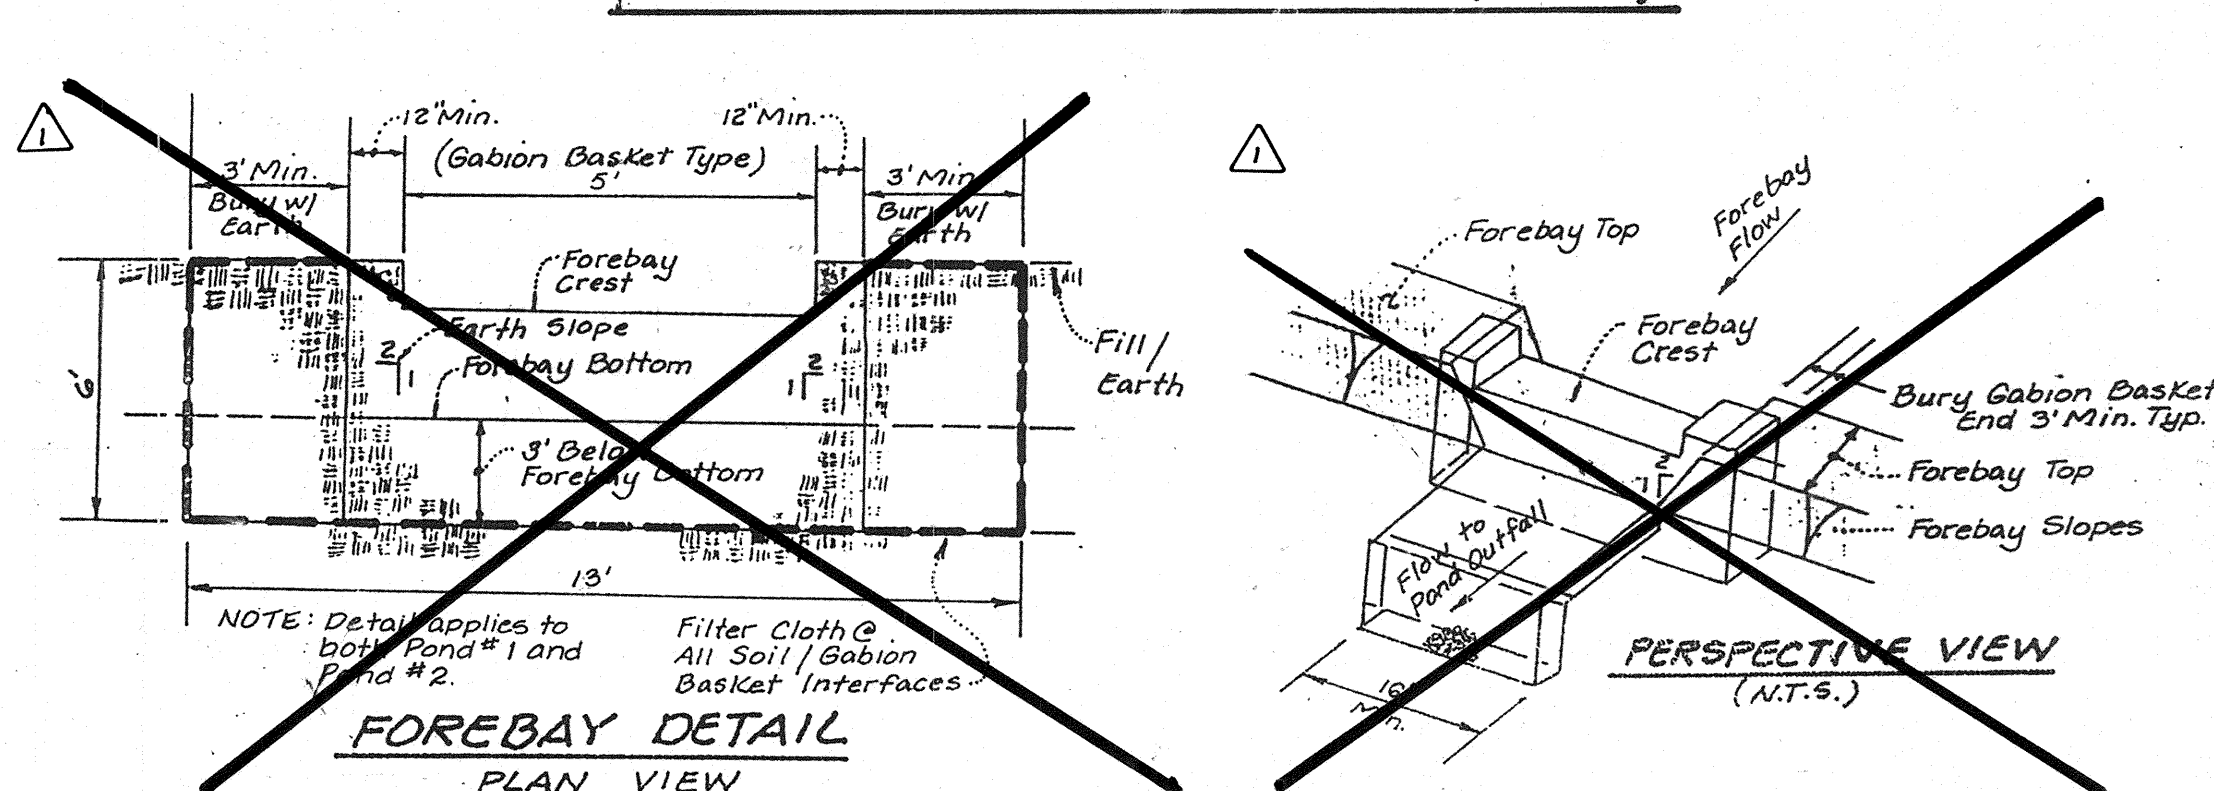

FOREBAY DETAIL
PLAN VIEW (N.T.S.)

NOTE: Detail applies to both Pond #1 and Pond #2. Filter Cloth @ All Soil/Gabion Basket Interfaces.

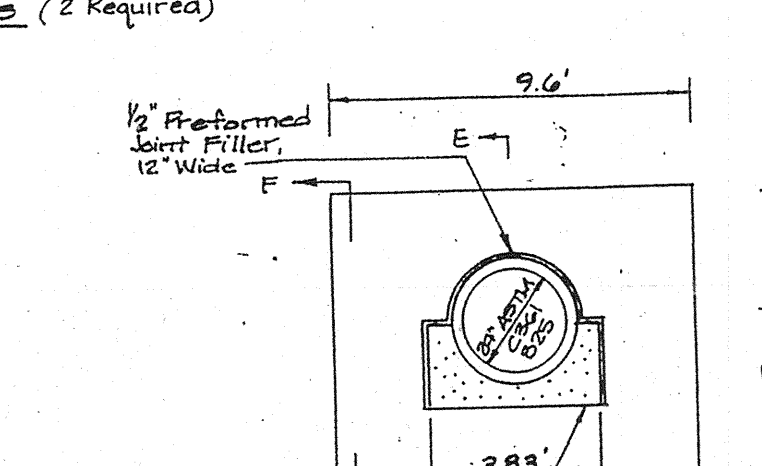

Section E-E
Section F-F (Showing Steel)

Min. Collar Spacing = 12" Collar Must Be 2" From Pipe Joint

Detail of Anti-Seep Collar (Use S1, S4, T42)

N.T.S.

APPROVED: DEPARTMENT OF PLANNING AND ZONING

Signature of Chief, Development Engineering Division, dated 6/26/00.
Signature of Chief, Division of Land Development, dated 7/12/00.
Signature of Chief, Bureau of Highways, dated 5-26-00.

THESE PLANS HAVE BEEN REVIEWED FOR THE HOWARD SOIL CONSERVATION DISTRICT AND MEET THE TECHNICAL REQUIREMENTS FOR SMALL POND CONSTRUCTION, SOIL EROSION, AND SEDIMENT CONTROL.

Signature of Howard Soil Conservation District, dated 5/18/00.
Signature of Howard Soil Conservation District, dated 5/18/00.

ENGINEER'S CERTIFICATE

Signature of Engineer, dated 5/18/00.

DEVELOPER'S CERTIFICATE




Signature of Developer, dated 11-12-99.

LDE, INC.
9250 Rumsey Road, Suite 106, Columbia, MD, 21045
(410) 715-1070 (301) 596-3424 (410) 715-9540 (Fax)

DESIGNED: Stormwater Management Details & Notes
DRAWN: Scott Farm
CHECKED: Lots 29-42 and Open Space Lots 27, 28, 43 & 44
DATE: 11/99

SCALE: As Shown
DRAWING: 7 of 20
JOB NO.: 98009
FILE NO.: F-00-73

Tax Map No. 35 - P/O Parcel 354
5th Election District - Howard County, Maryland
Previous Submittals: P76-104, P84-144, P87-162, 169-223, BA91-84E, 325-10, 329-20, P86-13 & 329-04
Owner/Developer: Scarlet Wilkinson & Earl Omer
6709 Guilford Road, Clarksville, Maryland 21029
(410) 531-2668 or (410) 987-0497

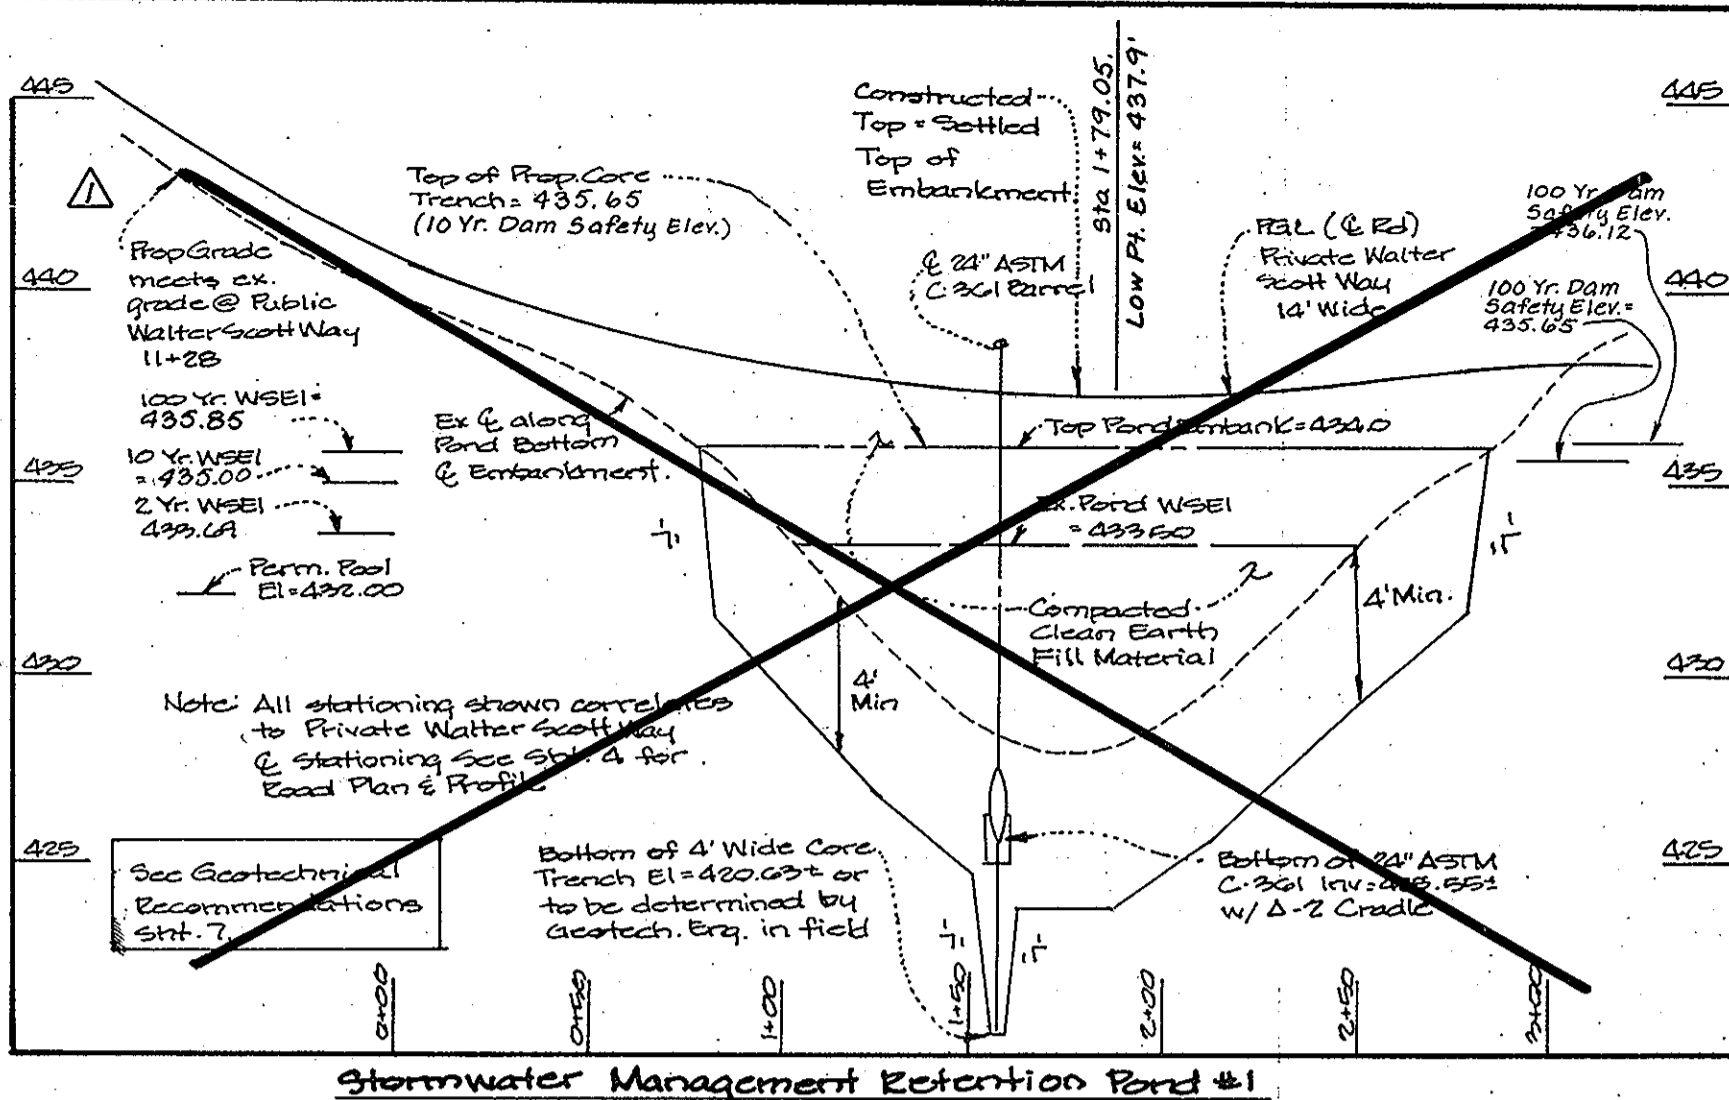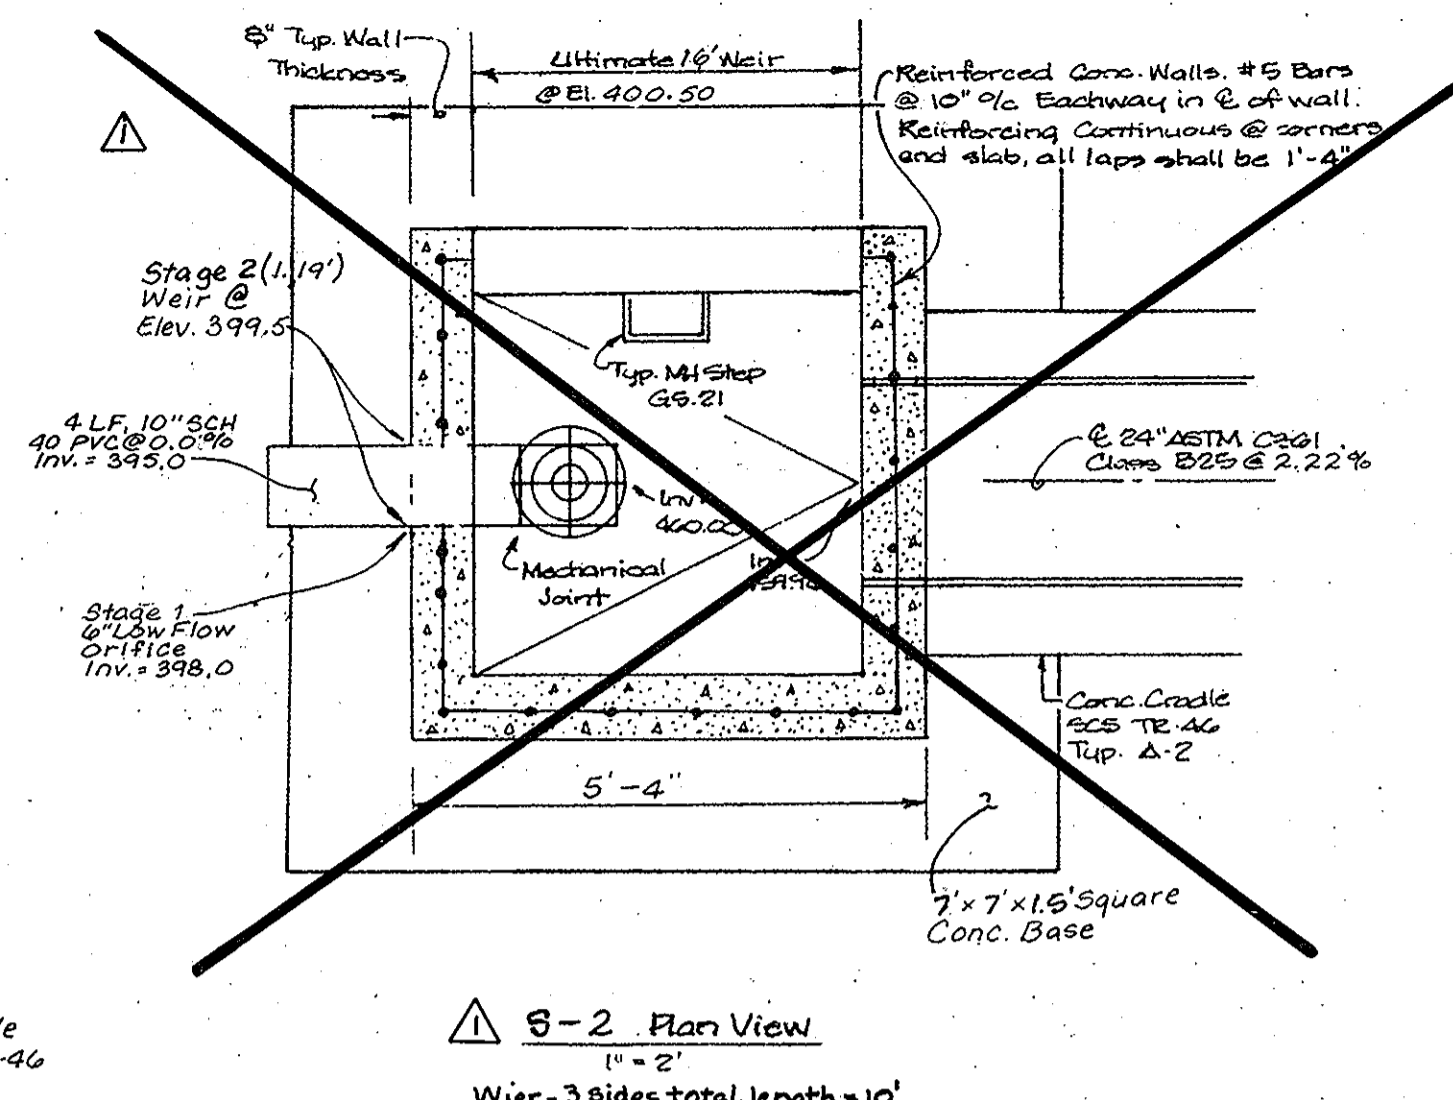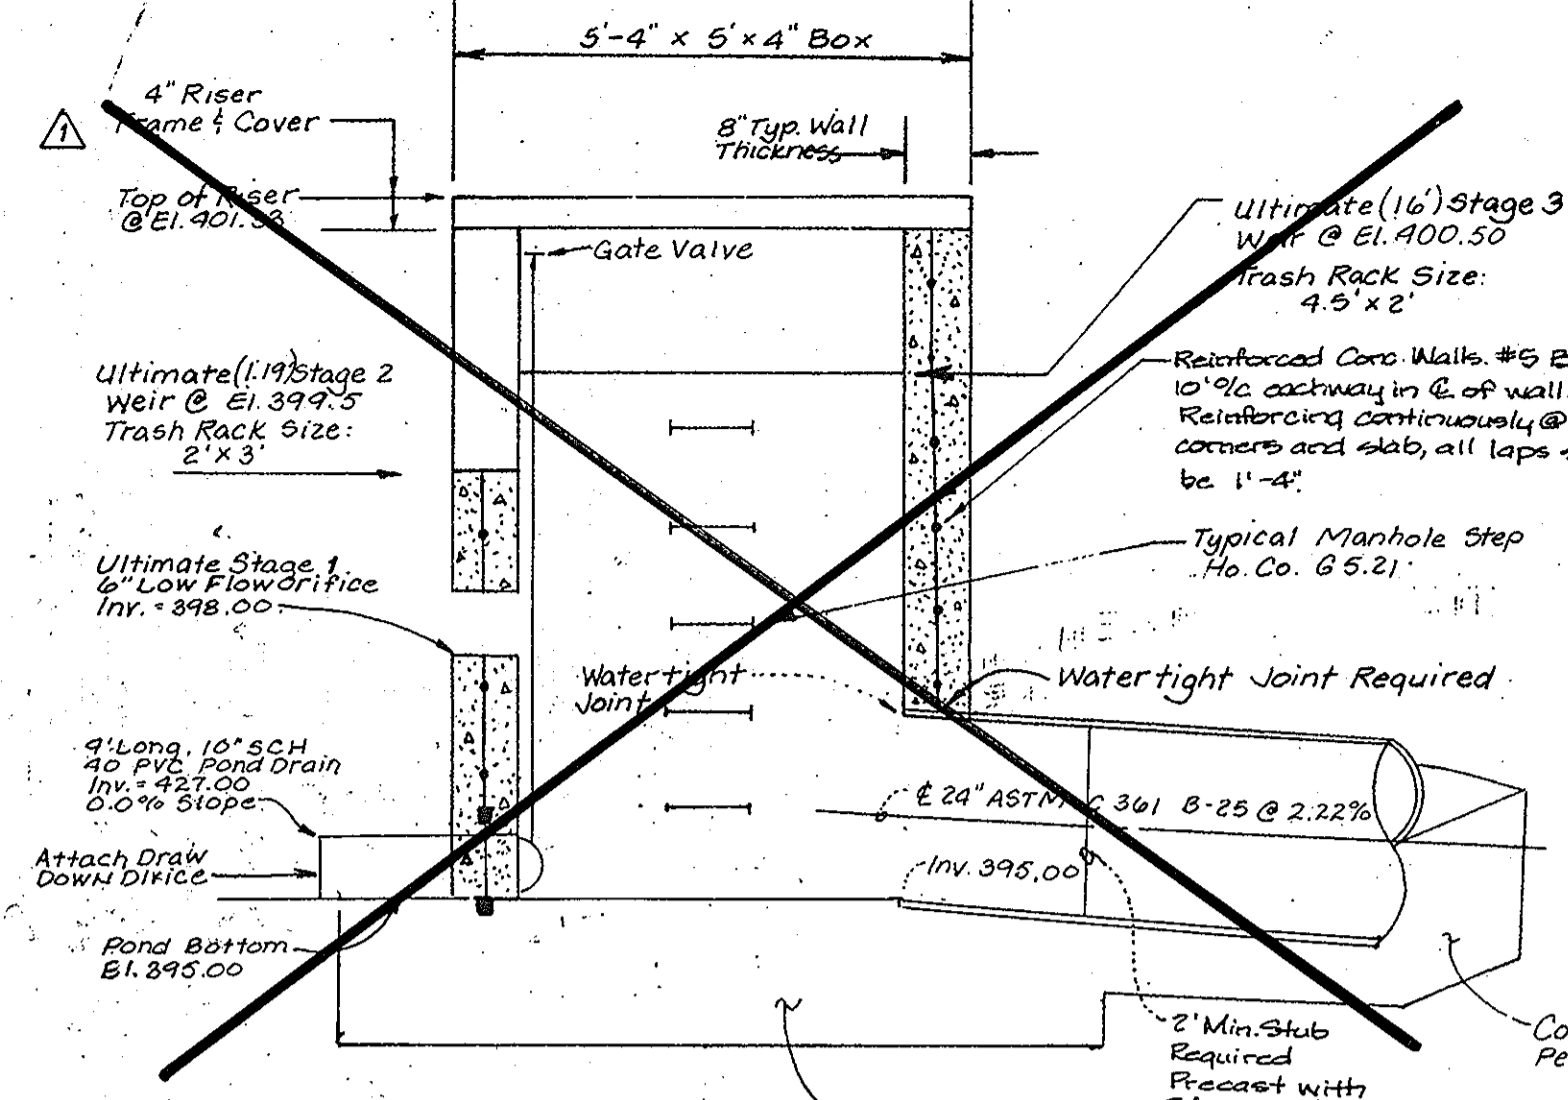

OPERATION AND MAINTENANCE SCHEDULE FOR PRIVATELY OWNED AND MAINTAINED RETENTION PONDS




- ROUTINE MAINTENANCE:**
1. Facility shall be inspected annually & after major storms. Inspections shall be performed during wet weather to determine if the pond is functioning properly.
 2. Top & side slopes of the embankment shall be mowed a minimum of two (2) times per year, once in June & once in September. Other side slopes & maintenance access shall be mowed as needed.
 3. Debris & litter shall be removed during regular mowing operations and as needed.
 4. Visible signs of erosion in the pond as well as the rip-rap or gabion outlet area shall be repaired as soon as it is noticed.

- NON-ROUTINE MAINTENANCE:**
1. Structural components of the pond, such as the dam, riser, and pipes shall be repaired upon the detection of any damage. The components shall be inspected during routine maintenance operations.
 2. Sediment shall be removed from the pond, and forebay, no later than when the capacity of the pond or forebay is half full. Professional engineering approval is required for aesthetic reasons. I am a duly licensed Professional Engineer under the laws of the State of Maryland.




STATE OF MARYLAND
PIERO VAN MELLITS
 No. 21875
 REGISTERED PROFESSIONAL ENGINEER
 12-31-09
 FOR REVISIONS NOTED DATED 5-18-09 ONLY
REVISION #3 BY:
 BOWMAN CONSULTING
 2350 RINA ROAD, SUITE 200
 ANNAPOLIS, MD 21401
 410-224-7590

NO.	REVISION	DATE	BY
1	REVISED SHM Retention Pond 1 Profile S-2 & S-5 Details. Deleted Details. Revised Title Block & Sheet No.	09-09-05	MD
3	REVISED S-5 PROFILE VIEW	05-18-09	PM

NOTES: 1. Refer to Plan View S-2 for weir location.

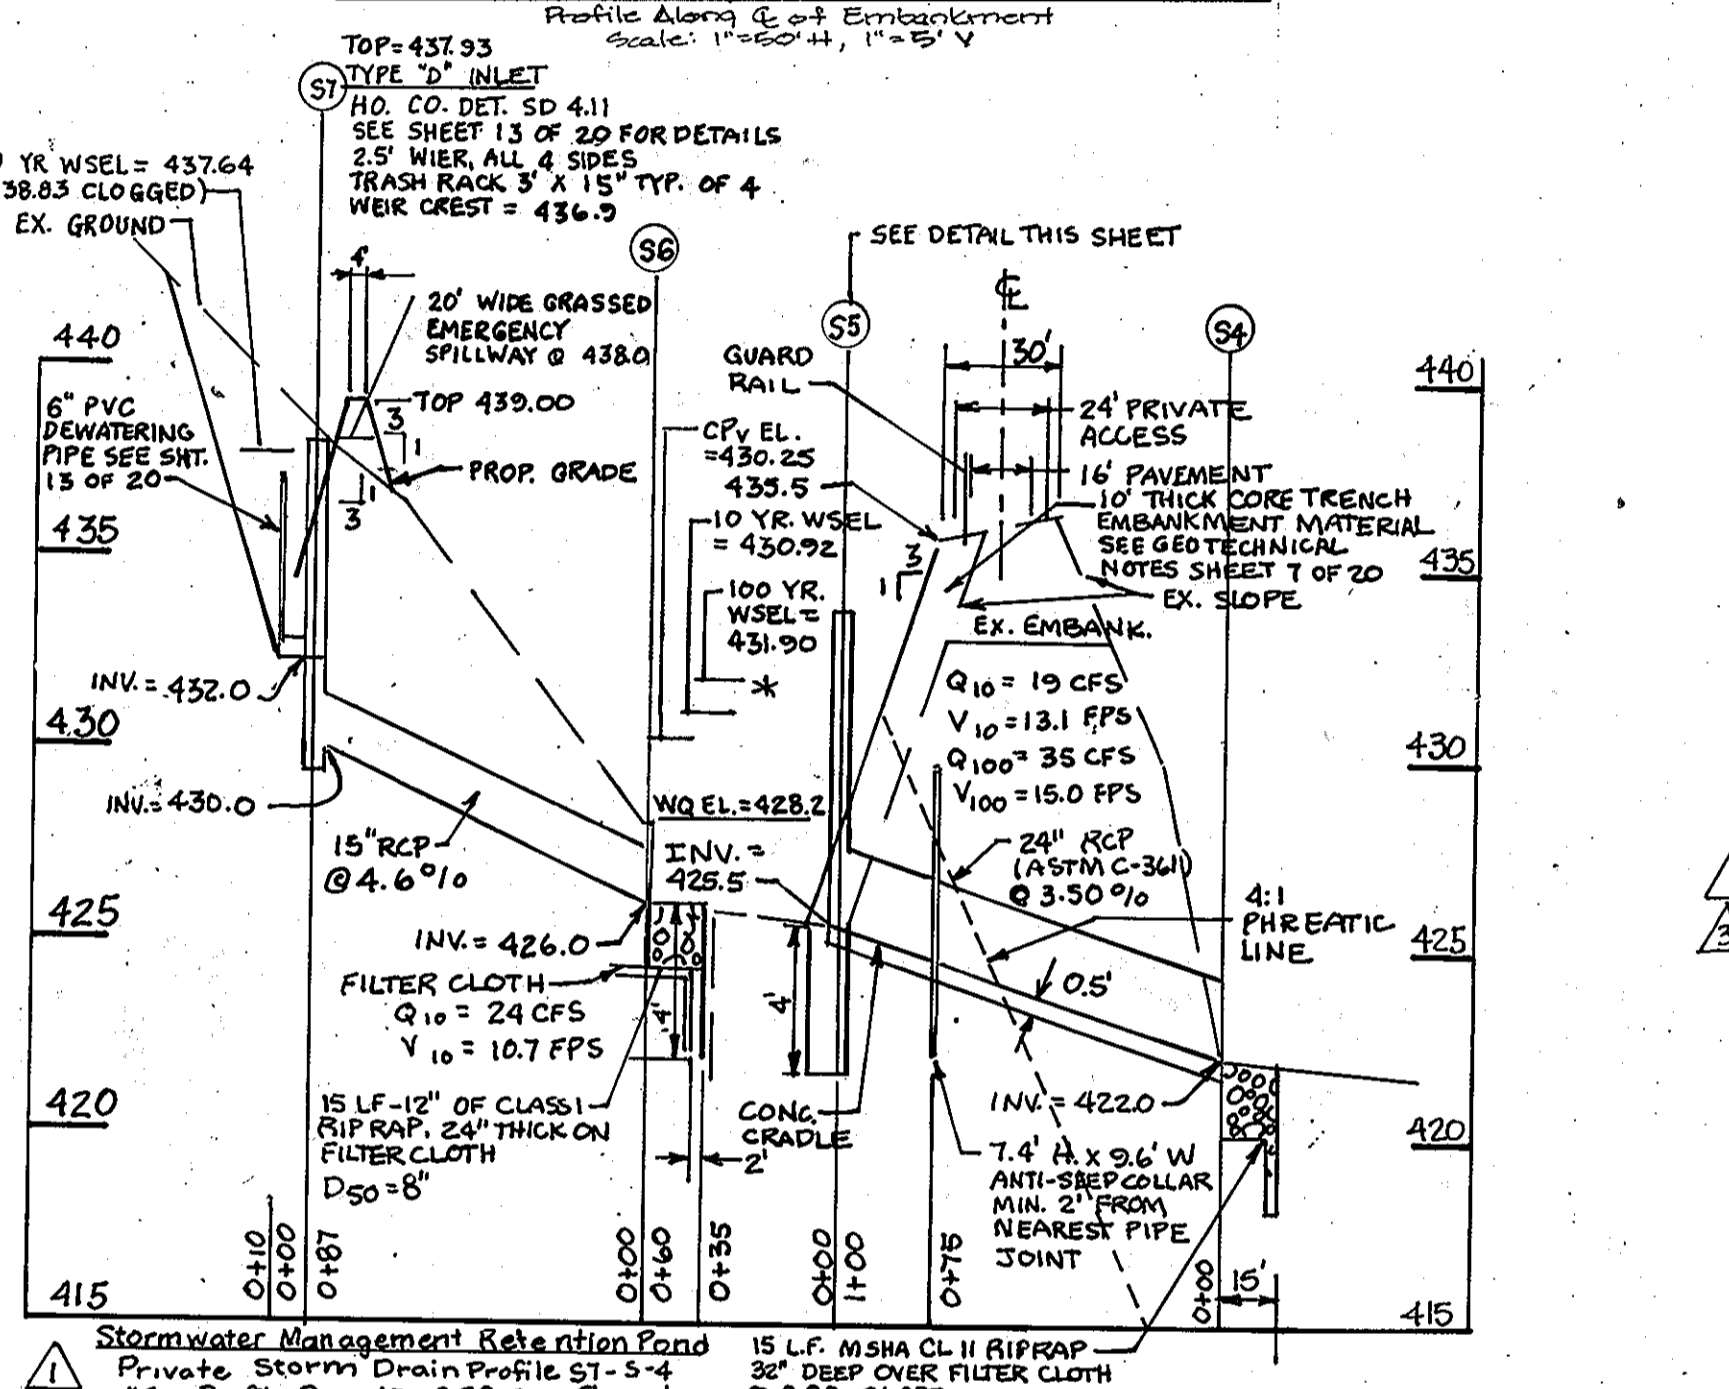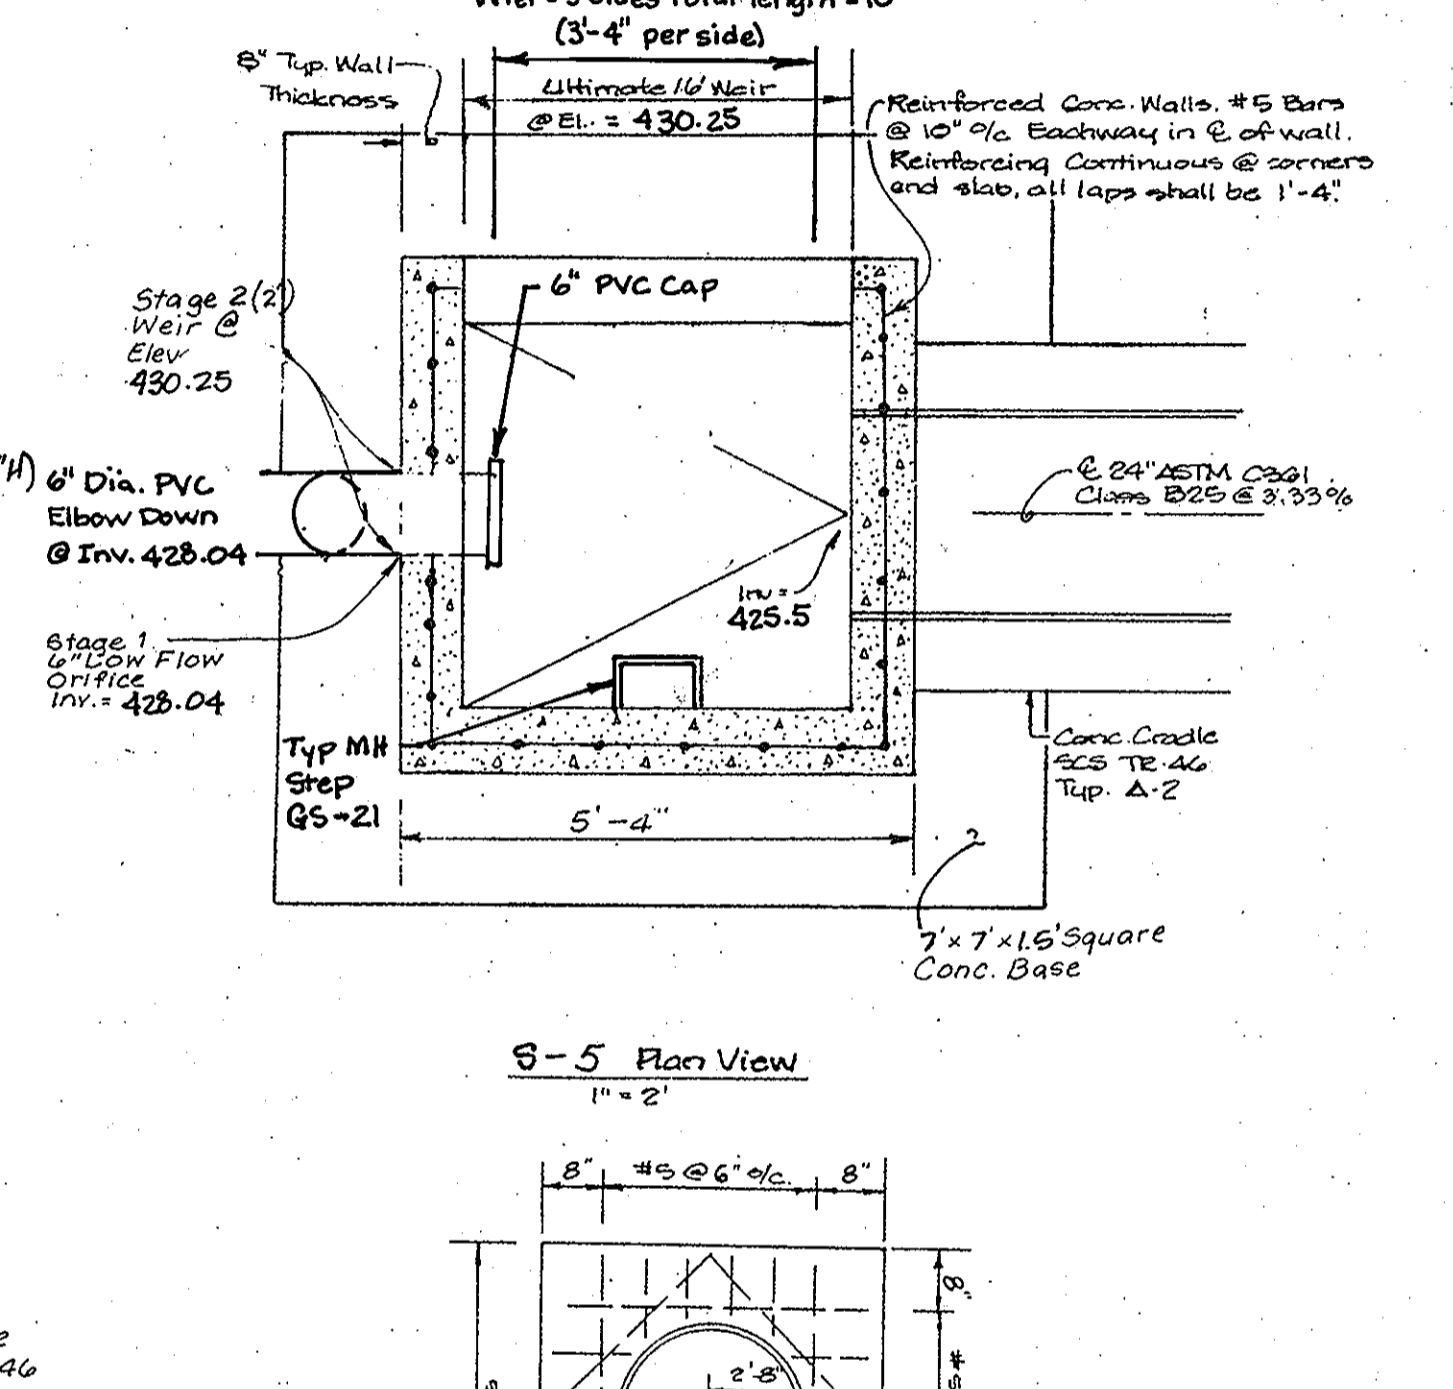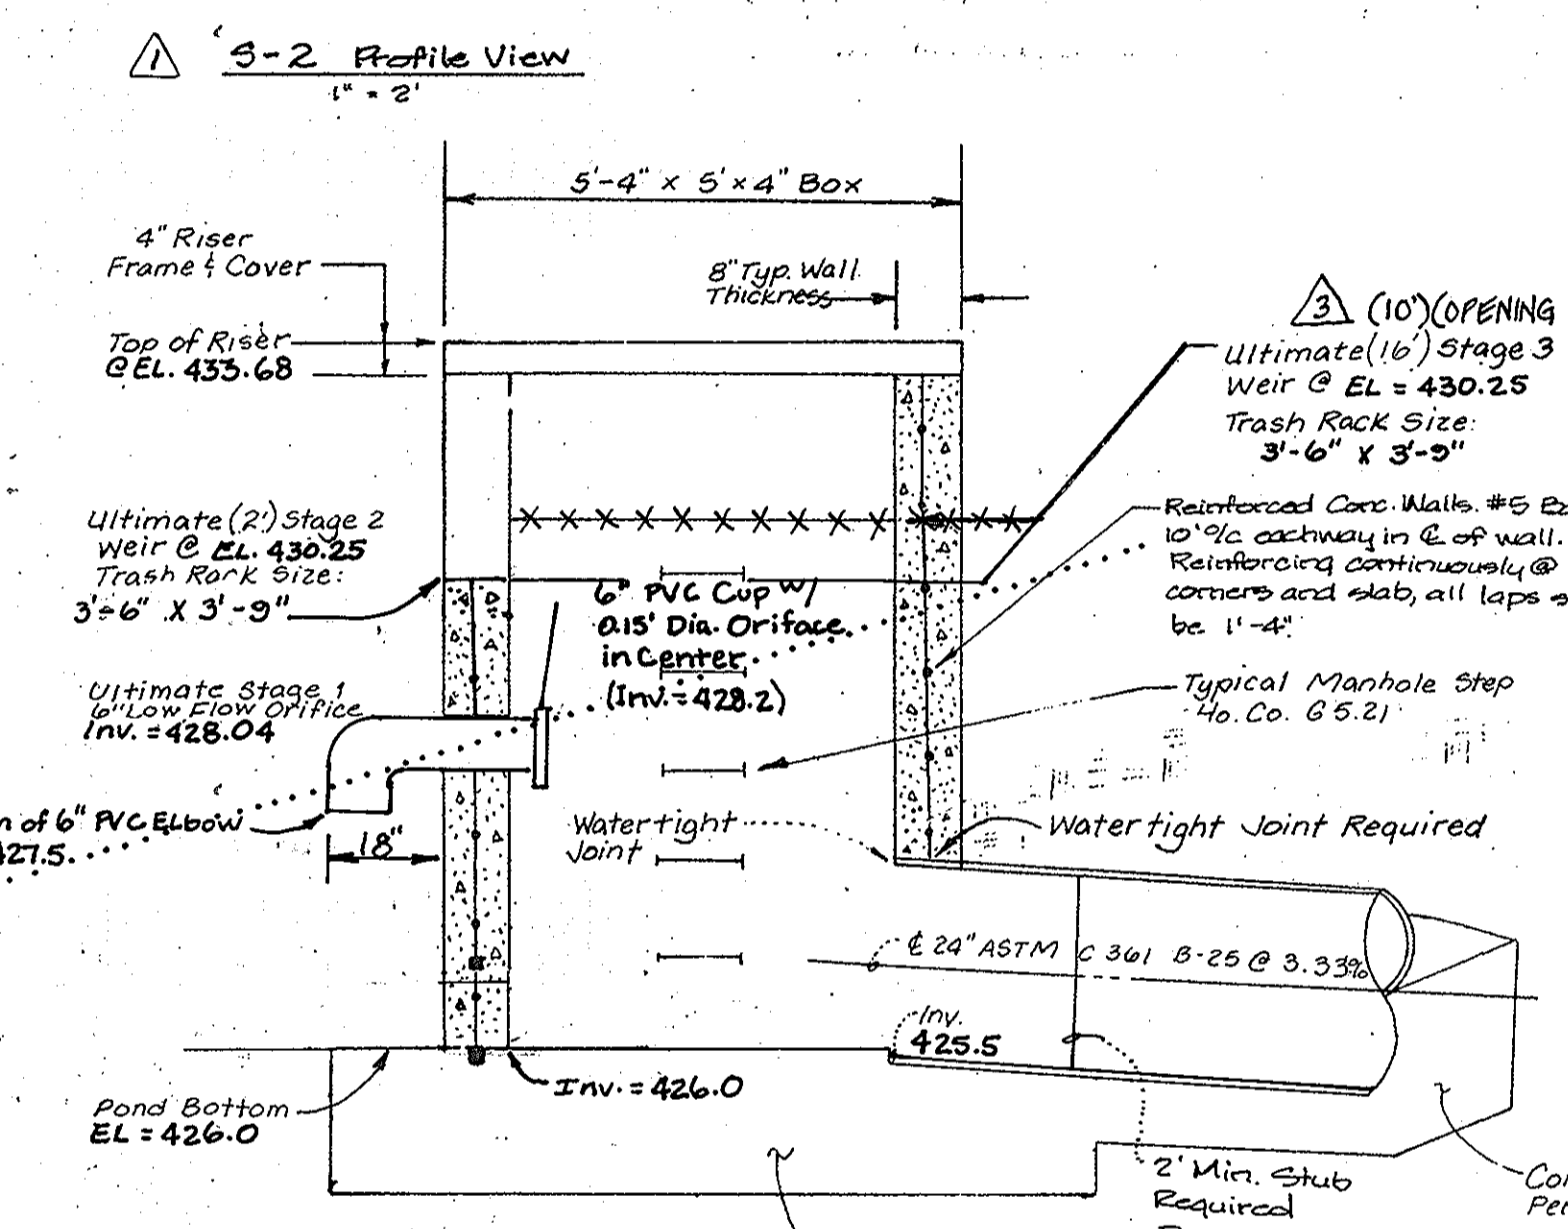

NOTES: 1. Refer to Plan View S-5 for weir location.

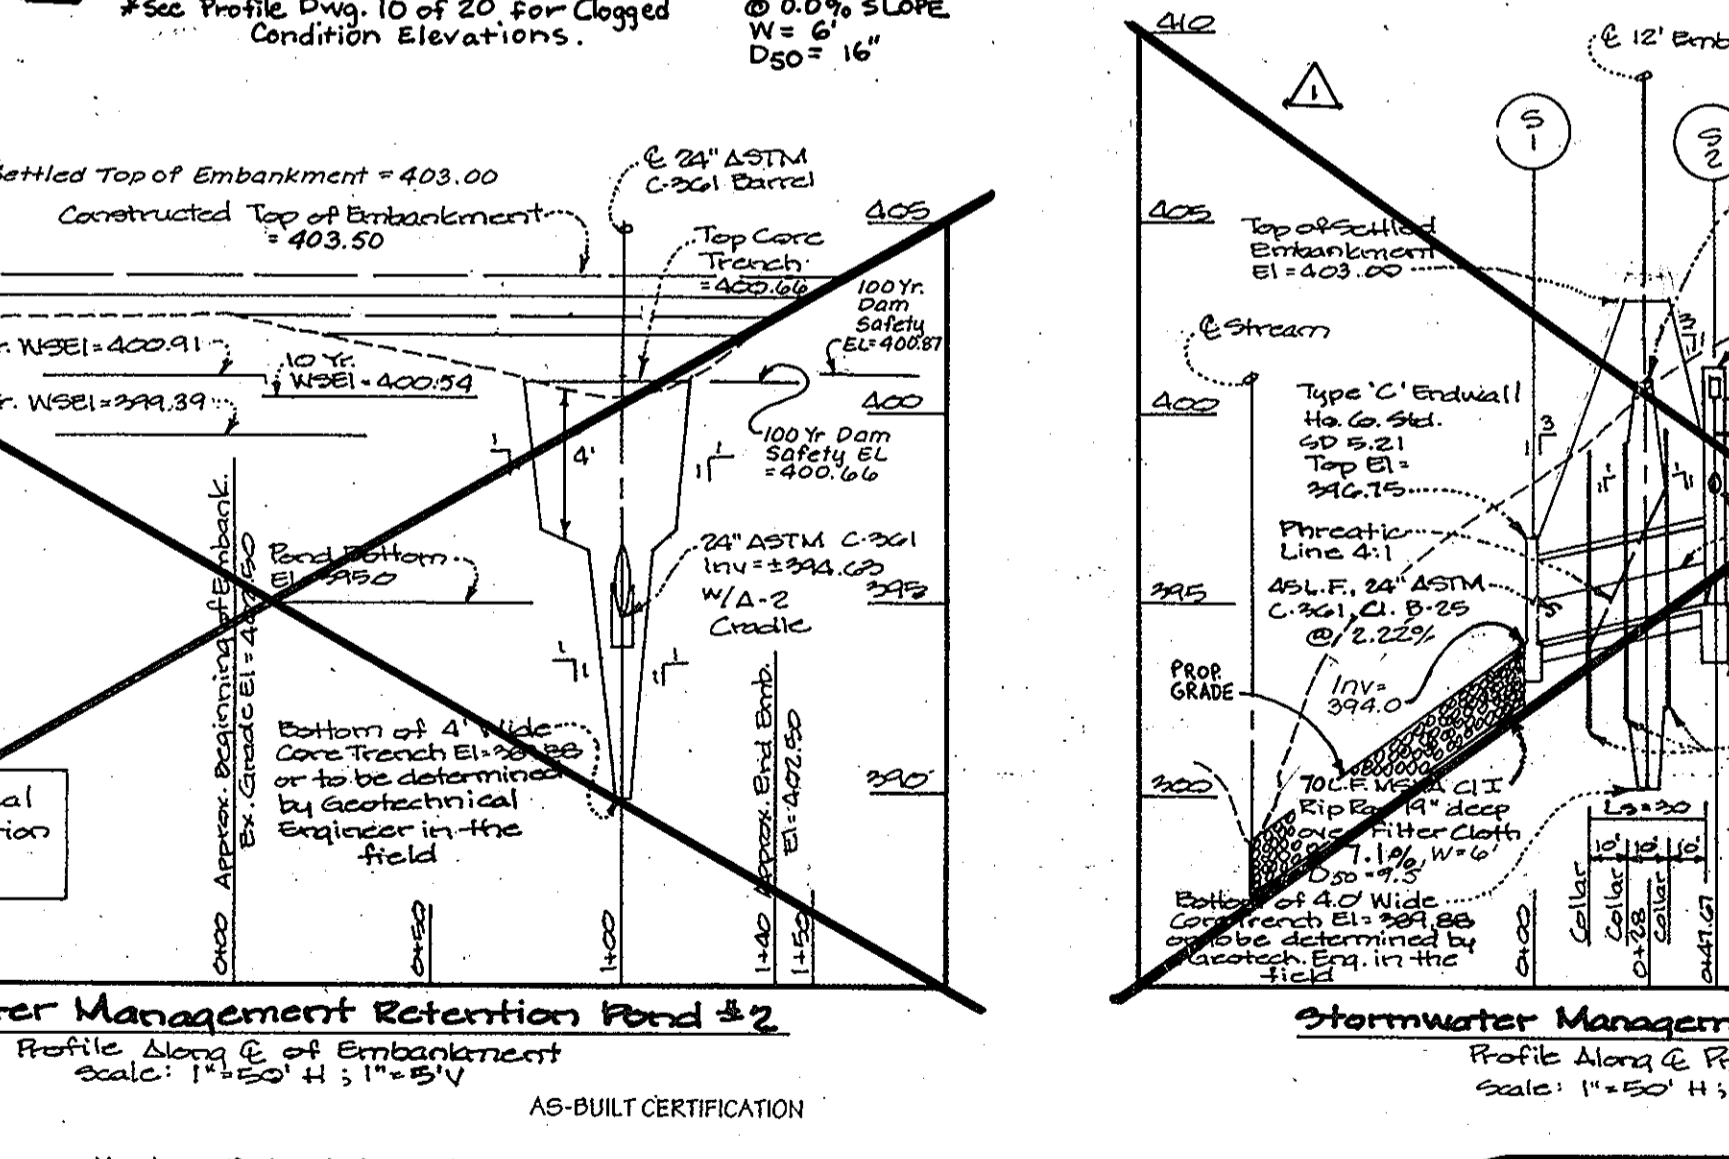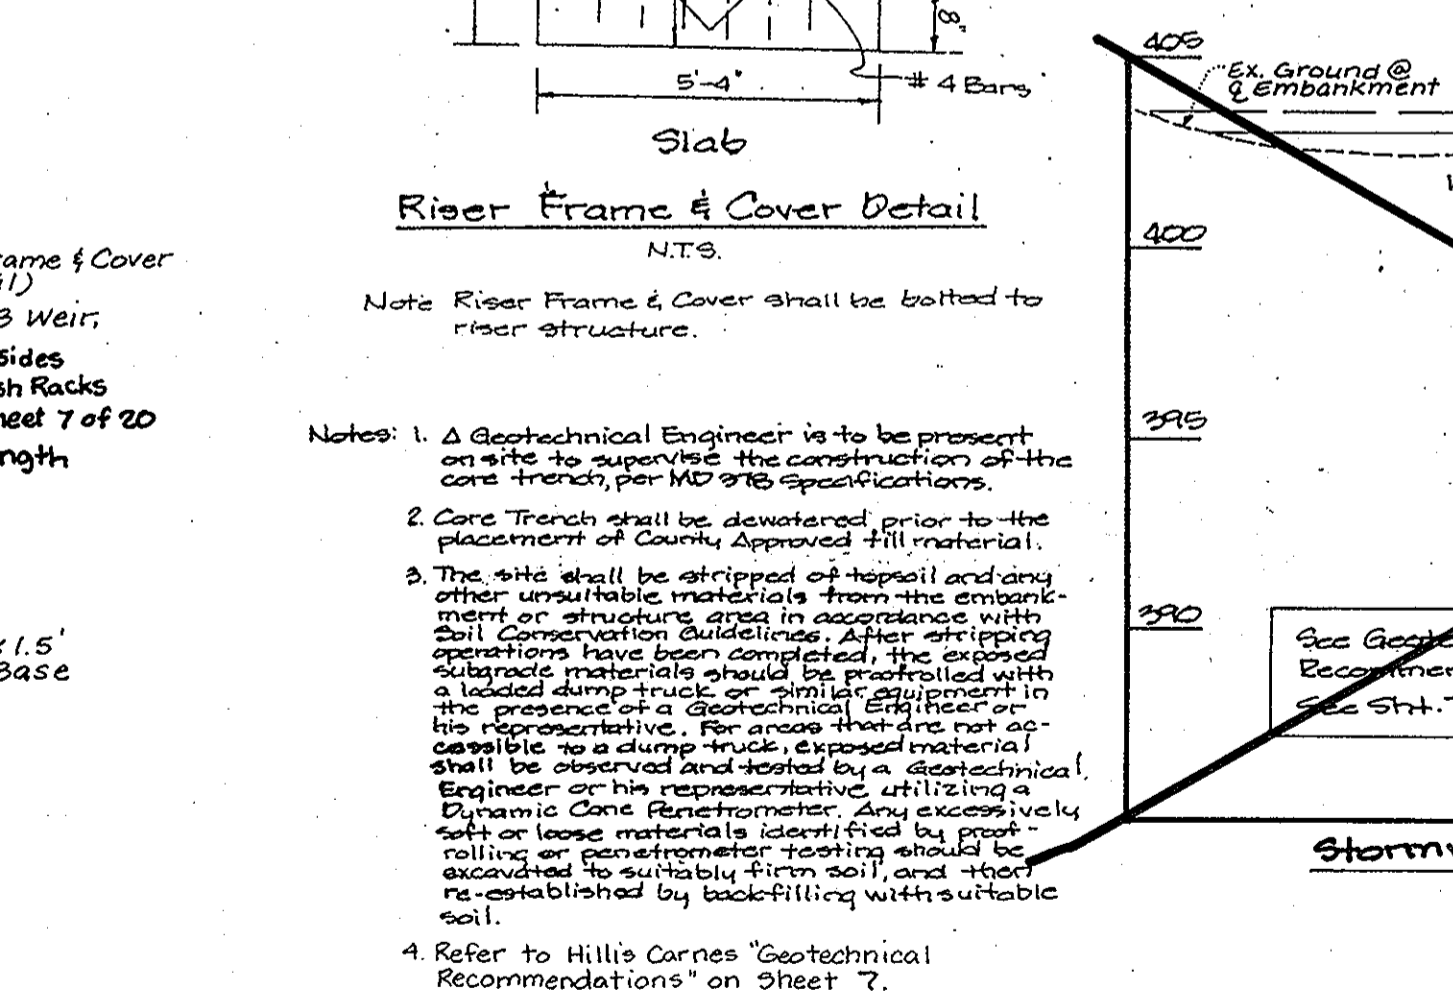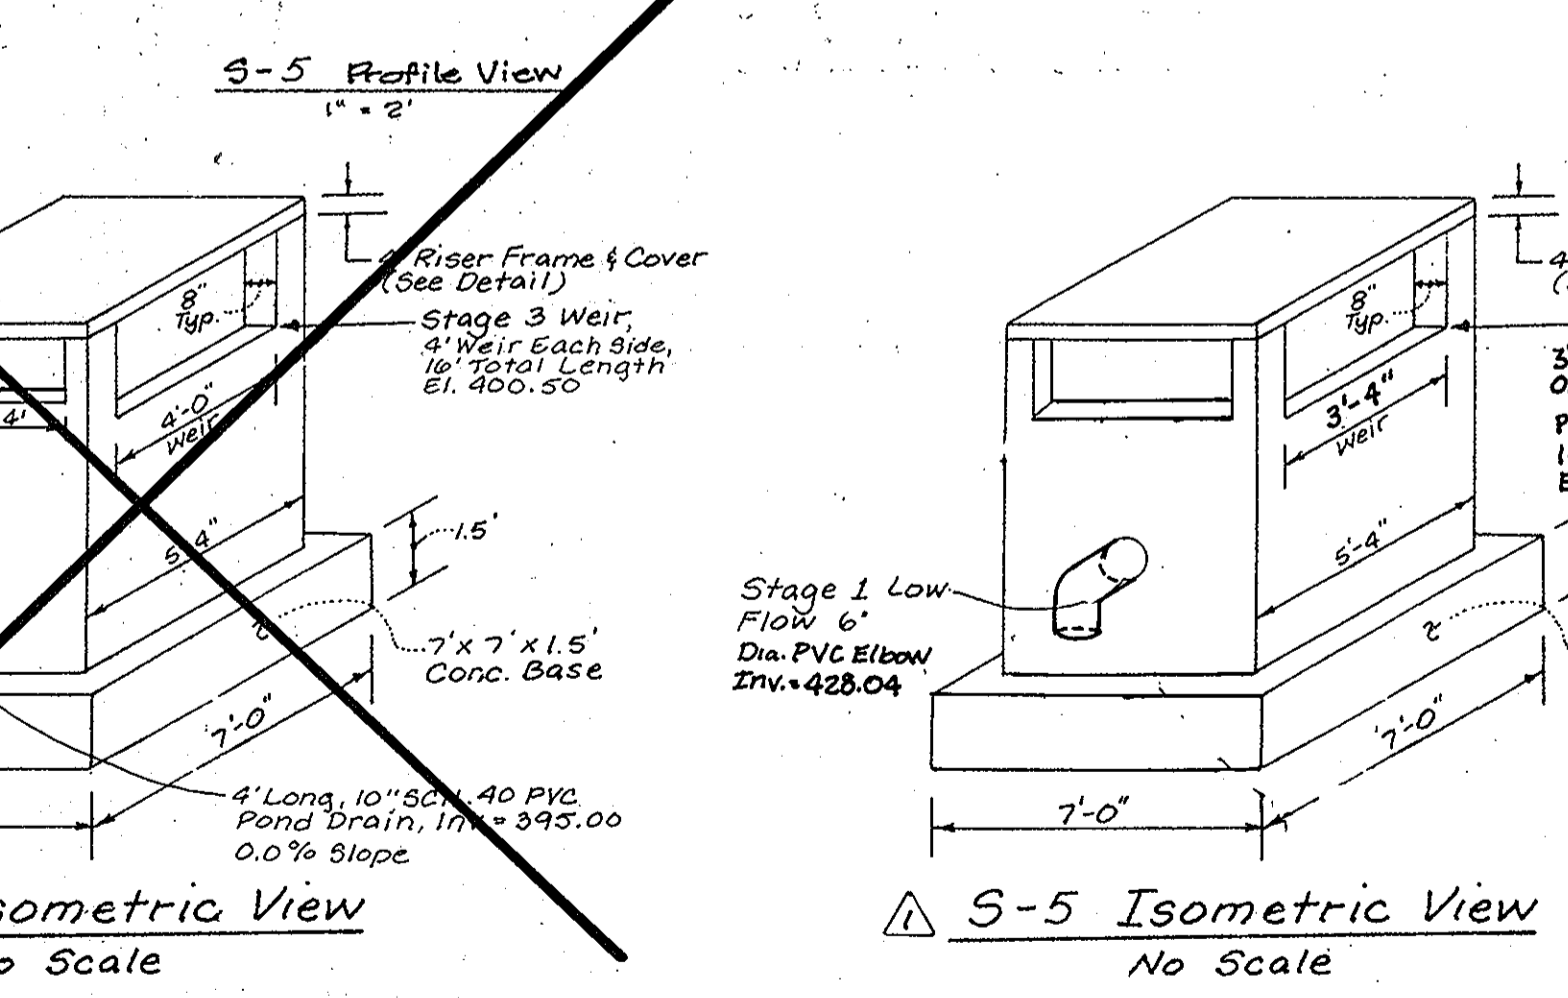

STATE OF MARYLAND
PIERO VAN MELLITS
 No. 21875
 REGISTERED PROFESSIONAL ENGINEER
 9-8-05

APPROVED: DEPARTMENT OF PLANNING AND ZONING
Chief, Development Engineering Division
 DATE: 6/26/00

THESE PLANS HAVE BEEN REVIEWED FOR THE HOWARD SOIL CONSERVATION DISTRICT AND MEET THE TECHNICAL REQUIREMENTS FOR SMALL POND CONSTRUCTION, SOIL EROSION, AND SEDIMENT CONTROL.
Chief, Natural Resource Conservation Service
 DATE: 5/18/00

ENGINEER'S CERTIFICATE
 I certify that this plan for pond construction...
Engineer
 DATE: 5/18/00

DEVELOPER'S CERTIFICATE
 I/We certify that all development and/or construction will be done according to these plans...
Developer
 DATE: 5/18/00

AS-BUILT CERTIFICATION
 I hereby certify that the facility shown on this plan was constructed as shown on the "as-built" plans and meets the approved plans and specifications.
Signature _____ **P.E. No.** _____
Date _____

LDE, INC.
 9250 Rumsey Road, Suite 106, Columbia, MD. 21045
 (410) 715-1070 (301) 596-3424 (410) 715-9540 (Fax)

Stormwater Management Details & Notes

Scott Farm
 Lots 29-42 and Open Space Lots 27, 28, 43 & 44

Tax Map No. 35 - P/O Parcel 354
 5th Election District - Howard County, Maryland

Previous Submittals: 776-104, 784-144, 787-162, 507-23, 8491-24X, 895-10, 898-23, 930-13 & 938-04

Owmer/Developer: **Scarlet Wilkinson & Earl Omer**
 6708 Guilford Road
 Clarksville, Maryland 21029
 (410) 531-2826 or (410) 987-0497

DESIGNED	S.D.H.	SCALE	As Shown
DRAWN	CADD	DRAWING	8 of 20
CHECKED	B.D.B.	JOB NO.	98009
DATE	11/99	FILE NO.	F-00-73

WPD 5.2: UTILITY CROSSING

Temporarily install construction:



DESCRIPTION The work shall consist of installing erosion control devices in and adjacent to the construction of utility crossings.

MATERIAL SPECIFICATIONS Materials for sandbag and stone stream diversion structures shall meet the following requirements:

- Riprap shall be washed and have a minimum diameter of 6 inches (15 centimeters).
- Sandbags shall consist of materials which are resistant to ultraviolet radiation, tearing, and puncture and shall be woven tightly enough to prevent leakage of the fill material (i.e., sand, fine gravel, etc.).


INSTALLATION GUIDELINES All erosion and sediment control devices, including diverting basins, shall be implemented as the first order of business according to a plan approved by the Water Management Administration (WMA). (See Maryland Standards and Specifications for Sediment Control.) The proposed construction sequence is as follows (refer to the attached figures):

- The contractor shall ensure that a continuous perimeter control barrier is in place to minimize the amount of pollutants entering the flow.
- Excavated topsoil and subsoil shall be kept separate, placed on the upland side of the excavation, and replaced in their natural order.
- All construction shall take place during stream low flows. The length of construction time shall be limited to a maximum of 5 days for each crossing.
- All utility crossings shall be placed a minimum of 3 feet (1 meter) beneath the structure unless an alternative section is specifically approved by the WMA. (For instances where a 3-foot cover is not visible, two alternate stabilization options are given in the attached detail.)
- The stream shall be diverted by an approved temporary stream diversion, the construction area shall be dewatered, and any disturbed banks shall be stabilized. (The contractor may elect to construct the utility crossing in two stages. In this case, a WMA approved flow barrier may be constructed to keep the construction area dry.)
- Once the crossing is completed, the diversion shall be removed from upstream to downstream. Sediment control devices, including perimeter erosion controls, are to remain in place until all disturbed areas are stabilized in accordance with an approved sediment and erosion control plan and the inspection authority approves their removal.

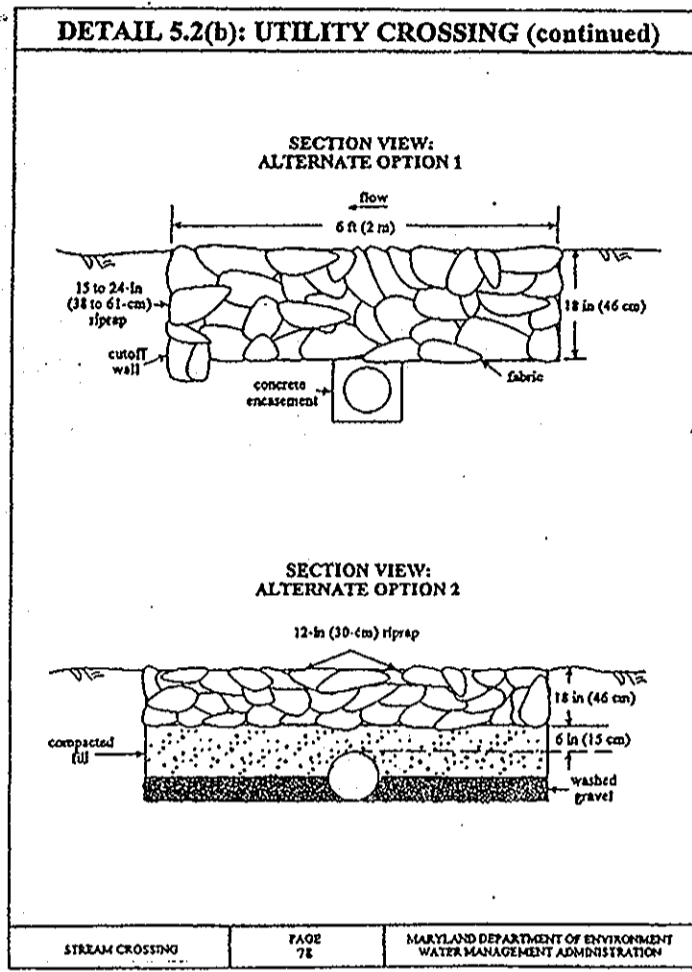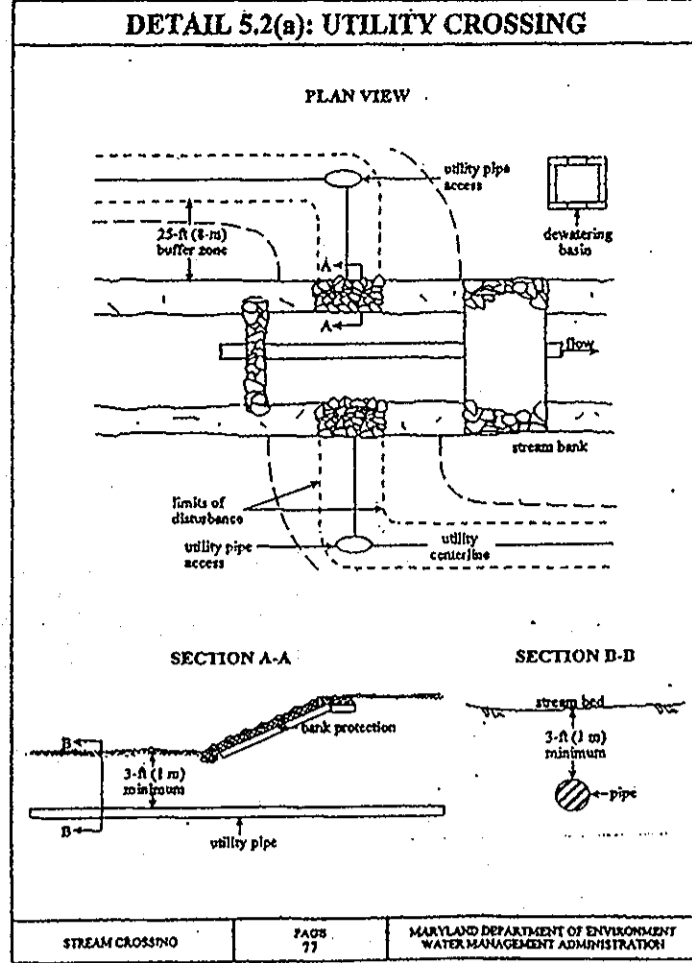


STREAM CROSSING DETAILS FOR PROPOSED 8" SEWER CROSSING SHOWN ON SHEET 10 OF 18.

Trap No.	Max. D.A. Acres	Dry Stor. Req'D ft ³	Wet Stor. Req'D ft ³	Dry Stor. Prov'D ft ³	Wet Stor. Prov'D ft ³	Stor. Depth ft.	Weir Length ft.	Bottom Elev. ft.	Clean. Elev. ft.	Top Embank. Elev. ft.	Weir Inv. Elev. ft.	Weir Depth Elev. ft.	Trap Size	Type	Outlet Elev. ft.	Wet Storage Elev. ft.	Dry Storage Elev. ft.
1	2.66	4788	4788	6275	6275	5	6.0	455.10	457.40	461.60	1.5	425.04	see plan	ST-II	458.20	458.2	460.10

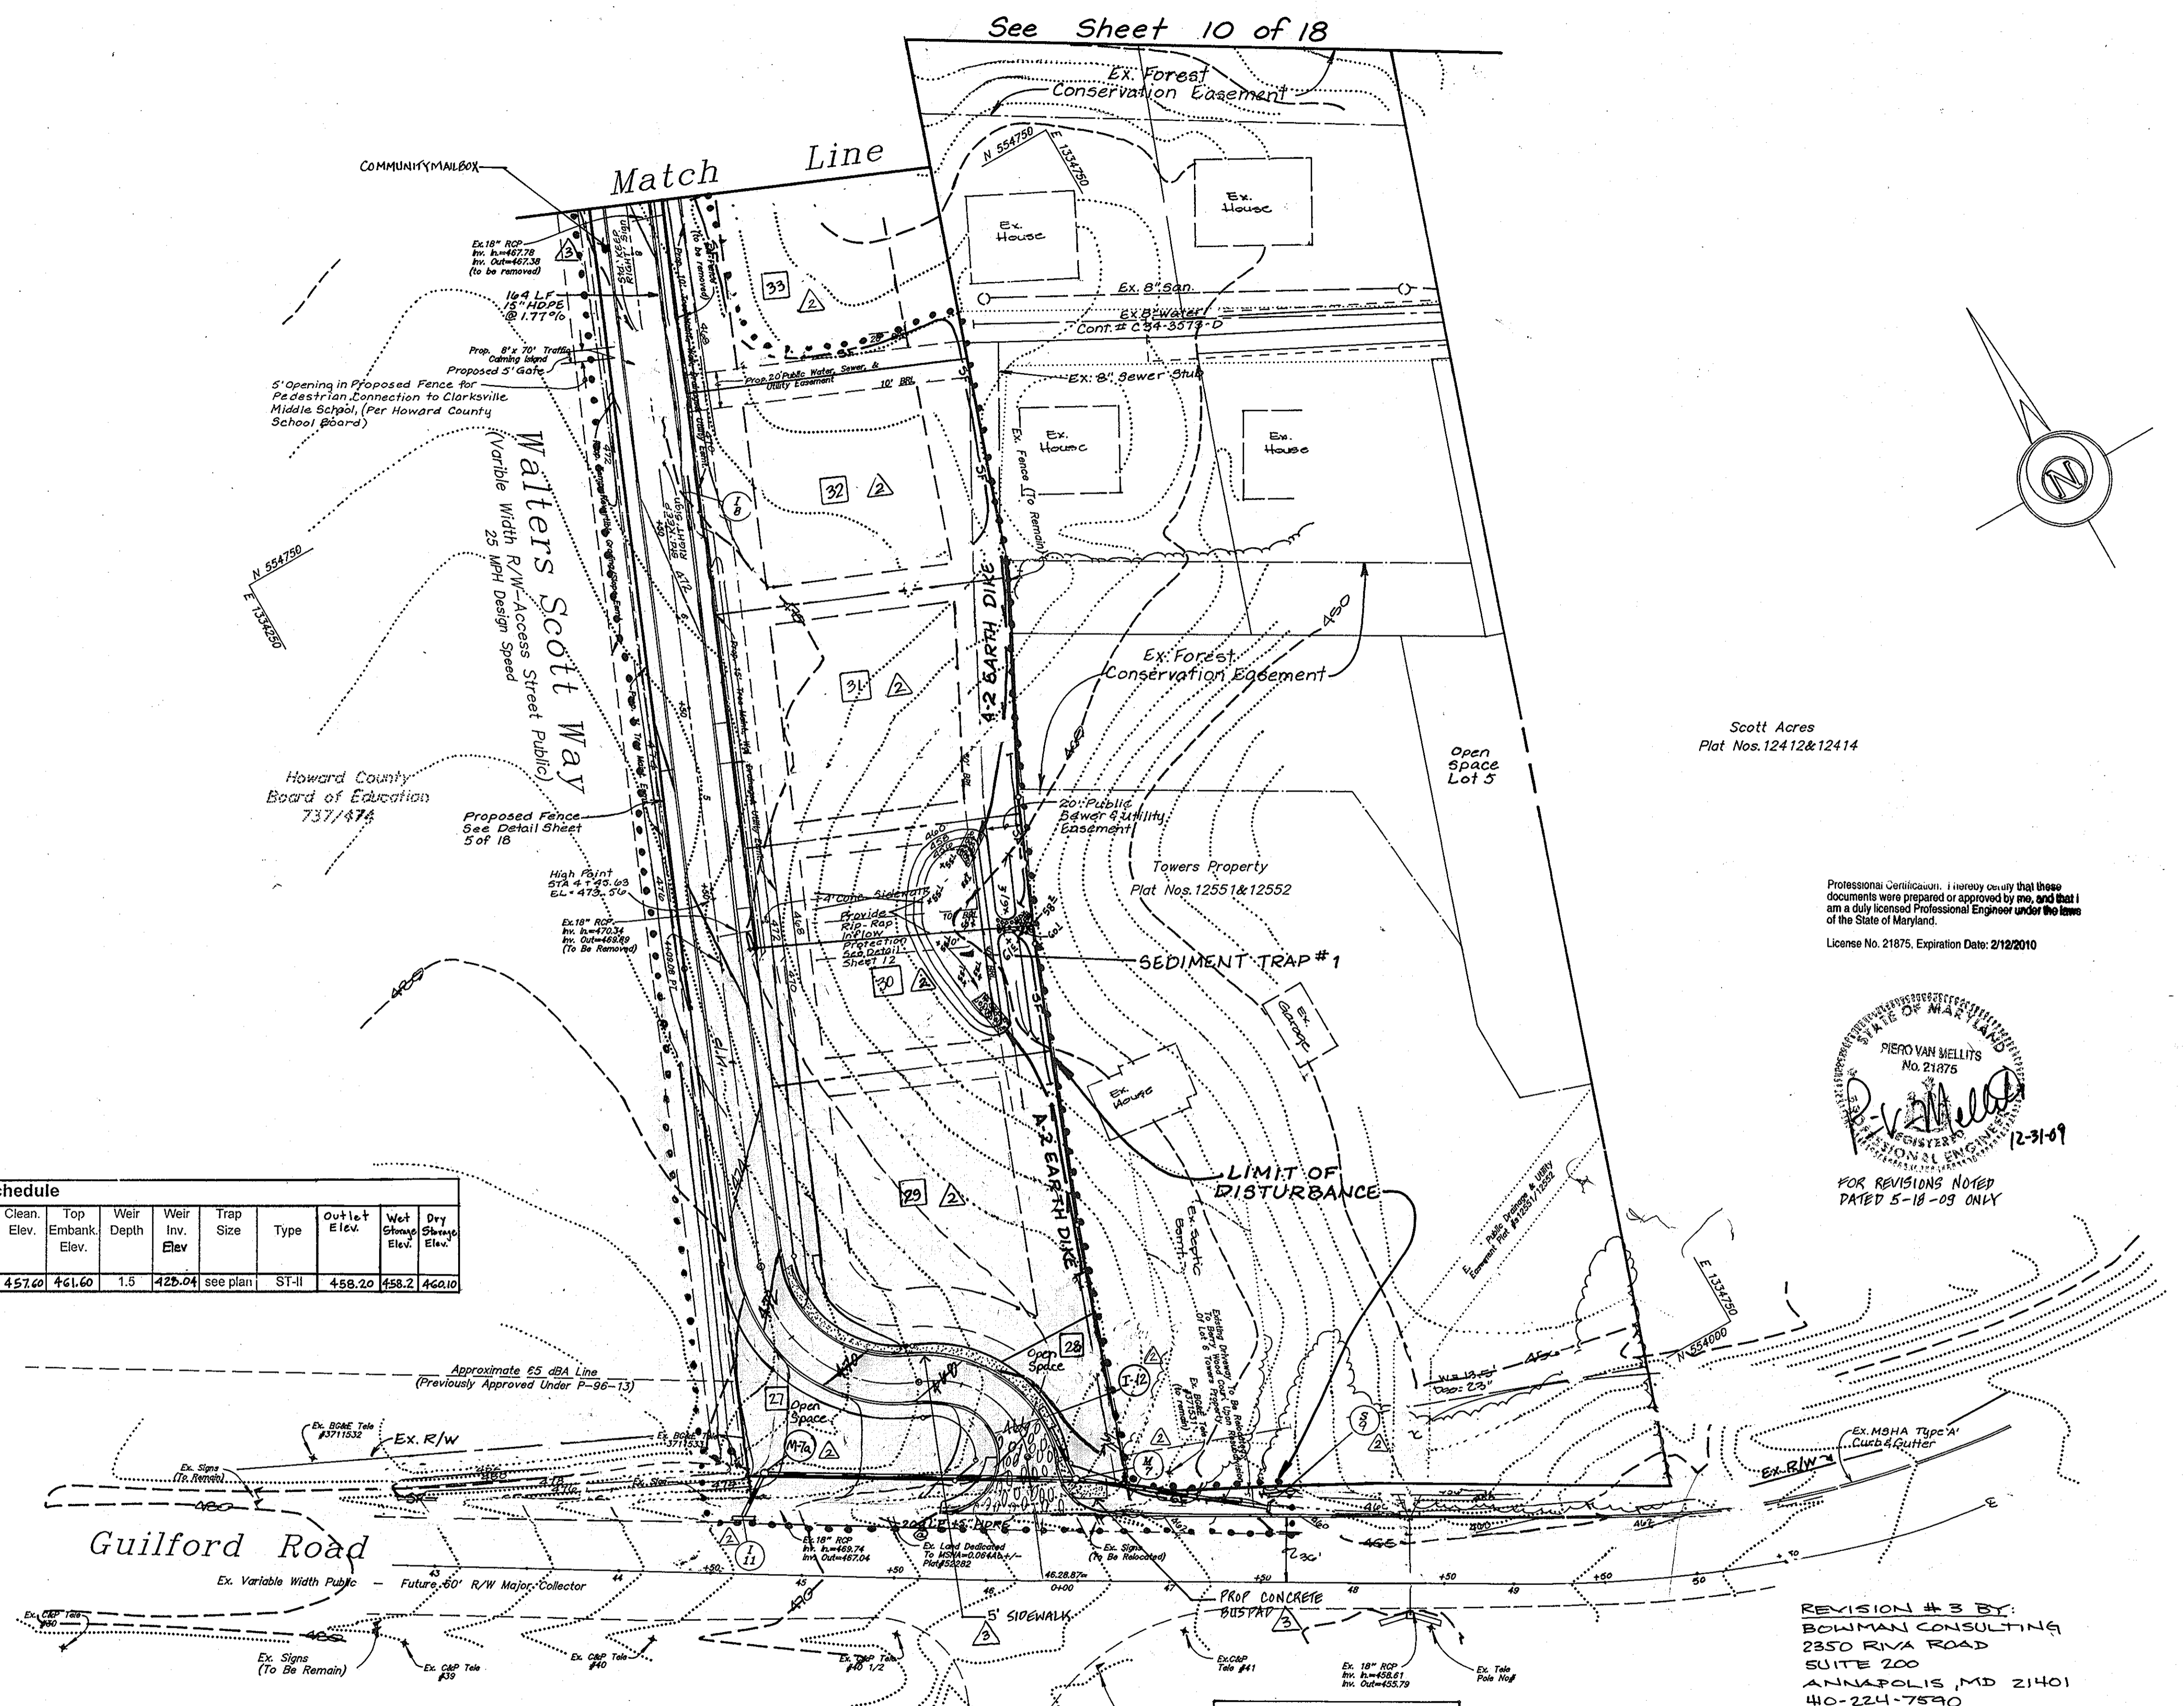

Professional Certification: I hereby certify that these documents were prepared or approved by me, and that I am a duly licensed Professional Engineer under the laws of the State of Maryland.
License No. 21875, Expiration Date: 2/18/2010

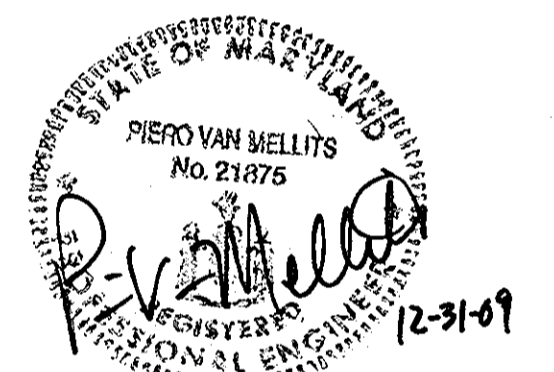

FOR REVISIONS NOTED DATED 5-18-09 ONLY

REVISION # 3 BY:
BOWMAN CONSULTING
2850 RIVA ROAD
SUITE 200
ANNAPOLIS, MD 21401
410-224-7590

APPROVED: DEPARTMENT OF PLANNING AND ZONING
DATE: 6/20/09
APPROVED: Department of Public Works for Storm Drainage Systems and Roads
DATE: 8-26-00

THESE PLANS HAVE BEEN REVIEWED FOR THE HOWARD SOIL CONSERVATION DISTRICT AND MEET THE TECHNICAL REQUIREMENTS FOR SMALL POND CONSTRUCTION, SOIL EROSION, AND SEDIMENT CONTROL.
DATE: 5/18/00
THESE PLANS FOR SMALL POND CONSTRUCTION, SOIL EROSION, AND SEDIMENT CONTROL, MEET THE REQUIREMENTS OF THE HOWARD COUNTY SOIL CONSERVATION DISTRICT
DATE: 5/18/00

ENGINEER'S CERTIFICATE
I certify that all development and/or construction will be done according to these plans, and that my responsibility as a Professional Engineer is to ensure that the project will have a Certificate of Approval from the Department of the Environment Approved Training Program...
DATE: 5/19/00

DEVELOPER'S CERTIFICATE
I certify that this plan for pond construction, erosion and sediment control represents a practical and workable plan based on my personal knowledge of the site conditions...
DATE: 11-11-99

STATE OF MARYLAND
PROFESSIONAL ENGINEER
DAVID J. BURTON
DATE: 5/19/00

STATE OF MARYLAND
PROFESSIONAL ENGINEER
DATE: 5/19/00

REVISION #1 BY: CENTURY ENGINEERING INC.
30 WEST POPE TOWNSHIP, MD 21024
410-829-0070

REVISION #2 BY: CENTURY ENGINEERING INC.
30 WEST POPE TOWNSHIP, MD 21024
410-829-0070

REVISION #3 BY: BOWMAN CONSULTING
2850 RIVA ROAD
SUITE 200
ANNAPOLIS, MD 21401
410-224-7590

LDE, INC.
9250 Rumsey Road, Suite 106, Columbia, MD. 21045
(410) 715-1070 (301) 596-3424 (410) 715-9540 (Fax)

Grading & Erosion & Sediment Control Plan

Scott Farm
Lots 29 to 42 and Open Space Lots 27, 28, 43 & 44

Tax Map No. 35 - P/O Parcel 354
5th Election District - Howard County, Maryland

Owner/Developer: Scarlett Williams & Earl Omer
6700 Guilford Road
Clarksville, Maryland 21029
(410) 531-2828 or (410) 987-0497

SCALE: 1" = 50'
DRAWING: 9 of 20
JOB NO.: 98009
FILE NO.: F-00-73

DESIGNED: S.D.H.
DRAWN: CADD STB
CHECKED: B.D.B.
DATE: 11/99

DATE: 5-18-09
DATE: 09-09-05
DATE: 9-19-01
DATE: 11-11-99

THESE PLANS HAVE BEEN REVIEWED FOR THE HOWARD SOIL CONSERVATION DISTRICT AND MEET THE TECHNICAL REQUIREMENTS FOR SMALL POND CONSTRUCTION, SOIL EROSION AND SEDIMENT CONTROL.

Jim Myer / 08 9/26/05
 NATURAL RESOURCE CONSERVATION SERVICE

THESE PLANS FOR SMALL POND CONSTRUCTION, SOIL EROSION AND SEDIMENT CONTROL MEET THE REQUIREMENTS OF THE HOWARD COUNTY SOIL CONSERVATION DISTRICT.

John A. ... 9/26/05
 HOWARD COUNTY SOIL CONSERVATION DISTRICT

ENGINEER'S CERTIFICATE
 I certify that this plan for pond construction and sediment control represents a practical and verifiable plan based on my personal knowledge of the site conditions. This plan was prepared in accordance with the requirements of the Howard Soil Conservation District and I have certified the engineer that he/she shall engage a registered professional engineer to supervise pond construction and provide the Howard Soil Conservation District with an "as-built" plan of the pond within 30 days of completion.

Charles Sten 9/26/05
 SIGNATURE OF ENGINEER

DEVELOPER'S CERTIFICATE
 I/We certify that all development and/or construction will be done according to these plans, and that my responsible personnel involved in the construction project will have a Certificate for Attendance of a Department of the Environment Approval Training Program for the Control of Sediment and Erosion before beginning the project. I shall engage a registered professional engineer to supervise pond construction and provide the Howard Soil Conservation District with an "as-built" plan of the pond within 30 days of completion. I also authorize the periodic onsite inspection by Howard Soil Conservation District.

Scott H. ... 9/15/05
 SIGNATURE OF ENGINEER

APPROVED: DEPARTMENT OF PLANNING AND ZONING


[Signature] 10/10/05
 CHIEF, DEVELOPMENT ENGINEERING DIVISION

[Signature] 10/23/05
 CHIEF, DIVISION OF LAND DEVELOPMENT

[Signature] 10-14-05
 CHIEF, BUREAU OF HIGHWAYS

FOR REVISIONS NOTED DATED 5-18-09 ONLY

PIERO VAN MELLITS
 No. 21875
 REGISTERED PROFESSIONAL ENGINEER
 License No. 21875, Expiration Date: 2/12/2010

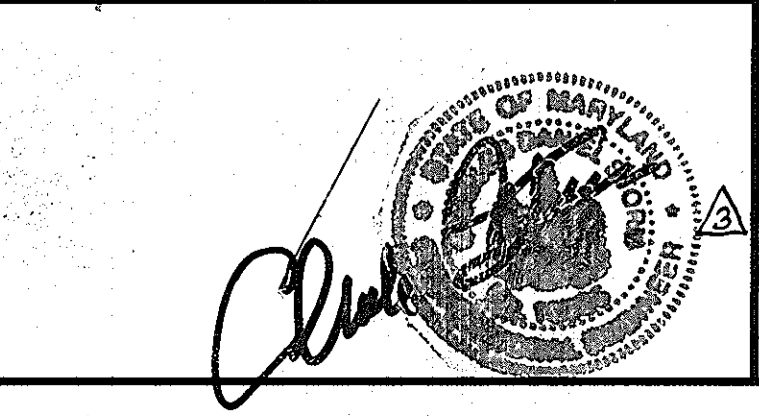

No.	REVISION	DATE	BY
1	Shows realignment of private road & resubdivision of lots. Added trash pad, rip rap channel, Revised SWM Pond 1 & storm drain layout. Added notes, legend, shaded core material & embankment toe. Revised title block & added purpose statement.	09-09-05	KD
3	REVISED TREE TOLERANCE INCLUDING BOLLARD LOCATIONS & PUMP/STRIKER ENCLOSURE, ADDED COMMUNITY MAILBOX, AND SWM CONC. SWANES	5-18-09	PM

REVISION # 3 BY:
 BOWMAN CONSULTING
 2350 RIVA ROAD, SUITE 200
 ANNAPOLIS, MD 21401
 410-224-7590





ENGINEERS • PLANNERS • SCIENTISTS • SURVEYORS
GREENHORNE & O'MARA, INC.
 200 HARRY S TRUMAN PKWY. SUITE-200 ANNAPOLIS, MARYLAND 21401
 (410) 266-0066











Greenbelt, MD - Annapolis, MD - Atlanta, GA - Fairfax, VA - Fredericksburg, VA - Mechanicsburg, PA
 Raleigh, NC - Rockville, MD - Tampa, FL - West Palm Beach, FL

GRADING, SOIL, SEDIMENT AND EROSION CONTROL PLAN
 REVISED FINAL ROAD CONSTRUCTION PLAN
SCOTT FARM
 LOTS 29-42 and Open Space Lots 27, 28, 43 & 44
 TAX MAP NO. 35 P/O PARCEL 35A

5th ELECTION DISTRICT
 HOWARD COUNTY, MARYLAND

CF DESIGN	SCALE	1" = 50'
LMM DRAWN	10	OF 20
GRK CHECKED	SHEET	
OCT, '04 DATE	PROJ No.	F-00-73 FILE No.

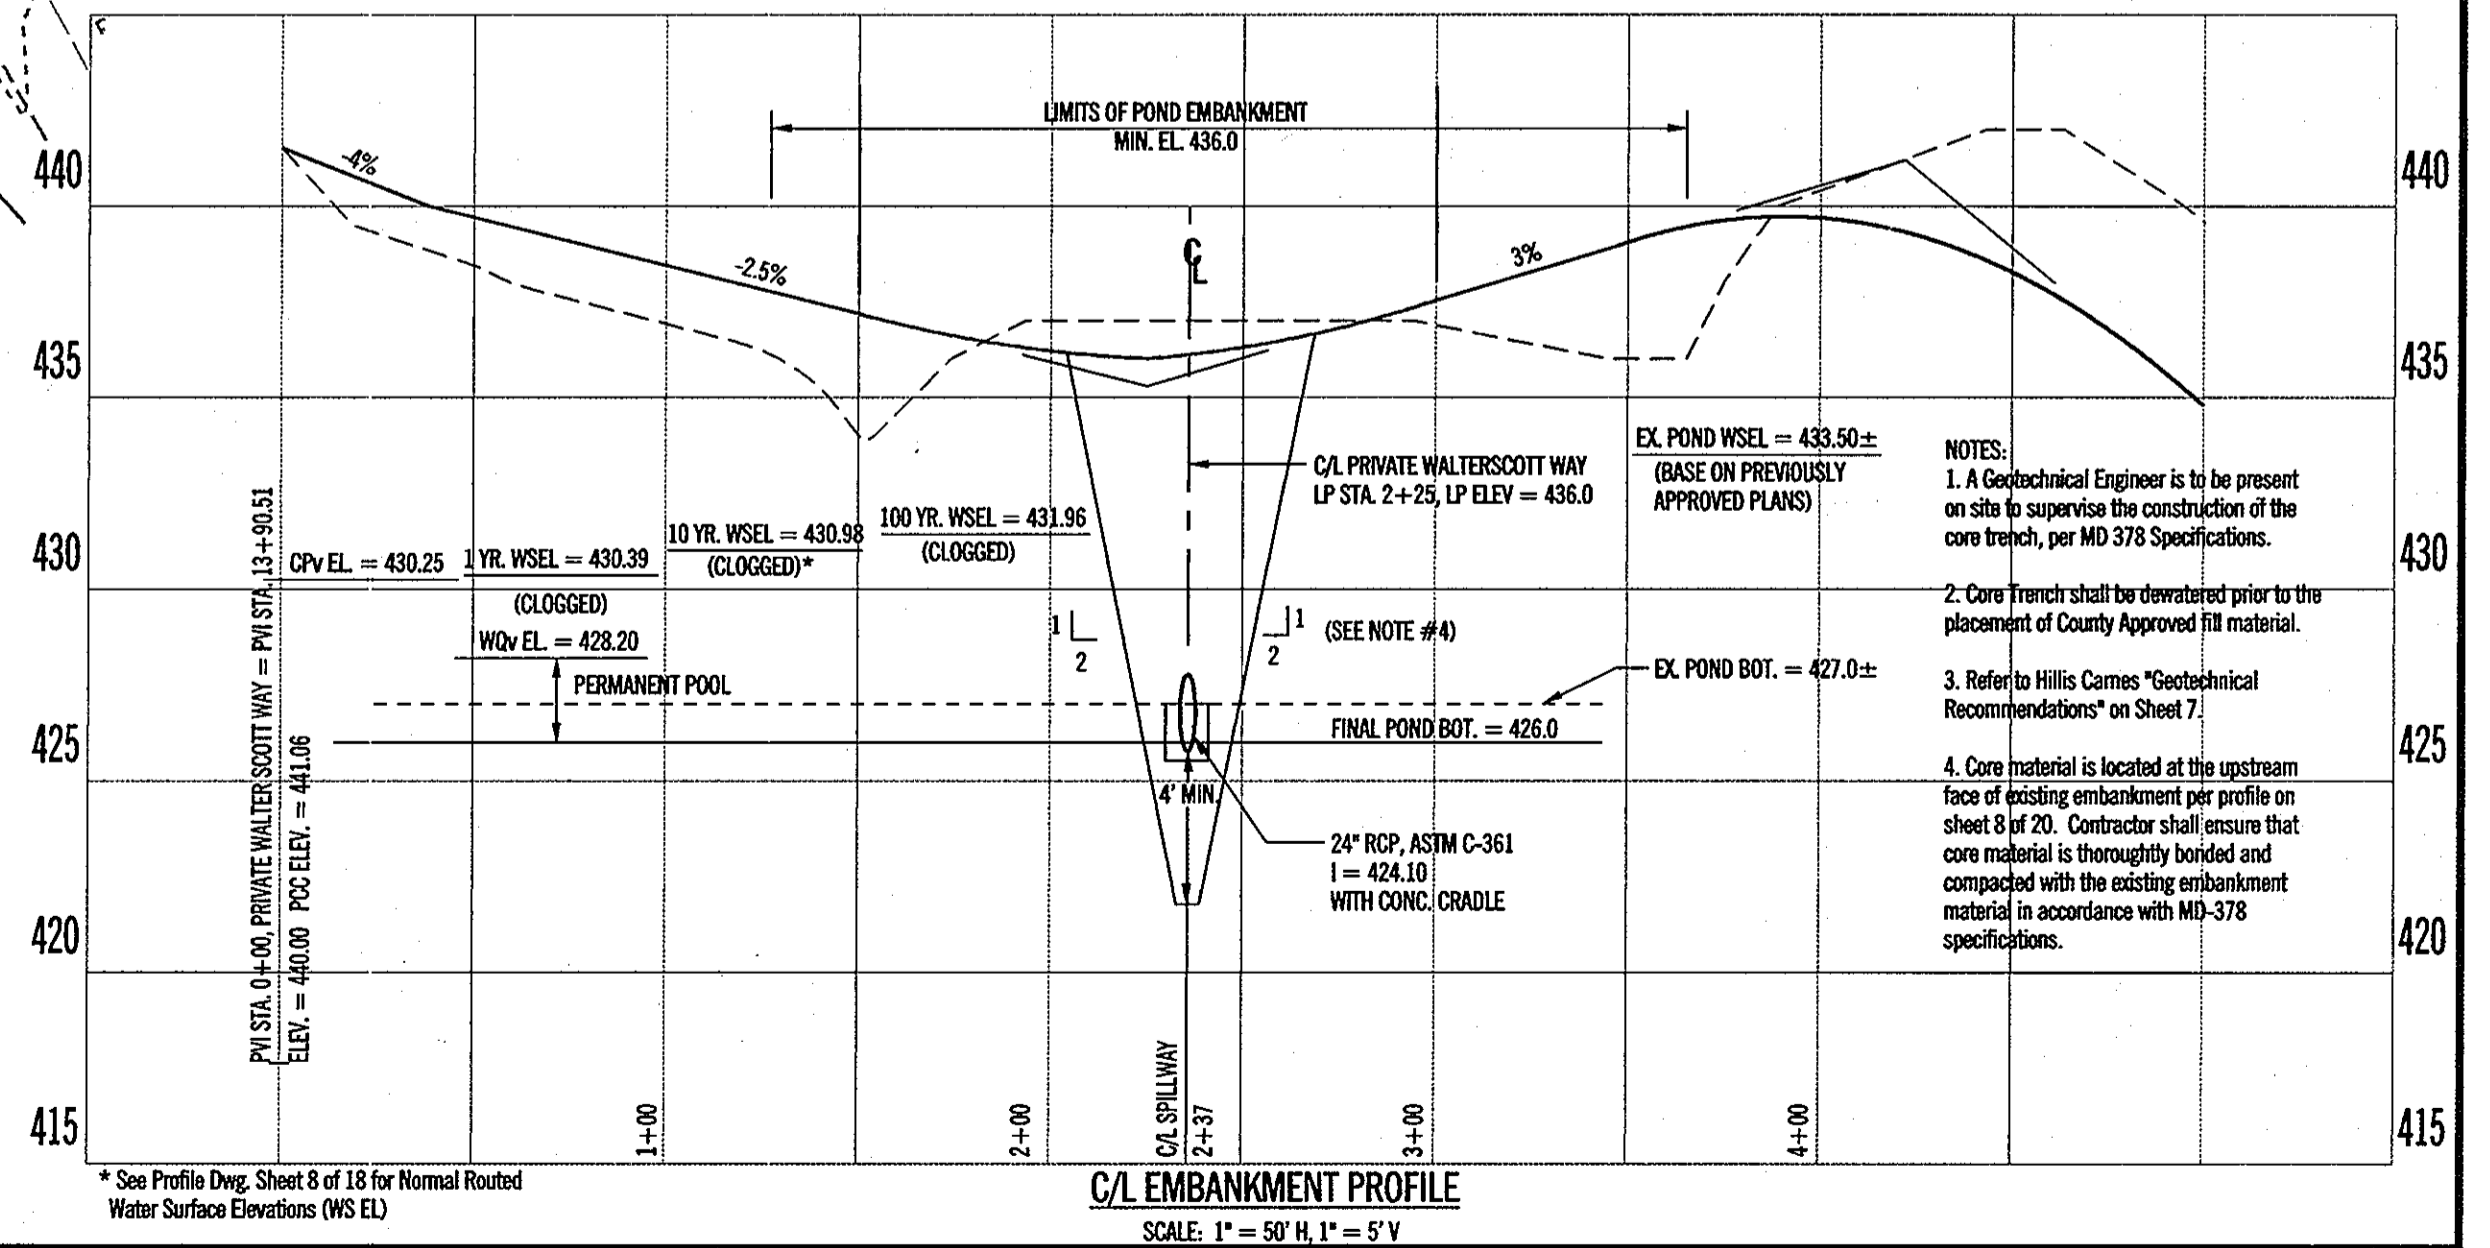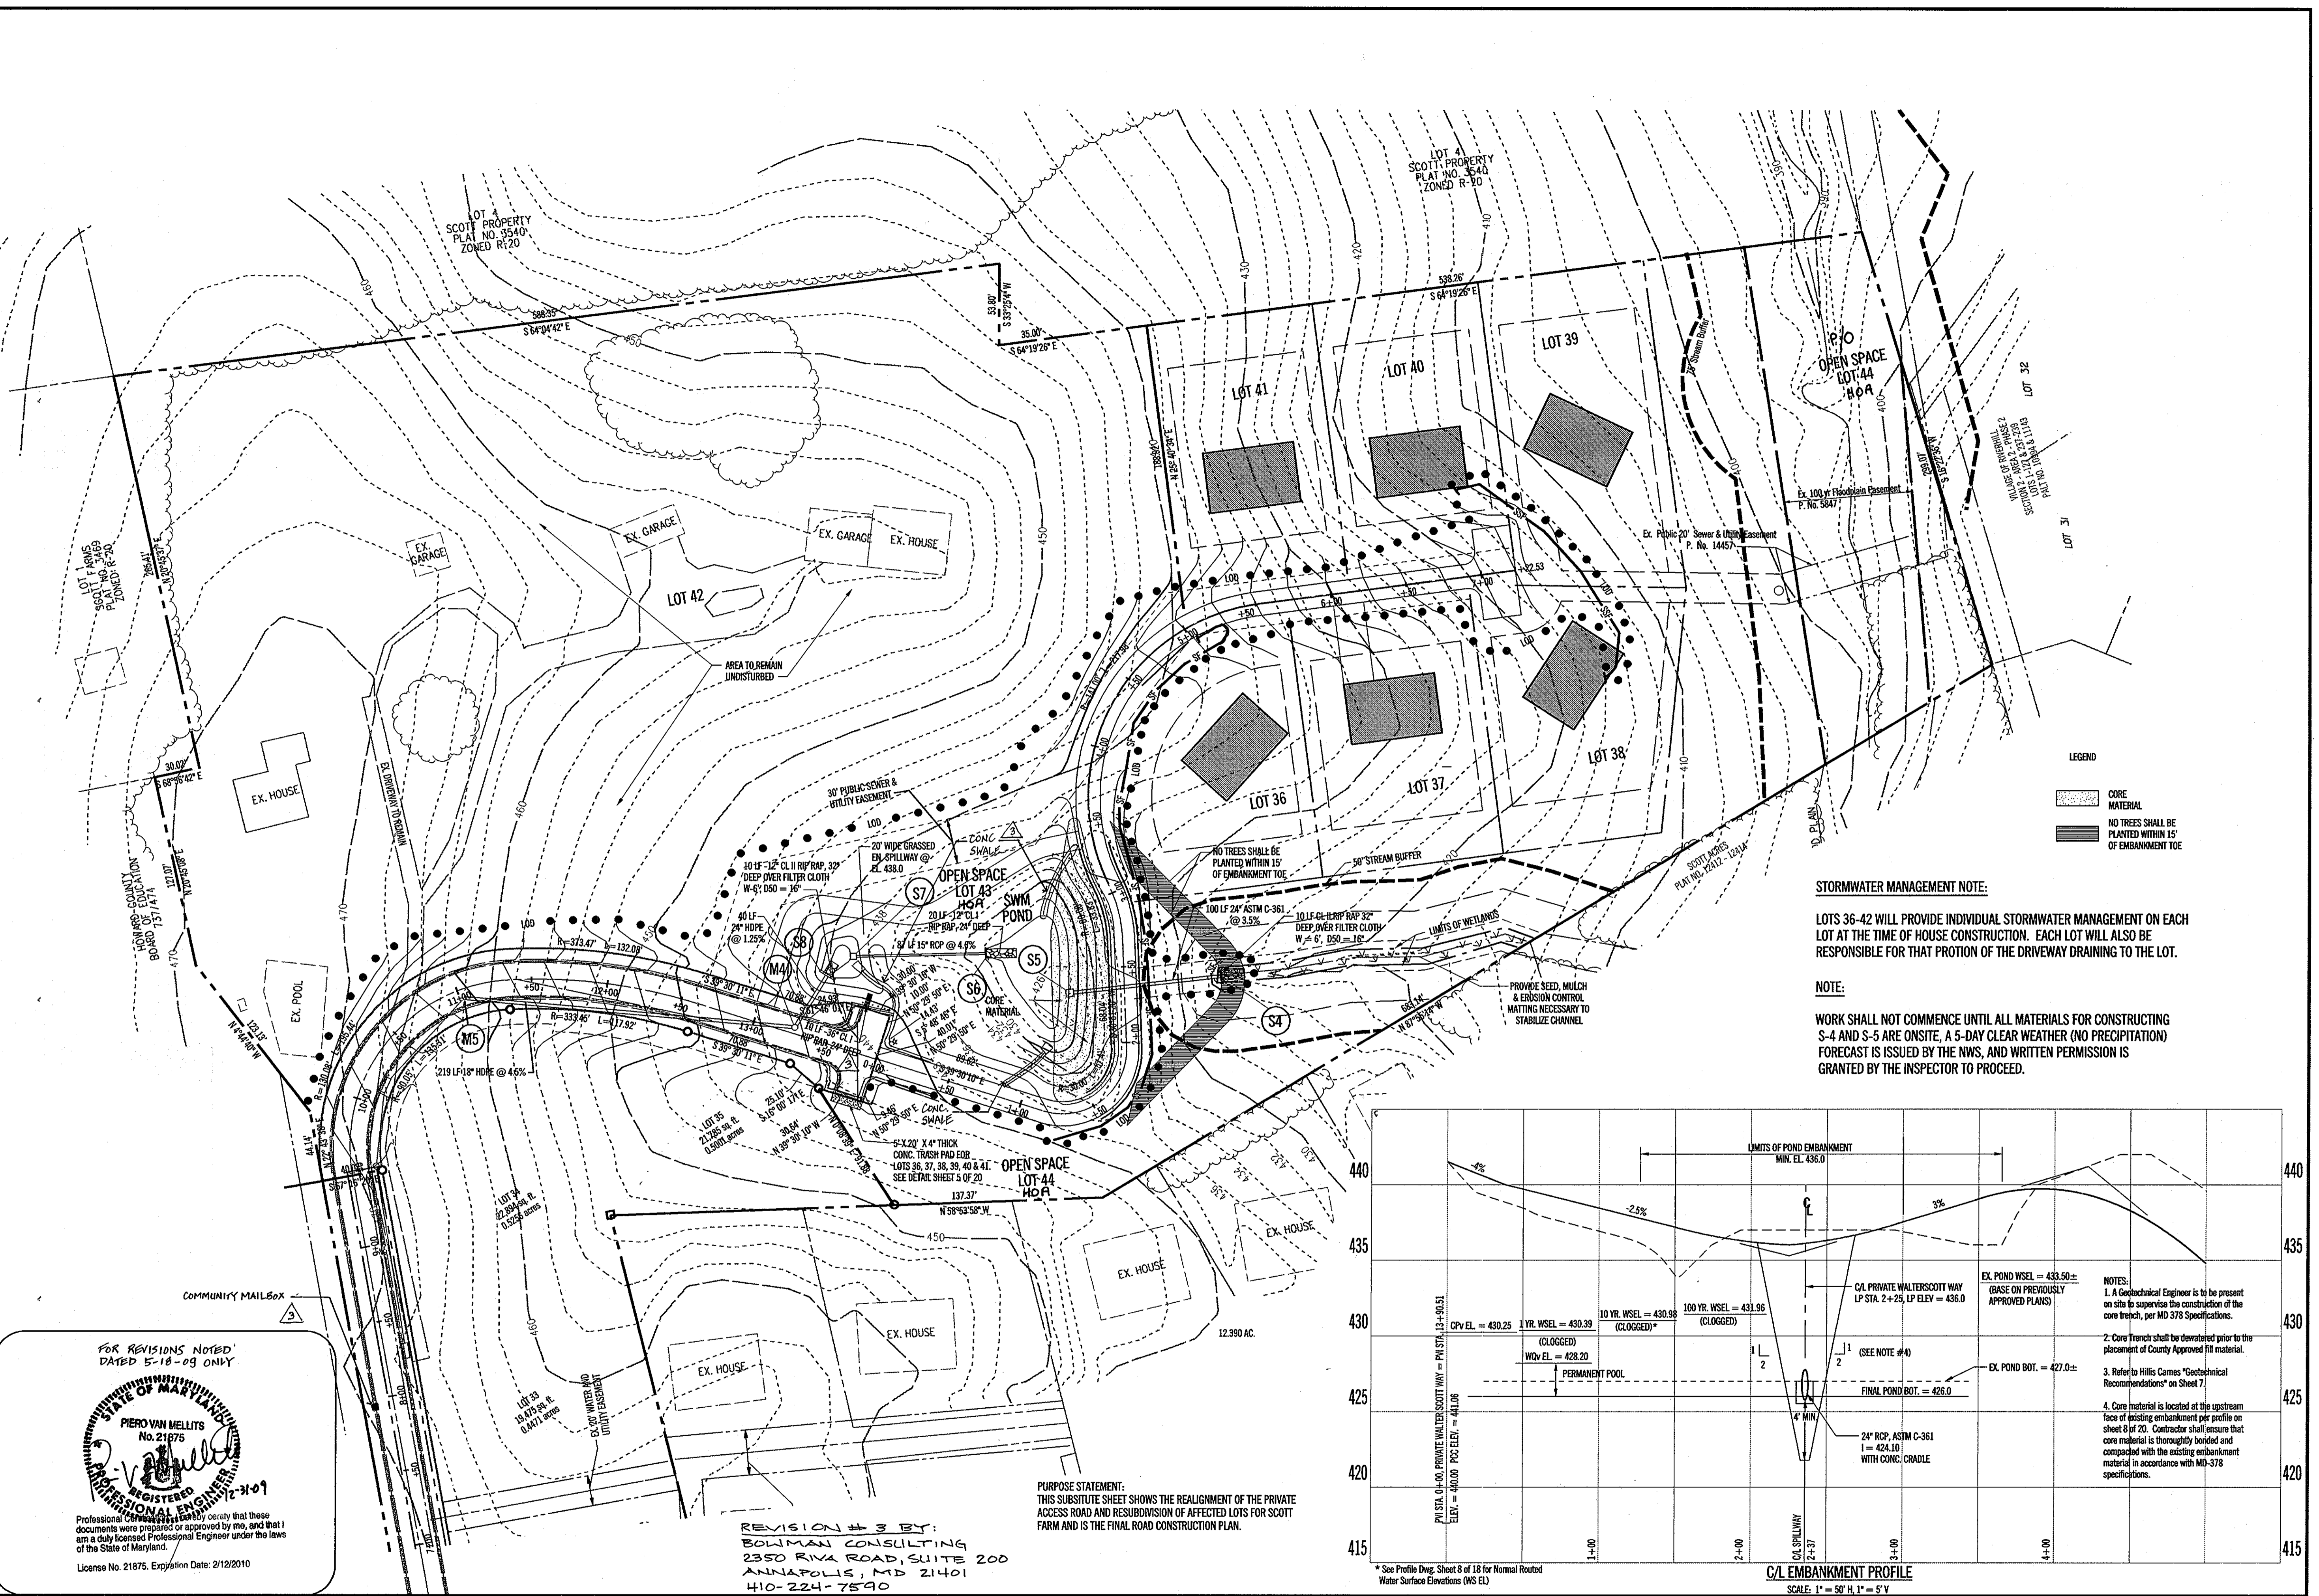

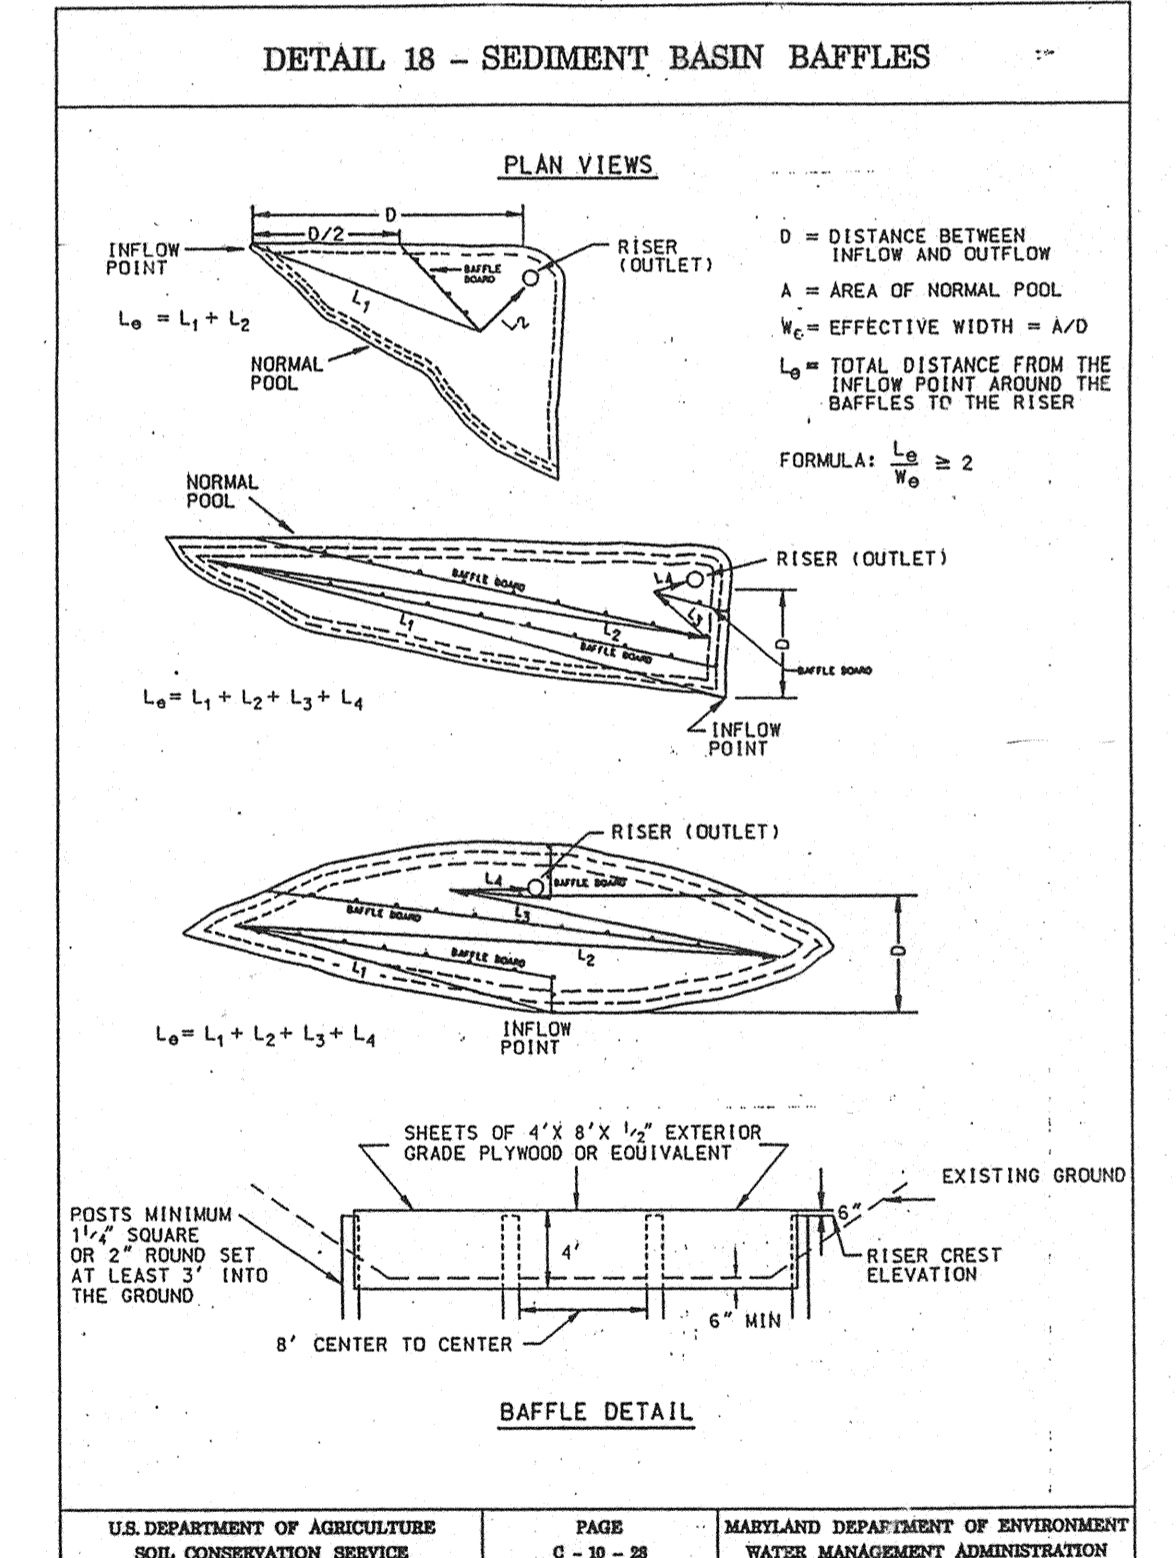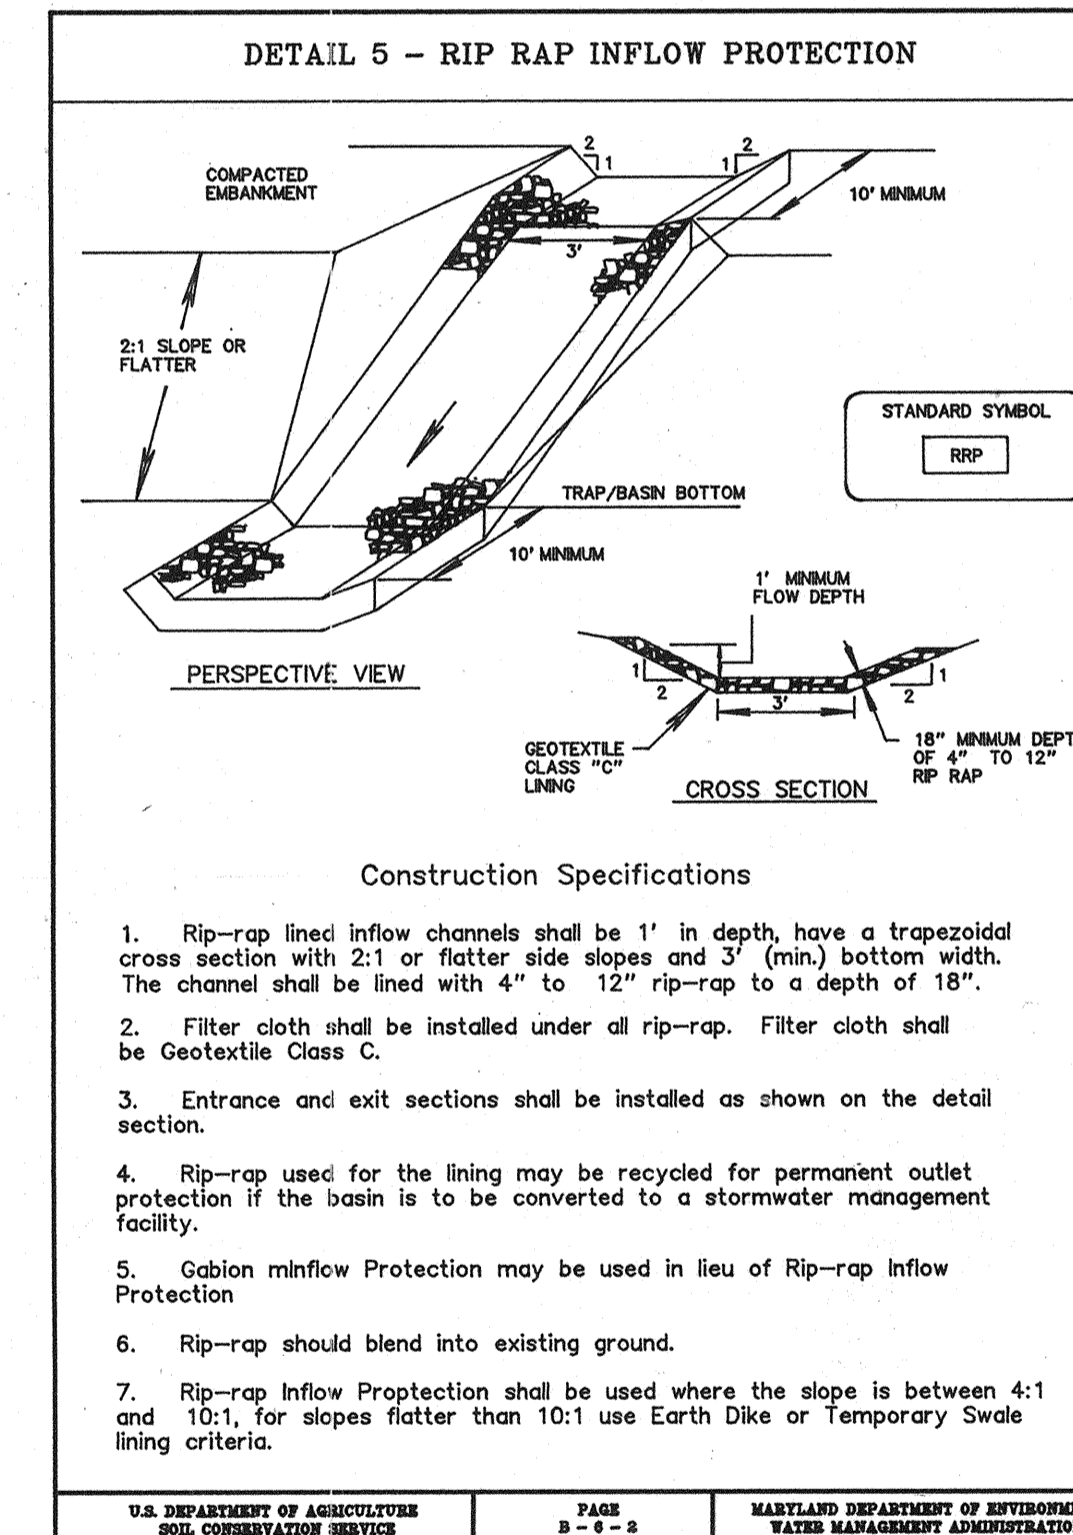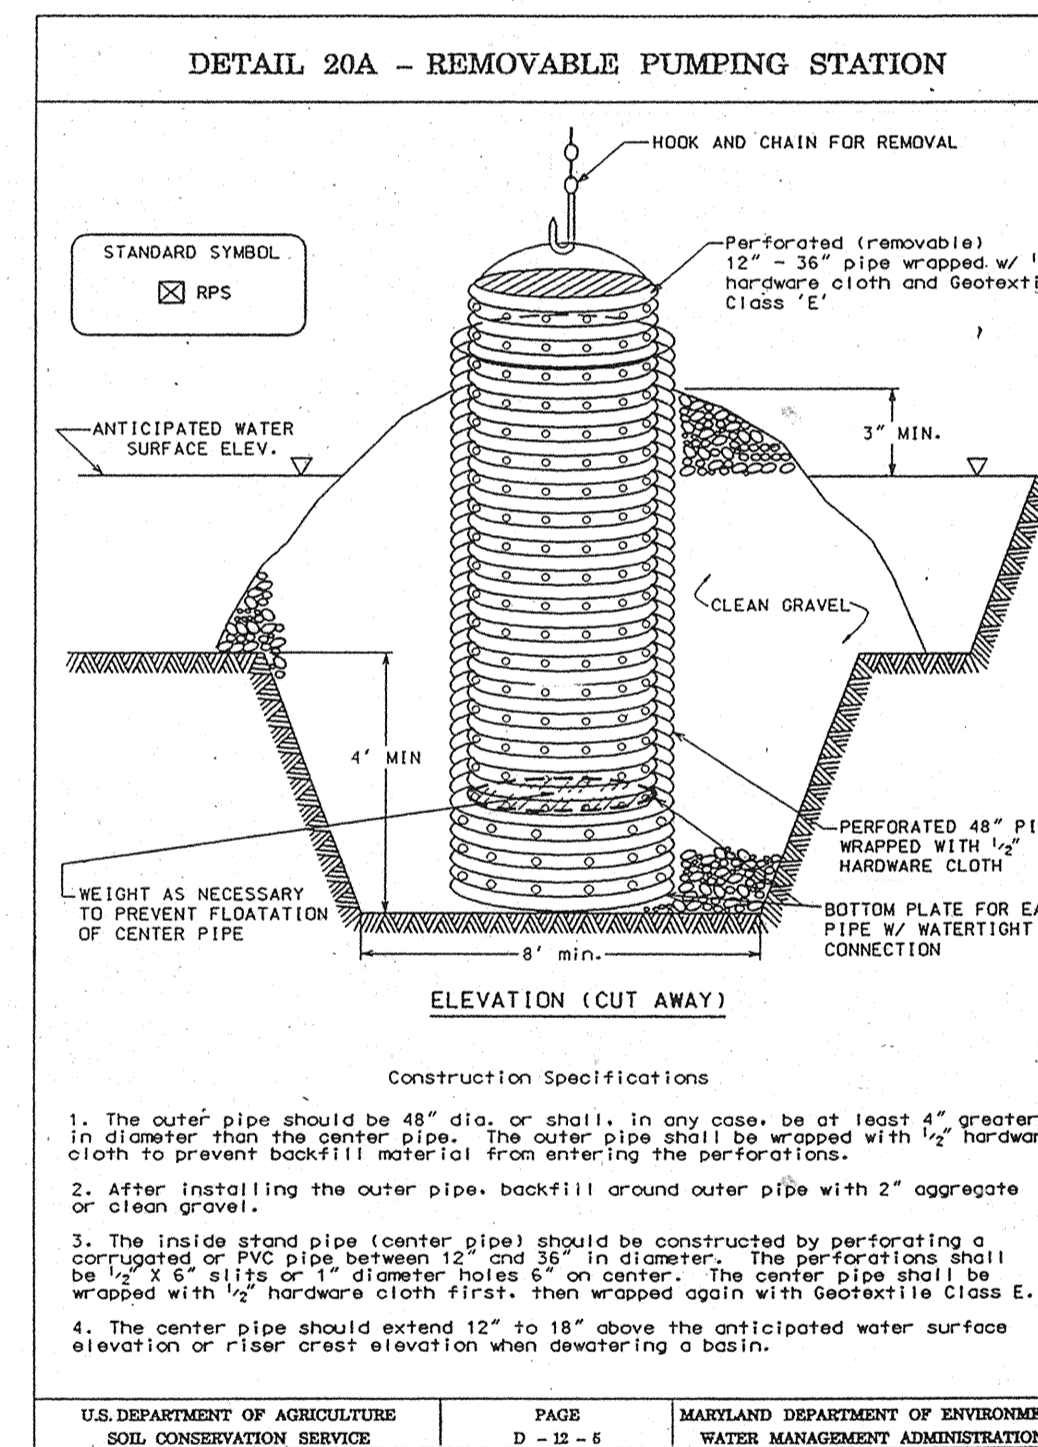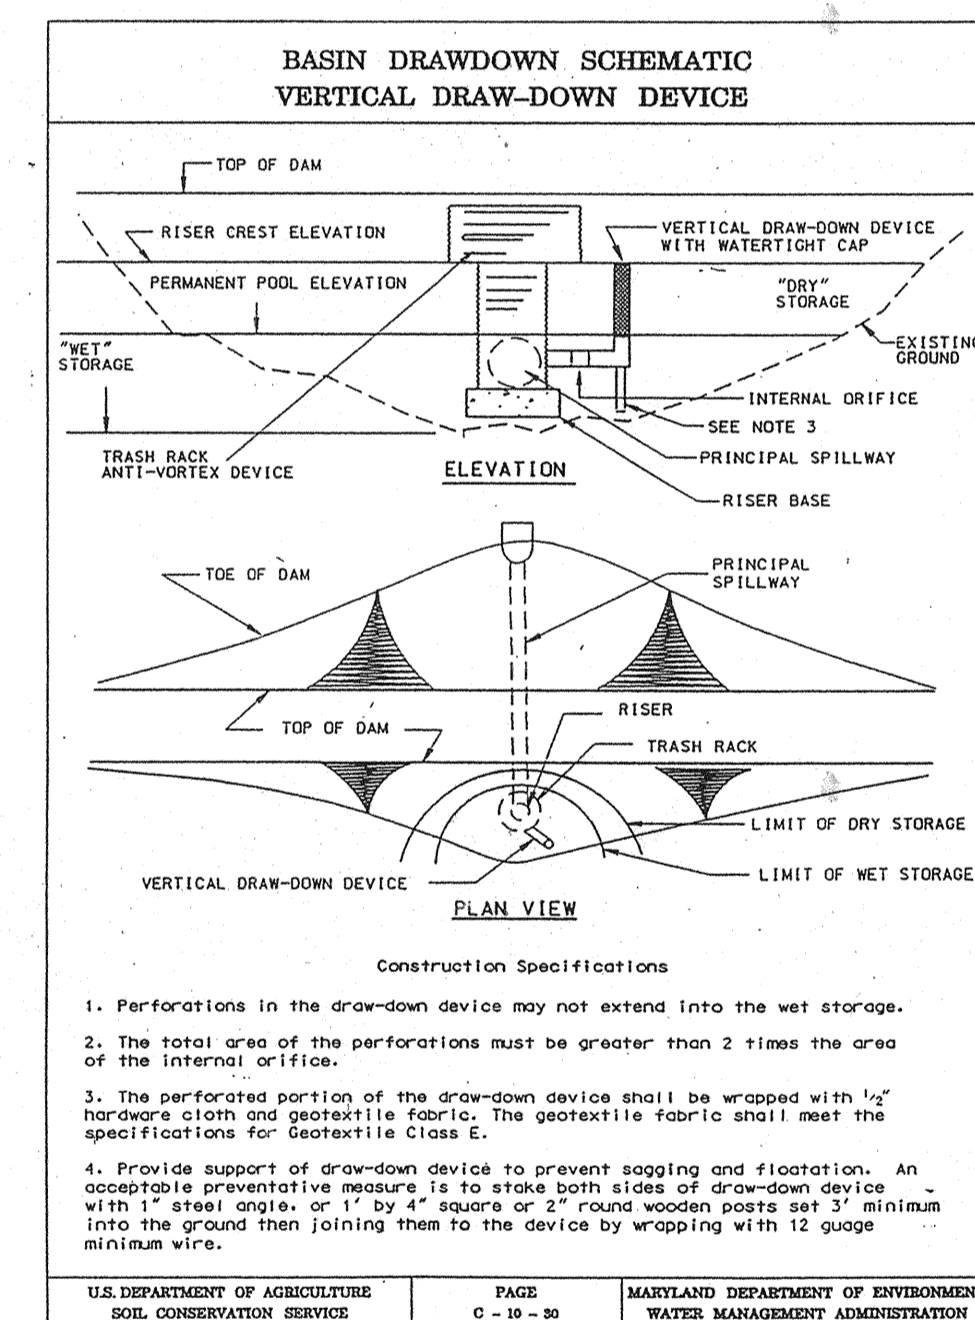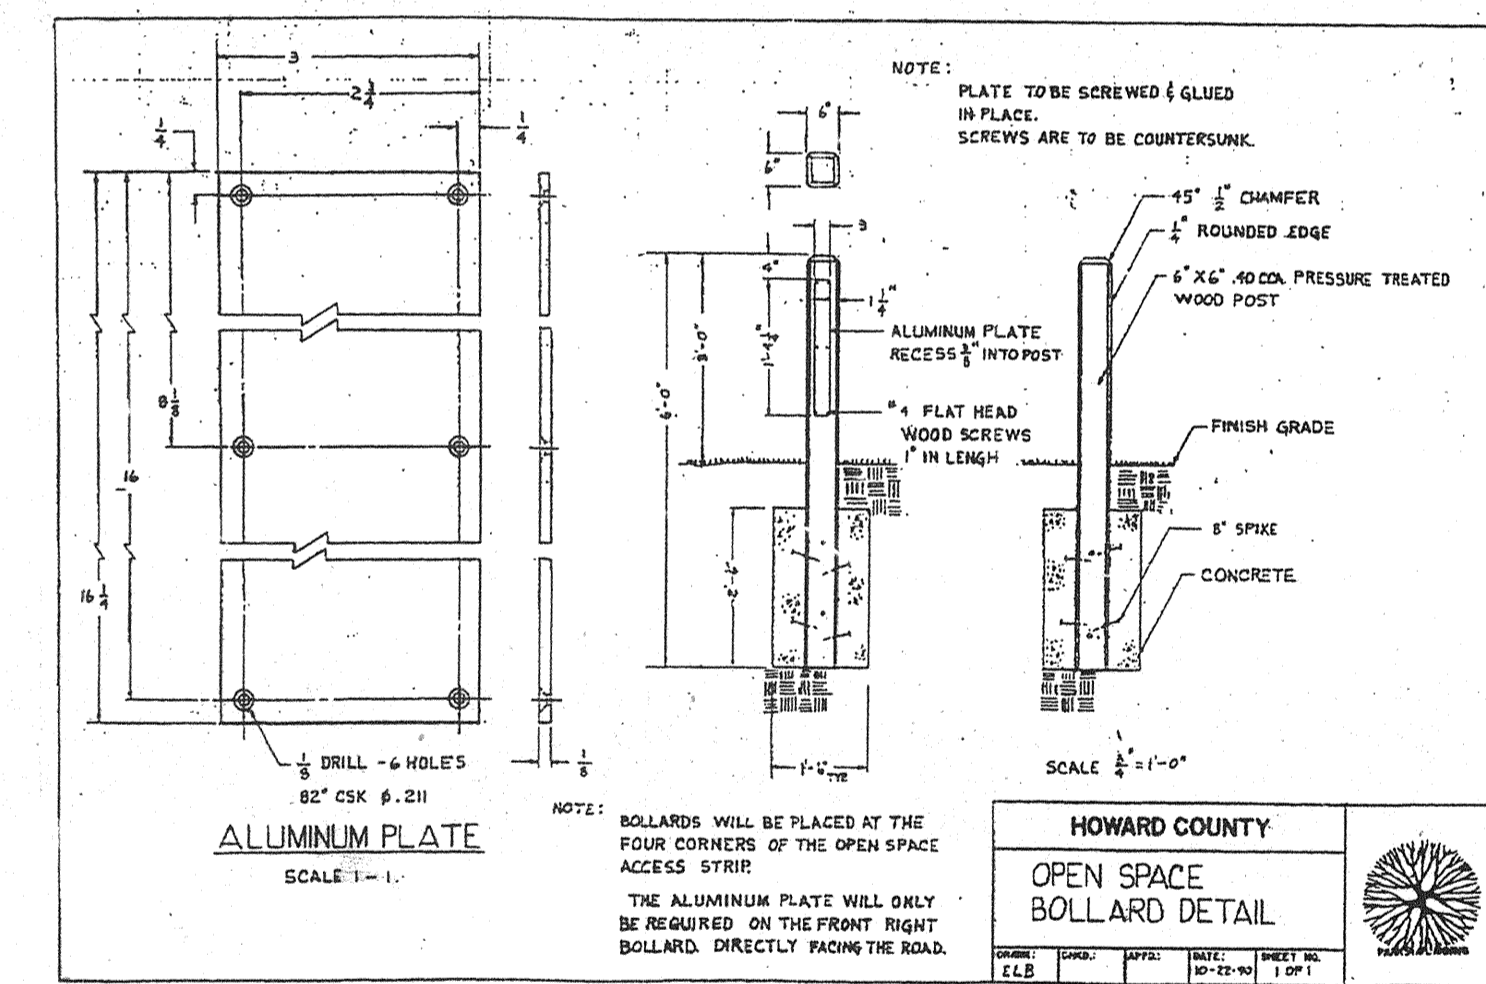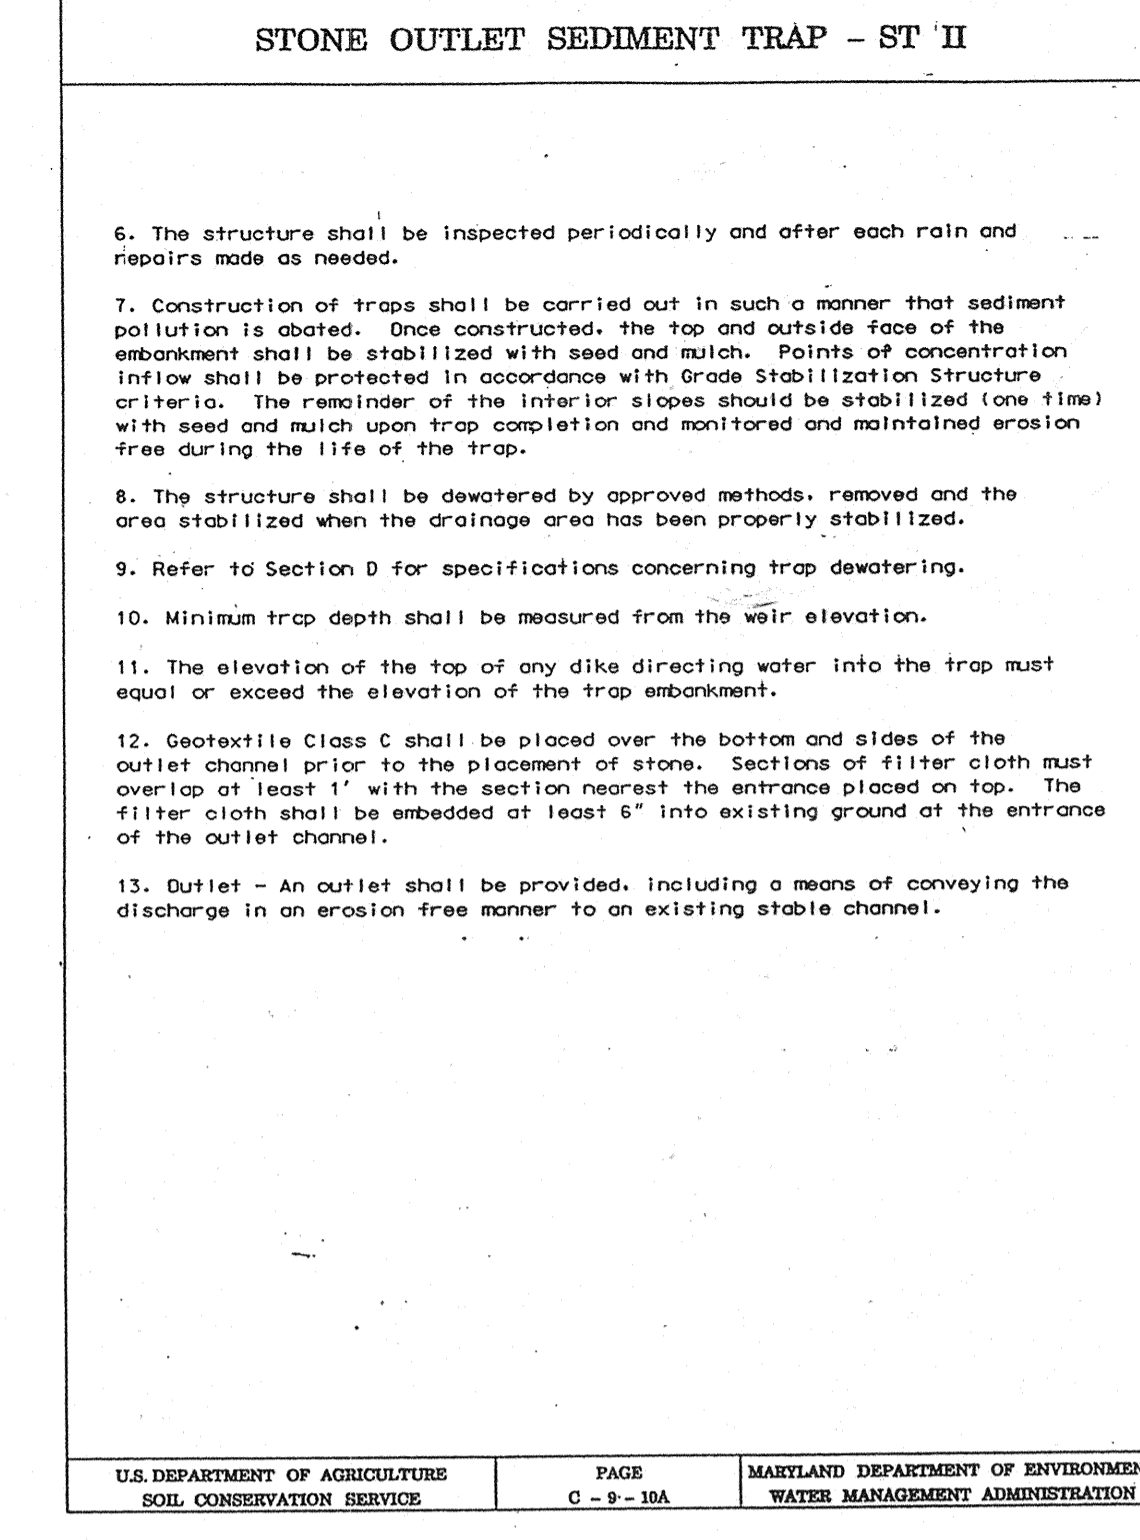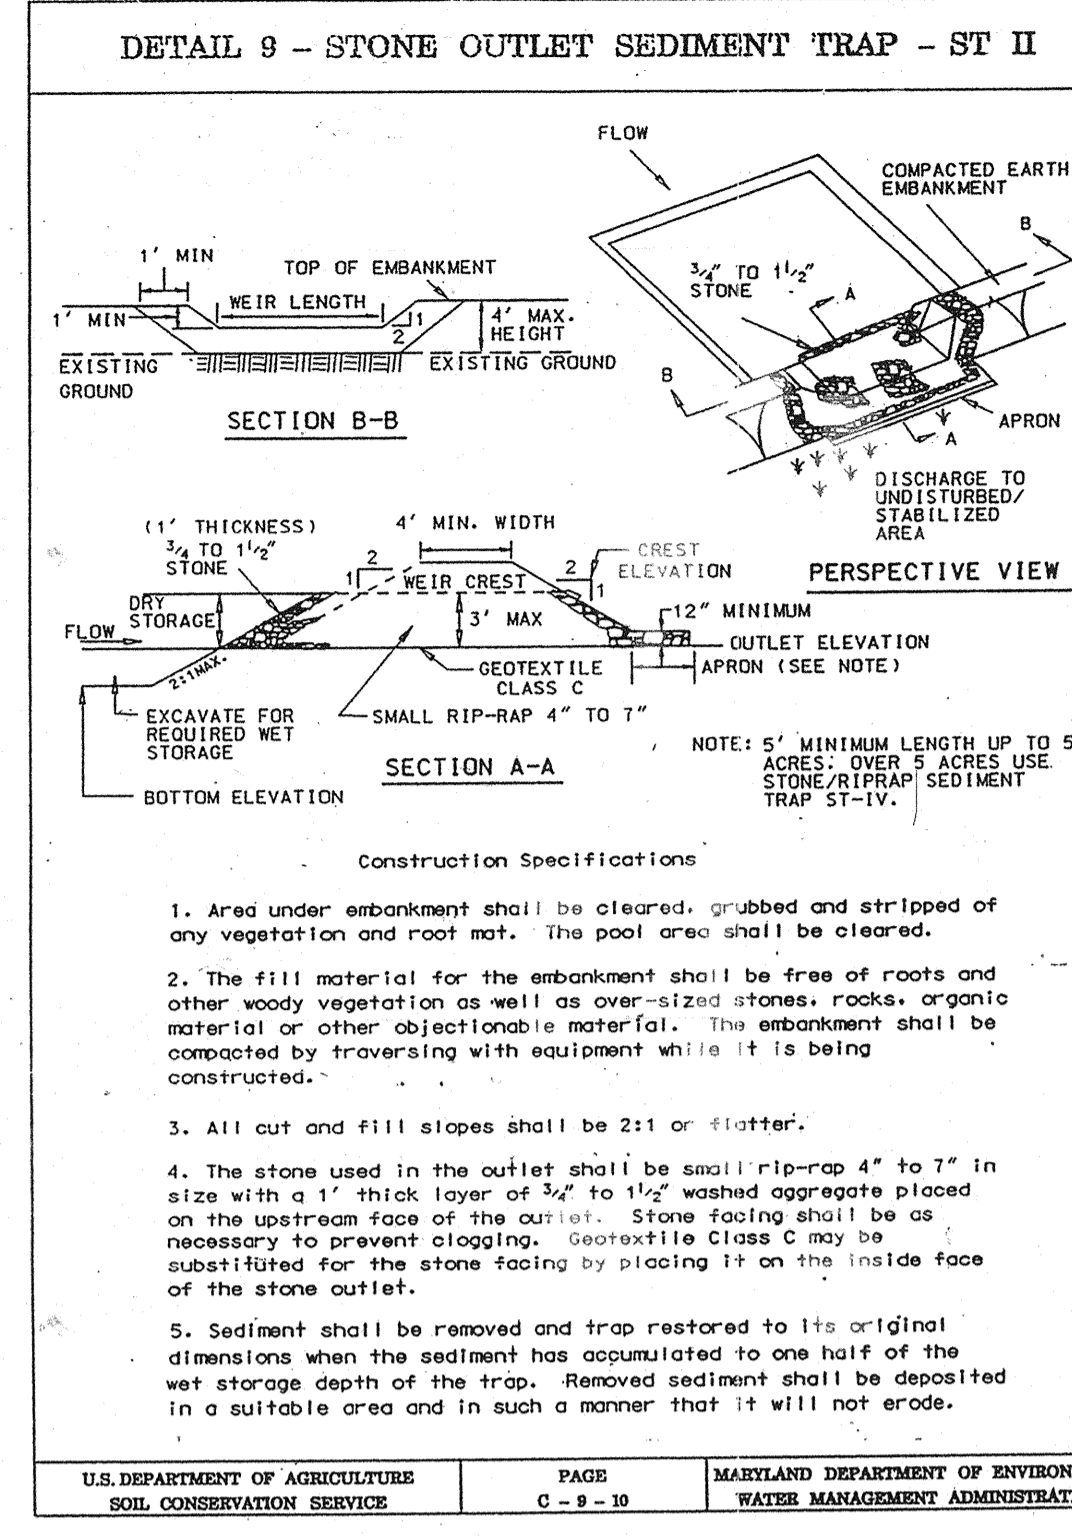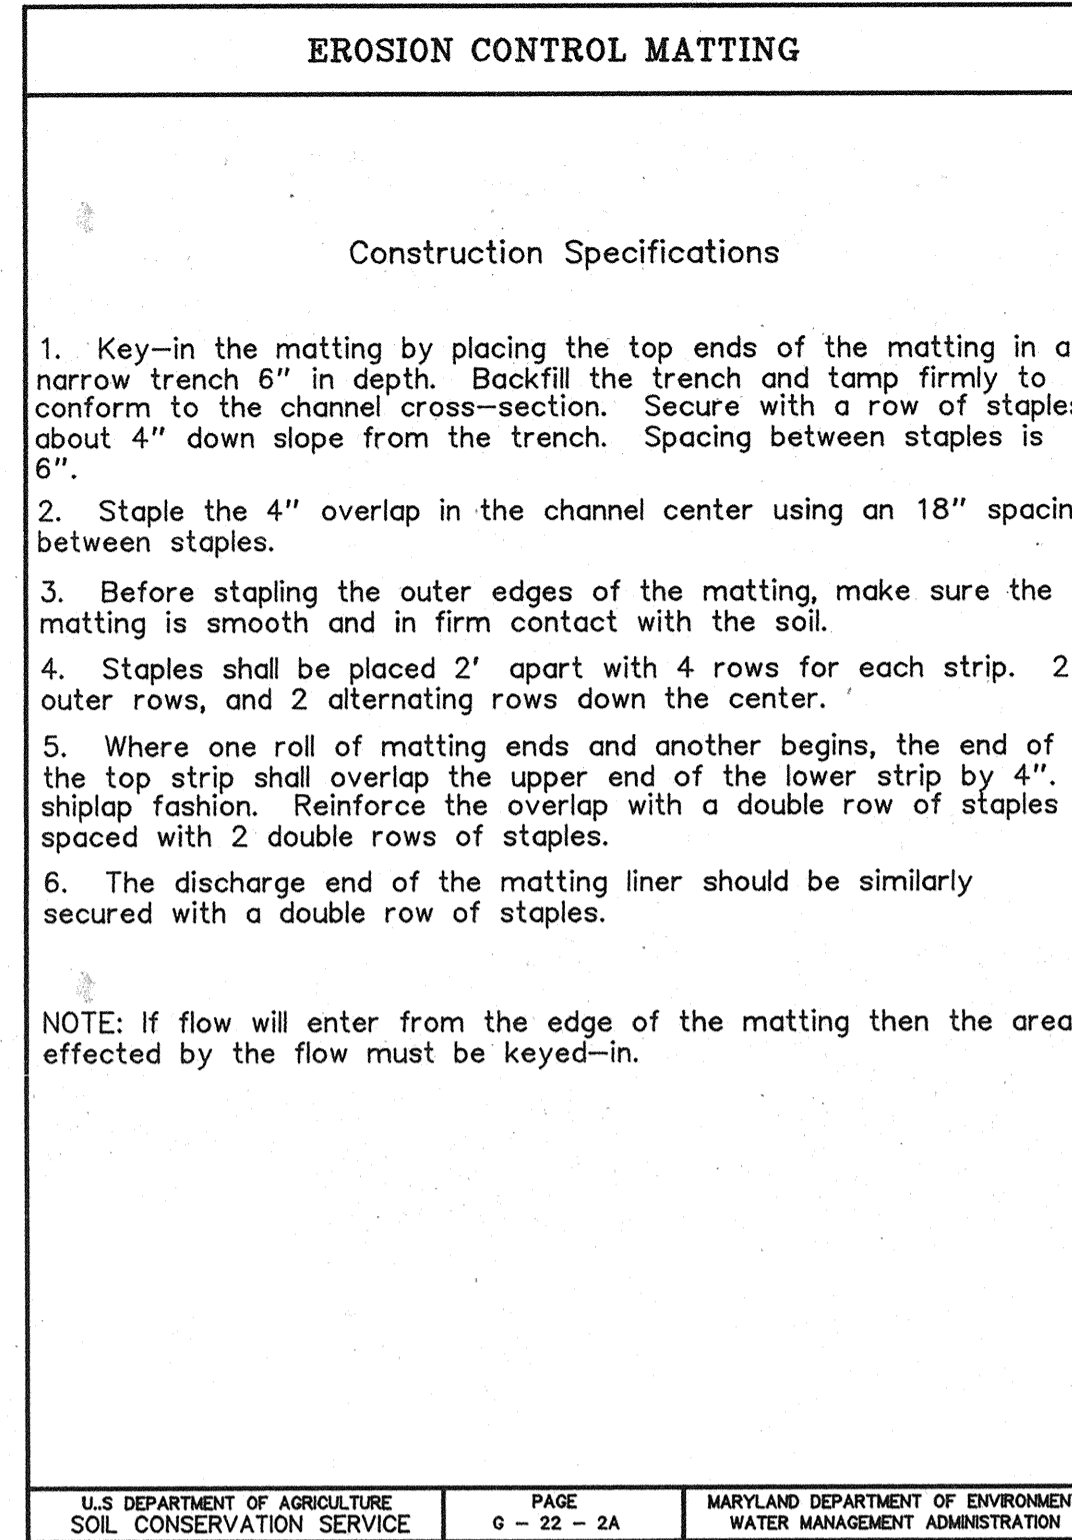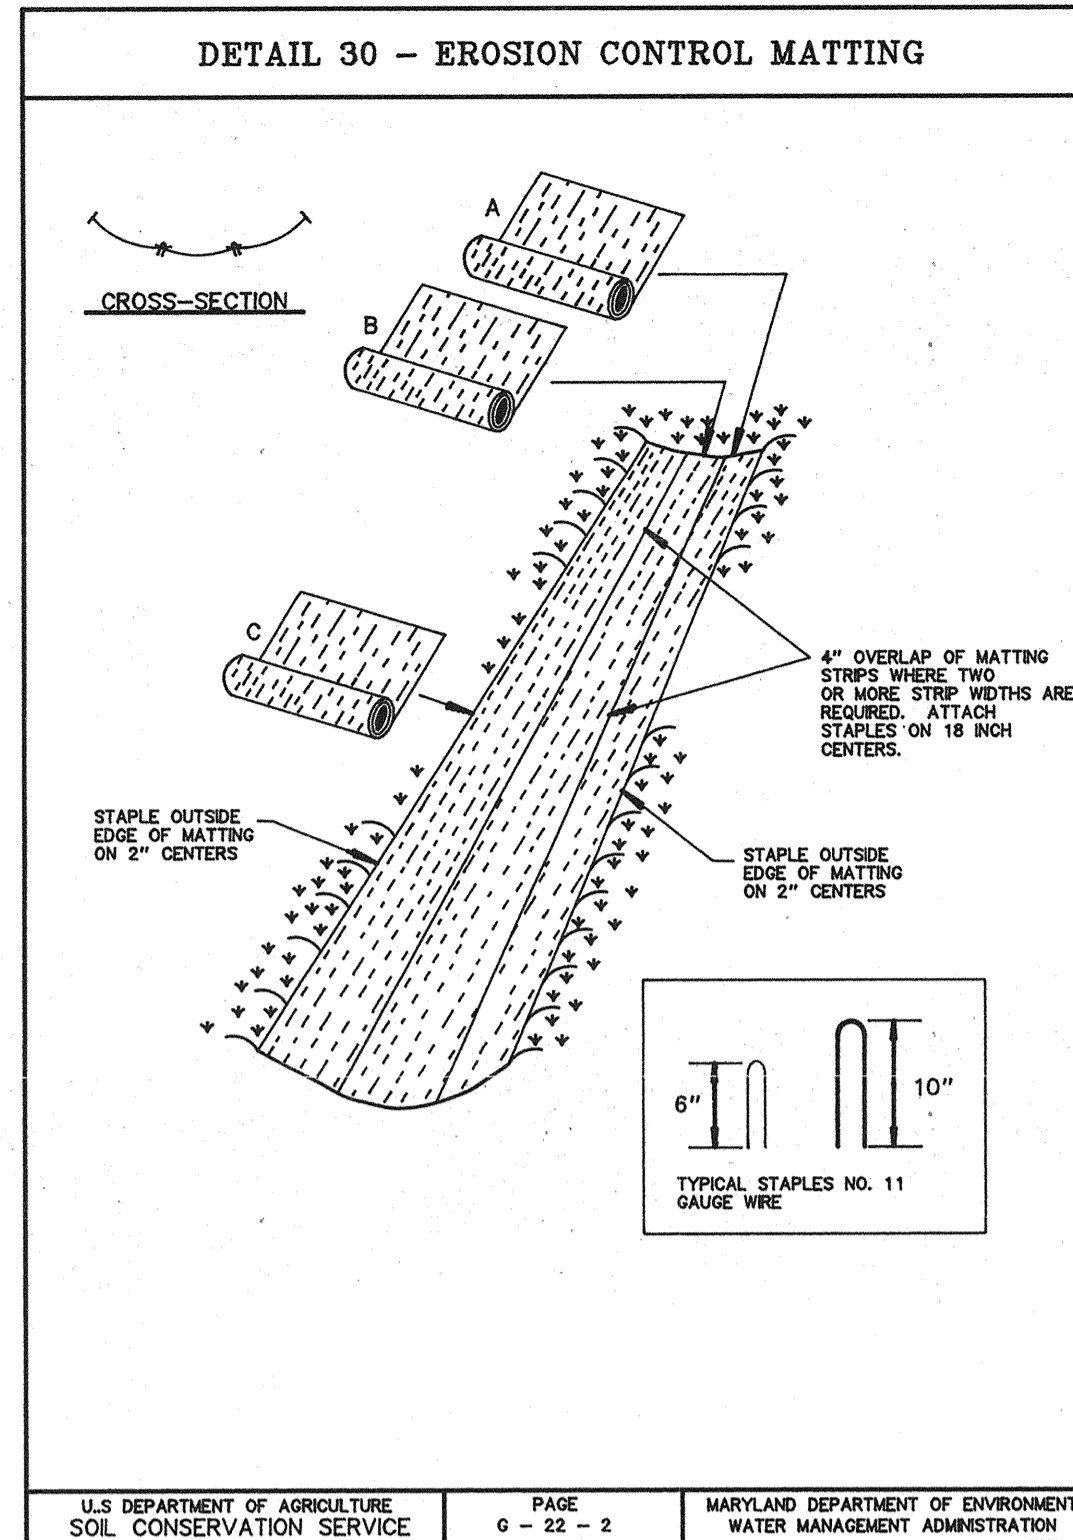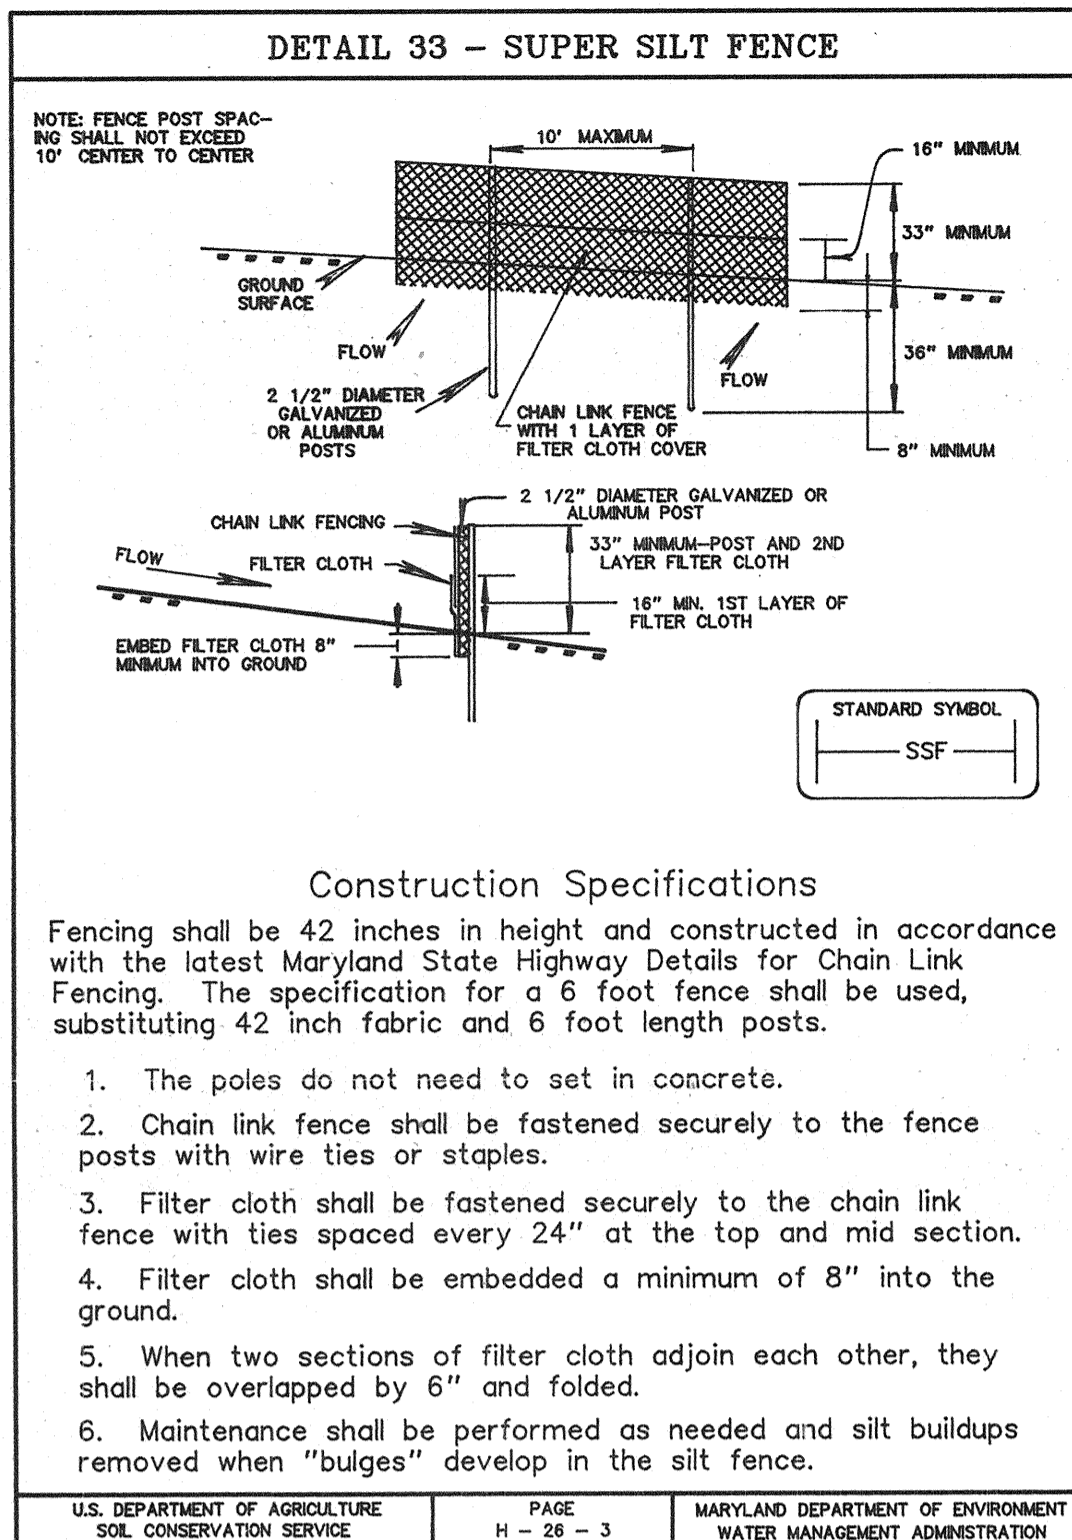

APPROVED: DEPARTMENT OF PLANNING AND ZONING

[Signature] 4/26/00
CHIEF, DEVELOPMENT ENGINEERING DIVISION

[Signature] 7/12/00
CHIEF, DIVISION OF LAND DEVELOPMENT

[Signature] 5-26-00
CHIEF, BUREAU OF HIGHWAYS

THESE PLANS HAVE BEEN REVIEWED FOR THE HOWARD SOIL CONSERVATION DISTRICT AND MEET THE TECHNICAL REQUIREMENTS FOR SMALL POND CONSTRUCTION, SOIL EROSION, AND SEDIMENT CONTROL.

[Signature] 5/18/00
NATURAL RESOURCE CONSERVATION SERVICE

THESE PLANS FOR SMALL POND CONSTRUCTION, SOIL EROSION, AND SEDIMENT CONTROL, MEET THE REQUIREMENTS OF THE HOWARD COUNTY SOIL CONSERVATION DISTRICT.

[Signature] 5/18/00
HOWARD COUNTY SOIL CONSERVATION DISTRICT

ENGINEER'S CERTIFICATE

I certify that this plan for pond construction, erosion and sediment control represents a practical and workable plan. My professional knowledge of the site conditions, and the requirements of the Howard County Soil Conservation District, have been used in the preparation of this plan. I have notified the District of my certification and have notified the District of my certification and have notified the District of my certification.

[Signature] 5/19/00
REGISTERED PROFESSIONAL ENGINEER

DEVELOPER'S CERTIFICATE

I certify that all development and/or construction will be done according to these plans, and that any responsible personnel involved in the construction project will have a Certificate of Attendance at a Department of the Environment Approved Training Program for the Control of Sediment and Erosion before beginning the project. I shall engage a registered professional engineer to supervise construction and provide the Howard Soil Conservation District with an "as-built" plan of the pond within 30 days of completion. I also authorize periodic on-site inspections by Howard Soil Conservation District.

[Signature] 11-11-99
SIGNATURE OF DEVELOPER

REGISTERED PROFESSIONAL ENGINEER

[Signature] 5/19/00

REGISTERED PROFESSIONAL ENGINEER


[Signature] 9-8-05

KD	1	REVISED THIS BLOCK & DRAWING NUMBER	9-18-09
BY	NR	REVISION	DATE

LDE, INC.
9250 Rumsey Road, Suite 106, Columbia, MD 21045
(410) 715-1070 (301) 596-3424 (410) 715-9540 (Fax)

DESIGNED	Grading & Soil Erosion & Sediment Control Plan - Details	SCALE	As Shown
S.D.H.			
DRAWN	Scott Farm	DRAWING	12 of 20
CADD	Lots 29 - 42 and Open Space Lots 27, 28, 43 & 44	JOB NO.	98009
CHECKED	Tax Map No. 35 - P/O Parcel 354	FILE NO.	F-00-73
B.D.B.	5th Election District - Howard County, Maryland		
DATE	11-99		
Owner/Developer	Scarlet Wilkinson & Earl Omer		
	8799 Guilford Road Clarksville, Maryland 21029 (410) 531-2828 or (410) 987-0497		

REVISION #3 BY:
BOLMAN CONSULTING
2350 RIVA ROAD
SUITE 200
ANNAPOLIS, MD 21401
410-224-7590

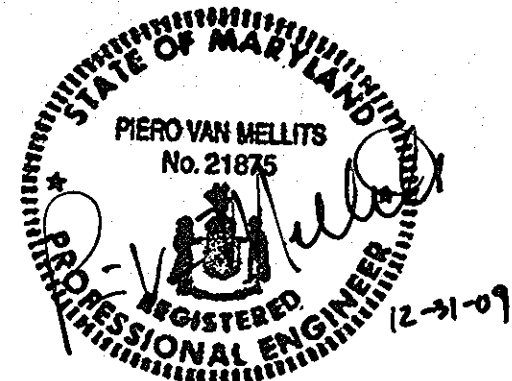


FOR REVISIONS NOTED
DATED 5-18-09 ONLY


Professional Certification. I hereby certify that these documents were prepared or approved by me, and that I am a duly licensed Professional Engineer under the laws of the State of Maryland.

License No. 21875, Expiration Date: 2/12/2010

See Sheet 14 of 18

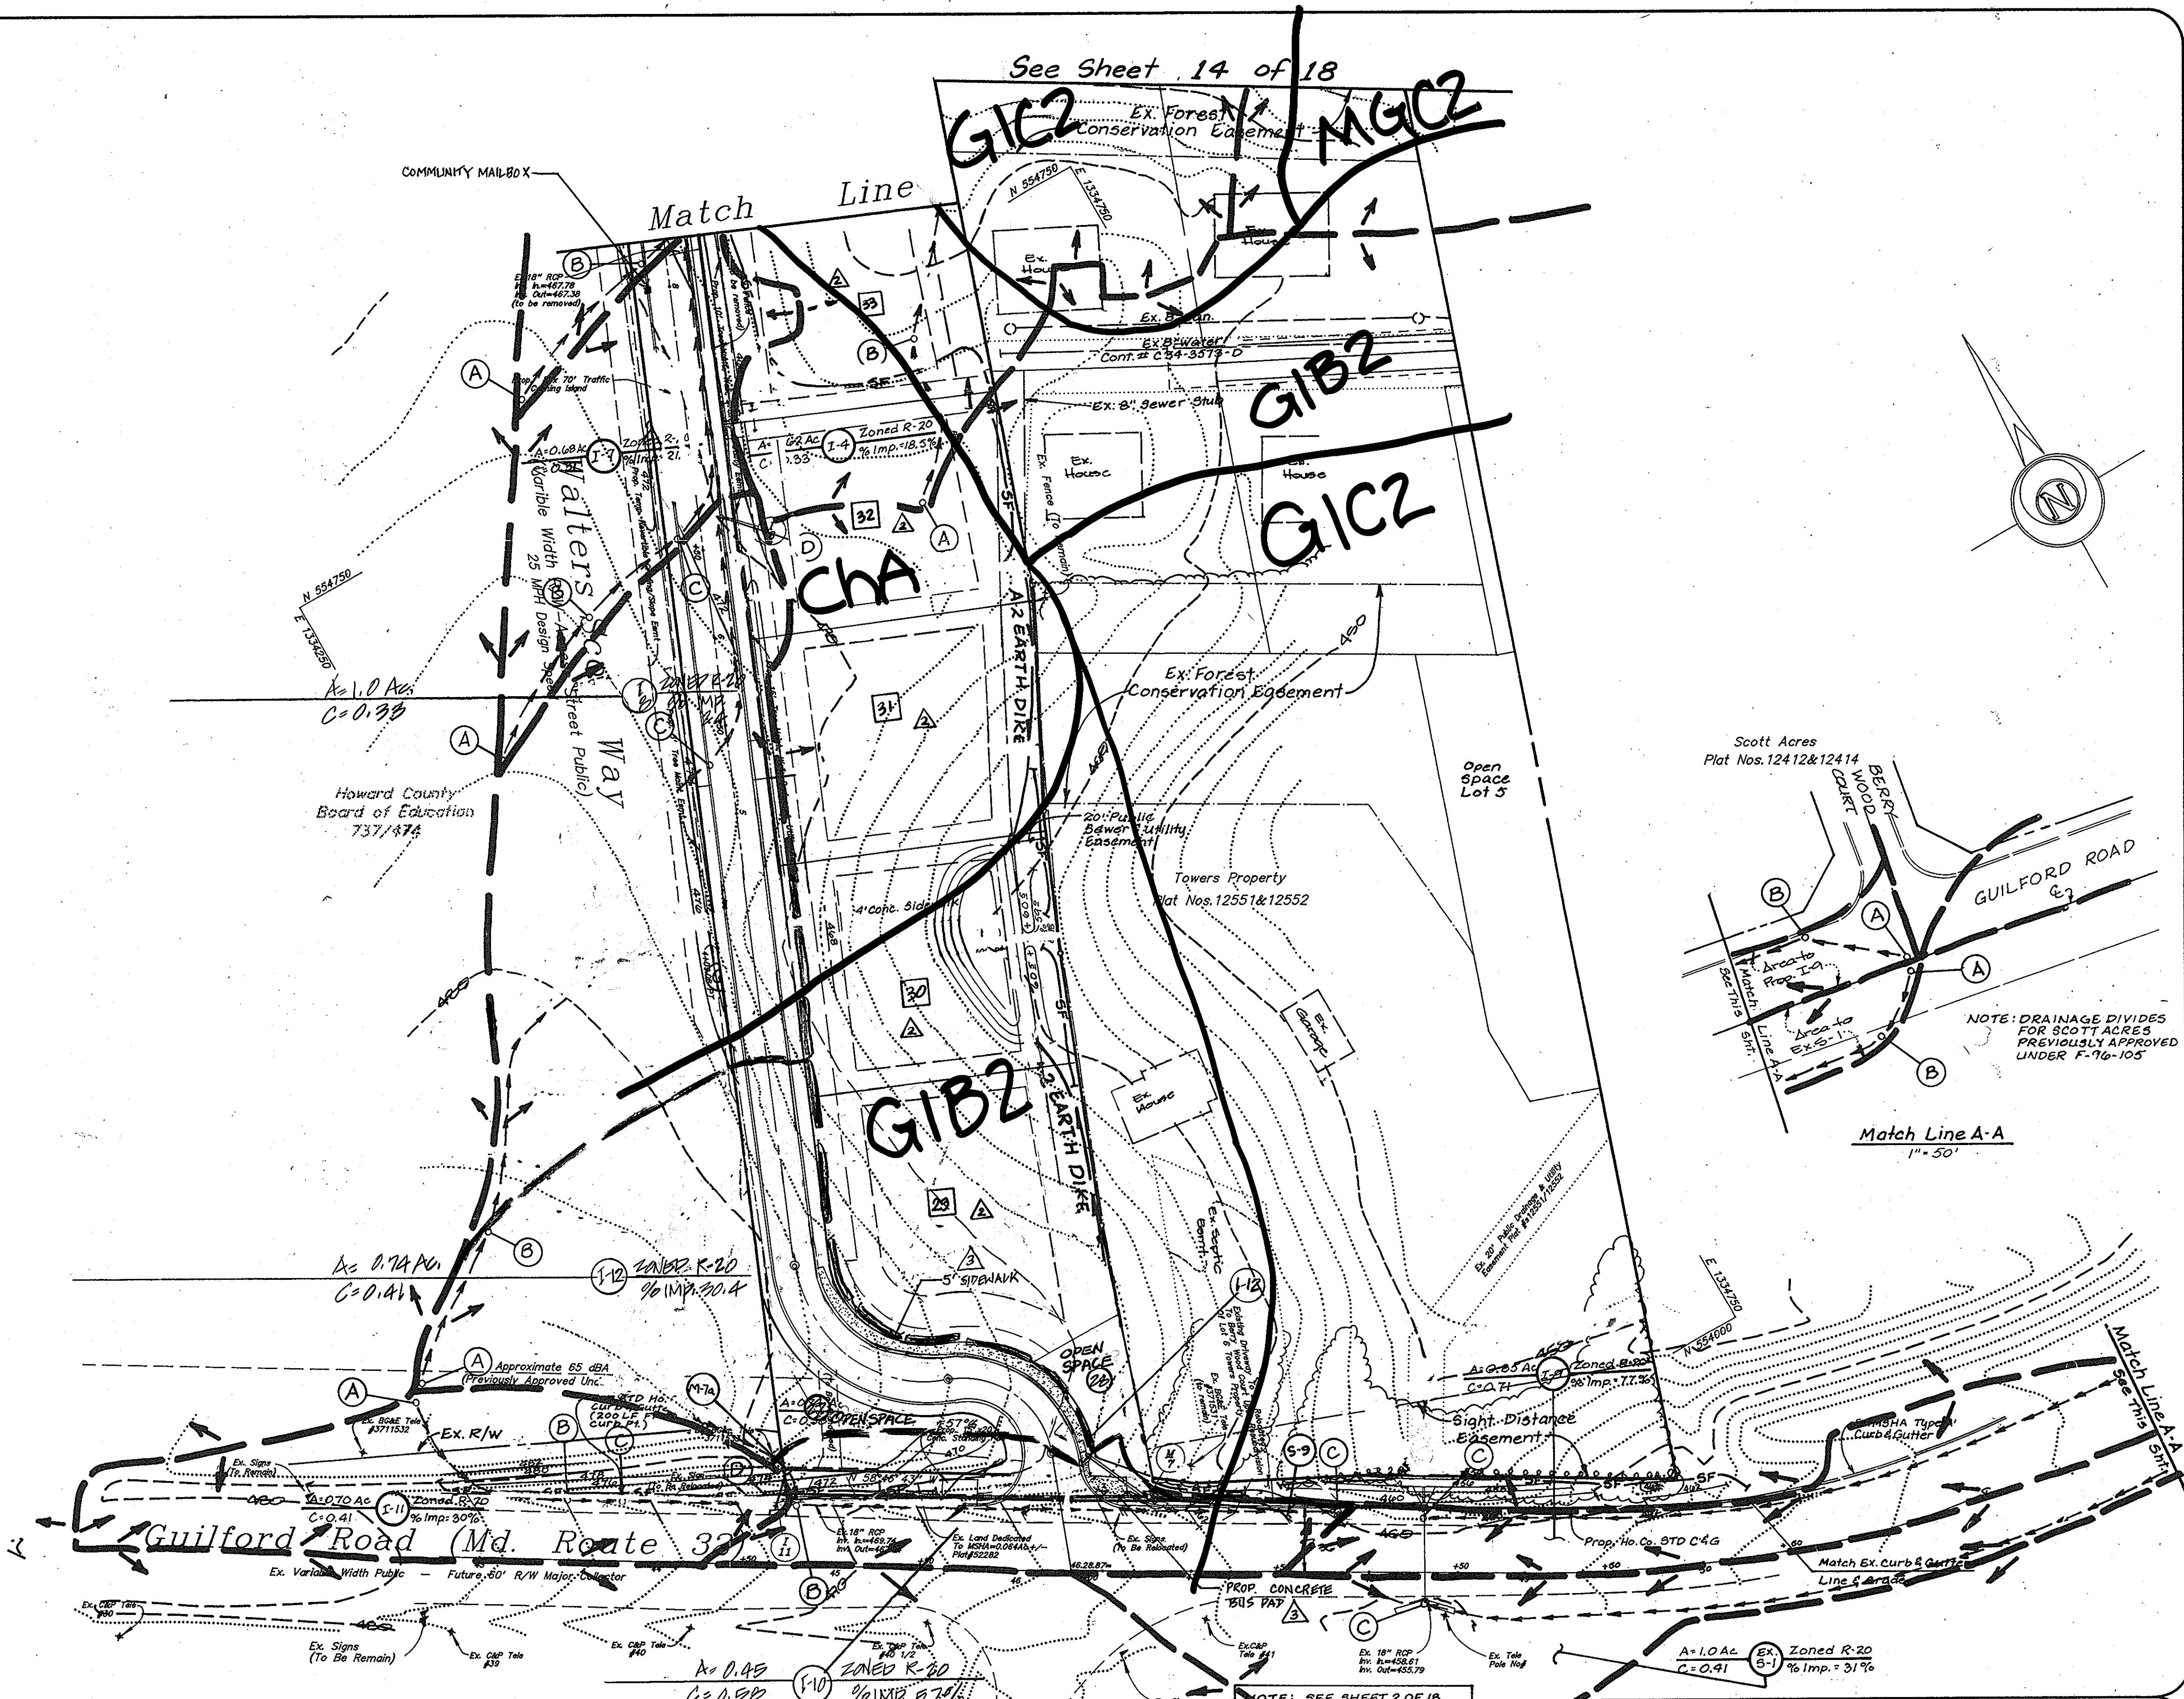

TIME OF CONCENTRATION FLOWPATH SEGMENT TABLE-INLETS					
DRAINAGE AREA	SEGMENT A-B	SEGMENT B-C	SEGMENT C-D	SEGMENT D-E	SEGMENT E-F
I-1	100' overland flow @ 12% (grass)	175' shallow conc. ft. @ 9% (grass)	145' gutter flow @ 7.3%		
I-2	100' overland flow @ 3.5% (grass)	170' shallow conc. ft. @ 9% (grass)	385' ditch flow @ 7.3%		
I-3	100' overland flow @ 14% (grass)	55' shallow conc. ft. @ 9% (grass)	150' gutter flow @ 4.0%		
I-4	100' overland flow @ 7% (woods)	50' shallow conc. ft. @ 8.5% (grass)	50' gutter flow @ 5%		
I-5	100' overland flow @ 6.5% (grass)	45' gutter flow @ 12.3%	245' gutter flow @ 6.94%		
I-6	100' overland flow @ 2% (paved)	210' gutter flow ft. @ 1% (grass)	200' gutter flow @ 1%		
I-7	100' overland flow @ 2.5% (grass)	110' shallow conc. ft. @ 3.6% (grass)	185' gutter flow @ 4.4%		
I-8	100' overland flow @ 3% (grass)	60' shallow conc. ft. @ 3% (grass)	185' gutter flow @ 4.4%		
I-9	60' overland flow @ 3% (paved)	545' gutter flow @ 4%	185' gutter flow @ 4.4%		
I-10	70' overland flow @ 3% (grass)	300' gutter flow @ 2.5%	185' gutter flow @ 4.4%		
I-11	100' overland flow @ 8% (grass)	30' shallow conc. ft. @ 3% (grass)	185' gutter flow @ 4.4%		
I-12	100' overland flow @ 4% (grass)	80' shallow conc. ft. @ 4% (grass)	185' gutter flow @ 4.4%		
I-13	100' overland flow @ 4% (grass)	240' shallow conc. ft. @ 3.5% (grass)	185' gutter flow @ 4.4%		
EX. S-1	40' overland flow @ 2% (paved)	520' ditch flow @ 1.94% (grass)			

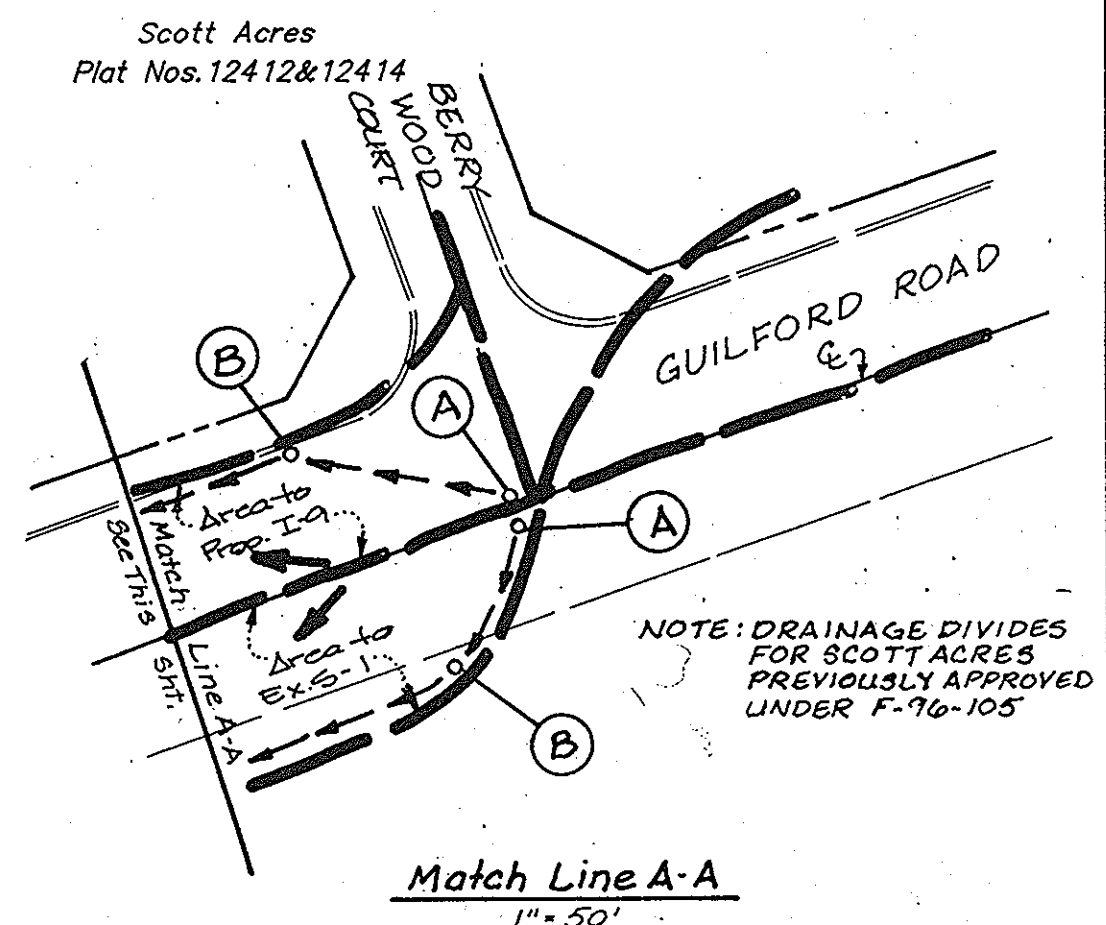

APPROVED: DEPARTMENT OF PLANNING AND ZONING
 [Signature] 6/26/09
 [Signature] 7/12/10
 APPROVED: Department of Public Works for Storm Drainage Systems and Roads
 [Signature] 5-26-09

THESE PLANS HAVE BEEN REVIEWED FOR THE HOWARD SOIL CONSERVATION DISTRICT AND MEET THE TECHNICAL REQUIREMENTS FOR SMALL POND CONSTRUCTION, SOIL EROSION, AND SEDIMENT CONTROL.
 [Signature] 5/18/09
 THESE PLANS FOR SMALL POND CONSTRUCTION, SOIL EROSION, AND SEDIMENT CONTROL, MEET THE REQUIREMENTS OF THE HOWARD COUNTY SOIL CONSERVATION DISTRICT.
 [Signature] 5/18/09

ENGINEER'S CERTIFICATE
 I/We certify that all development and construction will be done according to these plans, and that any responsible party involved in the construction project will have a Certificate of Approval from the Department of the Environment approved Training Program for the Control of Sediment and Erosion before beginning the project. This plan was prepared in accordance with the requirements of the Howard Soil Conservation District. I have notified the developer that he/she must engage a registered professional engineer to supervise pond construction and provide the Howard Soil Conservation District with an "as-built" plan of the pond within 30 days of completion.
 [Signature] 5/19/09

DEVELOPER'S CERTIFICATE
 I certify that this plan for pond construction, erosion and sediment control represents a practical and workable plan based on my personal knowledge of the site conditions. This plan was prepared in accordance with the requirements of the Howard Soil Conservation District. I have notified the developer that he/she must engage a registered professional engineer to supervise pond construction and provide the Howard Soil Conservation District with an "as-built" plan of the pond within 30 days of completion.
 [Signature] 11-11-09

STATE OF MARYLAND
 PROFESSIONAL ENGINEER
 [Signature] 5/19/09

STATE OF MARYLAND
 PROFESSIONAL ENGINEER
 [Signature] 5/19/09

REVISION #1 BY: CENTURY ENGINEERING INC. 32 WISSEY ROAD TOWSON, MARYLAND 21284 410-823-8070
 NOTE: DRAINAGE DIVIDE SHOWN ARE BASED ON ULTIMATE SITE GRADING, INCLUDING INDIVIDUAL LOT GRADING.
 THIS SEAL FOR REVISION #1 & 2


NO.	BY	REVISION	DATE
3	PM	ADD COMMUNITY MAILBOX, 5' SIDEWALK AND CONCRETE BUS PAD	5-18-09
2	KD	REVISED TO TABLE 1-1 THRU 1-4, ADDED 5' SIDEWALK, REVISED LOT LAYOUT, NO. 6 EXISTING, AND 5D	9-09-05
1	CSB	REVISED TIME BLOCK & SHEET #. REMOVED CURB CUTS.	9-19-04

LDE, INC.
 9250 Rumsey Road, Suite 106, Columbia, MD. 21045
 (410) 715-1070 (301) 596-3424 (410) 715-9540 (Fax)

DESIGNED: Drainage Area Map
 S.D.H.
 DRAWN: CADD 5T B
 CHECKED: B.D.B.
 DATE: 11/99

Scott Farm
 Lots 29 to 42 and Open Space Lots 27, 28, 43 & 44
 A Re-division of Lots 5 & 10 "Wilkinson Acres"
 Tax Map No. 35 - F/O Parcel 954
 5th Election District - Howard County, Maryland
 Previous Submittals: 778-104, F84-144, F87-162, S97-23, B491-24E, S95-10, E298-28, P86-13 & SP98-04
 Owner/Developer: Scarlet Wilkinson & Earl Omer
 8799 Guilford Road
 Clarksville, Maryland 21029
 (410) 531-2828 or (410) 987-0487

SCALE: 1" = 50'
 DRAWING: 13 of 20
 JOB NO.: 98009
 FILE NO.: F-00-73

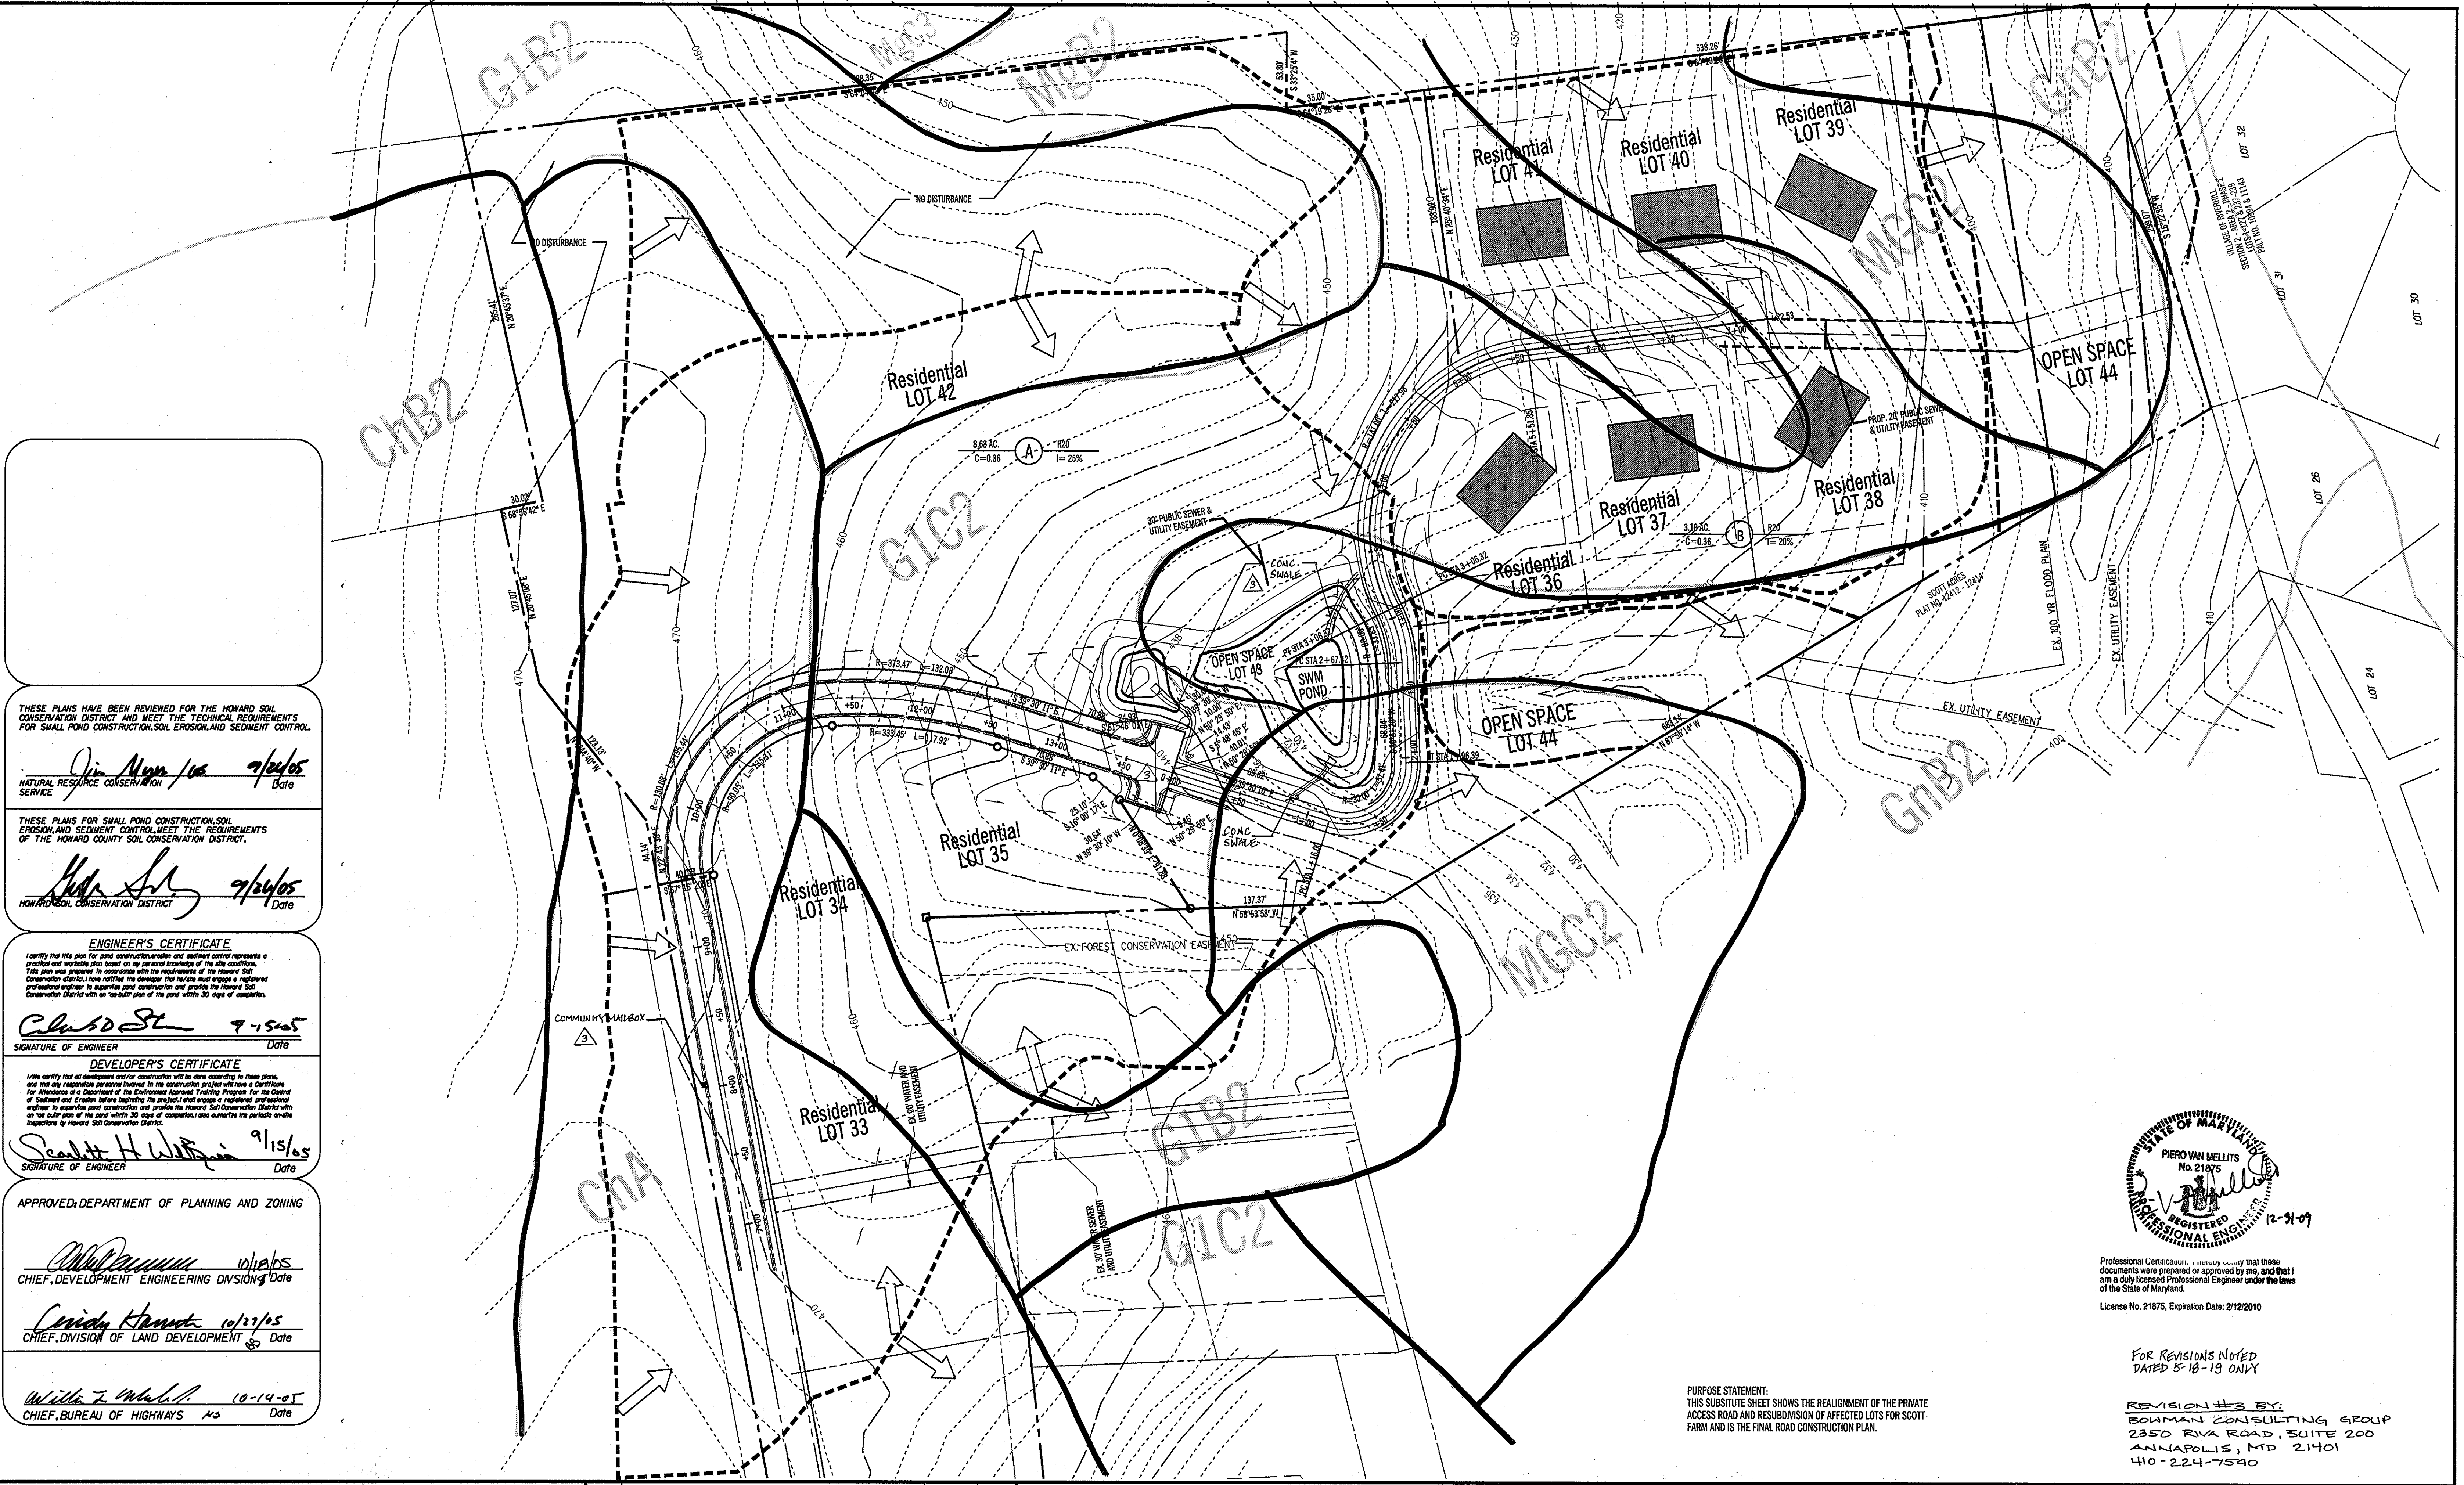

THESE PLANS HAVE BEEN REVIEWED FOR THE HOWARD SOIL CONSERVATION DISTRICT AND MEET THE TECHNICAL REQUIREMENTS FOR SMALL POND CONSTRUCTION, SOIL EROSION, AND SEDIMENT CONTROL.

Jim Munn / 10 9/24/05
 NATURAL RESOURCE CONSERVATION SERVICE

THESE PLANS FOR SMALL POND CONSTRUCTION, SOIL EROSION, AND SEDIMENT CONTROL MEET THE REQUIREMENTS OF THE HOWARD COUNTY SOIL CONSERVATION DISTRICT.

Mark Saly 9/24/05
 HOWARD SOIL CONSERVATION DISTRICT

ENGINEER'S CERTIFICATE
 I certify that this plan for pond construction and sediment control represents a practical and workable plan based on my personal knowledge of the site conditions. This plan was prepared in accordance with the requirements of the Howard Soil Conservation District. I have certified the design and that the owner must engage a registered professional engineer to supervise pond construction and provide the Howard Soil Conservation District with a final plan of the pond within 30 days of completion.

Charles St... 9/15/05
 SIGNATURE OF ENGINEER

DEVELOPER'S CERTIFICATE
 I/We certify that all development and/or construction will be done according to these plans, and that any responsible personnel involved in the construction project will have a Certificate for Maintenance of a Department of the Environment Approval. I/We certify that the owner must engage a registered professional engineer to supervise pond construction and provide the Howard Soil Conservation District with a final plan of the pond within 30 days of construction. I/We certify that the owner must engage a registered professional engineer to supervise pond construction and provide the Howard Soil Conservation District with a final plan of the pond within 30 days of completion.


Scott H. Williams 9/15/05
 SIGNATURE OF ENGINEER

APPROVED: DEPARTMENT OF PLANNING AND ZONING

William J. Williams 10/15/05
 CHIEF, DEVELOPMENT ENGINEERING DIVISION

Cindy Hammett 10/27/05
 CHIEF, DIVISION OF LAND DEVELOPMENT

William F. Williams 10-14-05
 CHIEF, BUREAU OF HIGHWAYS

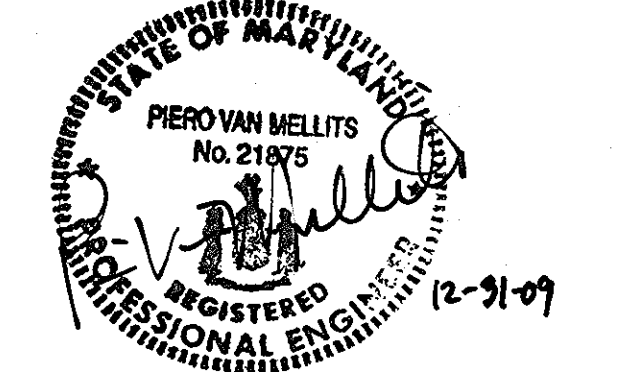


Professional Certificate... I certify that these documents were prepared or approved by me, and that I am a duly licensed Professional Engineer under the laws of the State of Maryland.
 License No. 21875, Expiration Date: 2/21/2010

FOR REVISIONS NOTED DATED 5-18-19 ONLY

REVISION #3 BY:
 BOUMAN CONSULTING GROUP
 2350 RIVA ROAD, SUITE 200
 ANNAPOLIS, MD 21401
 410-224-7590

PURPOSE STATEMENT:
 THIS SUBSTITUTE SHEET SHOWS THE REALIGNMENT OF THE PRIVATE ACCESS ROAD AND RESUBDIVISION OF AFFECTED LOTS FOR SCOTT FARM AND IS THE FINAL ROAD CONSTRUCTION PLAN.

OWNER:
 SCARLET WILKINSON AND EARL OMER
 6799 GUILFORD ROAD
 CLARKSVILLE, MARYLAND 21029
 (410)531-2626, (410)987-0497

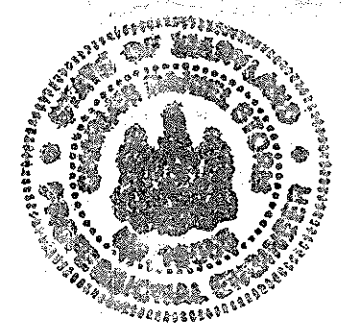

No.	REVISION	DATE	BY
1	Revised Post DA for realignment to road & subdivision, labeled land use, showed soils and Tc paths. Revised Title Block and Added Purpose Statement.	09-09-05	KD
3	REVISED THE TORN-AROUND INCLUDING BARBER LOCATIONS AND DUMPSTER ENCLOSURE, ADDED COMMUNITY MAILBOX & SWM CONCRETE SWALES	5-18-09	PM

ENGINEERS • PLANNERS • SCIENTISTS • SURVEYORS

GREENHORNE & O'MARA, INC.
 200 HARRY S TRUMAN PKWY. SUITE-200 ANNAPOLIS, MARYLAND 21401
 (410) 266-0066

Greenbelt, MD - Annapolis, MD - Atlanta, GA - Fairfax, VA - Fredericksburg, VA - Mechanicsburg, PA
 Raleigh, NC - Rockville, MD - Tampa, FL - West Palm Beach, FL

DRAINAGE AREA MAP
 REVISED FINAL ROAD CONSTRUCTION PLAN
SCOTT FARM
 LOTS 29-42 and Open Space Lots 27, 28, 43 & 44
 TAX MAP NO. 35 P/O PARCEL 354


5th ELECTION DISTRICT
 HOWARD COUNTY, MARYLAND

CVF DESIGN	SCALE	1" = 50'
LMM DRAWN		14 OF 20
GRK CHECKED	SHEET	
OCT, '04 DATE	PROJ No.	F - 00 - 73 FILE No.


Construction Specifications For Sediment Basins

- Site Preparation:** Perimeter sediment control devices must be installed prior to clearing and grubbing. Areas where the embankment is to be placed shall be cleared, grubbed, and stripped of topsoil to remove trees, vegetation, roots or other objectionable material. The pool area shall not be cleared until completion of the dam embankment unless the pool area is to be used for borrow. In order to facilitate clean-out and restoration, the pool area (measured at the top of the pipe spillway) shall be cleared of all brush, trees, and other objectionable materials.
- Cut-off Trench:** A cut-off trench shall be excavated along the centerline of earth fill embankments. The minimum depth shall be four feet. The cut-off trench shall extend to both abutments to the riser crest elevation. The minimum bottom width shall be two feet, but wide enough to permit operation of excavation and compaction equipment. The side slopes shall be no steeper than 1:1. Compaction requirements shall be the same as those for the embankment. The trench shall be dewatered during the backfilling-compaction operations. For dewatering see Section D.
- Embankment:** The fill material shall be taken from approved areas shown on the plans. It shall be clean mineral soil free of roots, woody vegetation, oversized stones, rocks, or other objectionable material. Relatively pervious materials such as sand or gravel (Unified Soil Classes GW, GP, SW & SP) or organic materials (Unified Soil Classes OL and OH) shall not be placed in the embankment. Areas on which fill is to be placed shall be scarified prior to placement of fill. The fill material shall contain sufficient moisture so that it can be formed by hand into a ball without crumbling. If water can be squeezed out of the ball, it is too wet for proper compaction. Fill material shall be placed in six-inch to eight-inch thick continuous lifts over the entire length of the fill. Compaction shall be obtained by roting and hauling the construction equipment over the fill so that the entire surface of each layer of the fill is traversed by at least one wheel or tread track of the equipment or by the use of a compactor. The embankment shall be constructed to an elevation 10 percent higher than the design height to allow for settlement.
- Principal Spillway:** Steel risers shall be securely attached to the barrel or barrel stub by welding the full circumference making a watertight structural connection. Concrete risers shall be poured with the principal spillway in place or present with concrete around the principal spillway filled with concrete or slotted proof grout for watertight connection. The barrel stub must be attached to the riser at the same percent (angle) of grade as the outlet conduit. The connection between the riser and the riser base shall be watertight. All connections between barrel sections must be achieved by approved watertight hand assemblies. The barrel and riser shall be placed on a firm, smooth foundation of impervious soil as the embankment is constructed. Breaching the embankment to install the barrel is unacceptable. Pervious materials such as sand, gravel, or crushed stone shall not be used as backfill around the pipe or anti-seep collars. The fill material around the pipe spillway shall be placed in four inch lifts and hand compacted under and around the pipe to at least the same density as the adjacent embankment. A depth of 1.5 times the pipe diameter (min.) shall be backfilled over the principal spillway and hand compacted before crossing it with construction equipment.
- Emergency Spillway:** The emergency spillway shall be installed in undisturbed ground. The achievement of planned elevations, grades, design width, entrance and exit channel slopes are critical to the successful operation of the emergency spillway and must be constructed within a tolerance of ± 0.2 feet.
- Vegetative Treatment:** Stabilize the embankment in accordance with the appropriate vegetative Standard and Specifications immediately following construction. In no case shall the embankment remain unstabilized for more than seven (7) days. Once constructed, the top and outside face of the embankment shall be stabilized with seed and mulch. The remainder of the interior slopes should be stabilized (one time) with seed and mulch upon basin completion and monitored and maintained erosion free during the life of the basin.
- Safety:** Local requirements concerning fencing and signs shall be met, warning the public of hazards of soft sediment and floodwater.
- Maintenance:** Repair all damage caused by soil erosion and construction equipment at or before the end of each working day. Sediment shall be removed from the basin when it reaches the specified distance below the top of the riser as shown on the riser. This sediment shall be placed in such a manner that it will not erode from the site. The sediment shall not be deposited downstream from the embankment, adjacent to a stream or floodplain. Disposal areas must be stabilized.
- Final Disposal:** When temporary structures have served their intended purpose and the contributing drainage area has been properly stabilized, the embankment and resulting sediment deposits are to be leveled in accordance with the approved sediment control plan. The proposed use of a sediment basin site will often dictate final disposition of the basin and any sediment contained therein. If the site is scheduled for future construction, then the basin material and trapped sediment must be removed and safely disposed of and the basin shall be backfilled with a structural fill. When the basin area is to remain open space, the pond may be pumped dry (using methods in Section D - Dewatering), graded, and back filled.
- Conversion to Stormwater Management Structure:** After permanent stabilization of all disturbed contributory drainage areas, temporary sediment basins, if initially built and certified to meet permanent standards, may be converted to permanent stormwater management structures. To convert the basin from temporary to permanent use, the outlet structure must be modified in accordance with approved stormwater management design plans. Additional grading may also be necessary to provide the required storage volume in the basin. Conversion can only take place after all disturbed areas have been permanently stabilized to the satisfaction of the inspection authority and storm drains have been flushed.


- Emergency Spillway (O/S) N/A**
- Emergency spillway cap, $Q_u = Q_a - Q_b = 10.7$ cfs
 - Width = 8' ft; H = 10' ft
 - Entrance channel slope = 5%
 - Exit channel slope = 5%
- Anti-Seep Collar Design (If Required) SEE SWM COMPUTATIONS**
- Use 3/4" dia. pipe with 1/2" dia. square projection, $L_s = 30$ ft
 - Use 3/4" dia. pipe with 1/2" dia. square projection, $L_s = 30$ ft
- Design Elevations**
- Riser Crest = 432.3 ft
 - Emergency Spillway Crest = N/A ft
 - Permanent pool = 430.13 ft
 - Draw-down orifice invert = 426.0 ft
 - Design High Water = 430.92 ft
 - Min. settled top of dam = 430.0 ft
 - Bottom of Basin = 426.0 ft
- Surface Area Design**
- Min. basin surface area; $SA \geq 0.0035 \times Q_u = 0.0035 \times 10$ cfs = 0.035 ac.
- Draw-down Device**
- Draw-down device orifice diameter = 4" in. (From Table 11)
 - $A = \text{Total area of perforations} \geq 4A$, Use 1.0" Diam. Holes, Area 0.0056 ft²
 $A = (\# \text{ of perforations}) \times (\text{perforation area}) \times (\text{perforation length})$
 $A = 0.355 \text{ ft}^2$
 - Internal orifice area (from Table 11 or computed) $A_o = 4" \text{ Orifice} \times 0.087 \text{ ft}^2$
 Use 65 holes in each draw-down device
 Use a 1/2" draw-down to obtain required number of holes for both ponds.

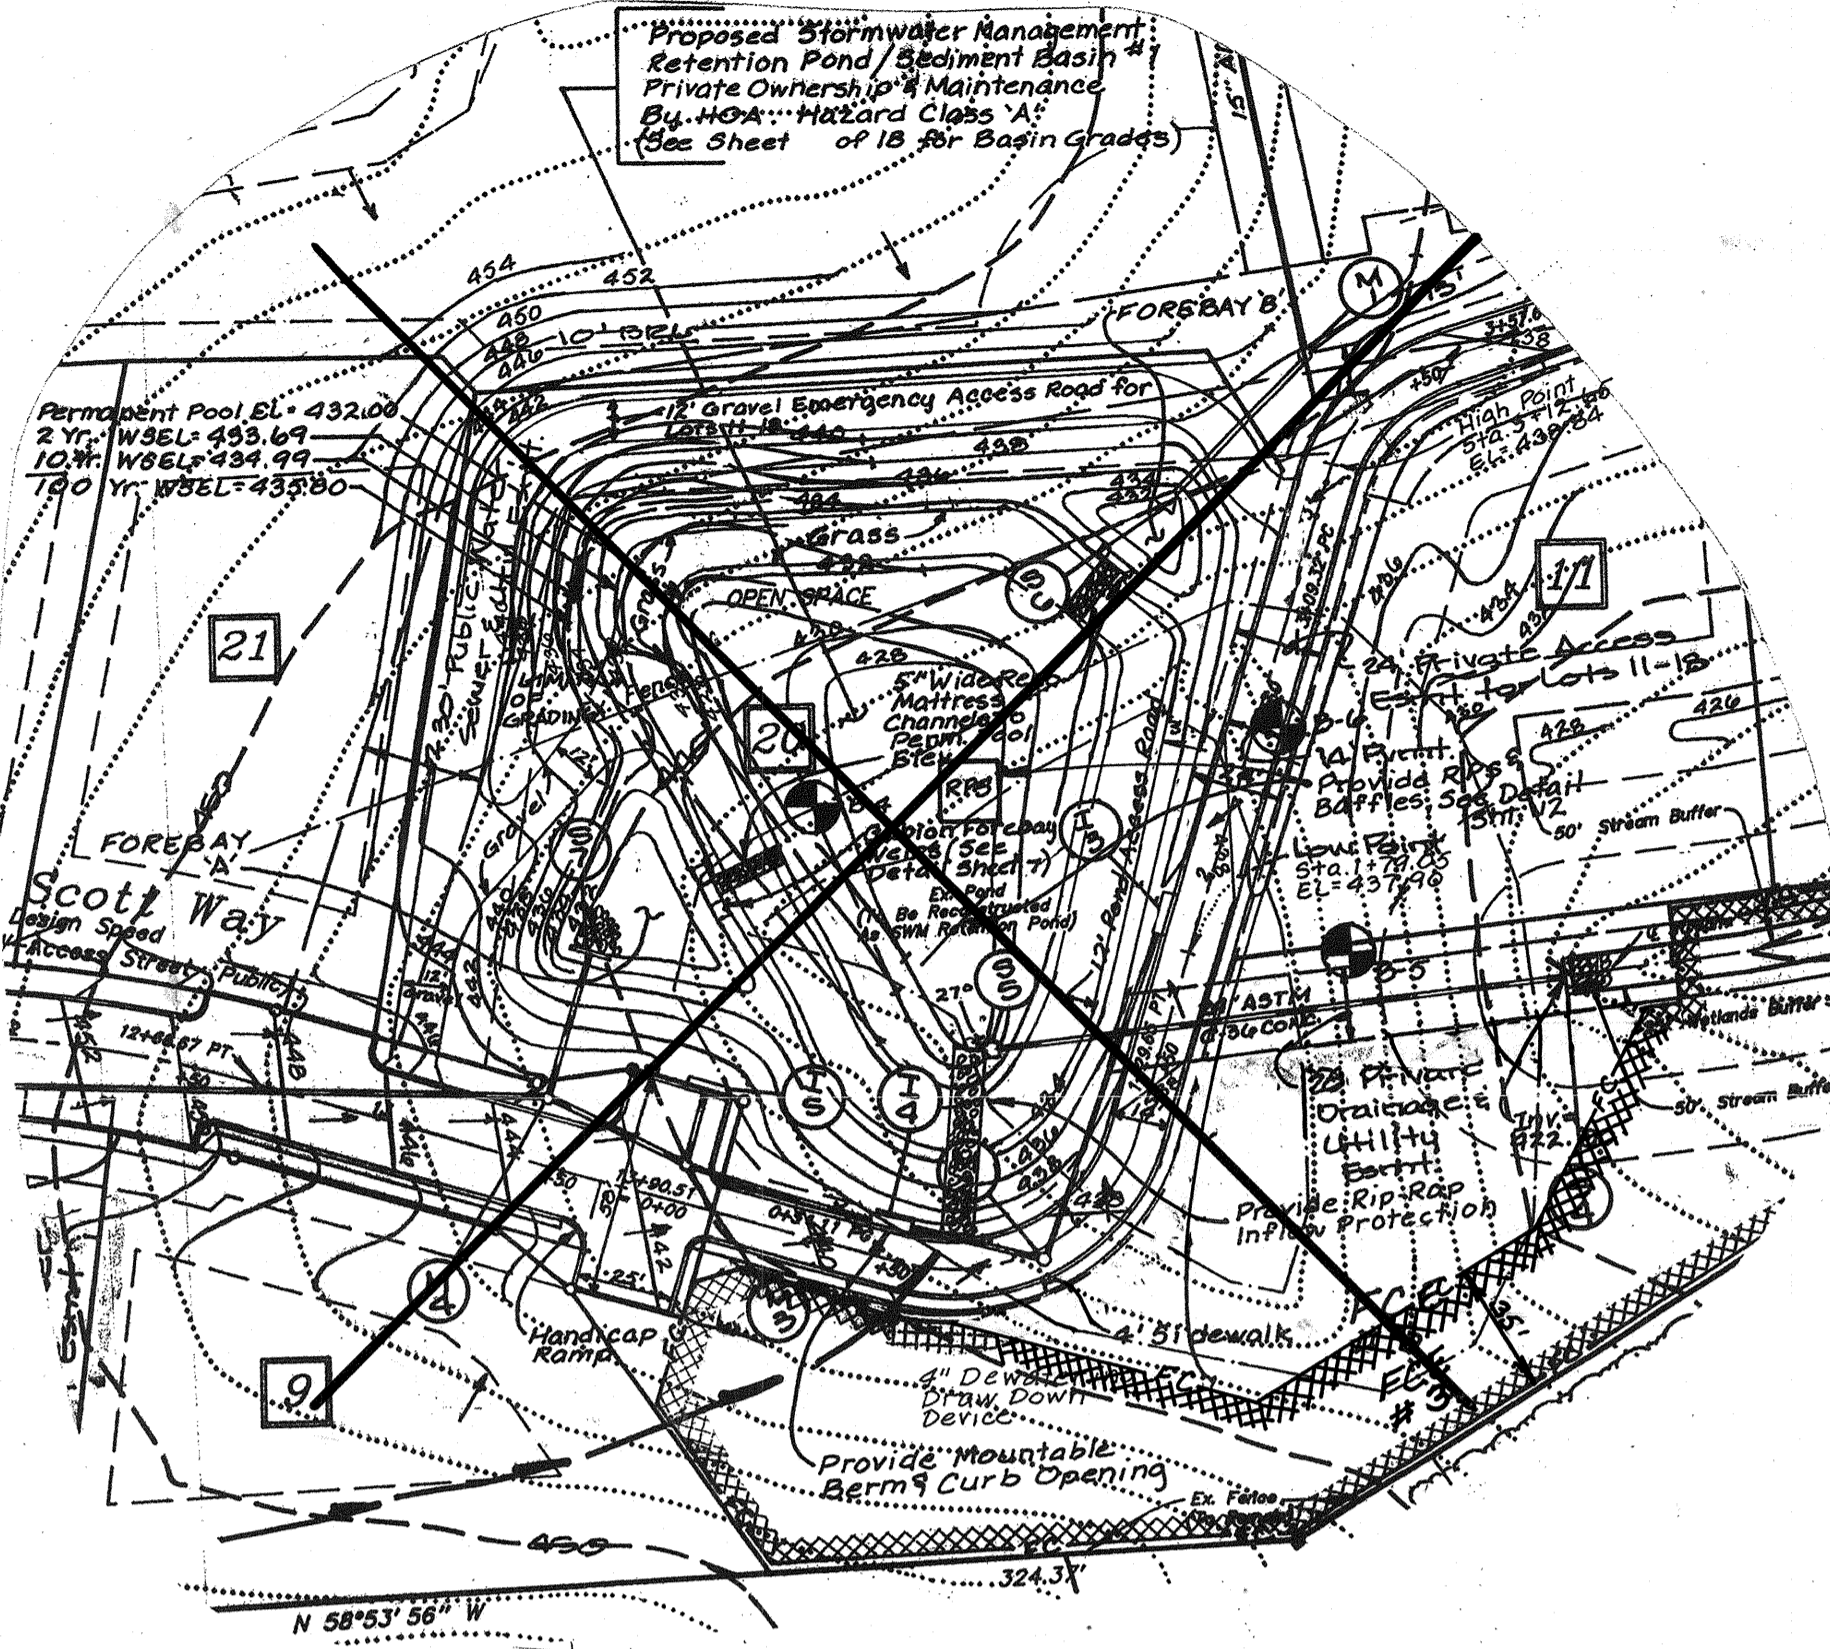

Sediment Basin #1 Plan View
1" = 50'

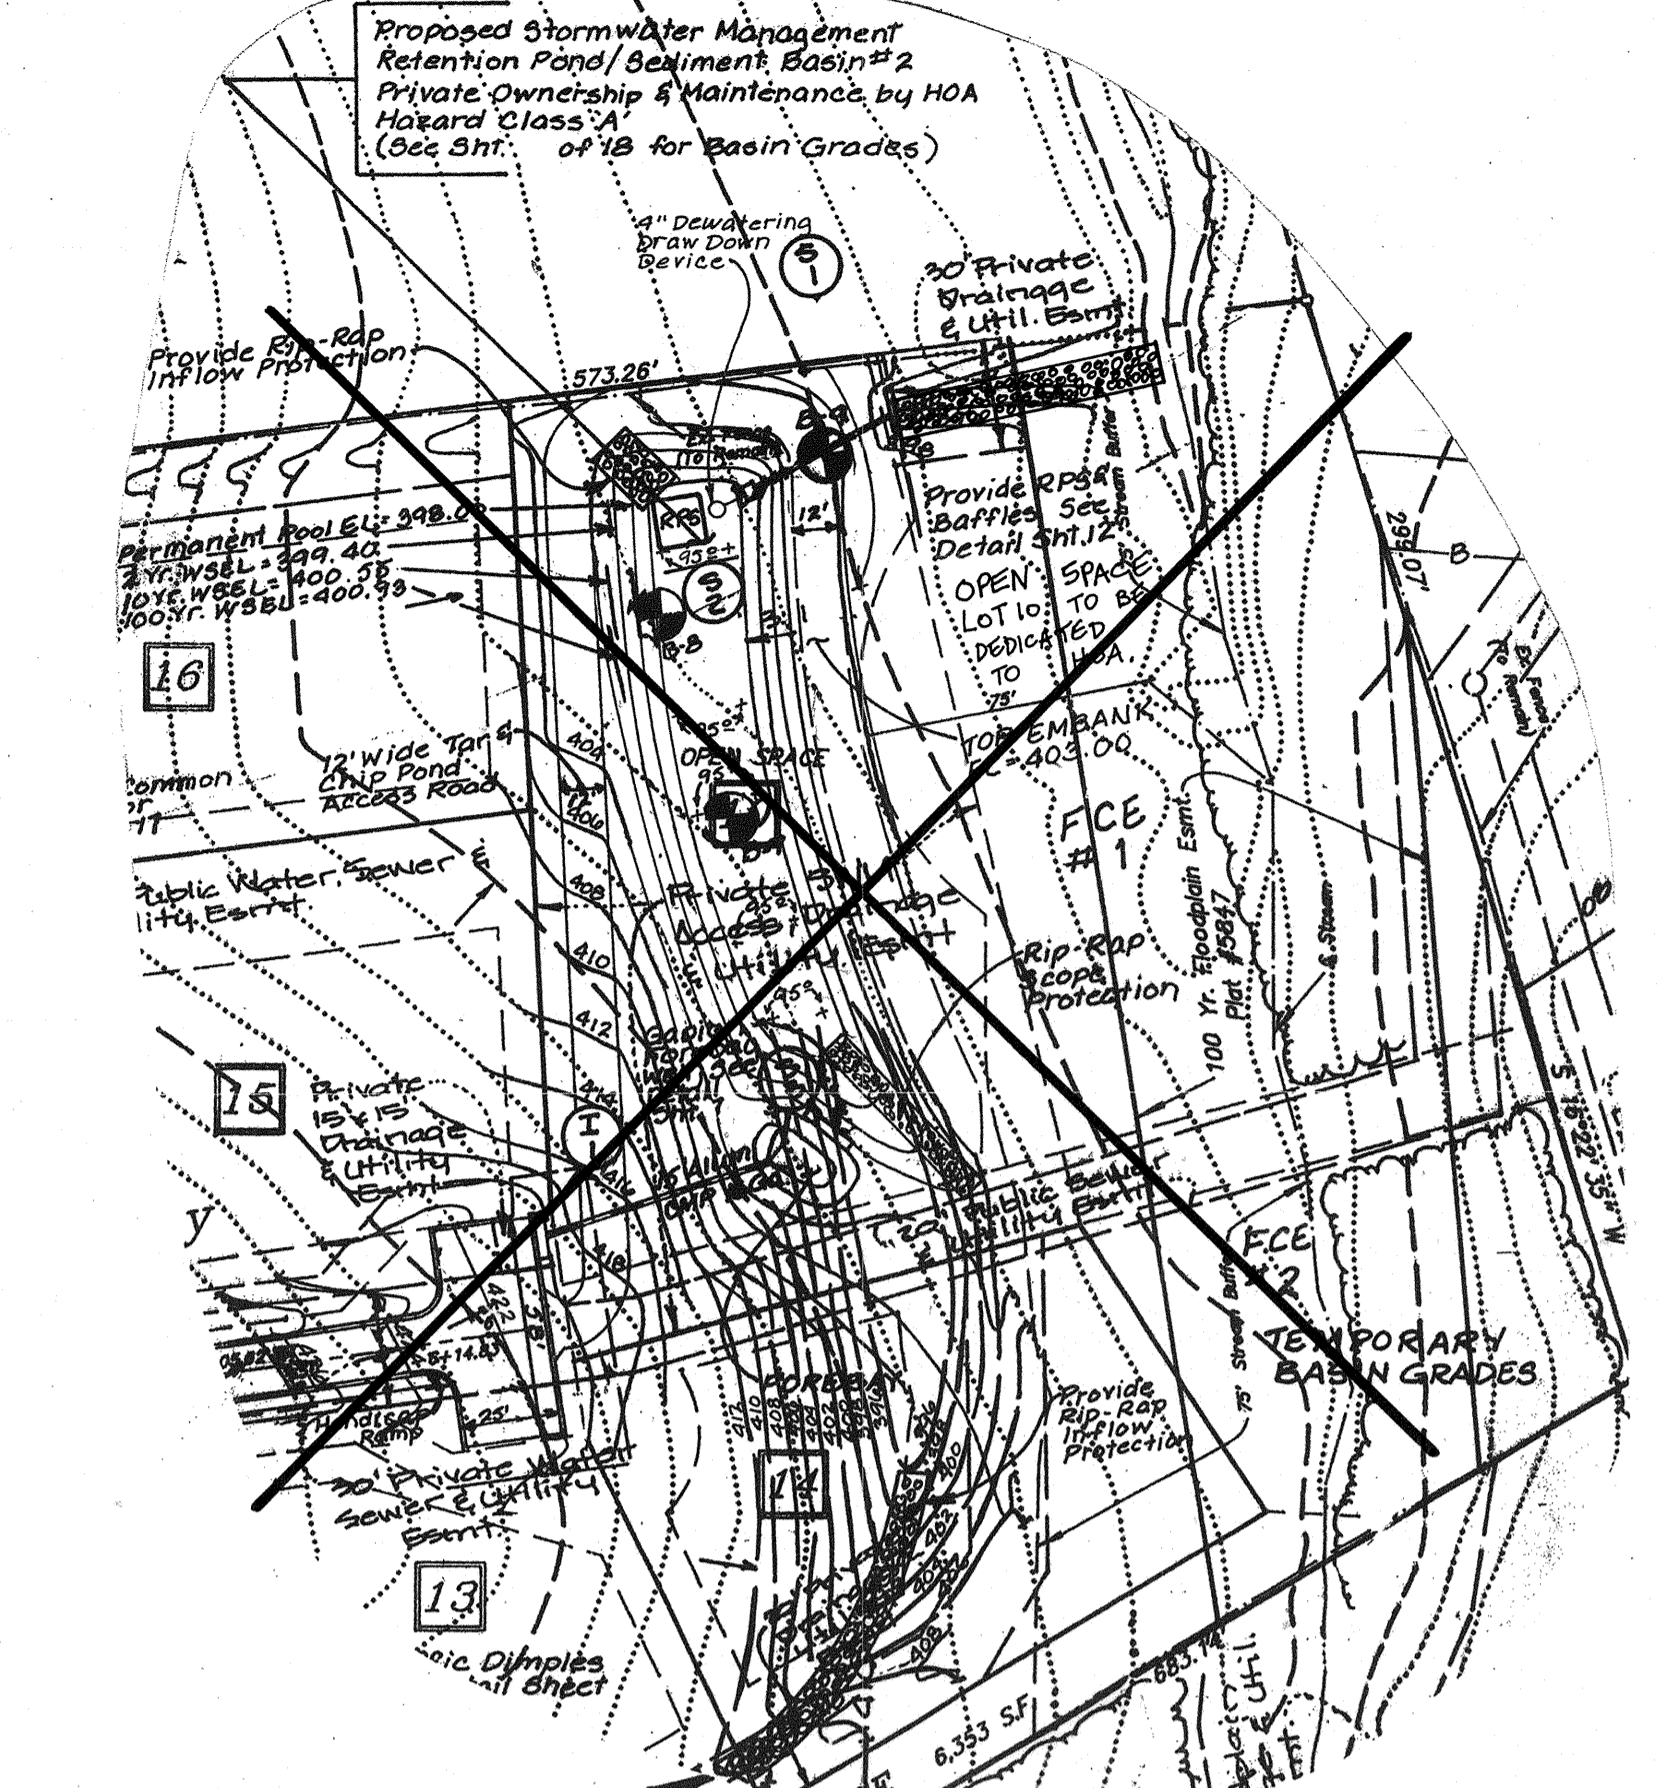


Sediment Basin #2 Plan View
1" = 50'

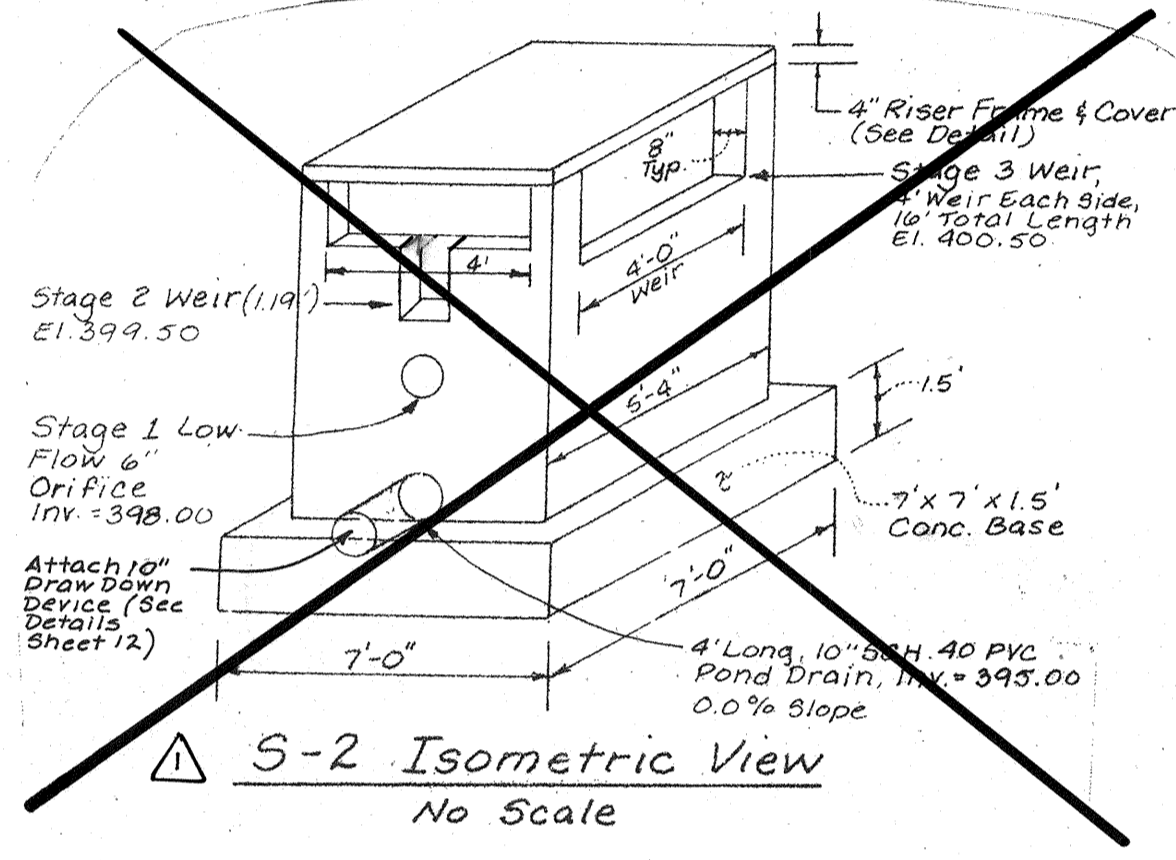


S-2 Isometric View
No Scale

BASIN DESIGN DATA SUMMARY


	Basin #1	Basin #2
Top of Wet Storage Volume, Elev.	430.70	397.47
Begin Temp. SWM Storage Vol. Elev.	430.70	397.47
Top of Dry Storage Vol. Elev.	432.20	398.85
Top of 4" Draw Down Standpipe	432.40	399.17
Basin Perforations on Draw-down Standpipe	430.70	397.47

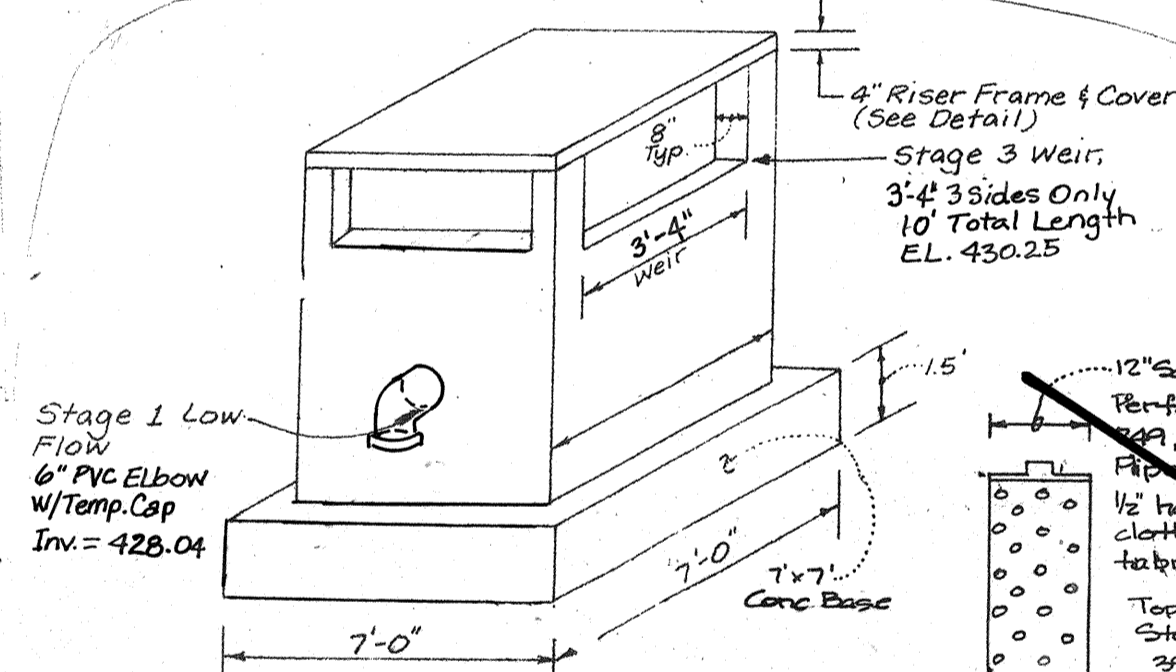

S-5 Isometric View
No Scale

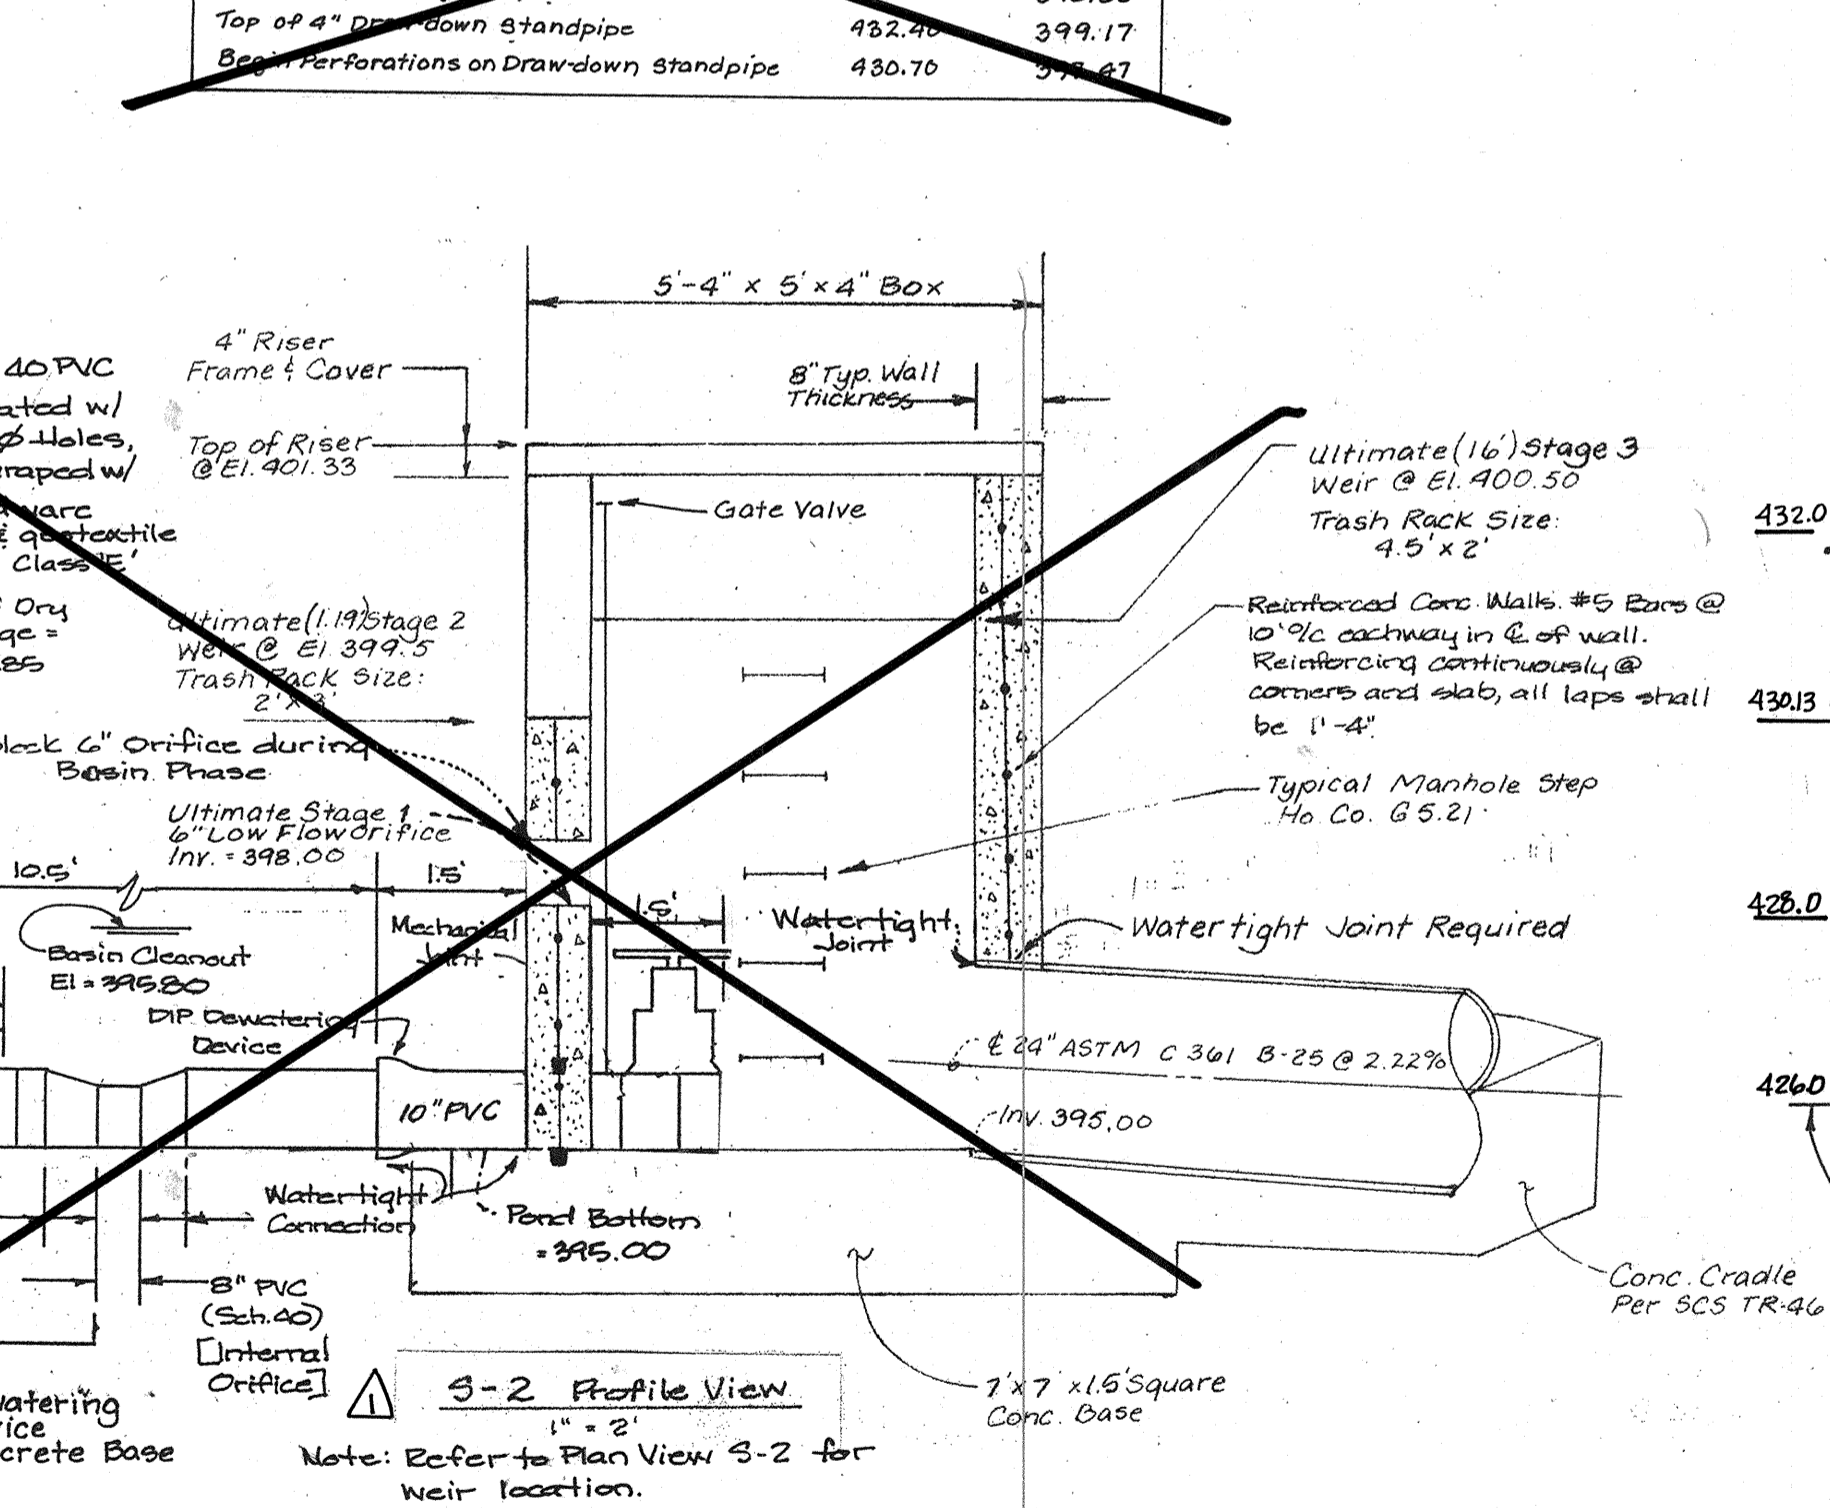

S-2 Profile View
1" = 2'

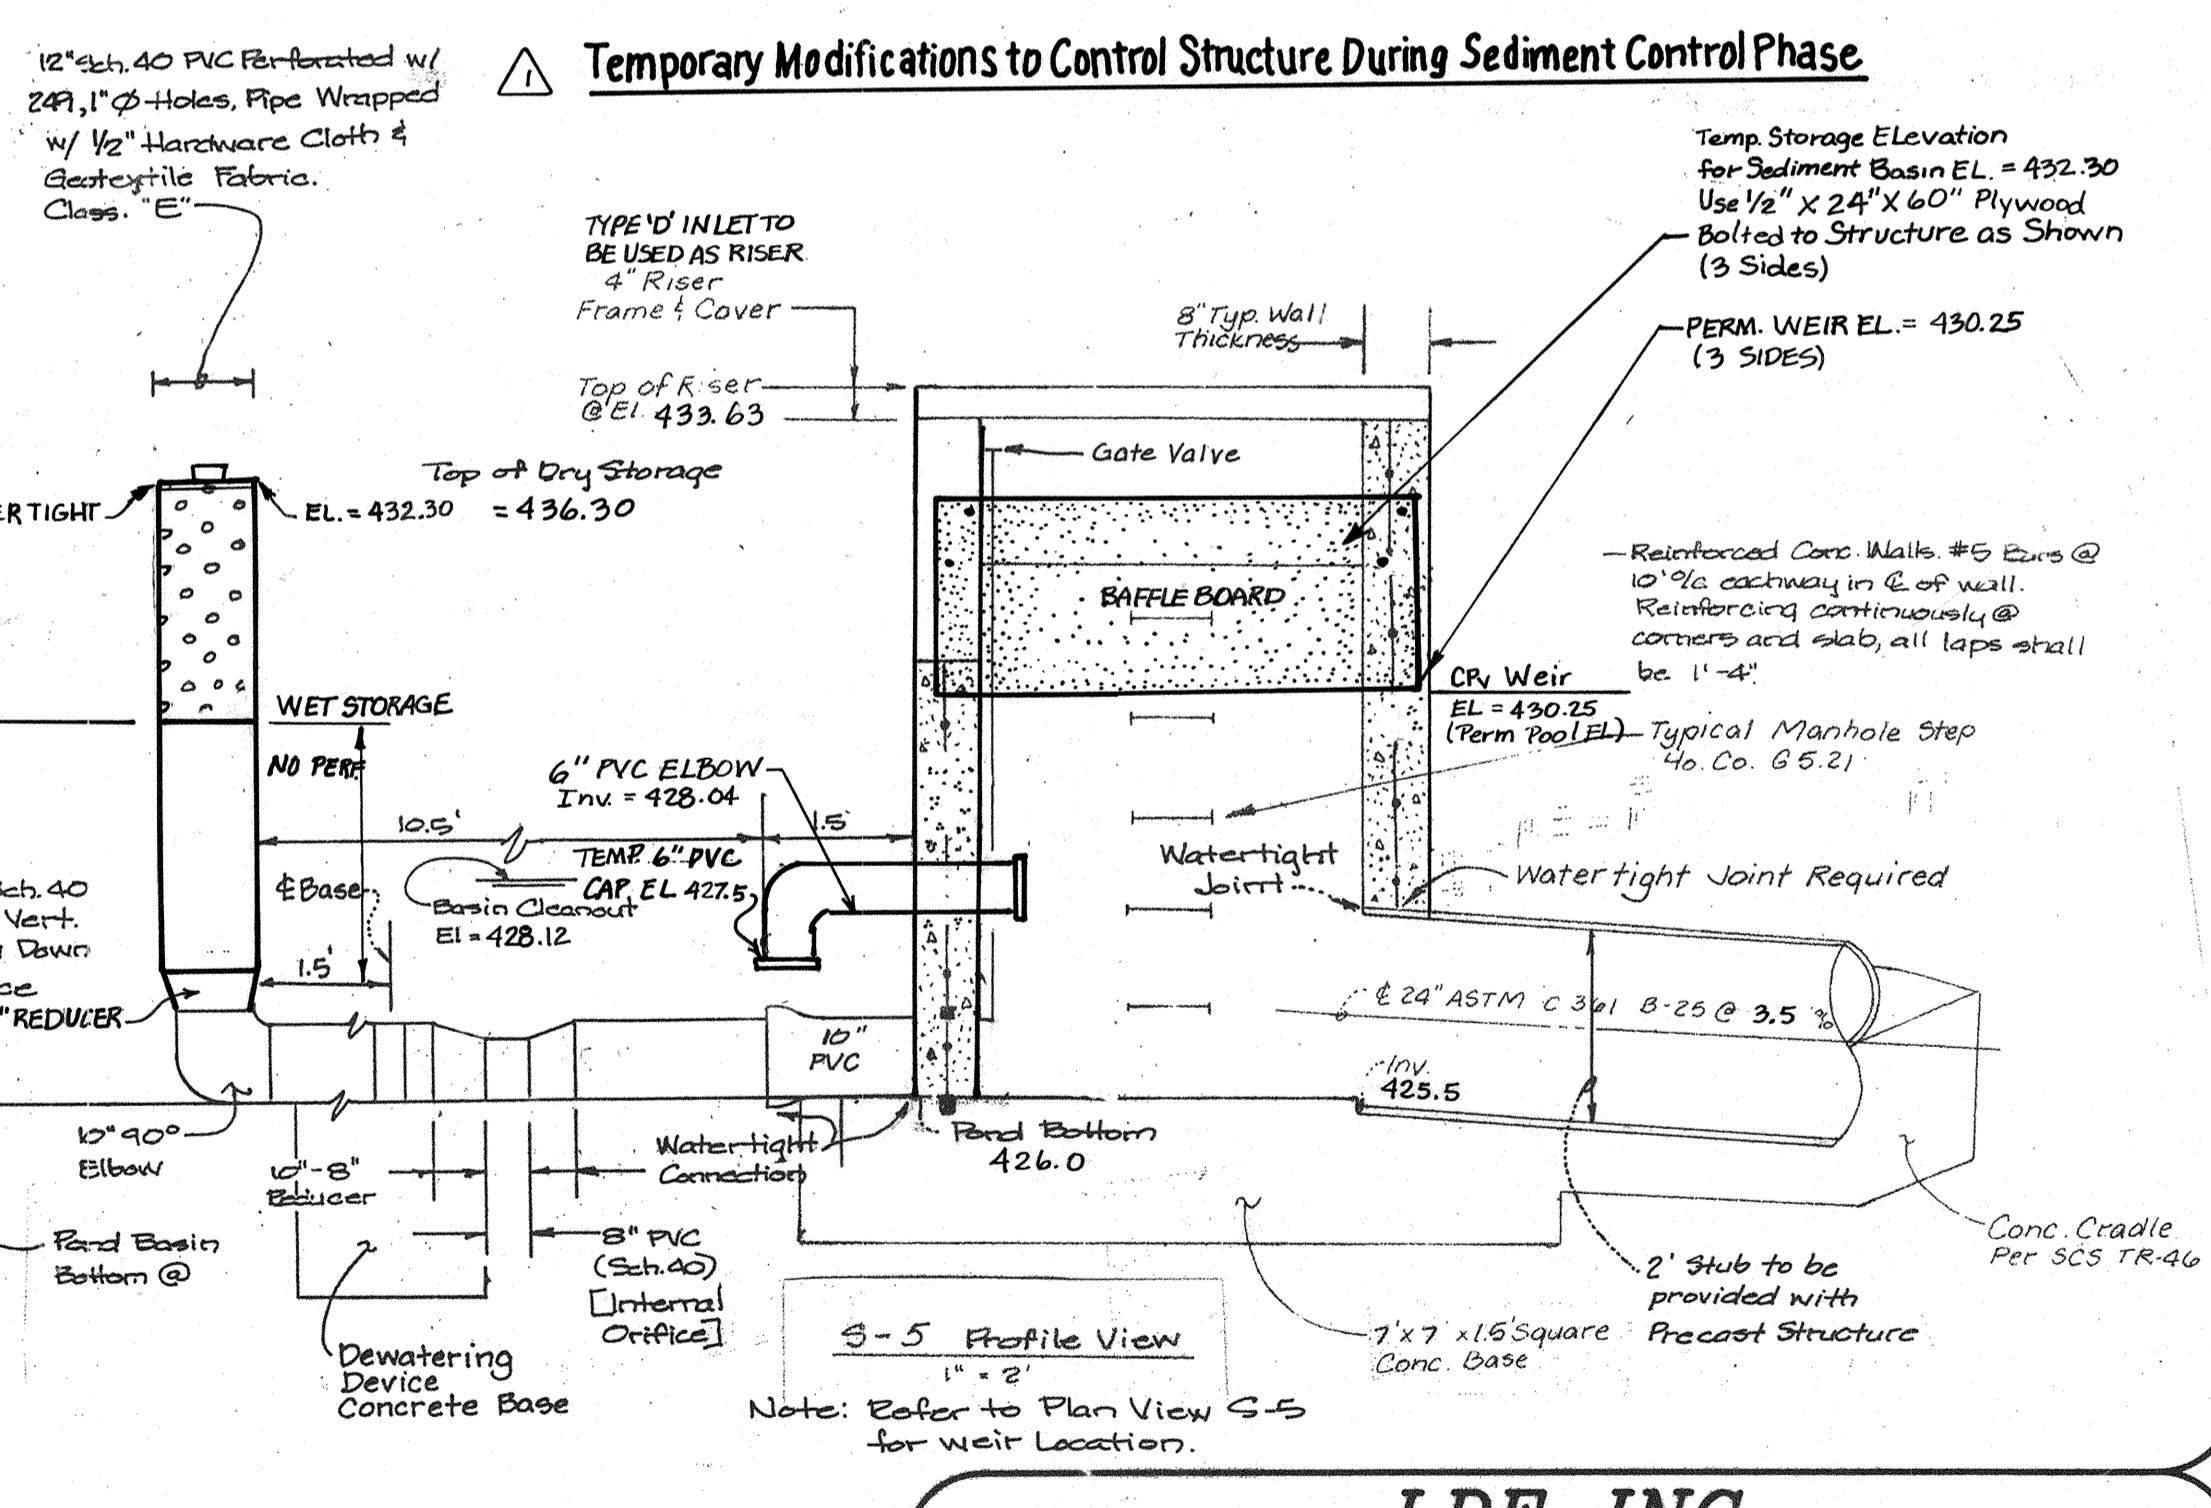

S-5 Profile View
1" = 2'

Figure 2. Temporary Sediment Basin Design Data Sheet

Computed by: SDH Date: 11-11-99 Checked by: BDB Date: 11-11-99
 Project name: Scott Farm Basin #: _____
 Location: Intx. Guilford Road/Hall Shop Road
 Clarksville, Howard County, MD Basin #1/
 Basin #2

Total area draining to basin: 8.63 acres (ac)

Basin Volume Design

Note: 1. Also see Surface Area Design #30, this form.
 2. To convert ft³ to yd³, divide ft³ by 27. To convert ft³ to yd³, divide ft³ by 9.

- Min. required vol. = 3600 ft³/ac x 8.63 ac drainage = 31068 ft³
- Actual Volume of basin = 31068 ft³
- Excavate N/A ft³ to obtain required capacity.
- Vol. of dewatering elev. = 1800 ft³/ac x 8.63 ac = 15534 ft³
- Vol. of basin at cleanout = 500 ft³/ac x 8.63 ac = 4315 ft³
- Permanent pool elevation: 430.13 ft.
- Distance from riser crest elevation to permanent pool elevation: 2.17 ft.
- Basin cleanout elevation: 426.12 ft.
- Distance from riser crest elevation to cleanout elevation: 4.18 ft.

Spillway Design

- $Q_u = 10$ cfs (peak discharge from 10-yr, 24-hr storm event, attach computations)

Principal Spillway (O/S) (See Detail 11)

Design Principal Spillway (Barrel) discharge, Design $Q_u = 10.7$ cfs (min. 10% of 1 year peak of 8" Diameter Pipe)

- $H = 13/10$ ft Barrel length = 150/45 ft.
- Barrel Diam 24/24 in. Q_u must equal or exceed Design Q_u .
- $Q_u = Q$ (from Table 13 or 14) $Q_u = 10.7$ cfs
- Riser Diameter 48/48 in.; Riser Height 7 ft; Riser Head (h) = 10 ft.
- Trash Rack Diam. = 1/2 in.; Trash Rack Height = 1/2 in.

NOTE: A table showing design data shall be included on the plan for each basin.

Basin #1	Basin #2
2 Yr. WSEL = 424.38' / $Q_{10} = 1.0$ cfs	2 Yr. WSEL = 399.75' / $Q_{10} = 1.0$ cfs
10 Yr. WSEL = 435.50' / $Q_{10} = 10.0$ cfs	10 Yr. WSEL = 400.58' / $Q_{10} = 10.0$ cfs

APPROVED: DEPARTMENT OF PLANNING AND ZONING

Chief, Development Engineering Division
 DATE: 10/20/00

Chief, Division of Land Development
 DATE: 7/12/00

Chief, Bureau of Highways
 DATE: 5-26-00

THESE PLANS HAVE BEEN REVIEWED FOR THE HOWARD SOIL CONSERVATION DISTRICT AND MEET THE TECHNICAL REQUIREMENTS FOR SMALL POND CONSTRUCTION, SOIL EROSION, AND SEDIMENT CONTROL.

Chief, Natural Resource Conservation
 DATE: 5/10/00

THESE PLANS FOR SMALL POND CONSTRUCTION, SOIL EROSION, AND SEDIMENT CONTROL, MEET THE REQUIREMENTS OF THE HOWARD COUNTY SOIL CONSERVATION DISTRICT.

Chief, Natural Resource Conservation
 DATE: 5/10/00

ENGINEER'S CERTIFICATE

I certify that this plan for pond construction, erosion and sediment control represents a practical and workable design and that I have the personal knowledge of the conditions shown on these plans. This plan was prepared in accordance with the requirements of the Howard Soil Conservation District and I have notified the District that these plans must be approved by the District before construction begins. I am a duly licensed Professional Engineer in the State of Maryland.

Professional Engineer
 DATE: 5/19/00

DEVELOPER'S CERTIFICATE

I, the undersigned, certify that all development and/or construction will be done according to these plans, and that any responsible personnel involved in the construction project will have a Certificate of Attendance at a Department of the Environment Approved Training Program for the Control of Sediment and Erosion before beginning the project. I shall engage a registered professional engineer to supervise construction and provide the Howard Soil Conservation District with an "as-built" plan of the pond within 30 days of completion. I shall authorize periodic inspections by Howard Soil Conservation District.

Developer
 DATE: 11-11-99

REVISIONS

N.O.	REVISION	DATE	BY
1.	Revised S-5 Detail & Profile. Deleted Plans & Details. Revised Title Block & Sheet No.	09-09-05	KD

LDE, INC.

9250 Rumsey Road, Suite 106, Columbia, MD 21045
 (410) 715-1070 (301) 596-3424 (410) 715-9540 (Fax)

DESIGNED: S.D.H.
 DRAWN: CADD
 CHECKED: B.D.B.
 DATE: 11/99

SCALE: As Shown
 DRAWING: 15 of 20
 JOB NO.: 98009
 FILE NO.: F-00-73

Scott Farm
 Lots 29, 42 and Open Space Lots 21, 28, 43 & 44
 Tax Map No. 35 - P/O Parcel 356
 5th Election District - Howard County, Maryland
 Previous Submittals: F76-104, F76-144, F77-102, S97-23, RA91-34E, S95-10, S99-23, F43 & S99-06
 Owner/Developer: Scarlett Williams & Earl Omer
 6799 Guilford Road
 Clarksville, Maryland 21089
 (410) 531-8888 or (410) 987-0497

AFFORESTATION
PLANTING SPECIFICATIONS AND NOTES

- GENERAL NOTES**
- This afforestation planting plan is provided in accordance with the requirements set forth by the Forest Conservation Program administered by the Howard County Department of Planning and Zoning. The preparation of these plans, the notes and details incident thereto were prepared using the guidelines of the Howard County Forest Conservation Manual, the State of Maryland Forest Conservation Manual, as well as sound professional forestry, arborist, and nurseryman practices.
 - This plan shall be implemented by a contractor that is knowledgeable and experienced in the methods set forth herein.
 - The survival rate of the plantings shall be 75% of the total number of plantings per acre as provided by this plan.
 - Base sheet information as provided by LDE, Inc. of Columbia, Maryland.

- QUALITY ASSURANCE**
- Names of plant material listed conform generally with names accepted by the nursery trade. The contractor is to provide stock true to botanical/scientific name.
 - Material shall be grown and delivered so as to be that specified herein.
 - If specified material is not available or where are other technical, logistical, financial impediments that shall necessitate the substitution of plant materials, the contractor shall contact the plan preparer for permission to use equivalent material. These changes are subject to final approval by Howard County Department of Planning and Zoning, Forest Conservation Program.

- SITE PREPARATION AND CARE**
- Disturbance of soils should be limited to the planting field for each plant unless an area has been prepared with soil amendments and/or broadcast seeding for groundcovers, etc.
 - Soil amendments should be considered for any site only after careful analysis of existing conditions. Soil samples should be analyzed by a qualified soil lab to determine the need for any amendments. The results of the soil analysis should be provided to the landscaping contractor and/or the local county Cooperative Extension agent or interpretation in the context of the intended plantings. Their recommendations should be followed closely. In the case of highly compacted sites that do not allow soil aeration or loosening treatment, a minimum of 25% leaf soil and 25% manure, the remainder being landscape topsoil, may be added. This mixture should be applied at the rate of one cubic yard per 165 square feet of area. Till deep taking care not to bring subsoils to the surface. Amendments should be tilled in after the initial planting. This method is particularly suitable when broadcast seeding or perennial beds are involved.
 - Soil mix for arbuscular mycorrhizal: Active topsoil into which the contractor shall thoroughly incorporate 25% by volume peat moss and 25% leaf soil may be added into soil.

- PLANT STORAGE AND INSPECTION**
- For container grown nursery stock, planting should occur within two weeks after delivery to site.
 - Planting stock should be inspected prior to planting. Plants not conforming to standard nurseryman specifications for size, form and vigor, roots, trunk wounds, insects and disease should be replaced.
 - Container stock, if not planted within two weeks, may be banked up with mulch and watered every other day or as needed until planting. Bare root stock may not be delivered and left on site prior to planting.

- SEASONAL PLANTING LIMITATIONS**
- Planting activities shall conform with established nurseryman's practice and approximate the growing season for the geographic area. Planting of bare-root stock after March should be avoided unless seasonal protection is measurably retarded by observable temperature or weather patterns and stock has been kept appropriately dormant through proper storage.
 - Planting shall not take place in sub-freezing temperatures, when the ground is frozen, or when the soil is saturated with water or otherwise in a condition not generally accepted as satisfactory for planting and may adversely affect plant survival.

- Planting Schedule/Timeframe**
- Planting shall occur after construction activities have ceased. If the planting stock is to be bare root material, it shall be planted no earlier than immediately after the first frost and no later than March 15. Container stock may be planted at any time and if such stock is chosen, planting shall be accomplished by the end of the first growing season after completion of construction activities.






- Binding Maintenance Agreement/Schedule**
- Annual maintenance during the growing season for a period of two years. These tasks are the responsibility of the owner or individual to whom ownership has been conveyed or who has legally accepted responsibility for these tasks. Management include the following: watering, fertilizing, pruning, removal of dead material and the control of pests and competing vegetation.
 - Schedule: Year 1 (March-April), (July-August); (October-December); Year 2 (March-April), (July-August); (October-December). At the end of the time period specified in the schedule, the contractor shall submit a report showing the survival of the total number of trees planted. If the survival rate is determined to have fallen below 75%, material identical to that not surviving shall be planted as replacement.
 - Assess tree mortality of planting stock, remove and replace any dead or diseased plants.
 - Volunteer seeding of native, local and endemic vegetation is to be encouraged. Do not discourage this effort unless it is negatively affecting the planted stock.
 - Remove through manual means (grubbing, pulling, cutting) aggressive weeds, invasive species, herbaceous and otherwise, if deemed necessary. Twice annual mowing/brushcutting and spot treatments with Roundup is one of the most effective means to control exotic/invasive species. No mowing shall occur during the wildlife nesting period of early April through mid-May.
 - Remove and dispose of man-made trash. Do not remove down and dead material naturally occurring or accumulating, unless it is smothering planting stock.
 - Construction of survival as required shall be completed by a licensed forester, licensed landscape architect or other qualified professional per COMAR and submitted to Howard County Department of Planning and Zoning, Forest Conservation Program Release of security shall occur at the time.
 - Perimeter signage, placed at minimum 100' intervals, shall be permanent.

PLANT INSTALLATION

- Container grown stock should be removed from the container and roots gently loosened from the soil. If the roots are circling the root ball, substitution is strongly recommended. If roots are not to be removed, the roots should be pruned on site, due to the increased chance of soil borne diseases.
- Bare root stock should be unwrapped on-site only when ready to plant them held in water. When handled for planting, stock shall be immediately dipped in Super-soak or equivalent water-soluble polymer prepared with water as a slurry per manufacturer's specification. Roots must be thoroughly coated upon withdrawal from solution and stock immediately after digging. If not planted immediately, wrap in burlap. Roots are not to be exposed to air.
- For trees planted in the afforestation area, contractor shall evenly disperse species in groups of two to four per species over the entire designated area to be planted or on random center spacing by species as dictated by planting density.
- Avoid planting in a straight grid pattern. Trees shall be planted on a average spacing of ten feet or more, randomly.
- As shown on the detail view, a planting field diameter of two - three times the diameter of the root ball or container is recommended. The depth of the hole should be no more than 1 - 1.5 times the length of the root mass. The hole should be excavated with an auger. If the walls of the hole should glaze due to auger rotation, they can be scored with a spoke or the auger may be "wiggle" upon withdrawal to assure no glazing occurs. Additionally, there will be loose earth in the bottom of any hole. This should be lightly tamped with the foot to keep the planting unit from settling too much.
- Native stockpiled soil should be used to backfill planting field except where soil amendments are site-wide and specific. After backfilling, move stock around in hole to allow settling of initial fill to avoid air pockets. Finish filling hole and use water to further settle soil backfilled around tree. Match with composted wood chips (> 1 year of composting). Match should be 2" deep and extend to limits of prepared hole. This should keep weeds down for about one year.
- Newly planted trees may need watering as much as once a week for the entire growing season in well drained sites. This combined with the loosening of the backfilled, newly amended soil is an additional maintenance enhancement within the planting field. The next two years may require watering only a few times a year during summer and dry months. After that period, trees should only need water in severe droughts. Any watering should compensate for recent rainfall patterns.
- Do not fertilize newly planted trees within the first growing season after planting. Doing so may cause a surge of canopy growth which roots cannot support and add additional shock to the already disturbed plant. Fertilize by sidecasting after one year, if desirable.
- If and when it is time to fertilize, organic fertilizers are preferred to synthetic fertilizers. Some meal or seaweed based products are available commercially and are recommended. They have the ability to supply nutrients to the plant as needed while minimizing the risk of excess nutrients entering the forest system and water supply.
- All tags, labels, string, wire, etc., shall be removed from plant material.
- The landscape contractor is responsible for the location of all existing underground utilities and the repair of utilities damaged during planting shall be the landscape contractor's expense.

AFFORESTATION PLANT LIST

QTY	SPECIES	SIZE	REMARKS
56	Tulip Poplar Liriodendron tulipifera	4 Ft.	cont. or BR
56	Flowering Dogwood Cornus florida	4 Ft.	"
56	Red Maple Acer rubrum	4 Ft.	"
56	White Oak Quercus alba	4 Ft.	"
280 Total	0.8 A.L. Afforestation - 950 Whips or Seedlings Per Acre = 280 (Less 5% Contractor's Expense)		"

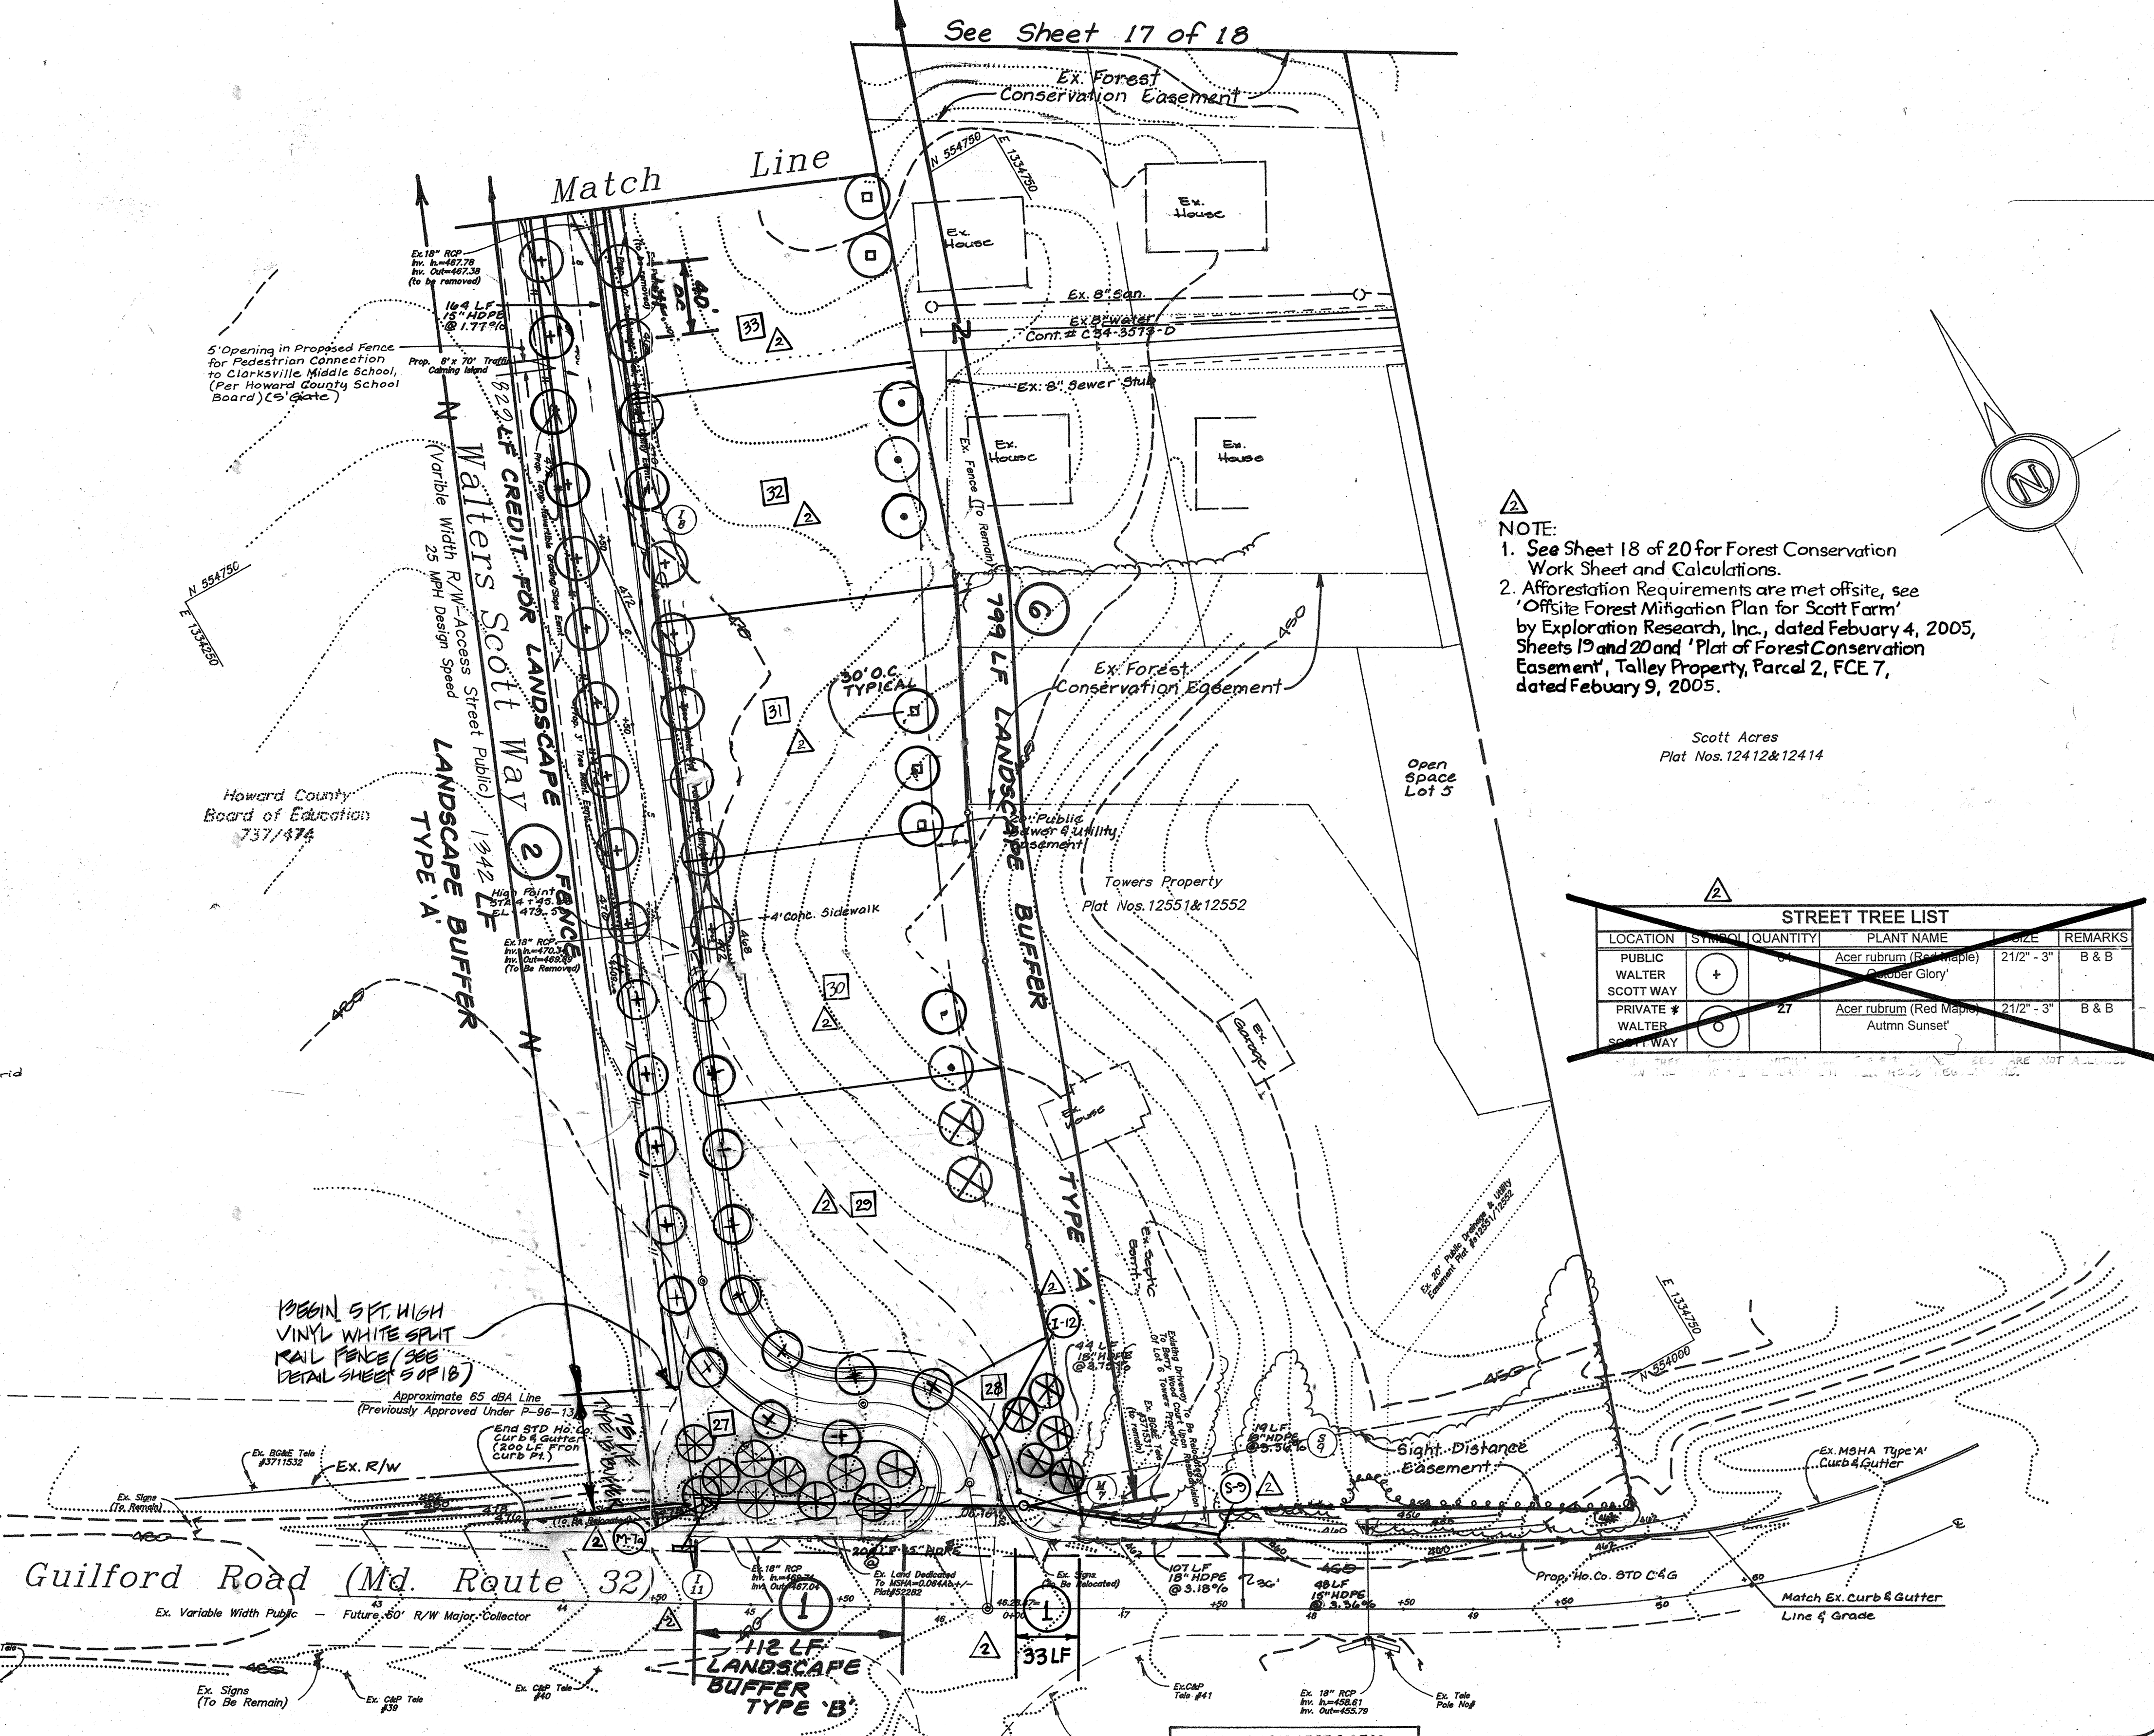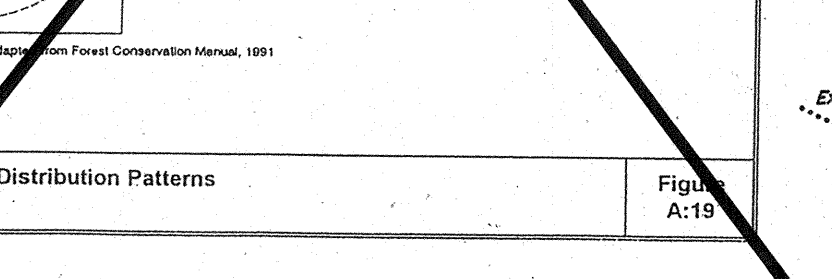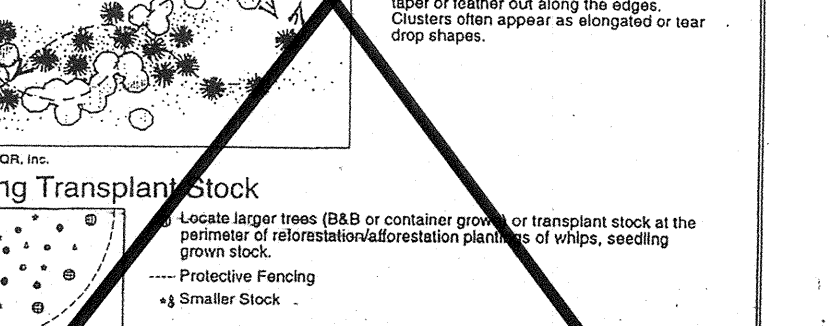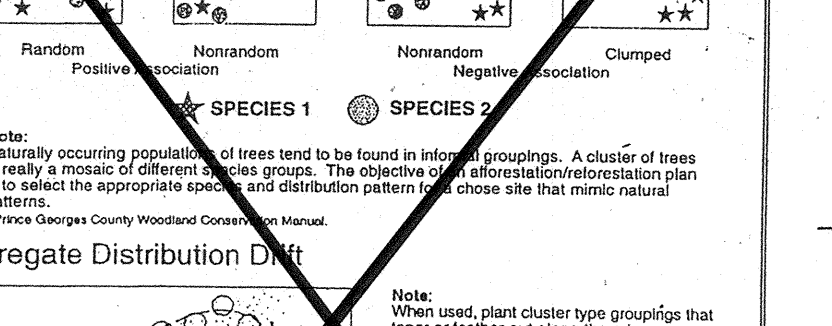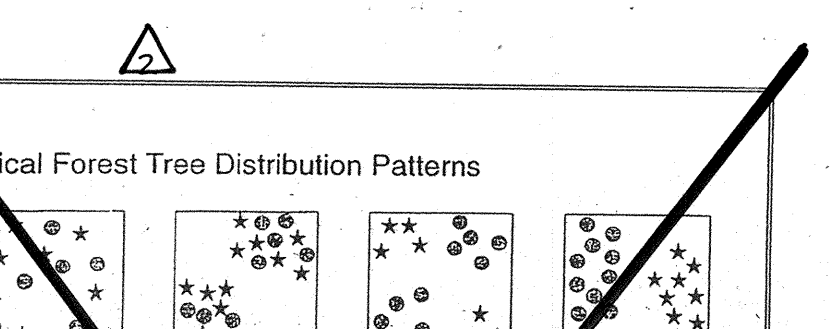

NOTE:

- See Sheet 18 of 20 for Forest Conservation Work Sheet and Calculations.
- Afforestation Requirements are met offsite, see 'Offsite Forest Mitigation Plan for Scott Farm' by Exploration Research, Inc., dated February 4, 2005, Sheets 19 and 20 and 'Plan of Forest Conservation Easement', Talley Property, Parcel 2, FCE 7, dated February 9, 2005.

STREET TREE LIST

LOCATION	SYMBOL	QUANTITY	PLANT NAME	SIZE	REMARKS
PUBLIC WALTER SCOTT WAY	+		Acer rubrum (Red Maple)	2 1/2" - 3"	B & B
PRIVATE WALTER SCOTT WAY	o	27	Acer rubrum (Red Maple) Autumn Sunset	2 1/2" - 3"	B & B

APPROVED: DEPARTMENT OF PLANNING AND ZONING

John Deamus, Chief, Development Engineering Division, 6/26/05

Christy Hamilton, Chief, Division of Land Development, 7/2/05

APPROVED: Department of Public Works for Storm Drainage Systems and Roads

Andrew M. Danks, Chief, Bureau of Highways, 5-26-05

THESE PLANS HAVE BEEN REVIEWED FOR THE HOWARD SOIL CONSERVATION DISTRICT AND MEET THE TECHNICAL REQUIREMENTS FOR SMALL POND CONSTRUCTION, SOIL EROSION, AND SEDIMENT CONTROL.

NATURAL RESOURCE CONSERVATION SERVICE, DATE: 5/9/00

THESE PLANS FOR SMALL POND CONSTRUCTION, SOIL EROSION, AND SEDIMENT CONTROL, MEET THE REQUIREMENTS OF THE HOWARD COUNTY SOIL CONSERVATION DISTRICT.

HOWARD SOIL CONSERVATION DISTRICT, DATE: 5/9/00

ENGINEER'S CERTIFICATE

I certify that all development construction will be done according to these plans, and that any construction involved in the construction project will have a Certificate of Approval from the Department of the Environment, approved by the Department of the Environment and Erosion before beginning the project. This plan was prepared in accordance with the requirements of the Howard Soil Conservation District. I have notified the Conservation District with 30 days of completion of this plan of the construction of the pond within 30 days of completion.

Signature: James V. [unclear], DATE: 5/9/00

DEVELOPER'S CERTIFICATE

I certify that this plan for pond construction, erosion and sediment control represents a practical and suitable plan based on my personal knowledge of the site conditions. This plan was prepared in accordance with the requirements of the Howard Soil Conservation District. I have notified the developer that he/she must engage a registered professional engineer to supervise pond construction and provide the Howard Soil Conservation District with an "as-built" plan of the pond within 30 days of completion.

Signature: [unclear], DATE: 11-11-99

PROFESSIONAL ENGINEER

STATE OF MARYLAND

Professional Engineer Seal

REVISION NO. 1 BY: CENTURY ENGINEERING INC. 322 WIGHT DRIVE TOWSON, MD 21284 410-827-0070

THIS PLAN FOR REVISION #1 & #2

Revised Lot Line & #7, and Storm Drain. Deleted Forest Conservation Notes. Labeled Buffer 1. Added Notes. Replaced street Tree P-1 to S-11B. Revised The B-1 & S-11F.

DATE: 9-9-05

LDE, INC.

9250 Rumsey Road, Suite 106, Columbia, MD 21045
(410) 715-1070 (301) 596-3424 (410) 715-9540 (Fax)

DESIGNED: S.D.H. FOREST CONSERVATION & LANDSCAPE PLANTING PLAN

DRAWN: CADD

CHECKED: B.D.B.

DATE: 11/99

Scale: 1" = 50'

Scott Farm

Lots 29 - 42 and Open Space Lots 27, 28, 43 & 44

Tax Map No. 35 - P/O Parcel 354

5th Election District - Howard County, Maryland

Job No. 98009

Owner/Developer: Scarlet Wilkinson & Bari Omer

8799 Guilford Road, Clarksville, Maryland 21029
(410) 531-2626 or (410) 987-0497


FILE NO. F-00-73

THESE PLANS HAVE BEEN REVIEWED FOR THE HOWARD SOIL CONSERVATION DISTRICT AND MEET THE TECHNICAL REQUIREMENTS FOR SMALL POND CONSTRUCTION, SOIL EROSION, AND SEDIMENT CONTROL.

NATURAL RESOURCE CONSERVATION SERVICE DATE

THESE PLANS FOR SMALL POND CONSTRUCTION, SOIL EROSION, AND SEDIMENT CONTROL MEET THE REQUIREMENTS OF THE HOWARD COUNTY SOIL CONSERVATION DISTRICT.

HOWARD SOIL CONSERVATION DISTRICT DATE

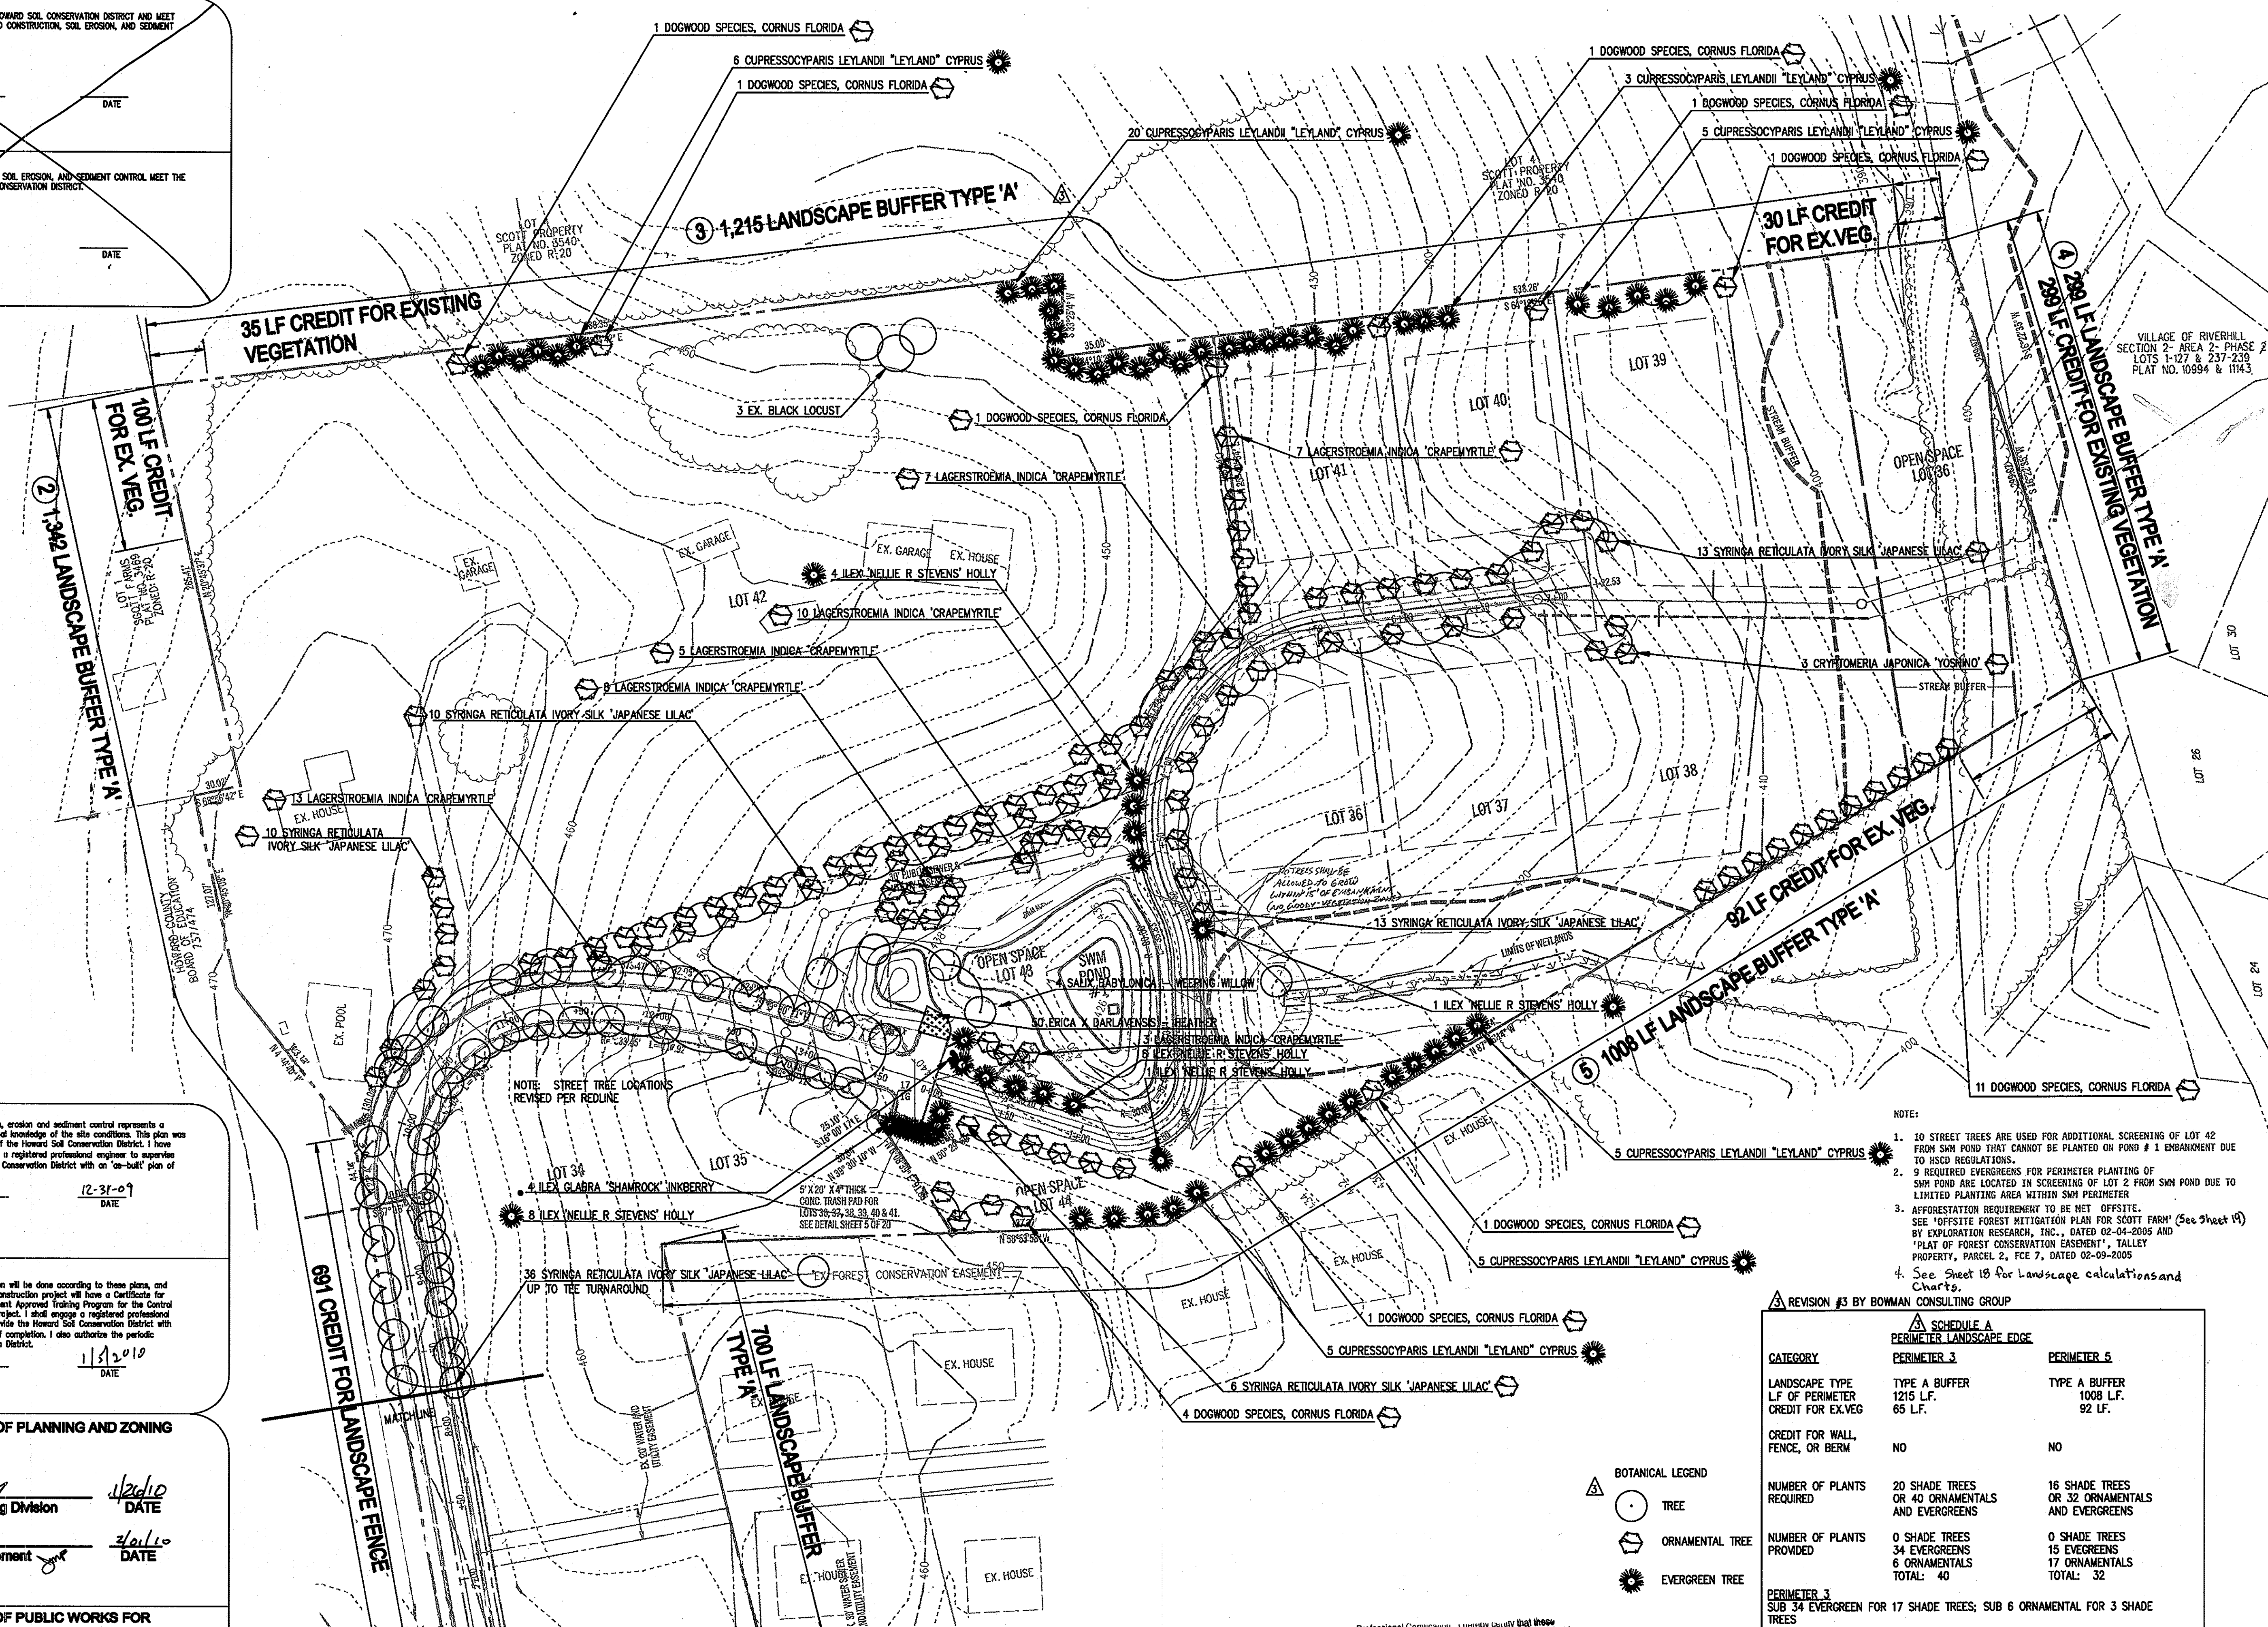

NOTE: STREET TREE LOCATIONS REVISED PER REDLINE

- NOTE:
- 10 STREET TREES ARE USED FOR ADDITIONAL SCREENING OF LOT 42 FROM SWM POND THAT CANNOT BE PLANTED ON POND # 1 ENBANKMENT DUE TO HSDC REGULATIONS.
 - 9 REQUIRED EVERGREENS FOR PERIMETER PLANTING OF SWM POND ARE LOCATED IN SCREENING OF LOT 2 FROM SWM POND DUE TO LIMITED PLANTING AREA WITHIN SWM PERIMETER.
 - AFFORESTATION REQUIREMENT TO BE MET OFFSITE. SEE 'OFFSITE FOREST MITIGATION PLAN FOR SCOTT FARM' (See Sheet 19) BY EXPLORATION RESEARCH, INC., DATED 02-04-2005 AND 'PLAN OF FOREST CONSERVATION EASEMENT', TALLEY PROPERTY, PARCEL 2, FCE #, DATED 02-09-2005
 - See Sheet 18 for Landscape calculations and Charts.

REVISION #3 BY BOWMAN CONSULTING GROUP

CATEGORY	PERIMETER LANDSCAPE EDGE	
	PERIMETER 3	PERIMETER 5
LANDSCAPE TYPE L.F. OF PERIMETER CREDIT FOR EX.VEG	TYPE A BUFFER 1215 L.F. 65 L.F.	TYPE A BUFFER 1008 L.F. 92 L.F.
CREDIT FOR WALL, FENCE, OR BERM	NO	NO
NUMBER OF PLANTS REQUIRED	20 SHADE TREES OR 40 ORNAMENTALS AND EVERGREENS	16 SHADE TREES OR 32 ORNAMENTALS AND EVERGREENS
NUMBER OF PLANTS PROVIDED	0 SHADE TREES 34 EVERGREENS 6 ORNAMENTALS TOTAL: 40	0 SHADE TREES 15 EVERGREENS 17 ORNAMENTALS TOTAL: 32
PERIMETER 3 SUB 34 EVERGREEN FOR 17 SHADE TREES; SUB 6 ORNAMENTAL FOR 3 SHADE TREES		
PERIMETER 4 SUB 15 EVERGREEN FOR 7.5 SHADE TREES; SUB 17 ORNAMENTAL FOR 8.5 SHADE TREES		

- BOTANICAL LEGEND
- △ TREE
 - ORNAMENTAL TREE
 - EVERGREEN TREE

NOTE: 30 STREET TREES ON THIS SHEET

Professional Certification: I hereby certify that these documents were prepared or approved by me, and that I am a duly licensed Professional Engineer under the laws of the State of Maryland.
License No. 21875, Expiration Date: 2/12/2010

I/We certify that this plan for pond construction, erosion and sediment control represents a practical and workable plan based on my personal knowledge of the site conditions. This plan was prepared in accordance with the requirements of the Howard Soil Conservation District. I have notified the developer that he/she must engage a registered professional engineer to supervise upon certification and provide the Howard Soil Conservation District with an "as-built" plan of the pond within 30 days of completion.

Signature of Engineer: *[Signature]* DATE: 12-31-09

I certify that all development and/or construction will be done according to these plans, and that any responsible personnel involved in the construction project will have a Certificate for Attendance of a Department of the Environment Approved Training Program for the Control of Sediment and Erosion before beginning the project. I shall engage a registered professional engineer to supervise pond construction and provide the Howard Soil Conservation District with an "as-built" plan of the pond within 30 days of completion. I also authorize the periodic on-site inspections by Howard Soil Conservation District.

Signature of Developer: *[Signature]* DATE: 1/12/10

APPROVED: DEPARTMENT OF PLANNING AND ZONING

Chief, Development Engineering Division DATE: 1/26/10
Chief, Division of Land Development DATE: 2/1/10

APPROVED: DEPARTMENT OF PUBLIC WORKS FOR STORM DRAINAGE SYSTEMS AND ROADS

Chief, Bureau of Highways DATE: 1-21-10

OWNERS:
SCARLET WILKINSON AND EARL OMER
6799 GUILFORD ROAD
CLARKSVILLE, MARYLAND 21029
410-531-2626 410-987-0497

Bowman

CONSULTING

Bowman Consulting Group, Ltd.
2000 Pine Point
Columbia, Maryland 21041
Phone: (410) 224-7890
Fax: (410) 224-7892
www.bowmanconsulting.com
© Bowman Consulting Group, Ltd.

STORM WATER MANAGEMENT, STREET TREE, & LANDSCAPE PLANTING PLAN
SCOTT FARM
TAX MAP 68B - PD PARCEL 94
6TH ELECTION DISTRICT
HOWARD COUNTY, MARYLAND

STATE OF MARYLAND
PIERO VAN MELLTUS
No. 21875
REGISTERED PROFESSIONAL ENGINEER
PLAN STATUS

DATE	DESCRIPTION
8/9	DESIGN
AM	CHKD
CLW	CHKD
SCALE: 1" = 60'	
JOB No. 6245	
DATE: 12-14-2009	
FILE No.	



APPROVED: HOWARD COUNTY DEPARTMENT OF PLANNING AND ZONING

Howard County
CHIEF, DEVELOPMENT ENGINEERING DIVISION

Cindy Hamlett
CHIEF, DIVISION OF LAND DEVELOPMENT

DATE: 10/18/05

DATE: 10/27/05

SYMBOL	NAME / DESCRIPTION	SOIL GROUP
CHB2	Chester silt loam, 3 to 8 percent slopes, moderately eroded	B
Co	Codorus silt loam	B
CuB	Comus silt loam, local alluvium, 3 to 8 percent slopes	C
GIB2	Glenela loam, 3 to 8 percent slopes, moderately eroded	B
GIC2	Glenela loam, 8 to 15 percent slopes, moderately eroded	B
GIC3	Glenela loam, 8 to 15 percent slopes, severely eroded	B
GID2	Glenela loam, 15 to 25 percent slopes, moderately eroded	B
GID3	Glenela loam, 15 to 25 percent slopes, severely eroded	B
GnA	Glenville silt loam, 0 to 3 percent slopes	C
GnB2	Glenville silt loam, 3 to 8 percent slopes, moderately eroded	C
Ha	Hubbard silt loam	D
MIB2	Manor loam, 3 to 8 percent slopes, moderately eroded	B
MIC2	Manor loam, 8 to 15 percent slopes, moderately eroded	B
MIC3	Manor loam, 8 to 15 percent slopes, severely eroded	B
MID2	Manor loam, 15 to 25 percent slopes, moderately eroded	B
MID3	Manor loam, 15 to 25 percent slopes, severely eroded	B
MIE	Mt. Airy channery loam, 25 to 45 percent slopes	A

SYMBOL	DESCRIPTION
Proposed	Forest Easement Signage
Existing	Forest Conservation Easement
Existing Contour 5	Property Boundary Line
Existing Contour 25	Soils Division Line
Existing Stream Type Boundary	Forest Stand Type Boundary
Existing Stream	Stream Buffer
Wetlands	Wetlands
Wetlands Buffer	Wetlands Buffer
SB	Steep Slopes 15-24.9%
WB	Steep Slopes >25%

* Surety in the amount of \$17,424.00 shall be posted as part of the Developer's Agreement for 0.80 ac/34,848 sq. ft. of reforestation (off-site) at planting shall be paid under F-05-55.



This property is encumbered with a Ho. Co. Agricultural Land Preservation Easement which is held by the Ho. Co. Agricultural Land Preservation Program, under HO-03-01-PPSP.

Area in lieu for the remaining obligation of 1.7 A.

OWNER
Talley Family LLP
1525 Daisy Road
Woodbine, MD 21747
410-442-2300

FSH Associates
Engineers Planners Surveyors
8318 Forest Street, Elliott City, MD 21043
Tel: 410-750-2251 Fax: 410-750-7350
E-mail: FSHAssociates@cs.com

OFFSITE FOREST MITIGATION PLAN (Easement) for SCOTT FARM

LOTS 36-44 for FCE obligations from LOTS 1-24, F-00-73 revisions, on Talley Property Parcel 2, RE-03-02 DS2, P.N. 15816, F-04-054 FC, P.N. 17192, F-05-94


TAX MAP 8 GRID 13 4TH ELECTION DISTRICT

PARCEL 392 HOWARD COUNTY, MARYLAND




DESIGN BY: RAB
DRAWN BY: RAB
CHECKED BY: SLH
SCALE: 1"=100'
DATE: Sept. 14, 2005
SHEET No.: 3082
W.O. No.: 19 OF 20

EXPLORATION RESEARCH, INC.
ENVIRONMENTAL CONSULTANTS
LANDSCAPE ARCHITECTS
6518 PINEBURY FOREST
ELLSWORTH CITY, MARYLAND 21043
TEL: (410) 765-1150 FAX: (410) 765-7860
EMAIL: EXPLORATION@RESEARCH.COM

KEY	TYPE OF COMMUNITY	AREA Acres	SOIL INFORMATION			STAND CHARACTERISTICS			FOREST AREA IN SENSITIVE ENVIRONMENTS		
			TYPICAL FOREST COVER	WOODLAND SUITABILITY INDEX	HABITAT VALUE	EXISTING VEGETATION (Type and approx. %)	SIZE AVG. DIAM.	AGE		GENERAL CONDITIONS	
F-1	Upland Hardwoods	4.59	MID2 MIB2 GIB2	Mixed upland Hardwood	65-74 95+ 65-74	fair fair good	Black oak 60% White oak 20% Mockernut Hickory 20%	12-18 10-16 6-12	48-72 50-80 36-72	Poor Heavy understory grazing	1.2 Ac. Steep slopes 15-25%
OF-1	Open Field	41.01	Co Ha GnB2	Mixed water tolerant Hardwoods	75-84 95+ 65-74	good good good	N/A	N/A	N/A	N/A	N/A
C-1	Crop Field	27.16	GnA GIB2 GIC2 MIC3 MIB2 CHB2	Mixed water tolerant Hardwoods	65-74 75-84 75-84 65-74 65-74 65-74	good good fair fair fair	N/A	N/A	N/A	N/A	N/A
C-2	Crop Field	32.21	Co CuB GnA GIB2 GIC3 MIB2 MIC2	Mixed water tolerant Hardwoods	75-84 75-84 65-74 75-84 75-84 65-74 65-74	good good good good good fair fair	N/A	N/A	N/A	N/A	N/A
L-1	Laun (Farm Stead)	2.86	GIB2	Mixed upland Hardwood	65-74	fair	N/A	N/A	N/A	N/A	N/A
L-2	Laun	1.62	MIB2	Mixed upland Hardwood	65-74	fair	N/A	N/A	N/A	N/A	N/A

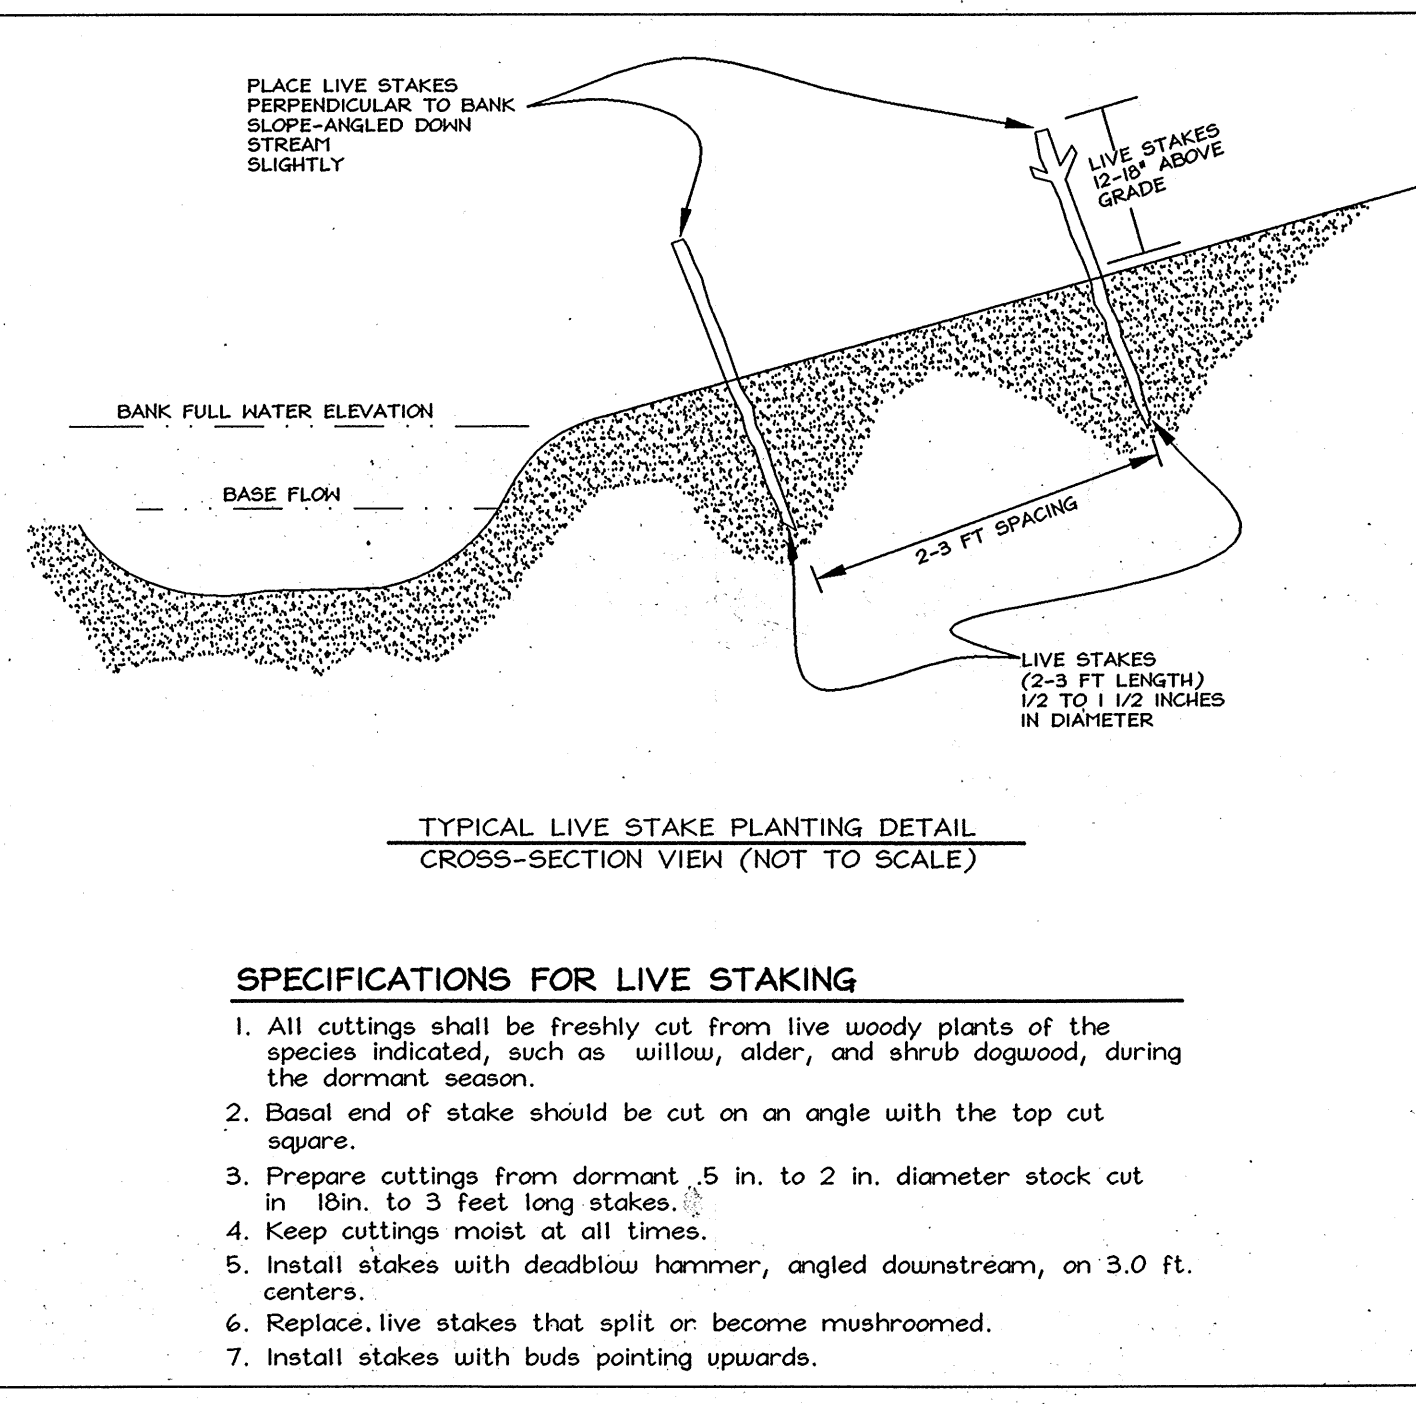

- SPECIFICATIONS FOR LIVE STAKING**
- All cuttings shall be freshly cut from live woody plants of the species indicated, such as willow, alder, and shrub dogwood, during the dormant season.
 - Basal end of stake should be cut on an angle with the top cut square.
 - Prepare cuttings from dormant .5 in. to 2 in. diameter stock cut in 18 in. to 3 feet long stakes.
 - Keep cuttings moist at all times.
 - Install stakes with deadblow hammer, angled downstream, on 3.0 ft. centers.
 - Replace live stakes that split or become mushroomed.
 - Install stakes with buds pointing upwards.

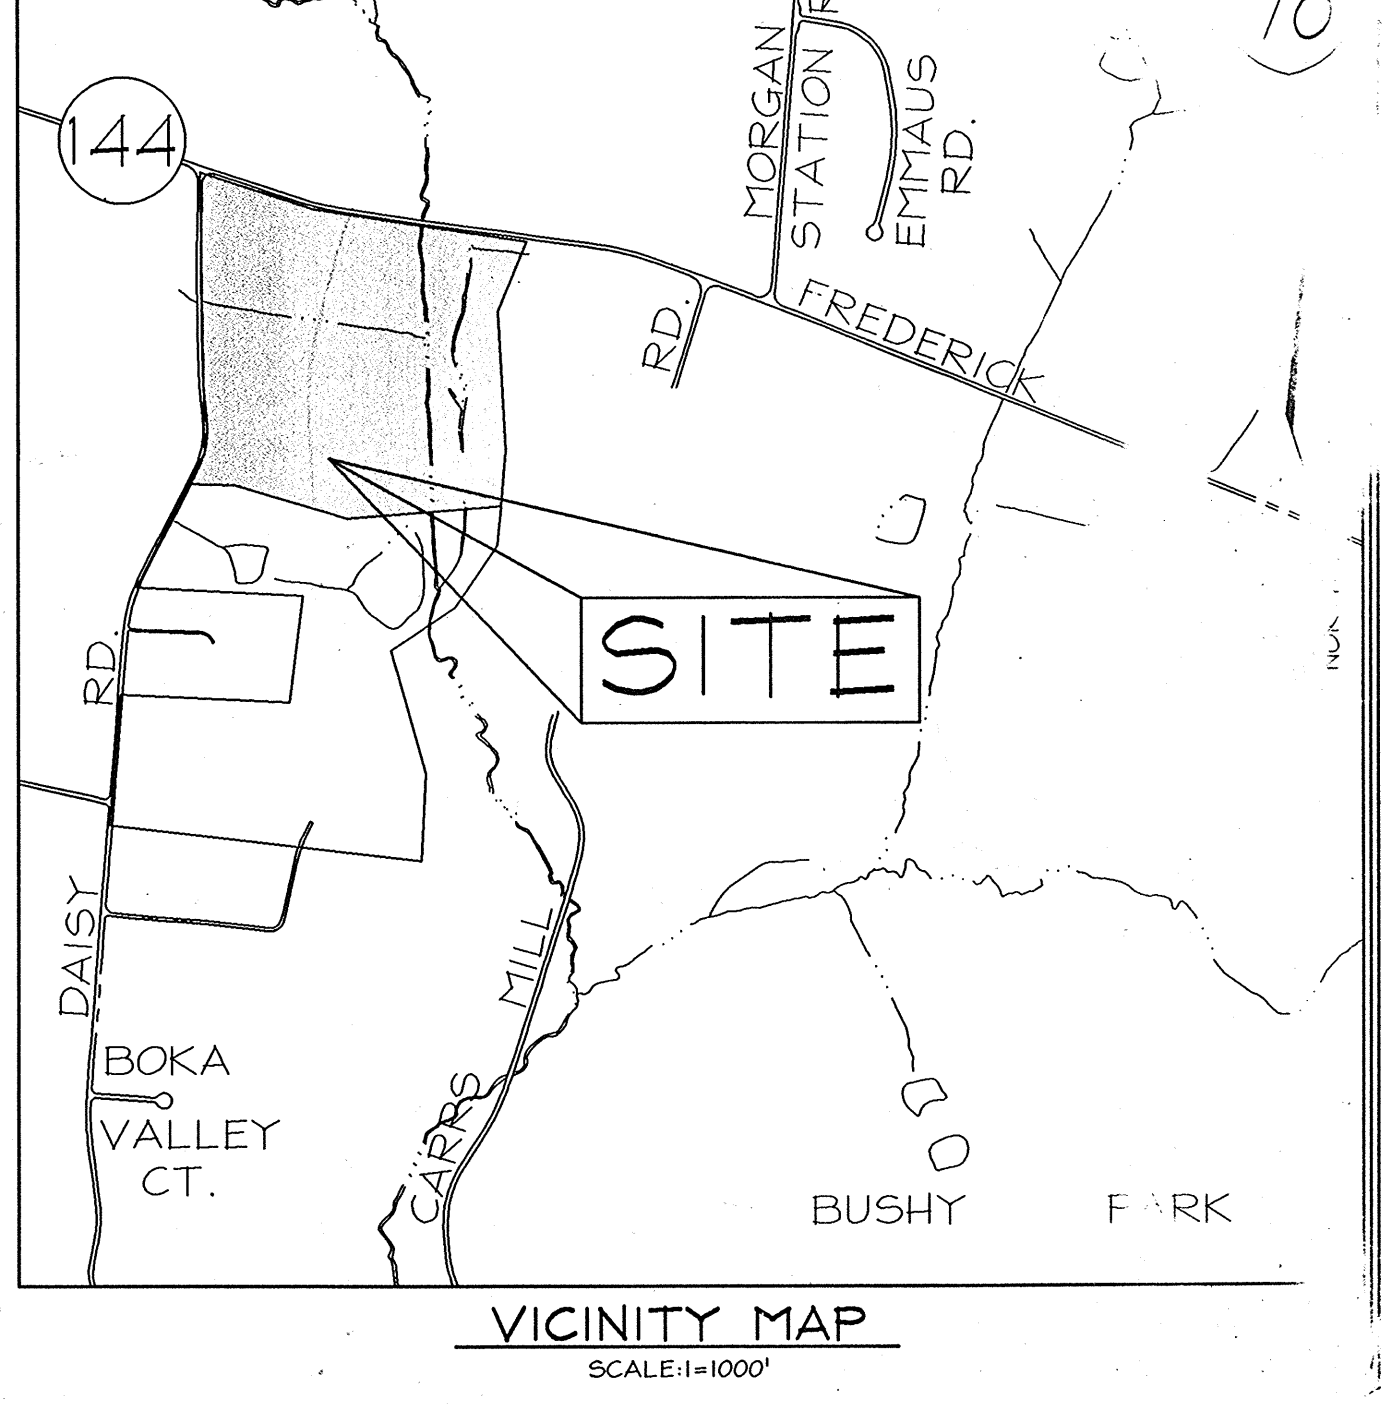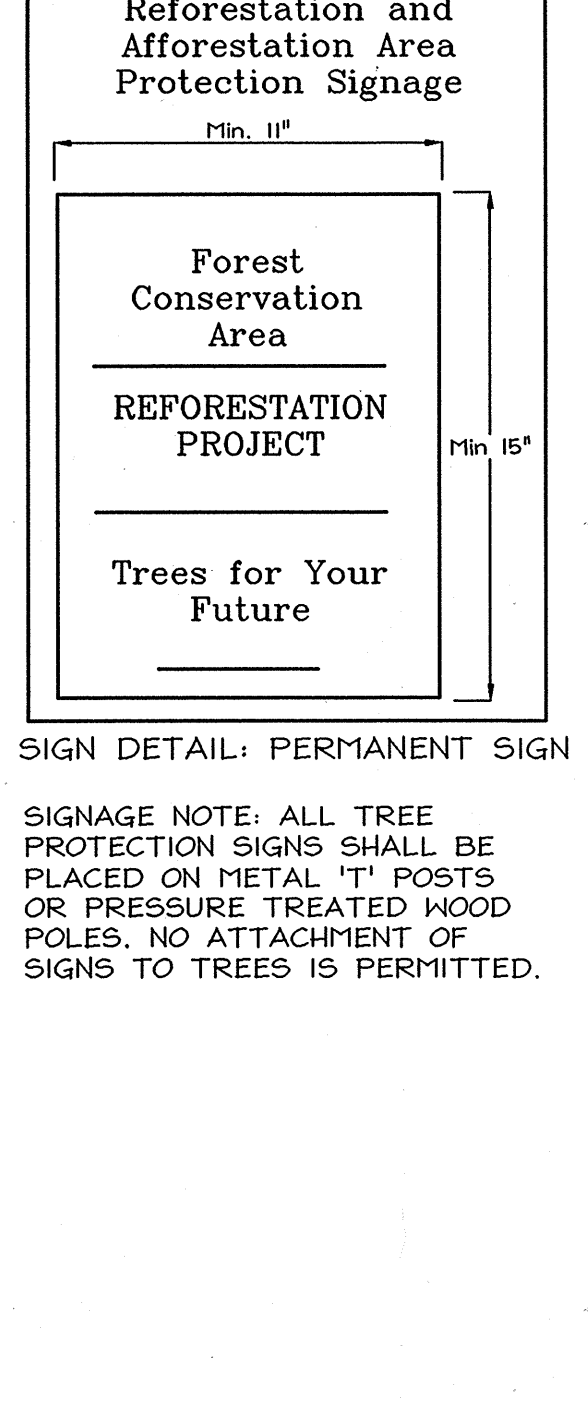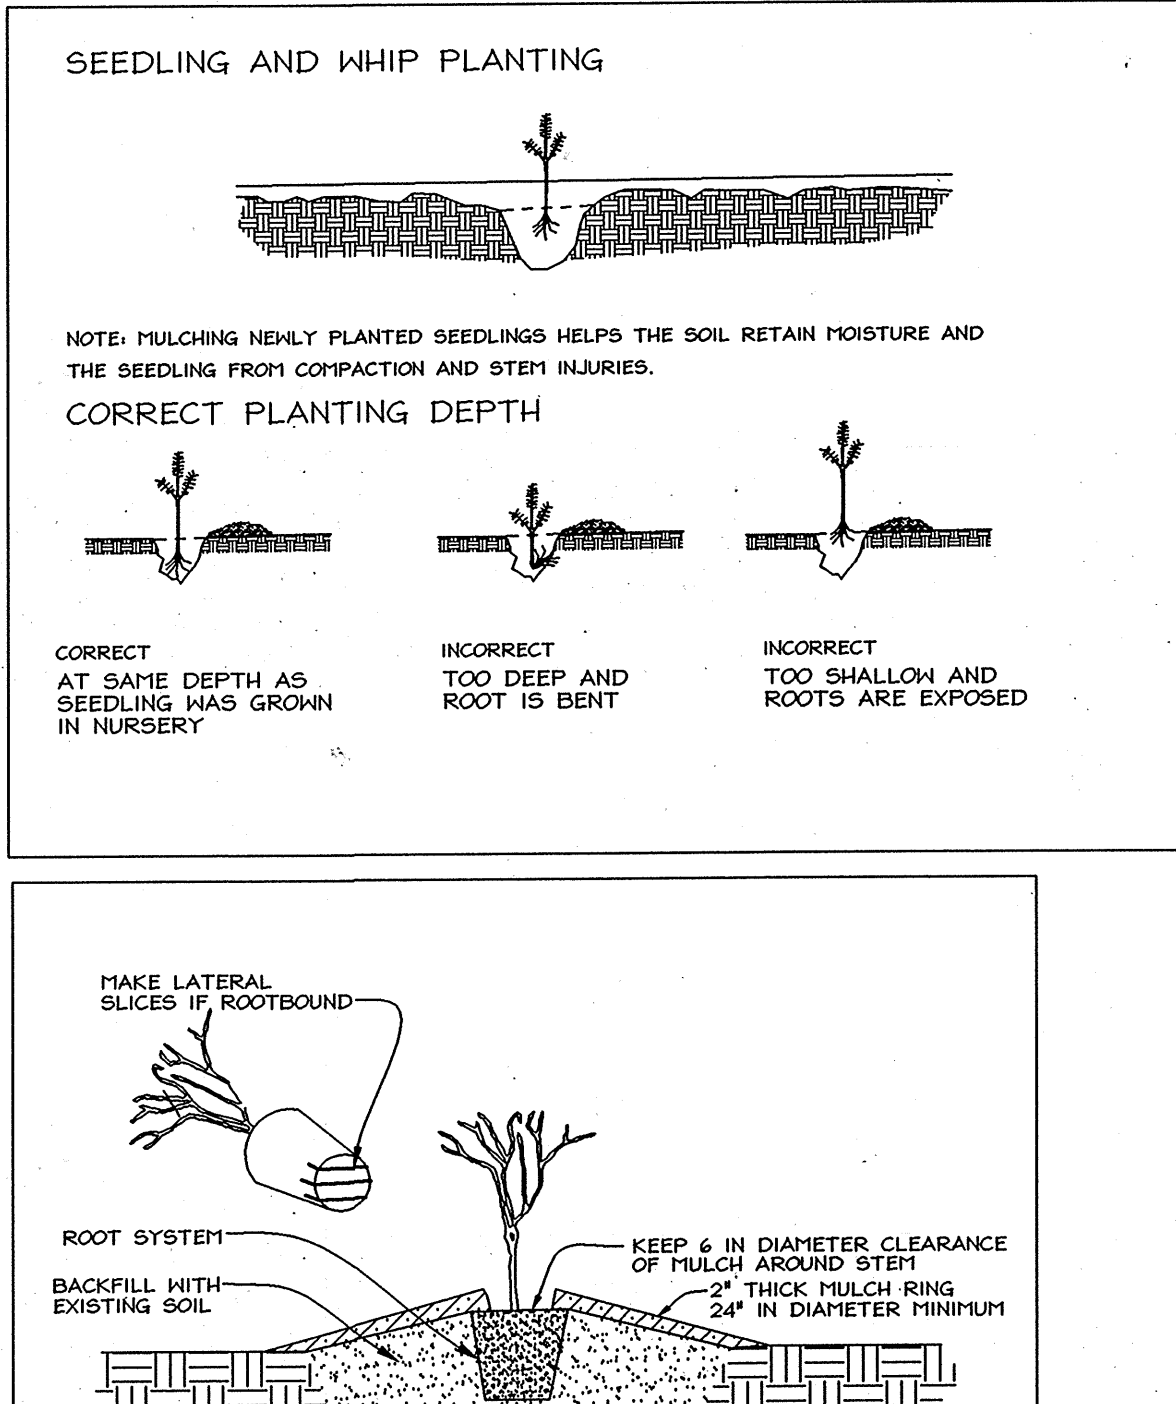

Forest Stand Narrative
 F-1 This forest stand is 4.59 Ac. in size and contains steep slopes. The canopy is dominated by black oak, Quercus velutina, white oak, Quercus alba and mockernut hickory, Carya tomentosa. The area is currently grazed and the understorey is sparse.
 L-1 This 2.86 Ac. area surrounds an existing house and various farm out buildings. The area contains lawn, and ornamental tree plantings. No environmentally sensitive areas are covered by L-1.
 L-2 This 1.62 Ac. area surrounds an existing house located on the south west corner of the property. The area contains lawn and various ornamental plantings. The area contains no environmentally sensitive areas.
 C-1 This 27.16 Ac. crop area is currently in active crop land production. There are no environmentally sensitive areas.
 C-2 This 32.21 Ac. crop area is currently in active crop production. The area contains environmentally sensitive areas including streams and associated buffers.
 OF-1 This 41.01 Ac. open field area contains grazing pastures and open field. The area contains wetlands, streams and associated buffers.

Easement 7: PLANTING AREA: 0.80 Ac.

Qty	Botanical Name	Common Name	Size	Credit/Plant	Total Credit
15	Acer rubrum	Red Maple	1" cal.	217.8	3267
20	Acer rubrum	Red Maple	2-3" ht.	125.0	2500
10	Amelanchier canadensis	Serviceberry	1" cal.	217.8	2178
16	Amelanchier canadensis	Serviceberry	2-3" ht.	125.0	2000
10	Betula nigra	River Birch	1" cal.	217.8	2178
20	Betula nigra	River Birch	2-3" ht.	125.0	2500
10	Carpinus caroliniana	Hornbeam	1" cal.	217.8	2178
15	Carpinus caroliniana	Hornbeam	2-3" ht.	125.0	1875
5	Cercis canadensis	Redbud	1" cal.	217.8	1089
10	Cercis canadensis	Redbud	2-3" ht.	125.0	1250
15	Liquidambar styraciflua	Sweetgum	1" cal.	217.8	3267
20	Liquidambar styraciflua	Sweetgum	2-3" ht.	125.0	2500
10	Nyssa sylvatica	Black Gum	1" cal.	217.8	2178
15	Nyssa sylvatica	Black Gum	2-3" ht.	125.0	1875
10	Platanus occidentalis	Sycamore	1" cal.	217.8	2178
15	Platanus occidentalis	Sycamore	2-3" ht.	125.0	1875
216	Total Plantings			34,888 s.f. = 0.80 Ac.	

Planting Areas Description
 The proposed planting area is 0.80 Ac. are proposed entirely within stream and wetland buffer areas on OF-1, per ALPP criteria. The current land use is pasture land, making it an ideal area to plant and provide a forested stream buffer.
 Planting will utilize a variety of sizes and species as shown in the proposed planting schedule. The larger stock will be placed further upland. All container grown stock will utilize tree shelters. The entire area will be stabilized with the described seed mix cover crop. The planting as specified will more than satisfy the required acreage.
Plant Selection and Density Spacing Requirements.
 Planting size and density shall be varied with a combination of planting stock. Planting quantity and spacing are based on square footage credit, which varies by material size. A total of 43,560 sq. ft. of planting credit must be fulfilled for each acre planted. This credit can be fulfilled with any combination of material size in accordance with the following chart.

Plant Material Size Table.


Material Size	Spacing	TPA	Sq. Ft. Credit	Comments
2" caliper trees	20' x 20'	100	435.6	B & B
1" caliper trees	15' x 15'	200	217.8	B & B
seedlings or whips	11' x 11'	350	125	Container 1-3 gal w/tree shelters
seedlings or shrubs	8' x 8'	700	62	Bare root

FOREST CONSERVATION EASEMENT TABLE



EASEMENT	TYPE	AREA (ACRES)
7	Reforestation	0.80
TOTAL		0.80

Native Seed Mix

Percentage	Botanical Name	Common Name
25%	Agrostis alba	Redtop
25%	Carex vulpinoideis	Fox Sedge
25%	Alopecurus pratensis	Meadow Fox Tail
20%	Andropogon scoparius	Little Bluestem
5%	Chrysanthemum leucanthemum	Ox Eye Daisy

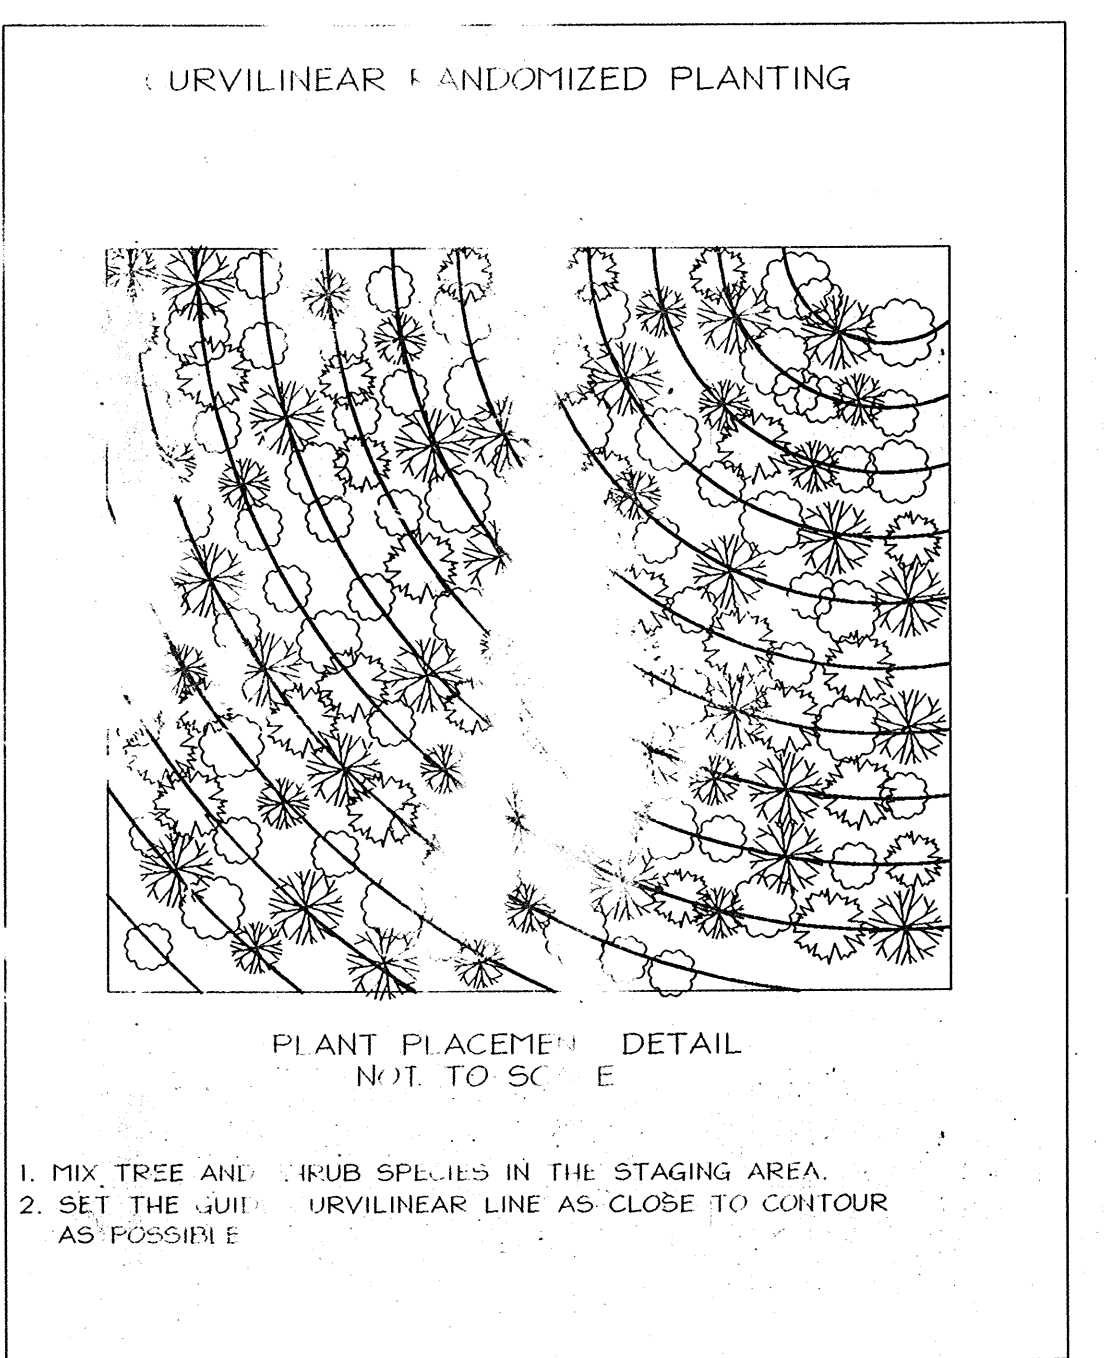

APPROVAL: HAWK COUNTY DEPARTMENT OF PLANNING AND ZONING
 CHIEF DEVELOPMENT ENGINEERING DIVISION: [Signature] 10/16/05
 CHIEF DIVISION OF LAND DEVELOPMENT: [Signature] 10/27/05

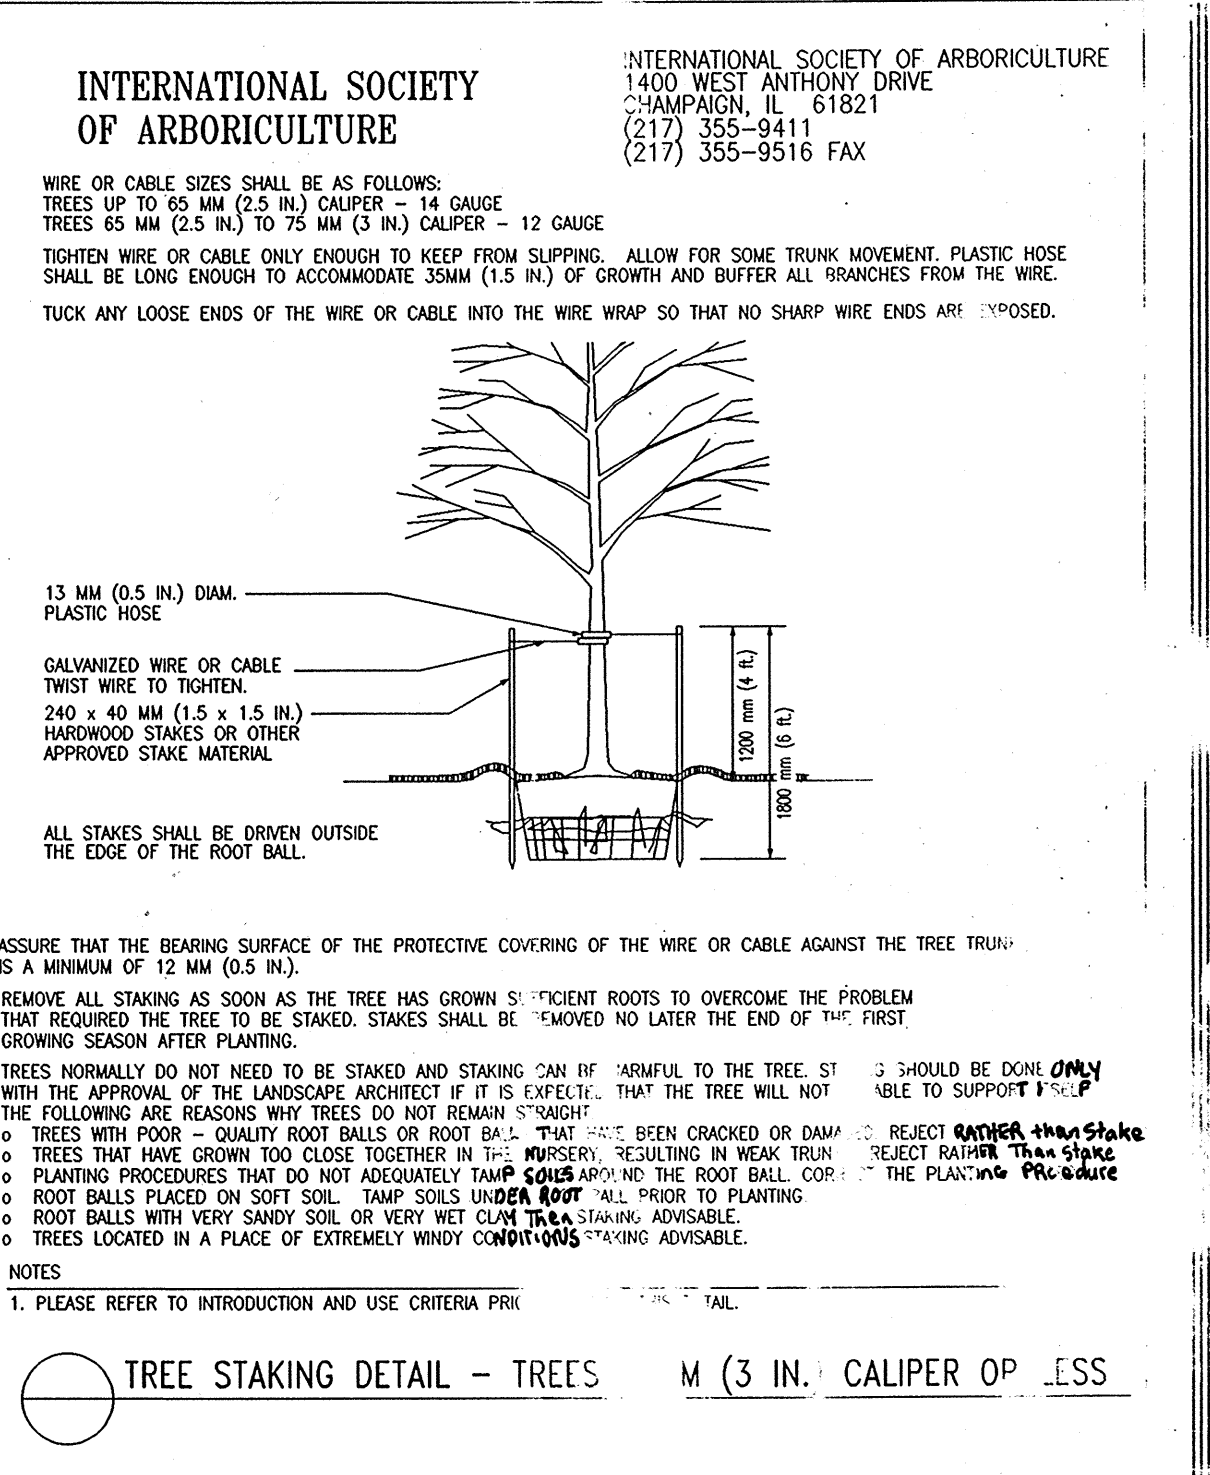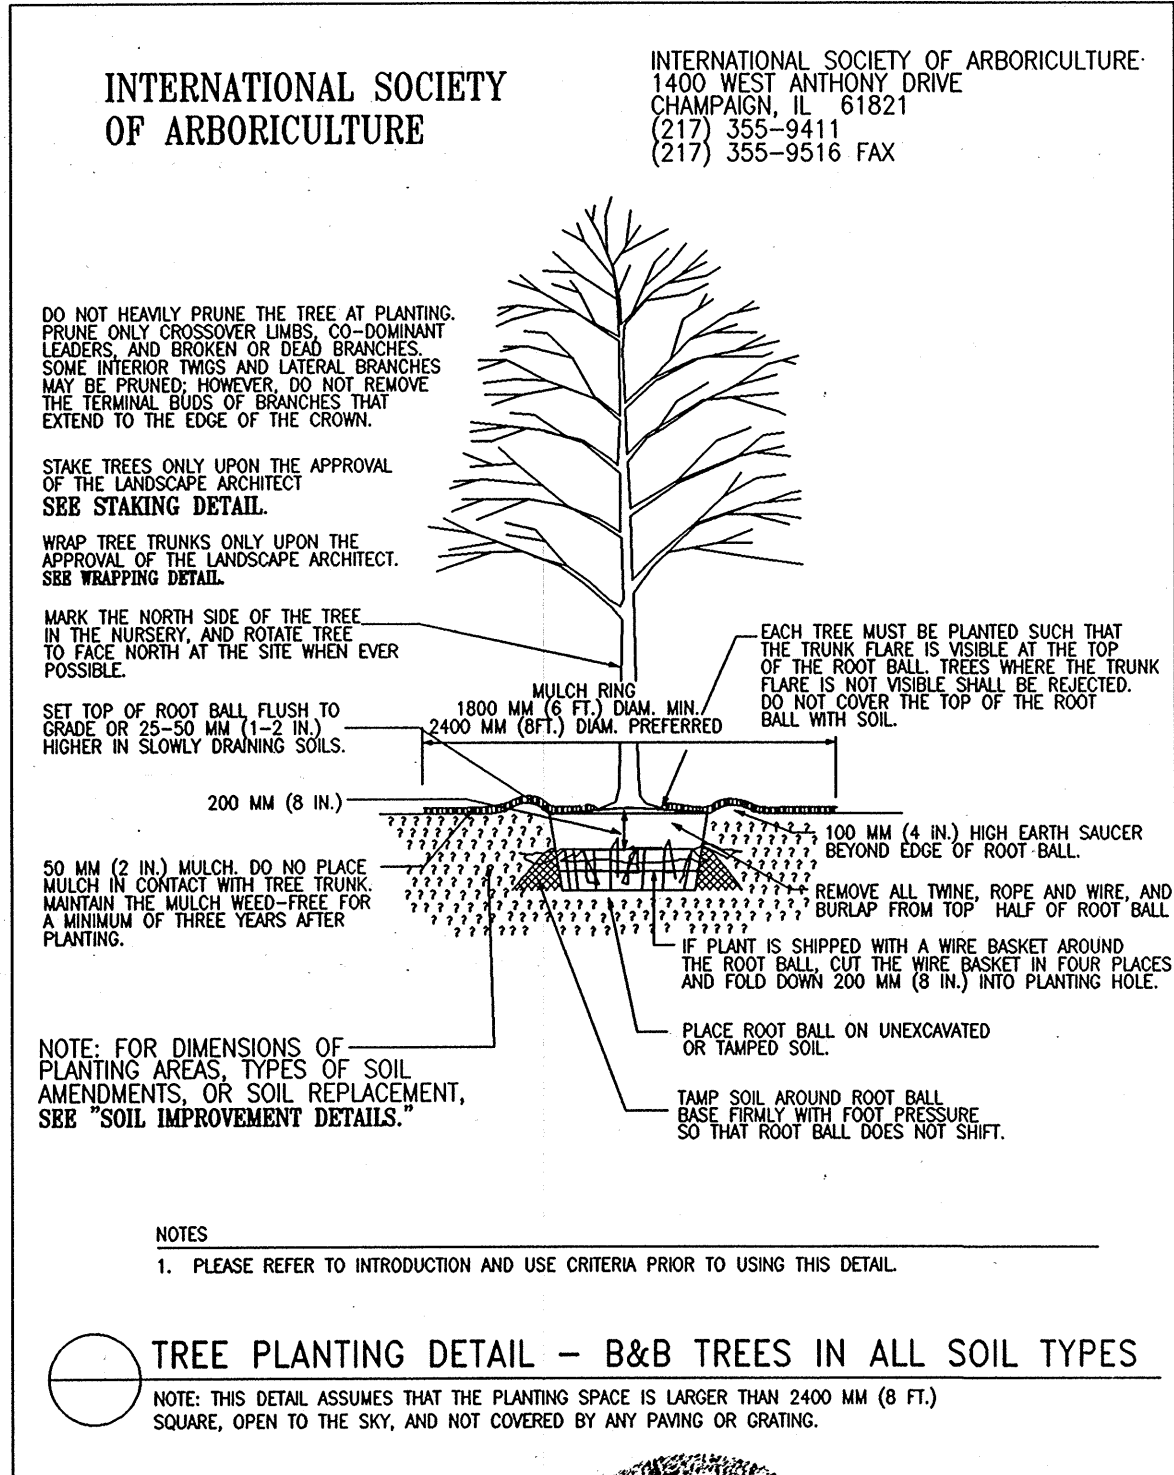

Reforestation Area Monitoring Notes

- Monthly visits during the first growing season are to assess the success of the plantings and to determine if supplemental watering, pest control, invasive plant management, mowing or other actions are necessary. Early spring visits will document winter kill and autumn visits will document summer kill.
- The minimum survival rate shall be 75% of the total number of trees planted per acre at the end of the two year maintenance period. Mild tree seedlings from natural regeneration at the planting site may be counted up to 50% toward the total survival number if they are healthy native species at least 12 inches tall.
- Survival will be determined by a stratified random sample of the plantings. The species composition of the sample population should be proportionate to the amount of each species in the entire planting to be sampled.
- Effective monitoring will assess plant survivability during the first growing season and make recommendations for reinforcement planting if required at that time.

Forest Tree Protection and Management Notes

- Any significant changes made to the Forest Conservation Plan shall be made with the prior approval if the Howard County Dept. Of Planning and Zoning.
- Forest protection and management to be in accordance with a forest management plan. The plan shall be prepared by a MD. licensed forester to facilitate the landowners management objectives, such as wildlife enhancement, water quality, aesthetics, forest products, etc.
- Future forest harvests may be conducted under a Howard County approved forest harvest plan, prepared by a MD. licensed forester.

PROTECTED BY COPYRIGHT - 145-001 03/02/00

FSH Associates
 Engineers Planners Surveyors
 8318 Forrest Street Elkton City, MD 21043
 Tel: 410-750-2251 Fax: 410-750-7390
 E-mail: FSHAssociates@a.com

OWNER
 Talley Family LLP
 1525 Daisy Road
 Woodbine, MD 21797
 Tel: 410-750-1150 Fax: 410-442-2300

OFFSITE FORES MITIGATION PLAN
 (Easement 7)
 for SCOTT FARM
 LOTS 36-44 for FCE obligations from LOTS 1-2
 F-00-73 revisions, on Talley Property Parcel
 RE-03-02 DS2, P.N. 15812, F-C4-054 FC, P 17192
 F-05-94

TAX MAP & GRID B 14TH ELECTION DISTRICT HOWA COUNTY, MARYLAND PARCEL 392

EXPLORATION RESEARCH, INC.
 ENVIRONMENTAL CONSULTANTS
 LANDSCAPE ARCHITECTS
 6318 FOREST STREET
 2ND FLOOR
 WOODBINE, MD 21797
 TEL: (410) 750-1150
 FAX: (410) 750-7380

SHEET No. 20 OF 20