


SHEET INDEX

COVER SHEET	1
ROAD PLAN AND PROFILE	2
ROAD PLAN AND PROFILE	3
ROAD PLAN AND PROFILE & TYPICAL SECTIONS	4
GRADING AND SEDIMENT CONTROL PLAN	5
GRADING AND SEDIMENT CONTROL PLAN	6
GRADING AND SEDIMENT CONTROL PLAN	7
EROSION & SEDIMENT CONTROL NOTES AND DETAILS	8
STORMDRAIN DRAINAGE AREA MAP	9
STORM DRAIN PROFILES	10
STORMWATER MANAGEMENT PLAN AND PROFILES, POND # 2	11
STORMWATER MANAGEMENT PLAN AND PROFILES, POND # 3	12
STORMWATER MANAGEMENT TYPICAL DETAILS	13
POND SPECIFICATIONS AND SOIL BORINGS	14
FILLET PROFILES	15
LANDSCAPE PLAN	16
LANDSCAPE PLAN	17
LANDSCAPE PLAN	18
FOREST CONSERVATION PLAN	19
RETAINING WALL DETAILS	20
RETAINING WALL DETAILS	21

ROAD CONSTRUCTION PLANS AUTUMN VIEW SECTION 5, PHASE 1 LOT 211 THRU 259 SECOND ELECTION DISTRICT HOWARD COUNTY, MARYLAND

OWNER/DEVELOPER

BONNIE BRANCH CORPORATION
P.O. BOX 396
ELLCOTT CITY, MD 21043

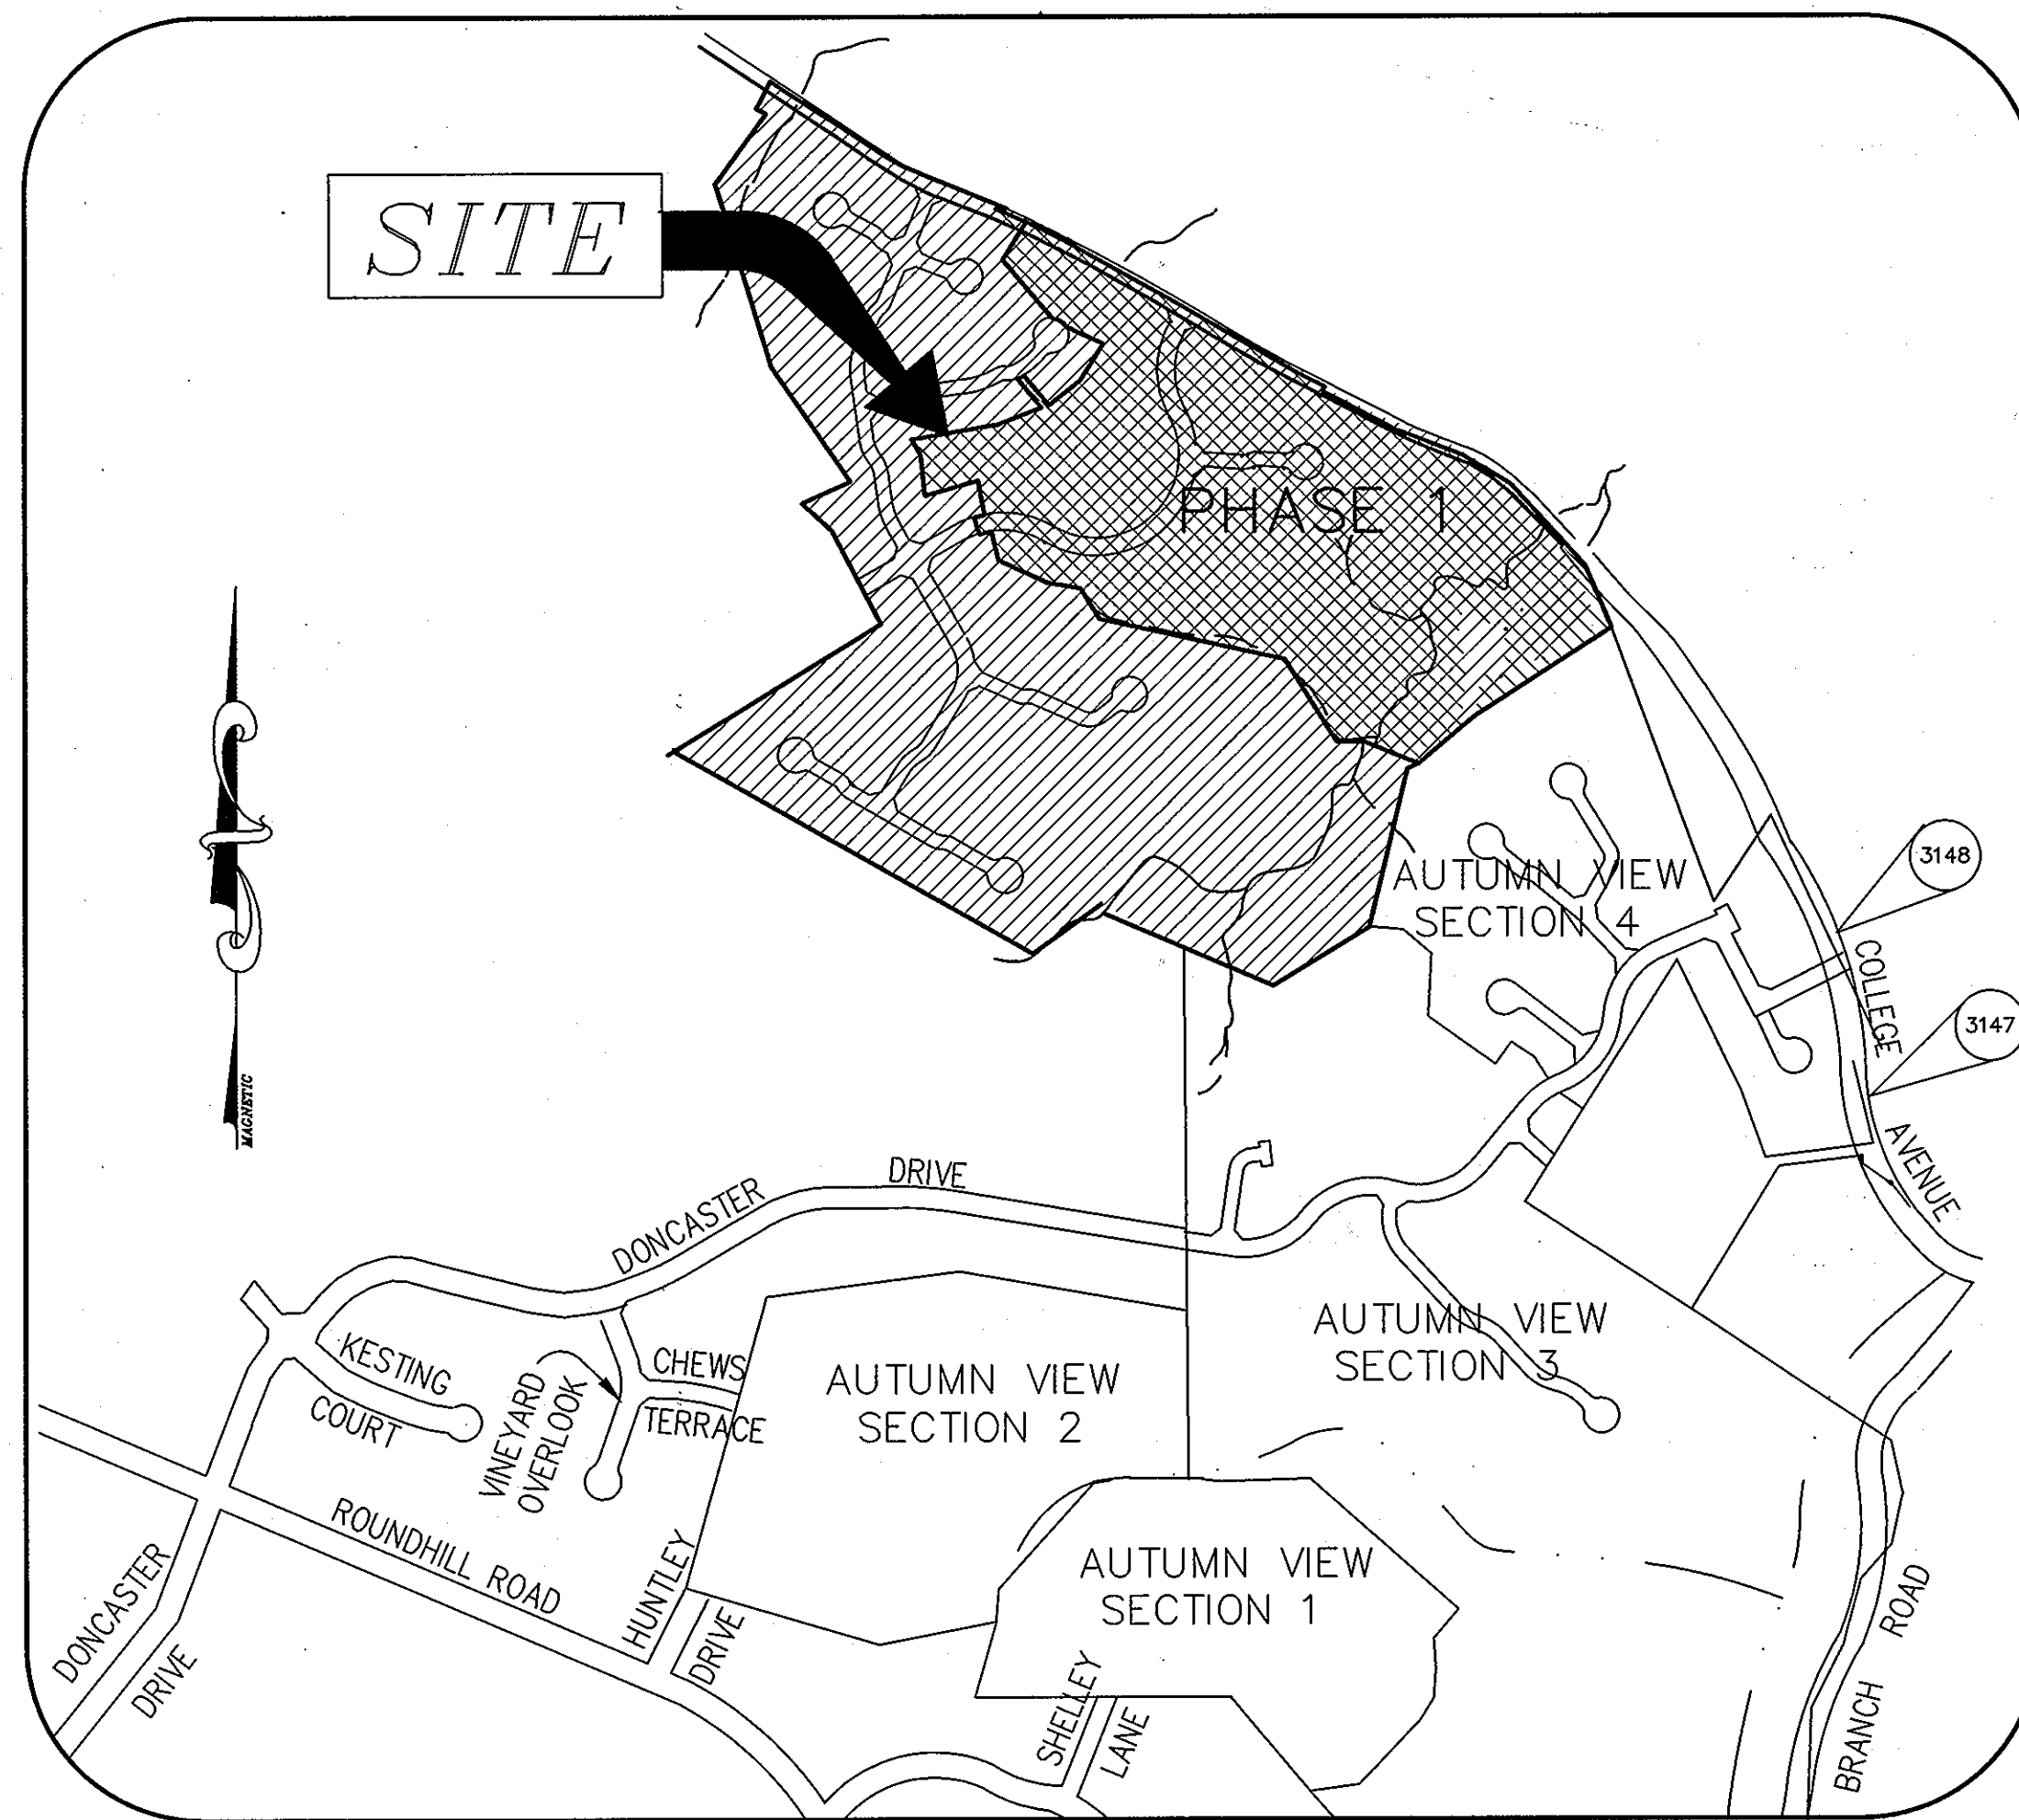

VICINITY MAP

SCALE: 1"=500'

GENERAL NOTES

- ALL CONSTRUCTION SHALL BE IN ACCORDANCE WITH THE LATEST STANDARDS AND SPECIFICATIONS OF HOWARD COUNTY PLUS MSHA STANDARDS AND SPECIFICATIONS IF APPLICABLE.
- THE CONTRACTOR SHALL NOTIFY THE DEPARTMENT OF PUBLIC WORKS/CONSTRUCTION INSPECTIONS DIVISION AT (410) 313-1880 AT LEAST FIVE (5) WORKING DAYS PRIOR TO THE START OF WORK.
- THE CONTRACTOR SHALL NOTIFY THE FOLLOWING UTILITIES OR AGENCIES AT LEAST FIVE (5) DAYS PRIOR TO ANY EXCAVATION WORK:

MISS UTILITY	1-800-257-7777
C&P TELEPHONE COMPANY	(410) 725-9976
HOWARD COUNTY BUREAU OF UTILITIES	(410) 313-4900
AT&T CABLE LOCATION DIVISION	(410) 393-3533
BALTIMORE GAS & ELECTRIC	(410) 685-0123
STATE HIGHWAY ADMINISTRATION	(410) 531-5533
HOWARD COUNTY DEPT. OF PUBLIC WORKS/CONSTRUCTION INSPECTION DIVISION	(410) 313-1880
- PROJECT BACKGROUND:

LOCATION:	TAX MAP 25 & 31, P/O PARCEL 75
ZONING:	R-ED
ELECTION DISTRICT:	2ND
SECTION:	5
PHASE:	1
TOTAL AREA:	31.14 AC ±
DPZ FILES:	S-99-01 APPROVED 7/1/99, PB 329 P-00-08 APPROVED 5/14/00
- TOPOGRAPHIC INFORMATION ARE BASED ON AERIAL TOPOGRAPHIC SURVEY BY WINGS AERIAL MAPPING CO., INC. FLOWN ON MARCH 25, 1995. VERTICAL DATUM IS NAD 83.
- COORDINATES BASED ON NAD'83 MARYLAND COORDINATE SYSTEM AS PROJECTED BY HOWARD COUNTY GEODETIC CONTROL STATIONS NO. 3147 AND 3148.
VSTA. 3147 N575598.0794, E137581.7684 EL.335.987
VSTA. 3148 N576015.4313, E1375770.4364 EL.379.248
- BOUNDARY INFORMATION IS BASED ON MONUMENTED FIELD RUN SURVEY BY MILDENBERG, BOENDER AND ASSOC., INC. PERFORMED IN OR ABOUT MAY, 2000.
- STORMWATER MANAGEMENT CONTROL WILL BE PROVIDED BY THE METHOD OF EXTENDED DETENTION STORMWATER MANAGEMENT FACILITIES WILL BE PRIVATELY OWNED AND MAINTAINED BY H.O.A.
- HOUSES NOT CONTROLLED BY THE SWM PONDS TO HAVE DRY WELLS AT SDP STAGE. SEE DETAIL ON SHEET 8 OF 21.
- WETLANDS AND STREAM DELINEATION IS BY WILDMAN ENVIRONMENTAL SERVICES. DATED OCTOBER 1998.
- FLOODPLAIN STUDY PERFORMED BY MILDENBERG, BOENDER & ASSOC., INC. IN OCTOBER 1999.
- GEOTECHNICAL REPORT PREPARED BY HILLIS-CARNES ENGINEERING ASSOC. INC. IN OCTOBER 1999.
- DEED REFERENCE: P/O PARCEL 4, L.380, F. 426; P/P PARCEL 75, L. 530, F. 165.
- NO CEMETERIES OR HISTORIC STRUCTURES EXIST ON SITE.
- ALL EXISTING STRUCTURES AND DRIVEWAYS ARE TO BE REMOVED UNLESS OTHERWISE NOTED.
- TRAFFIC STUDY BY TRAFFIC GROUP, DATED JUNE 4, 1998.
- PROPERTY IS LOCATED WITHIN THE METROPOLITAN DISTRICT. WATER AND SEWER ARE PUBLIC WATER CONTRACT NO. 266-W. SEWER PROVIDED VIA PROPOSED PUMP STATION.
- PROPOSED WATER AND SEWER ARE PUBLIC, CONTRACT # 14-3895-D.
- LOTS 216-220 SHALL HAVE UNITS FACING COLLEGE AVE. IN ACCORDANCE WITH P.B. CASE 329, S-99-01 AND THE SCENIC ROAD GUIDELINES OF SUBDIVISION SECTION 16.125.
- ON PROPOSED LOTS WHERE SLOPES EXCEED 10%, RETAINING WALLS, CUSTOM HOUSES AND/OR HOMES WITH WALK-OUT WILL BE PROPOSED AT THE SITE DEVELOPMENT PLAN STAGE.
- P.B. CASE NO. 329, APPROVED ON JULY 1, 1999. PB 354 APPROVED 01/10/02
- ALL LOTS WILL HAVE A MINIMUM OF 2 ON-SITE PARKING SPACES. NO STREET PARKING SPACES ARE REQUIRED.
- THE FOREST CONSERVATION OBLIGATION IN ACCORDANCE WITH SECTION 16.1202 OF THE HOWARD COUNTY CODE AND THE FOREST CONSERVATION MANUAL HAVE BEEN SATISFIED UNDER AUTUMN VIEW SECTION 3 (P-99-45), BY THE PLACEMENT OF 41.22 ACRES IN FOREST CONSERVATION EASEMENT, AND UNDER AUTUMN VIEW SECTION 5 PHASE 1 (F-01-12), BY THE PLACEMENT OF 7.59 ACRES IN FOREST CONSERVATION EASEMENT, TOTAL FOREST CONSERVATION PROVIDED IS 48.81 ACRES, OF WHICH 43.84 IS THE REQUIRED BREAK EVEN POINT FOR THE ACREAGE OF AUTUMN VIEW, SECTION 3, 4 AND 5 PHASE 1) COMBINED. THE REMAINING 4.97 ACRES IS TO BE CREDITED TOWARD THE REMAINING PHASES OF AUTUMN VIEW, SECTION 5.
- TRAFFIC CONTROL DEVICES, MARKINGS, AND SIGNING SHALL BE IN ACCORDANCE WITH THE LATEST EDITION OF THE MANUAL ON UNIFORM TRAFFIC CONTROL DEVICES (MUTCD). ALL STREET AND REGULATORY SIGNS SHALL BE IN PLACE PRIOR TO THE PLACEMENT OF ANY ASPHALT.
- COMPACTION IN FILL AREAS TO BE 95% AS DETERMINED PER AASHTO T-180.
- CONTRACTOR TO VERIFY THE LOCATION OF ALL EXISTING UTILITIES ON SITE PRIOR TO COMMENCING CONSTRUCTION.
- ALL STORM DRAIN PIPES TO BE HDPE PIPES UNLESS OTHERWISE NOTED.
- ALL DRIVEWAYS ENTRANCES TO BE H.C.STD. R-6.03 UNLESS OTHERWISE NOTED.
- STREET LIGHTS WILL BE REQUIRED IN THIS DEVELOPMENT IN ACCORDANCE WITH THE DESIGN MANUAL STREET LIGHT PLACEMENT AND THE TYPE OF FIXTURE AND POLE SELECTED SHALL BE IN ACCORDANCE WITH THE LATEST HOWARD COUNTY DESIGN MANUAL, VOLUME III(1993) AND AS MODIFIED BY GUIDELINES FOR STREET LIGHTS IN RESIDENTIAL DEVELOPMENTS (JUNE 1993) THE JUNE 1993 POLICY INCLUDES GUIDELINES FOR LATERAL AND LONGITUDINAL PLACEMENT. A MINIMUM SPACING OF 20' SHALL BE MAINTAINED BETWEEN ANY STREET LIGHT AND ANY TREE.
- PROVIDE 150-WATT HPS VAPOR PENDANT FIXTURE (CUTOFF) MOUNTED ON A 30' BRONZE FIBERGLASS POLE USING 12' ARM AT HIGH CASTLE ROAD, STA. 0+28, OFFSET 28' RIGHT. PROVIDE 100-WATT HPS VAPOR TRADITIONAL POST TOP FIXTURE MOUNTED ON A 14' BLACK FIBERGLASS POLE AT HIGH CASTLE ROAD, STA. 4+70 OFFSET 20' LEFT; STA. 7+91, OFFSET 16' LEFT; STA. 10+92, OFFSET 16' RIGHT AND AT BROADGATE CIRCLE L.P. STA. 1+92, OFFSET 3'.

AREA TABULATION:

	SECTION 3 (EXISTING)	SECTION 4	SECTION 5	SECTION 3, 4 & 5	SECTION 5 PHASE 1
GROSS AREA:	87.39 AC ±	19.08 AC ±	84.91 AC ±	191.38 AC ±	31.15 AC ±
AREA OF STEEP SLOPES:	13.44 AC ±	2.05 AC ±	11.44 AC ±	26.89 AC ±	6.28 AC ±
AREA OF FLOODPLAIN:	6.19 AC ±	0	2.03 AC ±	8.22 AC ±	0.30 AC ±
NET AREA:	68.00 AC ±	17.03 AC ±	71.44 AC ±	156.47 AC ±	23.97 AC ±
AREA OF PROPOSED BUILDABLE LOTS SFD:	16.46 AC ±	14.39 AC ±	32.64 AC ±	63.49 AC ±	9.93 AC ±
AREA OF PROPOSED BUILDABLE LOTS SFA:	0	0	1.12 AC ±	1.12 AC ±	0
TOTAL AREA OF PROPOSED BUILDABLE LOTS:	16.46 AC ±	14.39 AC ±	33.76 AC ±	64.61 AC ±	9.93 AC ±
AREA OF PROPOSED ROAD (R/W):	6.11 AC ±	2.12 AC ±	7.62 AC ±	15.85 AC ±	2.75 AC ±
REQUIRED OPEN SPACE (25% OF GROSS AREA):	21.85 AC ±	4.77 AC ±	21.23 AC ±	47.85 AC ±	7.85 AC ±
PROVIDED OPEN SPACE:	60.50 AC ±	6.89 AC ±	41.67 AC ±	109.06 AC ±	18.47 AC ±
NON CREDITED OPEN SPACE:	0.06 AC ±	0.08 AC ±	0.20 AC ±	0.34 AC ±	0.09 AC ±
NET OPEN SPACE:	60.44 AC ±	6.79 AC ±	41.47 AC ±	108.57 AC ±	18.38 AC ±
REQUIRED RECREATIONAL OPEN SPACE (250 S.F. PER LOT):	18,000 S.F.	14,250 S.F.	44,500 S.F.	76,750 S.F.	11,500 S.F.
PROVIDED RECREATIONAL OPEN SPACE:	18,000 S.F.	14,250 S.F.	44,500 S.F.	76,750 S.F.	15,000 S.F.
NUMBER OF BUILDABLE LOTS ALLOWED (NET AREA x 2):	136	34	142	312	48
NUMBER OF PROPOSED BUILDABLE LOTS (SFD):	72	56	156	284	46
NUMBER OF PROPOSED BUILDABLE LOTS (SFA):	0	0	22	22	0
NUMBER OF PROPOSED BUILDABLE LOTS:	72	56	178	306	46
NUMBER OF PROPOSED OPEN SPACE LOTS:	4	3	7	14	3
NUMBER OF BULK PARCELS:	1	0	0	1	0
TOTAL NUMBER OF PROPOSED LOTS:	76	59	185	320	49

AREA OF BULK PARCEL "A": 4.32 AC ±

*GROSS AREA OF PHASE 4 (INCLUDING PARCEL "A"): 23.40 AC ±

SECTION 5 SUMMARY

TOTAL NUMBER OF BUILDABLE LOTS/UNITS ALLOWED:	178
TOTAL NUMBER OF BUILDABLE LOTS/UNITS -PHASE 1-ALLOWED:	46
TOTAL NUMBER OF BUILDABLE LOTS/UNITS -PHASE 1-PROPOSED:	46
TOTAL NUMBER OF BUILDABLE LOTS/UNITS REMAIN:	132

BY THE DEVELOPER:

I, Bruce Taylor, P.E. DATE 12/6/01
CERTIFY THAT ALL DEVELOPMENT AND/OR CONSTRUCTION WILL BE DONE ACCORDING TO THESE PLANS, AND THAT ANY RESPONSIBLE PERSONNEL INVOLVED IN THE CONSTRUCTION PROJECT WILL HAVE A CERTIFICATE OF ATTENDANCE AT A DEPARTMENT OF THE ENVIRONMENT APPROVED TRAINING PROGRAM FOR THE CONTROL OF SEDIMENT AND EROSION BEFORE BEGINNING THE PROJECT. I SHALL ENGAGE A REGISTERED PROFESSIONAL ENGINEER TO SUPERVISE POND CONSTRUCTION AND PROVIDE THE HOWARD SOIL CONSERVATION DISTRICT WITH AN "AS-BUILT" PLAN OF THE POND WITHIN 30 DAYS OF COMPLETION. I ALSO AUTHORIZE PERIODIC ON-SITE INSPECTIONS BY THE HOWARD SOIL CONSERVATION DISTRICT.

SIGNATURE OF DEVELOPER: Bruce Taylor, P.E. DATE 12/6/01
PRINTED NAME OF DEVELOPER: Bruce Taylor, P.E.

BY THE ENGINEER:

I CERTIFY THAT THIS PLAN FOR POND CONSTRUCTION, EROSION AND SEDIMENT CONTROL REPRESENTS A PRACTICAL AND WORKABLE PLAN BASED ON MY PERSONAL KNOWLEDGE OF THE SITE CONDITIONS. THIS PLAN WAS PREPARED IN ACCORDANCE WITH THE REQUIREMENTS OF THE HOWARD SOIL CONSERVATION DISTRICT. I HAVE NOTIFIED THE DEVELOPER AND SHE MUST ENGAGE A REGISTERED PROFESSIONAL ENGINEER TO SUPERVISE POND CONSTRUCTION AND PROVIDE THE HOWARD SOIL CONSERVATION DISTRICT WITH AN "AS-BUILT" PLAN OF THE POND WITHIN 30 DAYS OF COMPLETION.

SIGNATURE OF ENGINEER: [Signature] DATE 12/6/01
PRINTED NAME OF ENGINEER: [Name]

THESE PLANS HAVE BEEN REVIEWED FOR THE HOWARD SOIL CONSERVATION DISTRICT AND MEET THE TECHNICAL REQUIREMENTS FOR SMALL POND CONSTRUCTION, SOIL EROSION AND SEDIMENT CONTROL.

USDA - NATURAL RESOURCES CONSERVATION SERVICE
DATE 12/18/01

THESE PLANS FOR SMALL POND CONSTRUCTION, SOIL EROSION AND SEDIMENT CONTROL MEET THE REQUIREMENTS OF THE HOWARD SOIL CONSERVATION DISTRICT.
DATE 12/18/01

APPROVED: DEPARTMENT OF PUBLIC WORKS
DATE 1-30-02

APPROVED: DEPARTMENT OF PLANNING AND ZONING
DATE 2/5/02


DATE 12/28/01

Project	99072	date	DEC. 2001
Illustration	MMP	engineering	MMP
Scale	MMP	approval	AS SHOWN JBM



Project	99072	date	12/01
Illustration	MMP	description	REVISED FOR ROAD AS-BUILT
Scale	MMP	revisions	

AUTUMN VIEW, SECTION 5, PHASE 1
LOTS: 211-259
TAX MAP 25 & 31, P/O PARCEL 75
SECOND ELECTION DISTRICT
HOWARD COUNTY, MARYLAND
COVER SHEET

MILDENBERG, BOENDER & ASSOC., INC.
Engineers Planners Surveyors
5072 Dorsey Hall Drive, Suite 202, Ellicott City, Maryland 21042
(410) 997-0296 Balt. (301) 821-5521 Wash. (410) 997-0298 Fax.

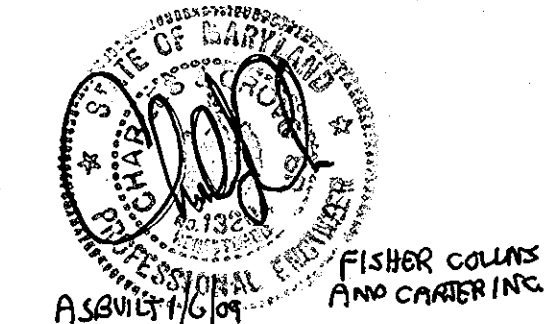


BEGIN CONSTRUCTION
HIGH CASTLE ROAD
STA. 0+12

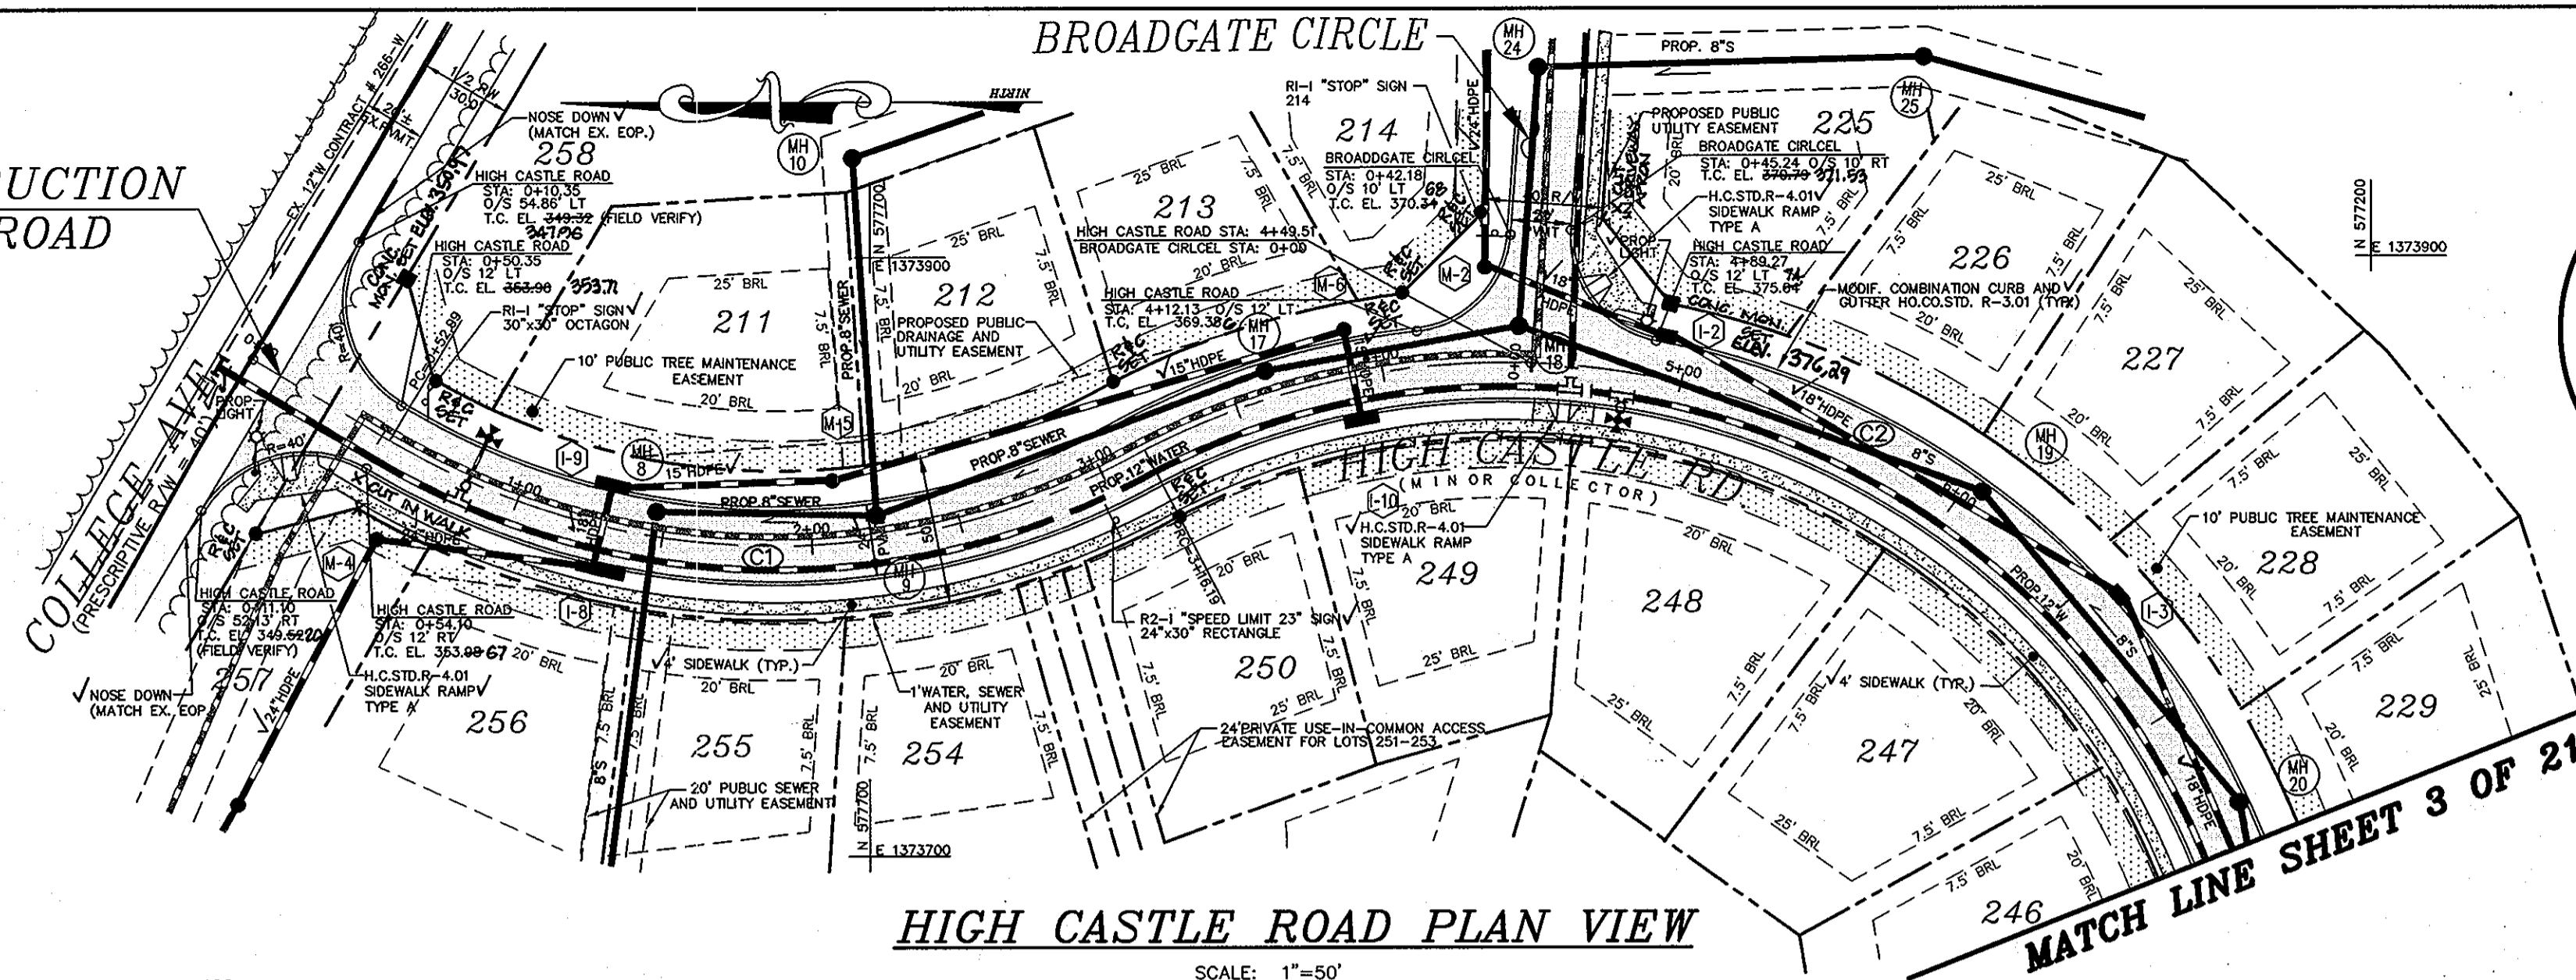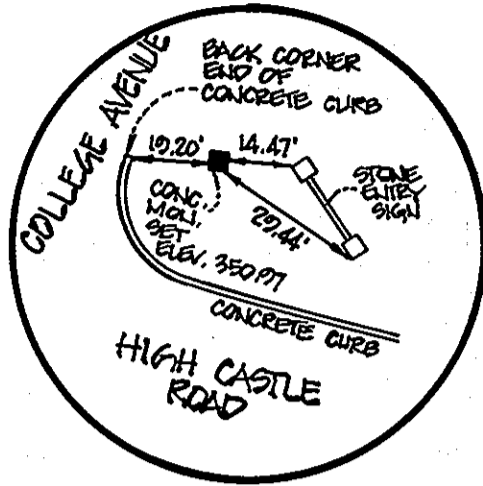

CURVE TABLE						
CURVE	RADIUS	LENGTH	TANGENT	CHORD	BEARING	DELTA
C1	251.34'	263.20'	145.11'	251.34'	S00°48'16"W	60°00'00"
C2	260.00'	279.14'	154.73'	265.93'	N03°25'33"E	61°30'52"

- NOTES:
- FOR STREET TREE LOCATION SEE LANDSCAPE PLAN.
 - ALL SIDEWALK RAMPS TO BE TYPE "A" HOWARD COUNTY STD R-4.01.

HIGH CASTLE ROAD PLAN VIEW

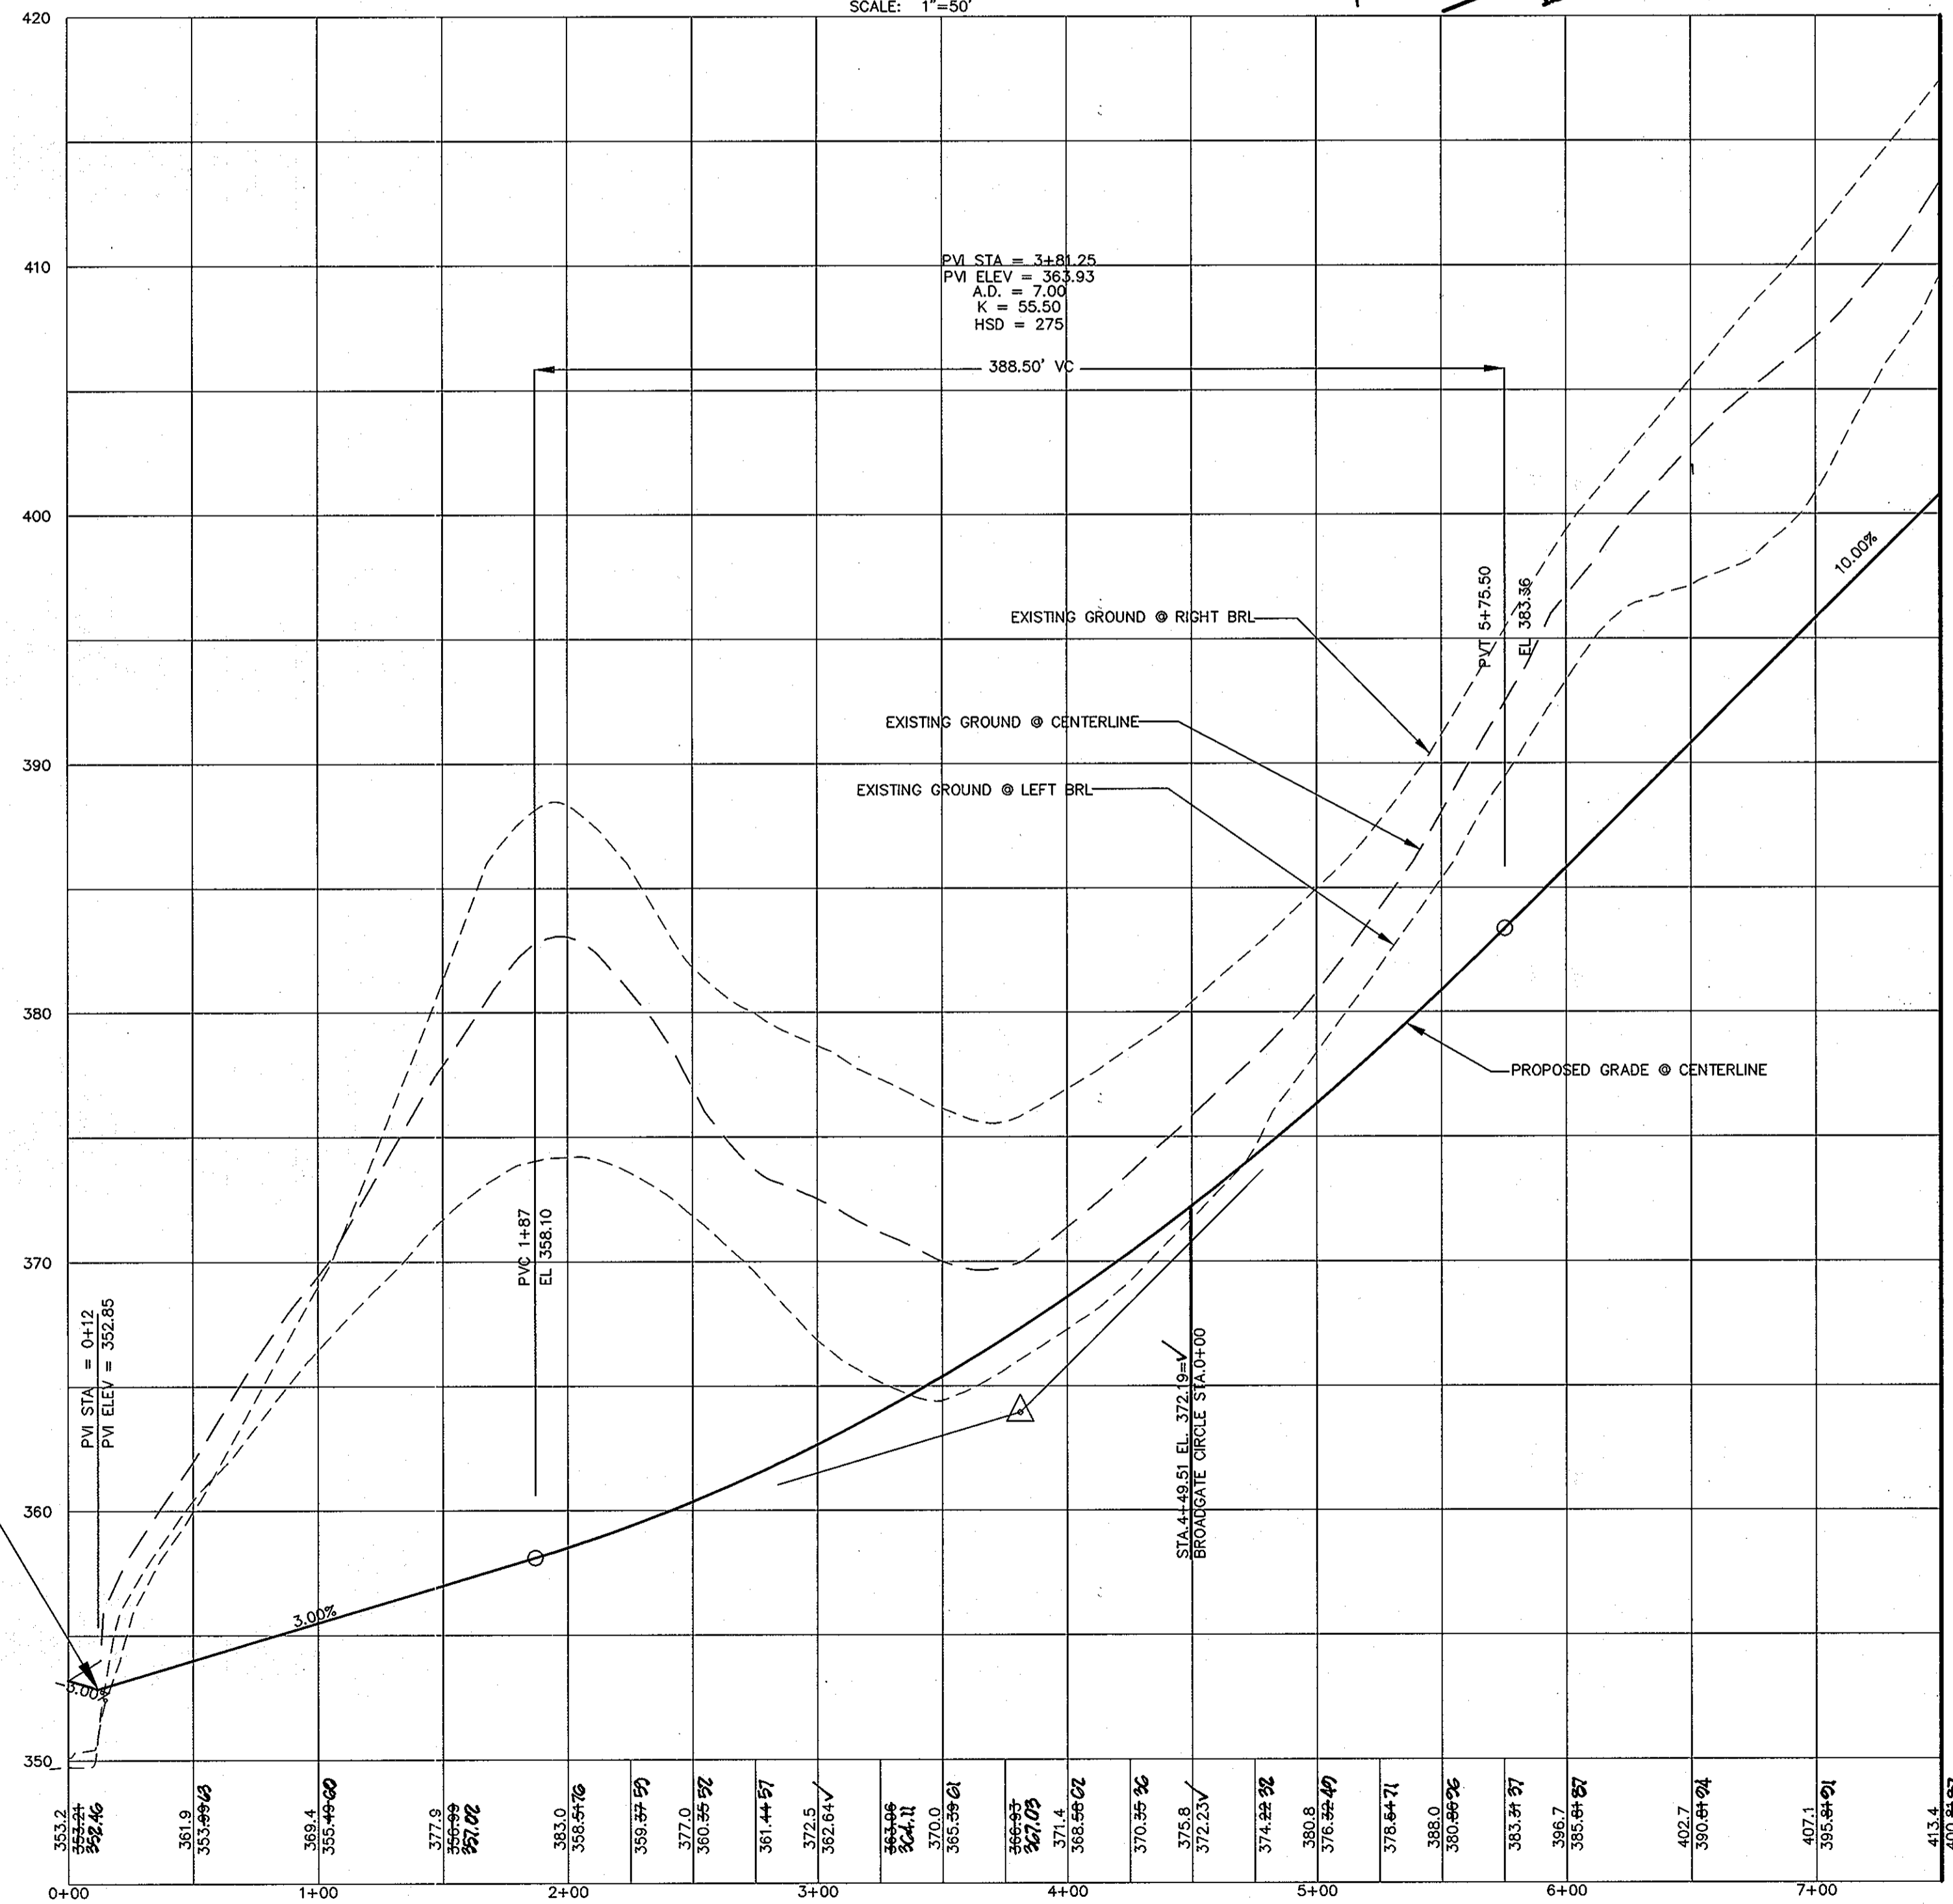

HIGH CASTLE ROAD PROFILE

CLASSIFICATION: MINOR COLLECTOR
DESIGN SPEED: 35 MPH




BEGIN CONSTRUCTION
HIGH CASTLE ROAD
STA. 0+12

APPROVED: DEPARTMENT OF PUBLIC WORKS
Richard M. Ancker 1/30/02
CHIEF, BUREAU OF HIGHWAYS
DATE

APPROVED: DEPARTMENT OF PLANNING AND ZONING
Christy Kramer 2/15/02
CHIEF, DIVISION OF LAND DEVELOPMENT
DATE

Mark H. ... 12/28/01
CHIEF, DEVELOPMENT ENGINEERING DIVISION
DATE

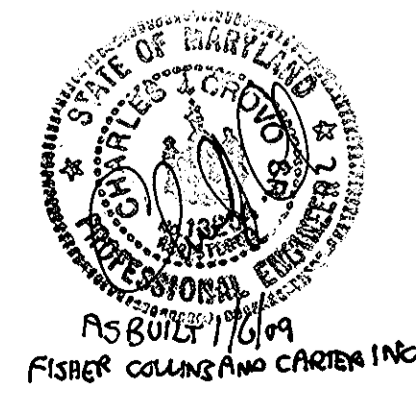


OWNER/DEVELOPER
BONNIE BRANCH CORPORATION
P.O. BOX 396
ELlicott CITY, MD 21043

Project	99072	date	DEC. 2001
Illustration	MMP	engineering	JBM
scale	1"=50'	approval	JBM

1	REVISION PER ROAD 22-0117	description	1/10/02	date
---	---------------------------	-------------	---------	------

AUTUMN VIEW SECTION 5, PHASE 1
LOTS 211-259
TAX MAP 25 & 31, P/O PARCEL 75
HOWARD COUNTY, MARYLAND
SECOND ELECTION DISTRICT
ROAD PLAN AND PROFILE

MILDENBERG, & ASSOC., INC.
Engineers Planners Surveyors
5072 Dorsey Hall Drive, Suite 202, Ellicott City, Maryland, 21042
(410) 987-0298 Bal. (301) 621-5521 Wash. (410) 997-0298 Fax.

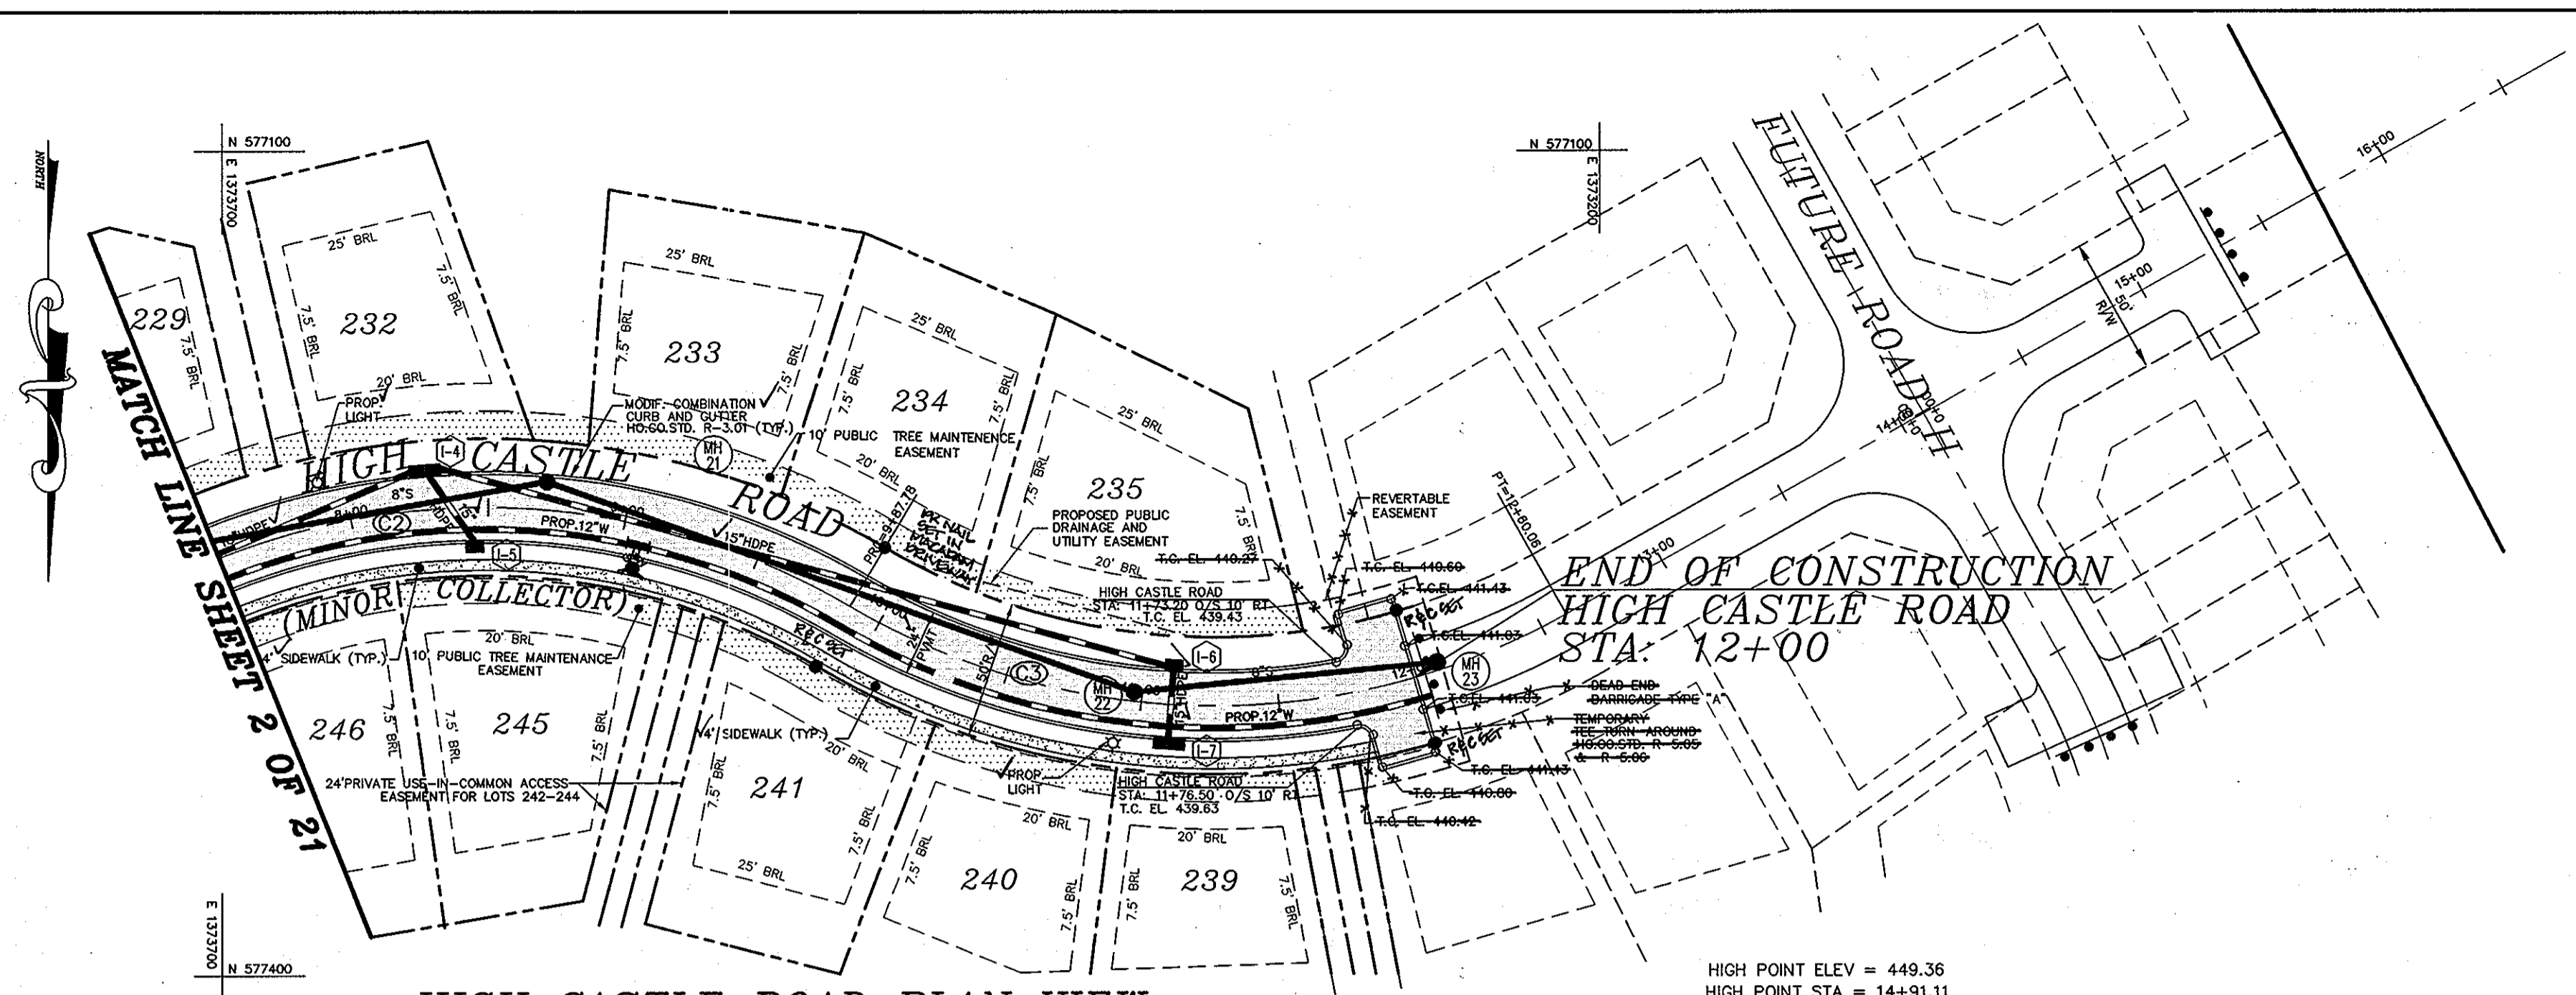

HIGH CASTLE ROAD PLAN VIEW


SCALE: 1"=50'

HIGH POINT ELEV = 449.36
 HIGH POINT STA = 14+91.11
 PVI STA = 13+25
 PVI ELEV = 458.30
 A.D. = -13.50

LOW POINT ELEV = 443.03
 LOW POINT STA = 18+47.33
 PVI STA = 18+84.12
 PVI ELEV = 438.73
 A.D. = 8.50


CURVE TABLE						
CURVE	RADIUS	LENGTH	TANGENT	CHORD	BEARING	DELTA
C2	260.00'	279.14'	154.73'	285.93'	N03°25'33"E	61°30'52"
C3	260.00'	272.27'	150.11'	260.00'	N89°20'03"W	60°00'00"

- NOTES:
- FOR STREET TREE LOCATION SEE LANDSCAPE PLAN.
 - ALL SIDEWALK RAMPS TO BE TYPE "A" HOWARD COUNTY STD R-4.01.

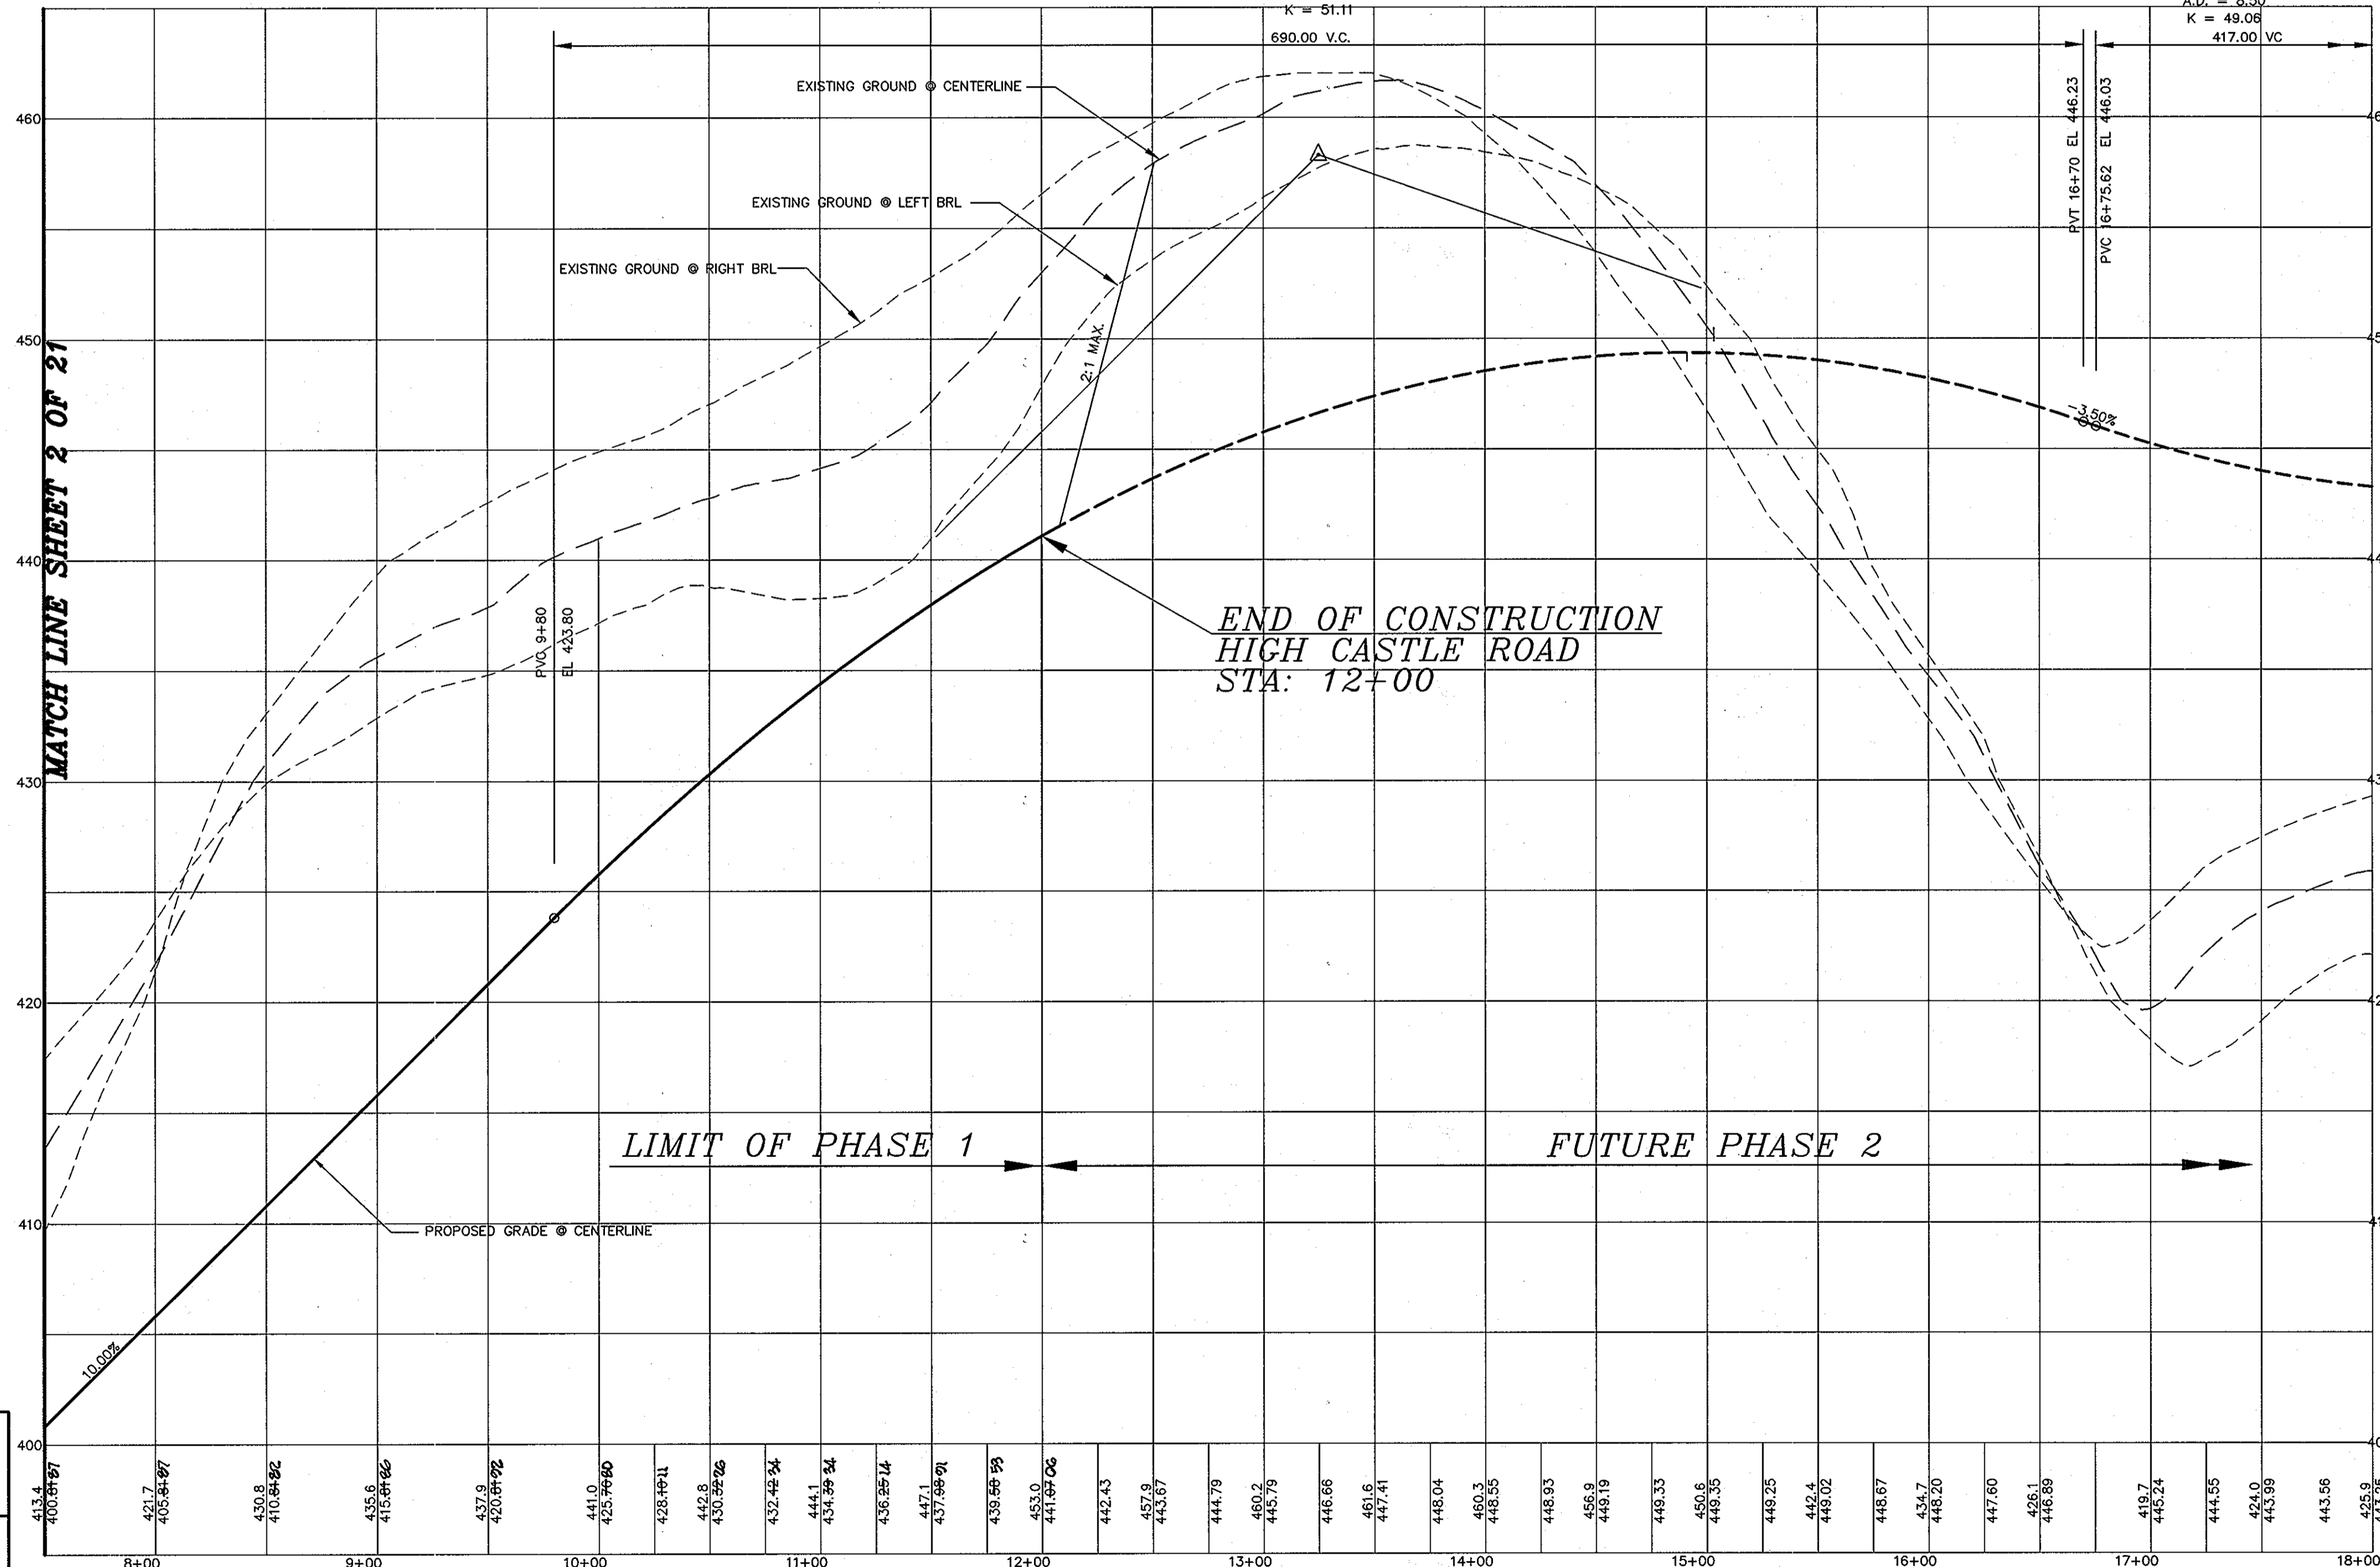

HIGH CASTLE ROAD PROFILE
 CLASSIFICATION: MINOR COLLECTOR - DESIGN SPEED: 35 MPH

SCALE: HOR. 1"=50'
 VER. 1"=5'

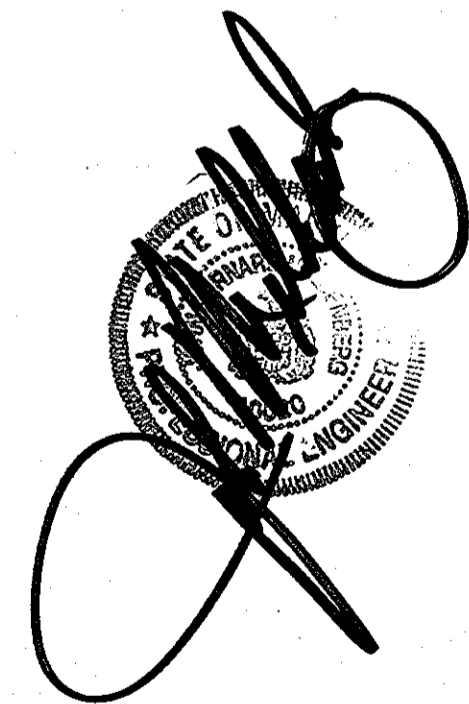


OWNER/DEVELOPER

BONNIE BRANCH CORPORATION
 P.O. BOX 396
 ELLICOTT CITY, MD 21043

APPROVED: DEPARTMENT OF PUBLIC WORKS
Richard M. Daulton 1-30-02
 CHIEF, BUREAU OF HIGHWAYS

APPROVED: DEPARTMENT OF PLANNING AND ZONING
Cindy Kramata 2/5/02
 CHIEF, DIVISION OF LAND DEVELOPMENT

Mark Taylor 12/20/01
 CHIEF, DEVELOPMENT ENGINEERING DIVISION

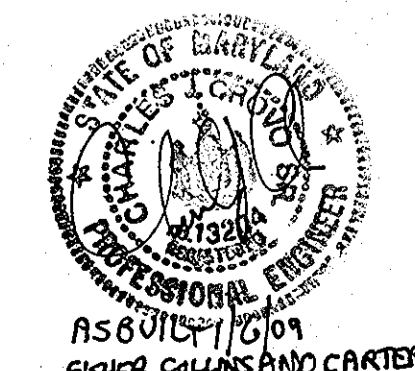

Project	99072	Date	DEC 2001
Illustration	MMP	Engineering	MMP
Scale	1"=50'	Approval	JBM


1	REVISION	DATE	DESCRIPTION
1	REVISION	1/6/02	REVISED PER ROAD 15-2-BUILT

AUTUMN VIEW SECTION 5, PHASE 1
 LOTS: 211-259
 TAX MAP 25 & 31, P/O PARCEL 75
 SECOND ELECTION DISTRICT
 HOWARD COUNTY, MARYLAND
 ROAD PLAN AND PROFILE


MILDENBERG, BOENDER & ASSOC., INC.
 Engineers Planners Surveyors
 5072 Dorsey Hall Drive, Suite 202, Ellicott City, Maryland 21042
 (410) 997-0296 Fax: (301) 821-5521 Wash. (410) 997-0298 Fax

CURVE TABLE						
CURVE	RADIUS	LENGTH	TANGENT	CHORD	BEARING	DELTA
C4	50.00'	26.18'	13.40'	25.88'	N79°19'18"E	30°00'00"
C5	50.00'	26.18'	13.40'	25.88'	S79°19'18"W	30°00'00"


- NOTES:
- FOR STREET TREE LOCATION SEE LANDSCAPE PLAN.
 - ALL SIDEWALK RAMPS TO BE TYPE "A" HOWARD COUNTY STD R-4.01.

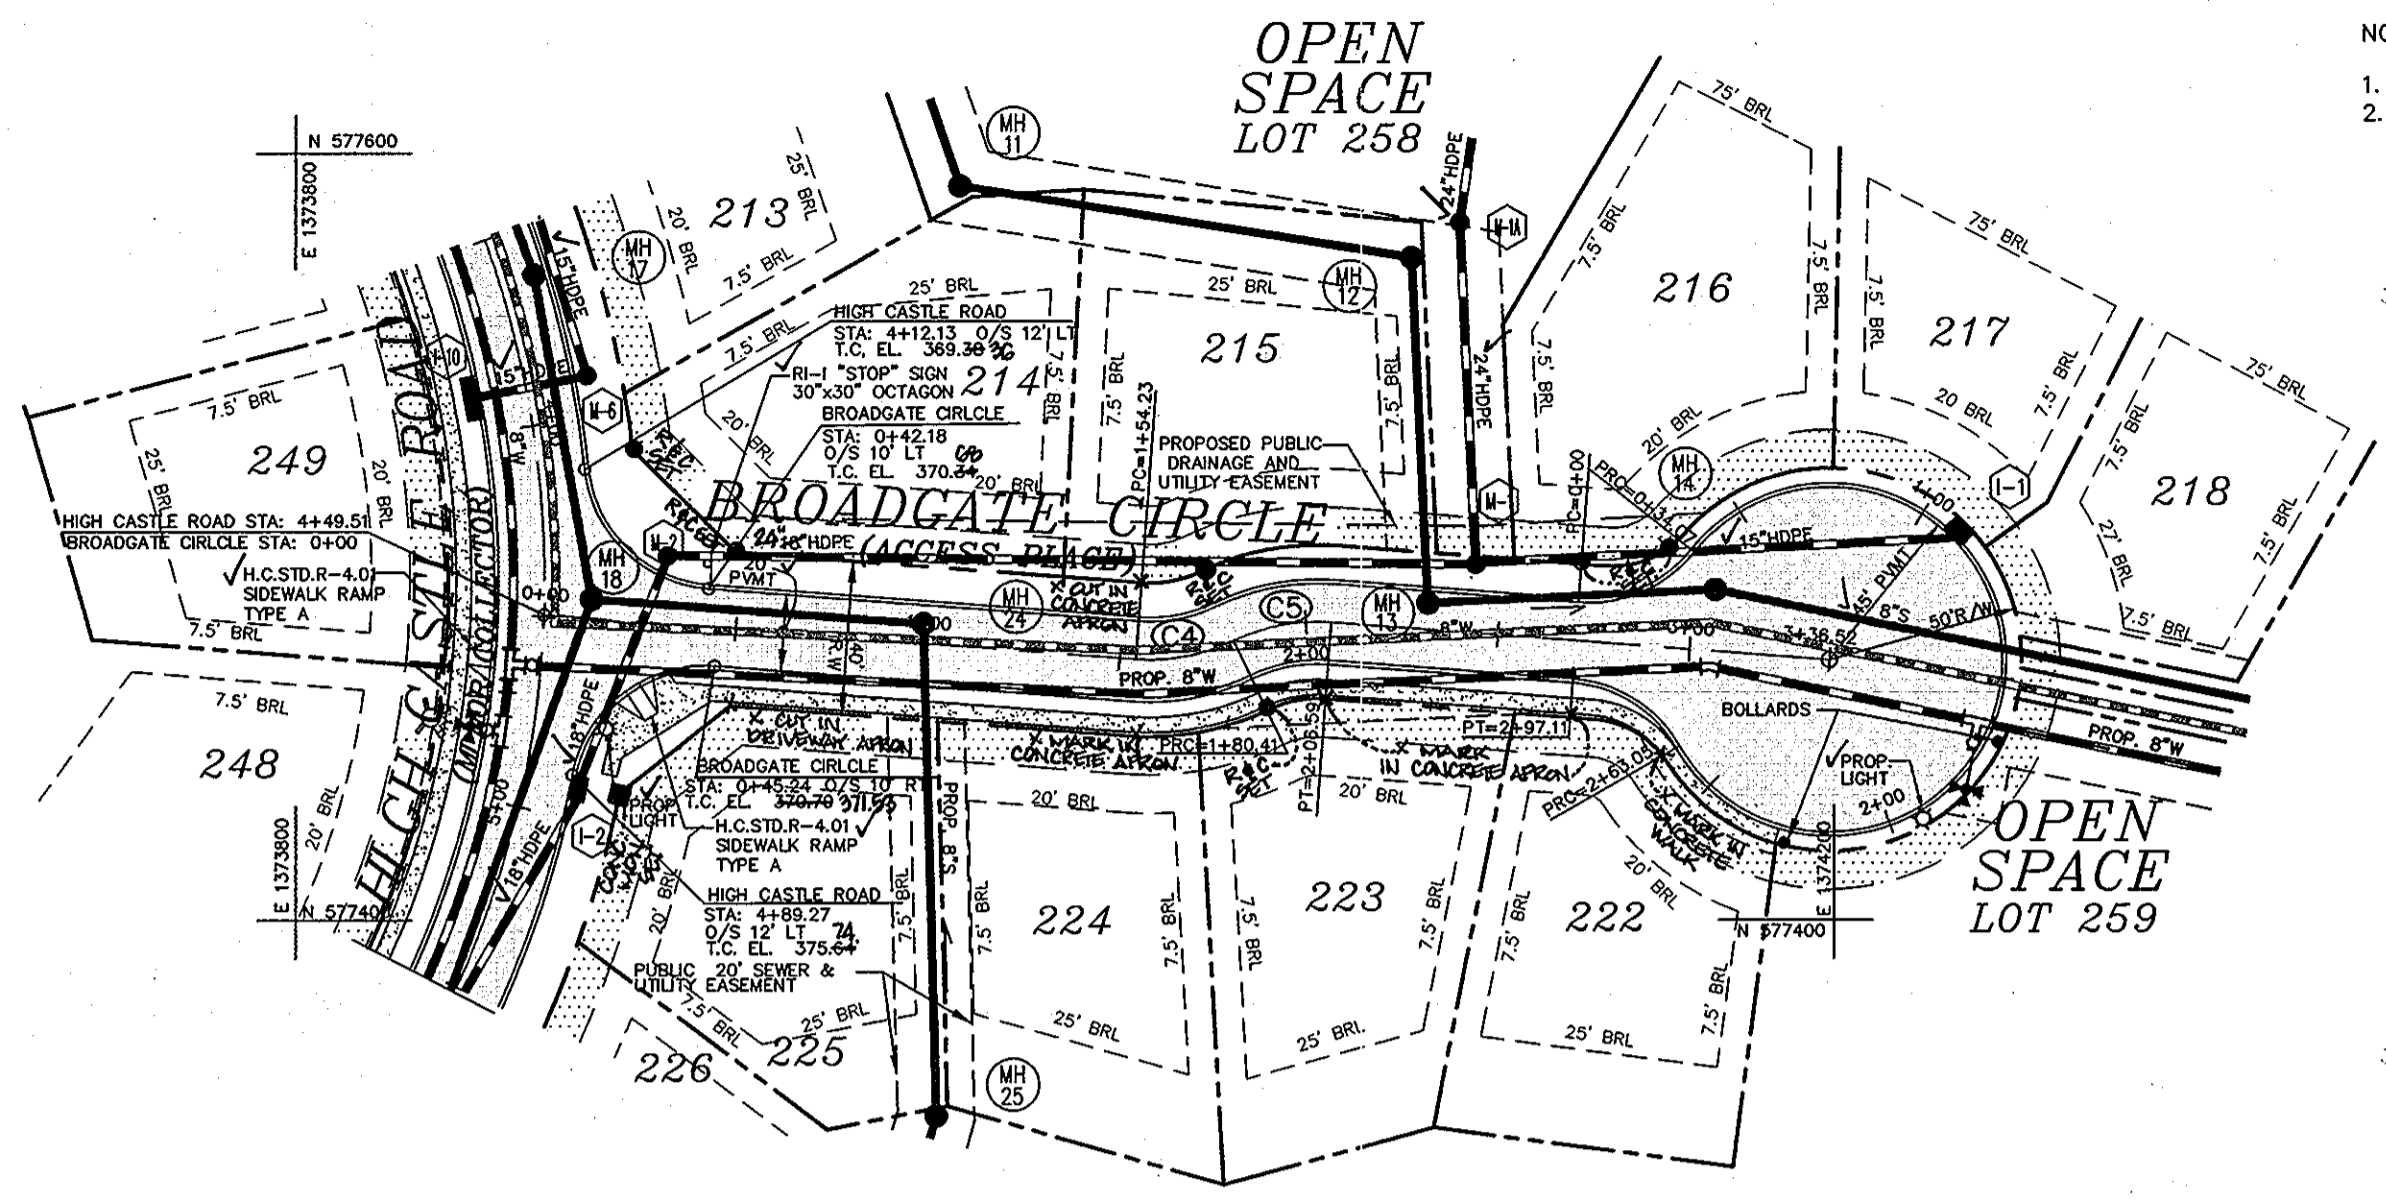

BROADGATE CIRCLE PLAN VIEW
SCALE: 1"=50'

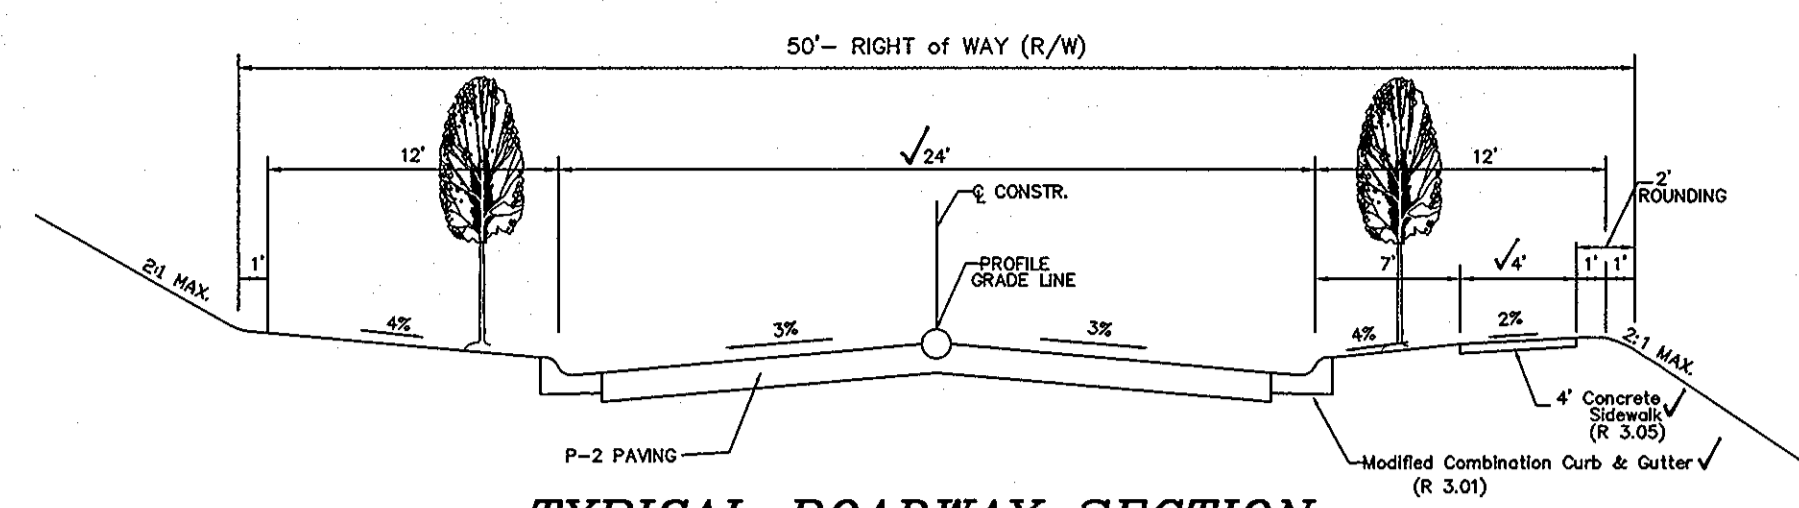


TYPICAL ROADWAY SECTION
CLASSIFICATION: MINOR COLLECTOR
DESIGN SPEED: 35 MPH
HIGH CASTLE ROAD
SECTION NOT TO SCALE

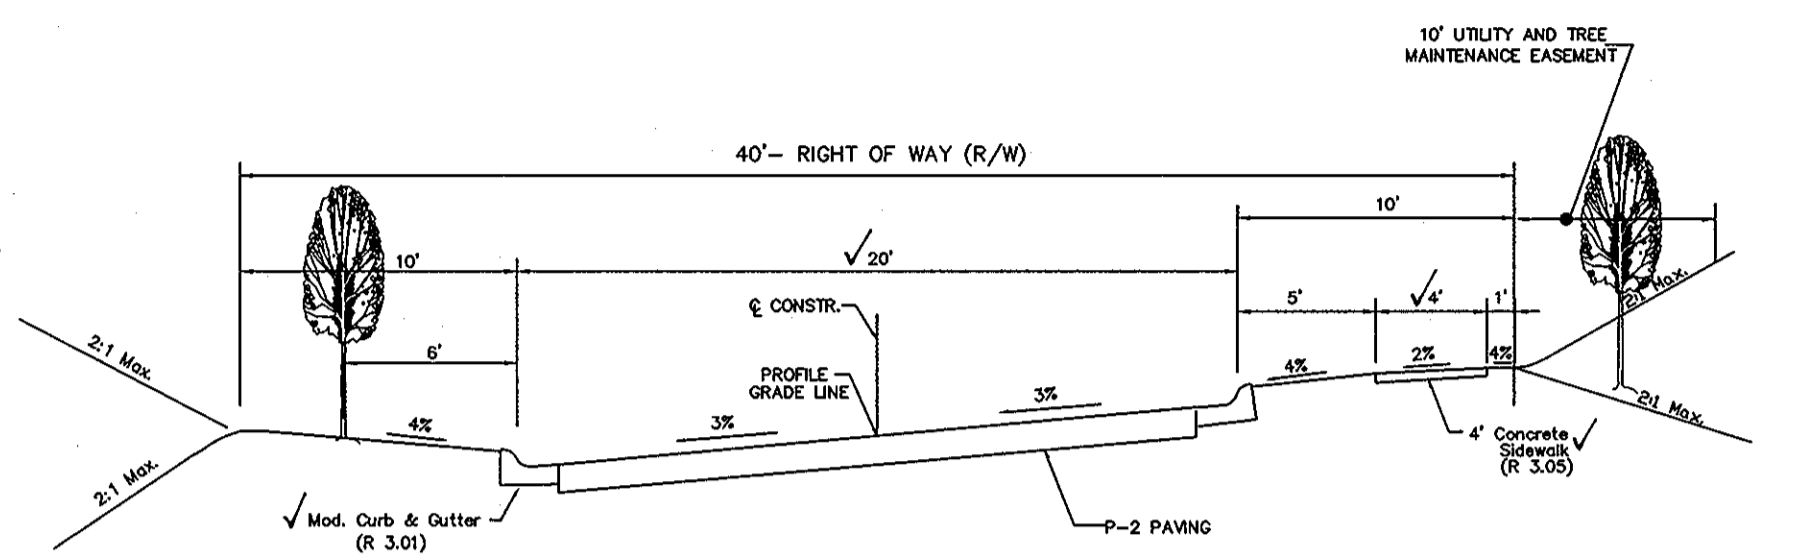


TYPICAL ROADWAY SECTION
CLASSIFICATION: ACCESS PLACE
DESIGN SPEED: 15 MPH
BROADGATE CIRCLE
SECTION NOT TO SCALE


LOW POINT STA = 14+09.03
LOW POINT ELEV = 355.85
PVI STA = 04+83.03
PVI ELEV = 355.05
A.D. = 6.00
K = 20.00

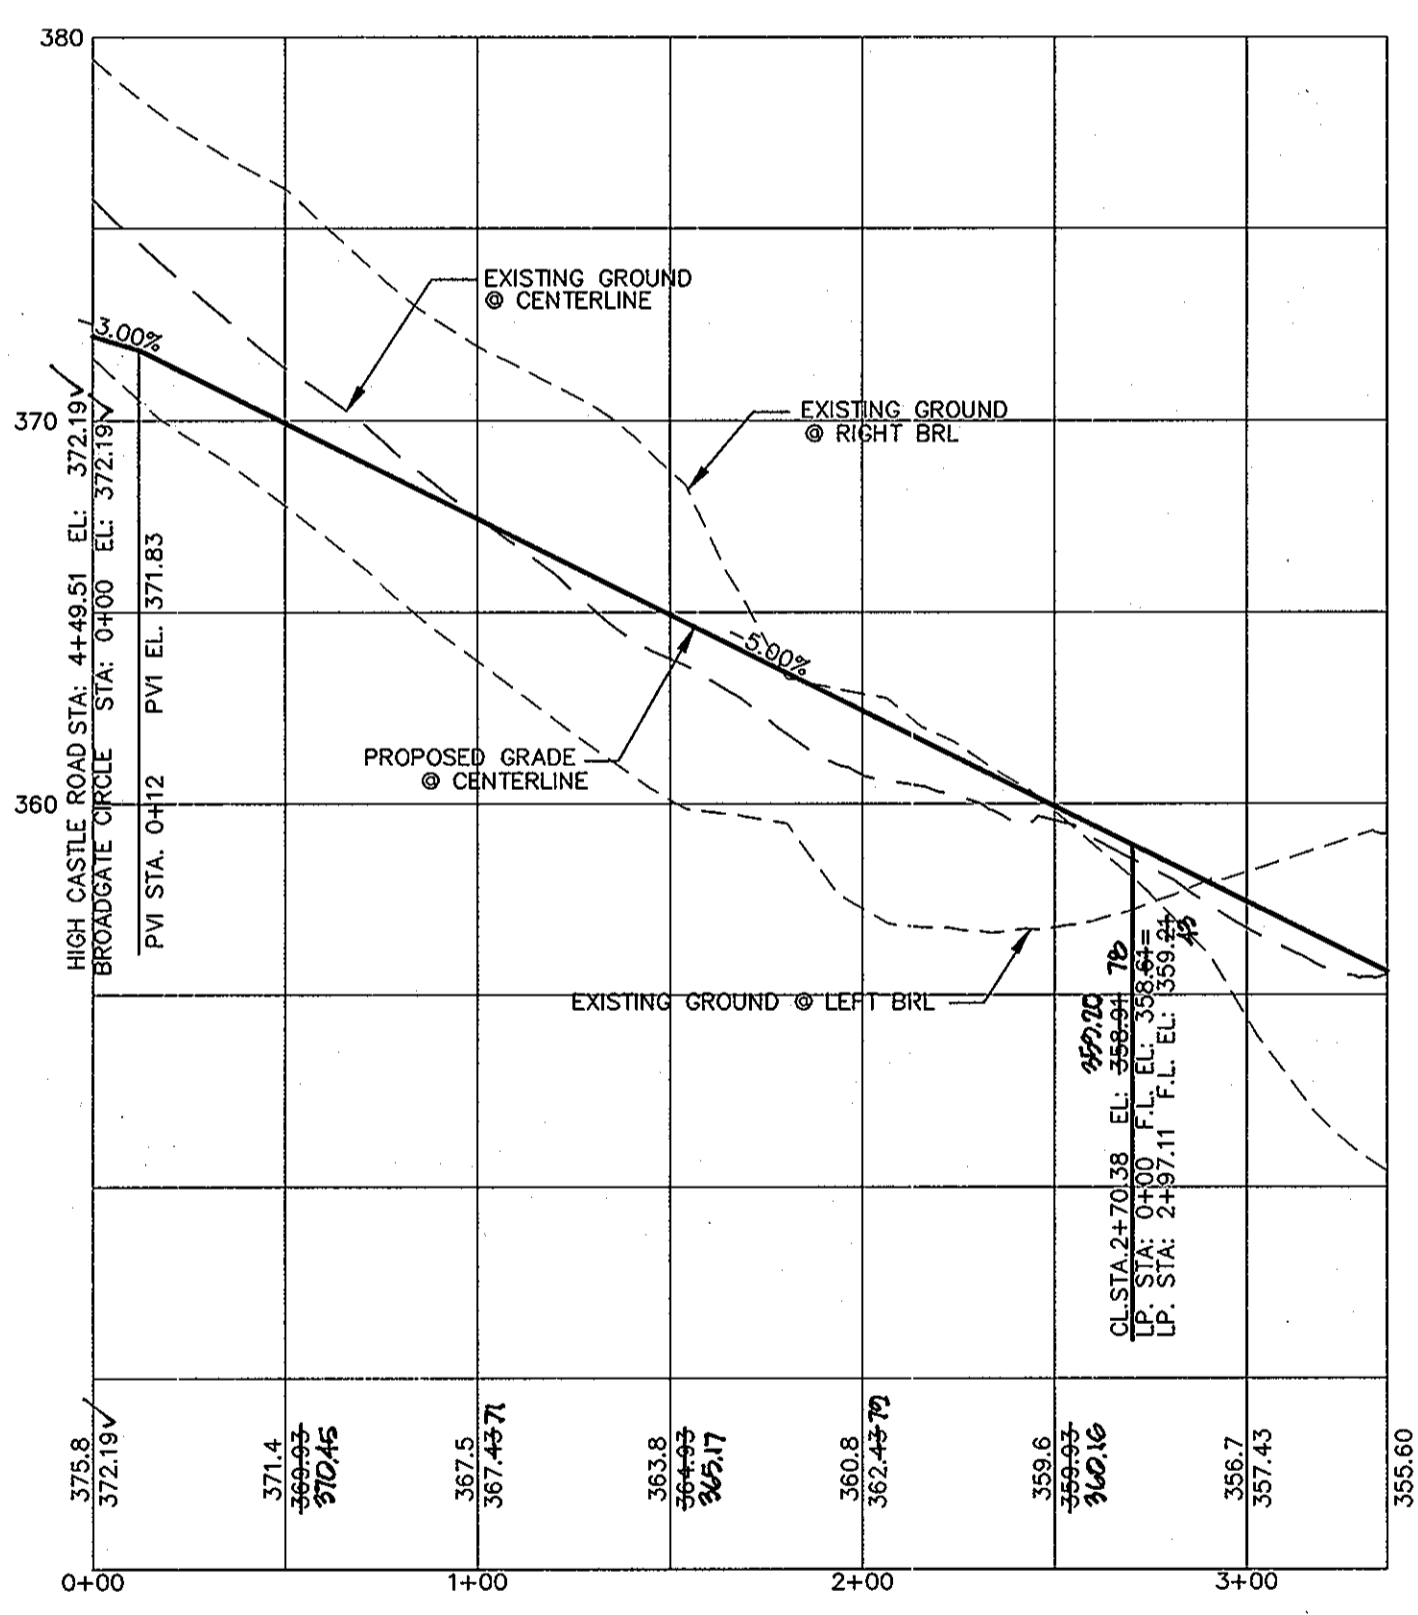

BROADGATE CIRCLE PROFILE
CLASSIFICATION: ACCESS PLACE
DESIGN SPEED: 15 MPH
SCALE: HOR. 1"=50'
VER. 1"=5'

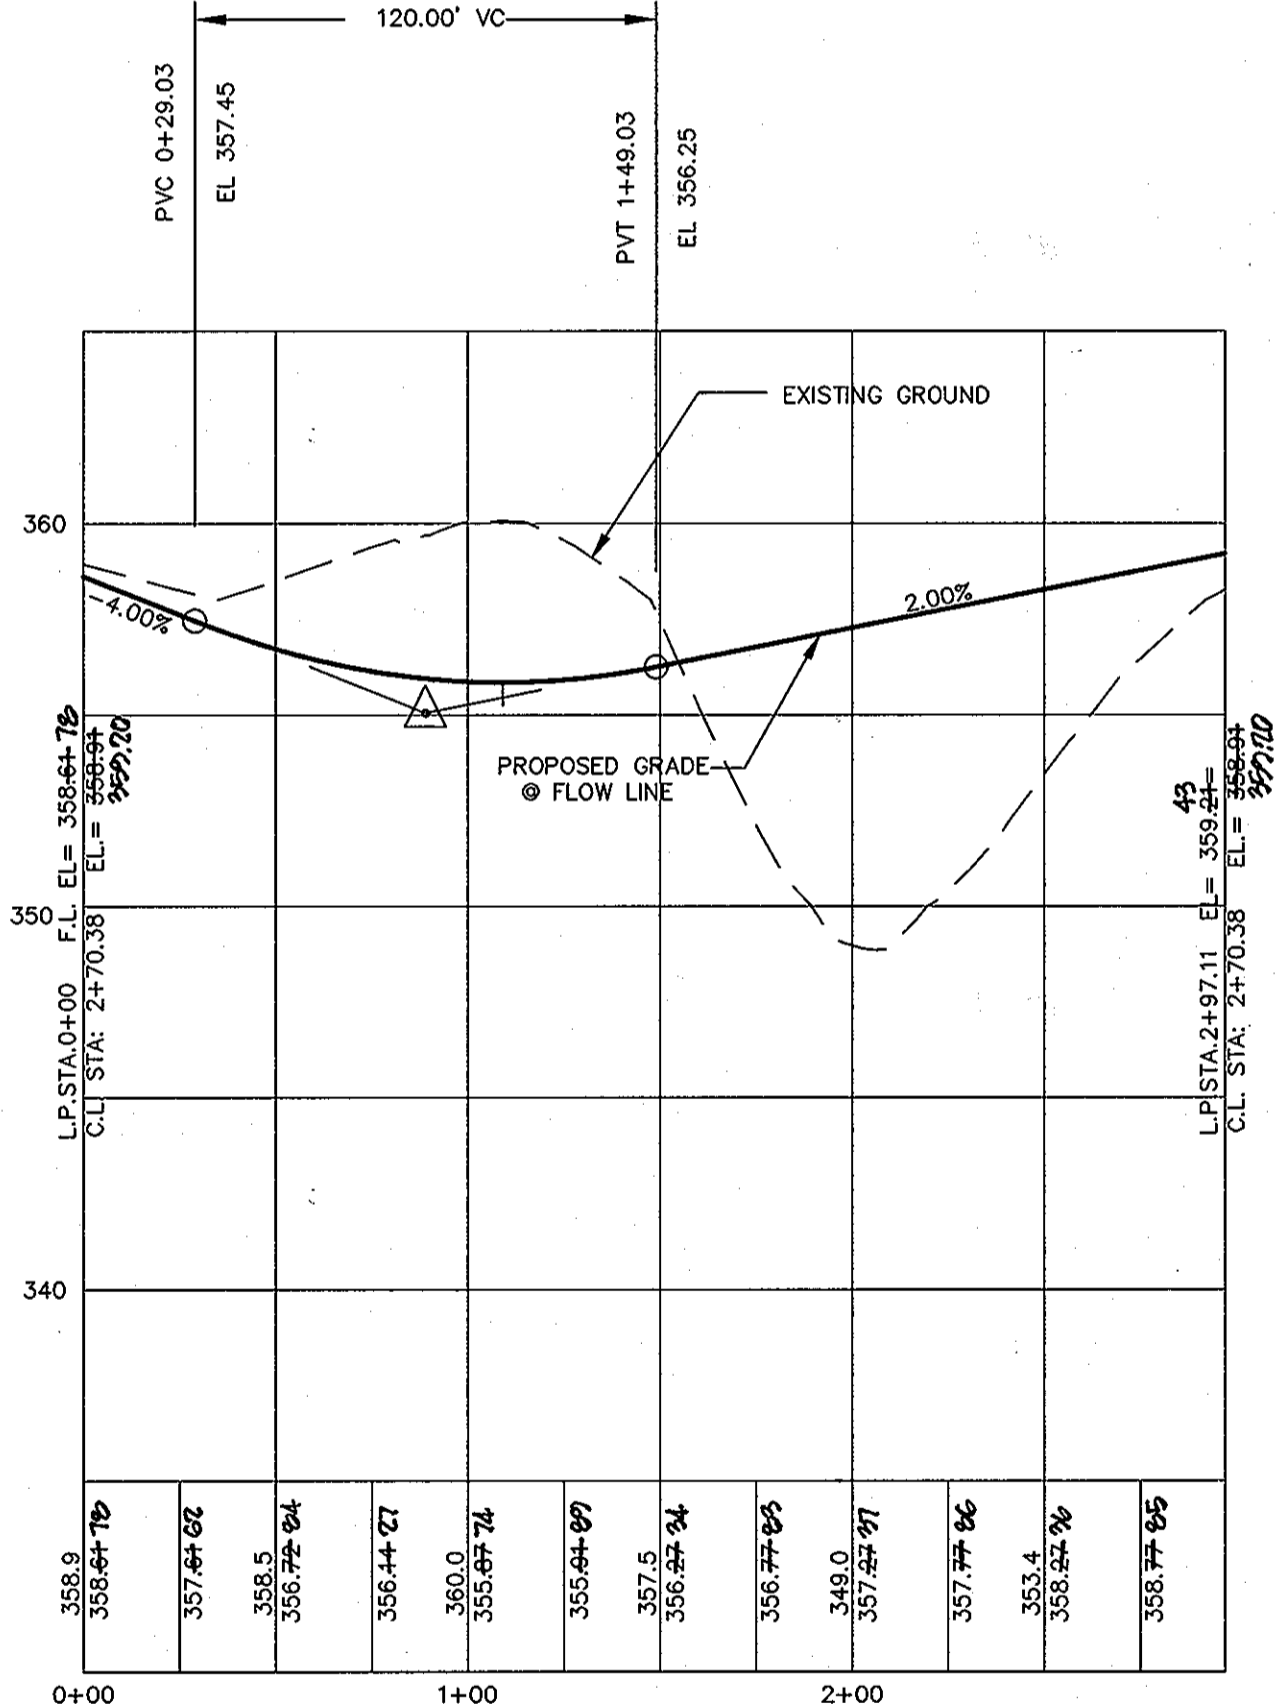

LINEAR PROFILE
SCALE: HOR. 1"=50'
VER. 1"=5'

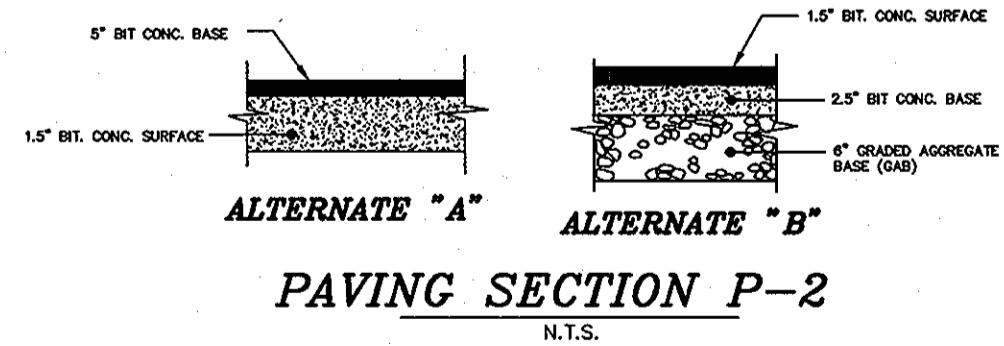


OWNER/DEVELOPER
BONNIE BRANCH CORPORATION
P.O. BOX 396
ELlicott CITY, MD 21043

APPROVED: DEPARTMENT OF PUBLIC WORKS
Richard M. Conner 1-30-02
CHIEF, BUREAU OF HIGHWAYS
DATE

APPROVED: DEPARTMENT OF PLANNING AND ZONING
Cindy Hamden 2/3/02
CHIEF, DIVISION OF LAND DEVELOPMENT
DATE

Michael J. ... 12/28/01
CHIEF, DEVELOPMENT ENGINEERING DIVISION
DATE

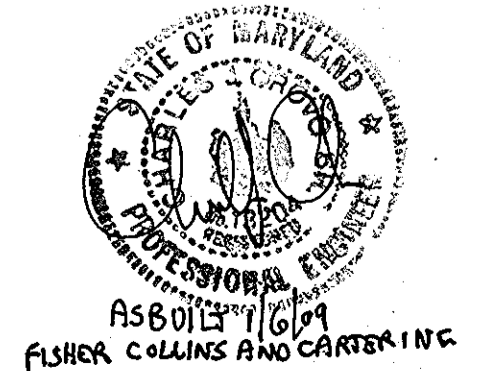


date	DEC. 2001
project	99072
illustration	MAP
scale	1"=50'
approval	JBM

no.	1	description	REVISED PER ROAD 25-31	date	1/2/02
-----	---	-------------	------------------------	------	--------

AUTUMN VIEW SECTION 5, PHASE 1
LOTS: 211-259
TAX MAP 25 & 31, P/O PARCEL 75
HOWARD COUNTY, MARYLAND
SECOND ELECTION DISTRICT
ROAD PLAN, PROFILE AND TYPICAL SECTIONS

MILDENBERG, BOENDER & ASSOC., INC.
Engineers Planners Surveyors
5072 Dorsy Hill Drive, Suite 202, Ellicott City, Maryland, 21042
(410) 987-0296 Balt. (301) 621-5521 Wash. (410) 987-0298 Fax.

NOTE: THIS PLAN IS TO BE USED FOR GRADING PURPOSES ONLY

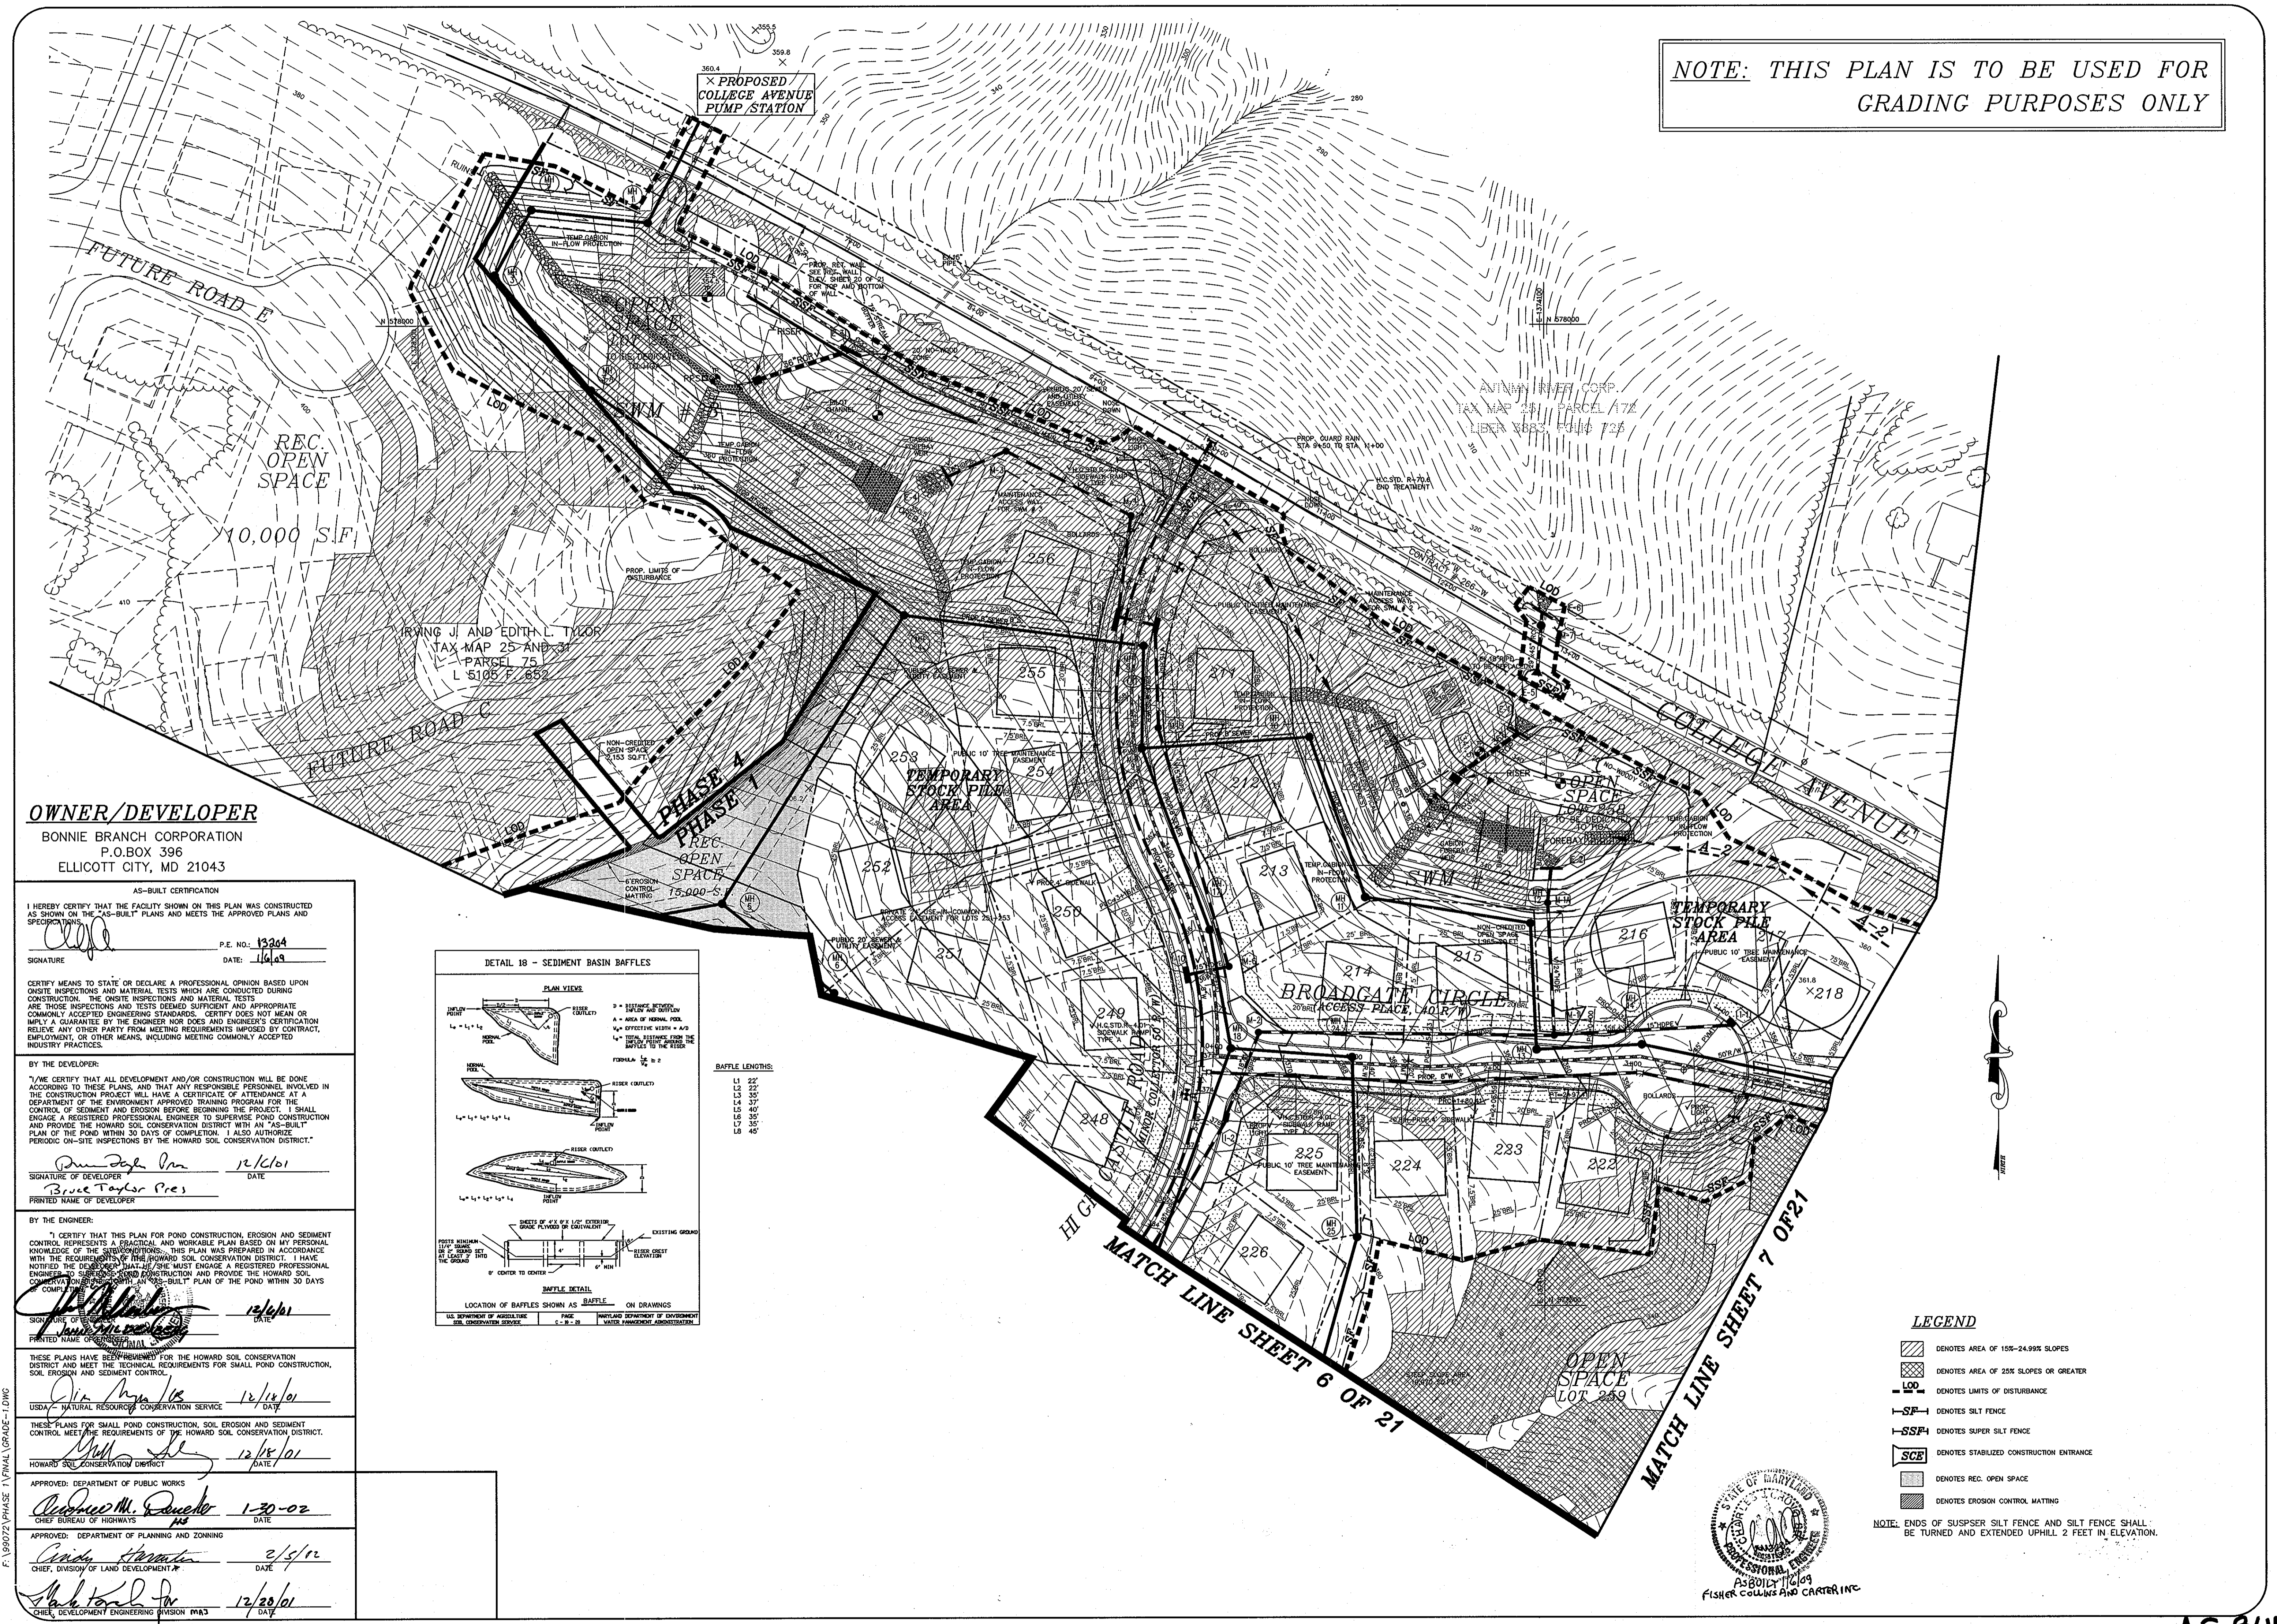

PROPOSED COLLEGE AVENUE PUMP STATION

REC. OPEN SPACE
10,000 S.F.

IRVING JI AND EDITH L. TYLOR
TAX MAP 25 AND 31
PARCEL 75
L 5105 F 852

TEMPORARY STOCK PILE AREA

TEMPORARY STOCK PILE AREA

OPEN SPACE
LOT 249

OWNER/DEVELOPER
BONNIE BRANCH CORPORATION
P.O. BOX 396
ELLCOTT CITY, MD 21043

AS-BUILT CERTIFICATION
I HEREBY CERTIFY THAT THE FACILITY SHOWN ON THIS PLAN WAS CONSTRUCTED AS SHOWN ON THE "AS-BUILT" PLANS AND MEETS THE APPROVED PLANS AND SPECIFICATIONS.
SIGNATURE: *[Signature]* P.E. NO.: 13204
DATE: 11/16/03

CERTIFY MEANS TO STATE OR DECLARE A PROFESSIONAL OPINION BASED UPON ON-SITE INSPECTIONS AND MATERIAL TESTS WHICH ARE CONDUCTED DURING CONSTRUCTION. THE ON-SITE INSPECTIONS AND MATERIAL TESTS ARE THOSE INSPECTIONS AND TESTS DEEMED SUFFICIENT AND APPROPRIATE COMMONLY ACCEPTED ENGINEERING STANDARDS. CERTIFY DOES NOT MEAN OR IMPLY A GUARANTEE BY THE ENGINEER NOR DOES THE ENGINEER'S CERTIFICATION RELIEVE ANY OTHER PARTY FROM MEETING REQUIREMENTS IMPOSED BY CONTRACT, EMPLOYMENT OR OTHER MEANS, INCLUDING MEETING COMMONLY ACCEPTED INDUSTRY PRACTICES.

BY THE DEVELOPER:
"I/WE CERTIFY THAT ALL DEVELOPMENT AND/OR CONSTRUCTION WILL BE DONE ACCORDING TO THESE PLANS, AND THAT ANY RESPONSIBLE PERSONNEL INVOLVED IN THE CONSTRUCTION PROJECT WILL HAVE A CERTIFICATE OF ATTENDANCE AT A DEPARTMENT OF THE ENVIRONMENT APPROVED TRAINING PROGRAM FOR THE CONTROL OF SEDIMENT AND EROSION BEFORE BEGINNING THE PROJECT. I SHALL ENGAGE A REGISTERED PROFESSIONAL ENGINEER TO SUPERSEDE POND CONSTRUCTION AND PROVIDE THE HOWARD SOIL CONSERVATION DISTRICT WITH AN "AS-BUILT" PLAN OF THE POND WITHIN 30 DAYS OF COMPLETION. I ALSO AUTHORIZE PERIODIC ON-SITE INSPECTIONS BY THE HOWARD SOIL CONSERVATION DISTRICT."

SIGNATURE OF DEVELOPER: *[Signature]* 12/16/01
DATE
PRINTED NAME OF DEVELOPER: Bruce Taylor Pres

BY THE ENGINEER:
"I CERTIFY THAT THIS PLAN FOR POND CONSTRUCTION, EROSION AND SEDIMENT CONTROL REPRESENTS A PRACTICAL AND WORKABLE PLAN BASED ON MY PERSONAL KNOWLEDGE OF THE SITE CONDITIONS. THIS PLAN WAS PREPARED IN ACCORDANCE WITH THE REQUIREMENTS OF THE HOWARD SOIL CONSERVATION DISTRICT. I HAVE NOTICED THE DEVELOPER THAT HE/SHE MUST ENGAGE A REGISTERED PROFESSIONAL ENGINEER TO SUPERSEDE POND CONSTRUCTION AND PROVIDE THE HOWARD SOIL CONSERVATION DISTRICT WITH AN "AS-BUILT" PLAN OF THE POND WITHIN 30 DAYS OF COMPLETION."


SIGNATURE OF ENGINEER: *[Signature]* 12/16/01
DATE
PRINTED NAME OF ENGINEER: [Name]

THESE PLANS HAVE BEEN REVIEWED FOR THE HOWARD SOIL CONSERVATION DISTRICT AND MEET THE TECHNICAL REQUIREMENTS FOR SMALL POND CONSTRUCTION, SOIL EROSION AND SEDIMENT CONTROL.
USDA, NATURAL RESOURCES CONSERVATION SERVICE
DATE: 12/16/01

APPROVED: DEPARTMENT OF PUBLIC WORKS
DATE: 1-30-02


APPROVED: DEPARTMENT OF PLANNING AND ZONING
DATE: 2/5/02

DATE: 12/28/01

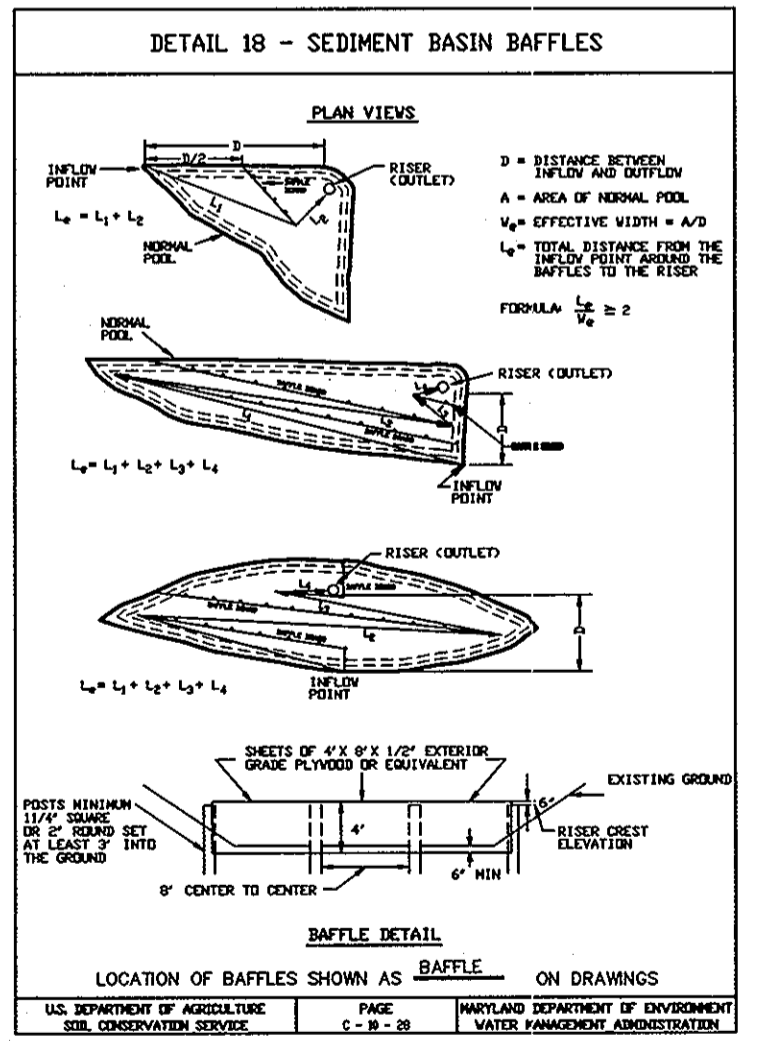

- LEGEND**
- DENOTES AREA OF 15%-24.9% SLOPES
 - DENOTES AREA OF 25% SLOPES OR GREATER
 - DENOTES LIMITS OF DISTURBANCE
 - DENOTES SILT FENCE
 - DENOTES SUPER SILT FENCE
 - DENOTES STABILIZED CONSTRUCTION ENTRANCE
 - DENOTES REC. OPEN SPACE
 - DENOTES EROSION CONTROL MATTING

NOTE: ENDS OF SUSPENSER SILT FENCE AND SILT FENCE SHALL BE TURNED AND EXTENDED UPHILL 2 FEET IN ELEVATION.

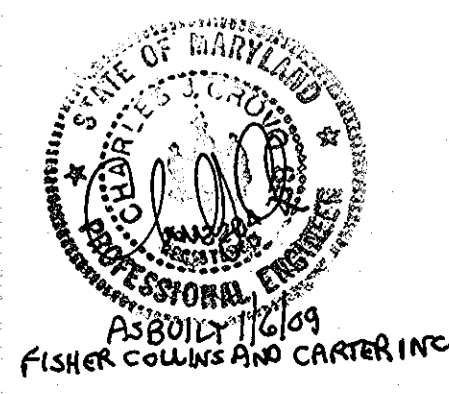

Project	99072	date	DEC 2001
Illustration	MAP	engineering	JBM
MAP	MAP	approval	JBM
scale	1"=50'		

REVISION	DATE	DESCRIPTION
1	1/16/02	REVISED PER ROAD #2 BUILD

AUTUMN VIEW SECTION 5, PHASE 1
LOTS: 211-259
TAX MAP 25 & 31, P/O PARCEL 75
SECOND ELECTION DISTRICT
HOWARD COUNTY, MARYLAND
GRADING AND SEDIMENT CONTROL PLAN

MILDENBERG, BOENDER & ASSOC., INC.
Engineers Planners Surveyors
5072 Dorsey Hall Drive, Suite 202, Ellicott City, Maryland 21042
(410) 997-0296 Fax. (301) 821-5521 Wash. (410) 997-0298 Fax.

NOTE: THIS PLAN IS TO BE USED FOR GRADING PURPOSES ONLY

LEGEND

- DENOTES AREA OF 15%-24.99% SLOPES
- DENOTES AREA OF 25% SLOPES OR GREATER
- DENOTES AREA OF 100 YEAR FLOODPLAIN
- LOD DENOTES LIMITS OF DISTURBANCE
- S DENOTES SILT FENCE
- SS DENOTES SUPER SILT FENCE
- SC DENOTES STABILIZED CONSTRUCTION ENTRANCE
- DENOTES EROSION CONTROL MATTING

NOTE: ENDS OF SUSPENS SILT FENCE AND SILT FENCE SHALL BE TURNED AND EXTENDED UPHILL 2 FEET IN ELEVATION.



AS-BUILT CERTIFICATION
I HEREBY CERTIFY THAT THE FACILITY SHOWN ON THIS PLAN WAS CONSTRUCTED AS SHOWN ON THE AS-BUILT PLANS AND MEETS THE APPROVED PLANS AND SPECIFICATIONS.

P.E. NO.: _____
DATE: _____

SIGNATURE: _____

CERTIFICATION
CERTIFY MEANS TO STATE OR DECLARE A PROFESSIONAL OPINION BASED UPON ON-SITE INSPECTIONS AND MATERIAL TESTS WHICH ARE CONDUCTED DURING CONSTRUCTION. THE ON-SITE INSPECTIONS AND MATERIAL TESTS ARE THOSE INSPECTIONS AND TESTS DEEMED SUFFICIENT AND APPROPRIATE COMMONLY ACCEPTED ENGINEERING STANDARDS. CERTIFY DOES NOT MEAN OR IMPLY A GUARANTEE BY THE ENGINEER NOR DOES THE ENGINEER'S CERTIFICATION RELIEVE ANY OTHER PARTY FROM MEETING REQUIREMENTS IMPOSED BY CONTRACT, EMPLOYMENT, OR OTHER MEANS, INCLUDING MEETING COMMONLY ACCEPTED INDUSTRY PRACTICES.

BY THE DEVELOPER:
I, THE DEVELOPER, CERTIFY THAT ALL DEVELOPMENT AND/OR CONSTRUCTION WILL BE DONE ACCORDING TO THESE PLANS, AND THAT ANY RESPONSIBLE PERSONNEL INVOLVED IN THE CONSTRUCTION PROJECT WILL HAVE A CERTIFICATE OF ATTENDANCE AT A DEPARTMENT OF THE ENVIRONMENT APPROVED TRAINING PROGRAM FOR THE CONTROL OF SEDIMENT AND EROSION BEFORE BEGINNING THE PROJECT. I SHALL ENGAGE A REGISTERED PROFESSIONAL ENGINEER TO SUPERVISE POND CONSTRUCTION AND PROVIDE THE HOWARD SOIL CONSERVATION DISTRICT WITH AN AS-BUILT PLAN OF THE POND WITHIN 30 DAYS OF COMPLETION. I ALSO AUTHORIZE PERIODIC ON-SITE INSPECTIONS BY THE HOWARD SOIL CONSERVATION DISTRICT.

Signature: *Bruce Taylor* DATE: 12/16/01
PRINTED NAME OF DEVELOPER: Bruce Taylor (Pres)

BY THE ENGINEER:
I CERTIFY THAT THIS PLAN FOR POND CONSTRUCTION, EROSION AND SEDIMENT CONTROL REPRESENTS A FEASIBLE AND WORKABLE PLAN BASED ON MY PERSONAL KNOWLEDGE OF THE SITE CONDITIONS. THIS PLAN WAS PREPARED IN ACCORDANCE WITH THE HOWARD SOIL CONSERVATION DISTRICT. I HAVE NOTIFIED THE HOWARD SOIL CONSERVATION DISTRICT AND I HAVE ENGAGED A REGISTERED PROFESSIONAL ENGINEER TO SUPERVISE POND CONSTRUCTION AND PROVIDE THE HOWARD SOIL CONSERVATION DISTRICT WITH AN AS-BUILT PLAN OF THE POND WITHIN 30 DAYS OF COMPLETION.

Signature: *[Signature]* DATE: 12/16/01
PRINTED NAME OF ENGINEER: [Name]

THESE PLANS HAVE BEEN REVIEWED FOR THE HOWARD SOIL CONSERVATION DISTRICT AND MEET THE TECHNICAL REQUIREMENTS FOR SMALL POND CONSTRUCTION, SOIL EROSION AND SEDIMENT CONTROL.

USDA - NATURAL RESOURCE CONSERVATION SERVICE
Signature: *[Signature]* DATE: 12/18/01

THESE PLANS FOR SMALL POND CONSTRUCTION, SOIL EROSION AND SEDIMENT CONTROL MEET THE REQUIREMENTS OF THE HOWARD SOIL CONSERVATION DISTRICT.


Signature: *[Signature]* DATE: 12/18/01
HOWARD SOIL CONSERVATION DISTRICT

APPROVED: DEPARTMENT OF PUBLIC WORKS
Signature: *[Signature]* DATE: 1-30-02
CHIEF BUREAU OF HIGHWAYS

APPROVED: DEPARTMENT OF PLANNING AND ZONING
Signature: *[Signature]* DATE: 2/1/02
CHIEF, DIVISION OF LAND DEVELOPMENT

Signature: *[Signature]* DATE: 12/28/01
CHECK DEVELOPER ENGINEERING DIVISION M13

OWNER/DEVELOPER
BONNIE BRANCH CORPORATION
P.O. BOX 396
ELLCOTT CITY, MD 21043

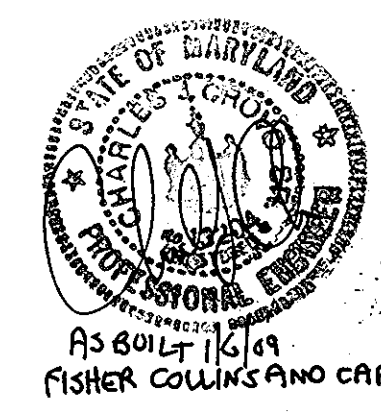


Project	99072	date	DEC. 2001
Illustration	MMP	engineering	MMP
scale	1"=60'	approval	JBM

no.	1	description	REVISIONS PER ROAD AS-BUILT	date	1/6/02
-----	---	-------------	-----------------------------	------	--------

AUTUMN VIEW SECTION 5, PHASE 1
LOTS: 211-259
TAX MAP 25 & 31, P/O PARCEL 75
HOWARD COUNTY, MARYLAND
SECOND ELECTION DISTRICT
GRADING AND SEDIMENT CONTROL PLAN

MILDENBERG, BOENDER & ASSOC., INC.
Engineers Planners Surveyors
5072 Dorsey Hall Drive, Suite 202, Ellicott City, Maryland 21042
(410) 987-0298 Fax (301) 621-5521 Wash. (410) 997-0298 Fax

NOTE: THIS PLAN IS TO BE USED FOR GRADING PURPOSES ONLY

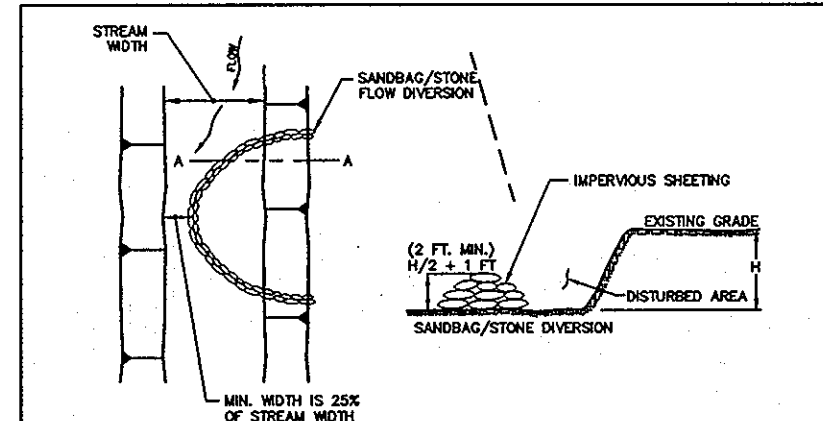

1. DESCRIPTION
THE WORK SHALL CONSIST OF INSTALLING FLOW DIVERSIONS FOR THE PURPOSE OF EROSION CONTROL WHEN CONSTRUCTION ACTIVITIES TAKE PLACE WITHIN THE STREAM CHANNELS WITH AS BARE STABILIZATION OR BRIDGE ABUTMENT CONSTRUCTION.
2. MATERIAL SPECIFICATIONS
a. SANDBAG/STONE DIVERSIONS SHALL CONSIST OF MATERIALS WHICH ARE RESISTANT TO ULTRAVIOLET RADIATION, TEARING AND PUNCTURE AND WHICH MUST BE CAPABLE OF WITHSTANDING THE FORCE OF FLOWING WATER.
b. SILT FENCES SHALL BE MADE OF POLYPROPYLENE OR OTHER MATERIAL WHICH IS RESISTANT TO PUNCTURE AND TEARING.
3. CONSTRUCTION REQUIREMENTS
a. ALL DIVERSION AND CONTROL DEVICES SHALL BE INSTALLED AS THE FIRST ORDER OF WORK.
b. THE DIVERSION STRUCTURE SHALL BE INSTALLED FROM UPSTREAM TO DOWNSTREAM.
c. THE HEIGHT OF THE DIVERSION STRUCTURE SHALL BE ONE HALF THE DISTANCE FROM THE END TO STREAM BANK PLUS ONE FOOT, AS INDICATED ON THE CROSS SECTION VIEW.
d. ALL EXCESSIVE MATERIALS SHALL BE DEPOSITED IN A SOD APPROVED DISPOSAL AREA OUTSIDE THE 100-YEAR FLOODPLAIN UNLESS OTHERWISE APPROVED BY THE HOWARD SOIL CONSERVATION DISTRICT.
e. SOD APPROVED DISPOSAL AREAS SHALL BE PROVIDED TO A SUFFICIENT DEPTH PRIOR TO RE-ENTRANCE TO THE STREAM.
f. SOD APPROVED DISPOSAL AREAS SHALL BE OVERLAPPED SUCH THAT THE UPSTREAM PORTION COVERS THE DOWNSTREAM PORTION WITH AT LEAST AN 18-INCH OVERLAP.
g. SEDIMENT CONTROL DEVICES ARE TO BE MAINTAINED IN PLACE UNTIL ALL DISTURBED AREAS ARE STABILIZED IN ACCORDANCE WITH AN APPROVED SEDIMENT AND EROSION CONTROL PLAN AND THE RESPECTIVE AUTHORITY APPROVES THESE.

WATER RESOURCES ADMINISTRATION	SANDBAG/STONE DIVERSION	APPROVED ON _____	MFD
		DATE: 12/18/01	2,3

NOTE: REFER TO MDE PERMIT AND DETAIL FOR STREAM CROSSING.

LEGEND

- DENOTES AREA OF 15%-24.9% SLOPES
- DENOTES AREA OF 25% SLOPES OR GREATER
- DENOTES LIMITS OF DISTURBANCE
- DENOTES SILT FENCE
- DENOTES SUPER SILT FENCE
- DENOTES STABILIZED CONSTRUCTION ENTRANCE

NOTE: ENDS OF SUSPENSER SILT FENCE AND SILT FENCE SHALL BE TURNED AND EXTENDED UPHILL 2 FEET IN ELEVATION.

AS-BUILT CERTIFICATION

I HEREBY CERTIFY THAT THE FACILITY SHOWN ON THIS PLAN WAS CONSTRUCTED AS SHOWN ON THE "AS-BUILT" PLANS AND MEETS THE APPROVED PLANS AND SPECIFICATIONS.

SIGNATURE: _____ P.E. NO.: _____
DATE: _____

CERTIFY MEANS TO STATE OR DECLARE A PROFESSIONAL OPINION BASED UPON ON-SITE INSPECTIONS AND MATERIAL TESTS WHICH ARE CONDUCTED DURING CONSTRUCTION. THE ON-SITE INSPECTIONS AND MATERIAL TESTS ARE THOSE INSPECTIONS AND TESTS DEEMED SUFFICIENT AND APPROPRIATE COMMONLY ACCEPTED ENGINEERING STANDARDS. CERTIFY DOES NOT MEAN OR IMPLY A GUARANTEE BY THE ENGINEER NOR DOES AND ENGINEER'S CERTIFICATION RELIEVE ANY OTHER PARTY FROM MEETING REQUIREMENTS IMPOSED BY CONTRACT, EMPLOYMENT OR OTHER MEANS, INCLUDING MEETING COMMONLY ACCEPTED INDUSTRY PRACTICES.

BY THE DEVELOPER:
"I, WE CERTIFY THAT ALL DEVELOPMENT AND/OR CONSTRUCTION WILL BE DONE ACCORDING TO THESE PLANS, AND THAT ANY RESPONSIBLE PERSONNEL INVOLVED IN THE CONSTRUCTION PROJECT WILL HAVE A CERTIFICATE OF ATTENDANCE AT A DEPARTMENT OF THE ENVIRONMENT APPROVED TRAINING PROGRAM FOR THE CONTROL OF SEDIMENT AND EROSION BEFORE BEGINNING THE PROJECT. I SHALL ENGAGE A REGISTERED PROFESSIONAL ENGINEER TO SUPERVISE POND CONSTRUCTION AND PROVIDE THE HOWARD SOIL CONSERVATION DISTRICT WITH AN "AS-BUILT" PLAN OF THE POND WITHIN 30 DAYS OF COMPLETION. I ALSO AUTHORIZE PERIODIC ON-SITE INSPECTIONS BY THE HOWARD SOIL CONSERVATION DISTRICT."

SIGNATURE OF DEVELOPER: *Bruce Taylor, Pres* 12/6/01
DATE: 12/6/01
PRINTED NAME OF DEVELOPER: Bruce Taylor, Pres

BY THE ENGINEER:
"I CERTIFY THAT THIS PLAN FOR POND CONSTRUCTION, EROSION AND SEDIMENT CONTROL REPRESENTS A PRACTICAL AND WORKABLE PLAN BASED ON MY PERSONAL KNOWLEDGE OF THE SITE CONDITIONS. THIS PLAN WAS PREPARED IN ACCORDANCE WITH THE REQUIREMENTS OF THE HOWARD SOIL CONSERVATION DISTRICT. I HAVE NOTICED THE DEVELOPER THAT HE/MUST ENGAGE A REGISTERED PROFESSIONAL ENGINEER TO SUPERVISE POND CONSTRUCTION AND PROVIDE THE HOWARD SOIL CONSERVATION DISTRICT WITH AN "AS-BUILT" PLAN OF THE POND WITHIN 30 DAYS OF COMPLETION."

SIGNATURE OF ENGINEER: *Jim Myers* 12/18/01
DATE: 12/18/01
PRINTED NAME OF ENGINEER: Jim Myers

THESE PLANS HAVE BEEN REVIEWED FOR THE HOWARD SOIL CONSERVATION DISTRICT AND MEET THE TECHNICAL REQUIREMENTS FOR SMALL POND CONSTRUCTION, SOIL EROSION AND SEDIMENT CONTROL.

USDA - NATURAL RESOURCES CONSERVATION SERVICE
SIGNED: *Jim Myers* 12/18/01
DATE: 12/18/01


APPROVED: DEPARTMENT OF PUBLIC WORKS
Charles W. Edwards 1/30/02
DATE: 1/30/02

APPROVED: DEPARTMENT OF PLANNING AND ZONING
Cinda Hunt 2/5/02
DATE: 2/5/02



TAX MAP 25, PARCEL 75
LIBER 530, FOLIO 104
48.191 ACRES ±

OWNER/DEVELOPER
BONNIE BRANCH CORPORATION
P.O. BOX 396
ELLICOTT CITY, MD 21103

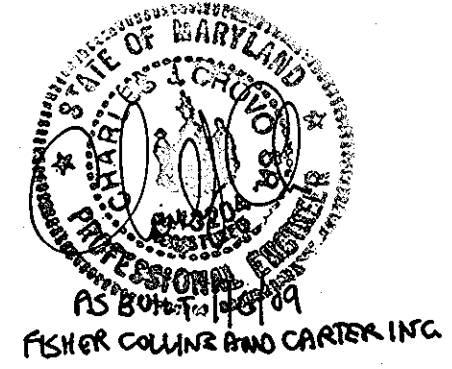

FISHER COLLIER POND CATCHMENT INC.

NOTE: TRENCH EXCAVATION SHALL BE LIMITED TO AN AREA WHICH CAN BE CONSTRUCTED, BACKFILLED AND STABILIZED WITHIN ONE WORKING DAY. PROVIDE SILT FENCE AT DOWNSTREAM LIMIT OF EACH DAY CONSTRUCTION.

P: 1990722 \PHASE 1\FINAL GRADING - LDWG

Project	99072	date	SEP 2001
Illustration	MMP	engineering	JBM
Scale	1" = 60'	approval	JBM

no.	description	date

AUTUMN VIEW SECTION 5, PHASE 1
LOTS: 211-259
TAX MAP 25 & 31, P/O PARCEL 75
HOWARD COUNTY, MARYLAND
SECOND ELECTION DISTRICT
GRADING AND SEDIMENT CONTROL PLAN

MILDENBERG, BOENDER & ASSOC., INC.
Engineers Planners Surveyors
502 Dorsey Hall Drive, Suite 202, Ellicott City, Maryland 21042
(410) 997-0296 Fax: (301) 621-5521 Wash. (410) 997-0298 Fax.

HOWARD SOIL CONSERVATION DISTRICT

PERMANENT SEEDING NOTES

APPLY TO GRADED OR CLEARED AREAS NOT SUBJECT TO IMMEDIATE FURTHER DISTURBANCE WHERE A PERMANENT LONG-LIVED VEGETATIVE COVER IS NEEDED.

SEEDING PREPARATION: LOOSEN UPPER THREE INCHES OF SOIL BY RAKING, DISKING OR OTHER ACCEPTABLE MEANS BEFORE SEEDING. IF NOT FRESHLY LOOSENED.

- SOL AMENDMENTS: IN LIEU OF SOIL TEST RECOMMENDATIONS, USE ONE OF THE FOLLOWING SCHEDULES: 1) PREFERRED - APPLY 2 TONS PER ACRE DOLOMITIC LIMESTONE (92 LBS./1000 SOFT)... 2) ACCEPTABLE - APPLY 2 TONS PER ACRE DOLOMITIC LIMESTONE (92 LBS./1000 SOFT)...

SEEDING - FOR PERIODS MARCH 1 THRU APRIL 30, AND AUGUST 1 THRU OCTOBER 15, SEED WITH 60 LBS. PER ACRE 1.4 LBS./1000 SOFT... FOR PERIOD MAY 1 THRU JULY 31, SEED WITH 60 LBS. PER ACRE...

MULCHING - APPLY 1-1/2 TO 2 TONS PER ACRE (70 TO 90 LBS./1000 SOFT) OF UNROTTED WOOD FREE SMALL GRASS STRAW IMMEDIATELY AFTER SEEDING...

MAINTENANCE - INSPECT ALL SEEDING AREAS AND MAKE NEEDED REPAIRS, REPLACEMENTS AND RESEEDINGS.

TEMPORARY SEEDING NOTES

APPLY TO GRADED OR CLEARED AREAS LIKELY TO BE REDISTURBED WHERE A SHORT-TERM VEGETATIVE COVER IS NEEDED.

SEEDING PREPARATION: LOOSEN UPPER THREE INCHES OF SOIL BY RAKING, DISKING OR OTHER ACCEPTABLE MEANS BEFORE SEEDING, FOR NOT PREVIOUSLY LOOSENED.

SOL AMENDMENTS: APPLY 600 LBS. PER ACRE 10-10-10 FERTILIZER (14 LBS./1000 SOFT).

SEEDING: FOR PERIODS MARCH 1 THRU APRIL 30, AND FROM AUGUST 15 THRU OCTOBER 15, SEED WITH 2-1/2 BUSHEL PER ACRE ANNUAL RYE (3.2 LBS./1000 SOFT)...

MULCHING: APPLY 1-1/2 TO 2 TONS PER ACRE (70 TO 90 LBS./1000 SOFT) OF UNROTTED WOOD FREE SMALL GRASS STRAW IMMEDIATELY AFTER SEEDING...

REFER TO THE 1983 MARYLAND STANDARDS AND SPECIFICATIONS FOR SOIL EROSION AND SEDIMENT CONTROL FOR ADDITIONAL RATES AND METHODS NOT COVERED.

STANDARD SEDIMENT CONTROL NOTES

1) A MINIMUM OF 48 HOURS NOTICE MUST BE GIVEN TO THE HOWARD COUNTY DEPARTMENT OF INSPECTIONS, LICENSES AND PERMITS, SEDIMENT CONTROL DIVISION PRIOR TO THE START OF ANY CONSTRUCTION, (315-1855).

2) ALL VEGETATIVE AND STRUCTURAL PRACTICES ARE TO BE INSTALLED ACCORDING TO THE PROVISIONS OF THIS PLAN AND ARE TO BE IN CONFORMANCE WITH THE MOST CURRENT MARYLAND STANDARDS AND SPECIFICATIONS FOR SOIL EROSION AND SEDIMENT CONTROL.

3) FOLLOWING INITIAL SOL DISTURBANCE OR REDISTURBANCE, PERMANENT OR TEMPORARY STABILIZATION SHALL BE COMPLETED WITHIN: A) 7 CALENDAR DAYS FOR ALL PERMETER SEDIMENT CONTROL STRUCTURES AND AREAS GREATER THAN 315, 8) 14 DAYS AS TO ALL OTHER DISTURBED OR GRADED AREAS ON THE PROJECT SITE.

4) ALL SEDIMENT TRAPS/SHOWN MUST BE SITED AND WARNING SIGNS POSTED AROUND THEIR PERMETER IN ACCORDANCE WITH VOL. 1, CHAPTER 12, OF THE HOWARD COUNTY DESIGN MANUAL, STORM DRAINAGE.

5) ALL DISTURBED AREAS MUST BE STABILIZED WITHIN THE TIME PERIOD SPECIFIED ABOVE IN ACCORDANCE WITH THE 1983 MARYLAND STANDARDS AND SPECIFICATIONS FOR SOIL EROSION AND SEDIMENT CONTROL (SEC. 50) AND MULCHING (SEC. 54). TEMPORARY STABILIZATION WITH MULCH ALONE CAN ONLY BE DONE WHEN RECOMMENDED SEEDING DATES DO NOT ALLOW FOR PROPER SEEDING AND ESTABLISHMENT OF GRASSES.

6) ALL SEDIMENT CONTROL STRUCTURES ARE TO REMAIN IN PLACE AND ARE TO BE MAINTAINED IN OPERATIVE CONDITION UNTIL PERMITS FOR THEIR REMOVAL HAS BEEN OBTAINED FROM THE HOWARD COUNTY SEDIMENT CONTROL INSPECTOR.

7) SITE ANALYSIS: TOTAL AREA OF SITE: 31.14 ACRES... AREA TO BE RIPPED OR PAVED: 18.95 ACRES... AREA TO BE VEGETATIVELY STABILIZED: 13.08 ACRES...

THESE QUANTITIES ARE FOR PERMIT PURPOSES ONLY. CONTRACTOR IS REQUIRED TO PROVIDE HIS OWN QUANTITY MEASUREMENTS.

AS-BUILT CERTIFICATION: I HEREBY CERTIFY THAT THE FACILITY SHOWN ON THIS PLAN WAS CONSTRUCTED AS SHOWN ON THE AS-BUILT PLANS AND MEETS THE APPROVED PLANS AND SPECIFICATIONS.

SIGNATURE: Bruce Taylor Pres DATE: 12/16/01

CERTIFY MEANS TO STATE OR DECLARE A PROFESSIONAL OPINION BASED UPON ON-SITE INSPECTIONS AND MATERIAL TESTS WHICH ARE CONDUCTED DURING CONSTRUCTION. THE ON-SITE INSPECTIONS AND MATERIAL TESTS ARE THOSE INSPECTIONS AND TESTS DEEMED SUFFICIENT AND APPROPRIATE COMMUNITY ACCEPTED ENGINEERING STANDARDS.

BY THE DEVELOPER: THESE PLANS HAVE BEEN REVIEWED FOR THE HOWARD SOIL CONSERVATION DISTRICT AND MEET THE TECHNICAL REQUIREMENTS FOR SMALL POND CONSTRUCTION, SOIL EROSION AND SEDIMENT CONTROL.

USDA - NATURAL RESOURCES CONSERVATION SERVICE DATE: 12/16/01

THESE PLANS HAVE BEEN REVIEWED FOR THE HOWARD SOIL CONSERVATION DISTRICT AND MEET THE TECHNICAL REQUIREMENTS FOR SMALL POND CONSTRUCTION, SOIL EROSION AND SEDIMENT CONTROL.

APPROVED: DEPARTMENT OF PUBLIC WORKS DATE: 1-30-02

APPROVED: DEPARTMENT OF PLANNING AND ZONING DATE: 2/5/02

APPROVED: HOWARD SOIL CONSERVATION DISTRICT DATE: 12/28/01

OWNER/DEVELOPER: BONNIE BRANCH CORPORATION, ELLICOTT CITY, MD 21043

TEMPORARY DUST CONTROL MEASURES



- 1. MULCHES - SEE STANDARDS FOR VEGETATIVE STABILIZATION WITH MULCHES ONLY. MULCH SHOULD BE CRUMPED OR TACKED TO PREVENT... 2. VEGETATIVE COVER - SEE STANDARDS FOR VEGETATIVE COVER... 3. TILLAGE - TO ROUGHEN SURFACE AND BRING CLODS TO THE SURFACE... 4. IRRIGATION - THIS IS GENERALLY DONE AS AN EMERGENCY TREATMENT... 5. BARRIERS - SOLID ROAD FENCES, SILT FENCES, SNOW FENCES, BURLAP FENCES, STRAW BALES, AND SIMILAR MATERIAL CAN BE USED TO CONTROL AIR CURRENTS... 6. CALCIUM CHLORIDE - APPLY AT RATES THAT WILL KEEP SURFACE MOIST.

SEQUENCE OF CONSTRUCTION



- 1. OBTAIN GRADING PERMIT. 2. CONSTRUCT STABILIZED CONSTRUCTION ENTRANCE WITH MOUNTABLE BERM AT LOCATION INDICATED. (1 DAY) 3. CONSTRUCT SILT FENCES, SUPER SILT FENCES AND TREE PROTECTION FENCES (4 DAYS) 4. CONSTRUCT AND STABILIZE STORMWATER MANAGEMENT PONDS 2 & 3, INCLUDING TEMPORARY LOW FLOW PLATES, CREST OF EMERGENCY SPILLWAY FOR SED. BASIN NO. 2 PER DETAILS. (10 DAYS) 5. MANUALLY STABILIZE DISTURBED AREA BELOW E-1 & E-3 WITH EROSION CONTROL MATTING, SEED AND MULCH. 6. BLOCK SWM POND RESS AS SHOWN IN THEIR BLOCKING DETAILS ON SHEETS NO 20 OR 21. INSTALL TEMPORARY STANDPIPES. CONSTRUCT EARTH DIKE AS INDICATED. (2 DAYS) 7. AFTER RECEIVING PERMISSION FROM THE SEDIMENT CONTROL INSPECTOR, CLEAR SITE PER LIMITS INDICATED. (30 DAYS) 8. BRING SITE TO GRADE INDICATED ON THE PLANS, CONSTRUCT STORM DRAIN SYSTEM & UTILITIES. (PROVIDE DUST CONTROL MEASURES AS REQUIRED) (30 DAYS) 9. DURING CONSTRUCTION, SEDIMENT SHALL BE REMOVED FROM THE STORMWATER MANAGEMENT PONDS WHEN THEIR CLEANOUT ELEVATIONS HAVE BEEN REACHED. 10. CONSTRUCT PAVEMENT AND CURB AND GUTTER AS INDICATED. (10 DAYS) 11. STABILIZE REMAINING DISTURBED AREAS. (10 DAYS) 12. WHEN ALL CONTRIBUTING DRAINAGE AREAS TO SEDIMENT CONTROL DEVICES HAVE BEEN STABILIZED AND WITH THE APPROVAL OF THE SEDIMENT CONTROL INSPECTOR, REMOVE SEDIMENT CONTROL DEVICES AND STABILIZE REMAINING DISTURBED AREAS (10 DAYS) 13. CONTRACTOR SHALL FLUSH ALL STORM DRAIN SYSTEMS PRIOR TO CONVERSION OF SEDIMENT BASIN TO STORM WATER MANAGEMENT POND. (2 DAYS) 14. AFTER RECEIVING PERMISSION FROM THE SEDIMENT CONTROL INSPECTOR CONVERT SEDIMENT BASIN TO PERMANENT STORM WATER MANAGEMENT FACILITIES. REMOVE AND REPLACE PERFORATED STANDPIPES AND LOW FLOW PLATES. CONSTRUCT CREST OF EMERGENCY SPILLWAY TO 33.90 FOR PERM # 2 AND STABILIZE. 15. FOLLOWING INITIAL SOL DISTURBANCE OR REDISTURBANCE, PERMANENT OR TEMPORARY STABILIZATION SHALL BE COMPLETED WITHIN: A. 7 CALENDAR DAYS FOR ALL PERMETER SLOPES AND ALL SLOPES GREATER THAN 1:1. B. 14 CALENDAR DAYS FOR ALL OTHER DISTURBED AREAS ON THE SITE.

SEQUENCE OF CONSTRUCTION FOR CULVERT REPLACEMENT UNDER COLLEGE AVE.











- 1. DIVERT ALL TRAFFIC TO EXISTING WESTBOUND LANE. FLAGMEN ARE REQUIRED DURING ENTIRE DIVERSION ACTIVITY. 2. CONSTRUCT CULVERT TO CULVERT STATION 0+51± 3. BACKFILL CULVERT TO DESIGN GRADES. 4. DIVERT ALL TRAFFIC TO NEWLY CONSTRUCTED LANE. 5. COMPLETE CONSTRUCTION OF CULVERT. 6. BACKFILL REMAINING CULVERT TRENCH. 7. REFER TO MUTCD STANDARD 68-7 FOR DETAILS NOT SHOWN.

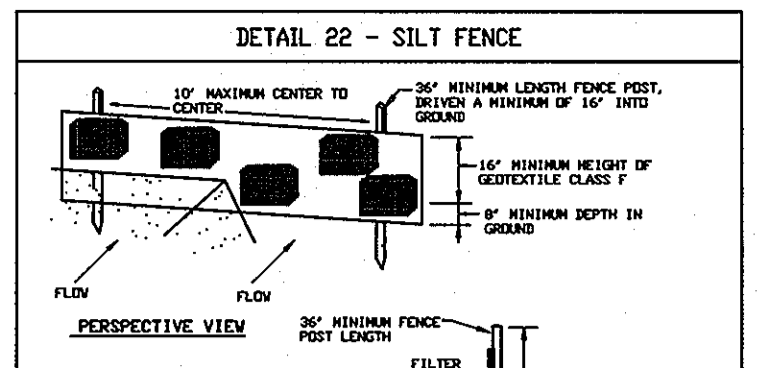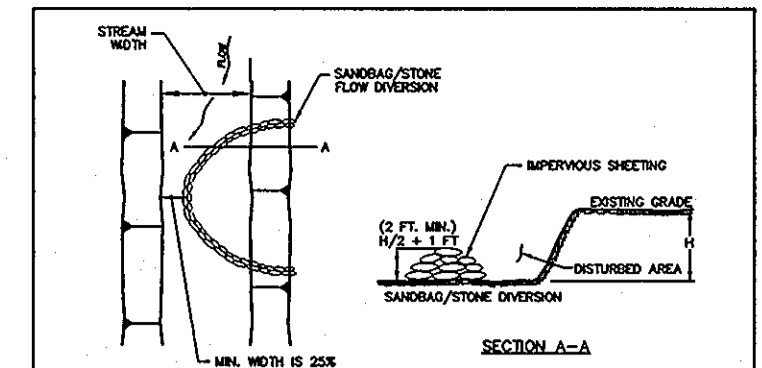

SILT FENCE table with columns for Slope Steepness, Maximum Slope Length, and Silt Fence Length.

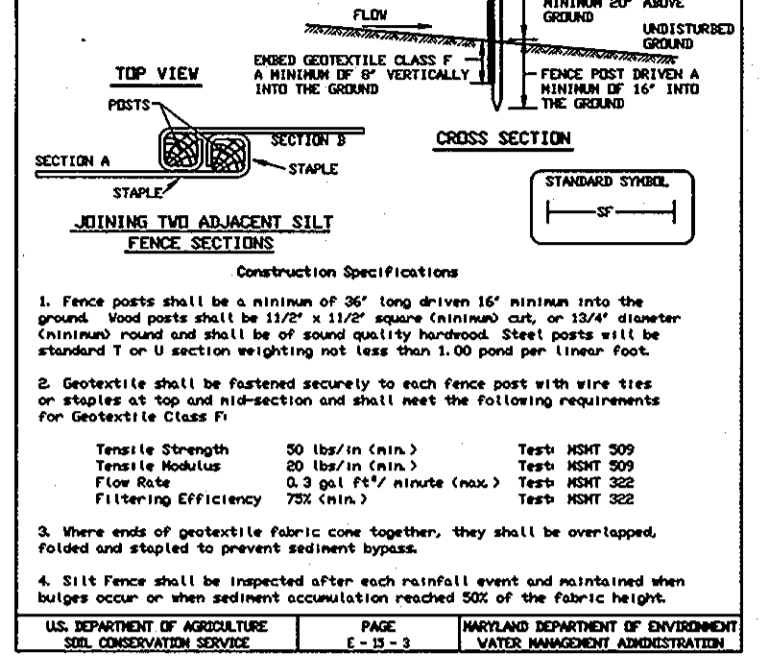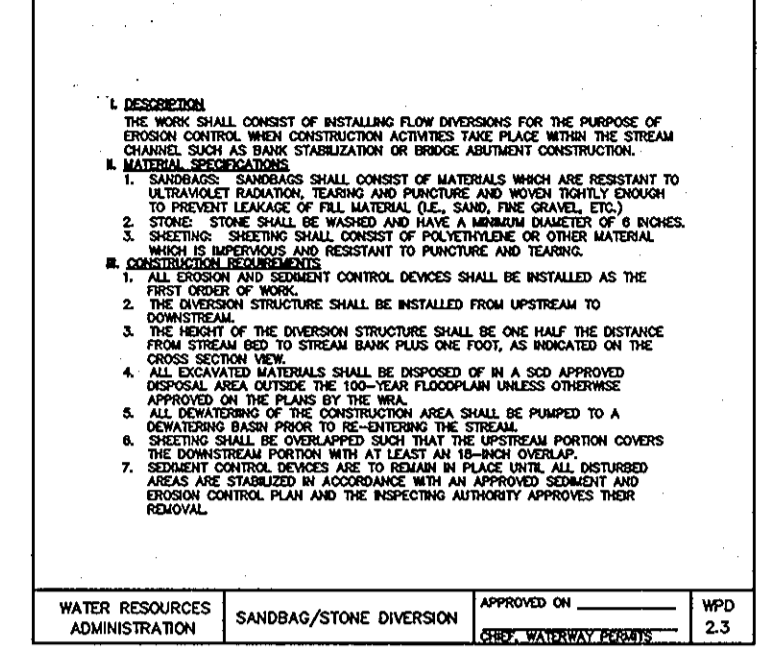

SUPER SILT FENCE table with columns for Slope Steepness, Slope Length, and Silt Fence Length.

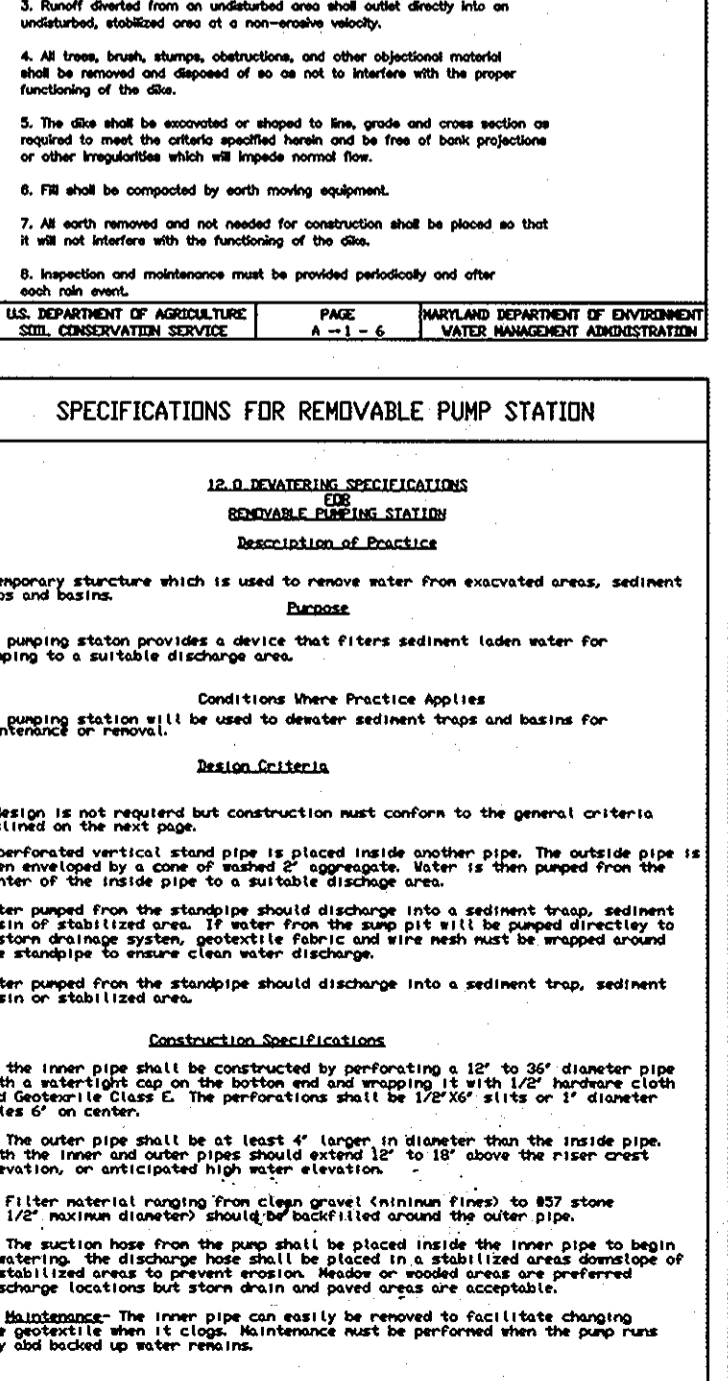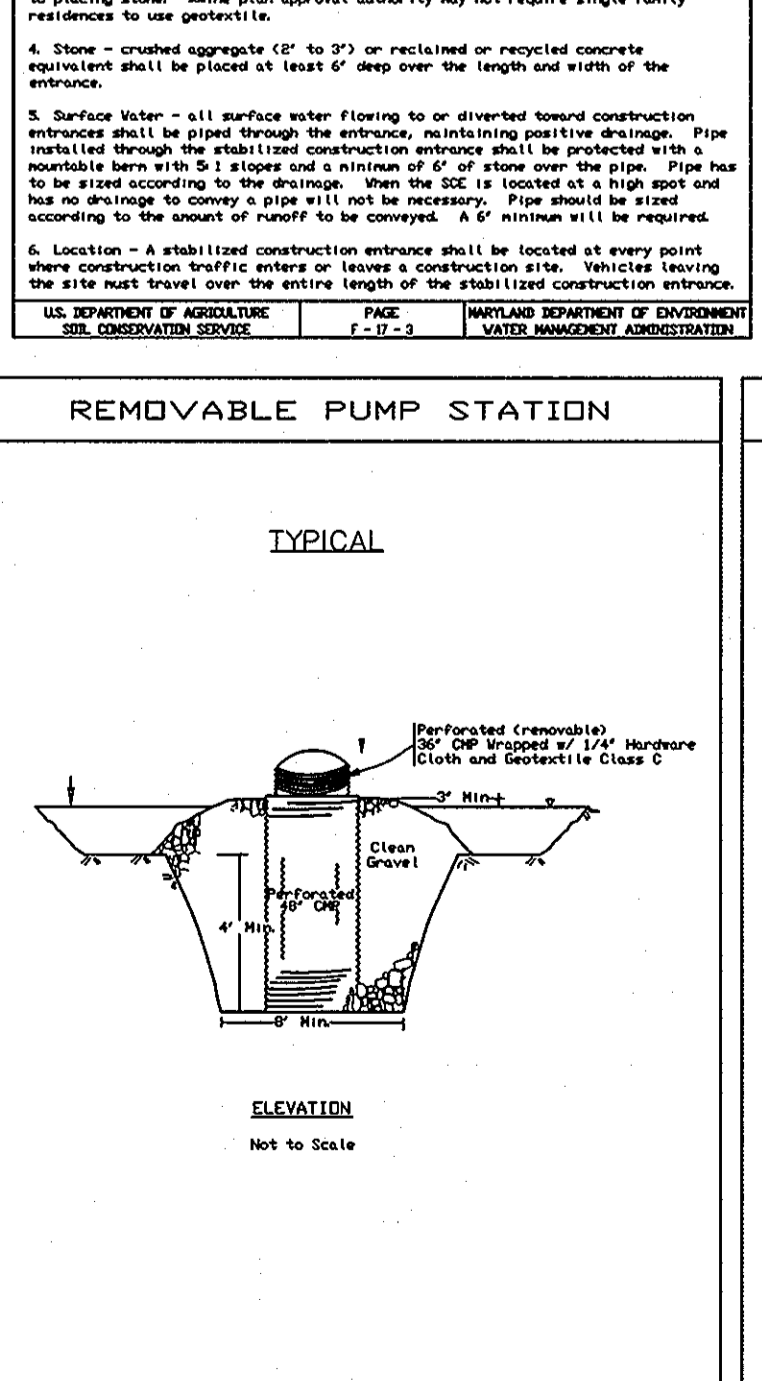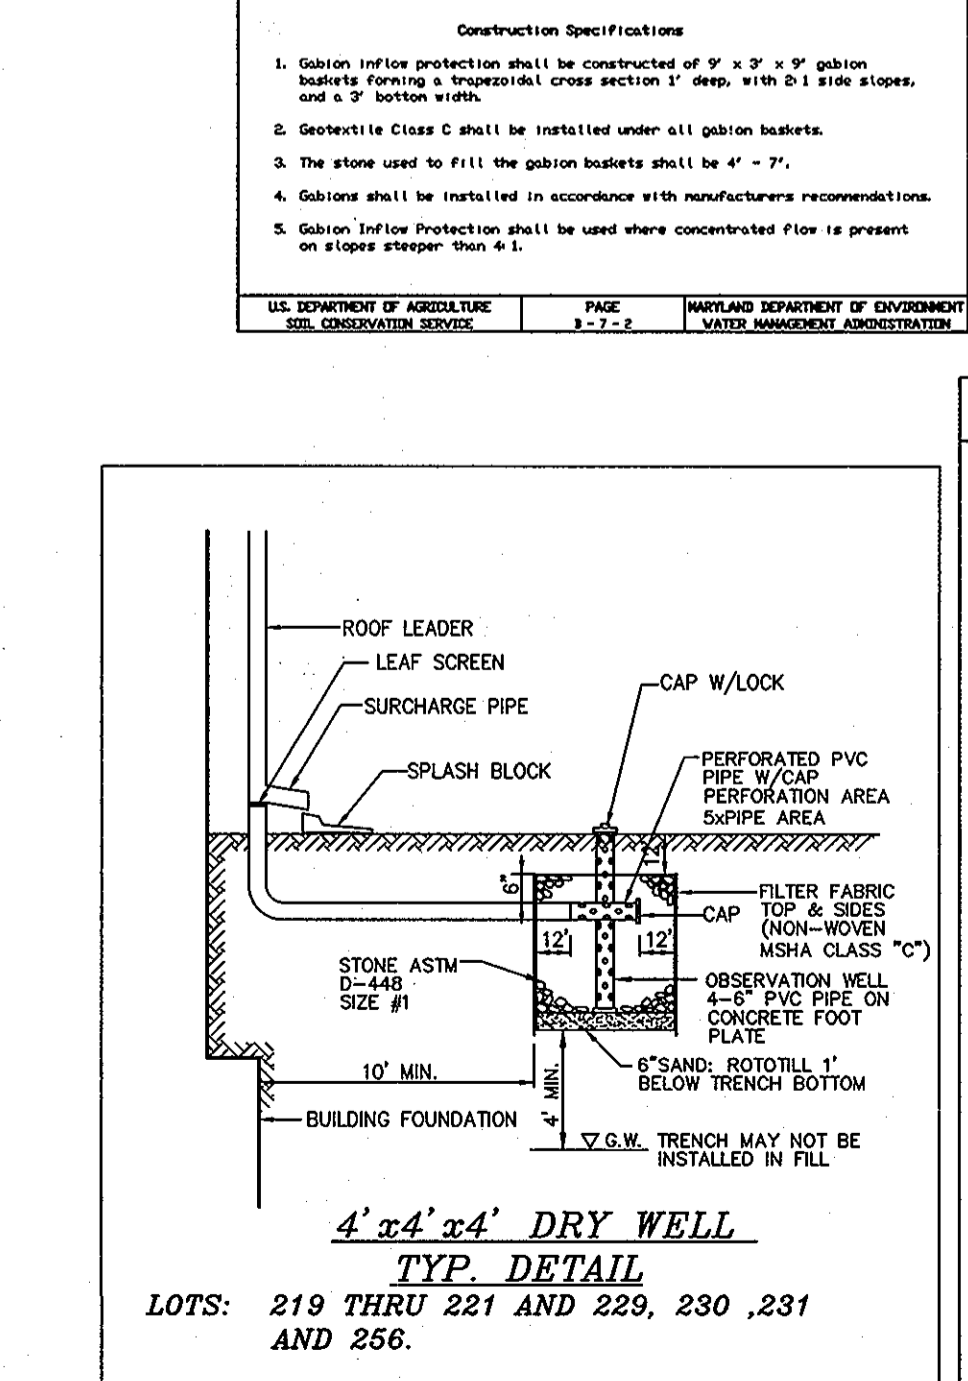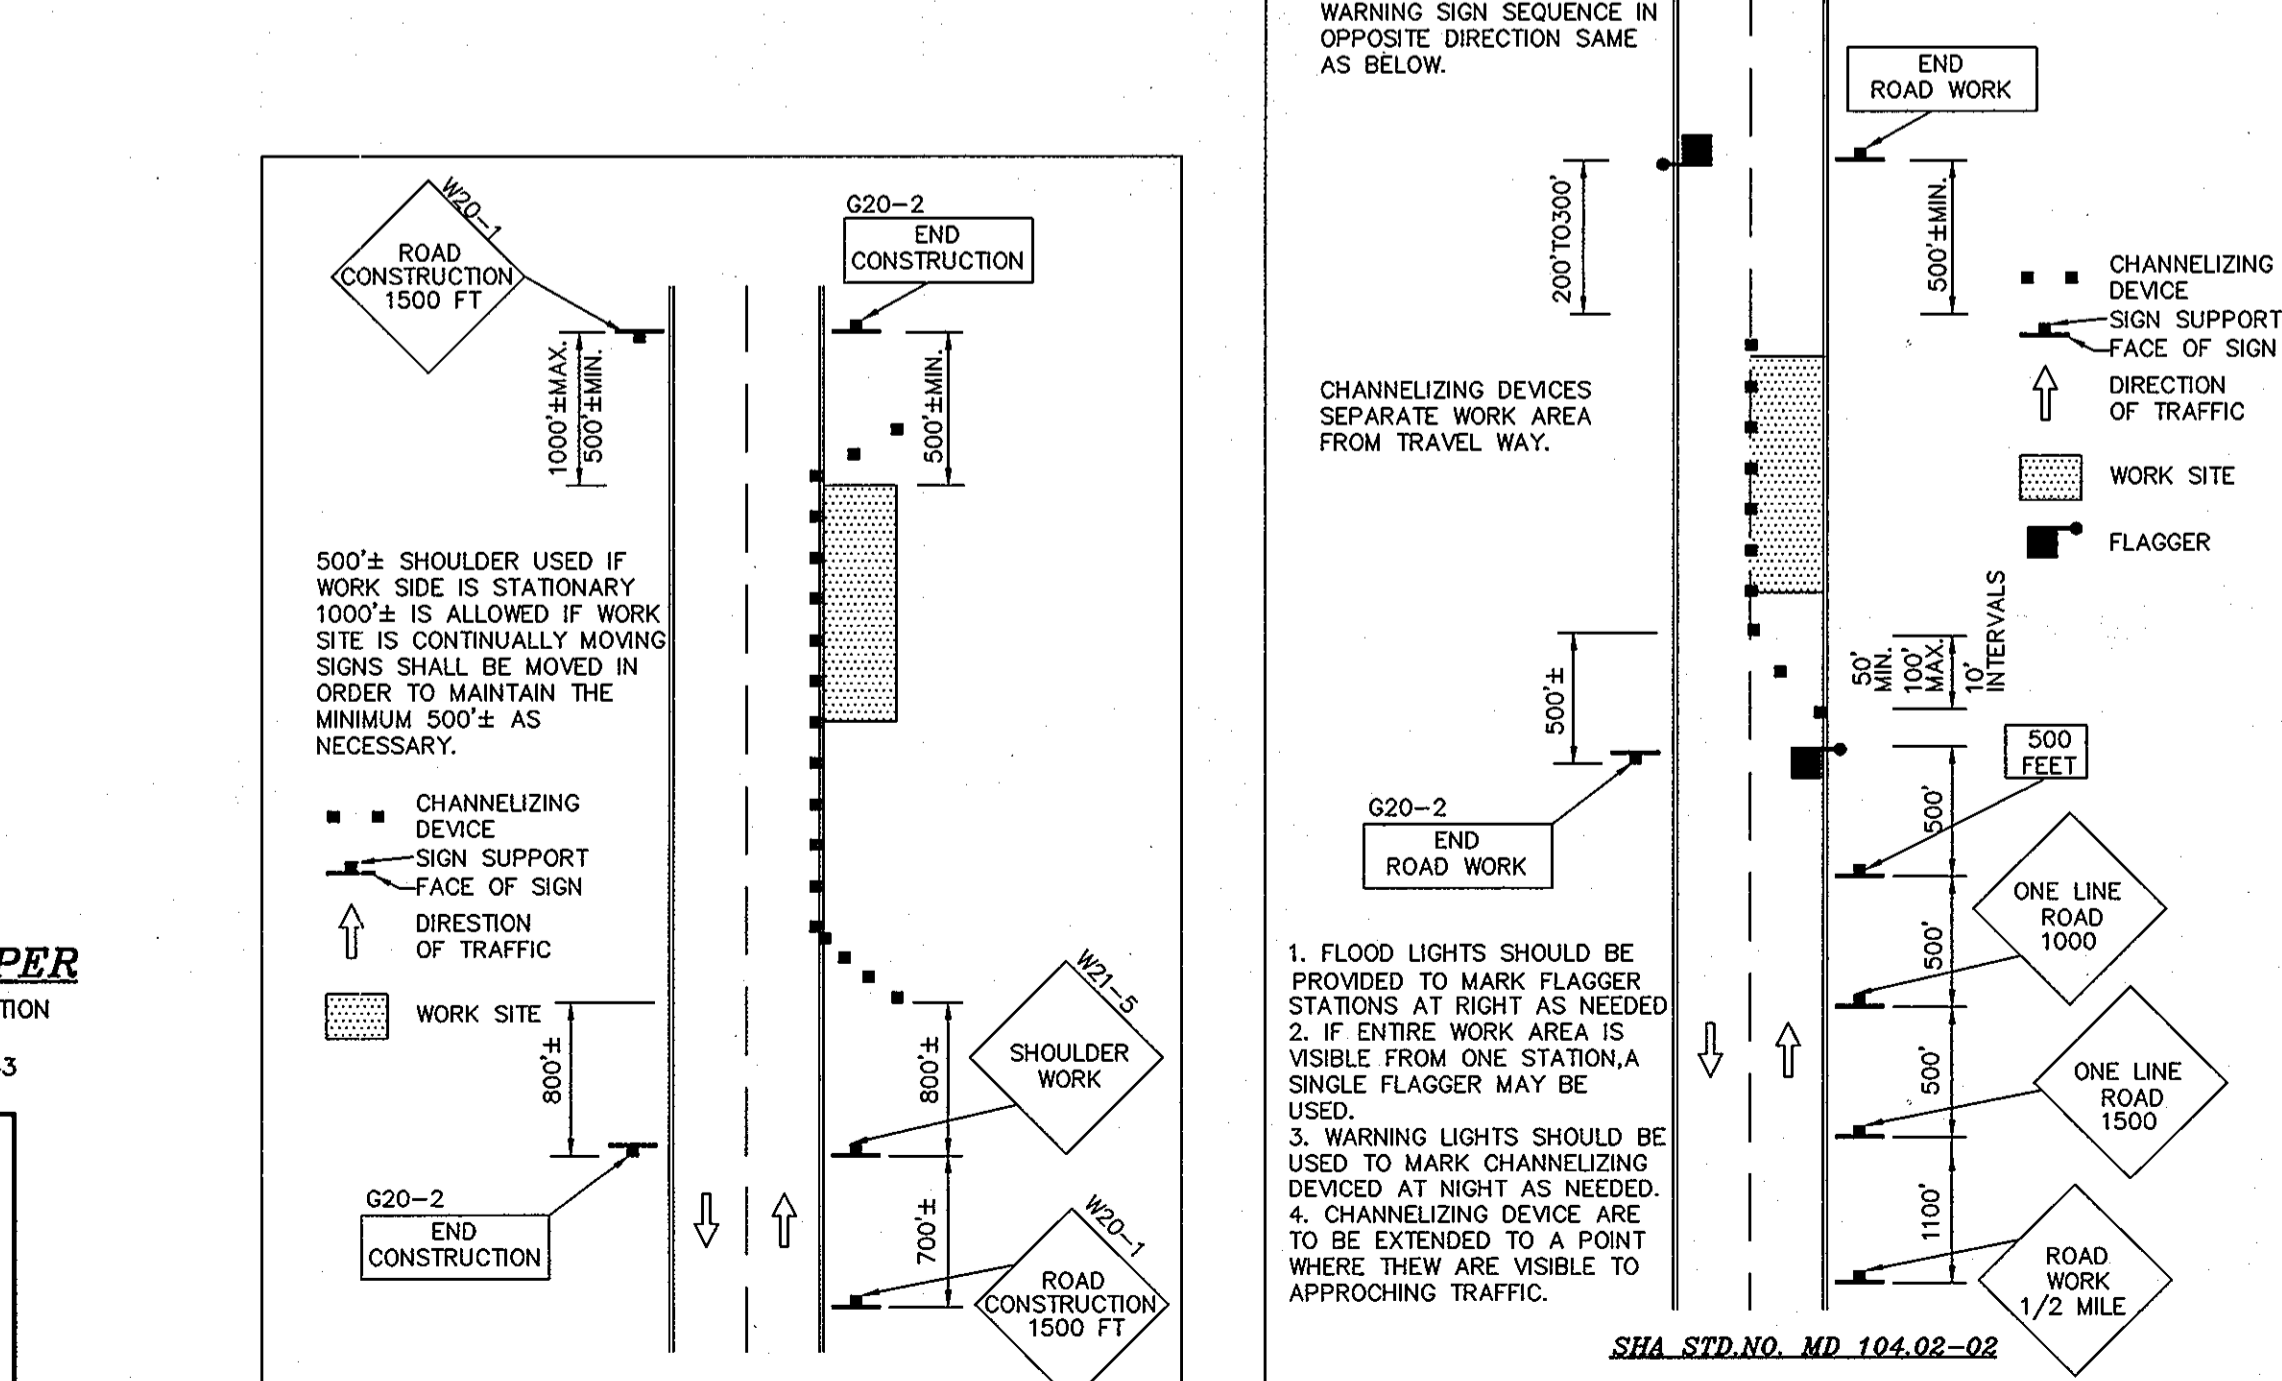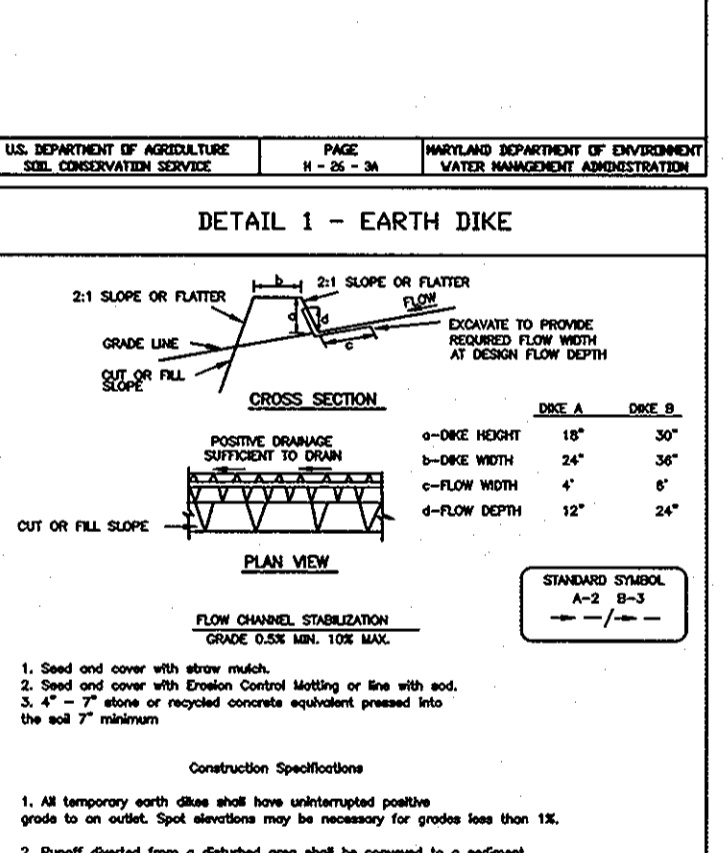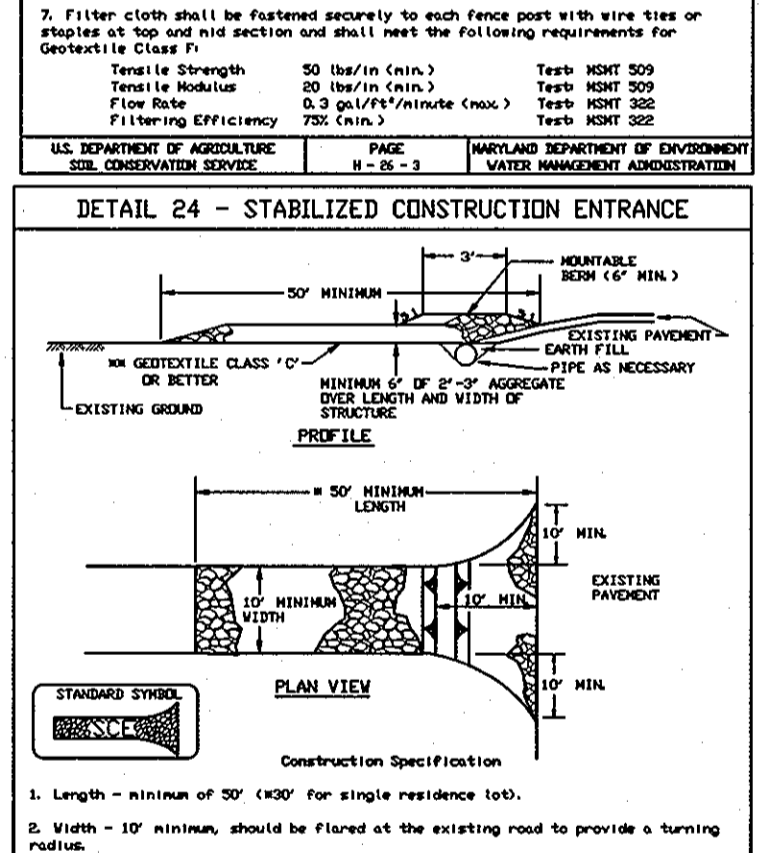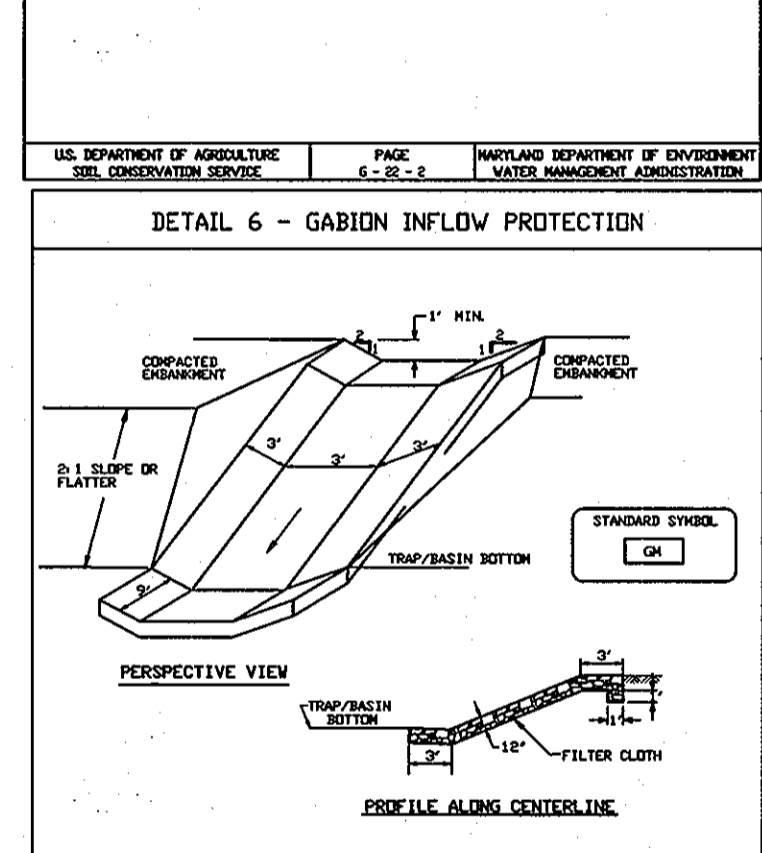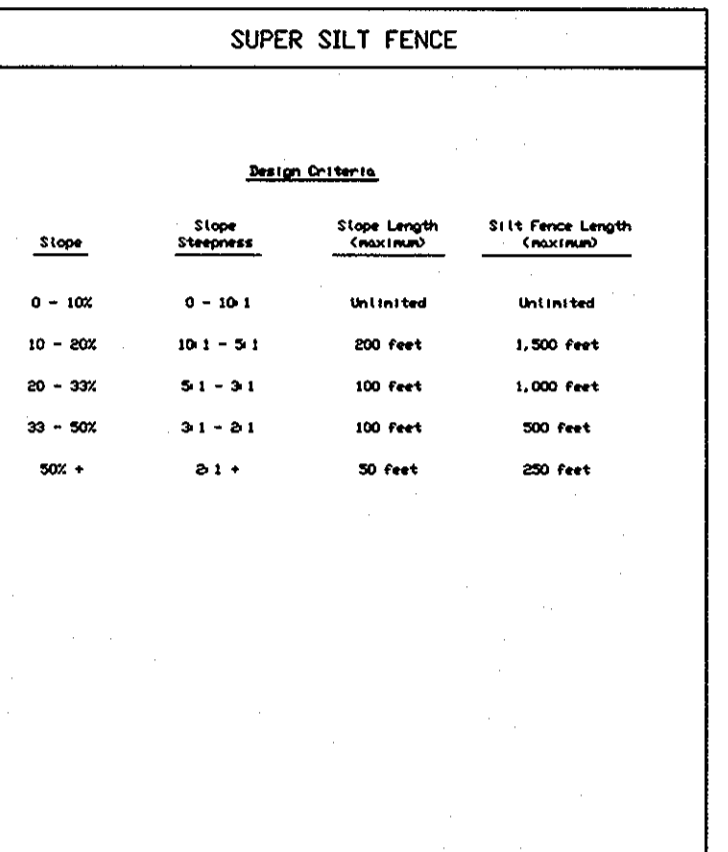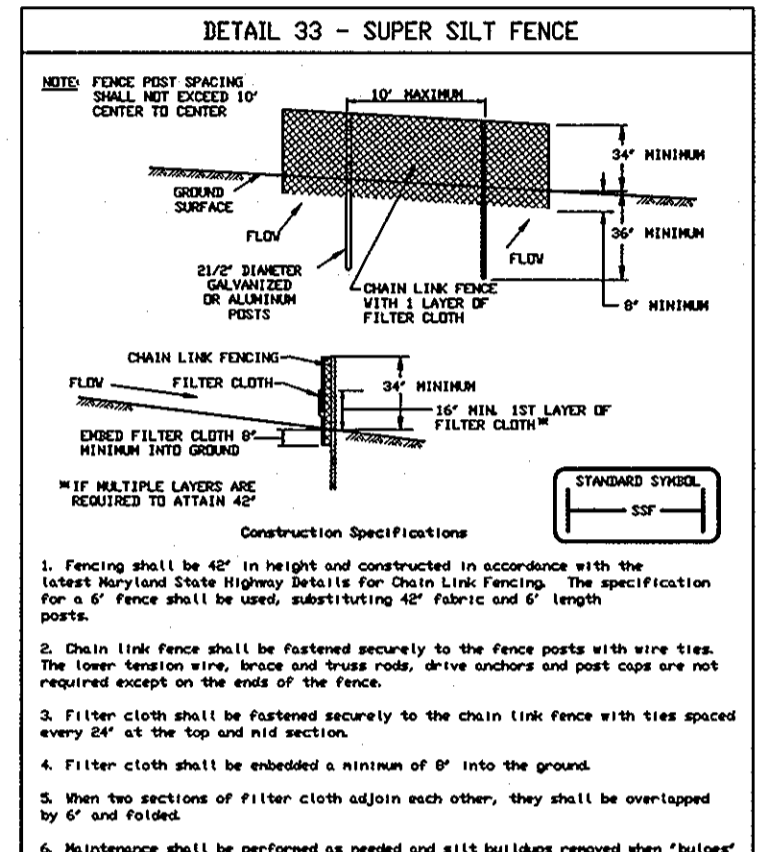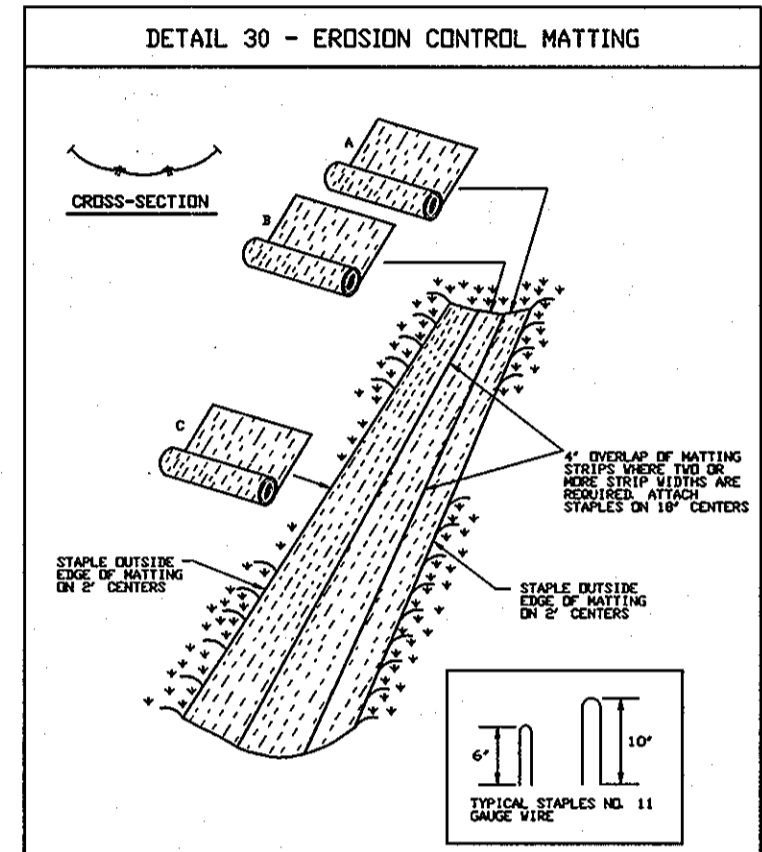


Project information table with fields for date, project name, illustration, scale, and approval.

Revisions table with columns for no., description, and date.

AUTUMN VIEW, SECTION 5, PHASE 1. LOTS: 211-259. TAX MAP 25 AND 31, P/O PARCEL 75. HOWARD COUNTY, MARYLAND. SECOND ELECTION DISTRICT. EROSION AND SEDIMENT CONTROL NOTES AND DETAILS.

MILDENBERG, BOENDER & ASSOC., INC. Engineers Planners Surveyors. 5072 Dorsey Hall Drive, Suite 202, Belkoort City, Maryland 21042. (410) 997-0286 Fax. (410) 997-0288 Fax.

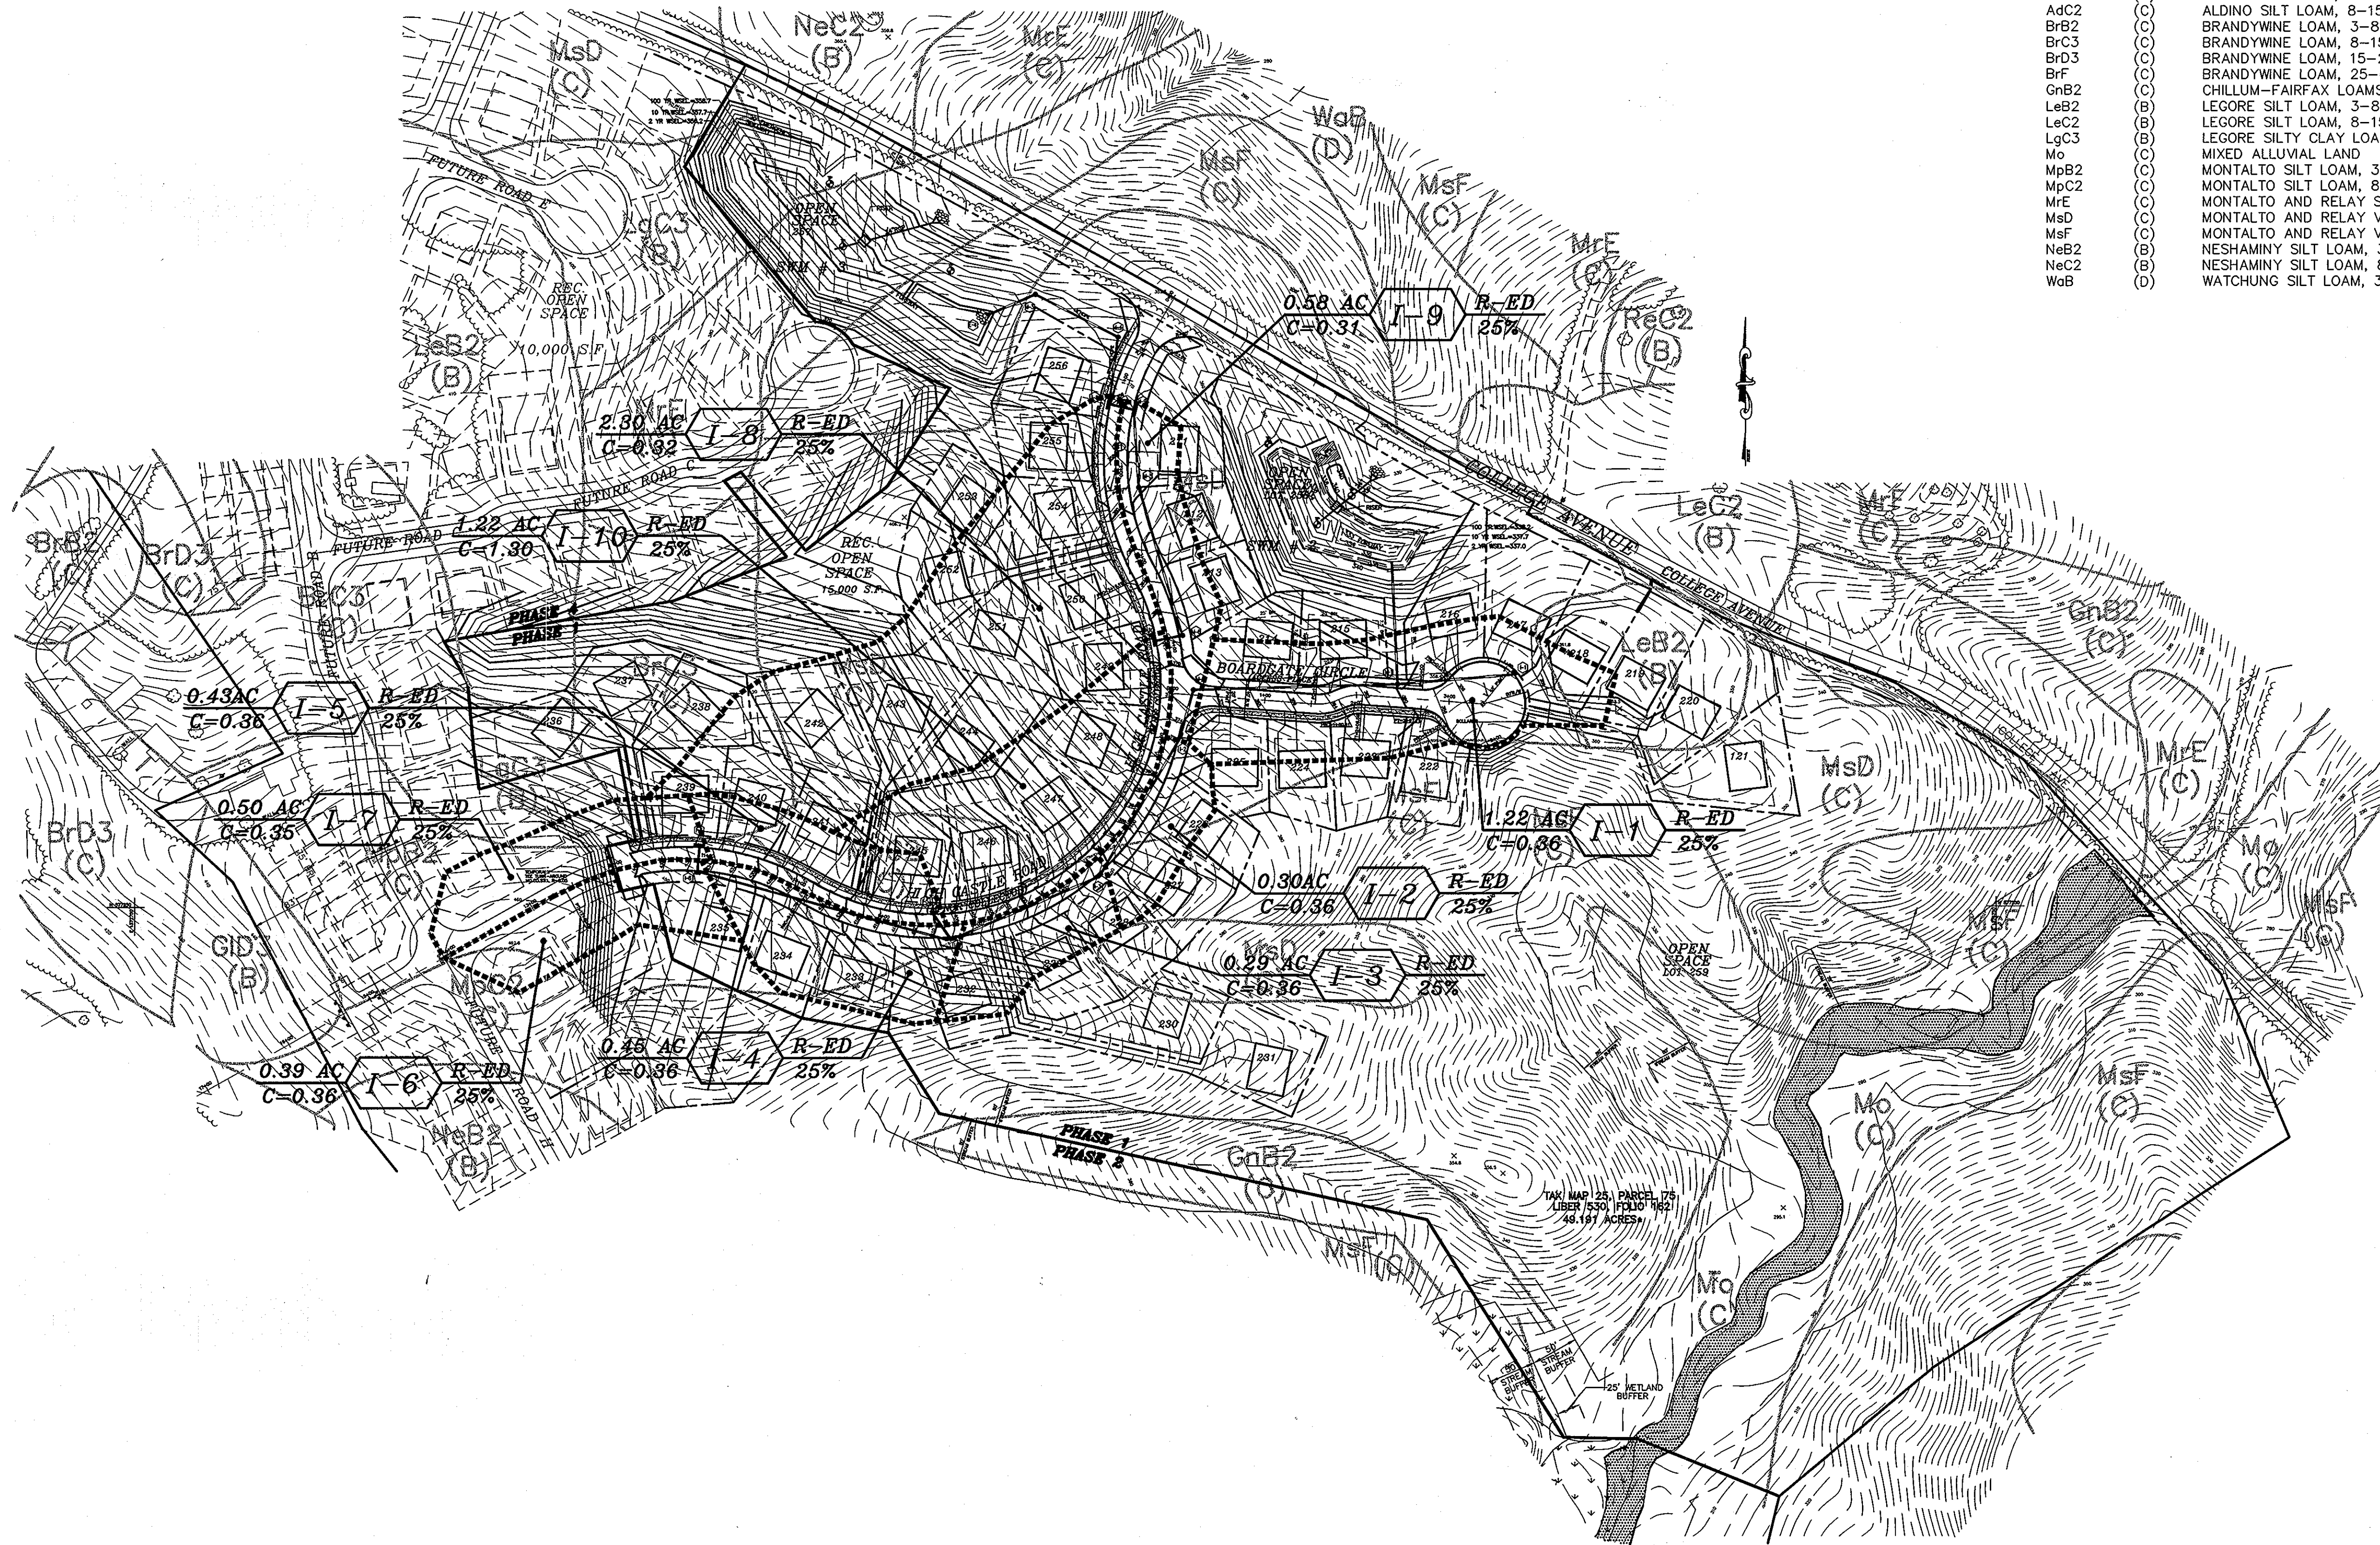

SOIL CLASSIFICATION CHART

AdB2	(B)	ALDINO SILT LOAM, 3-8% SLOPES, MODERATELY ERODED
AdC2	(C)	ALDINO SILT LOAM, 8-15% SLOPES, MODERATELY ERODED
BrB2	(C)	BRANDYWINE LOAM, 3-8% SLOPES, MODERATELY ERODED
BrC3	(C)	BRANDYWINE LOAM, 8-15% SLOPES, SEVERELY ERODED
BrD3	(C)	BRANDYWINE LOAM, 15-25% SLOPES, SEVERELY ERODED
BrF	(C)	BRANDYWINE LOAM, 25-60% SLOPES
GnB2	(C)	CHILLUM-FAIRFAX LOAMS, 1-5% SLOPES, MODERATELY ERODED
LeB2	(B)	LEGORE SILT LOAM, 3-8% SLOPES, MODERATELY ERODED
LeC2	(B)	LEGORE SILT LOAM, 8-15% SLOPES, MODERATELY ERODED
LgC3	(B)	LEGORE SILTY CLAY LOAM, 8-15% SLOPES, SEVERELY ERODED
Mo	(C)	MIXED ALLUVIAL LAND
MpB2	(C)	MONTALTO SILT LOAM, 3-8% SLOPES, MODERATELY ERODED
MpC2	(C)	MONTALTO SILT LOAM, 8-15% SLOPES, MODERATELY ERODED
MrE	(C)	MONTALTO AND RELAY SOILS, 15-45% SLOPES
MsD	(C)	MONTALTO AND RELAY VERY STONY SILT LOAMS, 3-25% SLOPES
MsF	(C)	MONTALTO AND RELAY VERY STONY SILT LOAMS, 25-60% SLOPES
NeB2	(B)	NESHAMINY SILT LOAM, 3-8% SLOPES, MODERATELY ERODED
NeC2	(B)	NESHAMINY SILT LOAM, 8-15% SLOPES, MODERATELY ERODED
WaB	(D)	WATCHUNG SILT LOAM, 3-8% SLOPES

Project	99072	date	DEC.2001
Illustration	MMP	engineering	JBM
Scale	1"=100'	approval	JBM

no.	1	description	REVISED PER ROAD AB-101	date	1/6/02
-----	---	-------------	-------------------------	------	--------


AUTUMN VIEW SECTION 5, PHASE 1
 LOTS: 211-259
 TAX MAP 25 & 31, P/O PARCEL 75
 HOWARD COUNTY, MARYLAND
 SECOND ELECTION DISTRICT
 STORM DRAIN DRAINAGE AREA MAP

MILDENBERG, BOENDER & ASSOC., INC.
 Engineers Planners Surveyors
 5072 Dorsey Hall Drive, Suite 202, Ellicott City, Maryland 21042
 (410) 997-0296 Bal. (301) 621-5521 Wash. (410) 997-0298 Fax.


APPROVED: DEPARTMENT OF PUBLIC WORKS
Richard M. Condo 1-30-02
 CHIEF BUREAU OF HIGHWAYS DATE

APPROVED: DEPARTMENT OF PLANNING AND ZONING
Linda Hermitz 2/3/02
 CHIEF, DIVISION OF LAND DEVELOPMENT DATE


Michael S. 12/20/01
 CHIEF, DEVELOPMENT ENGINEERING DIVISION DATE

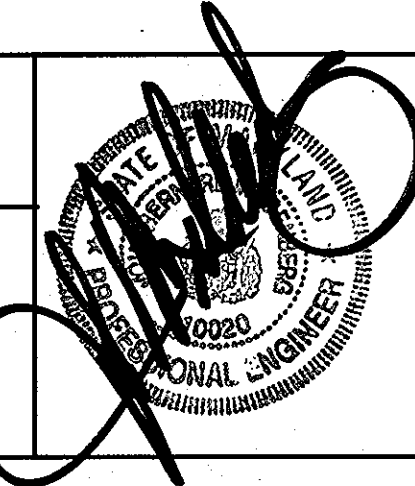


OWNER/DEVELOPER
 BONNIE BRANCH CORPORATION
 P.O. BOX 396
 ELLICOTT CITY, MD 21042

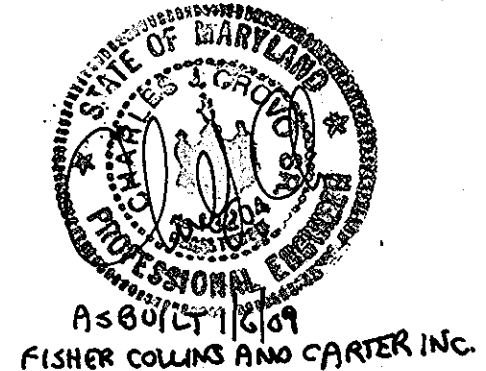


F:\99072\PHASE 1\FINAL\SD-04M

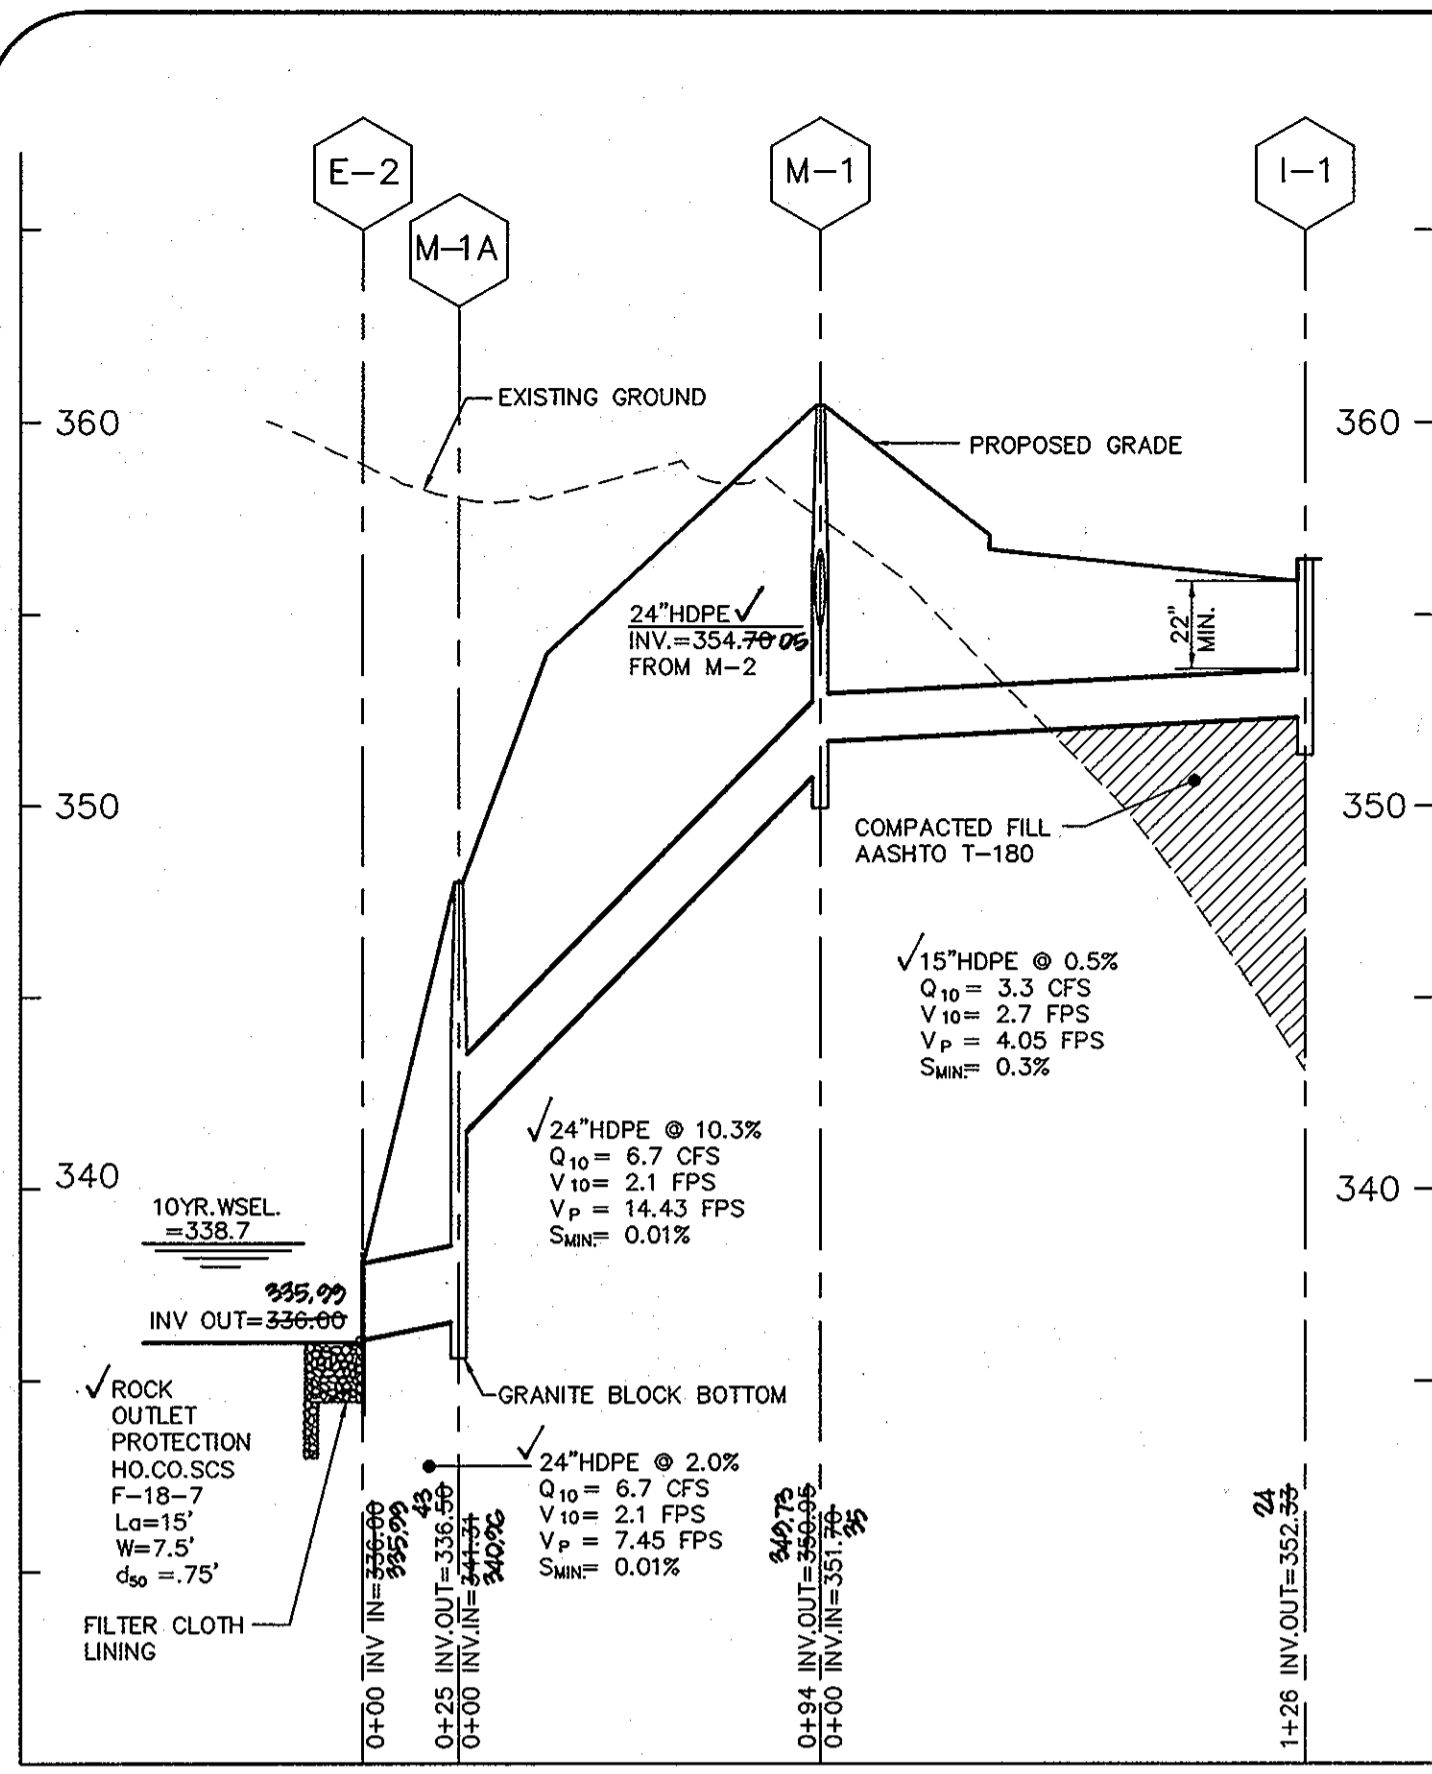


STORM DRAIN PROFILES 1-1 TO E-2
SCALE: HOR. 1"=50'
VER. 1"=5'

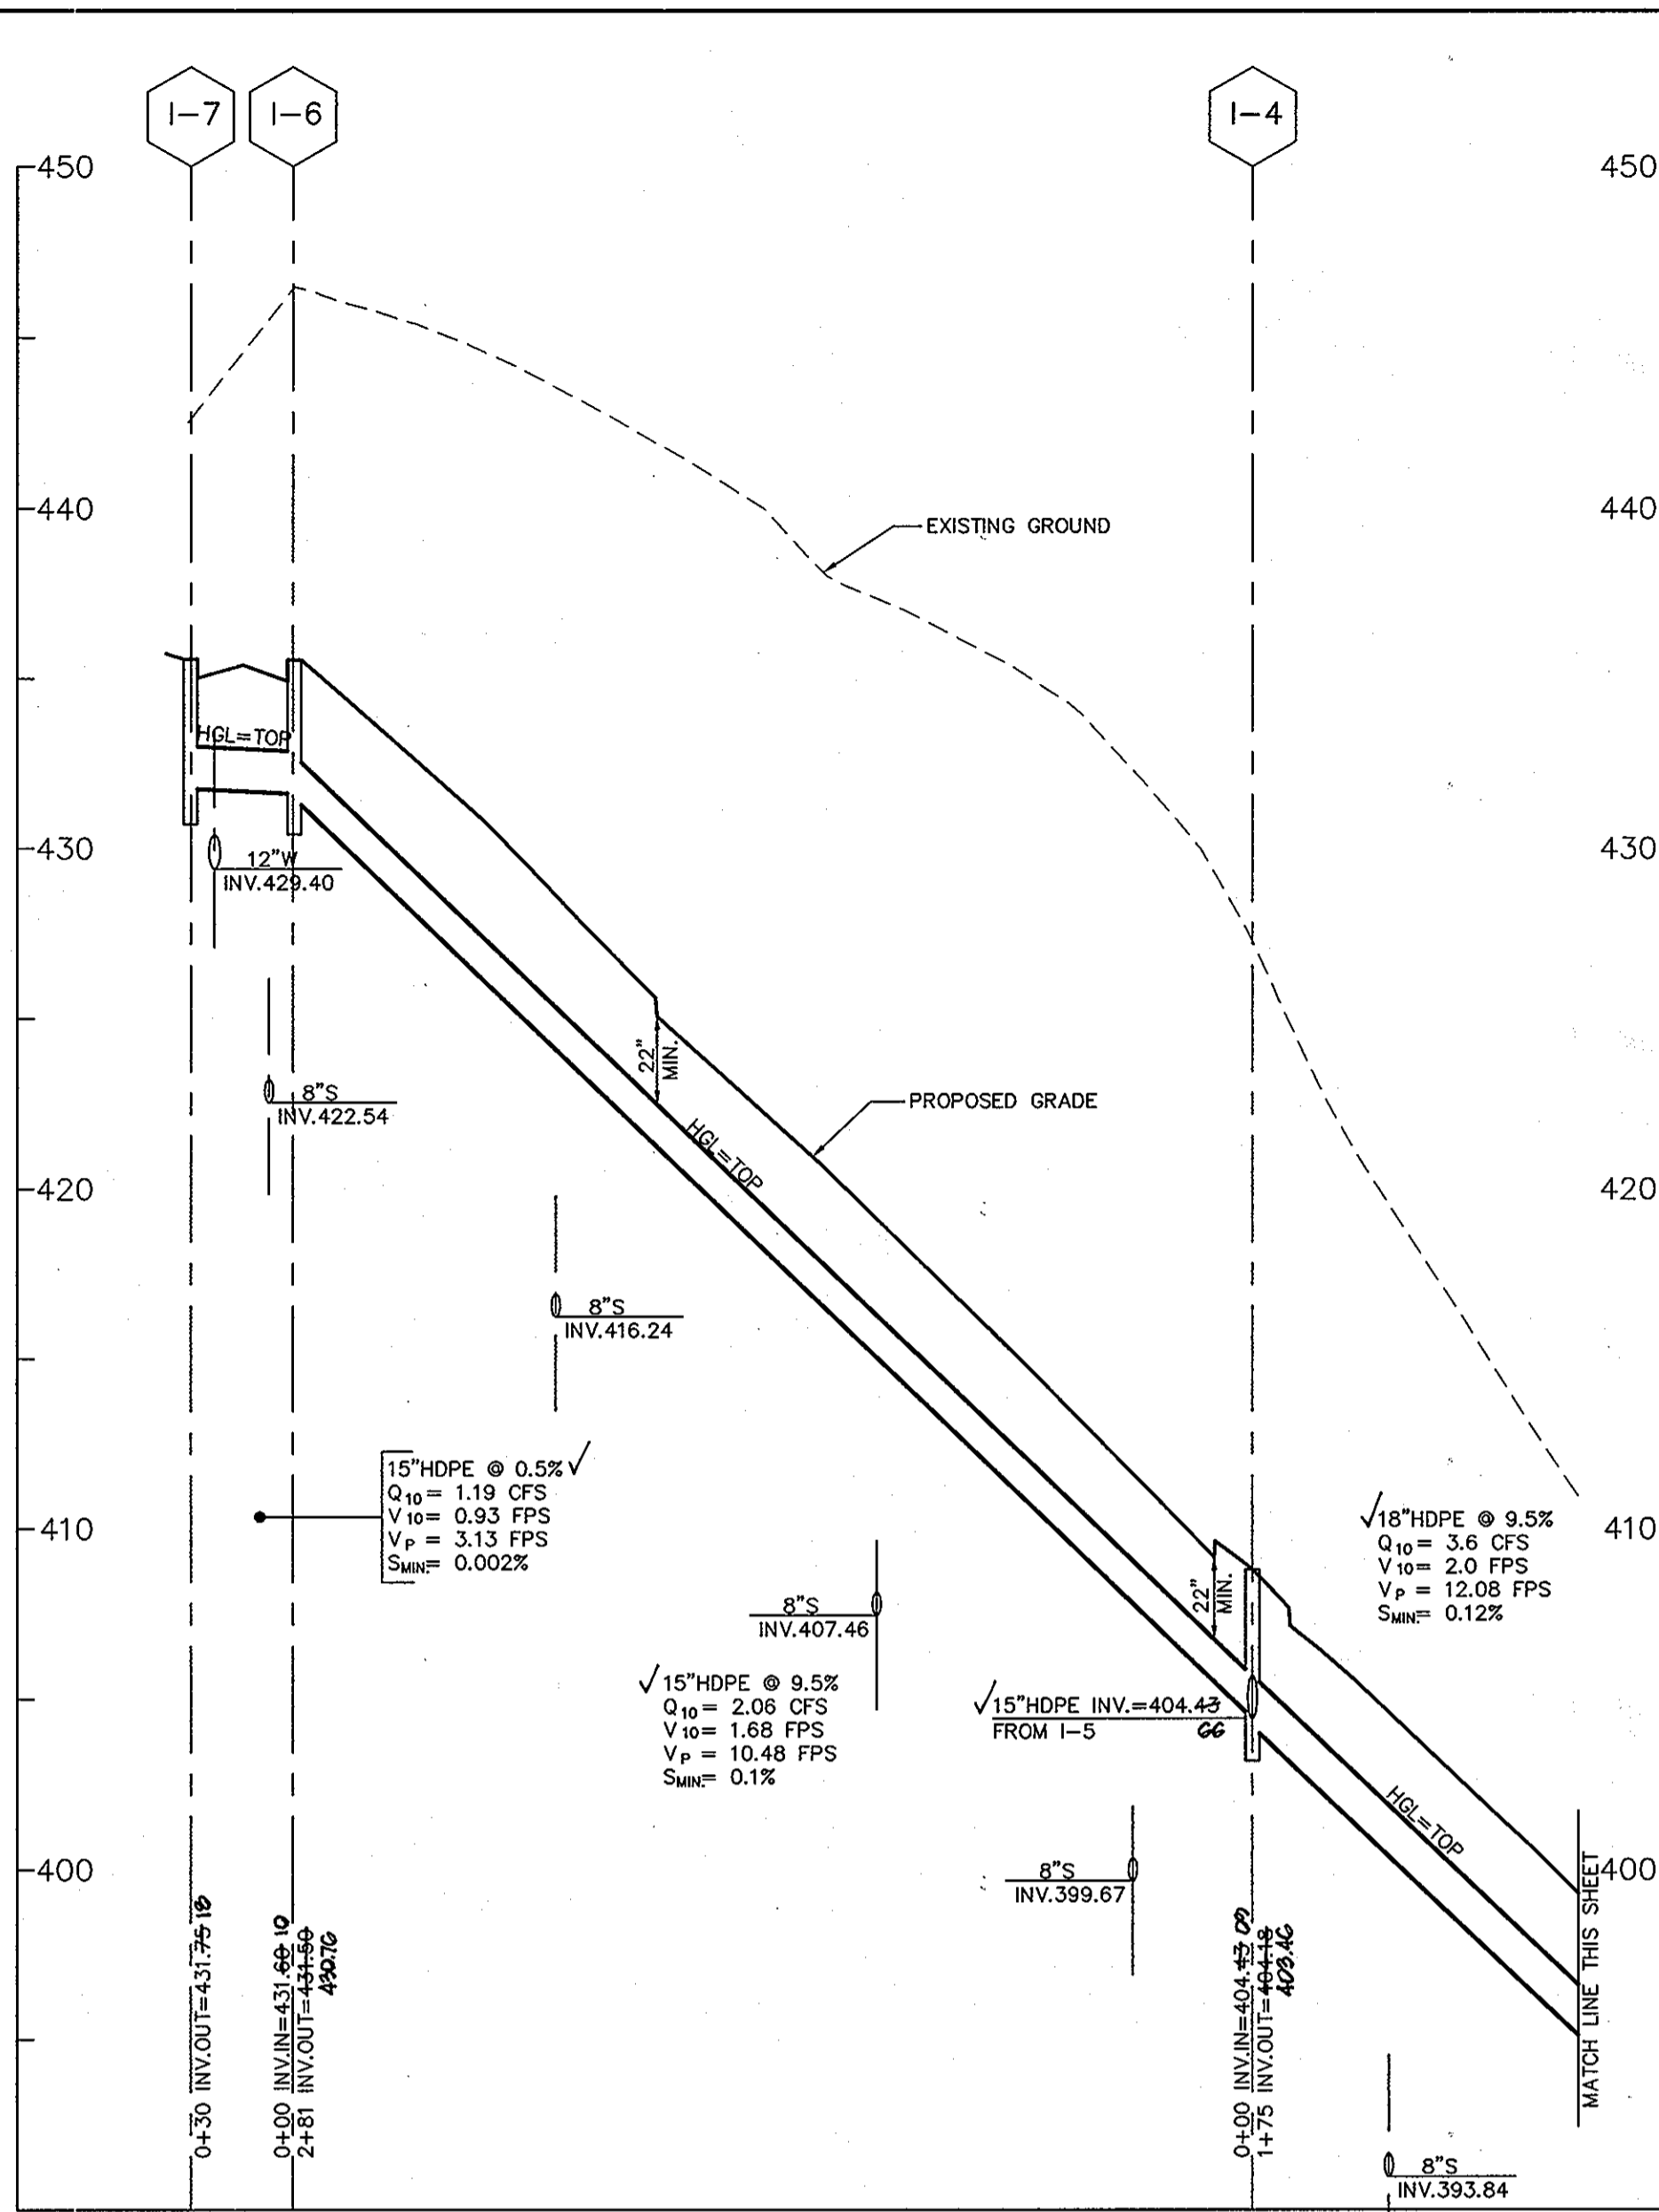


STORM DRAIN PROFILES 1-7 TO 1-5
SCALE: HOR. 1"=50'
VER. 1"=5'

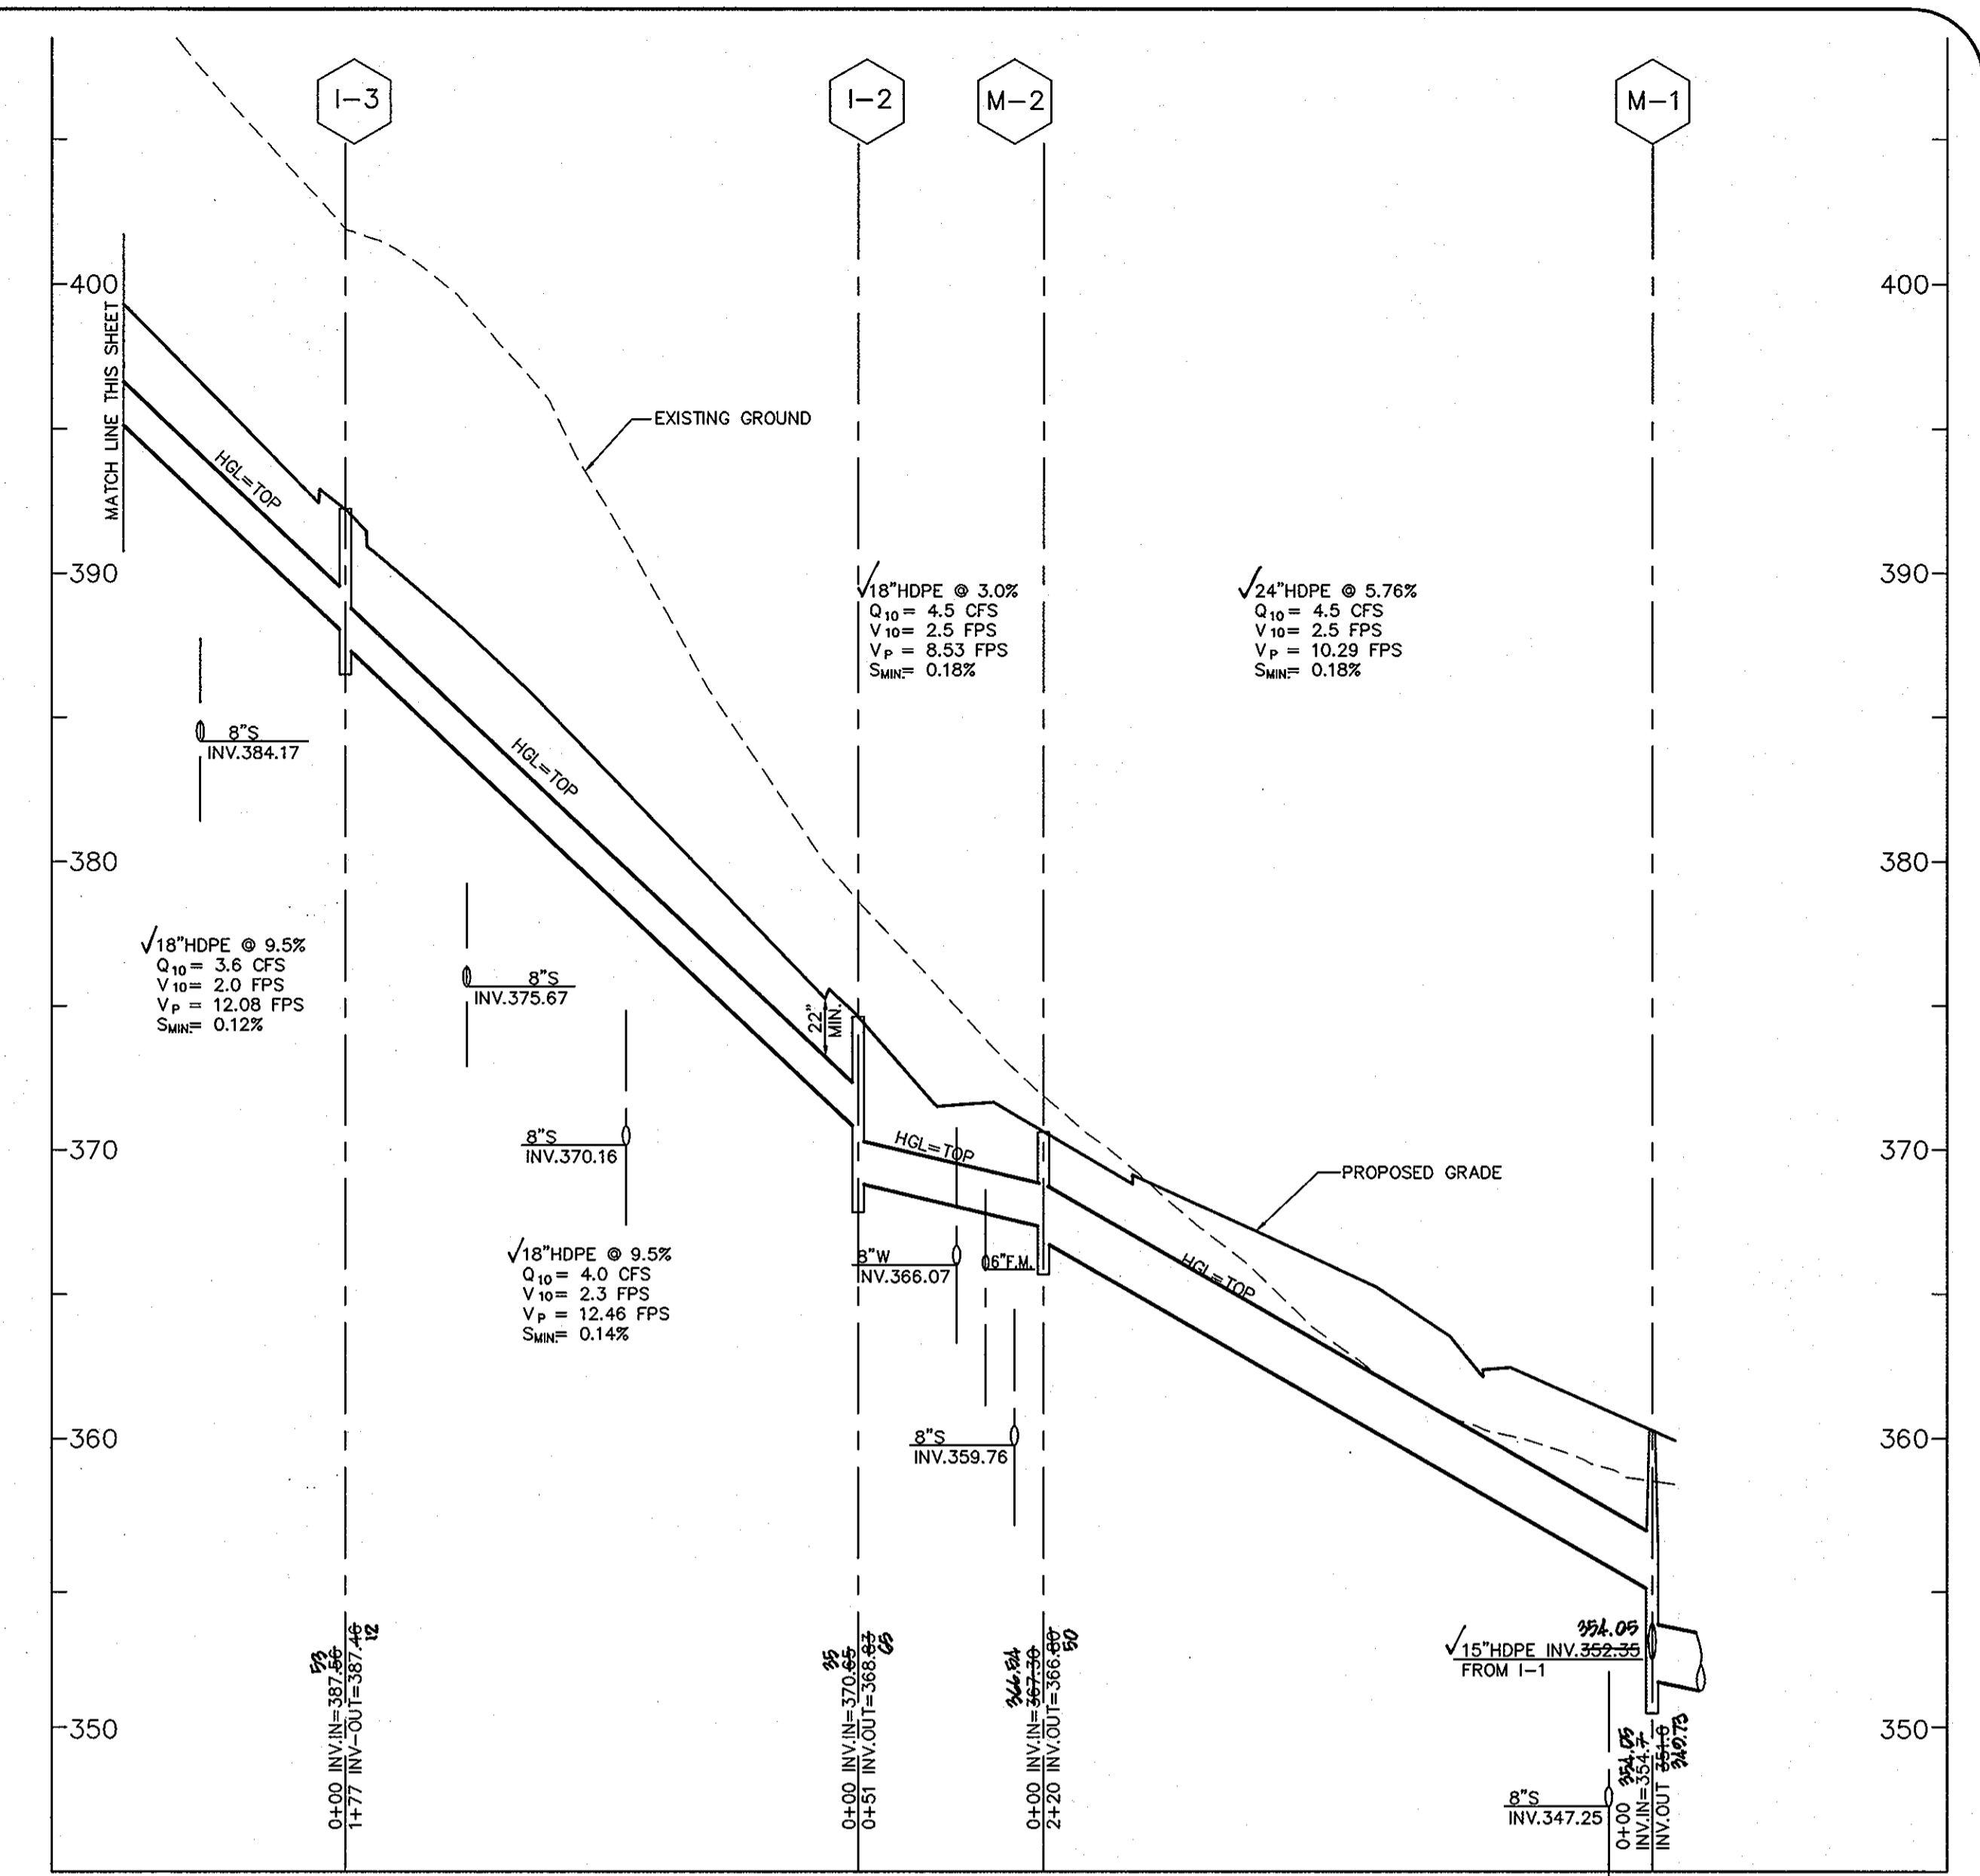


STORM DRAIN PROFILES 1-5 TO M-1
SCALE: HOR. 1"=50'
VER. 1"=5'

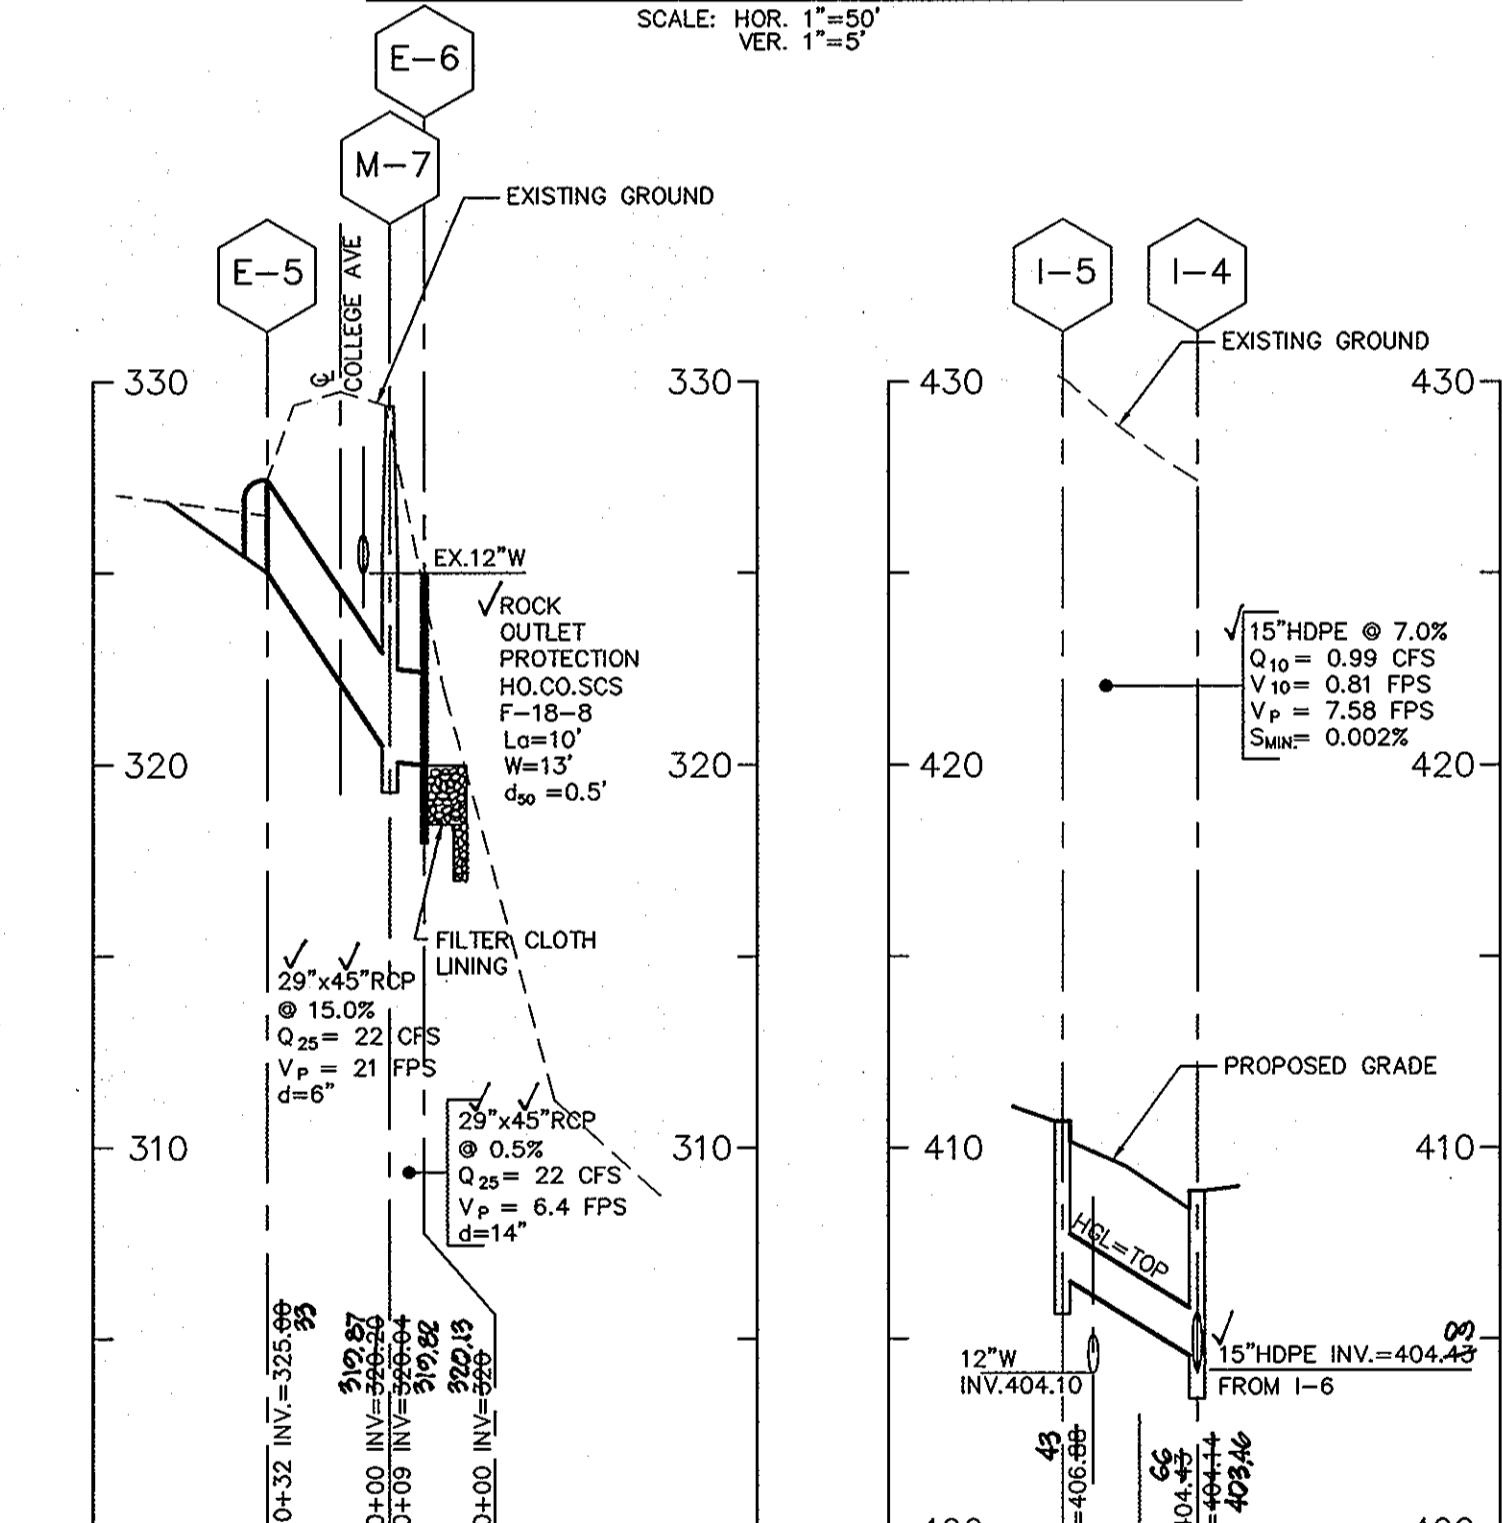

CULVERT PROFILE E-5 TO E-6
SCALE: HOR. 1"=50'
VER. 1"=5'

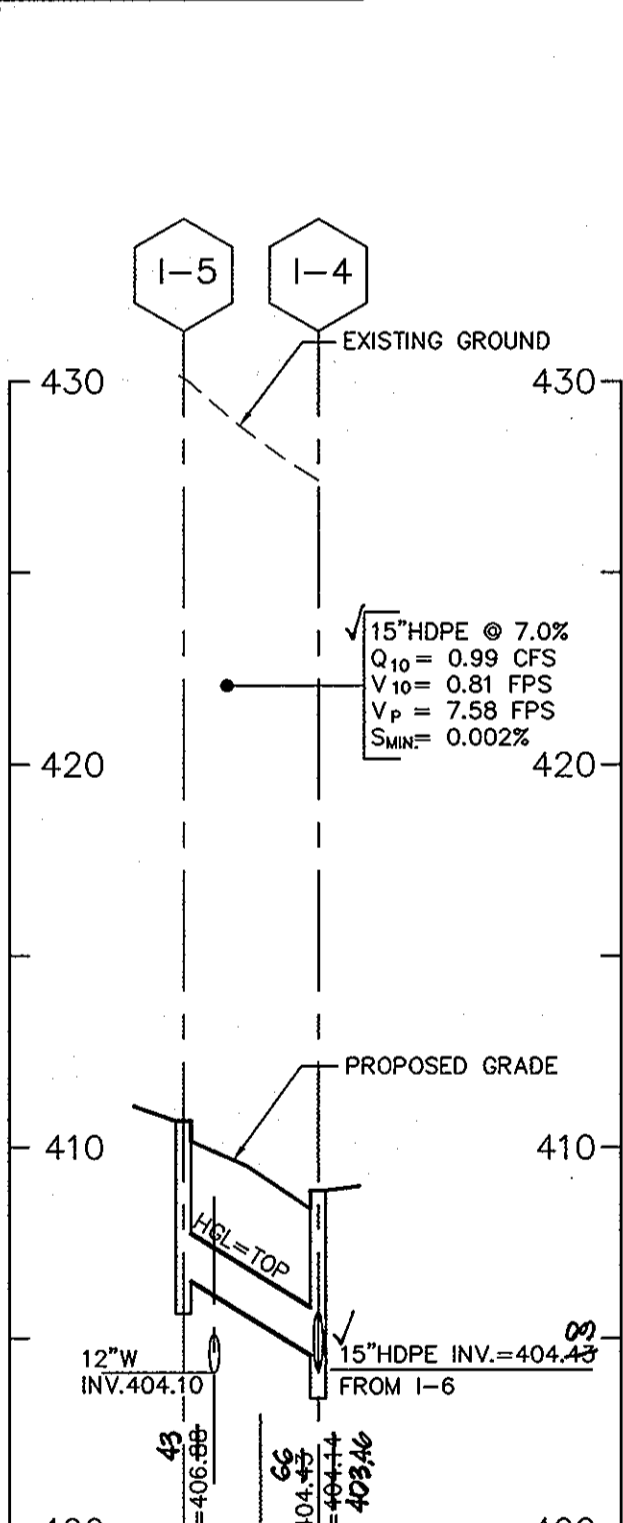



STORM DRAIN PROFILES 1-5 TO 1-4
SCALE: HOR. 1"=50'
VER. 1"=5'

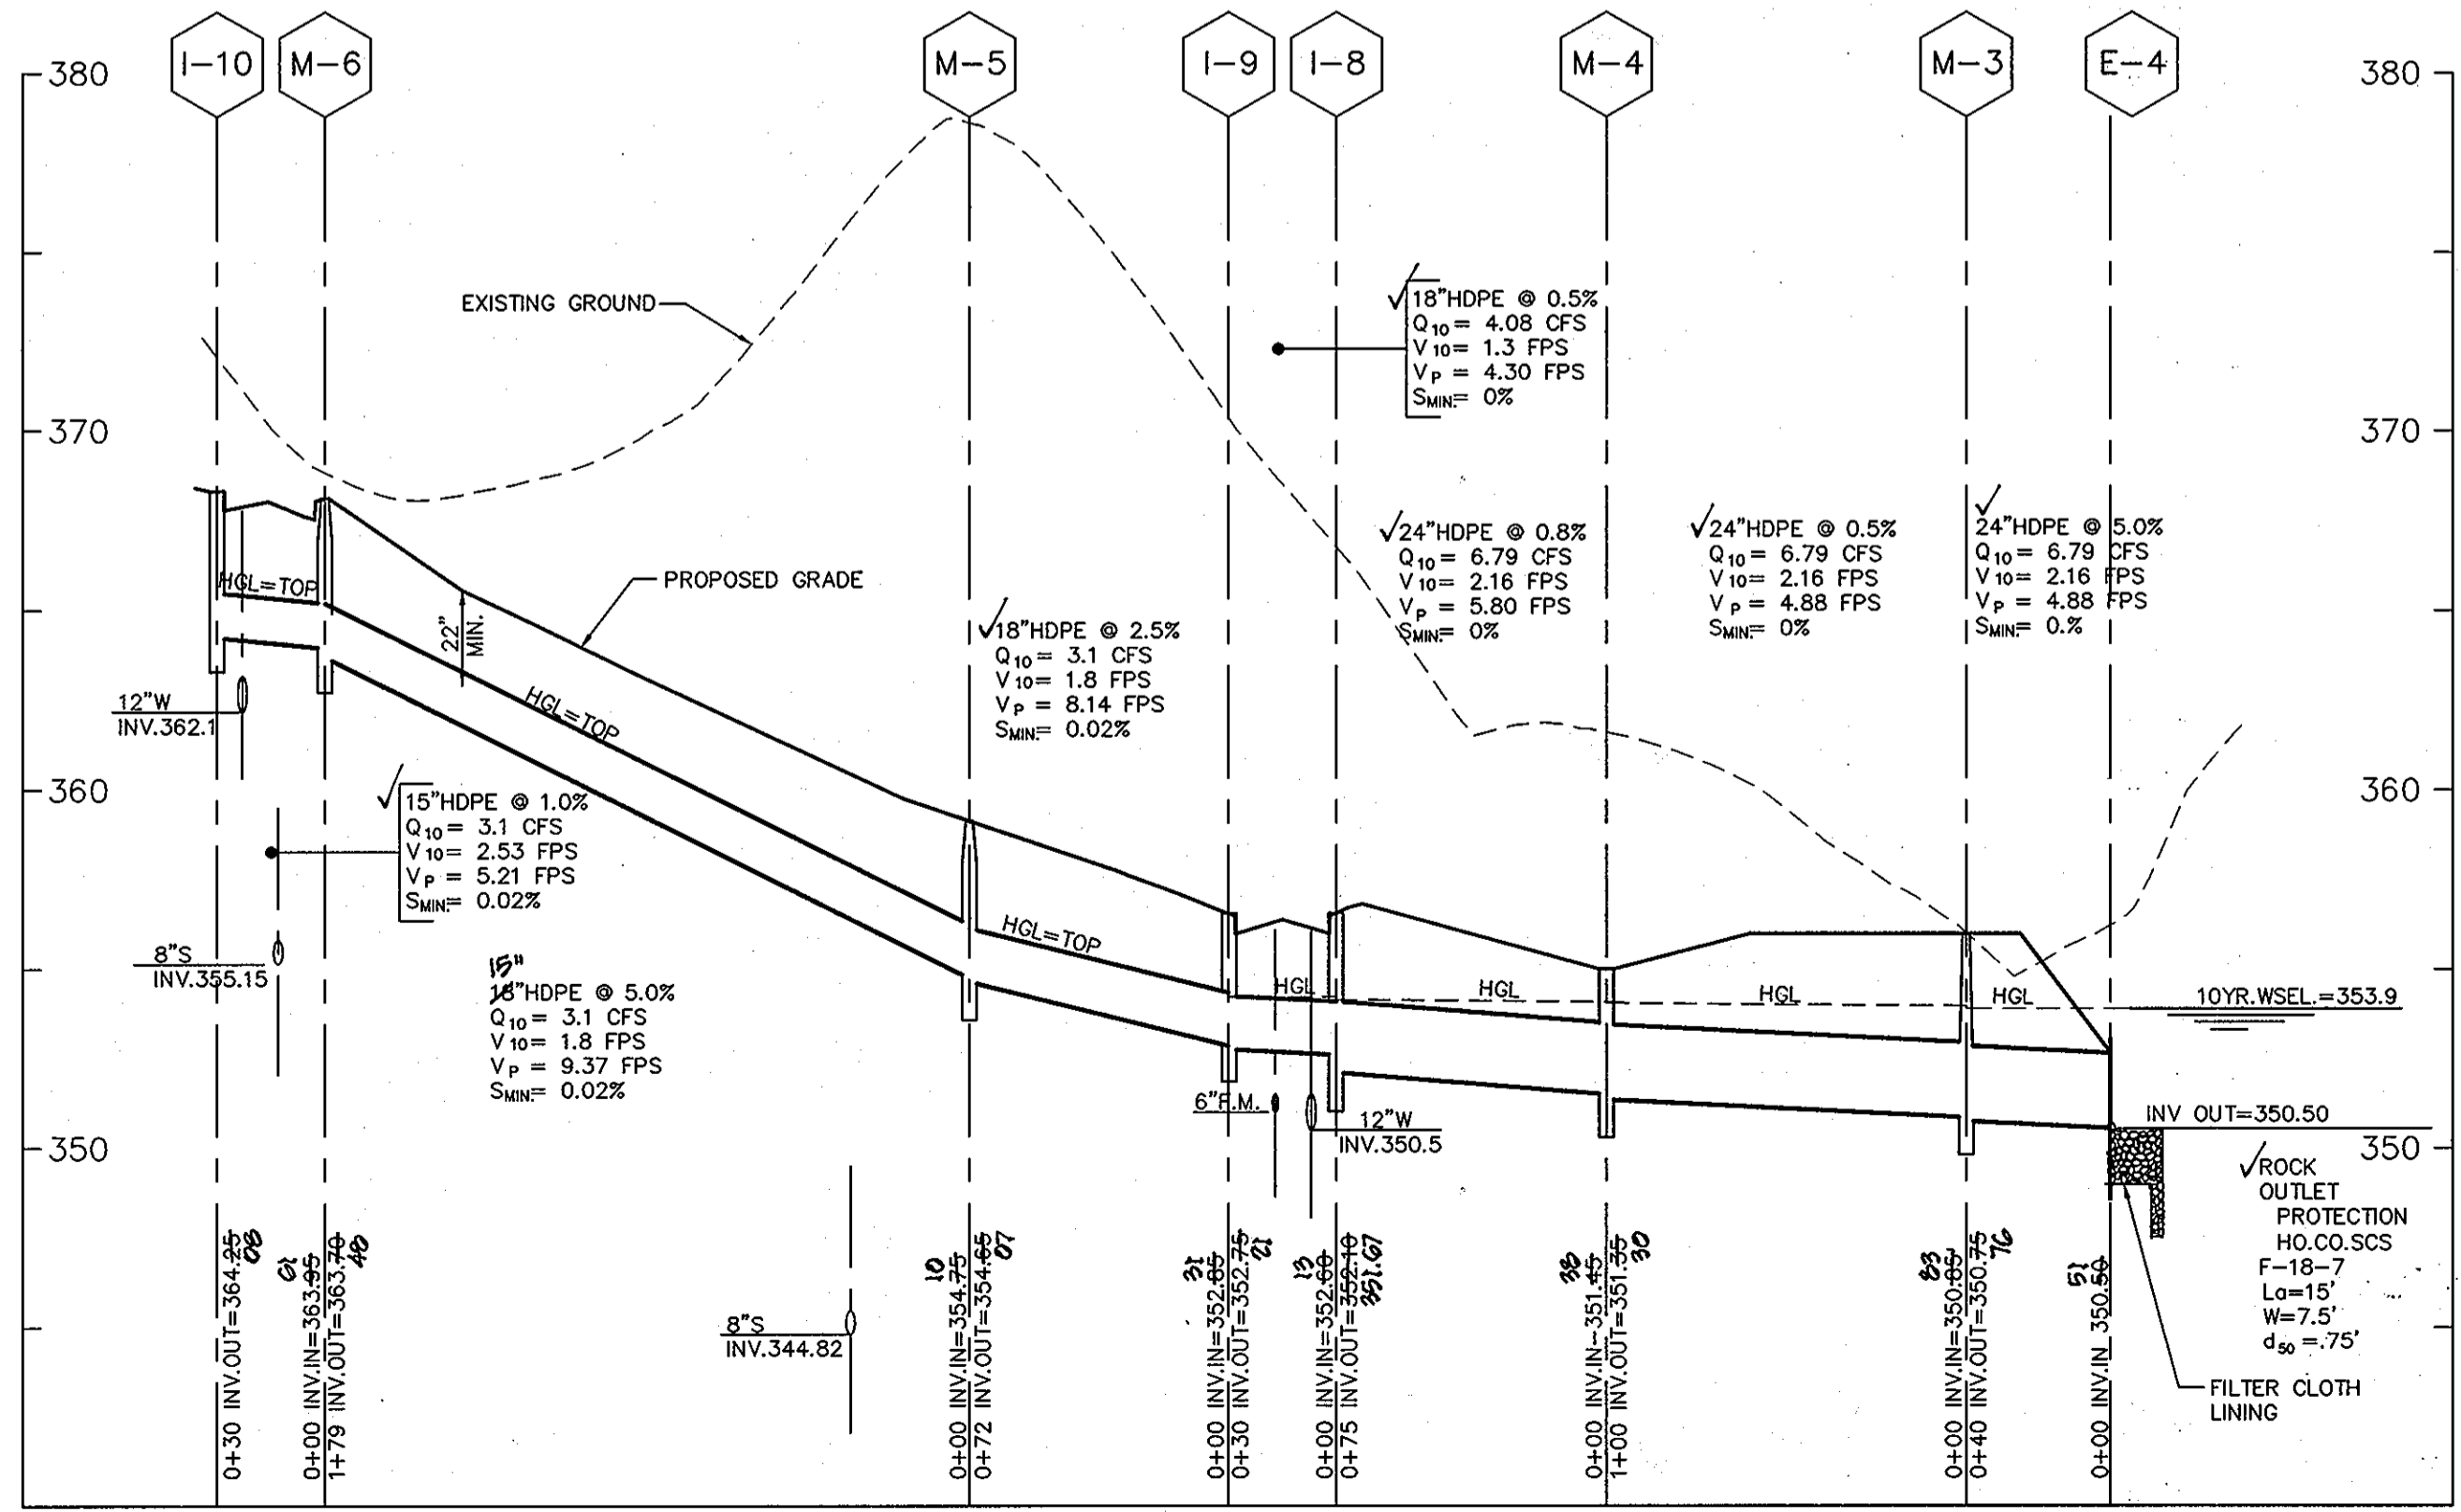

STORM DRAIN PROFILES 1-10 TO E-4
SCALE: HOR. 1"=50'
VER. 1"=5'

NO.	LOCATION	TOP EL.	INV. IN	INV. OUT	COMMENTS
I-1	LINEAR PROF. STA. 1+09	356.46	-	352.36	√TYPE A-5, H.C.STD. SD-4.01
I-2	HIGH CASTLE RD. STA. 4+92	375.64	370.66	368.83	√TYPE A-5, H.C.STD. SD-4.01
I-3	HIGH CASTLE RD. STA. 6+80	392.04	387.86	387.46	√TYPE A-5, H.C.STD. SD-4.01
I-4	HIGH CASTLE RD. STA. 8+28	408.84	404.43	403.76	√TYPE A-10, H.C.STD. SD-4.02
I-5	HIGH CASTLE RD. STA. 8+48	410.84	405.88	405.19	√TYPE A-5, H.C.STD. SD-4.01
I-6	HIGH CASTLE RD. STA. 11+11	435.49	431.60	431.18	√TYPE A-5, H.C.STD. SD-4.01
I-7	HIGH CASTLE RD. STA. 11+11	435.49	431.60	431.18	√TYPE A-5, H.C.STD. SD-4.02
I-8	HIGH CASTLE RD. STA. 1+30	356.62	352.66	352.18	√TYPE A-15, H.C.STD. SD-4.02
I-9	HIGH CASTLE RD. STA. 1+30	356.62	352.66	352.18	√TYPE A-10, H.C.STD. SD-4.02
I-10	HIGH CASTLE RD. STA. 3+90	368.43	364.46	364.06	√TYPE A-10, H.C.STD. SD-4.02
M-1	BROADGATE CIR. STA. 2+45	360.60	351.26	354.76	√H.C.STD. G-5.12
M-2	BROADGATE CIR. STA. 0+25	370.40	366.80	366.50	√H.C.STD. G-5.12
M-3	N577910	356.60	350.66	350.76	√H.C.STD. G-5.12
M-4	HIGH CASTLE RD. STA. 0+64	355.02	351.46	351.84	√H.C.STD. G-5.12
M-5	HIGH CASTLE RD. STA. 2+25	359.47	354.76	354.66	√H.C.STD. G-5.12
M-6	HIGH CASTLE RD. STA. 3+90	363.99	363.99	363.99	√H.C.STD. G-5.12
M-1A	N577821	341.10	336.24	336.43	√H.C.STD. S-1.32 TYPE A
M-7	N577821	328.50	326.07	326.07	√H.C.STD. S-1.32 TYPE A
E-1	N577901	329.70	326.70	326.70	√H.C.STD. SD-5.21
E-2	N577612	329.70	326.70	326.70	√H.C.STD. SD-5.21
E-3	N577982	329.70	326.70	326.70	√H.C.STD. SD-5.21
E-4	N577832	329.70	326.70	326.70	√H.C.STD. SD-5.21
E-5	N577752	329.70	326.70	326.70	√H.C.STD. SD-5.42
E-6	N577752	329.70	326.70	326.70	√MSHA STD. MD-354.01 *

* USE DIMENSIONS AND DETAILS FOR 48" RCP.

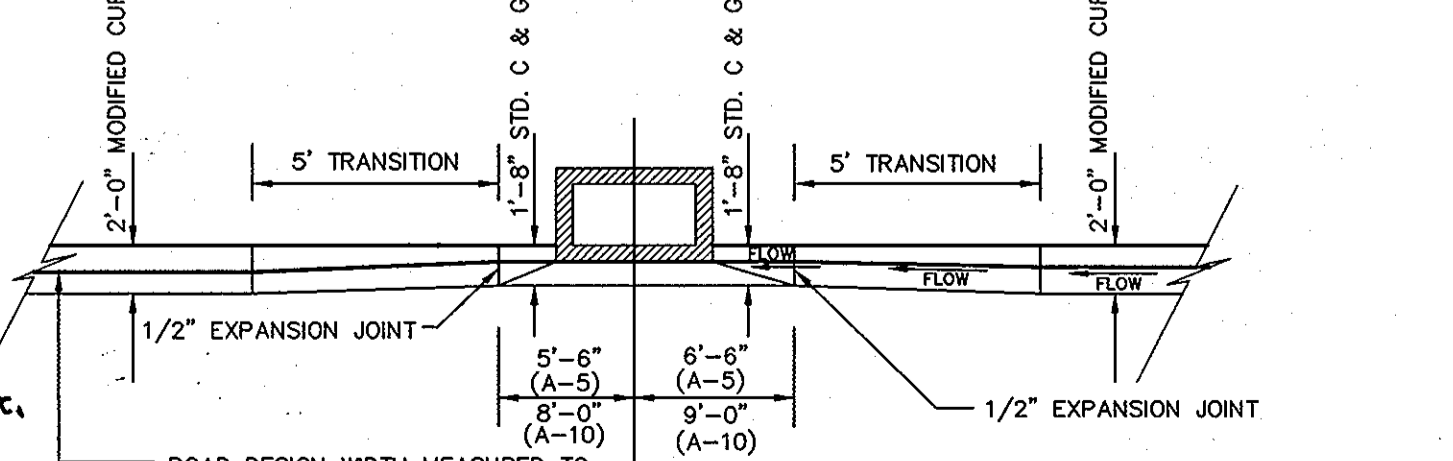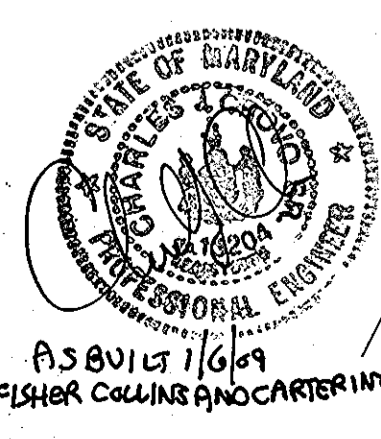

CURB TRANSITION - INLETS
NTS

OWNER/DEVELOPER
BONNIE BRANCH CORPORATION
P.O. BOX 396
ELLCOTT CITY, MD 21043

APPROVED: DEPARTMENT OF PUBLIC WORKS
Richard M. Conkle 1-30-02
CHIEF BUREAU OF HIGHWAYS

APPROVED: DEPARTMENT OF PLANNING AND ZONING
Cindy Banat 2/5/02
CHIEF, DIVISION OF LAND DEVELOPMENT


Michael S. For 12/28/01
CHIEF, DEVELOPMENT ENGINEERING DIVISION

Project	SEP. 2001	date	JBM
Illustration	MMP	scale	1"=50'
Approval	MMP	description	STORM DRAIN
Revisions	1	date	1/10/02

Project	SEP. 2001	date	JBM
Illustration	MMP	scale	1"=50'
Approval	MMP	description	STORM DRAIN
Revisions	1	date	1/10/02

AUTUMN VIEW SECTION 5, PHASE 1
LOTS: 211-159
TAX MAP 25 & 31, P/O PARCEL 75
HOWARD COUNTY, MARYLAND
SECOND ELECTION DISTRICT
STORM DRAIN PROFILE







MILDENBERG, BOENDER & ASSOC., INC.
Engineers Planners Surveyors
5072 Dorsey Hall Drive, Suite 202, Ellicott City, Maryland 21042
(410) 997-0296 Fax: (301) 621-5321 Wash. (410) 997-0288 Fax.

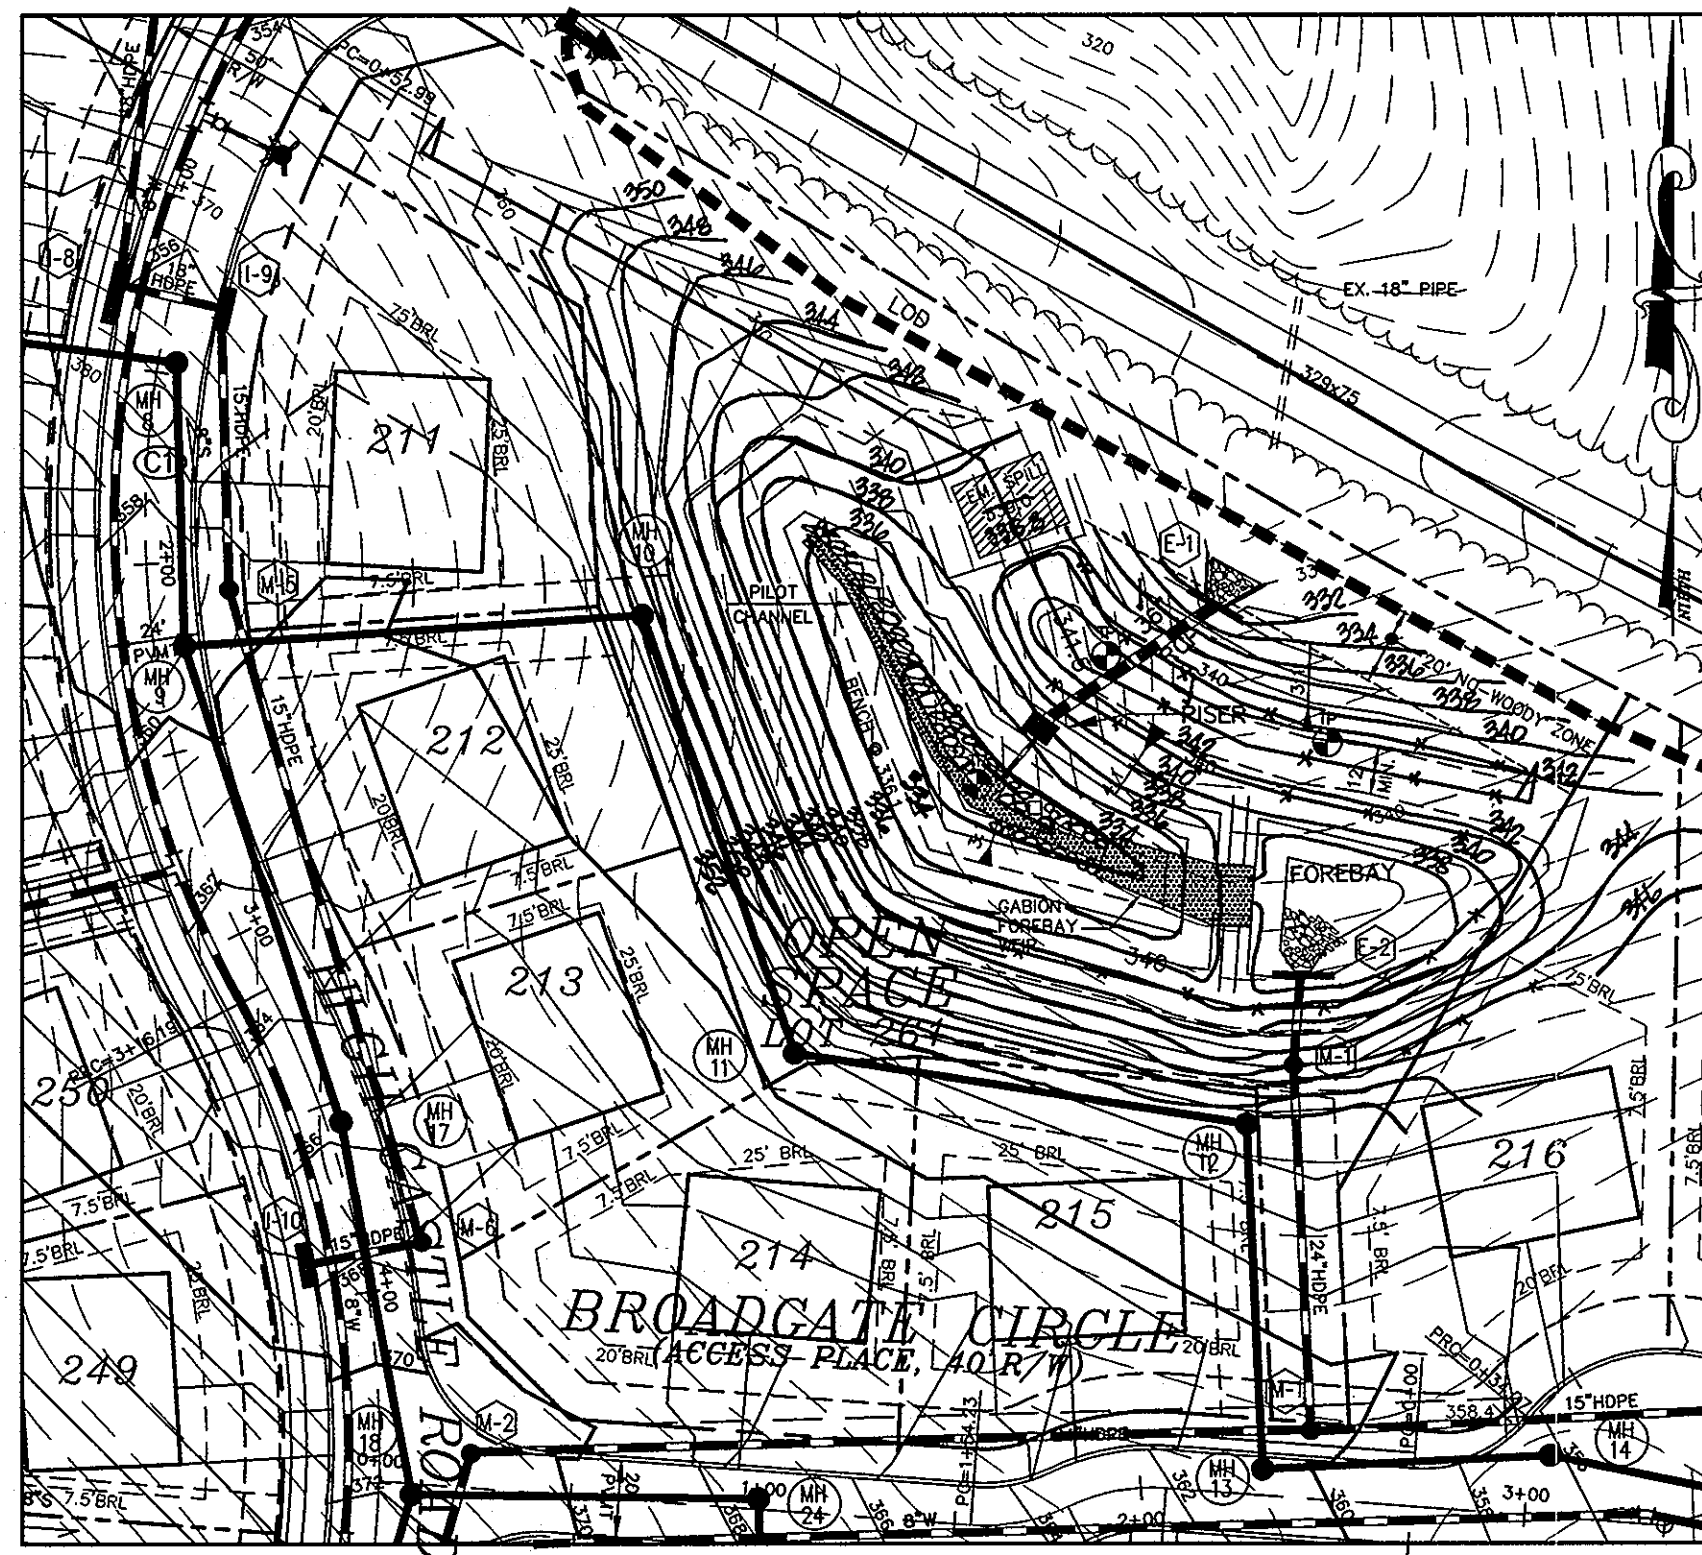

SWM #2 SUMMARY			
	2 YR.	10 YR.	100 YR.
Q EXISTING	7.4	20.3	N/A
Q DEVELOPED	2.1	18.4	N/A
Q FROM SWMF	1.3	16.8	34.5
WSEL	338.1	338.7	339.1

TEMPORARY SWM		
	2 YR.	10 YR.
Q EXISTING	7.5	N/A
Q DEVELOPED	7.5	29.1
WSEL	339.0	339.7

BASIN #2	
EXIST. DRAINAGE AREA	5.93 AC
PROP. DRAINAGE AREA	5.93 AC
REQ'D STORAGE	21,348 CU. FT.
STORAGE PROVIDED @ 338.0	21,348 CU. FT.
WET STORAGE REQ'D	10,674 CU. FT.
WET STORAGE PROVIDED @ 336.5	10,674 CU. FT.
CLEANOUT ELEV.	335.3
BOTTOM ELEV.	332.0
Q2 EXIST.	7.5
Q2 PROP.	7.5
EMBANKMENT ELEV. (INITIAL)	342.5

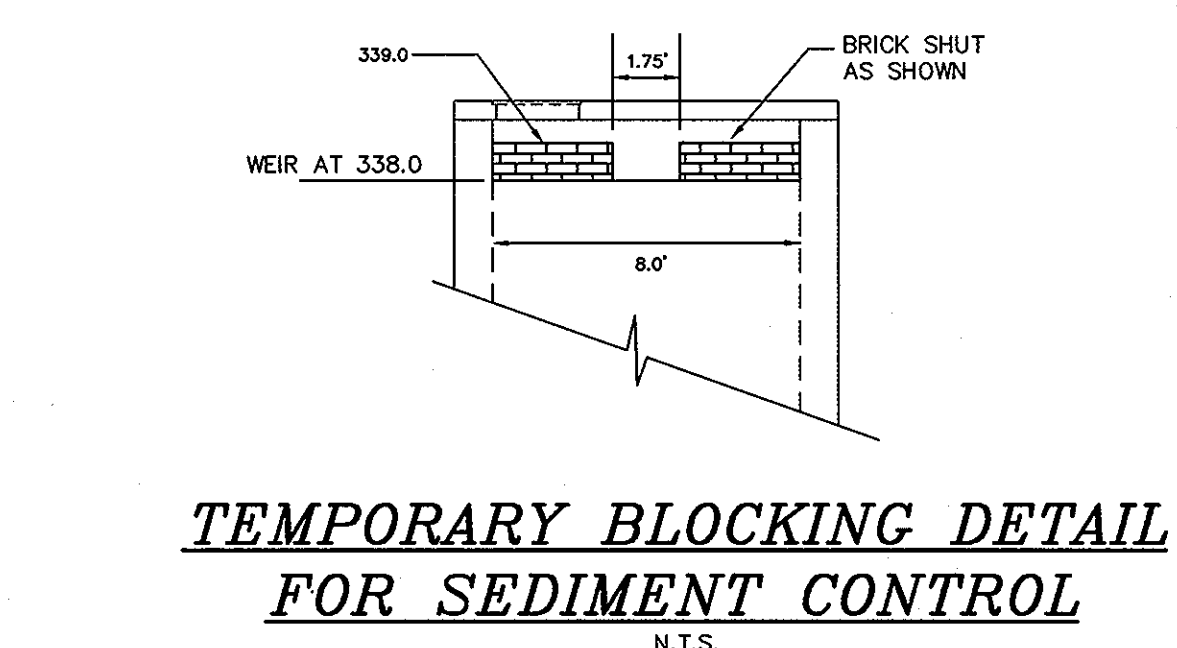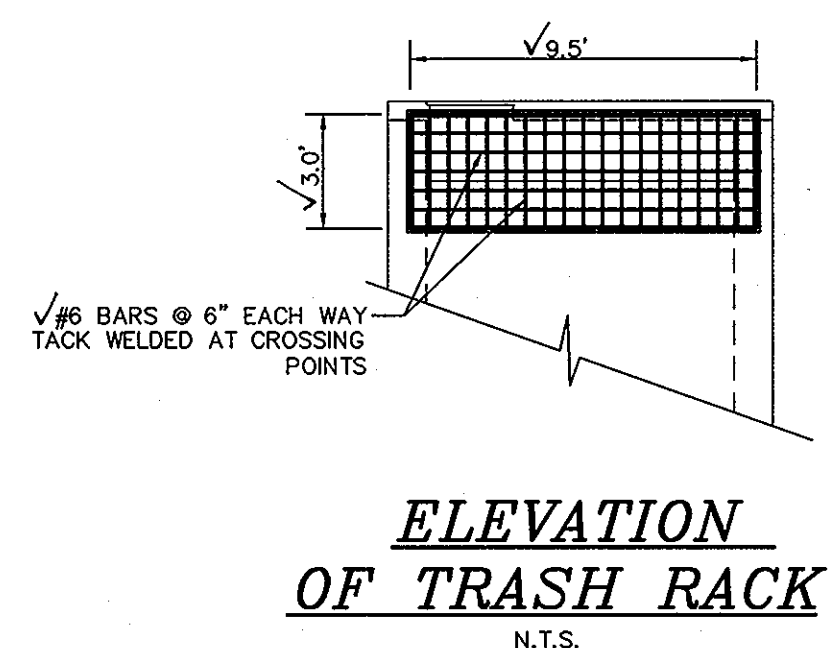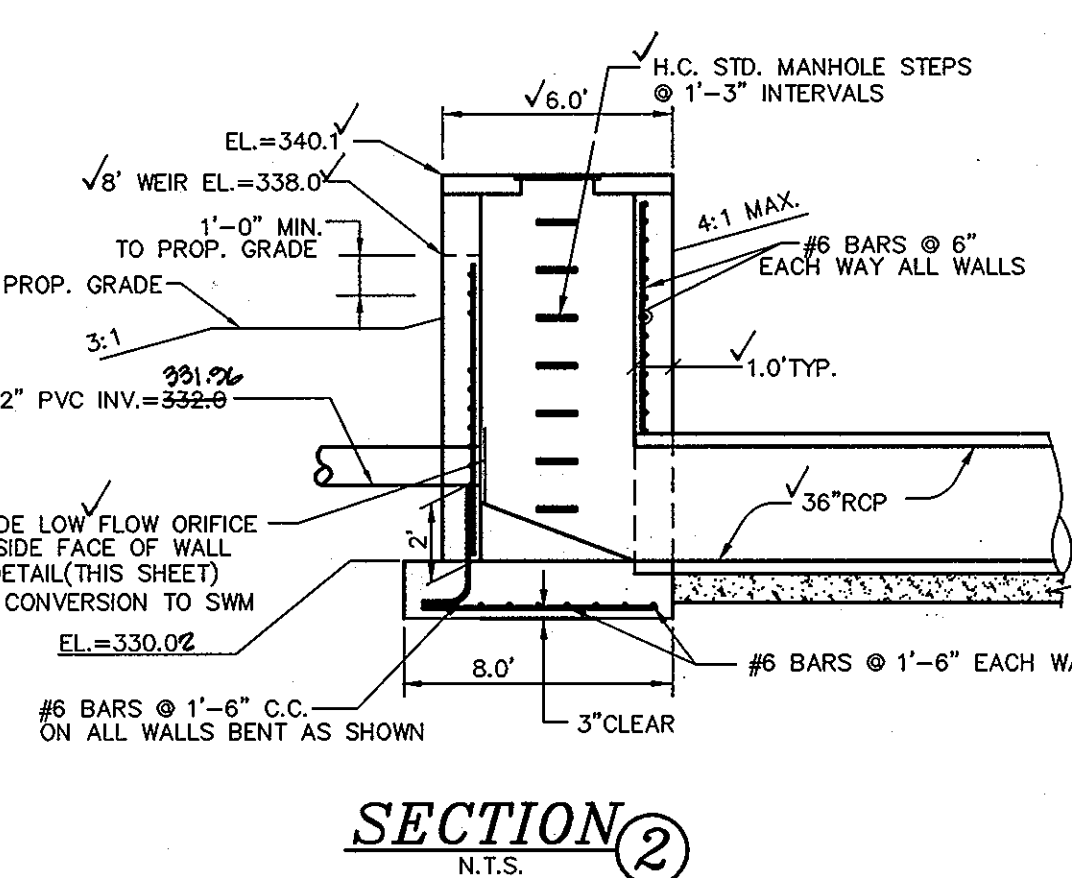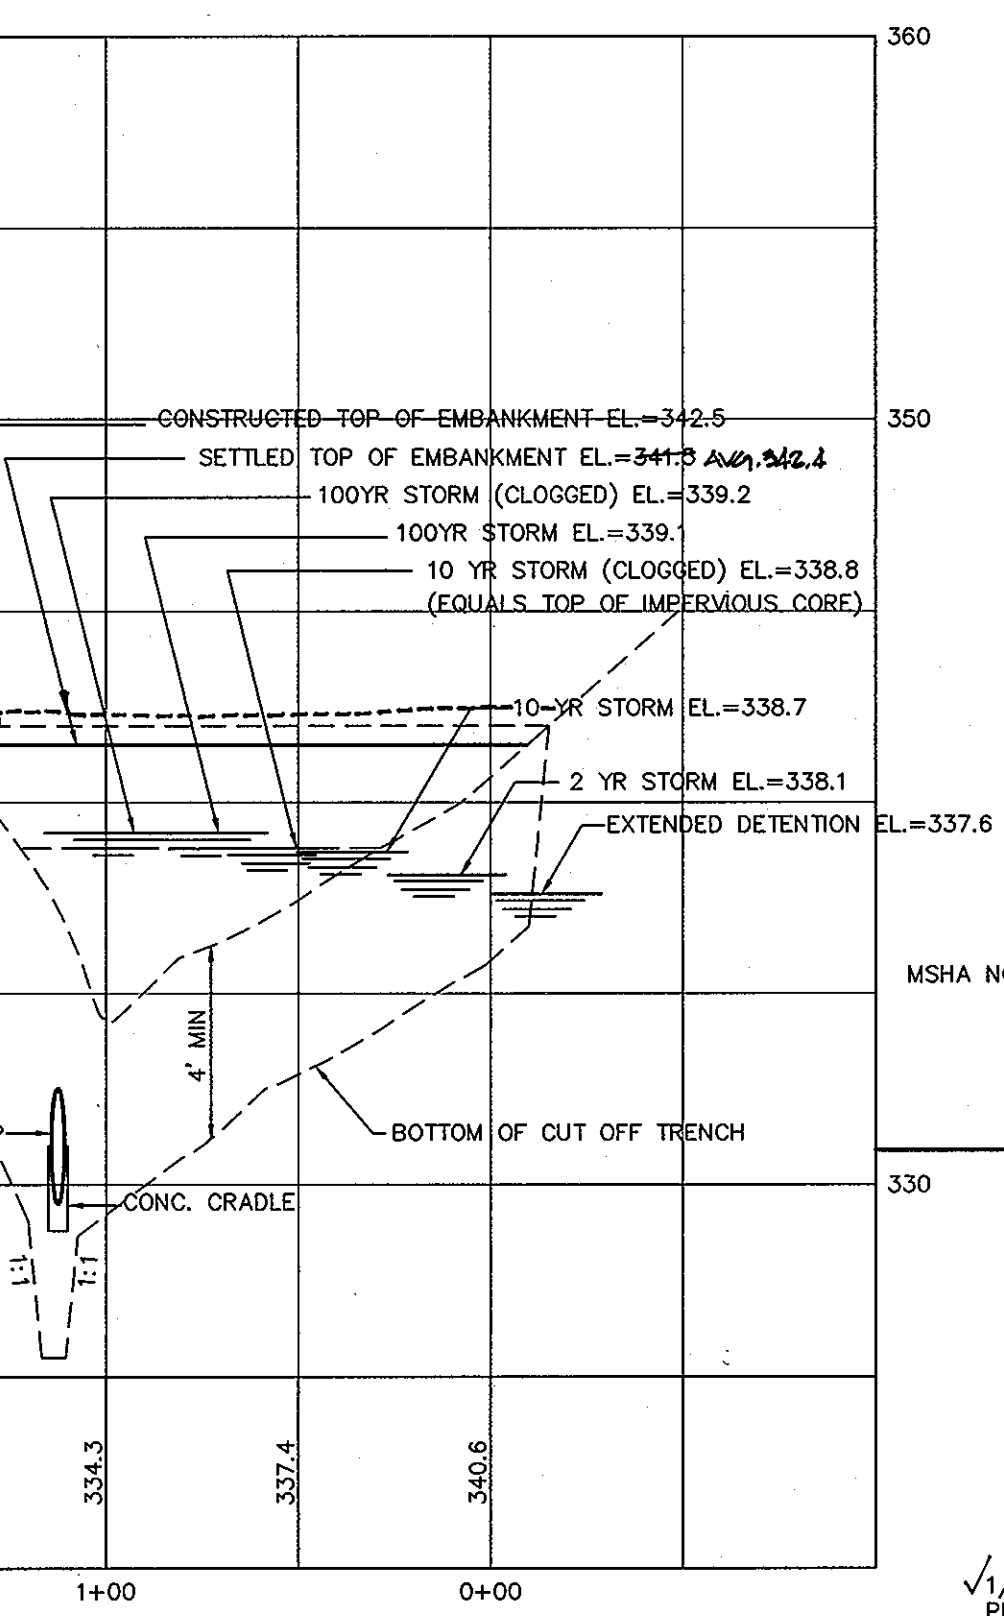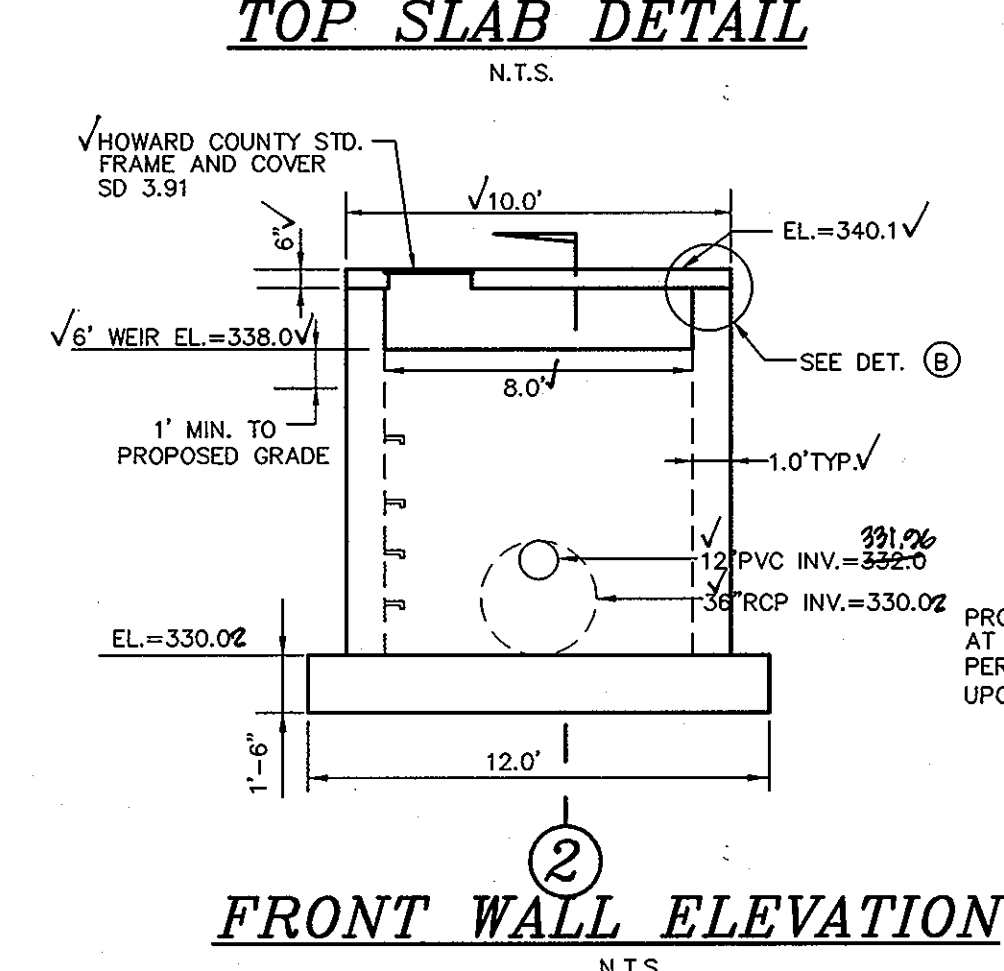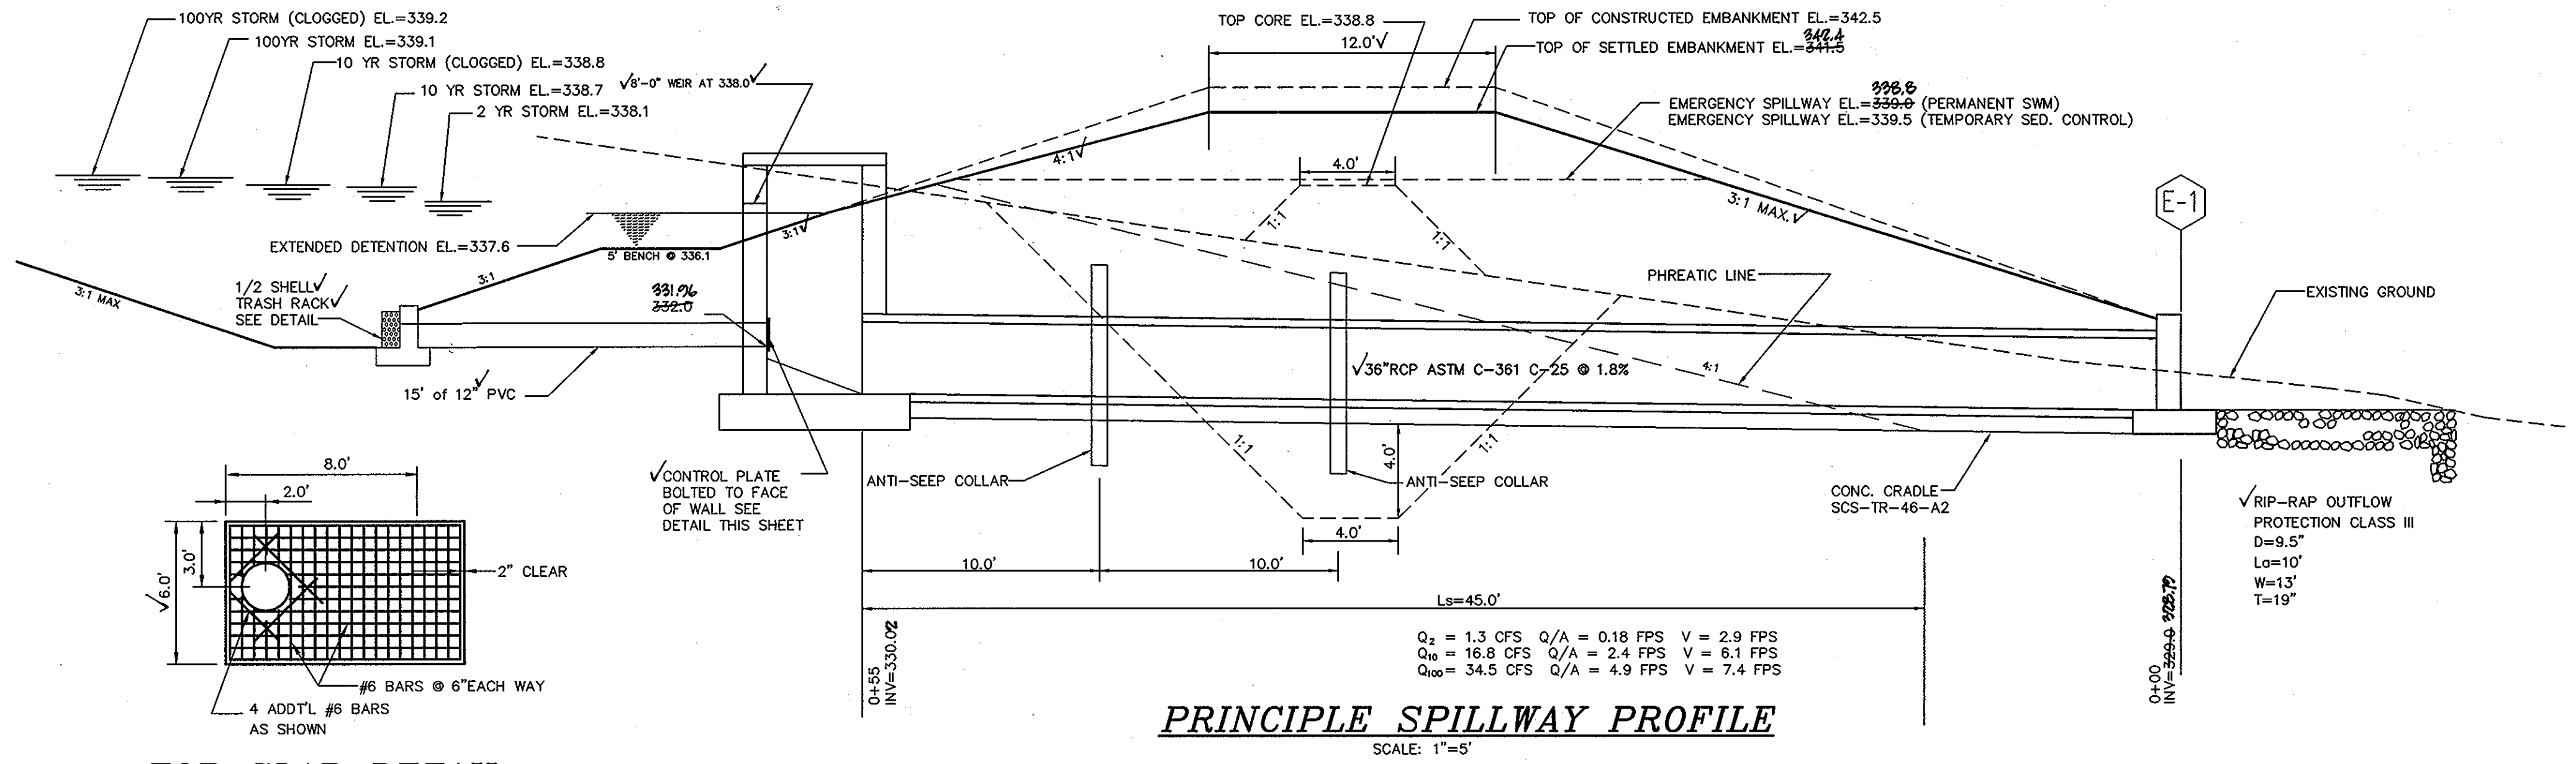

AS-BUILT CERTIFICATION

I HEREBY CERTIFY THAT THE FACILITY SHOWN ON THIS PLAN WAS CONSTRUCTED AS SHOWN ON THE AS-BUILT PLANS AND MEETS THE APPROVED PLANS AND SPECIFICATIONS.

SIGNATURE: *[Signature]* P.E. NO.: 13204 DATE: 11/6/09

CERTIFY MEANS TO STATE OR DECLARE A PROFESSIONAL OPINION BASED UPON ON-SITE INSPECTIONS AND MATERIAL TESTS WHICH ARE CONDUCTED DURING CONSTRUCTION. THE ON-SITE INSPECTIONS AND MATERIAL TESTS ARE THOSE INSPECTIONS AND TESTS DEEMED SUFFICIENT AND APPROPRIATE COMMONLY ACCEPTED ENGINEERING STANDARDS. CERTIFY DOES NOT MEAN OR IMPLY A GUARANTEE BY THE ENGINEER NOR DOES THE ENGINEER'S CERTIFICATION RELIEVE ANY OTHER PARTY FROM MEETING REQUIREMENTS IMPOSED BY CONTRACT, EMPLOYMENT, OR OTHER MEANS, INCLUDING MEETING COMMONLY ACCEPTED INDUSTRY PRACTICES.

BY THE DEVELOPER:

"I/WE CERTIFY THAT ALL DEVELOPMENT AND/OR CONSTRUCTION WILL BE DONE ACCORDING TO THESE PLANS, AND THAT ANY RESPONSIBLE PERSONNEL INVOLVED IN THE CONSTRUCTION PROJECT WILL HAVE A CERTIFICATE OF ATTENDANCE AT A DEPARTMENT OF THE ENVIRONMENT APPROVED TRAINING PROGRAM FOR THE CONTROL OF SEDIMENT AND EROSION BEFORE BEGINNING THE PROJECT. I SHALL ENGAGE A REGISTERED PROFESSIONAL ENGINEER TO SUPERVISE POND CONSTRUCTION AND PROVIDE THE HOWARD SOIL CONSERVATION DISTRICT WITH AN AS-BUILT PLAN OF THE POND WITHIN 30 DAYS OF COMPLETION. I ALSO AUTHORIZE PERIODIC ON-SITE INSPECTIONS BY THE HOWARD SOIL CONSERVATION DISTRICT."

SIGNATURE OF DEVELOPER: *[Signature]* DATE: 12/6/09
PRINTED NAME OF DEVELOPER: Bruce Taylor, Inc.

BY THE ENGINEER:

"I CERTIFY THAT THIS PLAN FOR POND CONSTRUCTION, EROSION AND SEDIMENT CONTROL REPRESENTS A REASONABLY WORKABLE PLAN BASED ON MY PERSONAL KNOWLEDGE OF THE SITE CONDITIONS. THIS PLAN WAS PREPARED IN ACCORDANCE WITH THE REQUIREMENTS OF THE HOWARD SOIL CONSERVATION DISTRICT. I HAVE NOTICED THE DEVELOPER'S SIGNATURE AND ENGAGE A REGISTERED PROFESSIONAL ENGINEER TO SUPERVISE POND CONSTRUCTION AND PROVIDE THE HOWARD SOIL CONSERVATION DISTRICT WITH AN AS-BUILT PLAN OF THE POND WITHIN 30 DAYS OF COMPLETION."

SIGNATURE OF ENGINEER: *[Signature]* DATE: 12/6/09
PRINTED NAME OF ENGINEER: [Name]








THESE PLANS HAVE BEEN REVIEWED FOR THE HOWARD SOIL CONSERVATION DISTRICT AND MEET THE TECHNICAL REQUIREMENTS FOR SMALL POND CONSTRUCTION, SOIL EROSION AND SEDIMENT CONTROL.

USDA - NATURAL RESOURCES CONSERVATION SERVICE DATE: 12/18/09
HOWARD SOIL CONSERVATION DISTRICT DATE: 12/18/09

APPROVED: DEPARTMENT OF PUBLIC WORKS
DATE: 1/30/02

APPROVED: DEPARTMENT OF PLANNING AND ZONING
DATE: 2/9/02

APPROVED: DEVELOPMENT ENGINEERING DIVISION
DATE: 12/28/01

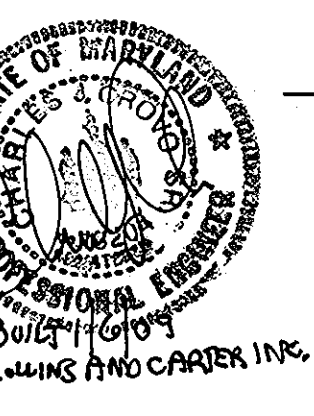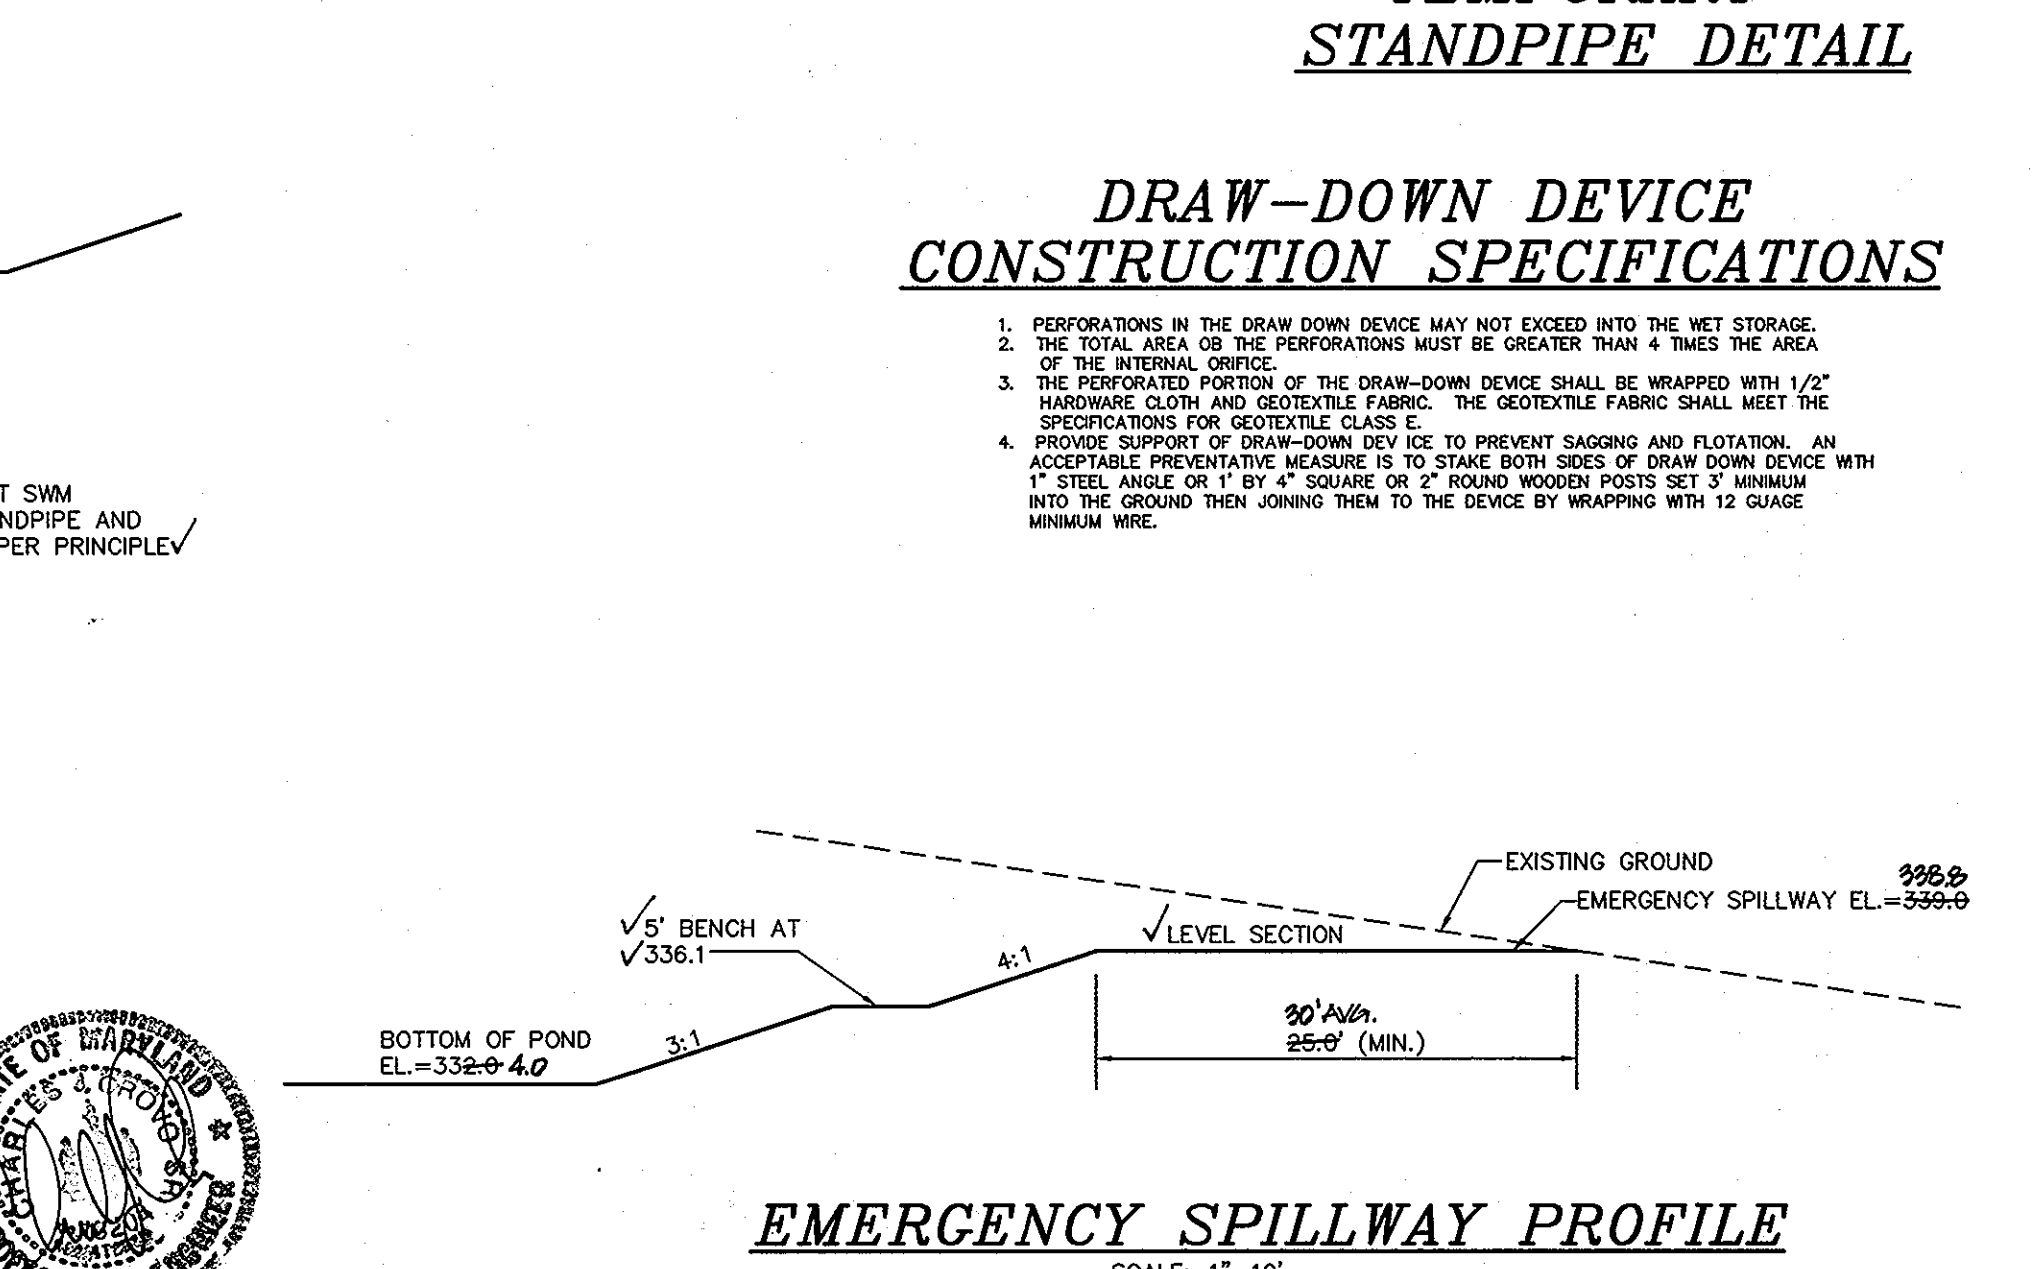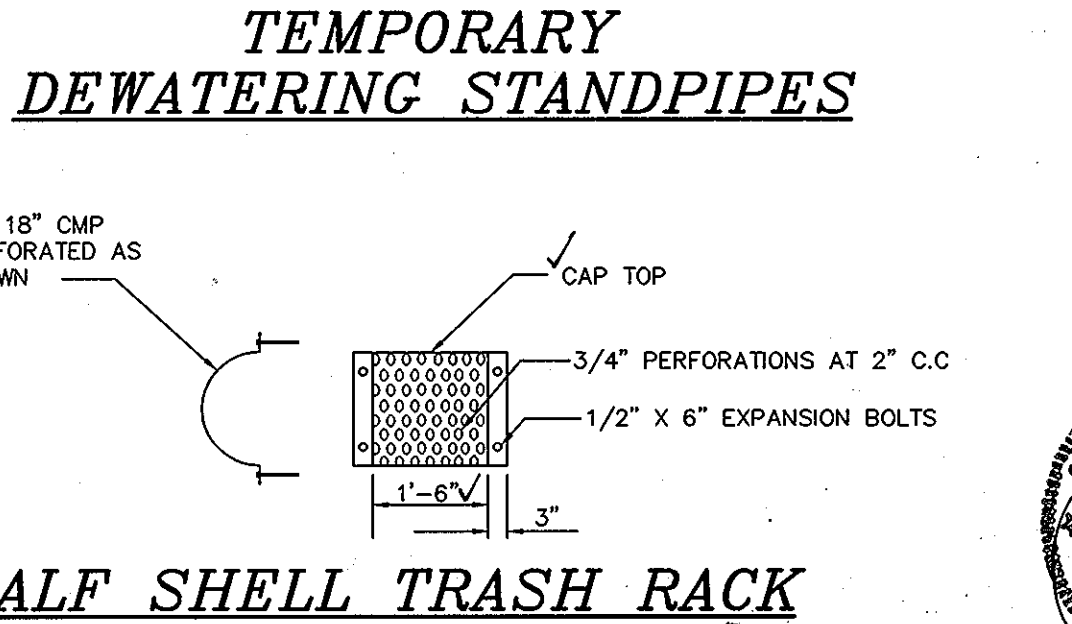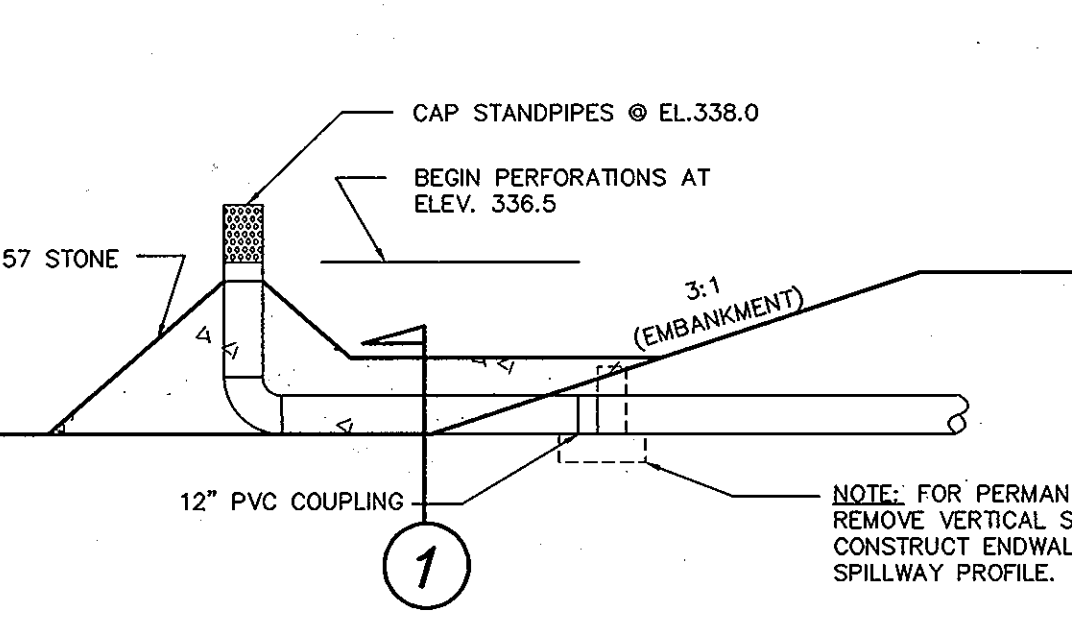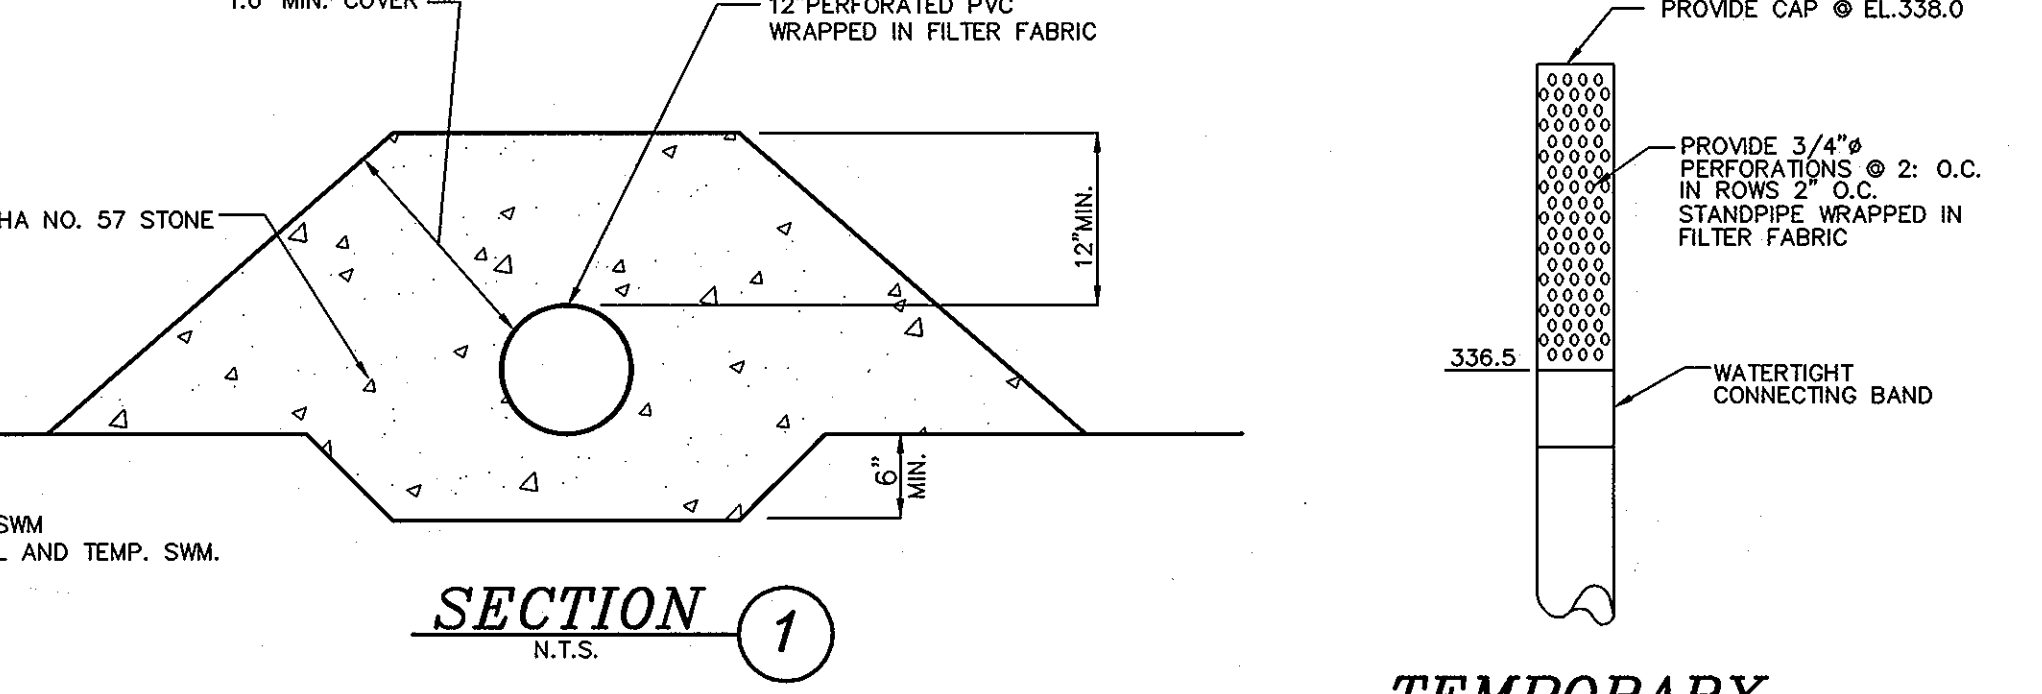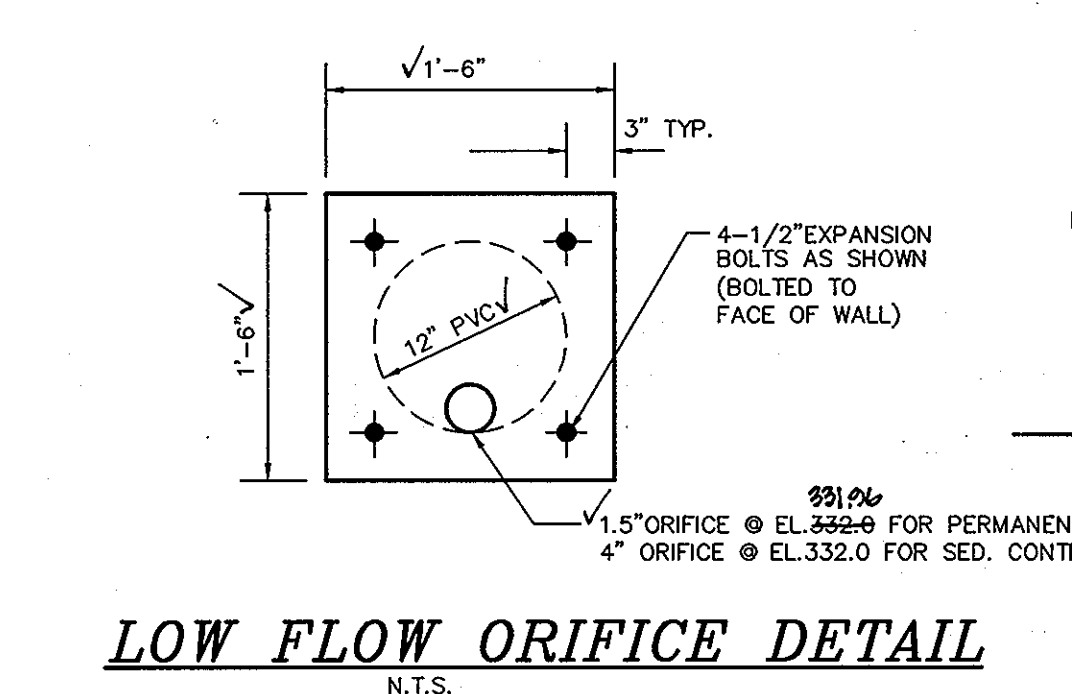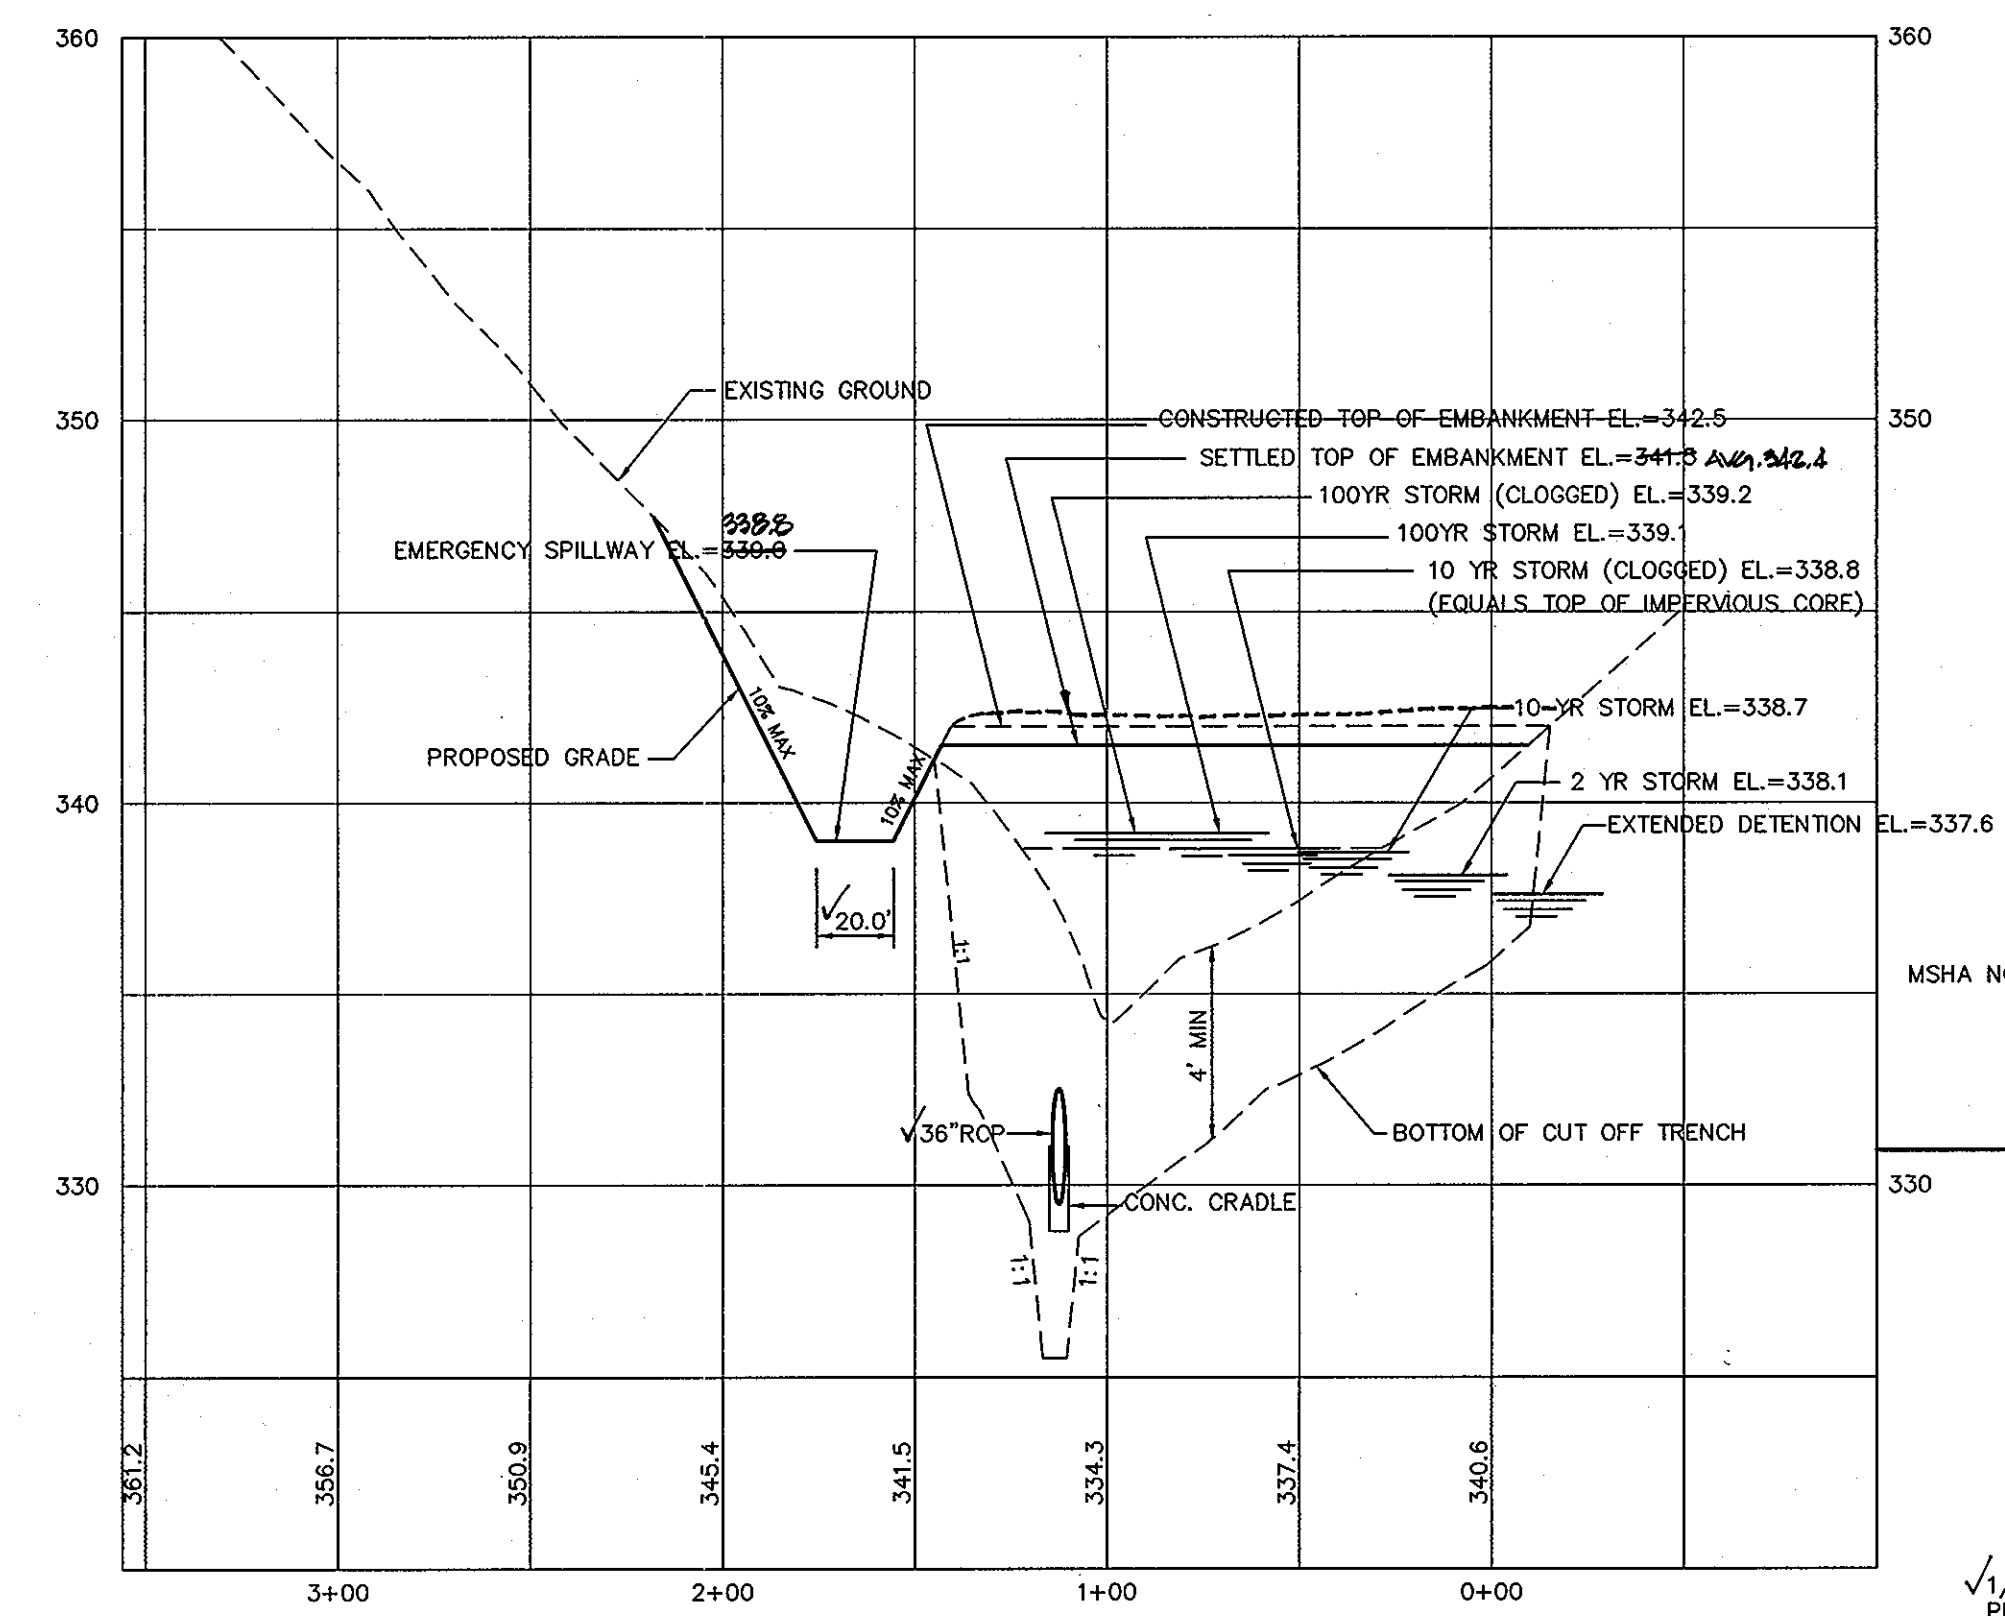


date: 12/28/01
project: 99072
illustration: MMP
scale: AS SHOWN
approval: JBM

1. REVISIONS PER LEAD AS-BUILT
no. 1
description: REVISIONS
date: 1/6/09

AUTUMN VIEW SECTION 5, PHASE 1
LOTS: 211-259
TAX MAP 25 & 31, P/O PARCEL 75
HOWARD COUNTY, MARYLAND
SECOND ELECTION DISTRICT
SWM PLAN, PROFILES AND DETAILS, POND #2

MILDENBERG, BOENDER & ASSOC., INC.
Engineers Planners Surveyors
5072 Dorsey Hall Drive, Suite 202, Ellicott City, Maryland, 21042
(410) 987-0286 Fax: (301) 821-5521 Wash. (410) 997-0288 Fax.

11 OF 21
AS BUILT F-01-23

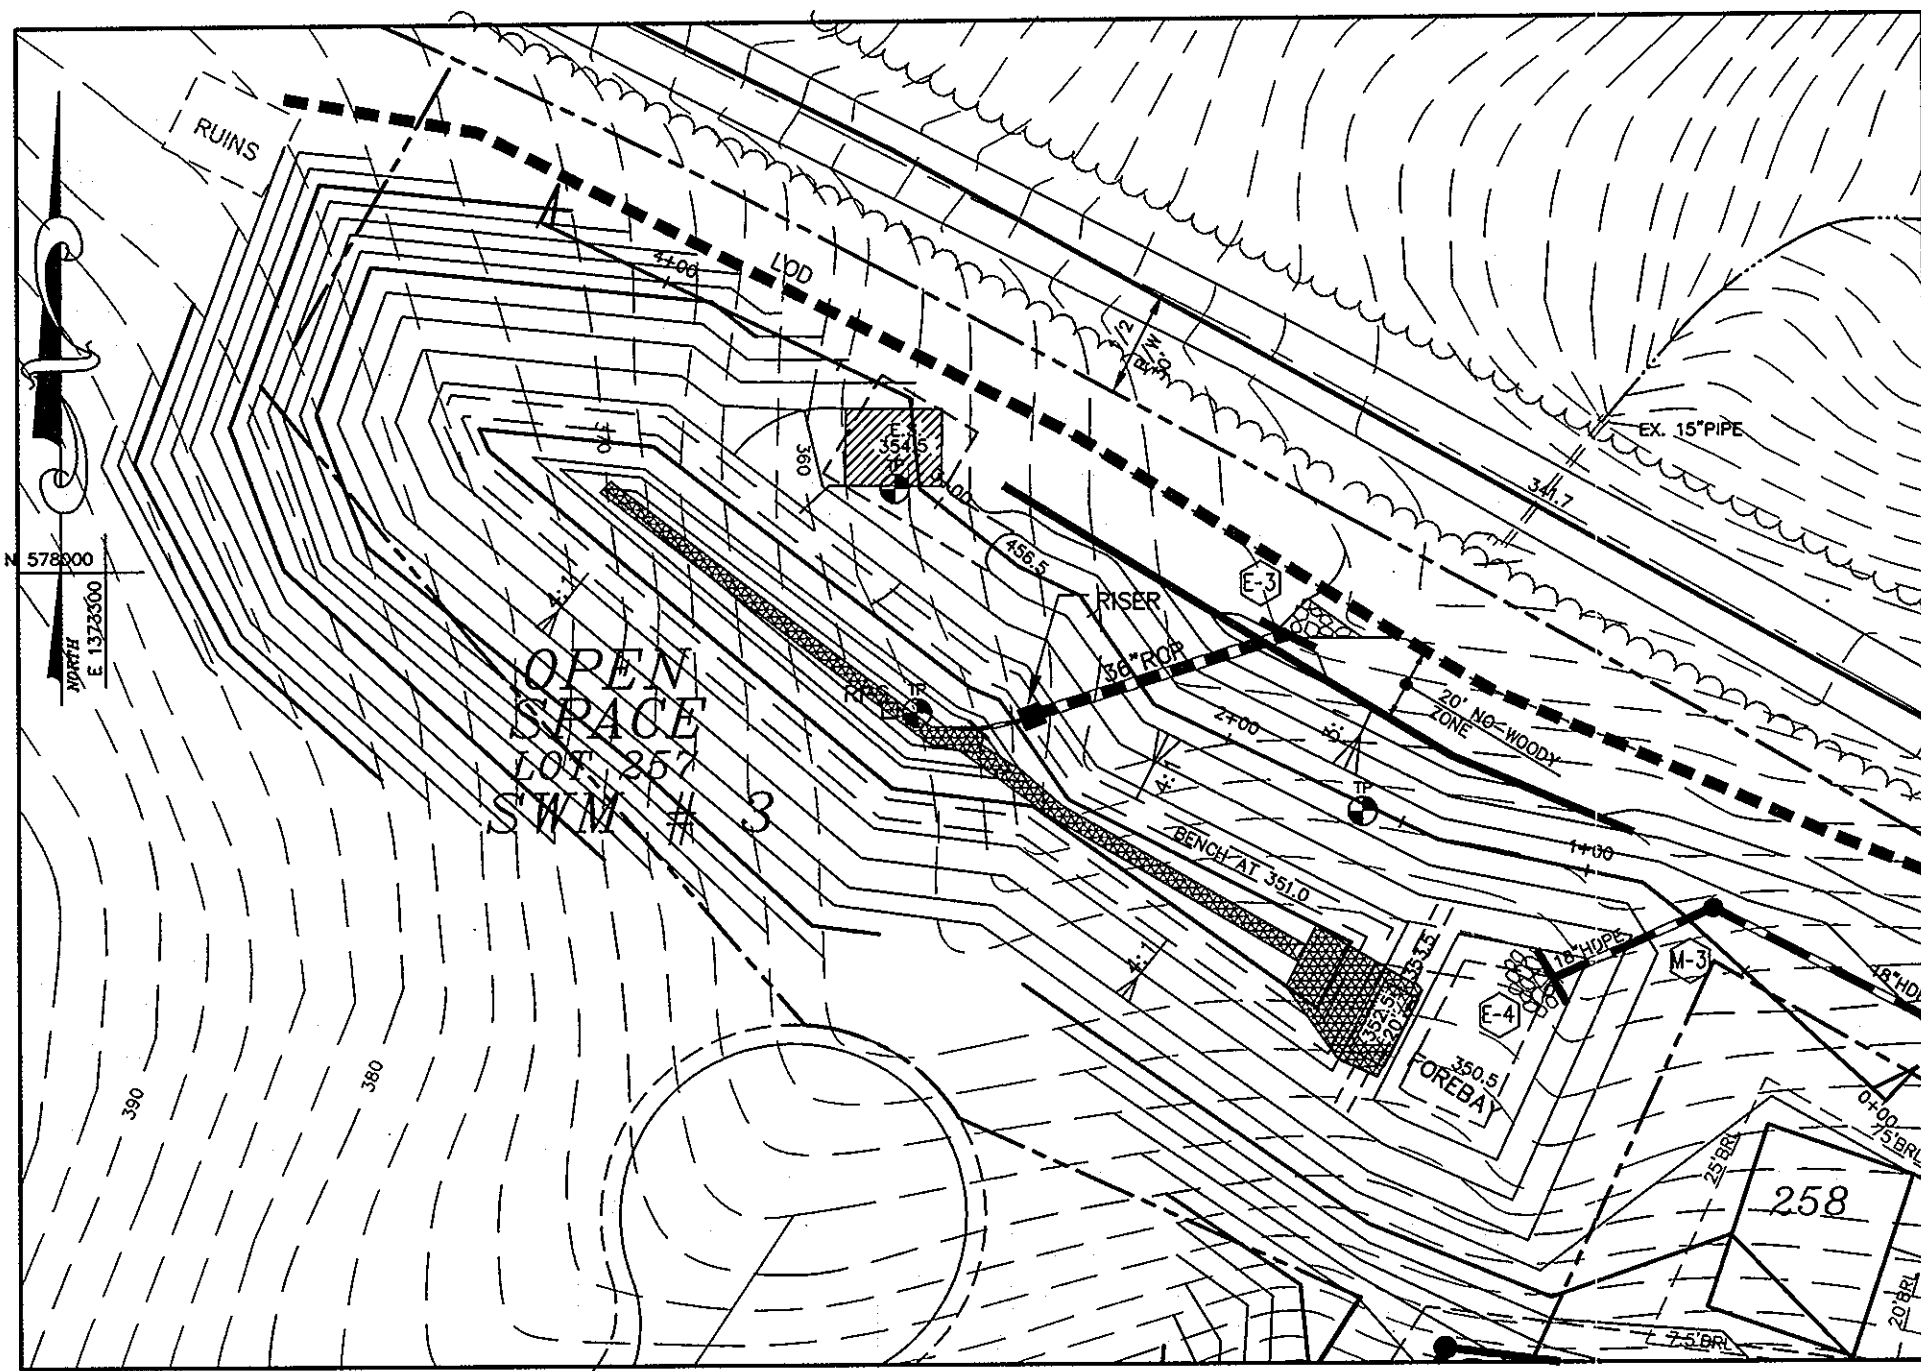


SWM POND # 3 PLAN VIEW

SCALE: 1"=50'

SWM #3 SUMMARY			
	2 YR.	10 YR.	100 YR.
Q EXISTING	6.8	22.0	42.2
Q DEVELOPED	3.7	14.8	N/A
Q FROM SWMF	1.3	12.2	35.2
WSEL	352.5	353.9	355.2


TEMPORARY SWM		
	2 YR.	10 YR.
Q EXISTING	6.8	N/A
Q DEVELOPED	6.6	50.9
WSEL	354.5	355.3

BASIN #3	
EXIST. DRAINAGE AREA	10.4 AC
PROP. DRAINAGE AREA	12.98 AC
REQ'D STORAGE	46,728 CU. FT.
STORAGE PROV'D @ 354.0	69,485 CU. FT.
WET STORAGE REQ'D	23,364 CU. FT.
WET STORAGE PROV'D @ 351.5	23,364 CU. FT.
CLEANOUT ELEV.	350.0
BOTTOM ELEV.	345.5
O2 EXIST.	6.8
O2 PROP.	6.6
EMBANKMENT ELEV. (INITION)	357.5

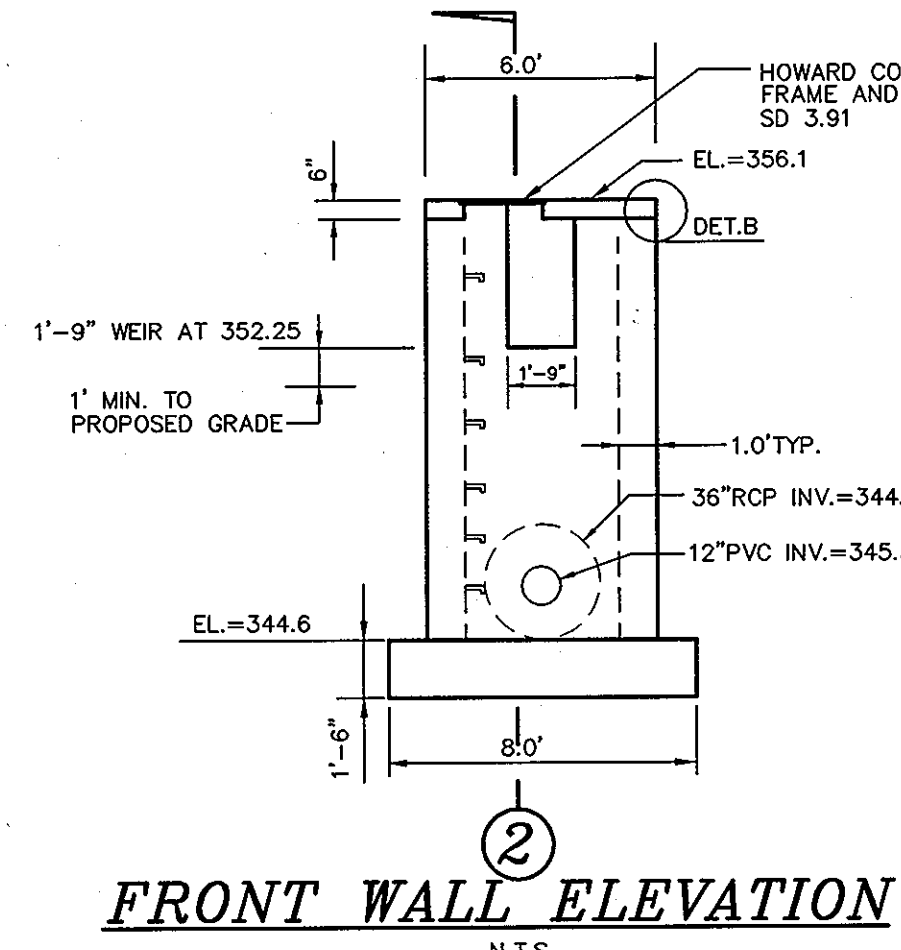


FRONT WALL ELEVATION

N.T.S.

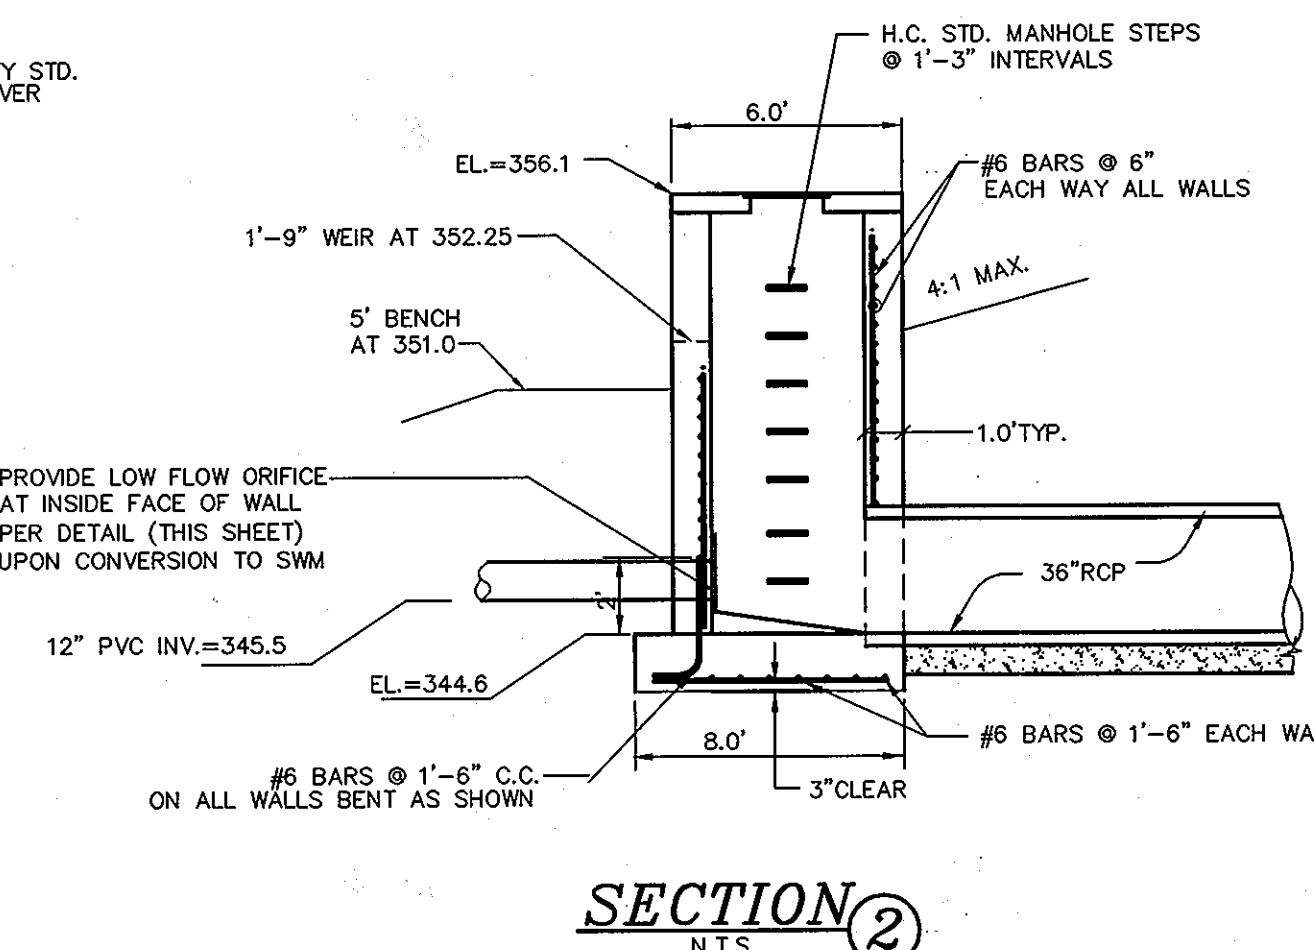


SECTION 2

N.T.S.

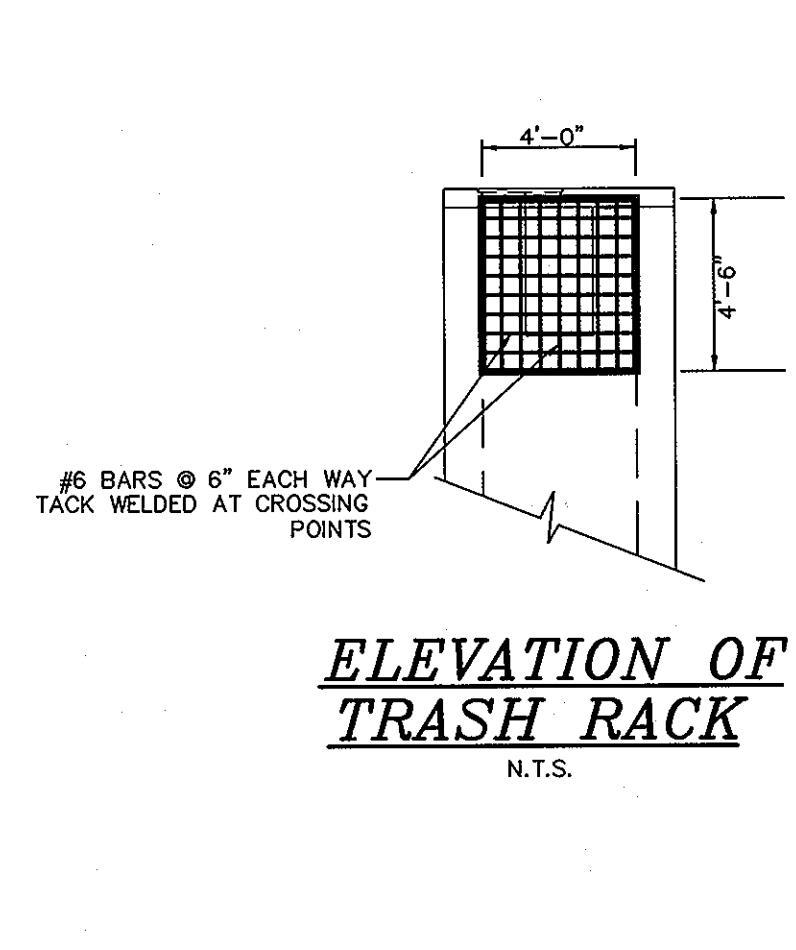


ELEVATION OF TRASH RACK

N.T.S.

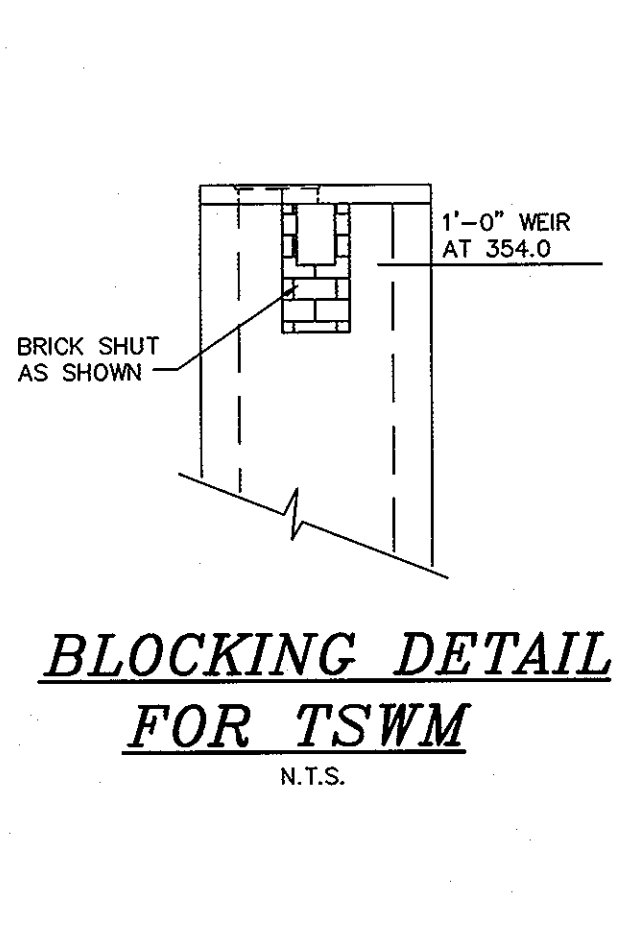


BLOCKING DETAIL FOR TSWM

N.T.S.

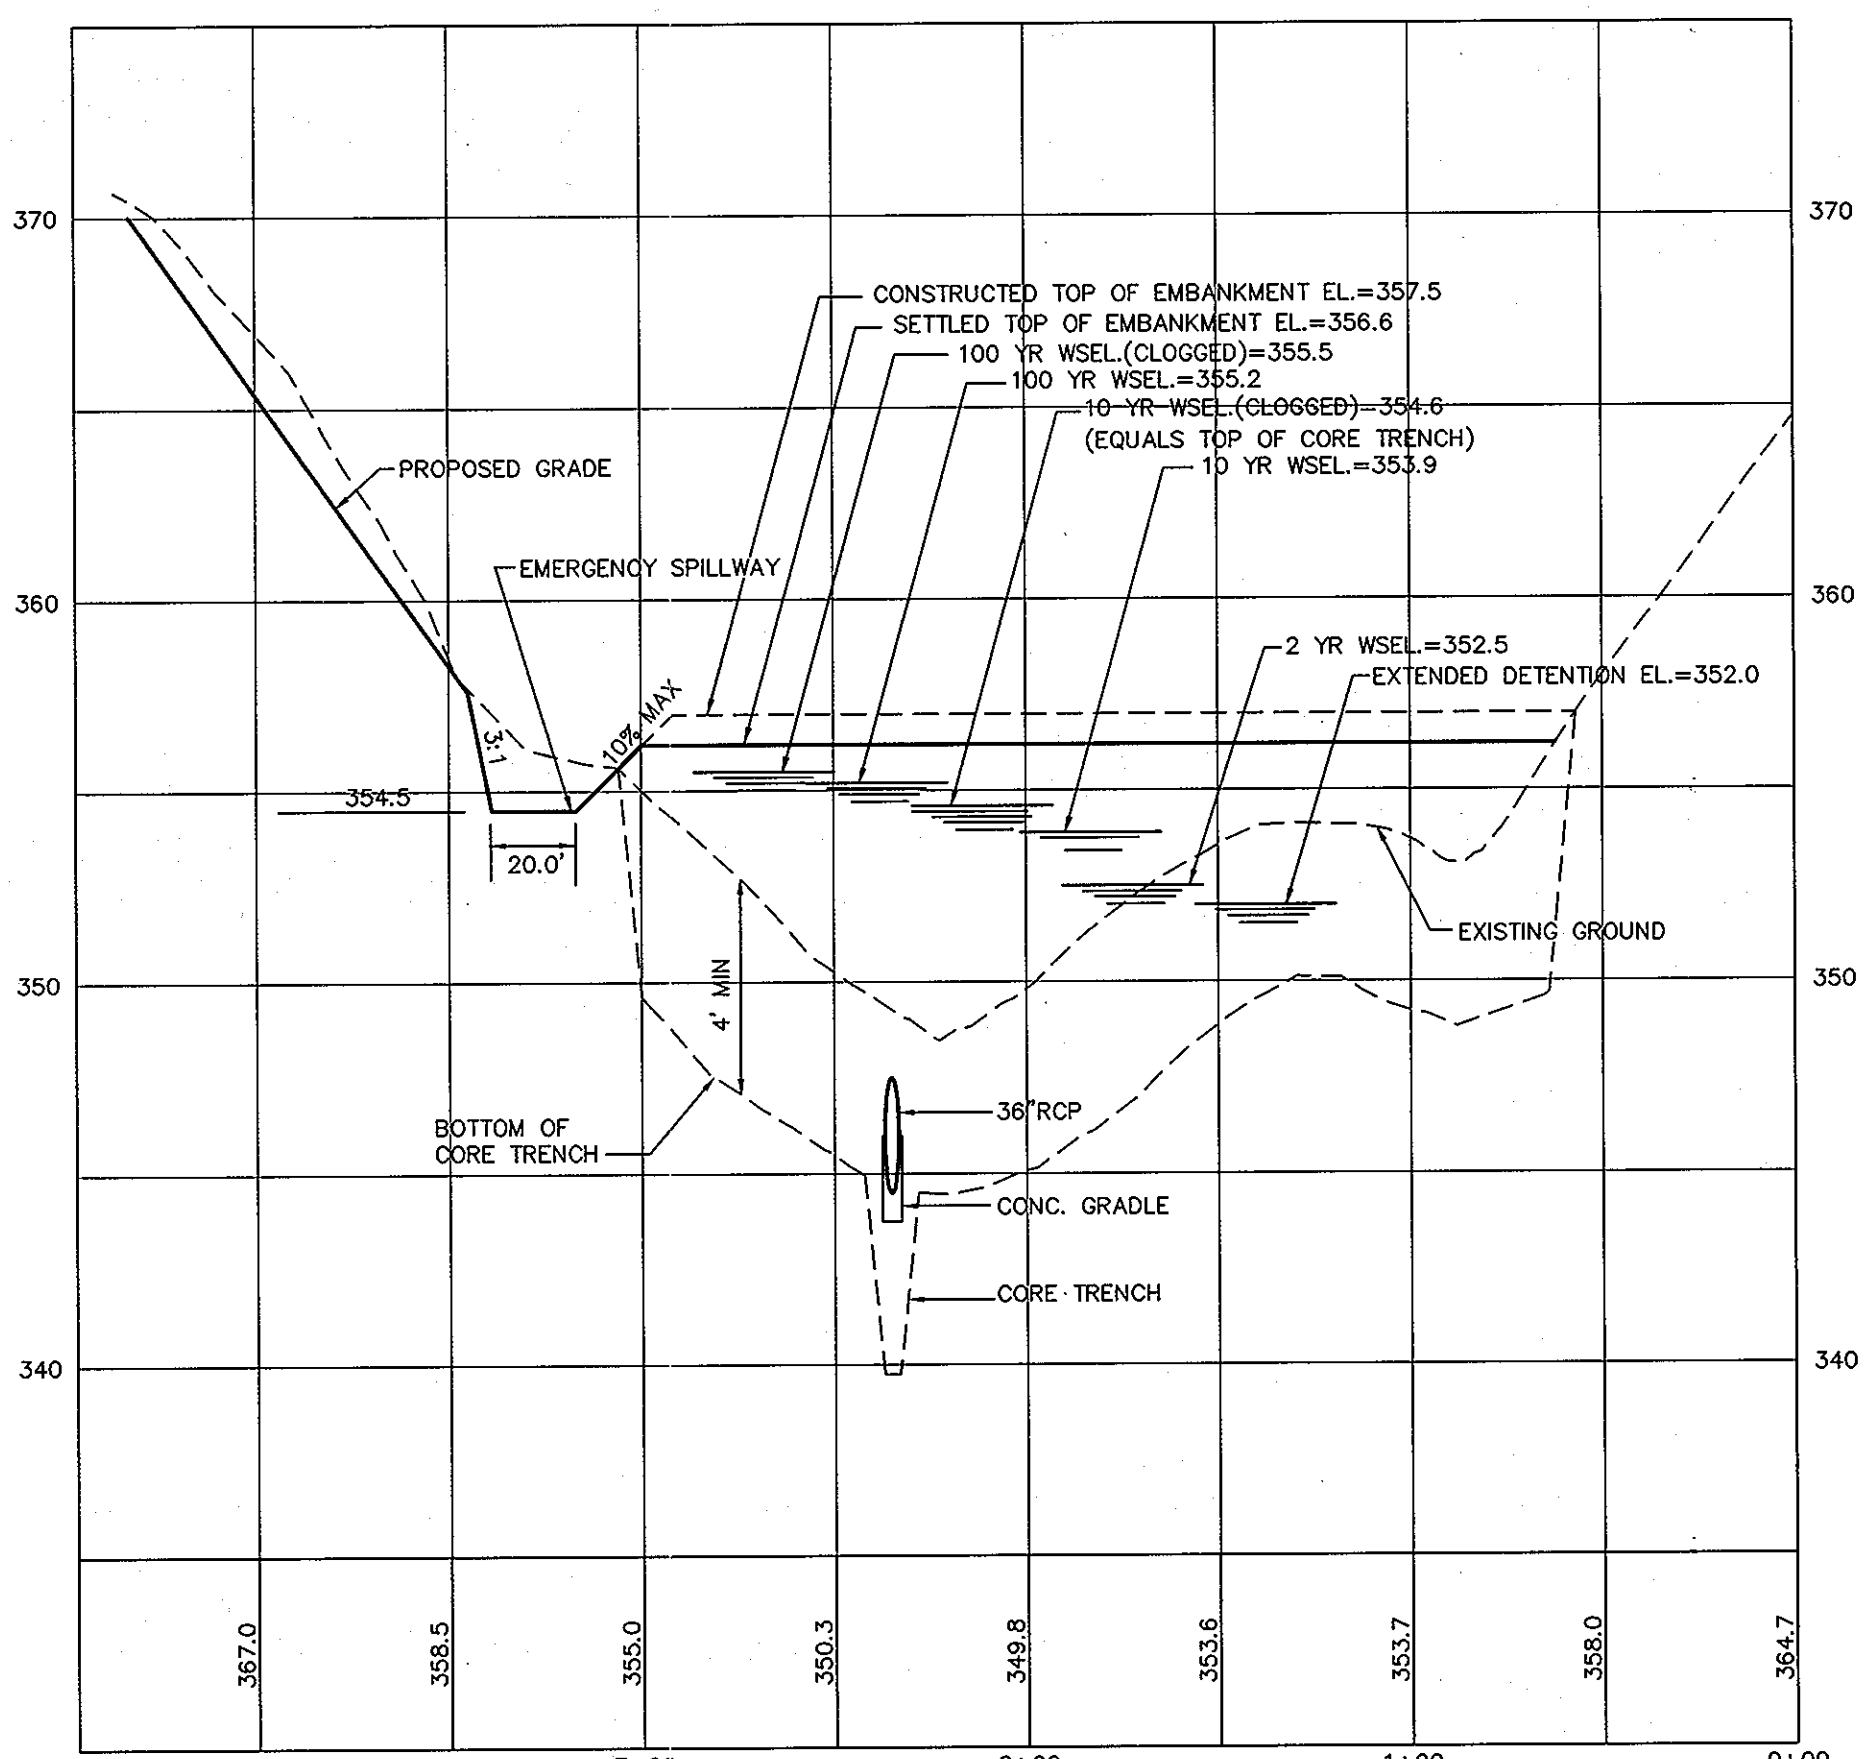


CENTERLINE DAM PROFILE

SCALE: HOR. 1"=50' VER. 1"=5'

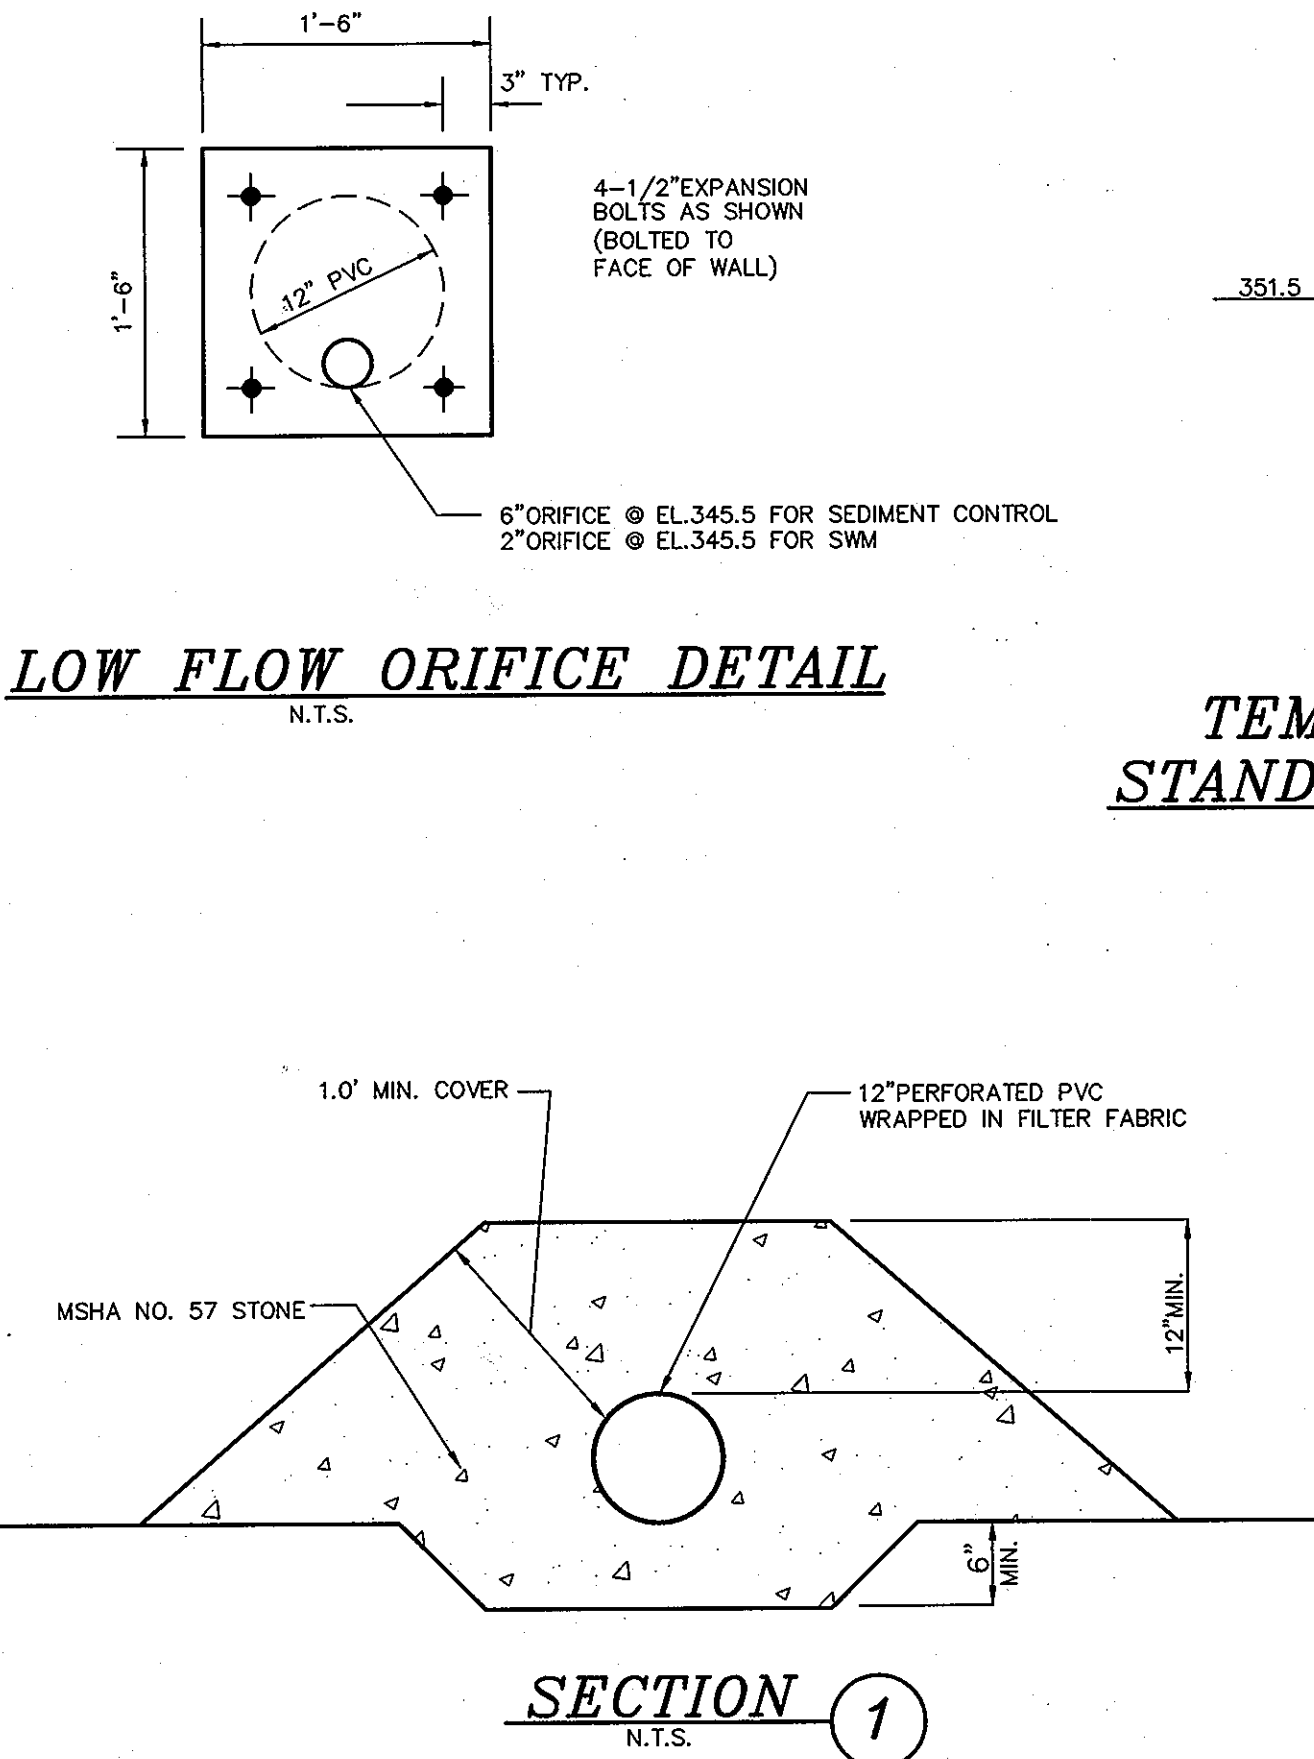


LOW FLOW ORIFICE DETAIL

N.T.S.

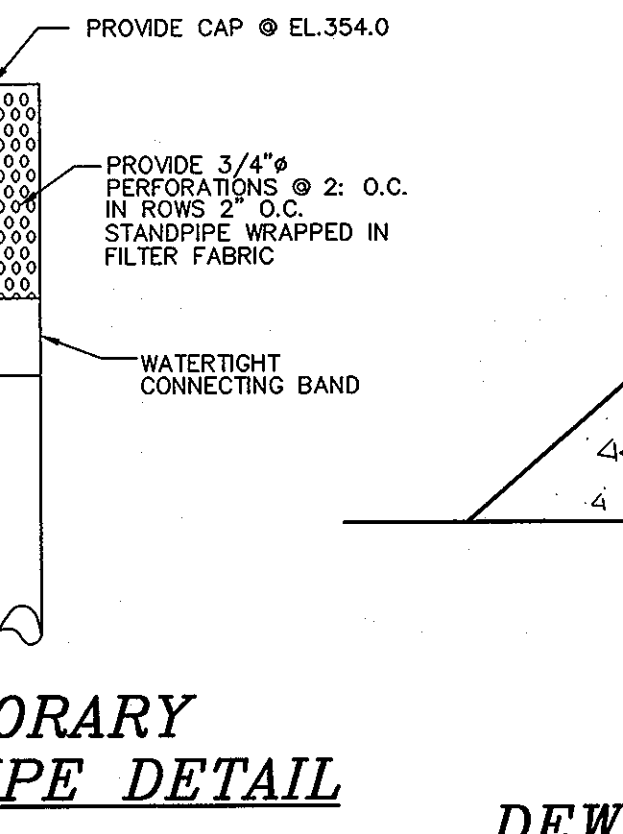


TEMPORARY STANDPIPE DETAIL

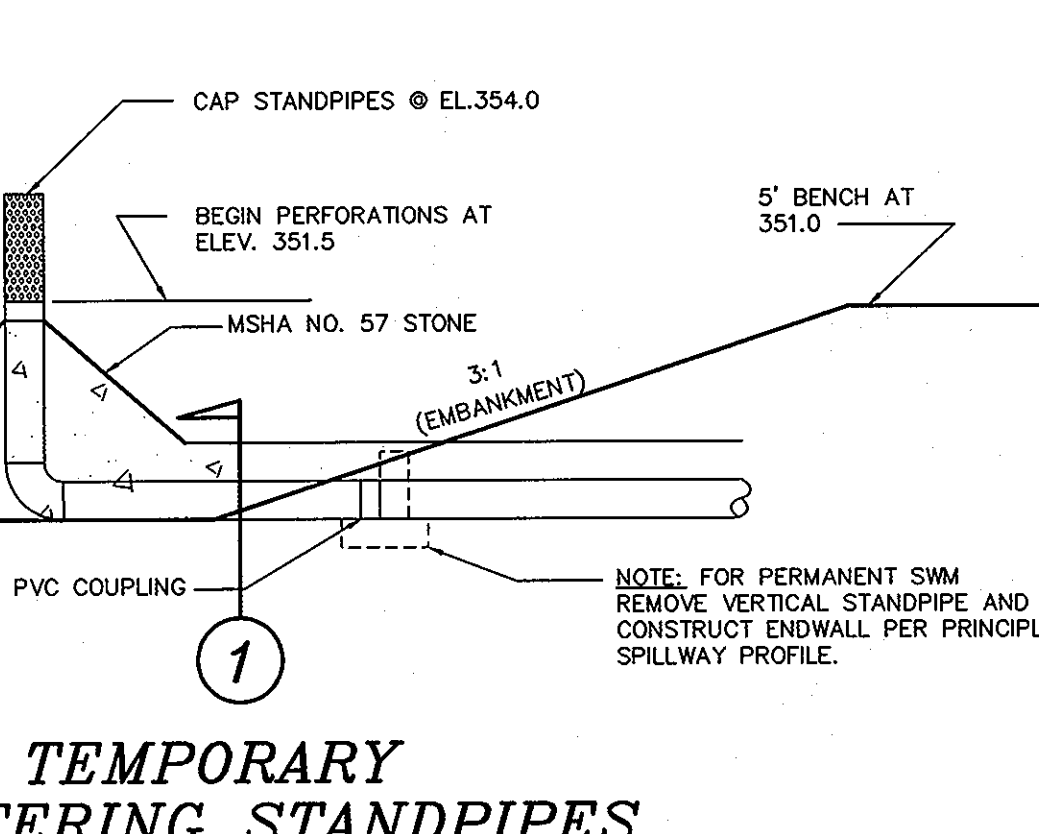


TEMPORARY DEWATERING STANDPIPES

DRAW-DOWN DEVICE CONSTRUCTION SPECIFICATIONS

- PERFORATIONS IN THE DRAW-DOWN DEVICE MAY NOT EXCEED INTO THE WET STORAGE.
- THE TOTAL AREA OF THE PERFORATIONS MUST BE GREATER THAN 4 TIMES THE AREA OF THE INTERNAL ORIFICE.
- THE PERFORATED PORTION OF THE DRAW-DOWN DEVICE SHALL BE WRAPPED WITH 1/2" HARDWARE CLOTH AND GEOTEXTILE FABRIC. THE GEOTEXTILE FABRIC SHALL MEET THE SPECIFICATIONS FOR GEOTEXTILE FABRIC.
- PROVIDE SUPPORT OF DRAW-DOWN DEVICE TO PREVENT SAGGING AND FLOTATION. AN ACCEPTABLE PREVENTIVE MEASURE IS TO STAKE BOTH SIDES OF DRAW DOWN DEVICE WITH 1" STEEL ANGLE OR 1" BY 4" SQUARE OR 2" ROUND WOODEN POSTS SET 5' MINIMUM INTO THE GROUND THEN JOINING THEM TO THE DEVICE BY WRAPPING WITH 12 GAUGE MINIMUM WIRE.

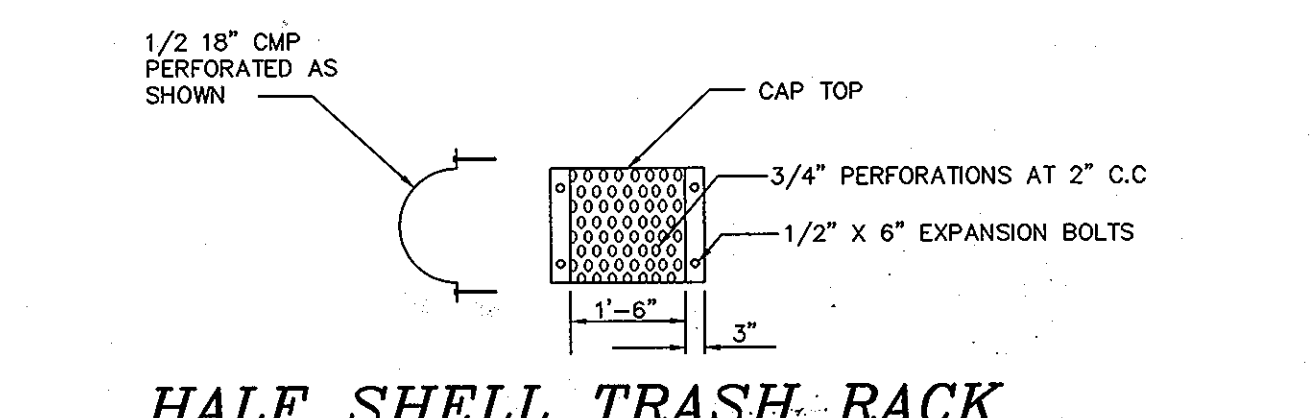

HALF SHELL TRASH RACK

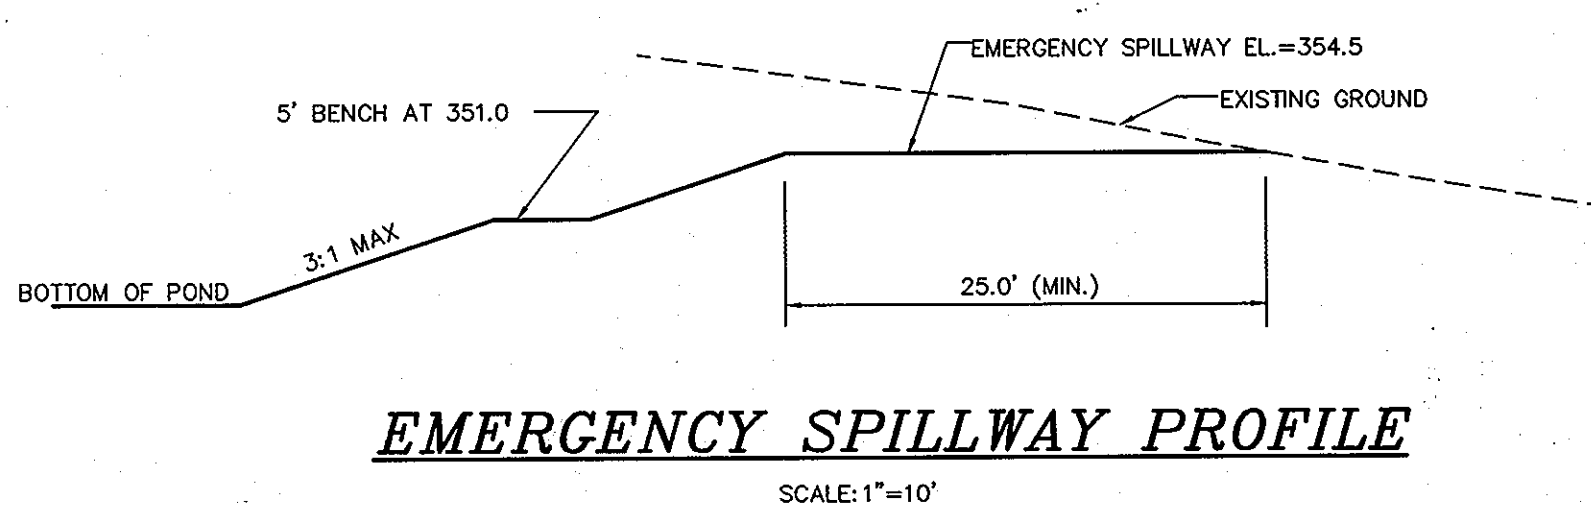

EMERGENCY SPILLWAY PROFILE

SCALE: 1"=10'

AS-BUILT CERTIFICATION

I HEREBY CERTIFY THAT THE FACILITY SHOWN ON THIS PLAN WAS CONSTRUCTED AS SHOWN ON THE "AS-BUILT" PLANS AND MEETS THE APPROVED PLANS AND SPECIFICATIONS.

SIGNATURE: _____ DATE: _____

P.E. NO.: _____

CERTIFY MEANS TO STATE OR DECLARE A PROFESSIONAL OPINION BASED UPON ON-SITE INSPECTIONS AND MATERIAL TESTS WHICH ARE CONDUCTED DURING CONSTRUCTION. THE ON-SITE INSPECTIONS AND MATERIAL TESTS ARE THOSE INSPECTIONS AND TESTS DEEMED SUFFICIENT AND APPROPRIATE COMMONLY ACCEPTED ENGINEERING STANDARDS. CERTIFY DOES NOT MEAN OR IMPLY A GUARANTEE BY THE ENGINEER NOR DOES AN ENGINEER'S CERTIFICATION RELIEVE ANY OTHER PARTY FROM MEETING REQUIREMENTS IMPOSED BY CONTRACT, EMPLOYMENT, OR OTHER MEANS, INCLUDING MEETING COMMONLY ACCEPTED INDUSTRY PRACTICES.

BY THE DEVELOPER:

"I/WE CERTIFY THAT ALL DEVELOPMENT AND/OR CONSTRUCTION WILL BE DONE ACCORDING TO THESE PLANS AND THAT ANY RESPONSIBLE PERSONNEL INVOLVED IN THE CONSTRUCTION PROJECT WILL HAVE A CERTIFICATE OF ATTENDANCE AT A DEPARTMENT OF THE ENVIRONMENT APPROVED TRAINING PROGRAM FOR THE CONTROL OF SEDIMENT AND EROSION BEFORE BEGINNING THE PROJECT. I SHALL ENGAGE A REGISTERED PROFESSIONAL ENGINEER TO SUPERVISE POND CONSTRUCTION AND PROVIDE THE HOWARD SOIL CONSERVATION DISTRICT WITH AN "AS-BUILT" PLAN OF THE POND WITHIN 30 DAYS OF COMPLETION. I ALSO AUTHORIZE PERIODIC ON-SITE INSPECTIONS BY THE HOWARD SOIL CONSERVATION DISTRICT."

SIGNATURE OF DEVELOPER: *Bruce Taylor* DATE: 12/6/01

PRINTED NAME OF DEVELOPER: Bruce Taylor, P.E.

BY THE ENGINEER:

"I CERTIFY THAT THIS PLAN FOR POND CONSTRUCTION, EROSION AND SEDIMENT CONTROL, REPRESENTS A PRACTICAL AND WORKABLE PLAN BASED ON MY PERSONAL KNOWLEDGE OF THE SITE AND CONDITIONS. THIS PLAN WAS PREPARED IN ACCORDANCE WITH THE HOWARD SOIL CONSERVATION DISTRICT. I HAVE NOTICED THE DEVELOPER'S OBLIGATION TO ENGAGE A REGISTERED PROFESSIONAL ENGINEER TO SUPERVISE POND CONSTRUCTION AND PROVIDE THE HOWARD SOIL CONSERVATION DISTRICT WITH AN "AS-BUILT" PLAN OF THE POND WITHIN 30 DAYS OF COMPLETION."

SIGNATURE OF ENGINEER: *[Signature]* DATE: 12/6/01

PRINTED NAME OF ENGINEER: _____

THESE PLANS HAVE BEEN REVIEWED FOR THE HOWARD SOIL CONSERVATION DISTRICT AND MEET THE TECHNICAL REQUIREMENTS FOR SMALL POND CONSTRUCTION, SOIL EROSION AND SEDIMENT CONTROL.

USA - NATURAL RESOURCES CONSERVATION SERVICE DATE: 12/18/01

THESE PLANS FOR SMALL POND CONSTRUCTION, SOIL EROSION AND SEDIMENT CONTROL MEET THE REQUIREMENTS OF THE HOWARD SOIL CONSERVATION DISTRICT.

HOWARD SOIL CONSERVATION DISTRICT DATE: 12/18/01

APPROVED: DEPARTMENT OF PUBLIC WORKS DATE: 1-30-02

APPROVED: DEPARTMENT OF PLANNING AND ZONING DATE: 2/3/02

APPROVED: CHIEF, DIVISION OF LAND DEVELOPMENT DATE: 12/20/01

OWNER/DEVELOPER

BONNIE BRANCH CORPORATION
P.O. BOX 396
ELLCOTT CITY, MD 21043

project	DEC 2001	date	
illustration	98072	engineering	MMP
scale	MMP	approval	AS SHOWN
no.		revisions	

AUTUMN VIEW SECTION 5, PHASE 1

LOTS: 211-259

TAX MAP 25 & 31, P/O PARCEL 4 & 75

HOWARD COUNTY, MARYLAND

SECOND ELECTION DISTRICT


SWM PLAN, PROFILES AND DETAILS, POND #3

MILDENBERG, BOENDER & ASSOC., INC.

Engineers Planners Surveyors


5072 Dorsey Hall Drive, Suite 202, Ellicott City, Maryland 21042

(410) 997-0296 Fax (301) 621-5521 Wash. (410) 997-0298 Fax

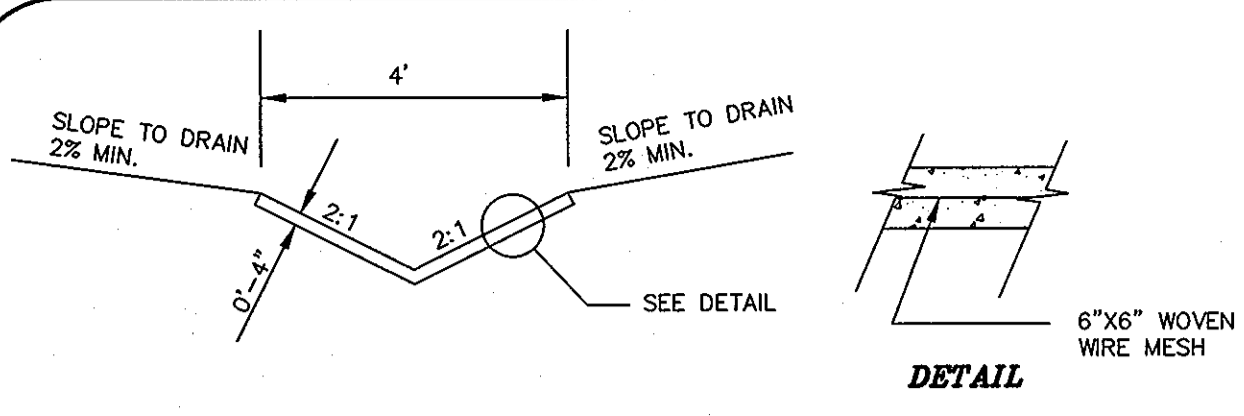


DETAIL OF PILOT CHANNEL

N.T.S.

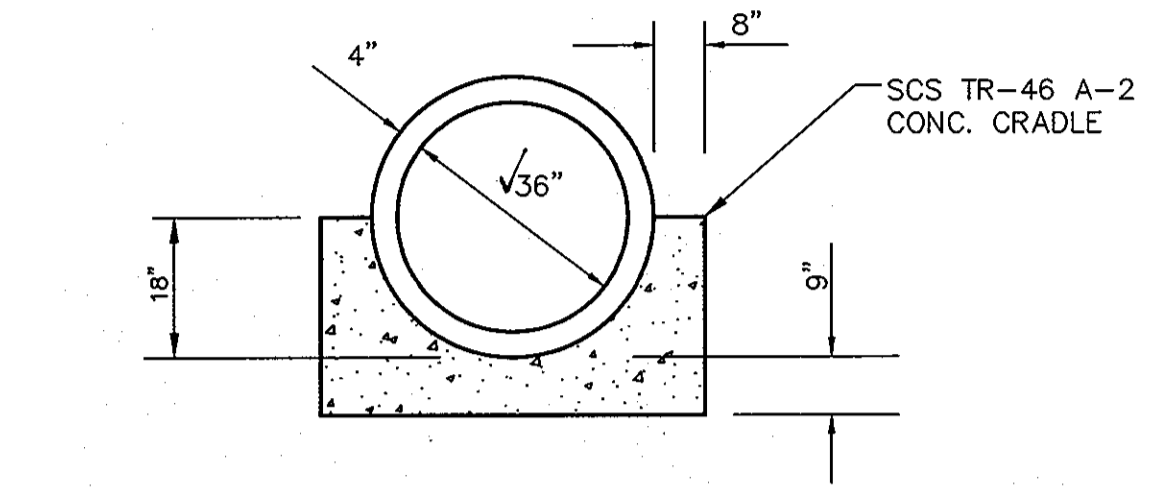


DETAIL OF CONCRETE CRADLE

N.T.S.

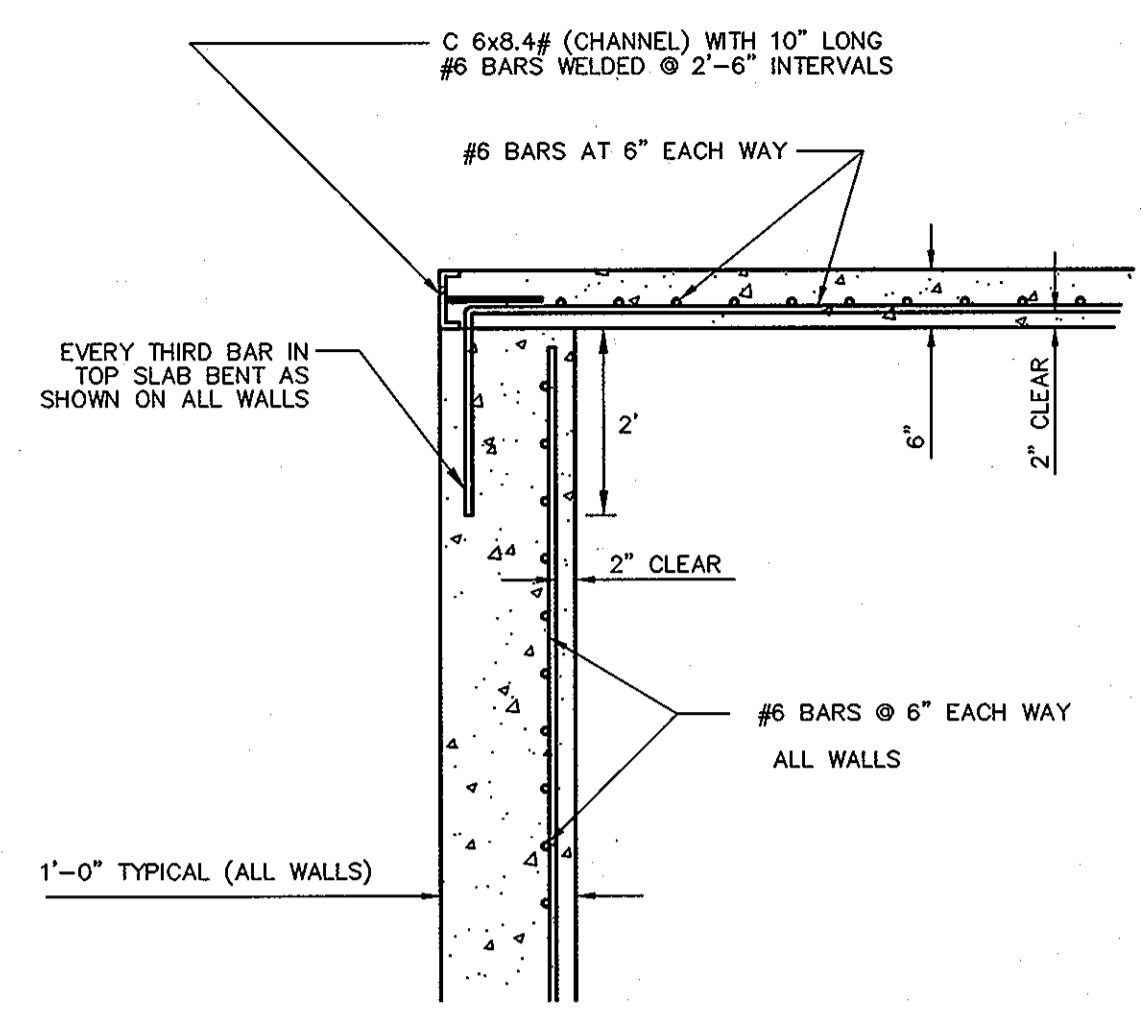


DETAIL B

N.T.S.

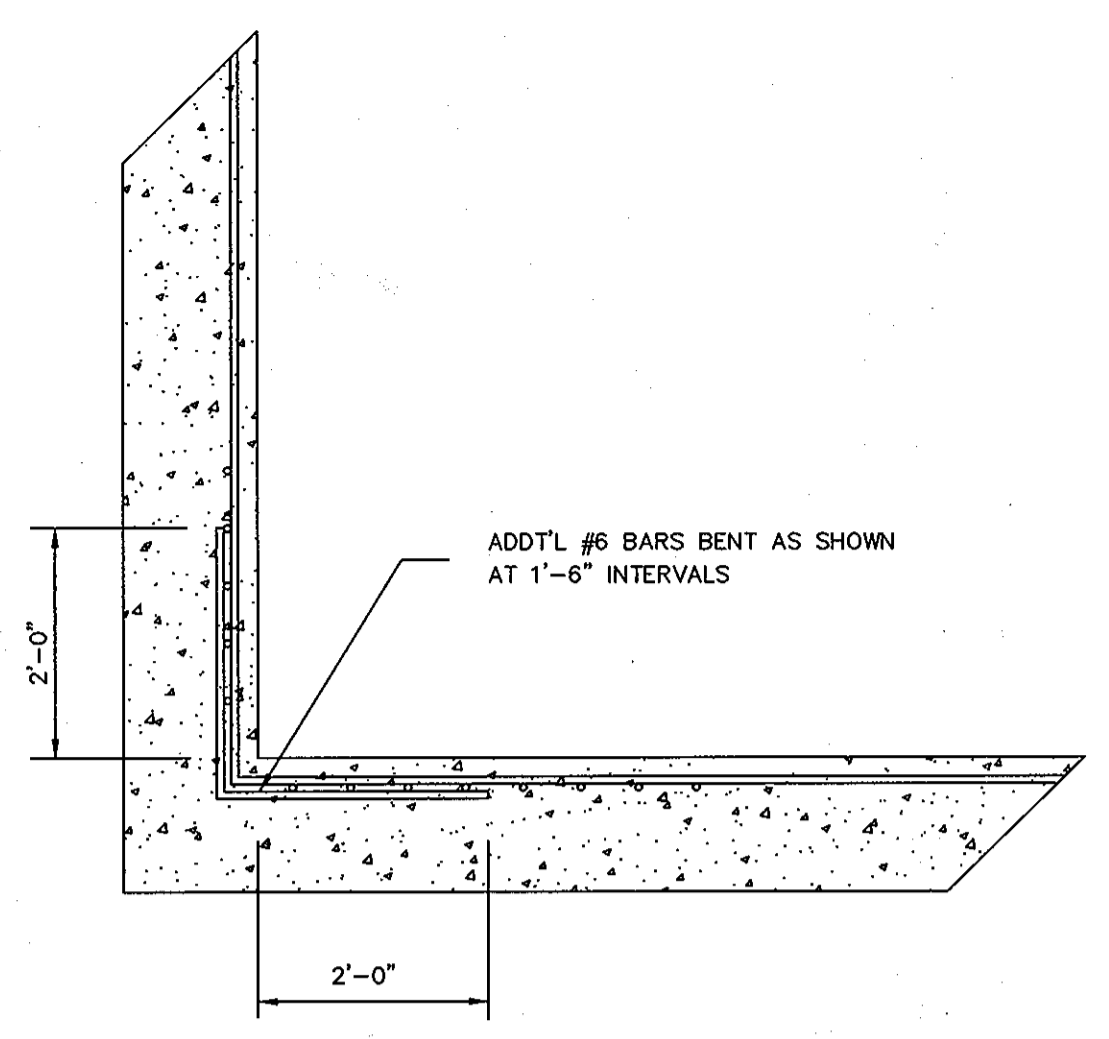

CORNER TREATMENT DETAIL C


N.T.S.

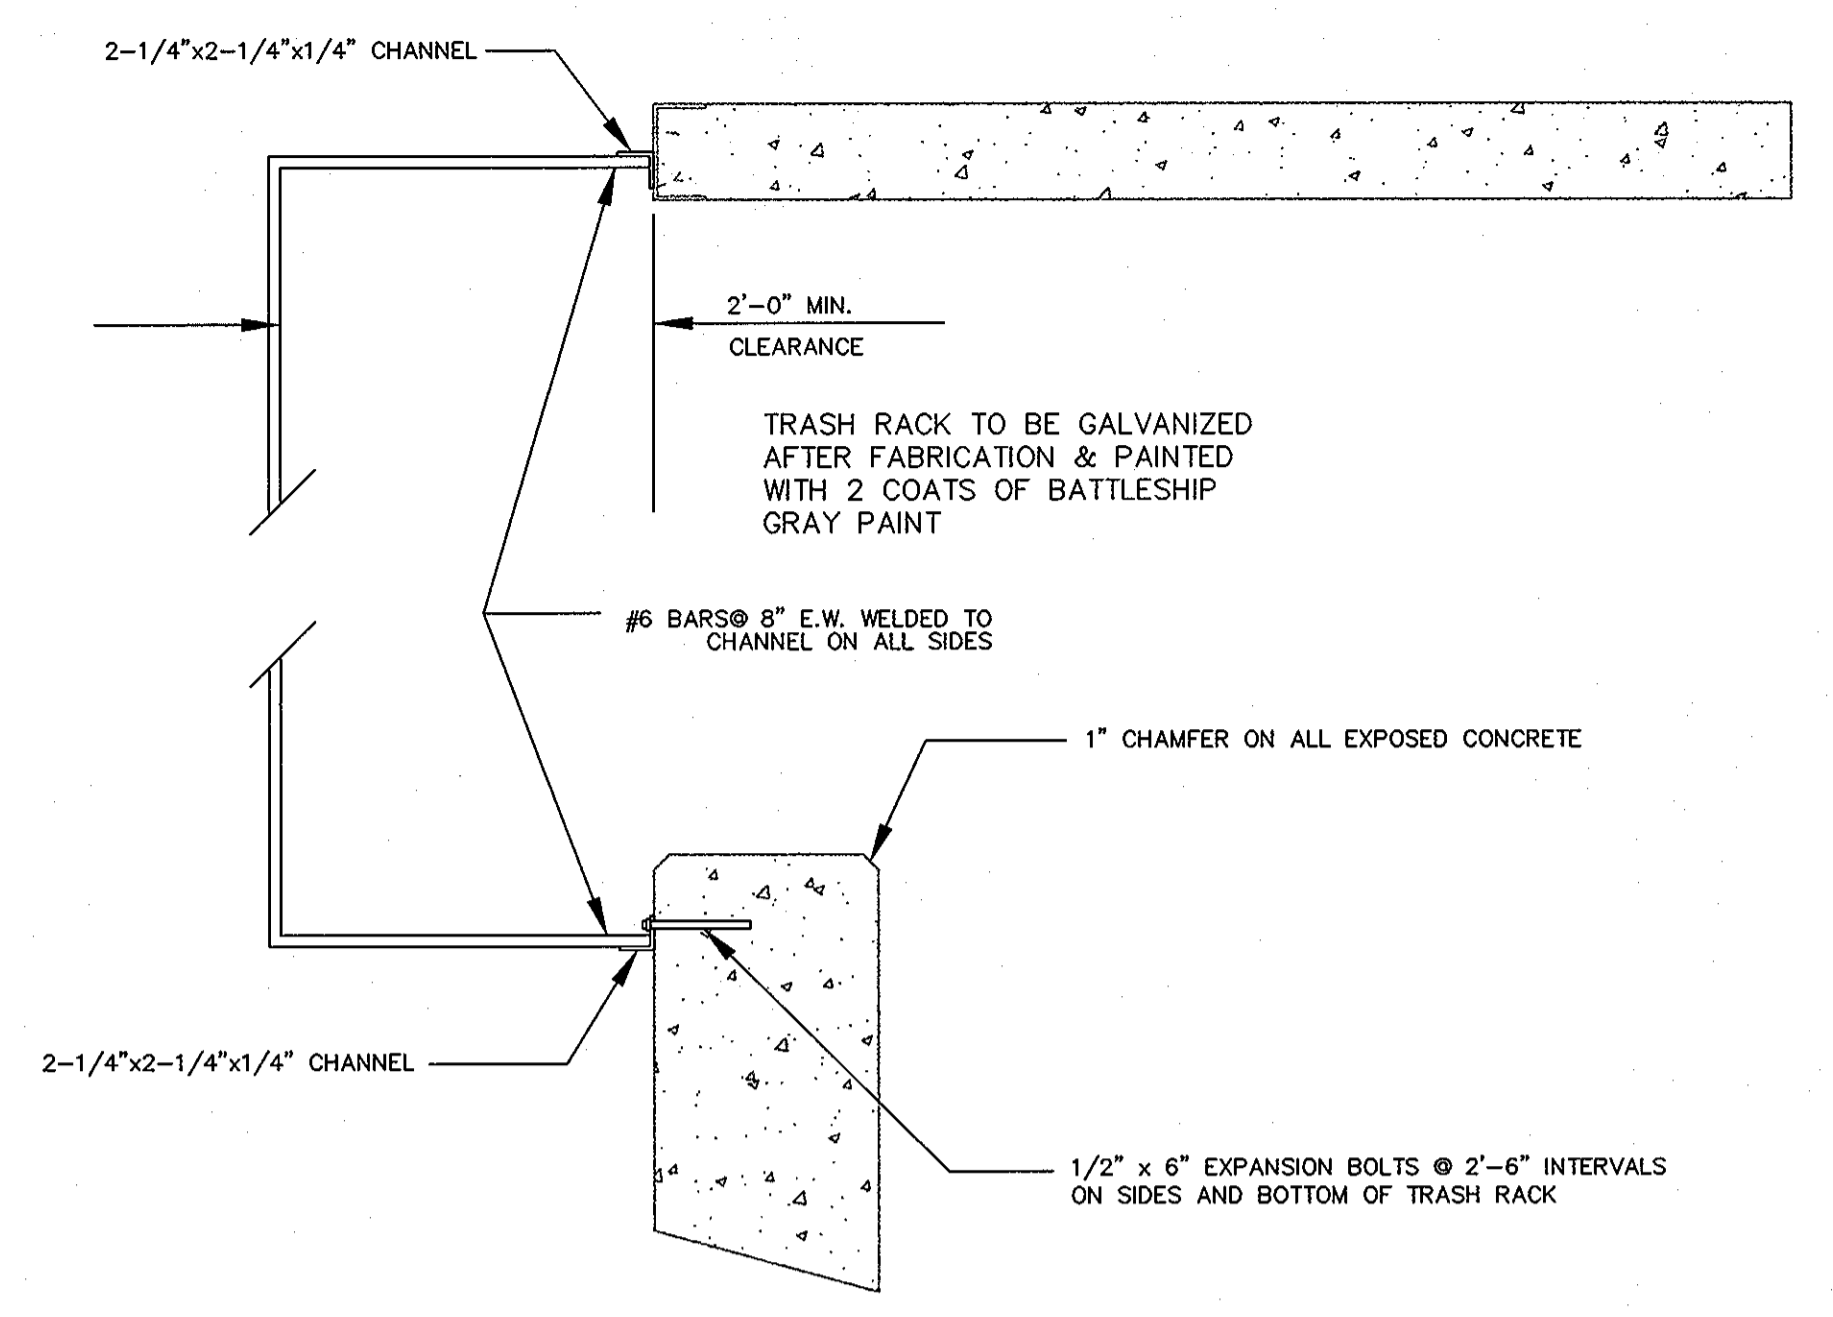

SECTION 3


N.T.S.

	POND # 2	POND # 3
A	8'-5"	8'-11"
B	9'-0"	9'-6"
C	2'-0"	2'-3"
D	2'-0"	2'-3"

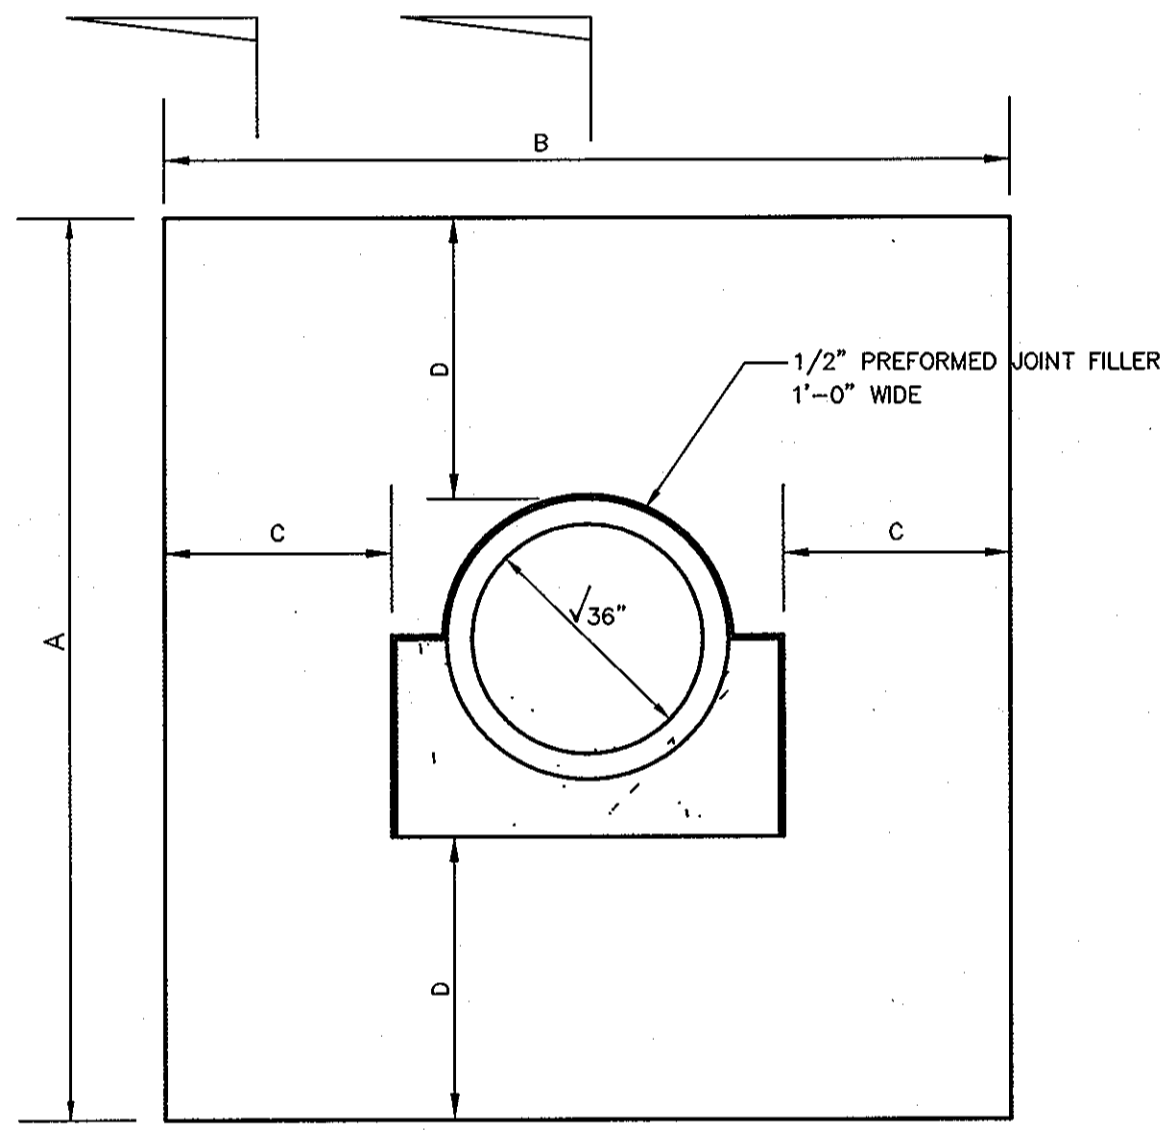


ANTI-SEEP COLLAR DETAIL D

N.T.S.

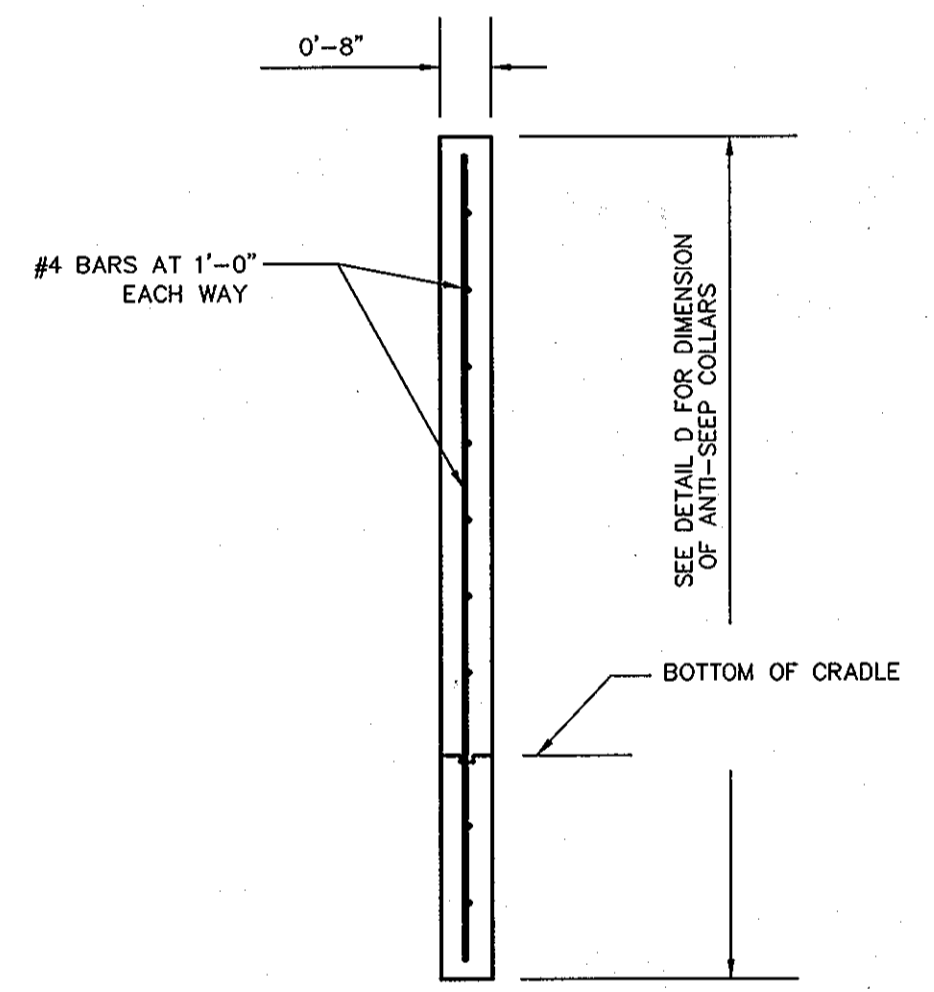

SECTION 4

N.T.S.

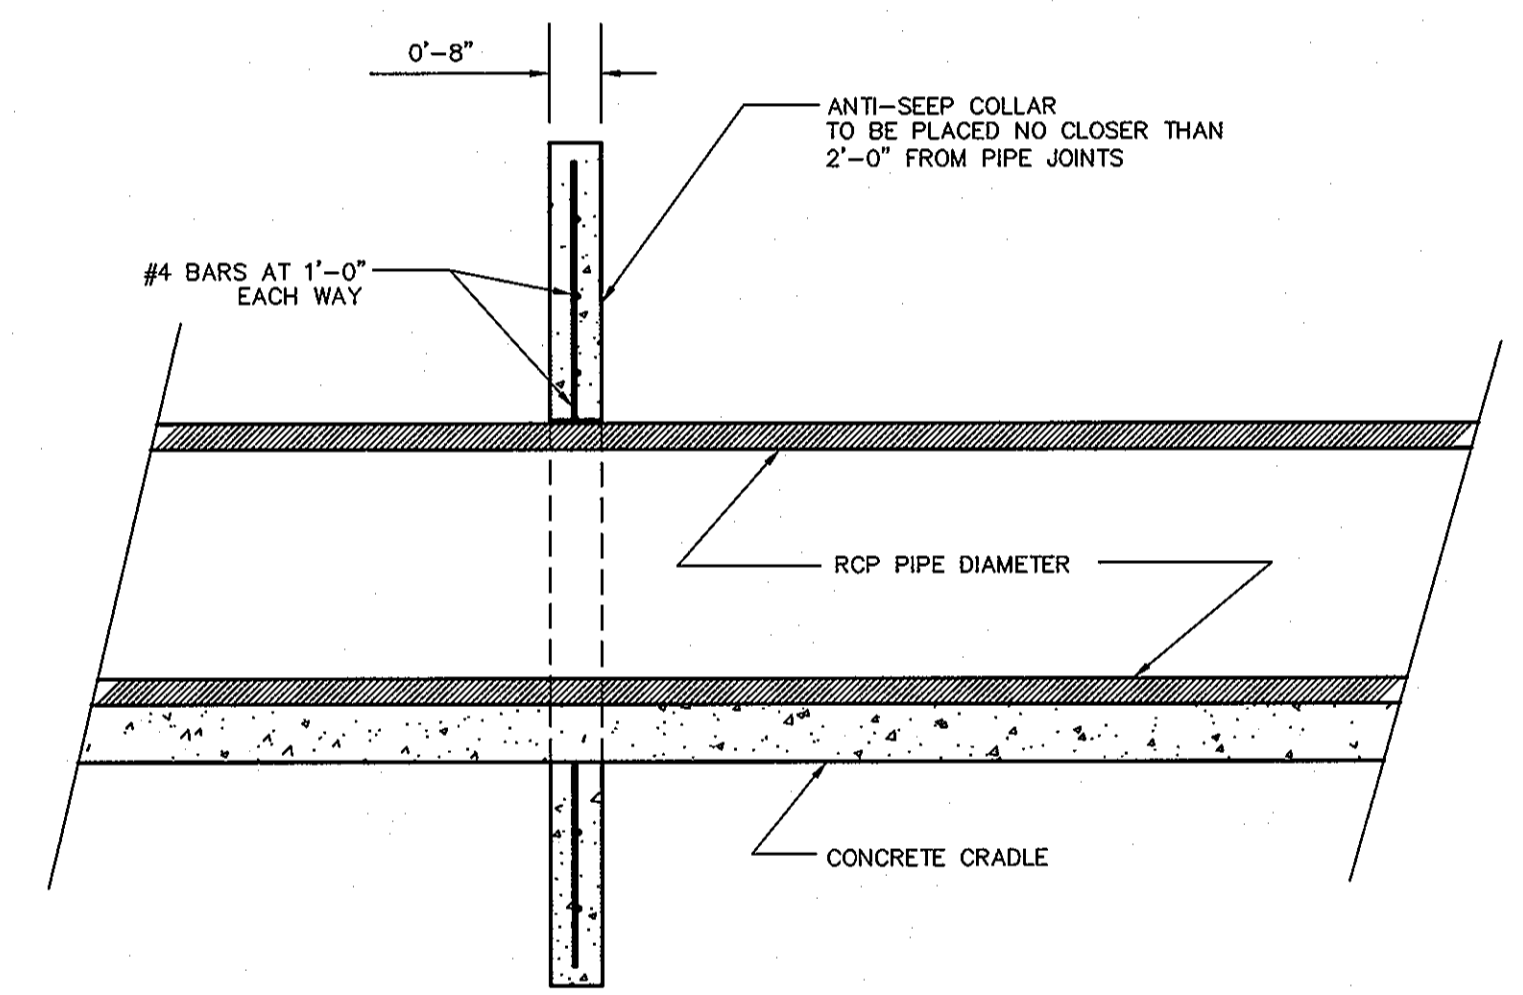

SECTION 5

N.T.S.

AS-BUILT CERTIFICATION
I HEREBY CERTIFY THAT THE FACILITY SHOWN ON THIS PLAN WAS CONSTRUCTED AS SHOWN ON THE "AS-BUILT" PLANS AND MEETS THE APPROVED PLANS AND SPECIFICATIONS.
SIGNATURE: *[Signature]* P.E. NO. 13224
DATE: 1/6/01

CERTIFY MEANS TO START OR DECLARE A PROFESSIONAL OPINION BASED UPON ON-SITE INSPECTIONS AND MATERIAL TESTS WHICH ARE CONDUCTED DURING CONSTRUCTION. THE ON-SITE INSPECTIONS AND MATERIAL TESTS ARE THOSE INSPECTIONS AND TESTS DEEMED SUFFICIENT AND APPROPRIATE COMMONLY ACCEPTED ENGINEERING STANDARDS. CERTIFY DOES NOT MEAN OR IMPLY A GUARANTEE BY THE ENGINEER NOR DOES ENGINEER'S CERTIFICATION RELIEVE ANY OTHER PARTY FROM MEETING REQUIREMENTS IMPOSED BY CONTRACT, EMPLOYMENT, OR OTHER MEANS, INCLUDING MEETING COMMONLY ACCEPTED INDUSTRY PRACTICES.

BY THE DEVELOPER:
I/WE CERTIFY THAT ALL DEVELOPMENT AND/OR CONSTRUCTION WILL BE DONE ACCORDING TO THESE PLANS, AND THAT ANY RESPONSIBLE PERSONNEL INVOLVED IN THE CONSTRUCTION PROJECT WILL HAVE A CERTIFICATE OF ATTENDANCE AT A DEPARTMENT OF THE ENVIRONMENT APPROVED TRAINING PROGRAM FOR THE CONTROL OF SEDIMENT AND EROSION BEFORE BEGINNING THE PROJECT. I SHALL ENGAGE A REGISTERED PROFESSIONAL ENGINEER TO SUPERVISE POND CONSTRUCTION AND PROVIDE THE HOWARD SOIL CONSERVATION DISTRICT WITH AN "AS-BUILT" PLAN OF THE POND WITHIN 30 DAYS OF COMPLETION. I ALSO AUTHORIZE PERIODIC ON-SITE INSPECTIONS BY THE HOWARD SOIL CONSERVATION DISTRICT.
SIGNATURE OF DEVELOPER: *[Signature]* DATE: 12/6/01
PRINTED NAME OF DEVELOPER: Bruce Taylor Pres

BY THE ENGINEER:
I CERTIFY THAT THIS PLAN FOR POND CONSTRUCTION, EROSION AND SEDIMENT CONTROL, REPRESENTS A PRACTICAL AND WORKABLE PLAN BASED ON MY PERSONAL KNOWLEDGE OF THE SITE CONDITIONS. THIS PLAN WAS PREPARED IN ACCORDANCE WITH THE REQUIREMENTS OF THE HOWARD SOIL CONSERVATION DISTRICT. I HAVE NOTICED THE DEVELOPER THAT HE/SHE MUST ENGAGE A REGISTERED PROFESSIONAL ENGINEER TO SUPERVISE POND CONSTRUCTION AND PROVIDE THE HOWARD SOIL CONSERVATION DISTRICT WITH AN "AS-BUILT" PLAN OF THE POND WITHIN 30 DAYS OF COMPLETION.
SIGNATURE OF ENGINEER: *[Signature]* DATE: 12/6/01
PRINTED NAME OF ENGINEER: [Name]


THESE PLANS HAVE BEEN REVIEWED FOR THE HOWARD SOIL CONSERVATION DISTRICT AND MEET THE TECHNICAL REQUIREMENTS FOR SMALL POND CONSTRUCTION, SOIL EROSION AND SEDIMENT CONTROL.
USDA - NATURAL RESOURCES CONSERVATION SERVICE DATE: 12/18/01

THESE PLANS FOR SMALL POND CONSTRUCTION, SOIL EROSION AND SEDIMENT CONTROL MEET THE REQUIREMENTS OF THE HOWARD SOIL CONSERVATION DISTRICT.
HOWARD SOIL CONSERVATION DISTRICT DATE: 12/18/01

APPROVED: DEPARTMENT OF PUBLIC WORKS
DATE: 1/30/02

APPROVED: DEPARTMENT OF PLANNING AND ZONING
DATE: 2/5/02


DATE: 12/28/01

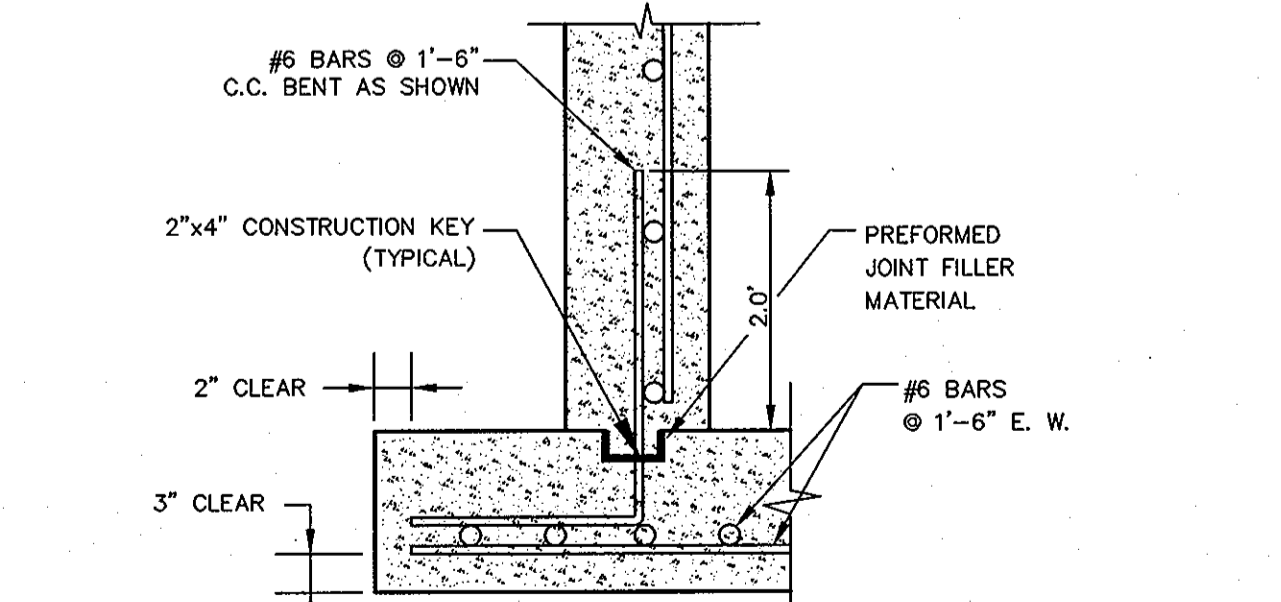

WALL TO BOTTOM SLAB CONNECTION DETAIL


N.T.S.

OWNER/DEVELOPER
BONNIE BRANCH CORPORATION
P.O. BOX 396
ELLCOTT CITY, MD 21043

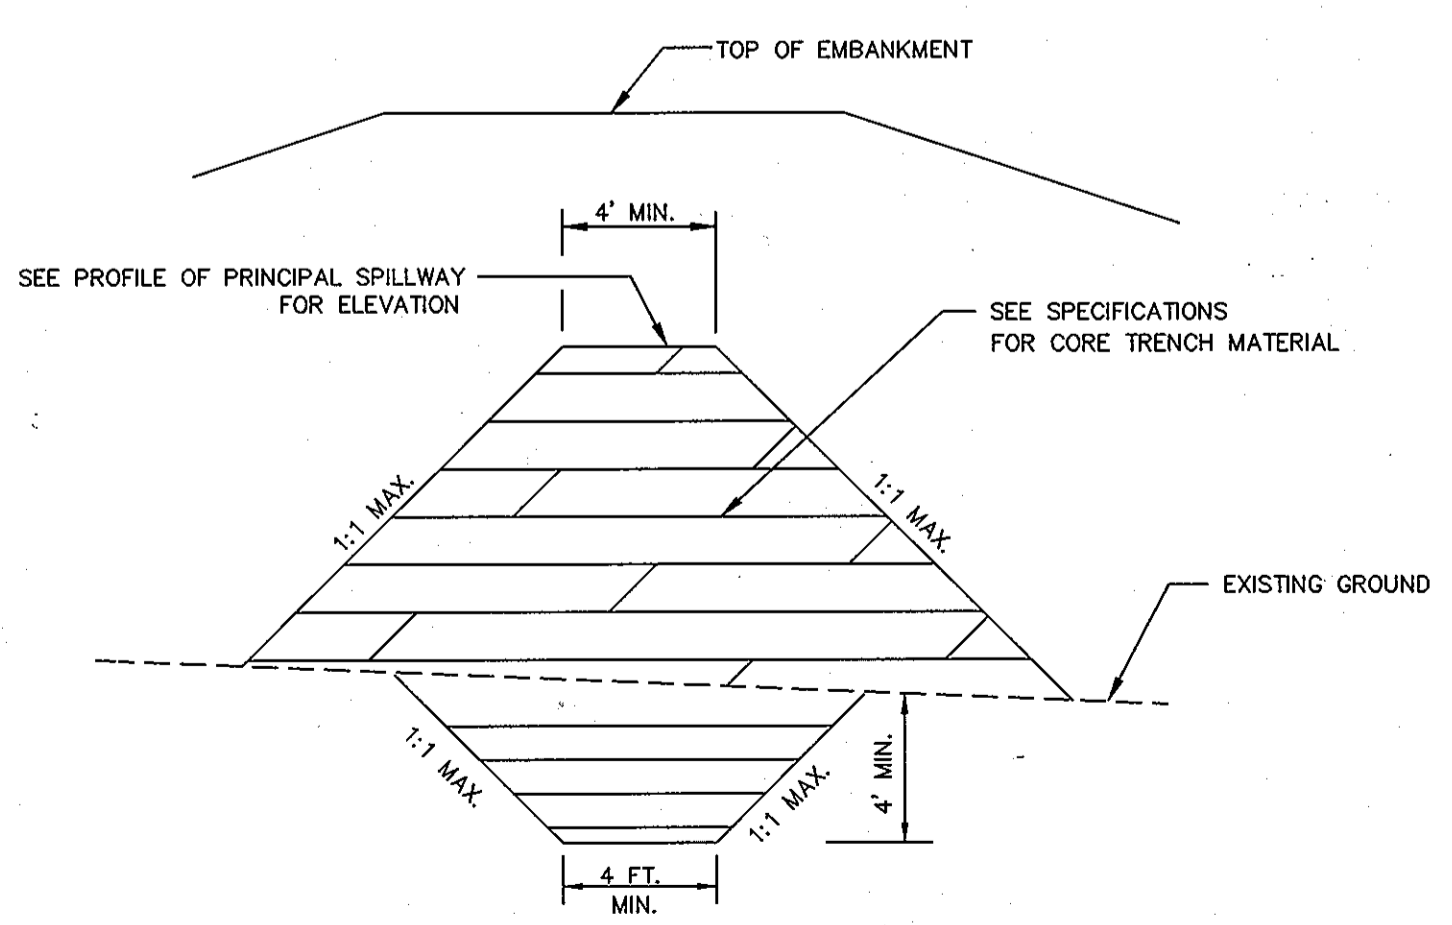


CORE TRENCH DETAIL

N.T.S.

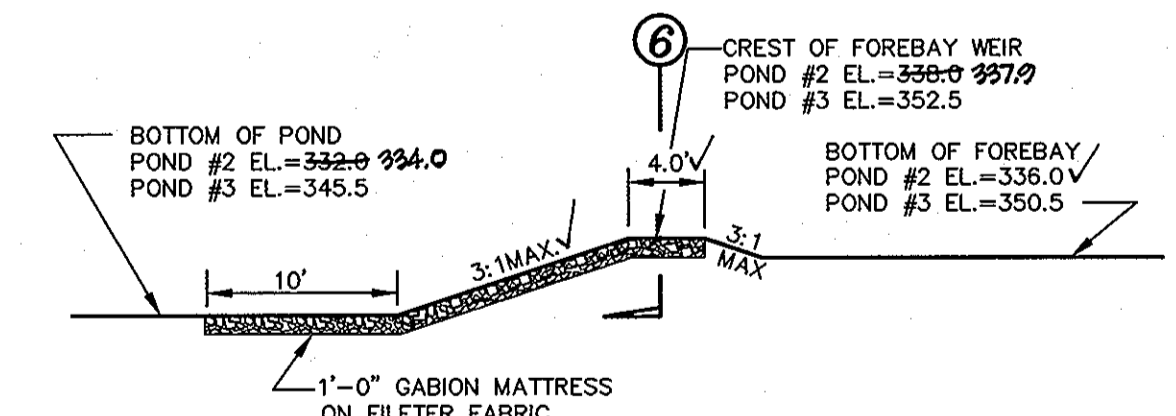


DETAIL OF FOREBAY WEIR

N.T.S.

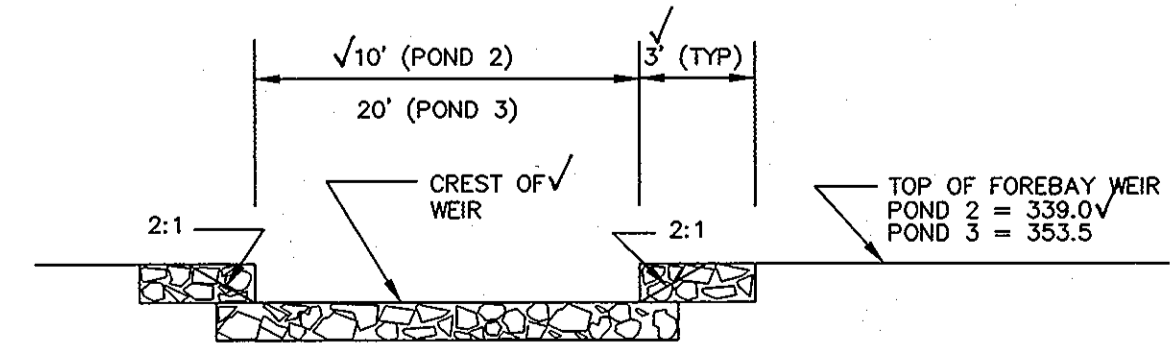

FOREBAY WEIR SECTION 6

N.T.S.

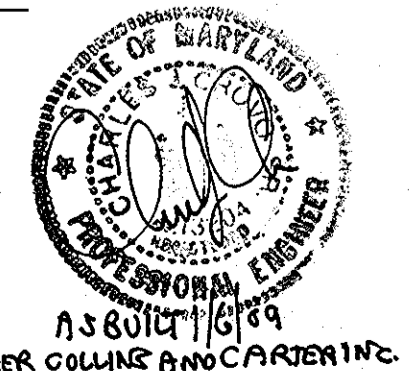


Project	Date	Illustration	Scale	Approval
99072	DBC 2001	M&P	M&P	JBM


Revisions	Date	Description
1	1/6/02	AS-BUILT

AUTUMN VIEW, SECTION 5, PHASE 1
LOTS: 211-259
TAX MAP 25 & 31, P/O PARCEL 75
SECOND ELECTION DISTRICT
HOWARD COUNTY, MARYLAND
STORMWATER MANAGEMENT DETAILS


MILDENBERG, BOENDER & ASSOC., INC.
Engineers Planners Surveyors
5072 Borsley Hall Drive, Suite 202, Ellicott City, Maryland 21042
(410) 997-0298 Fax (410) 997-0298

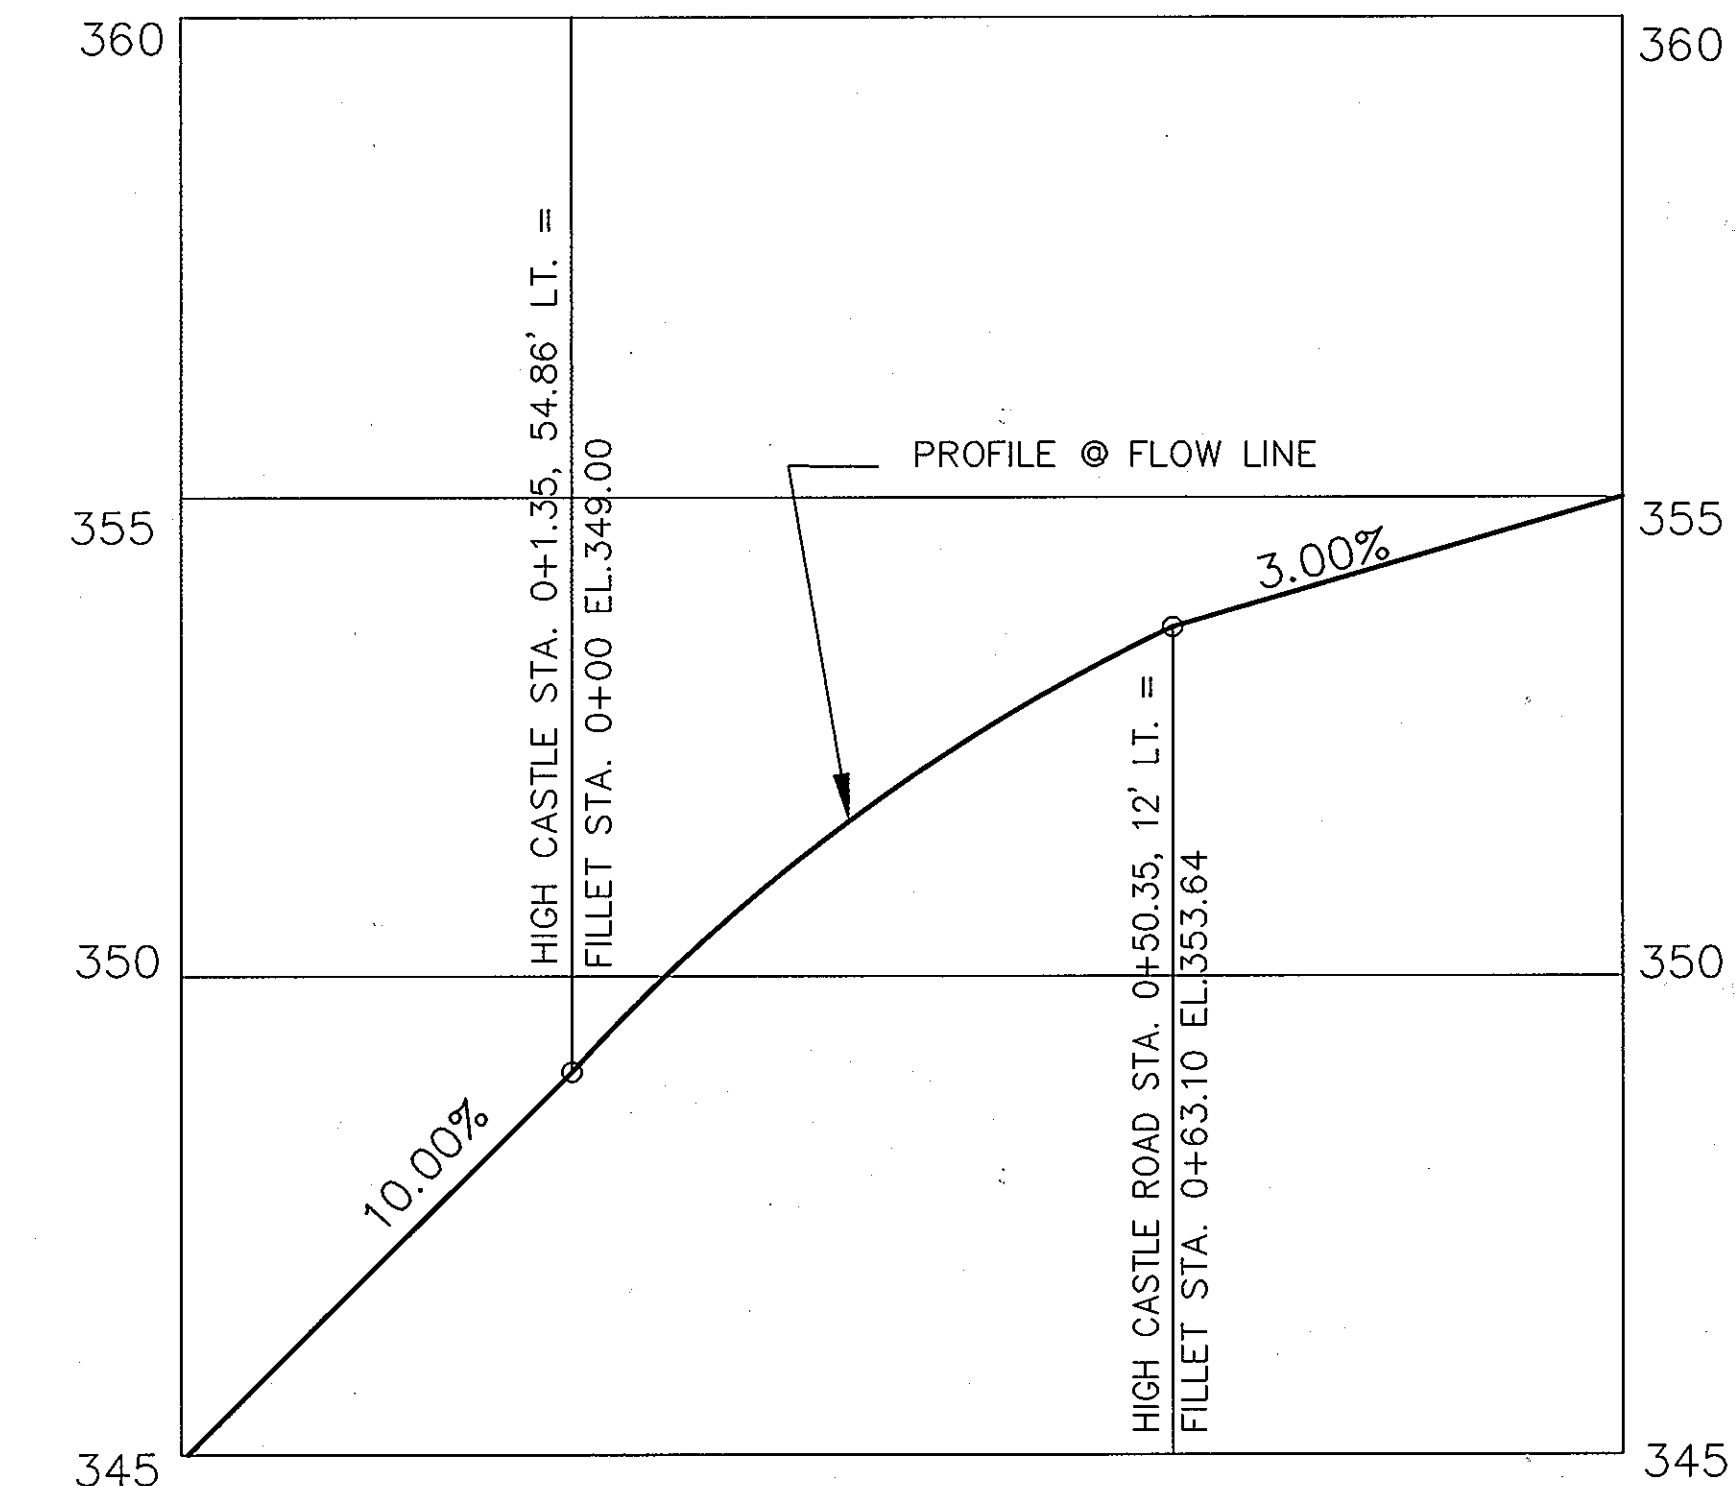


COLLEGE AVENUE LEFT TURN TO HIGH CASTLE ROAD
SCALE: HOR. 1" = 20', VER 1" = 2'

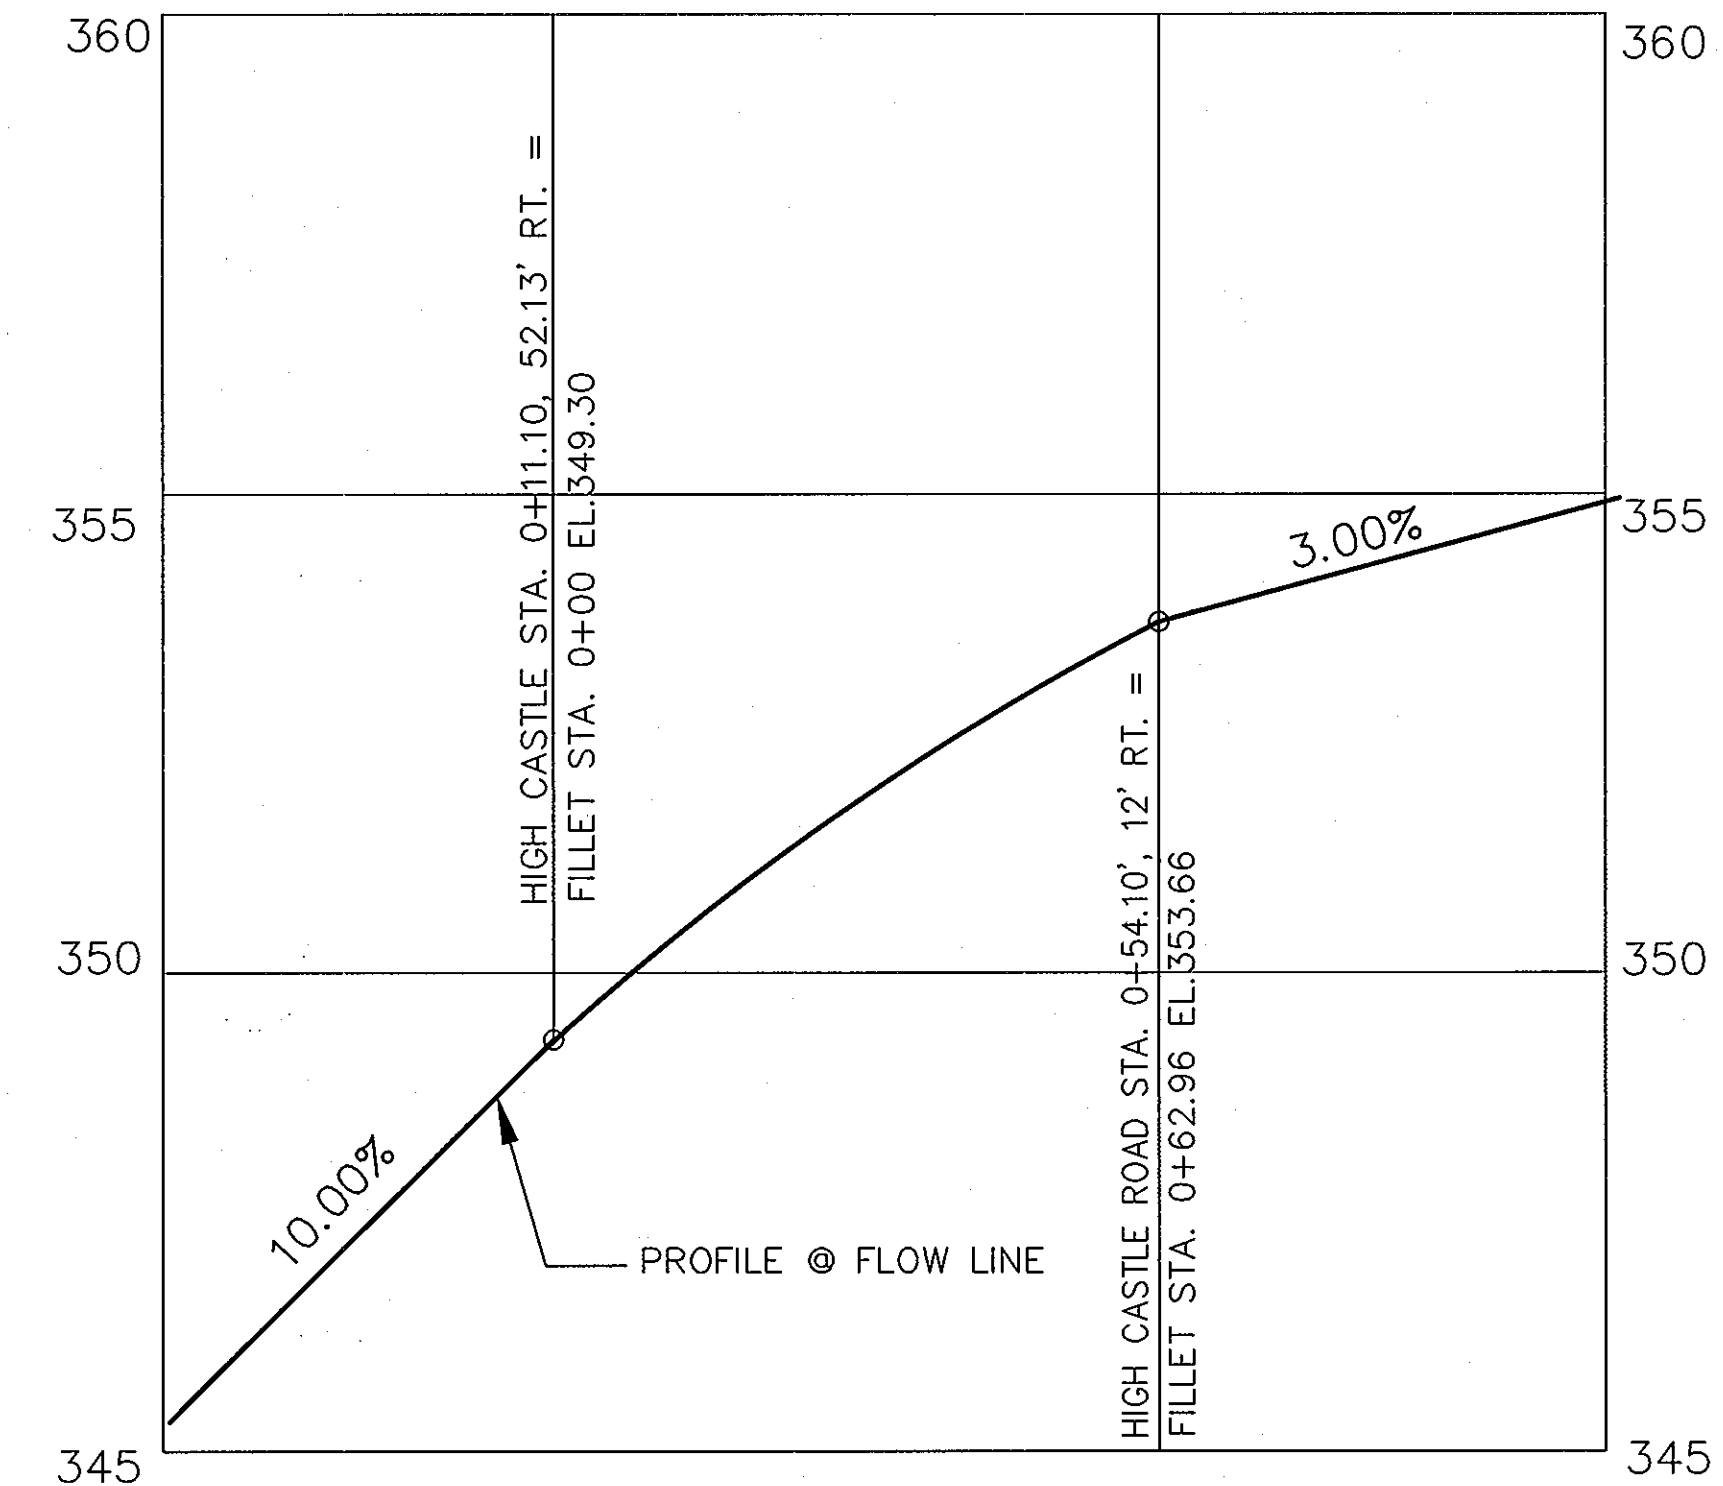

COLLEGE AVENUE RIGHT TURN TO HIGH CASTLE ROAD
SCALE: HOR. 1" = 20', VER 1" = 2'

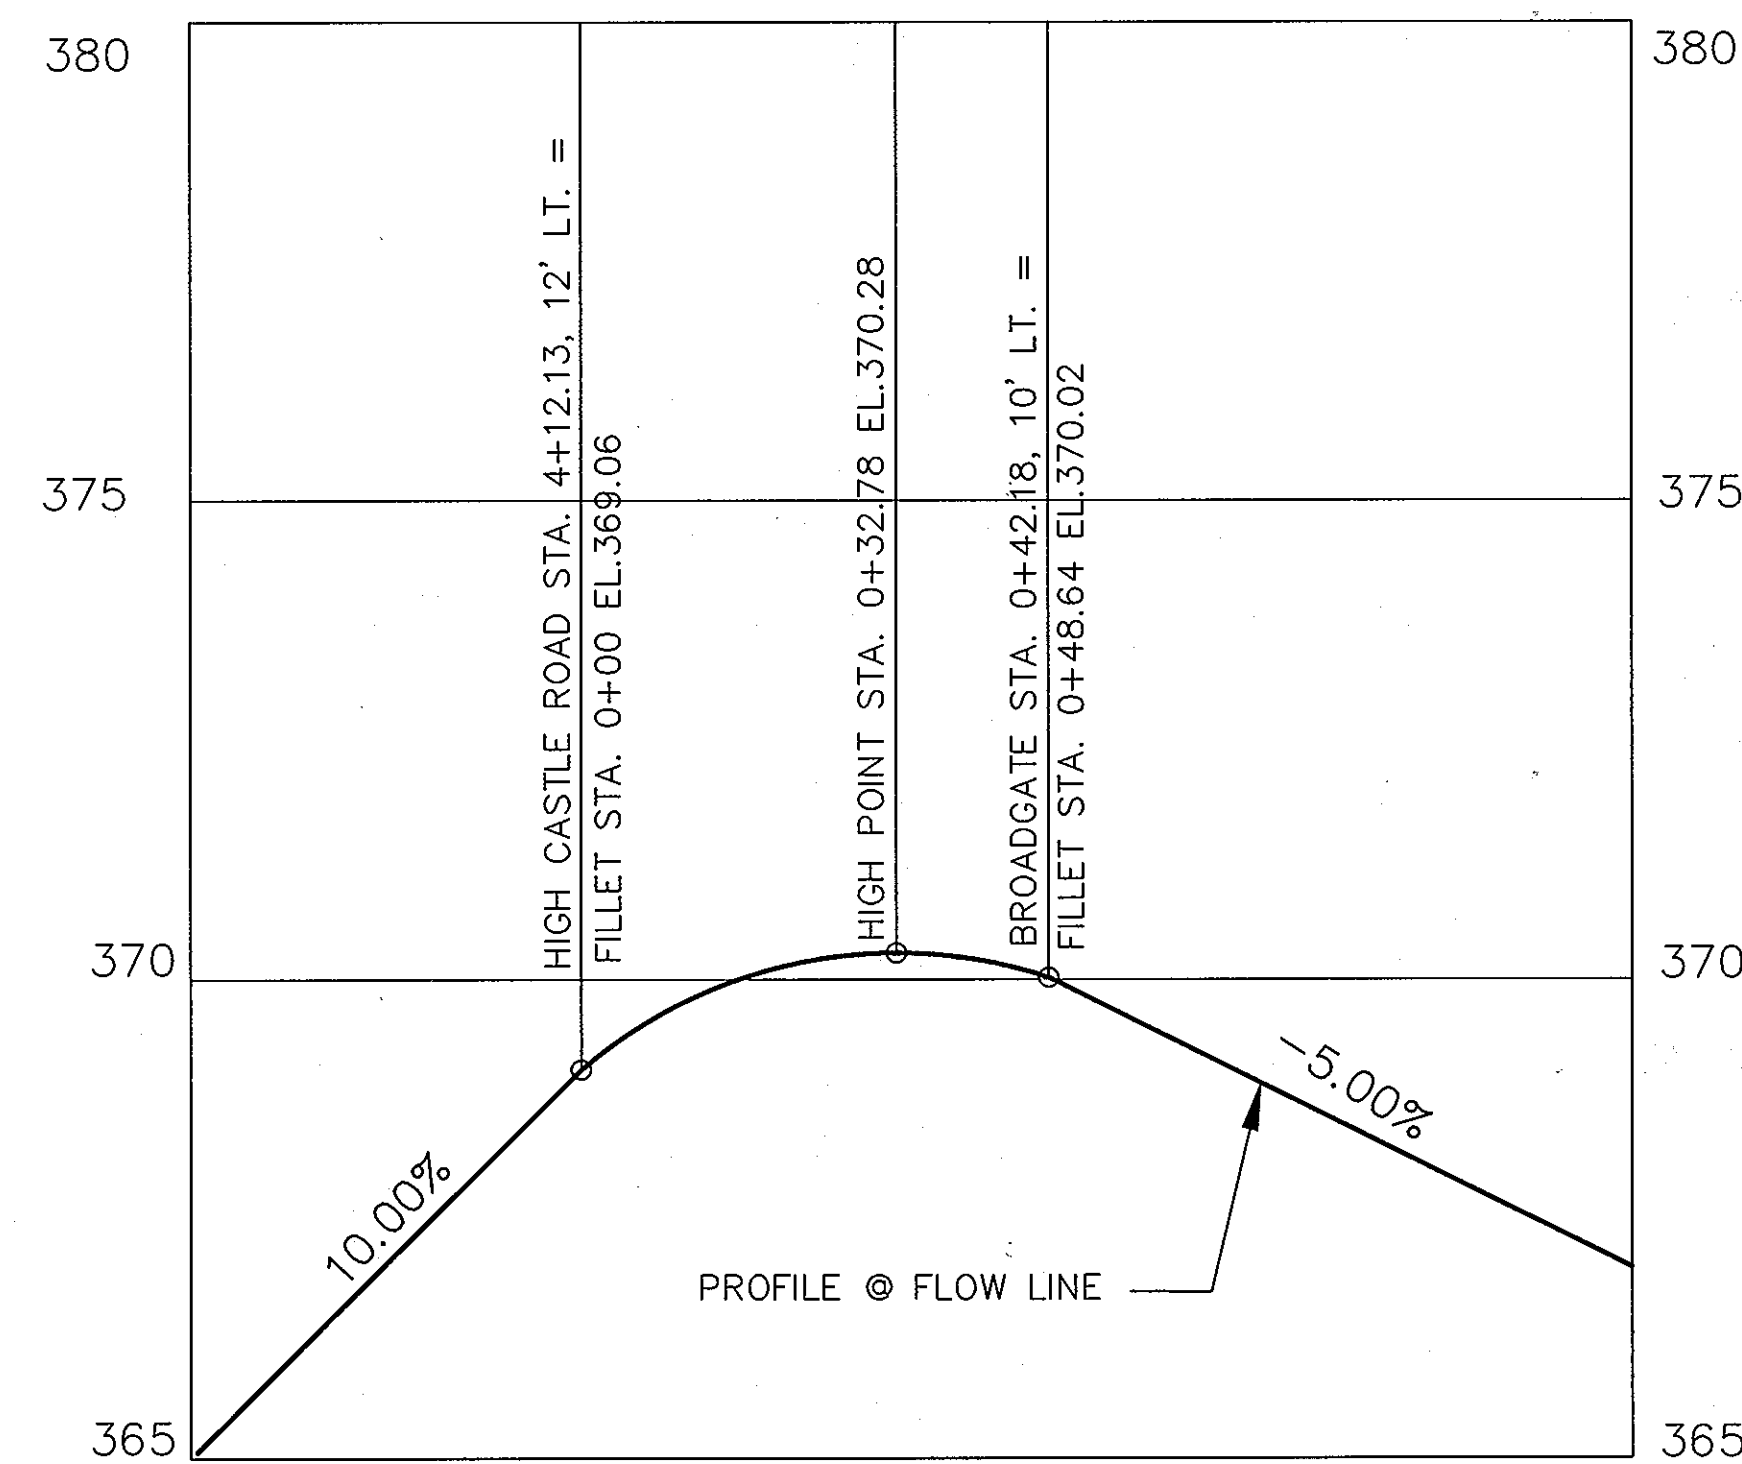

HIGH CASTLE ROAD LEFT TURN TO BROADGATE CIRCLE
SCALE: HOR. 1" = 20', VER 1" = 2'

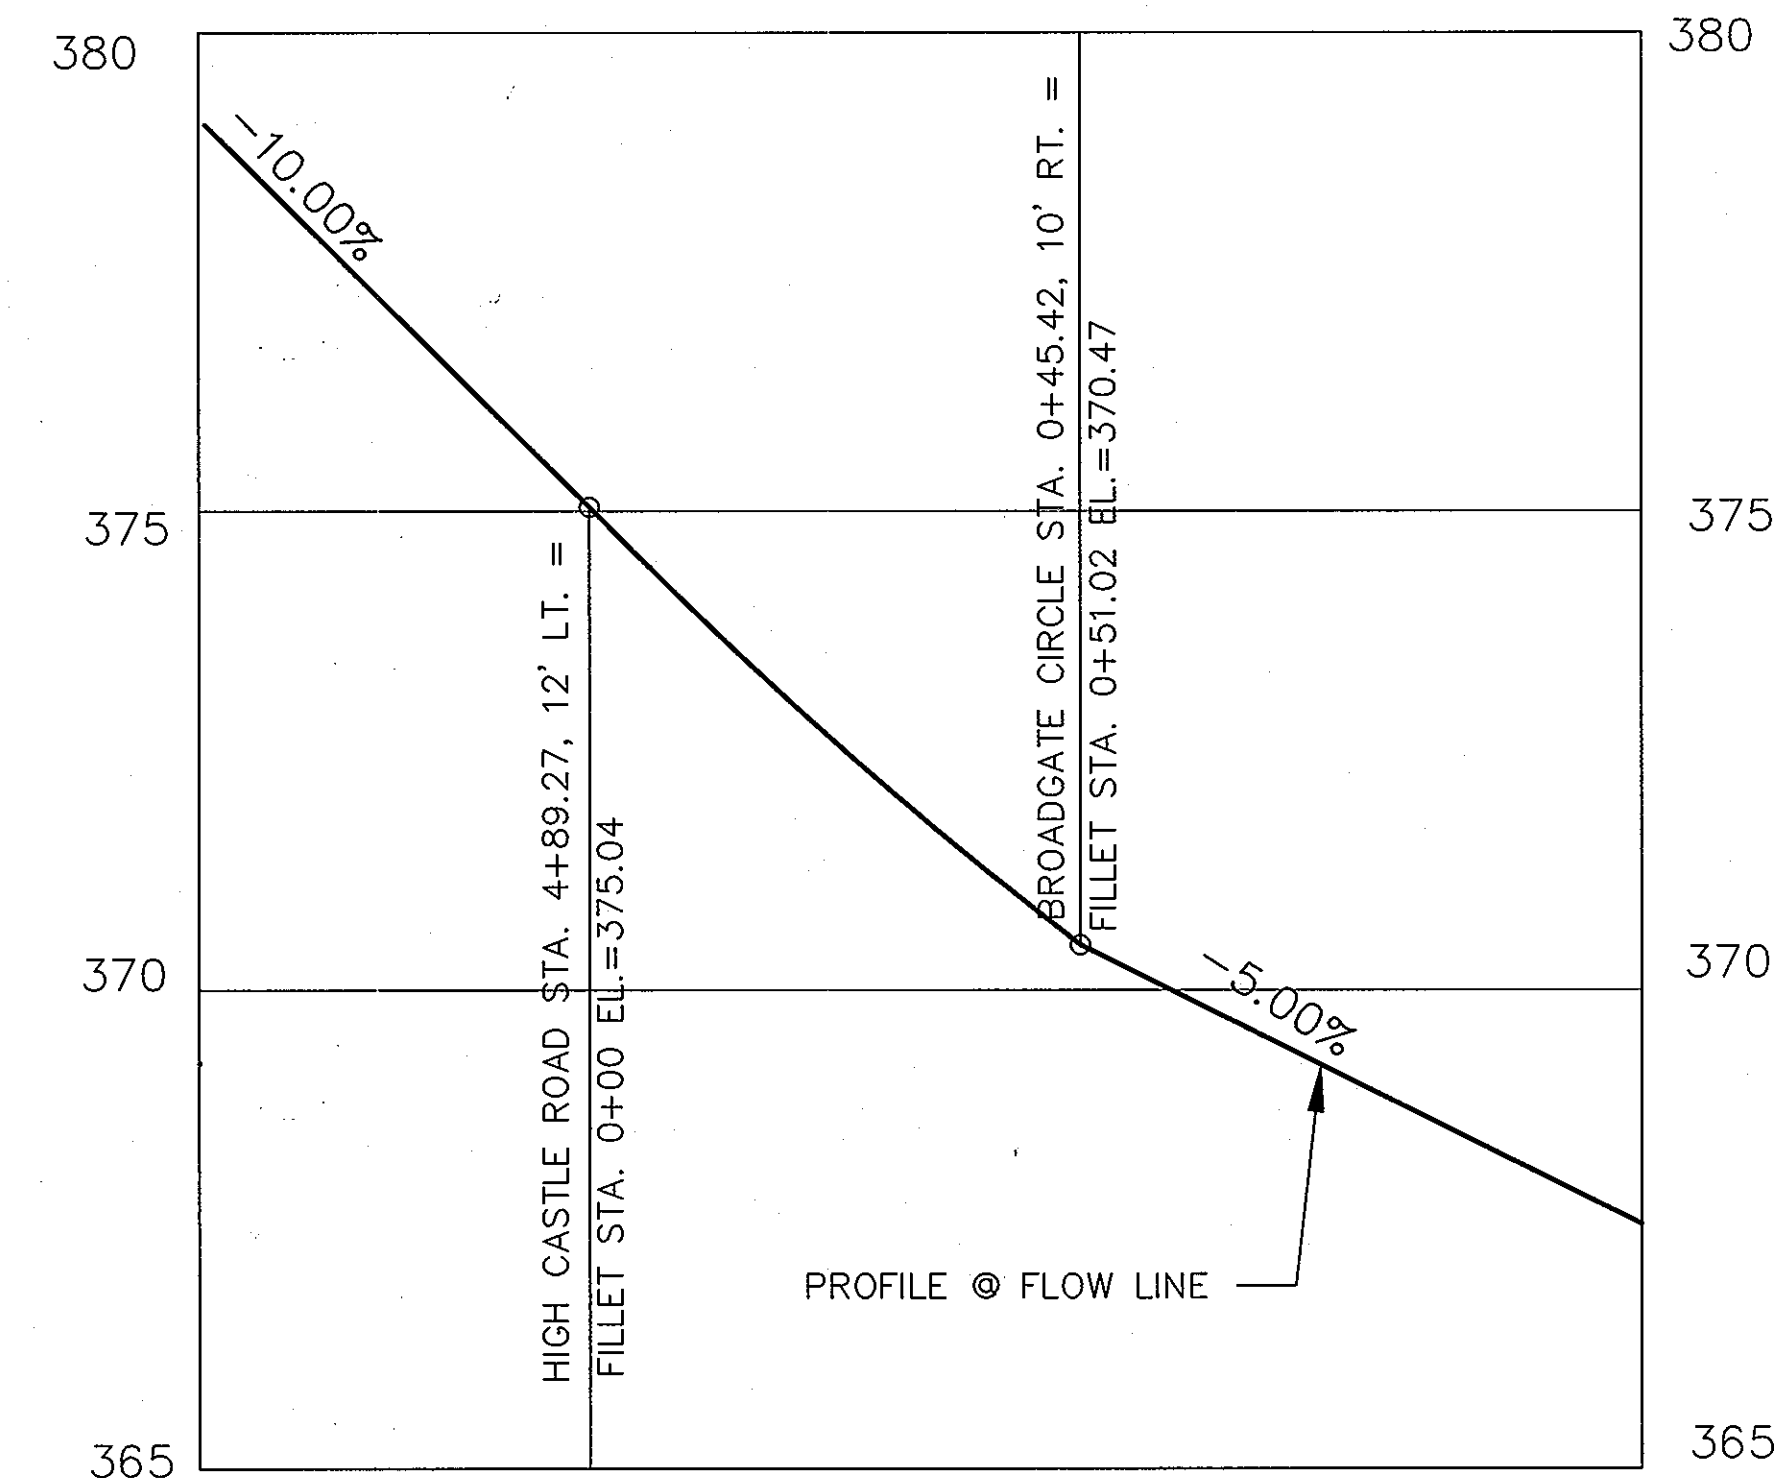

HIGH CASTLE ROAD RIGHT TURN TO BROADGATE CIRCLE
SCALE: HOR. 1" = 20', VER 1" = 2'

OWNER/DEVELOPER

BONNIE BRANCH CORPORATION
P.O. BOX 396
ELLICOTT CITY, MD 21043

APPROVED: DEPARTMENT OF PUBLIC WORKS
Richard M. Coughlin 1-30-02
CHIEF BUREAU OF HIGHWAYS DATE

APPROVED: DEPARTMENT OF PLANNING AND ZONING
Cinda Harsh 2/3/02
CHIEF, DIVISION OF LAND DEVELOPMENT DATE


Michael J. ... 12/28/01
CHIEF, DEVELOPMENT ENGINEERING DIVISION P1A3 DATE

project	99072	date	DEC-2001
illustration	SAA	engineering	SAA
scale	AS SHOWN	approval	IBM

no.	description	revisions	date

AUTUMN VIEW SECTION 5, PHASE 1
LOTS: 211-259
TAX MAP 25 & 31, P/O PARCEL 75
HOWARD COUNTY, MARYLAND
SECOND ELECTION DISTRICT
FILLET PROFILES

MILDENBERG, BOENDER & ASSOC., INC.
Engineers Planners Surveyors
5072 Dorsey Hall Drive, Suite 202, Ellicott City, Maryland, 21042
(410) 997-0296 Fax: (301) 621-5521 Wash. (410) 997-0298 Fax

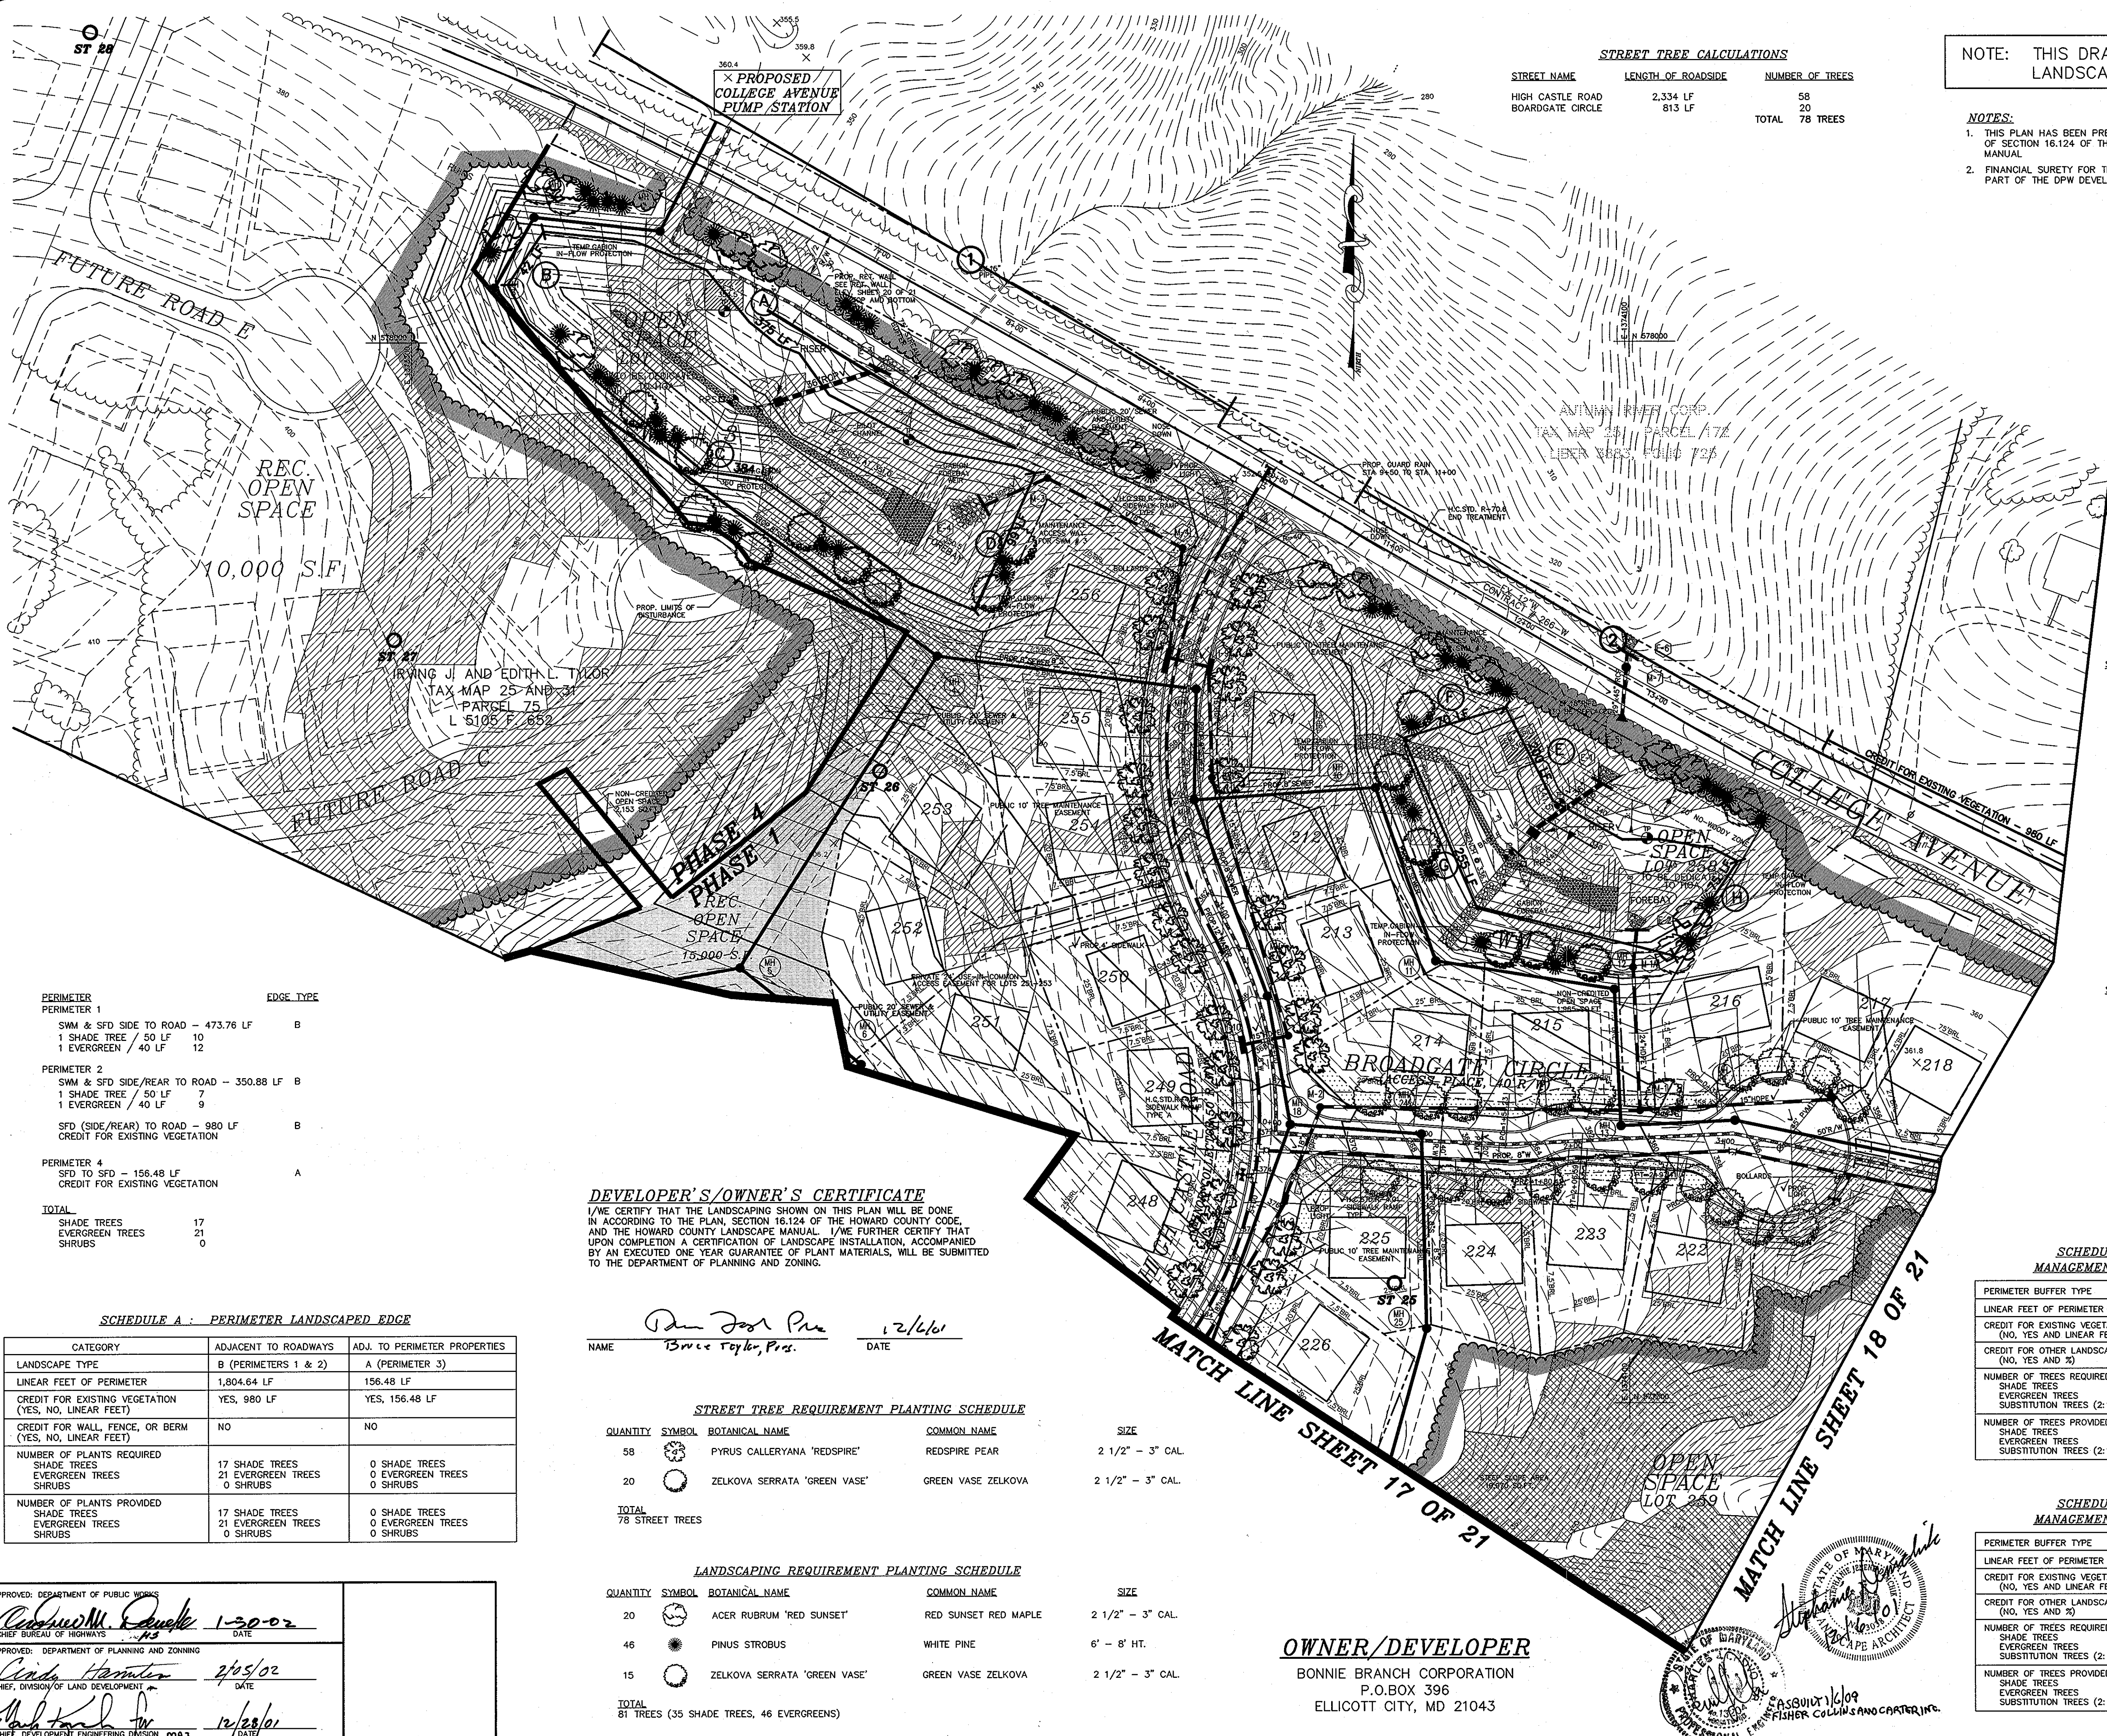

STREET TREE CALCULATIONS

STREET NAME	LENGTH OF ROADSIDE	NUMBER OF TREES
HIGH CASTLE ROAD	2,334 LF	58
BOARDGATE CIRCLE	813 LF	20
TOTAL		78 TREES

NOTE: THIS DRAWING IS TO BE USED FOR LANDSCAPE PLAN PURPOSES ONLY.

- NOTES:**
- THIS PLAN HAS BEEN PREPARED IN ACCORDANCE WITH THE PROVISIONS OF SECTION 16.124 OF THE HOWARD COUNTY CODE AND THE LANDSCAPE MANUAL.
 - FINANCIAL SURETY FOR THE REQUIRED LANDSCAPING HAS BEEN POSTED AS PART OF THE DPW DEVELOPERS AGREEMENT IN THE AMOUNT OF \$17,400.00.

LEGEND

- DENOTES AREA OF 15%-24.9% SLOPES
- DENOTES AREA OF 25% SLOPES OR GREATER
- DENOTES PERIMETER LANDSCAPE EDGE

SWM #3 PERIMETER EDGE

SWM PERIMETER	EDGE TYPE
SWM PERIMETER A - 375 LF CREDIT FOR PERIMETER #1 LANDSCAPING	B
SWM PERIMETER B - 42 LF 1 SHADE TREE / 50 LF 1 EVERGREEN / 40 LF	B
SWM PERIMETER C - 384 LF 1 SHADE TREE / 50 LF 1 EVERGREEN / 40 LF	B
SWM PERIMETER D - 99 LF 1 SHADE TREE / 50 LF 1 EVERGREEN / 40 LF	B
TOTAL PLANTING OBLIGATION SHADE TREES 11 EVERGREEN TREES 13 SHRUBS 0	

SWM #2 PERIMETER EDGE

SWM PERIMETER	EDGE TYPE
SWM PERIMETER E - 200 LF CREDIT FOR PERIMETER #1 LANDSCAPING	B
SWM PERIMETER F - 70 LF 1 SHADE TREE / 50 LF 1 EVERGREEN / 40 LF	B
SWM PERIMETER G - 255 LF 1 SHADE TREE / 50 LF 1 EVERGREEN / 40 LF	B
SWM PERIMETER D - 75 LF 1 SHADE TREE / 50 LF 1 EVERGREEN / 40 LF	B
TOTAL PLANTING OBLIGATION SHADE TREES 8 EVERGREEN TREES 10 SHRUBS 0	

SCHEDULE D : STORMWATER MANAGEMENT AREA #3 LANDSCAPING

PERIMETER BUFFER TYPE	B
LINEAR FEET OF PERIMETER	900 LF (PERIMETERS A THRU D)
CREDIT FOR EXISTING VEGETATION (NO, YES AND LINEAR FEET)	NO
CREDIT FOR OTHER LANDSCAPING (NO, YES AND %)	YES, 375 LF
NUMBER OF TREES REQUIRED SHADE TREES 11 EVERGREEN TREES 13 SUBSTITUTION TREES (2:1)	11 SHADE TREES 13 EVERGREEN TREES 0 SUBSTITUTION TREES
NUMBER OF TREES PROVIDED SHADE TREES 10 EVERGREEN TREES 13 SUBSTITUTION TREES (2:1)	10 SHADE TREES 13 EVERGREEN TREES 2 SUBSTITUTION TREES

SCHEDULE D : STORMWATER MANAGEMENT AREA #2 LANDSCAPING

PERIMETER BUFFER TYPE	B
LINEAR FEET OF PERIMETER	600 LF (PERIMETERS E THRU H)
CREDIT FOR EXISTING VEGETATION (NO, YES AND LINEAR FEET)	NO
CREDIT FOR OTHER LANDSCAPING (NO, YES AND %)	YES, 200 LF
NUMBER OF TREES REQUIRED SHADE TREES 8 EVERGREEN TREES 10 SUBSTITUTION TREES (2:1)	8 SHADE TREES 10 EVERGREEN TREES 0 SUBSTITUTION TREES
NUMBER OF TREES PROVIDED SHADE TREES 8 EVERGREEN TREES 10 SUBSTITUTION TREES (2:1)	8 SHADE TREES 10 EVERGREEN TREES 0 SUBSTITUTION TREES

PERIMETER LANDSCAPED EDGE

PERIMETER	EDGE TYPE
PERIMETER 1 SWM & SFD SIDE TO ROAD - 473.76 LF 1 SHADE TREE / 50 LF 10 1 EVERGREEN / 40 LF 12	B
PERIMETER 2 SWM & SFD SIDE/REAR TO ROAD - 350.88 LF 1 SHADE TREE / 50 LF 7 1 EVERGREEN / 40 LF 9	B
SFD (SIDE/REAR) TO ROAD - 980 LF CREDIT FOR EXISTING VEGETATION	B
PERIMETER 4 SFD TO SFD - 156.48 LF CREDIT FOR EXISTING VEGETATION	A
TOTAL SHADE TREES 17 EVERGREEN TREES 21 SHRUBS 0	

DEVELOPER'S/OWNER'S CERTIFICATE
I/WE CERTIFY THAT THE LANDSCAPING SHOWN ON THIS PLAN WILL BE DONE IN ACCORDANCE TO THE PLAN, SECTION 16.124 OF THE HOWARD COUNTY CODE, AND THE HOWARD COUNTY LANDSCAPE MANUAL. I/WE FURTHER CERTIFY THAT UPON COMPLETION A CERTIFICATION OF LANDSCAPE INSTALLATION, ACCOMPANIED BY AN EXECUTED ONE-YEAR GUARANTEE OF PLANT MATERIALS, WILL BE SUBMITTED TO THE DEPARTMENT OF PLANNING AND ZONING.

NAME: Bruce Taylor, Pres. DATE: 12/6/01

STREET TREE REQUIREMENT PLANTING SCHEDULE

QUANTITY	SYMBOL	BOTANICAL NAME	COMMON NAME	SIZE
58		PYRUS CALLERYANA 'REDSPIRE'	REDSPIRE PEAR	2 1/2" - 3" CAL.
20		ZELKOVA SERRATA 'GREEN VASE'	GREEN VASE ZELKOVA	2 1/2" - 3" CAL.
TOTAL				78 STREET TREES

LANDSCAPING REQUIREMENT PLANTING SCHEDULE

QUANTITY	SYMBOL	BOTANICAL NAME	COMMON NAME	SIZE
20		ACER RUBRUM 'RED SUNSET'	RED SUNSET RED MAPLE	2 1/2" - 3" CAL.
46		PINUS STROBUS	WHITE PINE	6" - 8" HT.
15		ZELKOVA SERRATA 'GREEN VASE'	GREEN VASE ZELKOVA	2 1/2" - 3" CAL.
TOTAL				81 TREES (35 SHADE TREES, 46 EVERGREENS)

OWNER/DEVELOPER
BONNIE BRANCH CORPORATION
P.O. BOX 396
ELlicott CITY, MD 21043

SCHEDULE A : PERIMETER LANDSCAPED EDGE

CATEGORY	ADJACENT TO ROADWAYS	ADJ. TO PERIMETER PROPERTIES
LANDSCAPE TYPE	B (PERIMETERS 1 & 2)	A (PERIMETER 3)
LINEAR FEET OF PERIMETER	1,804.64 LF	156.48 LF
CREDIT FOR EXISTING VEGETATION (YES, NO, LINEAR FEET)	YES, 980 LF	YES, 156.48 LF
CREDIT FOR WALL, FENCE, OR BERM (YES, NO, LINEAR FEET)	NO	NO
NUMBER OF PLANTS REQUIRED SHADE TREES 17 EVERGREEN TREES 21 SHRUBS 0	17 SHADE TREES 21 EVERGREEN TREES 0 SHRUBS	0 SHADE TREES 0 EVERGREEN TREES 0 SHRUBS
NUMBER OF PLANTS PROVIDED SHADE TREES 17 EVERGREEN TREES 21 SHRUBS 0	17 SHADE TREES 21 EVERGREEN TREES 0 SHRUBS	0 SHADE TREES 0 EVERGREEN TREES 0 SHRUBS

APPROVED: DEPARTMENT OF PUBLIC WORKS
Richard M. Duple 1/30/02
CHIEF BUREAU OF HIGHWAYS

APPROVED: DEPARTMENT OF PLANNING AND ZONING
Cinda Hamster 2/05/02
CHIEF, DIVISION OF LAND DEVELOPMENT

Mark Taylor 12/6/01
CHIEF, DEVELOPMENT ENGINEERING DIVISION

Project	date	description	scale	approval
99072	DEC 2001	engineering	MPP/SJD	JBM
		illustration	MPP/SJD	
		revision		

no.	description	date
1	AS BUILT	1/30/02




AUTUMN VIEW SECTION 5, PHASE 1
LOTS: 211-259
TAX MAP 25 & 31, P/O PARCEL 75
HOWARD COUNTY, MARYLAND
SECOND ELECTION DISTRICT
LANDSCAPE PLAN


MILDENBERG, BOENDER & ASSOC., INC.
Engineers Planners Surveyors
5072 Dorsey Hall Drive, Suite 202, Ellicott City, Maryland 21042
(410) 997-0296 Balt. (301) 621-5521 Wash. (410) 997-0298 F.tx.

NOTE: THIS DRAWING IS TO BE USED FOR LANDSCAPE PLAN PURPOSES ONLY.

- NOTES:**
1. THIS PLAN HAS BEEN PREPARED IN ACCORDANCE WITH THE PROVISIONS OF SECTION 16.124 OF THE HOWARD COUNTY CODE AND THE LANDSCAPE MANUAL.
 2. FINANCIAL SURETY FOR THE REQUIRED LANDSCAPING HAS BEEN POSTED AS PART OF THE DPW DEVELOPERS AGREEMENT IN THE AMOUNT OF \$ 17,400.00.
 3. A MINIMUM SPACING OF 20' SHALL BE MAINTAINED BETWEEN ANY STREET LIGHT AND ANY TREE.
 4. SEE SHEET 18 FOR SCHEDULES A & D, PLANTING SCHEDULES, AND PERIMETER EDGE CALCULATIONS.

LEGEND

-  DENOTES AREA OF 15%-24.99% SLOPES
-  DENOTES AREA OF 25% SLOPES OR GREATER
-  DENOTES PERIMETER LANDSCAPE EDGE

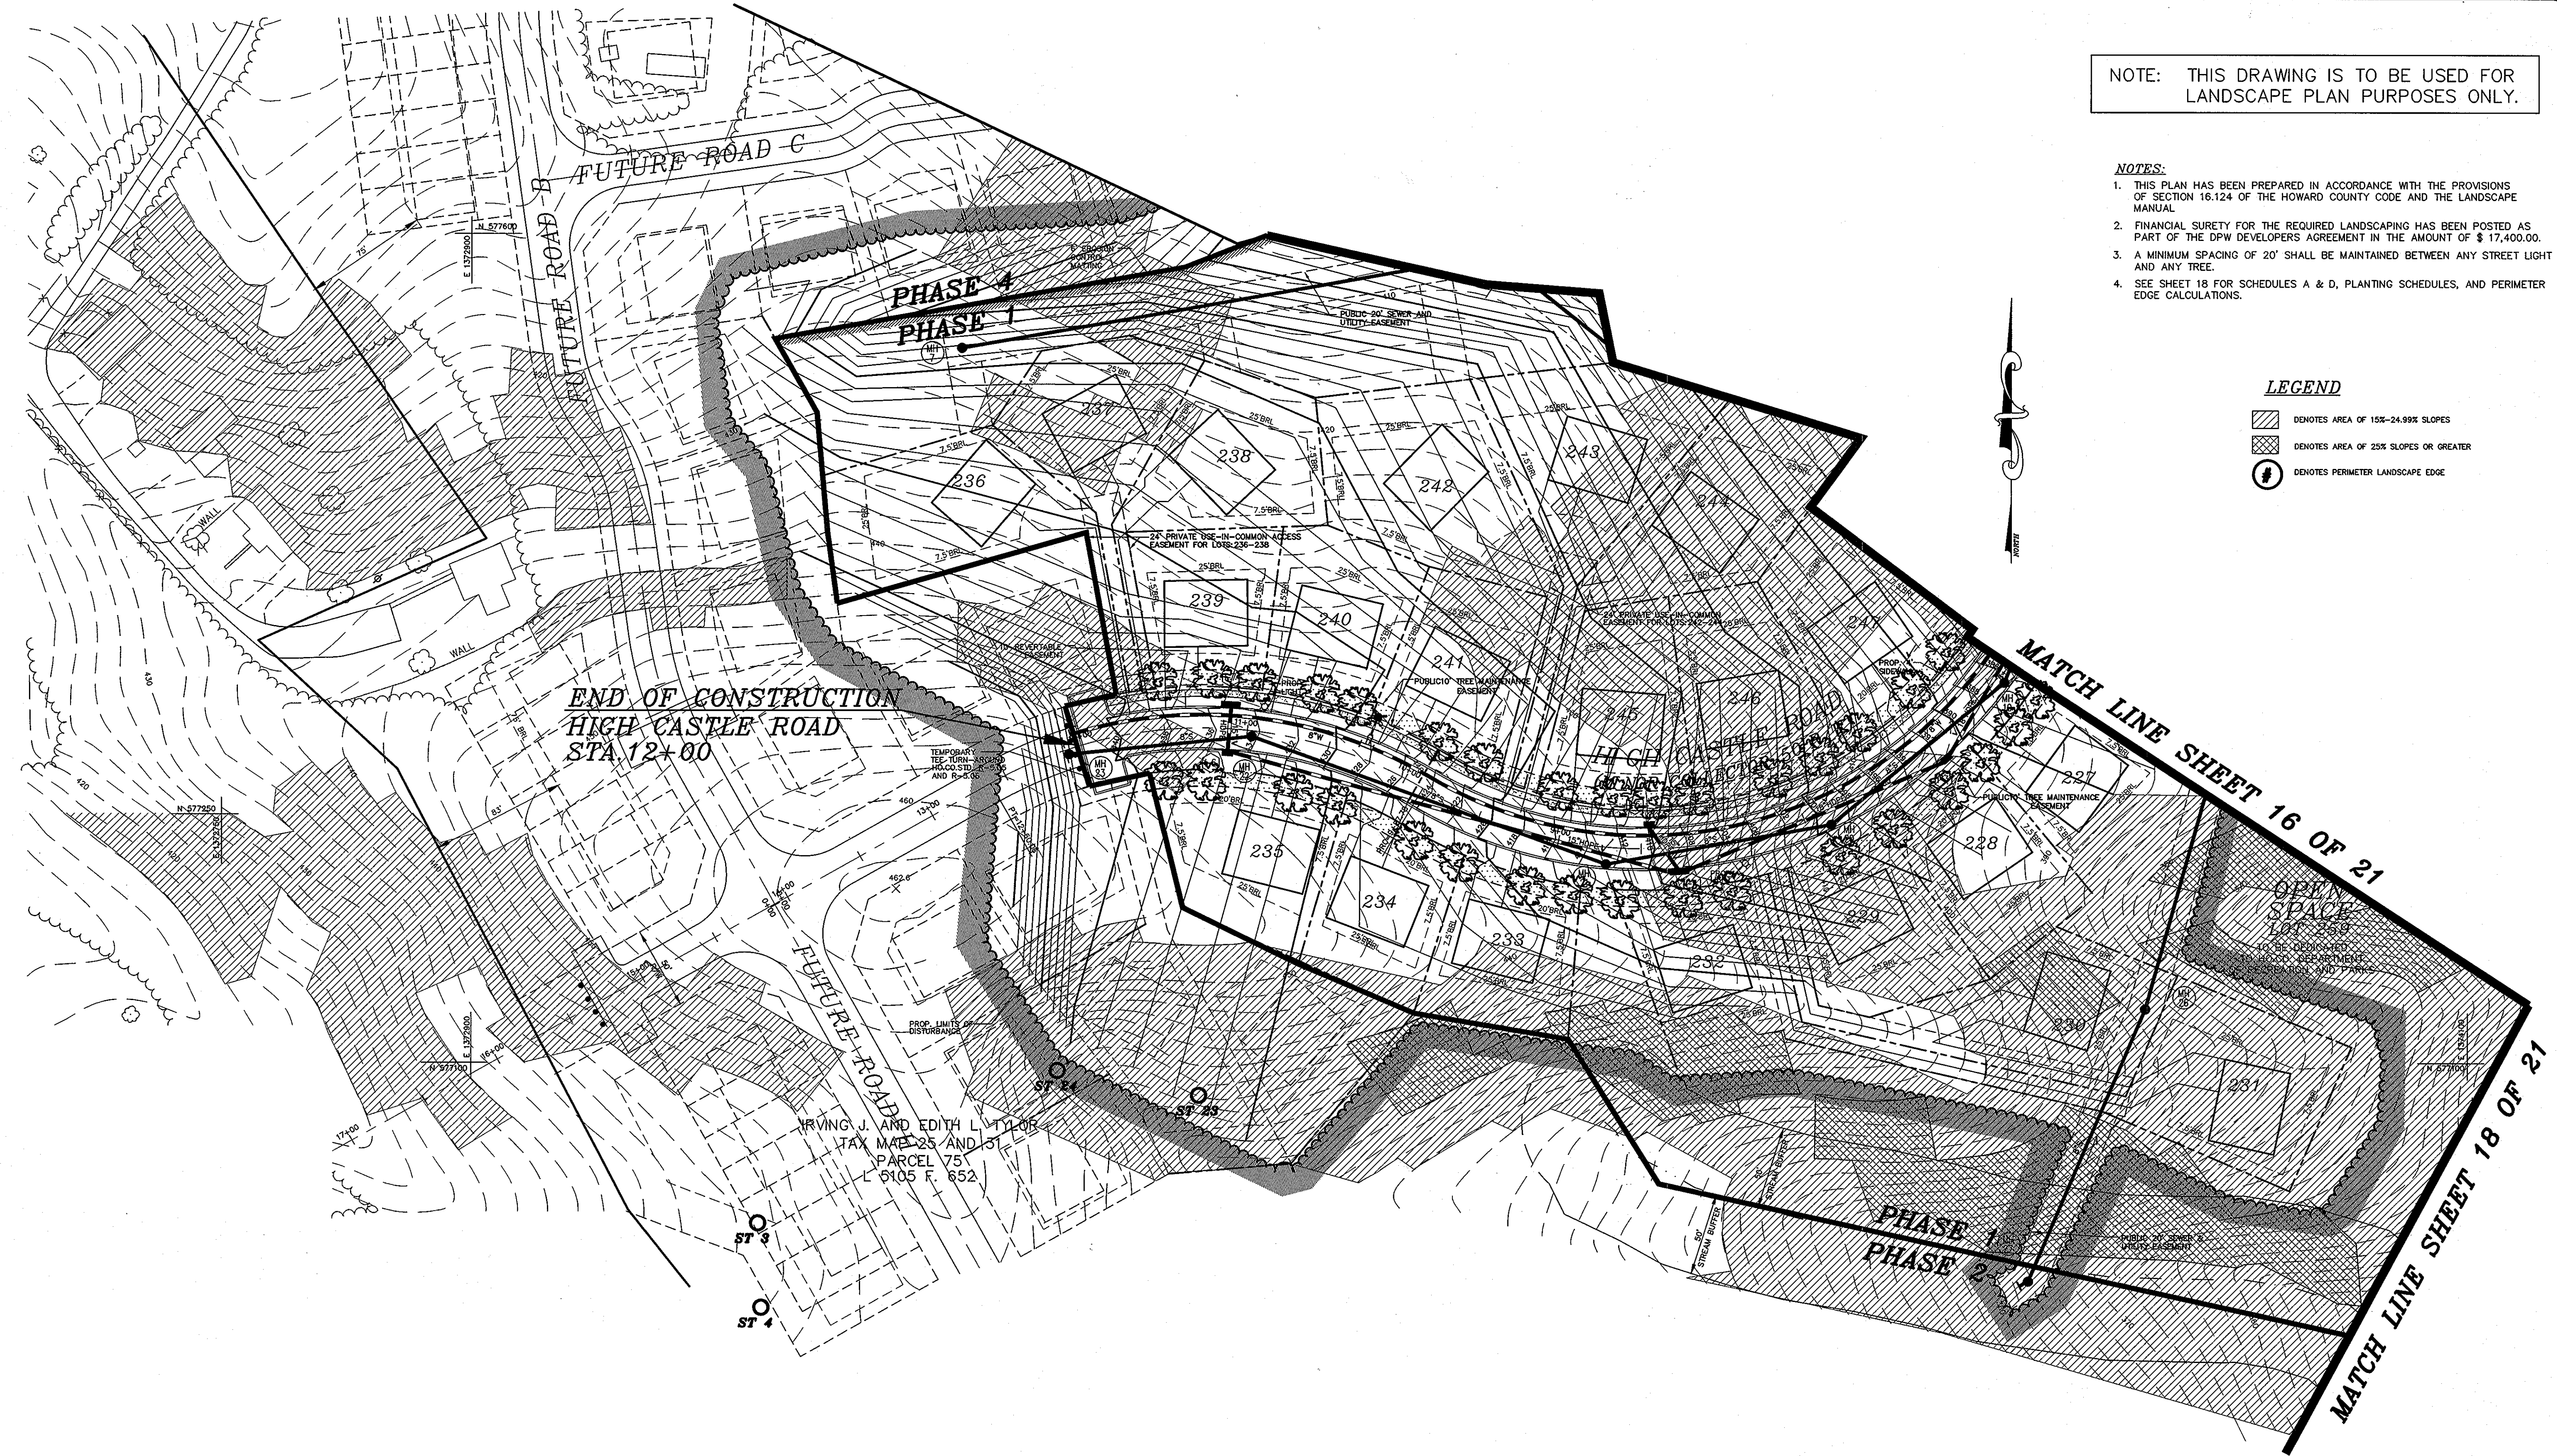

DEVELOPER'S/OWNER'S CERTIFICATE
 I/WE CERTIFY THAT THE LANDSCAPING SHOWN ON THIS PLAN WILL BE DONE IN ACCORDANCE WITH THE PLAN, SECTION 16.124 OF THE HOWARD COUNTY CODE, AND THE HOWARD COUNTY LANDSCAPE MANUAL. I/WE FURTHER CERTIFY THAT UPON COMPLETION A CERTIFICATION OF LANDSCAPE INSTALLATION, ACCOMPANIED BY AN EXECUTED ONE YEAR GUARANTEE OF PLANT MATERIALS, WILL BE SUBMITTED TO THE DEPARTMENT OF PLANNING AND ZONING.


NAME Steve Taylor, Pres DATE 12/6/01

APPROVED: DEPARTMENT OF PUBLIC WORKS
Richard D. Davis 1/30/02
 CHIEF BUREAU OF HIGHWAYS DATE

APPROVED: DEPARTMENT OF PLANNING AND ZONING
Cindy Hamer 2/5/02
 CHIEF, DIVISION OF LAND DEVELOPMENT DATE

Mark Taylor 12/28/01
 CHIEF DEVELOPMENT ENGINEERING DIVISION DATE

OWNER/DEVELOPER
 BONNIE BRANCH CORPORATION
 P.O. BOX 396
 ELLICOTT CITY, MD 21043

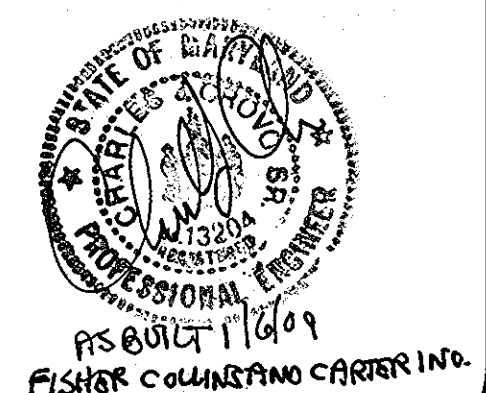

date	DEC 2001
project	99072
illustration	MMP/SID
scale	1"=50'
approval	JBM

date	1/1/02
description	REVISIONS
no.	1

AUTUMN VIEW SECTION 5, PHASE 1
 LOTS: 211-259
 TAX MAP 25 & 31, P/O PARCEL 75
 SECOND ELECTION DISTRICT
 HOWARD COUNTY, MARYLAND
 LANDSCAPE PLAN




MILDENBERG, BOENDER & ASSOC., INC.
 Engineers Planners Surveyors
 5072 Dorsey Hall Drive, Suite 202, Ellicott City, Maryland 21042
 (410) 997-0296 Fax (301) 621-5521 Wash. (410) 997-0298 Fax

NOTE: THIS DRAWING IS TO BE USED FOR LANDSCAPE PLAN PURPOSES ONLY.

NOTES:

1. THIS PLAN HAS BEEN PREPARED IN ACCORDANCE WITH THE PROVISIONS OF SECTION 16.124 OF THE HOWARD COUNTY CODE AND THE LANDSCAPE MANUAL.
2. FINANCIAL SURETY FOR THE REQUIRED LANDSCAPING HAS BEEN POSTED AS PART OF THE DPW DEVELOPERS AGREEMENT IN THE AMOUNT OF \$ 17,400.00.
3. SEE SHEET 18 FOR SCHEDULES A & D, PLANTING SCHEDULES, AND PERIMETER EDGE CALCULATIONS.

LEGEND

-  DENOTES AREA OF 15%-24.99% SLOPES
-  DENOTES AREA OF 25% SLOPES OR GREATER
-  DENOTES PERIMETER LANDSCAPE EDGE



DEVELOPER'S/OWNER'S CERTIFICATE

I/WE CERTIFY THAT THE LANDSCAPING SHOWN ON THIS PLAN WILL BE DONE IN ACCORDANCE TO THE PLAN, SECTION 16.124 OF THE HOWARD COUNTY CODE, AND THE HOWARD COUNTY LANDSCAPE MANUAL. I/WE FURTHER CERTIFY THAT UPON COMPLETION A CERTIFICATION OF LANDSCAPE INSTALLATION, ACCOMPANIED BY AN EXECUTED ONE YEAR GUARANTEE OF PLANT MATERIALS, WILL BE SUBMITTED TO THE DEPARTMENT OF PLANNING AND ZONING.

NAME Bruce Taylor, P.E. DATE 1/30/02


APPROVED: DEPARTMENT OF PUBLIC WORKS
[Signature]
 CHIEF BUREAU OF HIGHWAYS

APPROVED: DEPARTMENT OF PLANNING AND ZONING
[Signature]
 CHIEF, DIVISION OF LAND DEVELOPMENT

[Signature]
 CHIEF DEVELOPMENT ENGINEERING DIVISION

OWNER/DEVELOPER
 BONNIE BRANCH CORPORATION
 P.O. BOX 396
 ELLICOTT CITY, MD 21043

TAX MAP 25, PARCEL 75
 LIBER 530, FOLIO 16A
 48.191 ACRES

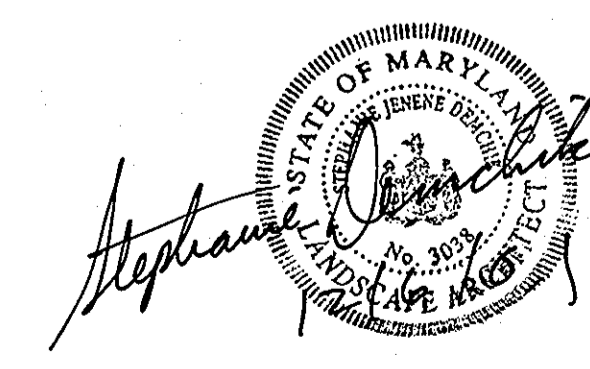

Project	date	approval
99072	DEC 2001	JBM
Illustration	scale	description
MMP/SID	1"=50'	revisions

no.	description	date

AUTUMN VIEW SECTION 5, PHASE 1
 LOTS: 211-259
 TAX MAP 25 & 31, P/O PARCEL 75
 HOWARD COUNTY, MARYLAND
 SECOND ELECTION DISTRICT
 LANDSCAPE PLAN

MILDENBERG, BOENDER & ASSOC., INC.
 Engineers Planners Surveyors
 5072 Dorsey Hall Drive, Suite 202, Elkton City, Maryland 21042
 (410) 997-0296, Fax: (301) 621-5521, Wash. (410) 997-0298 Fax.

NOTE: THIS PLAN IS TO BE USED FOR FOREST CONSERVATION PURPOSES ONLY.

- NOTE:**
1. THE FOREST CONSERVATION REQUIREMENTS PER SECTION 16.1202 OF THE HOWARD COUNTY CODE FOR FOREST CONSERVATION BY RETENTION OF 7.59 ACRES OF FOREST, FINANCIAL SURETY FOR THE ON-SITE RETENTION (7.59 ACRES OR 330,600 SQ. FT.) HAS BEEN POSTED AS PART OF THE DEVELOPER'S AGREEMENT IN THE AMOUNT OF \$66,124.08.
 2. THE FOREST CONSERVATION EASEMENT HAS BEEN ESTABLISHED TO FULFILL THE REQUIREMENTS OF SECTION 16.1202 OF THE HOWARD COUNTY CODE, FOREST CONSERVATION ACT. NO CLEARING, GRADING, OR CONSTRUCTION IS PERMITTED WITHIN THE FOREST CONSERVATION EASEMENT; HOWEVER, FOREST MANAGEMENT PRACTICES AS DEFINED IN THE DEED OF FOREST CONSERVATION EASEMENT ARE ALLOWED.
 3. SILT FENCE AND SUPER SILT FENCE SHALL SERVE AS PROTECTIVE FENCING ALONG THE LIMITS OF DISTURBANCE OF THE FORESTED AREAS. ADDITIONAL TREE PROTECTIVE FENCING SHALL BE INSTALLED AS NECESSARY.

SPECIMEN TREE LIST

No#	COMMON NAME	SCIENTIFIC NAME	DIA.	CONDITION
1	Silver Maple	Acer saccharinum	36"	Excellent
3	Red Oak	Quercus rubra	33"	Excellent
4	American Elm	Ulmus americana	40"	Excellent
23	American Beech	Fagus grandifolia	39"	Excellent
24	White Ash	Fraxinus americana	54"	Excellent
25	Tulip Poplar	Liriodendron tulipifera	39"	Excellent
26	Red Oak	Quercus rubra	31"	Excellent
27	Tulip Poplar	Liriodendron tulipifera	38"	Excellent
28	Tulip Poplar	Liriodendron tulipifera	36"	Excellent

GENERAL NOTES

- FOREST PROTECTION**
1. ALL FOREST RETENTION AREAS SHALL BE TEMPORARILY PROTECTED BY WELL ANCHORED BLAZE ORANGE PLASTIC MESH FENCING AND SIGNAGE AS INDICATED ON THE PLANS. THE DEVICES SHALL BE INSTALLED ALONG THE FOREST RETENTION BOUNDARY PRIOR TO ANY LAND CLEARING, GRUBBING, OR GRADING ACTIVITIES.
 2. THE FOREST PROTECTION DEVICES SHALL BE INSTALLED SUCH THAT THE CRITICAL ROOT ZONES OF ALL TREES WITHIN THE RETENTION AREA NOT OTHERWISE PROTECTED WILL BE WITHIN FOREST PROTECTION DEVICES.
 3. ALL PROTECTION DEVICES SHALL BE MAINTAINED THROUGHOUT CONSTRUCTION, INCLUDING SILT FENCE BEING USED AS PROTECTIVE FENCING; ALL DEVICES SHALL REMAIN IN PLACE UNTIL ALL CONSTRUCTION HAS CEASED IN THE IMMEDIATE VICINITY.
 4. ATTACHMENT OF SIGNS, OR ANY OTHER OBJECTS TO TREES IS PROHIBITED. NO EQUIPMENT, MACHINERY, VEHICLES, MATERIALS OR EXCESSIVE PEDESTRIAN TRAFFIC SHALL BE ALLOWED WITHIN THESE PROTECTED AREAS. INSTALLATION AND MAINTENANCE OF PROTECTIVE FENCING AND SIGNAGE SHALL BE THE RESPONSIBILITY OF THE GENERAL CONTRACTOR. THE GENERAL CONTRACTOR SHALL TAKE THE LUTMOST CARE TO PROTECT TREE ROOT SYSTEMS DURING ALL CONSTRUCTION ACTIVITIES. TREE ROOT SYSTEMS SHALL BE PROTECTED FROM SMOTHERING, FLOODING, EXCESSIVE WETTING FROM DE-WATERING OPERATIONS, OFF-SITE RUN OFF, SPILLAGE AND DRAINING OF MATERIALS THAT MAY BE HARMFUL TO TREES.
 5. THE GENERAL CONTRACTOR SHALL PREVENT PARKING OF CONSTRUCTION VEHICLES AND EQUIPMENT, AND THE STORING OF BUILDING SUPPLIES OR STOCKPILING OF EARTH WITHIN FOREST CONSERVATION EASEMENTS.
 6. REMOVAL OF TOPSOIL OR ROOT MAT WITHIN THE TREE PRESERVATION AREA SHALL BE PROHIBITED.
 7. THE GENERAL CONTRACTOR SHALL BE HELD RESPONSIBLE FOR ANY TREES DAMAGED OR DESTROYED WITHIN THE FOREST CONSERVATION EASEMENTS. ROOT PRUNING SHALL BE USED AT THE LIMIT OF DISTURBANCE OR LIMIT OF GRADING WITHIN AND ADJACENT TO ALL PRESERVATION AREAS, AS NECESSARY.

- CONSTRUCTION MONITORING**
1. THE SITE SHALL BE INSPECTED PERIODICALLY DURING THE CONSTRUCTION PHASE OF THE PROJECT. A QUALIFIED PROFESSIONAL SHALL BE RESPONSIBLE FOR IDENTIFYING DAMAGE TO PROTECTED FOREST AREAS OR INDIVIDUAL TREES WHICH MAY HAVE BEEN CAUSED BY CONSTRUCTION ACTIVITIES, SUCH AS SOIL COMPACTION, ROOT INJURY, TRUNK WOUNDS, LIMB INJURY, OR STRESS CAUSED BY FLOODING OR DROUGHT CONDITIONS. ANY SUCH DAMAGE THAT MAY OCCUR SHALL BE REMEDIATED IMMEDIATELY USING APPROPRIATE MEASURES. SEVERE PROBLEMS MAY REQUIRE CONSULTATION WITH A PROFESSIONAL ARBORIST.
 2. THE CONSTRUCTION PROCEDURE SHALL NOT DAMAGE AREAS OUTSIDE OF THE LIMITS OF DISTURBANCE AS DESIGNATED ON THE PLANS. ANY DAMAGE SHALL BE RESTORED BY THE CONTRACTOR AT HIS EXPENSE AND TO THE SATISFACTION OF THE DESIGN TEAM OR ENGINEER.

NOTE:

THERE SHALL BE NO CLEARING, GRADING, CONSTRUCTION OR DISTURBANCE OF VEGETATION IN THE FOREST CONSERVATION EASEMENTS EXCEPT AS PERMITTED BY THE HOWARD COUNTY FOREST CONSERVATION PROGRAM.

THERE SHALL BE NO CLEARING, GRADING, CONSTRUCTION, SOIL COMPACTION, OR EXCAVATION, INTRODUCTION OF TOXIC CHEMICALS OR OTHER DISTURBANCES DETRIMENTAL TO THE LIVE SPECIMEN TREES OR CRITICAL ROOT ZONES FOR THESE TREES EXCEPT AS PERMITTED BY THE HOWARD COUNTY FOREST CONSERVATION PROGRAM.

FOR FOREST STAND DELINEATION INFORMATION, SEE PLAN PREPARED BY WILDMAN ENVIRONMENTAL SERVICES, INC.

PRE-CONSTRUCTION MEETING

1. AFTER THE BOUNDARIES OF THE FOREST RETENTION AREAS HAVE BEEN FIELD LOCATED AND MARKED, AND AFTER THE FOREST PROTECTION DEVICES HAVE BEEN INSTALLED, BUT BEFORE ANY OTHER DISTURBANCE HAS TAKEN PLACE ON SITE, A PRE-CONSTRUCTION MEETING SHALL TAKE PLACE ON SITE. THE DEVELOPER, CONTRACTOR OR PROJECT MANAGER, AND HOWARD COUNTY INSPECTORS SHALL ATTEND. THE PURPOSE OF THIS MEETING WILL BE:
 - A. TO IDENTIFY THE LOCATIONS OF THE FOREST RETENTION AREAS, SPECIMEN TREES WITHIN 50 FEET OF THE LIMIT OF DISTURBANCE, LIMITS OF CONSTRUCTION, EMPLOYEE PARKING AREAS AND EQUIPMENT STAGING AREAS;
 - B. INSPECT ALL FLAGGED BOUNDARIES AND PROTECTION DEVICES;
 - C. MAKE ALL NECESSARY ADJUSTMENTS;
 - D. ASSIGN RESPONSIBILITIES AS APPROPRIATE AND DISCUSS PENALTIES.

AUTUMN VIEW, SECTIONS 3 THRU 5 (PHASE 1)

FOREST CONSERVATION DATA

I. BASIC SITE DATA	ACRES
GROSS SITE AREA	137.64
AREA WITHIN 100 YEAR FLOODPLAIN	6.99
AREA WITHIN AGRICULTURAL USE OR PRESERVATION PARCEL	0.00
NET TRACT AREA	130.65
LAND USE CATEGORY	RESIDENTIAL - SUBURBAN

II. FOREST CONSERVATION WORKSHEET DATA SUMMARY


B. REFORESTATION THRESHOLD (20%)	26.13
AFFORESTATION MINIMUM (15%)	19.60
D. EXISTING FOREST ON NET TRACT AREA	114.66
E. FOREST AREAS TO BE CLEARED	65.61
F. FOREST AREAS TO BE RETAINED	48.81

IV. REFORESTATION CALCULATIONS

G. FOREST AREAS CLEARED ABOVE REFORESTATION THRESHOLD	65.61
H. FOREST AREAS CLEARED BELOW REFORESTATION THRESHOLD	0.00
I. FOREST AREAS RETAINED ABOVE REFORESTATION THRESHOLD	22.68
REFORESTATION FOR CLEARING ABOVE THRESHOLD	16.40
CREDIT FOR FOREST AREAS RETAINED ABOVE THRESHOLD	22.68
TOTAL REFORESTATION REQUIRED	0.00 (6.28 CREDIT)
TOTAL REFORESTATION PROVIDED	0.00
RETENTION PROVIDED UNDER AUTUMN VIEW, SECTION 3 (F-99-45)	41.22 (CREDITED)
RETENTION PROVIDED UNDER AUTUMN VIEW, SECTION 5 (PHASE 1)	7.59
TOTAL RETENTION PROVIDED UNDER AUTUMN VIEW, SECTION 3 & 5 (PHASE 1)	48.81

FOREST CONSERVATION TABULATION

EASEMENT A-1 (RETENTION)	3.33 ACRES
EASEMENT B-1 (RETENTION)	4.26 ACRES
TOTAL EASEMENT AREA	7.59 ACRES

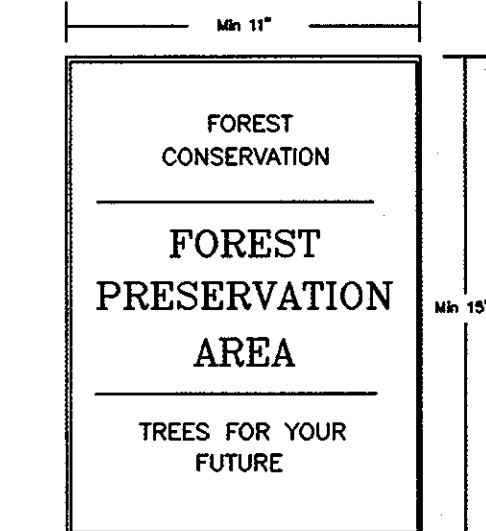


SIGNAGE DETAIL
NOT TO SCALE

LEGEND

- DENOTES AREA OF 15%-24.99% SLOPES
- DENOTES AREA OF 25% SLOPES OR GREATER
- DENOTES AREA OF 100 YEAR FLOODPLAIN
- DENOTES FOREST CONSERVATION EASEMENT
- DENOTES FOREST CONSERVATION SIGNAGE


SOIL CLASSIFICATION CHART

A#B2	(B)	ALDINO SILT LOAM, 3-8% SLOPES, MODERATELY ERODED
A#C2	(C)	ALDINO SILT LOAM, 8-15% SLOPES, MODERATELY ERODED
B#B2	(C)	BRANDYWINE LOAM, 3-8% SLOPES, MODERATELY ERODED
B#C3	(C)	BRANDYWINE LOAM, 8-15% SLOPES, SEVERELY ERODED
B#D3	(C)	BRANDYWINE LOAM, 15-25% SLOPES, SEVERELY ERODED
B#F	(C)	BRANDYWINE LOAM, 25-60% SLOPES
G#B2	(C)	CHILLUM-FAIRFAX LOAMS, 1-5% SLOPES, MODERATELY ERODED
L#B2	(C)	LEGORE SILT LOAM, 3-8% SLOPES, MODERATELY ERODED
L#C2	(C)	LEGORE SILT LOAM, 8-15% SLOPES, MODERATELY ERODED
L#C3	(B)	LEGORE SILTY CLAY LOAM, 8-15% SLOPES, SEVERELY ERODED
M#	(C)	MIXED ALLUVIAL LAND
M#B2	(C)	MONTALTO SILT LOAM, 3-8% SLOPES, MODERATELY ERODED
M#C2	(C)	MONTALTO SILT LOAM, 8-15% SLOPES, MODERATELY ERODED
M#E	(C)	MONTALTO AND RELAY SOILS, 15-45% SLOPES
M#D	(C)	MONTALTO AND RELAY VERY STONY SILT LOAMS, 3-25% SLOPES
M#F	(C)	MONTALTO AND RELAY VERY STONY SILT LOAMS, 25-60% SLOPES
N#B2	(B)	NESHAMINY SILT LOAM, 3-8% SLOPES, MODERATELY ERODED
N#C2	(B)	NESHAMINY SILT LOAM, 8-15% SLOPES, MODERATELY ERODED
W#B	(D)	WATCHUNG SILT LOAM, 3-8% SLOPES

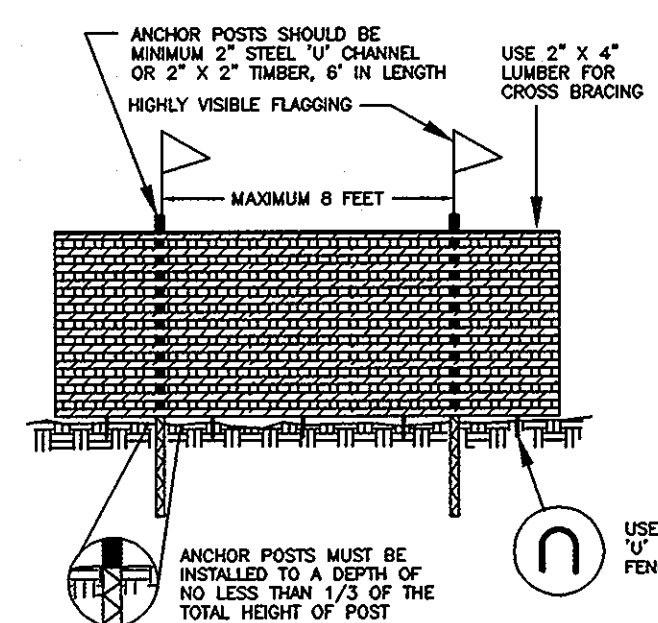

PROTECTIVE FENCE DETAIL
BLAZE ORANGE PLASTIC MESH

- NOTES:**
1. FOREST PROTECTION DEVICES ONLY.
 2. FOREST RETENTION AREA WILL BE SET AS PART OF THE REVIEW PROCESS.
 3. BOUNDARIES OF RETENTION AREA SHOULD BE STAKED AND FLAGGED PRIOR TO INSTALLING DEVICES.
 4. ROOT DAMAGE SHOULD BE AVOIDED.
 5. PROTECTIVE SIGNAGE MAY ALSO BE USED.
 6. DEVICE SHOULD BE MAINTAINED THROUGHOUT CONSTRUCTION.

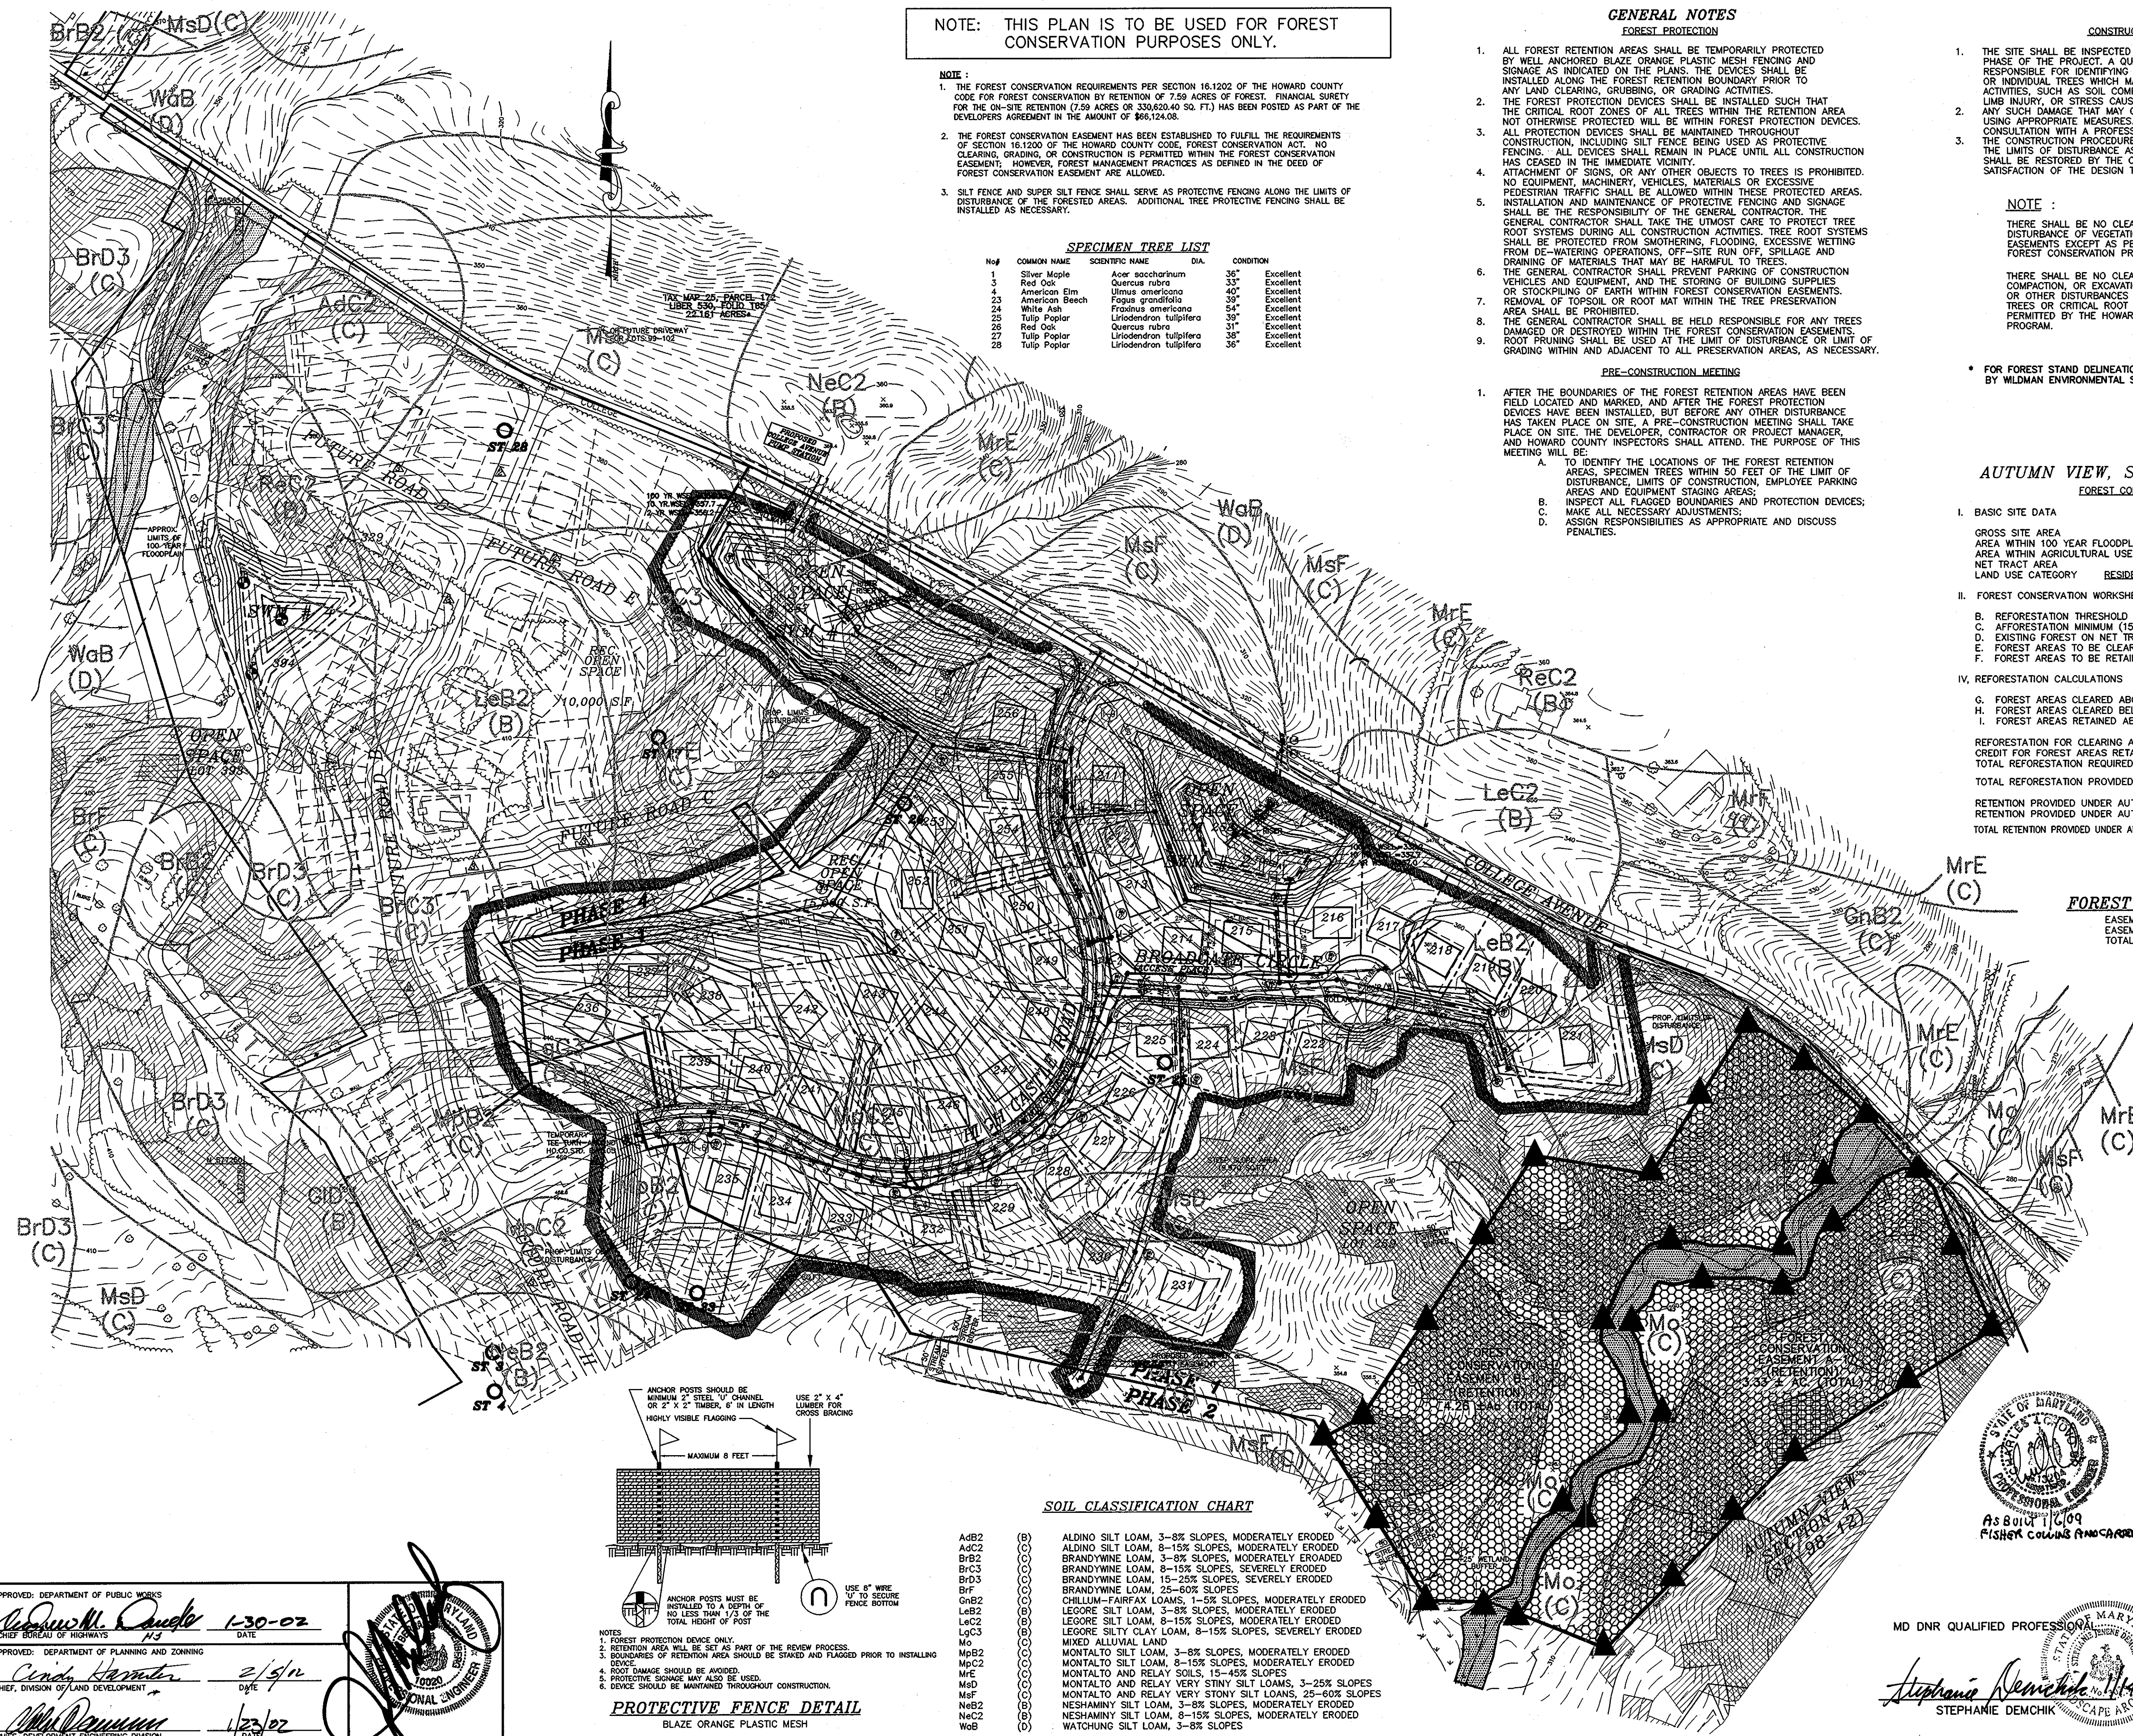

APPROVED: DEPARTMENT OF PUBLIC WORKS
Richard M. Quade 1/30-02
 CHIEF BUREAU OF HIGHWAYS

APPROVED: DEPARTMENT OF PLANNING AND ZONING
Cindy Hamilton 2/5/02
 CHIEF, DIVISION OF LAND DEVELOPMENT


APPROVED: *Stephanie Demchik* 1/23/02
 CHIEF, DEVELOPMENT ENGINEERING DIVISION

Project	date	description	approval
99072	DEC 2001	engineering	JBM
1/07/02	1/7/02	scale	1"=100'


AUTUMN VIEW SECTION 5, PHASE 1
 LOTS: 211-259
 TAX MAP 25 & 31, P/O PARCEL 75
 SECOND ELECTION DISTRICT
 HOWARD COUNTY, MARYLAND
FOREST CONSERVATION PLAN

MILDENBERG, BOENDER & ASSOC., INC.
 Planners Surveyors
 Engineers
 5012 Dorsey Hall Drive, Suite 202, Ellicott City, Maryland, 21042
 (410) 987-0296 Fax: (301) 621-5521 Wash. (410) 987-0298 Fax.


RETAINING WALL - SPECIFICATIONS

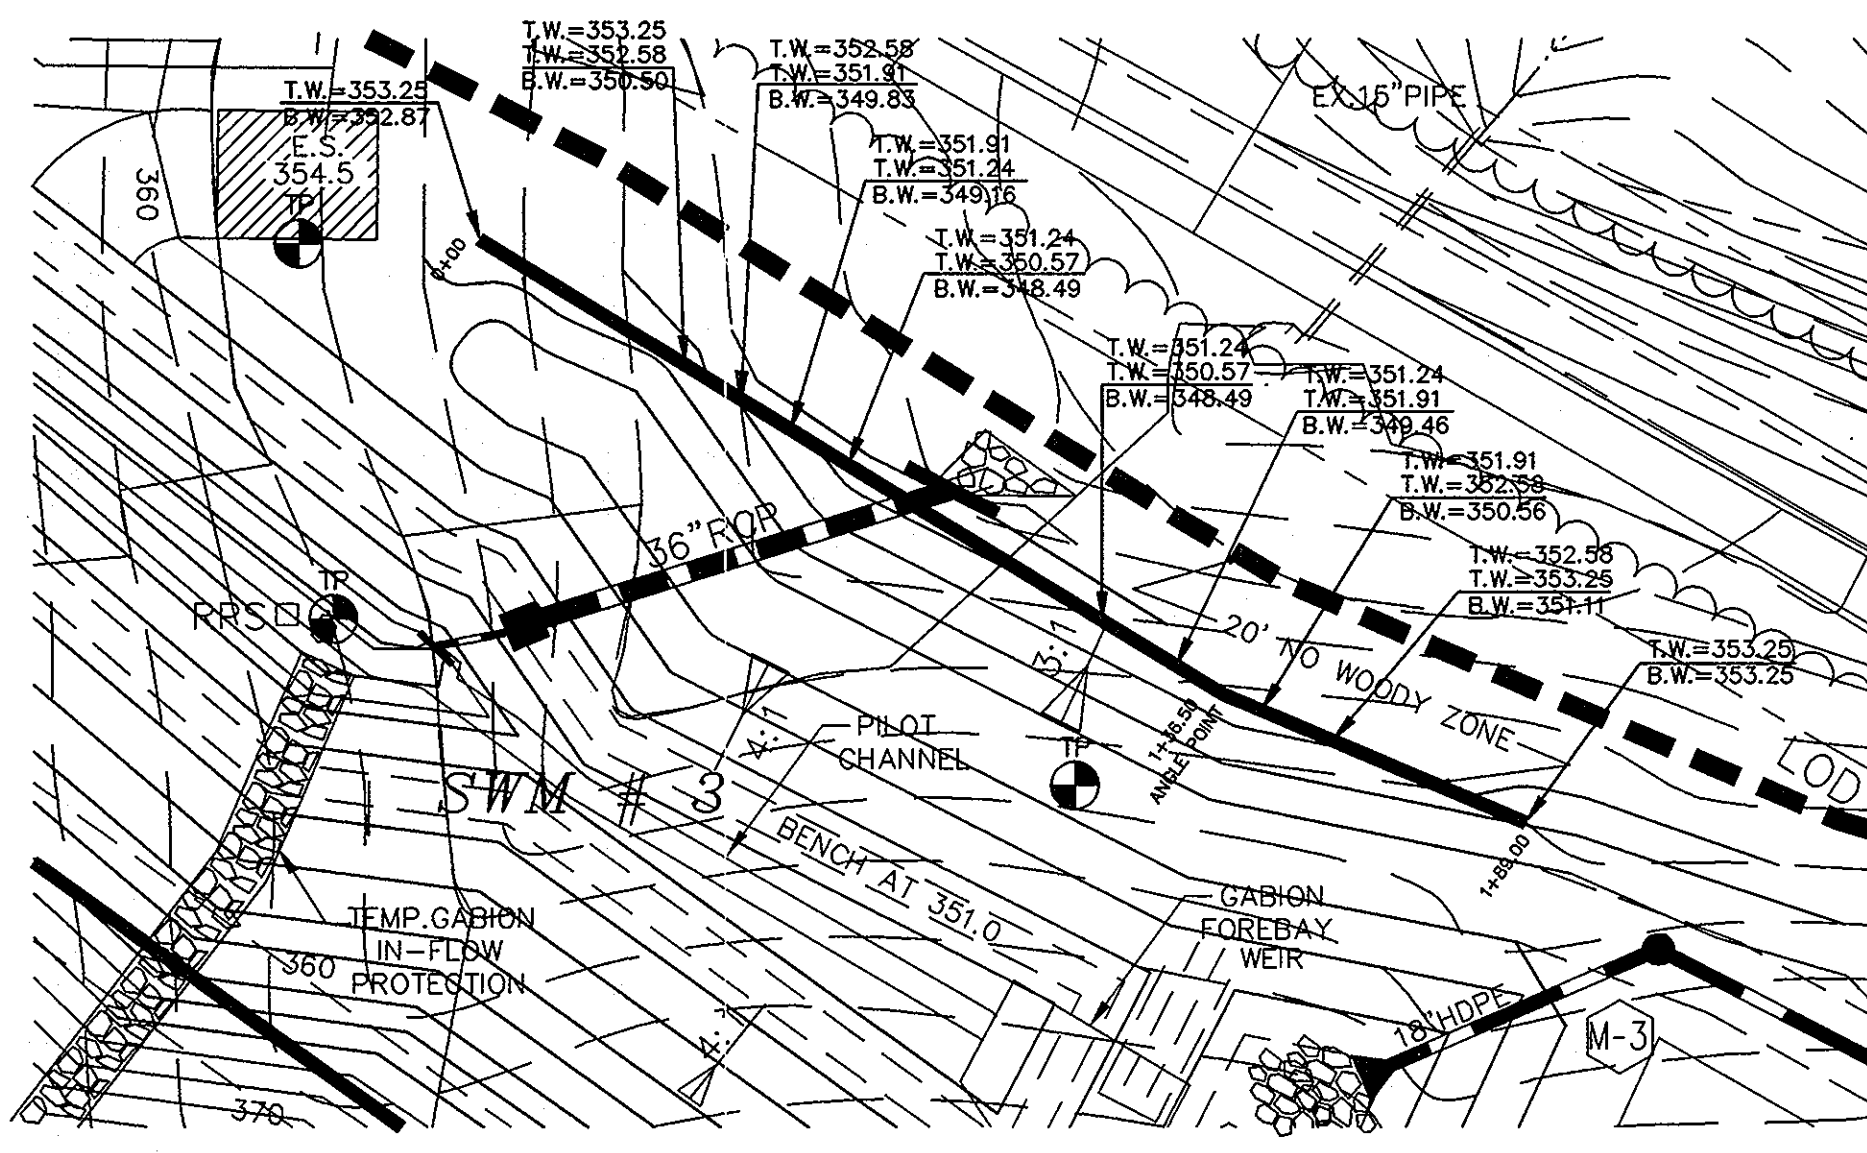


RETAINING WALL - SITE PLAN
1" = 30'

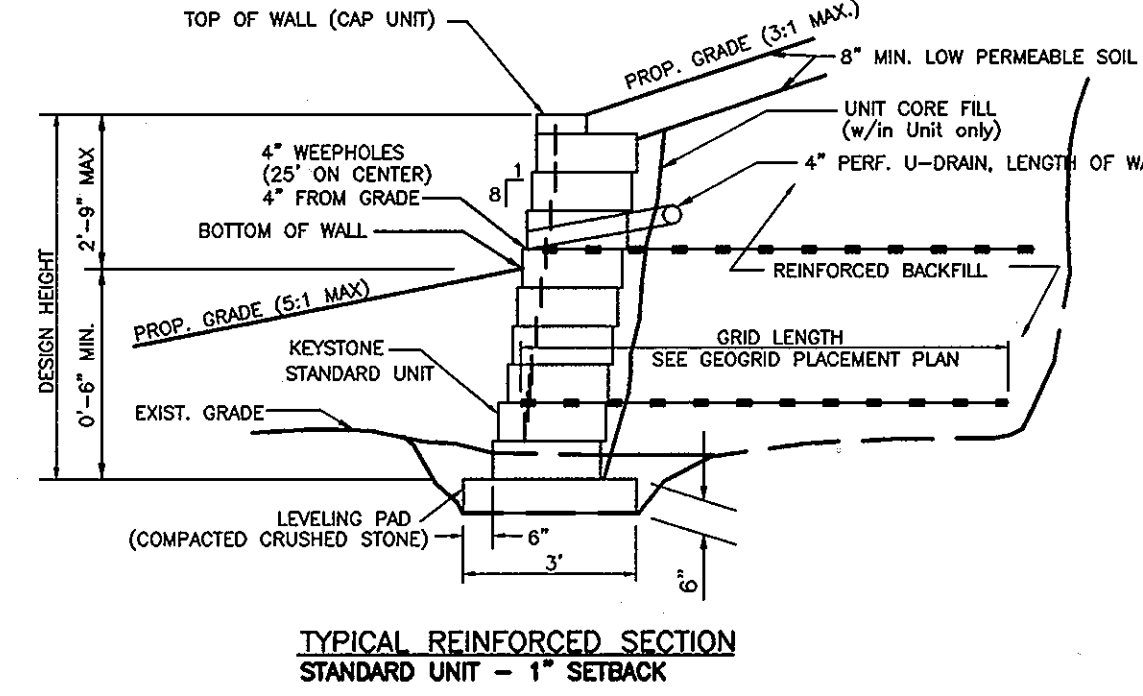


TYPICAL REINFORCED SECTION
STANDARD UNIT - 1" SETBACK

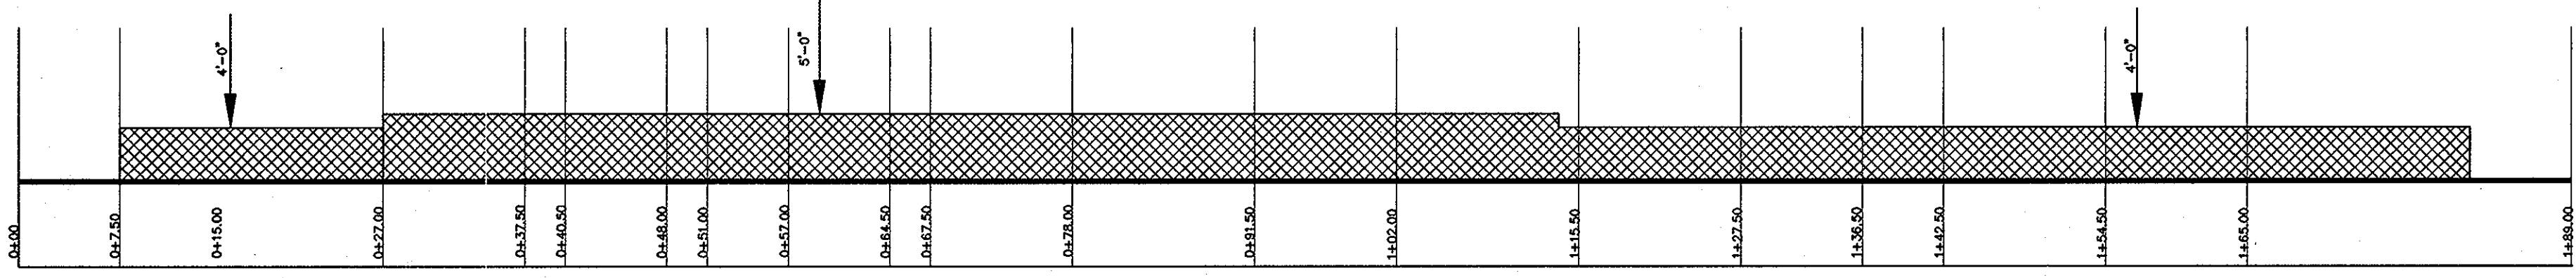

KEYSTONE PLAN - GEOGRID PLACEMENT



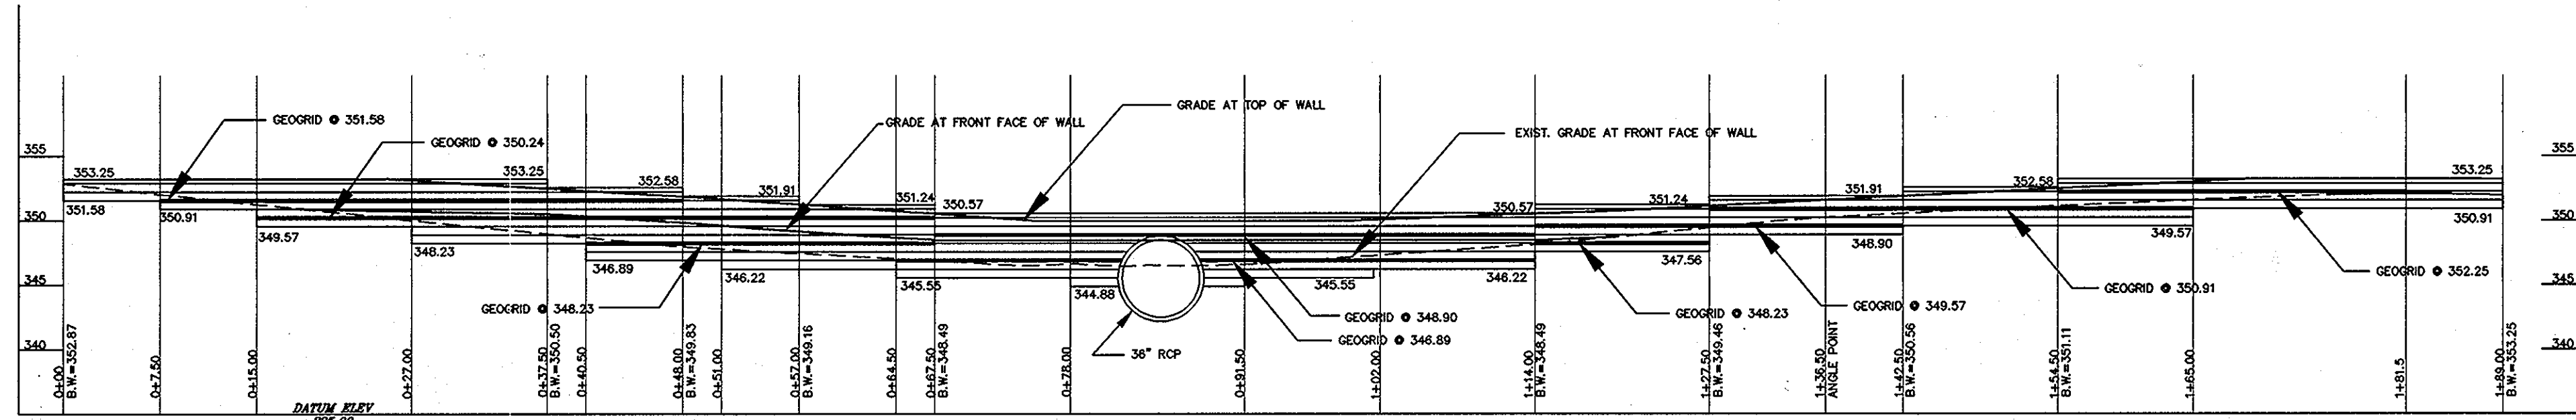


KEYSTONE RETAINING WALL - ELEVATION

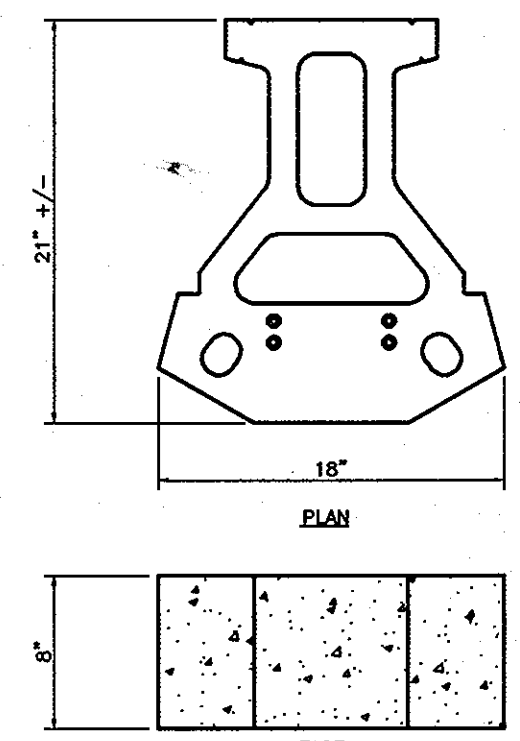

KEYSTONE STANDARD UNIT

KEYSTONE STD. UNIT

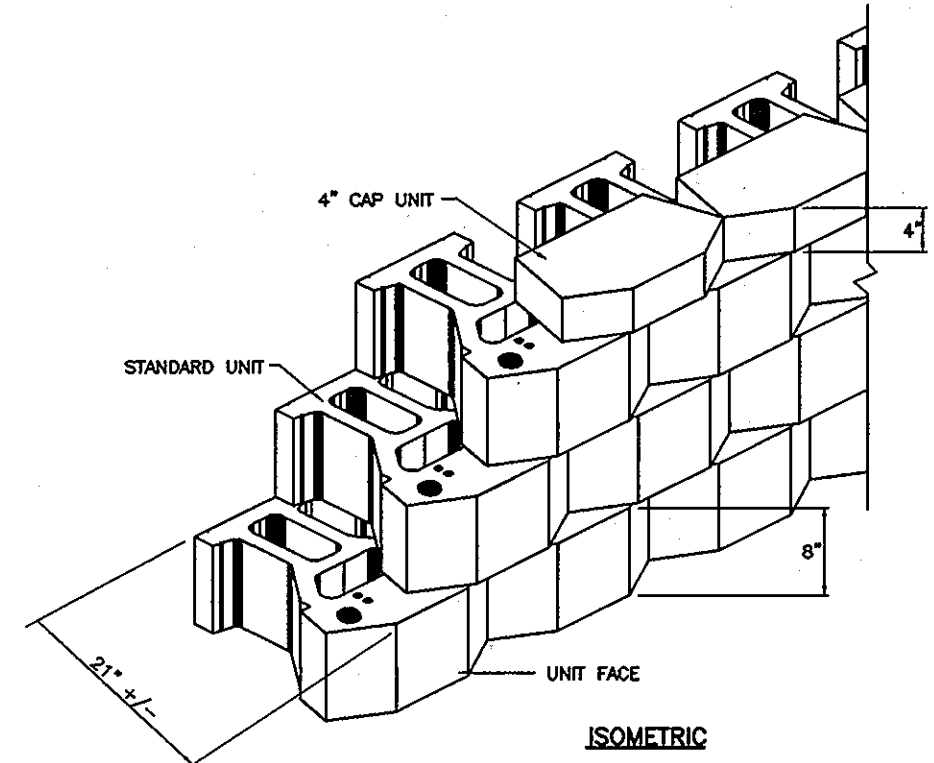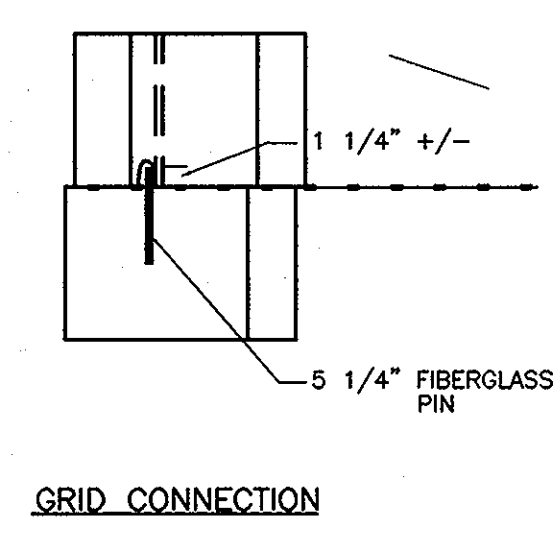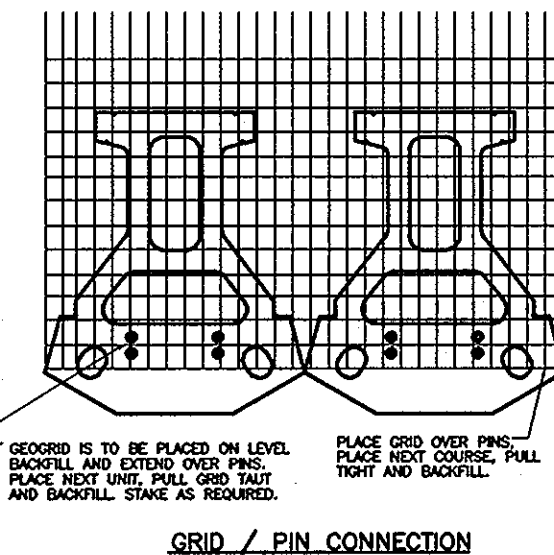

OWNER/DEVELOPER

BONNIE BRANCH CORPORATION
P.O. BOX 396
ELlicott CITY, MD 21043

- 2.02 MODULAR CONCRETE RETAINING WALL UNITS
- A. MODULAR CONCRETE UNITS SHALL CONFORM TO THE FOLLOWING ARCHITECTURAL REQUIREMENTS:
- FACE COLOR - STANDARD MANUFACTURER'S COLOR OR CUSTOM COLOR AS SPECIFIED BY THE OWNER.
 - FACE FINISH - SCULPTURED ROCK FACE IN ANGULAR MULTIPLANER CONFIGURATION. OTHER FACE FINISHES WILL NOT BE ALLOWED WITHOUT WRITTEN APPROVAL OF OWNER.
 - BOND CONFIGURATION - RUNNING WITH BONDS NORMALLY LOCATED AT MIDPOINT VERTICALLY ADJACENT UNITS, IN BOTH STRAIGHT AND CURVED ALIGNMENTS.
 - EXPOSED SURFACES OF UNITS SHALL BE FREE OF CHIPS, CRACKS OR OTHER IMPERFECTIONS WHEN VIEWED FROM A DISTANCE OF 10 FEET UNDER DIFFUSED LIGHTING.
- B. MODULAR CONCRETE UNITS SHALL CONFORM TO THE FOLLOWING MATERIAL SPECIFICATIONS:
- CEMENT - MATERIALS SHALL CONFORM TO THE FOLLOWING APPLICABLE SPECIFICATIONS.
 - A. PORTLAND CEMENT - ASTM C 150
 - B. MODIFIED PORTLAND CEMENT - PORTLAND CEMENT CONFORMING TO ASTM C 150, MODIFIED AS FOLLOWS: LIMESTONE - CALCIUM CARBONATE, WITH A MINIMUM 85% CONTENT, MAY BE ADDED TO THE CEMENT, PROVIDED THESE REQUIREMENTS OF C 150 AS MODIFIED ARE MET: (1) LIMITATION ON INSOLUBLE RESIDUE 1.5% (2) LIMITATION ON AIR CONTENT OF MORTAR - VOLUME PERCENT, 22% MAXIMUM; AND (3) LIMITATIONS OF LOSS OF IGNITION - 7%
 - C. BLENDED CEMENTS - ASTM C 618
 - D. POZZOLANS - ASTM C 618
 - E. BLAST FURNACE SLAG CEMENT - ASTM C 989
 - AGGREGATES - AGGREGATES SHALL CONFORM TO THE FOLLOWING SPECIFICATIONS, AS APPLICABLE.
 - A. NORMAL WEIGHT AGGREGATES - ASTM C 33
 - B. LIGHTWEIGHT AGGREGATES - ASTM C 331
 - OTHER CONSTITUENTS - AIR ENTRAINING AGENTS, COLORING PIGMENTS, INTEGRAL WATER REPELLENTS, FINELY GROUND SILICA, AND OTHER CONSTITUENTS SHALL BE PREVIOUSLY ESTABLISHED AS SUITABLE FOR USE IN MODULAR CONCRETE RETAINING WALL UNITS AND SHALL CONFORM TO APPLICABLE ASTM STANDARDS OR, SHALL BE SHOWN BY TEST OR EXPERIENCE TO BE NOT DETRIMENTAL TO THE DURABILITY OF THE MODULAR CONCRETE UNITS OR ANY MATERIAL CUSTOMARILY USED IN RETAINING WALL CONSTRUCTION.
- C. MODULAR CONCRETE UNITS SHALL CONFORM TO THE FOLLOWING STRUCTURAL AND GEOMETRIC REQUIREMENTS:
- COMPRESSIVE STRENGTH = 3000 PSI MINIMUM;
 - ABSORPTION = 8% MAXIMUM (6% IN NORTHERN STATES) FOR STANDARD WEIGHT AGGREGATES;
 - UNIT DEPTH - 20 INCHES MINIMUM;
 - UNIT WIDTH TO HEIGHT RATIO = 2.25: 1;
 - UNIT WEIGHT - 90 LBS./UNIT MINIMUM FOR STANDARD WEIGHT AGGREGATES
 - INTER-UNIT SHEAR STRENGTH - 1500 PLF MINIMUM AT 2 PSI NORMAL PRESSURE;
 - GEOGRID/UNIT PEAK CONNECTION STRENGTH - 1000 PLF MINIMUM AT 2 PSI NORMAL FORCE
 - MAXIMUM HORIZONTAL GAP BETWEEN ERECTED UNITS SHALL BE - 1/2 INCH.
- D. MODULAR CONCRETE UNITS SHALL CONFORM TO THE FOLLOWING CONSTRUCTABILITY REQUIREMENTS:
- VERTICAL SETBACK = 1/8" ± PER COURSE (NEAR VERTICAL) OR 1" ± PER COURSE PER THE DESIGN DRAWINGS;
 - ALIGNMENT AND GRID POSITIONING MECHANISM - FIBERGLASS PINS, TWO PER UNIT MINIMUM;
- 2.03 SHEAR CONNECTORS
- STRENGTH OF SHEAR CONNECTORS BETWEEN VERTICAL ADJACENT UNITS SHALL BE APPLICABLE OVER A DESIGN TEMPERATURE OF 10 DEGREES F TO + 100 DEGREES F. SHEAR CONNECTORS SHALL BE 1/2" INCH DIAMETER THERMOSET ISOPHTHALIC POLYESTER RESIN-PULTRUDED FIBERGLASS REINFORCEMENT RODS. CONNECTORS SHALL HAVE A MINIMUM FLEXURAL STRENGTH OF 128,000 PSI AND SHORT BEAM SHEAR OF 6,400 PSI.
 - SHEAR CONNECTORS SHALL BE CAPABLE OF HOLDING THE GEOGRID IN THE PROPER DESIGN POSITION DURING GRID PRE-TENSIONING AND BACKFILLING.
- 2.04 BASE LEVELING PAD MATERIAL
- MATERIAL SHALL CONSIST OF A COMPACTED CRUSHED STONE BASE OR NON-REINFORCED CONCRETE AS SHOWN ON THE CONSTRUCTION DRAWINGS. THE LEVELING PAD SHALL BE A MINIMUM OF 6 INCHES THICK. AS AN OPTION, CONCRETE MAY BE 3 INCHES THICK WITH A COMPACTED GRANULAR BASE FOR A TOTAL THICKNESS OF 6 INCHES.
- 2.05 UNIT FILL
- UNIT FILL SHALL CONSIST OF CLEAN 1" MINUS CRUSHED STONE OR CRUSHED GRAVEL MEETING THE GRADATION LISTED BELOW.

SIIEVE SIZE	PERCENT PASSING
1 INCH	100
3/4 INCH	75-100
NO. 4	0 - 10
NO. 50	0 - 5
 - ONE CUBIC FOOT, MINIMUM, OF DRAIN FILL SHALL BE USED FOR EACH SQUARE FOOT OF WALL FACE. DRAIN FILL SHALL BE PLACED WITHIN CORES OF, BETWEEN, AND BEHIND UNITS TO MEET THIS REQUIREMENT.
- 2.06 REINFORCED BACKFILL
- REINFORCED BACKFILL SHALL BE FREE OF DEBRIS AND MEET THE FOLLOWING GRADATION REQUIREMENTS:

SIIEVE SIZE	PERCENT PASSING
2 INCH	100-75
3/4 INCH	100-75
NO. 4	100-20
NO. 40	0-60
NO. 200	0-35

 PHI ANGLE = 28°
C = 0
UNIT WGT. = 120 LBS./CU.FT.
PLASTICITY INDEX (PI) < 10 AND LIQUID LIMIT < 40.
 - THE MAXIMUM AGGREGATE SIZE SHALL BE LIMITED TO 3/4 INCH UNLESS FIELD TESTS HAVE BEEN OR WILL BE PERFORMED TO EVALUATE POTENTIAL STRENGTH REDUCTIONS TO THE GEOGRID DESIGN DUE TO DAMAGE DURING CONSTRUCTION.
 - MATERIAL CAN BE SITE EXCAVATED SOILS WHERE THE ABOVE REQUIREMENTS CAN BE MET. UNSUITABLE SOILS FOR BACKFILL (HIGH PLASTIC CLAYS OR ORGANIC SOILS) SHALL NOT BE USED IN THE BACKFILL OR IN THE REINFORCED SOIL MASS.
 - CONTRACTOR SHALL SUBMIT REINFORCED FILL SAMPLE AND LABORATORY TEST RESULTS TO THE ARCHITECT/ENGINEER FOR APPROVAL PRIOR TO THE USE OF ANY PROPOSED REINFORCED FILL MATERIAL.


- 2.07 GEOGRID
- ALLOWABLE TENSILE DESIGN LOAD, SHALL BE DETERMINED AS FOLLOWS:
TA = TC/(FD*CF*FS)
TA SHALL BE EVALUATED BASED ON A 75 YEAR DESIGN LIFE.
 - TCR, CREEP LIMITED TENSILE LOAD
TCR SHALL BE DETERMINED FROM 10,000 HOUR CREEP TESTING PERFORMED IN ACCORDANCE WITH ASTM D5262.
 - FD, FACTOR FOR DURABILITY/AGING
FD SHALL BE DETERMINED FROM POLYMER SPECIFIC DURABILITY TESTING COVERING THE RANGE OF EXPECTED SOIL ENVIRONMENTS.
 - FC, FACTOR FOR CONSTRUCTION DAMAGE
FC SHALL BE DETERMINED FROM PRODUCT SPECIFIC CONSTRUCTION DAMAGE TESTING PERFORMED IN ACCORDANCE WITH GRI-G64. TEST RESULTS SHALL BE PROVIDED FOR EACH PRODUCT TO BE USED WITH PROJECT SPECIFIC OR MORE SEVERE SOIL TYPE.
 - FS, OVERALL FACTOR OF SAFETY
FS SHALL BE 1.5 UNLESS OTHERWISE NOTED.
 - THE MAXIMUM DESIGN TENSILE LOAD OF THE GEOGRID SHALL NOT EXCEED THE LABORATORY TESTED ULTIMATE STRENGTH OF THE GEOGRID/FACING UNIT CONNECTION AS LIMITED BY THE "HINGE HEIGHT" DIVIDED BY A FACTOR OF SAFETY OF 1.5. THE CONNECTION STRENGTH TESTING AND COMPUTATION PROCEDURES SHALL BE IN ACCORDANCE WITH NCMC TEST METHODS.
 - SOIL INTERACTION COEFFICIENT, CI
CI VALUES SHALL BE DETERMINED PER GRI-G65 AT A MAXIMUM 0.75 INCH DISPLACEMENT.
 - MANUFACTURING QUALITY CONTROL
THE GEOGRID MANUFACTURER SHALL HAVE A MANUFACTURING QUALITY CONTROL PROGRAM THAT INCLUDES QC TESTING FOR EACH 40,000 SF OF PRODUCTION, EACH LOT, OR EACH PRODUCTION DAY. THE QC TESTING SHALL INCLUDE:
TENSILE MODULUS
SPECIFIC GRAVITY
MELT FLOW INDEX (PP&HDPE)
MOLECULAR WEIGHT (PETP)
- G. GEOGRID SHALL CONFORM TO MIRAFI "MIRAGRID XT (8X1)" FABRIC.
- PART 3 EXECUTION
- 3.01 EXCAVATION
- CONTRACTOR SHALL EXCAVATE TO THE LINES AND GRADES SHOWN ON THE CONSTRUCTION DRAWINGS. ARCHITECT/ENGINEER WILL INSPECT THE EXCAVATION AND APPROVE PRIOR TO PLACEMENT OF LEVELING MATERIAL OR FILL SOILS.
 - OVER-EXCAVATION OF DELETERIOUS SOILS AND REPLACEMENT WITH SUITABLE FILL WILL BE PAID AT UNIT COST RATES.
- 3.02 BASE LEVELING PAD
- LEVELING PAD MATERIAL(S) SHALL BE PLACED TO THE LINES AND GRADES SHOWN ON THE CONSTRUCTION DRAWINGS, TO A MINIMUM THICKNESS OF 6 INCHES.
 - SOIL LEVELING PAD MATERIALS SHALL BE COMPACTED TO A MINIMUM OF 95% STANDARD OR 90% MODIFIED PROCTOR.
 - LEVELING PAD SHALL BE PREPARED TO INSURE FULL CONTACT TO THE BASE SURFACE OF THE CONCRETE UNITS.
- 3.03 KEYSTONE UNIT INSTALLATION
- FIRST COURSE OF UNITS SHALL BE PLACED ON THE LEVELING PAD, AND ALIGNMENT AND LEVEL CHECKED. PINS OR MOLDED SURFACES OF MODULAR CONCRETE UNITS SHALL BE USED FOR ALIGNMENT CONTROL.
 - POSITION VERTICALLY ADJACENT MODULAR CONCRETE UNITS AS RECOMMENDED BY THE MANUFACTURER.
 - MAXIMUM STACKED VERTICAL HEIGHT OF WALL UNITS, PRIOR TO WALL DRAIN FILL AND BACKFILL PLACEMENT AND COMPACTION, SHALL NOT EXCEED TWO COURSES.
 - WHOLE, OR CUT, UNITS ON CURVES AND CORNERS TO SHALL BE ERECTED WITH RUNNING BOARD APPROXIMATELY CENTERED ON UNITS ABOVE AND BELOW.
 - CAP UNITS SHALL BE GLUED TO UNDERLAYING UNITS WITH AN ADHESIVE RECOMMENDED BY THE MANUFACTURER.
- 3.04 STRUCTURAL GEOGRID INSTALLATION
- GEOGRID SHALL BE ORIENTED WITH THE HIGHEST STRENGTH AXIS PERPENDICULAR TO THE WALL ALIGNMENT.
 - GEOGRID REINFORCEMENT SHALL BE PLACED AT THE ELEVATIONS AND TO THE EXTENT SHOWN ON THE CONSTRUCTION DRAWINGS OR AS DIRECTED BY THE ENGINEER.
 - THE GEOGRID SHALL BE LAID HORIZONTALLY ON COMPACTED BACKFILL. PLACE THE NEXT COURSE OF MODULAR CONCRETE UNITS OVER GEOGRID. THE GEOGRID SHALL BE PULLED TAUT, AND ANCHORED PRIOR TO BACKFILL PLACEMENT ON THE GEOGRID.
 - GEOGRID REINFORCEMENTS SHALL BE CONTINUOUS THROUGHOUT THEIR EMBEDMENT LENGTHS. SPICED CONNECTIONS BETWEEN SHORTER PIECES OF GEOGRID IS NOT ALLOWED UNLESS PRE-APPROVED BY THE ARCHITECT/ENGINEER PRIOR TO CONSTRUCTION.
- 3.05 REINFORCED BACKFILL PLACEMENT
- REINFORCED BACKFILL SHALL BE PLACED, SPREAD, AND COMPACTED IN SUCH A MANNER THAT MINIMIZES THE DEVELOPMENT OF SLACK IN THE GEOGRID.
 - REINFORCED BACKFILL SHALL BE PLACED AND COMPACTED IN LIFTS NOT TO EXCEED 8 INCHES WHERE HAND COMPACTION IS USED, OR 12 INCHES WHERE HEAVY COMPACTION EQUIPMENT IS USED.
 - REINFORCED BACKFILL SHALL BE COMPACTED TO 95% OF THE MAXIMUM DENSITY AS DETERMINED BY ASTM D695. THE MOISTURE CONTENT OF THE BACKFILL MATERIAL SHALL BE KEPT TO A MINIMUM TO PREVENT TRACKS FROM DISPLACING THE FILL AND DAMAGING THE GEOGRID. PERCENTAGE POINTS DRY OF OPTIMUM.
 - ONLY LIGHTWEIGHT HAND-OPERATED EQUIPMENT SHALL BE ALLOWED WITHIN 3 FEET FROM THE TAIL OF THE MODULAR CONCRETE UNIT.
 - TRACKED CONSTRUCTION EQUIPMENT SHALL NOT BE OPERATED DIRECTLY UPON THE GEOGRID REINFORCEMENT. A MINIMUM FILL THICKNESS OF 6 INCHES IS REQUIRED PRIOR TO OPERATION OF TRACKED VEHICLES OVER THE GEOGRID. TRACKED VEHICLE TURNING SHOULD BE KEPT TO A MINIMUM TO PREVENT TRACKS FROM DISPLACING THE FILL AND DAMAGING THE GEOGRID.
 - RUBBER Tired EQUIPMENT MAY PASS OVER GEOGRID REINFORCEMENT AT SLOW SPEEDS, LESS THAN 10 MPH. SUDDEN BRAKING AND SHARP TURNING SHALL BE AVOIDED.
 - AT THE END OF EACH DAY'S OPERATION, THE CONTRACTOR SHALL SLOPE THE LAST LIFT OF REINFORCED BACKFILL AWAY FROM THE WALL UNITS TO DIRECT RUNOFF AWAY FROM WALL FACE. THE CONTRACTOR SHALL NOT ALLOW SURFACE RUNOFF FROM ADJACENT AREAS TO ENTER THE WALL CONSTRUCTION SITE.

99072 (PHASE 1) (M) (FINAL) WALL-3-28

APPROVED: DEPARTMENT OF PUBLIC WORKS
Richard M. Dwyer 1-30-02
CHIEF BUREAU OF HIGHWAYS DATE

APPROVED: DEPARTMENT OF PLANNING AND ZONING
Andy Hamt 2/5/02
CHIEF, DIVISION OF LAND DEVELOPMENT DATE

John Dammann 1/23/02
CHIEF, DEVELOPMENT ENGINEERING DIVISION DATE

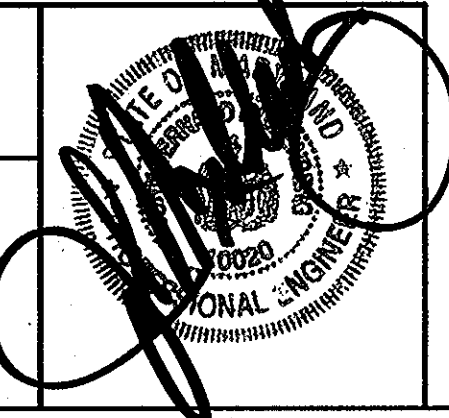


date	DEC. 2001	approval	JBM
project	99072	illustration	JBM
scale	JBM	score	JBM
description	AS SHOWN	revisions	




no.	description	revisions

AUTUMN VIEW, SECTION 5, PHASE 1
 Lots: 211-259
 TAX MAP 25 & 31, P/O PARCEL 75
 HOWARD COUNTY, MARYLAND
 SECOND ELECTION DISTRICT
RETAINING WALL DETAILS

MILDENBERG, BOENDER & ASSOC., INC.
 Engineers Planners Surveyors
 5072 Dorsey Hall Drive, Suite 202, Ellicott City, Maryland 21042
 (410) 987-0298 Fax: (301) 621-5521

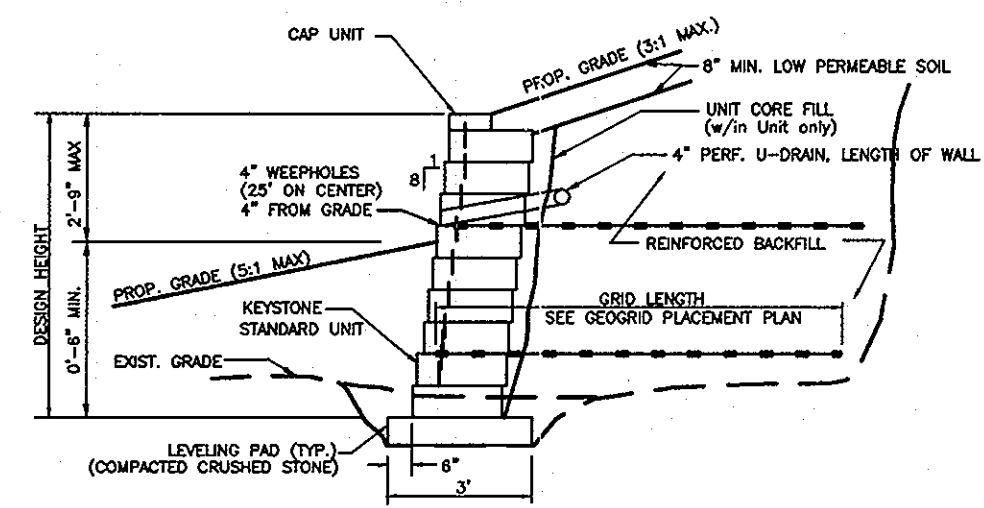

TYPICAL REINFORCED SECTION
STANDARD UNIT - 1' SETBACK

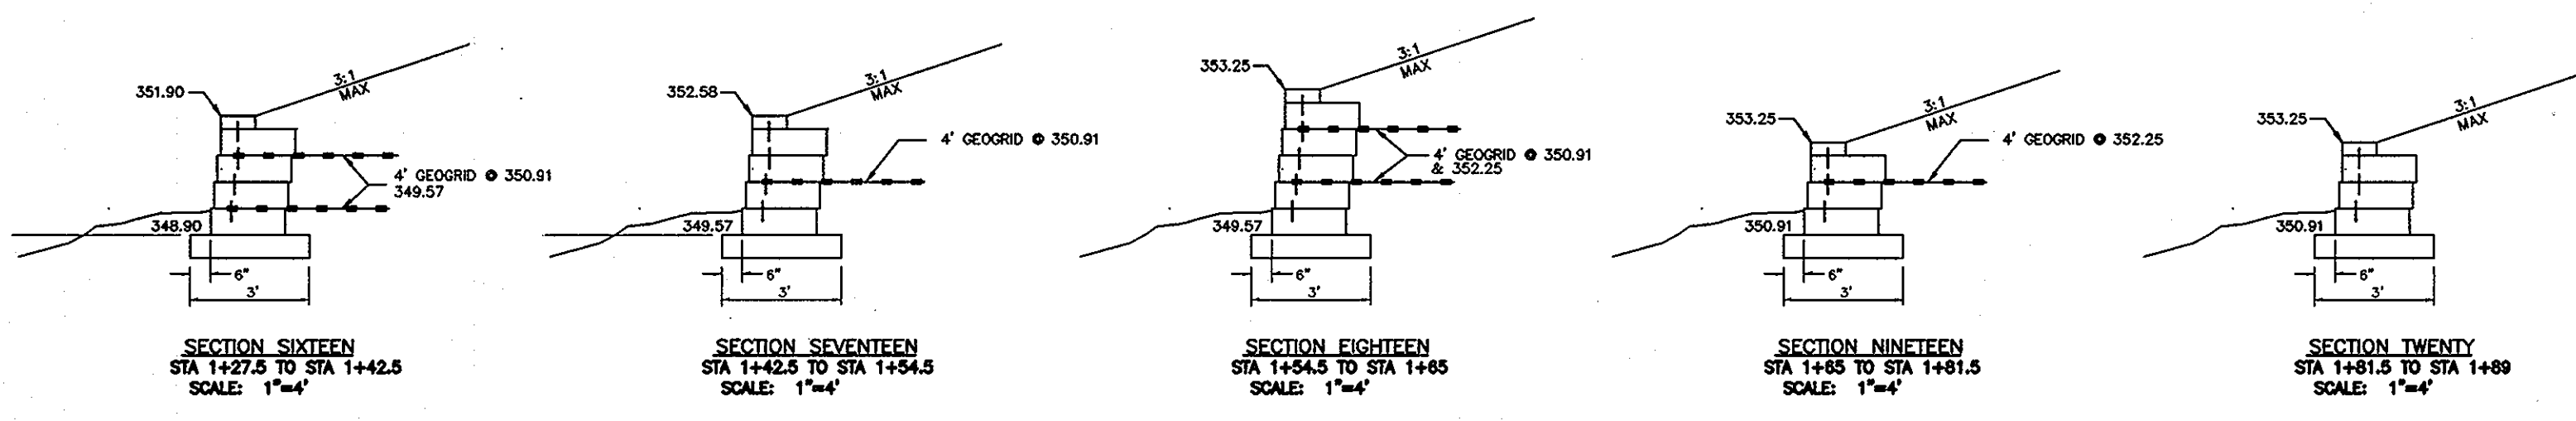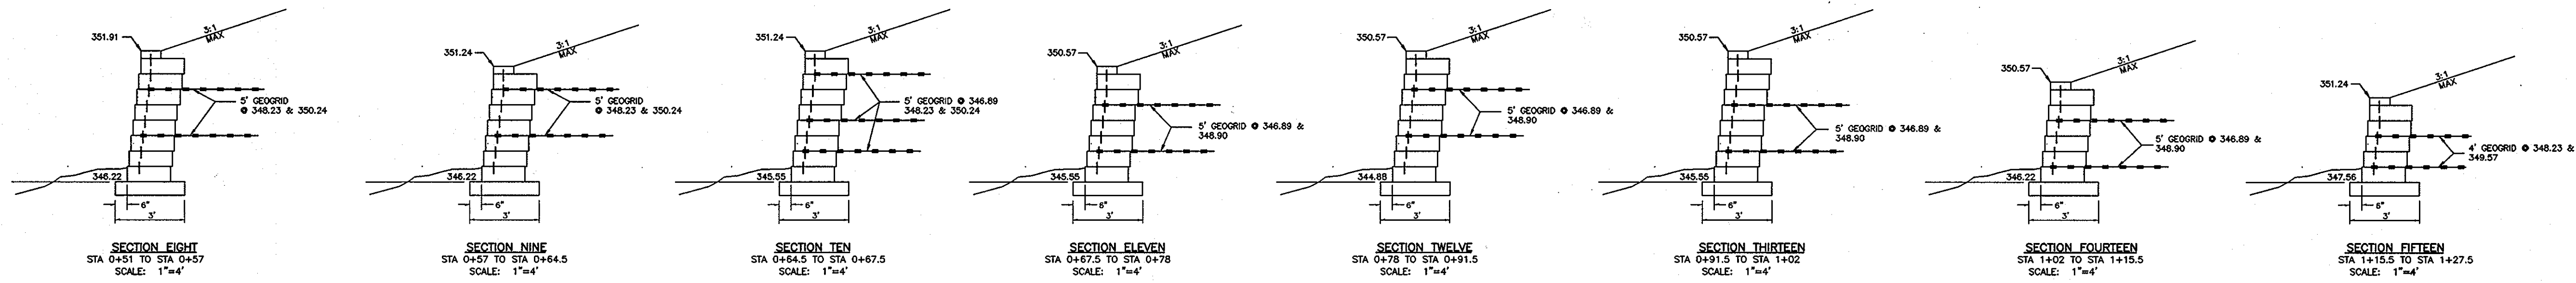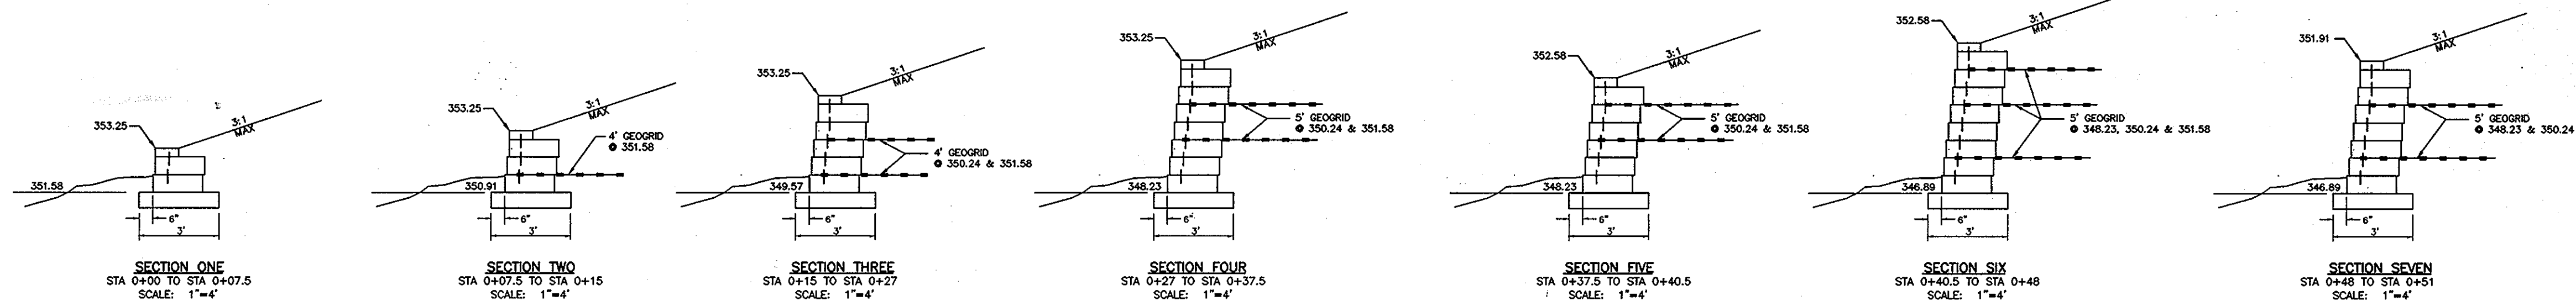


NOTE: GEOTECHNICAL ENGINEER WILL CERTIFY THE SUITABILITY OF
FILL MATERIALS AND THE BEARING PRESSURES REQUIRED
FOR EACH WALL SECTION.

APPROVED: DEPARTMENT OF PUBLIC WORKS
[Signature] 1-30-02
CHIEF BUREAU OF HIGHWAYS DATE

APPROVED: DEPARTMENT OF PLANNING AND ZONING
[Signature] 2/5/02
CHIEF, DIVISION OF LAND DEVELOPMENT DATE

[Signature] 1/23/02
CHIEF, DEVELOPMENT ENGINEERING DIVISION DATE

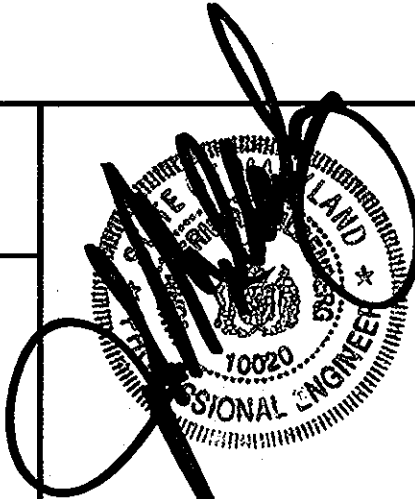

OWNER/DEVELOPER

BONNIE BRANCH CORPORATION
P.O. BOX 396
ELLCOTT CITY, MD 21043

Project	date
99072	DEC. 2001
Illustration	engineering
IBM	IBM
scale	approval
AS SHOWN	IBM

No.	date	description	revisions

AUTUMN VIEW, SECTION 5, PHASE 1
LOTS: 211-259
TAX MAP 25 & 31; P/O PARCEL 75
SECOND ELECTION DISTRICT HOWARD COUNTY, MARYLAND
RETAINING WALL SECTIONS

MILDENBERG,
BOENDER & ASSOC., INC.
Engineers Planners Surveyors
5072 Dorsey Hall Drive, Suite 202, Ellicott City, Maryland 21042
(410) 997-0296 Fax (301) 621-5521 Wash. (410) 997-0298 Fax