PHASE 5, LOTS 60-89 AND NON-BUILDABLE PARCEL B-4 A RESUBDIVION OF NON-BUILDABLE PARCEL B-3, PHASE 4 HOWARD COUNTY, MARYLAND

BENCHMARK NO. 1: COUNTY CONTROL #3044005R 3/4" REBAR 0.8' BELOW SURFACE N. 578233.92, E. 1373142.33

BENCHMARK NO. 2: COUNTY CONTROL #3044004RV 3/4" REBAR 0.6' BELOW SURFACE

DENSITY TABULATION

4.42 AC (POR)* 0.00 AC. 0.00 AC. 4.42 AC. N/A

1 (F-01-60) 50.46 AC. (R-ED)*** 1.62 AC. 8.36 AC. 40.48 AC. 80 D.U. 42 D.U. 102 D.U.


2 (F-01-206) 0.89 AC. (R-ED)*** 0.00 AC. 0.00 AC. 0.89 AC. 1 D.U. 3 D.U. 99 D.U.

4 (F-03-207) 1.20 AC. (R-ED)*** 0.00 AC. 0.00 AC. 1.20 AC. 2 D.U. 5 D.U. 89 D.U.

3 (F-02-170) 2.06 AC. (R-ED)*** 0.00 AC. 0.00 AC. 2.06 AC. 4 D.U. 5 D.U. 94 D.U.

AREA(GROSS AREA) | FLOODPLAIN STEEP SLOPES NET AREA ALLOWED PROPOSED | REMAINING

83.27 AC (R-ED) 1.62 AC. 8.36 AC. 73.29 AC. 146 D.U. 144 D.U.**

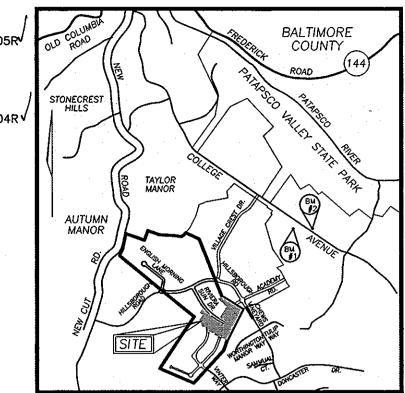

VICINITY MAP

LIMIT OF DISTURBANCE FOR PHASE 5 PLAN SUBMISSION: 9.44 AC.±

AREA OF PROPOSED BUILDABLE LOTS: 8.63 AC.

AREA OF PROPOSED ROAD RIGHT OF WAY: 1.33 AC

AREA OF 100 YEAR FLOODPLAIN ON SITE: 0.00 AC.

AREA OF PHASE 5 PLAN SUBMISSION: 34.37 AC (R-ED)

NUMBER OF LOTS/PARCELS PROPOSED: 30 BUILDABLE LOTS

LOCATION: TAX MAP 25 & 31, BLOCKS 2 & 20, PARCEL P/O '98'

DPZ REFERENCES: S-98-18, PB-336 (APP. 6/16/99), P-00-07, F-01-60 (PHASE 1),

P-01-01, F-01-206 (PHASE 2), P-02-08, F-02-170 (PHASE 3), P-03-07, F-03-207 (PHASE 4),

GENERAL NOTES

SITE DATA

2ND ELECTION DISTRICT EXISTING ZONING: R-ED

P-04-012 (PHASE 5)

TOTAL AREA OF SITE: 83.27 AC.(R-ED)

OPEN SPACE TABULATIONS: 0.00 AC.

- 1. ALL ASPECTS OF THE PROJECT ARE IN CONFORMANCE WITH THE LATEST HOWARD COUNTY STANDARDS UNLESS WAIVERS
- 2. ALL CONSTRUCTION SHALL BE IN ACCORDANCE WITH THE LATEST STANDARDS AND SPECIFICATIONS OF HOWARD COUNTY PLUS MSHA STANDARDS AND SPECIFICATIONS IF APPLICABLE.
- 3. THE CONTRACTOR SHALL NOTIFY THE DEPARTMENT OF PUBLIC WORKS/BUREAU OF ENGINEERING/CONSTRUCTION INSPECTION
- DIVISION AT (410) 313-1880 AT LEAST FIVE (5) WORKING DAYS PRIOR TO THE START OF WORK. 4. THE CONTRACTOR SHALL NOTIFY "MISS UTILITY" AT 1-800-257-7777 AT LEAST 48 HOURS PRIOR TO ANY EXCAVATION
- 5. TRAFFIC CONTROL DEVICES, MARKINGS AND SIGNING SHALL BE IN ACCORDANCE WITH THE LATEST EDITION OF THE MANUAL OF UNIFORM TRAFFIC CONTROL DEVICES (MUTCD). ALL STREET AND REGULATORY SIGNS SHALL BE IN PLACE PRIOR TO THE
- 7. THE PROJECT BOUNDARY IS BASED ON A BOUNDARY SURVEY PREPARED BY VOGEL & ASSOCIATES, INC., DATED NOVEMBER 1998 8. THE TOPOGRAPHY SHOWN HEREON IS BASED ON AERIAL PHOTOGRAMETRIC SURVEY PREPARED BY WINGS AERIAL MAPPING
- 9. COORDINATE DATUM IS BASED ON THE MARYLAND COORDINATE SYSTEM (NAD 83) AS PROJECTED BY THE FOLLOWING HOWARD COUNTY GEODETIC CONTROL STATIONS: 3044005R & 3044004R
- 10. WATER AND SEWER FOR THIS PROJECT WILL BE PUBLIC. EXISTING WATER CONTRACT NO. 14-3160-D AND CONTRACT NO.14-3375-D WILL BE EXTENDED FROM RIVIERA SUN DRIVE AND ACADEMY ROAD, RESPECTIVELY. A NEW SEWER WILL BE PROPOSED TO DRAIN TO THE PLANNED PUMPING STATION TO BE CONSTRUCTED AS CONTRACT NO. 14-3855-D.
- 11. STORMWATER MANAGEMENT (2-YR & 10-YR) IS PROVIDED UNDER PHASE 1, F-01-60, AS A WET POND.
- 12. HDPE BEDDING SPECIFICATIONS ARE TO BE AS PER ASTM STANDARDS. 13. THERE ARE NO WETLANDS OR STREAMS WITHIN THIS PHASE BASED ON A WETLANDS REPORT PREPATED BY REIMER, MUEGGE
- AND ASSOCIATES, DATED SEPTEMBER 25, 1998, AND APPROVED UNDER S-98-18. 14. THERE IS NO 100-YR FLOODPLAIN LOCATED WITHIN THIS PHASE.
- 15. A FOREST STAND DELINEATION PLAN WAS PREPARED FOR THE ENTIRE SITE PREPARED BY CHESAPEAKE ENVIRONMENTAL
- DATED MARCH 1995, AND APPROVED UNDER S-98-18. 16. FOREST CONSERVATION PLAN PREPARED BY EXPLORATION RESEARCH, INC., DATED OCTOBER 1999, FOR THE ENTIRE SITE. FOREST CONSERVATION OBLIGATIONS HAVE BEEN MET BY A KETELITION EASEMENT OF 20.32 AC. THE OUTSTANDING
- FOREST CONSERVATION OBLIGATION OF 10.28 AC. FOR THE ENTIRE SITE WILL BE PROVIDED AT PHASE 6. 17. APFO TRAFFIC STUDY PREPARED BY THE TRAFFIC GROUP, DATED JUNE 8, 1998, AND APPROVED UNDER S-98-18. 18. PERIMETER LANDSCAPING REQUIREMENTS AS SET FORTH IN SECTION 16.124 OF THE SUBDIVISION REGULATIONS AND THE
- HOWARD COUNTY LANDSCAPE MANUAL SHALL BE COMPLIED WITH. A FINANCIAL SURETY IN THE AMOUNT OF \$6,000.00 FOR THE REQUIRED 20 SHADE TREES WILL BE POSTED AS PART OF THE DEVELOPERS AGREEMENT. 19. STREET TREES ARE REQUIRED FOR THIS PROJECT IN ACCORDANCE WITH SECTION 16.124(e)(1) OF THE SUBDIVISION
- REGULATIONS AND THE LANDSCAPE MANUAL. A FINANCIAL SURETY IN THE AMOUNT OF \$20,400.00 TO BE POSTED AS PART OF THE DEVELOPER'S AGREEMENT FOR THE REQUIRED 68 PUBLIC STREET TREES. 20. STREET LIGHTING HAS BEEN PROVIDED FOR THE PUBLIC ROADS IN ACCORDANCE WITH SECTION 16.135 OF THE HOWARD COUNTY SUBDIVISION AND LAND DEVELOPMENT REGULATIONS AND THE DESIGN MANUAL. A MINIMUN OF 20' SHALL BE
- MAINTAINED BETWEEN ANY STREET LIGHT AND ANY TREE. 21. SEDIMENT AND EROSION CONTROL HAS BEEN PROVIDED FOR THIS SITE.

APPROVED: HOWARD COUNTY DEPARTMENT OF PUBLIC WORKS

CHIEF, BUREAU OF HIGHWAYS

- 22. THIS PROPERTY IS WITHIN THE METROPOLITAN DISTRICT. 23. TO THE BEST OF THE OWNERS KNOWLEDGE, THERE ARE NO BURIAL/CEMETARY LOCATIONS ON SITE.
- 24. A NOISE STUDY IS NOT REQUIRED FOR THIS SITE. 25. REFERENCE PLANNING BOARD CASE PB-336 FOR APPROVAL OF THIS DEVELOPMENT WITHIN THE
- R-ED DISTRICT ON JUNE 16, 1999, SUBJECT TO THE FOLLOWING CONDITIONS: 1. COMPLIANCE WITH THE SUBDIVISION REVIEW COMMITTEE COMMENTS FOR SKETCH PLAN S-98-19.
- 2. THE DEVELOPERS SHALL PROVIDE PEDESTRIAN ACCESS FROM THIS SUBDIVISION TO THE ADJACENT WORTHINGTON ELEMENTARY SCHOOL SITE. 26. AS A RESULT OF THIS PRELIMINARY PLAN BEING SUBMITTED TO THE COUNTY FOR REVIEW PRIOR TO 11/15/01. IT IS SUBJECT TO COMPLIANCE WITH THE FOURTH EDITION OF THE SUBDIVISION
- AND LAND DEVELOPMENT REGULATIONS. IN ADDITION, BECAUSE THIS PHASE OF THE SUBDIVISION DID NOT OBTAIN SIGNATURE APPROVAL OF THIS PRELIMINARY PLAN PRIOR TO 11/01/01. IT IS SUBJECT TO COMPLIANCE WITH COUNTY COUNCIL BILL 50-2001 WHICH AMENDS THE ZONING REGULATIONS, AND THE AMENDED ZONING REGULATIONS WHICH BECOME EFFECTIVE ON 01/08/02.
- 27. FOR FLAG OR PIPE STEM LOTS, REFUSE COLLECTION, SNOW REMOVAL AND ROAD MAINTENANCE ARE PROVIDED TO THE JUNCTION OF THE FLAG OR PIPE STEM AND THE ROAD RIGHT-OF-WAY ONLY AND NOT ONTO THE FLAG OR PIPE STEM DRIVEWAY.
- 28. ALL FILLED AREAS OF EARTHWORK REQUIRE 95% COMPACTION PER AASHTO-180 SPECIFICATIONS. 29. DRIVEWAY PLACEMENT AND GRADING WILL BE FINALIZED AT SITE DEVELOPMENT PHASE.
- 30. DEVELOPMENT OR CONSTRUCTION ON THESE LOTS MUST COMPLY WITH THE SETBACK AND BUFFER REGULATIONS IN EFFECT AT THE TIME OF THE SUBMISSION OF THE SITE DEVELOPMENT PLAN, WAIVER PETITION OR BUILDING/ GRADING PERMIT.
- 31. A MINIMUM OF 20' IS REQUIRED BETWEEN ANY STREET LIGHT AND ANY TREE. 32. ALL SIGN POST USED FOR TRAFFIC CONTROL SIGNS INSTALLED IN THE COUNTY RIGHT-OF-WAY SHALL BE MOUNTED ON A 2" GALVANIZED STEEL, PERFORATED, SQUARE TUBE POST (14 GAUGE) INSERTED INTO A 2-1/2" GALVANIZED STEEL, PERFORATED, SQUARE TUBE SLEEVE (12 GAUGE)-3' LONG. A GALVANIZED STEEL POLE CAP SHALL BE MOUNTED ON TOP OF EACH POST.

2-14-05

PHASE 1 FOREST RETENTION PARCEL C-1' VILLULE GREST PARCELS C-1 VILLUL
PARCEL O-1
WORTHBRIGTON PARKETUTURE SITE) PRIVIOUS SITE OF INV CUT ROUD LANGELL NOW CUSED COUNTY COMMISSIONERS OF HOWARD COUNTY OF PARKET OF DEPARTMENT OF DEPARTMENT OF TORRES 1. 1. 1. 2 1 1 1 1 1 1 1 1 1 1 1 1 1 1
WORTHWATTON PARK (FUTURE SITE) PREVIOUS SITE OF INSPICULATION LONG ALL NOW CLOSED COUNTY COMMUNISCIONERS OF HOWARD COUNTY DEPARTMENT OF PUBLIC WORKS 20(HD I R-20 190309 P-239 (SEE SOP-90-109) PHASE 2 PHASE 3
PHASE 3 WORTHINGTON RESERVES LOTS 1-143 SECTION 2 ZONED: R20 PLATE 11399,11400 PHASE 5 PHASE 5 PHASE 5 PHASE 5
COORDINATE CHART
610 578,032.1616 1,370,870.344 618 578,081.1422 1,371,146.920 242 577,955.5100 1,371.620.520 243 576,754.7600 1,372.055.889 529 576,482.7908 1,371,730.762 530 575,844.1251 1,371,730.762 130 575,623.8142 1,371,654.758 125 574,948.0467 1,371,033.450 252 575,251.6521 1,370,334.508 88 576,332.2271 1,371,039.300

LOCATION PLAN SCALE: 1"=600"

FOREST CONSERVATION TABULATION (LAND USE: HDR)							
	F-01-60	F-01-206	F-02-170	F-03-207	F-05-019		
PHASES	PHASE 1	PHASE 2	PHASE 3	PHASE 4	PHASE 5	PHASE 6	ENTIRE SITE
TOTAL TRACT AREA	47.22 AC	0.89 AC	2.04 AC	1.20 AC	8.83 AC	44	83.27 AC
FLOODPLAIN	1.62 AC	0.00 AC	0.00 AC	0.00 AC	0.00 AC		1.62 AC
NET TRACT AREA	45.60 AC	0.89 AC	2.04 AC	1.20 AC	8.83 AC		81.65 AC
AFFORESTATION THRESHOLD -15%	6.84° AC	0.13 AC	0.31 AC	0.18 AC	1.32 AC		12.25 AC
REFORESTATION THRESHOLD -20%	9.12 AC	0.18 AC	0.41 AC	0.24 AC	1.77 AC		16.33 AC
EX. FOREST LESS FLOODPLAIN	31.37 AC	0.00 AC	0.00 AC	0.00 AC	0.00 AC		51.10 AC
FOREST ABOVE AFF. THRESHOLD	24.61 AC	0.00 AC	0.00 AC	0.00 AC	0.00 AC		38.85 AC
FOREST ABOVE REF. THRESHOLD	22.25 AC	0.00 AC	0.00 AC	0.00 AC	0.00 AC		~ 34.75 AC_
BREAK EVEN POINT	13.57 AC	N/A	N/A	N/A	N/A		23.29 AC
RET. W. NO MITIGATION REQUIRED	13.57 AC	N/A	N/A	N/A	N/A		23.29 AC
CLEARING W. NO MITIGATION REQUIRED	17.80 AC	N/A	N/A	N/A	N/A		27.81 AC
FOREST AREA CLEARED	11.05 AC	0.00 AC	0.00 AC	0.00 AC	0.00 AC		20.50 AC
FOREST AREA RETAINED	20.32 AC	0.00 AC	0.00 AC	0.00 AC	0.00 AC	10.28 AC	30.60 AC
REFOREST FOR CLEARING ABOVE CON.THRESH.	2.76 AC	0.00 AC	0.00 AC	0.00 AC	0.00 AC		5.13 AC
REFOREST FOR CLEARING BELOW CON.THRESH.	0.00 AC		0.00 AC				
CREDIT FOR RETENTION ABOVE CON.THRESH.	11.20 AC	0.00 AC	0.00 AC	0.00 AC	0.00 AC		14.27 AC
TOTAL REFORESTATION REQUIRED	0.00 AC		0.00 AC				
TOTAL AFFORESTATION REQUIRED	0.00 AC	N/A	N/A	N/A	N/A		0.00 AC
TOTAL RE AND AFFORESTATION REQUIRED	0.00 AC		0.00 AC				
RE/AFFORESTATION PROVIDED	0.00 AC		0.00 AC				

1. THIS PLAN IS IN ACCORDANCE WITH APPROVED SKETCH PLAN S-98-18. NOTE THAT THE 4.42 ACRE (3.23 AC. AFTER DEDICATION TO ROADS) POR ZONED NON-BUILDABLE PARCEL A IS NOW PART OF VILLAGE CREST SUBDIVISION. FOREST CONSERVATION FOR THAT PARCEL IS PROVIDED IN VILLAGE CREST F-02-47.

2. IN ACCORDANCE WITH APPROVED PB-366 AND S-98-18, A MINIMUM OF 30.60 AC. OF FOREST RETENTION IS REQUIRED FOR THE ENTIRE WORTHINGTON FIELDS SUBDIVISION AREA. THIS INCLUDES A STATEMENT THAT FOREST CONSERVATION OBLIGATIONS CAN BE MET BY RETENTION OF FOREST STANDS EQUAL TO OR ABOVE THE BREAK-EVEN-POINT. ANY CHANGES TO THE PLAN WHICH ARE NOT IN ACCORDANCE WITH THE SKETCH PLAN EXHIBIT THAT WAS SUBMITTED AT PLANNING BOARD WILL REQUIRE ANOTHER PLANNING BOARD HEARING.

3. THIS PROJECT IS LOCATED IN THE WORTHINGTON ELEMENTARY SCHOOL DISTRICT AND THE ELLICOTT MILLS MIDDLE SCHOOL DISTRICT. AS A CONSEQUENCE OF THE COUNCIL'S APPROVAL OF RESOLUTION "95-2003 AND RESOLUTION 96-2003". THE 30 UNITS COMPRISING PHASE V HAVE NOW PASSED THE APFO TEST FOR OPEN SCHOOL REGION, REPHASING PROPOSAL HAS BEEN ENDORSED BY DEPARTMENT OF PLANNING & ZONING BY LETTER DATED JUNE 26, 2003 AND HAD GRANTED 30 TENTATIVE HOUSING UNIT ALLOCATIONS FOR THE YEAR 2006 (PHASE V) AND 59 FOR THE YEAR 2007 (PHASE VI).

DHR QUALIFIED PROPESSIONAL

OWNER TAYLOR FAMILY LIMITED PARTNERSHIP B 4100 COLLEGE AVE. ELLICOTT CITY, MARYLAND 21043-5506

DEVELOPER NEW CUT ROAD DEVELOPMENT 2, INC. C/O LAND DESIGN & DEVELOPMENT, INC. 8000 MAIN STREET ELLICOT CITY MARYLAND 21043 ATTN.: DONALD R. REUWER (410) 480-9105

	5 (F-05-019)	8.83 AC. (R-E	D)*** 0.00 AC.	0.00 AC.	8.83 AC. 18 I	D.U. 30 D.U.	59 D.U.			
	6									
	TOTAL	54.61 AC (R-E	D)*** 1.62 AC.	8.36 AC.	44.63 AC. 105	D.U. 85 D.U.	0 D.U.			
,	*THE POR ZONED AREA RECORDED AS NON-BUILDABLE PARCEL 'A' (3.23 AC.) ON WORTHINGTON FIELDS PHASE 1, PLAT NO. 14946-14955, HAS SUBSEQUENTLY BEEN RESUBDIMIDED TO CREATE VILLAGE CREST, PARCELS A-1, A-2 AND NON-BUILDABLE PARCEL A-3 AND RECORDED AS PLAT NO. 15359. THE REMAINING PORTION OF THE POR ZONED AREA (1.19 AC.) HAS BEEN DEDICATED TO HOWARD COUNTY, MARYLAND, FOR THE PURPOSE OF A PUBLIC ROAD AS PER WORTHINGTON FIELDS PHASE 1, PLAT NO. 14946-14955. **MAXIMUM ALLOWABLE DENSITY OF 144 UNITS APPROVED UNDER S-98-18. ***DOES NOT INCLUDE RESIDUE PORTIONS OF NON-BUILDABLE PARCEL 'B'.									
					OPEN_SPACE	TABULAT	ION			
	PHASE	TOTAL AREA	REQUIRED OPEN SPACE*	PROVIDED CREDITED OPEN SPACE	PROVIDED NON-CREDITED OPEN SPACE	TOTAL PROVIDED OPEN SPACE	OPEN SPACE	REQ. REC. OPEN SPACE*	PROV. REC.	REC IN R
	TOTAL		1	OF LIT SPACE	OI LIT SI ACE	OI EN SIACE	III KESEKVE		OI ER SI ACE	
	SUBDIVISION	83.27 AC.	20.82 AC.	_		ļ 		0.83 AC.		

OPEN_SPACE TABULATION										
PH	ASE	TOTAL AREA	REQUIRED		PROVIDED NON-CREDITED	TOTAL PROVIDED OPEN SPACE	OPEN SPACE IN RESERVE	REQ. REC. OPEN SPACE*	PROV. REC.	REC. O.S. IN RESERVE
то	OTAL	TOTAL AREA	OPEN SPACE*	OPEN SPACE	OPEN SPACE	OPEN SPACE	IN RESERVE	OFEN SPACE	OPEN SPACE	IN KESEKVE
SU	JBDIVISION	83.27 AC.	20.82 AC.	_		<u> </u>	· –	0.83 AC.	_	
1	(F-01-60)	50.46 AC.***	12.62 AC.	32.49 AC. (39%)	0.54 AC.	33.03 AC.	19.87 AC.	0.24 AC.	1.01 AC.	0.77 AC.
2	(F-01-206)	0.89 AC.***	0.22 AC.	0.00 AC.	0.00 AC.	0.00 AC.**	19.65 AC.	0.02 AC.	0.00** AC.	0.75 AC.
3	(F-02-170)	2.06 AC***	0.52 AC.	0.00 AC.	0.00 AC.	0.00 AC.**	19.13 AC.	0.03 AC.	0.00** AC.	0.72 AC.
4	(F-03-207)	1.20 AC***	0.30 AC.	0.00 AC.	0.00 AC.	0.00 AC.**	18.83 AC.	0.03 AC.	0.00** AC.	0.69 AC.
5 ((F-05-019)	8.83 AC***	2.21 AC.	0.00 AC.	0.00 AC.	0.00 AC.**	16.62 AC.	0.09 AC.	0.00** AC.	0.60 AC.
6										
TC	DTAL	63.44 AC***	15.87 AC.	32.49 AC.	0.54 AC.	33.03 AC.	16.62 AC.	0.41 AC.	1.01 AC.	0.60 AC.

*REQUIRED OPEN SPACE CALCULATED FOR THE ENTIRE R-ED PORTION OF THE SUBDIVISION AS 25% OF GROSS AREA. (83.27 AC. X 25% = 20.82 AC.) REQUIRED RECREATIONAL OPEN SPACE CALCULATED AS 250 SF PER D.U. $(144 \text{ D.U. } \times 250 \text{ SF} = 36,000 \text{ SF OR } 0.83 \text{ AC})$


**REQUIRED OPEN SPACE AND REQUIRED RECREATIONAL OPEN SPACE FOR THE ENTIRE SUBDIVISION PROVIDED


UNDER WORTHINGTON FIELDS PHASE 1, PLAT NO. 14946-14955. ***DOES NOT INCLUDE RESIDUE PORTIONS OF NON-BUILDABLE PARCEL 'B' TO BE DEVELOPED IN FUTURE PHASES.

	SHEET INDEX		
SHEET NO.	TITLE		
1 OF 8	COVER SHEET		
2 OF 8	ROAD CONSTRUCTION PLAN AND PROFILE		
3 OF 8	ROAD CONSTRUCTION PLAN AND PROFILE	0.00	
4 OF 8	GRADING AND SEDIMENT AND EROSION CONTROL PLAN		
5 OF 8	SEDIMENT AND EROSION CONTROL DETAILS		
6 OF 8	STORM DRAIN DRAINAGE AREA MAP		
7 OF 8	STORM DRAIN PROFILES		
8 OF 8	LANDSCAPE PLAN		

COVER SHEET WORTHINGTON FIELDS, PHASE 5 LOTS 60-89 AND NON-BUILDABLE PARCEL 'B-4' A RESUBDIVISION OF NON-BUILDABLE

PARCEL 'B-3', PHASE 4 TAX MAP 25 BLOCK 20 HOWARD COUNTY, MARYLAND 2ND ELECTION DISTRICT REF.: S-98-18, PB-366 (APP. 6/16/99), P-00-07, F-01-60 (PHASE 1), P-01-01, F-01-206 (PHASE 2), P-02-08, F-02-170 (PHASE 3),

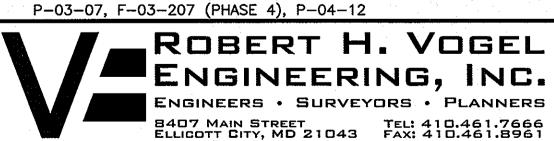

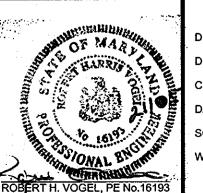

DESIGN BY: СМН CHECKED BY: JANUARY, 2005 AS SHOWN SCALE: 00-11.00

AS-BUILT


DIVISION OF LAND DEVELOPMENT


APPROVED: HOWARD COUNTY DEPARTMENT OF PLANNING AND ZONING

DEMONSTRATE ENGINEERING DIVISION MAS


W.O. NO.: .


F-05-019

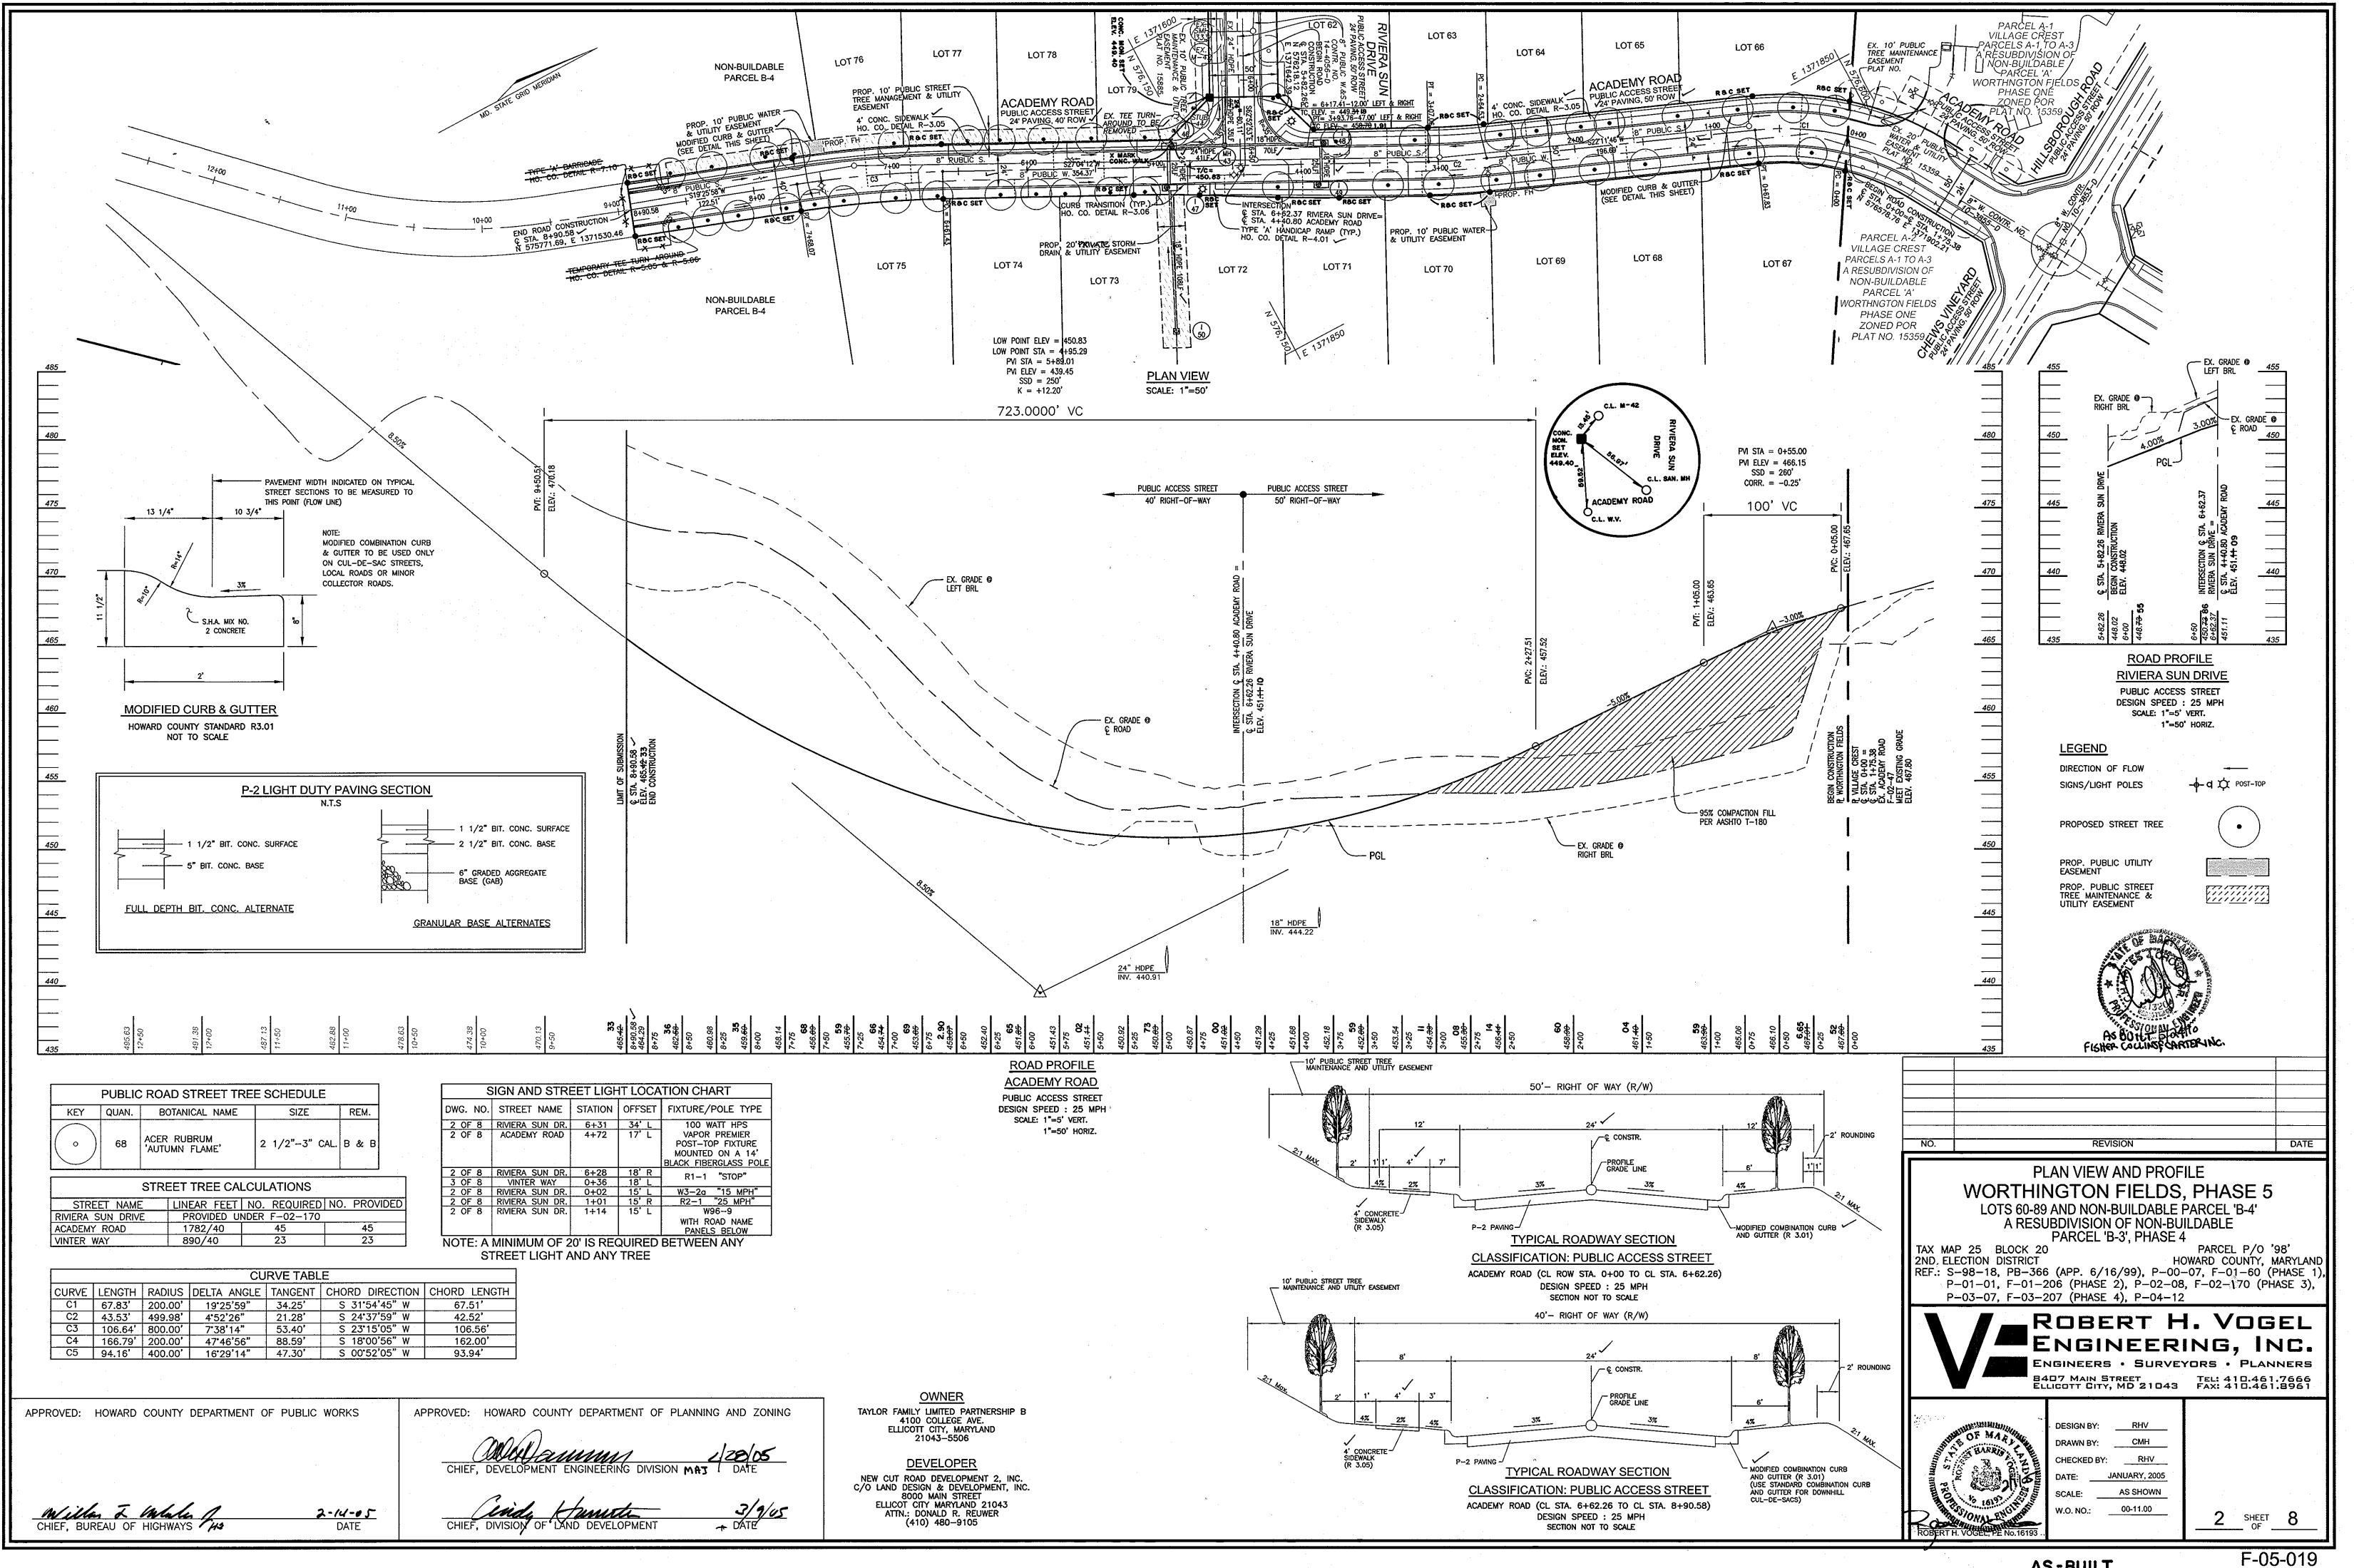


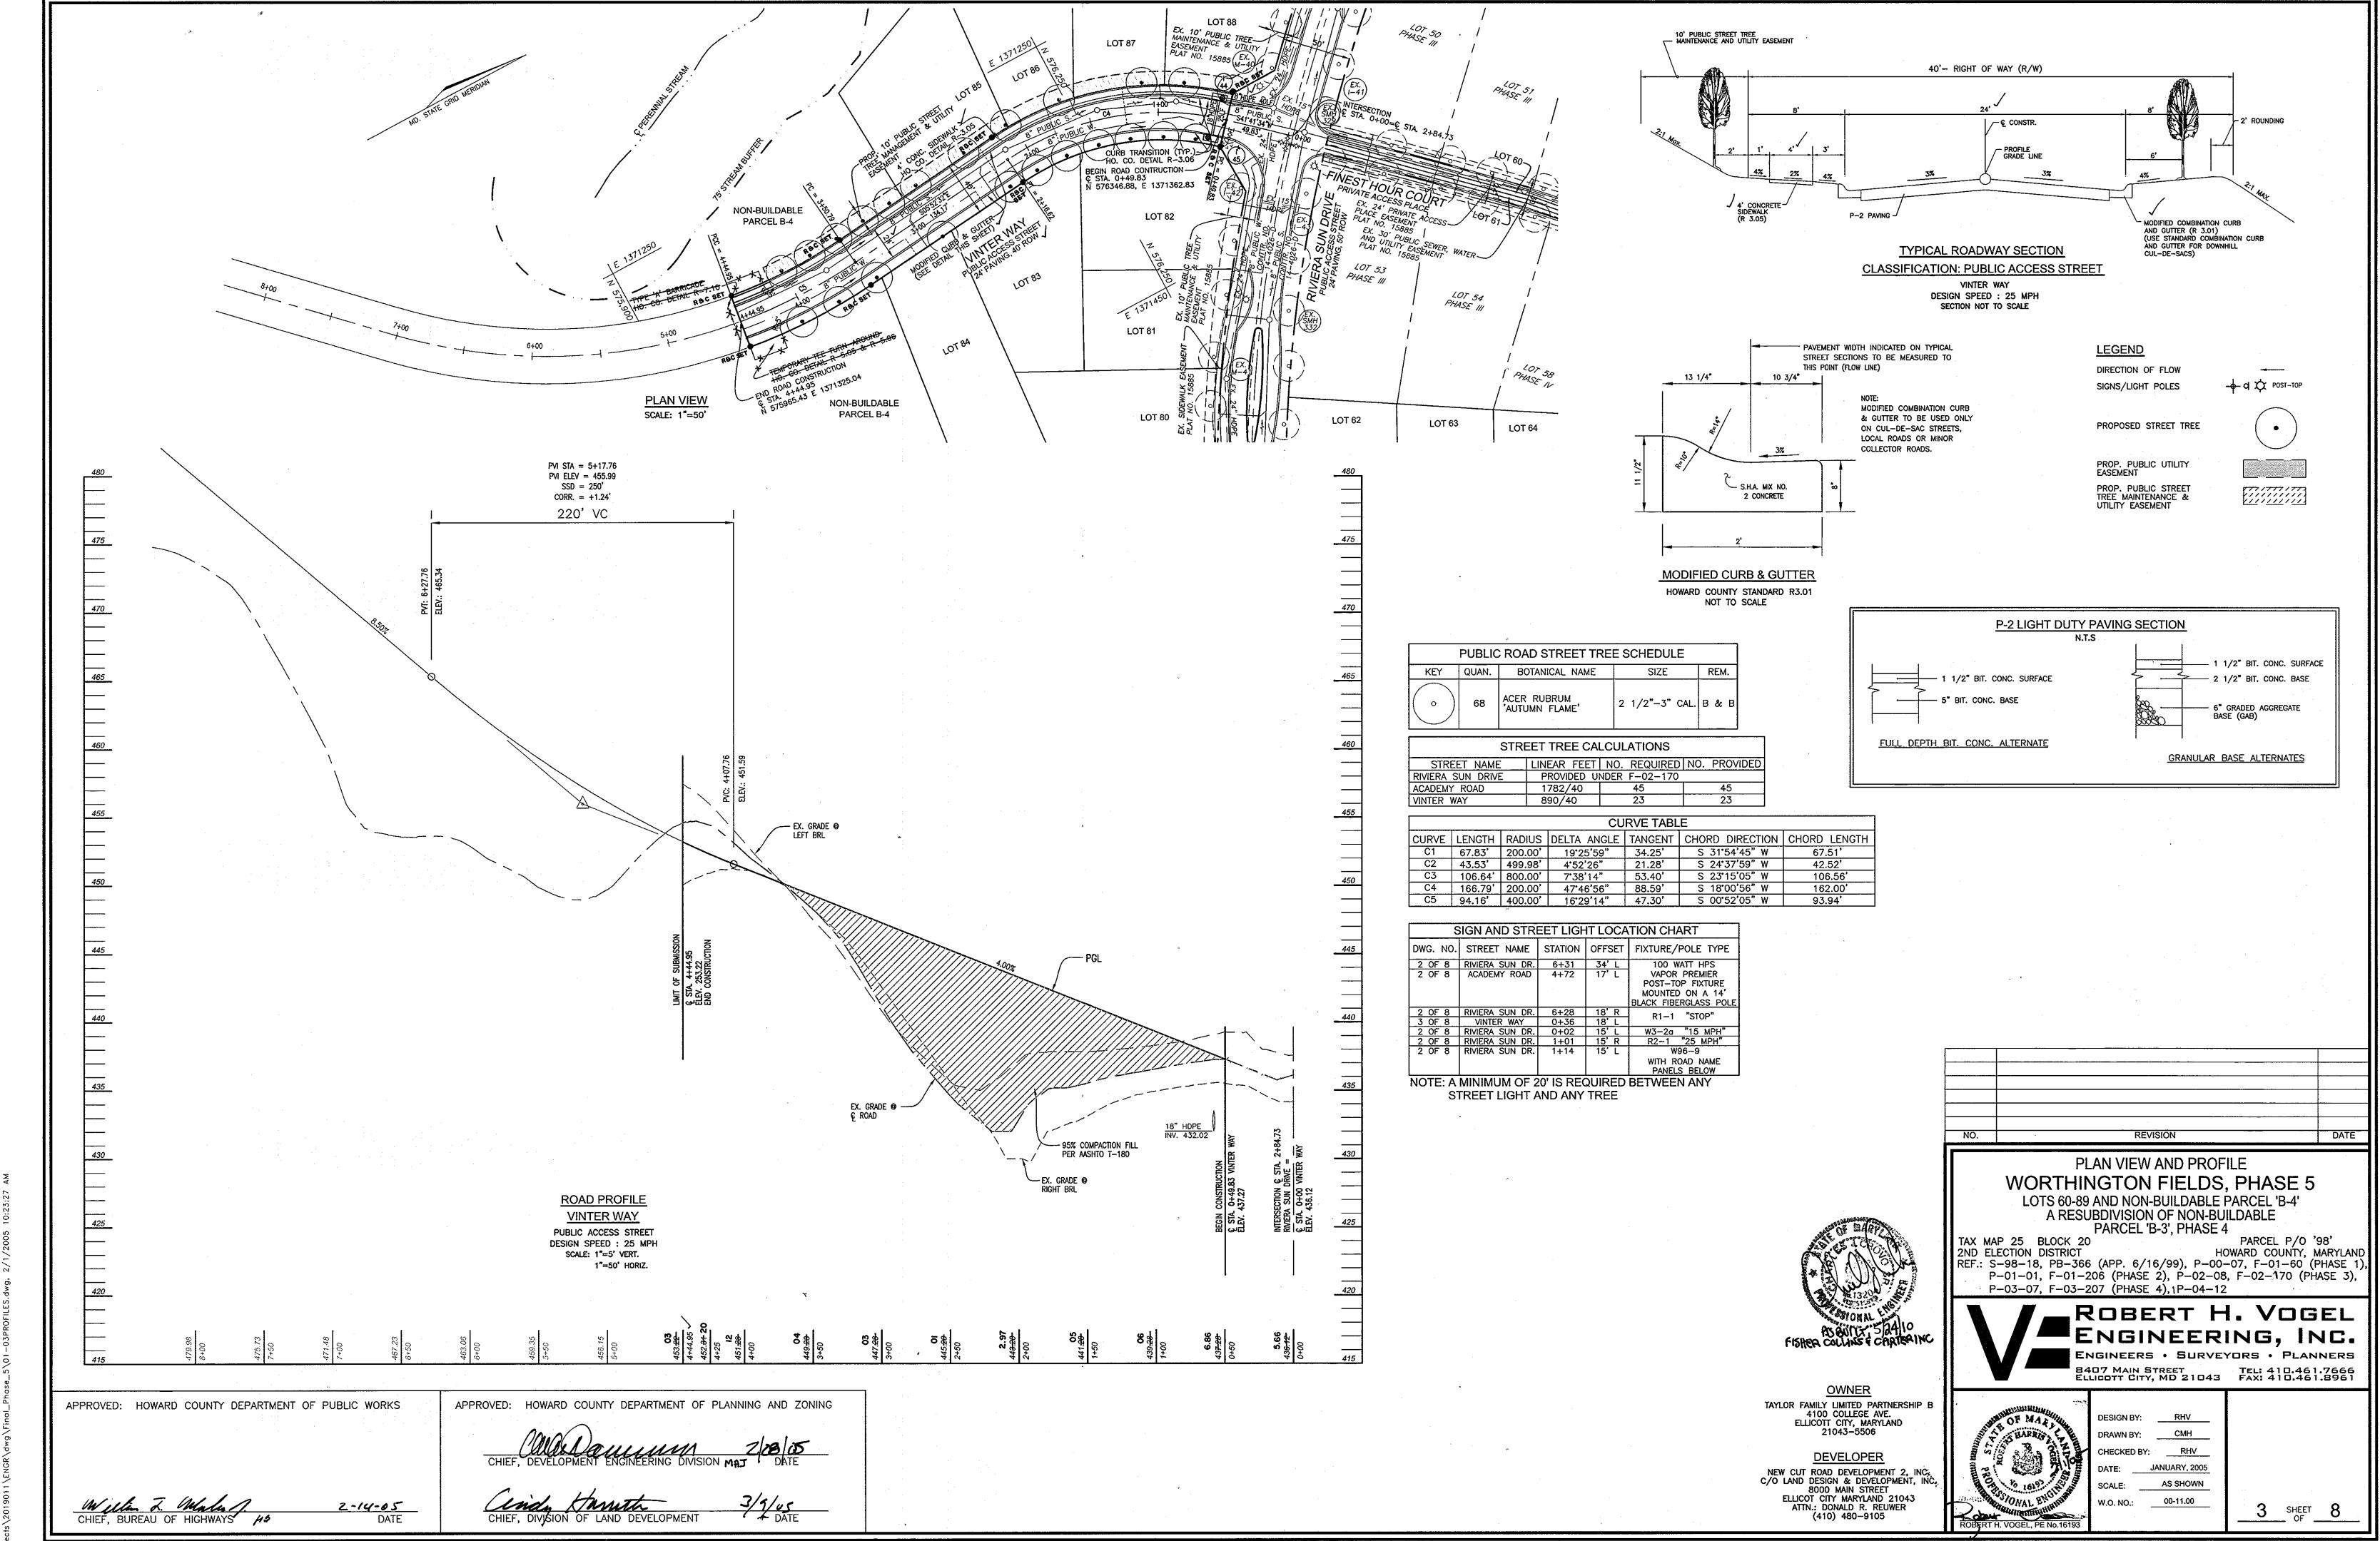



F-05-019

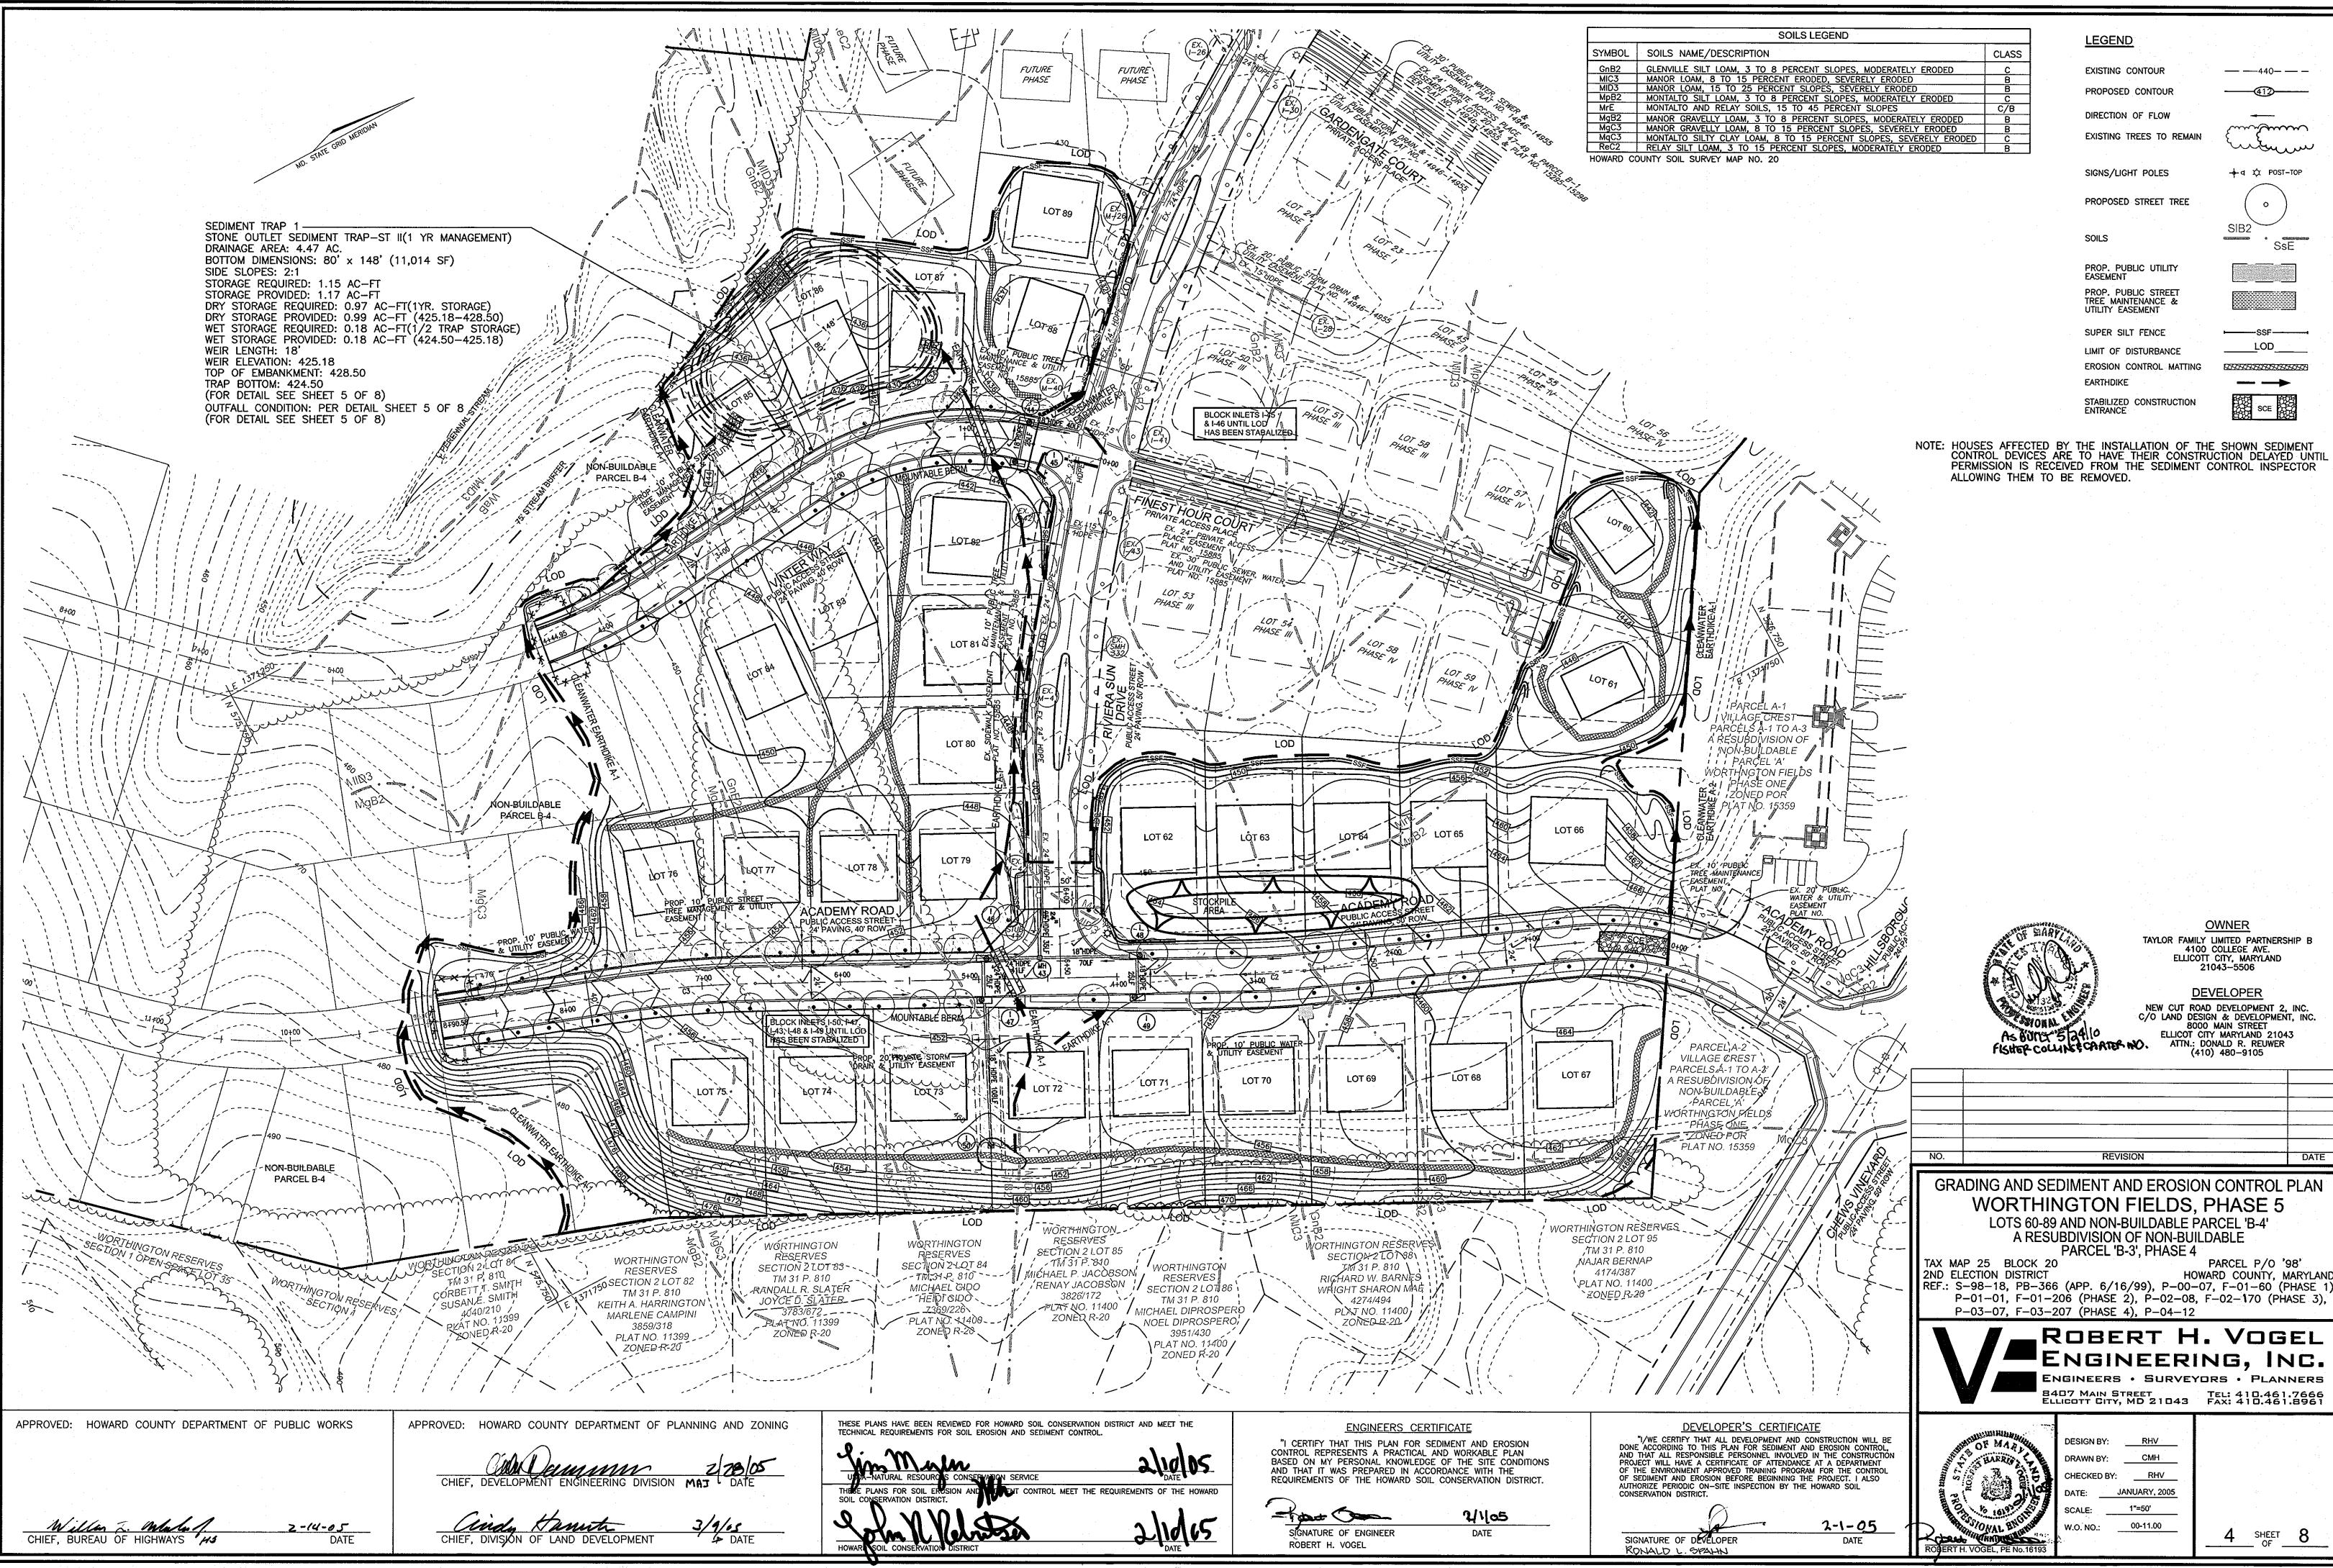

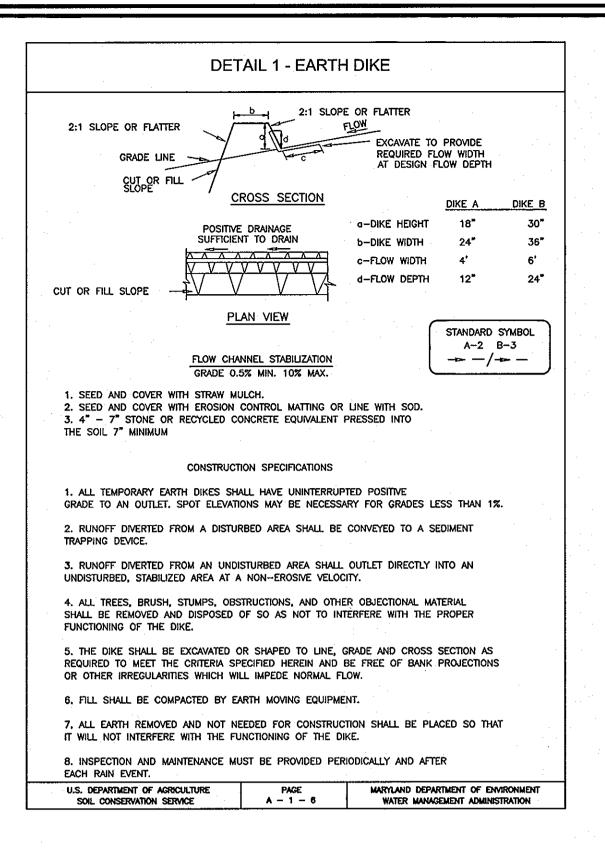

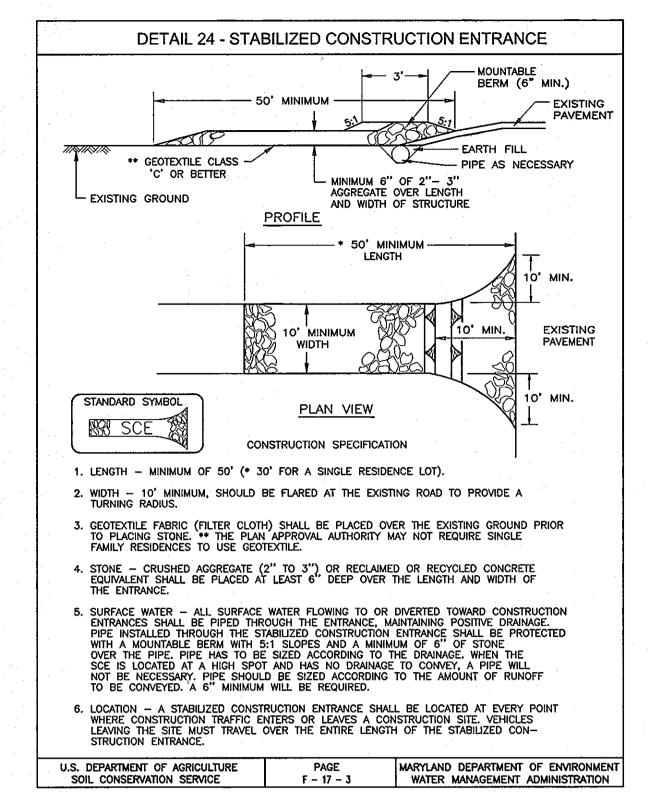

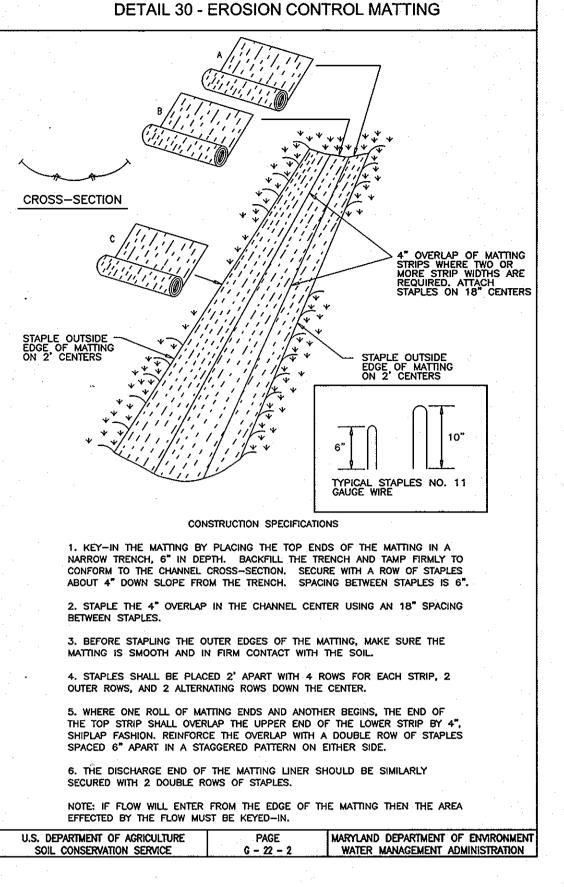

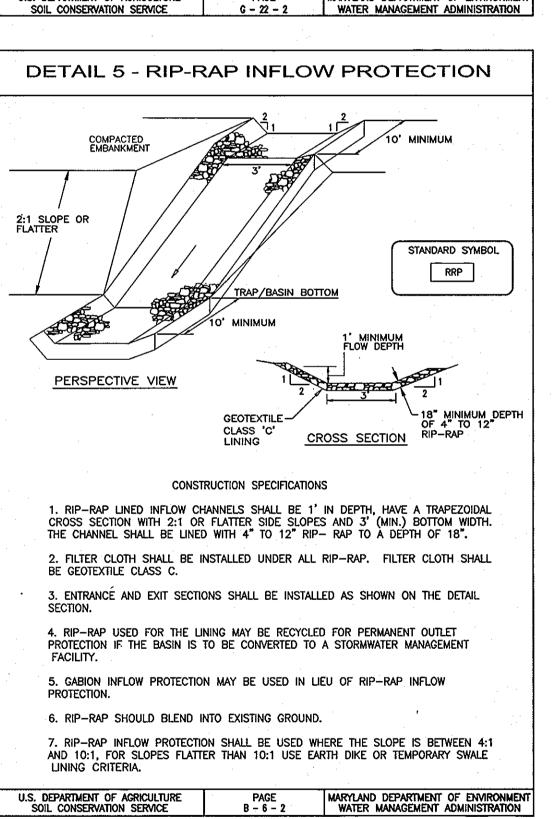

2 / ELEVATION PERSPECTIVE VIEW WEIR CREST STORAGE OUTLET ELEVATION - GEOTEXTILE - APRON (SEE NOTE) -SMALL RIP-RAP 4" TO 7 REQUIRED NOTE: 5' MINIMUM LENGTH UP TO S ACRES. OVER 5 ACRES USE STONE/RIPRAP SEDIMENT TRAP ST-IV. SECTION A-A BOTTOM ELEVATION CONSTRUCTION SPECIFICATIONS 1. AREA UNDER EMBANKMENT SHALL BE CLEARED, GRUBBED AND STRIPPED OF ANY VEGETATION AND ROOT MAT. THE POOL AREA SHALL BE CLEARED. 2. THE FILL MATERIAL FOR THE EMBANKMENT SHALL BE FREE OF ROOTS AND OTHER WOODY VEGETATION AS WELL AS OVERSIZED STONES, ROCKS, ORGANIC MATERIAL OR OTHER OBJECTIONABLE MATERIAL. THE EMBANKMENT SHALL BE COMPACTED BY TRAVERSING WITH EQUIPMENT WHILE IT IS BEING 3. ALL CUT AND FILL SLOPES SHALL BE 2:1 OR FLATTER. 4. THE STONE USED IN THE OUTLET SHALL BE SMALL RIP-RAP 4" TO 7" IN SIZE WITH A 1' THICK LAYER OF 3/4" TO 11/2" WASHED AGGREGATE PLACED ON THE UPSTREAM FACE OF THE OUTLET. STONE FACING SHALL BE AS NECESSARY TO PREVENT CLOGGING. GEOTEXTILE CLASS C MAY BE SUBSTITUTED FOR THE STONE FACING BY PLACING IT ON THE INSIDE FACE 5. SEDIMENT SHALL BE REMOVED AND TRAP RESTORED TO ITS ORIGINAL DIMENSIONS WHEN THE SEDIMENT HAS ACCUMULATED TO ONE HALF OF THE WET STORAGE DEPTH OF THE TRAP. REMOVED SEDIMENT SHALL BE DEPOSITED IN A SUITABLE AREA AND IN SUCH A MANNER THAT IT WILL NOT ERODE. U.S. DEPARTMENT OF AGRICULTURE MARYLAND DEPARTMENT OF ENVIRONMENT WATER MANAGEMENT ADMINISTRATION STONE OUTLET SEDIMENT TRAP - ST II

DETAIL 9 - STONE OUTLET SEDIMENT TRAP - ST II

L HEIGH

EXISTING GROUND

TOP OF EMBANKMENT

WEIR I FNGTH

SECTION B-E

EXISTING

GROUND

SUBSTITUTE GEOTEXTILE

(SEE NOTE 4)

COMPACTED EARTH



6. THE STRUCTURE SHALL BE INSPECTED PERIODICALLY AFTER EACH RAIN AND REPAIRS

MADE AS NEEDED. 7. CONSTRUCTION OF TRAPS SHALL CARRIED OUT IN SUCH A MANNER THAT SEDIMENT POLLUTION IS ABATED. ONCE CONSTRUCTED, THE TOP AND OUTSIDE FACE OF THE SHALL BE STABILIZED WITH SEED AND MULCH. POINTS OF CONCENTRATION INFLOW SHALL BE PROTECTED IN ACCORDANCE WITH GRADE STABILIZATION STRUCTURE CRITERIA. THE REMAINDER OF THE INTERIOR SLOPES SHOULD BE STABILIZED (ONE TIME) WITH SEED AND MULCH UPON TRAP COMPLETION AND MONITORED AND

B. THE STRUCTURE SHALL BE DEWATERED BY APPROVED METHODS, REMOVED AND THE

AREA STABILIZED WHEN THE DRAINAGE AREA HAS BEEN PROPERLY STABILIZED. 9. REFER TO SECTION D FOR SPECIFICATIONS CONCERNING TRAP DEWATERING.


10. MINIMUM TRAP DEPTH SHALL BE MEASURED FROM WEIR ELEVATION.

11. THE ELEVATION OF THE TOP OF ANY DIKE DIRECTING WATER INTO THE TRAP MUST EQUAL OR EXCEED THE ELEVATION OF THE TRAP EMBANKMENT.

12. GEOTEXTILE CLASS C SHALL BE PLACED OVER THE BOTTOM AND SIDES OF THE OUTLET CHANNEL PRIOR TO THE PLACEMENT OF STONE. SECTIONS OF FILTER CLOTH MUST OVERLAP AT LEAST 1' WITH THE SECTION NEAREST THE ENTRANCE PLACED ON ON TOP. THE FILTER CLOTH SHALL BE EMBEDDED AT LEAST 6" INTO EXISTING GROUND AT THE ENTRANCE OF THE OUTLET CHANNEL.

13. OUTLET-AN OUTLET SHALL BE PROVIDED, INCLUDING A MEANS OF CONVEYING THE DISCHARGE IN AN EROSION FREE MANNER TO AN EXISTING STABLE CHANNEL.

U.S. DEPARTMENT OF AGRICULTURE MARYLAND DEPARTMENT OF ENVIRONMENT WATER MANAGEMENT ADMINISTRATION SOIL CONSERVATION SERVICE

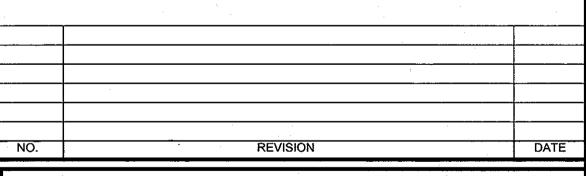


SEDIMENT AND EROSION CONTROL DETAILS **WORTHINGTON FIELDS, PHASE 5** LOTS 60-89 AND NON-BUILDABLE PARCEL 'B-4' A RESUBDIVISION OF NON-BUILDABLE

PARCEL 'B-3', PHASE 4 TAX MAP 25 BLOCK 20 PARCEL P/O '98' 2ND ELECTION DISTRICT HOWARD COUNTY, MARYLAND

REF.: S-98-18, PB-366 (APP. 6/16/99), P-00-07, F-01-60 (PHASE 1 P-01-01, F-01-206 (PHASE 2), P-02-08, F-02-170 (PHASE 3), P-03-07, F-03-207 (PHASE 4), P-04-12




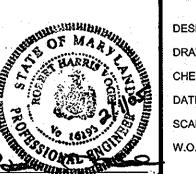


AS SHOWN 00-11.00

SHEET

F-05-019

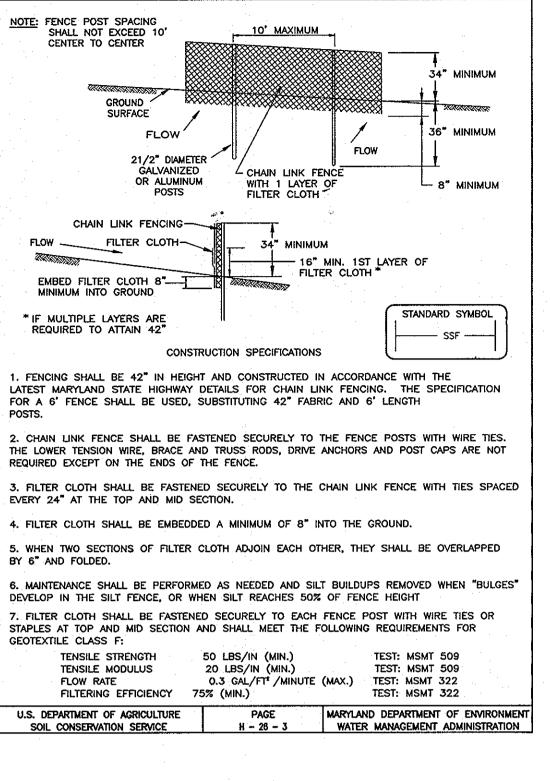

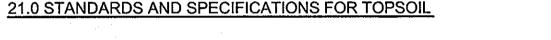

PLACEMENT OF TOPSOIL OVER A PREPARED SUBSOIL PRIOR TO ESTABLISHMENT OF PERMANENT VEGETATION.

TO PROVIDE A SUITABLE SOIL MEDIUM FOR VEGETABLE GROWTH. SOILS OF CONCERN HAVE LOW MOISTURE CONTENT, LOW NUTRIENT LEVELS. LOW PH, MATERIALS TOXIC TO PLANTS, AND/OR UNACCEPTABLE SOIL GRADATION. CONDITIONS WHERE PRACTICE APPLIES

THIS PRACTICE IS LIMITED TO AREAS HAVING 2:1 OR FLATTER SLOPES WHERE: A. THE TEXTURE OF THE EXPOSED SUBSOIL/PARENT MATERIAL IS NOT ADEQUATE TO PRODUCE VEGETATIVE GROWTH.

THE SOIL MATERIAL IS SO SHALLOW THAT THE ROOTING ZONE IS NOT DEEP ENOUGH TO SUPPORT PLANTS OR FURNISH CONTINUING SUPPLIES OF MOISTURE AND PLANT NUTRIENTS.

C. THE ORIGINAL SOIL TO BE VEGETATED CONTAINS MATERIAL TOXIC TO PLANT GROWTH.

THE SOIL IS SO ACIDIC THAT TREATMENT WITH LIMESTONE IS NOT FEASIBLE.

FOR THE PURPOSE OF THESE STANDARDS AND SPECIFICATIONS. AREAS HAVING SLOPES STEEPER THAN 2:1 REQUIRE SPECIAL CONSIDERATION AND DESIGN FOR ADEQUATE STABILIZATION. AREAS FAVING SLOPES STEEPER THAN 2:1 SHALL HAVE THE APPROPRIATE

CONSTRUCTION AND MATERIAL SPECIFICATIONS TOPSOIL SALVAGED FROM THE EXISTING SITE MAY BE USED

PROVIDED THAT IT MEETS THE STANDARDS AS SET FORTH IN THESE SPECIFICATIONS. TYPICALLY, THE DEPTH OF TOPSOIL TO BE SALVAGED FOR A GIVEN SOIL TYPE CAN BE FOUND IN THE REPRESENTATIVE SOIL PROFILE SECTION IN THE SOIL SURVEY PUBLISHED BY USDA-SCS IN COOPERATION WITH MARYLAND AGRICULTURAL EXPERIMENTAL STATION.

. TOPSOIL SPECIFICATIONS - SOIL TO BE USED AS TOPSOIL MUST MEET THE FOLLOWING:

TOPSOIL SHALL BE A LOAM, SANDY LOAM, CLAY LOAM, SILT LOAM, SANDY CLAY LOAM, LOAMY SAND. OTHER SOILS MAY BE USED IF RECOMMENDED BY AN AGRONOMIST OR A SOIL SCIENTIST AND APPROVED BY THE APPROPRIATE APPROVAL AUTHORITY. REGARDLESS, OPSOIL SHALL NOT BE A MIXTURE OF CONTRASTING TEXTURED Subsoils and shall contain less than 5% by volume of CINDERS, STONES, SLAG, COARSE FRAGMENTS, GRAVEL, STICKS, ROOTS, TRASH, OR OTHER MATERIALS LARGER THAT 1 AND 1/2" IN

II. TOPSOIL MUST BE FREE OF PLANTS OR PLANT PARTS SUCH AS BERMUDA GRASS, QUACKGRASS, JOHNSONGRASS, NUTSEDGE, POISON

II. WHERE THE SUBSOIL IS EITHER HIGHLY ACIDIC OR COMPOSED OF HEAVY CLAYS, GROUND LIMESTONE SHALL BE SPREAD AT THE RATE OF 4-8 TONS/ACRE (200-400 POUNDS PER 1,000 SQUARE FEET) PRIOR TO THE PLACEMENT OF TOPSOIL. LIME SHALL BE STRIBUTED UNIFORMLY OVER DESIGNATED AREAS AND WORKED INTO SOIL IN CONJUNCTION WITH TILLAGE OPERATIONS AS DESCRIBED THE FOLLOWING PROCEDURES.

FOR SITES HAVING DISTURBED AREAS UNDER 5 ACRES: I. PLACE TOPSOIL (IF REQUIRED) AND APPLY SOIL AMENDMENTS AS SPECIFIED IN 20.0 VEGETATIVE STABILIZATION -SECTION I - VEGETATIVE STABILIZATION METHODS AND MATERIALS.

III. FOR SITES HAVING DISTURBED AREAS OVER 5 ACRES: I. ON SOIL MEETING TOPSOIL SPECIFICATIONS, OBTAIN TEST RESULTS DICTATING FERTILIZER AND LIME AMENDMENTS REQUIRED

O BRING THE SOIL INTO COMPLIANCE WITH THE FOLLOWING: A. PH FOR TOPSOIL SHALL BE BETWEEN 6.0 AND 7.5. IF THE TESTED SOIL DEMONSTRATES A PH OF LESS THAN 6.0, SUFFICIENT LIME SHALL BE PRESCRIBED TO RAISE -THE PH TO 6.5 OR HIGHER.

B. ORGANIC CONTENT OF TOPSOIL SHALL BE NOT LESS THAN

1.5 PERCENT BY WEIGHT. TOPSOIL HAVING SOLUBLE SALT CONTENT GREATER THAN 00 PARTS PER MILLION SHALL NOT BE USED. D. NO SOD OR SEED SHALL BE PLACED ON SOIL SOIL WHICH HAS BEEN TREATED WITH SOIL STERILANTS OR CHEMICALS ELAPSED (14 DAYS MIN.) TO PERMIT DISSIPATION OF PHYTO-TOXIC MATERIALS. NOTE: TOPSOIL SUBSTITUTES OR AMENDMENTS. AS RECOMMENDED

Y A QUALIFIED AGRONOMIST OR SOIL SCIENTIST AND APPROVED B HE APPROPRIATE APPROVAL AUTHORITY, MAY BE USED IN LIEU OF NATURAL TOPSOIL II. PLACE TOPSOIL (IF REQUIRED) AND APPLY SOIL AMMENDMENTS SPECIFIED IN 20.0 VEGETATIVE STABILIZATION—SECTION I—VEGETATIVE STABILIZATION METHODS AND MATERIALS.

V. TOPSOIL APPLICATION

WHEN TOPSOILING, MAINTAIN NEEDED EROSION AND SEDIMENT CONTROL PRACTICES SUCH AS DIVERSIONS, GRADE STABILIZATION STRUCTURES, EARTH DIKES, SLOPE SILT FENCE AND SEDIMENT TRAPS AND BASINS

II. GRADES ON THE AREAS TO BE TOPSOILED, WHICH HAVE BEEN PREVIOUSLY ESTABLISHED, SHALL BE MAINTAINED, ALBEIT 4" - 8" HIGHER IN ELEVATION.

III. TOPSOIL SHALL BE UNIFORMLY DISTRIBUTED IN A 4" -8" LAYER AND LIGHTLY COMPACTED TO A MINIMUM THICKNESS OF 4". SPREADING SHALL BE PERFORMED IN SUCH A MANNER THAT SODDING OR SEEDING CAN PROCEED WITH A MINIMUM OF ADDITIONAL SOIL PREPARATION AND TILLAGE. ANY IRREGULARITIES IN THE SURFACE RESULTING FROM TOPSOILING OR OTHER OPERATIONS SHALL BE CORRECTED IN ORDER TO PREVENT THE FORMATION OF DEPRESSIONS

IV. TOPSOIL SHALL NOT BE PLACE WHILE THE TOPSOIL OR SUBSOIL IS IN A FROZEN OR MUDDY CONDITION, WHEN THE SUBSOIL IS EXCESSIVELY WET OR IN A CONDITION THAT MAY OTHERWISE BE DETRIMENTAL TO PROPER GRADING AND SEEDBED PREPARATION.

NOTES

DURING GRADING AND AFTER EACH RAINFALL, THE CONTRACTOR SHALL INSPECT AND PROVIDE THE NECESSARY MAINTENANCE ON THE SEDIMENT AND EROSION CONTROL MEASURES SHOWN

FOLLOWING INITIAL SOIL DISTURBANCE OR REDISTURBANCE PERMANENT OR TEMPORARY STABILIZATION SHALL BE COMPLIED

A. 7 CALENDAR DAYS FOR ALL PERIMETER SEDIMENT CONTROL STRUCTURES, DIKES, SWALES, DITCH PERIMETER SLOPES SLOPES AND ALL SLOPES GREATER THAN 3:1. B. 14 CALENDAR DAYS FOR ALL OTHER DISTURBED AREAS.

PERMANENT SEEDING NOTES

APPLY TO GRADED OR CLEARED AREAS NOT SUBJECT TO IMMEDIATION FURTHER DISTURBANCE WHERE A PERMANENT LONG-LIVED VEGETATIVE

SEEDBED PREPARATION: LOOSEN UPPER THREE INCHES OF SOIL BY RAKING, DISCING OR OTHER ACCEPTABLE MEANS BEFORE SEEDING, IF NOT PREVIOUSLY

SOIL AMENDMENTS: IN LIEU OF SOIL TEST RECOMMENDATIONS, USE ONE OF THE FOLLOWING SCHEDULES: PREFERRED-APPLY 2 TONS PER ACRE DOLOMITIC LIMESTONE (92 LBS/ 100 SQ.FT.) AND 600 LBS PER ACRE 10-10-10 FERTILIZER (14 LBS./

1000 SQ.FT.) BEFORE SEEDING. HARROW OR DISC INTO UPPER THREE INCHES OF SOIL. AT THE TIME OF SEEDING, APPLY 400 LBS. PER ACRE 30-0-0 UREAFORM FERTILIZER (9 LBS/1000 SQ.FT.) 2) ACCEPTABLE-APPLY 2 TONS PER ACRE DOLOMATIC LIMESTONE (92 LBS/ 1000 SQ.FT.) AND APPLY 1000 LBS. PER ACRE 10-10-10- FERTILIZER (23 LBS./1000 SQ.FT.) BEFORE SEEDING. HARROW OR DISC INTO UPPER THREE INCHES OF SOIL.

SEEDING: FOR THE PERIODS MARCH 1 THRU APRIL 30, AND AUGUST 1 THRU OCTOBER 15, SEED WITH 60 LBS. PER ACRE (1.4 LBS/1000 SQ.FT.) OF KENTUCKY 31 TALL FESCUE. FOR THE PERIOD MAY 1 THRU JULY 31, SEED WITH 60 LBS. KENTUCKY 31 TALL FESCUE PER ACRE AND 2 LBS. PER ACRE (.05 LBS./1000 SQ.FT.) OF WEEPING LOVEGRASS. DURING THE PERIOD OF OCTOBER 16 THRU FEBRUARY 28, PROTECT SITE BY: OPTION (1) 2 TONS PER ACRE WELL ANCHORED STRAW MULCH AND SEED AS SOON AS POSSIBLE IN THE SPRING. OPTION (2) USE SOD. OPTION (3) SEED WITH 60 LBS/ACRE KENTUCKY 31 TALL FESCUE AND MULCH WITH 2 TONS/ACRE WELL ANCHORED

MULCHING: APPLY 1 1/2 TO 2 TONS PER ACRE (70 TO 90 LBS/1000 SQ. FT.) OF UNROTTED SMALL GRAIN STRAW IMMEDIATELY AFTER SEEDING. ANCHOR MULCH IMMEDIATELY AFTER APPLICATION USING MULCH ANCHORING TOOL OR 218 GALLONS PER ACRE (5 GAL/1000 SQ.FT.) OF EMULSIFIED ASPHALT ON FLAT AREAS. ON SLOPES 8 FEET OR HIGHER, USE 348 GALLONS PER ACRE (8 GAL/1000 SQ.FT.) FOR ANCHORING.

IAINTENANCE: INSPECT ALL SEEDED AREAS AND MAKE NEEDED REPAIRS, REPLACEMENTS AND RESEEDINGS.

TEMPORARY SEEDING NOTES

SEEDBED PREPARATION: LOOSEN UPPER THREE INCHES OF SOIL BY RAKING, DISCING OR OTHER ACCEPTABLE MEANS BEFORE SEEDING, IF NOT PREVIOUSLY SOIL AMENDMENTS: APPLY 600 LBS. PER ACRE 10-10-10 FERTILIZER

(14 LBS./1000 SQ.FT). SEEDING: FOR PERIODS MARCH 1 THRU APRIL 30 AND FROM AUGUST 15 THRU NOVEMBER 15, SEED WITH 2 1/2 BUSHEL PER ACRE OF ANNUAL RYE (3.2 LBS./1000 SQ.FT.) FOR THE PERIOD MAY 1 THRU AUGUST 14, SEED WITH 3 LBS. PER ACRE OF WEEPING LOVEGRASS (.07 LBS./1000 SQ.FT.). FOR THE PERIOD NOVEMBER 1 THRU FEBRUARY 28, PROTECT SITE BY APPLYING 2 TONS

PER ACRE OF WELL ANCHORED STRAW MULCH AND SEED AS SOON AS POSSIBLE IN THE SPRING, OR USE SOD. MULCHING: APPLY 1 1/2 TO 2 TONS PER ACRE (70 TO 90 LBS./1000 SQ.FT.) OF UNROTTED SMALL GRAIN STRAW IMMEDIATELY AFTER SEEDING. ANCHOR MULCH IMMEDIATELY AFTER APPLICATION USING MULCH ANCHORING TOOL OR 218 GALLONS PER ACRE (5 GAL/1000 SQ.FT.) OF EMULSIFIED ASPHALT ON FLAT AREAS. ON SLOPES 8 FEET OR HIGHER, USE 348 GALLONS PER ACRE (8 GAL/1000 SQ.FT.) FOR ANCHORING

(8 GAL/1000 SQ.FT.) FOR ANCHORING. REFER TO THE 1994 MARYLAND STANDARDS AND SPECIFICATIONS FOR SOIL EROSION AND SEDIMENT CONTROL FOR RATE AND METHODS NOT COVERED.

SEDIMENT CONTROL NOTES

1. A MINIMUM OF 48 HOURS NOTICE MUST BE GIVEN TO THE HOWARD COUNTY DEPARTMENT OF INSPECTION, LICENSE AND PERMITS SEDIMENT CONTROL DIVISION PRIOR TO THE START OF ANY CONSTRUCTION (313-1855).

2. ALL VEGETATION AND STRUCTURAL PRACTICES ARE TO BE INSTALLED ACCORDING TO THE PROVISIONS OF THIS PLAN AND ARE TO BE IN CONFORMANCE WITH THE 1994 MARYLAND STANDARDS AND SPECIFICATIONS FOR SOIL EROSION AND SEDIMENT CONTROL. AND REVISIONS THERETO.

FOLLOWING INITIAL SOIL DISTURBANCE OR REDISTURBANCE, PERMANENT OR TEMPORARY STABILIZATION SHALL BE COMPLETED WITHIN: (A) 7 CALENDAR DAYS FOR ALL PERIMETER SEDIMENT CONTROL STRUCTURES, DIKES, PERIMÉTER SLOPES, AND ALL SLOPES GREATER THAN 3:1, (B) 14 DAYS AS TO ALL OTHER DISTURBED OR GRADED AREAS ON THE

4. ALL SEDIMENT TRAPS/BASINS SHOWN MUST BE FENCED AND WARNING SIGNS POSTED AROUND THEIR PERIMETER IN ACCORDANCE WITH VOL. 1, CHAPTER 7, HOWARD COUNT DESIGN MANUAL, STORM DRAINAGE.

5. ALL DISTURBED AREAS MUST BE STABILIZED WITHIN THE TIME PERIOD SPECIFIED ABOVE IN ACCORDANCE WITH THE 1994 MARYLAND STANDARDS AND SPECIFICATIONS FOR SOIL EROSION AND SEDIMENT CONTROL FOR PERMANENT SEEDING, SOD, TEMPORARY SEEDING, AND MULCHING (SEC. G). TEMPORARY STABILIZATION WITH MULCH ALONE SHALL BE DONE WHEN RECOMMENDED SÉEDING DATES DO NOT ALLOW FOR PROPER GERMINATION AND

6. ALL SEDIMENT CONTROL STRUCTURES ARE TO REMAIN IN PLACE AND ARE TO BE MAINTAINED IN OPERATIVE CONDITION UNTIL PERMISSION FOR THEIR REMOVAL HAS BEEN OBTAINED FROM THE HOWARD COUNTY SEDIMENT CONTROL INSPECTOR.

AREA DISTURBED AREA TO BE ROOFED OR PAVED_ AREA TO BE VEGETATIVELY STABILIZED OFFSITE WASTE/BORROW AREA LOCATION

8. ANY SEDIMENT CONTROL PRACTICE WHICH IS DISTURBED BY GRADING ACTIVITY FOR PLACEMENT OF UTILITIES MUST BE REPAIRED ON THE SAME DAY OF DISTURBANCE.

9. ADDITIONAL SEDIMENT CONTROLS MUST BE PROVIDED, IF DEEMED NECESSARY BY THE HOWARD COUNTY SEDIMENT CONTROL INSPECTOR.

10. ON ALL SITES WITH DISTURBED AREAS IN EXCESS OF 2 ACRES. APPROVAL OF THE INSPECTION AGENCY SHALL BE REQUESTED UPON COMPLETION OF INSTALLATION OF PERIMETER EROSION AND SEDIMENT CONTROLS, BUT BEFORE PROCEEDING WITH ANY OTHER EARTH DISTURBANCE OR GRADING. OTHER BUILDING OR GRADING INSPECTION APPROVALS MAY NOT BE AUTHORIZED UNTIL THIS INITIAL APPROVAL BY THE INSPECTION AGENCY IS MADE.

11. TRENCHES FOR THE CONSTRUCTION OF UTILITIES IS LIMITED TO THREE PIPE LENGTHS OR THAT WHICH SHALL BE BACK-FILLED AND STABILIZED WITHIN ONE WORKING DAY. WHICHEVER IS SHORTER. * TO BE DETERMINED BY CONTRACTOR, WITH PRE-APPROVAL OF THE SEDIMENT CONTROL INSPECTOR WITH AN APPROVED AND ACTIVE GRADING PERMIT

SEQUENCE OF CONSTRUCTION

1. OBTAIN GRADING PERMIT. 2. NOTIFY HOWARD COUNTY BUREAU OF INSPECTIONS AND PERMITS (313-1880) AT LEAST 24 HOURS

BEFORE STARTING ANY WORK 3. CONSTRUCT STABILIZED CONSTRUCTION ENTRANCE, SEDIMENT TRAP 1 PERIMETER SUPER SILT FENCE, EARTHDIKES AND CLEANWATER EARTHDIKES. 4. WITH INSPECTOR'S APPROVAL CLEAR AND GRUB SITE TO LOD. 5. INSTALL WATER, SEWER AND STORM DRAIN AND BLOCK INLETS. 6. GRADE ROAD TO SUB-BASE AND INSTALL CURB AND GUTTER

8. AS PAVING IS COMPLETED, INSTALL SIDEWALK AND FINALIZE LOT GRADING. 7. WITH INSPECTOR'S APPROVAL AND WITH ROAD PAVING COMPLETE REMOVE TRAP 1 AND STABALIZE REMAINING AREAS. UNBLOCK INLETS. 8. INSTALL STREET TREES

1. DURING GRADING AND AFTER EACH RAINFALL, THE CONTRACTOR SHALL INSPECT AND PROVIDE THE NECESSARY MAINTENANCE ON THE SEDIMENT AND EROSION CONTROL MEASURES SHOWN

2. FOLLOWING INITIAL SOIL DISTURBANCE OR REDISTURBANCE PERMANENT OR TEMPORARY STABILIZATION SHALL BE COMPLIED WITH: A. 7 CALENDAR DAYS FOR ALL PERIMETER SEDIMENT CONTROL STRUCTURES, DIKES, SWALES, DITCH PERIMETER SLOPES SLOPES AND ALL SLOPES GREATER THAN 3:1. B. 14 CALENDAR DAYS FOR ALL OTHER DISTURBED AREAS.

OWNER TAYLOR FAMILY LIMITED PARTNERSHIP I 4100 COLLEGE AVE. ELLICOTT CITY, MARYLAND

> DEVELOPER 8000 MAIN STREET ELLICOT CITY MARYLAND 21043 ATTN.: DONALD R. REUWER (410) 480-9105

21043-5506 NEW CUT ROAD DEVELOPMENT 2, INC. C/O LAND DESIGN & DEVELOPMENT, INC.

THESE PLANS HAVE BEEN REVIEWED FOR HOWARD SOIL CONSERVATION DISTRICT AND MEET THE TECHNICAL REQUIREMENTS FOR SOIL EROSION AND SEDIMENT CONTROL. DA-NATURAL RESOURCES CONSERVANCE CONTROL MEET THE REQUIREMENTS OF THE HOWARD

"I CERTIFY THAT THIS PLAN FOR SEDIMENT AND EROSION CONTROL REPRESENTS A PRACTICAL AND WORKABLE PLAN BASED ON MY PERSONAL KNOWLEDGE OF THE SITE CONDITIONS AND THAT IT WAS PREPARED IN ACCORDANCE WITH THE REQUIREMENTS OF THE HOWARD SOIL CONSERVATION DISTRICT.

> 2/1/05 DATE

DEVELOPER'S CERTIFICATE "I/WE CERTIFY THAT ALL DEVELOPMENT AND CONSTRUCTION WILL BE DONE ACCORDING TO THIS PLAN FOR SEDIMENT AND EROSION CONTROL, AND THAT ALL RESPONSIBLE PERSONNEL INVOLVED IN THE CONSTRUCTION PROJECT WILL HAVE A CERTIFICATE OF ATTENDANCE AT A DEPARTMENT

SIGNATURE OF DEVELOPER DATE ROYALD L. SPAHN

APPROVED: HOWARD COUNTY DEPARTMENT OF PUBLIC WORKS

APPROVED: HOWARD COUNTY DEPARTMENT OF PLANNING AND ZONING

a lemmin

DEVELOPMENT ENGINEERING DIVISION MAJ

___RHV CHECKED BY:

Willer I. Wale 1. CHIEF, BUREAU OF HIGHWAYS 2-14-05

Munich

CHIEF, DIVISION OF LAND DEVELOPMENT

THESE LANS FOR SOIL EROSION AND S SOIL CONSERVATION DISTRICT.

House () SIGNATURE OF ENGINEER ROBERT H. VOGEL

DURATION

5 DAYS

3 DAYS

2 WEEKS 1 MONTH


2 WEEKS


2 WEEKS


1 WEEK


2 DAYS

AS-BUILT

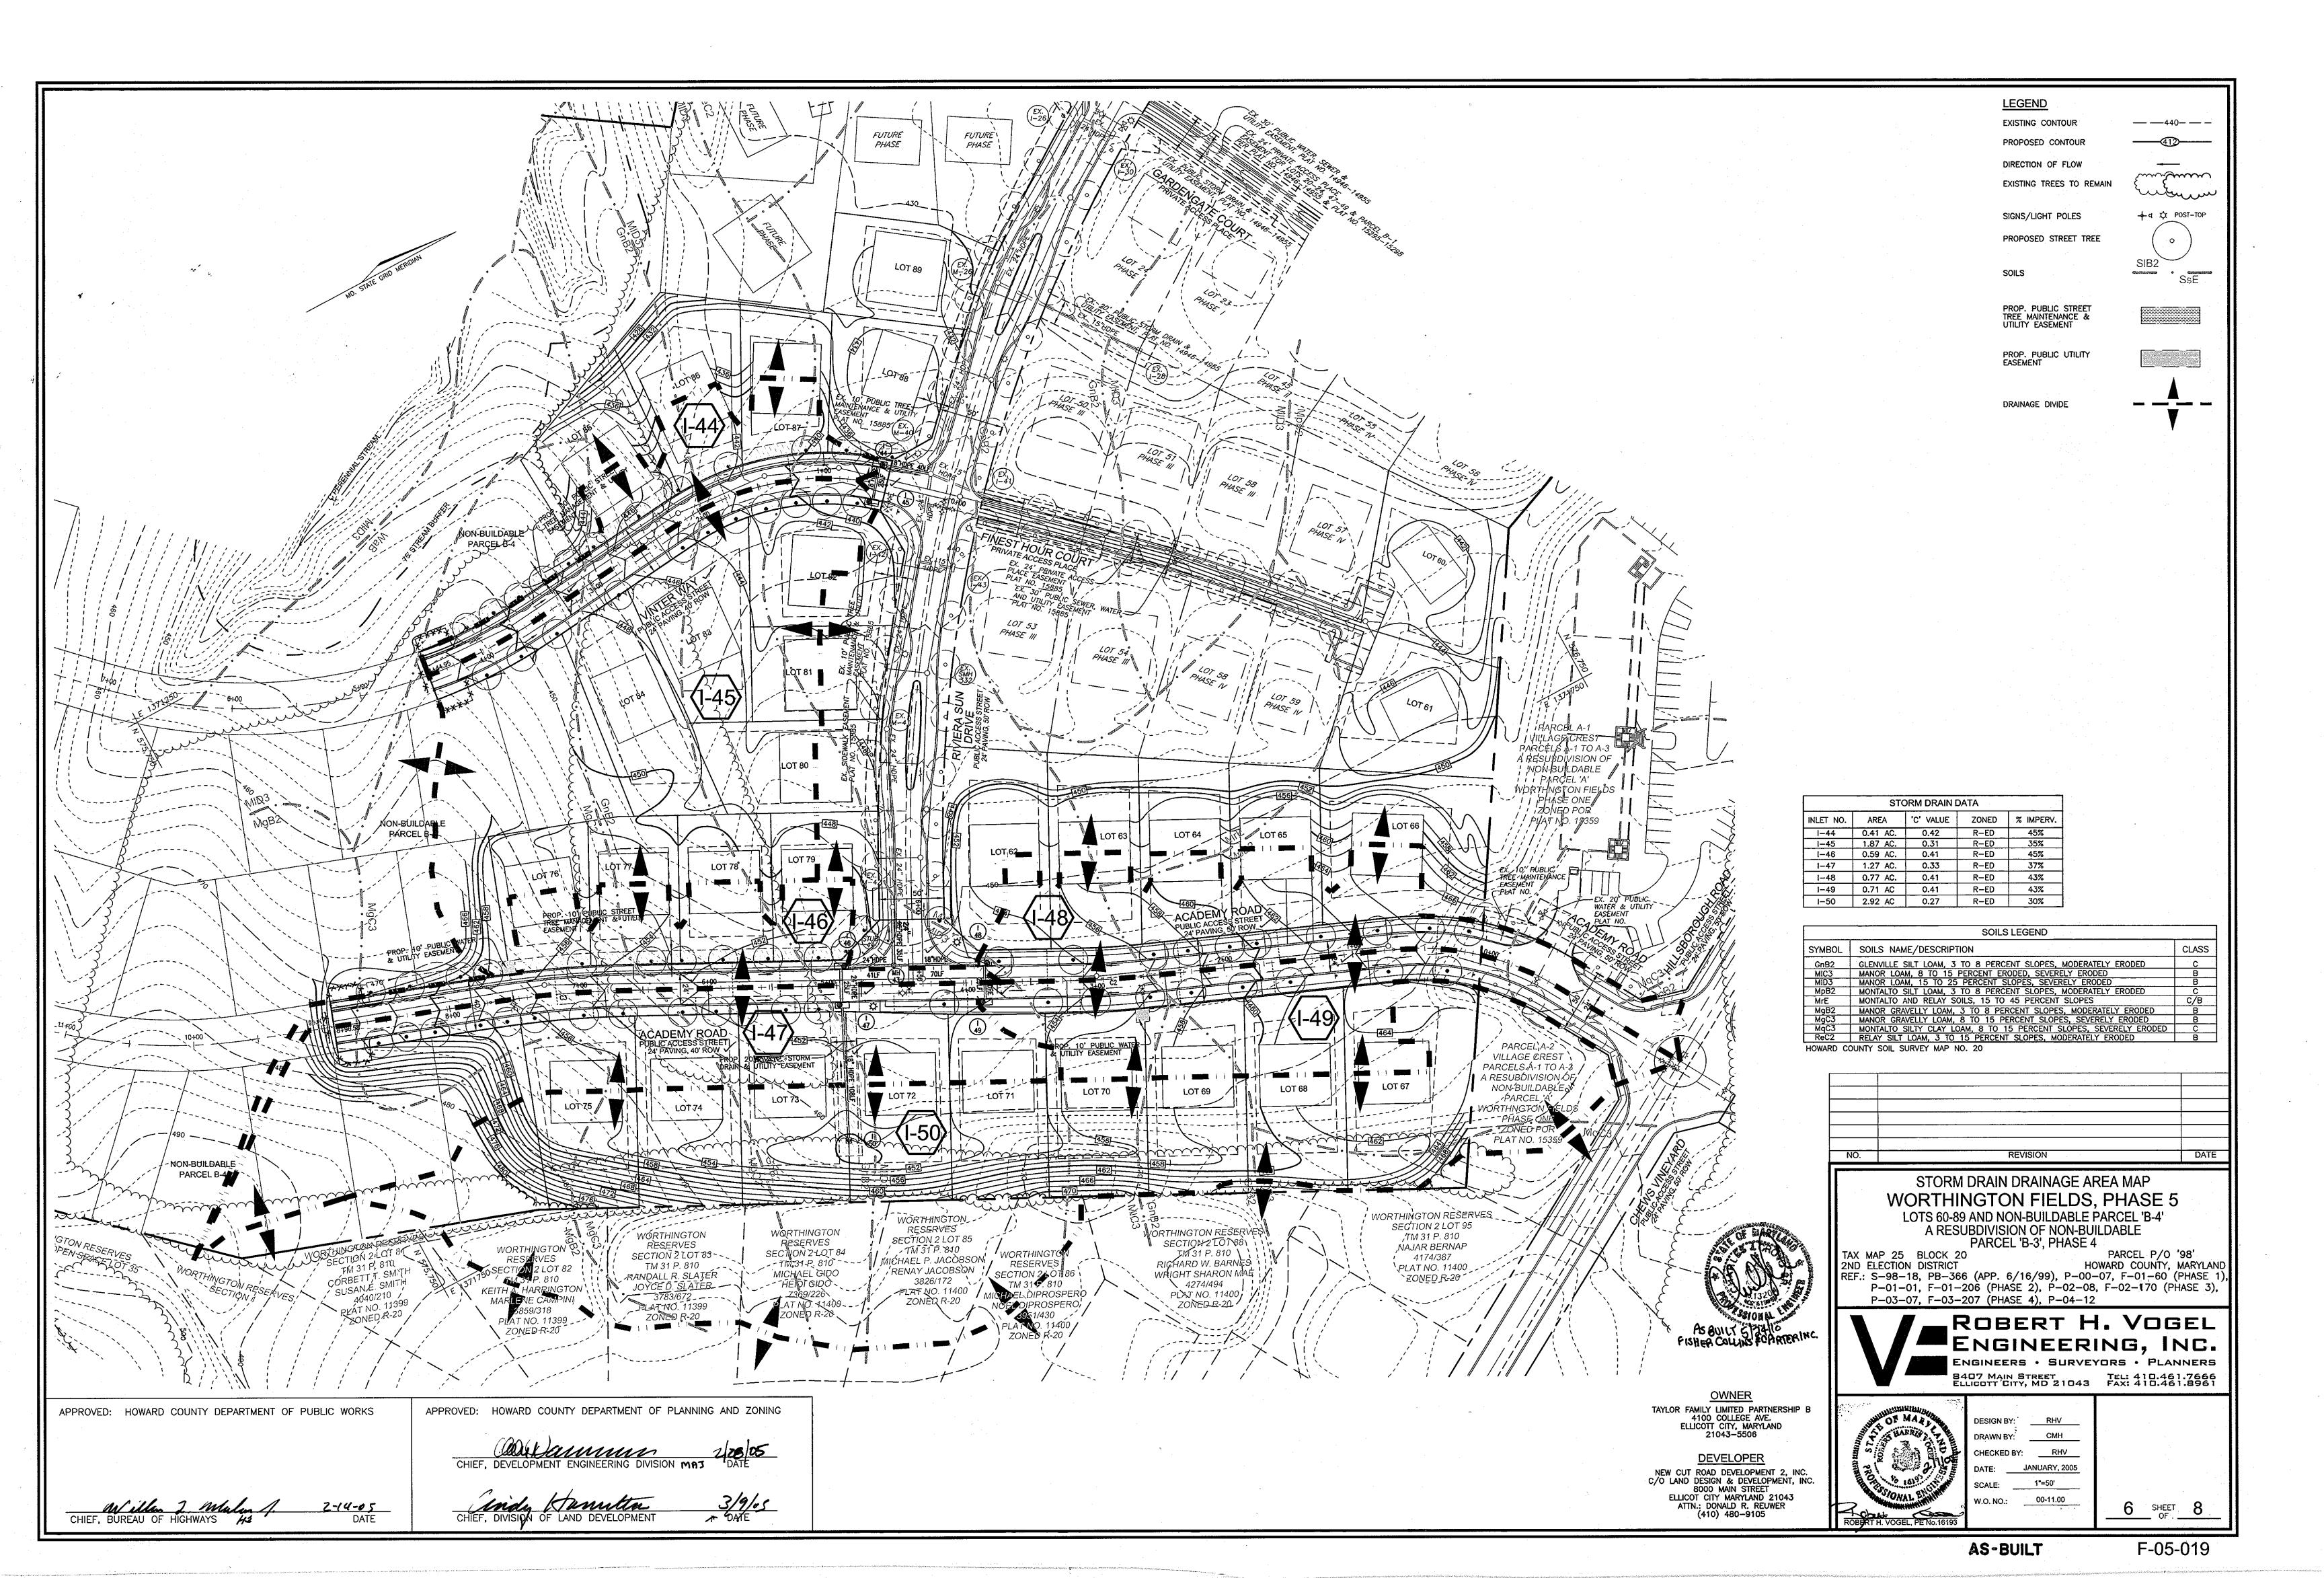

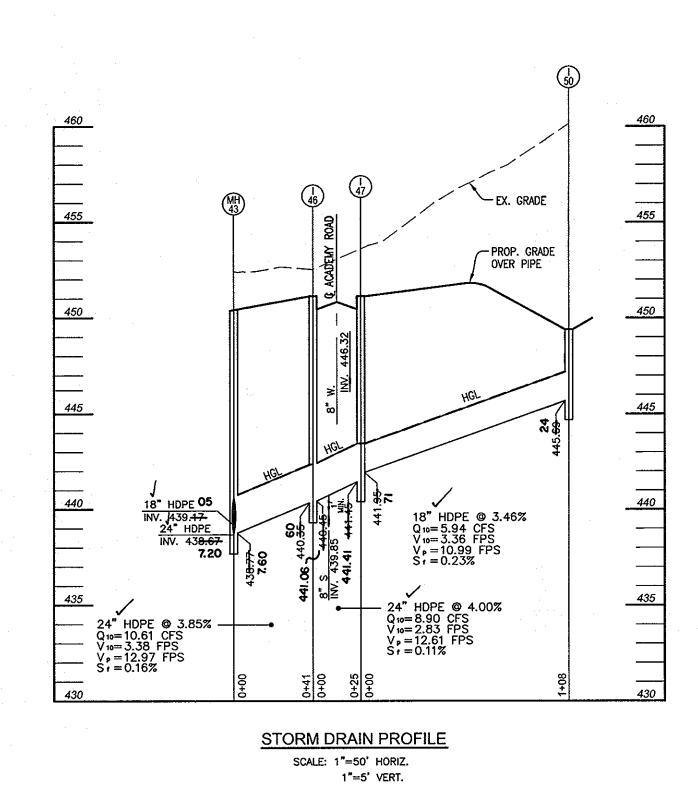

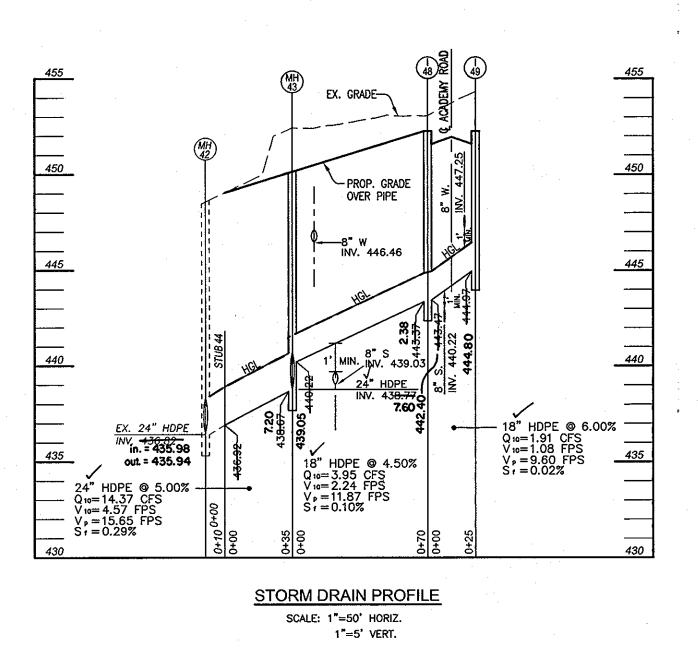

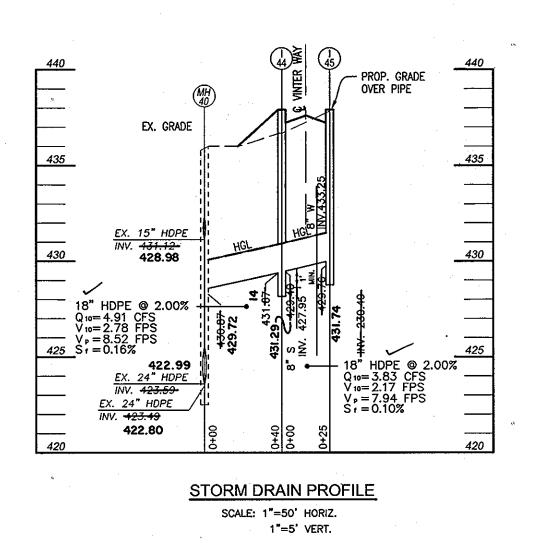

		STRUCTURE SCHEDULE				
NO.	TYPE	LOCATION	TOP ELEV.	INV IN	INV OUT	REMARKS
1-44	TYPE 'A-10' INLET	CL STA. 0+57.97-12.43' RIGHT	43 7.23 * 6.47	18" 431. 77	18" 431. 67	SD 4.41
1-45	TYPE 'A-10' INLET	CL STA. 0+57.97-12.43' LEFT	437. 23 *	_	18" 43 2.27	SD 4.41
I-46	TYPE 'A-10' INLET ✓	CL STA. 4+96.59-12.43' RIGHT	450. 46 *	√24" 44 0,41 1. 06	24" 440. 31	SD 4.41
I-47	TYPE 'A-10' INLET ✓	CL STA. 4+96.59-12.43' LEFT	450. 46 *	18" 441. 91	24" 441.41	SD 4.41
I-48	TYPE 'A-10' INLET ✓	CL STA. 3+85.42-12.43' RIGHT	351.59 * 451.30	√18" 44 3.47 2. 40	18" 443.37 2.38	SD 4.41
. I-49	TYPE 'A-10' INLET	CL STA. 3+85.42-12.43' LEFT	351.59 * 451.30	-	18° 444. 07	SD 4.41
I-50	TYPE 'D' INLET	N 576080. 05 , E 1371797 .09	449. 50	- 05	18" 445. 69	SD 4.39
M-43	STANDARD 5' MANHOLE	CL STA. 4+55.62-15.46' RIGHT	450. 43	18" 439. 47 24" 43 8.77	24" 43 8.67	SD 4.40

*ELEVATION AT THROAT OPENING

HDPE BEDDING SPECIFICATIONS ARE TO BE AS PER ASTM STANDARDS.

APPROVED: HOWARD COUNTY DEPARTMENT OF PUBLIC WORKS

2-14-05 DATE

Willer Z. Malu J.
CHIEF, BUREAU OF HIGHWAYS HS

ĺ	PIPE SCHEDULE							
	PIPE SIZE	TYPE	TOTAL LENGTH					
	18 "	HDPE	268 LF					
	24"	HDPE	101 LF					




TAYLOR FAMILY LIMITED PARTNERS 4100 COLLEGE AVE. ELLICOTT CITY, MARYLAND 21043-5506

DEVELOPER NEW CUT ROAD DEVELOPMENT 2, C/O LAND DESIGN & DEVELOPMENT 8000 MAIN STREET ELLICOT CITY MARYLAND 2104: ATTN.: DONALD R. REUWER (410) 480-9105

	NO.	
		WOF LOT
	2ND EL REF.: S P	P 25 BL ECTION DI -98-18, -01-01, -03-07,
Mc.		
RSHIP B 2, INC. ENT, INC.	tumining ST.	2 2 3 3 3 3
043 :R		MONAL S


STORM DRAIN PROFILES RTHINGTON FIELDS, PHASE 5 OTS 60-89 AND NON-BUILDABLE PARCEL 'B-4'
A RESUBDIVISION OF NON-BUILDABLE
PARCEL 'B-3', PHASE 4 BLOCK 20 PARCEL P/O '98'
DISTRICT HOWARD COUNTY, MARYLAND
8, PB-366 (APP. 6/16/99), P-00-07, F-01-60 (PHASE 1),
1, F-01-206 (PHASE 2), P-02-08, F-02-170 (PHASE 3),
7, F-03-207 (PHASE 4), P-04-12 ROBERT H. VOGEL ENGINEERING, INC. ENGINEERS • SURVEYORS • PLANNERS 8407 MAIN STREET TEL: 410.461.7666 ELLICOTT CITY, MD 21043 FAX: 410.461.8961 DESIGN BY: RHV

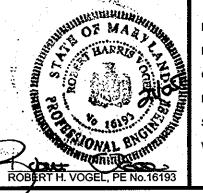

CHECKED BY: JANUARY, 2005 AS SHOWN 00-11.00

F-05-019

APPROVED: HOWARD COUNTY DEPARTMENT OF PLANNING AND ZONING

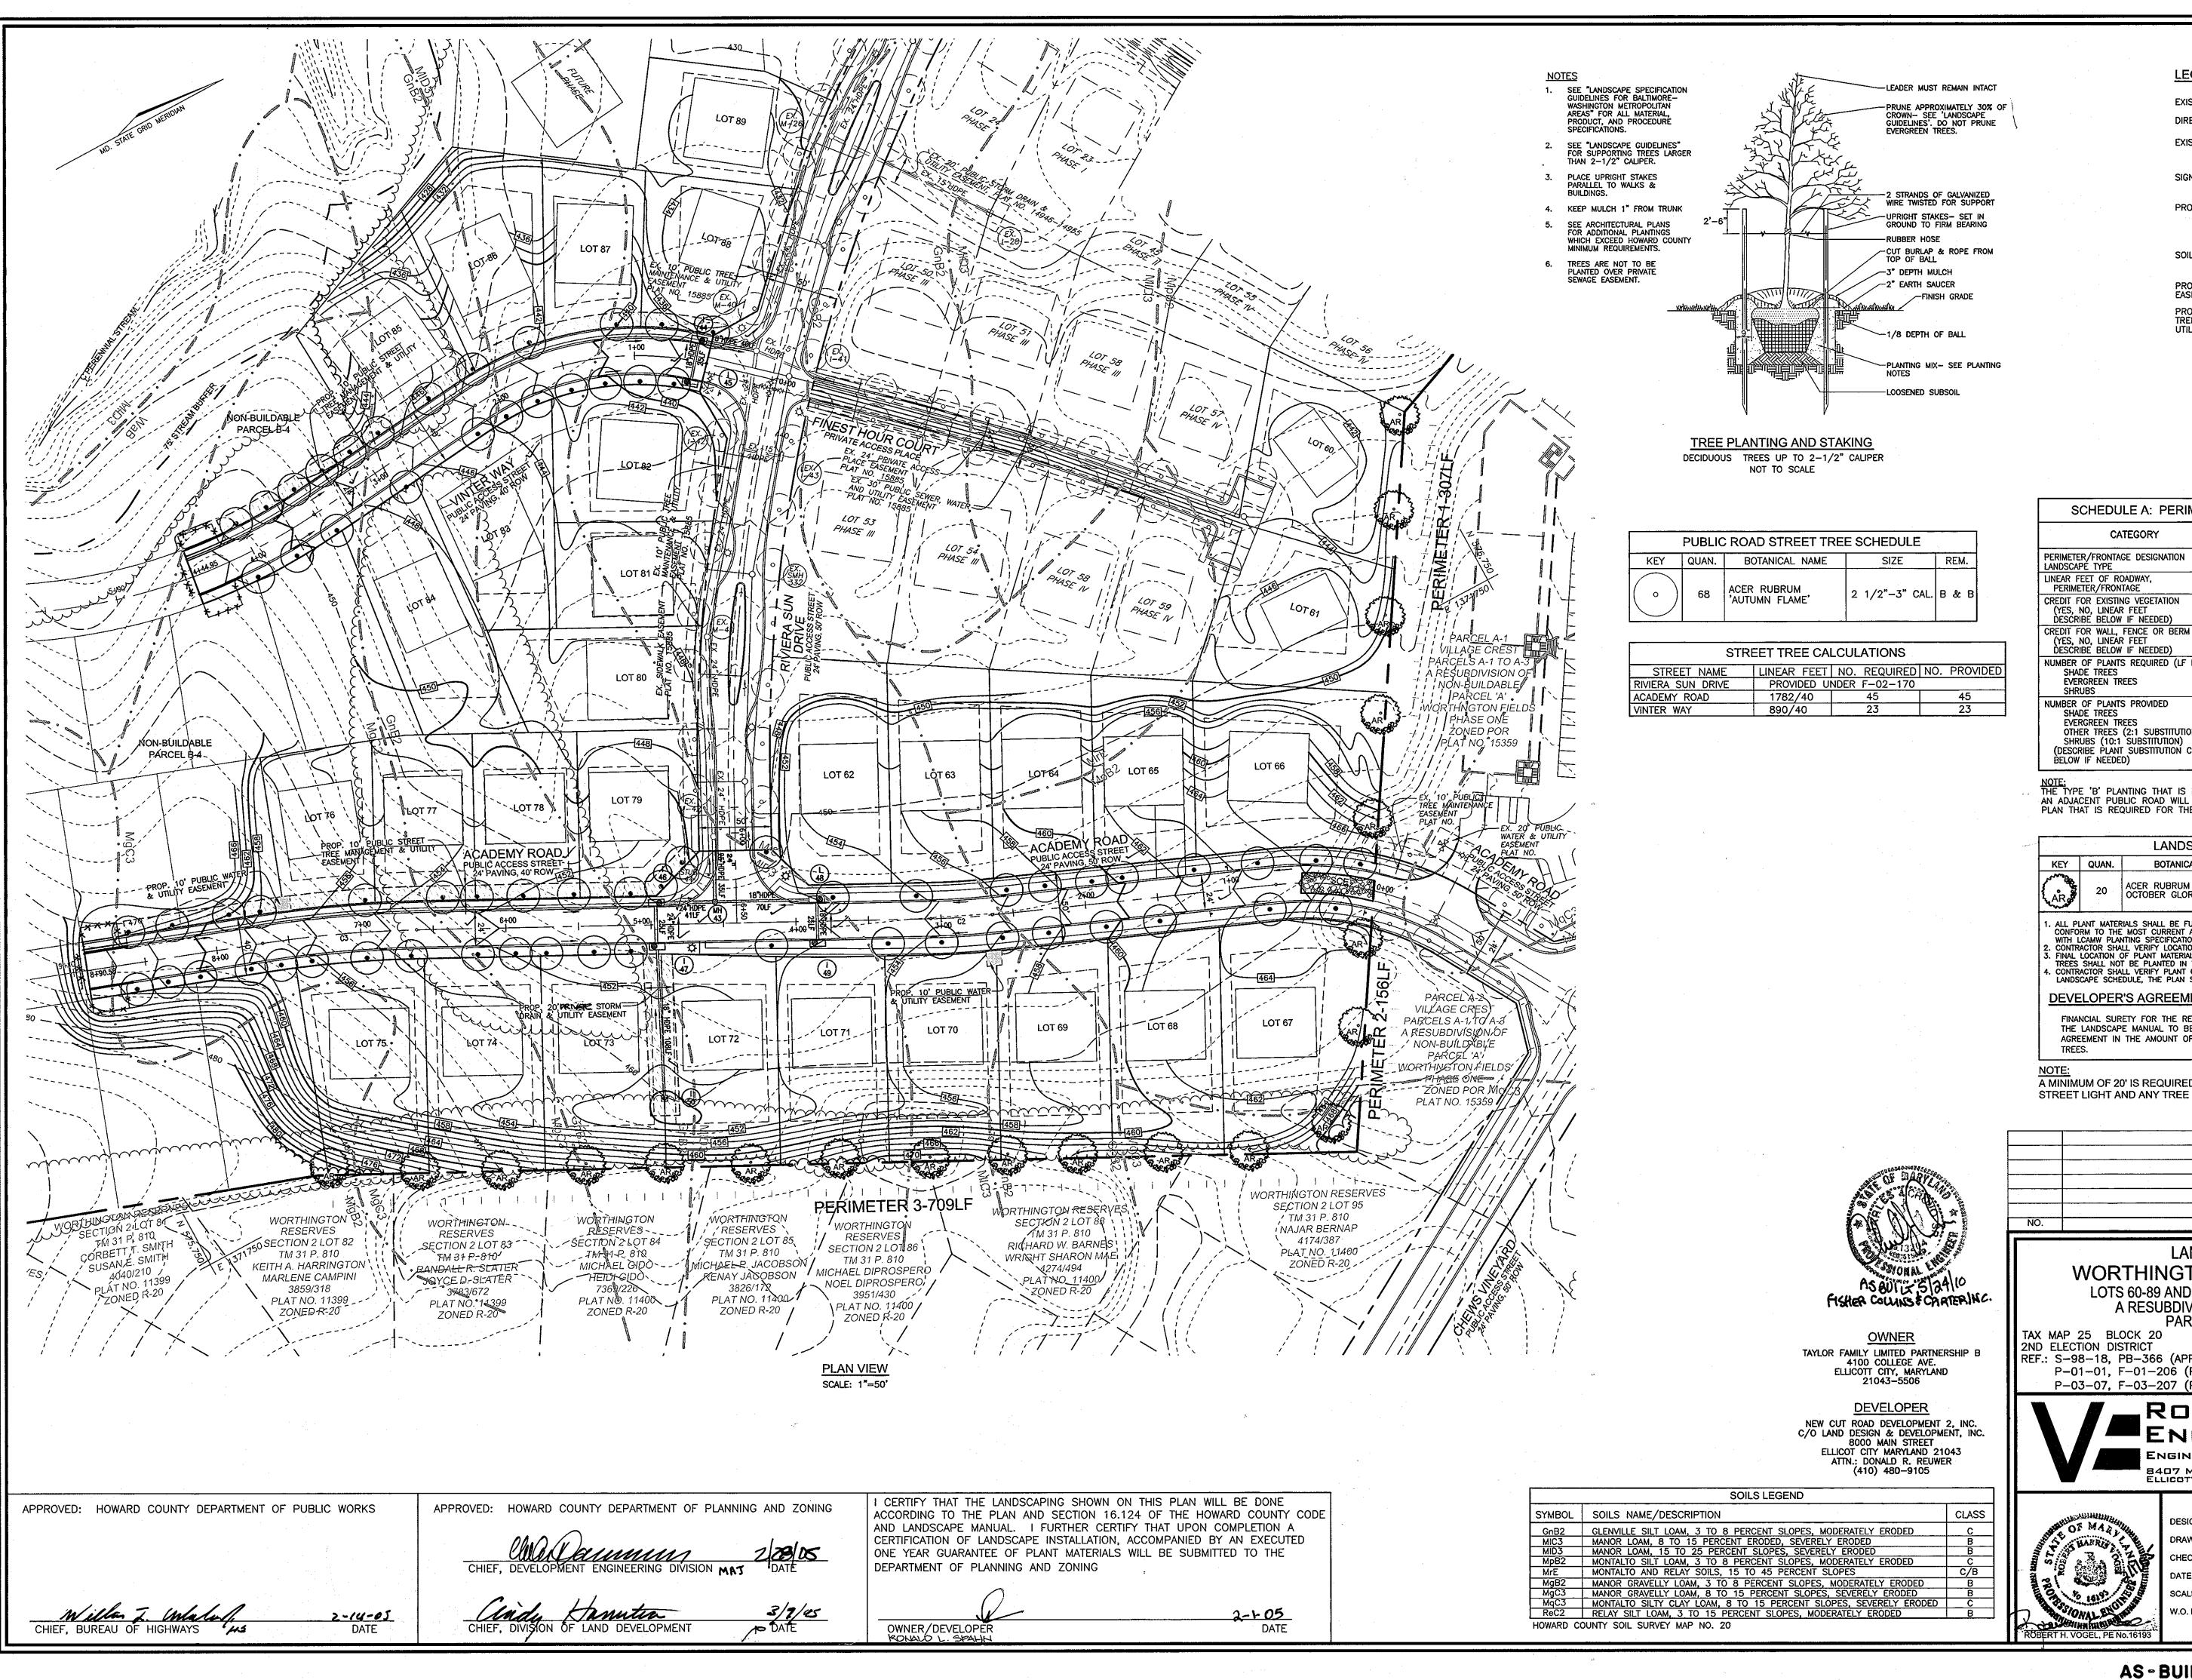

LEGEND EXISTING CONTOUR DIRECTION OF FLOW EXISTING TREES TO REMAIN → a ☆ POST-TOP SIGNS/LIGHT POLES PROPOSED STREET TREE 0 SOILS Control district PROP. PUBLIC UTILITY EASEMENT PROP. PUBLIC STREET TREE MAINTENANCE & UTILITY EASEMENT

SCHEDULE A: PERIMETER LANDSCAPE EDGE						
CATEGORY		ADJACENT TO ETER PROPE				
PERIMETER/FRONTAGE DESIGNATION LANDSCAPE TYPE	1 A	2 A	3 A			
LINEAR FEET OF ROADWAY, PERIMETER/FRONTAGE	307'	156'	709'			
CREDIT FOR EXISTING VEGETATION (YES, NO, LINEAR FEET DESCRIBE BELOW IF NEEDED)	-	<u>-</u>	1 1			
CREDIT FOR WALL, FENCE OR BERM (YES, NO, LINEAR FEET DESCRIBE BELOW IF NEEDED)			1 1			
NUMBER OF PLANTS REQUIRED (LF REMAINING) SHADE TREES EVERGREEN TREES SHRUBS	1:60 5 - -	1:60 3 - -	1:60 12 - -			
NUMBER OF PLANTS PROVIDED SHADE TREES EVERGREEN TREES OTHER TREES (2:1 SUBSTITUTION) SHRUBS (10:1 SUBSTITUTION) (DESCRIBE PLANT SUBSTITUTION CREDITS BELOW IF NEEDED)	5 	3	12 - - - - -			

NOTE:
THE TYPE 'B' PLANTING THAT IS REQUIRED BETWEEN THE SIDE OF THE HOUSE AND AN ADJACENT PUBLIC ROAD WILL BE PROVIDED ON THE FUTURE SITE DEVELOPMENT PLAN THAT IS REQUIRED FOR THE DEVELOPMENT OF THESE LOTS.

		LANDSCAPE SCHEDUL	-E		
KEY	QUAN.	BOTANICAL NAME	SIZE	REM.	
åR.	20	ACER RUBRUM 'OCTOBER GLORY' OCTOBER GLORY RED MAPLE	2 1/2"-3" Cal.	B & B	

1. ALL PLANT MATERIALS SHALL BE FULL AND HEAVY, BE WELL FORMED AND SYMMETRICAL, CONFORM TO THE MOST CURRENT AAN SPECIFICATIONS AND BE INSTALLED IN ACCORDANCE WITH LCAMW PLANTING SPECIFICATIONS.

2. CONTRACTOR SHALL VERIFY LOCATION OF ALL UNDERGROUND UTILITIES PRIOR TO DIGGING.

3. FINAL LOCATION OF PLANT MATERIAL MAY NEED TO VARY TO MEET FINAL FIELD CONDITIONS. TREES SHALL NOT BE PLANTED IN THE BOTTOM OF DRAINAGE SWALES.

4. CONTRACTOR SHALL VERIFY PLANT QUANTITIES PRIOR TO BIDDING. IF PLAN DIFFERS FROM LANDSCAPE SCHEDULE, THE PLAN SHALL GOVERN.

DEVELOPER'S AGREEMENT

FINANCIAL SURETY FOR THE REQUIRED LANDSCAPING PROVIDED PER THE LANDSCAPE MANUAL TO BE POSTED WITH THE DEVELOPER'S AGREEMENT IN THE AMOUNT OF \$6,000.00 FOR THE REQUIRED 20 SHADE

A MINIMUM OF 20' IS REQUIRED BETWEEN ANY

	_				
			٠,٠		
		·			
				 ·	
NO.			REVISION		DATE

LANDSCAPE PLAN **WORTHINGTON FIELDS, PHASE 5** LOTS 60-89 AND NON-BUILDABLE PARCEL 'B-4'

A RESUBDIVISION OF NON-BUILDABLE PARCEL 'B-3', PHASE 4 PARCEL P/O '98'


TAX MAP 25 BLOCK 20 2ND ELECTION DISTRICT

HOWARD COUNTY, MARYLAND REF.: S-98-18, PB-366 (APP. 6/16/99), P-00-07, F-01-60 (PHASE 1 P-01-01, F-01-206 (PHASE 2), P-02-08, F-02-170 (PHASE 3), P-03-07, F-03-207 (PHASE 4), P-04-12



ROBERT H. VOGEL ENGINEERING, INC. ENGINEERS • SURVEYORS • PLANNERS

8407 MAIN STREET TEL: 410.461.7666 ELLICOTT CITY, MD 21043 FAX: 410.461.8961

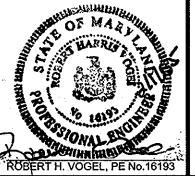

	DESIGN BY:	RHV
	DRAWN BY:	СМН
5	CHECKED BY	: RHV
711417	DATE:	JANUARY, 2005
	SCALE:	AS SHOWN
	W.O. NO.:	00-11.00
٠; •		•

8 SHEET 8

F-05-019