

GENERAL NOTES

- 1) THE PROJECT IS IN CONFORMANCE WITH THE LATEST HOWARD COUNTY STANDARDS UNLESS WAIVERS HAVE BEEN APPROVED.
- 2) THE EXISTING TOPOGRAPHY SHOWN IS BASED ON FIELD SURVEY BY BENCHMARK ENGINEERING, INC. IN APRIL, 2013, AND SUPPLEMENTED WITH DIGITAL GCS TOPOGRAPHY PURCHASED FROM HOWARD COUNTY.
- 3) THE COORDINATES SHOWN HEREON ARE BASED UPON THE HOWARD COUNTY GEODETIC CONTROL WHICH IS BASED UPON THE MARYLAND STATE PLANE COORDINATE SYSTEM. HOWARD COUNTY MONUMENT NOS. 077B AND 077A WERE USED FOR THIS PROJECT.
- 4) WATER IS PRIVATE.
- 5) SEWER IS PRIVATE.
- 6) STORMWATER MANAGEMENT SHALL BE PROVIDED BY POCKET PONDS AND SHALLOW WETLANDS ON NON-BUILDABLE PRESERVATION PARCELS 'B' THRU 'D'. SWM FACILITIES ARE TO BE PRIVATELY OWNED AND MAINTAINED.
- 7) EXISTING UTILITIES ARE BASED UPON FIELD SURVEY LOCATIONS.
- 8) WETLAND DELINEATION PROVIDED BY WILDMAN ENVIRONMENTAL SERVICES DATED JANUARY, 2001 AND WAS APPROVED UNDER S-01-21.
- 9) TRAFFIC STUDY WAS PREPARED BY LEE CUNNINGHAM & ASSOCIATES, INC. IN AUGUST, 2000 AND REVISED IN JANUARY, 2001 AND WAS APPROVED UNDER S-01-21.
- 10) A NOISE STUDY PREPARED BY BENCHMARK ENGINEERING, INC. IN AUGUST 2001 AND WAS APPROVED UNDER S-01-21.
- 11) THE GEOTECHNICAL REPORT FOR THIS PROJECT WAS PREPARED BY HILLIS CARNES ENGINEERING ASSOCIATES, INC. DATED JULY 7, 2003.
- 12) THE SUBJECT PROPERTY IS ZONED RC-DEO PER THE 2-2-04 COMPREHENSIVE ZONING PLAN. ALL ADJACENT PROPERTIES ARE ZONED RC-DEO PER THE 2-2-04 COMPREHENSIVE ZONING PLAN.
- 13) TO THE BEST OF OUR KNOWLEDGE, THERE ARE NO BURIAL GROUNDS OR CEMETERIES LOCATED ON THIS SITE.
- 14) THERE SHALL BE NO DISTURBANCE WITHIN THE 100-YR FLOODPLAIN, WETLANDS, STREAMS, THEIR BUFFERS OR STEEP SLOPES THAT ARE AT LEAST 20,000 S.F. UNLESS APPROVED BY THE DEPARTMENT OF PLANNING AND ZONING.
- 15) BOUNDARY IS BASED ON A FIELD RUN MONUMENTED BOUNDARY SURVEY PERFORMED BY BENCHMARK ENGINEERING, INC., DATED APRIL, 2003.
- 16) THIS PROJECT IS NOT LOCATED WITHIN THE METROPOLITAN DISTRICT.
- 17) THIS PLAN IS SUBJECT TO COMPLIANCE WITH THE SECOND AMENDMENT OF THE FOURTH EDITION OF THE SUBDIVISION AND LAND DEVELOPMENT REGULATIONS AS A CONSEQUENCE FOR ITS SUBMISSION PRIOR TO 11/1/2001. THIS PROJECT IS SUBJECT TO COMPLIANCE WITH THE 1993 ZONING REGULATIONS IN EFFECT PRIOR TO COUNCIL BILL 50-2001 BECAUSE THE PLAN HAS GIVEN TECHNICALLY COMPLETE APPROVAL PRIOR TO 11/1/01, IN ACCORDANCE WITH COUNCIL BILL 50-2003.
- 18) THIS AREA DESIGNATES A PRIVATE SEWERAGE EASEMENT OF 10,000 SQUARE FEET AS REQUIRED BY THE STATE DEPARTMENT OF THE ENVIRONMENT FOR INDIVIDUAL SEWERAGE DISPOSAL. IMPROVEMENTS OF ANY NATURE IN THIS AREA IS RESTRICTED UNTIL PUBLIC SEWER IS AVAILABLE. THIS EASEMENT SHALL BECOME NULL AND VOID UPON CONNECTION TO A PUBLIC SEWER SYSTEM. THE COUNTY HEALTH OFFICER SHALL HAVE THE AUTHORITY TO GRANT ADJUSTMENTS TO THE PRIVATE SEWERAGE EASEMENT. RECORDATION OF A MODIFIED SEWERAGE EASEMENT PLAT SHALL NOT BE NECESSARY.
- 19) THE PURPOSE OF THE PRESERVATION PARCELS AND THE JUSTIFICATION FOR THE DESIGN OF THE CLUSTER SUBDIVISION IS AS FOLLOWS:
PRESERVATION PARCEL 'A' IS PROPOSED AS A BUILDABLE PARCEL TO ALLOW FOR 1 DWELLING UNIT. IT WILL BE A PART OF THE HOWARD COUNTY AGRICULTURAL LAND PRESERVATION PROGRAM BY PLACEMENT IN A HOWARD COUNTY AGRICULTURAL LAND PRESERVATION EASEMENT. IT WILL BE PRIVATELY OWNED WITHIN HOWARD COUNTY AGRICULTURAL LAND PRESERVATION PROGRAM AS THE EASEMENT HOLDER. *There will be a Howard County Agricultural Land Preservation Program.*
PRESERVATION PARCELS 'B', 'C', AND 'D' ARE PROPOSED AS NON-BUILDABLE PRESERVATION PARCELS TO PROVIDE STORMWATER MANAGEMENT. THESE PARCELS ARE TO BE DEDICATED TO THE HOMEOWNERS ASSOCIATION WITHIN HOWARD COUNTY AS THE EASEMENT HOLDER.
- 20) THIS PROJECT COMPLIES WITH THE REQUIREMENTS OF SECTION 16.1200 OF THE HOWARD COUNTY CODE FOR FOREST CONSERVATION. BY RETENTION OF 7.54 ACRES OF FOREST AND REFORESTATION OF 1.68 ACRES FINANCIAL SURVEY FOR THE 7.54 ACRES (328,442.40 S.F.) OF RETENTION IN THE AMOUNT OF \$65,688.48 AND THE 1.68 ACRES (73,180.80 S.F.) OF REFORESTATION IN THE AMOUNT OF \$36,590.40 HAS BEEN POSTED AS PART OF THE DWP DEVELOPER'S AGREEMENT FOR THE TOTAL AMOUNT OF \$102,278.88.
- 21) THE 100-YEAR FLOODPLAIN LIMITS SHOWN ON THIS PLAN ARE FROM A DETAILED STUDY BY BENCHMARK ENGINEERING, INC., DATED MARCH 5, 2004, AND FROM INFORMATION PROVIDED IN THE CATTAIL CREEK WATERSHED STUDY, CAPITAL PROJECT #0-1079 DATED JUNE, 1994. THE UTILITIES AND CROSS-SECTION INFORMATION WAS OBTAINED THROUGH THE HOWARD COUNTY DEPARTMENT OF PUBLIC WORKS TRANSPORTATION AND WATERSEWER DIVISION'S GIS NETWORK.
- 22) ALL DRIVEWAY CULVERTS ARE TO BE 15" HOPEP. DESIGN CALCULATIONS ARE PROVIDED IN THE APPROVED STORM DRAIN REPORT.
- 23) HOWARD COUNTY MONUMENT #077A TO BE RELOCATED BY OTHERS.
- 24) THE 65 dBA NOISE CONTOUR LINE DRAWN ON THIS SUBDIVISION PLAN IS ADVISORY AS REQUIRED BY THE HOWARD COUNTY DESIGN MANUAL, CHAPTER 5, REVISED, FEBRUARY, 2003. IT CANNOT BE CONSIDERED TO EXACTLY LOCATE THE 65 dBA NOISE EXPOSURE. THE 65 dBA NOISE LINE WAS ESTABLISHED BY HOWARD COUNTY TO ALERT DEVELOPERS AND FUTURE RESIDENTS THAT THE AREAS BEYOND THIS THRESHOLD MAY EXCEED GENERALLY ACCEPTED NOISE LEVELS ESTABLISHED BY THE U.S. DEPARTMENT OF HOUSING AND URBAN DEVELOPMENT.
- 25) ALL SIGN POSTS USED FOR TRAFFIC CONTROL SIGNS INSTALLED IN THE COUNTY RIGHT-OF-WAY SHALL BE MOUNTED ON A 2" GALVANIZED STEEL PERFORATED SQUARE TUBE POST (14 GAUGE) INSERTED INTO A 2-1/2" GALVANIZED STEEL PERFORATED SQUARE TUBE SLEEVE (12 GAUGE) - 3' LONG. A GALVANIZED STEEL POLE CAP SHALL BE MOUNTED ON TOP OF EACH POST.
- 26) ALL LANDSCAPING REQUIREMENTS FOR THIS PROJECT SHALL BE IN ACCORDANCE WITH THE HOWARD COUNTY LANDSCAPE MANUAL AND SECTION 16.124(C)(3)(D) OF THE SUBDIVISION REGULATIONS. FINANCIAL SURETY FOR THE REQUIRED LANDSCAPING WILL BE POSTED AS PART OF THE DWP DEVELOPER'S AGREEMENT IN THE AMOUNT OF \$2,450.00.
- 27) THE DEVELOPER HAS FILED A JOINT FEDERAL/STATE APPLICATION FOR THE ALTERATION OF ANY FLOODPLAIN, WATERWAY, TIE-IN OR MONUMENT ROAD CROSSING. MARYLAND DEPARTMENT OF THE ENVIRONMENT HAS DETERMINED THAT THERE ARE NO IMPACTS TO STATE JURISDICTIONAL WETLANDS, WATERWAYS OR FLOODPLAINS. THE U.S. ARMY CORPS OF ENGINEERS HAS AUTHORIZED THE DEVELOPER TO PERFORM WORK IN ACCORDANCE WITH THE TERMS AND CONDITIONS SPECIFIED IN SECTION VI OF THE MDSFP-2 EFFECTIVE ON OCTOBER 1, 2001. THE TRACKING NUMBER IS 200662094/06-NT-3055.
- 28) THIS AREA DESIGNATES A SAND MOUND LOCATION FOR DISPOSAL OF SEWAGE. LOTS 6, 7, 10, 14 AND 15 CONTAIN SANDMOUNDS THAT ARE TO BE DESIGNED AT THE TIME OF PERMIT PLAN.
- 29) DISTURBANCE TO FLOOD PLAIN ASSOCIATED WITH THE CONSTRUCTION OF THE ROADWAY CROSSING HAS BEEN APPROVED UNDER SECTION 16.115(C) OF THE SUBDIVISION REGULATIONS BY THE DIVISION OF LAND DEVELOPMENT. THE DEPARTMENT OF PLANNING AND ZONING HAS DETERMINED THAT THE DISTURBANCE AT THE STREAM CROSSING IS CONSIDERED NECESSARY IN ACCORDANCE WITH SECTION 16.116(C) OF THE SUBDIVISION REGULATIONS. THE DISTURBANCE WAS APPROVED BECAUSE CONSTRUCTING A SEPARATE ACCESS ONTO ROUTE 94 WOULD REQUIRE EXTENSIVE CLEARING AND GRADING ALONG THE SCENIC ROAD AND DUE TO THE PRESENCE OF STEEP SLOPES IN THE AREA.
- 30) *There are no specimen trees on this site.*


THE CHASE AT STONEY BROOK

LOTS 1 - 20, PRESERVATION PARCEL 'A' AND NON-BUILDABLE PRESERVATION PARCELS 'B' THROUGH 'D'

ROADS, STORMWATER MANAGEMENT AND STORM DRAIN CONSTRUCTION PLANS


BENCH MARKS NAD'83
HO. CO. #077B
STAMPED BRASS DISK SET ON TOP OF CONCRETE BASE; 3.6' SOUTH OF EDGE OF PAVING OF ROUTE 94; 62.3' SOUTHWEST OF C&P POLE #19 AND 44.8' SOUTHEAST OF P.E. POLE #FS2601.
N 604983.426' E 1289326.119'
ELEV. 599.018'

HO. CO. #077A
STAMPED BRASS DISK SET ON TOP OF CONCRETE BASE; 6.1' SOUTH OF THE EDGE OF PAVING OF ROUTE 94; 45.3' SOUTH OF P.E. SYSTEM POLE #FS908 AND 26.6' NORTHEAST OF P.E. SYSTEM POLE #6909(C&P POLE #22).
N 604982.216' E 1288044.192'
ELEV. 593.432'

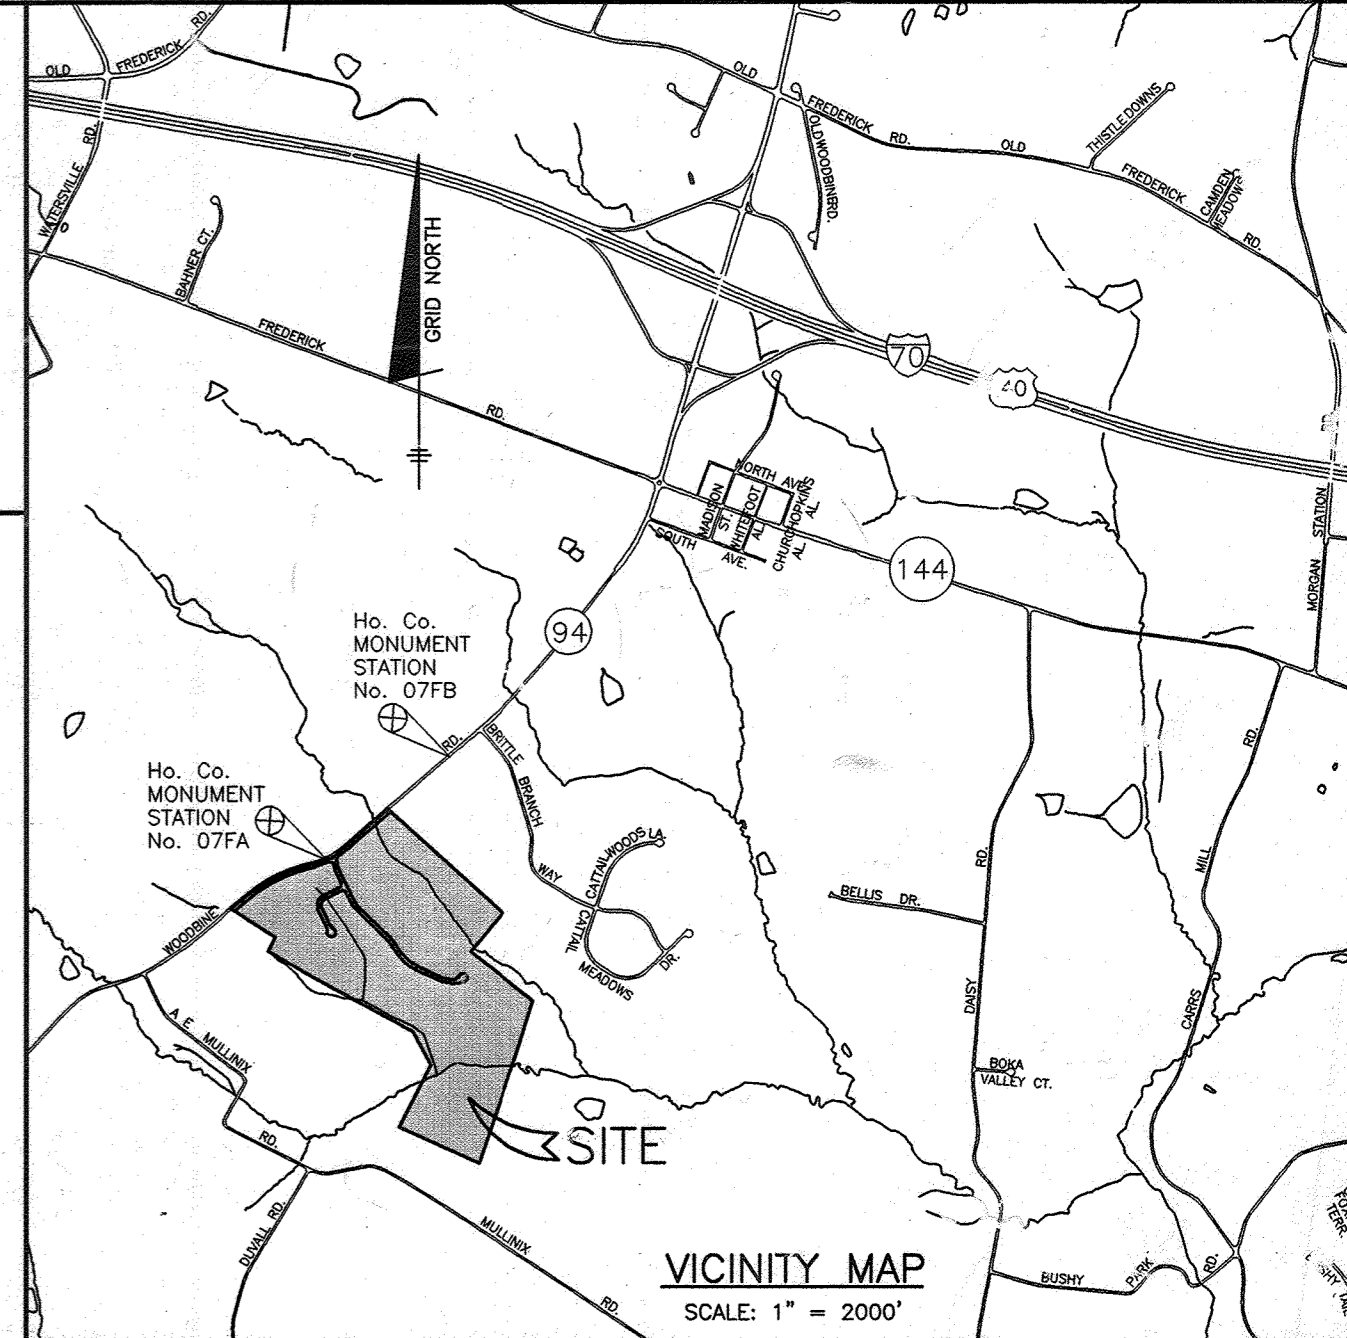


SHEET INDEX	
NO.	DESCRIPTION
1	TITLE SHEET
2	ROAD PLAN
3	ROAD PLAN
4	WOODBINE ROAD IMPROVEMENT PLAN
5	ROAD PROFILES
6	ROAD PROFILES AND DETAILS
7	STORMDRAIN DRAINAGE AREA MAP
8	STORMDRAIN PROFILES
9	STORMDRAIN PROFILES
10	GRADING, SEDIMENT AND EROSION CONTROL PLAN
11	GRADING, SEDIMENT AND EROSION CONTROL PLAN
12	SEDIMENT AND EROSION CONTROL NOTES AND DETAILS
13	LANDSCAPE PLAN
14	FOREST CONSERVATION PLAN
15	FOREST CONSERVATION PLAN
16	SWM DETAILS FACILITY #1
17	SWM DETAILS FACILITY #2
18	SWM DETAILS FACILITY #3
19	SWM NOTES AND BORING LOGS
20	RED-LINE REVISION FOR LOT-10 - BLOWUP & DETAILS

4/12/2003 REVISION
PURPOSE STATEMENT:
TO REVISE LOT 10, HOUSE
DRIVEWAY, SEPTIC, GRADING
& TO UPDATE ALL PAGE
NUMBERS.

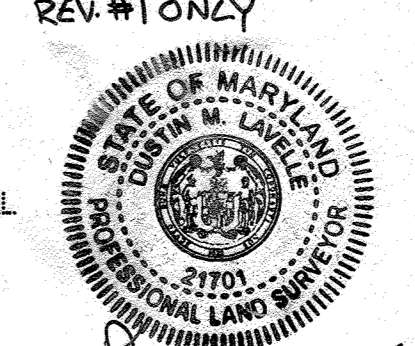

REV #1 ONLY
Justin M. Lovell
REG. NO. 21701, EXP. 6/11/2003
A LICENSEE EITHER PERSONALLY
PREPARED THIS RED-LINE REVISION
OR WAS IN RESPONSIBLE CHARGE
OVER ITS PREPARATION AND THE
SURVEYING WORK REFLECTED IN
IT, ALL IN COMPLIANCE WITH
REQUIREMENTS SET FORTH IN
REGULATION OR 13.06.01 OF THE
CODE OF MARYLAND REGULATIONS
(COMAR). 4/28/2003.

LEGEND	
LIMIT OF WETLANDS	[Symbol]
EXISTING WOODS LINE	[Symbol]
PROPOSED WOODS LINE	[Symbol]
EXISTING STRUCTURE	[Symbol]
EXISTING WELL	[Symbol]
PROPOSED SEPTIC FIELD	[Symbol]
100 YEAR FLOODPLAIN	[Symbol]
PROP. STREET TREE	[Symbol]
PROPOSED SANDMOUND AREA	[Symbol]
SLOPES 25% AND GREATER	[Symbol]
SLOPE BETWEEN 15% AND 24.9%	[Symbol]

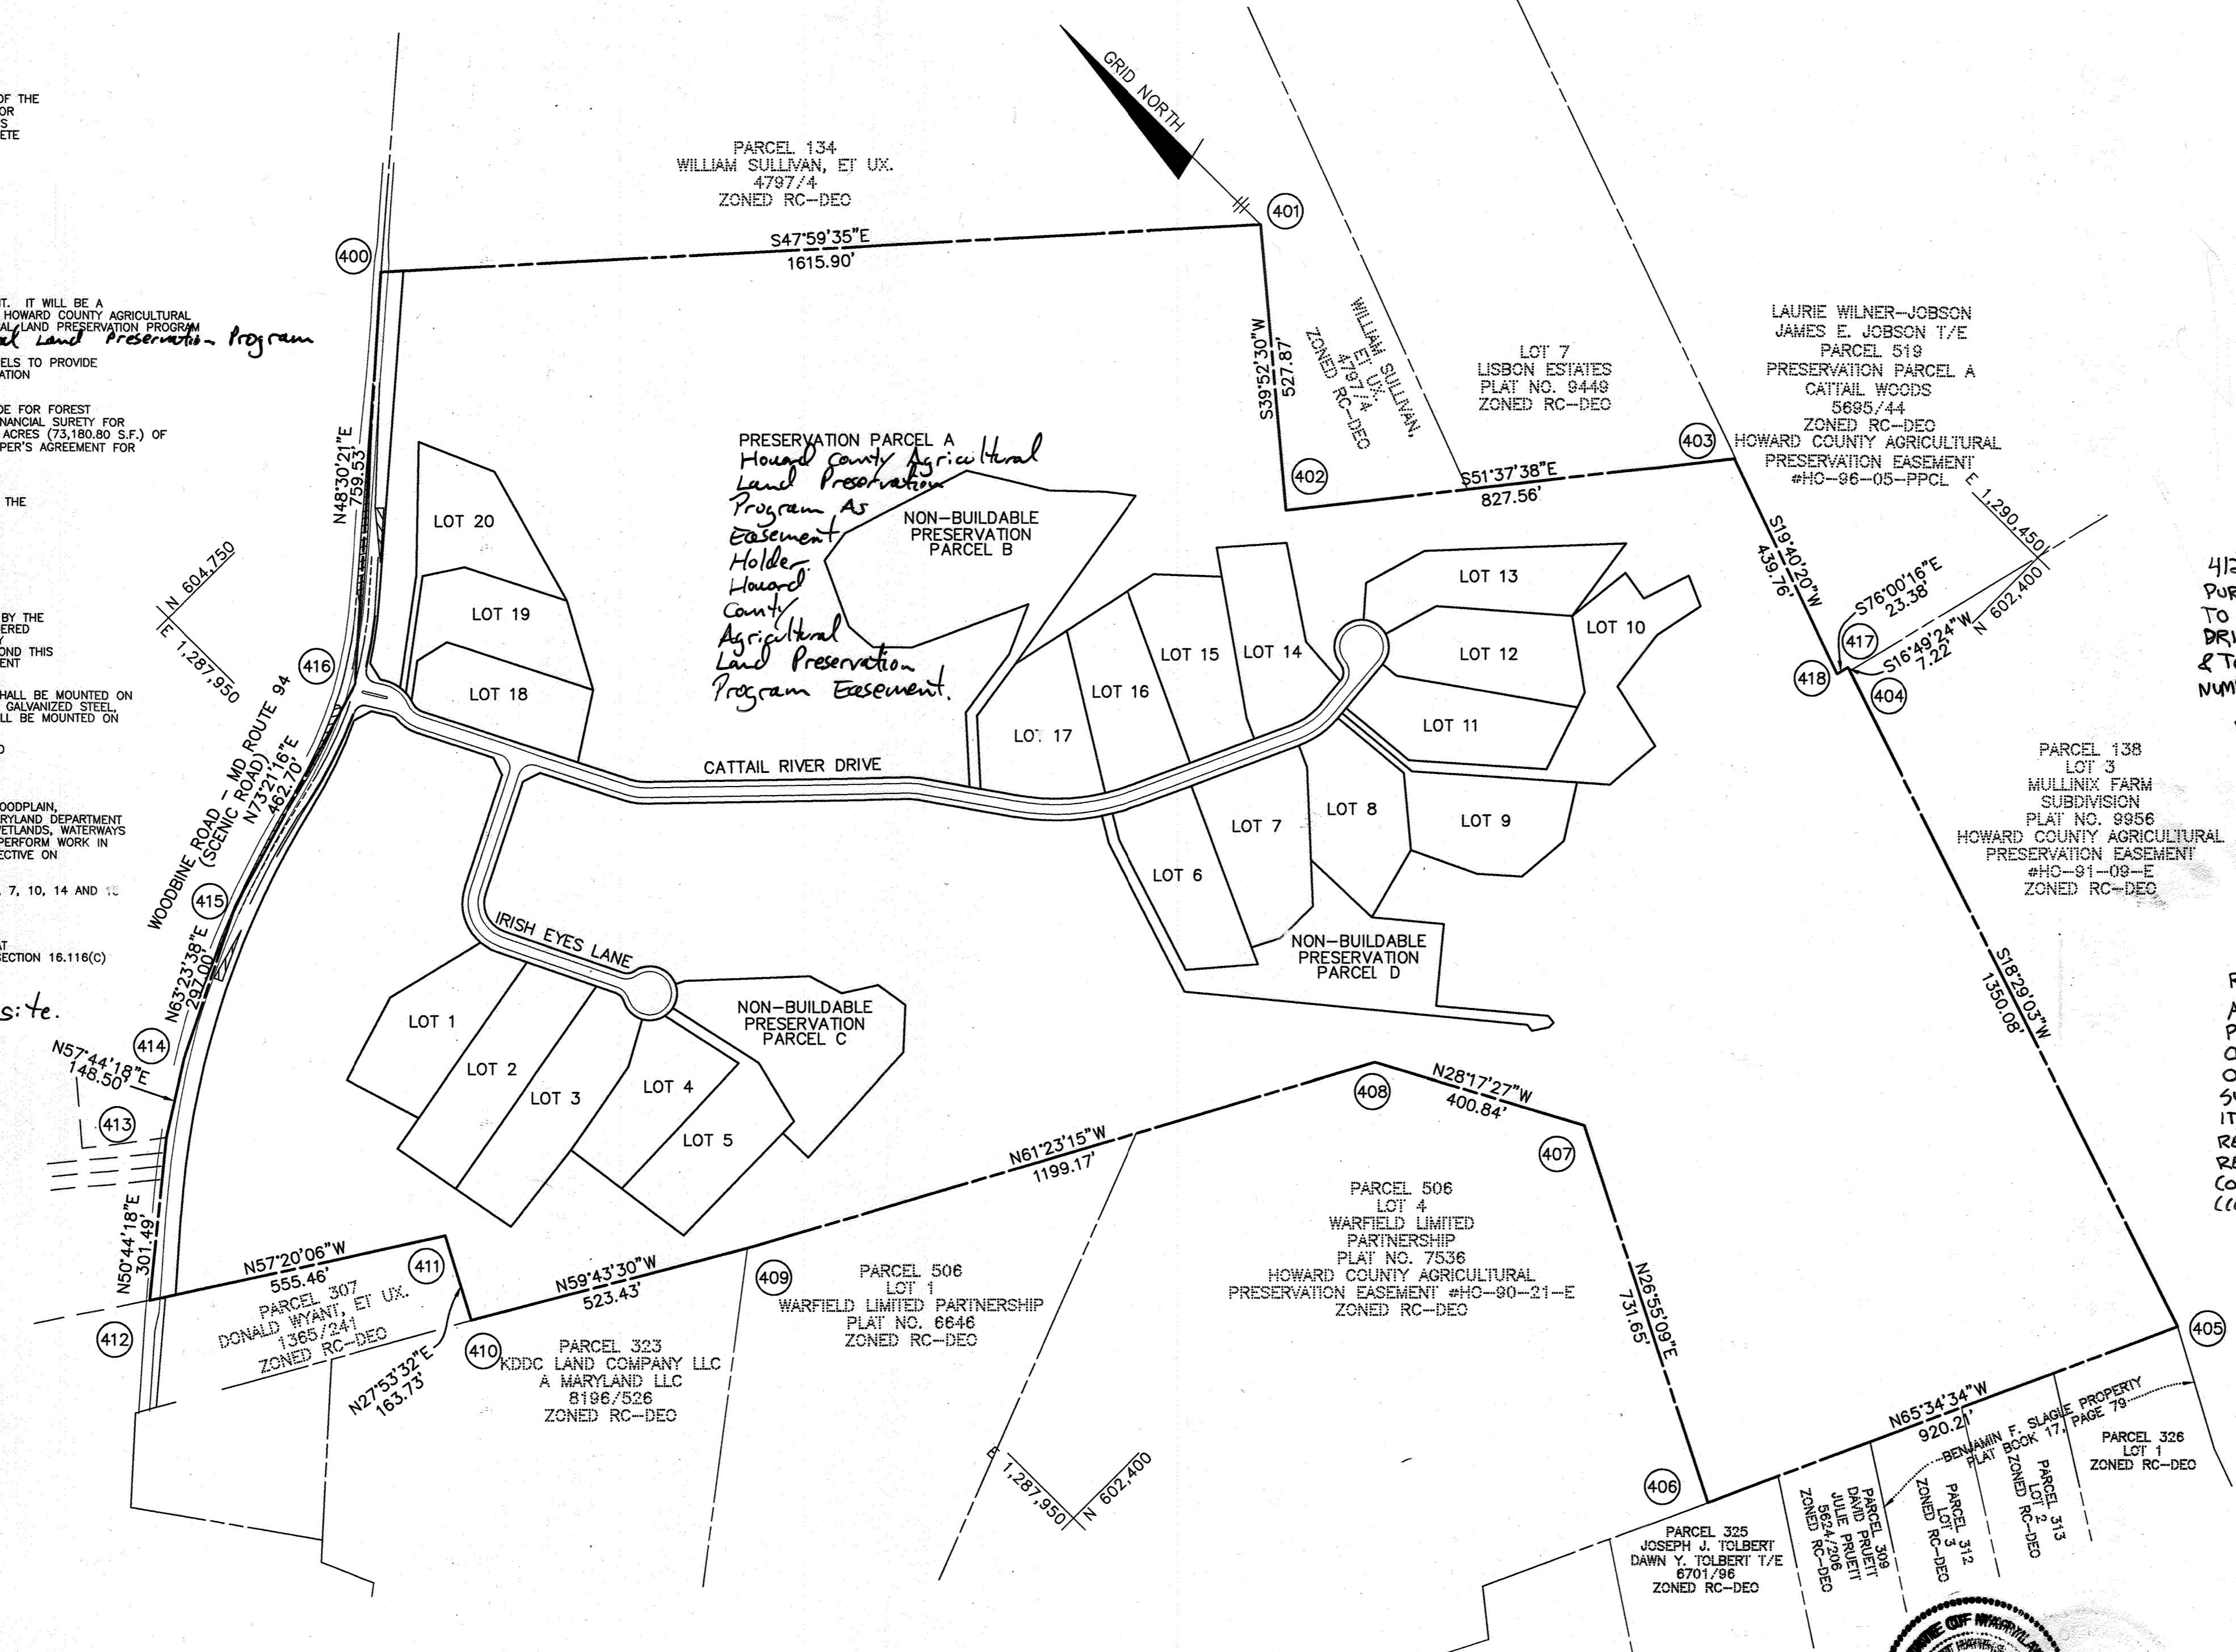

PLAN VIEW
SCALE: 1" = 200'



AS-BUILT CERTIFICATION
I HEREBY CERTIFY THAT THE FACILITY SHOWN ON THIS PLAN WAS CONSTRUCTED AS SHOWN ON THE AS-BUILT PLANS AND MEETS THE APPROVED PLANS & SPECIFICATIONS.
10/93
01/21/03

SITE ANALYSIS DATA CHART	
GENERAL SITE DATA	
1) PRESENT ZONING:	RC-DEO
2) APPLICABLE DPZ FILE REFERENCES:	S-01-21, P-05-001
3) PROPOSED USE OF SITE:	RESIDENTIAL (SFD)
4) PROPOSED WATER AND SEWER SYSTEMS:	PRIVATE
AREA TABULATION	
1) GROSS TRACT AREA	116.79 AC.±
2) AREA WITHIN 100-YEAR FLOODPLAIN	23.62 AC.±
3) TOTAL AREA OF 25% OR GREATER STEEP SLOPES	1.10 AC.±
4) NET TRACT AREA	92.07 AC.±
5) TOTAL NUMBER OF LOTS ALLOWED PER ZONING	27
1 UNIT PER 4.29 GROSS ACRES	
6) TOTAL NUMBER OF RESIDENTIAL UNITS/LOTS PROPOSED ON THIS SUBMISSION (20 CLUSTER LOTS+ PRES. PARCEL A)	21
7) AREA OF CLUSTER LOTS	22.72 AC.±
8) AREA OF BUILDABLE PRESERVATION PARCEL	83.33 AC.±
9) AREA OF NON-BUILDABLE PRESERVATION PARCELS	6.35 AC.±
10) AREA OF ROAD RIGHT-OF-WAY	4.39 AC.±
11) OPEN SPACE ON-TOTAL SITE	N/A
12) TOTAL NUMBER OF BUILDABLE PRESERVATION PARCELS	1
13) TOTAL NUMBER OF NON-BUILDABLE PRESERVATION PARCELS	3

APPROVED: HOWARD COUNTY DEPARTMENT OF PUBLIC WORKS
William F. Mahan 4-21-06
CHIEF, BUREAU OF HIGHWAYS DATE

APPROVED: HOWARD COUNTY DEPT. OF PLANNING AND ZONING
Cindy Hamer 5/12/06
CHIEF, DIVISION OF LAND DEVELOPMENT DATE

Mark 5/2/06
CHIEF, DEVELOPMENT ENGINEERING DIVISION DATE

<p>1 4/28/2003 RED-LINE REVISION - LOT 10 HOUSE DRIVEWAY, SEPTIC, & GRADING</p>		
NO.	DATE	REVISION
<p>BENCHMARK ENGINEERS & LAND SURVEYORS & PLANNERS ENGINEERING, INC. 8480 BALTIMORE NATIONAL PIKE & SUITE 418 ELLCOTT CITY, MARYLAND 21043 phone: 410-465-6105 A fax: 410-465-6644 www.bei-civilengineering.com</p>		
OWNER/DEVELOPER:		PROJECT:
<p>TRINITY QUALITY HOMES, INC. 3675 PARK AVENUE SUITE 301 ELLCOTT CITY, MD 21043 410-480-0023</p>		<p>THE CHASE AT STONEY BROOK LOTS 1-20, PRESERVATION PARCEL 'A' AND NON-BUILDABLE PRESERVATION PARCELS 'B' THROUGH 'D'</p>
LOCATION:		TITLE:
<p>TAX MAP 7, BLOCK 17 PARCEL 133 4th ELECTION DISTRICT HOWARD COUNTY, MARYLAND</p>		TITLE SHEET
DATE:	APRIL 2006	PROJECT NO. 1187
DATE:	MARCH 2006	SHEET 1 OF 20
DES: JMC	DRAFT: JMC	CHECK: DAM
SCALE:	AS SHOWN	

STREET LIGHT SCHEDULE		
SYMBOL	DESCRIPTION	LOCATION
	250-WATT NPS VAPOR PENDANT FIXTURE (S&D) MOUNTED AT 30' ON A BRONZE FIBERGLASS POLE, USING A 12' ARM	OFFSET 54.9' LT C/A STA. 6+42.58 CATTAIL RIVER ROAD

EXTEND ONE FOOT FULL DEPTH SAWCUT ONTO WOODBINE ROAD FOR ROAD WIDENING.

CENTERLINE CONTROL DATA			
STREET NAME	STATION	NORTH	EAST
CATTAIL RIVER DRIVE	BEGIN=0+00.00	604434.35	1288084.37
	PC=0+86.74	604360.39	1288129.68
	PT=1+26.01	604322.59	1288135.67
	PT=1+61.18	604288.37	1288139.65
	PC=5+63.11	603929.62	1288320.88
	PT=5+95.40	603902.93	1288340.52
	PC=10+81.38	603565.28	1288688.65
	PT=11+00.78	603550.51	1288701.18
	PC=12+80.13	603403.16	1288803.44
	PT=14+98.96	603264.31	1288969.20
IRISH EYES LANE	BEGIN=0+00.00	603160.70	1289457.46
	PC=2+62.72	603995.17	1287993.15
	PT=3+79.12	603896.22	1287959.40
	END=6+69.08	603634.99	1287959.40

CENTERLINE CURVE DATA						
STREET NAME	STATION	RADIUS	LENGTH	DELTA	TANGENT	CHORD
CATTAIL RIVER DRIVE	STA. 0+86.74 TO 1+26.01	50.00'	32.27'	45°00'00"	20.71'	N08°59'59"W 38.27'
	STA. 1+26.01 TO 1+61.18	50.00'	35.17'	40°18'24"	18.35'	S06°38'53"E 34.45'
	STA. 5+63.11 TO 5+96.40	100.00'	33.29'	19°04'26"	16.80'	S36°20'18"E 33.14'
	STA. 10+81.38 TO 11+00.78	100.00'	19.40'	11°06'58"	9.73'	N40°19'02"W 19.37'
	STA. 12+80.13 TO 14+98.96	410.00'	218.82'	30°34'45"	112.08'	S50°02'56"E 216.23'
IRISH EYES LANE	STA. 18+15.00 TO 18+92.99	150.00'	78.00'	29°47'31"	39.90'	S80°14'04"E 77.12'
	STA. 2+62.72 TO 3+79.12	75.00'	116.40'	88°55'13"	73.60'	S18°44'19"W 105.06'

APPROVED: HOWARD COUNTY DEPARTMENT OF PUBLIC WORKS
William F. Mahan 4-21-06
 CHIEF, BUREAU OF HIGHWAYS



APPROVED: HOWARD COUNTY DEPT. OF PLANNING AND ZONING
Cindy Hamstra 5/12/06
 CHIEF, DIVISION OF LAND DEVELOPMENT

Mike DeMunn
 CHIEF, DEVELOPMENT ENGINEERING DIVISION

LEGEND

- LIMIT OF WETLANDS
- EXISTING WOODS LINE
- PROPOSED WOODS LINE
- EXISTING STRUCTURE
- EXISTING WELL
- PROPOSED SEPTIC FIELD
- 100 YEAR FLOODPLAIN
- FOREST CONSERVATION
- PROP. STREET TREE
- STEEP SLOPES 15-24.9%
- STEEP SLOPES 25% OR GREATER

P:\1187\dwg\101742_3.dwg, SHEET 2, 3/31/2006 2:07:33 PM, Inc. Use TDS000 EBN for review

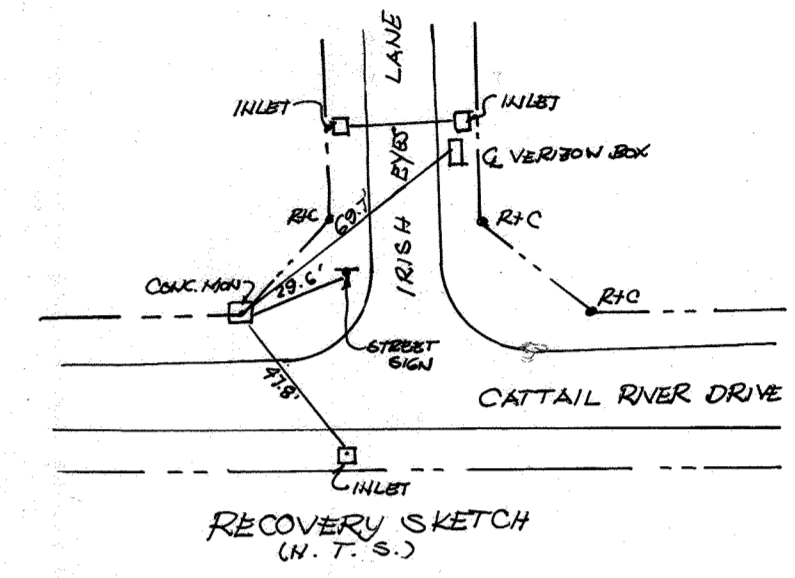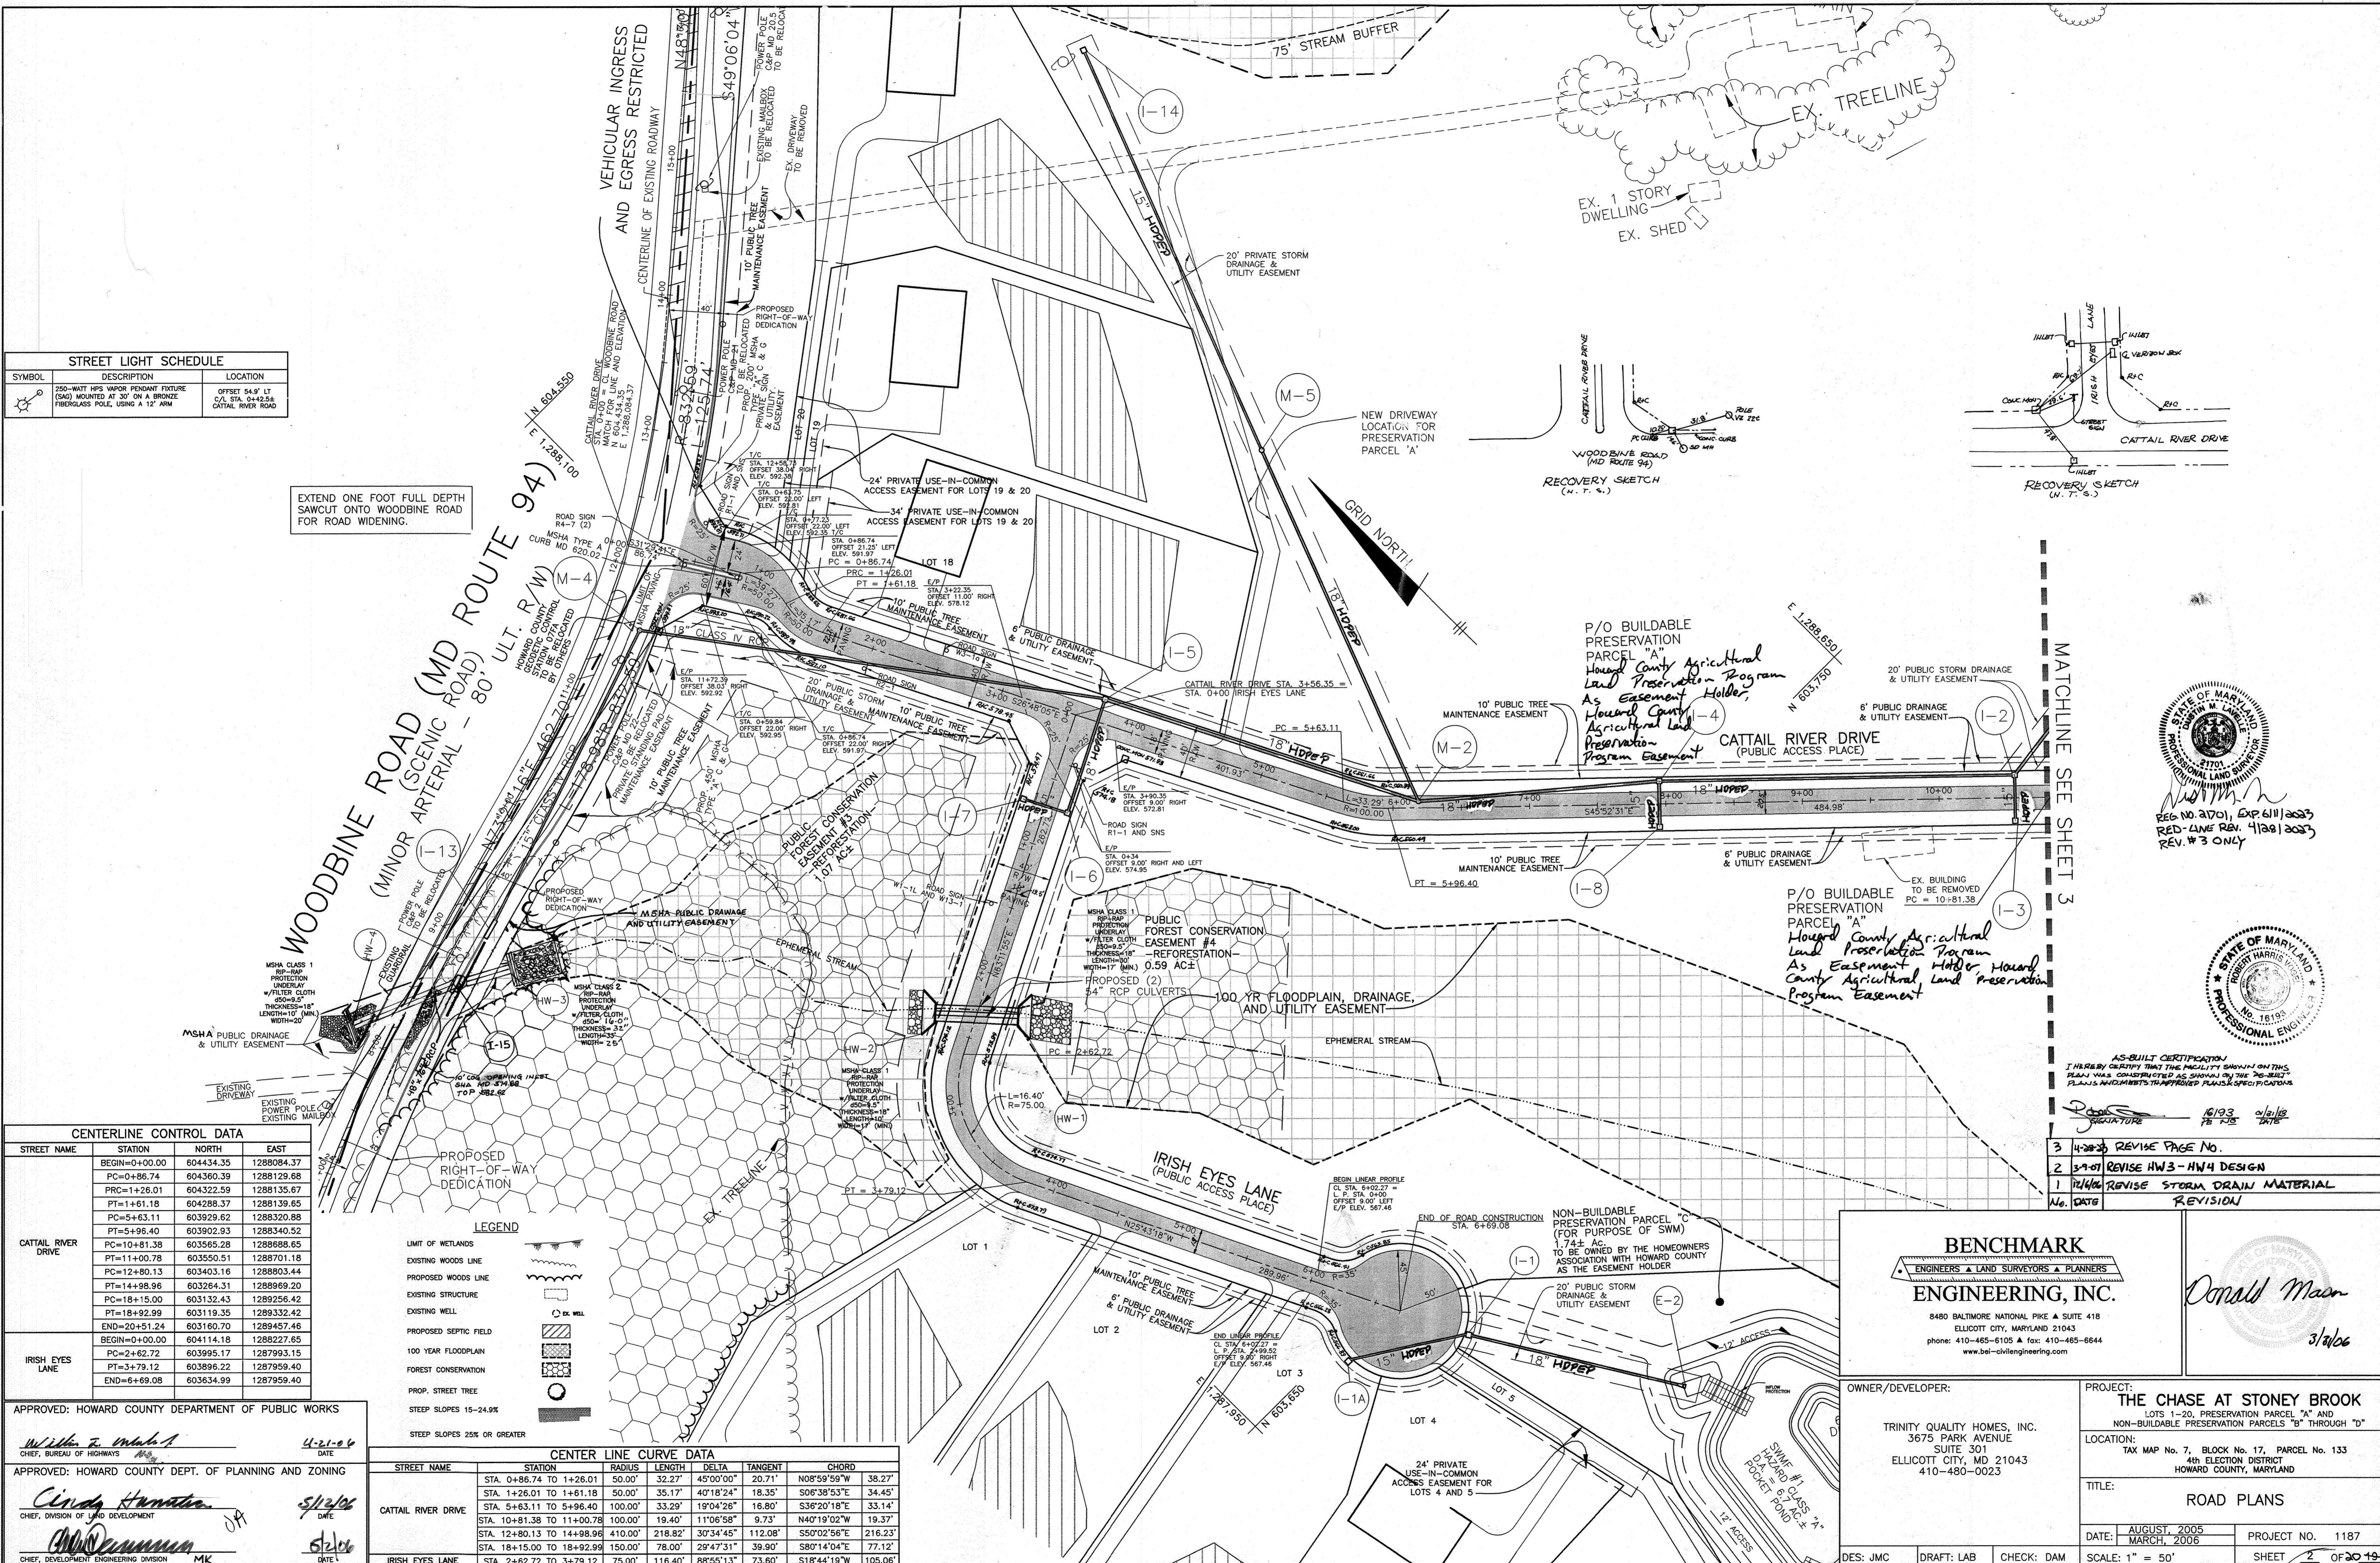

MATCHLINE SEE SHEET 3

STATE OF MARYLAND
 PROFESSIONAL LAND SURVEYOR
 REG. NO. 21701, EXP. 6/11/2007
 RED-LINE REV. 4/28/2007
 REV. #3 ONLY

STATE OF MARYLAND
 PROFESSIONAL ENGINEER
 REG. NO. 16193

AS-BUILT CERTIFICATION
 I HEREBY CERTIFY THAT THE ENGLISH SHOWN ON THIS PLAN WAS CONSIDERED AS SHOWN ON THE AS-BUILT PLANS AND MEETS THE APPROVED PLANS SPECIFICATIONS

No.	DATE	REVISION
3	4-28-06	REVISE PAGE NO.
2	3-9-07	REVISE HW3-HW4 DESIGN
1	12/16/06	REVISE STORM DRAIN MATERIAL

BENCHMARK ENGINEERING, INC.
 ENGINEERS & LAND SURVEYORS & PLANNERS
 8480 BALTIMORE NATIONAL PIKE A SUITE 418
 ELLICOTT CITY, MARYLAND 21043
 phone: 410-465-6105 • fax: 410-465-6644
 www.bel-ctiengineering.com

Donald Mason
 3/1/06

OWNER/DEVELOPER: TRINITY QUALITY HOMES, INC.
 3675 PARK AVENUE SUITE 301 ELLICOTT CITY, MD 21043 410-480-0023

PROJECT: THE CHASE AT STONEY BROOK
 LOTS 1-20, PRESERVATION PARCEL "A" AND NON-BUILDABLE PRESERVATION PARCELS "B" THROUGH "D"


LOCATION: TAX MAP No. 7, BLOCK No. 17, PARCEL No. 133 4th ELECTION DISTRICT HOWARD COUNTY, MARYLAND

TITLE: ROAD PLANS

DATE: AUGUST, 2005 PROJECT NO. 1187
 MARCH, 2006




DES: JMC DRAFT: LAB CHECK: DAM SCALE: 1" = 50' SHEET 2 OF 20

S51°37'38"E 827.56

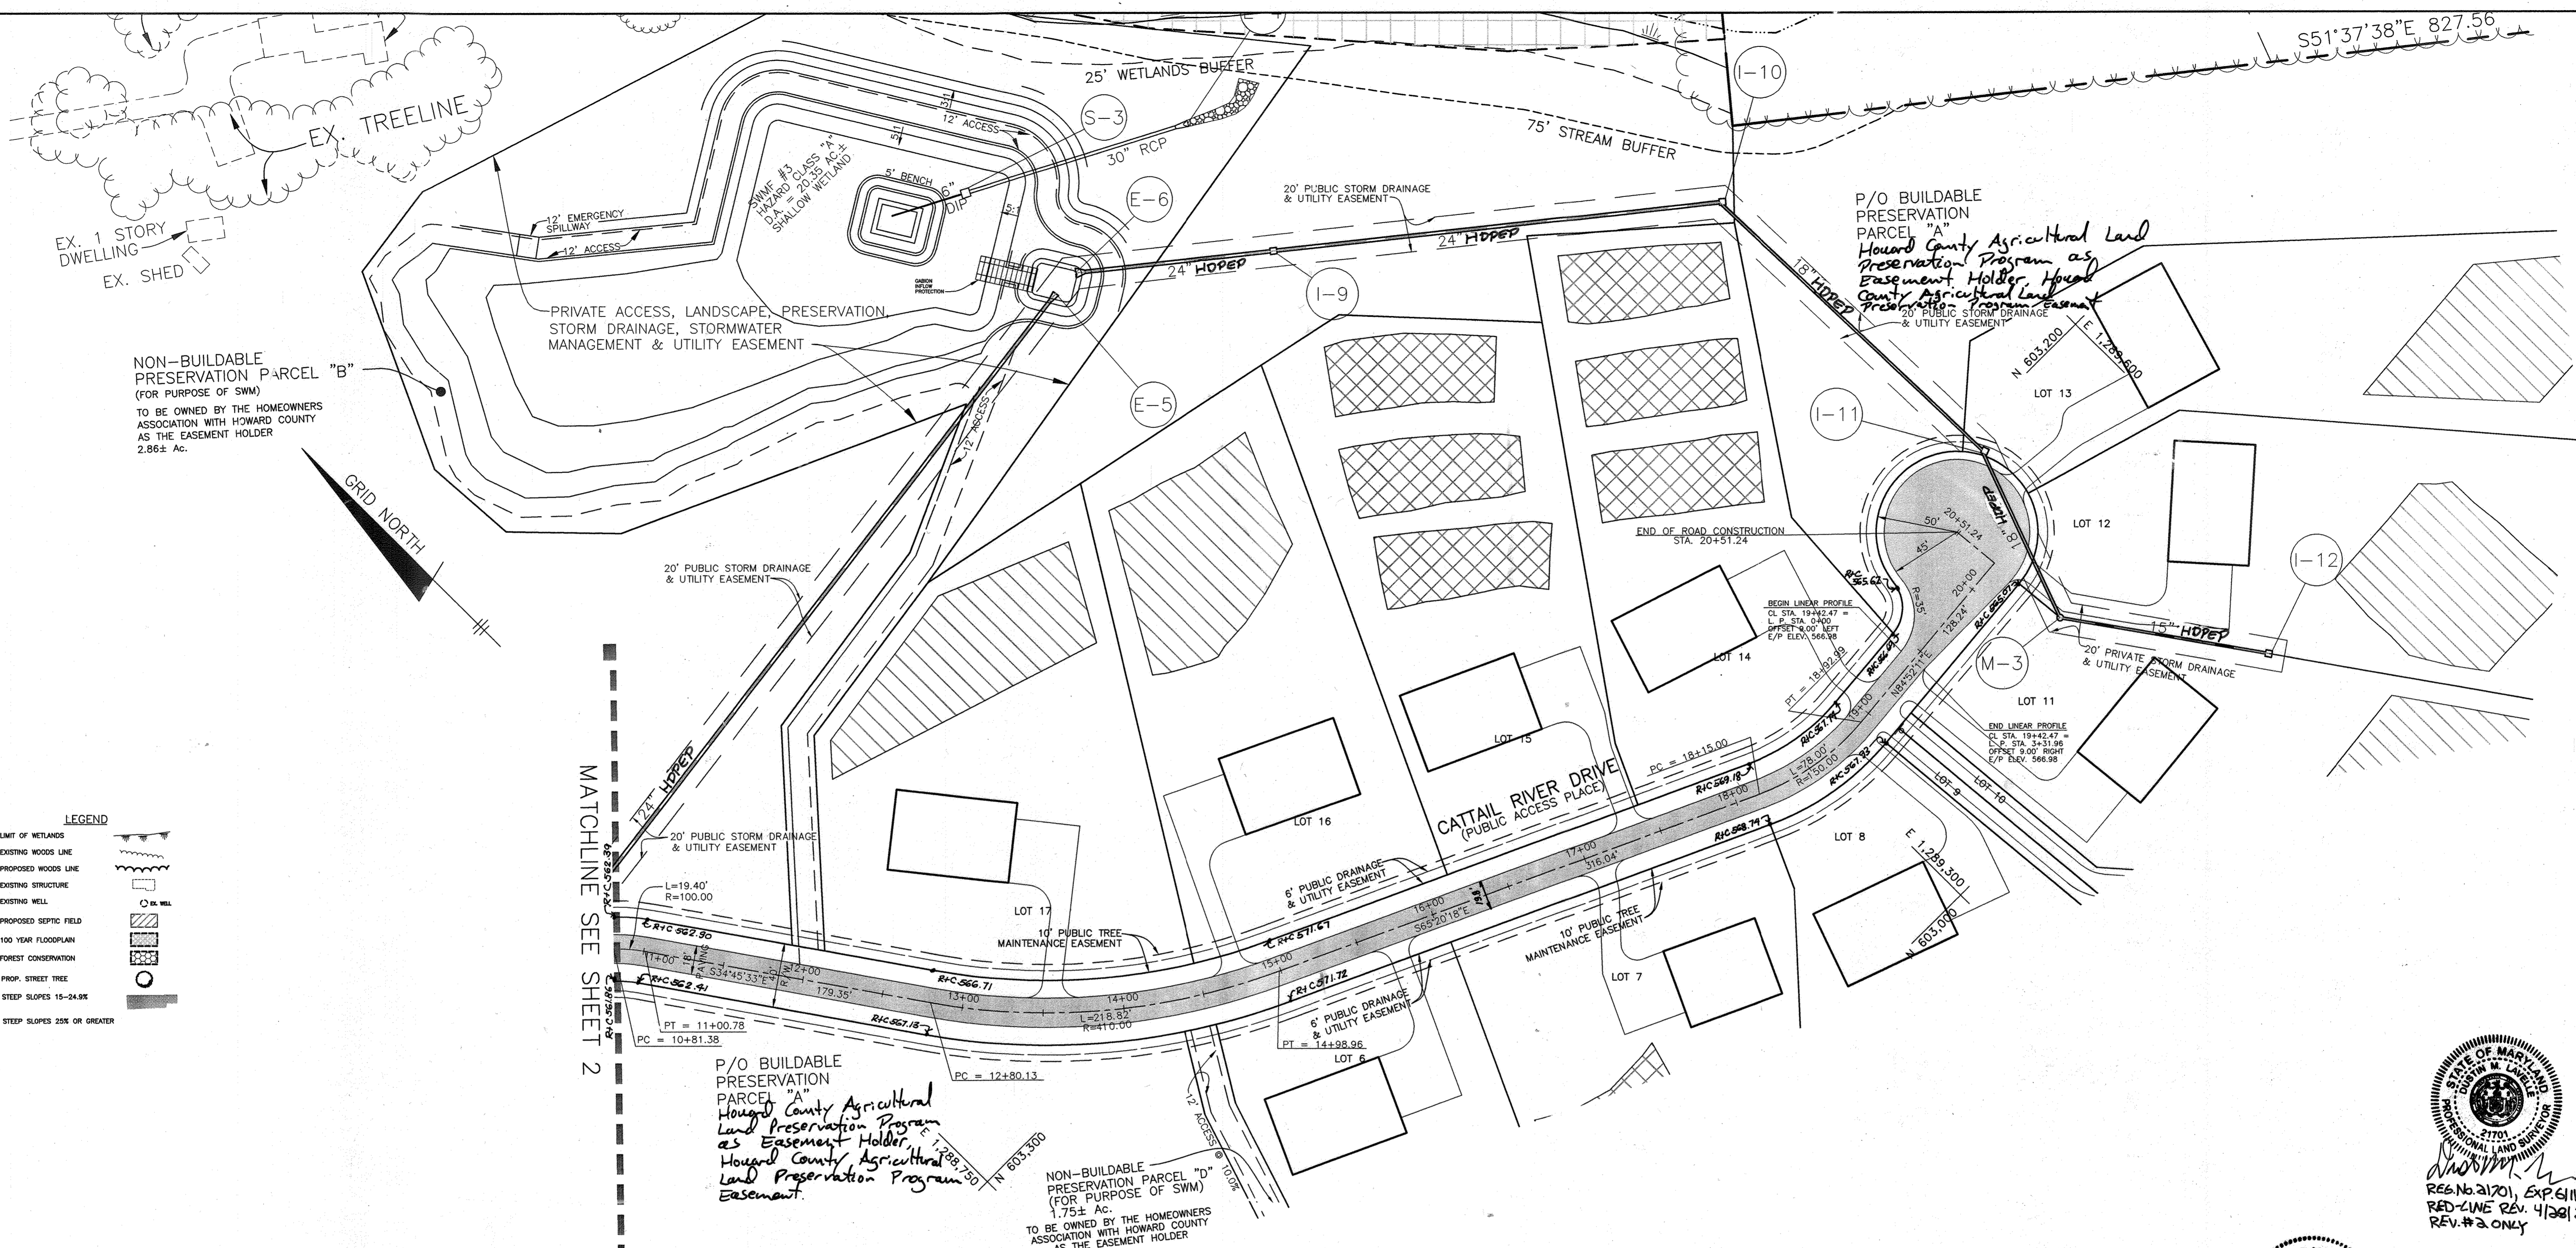






STATE OF MARYLAND
DEPARTMENT OF TRANSPORTATION
PROFESSIONAL ENGINEER
No. 16193
RES. No. 21701, EXP. 6/11/23
RED-LINE REV. 4/28/2023
REV. #2 ONLY

STATE OF MARYLAND
DEPARTMENT OF TRANSPORTATION
PROFESSIONAL ENGINEER
No. 16193
AS-BUILT CERTIFICATION
I HEREBY CERTIFY THAT THE FACILITY SHOWN ON THIS PLAN WAS CONSTRUCTED AS SHOWN ON THE AS-BUILT PLAN AND MEETS THE APPROVED PLAN'S SPECIFICATIONS

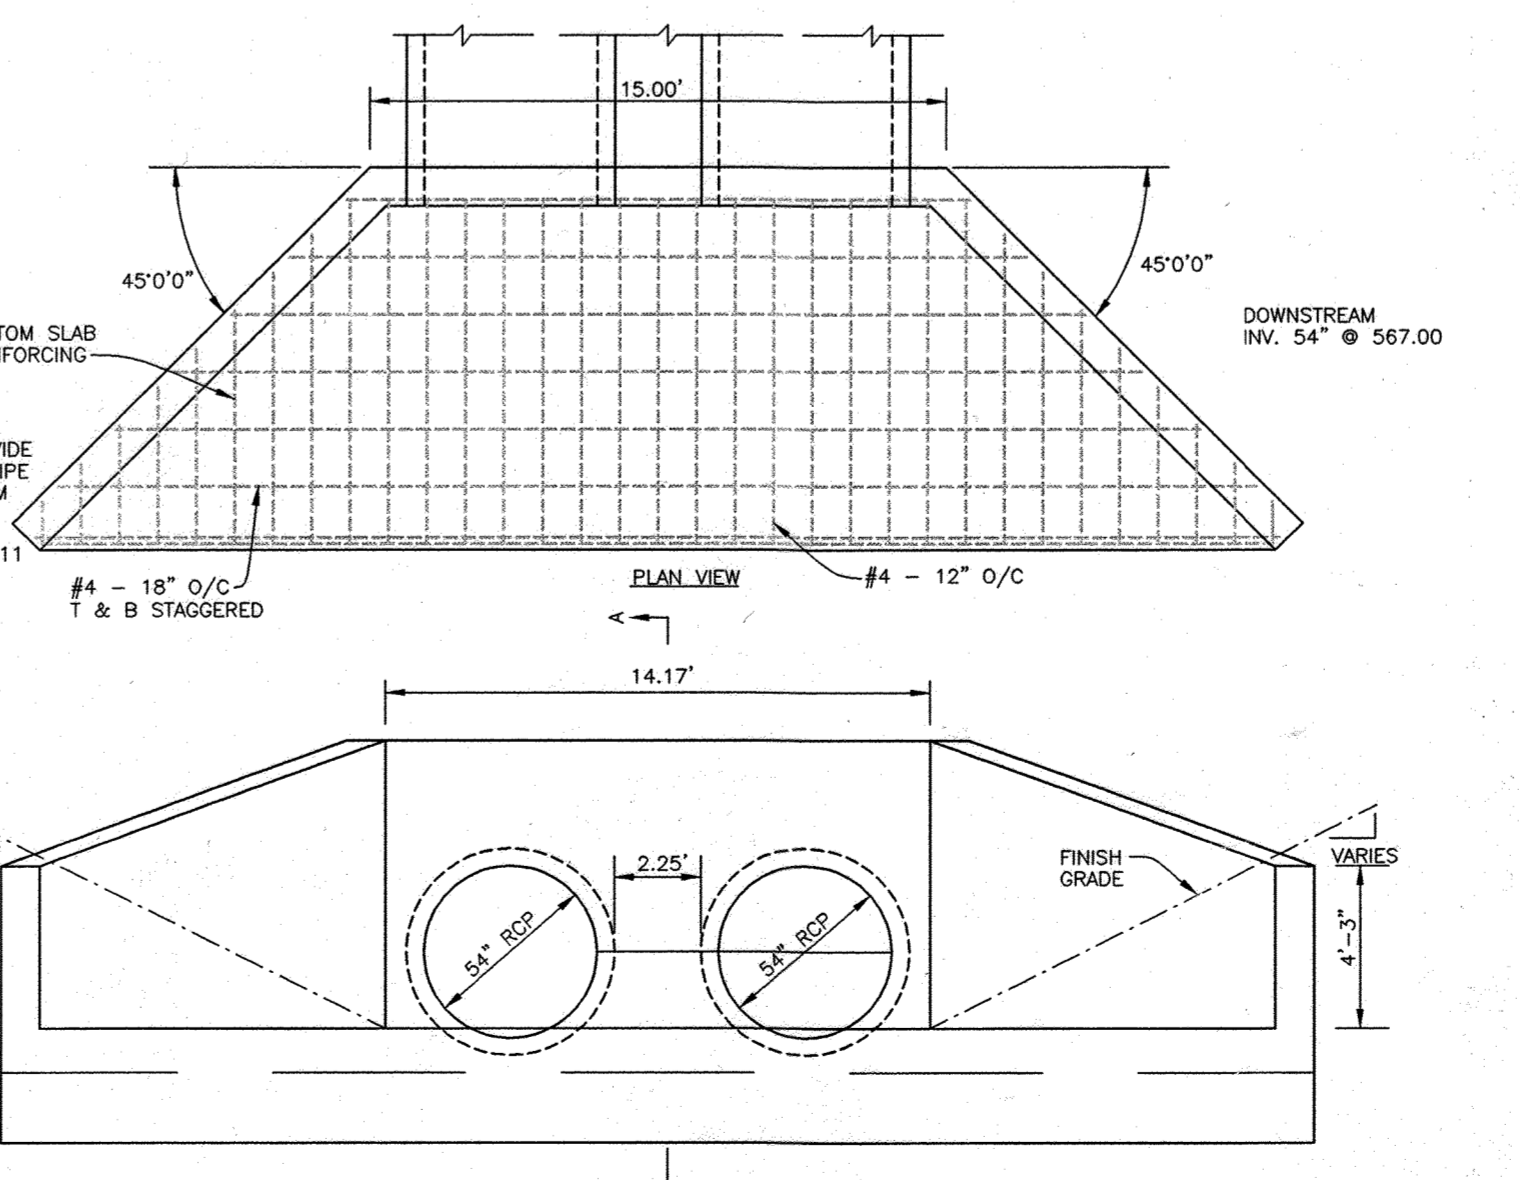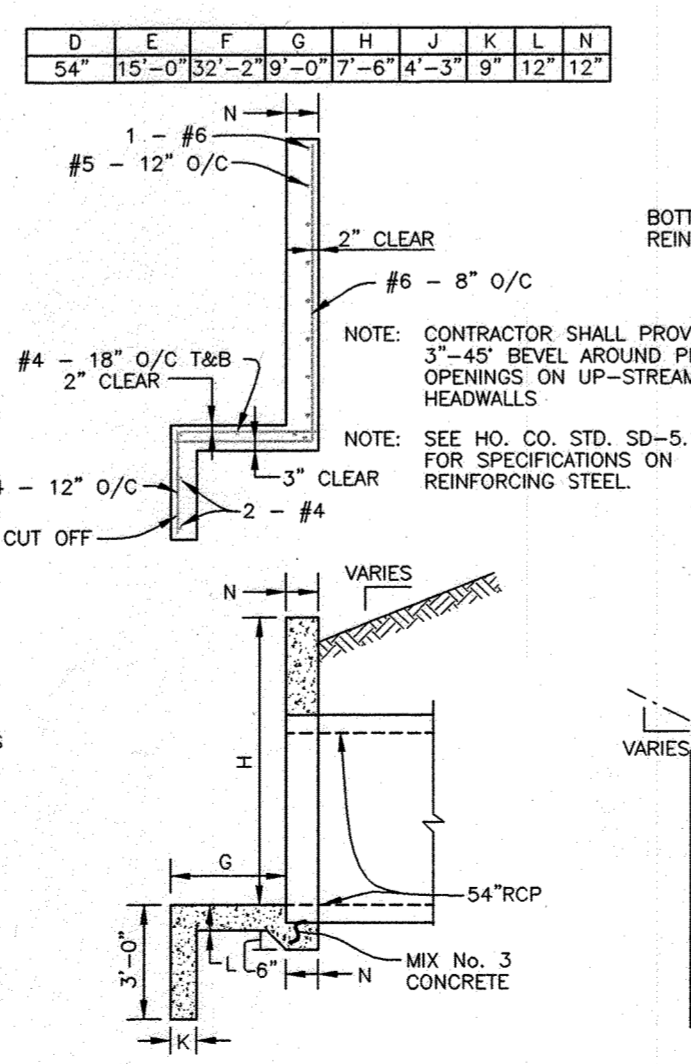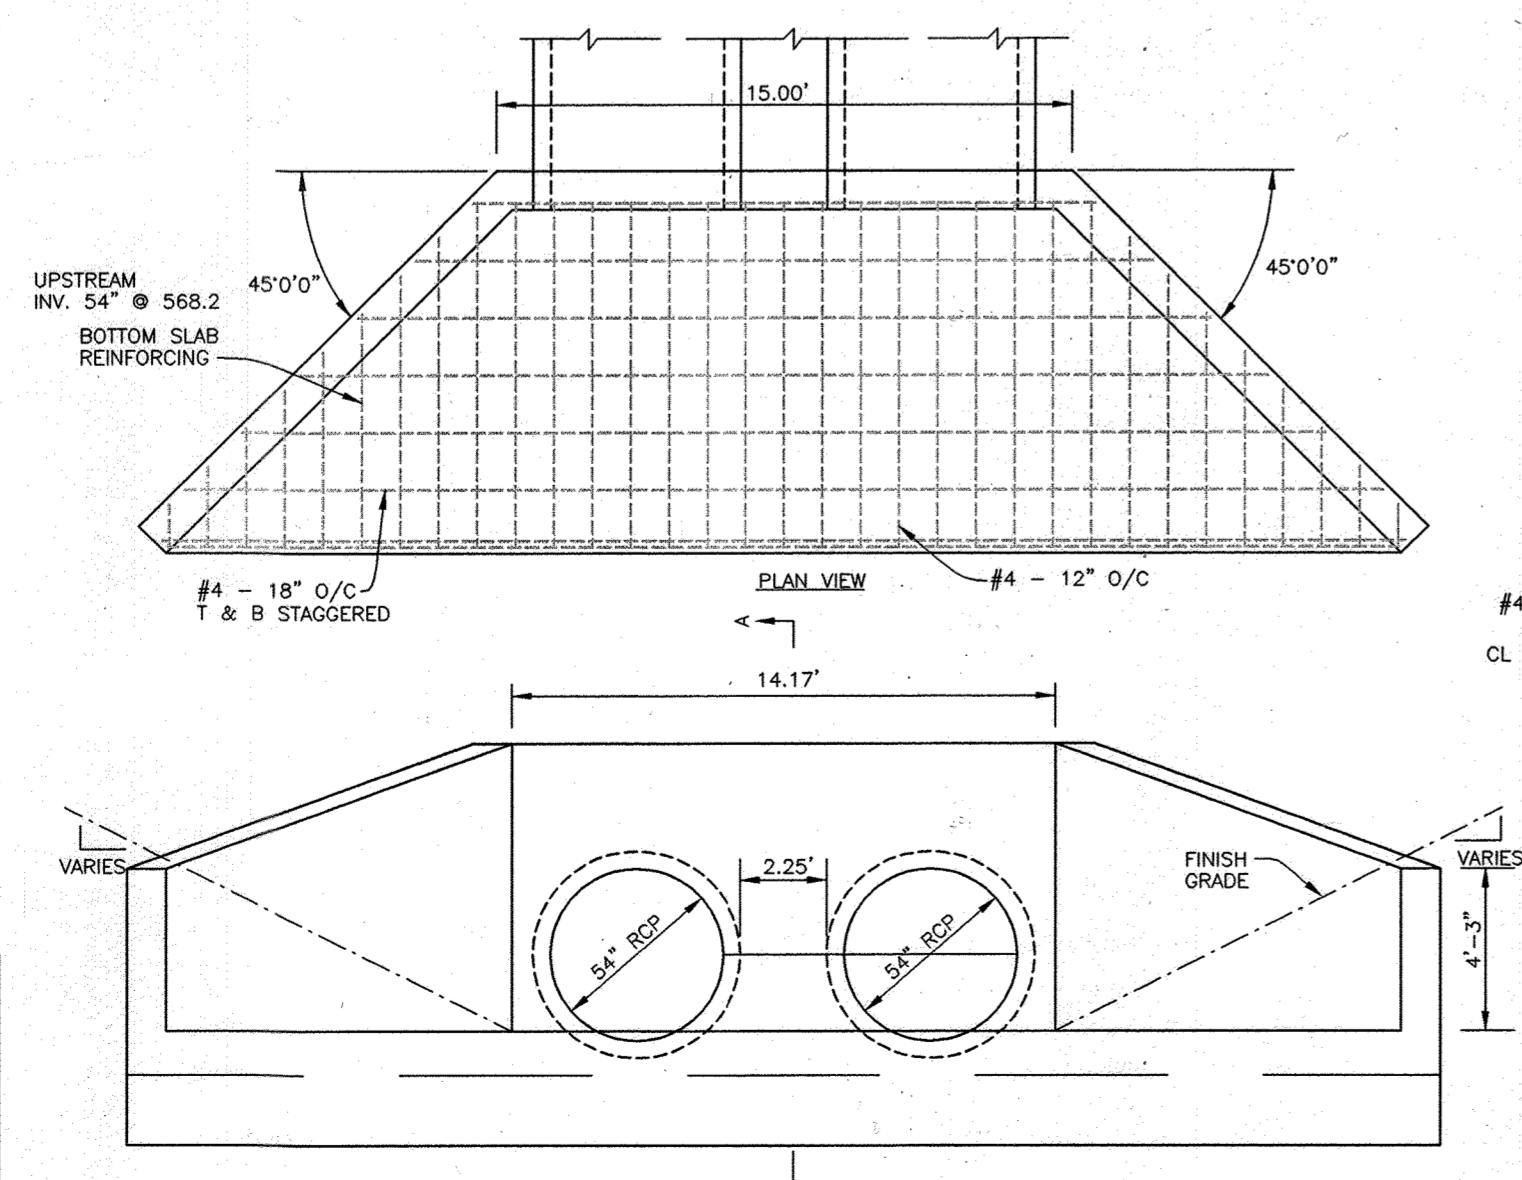

2	4/28/23	REVISE PAGE NO.	16193	01/31/23
1	12/4/06	REVISE STORM DRAIN MATERIAL	PE 118	DATE
No.	DATE	REVISION	SIGNATURE	DATE
<p>BENCHMARK ENGINEERS & LAND SURVEYORS & PLANNERS ENGINEERING, INC. 8480 BALTIMORE NATIONAL PIKE & SUITE 418 ELLICOTT CITY, MARYLAND 21043 PHONE: 410-465-6105 • FAX: 410-465-6644 WWW.BEL-CHIVENGINEERING.COM</p>		<p>OWNER/DEVELOPER: TRINITY QUALITY HOMES, INC. 3675 PARK AVENUE SUITE 301 ELLICOTT CITY, MD 21043 410-480-0023</p>		
<p>APPROVED: HOWARD COUNTY DEPARTMENT OF PUBLIC WORKS <i>William J. White</i> CHIEF, BUREAU OF HIGHWAYS APPROVED: HOWARD COUNTY DEPT. OF PLANNING AND ZONING <i>Cathy Hamsh</i> CHIEF, DIVISION OF LAND DEVELOPMENT <i>Donald M. ...</i> CHIEF, DEVELOPMENT ENGINEERING DIVISION</p>		<p>PROJECT: THE CHASE AT STONEY BROOK LOTS 1-20, PRESERVATION PARCEL "A" AND NON-BUILDABLE PRESERVATION PARCELS "B" THROUGH "D" LOCATION: TAX MAP No. 7, BLOCK No. 17, PARCEL No. 33 4th ELECTION DISTRICT HOWARD COUNTY, MARYLAND TITLE: ROAD PLANS DATE: MAY, 2005 MARCH, 2006 PROJ. NO. 1187 SCALE: 1" = 50' SHEET 3 OF 30</p>		

APPROVED: HOWARD COUNTY DEPARTMENT OF PUBLIC WORKS
William J. White
CHIEF, BUREAU OF HIGHWAYS
APPROVED: HOWARD COUNTY DEPT. OF PLANNING AND ZONING
Cathy Hamsh
CHIEF, DIVISION OF LAND DEVELOPMENT
Donald M. ...
CHIEF, DEVELOPMENT ENGINEERING DIVISION

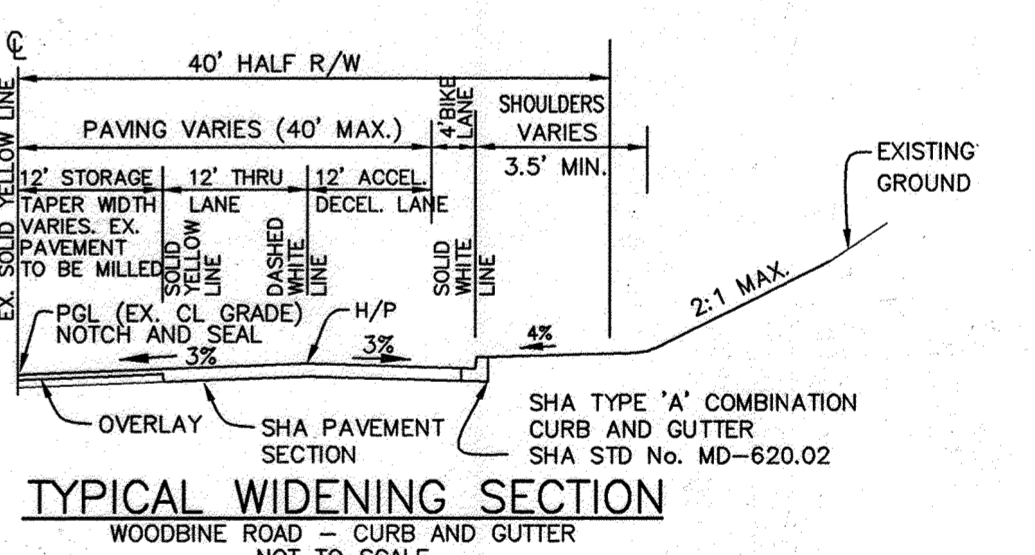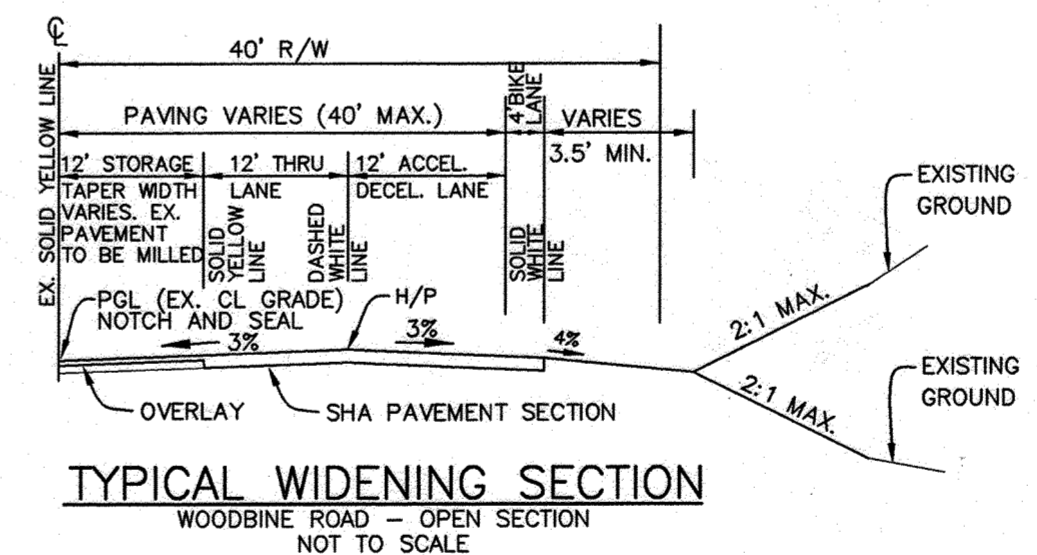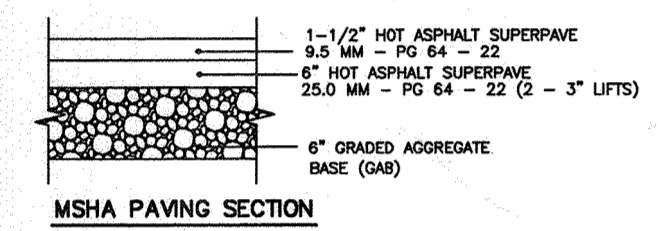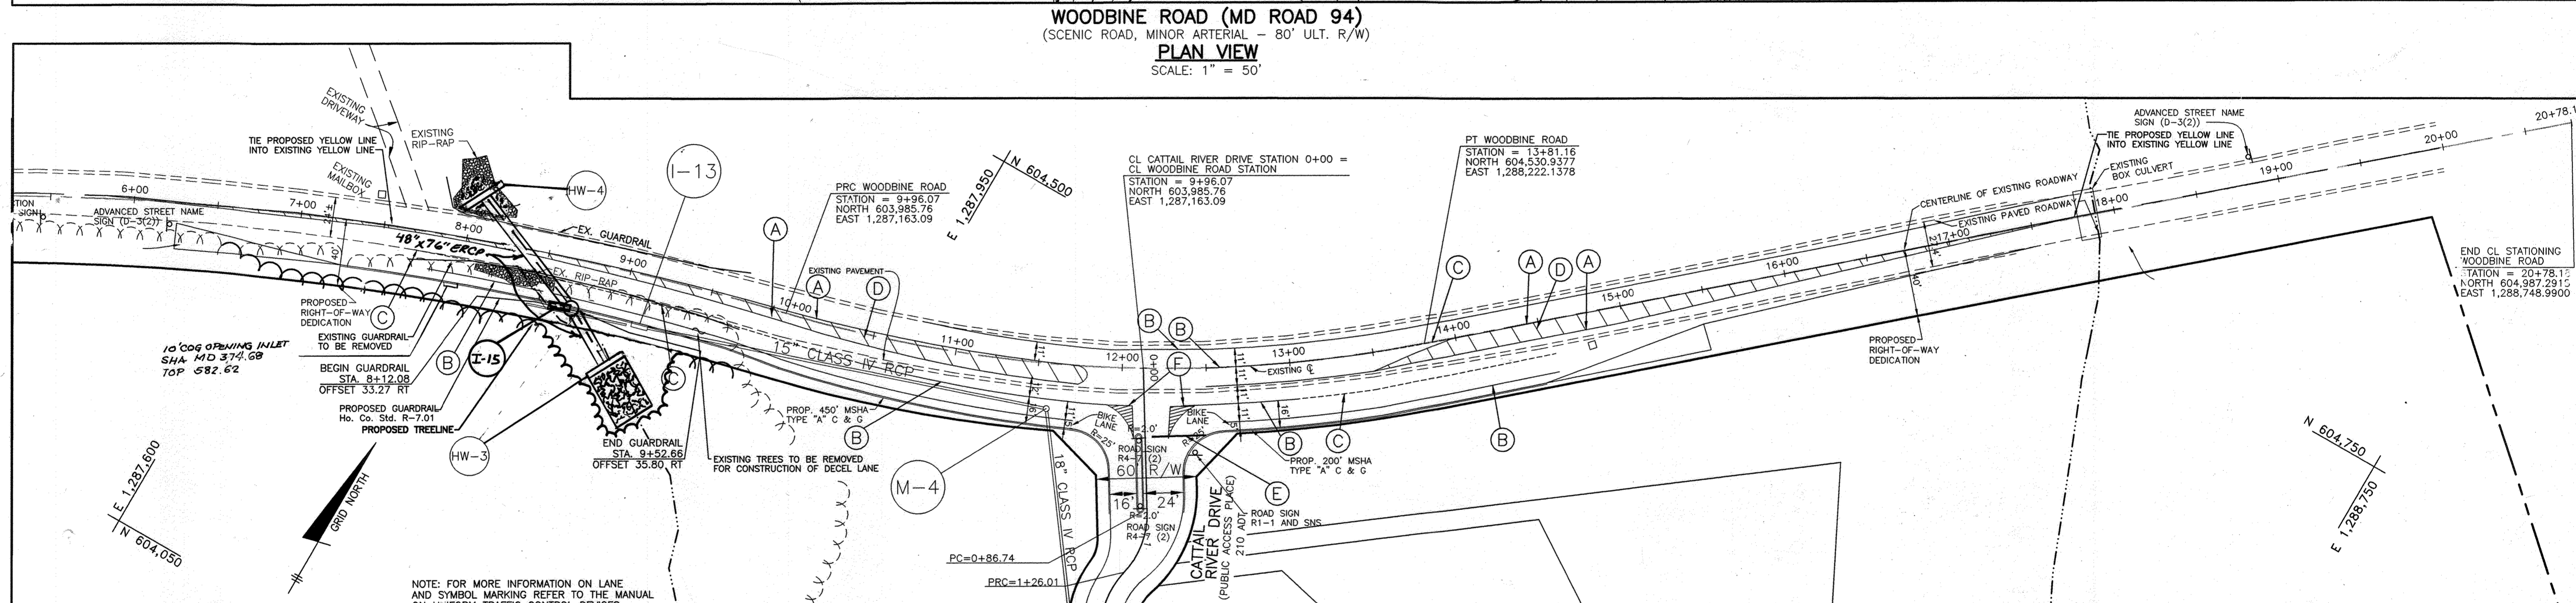
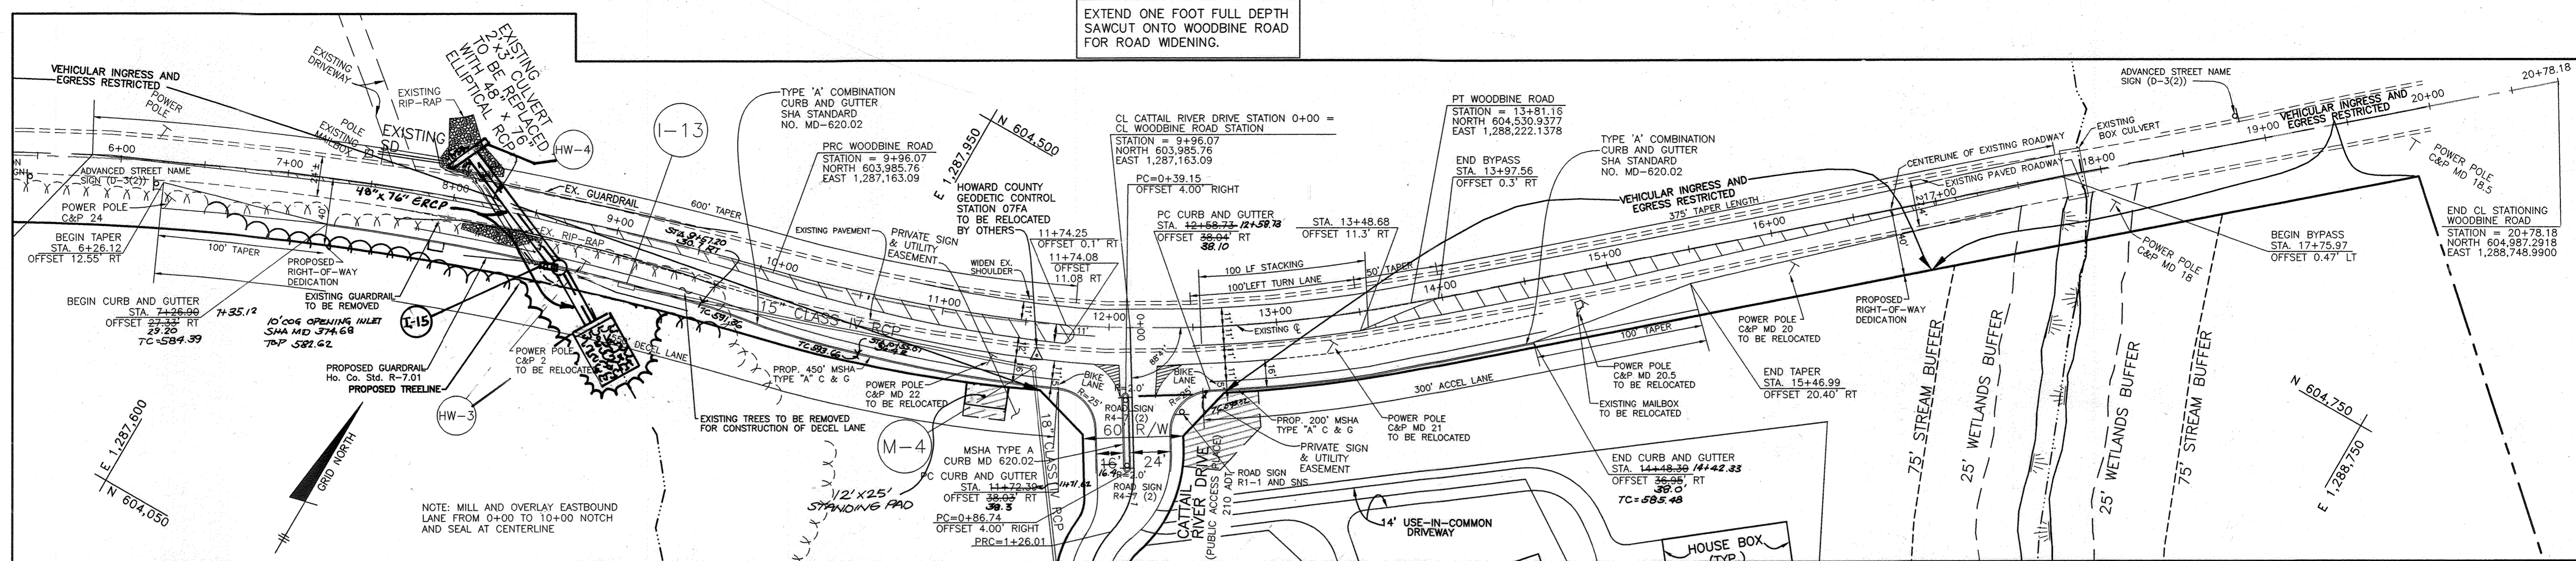


- LINE LEGEND**
- (A) DOUBLE YELLOW CENTERLINE 5" WIDE (EACH LINE)
 - (B) SOLID WHITE (5" WIDE)
 - (C) PUPPY TRACKS (5" WIDE - WHITE) (3' LONG/ 9' GAP)
 - (D) HATCH LINES 12" WIDE ON 45° ANGLE EVERY 100' (YELLOW)
 - (E) STOP BAR (24" WIDE - WHITE) (THERMAPLASTIC)

APPROVED: HOWARD COUNTY DEPARTMENT OF PUBLIC WORKS
W. J. ... 4-21-06
 CHIEF, BUREAU OF HIGHWAYS

APPROVED: HOWARD COUNTY DEPT. OF PLANNING AND ZONING
Cindy ... 5/12/06
 CHIEF, DIVISION OF LAND DEVELOPMENT

... 5/12/06
 CHIEF, DEVELOPMENT ENGINEERING DIVISION

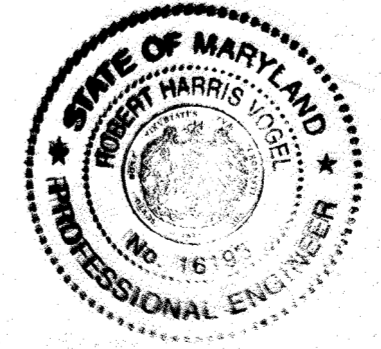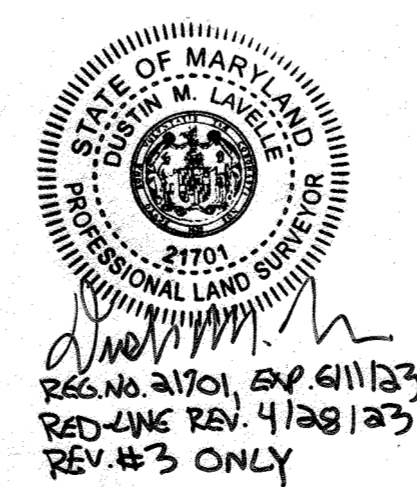

AS-BUILT CERTIFICATION
 I HEREBY CERTIFY THAT THE PROJECT SHOWN ON THIS PLAN WAS CONSTRUCTED AS SHOWN ON THE "AS-BUILT" PLAN, AND MEETS THE APPROVED PLAN SPECIFICATION.

ROBERT H. VOGEL, P.E.
 No. 16193
 FOR REVISION #2 ONLY [3] 4/28/03 REVISE PAGE NO.




2 6/11/12 ADD 12'x25' STANDING PAD
 1 3-9-07 REVISE HW3 - HW4 DESIGN
 No. DATE REVISION

BENCHMARK
 ENGINEERS & LAND SURVEYORS & PLANNERS
ENGINEERING, INC.

8480 BALTIMORE NATIONAL PIKE & SUITE 418
 ELLICOTT CITY, MARYLAND 21043
 phone: 410-485-6105 fax: 410-485-6644
 www.bel-civilengineering.com

Donald Moen
 5/11/06

OWNER/DEVELOPER: TRINITY QUALITY HOMES, INC. 3675 PARK AVENUE SUITE 301 ELLICOTT CITY, MD 21043 410-480-0023	PROJECT: THE CHASE AT STONEY CROOK LOTS 1-20, PRESERVATION PARCEL "A" AND NON-BUILDABLE PRESERVATION PARCELS "B" THROUGH "D"
LOCATION: TAX MAP NO. 7 BL'CK NO. 17 PARCEL NO. 133 4th COLLECTION DISTRICT HOWARD COUNTY, MARYLAND	TITLE: WOODBINE ROAD IMPROVEMENT PLAN
DATE: MARCH, 2006	PROJECT NO. 1187
DES: RPS	DRAFT: RPS
CHECK: DAM	SCALE: AS SHOWN
SHEET 4 OF 20	

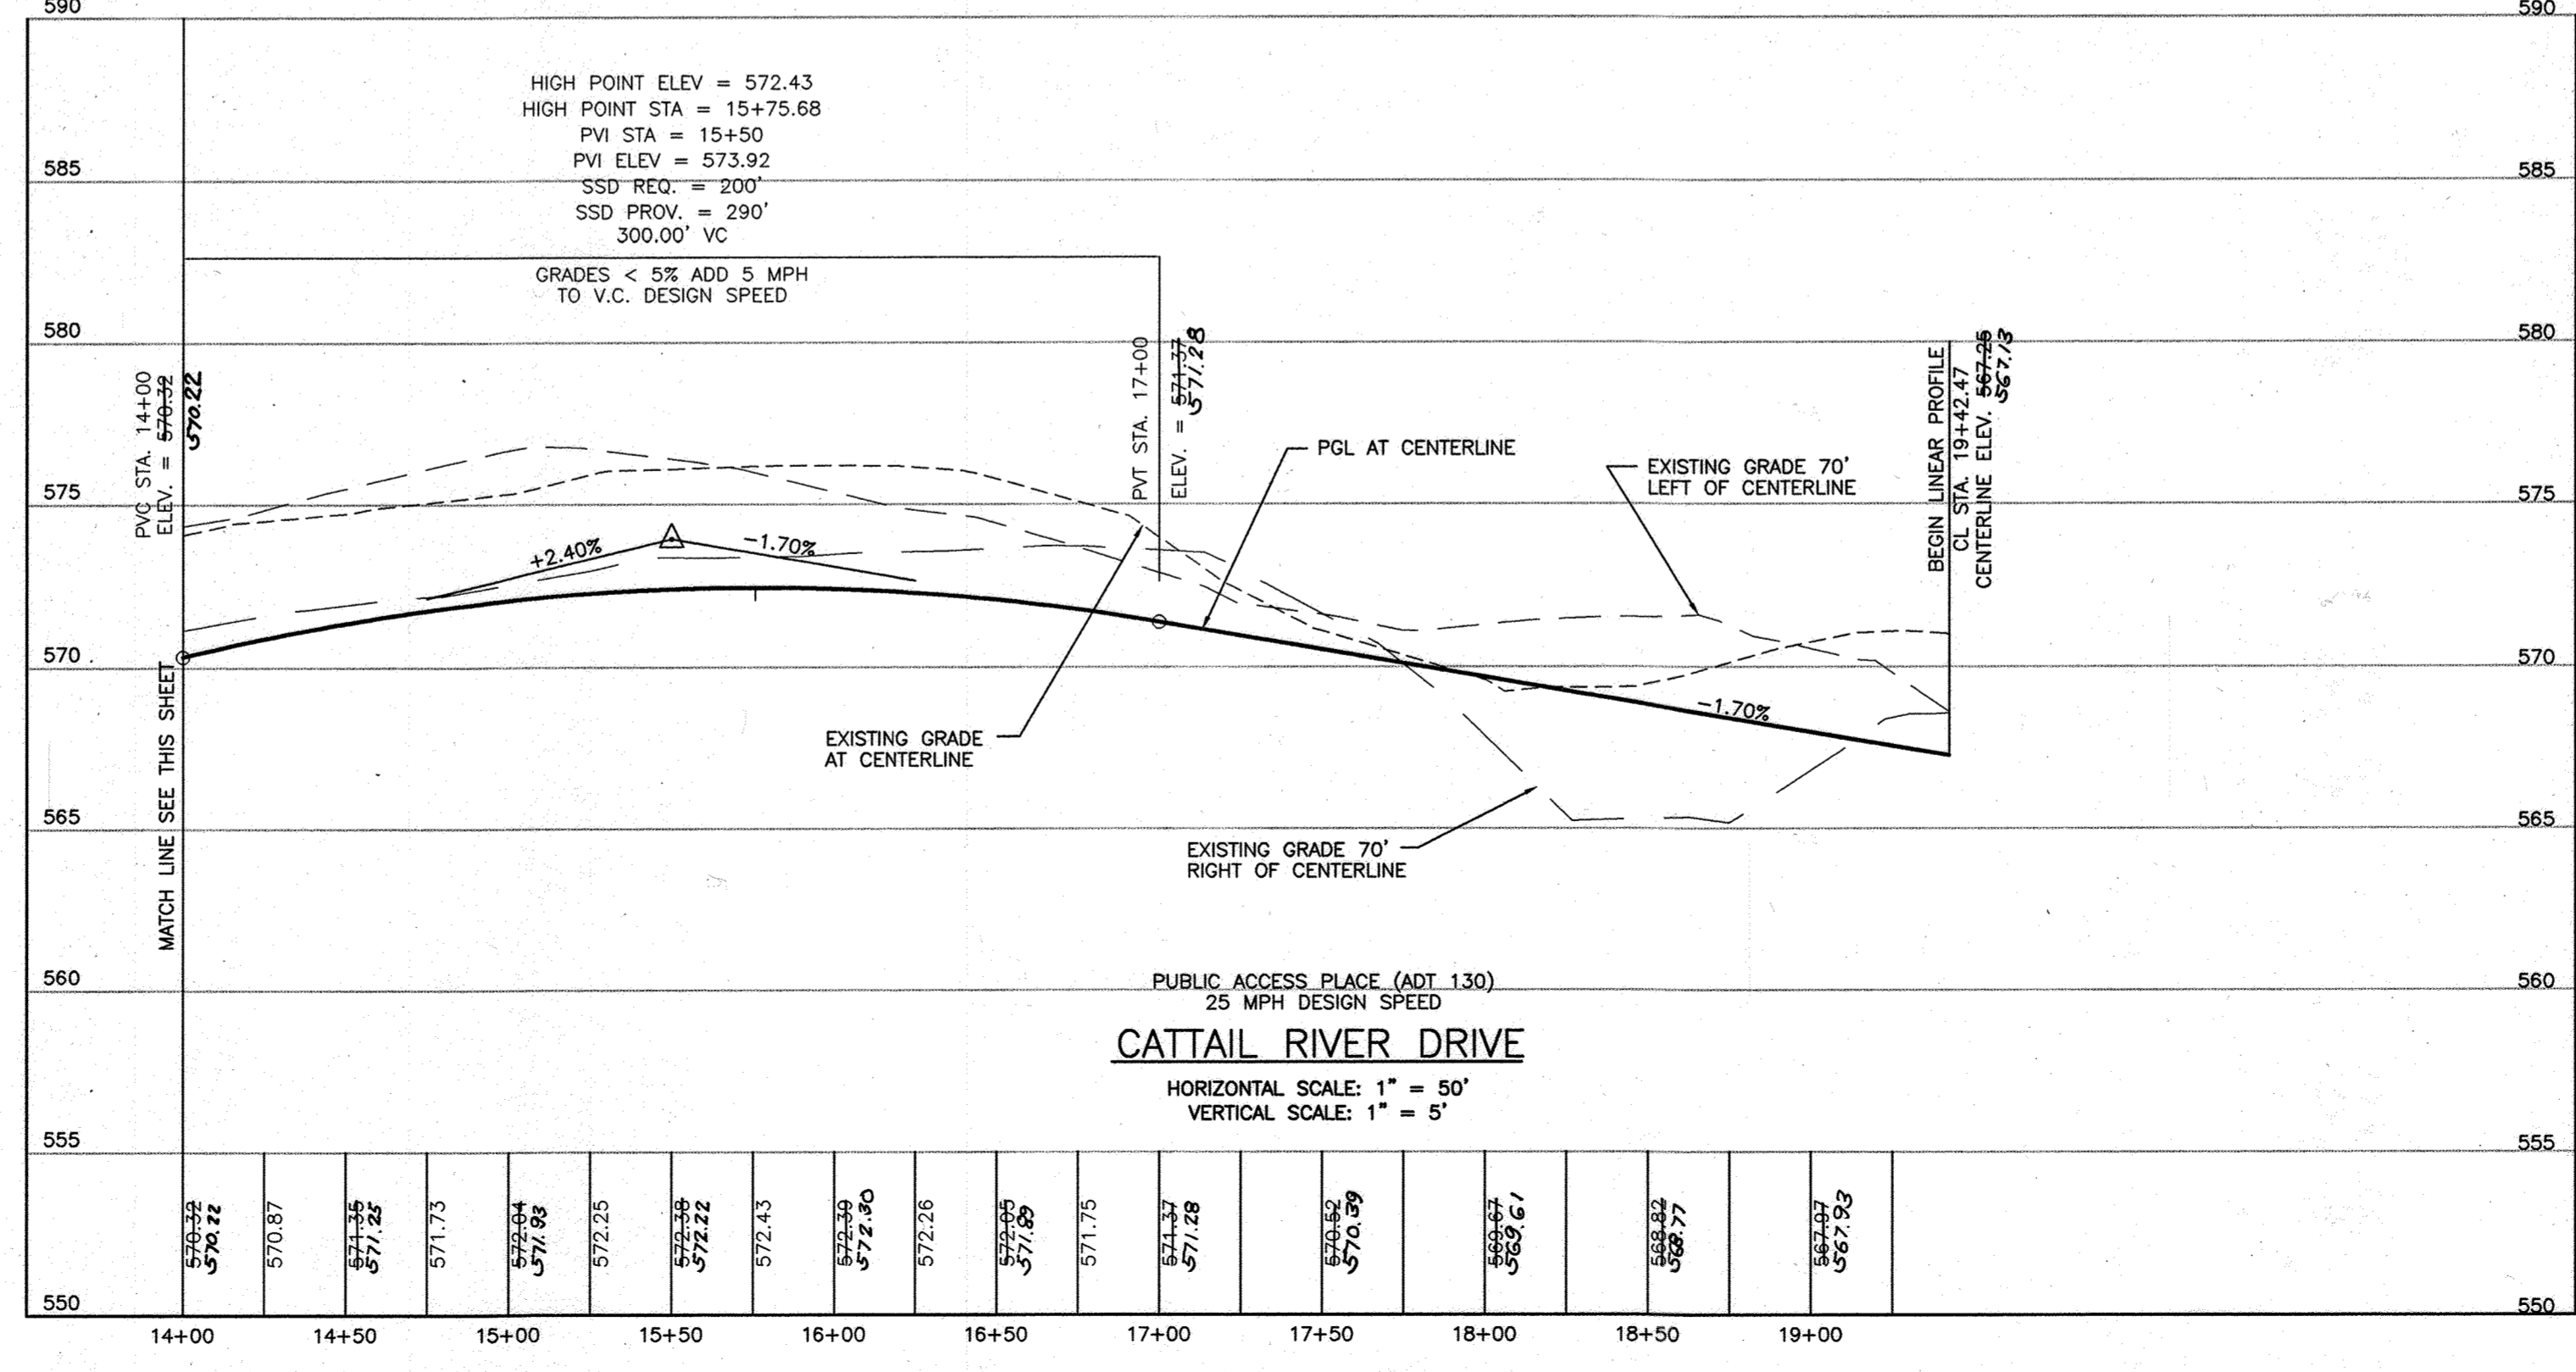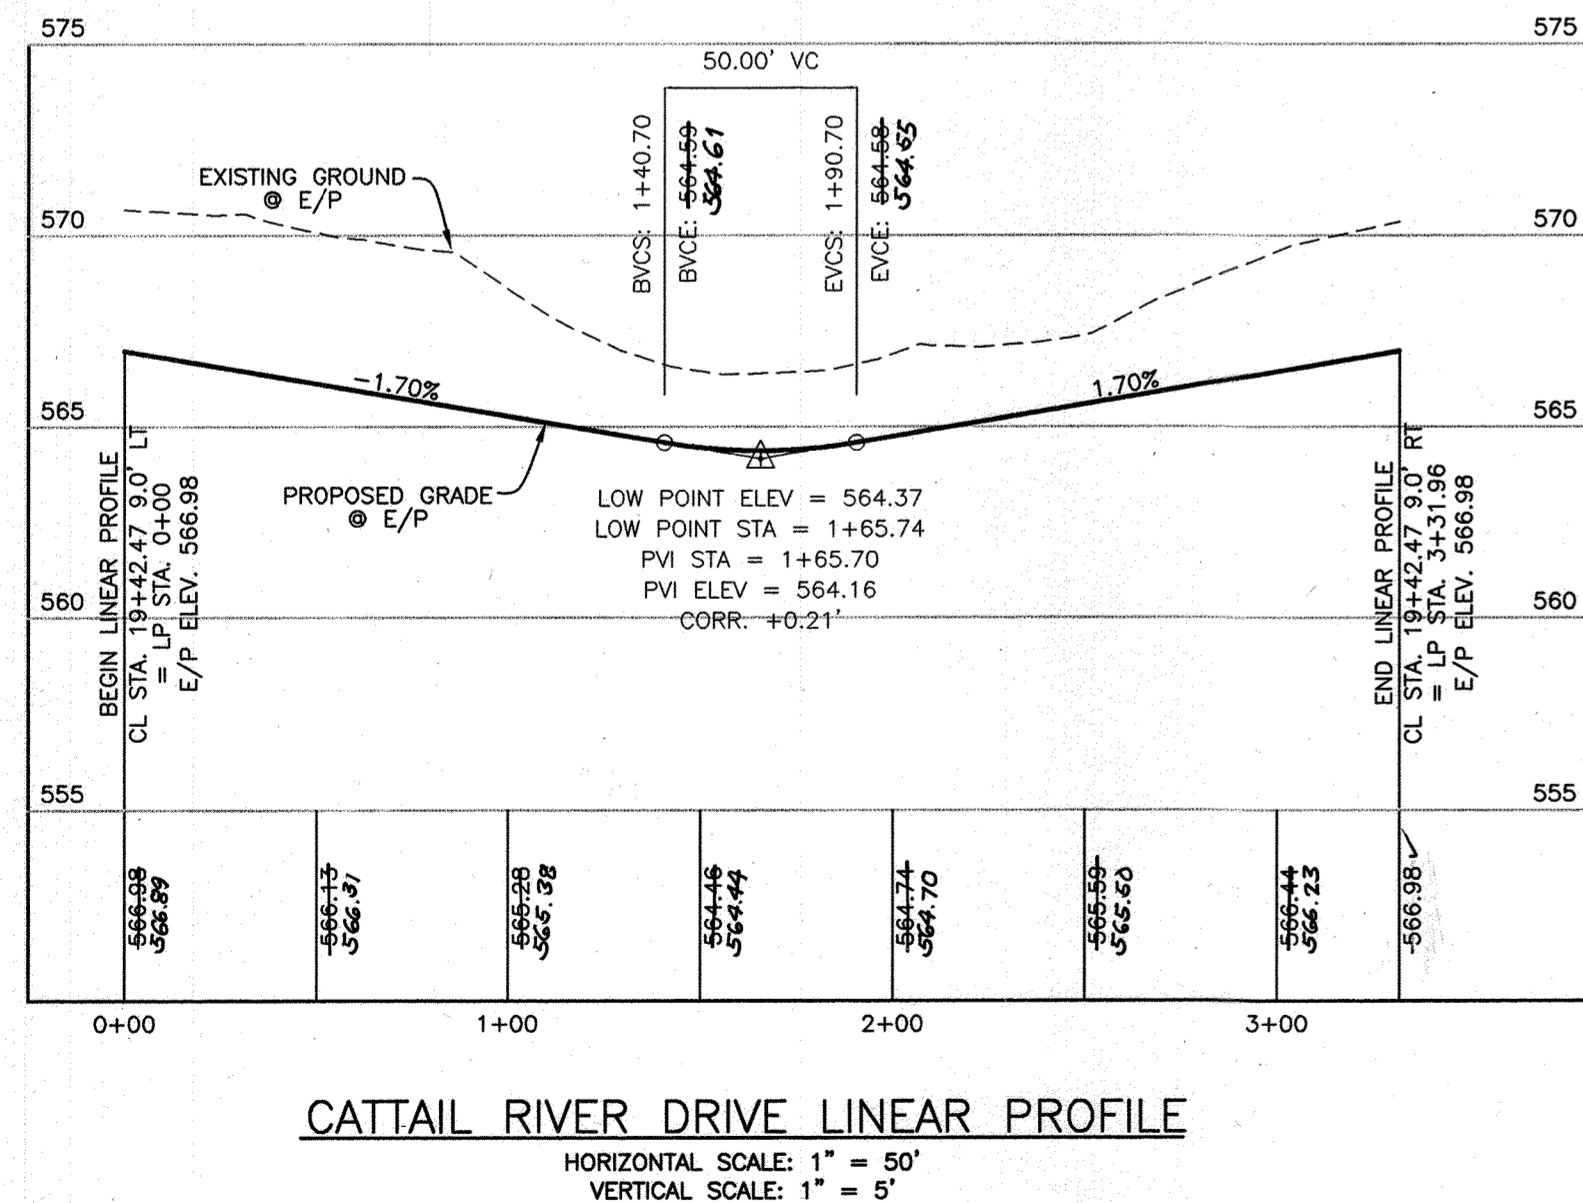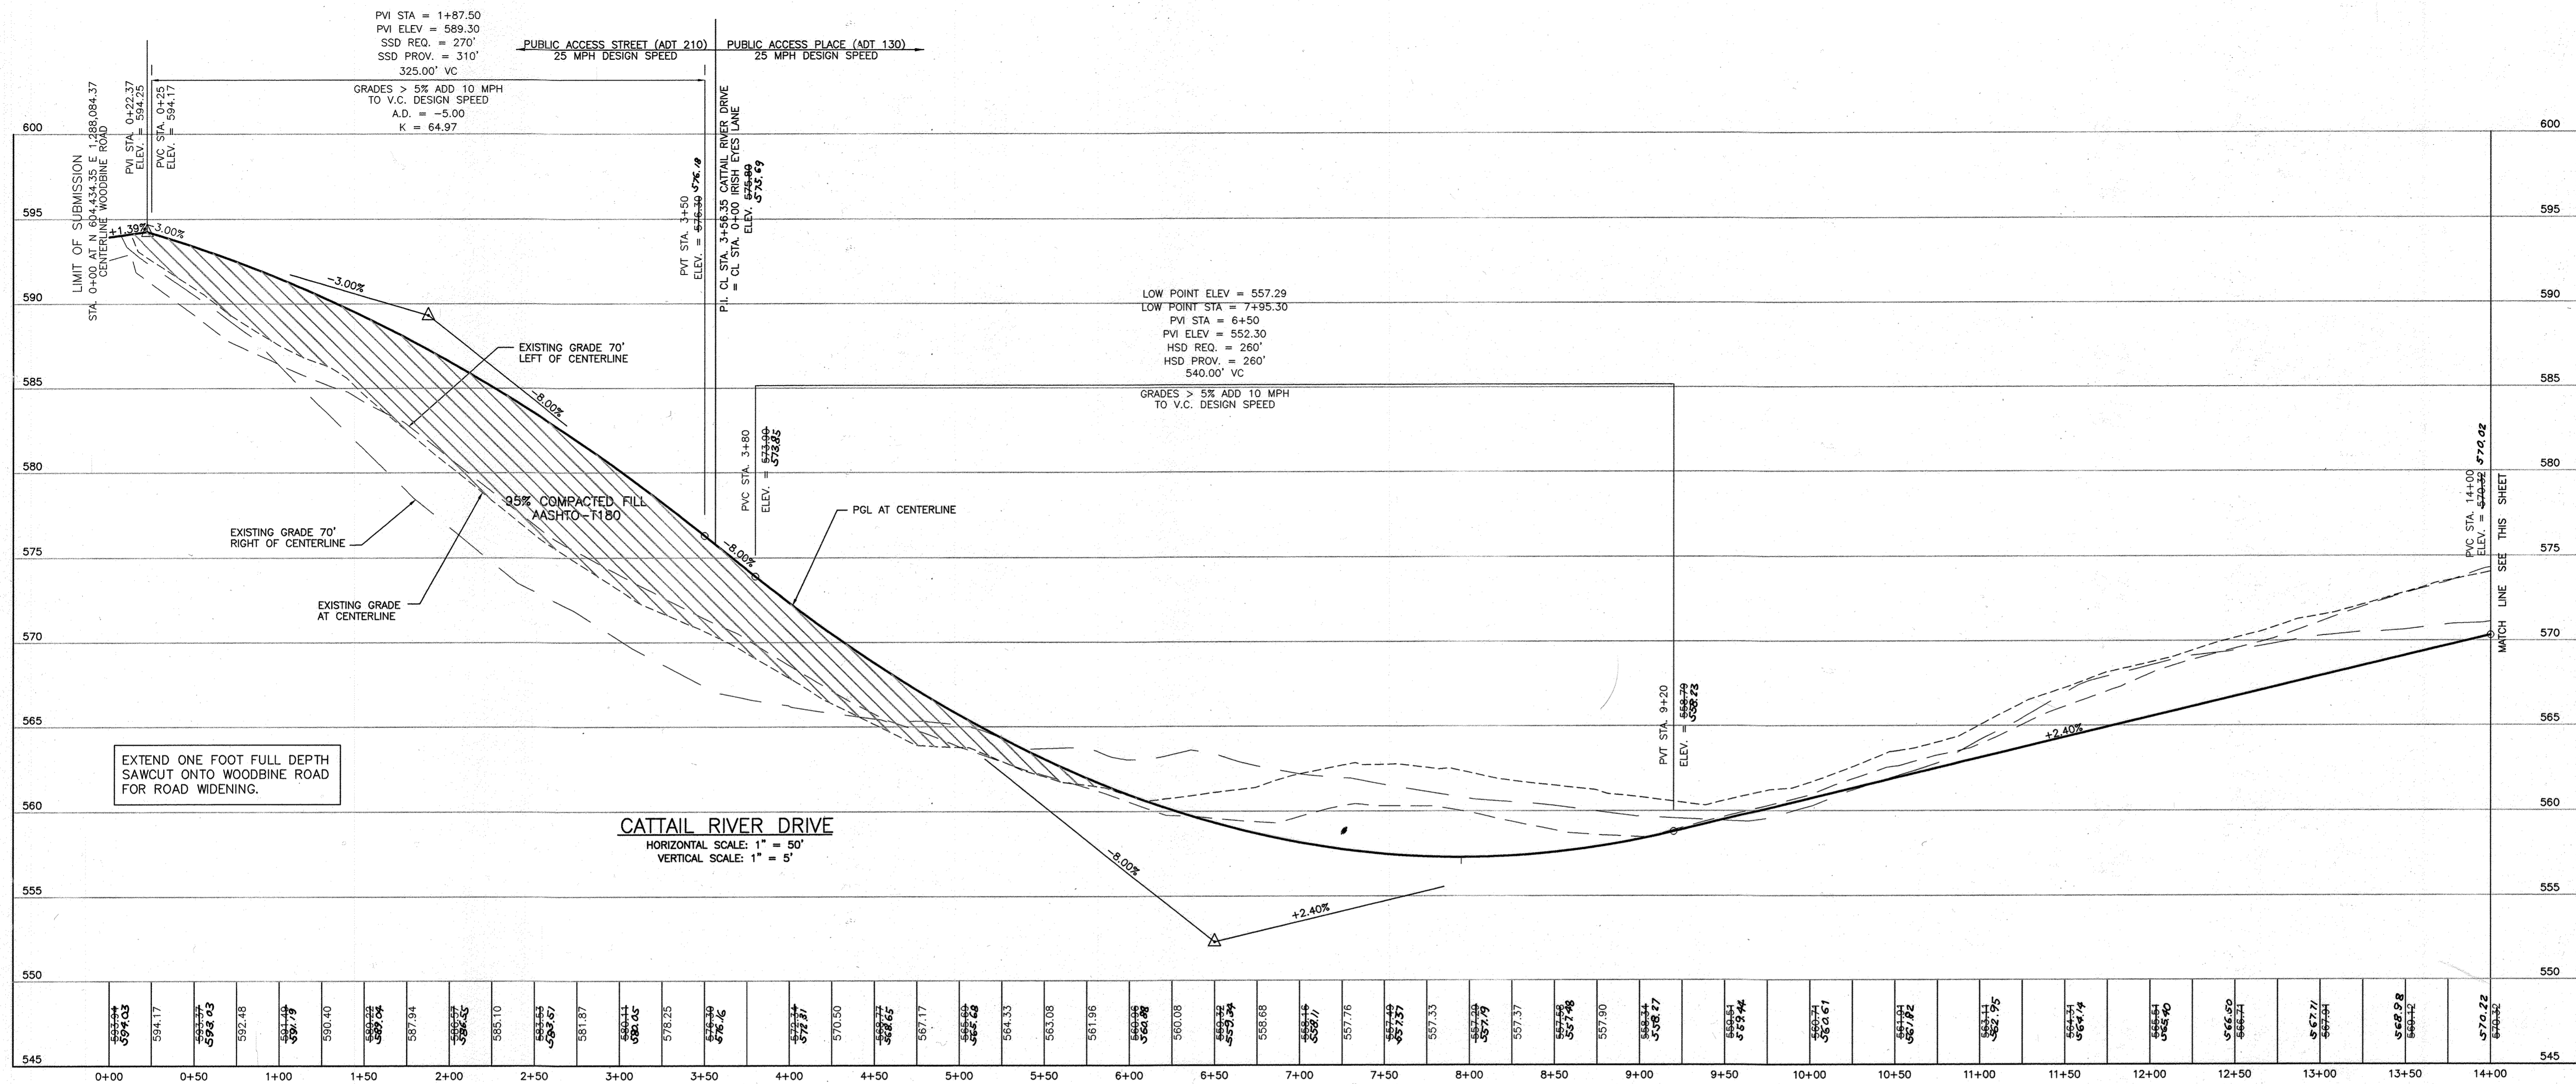

STATE OF MARYLAND
 DEPARTMENT OF PUBLIC SAFETY
 PROFESSIONAL LAND SURVEYOR
 No. 21701, Exp. 6/11/23
 RED LINE REV. 4/28/23
 REV. #1 ONLY

STATE OF MARYLAND
 REGISTERED PROFESSIONAL ENGINEER
 AS-BUILT CERTIFICATION
 I HEREBY CERTIFY THAT THE FACILITY SHOWN ON THIS PLAN
 WAS CONSTRUCTED AS SHOWN ON THE AS-BUILT
 PLANS AND MEETS THE APPROVED PLANS & SPECIFICATIONS

1	4/28/23	REVISE PAGE NO.
No.	DATE	REVISION

BENCHMARK ENGINEERING, INC.
 ENGINEERS & LAND SURVEYORS & PLANNERS
 8480 BALTIMORE NATIONAL PIKE & SUITE 418
 ELLICOTT CITY, MARYLAND 21043
 phone: 410-465-6105 ▲ fax: 410-465-6644
 www.bel-civilengineering.com

Donald Mason
3/3/16

OWNER/DEVELOPER: TRINITY QUALITY HOMES, INC.
 3675 PARK AVENUE SUITE 301
 ELLICOTT CITY, MD 21043
 410-480-0023

PROJECT: THE CHASE AT STONEY BROOK
 LOTS 1-20, PRESERVATION PARCEL "A" AND
 NON-BUILDABLE PRESERVATION PARCELS "B" THROUGH "D"

LOCATION: TAX MAP NO. 7 BLOCK NO. 17 PARCEL NO. 133
 4th ELECTION DISTRICT
 HOWARD COUNTY, MARYLAND

TITLE: ROAD PROFILES










DATE: AUGUST, 2005 PROJECT NO. 1187
 MARCH, 2006

DESIGN: JMC DRAFT: RPS SCALE: AS SHOWN DRAWING 5 OF 39

APPROVED: HOWARD COUNTY DEPARTMENT OF PUBLIC WORKS
William J. White 4-21-06
 CHIEF, BUREAU OF HIGHWAYS

APPROVED: HOWARD COUNTY DEPT. OF PLANNING AND ZONING
Cindy Hanna 5/10/06
 CHIEF, DIVISION OF LAND DEVELOPMENT

John P. ... 5/2/06
 CHIEF, DEVELOPMENT ENGINEERING DIVISION

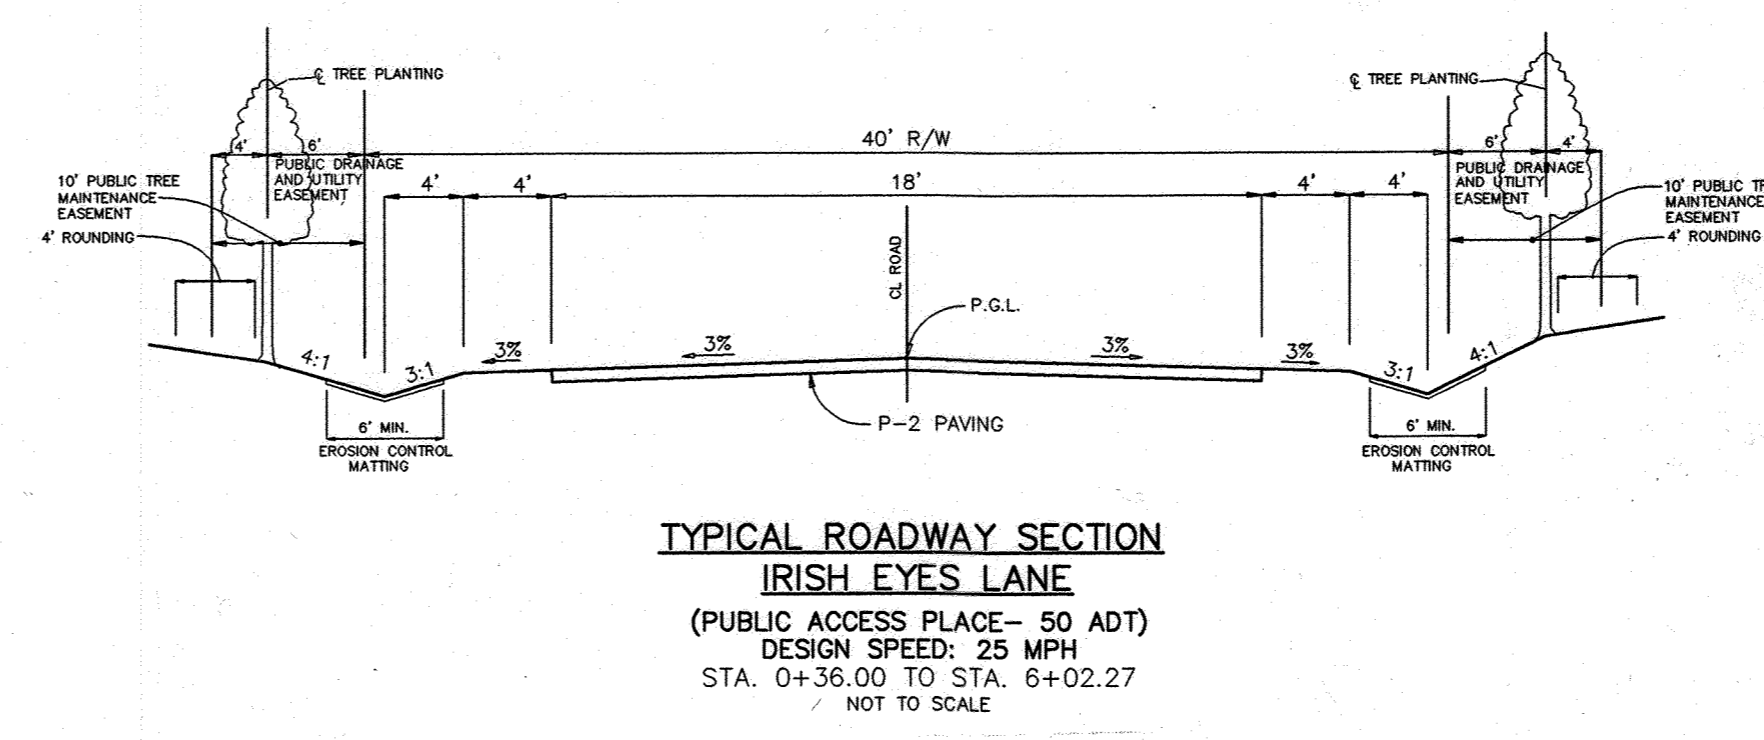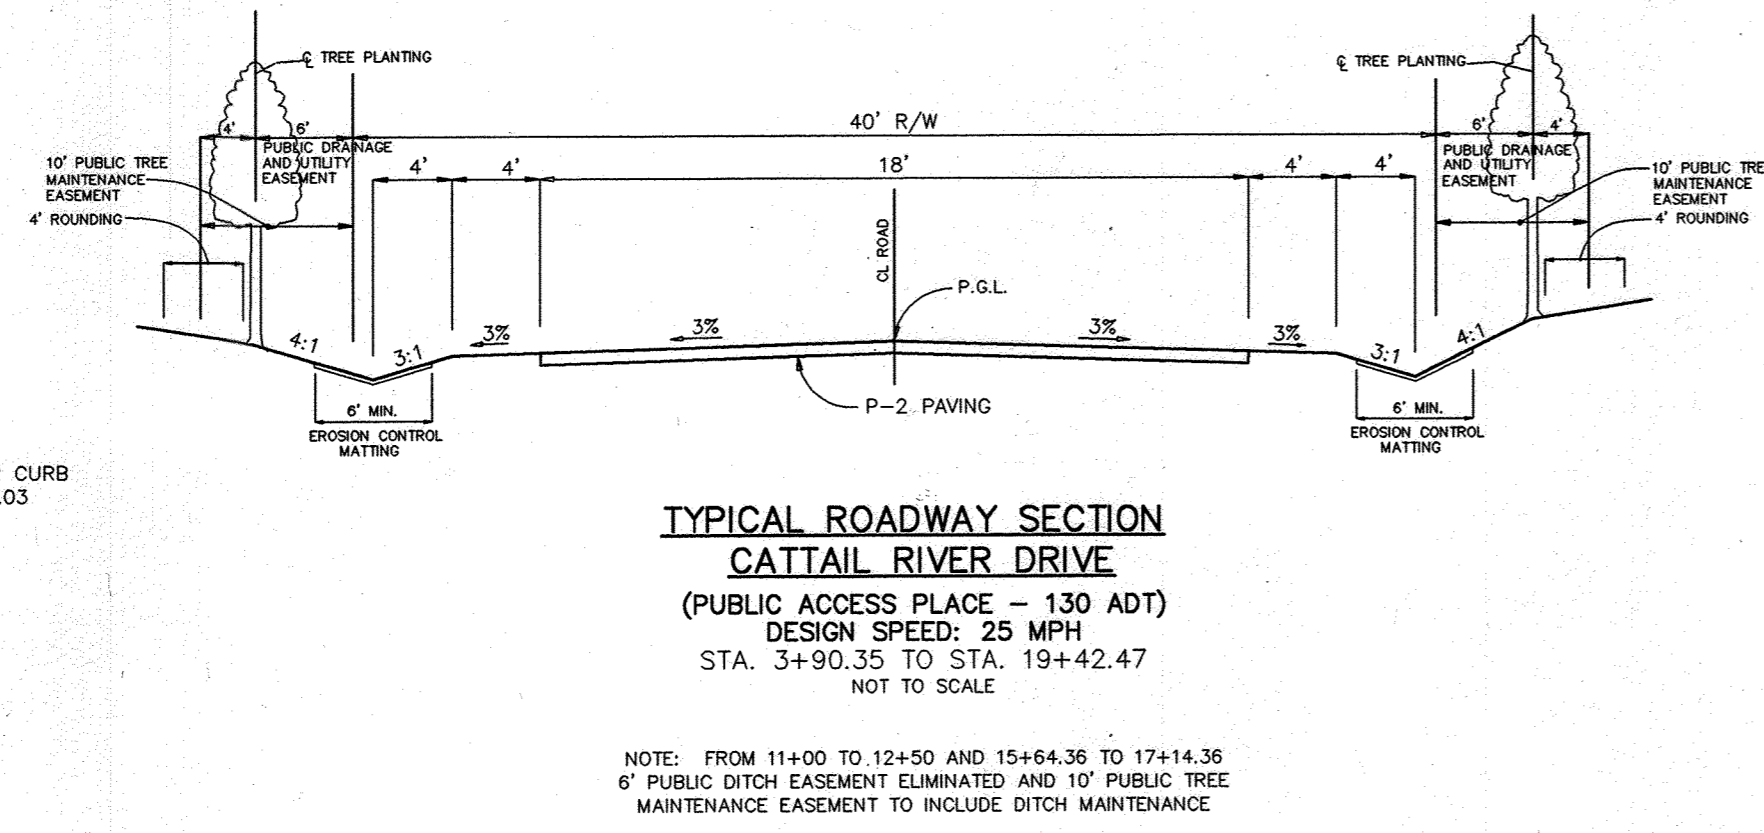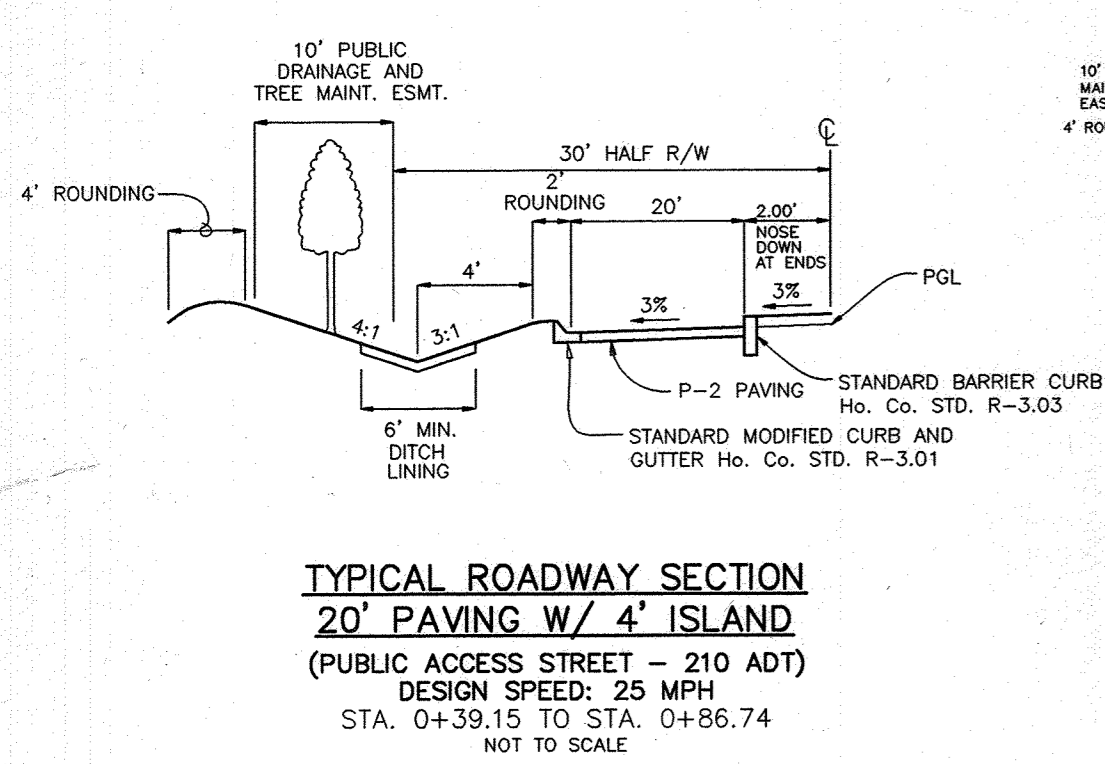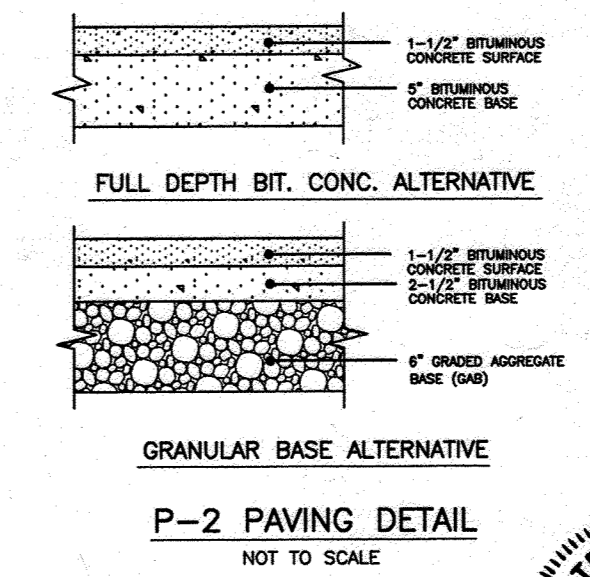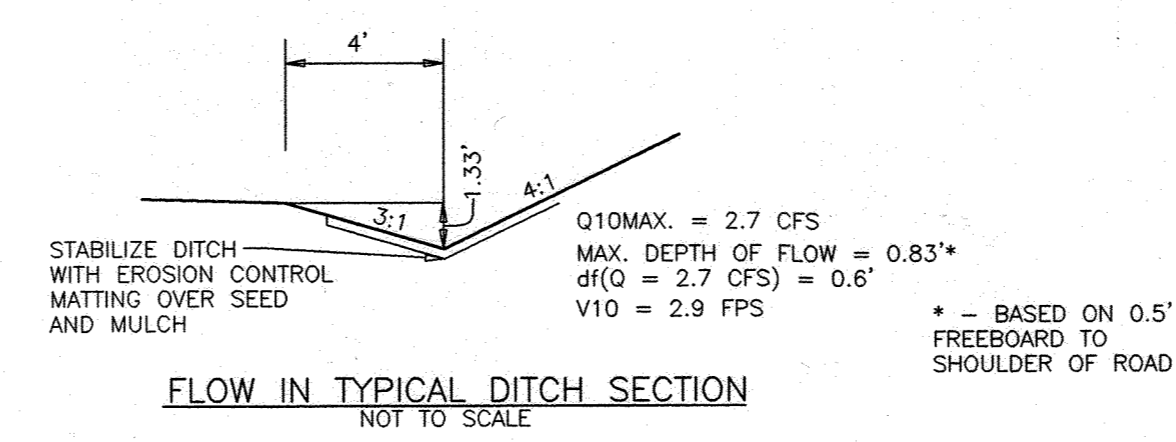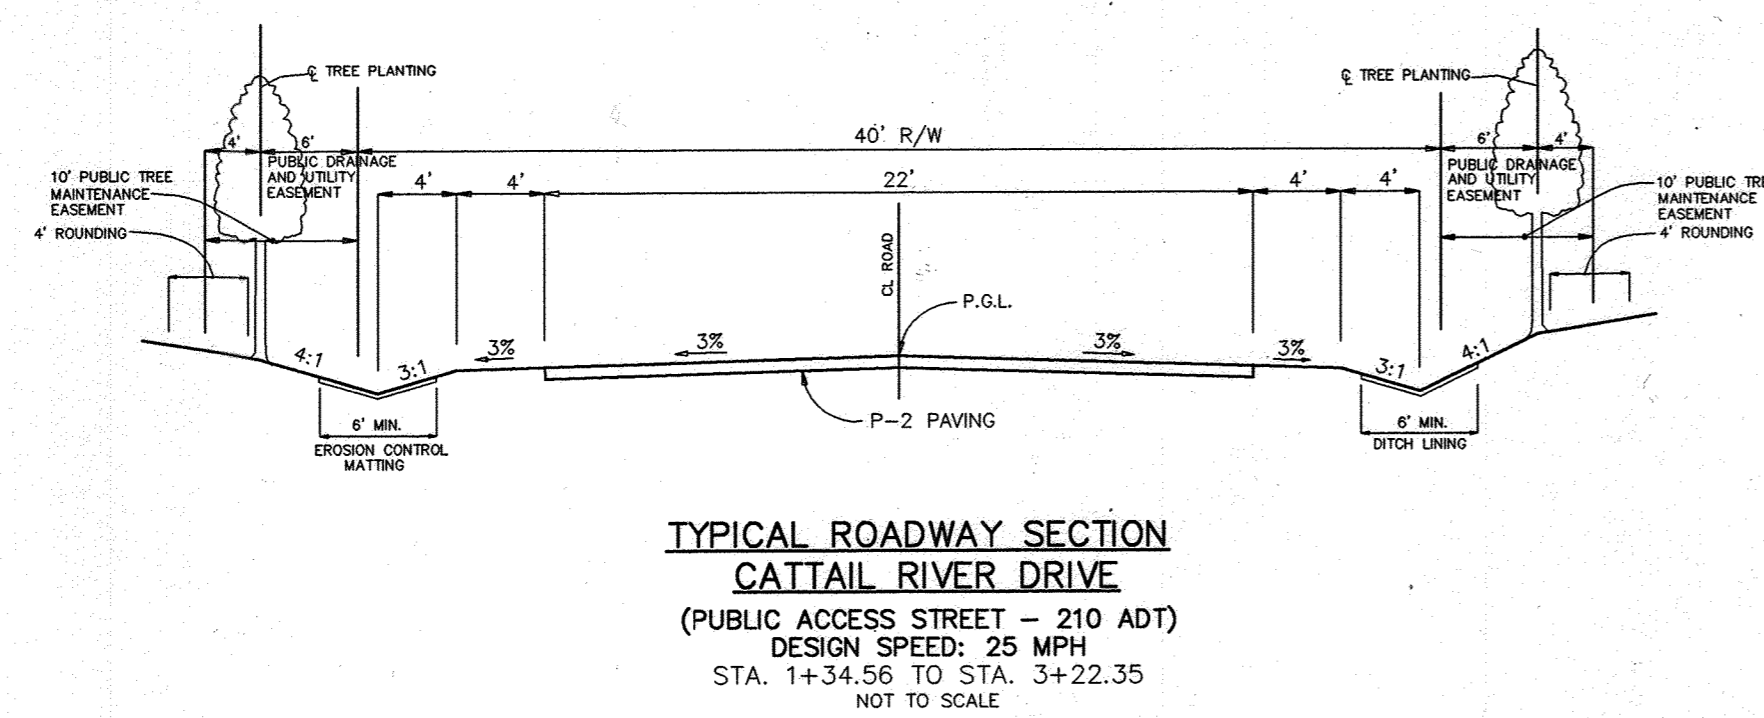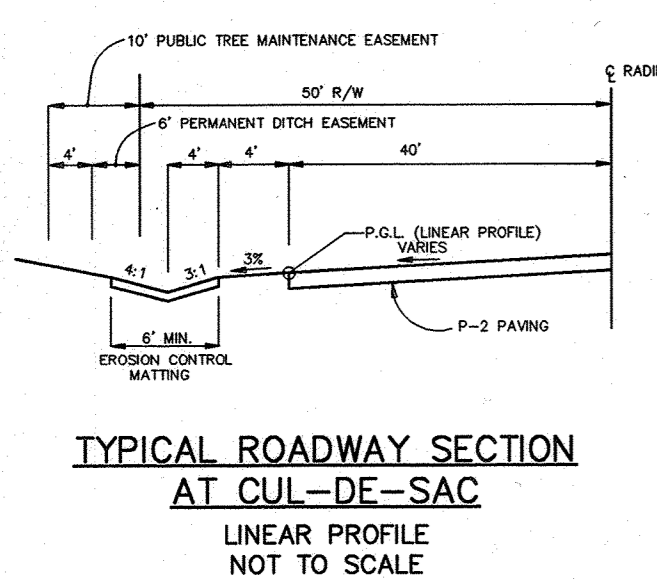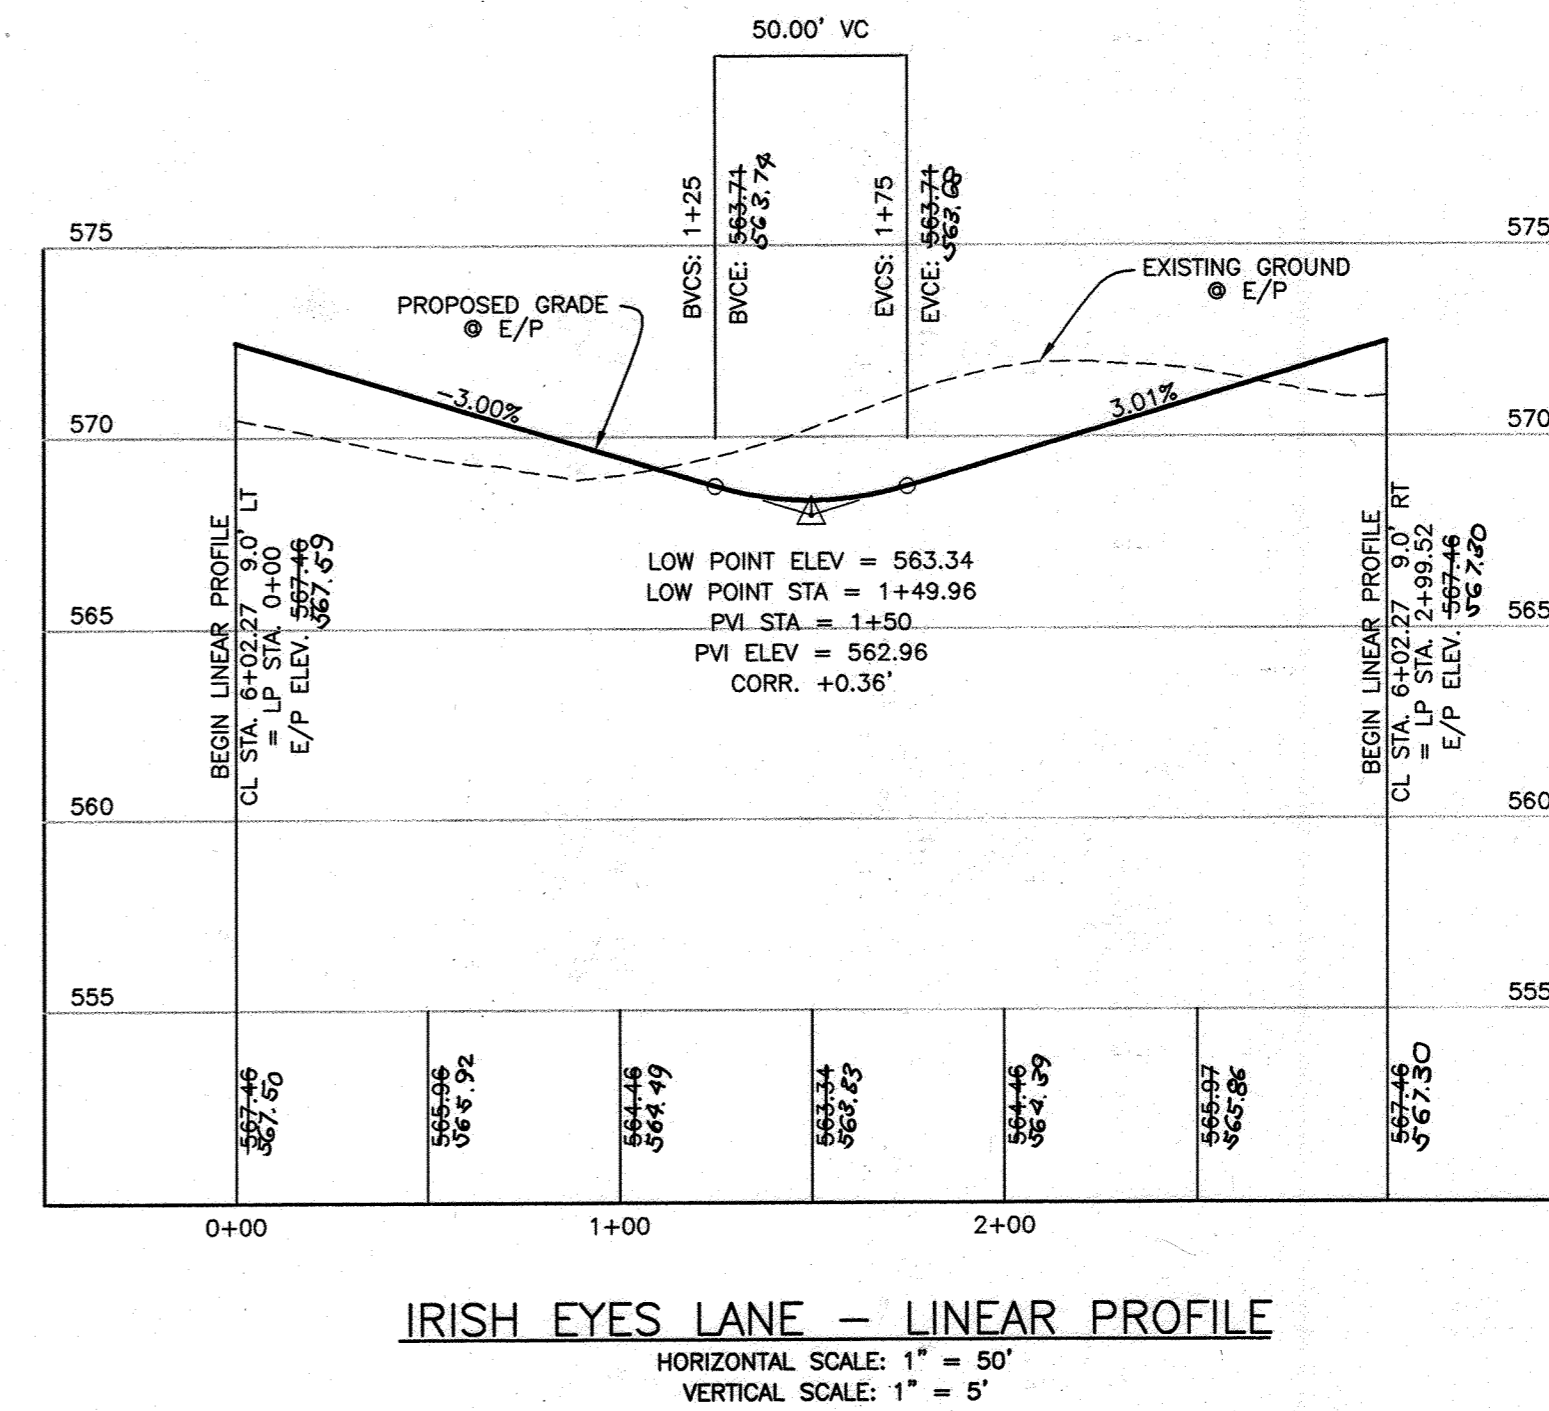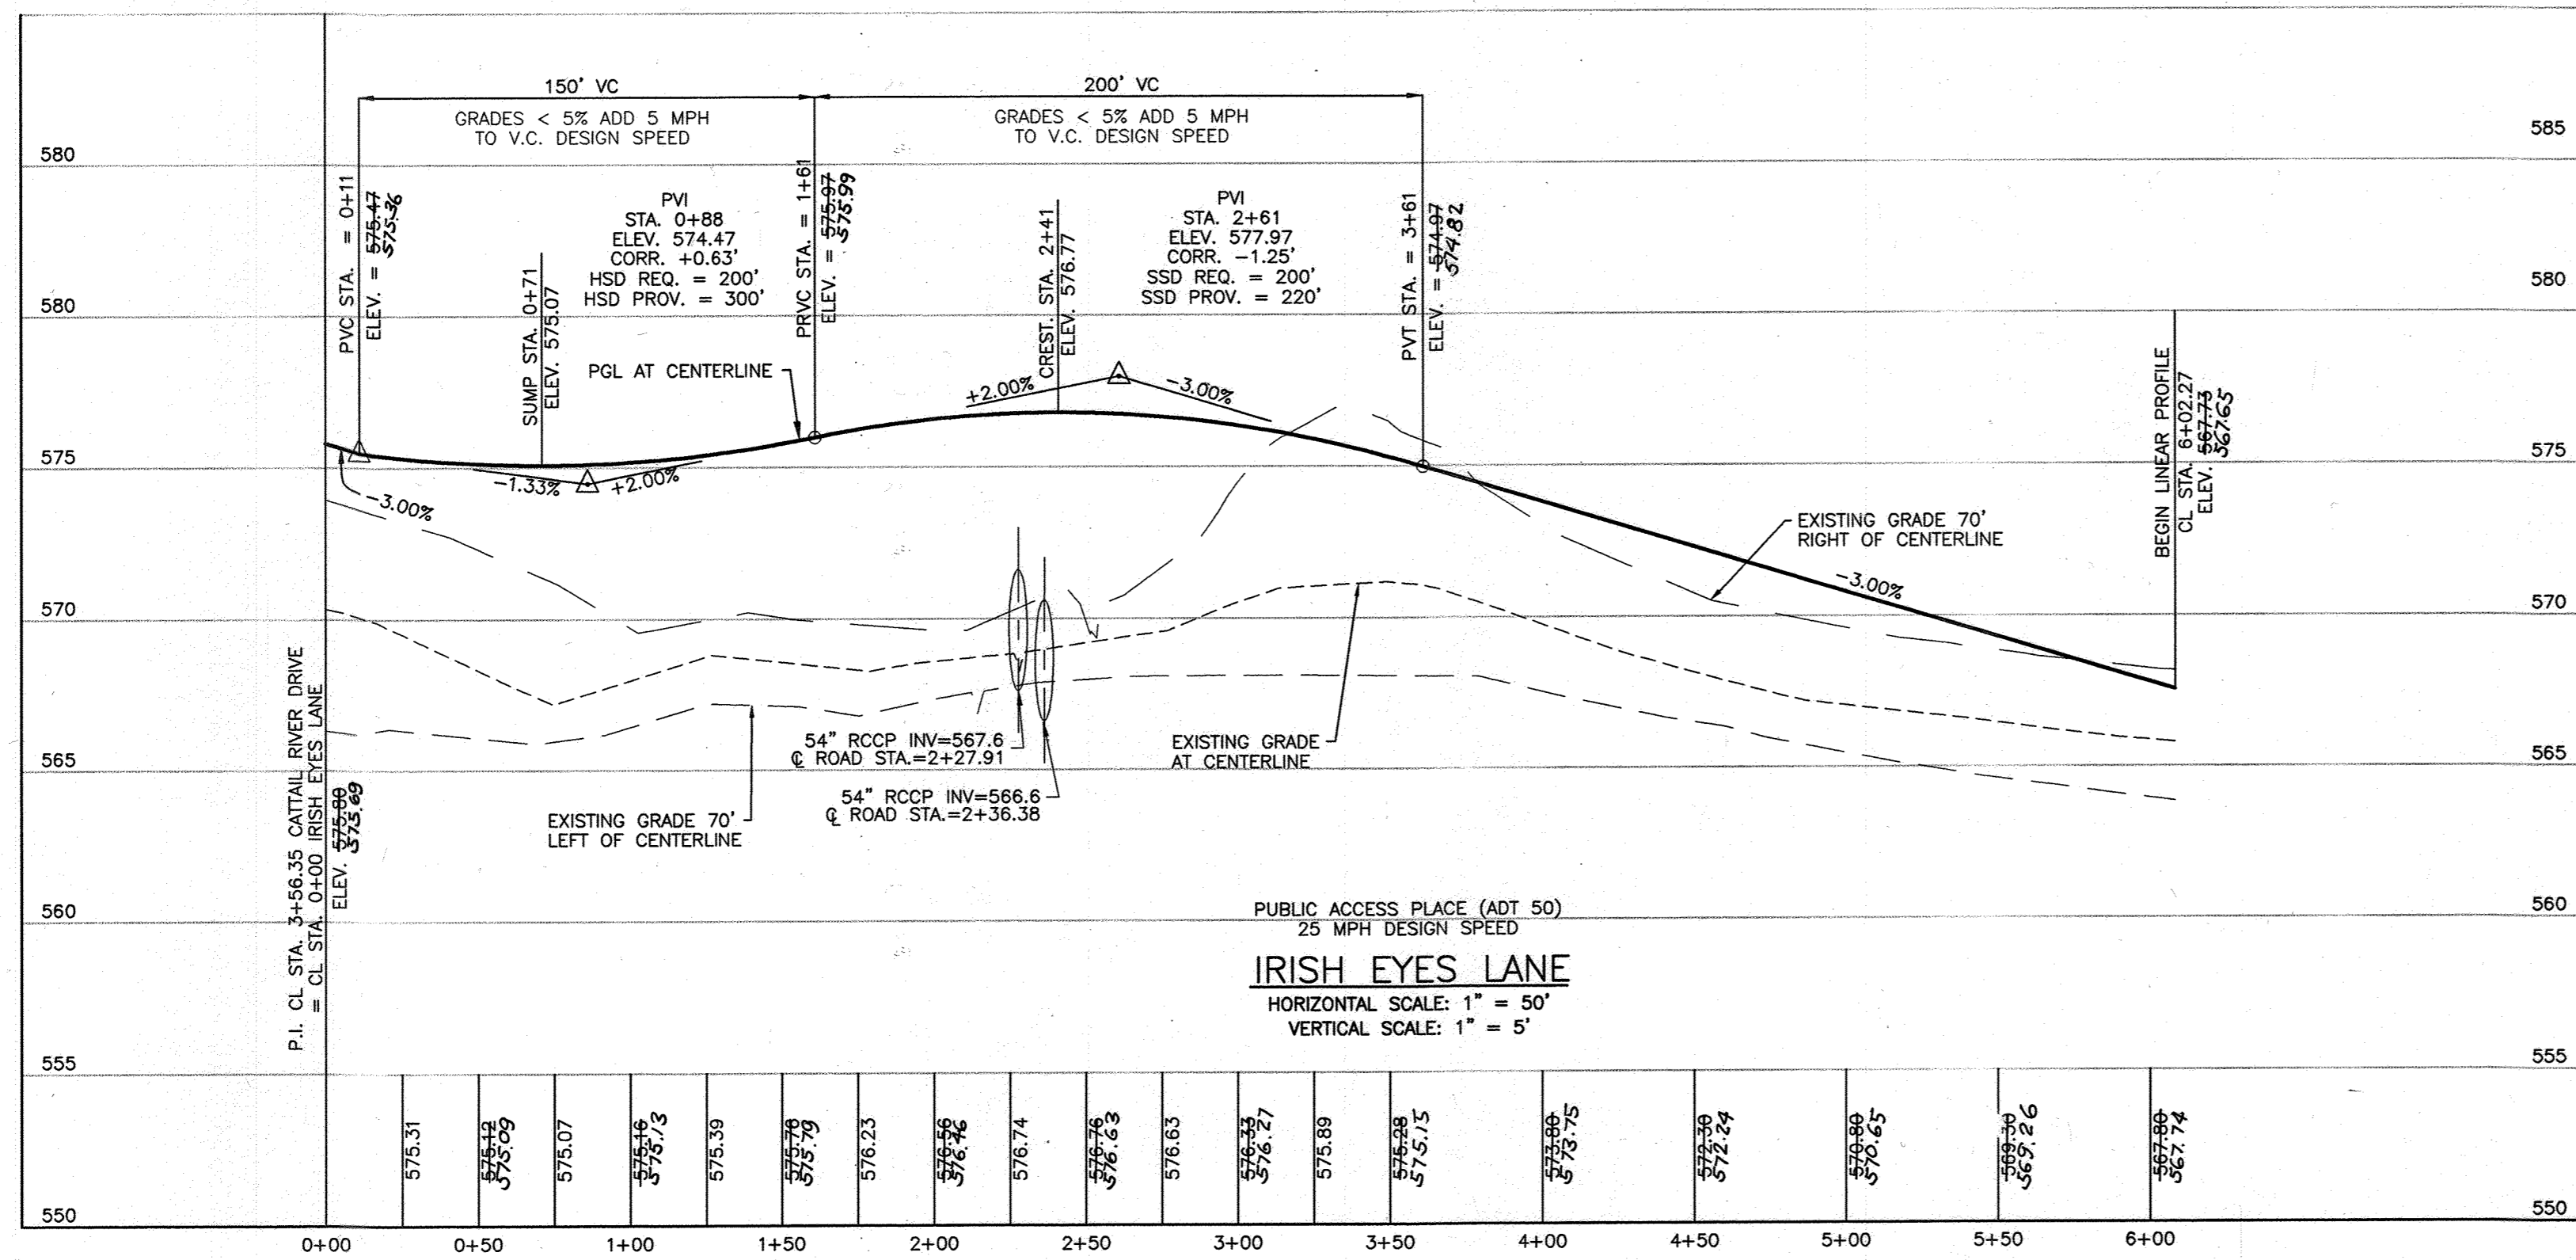

STATE OF MARYLAND
ROBERT M. LAMORE
PROFESSIONAL ENGINEER
No. 16193

REG. NO. 21701, EXP. 6/11/13
RED-LINE REV. 4/12/13
REV. BY ONLY

STATE OF MARYLAND
ROBERT HARRIS VOYLES
PROFESSIONAL ENGINEER
No. 16193

AS-BUILT CERTIFICATION
I HEREBY CERTIFY THAT THE FACILITY SHOWN ON THIS
PLAN WAS CONSTRUCTED AS SHOWN ON THE "AS-BUILT"
PLAN'S AND MEETS THE APPLICABLE STATE & FEDERAL
REQUIREMENTS.

1	4/12/13	PAGE NO.	
No.	DATE	REVISION	

BENCHMARK ENGINEERING, INC.
ENGINEERS • LAND SURVEYORS • PLANNERS
8480 BALTIMORE NATIONAL PIKE Δ SUITE 418
ELLICOTT CITY, MARYLAND 21043
phone: 410-465-6105 Δ fax: 410-465-6644
www.bel-civilengineering.com

16193 01/11/13
16193 01/11/13

OWNER/DEVELOPER: TRINITY QUALITY HOMES, INC. 3675 PARK AVENUE SUITE 301 ELLICOTT CITY, MD 21043 410-480-0023	PROJECT: THE CHASE AT STONEY BROOK LOTS 1-20, PRESERVATION PARCEL "A" AND NON-BUILDABLE PRESERVATION PARCELS "B" THROUGH "D"
TITLE: ROAD PROFILES AND DETAILS	LOCATION: TAX MAP NO. 7 BLOCK NO. 17 PARCEL NO. 133 4th ELECTION DISTRICT HOWARD COUNTY, MARYLAND
DATE: AUGUST, 2005 MARCH, 2006	PROJECT NO. 1187
DESIGN: JMC	DRAFT: RPS
SCALE: AS SHOWN	DRAWING 6 OF 20

APPROVED: HOWARD COUNTY DEPARTMENT OF PUBLIC WORKS
Walter Z. ... 4-21-06
CHIEF, BUREAU OF HIGHWAYS

APPROVED: HOWARD COUNTY DEPT. OF PLANNING AND ZONING
Cindy ... 5/26/06
CHIEF, DIVISION OF LAND DEVELOPMENT


APPROVED: ... 5/26/06
CHIEF, DEVELOPMENT ENGINEERING DIVISION

SOILS LEGEND

SOIL	NAME	CLASS
** Ba	Bulle silt loam	D
* CaB	Comus silt loam, local alluvium, 3 to 8 percent slopes	B
GLB2	Glenelg loam, 3 to 8 percent slopes, moderately eroded	B
GIC2	Glenelg loam, 8 to 15 percent slopes, moderately eroded	B
GIC3	Glenelg loam, 8 to 15 percent slopes, severely eroded	B
GLD3	Glenelg loam, 15 to 25 percent slopes, severely eroded	B
GLD2	Glenelg loam, 15 to 25 percent slopes, moderately eroded	B
* CnA	Clenville silt loam, 0 to 3 percent slopes	C
* CnB2	Clenville silt loam, 3 to 8 percent slopes, moderately eroded	C
** Ha	Hatboro silt loam	D
MC2	Mt. Airy channery loam, 8 to 15 percent slopes, moderately eroded	A
MC3	Mt. Airy channery loam, 8 to 15 percent slopes, severely eroded	A
MLD2	Mt. Airy channery loam, 15 to 25 percent slopes, moderately eroded	A
MLE	Mt. Airy channery loam, 25 to 45 percent slopes	A

NOTES:
 * Hydric soils and/or contains hydric inclusions
 ** May contain hydric inclusions
 † Generally only within 100-year floodplain areas

RED-LINE LEGEND 4/28/03
 SEE PAGE 20 FOR DETAILS
 DW-5" WIDE x 6" LONG x 5" DEEP DRAIN
 RB#1- 500 GALLON RAIN BARREL
 RB#2- 500 " " " " " "
 RB#3- 100 " " " " " "
 RB#4- 500 " " " " " "
 RB#5- 500 " " " " " "
 RB#6- 330 " " " " " "
 RB#7- 330 " " " " " "

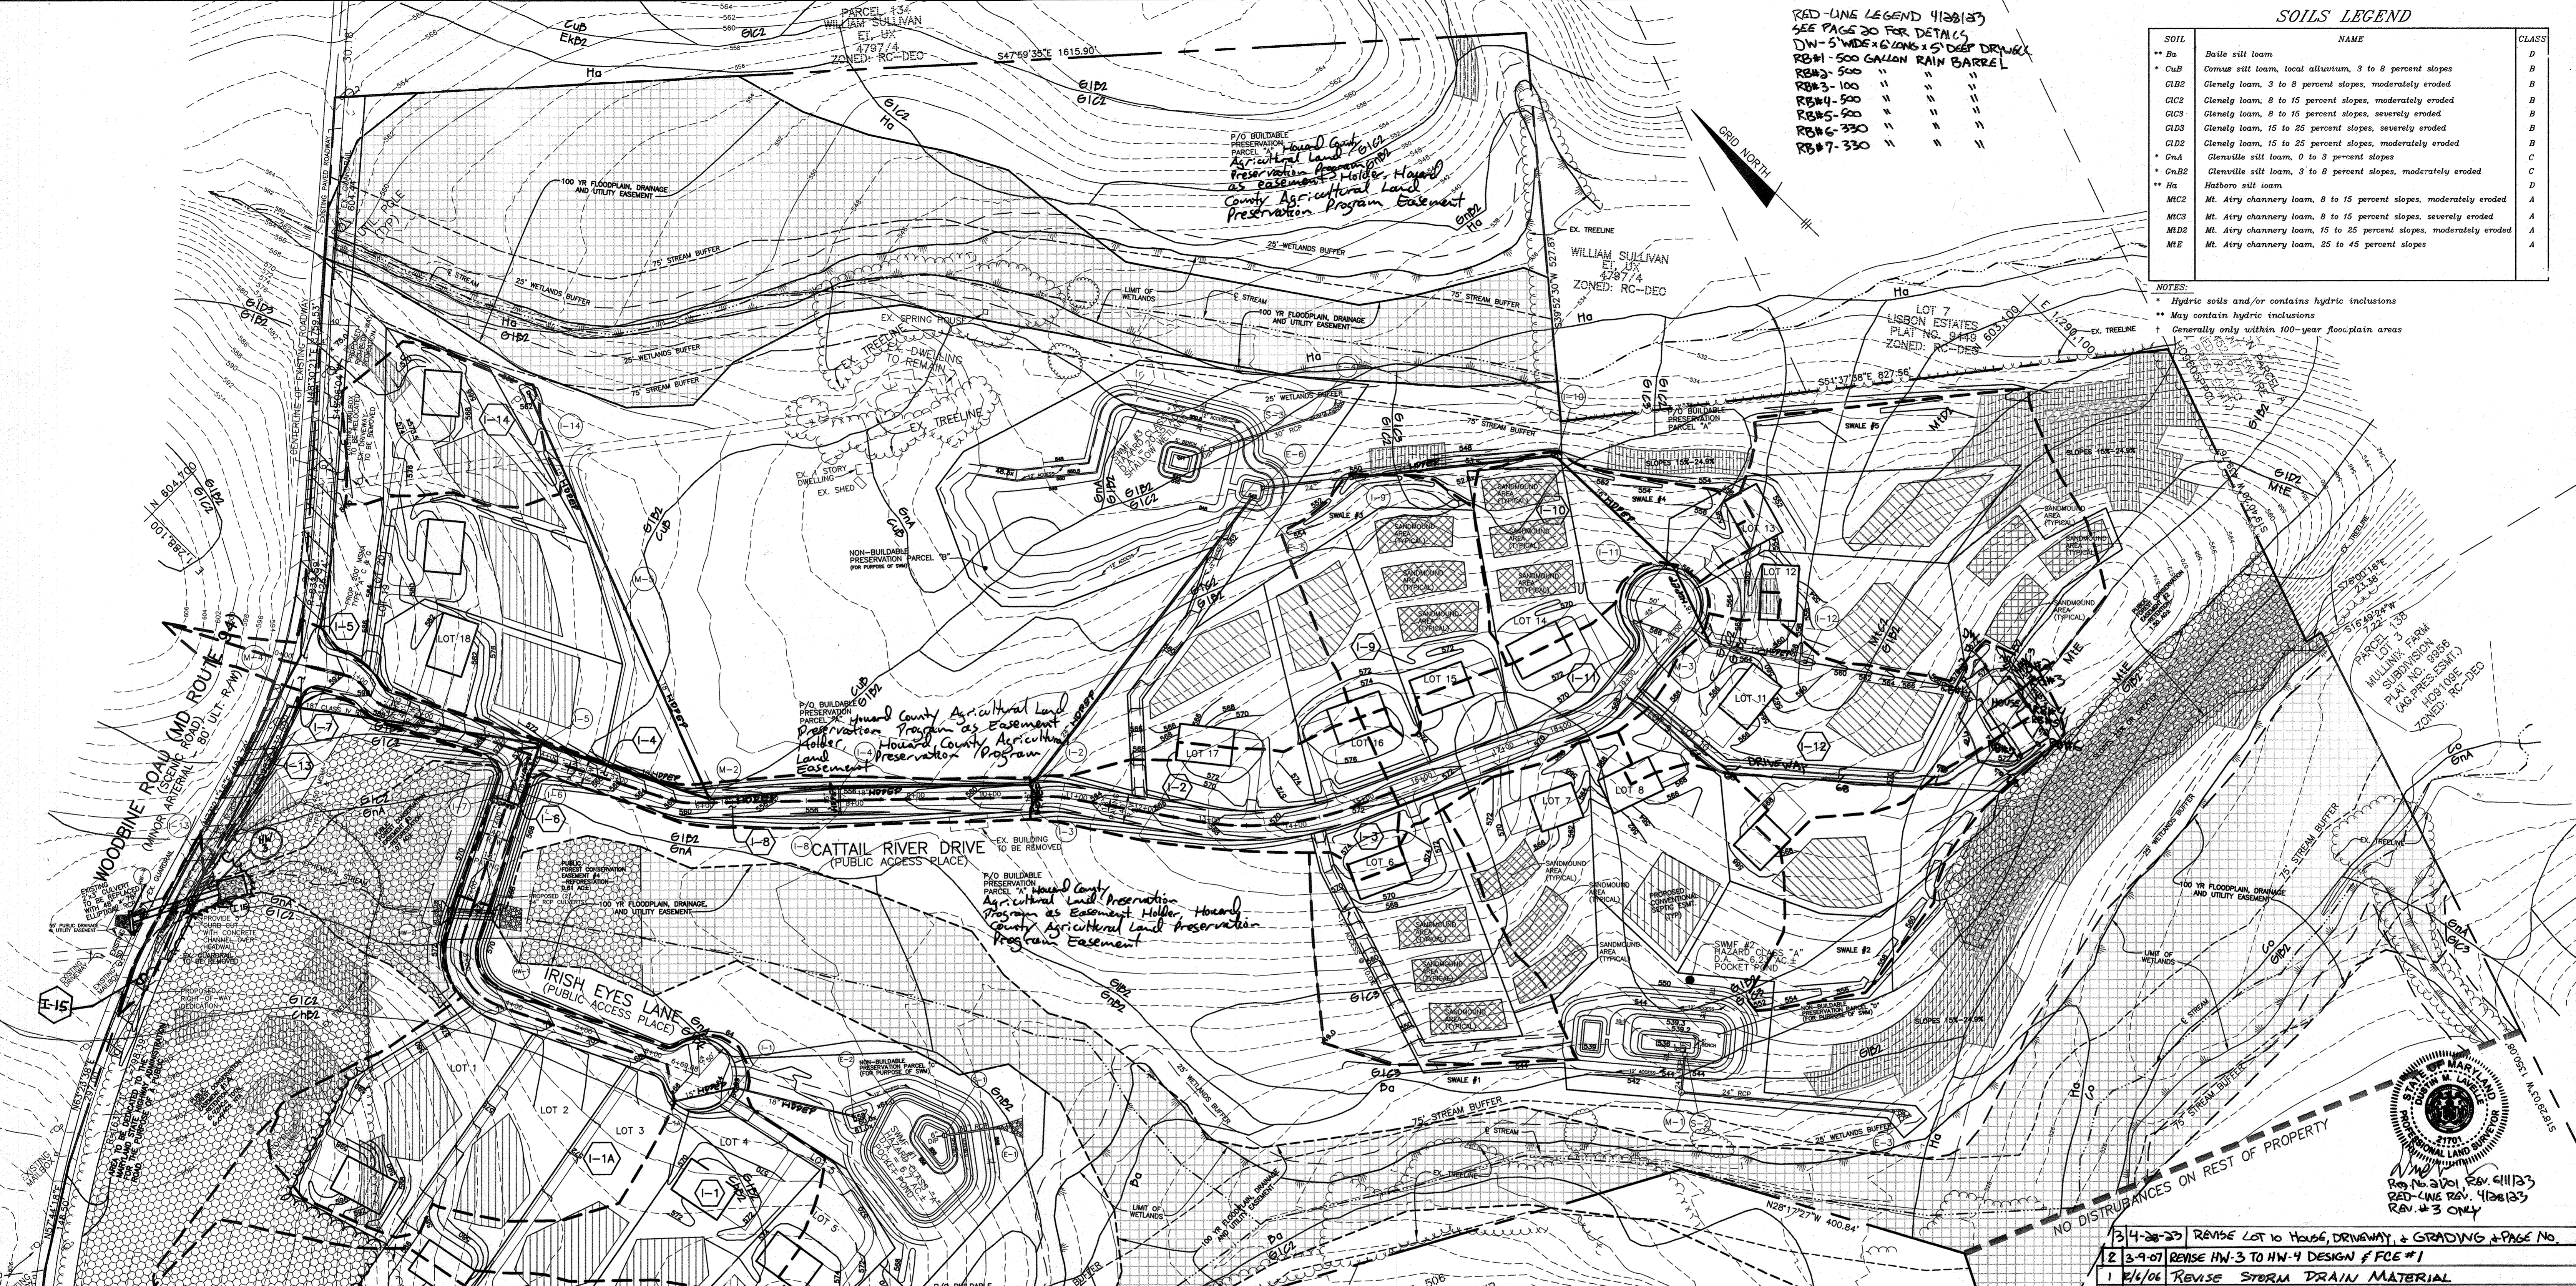

NO.	DATE	REVISION
1	2/1/06	REVISE STORM DRAIN MATERIAL
2	3-9-07	REVISE HW-3 TO HW-4 DESIGN & FCE #1
3	4-28-07	REVISE LOT 10 HOUSE, DRIVEWAY, & GRADING & PAGE NO.


STATE OF MARYLAND
 PROFESSIONAL LAND SURVEYOR
 No. 21701
 DONALD MAER
 3/8/06

STORM DRAIN DATA

INLET NO.	AREA (AC)	% IMPERVIOUS	SOIL CLASS	ZONING	C FACTOR
1-1	2.60	28	B, C	RC-DEO	0.28
1-1A	2.85	19	B, C	RC-DEO	0.28
1-2	0.90	38	B	RC-DEO	0.37
1-3	0.54	49	B	RC-DEO	0.47
1-4	0.43	100	B	RC-DEO	0.86
1-5	0.29	81	B	RC-DEO	0.71
1-6	0.09	100	B, C	RC-DEO	0.86
1-7	0.39	74	B, C	RC-DEO	0.67
1-8	0.48	69	B	RC-DEO	0.64
1-9	1.59	17	B	RC-DEO	0.20
1-10	0.26	13	B	RC-DEO	0.19
1-11	1.54	49	B	RC-DEO	0.71
1-12	2.26	20	A, B	RC-DEO	0.21
1-13	0.22	100	B, C	RC-DEO	0.86
1-14	1.15	15	B	RC-DEO	0.19

SWALE DATA

SWALE NO.	AREA (AC)	SOIL CLASS	ZONING	C FACTOR
1	1.54	B	RC-DEO	0.15
2	1.48	A, B	RC-DEO	0.17
3	1.59	B	RC-DEO	0.20
4	1.46	B	RC-DEO	0.19
5	3.56	A, B	RC-DEO	0.17

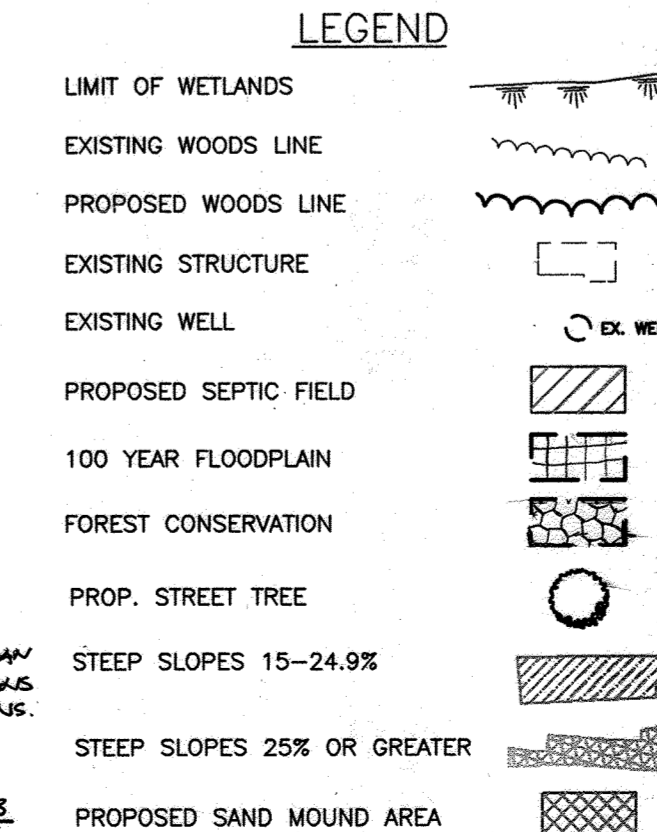

BENCHMARK
 ENGINEERS • LAND SURVEYORS • PLANNERS
ENGINEERING, INC.
 8480 BALTIMORE NATIONAL PIKE • SUITE 418
 ELLICOTT CITY, MARYLAND 21043
 phone: 410-465-6105 • fax: 410-465-6644
 www.bei-civilengineering.com


OWNER/DEVELOPER:
 TRINITY QUALITY HOMES, INC.
 3675 PARK AVENUE
 SUITE 301
 ELLICOTT CITY, MD 21043
 410-480-0023

PROJECT:
THE CHASE AT STONEY BROOK
 LOTS 1-20, PRESERVATION PARCEL "A" AND
 NON-BUILDABLE PRESERVATION PARCELS "B" THROUGH "D"
 LOCATION:
 TAX MAP No. 7, BLOCK No. 17, PARCEL No. 133
 4th ELECTION DISTRICT
 HOWARD COUNTY, MARYLAND
 TITLE:
STORM DRAINAGE AREA MAP

DATE: AUGUST, 2005 PROJECT NO. 1187
 MARCH, 2006
 DRAFT: RPS CHECK: DAM SCALE: 1" = 100' SHEET 7 OF 30 19
 DES: JMC

APPROVED: HOWARD COUNTY DEPARTMENT OF PUBLIC WORKS
 4-21-06
 APPROVED: HOWARD COUNTY DEPT. OF PLANNING AND ZONING
 3/26/06


AS-BUILT CERTIFICATION
 I HEREBY CERTIFY THAT THE FACILITY SHOWN ON THIS PLAN
 WAS CONSTRUCTED AS SHOWN ON THE "AS-BUILT" PLANS
 AND MEETS THE APPROVED PLANS & SPECIFICATIONS.
 16/03/06 16/03/06

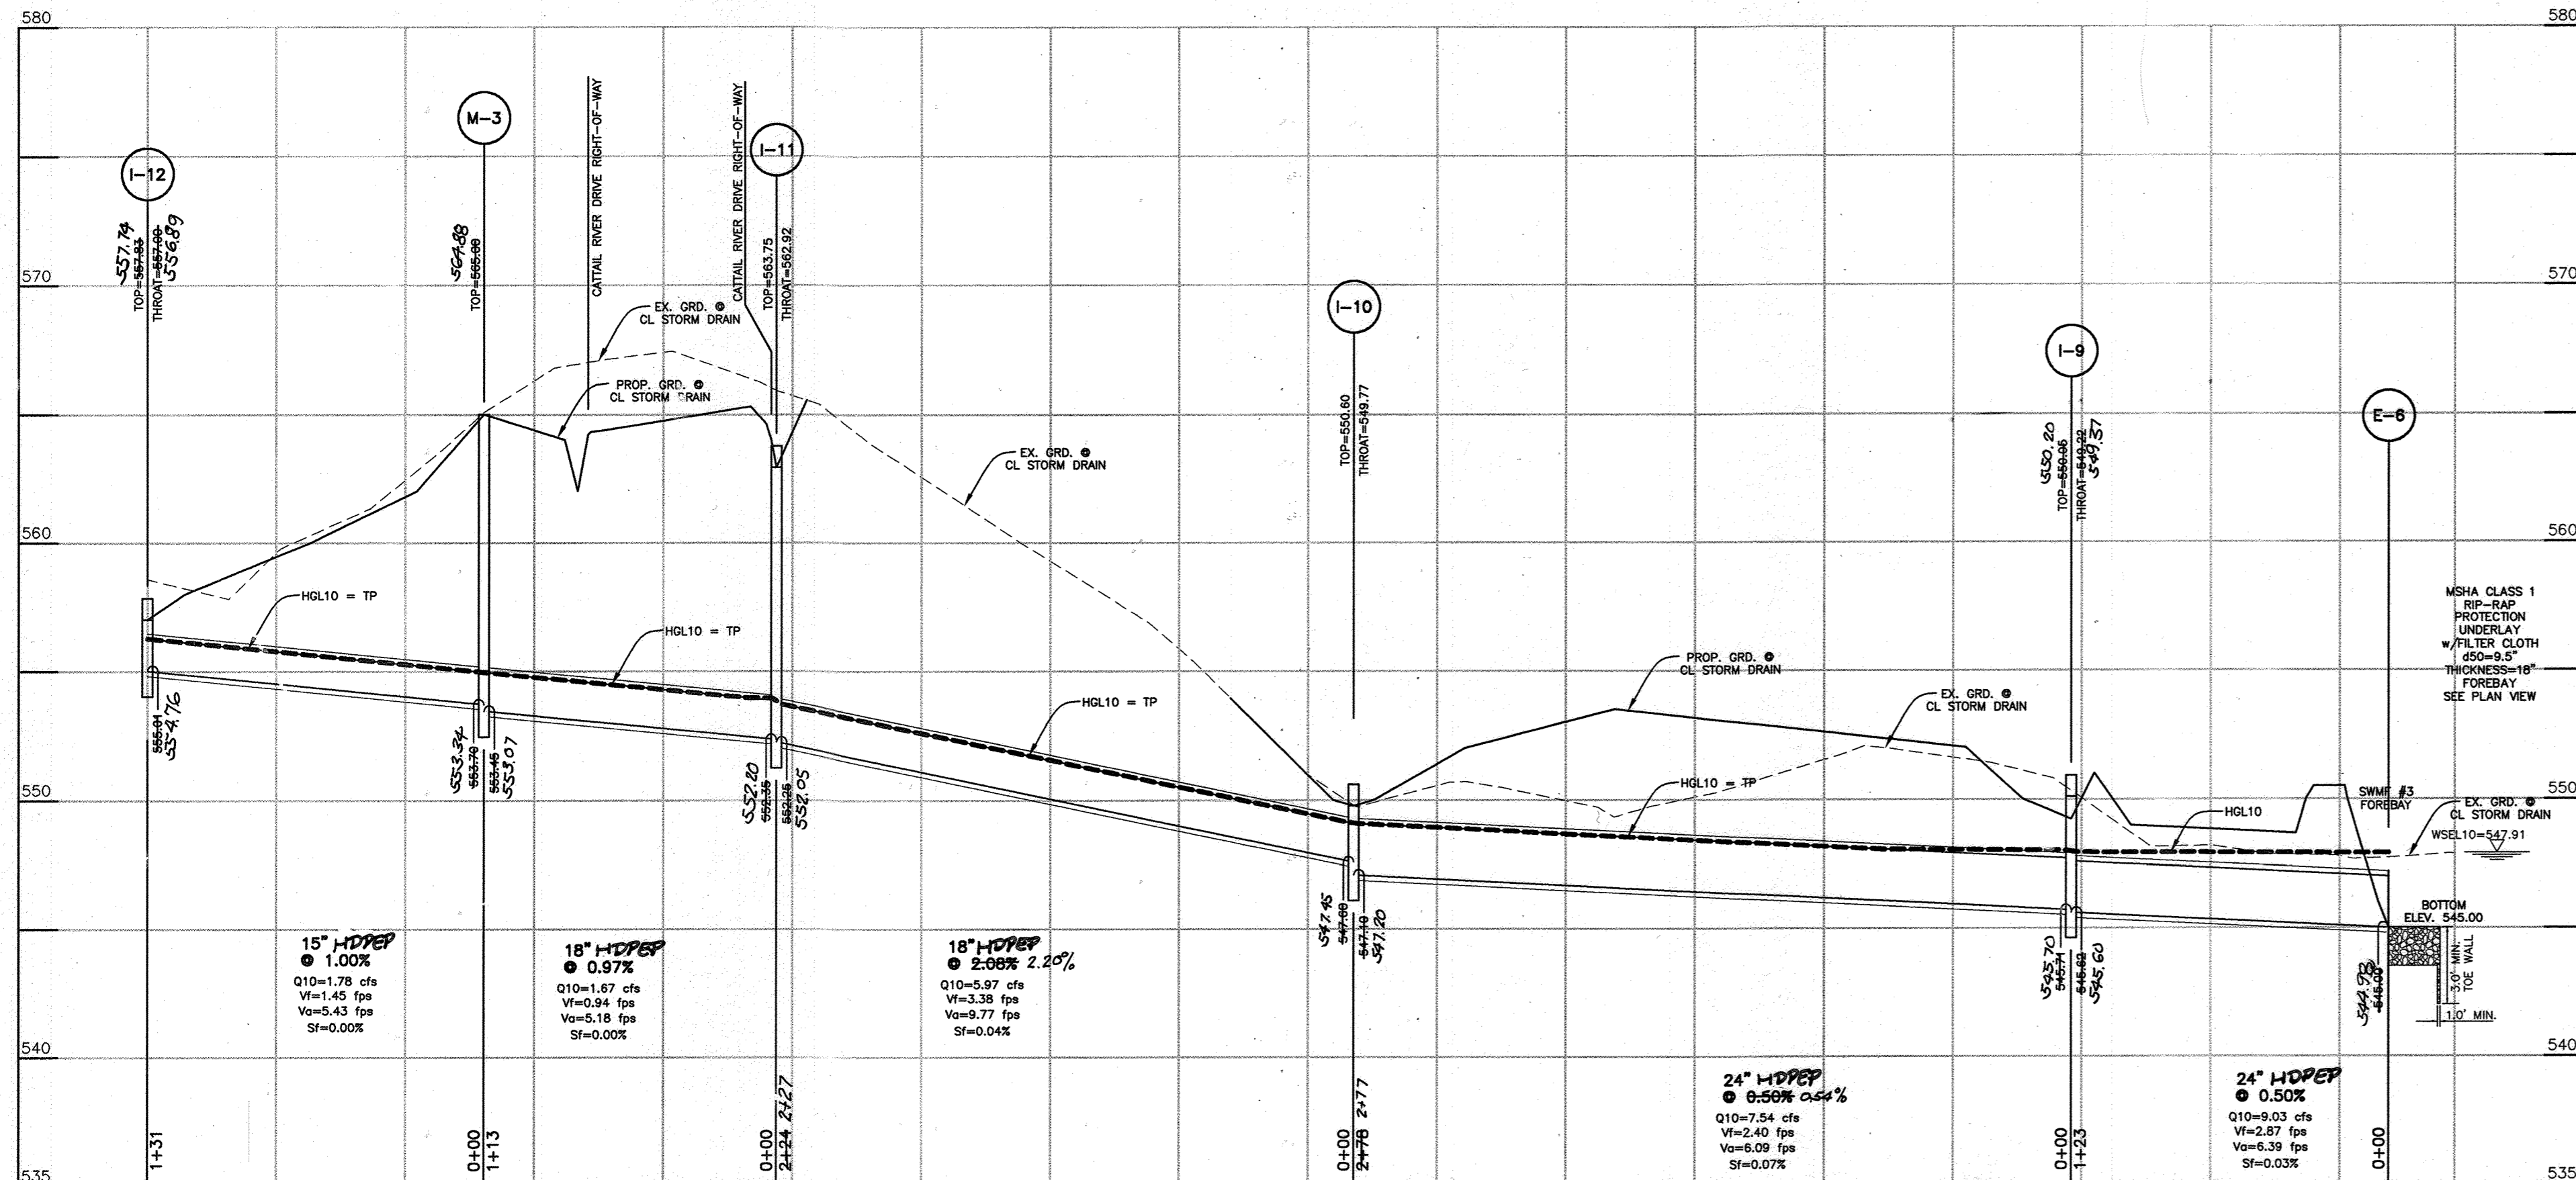

STORM DRAIN RUN E-8 TO I-12
 HORIZONTAL SCALE: 1" = 50'
 VERTICAL SCALE: 1" = 5'

NO.	TYPE	LOCATION	THROAT INV.	INVERT IN	INVERT OUT	TOP ELEV.	STANDARD	REMARKS
I-1	TYPE "D"	STA. 14+49.72 OFF. 8.00' LT.	562.33	562.33	562.33	562.33	Ho.Co.STD. SD-4.11	OPEN 4 SIDES
I-1A	TYPE "D"	STA. 2+41.22 OFF. 8.00' LT.	564.26	564.26	564.26	564.26	Ho.Co.STD. SD-4.11	OPEN 4 SIDES
I-2	TYPE "D"	STA. 10+55.62 OFF. 17.00' LT.	565.08	565.08	565.08	565.08	Ho.Co.STD. SD-4.11	OPEN 2 SIDES
I-3	TYPE "D"	STA. 10+55.62 OFF. 17.00' RT.	565.08	565.08	565.08	565.08	Ho.Co.STD. SD-4.11	OPEN 2 SIDES
I-4	TYPE "D"	STA. 7+95.30 OFF. 17.00' LT.	565.57	565.57	565.57	565.57	Ho.Co.STD. SD-4.11	OPEN 2 SIDES
I-5	TYPE "D"	STA. 3+73.35 OFF. 17.50' LT.	567.29	567.29	567.29	567.29	Ho.Co.STD. SD-4.11	OPEN 2 SIDES
I-6	TYPE "D"	STA. 0+70.69 OFF. 17.00' LT.	573.36	573.36	573.36	573.36	Ho.Co.STD. SD-4.11	OPEN 2 SIDES
I-7	TYPE "D"	STA. 0+70.69 OFF. 17.00' RT.	573.36	573.36	573.36	573.36	Ho.Co.STD. SD-4.11	OPEN 2 SIDES
I-8	TYPE "D"	STA. 3+95.30 OFF. 17.00' RT.	582.87	582.87	582.87	582.87	Ho.Co.STD. SD-4.11	OPEN 2 SIDES
I-9	TYPE "D"	N 603,582.83 E 1,289,282.13	582.87	582.87	582.87	582.87	Ho.Co.STD. SD-4.11	OPEN 2 SIDES
I-10	TYPE "D"	N 603,408.33 E 1,289,499.70	549.77	549.77	549.77	549.77	Ho.Co.STD. SD-4.11	OPEN 2 SIDES
I-11	TYPE "D"	STA. 1+65.74 OFF. 8.00' LT.	562.33	562.33	562.33	562.33	Ho.Co.STD. SD-4.11	OPEN 4 SIDES
I-12	TYPE "D"	N 602,971.22 E 1,289,539.93	562.33	562.33	562.33	562.33	Ho.Co.STD. SD-4.11	OPEN 2 SIDES
I-13	15" COG	STA. 9+15.30 OFF. 29.27' RT.	583.32	583.32	583.32	583.32	MD 374.51	15" OPENING
I-14	TYPE "D"	N 604,455.39 E 1,288,577.30	561.55	561.55	561.55	561.55	Ho.Co.STD. SD-4.11	OPEN 2 SIDES
M-1	4'-0" STANDARD	N 602,676.37 E 1,289,007.90	562.33	562.33	562.33	562.33	Ho.Co.STD. G-5.12	STANDARD PRECAST MANHOLE
M-2	4'-0" STANDARD	STA. 6+18.70 OFF. 5.00' LT.	565.08	565.08	565.08	565.08	Ho.Co.STD. G-5.12	STANDARD PRECAST MANHOLE
M-3	4'-0" STANDARD	N 603,078.08 E 1,289,464.88	565.08	565.08	565.08	565.08	Ho.Co.STD. G-5.12	STANDARD PRECAST MANHOLE
M-4	4'-0" STANDARD	STA. 11+56.92 OFF. 27.10' RT.	576.76	576.76	576.76	576.76	MD 383.01	STANDARD PRECAST MANHOLE
M-5	4'-0" STANDARD	N 604,155.14 E 1,288,461.68	582.87	582.87	582.87	582.87	Ho.Co.STD. G-5.12	STANDARD PRECAST MANHOLE
E-1	TYPICAL CONCRETE	N 603,298.46 E 1,288,320.36	562.33	562.33	562.33	562.33	Ho.Co.STD. SD-5.51	SWM OUTFALL
E-2	18" METAL	N 603,447.57 E 1,288,193.44	562.33	562.33	562.33	562.33	Ho.Co.STD. SD-5.61	OUTFALL INTO FOREBAY
E-3	TYPICAL CONCRETE	N 602,453.87 E 1,289,192.94	534.0	534.0	534.0	534.0	Ho.Co.STD. SD-5.51	SWM OUTFALL
E-4	TYPICAL CONCRETE	N 603,676.31 E 1,289,300.75	540.0	540.0	540.0	540.0	Ho.Co.STD. SD-5.51	SWM OUTFALL
E-5	24" METAL	N 603,659.54 E 1,289,168.42	540.0	540.0	540.0	540.0	Ho.Co.STD. SD-5.61	OUTFALL INTO FOREBAY
E-6	24" METAL	N 603,659.83 E 1,289,186.13	540.0	540.0	540.0	540.0	Ho.Co.STD. SD-5.61	OUTFALL INTO FOREBAY
HW-1	CAST IN PLACE	N 603,986.76 E 1,288,041.43	573.91	573.91	573.91	573.91	Ho.Co.STD. G-5.21	SEE DETAILS
HW-2	CAST IN PLACE	N 604,032.42 E 1,288,000.00	573.91	573.91	573.91	573.91	Ho.Co.STD. G-5.21	SEE DETAILS
HW-3	CAST IN PLACE	N 604,274.57 E 1,287,805.02	573.91	573.91	573.91	573.91	MSHA - 355.02	
HW-4	CAST IN PLACE	N 604,327.54 E 1,287,680.88	573.91	573.91	573.91	573.91	MSHA - 355.02	
I-15	5" COG (60 DIA)	N 604,291.91 E 1,287,766.71	581.70	581.70	581.70	581.70	MD 374.63	5" OPENING, 96" BASE

- STRUCTURE TOP ELEVATION AND LOCATION FOR MANHOLES IS AT THE TOP AND CENTER OF RIM.
- STRUCTURE TOP ELEVATION AND LOCATION FOR INLETS IS AT THE TOP, CENTER FACE OF THE INLET FOR CURB INLETS AND AT THE CENTER TOP FOR YARD INLETS.
- STRUCTURE TOP ELEVATION AND LOCATION FOR END SECTIONS IS AT THE CONNECTION OF PIPE AND END SECTION AT CENTERLINE.
- STRUCTURE TOP ELEVATION AND LOCATION FOR HEADWALLS IS AT THE MIDPOINT OF THE FACE OF THE MAIN WALL.

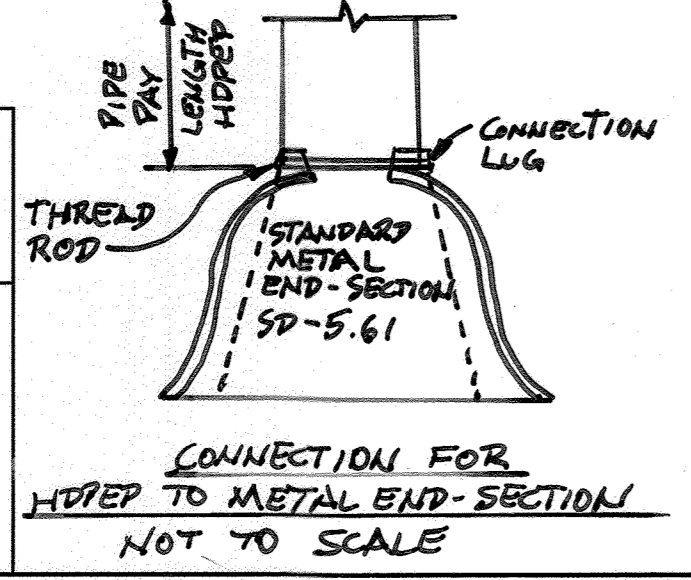


APPROVED: HOWARD COUNTY DEPARTMENT OF PUBLIC WORKS
 4-21-06
 APPROVED: HOWARD COUNTY DEPT. OF PLANNING AND ZONING
 5/10/06
 5/21/06

SIZE	TYPE	CLASS	TOTAL LENGTH
15"	RCP	IV	322'
18"	RCP	IV	283'
24"	HDPE	*	892'
54"	RCP	IV	120'
48" x 76"	RCP	IV	12.6'
15"	HDPE	*	567'
18"	HDPE	*	167'








* SMOOTH BORE INTERIOR FINISH

STRUCTURE	D-50	LENGTH	WIDTH	THICKNESS	SHA CLASS
E-1	9.5"	14'	17'	18"	1
E-2	9.5"	FOREBAY	FOREBAY	18"	1
E-3	9.5"	14'	17'	18"	1
E-4	9.5"	44'	20'	18"	1
E-5	9.5"	FOREBAY	FOREBAY	18"	1
E-6	9.5"	FOREBAY	FOREBAY	18"	1

RUN	SIZE	LENGTH	TYPE & CLASS
E-2 TO I-1	18"	164'	HDPE
I-1 TO I-1A	15"	90'	HDPE
E-5 TO I-2	24"	491'	HDPE
I-2 TO I-4	18"	260'	HDPE
I-4 TO M-2	18"	177'	HDPE
M-2 TO I-5	18"	242'	HDPE
I-5 TO M-4	18"	345'	RCP CLASS IV
M-4 TO I-13	15"	246'	RCP CLASS IV
M-2 TO M-5	18"	283'	HDPE
M-5 TO I-14	15"	322'	HDPE
I-5 TO I-6	18"	88'	HDPE
I-2 TO I-3	15"	34'	HDPE
I-4 TO I-8	15"	34'	HDPE
I-2 TO I-3	15"	34'	HDPE
E-6 TO I-9	24"	123'	HDPE
I-9 TO I-10	24"	278'	HDPE
I-10 TO I-11	18"	224'	HDPE
I-11 TO M-3	18"	113'	HDPE
M-3 TO I-12	15"	131'	HDPE
HW-1 TO HW-2	(2) 54"	80'	RCP CLASS IV
HW-3 TO I-15	48" x 76"	40'	RCP CLASS IV
I-15 TO HW4	48" x 76"	86'	RCP CLASS IV

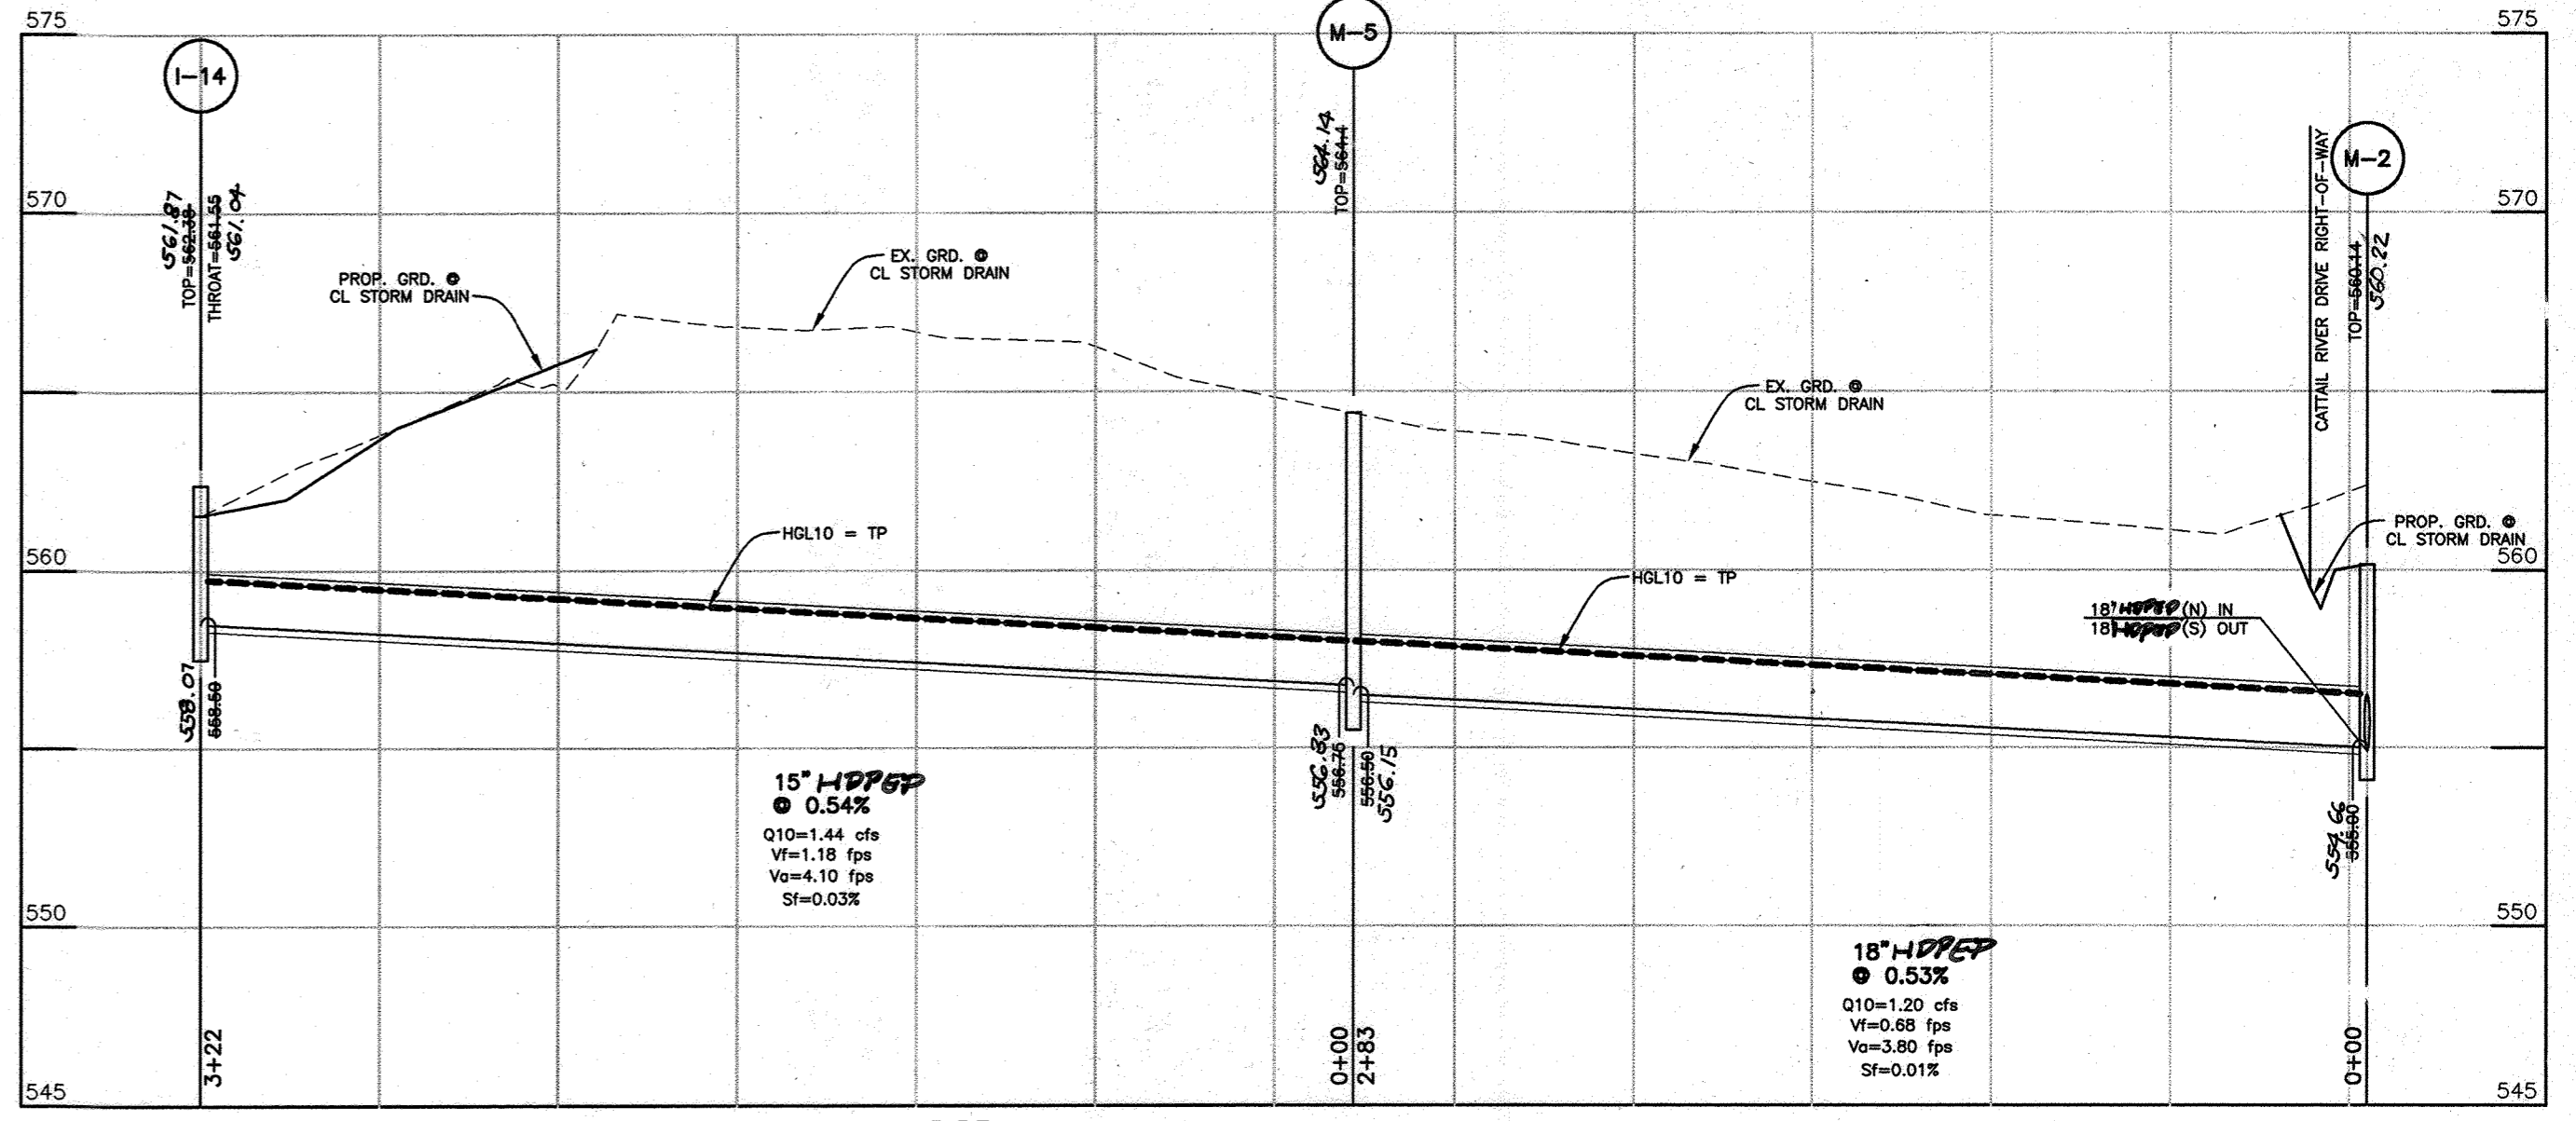

STORM DRAIN RUN M-2 TO I-14
 HORIZONTAL SCALE: 1" = 50'
 VERTICAL SCALE: 1" = 5'

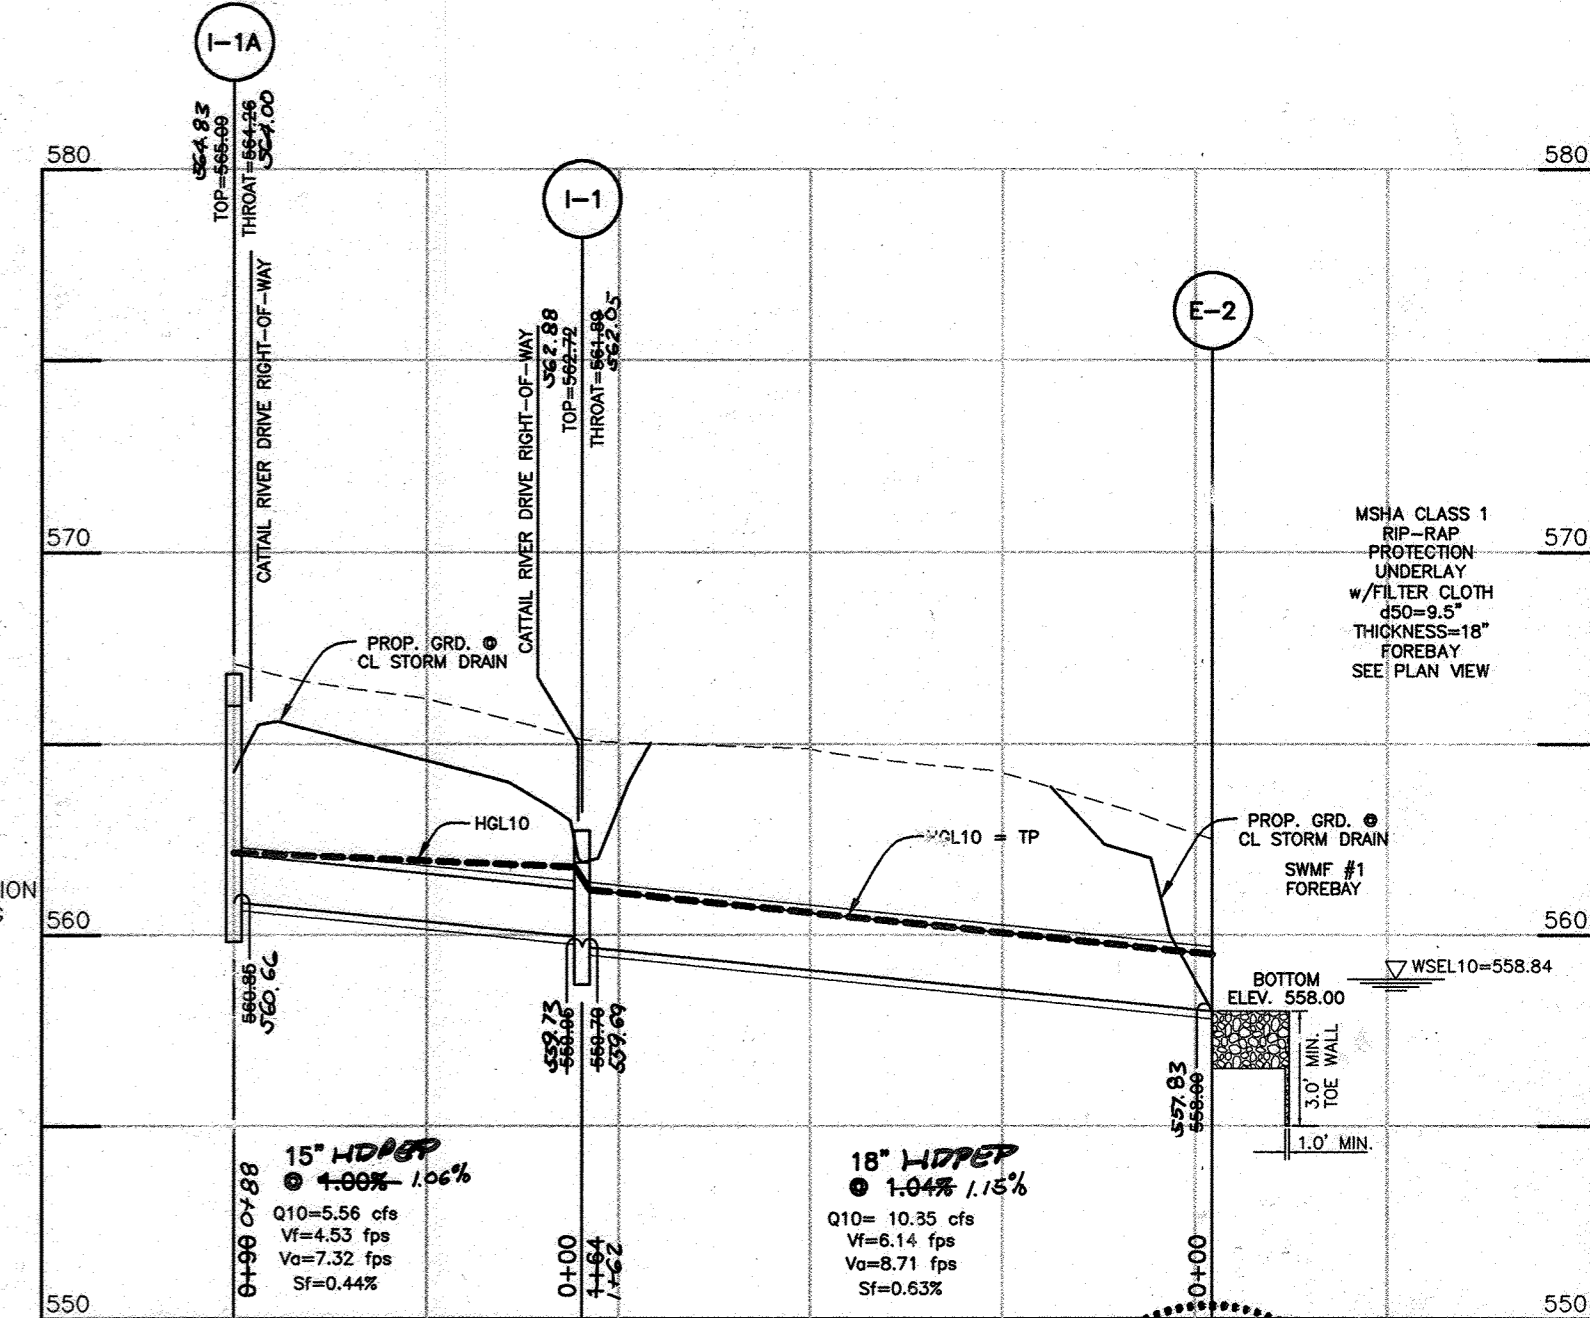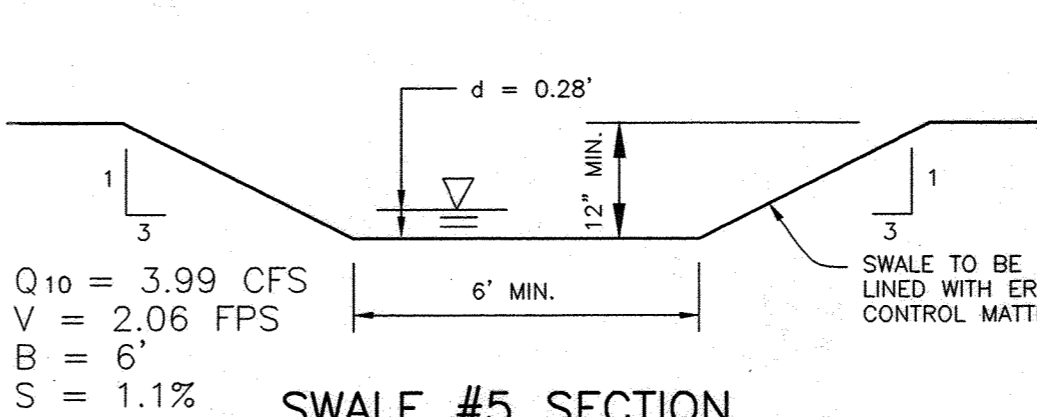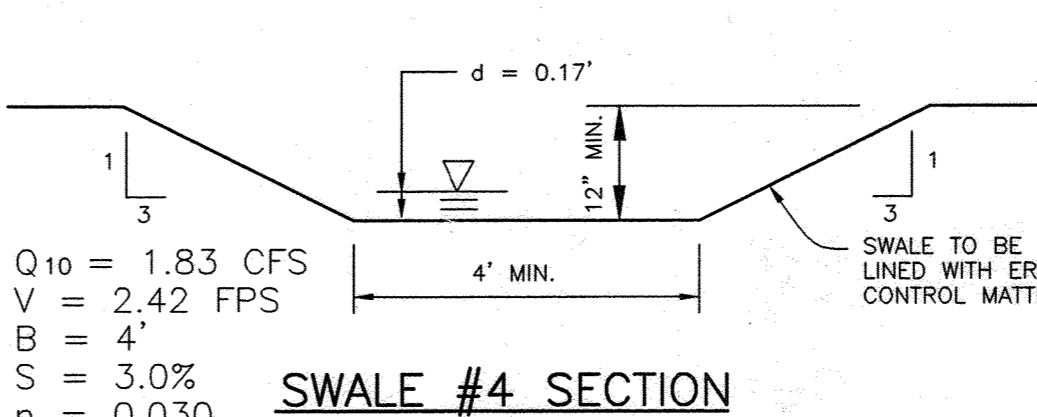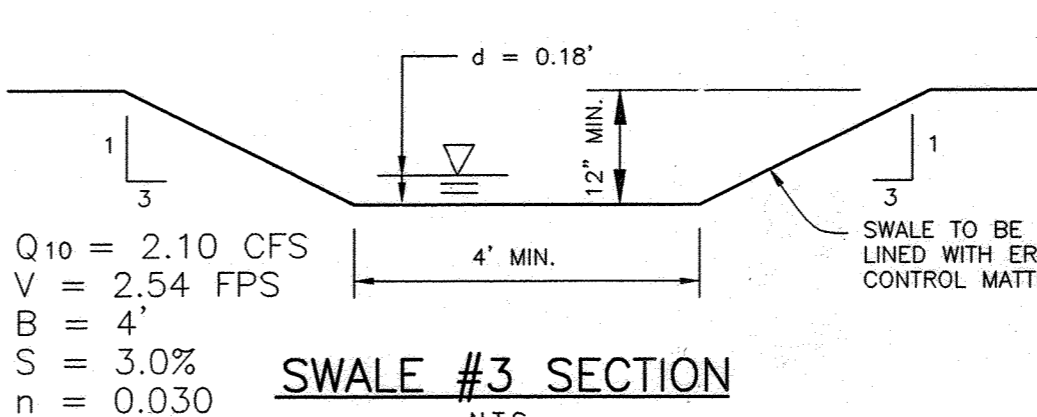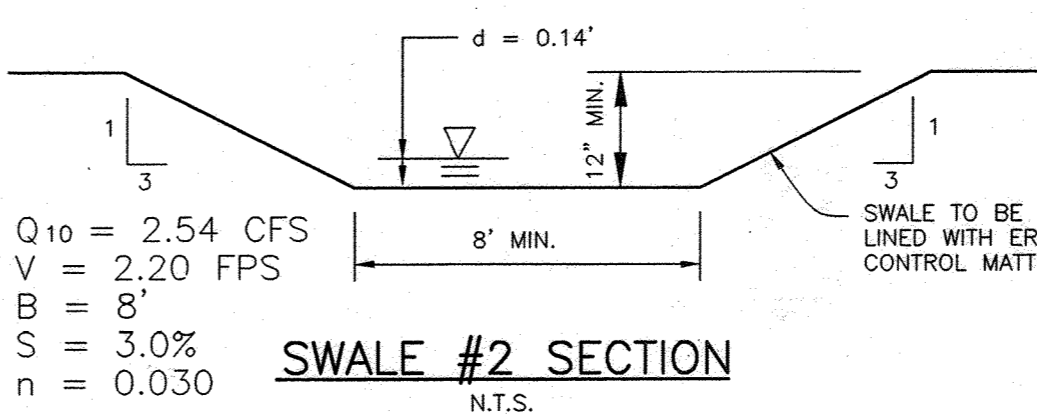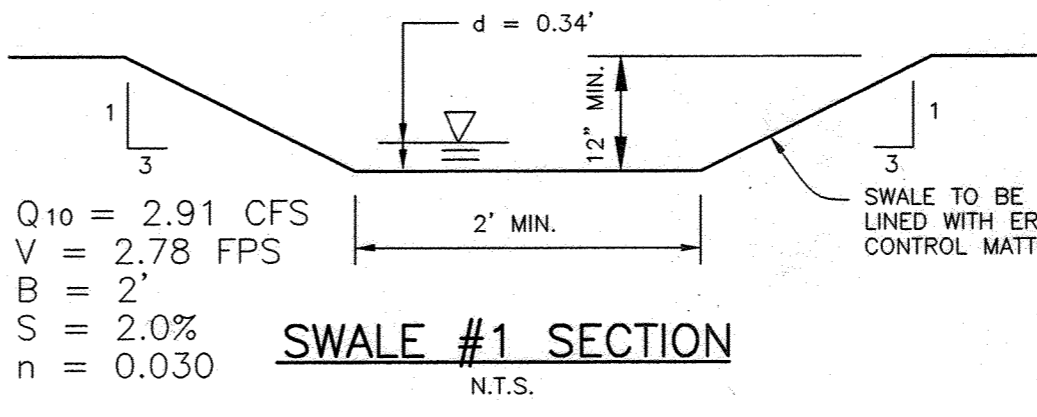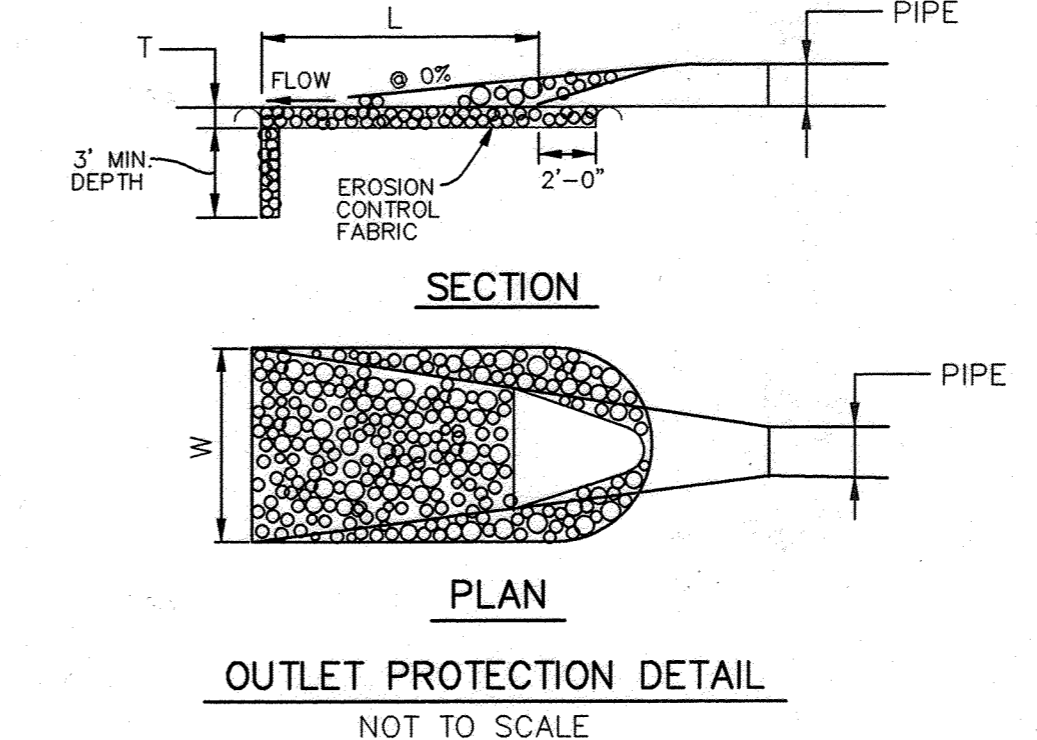

STORM DRAIN RUN E-2 TO I-1A
 HORIZONTAL SCALE: 1" = 50'
 VERTICAL SCALE: 1" = 5'

STATE OF MARYLAND
 PROFESSIONAL ENGINEER
 DONALD MAON
 No. 15193
 3/13/06

3/13/06
 3/13/06
 3/13/06

BENCHMARK ENGINEERING, INC.
 ENGINEERS & LAND SURVEYORS & PLANNERS
 8480 BALTIMORE NATIONAL PIKE # SUITE 418
 ELLICOTT CITY, MARYLAND 21043
 phone: 410-465-8105 • fax: 410-465-8644
 www.bei-ellincengineering.com

OWNER/DEVELOPER: TRINITY QUALITY HOMES, INC.
 3675 PARK AVENUE SUITE 301
 ELLICOTT CITY, MD 21043
 410-480-0023

PROJECT: THE CHASE AT STONEY BROOK
 LOTS 1-20, PRESERVATION PARCEL "A" AND NON-BUILDABLE PRESERVATION PARCELS "B" THROUGH "D"

LOCATION: TAX MAP NO. 7 BLOCK NO. 17 PARCEL NO. 133
 4th ELECTION DISTRICT
 HOWARD COUNTY, MARYLAND


TITLE: STORM DRAIN PROFILES

DATE: AUGUST, 2005
 MARCH, 2006

PROJECT NO. 1187

SCALE: AS SHOWN









DRAWING 8 OF 30

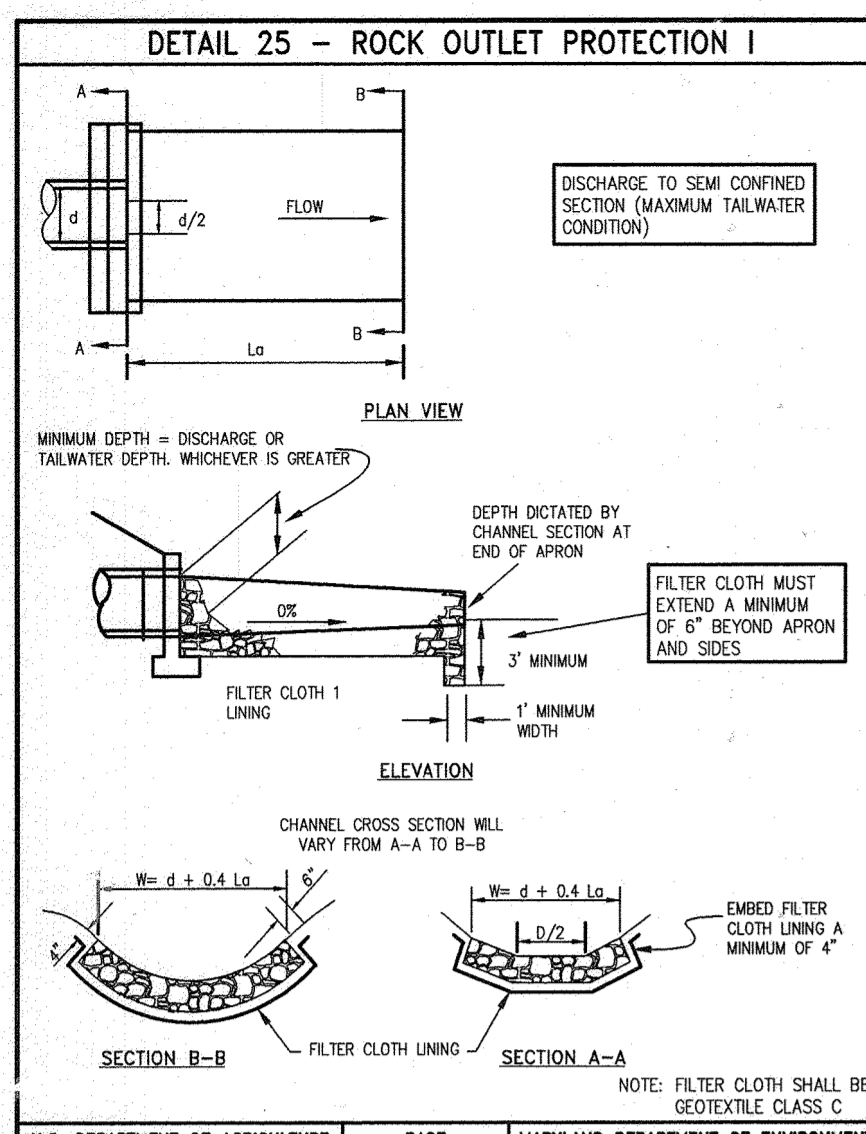

CONSTRUCTION SPECIFICATIONS

- The subgrade for the filter, rip-rap, or gabion shall be prepared to the required lines and grades. Any fill required in the subgrade shall be compacted to a density of approximately that of the surrounding undisturbed material.
- The rock or gravel shall conform to the specified grading limits when installed respectively in the rip-rap or filter.
- Geotextile shall be protected from punching, cutting, or tearing. Any damage other than an occasional small hole shall be repaired by placing another piece of geotextile over the damaged part or by completely replacing the geotextile. All overlaps whether for repairs or for joining two pieces of geotextile shall be a minimum of one foot.
- Stone for the rip-rap or gabion outlets may be placed by equipment. They shall be constructed to the full course thickness in one operation and in such a manner as to avoid displacement of underlying materials. The stone for rip-rap or gabion outlets shall be delivered and placed in a manner that will ensure that it is reasonably homogeneous with the smaller stones and spalls filling the voids between the larger stones. Rip-rap shall be placed in a manner to prevent damage to the filter blanket or geotextile. Hand placement will be required to the extent necessary to prevent damage to the permanent works.
- The stone shall be placed so that it blends in with the existing ground. If the stone is placed too high then the flow will be forced out of the channel and scour adjacent to the stone will occur.

U.S. DEPARTMENT OF AGRICULTURE SOIL CONSERVATION SERVICE PAGE F-18-8 MARYLAND DEPARTMENT OF ENVIRONMENT WATER MANAGEMENT ADMINISTRATION

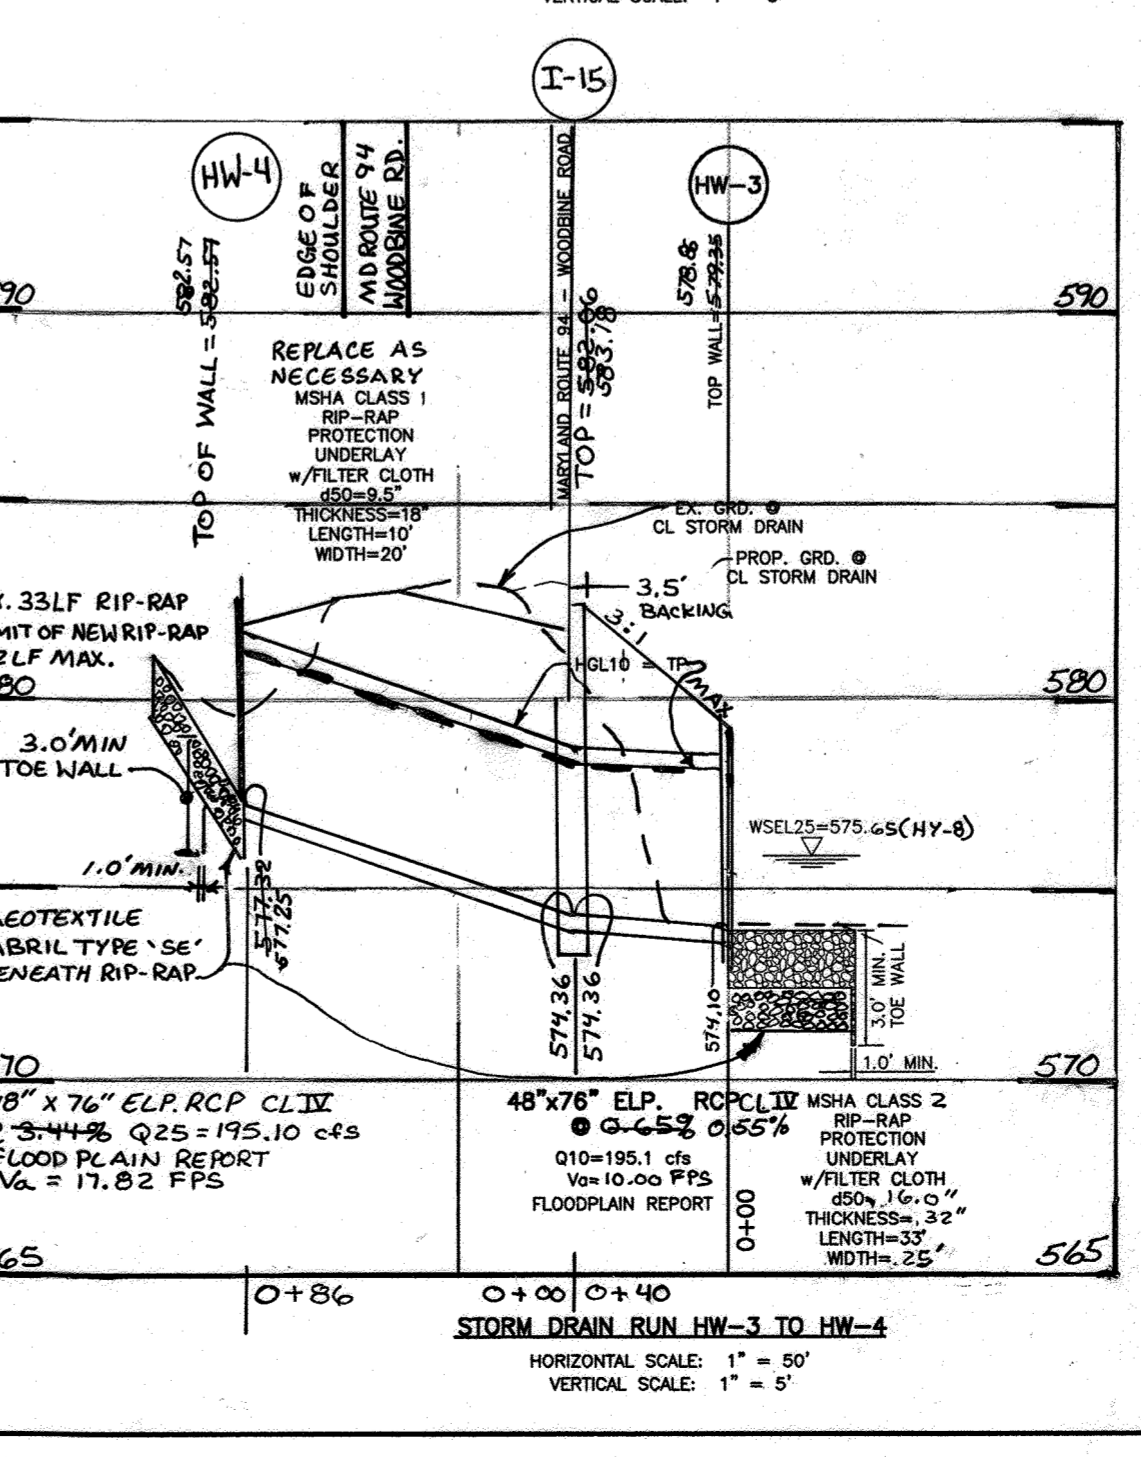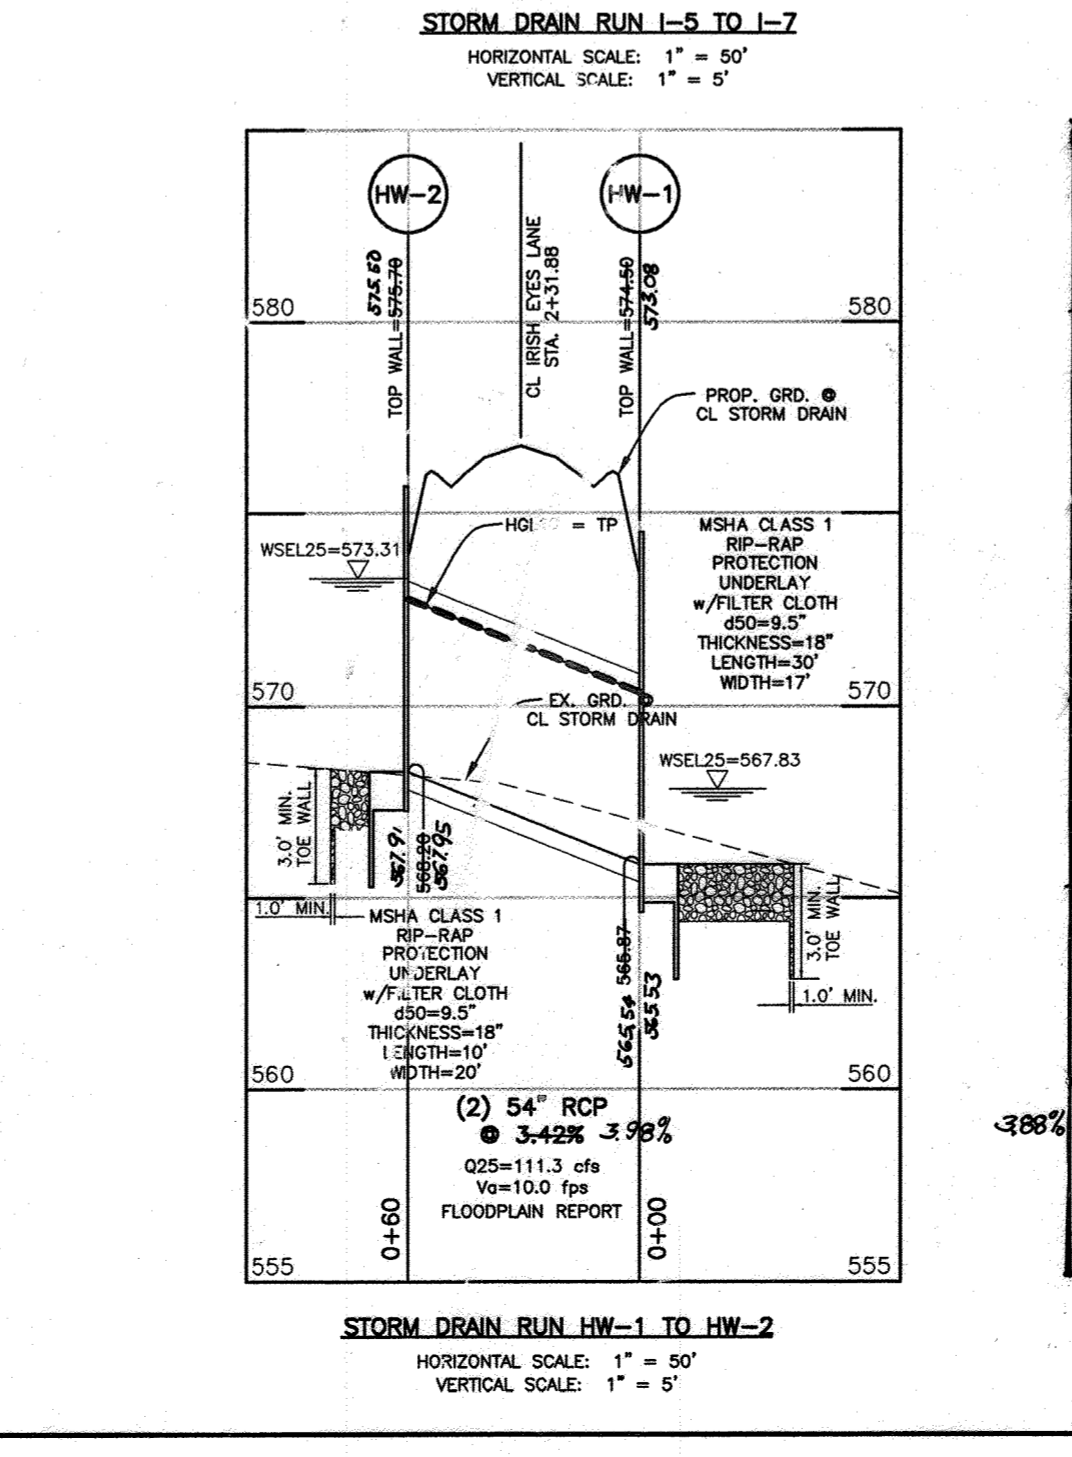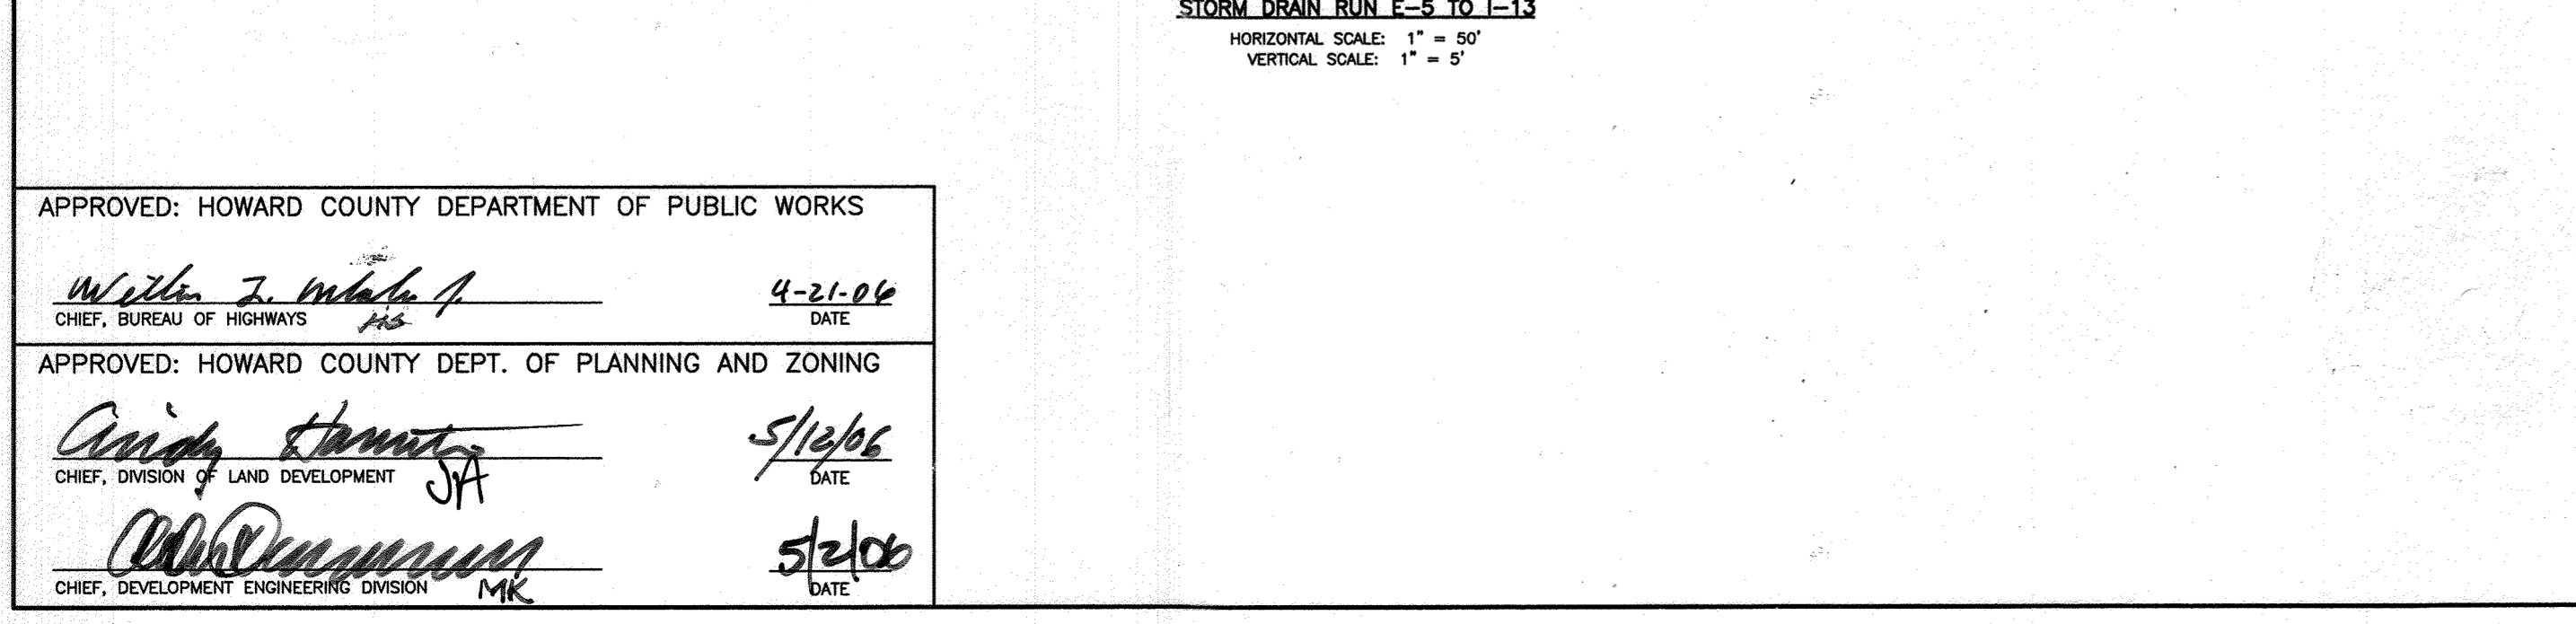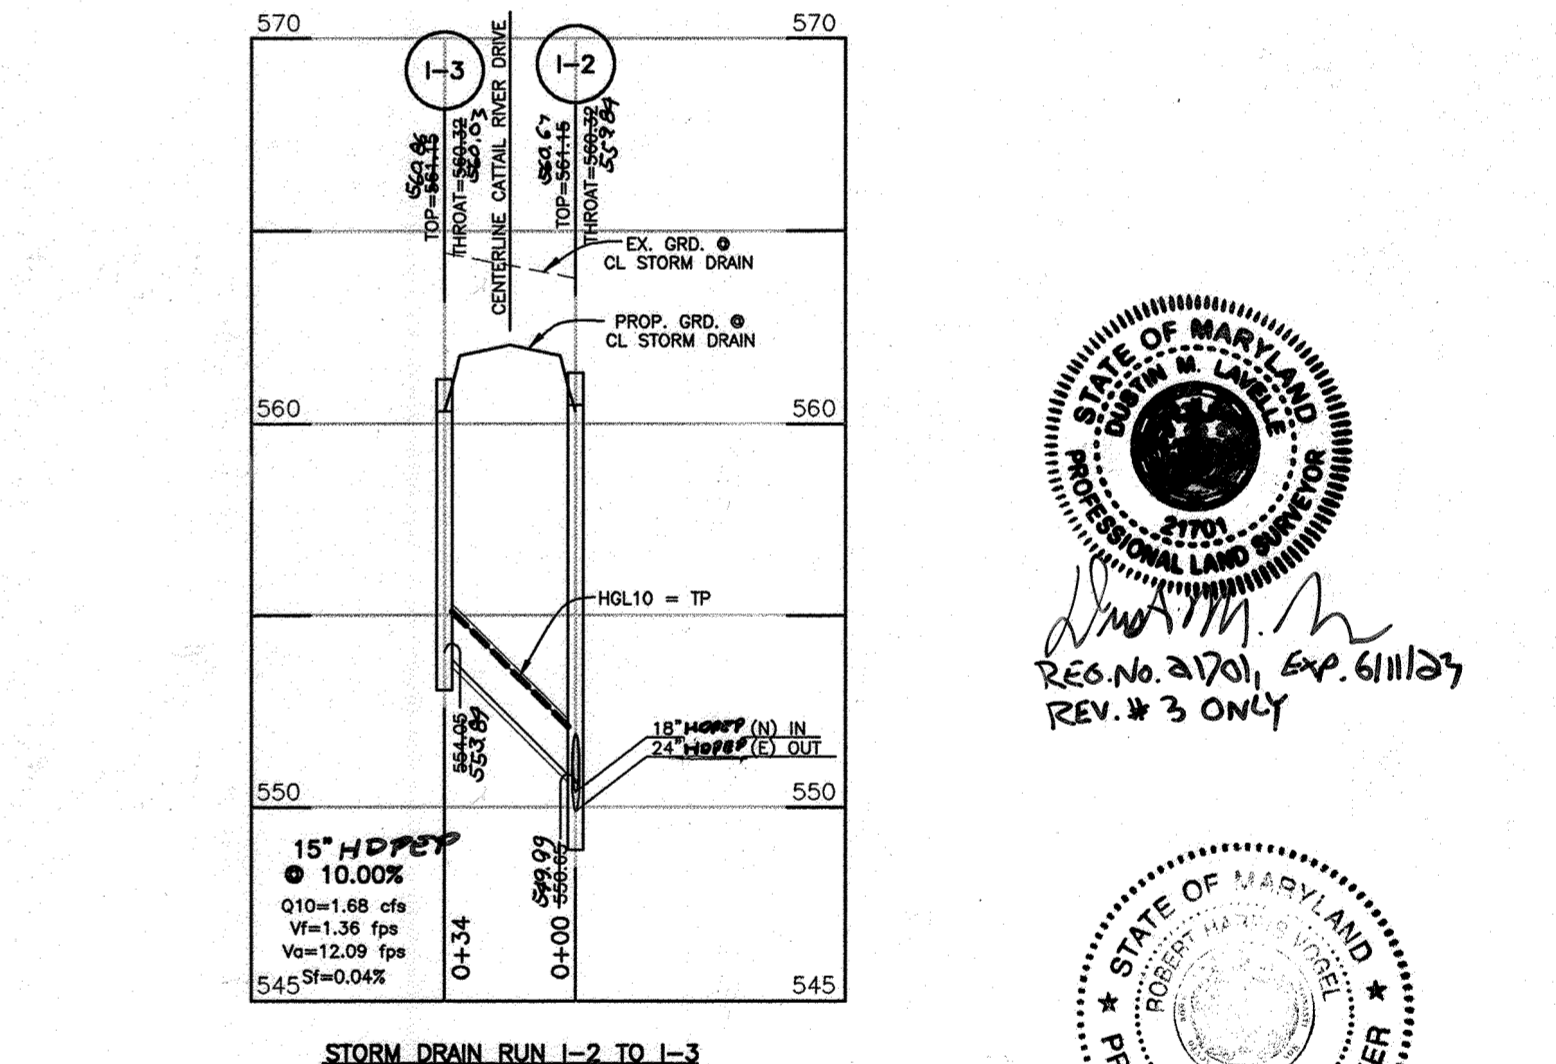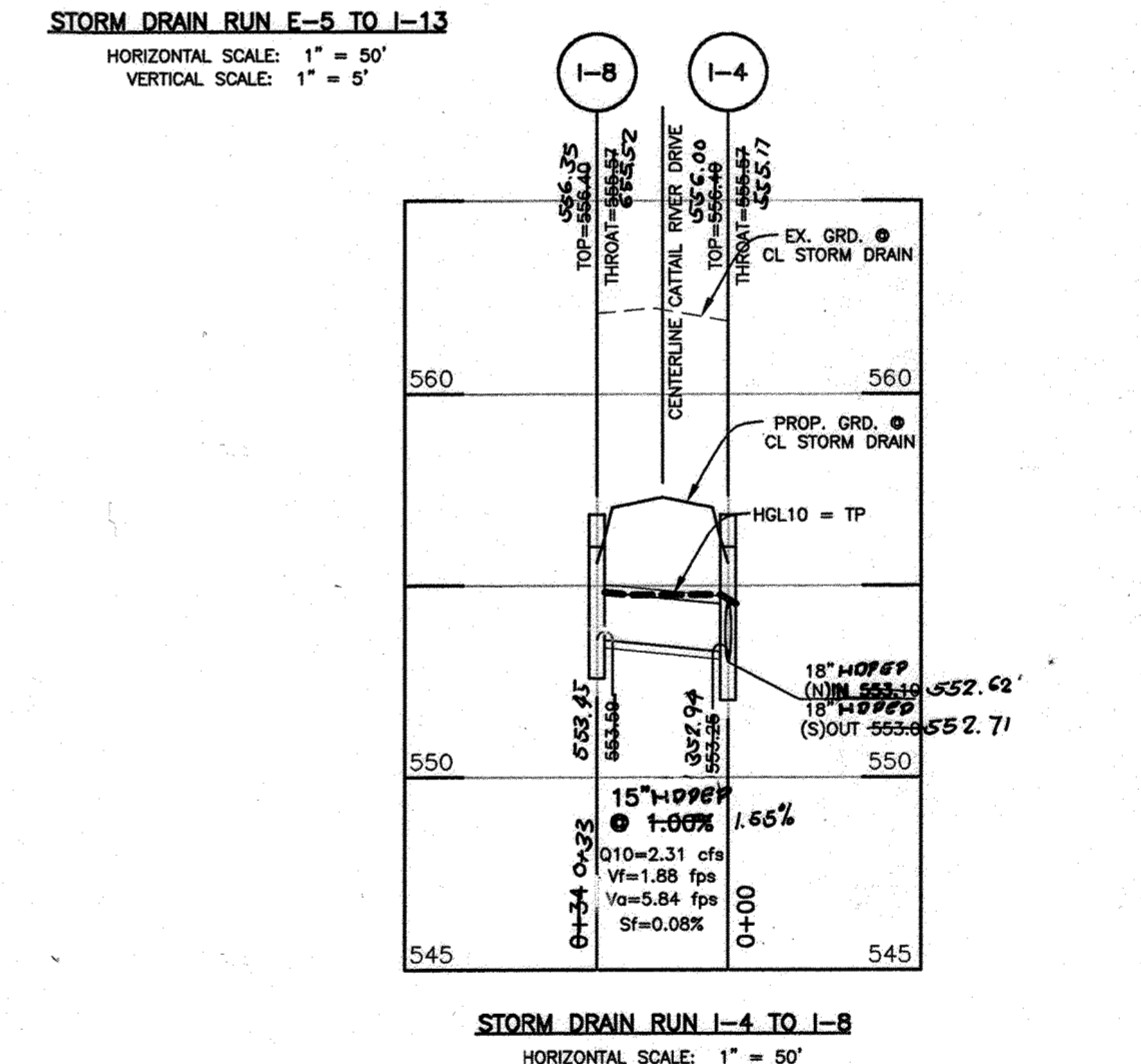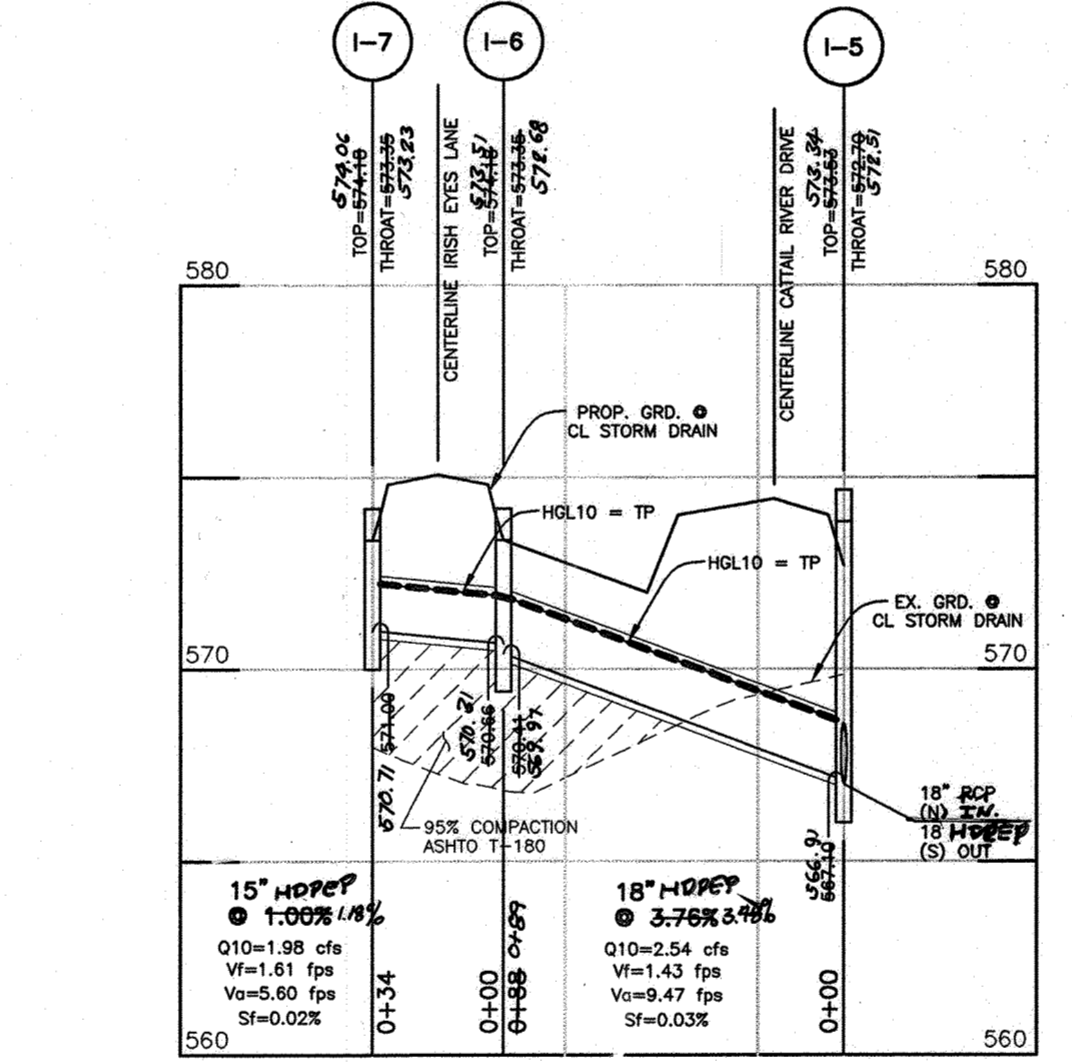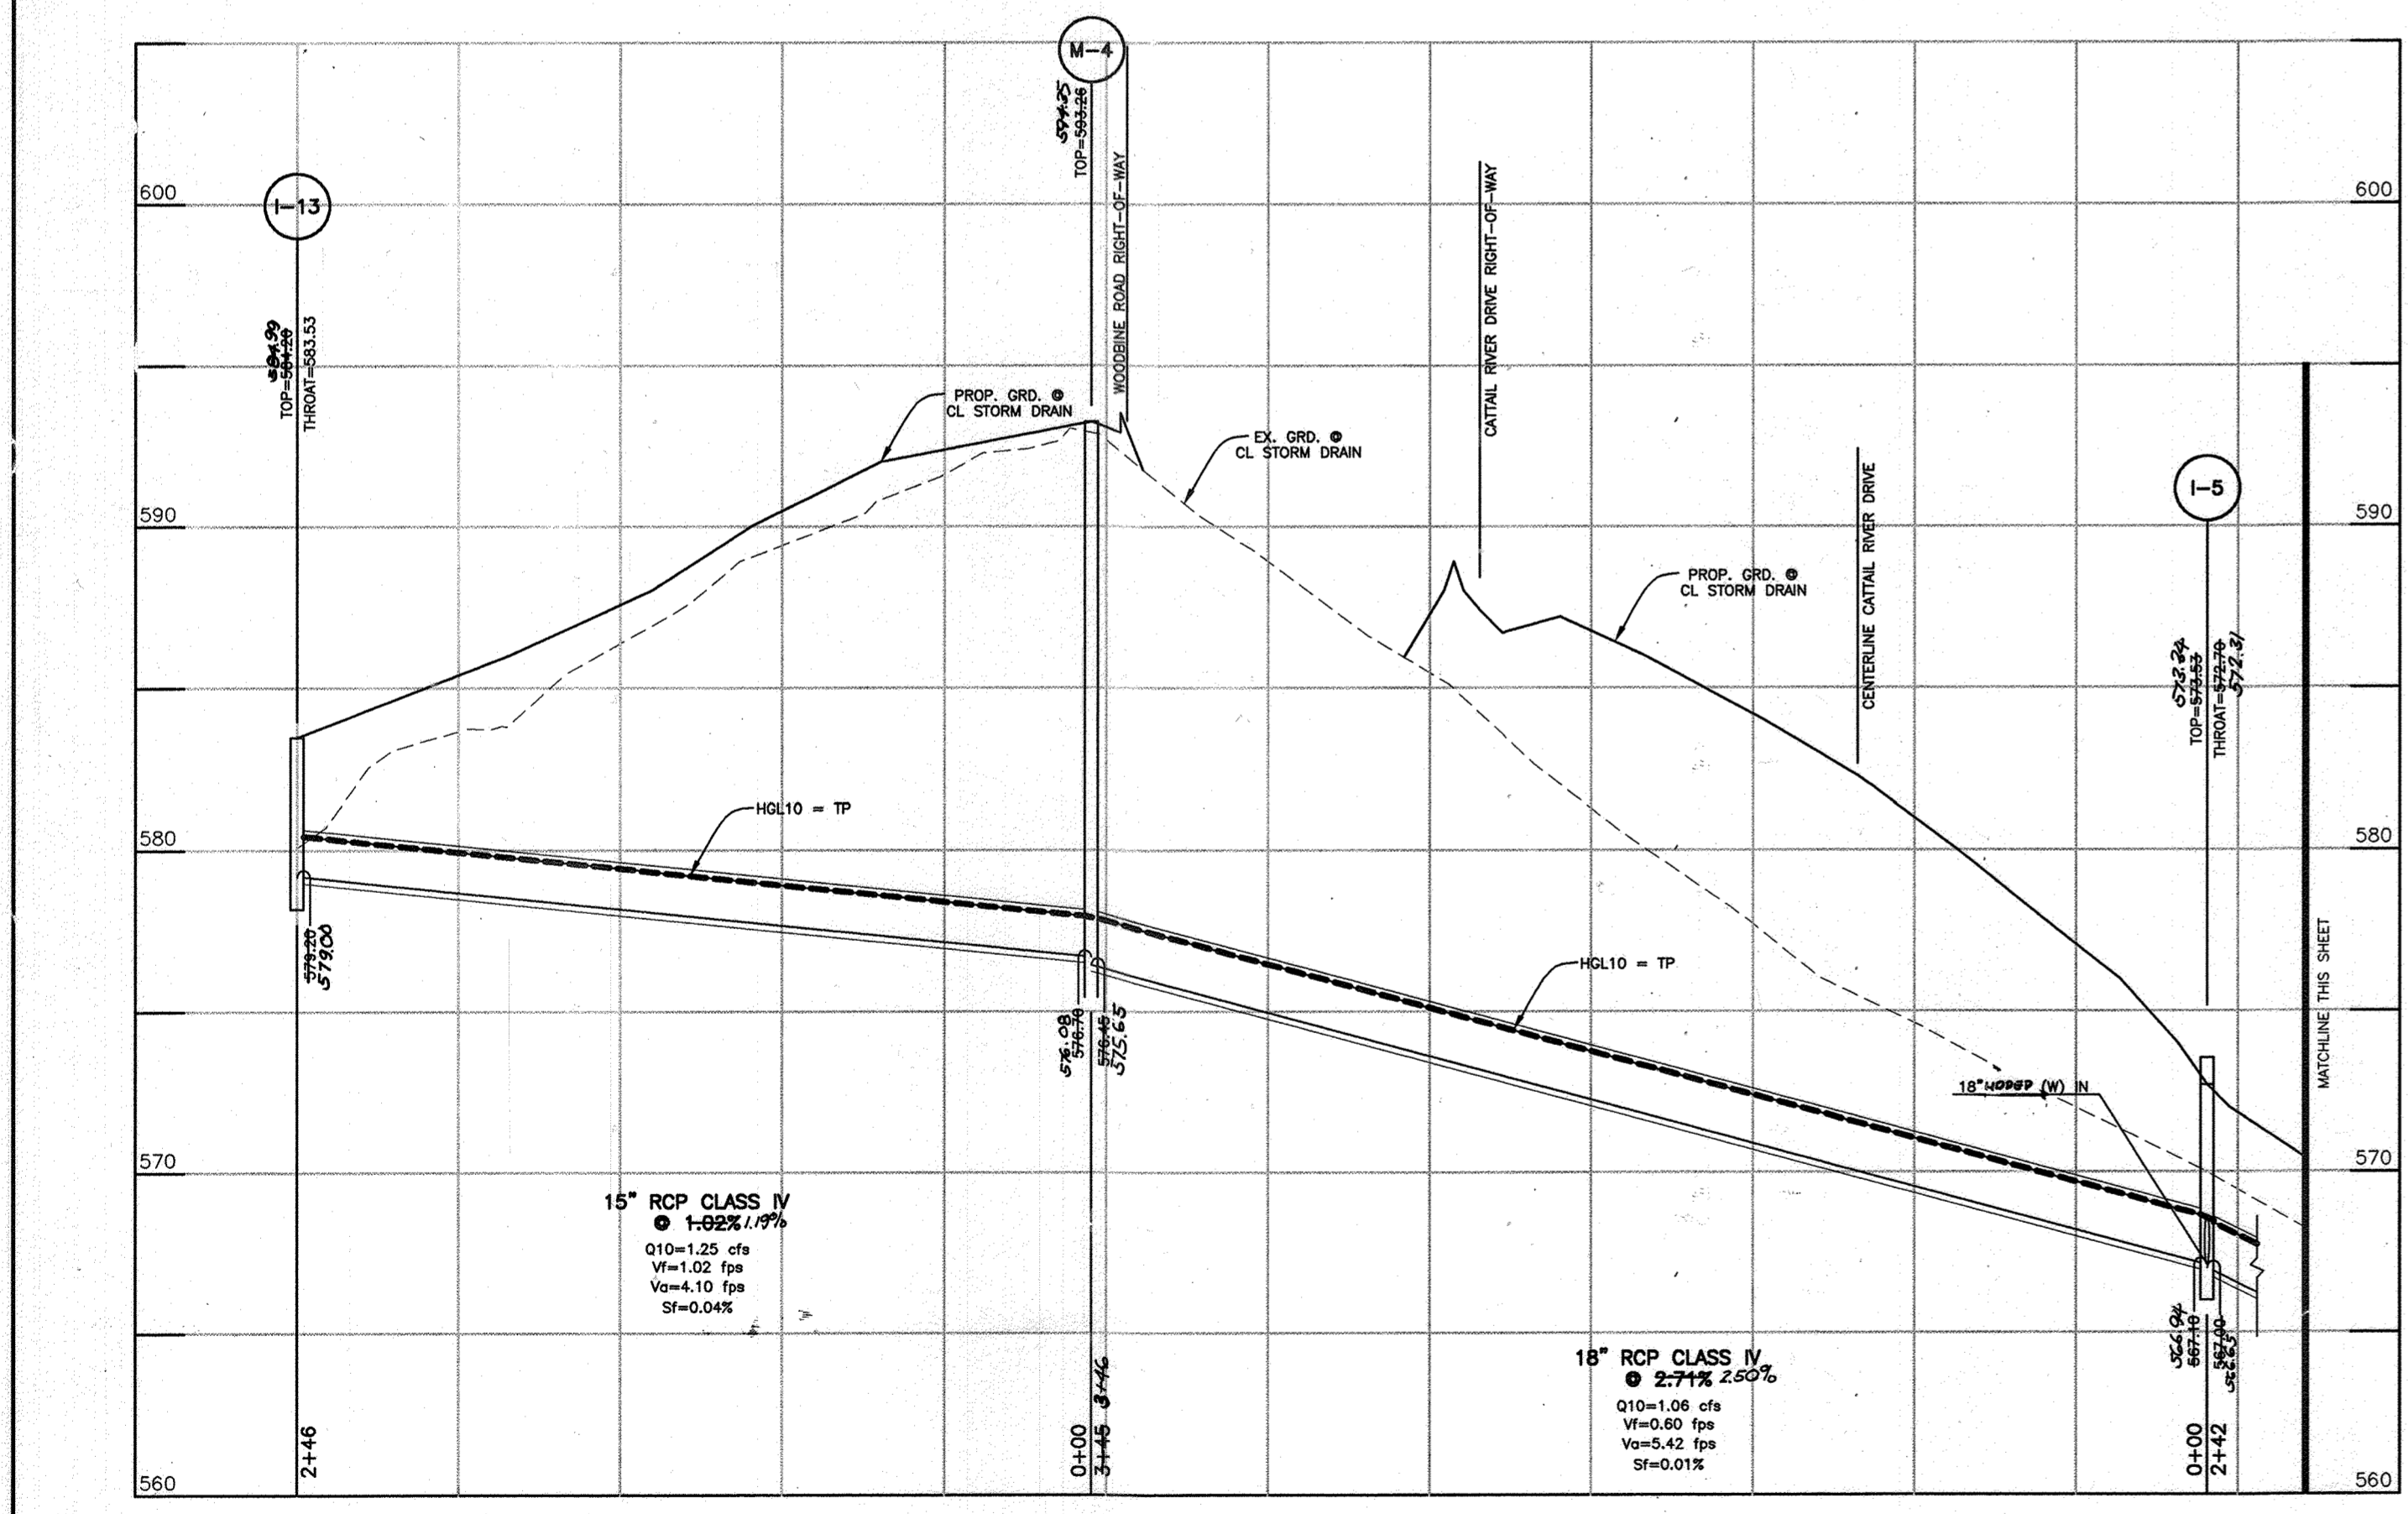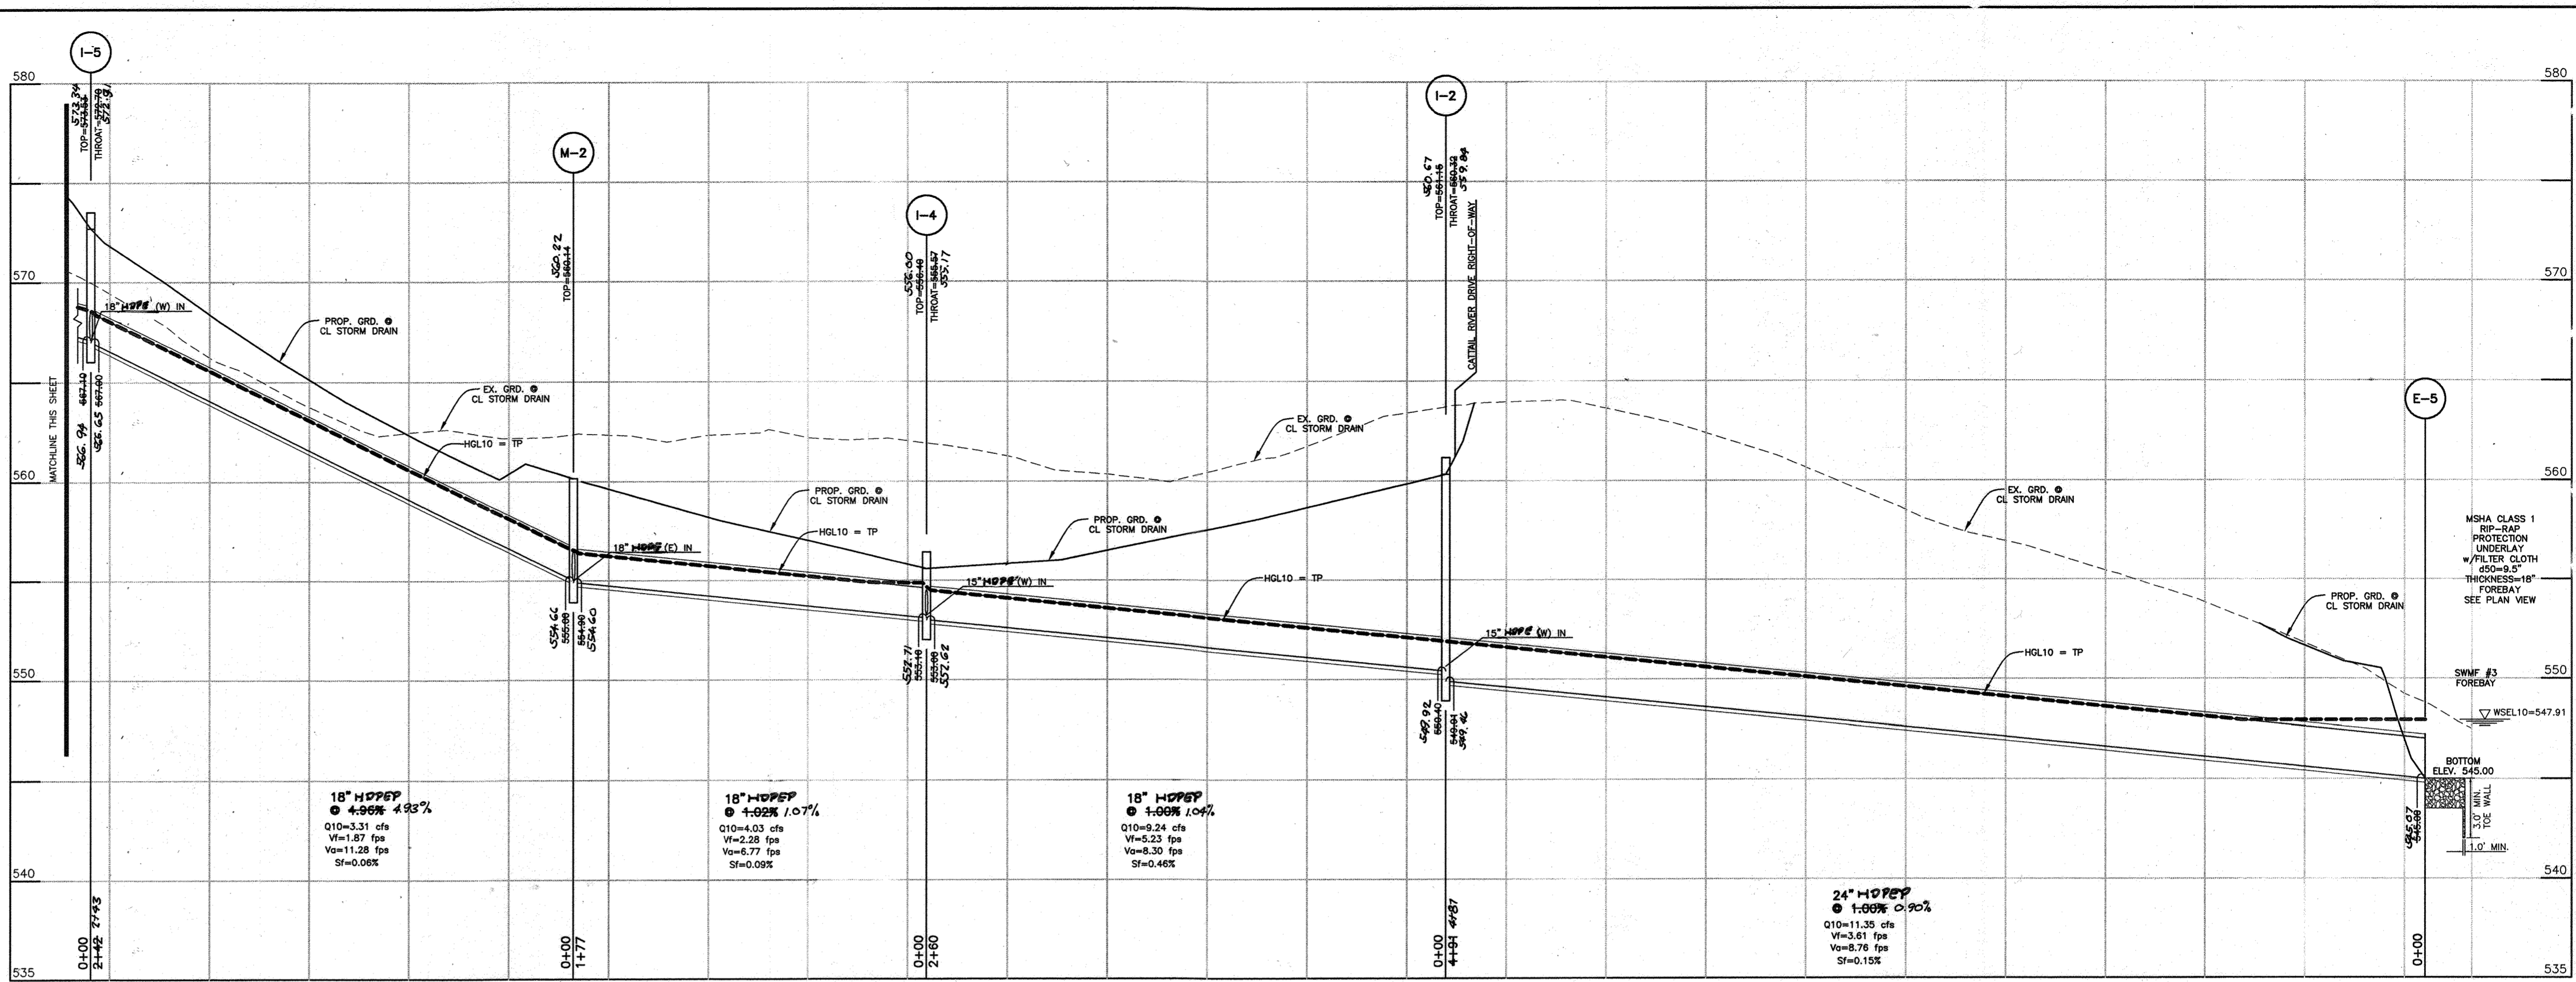

STATE OF MARYLAND PROFESSIONAL ENGINEER

REG. NO. 21701, Exp. 6/11/23
REV. # 3 ONLY

STATE OF MARYLAND PROFESSIONAL ENGINEER

REG. NO. 15183

AS-BUILT PARTICIPATION

I HEREBY CERTIFY THAT THE PROJECT SHOWN ON THIS PLAN WAS CONSIDERED BY ME AND I AM AN ENGINEER IN THE STATE OF MARYLAND AND I HAVE APPROVED THE PLAN AND SPECIFICATIONS.

3 418283 RANS PAGE NO.
2 3/7/07 REVISE HW-3 TO HW-4 PROFILE TO MATCH MSHA PERMIT
1 12/6/06 REVISE STORM DRAIN MATERIAL

BENCHMARK ENGINEERING, INC.
ENGINEERS & LAND SURVEYORS & PLANNERS
8480 BALTIMORE NATIONAL PIKE & SUITE 418
ELLICOTT CITY, MARYLAND 21043
PHONE: 410-485-6105 FAX: 410-485-6644
WWW.BEI-CIVILENGINEERING.COM

OWNER/DEVELOPER: TRINITY QUALITY HOMES, INC. 3675 PARK AVENUE SUITE 301 ELLICOTT CITY, MD 21043 410-480-0023

PROJECT: THE CHASE AT STONEY BROOK LOTS 1-20, PRESERVATION PARCEL "A" AND NON-BUILDABLE PRESERVATION PARCELS "B" THROUGH "D"

LOCATION: TAX MAP NO. 7 BLOCK NO. 17 PARCEL NO. 133 4th ELECTION DISTRICT HOWARD COUNTY, MARYLAND

TITLE: STORM DRAIN PROFILES

DATE: AUGUST, 2005 PROJECT NO. 1187
MARCH, 2006



DESIGN: JMC **DRAFT:** JMC **SCALE:** AS SHOWN **DRAWING:** 9 OF 20

AS-BUILT 1/31/13


MATCHLINE A-A THIS SHEET MATCHLINE C-C THIS SHEET

DELAY CONSTRUCTION OF CULVERTS UNDER ROUTE 94 AND IRISH EYES LANE UNTIL ALL MATERIALS ARE ONSITE, A 5 DAY CLEAR WEATHER (NO PRECIPITATION) FROM THE NWS IS PROVIDED AND PERMISSION FROM THE SEDIMENT CONTROL INSPECTOR IS RECEIVED

LEGEND

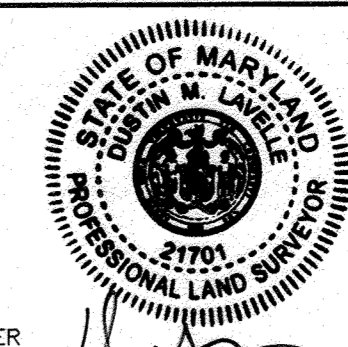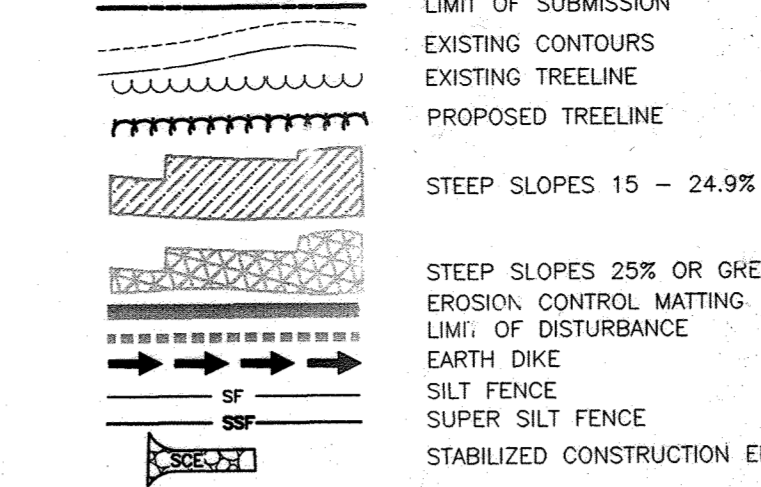

REG. NO. 2001, Exp. 6/1/13
RED-LINE REV. 4/18/06 R3
REV. # 3 ONLY

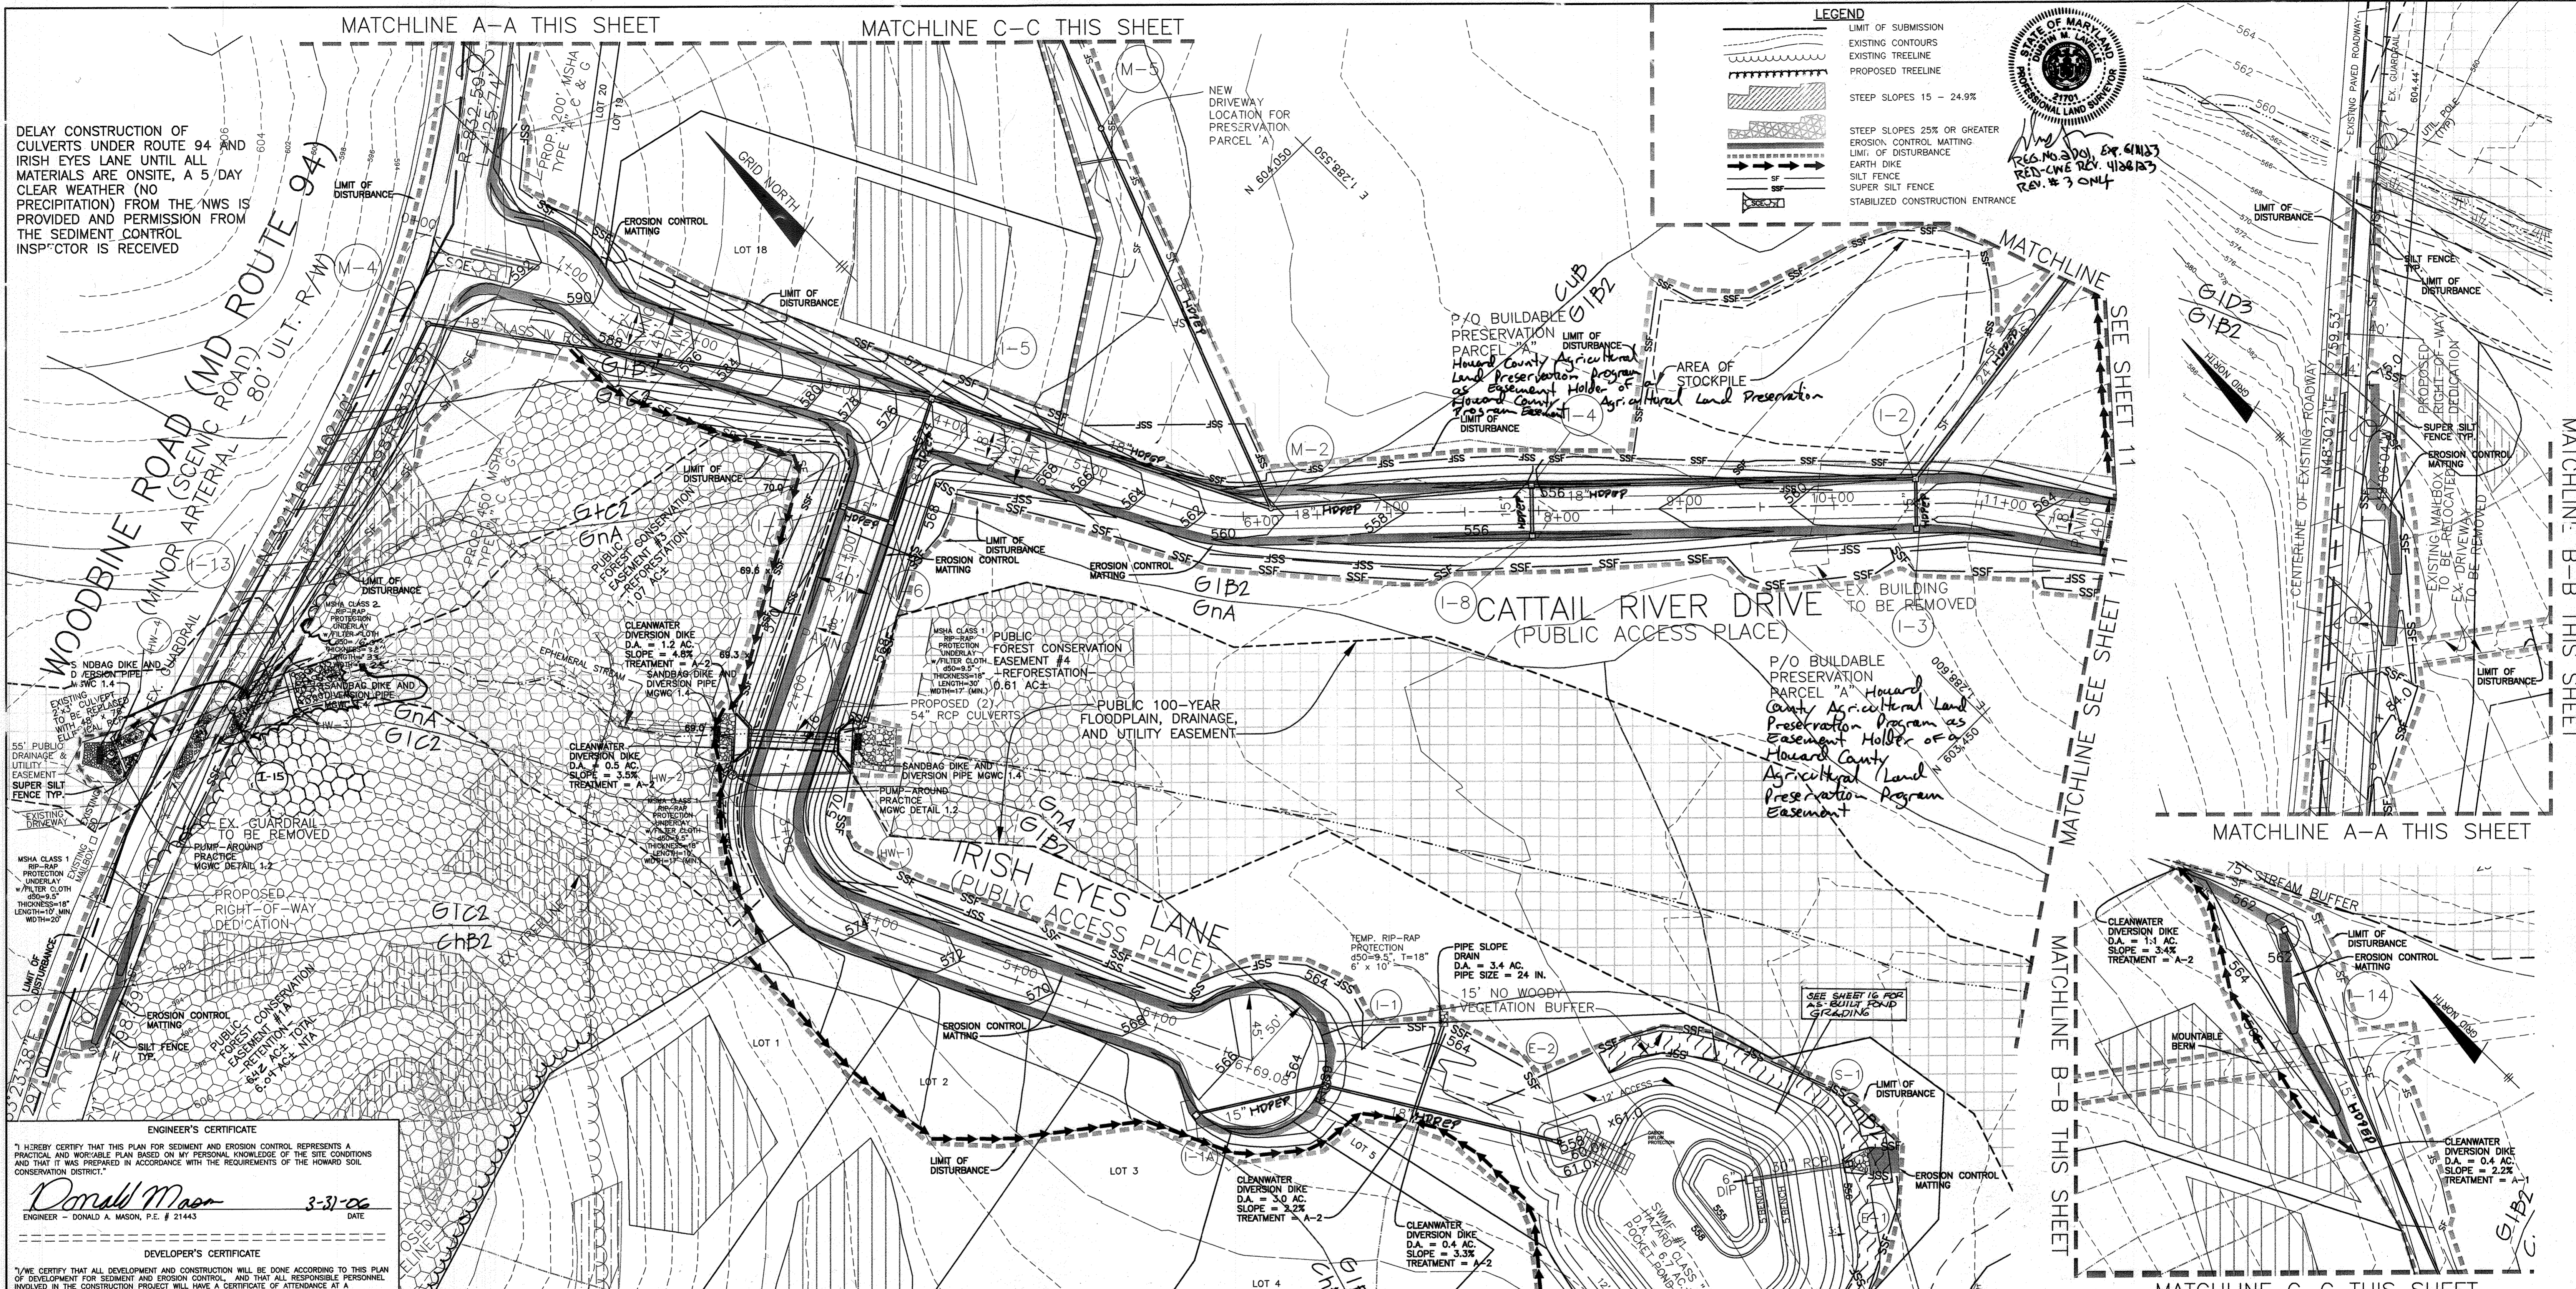

ENGINEER'S CERTIFICATE
I HEREBY CERTIFY THAT THIS PLAN FOR SEDIMENT AND EROSION CONTROL REPRESENTS A PRACTICAL AND WORKABLE PLAN BASED ON MY PERSONAL KNOWLEDGE OF THE SITE CONDITIONS AND THAT IT WAS PREPARED IN ACCORDANCE WITH THE REQUIREMENTS OF THE HOWARD SOIL CONSERVATION DISTRICT.

Donald A. Mason 3-31-06 DATE
ENGINEER - DONALD A. MASON, P.E. # 21443

DEVELOPER'S CERTIFICATE
I/WE CERTIFY THAT ALL DEVELOPMENT AND CONSTRUCTION WILL BE DONE ACCORDING TO THIS PLAN OF DEVELOPMENT FOR SEDIMENT AND EROSION CONTROL, AND THAT ALL RESPONSIBLE PERSONNEL INVOLVED IN THE CONSTRUCTION PROJECT WILL HAVE A CERTIFICATE OF ATTENDANCE AT A DEPARTMENT OF THE ENVIRONMENT APPROVED TRAINING PROGRAM FOR THE CONTROL OF SEDIMENT AND EROSION BEFORE BEGINNING THE PROJECT. I ALSO AUTHORIZE PERIODIC ON-SITE INSPECTION BY THE HOWARD SOIL CONSERVATION DISTRICT.

Michael R. ... 4/2/06 DATE
DEVELOPER

REVIEWED FOR HOWARD SCD AND MEETS TECHNICAL REQUIREMENTS
USDA - NATURAL RESOURCES CONSERVATION SERVICE

APPROVED: DEPARTMENT OF PUBLIC WORKS
John ... 4/1/06 DATE
CHIEF, BUREAU OF HIGHWAYS


APPROVED: DEPARTMENT OF PLANNING AND ZONING
Walter ... 4-21-06 DATE
CHIEF, DIVISION OF LAND DEVELOPMENT

Cheryl ... 5/2/06 DATE
CHIEF, DEVELOPMENT ENGINEERING DIVISION

SOILS LEGEND

SOIL	NAME	CLASS
Ba	Basal silt loam	D
CuB	Cornus silt loam, local alluvium, 3 to 8 percent slopes	D
ClB2	Glenelg loam, 3 to 8 percent slopes, moderately eroded	B
ClC2	Glenelg loam, 8 to 15 percent slopes, moderately eroded	B
ClC3	Glenelg loam, 8 to 15 percent slopes, severely eroded	B
ClD3	Glenelg loam, 15 to 25 percent slopes, severely eroded	B
ClD2	Glenelg loam, 15 to 25 percent slopes, moderately eroded	B
GnA	Glenville silt loam, 0 to 3 percent slopes	C
GnB2	Glenville silt loam, 3 to 8 percent slopes, moderately eroded	C
Ha	Hatboro silt loam	C
MIC2	Mt. Airy channery loam, 8 to 15 percent slopes, moderately eroded	A
MIC3	Mt. Airy channery loam, 8 to 15 percent slopes, severely eroded	A
MD2	Mt. Airy channery loam, 15 to 25 percent slopes, moderately eroded	A
ME	Mt. Airy channery loam, 25 to 45 percent slopes	A

NOTES:
* Hydric soils and/or contains hydric inclusions
** May contain hydric inclusions
† Generally only within 100-year floodplain areas

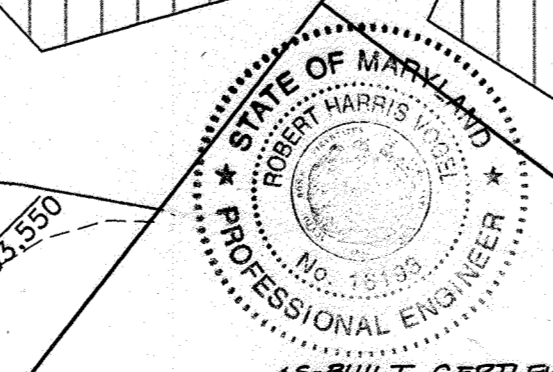

AS-BUILT CERTIFICATION
I HEREBY CERTIFY THAT THE QUALITY ASSURANCE ON THIS PLAN WAS CONDUCTED AS SHOWN ON THE "AS-BUILT" PLANS AND SPECIFICATIONS THE APPROVED PLANS AND SPECIFICATIONS

Donald A. Mason 1/3/13 DATE
P.E. # 21443

BENCHMARK ENGINEERING, INC.
ENGINEERS • LAND SURVEYORS • PLANNERS

8480 BALTIMORE NATIONAL PIKE & SUITE 418
ELLICOTT CITY, MARYLAND 21043
phone: 410-465-6105 • fax: 410-465-6644
www.bel-civilengineering.com

Donald A. Mason 3/3/06

OWNER/DEVELOPER: TRINITY QUALITY HOMES, INC. 3675 PARK AVENUE SUITE 301 ELLICOTT CITY, MD 21043 410-480-0023

PROJECT: THE CHASE AT STONEY BROOK
LOTS 1-20, PRESERVATION PARCEL "A" AND NON-BUILDABLE PRESERVATION PARCELS "B" THROUGH "D"


LOCATION: TAX MAP No. 7, BLOCK No. 17, PARCEL No. 133 4th ELECTION DISTRICT HOWARD COUNTY, MARYLAND

TITLE: GRADING, SEDIMENT AND EROSION CONTROL PLAN

DATE: MARCH, 2006 PROJECT NO. 1187
SCALE: 1" = 50' SHEET 10 OF 20

DES: JMC DRAFT: LAB CHECK: DAM

AS-BUILT 1/3/13 F-05-170

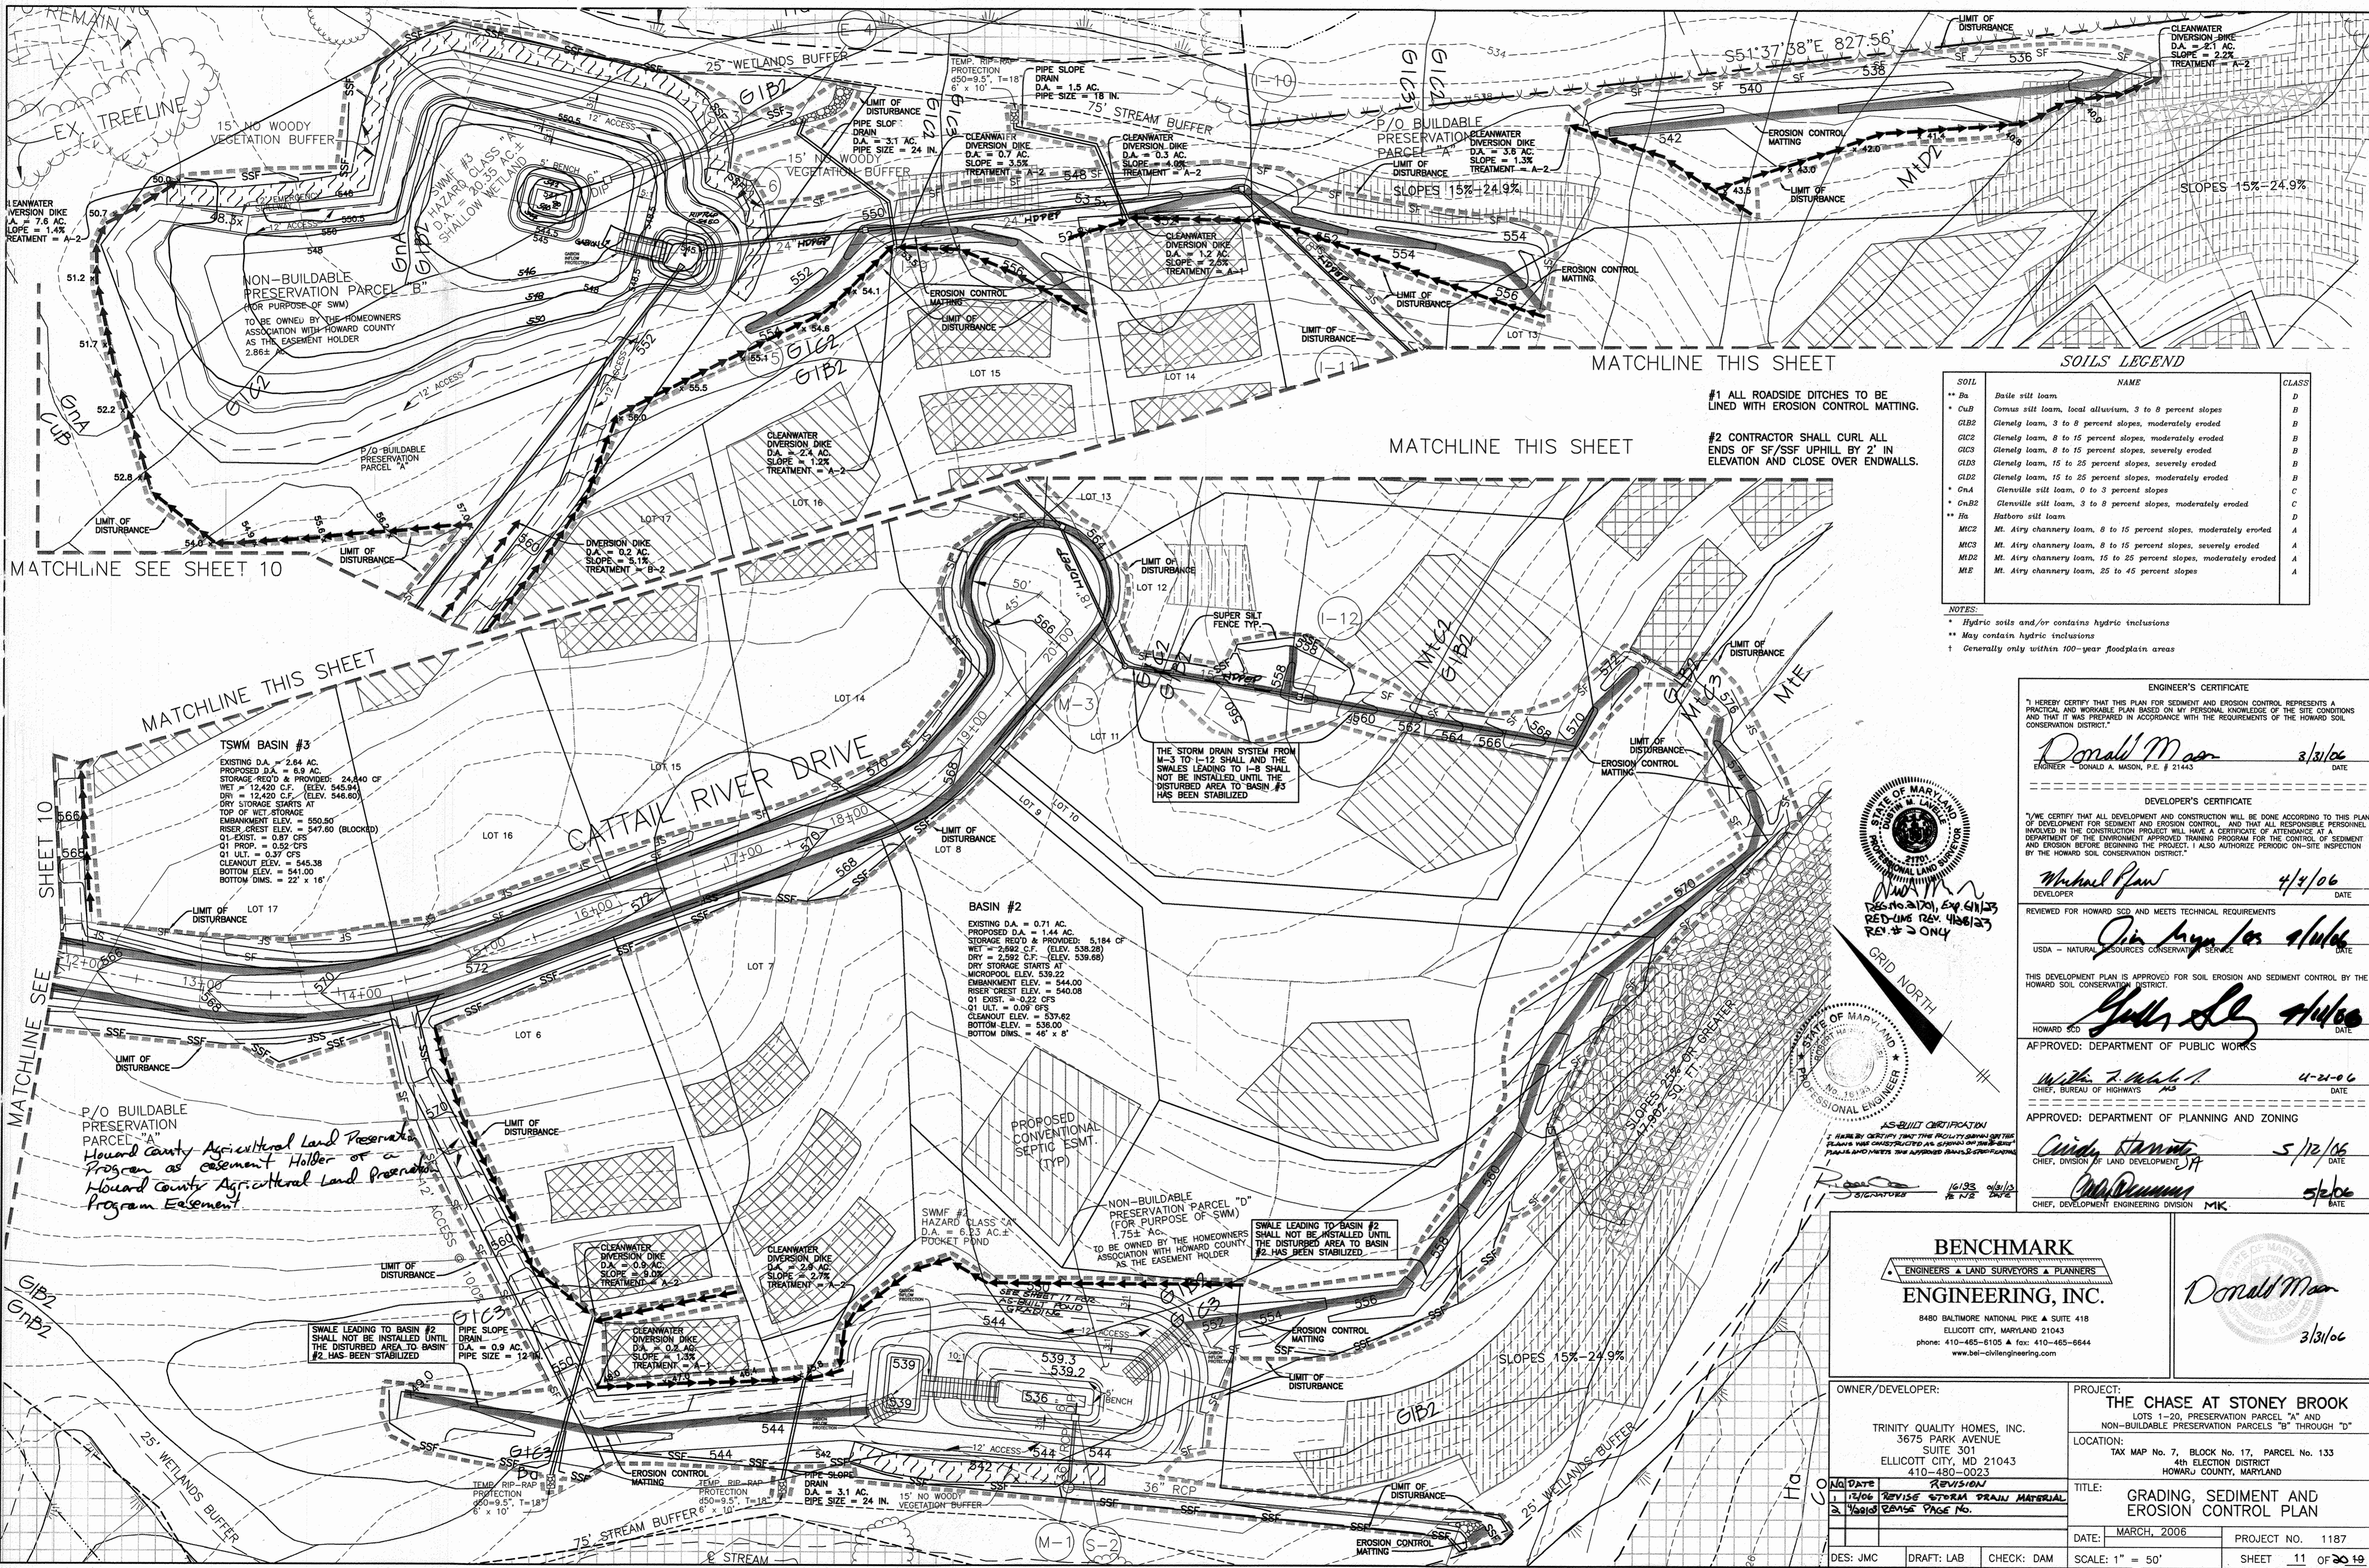

SOILS LEGEND

SOIL	NAME	CLASS
** Ba	Bate silt loam	D
* CuB	Comus silt loam, local alluvium, 3 to 8 percent slopes	B
GLB2	Glenelg loam, 3 to 8 percent slopes, moderately eroded	B
GLC2	Glenelg loam, 8 to 15 percent slopes, moderately eroded	B
GLC3	Glenelg loam, 8 to 15 percent slopes, severely eroded	B
GLD3	Glenelg loam, 15 to 25 percent slopes, severely eroded	B
CLD2	Glenelg loam, 15 to 25 percent slopes, moderately eroded	B
* OnA	Glenville silt loam, 0 to 3 percent slopes	C
* OnB2	Glenville silt loam, 3 to 8 percent slopes, moderately eroded	C
** Ha	Hatboro silt loam	D
MC2	Mt. Airy channery loam, 8 to 15 percent slopes, moderately eroded	A
MC3	Mt. Airy channery loam, 8 to 15 percent slopes, severely eroded	A
MD2	Mt. Airy channery loam, 15 to 25 percent slopes, moderately eroded	A
ME	Mt. Airy channery loam, 25 to 45 percent slopes	A

NOTES:
 * Hydric soils and/or contains hydric inclusions
 ** May contain hydric inclusions
 † Generally only within 100-year floodplain areas

#1 ALL ROADSIDE DITCHES TO BE LINED WITH EROSION CONTROL MATTING.
 #2 CONTRACTOR SHALL CURL ALL ENDS OF SF/SSF UPHILL BY 2' IN ELEVATION AND CLOSE OVER ENDWALLS.

ENGINEER'S CERTIFICATE
 I HEREBY CERTIFY THAT THIS PLAN FOR SEDIMENT AND EROSION CONTROL REPRESENTS A PRACTICAL AND WORKABLE PLAN BASED ON MY PERSONAL KNOWLEDGE OF THE SITE CONDITIONS AND THAT IT WAS PREPARED IN ACCORDANCE WITH THE REQUIREMENTS OF THE HOWARD SOIL CONSERVATION DISTRICT.

Donald Mason 3/31/06
 ENGINEER - DONALD A. MASON, P.E. # 21443 DATE

DEVELOPER'S CERTIFICATE

I/WE CERTIFY THAT ALL DEVELOPMENT AND CONSTRUCTION WILL BE DONE ACCORDING TO THE PLAN OF DEVELOPMENT FOR SEDIMENT AND EROSION CONTROL, AND THAT ALL RESPONSIBLE PERSONNEL INVOLVED IN THE CONSTRUCTION PROJECT WILL HAVE A CERTIFICATE OF ATTENDANCE AT A DEPARTMENT OF THE ENVIRONMENT APPROVED TRAINING PROGRAM FOR THE CONTROL OF SEDIMENT AND EROSION BEFORE BEGINNING THE PROJECT. I ALSO AUTHORIZE PERIODIC ON-SITE INSPECTION BY THE HOWARD SOIL CONSERVATION DISTRICT.

Michael Pflaw 4/2/06
 DEVELOPER DATE

REVIEWED FOR HOWARD SCD AND MEETS TECHNICAL REQUIREMENTS
 USDA - NATURAL RESOURCES CONSERVATION SERVICE
Jim Bryan 4/14/06
 DATE


THIS DEVELOPMENT PLAN IS APPROVED FOR SOIL EROSION AND SEDIMENT CONTROL BY THE HOWARD SOIL CONSERVATION DISTRICT.

HOWARD SCD
Gulls 4/14/06
 DATE

APPROVED: DEPARTMENT OF PUBLIC WORKS
William J. ... 4-21-06
 CHIEF BUREAU OF HIGHWAYS DATE

APPROVED: DEPARTMENT OF PLANNING AND ZONING
Cindy ... 5/12/06
 CHIEF, DIVISION OF LAND DEVELOPMENT DATE

Michael ... 5/2/06
 CHIEF, DEVELOPMENT ENGINEERING DIVISION MK DATE

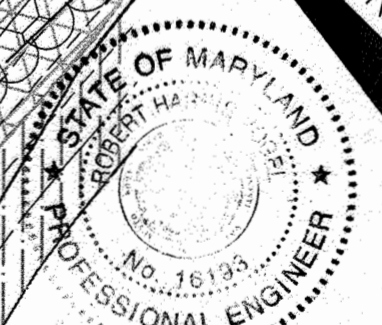

AS-BUILT CERTIFICATION
 I HEREBY CERTIFY THAT THE FACILITY SHOWN ON THIS PLAN WAS CONSTRUCTED AND SHOWN ON THIS AS-BUILT PLAN ACCORDING TO THE APPROVED PLAN AND SPECIFICATIONS.

Michael ... 10/23/06
 DATE

BENCHMARK ENGINEERS & LAND SURVEYORS & PLANNERS
ENGINEERING, INC.
 8480 BALTIMORE NATIONAL PIKE & SUITE 418
 ELLICOTT CITY, MARYLAND 21043
 phone: 410-465-6105 & fax: 410-465-6644
 www.bel-civilengineering.com

Donald Mason 3/31/06

OWNER/DEVELOPER: TRINITY QUALITY HOMES, INC. 3675 PARK AVENUE SUITE 301 ELLICOTT CITY, MD 21043 410-480-0023	PROJECT: THE CHASE AT STONEY BROOK LOTS 1-20, PRESERVATION PARCEL "A" AND NON-BUILDABLE PRESERVATION PARCELS "B" THROUGH "D"
LOCATION: TAX MAP No. 7, BLOCK No. 17, PARCEL No. 133 4th ELECTION DISTRICT HOWARD COUNTY, MARYLAND	TITLE: GRADING, SEDIMENT AND EROSION CONTROL PLAN
DATE: MARCH, 2006	PROJECT NO. 1187
DES: JMC DRAFT: LAB CHECK: DAM	SCALE: 1" = 50'
SHEET 11 OF 30	

TOPSOIL SPECIFICATIONS

- I. Topsoil salvaged from the existing site may be used provided that it meets that standards as set forth in these specifications. Typically, the depth of topsoil to be salvaged for a given soil type can be found in the representative soil profile section in the Soil Survey published by USDA-SCS in cooperation with Maryland Agricultural Experiment Station.
II. Topsoil Specifications - Soil to be used as topsoil must meet the following:
1. Topsoil shall be a loam, sandy loam, clay loam, all loam, sandy clay loam, loamy sand, Other soils may be used if recommended by an agronomist or soil scientist and approved by the appropriate authority.
2. Topsoil shall be free of stumps or plant parts such as Bermuda grass, quack grass, Johnson grass, nutgrass, poison ivy, thistle, or others as specified.
3. Where the subsoil is either highly acidic or composed of heavy clays, ground limestone shall be spread at the rate of 4-8 tons/acre (200-400 pounds per 1,000 square feet) prior to the placement of topsoil.
4. Topsoil shall be free of stumps or plant parts such as Bermuda grass, quack grass, Johnson grass, nutgrass, poison ivy, thistle, or others as specified.
5. For sites having disturbed areas over 5 acres:
I. Place topsoil (if required) and apply soil amendments as specified in 20.0 Vegetative Stabilization - Section I - Vegetative Stabilization Methods and Materials.
II. For sites having disturbed areas over 5 acres:
1. On soil meeting Topsoil specifications, obtain test results dictating fertilizer and lime amendments to bring the soil into compliance with the following:
a. pH for topsoil shall be between 6.0 and 7.5. If the tested soil demonstrates a pH of less than 6.0, sufficient lime shall be prescribed to raise the pH to 6.0 or higher.
b. Organic content or topsoil shall be not less than 1.5 percent by weight.
c. Topsoil having soluble salt content greater than 500 parts per million shall not be used.
d. No soil or seed shall be placed on soil which has been treated with soil sterilants or chemicals used for weed control unless sufficient time has elapsed (14 days min.) to permit dissipation of phytotoxic materials.
2. Topsoil substitutes or amendments, as recommended by a qualified agronomist or soil scientist and approved by the appropriate authority, may be used in lieu of natural topsoil.
3. Place topsoil (if required) and apply soil amendments as specified in 20.0 Vegetative Stabilization - Section I - Vegetative Stabilization Methods and Materials.
V. Topsoil Application
1. When topsoiling, maintain needed erosion and sediment control practices such as diversions, grade stabilization structures, earth dikes, slope fill and sediment traps and basins.
2. Grades on the areas to be topsoiled, which have been previously established, shall be maintained, albeit 4" - 8" higher in elevation.
3. Topsoil shall be uniformly distributed in a 4" - 8" layer and lightly compacted to a minimum thickness of 4". Spreading shall be performed in such a manner that seeding or sodding can proceed to a minimum of 100% coverage.
4. Any irregularities in the surface resulting from topsoiling or other operations shall be corrected in order to prevent the formation of depressions or water pockets.
5. Topsoil shall not be placed while the topsoil or subsoil is in a frozen or muddy condition, when the subsoil is in a condition that is so friable that it may otherwise be detrimental to proper grading and seeded preparation.
VI. Alternative for Permanent Seeding - Instead of applying the full amounts of lime and commercial fertilizer, composted sludge and amendments may be applied as specified below.
I. Composted Sludge Material for use as a soil conditioner for sites having disturbed areas over 5 acres shall be tested to prescribe amendments and for sites having disturbed areas over 5 acres shall conform to the following requirements:
a. Composted sludge shall be supplied by, or originate from, a person or persons that are permitted (at the time of acquisition of the compost) by the Maryland Department of the Environment under COMAR 26.04.06.
b. Composted sludge shall contain at least 1 percent nitrogen, 1.5 percent phosphorus, and 0.2 percent potassium and have a pH of 6.0 or higher. If compost does not meet these requirements, the appropriate constituents must be added to meet the requirements prior to use.
c. Composted sludge shall be applied at a rate of 1/4 to 1/2 ton/1,000 square feet.
d. Composted sludge shall be amended with a potassium fertilizer applied at the rate of 4 lb/1,000 square feet and 1/2 the normal lime application rate.
References: Guidelines Specifications, Soil Preparation and Sodding, MD-VA, Pub. #1, Cooperative Extension Service, University of Maryland and Virginia Polytechnic Institute, Revised 1973.


30.0 DUST CONTROL

- Definition
Controlling dust blowing and movement on construction sites and roads.
Purpose
To prevent blowing and movement of dust from exposed soil surfaces, reduce on and off-site damage, health hazards, and improve traffic safety.
Conditions Where Practice Applies
This practice is applicable to areas subject to dust blowing and movement where on and off-site damage is likely without treatment.
Specifications
1. Mulches - See standards for vegetative stabilization with mulches only. Mulch should be crimped or trolled to prevent blowing.
2. Vegetative Cover - See standards for temporary vegetative cover.
3. Tillage - To roughen surface and bring clods to the surface. This is an emergency measure which should be used before soil blowing starts. Begin plowing on windward side of site. Tillage-type plows spaced about 12' apart, spring-toothed harrows, and similar plows are examples of equipment which may produce the desired effect.
4. Irrigation - This is generally done as an emergency treatment. Site is sprinkled with water until the surface is moist. Repeat as needed. At no time should the site be irrigated to the point that runoff begins to flow.
5. Barriers - Solid board fences, silt fences, snow fences, burlap fences, straw bales, and similar material can be used to control current and soil blowing. Barriers placed at right angles to prevailing currents at intervals of about 10 times their height are effective in controlling soil blowing.
6. Calcium Chloride - Apply at rates that will keep surface moist. May need reapplication.
Permanent Mulch
1. Permanent Vegetation - See standards for permanent vegetative cover, and permanent stabilization with trees. Existing trees or large shrubs may offer valuable protection if left in place.
2. Topsoiling - Covering with less erosive soil surface. See standards for topsoiling.
3. Stone - Cover surface with crushed stone or coarse gravel.
References
1. Agriculture Handbook 346. Wind Erosion Forces in the United States and Their Use in Soil Conservation.
2. Agriculture Information Bulletin 354. How to Control Wind Erosion, USDA-ARS.


SEDIMENT CONTROL NOTES

- 1. A MINIMUM OF 24 HOURS NOTICE MUST BE GIVEN TO THE HOWARD COUNTY DEPARTMENT OF INSPECTION, LICENSES AND PERMITS, SEDIMENT CONTROL DIVISION PRIOR TO THE START OF ANY CONSTRUCTION. (313-1850).
2. ALL VEGETATIVE AND STRUCTURAL PRACTICES ARE TO BE INSTALLED ACCORDING TO THE PROVISIONS OF THIS PLAN AND ARE TO BE IN CONFORMANCE WITH THE MOST CURRENT 'MARYLAND STANDARDS AND SPECIFICATION FOR SOIL EROSION AND SEDIMENT CONTROL', REVISIONS THERETO.
3. FOLLOWING INITIAL SOIL DISTURBANCE OR REDISTURBANCE, PERMANENT OR TEMPORARY STABILIZATION SHALL BE COMPLETED WITHIN: A) 7 CALENDAR DAYS FOR ALL PERMANENT SEDIMENT CONTROL STRUCTURES, DIKES, PERIMETER SLOPES AND ALL SLOPES GREATER THAN 3:1, B) 14 DAYS AS TO ALL OTHER DISTURBED OR GRADED AREAS ON THE PROJECT SITE.
4. ALL SEDIMENT TRAPS/BASINS SHOWN MUST BE FENCED AND WARNING SIGNS POSTED AROUND THEIR PERIMETER IN ACCORDANCE WITH VOL. 1, CHAPTER 12, OF THE HOWARD COUNTY DESIGN MANUAL, STORM DRAINAGE.
5. ALL DISTURBED AREAS MUST BE STABILIZED WITHIN THE TIME PERIOD SPECIFIED ABOVE IN ACCORDANCE WITH THE 1994 MARYLAND STANDARDS AND SPECIFICATIONS FOR SOIL EROSION AND SEDIMENT CONTROL PERMANENT SEEDINGS (SEC. 51) SITE SPECIFIC TO THE PROJECT. PARTICIPANTS WILL BE REQUIRED TO MAINTAIN STABILIZATION WITH MULCH ALONE CAN ONLY BE DONE WHEN RECOMMENDED SEEDING DATES DO NOT ALLOW FOR PROPER GERMINATION AND ESTABLISHMENT OF GRASSES.
6. ALL SEDIMENT CONTROL STRUCTURES ARE TO REMAIN IN PLACE AND ARE TO BE MAINTAINED IN OPERATIVE CONDITION UNTIL PERMITS FOR THEIR REMOVAL HAS BEEN OBTAINED FROM THE HOWARD COUNTY SEDIMENT CONTROL INSPECTOR.
7. SITE ANALYSIS:
TOTAL AREA OF SITE 116.79 ACRES
AREA DISTURBED 16.73 ACRES
AREA TO BE ROOFED OR PAVED 8.60 ACRES
AREA TO BE VEGETATIVELY STABILIZED 10.13 ACRES
TOTAL CUT 19.03 CY
TOTAL FILL 16.08 CY
OFFSITE WASTE AREA LOCATION IF AN OFFSITE LOCATION IS NEEDED THAT SITE MUST HAVE AN APPROVED SEDIMENT CONTROL PLAN AND GRADING PERMIT.


Maryland's Guidelines To Waterway Construction DETAIL 1.4: DIVERSION PIPE

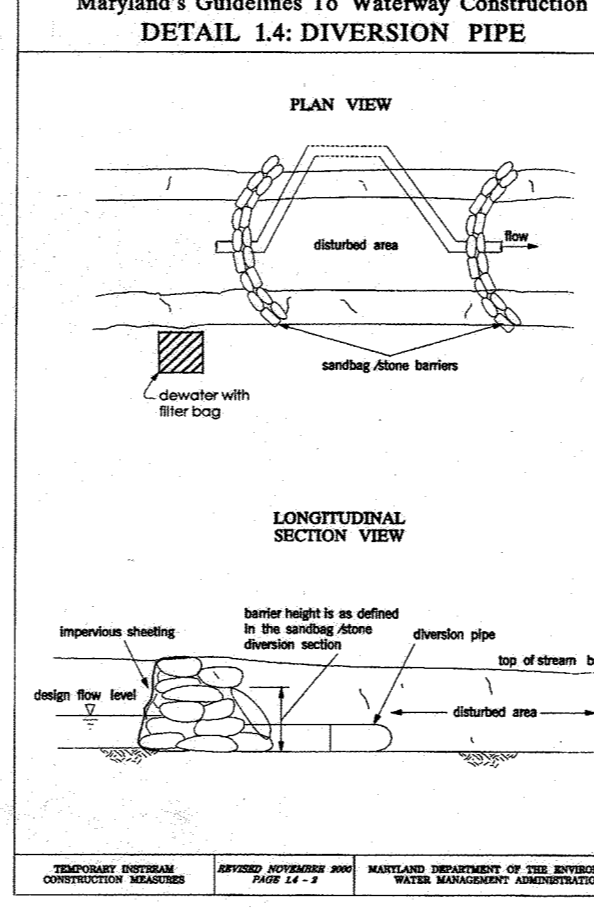


Maryland's Guidelines To Waterway Construction DETAIL 1.2: PUMP-AROUND PRACTICE

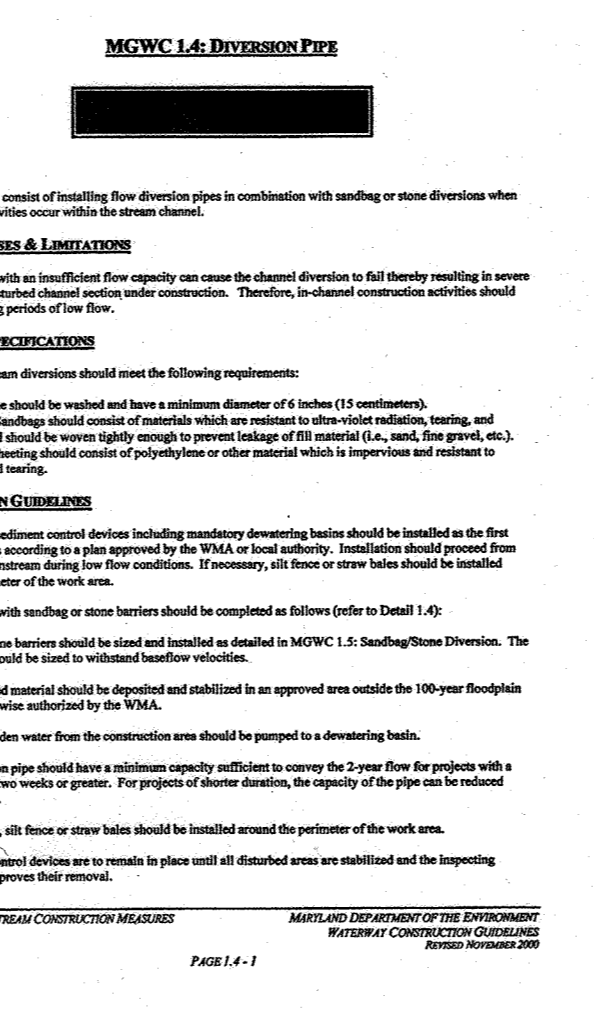

Maryland's Guidelines To Waterway Construction DETAIL 1.5: SANDBAGSTONE DIVERSION

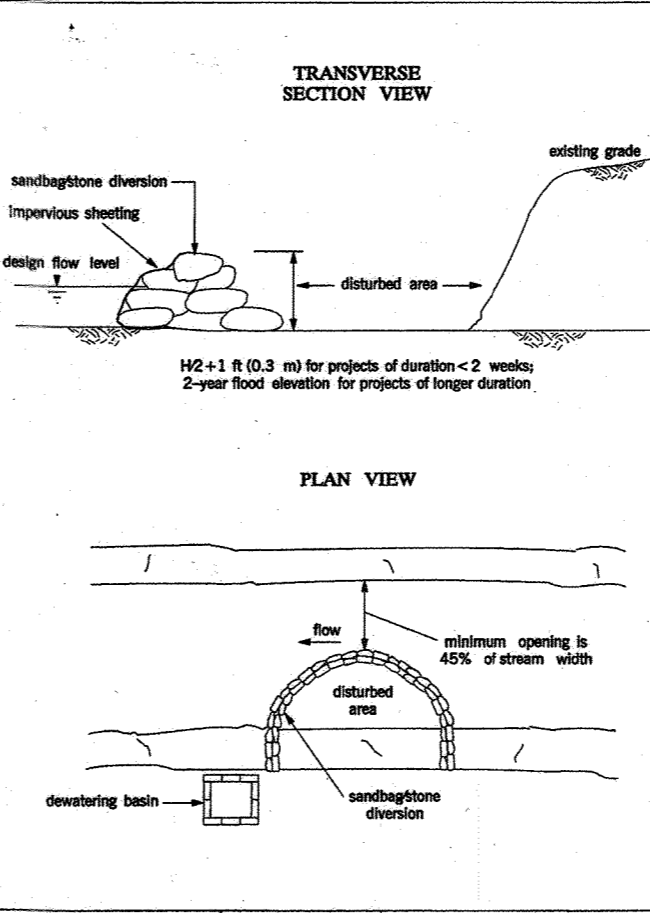

Maryland's Guidelines To Waterway Construction DETAIL 1.2: PUMP-AROUND PRACTICE

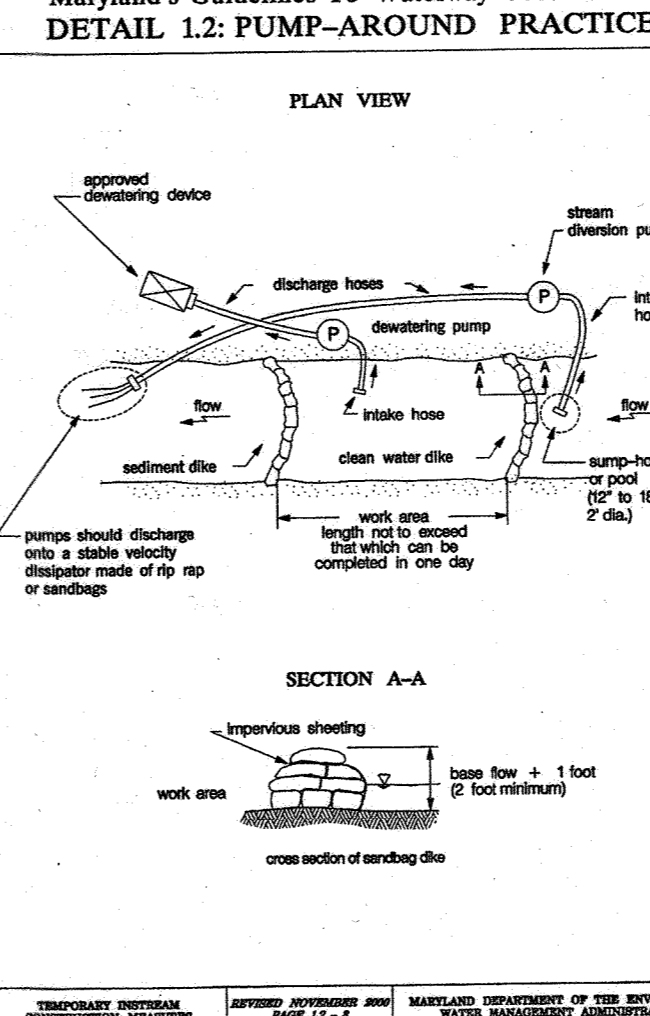

MGWIC 1.2: PUMP-AROUND PRACTICE

- DESCRIPTION
The work shall consist of installing a temporary pump around and supporting measures to divert flow around in-stream construction activities.
IMPLEMENTATION SEQUENCE
Sediment control measures, pump-around practices, and associated channel and bank construction should be completed in the following sequence (refer to Detail 1.2):
1. Construction activities including the installation of erosion and sediment control measures shall not begin until all necessary easements and/or right-of-ways have been acquired. All existing utilities should be marked in the field prior to construction. The contractor is responsible for any damage to existing utilities that may result from construction and should repair the damage at his/her own expense to the county's or utility company's satisfaction.
2. The contractor should notify the Maryland Department of the Environment or WMA sediment control inspector at least 5 days before beginning construction. Additionally, the contractor should notify the local environmental protection and resource management inspection and enforcement division and the provider of local utilities a minimum of 48 hours before starting construction.
3. The contractor should conduct a pre-construction meeting on site with the WMA sediment control inspector, the county project manager, and the engineer to review limits of disturbance, erosion and sediment control requirements, and the sequence of construction. The contractor should state on all limits of disturbance prior to the pre-construction meeting and the contractor should be required to provide a written description of the contractor's staging areas and flag all trees within the limit of disturbance which will be removed for construction access. Trees should not be removed within the limit of disturbance without approval from the WMA or local authority.
4. Construction should not begin until all sediment and erosion control measures have been installed and approved by the engineer and the sediment control inspector. The contractor should stay within the limits of the disturbance as shown on the plans and minimize disturbance within the work area whenever possible.
5. Upon installation of all sediment control measures and approval by the sediment control inspector and the local environmental protection and resource management inspection and enforcement division, the contractor should begin work at the upstream section and proceed downstream beginning with the establishment of stabilized construction entrances. In some cases, work may begin downstream if approved. The sequence of construction must be followed unless the contractor gets written approval for deviations from the WMA or local authority. The contractor should only begin work in an area which can be completed by the end of the day including grading adjacent to the channel. At the end of each work day, the work area must be stabilized and the pump-around removed from the channel. Work should not be conducted in the channel during rain events.
6. Sandbag dikes should be situated at the upstream and downstream ends of the work area as shown on the plans, and stream flow should be pumped around the work area. The pump should discharge onto a stable velocity dissipater made of riprap or sandbags.
7. Water from the work area should be pumped to a sediment filtering measure such as a dewatering basin, sediment bag, or other approved device. The measure should be located such that the dewatering basin back into the channel below the downstream sandbags.
8. If traversing a channel reach with equipment within the work area where no pump is proposed should be avoided. If equipment has to traverse such a reach for access to another area, then timber mats or similar measures should be used to minimize disturbance to the channel. Temporary stream crossings should be used only when necessary to cross the channel and the contractor should be required to stabilize the channel before and after crossing.
9. All stream restoration measures should be installed as indicated by the plans and all banks graded in accordance with the grading plans and typical cross-sections. All grading must be stabilized at the end of each day with seed and mulch or soil and matting as specified on the plans.
10. After an area is completed and stabilized, the clean water dike should be removed. After the first sediment flush, a new clean water dike should be established upstream from the sediment dike. Finally, once establishment of a new sediment dike below the old one, the old sediment dike should be removed.
11. A pump-around must be installed on any tributary or storm drain outfall which contributes baseflow to the work area. This should be accomplished by locating a sandbag dike at the downstream end of the tributary or storm drain and pumping the stream flow around the work area. This water should discharge onto a stable velocity dissipater used for the main stem pump-around.
12. If a tributary is to be restored, construction should take place on the tributary before work on the main stem reaches the tributary confluence. Construction in the tributary, including pump-around practices, should follow the same sequence as the main stem of the river or stream. When construction on the tributary is completed, work on the main stem should resume. Water from the tributary should continue to be pumped around the work area in the main stem.
13. The contractor is responsible for providing access to and maintaining all erosion and sediment control devices until the sediment control inspector approves their removal.
14. After construction, all disturbed areas should be regraded and revegetated as per the planting plan.

MGWIC 1.5: SANDBAGSTONE CHANNEL DIVERSION

- DESCRIPTION
The work should consist of installing sandbag or stone flow diversions for the purpose of erosion control when construction activities occur within the stream channel.
EFFECTIVE USES & LIMITATIONS
Diversions are used to isolate work areas from flow during the construction of in-stream projects. Diversions which have an insufficient flow capacity can fail and severely erode the disturbed channel section under construction. Therefore, in-channel construction activities should occur only during periods of low rainfall. This temporary measure may not be practical in large channels.
MATERIALS SPECIFICATIONS
Materials for sandbags and stone stream diversions should meet the following requirements:
• Riprap: Riprap should be washed and have a minimum diameter of 6 inches (0.15 meters).
• Sandbags: Sandbags which are made of materials which are resistant to ultra-violet radiation, tearing, and puncture and should be woven tightly enough to prevent leakage of the fill material (i.e., sand, fine gravel, etc.).
• Sheeting: Sheeting should consist of polyethylene or other materials which are impervious and resistant to puncture and tearing.
INSTALLATION GUIDELINES
All erosion and sediment control devices, including dewatering basins, should be implemented as the first order of streamwork according to a plan approved by the WMA or local authority. Installation should proceed from upstream to downstream during periods of low flow. If necessary, all fence or straw bales should be installed around the perimeter of the work area.
Sanitation/diversion can be used independently or as components of other stream diversion techniques. Installation of this measure should proceed as follows (refer to Detail 1.5):
1. The diversion structure should be installed from upstream to downstream.
2. The height of the sandbag/stone diversion should be a function of the duration of the project in the stream reach. For projects with a duration less than two weeks, the height of the diversion should be one half the streambank height measured from the channel bed, plus 1 foot (0.3 meters) or bankfull height, whichever is greater. For projects of longer duration, the top of the sandbag or stone diversion should correspond to bankfull height. For diversion structures utilizing sandbags, the stream bed should be hand prepared prior to placement of the base layer of sandbags in order to ensure a water tight fit. Additionally, it may be necessary to prepare the bank in a similar fashion.
3. All excavated material should be deposited and stabilized in an approved area outside the 100-year floodplain unless otherwise authorized by the WMA.
4. Sediment-laden water from the construction area should be pumped to a dewatering basin.
5. Sheeting on the diversion should be positioned such that the upstream portion covers the downstream portion with at least a 18-inch (0.45 meters) overlap.
6. Sandbag or stone diversions should not obstruct more than 45% of the stream width. Additionally, bank stabilization measures should be placed in the constricted section if accelerated erosion and bank scour are observed during the construction time or if project time is expected to last more than 2 weeks.
7. Prior to removal of the temporary structures, any accumulated sediment should be removed, deposited and stabilized in an approved area outside the 100-year floodplain unless authorized by the WMA.
8. Sediment control devices are to remain in place until all disturbed areas are stabilized in accordance with an approved sediment and erosion control plan and the inspecting authority approves their removal.

BEST MANAGEMENT PRACTICES FOR WORKING IN NONTIDAL WETLANDS AND WATERS OF THE STATE

- 1) NO EXCESS FILL CONSTRUCTION MATERIAL, OR DEBRIS SHALL BE STOCKPILED OR STORED IN NONTIDAL WETLANDS, THE NONTIDAL WETLAND BUFFER, OR WATERS OF THE STATE.
2) PLACE MATERIALS IN A LOCATION AND MANNER THAT DOES NOT ADVERSELY IMPACT SURFACE OR SUBSURFACE WATER FLOW INTO OR OUR OF NONTIDAL WETLANDS OR WATERS OF THE STATE.
3) DO NOT USE EXCAVATED MATERIAL AS BACKFILL IF IT CONTAINS WASTE METAL PRODUCTS, UNSIGHTLY DEBRIS, TOXIC MATERIAL, OR ANY OTHER DELETERIOUS SUBSTANCE. IF ADDITIONAL BACKFILL IS REQUIRED, USE CLEAN MATERIAL AND BE SURE TO REMOVE ALL EXCESS MATERIAL FROM THE WORK AREA.
4) DO NOT USE HEAVY EQUIPMENT ON MATS OR SUITABLY OPERATE THEM EQUIPMENT TO PREVENT DAMAGE TO NONTIDAL WETLANDS, THE NONTIDAL WETLAND BUFFER, AND WATERS OF THE STATE.
5) REPAIR AND MAINTAIN ANY SERVICABLE STRUCTURE OR FILL SO THERE IS NO PERMANENT LOSS OF NONTIDAL WETLANDS OR PERMANENT MODIFICATION OF WATERS OF THE STATE IN EXCESS OF THAT LOST UNDER THE ORIGINALLY AUTHORIZED STRUCTURE OR FILL.
6) RECTIFY ANY NONTIDAL WETLANDS, NONTIDAL WETLANDS BUFFER, OR WATERS OF THE STATE TEMPORARILY IMPACTED BY ANY CONSTRUCTION RELATED ACTIVITIES.
7) SEED MIX USED FOR STABILIZATION IN NONTIDAL WETLANDS AND THE NONTIDAL WETLAND BUFFER SHALL CONSIST OF ONE OR MORE OF THE FOLLOWING SPECIES: ANNUAL Ryegrass (Lolium multiflorum), MILLET (Setaria Italica), BARLEY (Hordeum sp.), OATS (Urtioia sp.), AND/OR RYE (Secale cereale). THESE SPECIES WILL ALLOW FOR STABILIZATION OF THE SITE WHILE ALSO ALLOWING OF THE VOLUNTARY REGENERATION OF NATIVE WETLAND SPECIES. OTHER NONPERENNIAL VEGETATION MAY BE ACCEPTABLE BUT MUST BE APPROVED BY THE NONTIDAL WETLANDS AND WATERS DIVISION. KENTUCKY 31 FESCUE SHALL NOT BE USED IN NONTIDAL WETLANDS, NONTIDAL WETLAND BUFFER AREAS. THE AREA SHOULD BE SEEDED AND MULCHED TO REDUCE EROSION AFTER CONSTRUCTION ACTIVITIES HAVE BEEN COMPLETED.
8) AFTER INSTALLATION OF UNDERGROUND UTILITY LINES IN NONTIDAL WETLANDS AND WATERS OF THE STATE HAS BEEN COMPLETED, GRADES AND ELEVATIONS SHALL BE RETURNED TO PRE-CONSTRUCTION CONDITIONS.
9) TO PROTECT AQUATIC SPECIES, IN STREAM WORK IS PROHIBITED AS DETERMINED BY THE CLASSIFICATION OF STREAM:
USE III WATERS: IN-STREAM WORK SHALL NOT BE CONDUCTED DURING THE PERIOD OCTOBER 1 THROUGH APRIL 30, INCLUSIVE, EACH YEAR.
10) STORMWATER RUNOFF FROM IMPERVIOUS SURFACES SHALL BE CONTROLLED TO PREVENT THE DISCHARGE OF POLLUTANTS INTO NONTIDAL WETLANDS AND WATERSHEDS.
11) CULTURIS AND ASSOCIATED RIPRAP EROSION PROTECTION SHALL BE CONSTRUCTED SO AS NOT TO OBSTRUCT THE MOVEMENT OF AQUATIC SPECIES, UNLESS THE PURPOSE OF THE ACTIVITY IS TO IMPOUND WATER.

TEMPORARY SEEDBED PREPARATIONS









- APPLY TO GRADED OR CLEARED AREAS LIKELY TO BE REDISTURBED WHERE A SHORT-TERM VEGETATIVE COVER IS NEEDED.
SEEDBED PREPARATION: LOOSEN UPPER THREE INCHES OF SOIL BY RAKING, DISCING OR OTHER ACCEPTABLE MEANS BEFORE SEEDING, IF NOT PREVIOUSLY LOOSENED.
SOIL AMENDMENTS: APPLY 600 LBS PER ACRE 10-10-10 FERTILIZER (14 LBS/1000 SQ FT).
SEEDING: FOR PERIOD MARCH 1 THROUGH APRIL 30 AND FROM AUGUST 1 THROUGH NOV. 15, SEED WITH 2-1/2 BUSHELS PER ACRE OF ANNUAL RYE (3.2 LBS/1000 SQ FT). FOR THE PERIOD MAY 1 THROUGH AUGUST 14, SEED WITH 3 LBS PER ACRE OF WEEPING LOVEGRASS (0.7 LBS/1000 SQ FT). FOR THE PERIOD NOVEMBER 16 THROUGH FEBRUARY 28, PROTECT SITE BY APPLYING 2 TONS PER ACRE OF WELL ANCHORED STRAW MULCH AND SEED AS SOON AS POSSIBLE IN THE SPRING, OR USE SOO.
MULCHING: APPLY 1-1/2 TO 2 TONS PER ACRE (70 TO 90 LBS/1000 SQ FT) OF UNROTTED SMALL GRASS STRAW IMMEDIATELY AFTER SEEDING. ANCHOR MULCH IMMEDIATELY AFTER APPLICATION USING MULCH ANCHORING TOOL OR 2 1/8 GALLONS PER ACRE (5 GAL/1000 SQ FT) OF EMULSIFIED ASPHALT ON FLAT AREAS, ON SLOPES 8 FT. OR HIGHER, USE 348 GALLONS PER ACRE (8 GAL/1000 SQ FT) FOR ANCHORING.
REFER TO THE 1994 MARYLAND STANDARDS AND SPECIFICATIONS FOR SOIL EROSION AND SEDIMENT CONTROL FOR RATE AND METHODS NOT COVERED.

TEMPORARY SEEDBED PREPARATIONS

- SEEDBED PREPARATION: LOOSEN UPPER THREE INCHES OF SOIL BY RAKING, DISCING OR OTHER ACCEPTABLE MEANS BEFORE SEEDING, IF NOT PREVIOUSLY LOOSENED.
SOIL AMENDMENTS: IN LIEU OF SOIL TEST RECOMMENDATIONS, USE ON OF THE FOLLOWING SCHEDULES:
1. PREFERRED - APPLY 2 TONS PER ACRE DOLOMITIC LIMESTONE (92 LBS/1000 SQ FT) AND 600 LBS PER ACRE 10-10-10 FERTILIZER (14 LBS/1000 SQ FT) BEFORE SEEDING. HARROW OR DISC INTO UPPER THREE INCHES OF SOIL. AT THE END OF SEEDING, APPLY 400 LBS PER ACRE 30-0-0- UREAFORM FERTILIZER (9 LBS/1000 SQ FT).
2. ACCEPTABLE - APPLY 2 TONS PER ACRE DOLOMITIC LIMESTONE (92 LBS/1000 SQ FT) AND 1000 LBS PER ACRE 10-10-10 FERTILIZER (23 LBS/1000 SQ FT) BEFORE SEEDING. HARROW OR DISC INTO UPPER THREE INCHES OF SOIL.
SEEDING: FOR THE PERIODS MARCH 1 THROUGH APRIL 30 AND AUGUST 1 THROUGH OCTOBER 15, SEED WITH 60 LBS PER ACRE (1.4 LBS/1000 SQ FT) OF KENTUCKY 31 TALL FESCUE PER ACRE AND 2 LBS PER ACRE (0.8 LBS/1000 SQ FT) OF WEEPING LOVEGRASS DURING THE PERIOD OF OCTOBER 16 THROUGH FEBRUARY 28. PROTECT SITE BY OPTION (1) 2 TONS PER ACRE OF WELL ANCHORED STRAW MULCH AND SEED AS SOON AS POSSIBLE IN THE SPRING. OPTION (2) USE SOO. OPTION (3) SEED WITH 60 LBS PER ACRE OF KENTUCKY 31 TALL FESCUE AND MULCH WITH 2 TONS PER ACRE OF WELL ANCHORED STRAW.
MULCHING: APPLY 1-1/2 TO 2 TONS PER ACRE (70 TO 90 LBS/1000 SQ FT) OF UNROTTED SMALL GRASS STRAW IMMEDIATELY AFTER SEEDING. ANCHOR MULCH IMMEDIATELY AFTER APPLICATION USING MULCH ANCHORING TOOL OR 2 1/8 GALLONS PER ACRE (5 GAL/1000 SQ FT) OF EMULSIFIED ASPHALT ON FLAT AREAS, ON SLOPES 8 FEET OR HIGHER, USE 348 GALLONS PER ACRE (8 GAL/1000 SQ FT) FOR ANCHORING.
MAINTENANCE: INSPECT ALL SEEDBED AREAS AND MAKE NEEDED REPAIRS, REPLACEMENTS AND RESEEDINGS.

SEQUENCE OF CONSTRUCTION

- NOTIFY SEDIMENT CONTROL DIVISION 48 HOURS PRIOR TO START OF CONSTRUCTION
1. OBTAIN GRADING PERMIT AND MSHA ACCESS PERMIT. OBTAIN MDE PERMIT PRIOR TO ANY DISTURBANCES IN REGULATED AREAS. (DAY 1)
2. INSTALL STABILIZED CONSTRUCTION ENTRANCE, TREE PROTECTION FENCES, SUPER SILT FENCES, SILT FENCES AND TEMPORARY CLEANWATER DIVERSION DIKES. RELOCATE UTILITY POLES ALONG ROUTE 94. (DAY 2-12)
3. UPON APPROVAL OF THE HOWARD COUNTY SEDIMENT CONTROL INSPECTOR, INSTALL THE ELLIPTICAL (ROUTE 94) AND S-4' CURVEITS DURING A 3-DAY CLEAR WEATHER FORECAST FROM NWS. CLOSE S4F OVER ENDWALLS. (DAY 13-17)
4. INSTALL SEDIMENT BASINS. (DAY 17-45)
5. INSTALL ANY REMAINING SEDIMENT CONTROL DEVICES. (DAY 46-50)
6. UPON APPROVAL OF THE HOWARD COUNTY SEDIMENT CONTROL INSPECTOR, BRING ROAD BEDS TO SUBGRADE AND STABILIZE SLOPES IN ACCORDANCE WITH TEMPORARY SEEDBED NOTES. UTILIZE ZUD CONTROL METHODS. (DAY 51-81)
7. UPON APPROVAL OF THE HOWARD COUNTY SEDIMENT CONTROL INSPECTOR, INSTALL STORM DRAINS, THE STORM DRAIN SYSTEMS FROM M-3 TO I-12 AND THE SWALES THAT DRAINS TO POND #2 SHALL NOT BE INSTALLED AT THIS TIME. (DAY 82-112)
8. PAVE ROADWAYS. (DAY 113-128)
9. COMPLETE GRADING OF SITE AND STABILIZE DISTURBED AREAS IN ACCORDANCE WITH THE PERMANENT SEEDBED NOTES. (DAY 129-144)
10. UPON APPROVAL OF THE HOWARD COUNTY SEDIMENT CONTROL INSPECTOR, INSTALL THE STORM DRAINS FROM M-3 TO I-12 AND THE SWALES THAT DRAIN TO POND #2. (DAY 145-147)
11. UPON APPROVAL OF THE HOWARD COUNTY SEDIMENT CONTROL INSPECTOR, CONVERT SEDIMENT BASINS TO STORMWATER MANAGEMENT FACILITIES, SHAPE FACILITIES PER FINAL GRADES SHOWN ON THE PLANS AND STABILIZE DISTURBED AREAS IN ACCORDANCE WITH THE PERMANENT SEEDBED NOTES. CONTRACTOR SHALL REMOVE ALL OLD AND NEW TRASH, JUNK AND DEBRIS FROM ENTIRE SITE. (DAY 148-153)
12. UPON APPROVAL OF THE HOWARD COUNTY SEDIMENT CONTROL INSPECTOR, REMOVE REMAINING SEDIMENT CONTROL DEVICES, WITH THE EXCEPTION OF THE CLEANWATER DIVERSION DIKES, AND STABILIZED DISTURBED AREAS IN ACCORDANCE WITH THE PERMANENT SEEDBED NOTES. (DAY 154-161)
13. ONCE ALL PONDS ARE COMPLETE AND DISTURBED AREAS ARE STABILIZED REMOVE CLEANWATER DIVERSION DIKES. (DAY 162-170)

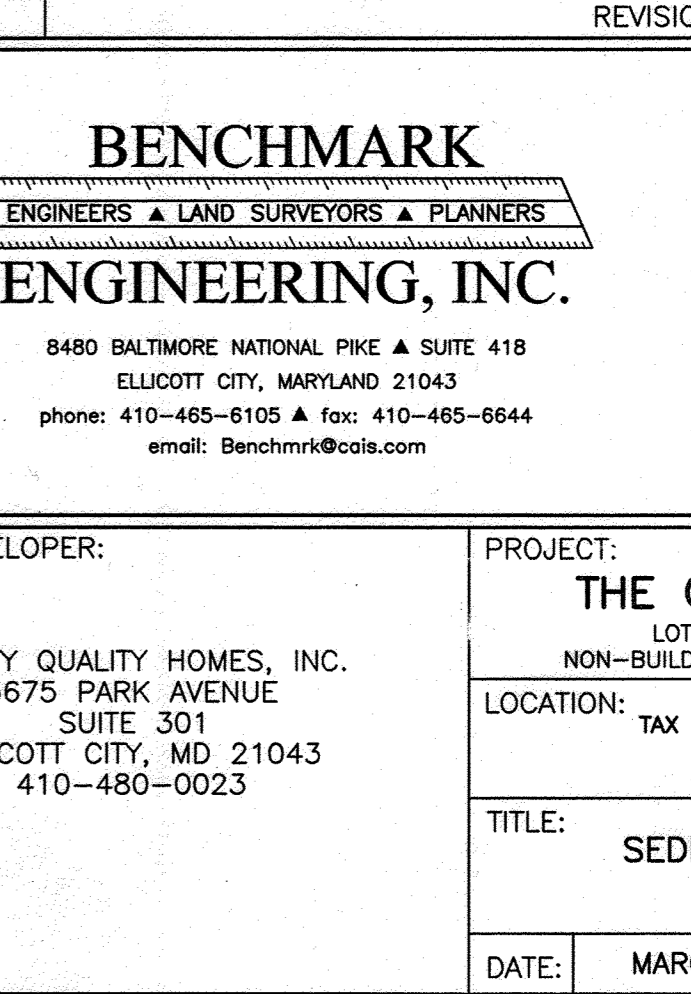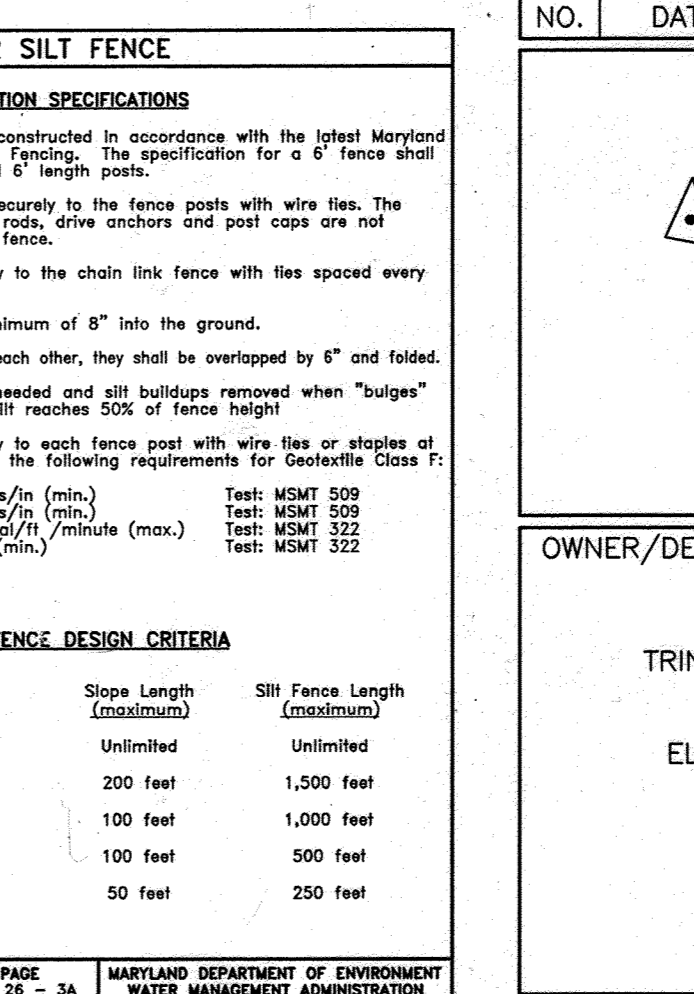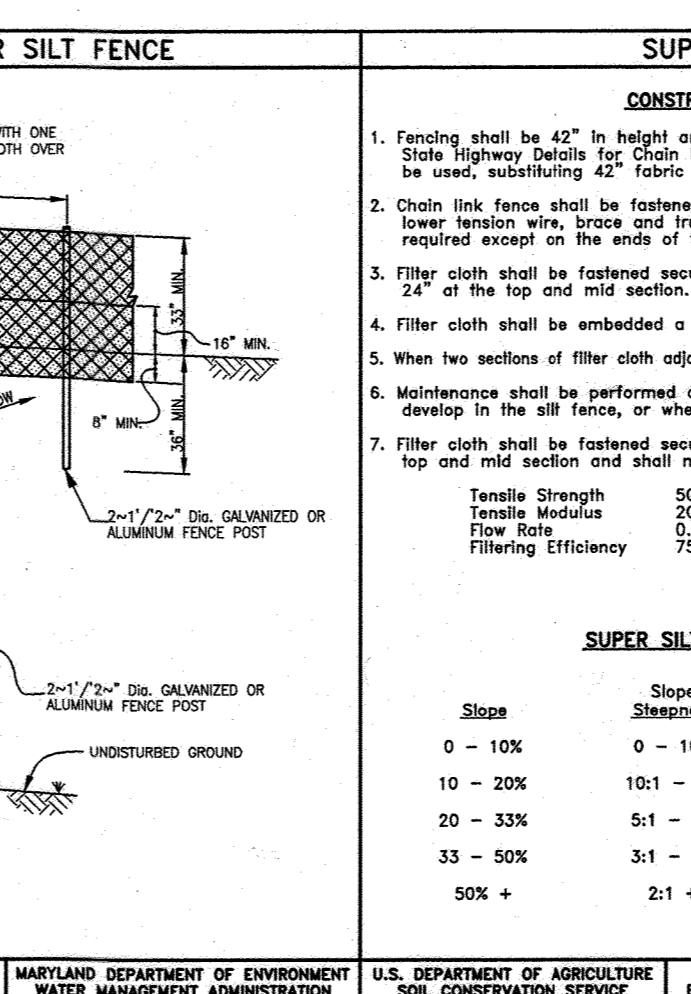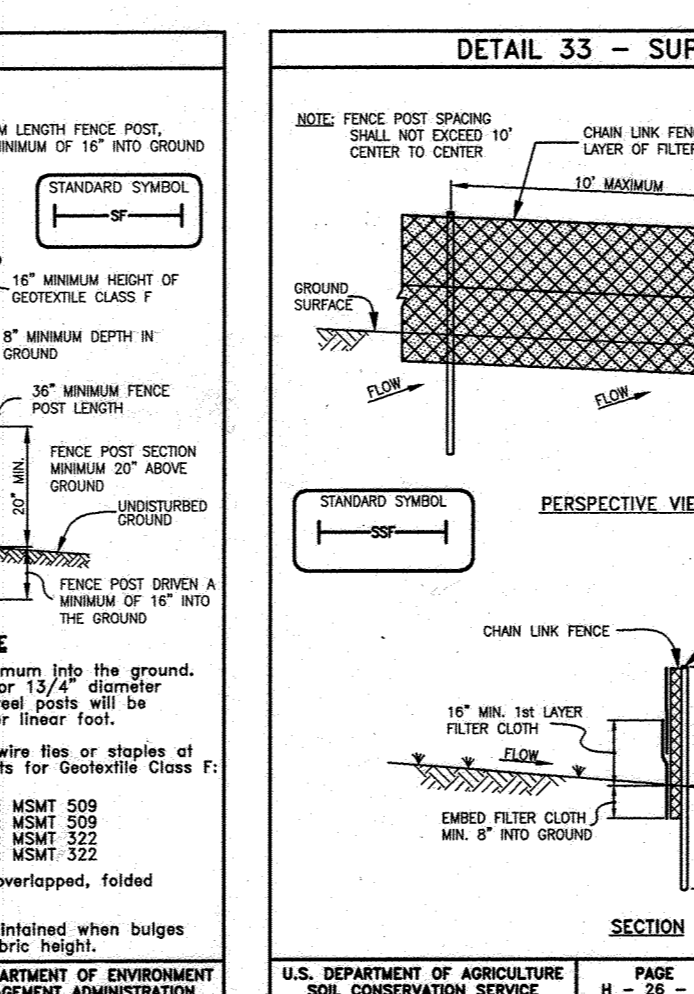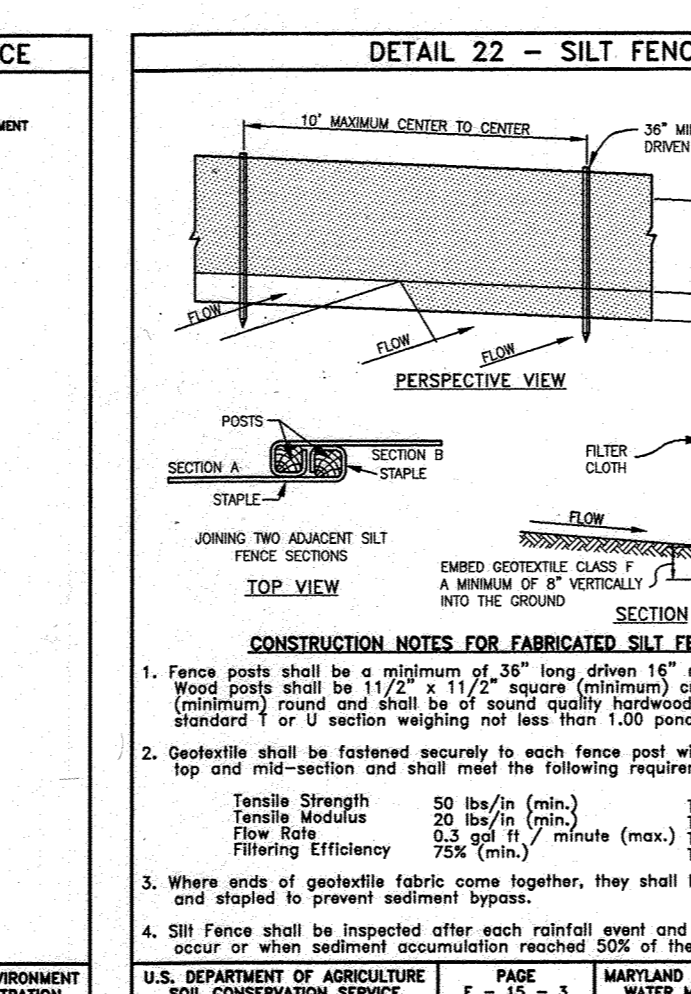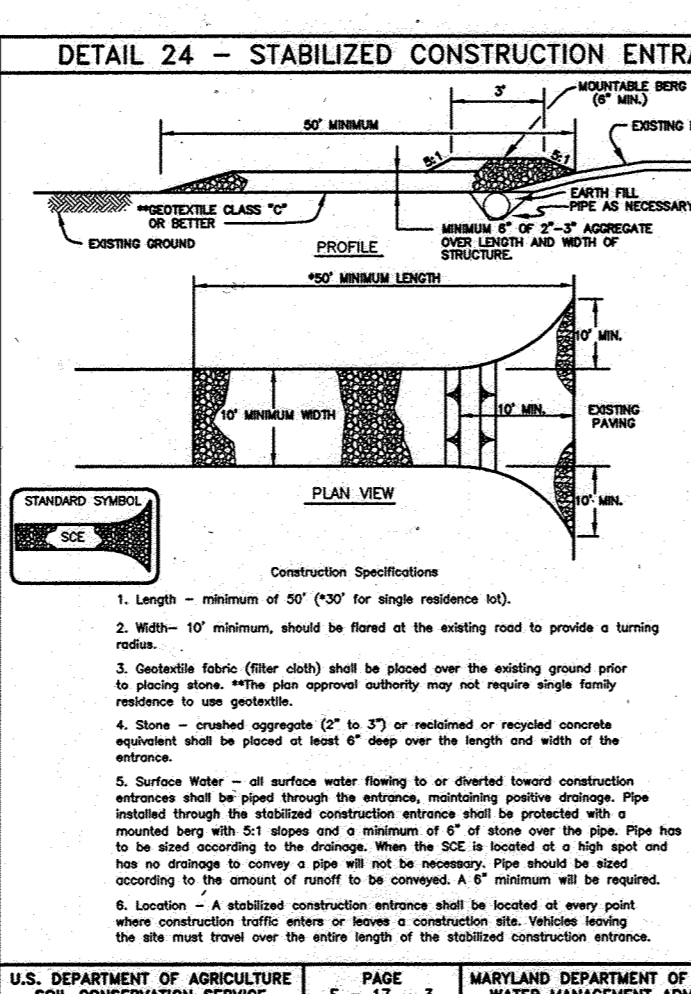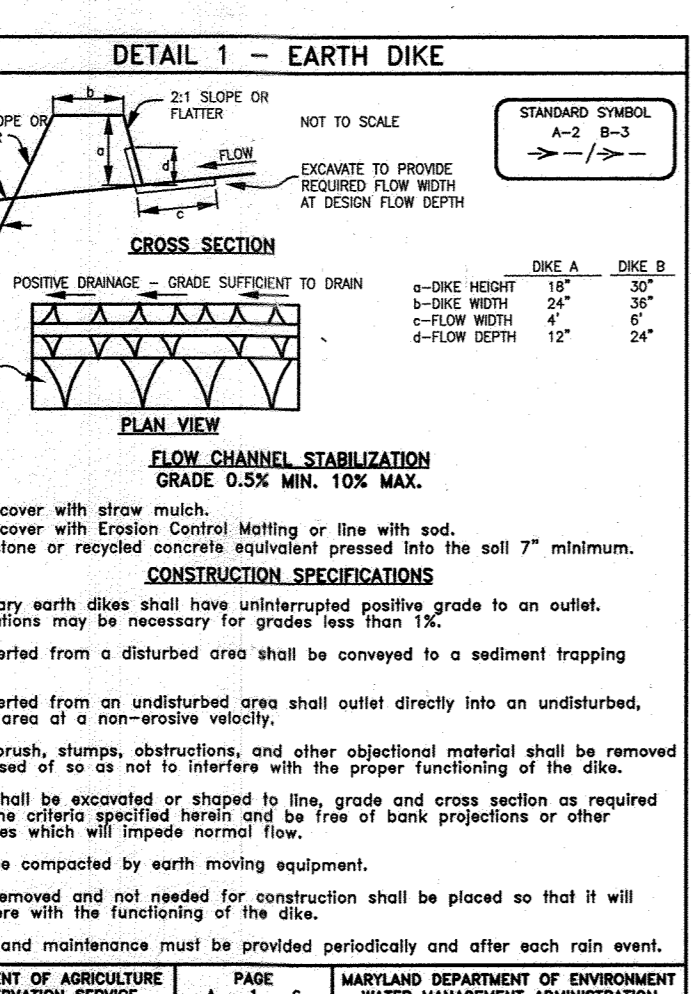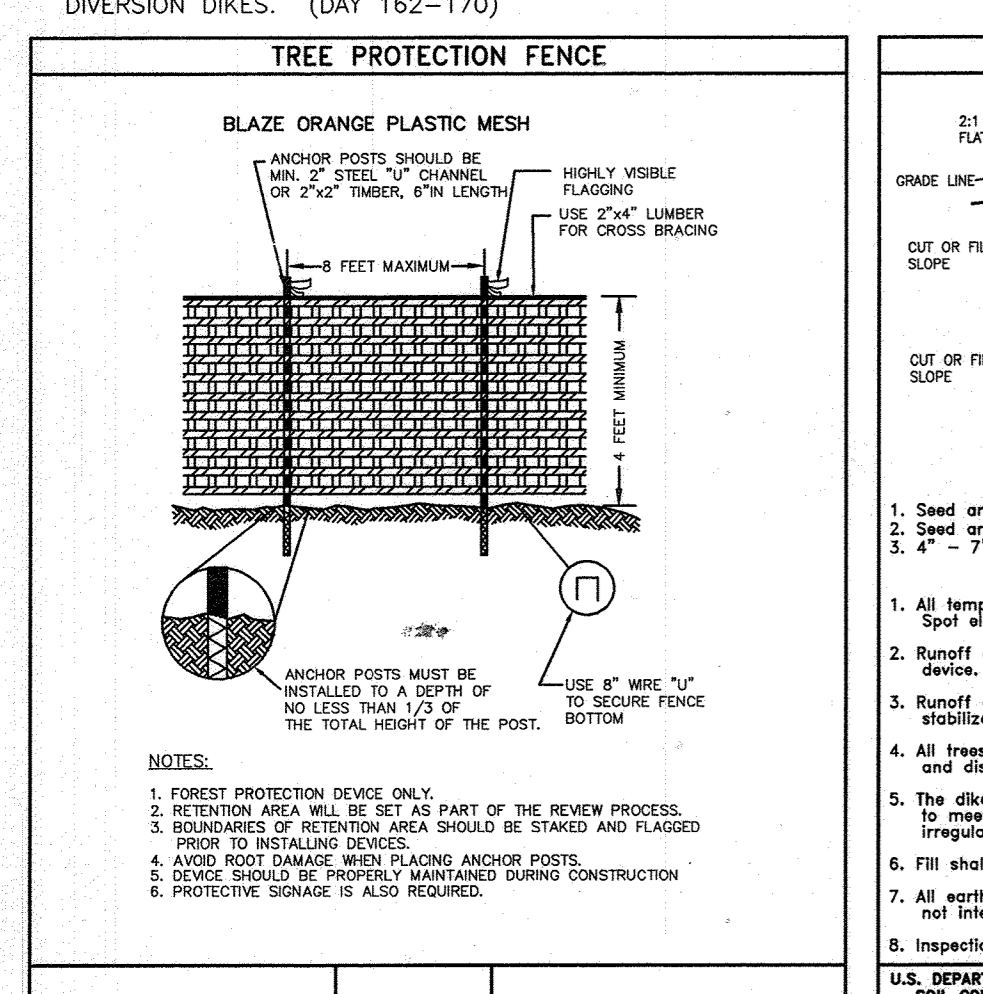

AS-BUILT CERTIFICATION
I, DONALD A. MASON, P.E., CERTIFY THAT THE PROJECT SHOWN ON THIS PLAN HAS BEEN CONSTRUCTED IN ACCORDANCE WITH THE PLAN AND MEETS THE APPROVED PLAN AND SPECIFICATION REQUIREMENTS.
DATE: 1/31/03

ENGINEER'S CERTIFICATE
I, HEREBY CERTIFY THAT THIS PLAN FOR SEDIMENT AND EROSION CONTROL REPRESENTS A PRACTICAL AND WORKABLE PLAN BASED ON MY PERSONAL KNOWLEDGE OF THE SITE CONDITIONS AND THAT I HAVE PREPARED IN ACCORDANCE WITH THE REQUIREMENTS OF THE HOWARD SOIL CONSERVATION DISTRICT.
Donald A. Mason 3/1/06
ENGINEER - DONALD A. MASON, P.E. # 21443 DATE

DEVELOPER'S CERTIFICATE
I, WE CERTIFY THAT ALL DEVELOPMENT AND CONSTRUCTION WILL BE DONE ACCORDING TO THIS PLAN OF DEVELOPMENT FOR SEDIMENT AND EROSION CONTROL, AND THAT ALL RESPONSIBLE PERSONNEL INVOLVED IN THE CONSTRUCTION PROJECT WILL HAVE A CERTIFICATE OF ATTENDANCE AT A DEPARTMENT OF THE ENVIRONMENT APPROVED TRAINING PROGRAM FOR THE CONTROL OF SEDIMENT AND EROSION BEFORE BEGINNING THE PROJECT. I ALSO AUTHORIZE PERIODIC ON-SITE INSPECTION BY THE HOWARD SOIL CONSERVATION DISTRICT.
Michael J. Spivey 4/4/06
DEVELOPER DATE

REVIEWED FOR HOWARD SCD AND MEETS TECHNICAL REQUIREMENTS
USDA - NATURAL RESOURCES CONSERVATION SERVICE DATE
John A. Mason 4/16/06

THIS DEVELOPMENT PLAN IS APPROVED FOR SOIL EROSION AND SEDIMENT CONTROL BY THE HOWARD SOIL CONSERVATION DISTRICT.
Howard SCD DATE
Shelly Slay 4/16/06
APPROVED: DEPARTMENT OF PUBLIC WORKS

APPROVED: DEPARTMENT OF PLANNING AND ZONING
With T. Smith 4-21-06
DATE
Candy Hammett 5/12/06
DATE
M. J. Mason 5/16/06
DATE
CHIEF, DIVISION OF LAND DEVELOPMENT
CHIEF, DEVELOPMENT ENGINEERING DIVISION MK

NO. 1 DATE 4/28/03 REUSE PAGE NO.

REVISION
NO. DATE

OWNER/DEVELOPER:
TRINITY QUALITY HOMES, INC.
3675 PARK AVENUE
SUITE 301
ELLCOTT CITY, MD 21043
410-480-0023

PROJECT:
THE CHASE AT STONEY BROOK
LOTS 1-20, PRESERVATION PARCEL "A" AND NON-BUILDABLE PRESERVATION PARCELS "B" THROUGH "D"
LOCATION:
TAX MAP NO. 7 BLOCK NO. 17 PARCEL NO. 133
44th ELECTION DISTRICT
HOWARD COUNTY, MARYLAND
TITLE:
SEDIMENT & EROSION CONTROL NOTES AND DETAILS
DATE: MARCH, 2006 PROJECT NO. 1187
DESIGN: JMC DRAFT: LAB CHECK: DAM SCALE: NOT TO SCALE SHEET 12 OF 30
AS-BUILT 1/31/03 F-05-170

NOTE:
 AT THE TIME OF INSTALLMENT, ALL SHRUBS AND OTHER PLANTINGS HEREWITH LISTED AND APPROVED FOR THIS SITE, SHALL BE OF THE PROPER HEIGHT REQUIREMENTS IN ACCORDANCE WITH THE HOWARD COUNTY LANDSCAPE MANUAL. IN ADDITION, NO SUBSTITUTIONS OR RELOCATION OF REQUIRED PLANTINGS MAY BE MADE WITHOUT PRIOR REVIEW AND APPROVAL FROM THE DEPARTMENT OF PLANNING AND ZONING. ANY DEVIATION FROM THIS APPROVED LANDSCAPE PLAN MAY RESULT IN DENIAL OR DELAY IN RELEASE OF LANDSCAPE SURETY UNTIL SUCH TIME AS ALL REQUIRED MATERIALS ARE PLANTED AND/OR REVISIONS ARE MADE TO APPLICABLE PLANS AND CERTIFICATIONS.

PARCEL 134
 WILLIAM SULLIVAN, ET UX.
 4797/4
 ZONED RC-DEO


PUBLIC STREET TREE PLANTING LIST			
SYMBOL	QUANTITY	NAME	REMARKS
⊙	100	PLATANUS X ACERFOLIO 'BLOODGOOD' (Bloodgood London Plane)	2 1/2" MIN. CAL. B&B FULL HEAD
⊙	37	ACER RUBRUM 'OCTOBER GLORY' (October Glory Red Maple)	2 1/2" MIN. CAL. B&B FULL HEAD
⊕	32	MALVA RUBRIFLORA 'HARVEST GOLD' (FLOWERING CRABAPPLE)	2 1/2" MIN. CAL. B&B FULL HEAD

LANDSCAPE PLANTING LIST				
SYMBOL	QUANTITY	NAME	REMARKS	DESCRIPTION
⊙	102	QUERCUS RUBRA (Red Oak)	2-1/2" - 3" cal.	SHADE TREES ALONG PERIMETER TO BE PROVIDED BY THE DEVELOPER
⊙	89	PINUS STROBUS (Eastern White Pine)	6' - 8' ht.	EVERGREEN TREES ALONG SWM FACILITIES TO BE PROVIDED BY THE DEVELOPER
⊙	65	TILIA CORDATA 'GREENSPRING' (Greenspire Littleleaf Linden)	2-1/2" - 3" cal.	SHADE TREES ALONG SWM FACILITIES TO BE PROVIDED BY THE DEVELOPER

TOTAL NUMBER OF EVERGREEN TREES: 89
 TOTAL NUMBER OF SHADE TREES: 328

DEVELOPER'S/BUILDER'S CERTIFICATE
 I/WE CERTIFY THAT THE LANDSCAPING SHOWN ON THIS PLAN WILL BE DONE ACCORDING TO THE PLAN, SECTION 16.124 OF THE HOWARD COUNTY CODE AND THE HOWARD COUNTY LANDSCAPE MANUAL. I/WE FURTHER CERTIFY THAT UPON COMPLETION OF A LETTER OF LANDSCAPE INSTALLATION, ACCOMPANIED BY AN EXECUTED ONE-YEAR GUARANTEE OF PLANT MATERIALS, WILL BE SUBMITTED TO THE DEPARTMENT OF PLANNING AND ZONING.

Michael Pfa
 MICHAEL PFA
 TRINITY QUALITY HOMES, INC.
 DATE: 3/13/06

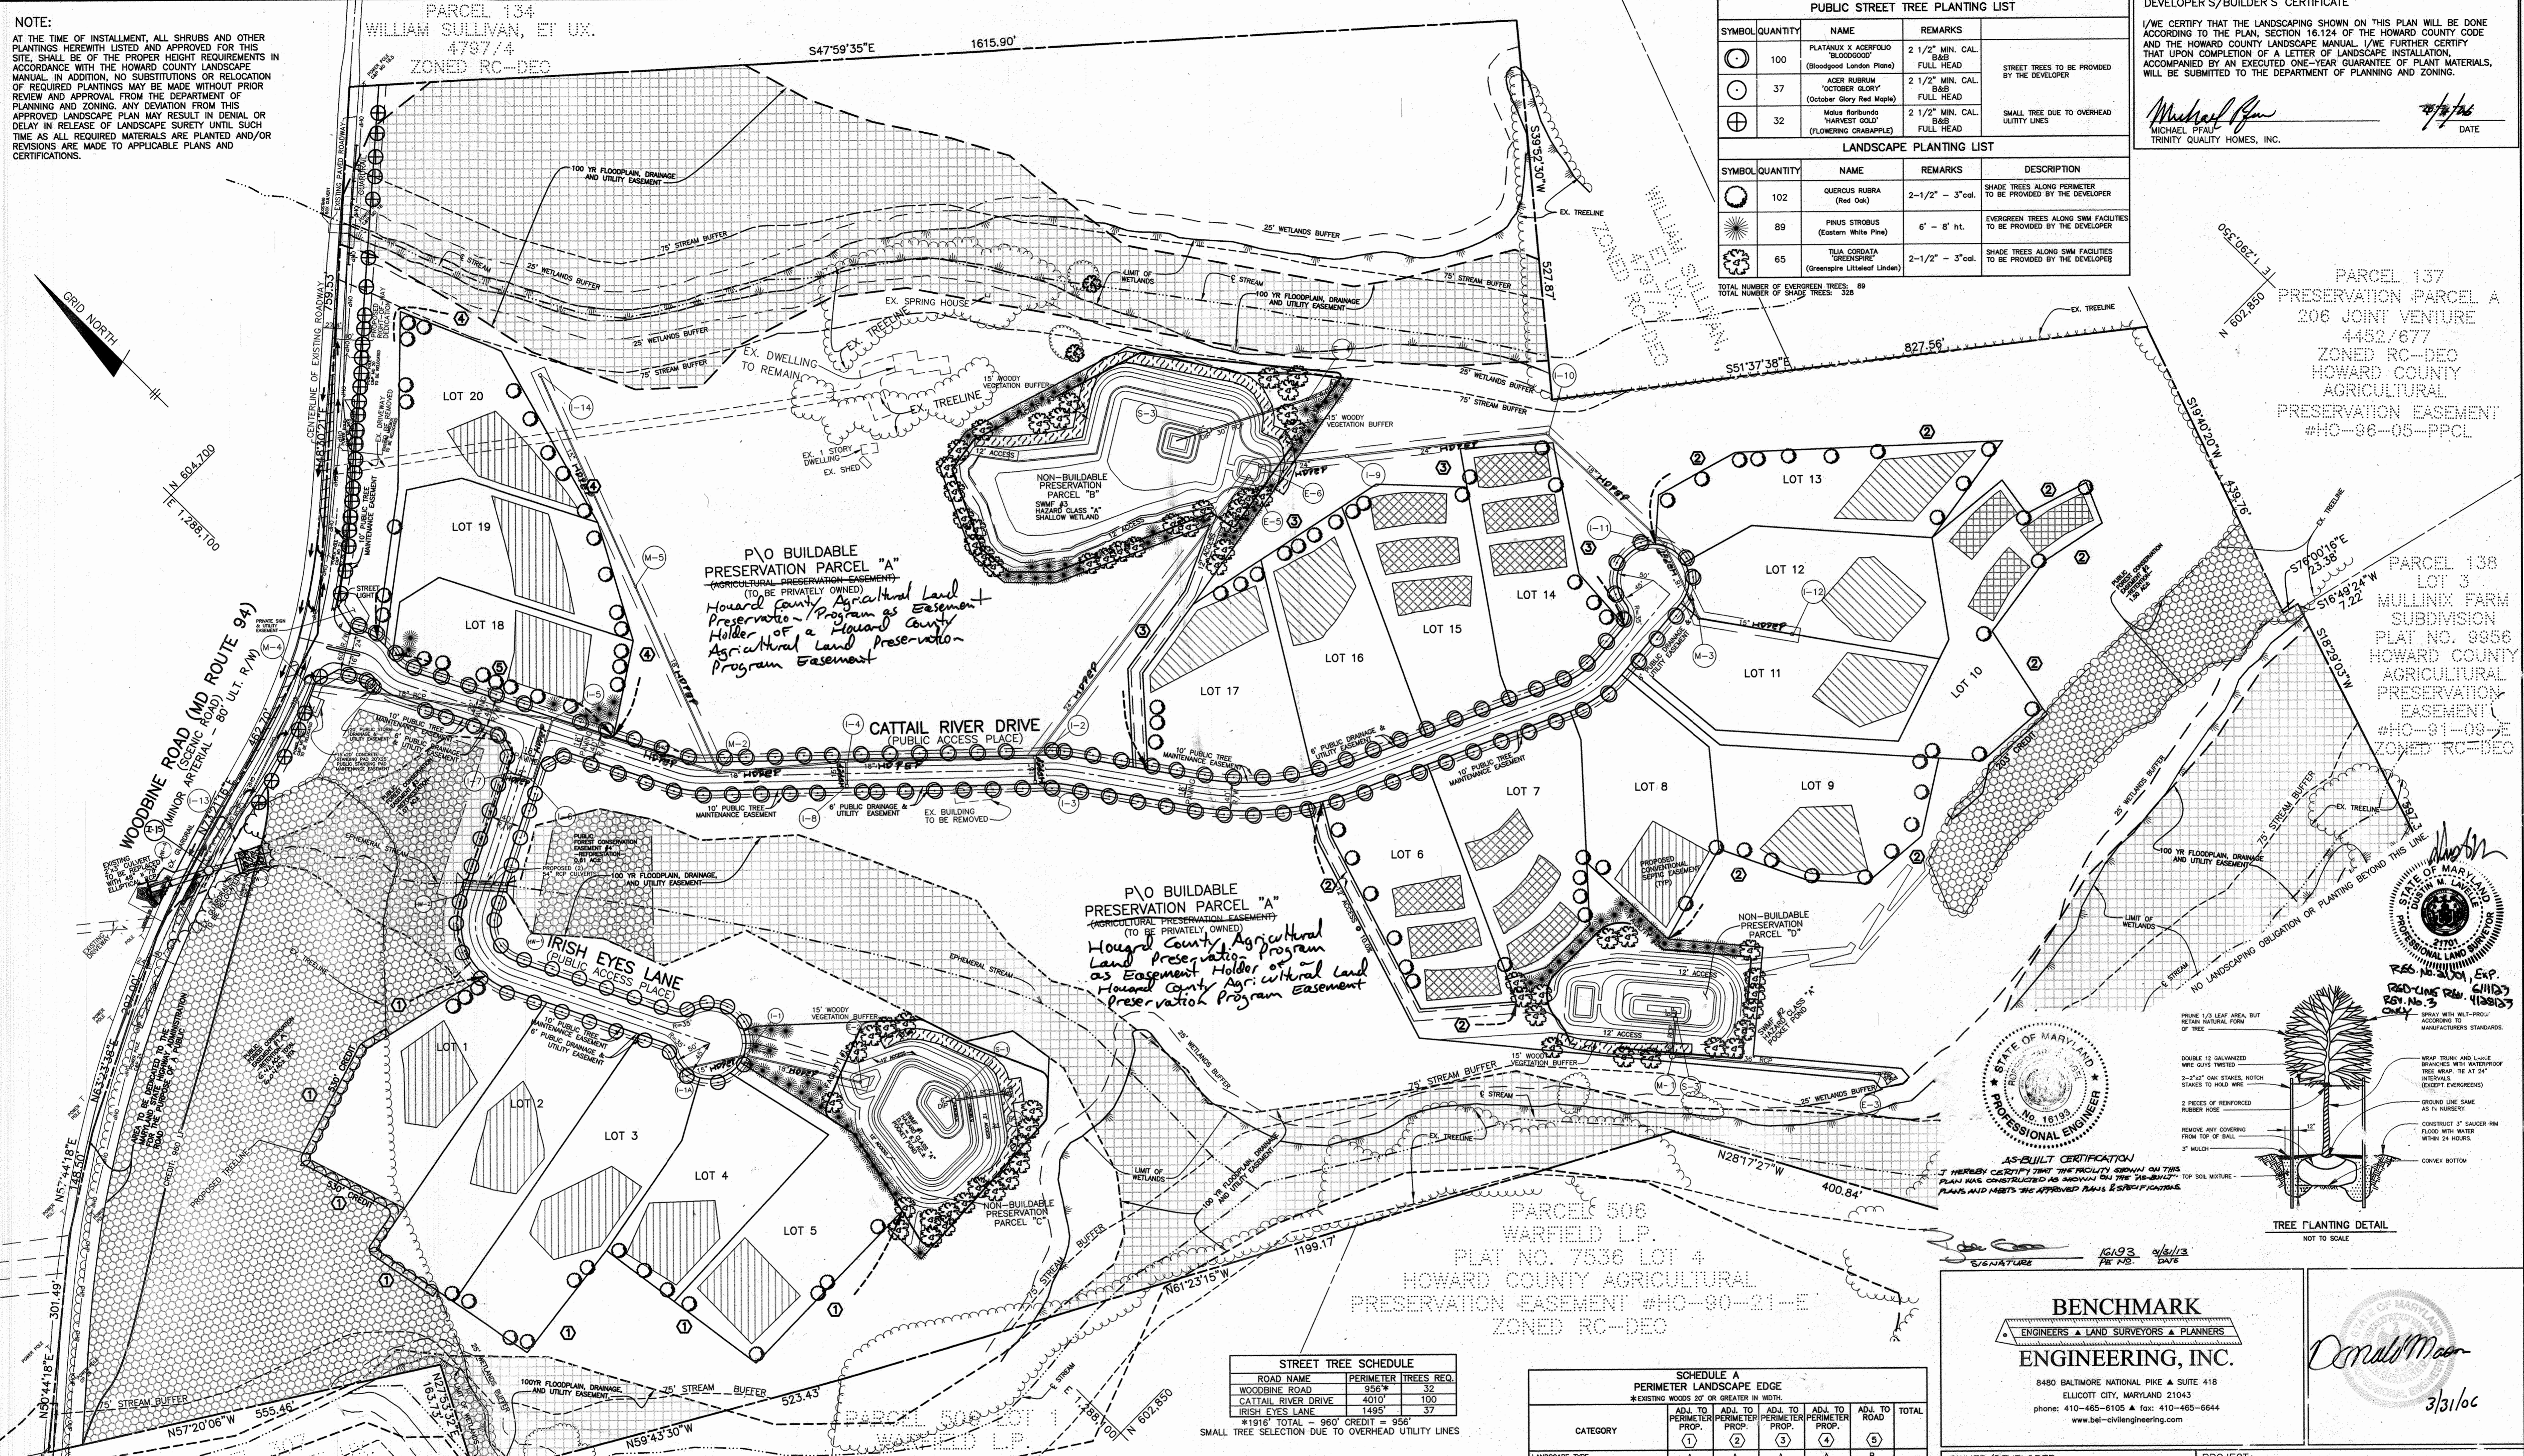

PARCEL 137
 PRESERVATION PARCEL A
 206 JOINT VENTURE
 4452/677
 ZONED RC-DEO
 HOWARD COUNTY
 AGRICULTURAL
 PRESERVATION EASEMENT
 #HC-96-05-PPCL

PARCEL 138
 LOT 3
 MULLINIX FARM
 SUBDIVISION
 PLAT NO. 9856
 HOWARD COUNTY
 AGRICULTURAL
 PRESERVATION EASEMENT
 #HC-91-09-E
 ZONED RC-DEO

STREET TREE SCHEDULE

ROAD NAME	PERIMETER TREES REQ.
WOODBINE ROAD	956*
CATTAIL RIVER DRIVE	401*
IRISH EYES LANE	1495*



*1916' TOTAL - 960' CREDIT = 956'
 SMALL TREE SELECTION DUE TO OVERHEAD UTILITY LINES

SCHEDULE D
 SWM AREA LANDSCAPING

	FACILITY 1	FACILITY 2	FACILITY 3	TOTAL
LINEAR FEET OF PERIMETER	966	804	1479	3249
LINEAR FEET OF EXISTING WOODS LINE	0	0	0	0
LINEAR FEET OF REQUIRED PLANTING	966	804	1479	3249
NUMBER OF TREES REQUIRED	19	16	30	65
NUMBER OF TREES PROVIDED	24	20	37	81
CREDIT FOR EXISTING VEGETATION (NO, YES AND %)	NO	NO	NO	NO
CREDIT FOR OTHER LANDSCAPING (NO, YES AND %)	NO	NO	NO	NO

SCHEDULE A
 PERIMETER LANDSCAPE EDGE
 *EXISTING WOODS 20' OR GREATER IN WIDTH

CATEGORY	ADJ. TO PERIMETER PROP.					TOTAL
	(1)	(2)	(3)	(4)	(5)	
LANDSCAPE TYPE	A	A	A	A	B	
LINEAR FEET OF ROADWAY FRONTAGE/PERIMETER	1567*	2564*	1145*	1186*	329*	6,798*
CREDIT FOR EXISTING VEGETATION (YES, NO, LINEAR FEET) (DESCRIBE BELOW IF NEEDED)	YES* 530*	YES* 203*	NO	NO	NO	733
CREDIT FOR WALL, FENCE OR BERM (YES, NO, LINEAR FEET) (DESCRIBE BELOW IF NEEDED)	NO	NO	NO	NO	NO	
NUMBER OF PLANTS REQUIRED	1037*	2361*	1145*	1186*	328*	6,057*
SHADE TREES	17	39	19	20	8	102
EVERGREEN TREES	-	-	-	-	-	-
OTHER TREES (2:1 SUBSTITUTE)	-	-	-	-	-	-
SHRUBS	1037	2361	1145	1186	328	6,057
NUMBER OF PLANTS PROVIDED	1037	2361	1145	1186	328	6,057
SHADE TREES	17	39	19	20	8	102
EVERGREEN TREES	-	-	-	-	-	-
OTHER TREES (2:1 SUBSTITUTE)	-	-	-	-	-	-
SHRUBS	-	-	-	-	-	-

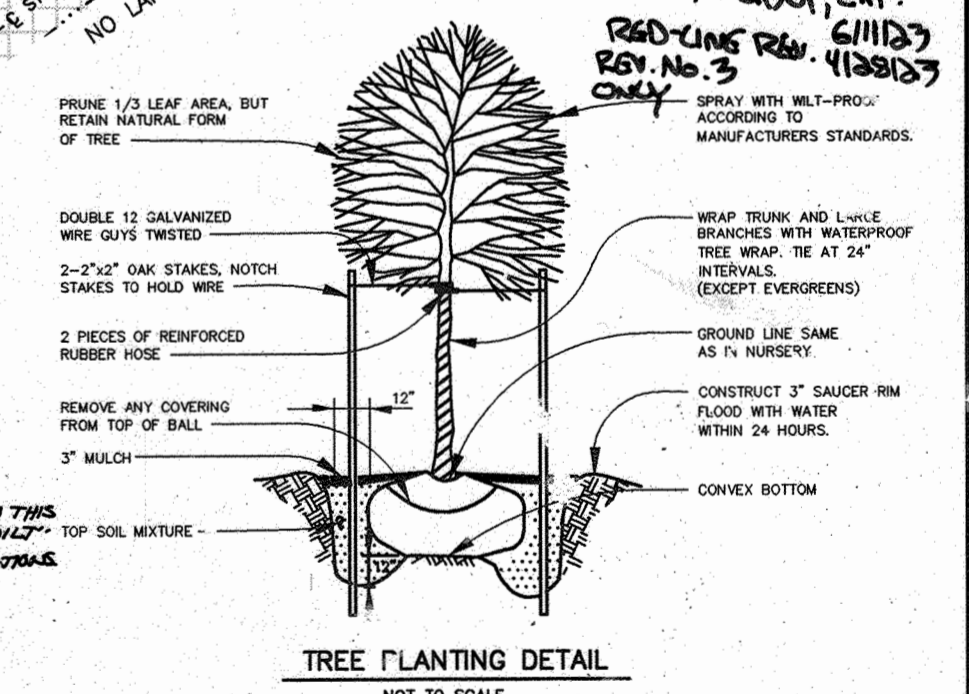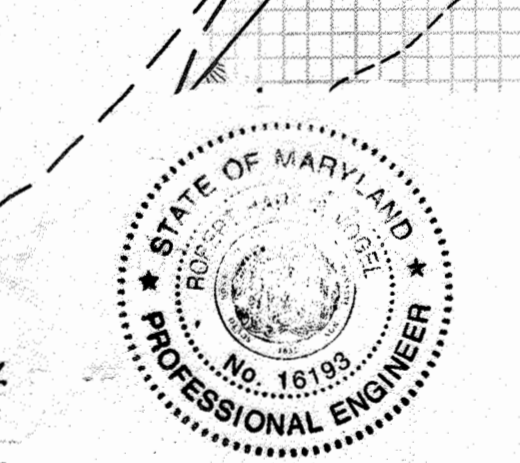

APPROVED: HOWARD COUNTY DEPARTMENT OF PUBLIC WORKS
William F. Mohr
 CHIEF, BUREAU OF HIGHWAYS
 DATE: 4-21-06

APPROVED: HOWARD COUNTY DEPT. OF PLANNING AND ZONING
Cindy Kanter
 CHIEF, DIVISION OF LAND DEVELOPMENT
 DATE: 3/14/06

Michael Pfa
 CHIEF, DEVELOPMENT ENGINEERING DIVISION
 DATE: 3/13/06

PARCEL 323
 JAMES F. MORNINGSTAR, ET UX.
 547/619 ZONED RC-DEO

BENCHMARK
 ENGINEERS • LAND SURVEYORS • PLANNERS
ENGINEERING, INC.
 8480 BALTIMORE NATIONAL PIKE • SUITE 418
 ELLICOTT CITY, MARYLAND 21043
 PHONE: 410-465-6105 • FAX: 410-465-6844
 www.benchmark-engineering.com

Donald Moon
 3/31/06

OWNER/DEVELOPER: TRINITY QUALITY HOMES, INC.
 3675 PARK AVENUE, SUITE 301, ELLICOTT CITY, MD 21043, 410-480-0323

PROJECT: THE CHASE AT STONEY BROOK
 LOIS 1-20, PRESERVATION PARCEL "A" AND NON-BUILDABLE PRESERVATION PARCELS "B" THROUGH "D"


LOCATION: TAX MAP NO. 7 BLOCK NO. 17 PARCEL NO. 133
 4TH ELECTION DISTRICT
 HOWARD COUNTY, MARYLAND

TITLE: LANDSCAPE PLAN

DATE: AUGUST, 2005
 MARCH, 2006
 PROJECT NO. 1187

DES: JMC DRAFT: RP CHECK: DAM SCALE: 1" = 100' SHEET 13 OF 20

AS-BUILT 1/3/13 F-05-170

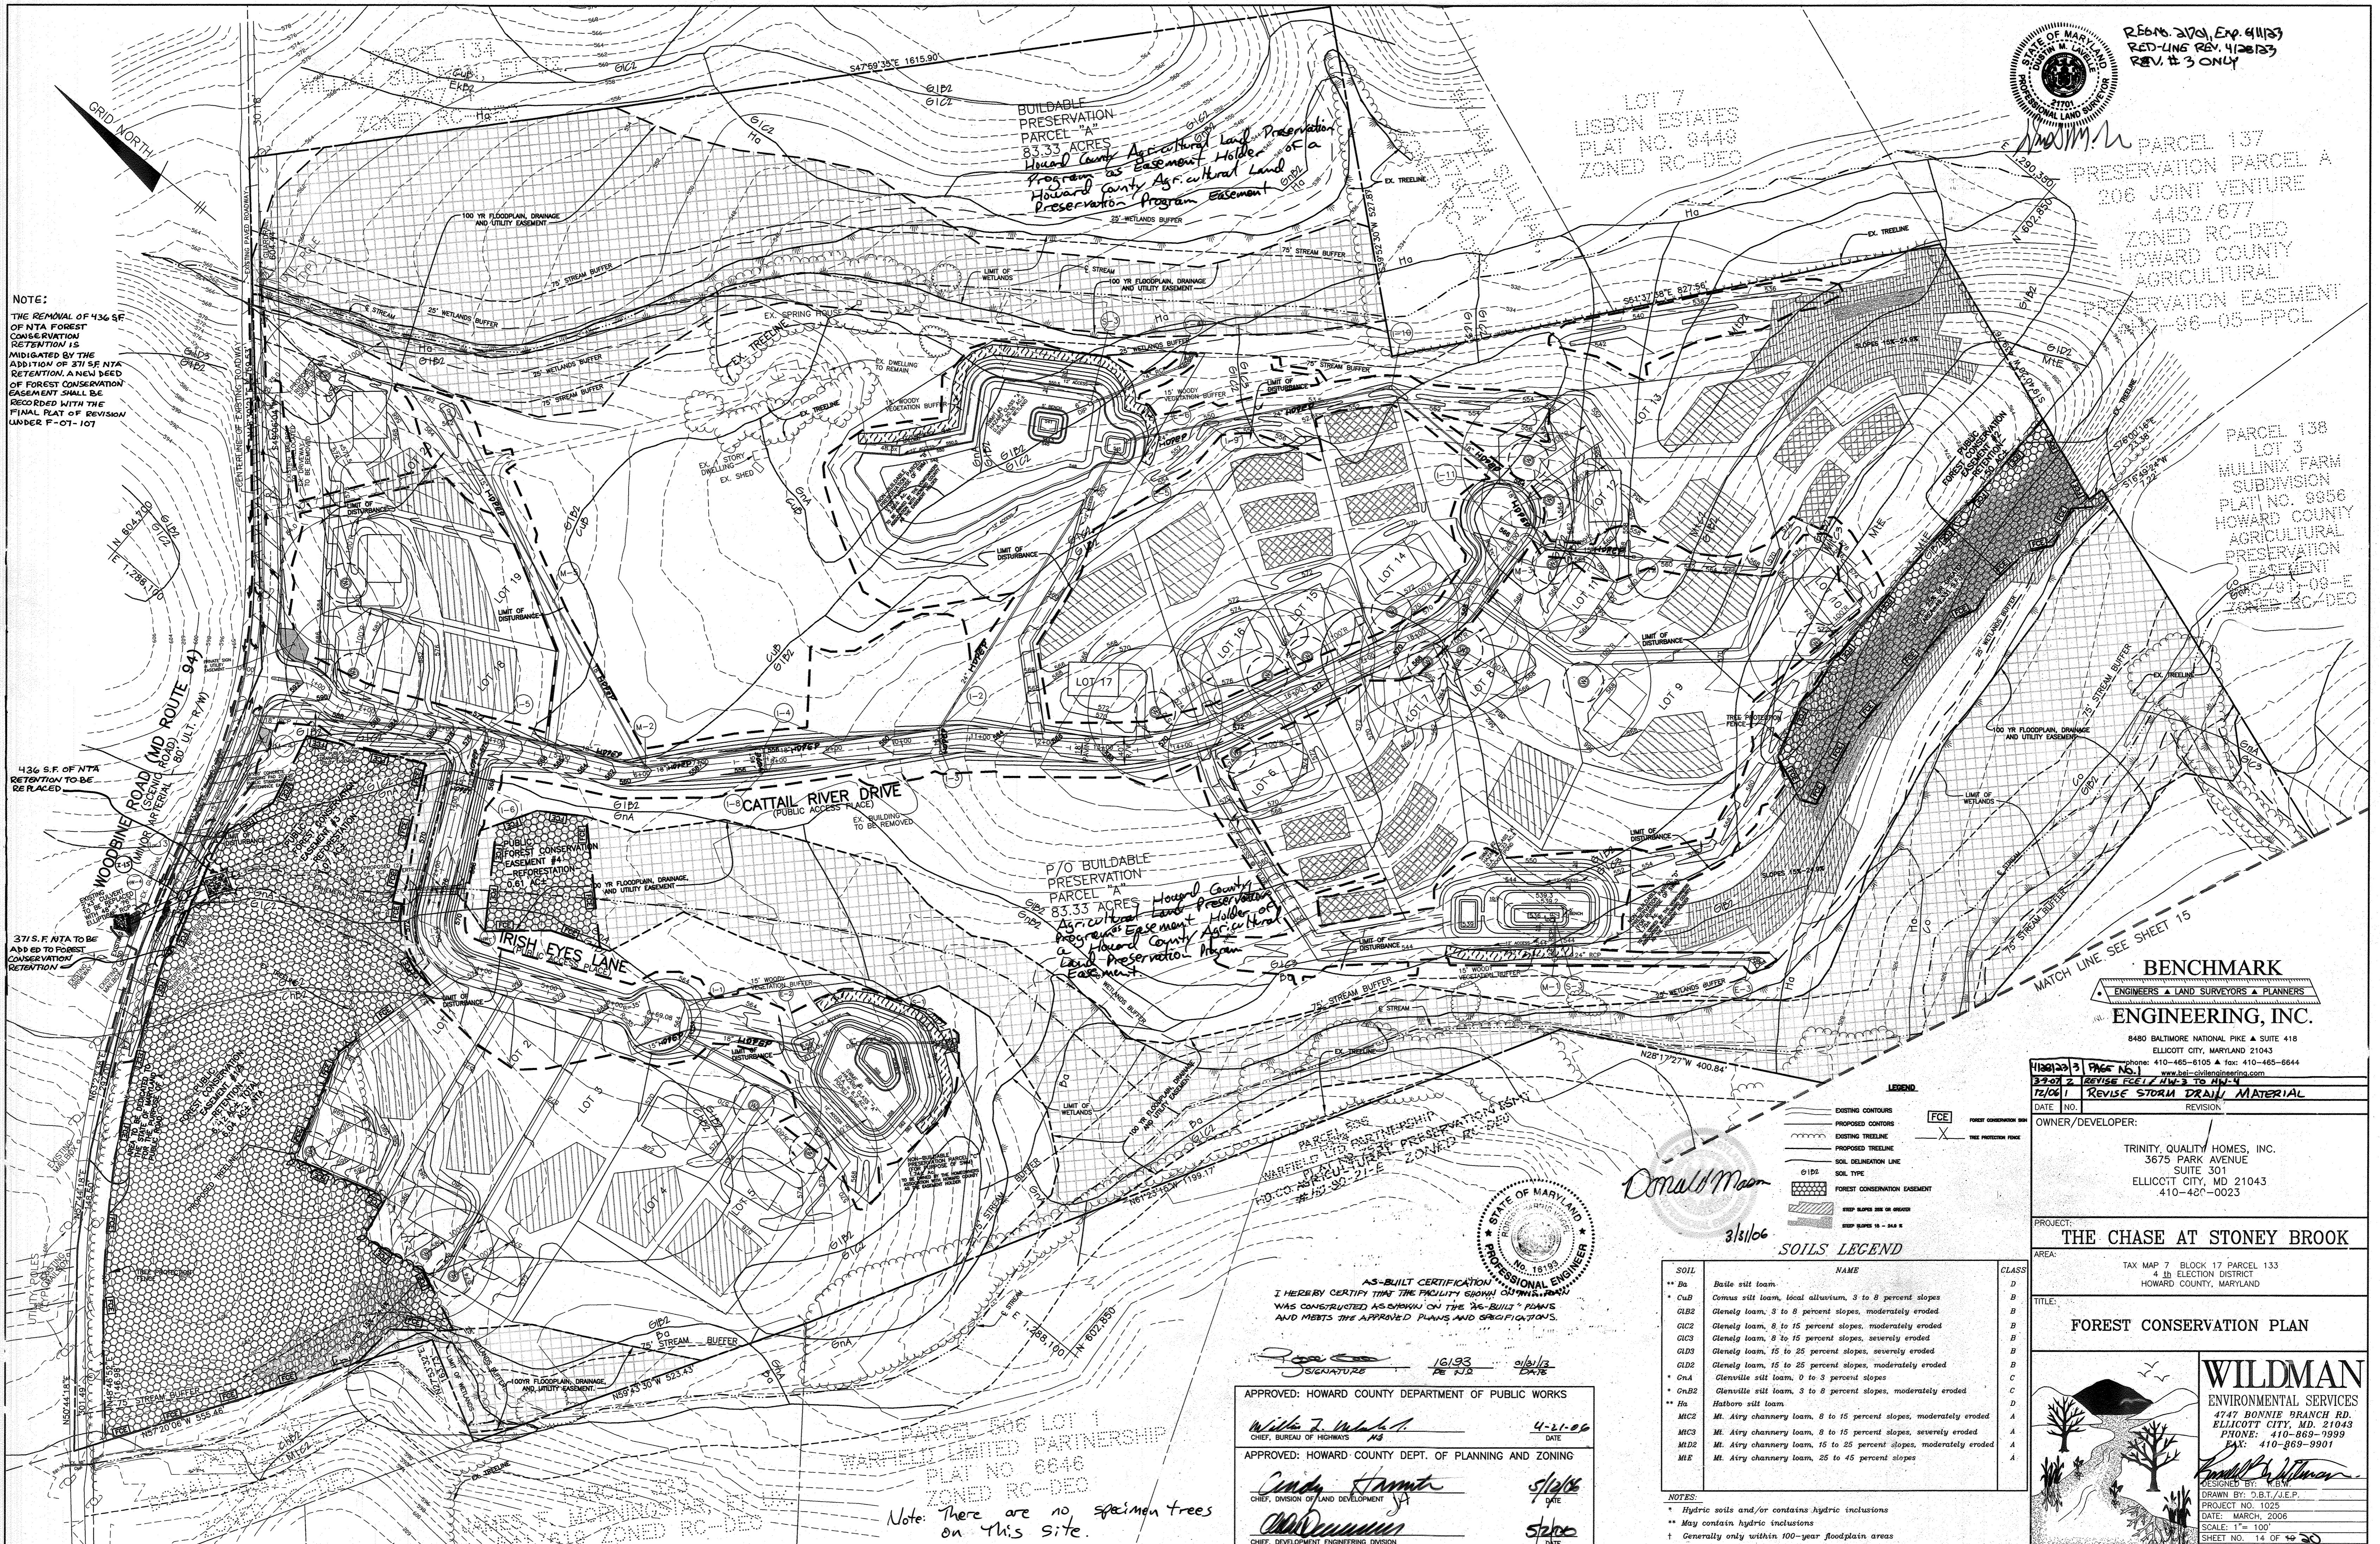

NOTE:
 THE REMOVAL OF 436 SF OF NTA FOREST CONSERVATION RETENTION IS MITIGATED BY THE ADDITION OF 371 SF NTA RETENTION. A NEW DEED OF FOREST CONSERVATION EASEMENT SHALL BE RECORDED WITH THE FINAL PLAT OF REVISION UNDER F-07-107

436 S.F. OF NTA RETENTION TO BE REPLACED

371 S.F. NTA TO BE ADDED TO FOREST CONSERVATION RETENTION

BUILDABLE PRESERVATION PARCEL "A"
 83.33 ACRES
 Howard County Agricultural Land Preservation Program as Easement Holder of a Howard County Agricultural Land Preservation Program Easement

LOT 7
 LISBON ESTATES
 PLAT NO. 8448
 ZONED RC-DEO

PARCEL 137
 PRESERVATION PARCEL A
 206 JOINT VENTURE
 4452/677
 ZONED RC-DEO
 HOWARD COUNTY
 AGRICULTURAL
 PRESERVATION EASEMENT
 #10-96-05-PPOL

PARCEL 138
 LOT 3
 MULLINX FARM
 SUBDIVISION
 PLAT NO. 8856
 HOWARD COUNTY
 AGRICULTURAL
 PRESERVATION EASEMENT
 #10-96-05-PPOL

P/O BUILDABLE PRESERVATION PARCEL "A"
 83.33 ACRES
 Howard County Agricultural Land Preservation Program as Easement Holder of a Howard County Agricultural Land Preservation Program Easement

MATCH LINE - SEE SHEET 15

BENCHMARK
 ENGINEERS & LAND SURVEYORS & PLANNERS
 ENGINEERING, INC.

8480 BALTIMORE NATIONAL PIKE & SUITE 418
 ELLICOTT CITY, MARYLAND 21043
 phone: 410-465-6105 fax: 410-465-6644
 www.bcl-civilengineering.com

1/18/03 3 PAGE NO. 1
 3/7/03 2 REVISE FCE/NTA #1 TO #11-4
 7/2/06 1 REVISE STORM DRAIN MATERIAL

OWNER/DEVELOPER:
 TRINITY QUALITY HOMES, INC.
 3675 PARK AVENUE
 SUITE 301
 ELLICOTT CITY, MD 21043
 410-420-0023

PROJECT:
THE CHASE AT STONEY BROOK

AREA:
 TAX MAP 7 BLOCK 17 PARCEL 133
 4th ELECTION DISTRICT
 HOWARD COUNTY, MARYLAND

TITLE:
FOREST CONSERVATION PLAN

WILDMAN
 ENVIRONMENTAL SERVICES
 4747 BONNIE BRANCH RD.
 ELLICOTT CITY, MD 21043
 PHONE: 410-868-9999
 FAX: 410-868-9901

DESIGNED BY: D.B.T./J.P.P.
 DRAWN BY: D.B.T./J.P.P.
 PROJECT NO. 1025
 DATE: MARCH, 2006
 SCALE: 1" = 100'
 SHEET NO. 14 OF 20

LEGEND

[Symbol]	EXISTING CONTOURS	[Symbol]	FOREST CONSERVATION
[Symbol]	PROPOSED CONTOURS	[Symbol]	FOREST PROTECTION
[Symbol]	EXISTING TREELINE	[Symbol]	
[Symbol]	PROPOSED TREELINE	[Symbol]	
[Symbol]	SOIL DELINEATION LINE	[Symbol]	
[Symbol]	SOIL TYPE	[Symbol]	
[Symbol]	FOREST CONSERVATION EASEMENT	[Symbol]	
[Symbol]	DEEP SLOPES 25% OR GREATER	[Symbol]	
[Symbol]	DEEP SLOPES 15% - 25%	[Symbol]	

SOILS LEGEND

SOIL	NAME	CLASS
** Da	Basile silt loam	D
* CuB	Comus silt loam, local alluvium, 3 to 8 percent slopes	B
GlB2	Glenylee loam, 3 to 8 percent slopes, moderately eroded	B
GlC2	Glenylee loam, 8 to 15 percent slopes, moderately eroded	B
GlC3	Glenylee loam, 8 to 15 percent slopes, severely eroded	B
GlD3	Glenylee loam, 15 to 25 percent slopes, severely eroded	B
GlD2	Glenylee loam, 15 to 25 percent slopes, moderately eroded	B
* OnA	Glenville silt loam, 0 to 3 percent slopes	C
* OnB2	Glenville silt loam, 3 to 8 percent slopes, moderately eroded	C
** Ha	Hatboro silt loam	D
MtC2	Mt. Airy channery loam, 8 to 15 percent slopes, moderately eroded	A
MtC3	Mt. Airy channery loam, 8 to 15 percent slopes, severely eroded	A
MtD2	Mt. Airy channery loam, 15 to 25 percent slopes, moderately eroded	A
ME	Mt. Airy channery loam, 25 to 45 percent slopes	A

NOTES:
 * Hydric soils and/or contains hydric inclusions
 ** May contain hydric inclusions
 † Generally only within 100-year floodplain areas

AS-BUILT CERTIFICATION
 I HEREBY CERTIFY THAT THE FACILITY SHOWN ON THIS PLAN WAS CONSTRUCTED AS SHOWN ON THE "AS-BUILT" PLANS AND MEETS THE APPROVED PLANS AND SPECIFICATIONS.


16/93
 3/11/06

APPROVED: HOWARD COUNTY DEPARTMENT OF PUBLIC WORKS
 [Signature] 4-21-06 DATE

APPROVED: HOWARD COUNTY DEPT. OF PLANNING AND ZONING
 [Signature] 5/2/06 DATE

[Signature] 5/2/06 DATE

Note: There are no specimen trees on this site.

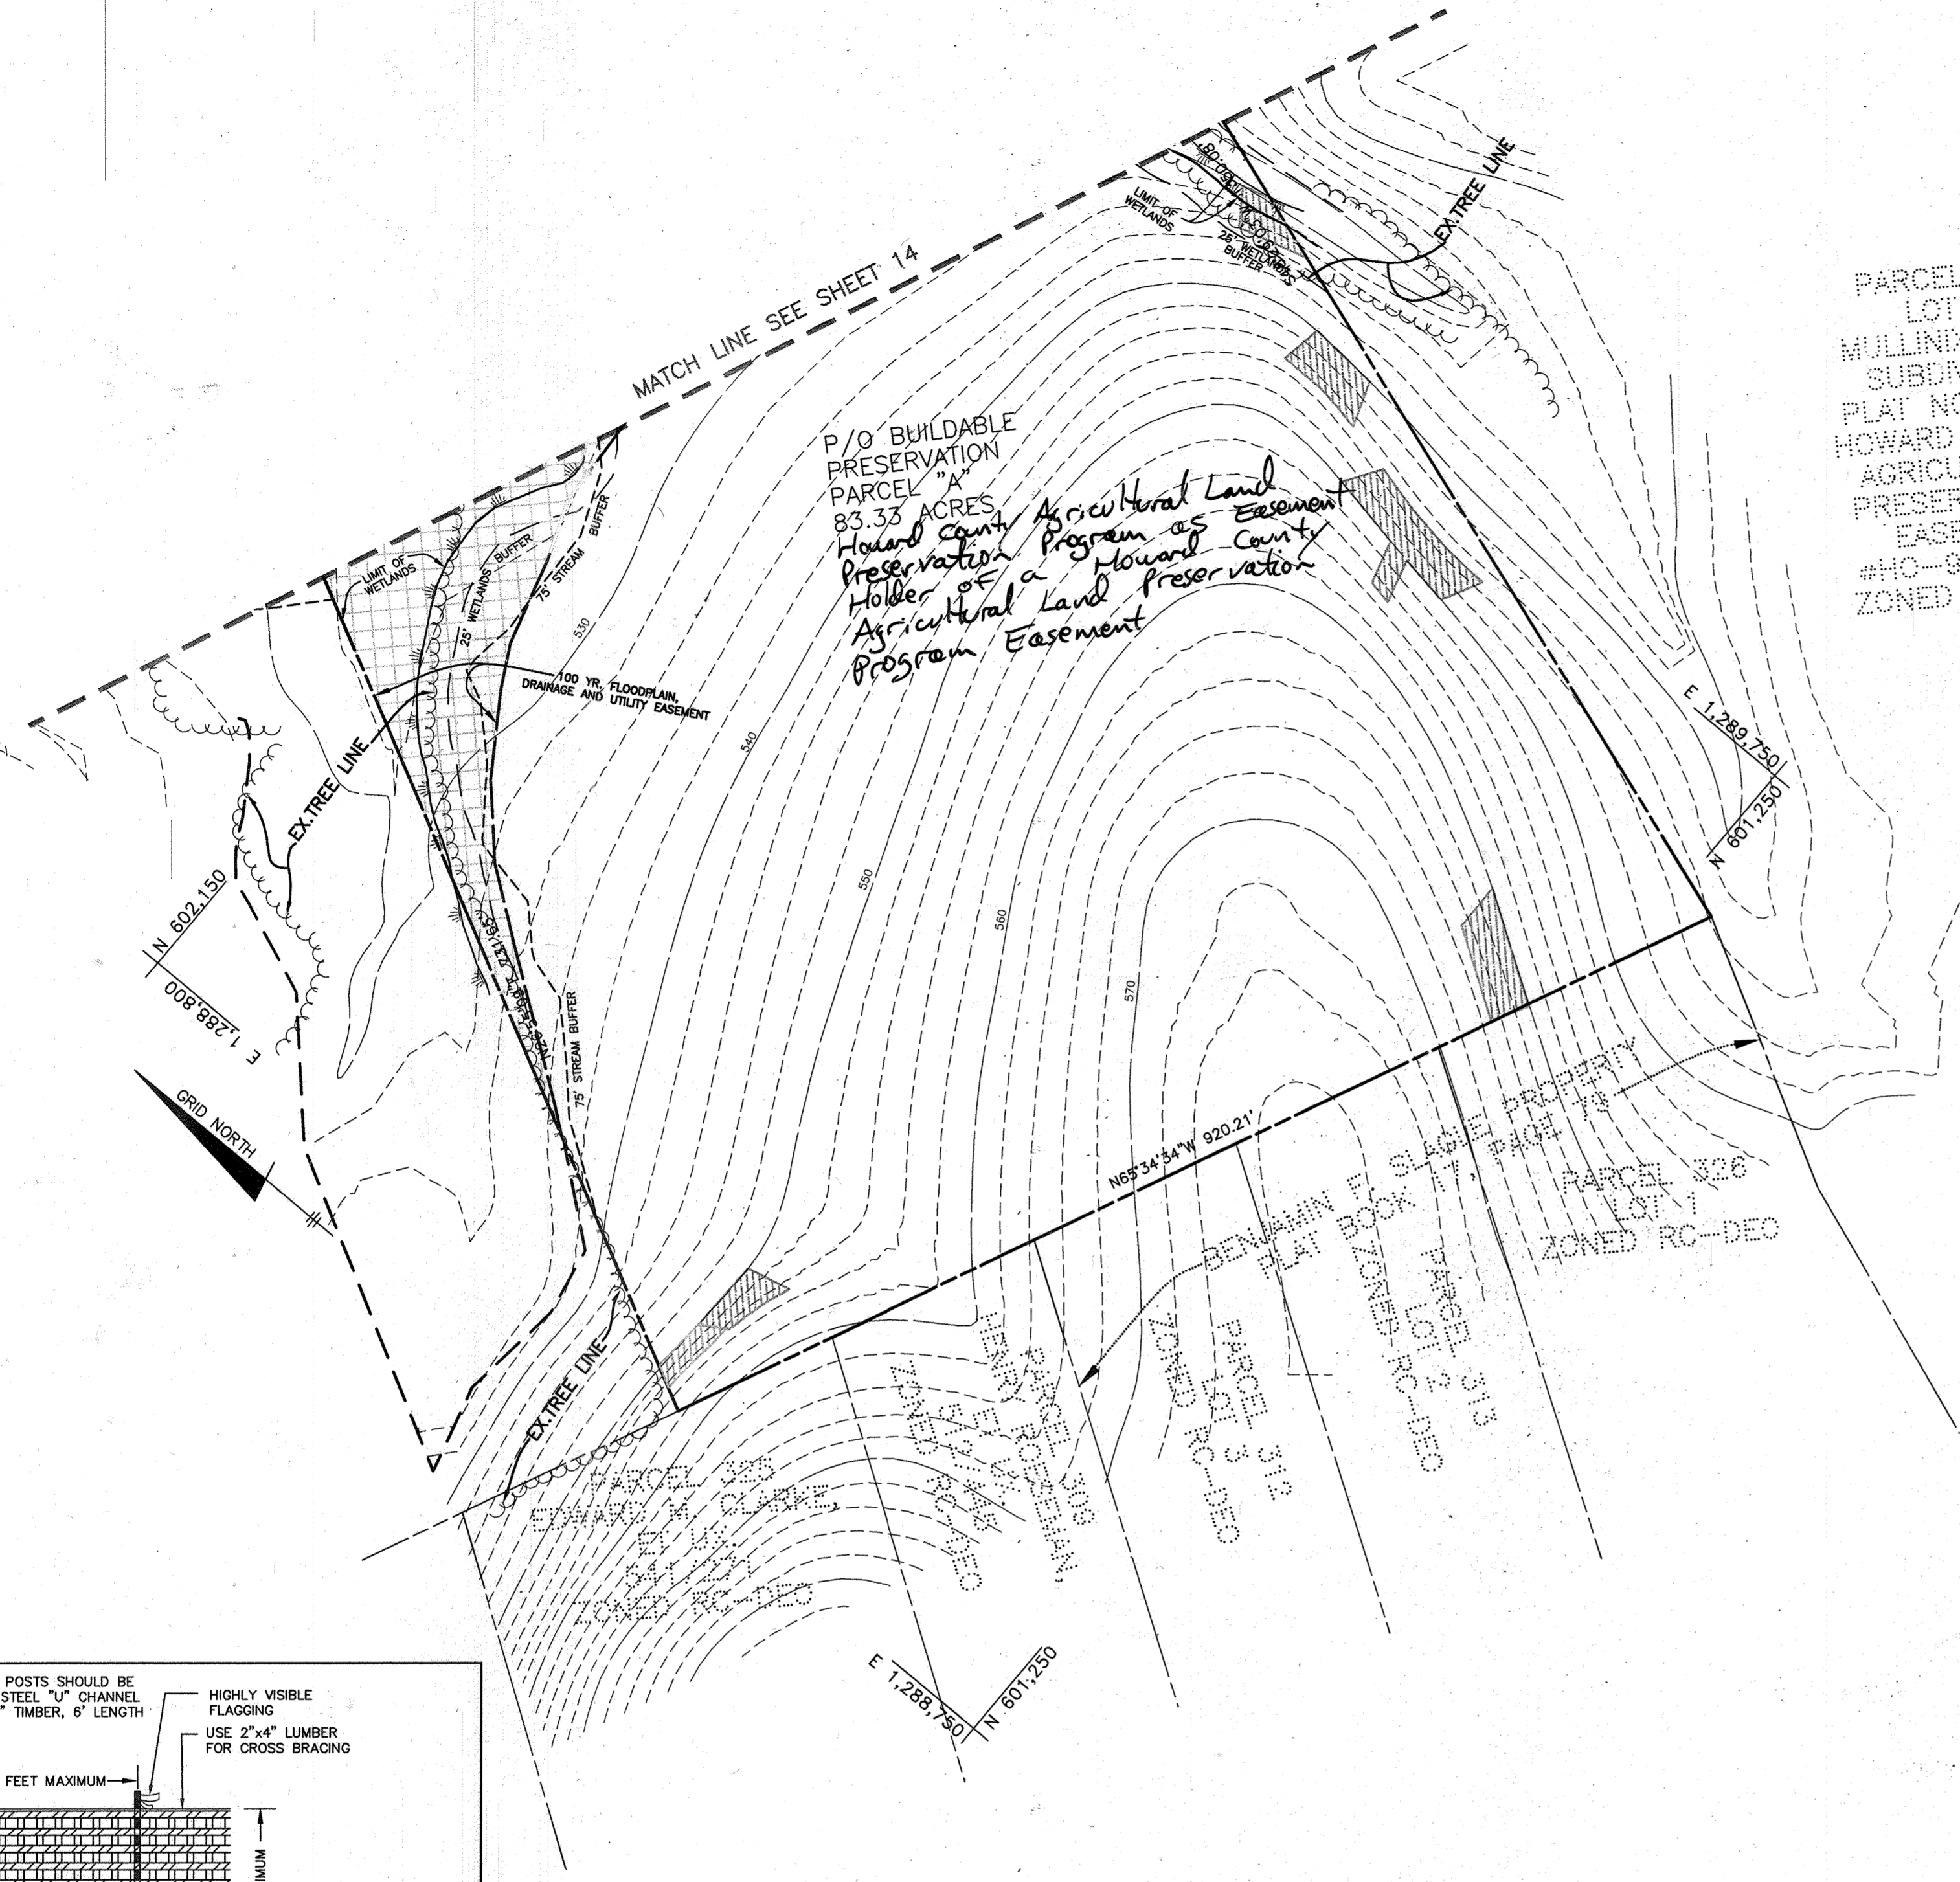

FOREST CONSERVATION NOTES:

- ANY FOREST CONSERVATION EASEMENT (FCE) AREA SHOWN HEREON IS SUBJECT TO PROTECTIVE COVENANTS WHICH WILL BE RECORDED IN THE LAND RECORDS OF HOWARD COUNTY WHICH RESTRICT THE DISTURBANCE AND USE OF THESE AREAS.
- FORESTED AREAS OCCURRING OUTSIDE OF THE FCE SHALL NOT BE CONSIDERED PART OF THE FCE AND SHALL NOT BE SUBJECT TO PROTECTIVE LAND COVENANTS.
- LIMITS OF DISTURBANCE SHALL BE RESTRICTED TO AREAS OUTSIDE THE LIMIT OF TEMPORARY FENCING OR THE FCE BOUNDARY, WHICHEVER IS GREATER.
- THERE SHALL BE NO CLEARING, GRADING, CONSTRUCTION OR DISTURBANCE OF VEGETATION IN THE FOREST CONSERVATION EASEMENT, EXCEPT AS PERMITTED BY HOWARD COUNTY DPZ.
- NO STOCKPILES, PARKING AREAS, EQUIPMENT CLEANING AREAS, ETC. SHALL OCCUR WITHIN AREAS DESIGNATED AS FOREST CONSERVATION EASEMENTS.
- TEMPORARY FENCING SHALL BE USED TO PROTECT FOREST RESOURCES DURING CONSTRUCTION. THE FENCING SHALL BE PLACED ALONG ALL FCE BOUNDARIES WHICH OCCUR WITHIN 15 FEET OF THE PROPOSED LIMITS.
- PERMANENT SIGNAGE SHALL BE PLACED 50-100' APART ALONG THE BOUNDARIES OF ALL AREAS INCLUDED IN FOREST CONSERVATION EASEMENTS.
- FOREST CONSERVATION OBLIGATIONS ARE MET BY 7.54 ACRES OF RETENTION AND 1.68 ACRES OF REFORESTATION ON SITE. FINANCIAL SURETY FOR THE REQUIRED OBLIGATION MUST BE POSTED AS PART OF THE DEVELOPER'S AGREEMENT IN THE AMOUNT OF \$102,278.88. THE TOTAL FOREST CONSERVATION OBLIGATION IS 9.22 ACRES.

NOTE:
WHIP PLANTINGS SHOULD BE INSTALLED IN A CURVILINEAR PATTERN TO FACILITATE MAINTENANCE BUT AVOID A GRID APPEARANCE. TREE SHELTERS SHOULD BE INSTALLED ON ALL WHIP PLANTINGS.

FOREST CONSERVATION EASEMENT #3 (1.07 ACRES±)

QTY.***	SPECIES	SIZE	SPACING
40	Acer rubrum - RED MAPLE	2-3" WHIP	**
35	Robinia pseudoacacia - BLACK LOCUST	2-3" WHIP	**
50	Juglans nigra - BLACK WALNUT	2-3" WHIP	**
25	Juniperus virginiana - RED CEDAR	2-3" WHIP	**
50	Liriodendron tulipifera - YPOCRASS	2-3" WHIP	**
20	Nyssa sylvatica - BLACK GUM	2-3" WHIP	**
50	Prunus serotina - BLACK CHERRY	2-3" WHIP	**
45	Potamogeton occidentalis - SYCAMORE	2-3" WHIP	**
30	Quercus rubra - RED OAK	2-3" WHIP	**
15	Sassafras albidum - SASSAFRAS	2-3" WHIP	**
375	TOTAL	375 PLANTINGS REQUIRED	

FOREST CONSERVATION EASEMENT #4 (0.61 ACRES±)

QTY.***	SPECIES	SIZE	SPACING
30	Acer rubrum - RED MAPLE	2-3" WHIP	**
15	Robinia pseudoacacia - BLACK LOCUST	2-3" WHIP	**
24	Juglans nigra - BLACK WALNUT	2-3" WHIP	**
25	Juniperus virginiana - RED CEDAR	2-3" WHIP	**
30	Liriodendron tulipifera - YPOCRASS	2-3" WHIP	**
10	Nyssa sylvatica - BLACK GUM	2-3" WHIP	**
50	Prunus serotina - BLACK CHERRY	2-3" WHIP	**
25	Potamogeton occidentalis - SYCAMORE	2-3" WHIP	**
15	Quercus rubra - RED OAK	2-3" WHIP	**
15	Sassafras albidum - SASSAFRAS	2-3" WHIP	**
214	TOTAL	207 PLANTINGS REQUIRED	

KEY:
** PLANTINGS TO BE SPACED AN AVERAGE OF 11 FOOT CENTERS - PLANTINGS SHOULD BE INSTALLED AS RANDOM OF AN ARRANGEMENT AS POSSIBLE WITH GROUPING 3 TO 5 PLANTINGS AS EACH LOCATION.
PER COUNTY REQUIREMENTS, TREE SHELTERS SHOULD BE USED.
*** THE DEVELOPER RESERVE THE OPTION TO USE THE ALTERNATIVE PLANT MATERIAL SIZE AND DENSITY. IF 1" CALIPER TREES ARE USED THE QUANTITY REQUIRED SHALL BE 57.1% OF THE QUANTITY SPECIFIED IN THE ABOVE TABLE. IF 2" CALIPER TREES ARE PLANTED THE QUANTITY SHALL BE 28.6% OF THE QUANTITY SPECIFIED.

1" = 214 TREES
2" = 107 TREES

1" = 122 TREES
2" = 61 TREES

**APPENDIX E
FOREST CONSERVATION WORKSHEET**

I. BASIC SITE DATA		ACRES (1/10 acre)		IV. REFORESTATION CALCULATIONS (1/10 acre)	
GROSS SITE AREA	116.79	A. NET TRACT AREA	33.46	B. REFORESTATION THRESHOLD (25% x A)	8.37
AREA WITHIN 100 YEAR FLOOD PLAIN	23.62	C. AFFORESTATION MINIMUM (20% x A)	6.69	D. EXISTING FOREST ON NET TRACT AREA	8.46
AREA OF PRESERVATION PARCEL	83.33	E. FOREST AREAS TO BE CLEARED	J.92	F. FOREST AREAS TO BE RETAINED	7.54
AREA WITHIN AGRICULTURAL USE OR PRESERVATION PARCEL OUTSIDE OF FLOODPLAIN (IF APPLICABLE)	59.71	G. FOREST AREAS CLEARED ABOVE REFORESTATION THRESHOLD (D-F, If F equals or is greater than B, Alternate 1) (D-B, If F is less than B, Alternate 2)	0.09	H. FOREST AREAS CLEARED BELOW REFORESTATION THRESHOLD	0.83
NET TRACT AREA	33.46	I. FOREST AREAS RETAINED ABOVE REFORESTATION THRESHOLD (F-B, Retention Credit, if applicable)			
LAND USE CATEGORY (R-RLD, R-RMD, R-S, C/VO, I)	R-RMD				
II. INFORMATION FOR CALCULATIONS				SELECT THE ALTERNATE THAT APPLIES:	
A. NET TRACT AREA	33.46			1. Clearing above the threshold only	
B. REFORESTATION THRESHOLD (25% x A)	8.37			If forest areas to be retained equal or are greater than the reforestation threshold (if F equals or is greater than B), the following calculations apply:	
C. AFFORESTATION MINIMUM (20% x A)	6.69			REFORESTATION FOR CLEARING ABOVE THRESHOLD $G \times 1/4$ 0.02	
D. EXISTING FOREST ON NET TRACT AREA	8.46			CREDIT FOR FOREST AREAS RETAINED ABOVE THRESHOLD 0	
E. FOREST AREAS TO BE CLEARED	0.92			TOTAL REFORESTATION REQUIRED 0	
F. FOREST AREAS TO BE RETAINED (RETENTION)	7.54			$(G \times 1/4) - I$	
III. DETERMINING REQUIREMENTS: AFFORESTATION OR REFORESTATION				If the total reforestation requirement is equal to or less than 0, no reforestation is required.	
1. Reforestation				2. Clearing below the threshold	
If existing forest areas equal or exceed the afforestation minimum (if D equals or is more than C), and no clearing of existing forest resources is proposed, no reforestation is required. No further calculations are needed.				If forest areas to be retained are less than the reforestation threshold (if F is less than B), the following calculations apply:	
2. Afforestation				REFORESTATION FOR CLEARING ABOVE THRESHOLD $G \times 1/4$ 0.02	
If existing forest areas are less than the afforestation minimum (if D is less than C), afforestation requirements apply.				REFORESTATION FOR CLEARING BELOW THRESHOLD $H \times 2$ 1.66	
				TOTAL REFORESTATION REQUIRED $(G \times 1/4) + (H \times 2)$ 1.68	


Site Data

	Areas
Gross Area:	116.79
100 Year Floodplain:	23.62
Agricultural Pres.	83.33
Net Tract Area (NTA):	33.46
Existing Forest on NTA:	8.46
Afforestation Threshold:	6.69
Reforestation Threshold:	8.37
Forest not retained in FCE:	0.92
NTA Forest to be Retained in FCE:	7.54

FOREST CONSERVATION TABULATION

DESIGNATION	TYPE	ACREAGE
#1A	RETENTION	6.04 NTA
#2	RETENTION	1.50
#3	REFORESTATION	1.07
#4	REFORESTATION	0.61
TOTAL:	MIX	9.24

NOTE:
1. THIS PROJECT IS USING RURAL CLUSTER OPTION 'C' PER APPENDIX 'L' OF THE FOREST CONSERVATION MANUAL TO CALCULATE ITS FOREST CONSERVATION OBLIGATION.
2. THE 83.33 ACRES EXCLUDED FROM THE NET TRACT AREA IS PRESERVATION PARCEL 'A'.
3. There are no specimen trees on this site.

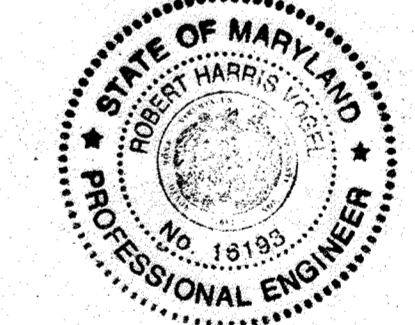

AS-BUILT CERTIFICATION
I HEREBY CERTIFY THAT THE FACILITY SHOWN ON THIS PLAN WAS CONSTRUCTED AS SHOWN ON THE 'AS-BUILT' PLANS AND MEETS THE APPROVED PLANS AND SPECIFICATIONS.
DATE: 3/31/06
SIGNATURE: Donald M. Mason
PE NO. 18199

BENCHMARK ENGINEERING, INC.

8480 BALTIMORE NATIONAL PIKE # SUITE 418
ELLICOTT CITY, MARYLAND 21043
PHONE: 410-489-6105 FAX: 410-485-8644
www.benchmark-engineering.com

1138/33 2nd PAGE NO.

DATE	NO.	REVISION
3/9/01		REVISE FCE #1


OWNER/DEVELOPER: TRINITY QUALITY HOMES, INC.
3675 PARK AVENUE SUITE 301
ELLICOTT CITY, MD 21043
410-480-0023

PROJECT: THE CHASE AT STONEY BROOK
AREA: TAX MAP 7 BLOCK 17 PARCEL 133 4th ELECTION DISTRICT HOWARD COUNTY, MARYLAND

FOREST CONSERVATION PLAN

WILDMAN ENVIRONMENTAL SERVICES
4747 BONNIE BRANCH RD.
ELLICOTT CITY, MD 21043
PHONE: 410-669-9999
FAX: 410-669-9901

DESIGNED BY: R.E.M.
DRAWN BY: D.B.T./J.E.P.
PROJECT NO. 1025
DATE: MARCH, 2006
SCALE: 1" = 100'
SHEET NO. 15 OF 49

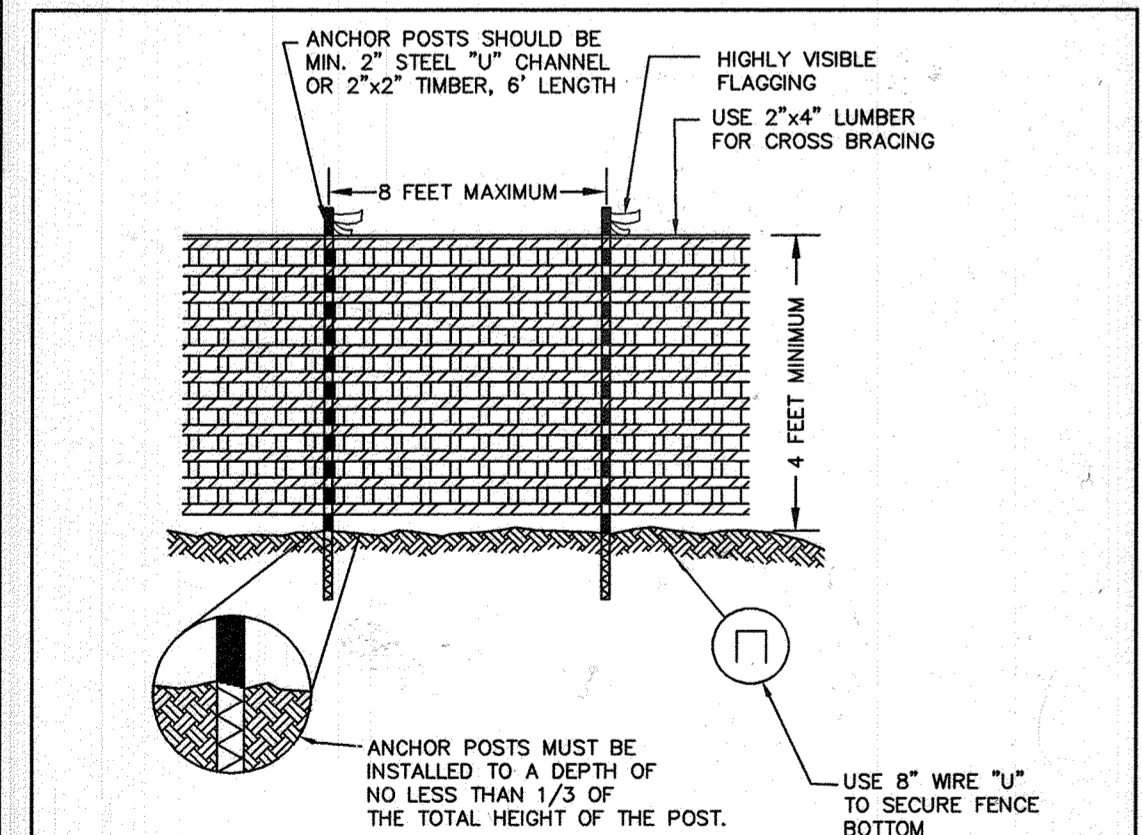

PLASTIC MESH TREE PROTECTION FENCE

ANCHOR POSTS SHOULD BE MIN. 2" STEEL "U" CHANNEL OR 2"x2" TIMBER, 6' LENGTH
HIGHLY VISIBLE FLAGGING USE 2"x4" LUMBER FOR CROSS BRACING
8 FEET MAXIMUM
4 FEET MINIMUM

ANCHOR POSTS MUST BE INSTALLED TO A DEPTH OF NO LESS THAN 1/3 OF THE TOTAL HEIGHT OF THE POST.
USE "B" WIRE "U" TO SECURE FENCE BOTTOM

NOTES:
1. BLAZE ORANGE OR BLUE PLASTIC MESH FENCE FOR FOREST PROTECTION DEVICE ONLY.
2. BOUNDARIES OF RETENTION AREA WILL BE ESTABLISHED AS PART OF THE FOREST CONSERVATION PLAN REVIEW PROCESS.
3. BOUNDARIES OF RETENTION AREA SHOULD BE STAKED AND FLAGGED PRIOR TO INSTALLATION.
4. AVOID DAMAGE TO CRITICAL ROOT ZONE. DO NOT DAMAGE OR SEVERE LARGE ROOTS WHEN INSTALLING POSTS.
5. PROTECTIVE SIGNS ARE REQUIRED.
6. DEVICE SHOULD BE MAINTAINED THROUGHOUT CONSTRUCTION.
ADAPTED FROM PRINCE GEORGE'S COUNTY, MD. WOODLAND CONSERVATION MANUAL AND FOREST CONSERVATION MANUAL, 1991.

APPROVED: HOWARD COUNTY DEPARTMENT OF PUBLIC WORKS
W. J. Mullinix, Chief, Bureau of Highways, 4-21-06
APPROVED: HOWARD COUNTY DEPT. OF PLANNING AND ZONING
Cindy Hammons, Chief, Division of Land Development, 5/12/06
M. J. Dammann, Chief, Development Engineering Division, 5/2/06


<p>FOREST RETENTION AREA</p> <p>MACHINERY, DUMPING OR STORAGE OF ANY MATERIALS IS PROHIBITED</p> <p>VIOLATORS ARE SUBJECT TO FINES AS IMPOSED BY THE HOWARD COUNTY FOREST CONSERVATION ACT OF 1992</p> <p>MIN. 15" MIN. 11"</p>	<p>SPECIMEN TREE</p> <p>DO NOT REMOVE</p> <p>MACHINERY, DUMPING OR STORAGE OF ANY MATERIALS IS PROHIBITED</p> <p>VIOLATORS ARE SUBJECT TO FINES AS IMPOSED BY THE HOWARD COUNTY FOREST CONSERVATION ACT OF 1992</p> <p>MIN. 15" MIN. 11"</p>	<p>Forest Conservation Area</p> <p>REFORESTATION PROJECT</p> <p>Trees For Your Future</p> <p>MIN. 15" MIN. 11"</p>
---	--	---

PROTECTIVE SIGNAGE





SOILS LEGEND

SOIL	NAME	CLASS
**Ba	Battle silt loam	D
*CuB	Cornus silt loam, local alluvium, 3 to 8 percent slopes	B
GLB2	Glenelg loam, 3 to 8 percent slopes, moderately eroded	B
GLC2	Glenelg loam, 8 to 15 percent slopes, moderately eroded	B
*GLC3	Glenelg loam, 8 to 15 percent slopes, severely eroded	B
GLD3	Glenelg loam, 15 to 25 percent slopes, severely eroded	B
GLD2	Glenelg loam, 15 to 25 percent slopes, moderately eroded	B
*CnA	Cleenville silt loam, 0 to 3 percent slopes	C
*CnB2	Cleenville silt loam, 3 to 8 percent slopes, moderately eroded	C
**Hs	Halbors silt loam	D
MIC2	Mt. Atry channery loam, 8 to 15 percent slopes, moderately eroded	A
MIC3	Mt. Atry channery loam, 8 to 15 percent slopes, severely eroded	A
MID2	Mt. Atry channery loam, 15 to 25 percent slopes, moderately eroded	A
MIE	Mt. Atry channery loam, 25 to 45 percent slopes	A

NOTES:
* Hydric soils and/or contains hydric inclusions
** May contain hydric inclusions
† Generally only within 100-year floodplain areas

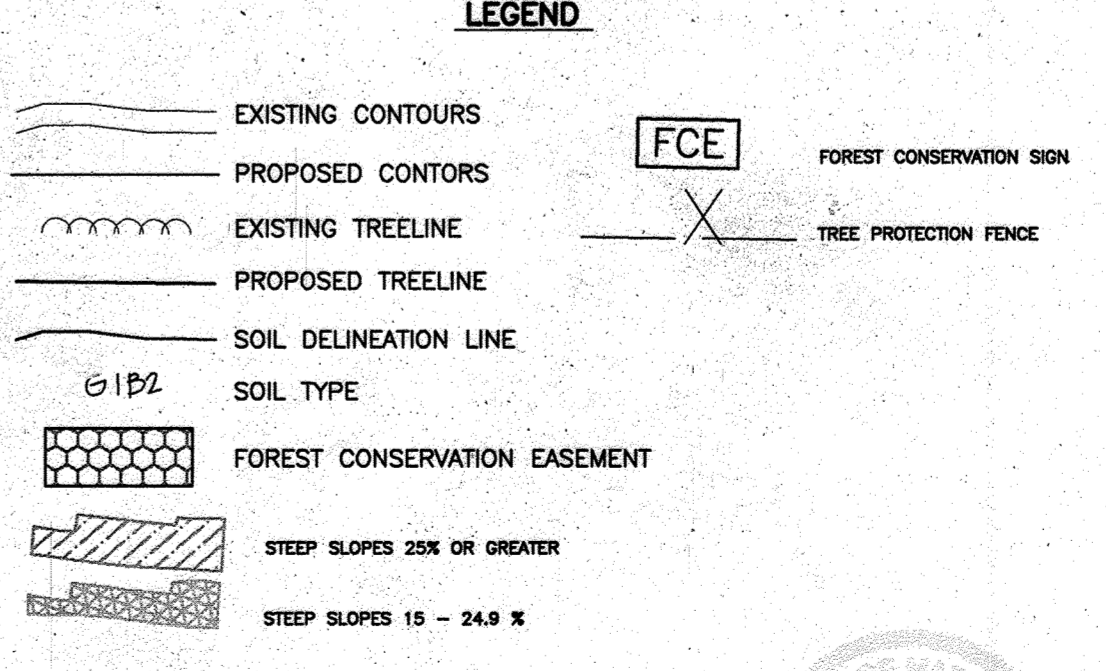

Donald M. Mason
3/31/06

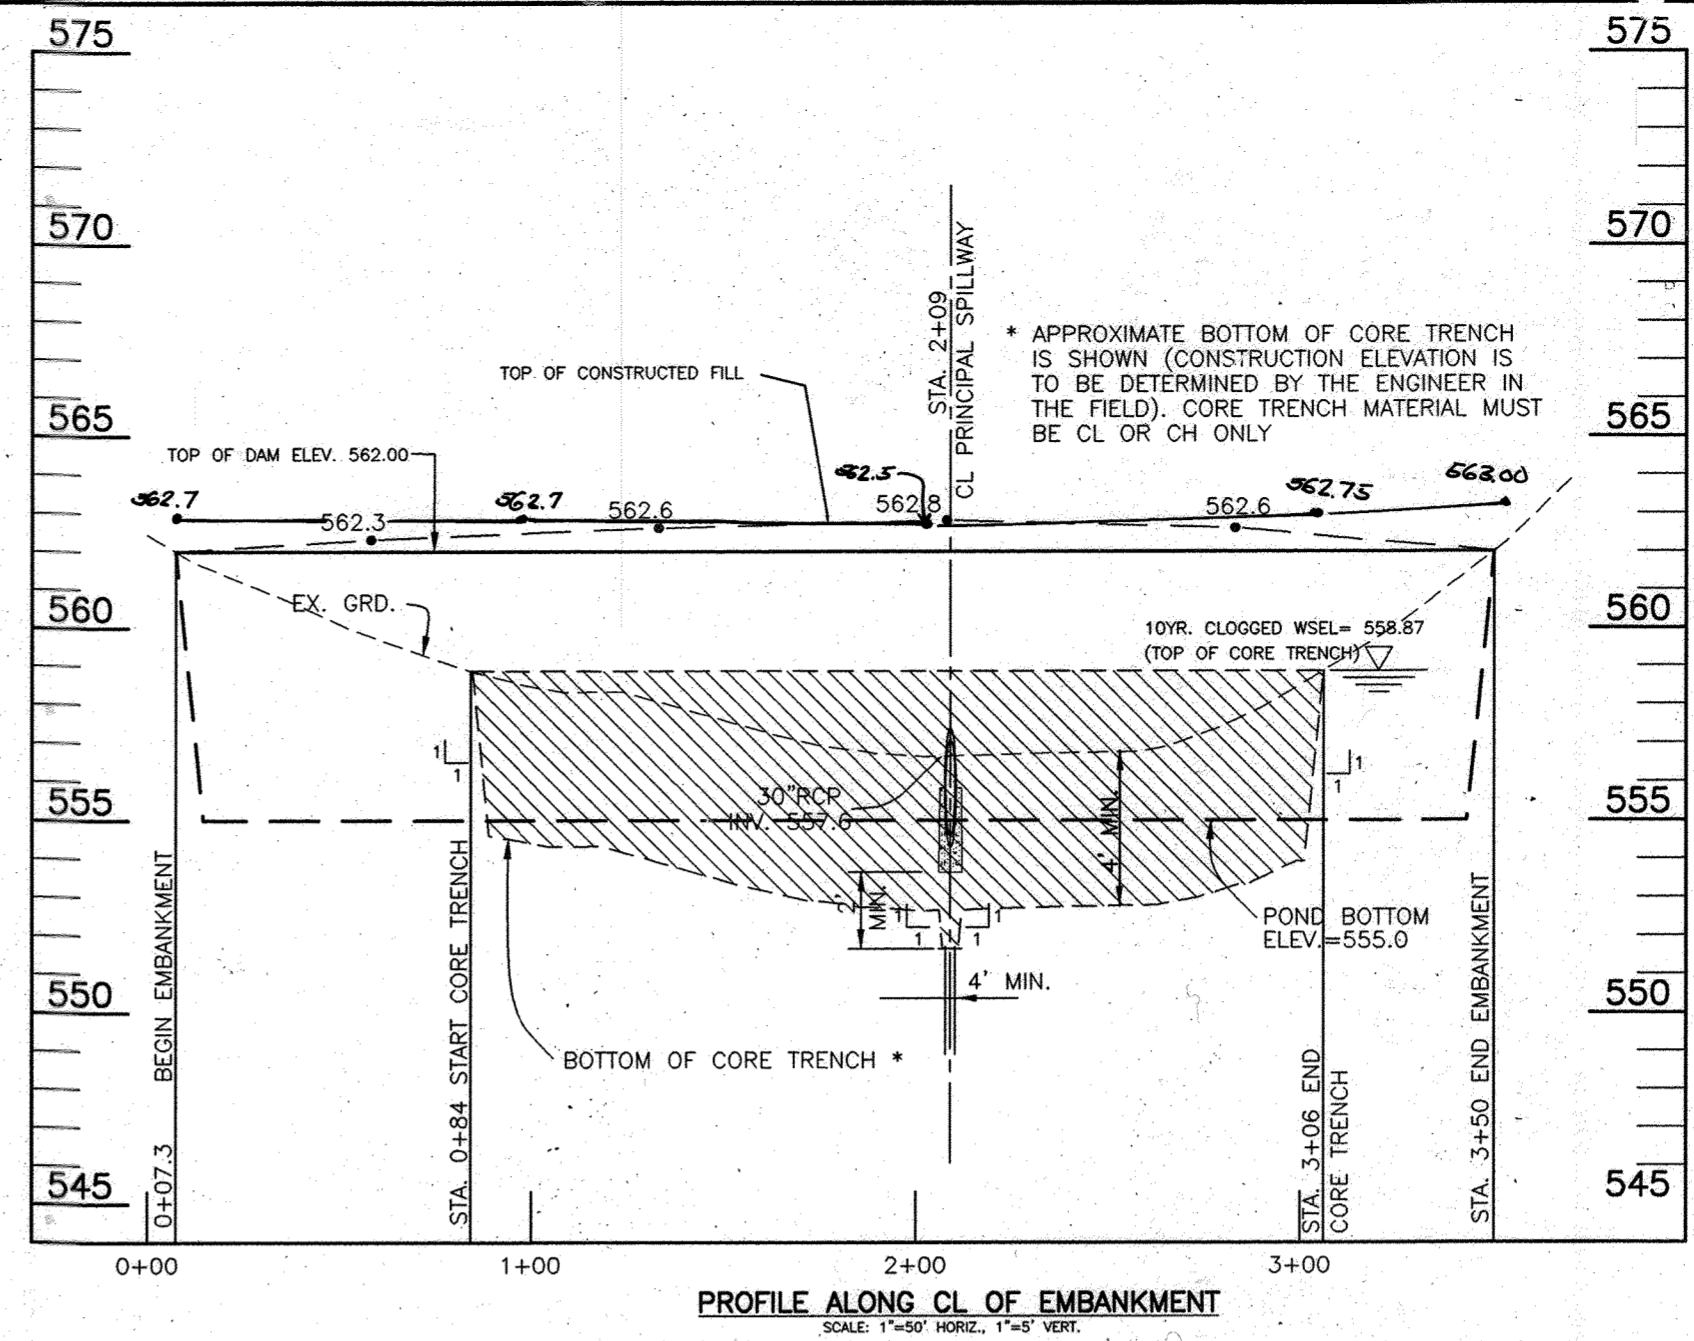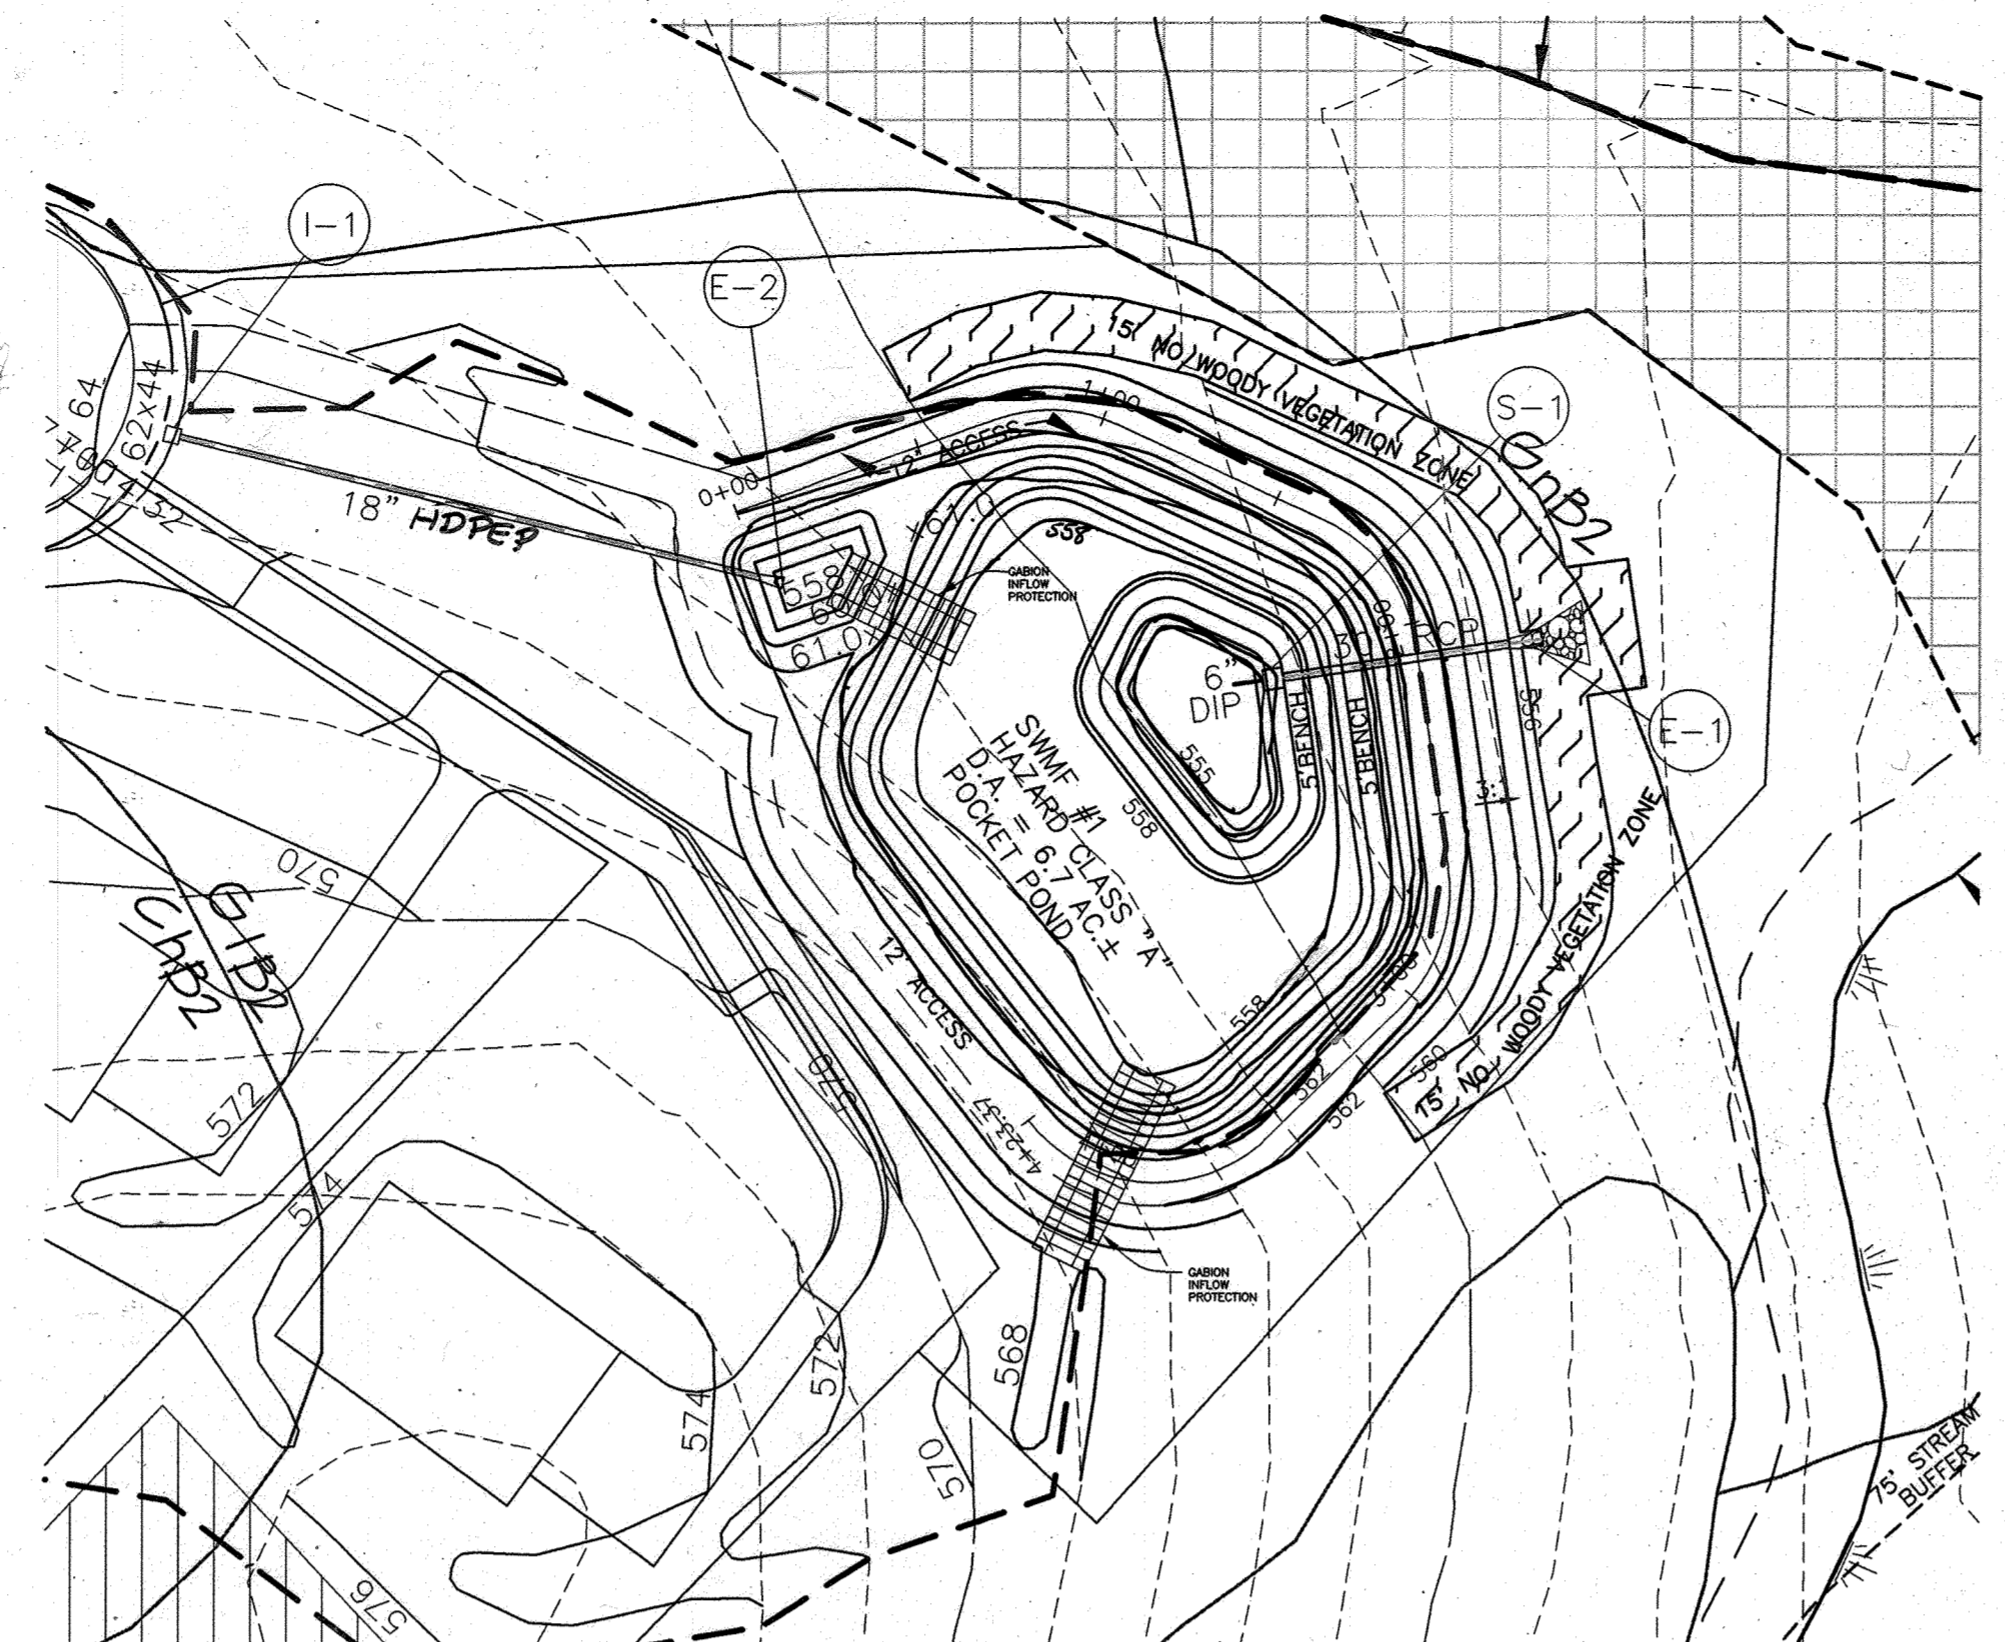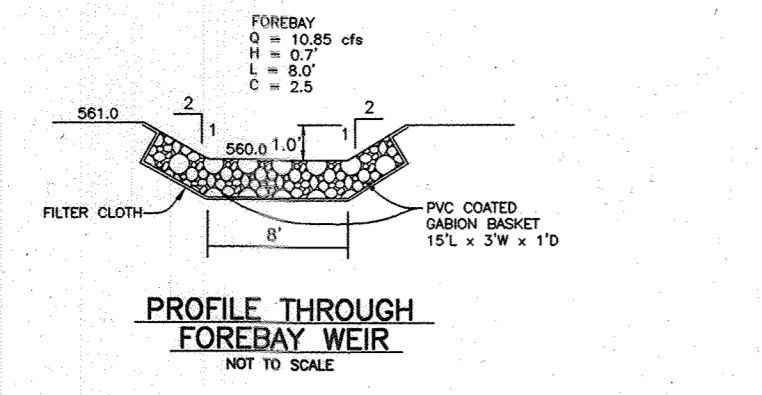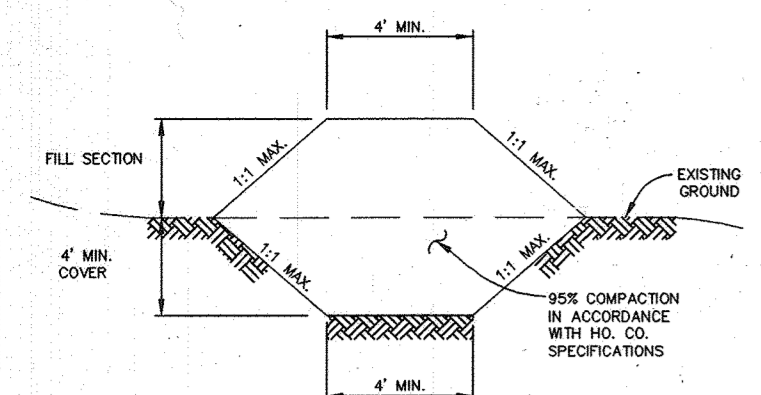




FOREST CULHS

FACING	QTY	SPEC.
30	Acres	...
15	Acres	...
24	Acres	...
25	Acres	...
30	Acres	...
19	Acres	...
30	Acres	...
15	Acres	...

- OPERATION AND MAINTENANCE SCHEDULE FOR PRIVATELY OWNED AND MAINTAINED EXTENDED DETENTION POND**
- ROUTINE MAINTENANCE:**
- FACILITY SHALL BE INSPECTED ANNUALLY AND AFTER MAJOR STORMS. INSPECTIONS SHALL BE PERFORMED DURING WET WEATHER TO DETERMINE IF THE POND IS FUNCTIONING PROPERLY.
 - TOP AND SIDE SLOPES OF THE EMBANKMENT SHALL BE MOWED A MINIMUM OF TWO (2) TIMES PER YEAR, ONCE IN JUNE AND ONCE IN SEPTEMBER. OTHER SIDE SLOPES AND MAINTENANCE ACCESS SHALL BE MOWED AS NEEDED.
 - DEBRIS AND LITTER SHALL BE REMOVED DURING REGULAR MOWING OPERATIONS AND AS NEEDED.
 - VISIBLE SIGNS OF EROSION IN THE POND AS WELL AS THE RIP-RAP OR GABION OUTLET AREA SHALL BE REPAIRED AS SOON AS IT IS NOTICED.
- NON-ROUTINE MAINTENANCE:**
- STRUCTURAL COMPONENTS OF THE POND SUCH AS THE DAM, THE RISER, AND THE PIPES SHALL BE REPAIRED UPON THE DETECTION OF ANY DAMAGE. THE COMPONENTS SHALL BE INSPECTED DURING ROUTINE MAINTENANCE OPERATIONS.
 - SEDIMENTS SHALL BE REMOVED FROM THE POND, AT THE FOREBAY, NO LATER THAN WHEN THE CAPACITY OF THE POND OR FOREBAY IS HALF FULL OF SEDIMENT, OR WHEN DEEMED NECESSARY FOR AESTHETIC REASONS, UPON APPROVAL FROM THE DEPARTMENT OF PUBLIC WORKS.




NOTES:

- IF WATER IS ENCOUNTERED DURING THE CONSTRUCTION OF THE CORE TRENCH, IT IS TO BE REMOVED BY PUMPING.
- CORE TRENCH SHALL CONSIST OF IMPERVIOUS MATERIAL (LOC. 55, CH) AS DIRECTED BY A GEOTECHNICAL ENGINEER ON-SITE AND MAY REQUIRE TO BE HAULED FROM AN OFFSITE LOCATION.

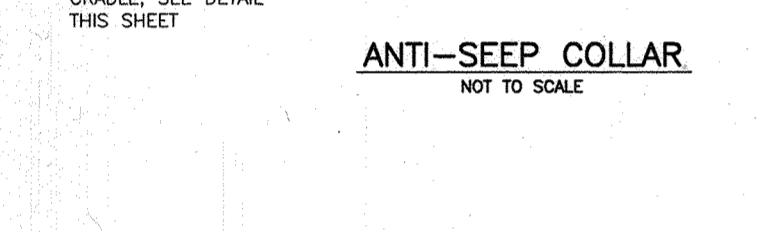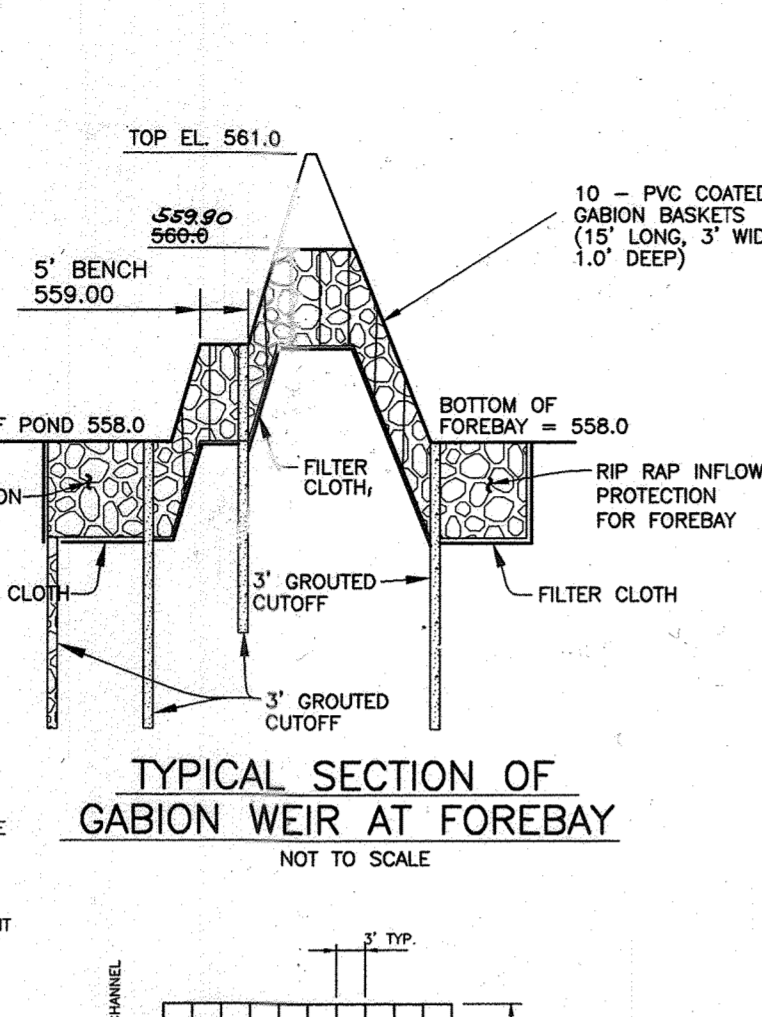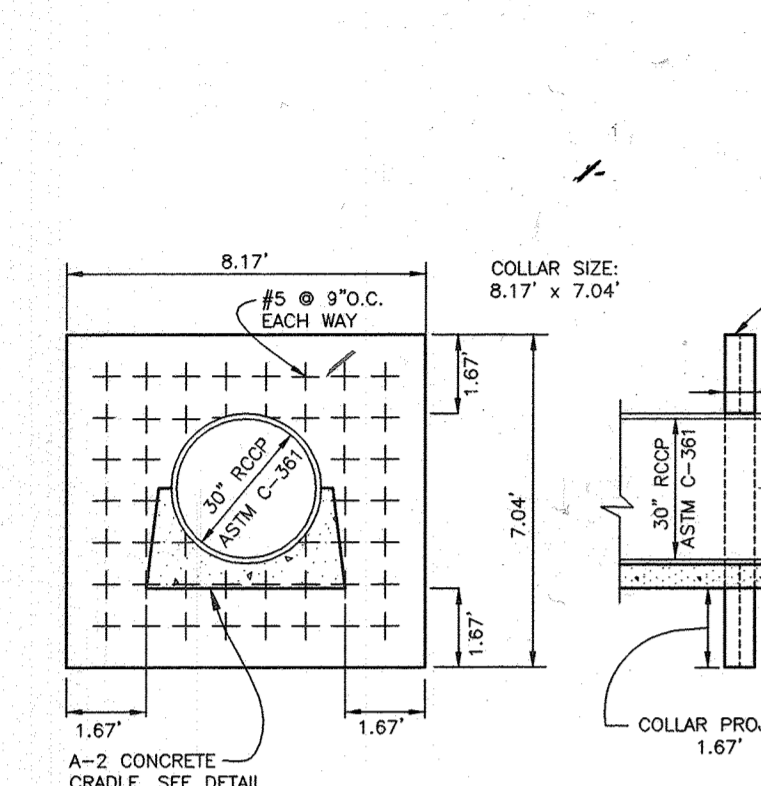


ANTI-SEEP COLLAR
NOT TO SCALE

TYPICAL SECTION OF GABION WEIR AT FOREBAY
NOT TO SCALE

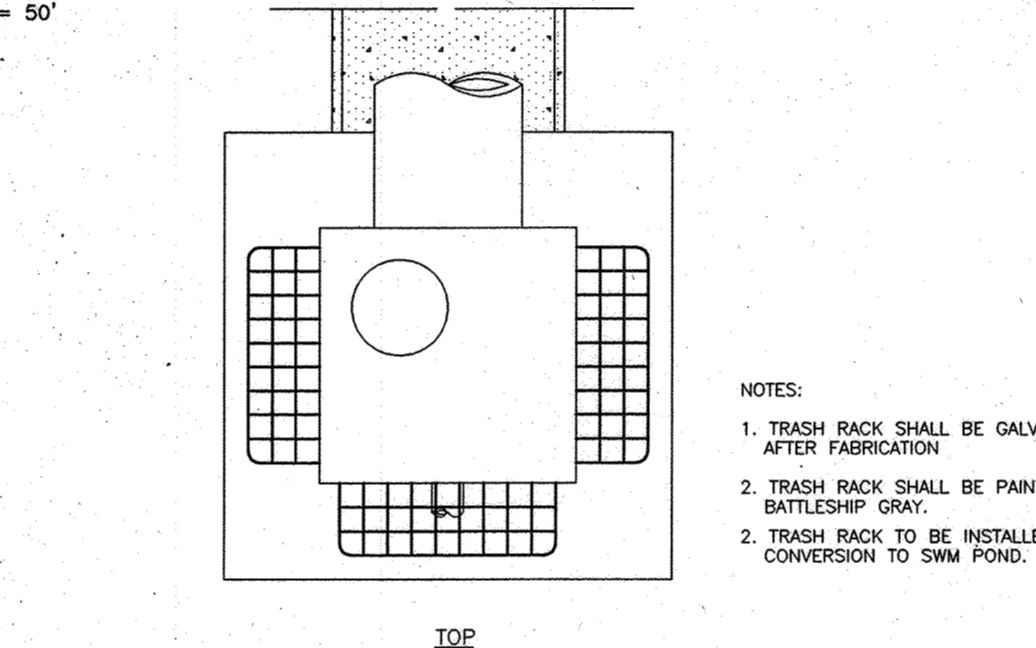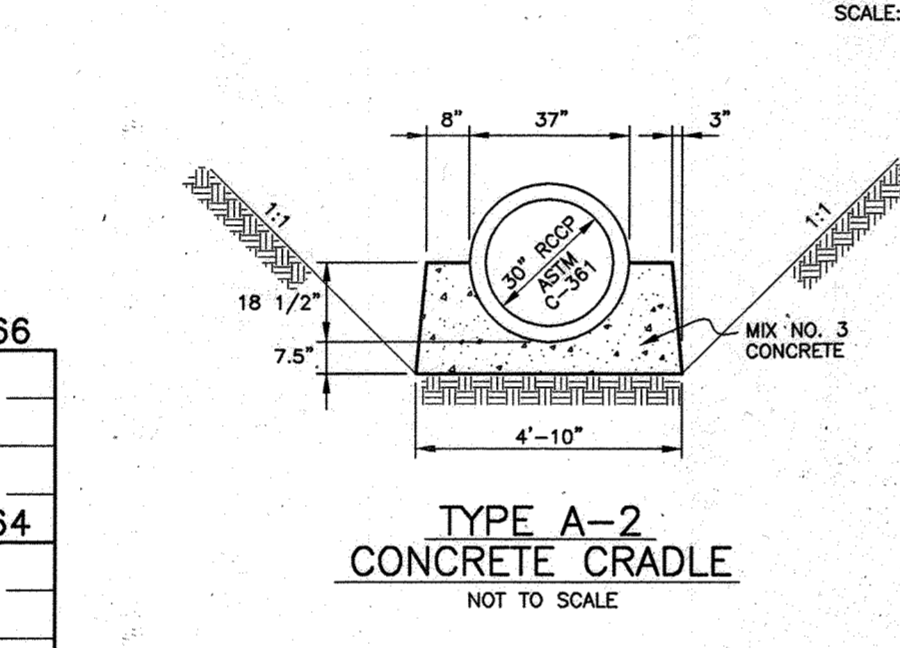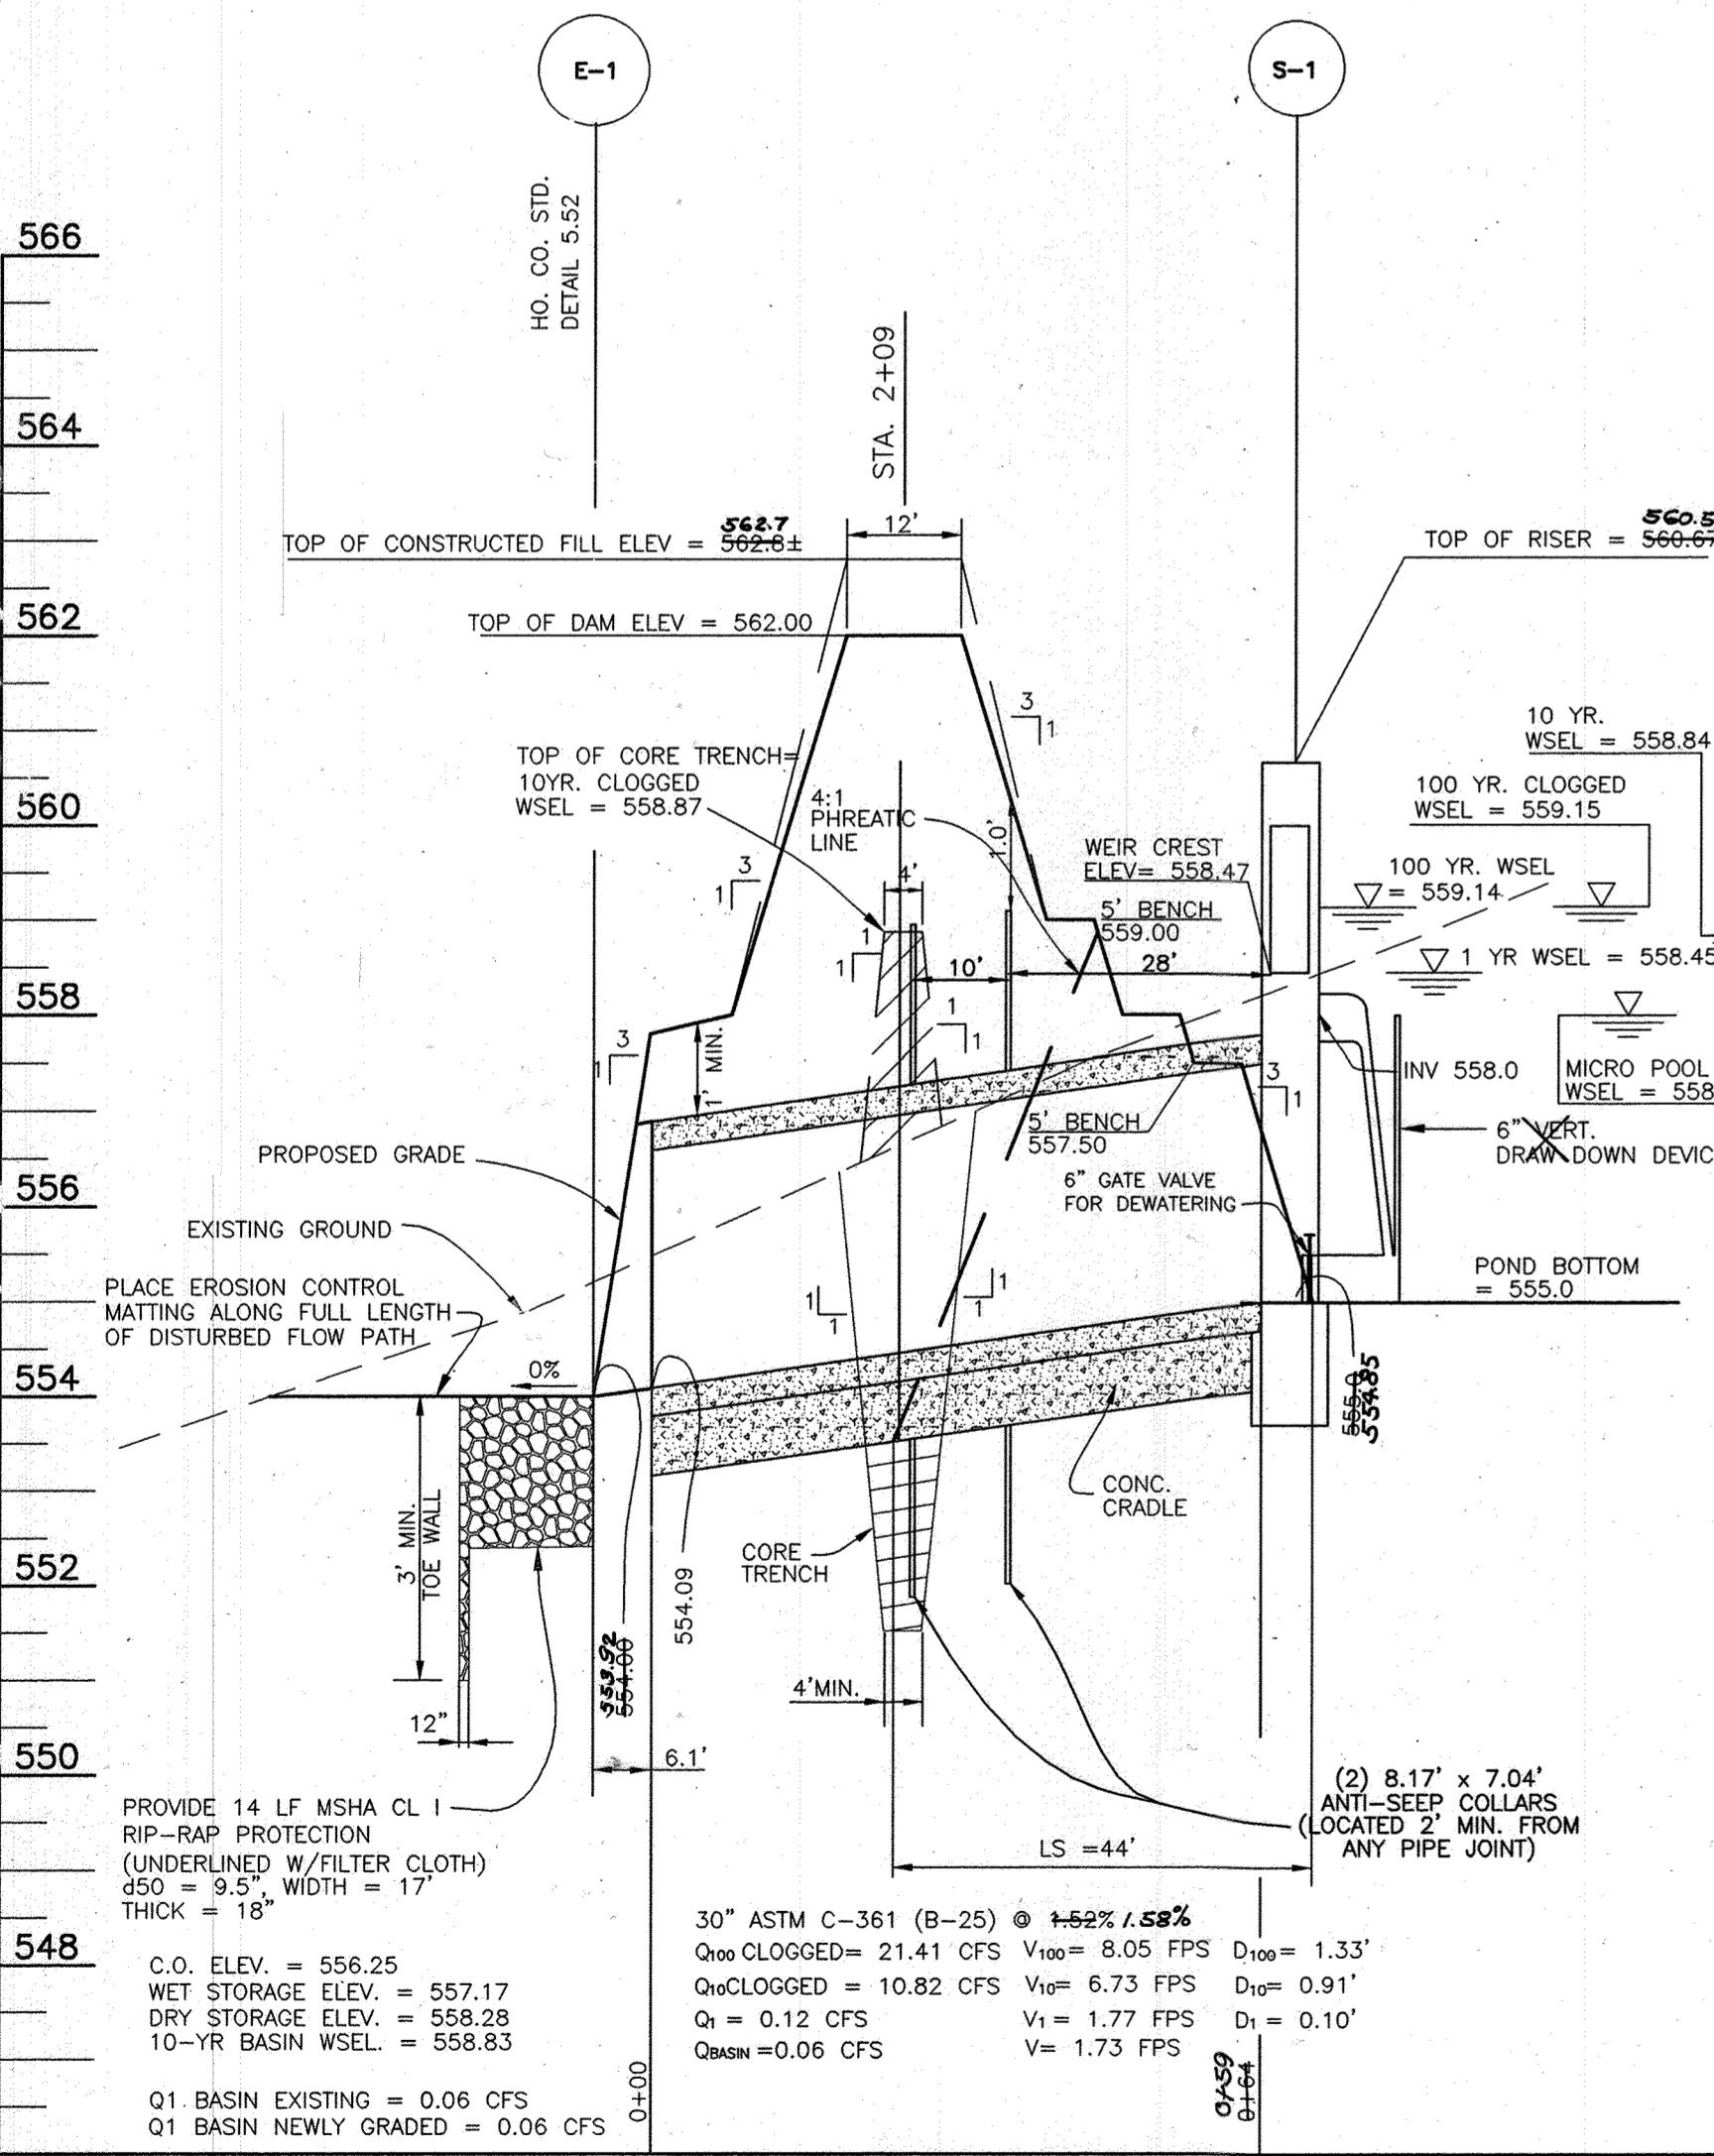










SOILS LEGEND

SOIL	NAME	CLASS
** Ba	Basic silt loam	D
** Cw1	Comus silt loam, local alluvium, 3 to 8 percent slopes	B
GLB2	Glenelg loam, 3 to 8 percent slopes, moderately eroded	B
GIC2	Glenelg loam, 8 to 15 percent slopes, moderately eroded	B
GCS	Glenelg loam, 8 to 15 percent slopes, severely eroded	B
GDS	Glenelg loam, 15 to 25 percent slopes, severely eroded	B
GLD2	Glenelg loam, 15 to 25 percent slopes, moderately eroded	B
* CnA	Glenville silt loam, 0 to 3 percent slopes	C
* CnB2	Glenville silt loam, 3 to 8 percent slopes, moderately eroded	C
** Ha	Hatboro silt loam	D
MC2	Mt. Airy channery loam, 8 to 15 percent slopes, moderately eroded	A
MC3	Mt. Airy channery loam, 8 to 15 percent slopes, severely eroded	A
MD2	Mt. Airy channery loam, 15 to 25 percent slopes, moderately eroded	A
ME	Mt. Airy channery loam, 25 to 45 percent slopes	A

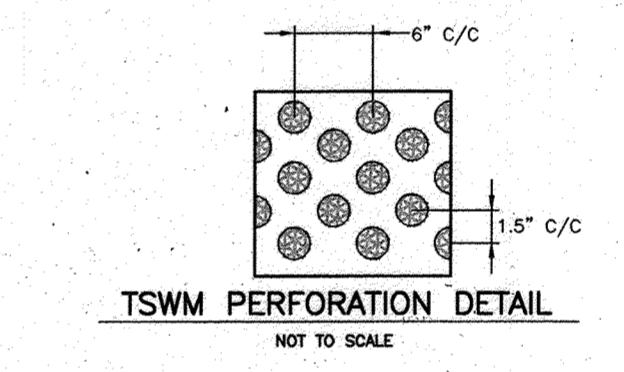

NOTES:

- Hydric soils and/or contains hydric inclusions
- May contain hydric inclusions
- Generally only within 100-year floodplain areas

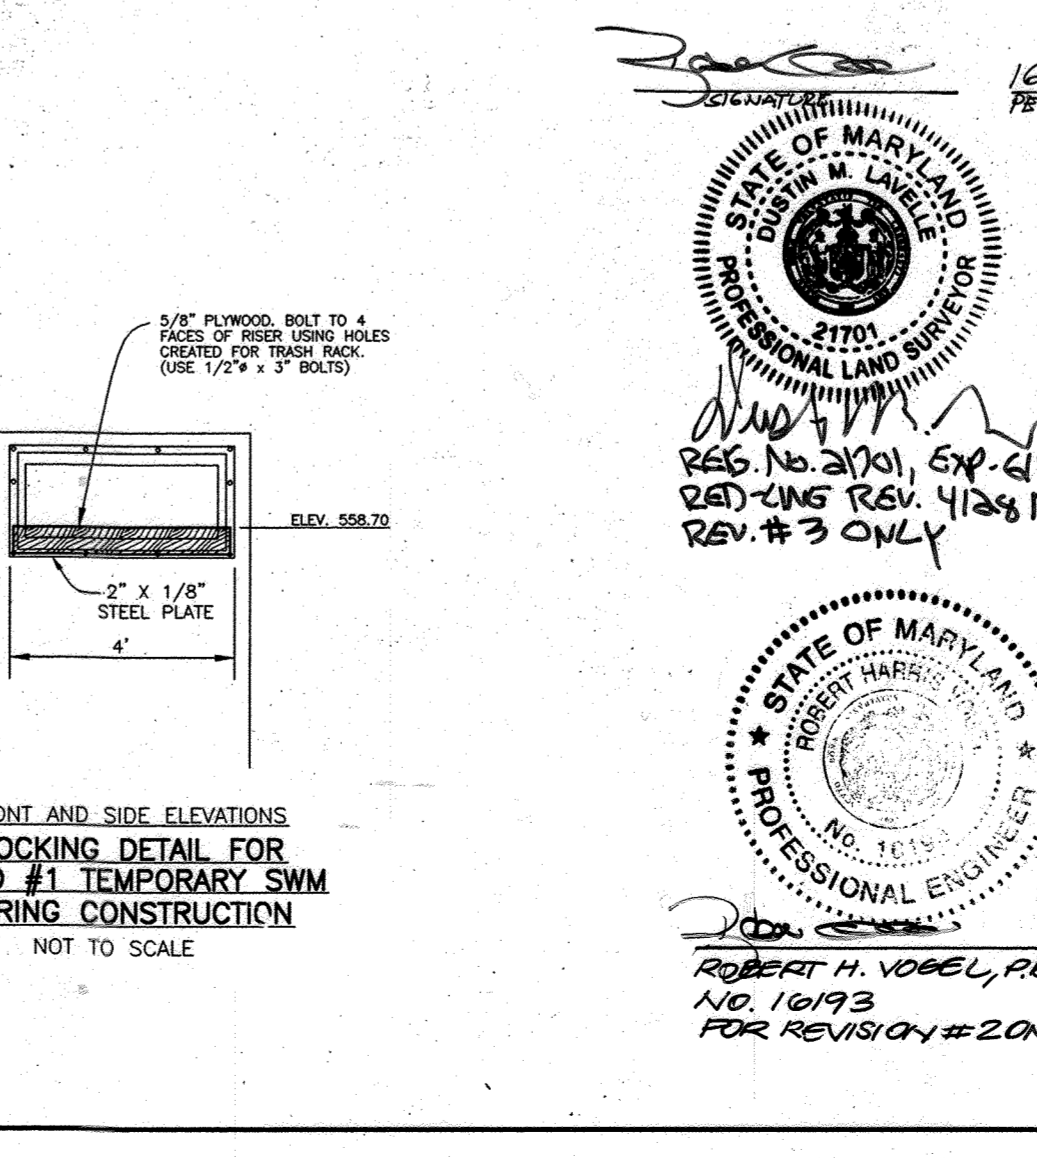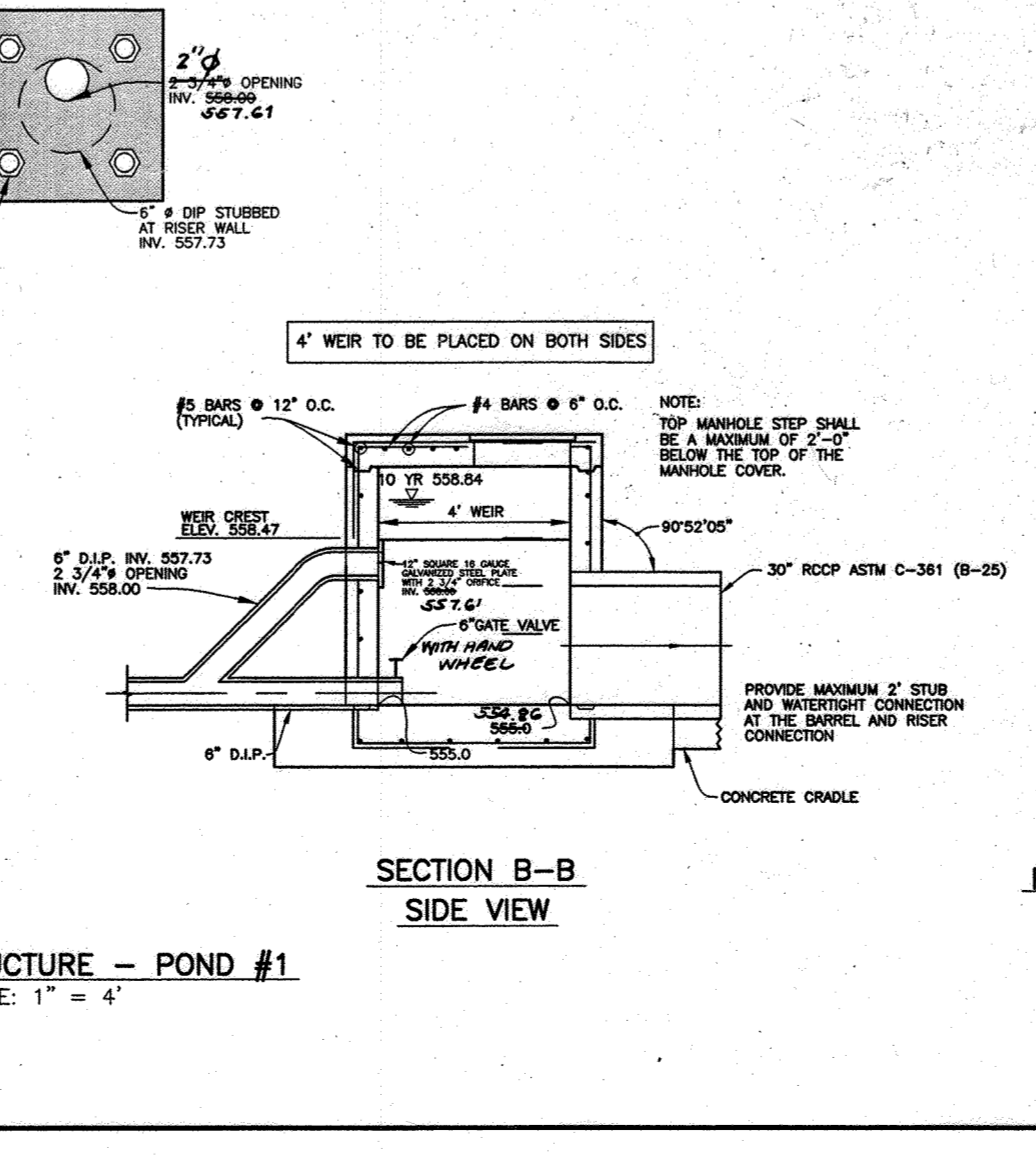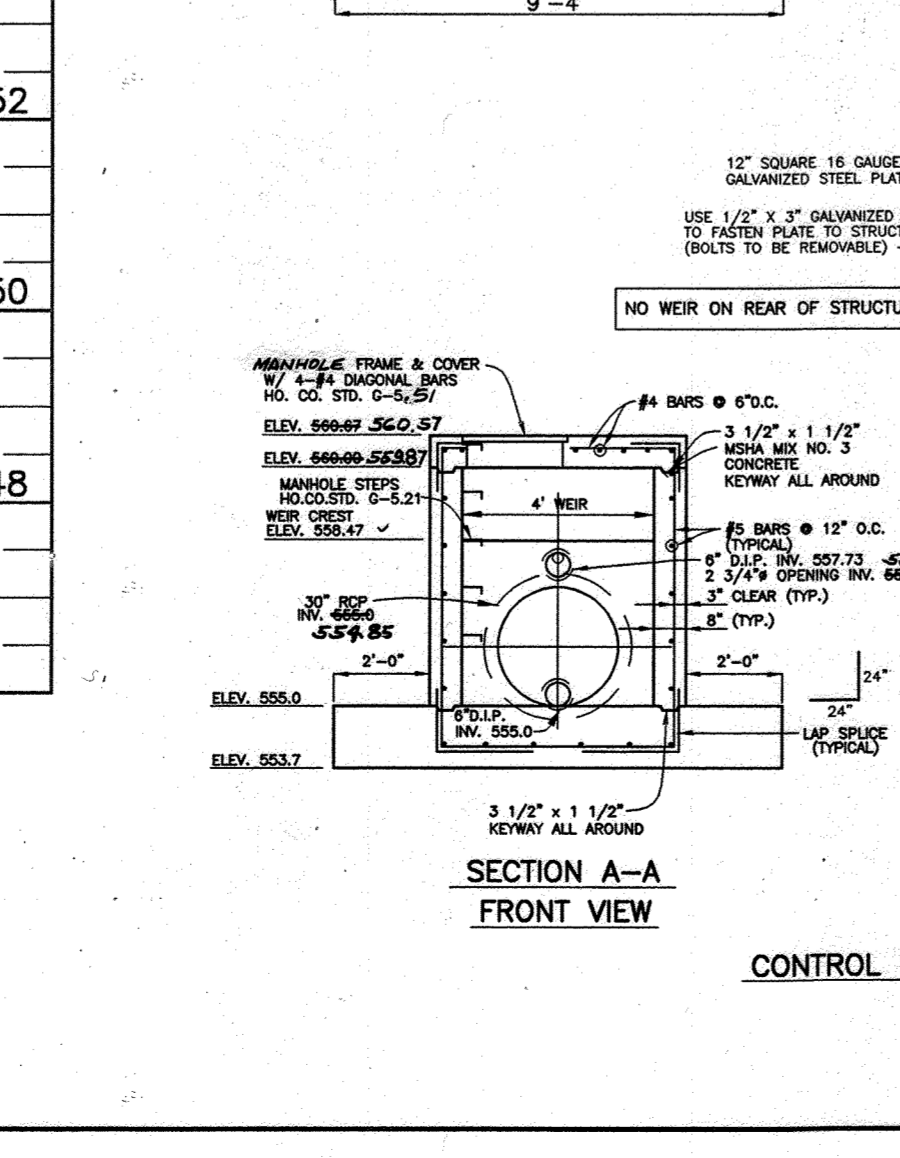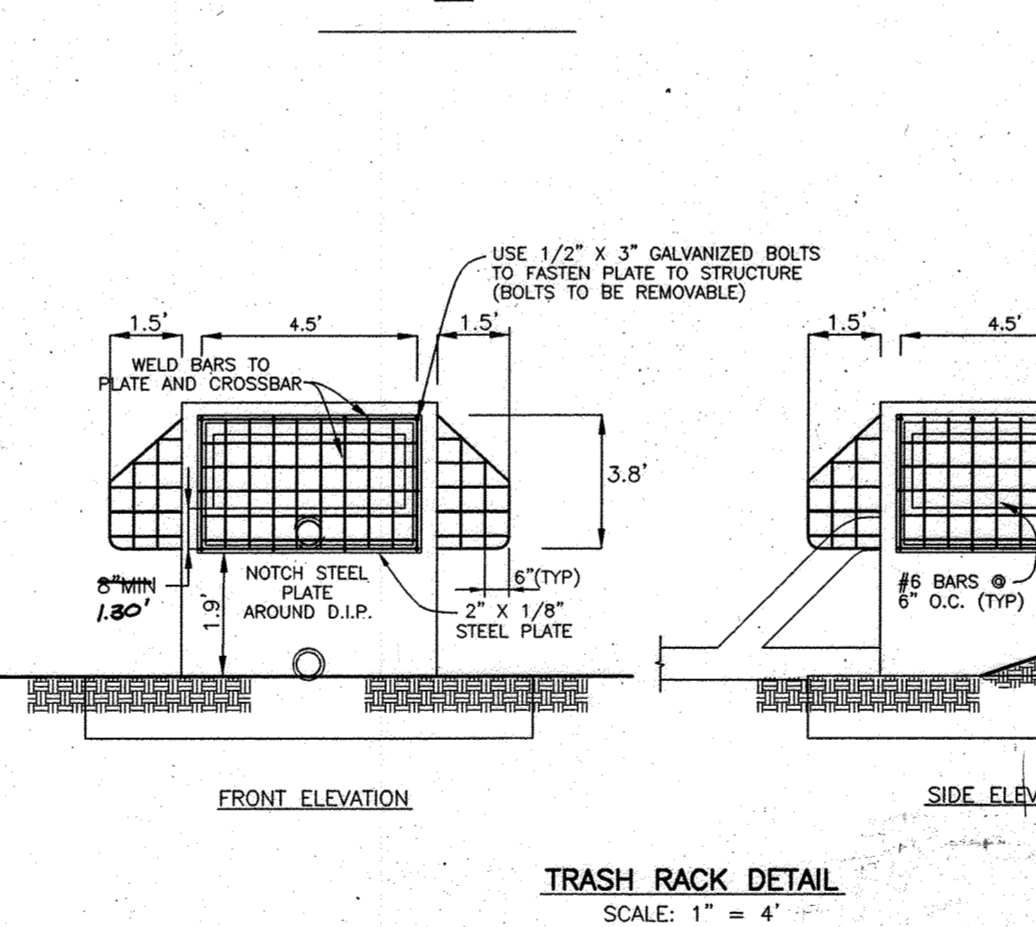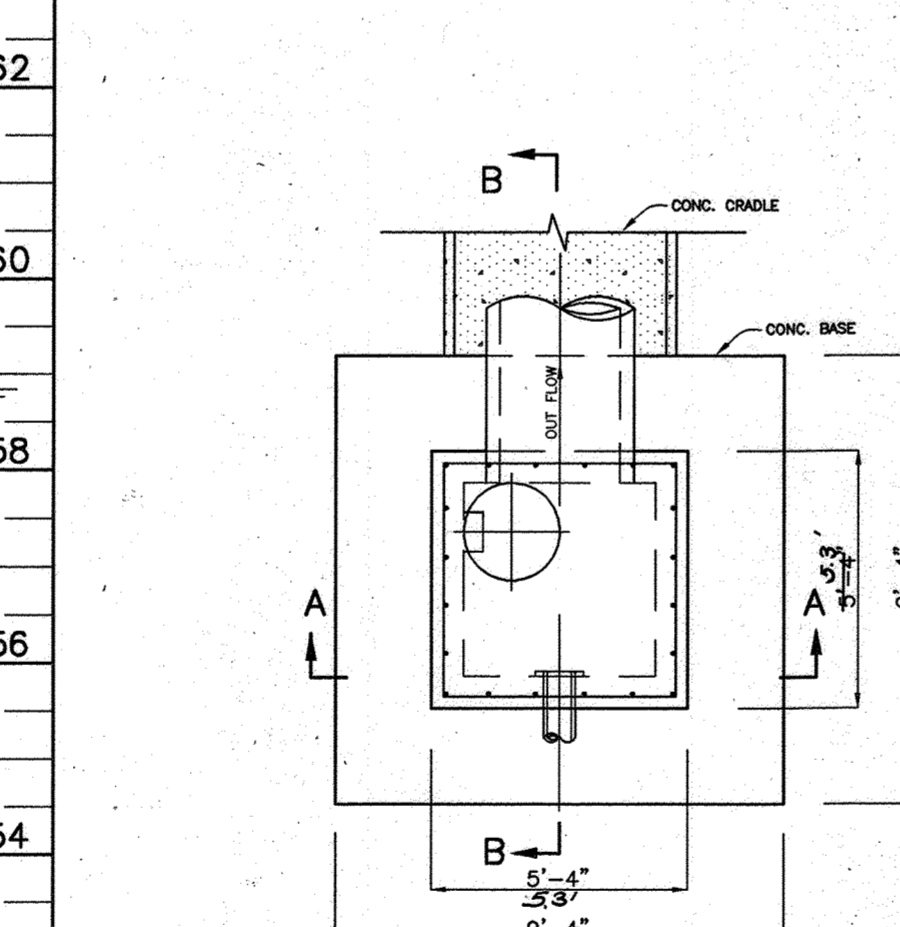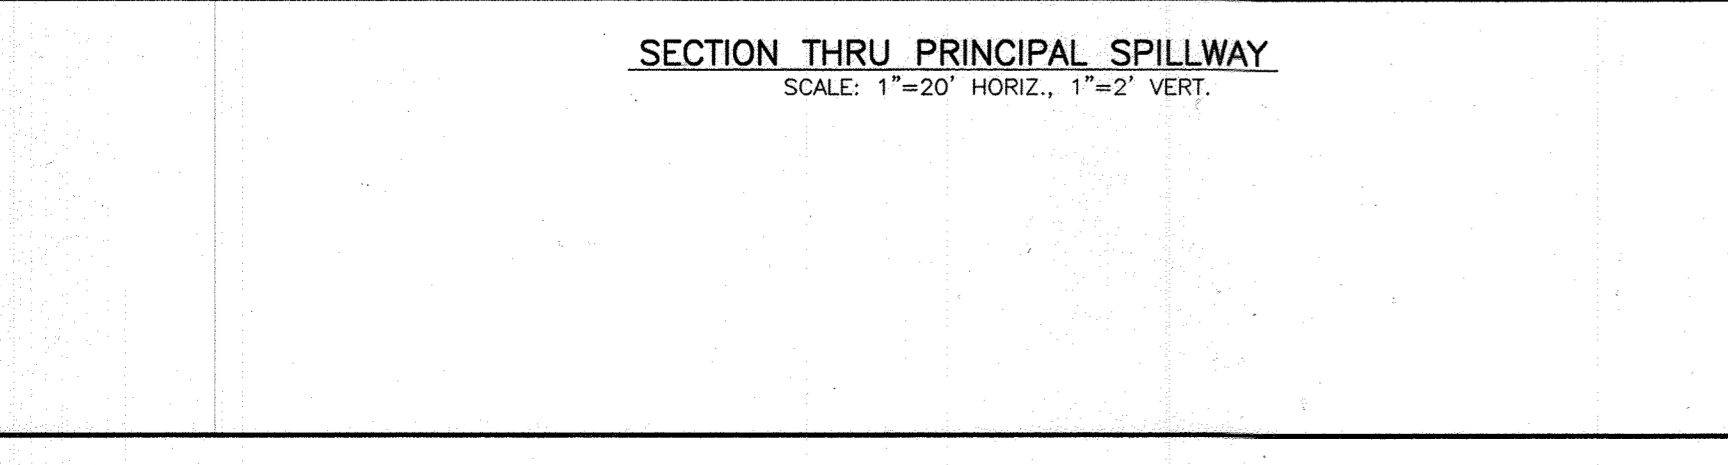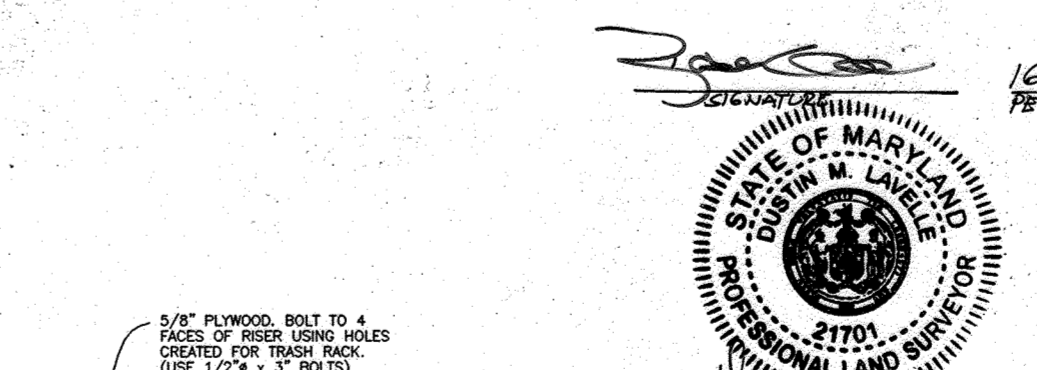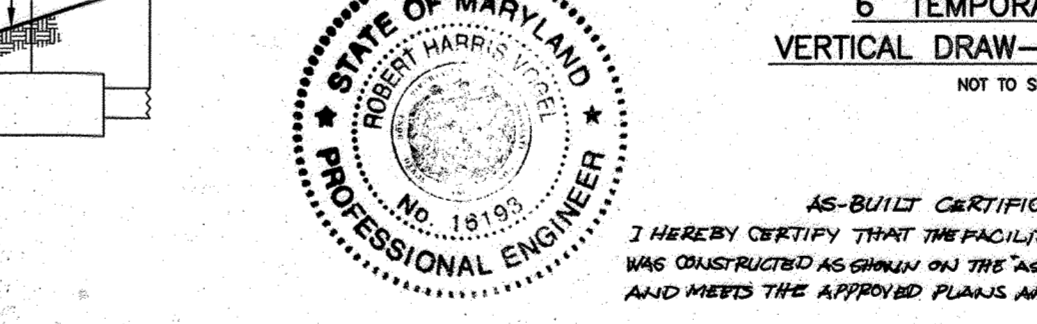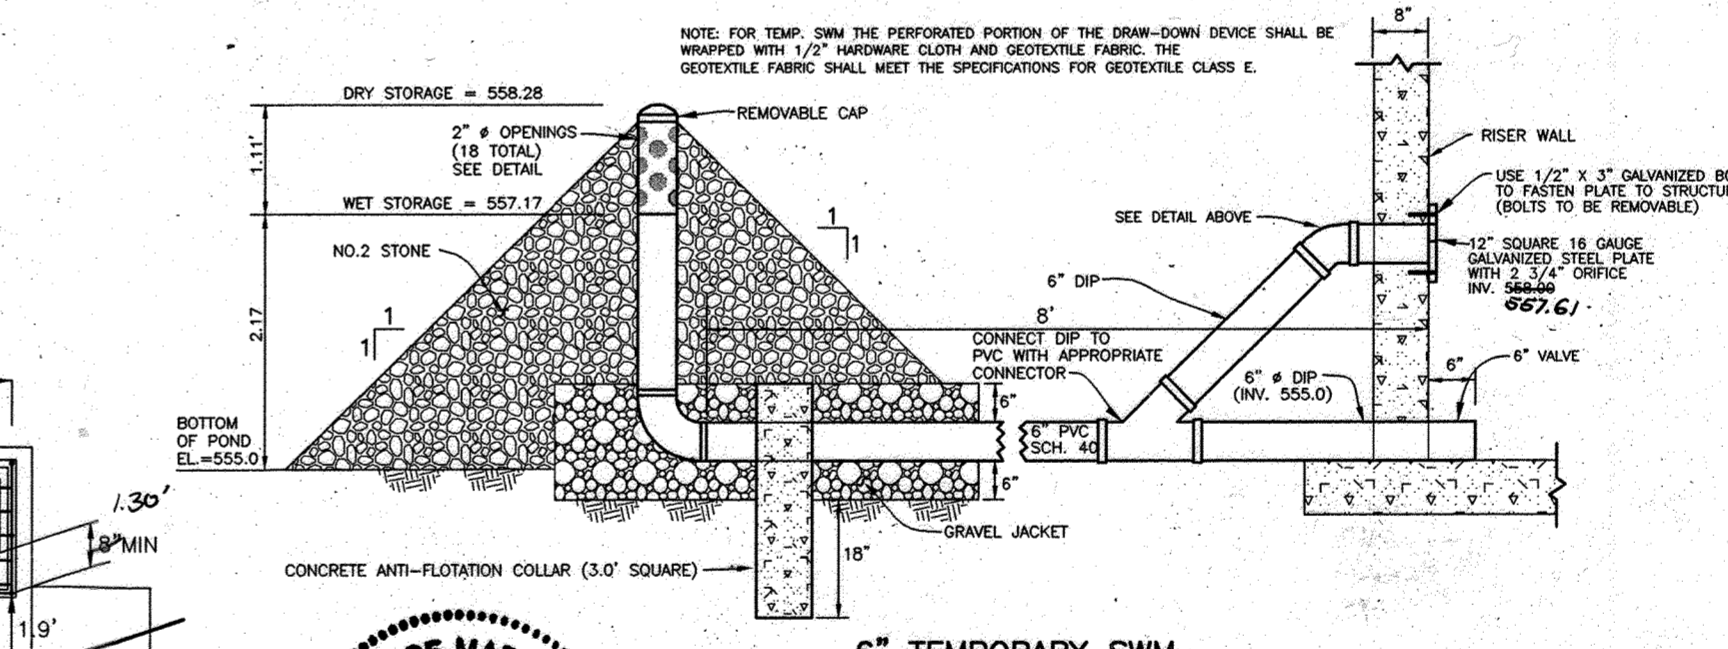

AS-BUILT CERTIFICATION

I HEREBY CERTIFY THAT THE FACILITY SHOWN ON THIS PLAN WAS CONSTRUCTED AS SHOWN ON THE "AS-BUILT" PLANS AND MEETS THE APPROVED PLANS AND SPECIFICATIONS.

16/93 PE NO. 21443

CONRAD A. MASON
ROBERT H. VOGEL

BY THE DEVELOPER:

I HEREBY CERTIFY THAT ALL DEVELOPMENT AND/OR CONSTRUCTION WILL BE DONE ACCORDING TO THESE PLANS AND THAT ANY RESPONSIBLE PERSONNEL INVOLVED IN THE CONSTRUCTION PROJECT WILL HAVE A REGISTERED PROFESSIONAL ENGINEER AT A DEPARTMENT OF THE ENVIRONMENT APPROVED TRAINING PROGRAM FOR THE CONTROL OF SEDIMENT AND EROSION BEFORE BEGINNING THE PROJECT. I SHALL ENGAGE A REGISTERED PROFESSIONAL ENGINEER TO SUPERVISE POND CONSTRUCTION AND PROVIDE THE HOWARD SOIL CONSERVATION DISTRICT WITH AN "AS-BUILT" PLAN OF THE POND WITHIN 30 DAYS OF COMPLETION. I ALSO AUTHORIZE PERIODIC ON-SITE INSPECTIONS BY THE HOWARD SOIL CONSERVATION DISTRICT.

Michael How 4/9/06 DEVELOPER

BY THE ENGINEER:

I HEREBY CERTIFY THAT THIS PLAN FOR POND CONSTRUCTION, EROSION AND SEDIMENT CONTROL REPRESENTS A PRACTICAL AND WORKABLE PLAN BASED ON MY PERSONAL KNOWLEDGE OF THE SITE CONDITIONS. THIS PLAN WAS PREPARED IN ACCORDANCE WITH THE REQUIREMENTS OF THE HOWARD SOIL CONSERVATION DISTRICT. I HAVE NOTICED THE DEVELOPER THAT HE/SHE MUST ENGAGE A REGISTERED PROFESSIONAL ENGINEER TO SUPERVISE POND CONSTRUCTION AND PROVIDE THE HOWARD SOIL CONSERVATION DISTRICT WITH AN "AS-BUILT" PLAN OF THE POND WITHIN 30 DAYS OF COMPLETION.

Donall Mason 3/31/06 ENGINEER - DONALD A. MASON, P.E. # 21443

USDA - NATURAL RESOURCES CONSERVATION SERVICE

Jim Lynd 4/16/06

HOWARD SOIL CONSERVATION DISTRICT

Shelly 4/16/06

APPROVED: DEPARTMENT OF PUBLIC WORKS

Walter 4-21-06

APPROVED: DEPARTMENT OF PLANNING AND ZONING

Cindy 5/12/06

5/2/06

BENCHMARK ENGINEERS & LAND SURVEYORS & PLANNERS

8480 BALTIMORE NATIONAL PIKE A SUITE 418
ELLICOTT CITY, MARYLAND 21043
PHONE: 410-465-6105 FAX: 410-465-6644
WWW.BEL-CHLINGENGINEERING.COM

OWNER/DEVELOPER: TRINITY QUALITY HOMES, INC. 3675 PARK AVENUE SUITE 301 ELLICOTT CITY, MD 21043 410-480-0023

PROJECT: THE CHASE AT STONEY BROOK LOTS 1-20, PRESERVATION PARCEL "A" AND NON-BUILDABLE PRESERVATION PARCELS "B" THROUGH "D"


LOCATION: TAX MAP 7, BLOCK 17, PARCEL 133 4TH ELECTION DISTRICT HOWARD COUNTY, MARYLAND

TITLE: STORMWATER MANAGEMENT FACILITY #1 (POCKET POND)


DATE: MARCH, 2006 **PROJECT NO.:** 1187

DESIGNER: JMC **DRAFTER:** JMC **CHECKER:** DAM **SCALE:** AS SHOWN **SHEET:** 16 OF 30

AS-BUILT 1/31/13

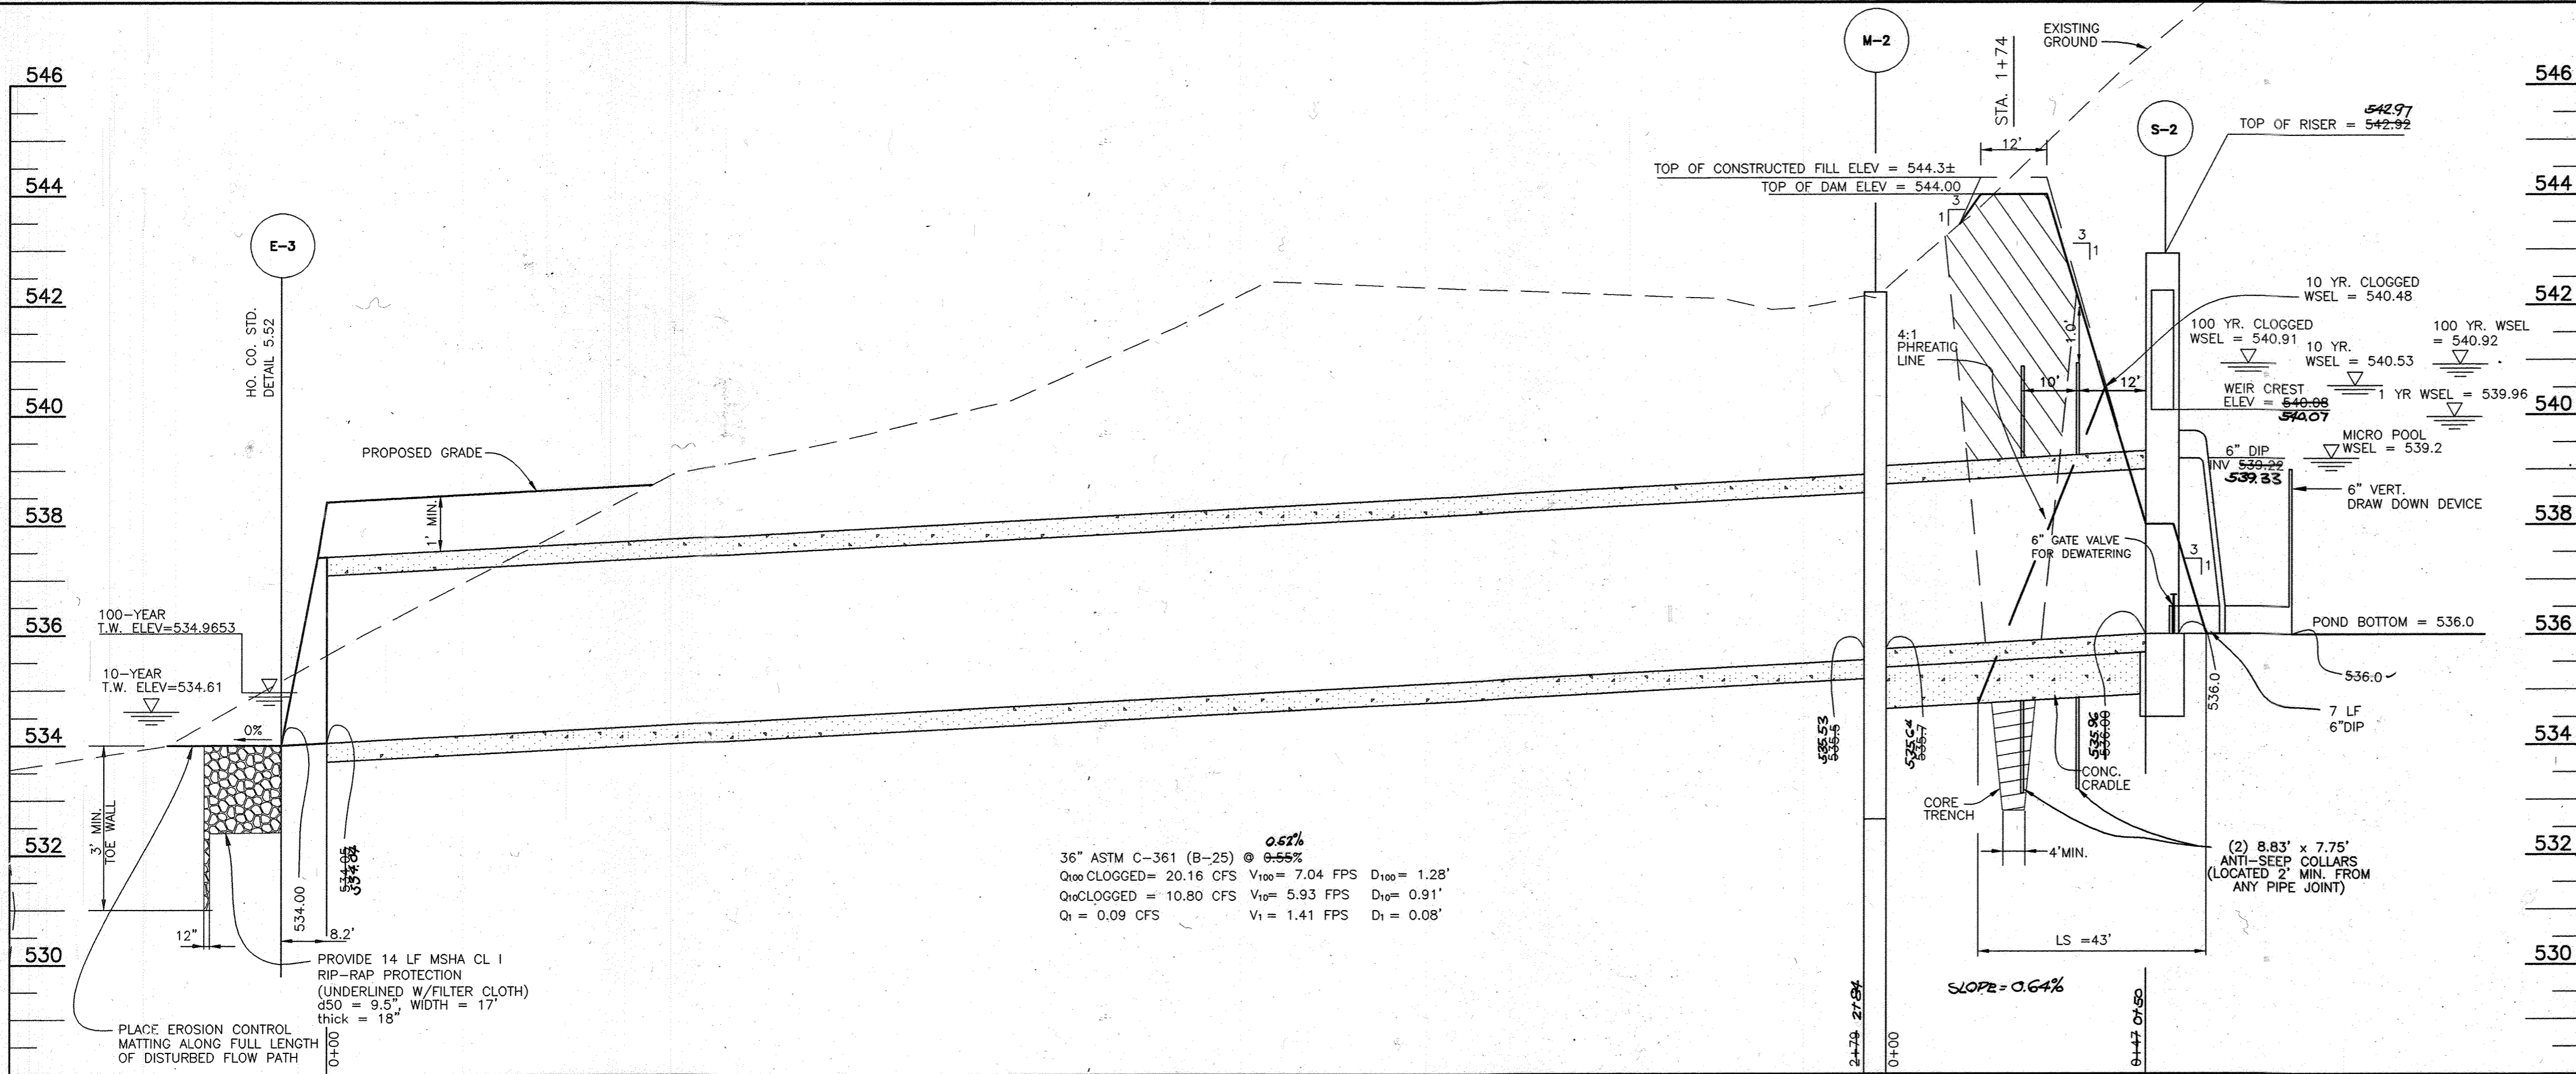

SECTION THRU PRINCIPAL SPILLWAY
SCALE: 1"=20' HORIZ., 1"=2' VERT.

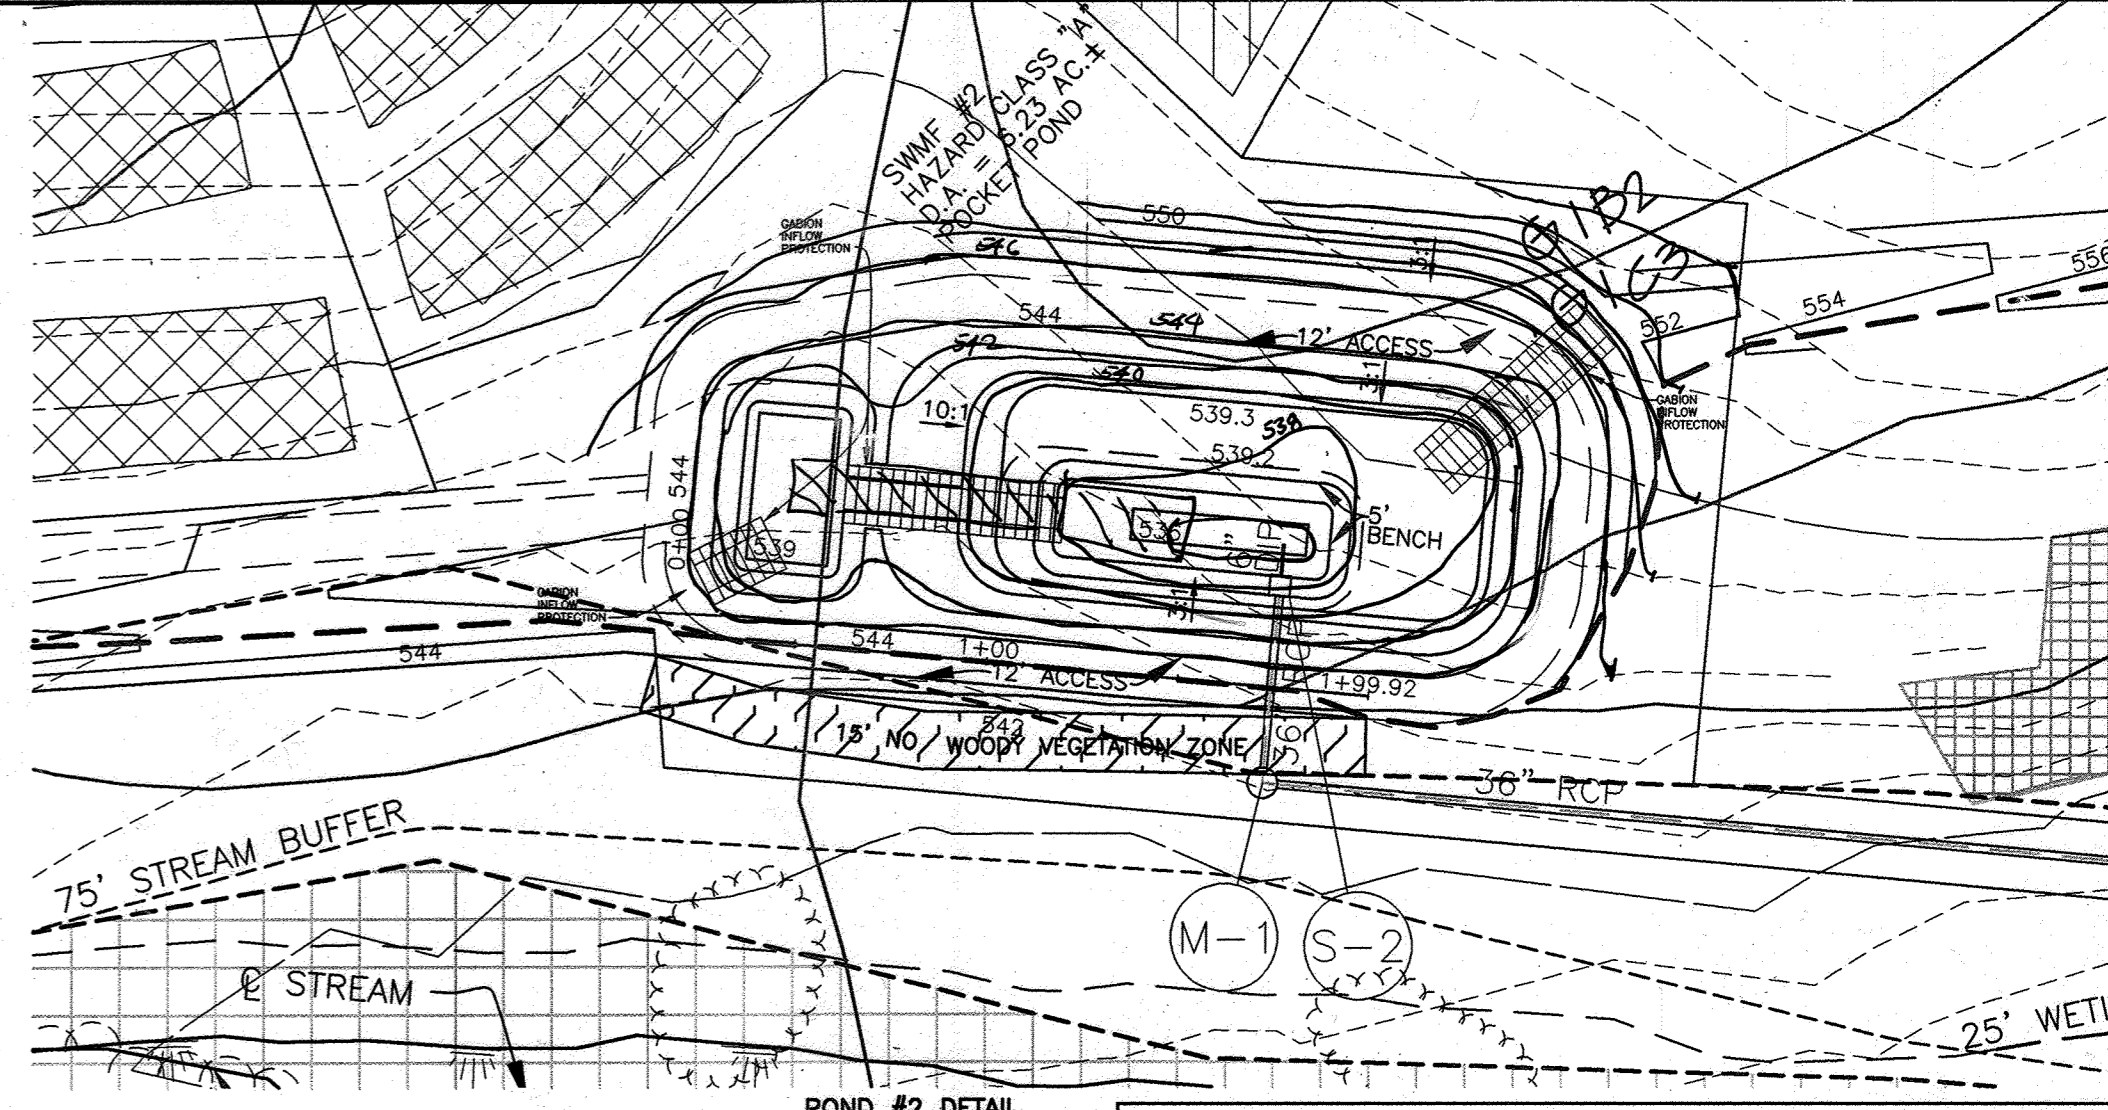

AS-BUILT CERTIFICATION
SCALE: 1" = 50'

OPERATION AND MAINTENANCE SCHEDULE FOR PRIVATELY OWNED AND MAINTAINED EXTENDED DETENTION POND














- ROUTINE MAINTENANCE:**
- FACILITY SHALL BE INSPECTED ANNUALLY AND AFTER MAJOR STORMS. INSPECTIONS SHALL BE PERFORMED DURING WET WEATHER TO DETERMINE IF THE POND IS FUNCTIONING PROPERLY.
 - TOP AND SIDE SLOPES OF THE EMBANKMENT SHALL BE MOWED A MINIMUM OF TWO (2) TIMES PER YEAR, ONCE IN JUNE AND ONCE IN SEPTEMBER. OTHER SIDE SLOPES AND MAINTENANCE ACCESS SHALL BE MOWED AS NEEDED.
 - DEBRIS AND LITTER SHALL BE REMOVED DURING REGULAR MOWING OPERATIONS AND AS NEEDED.
 - VISIBLE SIGNS OF EROSION IN THE POND AS WELL AS THE RIP-RAP OR GABION OUTLET AREA SHALL BE REPAIRED AS SOON AS IT IS NOTICED.
- NON-ROUTINE MAINTENANCE:**
- STRUCTURAL COMPONENTS OF THE POND SUCH AS THE DAM, THE RISER, AND THE PIPES SHALL BE REPAIRED UPON THE DETECTION OF ANY DAMAGE. THE COMPONENTS SHALL BE INSPECTED DURING ROUTINE MAINTENANCE OPERATIONS.
 - SEDIMENTS SHALL BE REMOVED FROM THE POND, AND FOREBAY, NO LATER THAN WHEN THE CAPACITY OF THE POND, OR FOREBAY, IS HALF FULL OF SEDIMENT, OR WHEN DEEMED NECESSARY FOR AESTHETIC REASONS, UPON APPROVAL FROM THE DEPARTMENT OF PUBLIC WORKS.

I HEREBY CERTIFY THAT THE FACILITY SHOWN ON THIS PLAN WAS CONSTRUCTED AS SHOWN ON THE "AS-BUILT" PLANS AND MEETS THE APPROVED PLANS AND SPECIFICATIONS.

DATE: 16/93
FE NO.: 21443

BY THE DEVELOPER:
Donald A. Mason
DATE: 4/4/06

BY THE ENGINEER:
Donald A. Mason
DATE: 3/3/06

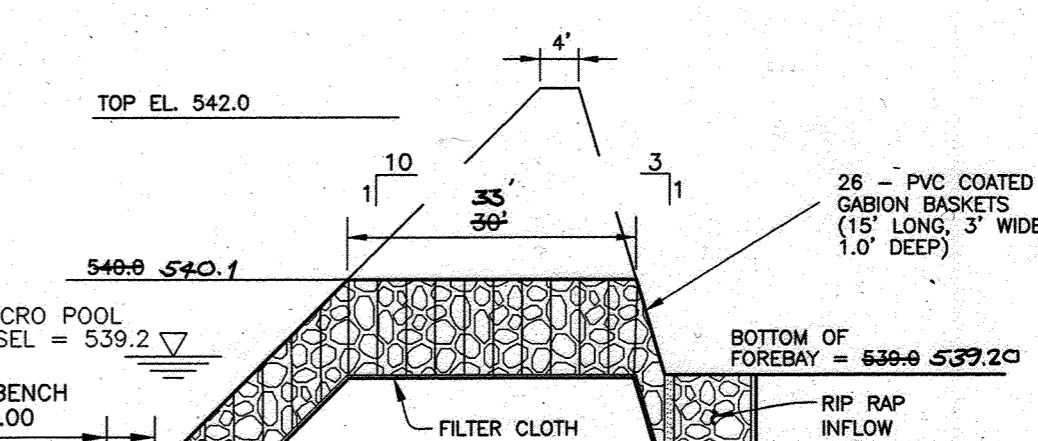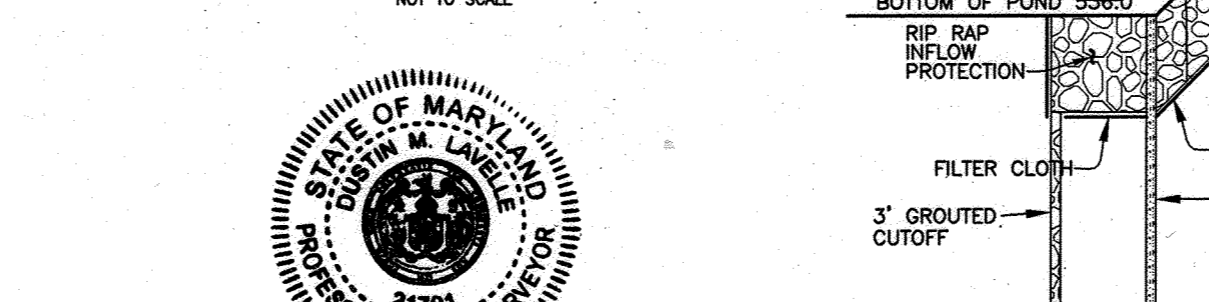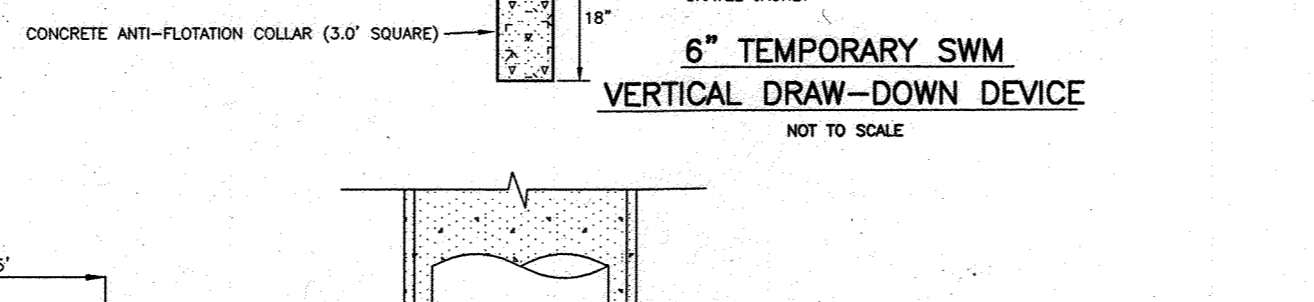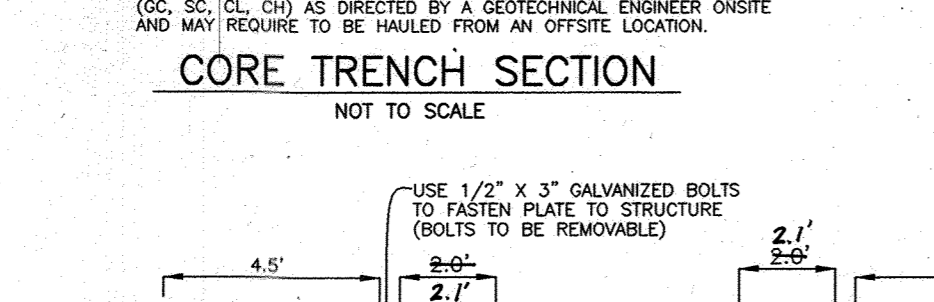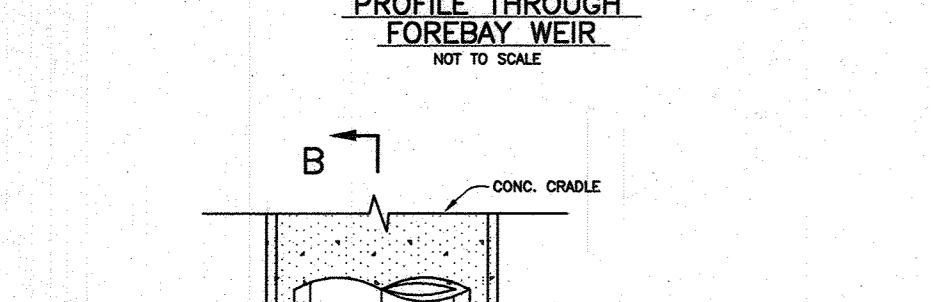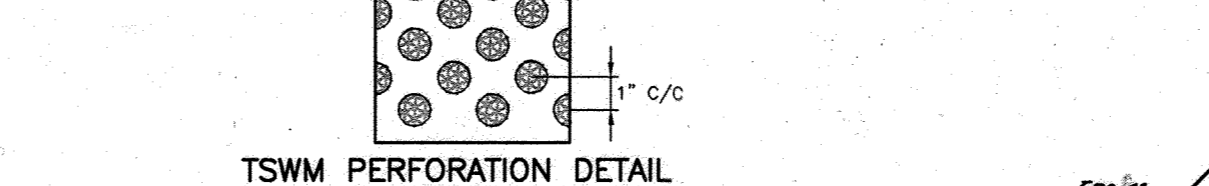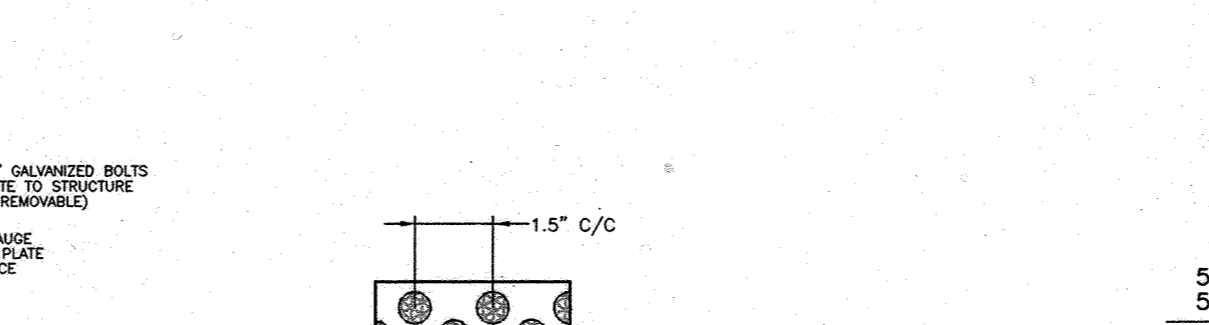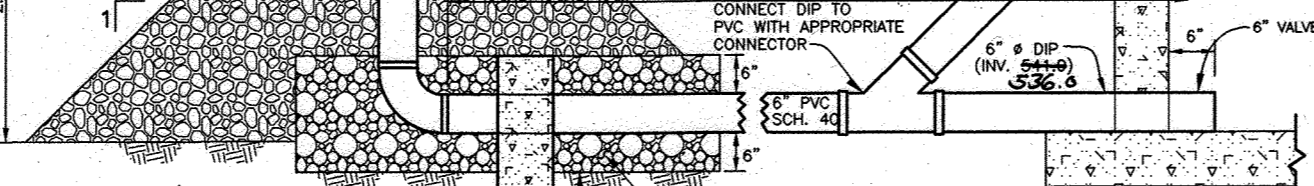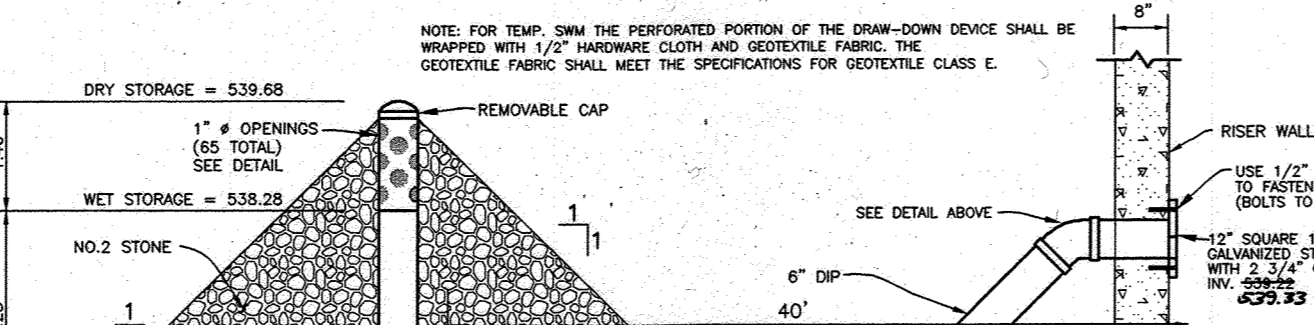
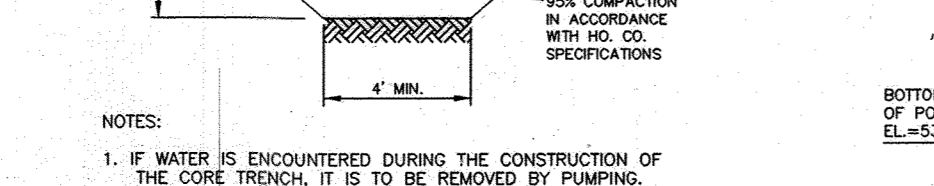
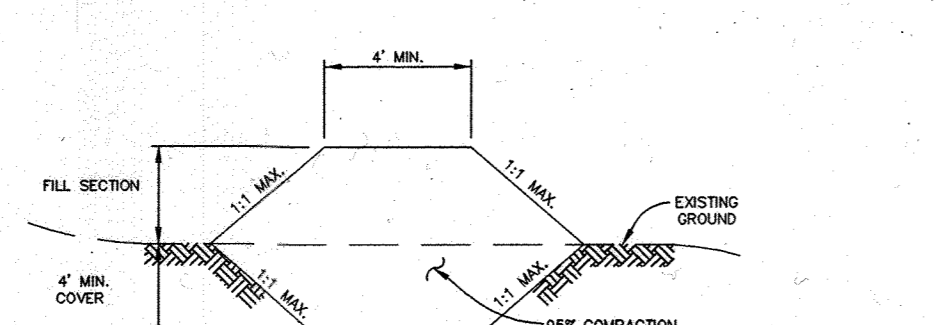
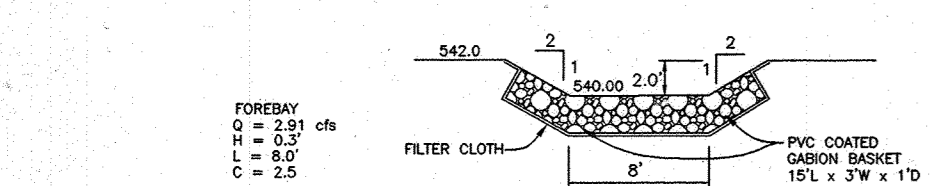
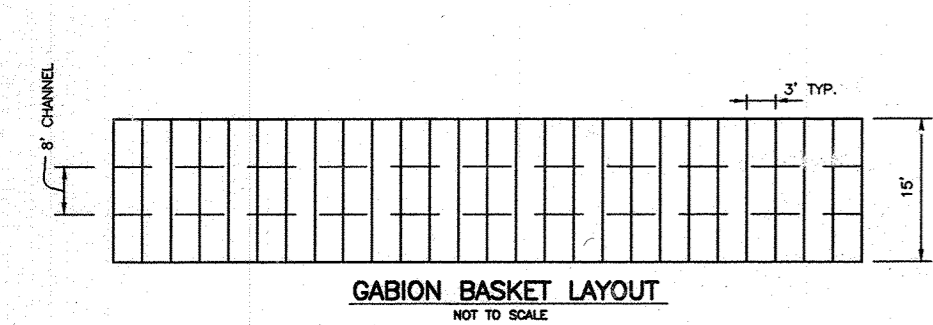


PROFILE ALONG CL OF EMBANKMENT
SCALE: 1"=50' HORIZ., 1"=5' VERT.

APPROVED: DEPARTMENT OF PUBLIC WORKS
William T. Mahan
DATE: 4-21-06

APPROVED: DEPARTMENT OF PLANNING AND ZONING
Christy Harris
DATE: 5/12/06

APPROVED: DEVELOPMENT ENGINEERING DIVISION
John P. ...
DATE: 5/16/06

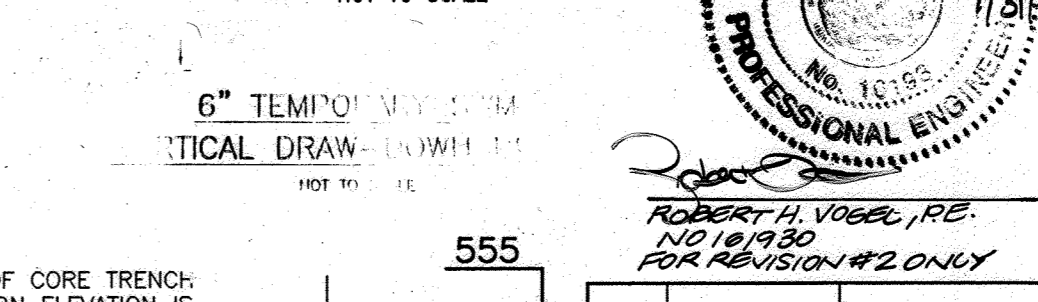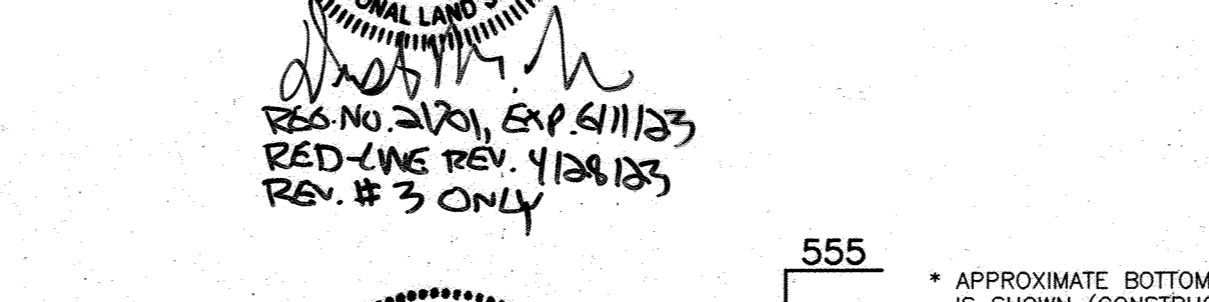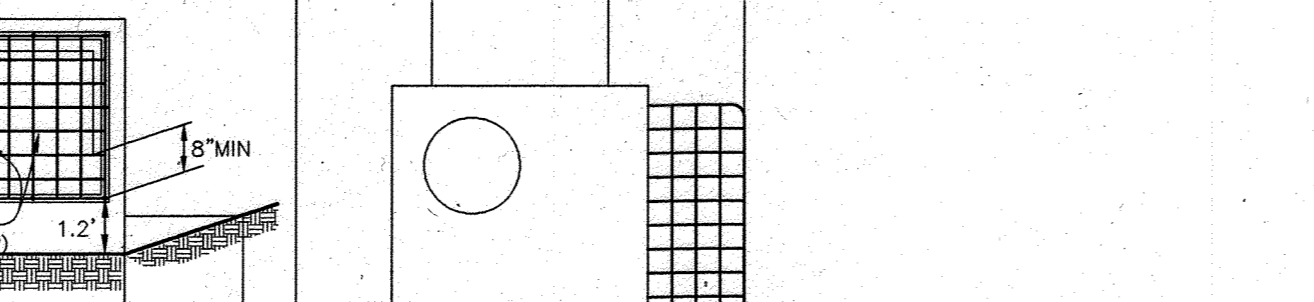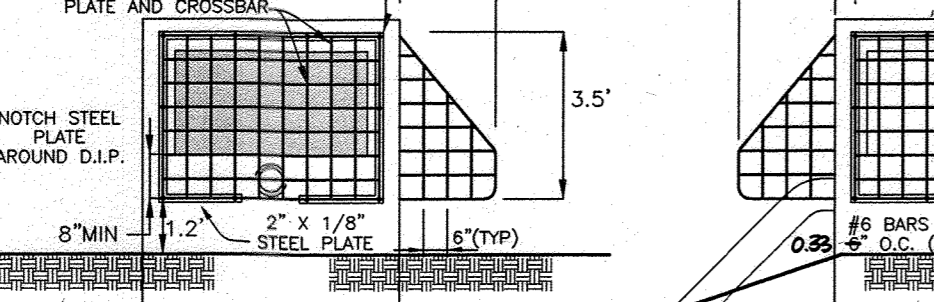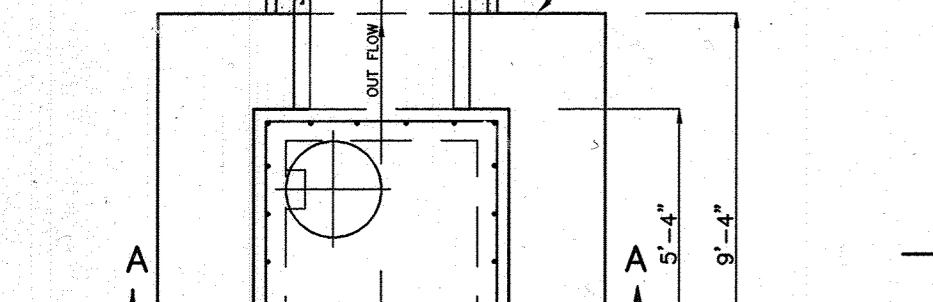

OWNER/DEVELOPER:
TRINITY QUALITY HOMES, INC.
3675 PARK AVENUE
SUITE 301
ELLICOTT CITY, MD 21043
410-480-3023





PROJECT:
THE CHASE AT STONEY BROOK
LOTS 1-20, PRESERVATION PARCEL "A" AND
NON-BUILDABLE PRESERVATION PARCELS "B" THROUGH "D"

LOCATION:
TAX MAP 7, BLOCK 17, PARCEL 133
4TH ELECTION DISTRICT
HOWARD COUNTY, MARYLAND

TITLE:
STORMWATER MANAGEMENT FACILITY #2
(POCKET POND)

DATE: MARCH, 2006
PROJECT NO. 1187






DES: JMC DRAFT: JMC CHECK: DAM SCALE: AS SHOWN SHEET 17 OF 20

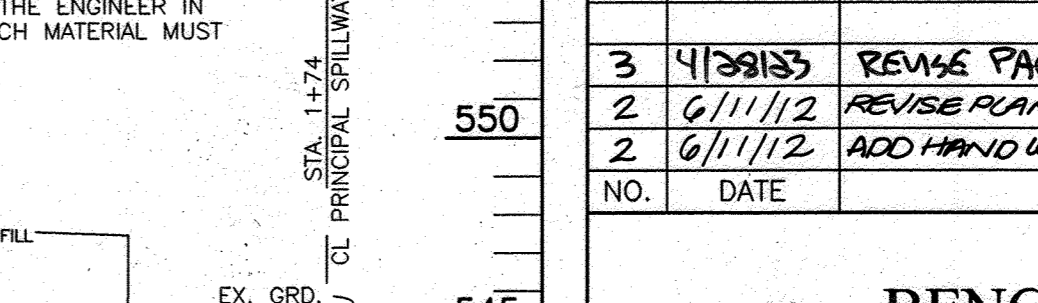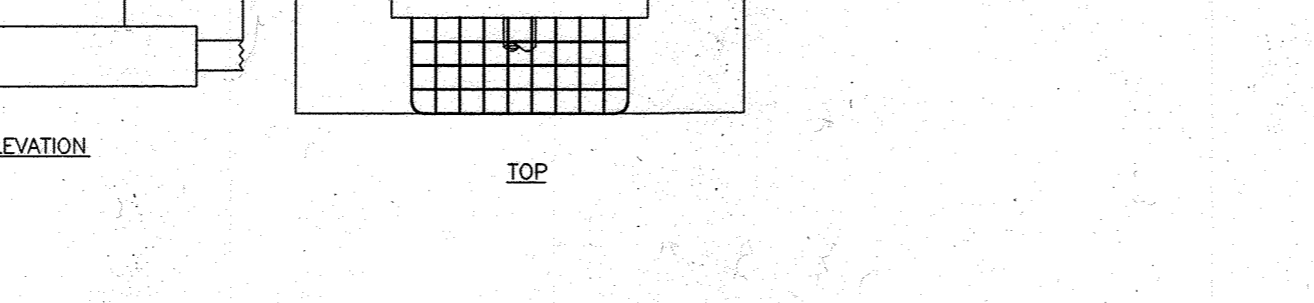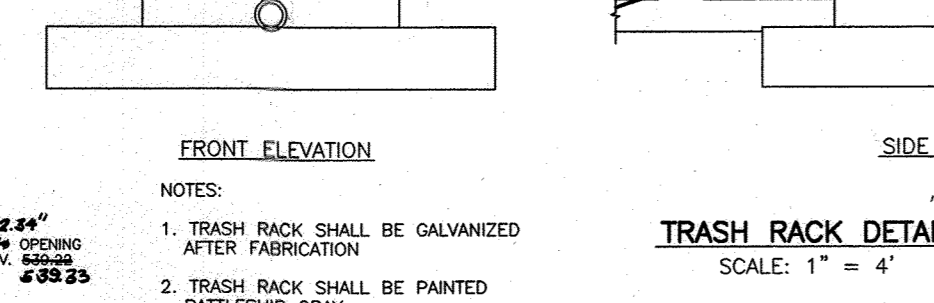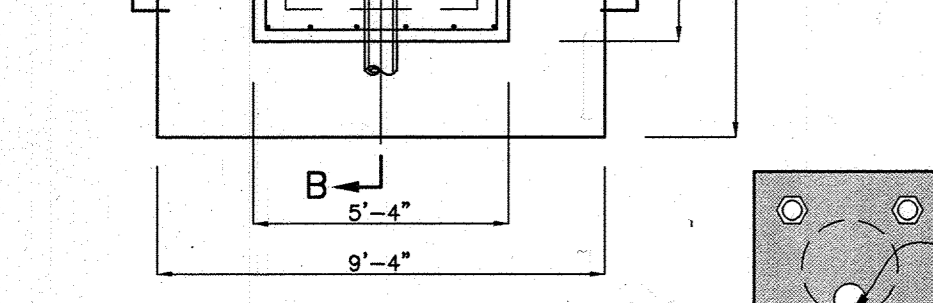

PROFILE ALONG CL OF EMBANKMENT
SCALE: 1"=50' HORIZ., 1"=5' VERT.






REVISIONS:

NO.	DATE	REVISION
3	4/13/03	REVISE PAGE NO.
2	6/11/02	REVISE PLAN TO DELETE WATER TIGHT MANHOLE FRAME AND COVER
2	6/11/02	ADD HAND WHEEL TO POND DRAIN, RELOCATE STANDING PAD

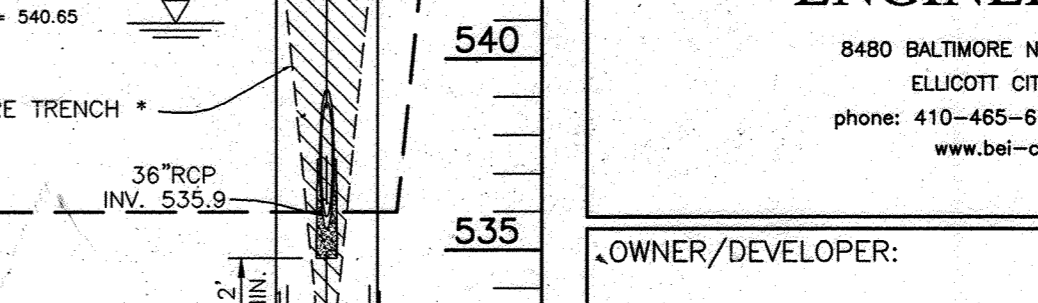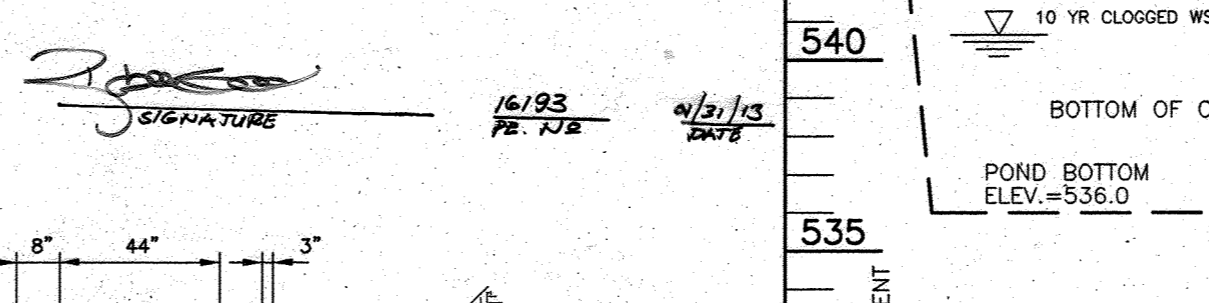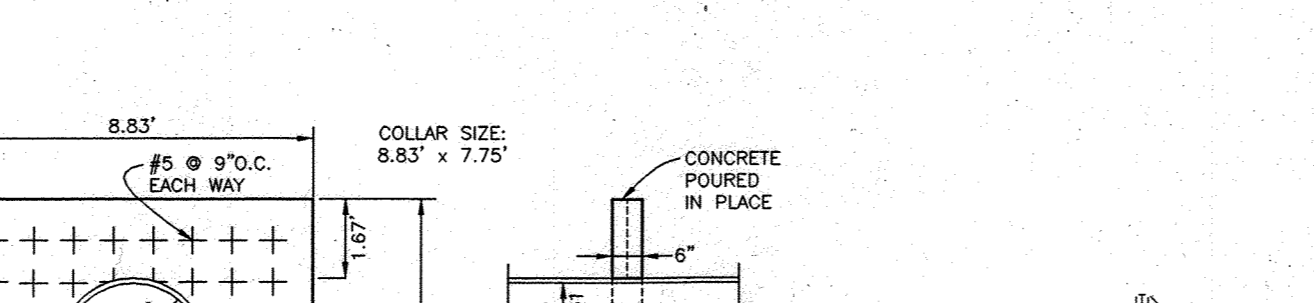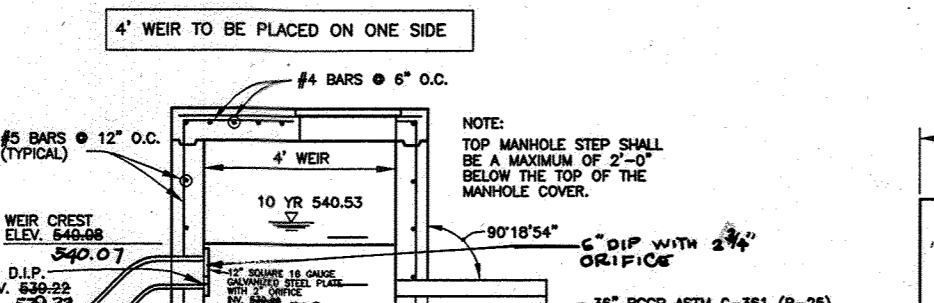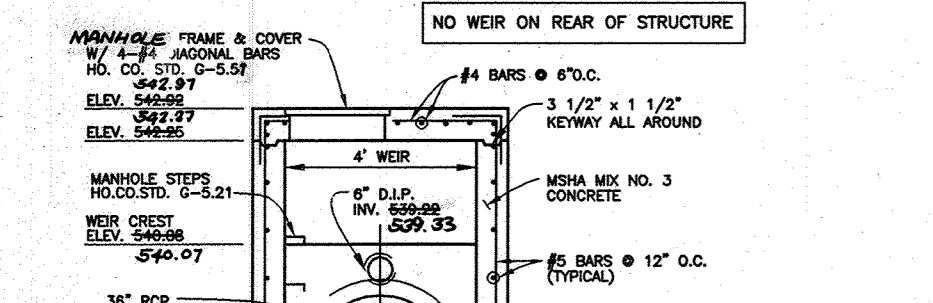


PROFILE ALONG CL OF EMBANKMENT
SCALE: 1"=50' HORIZ., 1"=5' VERT.

AS-BUILT 1/3/13

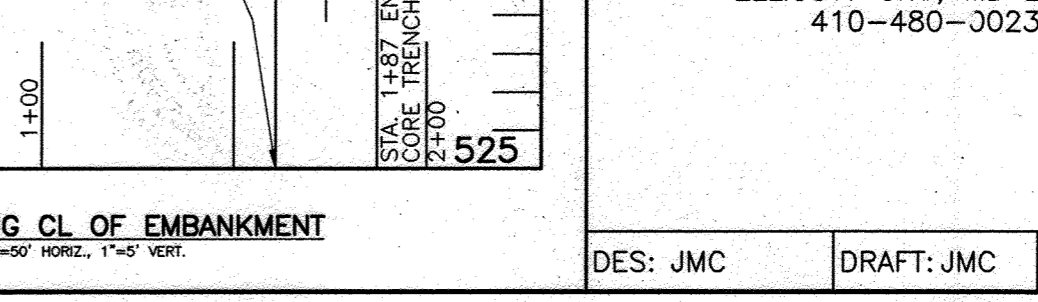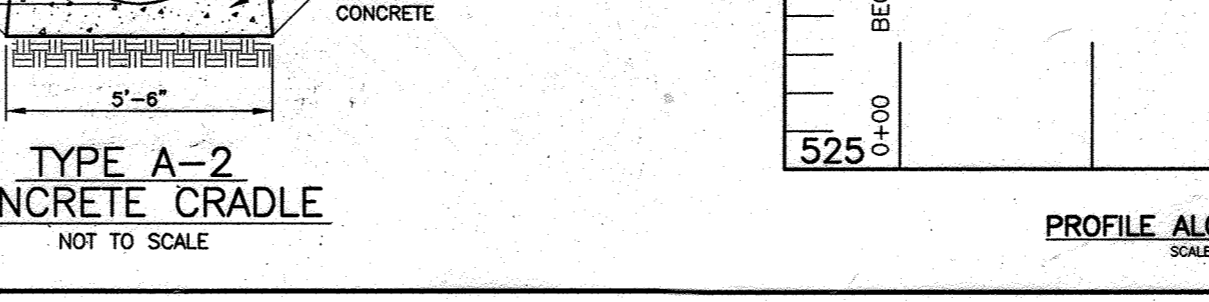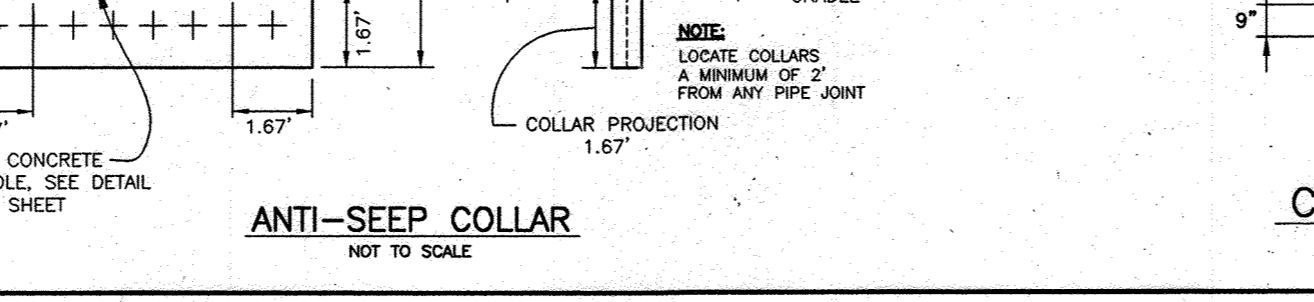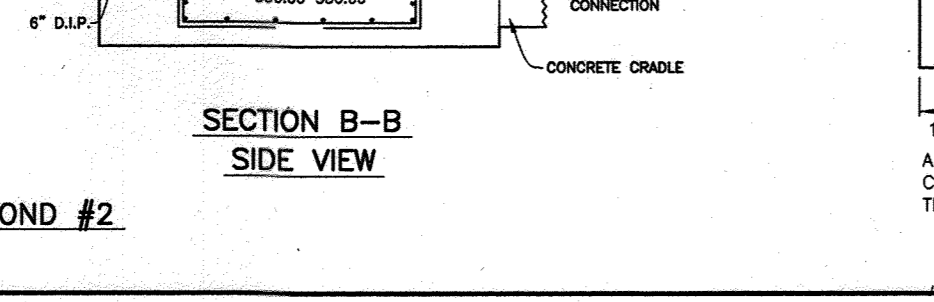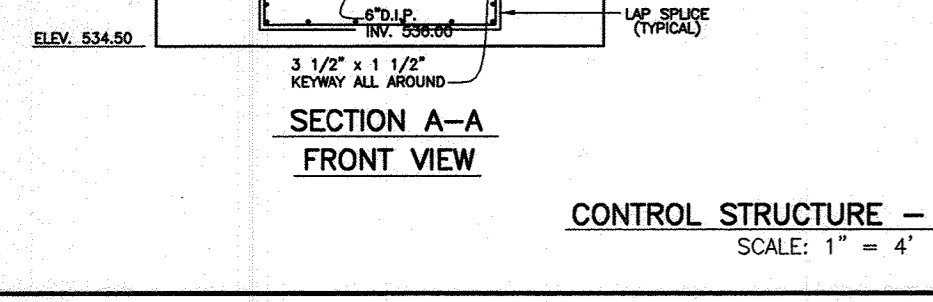


PROFILE ALONG CL OF EMBANKMENT
SCALE: 1"=50' HORIZ., 1"=5' VERT.


AS-BUILT 1/3/13

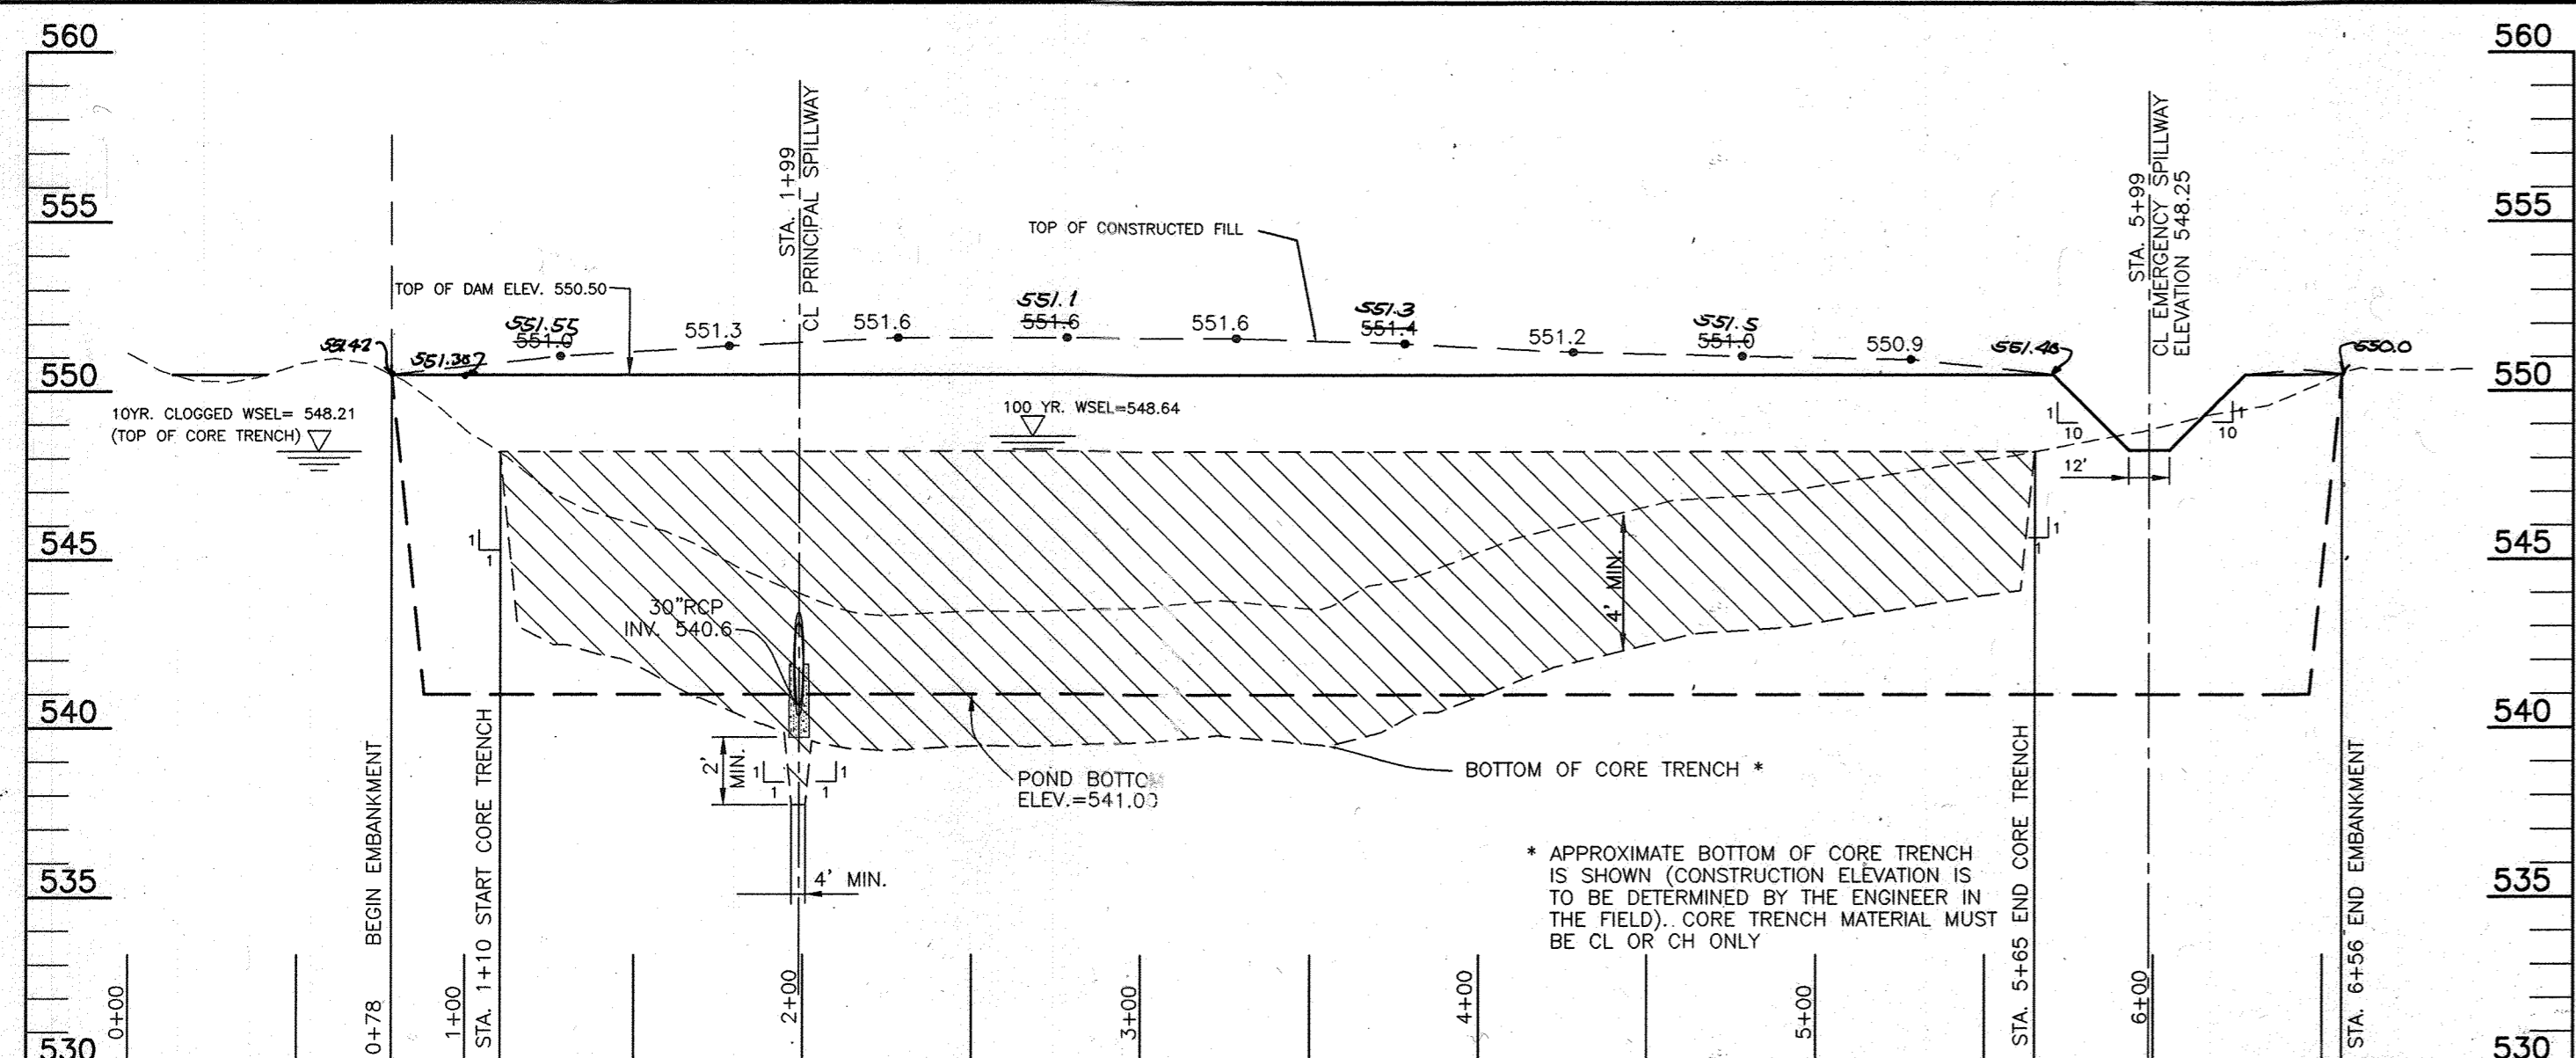


PROFILE ALONG CL OF EMBANKMENT
SCALE: 1"=50' HORIZ., 1"=5' VERT.

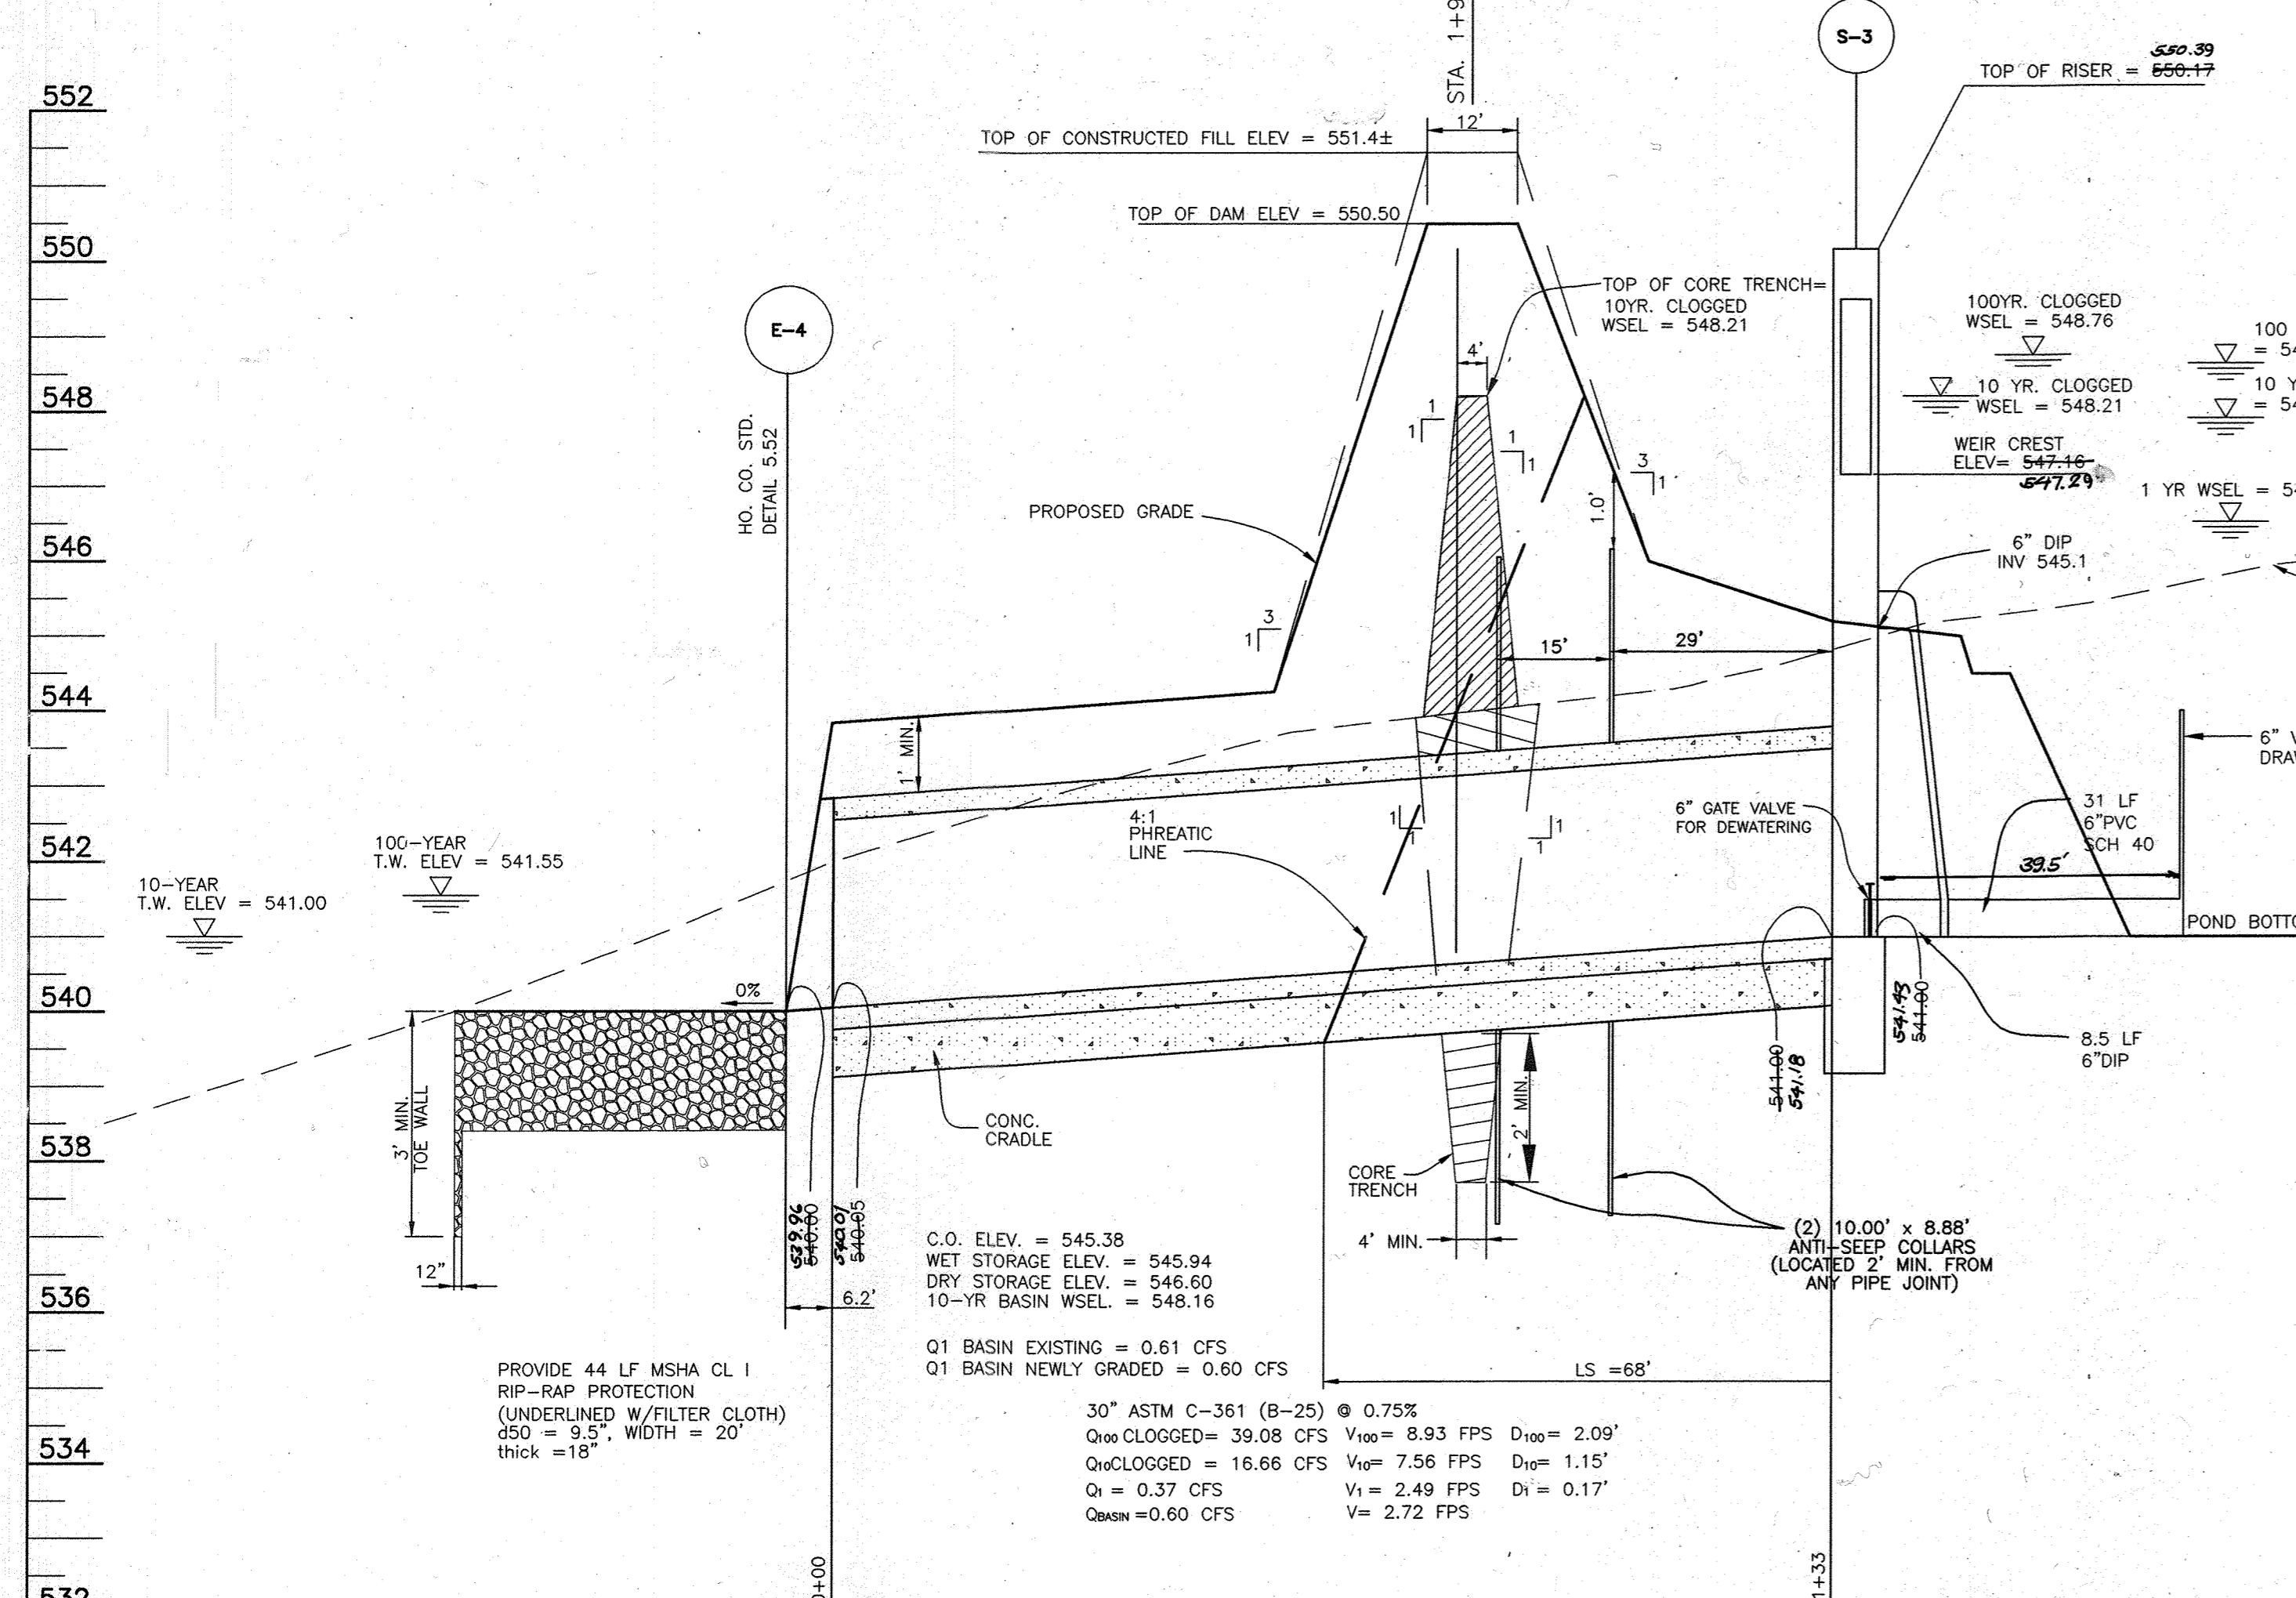


SECTION THRU PRINCIPAL SPILLWAY
SCALE: 1"=20' HORIZ., 1"=2' VERT.

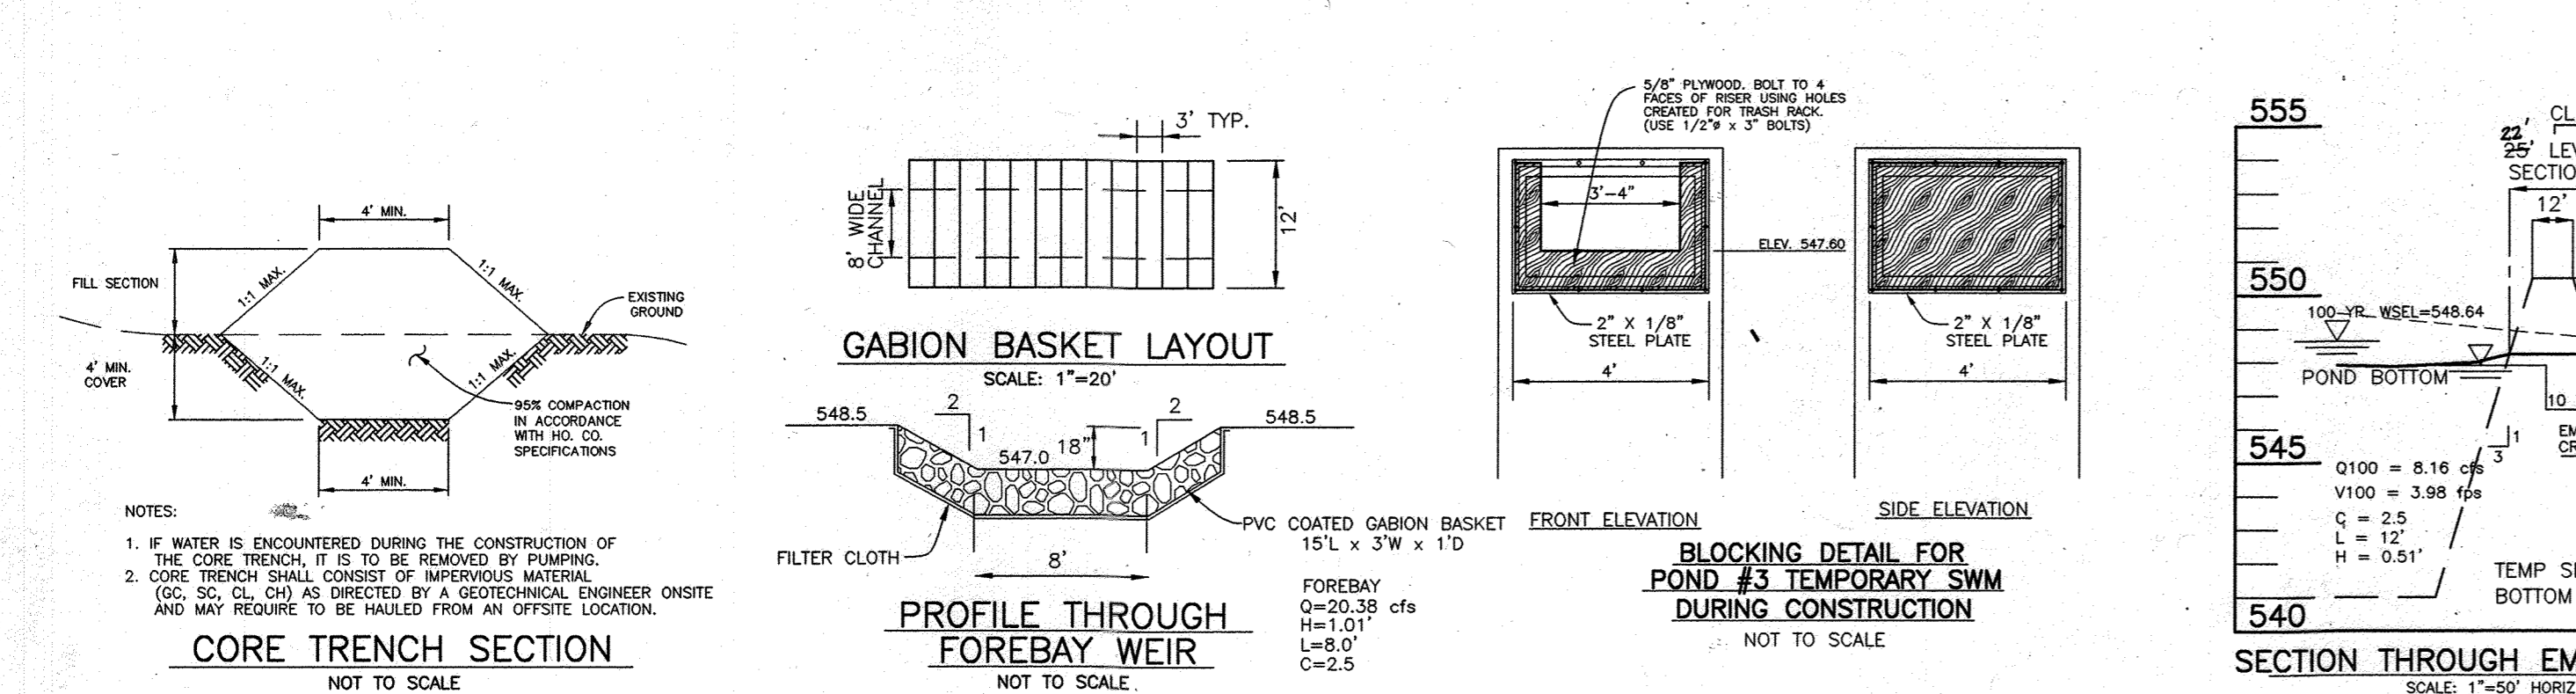


SECTION THROUGH EMERGENCY SPILLWAY
SCALE: 1"=50' HORIZ., 1"=5' VERT.

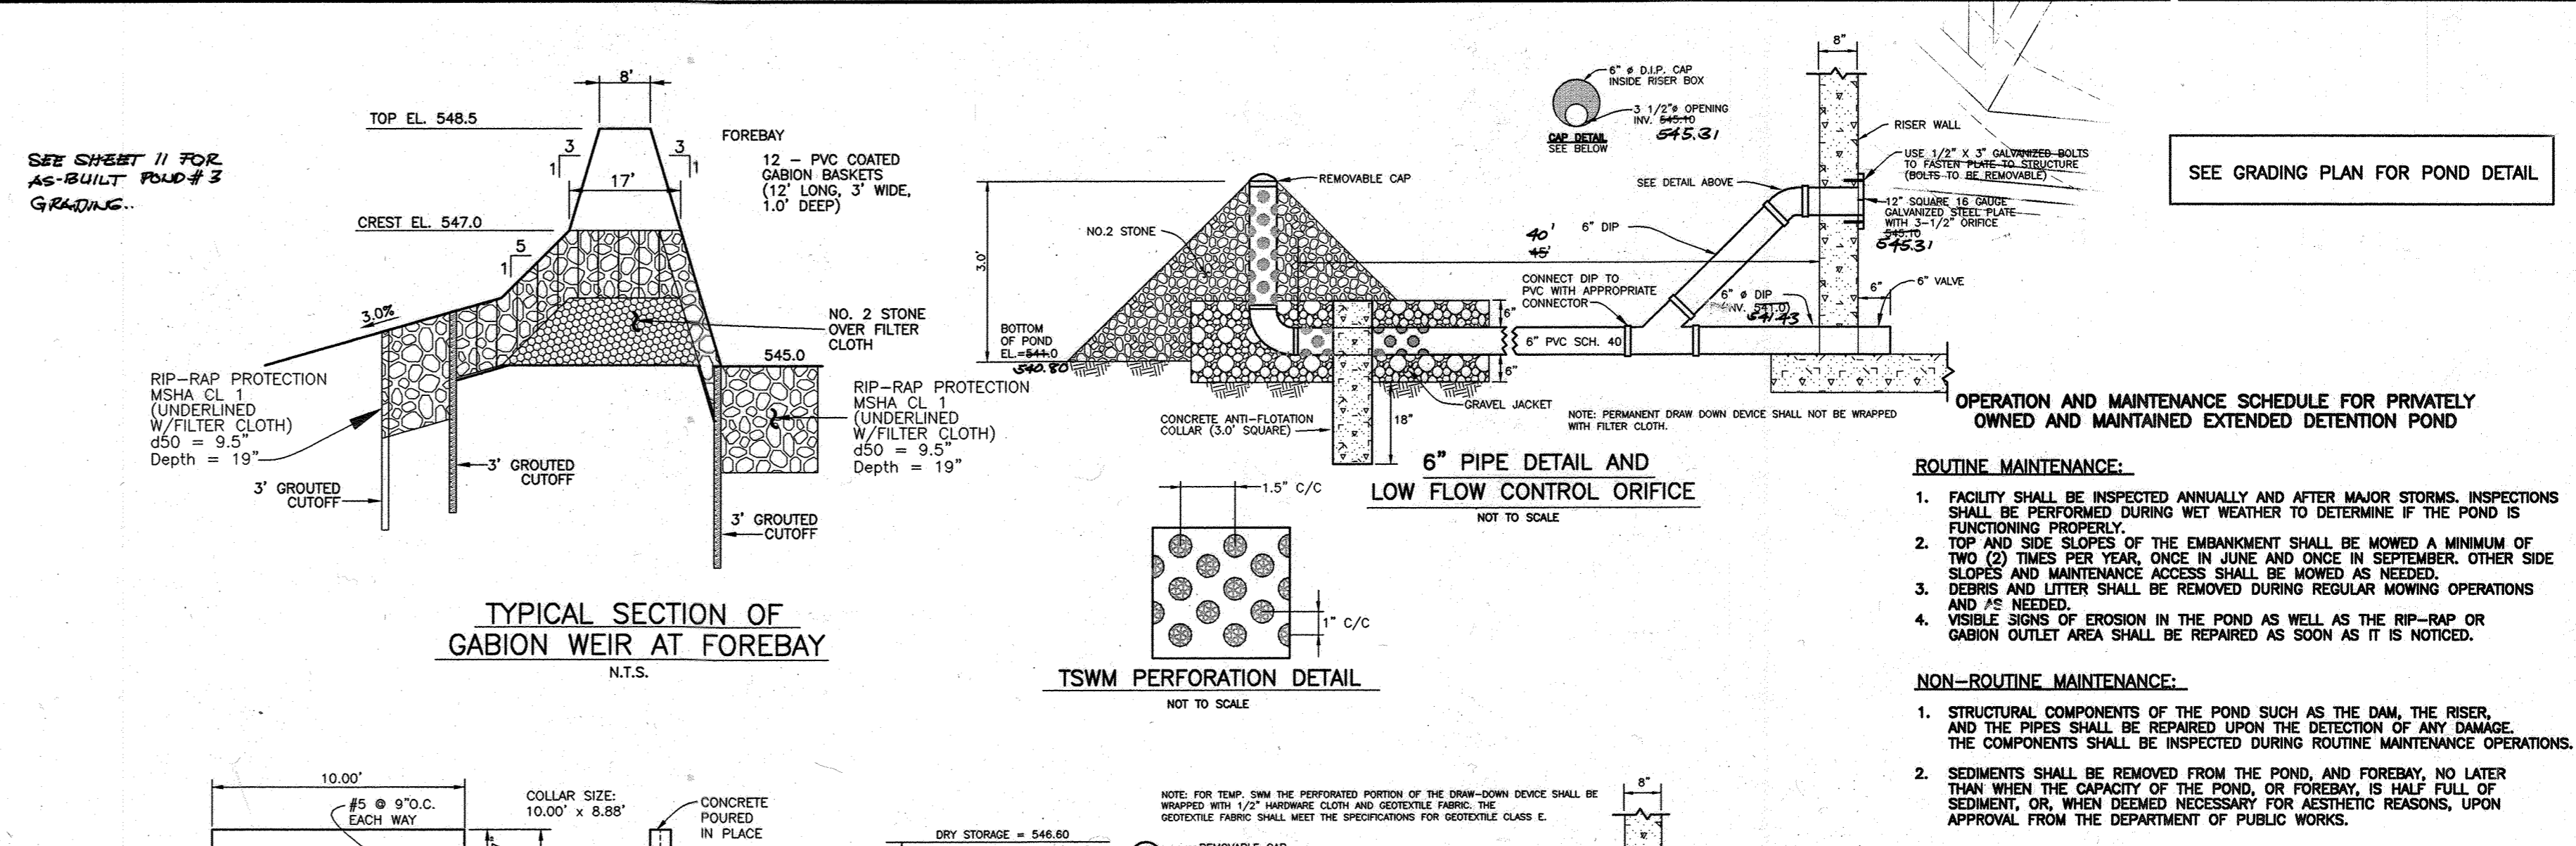


TYPICAL SECTION OF GABION WEIR AT FOREBAY
N.T.S.

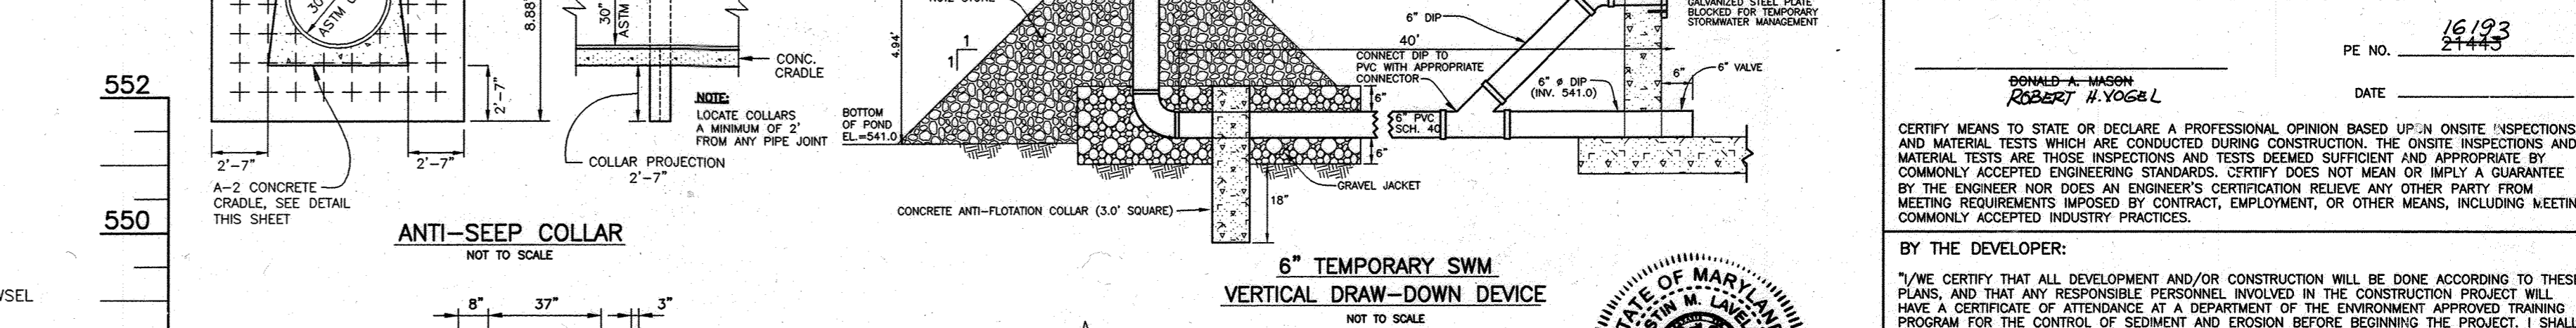


ANTI-SEEP COLLAR
NOT TO SCALE

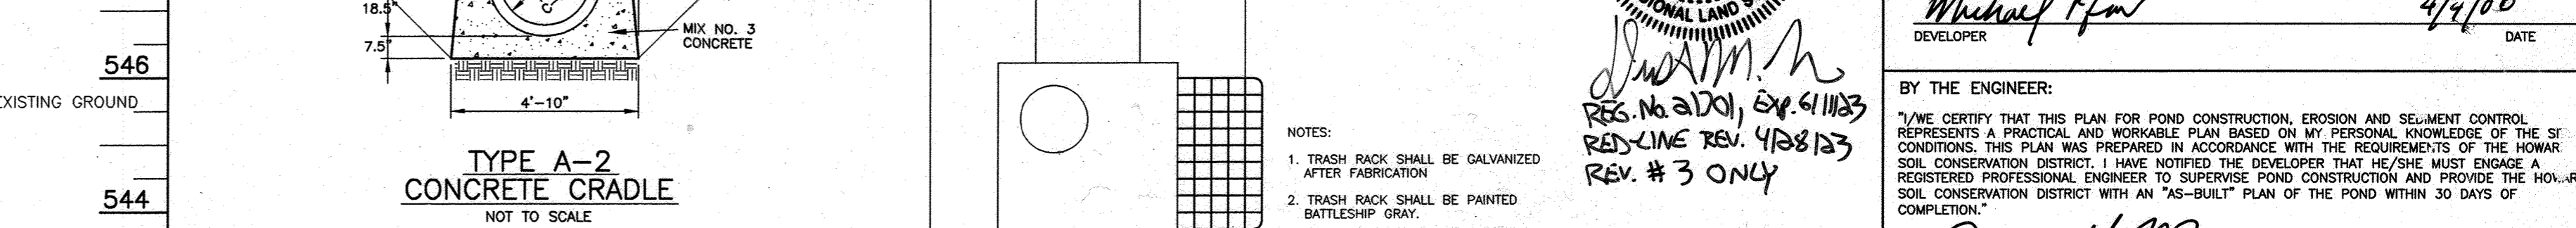

TYPE A-2 CONCRETE CRADLE
NOT TO SCALE

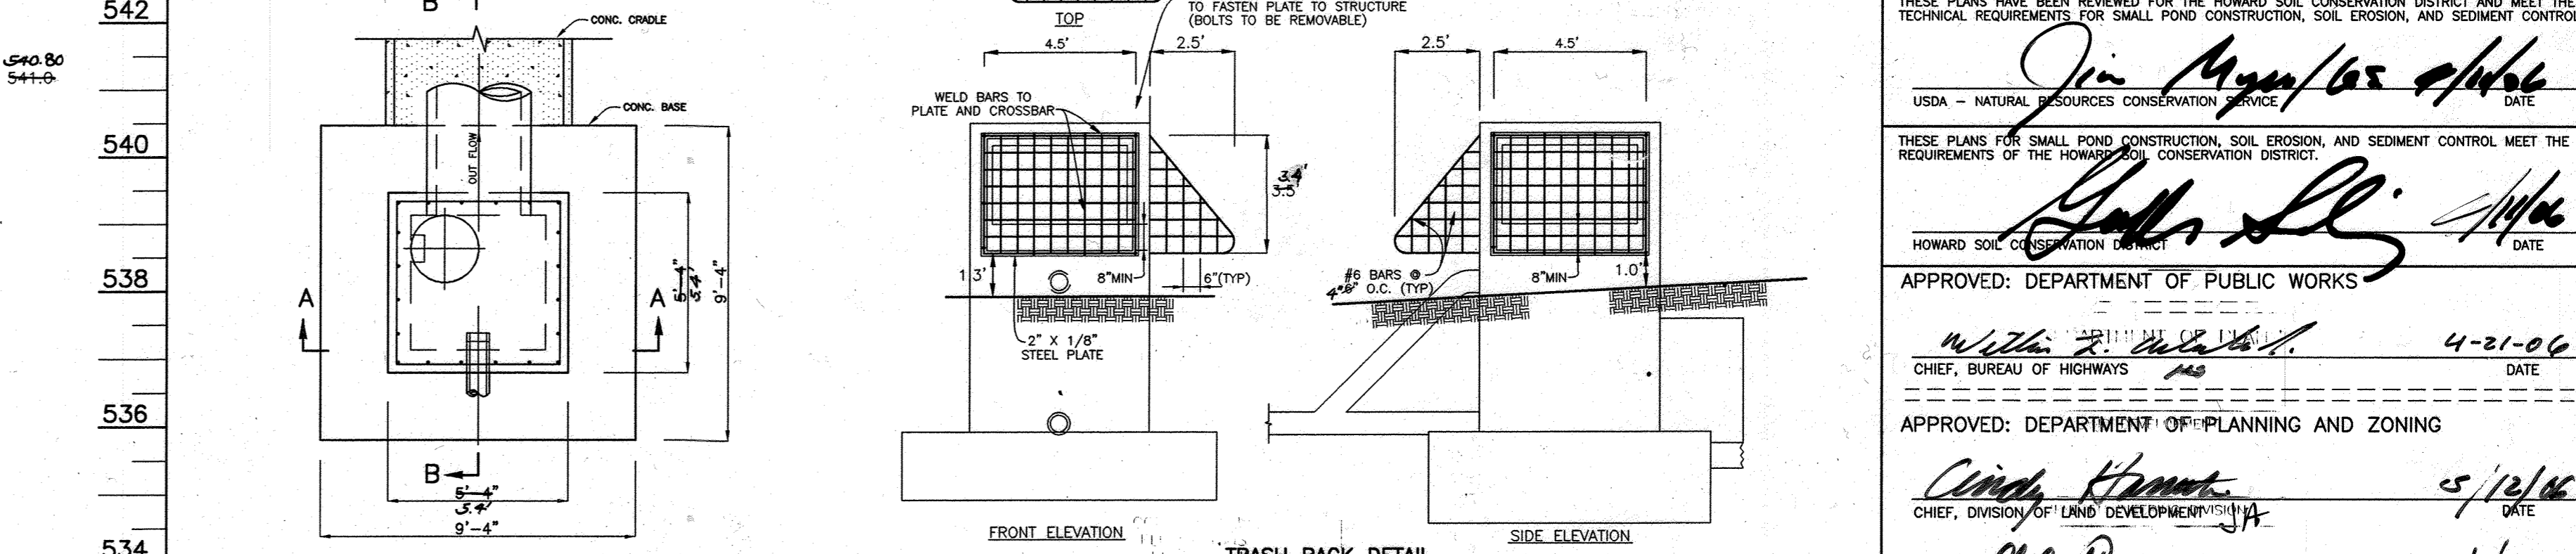

6" TEMPORARY SWM VERTICAL DRAW-DOWN DEVICE
NOT TO SCALE

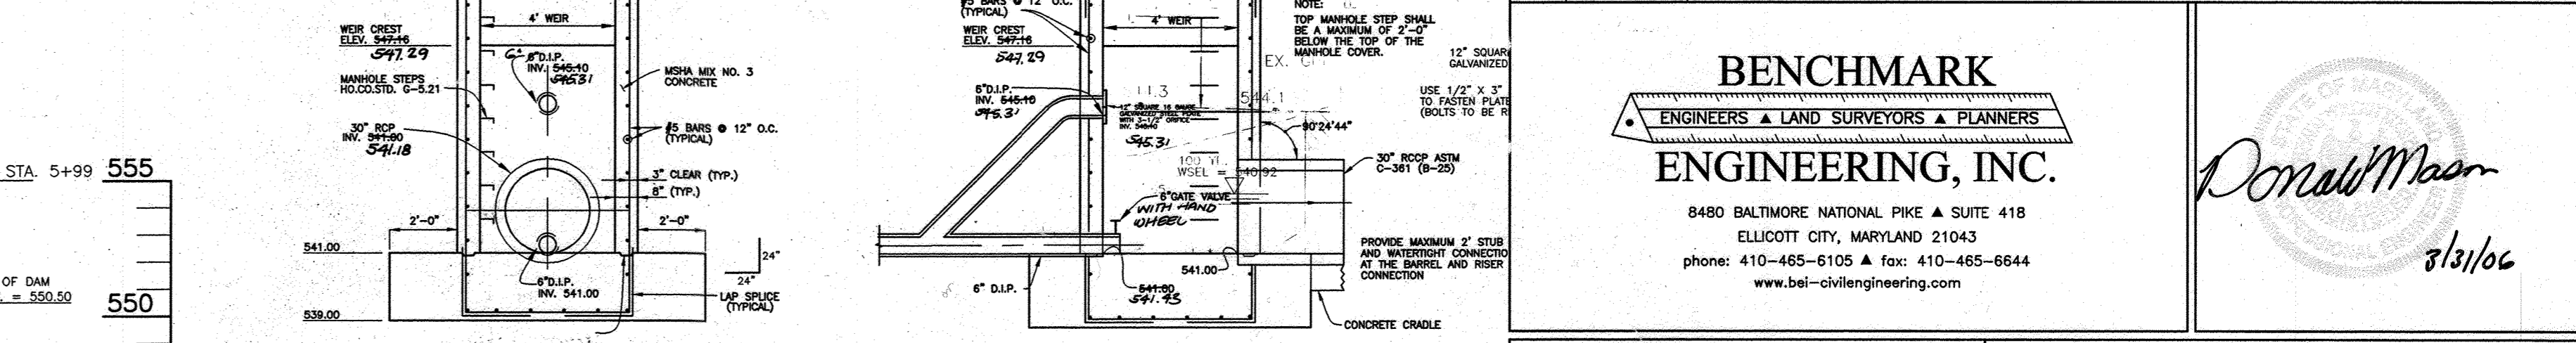

TRASH RACK DETAIL
SCALE: 1"=4'



SECTION A-A FRONT VIEW
SCALE: 1"=4'

SECTION B-B SIDE VIEW
SCALE: 1"=4'

OPERATION AND MAINTENANCE SCHEDULE FOR PRIVATELY OWNED AND MAINTAINED EXTENDED DETENTION POND

ROUTINE MAINTENANCE:

- FACILITY SHALL BE INSPECTED ANNUALLY AND AFTER MAJOR STORMS. INSPECTIONS SHALL BE PERFORMED DURING WET WEATHER TO DETERMINE IF THE POND IS FUNCTIONING PROPERLY.
- TOP AND SIDE SLOPES OF THE EMBANKMENT SHALL BE MOWED A MINIMUM OF TWO (2) TIMES PER YEAR, ONCE IN JUNE AND ONCE IN SEPTEMBER. OTHER SIDE SLOPES AND MAINTENANCE ACCESS SHALL BE MOWED AS NEEDED.
- DEBRIS AND LITTER SHALL BE REMOVED DURING REGULAR MOWING OPERATIONS AND AS NEEDED.
- VISIBLE SIGNS OF EROSION IN THE POND AS WELL AS THE RIP-RAP OR GABION OUTLET AREA SHALL BE REPAIRED AS SOON AS IT IS NOTICED.

NON-ROUTINE MAINTENANCE:

- STRUCTURAL COMPONENTS OF THE POND SUCH AS THE DAM, THE RISER, AND THE PIPES SHALL BE REPAIRED UPON THE DETECTION OF ANY DAMAGE. THE COMPONENTS SHALL BE INSPECTED DURING ROUTINE MAINTENANCE OPERATIONS.
- SEDIMENTS SHALL BE REMOVED FROM THE POND, AND FOREBAY, NO LATER THAN WHEN THE CAPACITY OF THE POND, OR FOREBAY, IS HALF FULL OF SEDIMENT, OR WHEN DEEMED NECESSARY FOR AESTHETIC REASONS, UPON APPROVAL FROM THE DEPARTMENT OF PUBLIC WORKS.

AS-BUILT CERTIFICATION

I HEREBY CERTIFY THAT THE FACILITY SHOWN ON THIS PLAN WAS CONSTRUCTED AS SHOWN ON THE "AS-BUILT" PLANS AND MEETS THE APPROVED PLANS AND SPECIFICATIONS.

PE NO. 16193
21443
DATE 4/4/06

DONALD A. MASON
ROBERT H. YOGEL

CERTIFY MEANS TO STATE OR DECLARE A PROFESSIONAL OPINION BASED UPON ON-SITE INSPECTIONS AND MATERIAL TESTS WHICH ARE CONDUCTED DURING CONSTRUCTION. THE GUESTS INSPECTIONS AND MATERIAL TESTS ARE THOSE INSPECTIONS AND TESTS DEEMED SUFFICIENT AND APPROPRIATE BY COMMONLY ACCEPTED ENGINEERING STANDARDS. CERTIFY DOES NOT MEAN OR IMPLY A GUARANTEE BY THE ENGINEER NOR DOES AN ENGINEER'S CERTIFICATION RELIEVE ANY OTHER PARTY FROM MEETING REQUIREMENTS IMPOSED BY CONTRACT, EMPLOYMENT, OR OTHER MEANS, INCLUDING MEETING COMMONLY ACCEPTED INDUSTRY PRACTICES.

BY THE DEVELOPER:

I/WE CERTIFY THAT ALL DEVELOPMENT AND/OR CONSTRUCTION WILL BE DONE ACCORDING TO THESE PLANS AND THAT ANY RESPONSIBLE PERSONNEL INVOLVED IN THE CONSTRUCTION PROJECT WILL HAVE A CERTIFICATE OF ATTENDANCE AT A DEPARTMENT OF THE ENVIRONMENT APPROVED TRAINING PROGRAM FOR THE CONTROL OF SEDIMENT AND EROSION BEFORE BEGINNING THE PROJECT. I SHALL ENGAGE A REGISTERED PROFESSIONAL ENGINEER TO SUPERVISE POND CONSTRUCTION AND PROVIDE THE HOWARD SOIL CONSERVATION DISTRICT WITH AN "AS-BUILT" PLAN OF THE POND WITHIN 30 DAYS OF COMPLETION. I ALSO AUTHORIZE PERIODIC ON-SITE INSPECTIONS BY THE HOWARD SOIL CONSERVATION DISTRICT.

Michael How
DEVELOPER
DATE 4/4/06

BY THE ENGINEER:

I/WE CERTIFY THAT THIS PLAN FOR POND CONSTRUCTION, EROSION AND SEDIMENT CONTROL REPRESENTS A PRACTICAL AND WORKABLE PLAN BASED ON MY PERSONAL KNOWLEDGE OF THE SITE CONDITIONS. THIS PLAN WAS PREPARED IN ACCORDANCE WITH THE REQUIREMENTS OF THE HOWARD SOIL CONSERVATION DISTRICT. I HAVE NOTICED THE DEVELOPER THAT HE/SHE MUST ENGAGE A REGISTERED PROFESSIONAL ENGINEER TO SUPERVISE POND CONSTRUCTION AND PROVIDE THE HOWARD SOIL CONSERVATION DISTRICT WITH AN "AS-BUILT" PLAN OF THE POND WITHIN 30 DAYS OF COMPLETION. I ALSO AUTHORIZE PERIODIC ON-SITE INSPECTIONS BY THE HOWARD SOIL CONSERVATION DISTRICT.

Donald Mason
ENGINEER - DONALD A. MASON, P.E. # 21443
DATE 3/31/06

Jim Meyer/As
USDA - NATURAL RESOURCES CONSERVATION SERVICE
DATE 4/4/06

These plans for small pond construction, soil erosion, and sediment control meet the requirements of the HOWARD SOIL CONSERVATION DISTRICT.

Walter R. ...
CHIEF, BUREAU OF HIGHWAYS
DATE 4-21-06

APPROVED: DEPARTMENT OF PLANNING AND ZONING
Cindy ...
CHIEF, DIVISION OF LAND DEVELOPMENT
DATE 5/12/06

APPROVED: DEPARTMENT OF PUBLIC WORKS
Oblin ...
CHIEF, DEVELOPMENT ENGINEERING DIVISION
DATE 5/6/06

NO.	DATE	REVISION
3	4/28/03	PAGE NO.
2	6/11/02	REVISE PLAN TO DELETE WATER TIGHT MANHOLE FRAME AND COVER ADD HAND WHEEL TO POND DRAIN, RELOCATE STANDING PAD

BENCHMARK ENGINEERS, INC.
8480 BALTIMORE NATIONAL PIKE & SUITE 418
ELLICOTT CITY, MARYLAND 21043
PHONE: 410-485-6105 FAX: 410-485-6644
WWW.BEL-CIVILENGINEERING.COM

OWNER/DEVELOPER: TRINITY QUALITY HOMES, INC.
3675 PARK AVENUE SUITE 301
ELLICOTT CITY, MD 21043
410-480-0023

PROJECT: THE CHASE AT STONEY BROOK
LOTS 1-20, PRESERVATION PARCEL "A" AND NON-BUILDABLE PRESERVATION PARCELS "B" THROUGH "D"

LOCATION: TAX MAP 7, BLOCK 17 PARCEL 133
4TH ELECTION DISTRICT
HOWARD COUNTY, MARYLAND

TITLE: STORMWATER MANAGEMENT FACILITY #3 (SHALLOW WETLAND)

DATE: JANUARY, 2006 PROJECT NO. 1187
SHEET 18 OF 20

DES: JMC DRAFT: JMC CHECK: DAM SCALE: AS SHOWN SHEET 18 OF 20

AS-BUILT 1/31/13 F-05-170

CONSTRUCTION SPECIFICATIONS

These specifications are appropriate to 16 soil borings within the scope of the Standard for practice MD-378. All references to ASTM and AASHTO specifications apply to the most recent version.

Site Preparation

Areas designated for borrow areas, embankment, and structural works shall be cleared, grubbed and stripped to topsoil. All trees, vegetation, roots and other objectionable material shall be removed. Channel banks and sharp breaks shall be sloped to no steeper than 1:1. All trees shall be cleared and grubbed within 15 feet of the toe of the embankment.

Areas to be covered by the reservoir will be cleared of all trees, brush, logs, fences, rubbish and other objectionable material unless otherwise designated on the plans. Trees, brush, and stumps shall be cut approximately level with the ground surface. For dry stormwater management ponds, a minimum of a 25-foot radius around the inlet structure shall be cleared.

All cleared and grubbed material shall be disposed of outside and below the limits of the dam and reservoir as directed by the owner or his representative. When specified, a sufficient quantity of topsoil will be stockpiled in a suitable location for use on the embankment and other designated areas.

Earth Fill

Material - The fill material shall be taken from approved designated borrow areas. It shall be free of roots, stumps, wood, rubbish, stones greater than 6" frozen or other objectionable material. Fill material for the center of the embankment, and cut off trench shall conform to Unified Soil Classification GC, SC, CH, or CL and must have at least 30% passing the #200 sieve. Consideration may be given to the use of other materials in the embankment if designed by a geotechnical engineer. Such special designs must have construction supervised by a geotechnical engineer.

Materials used in the outer shell of the embankment must have the capability to support vegetation of the quality required to prevent erosion of the embankment.

Placement - Areas on which fill is to be placed shall be scarified prior to placement of fill. Fill materials shall be placed in maximum 8 inch thick (before compaction) layers which are to be continuous over the entire length of the fill. The most permeable borrow material shall be placed in the downstream portions of the embankment. The principal spillway must be installed concurrently with fill placement and not excavated into the embankment.

Compaction - The movement of the hauling and spreading equipment over the fill shall be controlled so that the entire surface of each lift shall be traversed by not less than one track of heavy equipment or compaction shall be achieved by a minimum of four complete passes of a sheepsfoot, rubber tired or vibratory roller. Fill material shall contain sufficient moisture such that the required degree of compaction will be obtained with ten equipment used. The fill material shall contain sufficient moisture so that if formed into a ball it will not crumble, yet not be so wet that water can be squeezed out.

When required by the reviewing agency the minimum required density shall not be less than 95% of maximum dry density with a moisture content within +/- 2% of the optimum. Each layer of fill shall be compacted as necessary to obtain that density, and is to be certified by the Engineer at the time of construction. All compaction is to be determined by AASHTO Method T-99 (Standard Proctor).

Cut Off Trench - The cutoff trench shall be excavated into impervious material along or parallel to the centerline of the embankment as shown on the plans. The bottom width of the trench shall be governed by the equipment used for excavation, with the minimum width being four feet. The depth shall be a least four feet below existing grade or as shown on the plans. The side slopes of the trench shall be 1 to 1 or flatter. The backfill shall be compacted with construction equipment, rollers, or hand tampers to assure maximum density and minimum permeability. In addition, the core shall be placed concurrently with the outer shell of the embankment.

Embankment Core - The core shall be parallel to the centerline of the embankment as shown on the plans. The top of the core shall be a minimum of four feet. The bottom width of the core shall extend up to at least the 10 year water elevation or as shown on the plans. The side slopes shall be 1 to 1 or flatter. The core shall be compacted with construction equipment, rollers, or hand tampers to assure maximum density and minimum permeability. In addition, the core shall be placed concurrently with the outer shell of the embankment.

Structure Backfill

Backfill adjacent to pipes or structures shall be of the type and quality conforming to that specified for the adjoining fill material. The fill shall be placed in horizontal layers not to exceed four inches in thickness and compacted by hand tampers or other manually directed compaction equipment. The material needs to fill completely all spaces under and adjacent to the pipe. At no time during the backfilling operation shall driven equipment be allowed to operate closer than four feet measured horizontally to any part of a structure or pipe. No circumstances shall equipment be driven over any part of a concrete structure or pipe, unless there is a compacted fill of 24" or greater over the structure or pipe.

Structure backfill may be flowable fill meeting the requirements of Maryland Department of Transportation, State Highway Administration Standard Specifications for Construction and Materials, Section 313 as modified. The mixture shall have a 100-200 psi, 28 day unconfined compressive strength. The flowable fill shall have a minimum pH of 4.0 and a minimum resistivity of 2,000 ohm-cm. Material shall be placed such that a minimum of 6" (measured perpendicular to the outside of the pipe) of flowable fill is under (bedding) over and, on the sides of the pipe. It only needs to extend up to the spring line for rigid conduits. Average slump of the fill shall be 7" to assure flowability of the material. Adequate measures shall be taken (sand bags, etc.) to prevent floating the pipe. When using flowable fill, all metal pipe shall be bituminous coated. Any objectionable soil fill shall be placed in horizontal layers not to exceed four inches in thickness and compacted by hand tampers or other manually directed compaction equipment. The material shall completely fill all voids adjacent to the flowable fill zone. At no time during the backfilling operation shall driven equipment be allowed to operate closer than four feet, measured horizontally, to any part of a structure. Under no circumstances shall equipment be driven over any part of a structure or pipe unless there is a compacted fill of 24" or greater over the structure or pipe. Backfill material outside the structural backfill (flowable fill) zone shall be of the type and quality conforming to that specified for the core of the embankment or other embankment materials.

Pipe Conduits

All pipes shall be circular in cross section

Corrugated Metal Pipe - all of the following criteria shall apply for corrugated metal pipe:

1. Materials - (Polymer Coated Steel Pipe) - Steel pipes with polymeric coatings shall have a minimum coating thickness of 0.01 inch (10 mil) on both sides of the pipe. This pipe and its appurtenances shall conform to the requirements of AASHTO Specifications M-245 & M-246 with watertight coupling bands or flanges.

Materials - (Aluminum Coated Steel Pipe) - This pipe and its appurtenances shall conform to the requirements of AASHTO Specification M-274 with watertight coupling bands or flanges. Aluminum Coated Steel Pipe, when used with flowable fill or when soil and/or water conditions warrant the need for increased durability, shall be fully bituminous coated per requirements of AASHTO Specification M-190 Type A. Any aluminum coating damaged or otherwise removed shall be replaced with cold applied bituminous coating compound. Aluminum surfaces that are to be in contact with concrete shall be painted with one coat of zinc chromate primer or two coats of asphalt.

Materials - (Aluminum Pipe) - This pipe and its appurtenances shall conform to the requirements of AASHTO Specification M-96 or M-211 with watertight coupling bands or flanges. Aluminum Pipe, when used with flowable fill or when soil and/or water conditions warrant for increased durability, shall be fully bituminous coated per requirements of AASHTO Specification M-190 Type A. Aluminum surfaces that are to be in contact with concrete shall be painted with one coat of zinc chromate primer or two coats of asphalt. Hot dip galvanized bolts may be used for connections. The pH of the surrounding soil shall be between 4 and 9.

2. Coupling bands, anti-seep collars, and sections, etc., must be composed of the same material and coatings as the pipe. Metals must be insulated from dissimilar materials with use of rubber or plastic insulating materials at least 24 mils in thickness.

3. Connections - All connections with pipes must be completely watertight. The drain pipe or barrel connection to the riser shall be welded all around when the pipe and riser are metal. Anti-seep collars shall be connected to the pipe in such a manner as to be completely watertight. Dimple bands are not considered to be watertight.

All connection shall use a rubber or neoprene gasket when joining pipe sections. The end of each pipe shall be re-rolled an adequate number of corrugations to accommodate the bandwidth. The following type connections are acceptable for pipes less than 24 inches in diameter: flanges on both ends of the pipe with a circular 3/8 inch closed cell neoprene gasket, prepunched to the flange bolt circle, sandwiched between adjacent flanges; a 12-inch wide standard lap type band with 12-inch wide by 3/8-inch thick closed cell circular neoprene gasket; and a 12-inch wide hugger type band with o-ring gaskets having a minimum diameter of 1/2 inch greater than the corrugation depth. Pipes 24 inches in diameter and larger shall be connected by a 24 inch long annular corrugated band using a minimum of 4 (four) rods and lugs, 2 on each connecting pipe end. A 24-inch wide by 3/8-inch thick closed cell circular neoprene gasket will be installed, with 12 inches on the end of each pipe. Flanged joints with 3/8 inch closed cell gaskets the full width of the flange is also acceptable.

Helically corrugated pipe shall have either continuously welded seams or have lock seams with internal caulking or a neoprene bead.

4. Bedding - The pipe shall be firmly and uniformly bedded throughout its entire length. Where rock or soft, spongy or other unstable soil is encountered, all such material shall be removed and replaced with suitable earth compacted to provide adequate support.

5. Backfilling: shall conform to "Structure Backfill".

6. Other details (anti-seep collars, valves, etc.) shall be as shown on the drawings.

Reinforced Concrete Pipe - All of the following criteria shall apply for reinforced concrete pipe:

1. Materials - Reinforced concrete pipe shall have bell and spigot joints with rubber gaskets and shall equal or exceed ASTM C-361.

2. Bedding - Reinforced concrete pipe conduits shall be laid in a concrete bedding/cradle for their entire length. This bedding/cradle shall consist of high slump concrete placed under the pipe and up the sides of the pipe to at least 50% of its outside diameter with a minimum thickness of 6 inches. Where a concrete cradle is not needed for structural reasons, flowable fill may be used as described in the "Structure Backfill" section of this standard. Gravel bedding is not permitted.

3. Laying pipe - Bell and spigot pipe shall be placed with the bell end upstream. Joints shall be made in accordance with recommendations of the manufacturer of the material. After the joints are sealed for the entire line, the bedding shall be placed so that all spaces under the pipe are filled. Care shall be exercised to prevent any deviation from the original line and grade of the pipe. The first joint must be located within 4 feet from the riser.

4. Backfilling shall conform to "Structure Backfill".

5. Other details (anti-seep collars, valves, etc.) shall be as shown on the drawings.

Plastic Pipe - The following criteria shall apply for plastic pipe:

1. Materials - PVC pipe shall be PVC-1120 or PVC-1220 conforming to ASTM D-1785 or ASTM D-2241. Corrugated High Density Polyethylene (HDPE) pipe, couplings and fittings shall conform to the following: 4" - 10" inch pipe shall meet the requirements of AASHTO M252 Type S, and 12" through 24" inch shall meet the requirements of AASHTO M254 Type S.

2. Joints and connections to anti-seep collars shall be completely watertight.

3. Bedding - The pipe shall be firmly and uniformly bedded throughout its entire length. Where rock or soft, spongy or other unstable soil is encountered, all such material shall be removed and replaced with suitable earth compacted to provide adequate support.

4. Backfilling shall conform to "Structure Backfill".

5. Other details (anti-seep collars, valves, etc.) shall be as shown on the drawings.

Drainage Diaphragms - When a drainage diaphragm is used, a registered professional engineer will supervise the design and construction inspection.

Concrete

Concrete shall meet the requirements of Maryland Department of Transportation, State Highway Administration Standard Specifications for Construction and Materials, Section 414, Mix No. 3.

Rock Riprap

Rock riprap shall meet the requirements of Maryland Department of Transportation, State Highway Administration Standard Specifications for Construction and Materials, Section 311.

Geotextile shall be placed under all riprap and shall meet the requirements of Maryland Department of Transportation, State Highway Administration Standard Specifications for Construction and Materials, Section 921.00, Class C.

Coat of Water during Construction

All work on permanent structures shall be carried out in areas free from water. The contractor shall construct and maintain all temporary dikes, levees, cofferdams, drainage channels, and stream diversions necessary to protect the areas to be occupied by the permanent works. The contractor shall also furnish, install, operate, and maintain all necessary pumping and other equipment required for removal of water from various parts of the work and for maintaining the excavations, foundation, and other parts of the work free from water as required or directed by the engineer for constructing each part of the work. After having served their purpose, all temporary protective works shall be removed or leveled and graded to the extent required to prevent obstruction in any degree whatsoever of the flow of water to the spillway or outlet works and so as not to interfere in any way with the operation or maintenance of the structure. Stream diversions shall be maintained until the full flow can be passed through the permanent works. The removal of water from the required excavation and the foundation shall be accomplished in a manner and to the extent that will maintain stability of the excavated slopes and bottom required excavations and will allow satisfactory performance of all construction operations. During the placing and compacting of material in required excavations, the water level at the location being refilled shall be maintained below the bottom of the excavation at such locations which may require draining the water pumps from which the water shall be pumped.

Stabilization

All borrow areas shall be graded to provide proper drainage and left in a slightly condition. All exposed surfaces of the embankment, spillway, spoil and borrow areas, and berms shall be stabilized by seeding, liming, fertilizing and mulching in accordance with the Natural Resources Conservation Service Standards and Specifications for Critical Area Planting (MD-342) or as shown on the accompanying drawings.

Erosion and Sediment Control

Construction operations will be carried out in such a manner that erosion will be controlled and water and air pollution minimized. State and local laws concerning pollution abatement will be followed. Construction plans shall detail erosion and sediment control measures.

Table with columns: ELEV, SOL DESCRIPTION, STRA, DEPTH, SAMPLE, BLOWN, NO, BORING & SAMPLING NOTES. Includes data for borings 1 through 5.

Table with columns: SAMPLER TYPE, SAMPLE CONDITIONS, GROUND WATER DEPTH, BORING METHOD. Includes notes on testing procedures.

Table with columns: ELEV, SOL DESCRIPTION, STRA, DEPTH, SAMPLE, BLOWN, NO, BORING & SAMPLING NOTES. Includes data for borings 1 through 5.

Table with columns: SAMPLER TYPE, SAMPLE CONDITIONS, GROUND WATER DEPTH, BORING METHOD. Includes notes on testing procedures.

Table with columns: ELEV, SOL DESCRIPTION, STRA, DEPTH, SAMPLE, BLOWN, NO, BORING & SAMPLING NOTES. Includes data for borings 1 through 5.

Table with columns: SAMPLER TYPE, SAMPLE CONDITIONS, GROUND WATER DEPTH, BORING METHOD. Includes notes on testing procedures.

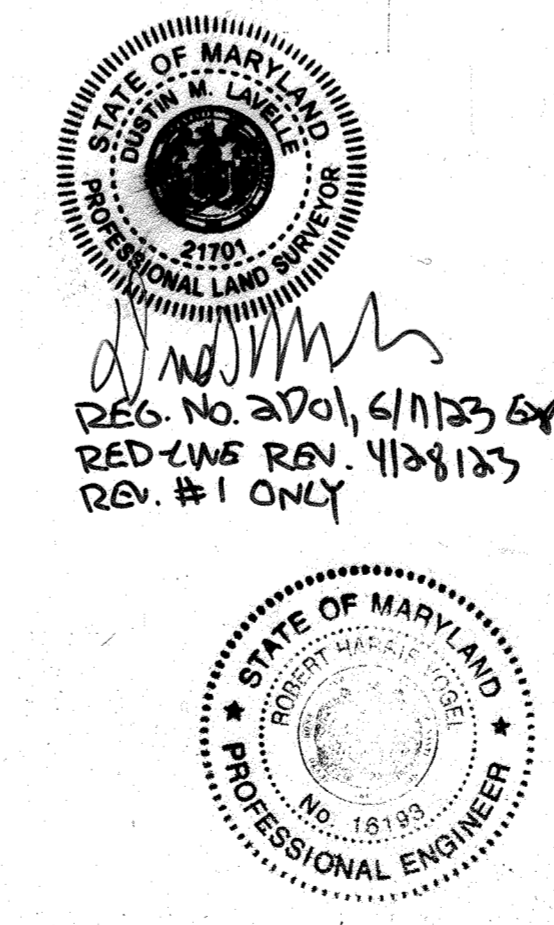

AS-BUILT CERTIFICATION. I HEREBY CERTIFY THAT THE FACILITY SHOWN ON THIS PLAN WAS CONSTRUCTED IN ACCORDANCE WITH THE AS-BUILT PLANS AND MEETS THE APPROVED PLANS & SPECIFICATIONS.

1/13/06 DATE. Includes signature and date.

Table with columns: ELEV, SOL DESCRIPTION, STRA, DEPTH, SAMPLE, BLOWN, NO, BORING & SAMPLING NOTES. Includes data for borings 1 through 5.

Table with columns: SAMPLER TYPE, SAMPLE CONDITIONS, GROUND WATER DEPTH, BORING METHOD. Includes notes on testing procedures.

Engineering drawing header and revision table. Includes project name 'THE CHASE AT STONEY BROOK', location, title 'SWM NOTES AND SOIL BORING LOGS', date 'MARCH, 2006', and revision table with entries for 'REVISE PAGE NO.' and 'REVISION'.

DES: JMC DRAFT: LAB CHECK: DAM SCALE: AS SHOWN SHEET 19 OF 20. Includes AS-BUILT 1/13/06 and F-05-170.

APPROVED: HOWARD COUNTY DEPARTMENT OF PUBLIC WORKS. Includes signatures of William J. Mahala and Candy Hammett, and dates 4-20-06 and 5/10/06.

APPROVED: HOWARD COUNTY DEPT. OF PLANNING AND ZONING. Includes signature of David Williamson and date 5/10/06.

