


GENERAL NOTES

- ALL ASPECTS OF THIS PROJECT SHALL BE IN CONFORMANCE WITH THE LATEST HOWARD COUNTY STANDARDS UNLESS WAIVER(S) HAVE BEEN APPROVED.
- PRIVATE WATER AND SEWER SYSTEMS SHALL BE PROVIDED FOR THIS DEVELOPMENT. WELLS SHALL BE DRILLED PRIOR TO FINAL PLAT RECORDED.
- TRACT BOUNDARY ESTABLISHED BY A BOUNDARY SURVEY PERFORMED BY BENCHMARK ENGINEERING, INC., DATED 12/20/02.
- THE EXISTING TOPOGRAPHY SHOWN IS TAKEN FROM AN AERIAL SURVEY WITH TWO-FOOT CONTOUR INTERVALS PREPARED BY WINGS INC. DATED DECEMBER, 2002.
- HORIZONTAL AND VERTICAL DATUMS FOR THIS PLAN ARE BASED UPON THE MARYLAND STATE PLANE COORDINATE SYSTEM NAD83 AS PROJECTED FROM HOWARD COUNTY CONTROL POINTS 28HA AND 34AA.
- WETLAND DELINEATION PERFORMED BY ECO-SCIENCE PROFESSIONALS, INC. DATED FEBRUARY 2003 IN THE AREAS OF ANY POTENTIAL DISTURBANCES. AREAS NOT NEAR POTENTIAL DISTURBANCES WERE NOT DELINEATED IN ACCORDANCE WITH SECTION 16.116(A)(4) OF THE HOWARD COUNTY SUBDIVISION REGULATIONS.
- TRAFFIC STUDY PREPARED BY TRAFFIC CONCEPTS, INC. IN FEBRUARY, 2003 AND WAS APPROVED UNDER SP-03-13 ON 8/28/03.
- FOREST STAND DELINEATION IS NOT PROVIDED BECAUSE ECO-SCIENCE PROFESSIONALS, INC. DETERMINED THAT THERE ARE NO FOREST RESOURCES ON SITE. FOREST CONSERVATION PLAN PREPARED BY ECO-SCIENCE PROFESSIONALS, INC., DATED FEBRUARY, 2003. THE FOREST CONSERVATION OBLIGATIONS WILL BE MET BY ON-SITE AFFORESTATION AND OFF-SITE RETENTION.
- NOISE MITIGATION IS NOT REQUIRED FOR THIS PROJECT.
- A SIGHT DISTANCE ANALYSIS FOR THE INTERSECTION OF BROCCOLINO WAY AND TRIADELPHIA MILL ROAD HAS BEEN COMPLETED BY BENCHMARK ENGINEERING, INC. DATED FEBRUARY, 2003 AND WAS SUBMITTED AS PART OF SP-03-013. A DESIGN MANUAL WAIVER WAS APPROVED BY D.E.T. LETTER DATED APRIL 3, 2003 TO USE STOPPING SIGHT DISTANCE IN LIEU OF INTERSECTION SIGHT DISTANCE AND TO ALLOW THE USE OF A 25 MPH DESIGN SPEED FOR THE COMPUTATION OF VERTICAL CURVES.
- MINIMUM BUILDABLE LOT SIZE SHALL BE 40,000 SQUARE FEET. MAXIMUM BUILDABLE LOT SIZE SHALL BE 50,000 SQUARE FEET.
- THIS PROPERTY IS NOT WITHIN THE METROPOLITAN DISTRICT.
- STORMWATER MANAGEMENT SHALL BE PROVIDED BY THE USE OF NON-STRUCTURAL METHODS FOR MEETING GROUND WATER RECHARGE VOLUMES, SHALLOW WETLAND, POCKET POND AND MICROPOOL ED FACILITIES SHALL BE CONSTRUCTED TO MEET THE WETLAND QUALITY AND CHANNEL PROTECTION REQUIREMENTS. ALL FACILITIES TO BE CL-2'S 'A' STRUCTURES. THESE FACILITIES WILL BE PRIVATELY OWNED AND MAINTAINED BY THE HOMEOWNERS ASSOCIATION.
- TO THE BEST OF OUR KNOWLEDGE THERE ARE NO CEMETERY LOCATIONS ON-SITE.
- SEDMIMENT CONTROL SHALL BE PROVIDED FOR THIS PROJECT. SEPTIC EASEMENT AREAS SHALL BE PROTECTED FROM ROAD CONSTRUCTION GRADING OPERATIONS.
- THERE ARE EXISTING STRUCTURES LOCATED ON THIS PROPERTY, NONE OF WHICH ARE TO REMAIN.
- ALL LANDSCAPING REQUIREMENTS AS SET FORTH IN THE LANDSCAPE MANUAL SHALL BE COMPLIED WITH.
- FOR FLAG OR PIPE STEM LOTS, REFUSE COLLECTION, SNOW REMOVAL AND ROAD MAINTENANCE ARE PROVIDED TO THE JUNCTION OF THE FLAG OR PIPE STEM AND ROAD RIGHT OF WAY LINE AND NOT THE FLAG OR PIPE STEM LOT DRIVEWAY.
- DRIVEWAYS SHALL BE PROVIDED PRIOR TO RESIDENTIAL OCCUPANCY TO INSURE SAFE ACCESS FOR FIRE AND EMERGENCY VEHICLES PER THE FOLLOWING MINIMUM REQUIREMENTS:
 - WIDTH - 12' (14' MINIMUM FOR ONE RESIDENCE).
 - SURFACE - 1" OF COMPACT CRUSHER RUN BASE WITH TAR AND CHIP COATING (1-1/2" MIN).
 - GEOMETRY - MAXIMUM 15% GRADE CHANGE AND MINIMUM 45' TURNING RADIUS.
 - STRUCTURES (CULVERTS/BRIDGES) - CAPABLE OF SUPPORTING 25 GROSS TONS (H25 LOADING).
 - DRAINAGE ELEMENTS - CAPABLE OF SAFELY PASSING 100 YEAR FLOODPLAIN WITH NO MORE THAN 1 FOOT DEPTH OVER DRIVEWAY.
 - STRUCTURE CLEARANCES - MINIMUM 12 FEET.
 - MAINTENANCE - SUFFICIENT TO INSURE ALL WEATHER USE.
- THIS PLAN IS SUBJECT TO THE FOLLOWING PLANNING AND ZONING FILE NUMBERS: WP-03-093, SP-03-013, RE-06-01, WP-06-102
- THIS AREA DESIGNATES A PRIVATE SEWAGE EASEMENT OF AT LEAST 10,000 SF AS REQUIRED BY THE MARYLAND STATE DEPARTMENT OF THE ENVIRONMENT FOR INDIVIDUAL SEWAGE DISPOSAL IMPROVEMENTS OF ANY NATURE IN THIS AREA ARE RESTRICTED UNTIL PUBLIC SEWER IS AVAILABLE. THIS EASEMENT SHALL BECOME NULL AND VOID UPON CONNECTION TO A PUBLIC SEWER SYSTEM. THE EASEMENT SHALL HAVE THE AUTHORITY TO GRANT ADJUSTMENTS TO THE PRIVATE SEWAGE EASEMENT. RECONSTRUCTION OF A MODIFIED SEWAGE EASEMENT PLAN SHALL NOT BE REQUIRED.
- THERE ARE NO CONTIGUOUS AREAS OF STEEP SLOPES (25% OR GREATER) OF 20,000 S.F. OR GREATER ON THIS SITE. GRADING OF STEEP SLOPE AREAS LESS THAN 20,000 S.F. IS PERMITTED UNDER SECTION 16.116(b)(1) OF THE SUBDIVISION REGULATIONS.
- EXISTING WELLS AND/OR SEWAGE EASEMENTS WITHIN 100' OF THE PROPERTY HAVE BEEN SHOWN FROM THE BEST AVAILABLE INFORMATION.
- THE PRINCIPAL USES OF PRESERVATION PARCEL 'A' ARE TO BE STORMWATER MANAGEMENT AND ENVIRONMENTAL CONSERVATION. THIS PARCEL SHALL BUFFER THE PROPOSED LOTS FROM EXISTING PROPERTIES TO THE WEST. THIS WILL LESSEN THE VISUAL IMPACTS THAT THE PROPOSED DEVELOPMENT WILL HAVE ON THE EXISTING LOTS. PRESERVATION PARCEL 'A' WILL BE PRIVATELY OWNED AND IS BUILDABLE.
- THE PRINCIPAL USES OF PRESERVATION PARCELS 'B' THROUGH 'D' ARE TO BE GREENSPACE CONSERVATION. THESE PARCELS SHALL BUFFER THE PROPOSED LOTS FROM EXISTING PROPERTIES TO THE WEST. THIS WILL LESSEN THE VISUAL IMPACTS THAT THE PROPOSED DEVELOPMENT WILL HAVE ON THE EXISTING LOTS. PRESERVATION PARCELS 'B' THROUGH 'D' WILL BE PRIVATELY OWNED AND ARE NON-BUILDABLE.
- THE SUBJECT PROPERTY IS ZONED RR-DEO PER THE 2/2/04 COMPREHENSIVE ZONING PLAN, AND THE COMP LITE ZONING REGULATION AMENDMENTS EFFECTIVE ON JULY 28, 2006.
- WAIVER PETITION WP-03-93 WAS APPROVED BY THE DIRECTOR OF THE DEPARTMENT OF PLANNING AND ZONING ON JULY 10, 2003. WP-03-93 WAVES SECTIONS 16.116(a)(1) & (2), PROTECTION OF WETLANDS & STREAMS; 16.147, FINAL SUBDIVISION PLAN AND FINAL PLAT FOR THE ADJOINING TRAFFIC; AND 16.116(a) AND (c), FLOODPLAIN PRESERVATION, OF THE SUBDIVISION REGULATIONS. TO ALLOW THE TWO PUBLIC ROAD CROSSINGS, THE USE-IN-COMMON DRIVEWAY CROSSING FOR LOTS 11 THRU 15 AND THE DIRECTIONAL BORE FOR THE PRESSURE SEWER LINE FOR PRESERVATION PARCEL A DISTURBANCES WITHIN THE ENVIRONMENTAL FEATURES AND THE REQUIRED WETLAND AND STREAM BUFFERS, AND TO ALLOW RECONFIGURATION OF THE PROPERTY BOUNDARY USING THE ADJOINING DEED CONVEYANCE PROCESS.
- A DESIGN MANUAL WAIVER WAS GRANTED BY THE DIRECTOR OF THE DEVELOPMENT ENGINEERING DIVISION ON JULY 17, 2003, GRANTING THE USE OF A USE-IN-COMMON DRIVEWAY TO ACCESS FIVE LOTS.
- ALL SIGNS POSTS USED FOR TRAFFIC CONTROL SIGNS INSTALLED IN THE COURSE RIGHT-OF-WAY SHALL BE MOUNTED ON A 2" GALVANIZED STEEL PERFORATED, SQUARE TUBE POST (14 GAUGE) INSERTED INTO A 2-1/2" GALVANIZED STEEL PERFORATED, SQUARE TUBE SLEEVE (12 GAUGE) - 3' LONG. A GALVANIZED STEEL POLE CAP SHALL BE MOUNTED ON TOP OF EACH POST.
- THE 100 YEAR FLOODPLAIN STUDY AND THE AFFO STUDY WERE FOR THIS PROJECT WAS PREPARED BY BENCHMARK ENGINEERING, INC. APPROVED BY HOWARD COUNTY ON 8/28/03.
- WAIVER PETITION WP-06-102 WAS APPROVED BY THE DIRECTOR OF THE DEPARTMENT OF PLANNING AND ZONING ON JANUARY 12, 2007. WP-06-102 WAVES SECTIONS 16.116(a)(1) & (2), PROTECTION OF WETLANDS & STREAMS AND 16.116(a) AND (c), FLOODPLAIN PRESERVATION, OF THE SUBDIVISION REGULATIONS. APPROVAL CONDITIONS ARE THE ALL NECESSARY WATER QUALITY CERTIFICATES AND NON-TIDAL WETLANDS PERMITS FROM THE MARYLAND DEPARTMENT OF THE ENVIRONMENT AND/OR THE ARMY CORPS OF ENGINEERS SHALL BE OBTAINED, DISTURBANCES SHALL BE MINIMIZED AND IN ACCORDANCE WITH THE SEDIMENT AND EROSION CONTROL PLANS AND PERMITS. BEST MANAGEMENT PRACTICES SHALL BE USED BY ALL CONTRACTORS WHEN CONSTRUCTING THE USE-IN-COMMON DRIVEWAY CROSSING. STABILIZATION SHALL BE INITIATED IMMEDIATELY UPON COMPLETION OF THE ROAD CONSTRUCTION, COMPLIANCE WITH THE REMOVAL OF THE ROAD/DITCH REMOVAL THROUGHOUT THE PLAN, COMPLIANCE WITH THE CONDITIONS OF APPROVAL OF WAIVER PETITION WP-03-093, AND COMPLIANCE WITH SRC AGENCIES COMMENTS ISSUED FOR FINAL PLAN, F-06-067.
- THE STATE OF MARYLAND, DEPARTMENT OF THE ENVIRONMENT, NON-TIDAL WETLANDS & WATERWAYS DIVISION HAS ISSUED A LETTER OF AUTHORIZATION, NUMBER 200661209/05-NT-3288, EFFECTIVE 8 SEPTEMBER 2006. THE LETTER OF AUTHORIZATION WILL NEED TO BE REVISED TO EXPAND THE LIMITS OF DISTURBANCES BASED ON COMMENTS FROM HOWARD COUNTY SUBDIVISION REVIEW COMMITTEE MEMBERS.


BRIGHTON MILL

ROAD, GRADING, STORM DRAIN, LANDSCAPE AND STORMWATER MANAGEMENT CONSTRUCTION PLANS

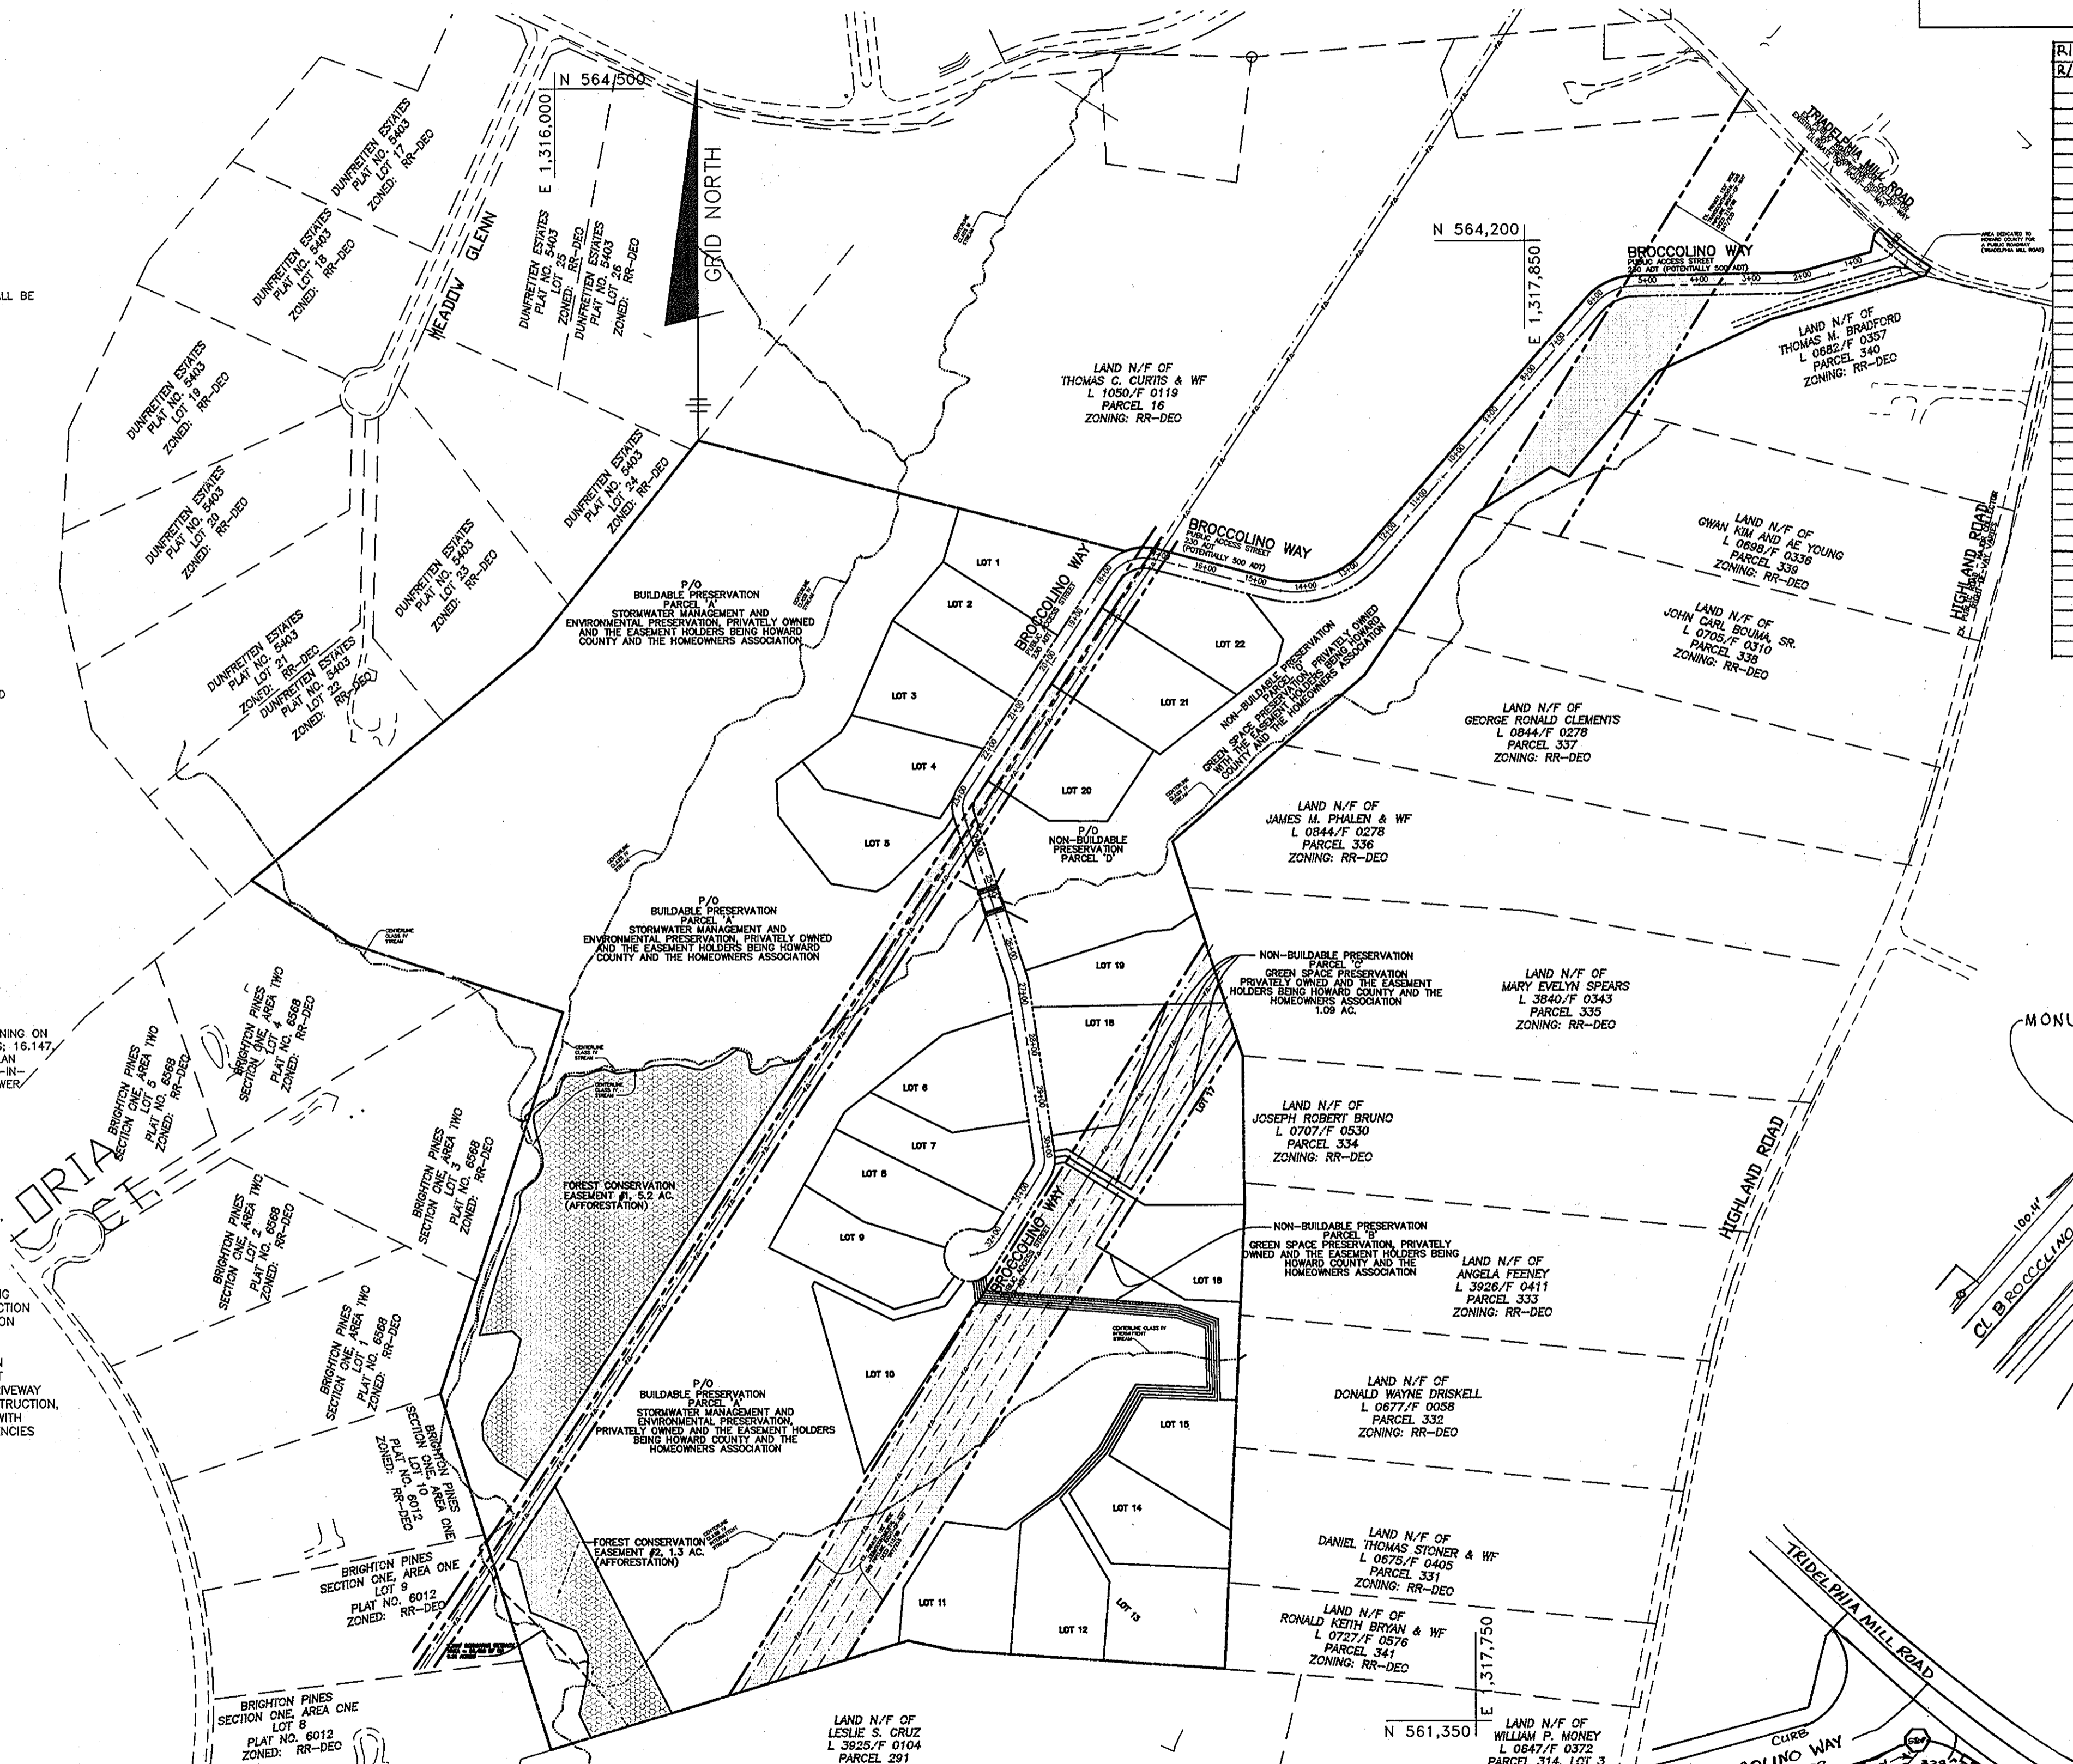

DENSITY EXCHANGE CHART	
RECEIVING PARCEL INFORMATION	CURTIS PROPERTY, TAX MAP NO. 34 BLOCK NO. 2, PARCEL NO. 2, PLAT NO. 18065
TOTAL AREA OF SUBDIVISION	80.75 AC (PARCEL NO. 2 WAS ENLARGED TO 80.75 ACRES BY ADJONING TRANSFER RECORDED AT LIBER 0857 FOLIO 157, SEE WAIVER PETITION WP-03-93)
DWELLING UNITS ALLOWED BY RIGHT	19 UNITS
GROSS AREA OF SUBDIVISION	80.75 AC±
INCREASE OF FLOODPLAIN	52.93 AC±
INCREASE OF STEEP SLOPES	6.3 AC±
OUTSIDE FLOODPLAIN	0.84 AC±
NET AREA OF SUBDIVISION	71.91 AC±
MAXIMUM DWELLING UNITS ALLOWED	35 UNITS
DWELLING UNITS PROPOSED	23 UNITS
NUMBER OF DED UNIT REQUIRED	4 UNITS
SENDING PARCEL INFORMATION	MATTINGLY PROPERTY TAX MAP NO. 14, GRID NO. 1, PARCEL NO. 112 RE-06-01, PLAT NUMBER 18064

RIGHT OF WAY ELEVATION CHART NAD83		
R/W PL. NO.	DESCRIPTION	ELEVATION
100	REBAR # CAP	564.44
102	REBAR # CAP	564.86
104	REBAR # CAP	564.28
105	CONCRETE MONUMENT	564.28
106	REBAR # CAP	562.07
107	REBAR # CAP	551.01
108	REBAR # CAP	557.67
109	REBAR # CAP	552.10
110	REBAR # CAP	508.63
111	REBAR # CAP	506.26
112	REBAR # CAP	502.42
113	REBAR # CAP	499.04
114	REBAR # CAP	470.77
115	REBAR # CAP	469.50
116	REBAR # CAP	472.44
117	REBAR # CAP	473.17
118	REBAR # CAP	472.83
119	REBAR # CAP	486.87
120	REBAR # CAP	479.46
121	REBAR # CAP	481.25
122	REBAR # CAP	482.92
123	REBAR # CAP	485.31
124	REBAR # CAP	486.44
125	REBAR # CAP	472.80
126	REBAR # CAP	472.77
127	MAGNAIL	469.98
128	REBAR # CAP	470.44
129	REBAR # CAP	470.24
214	REBAR # CAP	500.92
214a	REBAR # CAP	603.24
214b	REBAR # CAP	606.01
215	CONCRETE MONUMENT	593.05
215a	REBAR # CAP	597.40
215b	REBAR # CAP	591.57
215c	REBAR # CAP	592.56
215d	REBAR # CAP	598.40
215e	REBAR # CAP	560.80

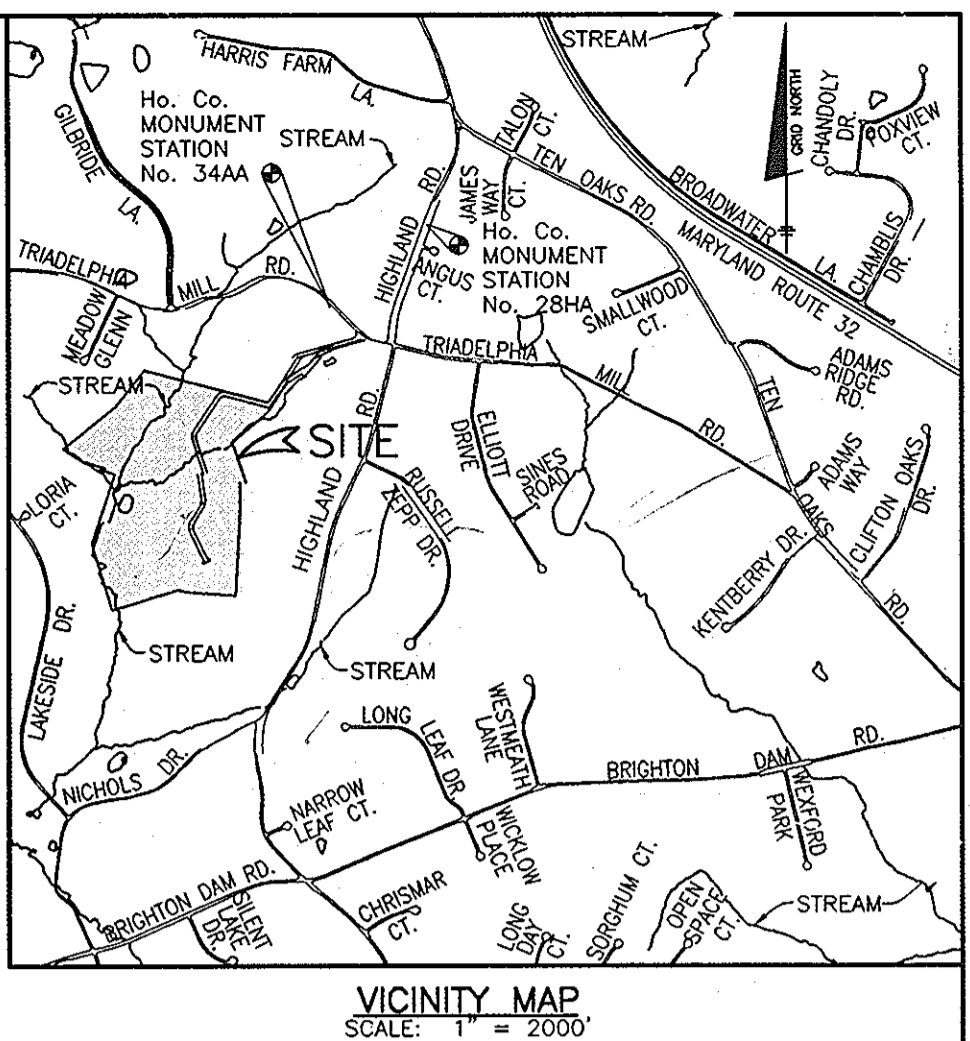

BENCHMARK INFORMATION NAD83	
Ho. Co. STATION 28HA STAMPED DISC SET ON TOP OF CONCRETE COLUMN 14.2' EAST OF THE EDGE OF PAVING OF HIGHLAND ROAD AND 29.0' NORTH OF 586E POLE No. 334368	Ho. Co. STATION 34AA STAMPED DISC SET ON TOP OF CONCRETE COLUMN 7.4' SOUTH OF THE EDGE OF PAVING OF TRIADELPHIA MILL ROAD AND 57.7' EAST OF COP POLE NUMBER 32.
NORTHING: 565347.937' EASTING: 1519266.269' ELEVATION: 588.708'	NORTHING: 564468.943' EASTING: 1518257.375' ELEVATION: 561.105'

SHEET INDEX	
NO.	TITLE
1	TITLE SHEET
2	ROAD PLAN
3	ROAD PLAN
4	ROAD PLAN
5	ROAD PROFILES
6	ROAD PROFILES
7	ROAD PROFILES
8	SIGHT DISTANCE ANALYSIS AND TRIADELPHIA MILL ROAD IMPROVEMENT PLAN
9	NORTH STRUCTURE DETAIL
10	NORTH STRUCTURE DETAIL
11	NORTH STRUCTURE DETAIL
12	NORTH STRUCTURE DETAIL
13	NORTH STRUCTURE DETAIL
14	NORTH STRUCTURE DETAIL
15	NORTH STRUCTURE DETAIL
16	NORTH STRUCTURE DETAIL
17	NORTH STRUCTURE DETAIL
18	STORM DRAIN DRAINAGE AREA MAP
19	STORM DRAIN DRAINAGE AREA MAP
20	STORM DRAIN PROFILES
21	STORM DRAIN PROFILES
22	STORM DRAIN PROFILES
23	GRADING, SEDIMENT AND EROSION CONTROL PLAN
24	GRADING, SEDIMENT AND EROSION CONTROL PLAN
25	GRADING, SEDIMENT AND EROSION CONTROL PLAN
26	SEDIMENT & EROSION CONTROL NOTES & DETAILS
27	LANDSCAPE PLAN
28	LANDSCAPE PLAN
29	FOREST CONSERVATION PLAN
30	FOREST CONSERVATION PLAN
31	OFF-SITE FOREST CONSERVATION PLAN AT MATTINGLY PROPERTY
32	STORMWATER MANAGEMENT FACILITY #1 PROFILES AND DETAILS
33	STORMWATER MANAGEMENT FACILITY #2 PROFILES AND DETAILS
34	SMW NOTES AND BORING LOGS

SITE DATA TABULATION

APPROVED: HOWARD COUNTY DEPARTMENT OF PUBLIC WORKS
 [Signature] 6-6-07
 CHIEF, BUREAU OF HIGHWAYS

APPROVED: HOWARD COUNTY DEPT. OF PLANNING AND ZONING
 [Signature] 6-11-07
 CHIEF, DIVISION OF LAND DEVELOPMENT

[Signature] 6/10/07
 CHIEF, DEVELOPMENT ENGINEERING DIVISION

1) GENERAL SITE DATA	a. PRESENT ZONING: RR-DEO	b. APPLICABLE DPZ FILE REFERENCES: WP-06-102, WP-03-93, SP-03-013, RE-06-01	c. DEED REF.: 9857/170	d. PROPOSED USE OF SITE: 22 BUILDABLE LOTS, 1 BUILDABLE PRESERVATION PARCEL AND 3 NON-BUILDABLE PRESERVATION PARCELS	e. PROPOSED WATER AND SEWER SYSTEMS: PRIVATE
2) AREA TABULATION	a. TOTAL AREA OF SITE: 80.75 AC±	b. AREA OF 100 YEAR FLOODPLAIN (APPROX.): 8.3 AC±	c. AREA OF STEEP SLOPES (25% OR GREATER): 0.67 AC±	d. NET AREA OF SITE: 71.91 AC±	e. AREA OF THIS PLAN SUBMISSION: 80.75 AC±
	f. AREA OF PROPOSED BUILDABLE LOTS: 22.69 AC±	g. AREA OF PROPOSED PRESERVATION PARCELS: 54.89 AC±	h. AREA OF PROPOSED PUBLIC ROAD R/W: 3.17 AC±		

PLAN SCALE: 1" = 200'

NO.	DATE	REVISION

BENCHMARK ENGINEERING, INC.

ENGINEERS • LAND SURVEYORS • PLANNERS

8480 BALTIMORE NATIONAL PIKE A SUITE 418
 ELICOTT CITY, MARYLAND 21043
 PHONE: 410-465-6105 FAX: 410-465-6644
 website: http://www.bei-civilengineering.com

[Signature] 5/16/07

OWNER/DEVELOPER: HIGHLAND DEVELOPMENT CORP
 P.O. BOX 228
 CLARKSVILLE, MARYLAND 21029
 410-531-5539

PROJECT: BRIGHTON MILL
 LOT 1 THROUGH 22, BUILDABLE PRESERVATION PARCEL 'A' AND NON-BUILDABLE PRESERVATION PARCELS 'B' THROUGH 'D'

LOCATION: TAX MAP NO. 34, GRID NO. 2
 5th ELECTION DISTRICT
 HOWARD COUNTY, MARYLAND

TITLE: TITLE SHEET

DATE: MAY, 2007 PROJECT NO. 1513

SCALE: 1"=200' DRAWING 1 OF 34


Design: JMC Draft: LAB Check: DAM

TEMPORARY TRAFFIC CONTROL TYPICAL APPLICATION

IMPORTANT: THIS DRAWING SHALL BE USED IN COMBINATION WITH THE GENERAL NOTES MD 104.00-01 - MD 104.00-18 AND STANDARD DETAILS MD 104.01-01 - MD 104.01-02

NOTE: FLAGGER SHALL NEVER BE STATIONED MORE THAN 1000' AWAY FROM THE ADVANCE FLAGGER SIGN.


KEY:

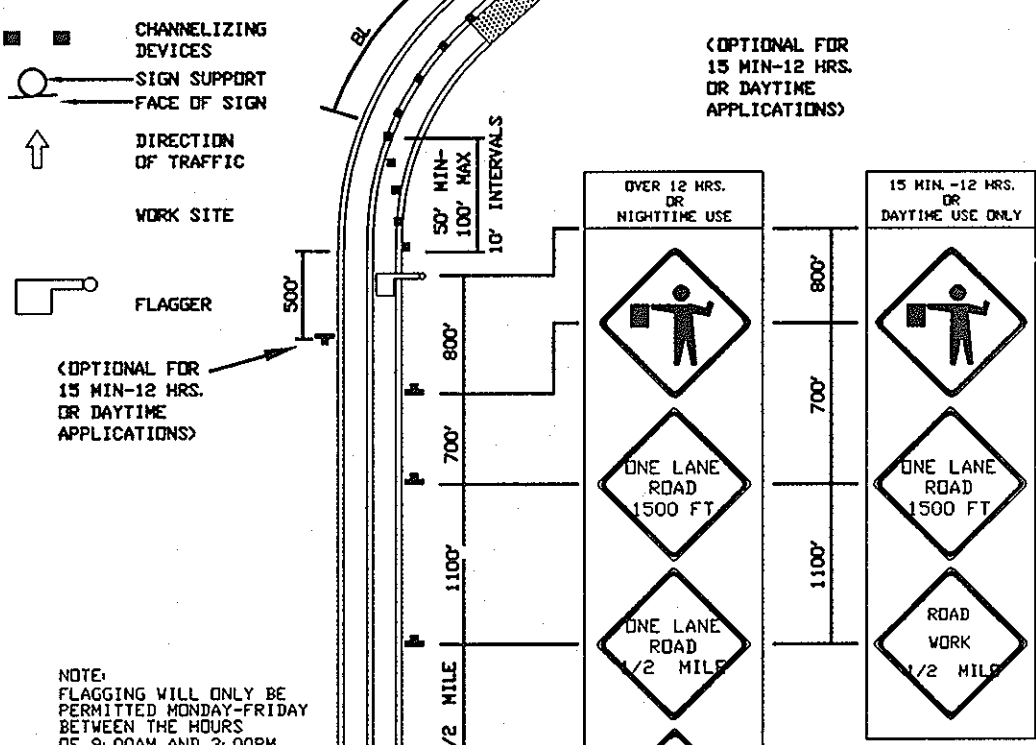

NOTE: FLAGGING WILL ONLY BE PERMITTED BETWEEN 5:00 AM AND 5:00 PM BETWEEN THE HOURS OF 9:00 AM AND 3:00 PM


FLAGGING OPERATION / 2-LANE, 2-WAY GREATER THAN 40 MPH

104 8-20-03 9-23-03

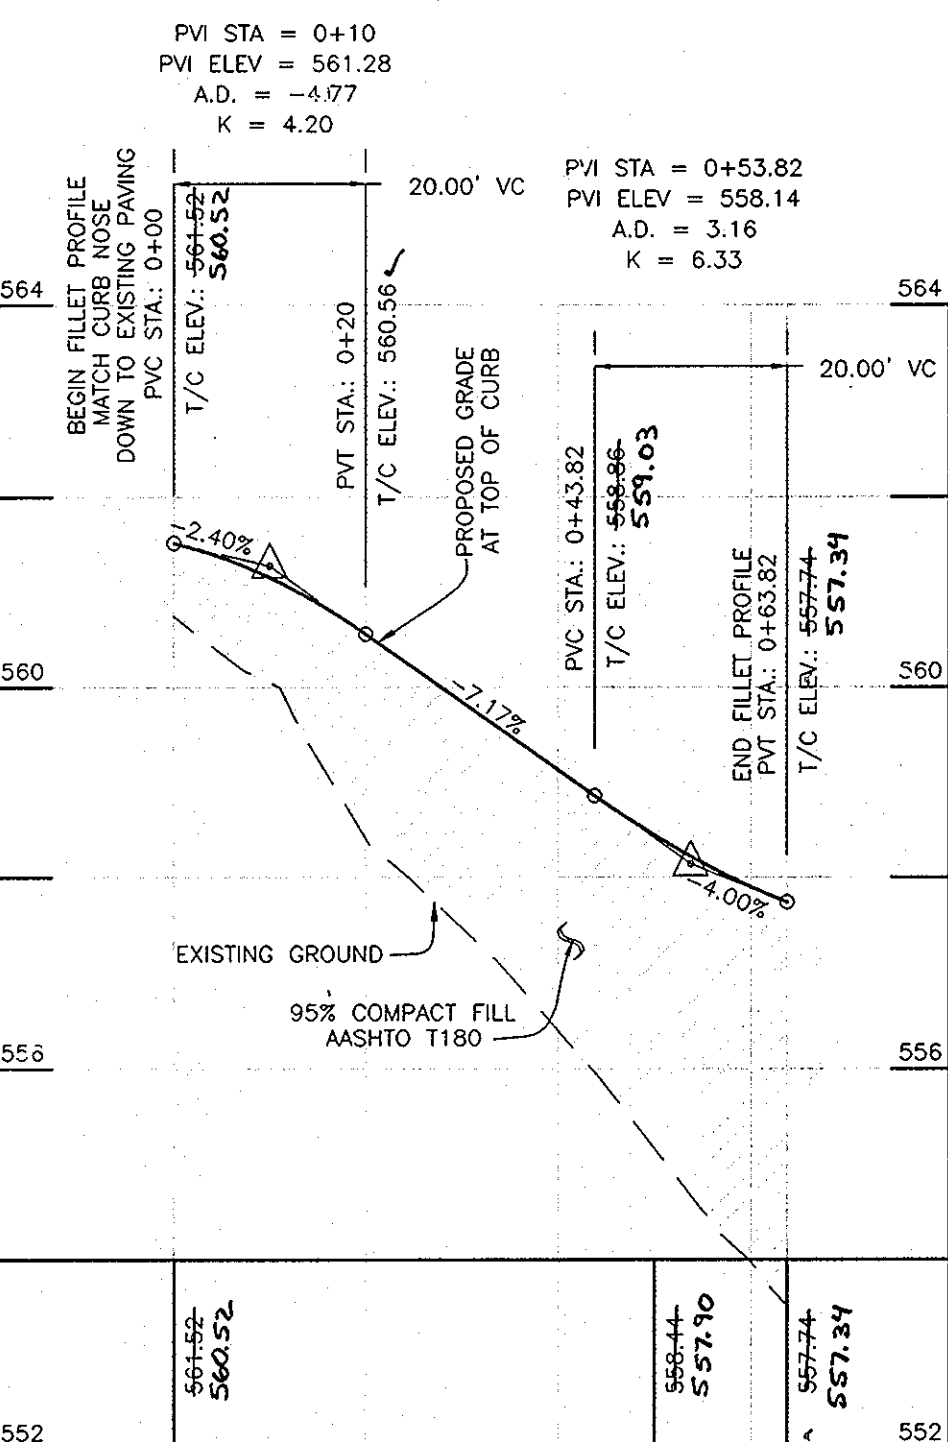


FILLET PROFILE - WEST FILLET

VERTICAL SCALE: 1" = 2'
HORIZONTAL SCALE: 1" = 20'

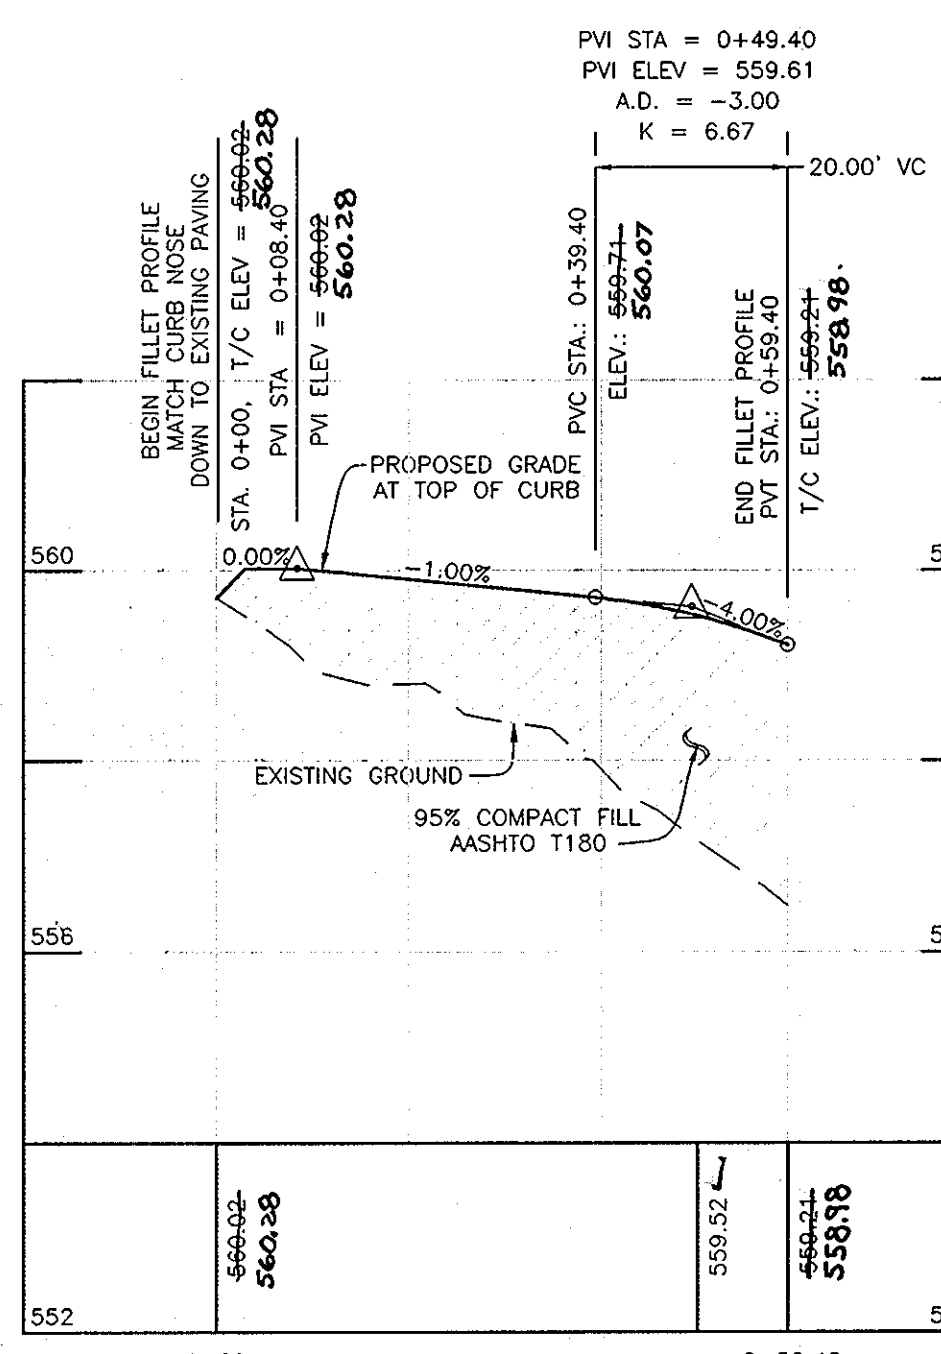

FILLET PROFILE - EAST FILLET

VERTICAL SCALE: 1" = 2'
HORIZONTAL SCALE: 1" = 20'

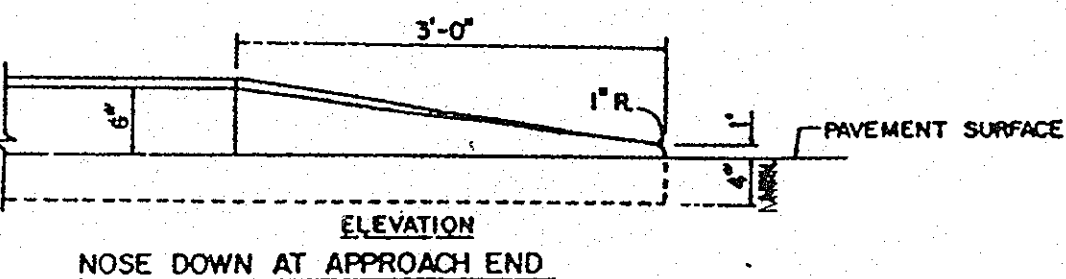

STREET LIGHT SCHEDULE			
ROAD	STATION	OFFSET	DESCRIPTION
BROCCOLINO WAY	0+45	30' RIGHT	150 WATT HPS VAPOR PREMIER POST-TOP MOUNTED ON A 14" BLACK FIBERGLASS POLE

CENTERLINE CONTROL DATA			
STREET NAME	STATION	NORTH	EAST
BROCCOLINO WAY	BEGIN=0+00.00	564187.7273	1318586.9734
	PC=0+13.95	564176.8984	1318558.1746
	PT=0+44.64	564160.3032	1318582.9315
	PC=1+97.76	564118.7724	1318385.5578
	PT=2+22.63	564115.2189	1318360.0137
	PC=5+22.94	564111.3500	1318060.7245
	PT=6+10.94	564075.5770	1317983.1225
	PC=12+55.45	563590.9423	1317558.2513
	PT=14+72.23	563531.0782	1317361.3638
	PC=16+97.29	563559.0826	1317143.9084
	PT=17+97.24	563555.7661	1317056.4642
	PC=22+94.52	563140.3745	1316783.0776
	PT=23+39.01	563097.7459	1316777.1912
	PC=26+72.60	562779.8116	1316878.2082
	PT=26+80.61	562772.0193	1316880.0128
	PC=30+15.05	562441.2038	1316929.1654
	PT=30+50.80	562407.1507	1316921.9795
	PC=31+99.20	562281.5235	1316842.6147
PT=32+44.87	562255.3788	1316806.5137	
END=32+64.36	562250.6283	1316787.6115	


LAND N/F OF THOMAS C. CURTIS & WF L 1050/F 0119 PARCEL 16 ZONING: RR-DEO

RADIUS=195.00'
ARC=216.78"
DELTA=63°41'42"
TANGENT=124.23'
CHORD=57°05'17"W

EXISTING OVERHEAD UTILITY LINES TO BE REMOVED

NON-BUILDABLE PRESERVATION STORABLE WATER MANAGEMENT AND GREEN SPACE PRESERVATION AND THE PRIVATELY OWNED HOMEOWNERS ASSOCIATION AS EASEMENT HOLDERS

APPROVED: HOWARD COUNTY DEPARTMENT OF PUBLIC WORKS
W. Z. ... 6-6-07
APPROVED: HOWARD COUNTY DEPT. OF PLANNING AND ZONING
T. Kiste-Maschall for C. Hamilton 6-11-07
... 6/8/07

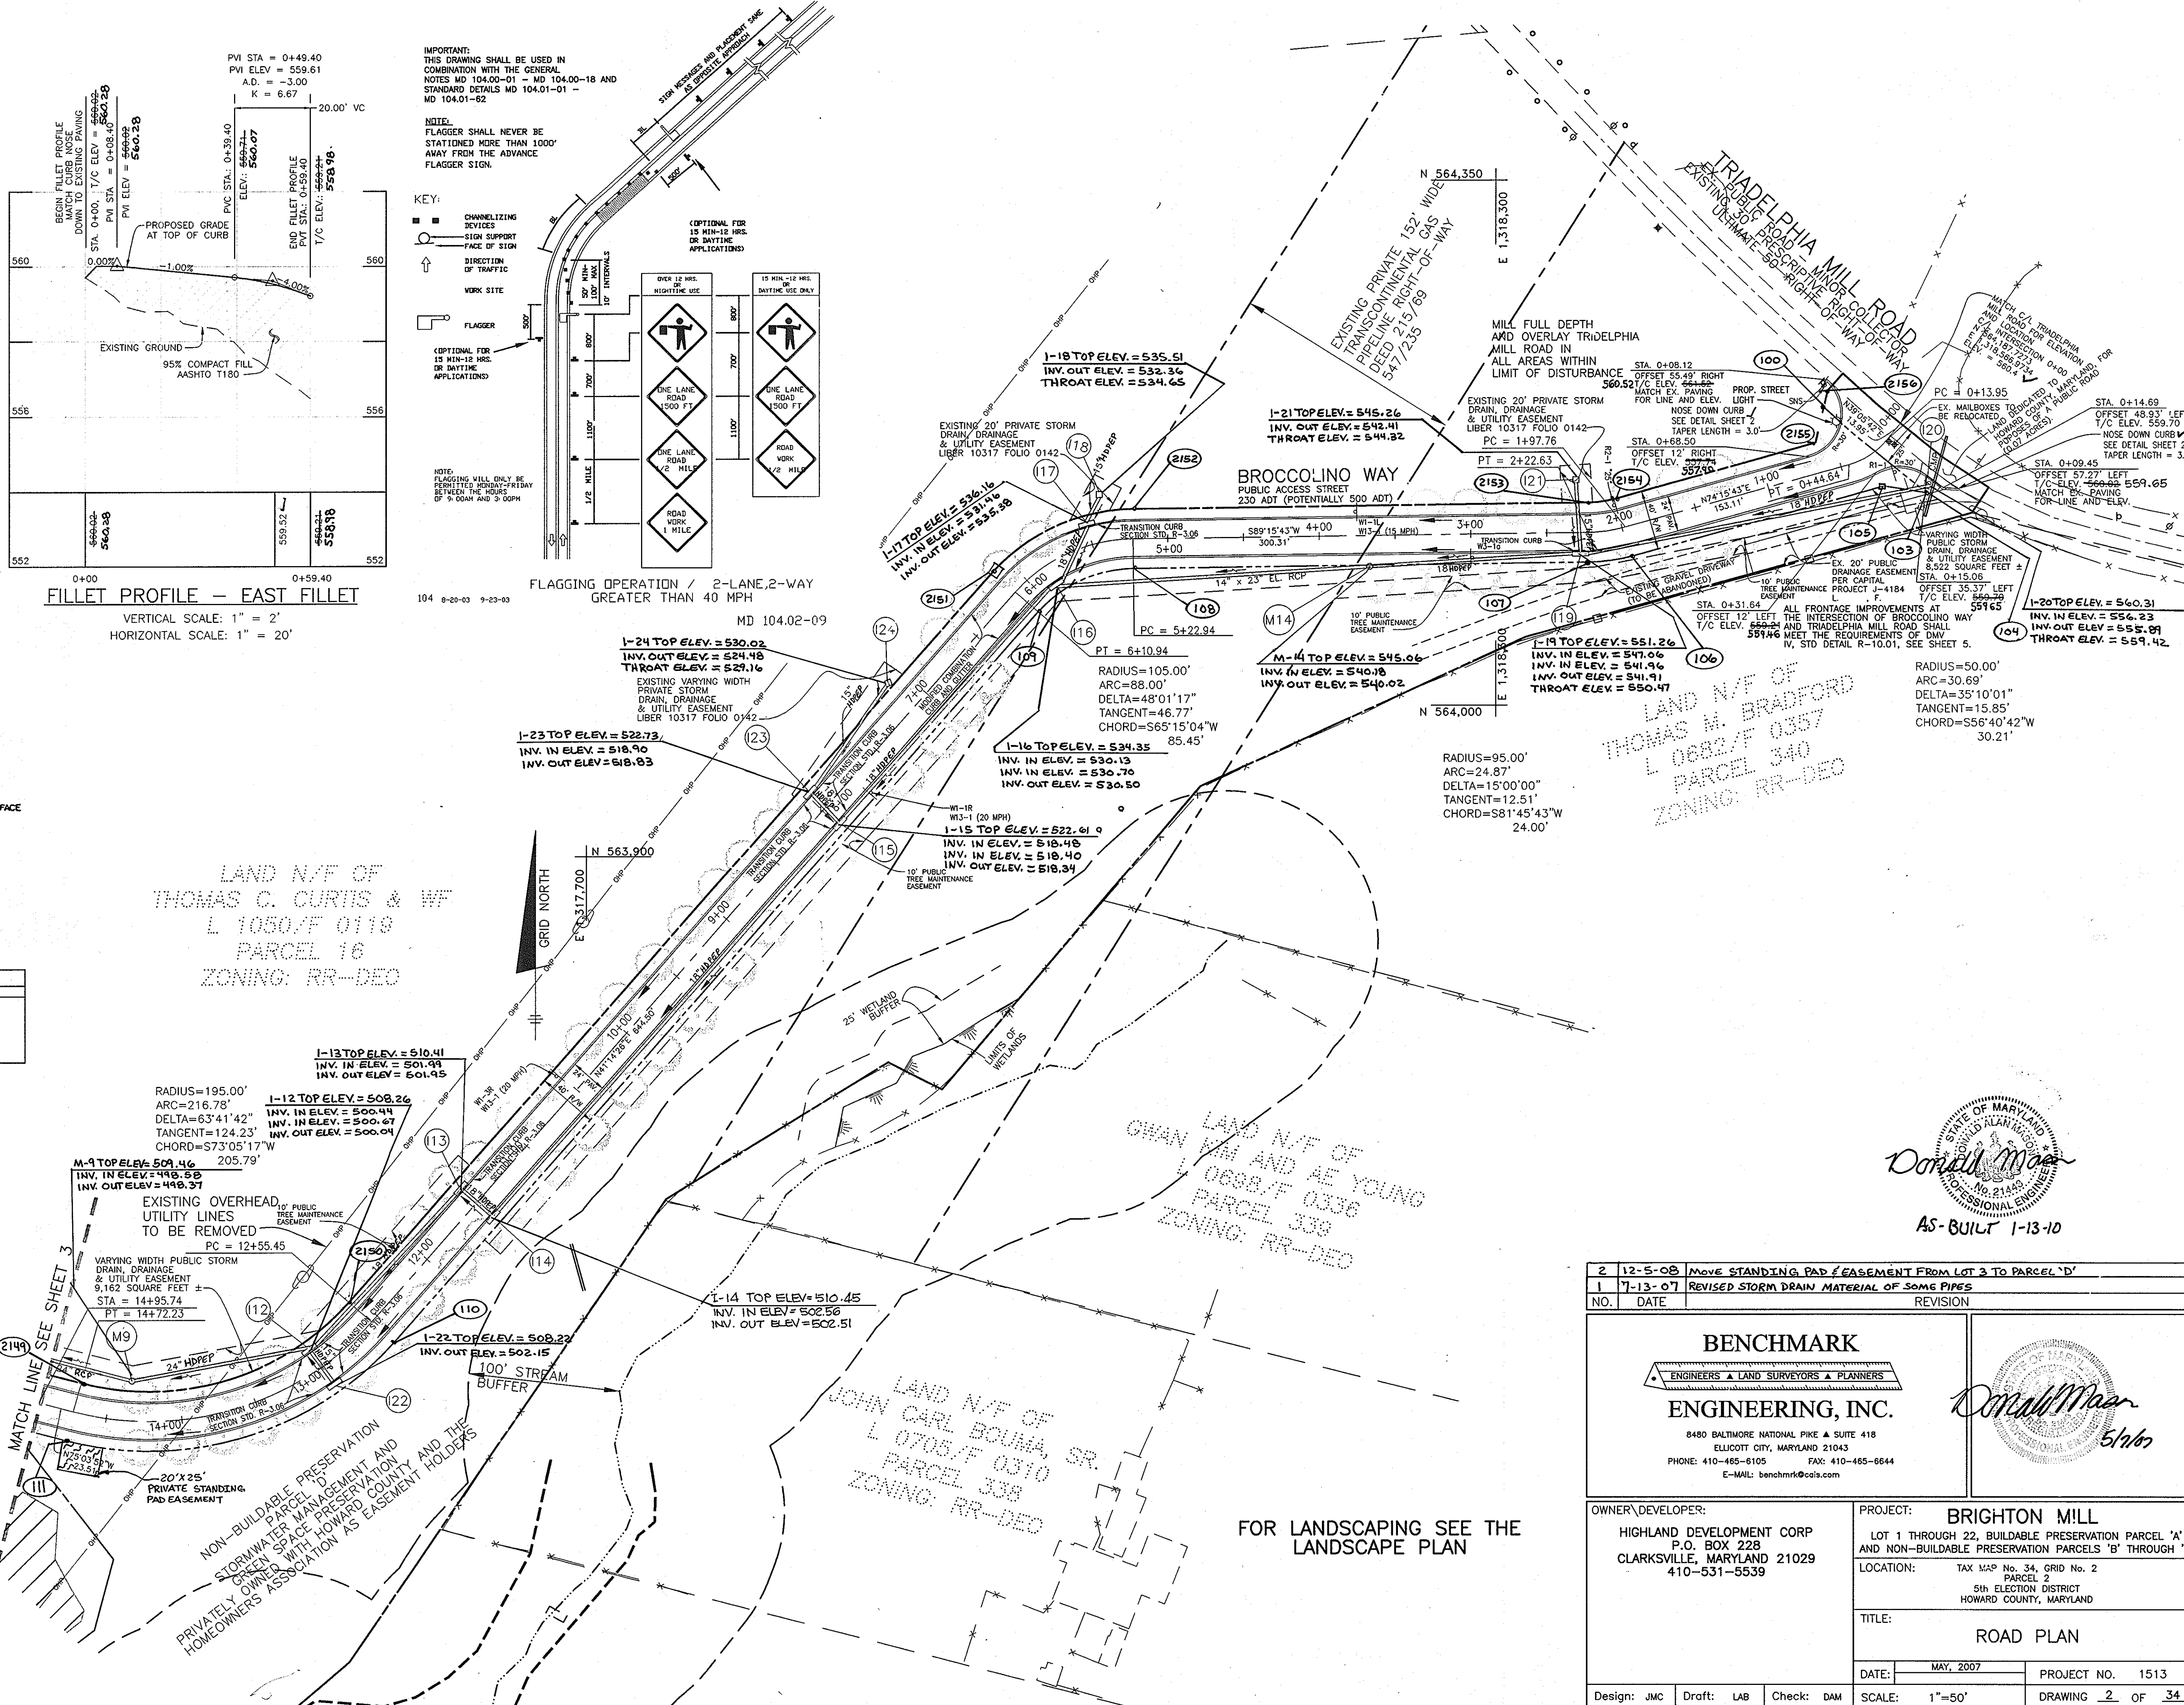

LAND N/F OF THOMAS M. BRADFORD L 0682/F 0357 PARCEL 340 ZONING: RR-DEO

LAND N/F OF GWAN YAI AND AE YOUNG L 0688/F 0336 PARCEL 338 ZONING: RR-DEO


LAND N/F OF JOHN CARL BOUMA, SR. L 0705/F 0310 PARCEL 339 ZONING: RR-DEO

Professional Engineer Seal for Donald M. ... AS-BUILT 1-13-10

NO.	DATE	REVISION
2	12-5-08	MOVE STANDING PAD EASEMENT FROM LOT 3 TO PARCEL 'D'
1	7-13-07	REVISED STORM DRAIN MATERIAL OF SOME PIPES

BENCHMARK ENGINEERING, INC.	
ENGINEERS • LAND SURVEYORS • PLANNERS	
8490 BALTIMORE NATIONAL PIKE • SUITE 418 ELLICOTT CITY, MARYLAND 21043 PHONE: 410-465-6105 FAX: 410-465-6644 E-MAIL: benchmark@cois.com	

OWNER/DEVELOPER: HIGHLAND DEVELOPMENT CORP P.O. BOX 228 CLARKSVILLE, MARYLAND 21029 410-531-5539	PROJECT: BRIGHTON MILL LOT 1 THROUGH 22, BUILDABLE PRESERVATION PARCEL 'A' AND NON-BUILDABLE PRESERVATION PARCELS 'B' THROUGH 'D'
TITLE: ROAD PLAN	LOCATION: TAX MAP No. 34, GRID No. 2 5th ELECTION DISTRICT HOWARD COUNTY, MARYLAND
DATE: MAY, 2007	PROJECT NO.: 1513
Design: JMC Draft: LAB Check: DAM	SCALE: 1"=50' DRAWING 2 OF 34

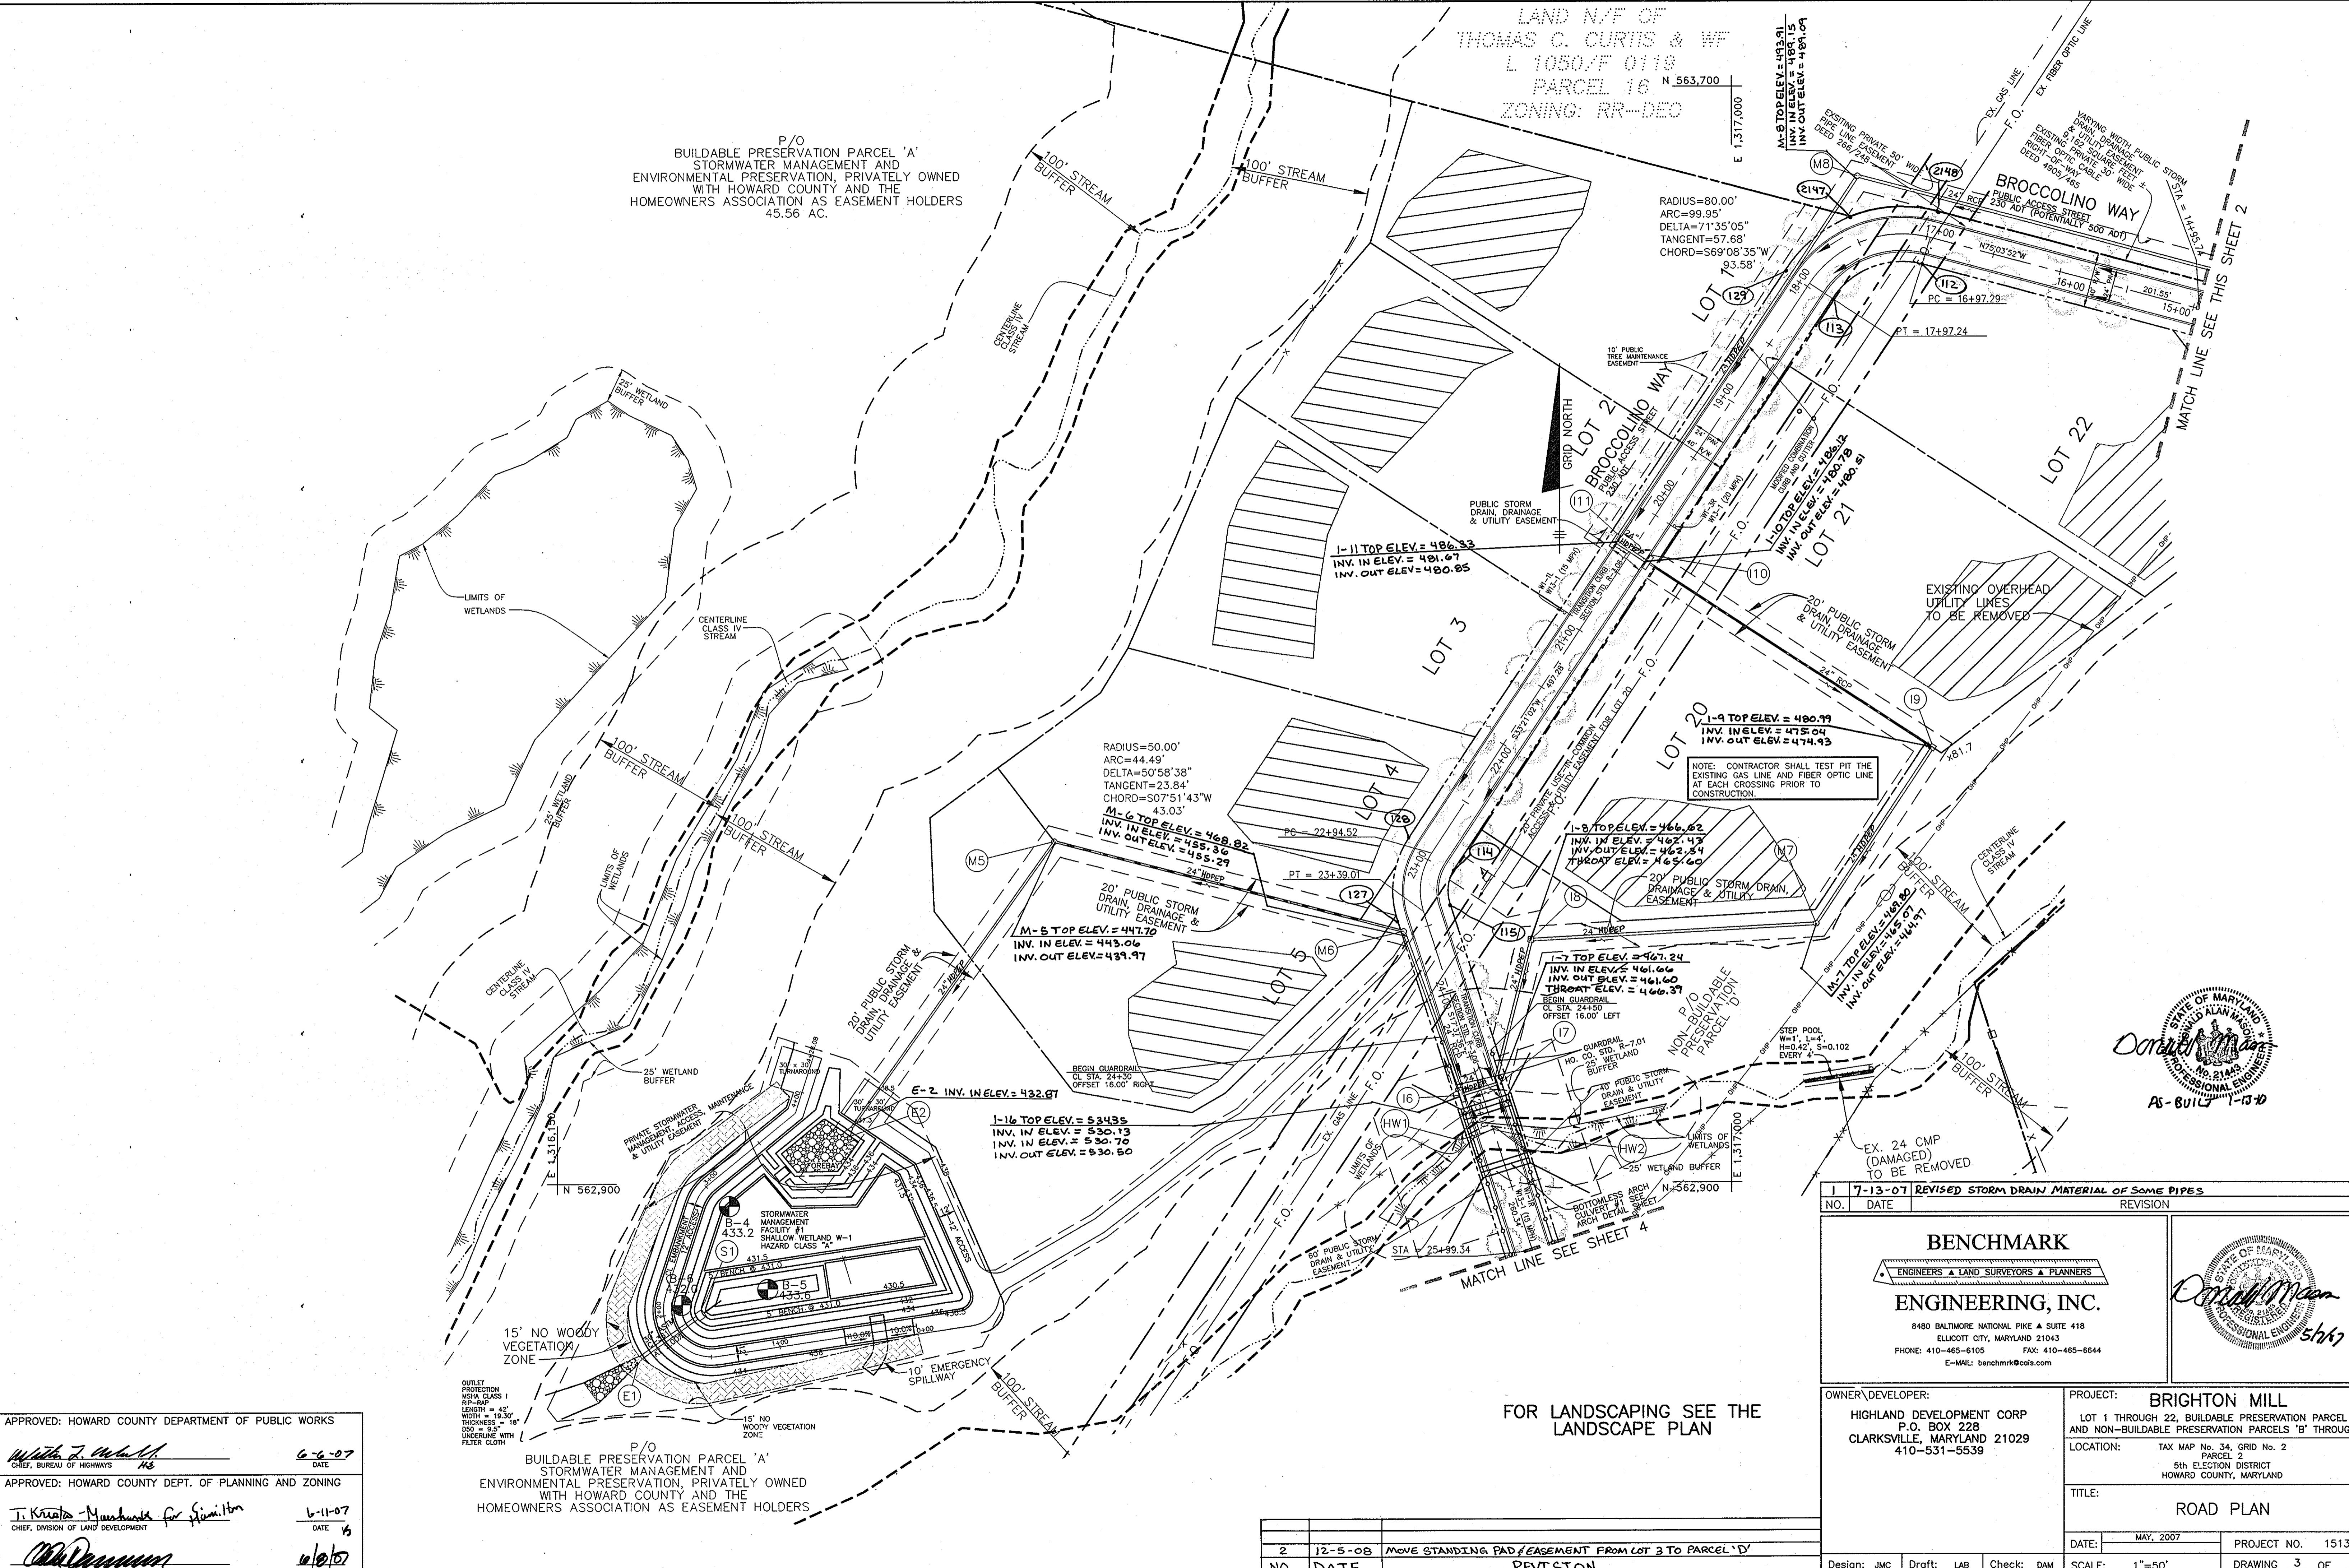

APPROVED: HOWARD COUNTY DEPARTMENT OF PUBLIC WORKS
Walter J. ... 6-6-07
 CHIEF, BUREAU OF HIGHWAYS

APPROVED: HOWARD COUNTY DEPT. OF PLANNING AND ZONING
J. Kratoch-Marchbanks for ... 6-11-07
 CHIEF, DIVISION OF LAND DEVELOPMENT

... 6/6/07
 CHIEF, DEVELOPMENT ENGINEERING DIVISION




P/O BUILDABLE PRESERVATION PARCEL 'A'
 STORMWATER MANAGEMENT AND ENVIRONMENTAL PRESERVATION, PRIVATELY OWNED WITH HOWARD COUNTY AND THE HOMEOWNERS ASSOCIATION AS EASEMENT HOLDERS

FOR LANDSCAPING SEE THE LANDSCAPE PLAN

NO.	DATE	REVISION
2	12-5-08	MOVE STANDING PAD/EASEMENT FROM LOT 3 TO PARCEL 'D'

BENCHMARK ENGINEERING, INC. ENGINEERS • LAND SURVEYORS • PLANNERS 8480 BALTIMORE NATIONAL PIKE & SUITE 418 ELLICOTT CITY, MARYLAND 21043 PHONE: 410-465-6105 FAX: 410-465-6644 E-MAIL: benchmark@ceils.com		
OWNER/DEVELOPER: HIGHLAND DEVELOPMENT CORP P.O. BOX 228 CLARKSVILLE, MARYLAND 21029 410-531-5539	PROJECT: BRIGHTON MILL LOT 1 THROUGH 22, BUILDABLE PRESERVATION PARCEL 'A' AND NON-BUILDABLE PRESERVATION PARCELS 'B' THROUGH 'D' LOCATION: TAX MAP No. 34, GRID No. 2 5th ELECTION DISTRICT HOWARD COUNTY, MARYLAND TITLE: ROAD PLAN DATE: MAY, 2007 PROJECT NO. 1513 SCALE: 1"=50' DRAWING 3 OF 34	

STATE OF MARYLAND
 DAVID M. ...
 PROFESSIONAL ENGINEER
 NO. 21483
 AS-BUILT 1-13-10

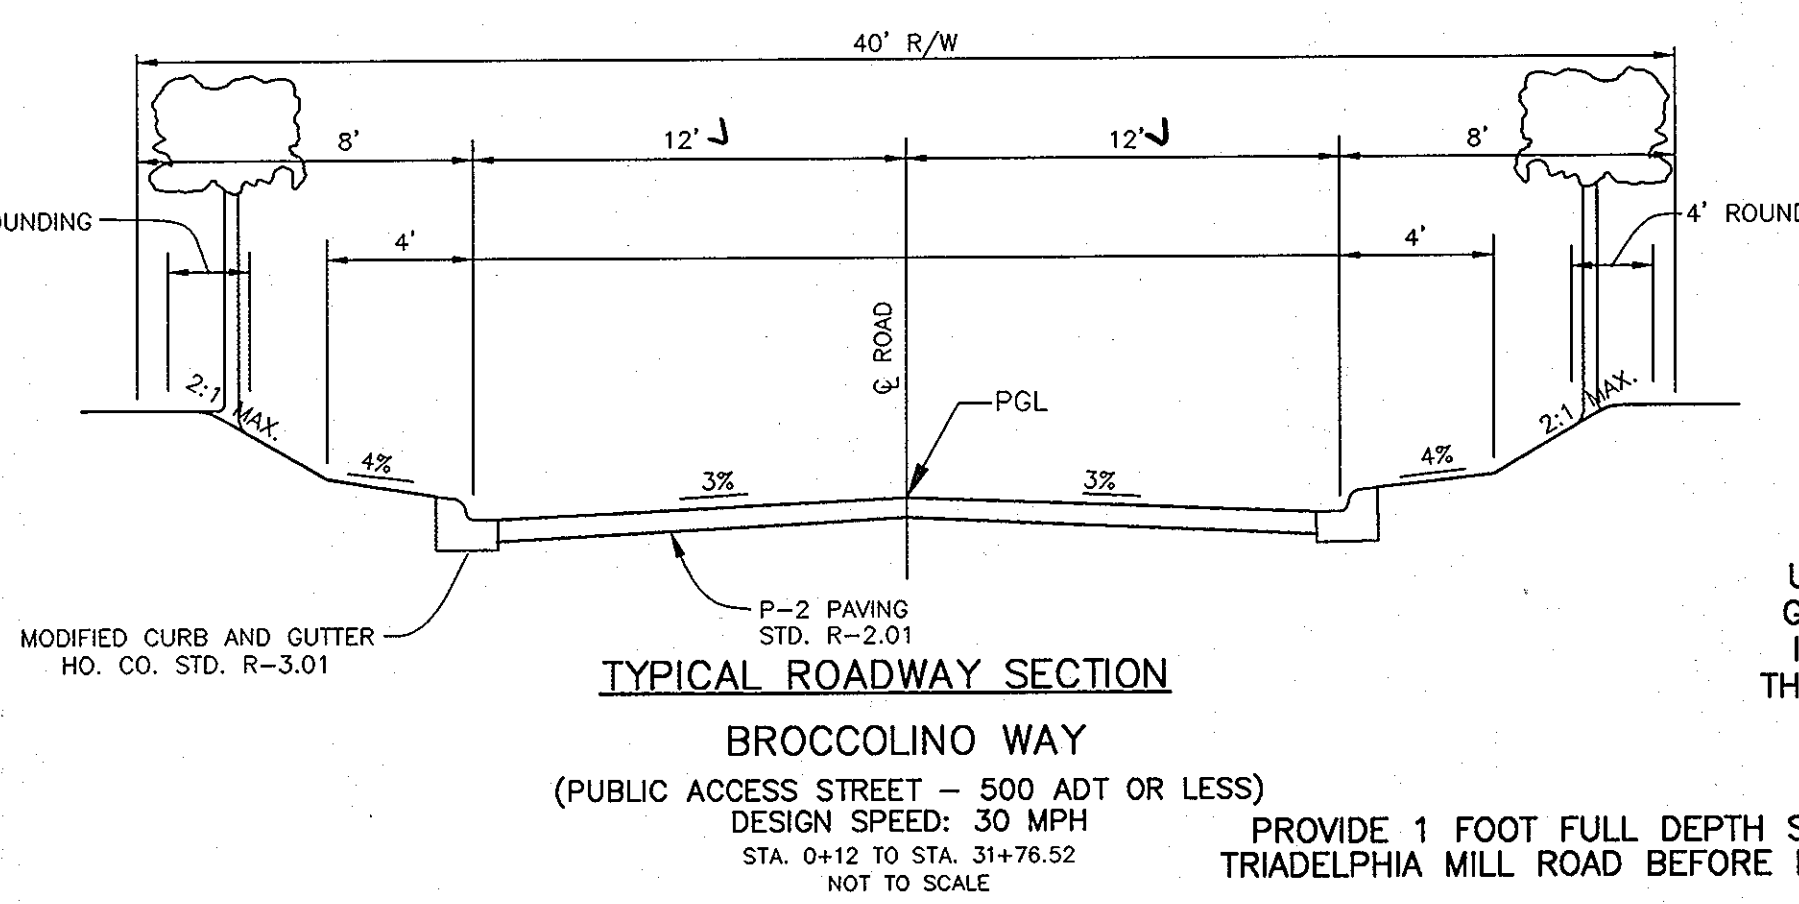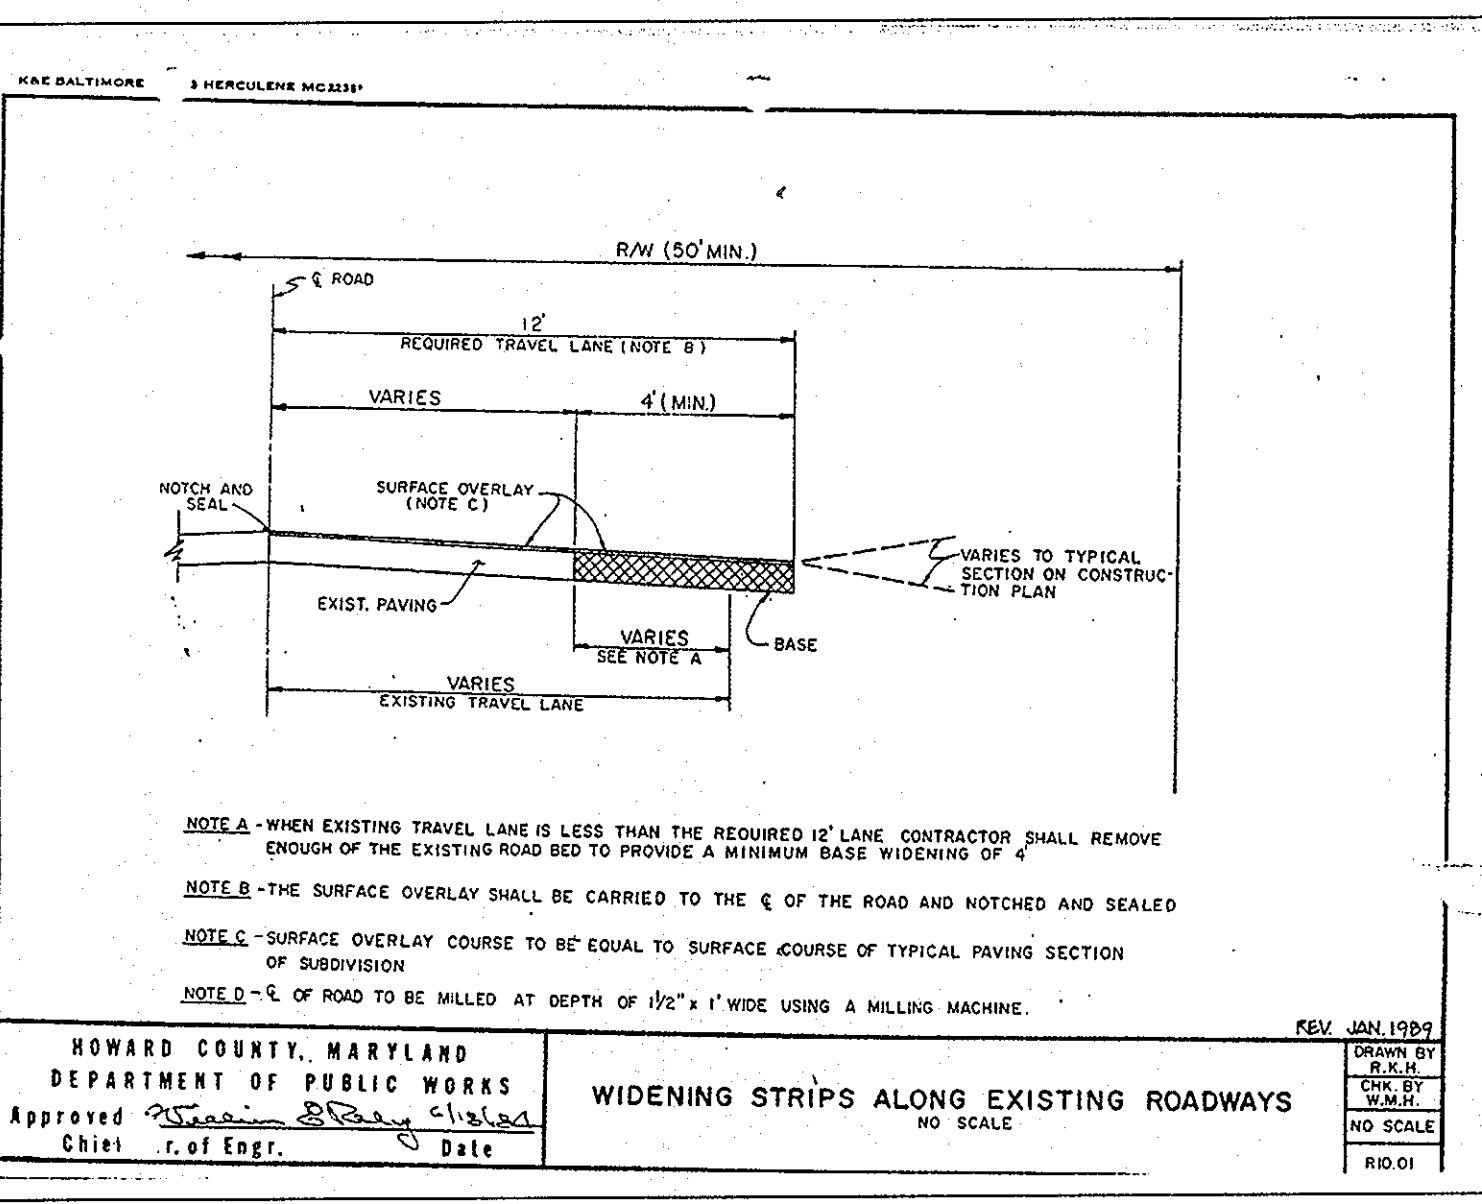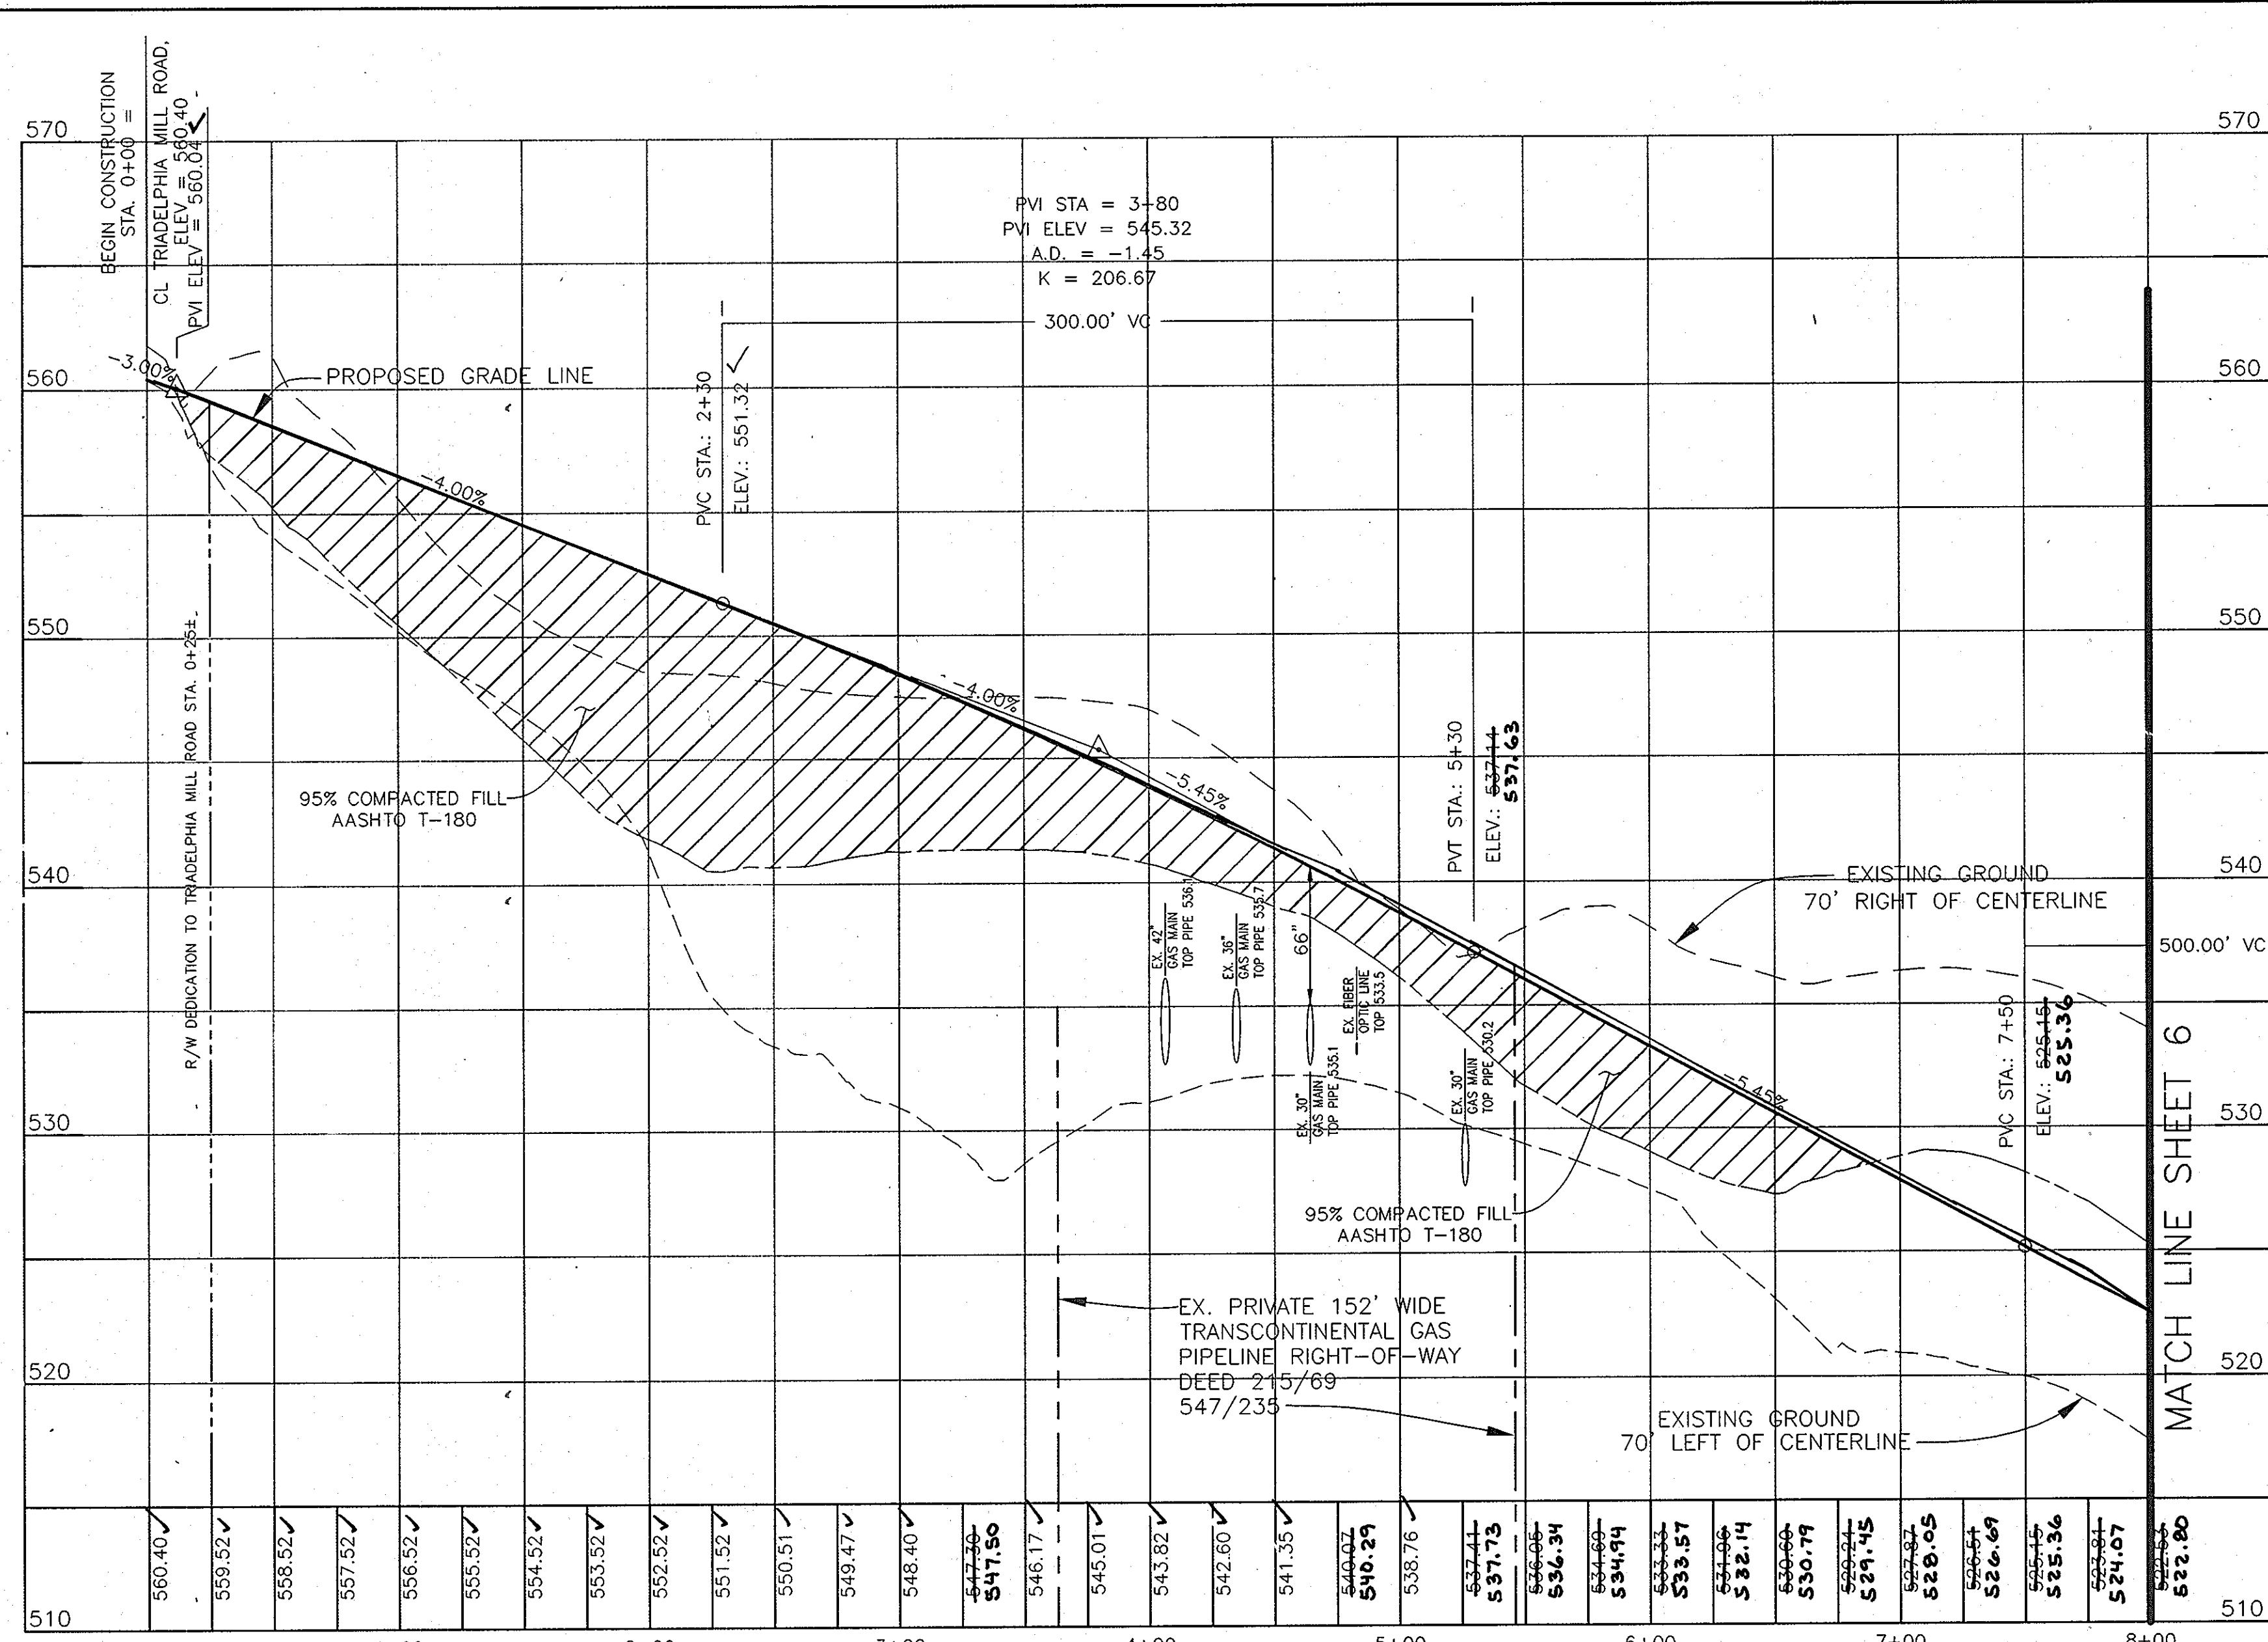

WILLIAMS GAS PIPELINE - TRANSCO ENCROACHMENT SPECIFICATIONS

The following Williams Gas Pipeline (WGP) specifications are minimum requirements for most proposed encroachments to avoid conflicts with regulations and existing right-of-way agreements. It is not WGP's intent to convey that these are the only types of activities permitted. Additional requirements may be imposed depending upon the scope of the proposed encroachment.

PIPELINE FACILITIES AND LEGISLATION

WGP owns and operates a 15,000-mile high-pressure natural gas pipeline system. WGP pipelines have diameters ranging from (20) inches to (48) inches and are buried from (9) inches to (24) inches in lateral. In addition to pipelines, WGP has storage facilities, compressor stations, meter stations, cathodic protection equipment, valve settings and other facilities located within the limits of its right-of-ways and fee properties.

WGP is regulated by the Department of Transportation, Office of Pipeline Safety. The pipeline safety regulations are set forth in Title 49, Code of Federal Regulations, Part 192 "Transportation of Natural and Other Gas by Pipeline - Minimum Federal Standards".

ENCROACHMENTS

It is WGP's philosophy to prevent encroachments by working with agencies and developers to design projects outside the pipeline right-of-way. Many of WGP's right-of-way agreements prohibit encroachments, and you should be aware that WGP will enforce applicable provisions in its right-of-way agreements when it believes the continued safe operation and maintenance of the pipeline facilities could be threatened.

NOTIFICATION AND CONSTRUCTION SAFETY REQUIREMENTS

- In order to prevent unnecessary delays, WGP encourages close communication with our representative throughout your entire project. WGP representative should participate in all pre-construction meetings. In addition, WGP can conduct a site/informational presentation to any interested parties, including contractors, local governmental maintenance crews and developers.
- "One Call" systems require (48) (72) hours notice prior to any excavation activities or equipment use on or in close proximity to WGP's pipeline facilities. No equipment use or excavation shall occur in the vicinity of WGP's facilities until notification to "One Call" has been made. A WGP representative must be on site prior to any equipment use or excavation activities. Any crossings made without a WGP representative on site will have to be re-excavated at the excavator's expense to provide WGP an opportunity to inspect all affected pipeline facilities.
- Excavations must be barricaded to protect WGP's pipelines from exposure to vehicular traffic and to ensure public safety. WGP representatives must be provided safe access to all open excavations. Excavations must be properly sloped or shored in accordance with OSHA regulations.

PLAN DESIGN AND REVIEW REQUIREMENTS

- Residential and/or commercial developments shall be laid out such that the right-of-way is designated as "open" or "common" space. Maintaining an open right-of-way reduces public exposure and minimizes disruptions during pipeline maintenance and construction. Lot divisions shall be established within the right-of-way designating the usual right-of-way as "open" or "common" areas.
- In most cases, WGP will require substantial plan and profile drawings for prior review and approval by WGP. All drawings must show, in detail, all of WGP's facilities and other features that will allow WGP to determine the effects of the proposed construction or maintenance activity on its facilities. Encroachment plans shall include a scope of work, description, and a location map depicting the project area, including sufficient geographical references such as local property lines, roads, and appropriate information for the properties involved.
- In order to ensure that all proposed improvements are designed in accordance with WGP's Encroachment Specifications, WGP requires a minimum of (30) business days lead-time to review proposed encroachments. Encroachments involving road crossings will require additional review time. Any proposed road which requires pipeline modifications or a dedicated right-of-way will require significant lead-time.

WGP EASEMENT, PERMITS AND AGREEMENTS

- At a minimum, a Foreign Line Permit will be required for any proposed construction or maintenance within WGP's right-of-way. This permit, prepared by WGP, will outline the responsibilities, conditions, and facilities of each party. This permit must be executed by the encroaching party and WGP's possession prior to any work being performed on the right-of-way.
- WGP will determine if a recorded Encroachment Agreement will be required for any proposed construction or maintenance within WGP's right-of-way. This agreement, prepared by WGP, will outline the responsibilities, conditions, and facilities of each party. This agreement will be fully executed and in WGP's possession prior to any work being performed on the right-of-way.
- WGP will determine if a Reimbursement Agreement will be required for any construction or maintenance within WGP's right-of-way. This agreement, prepared by WGP, will outline the reimbursement procedure for necessary and appropriate preliminary engineering and actual field inspection work. This recorded agreement, including a check made payable to "Transcontinental Gas Pipeline Corporation" for the estimated cost of WGP's services, will be in WGP's possession prior to any work being performed on the right-of-way.

Encroachment Specifications Page 1 of 4 February 16, 2008

STREETS, ROADS AND DRIVEWAYS

- WGP must complete a preliminary engineering evaluation for all roads, streets, driveways, etc. proposed on WGP's right-of-way. Any pipe casing, concrete slabs, or other protection required by WGP shall be installed at no expense to WGP. WGP may require a pipeline inspection prior to construction.
- The recommended minimum total cover over WGP existing pipelines is (66) inches at all driveways, highways, roads, streets, etc. The recommended minimum total cover over WGP existing pipelines in adjacent drainage ditches is (48) inches.
- Vibratory equipment is prohibited within the limits of the WGP right-of-way. Vibratory equipment is not permitted to be used for achieving applicable compaction requirements.
- Driveways, highways, roads, streets, etc. crossing over WGP pipeline facilities shall cross at an angle as near to 90 degrees as possible. All crossings must be over straight pipe and at locations free of any crossings. Parallel occupancy of the right-of-way shall not be permitted.
- WGP will retain the right to cut all present and proposed driveways, highways, roads, streets, etc. and will have no responsibility for restoration, loss of use or access, or any other costs.
- Access to the earth above each pipeline for leak detection (flame ionization) and cathodic protection surveys must be maintained.

EQUIPMENT USE IN CLOSE PROXIMITY TO THE PIPELINES

- To protect WGP's pipelines from external loading, WGP must perform an engineering evaluation to determine the effects of any proposed equipment use. Mats, timber bridges, or other protective materials deemed necessary by WGP shall be placed over WGP facilities for the duration of the loading. Protective materials shall be purchased, placed, and removed at no cost to WGP. The right-of-way must be returned to its original condition.
- WGP may require temporary markings to identify areas where equipment use is authorized.
- No vibratory equipment is permitted within the limits of, or in close proximity to, the WGP right-of-way.

DRAINAGE, IMPONDMENT OF WATER AND EROSION CONTROL

- WGP may conduct preliminary engineering studies for any proposed drainage channels or ditches within the right-of-way. Drainage channels or ditches must be adequately provided from erosion and provide a minimum of (66) inches of cover over the pipeline(s). Shoring (cleaning, re-grading or changing alignment of) an existing drainage channel or ditch requires approval from WGP.
- Impoundment of water on WGP's right-of-way is not permitted. Soil erosion control measures shall not be installed within the WGP right-of-way without prior WGP approval.

EXCAVATIONS AND BLASTING

- Plans for excavation on the right-of-way require prior approval by WGP. No machine excavation shall be performed within (24) inches of WGP's pipelines or related facilities. WGP's onsite representative may require hand digging at a distance greater than (24) inches.
- When a machine excavation is used, the bucket teeth should be curled under each time the bucket is brought back into the ditch to reduce the chance of the teeth contacting the pipeline. Stake cutters must be removed from all buckets. At the discretion of WGP's onsite representative, a bar may have to be welded across the bucket teeth.
- Prior to any piling or ripping of soil on the right-of-way, particularly in association with agricultural activities, plans should be reviewed with your local WGP representative to ensure proper cover exists. No vibratory plows are permitted to be used on the WGP right-of-way.
- A detailed blasting plan must be submitted for review and authorization prior to any proposed blasting within (200) feet of WGP's pipeline facilities. In order to provide for necessary and appropriate analysis by WGP, each licensed blasting contractor must also complete and submit a WGP's Blasting Data Sheet. The blasting plan and data sheet(s) must be submitted a minimum of (10) business days prior to the proposed blasting. Blasting contractors shall perform seismic monitoring on all blasting within 200 feet of WGP's pipeline facilities.

BURIED COMMUNICATION (TELEPHONE, TV, DATA TRANSMISSION, FIBER OPTIC) AND BURIED POWER LINE CROSSINGS

- All buried communications (other than single residential telephone and TV) crossing WGP facilities shall be installed in rigid steel casing (minimum of Schedule 40) for the full width of WGP's right-of-way.
- All buried electric cables, except (24) volt DC power including single residential service drops, crossing WGP facilities shall be installed in rigid steel casing (minimum of Schedule 40) for the full width of WGP's right-of-way.

Encroachment Specifications Page 3 of 4 February 16, 2008

GENERAL REQUIREMENTS

- No above ground structures or appurtenances are to be located within the WGP right-of-way. The structures include, but are not limited to: utility poles, towers, foundations, guy wires, satellite dishes, manholes, catch basins, utility pedestals, transformers, fire hydrants, etc.
- An authorized WGP representative must be on site prior to and during any surface disturbing work performed within the right-of-way. WGP representative will assist in determining the location of the pipeline, the right-of-way width and existing cover over the pipeline.
- No cut or fill on the WGP right-of-way is permitted without WGP approval.
- WGP will request entrance of general liability (minimum of \$1,000,000 coverage) and other appropriate and usual coverages prior to any activity and/or construction on or near WGP's right-of-way. In the event of excavation under WGP pipelines, WGP must be named as additional insured. Any rights of subrogation or recovery will be waived in favor of WGP. The insurance limits, terms and conditions that may be required will be dependent on the specific facilities potentially impacted and shall be obtained in writing and promptly obtained in writing by industry divisions.
- All foreign lines shall cross WGP's right-of-way at an angle as near to 90 degrees as possible. All foreign lines shall cross either over or under all of WGP's pipeline facilities. No horizontal or vertical bends are permitted within WGP's right-of-way. Parallel occupancy of WGP's right-of-way shall not be permitted.
- WGP facilities are electrically protected against corrosion. Each metallic foreign line that enters or crosses WGP's right-of-way must have a test lead installed. In addition, the utility contractor installing the metallic foreign line must install and expose one or more of WGP's existing pipelines to provide for the installation of test leads by WGP personnel. All necessary measures (coatings, electrical bonds, etc.) shall be taken to ensure that the proposed pipe or utility is adequately protected from potential interference effects. Requests for cooperative testing shall be directed to WGP's Division Office, "441 - Pipeline Integrity Team Lead".
- All foreign lines crossing WGP's pipeline or related facilities shall be installed with a minimum of (24) inches of clearance between the existing WGP facilities and the proposed foreign line. The foreign line shall be installed at a uniform depth across the full width of the WGP right-of-way. WGP may require that all foreign lines be installed under its existing pipeline(s) and related facilities.
- Foreign lines crossing WGP's facilities shall be installed in accordance with all applicable codes and requirements governing such installations.
- Stacking brush, trash, or other debris on the right-of-way is prohibited, as is any conceal pipeline markers and hinder pipeline inspections or routine maintenance.
- In some cases, there is a significant delay between the review of the developer's plans and the actual construction. If delays occur, all construction and maintenance activities are subject to WGP's requirements in effect at the time the work actually takes place.

FENCES

- Fence posts must be kept a minimum of (4) feet from the edge of any WGP pipeline or related pipeline facility. Posts installed within the right-of-way must be hand dug.
- WGP shall have the free right of ingress and egress. WGP may require that new fences have a (12) foot wide gate installed within the right-of-way at a location approved by WGP. The gate shall be installed so as to maintain vehicular and equipment travel over the existing WGP facilities.

LANDSCAPE GUIDELINES

- No trees or large deep-rooted shrubs are permitted on WGP's right-of-way. Shrubbery shall be limited to low-growing, shallow-rooted plantings with a maximum mature height of (10) feet.
- With prior approval from WGP, some types of shrubs may be permitted on the right-of-way. All shrubs must be located at least (5) feet from the edge any pipeline or related facility. Under no circumstances will mechanical equipment be used in the planting of shrubs.
- WGP reserves the right to cut and/or remove plantings as required in the operation, inspection and maintenance of its pipeline facilities; further, WGP assumes no responsibility for any cost involved in the replacement of the cut and/or removed landscape plantings.
- All sprinkler or irrigation systems will require review by a WGP representative. Sprinkler heads will not be permitted within (10) feet of any pipeline or related facility. All crossings of the WGP pipeline(s) or related facilities with feeder lines shall be hand dug.
- WGP may require that a recorded Encroachment Agreement be executed prior to any landscaping.

Encroachment Specifications Page 2 of 4 February 16, 2008

OVERHEAD LINE CROSSINGS

- Overhead line crossings shall be installed with a minimum of (30) feet of vertical clearance above the WGP right-of-way to provide adequate equipment clearance. No poles or appurtenances shall be located on the WGP right-of-way.
- Overhead line crossings shall not be installed within (25) feet (measured horizontally) of any gas vent (e.g. relief valve, blowdown vent).
- Overhead lines shall cross WGP's facilities at an angle as near to 90 degrees as possible. Parallel occupancy of a WGP right-of-way will not be permitted.

DISPOSAL SYSTEMS

No toxic liquids, liquid disposal systems, or hazardous waste disposal systems will be allowed on the right-of-way or within (25) feet of WGP's facilities. This prohibition includes, but is not limited to, facilities that have the potential of discharging effluent from sewage disposal systems, the discharge of any hydrocarbon substances, the discharge or disposal of any regulated waste, or any other discharge that may prove damaging or corrosive to WGP facilities.

STATEMENT REGARDING RIGHTS

- Nothing contained herein shall be construed to convey, waive, or subordinate any of WGP's existing rights or claims.
- WGP shall be fully and completely compensated for any damages to its facilities resulting from the acts of third parties who are working in the vicinity of WGP's facilities with or without WGP's consent.


Encroachment Specifications Page 4 of 4 February 16, 2008

APPROVED: HOWARD COUNTY DEPARTMENT OF PUBLIC WORKS
 Chief, Bureau of Highways
 DATE: 6-6-07


APPROVED: HOWARD COUNTY DEPT. OF PLANNING AND ZONING
 Chief, Division of Land Development
 DATE: 6-11-07

APPROVED: [Signature]
 Chief, Development Engineering Division
 DATE: 6/8/07


NO.	DATE	REVISION
BENCHMARK ENGINEERS • LAND SURVEYORS • PLANNERS ENGINEERING, INC. 8480 BALTIMORE NATIONAL PIKE • SUITE 418 ELLICOTT CITY, MARYLAND 21043 PHONE: 410-465-6105 FAX: 410-465-6644 E-MAIL: benchmark@ccis.com		
OWNER/DEVELOPER: HIGHLAND DEVELOPMENT CORP P.O. BOX 228 CLARKSVILLE, MARYLAND 21029 410-531-5539		PROJECT: BRIGHTON MILL LOT 1 THROUGH 22, BUILDABLE PRESERVATION PARCEL 'A' AND NON-BUILDABLE PRESERVATION PARCELS 'B' THROUGH 'D' LOCATION: TAX MAP No. 34, GRID No. 2 PARCEL 2 5th ELECTION DISTRICT HOWARD COUNTY, MARYLAND
TITLE: ROAD PROFILE AND DETAILS		
Design: JMC	Draft: LAB	Check: DAM
DATE: MAY, 2007	PROJECT NO. 1513	DRAWING 5 OF 34

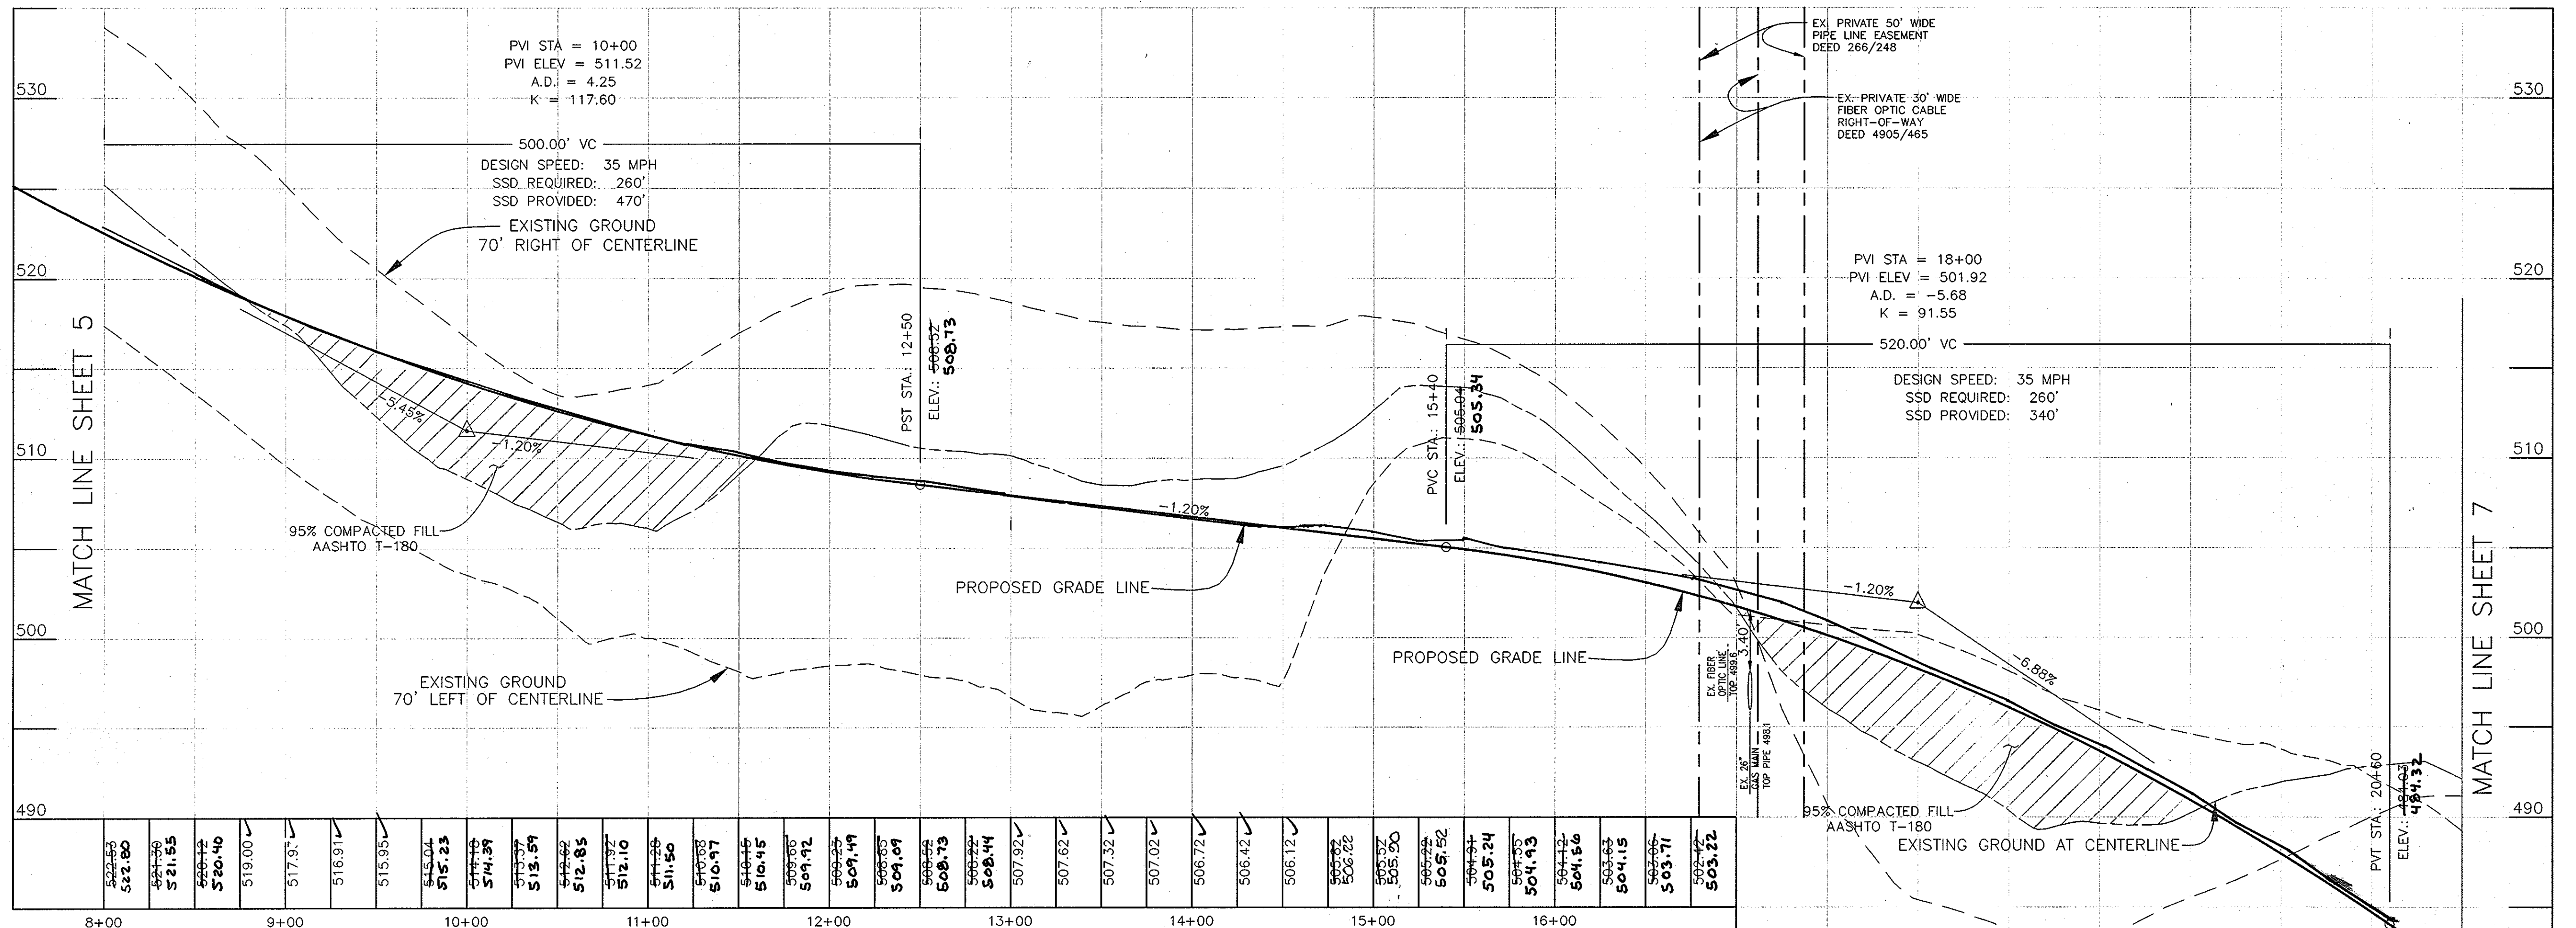

PROFILE - BROCCOLINO WAY
 PUBLIC ACCESS PLACE - 40' R/W
 230 ADT (500 ADT POTENTIAL)
 VERTICAL SCALE: 1" = 5'
 HORIZONTAL SCALE: 1" = 50'

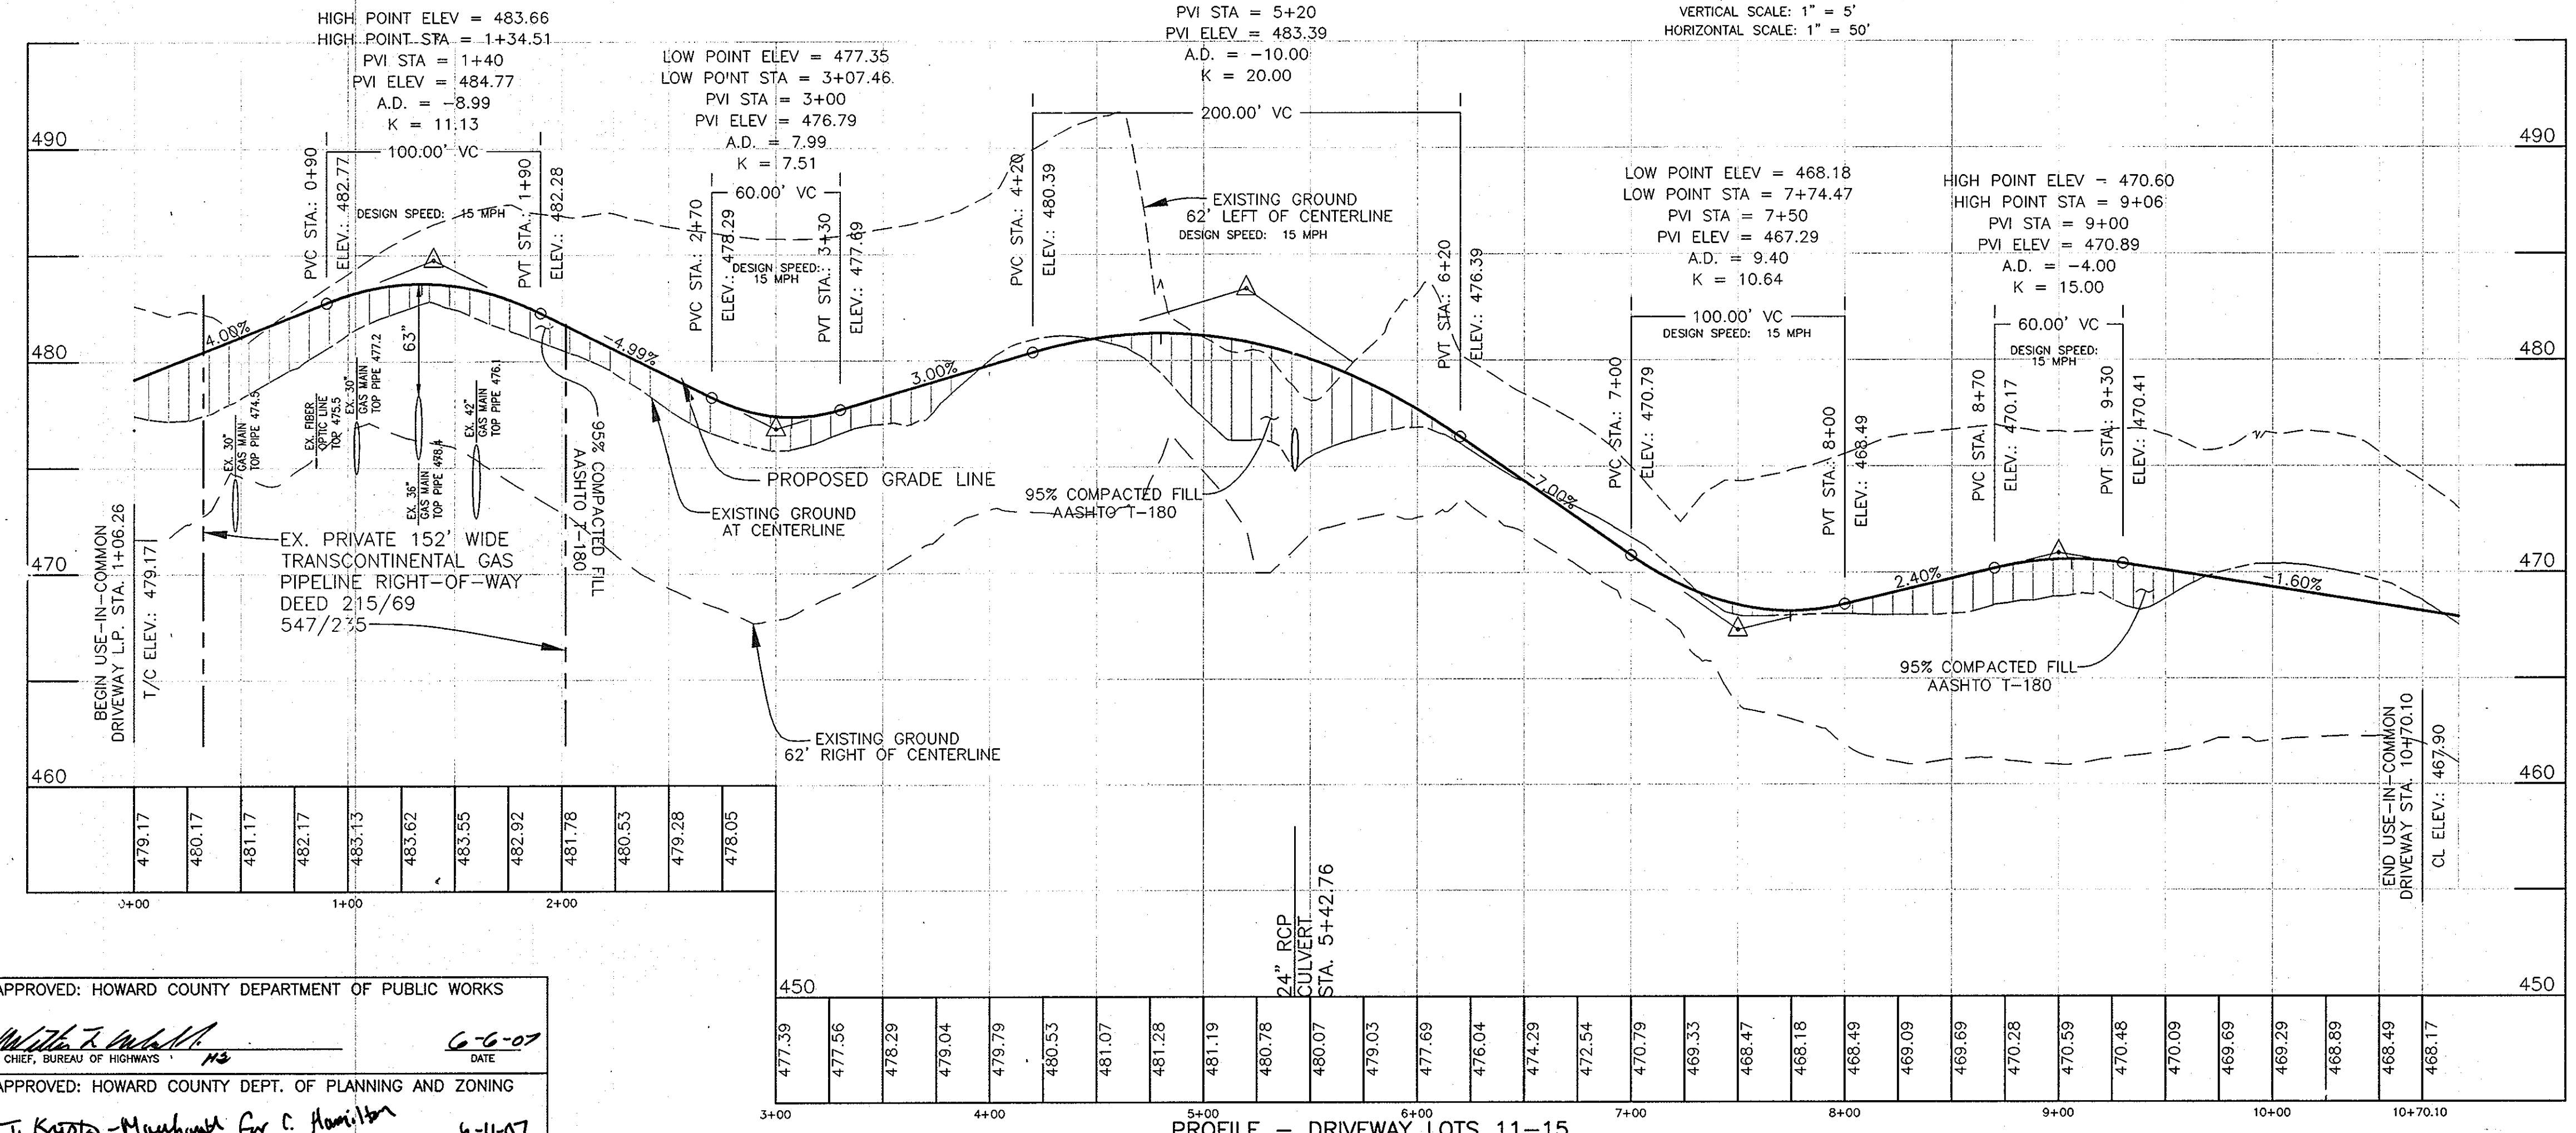

PROFILE - DRIVEWAY LOTS 11-15
 PRIVATE USE IN COMMON DRIVEWAY
 50 ADT, DESIGN SPEED 15 MPH
 VERTICAL SCALE: 1" = 5'
 HORIZONTAL SCALE: 1" = 50'

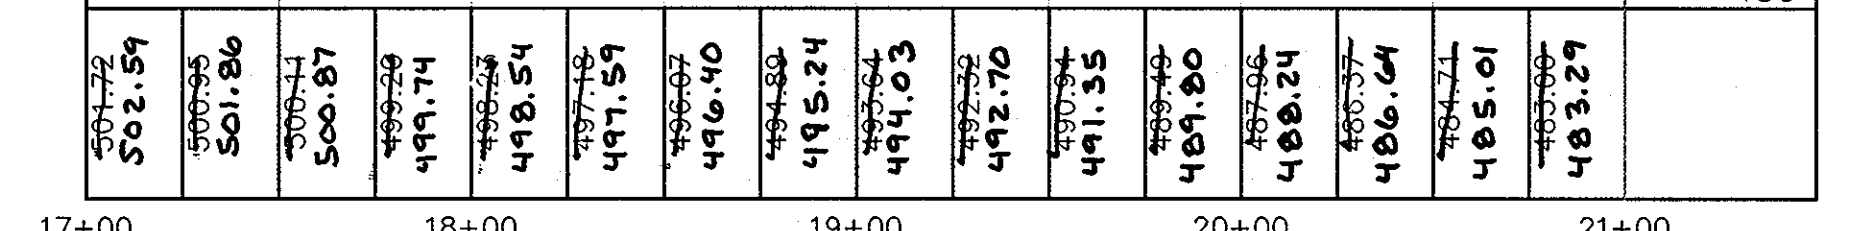


PROFILE - BROCCOLINO WAY
 PUBLIC ACCESS PLACE - 40' R/W
 230 ADT (500 ADT POTENTIAL)
 VERTICAL SCALE: 1" = 5'
 HORIZONTAL SCALE: 1" = 50'

APPROVED: HOWARD COUNTY DEPARTMENT OF PUBLIC WORKS
 [Signature] 6-6-07
 CHIEF, BUREAU OF HIGHWAYS

APPROVED: HOWARD COUNTY DEPT. OF PLANNING AND ZONING
 [Signature] 6-11-07
 CHIEF, DIVISION OF LAND DEVELOPMENT

[Signature] 6/6/07
 CHIEF, DEVELOPMENT ENGINEERING DIVISION

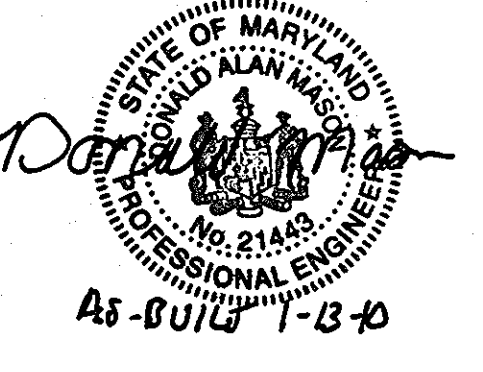


NO.	DATE	REVISION

BENCHMARK
 ENGINEERS • LAND SURVEYORS • PLANNERS


ENGINEERING, INC.

8480 BALTIMORE NATIONAL PIKE • SUITE 418
 ELLICOTT CITY, MARYLAND 21043
 PHONE: 410-465-6105 FAX: 410-465-6644
 E-MAIL: benchmark@ccis.com


OWNER/DEVELOPER: HIGHLAND DEVELOPMENT CORP P.O. BOX 228 CLARKSVILLE, MARYLAND 21029 410-531-5539	PROJECT: BRIGHTON MILL LOT 1 THROUGH 22, BUILDABLE PRESERVATION PARCEL 'A' AND NON-BUILDABLE PRESERVATION PARCELS 'B' THROUGH 'D'
	LOCATION: TAX MAP No. 34, GRID No. 2 PARCEL 2 5th ELECTION DISTRICT HOWARD COUNTY, MARYLAND
TITLE: ROAD PROFILE	
DATE: MAY, 2007	PROJECT NO. 1513
Design: JMC	Draft: LAB
Check: DAM	SCALE: AS SHOWN
DRAWING 6 OF 34	

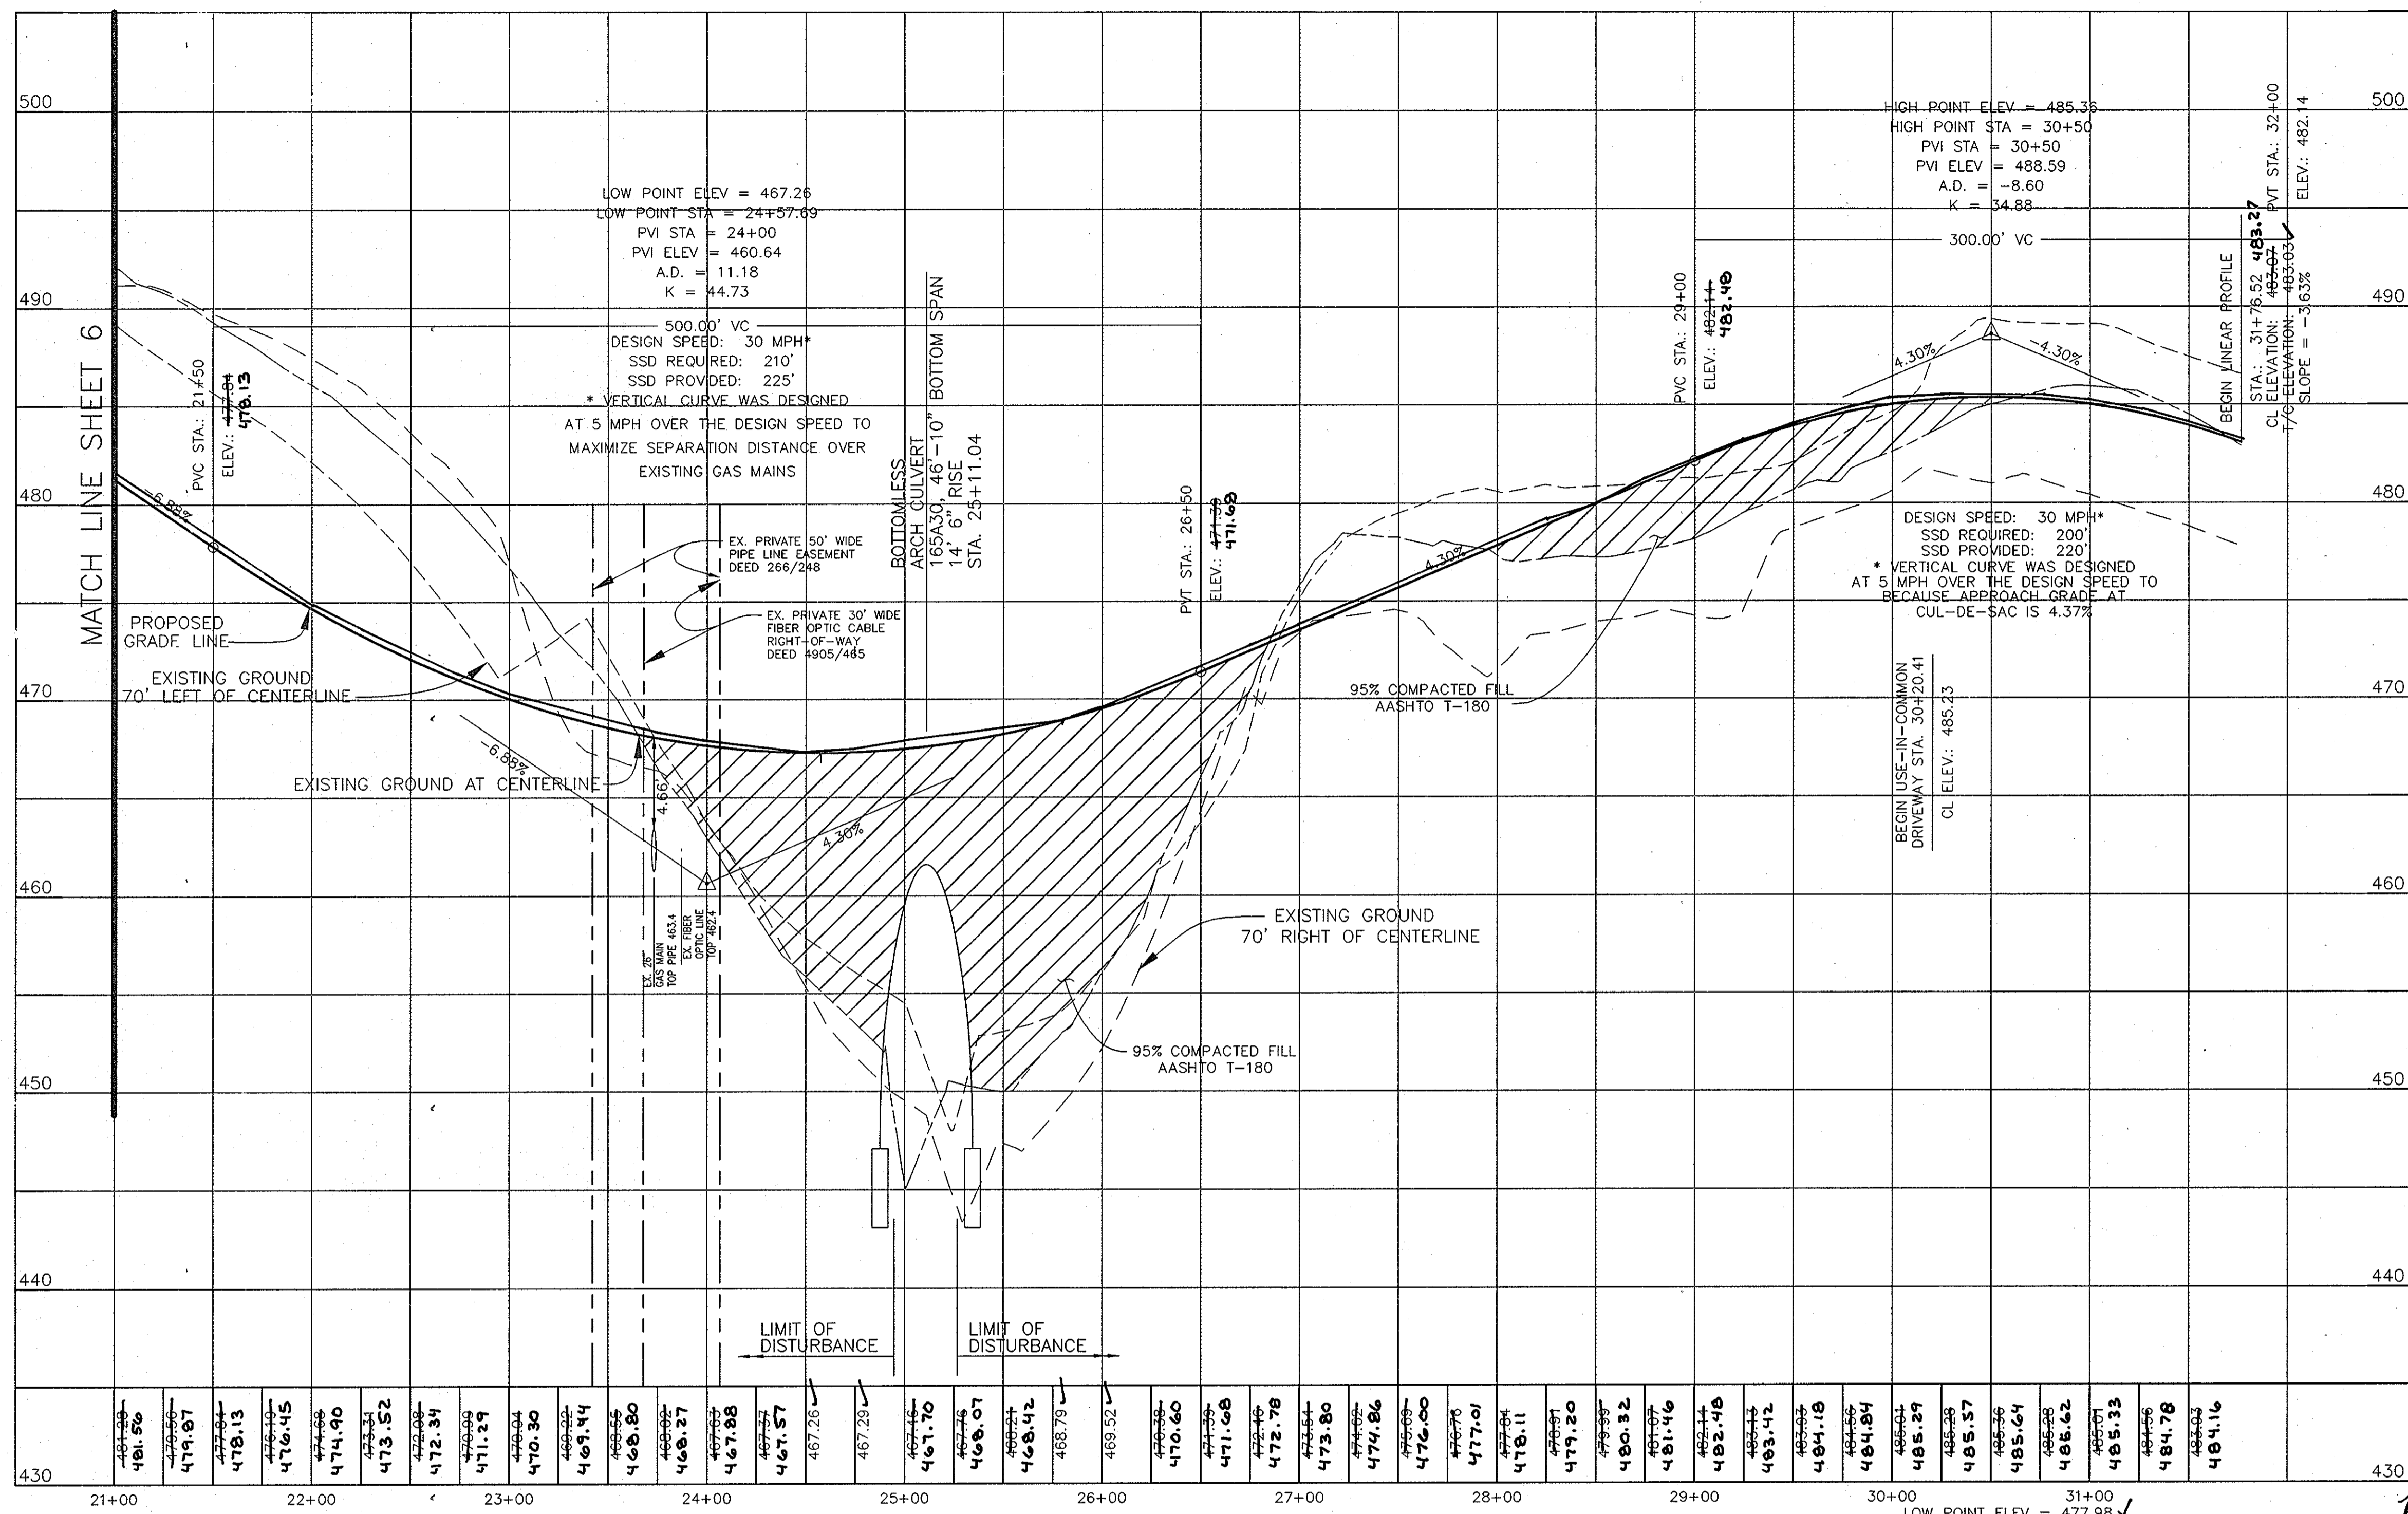

PROFILE - BROCCOLINO WAY
 PUBLIC ACCESS PLACE - 40' R/W
 230 ADT (500 ADT POTENTIAL)
 VERTICAL SCALE: 1" = 5'
 HORIZONTAL SCALE: 1" = 50'

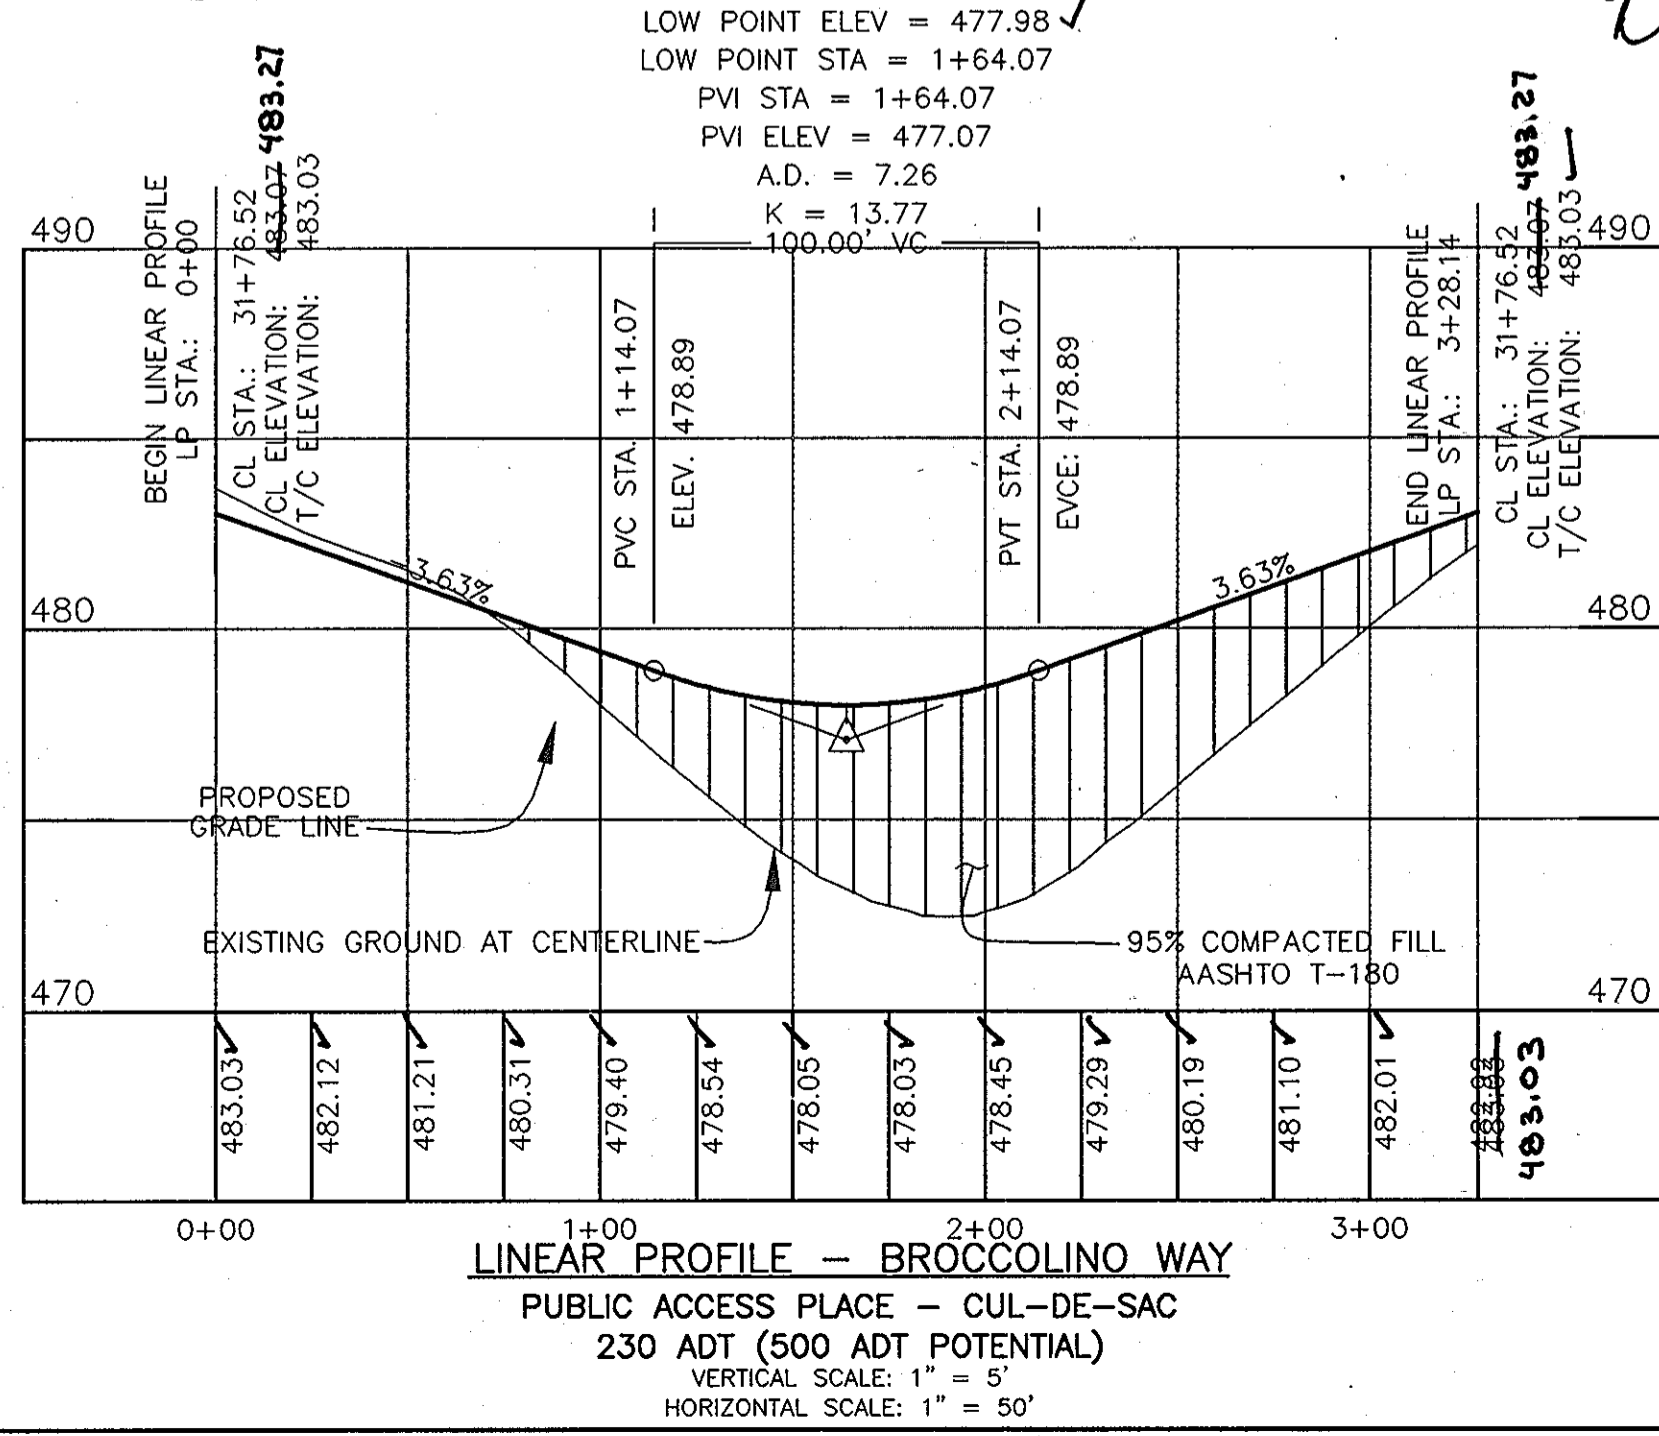

LINEAR PROFILE - BROCCOLINO WAY
 PUBLIC ACCESS PLACE - CUL-DE-SAC
 230 ADT (500 ADT POTENTIAL)
 VERTICAL SCALE: 1" = 5'
 HORIZONTAL SCALE: 1" = 50'

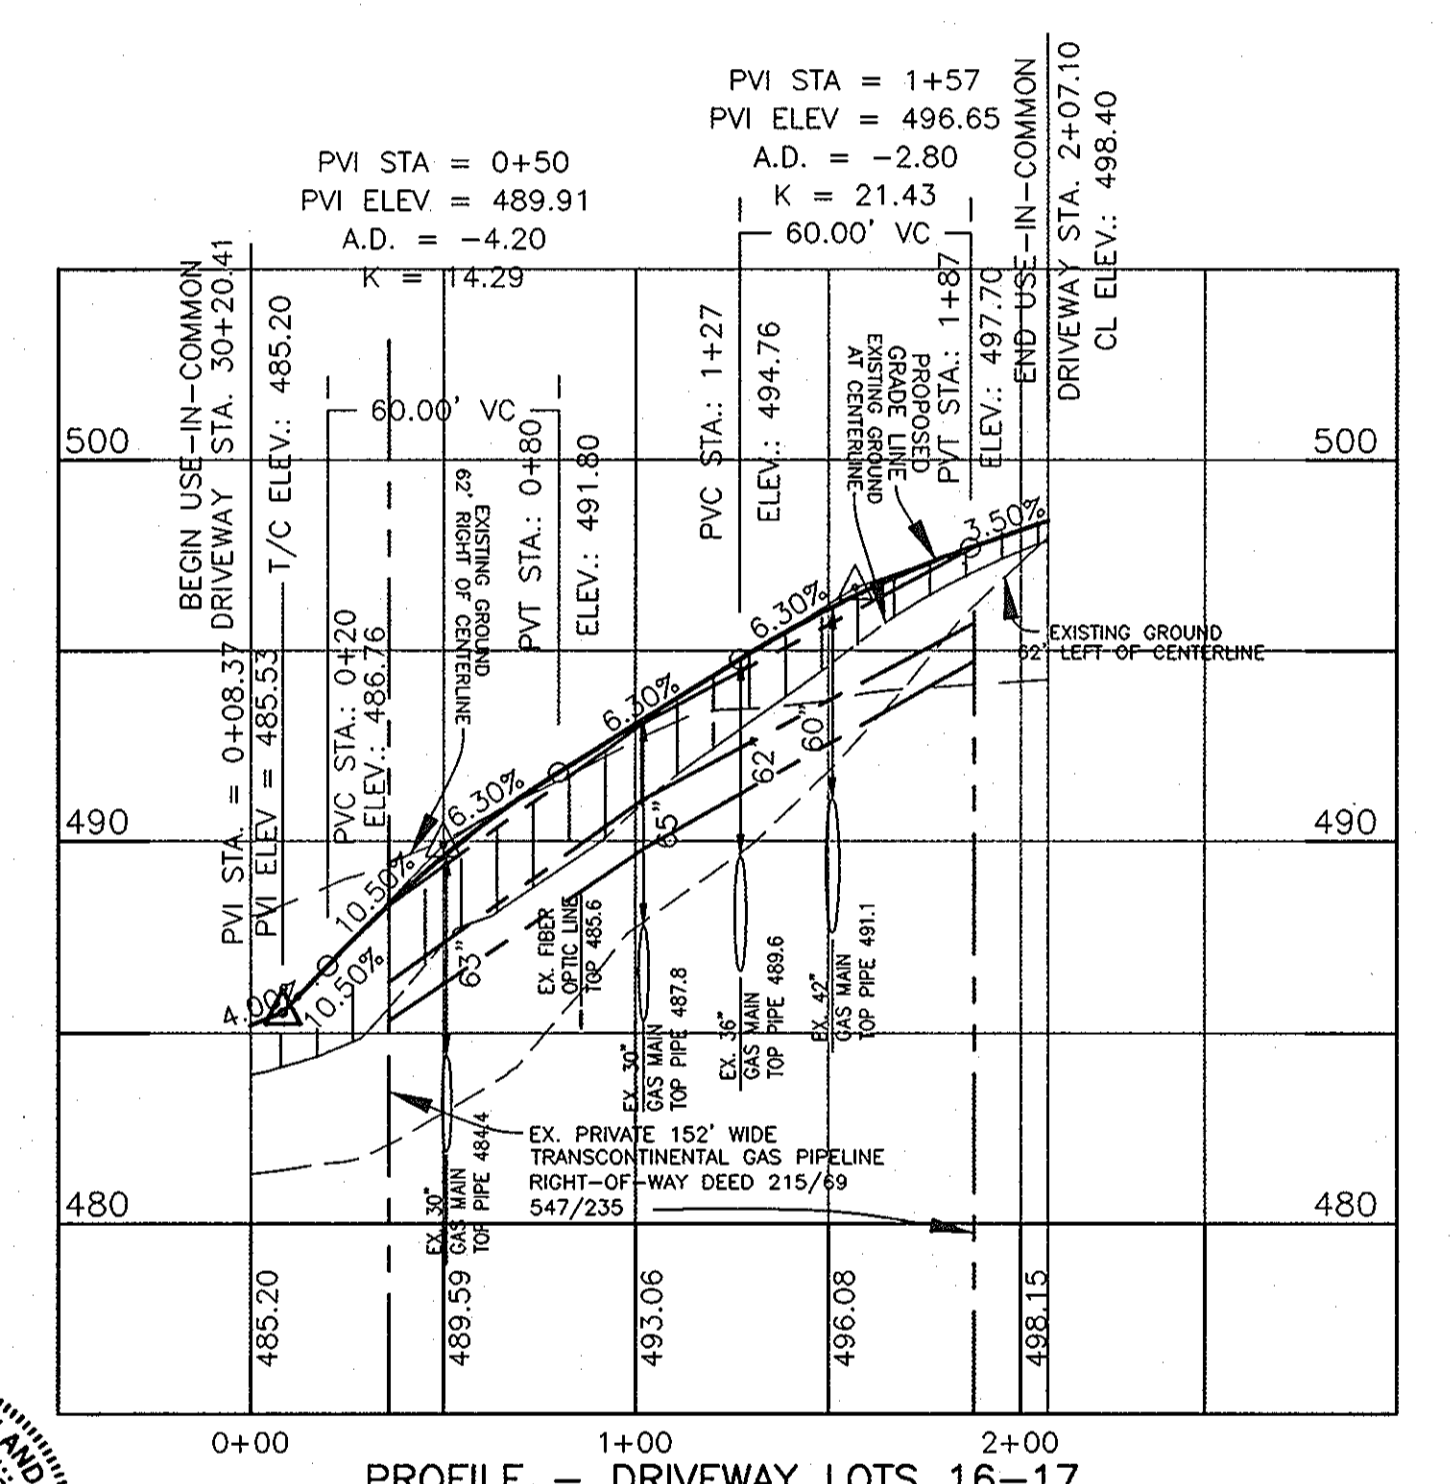

PROFILE - DRIVEWAY LOTS 16-17
 PRIVATE USE IN COMMON DRIVEWAY
 20 ADT, DESIGN SPEED 15 MPH
 VERTICAL SCALE: 1" = 5'
 HORIZONTAL SCALE: 1" = 50'

APPROVED: HOWARD COUNTY DEPARTMENT OF PUBLIC WORKS
Walter J. ... 6-6-07
 CHIEF, BUREAU OF HIGHWAYS

APPROVED: HOWARD COUNTY DEPT. OF PLANNING AND ZONING
J. Krista-Maschall for C. Hamber 6-11-07
 CHIEF, DIVISION OF LAND DEVELOPMENT

W. ... 6/10/07
 CHIEF, DEVELOPMENT ENGINEERING DIVISION

STATE OF MARYLAND
 PROFESSIONAL ENGINEER
 No. 21543
 AS-BUILT 1-13-10

NO.	DATE	REVISION

BENCHMARK
 ENGINEERS • LAND SURVEYORS • PLANNERS

ENGINEERING, INC.

8480 BALTIMORE NATIONAL PIKE • SUITE 418
 ELLICOTT CITY, MARYLAND 21043
 PHONE: 410-465-6105 FAX: 410-465-6644
 E-MAIL: benchmark@ccis.com

OWNER/DEVELOPER:
 HIGHLAND DEVELOPMENT CORP
 P.O. BOX 228
 CLARKSVILLE, MARYLAND 21029
 410-531-5539


PROJECT:
BRIGHTON MILL
 LOT 1 THROUGH 22, BUILDABLE PRESERVATION PARCEL 'A'
 AND NON-BUILDABLE PRESERVATION PARCELS 'B' THROUGH 'D'

LOCATION:
 TAX MAP No. 34, GRID No. 2
 PARCEL 2
 5TH ELECTION DISTRICT
 HOWARD COUNTY, MARYLAND


TITLE:
ROAD PROFILE

DATE: MAY, 2007 PROJECT NO. 1513

Design: JMC Draft: LAB Check: DAM SCALE: AS SHOWN DRAWING 7 OF 34

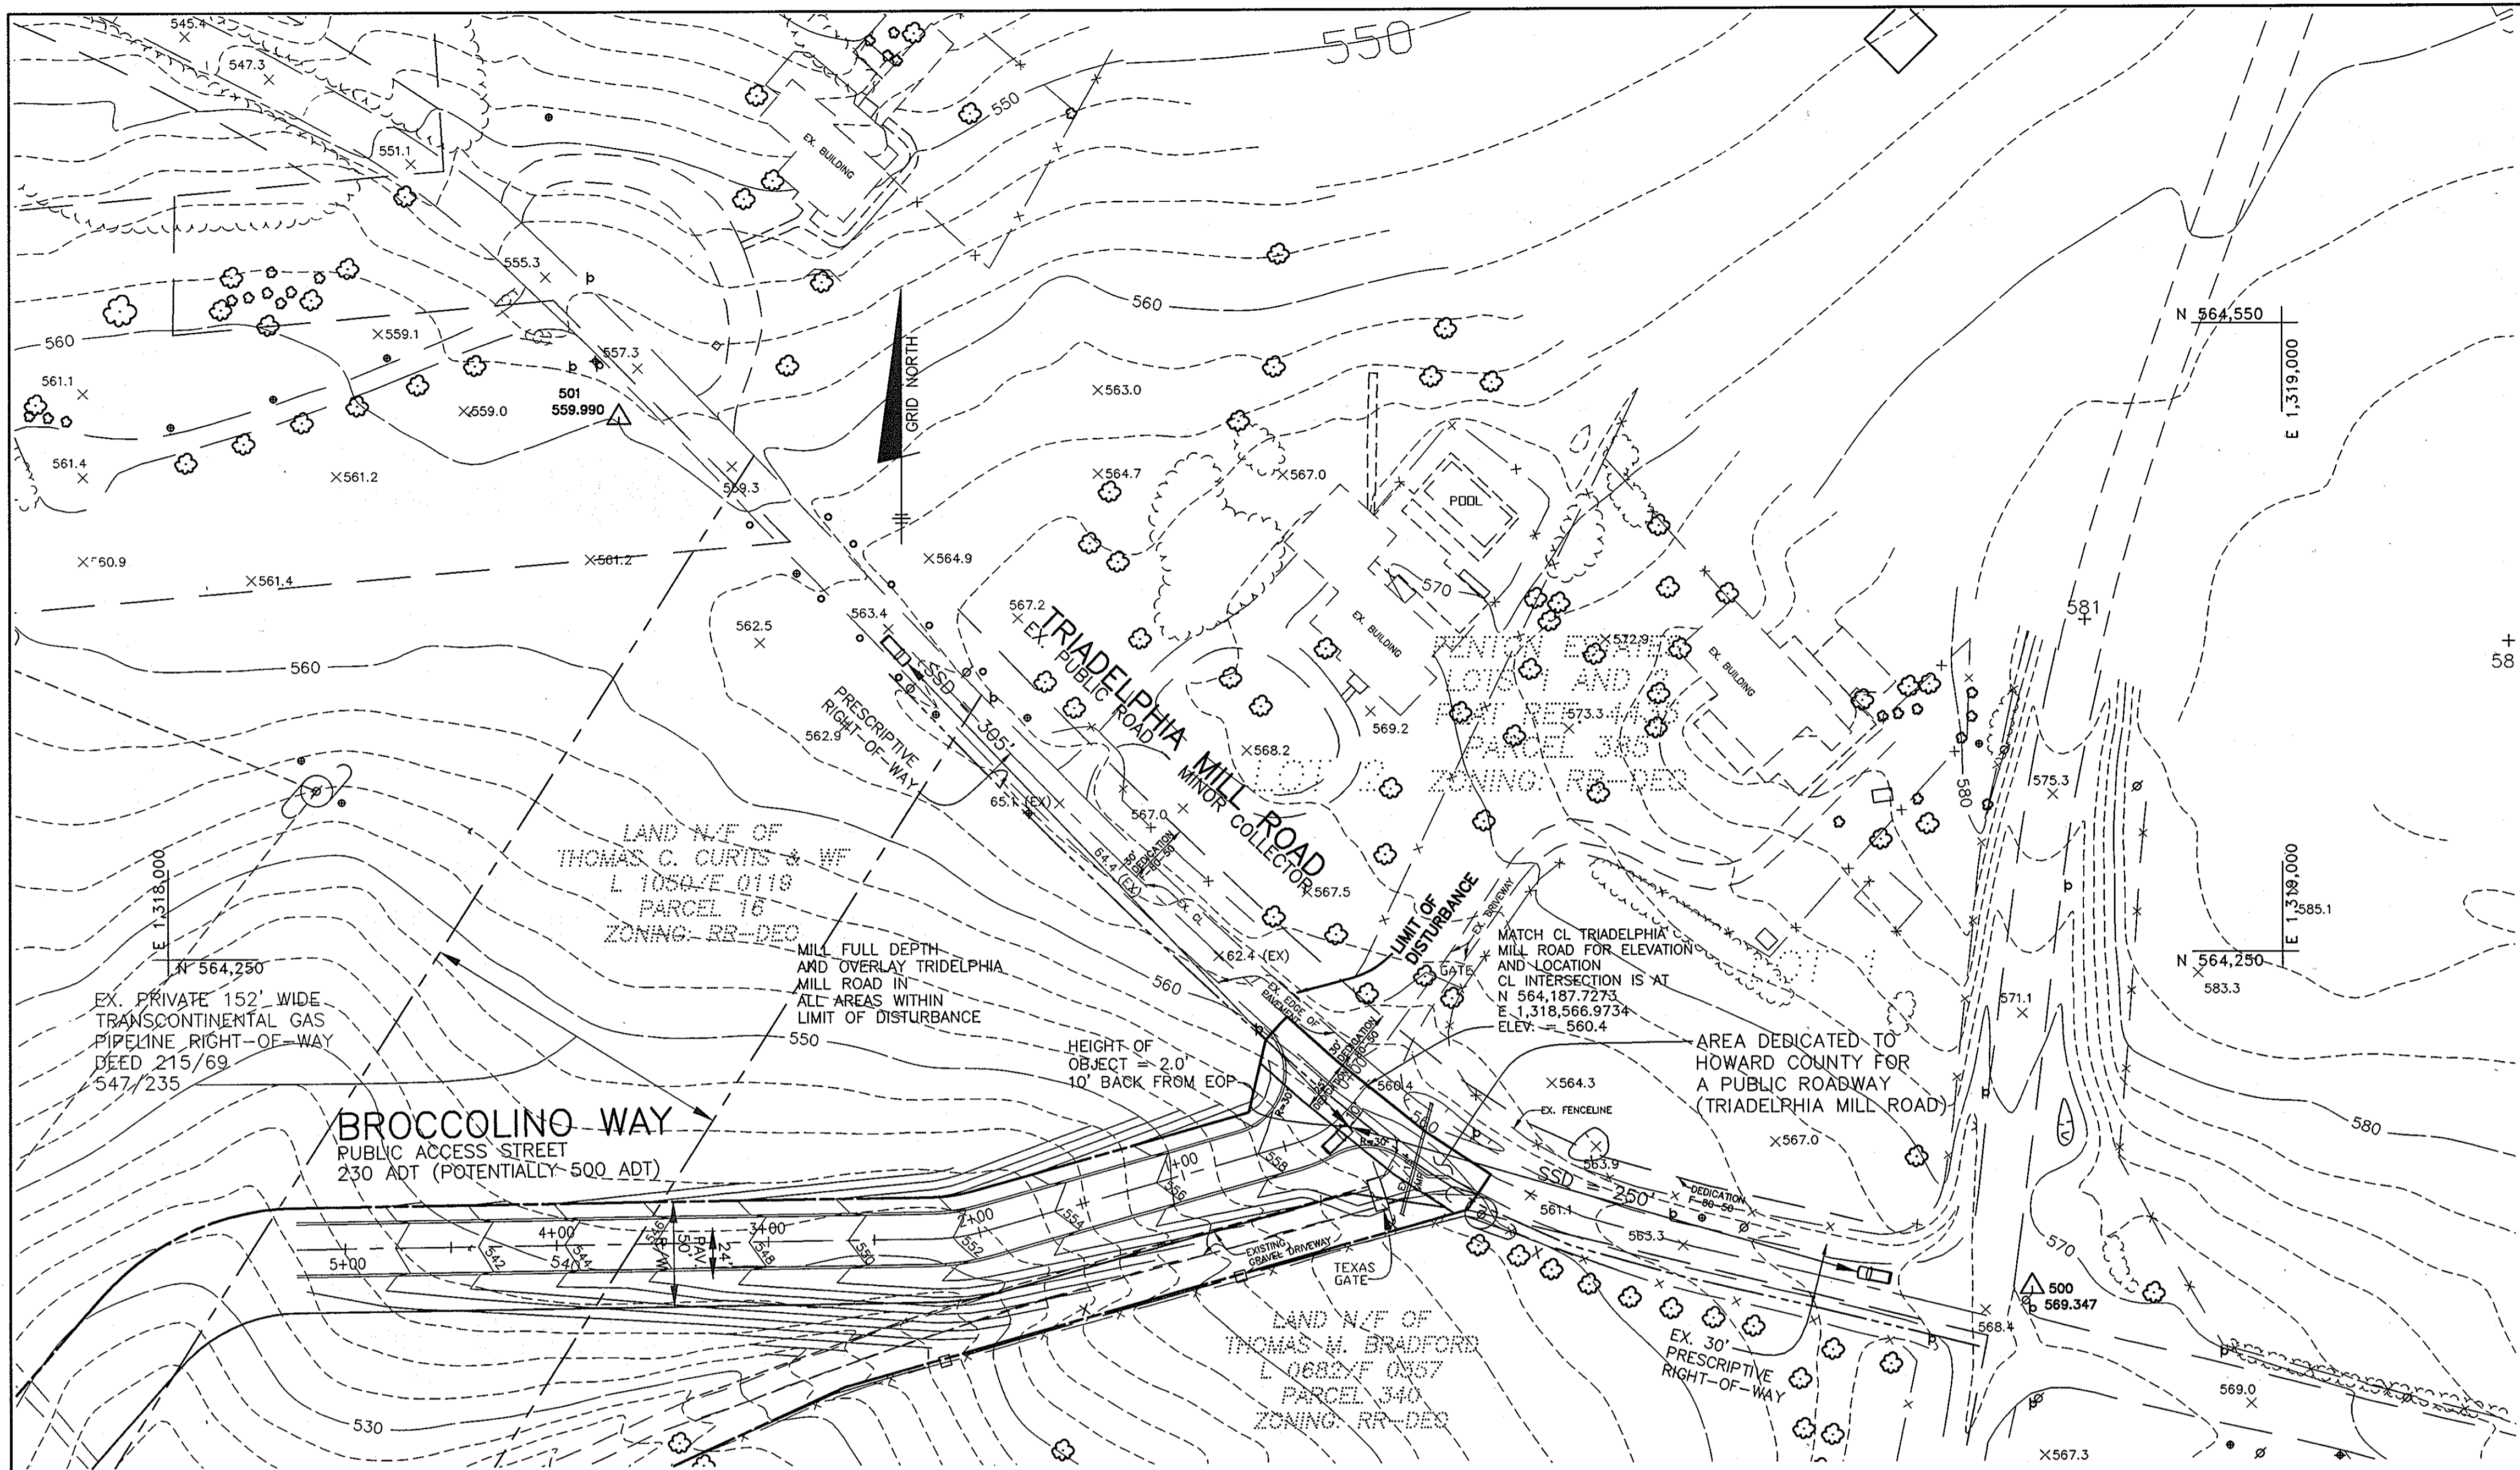

PLAN
SCALE: 1" = 50'

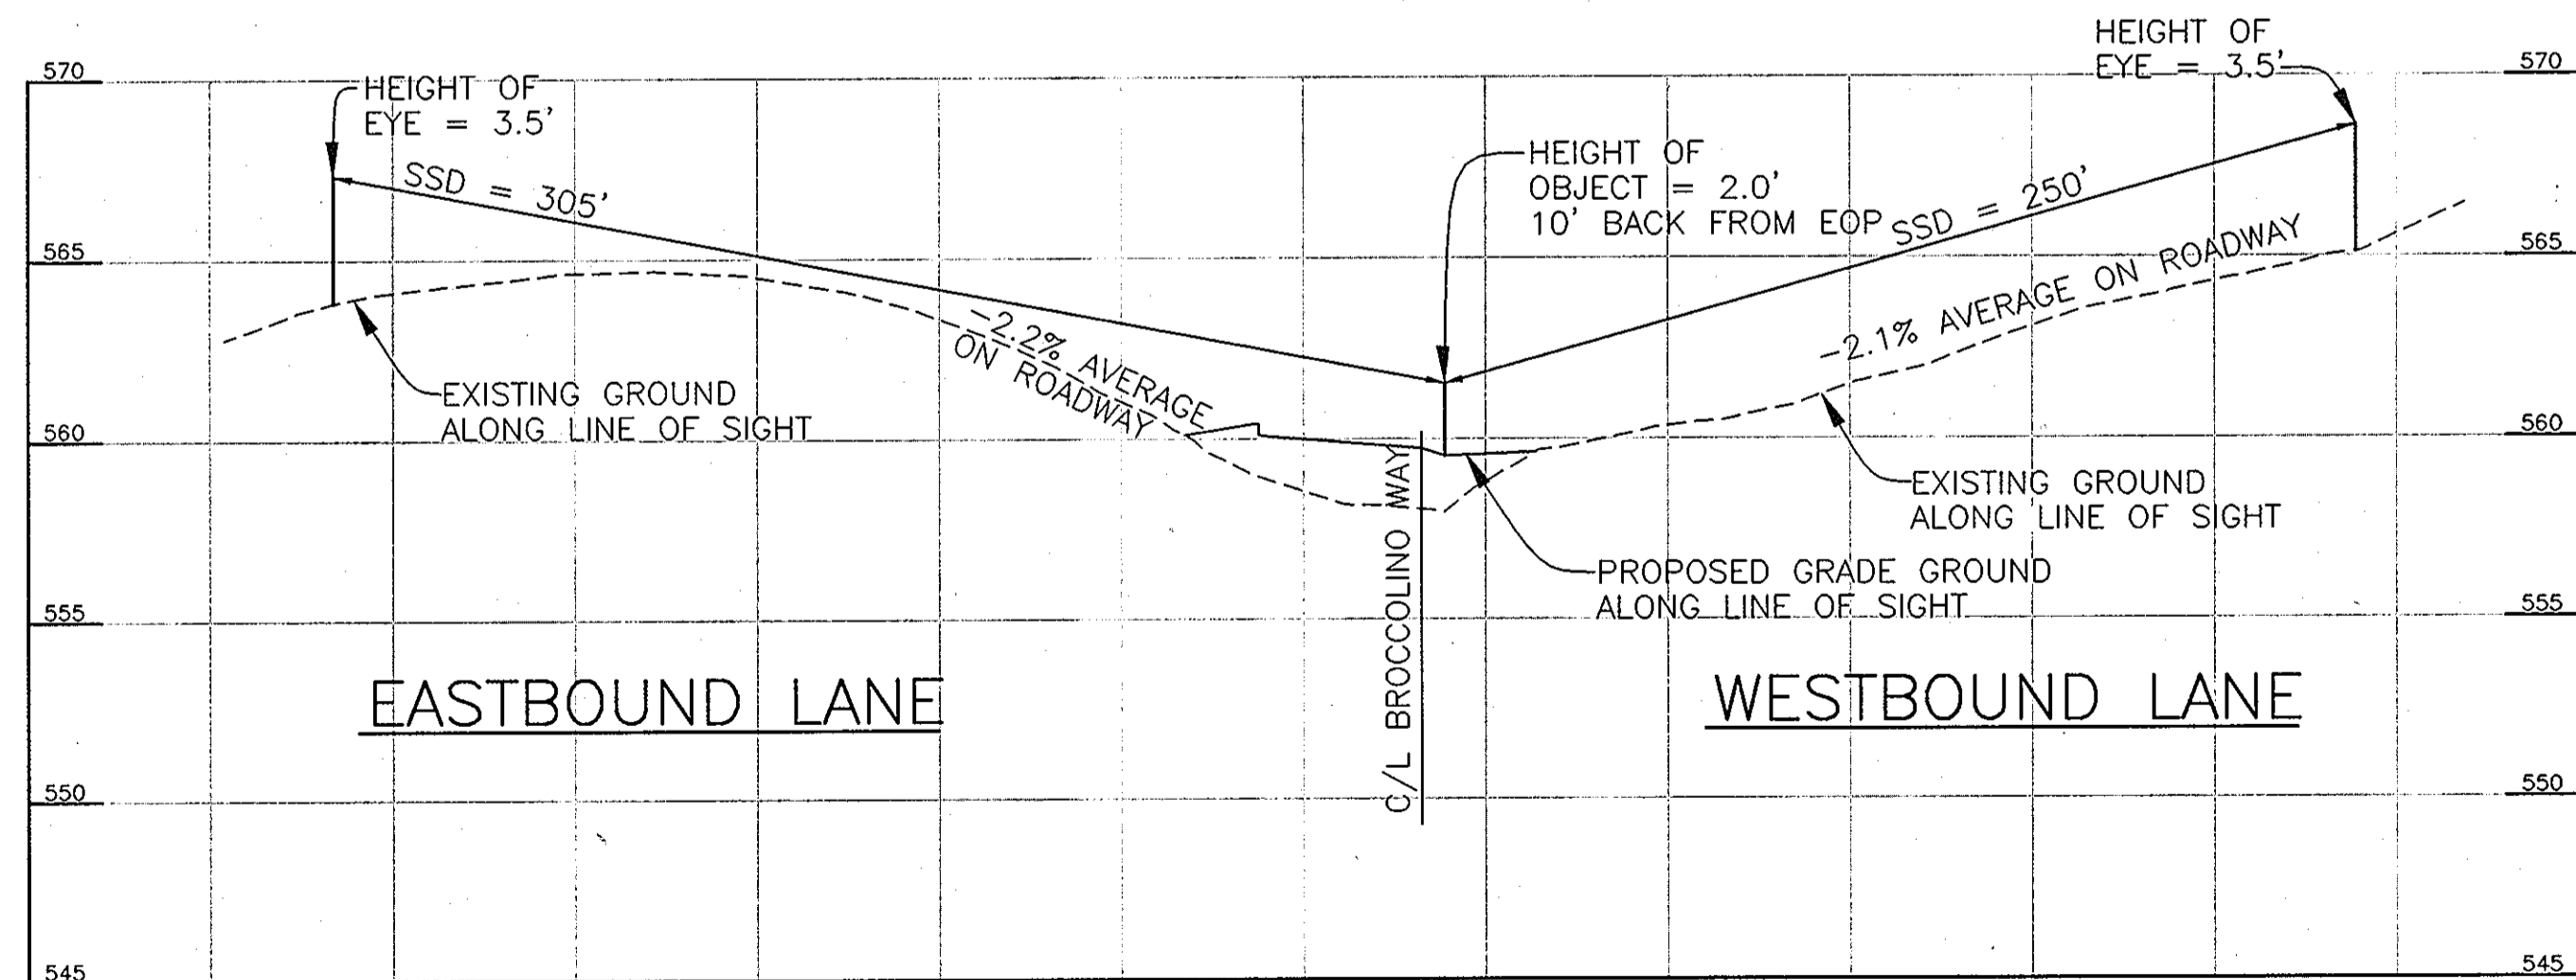

AASHTO STOPPING SIGHT DISTANCE
TRIADELPHIA MILL ROAD
SCALE: VERT. 1" = 5'
HOR. 1" = 50'

OPERATING SPEED = 40 MPH EASTBOUND
= 35 MPH WESTBOUND
BASED ON 85TH PERCENTILE AS DETERMINED BY TRAFFIC CONCEPTS, INC.

THIS INTERSECTION LOCATION DOES NOT PROVIDE ADEQUATE INTERSECTION SIGHT DISTANCE FOR A STOP CONTROLLED, AT-GRADE INTERSECTION (CASE B1 AND B2) ACCORDING TO "A POLICY ON GEOMETRIC DESIGN OF HIGHWAYS AND STREETS, 2004."

*THERE IS APPROXIMATELY 280' TO THE INTERSECTION OF TRIADELPHIA MILL ROAD AND HIGHLAND ROAD ON THE EAST SIDE OF THE ENTRANCE.

BASED ON EXHIBIT 3-1 - STOPPING SIGHT DISTANCE IN "A POLICY ON GEOMETRIC DESIGN OF HIGHWAYS AND STREETS, 2004" THIS ROADWAY WOULD REQUIRE 305' OF STOPPING SIGHT DISTANCE IN THE EASTBOUND LANE AND 250' OF STOPPING SIGHT DISTANCE IN THE WESTBOUND LANE. BASED ON AN EYE HEIGHT OF 3.5' AND AN OBJECT HEIGHT OF 2.0'. THE EYE IS SET IN THE TRAVEL LANE AND OBJECT IS SET BACK 10' FROM THE EDGE OF PAVING.

SINCE THE EXISTING ROAD (TRIADELPHIA MILL ROAD) HAS A SLOPE OF 2% TO 3% GRADE, NO GRADE ADJUSTMENT FACTORS WERE USED.

APPROVED: HOWARD COUNTY DEPARTMENT OF PUBLIC WORKS
Walter J. White
CHIEF, BUREAU OF HIGHWAYS
DATE: 6-6-07

APPROVED: HOWARD COUNTY DEPT. OF PLANNING AND ZONING
T. Krista Murchick for Hamilton
CHIEF, DIVISION OF LAND DEVELOPMENT
DATE: 6-11-07

Chad Ramsey
CHIEF, DEVELOPMENT ENGINEERING DIVISION
DATE: 6/6/07

NO.	DATE	REVISION
BENCHMARK ENGINEERS & LAND SURVEYORS & PLANNERS ENGINEERING, INC. 8480 BALTIMORE NATIONAL PIKE & SUITE 418 ELLICOTT CITY, MARYLAND 21043 PHONE: 410-465-6105 FAX: 410-465-6644 E-MAIL: benchmark@coals.com		
OWNER/DEVELOPER: HIGHLAND DEVELOPMENT CORP P.O. BOX 228 CLARKSVILLE, MARYLAND 21029 410-531-5539		PROJECT: BRIGHTON MILL LOT 1 THROUGH 22, BUILDABLE PRESERVATION PARCEL "A" AND NON-BUILDABLE PRESERVATION PARCELS "B" THROUGH "D" LOCATION: TAX MAP No. 34, GRID No. 2 PARCEL 2 5th ELECTION DISTRICT HOWARD COUNTY, MARYLAND
TITLE: AASHTO STOPPING SIGHT DISTANCE ANALYSIS FOR TRIADELPHIA MILL ROAD		
DATE: FEBRUARY, 2007 MAY, 2007	PROJECT NO. 1513	DESIGNER: JMC DRAFTER: JMC CHECKER: DAM
SCALE: AS SHOWN	DRAWING: 8 OF 34	DATE: 5/7/07



LEGEND

SOILS CLASSIFICATION	ChB2
SOILS DELINEATION	
EXISTING CONTOURS (AERIAL 12/02)	
LIMIT OF WETLANDS	
EXISTING WOODS LINE	
PROPOSED WOODS LINE	
EXISTING STRUCTURE	
EXISTING SEPTIC FIELD	
PROPOSED SEPTIC FIELD	
SLOPES 15% TO 24.9%	
SLOPES 25% OR GREATER	
EX. 100 YEAR FLOODPLAIN	
PROPOSED FOREST CONSERVATION EASEMENT	
SUPER SILT FENCE	
SILT FENCE	
EARTH DIKE	
STABILIZED CONSTRUCTION ENTRANCE	
SEDIMENT CONTROL DRAINAGE DIVIDE	
EROSION CONTROL MATTING	
LIMIT OF DISTURBANCE	

AS-BUILT CERTIFICATION

I HEREBY CERTIFY THAT THE FACILITY SHOWN ON THIS PLAN WAS CONSTRUCTED AS SHOWN ON THE "AS-BUILT" PLANS AND MEETS THE APPROVED PLANS AND SPECIFICATIONS.

PE NO. 21443
 DONALD A. MASON
 DATE

CERTIFY MEANS TO STATE OR DECLARE A PROFESSIONAL OPINION BASED UPON ON-SITE INSPECTIONS AND MATERIAL TESTS WHICH ARE CONDUCTED DURING CONSTRUCTION. THE ON-SITE INSPECTIONS AND MATERIAL TESTS ARE THOSE INSPECTIONS AND TESTS DEEMED SUFFICIENT AND APPROPRIATE BY COMMONLY ACCEPTED PROFESSIONAL STANDARDS. CERTIFY DOES NOT MEAN OR IMPLY A GUARANTEE BY THE ENGINEER NOR DOES AN ENGINEER'S CERTIFICATION RELIEVE ANY OTHER PARTY FROM MEETING REQUIREMENTS IMPOSED BY CONTRACT, EMPLOYMENT, OR OTHER MEANS, INCLUDING MEETING COMMONLY ACCEPTED INDUSTRY PRACTICES.

BY THE DEVELOPER:
 I/WE CERTIFY THAT ALL DEVELOPMENT AND/OR CONSTRUCTION WILL BE DONE ACCORDING TO THESE PLANS, AND THAT ANY RESPONSIBLE PERSONNEL INVOLVED IN THE CONSTRUCTION PROJECT WILL HAVE A CERTIFICATE OF ATTENDANCE AT A DEPARTMENT OF THE ENVIRONMENT APPROVED TRAINING PROGRAM FOR THE CONTROL OF SEDIMENT AND EROSION BEFORE BEGINNING THE PROJECT. I SHALL EMPLOY A REGISTERED PROFESSIONAL ENGINEER TO SUPERVISE POND CONSTRUCTION AND PROVIDE THE HOWARD SOIL CONSERVATION DISTRICT WITH AN "AS-BUILT" PLAN OF THE POND WITHIN 30 DAYS OF COMPLETION. I ALSO AUTHORIZE PERIODIC ON-SITE INSPECTIONS BY THE HOWARD SOIL CONSERVATION DISTRICT.

Richard W. Warrmitt 5-9-07
 DEVELOPER DATE

BY THE ENGINEER:
 I/WE CERTIFY THAT THIS PLAN FOR POND CONSTRUCTION, EROSION AND SEDIMENT CONTROL REPRESENTS A PRACTICAL AND WORKABLE PLAN BASED ON MY PERSONAL KNOWLEDGE OF THE SITE CONDITIONS. THIS PLAN WAS PREPARED IN ACCORDANCE WITH THE REQUIREMENTS OF THE HOWARD SOIL CONSERVATION DISTRICT. I HAVE NOTIFIED THE DEVELOPER THAT HE/SHE MUST ENGAGE A REGISTERED PROFESSIONAL ENGINEER TO SUPERVISE POND CONSTRUCTION AND PROVIDE THE HOWARD SOIL CONSERVATION DISTRICT WITH AN "AS-BUILT" PLAN OF THE POND WITHIN 30 DAYS OF COMPLETION.

Donald A. Mason 5/16/07
 ENGINEER - DONALD A. MASON, P.E. # 21443 DATE

THESE PLANS HAVE BEEN REVIEWED FOR THE HOWARD SOIL CONSERVATION DISTRICT AND MEET THE TECHNICAL REQUIREMENTS FOR SMALL POND CONSTRUCTION, SOIL EROSION, AND SEDIMENT CONTROL.

Jim Meyer /08 5/21/07
 NATURAL RESOURCES CONSERVATION SERVICE DATE

THESE PLANS FOR SMALL POND CONSTRUCTION, SOIL EROSION, AND SEDIMENT CONTROL MEET THE REQUIREMENTS OF THE HOWARD SOIL CONSERVATION DISTRICT.

Donald A. Mason 5/31/07
 HOWARD SOIL CONSERVATION DISTRICT DATE

APPROVED: HOWARD COUNTY DEPARTMENT OF PUBLIC WORKS

CHEF, BUREAU OF HIGHWAYS DATE

APPROVED: HOWARD COUNTY DEPARTMENT OF PLANNING AND ZONING

CHEF, DIVISION OF LAND DEVELOPMENT DATE

CHEF, DEVELOPMENT ENGINEERING DIVISION DATE

APPROVED: HOWARD COUNTY DEPARTMENT OF PUBLIC WORKS

W. J. ... 6-26-07
 CHEF, BUREAU OF HIGHWAYS DATE

APPROVED: HOWARD COUNTY DEPT. OF PLANNING AND ZONING

T. Krizan - ... 6-11-07
 CHEF, DIVISION OF LAND DEVELOPMENT DATE


... 6/6/07
 CHEF, DEVELOPMENT ENGINEERING DIVISION DATE

- NOTES:**
- #1 STREAM CLOSURE SHALL BE BETWEEN MARCH 1ST AND MAY 31ST.
 - #2 ALL SWALES AND DITCHES SHALL BE LINED WITH EROSION CONTROL MATTING.
 - #3 CONTRACTOR SHALL CURL ALL ENDS OF SF/SSF UPHILL BY 2' IN ELEVATION AND CLOSE OVER ENDWALLS WHERE SHOWN AND AS DIRECTED BY THE COUNTY INSPECTOR.
 - #4 CONTRACTOR SHALL MAINTAIN POSITIVE FLOW FROM ROAD GRADES AND SUMPS TO BASINS BY EARTH DIKE AND STORM DRAINS.
 - #5 CONTRACTOR SHALL REMOVE FARM ROAD AND ASSOCIATED DITCH AND GRADE TO PROVIDE A SMOOTH OVERLAND FLOW, PER THE CONTOURS SHOWN.
 - #6 CONTRACTOR TO USE MDE SEED MIX IN DISTURBED STREAM AREAS.



1	7-13-07	REVISED STORM DRAIN MATERIAL OF SOME PIPES
NO.	DATE	REVISION

BENCHMARK
 ENGINEERS & LAND SURVEYORS & PLANNERS
ENGINEERING, INC.
 8480 BALTIMORE NATIONAL PIKE A SUITE 418
 ELLICOTT CITY, MARYLAND 21043
 phone: 410-465-6105 A fax: 410-465-6844
 email: Benchmark@coie.com


OWNER/DEVELOPER:	PROJECT:
HIGHLAND DEVELOPMENT CORP P.O. BOX 228 CLARKSVILLE, MARYLAND 21029 410-531-5539	BRIGHTON MILL LOT 1 THROUGH 22, BUILDABLE PRESERVATION PARCEL 'A' AND NON-BUILDABLE PRESERVATION PARCELS 'B' THROUGH 'D'
	LOCATION: TAX MAP No. 14, GRID No. 2 PARCEL 2 5th ELECTION DISTRICT HOWARD COUNTY, MARYLAND
	TITLE: NORTH STRUCTURE DETAIL
DATE: MAY, 2007	PROJECT NO. 1513
Design: -- Draft: -- Check: --	SCALE: AS SHOWN DRAWING 9 OF 34

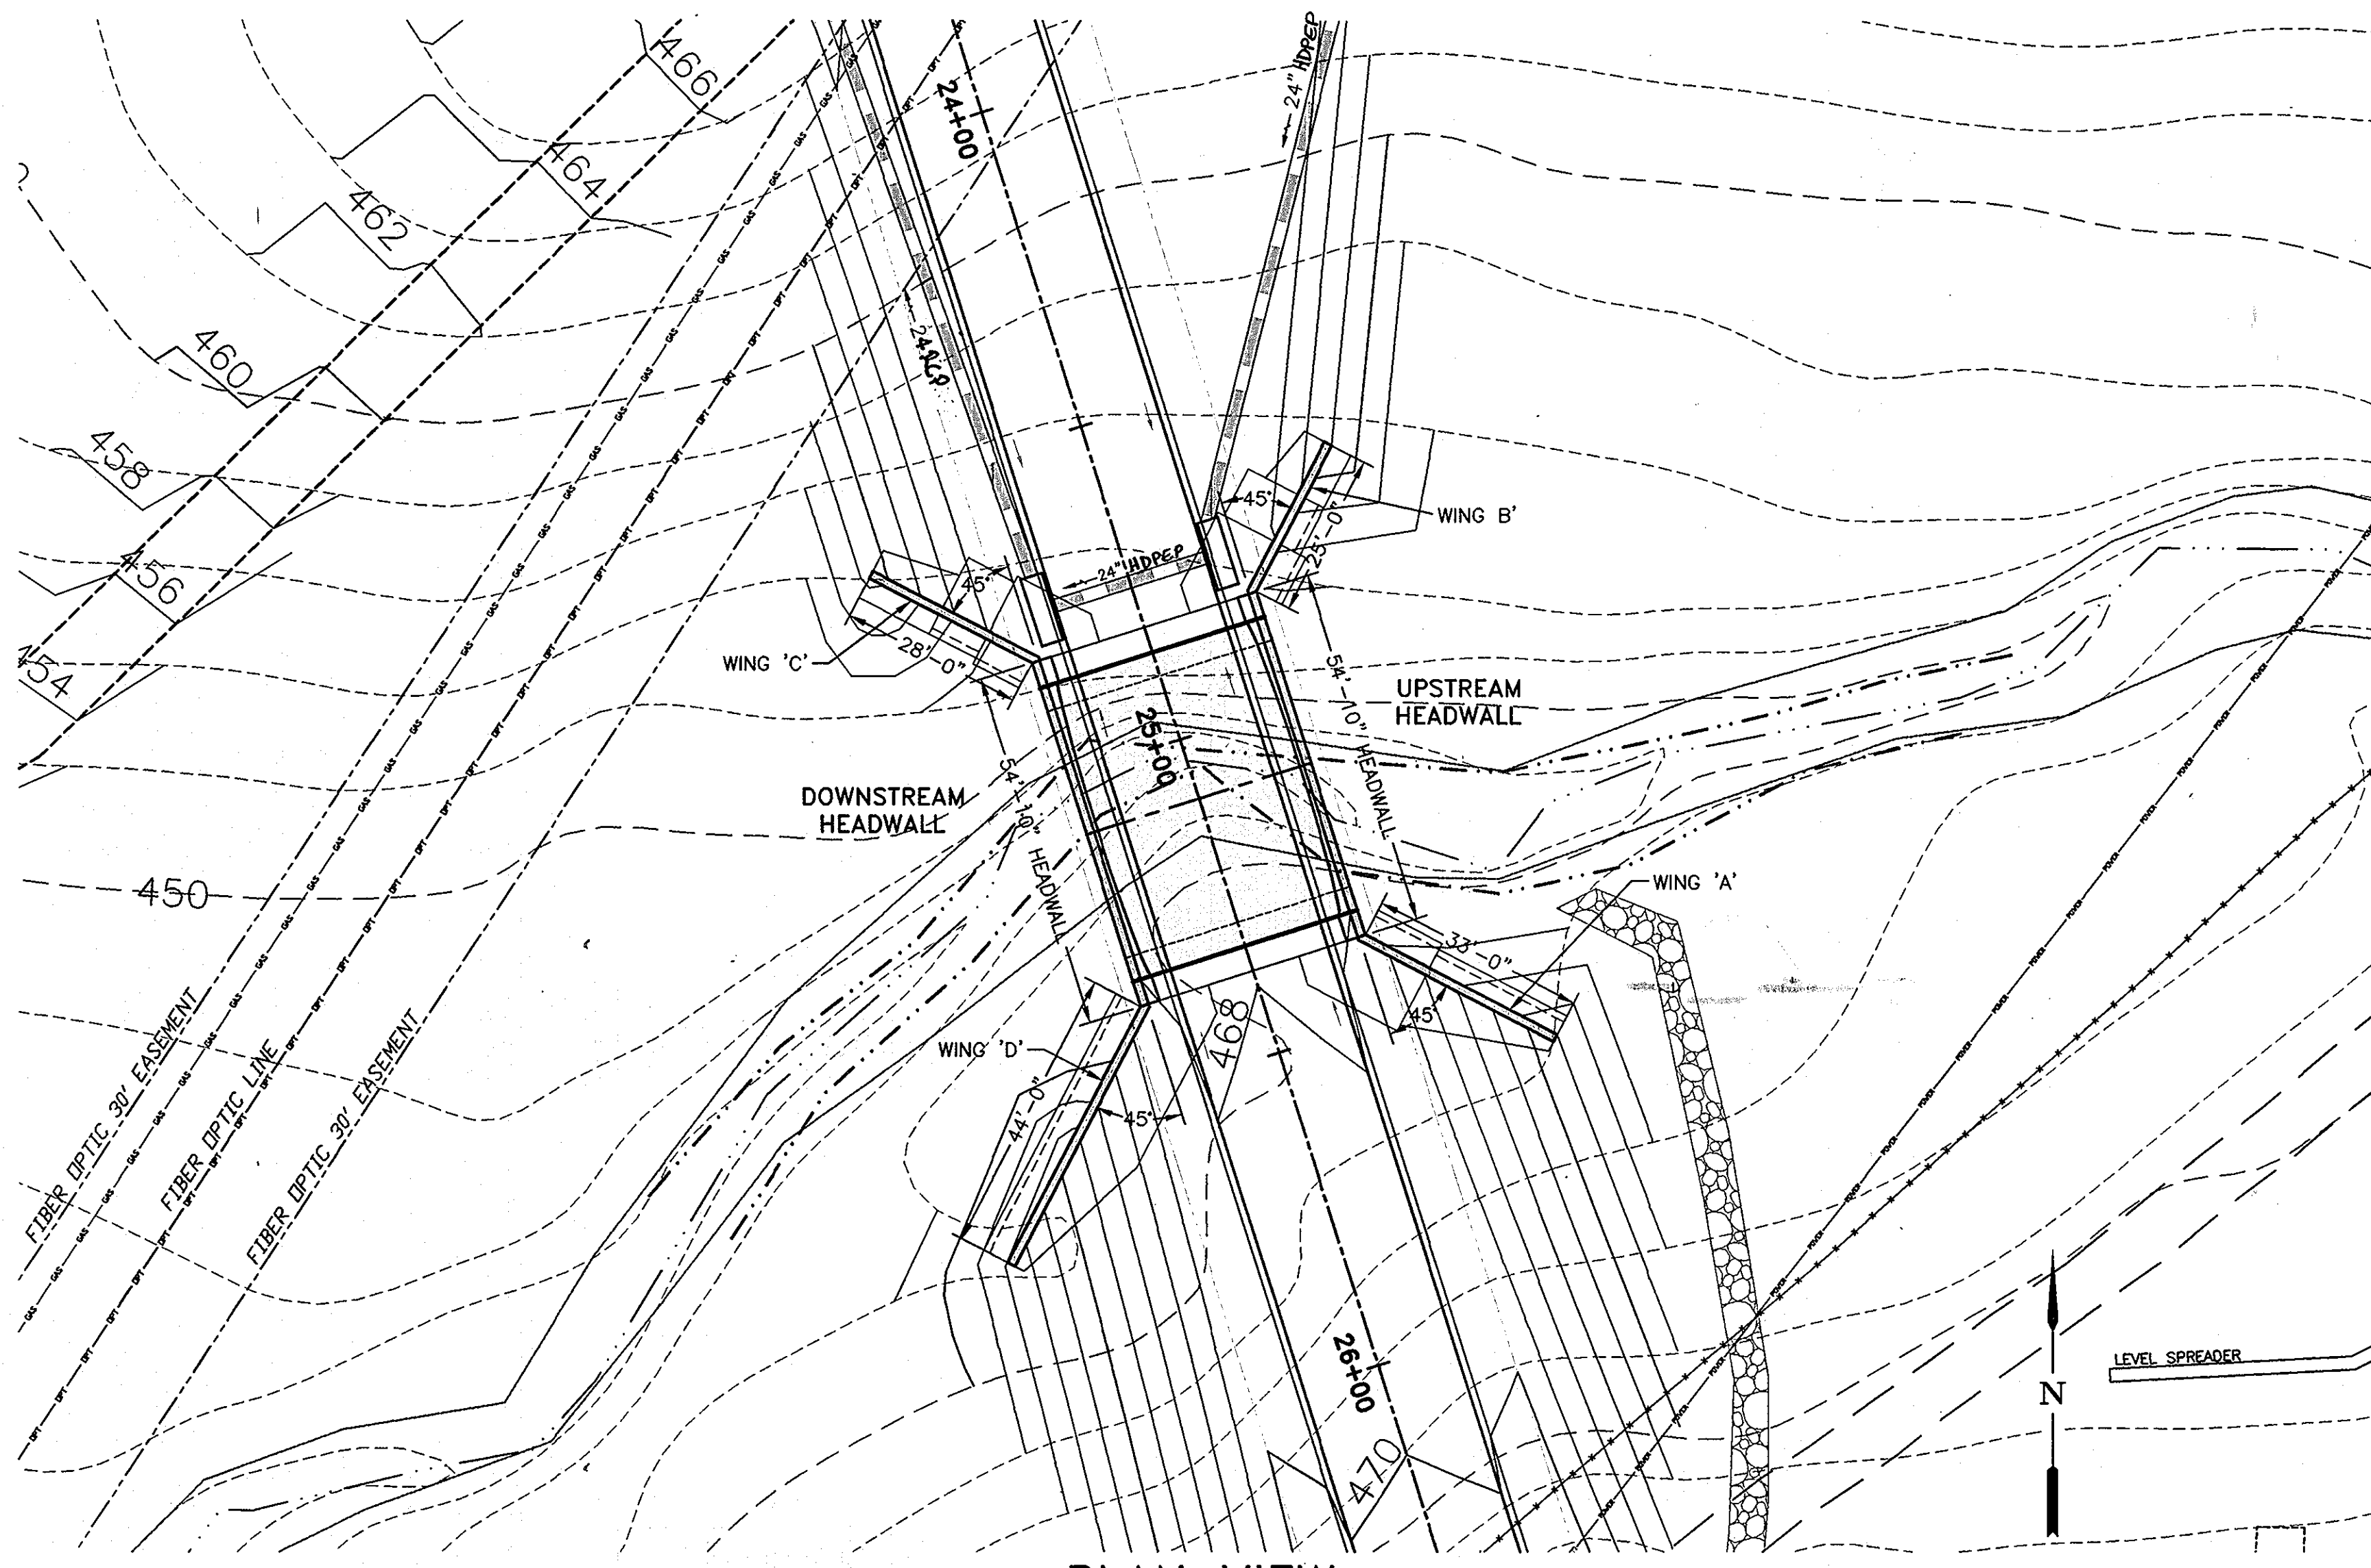

PLAN VIEW

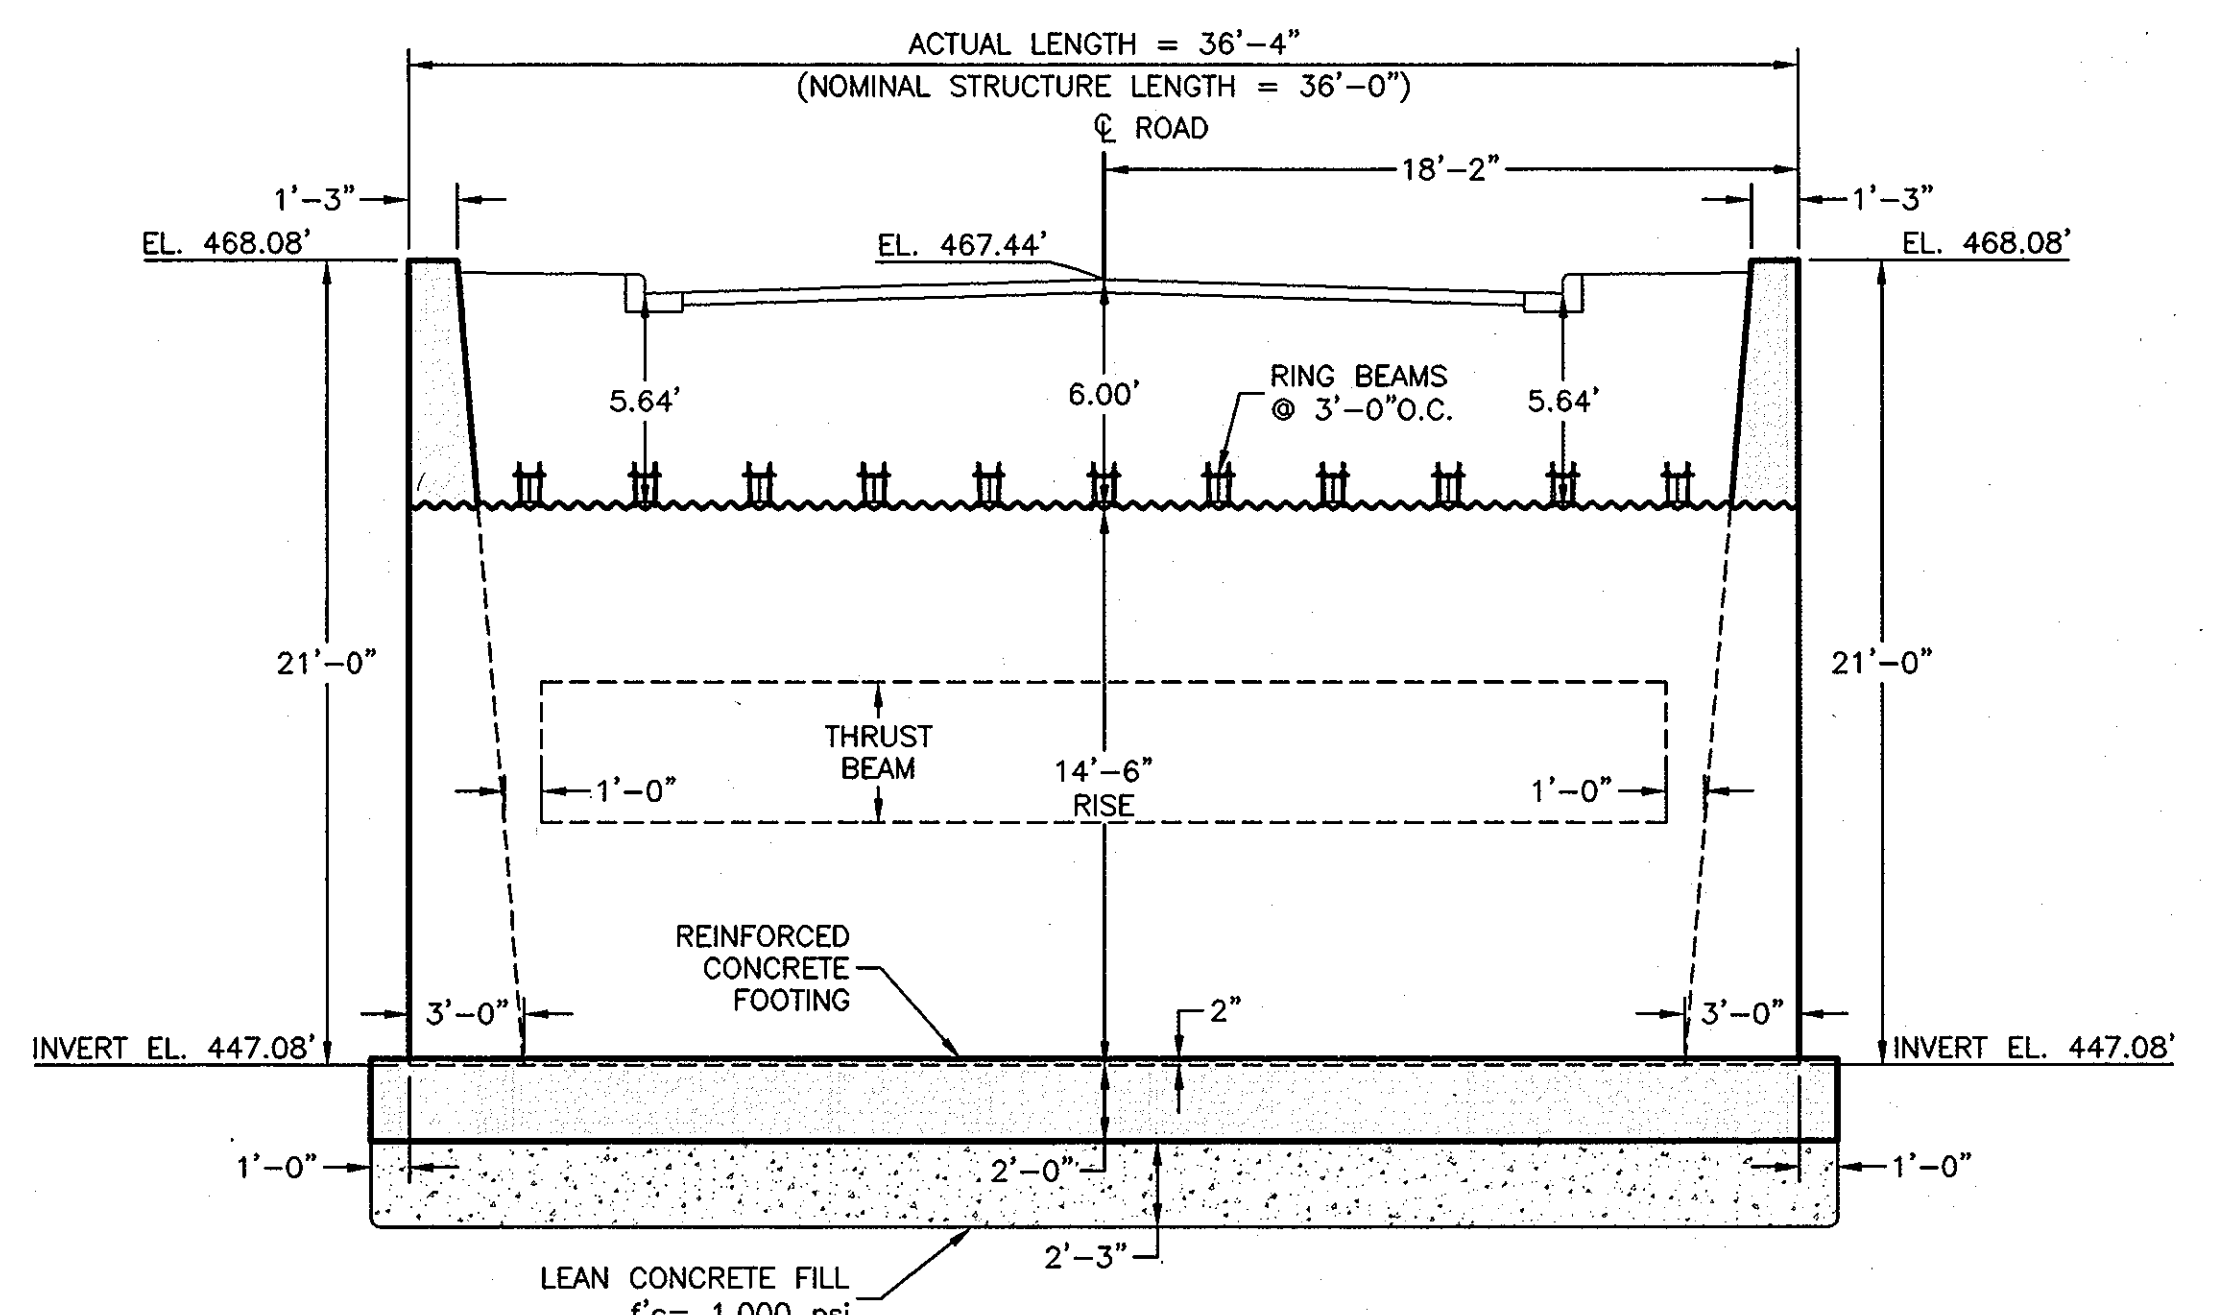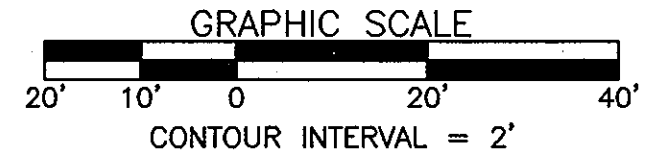


PROFILE THROUGH CENTERLINE OF STRUCTURE

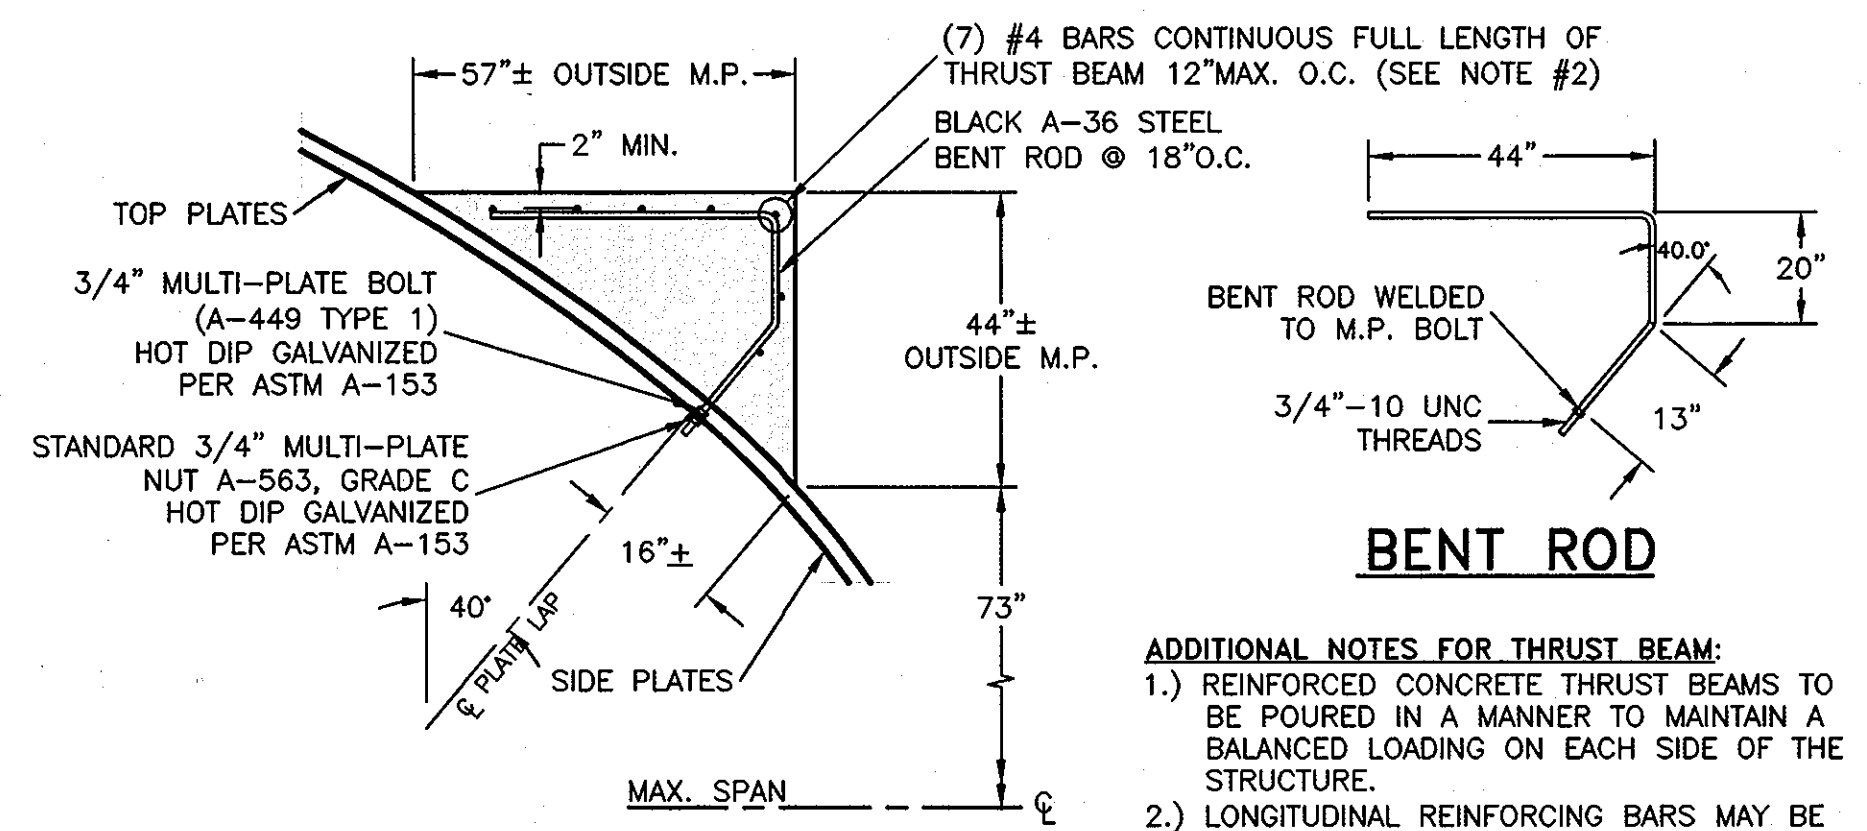

DETAIL OF THRUST BEAM


NOT TO SCALE

- ADDITIONAL NOTES FOR THRUST BEAM:**
- 1.) REINFORCED CONCRETE THRUST BEAMS TO BE POURED IN A MANNER TO MAINTAIN A BALANCED LOADING ON EACH SIDE OF THE STRUCTURE.
 - 2.) LONGITUDINAL REINFORCING BARS MAY BE PLACED ON EITHER SIDE OF BENT ROD.
 - 3.) CONCRETE MAY BE $f'_c = 2,400$ psi.
 - 4.) REINFORCEMENT SHALL BE ASTM A-615 GRADE 40.

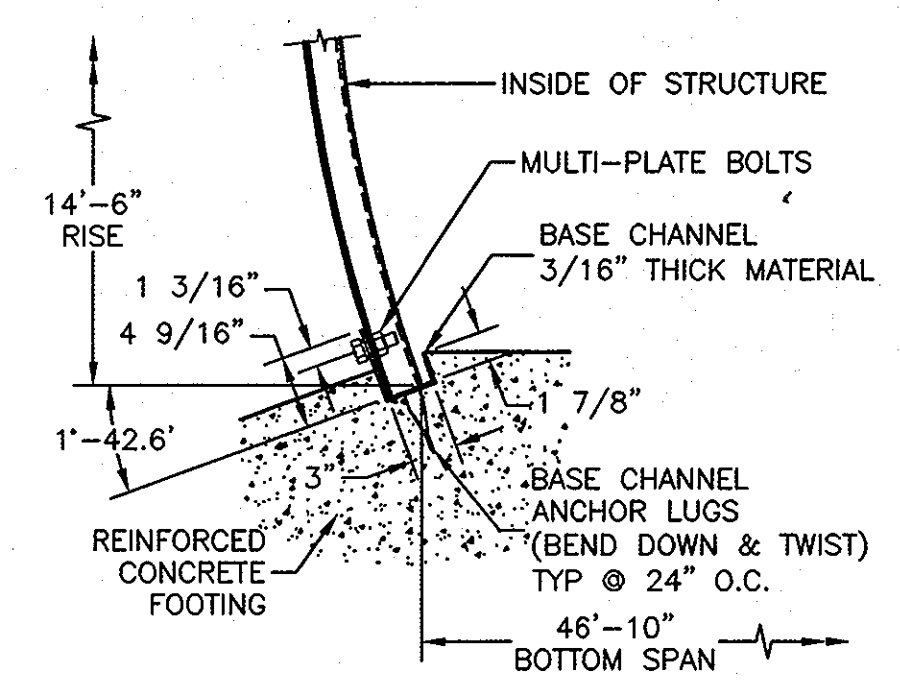


BASE CHANNEL DETAIL


NOT TO SCALE

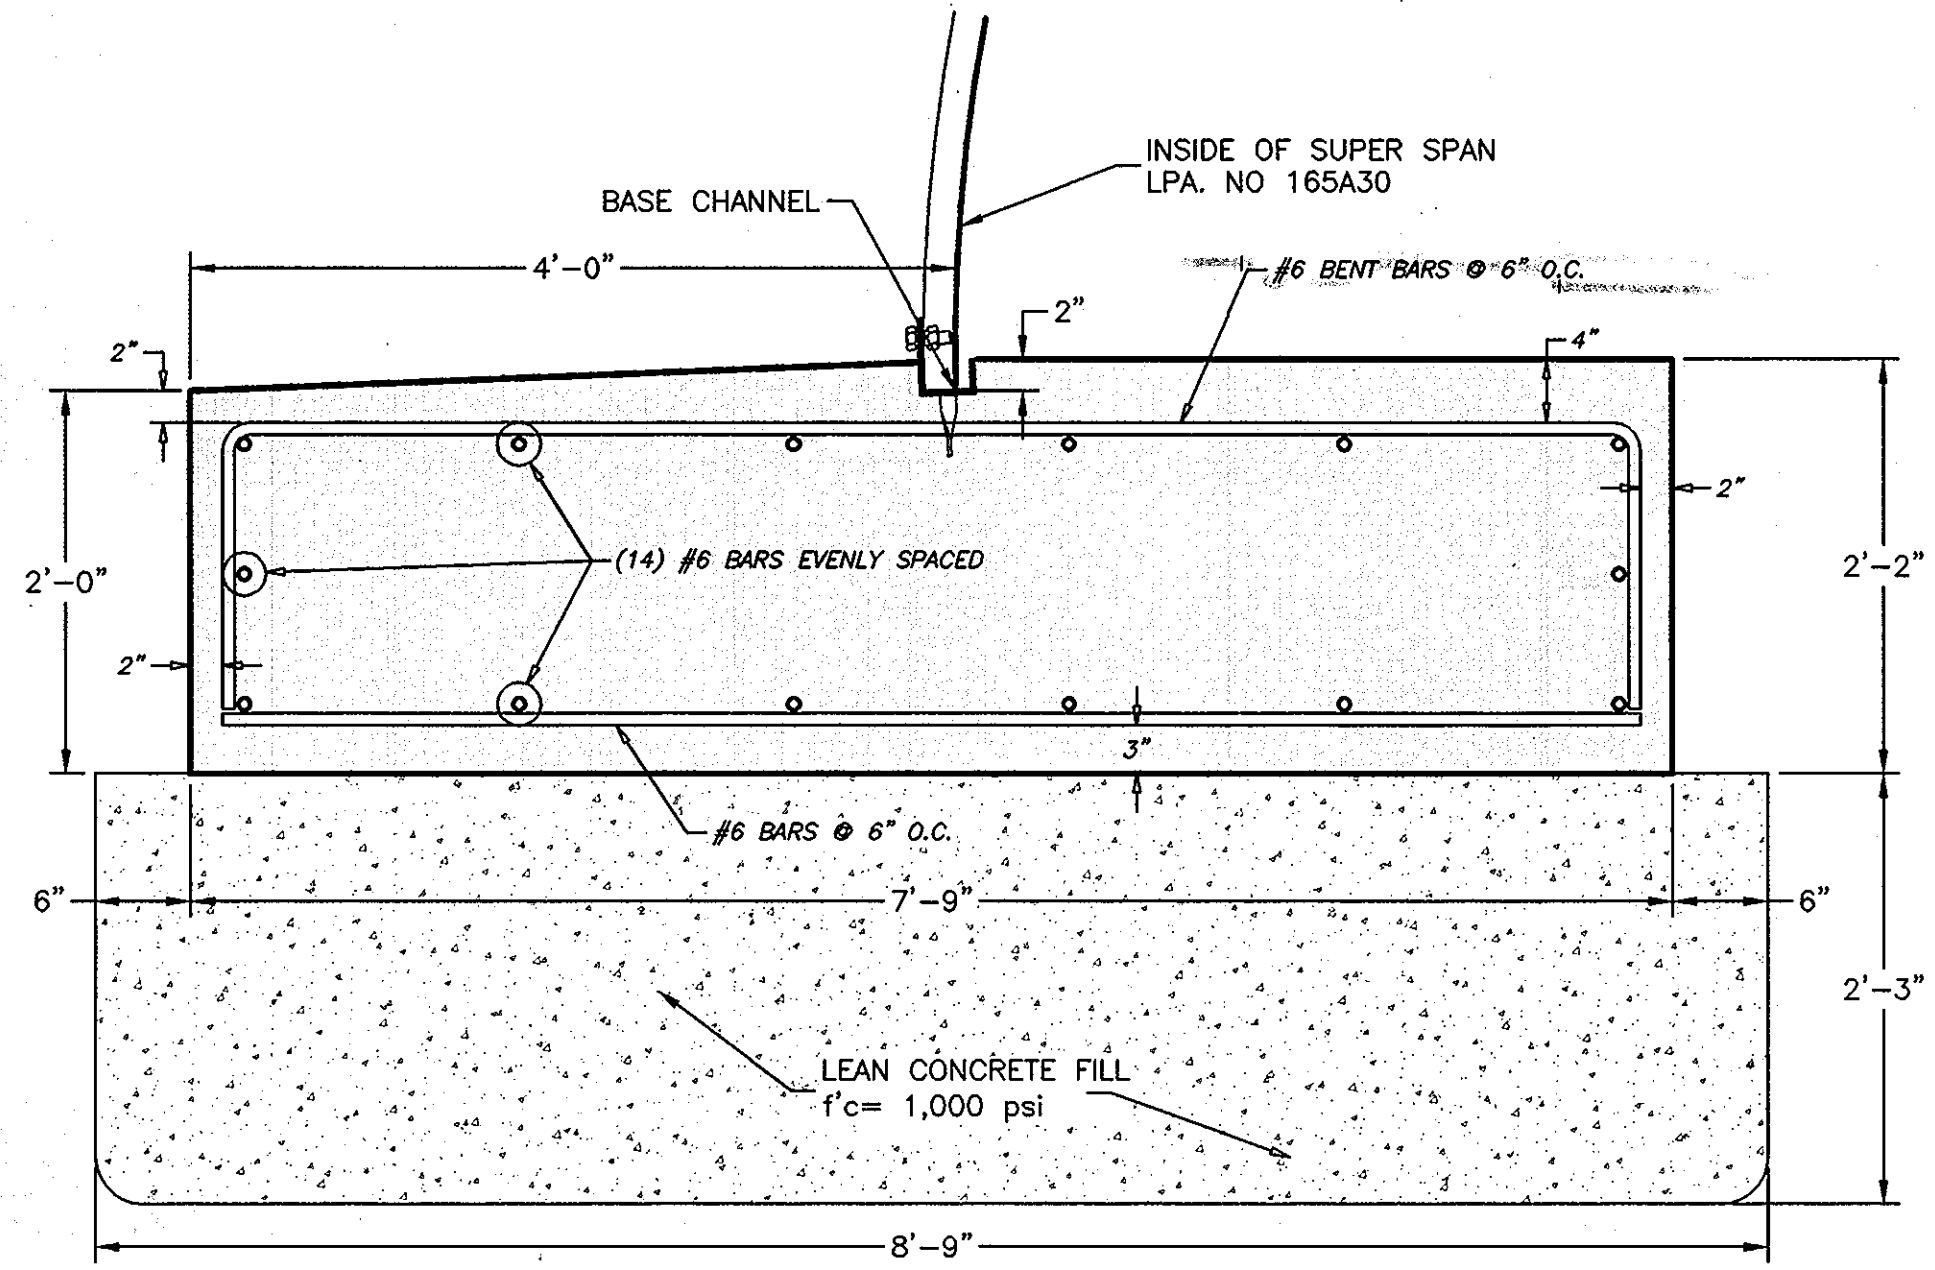


FOOTING SECTION

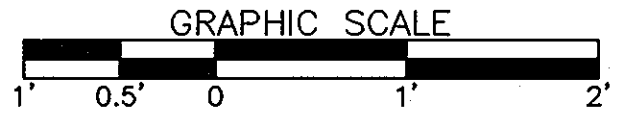


- NOTE:**
- 1.) CONCRETE SHALL BE $f'_c = 4,000$ psi
 - 2.) ALL REINFORCEMENT SHALL BE ASTM A-615, GRADE 60
 - 3.) FOOTING IS DESIGNED FOR A 4,600 psf ALLOWABLE BEARING CAPACITY ON UNDERCUT MAT & 3,000 psf ALLOWABLE BEARING CAPACITY ON NATIVE SOIL TO BE FIELD VERIFIED.

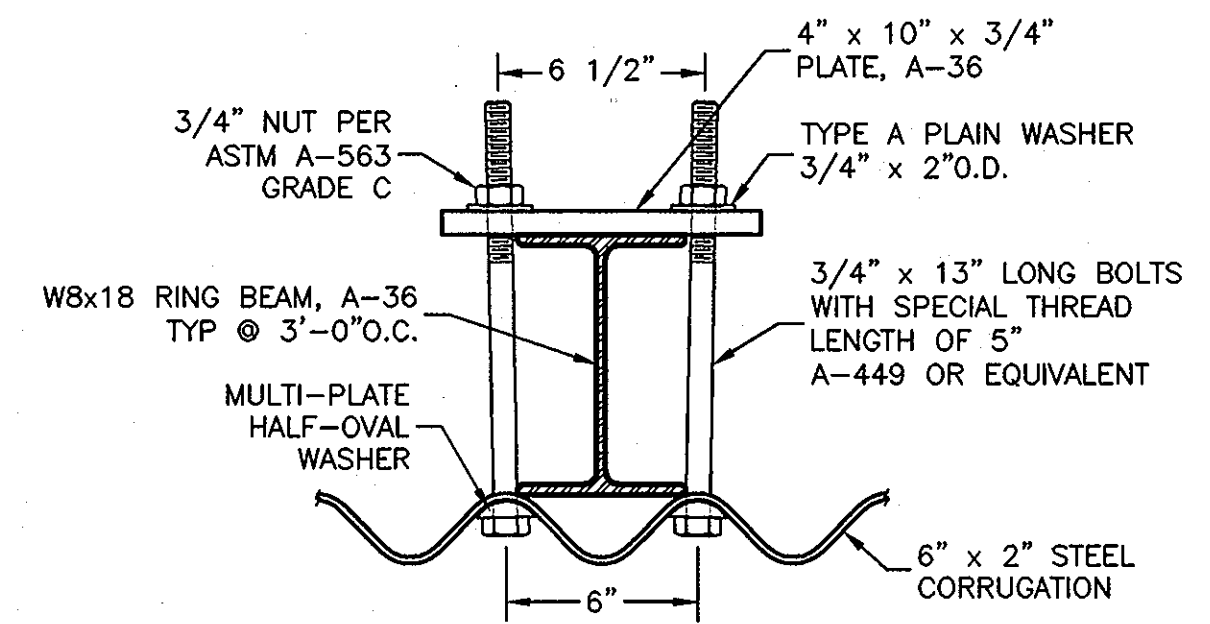

RING BEAM CONNECTION

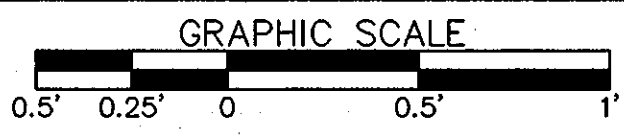

CBC ENGINEERS
DAYTON, OHIO
CBC Project No. 8045

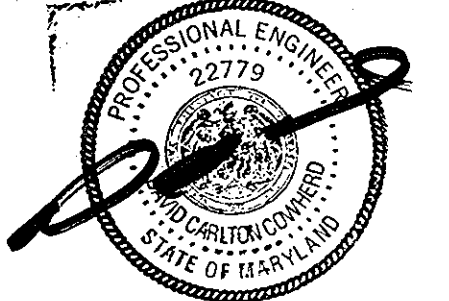


NO.	DATE	REVISION
3	7-13-07	REVISED STORM DRAIN MATERIAL OF SOME PIPES
2	3/27/07	ADDED LEAN CONCRETE FILL TO VIEWS SHEET 11
1	2/16/07	NEW STRUCTURE SIZE, ADDED CONCRETE WINGS



BENCHMARK ENGINEERING, INC.
ENGINEERS • LAND SURVEYORS • PLANNERS
8480 BALTIMORE NATIONAL PIKE • SUITE 418
ELLCOTT CITY, MARYLAND 21043
phone: 410-465-6105 • fax: 410-465-6644
email: Benchmark@cois.com

OWNER/DEVELOPER: HIGHLAND DEVELOPMENT CORP P.O. BOX 228 CLARKSVILLE, MARYLAND 21029 410-531-5539	PROJECT: BRIGHTON MILL LOT 1 THROUGH 22, BUILDABLE PRESERVATION PARCEL 'A' AND NON-BUILDABLE PRESERVATION PARCELS 'B' THROUGH 'D' LOCATION: TAX MAP No. 34, GRID No. 2 PARCEL 2 5th ELECTION DISTRICT HOWARD COUNTY, MARYLAND TITLE: NORTH STRUCTURE DETAIL PLAN, PROFILE & DETAILS DATE: FEBRUARY, 2007 PROJECT NO. 1513
Design: -- Draft: -- Check: --	SCALE: AS SHOWN DRAWING 10 OF 34



APPROVED: HOWARD COUNTY DEPARTMENT OF PUBLIC WORKS
Walter Z. ... 6-6-07
CHIEF, BUREAU OF HIGHWAYS
APPROVED: HOWARD COUNTY DEPT. OF PLANNING AND ZONING
T. Krueger - Mueschler for ... 6-11-07
CHIEF, DIVISION OF LAND DEVELOPMENT
... 6/6/07
CHIEF, DEVELOPMENT ENGINEERING DIVISION

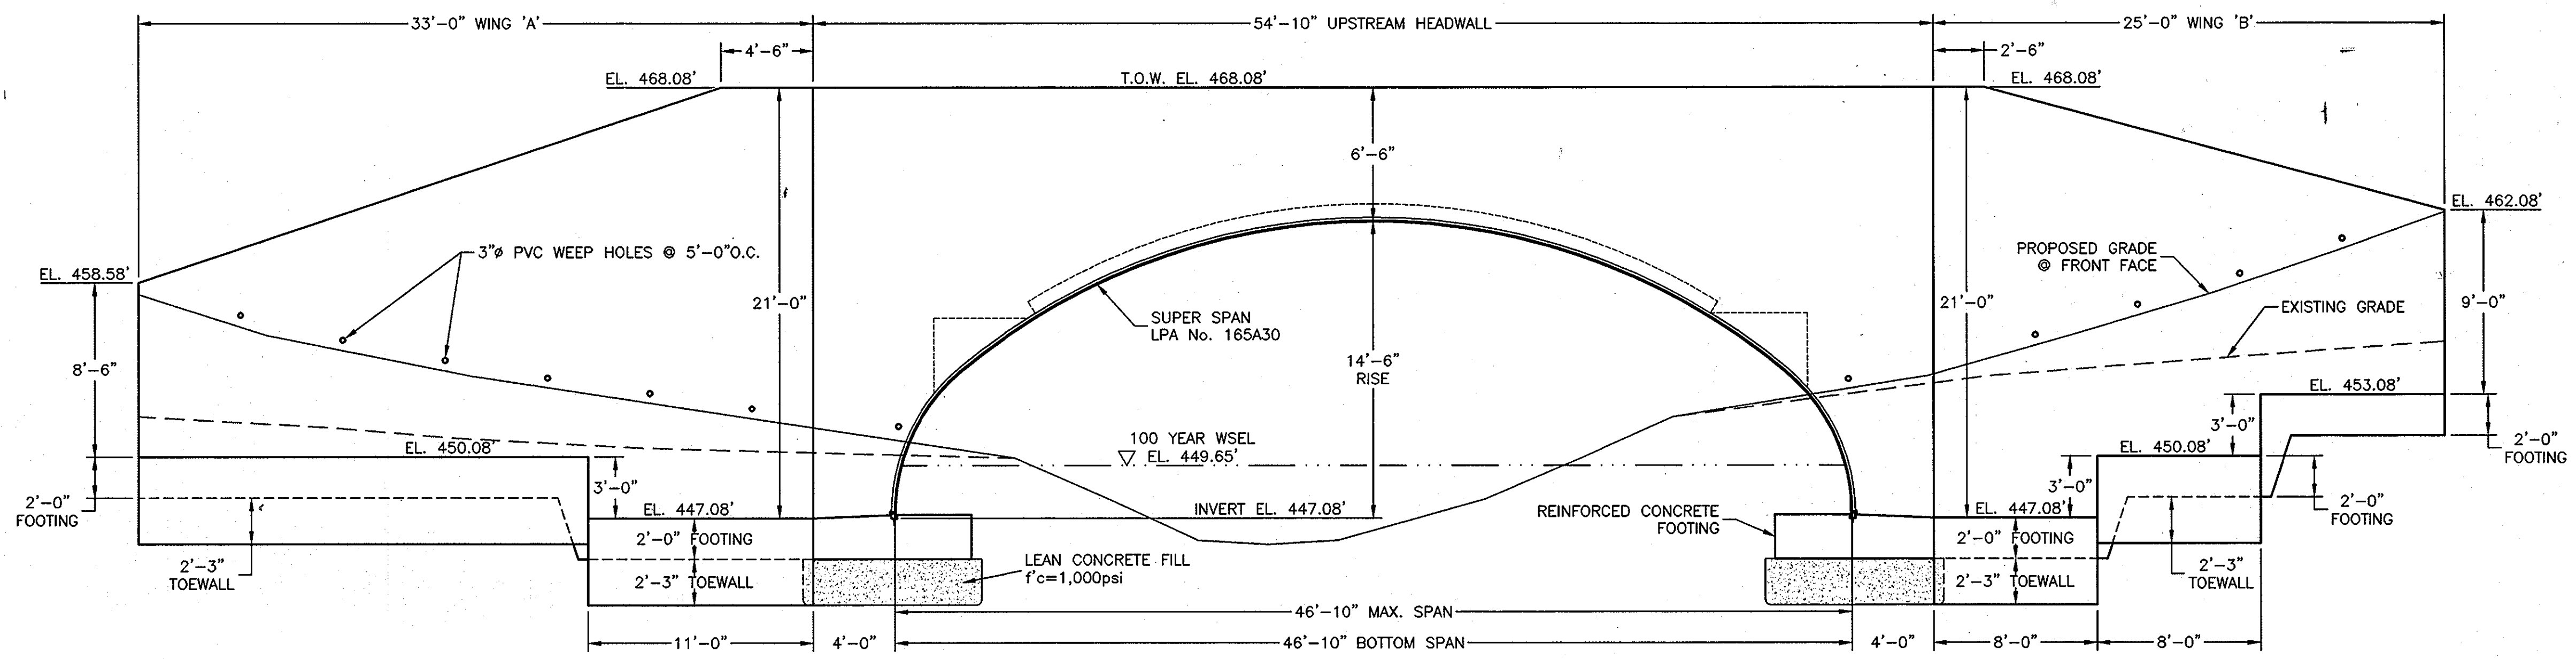

UPSTREAM END ELEVATION VIEW

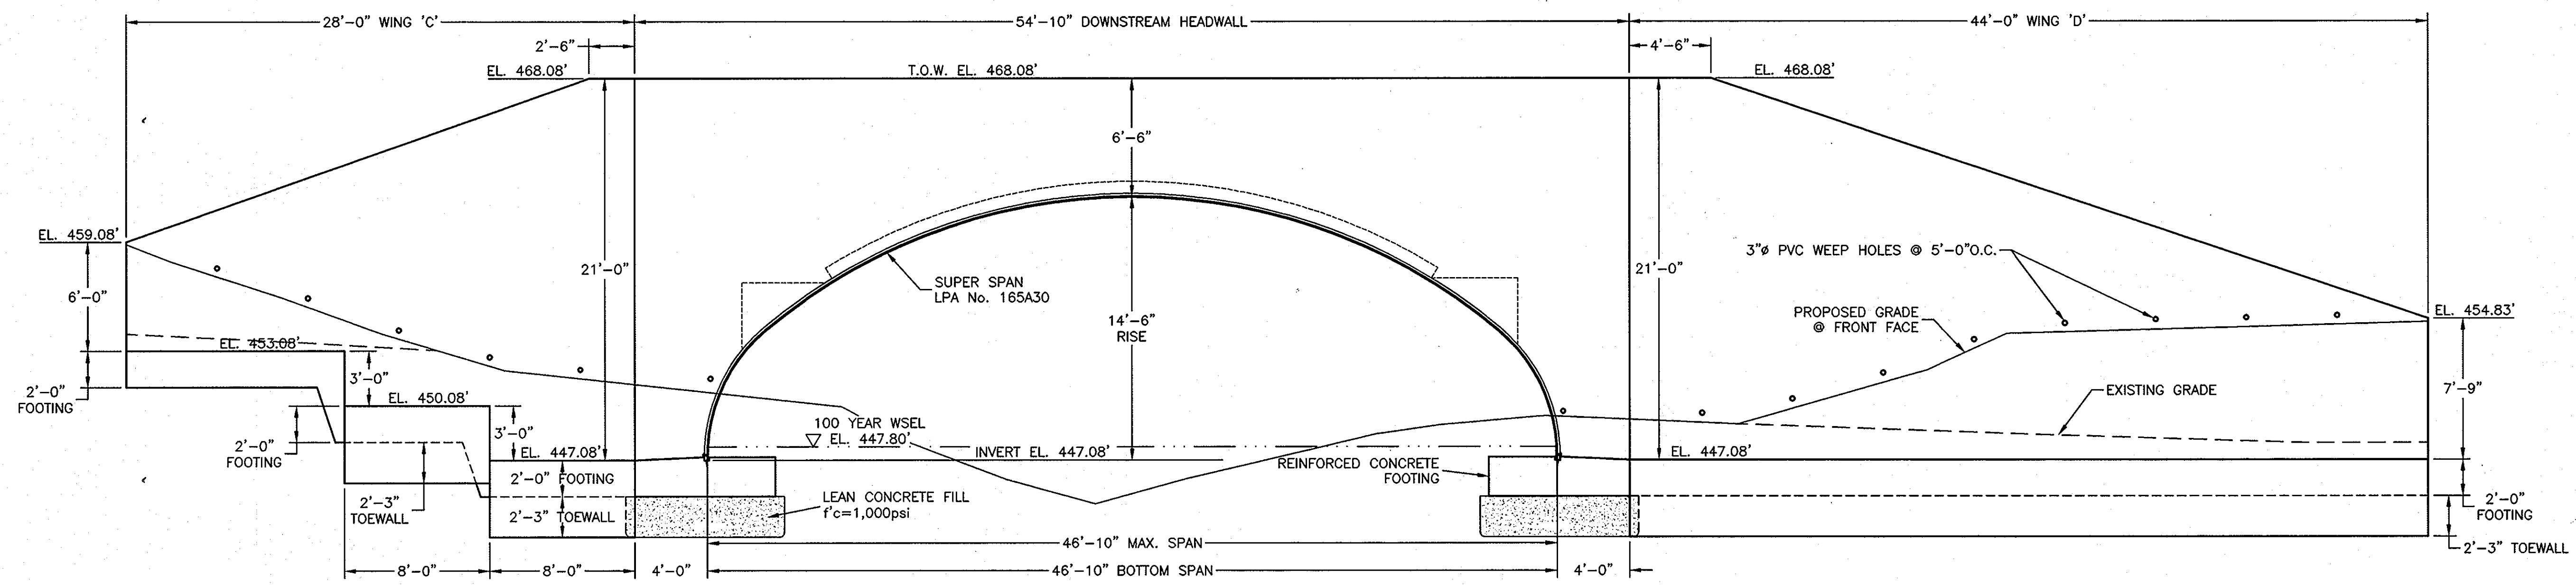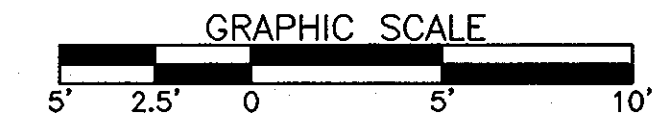

DOWNSTREAM END ELEVATION VIEW

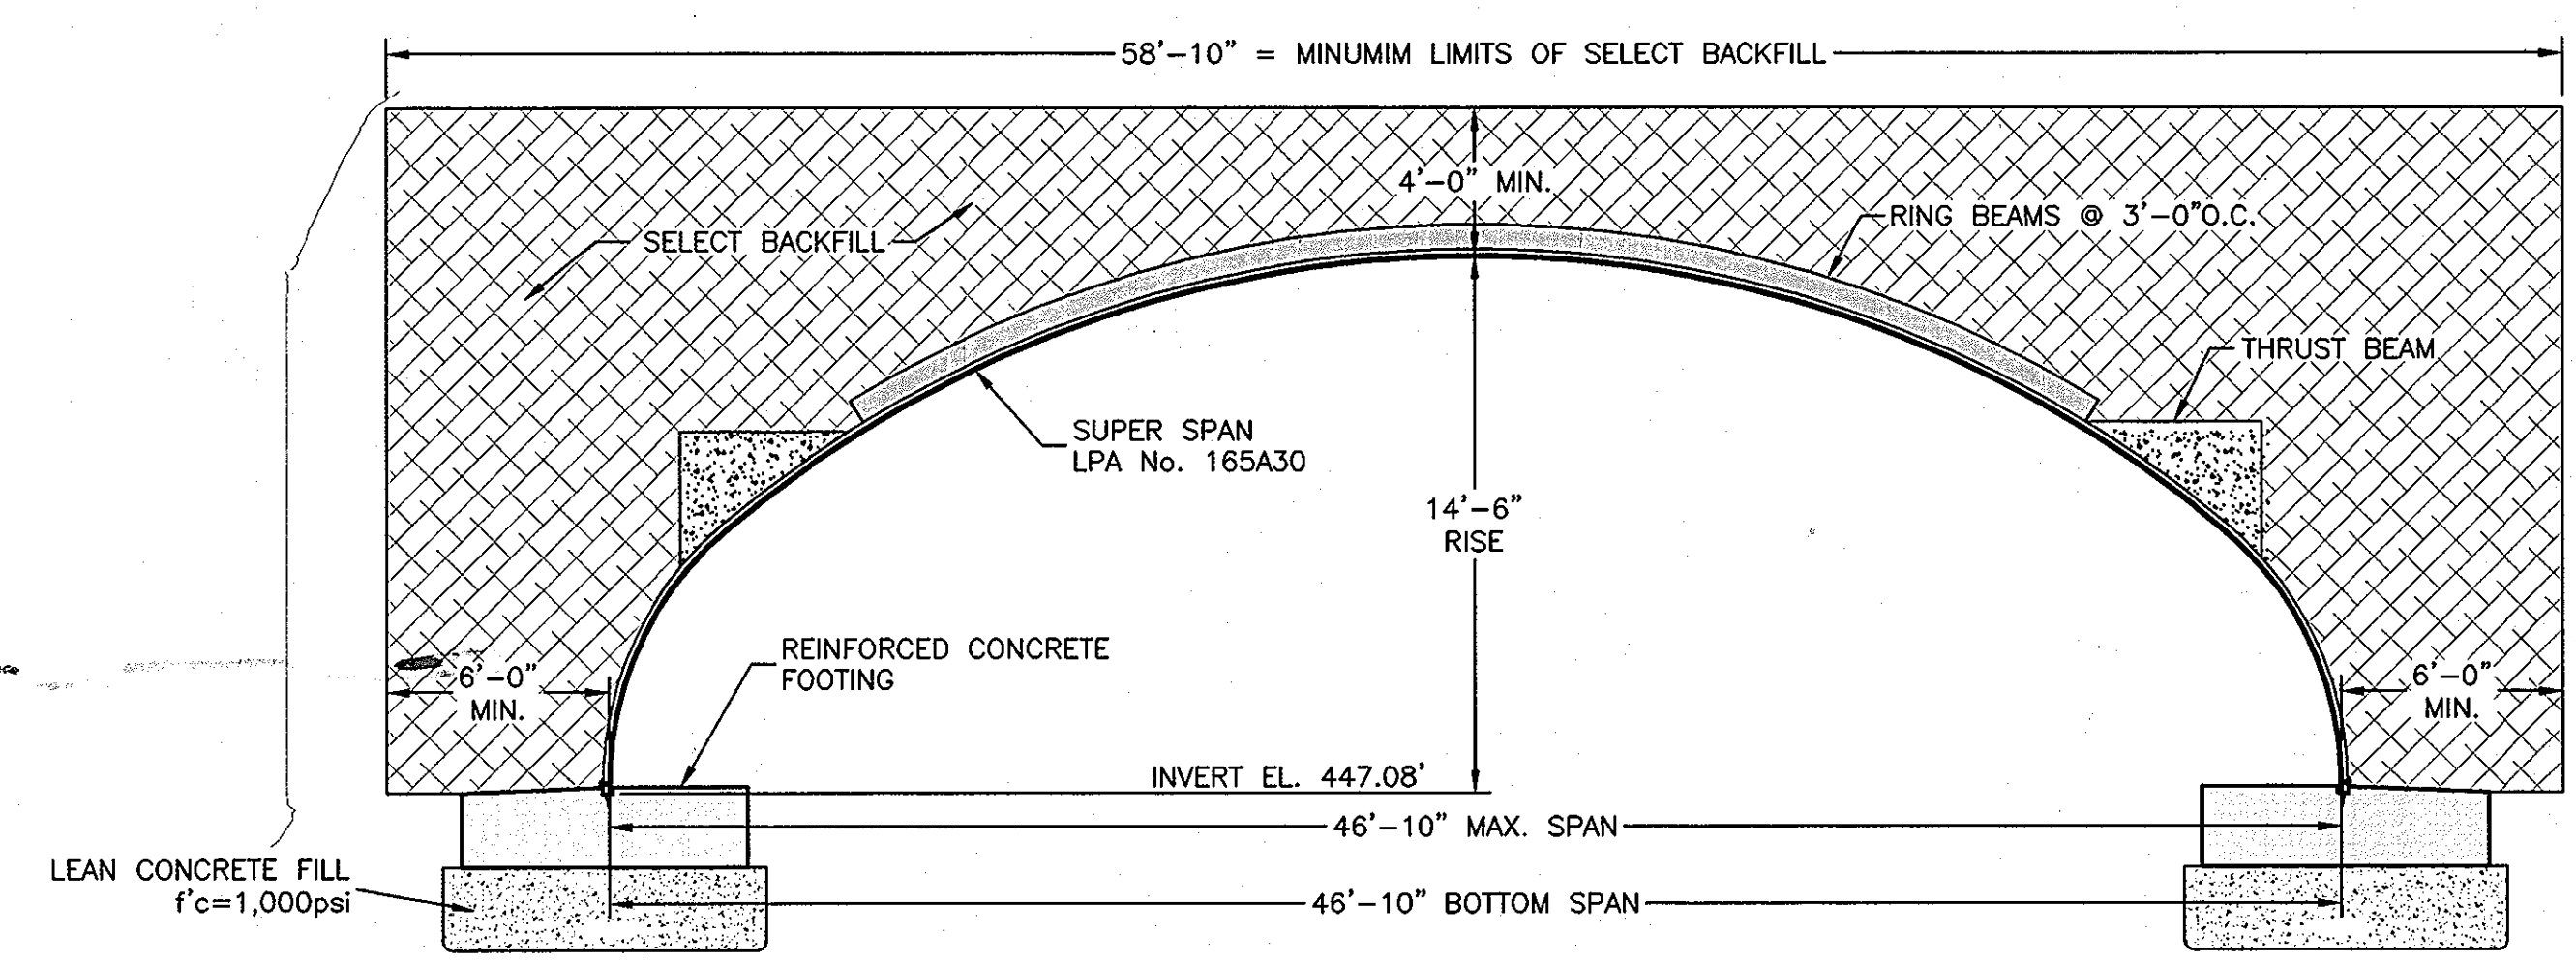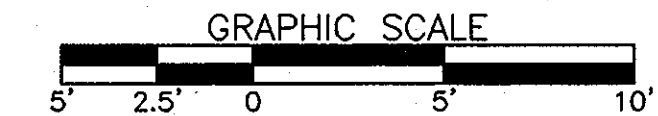


TYPICAL BACKFILL SECTION



NOTE:
 1.) CONCRETE SHALL BE $f'_c = 4,000$ psi
 2.) ALL REINFORCEMENT SHALL BE ASTM A-615, GRADE 60
 3.) FOOTING IS DESIGNED FOR A 4,600 psf ALLOWABLE BEARING CAPACITY ON UNDERCUT MAT & 3,000 psf ALLOWABLE BEARING CAPACITY ON NATIVE SOIL TO BE FIELD VERIFIED.

CBC ENGINEERS
 DAYTON, OHIO
 CBC Project No. 8045

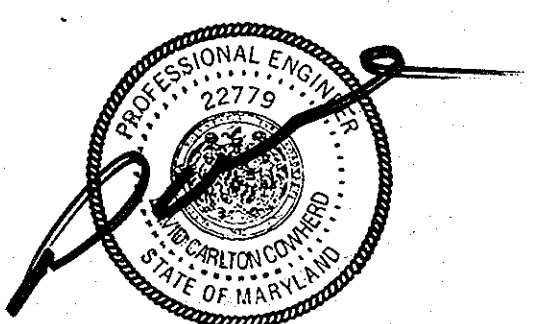

NO.	DATE	REVISION
2	3/27/07	ADDED LEAN CONCRETE FILL TO VIEWS SHEET 11
1	2/16/07	NEW STRUCTURE SIZE, ADDED CONCRETE WINGS

BENCHMARK ENGINEERING, INC.
 ENGINEERS • LAND SURVEYORS • PLANNERS
 8480 BALTIMORE NATIONAL PIKE • SUITE 418
 ELLICOTT CITY, MARYLAND 21043
 phone: 410-465-6105 • fax: 410-465-6644
 email: Benchmark@cbis.com

OWNER/DEVELOPER: HIGHLAND DEVELOPMENT CORP
 P.O. BOX 228
 CLARKSVILLE, MARYLAND 21029
 410-531-5539

PROJECT: BRIGHTON MILL
 LOT 1 THROUGH 22, BUILDABLE PRESERVATION PARCEL 'A' AND NON-BUILDABLE PRESERVATION PARCELS 'B' THROUGH 'D'
 LOCATION: TAX MAP No. 34, GRID No. 2
 PARCEL 2
 5th ELECTION DISTRICT
 HOWARD COUNTY, MARYLAND


TITLE: NORTH STRUCTURE DETAIL
 BACKFILL SECTION & END VIEWS

DATE: FEBRUARY, 2007 PROJECT NO. 1513
 SCALE: AS SHOWN DRAWING 11 OF 34


APPROVED: HOWARD COUNTY DEPARTMENT OF PUBLIC WORKS
Walter F. ... 6-6-07
 CHIEF, BUREAU OF HIGHWAYS

APPROVED: HOWARD COUNTY DEPT. OF PLANNING AND ZONING
T. Krista-Muschard for C. Hamilton 6-11-07
 CHIEF, DIVISION OF LAND DEVELOPMENT

... 6/6/07
 CHIEF, DEVELOPMENT ENGINEERING DIVISION

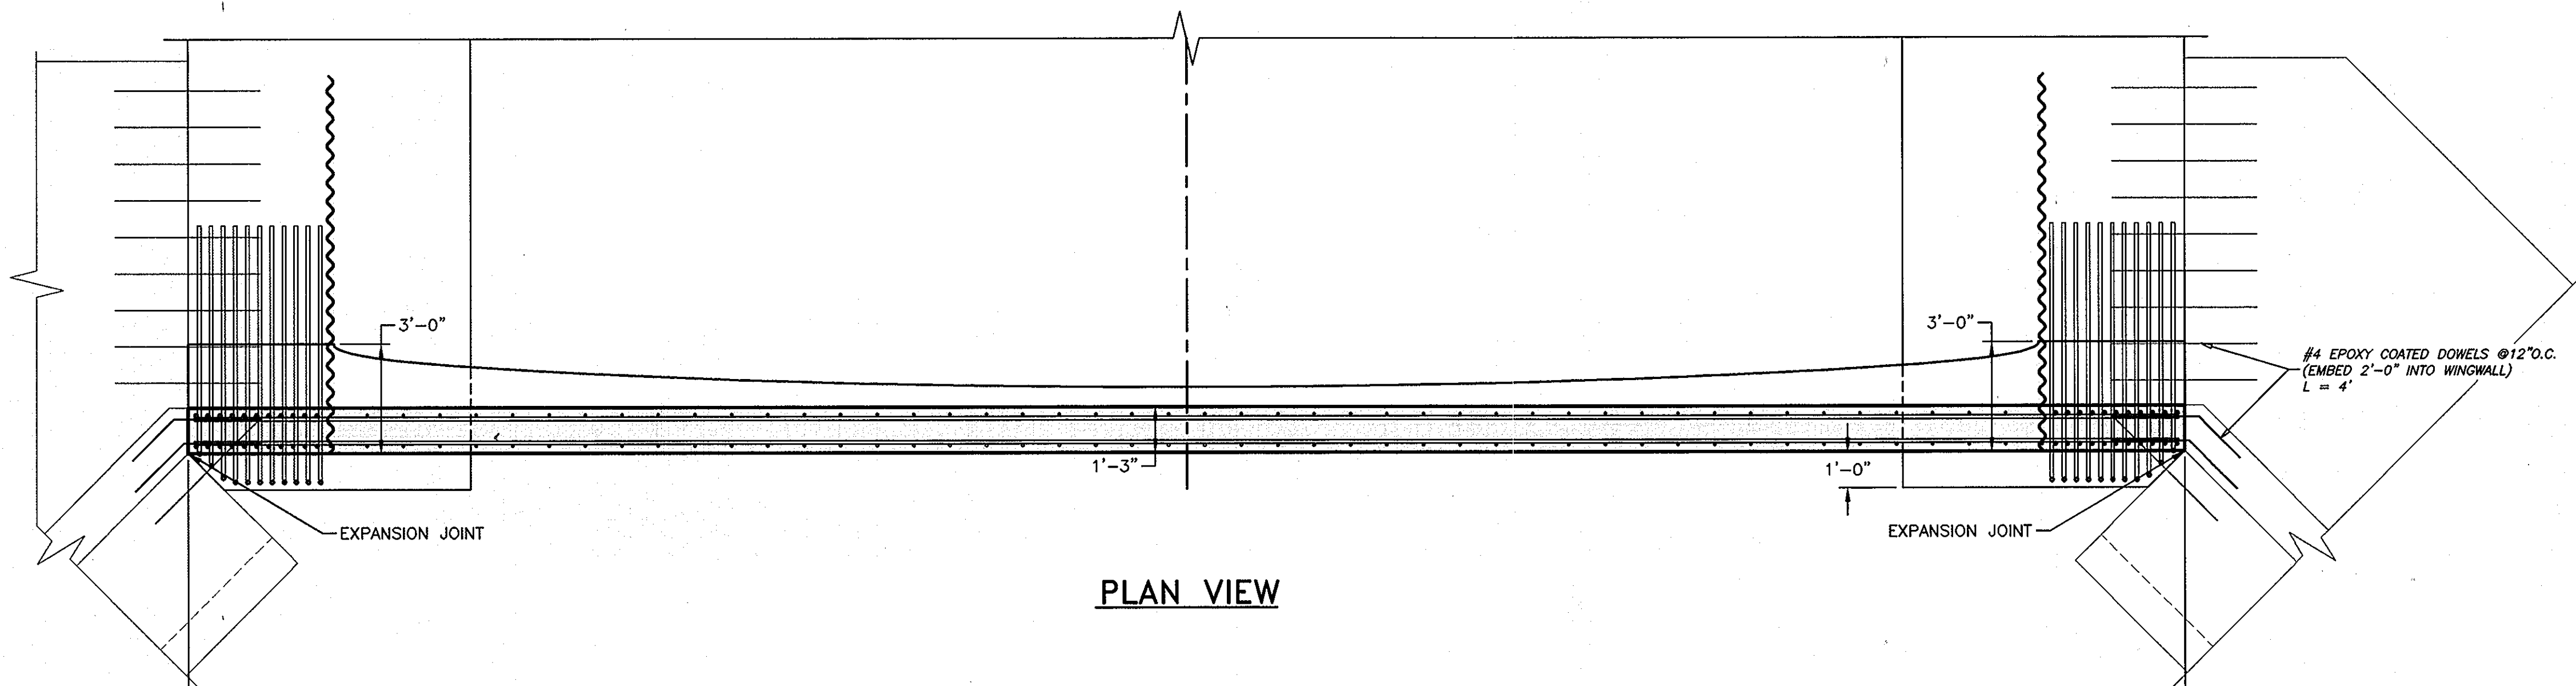


PLAN VIEW

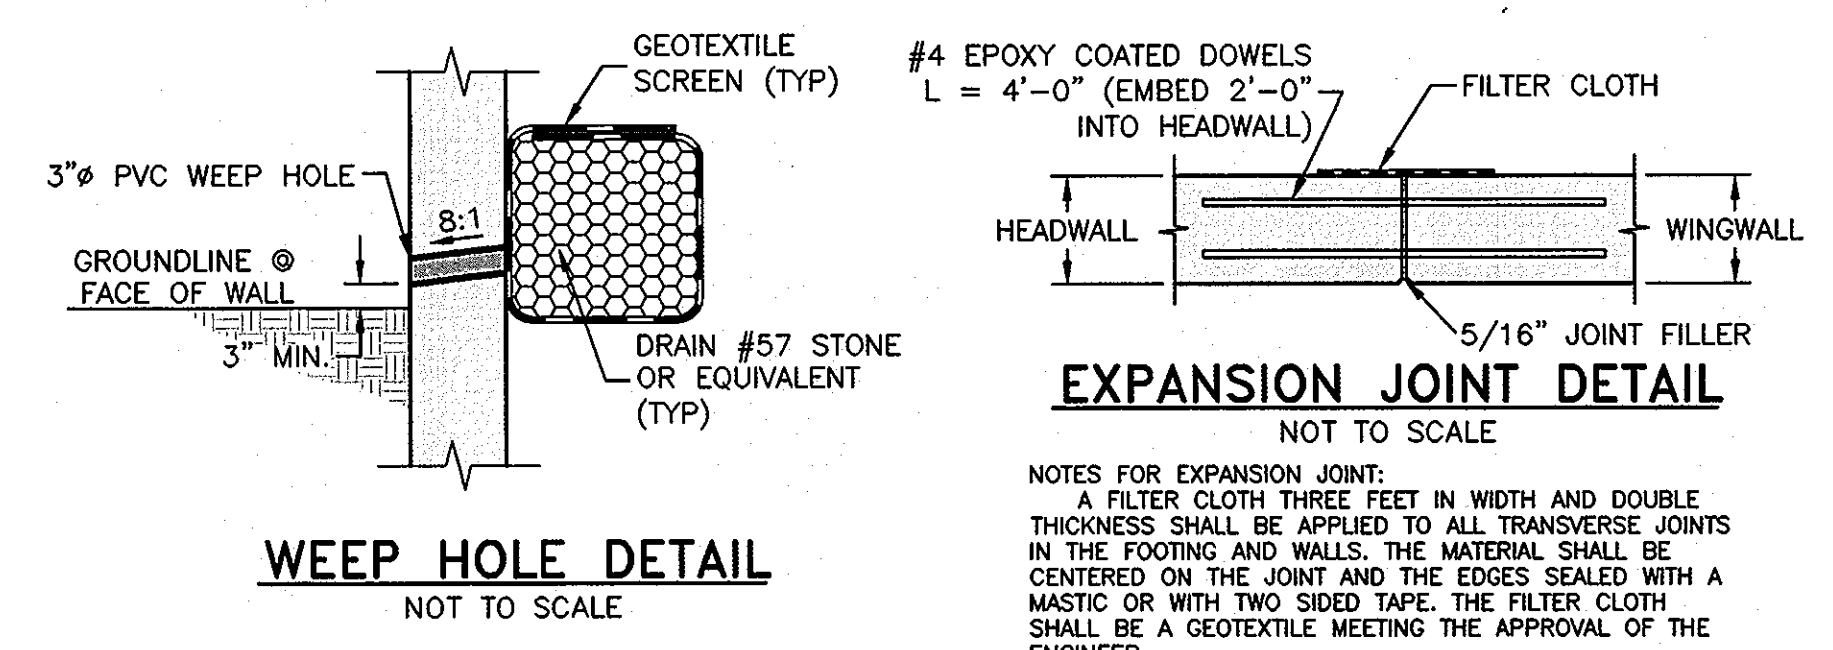


WEEP HOLE DETAIL
NOT TO SCALE

EXPANSION JOINT DETAIL
NOT TO SCALE

NOTES FOR EXPANSION JOINT:
A FILTER CLOTH THREE FEET IN WIDTH AND DOUBLE THICKNESS SHALL BE APPLIED TO ALL TRANSVERSE JOINTS IN THE FOOTING AND WALLS. THE MATERIAL SHALL BE CENTERED ON THE JOINT AND THE EDGES SEALED WITH A MASTIC OR WITH TWO SIDED TAPE. THE FILTER CLOTH SHALL BE A GEOTEXTILE MEETING THE APPROVAL OF THE ENGINEER.

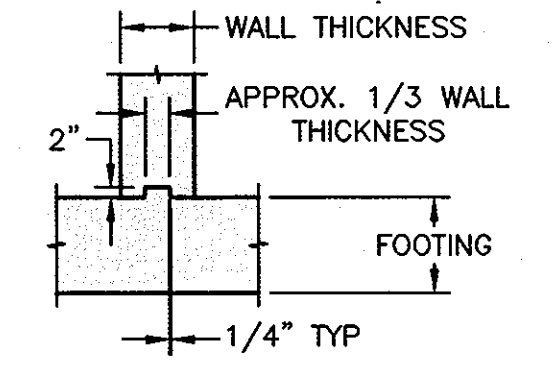


KEYED CONSTRUCTION JOINT DETAIL
NOT TO SCALE

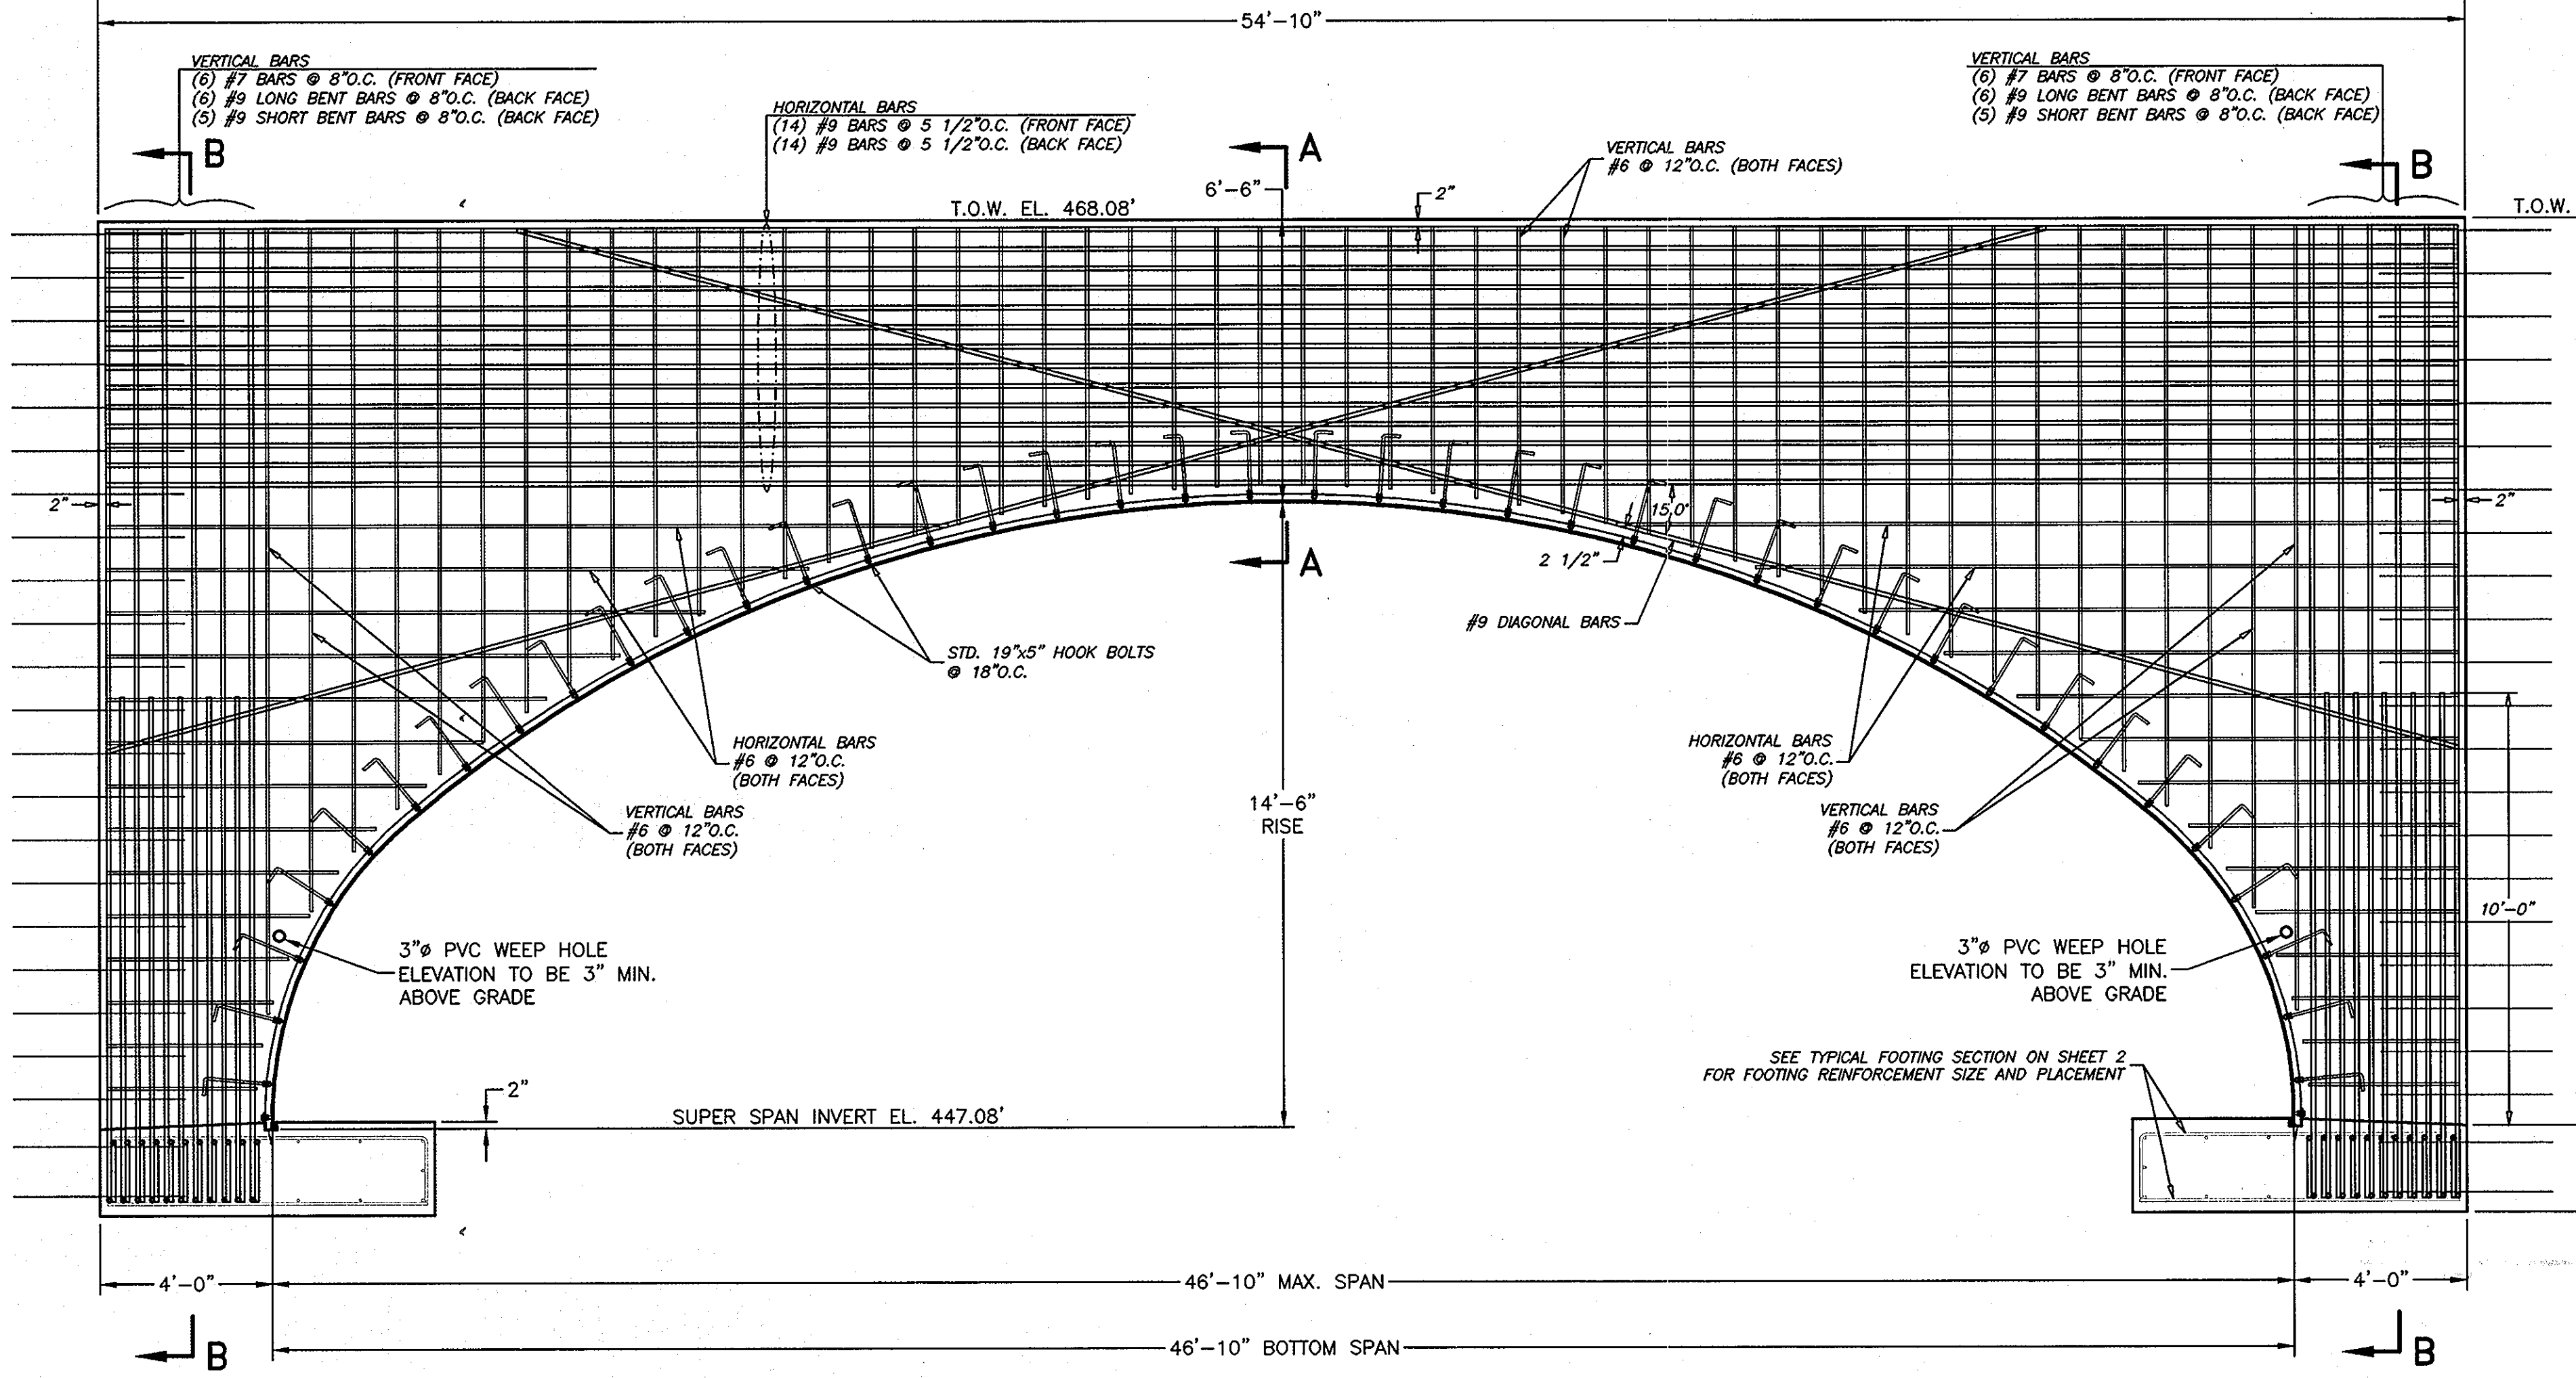


ELEVATION VIEW

HEADWALL DESIGN

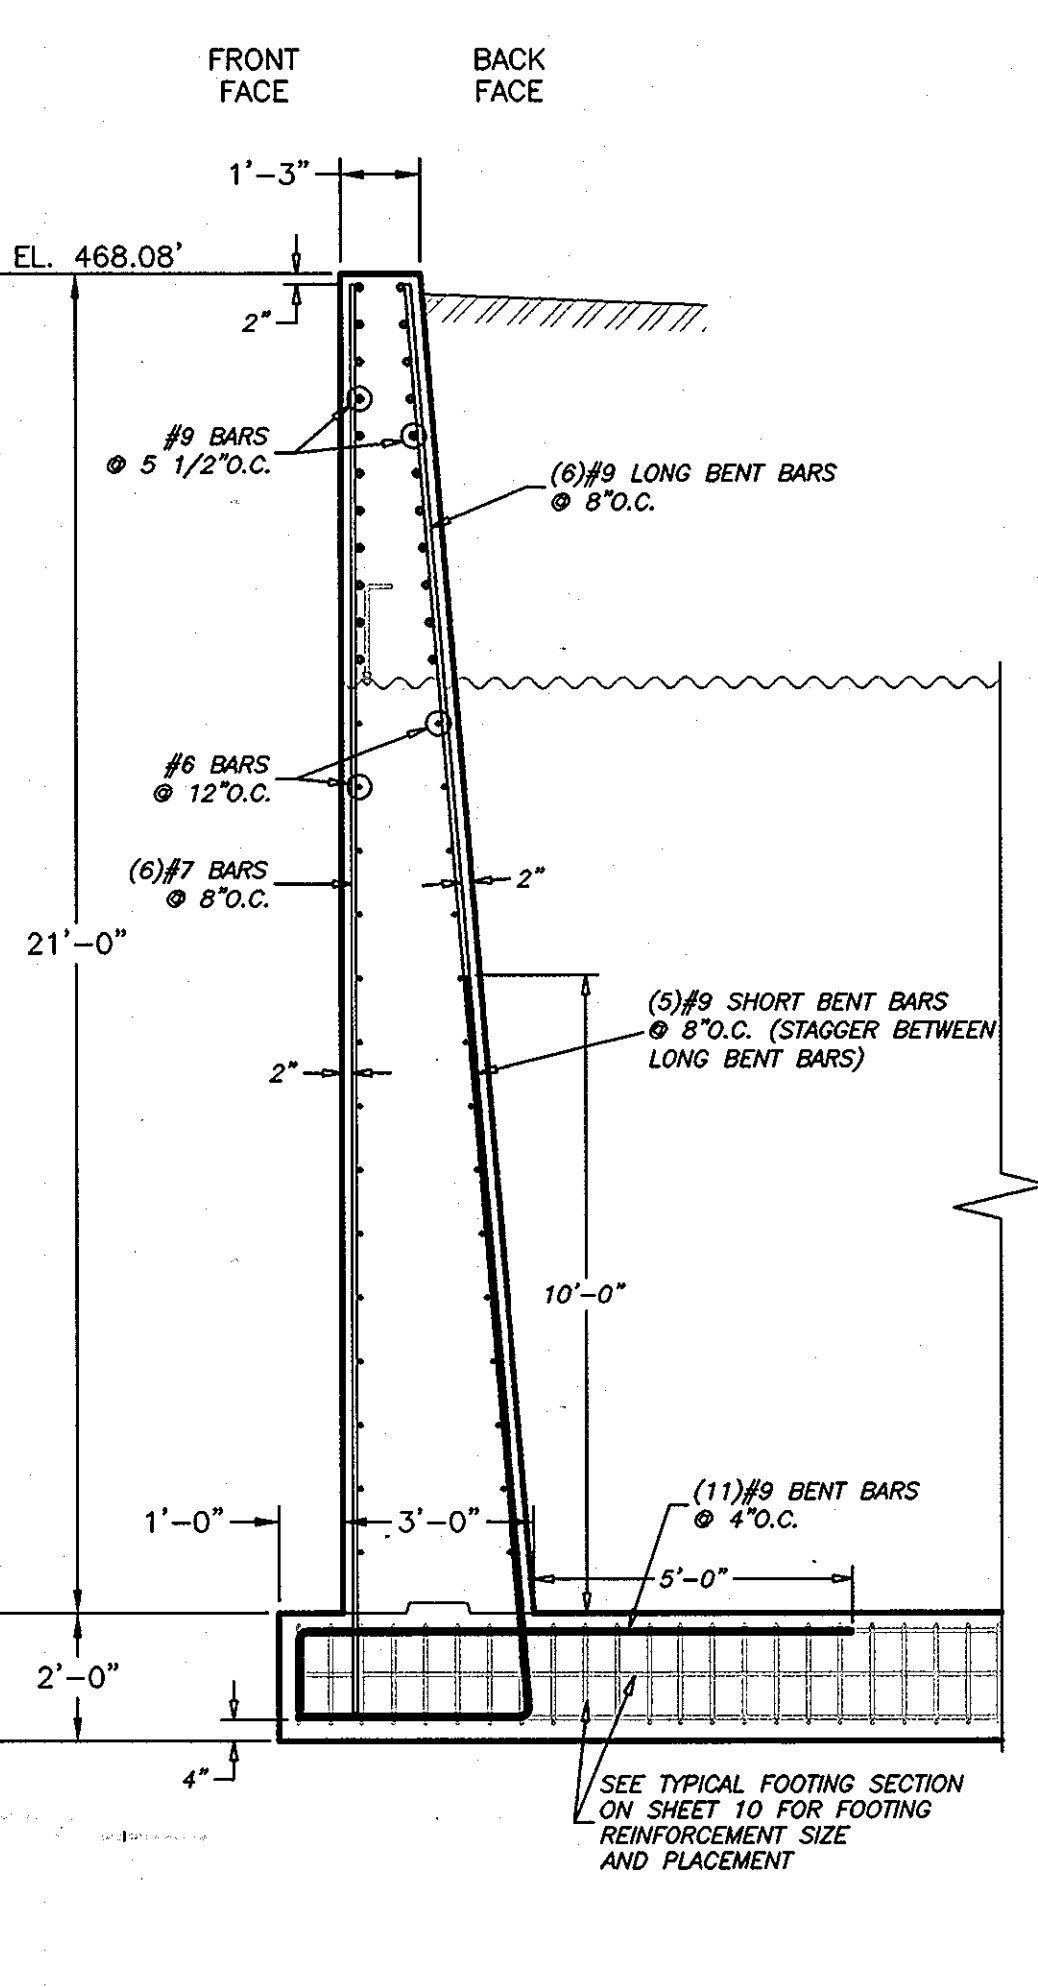

SIDE VIEW

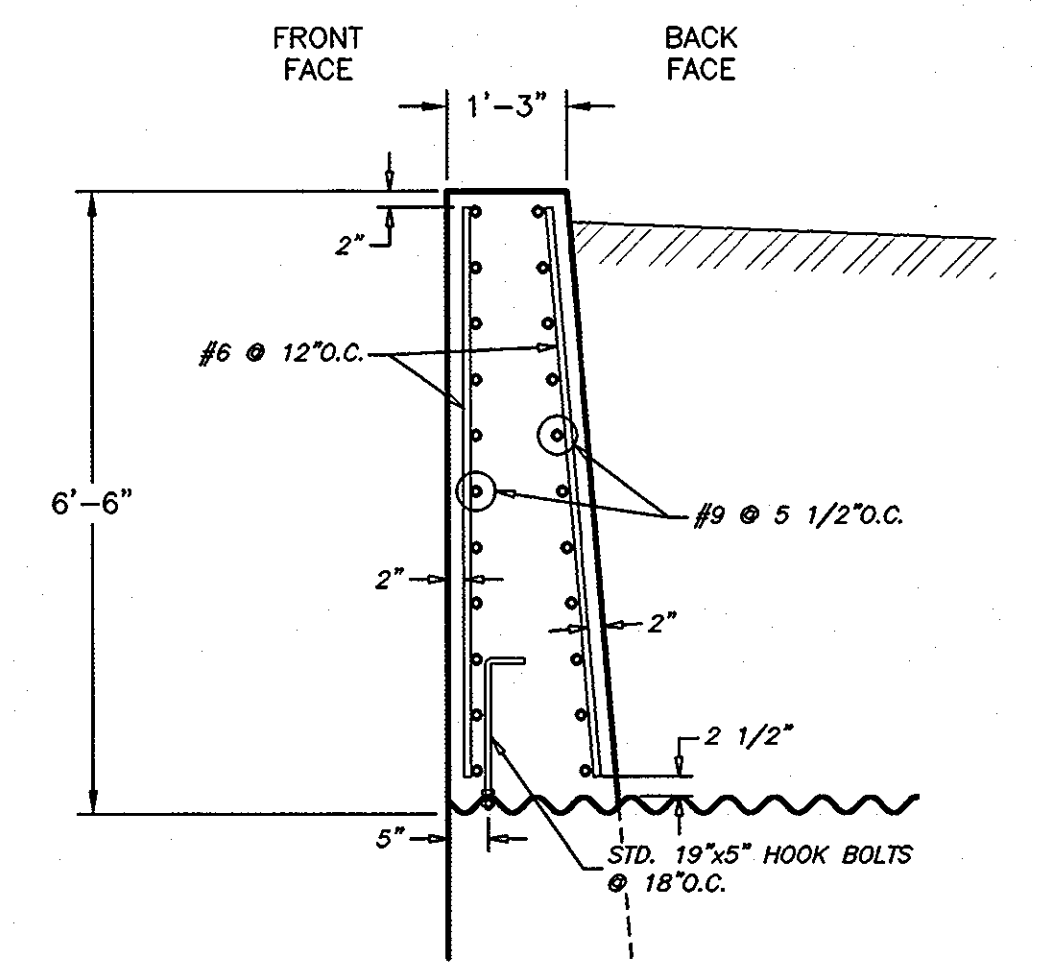


SECTION 'A-A'



NOTE:
1.) CONCRETE SHALL BE $f'c = 4,000$ psi
2.) ALL REINFORCEMENT SHALL BE ASTM A-615, GRADE 60
3.) FOOTING IS DESIGNED FOR A 4,600 psf ALLOWABLE BEARING CAPACITY ON UNDERCUT MAT & 3,000 psf ALLOWABLE BEARING CAPACITY ON NATIVE SOIL TO BE FIELD VERIFIED.

CBC ENGINEERS
DAYTON, OHIO
CBC Project No. 8045

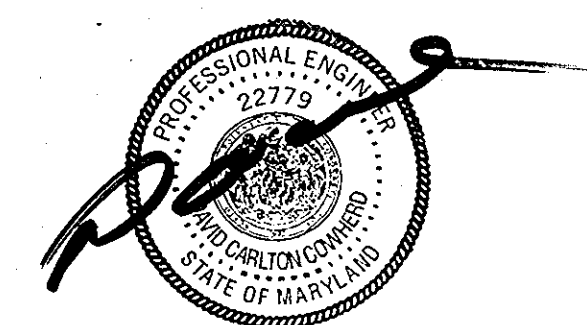

NO.	DATE	REVISION
2	3/27/07	ADDED LEAN CONCRETE FILL TO VIEWS SHEET 11
1	2/16/07	NEW STRUCTURE SIZE, ADDED CONCRETE WINGS


BENCHMARK ENGINEERING, INC.
ENGINEERS • LAND SURVEYORS • PLANNERS
8480 BALTIMORE NATIONAL PIKE & SUITE 418
ELLCOTT CITY, MARYLAND 21043
phone: 410-465-6105 A fax: 410-465-6644
email: Benchmark@ccis.com

OWNER/DEVELOPER: HIGHLAND DEVELOPMENT CORP P.O. BOX 228 CLARKSVILLE, MARYLAND 21029 410-531-5539	PROJECT: BRIGHTON MILL LOT 1 THROUGH 22, BUILDABLE PRESERVATION PARCEL 'A' AND NON-BUILDABLE PRESERVATION PARCELS 'B' THROUGH 'D' LOCATION: TAX MAP No. 34, GRID No. 2 PARCEL 2 5th ELECTION DISTRICT HOWARD COUNTY, MARYLAND
DATE: FEBRUARY, 2007	PROJECT NO. 1513
Design: --	Draft: --
Check: --	SCALE: AS SHOWN
	DRAWING 12 OF 34

APPROVED: HOWARD COUNTY DEPARTMENT OF PUBLIC WORKS
Walter F. ... 6-6-07
CHIEF, BUREAU OF HIGHWAYS

APPROVED: HOWARD COUNTY DEPT. OF PLANNING AND ZONING
J. ... 6-11-07
CHIEF, DIVISION OF LAND DEVELOPMENT

... 6/8/07
CHIEF, DEVELOPMENT ENGINEERING DIVISION

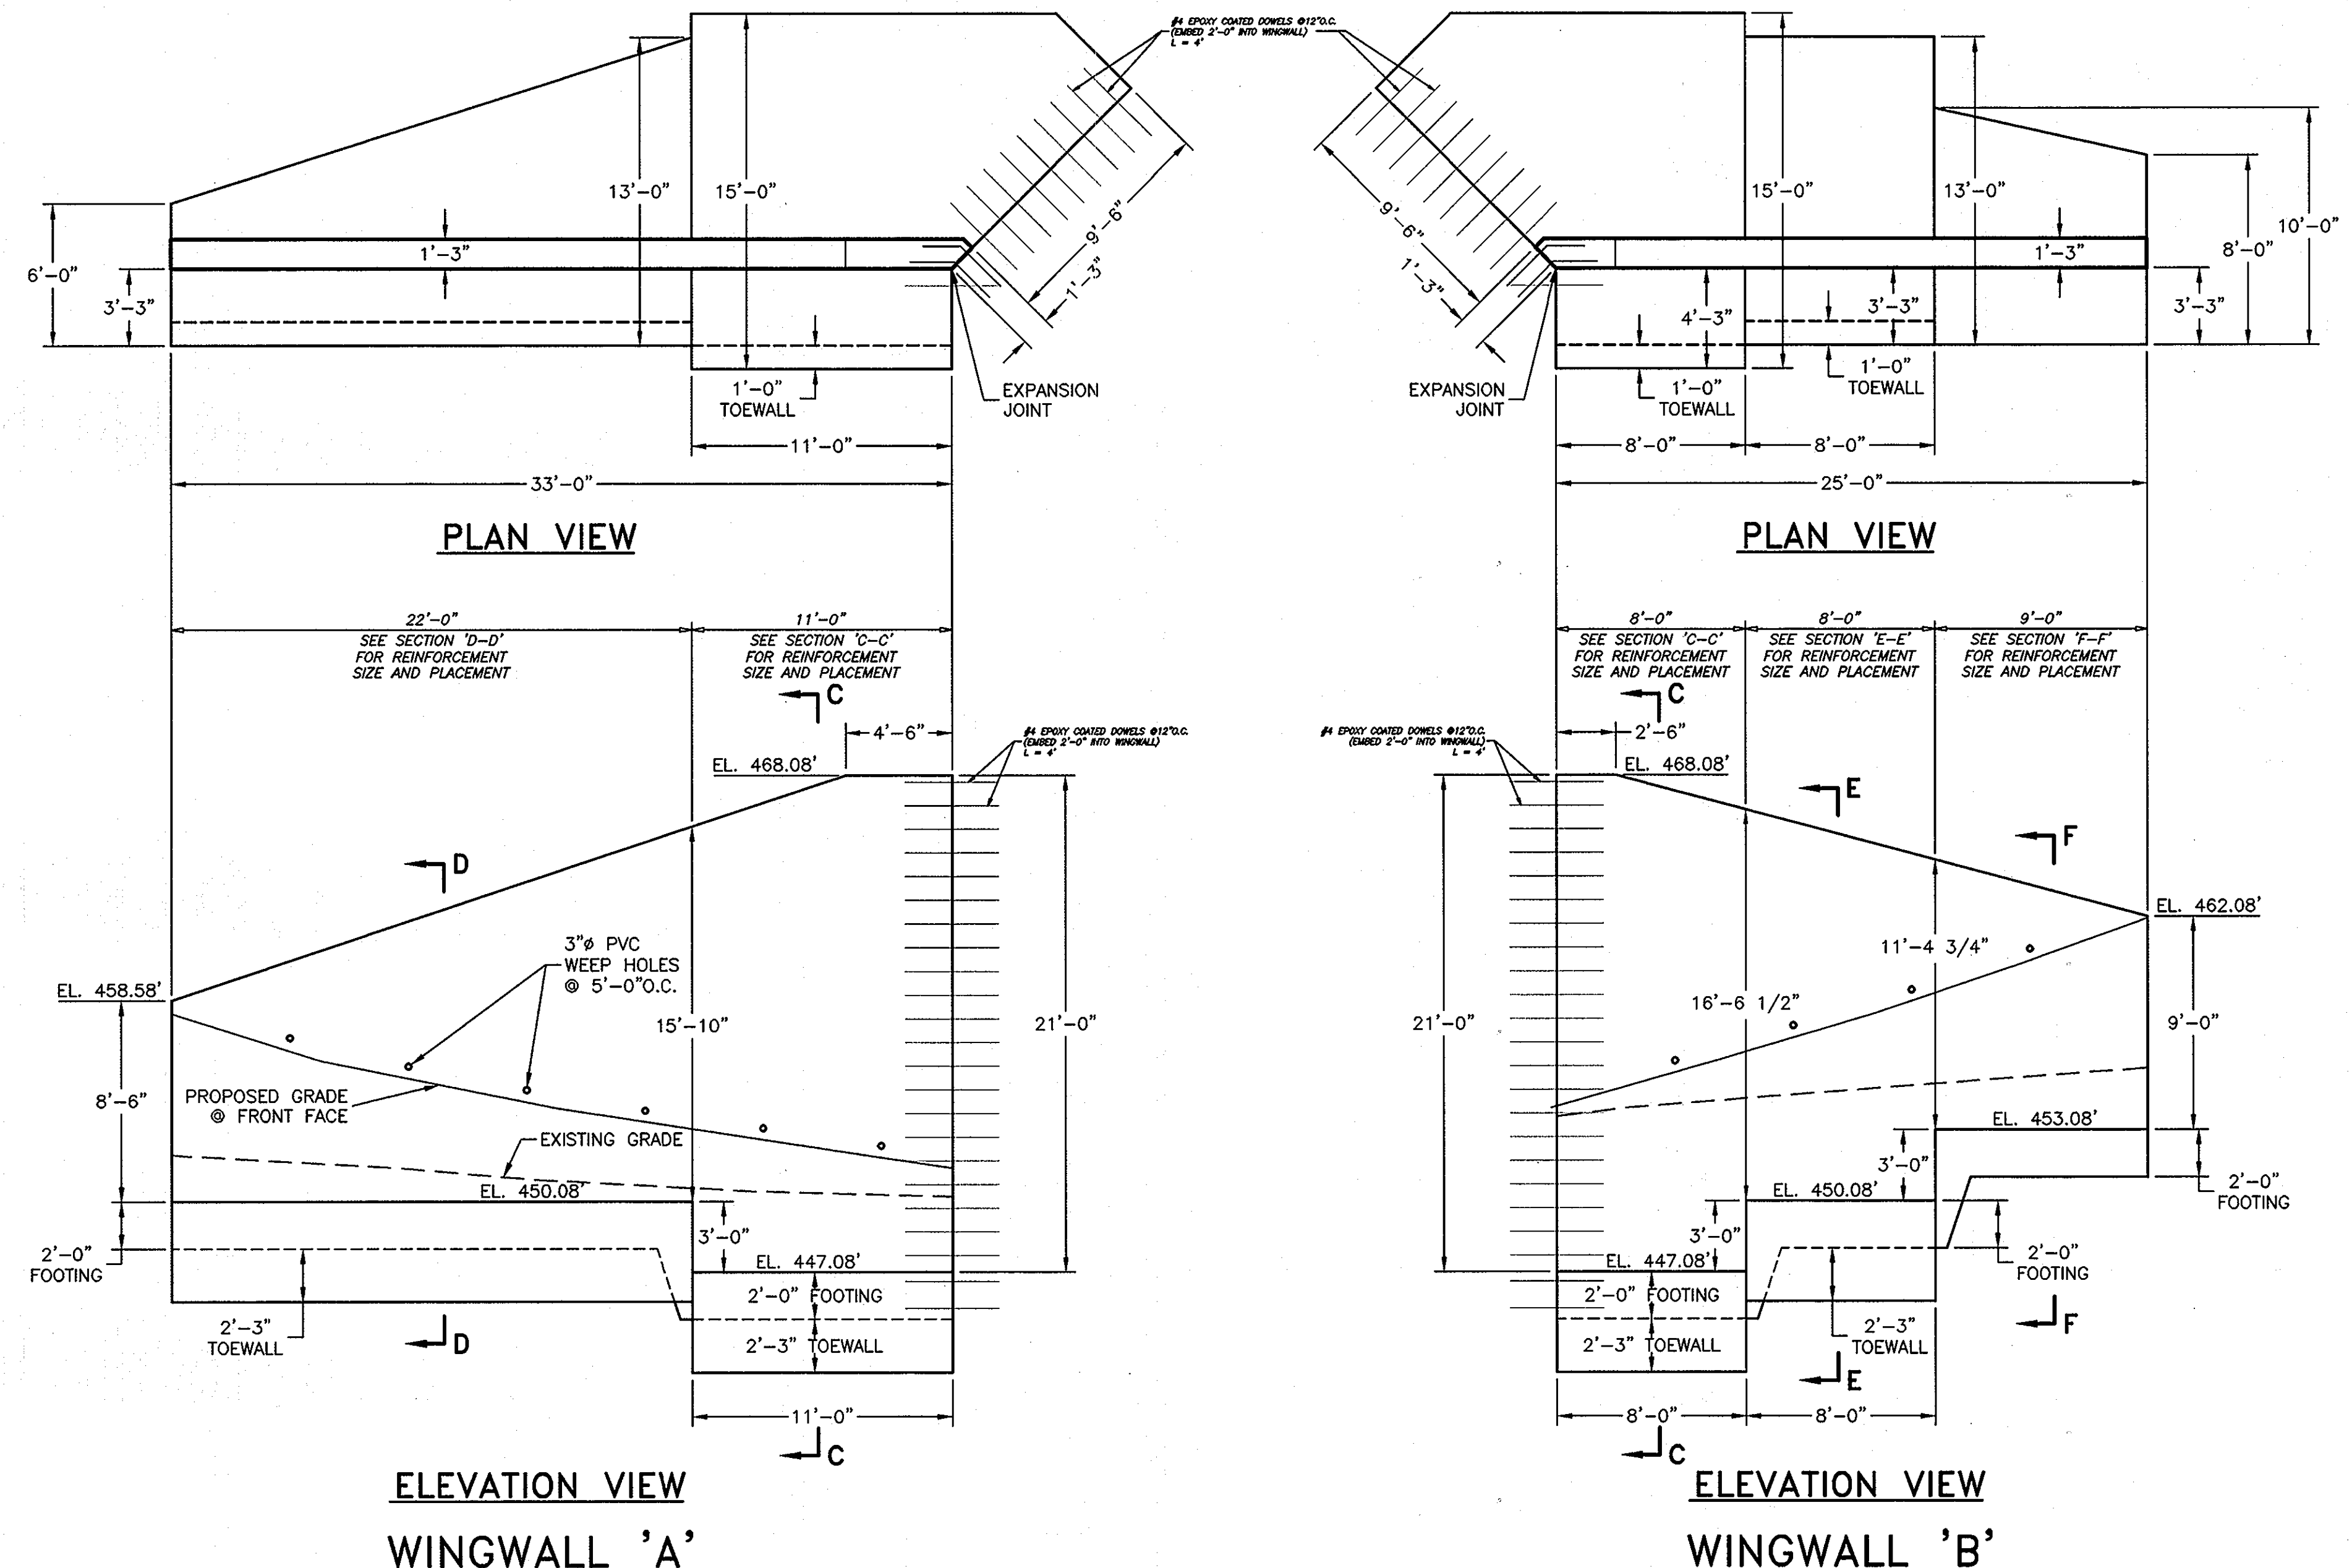


UPSTREAM WINGWALLS



SECTION VIEWS CAN BE FOUND ON SHEET 15

NOTE:
 1.) CONCRETE SHALL BE $f'_c = 4,000$ psi
 2.) ALL REINFORCEMENT SHALL BE ASTM A-615, GRADE 60
 3.) FOOTING IS DESIGNED FOR A 4,600 psf ALLOWABLE BEARING CAPACITY ON UNDERCUT MAT & 3,000 psf ALLOWABLE BEARING CAPACITY ON NATIVE SOIL TO BE FIELD VERIFIED.

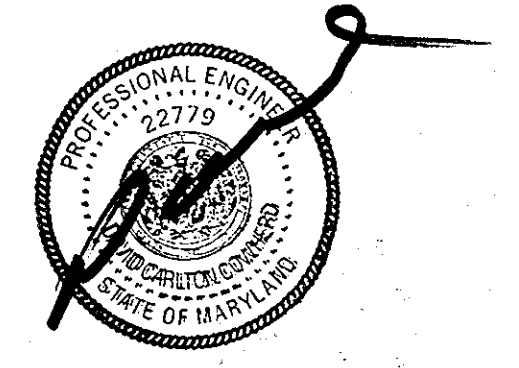

CBC ENGINEERS
 DAYTON, OHIO
 CBC Project No. 8045

NO.	DATE	REVISION
2	3/27/07	ADDED LEAN CONCRETE FILL TO VIEWS SHEET 11
1	2/18/07	NEW STRUCTURE SIZE, ADDED CONCRETE WINGS


BENCHMARK ENGINEERING, INC.
 ENGINEERS • LAND SURVEYORS • PLANNERS
 8480 BALTIMORE NATIONAL PIKE • SUITE 418
 ELLICOTT CITY, MARYLAND 21043
 phone: 410-465-6105 • fax: 410-465-6644
 email: Benchmark@cbcis.com

OWNER/DEVELOPER: HIGHLAND DEVELOPMENT CORP P.O. BOX 228 CLARKSVILLE, MARYLAND 21029 410-531-5539	PROJECT: BRIGHTON MILL LOT 1 THROUGH 22, BUILDABLE PRESERVATION PARCEL 'A' AND NON-BUILDABLE PRESERVATION PARCELS 'B' THROUGH 'D' LOCATION: TAX MAP No. 34, GRID No. 2 PARCEL 2 5th ELECTION DISTRICT HOWARD COUNTY, MARYLAND
TITLE: NORTH STRUCTURE DETAIL UPSTREAM WINGWALLS	
DATE: FEBRUARY, 2007	PROJECT NO. 1513
Design: --	Draft: --
Check: --	SCALE: AS SHOWN
	DRAWING 13 OF 34


APPROVED: HOWARD COUNTY DEPARTMENT OF PUBLIC WORKS
William J. ... 6-6-07
 CHIEF, BUREAU OF HIGHWAYS

APPROVED: HOWARD COUNTY DEPT. OF PLANNING AND ZONING
J. Kratochvil 6-11-07
 CHIEF, DIVISION OF LAND DEVELOPMENT

... 6/6/07
 CHIEF, DEVELOPMENT ENGINEERING DIVISION

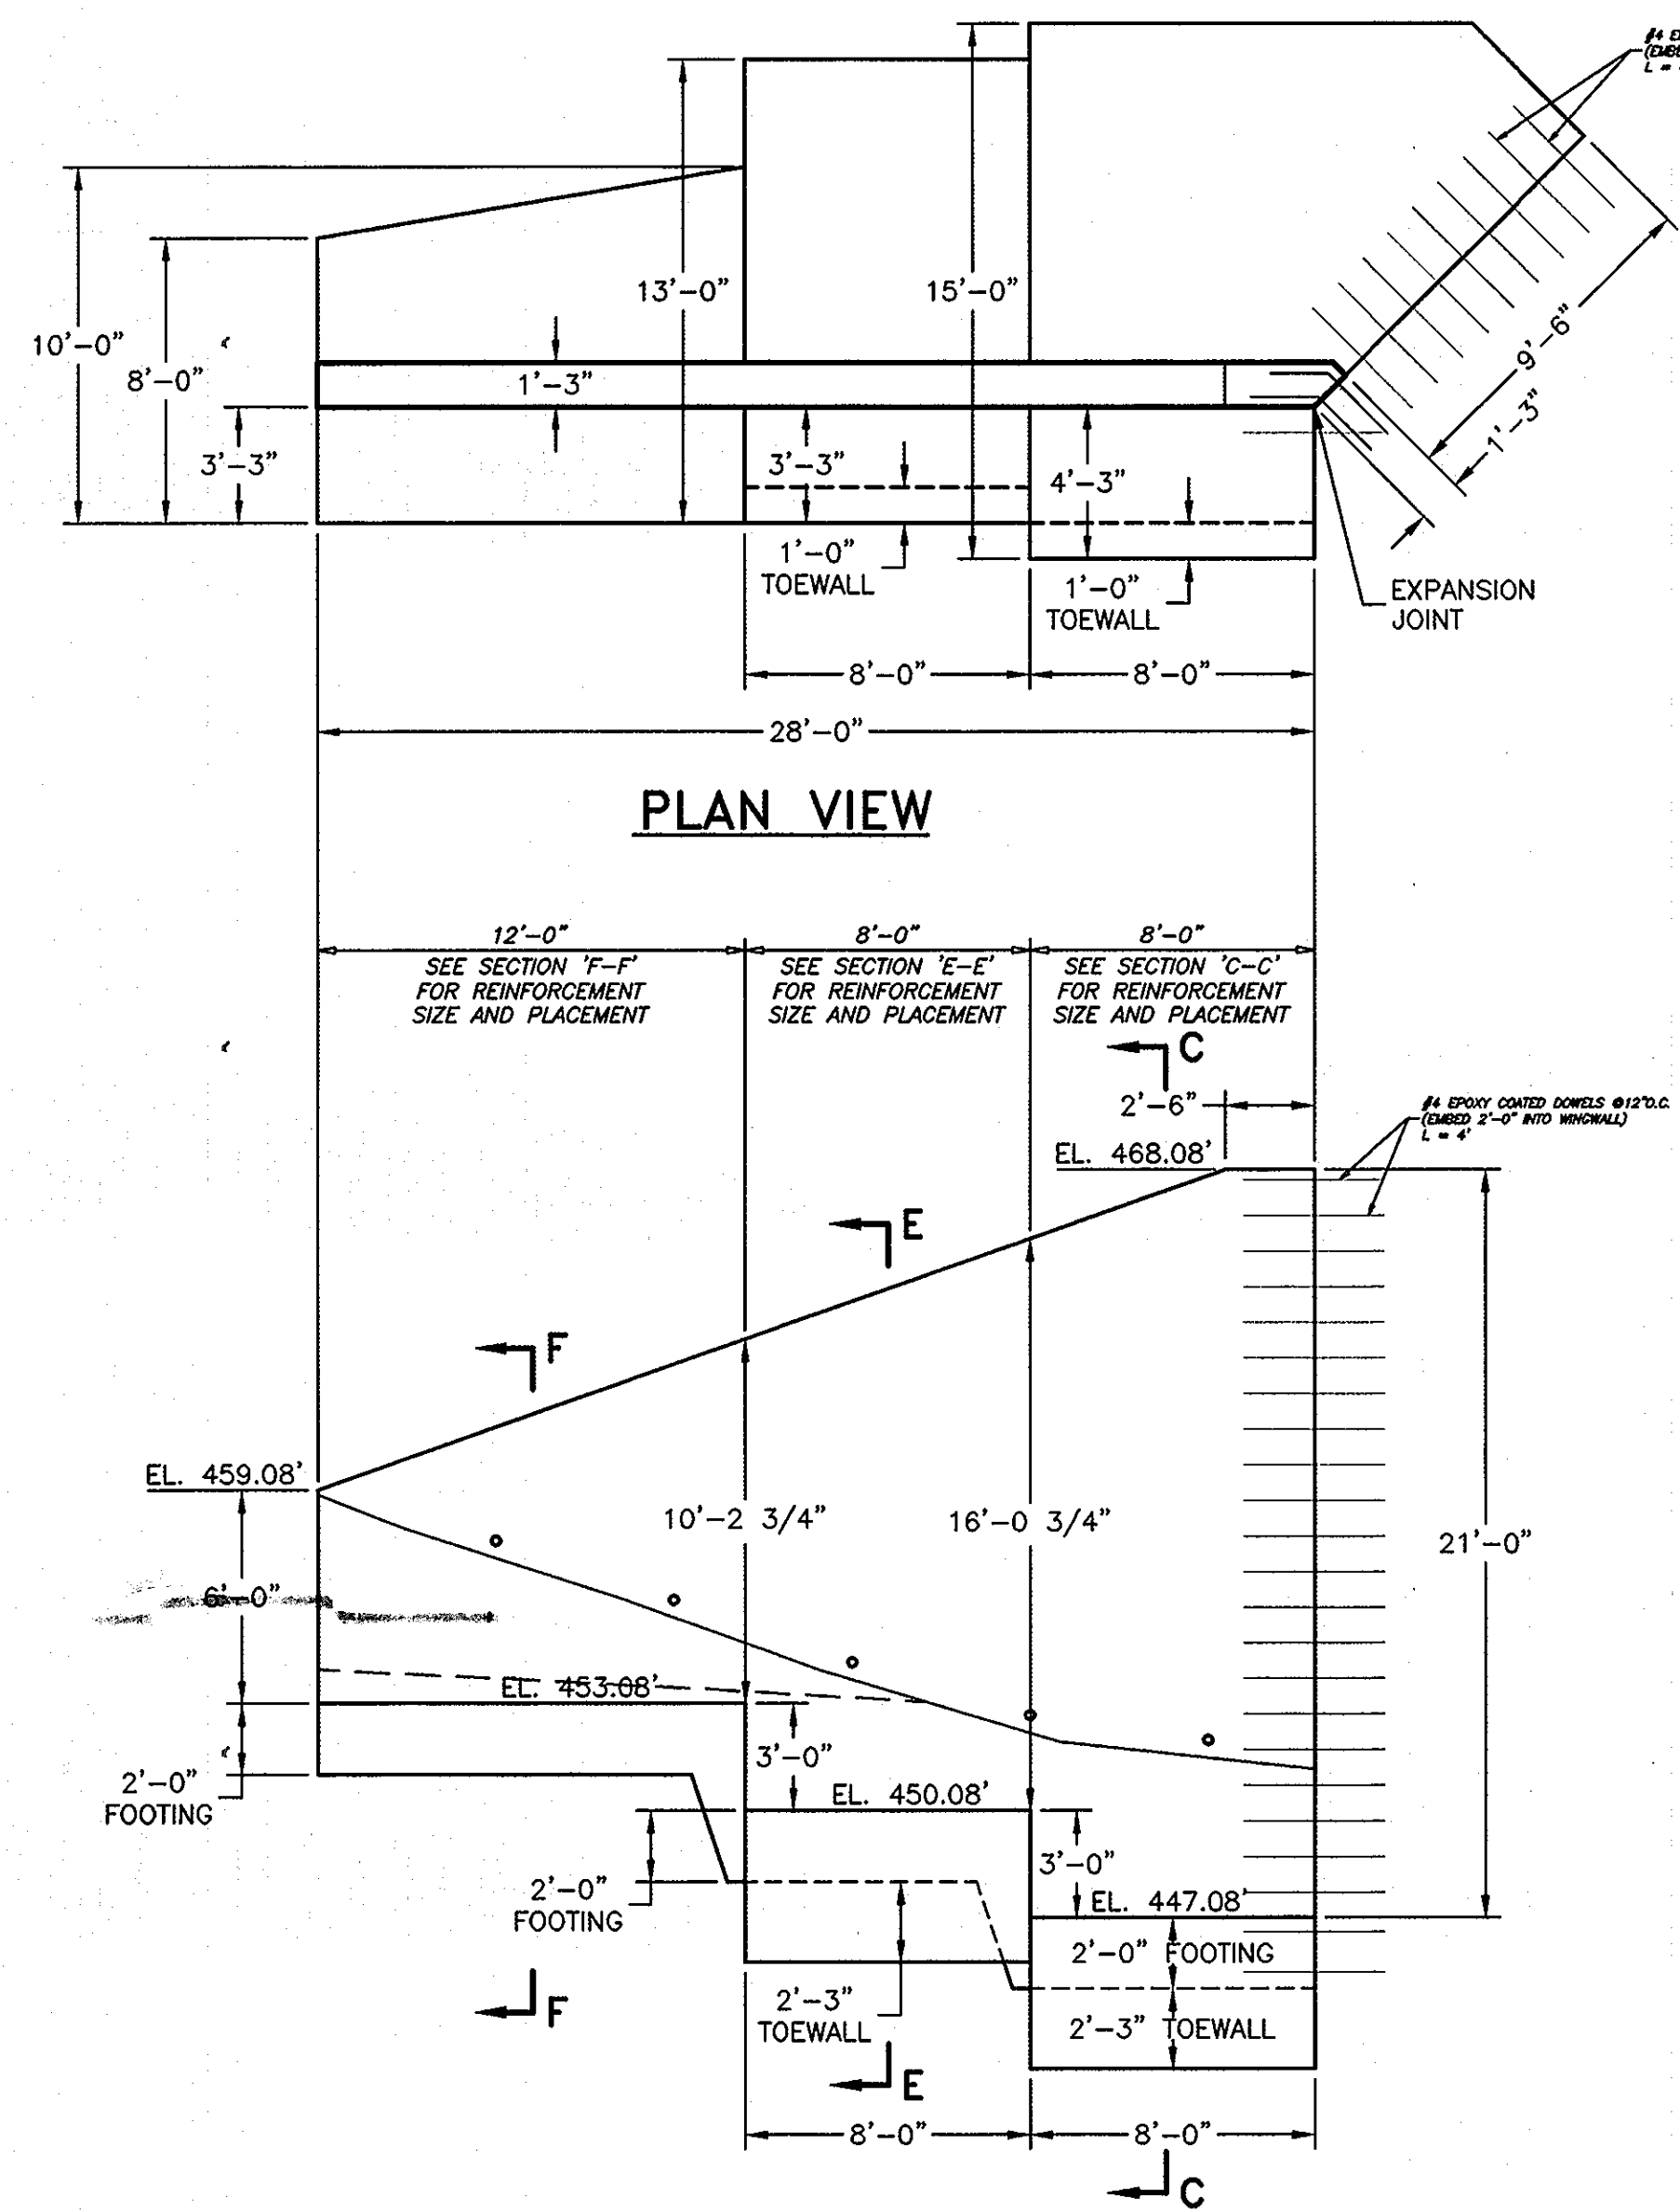

**ELEVATION VIEW
WINGWALL 'C'**

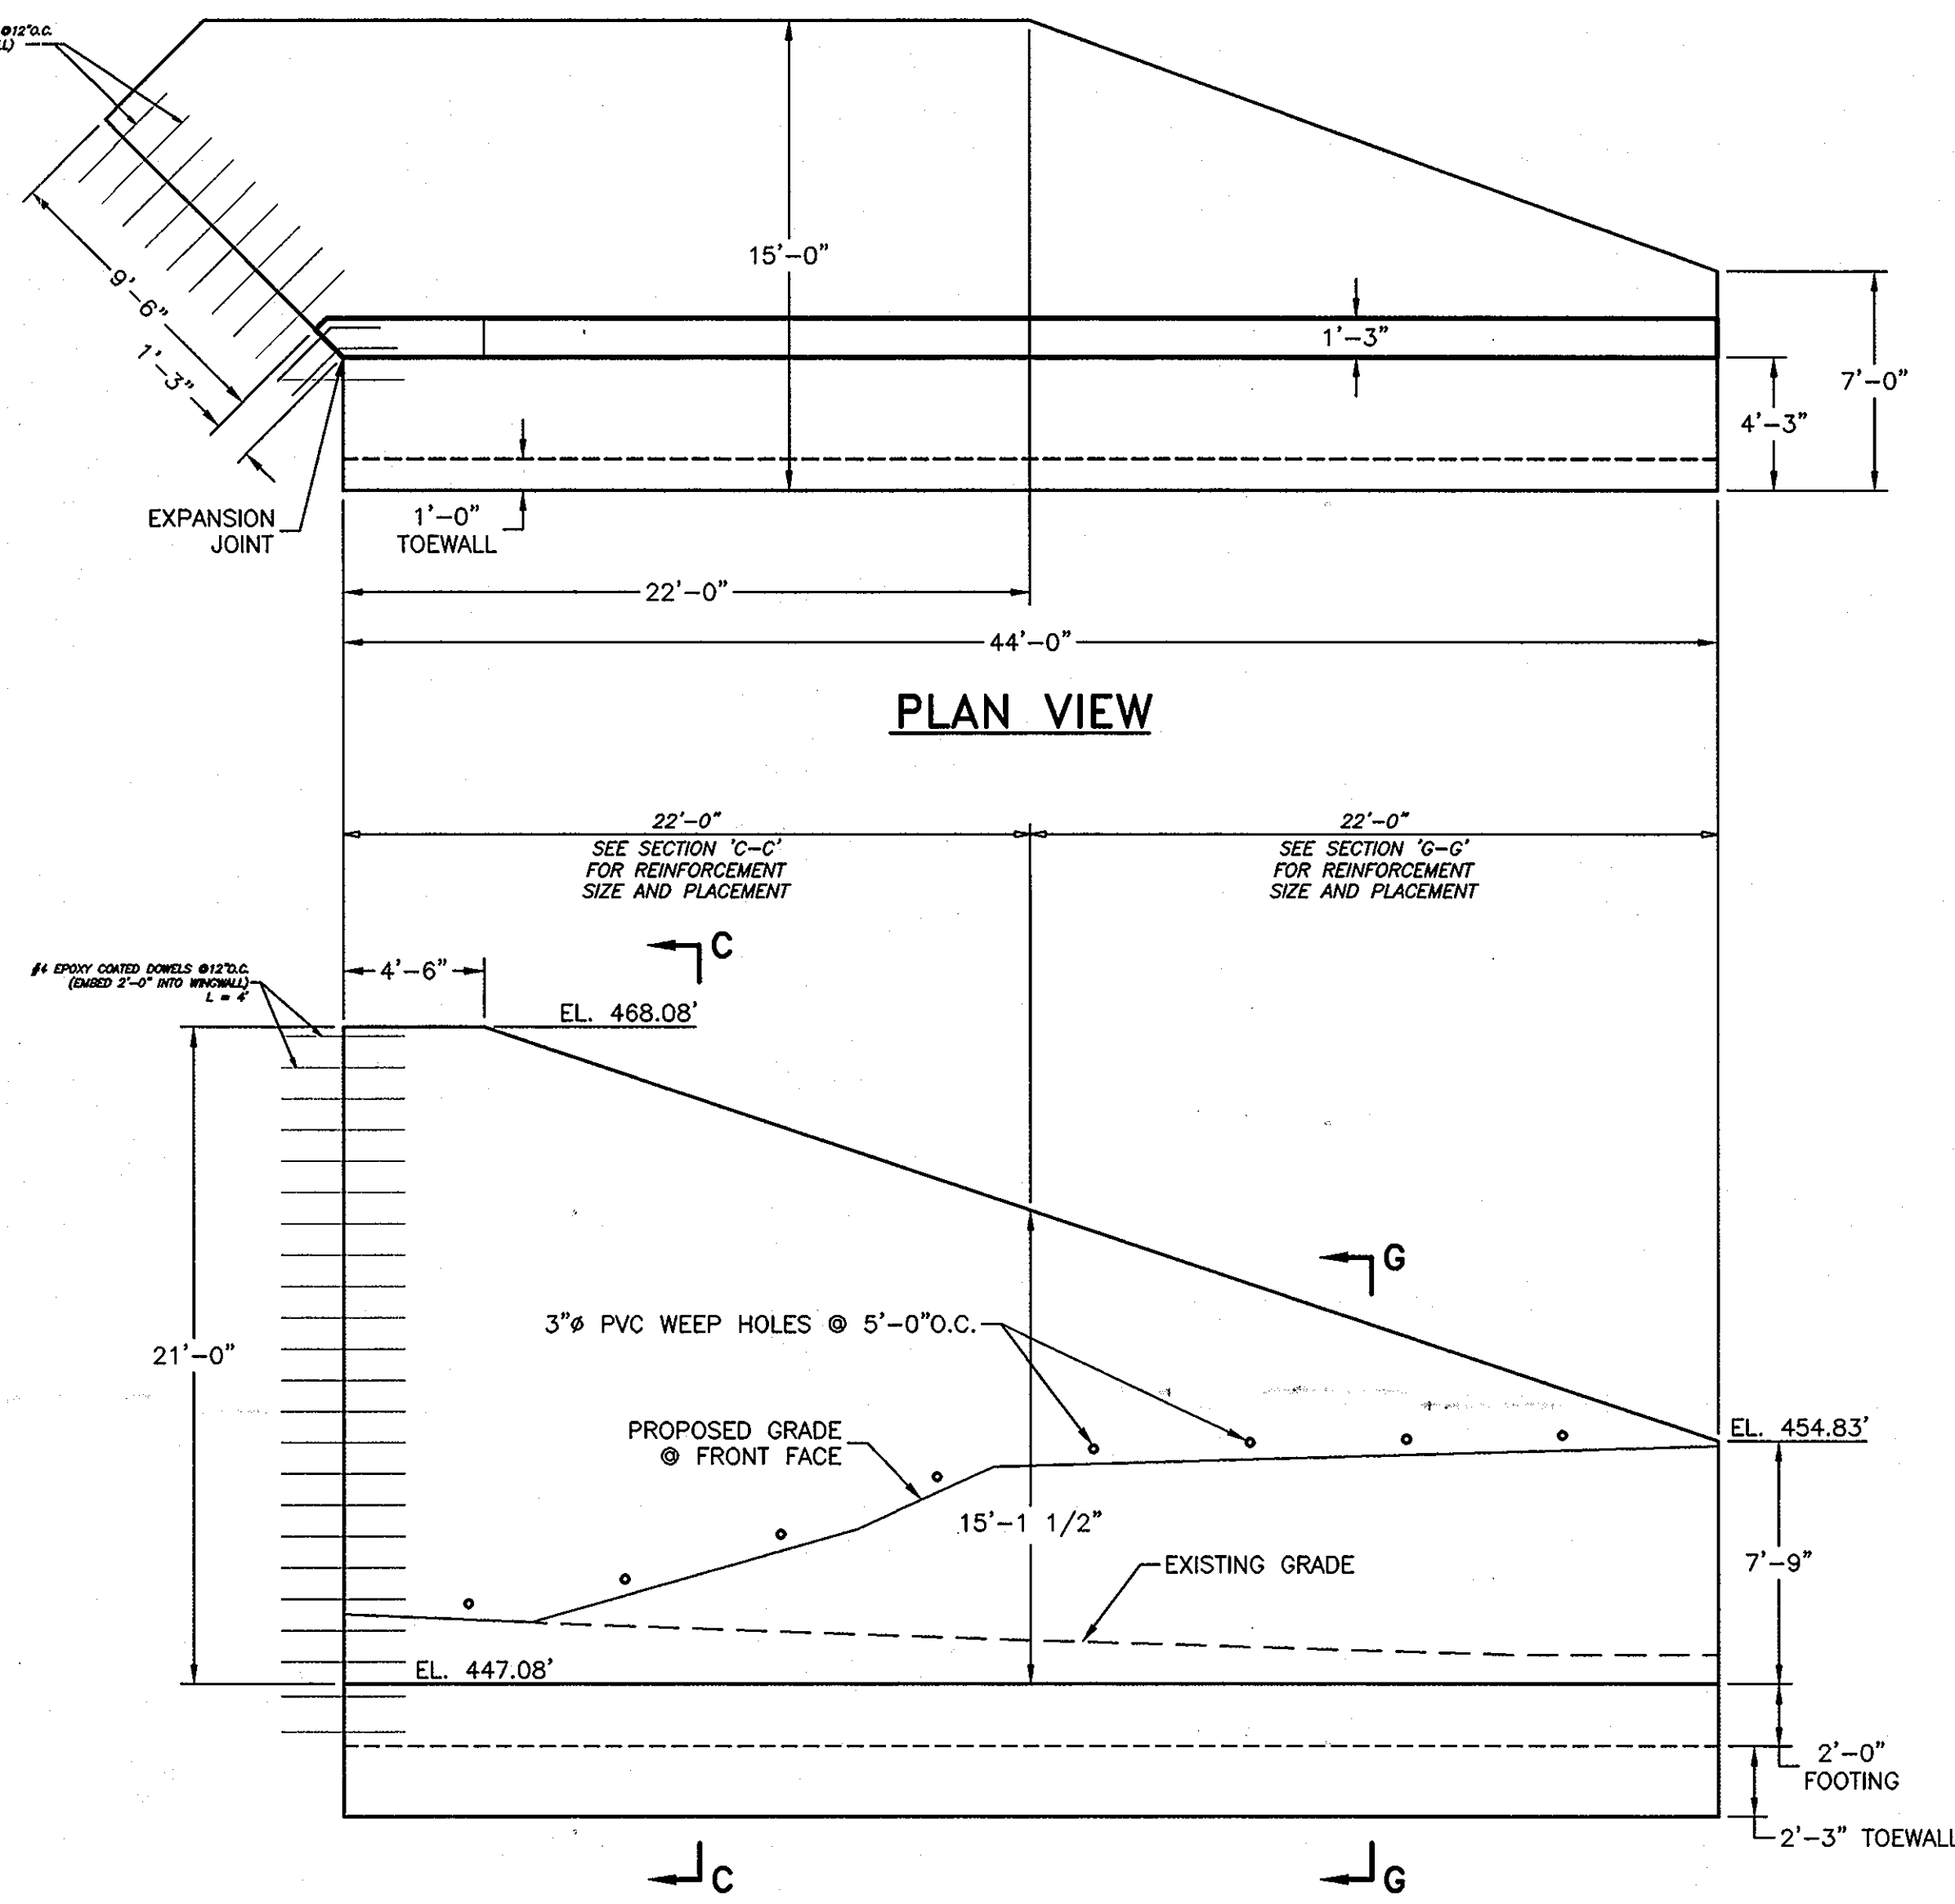

**ELEVATION VIEW
WINGWALL 'D'**


DOWNSTREAM WINGWALLS



SECTION VIEWS CAN BE FOUND ON SHEET 15

- NOTE:
- 1.) CONCRETE SHALL BE $f'c = 4,000$ psi
 - 2.) ALL REINFORCEMENT SHALL BE ASTM A-615, GRADE 60
 - 3.) FOOTING IS DESIGNED FOR A 4,600 psf ALLOWABLE BEARING CAPACITY ON UNDERCUT MAT & 3,000 psf ALLOWABLE BEARING CAPACITY ON NATIVE SOIL TO BE FIELD VERIFIED.

CBC ENGINEERS
DAYTON, OHIO
CBC Project No. 8045

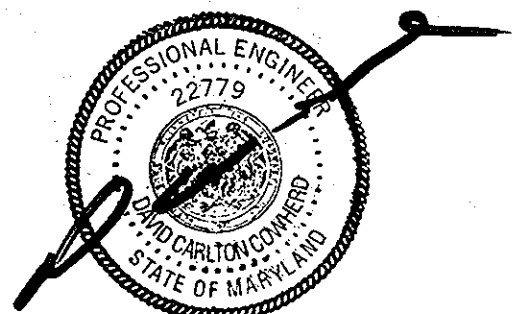

NO.	DATE	REVISION
2	3/27/07	ADDED LEAN CONCRETE FILL TO VIEWS SHEET 11
1	2/16/07	NEW STRUCTURE SIZE, ADDED CONCRETE WINGS


BENCHMARK ENGINEERING, INC.
ENGINEERS • LAND SURVEYORS • PLANNERS
8480 BALTIMORE NATIONAL PIKE • SUITE 418
ELLCOTT CITY, MARYLAND 21043
phone: 410-465-6105 • fax: 410-465-6844
email: Benchmark@ceis.com

APPROVED: HOWARD COUNTY DEPARTMENT OF PUBLIC WORKS
Walter F. Walsh 6-6-07
CHIEF, BUREAU OF HIGHWAYS DATE


APPROVED: HOWARD COUNTY DEPT. OF PLANNING AND ZONING
T. Krusta-Mueschinski for C. Hamilton 6-11-07
CHIEF, DIVISION OF LAND DEVELOPMENT DATE

Chad Pennington 6/15/07
CHIEF, DEVELOPMENT ENGINEERING DIVISION DATE


OWNER/DEVELOPER: HIGHLAND DEVELOPMENT CORP P.O. BOX 228 CLARKSVILLE, MARYLAND 21029 410-531-5539	PROJECT: BRIGHTON MILL LOT 1 THROUGH 22, BUILDABLE PRESERVATION PARCEL 'A' AND NON-BUILDABLE PRESERVATION PARCELS 'B' THROUGH 'D' LOCATION: TAX MAP No. 34, GRID No. 2 PARCEL 2 5th ELECTION DISTRICT HOWARD COUNTY, MARYLAND
TITLE: NORTH STRUCTURE DETAIL DOWNSTREAM WINGWALLS	
DATE: FEBRUARY, 2007	PROJECT NO. 1513
Design: --	Draft: --
Check: --	SCALE: AS SHOWN
DRAWING 14 OF 34	

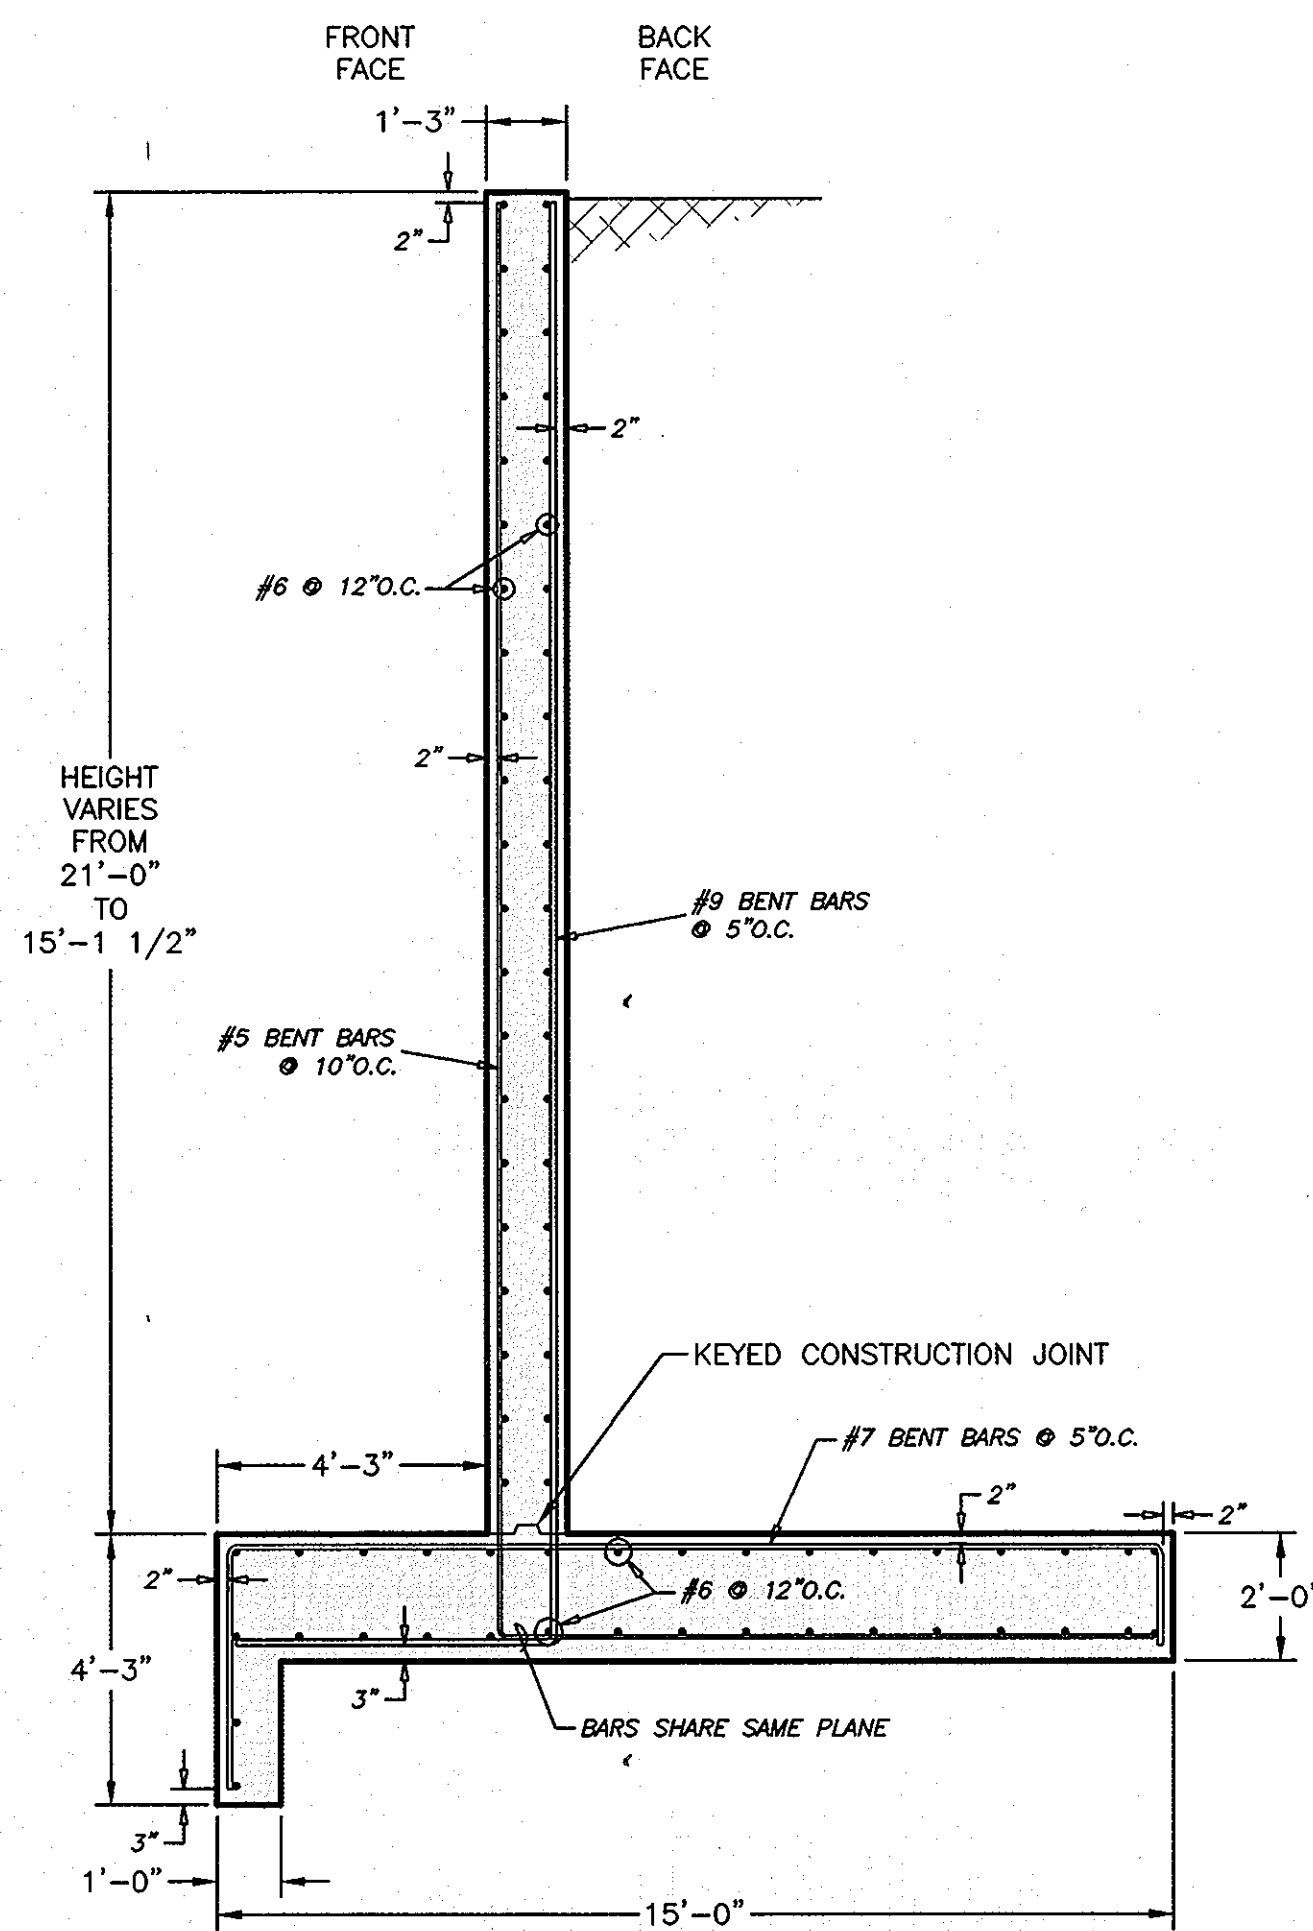


SECTION 'C-C'
GRAPHIC SCALE
3 1.5 0 3 6

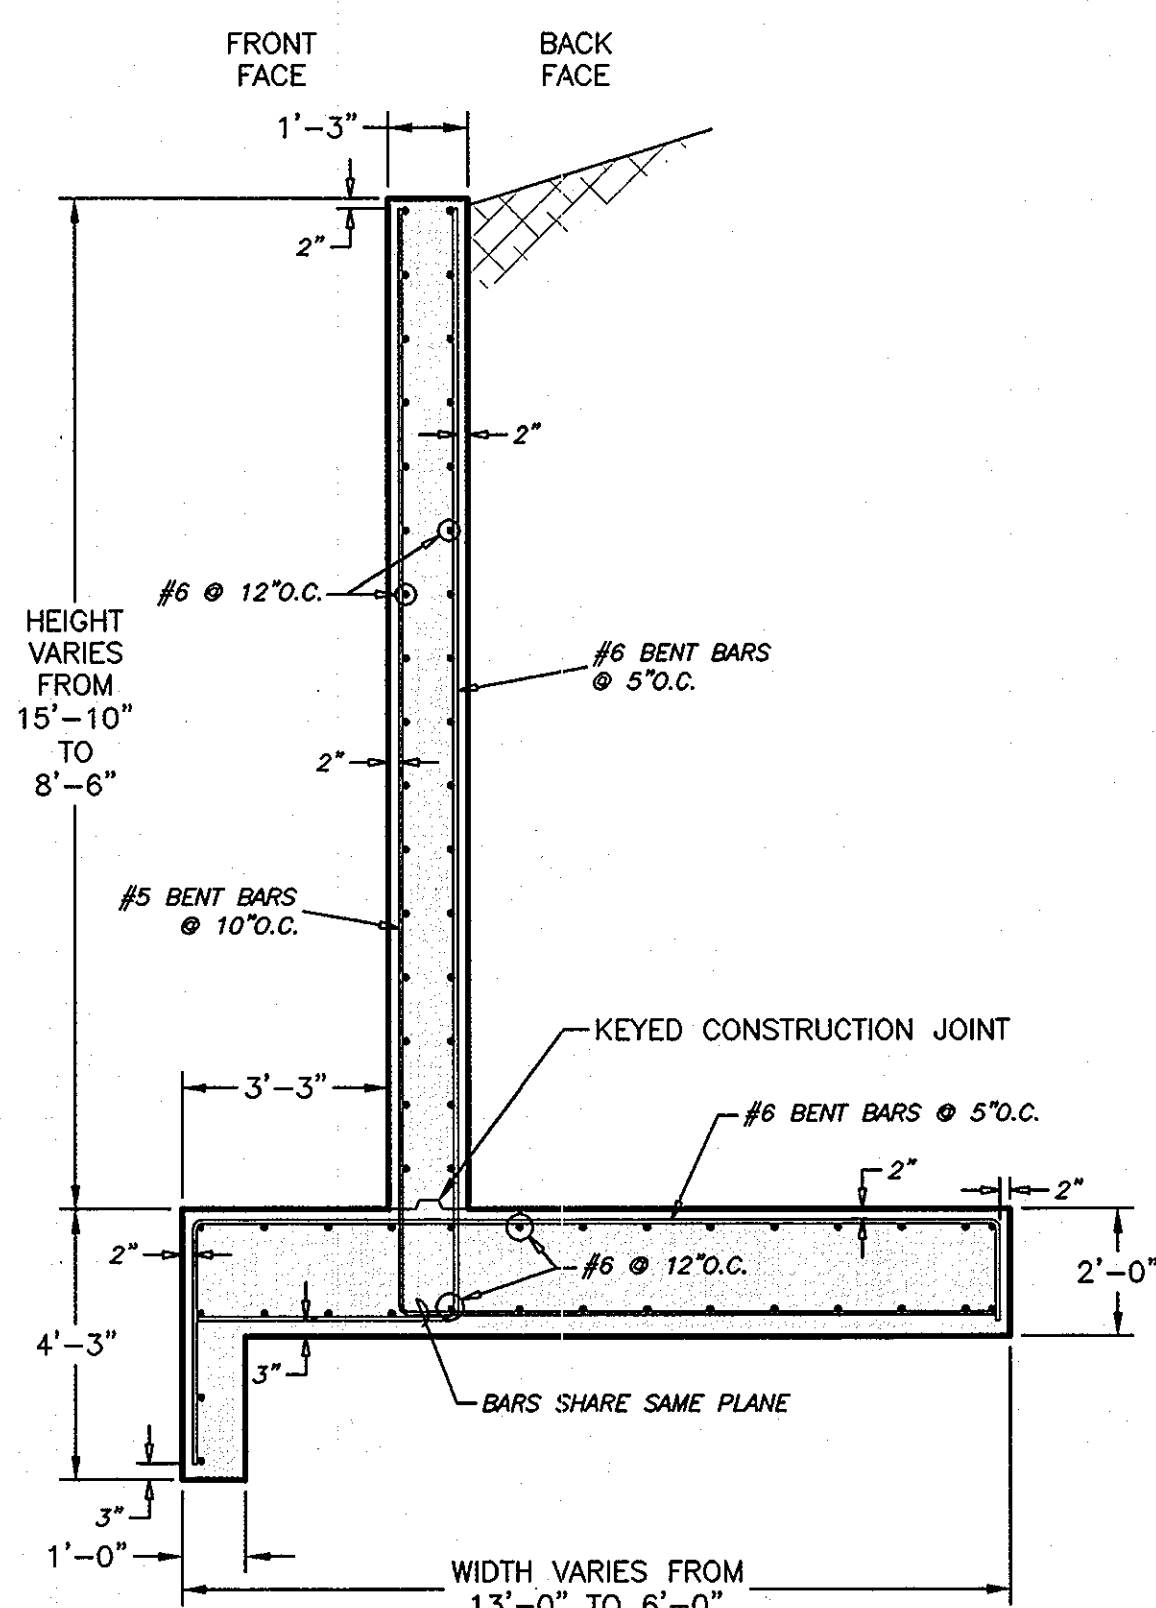


SECTION 'D-D'
GRAPHIC SCALE
3 1.5 0 3 6

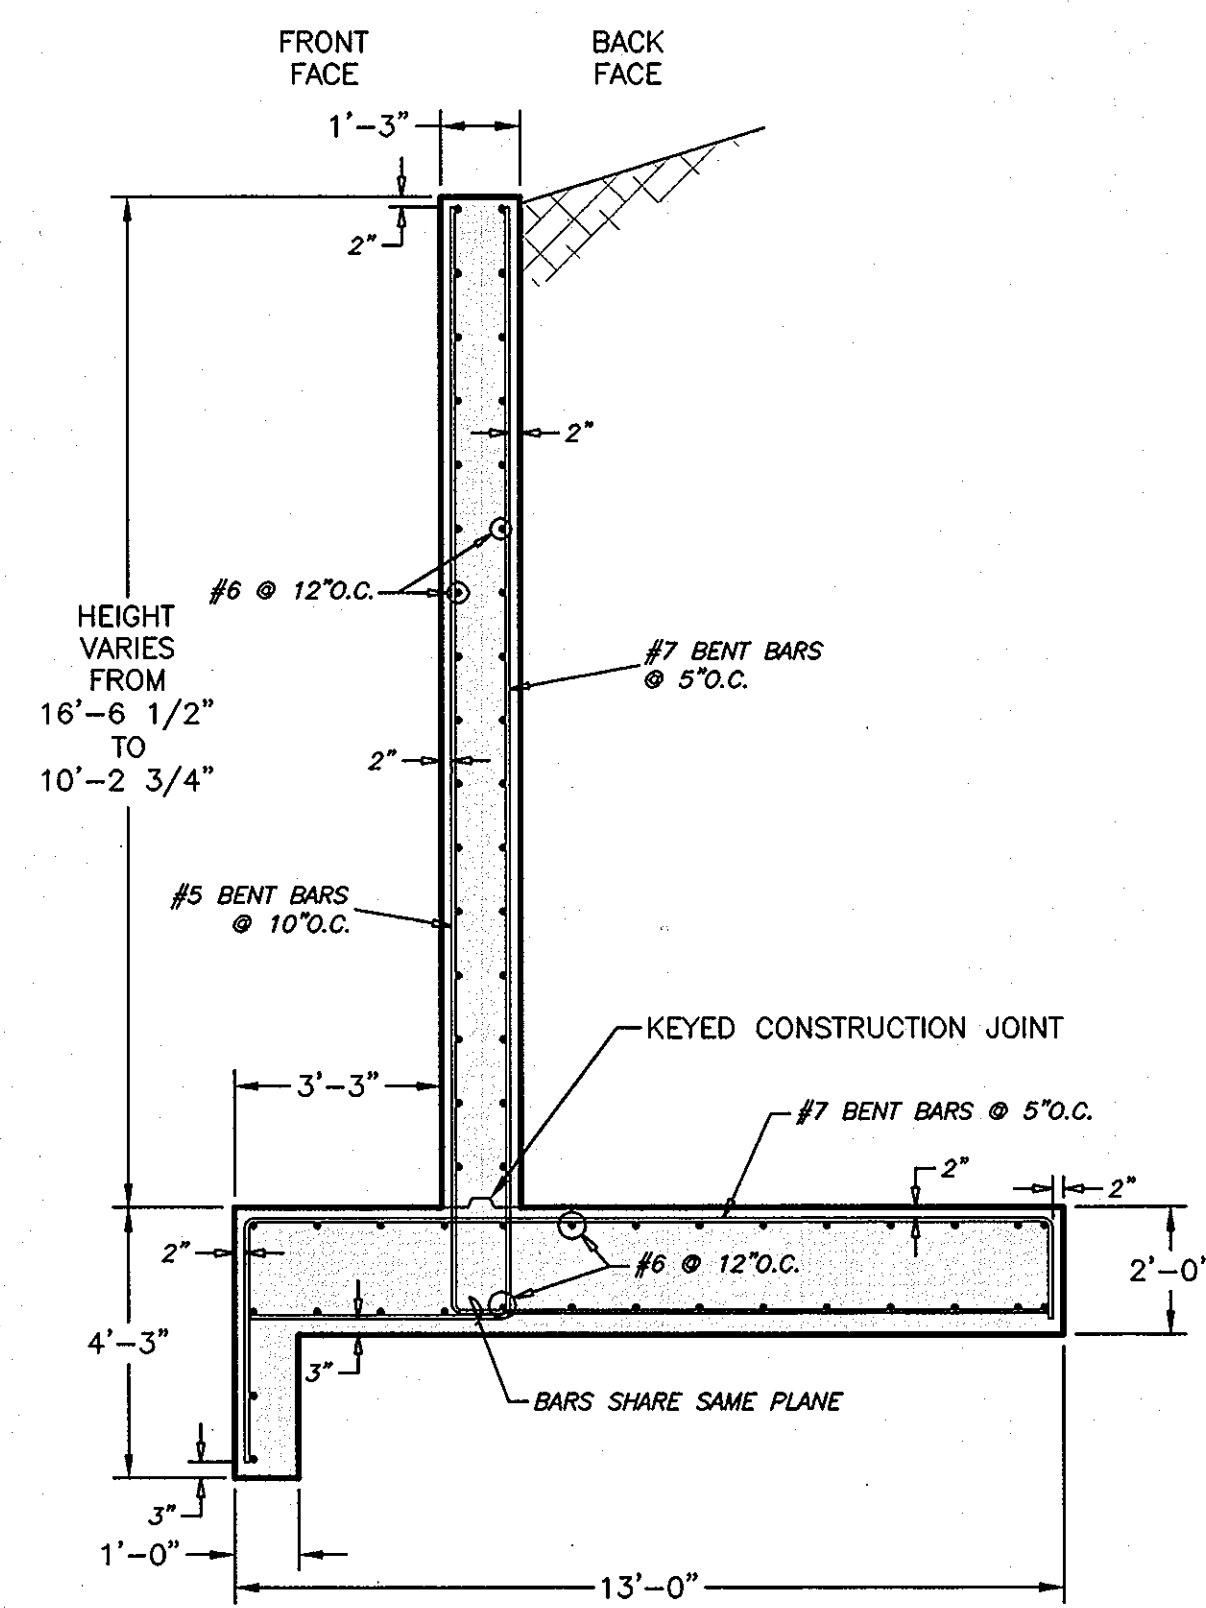


SECTION 'E-E'
GRAPHIC SCALE
3 1.5 0 3 6

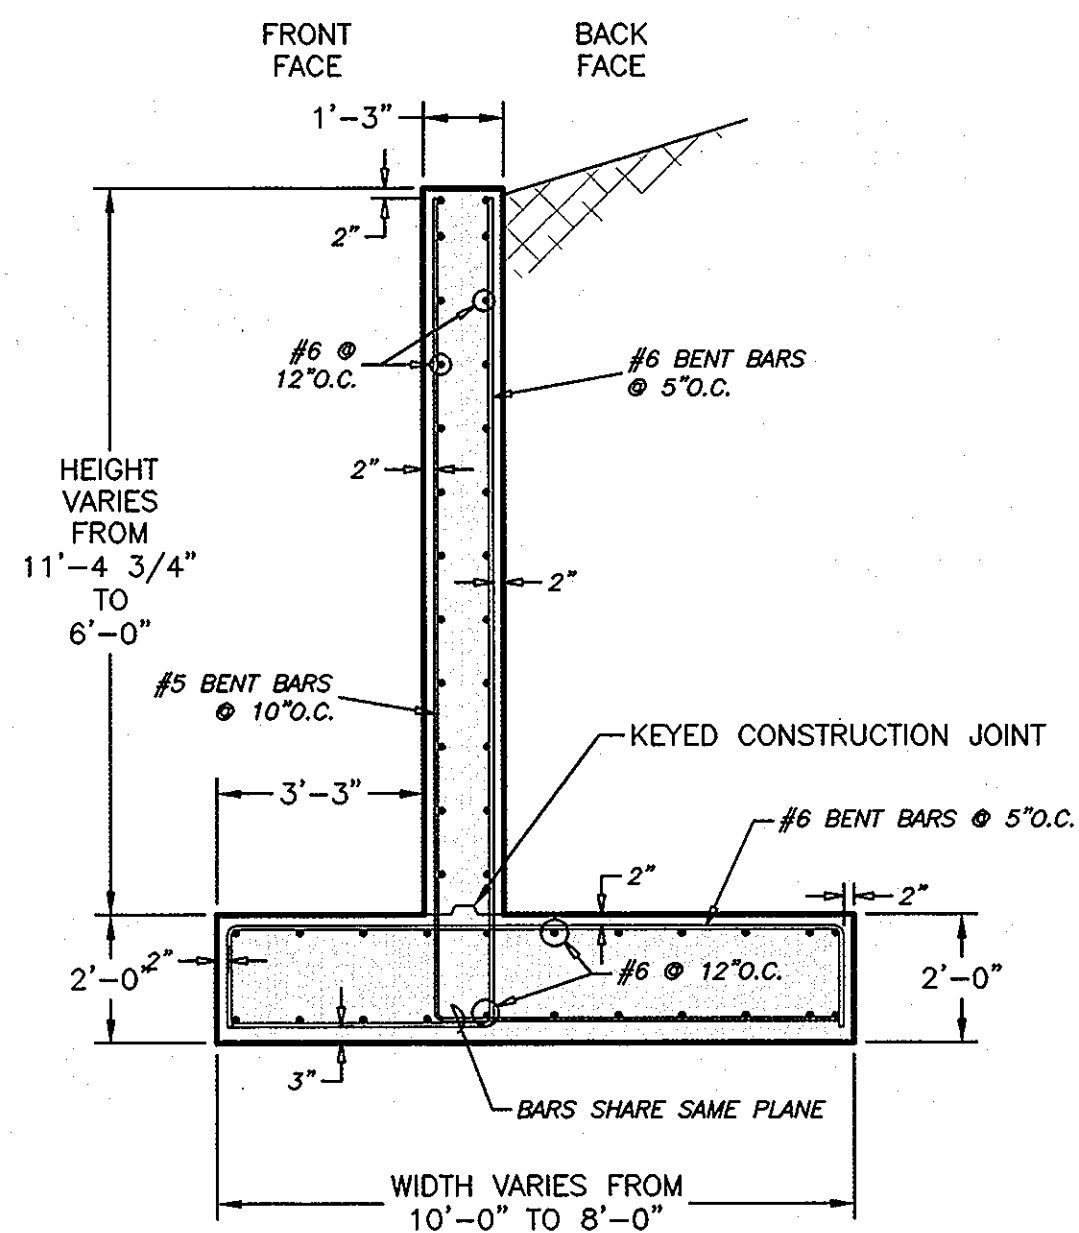

SECTION 'F-F'
GRAPHIC SCALE
3 1.5 0 3 6

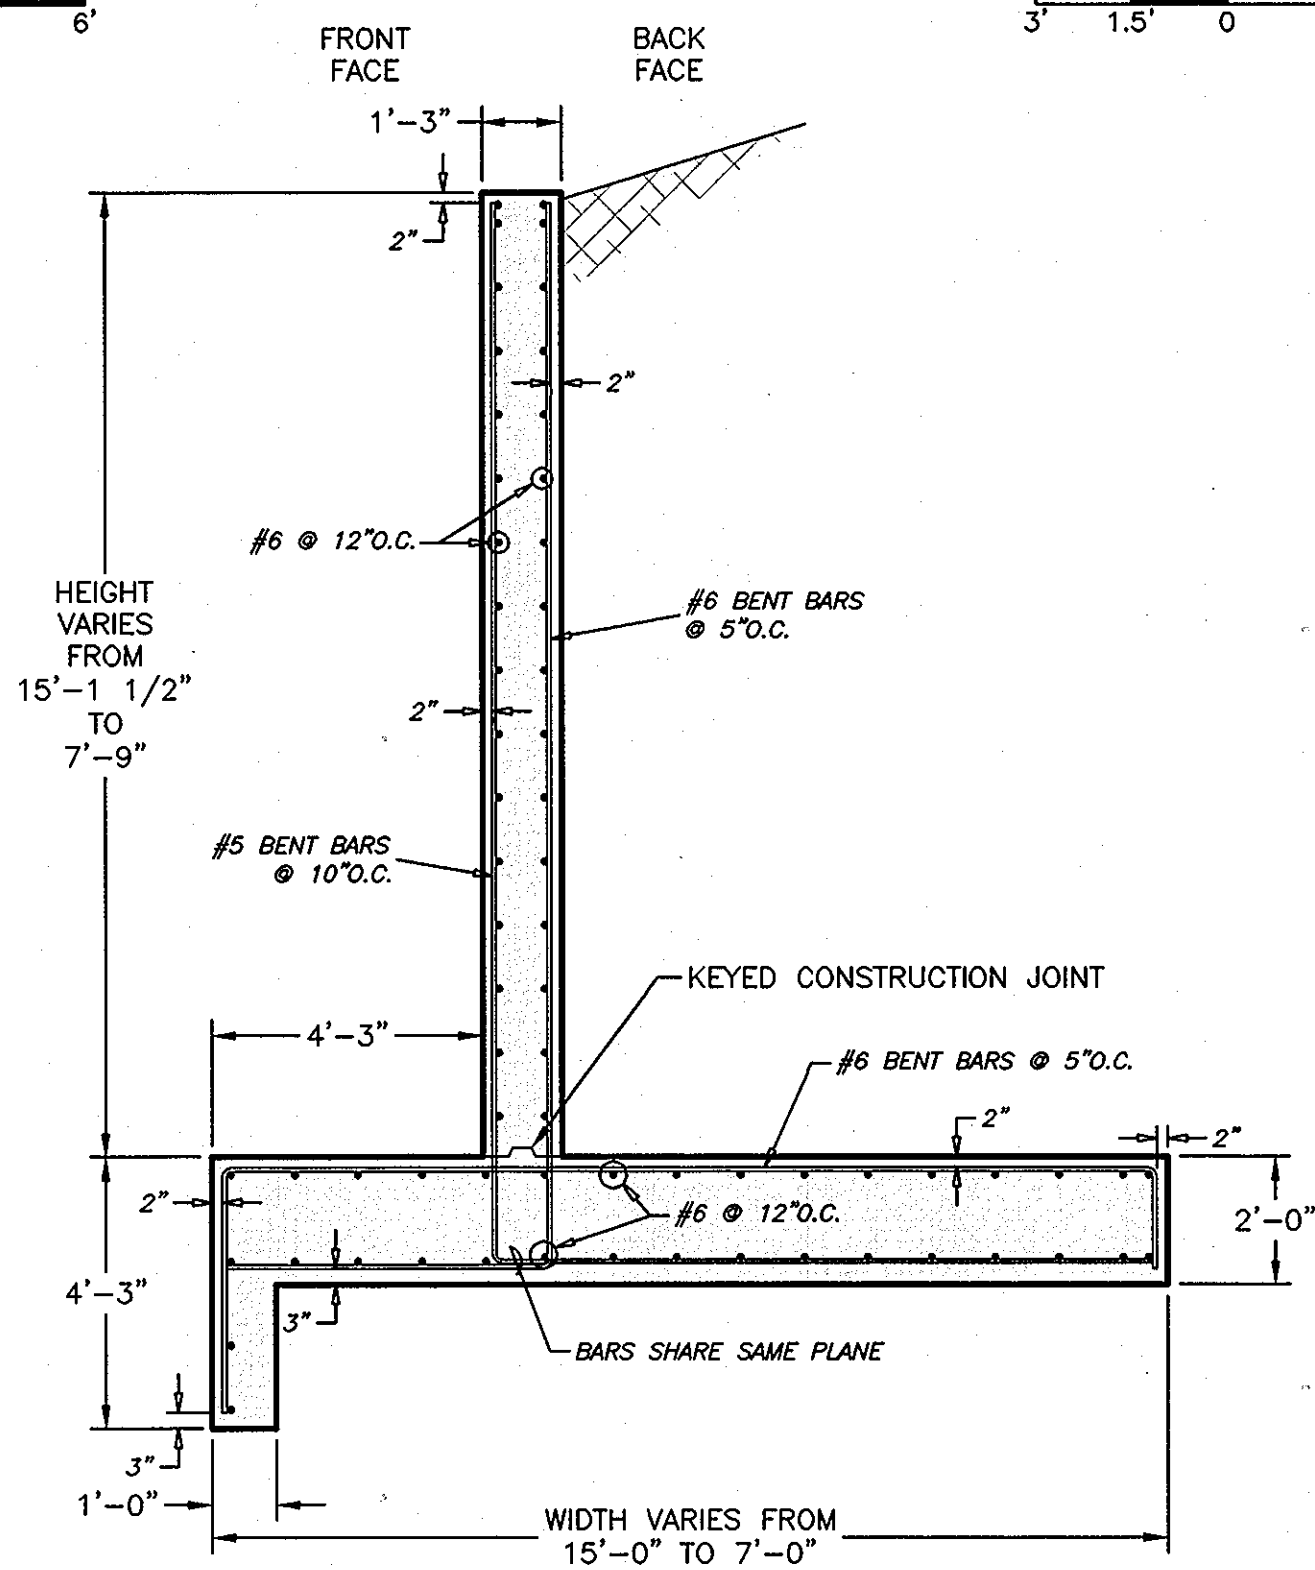


SECTION 'G-G'
GRAPHIC SCALE
3 1.5 0 3 6

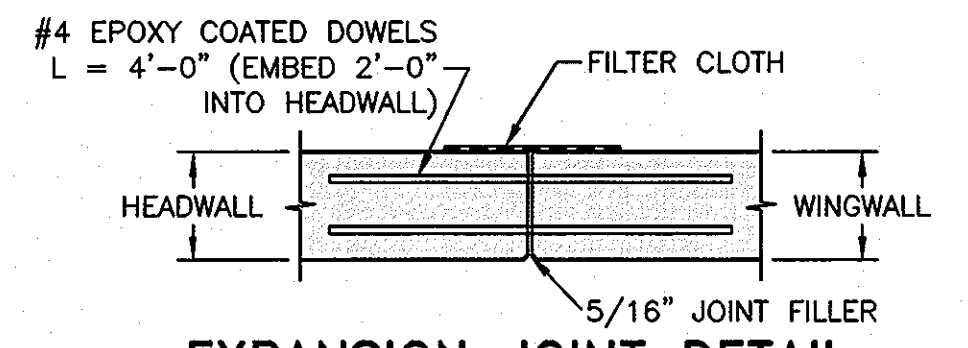


EXPANSION JOINT DETAIL
NOT TO SCALE

NOTES FOR EXPANSION JOINT:
A FILTER CLOTH THREE FEET IN WIDTH AND DOUBLE THICKNESS SHALL BE APPLIED TO ALL TRANSVERSE JOINTS IN THE FOOTING AND WALLS. THE MATERIAL SHALL BE CENTERED ON THE JOINT AND THE EDGES SEALED WITH A MASTIC OR WITH TWO SIDED TAPE. THE FILTER CLOTH SHALL BE A GEOTEXTILE MEETING THE APPROVAL OF THE ENGINEER.

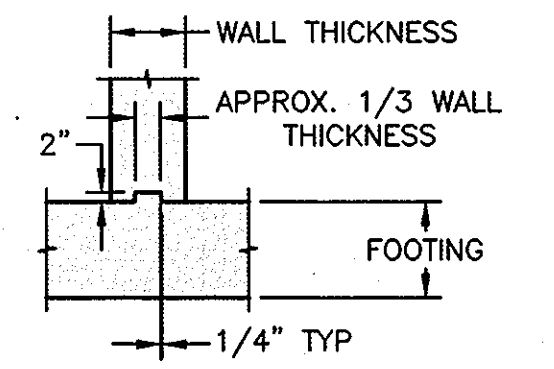

KEYED CONSTRUCTION JOINT DETAIL
NOT TO SCALE

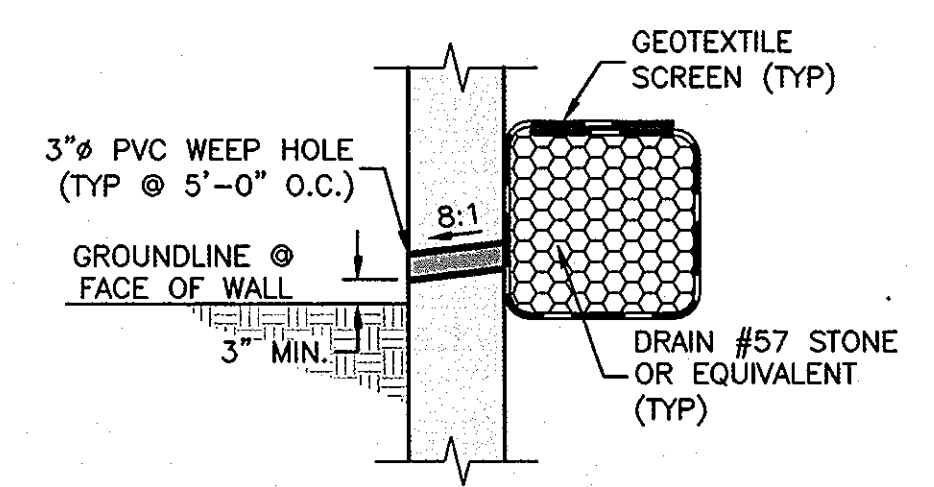


WEEP HOLE DETAIL
NOT TO SCALE

APPROVED: HOWARD COUNTY DEPARTMENT OF PUBLIC WORKS
With 7 initials 6-6-07
CHIEF, BUREAU OF HIGHWAYS
APPROVED: HOWARD COUNTY DEPT. OF PLANNING AND ZONING
T. K... M... G. Hamilton 6-11-07
CHIEF, DIVISION OF LAND DEVELOPMENT
W. ... 6/6/07
CHIEF, DEVELOPMENT ENGINEERING DIVISION

NOTE:
1.) CONCRETE SHALL BE f'c = 4,000 psi
2.) ALL REINFORCEMENT SHALL BE ASTM A-615, GRADE 60
3.) FOOTING IS DESIGNED FOR A 4,600 psf ALLOWABLE BEARING CAPACITY ON UNDERCUT MAT & 3,000 psf ALLOWABLE BEARING CAPACITY ON NATIVE SOIL TO BE FIELD VERIFIED.

CBC ENGINEERS
DAYTON, OHIO
CBC Project No. 8045

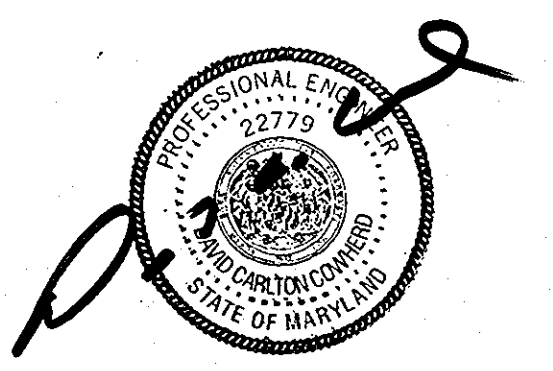

NO.	DATE	REVISION
2	3/27/07	ADDED LEAN CONCRETE FILL TO VIEWS SHEET 11
1	2/16/07	NEW STRUCTURE SIZE, ADDED CONCRETE WINGS

BENCHMARK ENGINEERING, INC.
ENGINEERS • LAND SURVEYORS • PLANNERS
8480 BALTIMORE NATIONAL PIKE • SUITE 418
ELLCOTT CITY, MARYLAND 21043
PHONE: 410-465-6105 • FAX: 410-465-6644
EMAIL: Benchmark@ccils.com

OWNER/DEVELOPER: HIGHLAND DEVELOPMENT CORP P.O. BOX 228 CLARKSVILLE, MARYLAND 21029 410-531-5539	PROJECT: BRIGHTON MILL LOT 1 THROUGH 22, BUILDABLE PRESERVATION PARCEL 'A' AND NON-BUILDABLE PRESERVATION PARCELS 'B' THROUGH 'D' LOCATION: TAX MAP No. 34, GRID No. 2 PARCEL 2 5th ELECTION DISTRICT HOWARD COUNTY, MARYLAND
TITLE: NORTH STRUCTURE DETAIL WINGWALL SECTIONS & DETAILS	DATE: FEBRUARY, 2007 PROJECT NO. 1513
Design: -- Draft: -- Check: --	SCALE: AS SHOWN DRAWING 15 OF 34

5.4 CONSTRUCTION OBSERVATION

Contech shall provide a Shape Control Technician who is a qualified representative of a professional soils engineering firm, or other qualified organization, to monitor the installation and backfilling of the structure. The Shape Control Technician shall monitor the structure shape during the placement of structural backfill to the minimum cover height over the structure. The Shape Control Technician shall take initial measurements of the erected structure before backfilling, monitor all backfill materials, their placement and their compaction. He shall record all density readings and ensure they meet the requirements of the plans and specifications. However, in no case shall the relative densities be less than 90% per AASHTO T-180. No structural backfill shall be placed without the Contech Shape Control Technician on site.

The Contech Shape Control Technician shall;

- monitor the structure's shape throughout the backfilling operation and report shape change rates to the contractor.
- contact the Contech Regional Engineer immediately if there are problems in meeting the established tolerances.
- have full authority to stop backfill work if necessary.

It is the Project Engineer's responsibility to insure that the requirements of AASHTO and Contech have been met relative to the installation and backfilling of the structure. The Project Engineer shall also provide field density tests of the compacted backfill as directed by the Contech Shape Control Technician.

The Contech Shape Control Technician is not directly responsible for additional project control matters. However, the Shape Control inspector is expected to make observations and notify the Engineer of Record, Contractor, Project Engineer and Contech Region Engineer of any apparent problems or site condition changes which, in his judgment, may affect the quality or performance of the finished installation. Such conditions may include, but are not limited to:

- Observed soft or weak spots in the foundation, trench wall, embankment, or area within the controlled backfill zone.
- Apparent improper or changing backfill material quality. Specific details of the backfill material approved for the job will be provided by the Contech Region Engineer. Any changes in the backfill requirements must be approved in writing by the Contech Region Engineer.
- Use of improper compaction methods and/or lift thicknesses.
- Structural backfill limits that are less than those required by the plans and specifications.
- Adverse reaction of the SUPER-SPAN or long span to backfill placement or compaction methods.
- All items discussed and outlined in the Installation and Inspection Practices included in the Inspection Plan.

6.0 SLOPE RATIO AND STORM WATER RUN-OFF

Protected slopes shall not be greater than 2.0 (horizontal) to one (1) (vertical) in both cut and fill, and storm water shall not be drained over the slopes.

7.0 GRADING

The Contractor shall furnish, operate, and maintain such equipment as is necessary to construct uniform layers, and control smoothness of grade for maximum compaction and drainage.

8.0 COMPACTING

8.1 The compaction equipment shall be approved equipment of such design, weight, and quantity to obtain the required density in accordance with these specifications, without distorting the structure.

8.2 During backfill, only small tracked vehicles (D-4 or smaller) shall be near the structure as fill progresses above the crown and to finished grade. The contractor is cautioned that the minimum cover may need to be increased to handle temporary construction vehicle loads (larger than a D-4).

9.0 TOP LOADING

9.1 If the structure rises, and chord dimensions have become distorted by more than ±2% of plan, top loading or bracing may be necessary.

9.2 The structure can carry legal highway loads once the backfill is placed and compacted to a minimum cover of 4 feet. For heavier construction loads in the unpaved conditions the Contractor shall consult the Engineer.

10.0 TESTING AND INSPECTION SERVICES

10.1 Testing and inspection services will be provided by the Owner. No structural backfill shall be placed without the Contech Shape Control Technician on site.

10.2 Regular inspection during erection and backfilling is required to achieve a structure with proper shape and backfill compacted to the specified density. The structure's shape shall be monitored at all times during installation, and soil materials and compaction methods must be verified by testing.

11.0 SPECIFICS OF SHAPE MONITORING

11.1 The shape of the structure shall be monitored during construction.

11.2 Monitoring points other than the shape control hooks shall be identified with permanent paint. These points shall be monitored periodically throughout the placement of the backfill to determine if the shape of the structure has changed and to determine the rate of change. Typically the rise and chord dimensions should be maintained to less than ±2% of design values.

11.3 A set of measurements shall be made for each 12 to 16 inches of fill placed or one time each day, whichever is greater. The structure measurements should continue throughout the backfilling operation until all of the select material has been placed and compacted. After placement of soil over the select fill and completion of the final grade and roadway surfacing, the structure's shape should be documented by preparing an as-built shape of the structure.

11.4 Additional measurements shall be made to provide a record of the shape of the structure for comparison during future inspections. Corrugated metal structures can deflect and distort during erection and backfilling and also under subsequent loading. Although these distortions are not generally serious, the initial shape of the structure shall be documented for comparison with future inspections.

VI - CONCRETE HEADWALLS/WINGWALLS

1.0 END TREATMENTS

1.1 The headwalls/wingwalls shall consist of reinforced concrete conforming to Chapter VII of these specifications and to Division II, Section 8, of the AASHTO Standard Specifications for highway bridges having a minimum compression strength of 4,000 psi.

1.2 Reinforcing steel shall conform to ASTM A-615, Grade 60, having a minimum yield strength of 60,000 psi.

1.3 The headwalls shall be anchored to the SUPER-SPAN arch in the manner shown on the plans and shall be formed and poured in accordance with the plan dimensions.

1.4 Round weep holes spaced not over 5 feet on center shall be placed in the walls as shown on the construction drawings. A granular envelope, consisting of #57 stone or equivalent, shall be placed behind each weep hole for a distance of approximately 1 foot from all edges of the weep hole. A free-draining geotextile screen shall be placed between the weep hole and the stone to prevent erosion of the stone.

VII - CONCRETE

1.0 CODES AND STANDARDS

1.1 Reinforced concrete shall conform to the requirements of AASHTO Standard Specifications for Highway Bridges, Division II - Construction, Section 8, "Concrete Structures", for Class A concrete, having a minimum compressive strength of 4,000 psi.

2.0 STANDARDS FOR MATERIALS

2.1 Portland Cement - Conforming to ASTM Specification C-150, Type I or II.

2.2 Water - The water shall be drinkable, clean free from injurious amounts of oils, acids, alkalis, organic materials, or deleterious substances.

2.3 Aggregates - Fine and coarse aggregates shall conform to current ASTM Specification C-33 "Specification for Concrete Aggregates" except that local aggregates which have been shown by tests and by actual service to produce satisfactory qualities may be used when approved by the Engineer.

2.4 Submittals - Test data and/or certifications to the Owner shall be furnished upon request.

3.0 PROPORTIONING OF CONCRETE

3.1 COMPOSITION

3.1.1 The concrete shall be composed of cement, fine aggregate, coarse aggregate and water.

3.1.2 The concrete shall be homogeneous, readily placeable and uniformly workable and shall be proportioned in accordance with ACI-211.1.

3.1.3 Proportions shall be established on the basis of field experience with the materials to be employed. The amount of water used shall not exceed the maximum 0.49 water/cement ratio, and shall be reduced as necessary to produce concrete of the specified consistency at the time of placement.

3.1.4 An air-entraining admixture, conforming to the requirements of ASTM C260, shall be used in all concrete furnished under this contract. The quantity of admixture shall be such as to produce an air content in the freshly mixed concrete of 6 percent plus or minus 1 percent as determined in accordance with ASTM C231 or C173.

3.2 Qualities Required - As indicated in the table below:

TABLE VII-1
QUALITIES REQUIRED

ITEM	QUALITY REQUIRED
Class	A
Type of Cement	I or II
Compressive Strength f_c @ 28 days	4,000 psi
Compressive Strength f_c @ 28 days for thrust beams	2,400 psi
Slump, inches	2 - 4 in.

3.3 Maximum Size of Coarse Aggregates - Maximum size of coarse aggregates shall not be larger than 38 mm (1 1/2 inches).

3.4 Rate of Hardening of Concrete - Concrete mix shall be adjusted to produce the required rate of hardening for varied climatic conditions:

Under 40°F Ambient Temperature - Accelerate calcium chloride at 2% is acceptable when used within the recommendations of ACI-306R "Cold Weather Concreting." Admixtures containing chloride ion in excess of 1% by weight of admixture shall not be used in reinforced concrete.

4.0 MIXING AND PLACING

4.1 Equipment - Ready Mix Concrete shall be used and shall conform to the "Specifications for Ready-Mix Concrete," ASTM C-94. Approval is required prior to using job mixed concrete.

4.2 Preparation - All work shall be in accordance with ACI-304, "Recommended Practice for Measuring, Mixing, Transporting and Placing Concrete." All construction debris and extraneous matter shall be removed from within the forms. Concrete shall be placed on clean surfaces, free from water. Concrete that has to be dropped four (4) feet or more shall be placed through a tremie.

4.3 All concrete shall be consolidated by internal mechanical vibration immediately after placement. Vibrators shall be of a size appropriate for the work, capable of transmitting vibration to concrete at frequencies of not less than 4,500 impulses per minute.

5.0 FORM WORK

5.1 Forms shall be of wood, steel or other approved material and shall be set and held true to the dimensions, lines and grades of the structure (footings) prior to and during the placement of concrete.

5.2 Forms shall not be removed until the concrete has sufficient strength to prevent concrete drainage.

6.0 CURING

6.1 Fresh concrete shall be protected from rains, flowing water and mechanical injury for a period of four (4) days.

7.0 REINFORCING STEEL

7.1 MATERIAL

7.1.1 All reinforcing bars shall be deformed bars (ASTM-A615) Grade 60.

7.2 BENDING AND SPLICING

7.2.1 Bar reinforcement shall be cut and bent to the shapes shown on the plans. Fabrication tolerances shall be in accordance with ACI 315. All bars shall be bent cold, unless otherwise permitted.

7.2.2 All reinforcement shall be furnished in the full lengths indicated on the plans unless otherwise permitted. Except for splices shown on the plans and splices for No. 5 or smaller bars, splicing of bars will not be permitted without written approval. Splices shall be staggered as far as possible.

7.2.3 In lapped splices, the bars shall be placed and wired in such a manner as to maintain the minimum distance to the surface of the concrete shown on the plans.

7.2.4 Substitution of different size bars will be permitted only when authorized by the engineer. The substituted bars shall have an area equivalent to the design area, or larger.

7.3 PLACING AND FASTENING

7.3.1 Steel reinforcement shall be accurately placed as shown on the plans and firmly held in position during the placing and setting of concrete. Bars shall be tied at all intersections around the perimeter of each mat and at not less than 2 foot centers or at every intersection, whichever is greater, elsewhere. Welding of cross bars (lack welding) will not be permitted for assembly of reinforcement.

7.3.2 Reinforcing steel shall be supported in its proper position by use of mortar blocks, wire bar supports, supplementary bars or other approved devices. Such devices shall be of such height and placed at sufficiently frequent intervals so as to maintain the distance between the reinforcing and the formed surface or the top surface within 1/4 inch of that indicated on the plans.

VIII - FILTER FABRIC (GEOTEXTILE SCREEN)

1.0 Geotextile (filter fabric) shall be placed over the #57 drainage stone at all weepholes. The filter fabric shall be placed between weepholes, #57 drainage stone and the granular backfill material. Filter fabric shall be placed at all locations shown on the construction drawings.

2.0 Filter fabric cloth shall conform to Contech specification for C60-NW or equivalent and shall meet the following ASTM tests:

2.1 ASTM D4751 - Apparent opening size equal to #70 U.S. Standard Sieve Size.

2.2 ASTM D4632 (Grab Tensile Test) - Minimum Strength = 160 pounds.

2.3 ASTM D4632 (Grab Elongation) - 30-70%.

2.4 ASTM D4533 (Trapezoidal Tear) - Minimum Strength = 60 pounds.

2.5 ASTM D4355 (Stabilized for Heat and Ultra-Violet Degradation) - 70% strength retained.


3.0 The minimum fabric coefficient of permeability (ASTM D4491) shall be 0.24 cm/sec.

4.0 The fabric shall be non-woven with a minimum thickness (ASTM D5199) of 60 mils.

5.0 Fabric shall not be placed over sharp or angular rocks that could tear or puncture it.

6.0 Care should be exercised to prevent any puncturing or rupture of the filter fabric. Should such rupture occur the damaged area should be covered with a patch of filter fabric using an overlap minimum of one (1) foot.

CBC ENGINEERS
DAYTON, OHIO
CBC Project No. 8045

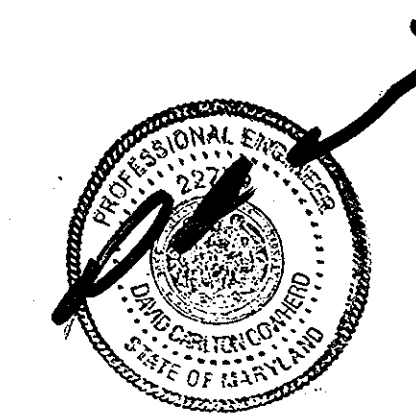

NO.	DATE	REVISION
2	3/27/07	ADDED LEAN CONCRETE FILL TO VIEWS SHEET 11
1	2/16/07	NEW STRUCTURE SIZE, ADDED CONCRETE WINGS

BENCHMARK ENGINEERING, INC.
ENGINEERS • LAND SURVEYORS • PLANNERS
8480 BALTIMORE NATIONAL PIKE & SUITE 418
ELLCOTT CITY, MARYLAND 21043
phone: 410-465-6105 • fax: 410-465-6644
email: Benchmark@bme.com

OWNER/DEVELOPER: HIGHLAND DEVELOPMENT CORP
P.O. BOX 228
CLARKSVILLE, MARYLAND 21029
410-531-5539

PROJECT: BRIGHTON MILL
LOT 1 THROUGH 22, BUILDABLE PRESERVATION PARCEL 'A' AND NON-BUILDABLE PRESERVATION PARCELS 'B' THROUGH 'D'

LOCATION: TAX MAP No. 34, GRID No. 2
PARCEL 2
5th ELECTION DISTRICT
HOWARD COUNTY, MARYLAND

TITLE: NORTH STRUCTURE DETAIL
SPECIFICATIONS CONT'D

DATE: FEBRUARY, 2007 PROJECT NO. 1513

Design: -- Draft: -- Check: -- SCALE: AS SHOWN DRAWING 17 OF 34

APPROVED: HOWARD COUNTY DEPARTMENT OF PUBLIC WORKS
[Signature] 6-6-07
CHIEF, BUREAU OF HIGHWAYS

APPROVED: HOWARD COUNTY DEPT. OF PLANNING AND ZONING
[Signature] 6-11-07
CHIEF, DIVISION OF LAND DEVELOPMENT

[Signature] 6/6/07
CHIEF, DEVELOPMENT ENGINEERING DIVISION



FLOODPLAIN CHART						
REACH	CROSS-SECTION NO.	EX. 100 YR. Q	PROP. 100 YR. Q	100 YR. EX. W.S.	100 YR. PROP. W.S.	
A	2000	835	823	448.1	448.0	
A	1900	835	823	445.1	445.1	
A	1800	835	823	441.3	441.2	
A	1700	835	823	438.3	438.3	
A	1600	835	823	435.4	435.4	
A	1500	835	823	431.8	431.7	
A	1400	835	823	430.4	430.4	
A	1300	835	823	424.1	424.0	
A	1200	835	823	423.6	423.5	
A	1100	1315	1315	421.0	421.0	
A	1000	1315	1315	419.9	419.9	
A	900	1315	1315	417.7	417.7	
A	800	1315	1315	415.0	415.0	
A	700	1315	1315	412.7	412.7	
A	600	1315	1315	410.9	410.9	
A	500	1315	1315	407.0	407.0	
A	400	1315	1315	407.3	407.3	
A	300	1315	1315	405.6	405.6	
A	200	1315	1315	405.5	405.5	
A	100	1315	1315	404.7	404.7	
B	11	181	181	450.7	450.7	
B	9	181	181	444.1	444.1	
B	7	181	181	438.3	438.3	
B	5	181	181	432.9	432.9	
B	3	181	181	427.5	427.5	
B	1	181	181	420.7	420.7	
C	30	254	203	482.2	489.0	
C	28	254	203	482.1	482.1	
C	26	254	203	477.4	477.2	
C	24	254	203	472.5	472.5	
C	22	254	203	465.5	465.4	
C	20	254	203	460.5	460.4	
C	18	254	203	451.2	451.0	
C	16	254	203	449.7	449.0	
C	15	254	203	448.4	N/A	
C	14	280	293	446.5	447.2	
C	12	280	293	446.4	446.5	
C	10	280	293	441.0	441.1	
C	8	280	293	436.7	436.7	
C	6	280	293	430.8	430.8	
C	4	280	293	426.9	427.0	
C	2	280	293	420.9	420.9	

AREA AND "C" FACTOR TABULATION						
PROJECT	BRIGHTON MILL	PROJECT 1513	DATE	05/03/07	JC	
PHASE	INLET #	ZONING	SUBAREA	AREA (Ac)	"C" FACTOR	% IMPERVIOUS
		(Z)	(B)	(A)	(C)	(F)
NA	I-1	RR		1.0	0.48	42
NA	I-2	RR		1.1	0.26	19
NA	I-2A	RR		0.3	0.25	17
NA	I-3	RR		3.0	0.26	20
NA	I-4	RR		2.3	0.26	20
NA	I-5	RR		1.0	0.32	28
NA	I-6	RR		0.7	0.60	66
NA	I-7	RR		2.7	0.33	25
NA	I-8	RR		1.9	0.26	18
NA	I-9	RR		1.1	0.26	19
NA	I-10	RR		0.2	0.86	100
NA	I-11	RR		0.3	0.71	77
NA	I-12	RR		1.0	0.33	18
NA	I-13	RR		2.3	0.25	7
NA	I-14	RR		0.2	0.86	100
NA	I-15	RR		0.1	0.86	100
NA	I-16	RR		0.2	0.86	100
NA	I-17	RR		0.5	0.60	65
NA	I-18	RR		2.3	0.21	0
NA	I-19	RR		0.11	0.86	100
NA	I-20	RR		0.01	0.86	100
NA	I-21	RR		1.32	0.32	21
NA	I-22	RR		0.17	0.86	100
NA	I-23	RR		0.32	0.44	36
NA	I-24	RR		1.16	0.21	0
NA	E-8	RR		12.80	0.26	20
NA	EX 15"	RR		1.62	0.30	25

1 7-13-07 REVISED STORM DRAIN MATERIAL OF SOME PIPES
 NO. DATE REVISION

BENCHMARK
 ENGINEERS • LAND SURVEYORS • PLANNERS
ENGINEERING, INC.
 8480 BALTIMORE NATIONAL PIKE • SUITE 418
 ELLICOTT CITY, MARYLAND 21043
 PHONE: 410-465-6105 FAX: 410-465-6644
 E-MAIL: benchmark@ccia.com

OWNER/DEVELOPER: HIGHLAND DEVELOPMENT CORP
 P.O. BOX 228
 CLARKSVILLE, MARYLAND 21029
 410-531-5539

PROJECT: BRIGHTON MILL
 LOTS 1 THROUGH 22, BUILDABLE PRESERVATION PARCEL 'A'
 AND NON-BUILDABLE PRESERVATION PARCELS 'B' THROUGH 'D'

LOCATION: TAX MAP No. 34, GRID No. 2
 PARCEL 2
 5th ELECTION DISTRICT
 HOWARD COUNTY, MARYLAND

TITLE: STORM DRAIN DRAINAGE AREA MAP

DATE: MAY, 2007 PROJECT NO. 1513


Design: JMC Draft: JMC/MCR Check: DAM SCALE: AS SHOWN DRAWING 19 OF 34

APPROVED: HOWARD COUNTY DEPARTMENT OF PUBLIC WORKS
W. Z. ... 6-6-07
 CHIEF, BUREAU OF HIGHWAYS

APPROVED: HOWARD COUNTY DEPT. OF PLANNING AND ZONING
J. ... 6-11-07
 CHIEF, DIVISION OF LAND DEVELOPMENT

... 6/6/07
 CHIEF, DEVELOPMENT ENGINEERING DIVISION

PLAN
 SCALE: 1" = 100'

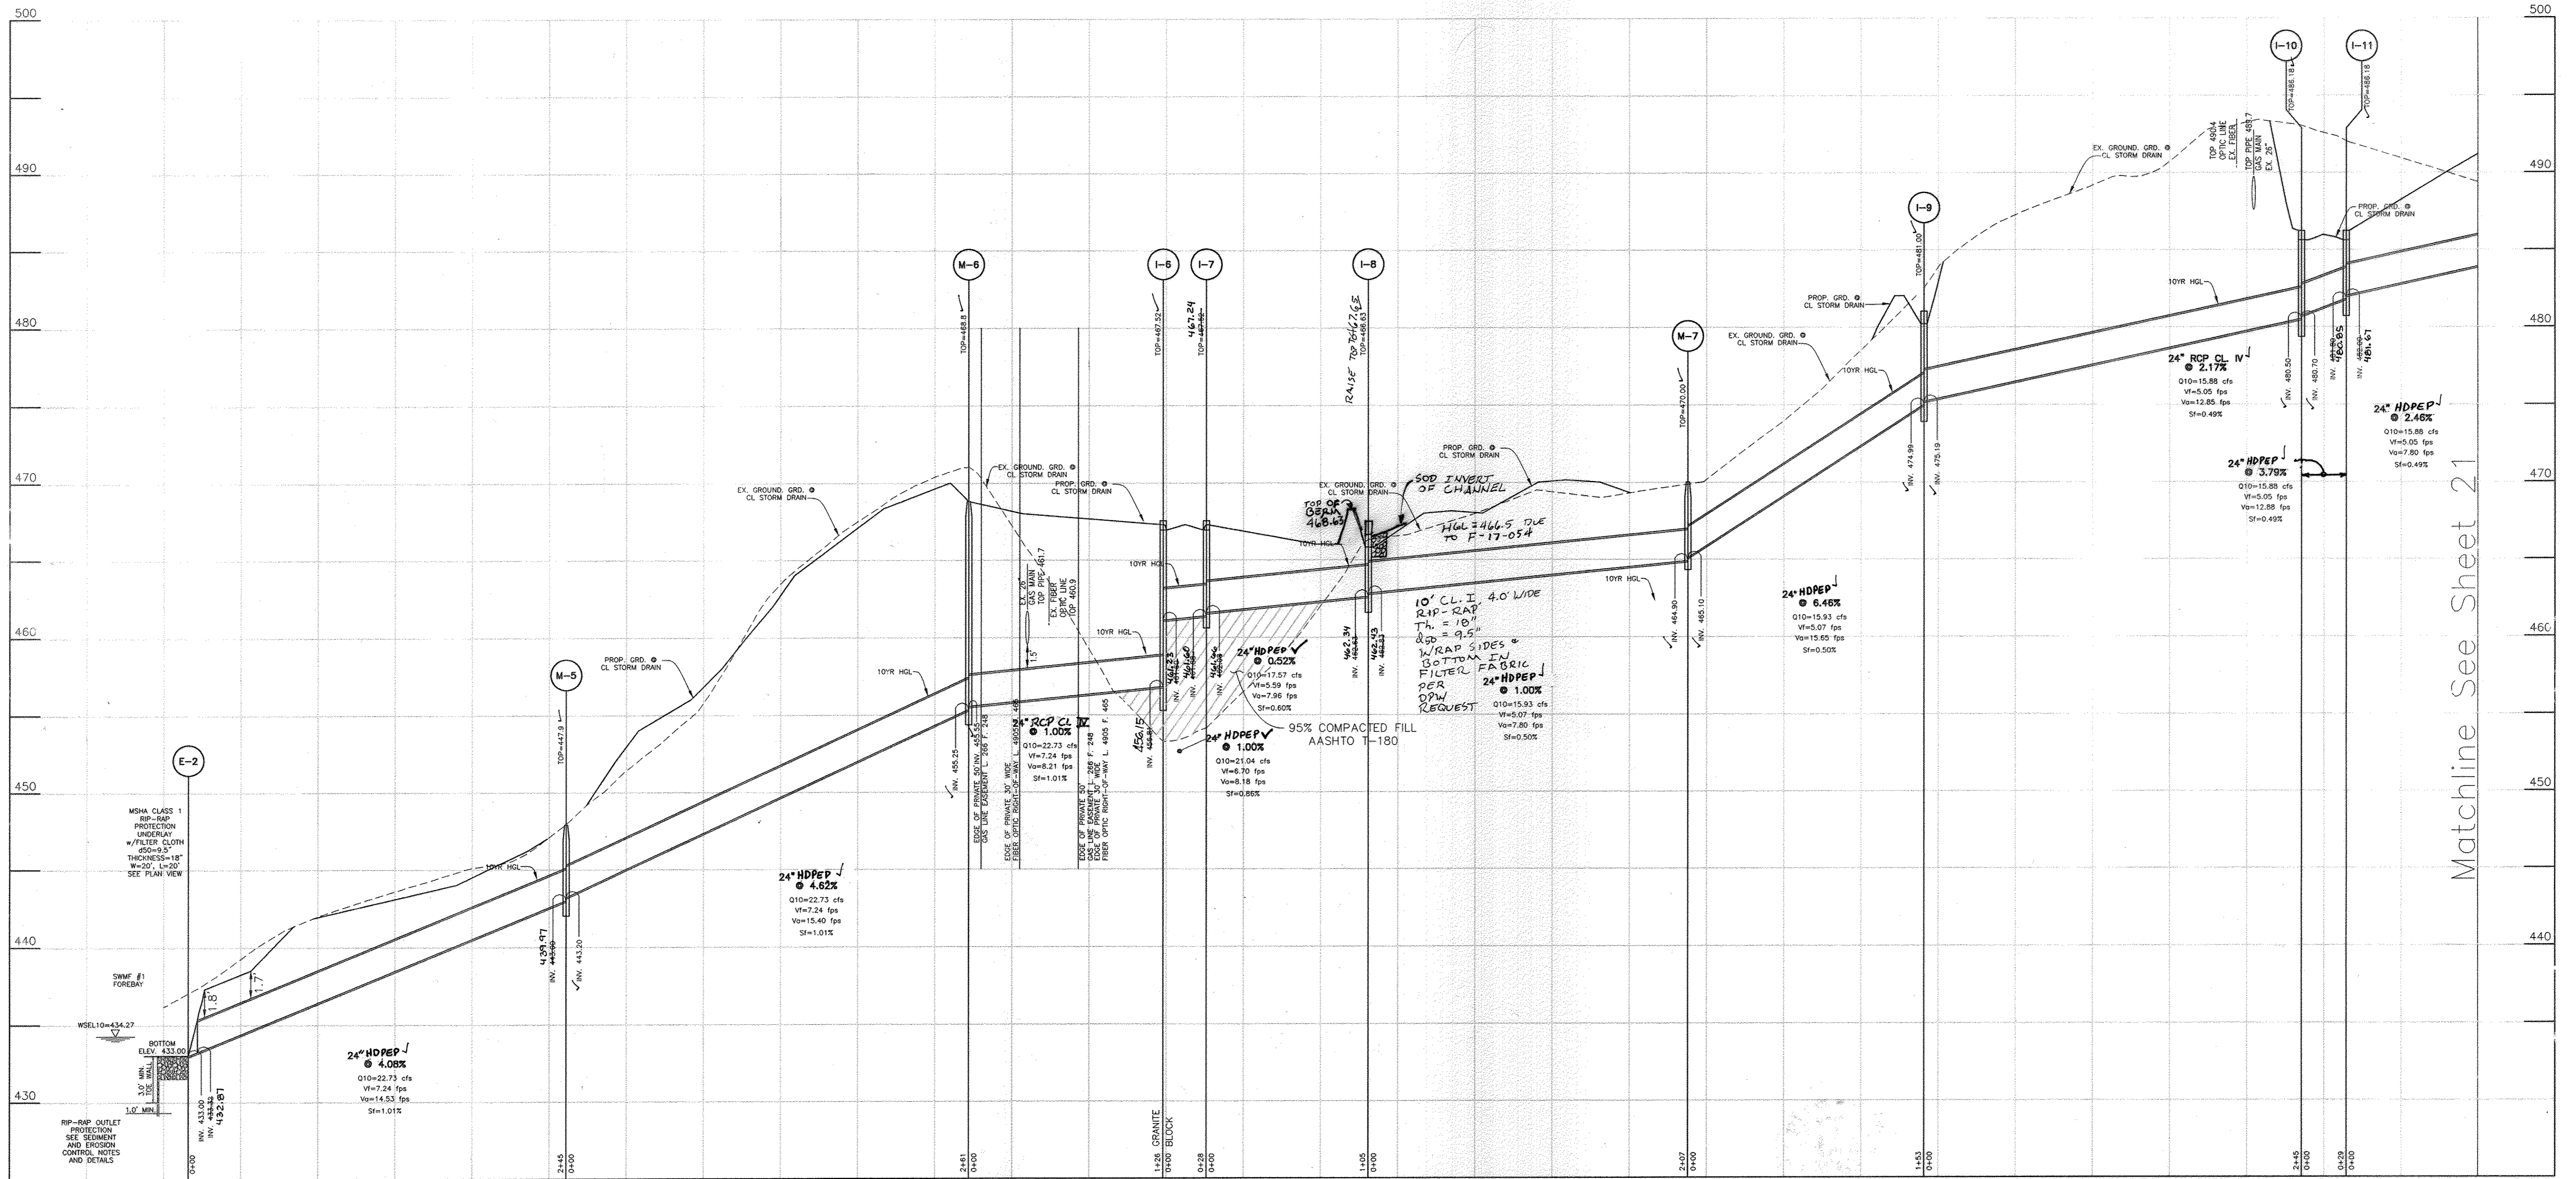

Matchline See Sheet 21

2	3-10-17	REVISE I-B DATE TO F-17-054 HGL (BRIGHTON MILL II)
1	7-13-07	REVISED STORM DRAIN MATERIAL OF SOME PIPES
NO.	DATE	REVISION

BENCHMARK
ENGINEERS • LAND SURVEYORS • PLANNERS

ENGINEERING, INC.

8480 BALTIMORE NATIONAL PIKE & SUITE 418
ELLICOTT CITY, MARYLAND 21043
PHONE: 410-485-8105 FAX: 410-485-6644
E-MAIL: benchmark@cois.com

Donald M. Moore
5/7/07

OWNER/DEVELOPER: HIGHLAND DEVELOPMENT CORP P.O. BOX 228 CLARKSVILLE, MARYLAND 21029 410-531-5539	PROJECT: BRIGHTON MILL LOT 1 THROUGH 22, BUILDABLE PRESERVATION PARCEL 'A' AND NON-BUILDABLE PRESERVATION PARCELS 'B' THROUGH 'D' LOCATION: TAX MAP No. 34, GRID No. 2 PARCEL 2 5th ELECTION DISTRICT HOWARD COUNTY, MARYLAND
TITLE: STORM DRAIN PROFILES	
DATE: MAY, 2007	PROJECT NO. 1513
Design: JMC	Draft: LAB
Check: DAM	SCALE: AS SHOWN
DRAWING 20 OF 34	

APPROVED: HOWARD COUNTY DEPARTMENT OF PUBLIC WORKS

Walter J. ... 6-6-07
CHIEF, BUREAU OF HIGHWAYS


APPROVED: HOWARD COUNTY DEPT. OF PLANNING AND ZONING

T. Krista ... 6-11-07
CHIEF, DIVISION OF LAND DEVELOPMENT

... 6/6/07
CHIEF, DEVELOPMENT ENGINEERING DIVISION

Donald M. Moore
 AS-BUILT 1-13-10

Matchline See Sheet 20


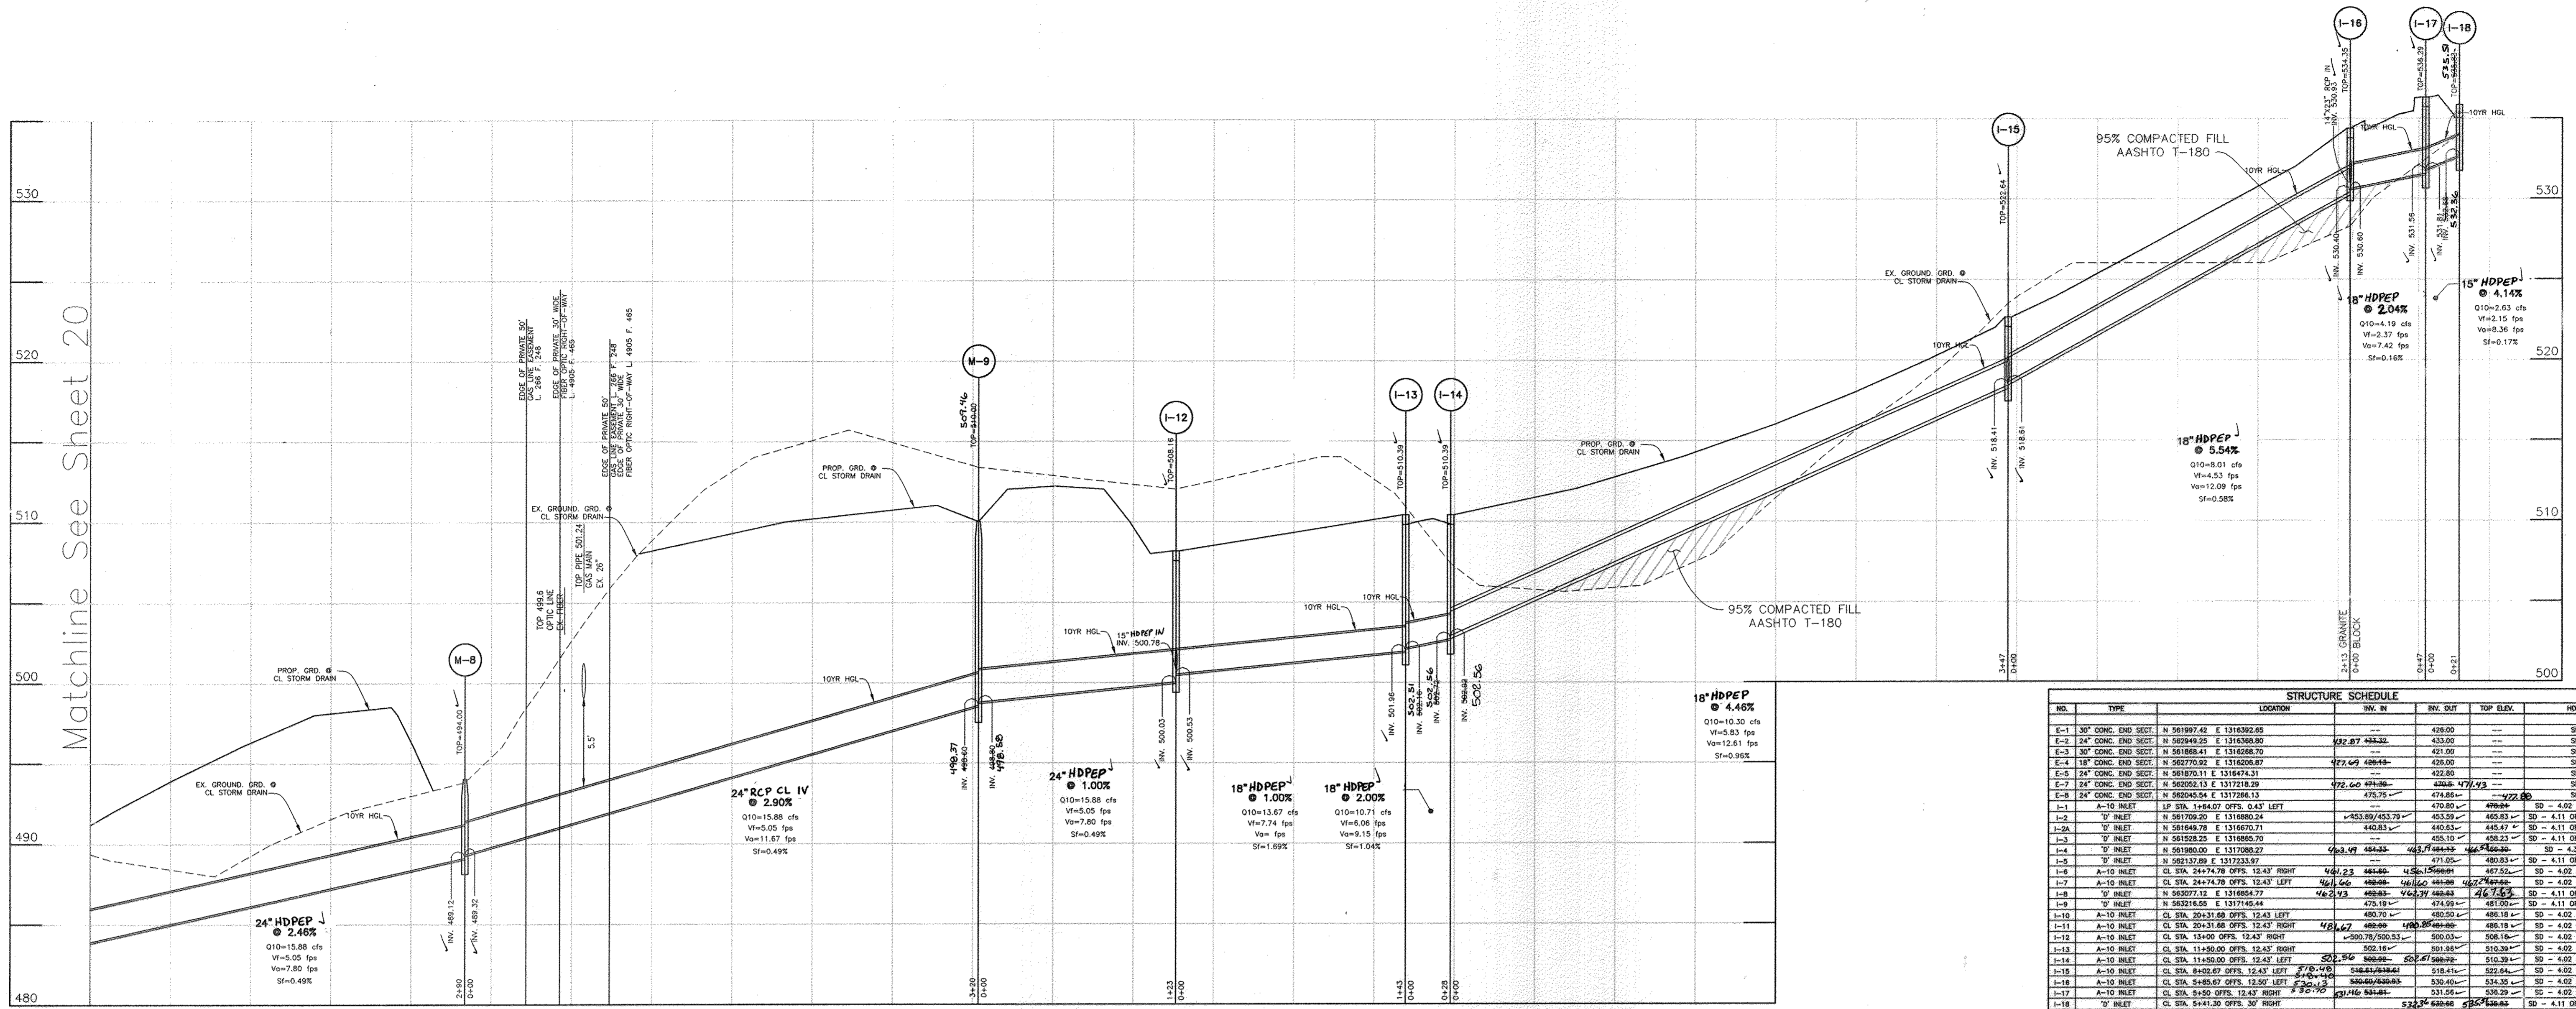


RUN	LENGTH	DIAMETER	MATERIAL	NOTES
E-2 TO M-5	257	24"	HDPEP	PUBLIC
M-5 TO M-6	119	24"	RCP CL IV	PUBLIC
M-6 TO I-6	75	24"	HDPEP	PUBLIC
I-6 TO I-7	100	24"	HDPEP	PUBLIC
I-7 TO M-7	203	24"	HDPEP	PUBLIC
M-7 TO I-8	148	24"	HDPEP	PUBLIC
I-8 TO I-10	243	24"	RCP CL IV	PUBLIC
I-10 TO I-11	25	24"	HDPEP	PUBLIC
I-11 TO M-8	312	24"	HDPEP	PUBLIC
M-8 TO M-9	316	24"	RCP CL IV	PUBLIC
M-9 TO I-12	114	24"	HDPEP	PUBLIC
I-12 TO I-13	136	18"	HDPEP	PUBLIC
I-13 TO I-14	75	18"	HDPEP	PUBLIC
I-14 TO I-15	337	18"	HDPEP	PUBLIC
I-15 TO I-16	203	18"	HDPEP	PUBLIC
I-16 TO I-17	39	18"	HDPEP	PUBLIC
I-17 TO I-18	18	15"	HDPEP	PRIVATE
I-18 TO M-12	150	18"	HDPEP	PRIVATE
M-12 TO I-2A	222	15"	HDPEP	PRIVATE
I-2 TO I-3	109	18"	HDPEP	PRIVATE
I-3 TO M-13	344	18"	HDPEP	PRIVATE
M-13 TO I-5	157	15"	HDPEP	PRIVATE
M-1 TO M-1	229	18"	HDPEP	PUBLIC
M-1 TO M-2	171	18"	HDPEP	PUBLIC
M-2 TO M-3	122	18"	HDPEP	PUBLIC
M-3 TO I-1	26	15"	HDPEP	PUBLIC
I-18 TO I-14	208	14" x 23"	RCP CL IV	PUBLIC
I-14 TO I-19	137	18"	HDPEP	PUBLIC
I-19 TO I-21	46	15"	HDPEP	PRIVATE
I-21 TO I-22	75	15"	HDPEP	PRIVATE
I-22 TO I-23	82	15"	HDPEP	PRIVATE
I-23 TO I-22	25	15"	HDPEP	PUBLIC
E-7 TO M-8	32	24"	HDPEP	PRIVATE
M-8 TO M-11	172	14" x 23"	RCP CL IV	PRIVATE
M-11 TO M-10	100	24"	HDPEP	PRIVATE
M-10 TO E-1	95	24"	HDPEP	PRIVATE

DIAMETER	MATERIAL	LENGTH	OWNERSHIP
15"	HDPEP	285	PUBLIC
18"	RCP CL IV	0	PUBLIC
24"	RCP CL IV	670	PUBLIC
14" x 23"	RCP CL IV	708	PUBLIC
24"	HDPEP	227	PRIVATE
18"	HDPEP	720	PRIVATE
15"	HDPEP	520	PRIVATE
14" x 23"	RCP CL IV	172	PRIVATE

APPROVED: HOWARD COUNTY DEPARTMENT OF PUBLIC WORKS
 DATE: 6-6-07

APPROVED: HOWARD COUNTY DEPT. OF PLANNING AND ZONING
 DATE: 6-11-07

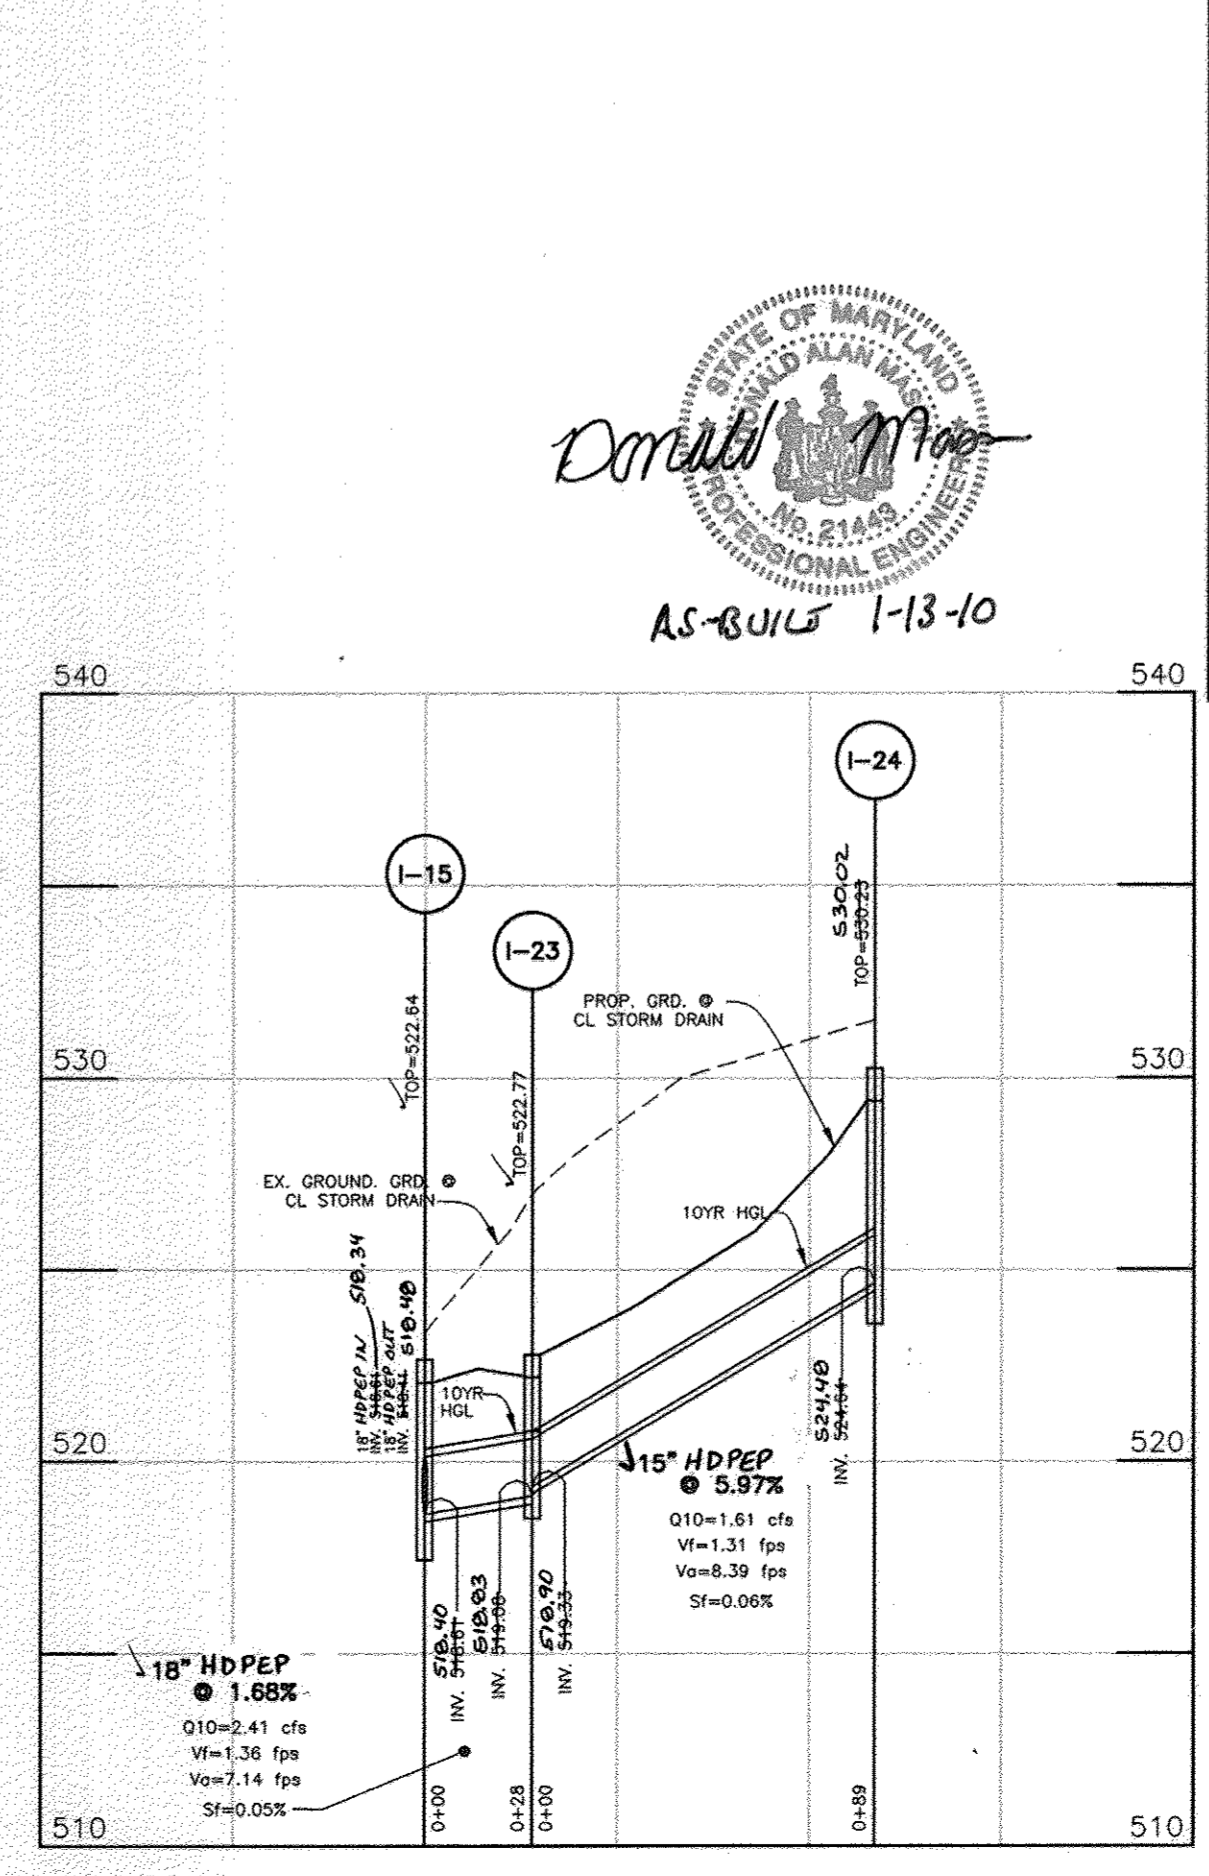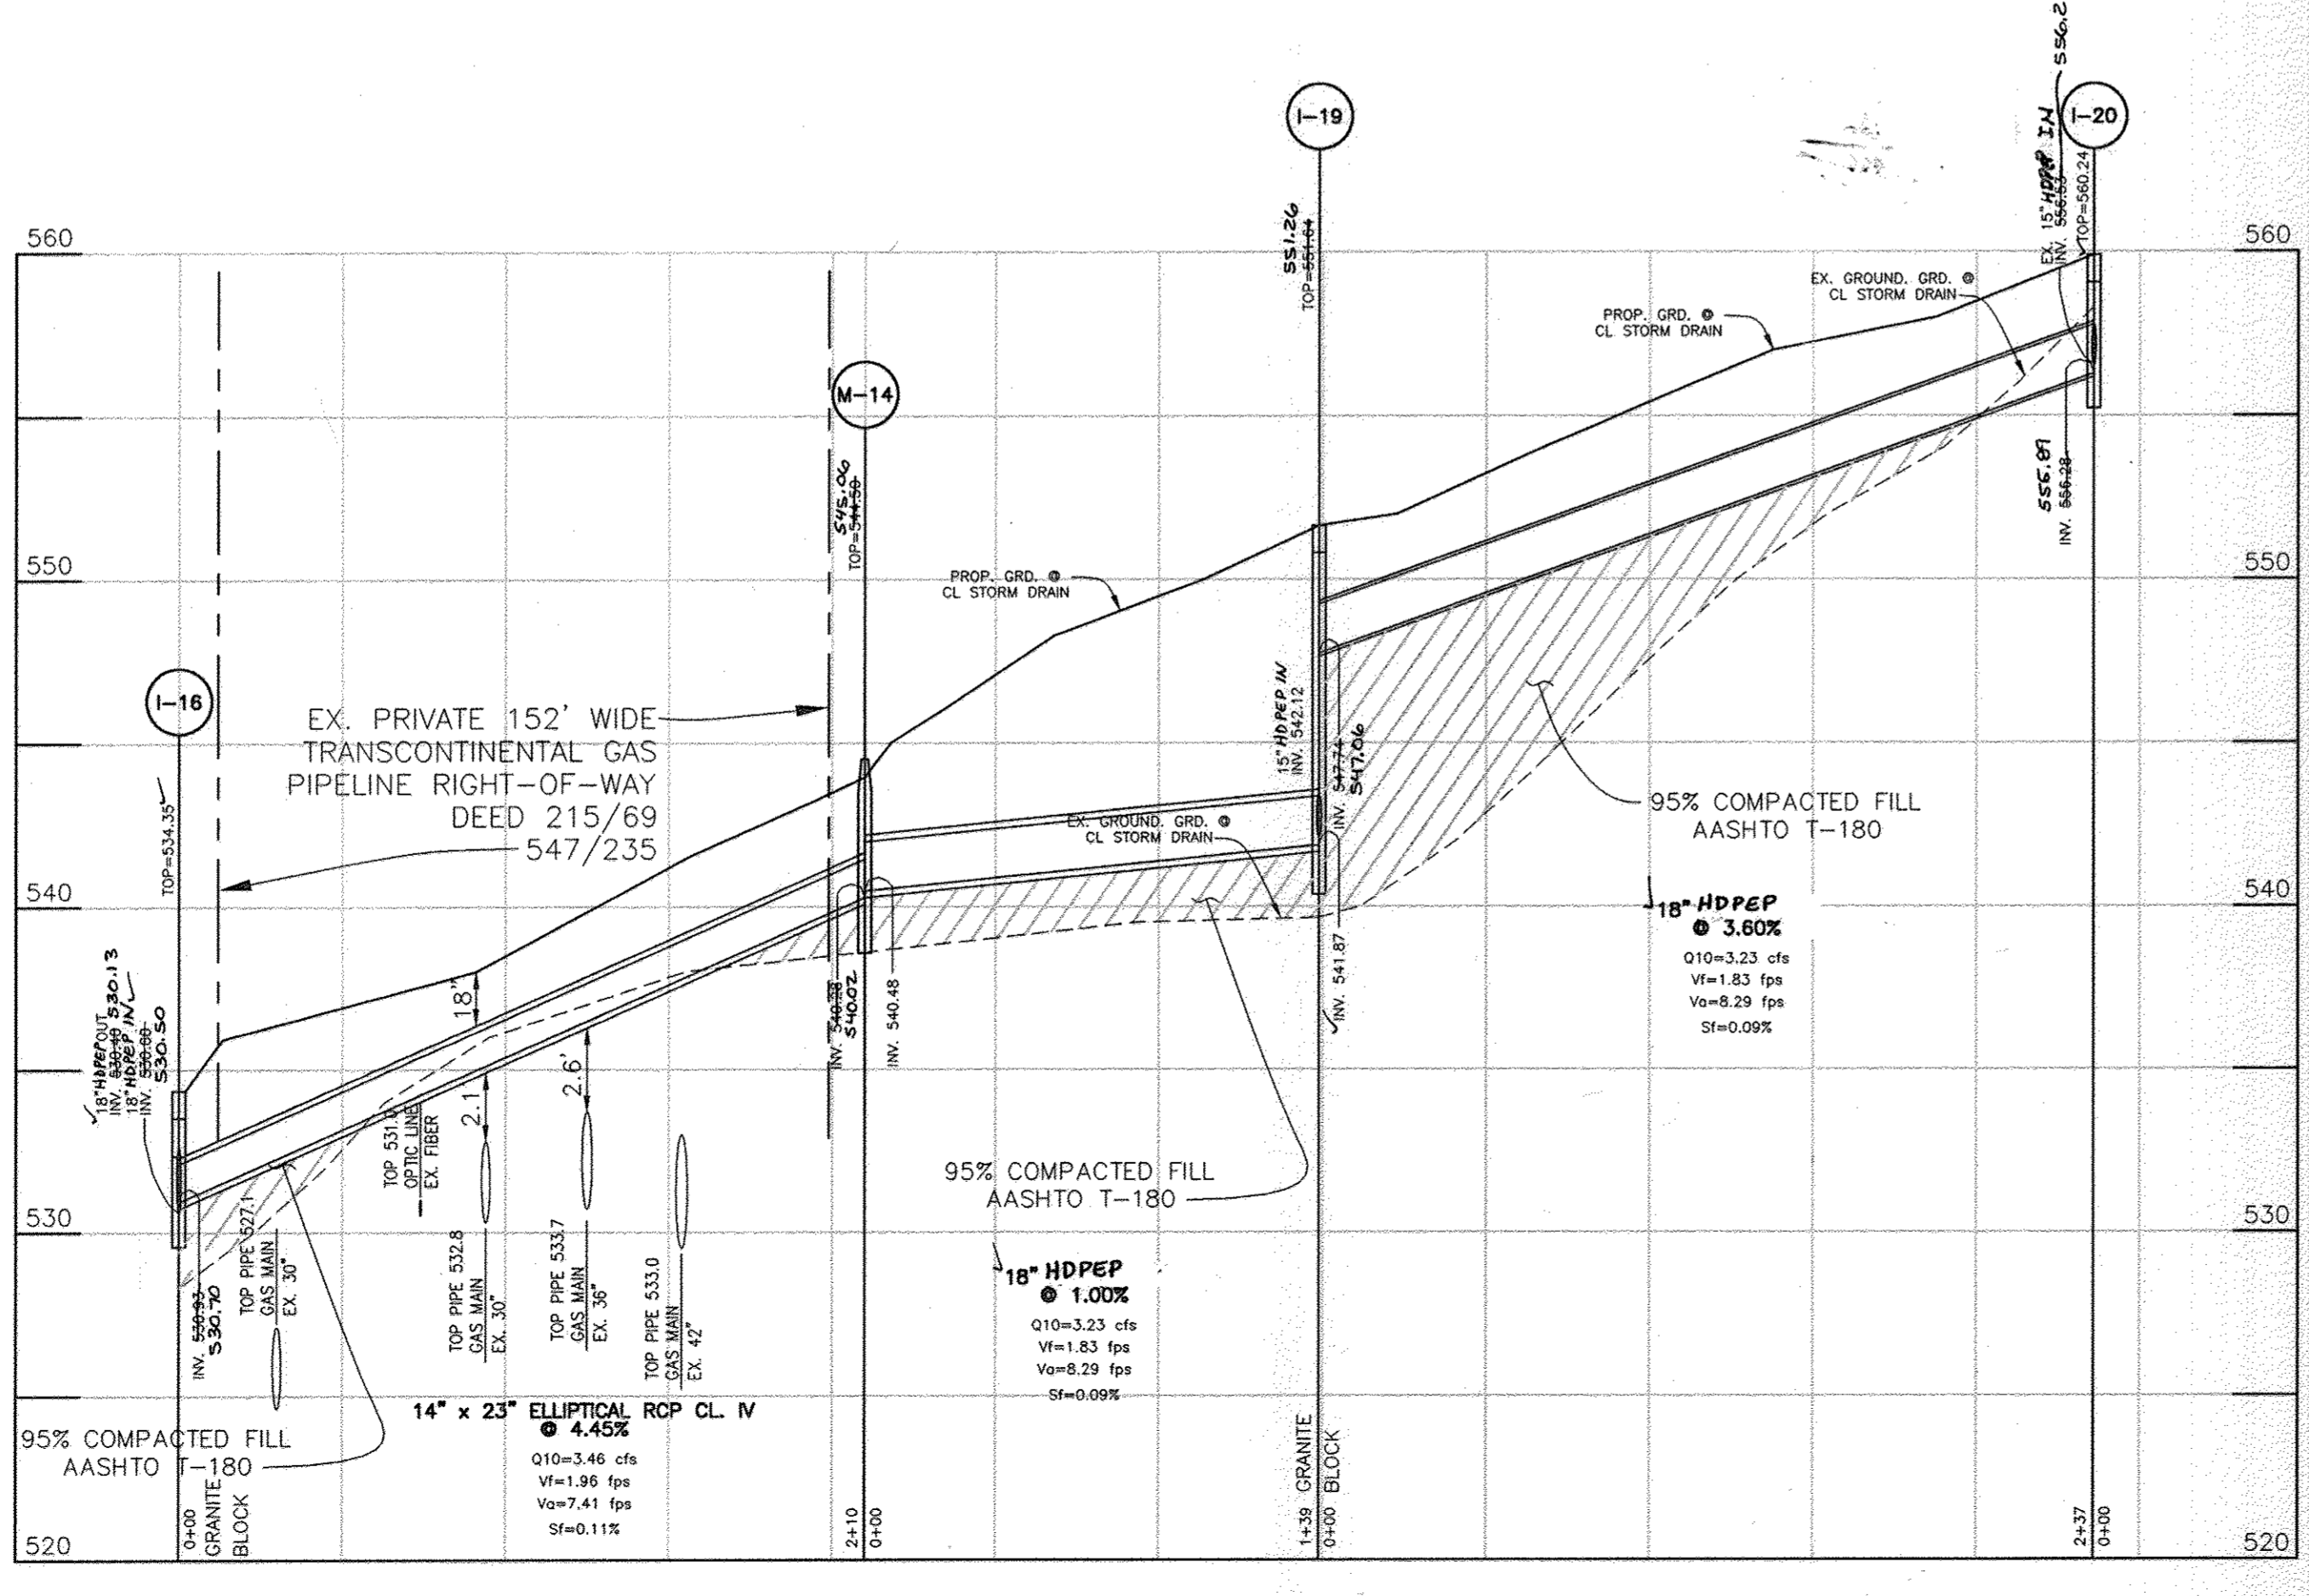

NO.	TYPE	LOCATION	INV. IN	INV. OUT	TOP ELEV.	HD. CO. STD.	OWNERSHIP	
E-1	30" CONC. END SECT.	N 561997.42 E 1316322.65	428.00	---	---	SD - 5.52	PUBLIC	
E-2	24" CONC. END SECT.	N 562949.25 E 1316306.80	427.87	428.30	---	SD - 5.52	PRIVATE	
E-3	30" CONC. END SECT.	N 561984.41 E 1316266.70	---	---	---	SD - 5.52	PRIVATE	
E-4	18" CONC. END SECT.	N 562770.92 E 1316206.87	427.67	428.00	---	SD - 5.52	PRIVATE	
E-5	24" CONC. END SECT.	N 561870.11 E 1316474.31	---	---	---	SD - 5.52	PRIVATE	
E-6	24" CONC. END SECT.	N 562025.13 E 1317178.29	428.00	428.50	---	SD - 5.52	PRIVATE	
E-7	24" CONC. END SECT.	N 562045.54 E 1317266.13	428.00	428.50	---	SD - 5.52	PRIVATE	
I-1	A-10 INLET	LP STA. 1464.07 OFFS. 0.43' LEFT	470.80	---	---	SD - 4.02 OR 4.41 2.5' WIDTH	PUBLIC	
I-2	"D" INLET	N 561709.20 E 1316880.24	453.29	453.79	---	SD - 4.11 OR 4.39 OPEN 4 SIDES	PRIVATE	
I-3	"D" INLET	N 561644.78 E 1316700.71	442.83	443.33	---	SD - 4.11 OR 4.39 OPEN 4 SIDES	PRIVATE	
I-4	"D" INLET	N 561528.25 E 1316865.70	455.10	455.60	---	SD - 4.11 OR 4.39 OPEN 4 SIDES	PRIVATE	
I-5	"D" INLET	N 561800.00 E 1317088.27	463.97	464.47	---	SD - 4.39 OPEN 4 SIDES	PRIVATE	
I-6	"D" INLET	N 562132.29 E 1317333.87	471.05	471.55	---	SD - 4.11 OR 4.39 OPEN 4 SIDES	PRIVATE	
I-7	A-10 INLET	CL STA. 24+74.78 OFFS. 12.43' RIGHT	461.23	461.73	456.15	SD - 4.02 OR 4.41 2.5' WIDTH	PUBLIC	
I-8	"D" INLET	CL STA. 24+74.78 OFFS. 12.43' LEFT	461.66	462.16	456.15	SD - 4.02 OR 4.41 2.5' WIDTH	PUBLIC	
I-9	"D" INLET	N 562077.12 E 1316884.77	462.93	463.43	456.15	SD - 4.11 OR 4.39 OPEN 4 SIDES	PUBLIC	
I-10	"D" INLET	N 562325.55 E 1317145.44	474.93	475.43	---	SD - 4.11 OR 4.39 OPEN 4 SIDES	PUBLIC	
I-11	A-10 INLET	CL STA. 20+31.88 OFFS. 12.43' LEFT	480.50	481.00	475.43	SD - 4.02 OR 4.41 2.5' WIDTH	PUBLIC	
I-12	A-10 INLET	CL STA. 13+40 OFFS. 12.43' RIGHT	500.70	501.20	495.18	SD - 4.02 OR 4.41 2.5' WIDTH	PUBLIC	
I-13	A-10 INLET	CL STA. 11+50.00 OFFS. 12.43' RIGHT	502.16	502.66	495.18	SD - 4.02 OR 4.41 2.5' WIDTH	PUBLIC	
I-14	A-10 INLET	CL STA. 11+50.00 OFFS. 12.43' LEFT	502.16	502.66	495.18	SD - 4.02 OR 4.41 2.5' WIDTH	PUBLIC	
I-15	A-10 INLET	CL STA. 8+02.87 OFFS. 12.43' LEFT	518.40	518.90	513.64	SD - 4.02 OR 4.41 2.5' WIDTH	PUBLIC	
I-16	A-10 INLET	CL STA. 5+85.87 OFFS. 12.50' LEFT	530.43	530.93	525.67	SD - 4.02 OR 4.41 2.5' WIDTH	PUBLIC	
I-17	A-10 INLET	CL STA. 5+40 OFFS. 12.43' RIGHT	536.29	536.79	531.50	SD - 4.02 OR 4.41 2.5' WIDTH	PUBLIC	
I-18	"D" INLET	CL STA. 5+41.30 OFFS. 30' RIGHT	522.34	522.84	517.58	SD - 4.11 OR 4.39 OPEN 4 SIDES	PRIVATE	
I-19	A-10 INLET	CL STA. 2+27.95 OFFS. 12.43' LEFT	542.12	542.62	537.36	SD - 4.02 OR 4.41 2.5' WIDTH	PUBLIC	
I-20	A-10 INLET	CL STA. 0+11.11 OFFS. 41.87' LEFT	560.24	560.74	555.48	SD - 4.02 OR 4.41 2.5' WIDTH	PUBLIC	
I-21	"D" INLET	CL STA. 2+30.28 OFFS. 35.12' RIGHT	542.81	543.31	538.05	SD - 4.11 OR 4.39 OPEN 4 SIDES	PRIVATE	
I-22	A-10 INLET	CL STA. 13+00.00 OFFS. 12.43' LEFT	502.18	502.68	497.42	SD - 4.02 OR 4.41 2.5' WIDTH	PUBLIC	
I-23	A-10 INLET	CL STA. 8+00.00 OFFS. 12.43' RIGHT	518.40	518.90	513.64	SD - 4.02 OR 4.41 2.5' WIDTH	PUBLIC	
I-24	"D" INLET	CL STA. 7+11.50 OFFS. 23.14' RIGHT	529.88	530.38	525.02	SD - 4.11 OR 4.39 OPEN 4 SIDES	PRIVATE	
M-1	4'-0" MANHOLE	N 56215.30 E 1316484.72	437.98	437.98	443.33	G - 5.12	PUBLIC	
M-2	4'-0" MANHOLE	N 562136.92 E 1316640.89	454.74	454.74	460.09	G - 5.12	PUBLIC	
M-3	4'-0" MANHOLE	N 562189.76 E 1316754.20	469.09	469.09	474.44	G - 5.12	PUBLIC	
M-4	4'-0" MANHOLE	N 562334.41 E 1316909.87	483.20	483.20	488.55	G - 5.12	PUBLIC	
M-5	4'-0" MANHOLE	CL STA. 23+48.47 OFFS. 18.09' RIGHT	455.55	455.55	460.90	G - 5.12	PUBLIC	
M-6	4'-0" MANHOLE	N 562065.69 E 1317061.29	465.10	465.10	470.45	G - 5.12	PUBLIC	
M-7	4'-0" MANHOLE	CL STA. 17+35.85 OFFS. 45.54' RIGHT	489.33	489.33	494.68	G - 5.12	PUBLIC	
M-8	4'-0" MANHOLE	CL STA. 14+34.98 OFFS. 35.53' RIGHT	478.50	478.50	483.85	G - 5.12	PUBLIC	
M-9	4'-0" MANHOLE	N 561800.35 E 1316539.35	433.87	433.87	439.22	G - 5.12	PRIVATE	
M-10	4'-0" MANHOLE	N 561748.14 E 1316733.39	428.40	428.40	433.75	G - 5.12	PRIVATE	
M-11	4'-0" MANHOLE	N 561803.65 E 1316801.25	444.27	444.27	449.62	G - 5.12	PRIVATE	
M-12	4'-0" MANHOLE	N 561868.66 E 1317236.15	460.22	460.22	465.57	G - 5.12	PRIVATE	
M-13	4'-0" MANHOLE	CL STA. 3+47.02 OFFS. 20.87' LEFT	540.18	540.18	545.53	G - 5.12	PUBLIC	
S-1	SEE DETAIL	N 562824.28 E 1316253.59	---	---	---	SEE SINA DETAILS	PRIVATE	
S-2	SEE DETAIL	N 561888.50 E 1316350.11	---	---	---	SEE SINA DETAILS	PRIVATE	
S-3	SEE DETAIL	N 561788.70 E 1316827.26	---	---	---	SEE SINA DETAILS	PRIVATE	
HW-1	NORTH STR. WEST WALL	CL STA. 25+09.45 OFFS. 18.00' RIGHT	---	---	445.86	482.53	SEE MANUFACT. SPECS.	PUBLIC
HW-2	NORTH STR. EAST WALL	CL STA. 25+09.45 OFFS. 18.00' LEFT	---	---	445.86	482.53	SEE MANUFACT. SPECS.	PUBLIC

1) STRUCTURE ELEVATION AND LOCATION FOR MANHOLES IS AT THE TOP AND CENTER OF RIM.
 2) STRUCTURE ELEVATION AND LOCATION FOR INLETS IS AT THE TOP OF CURB AT MIDPOINT OF THE INLET OR AT THE CENTER OF SLAB FOR "D" INLETS.
 3) STRUCTURE ELEVATION AND LOCATION FOR ENDSECTIONS IS AT CENTERLINE OF THE END OF THE END SECTION.
 4) PRECAST STRUCTURES HAVING HD-30 LININGS MAY BE USED.
 5) ALL STORM DRAINS SHALL BE SMOOTH CORE HIGH DENSITY POLYETHYLENE PIPE.

2 3-10-17 ADJUST I-B PER CHANGES REQUIRED BY F-17-054, BRIGHTMILL II.
 1 7-13-07 REVISED SD/DM DRAIN MATERIAL OF SOME PIPES

NO.	DATE	REVISION
2	3-10-17	ADJUST I-B PER CHANGES REQUIRED BY F-17-054, BRIGHTMILL II.
1	7-13-07	REVISED SD/DM DRAIN MATERIAL OF SOME PIPES

BENCHMARK ENGINEERS, INC.
 ENGINEERS & LAND SURVEYORS & PLANNERS
 8480 BALTIMORE NATIONAL PIKE & SUITE 418
 ELLICOTT CITY, MARYLAND 21043
 PHONE: 410-465-6105 FAX: 410-465-6844
 E-MAIL: benchmark@cais.com

OWNER/DEVELOPER: HIGHLAND DEVELOPMENT CORP
 P.O. BOX 228
 CLARKSVILLE, MARYLAND 21029
 410-531-5539

PROJECT: BRIGHTMILL
 LOT 1 THROUGH 22, BUILDABLE PRESERVATION PARCEL 'A' AND NON-BUILDABLE PRESERVATION PARCELS 'B' THROUGH 'D'




LOCATION: TAX MAP No. 34, GRID No. 2
 PARCEL 2
 5th ELECTION DISTRICT
 HOWARD COUNTY, MARYLAND

TITLE: STORM DRAIN PROFILES

DATE: MAY, 2007 PROJECT NO. 1513

Design: JMC Draft: LAB Check: DAM SCALE: AS SHOWN DRAWING 21 OF 34

FLOODPLAIN CHART						
REACH	CROSS-SECTION NO.	EX. 100 YR. Q	PROP. 100 YR. Q	100 YR. EX. W.S.	100 YR. PROP. W.S.	
A	2000	835	823	448.1	448.0	
A	1900	835	823	445.1	445.1	
A	1800	835	823	441.3	441.2	
A	1700	835	823	438.3	438.3	
A	1600	835	823	435.4	435.4	
A	1500	835	823	431.8	431.7	
A	1400	835	823	430.4	430.4	
A	1300	835	823	424.1	424.0	
A	1200	835	823	423.6	423.5	
A	1100	1315	1315	421.0	421.0	
A	1000	1315	1315	419.9	419.9	
A	900	1315	1315	417.7	417.7	
A	800	1315	1315	415.0	415.0	
A	700	1315	1315	412.7	412.7	
A	600	1315	1315	410.9	410.9	
A	500	1315	1315	407.0	407.0	
A	400	1315	1315	407.3	407.3	
A	300	1315	1315	405.6	405.6	
A	200	1315	1315	405.5	405.5	
A	100	1315	1315	404.7	404.7	
B	11	181	181	450.7	450.7	
B	9	181	181	444.1	444.1	
B	7	181	181	438.3	438.3	
B	5	181	181	432.9	432.9	
B	3	181	181	427.5	427.5	
B	1	181	181	420.7	420.7	
C	30	254	203	489.2	489.0	
C	28	254	203	482.1	482.1	
C	26	254	203	477.4	477.2	
C	24	254	203	472.5	472.5	
C	22	254	203	465.5	465.4	
C	20	254	203	460.5	460.4	
C	18	254	203	451.2	451.0	
C	16	254	203	449.7	449.0	
C	15	254	203	448.4	N/A	
C	14	280	293	446.5	447.2	
C	12	280	293	446.4	446.5	
C	10	280	293	441.0	441.1	
C	8	280	293	436.7	436.7	
C	6	280	293	430.8	430.8	
C	4	280	293	426.9	427.0	
C	2	280	293	420.9	420.9	

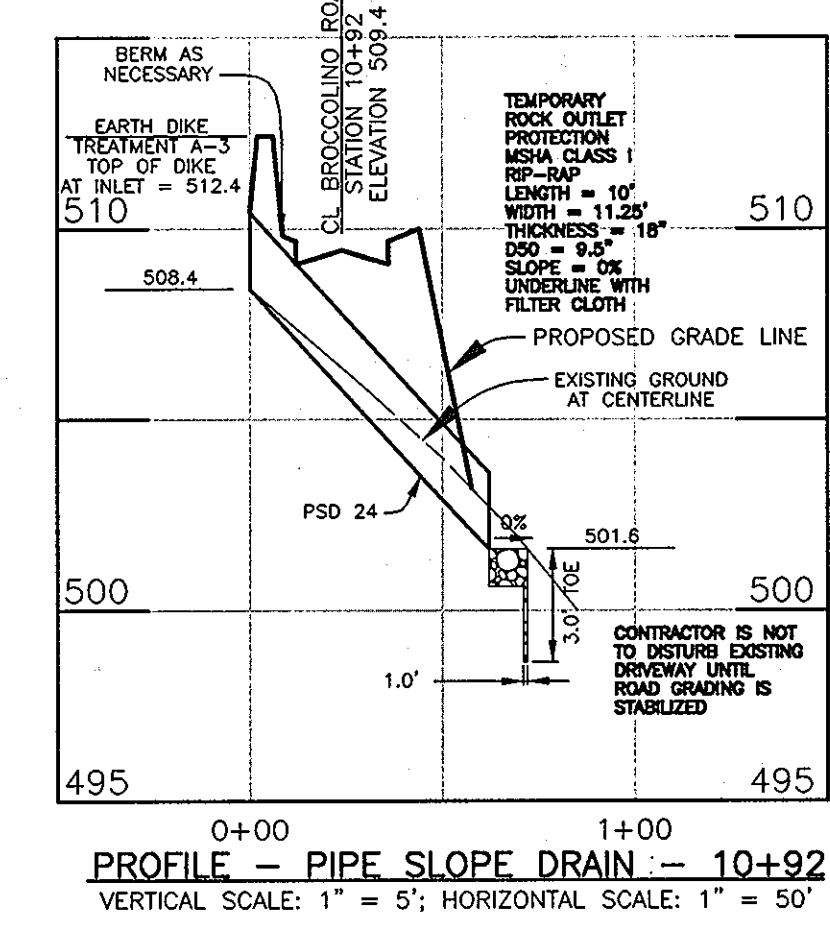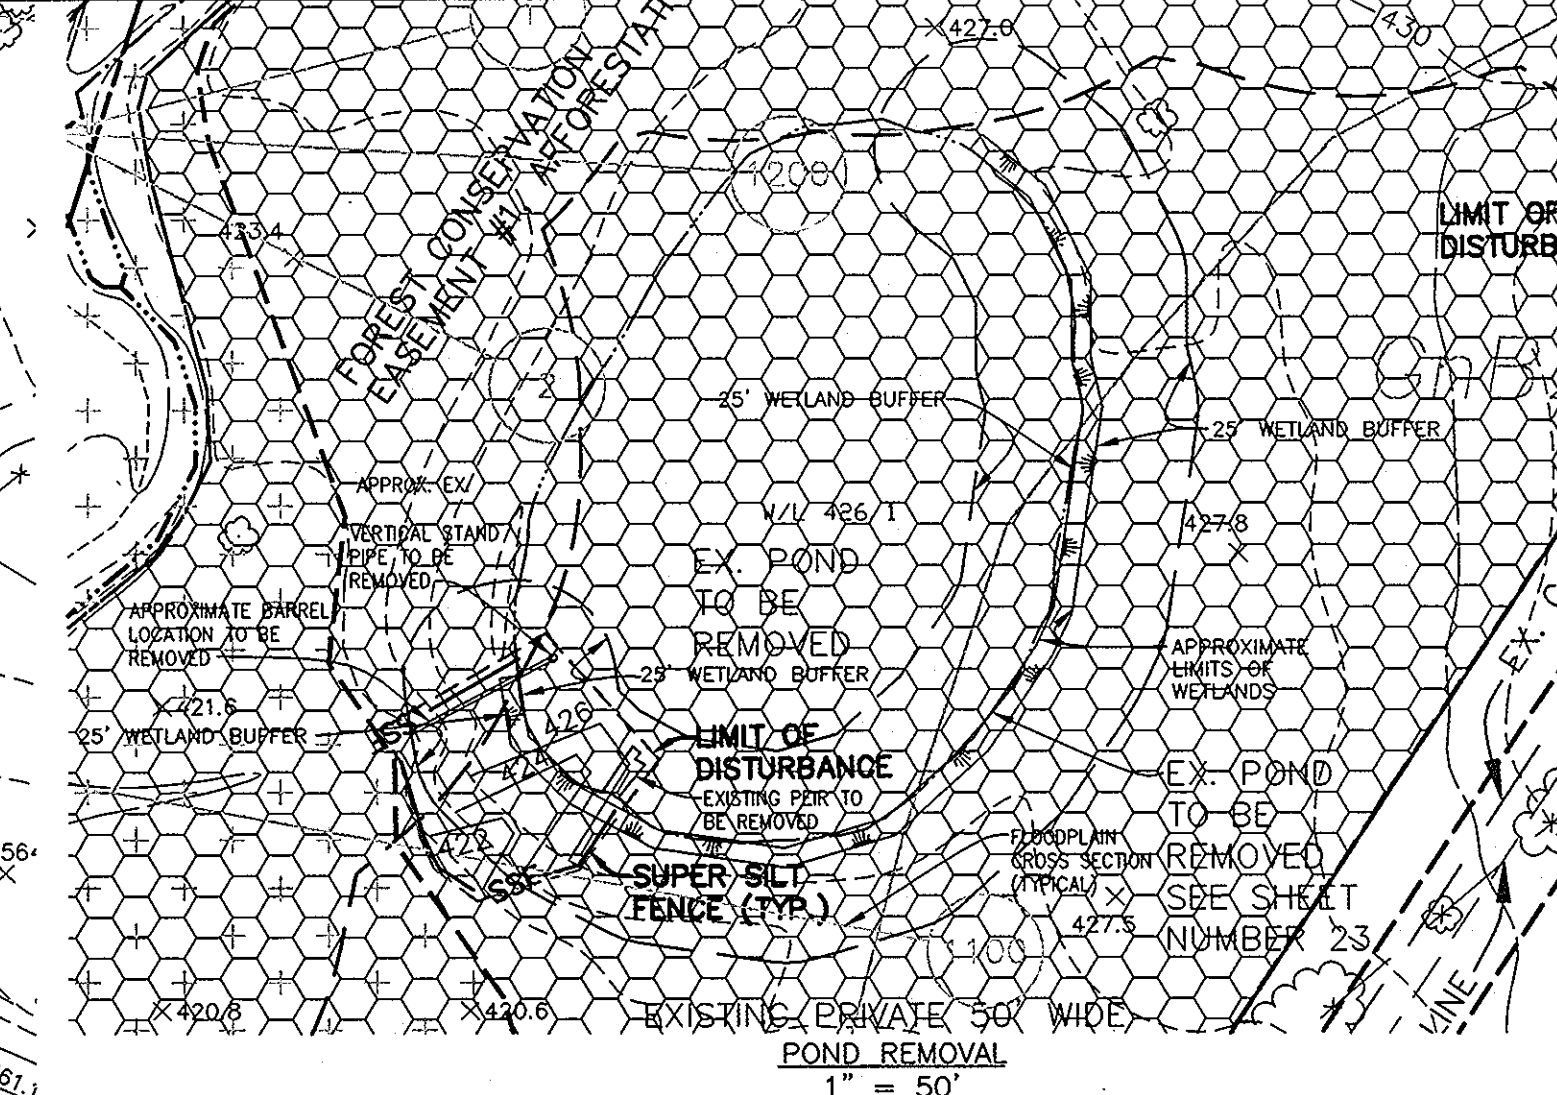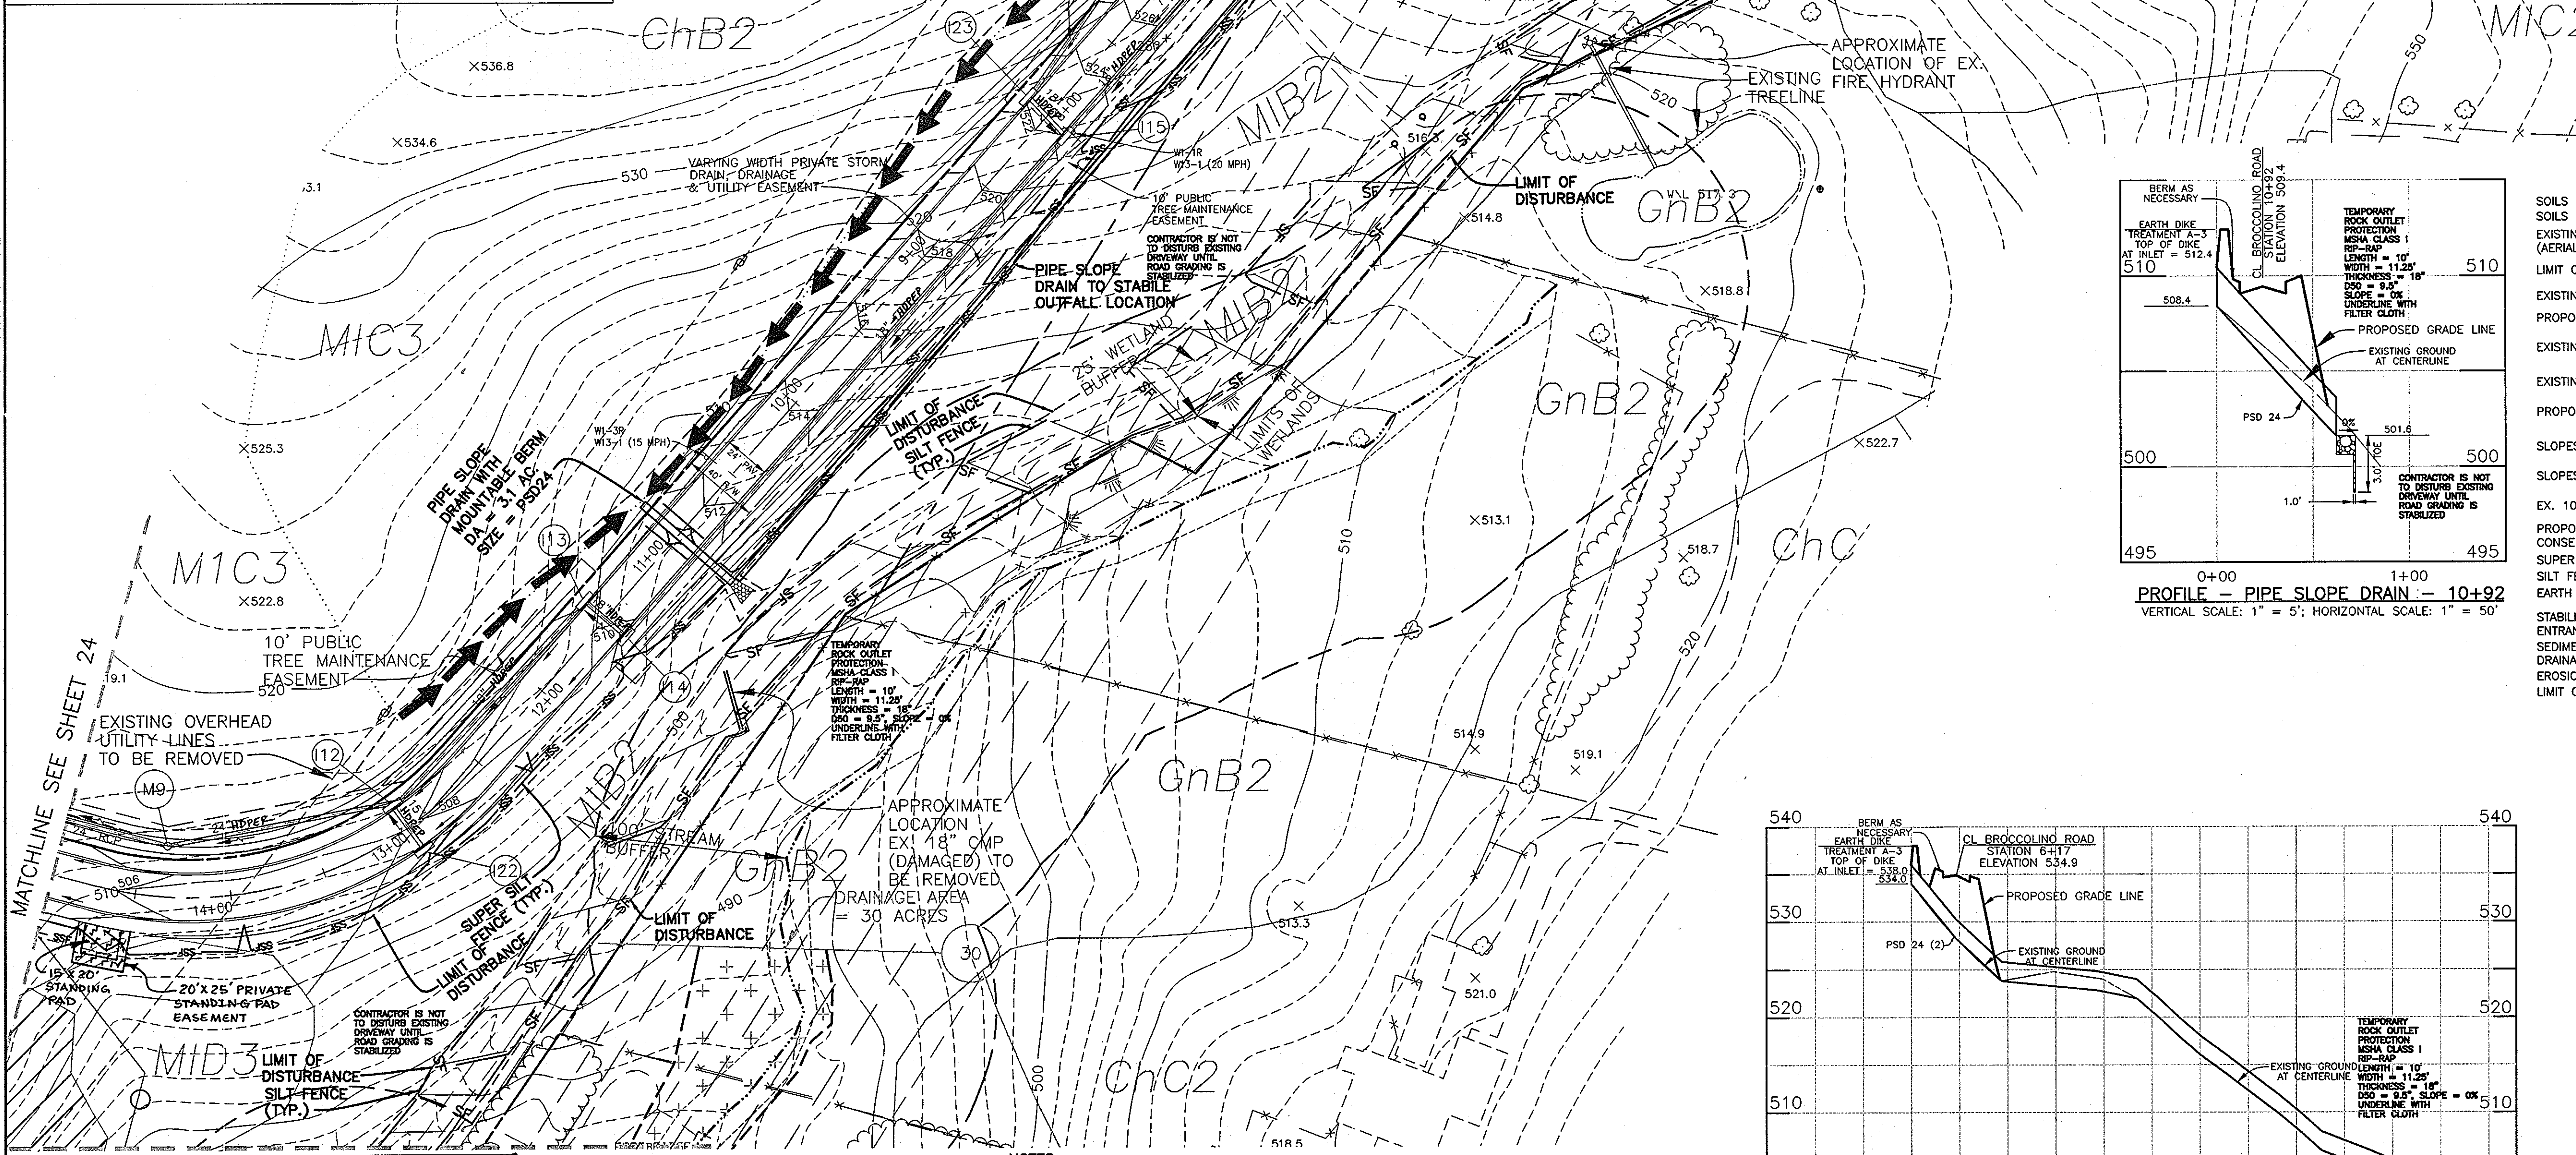

LEGEND

- SOILS CLASSIFICATION
- SOILS DELINEATION
- EXISTING CONTOURS (AERIAL 12/02)
- LIMIT OF WETLANDS
- EXISTING WOODS LINE
- PROPOSED WOODS LINE
- EXISTING STRUCTURE
- EXISTING SEPTIC FIELD
- PROPOSED SEPTIC FIELD
- SLOPES 15% TO 24.9%
- SLOPES 25% OR GREATER
- EX. 100 YEAR FLOODPLAIN
- PROPOSED FOREST CONSERVATION EASEMENT
- SUPER SILT FENCE
- SILT FENCE
- EARTH DIKE
- STABILIZED CONSTRUCTION ENTRANCE
- SEDIMENT CONTROL
- DRAINAGE DIVIDE
- EROSION CONTROL MATTING
- LIMIT OF DISTURBANCE

AS-BUILT CERTIFICATION

I HEREBY CERTIFY THAT THE FACILITY SHOWN ON THIS PLAN WAS CONSTRUCTED AS SHOWN ON THE "AS-BUILT" PLANS AND MEETS THE APPROVED PLANS AND SPECIFICATIONS.

PE NO. 21443
DATE

DONALD A. MASON

CERTIFY MEANS TO STATE OR DECLARE A PROFESSIONAL OPINION BASED UPON ON-SITE INSPECTIONS AND MATERIAL TESTS WHICH ARE CONDUCTED DURING THE CONSTRUCTION PROJECT. THE ON-SITE INSPECTIONS AND MATERIAL TESTS ARE THOSE INSPECTIONS AND TESTS DEEMED SUFFICIENT AND APPROPRIATE BY THE ENGINEER. I SHALL ENGAGE A REGISTERED PROFESSIONAL ENGINEER TO SUPERVISE POND CONSTRUCTION AND PROVIDE THE HOWARD SOIL CONSERVATION DISTRICT WITH AN "AS-BUILT" PLAN OF THE POND WITHIN 30 DAYS OF COMPLETION. I ALSO AUTHORIZE PERIODIC ON-SITE INSPECTIONS BY THE HOWARD SOIL CONSERVATION DISTRICT.

BY THE DEVELOPER:
Michael J. Demmitt 5-9-07
DEVELOPER

BY THE ENGINEER:
Donald A. Mason 5/1/07
ENGINEER - DONALD A. MASON, P.E. # 21443

THESE PLANS HAVE BEEN REVIEWED FOR THE HOWARD SOIL CONSERVATION DISTRICT AND MEET THE TECHNICAL REQUIREMENTS FOR SMALL POND CONSTRUCTION, SOIL EROSION, AND SEDIMENT CONTROL.

John A. Myers 5/31/07
NATURAL RESOURCES CONSERVATION SERVICE

THESE PLANS FOR SMALL POND CONSTRUCTION, SOIL EROSION, AND SEDIMENT CONTROL MEET THE REQUIREMENTS OF THE HOWARD SOIL CONSERVATION DISTRICT.

Howard Soil Conservation District 5/2/07
DATE

APPROVED: HOWARD COUNTY DEPARTMENT OF PUBLIC WORKS
Walter R. Mahler 6-6-07
CHIEF, BUREAU OF HIGHWAYS

APPROVED: HOWARD COUNTY DEPARTMENT OF PLANNING AND ZONING
J. Krista-Muehler for Hamilton 6-11-07
CHIEF, DIVISION OF LAND DEVELOPMENT

Walter R. Mahler 6/8/07
CHIEF, DEVELOPMENT ENGINEERING DIVISION


APPROVED: HOWARD COUNTY DEPARTMENT OF PUBLIC WORKS
CHIEF, BUREAU OF HIGHWAYS

APPROVED: HOWARD COUNTY DEPT. OF PLANNING AND ZONING
CHIEF, DIVISION OF LAND DEVELOPMENT

CHIEF, DEVELOPMENT ENGINEERING DIVISION

NOTES:

- #1 STREAM CLOSURE SHALL BE BETWEEN MARCH 1ST AND MAY 31ST.
- #2 ALL SWALES AND DITCHES SHALL BE LINED WITH EROSION CONTROL MATTING.
- #3 CONTRACTOR SHALL CURL ALL ENDS OF SF/SFS UPHILL BY 2' IN ELEVATION AND CLOSE OVER ENDWALLS WHERE SHOWN AND AS DIRECTED BY THE COUNTY INSPECTOR.
- #4 CONTRACTOR SHALL MAINTAIN POSITIVE FLOW FROM ROAD GRADES AND SUMPS TO BASINS BY EARTH DIKE AND STORM DRAINS.
- #5 CONTRACTOR SHALL REMOVE FARM ROAD AND ASSOCIATED DITCH AND GRADE TO PROVIDE A SMOOTH OVERLAND FLOW, PER THE CONTOURS SHOWN.
- #6 CONTRACTOR TO USE MDE SEED MIX IN DISTURBED STREAM AREAS.

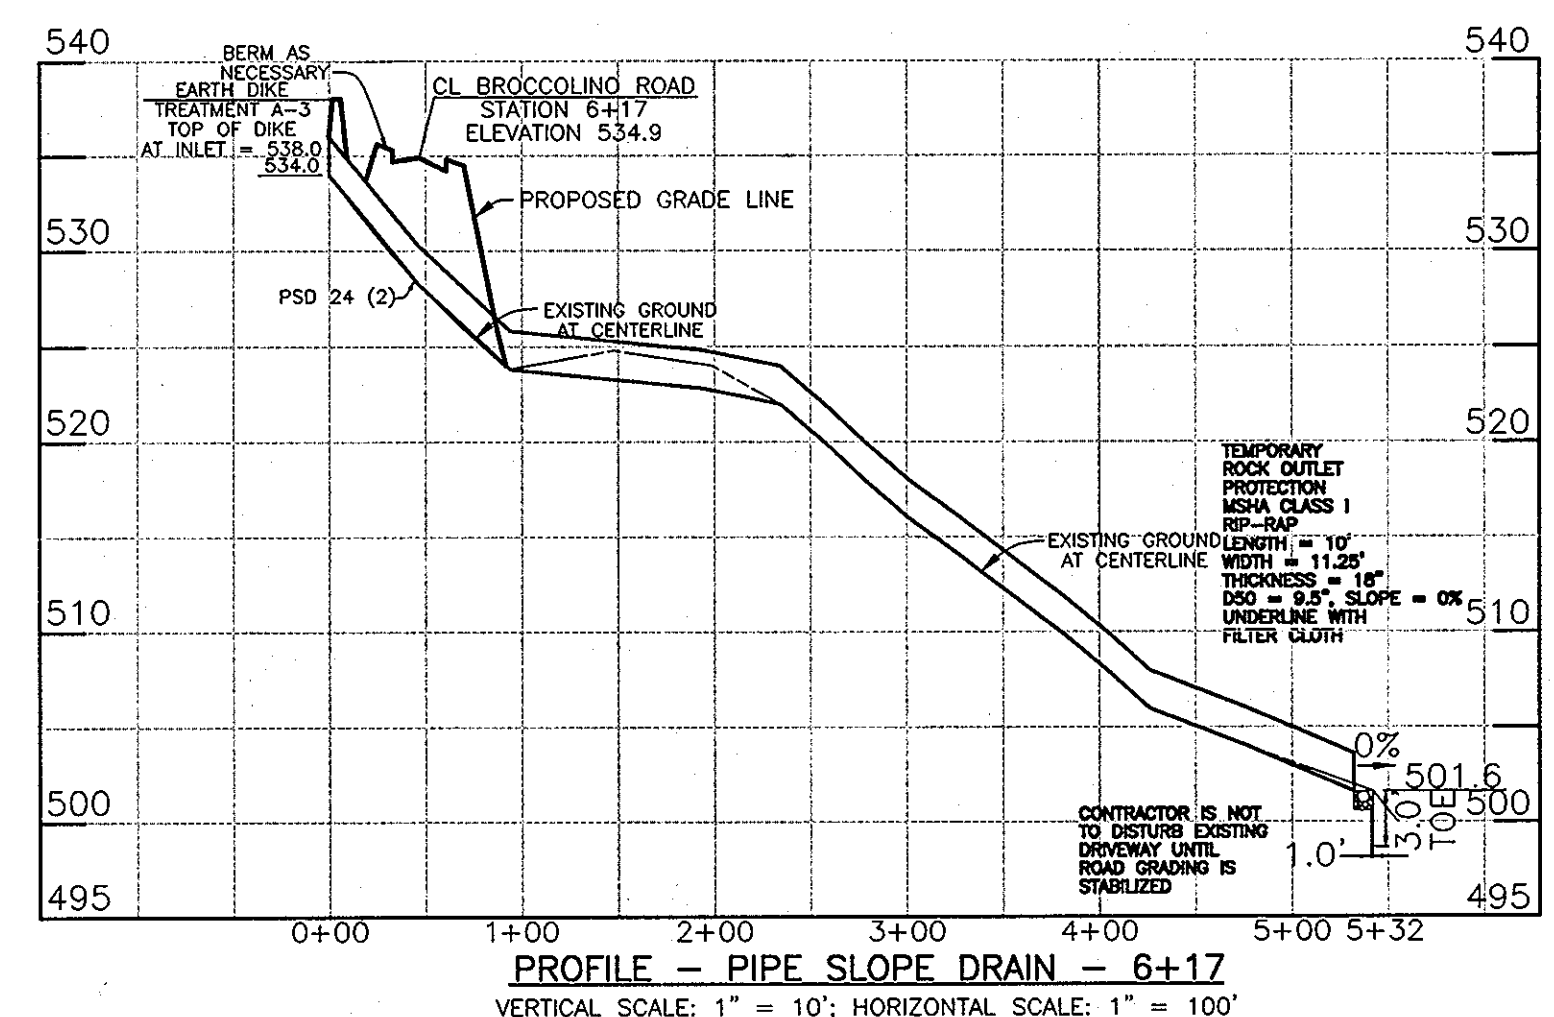

NO.	DATE	REVISION
2	12-5-08	MOVE STANDING PAD EASEMENT FROM LOT 3 TO PARCEL 'D'
1	7-13-07	REVISED STORM DRAIN MATERIAL OF SOME PIPES

BENCHMARK ENGINEERING, INC.

ENGINEERS • LAND SURVEYORS • PLANNERS

8480 BALTIMORE NATIONAL PIKE & SUITE 418
ELLCOTT CITY, MARYLAND 21043
PHONE: 410-465-6105 • FAX: 410-465-6644
EMAIL: Benchmark@eas.com

Professional Engineer Seal: Donald A. Mason, No. 21443, State of Maryland, 5/1/07

OWNER/DEVELOPER: HIGHLAND DEVELOPMENT CORP
P.O. BOX 228
CLARKSVILLE, MARYLAND 21029
410-531-5539


PROJECT: BRIGHTON MILL
LOT 1 THROUGH 22, BUILDABLE PRESERVATION PARCEL 'A' AND NON-BUILDABLE PRESERVATION PARCELS 'B' THROUGH 'D'

LOCATION: TAX MAP No. 34, GRID No. 2
PARCEL 2
5th ELECTION DISTRICT
HOWARD COUNTY, MARYLAND

TITLE: GRADING, SEDIMENT AND EROSION CONTROL PLAN

DATE: MAY, 2007
PROJECT NO. 1513

Design: JMC Draft: LAB Check: DAM SCALE: 1" = 50' DRAWING 23 OF 34

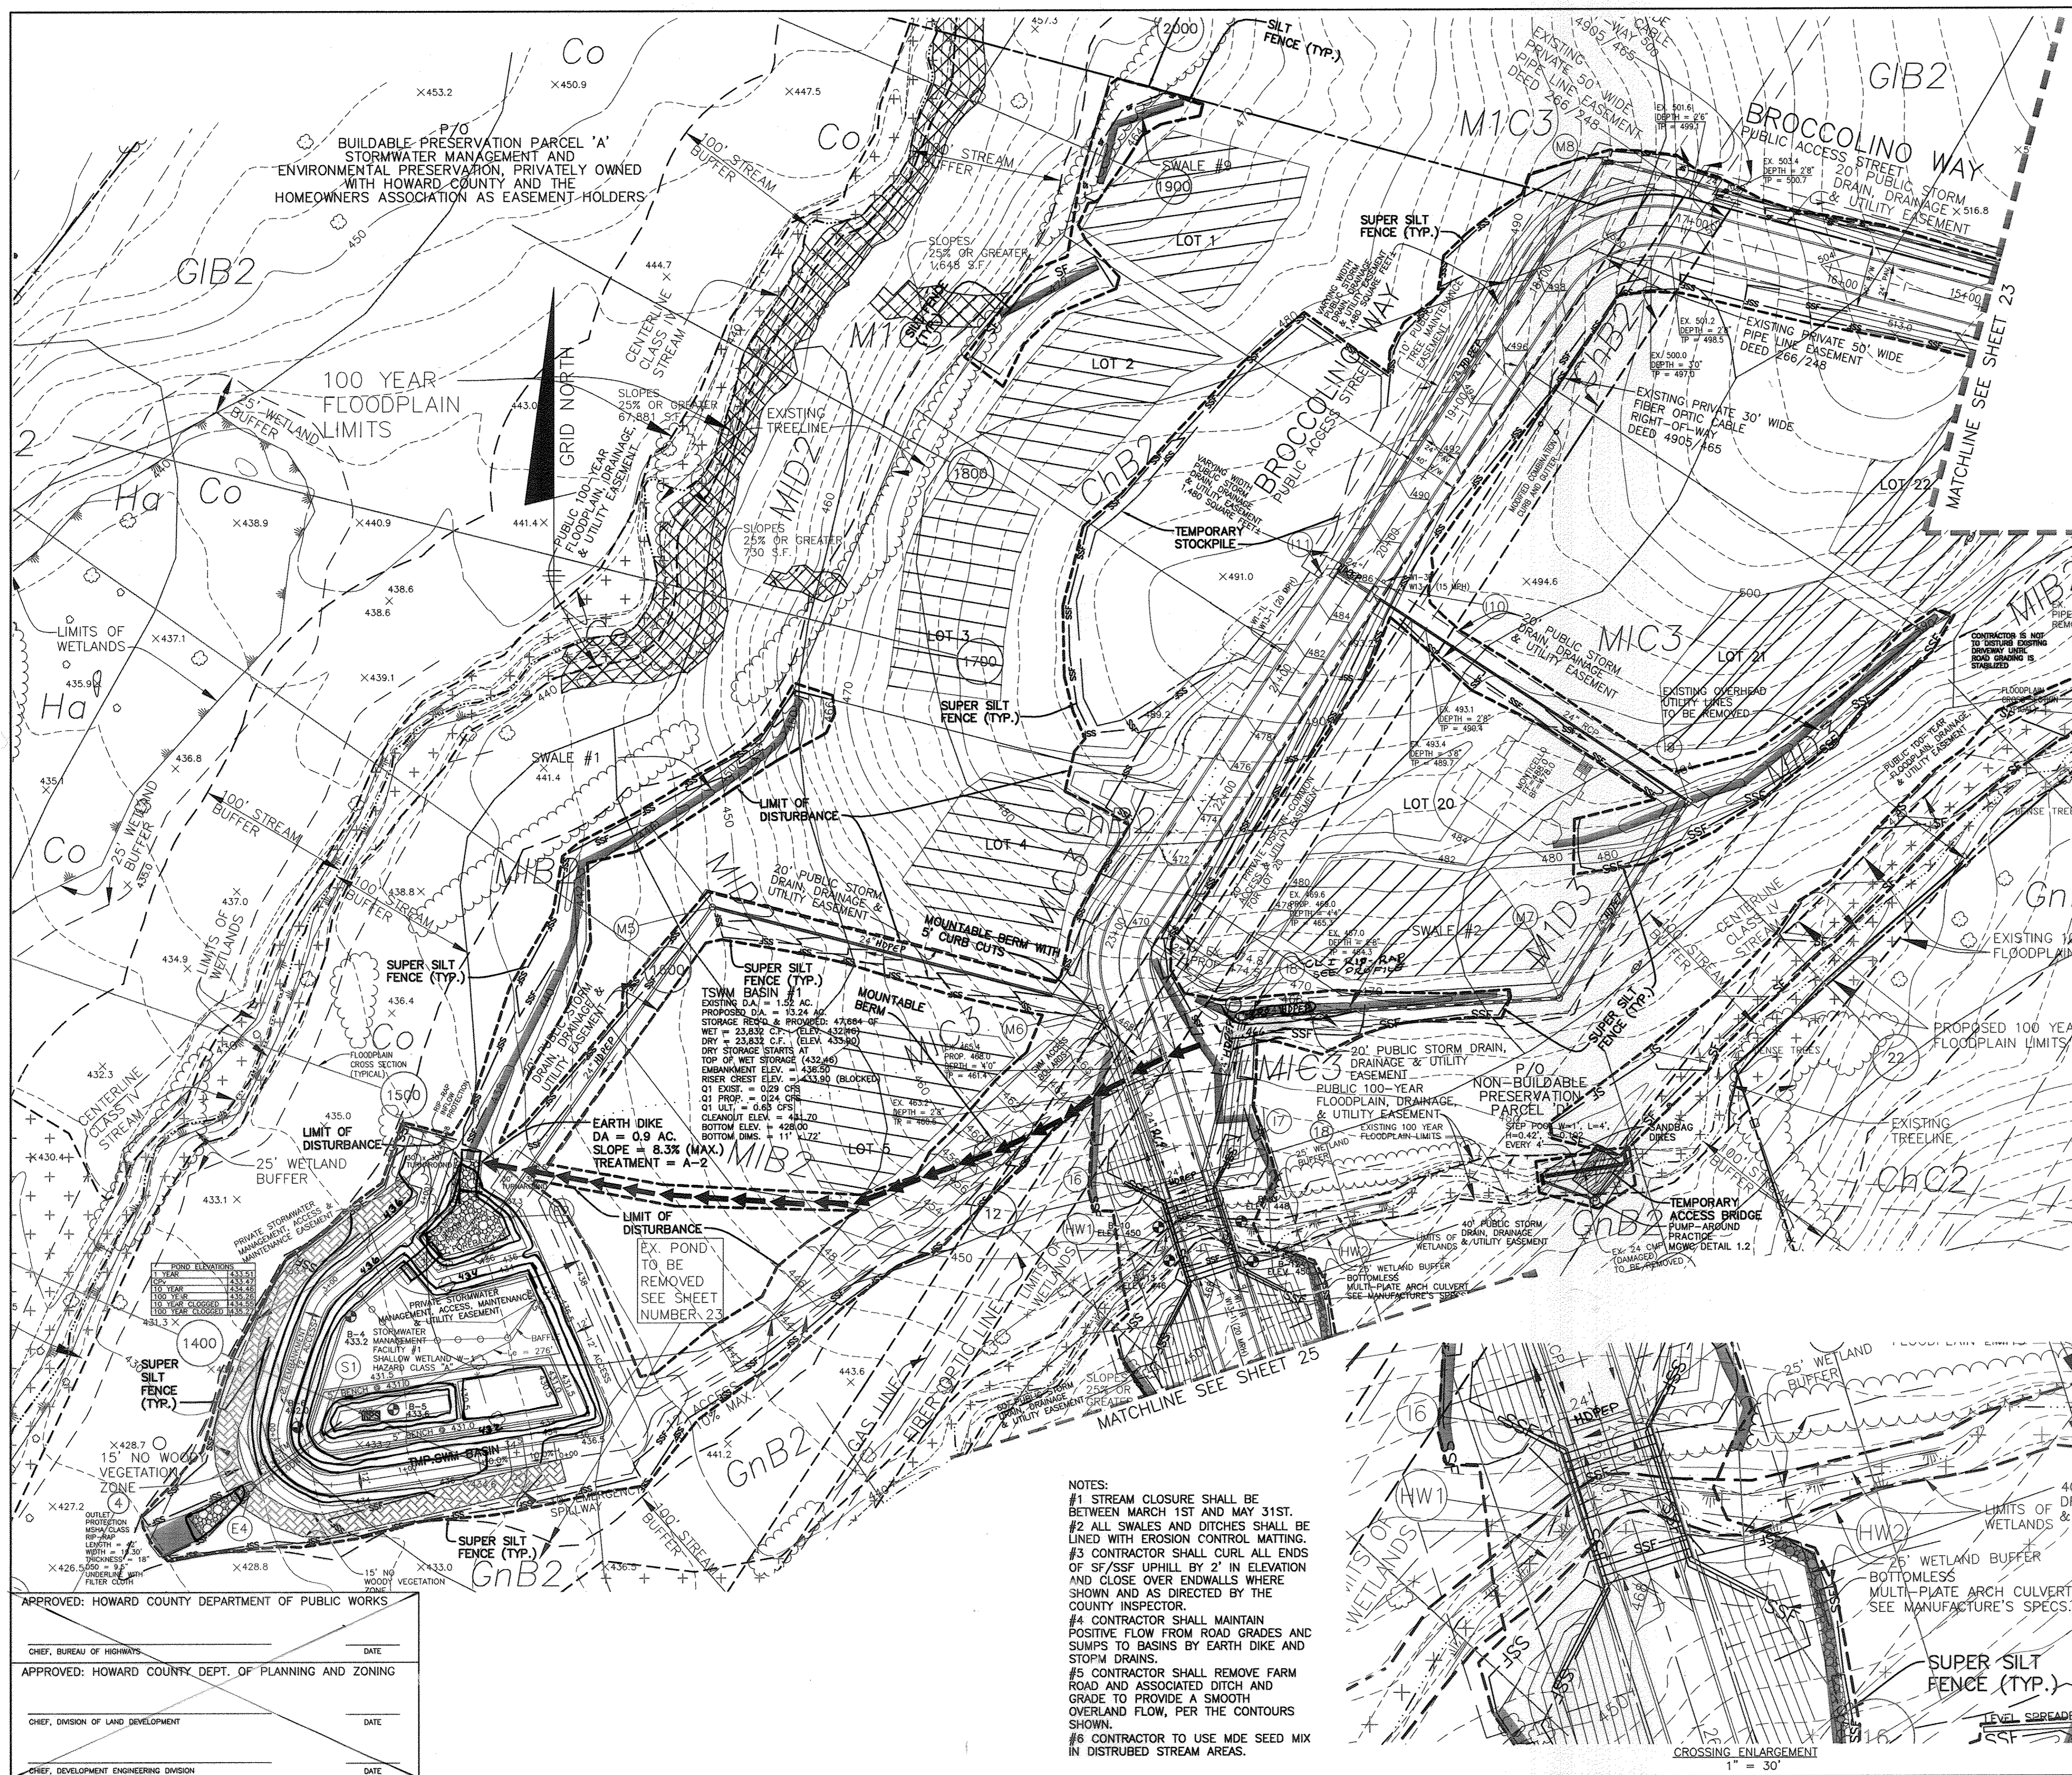

LEGEND

SOILS CLASSIFICATION	ChB2
SOILS DELINEATION	(Symbol)
EXISTING CONTOURS (AERIAL 12/02)	(Symbol)
LIMIT OF WETLANDS	(Symbol)
EXISTING WOODS LINE	(Symbol)
PROPOSED WOODS LINE	(Symbol)
EXISTING STRUCTURE	(Symbol)
EXISTING SEPTIC FIELD	(Symbol)
PROPOSED SEPTIC FIELD	(Symbol)
SLOPES 15% TO 24.9%	(Symbol)
SLOPES 25% OR GREATER	(Symbol)
EX. 100 YEAR FLOODPLAIN	(Symbol)
PROPOSED FOREST CONSERVATION EASEMENT	(Symbol)
SUPER SILT FENCE	(Symbol)
SILT FENCE	(Symbol)
EARTH DIKE	(Symbol)
STABILIZED CONSTRUCTION ENTRANCE	(Symbol)
SEDIMENT CONTROL	(Symbol)
DRAINAGE DIVIDE	(Symbol)
EROSION CONTROL MATTING	(Symbol)
LIMIT OF DISTURBANCE	(Symbol)

AS-BUILT CERTIFICATION

I HEREBY CERTIFY THAT THE FACILITY SHOWN ON THIS PLAN WAS CONSTRUCTED AS SHOWN ON THE "AS-BUILT" PLANS AND MEETS THE APPROVED PLANS AND SPECIFICATIONS.

Donald A. Mason DONALD A. MASON P.E. NO. 21443 DATE 1-18-10

CERTIFY MEANS TO STATE OR DECLARE A PROFESSIONAL OPINION BASED UPON ON-SITE INSPECTIONS AND MATERIAL TESTS WHICH ARE CONDUCTED DURING CONSTRUCTION. THE ON-SITE INSPECTIONS AND MATERIAL TESTS WHICH ARE CONDUCTED DURING CONSTRUCTION ARE CONDUCTED BY AN ENGINEER REGISTERED IN THE STATE OF MARYLAND. THE ENGINEER'S CERTIFICATION DOES NOT MEAN OR IMPLY A GUARANTEE. THE ENGINEER DOES AN ENGINEER'S CERTIFICATION RELIEVE ANY OTHER PARTY FROM MEETING REQUIREMENTS IMPOSED BY CONTRACT, EMPLOYMENT, OR OTHER MEANS, INCLUDING MEETING COMMONLY ACCEPTED INDUSTRY PRACTICES.

BY THE DEVELOPER:

I/WE CERTIFY THAT ALL DEVELOPMENT AND/OR CONSTRUCTION WILL BE DONE ACCORDING TO THESE PLANS, AND THAT ANY RESPONSIBLE PERSONNEL INVOLVED IN THE CONSTRUCTION PROJECT WILL HAVE A CERTIFICATE OF ATTENDANCE AT A DEPARTMENT OF THE ENVIRONMENT APPROVED TRAINING PROGRAM FOR THE CONTROL OF SEDIMENT AND EROSION BEFORE BEGINNING THE PROJECT. I SHALL ENGAGE A REGISTERED PROFESSIONAL ENGINEER TO SUPERVISE POND CONSTRUCTION AND PROVIDE THE HOWARD SOIL CONSERVATION DISTRICT WITH AN "AS-BUILT" PLAN OF THE POND WITHIN 30 DAYS OF COMPLETION. I ALSO AUTHORIZE PERIODIC ON-SITE INSPECTIONS BY THE HOWARD SOIL CONSERVATION DISTRICT.

Richard W. Bennett 5-9-07 DEVELOPER DATE

BY THE ENGINEER:

I/WE CERTIFY THAT THIS PLAN FOR POND CONSTRUCTION, EROSION AND SEDIMENT CONTROL, REPRESENTS A PRACTICAL AND WORKABLE PLAN BASED ON MY PERSONAL KNOWLEDGE OF THE SITE CONDITIONS. THIS PLAN WAS PREPARED IN ACCORDANCE WITH THE REQUIREMENTS OF THE HOWARD SOIL CONSERVATION DISTRICT. I HAVE NOTIFIED THE DEVELOPER THAT HE/SHE MUST ENGAGE A REGISTERED PROFESSIONAL ENGINEER TO SUPERVISE POND CONSTRUCTION AND PROVIDE THE HOWARD SOIL CONSERVATION DISTRICT WITH AN "AS-BUILT" PLAN OF THE POND WITHIN 30 DAYS OF COMPLETION.

Donald A. Mason 6/16/07 ENGINEER - DONALD A. MASON, P.E. # 21443 DATE

THESE PLANS HAVE BEEN REVIEWED FOR THE HOWARD SOIL CONSERVATION DISTRICT AND MEET THE TECHNICAL REQUIREMENTS FOR SMALL POND CONSTRUCTION, SOIL EROSION, AND SEDIMENT CONTROL.

Jim Meyer 5/31/07 NATURAL RESOURCES CONSERVATION SERVICE DATE

THESE PLANS FOR SMALL POND CONSTRUCTION, SOIL EROSION, AND SEDIMENT CONTROL MEET THE REQUIREMENTS OF THE HOWARD SOIL CONSERVATION DISTRICT.

John S. ... 5/31/07 HOWARD SOIL CONSERVATION DISTRICT DATE

APPROVED: HOWARD COUNTY DEPARTMENT OF PUBLIC WORKS

William J. ... 6-6-07 CHIEF, BUREAU OF HIGHWAYS DATE

APPROVED: HOWARD COUNTY DEPARTMENT OF PLANNING AND ZONING

J. Kravitz - Marchant for Hamilton 6-11-07 CHIEF, DIVISION OF LAND DEVELOPMENT DATE

Donald A. Mason 6/6/07 CHIEF, DEVELOPMENT ENGINEERING DIVISION DATE

NO.	DATE	REVISION
3	3-10-07	REVISE GRADING AT I-B PER E-17-054 (BRIGHTON MILL II)
2	12-5-06	MOVE STANDING PAD EASEMENT FROM LOT 3 TO PARCEL 'A'
1	7-13-07	REVISED STORM DRAIN MATERIAL OF SOME PIPES

BENCHMARK ENGINEERING, INC.

ENGINEERS • LAND SURVEYORS • PLANNERS

8480 BALTIMORE NATIONAL PIKE # SUITE 418
ELLICOTT CITY, MARYLAND 21043
PHONE: 410-465-6105 • FAX: 410-465-6644
EMAIL: Benchmark@cois.com

Donald A. Mason 5/1/07

OWNER/DEVELOPER: HIGHLAND DEVELOPMENT CORP
P.O. BOX 228
CLARKSVILLE, MARYLAND 21029
410-531-5539

PROJECT: BRIGHTON MILL
LOT 1 THROUGH 22, BUILDABLE PRESERVATION PARCEL 'A' AND NON-BUILDABLE PRESERVATION PARCELS 'B' THROUGH 'D'

LOCATION: TAX MAP No. 34, GRID No. 2
PARCEL 2
5th ELECTION DISTRICT
HOWARD COUNTY, MARYLAND

TITLE: GRADING, SEDIMENT AND EROSION CONTROL PLAN

DATE: MAY, 2007 PROJECT NO. 1513

Design: JMC Draft: LAB Check: DAM SCALE: 1" = 50' DRAWING 24 OF 34

NOTES:

- #1 STREAM CLOSURE SHALL BE BETWEEN MARCH 1ST AND MAY 31ST.
- #2 ALL SWALES AND DITCHES SHALL BE LINED WITH EROSION CONTROL MATTING.
- #3 CONTRACTOR SHALL CURL ALL ENDS OF SF/SSF UPHILL BY 2' IN ELEVATION AND CLOSE OVER ENDWALLS WHERE SHOWN AND AS DIRECTED BY THE COUNTY INSPECTOR.
- #4 CONTRACTOR SHALL MAINTAIN POSITIVE FLOW FROM ROAD GRADES AND SUMPS TO BASINS BY EARTH DIKE AND STORM DRAINS.
- #5 CONTRACTOR SHALL REMOVE FARM ROAD AND ASSOCIATED DITCH AND GRADE TO PROVIDE A SMOOTH OVERLAND FLOW, PER THE CONTOURS SHOWN.
- #6 CONTRACTOR TO USE MDE SEED MIX IN DISTURBED STREAM AREAS.


APPROVED: HOWARD COUNTY DEPARTMENT OF PUBLIC WORKS

CHIEF, BUREAU OF HIGHWAYS DATE

APPROVED: HOWARD COUNTY DEPT. OF PLANNING AND ZONING

CHIEF, DIVISION OF LAND DEVELOPMENT DATE

CHIEF, DEVELOPMENT ENGINEERING DIVISION DATE

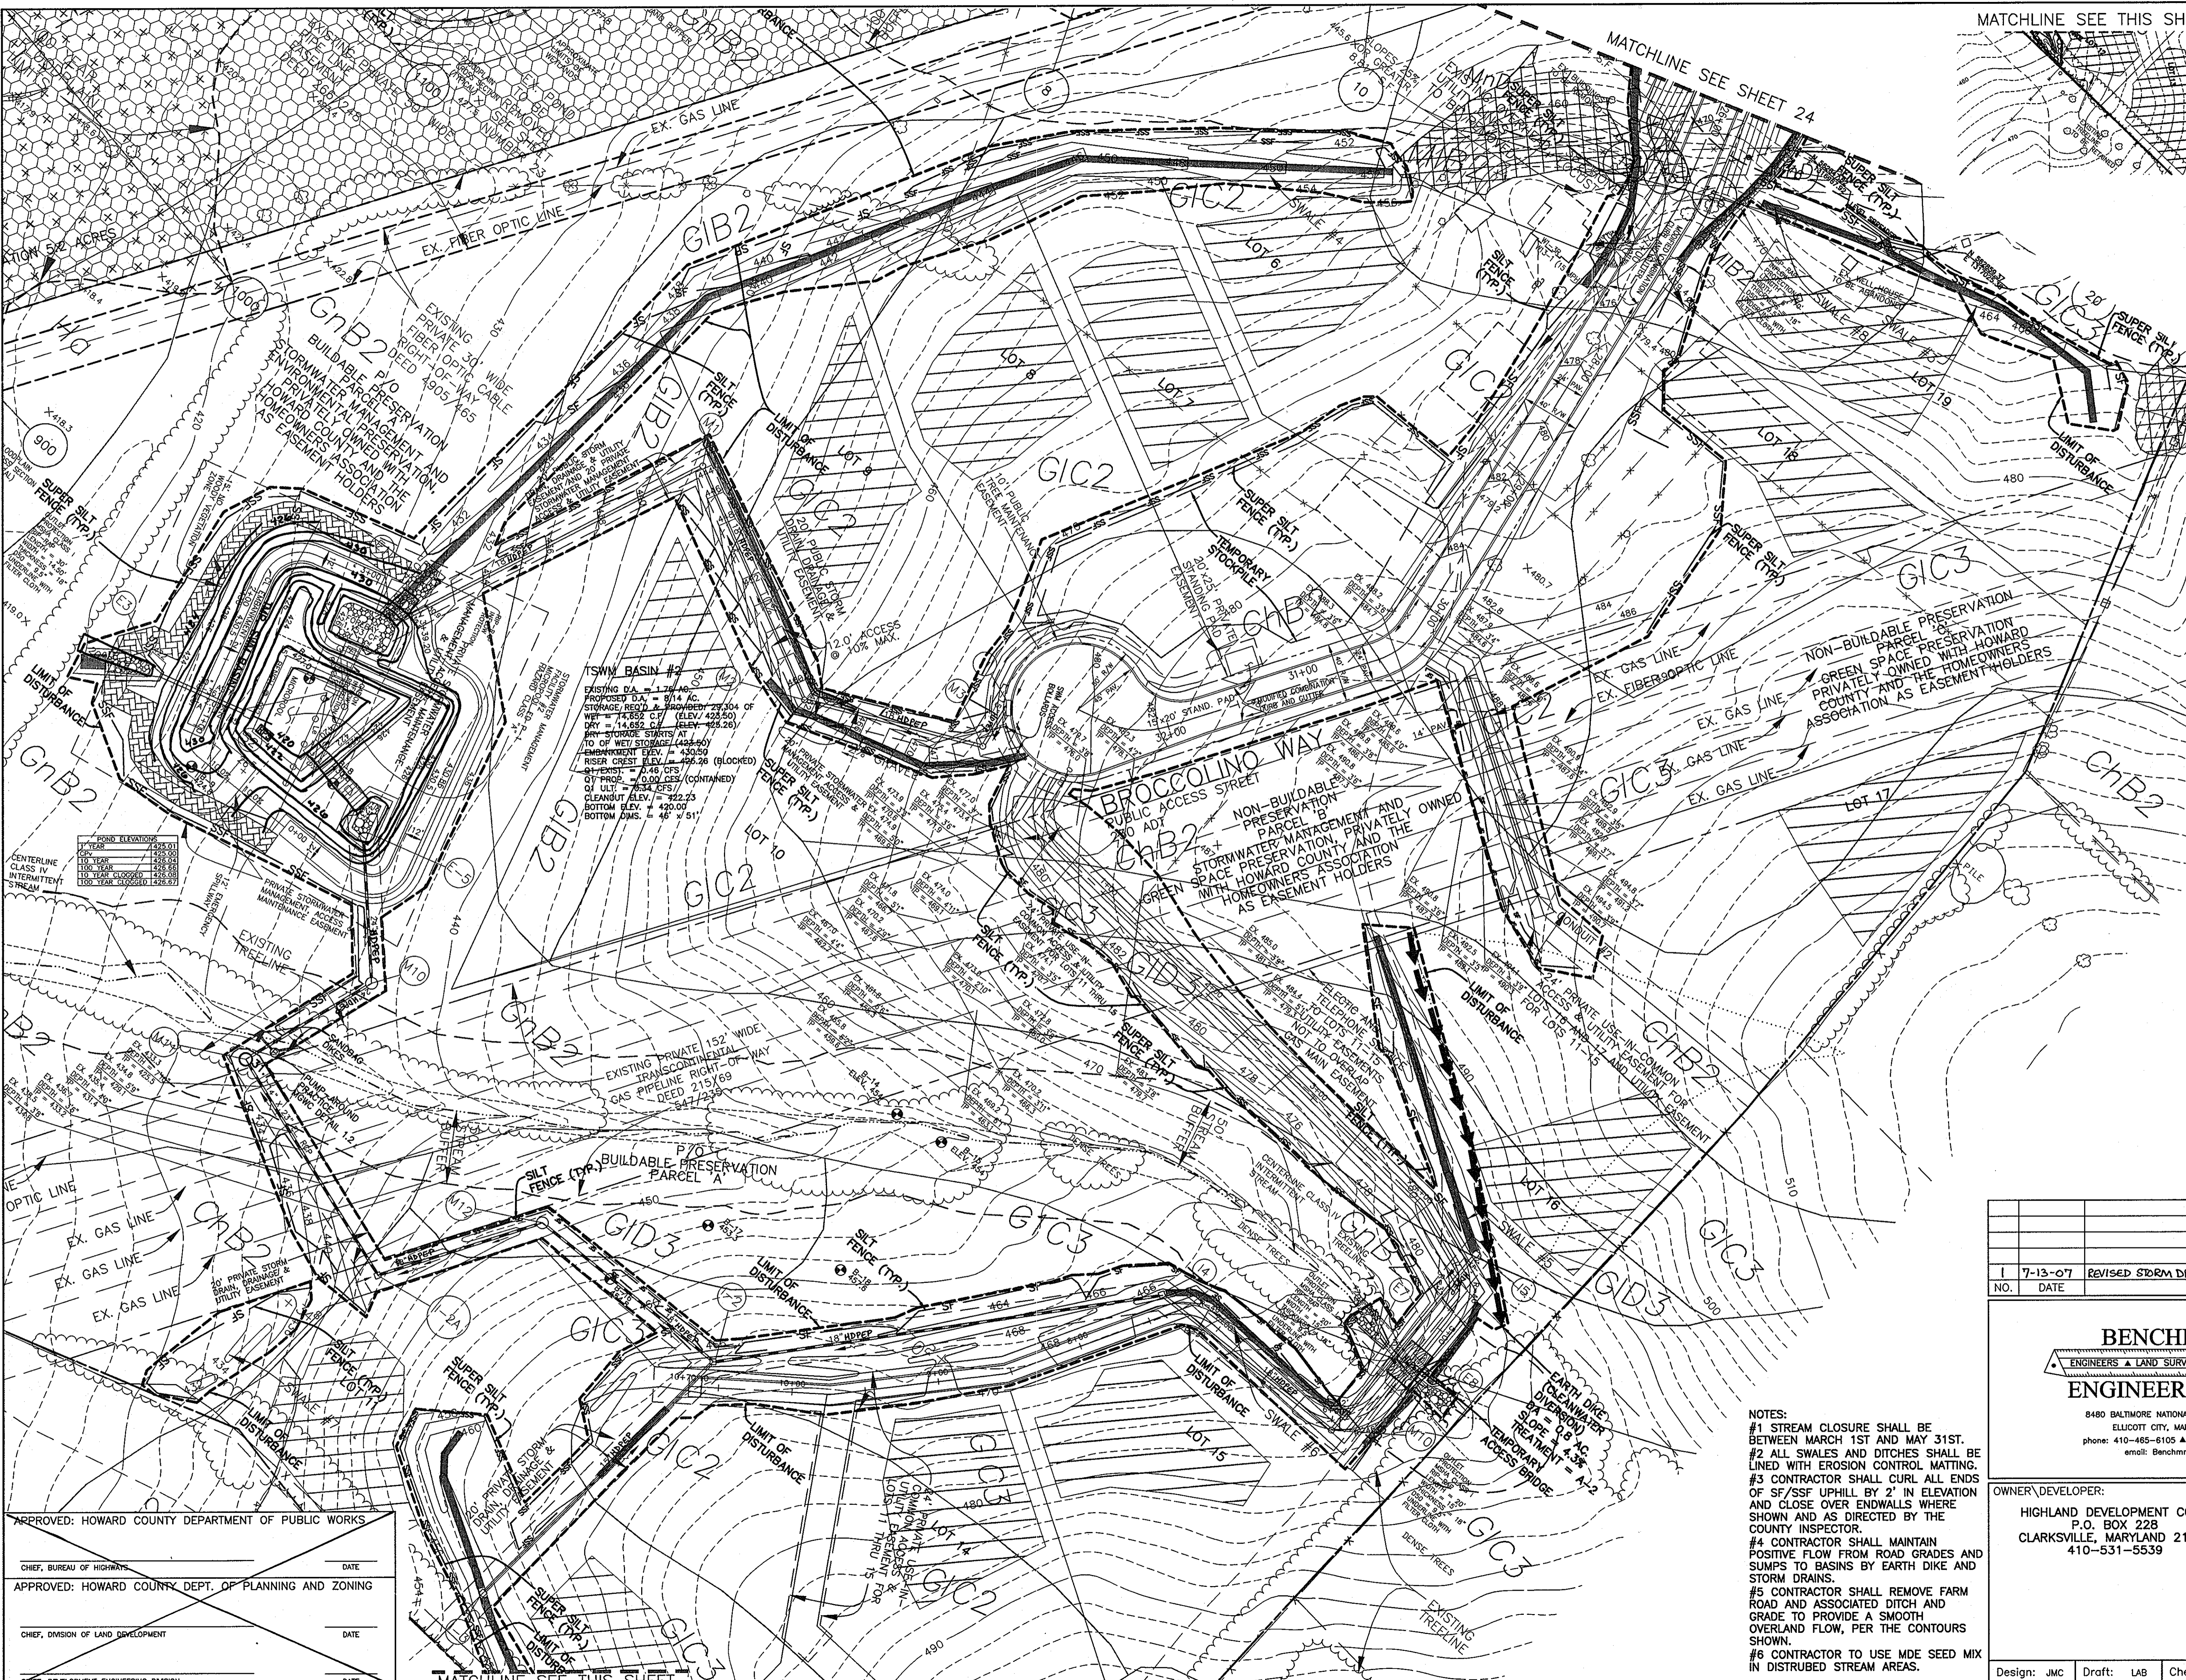

MATCHLINE SEE THIS SHEET

LEGEND

- SOILS CLASSIFICATION ChB2
- SOILS DELINEATION
- EXISTING CONTOURS (AERIAL 12/02)
- LIMIT OF WETLANDS
- EXISTING WOODS LINE
- PROPOSED WOODS LINE
- EXISTING STRUCTURE
- EXISTING SEPTIC FIELD
- PROPOSED SEPTIC FIELD
- SLOPES 15% TO 24.9%
- SLOPES 25% OR GREATER
- EX. 100 YEAR FLOODPLAIN
- PROPOSED FOREST CONSERVATION EASEMENT
- SUPER SILT FENCE
- SILT FENCE
- EARTH DIKE
- STABILIZED CONSTRUCTION ENTRANCE
- SEDIMENT CONTROL DRAINAGE DIVIDER
- EROSION CONTROL MATTING
- LIMIT OF DISTURBANCE

AS-BUILT CERTIFICATION

I HEREBY CERTIFY THAT THE FACILITY SHOWN ON THIS PLAN WAS CONSTRUCTED AS SHOWN ON THE "AS-BUILT" PLANS AND MEETS THE APPLICABLE REQUIREMENTS.

Donald Mason 21443
DONALD A. MASON 1-12-07

CERTIFY MEANS TO STATE OR DECLARE A PROFESSIONAL ENGINEER, BASED UPON ON-SITE INSPECTIONS AND MATERIAL TESTS WHICH ARE CONDUCTED THROUGHOUT CONSTRUCTION. THE ON-SITE INSPECTIONS AND MATERIAL TESTS ARE THOSE INSPECTIONS AND TESTS DEEMED SUFFICIENT AND APPROPRIATE BY COMMONLY ACCEPTED ENGINEERING STANDARDS. CERTIFY DOES NOT MEAN OR IMPLY A GUARANTEE BY THE ENGINEER NOR DOES AN ENGINEER'S CERTIFICATION RELIEVE ANY OTHER PARTY FROM MEETING REQUIREMENTS IMPOSED BY CONTRACT, EMPLOYMENT, OR OTHER MEANS, INCLUDING MEETING COMMONLY ACCEPTED INDUSTRY PRACTICES.

BY THE DEVELOPER:
I HEREBY CERTIFY THAT ALL DEVELOPMENT AND/OR CONSTRUCTION WILL BE DONE ACCORDING TO THESE PLANS AND THAT ANY RESPONSIBLE PERSONNEL INVOLVED IN THE CONSTRUCTION PROJECT WILL HAVE A CERTIFICATE OF ATTENDANCE AT A DEPARTMENT OF THE ENVIRONMENT APPROVED TRAINING PROGRAM FOR THE CONTROL OF SEDIMENT AND EROSION BEFORE BEGINNING THE PROJECT. I SHALL ENGAGE A REGISTERED PROFESSIONAL ENGINEER TO SUPERVISE POND CONSTRUCTION AND PROVIDE THE HOWARD SOIL CONSERVATION DISTRICT WITH AN "AS-BUILT" PLAN OF THE POND WITHIN 30 DAYS OF COMPLETION. I ALSO AUTHORIZE PERSONS ON-SITE INSPECTIONS BY THE HOWARD SOIL CONSERVATION DISTRICT.

Victor Bennett 5/9/07
DEVELOPER DATE

BY THE ENGINEER:
I HEREBY CERTIFY THAT THIS PLAN FOR POND CONSTRUCTION, EROSION AND SEDIMENT CONTROL, REPRESENTS A PRACTICAL AND WORKABLE PLAN BASED ON MY PERSONAL KNOWLEDGE OF THE SITE CONDITIONS. THIS PLAN WAS PREPARED IN ACCORDANCE WITH THE REQUIREMENTS OF THE HOWARD SOIL CONSERVATION DISTRICT. I HAVE NOTIFIED THE DEVELOPER THAT HE/SHE MUST ENGAGE A REGISTERED PROFESSIONAL ENGINEER TO SUPERVISE POND CONSTRUCTION AND PROVIDE THE HOWARD SOIL CONSERVATION DISTRICT WITH AN "AS-BUILT" PLAN OF THE POND WITHIN 30 DAYS OF COMPLETION.

Donald Mason 6/7/07
ENGINEER - DONALD A. MASON, P.E. # 21443 DATE

THESE PLANS HAVE BEEN REVIEWED FOR THE HOWARD SOIL CONSERVATION DISTRICT AND MEET THE TECHNICAL REQUIREMENTS FOR SMALL POND CONSTRUCTION, SOIL EROSION, AND SEDIMENT CONTROL.

Jim Meyer 5/2/07
NATURAL RESOURCES CONSERVATION SERVICE DATE

THESE PLANS FOR SMALL POND CONSTRUCTION, SOIL EROSION, AND SEDIMENT CONTROL MEET THE REQUIREMENTS OF THE HOWARD SOIL CONSERVATION DISTRICT.

Gillis 5/2/07
HOWARD SOIL CONSERVATION DISTRICT DATE

APPROVED: HOWARD COUNTY DEPARTMENT OF PUBLIC WORKS

Walter Z... 6-6-07
CHIEF, BUREAU OF HIGHWAYS DATE

APPROVED: HOWARD COUNTY DEPARTMENT OF PLANNING AND ZONING

J. Krista-M... 6-11-07
CHIEF, DIVISION OF LAND DEVELOPMENT DATE

... 6/8/07
CHIEF, DEVELOPMENT ENGINEERING DIVISION DATE

NO.	DATE	REVISION
1	7-13-07	REVISED STORM DRAIN MATERIAL OF SOME PIPES

BENCHMARK
ENGINEERS • LAND SURVEYORS • PLANNERS

ENGINEERING, INC.

8480 BALTIMORE NATIONAL PIKE & SUITE 418
ELLICOTT CITY, MARYLAND 21043
PHONE: 410-465-6105 • FAX: 410-465-6644
EMAIL: benchmark@coalis.com

OWNER/DEVELOPER: HIGHLAND DEVELOPMENT CORP P.O. BOX 228 CLARKSVILLE, MARYLAND 21029 410-531-5539	PROJECT: BRIGHTON MILL LOT 1 THROUGH 22, BUILDABLE PRESERVATION PARCEL 'A' AND NON-BUILDABLE PRESERVATION PARCELS 'B' THROUGH 'D'
TITLE: GRADING, SEDIMENT AND EROSION CONTROL PLAN	LOCATION: TAX MAP No. 34, GRID No. 2 PARCEL 2 5th ELECTION DISTRICT HOWARD COUNTY, MARYLAND
DATE: MAY, 2007	PROJECT NO. 1513
SCALE: 1" = 50'	DRAWING 25 OF 34

- NOTES:
- #1 STREAM CLOSURE SHALL BE BETWEEN MARCH 1ST AND MAY 31ST.
 - #2 ALL SWALES AND DITCHES SHALL BE LINED WITH EROSION CONTROL MATTING.
 - #3 CONTRACTOR SHALL CURL ALL ENDS OF SF/SSF UPHILL BY 2' IN ELEVATION AND CLOSE OVER ENDWALLS WHERE SHOWN AND AS DIRECTED BY THE COUNTY INSPECTOR.
 - #4 CONTRACTOR SHALL MAINTAIN POSITIVE FLOW FROM ROAD GRADES AND SUMPS TO BASINS BY EARTH DIKE AND STORM DRAINS.
 - #5 CONTRACTOR SHALL REMOVE FARM ROAD AND ASSOCIATED DITCH AND GRADE TO PROVIDE A SMOOTH OVERLAND FLOW, PER THE CONTOURS SHOWN.
 - #6 CONTRACTOR TO USE MDE SEED MIX IN DISTURBED STREAM AREAS.



APPROVED: HOWARD COUNTY DEPARTMENT OF PUBLIC WORKS

CHIEF, BUREAU OF HIGHWAYS DATE


APPROVED: HOWARD COUNTY DEPT. OF PLANNING AND ZONING

CHIEF, DIVISION OF LAND DEVELOPMENT DATE

CHIEF, DEVELOPMENT ENGINEERING DIVISION DATE

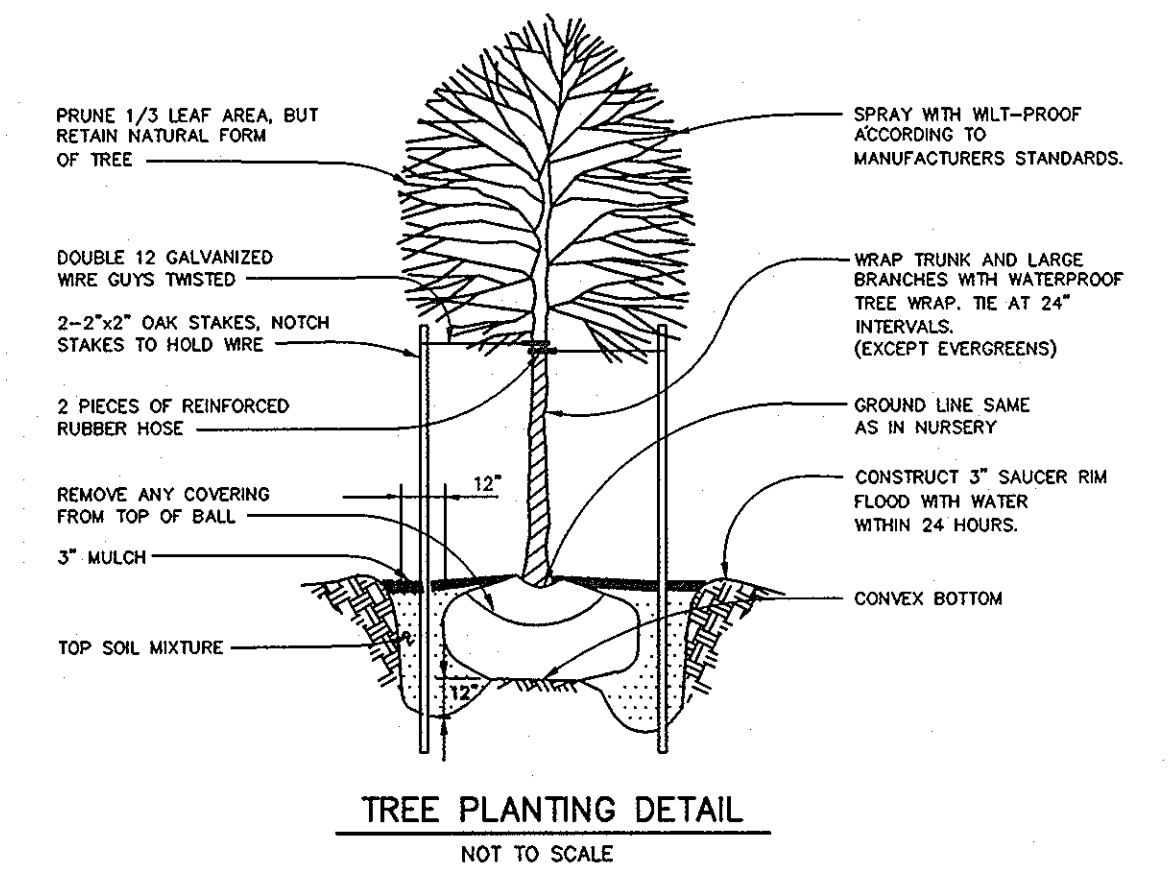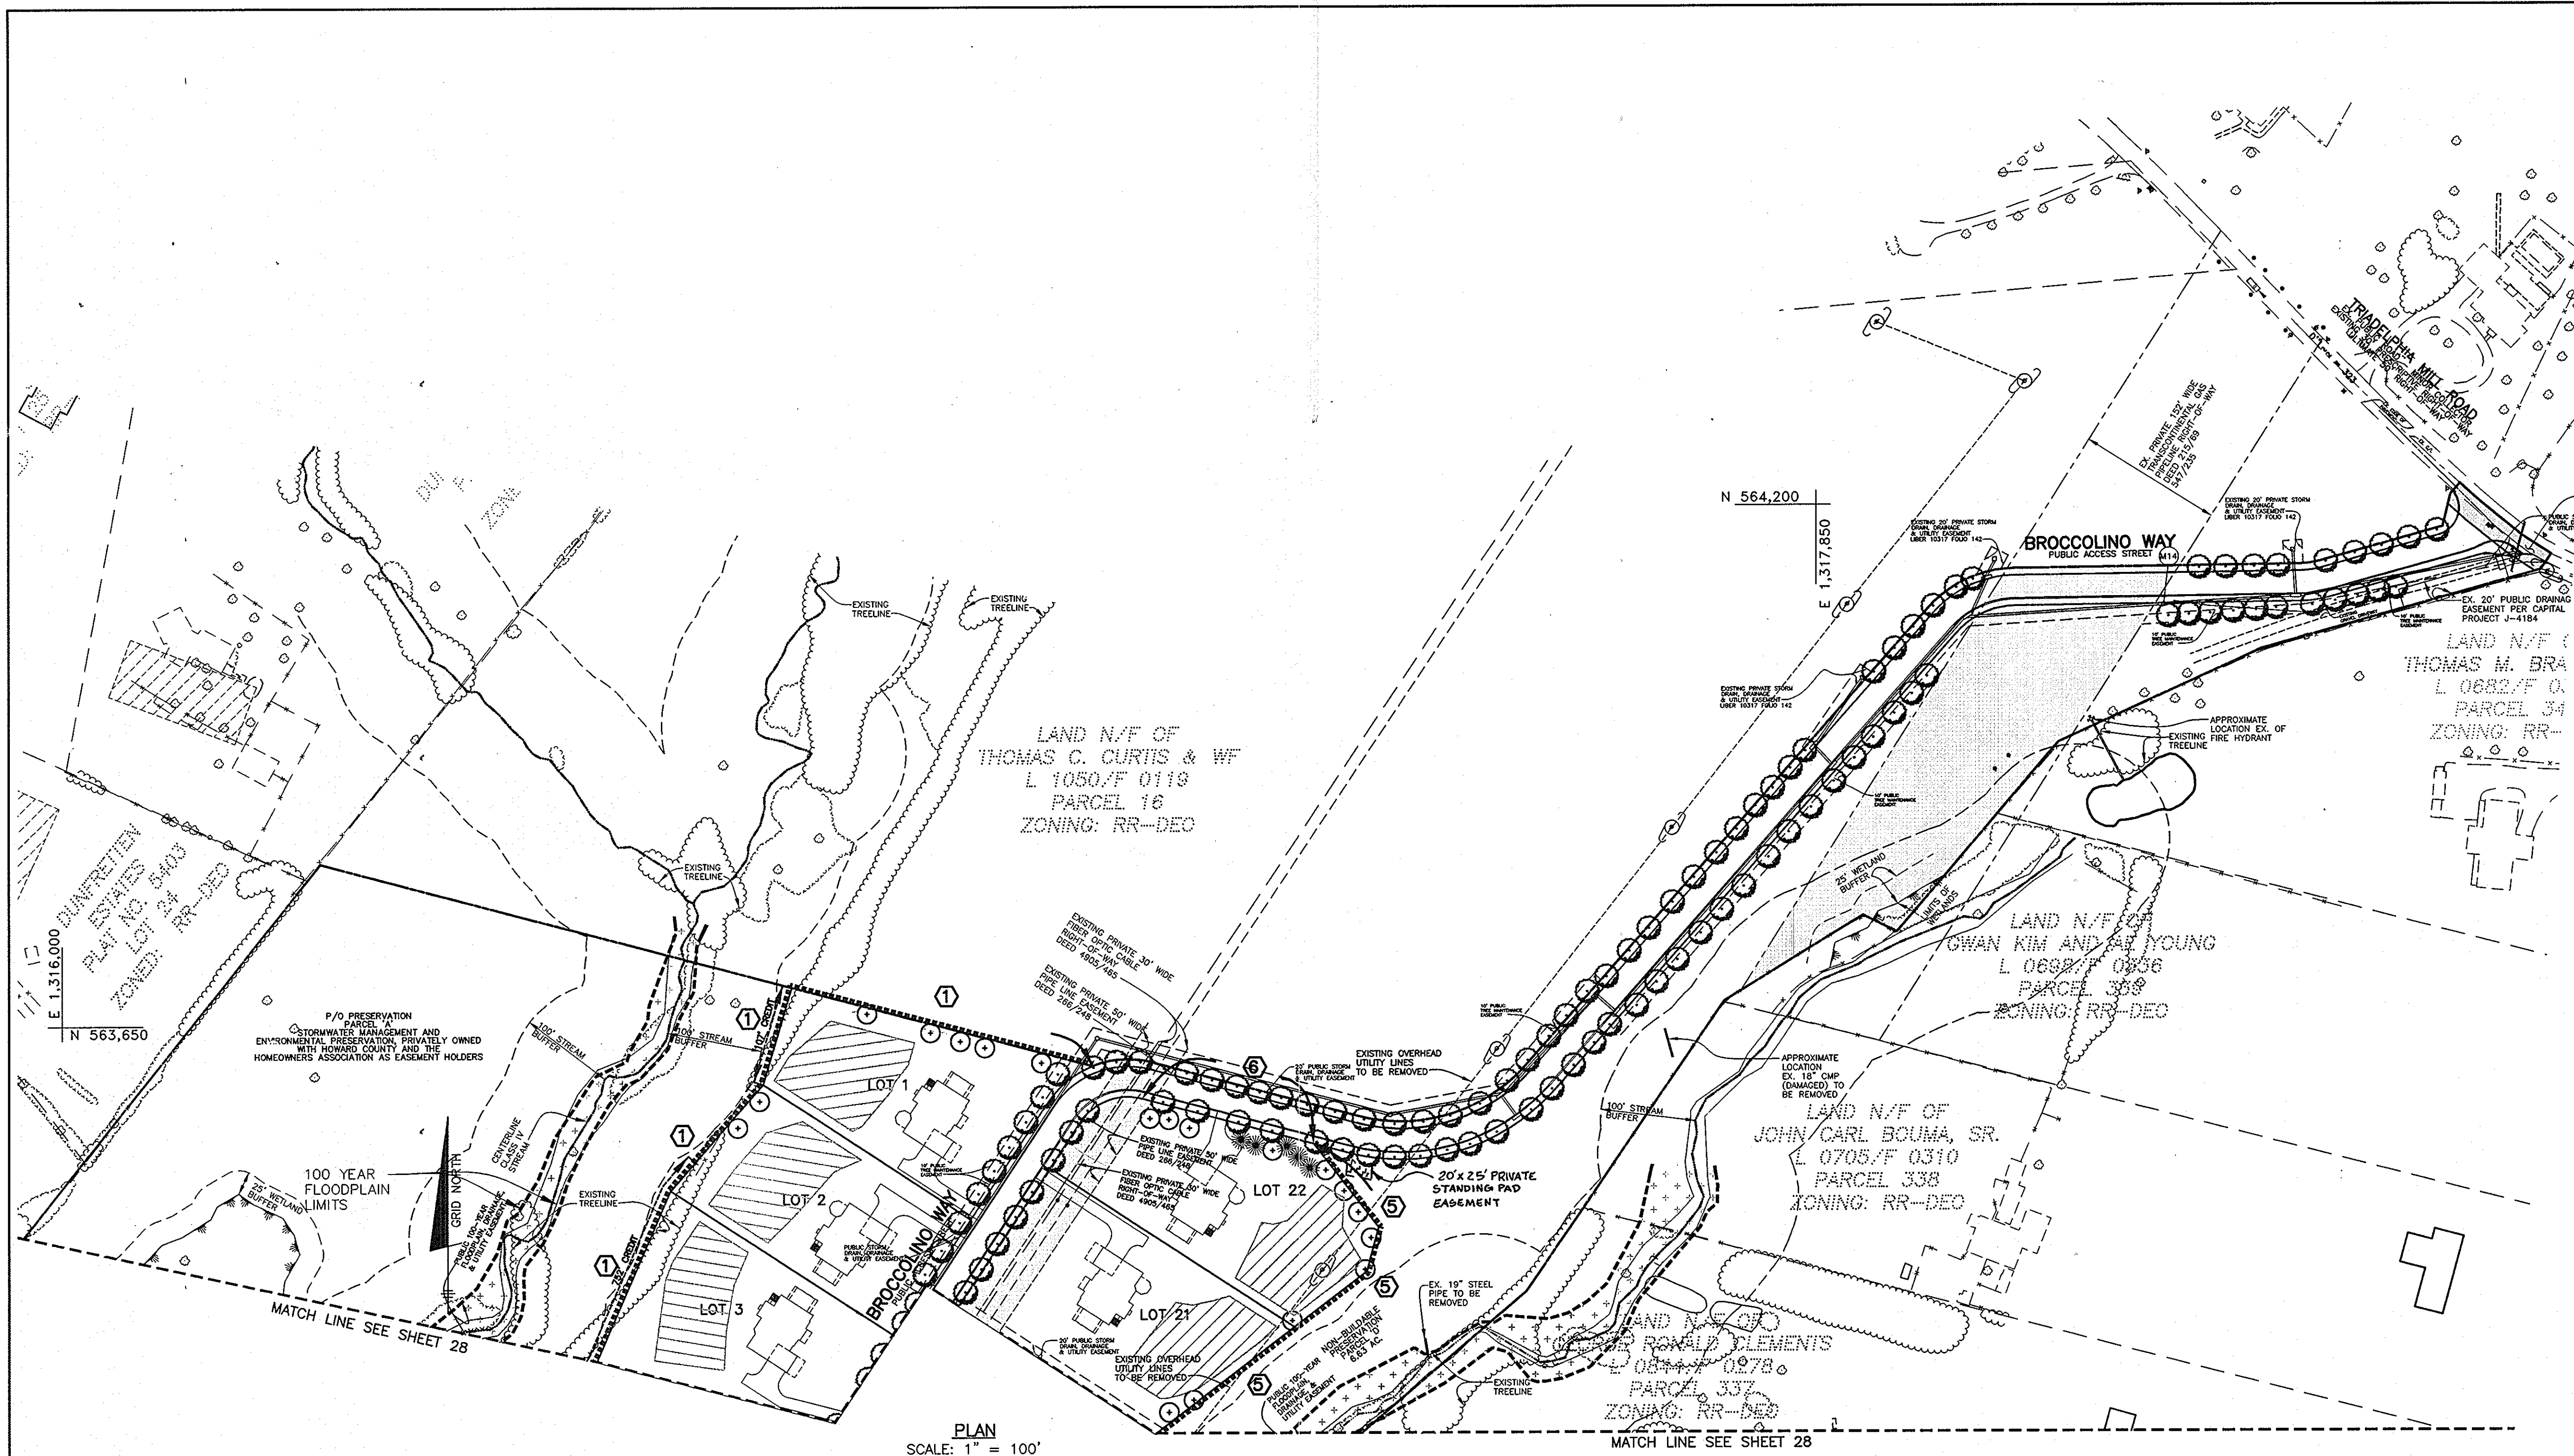

- LANDSCAPE NOTES:**
- TREES SHOULD BE PLANTED A MINIMUM OF 6 FEET FROM THE EDGE OF PAVING 5 FEET FROM ANY STORM DRAIN, 20 FEET FROM A STREET LIGHT AND OUTSIDE OF THE 6' PUBLIC STORM DRAIN AND UTILITY EASEMENT THAT RUNS PARALLEL TO THE RIGHT-OF-WAY.
 - TREES MUST BE PLANTED A MINIMUM OF 5 FEET FROM AN OPEN SPACE ACCESS STRIP AND 10 FEET FROM A DRIVEWAY.
 - SEE TREE PLANTING DETAIL - THIS SHEET.
 - THIS PLAN HAS BEEN PREPARED IN ACCORDANCE WITH THE PROVISIONS OF SECTION 16.124 OF THE HOWARD COUNTY CODE AND THE HOWARD COUNTY LANDSCAPE MANUAL.
 - THE DEVELOPER SHALL BE RESPONSIBLE FOR STREET TREES, STORMWATER MANAGEMENT FACILITY PERIMETER PLANTING AND PRESERVATION OF THE PERIMETER VEGETATION AS SHOWN ON THESE PLANS.
 - ALL VEGETATION IS TO BE REMOVED WITHIN 15' OF THE TOE OF THE SLOPE OF THE PROPOSED EMBANKMENT.
 - FINANCIAL SURETY FOR THE REQUIRED LANDSCAPING HAS BEEN POSTED AS PART OF THE DPW DEVELOPER'S AGREEMENT IN THE AMOUNT OF \$47,700.00. (\$40,500.00 FOR 135 SHADE TREES, \$7,200.00 FOR 48 EVERGREENS)
 - AT THE TIME OF PLANT INSTALLATION, ALL SHADE AND EVERGREEN TREES LISTED AND APPROVED ON THE LANDSCAPE PLANS, SHALL COMPLY WITH THE PROPER HEIGHT REQUIREMENTS IN ACCORDANCE WITH THE HOWARD COUNTY LANDSCAPE MANUAL. IN ADDITION NO SUBSTITUTIONS OR RELOCATIONS OF THE REQUIRED PLANTINGS MAY BE MADE WITHOUT PRIOR REVIEW AND APPROVAL FROM THE DEPARTMENT OF PLANNING AND ZONING. ANY DEVIATION FROM THE APPROVED LANDSCAPE PLANS MAY RESULT IN DENIAL OR DELAY IN THE RELEASE OF LANDSCAPE SURETY UNTIL SUCH TIME AS ALL REQUIRED MATERIALS ARE PLANTED AND/OR REVISIONS ARE MADE TO THE APPLICABLE PLANS.
 - THE OWNERS, TENANTS AND / OR THEIR AGENTS SHALL BE RESPONSIBLE FOR MAINTENANCE OF THE REQUIRED LANDSCAPING INCLUDING BOTH PLANT MATERIALS AND BERMS, FENCES AND WALLS. ALL PLANTS MATERIALS SHALL BE MAINTAINED IN GOOD GROWING CONDITION, AND WHEN NECESSARY, REPLACED WITH NEW MATERIALS TO ENSURE CONTINUED COMPLIANCE WITH APPLICABLE REGULATIONS. ALL OTHER REQUIRED LANDSCAPING SHALL BE PERMANENTLY MAINTAINED IN GOOD CONDITION, AND WHEN NECESSARY, REPAIRED OR REPLACED.

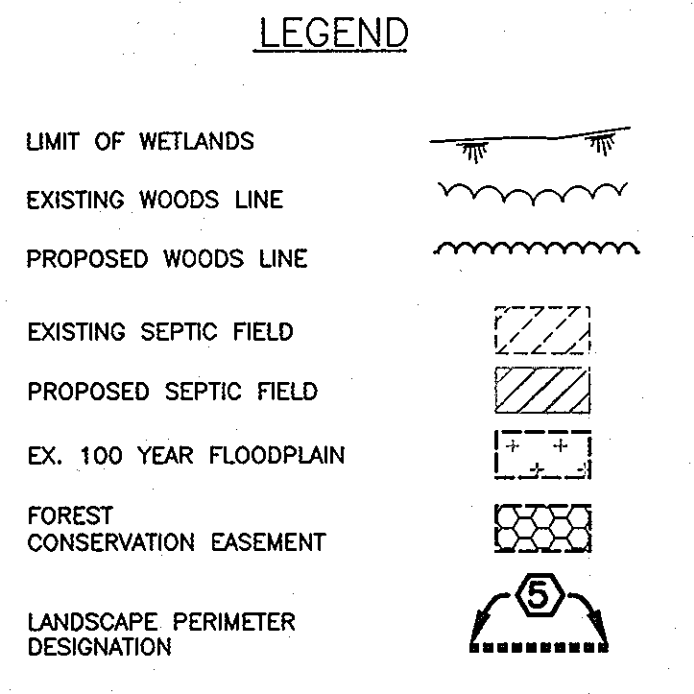

PLAN
SCALE: 1" = 100'

DEVELOPER'S/BUILDER'S CERTIFICATE

I/WE CERTIFY THAT THE LANDSCAPING SHOWN ON THIS PLAN WILL BE DONE ACCORDING TO THE PLAN, SECTION 16.124 OF THE HOWARD COUNTY CODE AND THE HOWARD COUNTY LANDSCAPE MANUAL. I/WE FURTHER CERTIFY THAT UPON COMPLETION OF A LETTER OF LANDSCAPE INSTALLATION, ACCOMPANIED BY AN EXECUTED ONE-YEAR GUARANTEE OF PLANT MATERIALS, WILL BE SUBMITTED TO THE DEPARTMENT OF PLANNING AND ZONING.

Richard J. Demmitt 5-9-07
RICHARD J. DEMMITT, PRESIDENT
HIGHLAND DEVELOPMENT CORP

APPROVED: HOWARD COUNTY DEPARTMENT OF PUBLIC WORKS
Walter J. Walsh 6-6-07
CHIEF, BUREAU OF HIGHWAYS

APPROVED: HOWARD COUNTY DEPT. OF PLANNING AND ZONING
J. Kevin Mumford for C. Hamilton 6-11-07
CHIEF, DIVISION OF LAND DEVELOPMENT

Michael J. Demmitt 6-6-07
CHIEF, DEVELOPMENT ENGINEERING DIVISION

**SCHEDULE A
PERIMETER LANDSCAPE EDGE**

CATEGORY	ADJ. TO PERIMETER PROPERTY (1)	ADJ. TO PERIMETER PROPERTY (2)	ADJ. TO PERIMETER PROPERTY (3)	ADJ. TO PERIMETER PROPERTY (4)	ADJ. TO PERIMETER PROPERTY (5)	ADJ. TO ROAD (6)	TOTALS
LANDSCAPE TYPE	A	A	A	A	A	B	
LINEAR FEET OF ROADWAY FRONTAGE/PERIMETER	1504'	1807'	2100'	1519'	872'	187'	
CREDIT FOR EXISTING VEGETATION (YES, NO, LINEAR FEET) (DESCRIBE BELOW IF NEEDED)	YES 605'	YES 124'	YES 602'	NO	NO	NO	
CREDIT FOR WALL, FENCE OR BERM (YES, NO, LINEAR FEET) (DESCRIBE BELOW IF NEEDED)	NO	NO	NO	NO	NO	NO	
NUMBER OF PLANTS REQUIRED	645'	1219'	1498'	1519'	872'	187'	101
SHADE TREES	11	20	25	26	15	4	5
EVERGREEN TREES	-	-	-	-	-	-	-
OTHER TREES (2:1 SUBSTITUTE)	-	-	-	-	-	-	-
SHRUBS (10:1 SUBSTITUTE)	-	-	-	-	-	-	-
NUMBER OF PLANTS PROVIDED	645'	1219'	1498'	1519'	872'	187'	101
SHADE TREES	11	20	25	26	15	4	5
EVERGREEN TREES	-	-	-	-	-	-	-
OTHER TREES (2:1 SUBSTITUTE)	-	-	-	-	-	-	-
SHRUBS (10:1 SUBSTITUTE)	-	-	-	-	-	-	-

**SCHEDULE D
SWM PERIMETER LANDSCAPING**

	SWMF 1	SWMF 2	TOTALS
LINEAR FEET OF PERIMETER	964'	984'	
CREDIT FOR EXISTING VEGETATION (NO, YES AND %)	NO	YES 22% (220')	
CREDIT FOR OTHER LANDSCAPING (NO, YES AND %)	NO	NO	
LINEAR FEET OF REQUIRED PLANTING	964'	764'	
BUFFER TYPE	"B"	"B"	
NUMBER OF TREES REQUIRED	19	15	34
SHADE TREES	24	19	43
EVERGREEN TREES	19	15	34
NUMBER OF TREES PROVIDED	19	15	34
SHADE TREES	24	19	43
EVERGREEN TREES	19	15	34

STREET TREE SCHEDULE

ROAD NAME	PERIMETER	TREES REQ.	TREES PROV.
BROCCOLINO WAY (LARGE TREES)	640'	160	160
BROCCOLINO WAY (SMALL TREES)	260'	9	9
TOTALS		169	169

PUBLIC STREET TREE PLANTING LIST - BROCCOLINO WAY

SYMBOL	QUANTITY	NAME	REMARKS	DESCRIPTION
⊙	160	ACER SACCHARUM 'Green Mountain' (Green Mountain Sugar Maple)	2 1/2" MIN. CAL. FULL HEAD	STREET TREES TO BE PROVIDED BY THE DEVELOPER
⊙	9	PRUNUS SERULLATA 'Kwanzan' (Kwanzon Cherry)	1 1/2" MIN. CAL. FULL HEAD	STREET TREES TO BE PROVIDED BY THE DEVELOPER

LANDSCAPE PLANTING LIST

SYMBOL	QUANTITY	NAME	REMARKS	DESCRIPTION
⊕	101	QUERCUS RUBRA (Red Oak)	2-1/2" - 3" cal.	SHADE TREES ALONG PERIMETER TO BE PROVIDED BY THE DEVELOPER
⊙	48	PINUS STROBUS (Eastern White Pine)	6' - 8' ht.	EVERGREEN TREES ALONG SWM FACILITIES TO BE PROVIDED BY THE DEVELOPER
⊙	34	TILIA CORDATA 'Greenspire' (Greenspire Littleleaf Linden)	2-1/2" - 3" cal.	SHADE TREES ALONG SWM FACILITIES TO BE PROVIDED BY THE DEVELOPER

12-5-08 REMOVE STANDING PAD & EASEMENT FROM LOT 3 TO PARCEL 'D'

BENCHMARK ENGINEERING, INC.
ENGINEERS • LAND SURVEYORS • PLANNERS
8480 BALTIMORE NATIONAL PIKE & SUITE 418
ELLICOTT CITY, MARYLAND 21043
PHONE: 410-465-6105 FAX: 410-465-6644
E-MAIL: benchmark@comcast.com

OWNER/DEVELOPER:
HIGHLAND DEVELOPMENT CORP
P.O. BOX 228
CLARKSVILLE, MARYLAND 21029
410-531-5539

PROJECT:
BRIGHTON MILL
LOT 1 THROUGH 22, BUILDABLE PRESERVATION PARCEL 'A' AND NON-BUILDABLE PRESERVATION PARCELS 'B' THROUGH 'J'

LOCATION: TAX MAP No. 34, GRID No. 2
PARCEL 2
5th ELECTION DISTRICT
HOWARD COUNTY, MARYLAND

TITLE:
LANDSCAPE AND STREET TREE PLAN, NOTES AND DETAILS

DATE: MAY, 2007 PROJECT NO. 1513
SCALE: 1"=100' DRAWING 27 OF 34

Design: JMC Draft: LAB Check: DAM



LEGEND

- LIMIT OF WETLANDS
- EXISTING WOODS LINE
- PROPOSED WOODS LINE
- EXISTING SEPTIC FIELD
- PROPOSED SEPTIC FIELD
- EX. 100 YEAR FLOODPLAIN
- FOREST CONSERVATION EASEMENT
- LANDSCAPE PERIMETER DESIGNATION


APPROVED: HOWARD COUNTY DEPARTMENT OF PUBLIC WORKS
William J. McCall 6-1-07
 CHIEF, BUREAU OF HIGHWAYS DATE

APPROVED: HOWARD COUNTY DEPT. OF PLANNING AND ZONING
T. Krout - Macdonald for C. Hamilton 6-11-07
 CHIEF, DIVISION OF LAND DEVELOPMENT DATE

John Deussen 6/2/07
 CHIEF, DEVELOPMENT ENGINEERING DIVISION DATE

NO.	DATE	REVISION
1	7-13-07	REVISED STORM DRAIN MATERIAL OF SOME PIPES

BENCHMARK
 ENGINEERS • LAND SURVEYORS • PLANNERS
ENGINEERING, INC.
 8490 BALTIMORE NATIONAL PIKE AND SUITE 418
 ELLICOTT CITY, MARYLAND 21043
 PHONE: 410-465-6105 FAX: 410-465-6644
 E-MAIL: benchmark@cois.com

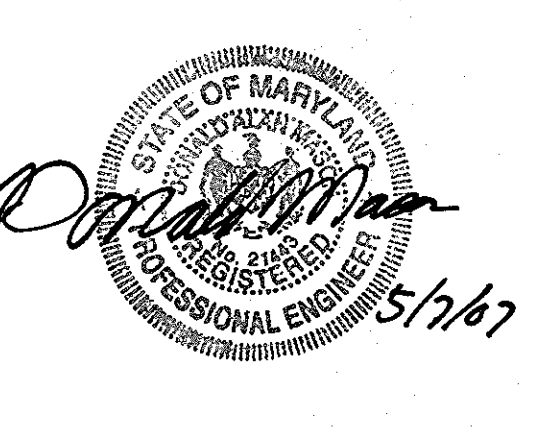


OWNER/DEVELOPER:
 HIGHLAND DEVELOPMENT CORP
 P.O. BOX 228
 CLARKSVILLE, MARYLAND 21029
 410-531-5539

PROJECT: **BRIGHTON MILL**
 LOT 1 THROUGH 22, BUILDABLE PRESERVATION PARCEL 'A' AND NON-BUILDABLE PRESERVATION PARCELS 'B' THROUGH 'D'
 LOCATION: TAX MAP No. 34, GRID No. 2
 PARCEL 2
 5th ELECTION DISTRICT
 HOWARD COUNTY, MARYLAND

TITLE: **LANDSCAPE AND STREET TREE PLAN**
 DATE: MAY, 2007 PROJECT NO. 1513
 SCALE: AS SHOWN DRAWING 28 OF 34

Design: JMC Draft: LAB Check: DAM

PLAN
 SCALE: 1" = 100'

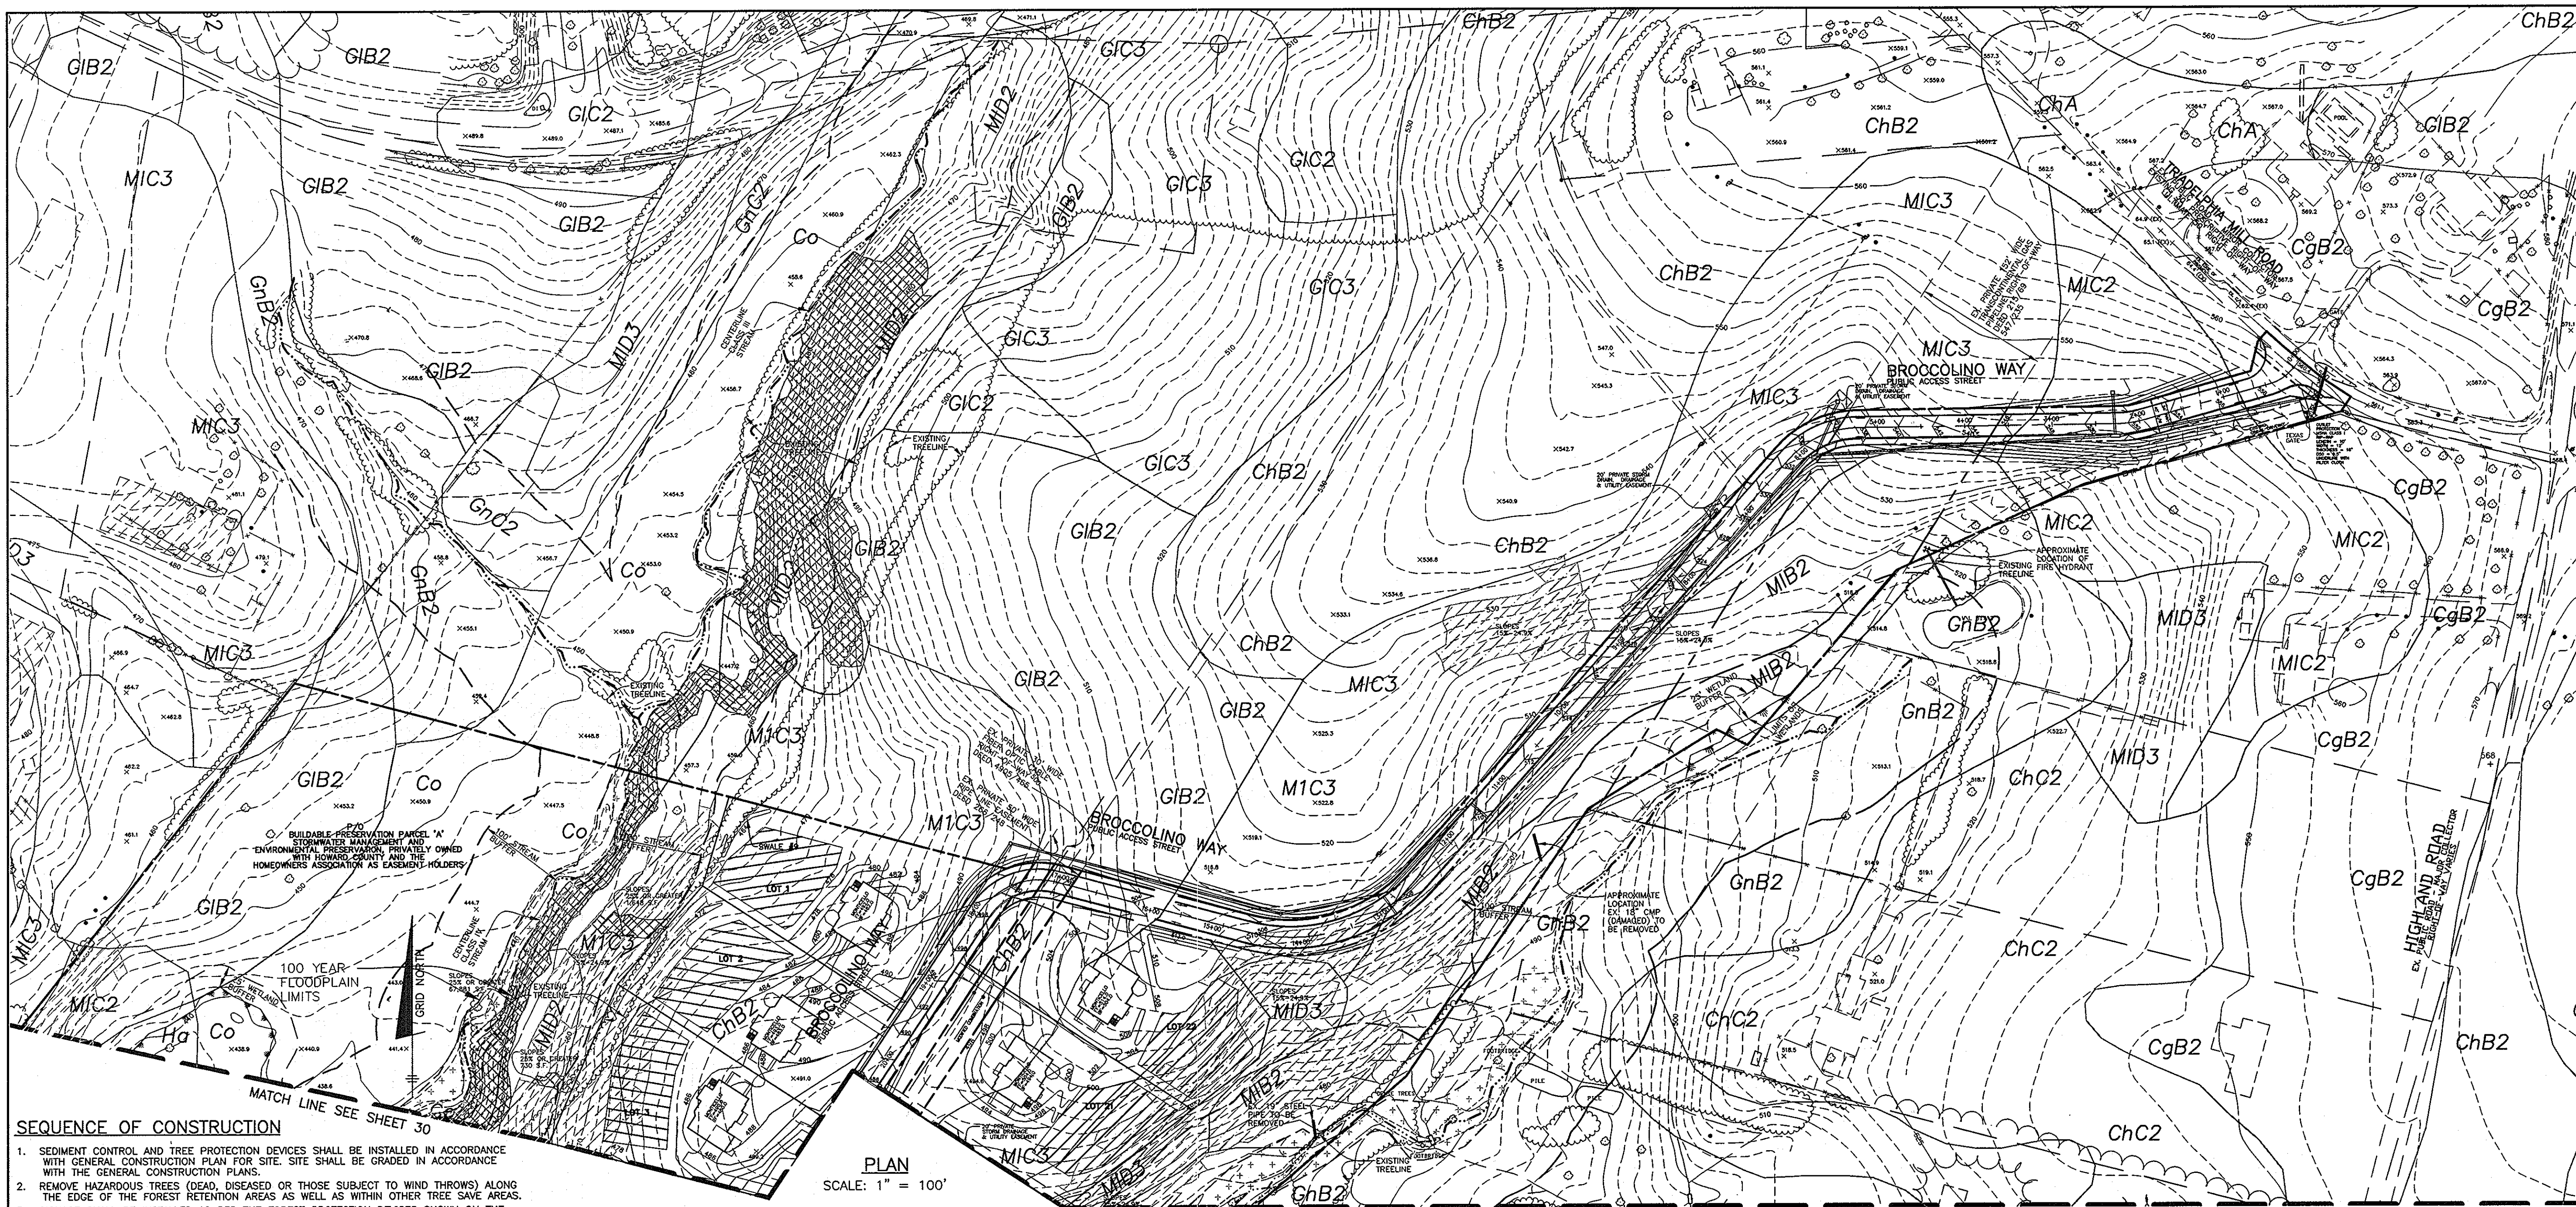

LEGEND


SOILS CLASSIFICATION	ChB2
SOILS DELINEATION	(Symbol)
EXISTING CONTOURS (AERIAL 12/02)	(Symbol)
PROPOSED CONTOURS	(Symbol)
LIMIT OF WETLANDS	(Symbol)
EXISTING WOODS LINE	(Symbol)
PROPOSED WOODS LINE	(Symbol)
EXISTING STRUCTURE	(Symbol)
PROPOSED STRUCTURE	(Symbol)
EXISTING WELL	(Symbol)
EXISTING SEPTIC FIELD	(Symbol)
PROPOSED SEPTIC FIELD	(Symbol)
PROPOSED WELL	(Symbol)
SLOPES 15% TO 24.9%	(Symbol)
SLOPES 25% OR GREATER	(Symbol)
EX. 100 YEAR FLOODPLAIN	(Symbol)
PROPOSED FOREST CONSERVATION EASEMENT	(Symbol)
TREE PROTECTION FENCE	(Symbol)
FCE PERMANENT SIGNAGE	(Symbol)

SEQUENCE OF CONSTRUCTION

1. SEDIMENT CONTROL AND TREE PROTECTION DEVICES SHALL BE INSTALLED IN ACCORDANCE WITH GENERAL CONSTRUCTION PLAN FOR SITE. SITE SHALL BE GRADED IN ACCORDANCE WITH THE GENERAL CONSTRUCTION PLANS.
2. REMOVE HAZARDOUS TREES (DEAD, DISEASED OR THOSE SUBJECT TO WIND THROWS) ALONG THE EDGE OF THE FOREST RETENTION AREAS AS WELL AS WITHIN OTHER TREE SAVE AREAS.
3. SIGNAGE SHALL BE INSTALLED AS PER THE FOREST PROTECTION DEVICES SHOWN ON THE FOREST CONSERVATION PLAN.

PLAN
SCALE: 1" = 100'

THIS PLAN IS FOR FOREST CONSERVATION ONLY

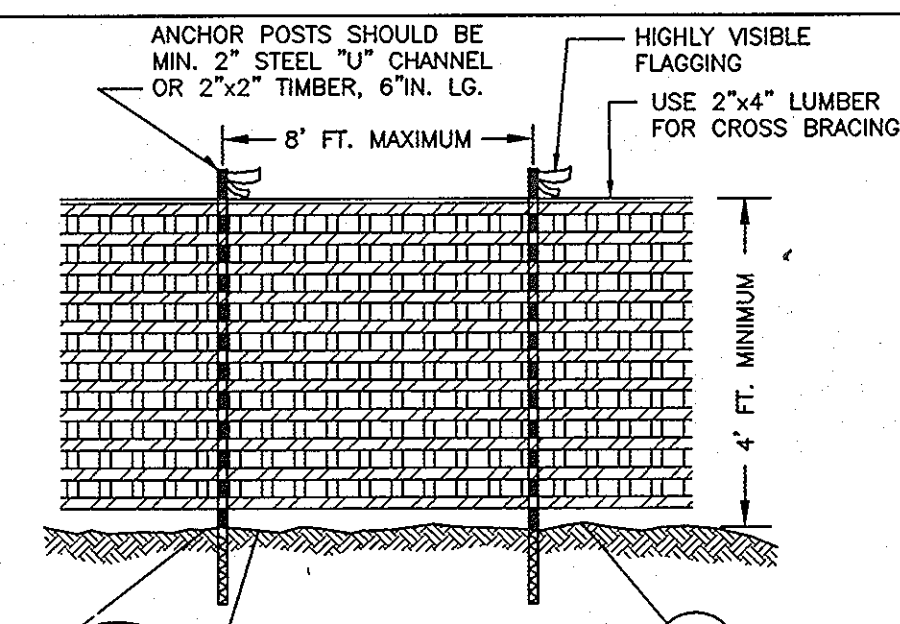

ANCHOR POSTS SHOULD BE MIN. 2" STEEL "U" CHANNEL OR 2"x2" TIMBER, 6" IN. LG.
HIGHLY VISIBLE FLAGGING
USE 2"x4" LUMBER FOR CROSS BRACING
ANCHOR POSTS MUST BE INSTALLED TO A DEPTH OF NO LESS THAN 1/3 OF THE TOTAL HEIGHT OF THE POST.
** BLAZE ORANGE PLASTIC MESH **

NOTES:
1. FOREST PROTECTION DEVICE ONLY.
2. RETENTION AREA WILL BE SET AS PART OF THE REVIEW PROCESS.
3. BOUNDARIES OF RETENTION AREA SHOULD BE STAKED AND FLAGGED PRIOR TO INSTALLING DEVICES.
4. AVOID ROOT DAMAGE WHEN PLACING ANCHOR POSTS.
5. DEVICE SHOULD BE PROPERLY MAINTAINED DURING CONSTRUCTION.
6. PROTECTIVE SIGNAGE IS ALSO REQUIRED.

TEMPORARY TREE PROTECTION FENCE
SCALE: NTS

APPROVED: HOWARD COUNTY DEPARTMENT OF PUBLIC WORKS
[Signature] 6-6-07
CHIEF, BUREAU OF HIGHWAYS


APPROVED: HOWARD COUNTY DEPT. OF PLANNING AND ZONING
[Signature] 6-11-07
CHIEF, DIVISION OF LAND DEVELOPMENT

SITE DATA

GROSS AREA (INCL. ALL PROP. LOTS)	.80.8 AC.±
PRES. PARCELS, TRANS. LINE R/W & FLOODPLAIN	.18.8 AC.±
NET TRACT AREA (NTA)	.62.0 AC.±
EXISTING FOREST (NTA)	.0.0 AC.±
AFFORESTATION THRESHOLD	.12.5 AC.±
AFFORESTATION PROPOSED	.6.5 AC.±
OFF-SITE RETENTION ON SENDING PARCEL	.12.0 AC.±

FOREST CONSERVATION TABULATION

DESIGNATION:	TYPE:	ACREAGE:
1	AFFORESTATION	5.2 AC.±
2	AFFORESTATION	1.3 AC.±
TOTAL:		6.5 AC.±

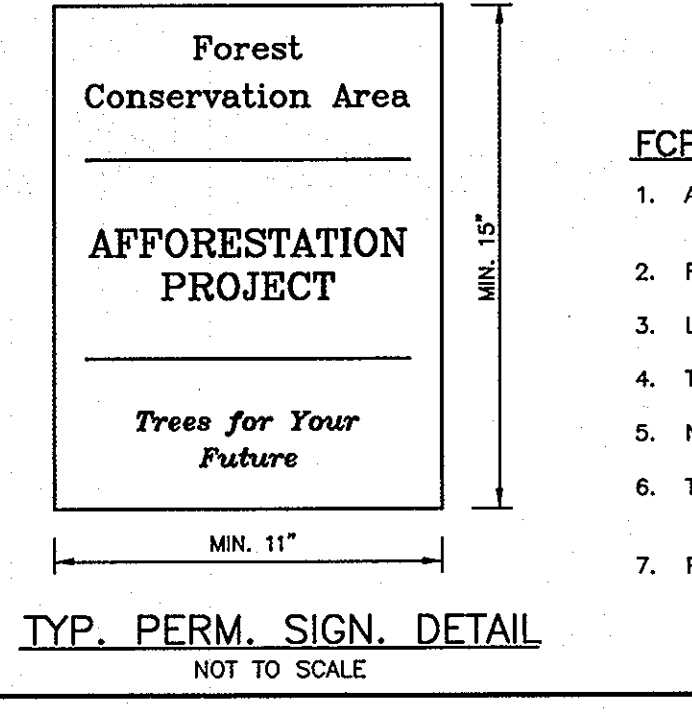

ACRES OF AFFORESTATION (APPENDIX E) FOREST CONSERVATION WORKSHEET

- I. BASIC SITE DATA**
- | | |
|---|--------------------------|
| GROSS SITE AREA (INCLUSIVE OF ALL PROPOSED LOTS) | .80.8 AC.± |
| AREA WITHIN 100 YEAR FLOOD PLAIN | .8.3 AC.± (PRES. PARCEL) |
| AREA WITHIN AGRICULTURAL USE OR PRESERVATION PARCEL | 3.5 AC.± |
| AREA WITHIN UNDERGROUND TRANSMISSION LINES | 6.5 AC.± |
| NET TRACT AREA | 62.5 AC.± |
| LAND USE CATEGORY (R-RLD, R-RMD, R-S, C/I/O, I) | RR-DEO |
- II. INFORMATION FOR CALCULATIONS**
- | | |
|--|------------|
| (A) NET TRACT AREA | .62.5 AC.± |
| (B) REFORESTATION THRESHOLD (25% x NTA) | .15.6 AC.± |
| (C) AFFORESTATION MINIMUM (20% x NTA) | .12.5 AC.± |
| (D) EXISTING FOREST ON NET TRACT AREA | .0 AC.± |
| (E) EXISTING FOREST ABOVE CONSERVATION THRESHOLD | .0 AC.± |
| (F) BREAK EVEN POINT (IF APPLICABLE) | .0 AC.± |
| (G) FOREST AREAS TO BE CLEARED | .0 AC.± |
| (H) FOREST AREAS TO BE RETAINED (RETENTION) | .0 AC.± |
- III. DETERMINING REQUIREMENTS: AFFORESTATION OR REFORESTATION**
1. **Reforestation**
If existing forest areas equal or exceed the afforestation minimum (if D equals or is more than C), and no clearing of existing forest resources is proposed, reforestation requirements may apply. GO TO SECTION IV.
If existing forest areas equal or exceed the afforestation minimum (if D equals or is more than C), and no clearing of existing forest resources is proposed, no reforestation is required. No further calculations are needed.
 2. **Afforestation**
If existing forest areas are less than the afforestation minimum (if D is less than C), afforestation requirements apply.

- SELECT THE ALTERNATE THAT APPLIES:**
1. **No clearing below the minimum**
If existing forests are less than the afforestation minimum (if D is less than C) and no clearing is proposed, the following calculations apply:
Total afforestation required: 12.5 AC.±
C - D
 2. **Clearing below the minimum**
If existing forest area less than the afforestation minimum (if D is less than C) and clearing is proposed, the following calculations apply:
Afforestation for unforested areas below minimum: C - D
Afforestation for Clearing below Minimum: E x 2
TOTAL AFFORESTATION REQUIRED: (C - D) + (E x 2)
Afforestation required the total forest area be equal to the minimum and it requires compensation for clearing.

V. AFFORESTATION CALCULATIONS

	ACRES (1/10 acre)
A. NET TRACT AREA	62.5 AC.±
B. AFFORESTATION MINIMUM (20% x A)	12.5 AC.±
C. EXISTING FOREST ON NET TRACT AREA	0
D. FOREST AREAS TO BE CLEARED	0
F. FOREST AREAS TO BE RETAINED	0

SITE DATA TABULATION

- 1) GENERAL SITE DATA
 - a. PRESENT ZONING: RR-DEO
 - b. APPLICABLE DPZ FILE REFERENCES: WP-03-093
 - c. DEED REF.: 2644/140
 - d. PROPOSED USE OF SITE: 22 BUILDABLE LOTS, 1 BUILDABLE PRESERVATION PARCEL AND 3 NON-BUILDABLE PRESERVATION PARCELS
 - e. PROPOSED WATER AND SEWER SYSTEMS: PRIVATE
- 2) AREA TABULATION
 - a. TOTAL AREA OF SITE: 80.75 AC.±
 - b. AREA OF 100 YEAR FLOODPLAIN (APPROX.): 8.3 AC.±
 - c. AREA OF STEEP SLOPES (25% OR GREATER): 0.87 AC.±
 - d. AREA OF STEEP SLOPES NOT IN THE FLOODPLAIN: 0.54 AC.±
 - e. NET AREA OF SITE: 71.91 AC.±
 - f. AREA OF THIS PLAN SUBMISSION: 80.75 AC.±
 - g. AREA OF PROPOSED BUILDABLE LOTS: 22.58 AC.±
 - h. AREA OF PROPOSED PRESERVATION PARCELS: 54.97 AC.±
 - i. AREA OF PROPOSED PUBLIC ROAD R/W: 3.20 AC.±

SOILS LEGEND

MAP SYMBOL	SOIL GROUP	SOIL TYPE
CgB2	B	CHESTER GRAVELLY SILT LOAM, 3 TO 8% SLOPES, MODERATELY ERODED
ChA	B	CHESTER SILT LOAM, 0 TO 3% SLOPES
ChB2	B	CHESTER SILT LOAM, 3 TO 8% SLOPES, MODERATELY ERODED
Co*	C	CODORUS SILT LOAM
CuB	B	COMUS SILT LOAM, LOCAL ALUMINUM, 3 TO 8% SLOPES
GIB2	B	GLENVILLE SILT LOAM, 3 TO 8% SLOPES, MODERATELY ERODED
GIC2	B	GLENVILLE SILT LOAM, 8 TO 15% SLOPES, MODERATELY ERODED
GIC3	B	GLENVILLE SILT LOAM, 8 TO 15% SLOPES, SEVERELY ERODED
GI03	B	GLENVILLE SILT LOAM, 15 TO 25% SLOPES, SEVERELY ERODED
GnA*	C	GLENVILLE SILT LOAM, 0 TO 3% SLOPES
GnB2*	C	GLENVILLE SILT LOAM, 3 TO 8% SLOPES, MODERATELY ERODED
GnB2*	C	GLENVILLE SILT LOAM, 8 TO 15% SLOPES, MODERATELY ERODED
Ma*	D	MANOR SILT LOAM
MIB	B	MANOR LOAM, 0 TO 3% SLOPES
MIB2	B	MANOR LOAM, 3 TO 8% SLOPES, MODERATELY ERODED
MIC2	B	MANOR LOAM, 8 TO 15% SLOPES, MODERATELY ERODED
MIC3	B	MANOR LOAM, 8 TO 15% SLOPES, SEVERELY ERODED
MID3	B	MANOR LOAM, 15 TO 25% SLOPES, SEVERELY ERODED
MnD	B	MANOR VERY STONY LOAM, 3 TO 25% SLOPES

* INDICATES HYDRIC SOILS
TAKEN FROM SOILS SURVEY, ISSUED JULY 1968, MAP NO. 22.

Eco-Science Professionals, Inc.
CONSULTING ECOLOGISTS
P.O. Box 506 Glen Arm, MD 21057 (410) 592-6752

MD DNR Qualified Professional
USACE Wetland Delineator
Certification #WDC93MD061004032
[Signature]
John P. Canales

BENCHMARK ENGINEERING, INC.
ENGINEERS • LAND SURVEYORS • PLANNERS
8480 BALTIMORE NATIONAL PIKE & SUITE 418
ELLIOTT CITY, MARYLAND 21043
PHONE: 410-465-6105 FAX: 410-465-6644
E-MAIL: benchmark@earthlink.net

OWNER/DEVELOPER:
HIGHLAND DEVELOPMENT CORP
P.O. BOX 228
CLARKSVILLE, MARYLAND 21029
410-531-5539

PROJECT:
BRIGHTON MILL
LOTS 1 THROUGH 22, BUILDABLE PRESERVATION PARCEL 'A' AND NON-BUILDABLE PRESERVATION PARCELS 'B' THROUGH 'D'

LOCATION: TAX MAP No. 34, GRID No. 2
PARCEL 2
5th ELECTION DISTRICT
HOWARD COUNTY, MARYLAND

TITLE: **FOREST CONSERVATION PLAN, NOTES AND DETAILS**

DATE: MAY, 2007 PROJECT NO. 1513
SCALE: AS SHOWN DRAWING 29 OF 34

Design: JMC Draft: LAB Check: DAM



MULTIFLORA ROSE CONTROL NOTE

MULTIFLORA ROSE IS PREVALENT IN CERTAIN AREAS TO BE REFORESTED. PRIOR TO PLANTING ALL MULTIFLORA ROSE SHOULD BE REMOVED. REMOVAL OF THE ROSE MAY BE PERFORMED WITH MOWING AND HERBICIDE TREATMENT. PHYSICAL REMOVAL OF ALL TOP GROWTH FOLLOWED BY A PERIODIC HERBICIDE TREATMENT OF STUMP SPROUTS IS RECOMMENDED. NATIVE TREE AND SHRUB SPECIES OCCURRING WITHIN THE ROSE THICKETS SHOULD BE IDENTIFIED AND WHERE POSSIBLE HERBICIDE TREATMENTS TO ADDRESS WOODY PLANT MATERIAL AND SHALL BE APPLIED AS PER MANUFACTURER'S SPECIFICATIONS. CARE SHOULD BE TAKEN NOT TO SPRAY PLANTED TREES OR NATURALLY OCCURRING NATIVE TREE/SHRUB SPECIES. IT IS RECOMMENDED THAT INTENTION OF ROSE REMOVAL BEGAIN AT LEAST SIX MONTHS PRIOR TO PLANTING.

PLANTING SCHEDULE #1

QTY.	SPECIES	SIZE	SPACING
175	Acer rubrum - RED MAPLE	2-3" WHIP	**
200	Cornus florida - FLOWERING DOGWOOD	2-3" WHIP	**
250	Fraxinus pennsylvanica - GREEN ASH	2-3" WHIP	**
250	Juglans nigra - BLACK WALNUT	2-3" WHIP	**
250	Liriodendron tulipifera - POPLAR	2-3" WHIP	**
150	Platanus occidentalis - SYCAMORE	2-3" WHIP	**
125	Prunus serotina - BLACK CHERRY	2-3" WHIP	**
125	Quercus alba - WHITE OAK	2-3" WHIP	**
125	Quercus rubra - RED OAK	2-3" WHIP	**
110	Sassafras obtusum - SASSAPARILLA	2-3" WHIP	**
125	Viburnum prunifolium - BLACKHAWK	2-3" WHIP	**

** PLANTINGS TO BE SPACED 11 FOOT CENTERS - PLANTINGS SHOULD BE INSTALLED IN ROWS TO FACILITATE FUTURE MAINTENANCE. WHERE POSSIBLE, ROWS SHOULD BE MADE ALONG CONTOUR. PER COUNTY REQUIREMENTS, TREE SHIELDS SHOULD BE USED. PLANTING IS BASED ON 350 TREES PER ACRE.

PLANTING SCHEDULE #2

QTY.	SPECIES	SIZE	SPACING
45	Acer rubrum - RED MAPLE	2-3" WHIP	**
25	Cornus florida - FLOWERING DOGWOOD	2-3" WHIP	**
60	Fraxinus pennsylvanica - GREEN ASH	2-3" WHIP	**
60	Juglans nigra - BLACK WALNUT	2-3" WHIP	**
60	Liriodendron tulipifera - POPLAR	2-3" WHIP	**
30	Platanus occidentalis - SYCAMORE	2-3" WHIP	**
30	Prunus serotina - BLACK CHERRY	2-3" WHIP	**
30	Quercus alba - WHITE OAK	2-3" WHIP	**
30	Quercus rubra - RED OAK	2-3" WHIP	**
30	Sassafras obtusum - SASSAPARILLA	2-3" WHIP	**
30	Viburnum prunifolium - BLACKHAWK	2-3" WHIP	**

** PLANTINGS TO BE SPACED 11 FOOT CENTERS - PLANTINGS SHOULD BE INSTALLED IN ROWS TO FACILITATE FUTURE MAINTENANCE. WHERE POSSIBLE, ROWS SHOULD BE MADE ALONG CONTOUR. PER COUNTY REQUIREMENTS, TREE SHIELDS SHOULD BE USED. PLANTING IS BASED ON 350 TREES PER ACRE.

LEGEND

- SOILS CLASSIFICATION ChB2
- SOILS DELINEATION
- EXISTING CONTOURS (AERIAL 12/02)
- PROPOSED CONTOURS
- LIMIT OF WETLANDS
- EXISTING WOODS LINE
- PROPOSED WOODS LINE
- EXISTING STRUCTURE
- PROPOSED STRUCTURE
- EXISTING WELL
- EXISTING SEPTIC FIELD
- PROPOSED SEPTIC FIELD
- PROPOSED WELL
- SLOPES 15% TO 24.9%
- SLOPES 25% OR GREATER
- EX. 100 YEAR FLOODPLAIN
- PROPOSED FOREST CONSERVATION EASEMENT

SEQUENCE OF CONSTRUCTION

1. PLANTINGS SHALL BE INSTALLED AS PER PLANTING SCHEDULE AND PLANTING/SOIL SPECIFICATIONS FOR THE PROJECT.
2. UPON COMPLETION OF THE PLANTING, SIGNAGE SHALL BE INSTALLED AS PER THE FOREST RETENTION AREA PROTECTION DEVICES SHOWN ON THE FOREST CONSERVATION PLAN.
3. PLANTINGS SHALL BE MAINTAINED AND GUARANTEED IN ACCORDANCE WITH THE MAINTENANCE AND GUARANTEE REQUIREMENTS FOR PROJECT.

MAINTENANCE OF PLANTINGS

1. MAINTENANCE OF ALL PLANTINGS SHALL LAST FOR A PERIOD OF 24 MONTHS.
2. ALL PLANT MATERIAL SHALL BE MAINTAINED TWICE A MONTH DURING THE 1ST GROWING SEASON, ONCE A MONTH DURING MAY-SEPTEMBER, IF NEEDED.
3. INVASIVE WEEDS AND NOXIOUS WEEDS WILL BE REMOVED FROM REFORESTATION AREAS. OLD FIELD SUCCESSIONAL SPECIES WILL BE REMOVED.
4. PLANTS WILL BE EXAMINED A MINIMUM OF TWO TIMES DURING THE GROWING SEASON FOR SERIOUS PLANT PESTS AND DISEASES. SERIOUS PROBLEMS WILL BE TREATED WITH THE APPROPRIATE AGENT.
5. DEAD BRANCHES WILL BE PRUNED FROM PLANTINGS.

GUARANTEE REQUIREMENTS


1. AFTER ONE GROWING SEASON, PLANT MATERIAL SHALL BE MAINTAINED AT 90% SURVIVAL THRESHOLD. AT A 75 PERCENT SURVIVAL RATE OF FORESTATION PLANTINGS WILL BE REQUIRED AT THE END OF THE 24 MONTH MAINTENANCE PERIOD. ALL PLANT MATERIAL BELOW THE 75 PERCENT THRESHOLD WILL BE REPLACED AT THE BEGINNING OF THE NEXT GROWING SEASON.
2. THE CONTRACTOR WILL NOT BE LIABLE FOR PLANT LOSS DUE TO THEFT OR VANDALISM.

SURETY FOR REFORESTATION

1. THE DEVELOPER SHALL POST A SURETY (BOND, LETTER OF CREDIT) TO ENSURE THAT REFORESTATION PLANTINGS ARE COMPLETED. UPON ACCEPTANCE OF THE PLANTINGS BY THE COUNTY, THE BOND SHALL BE RELEASED.

FLOODPLAIN NOTE:

PORTIONS OF THE SITE OCCURRING WITHIN THE 100-YEAR FLOODPLAIN ARE NOT INCLUDED AS PART OF THE NET TRACT AREA OF THE SITE. AREAS OF FLOODPLAIN APPROXIMATION OCCURRING WITHIN THE LIMITS OF A FOREST CONSERVATION EASEMENT WILL BE PROTECTED BY THE EASEMENT RESTRICTIONS.

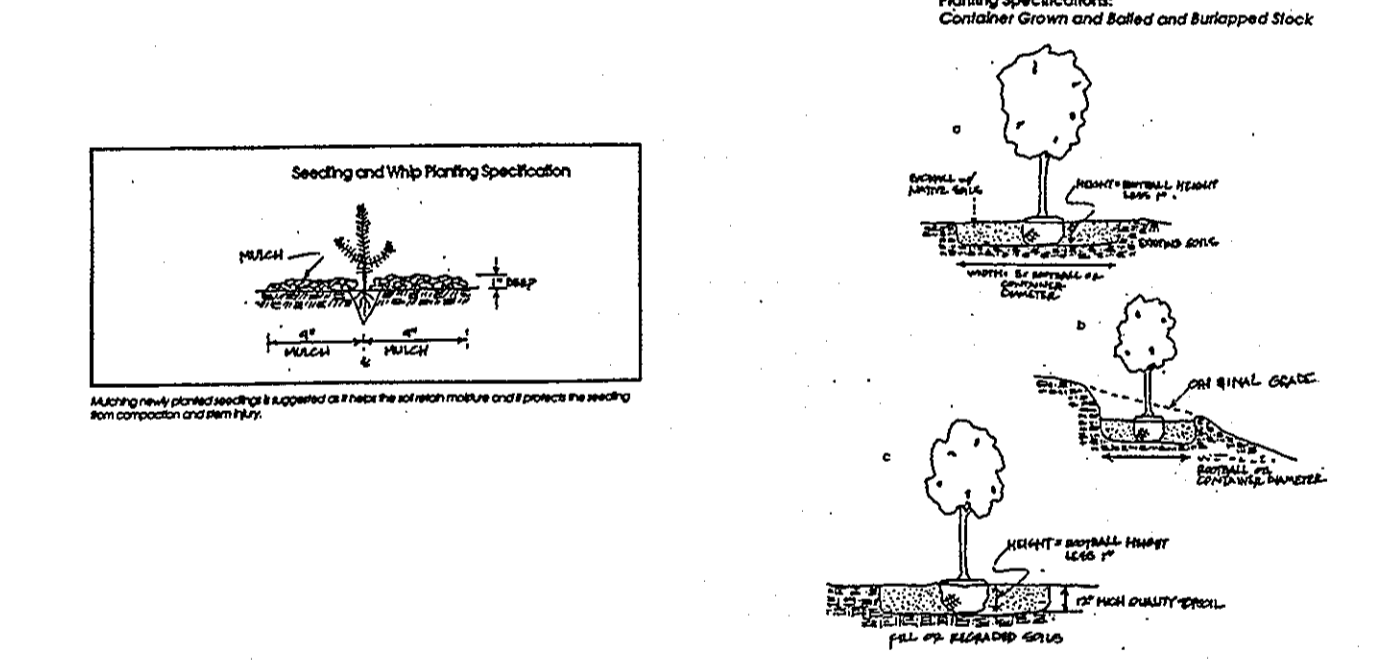

Eco-Science Professionals, Inc.
 CONSULTING ECOLOGISTS
 P.O. Box 5006 Glen Arm, MD 21057 (410) 592-6752

MD DNR Qualified Professional
 USA COE Wetland Professional
 Certification #WOC12MD06109402
 John F. Caneles

APPROVED: HOWARD COUNTY DEPARTMENT OF PUBLIC WORKS
 W. Z. Marshall, 6-6-07, DATE
 CHIEF, BUREAU OF HIGHWAYS

APPROVED: HOWARD COUNTY DEPT. OF PLANNING AND ZONING
 T. Krebs-Markwardt for Hamilton, 6-11-07, DATE
 CHIEF, DIVISION OF LAND DEVELOPMENT

APPROVED: M. J. ... 6/15/07, DATE
 CHIEF, DEVELOPMENT ENGINEERING DIVISION

7-13-07 REVISED STORM DRAIN MATERIAL OF SOME PIPES

NO.	DATE	REVISION

BENCHMARK ENGINEERING, INC.
 ENGINEERS • LAND SURVEYORS • PLANNERS
 8490 BALTIMORE NATIONAL PIKE & SUITE 418
 ELICOTT CITY, MARYLAND 21043
 PHONE: 410-465-6105 FAX: 410-465-6644
 E-MAIL: benchmark@eais.com

OWNER: THOMAS C. CURTIS AND BETTY JEAN CURTIS, H/W 13471 TRIADDELPHIA MILL ROAD CLARKSVILLE, MD 21029-1026

CONTRACT PURCHASER/DEVELOPER: HIGHLAND DEVELOPMENT CORPORATION P.O. BOX 228 CLARKSVILLE, MARYLAND 21029 410-531-5539

PROJECT: CURTIS PROPERTY
 LOTS 1 THROUGH 22, BUILDABLE PRESERVATION PARCEL 'A' AND NON-BUILDABLE PRESERVATION PARCELS 'B' THROUGH 'D'
 LOCATION: TAX MAP No. 34, GRID No. 2
 5TH ELECTION DISTRICT HOWARD COUNTY, MARYLAND


TITLE: FOREST CONSERVATION PLAN, NOTES AND DETAILS

DATE: MAY, 2007 PROJECT NO. 1513


Design: JMC Draft: LAB Check: DAM SCALE: AS SHOWN DRAWING 30 OF 34

THIS PLAN IS FOR FOREST CONSERVATION ONLY

PLAN SCALE: 1" = 100'

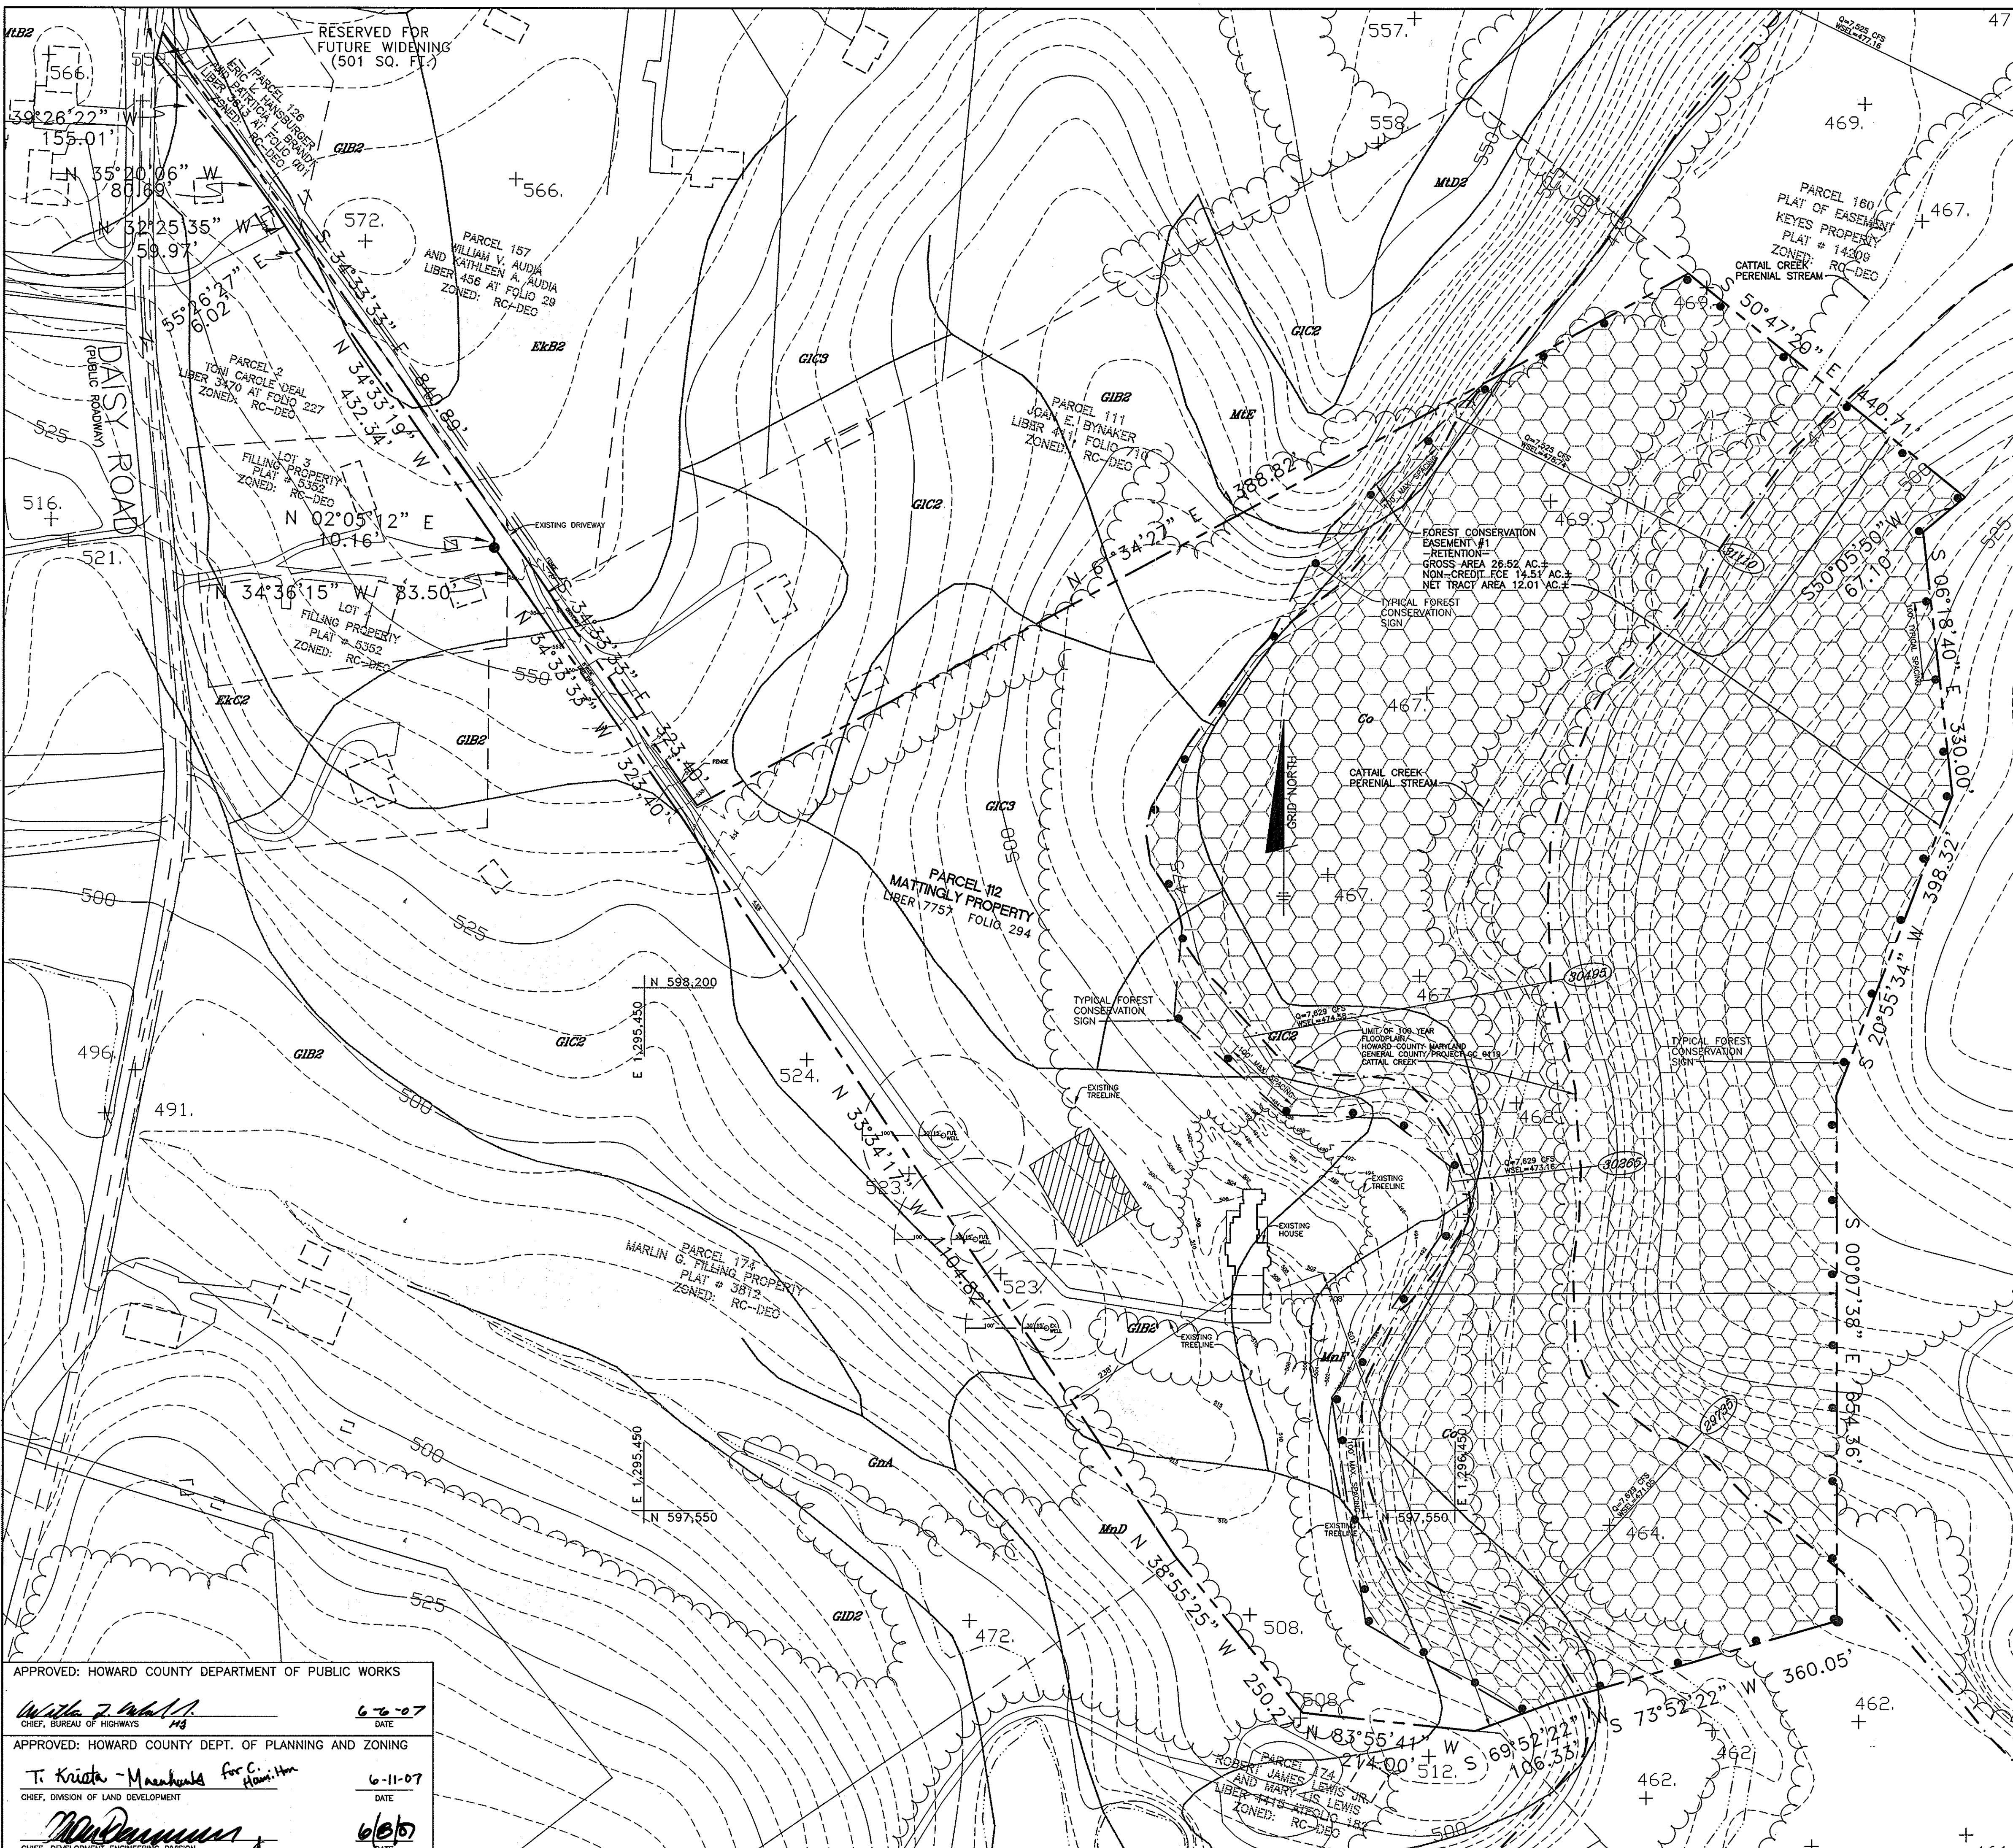

- FP NOTES:**
1. ANY FOREST CONSERVATION EASEMENT (FCE) AREA SHOWN HEREON IS SUBJECT TO PROTECTIVE COVENANTS WHICH MAY BE FOUND IN THE LAND RECORDS OF HOWARD COUNTY WHICH RESTRICT THE DISTURBANCE AND USE OF THESE AREAS.
 2. FORESTED AREAS OCCURRING OUTSIDE OF THE FCE SHALL NOT BE CONSIDERED PART OF THE FCE AND SHALL NOT BE SUBJECT TO PROTECTIVE LAND COVENANTS.
 3. LIMITS OF DISTURBANCE SHALL BE RESTRICTED TO AREAS OUTSIDE THE LIMIT OF TEMPORARY FENCING OR THE FCE BOUNDARY FROM BRIGHTON MILL, F-06-07, OR WHICHEVER IS GREATER.
 4. THERE SHALL BE NO CLEARING, GRADING, CONSTRUCTION OR DISTURBANCE OF VEGETATION IN THE FOREST CONSERVATION EASEMENT, EXCEPT AS PERMITTED BY HOWARD COUNTY DPZ.
 5. NO STOCKPILES, PARKING AREAS, EQUIPMENT CLEANING AREAS, ETC. SHALL OCCUR WITHIN AREAS DESIGNATED AS FOREST CONSERVATION EASEMENTS.
 6. TEMPORARY FENCING SHALL BE USED TO PROTECT FOREST RESOURCES DURING CONSTRUCTION. FENCING SHALL BE INSTALLED ALONG LIMITS OF DISTURBANCE OCCURRING WITHIN 50 FEET OF THE PROPOSED FCE LIMITS. PERMANENT SIGNAGE WILL BE POSTED AT 50-100 FOOT INTERVALS ALONG ALL FCE LIMITS.
 7. THE TOTAL FOREST CONSERVATION OBLIGATION FOR BRIGHTON MILL (SP-03-09) AND (F-06-07) 6.0 ACRES, WILL BE MET THROUGH THE RETENTION ON THE MATTINGLY PROPERTY, RE-06-01, OF 12.0 ACRES OF NET TRACT AREA FOREST WITHIN THE LIMITS OF A FOREST CONSERVATION EASEMENT. SURETY IN THE AMOUNT OF \$104,555.71 SHALL BE REQUIRED FOR THIS PROJECT.

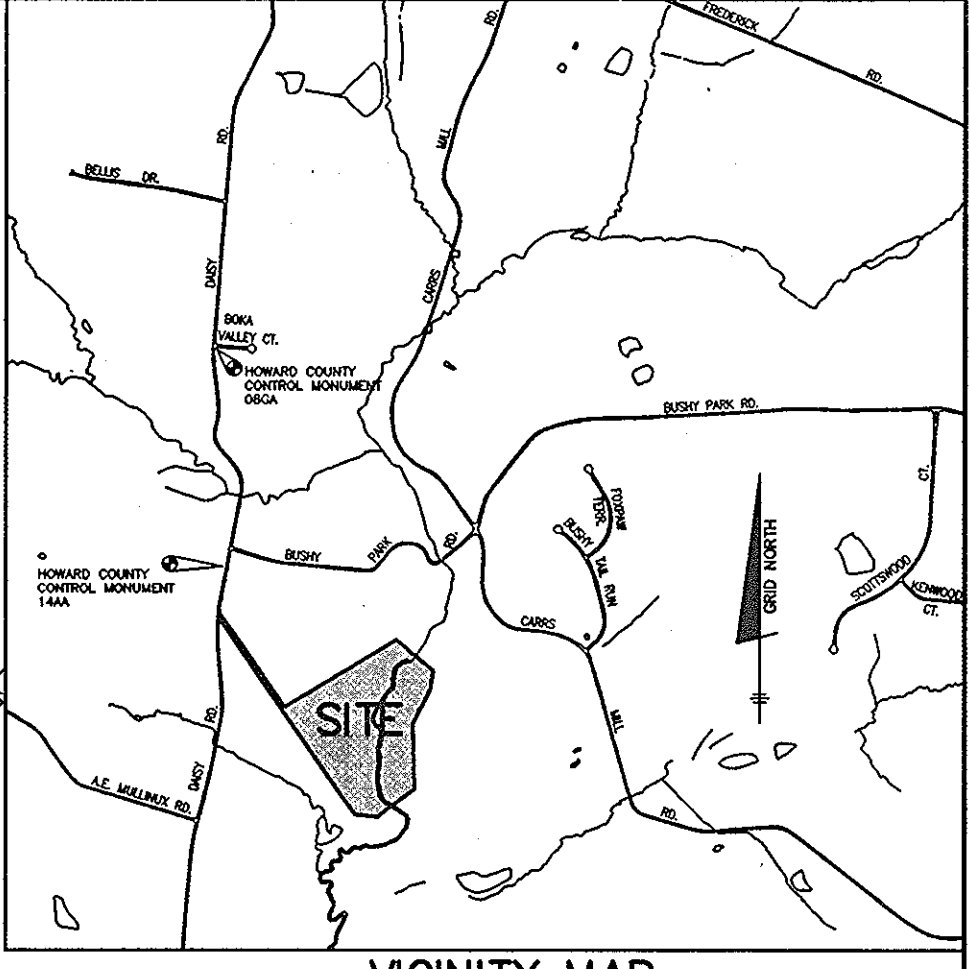

FOREST RETENTION AREA

MACHINERY, DUMPING OR STORAGE OF ANY MATERIALS IS PROHIBITED

VIOLATORS ARE SUBJECT TO FINES AS IMPOSED BY THE HOWARD COUNTY FOREST CONSERVATION ACT OF 1992

MIN. 11"

SIGNAGE
NOT TO SCALE

- NOTES:**
1. THERE ARE STREAMS, STREAM BUFFERS AND FLOODPLAINS LOCATED ON THIS SITE.
 2. THIS OFF-SITE PLANTING WILL BE REQUIRED TO SATISFY THE FOREST CONSERVATION REQUIREMENTS FOR THE CURTIS PROPERTY (SP-03-013) SUBDIVISION.
 3. SURETY REQUIRED FOR THE OFF-SITE RETENTION IN THE AMOUNT OF \$104,555.71 SHALL BE REQUIRED FOR THE FINAL PLAN SUBMISSION OF THE BRIGHTON MILL (F-06-067).
 4. THE OBLIGATION OF 6.0 ACRES OF AFFORESTATION FOR THE BRIGHTON MILL (F-06-067) WILL BE PROVIDED ON THE MATTINGLY PROPERTY, RE-06-01.
 5. 12.00 ACRES OF RETENTION ARE REQUIRED FOR THE BRIGHTON MILL SUBDIVISION AND 12.01 ACRES IS PROVIDED.

EASEMENT	RETENTION (NTA)	REFORESTATION
FCE#1	12.01 AC.**	N/A
TOTALS	12.01 AC.*	N/A

* 12.00 ACRES NTA ARE REQUIRED FOR THE CURTIS PROPERTY SUBDIVISION (SP-03-009)
 ** FCE #1 IS 26.52 ACRES IN TOTAL AREA BUT 14.51 ACRES ARE NON-CREDITED FCE DUE TO BEING WITHIN THE LIMITS OF THE 100 YEAR FLOODPLAIN.

- LEGEND**
- EXISTING CONTOUR
 - EX. TREE LINE
 - EX. SEPTIC RESERVE AREA
 - FOREST CONSERVATION SIGN

MAP SYMBOL	SOIL TYPE	MAPPING UNIT
EXB2	C	ELIOAK SILT LOAM, 3 TO 8 PERCENT SLOPES, MODERATELY ERODED
EXC2	C	ELIOAK SILT LOAM, 8 TO 15 PERCENT SLOPES, MODERATELY ERODED
ED3	C	ELIOAK SILTY CLAY LOAM, 15 TO 25 PERCENT SLOPES, SEVERELY ERODED
GIB2	B	GLENELG LOAM, 3 TO 8 PERCENT SLOPES, MODERATELY ERODED
GIC2	B	GLENELG LOAM, 8 TO 15 PERCENT SLOPES, MODERATELY ERODED
GIC3	B	GLENELG LOAM, 8 TO 15 PERCENT SLOPES, SEVERELY ERODED
GA	C	GLENVILLE SILT LOAM, 3 TO 3 PERCENT SLOPES
MnD	B	MANOR VERY STONY LOAM, 3 TO 25 PERCENT SLOPES
MnF	B	MANOR VERY STONY LOAM, 25 TO 60 PERCENT SLOPES
MIB2	A	MOUNT AIRY CHANNERY LOAM, 3 TO 8 PERCENT SLOPES, MODERATELY ERODED
MID2	A	MOUNT AIRY CHANNERY LOAM, 15 TO 25 PERCENT SLOPES, MODERATELY ERODED
MI	A	MOUNT AIRY CHANNERY LOAM, 25 TO 45 PERCENT SLOPES

SOILS MAP No. 6

NO.	DATE	REVISION

BENCHMARK
ENGINEERS & LAND SURVEYORS & PLANNERS
ENGINEERING, INC.

8480 BALTIMORE NATIONAL PIKE & SUITE 418
 ELLICOTT CITY, MARYLAND 21043
 PHONE: 410-465-6105 FAX: 410-465-6644
 EMAIL: benchmark@comcast.com

APPROVED: HOWARD COUNTY DEPARTMENT OF PUBLIC WORKS
William J. Caldwell 6-6-07
 CHIEF, BUREAU OF HIGHWAYS

APPROVED: HOWARD COUNTY DEPT. OF PLANNING AND ZONING
T. Krista - Maenhardt for C. Hamilton 6-11-07
 CHIEF, DIVISION OF LAND DEVELOPMENT

William J. Caldwell 6/6/07
 CHIEF, DEVELOPMENT ENGINEERING DIVISION

OWNER:
 BRIAN AND CONNIE MATTINGLY
 21020 BROOK KNOLLS ROAD
 LAYTONSVILLE, MARYLAND 20882
 301-785-8006

DEVELOPER:
 HIGHLAND DEVELOPMENT CORP
 P.O. BOX 228
 CLARKSVILLE, MARYLAND 21029
 410-531-5539

DESIGN: JMC DRAFT: JMC

















PROJECT:
MATTINGLY PROPERTY

LOCATION:
 TAX MAP No. 14, GRID No. 1, PARCEL No. 112
 4th ELECTION DISTRICT
 HOWARD COUNTY, MARYLAND

TITLE:
 FOREST STAND DELINEATION FOR MATTINGLY PROPERTY AND OFF-SITE FOREST CONSERVATION PLAN FOR BRIGHTON MILL (F-06-067)

DATE: MAY, 2007 PROJECT NO. 1673

SCALE: 1" = 100' DRAWING 31 OF 34

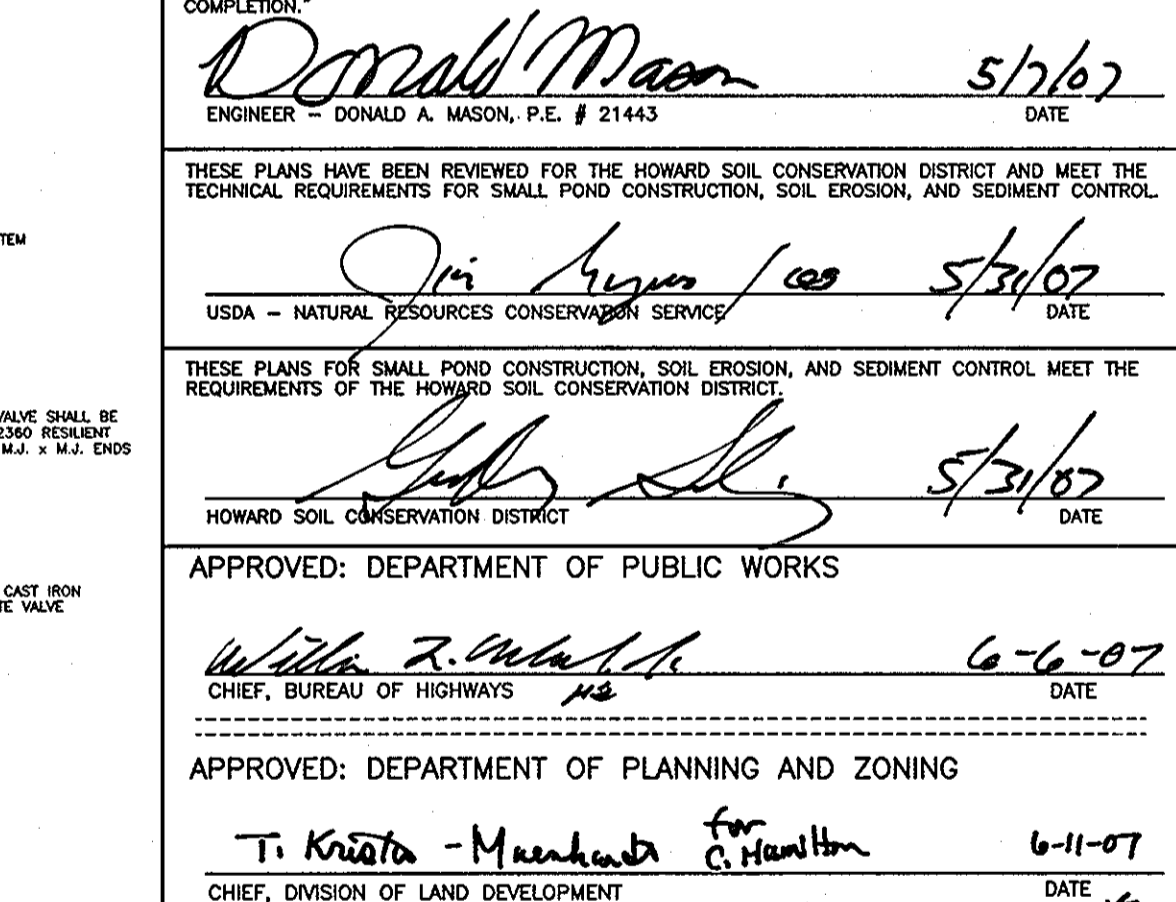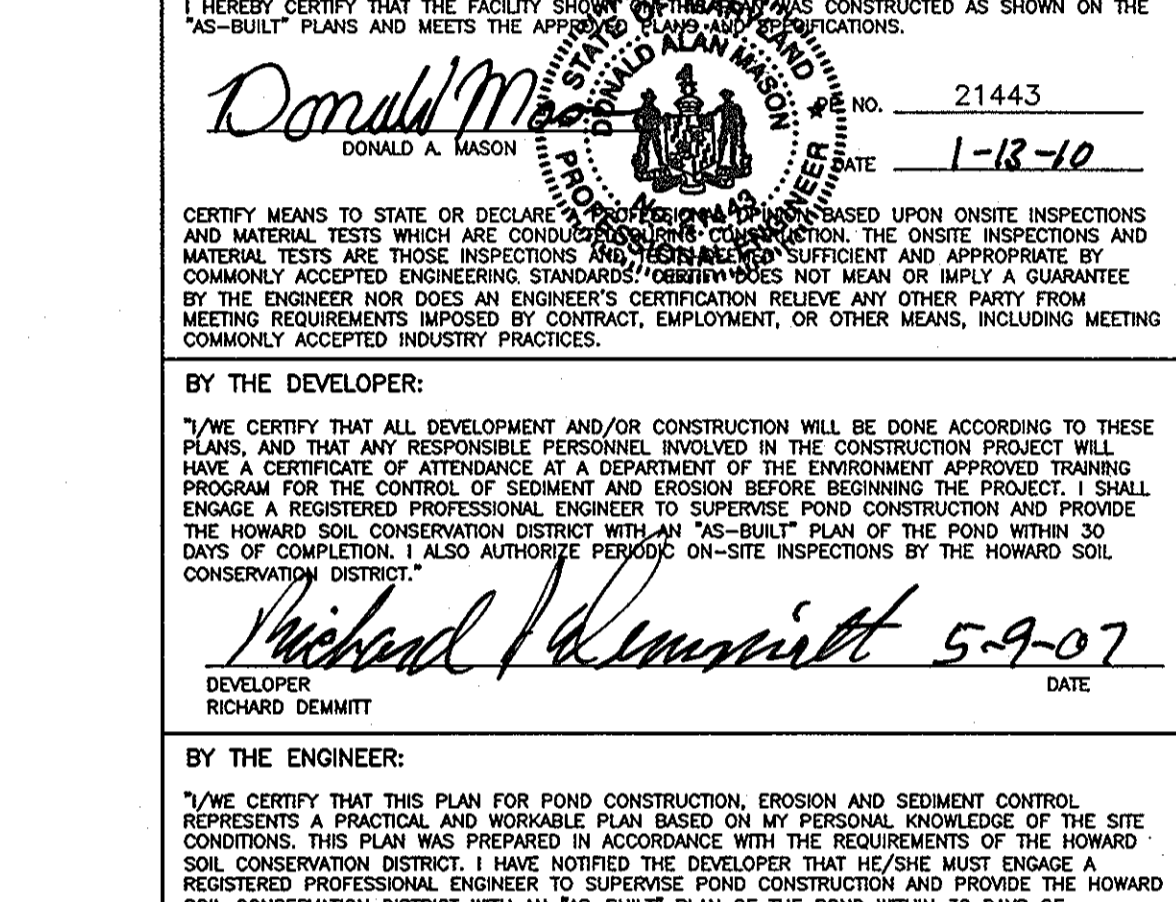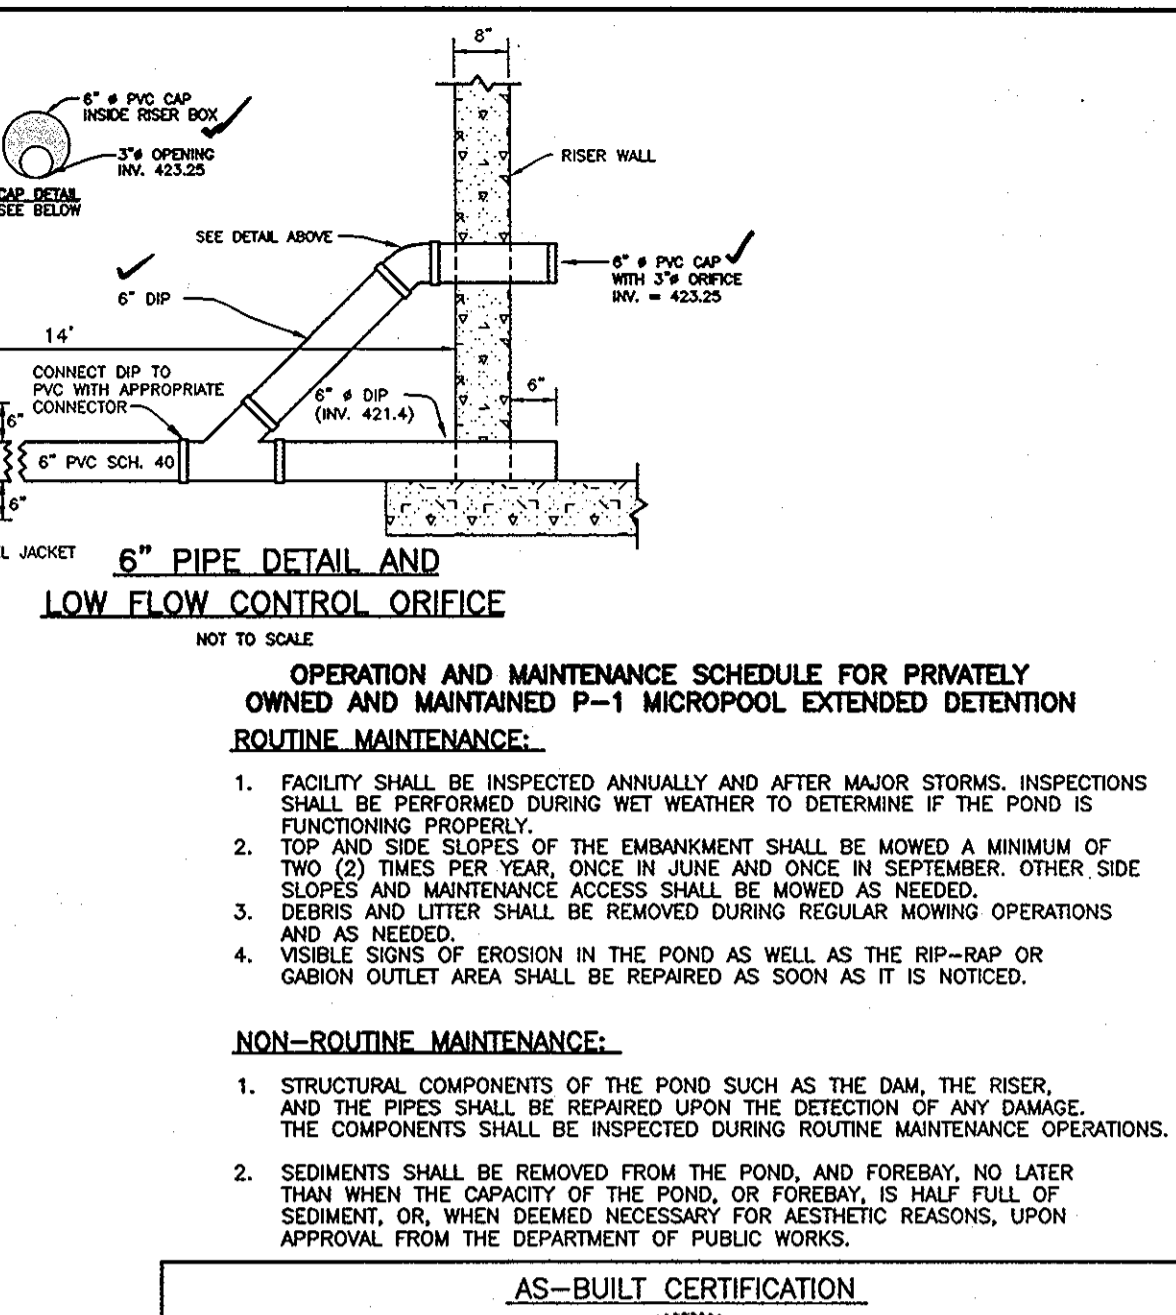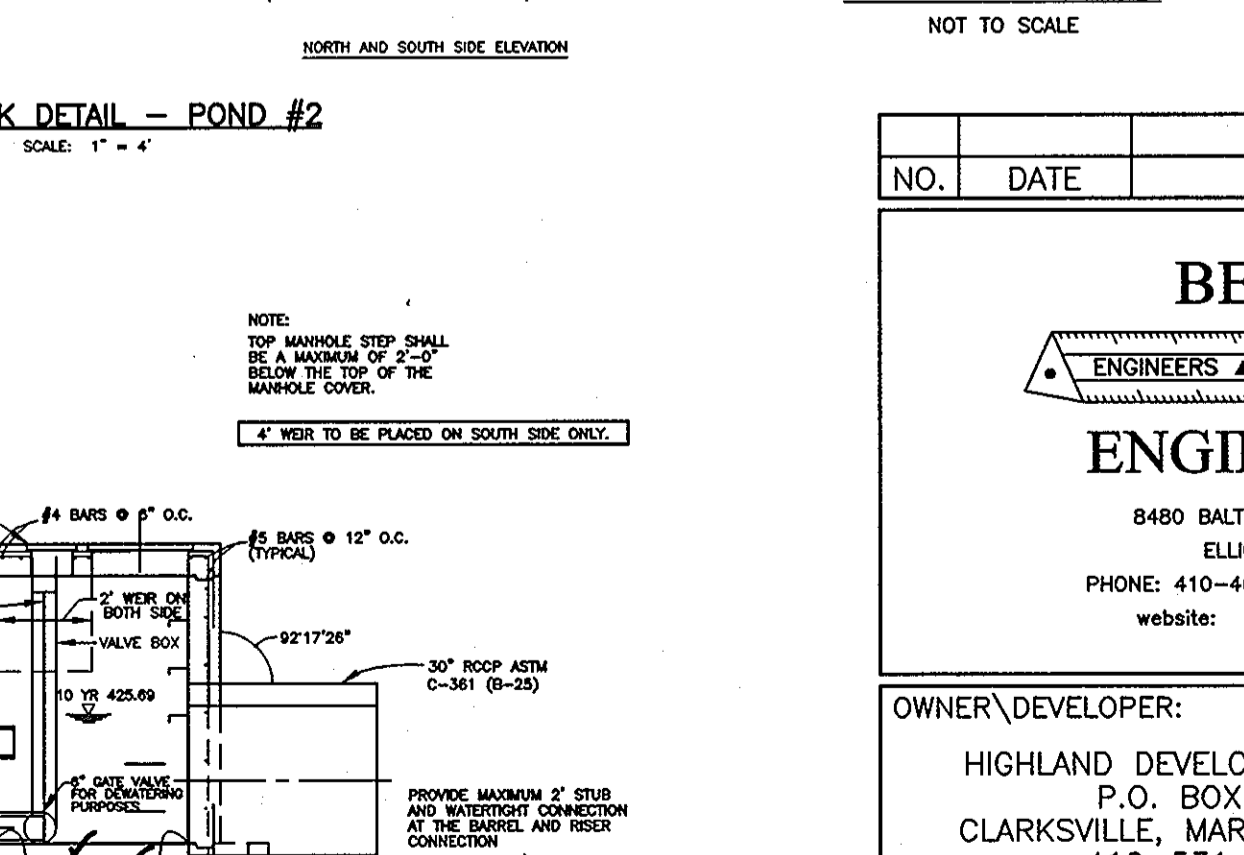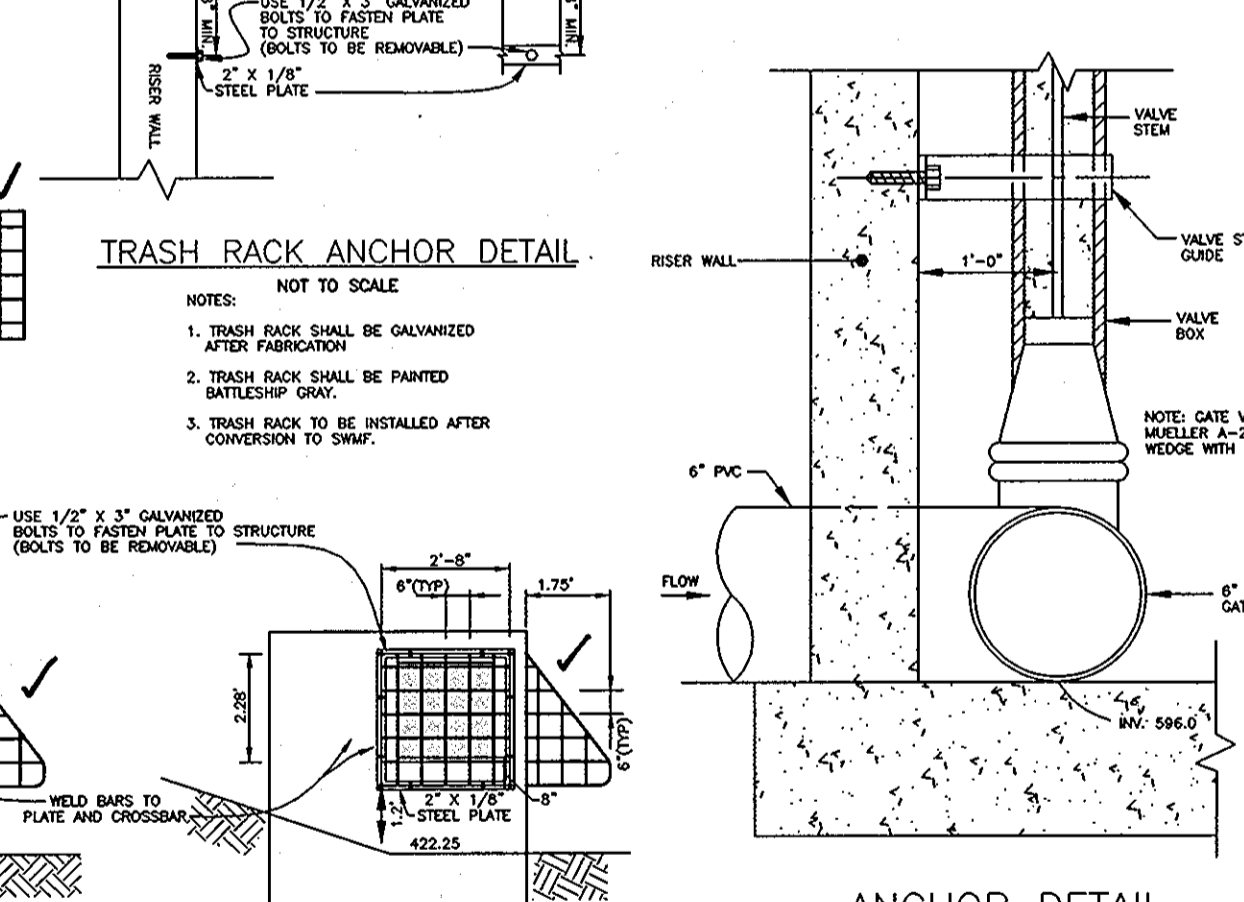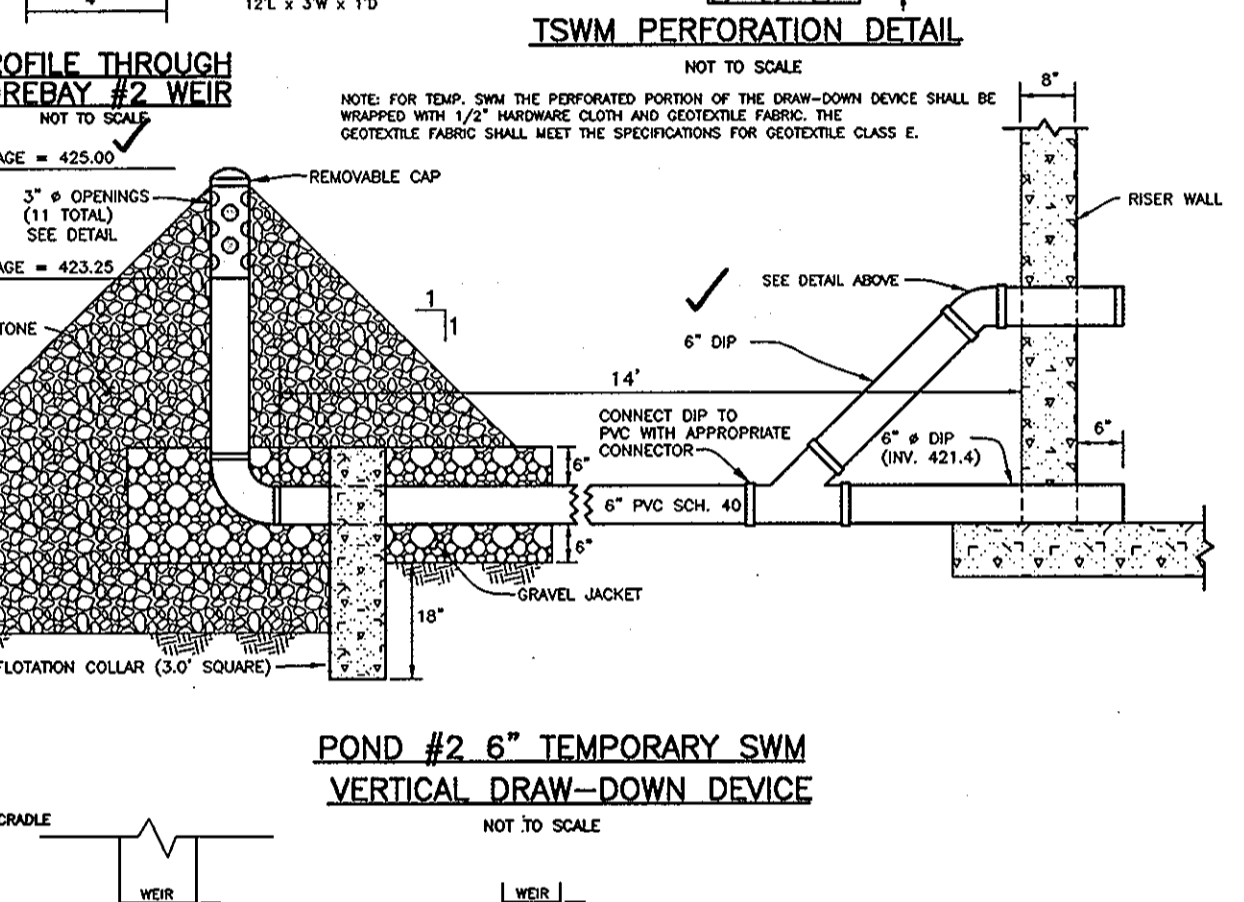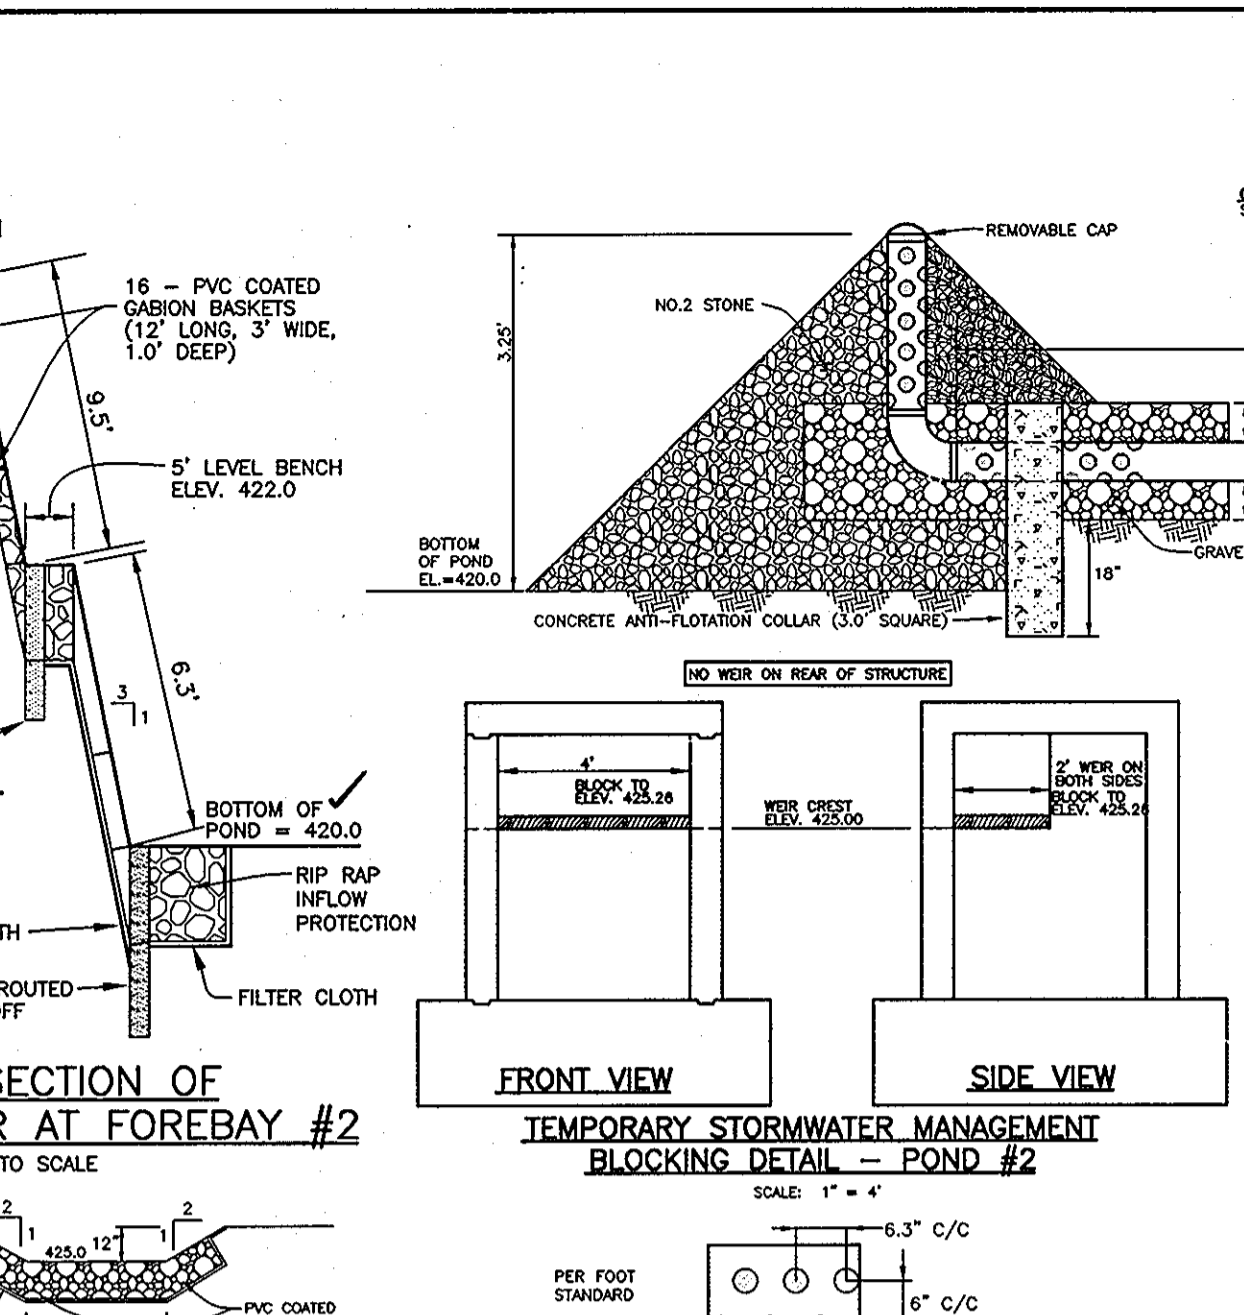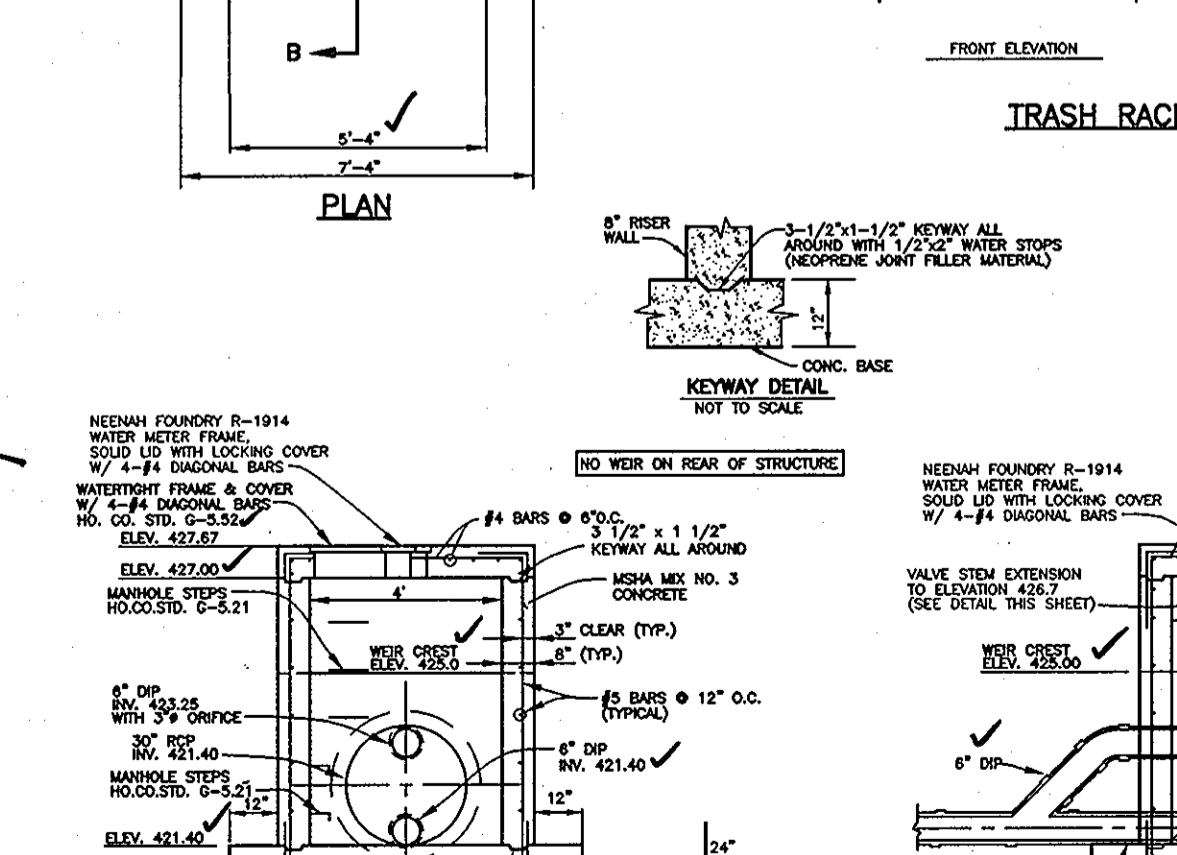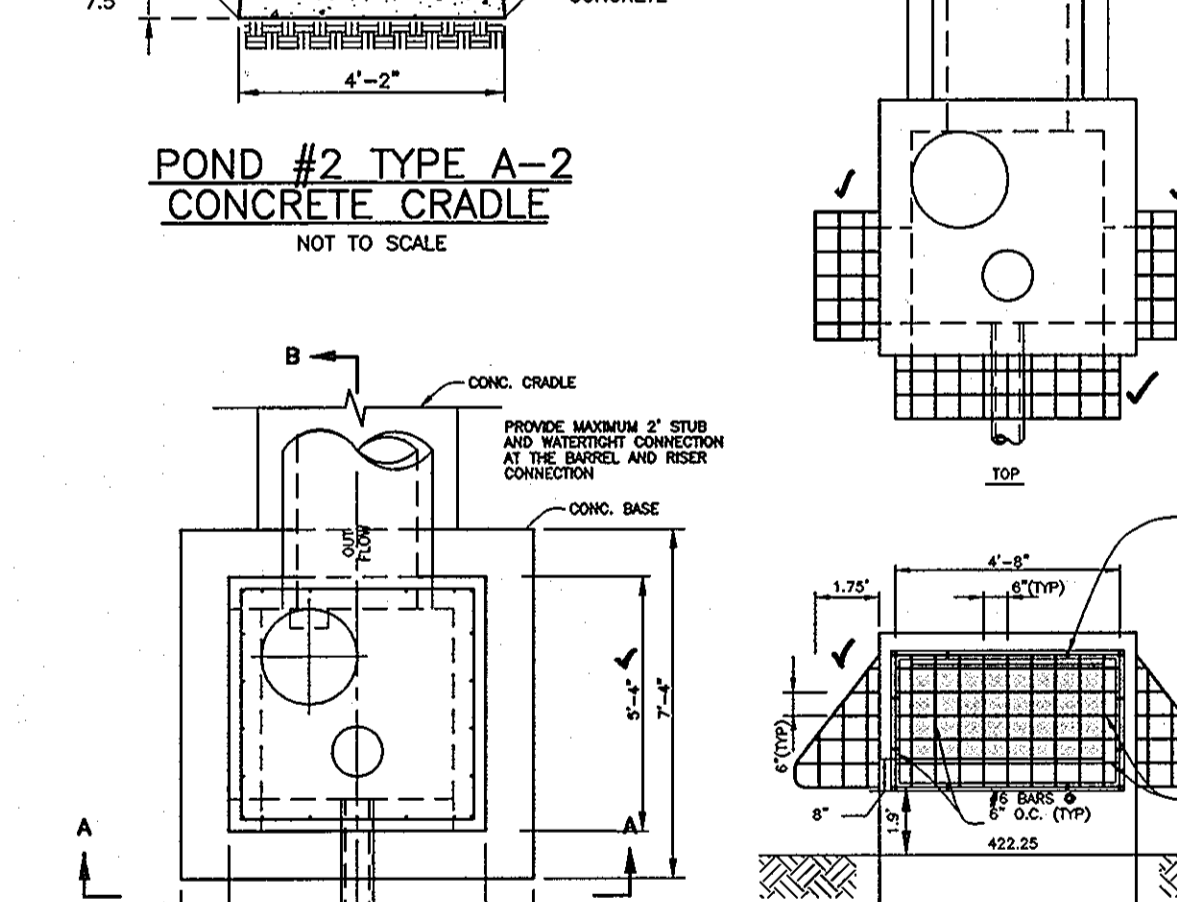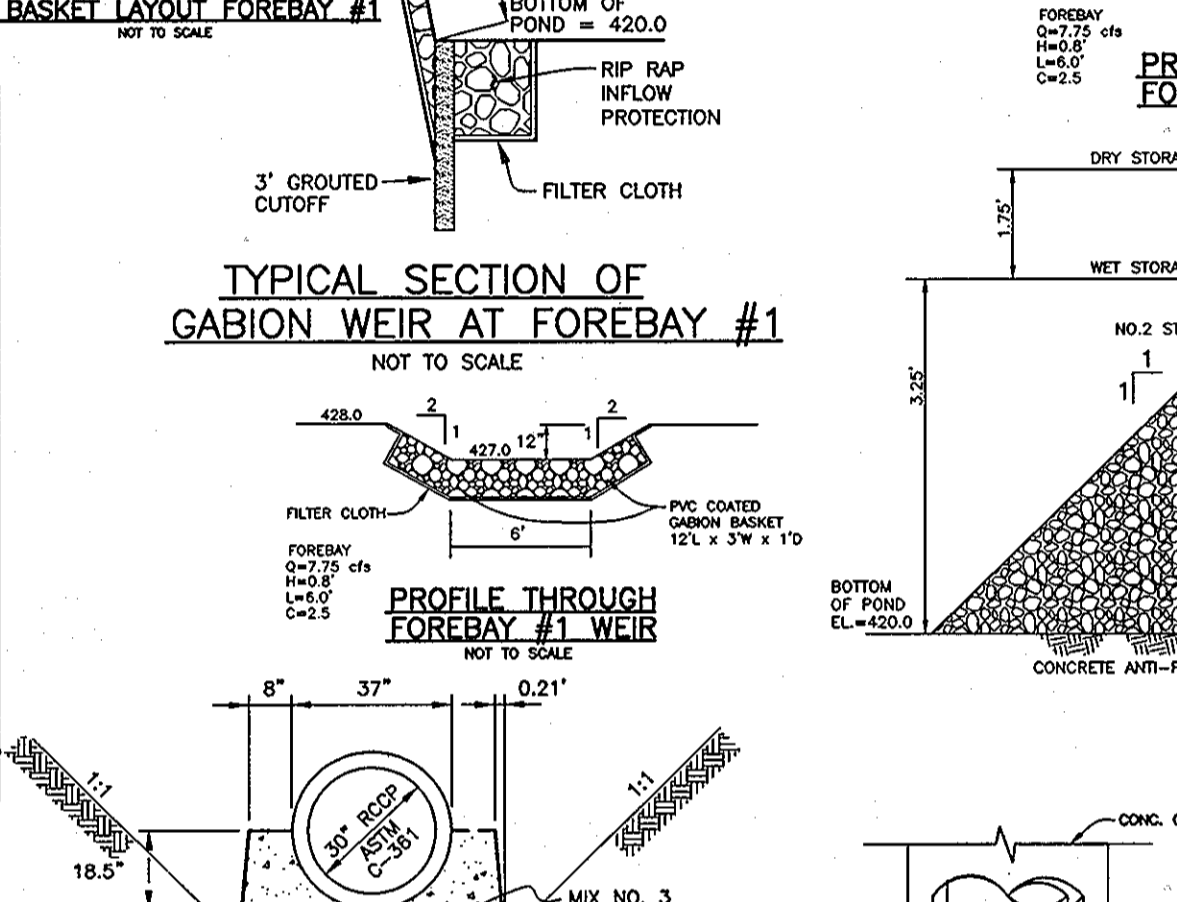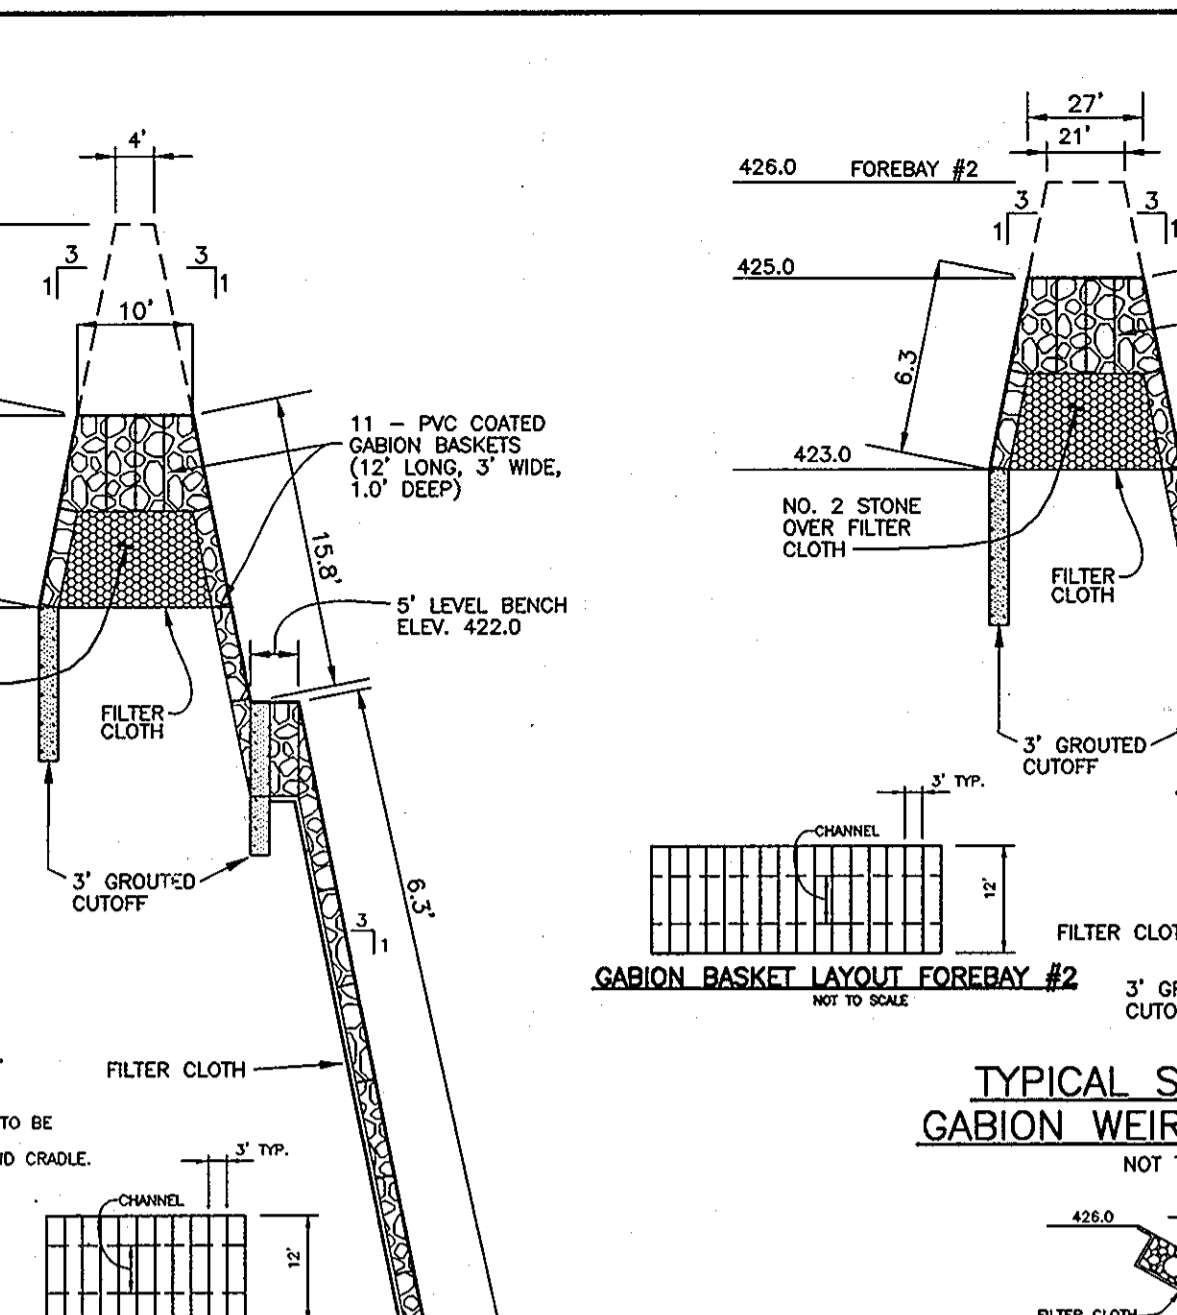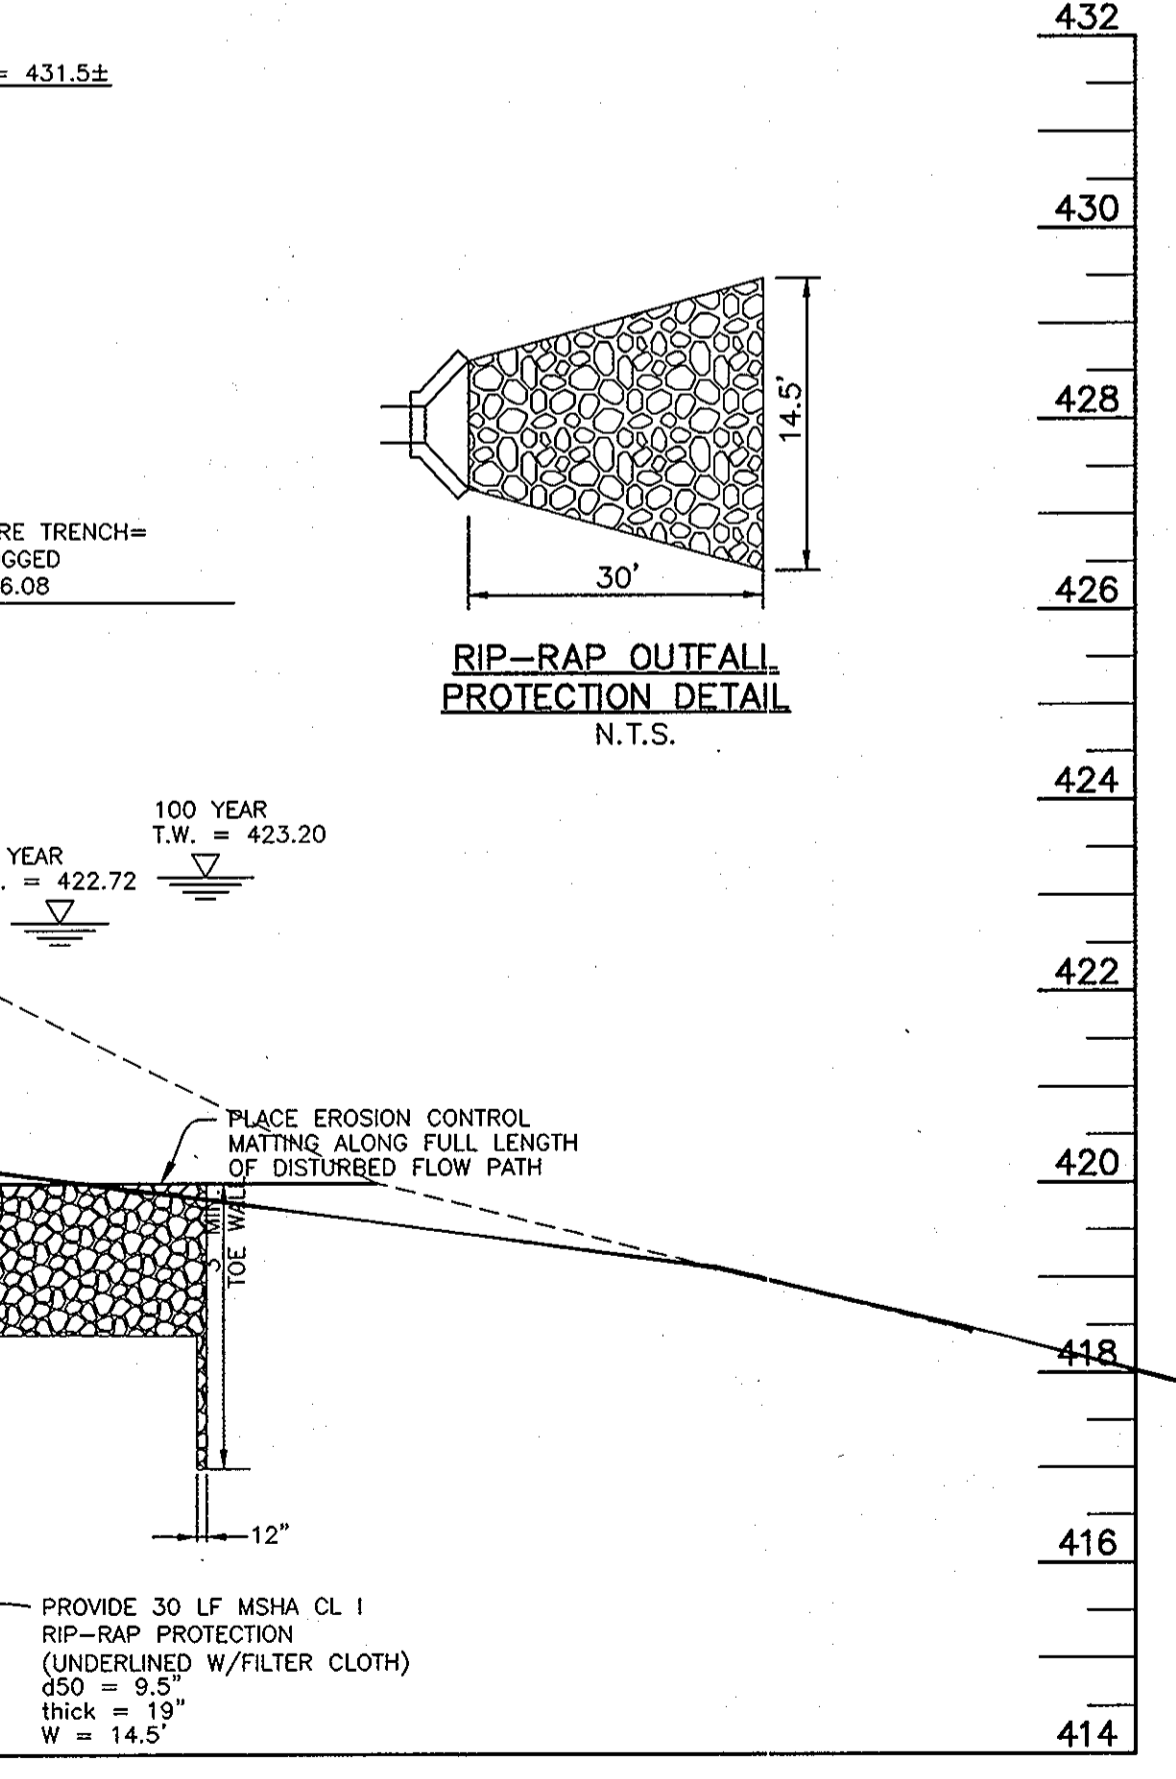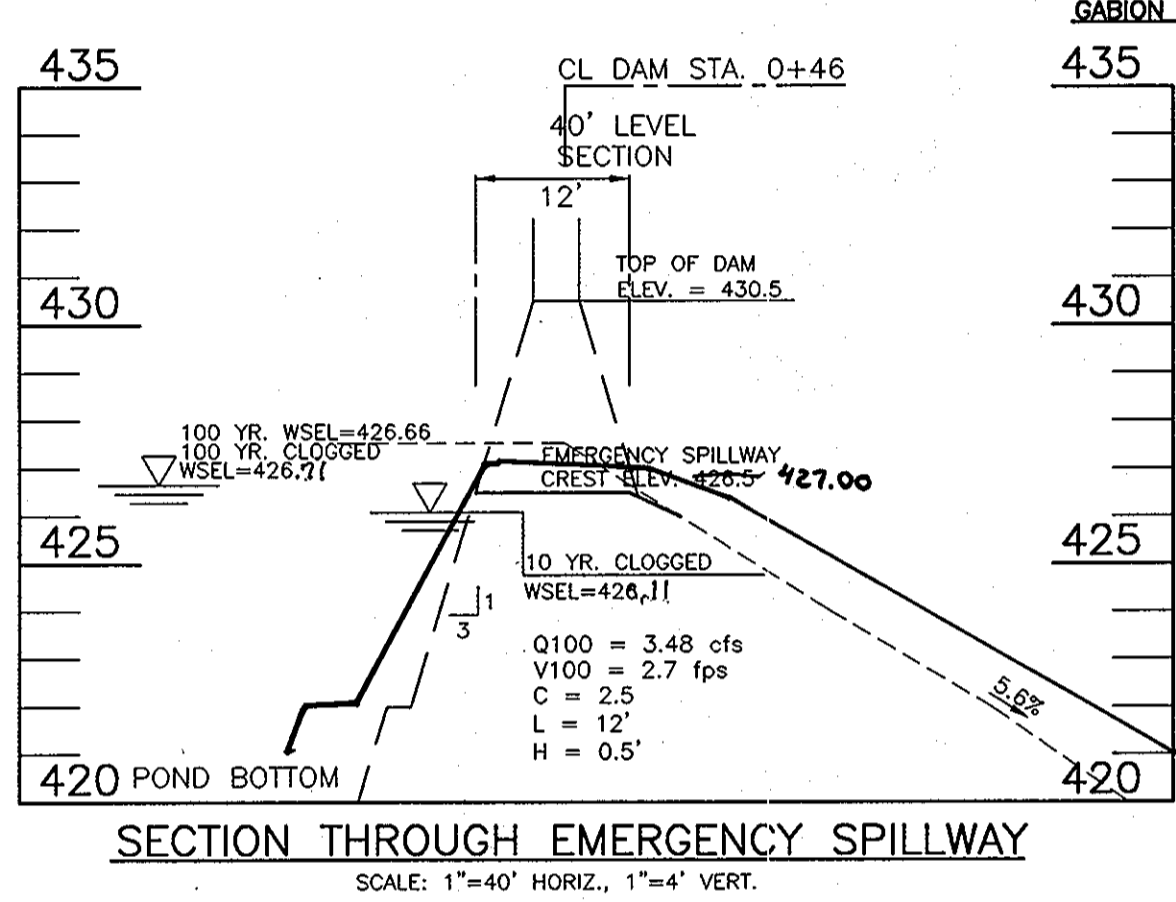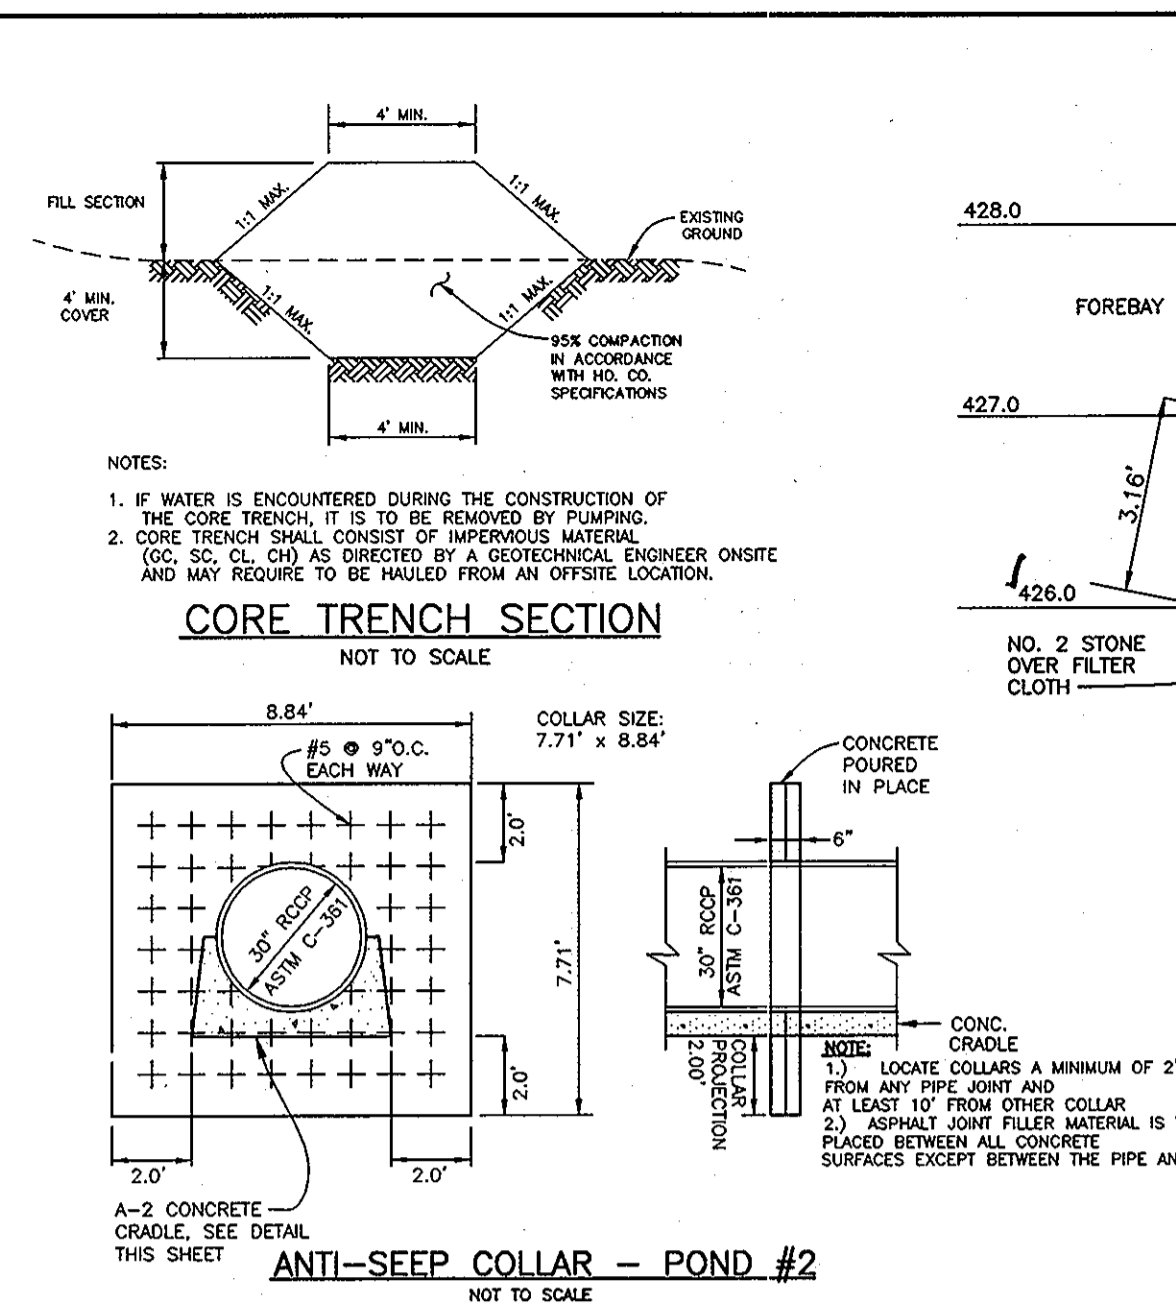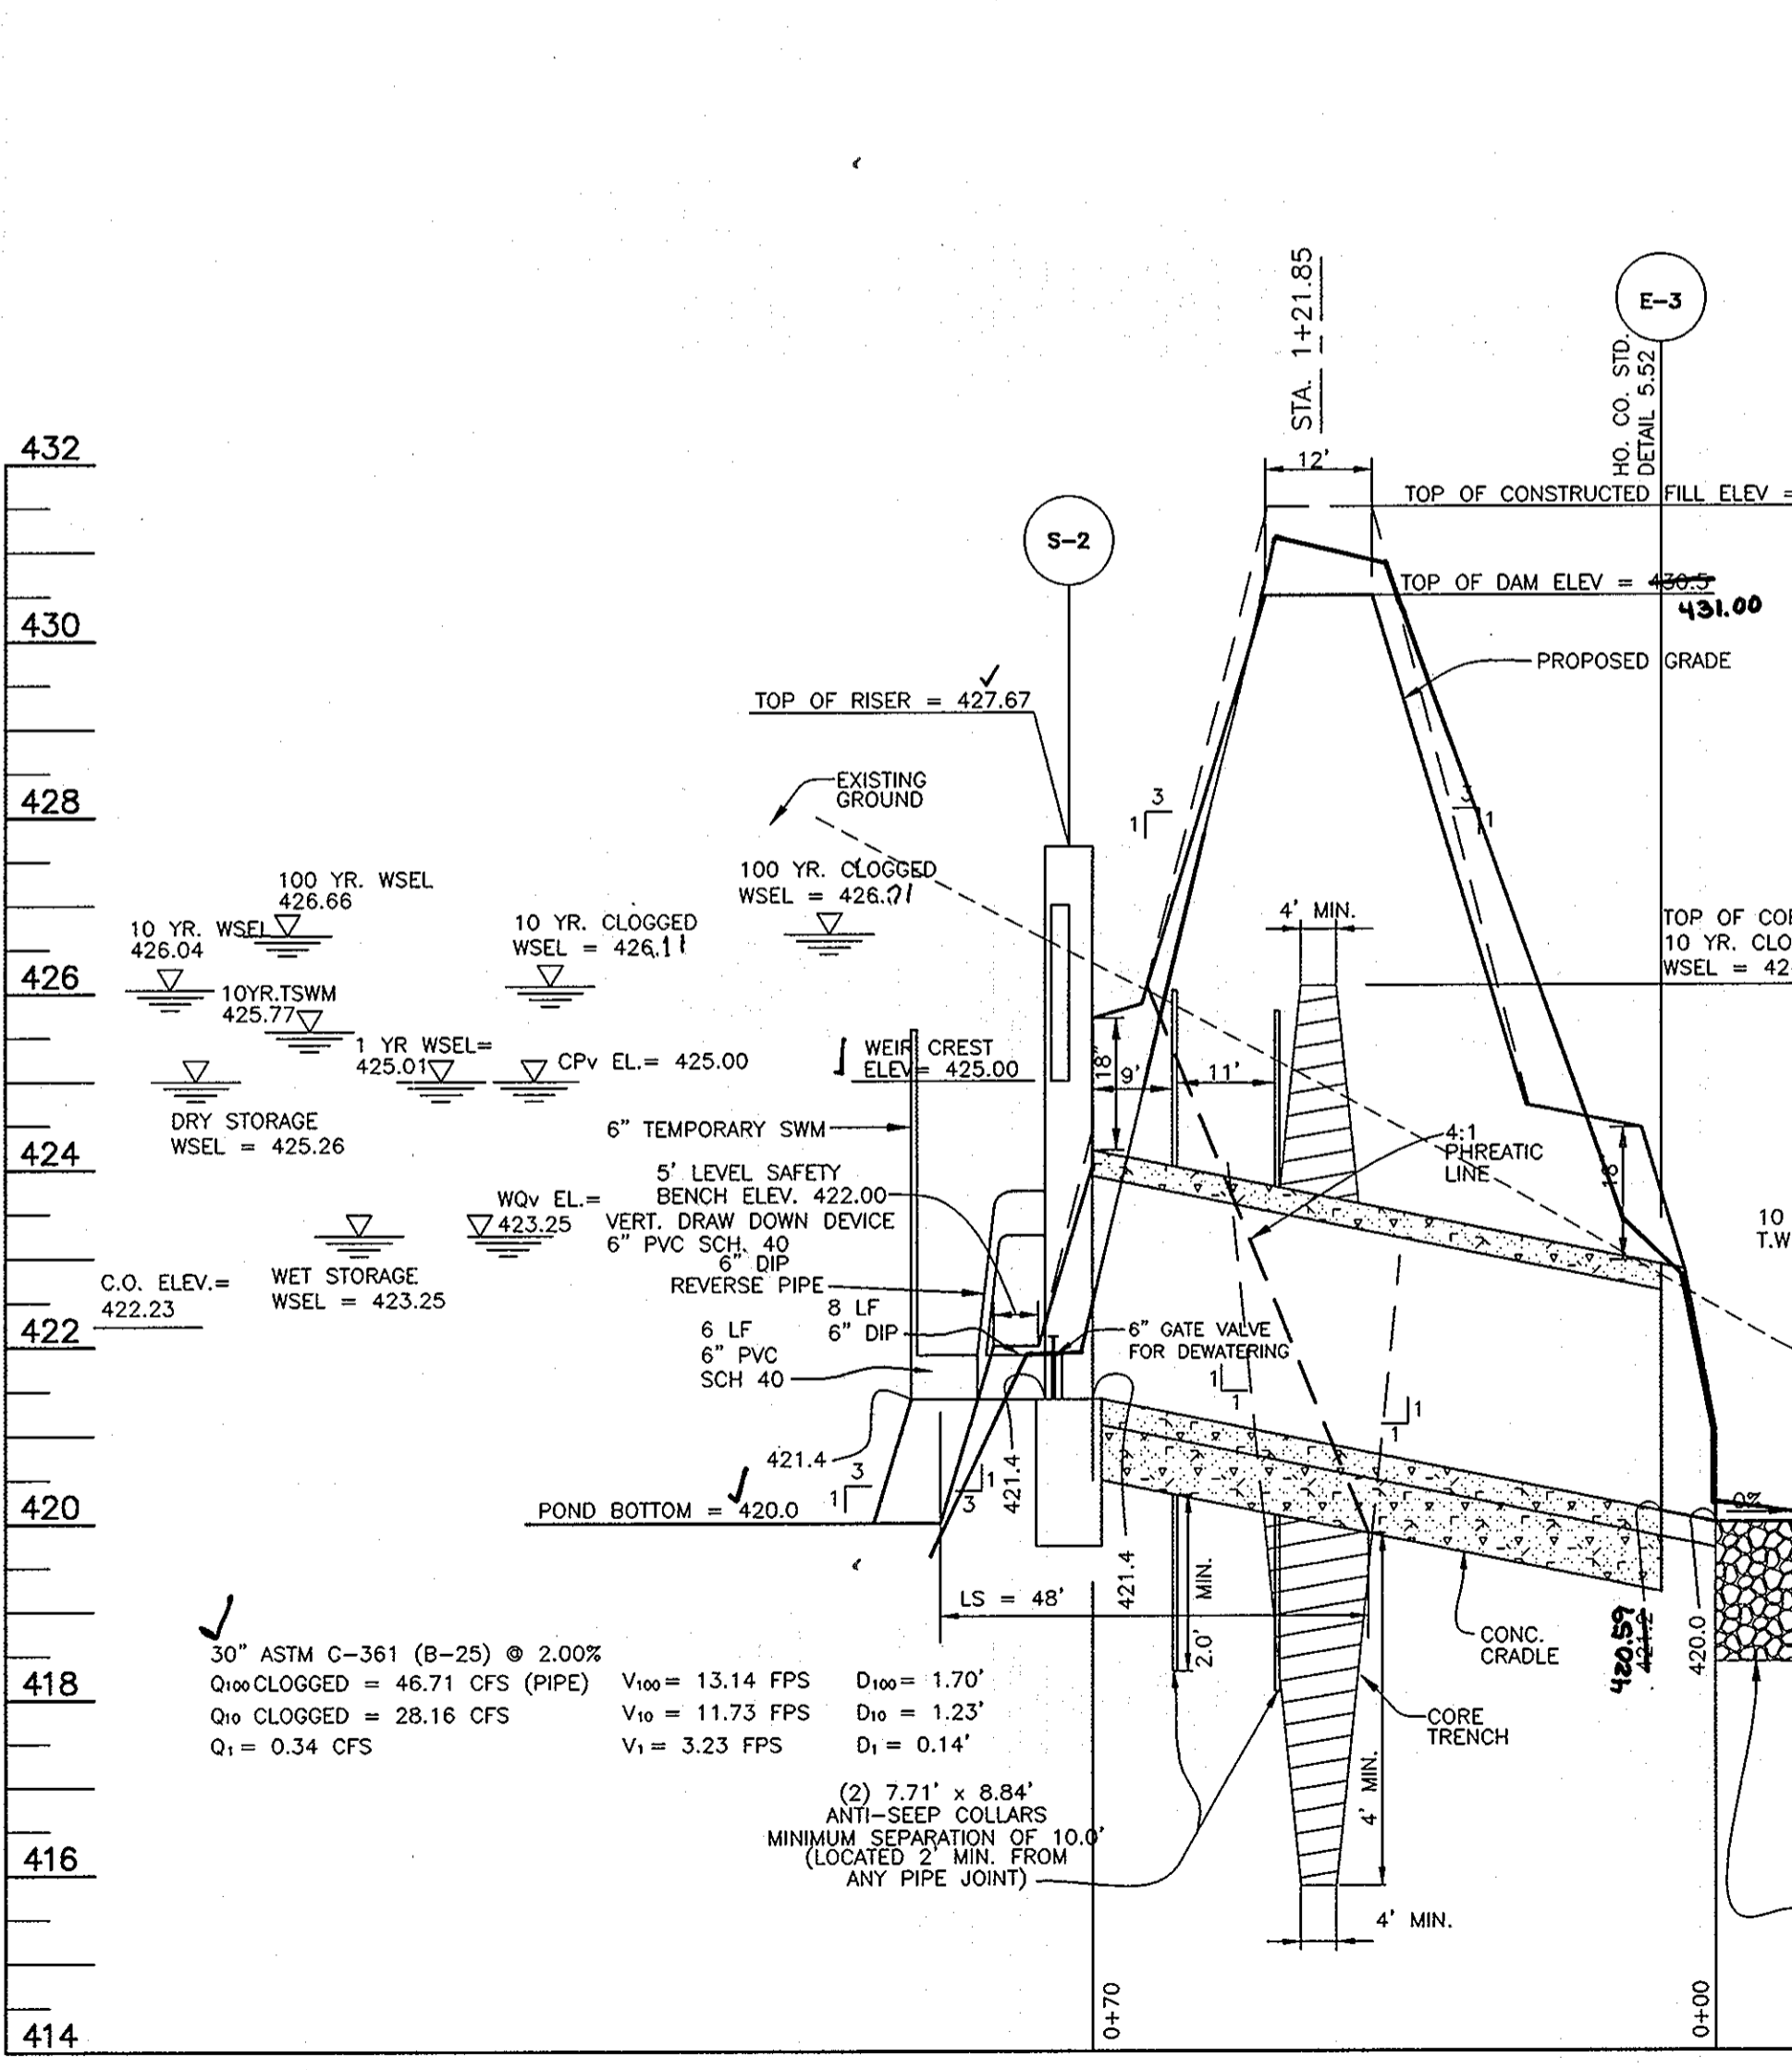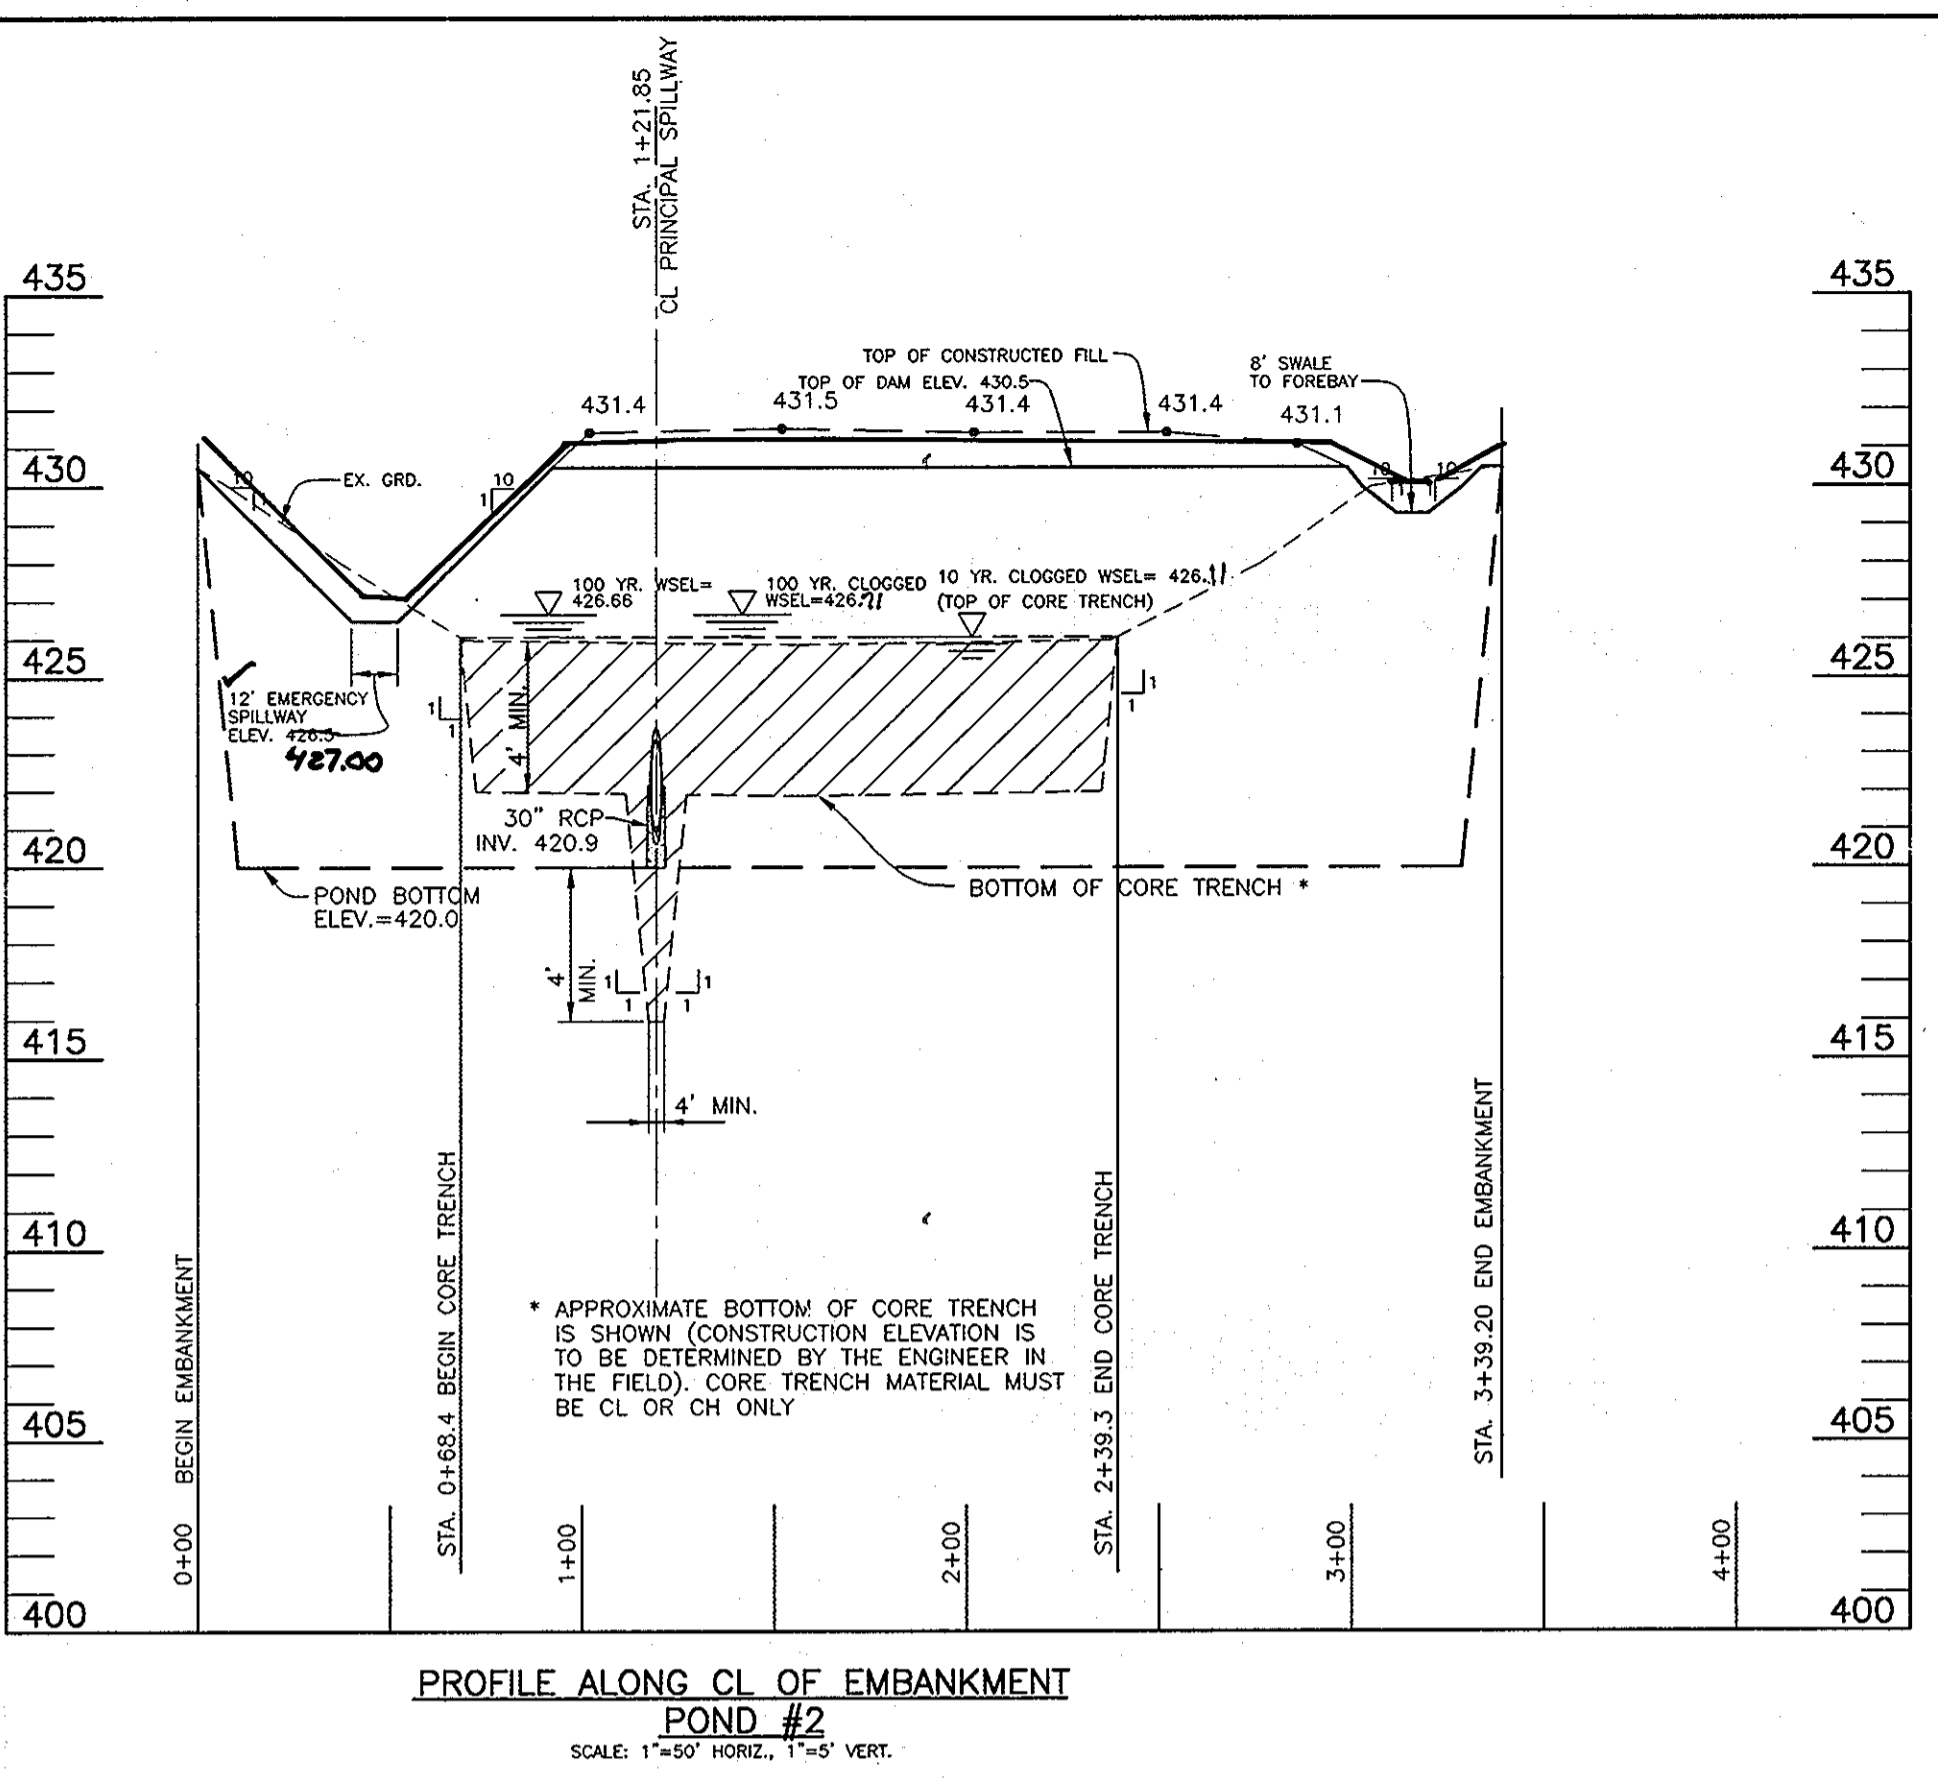

OPERATION AND MAINTENANCE SCHEDULE FOR PRIVATELY OWNED AND MAINTAINED P-1 MICROPOOL EXTENDED DETENTION ROUTINE MAINTENANCE:

- FACILITY SHALL BE INSPECTED ANNUALLY AND AFTER MAJOR STORMS. INSPECTIONS SHALL BE PERFORMED DURING WET WEATHER TO DETERMINE IF THE POND IS FUNCTIONING PROPERLY.
- TWO (2) TIMES PER YEAR, ONCE IN JUNE AND ONCE IN SEPTEMBER, OTHER SIDE SLOPES AND MAINTENANCE ACCESS SHALL BE MOWED AS NEEDED.
- DEBRIS AND LITTER SHALL BE REMOVED DURING REGULAR MOWING OPERATIONS AND AS NEEDED.
- VISIBLE SIGNS OF EROSION IN THE POND AS WELL AS THE RIP-RAP OR GABION OUTLET AREA SHALL BE REPAIRED AS SOON AS IT IS NOTICED.

NON-ROUTINE MAINTENANCE:

- STRUCTURAL COMPONENTS OF THE POND SUCH AS THE DAM, THE RISER, AND THE PIPES SHALL BE REPAIRED UPON THE DETECTION OF ANY DAMAGE. THE COMPONENTS SHALL BE INSPECTED DURING ROUTINE MAINTENANCE OPERATIONS.
- SEDIMENTS SHALL BE REMOVED FROM THE POND, AND FOREBAY, NO LATER THAN WHEN THE CAPACITY OF THE POND, OR FOREBAY, IS HALF FULL OF SEDIMENT, OR WHEN DEEMED NECESSARY FOR AESTHETIC REASONS, UPON APPROVAL FROM THE DEPARTMENT OF PUBLIC WORKS.

AS-BUILT CERTIFICATION

I HEREBY CERTIFY THAT THE FACILITY SHOWN ON THIS PLAN WAS CONSTRUCTED AS SHOWN ON THE "AS-BUILT" PLANS AND MEETS THE APPROVED REQUIREMENTS.

Donald Maon
DONALD A. MAON, P.E. NO. 21443
DATE: 1-18-10

CERTIFY MEANS TO STATE OR DECLARE THAT THE INFORMATION BASED UPON ON-SITE INSPECTIONS AND MATERIAL TESTS WHICH ARE CONDUCTED, THE ON-SITE INSPECTIONS AND MATERIAL TESTS ARE THOSE INSPECTIONS AND TESTS WHICH ARE NECESSARY TO VERIFY THAT THE MATERIALS ACCEPTED MEET THE ENGINEERING STANDARDS. ENGINEERS DO NOT MAKE OR BUY A GUARANTEE BY THE ENGINEER NOR DOES AN ENGINEER'S CERTIFICATION RELIEVE ANY OTHER PARTY FROM MEETING REQUIREMENTS IMPOSED BY CONTRACT, EMPLOYMENT, OR OTHER MEANS, INCLUDING MEETING COMMONLY ACCEPTED INDUSTRY PRACTICES.

BY THE DEVELOPER:

I/WE CERTIFY THAT ALL DEVELOPMENT AND/OR CONSTRUCTION WILL BE DONE ACCORDING TO THESE PLANS, AND THAT ANY RESPONSIBLE PERSONNEL INVOLVED IN THE CONSTRUCTION PROJECT WILL HAVE A CERTIFICATE OF ATTENDANCE AT A DEPARTMENT OF THE ENVIRONMENT APPROVED TRAINING PROGRAM FOR THE CONTROL OF SEDIMENT AND EROSION BEFORE BEGINNING THE PROJECT. I SHALL ENGAGE A REGISTERED PROFESSIONAL ENGINEER TO SUPERVISE POND CONSTRUCTION AND PROVIDE THE HOWARD SOIL CONSERVATION DISTRICT WITH AN "AS-BUILT" PLAN OF THE POND WITHIN 30 DAYS OF COMPLETION. I ALSO AUTHORIZE PERIODIC ON-SITE INSPECTIONS BY THE HOWARD SOIL CONSERVATION DISTRICT.

Richard W. Bennett 5-9-07
DEVELOPER
RICHARD W. BENNETT

BY THE ENGINEER:

I/WE CERTIFY THAT THIS PLAN FOR POND CONSTRUCTION, EROSION AND SEDIMENT CONTROL REPRESENTS A PRACTICAL AND WORKABLE PLAN BASED ON MY PERSONAL KNOWLEDGE OF THE SITE CONDITIONS. THIS PLAN WAS PREPARED IN ACCORDANCE WITH THE REQUIREMENTS OF THE HOWARD SOIL CONSERVATION DISTRICT. I HAVE NOTIFIED THE DEVELOPER THAT HE/SHE MUST ENGAGE A REGISTERED PROFESSIONAL ENGINEER TO SUPERVISE POND CONSTRUCTION AND PROVIDE THE HOWARD SOIL CONSERVATION DISTRICT WITH AN "AS-BUILT" PLAN OF THE POND WITHIN 30 DAYS OF COMPLETION.

Donald Maon 5/16/07
ENGINEER - DONALD A. MAON, P.E. # 21443

THESE PLANS HAVE BEEN REVIEWED FOR THE HOWARD SOIL CONSERVATION DISTRICT AND MEET THE TECHNICAL REQUIREMENTS FOR SMALL POND CONSTRUCTION, SOIL EROSION, AND SEDIMENT CONTROL.

Jim Ayers 5/16/07
USDA - NATURAL RESOURCES CONSERVATION SERVICE

THESE PLANS FOR SMALL POND CONSTRUCTION, SOIL EROSION, AND SEDIMENT CONTROL MEET THE REQUIREMENTS OF THE HOWARD SOIL CONSERVATION DISTRICT.

John S. ... 5/31/07
HOWARD SOIL CONSERVATION DISTRICT

APPROVED: DEPARTMENT OF PUBLIC WORKS

Walter Z. ... 6-6-07
CHIEF, BUREAU OF HIGHWAYS

APPROVED: DEPARTMENT OF PLANNING AND ZONING

T. Krista - Maclean for **C. Hamilton** 6-11-07
CHIEF, DIVISION OF LAND DEVELOPMENT

APPROVED: DEPARTMENT OF PLANNING AND ZONING

Walter Z. ... 6-6-07
CHIEF, BUREAU OF HIGHWAYS

APPROVED: DEPARTMENT OF PLANNING AND ZONING

T. Krista - Maclean for **C. Hamilton** 6-11-07
CHIEF, DIVISION OF LAND DEVELOPMENT

NO.	DATE	REVISION

BENCHMARK ENGINEERING, INC.
ENGINEERS • LAND SURVEYORS • PLANNERS
8480 BALTIMORE NATIONAL PIKE # SUITE 418
ELLIOTT CITY, MARYLAND 21043
PHONE: 410-465-6105 FAX: 410-465-6644
website: http://www.bei-civilengineering.com

OWNER/DEVELOPER:
HIGHLAND DEVELOPMENT CORP
P.O. BOX 228
CLARKSVILLE, MARYLAND 21029
410-531-5539

PROJECT: **BRIGHTON MILL**
LOT 1 THROUGH 22, BUILDABLE PRESERVATION PARCEL 'A' AND NON-BUILDABLE PRESERVATION PARCELS 'B' THROUGH 'D'

LOCATION: TAX MAP NO. 34, GRID NO. 2
5th ELECTION DISTRICT
HOWARD COUNTY, MARYLAND

TITLE: **STORMWATER MANAGEMENT FACILITY #2 PROFILES AND DETAILS**

DATE: MAY, 2007 PROJECT NO. 1513

Design: JMC Draft: LAB Check: DAM SCALE: AS SHOWN DRAWING 33 OF 34

HILLIS - CARNES ENGINEERING ASSOCIATES, INC. RECORD OF SOIL EXPLORATION

Page 1 of 1

Project Name: Curtis Property SWM, Location: Howard County, Maryland, Boring Number: 03071A-B-4, Date Started: 3/1/2003, Foreman: J. Malecki

ELEV.	SOIL DESCRIPTION	DEPTH	SCALE	CON.	SAMPLE	NO.	REC.	BORING & SAMPLING NOTES
433.2	Tan and gray moist stiff silty clay trace fine sand trace gravel trace mica (CL)	0.0	1.0		8-6-7	1	18"	5' Topsoil Caved in at 7.3 ft at completion
433.2		5.0	1.0		4-5-8	2	9"	
433.2		10.0	1.0		4-6-9	3	18"	
433.2		15.0	1.0		4-7-9	4	18"	
433.2		20.0	1.0		4-5-6	5	13"	

Bottom of test hole @ 15.0'

HILLIS - CARNES ENGINEERING ASSOCIATES, INC. RECORD OF SOIL EXPLORATION

Page 1 of 1

Project Name: Curtis Property SWM, Location: Howard County, Maryland, Boring Number: 03071A-B-5, Date Started: 3/1/2003, Foreman: J. Malecki

ELEV.	SOIL DESCRIPTION	DEPTH	SCALE	CON.	SAMPLE	NO.	REC.	BORING & SAMPLING NOTES
433.8	Tan and gray moist stiff silty clay trace fine sand trace gravel trace mica (CL)	0.0	1.0		3-4-8	1	18"	5' Topsoil Caved in at 6.2 ft at completion
433.8		5.0	1.0		5-6-7	2	18"	
433.8		10.0	1.0		4-8-9	3	10"	
433.8		15.0	1.0		4-5-13	4	16"	
433.8		20.0	1.0		6-6-7	5	15"	

Bottom of test hole @ 15.0'

HILLIS - CARNES ENGINEERING ASSOCIATES, INC. RECORD OF SOIL EXPLORATION

Page 1 of 1

Project Name: Curtis Property SWM, Location: Howard County, Maryland, Boring Number: 03071A-B-6, Date Started: 3/1/2003, Foreman: J. Malecki

ELEV.	SOIL DESCRIPTION	DEPTH	SCALE	CON.	SAMPLE	NO.	REC.	BORING & SAMPLING NOTES
432	Tan and gray moist stiff silty clay trace fine sand trace gravel trace mica (CL)	0.0	1.0		4-7-8	1	8"	4' Topsoil Caved in at 4.6 ft at completion
432		5.0	1.0		4-10-15	2	12"	
432		10.0	1.0		7-13-15	3	1"	
432		15.0	1.0		3-4-5	4	4"	
432		20.0	1.0		3-3-3	5	18"	

Bottom of test hole @ 15.0'

CONSTRUCTION SPECIFICATIONS

These specifications are appropriate to all ponds within the scope of the Standard for practice MD-378. All references to ASTM and AASHTO specifications apply to the most recent version.

Site Preparation

Areas designated for borrow areas, embankment, and structural works shall be cleared, grubbed and stripped to topsoil. All trees, vegetation, roots and other objectionable material shall be removed. Channel banks and storm breaks shall be sloped to no steeper than 1:1. All trees shall be cleared and grubbed within 15 feet of the toe of the embankment.

Areas to be covered by the reservoir will be cleared of all trees, brush, logs, fences, rubbish and other objectionable material unless otherwise designated on the plans. Trees, brush, and stumps shall be cut approximately level with the ground surface. For dry stormwater management ponds, a minimum of a 25-foot radius around the inlet structure shall be cleared.

All cleared and grubbed material shall be disposed of outside and below the limits of the dam and reservoir as directed by the owner or his representative. When specified, a sufficient quantity of topsoil will be stockpiled in a suitable location for use on the embankment and other designated areas.

Earth Fill

Material - The fill material shall be taken from approved designated borrow areas. If shall be free of roots, stumps, wood, rubbish, stones greater than 6", frozen or other objectionable material. Fill material for the center of the embankment, and cut-off trench shall conform to Unified Soil Classification GC, SC, CH, or CL and must have at least 30% passing the #200 sieve. Consideration may be given to the use of other materials in the embankment if designed by a geotechnical engineer. Such special designs must have construction supervised by a geotechnical engineer.

Materials used in the outer shell of the embankment must have the capability to support vegetation of the quality required to prevent erosion of the embankment.

Placement - Areas on which fill is to be placed shall be scarified prior to placement of fill. Fill materials shall be placed in maximum 8 inch thick (before compaction) layers which are to be continuous over the entire length of the fill. The most permeable borrow material shall be placed in the downstream portions of the embankment. The principal spillway must be installed concurrently with fill placement and not excavated into the embankment.

Compaction - The movement of the hauling and spreading equipment over the fill shall be controlled so that the entire surface of each lift shall be traversed by not less than one tread track of heavy equipment or compaction shall be achieved by a minimum of four complete passes of a sheepsfoot, rubber tired or vibratory roller. Fill material shall contain sufficient moisture such that the required degree of compaction will be obtained with the equipment used. The fill material shall contain sufficient moisture so that if formed into a ball it will not crumble, yet not be so wet that water can be squeezed out of the ball.

When required by the reviewing agency the minimum required density shall not be less than 95% of maximum dry density with a moisture content within ± 2% of the optimum. Each layer of fill shall be compacted as necessary to obtain that density, and is to be certified by the Engineer at the time of construction. All compaction is to be determined by AASHTO Method T-99 (Standard Proctor).

Cut-Off Trench - The cutoff trench shall be excavated into impervious material along or parallel to the centerline of the embankment as shown on the plans. The bottom width of the trench shall be governed by the equipment used for excavation, with the minimum width being four feet. The depth shall be at least four feet below existing grade as shown on the plans. The side slopes of the trench shall be 1 to 1 or flatter. The backfill shall be compacted with construction equipment, rollers, or hand tampers to assure maximum density and minimum permeability.

Embankment Core - The core shall be parallel to the centerline of the embankment as shown on the plans. The top width of the cores shall be a minimum of four feet. The height shall extend up to and top the 10 year water elevation shown on the plans. The core shall be placed in maximum 8 inch thick (before compaction) layers which are to be continuous over the entire length of the fill. The most permeable borrow material shall be placed in the downstream portions of the embankment. The principal spillway must be installed concurrently with fill placement and not excavated into the embankment.

Structure Backfill

Backfill adjacent to pipes or structures shall be of the type and quality conforming to that specified for the adjoining fill material. The fill shall be placed in horizontal layers not exceeding four inches in thickness and compacted by hand tampers or other manually directed compaction equipment. The material needs to fill completely all spaces under and adjacent to the pipe. At no time during the backfilling operation shall driven equipment be allowed to operate closer than four feet, measured horizontally, to any part of a structure. Under no circumstances shall equipment be driven over any part of a concrete structure or pipe, unless there is a compacted fill of 24" or greater over the structure or pipe.

Structure backfill may be flowable fill meeting the requirements of Maryland Department of Transportation, State Highway Administration Standard Specifications for Construction and Materials, Section 313 as modified. The mixture shall have a 100-200 psi, 28 day unconfined compressive strength. The flowable fill shall have a minimum pH of 4.0 and a minimum resistivity of 2,000 ohm-cm. Material shall be placed such that a minimum of 6" (measured perpendicular to the outside of the pipe) of flowable fill shall be under (bedding), over and, on the side of the pipe. It only needs to extend up to the spring line for rigid conduits. Average slump of the fill shall be 7" to assure flowability of the material. Adequate measures shall be taken (sand bags, etc.) to prevent floating the pipe. When using flowable fill, all metal pipe shall be bituminous coated. Any adjoining soil fill shall be placed in horizontal layers not to exceed four inches in thickness and compacted by hand tampers or other manually directed compaction equipment. The material shall completely fill all voids adjacent to the flowable fill zone. At no time during the backfilling operation shall driven equipment be allowed to operate closer than four feet, measured horizontally, to any part of a structure. Under no circumstances shall equipment be driven over any part of a structure or pipe unless there is a compacted fill of 24" or greater over the structure or pipe. Backfill material outside the structural backfill (flowable fill) zone shall be of the type and quality conforming to that specified for the core of the embankment or other embankment materials.

Pipe Conduits

Corrugated Metal Pipe - all of the following criteria shall apply for corrugated metal pipe:

- Materials - (Polymer Coated Steel Pipe) - Steel pipes with polymeric coatings shall have a minimum coating thickness of 0.01 inch (10 mil) on both sides of the pipe. This pipe and its appurtenances shall conform to the requirements of AASHTO Specifications M-245 & M-246 with watertight coupling bands or flanges.
- Materials - (Aluminum Coated Steel Pipe) - This pipe and its appurtenances shall conform to the requirements of AASHTO Specification M-274 with watertight coupling bands or flanges. Aluminum Coated Steel Pipes, when used with flowable fill or when soil and/or water conditions warrant the need for increased durability, shall be fully bituminous coated per requirements of AASHTO Specification M-190 Type A. Any aluminum coating damaged or otherwise removed shall be replaced with applied bituminous coating compound.
- Materials - (Aluminum Pipe) - This pipe and its appurtenances shall conform to the requirements of AASHTO Specification M-196 or M-211 with watertight coupling bands or flanges. Aluminum Pipes, when used with flowable fill or when soil and/or water conditions warrant for increased durability, shall be fully bituminous coated per requirements of AASHTO Specification M-190 Type A. Aluminum surfaces that are to be in contact with concrete shall be painted with one coat of zinc chromate primer or two coats of asphalt. Hot dip galvanized bolts may be used for connections. The pH of the surrounding soils shall be between 4 and 9.

Flow Enters as Sheet Flow

Flow Exits as Sheet Flow

SAMPLER TYPE
DRIVEN SPLIT SPOON UNLESS OTHERWISE NOTED.
PT-PRESSED SHELLEY TUBE
CA-CONTINUOUS FLIGHT AUGER
RC-ROCK CORE

SAMPLE CONDITIONS
D-DISINTEGRATED
H-HINTACT
U-UNDISTURBED
L-LOST

GROUND WATER DEPTH
AT COMPLETION
Dy FT.
AFTER 24 hrs Dy FT.

BORING METHOD
HS-HOLLOW STEM AUGERS
CF-CONT. FLIGHT AUGERS
DC-DRIVING CASING
MD-MUD DRILLING

STANDARD PENETRATION TEST-DRIVING 2" OD SAMPLER 1" WITH 140# HAMMER FALLING 30" COUNT MADE AT 6" INTERVALS

Structure Backfill

Backfill adjacent to pipes or structures shall be of the type and quality conforming to that specified for the adjoining fill material. The fill shall be placed in horizontal layers not exceeding four inches in thickness and compacted by hand tampers or other manually directed compaction equipment. The material needs to fill completely all spaces under and adjacent to the pipe. At no time during the backfilling operation shall driven equipment be allowed to operate closer than four feet, measured horizontally, to any part of a structure. Under no circumstances shall equipment be driven over any part of a concrete structure or pipe, unless there is a compacted fill of 24" or greater over the structure or pipe.

Structure backfill may be flowable fill meeting the requirements of Maryland Department of Transportation, State Highway Administration Standard Specifications for Construction and Materials, Section 313 as modified. The mixture shall have a 100-200 psi, 28 day unconfined compressive strength. The flowable fill shall have a minimum pH of 4.0 and a minimum resistivity of 2,000 ohm-cm. Material shall be placed such that a minimum of 6" (measured perpendicular to the outside of the pipe) of flowable fill shall be under (bedding), over and, on the side of the pipe. It only needs to extend up to the spring line for rigid conduits. Average slump of the fill shall be 7" to assure flowability of the material. Adequate measures shall be taken (sand bags, etc.) to prevent floating the pipe. When using flowable fill, all metal pipe shall be bituminous coated. Any adjoining soil fill shall be placed in horizontal layers not to exceed four inches in thickness and compacted by hand tampers or other manually directed compaction equipment. The material shall completely fill all voids adjacent to the flowable fill zone. At no time during the backfilling operation shall driven equipment be allowed to operate closer than four feet, measured horizontally, to any part of a structure. Under no circumstances shall equipment be driven over any part of a structure or pipe unless there is a compacted fill of 24" or greater over the structure or pipe. Backfill material outside the structural backfill (flowable fill) zone shall be of the type and quality conforming to that specified for the core of the embankment or other embankment materials.

Pipe Conduits

Corrugated Metal Pipe - all of the following criteria shall apply for corrugated metal pipe:

- Materials - (Polymer Coated Steel Pipe) - Steel pipes with polymeric coatings shall have a minimum coating thickness of 0.01 inch (10 mil) on both sides of the pipe. This pipe and its appurtenances shall conform to the requirements of AASHTO Specifications M-245 & M-246 with watertight coupling bands or flanges.
- Materials - (Aluminum Coated Steel Pipe) - This pipe and its appurtenances shall conform to the requirements of AASHTO Specification M-274 with watertight coupling bands or flanges. Aluminum Coated Steel Pipes, when used with flowable fill or when soil and/or water conditions warrant the need for increased durability, shall be fully bituminous coated per requirements of AASHTO Specification M-190 Type A. Any aluminum coating damaged or otherwise removed shall be replaced with applied bituminous coating compound.
- Materials - (Aluminum Pipe) - This pipe and its appurtenances shall conform to the requirements of AASHTO Specification M-196 or M-211 with watertight coupling bands or flanges. Aluminum Pipes, when used with flowable fill or when soil and/or water conditions warrant for increased durability, shall be fully bituminous coated per requirements of AASHTO Specification M-190 Type A. Aluminum surfaces that are to be in contact with concrete shall be painted with one coat of zinc chromate primer or two coats of asphalt. Hot dip galvanized bolts may be used for connections. The pH of the surrounding soils shall be between 4 and 9.

Flow Enters as Sheet Flow

Flow Exits as Sheet Flow

HILLIS - CARNES ENGINEERING ASSOCIATES, INC. RECORD OF SOIL EXPLORATION

Page 1 of 1

Project Name: Curtis Property SWM, Location: Howard County, Maryland, Boring Number: 03071A-B-7, Date Started: 2/28/2003, Foreman: J. Malecki

ELEV.	SOIL DESCRIPTION	DEPTH	SCALE	CON.	SAMPLE	NO.	REC.	BORING & SAMPLING NOTES
427	Brown moist soft to stiff silty clay trace to little fine sand trace mica (CL)	0.0	1.0		2-3-3	1	12"	6' Topsoil Caved in at 5.9 ft at completion
427		5.0	1.0		3-6-8	2	10"	
427		10.0	1.0		4-6-7	3	15"	
427		15.0	1.0		3-5-5	4	10"	
427		20.0	1.0		1-2-2	5	18"	

Bottom of test hole @ 15.0'

HILLIS - CARNES ENGINEERING ASSOCIATES, INC. RECORD OF SOIL EXPLORATION

Page 1 of 1

Project Name: Curtis Property SWM, Location: Howard County, Maryland, Boring Number: 03071A-B-8, Date Started: 2/28/2003, Foreman: J. Malecki

ELEV.	SOIL DESCRIPTION	DEPTH	SCALE	CON.	SAMPLE	NO.	REC.	BORING & SAMPLING NOTES
430.8	Brown moist medium stiff to stiff silty clay trace to little fine sand trace mica (CL)	0.0	1.0		3-3-4	1	12"	6' Topsoil Caved in at 5.4 ft at completion
430.8		5.0	1.0		6-6-8	2	10"	
430.8		10.0	1.0		4-6-7	3	6"	
430.8		15.0	1.0		4-4-5	4	9"	
430.8		20.0	1.0		2-3-3	5	3"	

Bottom of test hole @ 15.0'

HILLIS - CARNES ENGINEERING ASSOCIATES, INC. RECORD OF SOIL EXPLORATION

Page 1 of 1

Project Name: Curtis Property SWM, Location: Howard County, Maryland, Boring Number: 03071A-B-9, Date Started: 2/28/2003, Foreman: J. Malecki

ELEV.	SOIL DESCRIPTION	DEPTH	SCALE	CON.	SAMPLE	NO.	REC.	BORING & SAMPLING NOTES
424.8	Brown moist soft to stiff silty clay trace to little fine sand trace mica (CL)	0.0	1.0		3-3-4	1	9"	3' Topsoil Caved in at 7.2 ft at completion
424.8		5.0	1.0		4-5-7	2	17"	
424.8		10.0	1.0		3-5-5	3	18"	
424.8		15.0	1.0		2-2-2	4	18"	
424.8		20.0	1.0		3-3-3	5	9"	

Bottom of test hole @ 15.0'

Structure Backfill

Backfill adjacent to pipes or structures shall be of the type and quality conforming to that specified for the adjoining fill material. The fill shall be placed in horizontal layers not exceeding four inches in thickness and compacted by hand tampers or other manually directed compaction equipment. The material needs to fill completely all spaces under and adjacent to the pipe. At no time during the backfilling operation shall driven equipment be allowed to operate closer than four feet, measured horizontally, to any part of a structure. Under no circumstances shall equipment be driven over any part of a concrete structure or pipe, unless there is a compacted fill of 24" or greater over the structure or pipe.

Structure backfill may be flowable fill meeting the requirements of Maryland Department of Transportation, State Highway Administration Standard Specifications for Construction and Materials, Section 313 as modified. The mixture shall have a 100-200 psi, 28 day unconfined compressive strength. The flowable fill shall have a minimum pH of 4.0 and a minimum resistivity of 2,000 ohm-cm. Material shall be placed such that a minimum of 6" (measured perpendicular to the outside of the pipe) of flowable fill shall be under (bedding), over and, on the side of the pipe. It only needs to extend up to the spring line for rigid conduits. Average slump of the fill shall be 7" to assure flowability of the material. Adequate measures shall be taken (sand bags, etc.) to prevent floating the pipe. When using flowable fill, all metal pipe shall be bituminous coated. Any adjoining soil fill shall be placed in horizontal layers not to exceed four inches in thickness and compacted by hand tampers or other manually directed compaction equipment. The material shall completely fill all voids adjacent to the flowable fill zone. At no time during the backfilling operation shall driven equipment be allowed to operate closer than four feet, measured horizontally, to any part of a structure. Under no circumstances shall equipment be driven over any part of a structure or pipe unless there is a compacted fill of 24" or greater over the structure or pipe. Backfill material outside the structural backfill (flowable fill) zone shall be of the type and quality conforming to that specified for the core of the embankment or other embankment materials.

Pipe Conduits

Corrugated Metal Pipe - all of the following criteria shall apply for corrugated metal pipe:

- Materials - (Polymer Coated Steel Pipe) - Steel pipes with polymeric coatings shall have a minimum coating thickness of 0.01 inch (10 mil) on both sides of the pipe. This pipe and its appurtenances shall conform to the requirements of AASHTO Specifications M-245 & M-246 with watertight coupling bands or flanges.
- Materials - (Aluminum Coated Steel Pipe) - This pipe and its appurtenances shall conform to the requirements of AASHTO Specification M-274 with watertight coupling bands or flanges. Aluminum Coated Steel Pipes, when used with flowable fill or when soil and/or water conditions warrant the need for increased durability, shall be fully bituminous coated per requirements of AASHTO Specification M-190 Type A. Any aluminum coating damaged or otherwise removed shall be replaced with applied bituminous coating compound.
- Materials - (Aluminum Pipe) - This pipe and its appurtenances shall conform to the requirements of AASHTO Specification M-196 or M-211 with watertight coupling bands or flanges. Aluminum Pipes, when used with flowable fill or when soil and/or water conditions warrant for increased durability, shall be fully bituminous coated per requirements of AASHTO Specification M-190 Type A. Aluminum surfaces that are to be in contact with concrete shall be painted with one coat of zinc chromate primer or two coats of asphalt. Hot dip galvanized bolts may be used for connections. The pH of the surrounding soils shall be between 4 and 9.

Flow Enters as Sheet Flow

Flow Exits as Sheet Flow

SAMPLER TYPE
DRIVEN SPLIT SPOON UNLESS OTHERWISE NOTED.
PT-PRESSED SHELLEY TUBE
CA-CONTINUOUS FLIGHT AUGER
RC-ROCK CORE

SAMPLE CONDITIONS
D-DISINTEGRATED
H-HINTACT
U-UNDISTURBED
L-LOST

GROUND WATER DEPTH
AT COMPLETION
Dy FT.
AFTER 24 hrs Dy FT.

BORING METHOD
HS-HOLLOW STEM AUGERS
CF-CONT. FLIGHT AUGERS
DC-DRIVING CASING
MD-MUD DRILLING

STANDARD PENETRATION TEST-DRIVING 2" OD SAMPLER 1" WITH 140# HAMMER FALLING 30" COUNT MADE AT 6" INTERVALS

BENCHMARK ENGINEERING, INC.

8480 BALTIMORE NATIONAL PIKE & SUITE 418
ELLICOTT CITY, MARYLAND 21043
PHONE: 410-465-6105 FAX: 410-465-6644
website: http://www.bei-cvllengineering.com

NO. DATE REVISION

OWNER/DEVELOPER: HIGHLAND DEVELOPMENT CORP
P.O. BOX 228
CLARKSVILLE, MARYLAND 21029
410-531-5539

PROJECT: BRIGHTON MILL
LOT 17 THROUGH 22, BUILDABLE PRESERVATION PARCEL 'A' AND NON-BUILDABLE PRESERVATION PARCELS 'B' THROUGH 'D'
LOCATION: TAX MAP No. 34, GRID No. 2
PARCEL 2
5th ELECTION DISTRICT
HOWARD COUNTY, MARYLAND

TITLE: STORMWATER MANAGEMENT NOTES AND BORING LOGS

DATE: MAY, 2007 PROJECT NO. 1513

Design: JMC Draft: LAB Check: DAM SCALE: NA DRAWING 34 OF 34

APPROVED: HOWARD COUNTY DEPARTMENT OF PUBLIC WORKS
DATE: 6-10-07

APPROVED: HOWARD COUNTY DEPT. OF PLANNING AND ZONING
DATE: 6-11-07

HILLIS-CARNES GEOTECHNICAL ENGINEERING RECOMMENDATIONS:
EMBANKMENT AND CUT-OFF TRENCH CONSTRUCTION

THE AREA OF THE PROPOSED SWM FACILITIES SHOULD BE STRIPPED OF TOP SOIL AND ANY OTHER UNSUITABLE MATERIALS FROM THE EMBANKMENT OR STRUCTURE AREAS IN ACCORDANCE WITH SOIL CONSERVATION REGULATIONS. AFTER STRIPPING OPERATIONS HAVE BEEN COMPLETED, THE EXPOSED SUBGRADE MATERIALS SHOULD BE PROFFERROLLED WITH A LOADED DUMP TRUCK OR SIMILAR EQUIPMENT IN THE PRESENCE OF A GEOTECHNICAL ENGINEER OR HIS REPRESENTATIVE. FOR AREAS THAT ARE NOT ACCESSIBLE TO A DUMP TRUCK, THE EXPOSED MATERIALS SHOULD BE OBSERVED AND TESTED BY A GEOTECHNICAL ENGINEER OR HIS REPRESENTATIVE UTILIZING A DYNAMIC CONE PENETROMETER. ANY EXCESSIVELY SOFT OR LOOSE MATERIALS IDENTIFIED BY PROFFERROLLING OR PENETROMETER TESTING SHOULD BE EXCAVATED TO SUITABLE FIRM SOIL, AND THEN GRADES RE-ESTABLISHED BY BACKFILLING WITH SUITABLE FIRM SOIL.

A REPRESENTATIVE OF THE GEOTECHNICAL ENGINEER SHOULD BE PRESENT TO MONITOR PLACEMENT AND COMPACTION OF FILL FOR THE EMBANKMENT AND CUT-OFF TRENCH. IN ACCORDANCE WITH NRCS-MD CODE NO. 378, SOILS CONSIDERED SUITABLE FOR THE CENTER OF EMBANKMENT AND CUT-OFF TRENCH SHALL CONFORM TO UNIFIED SOIL CLASSIFICATION GC, SC, CH, OR CL AND MUST HAVE AT LEAST 30% PASSING THE #200 SIEVE.

IT IS OUR PROFESSIONAL OPINION THAT IN ADDITION TO THE SOIL MATERIALS DESCRIBED ABOVE A FINE-GRAINED SOIL INCLUDING SILT (ML) WITH A PLASTICITY INDEX OF 10 OR MORE CAN BE UTILIZED FOR THE CENTER OF THE EMBANKMENT AND CORE TRENCH. ALL FILL MATERIALS MUST BE PLACED AND COMPACTED IN ACCORDANCE WITH NRCS-MD CODE NO. 378 SPECIFICATIONS.

