

**FOREST CONSERVATION WORKSHEET**

<b>Net Tract Area</b>	<b>Acres</b>
A. Total Tract Area	14.71
B. Area Within 100 Year Floodplain	0.85
C. Other deductions	0
D. Net Tract Area	13.86
Zoning Use Category: RESIDENTIAL-SUBURBAN	
<b>Land Use Category</b>	
E. Afforestation Minimum (20 % x D)	2.77
F. Conservation Threshold (25 % x D)	3.47
<b>Existing Forest Cover</b>	
G. Existing Forest on Net Tract Area	13.25
H. Forest Area Above Conservation Threshold	9.78
<b>Breakeven Point</b>	
I. Forest Retention Above Threshold with no Mitigation	5.43
J. Clearing Permitted without Mitigation	7.82
<b>Proposed Forest Clearing</b>	
K. Forest Areas to be Cleared	8.53
L. Forest Areas to be Retained	4.72
<b>Planting Requirements</b>	
M. Reforestation for Clearing Above Threshold	2.13
N. Reforestation for Clearing Below the Threshold	0
P. Credit for Retention Above Conservation Threshold	1.25
Q. Total Reforestation Required	0.88
R. Total Afforestation Required	0
S. Total Reforestation and Afforestation Requirement	0.88


**CRITICAL ROOT ZONE**

For the edge of large areas, use the greater of the two choices below:


1" DBH of the tree = 1' radius of the critical root zone or 3 ft radius circle around the trunk of the tree

For isolated specimen trees:

1" DBH = 1.5' radius of the critical root zone

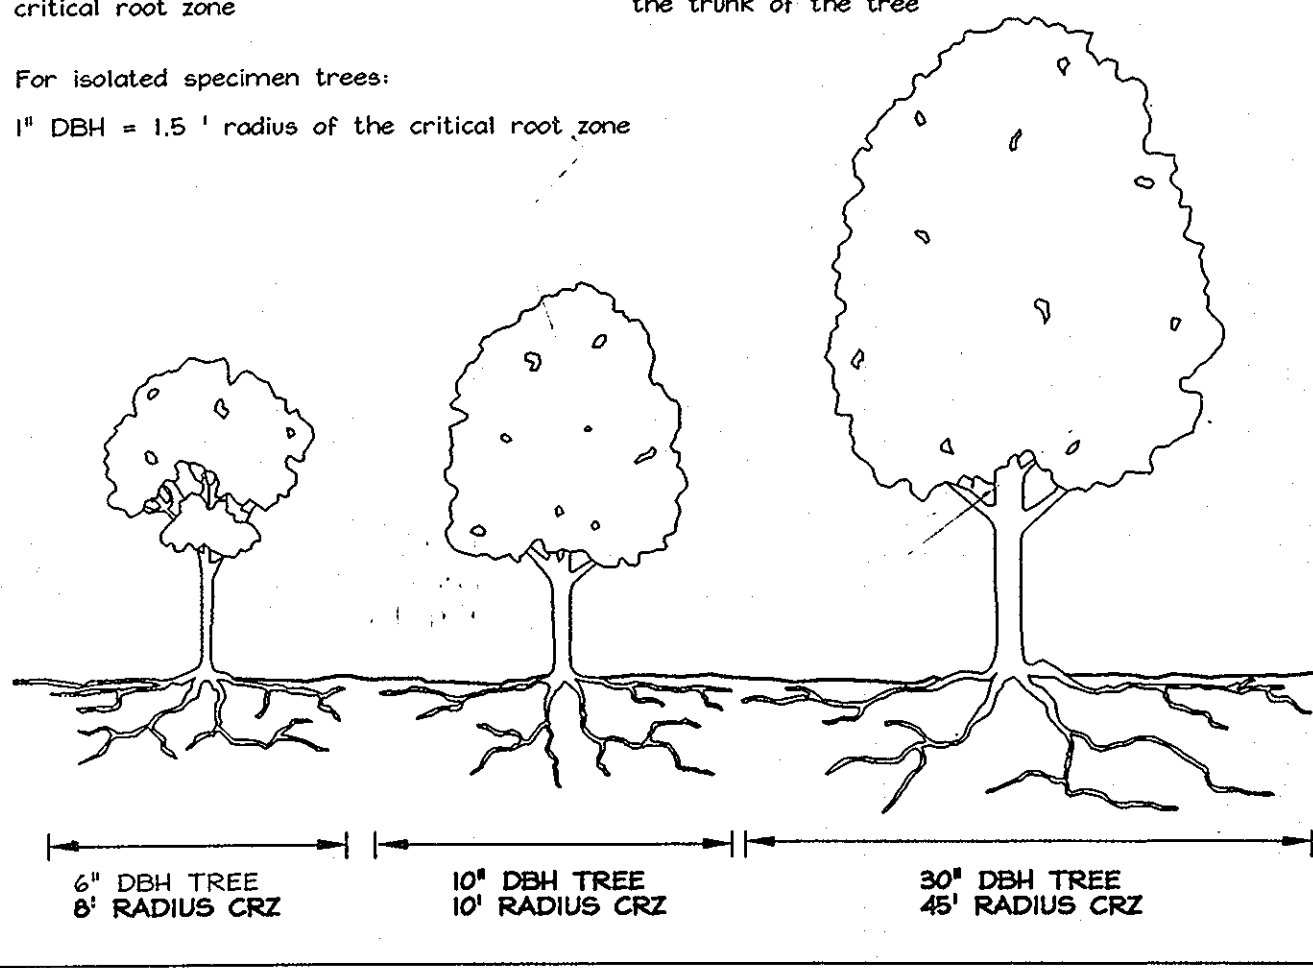

**ROOT PRUNING**

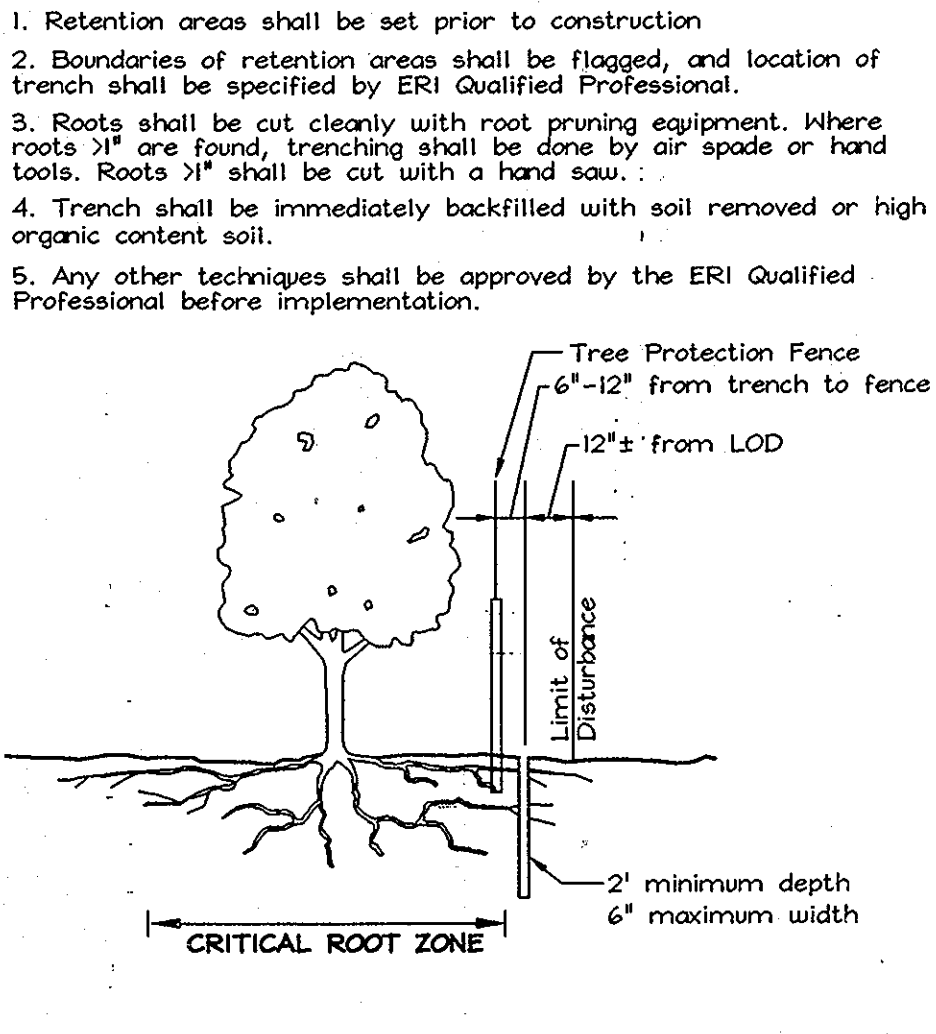

**Forest Tree Protection and Management Notes**

- Tree protection devices shall be installed prior to any grading or land clearing.
- After the boundaries of the retention areas have been staked and flagged and before any disturbance has taken place a pre-construction meeting with the Howard County Inspector is required.
- Provide maintenance to tree protection devices and signage to maintain their integrity throughout the duration of the project.
- Attachment of signs to tree protection devices to maintain their integrity throughout the duration of the project.
- Any significant changes made to the Forest Conservation Plan shall be made with the prior approval of the Howard County Dept. Of Planning and Zoning.
- No burial of discarded material is permitted within the Forest Conservation and Planting areas.
- No open burning within 100 feet of wooded areas is permitted.
- Post construction phase:
  - Inspect existing trees around the perimeter of the site for signs of root or trunk damage and excessive soil compaction.
  - Remove dead or dying trees and evaluate for hazard tree removal.
  - All temporary forest protection devices will be removed after construction.
  - Following completion of construction, prior to use, the county inspector shall inspect the entire site for compliance with this Forest Conservation Plan.
- A licensed Arborist or Forester should be retained for this service as needed.

**Forest Conservation Narrative**

This Forest Conservation Plan was prepared in accordance with the Howard County Forest Conservation Manual, using the option for rural cluster subdivisions. The subject property has a gross area of 14.71 Ac. Deduction of 0.85 Ac. of floodplain creates a net tract area of 13.86 Ac. There is 13.25 Ac. of forest on the net tract. There is one specimen tree on the site which will be preserved. Forest has been retained to the greatest extent possible, including all forest in sensitive environments. The forest will be retained in one easement of 2.95 Ac. on Parcel B and as 1.77 Ac. of retention on Parcel A. The retention on Parcel A is taken as retained on a lot larger than 60,000 s.f. without requiring an easement. This creates a forest mitigation obligation of 0.88 Ac.


Due to revised stormwater management requirements, significantly less retention is available, and there is no longer space for reforestation on-site. At this time we are seeking an off-site mitigation area and will temporarily request to pay a fee-in-lieu of \$19,166.50 (0.88 Ac = 38,333 s.f. @ \$0.50/s.f.).

The total bondable forest conservation obligation met on this site is 2.95 acres, with a total forest conservation surety amount of \$25,700.40 (128,502 s.f. retention @ \$0.20/s.f.).

**FOREST CONSERVATION EASEMENT TABLE**

EASEMENT	TYPE	AREA (ACRES)
1	Retention	2.95
<b>TOTAL</b>		<b>2.95</b>

**Forest Retention Area Protection Signage**

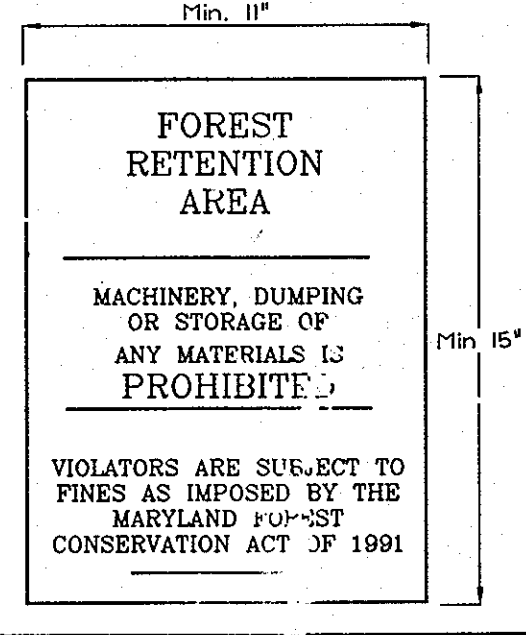

**SIGN DETAIL: PERMANENT SIGN**

SIGNAGE NOTE: ALL TREE PROTECTION SIGNS SHALL BE PLACED ON METAL T" POSTS OR PRESSURE TREATED WOOD POLES. NO ATTACHMENT OF SIGNS TO TREES IS PERMITTED.


APPROVED: HOWARD COUNTY DEPARTMENT OF PLANNING AND ZONING  
 Chief, Development Engineering Division: *[Signature]* 8/4/06 DATE  
 Chief, Division of Land Development: *[Signature]* 8/9/06 DATE

**Soil Protection Zone Notes**

- The Soil Protection Zone shall include all areas contained inside the Limit of Disturbance.
- Where possible, the Soil Protection Zone shall extend to the drip line of specimen trees. For other groups of trees, the zone shall be the drip line or 40% of the height of the tree, whichever is greater.
- No construction activity is permitted within the Soil Protection Zone.
- If soil has been compacted or grading has taken place in the vicinity of the Soil Protection Zone, root pruning shall be implemented per Root Pruning detail, shown on this plan.
- Root pruning shall occur prior to the beginning of construction.
- Where the Soil Protection Zone must encroach inside the Critical Root Zone of a tree, soil disturbance shall be mitigated with vertical mulching, radial trenching, or another method approved by the ERI Forest Conservation Professional.
- Prior to construction, the Limits of Disturbance shall be marked and the ERI Professional shall determine which trees will need preventative treatment or removal.
- Tree maintenance and removal shall be undertaken by a qualified MID Tree Expert to ensure damage to surrounding trees is minimized.
- Brush and limbs removed for construction shall be chipped and spread at the edge of the Soil Protection Zone to a depth of 6 inches. This shall occur outside the Soil Protection Zone where compaction could impact otherwise unprotected Critical Root Zone.

**LEGEND**

- Existing Contour: --- 552
- Existing Spot Elevation: 382.3
- Existing Stream Buffer: --- SB --- SB
- Existing Wetland Buffer: --- WB --- WB
- Existing Wetland: --- W --- W
- Existing Trees to Remain: [Symbol]
- Proposed Septic Area: [Symbol]
- Existing Septic Area: [Symbol]
- Proposed Well Area: [Symbol]
- Proposed House Site: [Symbol]

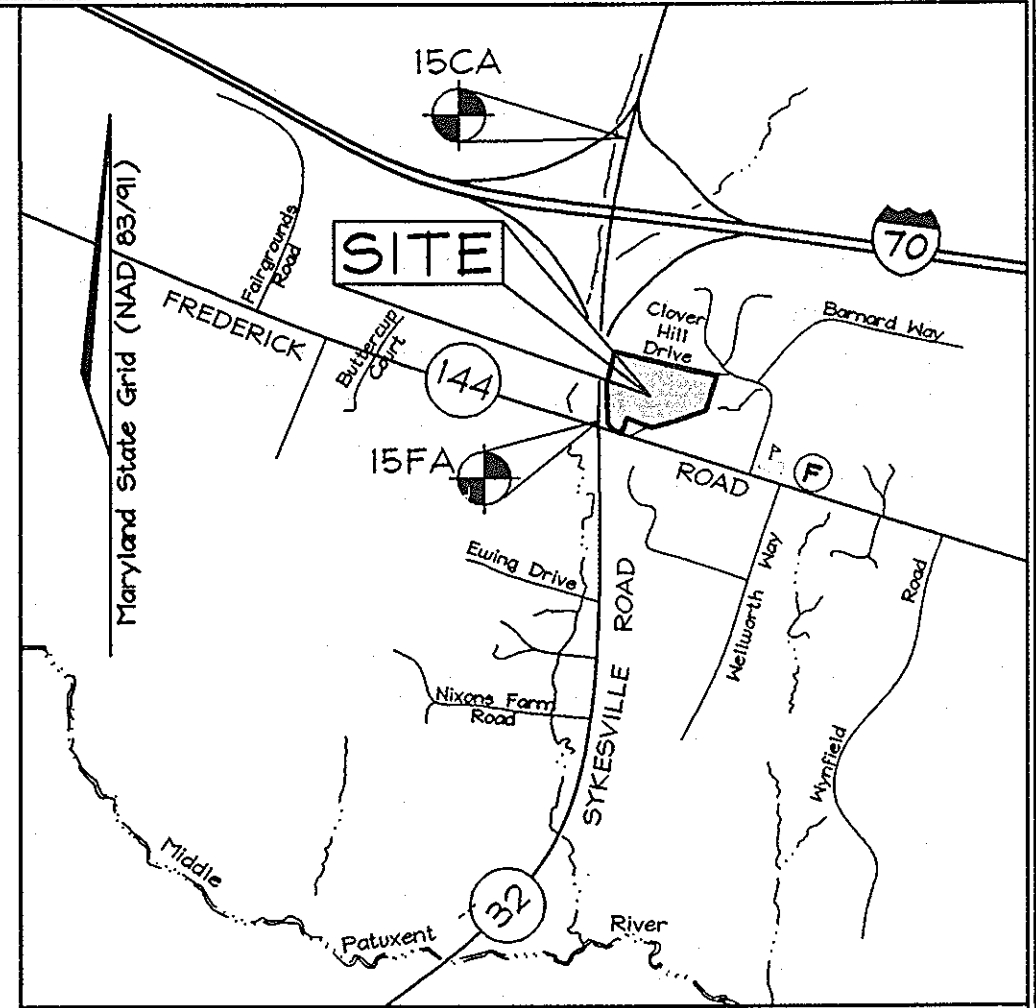

**VICINITY MAP**  
SCALE: 1"=200'

**GENERAL NOTES**

- Subject property zoned RR-DEO per 02/02/04 Comprehensive Zoning Plan.
- Denotes Public Forest Conservation Easement. The Forest Conservation Easement has been established to fulfill the requirements of Section 16.1200 of the Howard County Code and Forest Conservation Act. No clearing, grading or construction is permitted within the Forest Conservation Easement; however, Forest Management Practices as defined in the Deed of Forest Conservation Easements are allowed.
- Denotes Wetland Areas. Wetland areas delineated by Exploration Research Inc.
- Denotes existing centerline of Stream Channel.
- Denotes existing Wetland Buffer outline.
- Denotes Stream Buffer outline.
- This area designates a private sewage easement of at least 10,000 square feet as required by the Maryland State Department of the Environment for individual sewage disposal (COMAR 26.04.03). Improvements of any nature in this area are restricted until public sewerage is available. These easements shall become null and void upon connection to a public sewerage system. The County Health Officer shall have the authority to grant variances for encroachments into the private sewage easement. Recordation of a modified sewage easement shall not be necessary.
- BRL Denotes Building Restriction Line.
- This plot is based on field run Monumented Boundary Survey performed on or about June, 2004 by FSH Associates, Inc. All areas are more or less (+/-).
- For flag or pipelstem lots, refuse collection, snow removal and road maintenance are provided to the junction of the flag or pipelstem and road right-of-way line and not to the pipelstem lot driveway.
- Driveway(s) shall be provided prior to issuance of a use and occupancy permit to ensure safe access for fire and emergency vehicles per the following requirements:
  - Width - 2 feet (14 feet serving more than one residence)
  - Surface - six (6") inches of compacted crusher run base with tar and chip coating (1-1/2" Minimum)
  - Geometry - Maximum 14% grade, Maximum 10% grade change and 45-foot turning radius
  - Structures (cuiverts/bridges) - capable of supporting 25 gross tons (H25-loading)
  - Drainage elements - capable of safely passing 100 year flood with no more than 1 foot depth over surface
  - Structure clearances - minimum 12 feet
  - Maintenance - sufficient to ensure all weather use
- Distances shown are based on surface measurement and not reduced to MD NAD '83 grid measurement.
- No clearing, grading or construction is permitted within wetland or stream system buffers unless approved by the Department Of Planning and Zoning.
- Wetlands investigation prepared by Exploration Research Inc. on December 20, 2004.
- Density Calculations:
  - Base Density = 14.71 ac. / 4.25 ac./unit = 3.46 units; therefore, 3 units
  - Maximum Density based on DEO option: 14.71 ac. / 0.70 ac. / unit = 21.01 units; therefore, 21 units
  - 13.16 ac. / 2 ac./unit = 6.58 units; therefore, 6 units
  - Total DEO units required = 6 units - 3 units = 3 units
- Stormwater Management obligations are met as follows: Water Quality (WQv) and Recharge (Rcv) are provided by a grass channel and a dry swale. This site is exempt from providing Channel Protection (CPv) management. Surety for dry swale will be posted with the developers agreement.
- 65 dba noise study prepared by the Wilson T. Ballard company and approved under SP-05-12 on June 17, 2005.
- Adequate public facilities (APF) traffic study prepared by Lee Cunningham & Associates, Inc. and approved under SP-05-12 on June 17, 2005.
- Sight distance analysis for point of access prepared by FSH Associates and approved under SP-05-12 on June 17, 2005.
- 100 year Floodplain study prepared by FSH Associates and approved under SP-05-12 on June 17, 2005.
- Forest conservation obligations are fulfilled with the following measures: retention of 2.95 ac. of forest in Forest Conservation Easement #1; retention of 1.77 ac. of forest on a lot > 60,000 s.f. on Parcel A; and payment of a fee-in-lieu of \$19,166.50 for 0.88 ac/38,333 s.f. of forest obligation. Surety in the amount of \$25,700.40 will be posted with the Developer's Agreement.
- This plan has been prepared in accordance with the provisions of section 16.124 of the Howard County Code and Landscape Manual. Financial surety for the required landscaping will be posted as part of the Developer's Agreement in the amount of \$5,100.00 (17 shade trees @ \$300.00).
- This symbol denotes the 100-year floodplain elevation.
- Development rights for this property have been purchased from the Murray Property, RE-06-12. The sending Plat was approved on Dec. 22, 2005.
- Non-Buildable Environmental Parcel "B" is HOA owned and maintained with Howard County as an easement holder. Buildable Preservation Parcel "A" is privately owned and maintained with Howard County and the HOA as easement holders. The uses and restrictions of the aforementioned parcels are outlined in the Deed of Preservation Easement.
- The Contractor shall notify the following utility companies or agencies at least five (5) working days before starting work shown on these plans:
 

State Highway Administration	410.531.5333
BGE(Contractor Services)	410.850.4620
BGE(Underground Damage Control)	410.787.3268
Miss Utility	1.800.257.7777
Colonial Pipeline Company	410.795.1390
Howard County, Dept. of Public Works, Bureau of Utilities	410.313.4900
Howard County Health Department	410.313.2640
AT&T	1.800.252.1153
Verizon	1.800.743.0033/410.224.9210

**OWNER/DEVELOPER**

32-40 PARTNERSHIP  
 c/o Harry B. Cooper and Associates  
 10749 Falls Road, #202  
 Lutherville, Maryland 21093-7013  
 (410) 583-5540

**FINAL FOREST CONSERVATION AND SUPPLEMENTAL NOTES & DETAILS**

**TERRAPIN PRESERVE**

LOTS 1 THRU 5, BUILDABLE PRESERVATION PARCEL 'A' AND NON-BUILDABLE PRESERVATION PARCEL 'B'

TAX MAP 15 GRID II PARCEL 72  
 3RD ELECTION DISTRICT HOWARD COUNTY, MARYLAND





**EXPLORATION RESEARCH, INC.**  
 ENVIRONMENTAL CONSULTANTS  
 LANDSCAPE ARCHITECTS  
 8318 FOREST STREET #202  
 BELLEVILLE CITY, MARYLAND 21043  
 (410) 750-1100 / 750-7500  
 FAX: 410-750-7550  
 EMAIL: EXPLORATION@RSRCS.COM



**FSH Associates**  
 Engineers Planners Surveyors  
 8318 Forest Street, Suite 202, MD 21043  
 Tel: 410-750-2251 Fax: 410-750-7550  
 E-mail: info@fsha.biz

DESIGN BY: RAB  
 DRAWN BY: RAB  
 CHECKED BY: ZYE/SLH  
 SCALE: 1"=50'  
 DATE: June 9, 2006  
 W.O. No.: 3229  
 SHEET No. 1 OF 5



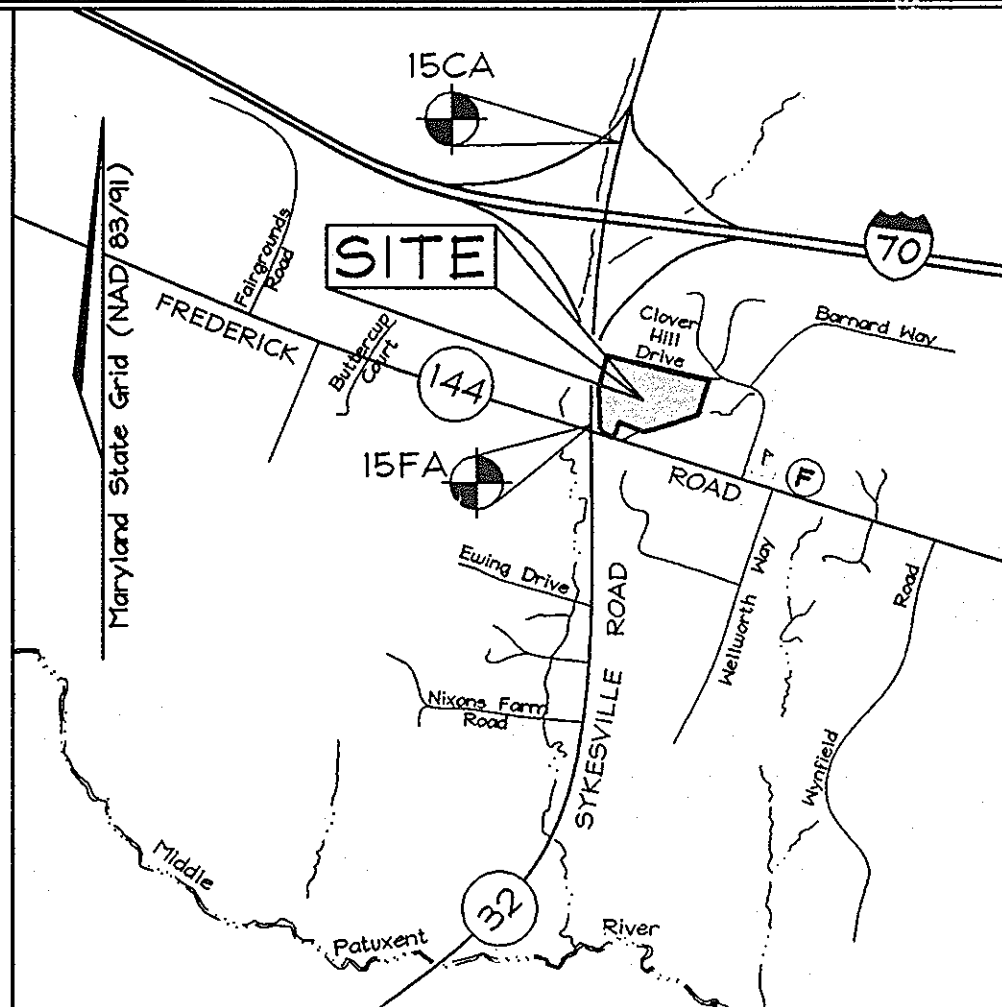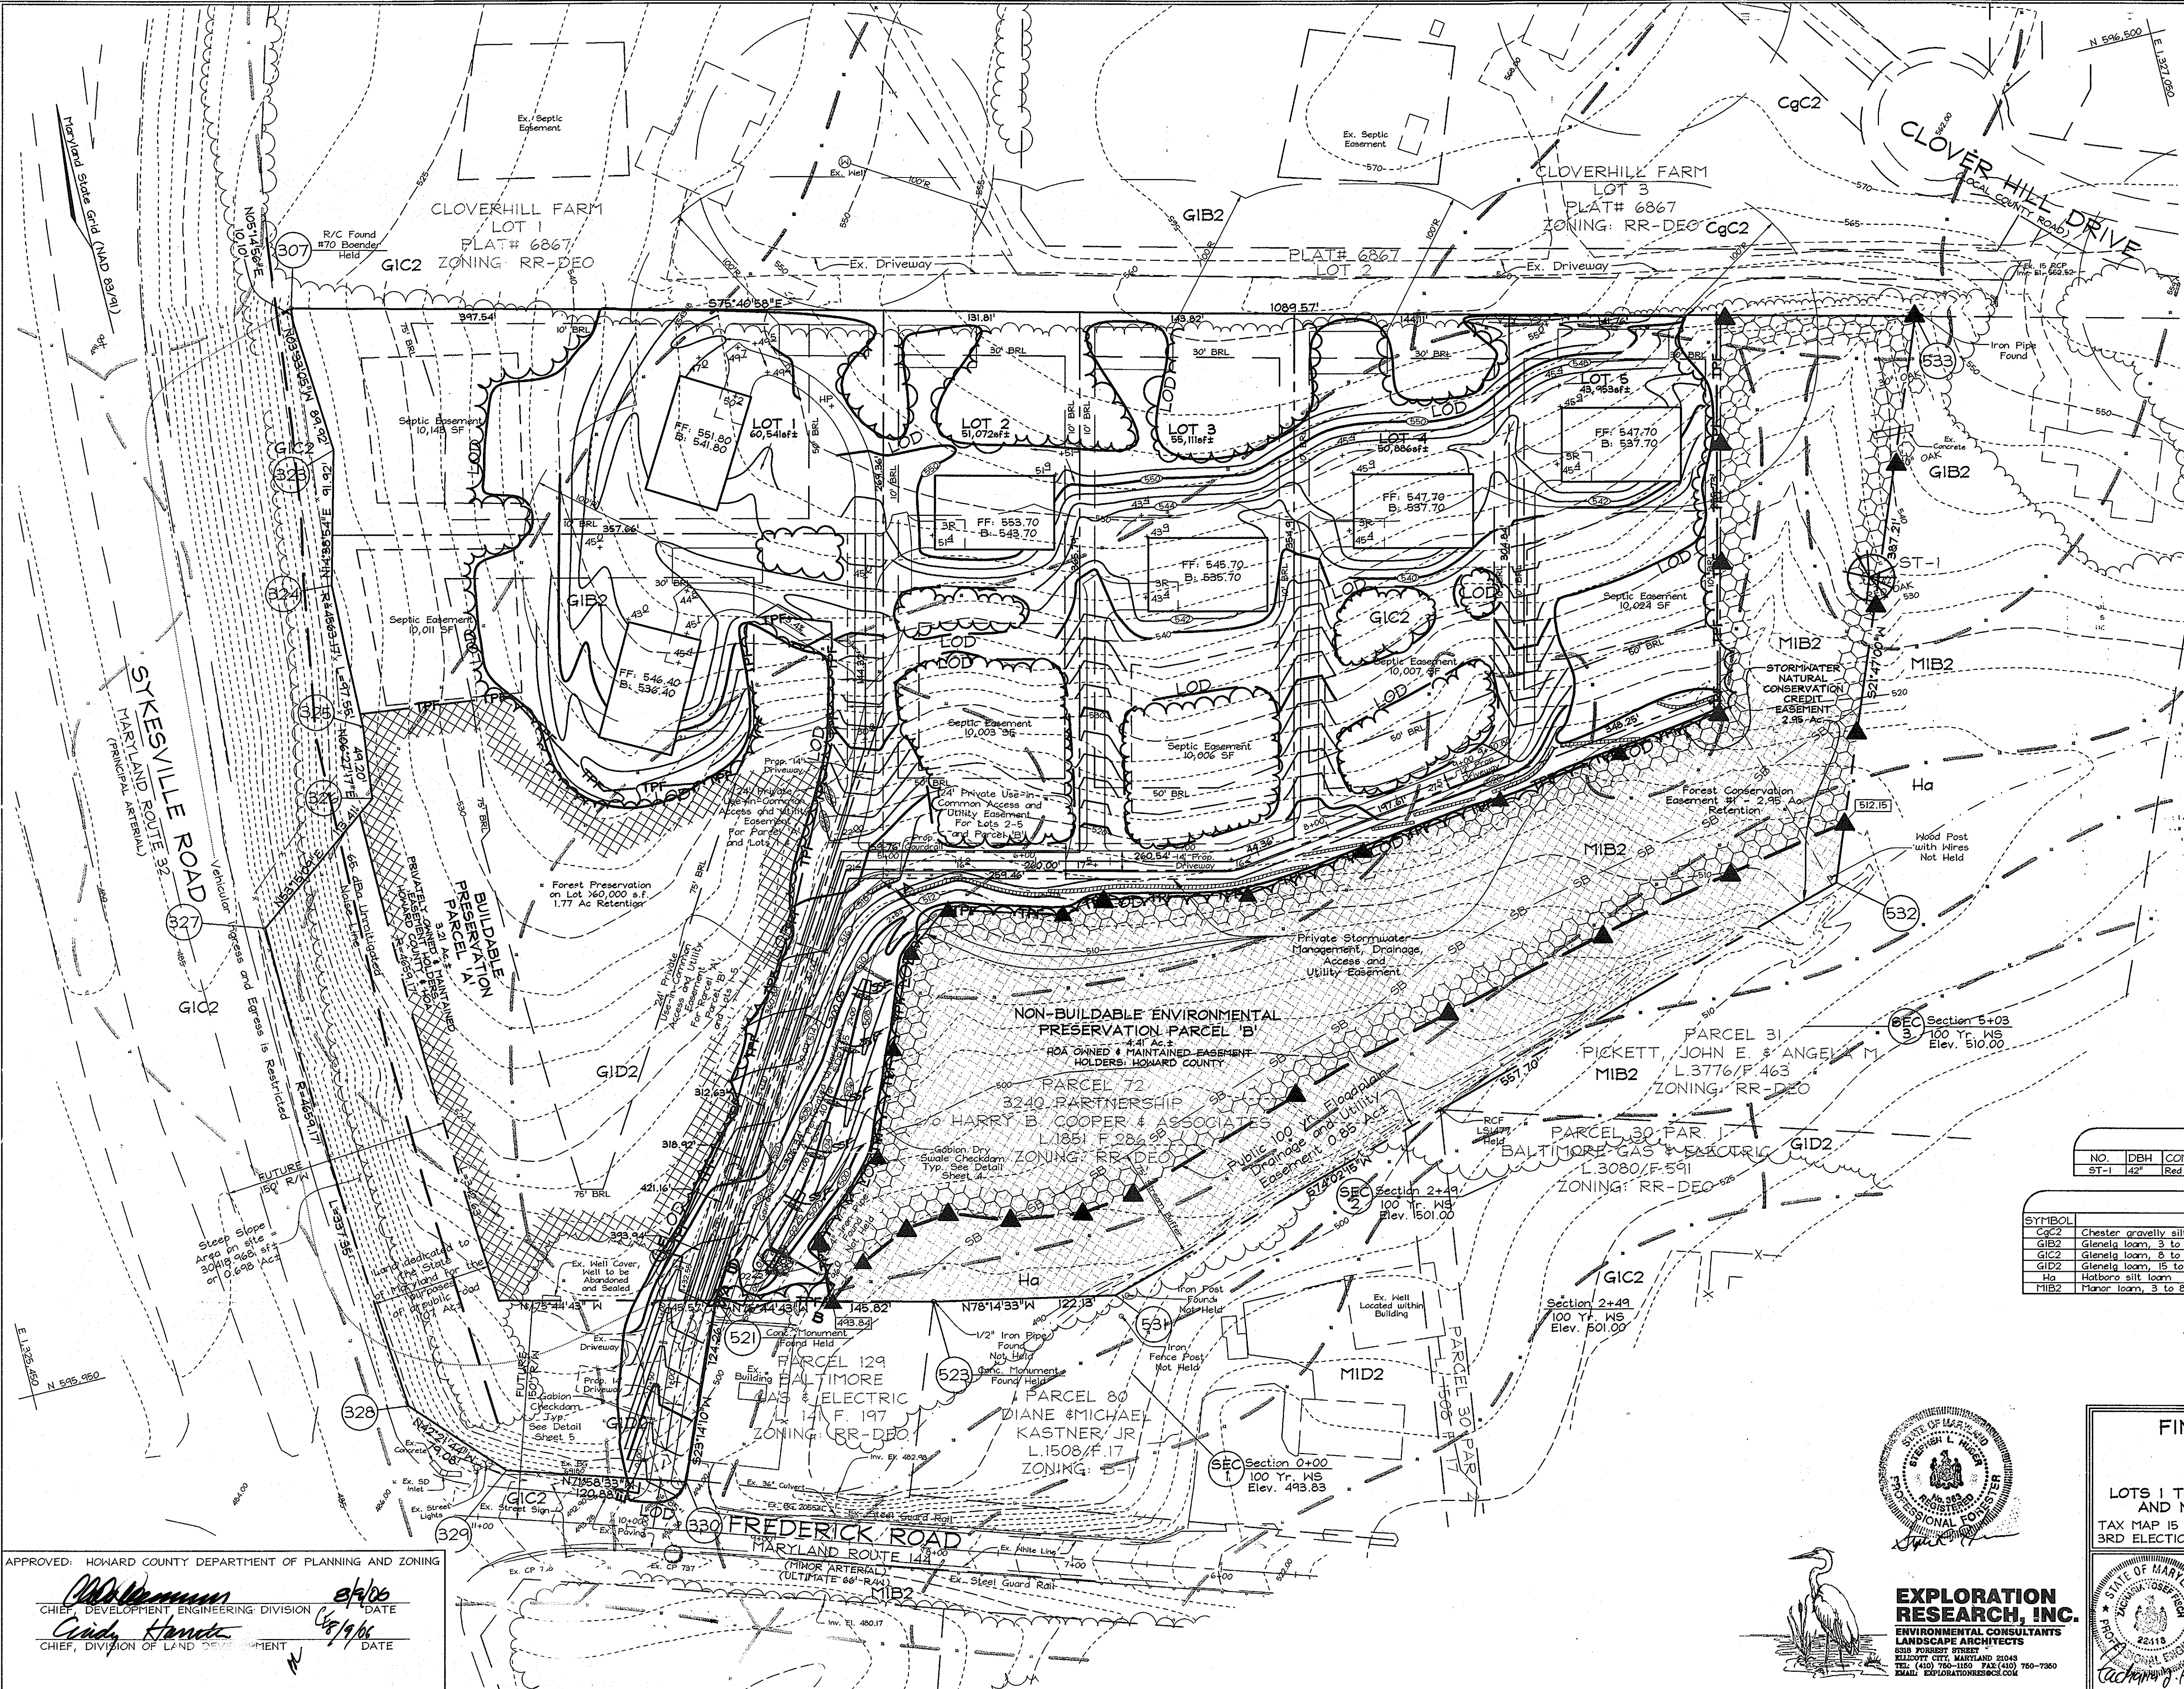

**VICINITY MAP**  
SCALE: 1"=2000'

**LEGEND**

- Existing Contour
- Proposed Contour
- Direction of Flow
- Existing Spot Elevation
- Proposed Spot Elevation
- Existing Trees
- Existing Septic Easement
- Proposed Septic Easement
- 15-24.9% Slopes
- 25-50% Slopes
- Wetlands
- Use-In-Common Access Easement
- Forest Conservation Easement Retention Area
- Forest Preservation on a Lot >60,000 SF
- Tree Protection Fence
- Forest Conservation Sign
- Specimen Tree

**SPECIMEN TREES**


NO.	DBH	COMMON NAME	SCIENTIFIC NAME	CONDITION	RETAIN
ST-1	42"	Red Oak	Quercus rubra	Good	Yes

**SOILS LEGEND**


SYMBOL	NAME / DESCRIPTION	SOIL GROUP
GcC2	Chester gravelly silt loam, 8 to 15 percent slopes, moderately eroded	B
GIB2	Gleneta loam, 3 to 8 percent slopes, moderately eroded	B
GIC2	Gleneta loam, 8 to 15 percent slopes, moderately eroded	B
GID2	Gleneta loam, 15 to 25 percent slopes, moderately eroded	B
Ha	Hatboro silt loam	D
MIB2	Manor loam, 3 to 8 percent slopes, moderately eroded	B

**OWNER/DEVELOPER**  
32-40 PARTNERSHIP  
c/o Harry B. Cooper & Associates  
10749 Falls Road, #202  
Lutherville, Maryland 21093-7013  
(410) 583-5540

**FINAL FOREST CONSERVATION PLAN**  
**TERRAPIN PRESERVE**  
LOTS 1 THRU 5, BUILDABLE PRESERVATION PARCEL 'A'  
AND NON-BUILDABLE PRESERVATION PARCEL 'B'  
TAX MAP 15 GRID II  
3RD ELECTION DISTRICT  
PARCEL 72  
HOWARD COUNTY, MARYLAND

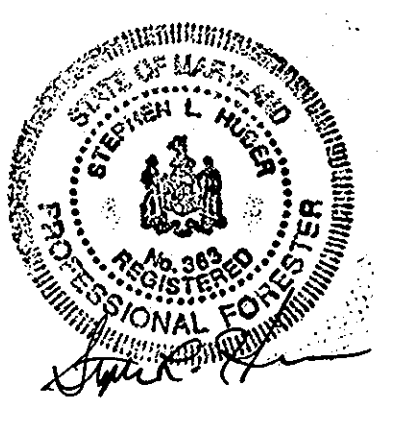

**EXPLORATION RESEARCH, INC.**  
ENVIRONMENTAL CONSULTANTS  
LANDSCAPE ARCHITECTS  
818 FOREST STREET  
BELTSVILLE, MARYLAND 21043  
TEL: (410) 760-1180 FAX: (410) 760-7800  
EMAIL: ERI@EXPLORATIONRESEARCH.COM

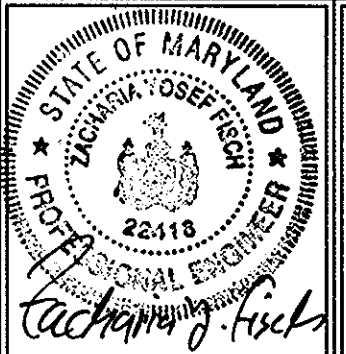


**FSH Associates**  
Engineers, Planners, Surveyors  
818 Forest Street  
Beltsville, MD 21043  
Tel: 410-760-2251  
E-mail: info@fshba.com

DESIGN BY: RAB  
DRAWN BY: RAB  
CHECKED BY: ZYE/SLH  
SCALE: 1"=50'  
DATE: June 9, 2006  
M.O. No.: 3222  
SHEET No. 2 OF 3

APPROVED: HOWARD COUNTY DEPARTMENT OF PLANNING AND ZONING  
  
CHIEF, DEVELOPMENT ENGINEERING DIVISION  
  
CHIEF, DIVISION OF LAND DEVELOPMENT

DATE: 6/9/06  
DATE: 6/9/06




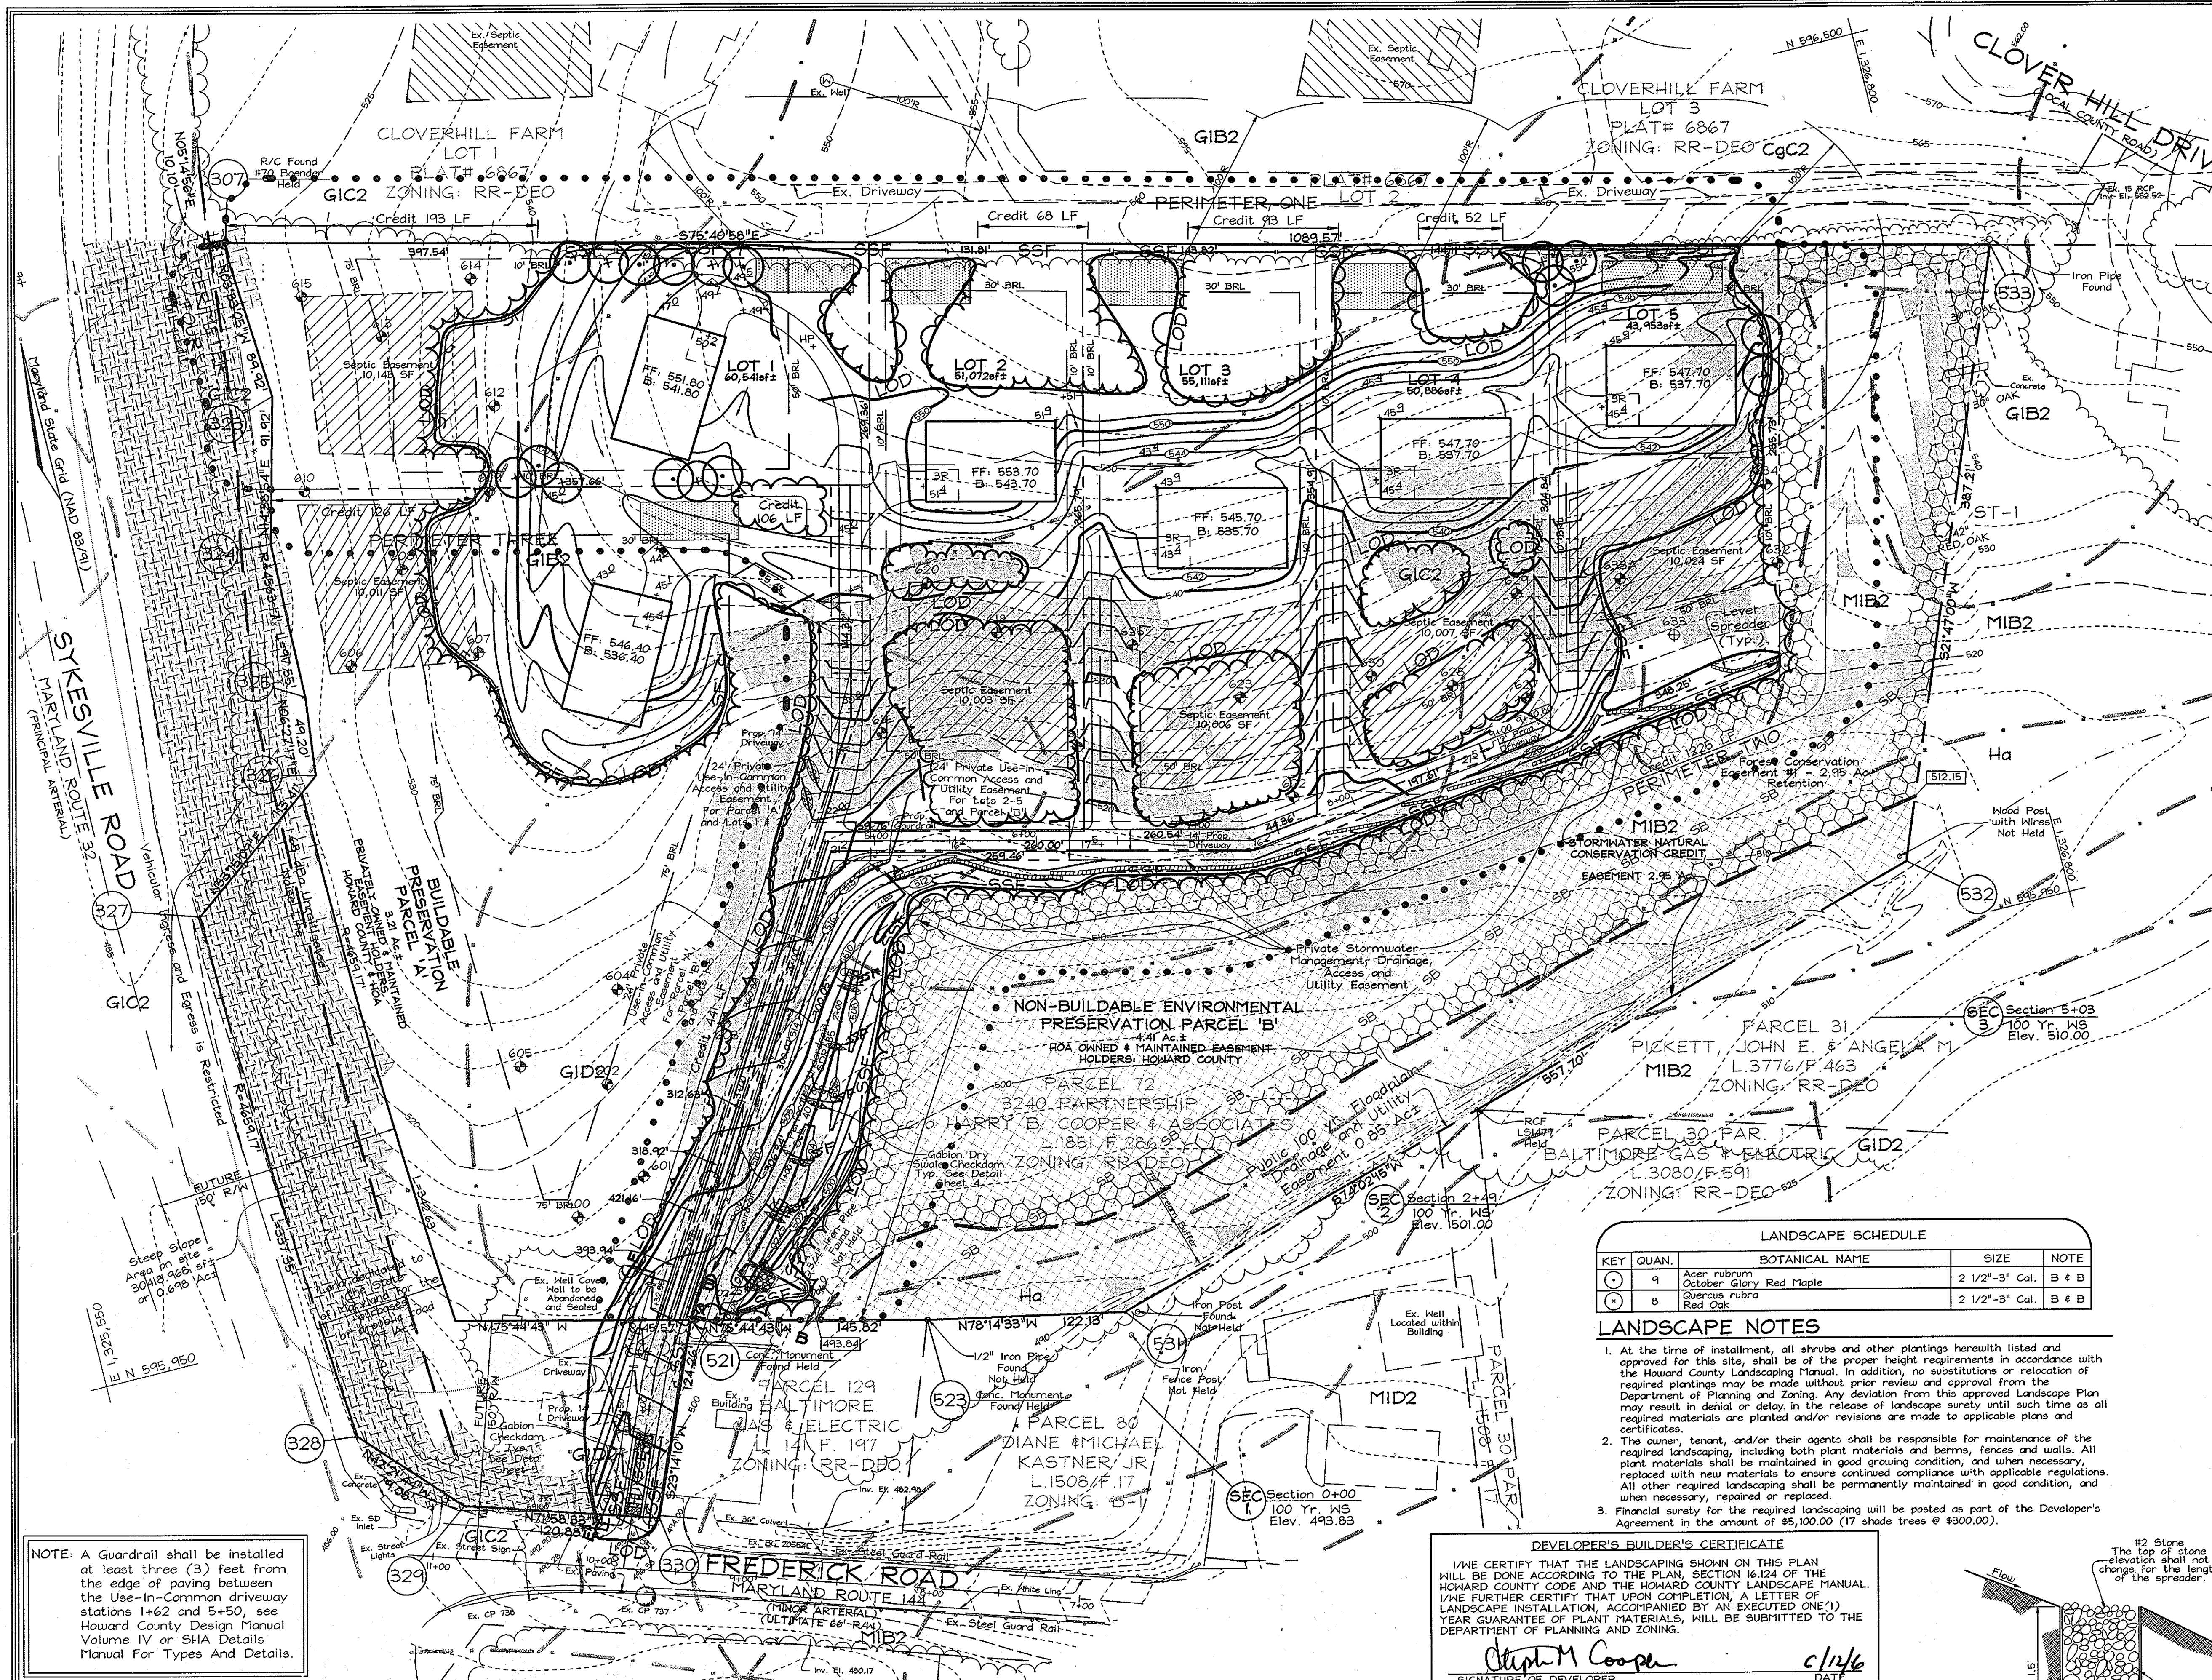


### LEGEND

- Existing contours: --- 552
- Existing Spot Elevation: 552.3
- Existing Trees to Remain: [Tree Symbol]
- Stream Bank Buffer: SB
- Utility Pole: [Pole Symbol]
- Stabilized Construction Entrance: [Hatched Box]
- Super Silt Fence: SSF
- Silt Fence: SF
- Limit of Disturbance: LOD
- Soil Boundary: [Dashed Line]
- 25% or greater slopes: [Hatched Box]
- 15% - 24.99% slopes: [Hatched Box]
- Proposed Landscape Tree: [Tree Symbol]
- Proposed Guardrail: [Line Symbol]

### SOILS LEGEND

SYMBOL	NAME / DESCRIPTION	SOIL GROUP
CgC2	Chester gravelly silt loam, 8 to 15 percent slopes, moderately eroded	B
GIB2	Glenelig loam, 3 to 8 percent slopes, moderately eroded	B
GIC2	Glenelig loam, 8 to 15 percent slopes, moderately eroded	B
GID2	Glenelig loam, 15 to 25 percent slopes, moderately eroded	B
Ha	Halboro silt loam	D
MIB2	Manor loam, 3 to 8 percent slopes, moderately eroded	B

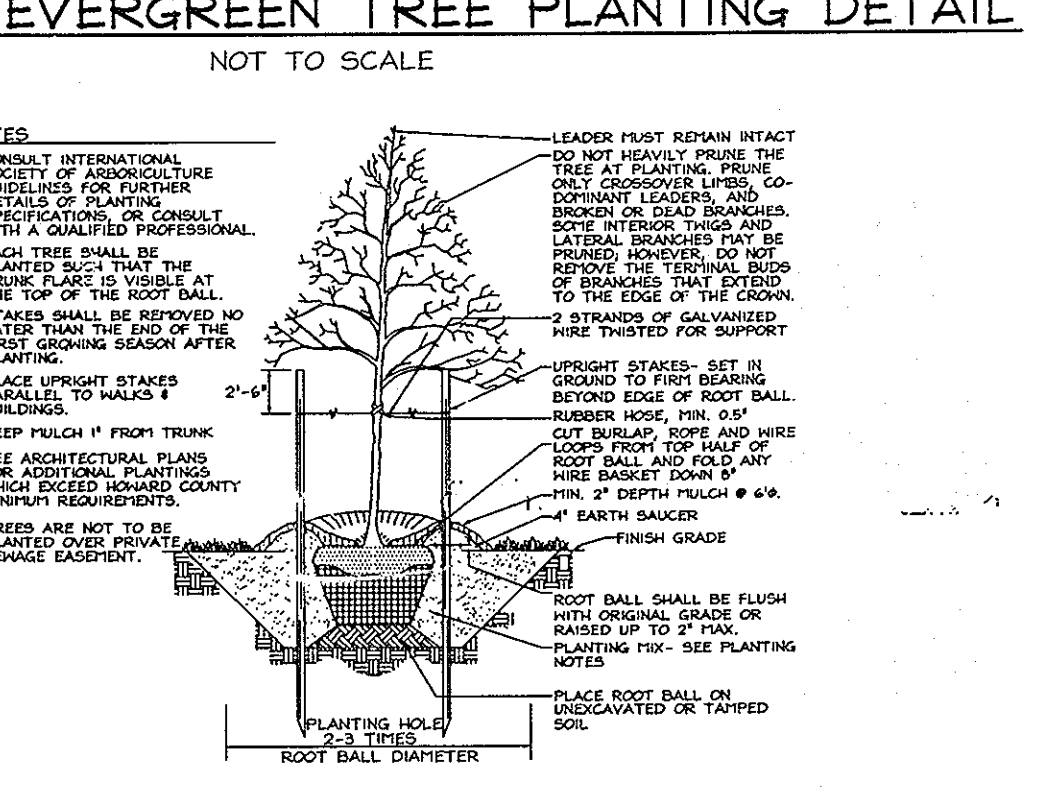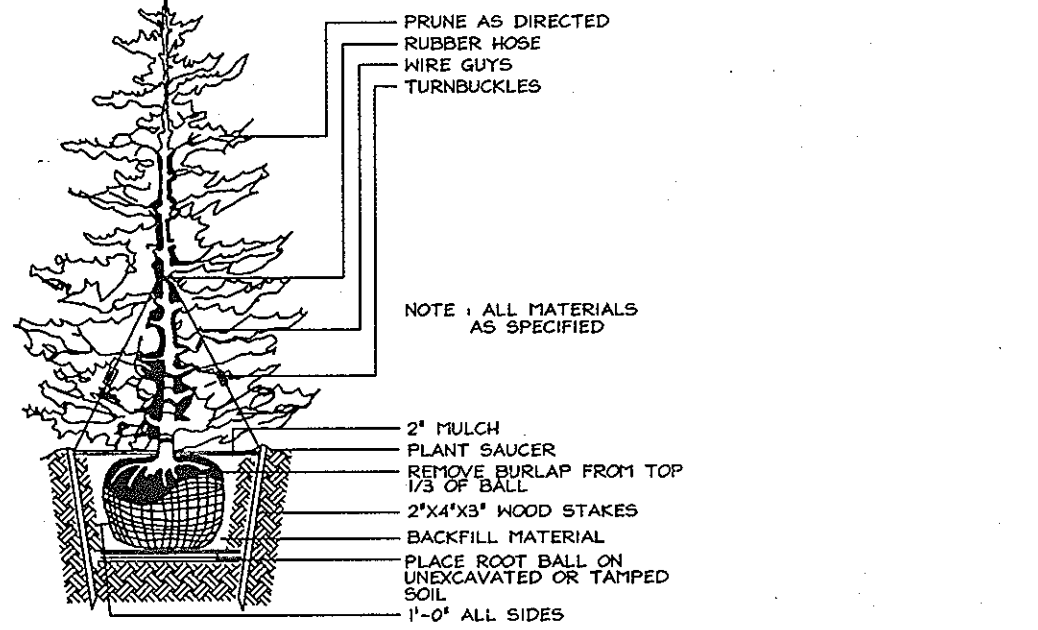

TYPICAL TREE PLANTING AND STAKING  
DECIDUOUS TREES UP TO 2-1/2" CALIPER  
NOT TO SCALE

### LANDSCAPE SCHEDULE

KEY	QUAN.	BOTANICAL NAME	SIZE	NOTE
(1)	9	Acer rubrum	2 1/2"-3" Cal.	B # B
(2)	8	Quercus rubra	2 1/2"-3" Cal.	B # B

### LANDSCAPE NOTES

- At the time of installation, all shrubs and other plantings herewith listed and approved for this site, shall be of the proper height requirements in accordance with the Howard County Landscaping Manual. In addition, no substitutions or relocation of required plantings may be made without prior review and approval from the Department of Planning and Zoning. Any deviation from this approved Landscape Plan may result in denial or delay in the release of landscape surety until such time as all required materials are planted and/or revisions are made to applicable plans and certificates.
- The owner, tenant, and/or their agents shall be responsible for maintenance of the required landscaping, including both plant materials and berms, fences and walls. All plant materials shall be maintained in good growing condition, and when necessary, replaced with new materials to ensure continued compliance with applicable regulations. All other required landscaping shall be permanently maintained in good condition, and when necessary, repaired or replaced.
- Financial surety for the required landscaping will be posted as part of the Developer's Agreement in the amount of \$5,100.00 (17 shade trees @ \$300.00).

### DEVELOPER'S BUILDER'S CERTIFICATE


I/WE CERTIFY THAT THE LANDSCAPING SHOWN ON THIS PLAN WILL BE DONE ACCORDING TO THIS PLAN, SECTION 16.124 OF THE HOWARD COUNTY CODE AND THE HOWARD COUNTY LANDSCAPE MANUAL. I/WE FURTHER CERTIFY THAT UPON COMPLETION A LETTER OF LANDSCAPE INSTALLATION, ACCOMPANIED BY AN EXECUTED ONE (1) YEAR GUARANTEE OF PLANT MATERIALS, WILL BE SUBMITTED TO THE DEPARTMENT OF PLANNING AND ZONING.

*Stephen M. Cooper* c/1/16  
SIGNATURE OF DEVELOPER DATE

### DEVELOPER'S CERTIFICATE

I/WE CERTIFY THAT ALL DEVELOPMENT AND CONSTRUCTION WILL BE DONE ACCORDING TO THIS PLAN FOR SEDIMENT AND EROSION CONTROL, AND THAT ALL RESPONSIBLE PERSONNEL INVOLVED IN THE CONSTRUCTION PROJECT WILL HAVE A CERTIFICATE OF ATTENDANCE AT A DEPARTMENT OF THE ENVIRONMENT APPROVED TRAINING PROGRAM FOR THE CONTROL OF SEDIMENT AND EROSION BEFORE BEGINNING THE PROJECT. I ALSO AUTHORIZE PERIODIC ON-SITE INSPECTION BY THE HOWARD SOIL CONSERVATION DISTRICT.

*Stephen M. Cooper* c/1/16  
SIGNATURE OF DEVELOPER DATE

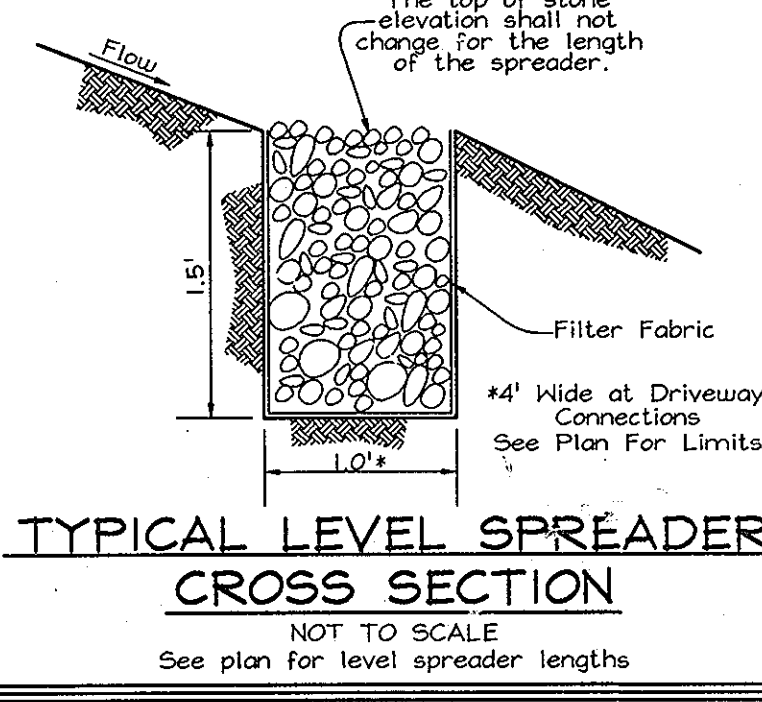

### SCHEDULE A PERIMETER LANDSCAPE EDGE

CATEGORY	ADJACENT TO ROADWAYS				ADJACENT TO PERIMETER PROPERTIES			
	1	2	3	4	1	2	3	4
Perimeter/Frontage Designation	A	A	A	A	A	A	A	A
Landscaping Type	99	1,287	1018	158				
Frontage/Perimeter								
Credit for Existing Vegetation (Yes, No, Linear Feet)	Yes	Yes	Yes	Yes				
Remaining Perimeter Length	406	1,164	695	158	(553)	(125)	(333)	(0)
Credit for Wall, Fence or Berm (Yes, No, Linear Feet)	No	No	No	No				
Remaining Perimeter Length								
Number of Plants Required								
Shade Trees	1:60	9	1:60	2	1:60	6	1:50	0
Evergreen Trees	-	-	-	-	-	-	-	-
Shrubs	-	-	-	-	-	-	-	-
Number of Plants Provided								
Shade Trees	1:60	9	1:60	2	1:60	6	1:50	0
Evergreen Trees	-	-	-	-	-	-	-	-
Shrubs	-	-	-	-	-	-	-	-

### OWNER/DEVELOPER

32-40 PARTNERSHIP  
c/o Harry B. Cooper and Associates  
10749 Falls Road, #202  
Lutherville, Maryland 21093-7013  
(410) 583-5540

### GRADING, SEDIMENT & EROSION CONTROLS, LANDSCAPING PLAN NOTES AND DETAILS

#### TERRAPIN PRESERVE

LOTS 1 THRU 5, BUILDABLE PRESERVATION PARCEL 'A' AND NON-BUILDABLE PRESERVATION PARCEL 'B'

TAX MAP 15 GRID II 3RD ELECTION DISTRICT

PARCEL 72 HOWARD COUNTY, MARYLAND

DESIGN BY: PS  
DRAWN BY: AT  
CHECKED BY: ZYF  
SCALE: 1"=50'  
DATE: June 9, 2008  
P.O. No.: 3223  
SHEET No.: 3 OF 5

**FSH Associates**  
Engineers Planners Surveyors  
8318 Forest Street, #300, Jct. 7043  
18410-750-2251 Fax: 410-750-7350  
E-mail: info@fsha.biz

NOTE: A Guardrail shall be installed at least three (3) feet from the edge of paving between the Use-in-Common driveway stations 1+62 and 5+50, see Howard County Design Manual Volume IV or SHA Details Manual For Types And Details.

APPROVED: HOWARD COUNTY DEPARTMENT OF PLANNING AND ZONING

*Chris Hamrick* 8/9/08  
CHIEF, DIVISION OF LAND DEVELOPMENT

REVIEWED FOR HOWARD SCD AND MPETS TECHNICAL REQUIREMENTS

*Jim Mues* 6/20/08  
DATE

USE IN COMMON REQUIREMENTS CONSERVATION SERVICE

THE DEVELOPMENT PLAN IS APPROVED FOR SOIL EROSION AND SEDIMENT CONTROL BY THE HOWARD SOIL CONSERVATION DISTRICT

*John R. Whitson* 6/20/08  
HOWARD SCD

ENGINEERS CERTIFICATE

I CERTIFY THAT THIS PLAN FOR SEDIMENT AND EROSION CONTROL REPRESENTS A PRACTICAL AND WORKABLE PLAN BASED ON MY PERSONAL KNOWLEDGE OF THE SITE CONDITIONS AND THAT IT WAS PREPARED IN ACCORDANCE WITH THE REQUIREMENTS OF THE HOWARD SOIL CONSERVATION DISTRICT.


*Zacharia Y. Fisch* 6/12/08  
SIGNATURE OF ENGINEER DATE  
ZACHARIA Y. FISCH

DEVELOPER'S CERTIFICATE


I/WE CERTIFY THAT ALL DEVELOPMENT AND CONSTRUCTION WILL BE DONE ACCORDING TO THIS PLAN FOR SEDIMENT AND EROSION CONTROL, AND THAT ALL RESPONSIBLE PERSONNEL INVOLVED IN THE CONSTRUCTION PROJECT WILL HAVE A CERTIFICATE OF ATTENDANCE AT A DEPARTMENT OF THE ENVIRONMENT APPROVED TRAINING PROGRAM FOR THE CONTROL OF SEDIMENT AND EROSION BEFORE BEGINNING THE PROJECT. I ALSO AUTHORIZE PERIODIC ON-SITE INSPECTION BY THE HOWARD SOIL CONSERVATION DISTRICT.

*Stephen M. Cooper* 6/12/08  
SIGNATURE OF DEVELOPER DATE



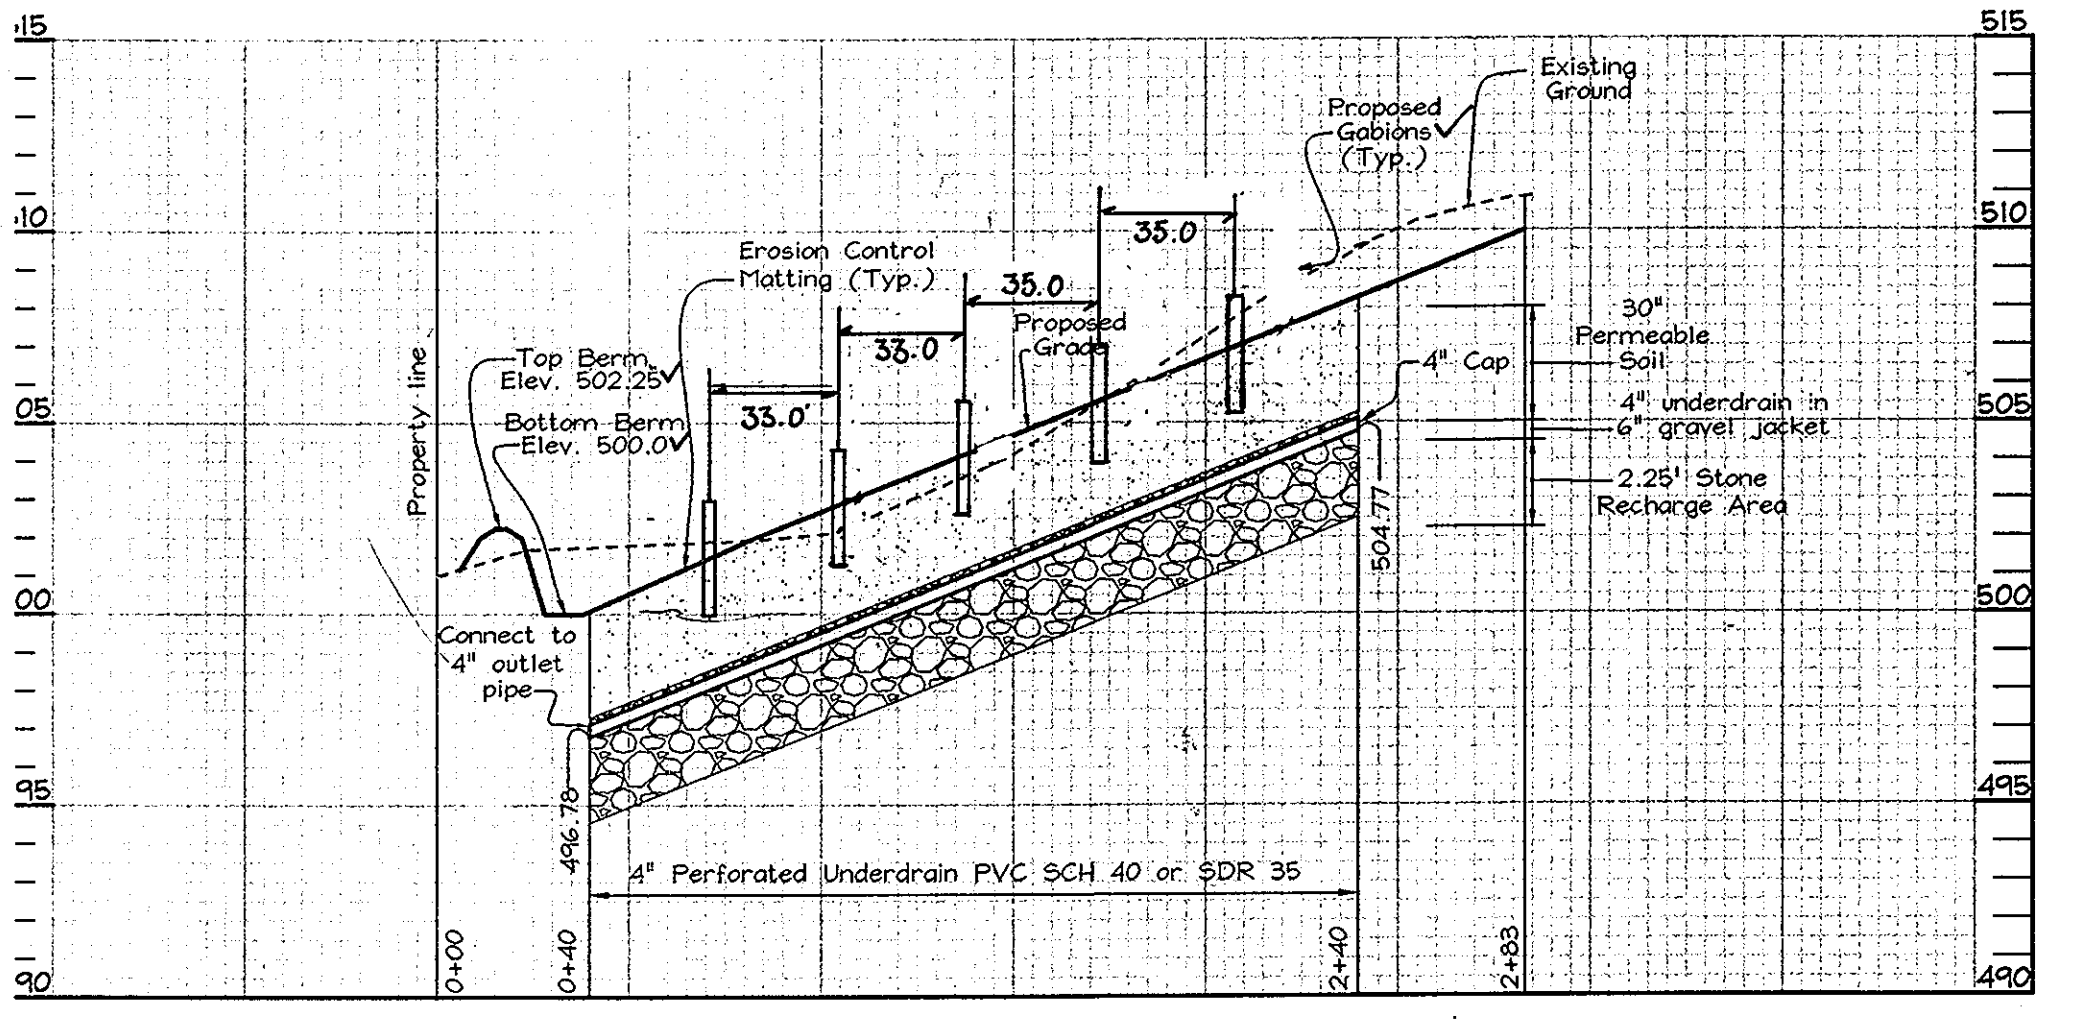

**WATER QUALITY (WQV) DRY SWALE/UNDERDRAIN PROFILE SECTION A-A**  
 SCALE: Horizontal: 1"=50'  
 Vertical: 1"=5'

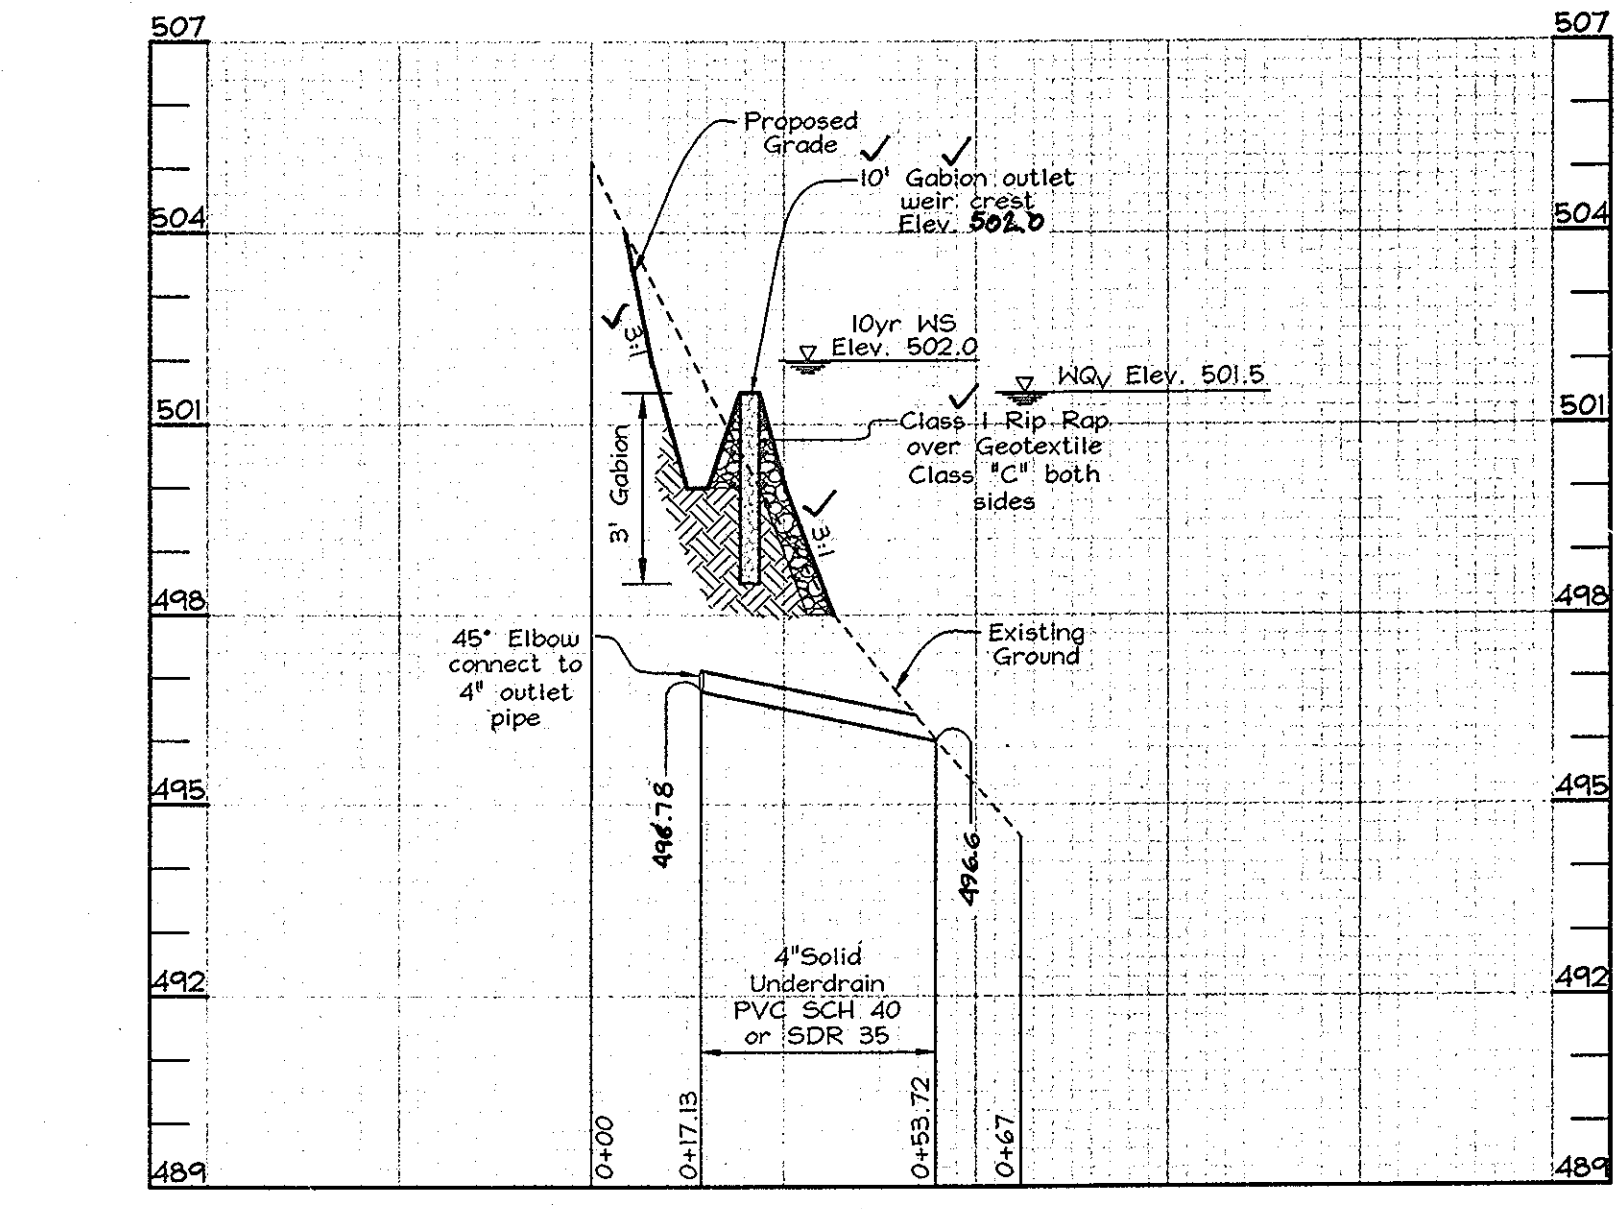


**WATER QUALITY (WQV) DRY SWALE PROFILE SECTION B-B @ OUTFALL PIPE**  
 SCALE: Horizontal: 1"=30'  
 Vertical: 1"=3'




**SEQUENCE OF CONSTRUCTION**

1. Obtain grading permit and contact Howard County Sediment Control Inspector (SCI) to arrange a pre-construction meeting. (1 Day)
2. Install Stabilized Construction Entrance. (1 Day)
3. Clear and grub as necessary for installation of sediment controls. (3 Days)
4. Install super-silt fence in locations shown. (2 Days)
5. Grade shared driveway to sub-grade and grade Dry Swale facility. (2 Weeks)
6. Install gravel trench, under drain, dewatering stand pipe, gabion check dams and rip rap outlet for Dry Swale facility. (1 Week)
7. Install Grass Channel and gabion check dams on west side of shared driveway. (1 Week)
8. Fine grade and pave shared driveways and stabilize all disturbed areas with seed and mulch. (2 Weeks)
9. With permission of SCI, remove super silt fences and stabilize those areas.

NOTE: Stockpiling of soil will not be permitted on site.

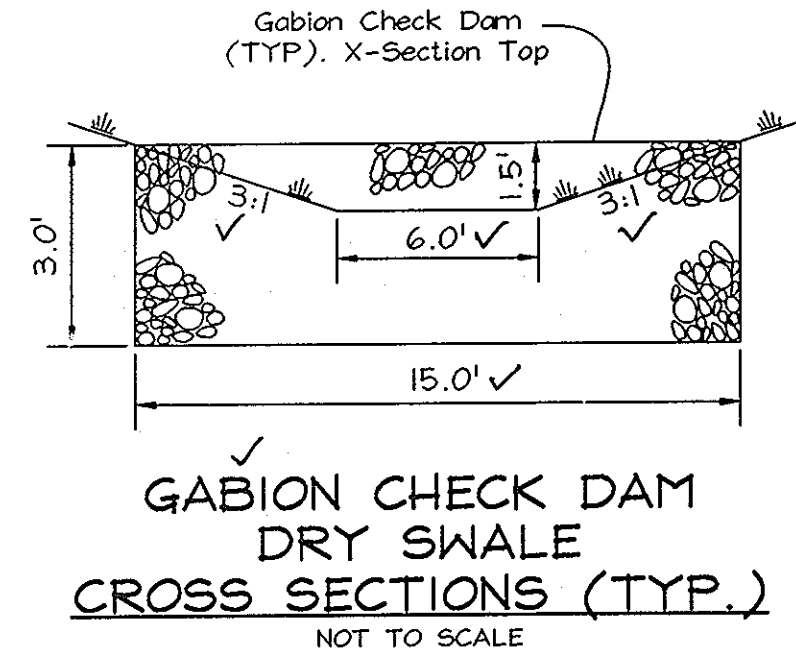

**GABION CHECK DAM DRY SWALE CROSS SECTIONS (TYP.)**  
 NOT TO SCALE

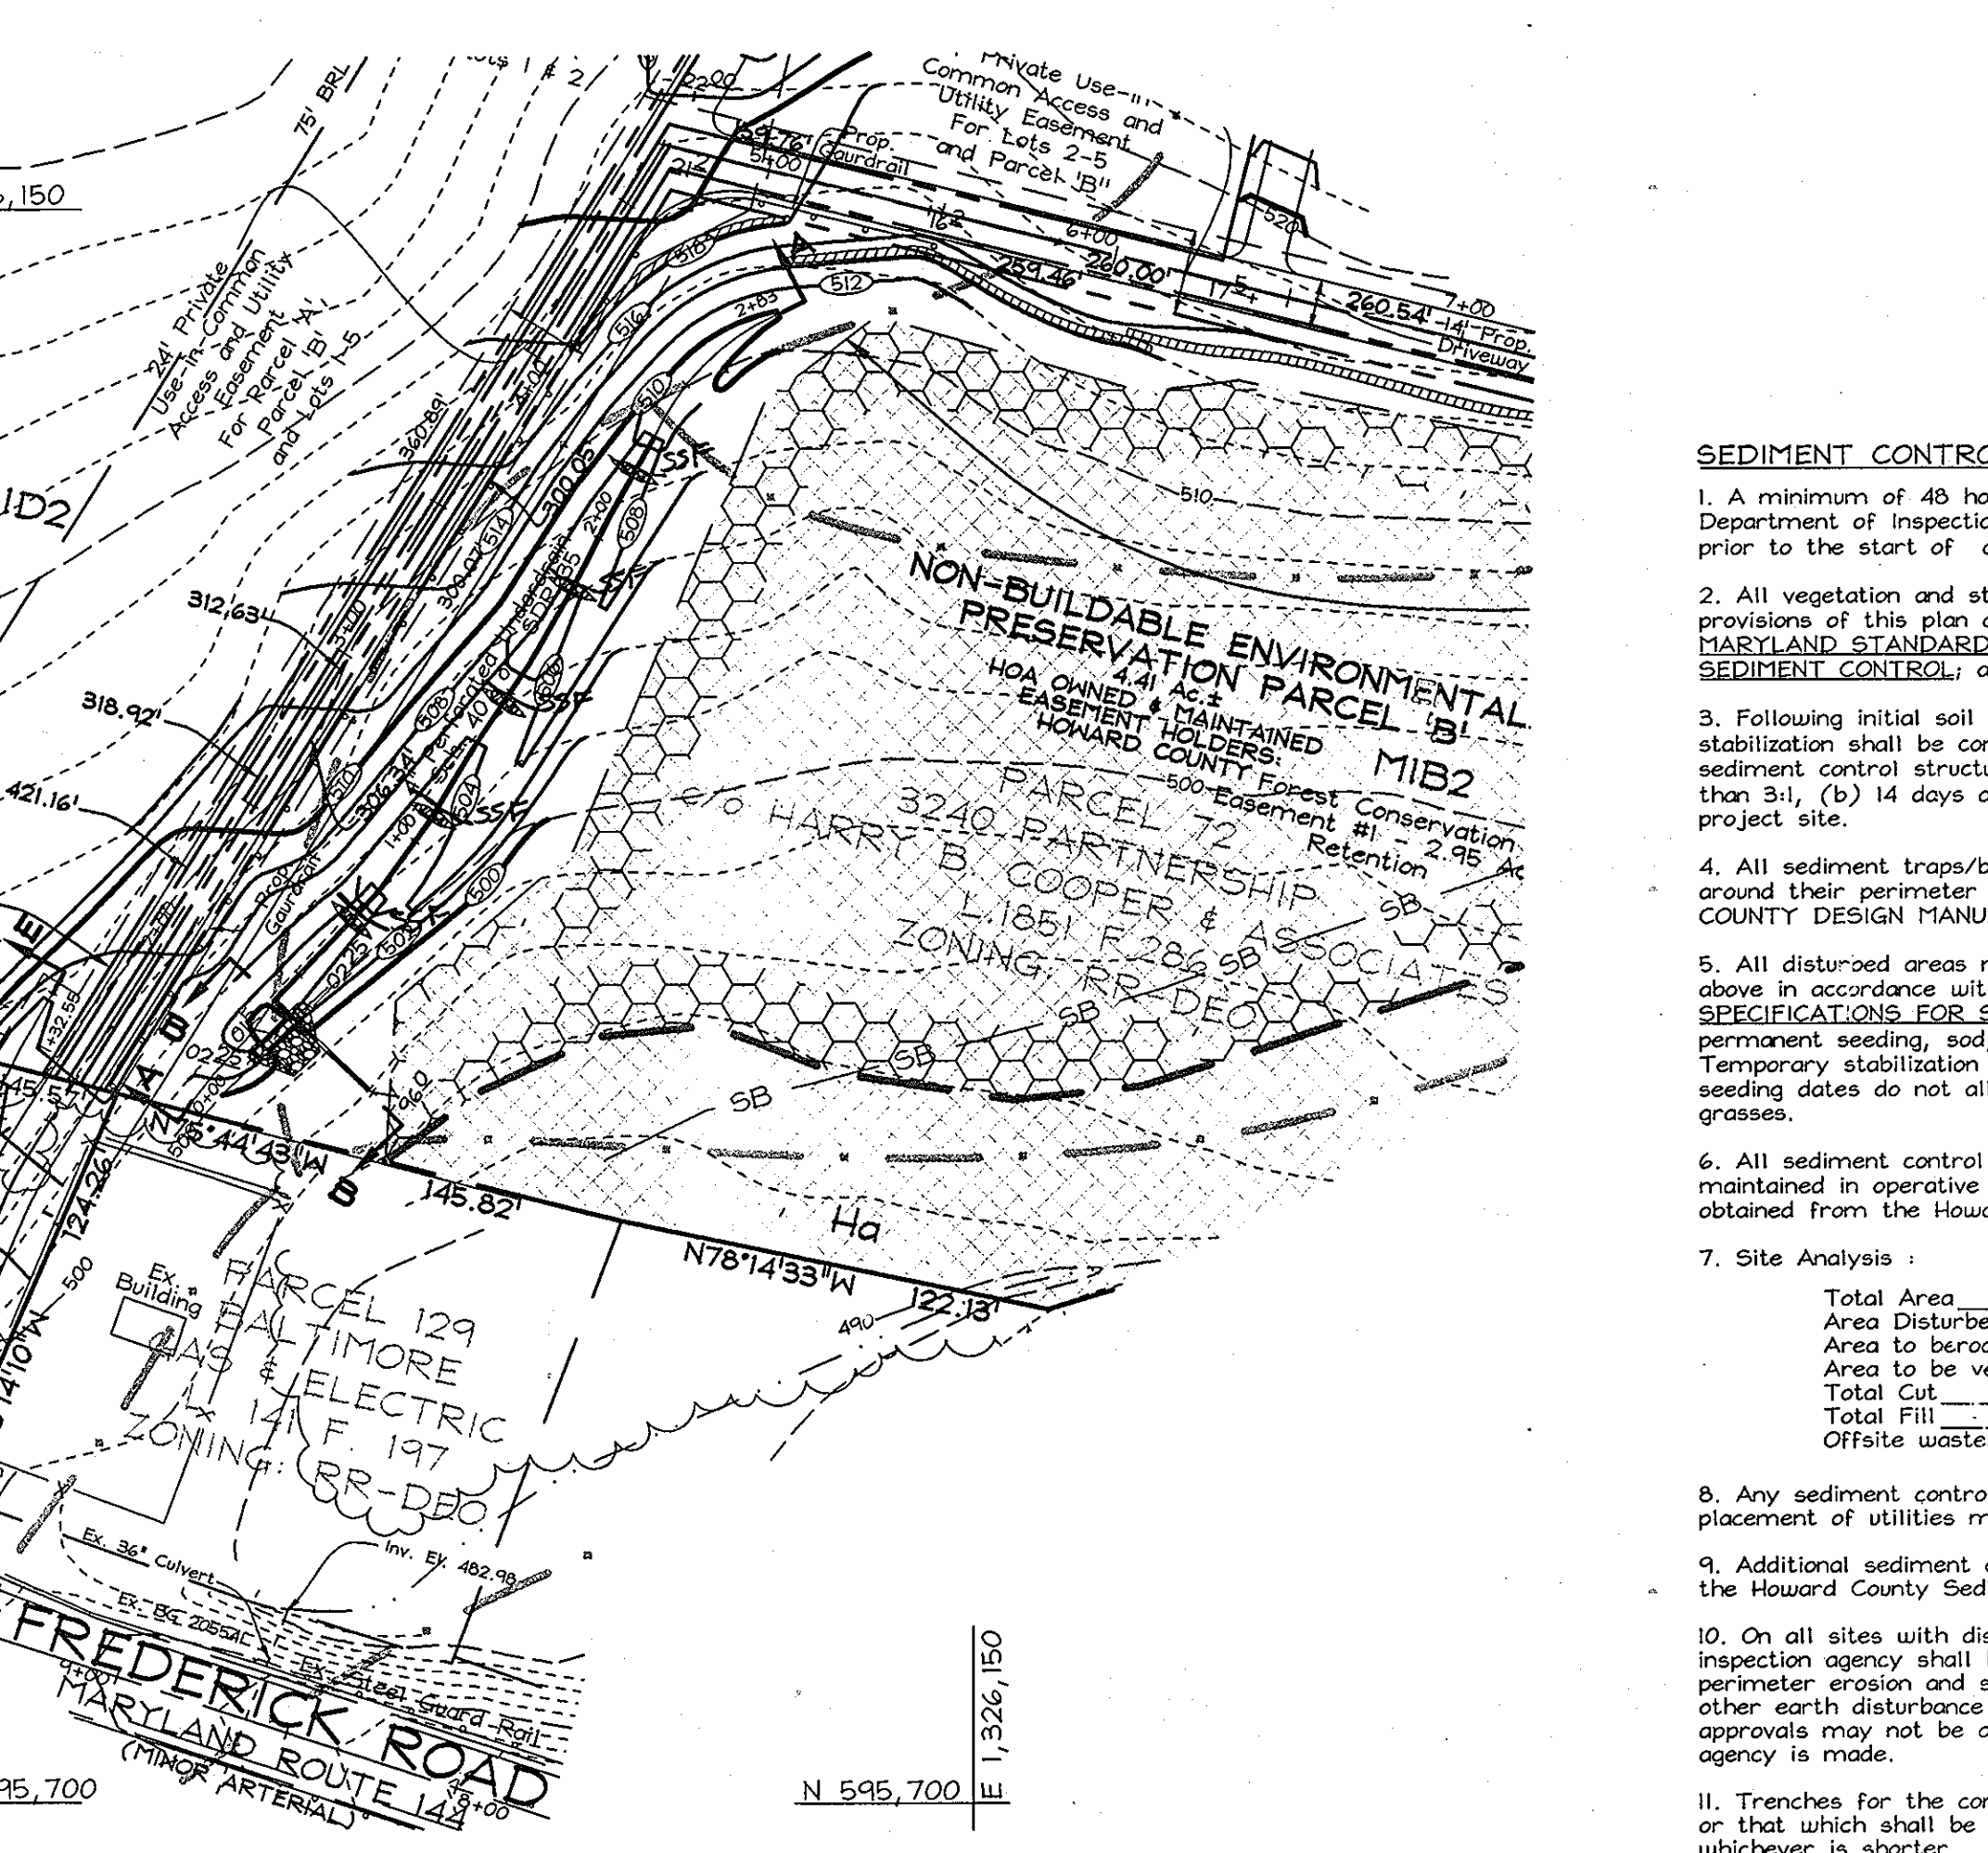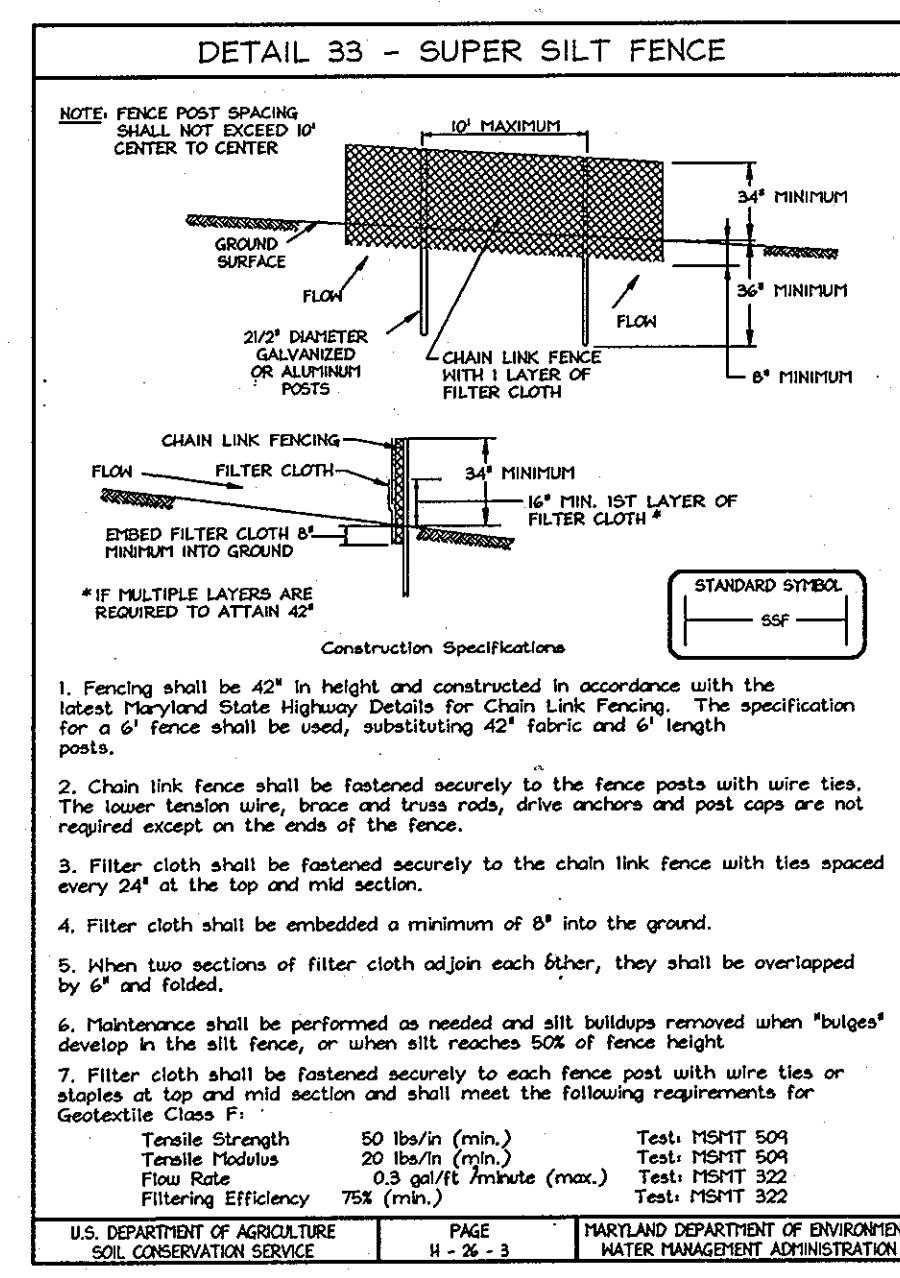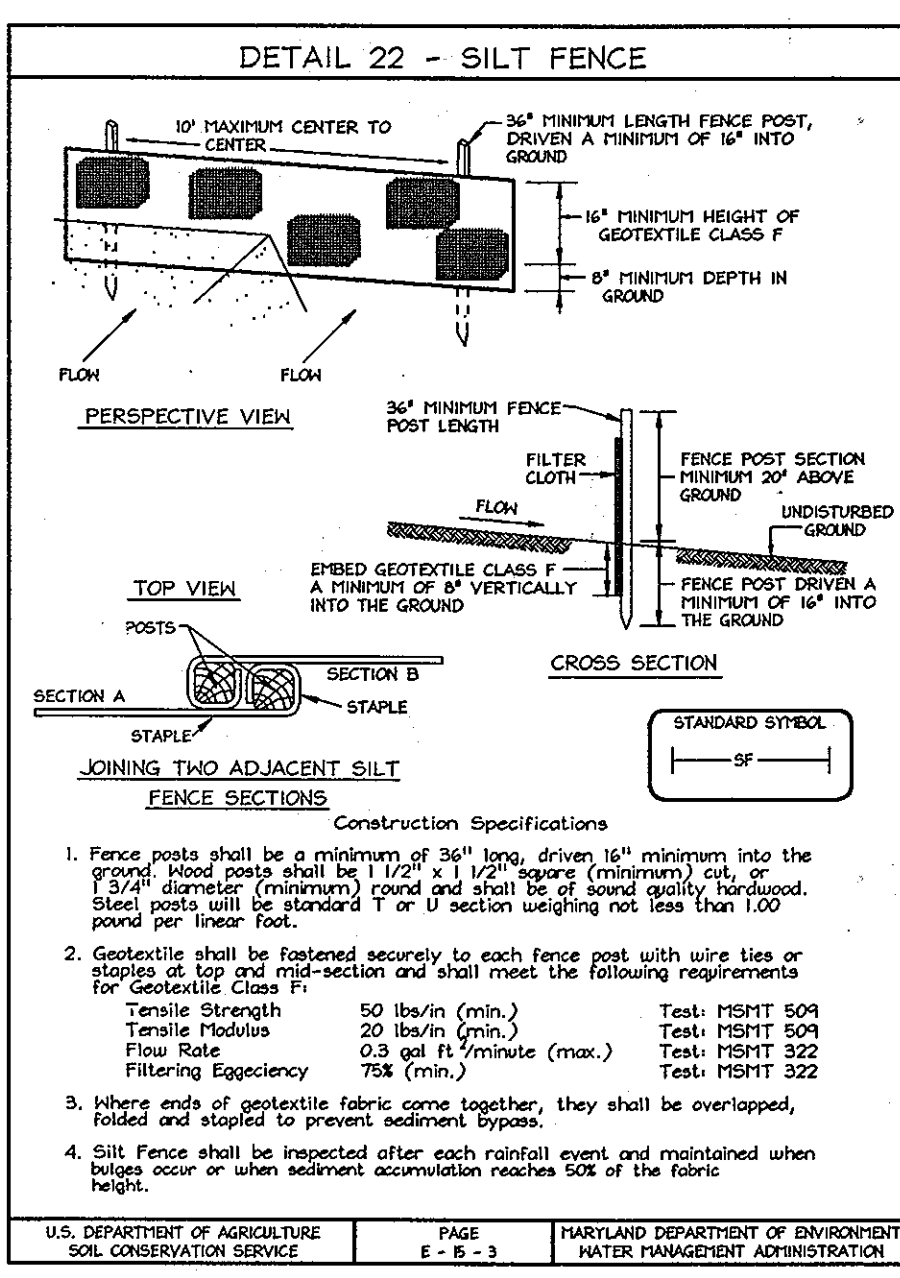

**DRY SWALE PLAN VIEW**  
 SCALE: 1"=50'

**SEDIMENT CONTROL NOTES**

1. A minimum of 48 hours notice must be given to the Howard County Department of Inspection, License and Permits Sediment Control Division prior to the start of any construction (410-315-1055).
2. All vegetation and structural practices are to be installed according to the provisions of this plan and are to be in conformance with the 1934 MARYLAND STANDARDS AND SPECIFICATIONS FOR SOIL EROSION AND SEDIMENT CONTROL; and revisions thereto.
3. Following initial soil disturbance or redistribution, permanent or temporary stabilization shall be completed within: (a) 7 calendar days for all perimeter sediment control structures, dikes, perimeter slopes, and all slopes greater than 3:1, (b) 14 days as to all other disturbed or graded areas on the project site.
4. All sediment traps/basins shown must be fenced and warning signs posted around their perimeter in accordance with Vol. 1, Chapter 7, HOWARD COUNTY DESIGN MANUAL, Storm Drainage.
5. All disturbed areas must be stabilized within the time period specified above in accordance with the 1934 MARYLAND STANDARDS AND SPECIFICATIONS FOR SOIL EROSION AND SEDIMENT CONTROL for permanent seeding, sod, temporary seeding, and mulching (Sec. G). Temporary stabilization with mulch alone shall be done when recommended seeding dates do not allow for proper germination and establishment of grasses.
6. All sediment control structures are to remain in place and are to be maintained in operative condition until permission for their removal has been obtained from the Howard County Sediment Control Inspector.
7. Site Analysis:
 

Total Area	14.71 Acres
Area Disturbed	6.28 Acres
Area to beurfed or paved	1.21 Acres
Area to be vegetatively stabilized	5.05 Acres
Total Fill	4,115.53 CY
Offsite waste/borrow area location	#2
8. Any sediment control practice which is disturbed by grading activity for placement of utilities must be repaired on the same day of disturbance.
9. Additional sediment controls must be provided, if deemed necessary by the Howard County Sediment Control Inspector.
10. On all sites with disturbed areas in excess of 2 acres, approval of the inspection agency shall be requested upon completion of installation of perimeter erosion and sediment controls, but before proceeding with any other earth disturbance or grading. Other building or grading inspection approvals may not be authorized until this initial approval by the inspection agency is made.
11. Trenches for the construction of utilities is limited to three pipe lengths or that which shall be back-filled and stabilized within one working day, whichever is shorter.

\* Earthwork quantities are solely for the purpose of calculating fees. Contractor to verify all quantities prior to the start of construction.  
 \*\* To be determined by contractor, with pre-approval of the Sediment Control Inspector with an approved and active grading permit.

**21.0 STANDARDS AND SPECIFICATIONS FOR TOPSOIL**

**Definition**  
 Placement of topsoil over a prepared subsoil prior to establishment of permanent vegetation.

**Purpose**  
 To provide a suitable soil medium for vegetable growth. Soils of concern have low moisture content, low nutrient levels, low pH, materials toxic to plants, and/or unacceptable soil gradation.

**Conditions Where Practice Applies**  
 I. This practice is limited to areas having 2:1 or flatter slopes where:  
 a. The texture of the exposed subsoil/parent material is not adequate to produce vegetative growth.  
 b. The soil material is so shallow that the rooting zone is not deep enough to support plants or furnish continuing supplies of moisture and plant nutrients.  
 c. The original soil to be vegetated contains material toxic to plant growth.  
 d. The soil is so acidic that treatment with limestone is not feasible.

II. For the purpose of these Standards and Specifications, areas having slopes steeper than 2:1 require special consideration and design for adequate stabilization. Areas having slopes steeper than 2:1 shall have the appropriate stabilization shown on the plans.

**Construction and Material Specifications**  
 I. Topsoil salvaged from the existing site may be used provided that it meets the standards as set forth in these specifications. Typically, the depth of topsoil to be salvaged for a given soil type can be found in the representative soil profile section in the Soil Survey published by USDA-SCS in cooperation with Maryland Agricultural Experimental Station.  
 II. Topsoil Specifications - Soil to be used as topsoil must meet the following:  
 i. Topsoil shall be a loam, sandy loam, clay loam, silt loam, sandy clay loam, loamy sand. Other soils may be used if recommended by an agronomist or a soil scientist and approved by the appropriate approval authority. Regardless, topsoil shall not be a mixture of contrasting textured subsoils and shall contain less than 5% by volume of cinders, stones, slag, coarse fragments of gravel, sticks, roots, trash, or other materials larger than 1 and 1/2" in diameter.  
 ii. Topsoil must be free of plants or plant parts such as Bermuda grass, quackgrass, Johnsongrass, nutgrass, poison ivy, thistle, or others as specified.  
 iii. Where the subsoil is either highly acidic or composed of heavy clays, ground limestone shall be spread at the rate of 4-8 tons/acre (200-400 pounds per 1,000 square feet) prior to the placement of topsoil. Lime shall be distributed uniformly over designated areas and worked into the soil in conjunction with tillage operations as described in the following paragraphs.  
 iv. Topsoil shall not be placed while the topsoil or subsoil is in a frozen or muddy condition, when the subsoil is excessively wet or in a condition that may otherwise be detrimental to proper grading and seedbed preparation.

III. For sites having disturbed areas under 5 acres:  
 i. Place topsoil (if required) and apply soil amendments as specified in 20.0 Vegetative Stabilization - Section I - Vegetative Stabilization Methods and Materials.  
 ii. For sites having disturbed areas over 5 acres:  
 i. On soil meeting topsoil specifications, obtain test results dictating fertilizer and lime amendments required to bring the soil into compliance with the following:  
 a. pH for topsoil shall be between 6.0 and 7.5. If the tested soil demonstrates a pH of less than 6.0, sufficient lime shall be prescribed to raise the pH to 6.5 or higher.  
 b. Organic content of topsoil shall be not less than 1.5 percent by weight.  
 c. Topsoil having soluble salt content greater than 500 parts per million shall not be used.  
 d. No sod or seed shall be placed on soil soil which has been treated with soil sterilants or chemicals used for weed control until sufficient time has elapsed (14 days min.) to permit dissipation of phytotoxic materials.  
 NOTE: Topsoil substitutes or amendments, as recommended by a qualified agronomist or soil scientist and approved by the appropriate approval authority, may be used in lieu of natural topsoil.  
 ii. Place topsoil (if required) and apply soil amendments specified in 20.0 Vegetative Stabilization - Section I - Vegetative Stabilization Methods and Materials.  
 V. Topsoil Application  
 i. When topsoiling, maintain needed erosion and sediment control practices such as diversions, Grade Stabilization Structures, Earth Dikes, Slope Silt Fence and Sediment Traps and Basins.  
 ii. Grades on the areas to be topsoiled, which have been previously established, shall be maintained, albeit 4"-8" higher in elevation.  
 iii. Topsoil shall be uniformly distributed in a 4"-8" layer and lightly compacted to a minimum thickness of 4". Spreading shall be performed in such a manner that sodding or seeding can proceed with a minimum of additional soil preparation and tillage. Any irregularities in the surface resulting from topsoiling or other operations shall be corrected in order to prevent the formation of depressions or water pockets.  
 iv. Topsoil shall not be placed while the topsoil or subsoil is in a frozen or muddy condition, when the subsoil is excessively wet or in a condition that may otherwise be detrimental to proper grading and seedbed preparation.

**PERMANENT SEEDING NOTES**

APPLY TO GRADED OR CLEARED AREAS NOT SUBJECT TO IMMEDIATE FURTHER DISTURBANCE WHERE A PERMANENT LONG-LEVED VEGETATIVE COVER IS NEEDED.

**SEEDBED PREPARATION:** Loosen upper three inches of soil by raking, discing or other acceptable means before seeding, if not previously loosened.

**SOIL AMENDMENTS:** In lieu of soil test recommendations, use one of the following schedules:

- 1) Preferred - Apply 2 tons per acre dolomitic limestone (92 lbs/1000 sq.ft.) and 600 lbs per acre 10-10-10 fertilizer (14 lbs/1000 sq.ft.) before seeding. Harrow or disc into upper three inches of soil. Use 2 tons of limestone, apply 400 lbs per acre 30-0-0 ureaform fertilizer (9 lbs/1000 sq.ft.).
- 2) Acceptable - Apply 2 tons per acre dolomitic limestone (92 lbs/1000 sq.ft.) and apply 1000 lbs per acre 10-10-10 fertilizer (23 lbs/1000 sq.ft.) before seeding. Harrow or disc into upper three inches of soil.

**SEEDING:** For the periods March 1 thru April 30, and August 1 thru October 15, seed with 60 lbs per acre (14 lbs/1000 sq.ft.) of Kentucky 31 Tall Fescue. For the periods May 1 thru July 31, seed with 60 lbs Kentucky 31 Tall Fescue per acre and 2 lbs per acre (0.05 lbs/1000 sq.ft.) of weeping lovegrass. During the period of October 16 thru February 28, protect site by:  
 Option (1) 2 tons per acre well anchored straw mulch and seed as soon as possible in the spring. Option (2) Use sod. Option (3) Seed with 60 lbs/acre Kentucky 31 Tall Fescue and mulch with 2 tons/acre well anchored straw.

**MULCHING:** Apply 1 1/2 to 2 tons per acre (70 to 90 lbs/1000 sq.ft.) of unrotted small grain straw immediately after seeding. Anchor mulch immediately after application using mulch anchoring tool or 218 gallons per acre (5 gal/1000 sq.ft.) of emulsified asphalt on flat areas. On slopes 8 feet or higher, use 348 gallons per acre (8 gal/1000 sq.ft.) for anchoring.

**MAINTENANCE:** Inspect all seeded areas and make needed repairs, replacements and reseeds.

**TEMPORARY SEEDING NOTES**

**SEEDBED PREPARATION:** Loosen upper three inches of soil by raking, discing or other acceptable means before seeding, if not previously loosened.

**SOIL AMENDMENTS:** Apply 600 lbs per acre 10-10-10 fertilizer (14 lbs/1000 sq.ft.).

**SEEDING:** For periods March 1 thru April 30 and from August 15 thru November 15, seed with 2 1/2 bushel per acre of annual rye (3.2 lbs/1000 sq.ft.) For the period May 1 thru August 15, seed with 3 lbs per acre of weeping lovegrass (0.07 lbs/1000 sq.ft.). For the period November 1 thru February 28, protect site by applying 2 tons per acre of well anchored straw mulch and seed as soon as possible in the spring, or use sod.

**MULCHING:** Apply 1 1/2 to 2 tons per acre (70 to 90 lbs/1000 sq.ft.) of unrotted small grain straw immediately after seeding. Anchor mulch immediately after application using mulch anchoring tool or 218 gallons per acre (5 gal/1000 sq.ft.) of emulsified asphalt on flat areas. On slopes 8 feet or higher, use 348 gallons per acre (8 gal/1000 sq.ft.) for anchoring.

REFER TO THE 1934 MARYLAND STANDARDS AND SPECIFICATIONS FOR SOIL EROSION AND SEDIMENT CONTROL FOR RATE AND METHODS NOT COVERED.

**OWNER/DEVELOPER**

32-40 PARTNERSHIP  
 c/o Harry B. Cooper and Associates  
 10749 Falls Road, #202  
 Lutherville, Maryland 21093-7013  
 (410) 583-5540

**SEDIMENT & EROSION CONTROL NOTES, DETAILS AND DRY SWALE PROFILES**  
**TERRAPIN PRESERVE**  
 LOTS 1 THRU 5, BUILDABLE PRESERVATION PARCEL 'A' AND NON-BUILDABLE PRESERVATION PARCEL 'B'  
 TAX MAP 15 GRID II PARCEL 72  
 3RD ELECTION DISTRICT HOWARD COUNTY, MARYLAND

I HEREBY CERTIFY THAT THE FACILITY SHOWN ON THIS PLAN WAS CONSTRUCTED AS SHOWN ON THE AS-BUILT PLANS AND MEETS WITH THE APPROVED EROSION SPECIFICATIONS.

DESIGN BY: PS  
 DRAWN BY: AY  
 CHECKED BY: ZYF  
 SCALE: As shown  
 DATE: June 9, 2023  
 H.O. No.: 3029  
 SHEET No.: 1 OF 5

**FSH Associates**  
 Engineers Planners Surveyors  
 8318 Forrest Street Elliott City, MD 21043  
 Tel: 410-750-2251 Fax: 410-750-7350  
 E-mail: info@fsha.biz

APPROVED: HOWARD COUNTY DEPARTMENT OF PLANNING AND ZONING

*Chad Hamilton* 6/1/06  
 CHIEF, DEVELOPMENT ENGINEERING DIVISION DATE

*Chad Hamilton* 6/1/06  
 CHIEF, DIVISION OF LAND DEVELOPMENT DATE

REVIEWED FOR HOWARD SCD AND MEETS TECHNICAL REQUIREMENTS

*Jim Myers* 6/20/06  
 USA - NATURAL RESOURCES CONSERVATION SERVICE DATE

*John R. Roberts* 6/20/06  
 THE DEVELOPMENT PLAN IS APPROVED FOR SOIL EROSION AND SEDIMENT CONTROL BY THE HOWARD SOIL CONSERVATION DISTRICT  
 HOWARD SCD DATE

**ENGINEER'S CERTIFICATE**

"I CERTIFY THAT THIS PLAN FOR SEDIMENT AND EROSION CONTROL REPRESENTS A PRACTICAL AND WORKABLE PLAN BASED ON MY PERSONAL KNOWLEDGE OF THE SITE CONDITIONS AND THAT IT WAS PREPARED IN ACCORDANCE WITH THE REQUIREMENTS OF THE HOWARD SOIL CONSERVATION DISTRICT."

*Zacharia Y. Fisch* 6/12/06  
 SIGNATURE OF ENGINEER DATE  
 ZACHARIA Y. FISCH

**DEVELOPER'S CERTIFICATE**


"I/WE CERTIFY THAT ALL DEVELOPMENT AND CONSTRUCTION WILL BE DONE ACCORDING TO THIS PLAN FOR SEDIMENT AND EROSION CONTROL AND THAT ALL RESPONSIBLE PERSONNEL INVOLVED IN THE CONSTRUCTION PROJECT WILL HAVE A CERTIFICATE OF ATTENDANCE AT A DEPARTMENT OF THE ENVIRONMENT APPROVED TRAINING PROGRAM FOR THE CONTROL OF SEDIMENT AND EROSION BEFORE BEGINNING THE PROJECT. I ALSO AUTHORIZE PERIODIC ON-SITE INSPECTION BY THE HOWARD SOIL CONSERVATION DISTRICT."

*William M. Cooper* 6/12/06  
 SIGNATURE OF DEVELOPER DATE

HOWARD COUNTY DEPARTMENT OF PLANNING AND ZONING

*William M. Cooper* 7/14/16  
 DATE



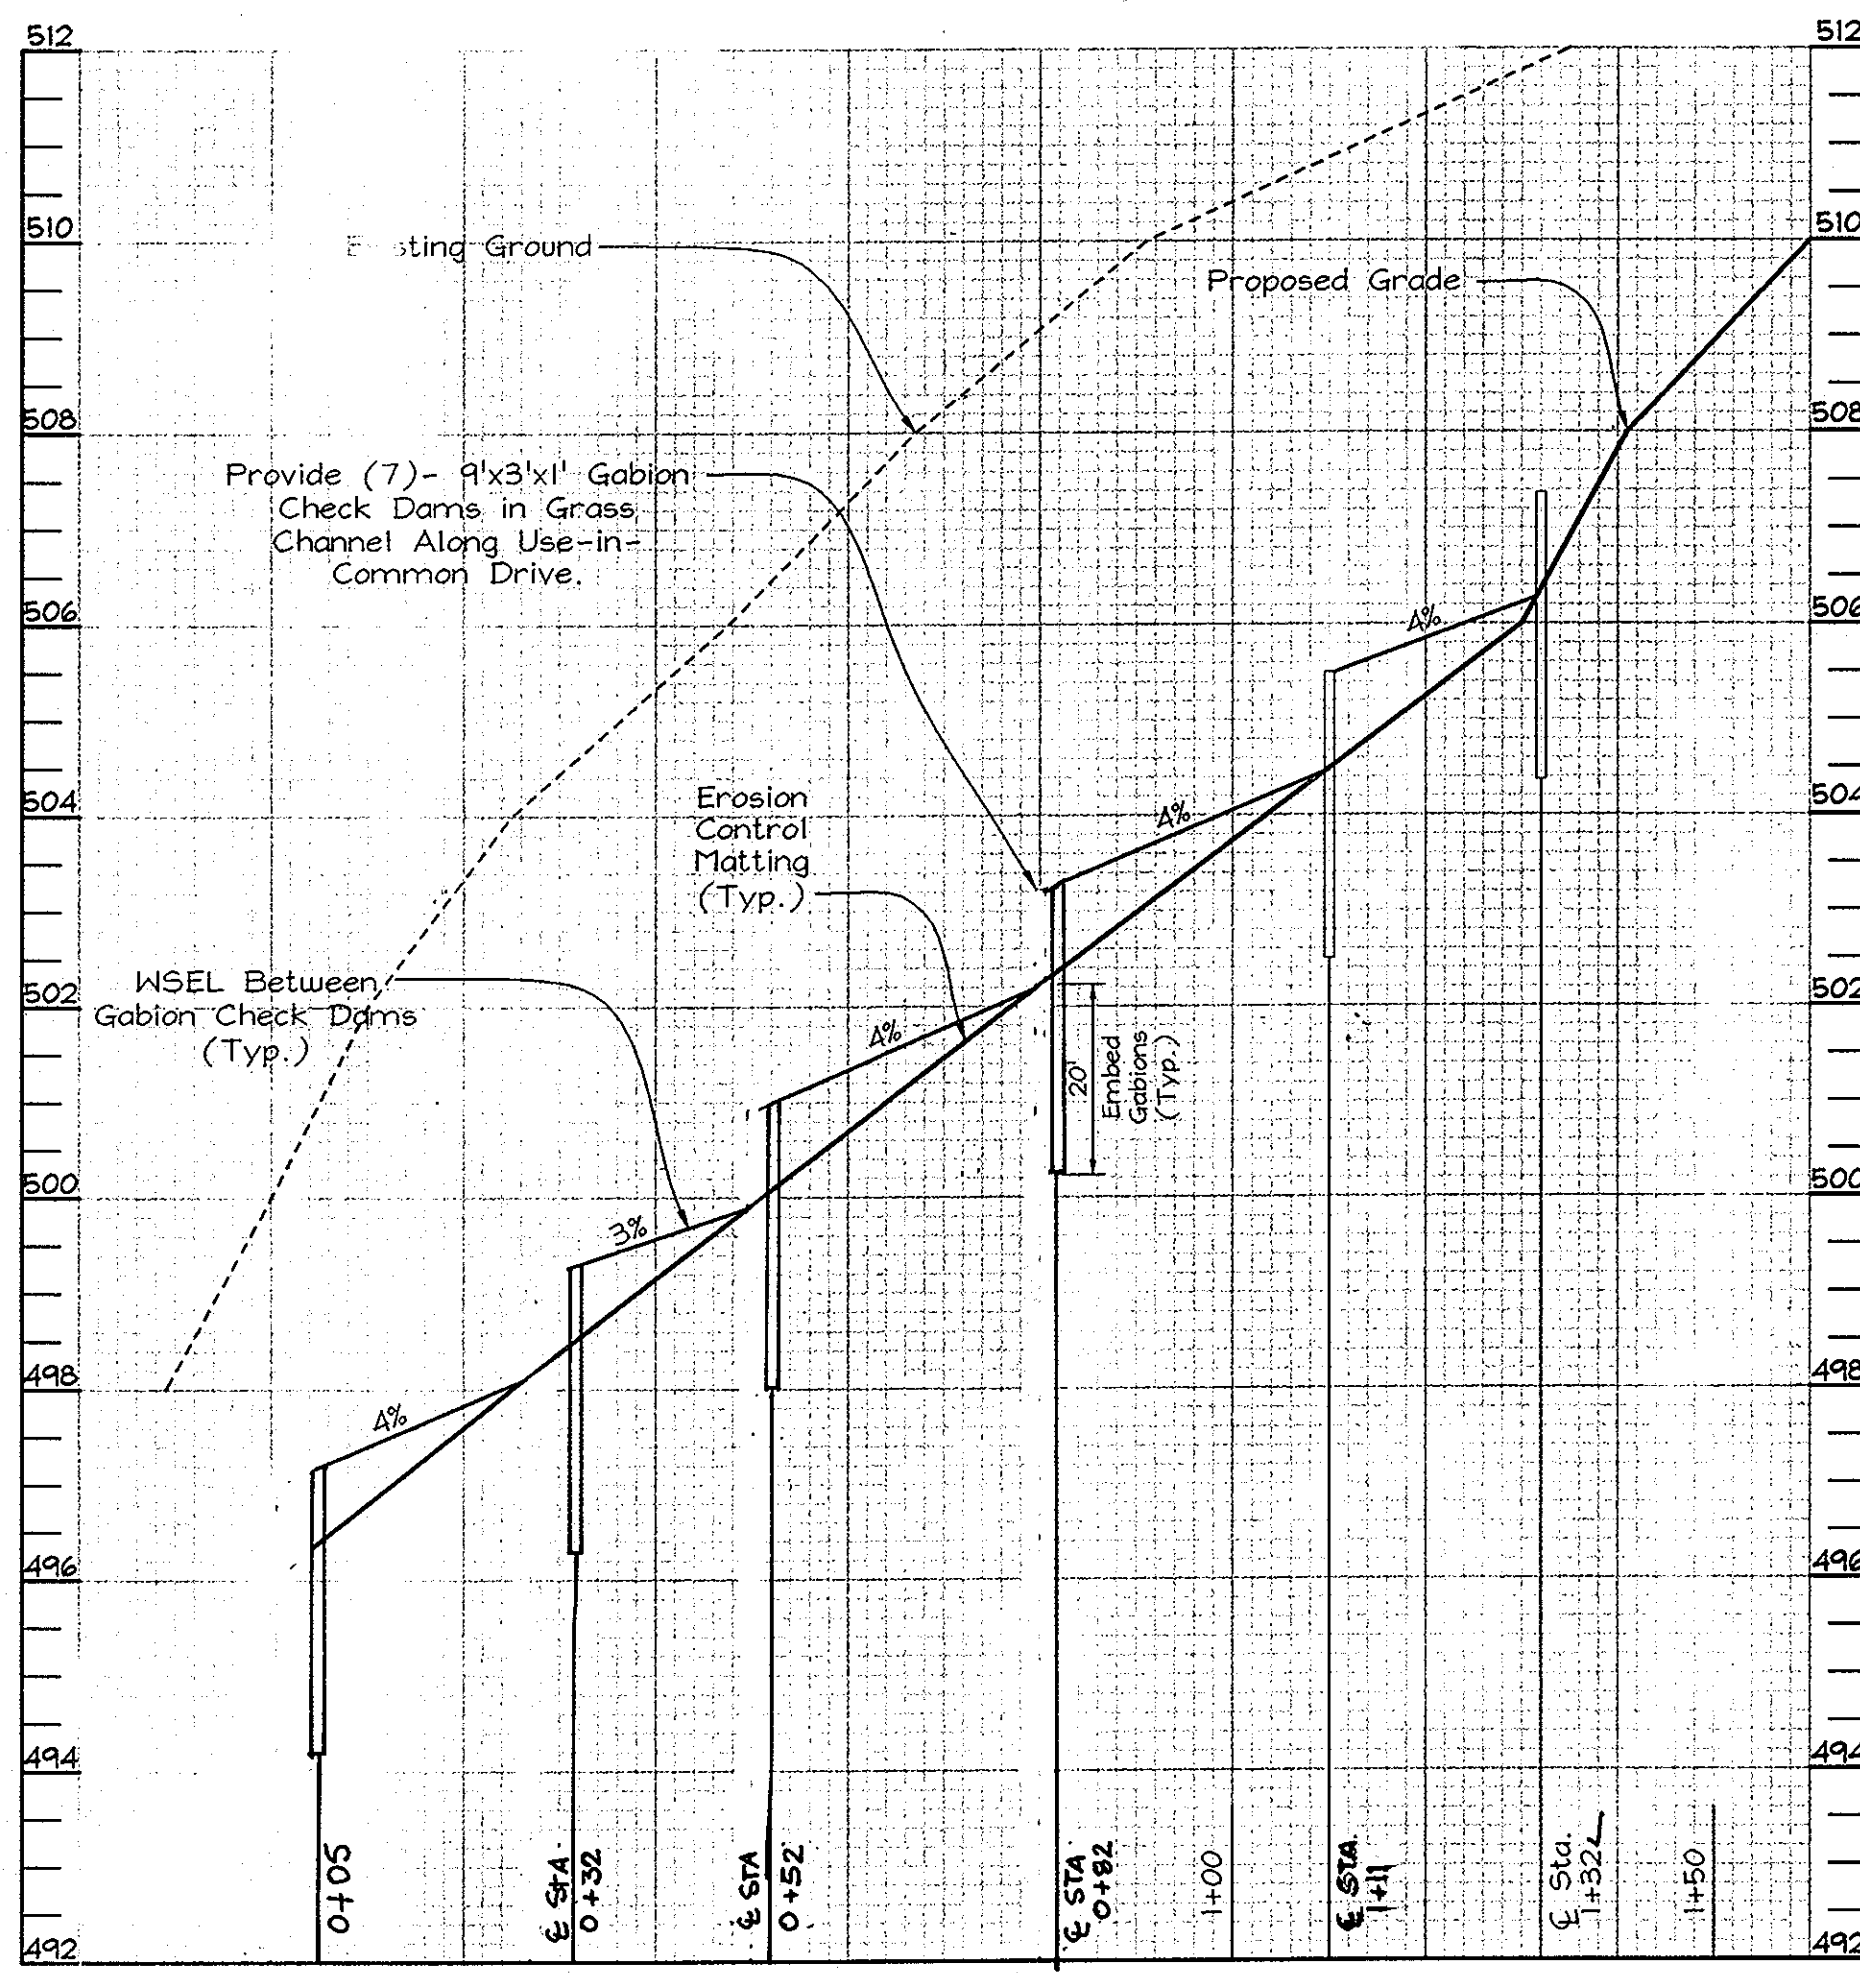

WATER QUALITY (WQv) GRASS CHANNEL PROFILE SECTION E-E  
SCALE: Horizontal: 1"=20'  
Vertical: 1"=2'


STORMWATER MANAGEMENT SUMMARY TABLE					
CATEGORY	DA-1	DA-2A	DA-2B	DA-3	COMMENTS
CHANNEL PROTECTION VOLUME (C <sub>pv</sub> )	N/A	N/A	N/A	N/A	01 < 2cfs for each DA
WATER QUALITY VOLUME (WQ <sub>v</sub> ) Required/Provided	N/A	0.0465 ac-ft	0.036 ac-ft	0.054 ac-ft	See Note No.2
RECHARGE VOLUME/AREA (Rev./Rea) Required/Provided		0.04 ac-ft/ 0.38 ac			See Note No.3
OVERBANK FLOOD STORAGE (O <sub>f</sub> )	N/A	N/A			Not Required by Howard County
EXTREME FLOOD VOLUME (E <sub>f</sub> )	N/A	N/A			Not Required by Howard County

NOTES:  
 1. Channel protection volume (C<sub>pv</sub>) is not required since developed runoff does not exceed 2.0 cfs for each drainage area.  
 2. The water quality volume (WQ<sub>v</sub>) is not required for DA-1 since no development of impervious area is planned. WQ<sub>v</sub> for Drainage Area 2A is provided within an engineered Dry Swale structure. WQ<sub>v</sub> for DA-3 is provided by grass channel credit. Water quality volume (WQ<sub>v</sub>) provided by sheet flow to buffer credits for the impervious area generated by lots 2 thru 5 and the shared driveway. The remaining area is credited as Natural Area Conservation Easement.  
 3. Proposed management of recharge volume/area (Rev/ Rea) will be provided in a gravel chamber beneath the Dry Swale structure for DA-2A and by grass channel credit treatment for DA-3. DA-1 has no impervious area and does not require treatment. DA-2B impervious area is treated by sheet flow to buffer credit.  
 4. Overbank and extreme flood storage volume is not required for this site.


OPEN CHANNEL SYSTEMS AND FILTER STRIP MATERIALS SPECIFICATIONS			
MATERIAL	SPECIFICATION	SIZE	NOTES
Dry swale soil	USCS: ML; SM; SC	N/A	Soil with a higher percentage organic content is preferred
Underdrain gravel	AASHTO M-43	0.25" to 0.75"	
Underdrain	F 750 Type PS 20 or AASHTO M-278	4" to 6" rigid schedule 40 PVC or SDR 35	3/8" perf. @ 6" on center, 4 holes per row; minimum of 3" of gravel over pipes; not necessary under mesh pipes
Geotextile	Class 'C' - apparent opening size (ASTM-D-4751), grab tensile strength (ASTM-D-4632), puncture resistance (ASTM-D-4833)	N/A	

OPERATION AND MAINTENANCE SCHEDULE FOR DRY SWALE (PRIVATELY OWNED AND MAINTAINED) (O-1)


1. Mow grass swale during growing season to maintain vegetation height of 4"-6".
2. Sediment build-up within the bottom of the channel to be removed when sediment has accumulated to 25% of the WQ<sub>v</sub>.

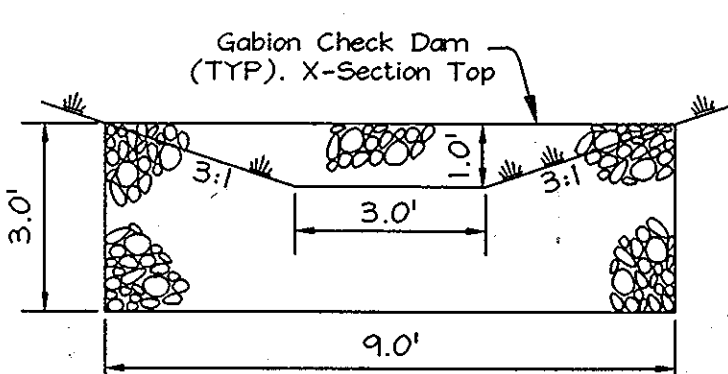


GABION CHECK DAM GRASS CHANNEL CROSS SECTIONS (TYP.) NOT TO SCALE

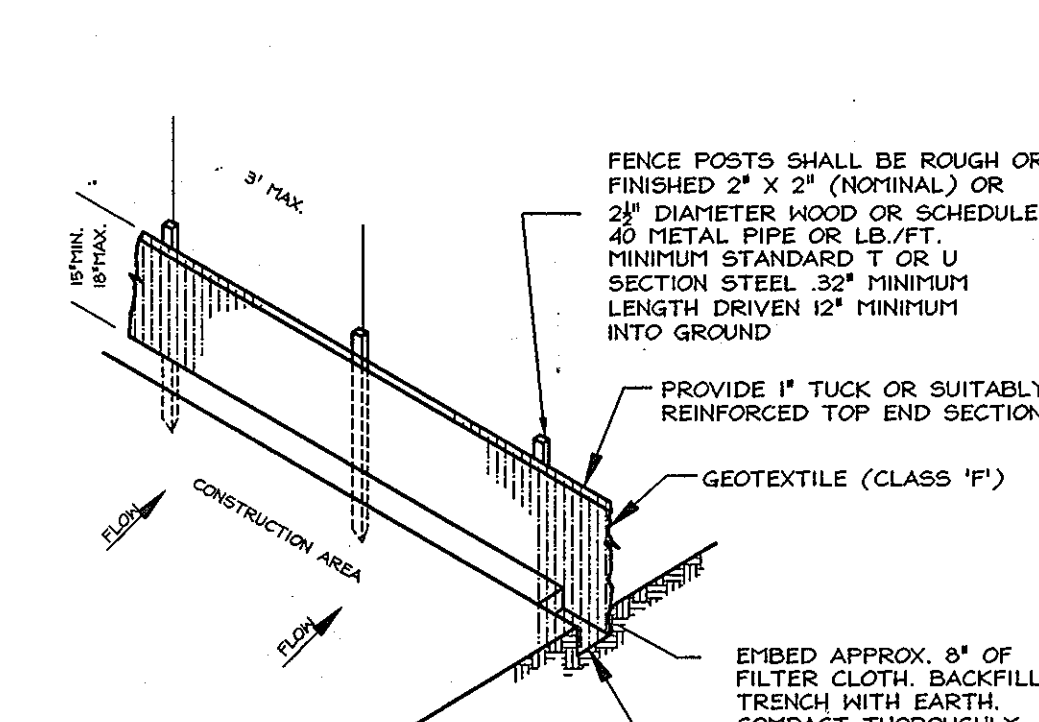

NOTE:  
 1. FILTER CLOTH FABRIC TO BE FASTENED SECURELY TO FENCE POST BY USE OF WIRE TIES OR HOG RINGS, 2 PER POST.

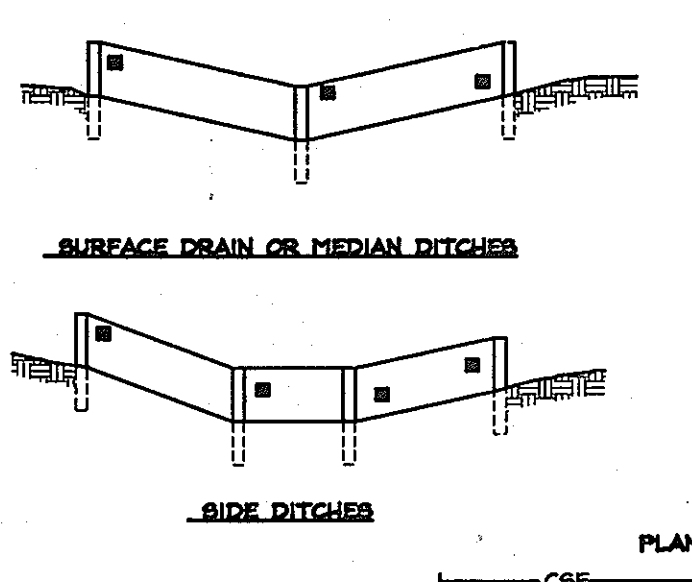


CHANNEL SILT FENCE (C.S.F.)

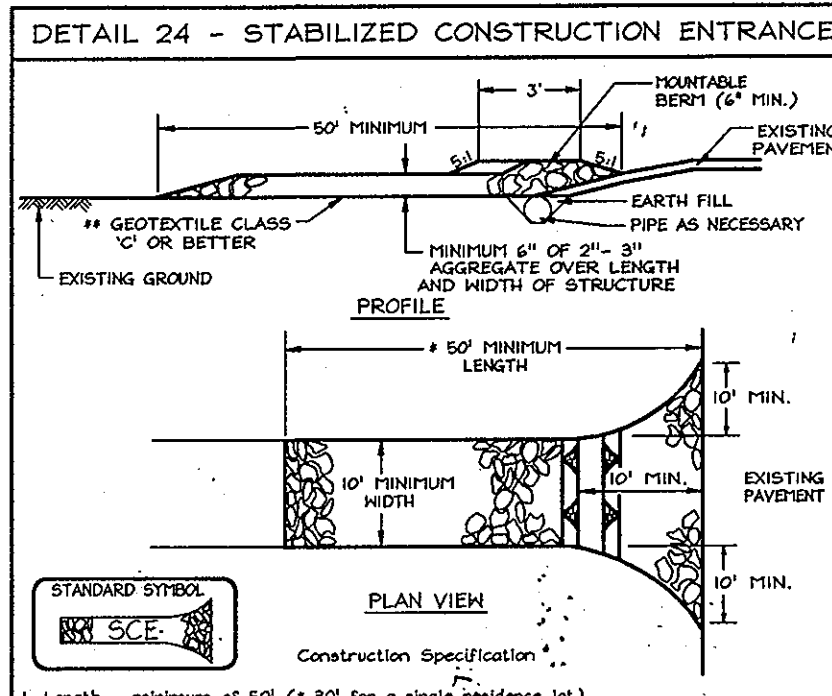

1. Length - minimum of 50' (+30' for a single residence lot).
2. Width - 10' minimum, should be flared at the existing road to provide a turning radius.
3. Geotextile fabric (filter cloth) shall be placed over the existing ground prior to placing stone. The plan approval authority may not require single family residences to use geotextile.
4. Stone - crushed aggregate (2" to 3") or reclaimed or recycled concrete equivalent shall be placed at least 6" deep over the length and width of the entrance.
5. Surface Water - all surface water flowing to or diverted toward construction entrance shall flow through the entrance, maintaining positive drainage. Pipe installed through the entrance, maintaining positive drainage with a minimum slope of 1/8" per foot. A minimum of 2" of stone over the pipe. Pipe has to be sized according to the drainage when the pipe is located at a high spot and has no drainage to convey, a pipe will not be necessary. Pipe should be sized according to the amount of runoff to be conveyed. A 2" minimum will be required.
6. Location - A stabilized construction entrance shall be located at every point where construction traffic enters or leaves a construction site. Vehicles leaving the site must travel over the entire length of the stabilized construction entrance.

U.S. DEPARTMENT OF AGRICULTURE SOIL CONSERVATION SERVICE PAGE 1-17-1 MARYLAND DEPARTMENT OF ENVIRONMENT AND NATURAL RESOURCES WATER MANAGEMENT ADMINISTRATION


DETAIL 30 - EROSION CONTROL MATTING

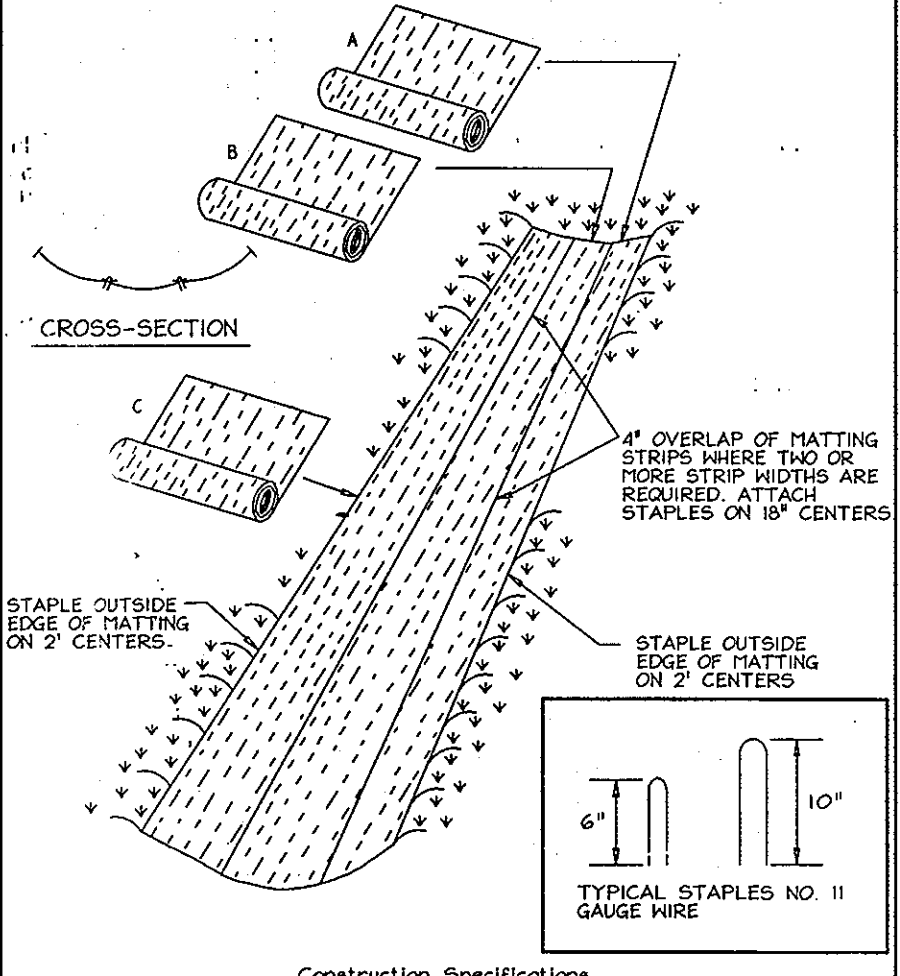

1. Key-in the matting by placing the top ends of the matting in a narrow trench, 6" in depth. Backfill the trench and tamp firmly to conform to the channel cross-section. Secure with a row of staples about 4' down slope from the trench. Spacing between staples is 6'.
  2. Staple the 4' overlap in the channel center using an 18" spacing between staples.
  3. Before stapling the outer edges of the matting, make sure the matting is smooth and in firm contact with the soil.
  4. Staples shall be placed 2' apart with 4 rows for each strip, 2 outer rows and 2 alternating rows down the center.
  5. Where roll of matting ends and another begins, the end of the strip shall overlap the upper end of the lower strip by 4' and be reinforced with a double row of staples in a staggered pattern on either side.
  6. The secure end of the matting liner should be similarly double rowed of staples.
- Note: If affected flow must be keyed-in.

U.S. DEPARTMENT OF AGRICULTURE SOIL CONSERVATION SERVICE PAGE 5-22-2 MARYLAND DEPARTMENT OF ENVIRONMENT AND NATURAL RESOURCES WATER MANAGEMENT ADMINISTRATION


I HEREBY CERTIFY THAT THE FACILITY SHOWN ON THIS PLAN WAS CONSTRUCTED AS SHOWN ON THE AS-BUILT PLANS AND MEETS WITH THE APPROVED PLAN SPECIFICATIONS.

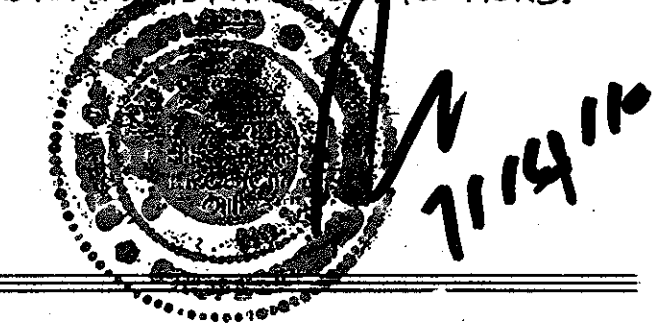


7/14/16

DATE: 6/12/06

SIGNATURE OF DEVELOPER: [Signature]

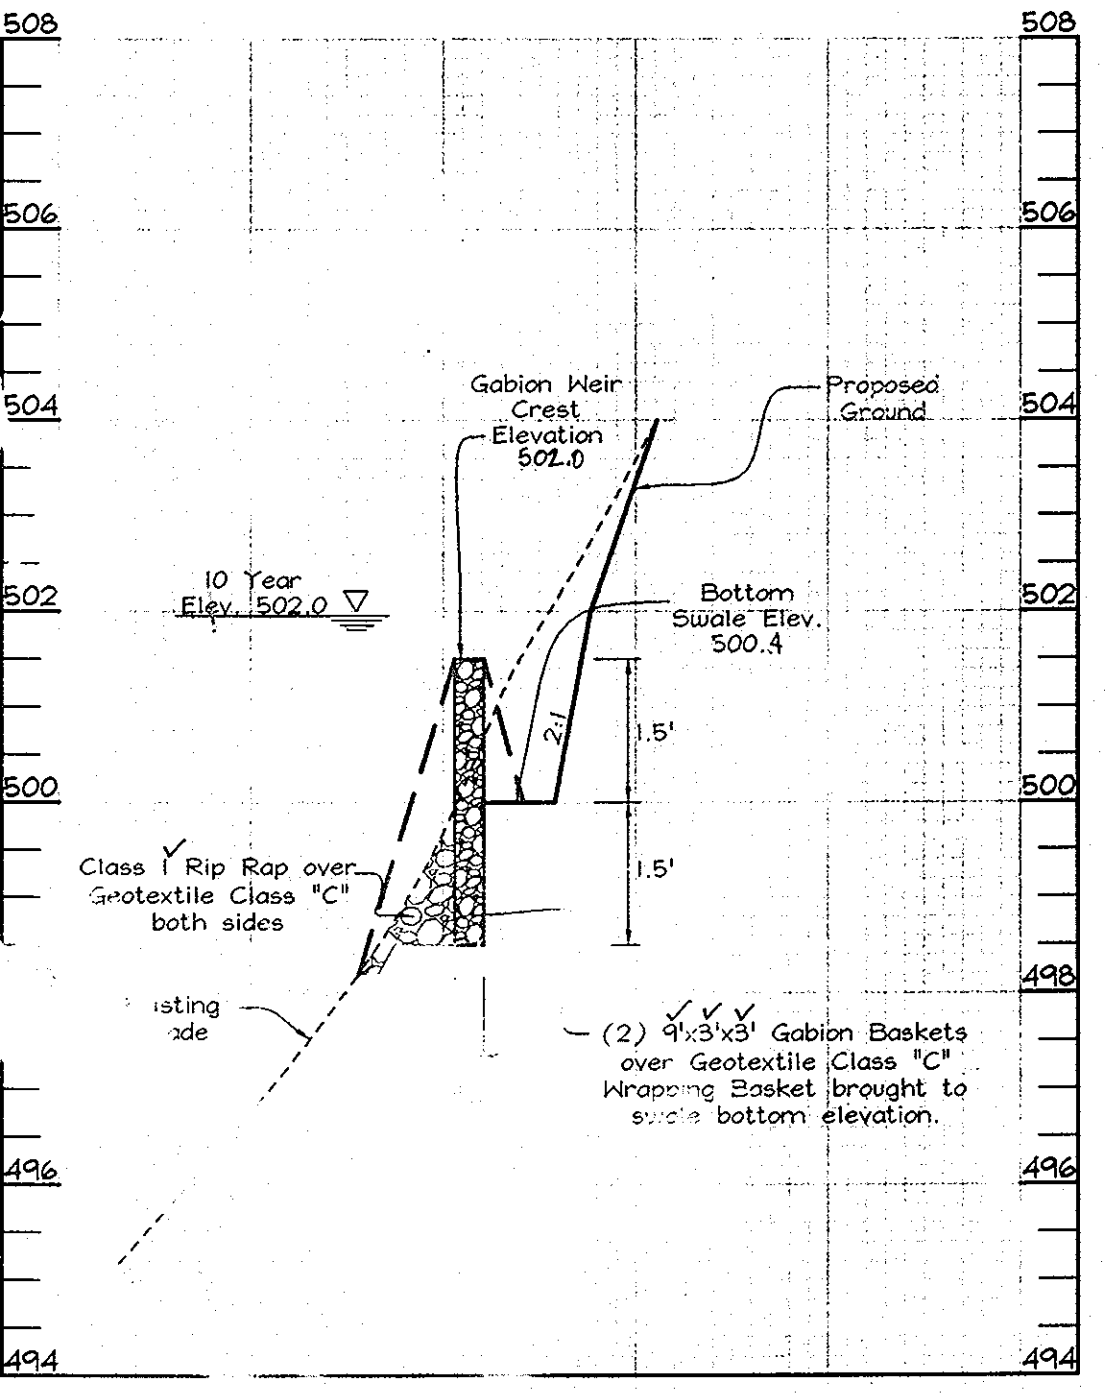

WATER QUALITY (WQv) GABION WEIR PROFILE SECTION C-C  
Scale Horizontal: 1"=20'  
Vertical: 1"=2'

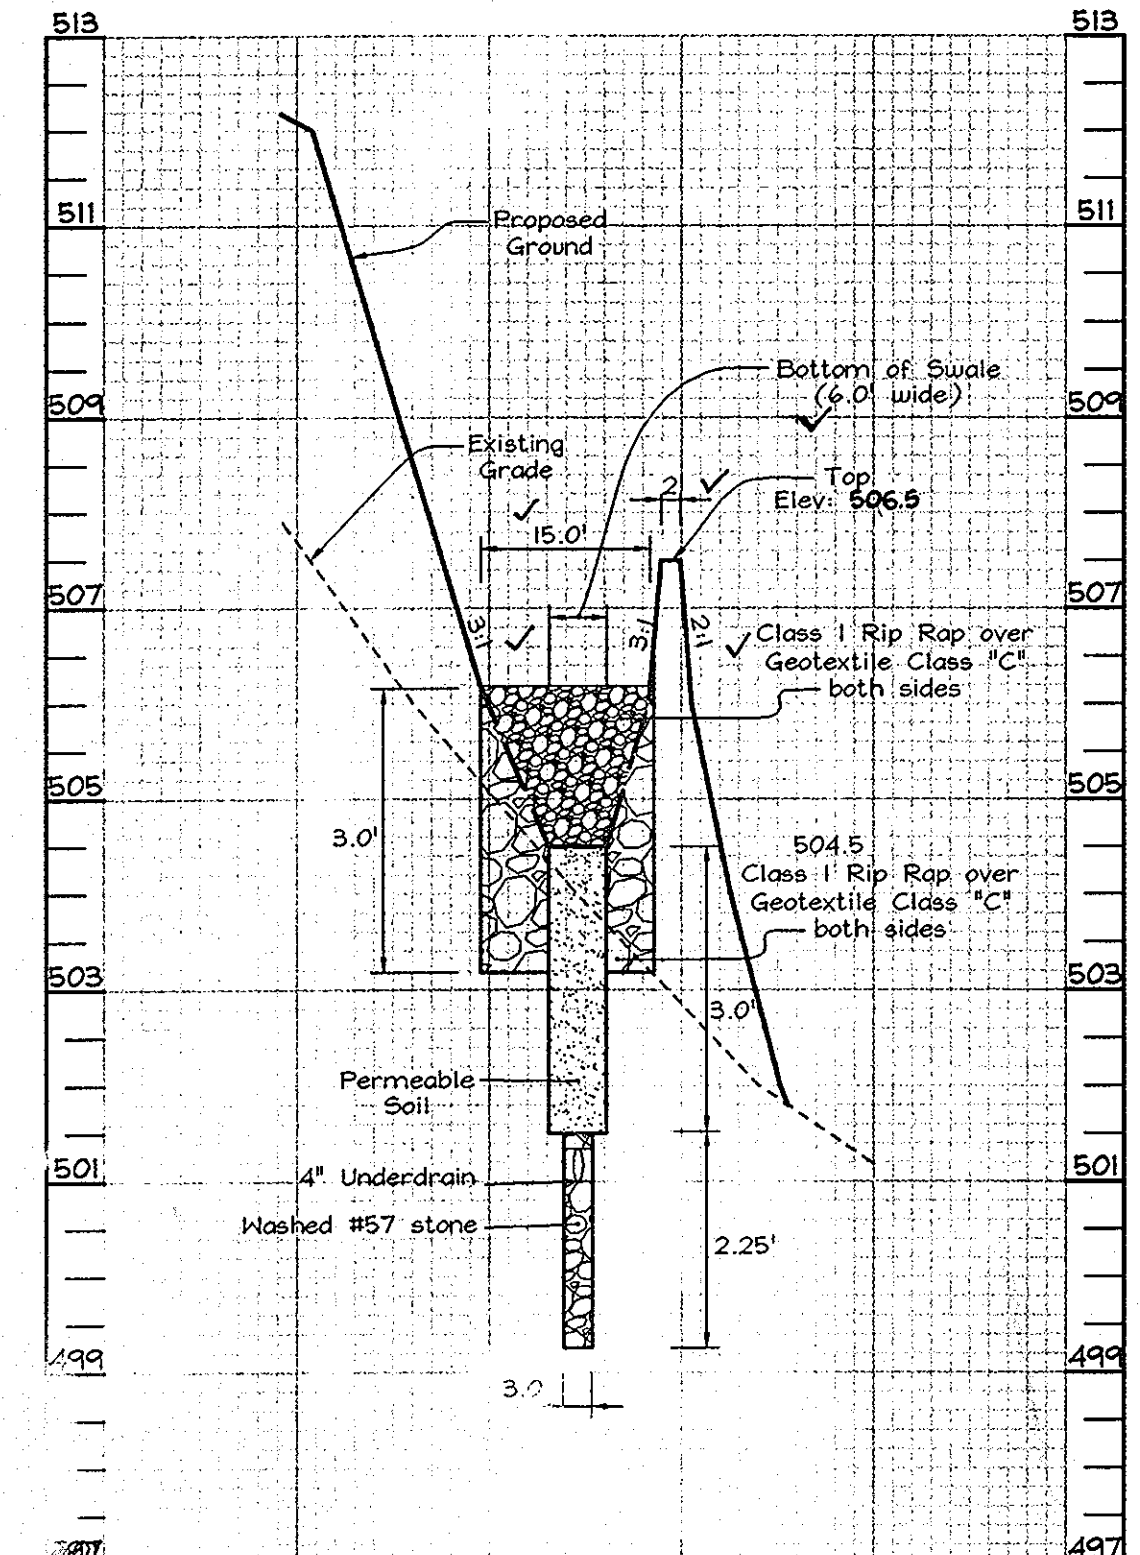

WATER QUALITY (WQv) DRY SWALE PROFILE SECTION D-D  
Scale Horizontal: 1"=20'  
Vertical: 1"=2'


APPROVED: HOWARD COUNTY...  
 CHIEF, DIVISION...  
 DATE: 6/20/06  
 DATE: 6/20/06

ENGINEER'S CERTIFICATE  
 I CERTIFY THAT THIS PLAN FOR SEDIMENT AND EROSION CONTROL REPRESENTS A PRACTICAL AND WORKABLE PLAN BASED ON MY PERSONAL KNOWLEDGE OF THE SITE CONDITIONS AND THAT IT HAS BEEN PREPARED IN ACCORDANCE WITH THE REQUIREMENTS OF THE HOWARD SOIL CONSERVATION DISTRICT.  
 SIGNATURE OF ENGINEER: Zacharia Y. Fisch  
 DATE: 6/12/06

DEVELOPER'S CERTIFICATE  
 I HEREBY CERTIFY THAT ALL DEVELOPMENT AND CONSTRUCTION WILL BE DONE ACCORDING TO THIS PLAN FOR SEDIMENT AND EROSION CONTROL, AND THAT ALL RESPONSIBLE PERSONNEL INVOLVED IN THE CONSTRUCTION PROJECT WILL HAVE A CERTIFICATE OF ATTENDANCE AT A DEPARTMENT OF ENVIRONMENT AND NATURAL RESOURCES TRAINING PROGRAM FOR THE CONTROL OF SEDIMENT AND EROSION BEFORE BEGINNING THE PROJECT. I ALSO AUTHORIZE PERIODIC ON-SITE INSPECTION BY THE HOWARD SOIL CONSERVATION DISTRICT.  
 SIGNATURE OF DEVELOPER: [Signature]  
 DATE: 6/12/06

OWNER/OPER:  
 c/o Harry B. Cooper  
 10749 Forest St  
 Lutherville, MD 21113  
 (410) 286-8300

DRY SWALE AND TERRAP  
 LOTS 1 THRU 5, BUILDABLE AND NON-BUILDABLE  
 TAX MAP 15 GRID II  
 3RD ELECTION DISTRICT

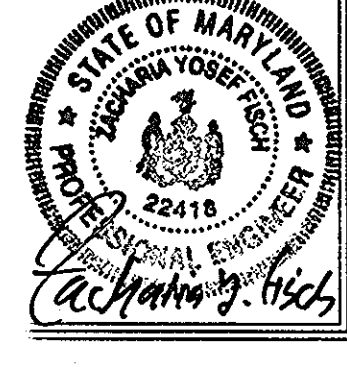

FSH Engineers P  
 8318 Forrest Street  
 Lutherville, MD 21113  
 Tel: 410-750-2251  
 E-mail: info@fsh.com

NOTE:  
 SHEET No. 5-C