
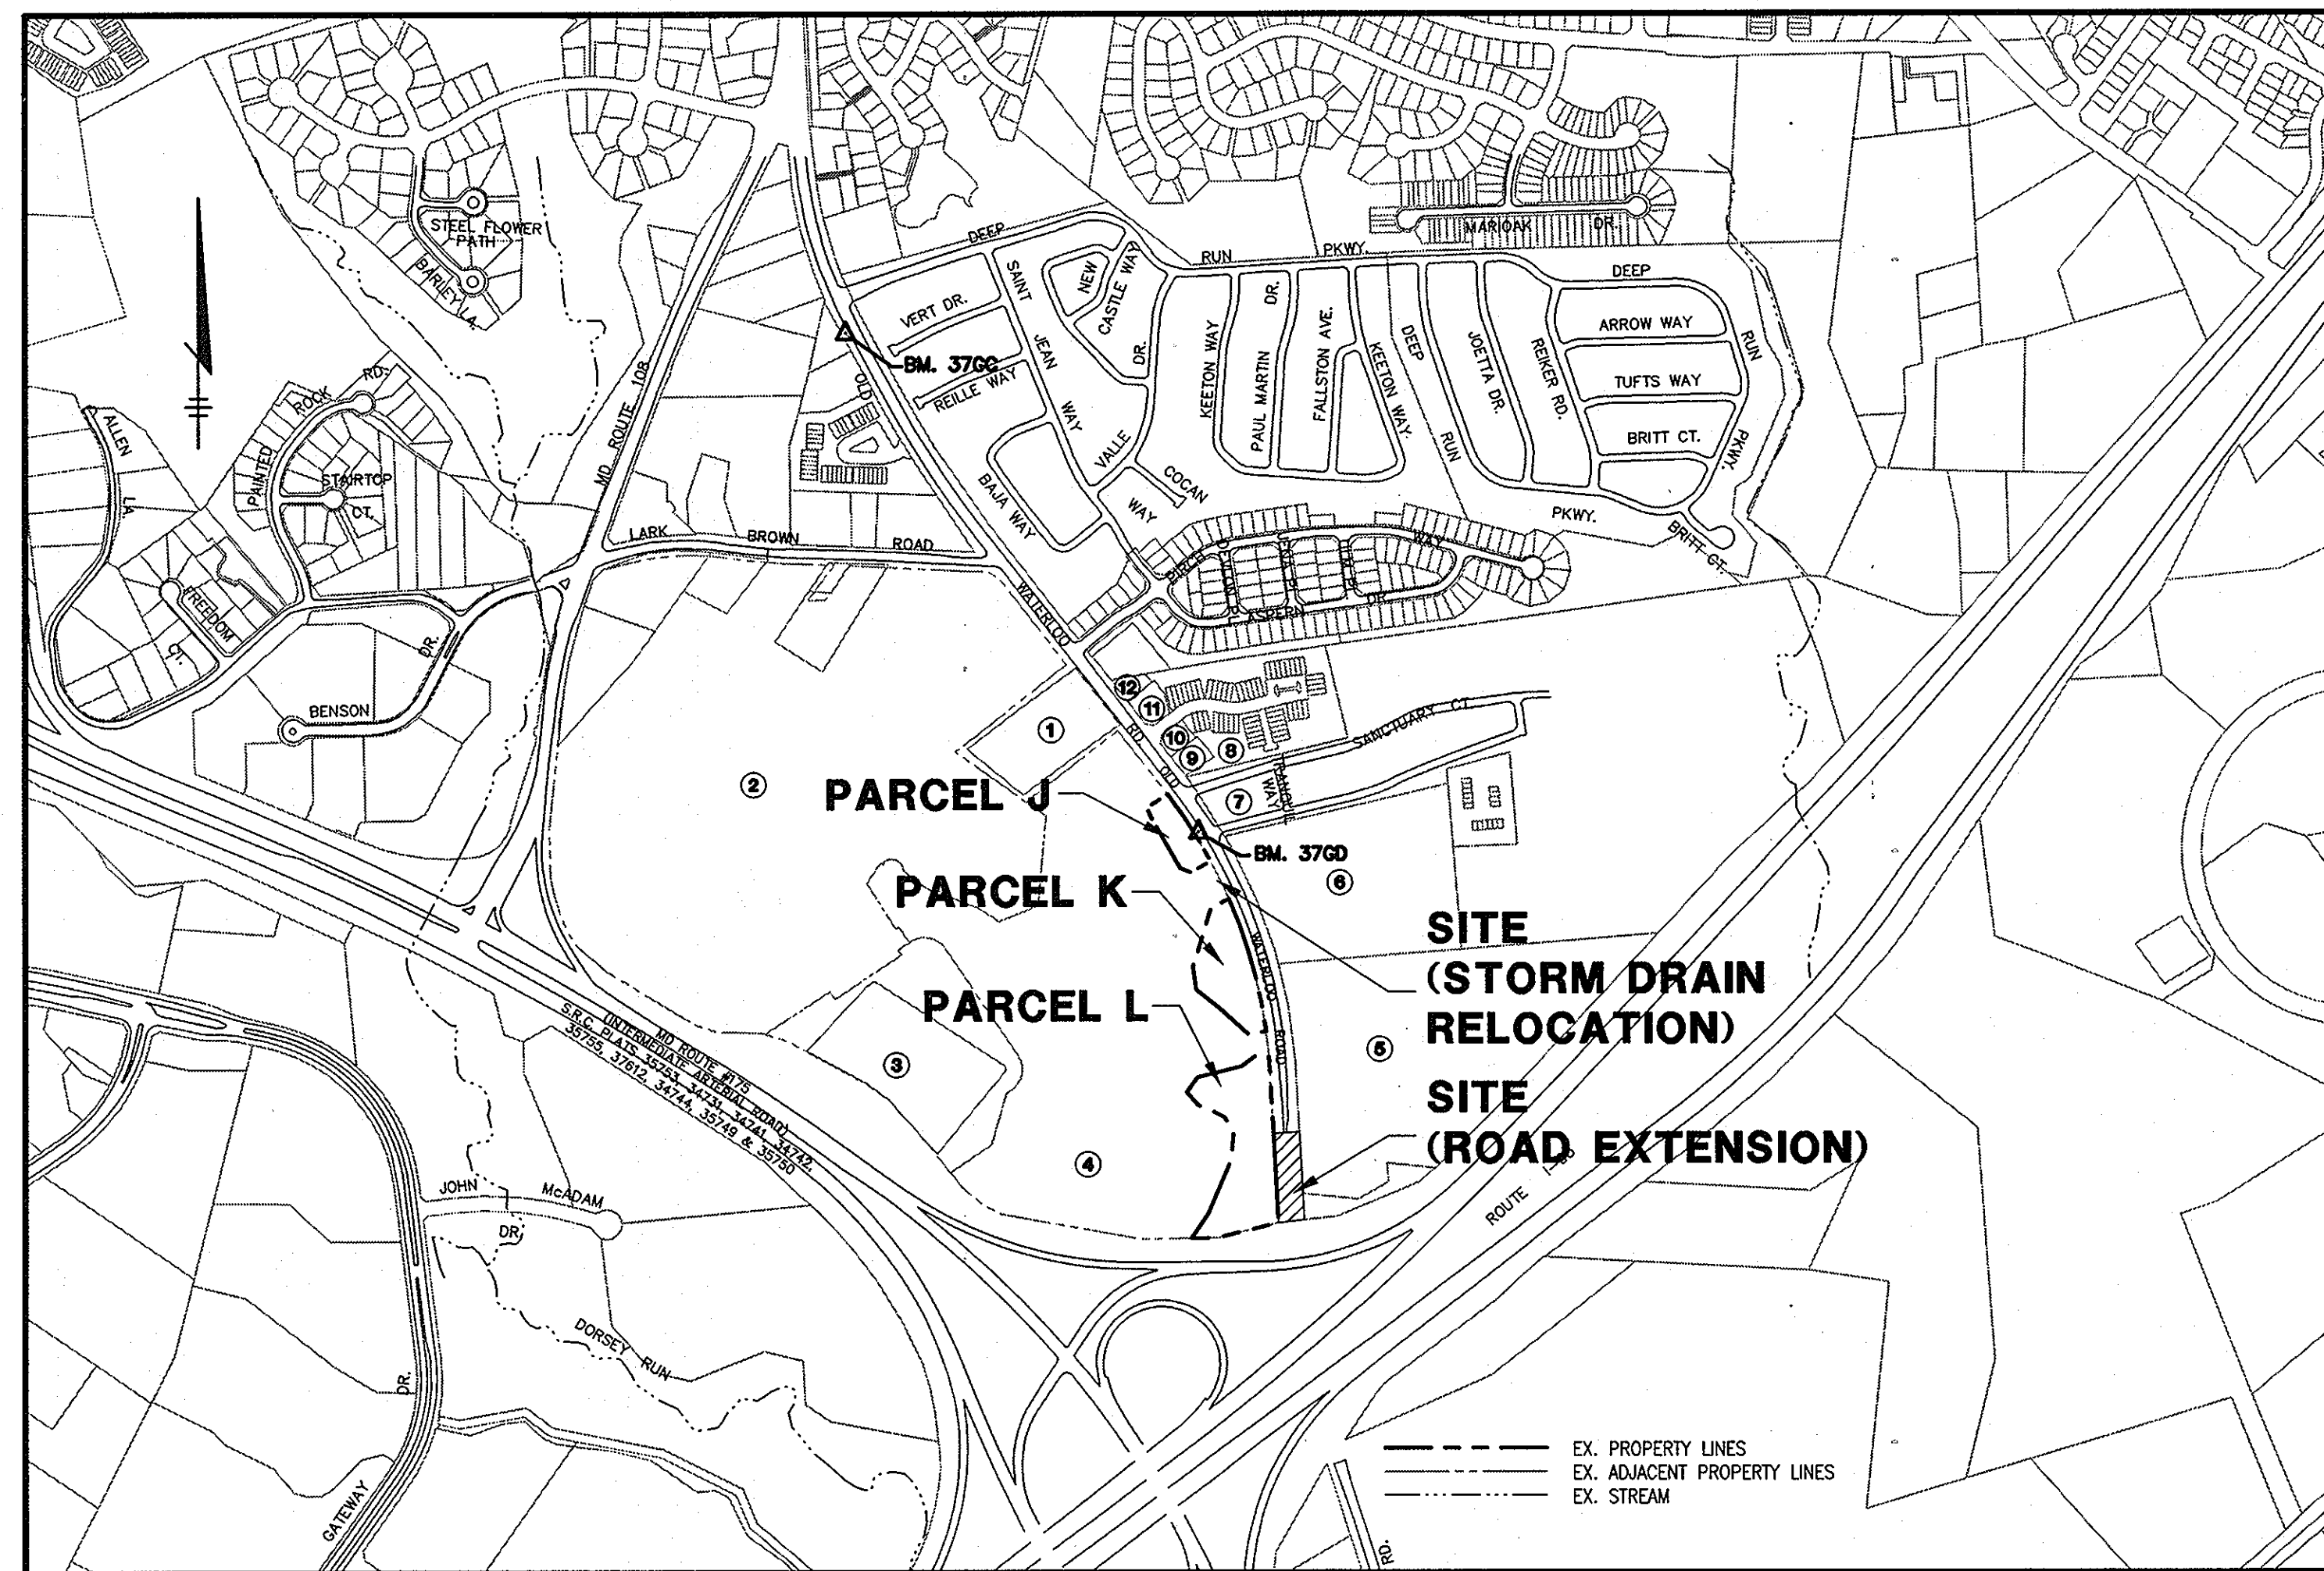


GENERAL NOTES

- ALL CONSTRUCTION SHALL BE IN ACCORDANCE WITH THE LATEST STANDARDS AND SPECIFICATIONS OF HOWARD COUNTY PLUS MSHA STANDARDS AND SPECIFICATIONS IF APPLICABLE.
- THE CONTRACTOR SHALL NOTIFY THE DEPARTMENT OF PUBLIC WORKS/BUREAU OF ENGINEERING/CONSTRUCTION INSPECTION DIVISION AT (410) 313-1880 AT LEAST FIVE (5) WORKING DAYS PRIOR TO START OF WORK.
- THE CONTRACTOR SHALL NOTIFY "MISS UTILITY" AT 1-800-257-7777 AT LEAST 48 HOURS PRIOR TO ANY EXCAVATION WORK BEING DONE.
- TRAFFIC CONTROL DEVICES, MARKINGS AND SIGNING SHALL BE IN ACCORDANCE WITH THE LATEST EDITION OF THE MANUAL OF UNIFORM TRAFFIC CONTROL DEVICES (MUTCD). ALL STREET AND REGULATORY SIGNS SHALL BE IN PLACE PRIOR TO THE PLACEMENT OF ANY ASPHALT.
- STREET LIGHT PLACEMENT AND THE TYPE OF FIXTURE AND POLE SHALL BE IN ACCORDANCE WITH THE HOWARD COUNTY DESIGN MANUAL, VOLUME II (1993) AND AS MODIFIED BY "GUIDELINES FOR STREET LIGHTS IN RESIDENTIAL DEVELOPMENTS (JUNE 1993)." A MINIMUM SPACING OF 20' SHALL BE MAINTAINED BETWEEN ANY STREET LIGHT AND TREE.
- THE EXISTING SITE TOPOGRAPHY IS TAKEN FROM FIELD RUN SURVEY WITH 2' CONTOUR INTERVALS PREPARED BY MORRIS & RITCHE ASSOCIATES, INC. DATED JANUARY 21, 2006.
- THE COORDINATES SHOWN HEREON ARE BASED UPON HOWARD COUNTY GEODETIC CONTROL WHICH IS BASED UPON THE MARYLAND STATE PLANE COORDINATE SYSTEM. HOWARD COUNTY MONUMENT NOS. 3760 & 370C WERE USED FOR THIS PROJECT.
- WATER IS PUBLIC.
- SEWER IS PUBLIC.
- THERE IS NO STORM WATER MANAGEMENT REQUIRED FOR THIS ROAD EXTENSION.
- EXISTING UTILITIES ARE BASED ON CONTRACT DRAWINGS FOR WATER & SEWER (CONTRACT #24-4284-D) AND CAD DRAWINGS FROM PATTON, HARRIS, RUST & ASSOCIATES, PC.
- THE 100-YEAR FLOODPLAIN LIMITS WERE ESTABLISHED USING A REVISED FLOODPLAIN STUDY BY MORRIS & RITCHE ASSOCIATES, INC., DATED JULY 31, 2006 AND SHOWN ON F-07-119.
- THE WETLANDS AND STREAMS FOR THIS PROJECT WERE TAKEN FROM PATTON, HARRIS, RUST & ASSOCIATES, PC FINAL PLAN F-05-058, DATED DECEMBER 12, 2005.
- THE TRAFFIC STUDY FOR THIS PROJECT WAS PREPARED BY WELLS & ASSOCIATES, LLC, DATED OCTOBER 7, 2002, LAST REVISED APRIL 13, 2005.
- CONTRACTOR IS RESPONSIBLE FOR ALL SITE CONDITIONS, CONSTRUCTION REQUIREMENTS, AND SHALL CONFORM TO ALL STATE, FEDERAL, AND COUNTY CONSTRUCTION REGULATIONS. THE CONTRACTOR IS NOT RELIEVED OF RESPONSIBILITY SHOULD ANY REQUIRED ITEMS PERTAINING TO SITE CONSTRUCTION NOT BE INCLUDED ON THESE PLANS. CONTRACTOR IS RESPONSIBLE FOR ALL ITEMS NECESSARY TO COMPLETE THE SITE IMPROVEMENTS AS SHOWN ON THESE PLANS.
- ANY DAMAGE TO EXISTING UTILITIES, PAVEMENT, OR CURB AND GUTTER DUE TO CONSTRUCTION ACTIVITY OUTSIDE THE LIMITS OF DISTURBANCE IS TO BE REPLACED BY THE CONTRACTOR AT HIS OWN EXPENSE.
- WHERE NECESSARY, THE CONTRACTOR SHALL TEST PIT ALL EXISTING UTILITIES AT LEAST FIVE (5) DAYS PRIOR TO STARTING ANY WORK SHOWN ON THESE DRAWINGS.
- CONTRACTOR IS RESPONSIBLE FOR REPLACING ANY PROPERTY MONUMENTS, MARKERS, SIGNS, LIGHTS, OR ANY OTHER EXISTING SITE FEATURES DISTURBED DURING CONSTRUCTION.
- ALL WORK SHALL COMPLY WITH ALL APPLICABLE PROVISIONS OF THE "1994 STANDARDS AND SPECIFICATIONS FOR SOIL EROSION AND SEDIMENT CONTROLS" PUBLISHED JOINTLY BY THE WATER RESOURCES ADMINISTRATION, SOIL CONSERVATION SERVICE, AND STATE SOIL CONSERVATION COMMITTEE.
- THE SUBJECT PROPERTY IS ZONED NT PER THE FEBRUARY 2, 2004 COMPREHENSIVE ZONING PLAN.
- NO CLEARING, GRADING OR CONSTRUCTION IS PERMITTED WITHIN THE WETLANDS, WETLAND BUFFERS, STREAMS OR STREAM BUFFERS AND FLOODPLAINS. NO GRADING, REMOVAL OF VEGETATIVE COVER OR TREES, PAVING AND NEW STRUCTURES SHALL BE PERMITTED WITHIN THE REQUIRED WETLANDS, STREAM(S) OR THEIR BUFFERS, FOREST CONSERVATION EASEMENT AREAS AND 100-YEAR FLOODPLAIN.
- THIS PROJECT IS EXEMPT FROM THE REQUIREMENTS OF SECTION 16.1200 OF THE HOWARD COUNTY CODE FOR FOREST CONSERVATION BECAUSE THE PROPERTY IS ZONED NT AND HAS PRELIMINARY PLAN APPROVAL PRIOR TO DECEMBER 31, 1992 PER SECTION 16.1201(b)(1)(v).
- A NOISE STUDY FOR THIS PROJECT WAS PREPARED BY THE MARS GROUP, DATED APRIL 2006.
- A GEO-TECHNICAL STUDY WAS CONDUCTED FOR THIS PROJECT BY GEO-TECHNOLOGY ASSOCIATES, INC. DATED NOVEMBER, 2005 & MARCH, 2006.
- TRENCH COMPACTION FOR STORM DRAINS WITHIN ROADWAYS AND PARKING AREAS SHALL BE IN ACCORDANCE WITH HOWARD COUNTY DESIGN MANUAL, VOL. IV, STANDARD NO. 6-2.01.
- ALL COMPACTED FILL SHALL BE IN ACCORDANCE WITH AASHTO T-180 REQUIREMENTS.
- ALL EXTERIOR LIGHTING SHALL COMPLY WITH ZONING REGULATIONS SECTION 134.
- SEE HOWARD COUNTY DEPARTMENT OF PUBLIC WORKS CONTRACT DRAWING NO. 24-4376-D FOR PUBLIC WATER & SANITARY SEWER DESIGN.
- SEE SITE DEVELOPMENT PLAN SDP-06-128 FOR ALL PROPOSED IMPROVEMENTS ON ADJACENT PARCELS J, K, L AND Q.
- WAIVER PETITION WP-06-110 FOR WAIVERS ASSOCIATED WITH SDP-06-128 HAS BEEN WITHDRAWN.
- CURRENT IMPROVEMENTS BEING DONE TO WATERLOO ROAD FOR ROAD WIDENING, NEW CURB & GUTTER, STORM DRAIN, LANDSCAPING AND SIDEWALKS ARE BEING DONE UNDER F-05-058 ARE SHOWN ON OUR PLAN AS EXISTING.
- THERE ARE NO STEEP SLOPES (25% OR >), WITHIN OUR LOD.
- MINIMUM BUILDING SETBACK RESTRICTIONS FROM PROPERTY LINES AND THE PUBLIC RIGHT-OF-WAY LINES TO BE IN ACCORDANCE WITH FDP-240 CRITERIA.
- DPZ FILE REFERENCES: F-05-058, FDP-240, PB-360, 24-4284-D, S-03-05, WP-04-113, WP-04-135, SDP-04-163, WP-06-110, 24-4376-D, SDP-06-128, F-06-102, F-07-119.
- ALL SIGN POSTS USED FOR TRAFFIC CONTROL SIGNS INSTALLED IN THE COUNTY RIGHT-OF-WAY SHALL BE MOUNTED ON A 2" GALVANIZED STEEL, PERFORATED, SQUARE TUBE POST (14 GAUGE) INSERTED INTO A 2-1/2" GALVANIZED STEEL, PERFORATED, SQUARE TUBE SLEEVE (12 GAUGE) - 3' LONG. A GALVANIZED STEEL POLE CAP SHALL BE MOUNTED ON TOP OF EACH POST.
- THERE ARE NO EXISTING STRUCTURES ON PARCELS J, K, L OR Q.
- ALL DIMENSIONS ARE TO FACE OF CURB. ALL SPOT GRADES ARE TO FLOWLINE UNLESS OTHERWISE NOTED.
- FINANCIAL SURETY FOR THE REQUIRED INSTALLATION OF STREET TREES WILL BE POSTED AS PART OF THE DPW DEVELOPERS AGREEMENT FOR ROAD CONSTRUCTION IN THE AMOUNT OF \$6,750.00 (17 SHADE TREES @ \$300.00 EA., 11 FLOWERING TREES @150.00 EA.). THIS AMOUNT REPRESENTS THE REQUIRED STREET TREE PLANTINGS FOR THE EXTENSION OF OLD WATERLOO ROAD. THE DEVELOPER/BUILDER WILL BE RESPONSIBLE FOR THE STREET TREE INSTALLATION. SEE SHEETS 4 & 5 OF 9 FOR PLANTING DETAIL AND NOTES FOR THE STREET TREE INSTALLATION.

FINAL PLAN OLD WATERLOO ROAD EXTENSION GATEWAY OVERLOOK AT BENSON EAST

6th ELECTION DISTRICT HOWARD COUNTY, MARYLAND F-06-203

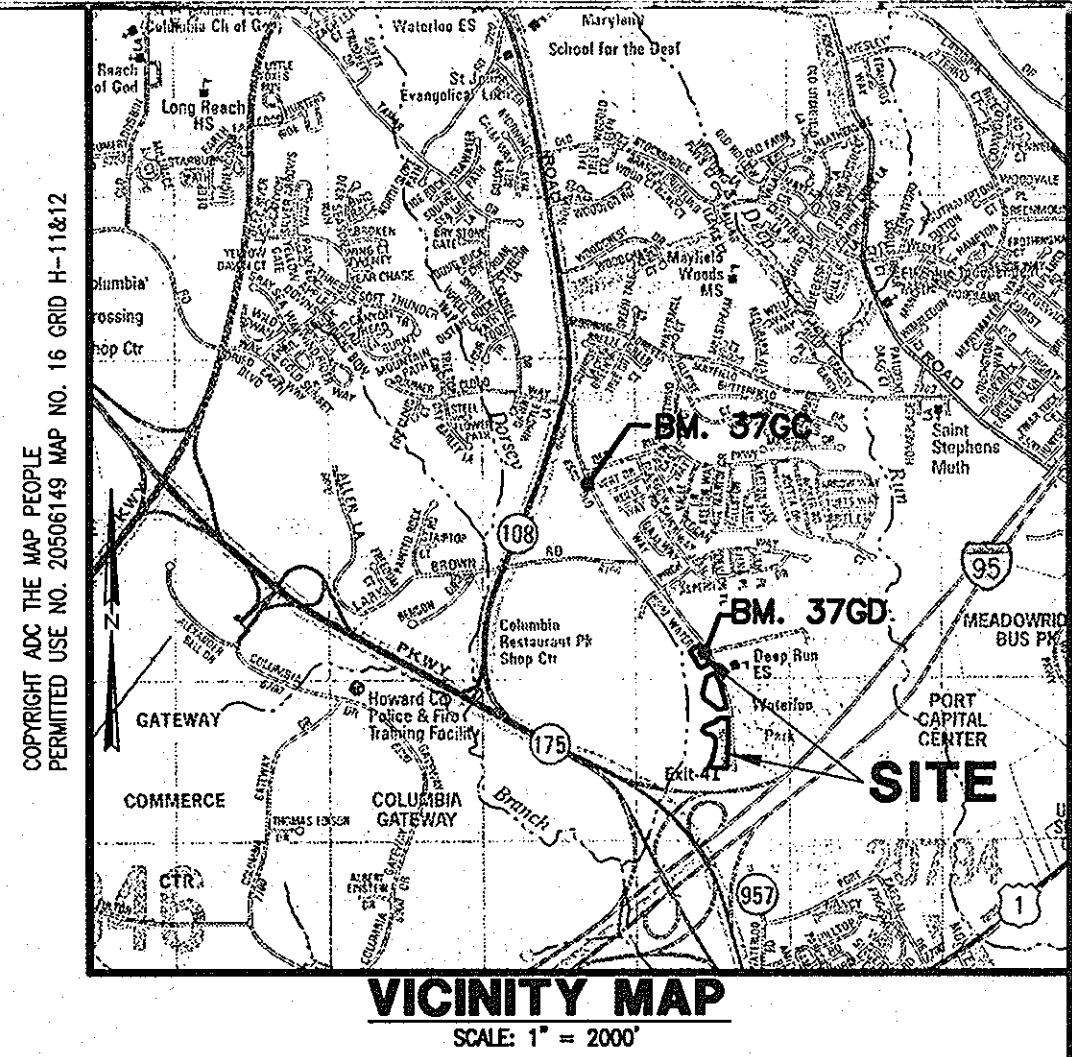

BENCHMARKS

GEODETIC SURVEY CONTROL: 3760
N 553,237.204
E 1,372,353.605
ELEVATION: 290.931
LOCATED 30' EAST OF FIRE HYDRANT ACROSS FROM DEEP RUN ELEMENTARY SCHOOL

GEODETIC SURVEY CONTROL: 370C
N 555,250.791
E 1,370,945.348
ELEVATION: 331.855
LOCATED 30' EAST ON THE SOUTH SIDE OF OLD WATERLOO ROAD ACROSS FROM DEEP RUN PARKWAY

AS-BUILT PLAN BY MRA 07/2010

AS-BUILT CERTIFICATION

I HEREBY CERTIFY THAT THE INFORMATION SHOWN ON THIS PLAN IS CORRECT AND THE PUBLIC IMPROVEMENTS WERE CONSTRUCTED AS SHOWN ON THE APPROVED PLANS AND SPECIFICATIONS.

Signature: *[Signature]* DATE: 7/2/10 23265
SIGNATURE ENGINEER-IN-CHARGE DATE MR. PE SEAL AND NO.

APPROVED: HOWARD COUNTY DEPARTMENT OF PUBLIC WORKS.

W. F. [Signature] 3-8-07
CHIEF, BUREAU OF HIGHWAYS DATE

APPROVED: HOWARD COUNTY DEPARTMENT OF PLANNING AND ZONING.

C. [Signature] 7/2/07
CHIEF, DIVISION OF LAND DEVELOPMENT DATE

[Signature] 3/2/07
CHIEF, DEVELOPMENT ENGINEERING DIVISION DATE

DATE	NO.	REVISION

OWNER / DEVELOPER: THE RYLAND GROUP
ATTN: MR. BRIAN KNAUFF
6011 UNIVERSITY BOULEVARD, SUITE 260
ELLICOTT CITY, MARYLAND 21043
PHONE: 410-480-2467
FAX: 410-480-0543

PROJECT: OLD WATERLOO ROAD EXTENSION
GATEWAY OVERLOOK AT BENSON EAST

AREA PLAT: 18885
ZONED: NT ~ TAX MAP: 37 AND 43 ~ GRID: 20, 21 AND 2, 3
PARCEL: 382 ~ LOTS: J, K & L
6TH ELECTION DISTRICT ~ HOWARD COUNTY, MARYLAND

TITLE: COVER SHEET

MORRIS & RITCHE ASSOCIATES, INC.
ENGINEERS, PLANNERS, SURVEYORS AND LANDSCAPE ARCHITECTS
14280 PARK CENTER DRIVE, SUITE A
LAUREL, MARYLAND 20707
(410) 792-9792 or (301) 776-1690
FAX (410) 792-7395

DATE: 2/27/07
DRAWN BY: MSP/MDC
DESIGNED BY: MSP
REVIEWED BY: KSK
PROJECT NO.: 14719
DATE: 2/27/07
SCALE: AS SHOWN
DRAWING NO. 1 OF 9

SHEET INDEX

1	COVER SHEET
2	ROAD & PUBLIC STORM DRAIN LAYOUT
3	ROAD & PUBLIC STORM DRAIN LAYOUT
4	STREET TREE PLAN
5	STREET TREE PLAN
6	ROAD & PUBLIC STORM DRAIN PROFILES
7	DETAILS
8	EROSION & SEDIMENT CONTROL DETAILS
9	SIGNAGE, STRIPING AND MOT PLANS

PURPOSE & INTENT STATEMENT

THE PURPOSE OF THIS F-PLAN IS THE EXTENSION OF OLD WATERLOO ROAD 350'± AND STORM DRAIN IMPROVEMENTS.

ADJACENT PROPERTY CHART

NO.	OWNER	TAX MAP	PARCEL	PREMISES ADDRESS
1	FRANK E. RHODES & WIFE	37	487	6686 WATERLOO ROAD, ELKDRIDGE, MD 21075
2	HOWARD RESEARCH & DEVELOPMENT	37	382-F	LARK BROWN ROAD ELKDRIDGE, MD 21075
3	HOWARD RESEARCH & DEVELOPMENT	37	382-I	RT 175 ELKDRIDGE, MD 21075
4	HOWARD RESEARCH & DEVELOPMENT	37	382-O	OLD WATERLOO RD ELKDRIDGE, MD 21075
5	HOWARD COUNTY MD PUBLIC RECREATION	43	1	6951 WATERLOO RD ELKDRIDGE, MD 21075
6	WATERLOO MIDDLE SCHOOL C/O HOWARD COUNTY BOARD OF EDUCATION	37	168	6925 E OLD WATERLOO ROAD ELKDRIDGE, MD 21075
7	SHERWOOD CROSSING APARTMENTS LLC	37	637	E OLD WATERLOO ROAD ELKDRIDGE, MD 21075
8	SANCTUARY HOMEOWNERS ASSOCIATION, INC.	37	700-59	S SANCTUARY COURT ELKDRIDGE, MD 21075
9	PATRICK ALEY	37	700-58	6719 OLD WATERLOO ROAD ELKDRIDGE, MD 21075
10	CHARLOTTE POWELL & JARED HEALY	37	700-57	6715 OLD WATERLOO ROAD ELKDRIDGE, MD 21075
11	LINDA BELLOFATTO SOPER	37	700-2	6693 OLD WATERLOO ROAD ELKDRIDGE, MD 21075
12	GLENN & CHERYL HAYES	37	700-1	6691 OLD WATERLOO ROAD ELKDRIDGE, MD 21075

RESERVATION OF PUBLIC UTILITY & FOREST CONSERVATION EASEMENTS

DEVELOPER RESERVES UNTO ITSELF, ITS SUCCESSORS AND ASSIGNS, ALL EASEMENTS SHOWN ON THIS PLAN FOR WATER, SEWER, STORM DRAINAGE, OTHER PUBLIC UTILITIES AND FOREST CONSERVATION (DESIGNATED AS "FOREST CONSERVATION AREA"). LOCATED IN, ON, OVER AND THROUGH LOTS/ PARCELS, ANY CONVEYANCES OF THE AFORESAID LOTS/ PARCELS SHALL BE SUBJECT TO THE EASEMENTS HEREIN RESERVED, WHETHER OR NOT EXPRESSLY STATED IN THE DEED(S) CONVEYING SAID LOTS/ PARCELS. DEVELOPER SHALL EXECUTE AND DELIVER DEEDS FOR THE EASEMENTS HEREIN RESERVED TO HOWARD COUNTY WITH A METES AND BOUNDS DESCRIPTION OF THE FOREST CONSERVATION AREA. UPON COMPLETION OF THE PUBLIC UTILITIES AND THEIR ACCEPTANCE BY HOWARD COUNTY, AND IN THE CASE OF THE FOREST CONSERVATION EASEMENT(S), UPON COMPLETION OF THE DEVELOPER'S OBLIGATIONS UNDER THE FOREST CONSERVATION INSTALLATION AND MAINTENANCE AGREEMENT EXECUTED BY THE DEVELOPER AND THE COUNTY, AND THE RELEASE OF DEVELOPER'S SURETY POSTED WITH SAID AGREEMENT, THE COUNTY SHALL ACCEPT THE EASEMENTS AND RECORD THE DEED(S) OF EASEMENT IN THE LAND RECORDS OF HOWARD COUNTY.


LEGEND

- 258 --- EX. 2' CONTOUR
- 260 --- EX. 10' CONTOUR
- 262 --- EX. BUILDING
- 264 --- EX. CURB
- 266 --- EX. EASEMENT
- 268 --- EX. FENCE
- 270 --- EX. FLOODPLAIN
- 272 --- EX. GAS
- 274 --- EX. PAVEMENT
- 276 --- EX. PROPERTY LINE
- 278 --- EX. ROAD CENTERLINE
- 280 --- EX. SANITARY SEWER
- 282 --- EX. STORM DRAIN
- 284 --- EX. TREE LINE
- 286 --- EX. WATERLINE
- 288 --- EX. WETLAND
- 290 --- EX. WETLAND BUFFER
- 292 --- PROP. 2' CONTOURS
- 294 --- PROP. 10' CONTOURS
- 296 --- PROP. CENTERLINE OF DRAINAGE SWALE
- 298 --- PROP. 6' CHAINLINK FENCE
- 300 --- PROP. CURB
- 302 --- PROP. REVERSE CURB & GUTTER
- 304 --- PROP. STANDARD CURB & GUTTER
- 306 --- PROP. TREE LINE
- 308 --- PROP. LIMIT OF DISTURBANCE
- 310 --- PROP. PAVEMENT
- 312 --- PROP. BUILDING SETBACK
- 314 --- PROP. PUBLIC SANITARY SEWER LINE
- 316 --- PROP. PUBLIC WATER LINE
- 318 --- PROP. PRIVATE STORM DRAIN LINE
- 320 --- PROP. PUBLIC STORM DRAIN LINE
- 322 --- PROP. PUBLIC SD & UTILITY ESMT
- 324 --- EX. 20' PUBLIC SD & UTILITY EASEMENT
- 326 --- PROP. SUPER SILT FENCE
- 328 --- EX. 2025 65 GBA LINE
- 330 --- PROP. MILL & OVERLAY
- 332 --- PROP. SITE LIGHTING
- 334 --- PROP. CURB INLET PROTECTION
- 336 --- SOIL BOUNDARY
- 338 --- SOIL TYPE

- ① STANDARD CURB & GUTTER
HOWARD CO STD. DETAIL R-3.01.
- ② REVERSE CURB & GUTTER
HOWARD CO STD. DETAIL R-3.01.
- ③ 4' CONC. SIDEWALK
HOWARD CO STD. DETAIL R-3.05.
- ④ CONC. HC RAMP
HOWARD CO STD. DETAIL R-4.01.
- ⑤ TEE TURN-AROUND
HOWARD CO STD. DETAIL R-5.05.
- ⑥ 3' MILL & OVERLAY.
- ⑦ REMOVE/ REPLACE EX. DEAD END
BARRICADE HOWARD CO. STD. DETAIL
R-7.12.
- ⑧ STREET LIGHT 150 WATT PREMIER.
- ⑨ REMOVE/ REPLACE EX. CURB &
PAVEMENT AS NECESSARY FOR
STORM DRAIN INSTALLATION.

SOILS LEGEND		
SYMBOL	NAME/DESCRIPTION	SOIL TYPE
RaB	RUSSETT, FINE SANDY LOAM, 2-5% SLOPES	C
Fa	FALLSINGTON, SANDY LOAM, 0-2% SLOPES	C
RaC	RUSSETT, FINE SANDY LOAM, 5-10% SLOPES	C
UD	URBAN LAND, UDORTHENTS COMPLEX, 0-15% SLOPES	C
UaF	UDORTHENTS, HIGHWAY 0-65% SLOPES	C

SPECIMEN	SPECIMEN SPECIES	DBH	CONDITION
A	LIRIODENDRON TULIPIFERA - TULIPTREE	40"	POOR

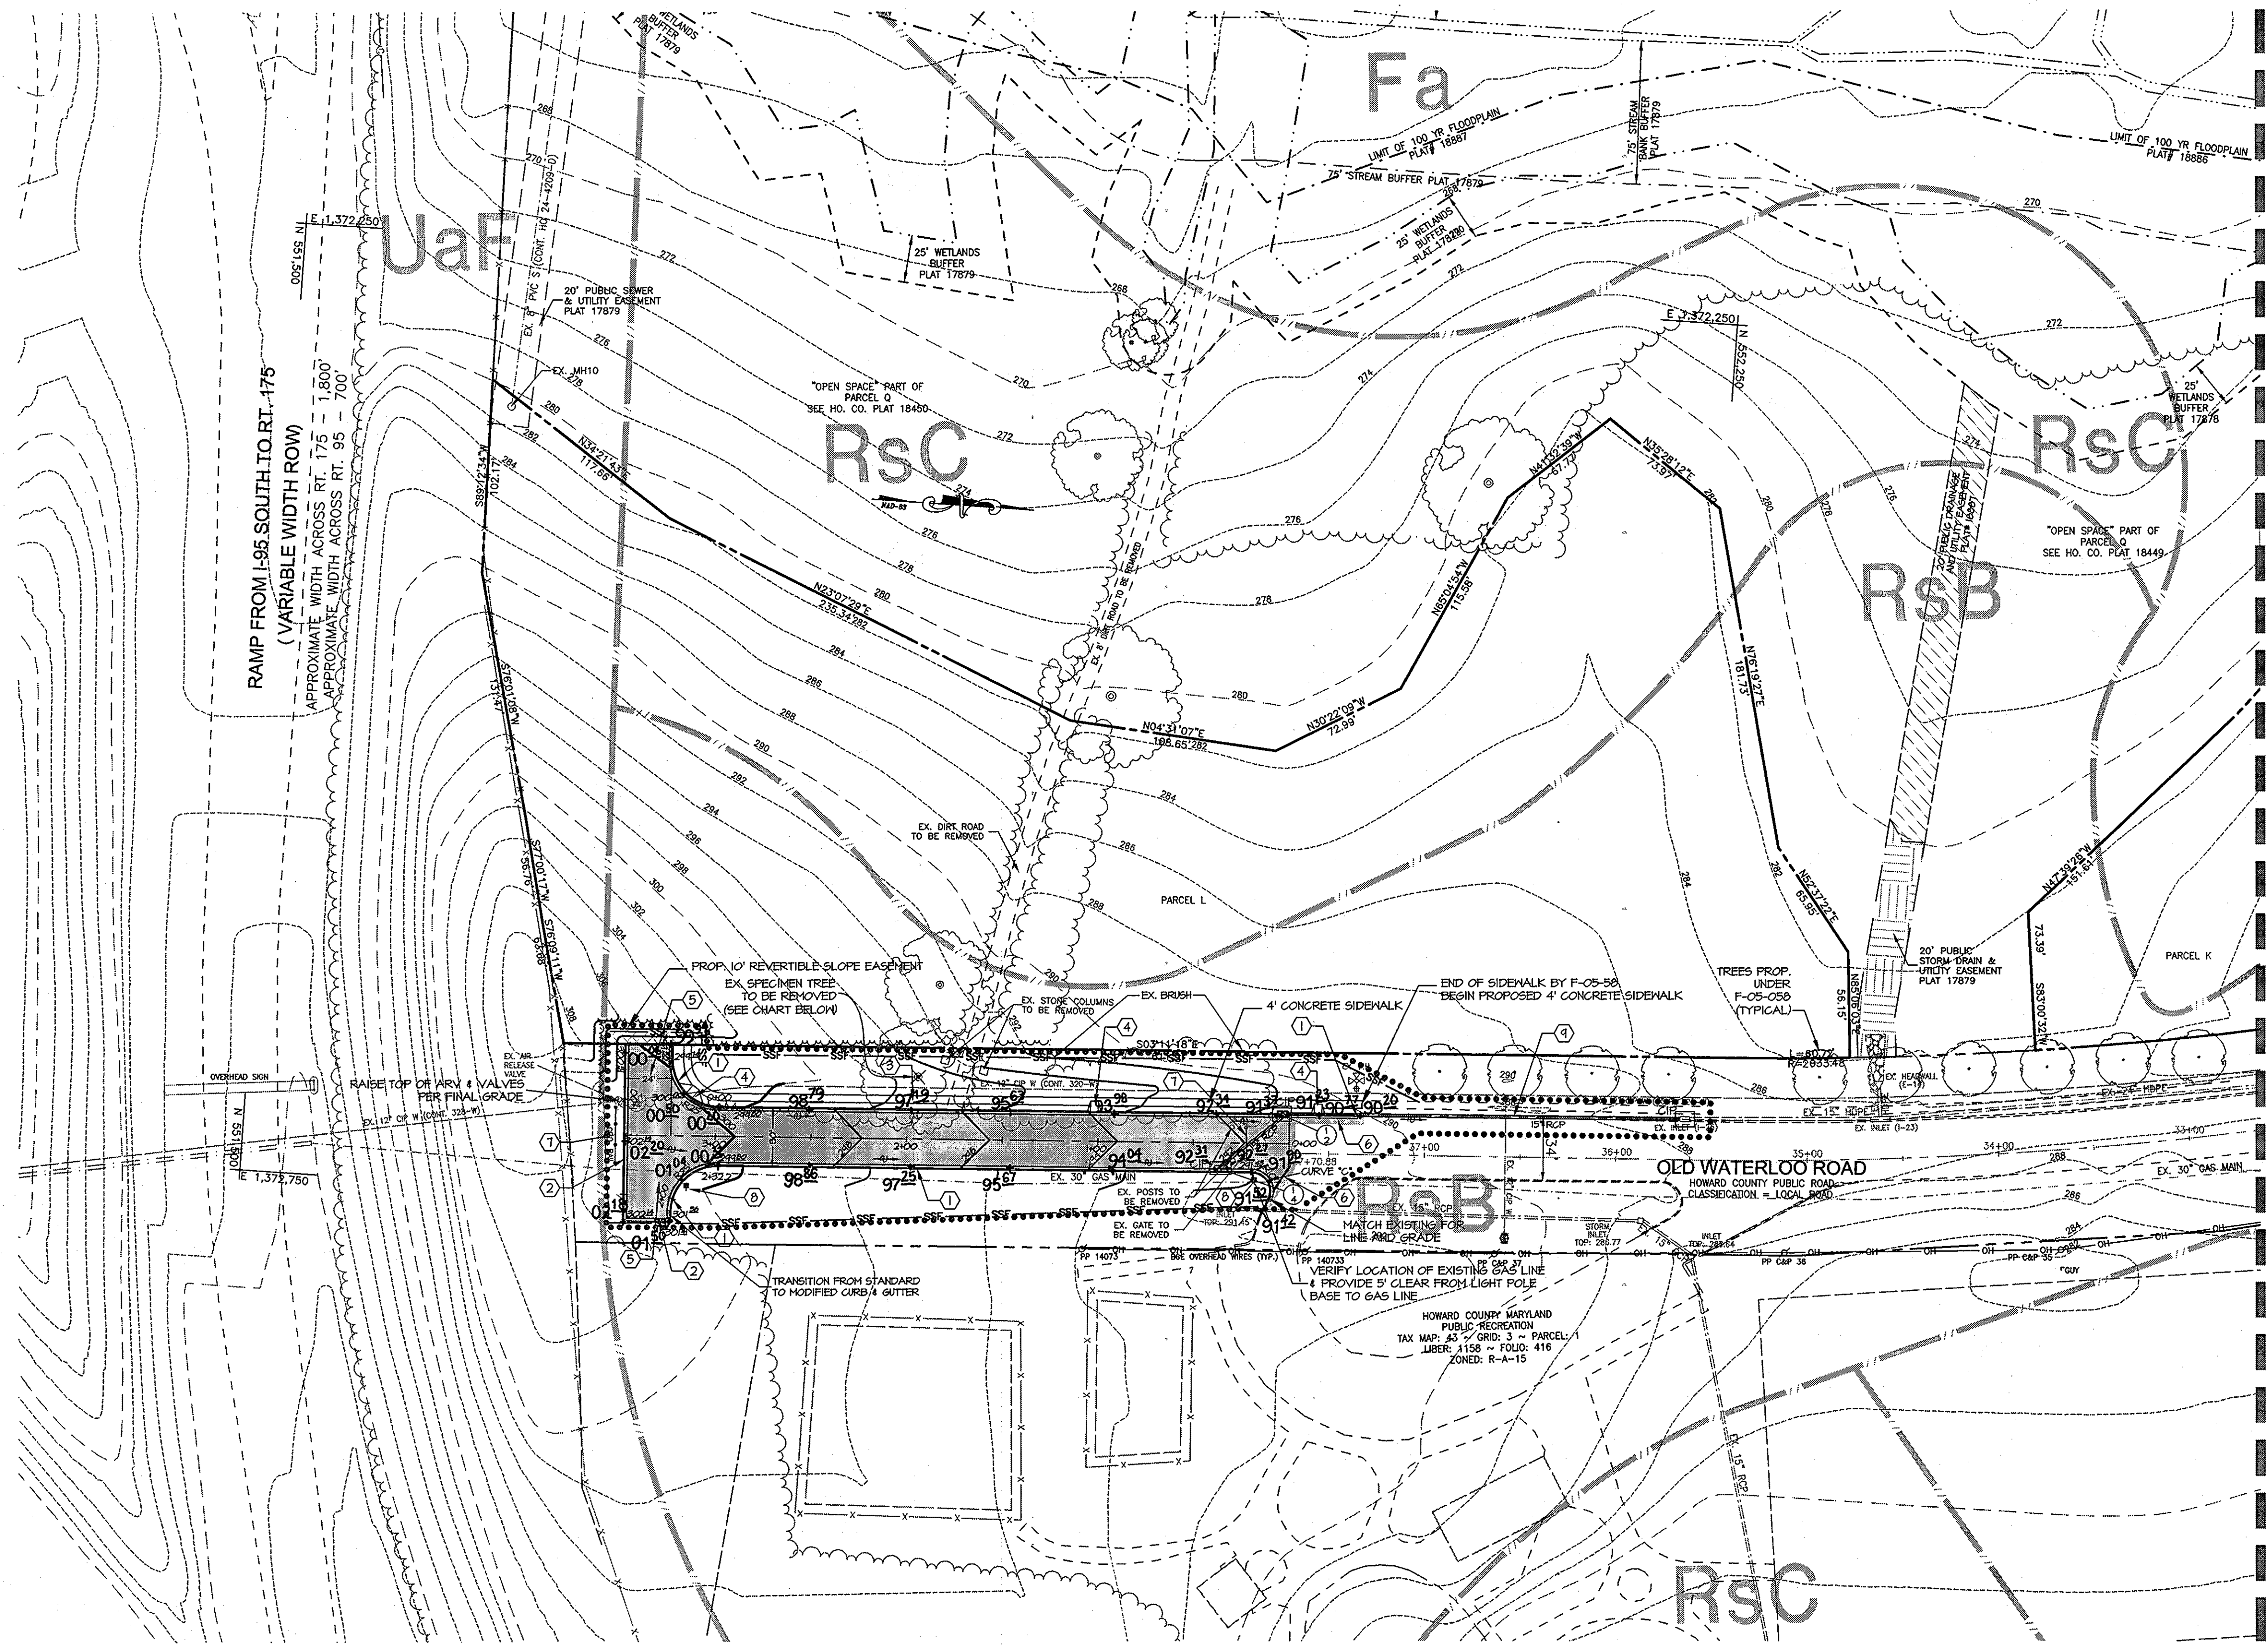

MATCHLINE - SEE SHEET 3 FOR CONTINUATION

AS-BUILT PLAN BY MRA 07/2010

ENGINEER'S CERTIFICATE
 I HEREBY CERTIFY THAT THIS PLAN FOR SEDIMENT AND EROSION CONTROL REPRESENTS A PRACTICAL AND WORKABLE PLAN BASED ON MY PERSONAL KNOWLEDGE OF THE SITE CONDITIONS AND THAT IT WAS PREPARED IN ACCORDANCE WITH THE REQUIREMENTS OF THE HOWARD SOIL CONSERVATION DISTRICT.
 SIGNATURE OF ENGINEER: *Kerri S. Knighten* DATE: 2/27/07
 KERRI S. KNIGHTEN, PE MD LICENSE 201135

DEVELOPER'S CERTIFICATE
 I/WE CERTIFY THAT ALL DEVELOPMENT AND CONSTRUCTION WILL BE DONE ACCORDING TO THIS PLAN OF DEVELOPMENT FOR SEDIMENT AND EROSION CONTROL, AND THAT ALL RESPONSIBLE PERSONNEL INVOLVED IN THE CONSTRUCTION PROJECT WILL HAVE A CERTIFICATE OF ATTENDANCE AT A DEPARTMENT OF ENVIRONMENT APPROVED TRAINING PROGRAM FOR THE CONTROL OF SEDIMENT AND EROSION BEFORE BEGINNING THE PROJECT. I ALSO AUTHORIZE PERIODIC ONSITE INSPECTIONS BY THE HOWARD SOIL CONSERVATION DISTRICT.
 SIGNATURE OF DEVELOPER: *Brian Knauff* DATE: 2/27/07
 BRIAN KNAUFF

REVIEWED FOR HOWARD SCD AND MEETS TECHNICAL REQUIREMENTS.
 SIGNATURE: *Jim Murray* DATE: 3/5/07
 JIM MURRAY
 USDA - NATURAL RESOURCES CONSERVATION SERVICE

THIS DEVELOPMENT PLAN IS APPROVED FOR SOIL EROSION AND SEDIMENT CONTROL BY THE HOWARD SOIL CONSERVATION DISTRICT.
 SIGNATURE: *John M. Whelan* DATE: 3/5/07
 JOHN M. WHELAN
 HOWARD SOIL CONSERVATION DISTRICT

APPROVED: HOWARD COUNTY DEPARTMENT OF PUBLIC WORKS.
 SIGNATURE: *Walter Z. Mahler* DATE: 3-8-07
 WALTER Z. MAHLER
 CHIEF, BUREAU OF HIGHWAYS

APPROVED: HOWARD COUNTY DEPARTMENT OF PLANNING AND ZONING.
 SIGNATURE: *Conrad Kramida* DATE: 7/2/07
 CONRAD KRAMIDA
 CHIEF, DIVISION OF LAND DEVELOPMENT

CHIEF, DEVELOPMENT ENGINEERING DIVISION
 SIGNATURE: *John P. Williams* DATE: 5/12/07
 JOHN P. WILLIAMS

DATE	NO.	REVISION

OWNER / DEVELOPER
 THE RYLAND GROUP
 ATTN: MR. BRIAN KNAUFF
 6011 UNIVERSITY BOULEVARD, SUITE 260
 ELLICOTT CITY, MARYLAND 21043
 PHONE: 410-480-2467
 FAX: 410-480-0543

PROJECT: **OLD WATERLOO ROAD EXTENSION GATEWAY OVERLOOK AT BENSON EAST**
 AREA PLAT: 18885
 ZONED: RT TAX MAP: 37 AND 43 ~ GRID: 20, 21 AND 2, 3
 PARCEL: 382 ~ LOTS: J, K & L
 6TH ELECTION DISTRICT ~ HOWARD COUNTY, MARYLAND

ROAD & PUBLIC STORM DRAIN PLAN


MRA MORRIS & RITCHIE ASSOCIATES, INC.
 ENGINEERS, PLANNERS, SURVEYORS AND LANDSCAPE ARCHITECTS
 14280 PARK CENTER DRIVE, SUITE A
 LAUREL, MARYLAND 20707
 (410) 792-8792 or (301) 776-1690
 FAX (410) 792-7395

DATE: 2/27/07
 DRAWN BY: MSP/MDC
 DESIGNED BY: LFB/MSP
 REVIEWED BY: KSK
 PROJECT NO.: 14719
 DATE: 2/27/07
 SCALE: 1" = 50'
 DRAWING NO. 2 OF 9

LEGEND

- 258 --- EX. 2' CONTOUR
- 260 --- EX. 10' CONTOUR
- EX. BUILDING
- EX. CURB
- EX. EASEMENT
- EX. FENCE
- EX. FLOODPLAIN
- EX. GAS
- EX. PAVEMENT
- N41°08'00"E 588.31' --- EX. PROPERTY LINE
- EX. ROAD CENTERLINE
- EX. 8" S --- EX. SANITARY SEWER
- EX. 22" RCSP --- EX. STORM DRAIN
- EX. 10" W --- EX. TREE LINE
- EX. WATERLINE
- EX. WETLAND
- EX. WETLAND BUFFER
- 260 --- PROP. 2' CONTOURS
- 10' --- PROP. 10' CONTOURS
- PROP. CENTERLINE OF DRAINAGE SWALE
- PROP. 6" CHAINLINK FENCE
- PROP. CURB
- PROP. REVERSE CURB & GUTTER
- PROP. STANDARD CURB & GUTTER
- PROP. TREE LINE
- PROP. LIMIT OF DISTURBANCE
- PROP. PAVEMENT
- PROP. BUILDING
- PROP. BUILDING SETBACK
- PROP. PUBLIC SANITARY SEWER LINE
- PROP. PUBLIC WATER LINE
- PROP. PRIVATE STORM DRAIN LINE
- PROP. PUBLIC STORM DRAIN LINE
- PROP. PUBLIC SD & UTILITY ESMT
- EX. 20" PUBLIC SD & UTILITY ESMENT
- PROP. SUPER SILT FENCE
- EX. 2025 65 68A LINE
- PROP. MILL & OVERLAY
- PROP. SITE LIGHTING
- PROP. CURB INLET PROTECTION
- SOIL BOUNDARY
- SOIL TYPE

MATCHLINE - SEE SHEET 2 FOR CONTINUATION

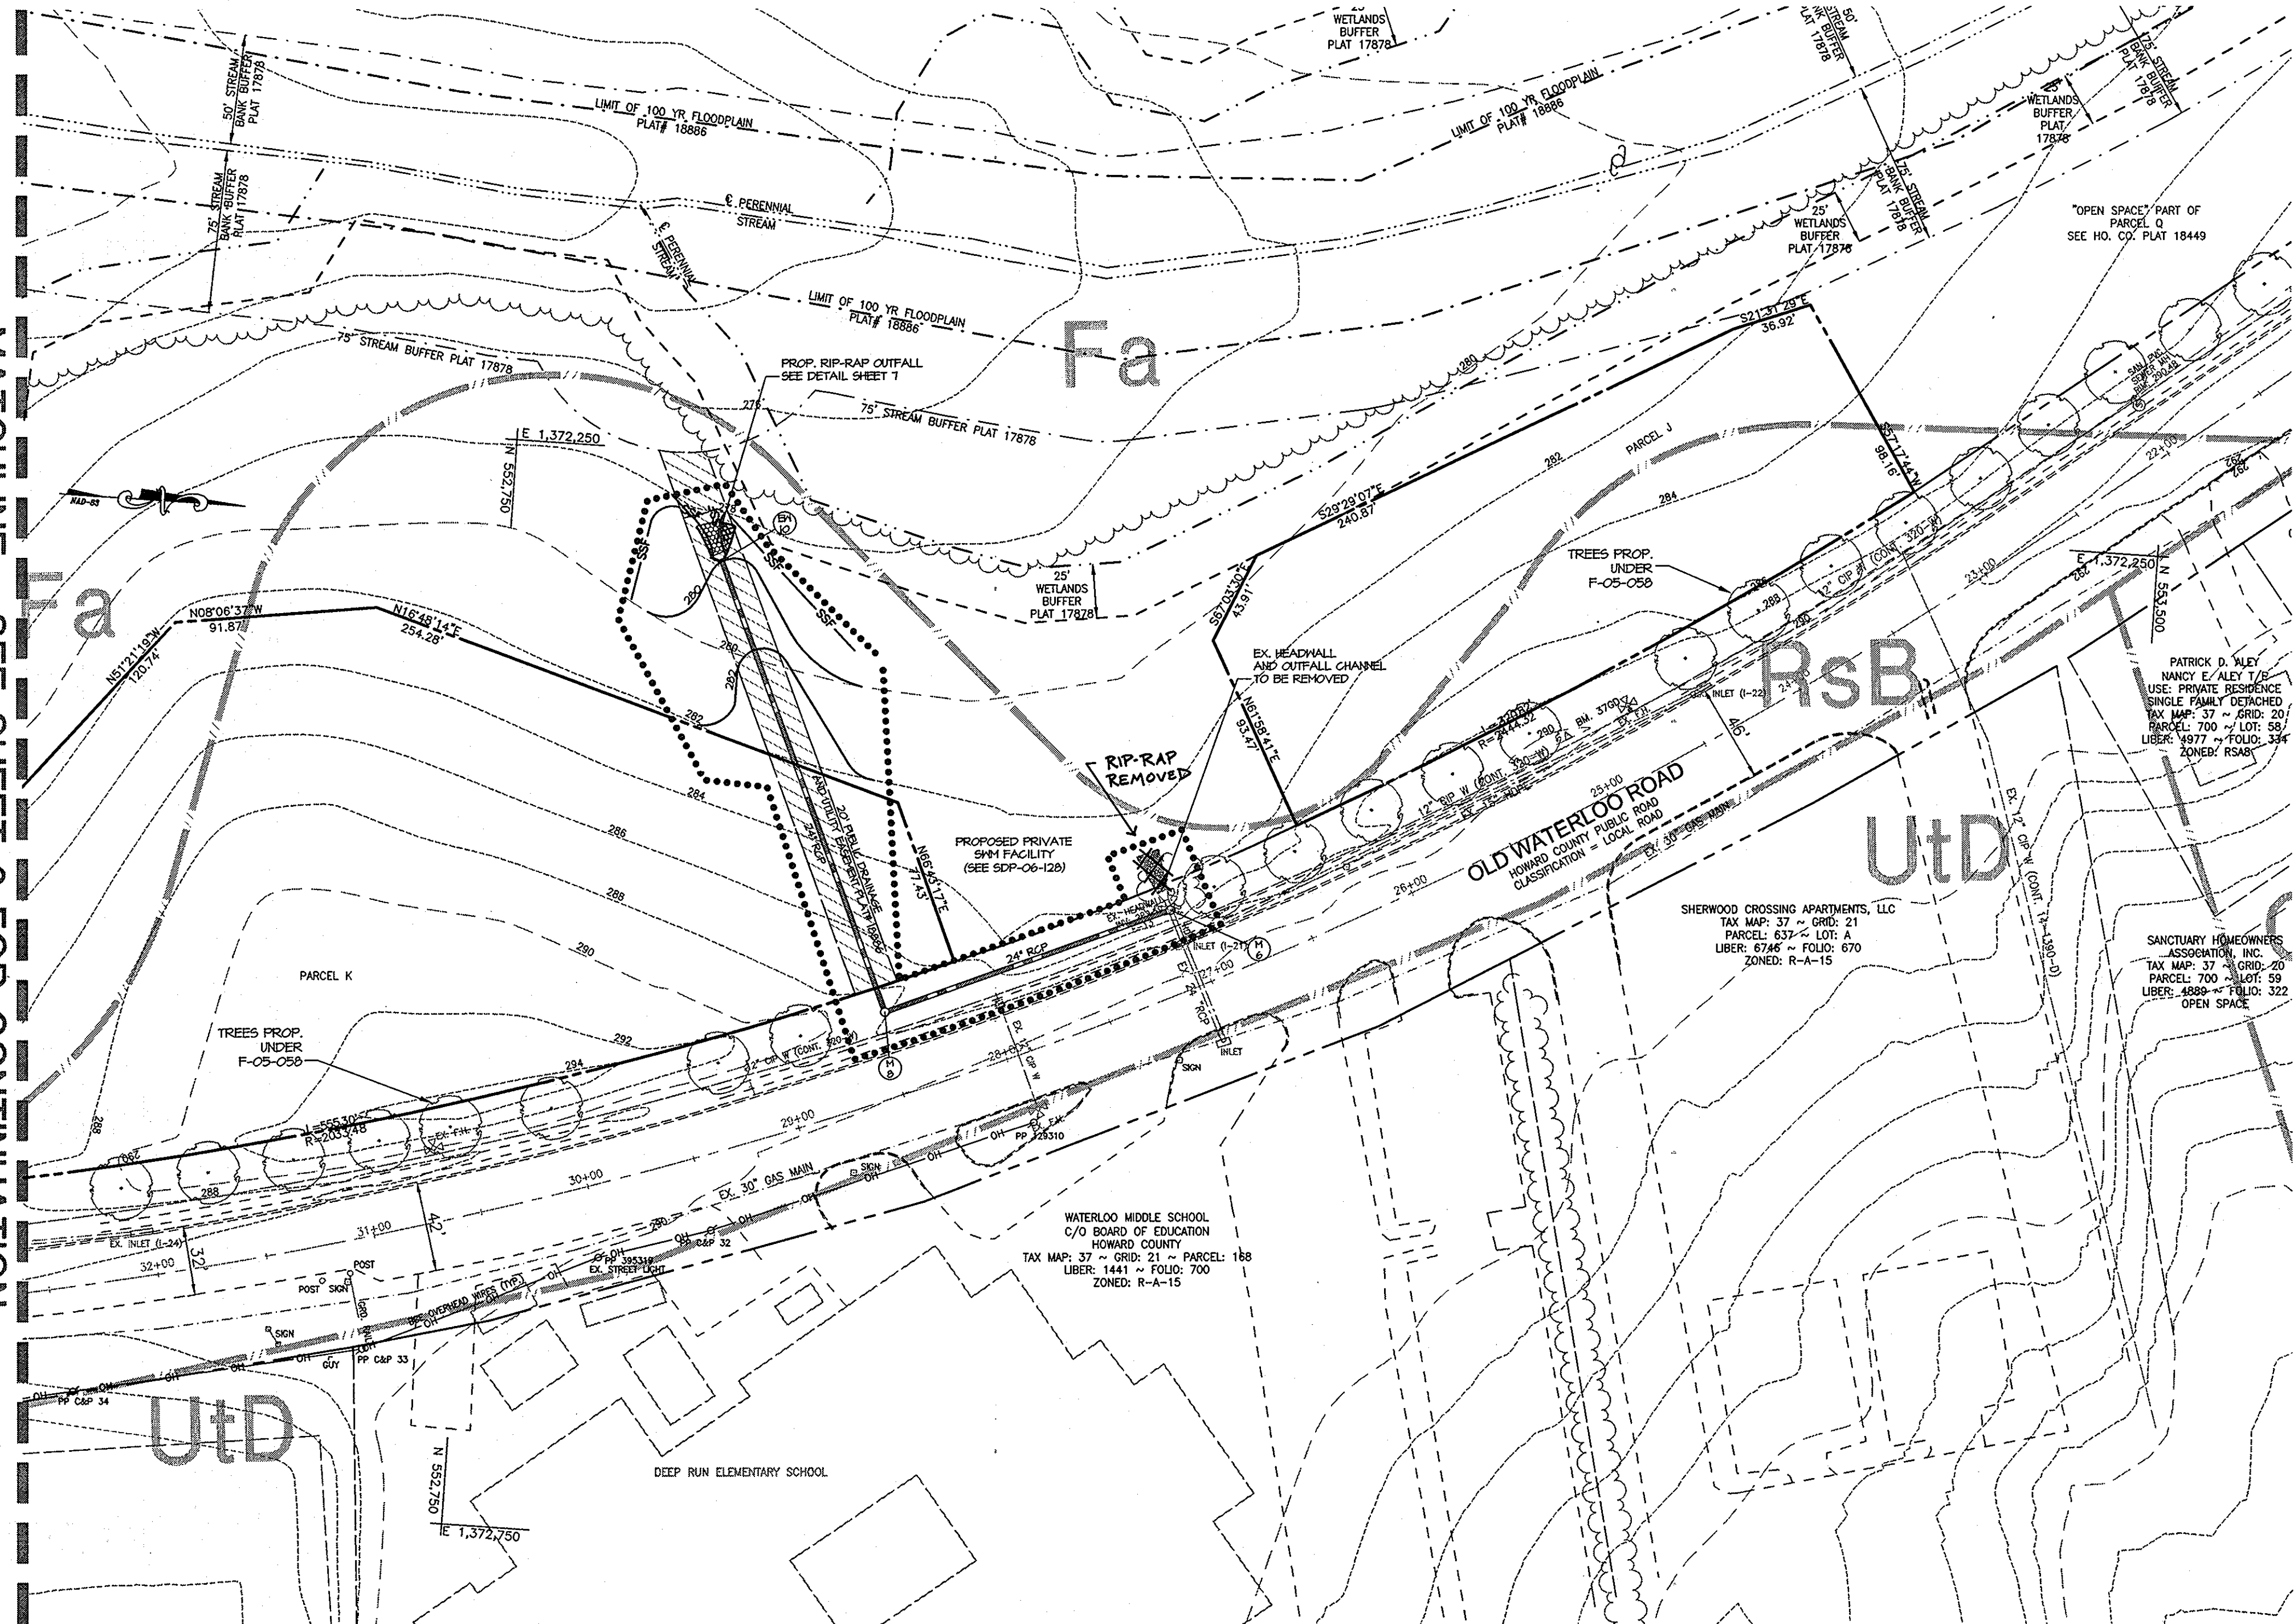

AS-BUILT PLAN
BY MRA
07/2010

SOILS LEGEND		
SYMBOL	NAME/DESCRIPTION	SOIL TYPE
Rsb	RUSSETT, FINE SANDY LOAM, 2-5% SLOPES	C
Fa	FALLSINGTON, SANDY LOAM, 0-2% SLOPES	C
Rsc	RUSSETT, FINE SANDY LOAM, 5-10% SLOPES	C
UtD	URBAN LAND, UDORTHERENTS COMPLEX, 0-15% SLOPES	C
Uof	UDORTHERENTS, HIGHWAY 0-65% SLOPES	C

ENGINEER'S CERTIFICATE
I HEREBY CERTIFY THAT THIS PLAN FOR SEDIMENT AND EROSION CONTROL REPRESENTS A PRACTICAL AND WORKABLE PLAN BASED ON MY PERSONAL KNOWLEDGE OF THE SITE CONDITIONS AND THAT IT WAS PREPARED IN ACCORDANCE WITH THE REQUIREMENTS OF THE HOWARD SOIL CONSERVATION DISTRICT.
Kerri S. Knighten 2/27/07
SIGNATURE OF ENGINEER DATE
KERRI S. KNIGHTEN, PE MD LICENSE 201135

DEVELOPER'S CERTIFICATE
I/WE CERTIFY THAT ALL DEVELOPMENT AND CONSTRUCTION WILL BE DONE ACCORDING TO THIS PLAN OF DEVELOPMENT FOR SEDIMENT AND EROSION CONTROL, AND THAT ALL RESPONSIBLE PERSONNEL INVOLVED IN THE CONSTRUCTION PROJECT WILL HAVE A CERTIFICATE OF ATTENDANCE AT A DEPARTMENT OF ENVIRONMENT APPROVED TRAINING PROGRAM FOR THE CONTROL OF SEDIMENT AND EROSION BEFORE BEGINNING THE PROJECT. I ALSO AUTHORIZE PERIODIC ONSITE INSPECTIONS BY THE HOWARD SOIL CONSERVATION DISTRICT.
Brian Knauff 2/27/07
SIGNATURE OF DEVELOPER DATE
BRIAN KNAUFF

REVIEWED FOR HOWARD SCD AND MEETS TECHNICAL REQUIREMENTS.
Nancy E. Aley 3/5/07
NANCY E. ALEY 1/5
USE: PRIVATE RESIDENCE
SINGLE FAMILY DETACHED
TAX MAP: 37 ~ GRID: 20
PARCEL: 700 ~ LOT: 59
LIBER: 8808 ~ FOLD: 322
ZONED: RSAB
JSDA - NATURAL RESOURCES CONSERVATION SERVICE DATE

THIS DEVELOPMENT PLAN IS APPROVED FOR SOIL EROSION AND SEDIMENT CONTROL BY THE HOWARD SOIL CONSERVATION DISTRICT.
John P. Blanton 3/5/07
HOWARD SOIL CONSERVATION DISTRICT DATE

APPROVED: HOWARD COUNTY DEPARTMENT OF PUBLIC WORKS.
Walter Z. Mabel 3-8-07
CHIEF, BUREAU OF HIGHWAYS DATE

APPROVED: HOWARD COUNTY DEPARTMENT OF PLANNING AND ZONING.
Cindy Harman 3/12/07
CHIEF, DIVISION OF LAND DEVELOPMENT DATE

Robert Cummings 3/12/07
CHIEF, DEVELOPMENT ENGINEERING DIVISION DATE

DATE	NO.	REVISION

OWNER / DEVELOPER THE RYLAND GROUP
ATTN: MR. BRIAN KNAUFF
6011 UNIVERSITY BOULEVARD, SUITE 260
ELLICOTT CITY, MARYLAND 21043
PHONE: 410-480-2467
FAX: 410-480-0543

PROJECT OLD WATERLOO ROAD EXTENSION
GATEWAY OVERLOOK AT BENSON EAST

AREA PLAT: 18885
ZONED: NT ~ TAX MAP: 37 AND 43 ~ GRID: 20, 21 AND 2, 3
PARCEL: 382 ~ LOTS: J, K & L
6TH ELECTION DISTRICT ~ HOWARD COUNTY, MARYLAND

TITLE ROAD & PUBLIC STORM DRAIN PLAN

MRA MORRIS & RITCHIE ASSOCIATES, INC.
ENGINEERS, PLANNERS, SURVEYORS AND LANDSCAPE ARCHITECTS
14280 PARK CENTER DRIVE, SUITE A
LAUREL, MARYLAND 20707
(410) 782-9792 or (301) 776-1690
FAX (410) 782-7395

2/27/07 DATE
Kerri S. Knighten
DRAWN BY: MSP/MDC
DESIGNED BY: JCW/MSP
REVIEWED BY: KSK
PROJECT NO.: 14719
DATE: 2/27/07
SCALE: 1" = 50'
DRAWING NO. 3 OF 9

P:\PROJECTS\14719\14719.DWG (MRA) (SC-02-02-LX.dwg) 2/27/2007 12:10:40 PM. C:\Users\...
1:1, Copyright 2007 Morris & Ritchie Associates, Inc.

LEGEND

- EX. 2' CONTOUR
- EX. 10' CONTOUR
- EX. BUILDING
- EX. CURB
- EX. BASEMENT
- EX. FENCE
- EX. FLOODPLAIN
- EX. GAS
- EX. PAVEMENT
- EX. PROPERTY LINE
- EX. ROAD CENTERLINE
- EX. 8" S
- EX. 27" RCCP
- EX. 10" W
- EX. TREE LINE
- EX. WATERLINE
- EX. WETLAND
- EX. WETLAND BUFFER
- PROP. 2' CONTOURS
- PROP. 10' CONTOURS
- PROP. CENTERLINE OF DRAINAGE SWALE
- PROP. 8" CHANNEL FENCE
- PROP. CURB
- PROP. REVERSE CURB & GUTTER
- PROP. STANDARD CURB & GUTTER
- PROP. TREE LINE
- PROP. LIMIT OF DISTURBANCE
- PROP. PAVEMENT
- PROP. BUILDING
- PROP. BUILDING SETBACK
- PROP. PUBLIC SANITARY SEWER LINE
- PROP. PUBLIC WATER LINE
- PROP. PRIVATE STORM DRAIN LINE
- PROP. PUBLIC STORM DRAIN LINE
- PROP. PUBLIC SD & UTILITY ESMT
- EX. 20" PUBLIC SD & UTILITY EASMENT
- PROP. SUPER SILT FENCE
- EX. 2025 65 gBA LINE
- PROP. MILL & OVERLAY
- PROP. SITE LIGHTING
- PROP. CURB INLET PROTECTION
- SOIL BOUNDARY
- SOIL TYPE

PLANT LEGEND

- EX. TREE
- PROP. TREE UNDER F-05-058
- PROP. STREET TREE
- PROP. ORNAMENTAL TREE

NOTE:

- FINANCIAL SURETY FOR THE REQUIRED INSTALLATION OF STREET TREES WILL BE POSTED AS PART OF THE DPW DEVELOPERS AGREEMENT FOR ROAD CONSTRUCTION IN THE AMOUNT OF \$6,750.00 (17 SHADE TREES @ \$300.00 EA., 11 FLOWERING TREES @ \$150.00 EA.). THIS AMOUNT REPRESENTS THE REQUIRED STREET TREE PLANTINGS FOR THE EXTENSION OF OLD WATERLOO ROAD.
- THE DEVELOPER/BUILDER WILL BE RESPONSIBLE FOR THE STREET TREE INSTALLATION.
- SEE SHEETS 4 & 5 OF 9 FOR PLANTING DETAIL AND NOTES FOR THE STREET TREE INSTALLATION.

SPECIMEN	SPECIMEN SPECIES	DBH	CONDITION
A	LIRIODENDRON TULIPIFERA - TULIPTREE	40"	POOR

GENERAL LANDSCAPE NOTES:

- CONTRACTOR SHALL CONTACT "MISS UTILITY" & SHALL VERIFY THE LOCATION OF ALL UNDERGROUND UTILITIES WITHIN THE PROJECT PRIOR TO INSTALLATION.
- TREES SHALL BE LOCATED A MINIMUM OF 5' FROM SEWER/WATER CONNECTIONS. CONTRACTOR SHALL BE LIABLE FOR DAMAGE TO ANY AND ALL PUBLIC AND PRIVATE UTILITIES, WATER AND SEWER LINES.
- CONTRACTOR SHALL SLIGHTLY ADJUST PLANT LOCATIONS IN THE FIELD AS NECESSARY TO BE CLEAR OF DRAINAGE SWALES AND UTILITIES. FINISHED PLANTING BEDS SHALL BE GRADED SO AS NOT TO IMPEDE DRAINAGE.
- ALL TREE PITS ARE TO BE COMPLETELY EXCAVATED IN ACCORDANCE WITH THE PLANTING DETAILS.
- CONTRACTOR MUST CONTACT THE OWNER AT LEAST TEN WORKING DAYS IN ADVANCE TO SCHEDULE ACCEPTANCE INSPECTION(S). CONTRACTOR MUST REPLACE ALL DEAD & UNACCEPTABLE PLANTINGS DURING THE FOLLOWING RECOMMENDED PLANTING SEASON.
- TREES SHALL BE PLANTED DURING ACCEPTABLE PLANTING SEASONS - BETWEEN MARCH 15 AND MAY 15 AND BETWEEN AUGUST 15 AND NOVEMBER 15 OR AS APPROVED BY OWNERS' REPRESENTATIVE.
- SEEDED AREAS THAT WASH OUT MUST BE FILLED AND GRADED AS NECESSARY AND THEN RESEEDED.
- QUANTITIES SHOWN ON THE PLANT LIST ARE FOR THE CONTRACTOR'S CONVENIENCE ONLY AND ARE NOT GUARANTEED TO BE ACCURATE. IN THE EVENT OF A DISCREPANCY BETWEEN QUANTITIES SHOWN ON THE PLAN AND QUANTITIES SHOWN IN THE PLANT LIST, THE QUANTITIES SHOWN ON THE PLAN SHALL APPLY.

SUBSTITUTIONS:
NO SUBSTITUTIONS OF PLANT MATERIAL SHALL BE PERMITTED WITHOUT WRITTEN AUTHORIZATION OF THE LANDSCAPE ARCHITECT OR HIS REPRESENTATIVE. THIS SHALL APPLY TO SUBSTITUTIONS OF SPECIES, SIZE AND QUANTITY.

PLANT QUALITY ASSURANCE:

- ALL PLANT MATERIAL AND ROOT BALLS SHALL CONFORM TO THE STANDARDS OF NURSERY STOCK AND THE AMERICAN ASSOCIATION OF NURSERYMEN.
- TREES SHALL BE TYPICAL OF THEIR SPECIES AND VARIETY, HAVE NORMAL GROWTH HABITS, WELL DEVELOPED, DENSELY FOLIATED BRANCHES, AND VIGOROUS, FIBROUS ROOT SYSTEMS.
- TREES SHALL BE FRESHLY DUG AND NURSERY GROWN. THEY SHALL HAVE BEEN GROWN UNDER CLIMATIC CONDITIONS SIMILAR TO THOSE IN THE LOCALITY OF THE PROJECT OR PROPERLY ACCLIMATED TO CONDITIONS OF THE LOCALITY OF THE PROJECT.
- ALL PLANT MATERIAL SHALL BE FREE FROM DEFECTS AND INJURIES AND CERTIFIED BY APPROPRIATE FEDERAL AND STATE AUTHORITIES TO BE FREE OF DISEASE AND INSECT.
- THE LANDSCAPE CONTRACTOR SHALL GUARANTEE ALL PLANT MATERIAL FOR A PERIOD OF ONE (1) FULL YEAR AFTER THE DATE OF SUBSTANTIAL COMPLETION AGAINST DEFECTS, UNSATISFACTORY GROWTH, DISEASE OR DEATH. UNSATISFACTORY, UNHEALTHY, DYING OR DEAD PLANT MATERIAL (IN THE OPINION OF THE LANDSCAPE ARCHITECT) SHALL BE REPLACED WITH THE SAME SIZE AND SPECIES.
- IT SHALL BE THE RESPONSIBILITY OF THE LANDSCAPE CONTRACTOR TO ADEQUATELY AND PROPERLY MAINTAIN THE LANDSCAPED AREAS, WHICH SHALL INCLUDE WATERING, CLEANING OF WEEDS AND DEBRIS, PRUNING AND TRIMMING, REPLACEMENT OF DEAD OR DISEASED PLANTINGS AND FERTILIZING TO MAINTAIN HEALTHY GROWTH.

PLANTING LAYOUT APPROVAL:
THE LANDSCAPE CONTRACTOR SHALL PROVIDE STAKES AND STAKEOUT PLANT LOCATIONS IN THE FIELD. THE LANDSCAPE ARCHITECT OR HIS REPRESENTATIVE SHALL OBSERVE THESE LOCATIONS PRIOR TO COMMENCING PLANT PIT EXCAVATION. THE LANDSCAPE CONTRACTOR SHALL MAKE ANY ADJUSTMENTS AS REQUESTED BY THE LANDSCAPE ARCHITECT.

TREE & SHRUB PLANTING:
1. TREE STAKING AND CUTTING SHALL BE DONE PER DETAILS. CONTRACTOR SHALL ENSURE THAT TREES REMAIN PLUMB AND UPRIGHT FOR THE DURATION OF THE GUARANTEED PERIOD. STAKING TO BE REMOVED BY CONTRACTOR.

2. BALLED AND BURLAPPED ROOTS - BURLAP TO BE LOOSENED AND SPREAD AWAY OR CUT FROM ENTIRE TOP OF PLANT BALL. FOLD DOWN WIRE BASKETS OR CUT TOP OF BASKET BELOW SOIL LEVEL. ROOTS OF BARE ROOT PLANTS SHALL BE SPREAD CAREFULLY IN NATURAL POSITION. AMENDED SOIL SHALL BE WORKED AROUND ROOTS.

3. FERTILIZER FOR TREES SHALL BE ADDED TO THE PLANTING SOIL PRIOR TO MIXING. FERTILIZER SHALL BE SLOW RELEASE PACKETS OR TABLETS TO BE ADDED DEPENDING ON PLANT SIZE AND GROWER'S RECOMMENDATIONS. THOROUGHLY MIX ALL AMENDMENTS AND EXISTING SOIL PRIOR TO PLACEMENT.

4. PACK SOIL MIX FIRMLY AROUND THE ROOTS TO ELIMINATE AIR POCKETS. WHEN HOLE IS 3/4 FULL WITH SOIL MIX, FLOOD THE HOLE WITH WATER. AFTER DRAINING, FILL HOLE TO THE SURFACE WITH SOIL.

PLANTING STORAGE AND HANDLING:
BALLED AND BURLAPPED - KEEP ROOT BALLS MOIST AT ALL TIMES. IF NOT PLANTED WITHIN SEVEN DAYS AFTER DELIVERY COVER THE BALL WITH MULCH/STRAW AND KEEP WATERED UNTIL PLANTED.

MULCHING:
THE LANDSCAPE CONTRACTOR SHALL INSTALL DOUBLE SHREDDED HARDWOOD BARK MULCH TO A DEPTH OF 3" UNDER AND SURROUNDING ALL NEW LANDSCAPED MASS PLANTING AREAS TO PROVIDE A UNIFORM AND CONTINUOUS SURFACE AND APPEARANCE BETWEEN AND AROUND ALL PLANT MATERIAL, BUILDING LINES AND PAVED AREAS. IN GENERAL, THIS PERTAINS TO ALL PLANT MATERIAL THAT IS PLANTED CLOSER THAN SIX FEET CENTER TO CENTER.

EDGING OF BEDS:
UPON COMPLETION OF PLANTING, MULCH BEDS SHALL BE NEATLY EDGED TO A DEPTH OF 3 INCHES WITH A VERTICAL CUT TAPERED BACK TO THE MULCH AREA.

CLEAN-UP/RESTORATION:
1. DURING THE COURSE OF PLANTING, EXCESS AND WASTE MATERIALS SHALL BE CONTINUOUSLY AND PROMPTLY REMOVED, ALL SITE AREAS KEPT CLEAN AND ALL REASONABLE PRECAUTIONS TAKEN TO AVOID DAMAGE TO EXISTING LAWNS, PAVING, ETC.

2. THE LANDSCAPE CONTRACTOR SHALL RESTORE TO THEIR ORIGINAL CONDITIONS ALL PAVEMENTS, SOODED AND PLANTED AREAS, NOT SPECIFICALLY PROVIDED FOR IN THE CONTRACT, WHICH ARE DISTURBED BY THE LANDSCAPE CONTRACTOR DURING PLANTING OPERATIONS. THE ENTIRE AREA SHALL BE LEFT NEAT AND CLEAN. SUCH RESTORATIONS SHALL BE IN A MANNER SATISFACTORY TO THE OWNER OR THE OWNER'S REPRESENTATIVE AND AT NO ADDITIONAL COST TO THE OWNER.

3. DEBRIS, RUBBISH AND SUBSOIL SHALL BE CLEANED AND REMOVED FROM THE SITE UPON COMPLETION OF PLANTING.

STREET TREE PLANT LIST (THIS SHEET ONLY)						
KEY	QTY	BOTANICAL NAME	COMMON NAME	SIZE	ROOT	COMMENT
AS	4	Acer buergerianum	Trident Maple	2" Cal.	BIB	Full 4 Uniform
AS	13	Acer saccharum 'Green Mountain'	'Green Mountain' Sugar Maple	2 1/2-3" Cal.	BIB	Full 4 Uniform
MS	11	Magnolia x soulangiana	Saucer Magnolia	8-10" Ht.	BIB	Full 4 Uniform


STREET TREE CALCULATIONS

- PROP. STREET EXTENSION: 752'
(380' WEST SIDE & 372' EAST SIDE)
REQUIRED STREET TREES (1 TREE/40') - 19 STREET TREES
PROVIDED STREET TREES - 17 STREET TREES
11 ORNAMENTAL TREES

2. ALL PROPOSED TREES SHOWN MEET COUNTY STREET TREE REQUIREMENTS & ARE NOT PART OF THE ONSITE LANDSCAPE REQUIREMENTS.

ADDITIONAL NOTES:

- THE OWNER, TENANT AND/OR THEIR AGENTS SHALL BE RESPONSIBLE FOR MAINTENANCE OF THE REQUIRED LANDSCAPING, INCLUDING BOTH PLANT MATERIALS AND BERMS, FENCES AND WALLS. ALL PLANT MATERIALS SHALL BE MAINTAINED IN GOOD GROWING CONDITION, AND WHEN NECESSARY, REPLACED WITH NEW MATERIALS TO ENSURE CONTINUED COMPLIANCE WITH APPLICABLE REGULATIONS. ALL OTHER REQUIRED LANDSCAPING SHALL BE PERMANENTLY MAINTAINED IN GOOD CONDITION AND WHEN NECESSARY, REPAIRED OR REPLACED.
- AT THE TIME OF INSTALLMENT, ALL SHRUBS AND OTHER PLANTINGS HEREWITH LISTED AND APPROVED FOR THIS SITE, SHALL BE OF THE PROPER HEIGHT REQUIREMENTS IN ACCORDANCE WITH THE HOWARD COUNTY LANDSCAPING MANUAL. IN ADDITION, NO SUBSTITUTIONS OR RELOCATION OF REQUIRED PLANTINGS MAY BE MADE WITHOUT PRIOR REVIEW AND APPROVAL FROM THE DEPARTMENT OF PLANNING AND ZONING. ANY DEVIATION FROM THIS LANDSCAPE PLAN MAY RESULT IN DENIAL OR DELAY IN THE RELEASE OF LANDSCAPE SURETY UNTIL SUCH TIME AS ALL REQUIRED MATERIALS ARE PLANTED AND/OR REVISIONS ARE MADE TO APPLICABLE PLANS AND CERTIFICATES.

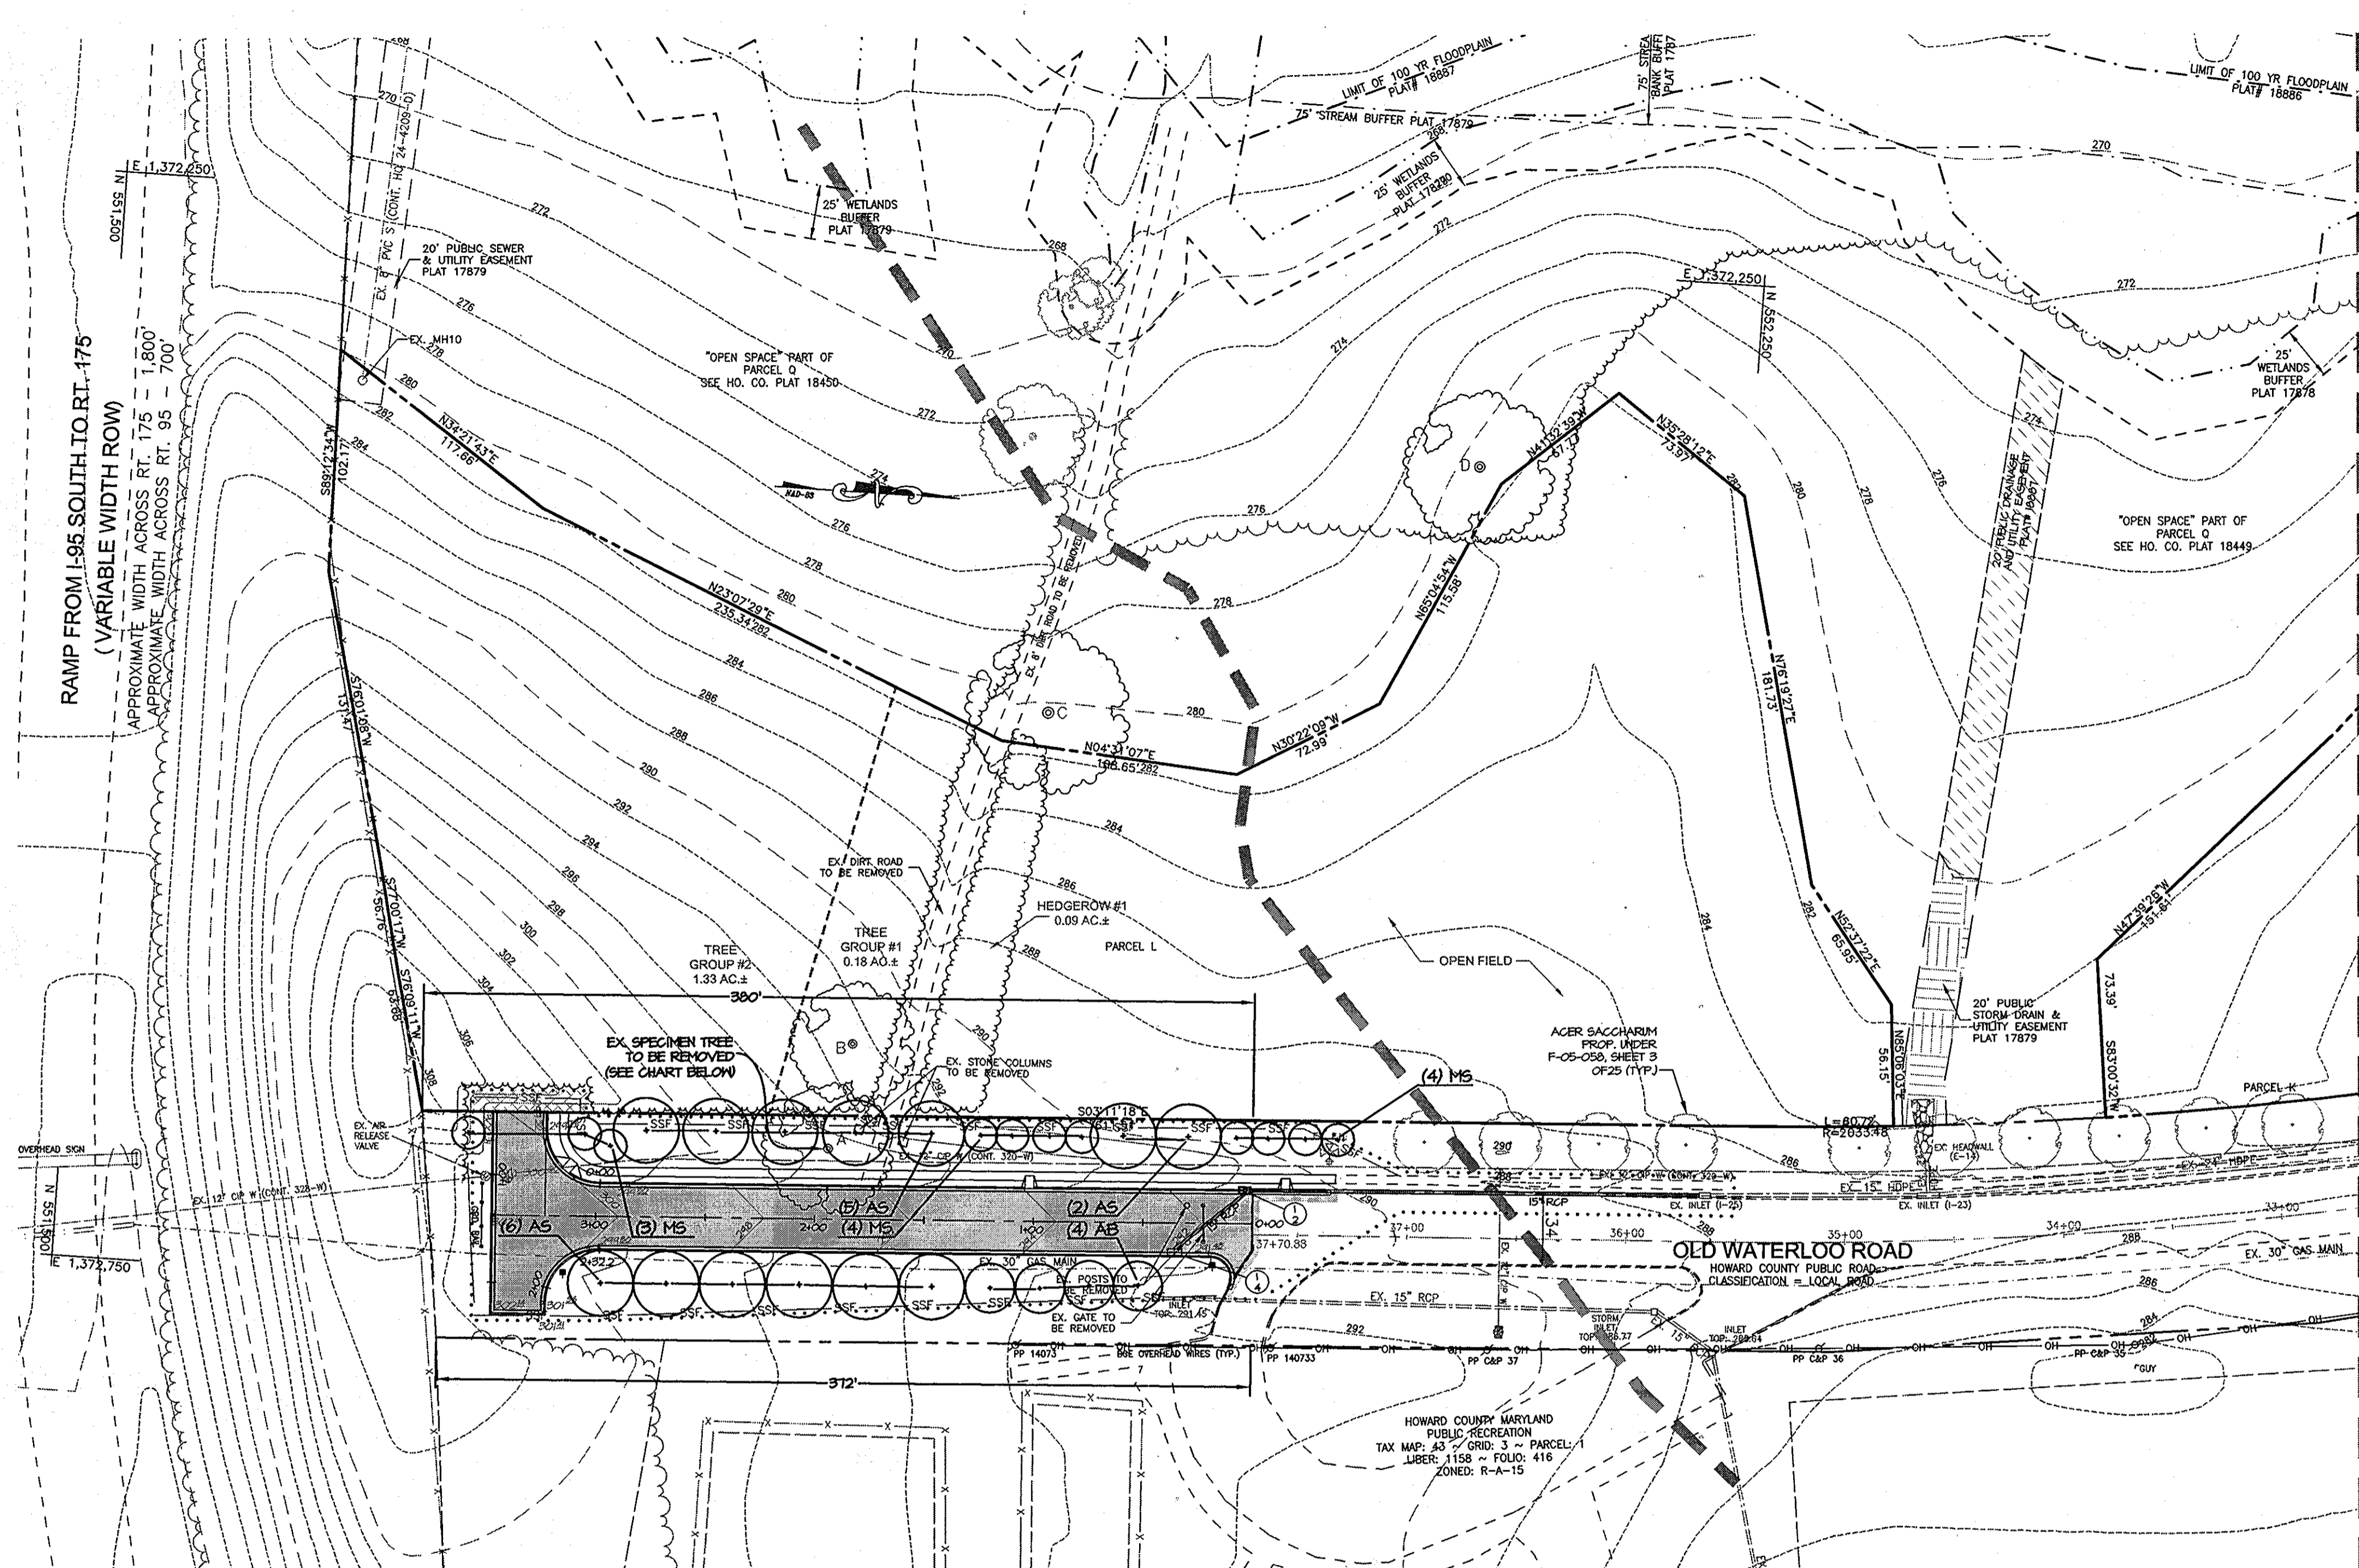

MATCHLINE - SEE SHEET 5 FOR CONTINUATION

APPROVED: HOWARD COUNTY DEPARTMENT OF PUBLIC WORKS
William K. Knauff 3-8-07
 CHIEF, BUREAU OF HIGHWAYS DATE

DEVELOPER'S/BUILDER'S CERTIFICATE
 I/WE CERTIFY THAT THE LANDSCAPING SHOWN ON THIS PLAN WILL BE DONE ACCORDING TO THE PLAN, SECTION 16.124 OF THE HOWARD COUNTY SUBDIVISION AND LAND DEVELOPMENT REGULATIONS AND THE LANDSCAPE MANUAL. I/WE FURTHER CERTIFY THAT UPON COMPLETION A LETTER OF LANDSCAPE INSTALLATION, ACCOMPANIED BY AN EXECUTED ONE YEAR GUARANTEE OF PLANT MATERIALS, WILL BE SUBMITTED TO THE DEPARTMENT OF PLANNING AND ZONING.
Brian Knauff 2/27/07
 NAME DATE
 BRIAN KNAUFF

APPROVED: HOWARD COUNTY DEPARTMENT OF PLANNING AND ZONING.
Cathy Harvath 3/16/07
 CHIEF, DIVISION OF LAND DEVELOPMENT DATE
William Knauff 3/16/07
 CHIEF, DEVELOPMENT ENGINEERING DIVISION DATE
 DATE NO. REVISION

OWNER / DEVELOPER
 THE RYLAND GROUP
 ATTN: MR. BRIAN KNAUFF
 6011 UNIVERSITY BOULEVARD, SUITE 260
 ELLICOTT CITY, MARYLAND 21043
 PHONE: 410-480-2467
 FAX: 410-480-0543

PROJECT
OLD WATERLOO ROAD EXTENSION GATEWAY OVERLOOK AT BENSON EAST
 AREA PLAT: 18885
 ZONED: UT TAX MAP: 37 AND 43 ~ GRID: 20, 21 AND 2, 3
 PARCEL: 382 ~ LOTS: J, K & L
 6TH ELECTION DISTRICT ~ HOWARD COUNTY, MARYLAND

TITLE
STREET TREE PLAN

MORRIS & RITCHIE ASSOCIATES, INC.
 ENGINEERS, PLANNERS, SURVEYORS AND LANDSCAPE ARCHITECTS
 14280 PARK CENTER DRIVE, SUITE A
 LAUREL, MARYLAND 20707
 (410) 792-9792 or (301) 776-1690
 FAX (410) 792-7995

2/27/07
 DRAWN BY: MSP/MDC
 DESIGNED BY: DRB/CMG
 REVIEWED BY: KSK
 PROJECT NO: 14719
 DATE: 2/27/07
 SCALE: 1" = 50'
 DRAWING NO. 4 OF 9


LEGEND

- EX. 2' CONTOUR
- EX. 10' CONTOUR
- EX. BUILDING
- EX. CURB
- EX. EASEMENT
- EX. FENCE
- EX. FLOODPLAIN
- EX. GAS
- EX. PAVEMENT
- EX. PROPERTY LINE
- EX. ROAD CENTERLINE
- EX. 8" S
- EX. 27" RCPP
- EX. 10" W
- EX. TREE LINE
- EX. WATERLINE
- EX. WETLAND
- EX. WETLAND BUFFER
- PROP. 2' CONTOURS
- PROP. 10' CONTOURS
- PROP. CENTERLINE OF DRAINAGE SWALE
- PROP. 6" CHAINLINK FENCE
- PROP. CURB
- PROP. REVERSE CURB & GUTTER
- PROP. STANDARD CURB & GUTTER
- PROP. TREE LINE
- PROP. LIMIT OF DISTURBANCE
- PROP. PAVEMENT
- PROP. BUILDING
- PROP. BUILDING SETBACK
- PROP. PUBLIC SANITARY SEWER LINE
- PROP. PUBLIC WATER LINE
- PROP. PRIVATE STORM DRAIN LINE
- PROP. PUBLIC STORM DRAIN LINE
- PROP. PUBLIC SD & UTILITY ESMT
- EX. 20" PUBLIC SD & UTILITY EASMENT
- PROP. SUPER SILT FENCE
- EX. 2025 65 ABA LINE
- PROP. MILL & OVERLAY
- PROP. SITE LIGHTING
- PROP. CURB INLET PROTECTION
- SOL. BOUNDARY
- SOL. TYPE

PLANT LEGEND


- PROP. TREE UNDER F-05-058

NOTE: THERE ARE NO PROPOSED TREES ON THIS SHEET.

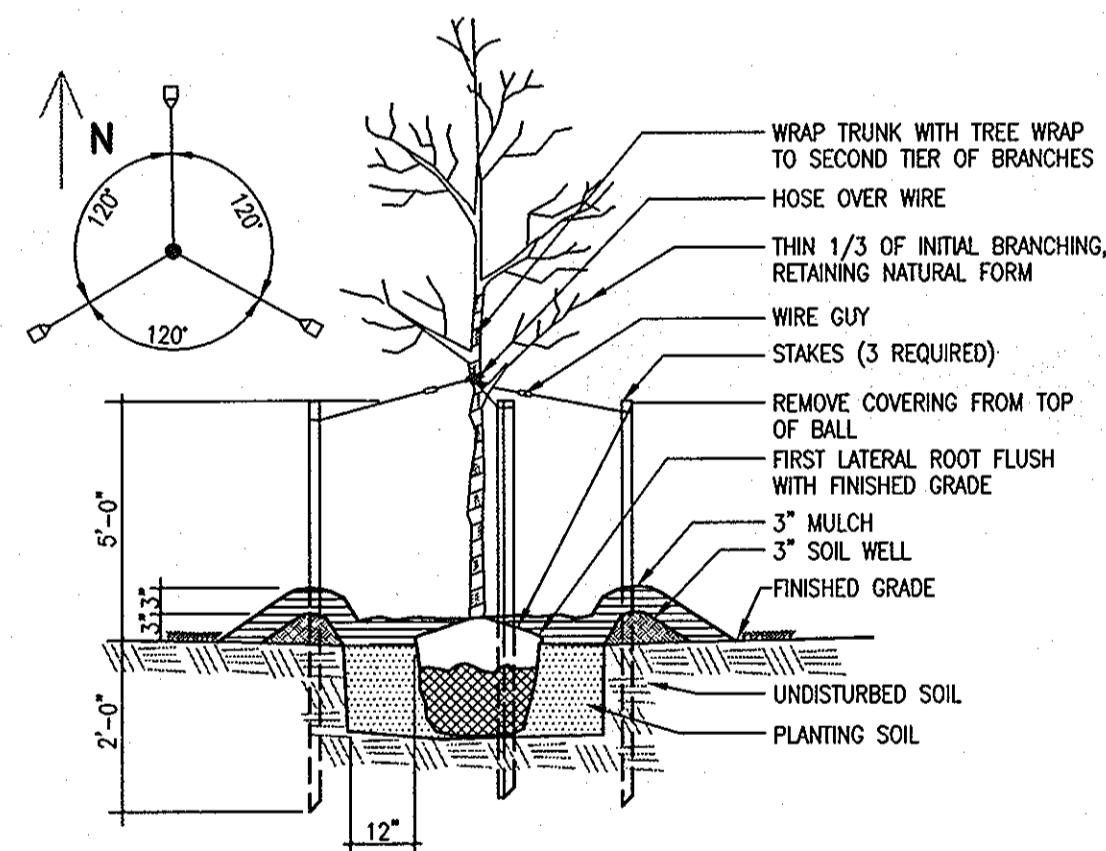

DECIDUOUS TREE DETAIL
NOT TO SCALE

MATCHLINE - SEE SHEET 4 FOR CONTINUATION

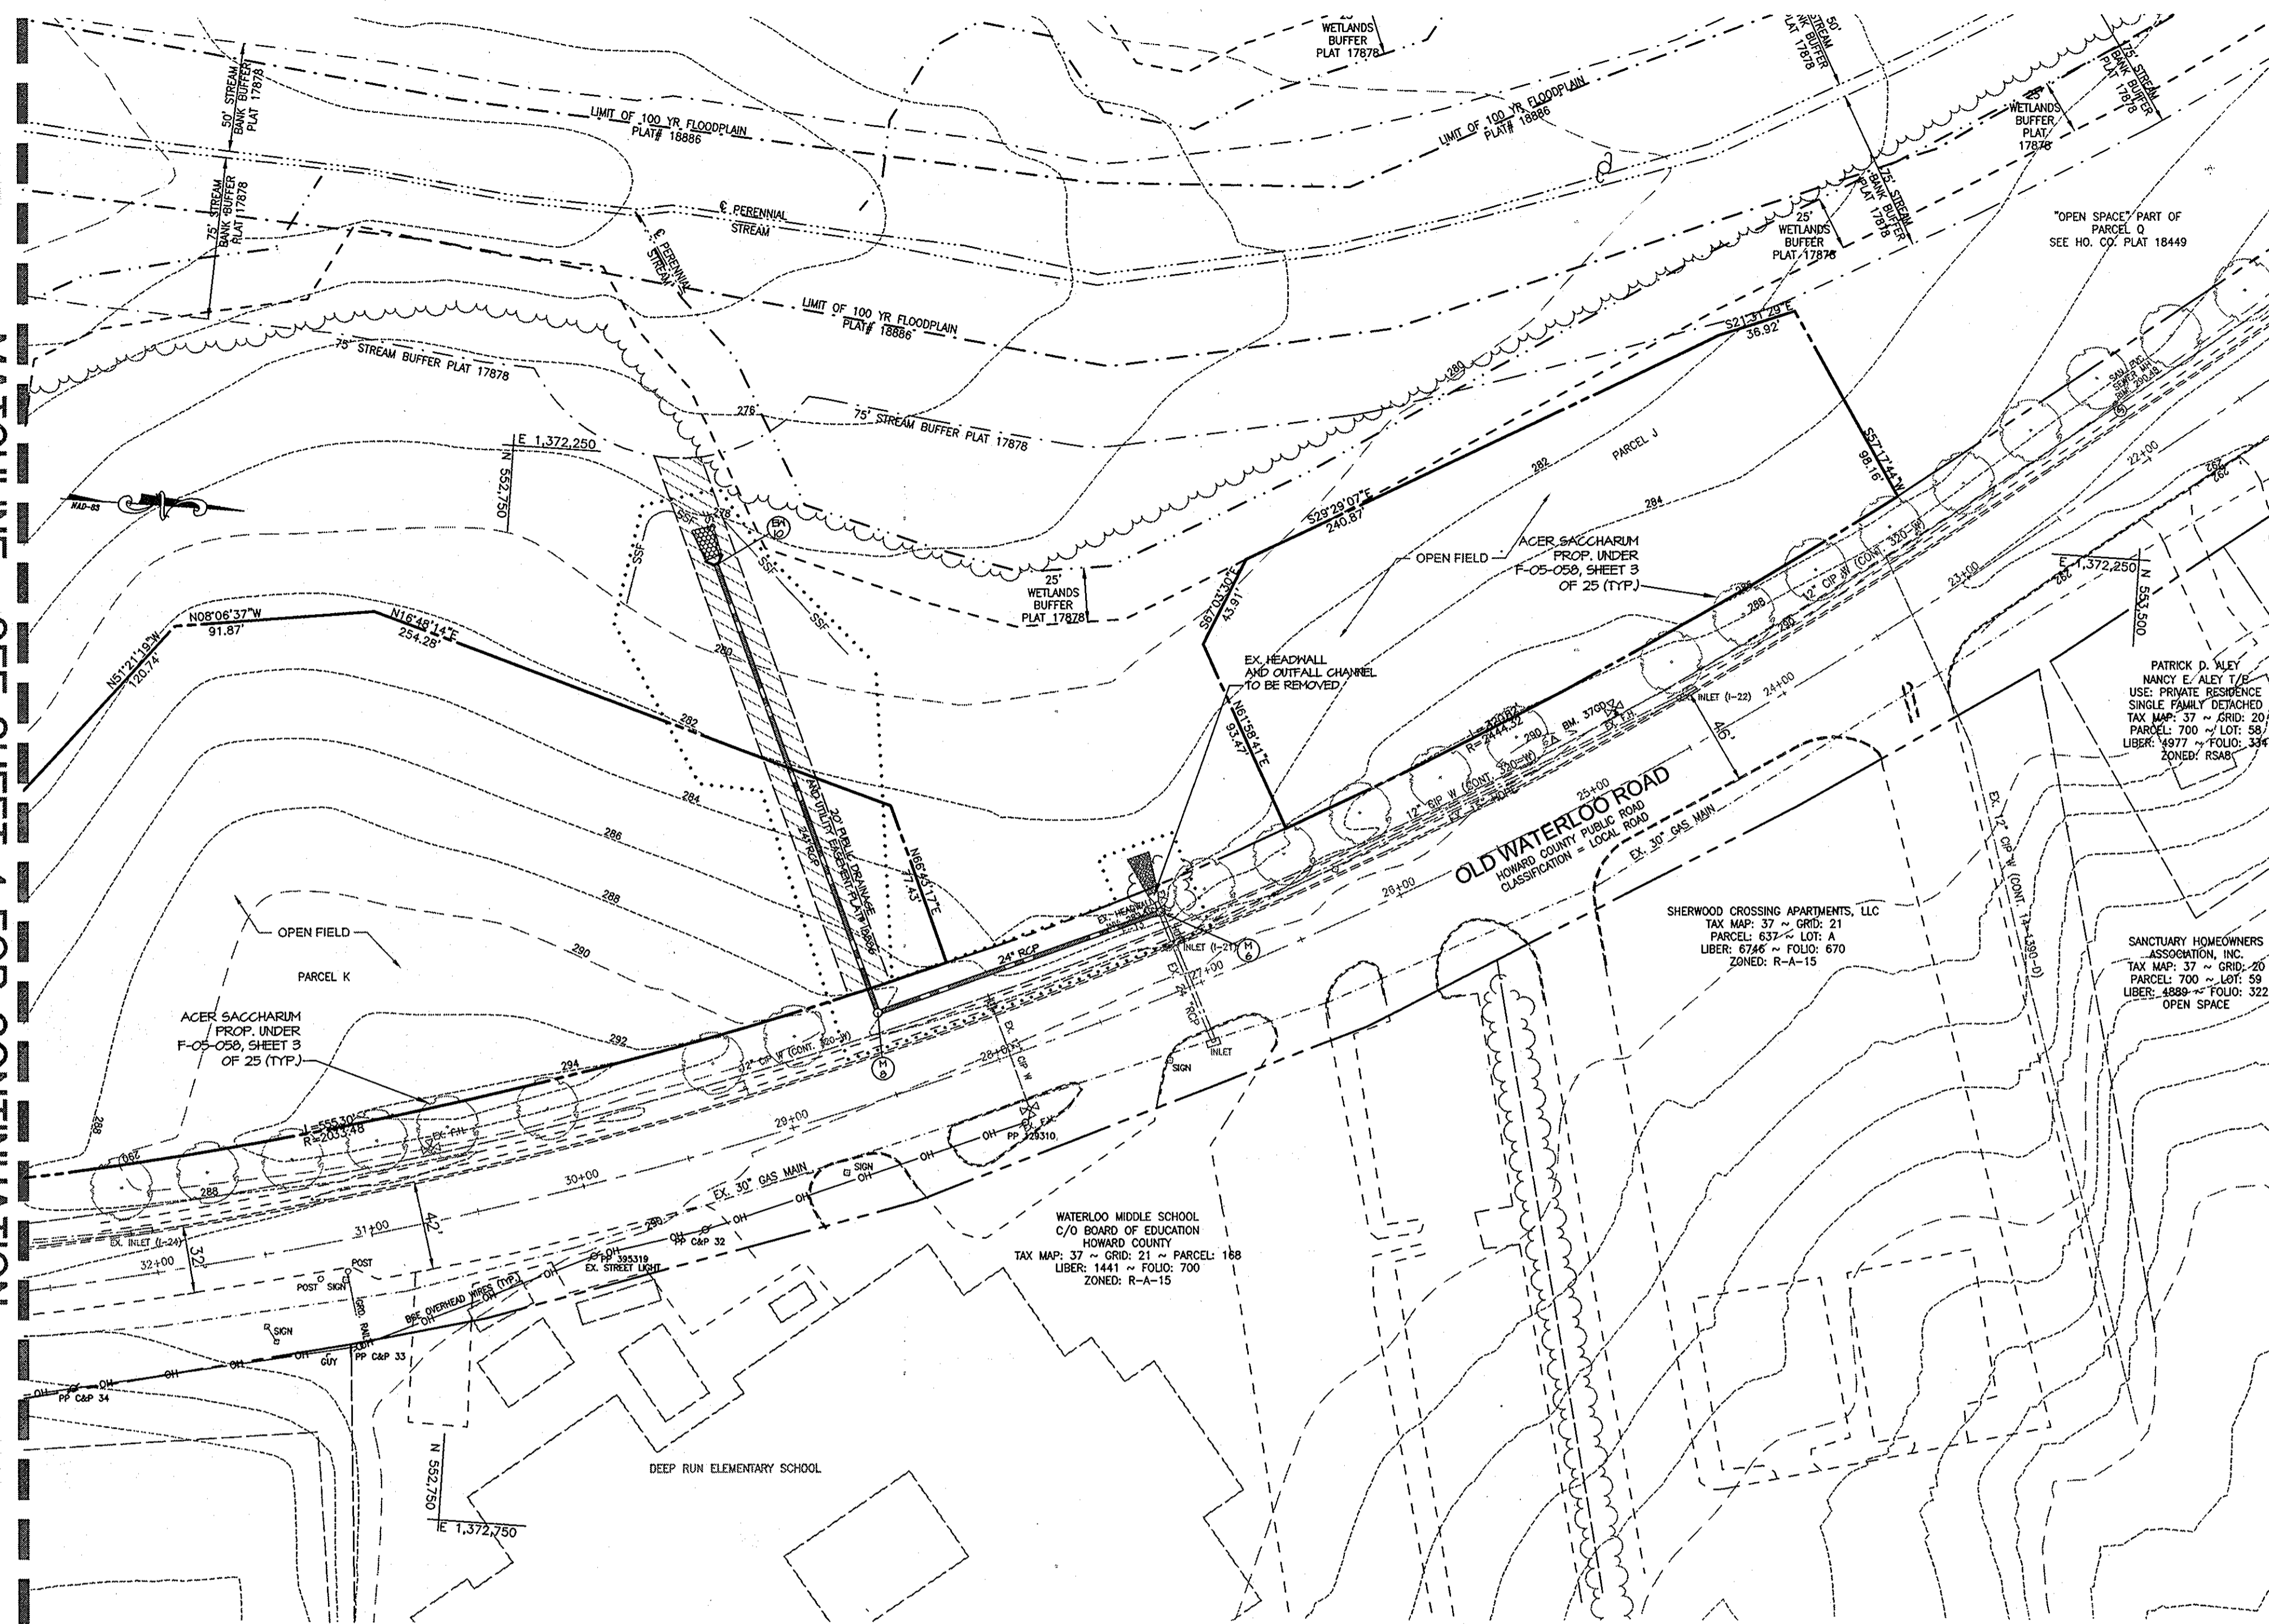

SEE SHEET 4 FOR LANDSCAPING NOTES

APPROVED: HOWARD COUNTY DEPARTMENT OF PUBLIC WORKS.
Walter Z. ... 3-8-07
CHIEF, BUREAU OF HIGHWAYS DATE

DEVELOPER'S/BUILDER'S CERTIFICATE
I/WE CERTIFY THAT THE LANDSCAPING SHOWN ON THIS PLAN WILL BE DONE ACCORDING TO THE PLAN, SECTION 16.124 OF THE HOWARD COUNTY SUBDIVISION AND LAND DEVELOPMENT REGULATIONS AND THE LANDSCAPE MANUAL. I/WE FURTHER CERTIFY THAT UPON COMPLETION A LETTER OF LANDSCAPE INSTALLATION, ACCOMPANIED BY AN EXECUTED ONE YEAR GUARANTEE OF PLANT MATERIALS, WILL BE SUBMITTED TO THE DEPARTMENT OF PLANNING AND ZONING.
Brian Knauff 2/27/07
NAME DATE
BRIAN KNAUFF

APPROVED: HOWARD COUNTY DEPARTMENT OF PLANNING AND ZONING.
Cathy Hansen 3/12/07
CHIEF, DIVISION OF LAND DEVELOPMENT DATE
John ... 2/12/07
CHIEF, DEVELOPMENT ENGINEERING DIVISION DATE
DATE NO. REVISION

OWNER / DEVELOPER
THE RYLAND GROUP
ATTN: MR. BRIAN KNAUFF
6011 UNIVERSITY BOULEVARD, SUITE 260
ELLCOTT CITY, MARYLAND 21043
PHONE: 410-480-2467
FAX: 410-480-0543


PROJECT **OLD WATERLOO ROAD EXTENSION GATEWAY OVERLOOK AT BENSON EAST**
AREA PLAT: 18885
ZONED: NT ~ TAX MAP: 37 AND 43 ~ GRID: 20, 21 AND 2, 3
PARCEL: 382 ~ LOTS: J, K & L
6TH ELECTION DISTRICT ~ HOWARD COUNTY, MARYLAND

TITLE
STREET TREE PLAN


MRA MORRIS & RITCHIE ASSOCIATES, INC.
ENGINEERS, PLANNERS, SURVEYORS AND LANDSCAPE ARCHITECTS
14280 PARK CENTER DRIVE, SUITE A
LAUREL, MARYLAND 20707
(410) 792-8792 or (301) 776-1690
FAX (410) 792-7395

2/27/07 DATE
DRAWN BY: MSP/MDC
DESIGNED BY: DRB/CMG
REVIEWED BY: KSK
PROJECT NO: 14719
DATE: 2/27/07
SCALE: 1" = 50'
DRAWING NO. 5 OF 9


P:\PROJECTS\14719\14719-06-05-14.dwg, 2/27/2007 12:12:37 PM, cchando, 1:1, Copyright 2007 Morris & Ritchie Associates, Inc.

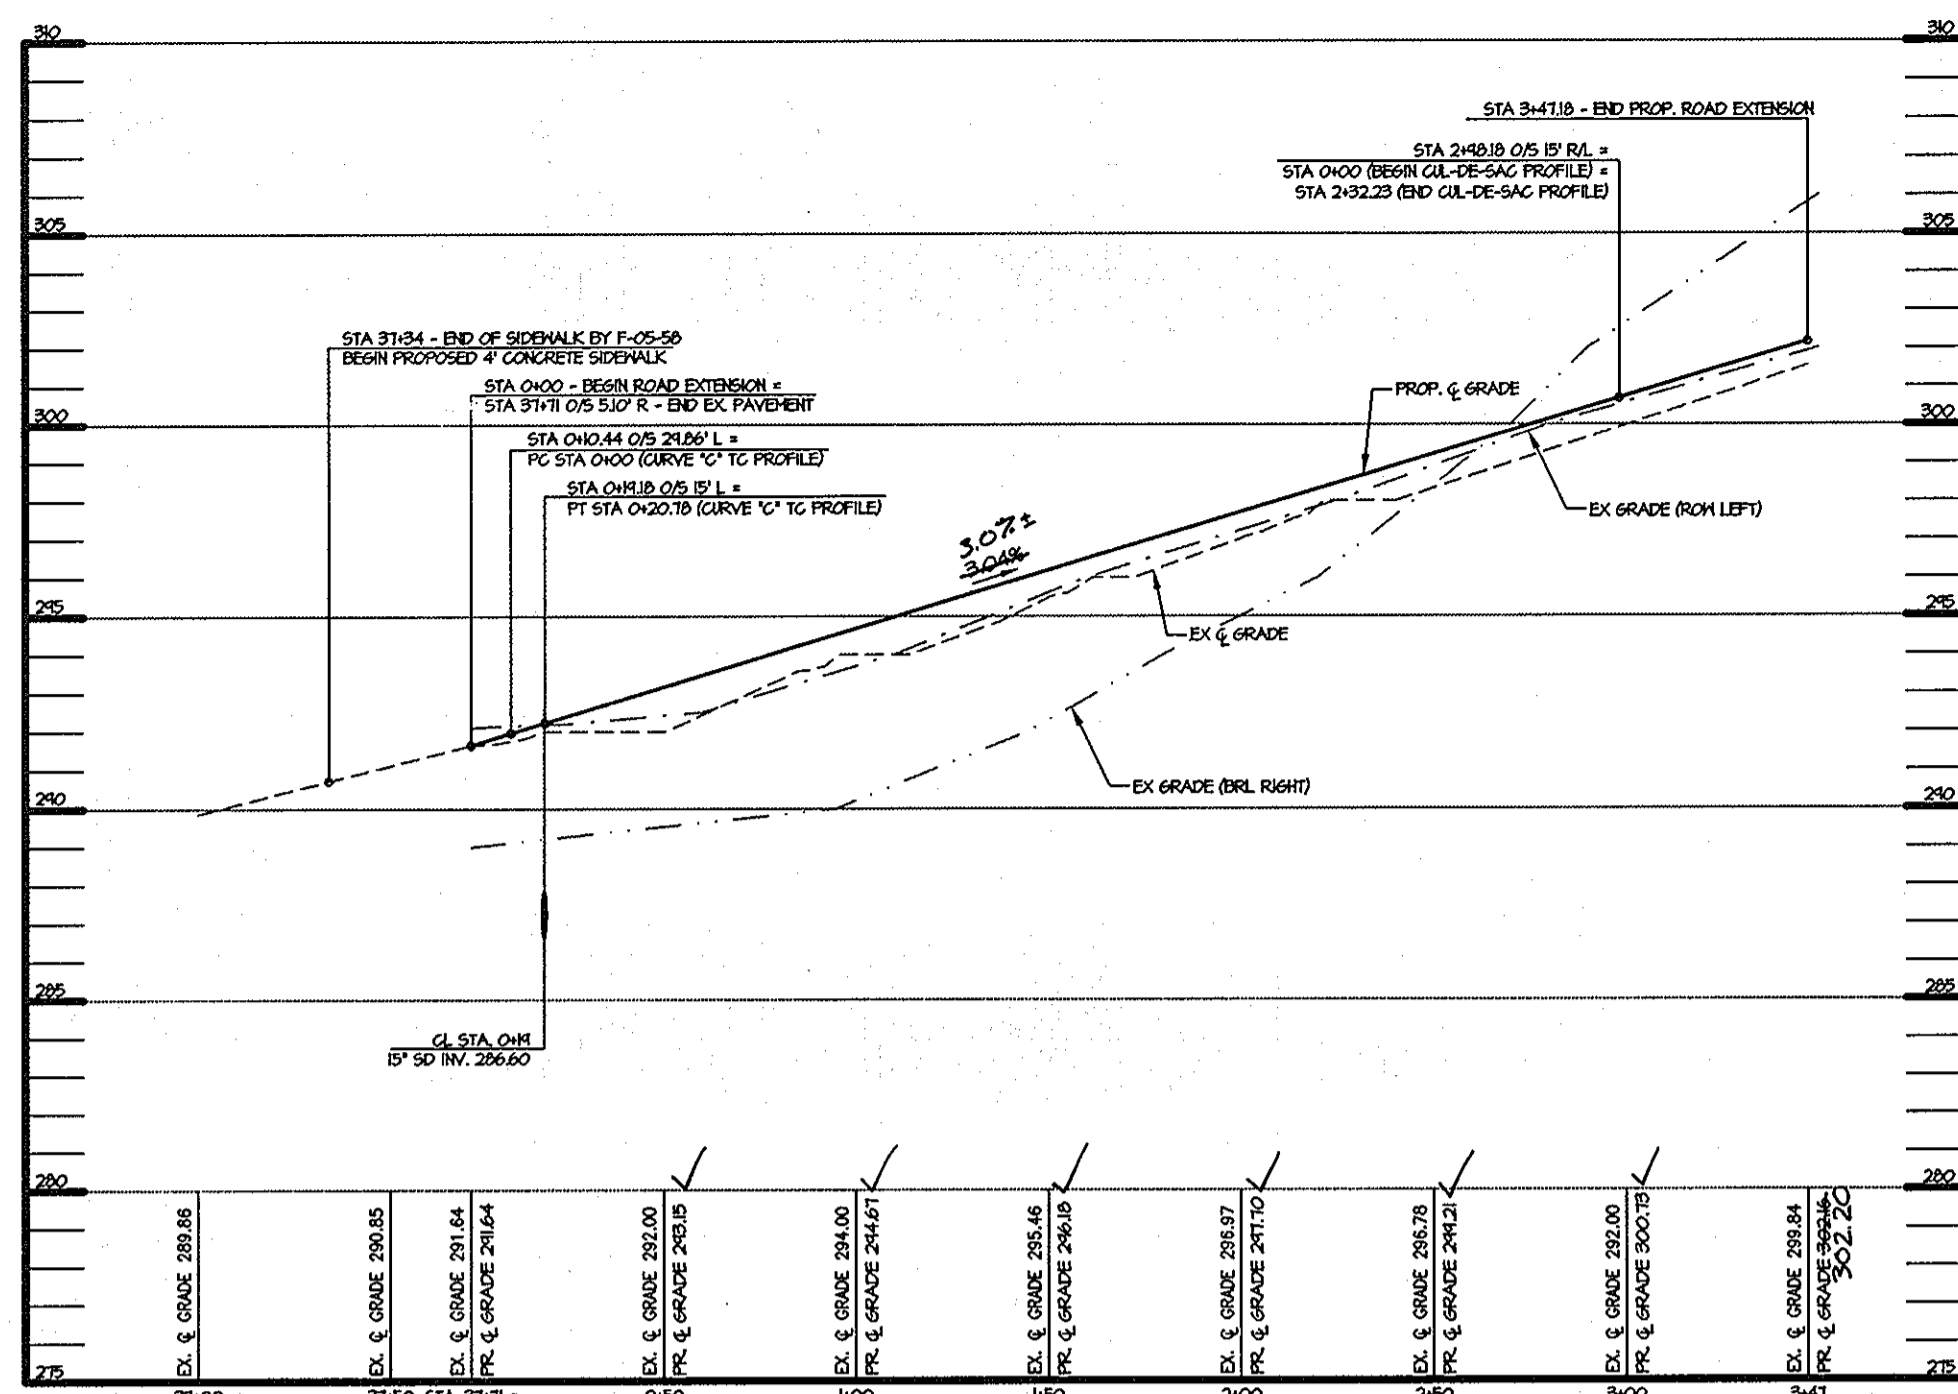

ROAD CENTERLINE PROFILE
 OLD WATERLOO ROAD - PUBLIC LOCAL ROAD - DESIGN SPEED 35 MPH*
 HOR. 1" = 50'
 VERT. 1" = 5'

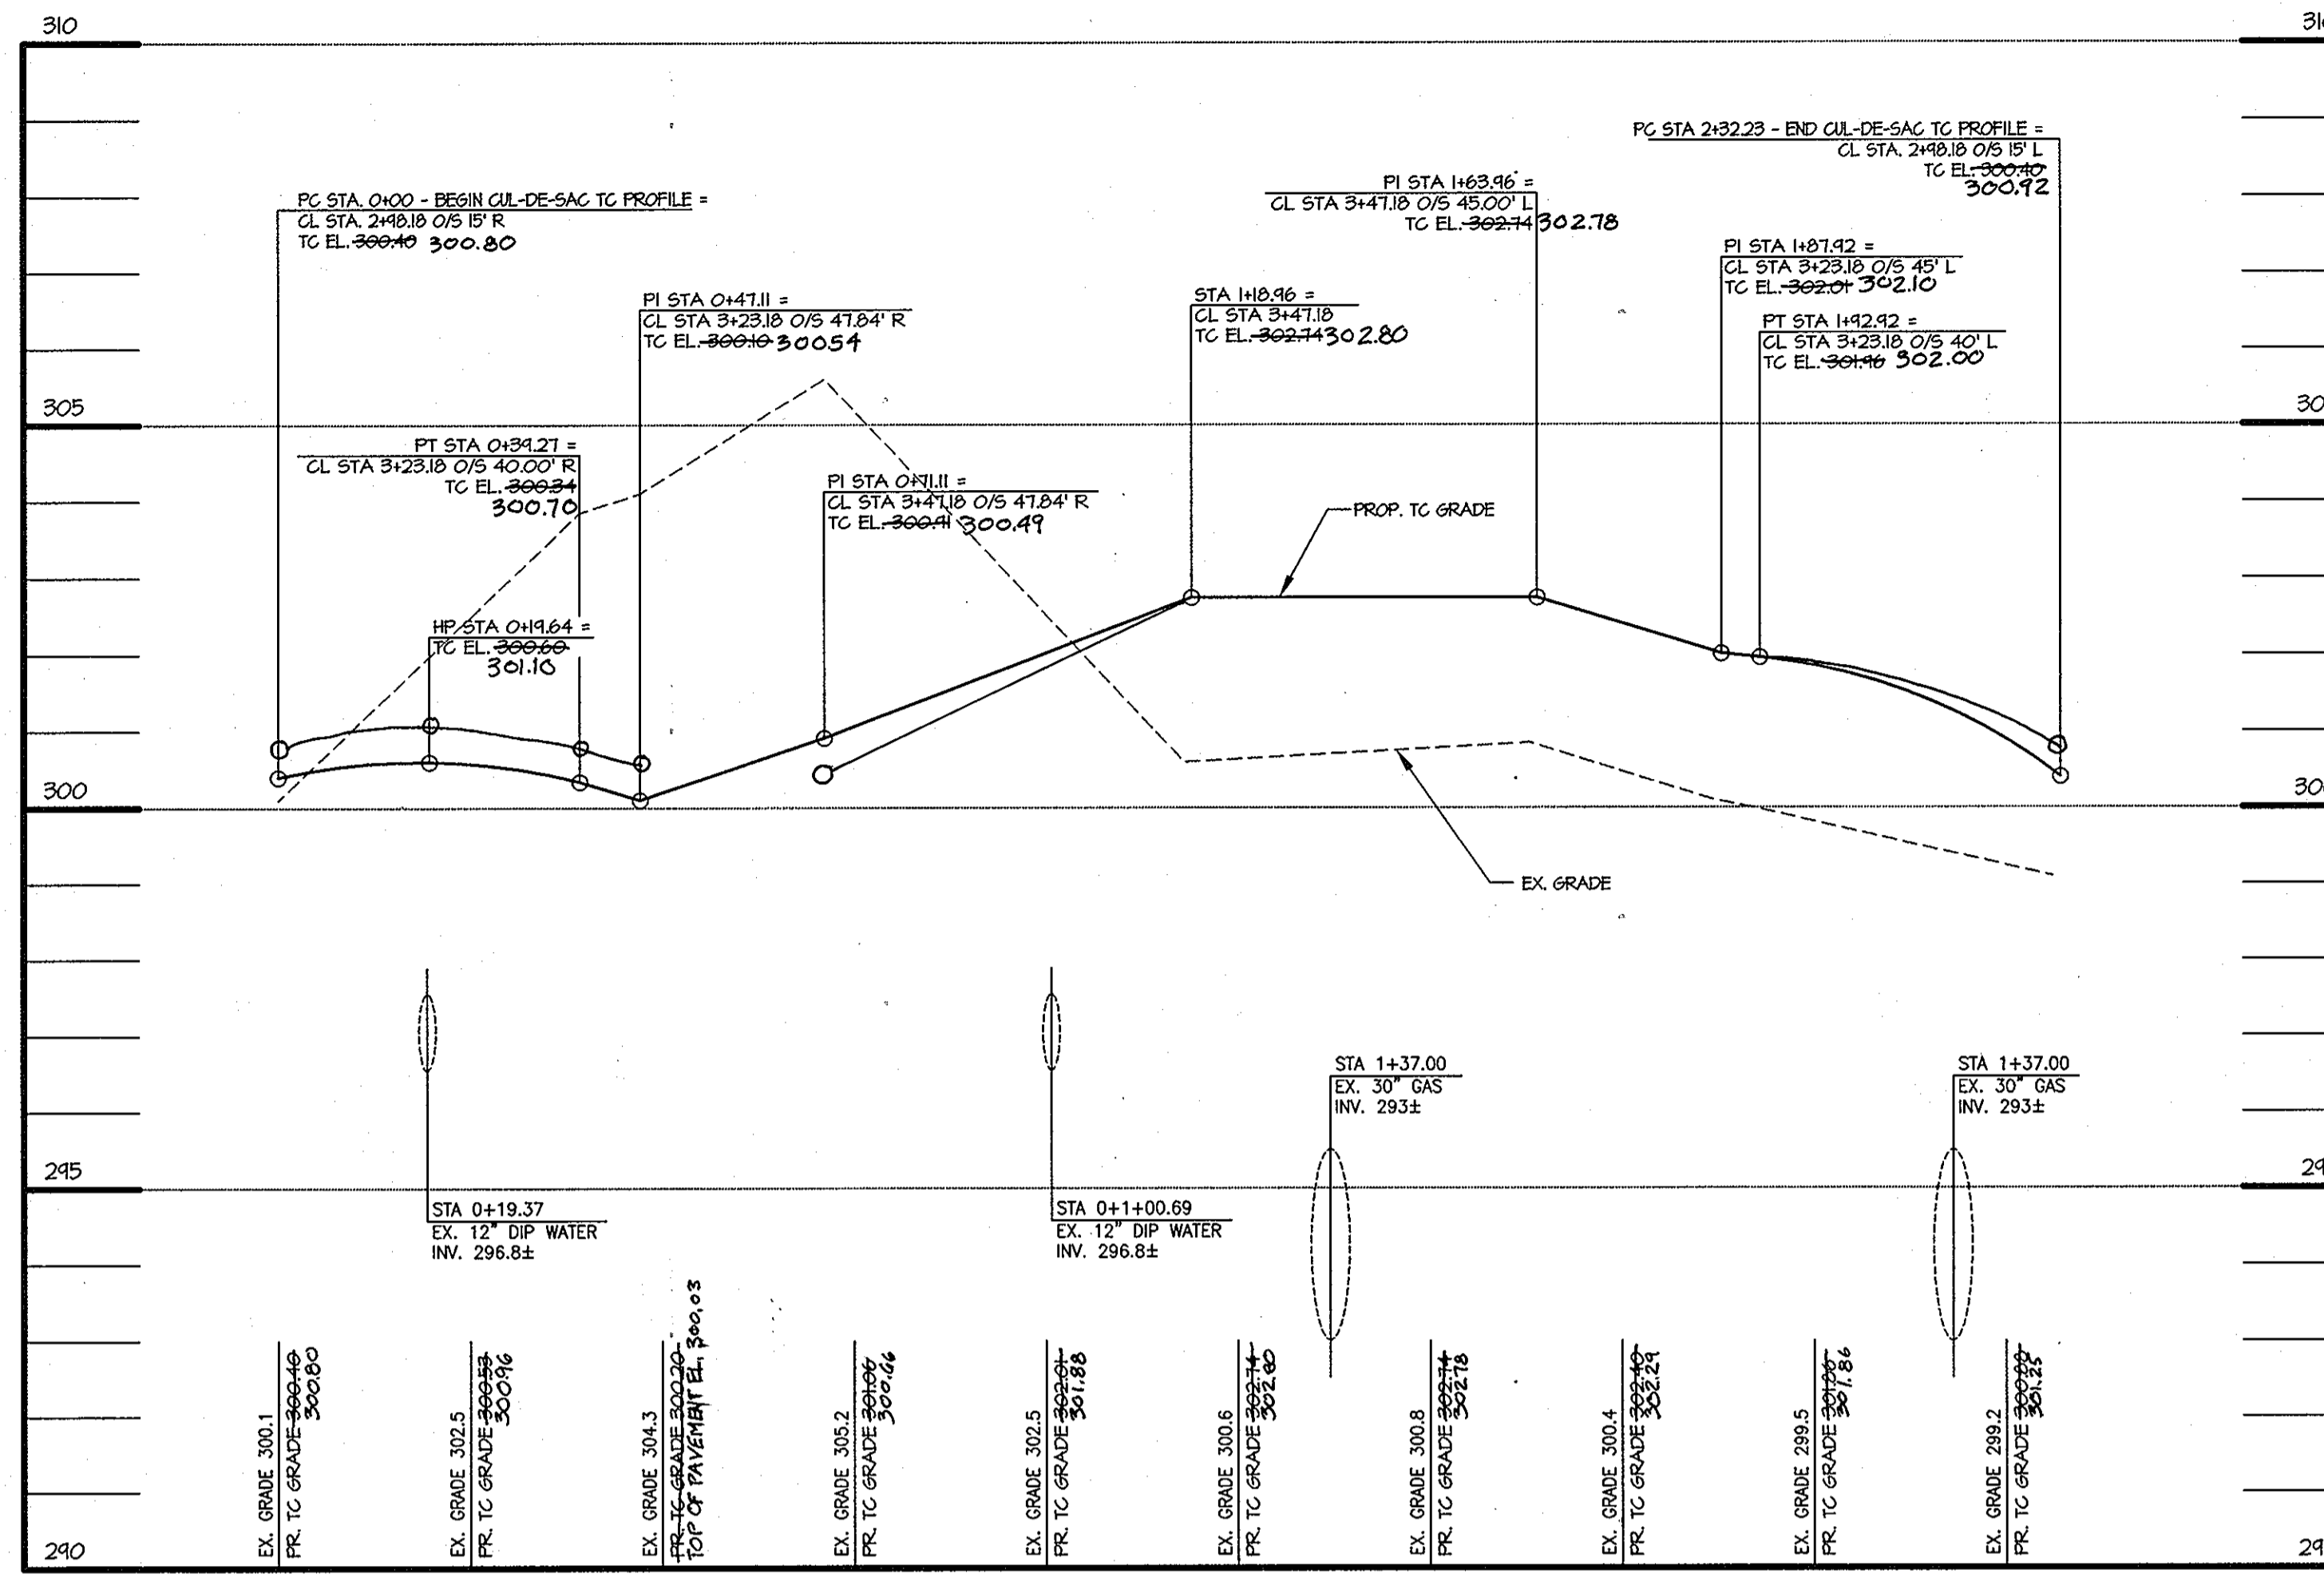

TEE-TURNAROUND CUL-DE-SAC TOP OF CURB PROFILE
 OLD WATERLOO ROAD - PUBLIC LOCAL ROAD - DESIGN SPEED 35 MPH*
 HOR. 1" = 20'
 VERT. 1" = 2'

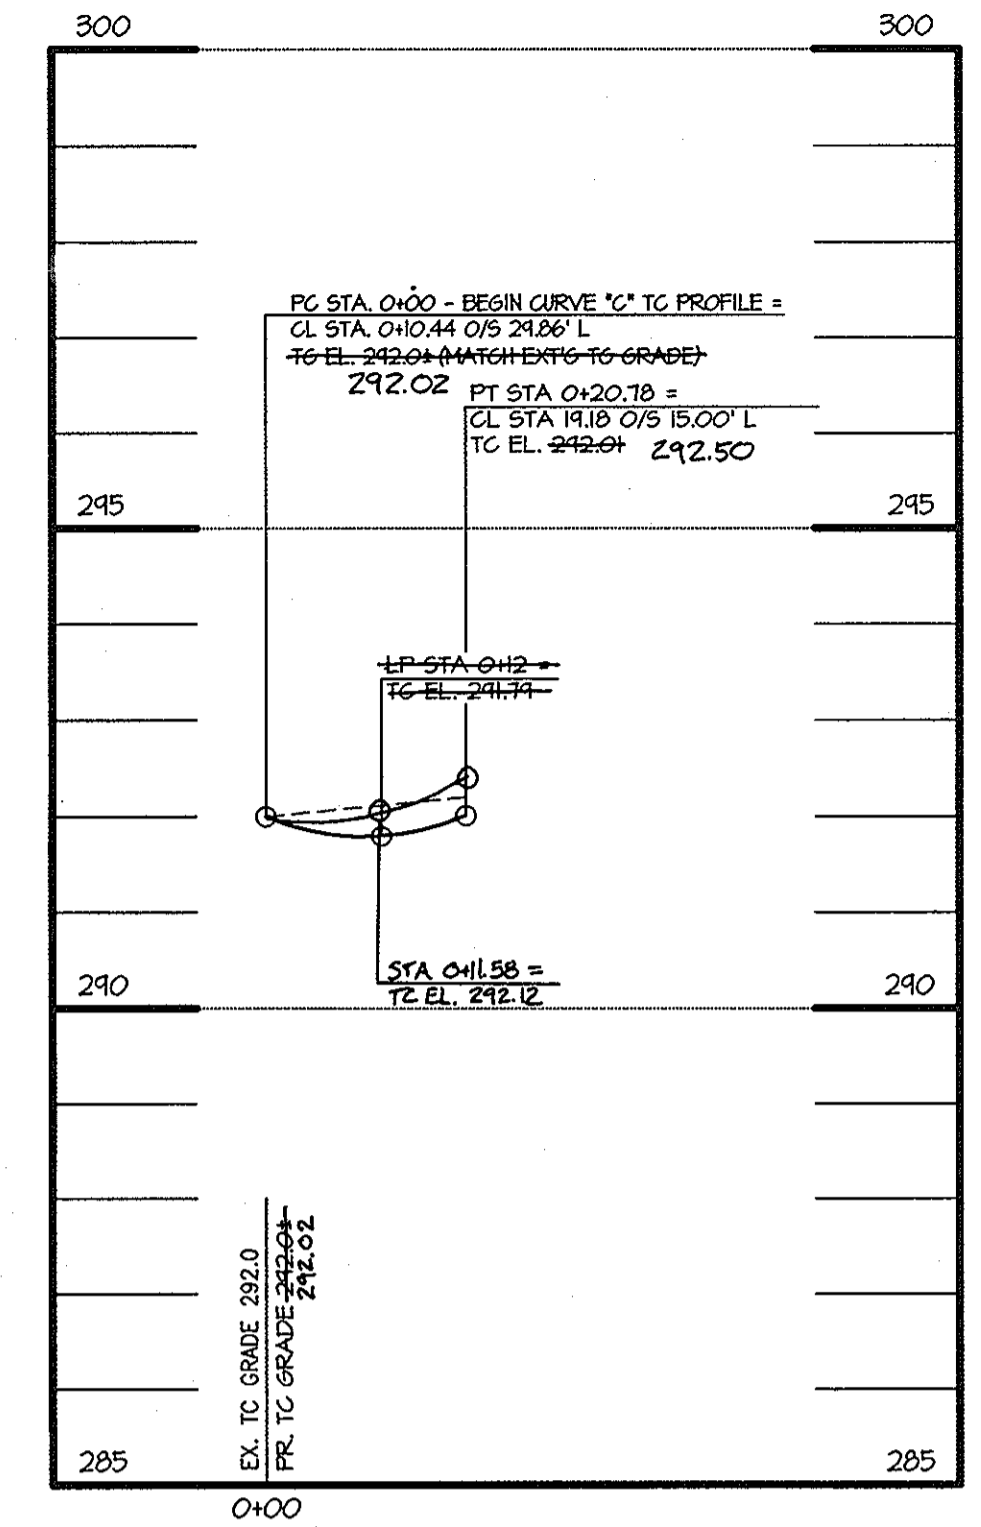

CURVE 'C' TOP OF CURB PROFILE
 OLD WATERLOO ROAD - PUBLIC LOCAL ROAD - DESIGN SPEED 35 MPH*
 HOR. 1" = 20'
 VERT. 1" = 2'

APPROVED: HOWARD COUNTY DEPARTMENT OF PUBLIC WORKS.
 [Signature] 3-8-07
 CHIEF, BUREAU OF HIGHWAYS DATE

* DESIGN SPEED FROM "FREE FLOW SPEED DETERMINATION" BY MARS GROUP DATED JULY 2006

APPROVED: HOWARD COUNTY DEPARTMENT OF PLANNING AND ZONING.
 [Signature] 3/12/07
 CHIEF, DIVISION OF LAND DEVELOPMENT DATE
 [Signature] 3/12/07
 CHIEF, DEVELOPMENT ENGINEERING DIVISION DATE

OWNER / DEVELOPER
 THE RYLAND GROUP
 ATTN: MR. BRIAN KNAUFF
 6011 UNIVERSITY BOULEVARD, SUITE 260
 ELLICOTT CITY, MARYLAND 21043
 PHONE: 410-480-2467
 FAX: 410-480-0543


PROJECT
**OLD WATERLOO ROAD EXTENSION
 GATEWAY OVERLOOK AT BENSON EAST**

AREA PLAT: 18885
 ZONED: NT - TAX MAP: 37 AND 43 ~ GRID: 20, 21 AND 2, 3
 PARCEL: 382 ~ LOTS: J, K & L
 6TH ELECTION DISTRICT ~ HOWARD COUNTY, MARYLAND


TITLE
STORM DRAIN AND ROAD PROFILES

MORRIS & RITCHIE ASSOCIATES, INC.
 ENGINEERS, PLANNERS, SURVEYORS AND LANDSCAPE ARCHITECTS
 14280 PARK CENTER DRIVE, SUITE A
 LAUREL, MARYLAND 20707
 (410) 792-8792 or (301) 776-1690
 FAX (410) 792-7395

DATE: 2/27/07
 DRAWN BY: MSP/MDC
 DESIGNED BY: MSP/KSK
 REVIEWED BY: KSK
 PROJECT NO.: 14719
 DATE: 2/27/07
 SCALE: AS SHOWN
 DRAWING NO. 6 OF 9

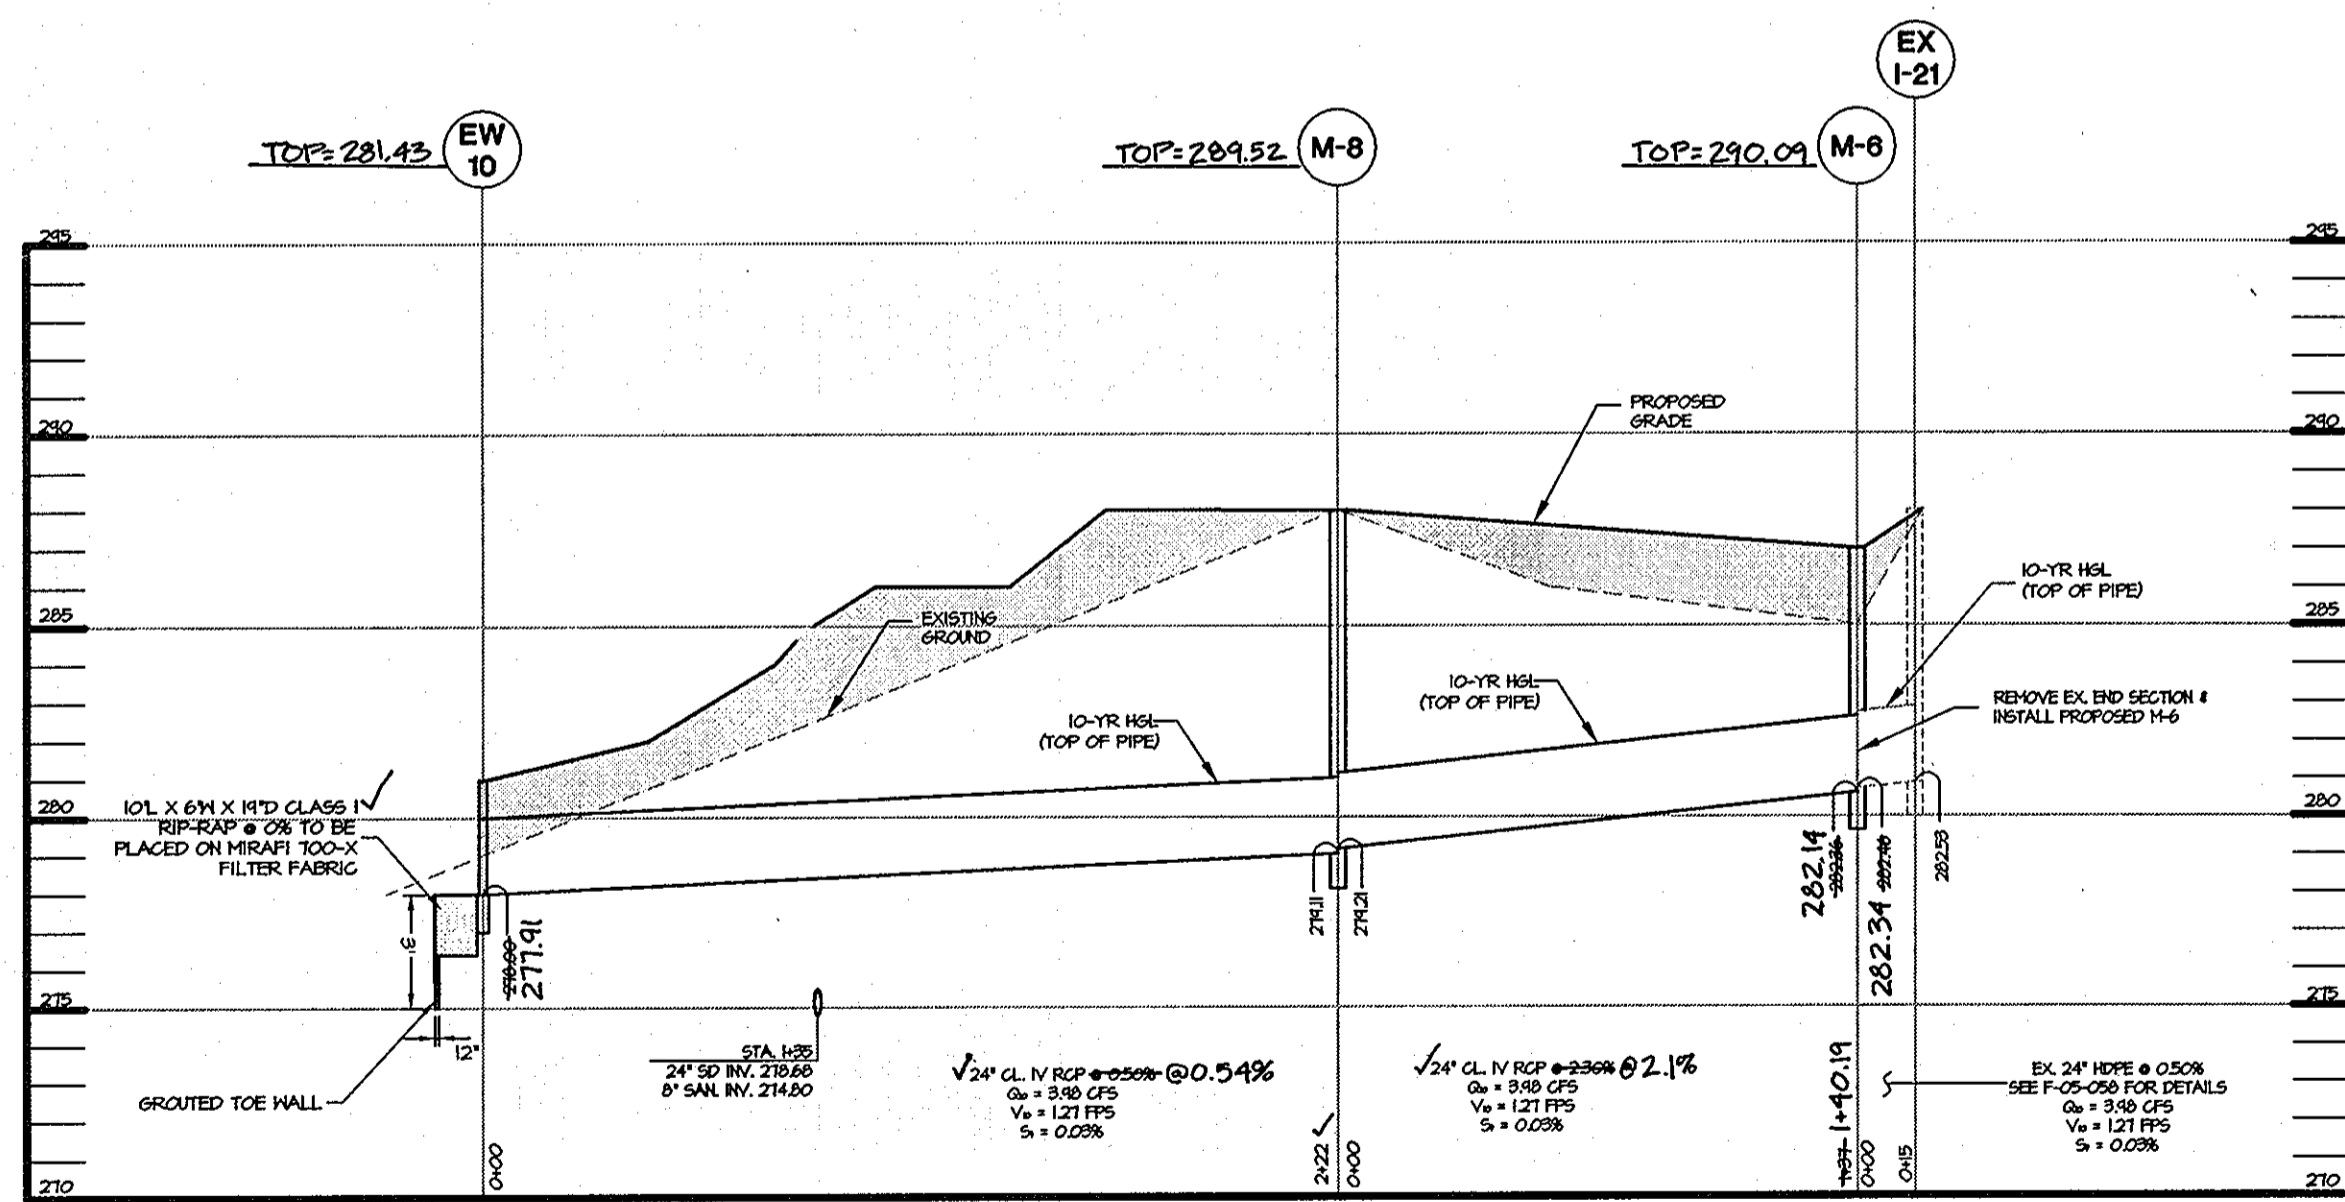

STORM DRAIN PROFILE (PUBLIC)
 EX. CURB INLET NO. 21 TO EW-10 (DIVERSION AROUND PROP. PRIVATE SWM POND SDP-06-128)
 HOR. 1" = 50'
 VERT. 1" = 5'

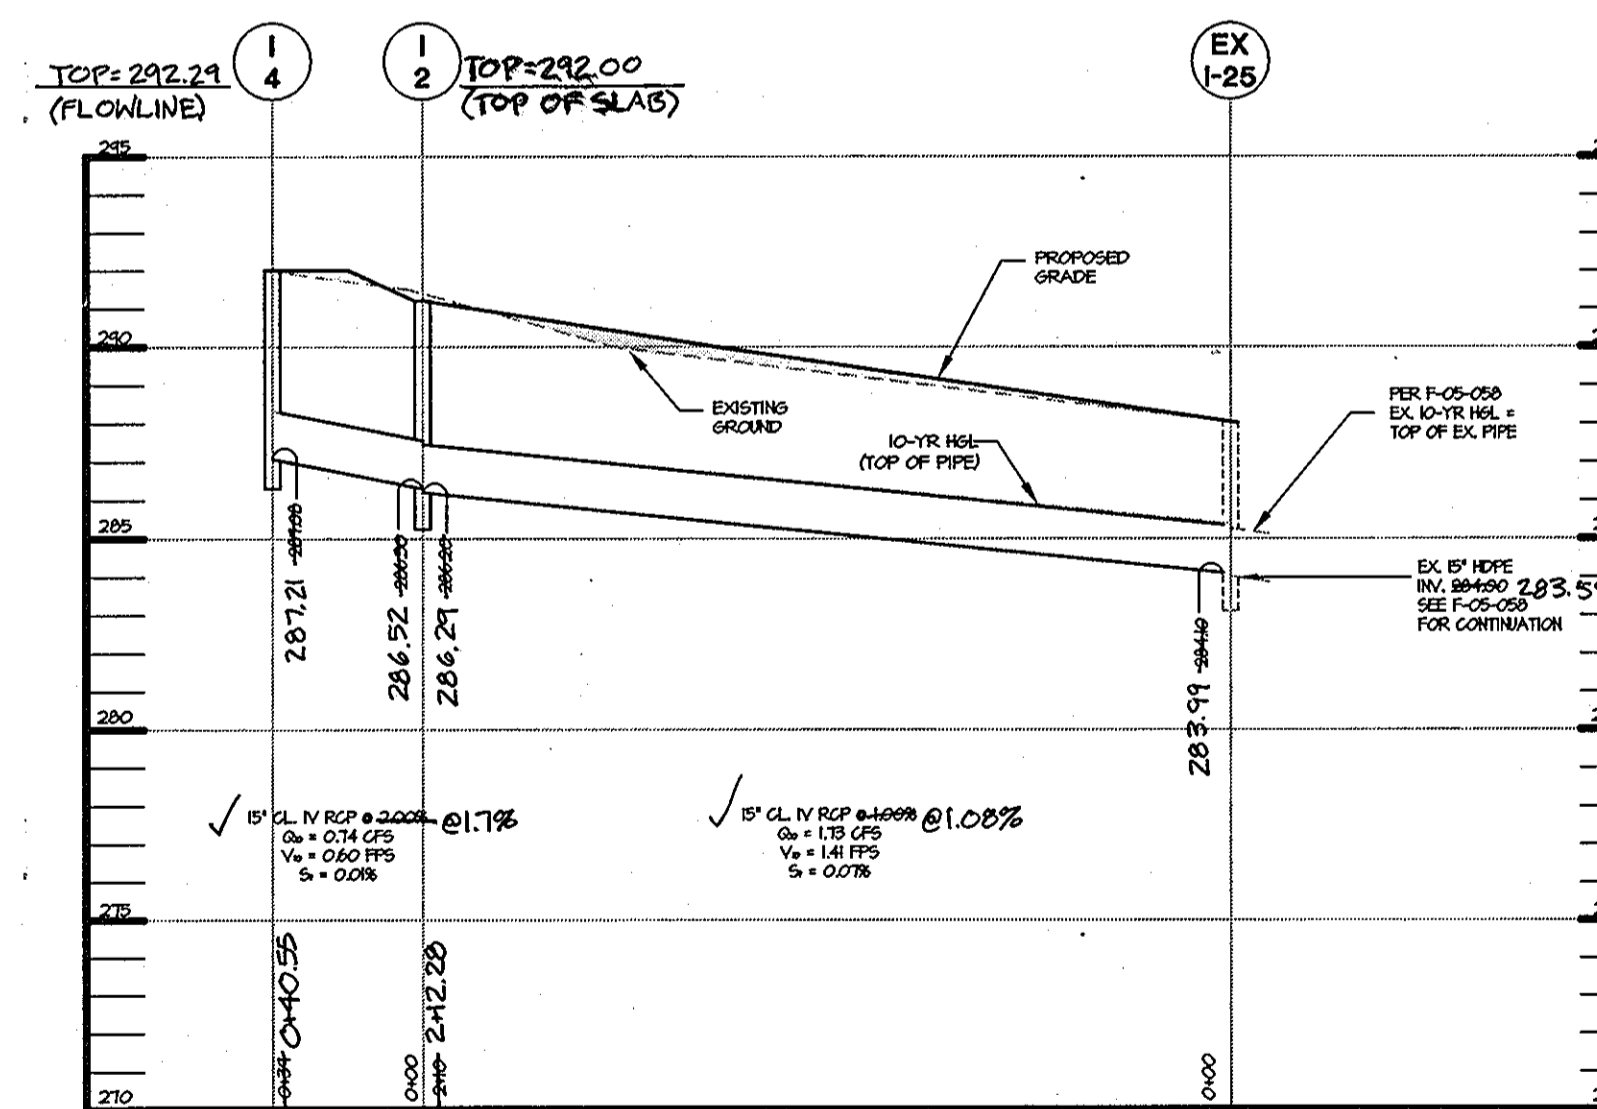

STORM DRAIN PROFILE (PUBLIC)
 I-4 TO EXISTING CURB INLET NO. 25
 HOR. 1" = 50'
 VERT. 1" = 5'

• COORDINATES TO CENTER OF STRUCTURE AT FLOWLINE FOR WR & CURB INLETS, CENTER OF STRUCTURE FOR YARD INLETS, CLEANOUTS & MANHOLES.
 * TOP OF GRATE ELEVATION AT CENTER OF STRUCTURE AT FLOWLINE FOR WR INLETS & YARD INLETS.

STR. NO.	TOP ELEV.	INV. IN.	INV. IN.	INV. OUT.	TYPE	REMARKS	NORTHING	EASTING
I-2	292.00	286.52	---	286.29	TYPE 'A-5' INLET, HOWARD COUNTY STANDARD DETAIL SD-4.01		552,041.8100	1,372,684.2028
I-4	292.24	---	---	287.21	WR INLET HOWARD COUNTY STANDARD DETAIL SD 4.35		552,011.6533	1,372,714.7624
M-6	290.09	282.34	---	282.14	SHALLOW PRECAST MANHOLE, HOWARD COUNTY STANDARD DETAIL G-5.12		553,061.1519	1,372,446.6833
M-8	289.52	279.22	---	279.12	STANDARD PRECAST MANHOLE, HOWARD COUNTY STANDARD DETAIL G-5.12		552,935.5241	1,372,501.5975
EW-10	281.45	277.91	---	---	TYPE 'A' HEADWALL, HOWARD COUNTY STANDARD DETAIL SD-5.11		552,847.1140	1,372,299.2698

SIZE	TYPE	LENGTH
15"	RCP, CL. IV	240 FT 252 FT
24"	RCP, CL. IV	360 FT 263 FT

AS-BUILT PLAN


BY MRA
 07/2010

CONTROLLED AND COMPACTED FILL PER AASHTO T-180, TO BE CERTIFIED BY AN APPROVED ON-SITE GEOTECHNICAL ENGINEER

COMPACTED SPECIFICATIONS FOR UTILITIES IN FILL

WHERE UTILITY PIPES ARE TO BE PLACED ON COMPACTED FILL, THE FOLLOWING APPLIES:

- PRIOR TO PLACEMENT OF COMPACTED FILL, ANY SOFT OR OTHERWISE UNSUITABLE SOILS ENCOUNTERED AT THE EXISTING RAINE BOTTOM OR SLOPE, SHALL BE UNDERCUT AND REMOVED FROM THE CONSTRUCTION AREA.
- ACCEPTABLE COMPACTED FILL SHALL BE PLACED IN SIX INCH THICK LOOSE LIFTS AND COMPACTED TO AT LEAST 98 PERCENT OF THE MAXIMUM DENSITY AS DETERMINED BY A.A.S.H.T.O. METHOD T-180.
- THE COMPACTED FILL SHALL BE BENCHED INTO THE EXISTING VIRGIN SLOPES WITH EACH LIFT PLACED TO A SMOOTH TRANSITION FROM VIRGIN TO FILL SOILS.

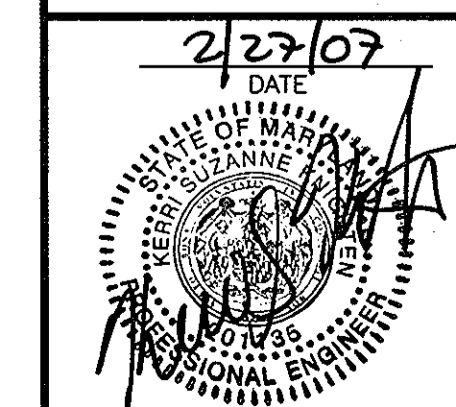

VEGETATIVE STABILIZATION

PERMANENT AND TEMPORARY SEEDING, SOODOING AND MULCHING

FOLLOWING INITIAL SOIL DISTURBANCE OR RESTORATION, PERMANENT OR TEMPORARY STABILIZATION SHALL BE COMPLETED WITHIN SEVEN CALENDAR DAYS FOR THE SURFACE OF ALL PERIMETER CONTROL, DIKES, SWALES, DITCHES, PERIMETER SLOPES, AND ALL SLOPES GREATER THAN 1:1 HORIZONTAL TO 1 VERTICAL (S1) AND FOURTEEN DAYS FOR ALL OTHER DISTURBED OR GRADED AREAS ON THE PROJECT SITE.

I. PERMANENT SEEDING

A. SOIL TEST: LINE FERTILIZATION WILL BE APPLIED PER SOIL TEST RESULTS FOR THE SITES GREATER THAN 5 ACRES. SOIL TESTS WILL BE DONE AT COMPLETION OF INITIAL GRADE GRADING OR AS RECOMMENDED BY THE SEDIMENT CONTROL INSPECTOR. RATES AND ANALYSIS WILL BE PROVIDED TO THE GRADING INSPECTOR AS WELL AS THE CONTRACTOR.

1. OCCURRENCE OF ACID SULFATE SOILS (GRAVELLY BLACK COLOR) WILL REQUIRE COVERING WITH A MINIMUM OF 12 INCHES OF CLEAN SOIL WITH 4 INCHES MINIMUM COVERING OF TOP SOIL. NO STOCKPIPING OF MATERIAL IS ALLOWED. IF NEEDED, SOIL TESTS SHOULD BE DONE BEFORE AND AFTER A FERTILIZATION PERIOD BY MEANS OF SOIL SAMPLES.

THE MINIMUM SOIL CONDITIONS REQUIRED FOR PERMANENT VEGETATIVE ESTABLISHMENT ARE:

- SOIL pH SHALL BE BETWEEN 6.0 AND 7.0.
- SOIL SALTS SHALL BE LESS THAN 500 PARTS PER MILLION (PPM).
- THE SOIL SHALL CONTAIN LESS THAN 40% CLAY BUT ENOUGH FINE GRAINED MATERIAL (0-30% SILT PLUS CLAY) TO PROVIDE THE CAPACITY TO HOLD A MODERATE AMOUNT OF MOISTURE.
- IN CASE OF A 1:1 SLOPE OR LESS, A LAYER OF 1/2" TO 1" OF TOP SOIL SHALL BE PLACED ON A SANDY SOIL (COARSE SILT PLUS CLAY) WOULD BE ACCEPTABLE.
- SOIL SHALL CONTAIN 1.0% MINIMUM ORGANIC MATTER BY WEIGHT.
- SOIL MUST CONTAIN SUFFICIENT PORE SPACE TO PERMIT ADEQUATE ROOT PENETRATION.
- IF THESE CONDITIONS CANNOT BE MET BY SOILS ON SITE, ADDITIONAL TOPSOIL IS REQUIRED IN ACCORDANCE WITH SECTION 21 STANDARDS AND SPECIFICATIONS FOR TOPSOIL OR AMENDMENTS MADE AS RECOMMENDED.

2. SEED PREPARATION: AREA TO BE SEEDING SHALL BE LOOSE AND FRAGILE TO A DEPTH OF AT LEAST 3 INCHES. THE TOP LAYER SHALL BE COVERED BY BROADCASTING, BROADCASTING OR OTHER ACCEPTABLE MEANS BEFORE SEEDING OCCURS. FOR SITES LESS THAN 5 ACRES, APPLY 100 POUNDS ORGANIC LIME AND 21 POUNDS OF 10-10-10 FERTILIZER PER 1,000 SQUARE FEET. HARBOR OR USE LIME AND FERTILIZER INTO THE SOIL TO A DEPTH OF AT LEAST 3 INCHES ON SLOPES FLATTER THAN 3:1.

3. SEEDING: APPLYING 5-6 POUNDS PER 1,000 SQUARE FEET OF TALL FESCUE BETWEEN FEBRUARY 1 AND APRIL 30 OR BETWEEN AUGUST 15 AND OCTOBER 31. APPLY SEED UNIFORMLY ON A MOST FIRM SOED WITH A CYLINDER SEEDER, OUTDRIPPER SEEDER OR HYDROSEEDER (SLURRY INCLUDES SEEDS AND FERTILIZER RECOMMENDED ON STEEP SLOPES). MAXIMUM SEED DEPTH SHOULD BE 3/4 INCH IN CLAYEY SOILS AND 1/2 INCH IN SANDY SOILS WHEN USING OTHER THAN THE HYDROSEEDER METHOD. BROADCASTING WHERE NECESSARY TO SUPPORT ADEQUATE GROWTH UNTIL VEGETATION IS FULLY ESTABLISHED. IF OTHER SEED MIXES ARE TO BE USED, SELECT FROM TABLE 23, ENTITLED "PERMANENT SEEDING FOR LOW MAINTENANCE AREAS FROM THE CURRENT STANDARDS AND SPECIFICATIONS FOR SOIL EROSION AND SEDIMENT CONTROL, MIXES SUITABLE FOR THIS TABLE 1, 3, AND 5-7. MIXES 5-7 ARE SUITABLE IN HIGH-MOISTURE SITUATIONS.

4. MULCHING: MULCH SHALL BE APPLIED TO ALL PERIMETER AREA IMMEDIATELY AFTER SEEDING. DURING THE TIME PERIOD WHEN SEEDING IS NOT PERMITTED, MULCH SHALL BE APPLIED IMMEDIATELY AFTER SEEDING.

MULCH SHALL BE UNLIMITED, UNKORRODED, SMALL CHAIN STRAW APPLIED AT A RATE OF 3 TONS PER ACRE OF 90 POUNDS PER 1,000 SQUARE FEET (3 BALS). IF A MULCH-ANCHORING TOOL IS USED, APPLY 2.5 TONS PER ACRE. MULCH MATERIAL SHALL BE SEPARATELY FREE OF ALL KINDS OF WEEDS AND SHALL BE COMPACTED TO PREVENT WIND-DRIVEN WEEDS. SPREAD MULCH UNIFORMLY, MECHANICALLY OR BY HAND, TO A DEPTH OF 1-2 INCHES.

5. SEEDING STRAW MULCH: STRAW MULCH SHALL BE SEEDING IMMEDIATELY FOLLOWING MULCH APPLICATION TO MINIMIZE MOVEMENT BY WIND OR WATER. THE FOLLOWING METHODS ARE PERMITTED:

- USE A MULCH-ANCHORING TOOL WHICH IS DESIGNED TO PUNCH AND ANCHOR MULCH INTO THE SOIL SURFACE TO A MINIMUM DEPTH OF 2 INCHES. THIS IS THE MOST EFFECTIVE METHOD FOR SEEDING MULCH. HOWEVER, IT IS LIMITED TO RELATIVELY FLAT AREAS WHERE EQUIPMENT CAN OPERATE SAFELY.
- WOOD CELLULOSE FIBER MAY BE USED FOR ANCHORING STRAW. APPLY THE FIBER BINDER AT A NET DRY WEIGHT OF 700 POUNDS PER ACRE. IF MIXED WITH WATER, USE 50 POUNDS OF WOOD CELLULOSE FIBER PER 100 GALLONS OF WATER.
- LIQUID BINDERS MAY BE USED. APPLY AT HIGHER RATES AT THE EDGES, WHERE WIND CATCHES SUCH AS IN CHANNELS AND ON STEEP SLOPES. THE BINDER SHOULD BE APPLIED TO THE AREA BEFORE UNIFORM AFTER BINDER APPLICATION. BINDERS LISTED IN THE 1994 STANDARDS AND SPECIFICATIONS FOR SOIL EROSION AND SEDIMENT CONTROL, OR APPROVED EQUIPMENT SHALL BE APPLIED AT RATES RECOMMENDED BY THE MANUFACTURER.
- LIGHTWEIGHT PLASTIC NETTING MAY BE USED TO CONTROL MULCH. THE NETTING WILL BE STAPLED TO THE GROUND ACCORDING TO MANUFACTURER'S RECOMMENDATIONS.

II. TEMPORARY SEEDING

LIME: 100 POUNDS OF ORGANIC LIME/PER 1,000 SQUARE FEET.

FERTILIZER: 15 POUNDS OF 10-10-10 PER 1,000 SQUARE FEET.

SEED: PERENNIAL RYE-0.92 POUNDS PER 1,000 SQUARE FEET (FEBRUARY 1 THROUGH APRIL 30 OR AUGUST 15 THROUGH NOVEMBER).

MULCH-0.92 POUNDS PER 1,000 SQUARE FEET (MAY 1 THROUGH AUGUST 15).

MULCH: SAME AS I D AND ABOVE.

III. FILL

NO FILLS MAY BE PLACED ON PROZEN GROUND. ALL FILL TO BE PLACED IN APPROXIMATELY HORIZONTAL LAYER EACH LAYER HAVING THICKNESS NOT MORE THAN 8 INCHES. ALL FILL IN ROADWAYS AND PARKING AREA IS TO BE CLASSIFIED TYPE 2 AS PER ANNE ANNEXE COUNTY CODE - ARTICLE 21, SECTION 2-30, AND COMPACTED TO MEET DESIGN COMPACTED TO BE DETERMINED BY ASTM D-1557-64 (MODIFIED PROCTOR). ANY FILL WITHIN THE BUILDING AREA IS TO BE COMPACTED TO A MINIMUM OF 95% DENSITY AS DETERMINED BY METHODS PREVIOUSLY MENTIONED. FILLS FOR POND FOUNDATIONS SHALL BE COMPACTED AS PER MD-27B CONSTRUCTION SPECIFICATIONS. ALL EXCESSIVE FILLS SHALL BE COMPACTED SUFFICIENTLY SO AS TO BE STABLE AND PREVENT EROSION AND SLURFAGE.

IV. PERMANENT SOO

INSTALLATION OF SOO SHOULD FOLLOW PERMANENT SEEDING DATES. SEEDING PREPARATION FOR SOO SHALL BE AS NOTED IN SECTION (B) ABOVE. PERMANENT SOO IS TO BE TALL FESCUE. STATE APPROVED SOO LIME AND FERTILIZER PER PERMANENT SEEDING SPECIFICATIONS AND LIGHTLY BROUATE SOO PRIOR TO LAYING SOO. SOO IS TO BE LAD ON THE CONTOUR WITH ALL ENDS TIGHTLY BUTTING. JOINTS ARE TO BE SECTORED WITH STRAW AND SOO OR TAMP SOO TO INSURE POSITIVE ROOT CONTACT WITH THE SOIL. ALL SLOPES STEEPER THAN 3:1 AS SHOWN, ARE TO BE PROTECTED WITH PERMANENT SOO. SOO IS NOT TO BE INSTALLED ON PROZEN GROUND. SOO SHALL NOT BE PLACED WITHIN 10 FEET OF EROSION CONTROL NETTING. ADDITIONAL WATER FOR ESTABLISHMENT MAY BE REQUIRED. SOO IS NOT TO BE PLACED WITHIN 10 FEET OF EROSION CONTROL NETTING. ADDITIONAL WATER FOR ESTABLISHMENT MAY BE ADVERSELY AFFECT ITS SURVIVAL. IN THE ABSENCE OF ADEQUATE WATER, IRRIGATION SHOULD PERFORMED TO ENSURE ESTABLISHMENT OF SOO.

V. BERING OPERATIONS

SEDIMENT CONTROL PLANS FOR MINING OPERATIONS MUST INCLUDE THE FOLLOWING SEEDING DATES AND MIXTURES:

FOR SEEDING DATES OF:

FEBRUARY 1 THROUGH APRIL 30 AND AUGUST 15 THROUGH OCTOBER 31, USE SEED MIXTURE OF TALL FESCUE AT THE RATE OF 2 POUNDS PER 1,000 SQUARE FEET AND SERVICIA LESPEZEA AT THE MINIMUM RATE OF 0.6 POUNDS PER 1,000 SQUARE FEET.

NO TOPSOIL SHALL BE APPLIED AS PER THE STANDARD SPECIFICATIONS FOR TOPSOIL FROM THE CURRENT MARYLAND STANDARDS AND SPECIFICATIONS FOR SOIL EROSION AND SEDIMENT CONTROL.

NOTE: USE OF THIS INFORMATION PRELUCE MEETING ALL OF THE REQUIREMENT OF THE CURRENT MARYLAND STANDARDS AND SPECIFICATIONS FOR SOIL EROSION AND SEDIMENT.

NOTE: PROJECTS WITHIN 4 MILES OF THE BW APPOINT WILL NEED TO ADHERE TO MARYLAND ANNON ADMINISTRATOR'S SEEDING SPECIFICATION RESTRICTIONS.

STANDARDS AND SPECIFICATION FOR TOPSOIL

DEFINITION

PLACEMENT OF TOPSOIL OVER A PREPARED SUBSOIL PRIOR TO ESTABLISHMENT OF PERMANENT VEGETATION.

PURPOSE

TO PROVIDE A SUITABLE SOIL MEDIUM FOR VEGETATIVE GROWTH. SOILS OF CONCERN HAVE LOW MOISTURE CONTENT, LOW NUTRIENT LEVELS, LOW pH, MATERIAL TOXIC TO PLANTS AND/OR UNACCEPTABLE SOIL GRAINAGE.

CONDITIONS WHERE PRACTICE APPLIES

1. THIS PRACTICE IS LIMITED TO AREAS HAVING 2:1 OR FLATTER SLOPES WHERE:

- THE TEXTURE OF THE EXPOSED SUBSOIL/PARENT MATERIAL IS NOT ADEQUATE TO PRODUCE VEGETATIVE GROWTH.
- THE SOIL MATERIAL IS SO FALLOW THAT THE ROOTING ZONE IS NOT DEEP ENOUGH TO SUPPORT PLANTS OR SHRUBS CONTAINING SUPPLIES OF MOISTURE AND PLANT NUTRIENTS.
- THE ORIGINAL SOIL TO BE VEGETATED CONTAINS MATERIAL TOXIC TO PLANT GROWTH.
- THE SOIL IS SO ACIDIC THAT TREATMENT WITH LIMESTONE IS NOT FEASIBLE.

2. FOR THE PURPOSE OF THESE STANDARDS AND SPECIFICATIONS, AREAS HAVING SLOPES STEEPER THAN 2:1 REQUIRE SPECIAL CONSIDERATION AND DESIGN FOR APPROPRIATE STABILIZATION. AREAS HAVING SLOPES STEEPER THAN 2:1 SHALL HAVE THE APPROPRIATE STABILIZATION SHOWN ON THE PLANS.

CONSTRUCTION AND MATERIAL SPECIFICATIONS

1. TOPSOIL SALVAGED FROM THE EXISTING SITE MAY BE USED PROVIDED THAT IT MEETS STANDARDS AS SET FORTH IN THESE SPECIFICATIONS. TYPICALLY, THE DEPTH OF TOPSOIL TO BE SALVAGED FOR A GIVEN SITE TYPE CAN BE FOUND IN REPRESENTATIVE SOIL PROFILE SECTION IN THE SOIL SURVEY PUBLISHED BY USGARS IN COOPERATION WITH MARYLAND AGRICULTURAL EXPERIMENTAL STATION.

2. TOPSOIL SPECIFICATIONS-SOIL TO BE USED AS TOPSOIL MUST MEET THE FOLLOWING:

- TOPSOIL SHALL BE A LOAM, SANDY LOAM, CLAY LOAM, SILTY LOAM, SANDY CLAY LOAM, LOAMY SAND, OTHER SOILS MAY BE USED IF BY AN AGRONOMIST OR SOIL SCIENTIST AND APPROVED BY THE APPROPRIATE APPROVAL AUTHORITY. REARLESS HOWSE SHALL NOT BE A Mixture OF COMBINED DISTURBED SUBSOILS AND SHALL CONTAIN LESS THAN 5% BY VOLUME OF CONCRETE, STONES, SLAG, COARSE FRAGMENTS, COMBLES, STICKS, ROOTS, TRASH, OR OTHER MATERIALS LARGER THAN 1 1/2" IN DIAMETER.
- TOPSOIL MUST BE FREE OF PLANTS OR PLANT PARTS SUCH AS BERMUDA GRASS, QUINQUAGRA, JOHNSONGRASS, NUTSEG, POISON IVY, THISTLE, OR OTHERS AS SPECIFIED.
- WHERE THE SUBSOIL IS EITHER HIGHLY ACIDIC OR COMPOSED OF HEAVY CLAYS, GROUND LIMESTONE SHALL BE SPREAD AT THE RATE OF 4-8 TONS/ACRE (200-400 POUNDS PER 1,000 SF) PRIOR TO THE PLACEMENT OF TOPSOIL. LIME SHALL BE DISTRIBUTED UNIFORMLY OVER DESIGNATED AREAS AND WORKED INTO THE SOIL IN CONJUNCTION WITH TILLAGE OPERATIONS AS DESCRIBED IN THE FOLLOWING PROCEDURES.
- FOR SITE HAVING DISTURBED AREAS UNDER 5 ACRE

1. PLACE TOPSOIL (OF REQUIRED) AND APPLY SOIL AMENDMENTS AS SPECIFIED IN SOO VEGETATION STABILIZATION SECTION 1-VEGETATIVE STABILIZATION METHODS AND MATERIALS.

2. TOPSOIL APPLICATION

- WHEN TOPSOILING, MAINTAIN NEEDED EROSION AND SEDIMENT CONTROL PRACTICES SUCH AS DIVERSIONS, GRADE STABILIZATION STRUCTURES, EARTH DIKES, SLOPE SILT FENCE AND SEDIMENT TRAPS AND BARRIERS.
- GRADES ON THE AREAS TO BE TOPSOILED, WHICH HAVE BEEN PREVIOUSLY ESTABLISHED, SHALL BE MAINTAINED, ALBERT 4"-8" HIGHER IN ELEVATION.
- TOPSOIL SHALL BE UNIFORMLY DISTRIBUTED IN A 4"-8" LAYER AND LIGHTLY COMPACTED TO A MINIMUM THICKNESS OF 4". SPREADING SHALL BE PERFORMED IN SUCH A MANNER THAT SOODOING OR SEEDING CAN PROCEED TO A MINIMUM OF ADDITIONAL SOIL PREPARATION AND TILLAGE. ANY IRREGULARITIES IN THE SURFACE RESULTING FROM TOPSOILING OR OTHER OPERATIONS SHALL BE CORRECTED IN ORDER TO PREVENT THE FORMATION OF DEPRESSIONS OR WATER POCKETS.
- TOPSOIL SHALL NOT PLACED WHILE THE TOPSOIL OR SUBSOIL IS IN A FROZEN OR MUDDY CONDITION, WHEN THE SUBSOIL IS EXCESSIVELY WET OR IN A CONDITION THAT MAY BE DETRIMENTAL TO PROPER GRADING AND SEEDING.
- ALTERNATIVE FOR PERMANENT SEEDING-INSTEAD OF APPLYING THE FULL AMOUNTS OF LIME AND COMMERCIAL FERTILIZER, COMPOSTED SLODGE AND AMENDMENTS MAY BE APPLIED AS SPECIFIED BELOW:

1. COMPOSTED SLODGE MATERIAL FOR USE AS A SOIL CONDITIONER FOR SITES HAVING DISTURBED AREAS OVER 5 ACRES SHALL BE TESTED TO PRESCRIBE AMENDMENTS AND FOR SITES HAVING DISTURBED AREAS UNDER 5 ACRES SHALL CONFORM TO THE FOLLOWING REQUIREMENTS:

- COMPOSTED SLODGE SHALL BE SUPPLIED BY, OR GROWN FROM, A PRODUCTION OPERATION THAT PERMITTED UNDER THE COMMISSION BY THE MARYLAND DEPARTMENT OF THE ENVIRONMENT UNDER COMAR 28-04-06.
- COMPOSTED SLODGE SHALL CONTAIN AT LEAST 1 PERCENT NITROGEN, 1.5 PERCENT PHOSPHORUS, AND 0.2 PERCENT POTASSIUM AND HAVE A pH OF 7.0 TO 8.0. IF COMPOST DOES NOT MEET THESE REQUIREMENTS, THE APPROPRIATE CONSTITUENTS MUST BE ADDED TO MEET THE REQUIREMENTS PRIOR TO USE.
- COMPOSTED SLODGE SHALL BE APPLIED AT A RATE OF 1 TON/1,000 SF.

2. COMPOSTED SLODGE SHALL BE AMENDED WITH A POTASSIUM FERTILIZER APPLIED AT A RATE OF 4LB/1,000 SF, AND 1/3 THE NORMAL LIME APPLICATION RATE.

REFERENCES: GUIDELINE SPECIFICATIONS: SOIL PREPARATION AND SEEDING, MVA, PLAN #1, COOPERATIVE EXTENSION SERVICE, UNIVERSITY OF MARYLAND AND VIRGINIA POLYTECHNIC INSTITUTE.

REVISED 1973.

STANDARDS AND SPECIFICATIONS FOR LAND GRADING

DEFINITION

RESHAPING OF THE EXISTING LAND SURFACE IN ACCORDANCE WITH A PLAN AS DETERMINED BY ENGINEERING SURVEY AND LAYOUT.

PURPOSE

THE PURPOSE OF A LAND GRADING SPECIFICATION IS TO PROVIDE FOR EROSION CONTROL AND VEGETATIVE ESTABLISHMENT ON THOSE AREAS WHERE THE EXISTING LAND SURFACE IS TO BE RESHAPED BY GRADING ACCORDING TO PLAN.

DESIGN CRITERIA

THE GRADING PLAN SHOULD BE BASED UPON THE INCORPORATION OF BUILDING DESIGN AND DESIGN PROVISIONS FOR THE UTILITY EXISTING TOPOGRAPHY AND DESIRABLE NATURAL SURROUNDINGS TO AVOID EXISTING GRADE MODIFICATIONS. INFORMATION SUBMITTED MUST PROVIDE SUFFICIENT TOPOGRAPHIC SURVEYS AND SOIL INVESTIGATION TO DETERMINE LIMITATIONS THAT MUST BE IMPROVED ON THE GRADING OPERATION RELATED TO SOIL STABILITY, EFFECT ON ADJACENT AND PROPERLY AND DRAINAGE PATTERNS, MEASURES FOR DRAINAGE AND WATER REMOVAL, AND SURFACE AND SUBSURFACE DRAINS. THE PLAN SHALL ALSO INCLUDE PRINCIPLES OF THE PRACTICES. THE FOLLOWING SHALL BE INCORPORATED INTO THE PLAN:

1. PROVISIONS SHALL BE MADE TO SAFELY CONDUIT SURFACE RUNOFF TO STORM DRAINS, PROTECTED OUTLETS OR TO STABLE AREAS TO BE ROOFED OR PAVED. AREA TO BE VEGETATIVELY STABILIZED TOTAL CUT 1500 CU. YDS.* TOTAL FILL 1500 CU. YDS.* TOTAL TOPSOIL 500 CU. YDS.*

2. SITE ANALYSIS: TOTAL AREA OF SITE 1.36 AC. AREA DISTURBED 1.36 AC. AREA TO BE ROOFED OR PAVED 0.33 AC. AREA TO BE VEGETATIVELY STABILIZED 1.33 AC. TOTAL CUT 1500 CU. YDS.* TOTAL FILL 1500 CU. YDS.* TOTAL TOPSOIL 500 CU. YDS.*

3. ANY SEDIMENT CONTROL PRACTICE WHICH IS DISTRIBUTED BY GRADING ACTIVITY FOR PLACEMENT OF UTILITIES MUST BE PREPARED ON THE SAME DAY OF DISTURBANCE.

4. ADDITIONAL SEDIMENT MUST BE PROVIDED, IF DEEMED NECESSARY BY THE HOWARD COUNTY SEDIMENT CONTROL INSPECTOR.

5. ON ALL SITES WITH DISTURBED AREAS IN ACCESS OF 2 ACRES, APPROVAL OF THE INSPECTION AGENCY SHALL BE REQUESTED UPON COMPLETION OF INSTALLATION OF PERIMETER EROSION AND SEDIMENT CONTROLS, BUT BEFORE PROCEEDING WITH ANY OTHER EARTH DISTURBANCE OR GRADING. OTHER BUILDING OR GRADING INSPECTION APPROVALS MAY NOT BE AUTHORIZED UNTIL THIS INITIAL APPROVAL BY THE INSPECTION AGENCY IS MADE.

6. TRENCHES FOR THE UTILITIES IS LIMITED TO THREE PIPE LENGTHS OR THAT WHICH SHALL BE BACK-FILLED AND STABILIZED BY THE END OF EACH WORK DAY, WHICHEVER IS SHORTER.

*THE EARTHWORK QUANTITIES SHOWN HEREON ARE FOR INFORMATION PURPOSES ONLY. MRA MAKES NO GUARANTEE OF ACCURACY OF QUANTITIES OR BALANCE OF SITE. THE DEVELOPER AND CONTRACTORS SHALL TAKE FULL RESPONSIBILITY OF ACTUAL EARTHWORK QUANTITIES ENCOUNTERED DURING CONSTRUCTION.

HOWARD SOIL CONSERVATION DISTRICTS STANDARD SEDIMENT CONTROL NOTES

- A MIN. OF 48 HOURS NOTICE MUST BE GIVEN TO THE HOWARD CO. DEPARTMENT OF INSPECTIONS, LICENSES AND PERMITS, SEDIMENT CONTROL DIVISION PRIOR TO THE START OF ANY CONSTRUCTION (313-1855).
- ALL VEGETATION AND STRUCTURAL ARE TO BE INSTALLED ACCORDING TO THE PROVISIONS OF THIS PLAN AND ARE TO BE IN CONFORMANCE WITH THE MOST CURRENT MARYLAND STANDARDS AND SPECIFICATIONS FOR SOIL EROSION AND SEDIMENT CONTROL AND REVISIONS THERETO.
- FOLLOWING INITIAL SOIL DISTURBANCE OR RE-DISTURBANCE, PERMANENT OR TEMPORARY STABILIZATION SHALL BE COMPLETED WITHIN 7 CALENDAR DAYS FOR ALL PERIMETER SEDIMENT CONTROL STRUCTURES, DIKES, PERIMETER SLOPES AND ALL SLOPES GREATER THAN 3:1, B) 14 DAYS AS TO ALL OTHER DISTURBED OR GRADED AREAS ON THE PROJECT SITE.
- ALL BASINS SHOWN MUST BE FENCED AND WARNING SIGNS POSTED AROUND THE PERIMETER IN ACCORDANCE WITH VOL. 1, CHAPTER 12 OF THE HOWARD COUNTY DESIGN MANUAL, STORM DRAINAGE.
- ALL DISTURBED AREAS MUST BE STABILIZED WITHIN THE TIME PERIOD SPECIFIED ABOVE IN ACCORDANCE WITH THE 1994 MARYLAND STANDARDS AND SPECIFICATIONS FOR SOIL EROSION AND SEDIMENT CONTROL FOR PERMANENT SEEDING (SEC. 51), SOO (SEC. 54), TEMPORARY SEEDING (SEC. 50) AND MULCHING (SEC. 52). TEMPORARY STABILIZATION WITH MULCH ALONE CAN ONLY BE DONE WHEN RECOMMENDED SEEDING DATES DO NOT ALLOW FOR PROPER GERMINATION AND ESTABLISHMENT OF GRASSES.
- ALL SEDIMENT CONTROL STRUCTURES ARE TO REMAIN IN PLACE AND ARE TO BE MAINTAINED IN OPERATIVE CONDITION UNTIL PERMSSION FOR THEIR REMOVAL HAS BEEN OBTAINED FROM HOWARD COUNTY SEDIMENT CONTROL INSPECTOR.
- AREA TO BE ROOFED OR PAVED AREA TO BE VEGETATIVELY STABILIZED TOTAL CUT 1500 CU. YDS.* TOTAL FILL 1500 CU. YDS.* TOTAL TOPSOIL 500 CU. YDS.*
- NOT YET DETERMINED, WASTE/BORROW AREA TO BE A SITE WITH AN APPROVED SEDIMENT CONTROL PERMIT
- ANY SEDIMENT CONTROL PRACTICE WHICH IS DISTRIBUTED BY GRADING ACTIVITY FOR PLACEMENT OF UTILITIES MUST BE PREPARED ON THE SAME DAY OF DISTURBANCE.
- ADDITIONAL SEDIMENT MUST BE PROVIDED, IF DEEMED NECESSARY BY THE HOWARD COUNTY SEDIMENT CONTROL INSPECTOR.
- ON ALL SITES WITH DISTURBED AREAS IN ACCESS OF 2 ACRES, APPROVAL OF THE INSPECTION AGENCY SHALL BE REQUESTED UPON COMPLETION OF INSTALLATION OF PERIMETER EROSION AND SEDIMENT CONTROLS, BUT BEFORE PROCEEDING WITH ANY OTHER EARTH DISTURBANCE OR GRADING. OTHER BUILDING OR GRADING INSPECTION APPROVALS MAY NOT BE AUTHORIZED UNTIL THIS INITIAL APPROVAL BY THE INSPECTION AGENCY IS MADE.
- TRENCHES FOR THE UTILITIES IS LIMITED TO THREE PIPE LENGTHS OR THAT WHICH SHALL BE BACK-FILLED AND STABILIZED BY THE END OF EACH WORK DAY, WHICHEVER IS SHORTER.
- THE EARTHWORK QUANTITIES SHOWN HEREON ARE FOR INFORMATION PURPOSES ONLY. MRA MAKES NO GUARANTEE OF ACCURACY OF QUANTITIES OR BALANCE OF SITE. THE DEVELOPER AND CONTRACTORS SHALL TAKE FULL RESPONSIBILITY OF ACTUAL EARTHWORK QUANTITIES ENCOUNTERED DURING CONSTRUCTION.

SEQUENCE OF CONSTRUCTION

- OBTAIN GRADING PERMIT. 1 DAY
- CLEAR FOR AND INSTALL PERIMETER SEDIMENT CONTROLS, SILT FENCE AND INLET PROTECTION FOR EX 1-25. 3 DAYS
- CONSTRUCT PROPOSED STORM DRAIN SYSTEM, EX 1-25 TO 1-4 AND EX-10 TO EX 24* HDPE. INSTALL INLET PROTECTION AS STORM DRAIN CONSTRUCTION PROCEEDS. 2 WEEKS
- FINE GRADE AND INSTALL CURB, GUTTER AND BASE PAVING. 1 WEEK
- CONSTRUCT WALKWAYS, RAMPS, AND VEGETATIVELY STABILIZE REMAINING AREAS. 1 WEEK
- FLUSH STORM DRAIN FOR ANY ACCUMULATED SEDIMENTATION. 1 DAY
- WITH HOWARD COUNTY SEDIMENT CONTROL INSPECTOR'S PERMISSION, REMOVE ALL SEDIMENT CONTROL DEVICES AND STABILIZE REMAINING DISTURBED AREAS. 1 WEEK

ENGINEER'S CERTIFICATE

I HEREBY CERTIFY THAT THIS PLAN FOR SEDIMENT AND EROSION CONTROL REPRESENTS A PRACTICAL AND WORKABLE PLAN BASED ON MY PERSONAL KNOWLEDGE OF THE SITE CONDITIONS AND THAT IT WAS PREPARED IN ACCORDANCE WITH THE REQUIREMENTS OF THE HOWARD SOIL CONSERVATION DISTRICT.

[Signature] 2/27/07 DATE

SIGNATURE OF ENGINEER
KERRI S. KNIGHTEN, PE MD LICENSE 201135

DATE

DEVELOPER'S CERTIFICATE

I/WE CERTIFY THAT ALL DEVELOPMENT AND CONSTRUCTION WILL BE DONE ACCORDING TO THIS PLAN OF DEVELOPMENT FOR SEDIMENT AND EROSION CONTROL, AND THAT ALL RESPONSIBLE PERSONNEL INVOLVED IN THE CONSTRUCTION PROJECT WILL HAVE A CERTIFICATE OF ATTENDANCE AT A DEPARTMENT OF ENVIRONMENT APPROVED TRAINING PROGRAM FOR THE CONTROL OF SEDIMENT AND EROSION BEFORE BEGINNING THE PROJECT. I ALSO AUTHORIZE PERIODIC ONSITE INSPECTIONS BY THE HOWARD SOIL CONSERVATION DISTRICT.

[Signature] 2/27/07 DATE

SIGNATURE OF DEVELOPER
BRIAN KNAUFF

DATE

REVIEWED FOR HOWARD SCD AND MEETS TECHNICAL REQUIREMENTS.

[Signature] 3/6/07 DATE

UDPA - NATURAL RESOURCES CONSERVATION SERVICE

THIS DEVELOPMENT PLAN IS APPROVED FOR SOIL EROSION AND SEDIMENT CONTROL BY THE HOWARD SOIL CONSERVATION DISTRICT.

[Signature] 3/6/07 DATE

HOWARD SOIL CONSERVATION DISTRICT

DATE

APPROVED: HOWARD COUNTY DEPARTMENT OF PUBLIC WORKS.

[Signature] 3-8-07 DATE

CHEF, BUREAU OF HIGHWAYS


APPROVED: HOWARD COUNTY DEPARTMENT OF PLANNING AND ZONING.

[Signature] 3/10/07 DATE

CHEF, DIVISION OF LAND DEVELOPMENT

[Signature] 3/12/07 DATE

CHEF, DEVELOPMENT ENGINEERING DIVISION

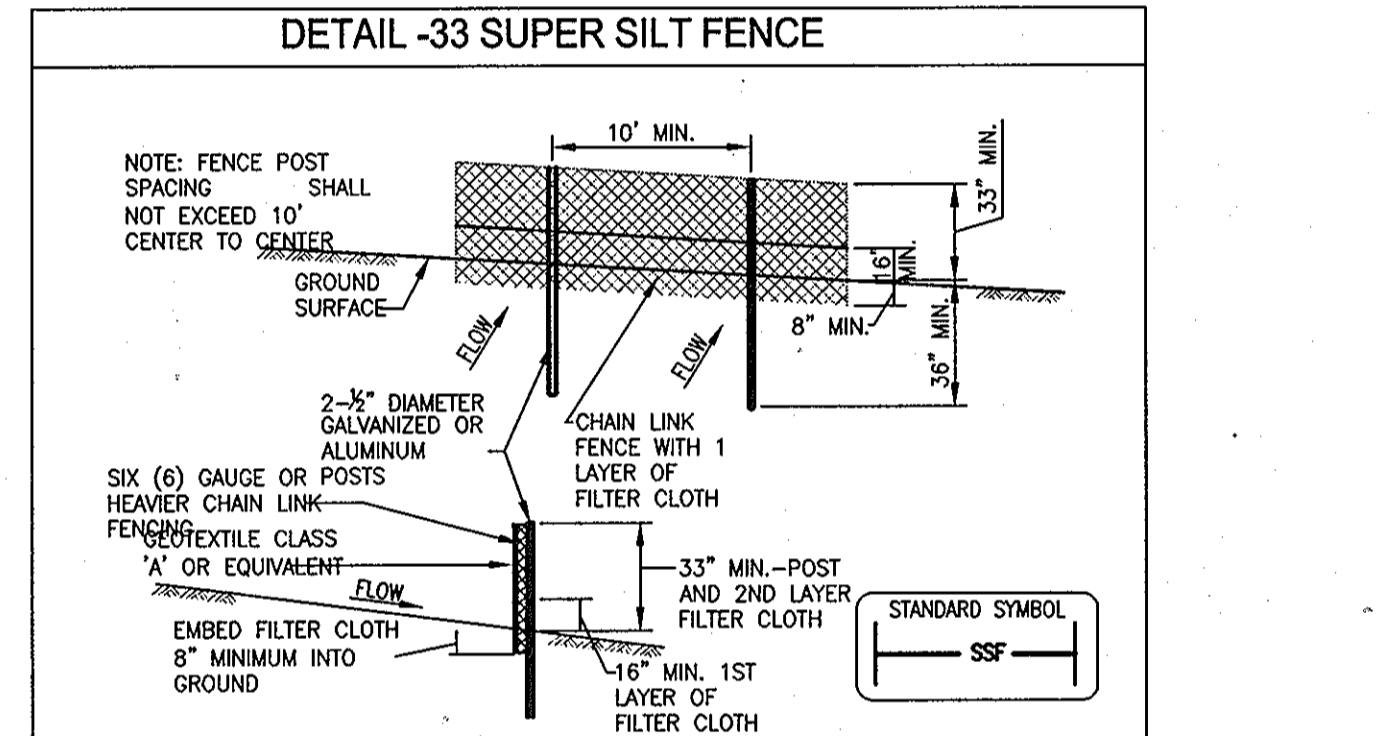

CONSTRUCTION SPECIFICATIONS

- FENCING SHALL BE 42" IN HEIGHT AND CONSTRUCTED IN ACCORDANCE WITH THE LATEST MARYLAND STATE HIGHWAY (SHA) DETAILS FOR CHAIN LINK FENCING. THE (SHA) SPECIFICATIONS FOR A 6" FENCE SHALL BE USED, SUBSTITUTING 42" FABRIC AND 6" LENGTH POSTS.
- THE POSTS DO NOT NEED TO BE SET IN CONCRETE.
- CHAIN LINK FENCE SHALL BE FASTENED SECURELY TO THE FENCE POSTS WITH WIRE TIES OR STAPLES.
- FILTER CLOTH SHALL BE FASTENED SECURELY TO THE CHAIN LINK FENCE WITH TIES SPACED EVERY 24" AT THE TOP AND MID SECTION.
- FILTER CLOTH SHALL BE EMBEDDED A MINIMUM OF 8" INTO THE GROUND.
- WHEN TWO SECTIONS OF GEOTEXTILE FABRIC ADJOIN EACH OTHER, THEY SHALL BE OVERLAPPED BY 6" AND FOLDED.
- MAINTENANCE SHALL BE PERFORMED AS NEEDED AND SILT BULLDUPS REMOVED WHEN "BULGES" DEVELOP IN THE SILT FENCE, OR WHEN SILT REACHES 50% OF THE FENCE HEIGHT.

U.S. DEPARTMENT OF AGRICULTURE H-26-3 MARYLAND DEPARTMENT OF ENVIRONMENT
SOIL CONSERVATION SERVICE WATER MANAGEMENT ADMINISTRATION


DETAIL 33 - SUPER SILT FENCE

SUPER SILT FENCE DESIGN CRITERIA


SLOPE	SLOPE STEEPNESS	SLOPE LENGTH (MAX.)	SILT FENCE LENGTH (MAX.)
0 - 10%	0 - 10:1	UNLIMITED	UNLIMITED
10 - 20%	10:1 - 5:1	200 FEET	1500 FEET
20 - 33%	5:1 - 3:1	100 FEET	1000 FEET
33 - 50%	3:1 - 2:1	100 FEET	500 FEET
50% & HIGHER	2:1 & STEEPER	50 FEET	250 FEET

U.S. DEPARTMENT OF AGRICULTURE H-26-3A MARYLAND DEPARTMENT OF ENVIRONMENT
SOIL CONSERVATION SERVICE MODIFIED WATER MANAGEMENT ADMINISTRATION

DETAIL 23B - AT GRADE INLET PROTECTION

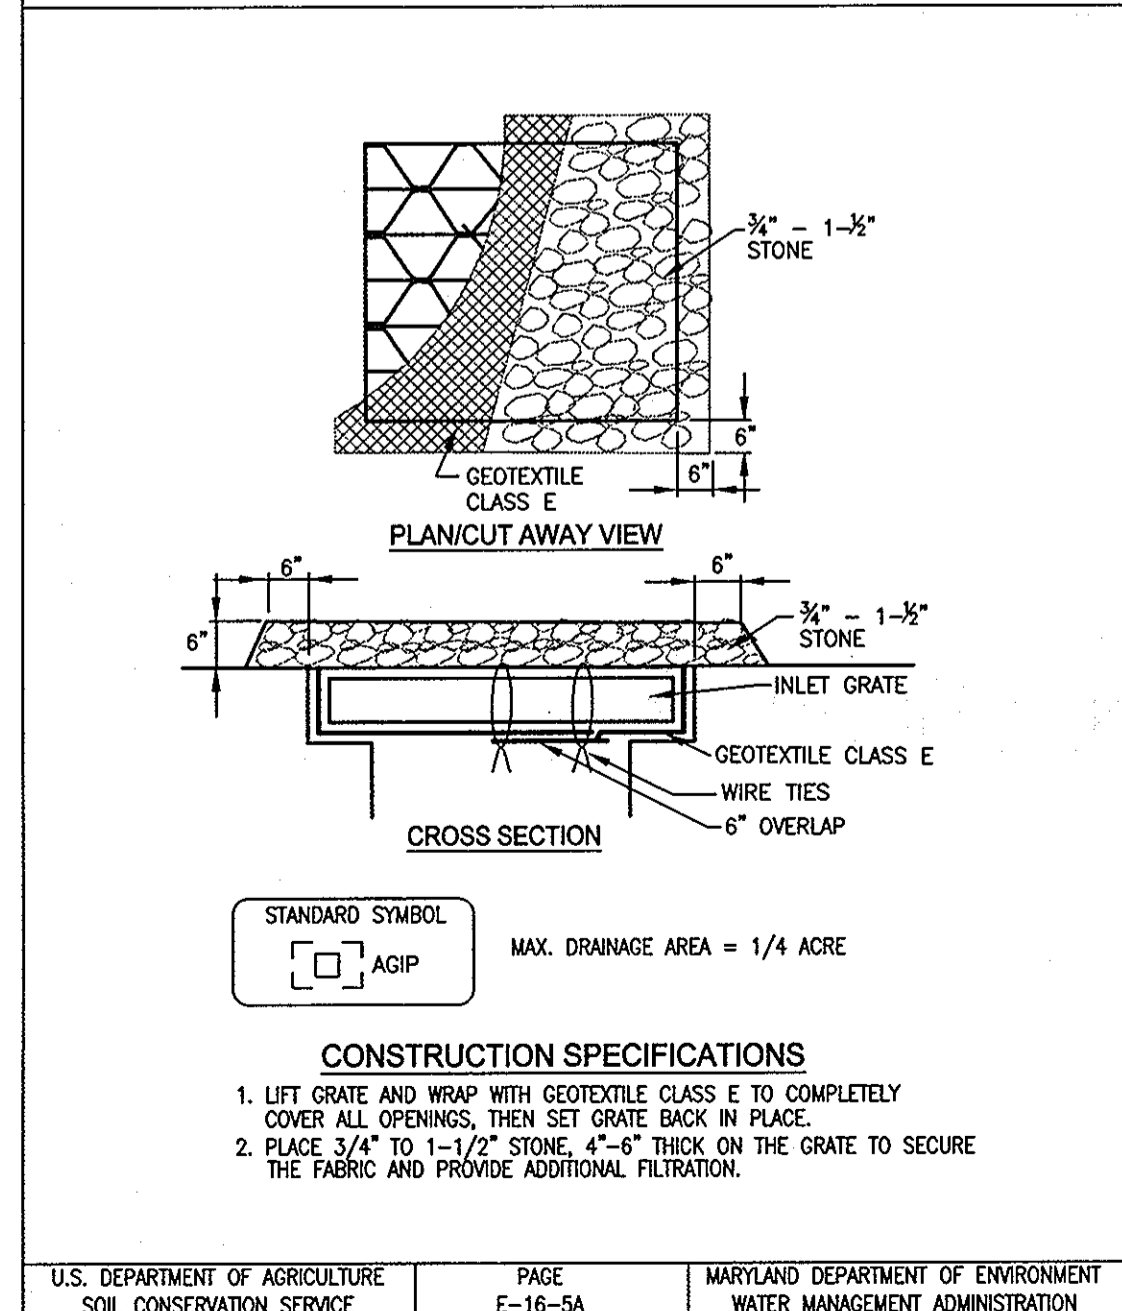

DETAIL 23C - CURB INLET PROTECTION (COG OR COS INLETS)

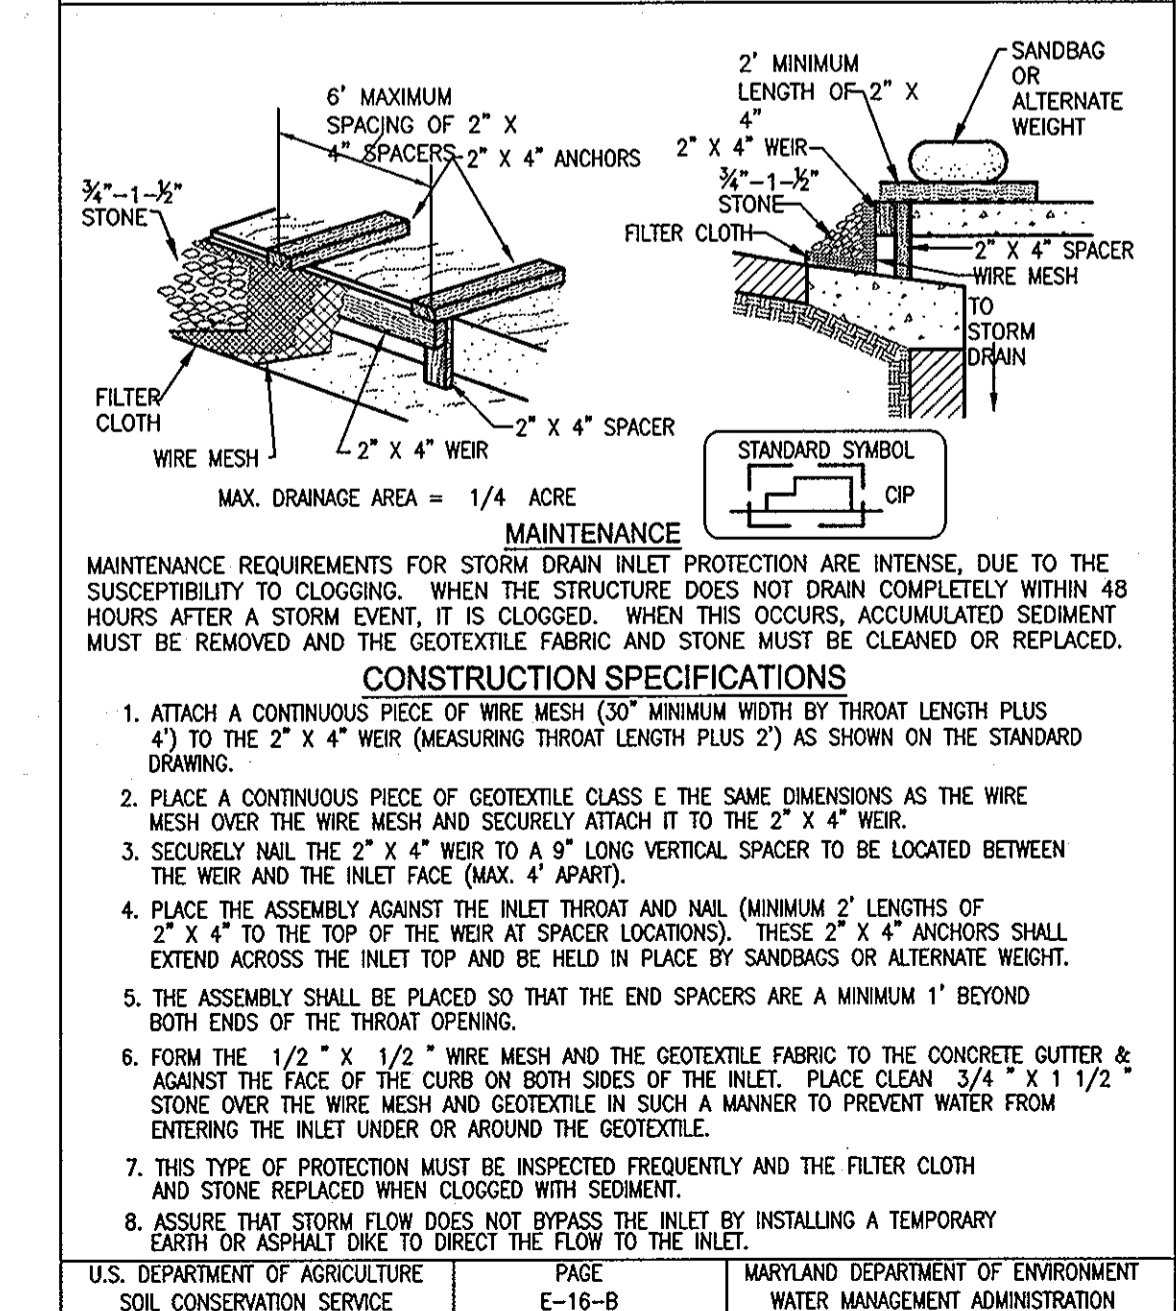

MORRIS & RITCHIE ASSOCIATES, INC.
ENGINEERS, PLANNERS, SURVEYORS AND LANDSCAPE ARCHITECTS

14280 PARK CENTER DRIVE, SUITE A
LAUREL, MARYLAND 20707
(410) 792-9792 or (301) 776-1890
FAX (410) 792-7395


2/27/07 DATE

[Signature]

DRAWN BY: MSP/MDC
DESIGNED BY: LFB/MSP
REVIEWED BY: KSK
PROJECT NO: 14719
DATE: 2/27/07
SCALE: AS SHOWN
DRAWING NO. 8 OF 9

LEGEND

	EX. 20' PUBLIC SD & UTILITY EASMENT
	EX. 20' PUBLIC SD & UTILITY
	EX. 2' CONTOUR
	EX. 10' CONTOUR
	EX. BUILDING
	EX. CURB
	EX. EASEMENT
	EX. FENCE
	EX. FLOOD PLAIN
	EX. GAS
	EX. PAVEMENT
	EX. PROPERTY LINE
	EX. ROAD CENTERLINE
	EX. SANITARY SEWER
	EX. STORM DRAIN
	EX. TREE LINE
	EX. WATERLINE
	EX. WETLAND
	EX. WETLAND BUFFER
	PROP. 2' CONTOURS
	PROP. 10' CONTOURS
	PROP. CENTERLINE OF DRAINAGE SWALE
	PROP. 5' CHAINLINK FENCE
	PROP. CURB
	PROP. REVERSE CURB & GUTTER
	PROP. STANDARD CURB & GUTTER
	PROP. TREE LINE
	PROP. LIMIT OF DISTURBANCE
	PROP. PAVEMENT
	PROP. BUILDING
	PROP. BUILDING SETBACK
	PROP. PUBLIC SANITARY SEWER LINE
	PROP. PUBLIC WATER LINE
	PROP. PRIVATE STORM DRAIN LINE
	PROP. PUBLIC STORM DRAIN LINE
	PROP. SITE LIGHTING

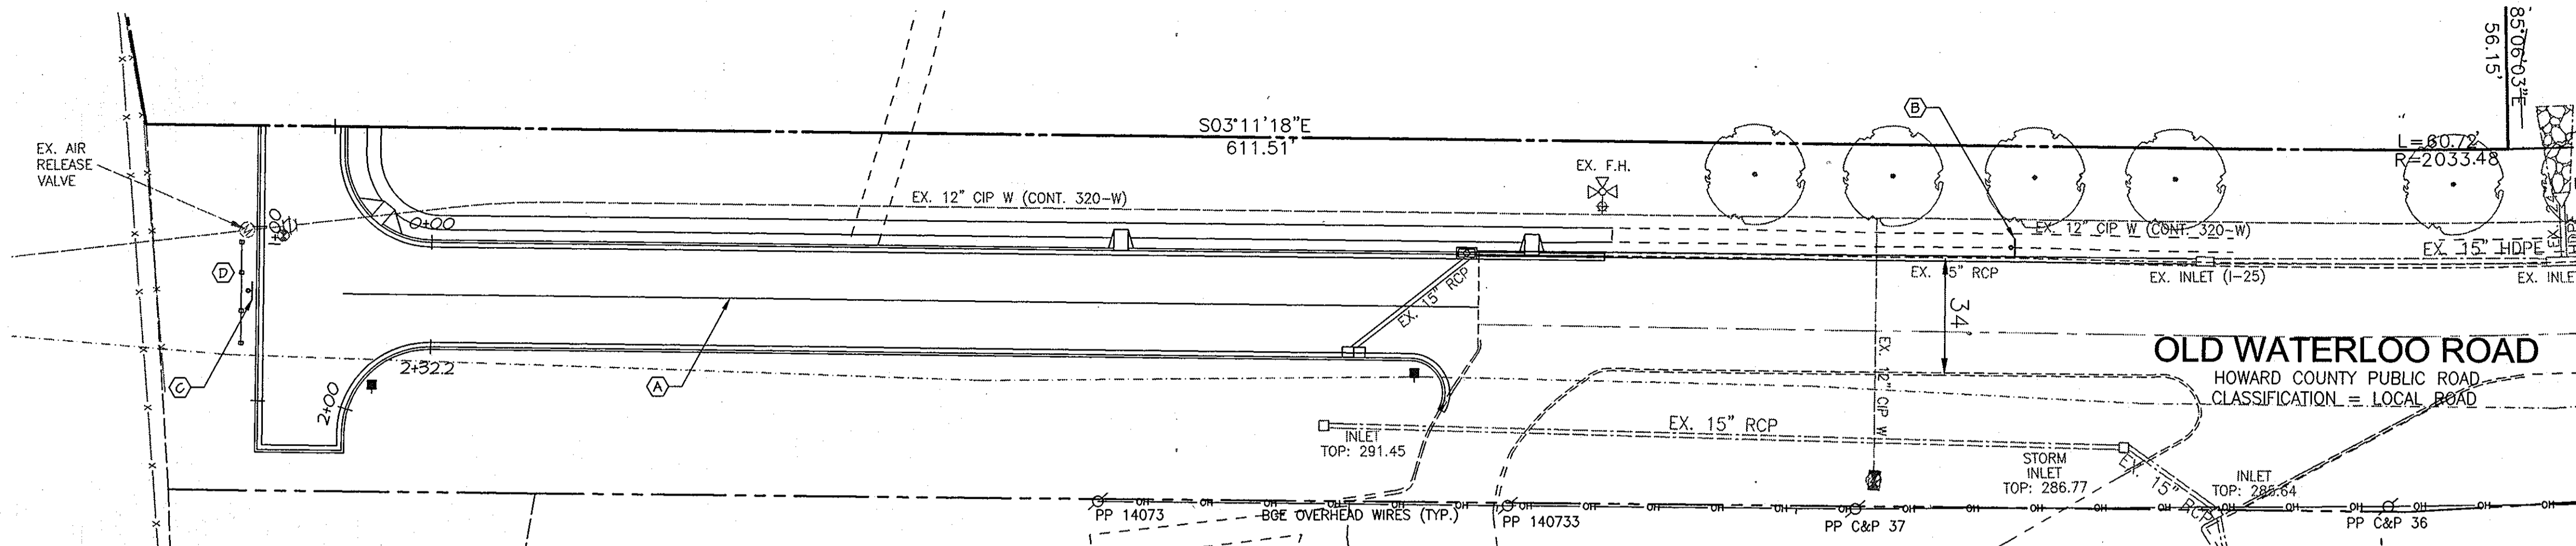


SIGNAGE & STRIPING PLAN

SCALE: 1" = 30'

- (A) 5" DOUBLE YELLOW LINE
- (B) SIGN - "ROAD ENDS 500 FT"
- (C) SIGN - "NO PARKING in TEE-TURNAROUND"
- (D) 4-18"x18" END-OF-ROAD MARKERS TO BE MOUNTED ON GUARD RAIL

NOTES

- NEW PAVEMENT MARKINGS SHALL TIE INTO EXISTING PAVEMENT MARKINGS
- MARKINGS AND SIGN LOCATIONS SHALL BE APPROVED BY THE TRAFFIC DIVISION PRIOR TO INSTALLATIONS (410-313-5752)

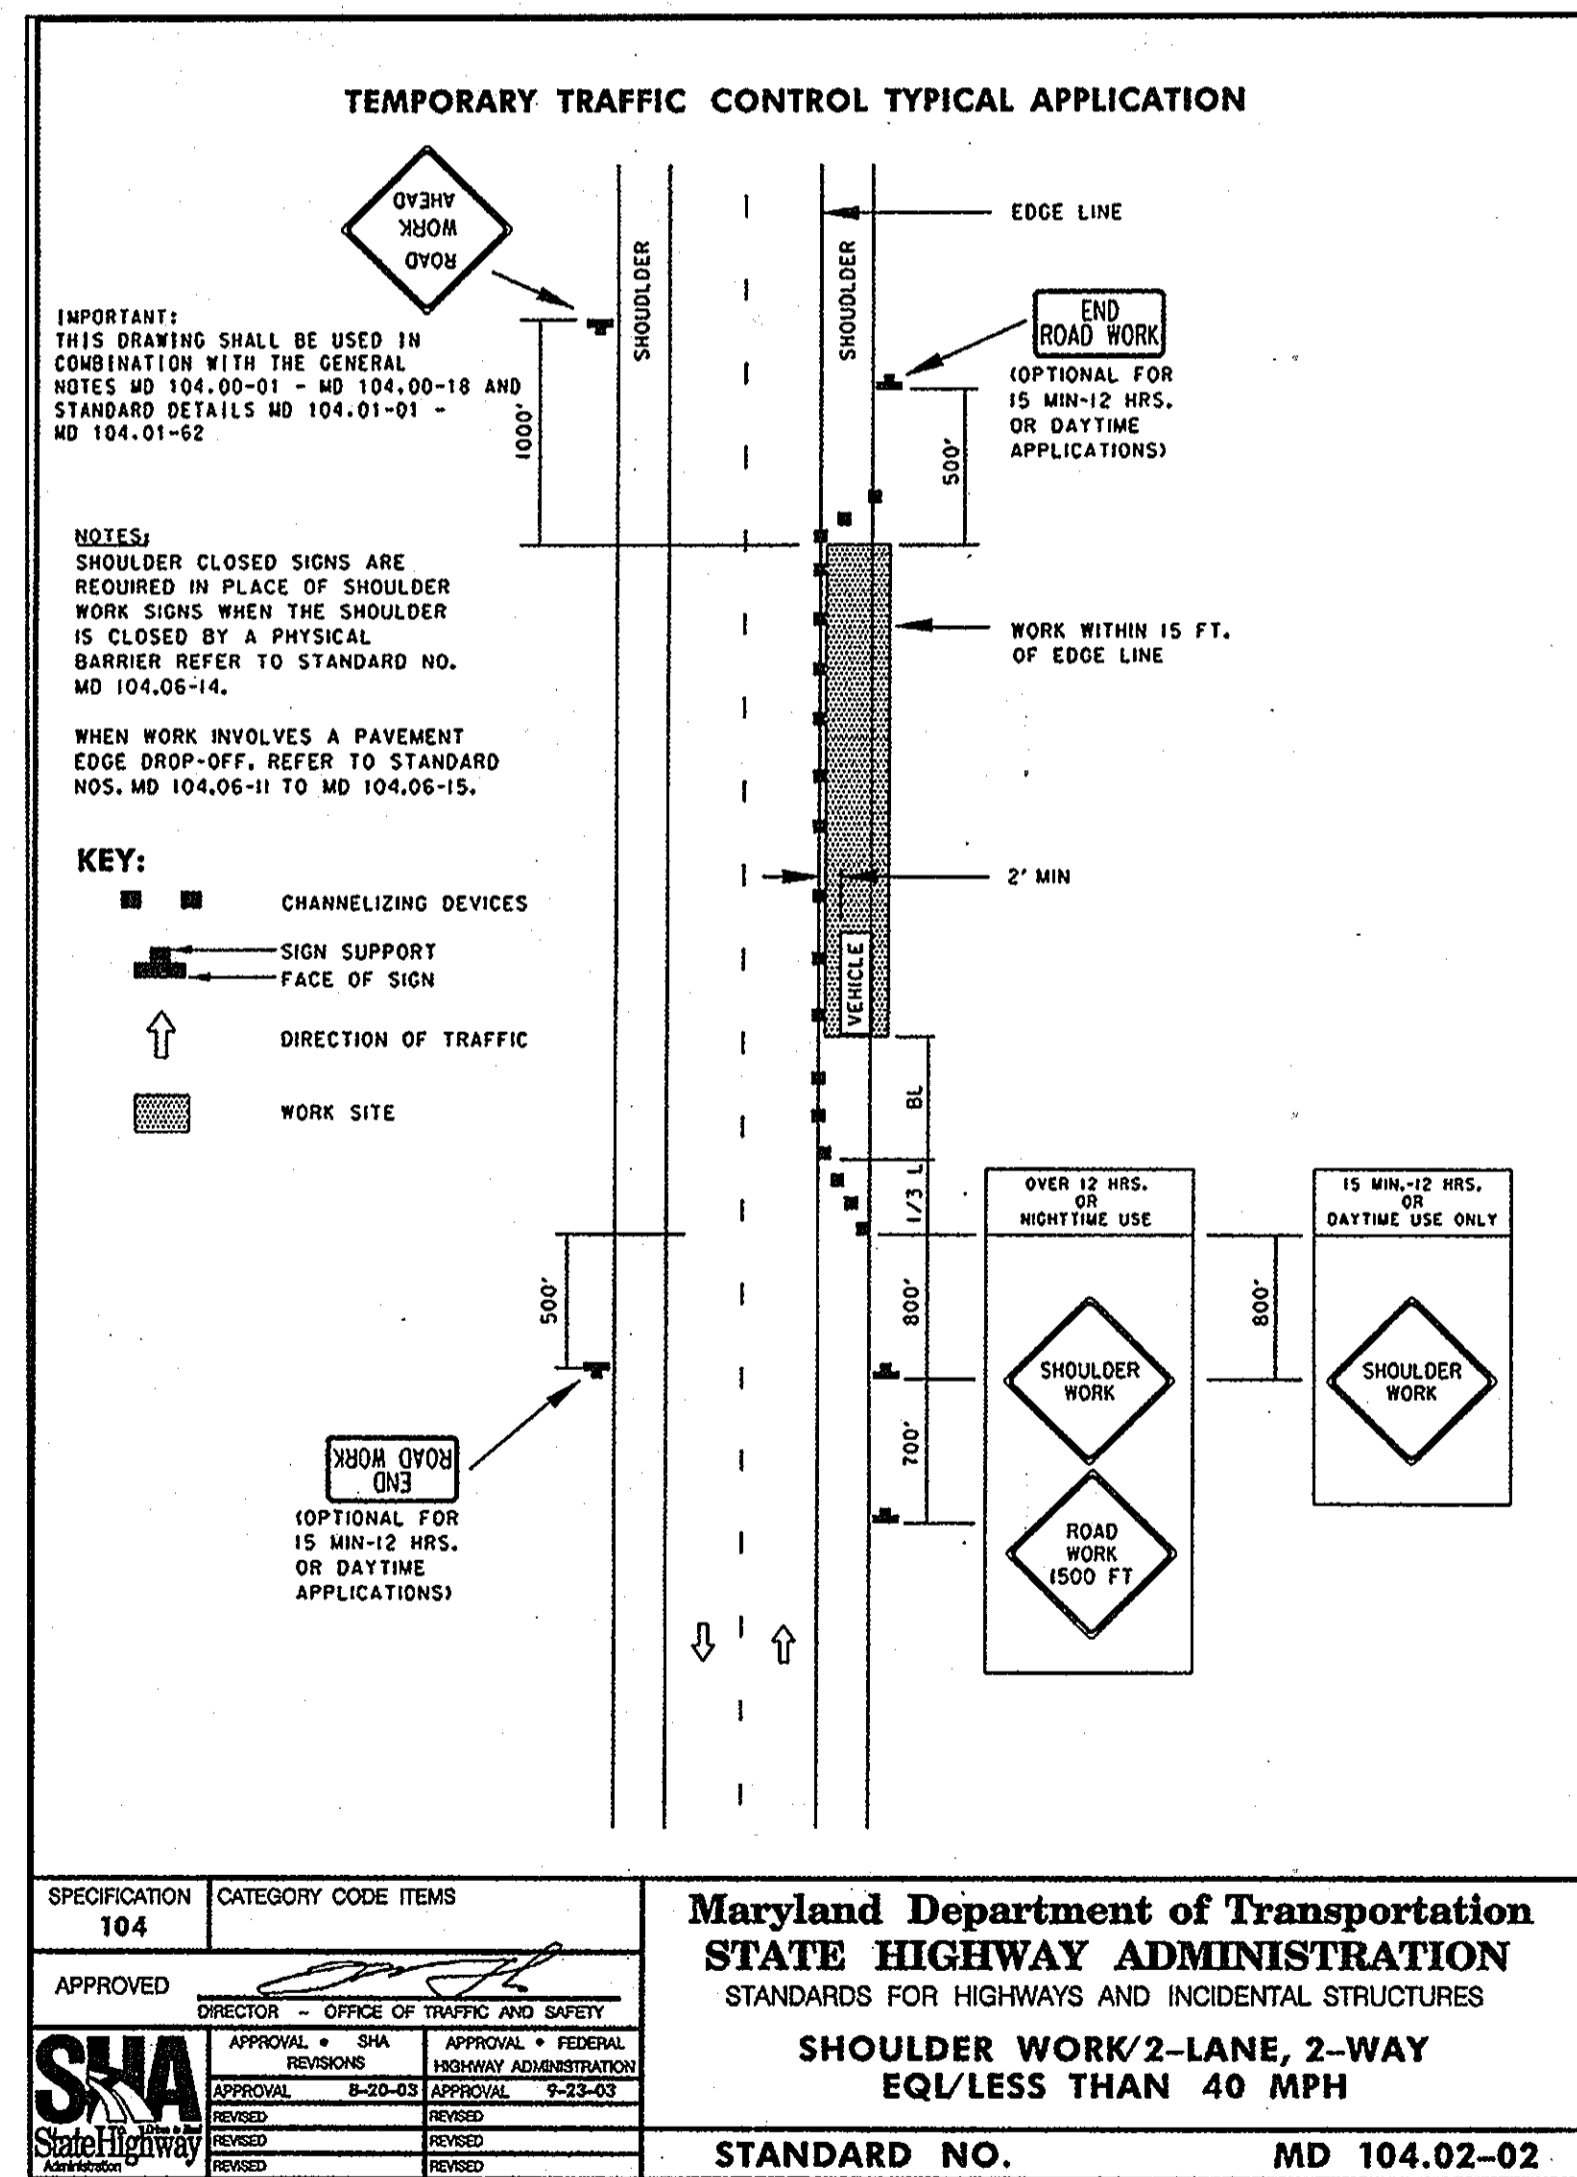

MAINTENANCE OF TRAFFIC DETAIL FOR SHOULDER WORK ON A TWO-LANE ROAD

Maryland Department of Transportation STATE HIGHWAY ADMINISTRATION
STANDARDS FOR HIGHWAYS AND INCIDENTAL STRUCTURES

SHOULDER WORK/2-LANE, 2-WAY
EQL/LESS THAN 40 MPH

STANDARD NO. MD 104.02-02

APPROVED	DIRECTOR - OFFICE OF TRAFFIC AND SAFETY
APPROVAL - SHA	APPROVAL - FEDERAL HIGHWAY ADMINISTRATION
APPROVAL - 8-23-03	APPROVAL - 9-23-03
REVISION	REVISION
REVISION	REVISION

APPROVED: HOWARD COUNTY DEPARTMENT OF PUBLIC WORKS.

Walter Z. ... 3-8-07
CHIEF, BUREAU OF HIGHWAYS

APPROVED: HOWARD COUNTY DEPARTMENT OF PLANNING AND ZONING.

Cathy ... 3/1/07
CHIEF, DIVISION OF LAND DEVELOPMENT

... 3/1/07
CHIEF, DEVELOPMENT ENGINEERING DIVISION

OWNER / DEVELOPER: THE RYLAND GROUP
ATTN: MR. BRIAN KNAUFF
6011 UNIVERSITY BOULEVARD, SUITE 260
ELLCOTT CITY, MARYLAND 21043
PHONE: 410-480-2467
FAX: 410-480-0543

PROJECT: OLD WATERLOO ROAD EXTENSION GATEWAY OVERLOOK AT BENSON EAST

AREA PLAT: 18885
ZONED: NT ~ TAX MAP: 37 AND 43 ~ GRID: 20, 21 AND 2, 3
PARCEL: 382 ~ LOTS: J, K & L
6TH ELECTION DISTRICT ~ HOWARD COUNTY, MARYLAND

TITLE: SIGNAGE, STRIPING & MOT PLANS

MRA MORRIS & RITCHIE ASSOCIATES, INC.
ENGINEERS, PLANNERS, SURVEYORS AND LANDSCAPE ARCHITECTS
14280 PARK CENTER DRIVE, SUITE A
LAUREL, MARYLAND 20707
(410) 792-8792 or (301) 776-1690
FAX (410) 792-7395

2/23/07
DATE

DRAWN BY: MSP/MDC
DESIGNED BY: LFB/MSP
REVIEWED BY: KSK
PROJECT NO.: 14719
DATE: 2/27/07
SCALE: AS SHOWN
DRAWING NO. 9 OF 9