

TAYLOR FARM

SECTION THREE PHASE TWO

ROADS, STORMWATER MANAGEMENT AND STORM DRAIN CONSTRUCTION PLANS


GENERAL NOTES

- 1.) THE PROJECT IS IN CONFORMANCE WITH THE LATEST HOWARD COUNTY STANDARDS UNLESS WAIVERS HAVE BEEN APPROVED.
- 2.) THE EXISTING TOPOGRAPHY SHOWN ON SITE IS BASED ON A FIELD SURVEY PERFORMED BY BENCHMARK ENGINEERING, INC. IN FEBRUARY, 2003. EXISTING TOPOGRAPHY SHOWN ON ADJACENT TAYLOR FARM SUBDIVISIONS WAS TAKEN FROM 8/21/99 AND 8/27/01 SURVEYS.
- 3.) THE COORDINATES SHOWN HEREON ARE BASED UPON THE HOWARD COUNTY GEODETIC CONTROL WHICH IS BASED UPON THE MARYLAND STATE PLANE COORDINATE SYSTEM. HOWARD COUNTY MONUMENT NOS. 1012 AND 16C3 WERE USED FOR THIS PROJECT.
- 4.) WATER IS PUBLIC. THE CONTRACT NUMBER IS 14-4395-D. THE DRAINAGE AREA IS PATAPSCO.
- 5.) SEWER IS PUBLIC. THE CONTRACT NUMBER IS 14-4395-D. THE DRAINAGE AREA IS PATAPSCO.
- 6.) STORMWATER MANAGEMENT QUALITY AND QUANTITY CONTROL IS PROVIDED WITHIN THE EXISTING FACILITY CONSTRUCTED UNDER F-95-174 (G.T.'S WAVERLY WOODS SECTION, AREA 2).
- 7.) EXISTING UTILITIES ARE BASED ON CONTRACT DRAWINGS AND FIELD SURVEY LOCATIONS.
- 8.) THE FLOODPLAIN STUDY WAS PERFORMED UNDER F-89-235. THE LIMITS SHOWN ON THESE PLANS WERE TAKEN FROM PLAT #9221.
- 9.) THE WETLANDS DELINEATION FOR THIS PROJECT WAS PREPARED BY ECO-SCIENCE PROFESSIONAL, INC. IN FEBRUARY, 2003.
- 10.) THE TRAFFIC STUDY FOR THIS PROJECT WAS PREPARED BY MARS GROUP, INC. IN MAY, 2003 AND APPROVED ON FEBRUARY 20, 2004 AS PART OF 5-03-019. THE REPORT INDICATED THAT MITIGATION WOULD BE NEEDED AT THE INTERSECTION OF MARVONVILLE ROAD AND ROUTE 99. A MITIGATION PLAN FOR THAT AREA WAS SUBMITTED ON 9-1-06 AS F-07-32 FOR GTW'S WAVERLY WOODS. THIS MITIGATION PLAN FULFILLS THE REQUIREMENTS OF THE MITIGATION NEEDED FOR THIS PLAN.
- 11.) A NOISE STUDY IS NOT REQUIRED FOR THIS PROJECT. THE 65 dBA NOISE CONTOUR LINE SHOWN ON THE PLANS WAS TAKEN FROM F-98-141. IT IS ADVISORY AS REQUIRED BY THE HOWARD COUNTY DESIGN MANUAL, CHAPTER 5, REVISED FEBRUARY, 1992 AND CANNOT BE CONSIDERED TO EXACTLY LOCATE THE 65 dBA NOISE EXPOSURE. THE 65 dBA NOISE LINE WAS ESTABLISHED BY HOWARD COUNTY TO ALERT DEVELOPERS, BUILDERS AND FUTURE RESIDENTS THAT AREAS BEYOND THIS THRESHOLD MAY EXCEED GENERALLY ACCEPTED NOISE LEVELS ESTABLISHED BY THE U.S. DEPARTMENT OF HOUSING AND URBAN DEVELOPMENT.
- 12.) THE GEOTECHNICAL REPORT WAS PREPARED BY HILLIS CARNES ENGINEERING ASSOCIATES, INC. IN SEPTEMBER, 2006.
- 13.) THE SUBJECT PROPERTY IS ZONED R-20 PER THE 2-2-2004 COMPREHENSIVE ZONING PLAN AND THE "COMP LITE" ZONING AMENDMENTS EFFECTIVE 7-28-2006.
- 14.) TO THE BEST OF OUR KNOWLEDGE, THERE ARE NO BURIAL GROUNDS OR CEMETERIES LOCATED ON THIS SITE.
- 15.) NO GRADING, REMOVAL OF VEGETATIVE COVER OR TREES, PAVING AND NEW STRUCTURES SHALL BE PERMITTED WITHIN THE LIMITS OF WETLANDS, STREAMS, OR THEIR REQUIRED BUFFERS, 100-YEAR FLOODPLAIN OR 25% OR GREATER STEEP SLOPES THAT ARE AT LEAST 20,000 S.F. OF CONTIGUOUS AREA EXCEPT FOR THE DISTURBANCES TO THE STREAM BUFFER AT THE TAYLOR FARM ROAD CROSSING. THE PROPOSED STREAM CROSSING HAS BEEN DETERMINED BY THE DEPARTMENT OF PLANNING AND ZONING TO BE "NECESSARY" IN ACCORDANCE WITH SECTION 16.116.C.1.(i).
- 16.) BOUNDARY IS BASED ON A FIELD RUN MONUMENTED SUBURBAN BOUNDARY SURVEY PERFORMED BY BENCHMARK ENGINEERING, INC. IN FEBRUARY, 2003.
- 17.) FOREST STAND DELINEATION WAS PREPARED BY ECO-SCIENCE PROFESSIONALS, INC. IN FEBRUARY, 2003.
- 18.) THIS PROJECT WAS INCORPORATED INTO THE METROPOLITAN DISTRICT ON 11-6-2006 LIBER/FOLIO REFERENCES 10121/264 AND 10121/272.
- 19.) THIS PROJECT IS SUBJECT TO THE FIFTH EDITION OF THE SUBDIVISION AND LAND DEVELOPMENT REGULATIONS PER COUNCIL BILL NO. 46-2003 AND THE ZONING REGULATIONS AS AMENDED BY COUNCIL BILL NO. 50-2001. DEVELOPMENT OR CONSTRUCTION ON THESE LOTS MUST COMPLY WITH SETBACK AND BUFFER REGULATIONS IN EFFECT AT THE TIME OF SUBMISSION OF THE BUILDING OR GRADING PERMIT APPLICATION.
- 20.) THE LOTS SHOWN HEREON COMPLY WITH THE MINIMUM OWNERSHIP WIDTH AND LOT AREA AS REQUIRED BY THE MARYLAND STATE DEPARTMENT OF THE ENVIRONMENT.
- 21.) DRIVEWAYS SHALL BE PROVIDED PRIOR TO ISSUANCE OF A USE AND OCCUPANCY PERMIT FOR ANY NEW DWELLINGS FOR FIRE AND EMERGENCY VEHICLES PER THE FOLLOWING MINIMUM REQUIREMENTS:
 - A) WIDTH - 12' (14' SERVING MORE THAN ONE RESIDENCE).
 - B) SURFACE - 8" OF COMPACT CRUSHER RUN BASE WITH TAR AND CHIP COATING.
 - C) GEOMETRY - MAX. 15% GRADE, MAX. 10% GRADE CHANGE & MIN. 45' TURNING RADIUS.
 - D) STRUCTURES (CULVERTS/BRIDGES) - CAP 24" 12" SUPPORTING 25 GROSS TONS (H2S LOAD).
 - E) "BRIDGE ELEMENTS" - CAPABLE OF SAFELY PASSING 7' 9" YEAR FLOODPLAIN WITH NO MORE THAN 1' FOLLOWS OVER DRIVEWAY.
 - F) VERTICAL CLEARANCES - MINIMUM 12 FEET.
 - G) MANOVANCE - SUFFICIENT TO INSURE ALL WEATHER USE.
- 22.) LANDSCAPING FOR THIS SUBDIVISION IS PROVIDED IN ACCORDANCE WITH A "CERTIFIED LANDSCAPE PLAN" INCLUDED WITH THE ROAD CONSTRUCTION PERMIT. THE LANDSCAPE PLAN SET IN ACCORDANCE WITH SECTION 16.124 OF THE HOWARD COUNTY CODE AND THE LANDSCAPE MANUAL. FINANCIAL SURETY FOR THE REQUIRED LANDSCAPING HAS BEEN POSTED AS PART OF THE DPW DEVELOPER'S AGREEMENT IN THE AMOUNT OF \$20,850.00 FOR 64 SHADE TREES, \$145,000 FOR 11 EVERGREENS.
- 23.) THE FOREST CONSERVATION EASEMENTS HAVE BEEN ESTABLISHED TO FULFILL THE REQUIREMENTS OF SECTION 16.1202 OF THE HOWARD COUNTY CODE AND FOREST CONSERVATION ACT. NO CLEARING, GRADING, OR CONSTRUCTION IS PERMITTED WITHIN THE FOREST CONSERVATION EASEMENT; HOWEVER, FOREST MANAGEMENT PRACTICES AS DEFINED IN THE DEED OF FOREST CONSERVATION ARE ALLOWED.
- 24.) THE TOTAL FOREST CONSERVATION OBLIGATION AMOUNT OF 3.14 ACRES SHALL BE MET BY THE RETENTION OF 1.87 AC. OF NET TRACT AREA FOREST WITHIN A FOREST CONSERVATION EASEMENT (1.76 AC. ON-SITE AND 0.11 AC. CREDITED FROM F#1 IN TAYLOR FARM SECT. 3 PHASE 1, F-05-162) AND THE ON-SITE AFFORESTATION OF 1.27 AC. WITHIN FOREST CONSERVATION EASEMENT. FINANCIAL SURETY FOR THE REQUIRED FOREST CONSERVATION HAS BEEN POSTED AS PART OF THE DPW DEVELOPER'S AGREEMENT IN THE AMOUNT OF \$42,993.72 (\$15,333.12 FOR RETENTION OF 76,665.6 S.F. OF FOREST AND \$27,660.6 FOR THE PLANTING OF 55,321.2 S.F. OF FOREST). SURETY FOR THE 0.11 AC. OF RETENTION IN FCE #1 HAS BEEN POSTED AS PART OF THE DEVELOPER'S AGREEMENT FOR F-05-162.
- 25.) FOR FLAG O' PIPESTEM LOTS, REFUSE COLLECTION, SNOW REMOVAL AND ROAD MAINTENANCE ARE PROVIDED TO THE JUNCTION OF THE FLAG OR PIPESTEM AND ROAD RIGHT-OF-WAY LINE AND NOT ONTO THE PIPESTEM LOT DRIVEWAY.
- 26.) THERE IS AN EXISTING DWELLING LOCATED ON LOT 62 TO REMAIN. NO NEW BUILDINGS, EXTENSIONS OR ADDITIONS TO THE EXISTING DWELLING IS TO BE CONSTRUCTED AT A DISTANCE LESS THAN THE ZONING REGULATIONS REQUIRE.
- 27.) RESERVATION OF PUBLIC UTILITY AND FOREST CONSERVATION EASEMENTS
DEVELOPER RESERVES UNTO HIMSELF, HIS SUCCESSORS AND ASSIGNS, ALL EASEMENTS SHOWN ON THIS PLAN FOR WATER, SEWER, STORM DRAINAGE, OTHER PUBLIC UTILITIES AND FOREST CONSERVATION (DESIGNATED AS "FOREST CONSERVATION AREA"), LOCATED IN, ON, OVER AND THROUGH LOTS 58-59, 63-66, 68-97 AND OPEN SPACE LOTS 88-100. ANY CONVEYANCES OF THE AFORESAID LOTS/PARCELS SUBJECT TO THE EASEMENTS HEREBY RESERVED, WHETHER OR NOT EXPRESSLY STATED IN THE DEED(S) CONVEYING SAID LOTS/PARCELS, DEVELOPER SHALL EXECUTE AND DELIVER DEEDS FOR THE EASEMENTS HEREBY RESERVED TO HOWARD COUNTY WITH A METES AND BOUNDS DESCRIPTION OF THE FOREST CONSERVATION AREA. UPON COMPLETION OF THE PUBLIC UTILITIES AND THEIR ACCEPTANCE BY HOWARD COUNTY, AND IN THE CASE OF THE FOREST CONSERVATION EASEMENT(S), UPON COMPLETION OF THE DEVELOPER'S OBLIGATION UNDER THE FOREST CONSERVATION INSTALLATION AND MAINTENANCE AGREEMENT EXECUTED BY THE DEVELOPER AND THE COUNTY, AND THE RELEASE OF DEVELOPER'S SURETY POSTED WITH SAID AGREEMENT, THE COUNTY SHALL ACCEPT THE EASEMENTS AND RECORD THE DEED(S) OF EASEMENT IN THE LAND RECORDS OF HOWARD COUNTY.
- 28.) WATER AND SEWER SERVICE TO THESE LOTS WILL BE GRANTED UNDER THE PROVISIONS OF SECTION 18.122B OF THE HOWARD COUNTY CODE. PUBLIC WATER AND PUBLIC SEWER ALLOCATIONS WILL BE GRANTED AT THE TIME OF THE ISSUANCE OF THE BUILDING PERMIT IF CAPACITY IS AVAILABLE AT THAT TIME.
- 29.) THE CONTRACTOR SHALL NOTIFY THE DEPARTMENT OF PUBLIC WORKS/BUREAU OF ENGINEERING/CONSTRUCTION INSPECTION DIVISION AT 410-313-1880 AT LEAST FIVE (5) WORKING DAYS PRIOR TO THE START OF WORK.
- 30.) THE CONTRACTOR SHALL NOTIFY "MISS UTILITY" AT 1-800-257-7777 AT LEAST 48 HOURS PRIOR TO ANY EXCAVATION WORK BEING DONE.
- 31.) TRAFFIC CONTROL DEVICES, MARKINGS AND SIGNING SHALL BE IN ACCORDANCE WITH THE LATEST EDITION OF THE MANUAL OF UNIFORM TRAFFIC CONTROL DEVICES (MUTCD). ALL STREET AND REGULATORY SIGNS SHALL BE IN PLACE PRIOR TO PLACEMENT OF ANY ASPHALT.
- 32.) STREET LIGHT PLACEMENT AND TYPE OF FIXTURE AND POLE SHALL BE IN ACCORDANCE WITH THE HOWARD COUNTY DESIGN MANUAL, VOLUME II (1993) AND AS MODIFIED BY "GUIDELINES FOR STREET LIGHTS IN RESIDENTIAL DEVELOPMENTS (JUNE 1993)". A MINIMUM SPACING OF 20 FEET SHALL BE MAINTAINED BETWEEN ANY STREETLIGHT AND ANY TREE.
- 33.) ALL SIGN POSTS USED FOR TRAFFIC CONTROL SIGNS INSTALLED IN THE COUNTY RIGHT-OF-WAY SHALL BE MOUNTED ON A 2" GALVANIZED STEEL TUBE POST (14 GAUGE) INSERTED INTO A 2-3/4" GALVANIZED STEEL, PERFORATED, SQUARE TUBE SLEEVE (12 GAUGE)-3" LONG. A GALVANIZED STEEL POLE CAP SHALL BE MOUNTED ON TOP OF EACH POST.

BENCH MARKS NAD'83 HORIZONTAL

HO. CO. #101A
CONCRETE MONUMENT AT SOUTHEAST CORNER
OF WOODSTOCK ROAD AND MD ROUTE 99 20.5'
FROM CL OF ROUTE 99.
N 500995.112 E 1345340.402
ELEV. 442.707'

HO. CO. #174B
CONCRETE MONUMENT AT SOUTHEAST CORNER
OF WETHERBURN ROAD AND MD ROUTE 99 18'
FROM BRICK WALL.
N 598435.251 E 1348615.251
ELEV. 509.178'

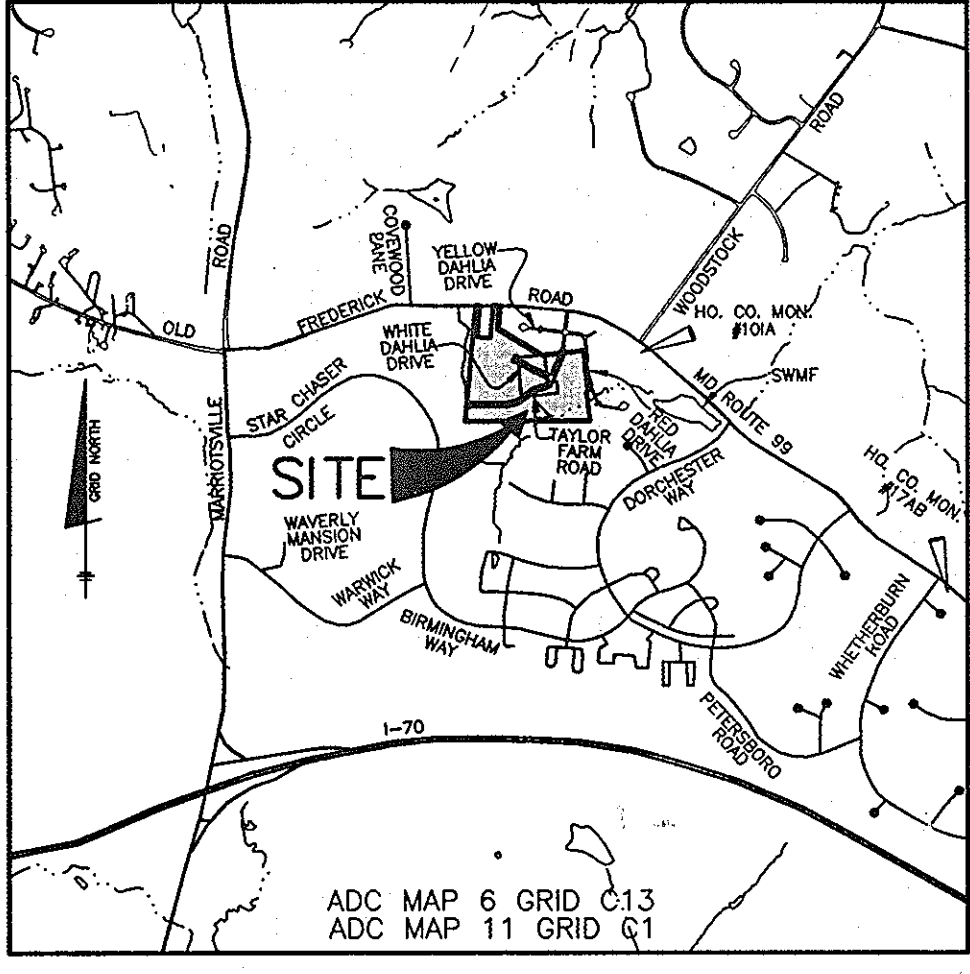

- AS-BUILT NOTES:**
- 1.) HORIZONTAL DATUM FOR THE AS-BUILT IS BASED ON THE MARYLAND STATE REFERENCE SYSTEM NAD 83/91 AS PROJECTED FROM HO. CO. GEODETIC CONTROL STATION 5 101A AND 174B. VERTICAL DATUM FOR THIS AS-BUILT IS NORTH AMERICAN VERTICAL DATUM NAD 29 AS PROJECTED FROM THE ABOVE MENTIONED HO. CO. GEODETIC CONTROL STATIONS.
 - 2.) THE INSTRUMENTS USED IN PERFORMING THE AS-BUILT WERE A 5" TOTAL STATION AND PRISM.
 - 3.) THIS AS-BUILT WAS PERFORMED BY BENCHMARK ENGINEERING, INC.

SITE ANALYSIS DATA CHART

GENERAL SITE DATA

- 1.) PRESENT ZONING: R-20
- 2.) APPLICABLE OPZ FILE REFERENCES: F-89-235, F-99-125, S-03-19, P-04-16, F-05-162, P-06-007
- 3.) PROPOSED USE OF SITE: RESIDENTIAL (SFD)
- 4.) PROPOSED WATER AND SEWER SYSTEMS: PUBLIC

AREA TABULATION

- 1.) GROSS TRACT AREA: 23.30 AC.±
- 2.) AREA WITHIN 100-YEAR FLOODPLAIN: 2.37 AC.±
- 3.) TOTAL AREA OF 25% OR GREATER STEEP SLOPES: 0.00 AC.±
- 4.) NET TRACT AREA: 20.93 AC.±
- 5.) TOTAL NUMBER OF LOTS ALLOWED PER ZONING: N/A
- 6.) TOTAL NUMBER OF RESIDENTIAL UNITS/LOTS PROPOSED ON THIS SUBMISSION: 41
- 7.) AREA OF BUILDABLE LOTS: 11.94± AC.
- 8.) AREA OF OPEN SPACE LOTS: 0.00± AC.
- 9.) AREA OF BULK PARCEL 'A': 0.36± AC.
- 10.) AREA OF PUBLIC RIGHT-OF-WAY: 1.55± AC.

OPEN SPACE DATA


- 1.) MINIMUM RESIDENTIAL LOT SIZE SELECTED: 12,000 S.F.
- 2.) OPEN SPACE REQUIRED (40% OF 23.93 AC.): 9.58± AC.
- 3.) OPEN SPACE PROVIDED (41.0%): 9.81± AC.***
- 4.) NON-CREDITED (LESS THAN 35' IN WIDTH): 0.00± AC. CREDITED: 9.81± AC.
- 5.) AREA OF RECREATION OPEN SPACE REQUIRED: 42 UNITS X 200 SF/UNIT = 8,400 SF.***
- 6.) AREA OF RECREATION OPEN SPACE PROVIDED: 8,884 S.F.

* 23.93± AC. IS THE TOTAL TRACT ACREAGE OF SECTION 3 (PHASES 1 AND 2).

** 9.45 AC. CREATED IN SECTION 3 PHASE 2 AND 0.36 AC. CREATED IN SECTION 3 PHASE 1 (F-05-162) WHICH IS CREDITED TOWARD THE OPEN SPACE OBLIGATION FOR SECTION 3 PHASE 2.

*** RECREATIONAL OPEN SPACE OBLIGATION INCLUDES THE ONE UNIT CREATED UNDER F-05-162 (EXISTING LOT 55).

AS-BUILT CERTIFICATION
I hereby certify, by my seal, that the facilities shown on this plan were constructed as shown on this AS-BUILT plan.
Donald Mason, P.E. No. 21443 Date 12-31-13

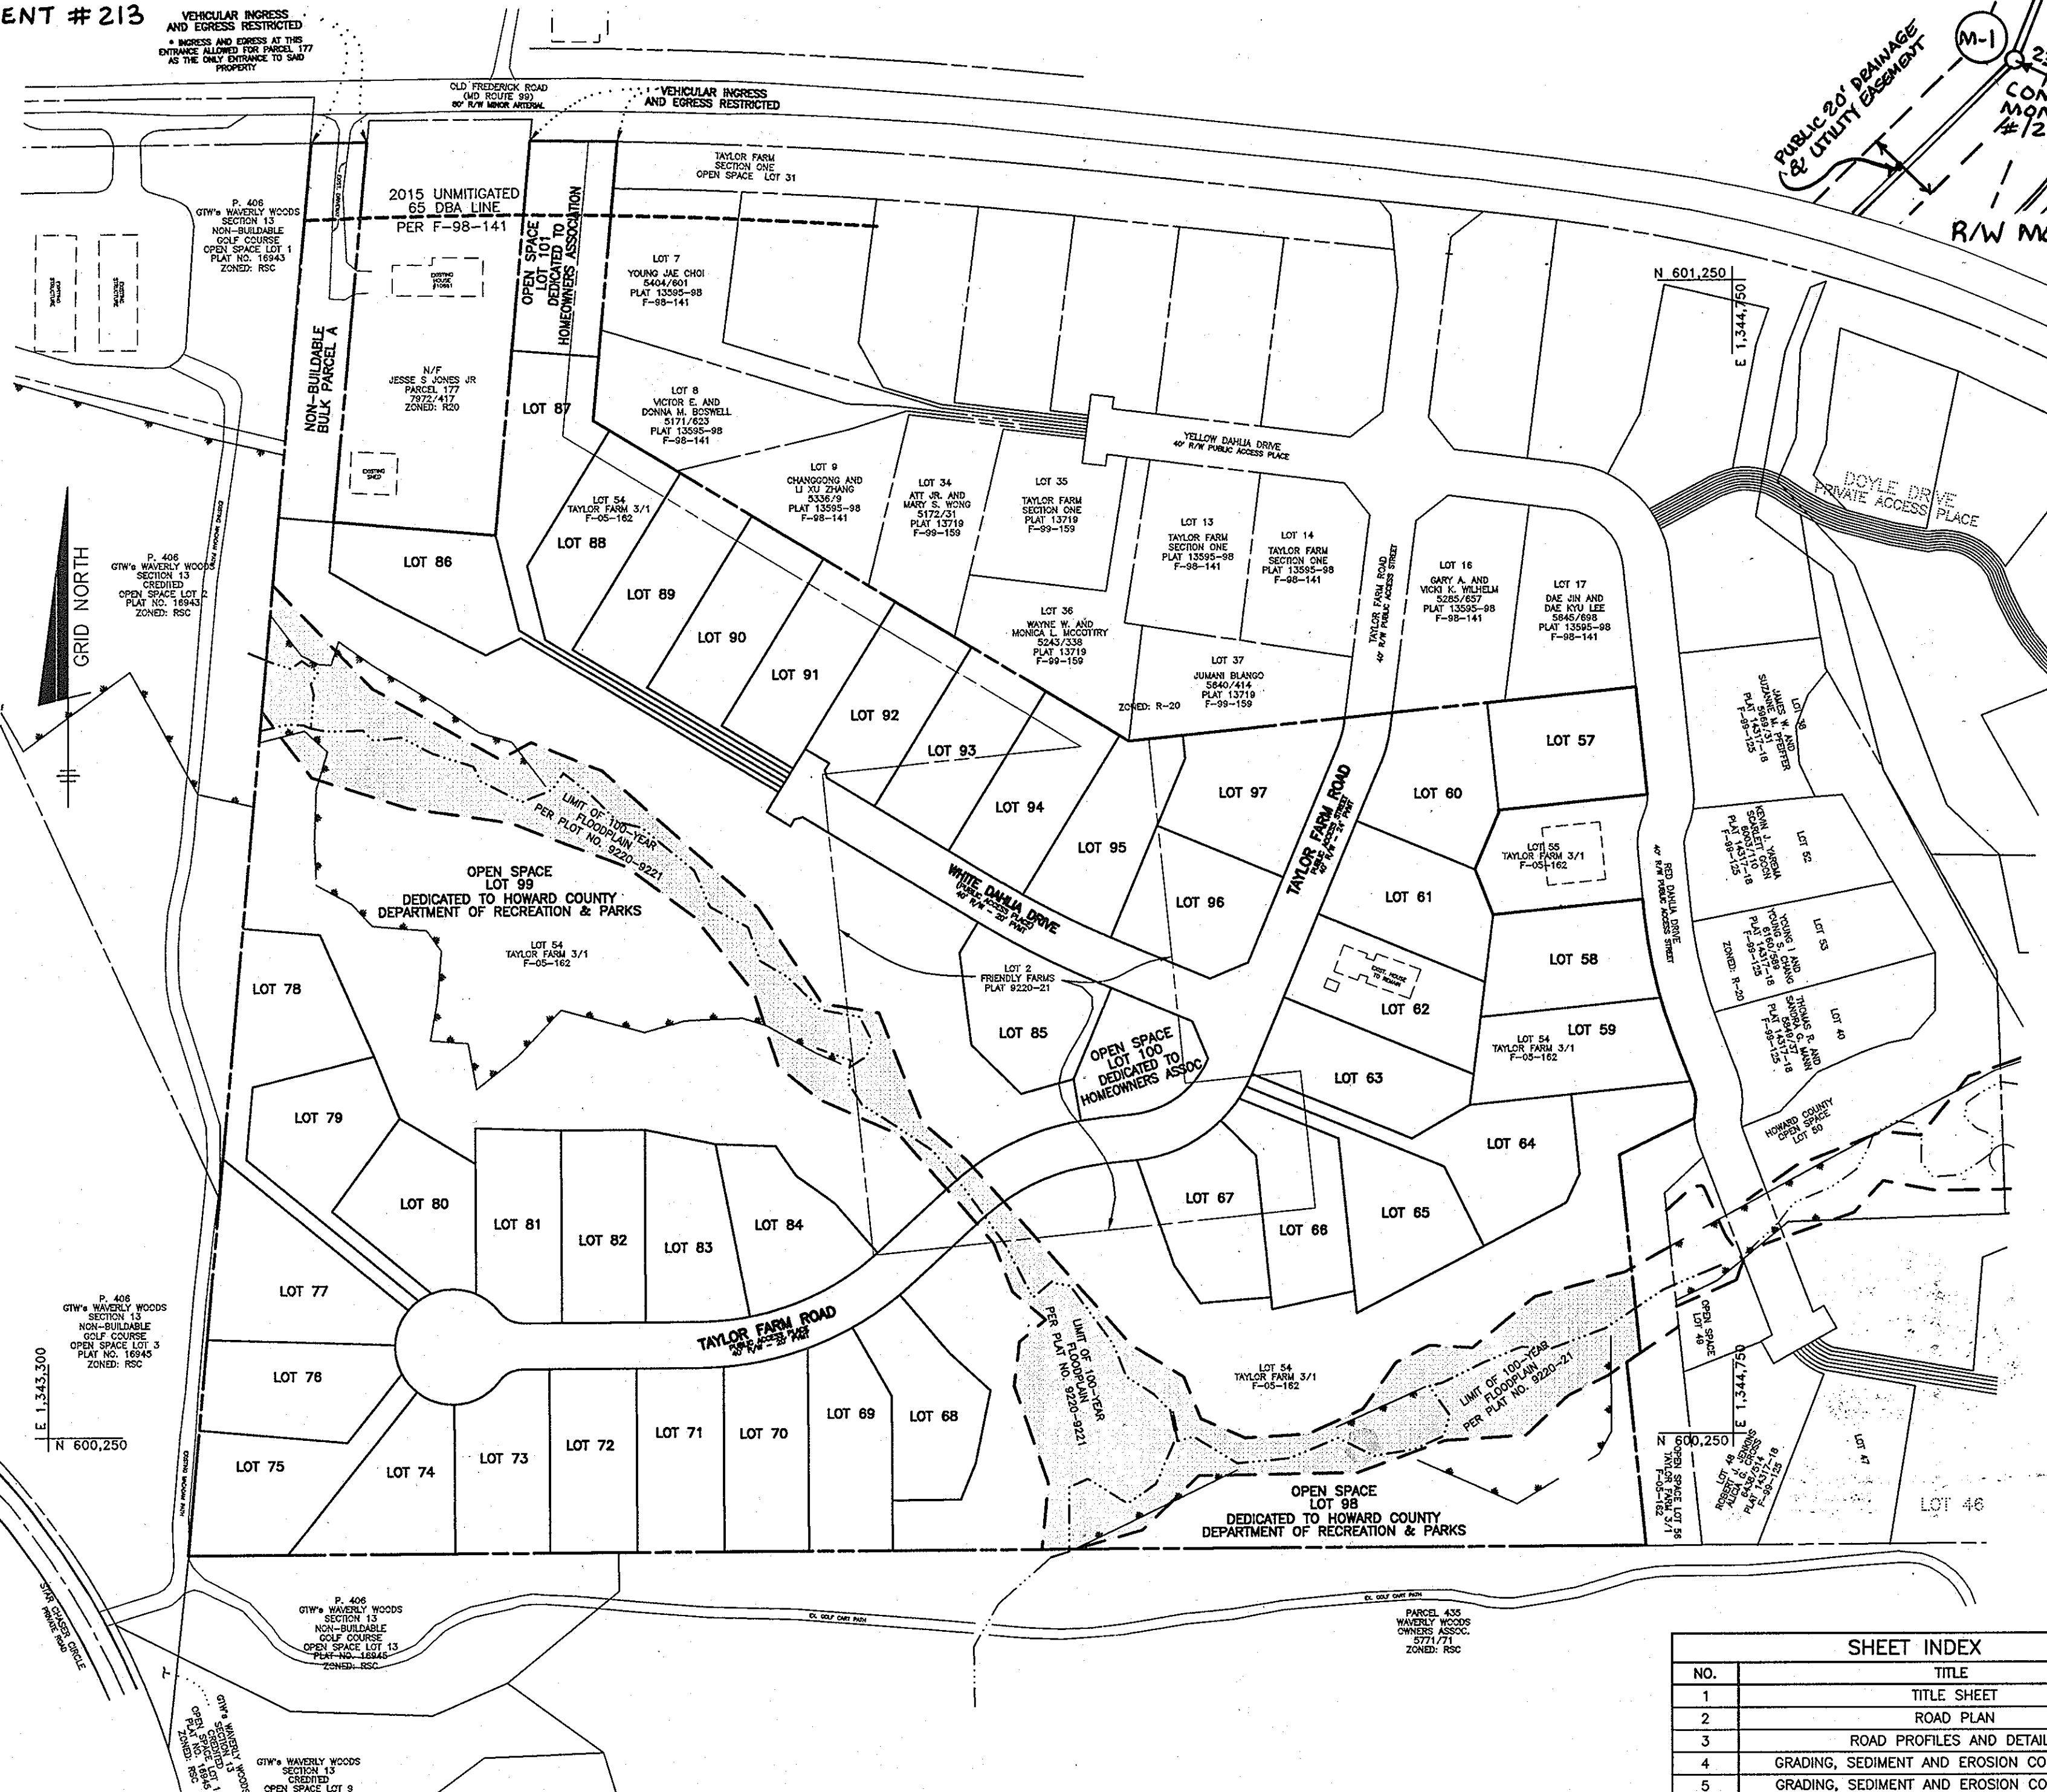

RIGHT OF WAY ELEVATION CHART NAD.83			RIGHT OF WAY ELEVATION CHART NAD.83			RIGHT OF WAY ELEVATION CHART NAD.83		
R/W PT. NO.	DESCRIPTION	ELEVATION	R/W PT. NO.	DESCRIPTION	ELEVATION	R/W PT. NO.	DESCRIPTION	ELEVATION
1	REBAR # CAP	434.35'	205	REBAR # CAP	439.12'	221	REBAR # CAP	442.31'
2	REBAR # CAP	435.42'	208	X-MARK IN DW	435.46'	225	REBAR # CAP	442.98'
5	REBAR # CAP	434.54'	209	X-CUT IN WALK	456.01'	226	REBAR # CAP	443.24'
6	REBAR # CAP	428.87'	210	REBAR # CAP	446.01'	227	REBAR # CAP	442.80'
7	REBAR # CAP	425.13'	211	REBAR # CAP	445.16'	228	REBAR # CAP	442.76'
8	REBAR # CAP	423.98'	213	CONCRETE MONUMENT	441.71'	229	X-MARK IN DW	445.415'
32	REBAR # CAP	441.24'	214	REBAR # CAP	438.76'	233	REBAR # CAP	440.99'
33	REBAR # CAP	441.05'	215	REBAR # CAP	438.14'	234	REBAR # CAP	440.97'
200	REBAR # CAP	440.42'	216	REBAR # CAP	438.28'	301	REBAR # CAP	434.35'
201	REBAR # CAP	440.84'	217	CONCRETE MONUMENT	439.31'	302	REBAR # CAP	440.93'
202	REBAR # CAP	439.25'	218	REBAR # CAP	441.53'			
203	REBAR # CAP	437.85'	219	REBAR # CAP	444.26'			
204	REBAR # CAP	437.88'	220	REBAR # CAP	444.54'			

SHEET INDEX	
NO.	TITLE
1	TITLE SHEET
2	ROAD PLAN
3	ROAD PROFILES AND DETAILS
4	GRADING, SEDIMENT AND EROSION CONTROL PLAN
5	GRADING, SEDIMENT AND EROSION CONTROL PLAN
6	SEDIMENT AND EROSION CONTROL NOTES AND DETAILS
7	STORM DRAIN DRAINAGE AREA MAP
8	STORM DRAIN DRAINAGE AREA MAP
9	STORM DRAIN DRAINAGE AREA MAP FOR CON/SPAN BRIDGE
10	STORM DRAIN PROFILES
11	LANDSCAPE AND STREET TREE PLAN
12	LANDSCAPE AND STREET TREE PLAN
13	FOREST CONSERVATION PLAN
14	FOREST CONSERVATION PLAN
15	CON/SPAN BRIDGE TITLE SHEET AND GENERAL NOTES
16	CON/SPAN BRIDGE DESIGN PLAN & DETAIL
17	CON/SPAN BRIDGE FOUNDATION PLAN
18	CON/SPAN BRIDGE FOOTING DESIGN AND DETAILS
19	CON/SPAN BRIDGE ELEVATIONS
20	CON/SPAN BRIDGE SECTION & DETAILS
21	CON/SPAN BRIDGE SPECIFICATIONS
22	CON/SPAN BRIDGE SPECIFICATIONS

APPROVED: DEPARTMENT OF PUBLIC WORKS
 [Signature] 9-7-07
 CHIEF, BUREAU OF HIGHWAYS

APPROVED: DEPARTMENT OF PLANNING AND ZONING
 [Signature] 9/19/07
 CHIEF, DIVISION OF LAND DEVELOPMENT

[Signature] 9/26/07
 CHIEF, DEVELOPMENT ENGINEERING DIVISION

BENCHMARK ENGINEERING, INC.
 ENGINEERS & LAND SURVEYORS & PLANNERS
 8480 BALTIMORE NATIONAL PIKE # SUITE 418
 ELLICOTT CITY, MARYLAND 21043
 PHONE: 410-465-6105 FAX: 410-465-6644
 WWW.BE-ENGINEERING.COM

OWNER/DEVELOPER: FRIENDLY FARMS LLC
 P.O. BOX 417
 ELLICOTT CITY, MARYLAND 21041
 410-465-4244

PROJECT: TAYLOR FARM SECTION THREE, PHASE TWO
 LOTS 57 THROUGH 101 AND NON-BUILDABLE BULK PARCEL 'A'
 A RESUBDIVISION OF LOT 64 TAYLOR FARM SECTION THREE, PHASE ONE (F-05-162) AND LOT 2 OF FRIENDLY FARMS (PLAT NO. 9220-9222)


LOCATION: TAX MAP: 10 GRID: 23 PARCEL: 309
 ZONED: R-20
 3rd ELECTION DISTRICT
 HOWARD COUNTY, MARYLAND

TITLE: TITLE SHEET

DATE: AUGUST, 2007 PROJECT NO. 1585
 SCALE: AS SHOWN SHEET 1 OF 22

DESIGN: DBT DRAFT: DBT CHECK: DAM

AS-BUILT F-07-051

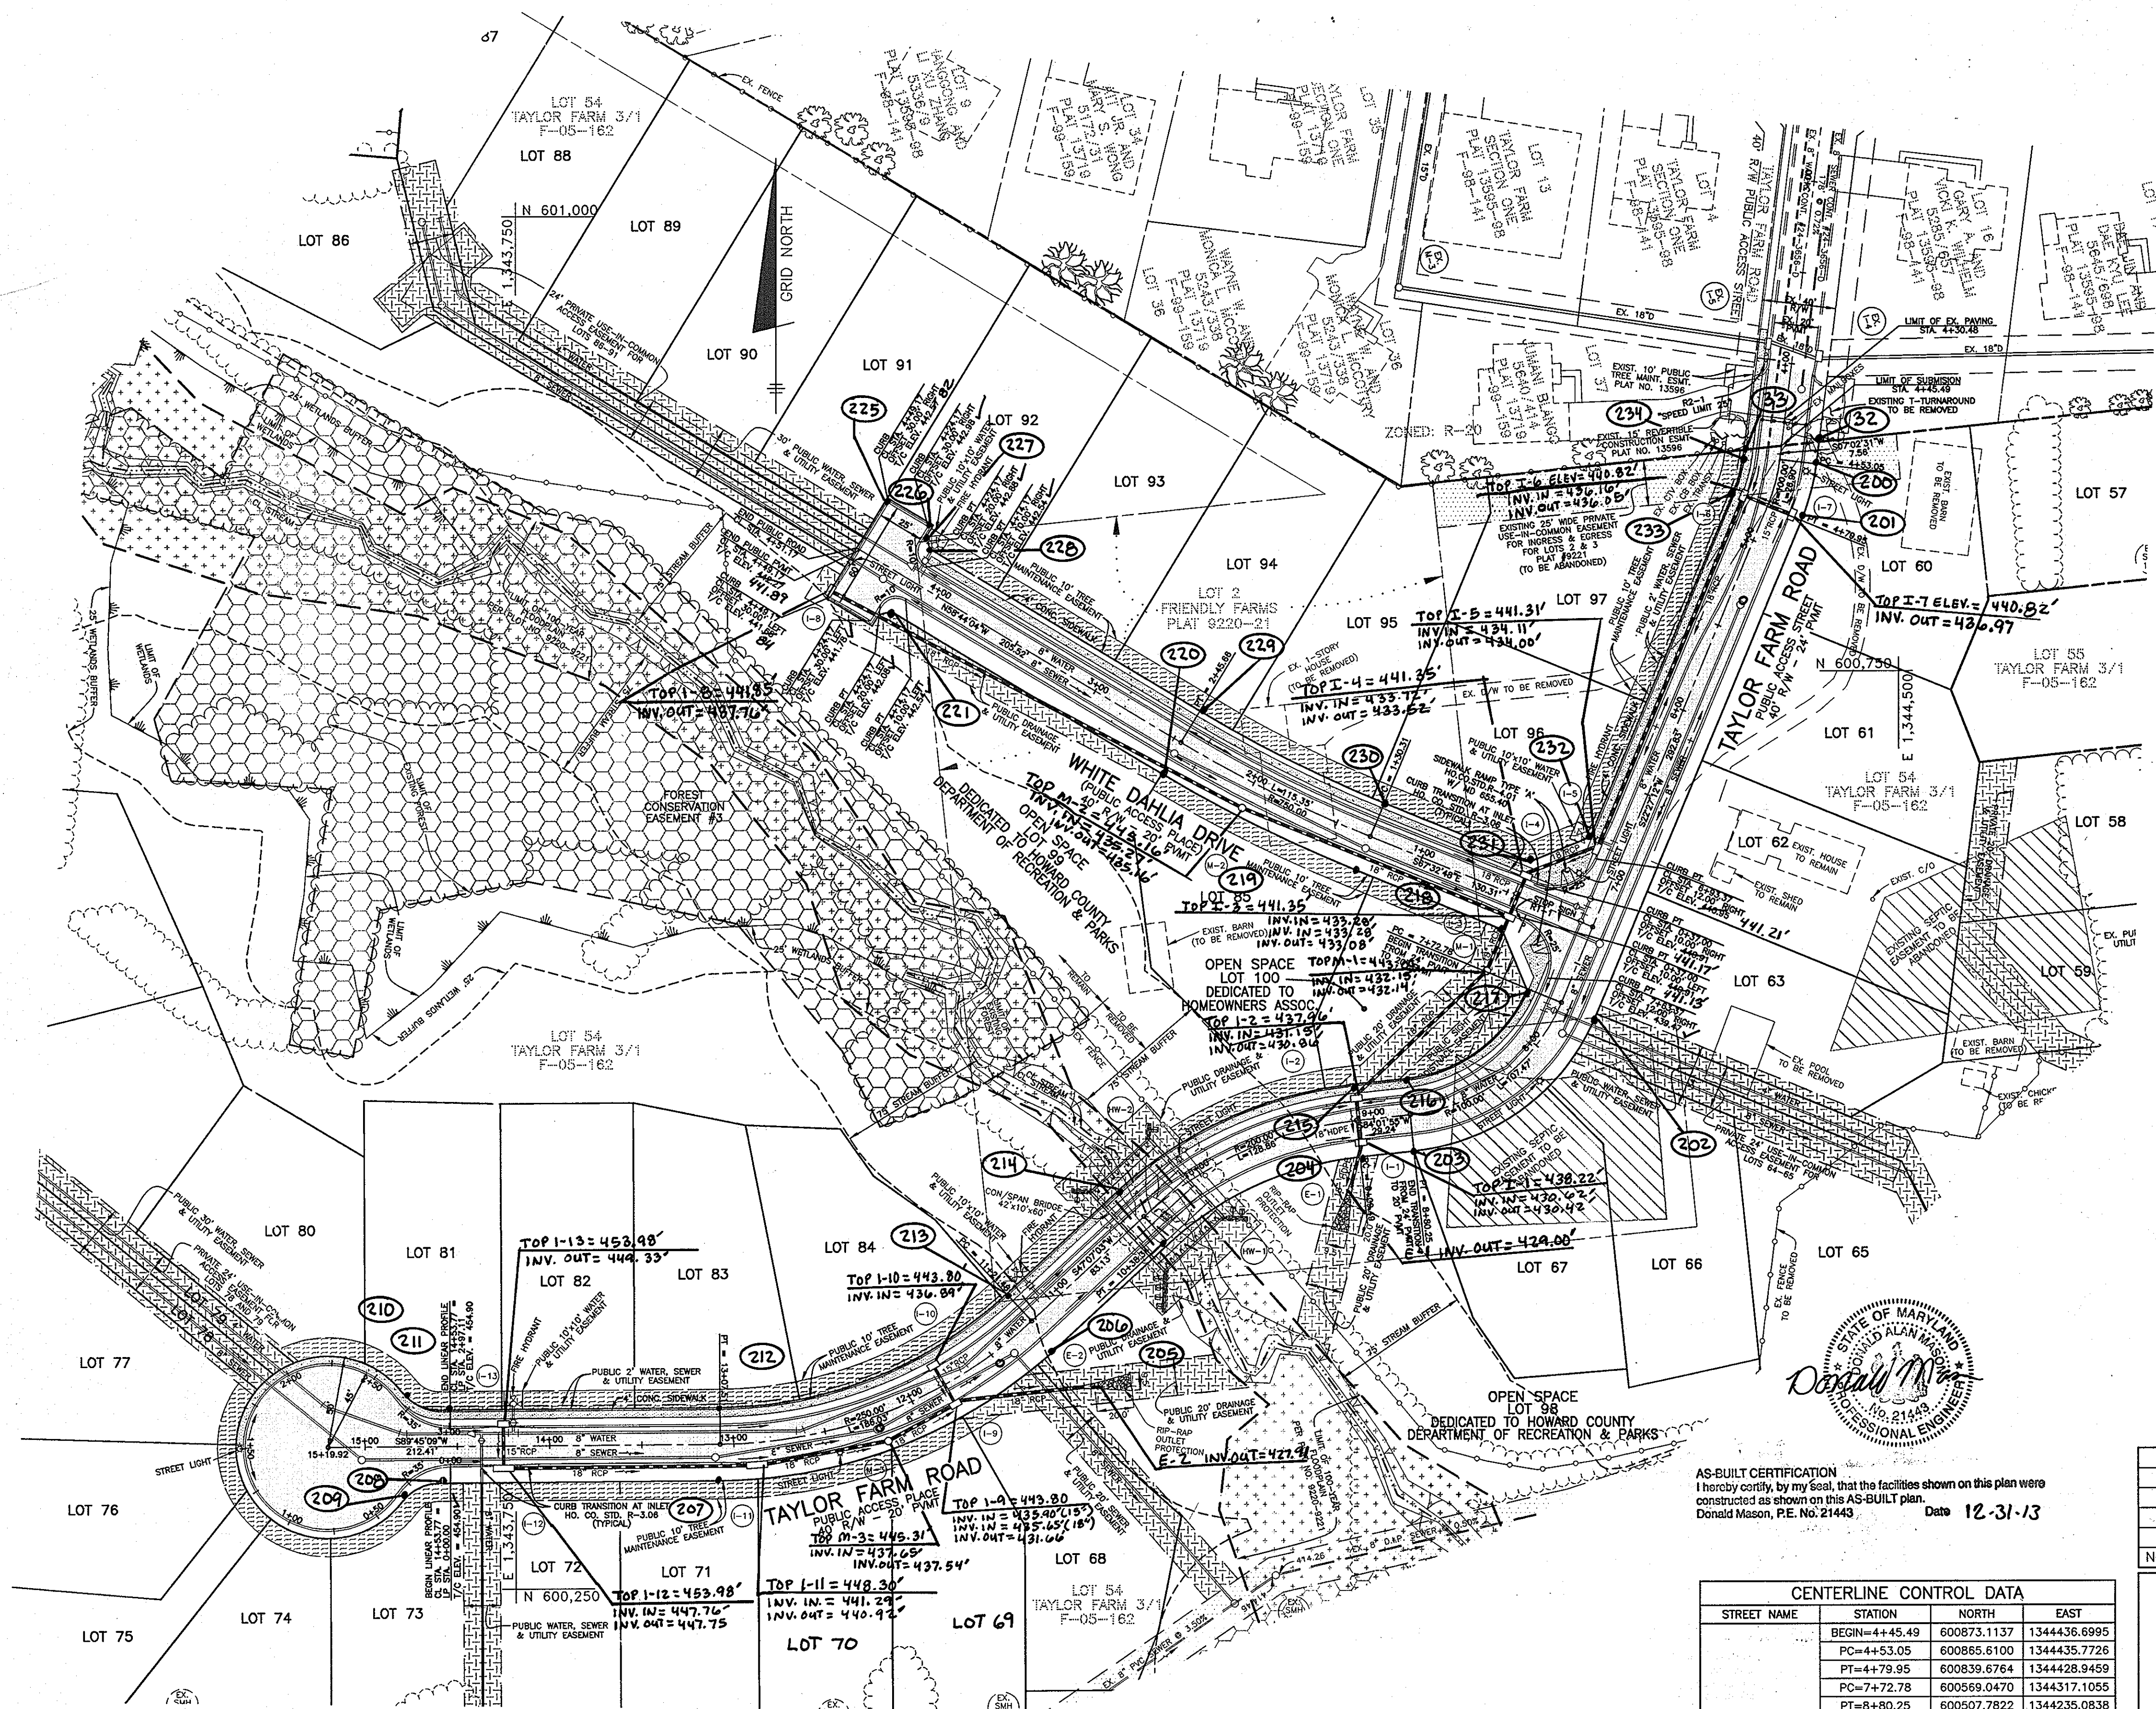

PLAN VIEW
SCALE: 1" = 50'

MAT DETAILS
SEE PLACEMENT GUIDELINES BELOW

DOME SPACING
1.6" TO 2.35"
SOS TO 60S
DIAMETER

DOME SECTION
SOS TO 60S
DIAMETER

PLACEMENT GUIDELINES

SHARED CURB RAMP
REFUGE ISLAND
BLENDED CURB

WHERE ISLANDS OR MEDIANS ARE LESS THAN 6 FEET WIDE, THE DETECTABLE WARNING SHOULD EXTEND ACROSS THE FULL LENGTH OF THE CUT THROUGH THE ISLAND OR MEDIAN.

NOTES

- THE DETECTABLE WARNING SURFACE SHALL BE LOCATED SO THAT THE EDGES NEAREST THE CURB LINE IS 6 TO 8 INCHES FROM THE FACE OF CURB.
- FOR SLOPED APPLICATIONS DETECTABLE WARNING SHALL BE PLACED SUCH THAT THE DOMES CLOSEST TO THE BACK OF CURB ARE NO LESS THAN 0.5' AND NO MORE THAN 3.0' FROM THE BACK OF CURB. TRUNCATED DOME SURFACES SHALL BE FABRICATED TO PROVIDE TRUE SQUARE CORNERS.
- DETECTABLE WARNING SURFACE SHALL BE PAID FOR IN ACCORDANCE WITH SECTION 411 OF THE SPECIFICATIONS.
- DETECTABLE WARNING SURFACES ARE REQUIRED AT STREET CROSSINGS & SIGNALIZED INTERSECTIONS.

APPROVED: *Mike M...*
STATE OF MARYLAND
DEPARTMENT OF TRANSPORTATION
STATE HIGHWAY ADMINISTRATION
STANDARDS FOR HIGHWAYS AND INCIDENTAL STRUCTURES
DETECTABLE WARNING SURFACES
STANDARD NO. MD 655.40

LEGEND

- EXISTING FOREST
- EXISTING HEDGEROW, SCATTERED TREES & BRUSH
- EXISTING 100-YR FLOODPLAIN
- EXISTING STREAM
- EXISTING STREAM BANK
- EXISTING WETLANDS
- FOREST CONSERVATION EASEMENT
- PROPOSED UTILITY AND ACCESS EASEMENTS
- EXISTING UTILITY AND ACCESS EASEMENTS
- PROPOSED TREE MAINTENANCE EASEMENTS

AS-BUILT CERTIFICATION
I hereby certify, by my seal, that the facilities shown on this plan were constructed as shown on this AS-BUILT plan.
Donald Mason, P.E. No. 21443 Date 12-31-13

CENTERLINE CONTROL DATA

STREET NAME	STATION	NORTH	EAST
TAYLOR FARM ROAD	BEGIN=4+45.49	600873.1137	1344436.6995
	PC=4+53.05	600865.6100	1344435.7726
	PT=4+79.95	600839.6764	1344428.9459
	PC=7+72.78	600569.0470	1344317.1055
	PT=8+80.25	600507.7822	1344235.0838
	PC=9+09.49	600504.7424	1344206.0058
	PT=10+38.34	600452.3767	1344090.7014
	PC=11+21.48	600395.8055	1344029.7880
	PT=13+07.51	600328.9958	1343860.7419
	END=15+19.92	600328.0783	1343648.3339
WHITE DAHLIA DRIVE	BEGIN=0+00	602610.0859	1344334.0653
	PC=1+30.31	600659.8538	1344213.6380
	PT=2+45.66	600711.9185	1344110.8327
	END=4+51.17	600818.5826	1343935.1633

CENTERLINE CURVE DATA

STREET NAME	STATION	RADIUS	LENGTH	DELTA	TANGENT	CHORD
TAYLOR FARM ROAD	STA. 4+53.05 TO 4+79.95	100.00'	26.90'	15°24'41"	13.53'	S14°44'52"W 26.82'
	STA. 7+72.78 TO 8+80.25	100.00'	107.47'	61°34'43"	59.59'	S53°14'34"W 102.38'
	STA. 9+09.49 TO 10+38.34	200.00'	128.86'	36°54'52"	66.75'	S65°34'29"W 126.64'
WHITE DAHLIA DRIVE	STA. 11+21.48 TO 13+07.51	250.00'	186.03'	42°39'06"	97.56'	S68°28'06"W 181.77'
	STA. 1+30.31 TO 2+45.66	750.00'	115.35'	8°48'44"	57.79'	N63°08'26"W 115.24'

STREET LIGHT SCHEDULE

SYMBOL	LOCATION	DESCRIPTION
☆	CL STA. 4+57 OFFSET 15' LEFT CL STA. 7+84 OFFSET 18' RIGHT CL STA. 8+12 OFFSET 15' LEFT CL STA. 10+05 OFFSET 13' RIGHT LP STA. 12+45 OFFSET 13' LEFT LP STA. 1450 OFFSET 3' LEFT CL STA. 4+50 OFFSET 8' LEFT	100 WATT HPS VAPOR PREMIERE COLORAL POST TOP MOUNTED ON A 14" BLACK FIBERGLASS POLE

APPROVED: DEPARTMENT OF PUBLIC WORKS
William T. Mahall 9-7-07
CHIEF, BUREAU OF HIGHWAYS

APPROVED: DEPARTMENT OF PLANNING AND ZONING
Sandy Hamer 9/15/07
CHIEF, DIVISION OF LAND DEVELOPMENT

John P. ... 9/12/07
CHIEF, DEVELOPMENT ENGINEERING DIVISION

NO. DATE REVISION

BENCHMARK ENGINEERING, INC.
ENGINEERS • LAND SURVEYORS • PLANNERS
8480 BALTIMORE NATIONAL PIKE SUITE 418
ELLICOTT CITY, MARYLAND 21043
PHONE: 410-465-6105 FAX: 410-465-6644
WWW.BEI-CVLENGINEERING.COM

Professional Certification. I hereby certify that these documents were prepared or approved by me, and that I am a duly licensed professional engineer under the laws of the State of Maryland, License No. 21443, Expiration Date: 12-31-2013.

Donald Mason 8/21/07
PROFESSIONAL ENGINEER

OWNER/DEVELOPER: FRIENDLY FARMS, LLC
P.O. BOX 417
ELLICOTT CITY, MARYLAND 21041
410-465-4244








PROJECT: TAYLOR FARM SECTION THREE, PHASE TWO
LOTS 57 THROUGH 101 AND NON-BUILDABLE BULK PARCEL 'A'
A RESUBDIVISION OF LOT 54 TAYLOR FARM SECTION THREE AND LOT 2 OF FRIENDLY FARMS (PLAT NO. 9220-9227)

LOCATION: TAX MAP: 10 GRID: 23 PARCEL: 309
TAX MAP: 18 GRID: 5 ZONED: R-20
3rd ELECTION DISTRICT HOWARD COUNTY, MARYLAND


TITLE: ROAD PLAN

DATE: AUGUST, 2007 PROJECT NO. 1585
SCALE: AS SHOWN SHEET 2 OF 22

DESIGN: DBT DRAFT: DBT CHECK: DAM

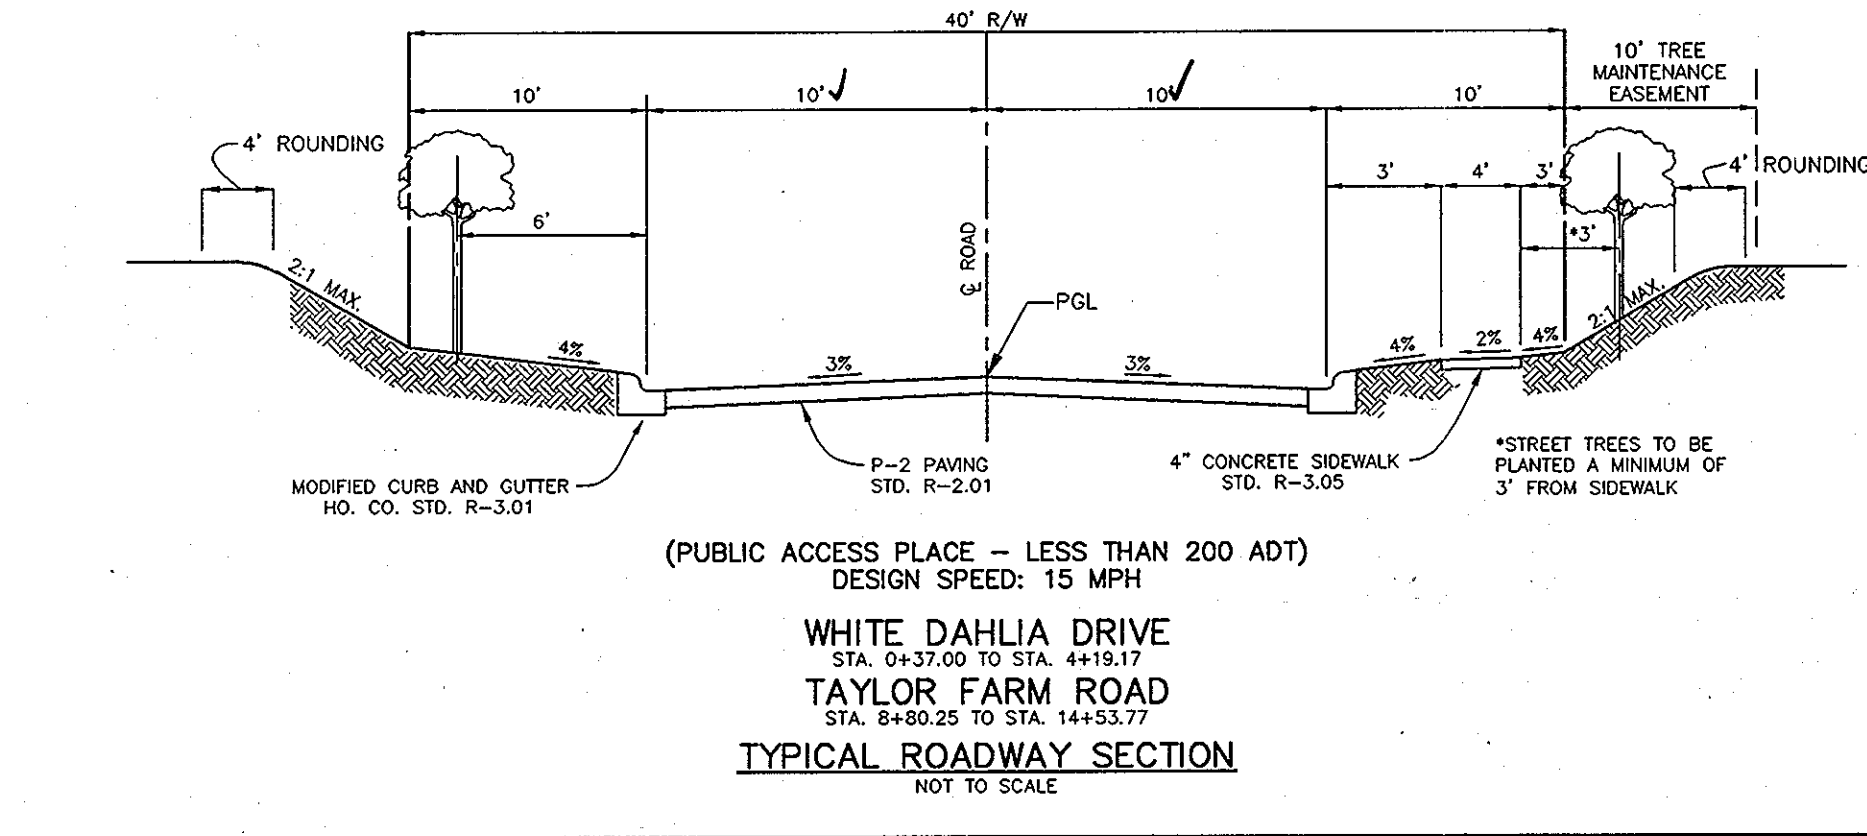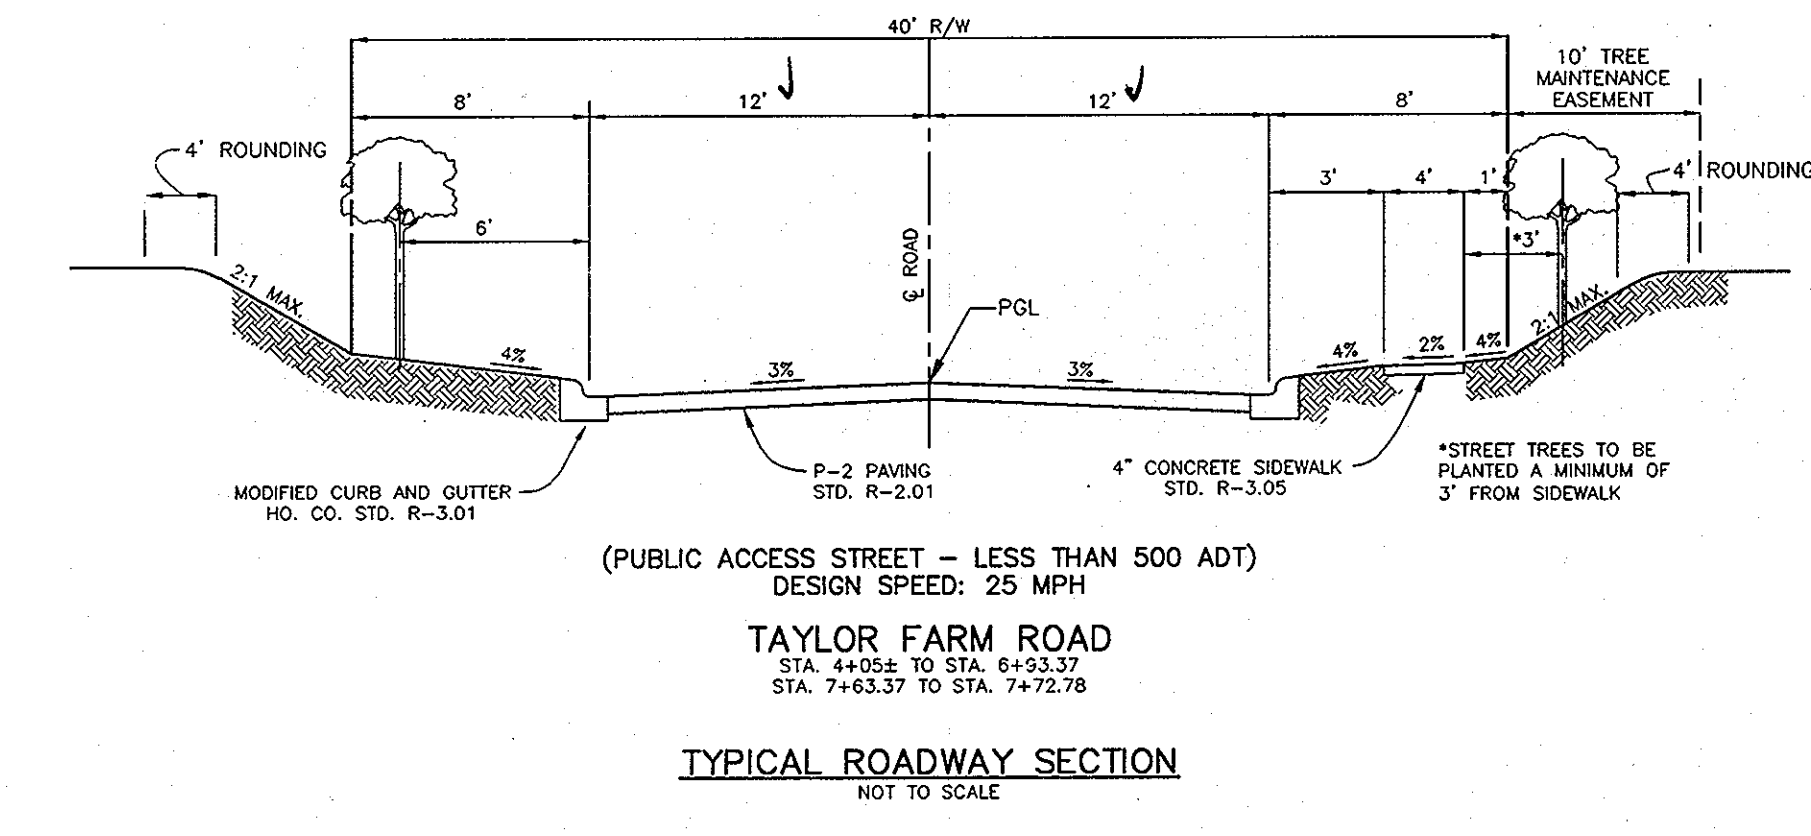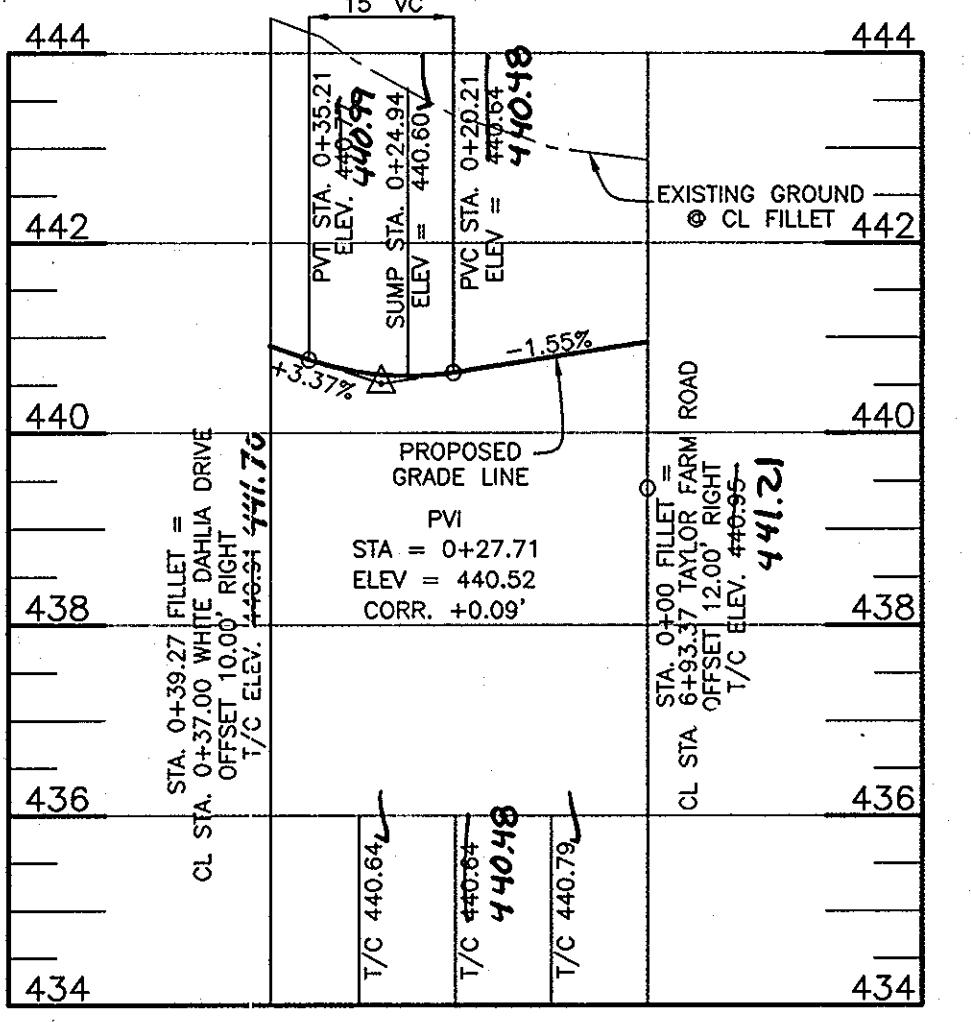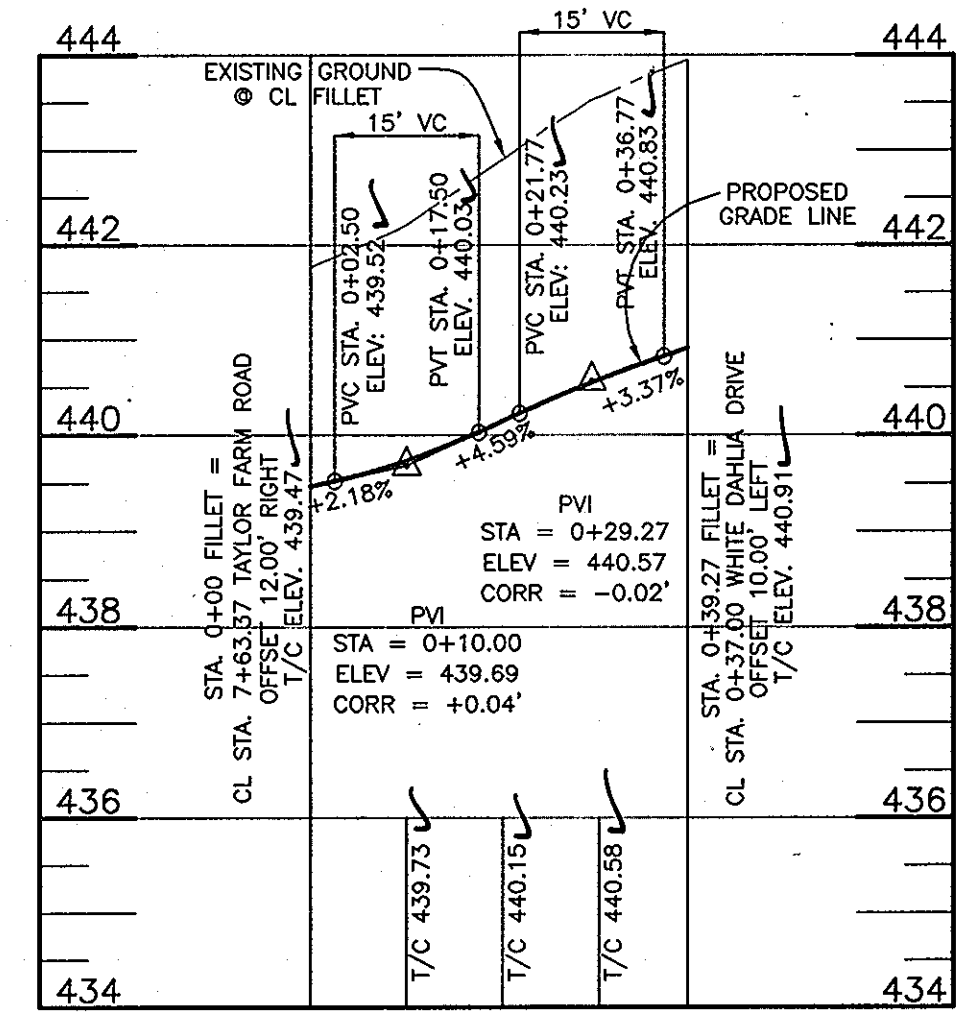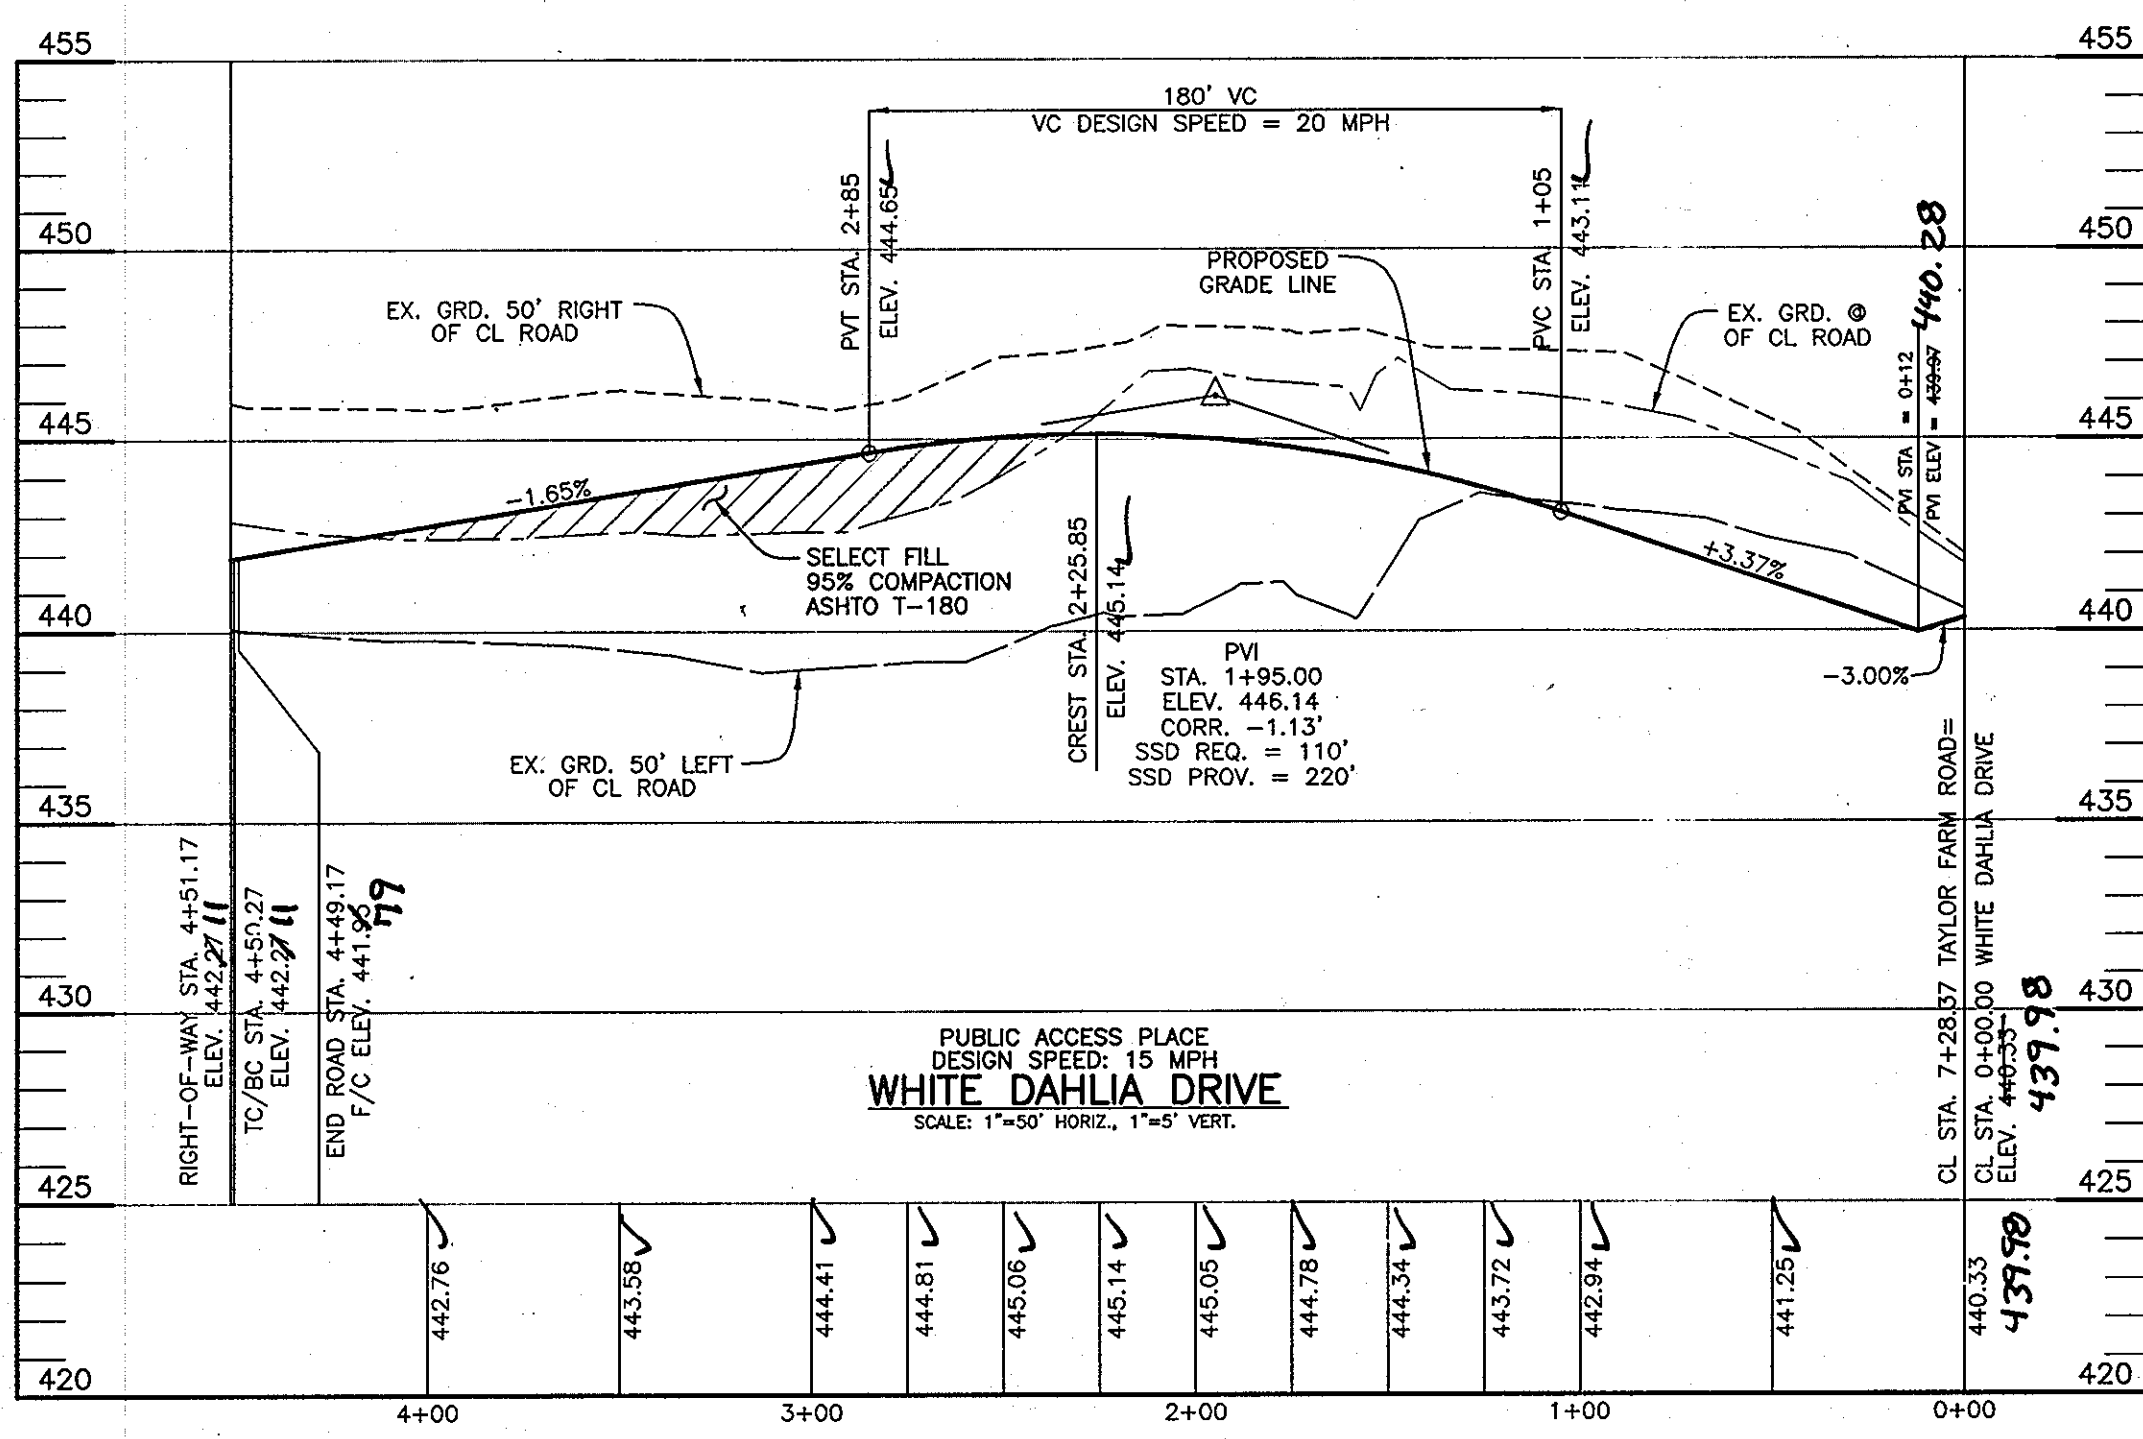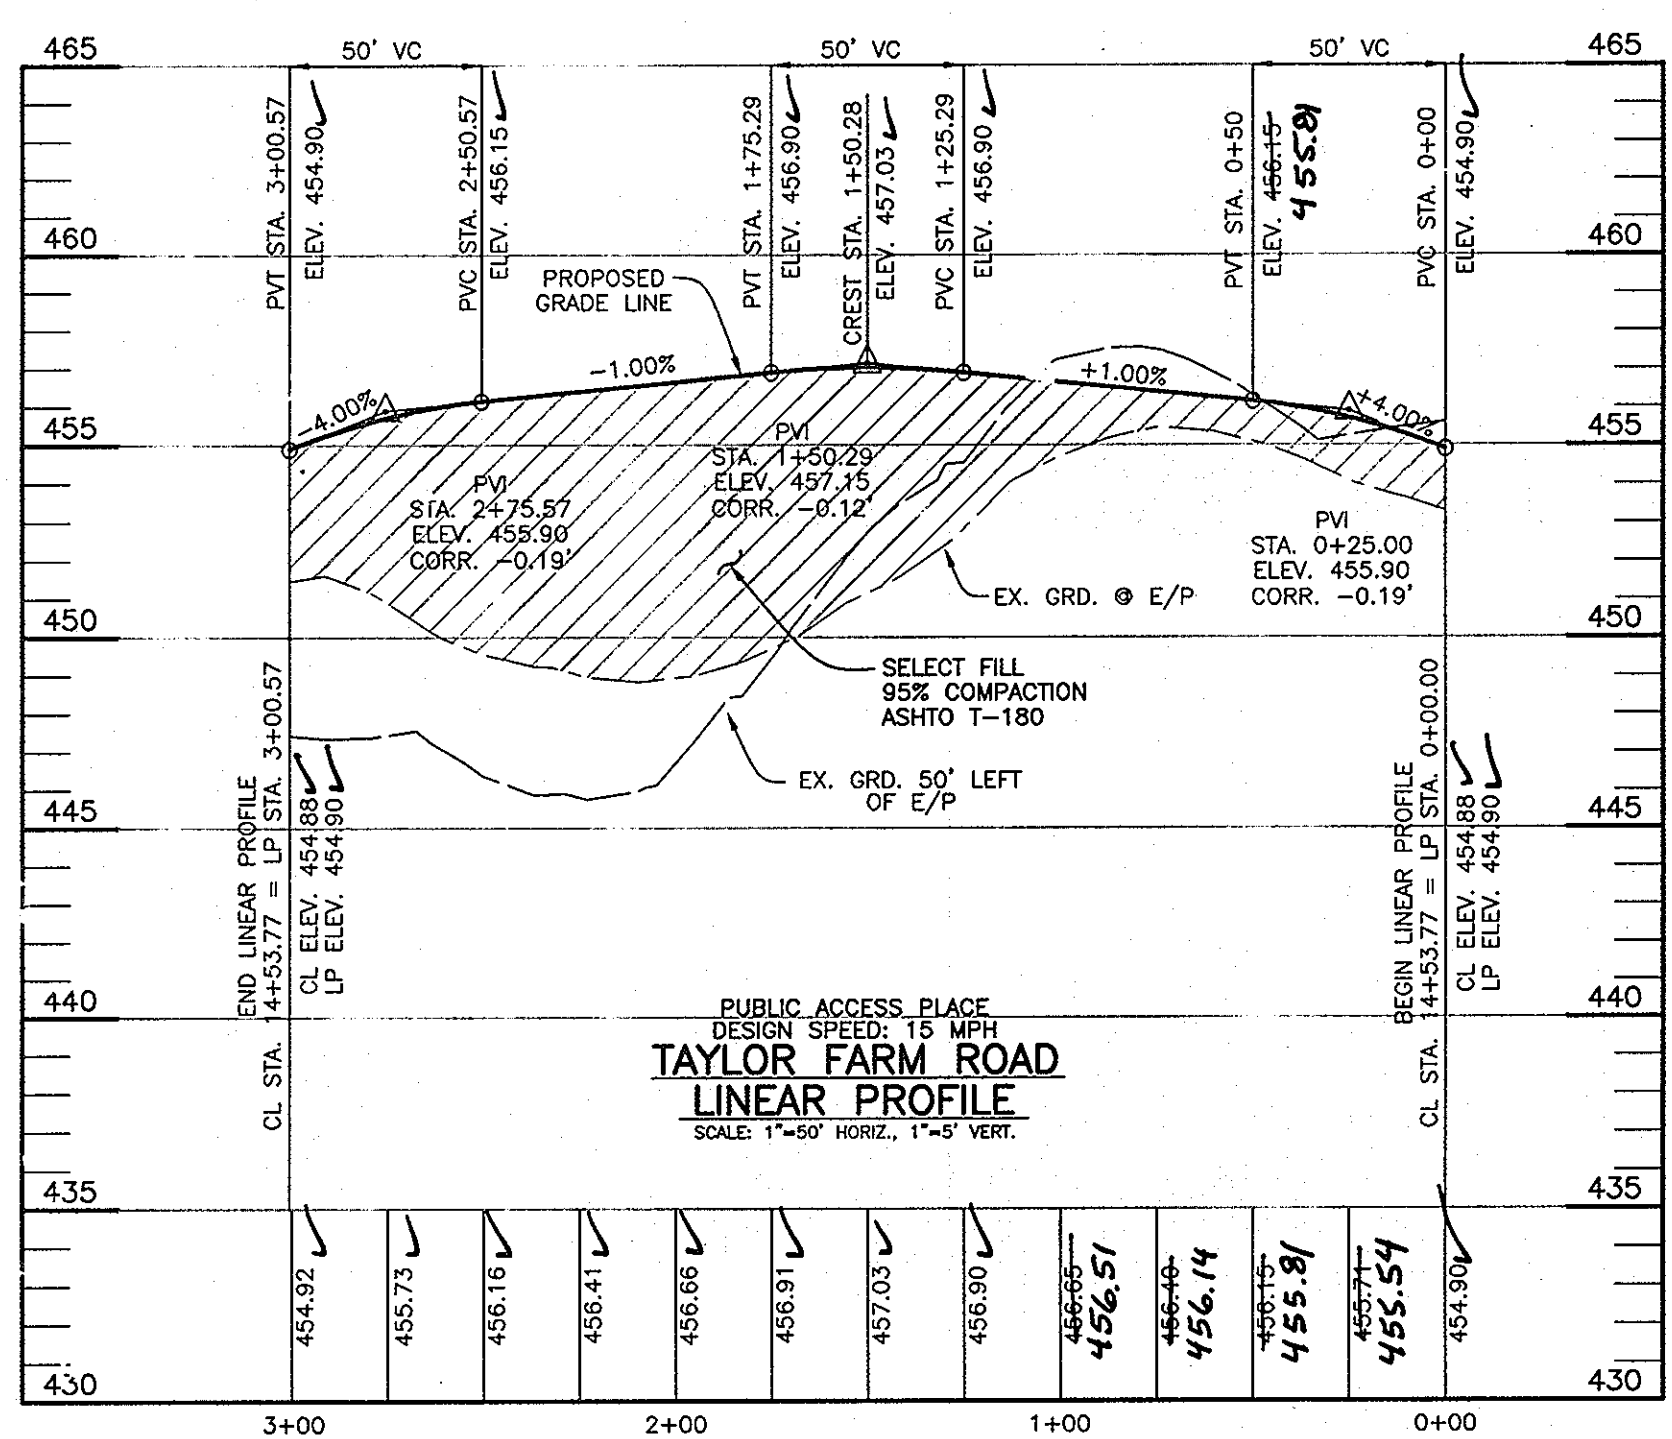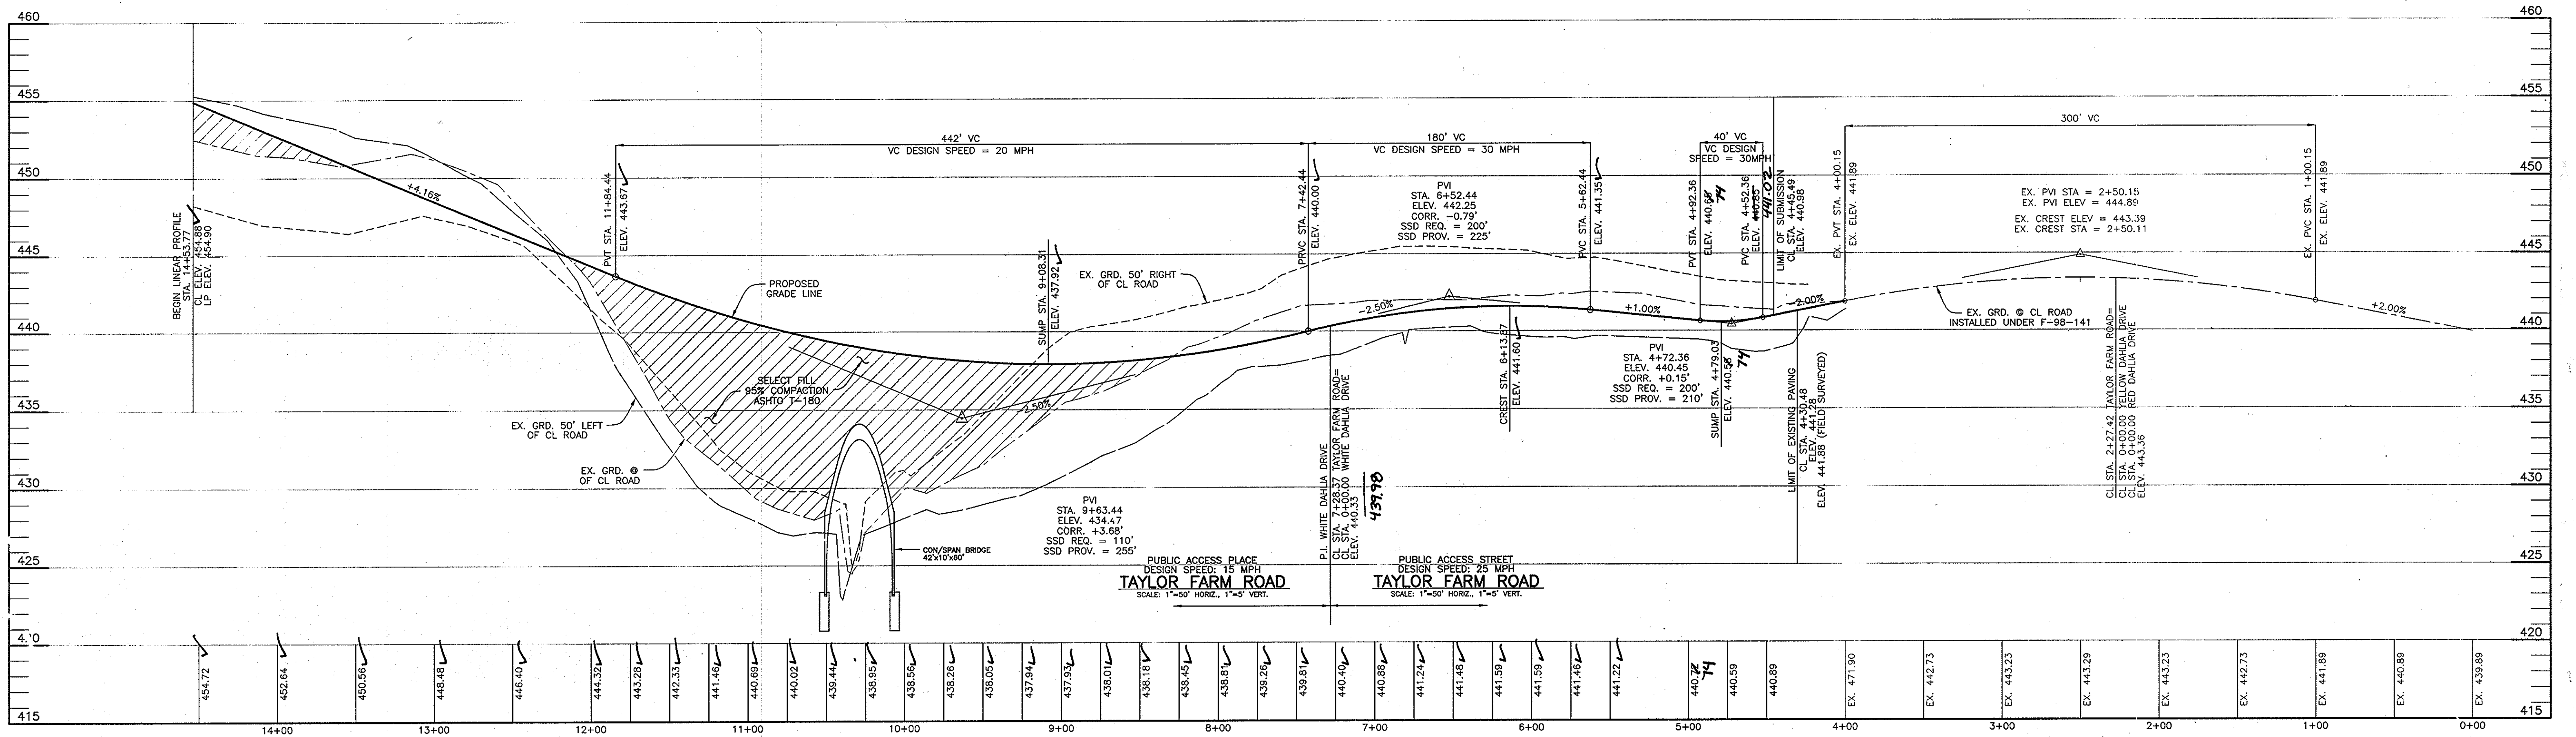

AS-BUILT CERTIFICATION
I hereby certify by my seal, that the facilities shown on this plan were constructed as shown on this AS-BUILT plan.
Donald Mason, P.E. No. 21443 Date 12-31-13

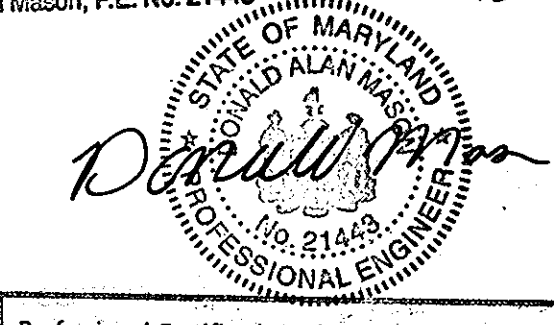

Professional Certification. I hereby certify that these documents were prepared or approved by me, and that I am a duly licensed professional engineer under the laws of the State of Maryland.
License No. 21443, Expiration Date: 12-31-14

APPROVED: DEPARTMENT OF PUBLIC WORKS
William J. ... 7-20-07
CHIEF, BUREAU OF HIGHWAYS


APPROVED: DEPARTMENT OF PLANNING AND ZONING
Cindy ... 9/15/09
CHIEF, DIVISION OF LAND DEVELOPMENT

... 7/24/07
CHIEF, DEVELOPMENT ENGINEERING DIVISION

NO.	DATE	REVISION

BENCHMARK ENGINEERING, INC.
ENGINEERS • LAND SURVEYORS • PLANNERS
8480 BALTIMORE NATIONAL PIKE # SUITE 418
ELLICOTT CITY, MARYLAND 21043
PHONE: 410-465-6105 FAX: 410-465-6844
WWW.BEI-CIVILENGINEERING.COM

OWNER/DEVELOPER: FRIENDLY FARMS LLC P.O. BOX 417 ELLICOTT CITY, MARYLAND 21041 410-465-4244	PROJECT: TAYLOR FARM SECTION THREE, PHASE TWO LOTS 57 THROUGH 101 AND NON-BUILDABLE BULK PARCEL 'A' A RESUBDIVISION OF LOT 54 TAYLOR FARM SECTION THREE AND LOT 2 OF FRIENDLY FARMS (PLAT NO. 9220-9227)
TITLE: ROAD PROFILES	LOCATION: TAX MAP: 10 GRID: 23 PARCEL: 309 ELLICOTT CITY, MARYLAND 21043 ZONED: R-20 3rd ELECTION DISTRICT HOWARD COUNTY, MARYLAND
DATE: JULY, 2007	PROJECT NO. 1585
DESIGN: DBT	DRAFT: DBT
CHECK: DAM	SCALE: AS SHOWN
SHEET 3 OF 22	

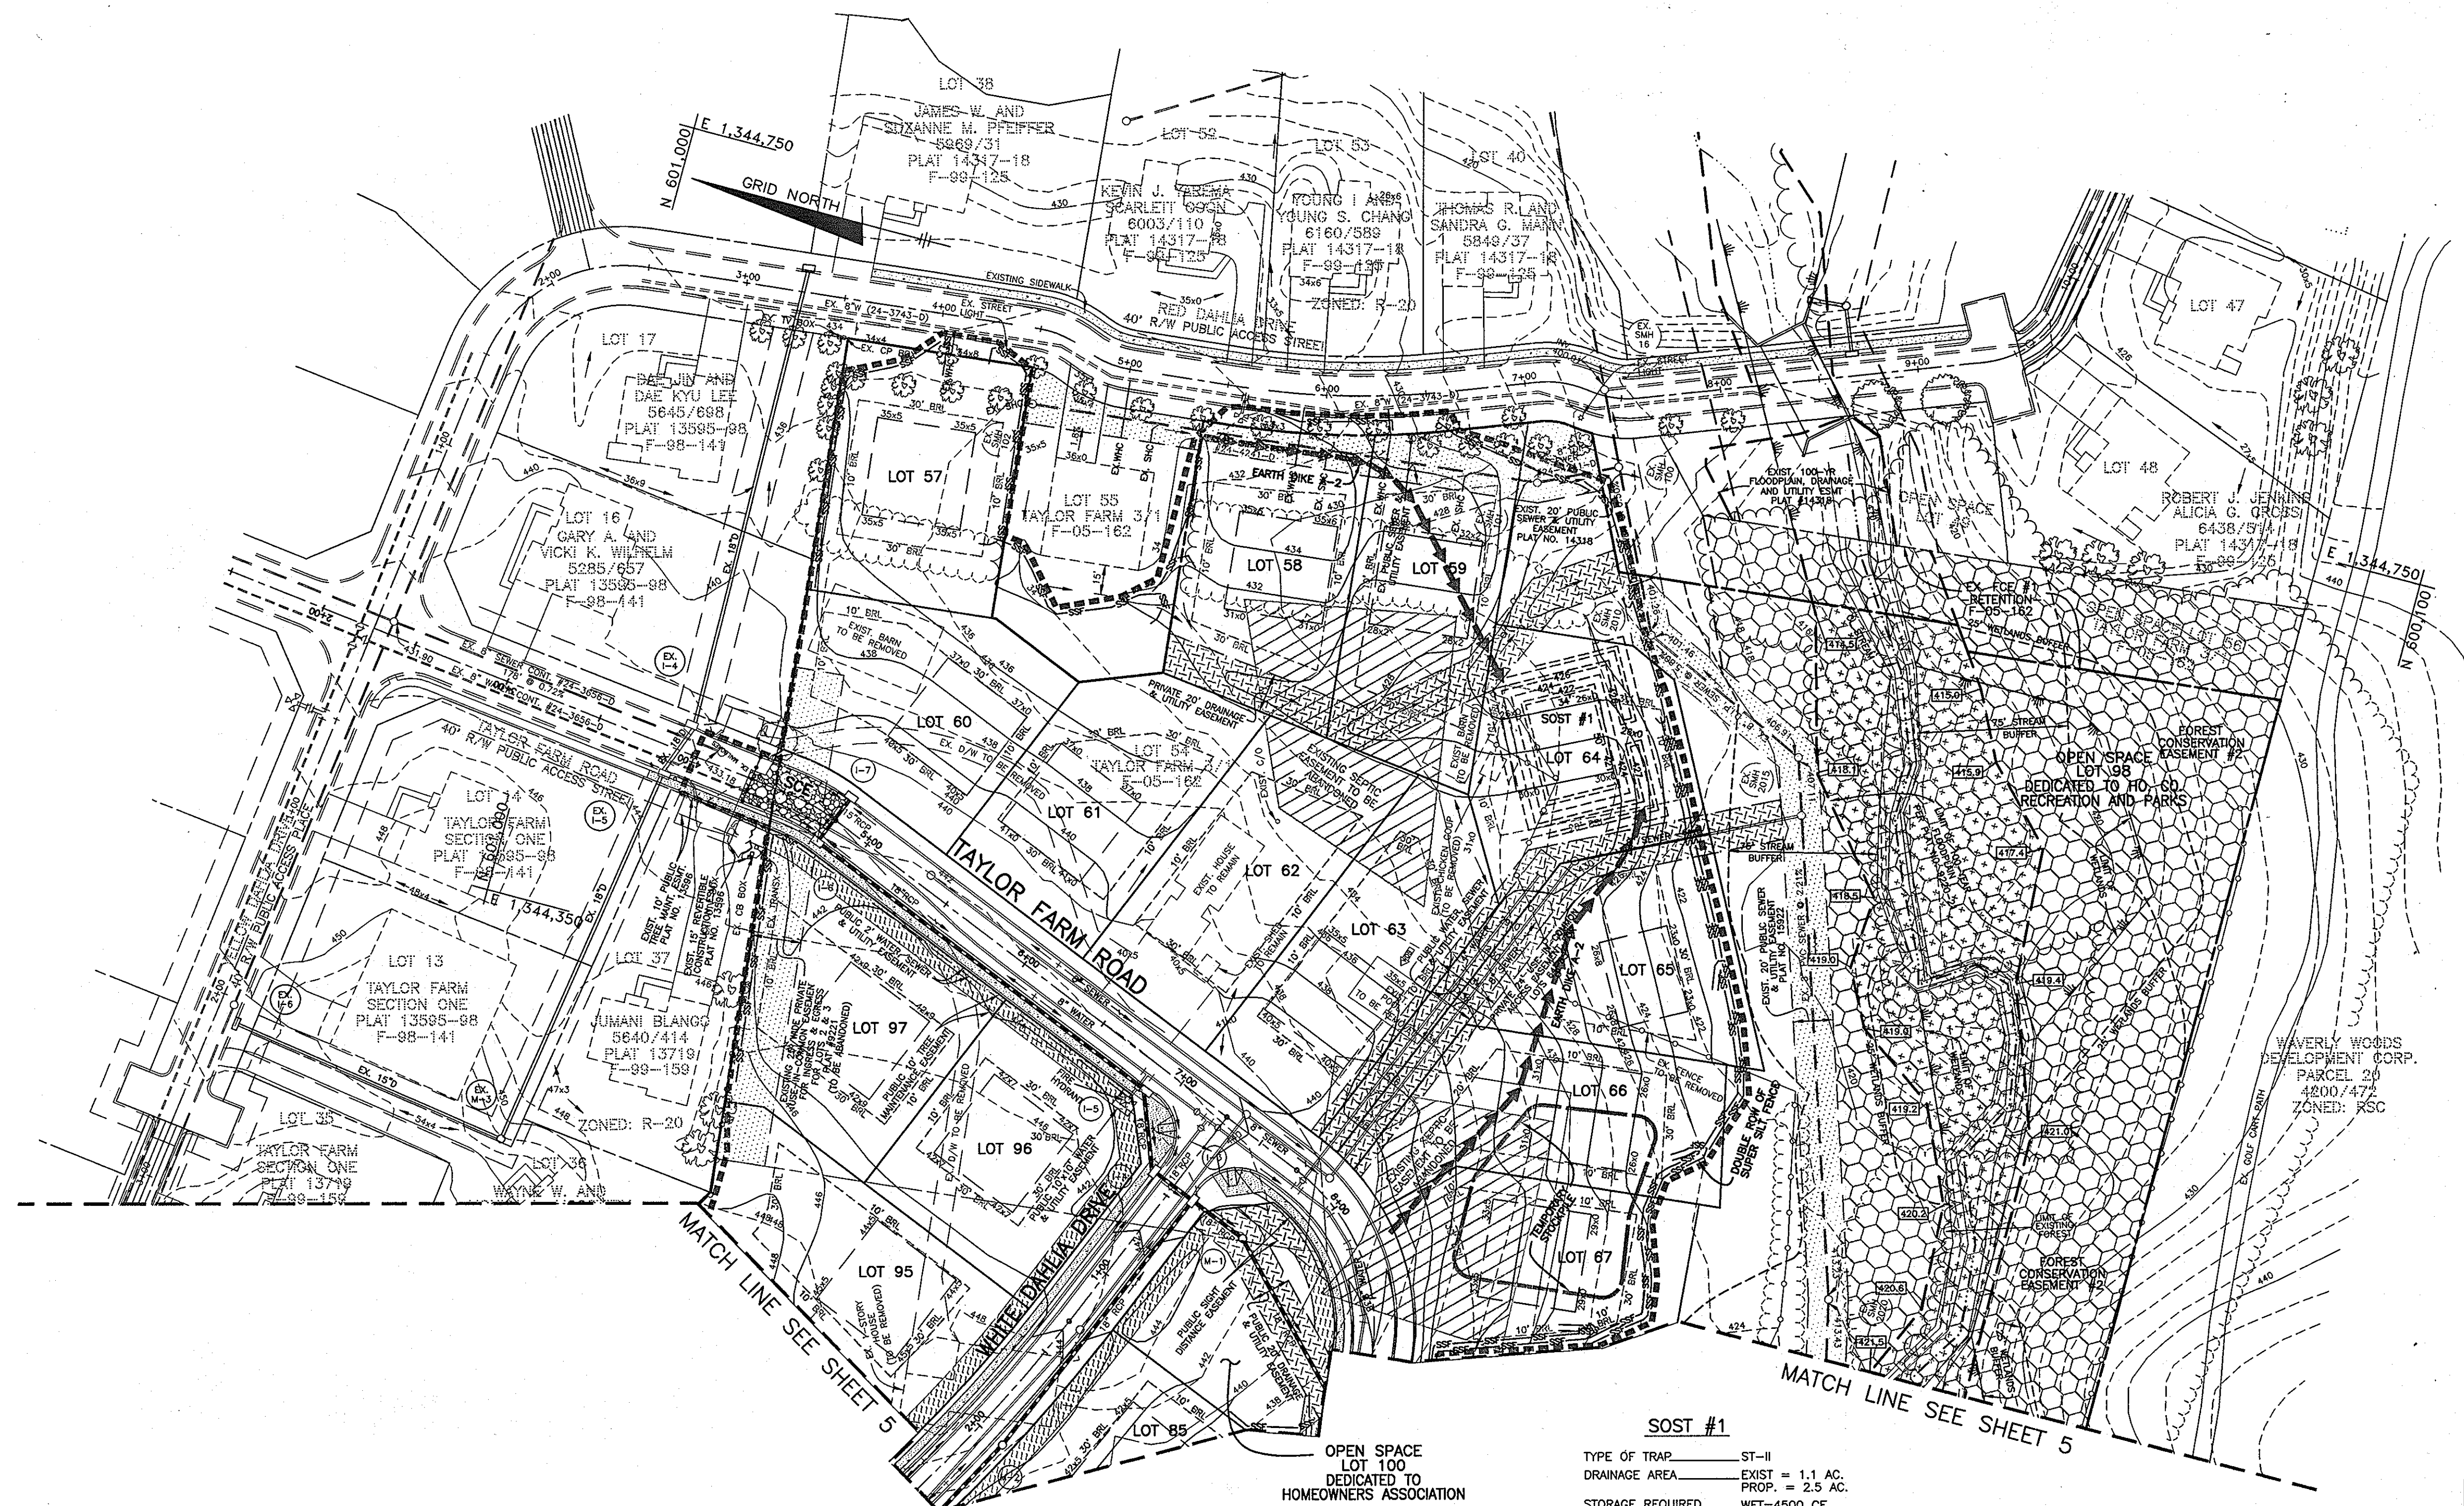

LEGEND

- EXISTING CONTOURS
- EXISTING FOREST
- EXISTING HEDGEROW, SCATTERED TREES & BRUSH
- EXISTING 100-YR FLOODPLAIN
- EXISTING STREAM
- EXISTING STREAM BANK
- EXISTING WETLANDS
- FOREST CONSERVATION EASEMENT RETENTION
- PROPOSED UTILITY AND ACCESS EASEMENTS
- EXISTING UTILITY AND ACCESS EASEMENTS
- PROPOSED TREE MAINTENANCE EASEMENTS
- EARTH DIKE
- SUPER SILT FENCE
- LIMIT OF DISTURBANCE
- TEMP SED. TRAP CONTOURS
- HOUSE PAD

ENGINEER'S CERTIFICATE

I HEREBY CERTIFY THAT THIS PLAN FOR SEDIMENT AND EROSION CONTROL REPRESENTS A PRACTICAL AND WORKABLE PLAN BASED ON MY PERSONAL KNOWLEDGE OF THE SITE CONDITIONS AND THAT IT WAS PREPARED IN ACCORDANCE WITH THE REQUIREMENTS OF THE HOWARD SOIL CONSERVATION DISTRICT.

Donald Mason 8/21/07
 ENGINEER - DONALD A. MASON, P.E. # 21443 DATE

DEVELOPER'S CERTIFICATE

I HAVE CERTIFIED THAT ALL DEVELOPMENT AND CONSTRUCTION WILL BE DONE ACCORDING TO THIS PLAN OF DEVELOPMENT FOR SEDIMENT AND EROSION CONTROL, AND THAT ALL RESPONSIBLE PERSONNEL INVOLVED IN THE CONSTRUCTION PROJECT WILL HAVE A CERTIFICATE OF ATTENDANCE AT A DEPARTMENT OF THE ENVIRONMENT APPROVED TRAINING PROGRAM FOR THE CONTROL OF SEDIMENT AND EROSION BEFORE BEGINNING THE PROJECT. I ALSO AUTHORIZE PERIODIC ON-SITE INSPECTION BY THE HOWARD SOIL CONSERVATION DISTRICT.

Steve K. Breeden 8/21/07 *James R. Schulte* 8/21/07
 STEVEN K. BREEDEN DATE JAMES R. SCHULTE DATE

REVIEWED FOR HOWARD SCD AND MEETS TECHNICAL REQUIREMENTS

Jim Meyer 8/21/07
 USA - NATURAL RESOURCES CONSERVATION SERVICE DATE

THIS DEVELOPMENT PLAN IS APPROVED FOR SOIL EROSION AND SEDIMENT CONTROL BY THE HOWARD SOIL CONSERVATION DISTRICT.

John R. Blanton 8/21/07
 HOWARD SCD DATE

APPROVED: DEPARTMENT OF PUBLIC WORKS

William F. Mahaffey 9-7-07
 CHIEF, BUREAU OF HIGHWAYS DATE

APPROVED: DEPARTMENT OF PLANNING AND ZONING

Cindy Hamstra 9/18/07
 CHIEF, DIVISION OF LAND DEVELOPMENT DATE


Donald Mason 9/21/07
 CHIEF, DEVELOPMENT ENGINEERING DIVISION DATE

PLAN VIEW
 SCALE: 1" = 50'

SOST #1

TYPE OF TRAP	ST-II
DRAINAGE AREA	EXIST = 1.1 AC. PROP. = 2.5 AC.
STORAGE REQUIRED (WET & DRY)	WET=4500 CF DRY=4500 CF
STORAGE PROVIDED (WET & DRY)	WET=6780 CF ELEV=424.00 DRY=6632 CF ELEV=426.00
WEIR LENGTH	10'
EMBANKMENT ELEV.	427.00 (4' WIDE)
WEIR CREST ELEV.	426.00
CLEANOUT ELEV.	422.15
BOTTOM ELEV.	421.00
BOTTOM DIMENSIONS	34' x 50'

No As-Built information is required on this sheet

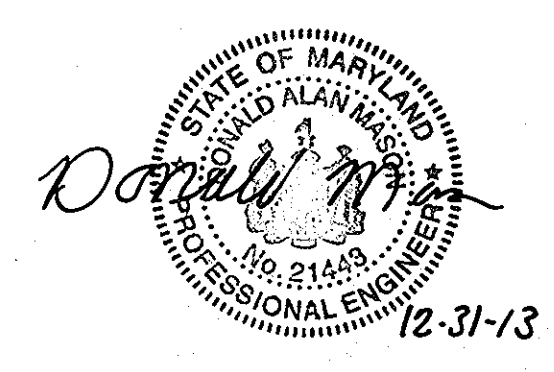

NO.	DATE	REVISION

BENCHMARK ENGINEERING, INC.
 ENGINEERS • LAND SURVEYORS • PLANNERS

8480 BALTIMORE NATIONAL PIKE • SUITE 418
 ELLICOTT CITY, MARYLAND 21043
 PHONE: 410-465-6105 FAX: 410-465-6644
 WWW.BEI-CIVLENGINEERING.COM

Professional Certification: I hereby certify that these documents were prepared or approved by me, and that I am a duly licensed professional engineer under the laws of the State of Maryland, License No. 21443, Expiration Date: 12-31-2008

Donald Mason 9/21/07
 PROFESSIONAL ENGINEER

OWNER/DEVELOPER: FRIENDLY FARMS LLC
 P.O. BOX 417
 ELLICOTT CITY, MARYLAND 21041
 410-465-4244


PROJECT: TAYLOR FARM SECTION THREE, PHASE TWO
 LOTS 57 THROUGH 101 AND NON-BUILDABLE BULK PARCEL 'A'
 A RESUBDIVISION OF LOT 54 TAYLOR FARM SECTION THREE AND LOT 2 OF FRIENDLY FARMS (PLAT NO. 9220-9227)

LOCATION: TAX MAP: 10 GRID: 23 PARCEL: 309
 TAX MAP: 18 GRID: 5 ZONED: R-20
 3rd ELECTION DISTRICT
 HOWARD COUNTY, MARYLAND

TITLE: GRADING, SEDIMENT & EROSION CONTROL PLAN

DATE: AUGUST, 2007 PROJECT NO. 1585

DESIGN: DBT DRAFT: DBT CHECK: DAM SCALE: AS SHOWN SHEET 4 OF 22

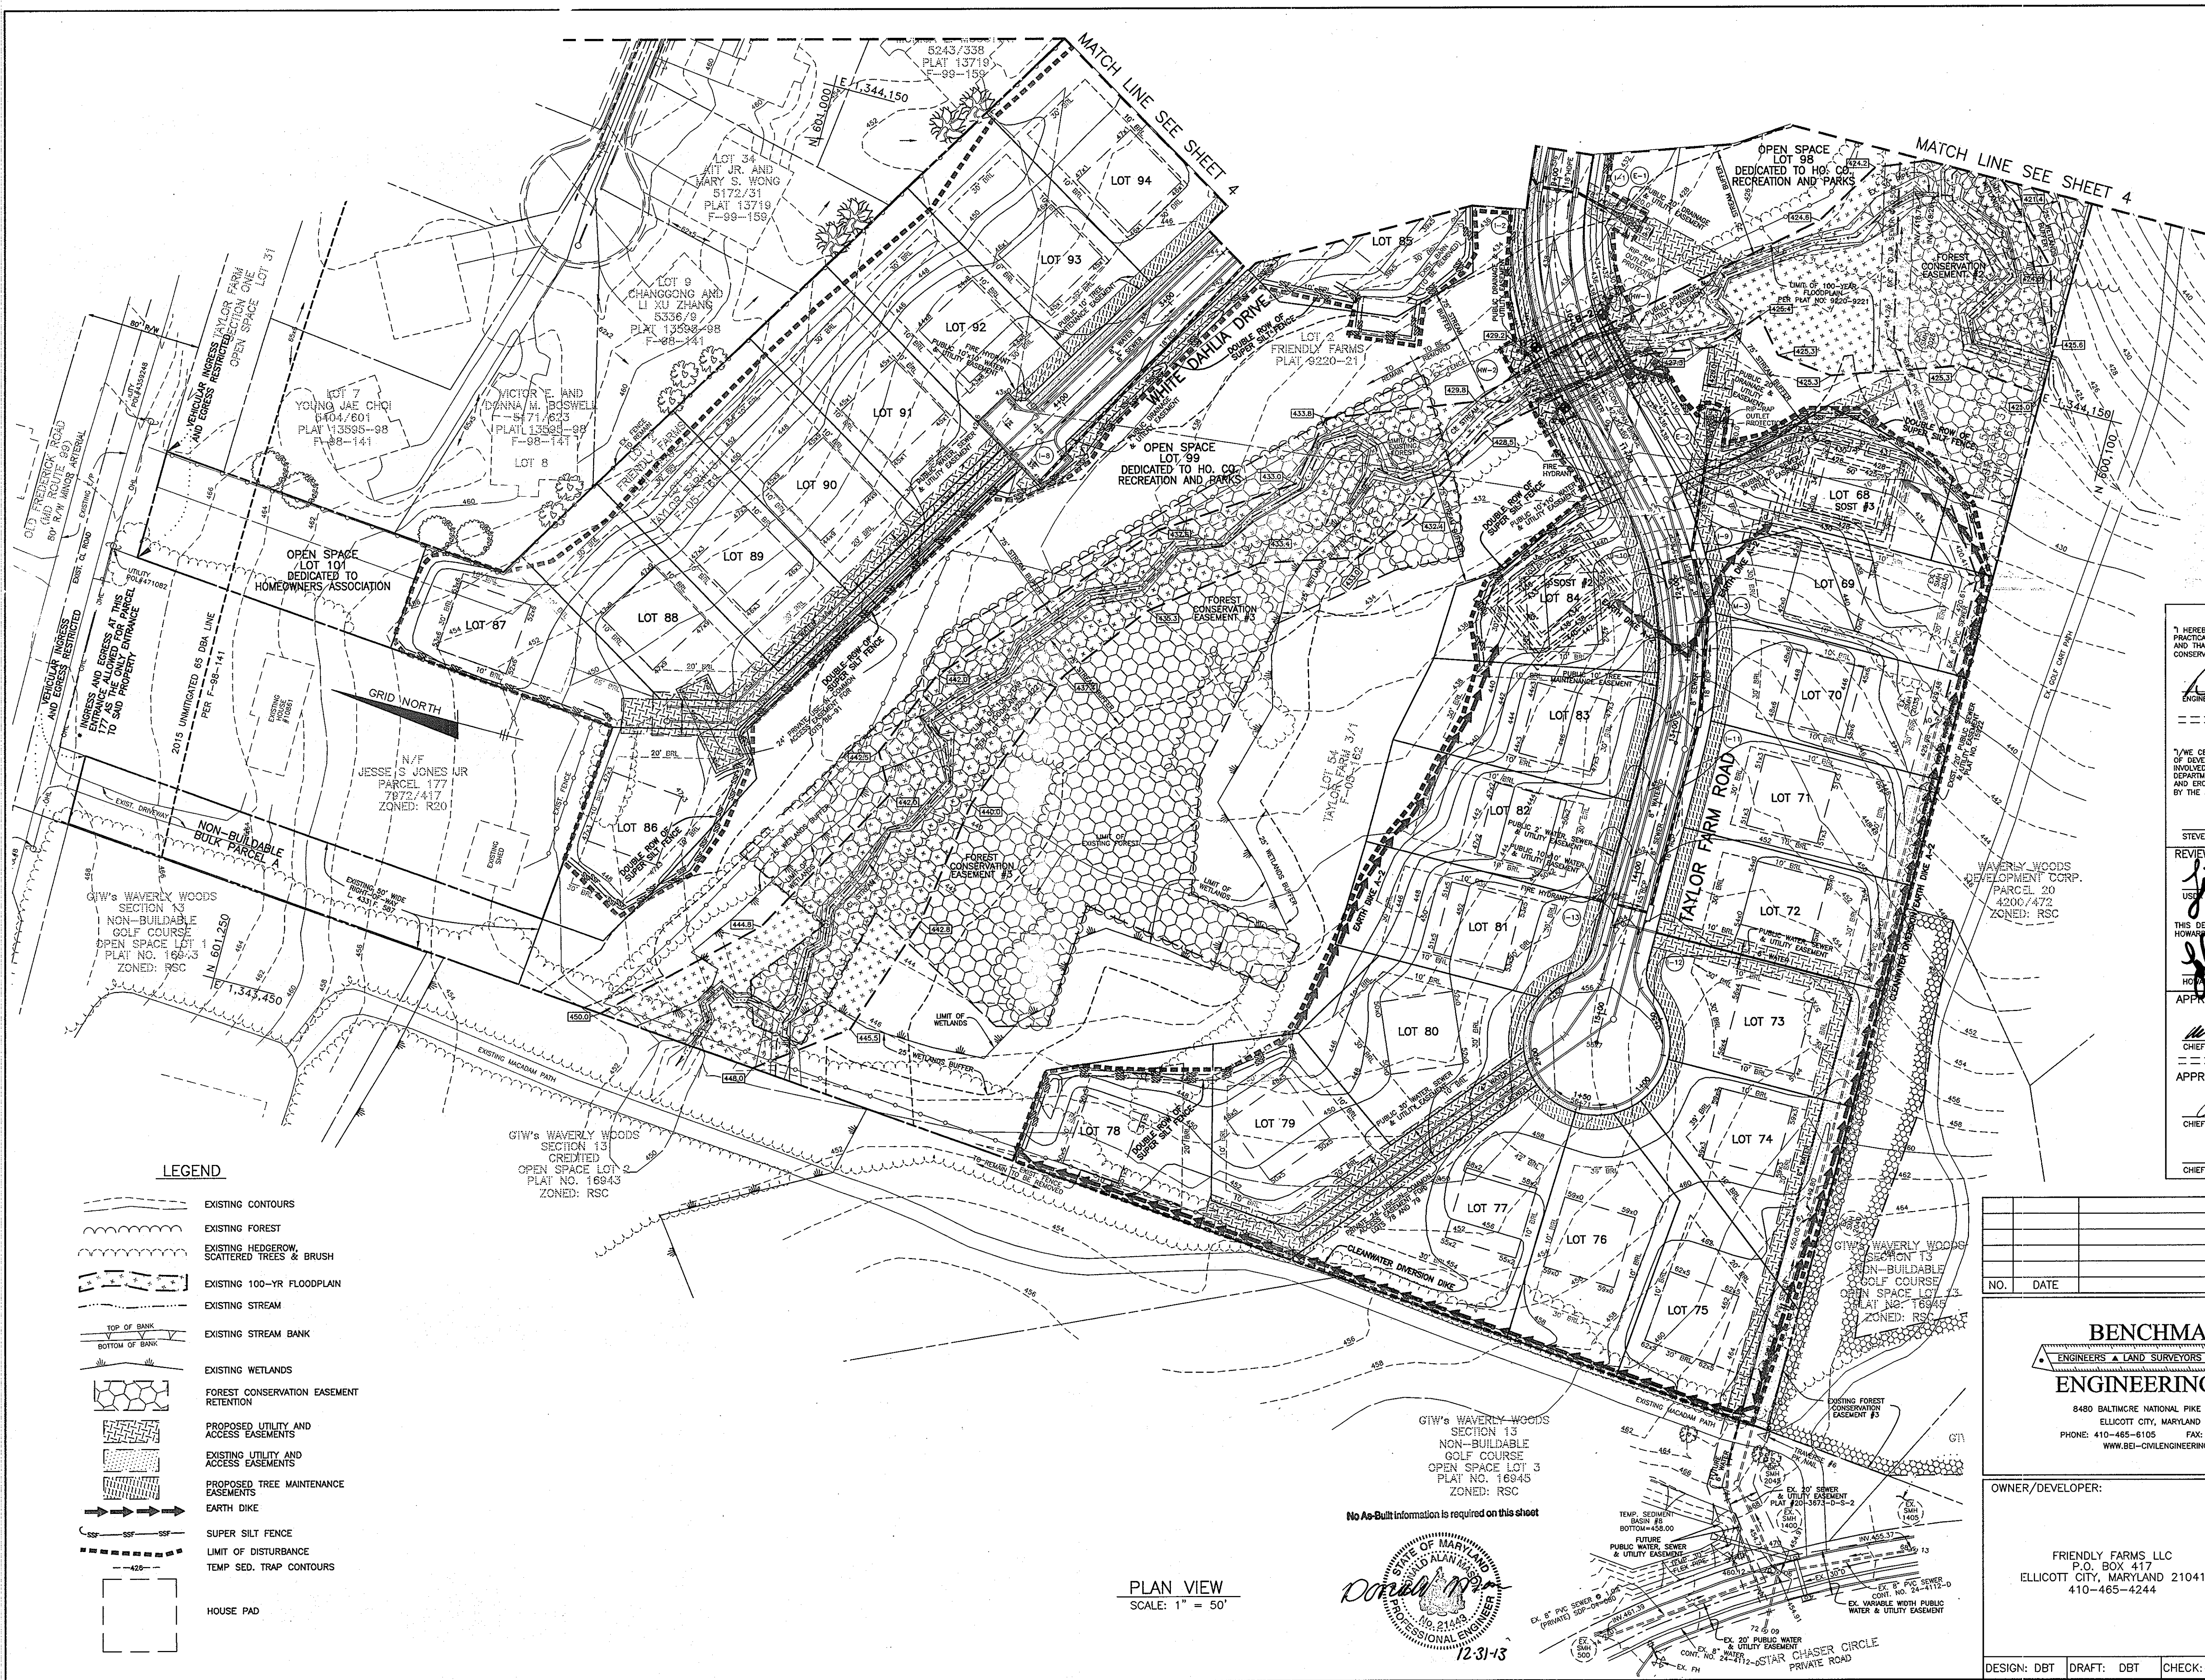

SOST #2

TYPE OF TRAP	ST-II
DRAINAGE AREA	EXIST = 0.6 AC. PROP. = 2.0 AC.
STORAGE REQUIRED	WET=3600 CF (WET & DRY) DRY=3600 CF
STORAGE PROVIDED	WET=5268 CF ELEV=436.00 (WET & DRY) DRY=5444 CF ELEV=438.00
WEIR LENGTH	10'
EMBANKMENT ELEV.	439.00 (4' WIDE)
WEIR CREST ELEV.	438.00
CLEANOUT ELEV.	434.20
BOTTOM ELEV.	433.00
BOTTOM DIMENSIONS	25' 50'

SOST #3

TYPE OF TRAP	ST-II
DRAINAGE AREA	EXIST = 1.5 AC. PROP. = 2.3 AC.
STORAGE REQUIRED	WET=4140 CF (WET & DRY) DRY=4140 CF
STORAGE PROVIDED	WET=6790 CF ELEV=428.00 (WET & DRY) DRY=6632 CF ELEV=430.00
WEIR LENGTH	10'
EMBANKMENT ELEV.	431.00 (4' WIDE)
WEIR CREST ELEV.	430.00
CLEANOUT ELEV.	426.08
BOTTOM ELEV.	425.00
BOTTOM DIMENSIONS	34' 50'

ENGINEER'S CERTIFICATE

I HEREBY CERTIFY THAT THIS PLAN FOR SEDIMENT AND EROSION CONTROL REPRESENTS A PRACTICAL AND WORKABLE PLAN BASED ON MY PERSONAL KNOWLEDGE OF THE SITE CONDITIONS AND THAT IT WAS PREPARED IN ACCORDANCE WITH THE REQUIREMENTS OF THE HOWARD SOIL CONSERVATION DISTRICT.

Donald Mason 8/21/07
ENGINEER - DONALD A. MASON, P.E. # 21443 DATE

DEVELOPER'S CERTIFICATE

I/WE CERTIFY THAT ALL DEVELOPMENT AND CONSTRUCTION WILL BE DONE ACCORDING TO THIS PLAN OF DEVELOPMENT FOR SEDIMENT AND EROSION CONTROL, AND THAT ALL RESPONSIBLE PERSONNEL INVOLVED IN THE CONSTRUCTION PROJECT WILL HAVE A CERTIFICATE OF ATTENDANCE AT A DEPARTMENT OF THE ENVIRONMENT APPROVED TRAINING PROGRAM FOR THE CONTROL OF SEDIMENT AND EROSION BEFORE BEGINNING THE PROJECT. I ALSO AUTHORIZE PERIODIC ON-SITE INSPECTION BY THE HOWARD SOIL CONSERVATION DISTRICT.

Steven K. Breeden 8/21/07 *James R. Schulte* 8/21/07
STEVEN K. BREEDEN DATE JAMES R. SCHULTE DATE

REVIEWED FOR HOWARD SCD AND MELTS TECHNICAL REQUIREMENTS

Jim Meyer 8/21/07
JIM MEYER, N.S. CONSULTING SERVICE DATE

THIS DEVELOPMENT PLAN IS APPROVED FOR SOIL EROSION AND SEDIMENT CONTROL BY THE HOWARD SOIL CONSERVATION DISTRICT.

John R. Hester 8/29/07
HOWARD SCD DATE

APPROVED: DEPARTMENT OF PUBLIC WORKS

Walter J. Schultz 9-7-07
CHIEF, BUREAU OF HIGHWAYS DATE

APPROVED: DEPARTMENT OF PLANNING AND ZONING

Cindy Hunter 9/15/07
CHIEF, DIVISION OF LAND DEVELOPMENT DATE

Chris Pappas 9/12/07
CHIEF, DEVELOPMENT ENGINEERING DIVISION DATE


LEGEND

- EXISTING CONTOURS
- EXISTING FOREST
- EXISTING HEDGEROW, SCATTERED TREES & BRUSH
- EXISTING 100-YR FLOODPLAIN
- EXISTING STREAM
- EXISTING STREAM BANK
- EXISTING WETLANDS
- FOREST CONSERVATION EASEMENT RETENTION
- PROPOSED UTILITY AND ACCESS EASEMENTS
- EXISTING UTILITY AND ACCESS EASEMENTS
- PROPOSED TREE MAINTENANCE EASEMENTS
- EARTH DIKE
- SUPER SILT FENCE
- LIMIT OF DISTURBANCE
- TEMP SED. TRAP CONTOURS
- HOUSE PAD

GIW'S WAVERLY WOODS SECTION 13 CREDITED OPEN SPACE LOT 3 PLAT NO. 16943 ZONED: RSC

GIW'S WAVERLY WOODS SECTION 13 NON-BUILDABLE GOLF COURSE OPEN SPACE LOT 3 PLAT NO. 16943 ZONED: RSC

No As-Built information is required on this sheet

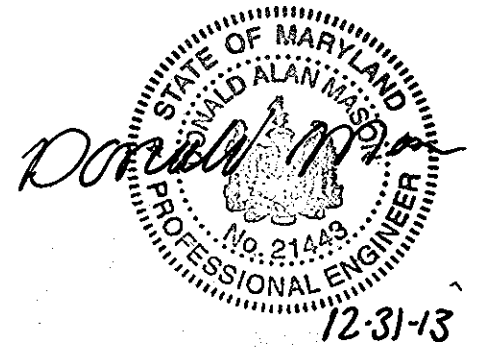


PLAN VIEW
SCALE: 1" = 50'

NO.	DATE	REVISION

BENCHMARK ENGINEERING, INC.

8480 BALTIMORE NATIONAL PIKE & SUITE 418
ELLICOTT CITY, MARYLAND 21043
PHONE: 410-465-8105 FAX: 410-465-6644
WWW.BEJ-CIVILENGINEERING.COM

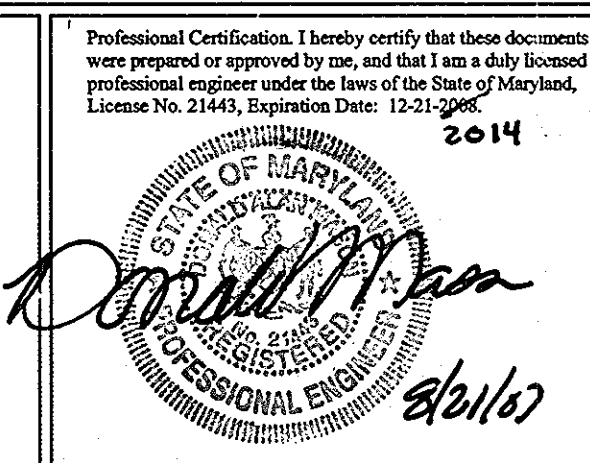

OWNER/DEVELOPER: FRIENDLY FARMS LLC
P.O. BOX 417
ELLICOTT CITY, MARYLAND 21041
410-465-4244

PROJECT: TAYLOR FARM SECTION THREE, PHASE TWO
LOTS 57 THROUGH 101 AND NON-BUILDABLE BULK PARCEL 'A'
A RESUBDIVISION OF LOT 54 TAYLOR FARM SECTION THREE AND LOT 2 OF FRIENDLY FARMS (PLAT NO. 9220-9227)

LOCATION: TAX MAP: 10 GRID: 23 PARCEL: 309
TAX MAP: 16 GRID: 5 ZONED: R-20
3rd ELECTION DISTRICT
HOWARD COUNTY, MARYLAND

TITLE: GRADING, SEDIMENT & EROSION CONTROL PLAN

DATE: AUGUST, 2007 PROJECT NO. 1585

SCALE: AS SHOWN SHEET 5 OF 22

DESIGN: DBT DRAFT: DBT CHECK: DAM

AS-BUILT

F-07-051

SEDIMENT CONTROL NOTES

TOPSOIL SPECIFICATIONS

30.0 DUST CONTROL

- 1. A MINIMUM OF 24 HOURS NOTICE MUST BE GIVEN TO THE HOWARD COUNTY DEPARTMENT OF INSPECTION, LICENSES AND PERMITS, SEDIMENT CONTROL DIVISION PRIOR TO THE START OF ANY CONSTRUCTION, (313-1850).


- 1. Topsoil salvaged from the existing site may be used provided that it meets that standards set forth in these specifications. Typically, the depth of topsoil to be salvaged for a given site shall be based on the representative soil profile section in the Soil Survey published by USDA-SCS in cooperation with Maryland Agricultural Experiment Station.

- 1. Topsoil Specifications - Soil to be used as topsoil must meet the following:
i. Topsoil shall be a loam, sandy loam, clay loam, silt loam, sandy clay loam, loamy sand. Other soils may be used if recommended by an agronomist or soil scientist and approved by the appropriate approval authority.

Table with 2 columns: Description and Value. Includes rows for TOTAL AREA OF SITE (23.3 ACRES), AREA DISTURBED (13.9 ACRES), AREA TO BE ROOFED OR PAVED (4.4 ACRES), etc.

- III. For sites having disturbed areas under 5 acres:
1. Place topsoil (if required) and apply soil amendments as specified in 20.0 Vegetative Stabilization - Section I - Vegetative Stabilization Methods and Materials.

- 1. Muckings - See standards for vegetative stabilization with muckings only. Muck should be crimped or trolled to prevent blowing.
2. Vegetative Cover - See standards for temporary vegetative cover.

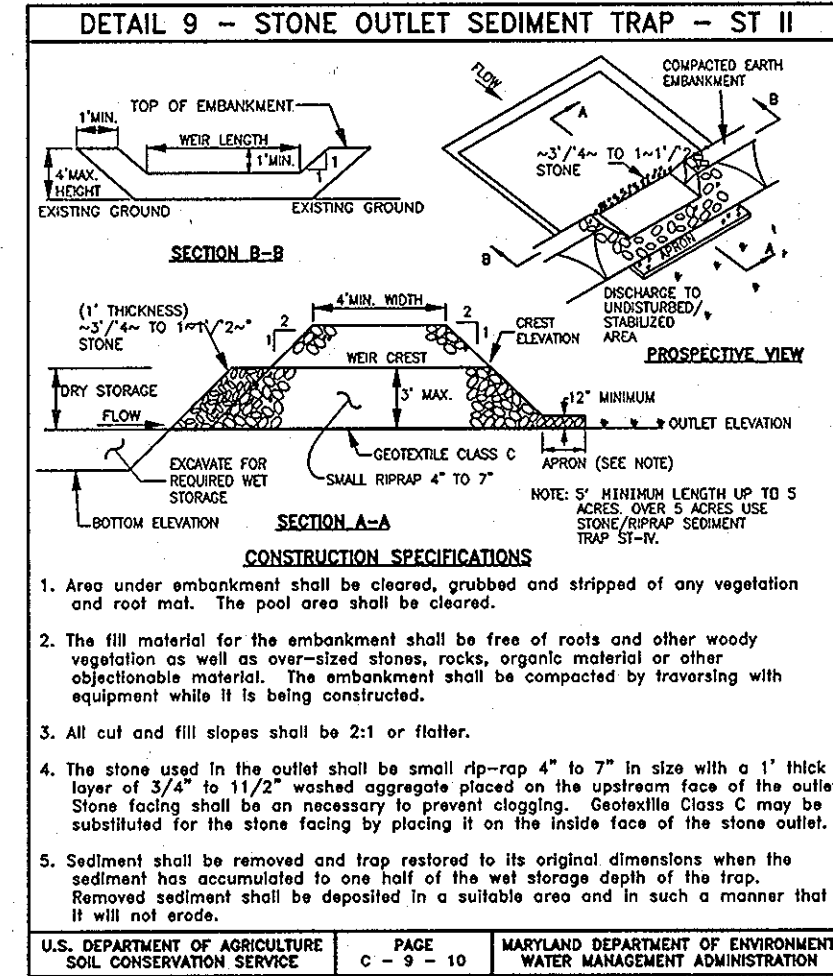

STONE OUTLET SEDIMENT TRAP - ST II. CONSTRUCTION SPECIFICATIONS. Table with 2 columns: Description and Value. Includes rows for 1. The structure shall be inspected periodically and other each rain and repairs made as needed.

SEQUENCE OF CONSTRUCTION

- NOTIFY SEDIMENT CONTROL DIVISION 48 HOURS PRIOR TO START OF CONSTRUCTION
1. OBTAIN GRADING PERMIT. (DAY 1)
2. INSTALL STABILIZED CONSTRUCTION ENTRANCE, TEMPORARY ACCESS BRIDGE, TREE PROTECTION FENCES, SUPER SILT FENCES, AND TEMPORARY CLEANWATER DIVERSION DIKES. (DAY 2-12)


TEMPORARY SEEDBED PREPARATIONS

- APPLY TO GRADED OR CLEARED AREAS LIKELY TO BE RESTORED THROUGH A SHORT-TERM VEGETATIVE COVER IS NEEDED.
SEEDBED PREPARATION: LOOSEN UPPER THREE INCHES OF SOIL BY RAKING, DISCING OR OTHER ACCEPTABLE MEANS BEFORE SEEDING, IF NOT PREVIOUSLY LOOSENED.

TOPSOIL APPLICATION

- V. Topsoil Application
1. When topsoiling, maintain needed erosion and sediment control practices such as diversions, grade stabilization structures, earth dikes, slope silt fence and sediment traps and basins.

Maryland's Guidelines To Waterway Construction DETAIL 4.8: TEMPORARY ACCESS BRIDGE

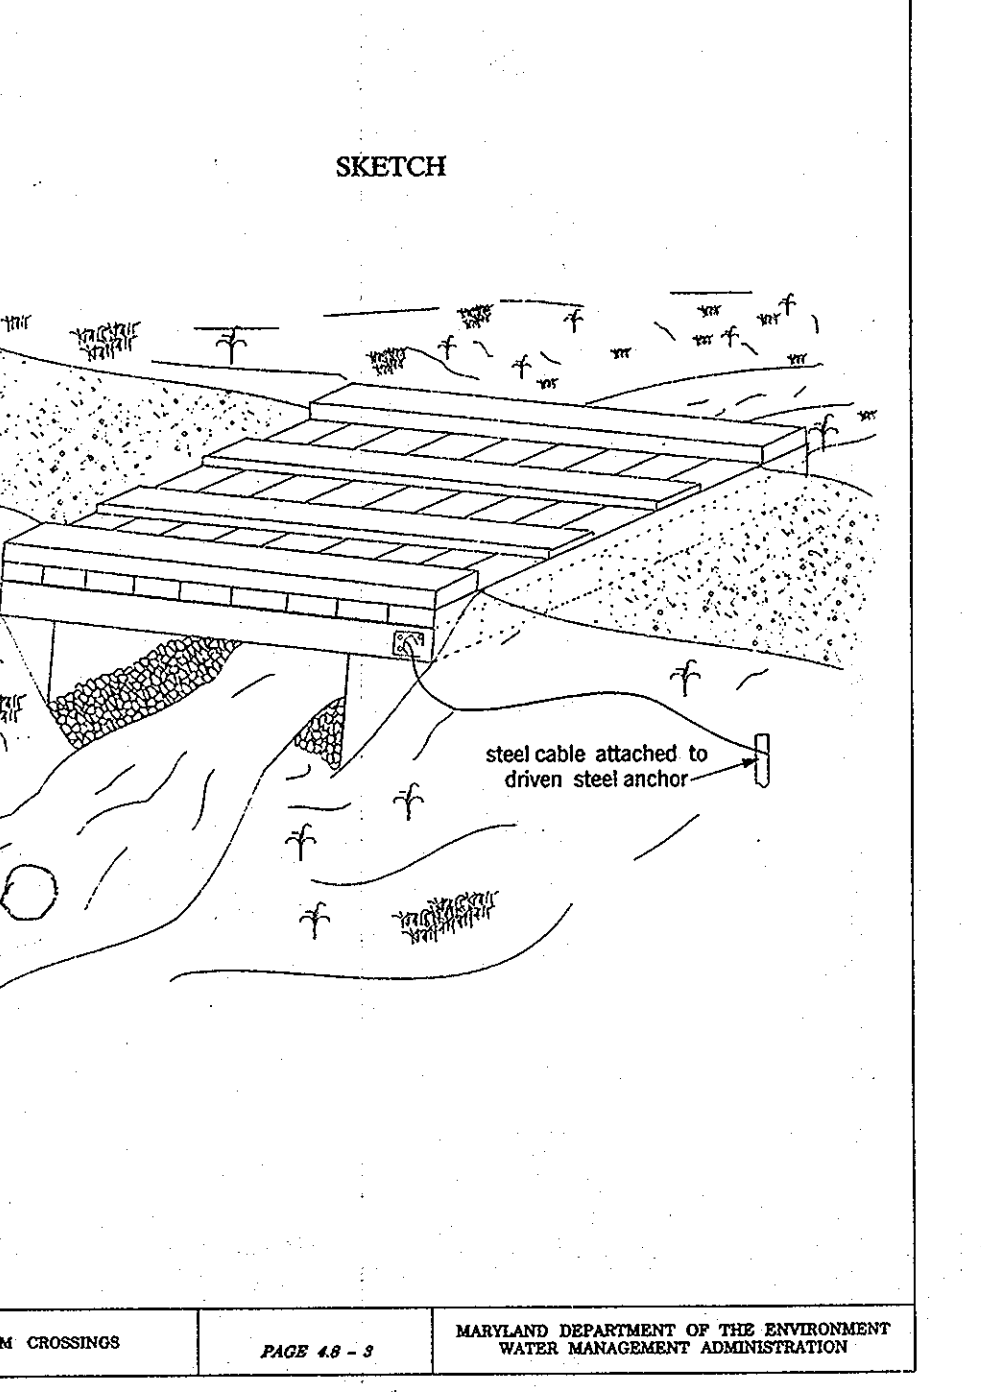

MGWC 4.8: TEMPORARY ACCESS BRIDGE

- DESCRIPTION
A temporary access bridge is a stream crossing made of wood, metal, or other materials designed to limit the amount of disturbance to the stream banks and bed.
EFFECTIVE USES & LIMITATIONS
Temporary access bridges are the preferred method of waterway crossing since they typically cause the least disturbance to the waterway bed and banks, pose the least chance for interference with fish migration, and can be quickly removed and reused.

MGWC 4.8: TEMPORARY ACCESS BRIDGE

- 7. All areas disturbed during installation should be stabilized within 14 calendar days in accordance with a revegetation plan approved by the WMA.
8. Periodic inspection should be performed by the user to ensure that the bridge, streambed, and stream banks are maintained and not damaged.

PERMANENT SEEDBED PREPARATIONS

- SEEDBED PREPARATION: LOOSEN UPPER THREE INCHES OF SOIL BY RAKING, DISCING OR OTHER ACCEPTABLE MEANS BEFORE SEEDING, IF NOT PREVIOUSLY LOOSENED.
SOIL AMENDMENTS: IN LIEU OF SOIL TEST RECOMMENDATIONS, USE ONE OF THE FOLLOWING SCHEDULES:
1. PREFERRED - APPLY 2 TONS PER ACRE DOLOMITIC LIMESTONE (92 LBS/1000 SQ FT) AND 600 LBS PER ACRE 10-10-10 FERTILIZER (14 LBS/1000 SQ FT) BEFORE SEEDING.

VEGETATIVE STABILIZATION





- 1. All temporary earth dikes shall have undisturbed positive grade to an outlet.
2. All temporary earth dikes shall be constructed of a non-erodible material.
3. Riprap diverted from a disturbed area shall be conveyed to a sediment trapping device.

Table with 2 columns: Description and Value. Includes rows for STREAM CROSSINGS, PAGE 4.8-3, MARYLAND DEPARTMENT OF THE ENVIRONMENT WATER MANAGEMENT ADMINISTRATION.

Table with 2 columns: Description and Value. Includes rows for STREAM CROSSINGS, PAGE 4.8-1, MARYLAND DEPARTMENT OF THE ENVIRONMENT WATERWAY CONSTRUCTION GUIDELINES REVISED NOVEMBER 2006.

Table with 2 columns: Description and Value. Includes rows for STREAM CROSSINGS, PAGE 4.8-2, MARYLAND DEPARTMENT OF THE ENVIRONMENT WATERWAY CONSTRUCTION GUIDELINES REVISED NOVEMBER 2006.

Table with 2 columns: NO. and REVISION. Includes rows for 1, 2, 3, 99, 100.

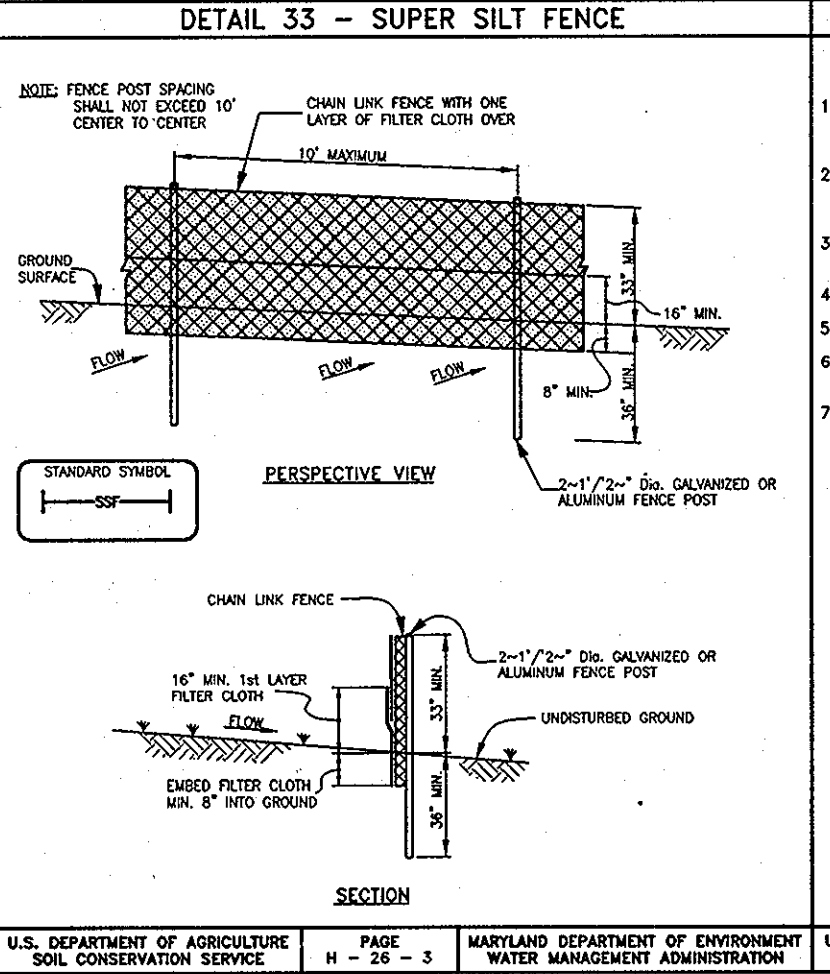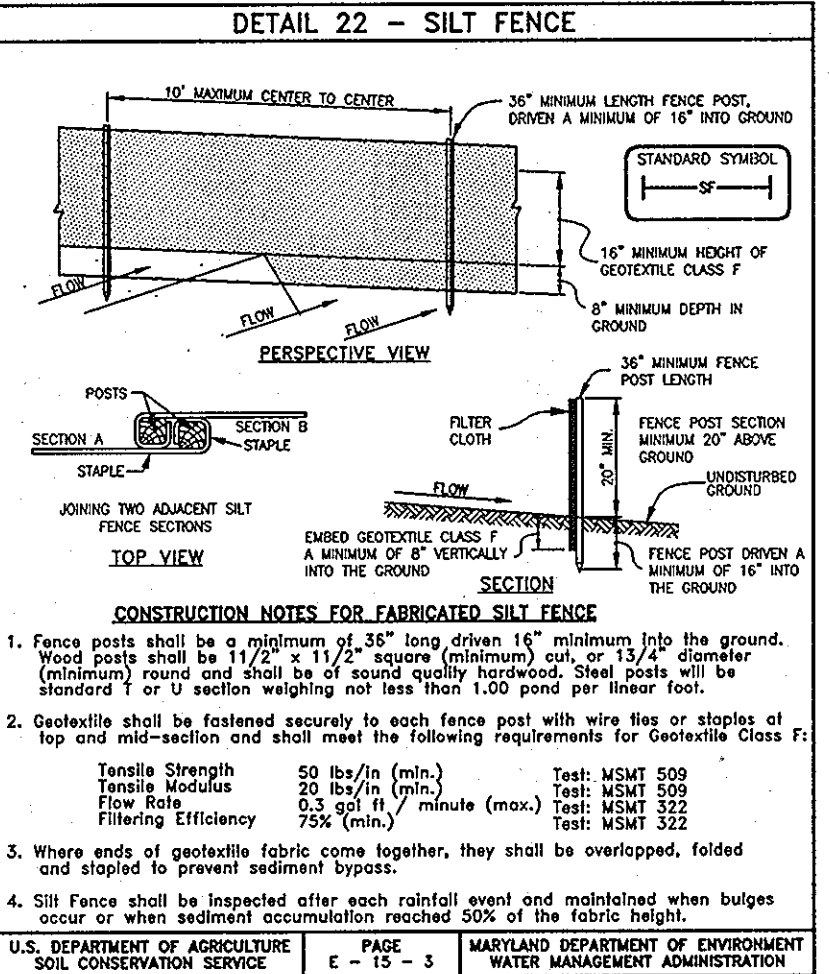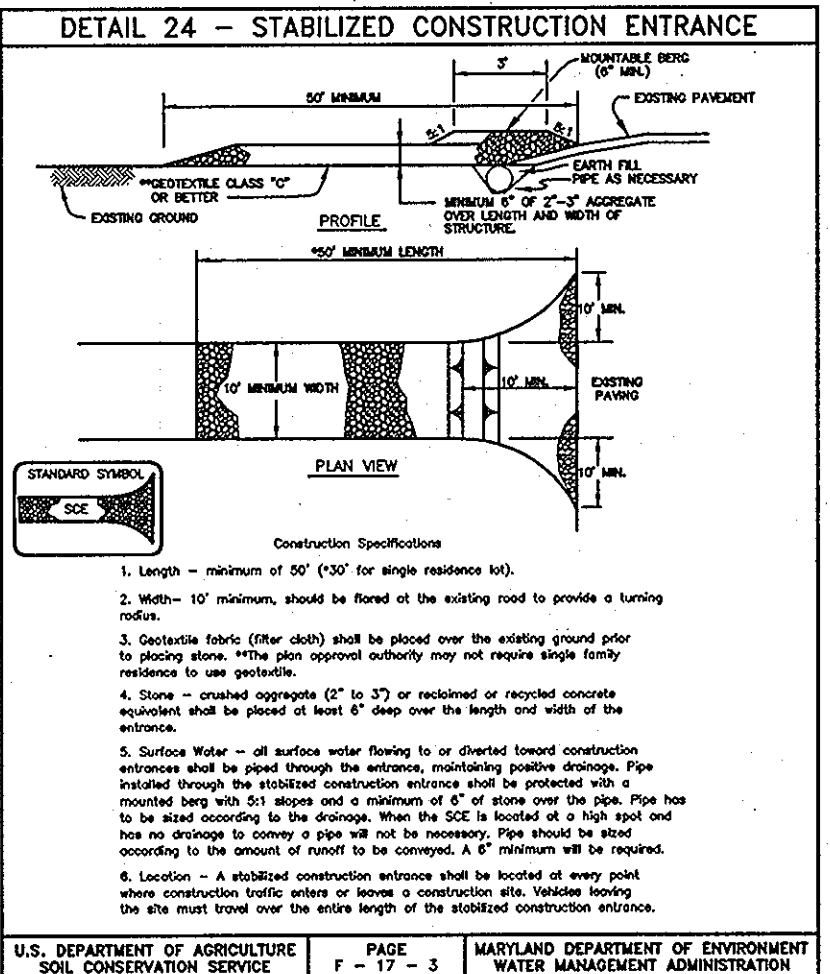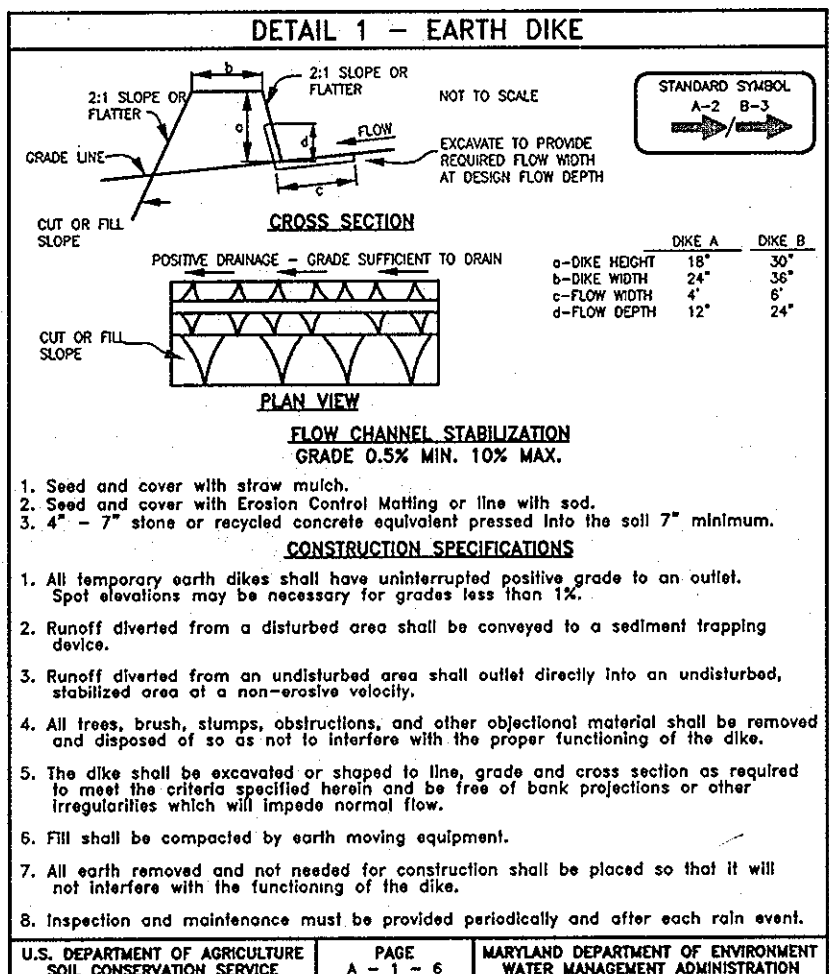


SUPER SILT FENCE. CONSTRUCTION SPECIFICATIONS. Table with 2 columns: Description and Value. Includes rows for 1. Fencing shall be 42" in height and constructed in accordance with the latest Maryland Standard Specification for Chain Link Fencing.

BENCHMARK ENGINEERING, INC. 8480 BALTIMORE NATIONAL PIKE & SUITE 418 ELLICOTT CITY, MARYLAND 21041 PHONE: 410-465-6105 FAX: 410-465-6544 WWW.BE-CIVILENGINEERING.COM

OWNER/DEVELOPER: FRIENDLY FARMS LLC P.O. BOX 417 ELLICOTT CITY, MARYLAND 21041 410-465-4244
PROJECT: TAYLOR FARM SECTION THREE, PHASE TWO
LOCATION: TAX MAP: 10 GRID: 23 PARCEL: 309 TAX MAP: 16 GRID: 5 ZONED: R-20 3rd ELECTION DISTRICT HOWARD COUNTY, MARYLAND
TITLE: SEDIMENT AND EROSION CONTROL NOTES AND DETAILS
DATE: JULY, 2007 PROJECT NO. 1585
DESIGN: DBT DRAFT: DBT CHECK: DAM SCALE: AS SHOWN SHEET 6 OF 22



- LEGEND**
- EXISTING CONTOURS
 - EXISTING FOREST
 - EXISTING HEDGEROW, SCATTERED TREES & BRUSH
 - EXISTING 100-YR FLOODPLAIN
 - EXISTING STREAM
 - EXISTING STREAM BANK
 - EXISTING W/TLANDS
 - PROPOSED UTILITY AND ACCESS EASEMENTS
 - EXISTING UTILITY AND ACCESS EASEMENTS
 - PROPOSED TREE MAINTENANCE EASEMENTS
 - FOREST CONSERVATION EASEMENT
 - SOILS DELINEATION LINE
 - SOILS TYPE
 - DRAINAGE AREA DIVIDE
 - DRAINAGE AREA DESIGNATION

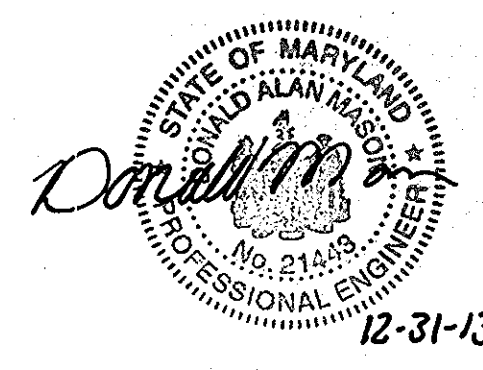

No As-Built Information is required on this sheet

PLAN VIEW
SCALE: 1" = 50'

STORM DRAIN DATA						
INLET NO.	AREA (AC)	'C' FACTOR	SOIL CLASS	ZONING	% IMPERVIOUS	
I-1	0.48	0.45	B,C	RC-20	50.0	
I-2	0.40	0.60	B,C	RC-20	63.5	
I-3	0.10	0.51	B	RC-20	50.0	
I-4	0.37	0.43	B	RC-20	53.1	
I-5	0.41	0.35	B	RC-20	44.0	
I-6	1.80	0.30	B	RC-20	35.2	
I-7	0.26	0.40	B	RC-20	46.5	
I-8	1.09	0.40	B	RC-20	49.9	
I-9	0.20	0.43	B	RC-20	53.5	
I-10	0.36	0.46	B	RC-20	56.9	
I-11	0.61	0.35	B	RC-20	44.1	
I-12	1.12	0.31	B	RC-20	35.9	
I-13	0.30	0.50	B,C	RC-20	60.7	

<p>NO. DATE REVISION</p>	
<p>BENCHMARK ENGINEERING, INC. ENGINEERS • LAND SURVEYORS • PLANNERS 8480 BALTIMORE NATIONAL PIKE • SUITE 418 ELLCOTT CITY, MARYLAND 21043 PHONE: 410-465-6105 FAX: 410-465-6544 WWW.BM-ENGINEERING.COM</p>	
<p>OWNER/DEVELOPER: FRIENDLY FARMS LLC P.O. BOX 417 ELLCOTT CITY, MARYLAND 21041 410-465-4244</p>	<p>PROJECT: TAYLOR FARM SECTION THREE, PHASE TWO LOTS 57 THROUGH 101 AND NON-BUILDABLE BULK PARCEL 'A' A RESUBDIVISION OF LOT 54 TAYLOR FARM SECTION THREE AND LOT 2 OF FRIENDLY FARMS (PLAT NO. 9220-9227)</p> <p>LOCATION: TAX MAP: 10 GRID: 23 PARCEL: 309 TAX MAP: 16 GRID: 5 ZONED: R-20 3RD ELECTION DISTRICT HOWARD COUNTY, MARYLAND</p> <p>TITLE: STORM DRAIN DRAINAGE AREA MAP</p> <p>DATE: AUGUST, 2007 PROJECT NO. 1585</p> <p>DESIGN: DBT DRAFT: DBT CHECK: DAM SCALE: AS SHOWN SHEET 7 OF 22</p>

APPROVED: DEPARTMENT OF PUBLIC WORKS
Willis F. Maltz 9-7-07
CHIEF, BUREAU OF HIGHWAYS DATE

APPROVED: DEPARTMENT OF PLANNING AND ZONING
Cynthia Hanna 9/15/07
CHIEF, DIVISION OF LAND DEVELOPMENT DATE

Michael Demers 9/16/07
CHIEF, DEVELOPMENT ENGINEERING DIVISION DATE

GRADES SHOWN ON THIS PLAN REPRESENT ULTIMATE GRADING.



- LEGEND**
- EXISTING CONTOURS
 - EXISTING FOREST
 - EXISTING HEDGEROW, SCATTERED TREES & BRUSH
 - EXISTING 100-YR FLOODPLAIN
 - EXISTING STREAM
 - EXISTING STREAM BANK
 - EXISTING WETLANDS
 - PROPOSED UTILITY AND ACCESS EASEMENTS
 - EXISTING UTILITY AND ACCESS EASEMENTS
 - PROPOSED TREE MAINTENANCE EASEMENTS
 - FOREST CONSERVATION EASEMENT
 - SOILS DELINEATION LINE
 - SOILS TYPE
 - DRAINAGE AREA DIVIDE
 - DRAINAGE AREA DESIGNATION

GRADES SHOWN ON THIS PLAN REPRESENT ULTIMATE GRADING.

NO.	DATE	REVISION

BENCHMARK ENGINEERING, INC.
 ENGINEERS • LAND SURVEYORS • PLANNERS
 8480 BALTIMORE NATIONAL PIKE & SUITE 418
 ELLICOTT CITY, MARYLAND 21043
 PHONE: 410-465-6105 FAX: 410-465-6844
 WWW.BEI-CIVILENGINEERING.COM

Professional Certification. I hereby certify that these documents were prepared or approved by me, and that I am a duly licensed professional engineer under the laws of the State of Maryland, License No. 21445, Expiration Date: 12-31-2008.

Professional Seal: State of Maryland, Professional Engineer, License No. 21445, Expiration Date: 12-31-13

APPROVED: DEPARTMENT OF PUBLIC WORKS
Walter F. ... 9-7-07
 CHIEF, BUREAU OF HIGHWAYS


APPROVED: DEPARTMENT OF PLANNING AND ZONING
Condy ... 9/18/10
 CHIEF, DIVISION OF LAND DEVELOPMENT

... 9/26/07
 CHIEF, DEVELOPMENT ENGINEERING DIVISION

PLAN VIEW
 SCALE: 1" = 50'

GIW's WAVERLY WOODS SECTION 13 NON-BUILDABLE GOLF COURSE OPEN SPACE LOT 3 PLAT NO. 16945 ZONED: RSC

OWNER/DEVELOPER: FRIENDLY FARMS LLC P.O. BOX 417 ELLICOTT CITY, MARYLAND 21041 410-465-4244	PROJECT: TAYLOR FARM SECTION THREE, PHASE TWO LOTS 57 THROUGH 101 AND NON-BUILDABLE BULK PARCEL 'A' A RESUBDIVISION OF LOT 54 TAYLOR FARM SECTION THREE AND LOT 2 OF FRIENDLY FARMS (PLAT NO. 9220-9227)
LOCATION: TAX MAP: 10 GRID: 23 PARCEL: 309 TAX MAP: 16 GRID: 5 ZONED: R-20 3rd ELECTION DISTRICT HOWARD COUNTY, MARYLAND	TITLE: STORM DRAIN DRAINAGE AREA MAP
DATE: AUGUST, 2007	PROJECT NO. 1585
DESIGN: DBT DRAFT: DBT CHECK: DAM	SCALE: AS SHOWN SHEET 8 OF 22

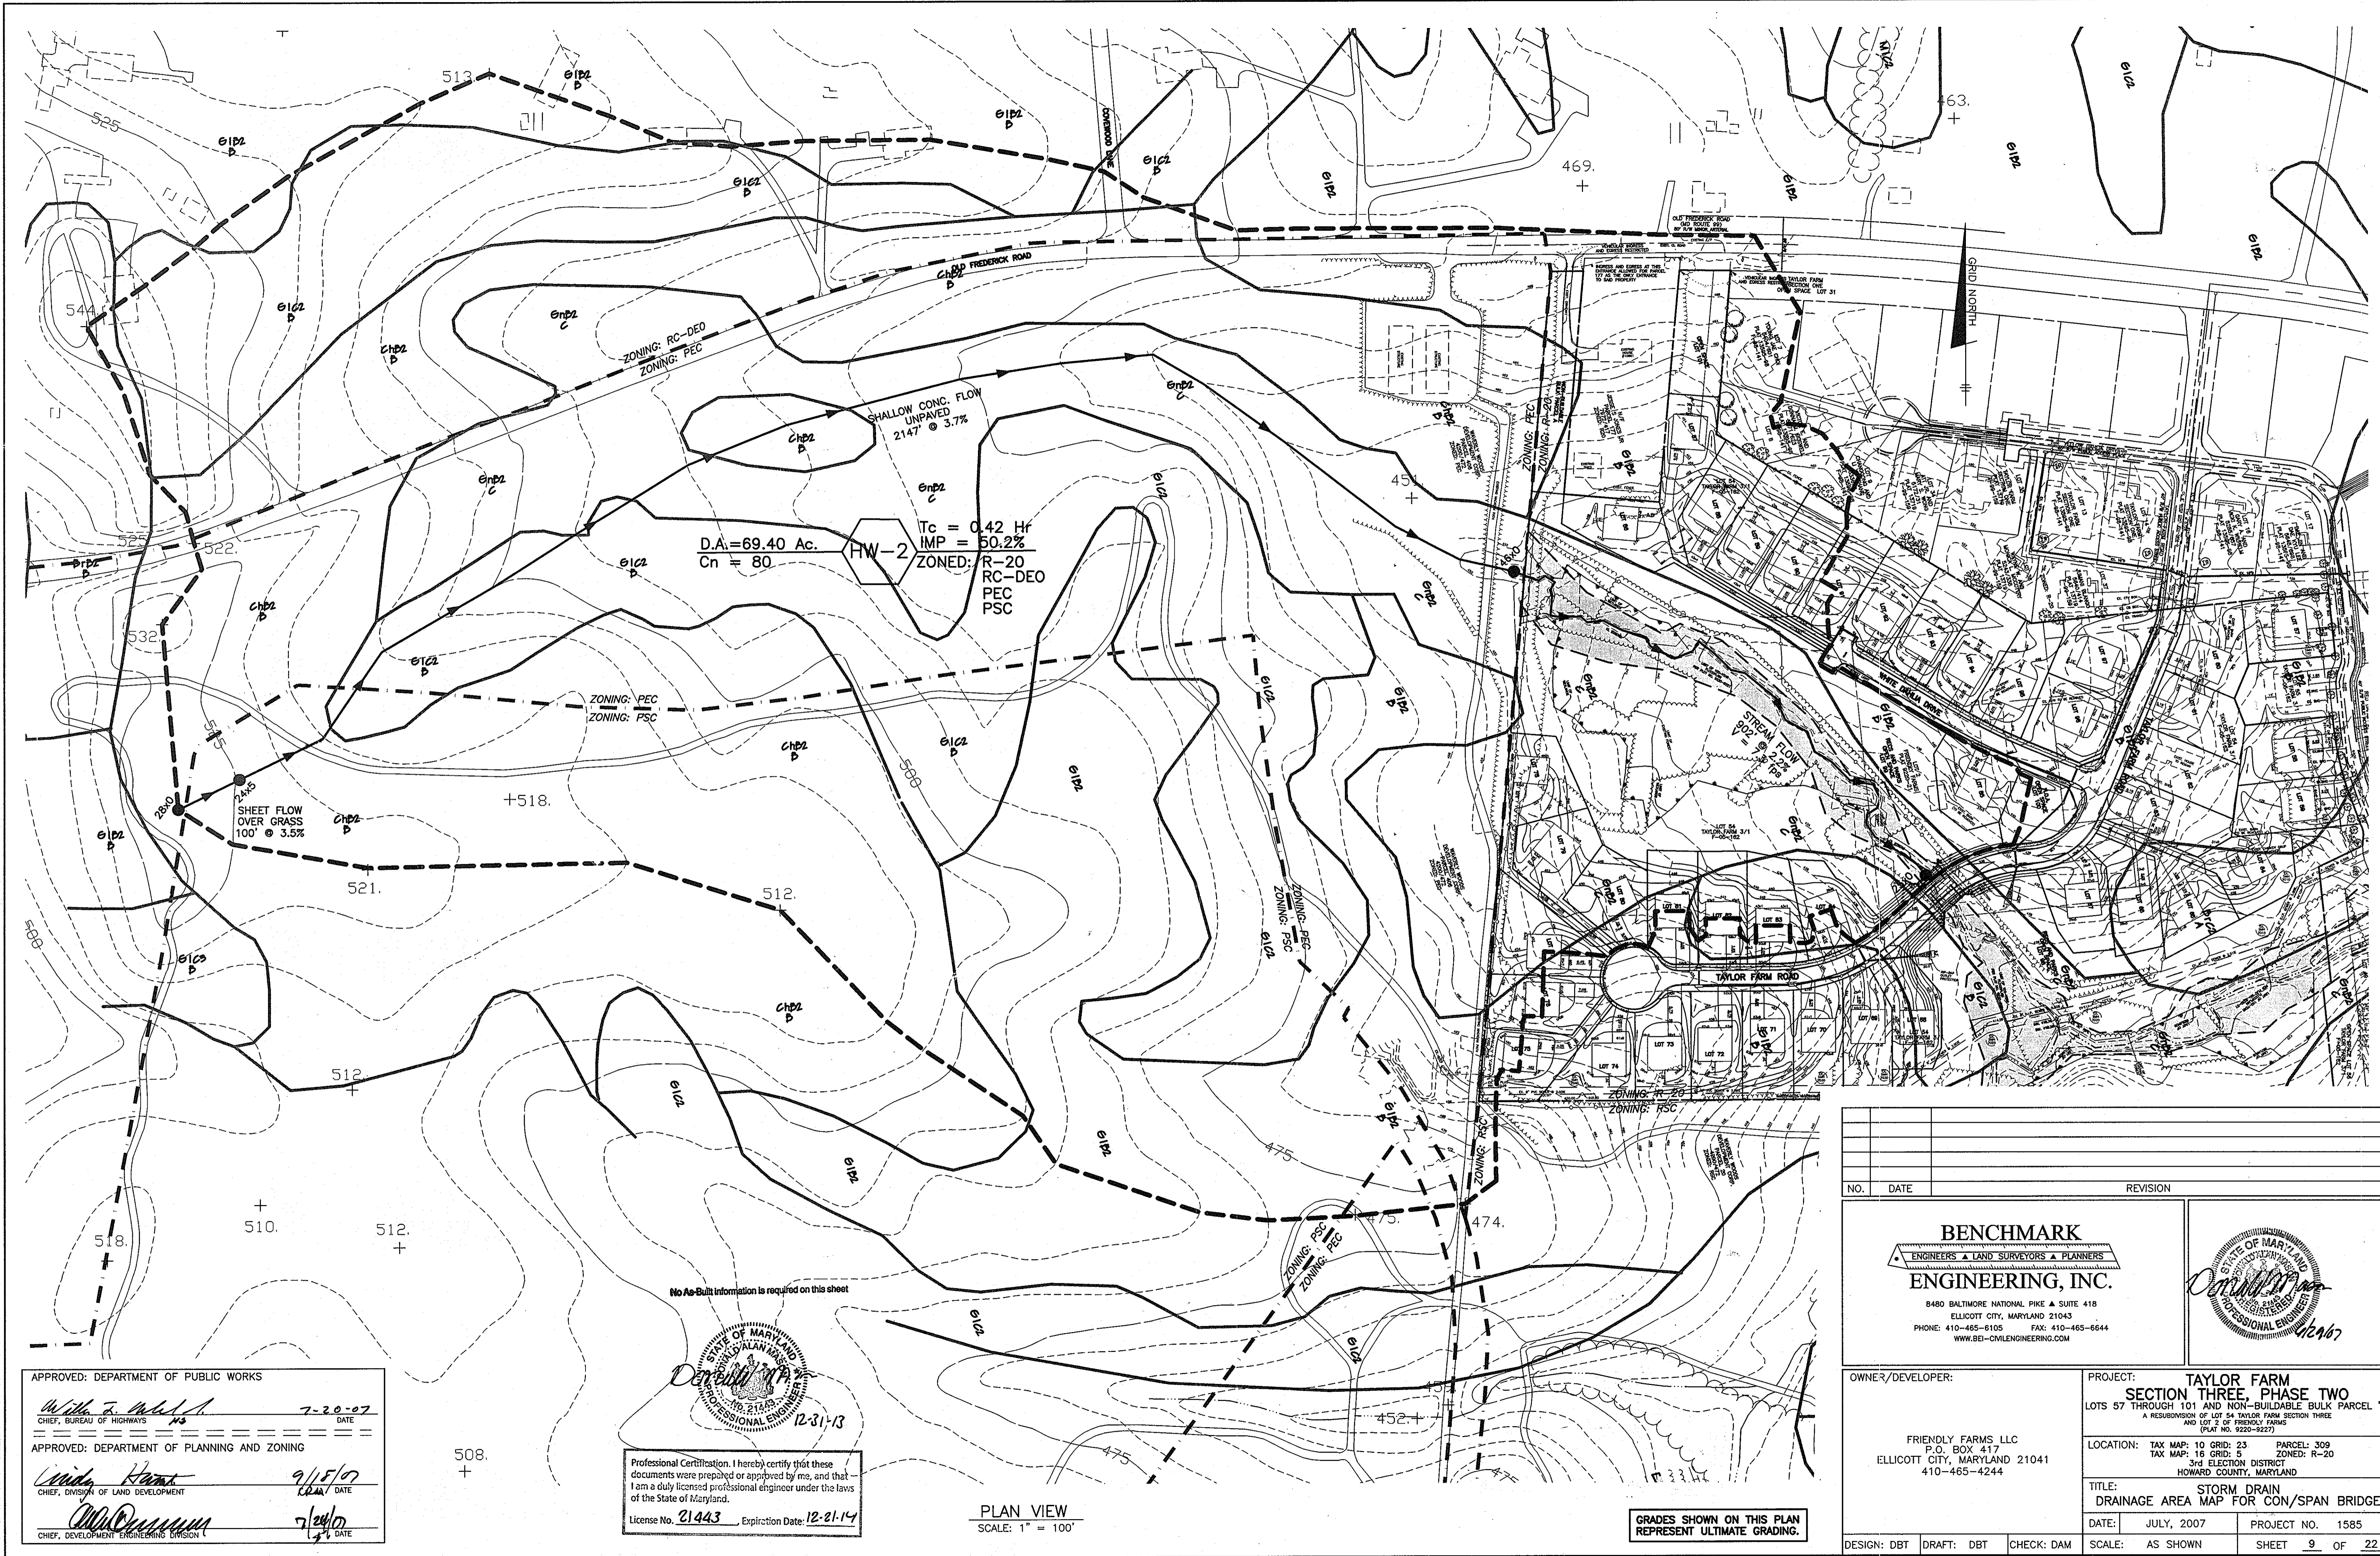


D.A. = 69.40 Ac.
 Cn = 80
 Tc = 0.42 Hr
 IMP = 50.2%
 ZONED: R-20
 RC-DEO
 PEC
 PSC

SHEET FLOW
 OVER GRASS
 100' @ 3.5%

SHALLOW CONC. FLOW
 UNPAVED
 2147' @ 3.7%

No As-Built information is required on this sheet

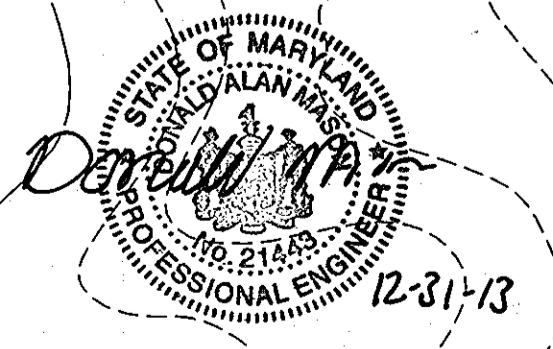

Professional Certification. I hereby certify that these documents were prepared or approved by me, and that I am a duly licensed professional engineer under the laws of the State of Maryland.
 License No. 21443 Expiration Date: 12-31-14

PLAN VIEW
 SCALE: 1" = 100'

GRADES SHOWN ON THIS PLAN
 REPRESENT ULTIMATE GRADING.





APPROVED: DEPARTMENT OF PUBLIC WORKS
 [Signature] 7-20-07
 CHIEF, BUREAU OF HIGHWAYS
 APPROVED: DEPARTMENT OF PLANNING AND ZONING
 [Signature] 9/15/07
 CHIEF, DIVISION OF LAND DEVELOPMENT
 [Signature] 7/24/07
 CHIEF, DEVELOPMENT ENGINEERING DIVISION

NO.	DATE	REVISION


BENCHMARK
 ENGINEERS & LAND SURVEYORS & PLANNERS
ENGINEERING, INC.
 8480 BALTIMORE NATIONAL PIKE & SUITE 418
 ELLICOTT CITY, MARYLAND 21043
 PHONE: 410-465-6105 FAX: 410-465-6644
 WWW.BEI-CVLENGINEERING.COM

OWNER/DEVELOPER: FRIENDLY FARMS LLC P.O. BOX 417 ELLICOTT CITY, MARYLAND 21041 410-465-4244	PROJECT: TAYLOR FARM SECTION THREE, PHASE TWO LOTS 57 THROUGH 101 AND NON-BUILDABLE BULK PARCEL 'A' A RESUBDIVISION OF LOT 54 TAYLOR FARM SECTION THREE AND LOT 2 OF FRIENDLY FARMS (PLAT NO. 9229-9227)
LOCATION: TAX MAP: 10 GRID: 23 PARCEL: 309 TAX MAP: 16 GRID: 5 ZONED: R-20 3rd ELECTION DISTRICT HOWARD COUNTY, MARYLAND	TITLE: STORM DRAIN DRAINAGE AREA MAP FOR CON/SPAN BRIDGE
DATE: JULY, 2007	PROJECT NO. 1585
DESIGN: DBT DRAFT: DBT CHECK: DAM	SCALE: AS SHOWN SHEET 9 OF 22

AS-BUILT

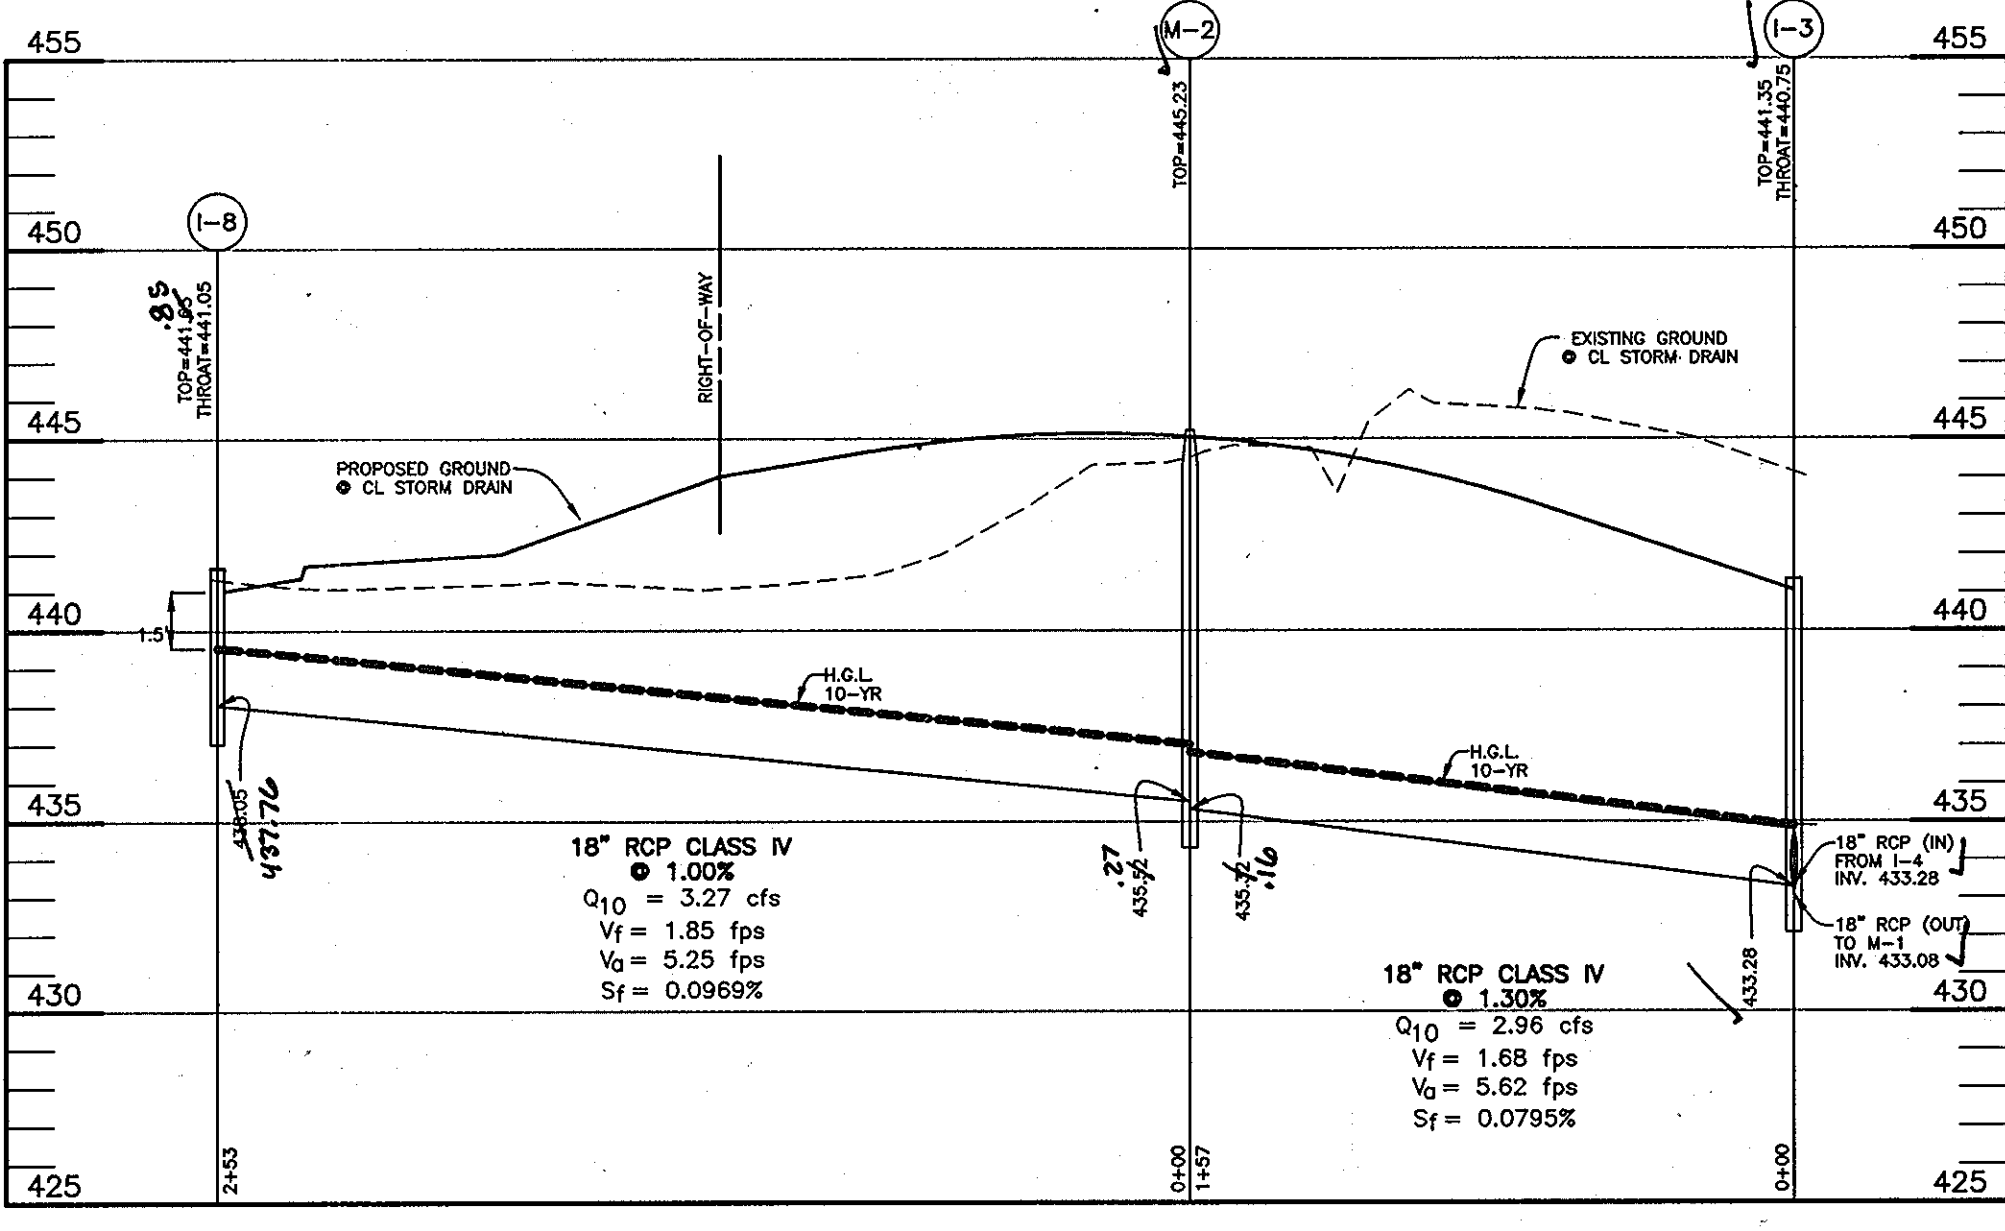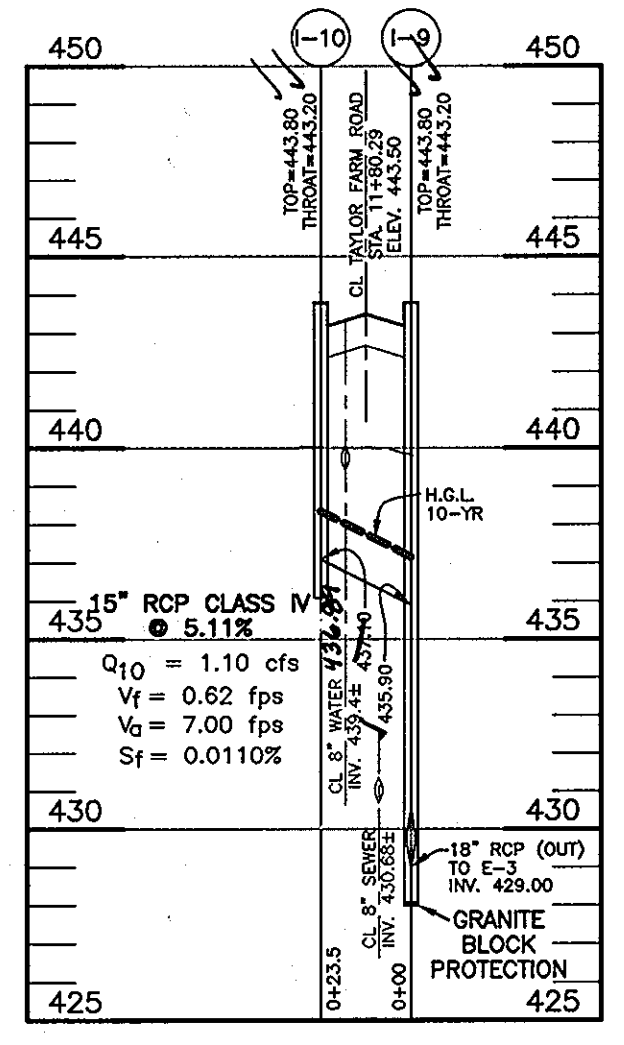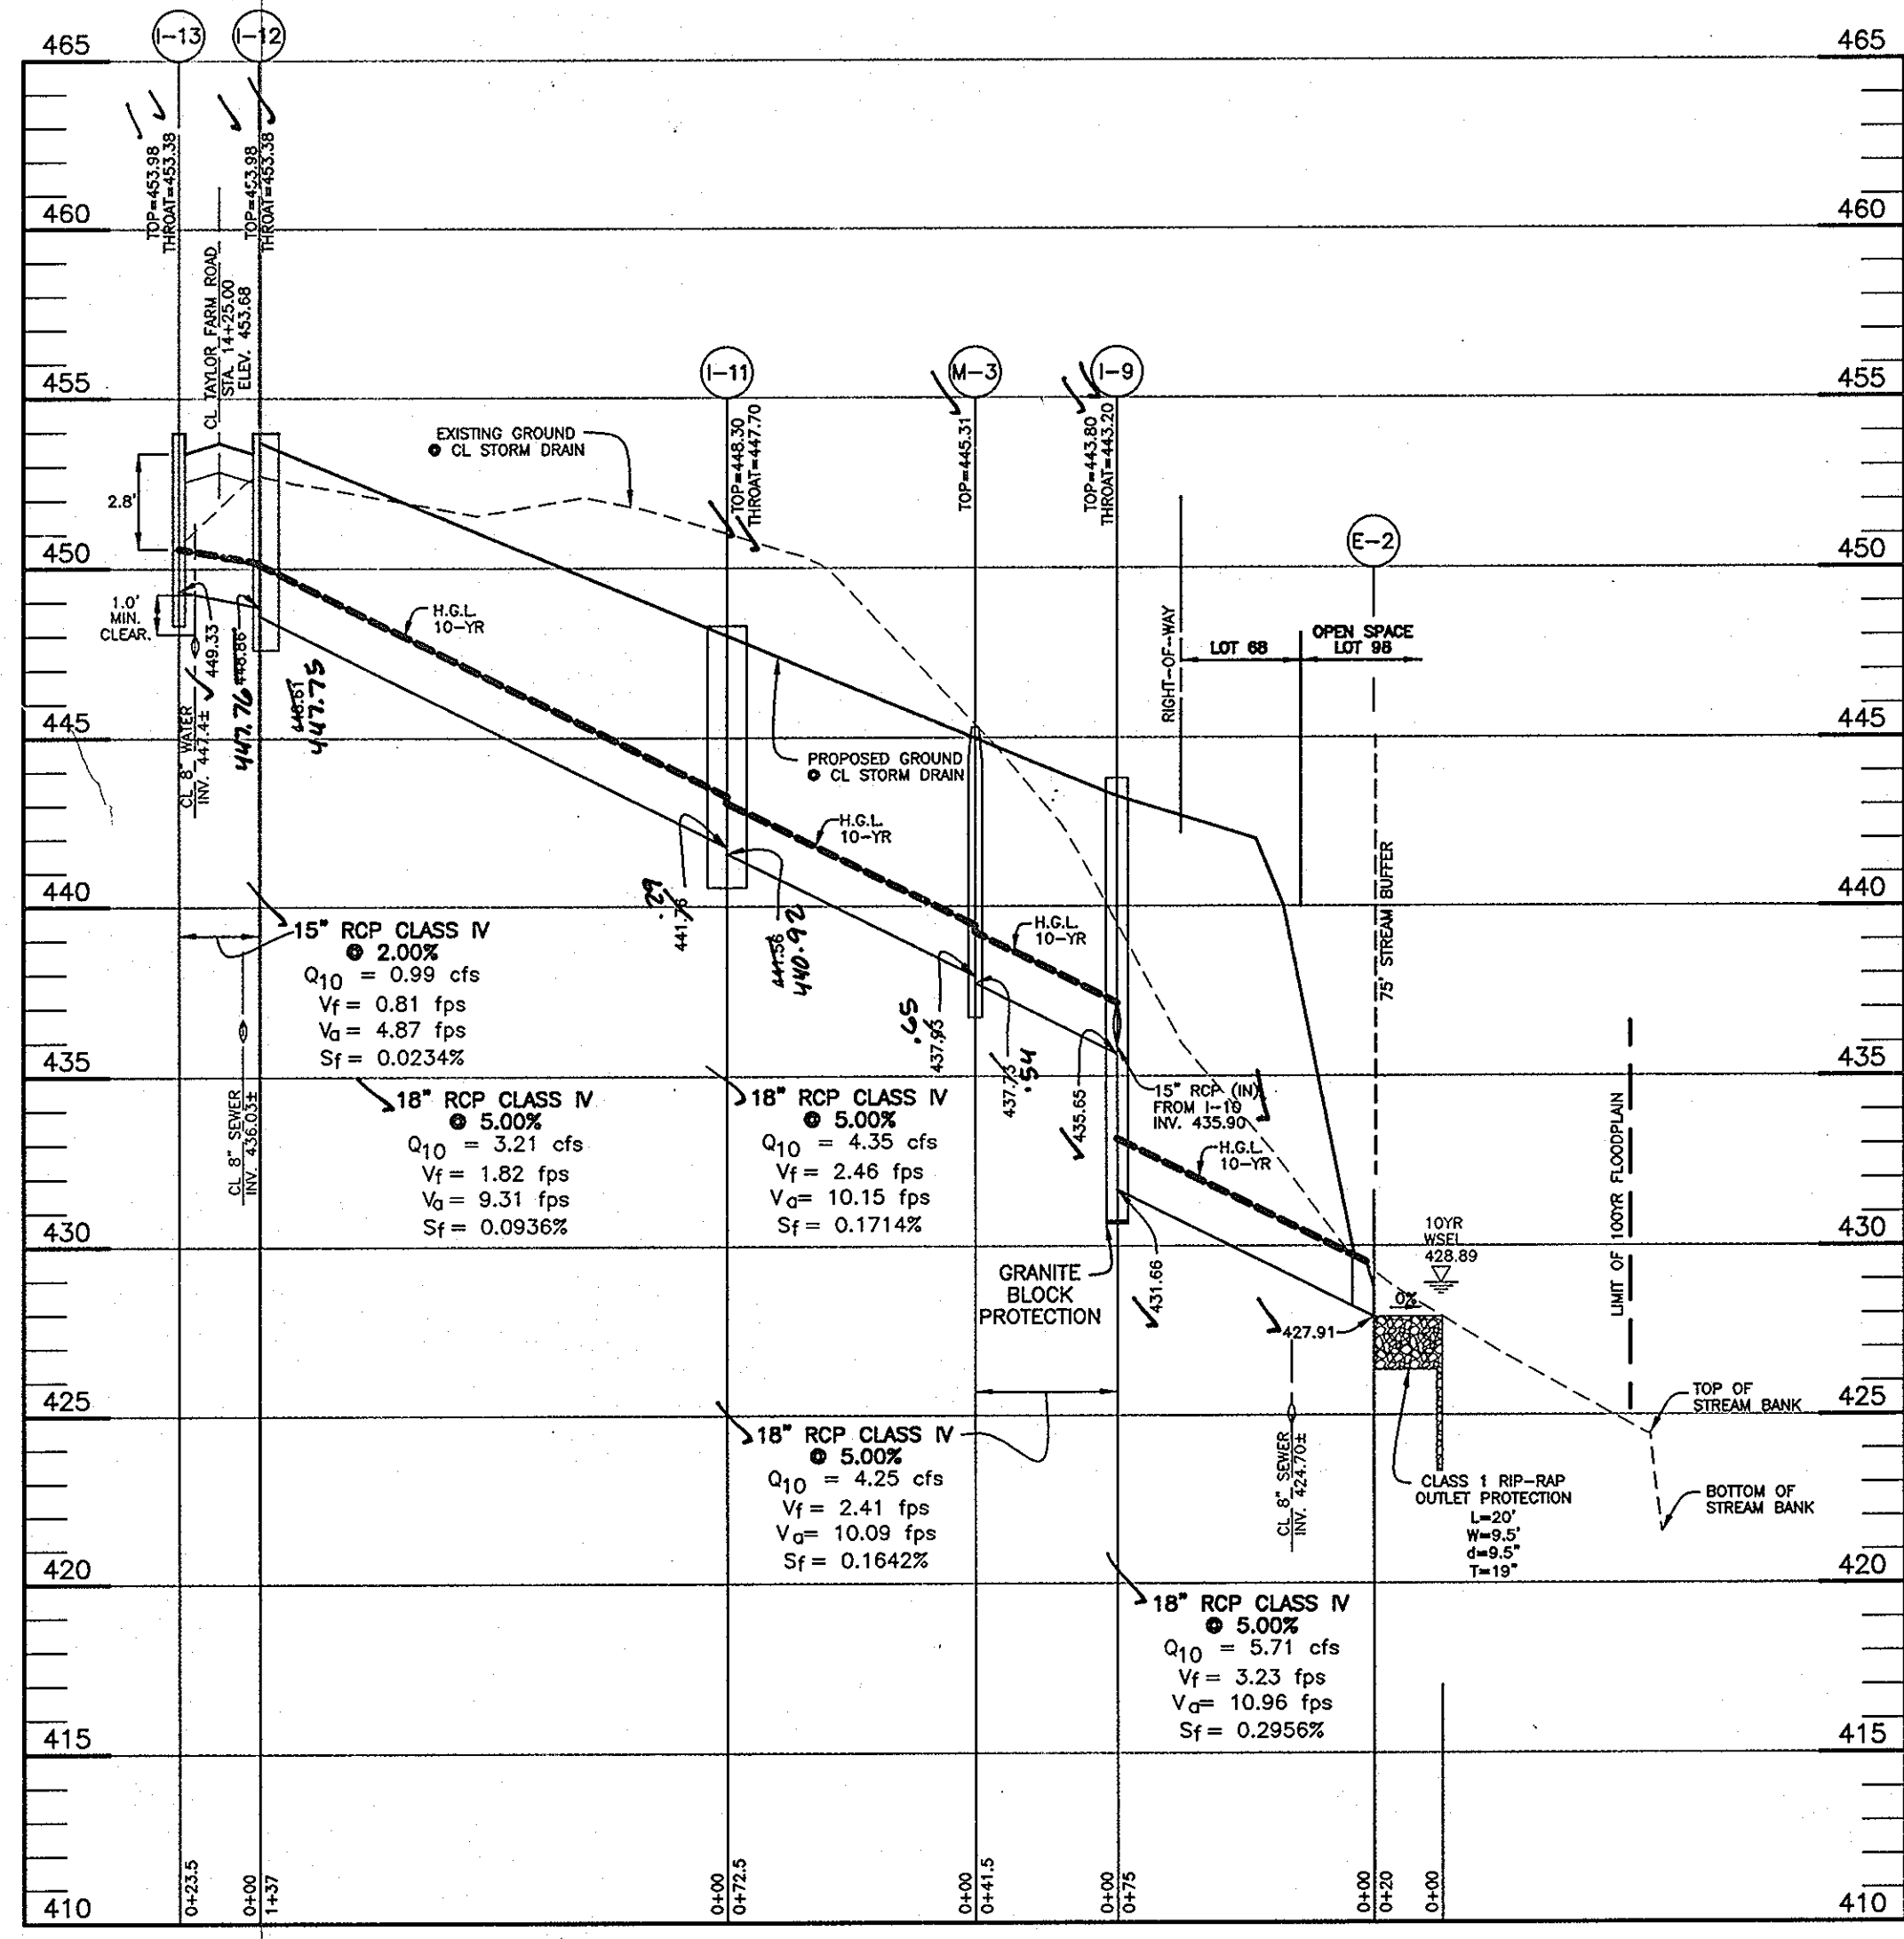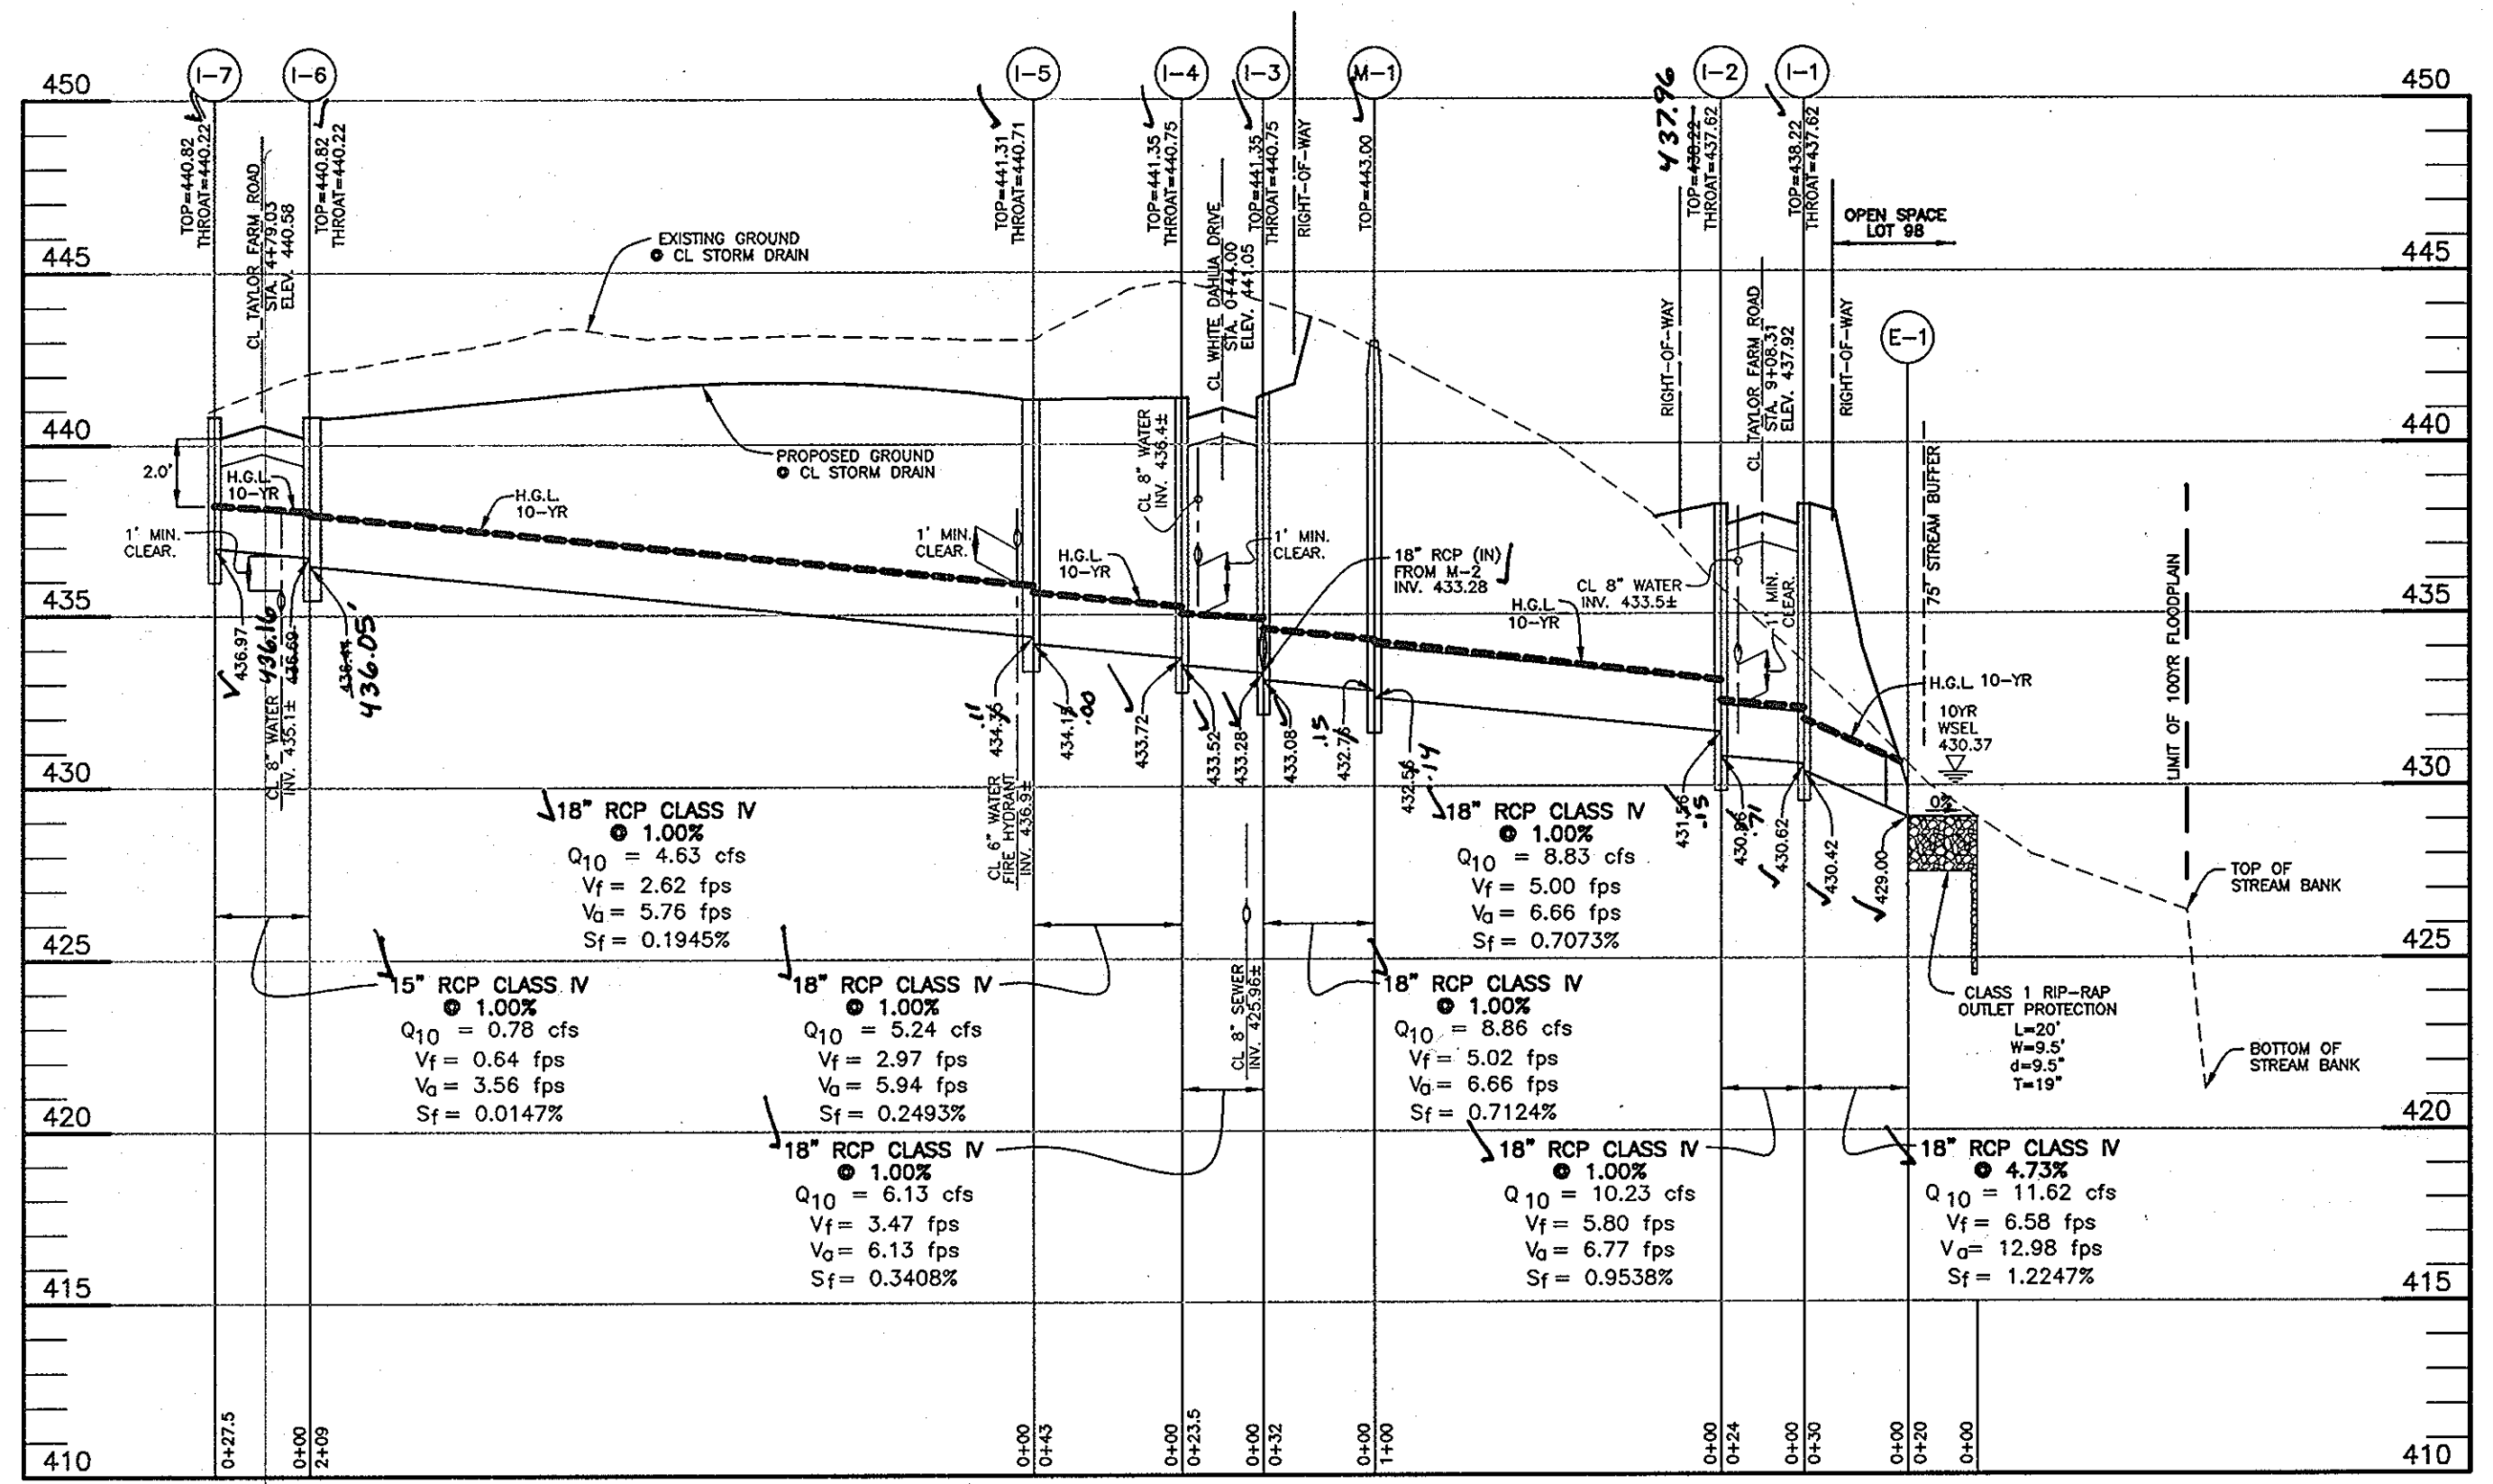

- CONSTRUCTION SPECIFICATIONS**
1. THE SUBGRADE FOR THE FILTER, RIP-RAP, OR GABION SHALL BE PREPARED TO THE REQUIRED LINES AND GRADES. ANY FILL REQUIRED IN THE SUBGRADE SHALL BE COMPACTED TO A DENSITY OF APPROXIMATELY THAT OF THE SURROUNDING UNDISTURBED MATERIAL.
 2. THE ROCK OR GRAVEL SHALL CONFORM TO THE SPECIFIED GRADING LIMITS WHEN INSTALLED RESPECTIVELY IN THE RIP-RAP OR FILTER.
 3. GEOTEXTILE CLASS C28 OR BETTER SHALL BE PROTECTED FROM PUNCHING, CUTTING, OR TEARING. ANY DAMAGE OTHER THAN AN OCCASIONAL SMALL HOLE SHALL BE PREPARED BY PLACING ANOTHER PIECE OF GEOTEXTILE FABRIC OVER THE DAMAGED PART OR BY COMPLETELY REPLACING THE GEOTEXTILE FABRIC. ALL OVERLAPS WHETHER FOR REPAIRS OR FOR JOINING TWO PIECES OF GEOTEXTILE FABRIC SHALL BE A MINIMUM OF ONE FOOT.
 4. STONE FOR THE RIP-RAP OR GABION OUTLETS MAY BE PLACED BY EQUIPMENT. THEY SHALL BE CONSTRUCTED TO THE FULL COURSE THICKNESS IN ONE OPERATION AND IN SUCH A MANNER AS TO AVOID DISPLACEMENT OF UNDERLYING MATERIALS. THE STONE FOR THE RIP-RAP OR GABION OUTLETS SHALL BE DELIVERED AND PLACED IN A MANNER THAT WILL ASSURE THAT IT IS REASONABLY HOMOGENEOUS WITH THE SMALLER STONES AND SPALLS FILLING THE HOLES BETWEEN THE LARGER STONES. RIP-RAP SHALL BE PLACED IN A MANNER TO PREVENT DAMAGE TO THE FILTER BLANKET OR GEOTEXTILE FABRIC. HAND PLACEMENT WILL BE REQUIRED TO THE EXTENT NECESSARY TO PREVENT DAMAGE TO THE PERMANENT WORKS.
 5. THE STONE SHALL BE PLACED SO THAT IT BLENDS IN WITH THE EXISTING GROUND. IF THE STONE IS PLACED TOO HIGH THEN THE FLOW WILL BE FORCED OUT OF THE CHANNEL AND SCOUR ADJACENT TO THE STONE WILL OCCUR.

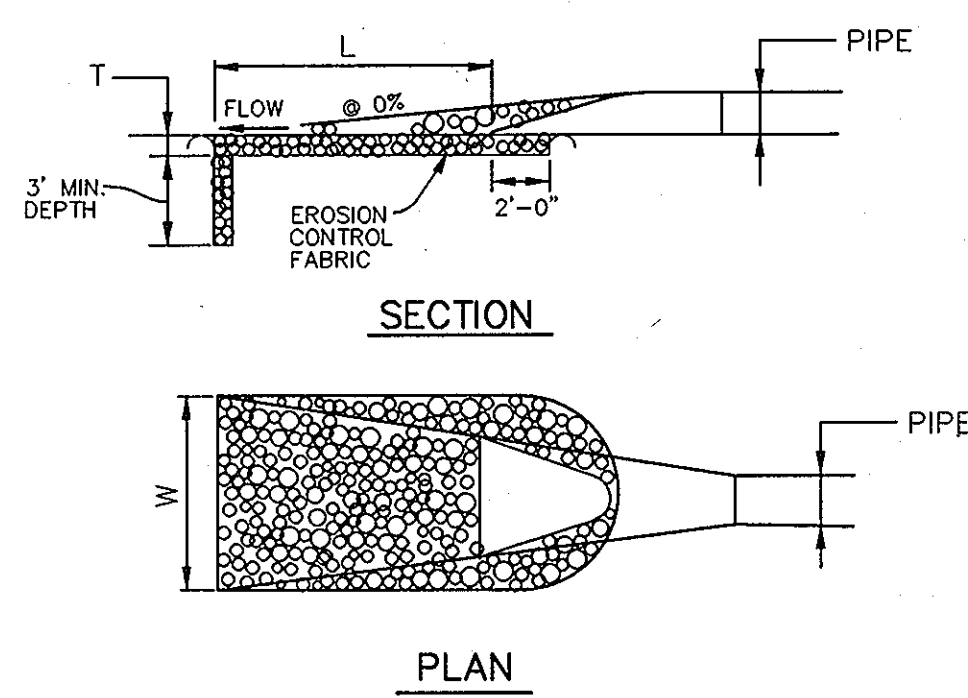

STRUCTURE	D-S	LENGTH (L)	WIDTH (W)	THICKNESS (T)	SHA CLASS
E-1	9.5"	20'	9.5'	19"	I
E-2	9.5"	20'	9.5'	19"	I

OUTLET PROTECTION DETAIL
NOT TO SCALE

STRUCTURE SCHEDULE						
NO.	TYPE	LOCATION	PIPE INV. IN	PIPE INV. OUT	TOP ELEV.	HO. CO. STD.
E-1	18" CONC. END SECT.	N 600463.6275 E 1344201.6810	NA	429.00	NA	SD - 5.51
E-2	18" CONC. END SECT.	N 600360.2715 E 1344063.7619	NA	427.91	NA	SD - 5.51
I-1	A-5	CL STA. 9+08.31 OFFSET 10.43' LEFT TAYLOR FARM ROAD	430.62	430.42	438.22	SD - 4.01
I-2	A-5	CL STA. 9+08.31 OFFSET 10.43' RIGHT TAYLOR FARM ROAD	431.56	430.76	438.22	SD - 4.01
I-3	A-5	CL STA. 0+44.00 OFFSET 10.43' LEFT WHITE DAHLIA DRIVE	433.28	433.08	441.35	SD - 4.01
I-4	A-5	CL STA. 0+44.00 OFFSET 10.43' RIGHT WHITE DAHLIA DRIVE	433.72	433.52	441.35	SD - 4.01
I-5	A-5	CL STA. 6+88.00 OFFSET 12.40' RIGHT TAYLOR FARM ROAD	434.35	434.15	441.31	SD - 4.01
I-6	A-5	CL STA. 4+79.03 OFFSET 12.40' RIGHT TAYLOR FARM ROAD	436.90	436.70	440.82	SD - 4.01
I-7	A-5	CL STA. 4+79.03 OFFSET 12.40' LEFT TAYLOR FARM ROAD	NA	436.97	440.82	SD - 4.01
I-8	A-5	CL STA. 4+49.17 OFFSET 26.83' LEFT WHITE DAHLIA DRIVE	NA	438.96	441.35	SD - 4.01
I-9	A-5	CL STA. 11+80.29 OFFSET 10.41' LEFT TAYLOR FARM ROAD	435.90	435.69	443.80	SD - 4.01
I-10	A-5	CL STA. 11+80.29 OFFSET 10.45' RIGHT TAYLOR FARM ROAD	NA	437.10	443.80	SD - 4.01
I-11	A-10	CL STA. 12+88.49 OFFSET 10.37' LEFT TAYLOR FARM ROAD	441.76	441.56	448.30	SD - 4.02
I-12	A-10	CL STA. 14+25.00 OFFSET 10.43' LEFT TAYLOR FARM ROAD	448.86	448.64	453.98	SD - 4.02
I-13	A-5	CL STA. 14+25.00 OFFSET 10.43' RIGHT TAYLOR FARM ROAD	NA	449.33	453.98	SD - 4.01
M-1	4'-0" MANHOLE	CL STA. 0+44.00 OFFSET 43.75' LEFT WHITE DAHLIA DRIVE	432.76	432.56	443.00	G - 5.12
M-2	4'-0" MANHOLE	CL STA. 1+99.46 OFFSET 15.00' LEFT WHITE DAHLIA DRIVE	435.52	435.32	445.23	G - 5.12
M-3	4'-0" MANHOLE	CL STA. 12+19.58 OFFSET 15.00' LEFT TAYLOR FARM ROAD	437.93	437.73	445.31	G - 5.12
HW-1	SEE SHEETS 14-20	CL STA. 10+29.25 OFFSET 30.00' LEFT TAYLOR FARM ROAD	NA	NA	432.20	NA
HW-2	SEE SHEETS 14-20	CL STA. 10+29.25 OFFSET 30.00' RIGHT TAYLOR FARM ROAD	NA	NA	432.20	NA

- 1) STRUCTURE ELEVATION AND LOCATION FOR MANHOLES IS AT THE TOP / CENTER OF RIM.
- 2) STRUCTURE ELEVATION AND LOCATION FOR INLETS IS AT THE FRONT MIDPOINT OF THE INLET.
- 3) STRUCTURE ELEVATION AND LOCATION FOR HEADWALLS IS AT THE MIDPOINT OF THE FRONT OF STRUCTURE.
- 4) STRUCTURE ELEVATION AND LOCATION FOR ENDSECTIONS IS AT THE MIDPOINT OF THE END OF STRUCTURE.
- 5) PRECAST STRUCTURES MEETING HS-20 LOADING MAY BE USED.

PIPE SCHEDULE		
PIPE SIZE	LENGTH	TYPE
15"	74.5'	RCCP CLASS IV
18"	1197.5'	RCCP CLASS IV
42' span x 10' height	60'	ASTM C150 TYPE 1, 2 OR 3

AS-BUILT CERTIFICATION
I hereby certify, by my seal, that the facilities shown on this plan were constructed as shown on this AS-BUILT plan.
Donald Mason, P.E. No. 21443 Date 12-31-13



Professional Certification. I hereby certify that these documents were prepared or approved by me, and that I am a duly licensed professional engineer under the laws of the State of Maryland.
License No. 21443, Expiration Date: 12-31-14

APPROVED: DEPARTMENT OF PUBLIC WORKS
William J. Smith 7-20-07
CHIEF, BUREAU OF HIGHWAYS
APPROVED: DEPARTMENT OF PLANNING AND ZONING
Cindy Kuntz 7/15/07
CHIEF, DIVISION OF LAND DEVELOPMENT
John P. ... 7/24/07
CHIEF, DEVELOPMENT ENGINEERING DIVISION

BENCHMARK ENGINEERING, INC.
ENGINEERS • LAND SURVEYORS • PLANNERS
8480 BALTIMORE NATIONAL PIKE & SUITE 418
ELLCOTT CITY, MARYLAND 21043
PHONE: 410-455-6105 FAX: 410-465-6844
WWW.BEE-CIVILENGINEERING.COM

OWNER/DEVELOPER: FRIENDLY FARMS LLC
P.O. BOX 417
ELLCOTT CITY, MARYLAND 21041
410-465-4244

PROJECT: TAYLOR FARM SECTION THREE, PHASE TWO
LOTS 57 THROUGH 101 AND NON-BUILDABLE BULK PARCEL 'A'
A RESUBDIVISION OF LOT 54 TAYLOR FARM SECTION THREE AND LOT 2 OF FRIENDLY FARMS (PLAT NO. 9220-9227)

LOCATION: TAX MAP: 10 GRID: 23 PARCEL: 309
TAX MAP: 16 GRID: 5 ZONED: R-20
3rd ELECTION DISTRICT HOWARD COUNTY, MARYLAND

TITLE: STORM DRAIN PROFILES

DATE: JULY, 2007 **PROJECT NO.:** 1585
SCALE: AS SHOWN **SHEET 10 OF 22**

DESIGN: DBT DRAFT: DBT CHECK: DAM
AS-BUILT



- LANDSCAPE NOTES:**
- TREES SHOULD BE PLANTED A MINIMUM OF 8 FEET FROM THE EDGE OF PAVING AND MUST BE A MINIMUM OF 5 FEET FROM ANY STORM DRAIN.
 - TREES MUST BE PLANTED A MINIMUM OF 5 FEET FROM AN OPEN SPACE ACCESS STRIP AND 10 FEET FROM A DRIVEWAY.
 - SEE TREE PLANTING DETAIL - THIS SHEET.
 - THIS PLAN HAS BEEN PREPARED IN ACCORDANCE WITH THE PROVISIONS OF SECTION 16.124 OF THE HOWARD COUNTY CODE AND THE HOWARD COUNTY LANDSCAPE MANUAL.
 - AT THE TIME OF INSTALLMENT, ALL SHRUBS AND OTHER PLANTINGS HEREWITH LISTED AND APPROVED FOR THIS SITE, SHALL BE OF THE PROPER HEIGHT REQUIREMENTS IN ACCORDANCE WITH THE HOWARD COUNTY LANDSCAPE MANUAL. IN ADDITION, NO SUBSTITUTIONS OR RELOCATION OF REQUIRED PLANTINGS MAY BE MADE WITHOUT PRIOR REVIEW AND APPROVAL FROM THE DEPARTMENT OF PLANNING AND ZONING. ANY DEVIATION FROM THIS APPROVED LANDSCAPE PLAN MAY RESULT IN DENIAL OR DELAY IN RELEASE OF LANDSCAPE SURETY UNTIL SUCH TIME AS ALL REQUIRED MATERIALS ARE PLANTED AND/OR REVISIONS ARE MADE TO APPLICABLE PLANS AND CERTIFICATIONS.
 - THE OWNER, TENANTS AND/OR THEIR AGENTS SHALL BE RESPONSIBLE FOR MAINTENANCE OF THE REQUIRED LANDSCAPING INCLUDING BOTH PLANT MATERIALS AND BERMS, FENCES AND WALLS. ALL PLANT MATERIALS SHALL BE MAINTAINED IN GOOD GROWING CONDITION, AND WHEN NECESSARY, REPLACED WITH NEW MATERIALS TO ENSURE CONTINUED COMPLIANCE WITH APPLICABLE REGULATIONS. ALL OTHER REQUIRED LANDSCAPING SHALL BE PERMANENTLY MAINTAINED IN GOOD CONDITION, AND WHEN NECESSARY, REPAIRED OR REPLACED.
 - FINANCIAL SURETY FOR THE REQUIRED LANDSCAPING HAS BEEN POSTED AS PART OF THE DPW DEVELOPER'S AGREEMENT IN THE AMOUNT OF \$20,850.00. (\$19,200.00 FOR 64 SHADE TREES, \$1,650.00 FOR 11 EVERGREENS)
 - TREE HEIGHTS AT MATURITY SHALL BE 25 FEET MAXIMUM WITHIN THE "GREEN ZONE". TREE HEIGHTS AT MATURITY SHALL BE 40 FEET MAXIMUM WITHIN THE "YELLOW ZONE". IF TREES ARE TO BE PLANTED ON BERMS THE TREE HEIGHTS SHALL BE REDUCED BY THE HEIGHT OF THE BERM AS MEASURED ABOVE MEAN GROUND ELEVATION OF THE UTILITY POLE LINE.

PUBLIC STREET TREE PLANTING LIST

SYMBOL	QUANTITY	NAME	REMARKS	DESCRIPTION
	56	ACER RUBRUM 'OCTOBER GLORY' (October Glory Red Maple)	2 1/2" - 3" col.	STREET TREES TO BE PROVIDED BY THE DEVELOPER
	19	TILIA CORDATA (Greenspire Littleleaf Linden)	2 1/2" - 3" col.	

LANDSCAPE PLANTING LIST

SYMBOL	QUANTITY	NAME	REMARKS	DESCRIPTION
	49	ACER SACCHARINUM 'GREEN MOUNTAIN' (Green Mountain Sugar Maple)	2-1/2" - 3" col.	SHADE TREES ALONG PERIMETER TO BE PROVIDED BY THE DEVELOPER
	35	PINUS STROBUS (Eastern White Pine)	6' - 8' ht.	EVERGREEN TREES ALONG PERIMETER TO BE PROVIDED BY THE DEVELOPER
	6	ILEX OPACA (American Holly)	5' - 6' ht.	

STREET TREE SCHEDULE

ROAD NAME	PERIMETER	TREES REQ.	TREES PROV.
TAYLOR FARM ROAD	2235'	56	56
WHITE DAHLIA DRIVE	744'	19	19
TOTAL		75	75

SCHEDULE A PERIMETER LANDSCAPE EDGE

CATEGORY	ADJ. TO PERIMETER PROPERTY							TOTALS
	①	②	③	④	⑤	⑥	⑦	
LANDSCAPE TYPE	A	A	A	B	A	B	B	
	1:60 (SHADE)	1:60 (SHADE)	1:60 (SHADE)	1:60 (SHADE)	1:60 (SHADE)	1:60 (SHADE)	1:40 (EVERGREEN)	
LINEAR FEET OF ROADWAY FRONTAGE/PERIMETER	211'	2577'	532'	75'	970'	193'	128'	
CREDIT FOR EXISTING VEGETATION (YES, NO, LINEAR FEET) (DESCRIBE BELOW IF NEEDED)	NO	YES* 1098'	NO	NO	NO	NO	NO	
CREDIT FOR WALL, FENCE OR BERM (YES, NO, LINEAR FEET) (DESCRIBE BELOW IF NEEDED)	NO	NO	NO	NO	NO	NO	NO	
NUMBER OF PLANTS REQUIRED	211*	1479*	532*	75*	970*	193*	128*	64
SHADE TREES	4	25	9	2	17	4	3	11
EVERGREEN TREES	-	-	-	-	-	-	-	-
OTHER TREES (2:1 SUBSTITUTE)	-	-	-	-	-	-	-	-
SHRUBS	-	-	-	-	-	-	-	-
NUMBER OF PLANTS PROVIDED	0	25	0	0	17	4	3	49
SHADE TREES	0	25	0	0	17	4	3	49
EVERGREEN TREES	8**	-	18**	6**	-	5	4	41
OTHER TREES (2:1 SUBSTITUTE)	-	-	-	-	-	-	-	-
SHRUBS	-	-	-	-	-	-	-	-

*EXISTING WOODS 20' OR GREATER IN WIDTH.
**EVERGREEN TREES SUBSTITUTED AT A 2:1 RATIO

PLAN VIEW
SCALE: 1" = 50'

LEGEND

- EXISTING FOREST
- EXISTING HEDGEROW, SCATTERED TREES & BRUSH
- EXISTING 100-YR FLOODPLAIN
- EXISTING STREAM
- EXISTING STREAM BANK
- EXISTING WETLANDS
- FOREST CONSERVATION EASEMENT
- PROPOSED UTILITY AND ACCESS EASEMENTS
- EXISTING UTILITY AND ACCESS EASEMENTS
- PROPOSED TREE MAINTENANCE EASEMENTS
- PERIMETER LANDSCAPE EDGE
- LENGTH OF CREDIT FOR EXISTING WOODS 20' OR GREATER


No As-Built information is required on this sheet



DEVELOPER'S/BUILDER'S CERTIFICATE

I/WE CERTIFY THAT THE LANDSCAPING SHOWN ON THIS PLAN WILL BE DONE ACCORDING TO THE PLAN, SECTION 16.124 OF THE HOWARD COUNTY CODE AND THE HOWARD COUNTY LANDSCAPE MANUAL. I/WE FURTHER CERTIFY THAT UPON COMPLETION OF A LETTER OF LANDSCAPE INSTALLATION, ACCOMPANIED BY AN EXECUTED ONE-YEAR GUARANTEE OF PLANT MATERIALS, WILL BE SUBMITTED TO THE DEPARTMENT OF PLANNING AND ZONING.

STEVEN K. BREEDEN DATE 8/21/07 JAMES R. SCHULTE DATE 8/21/07

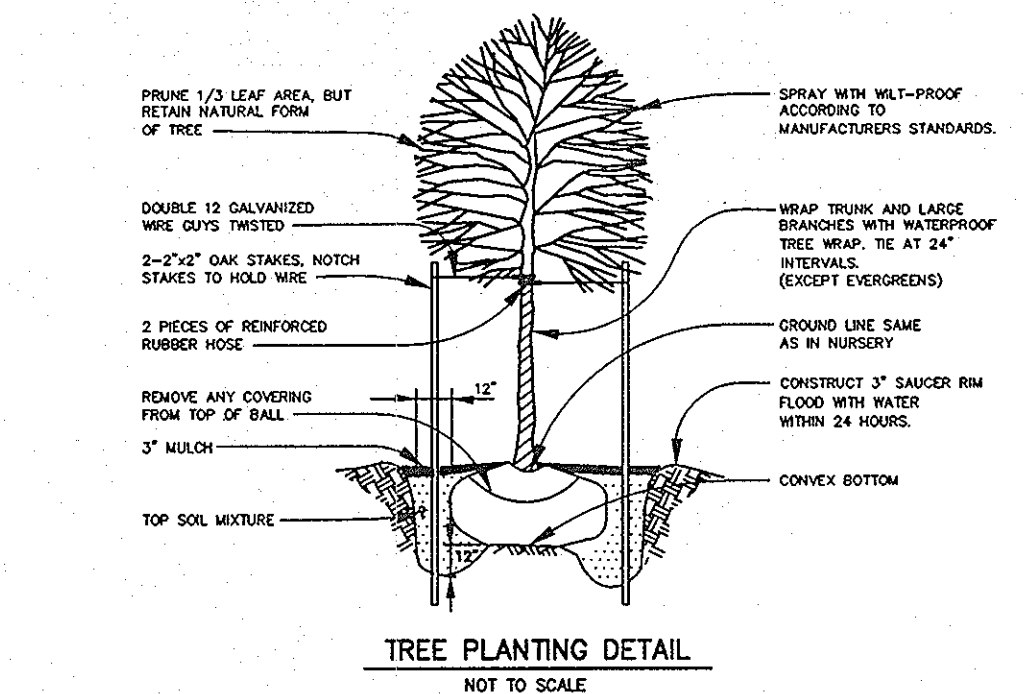

APPROVED: DEPARTMENT OF PUBLIC WORKS
Wade Z. ... 9-7-07
CHIEF, BUREAU OF HIGHWAYS

APPROVED: DEPARTMENT OF PLANNING AND ZONING
Quincy ... 9/15/07
CHIEF, DIVISION OF LAND DEVELOPMENT

... 9/12/07
CHIEF, DEVELOPMENT ENGINEERING DIVISION

BENCHMARK ENGINEERING, INC.
8480 BALTIMORE NATIONAL PIKE & SUITE 418
ELLICOTT CITY, MARYLAND 21043
PHONE: 410-465-6105 FAX: 410-465-6844
WWW.BEI-CVLENGINEERING.COM

OWNER/DEVELOPER: FRIENDLY FARMS LLC, P.O. BOX 417, ELLICOTT CITY, MARYLAND 21041, 410-465-4244

PROJECT: TAYLOR FARM SECTION THREE, PHASE TWO
LOTS 57 THROUGH 101 AND NON-BUILDABLE BULK PARCEL 'A'
A RESUBDIVISION OF LOT 54 TAYLOR FARM SECTION THREE AND LOT 2 OF FRIENDLY FARMS (PLAT NO. 9220-9227)


LOCATION: TAX MAP: 10 GRID: 23 PARCEL: 309
TAX MAP: 16 GRID: 5 ZONED: R-20
3rd ELECTION DISTRICT
HOWARD COUNTY, MARYLAND

TITLE: PERIMETER LANDSCAPE AND STREET TREE PLAN

DATE: AUGUST, 2007 **PROJECT NO.:** 1585

SCALE: AS SHOWN **SHEET:** 11 OF 22

DESIGN: DBT **DRAFT:** DBT **CHECK:** DAM **SCALE:** AS SHOWN **SHEET:** 11 OF 22

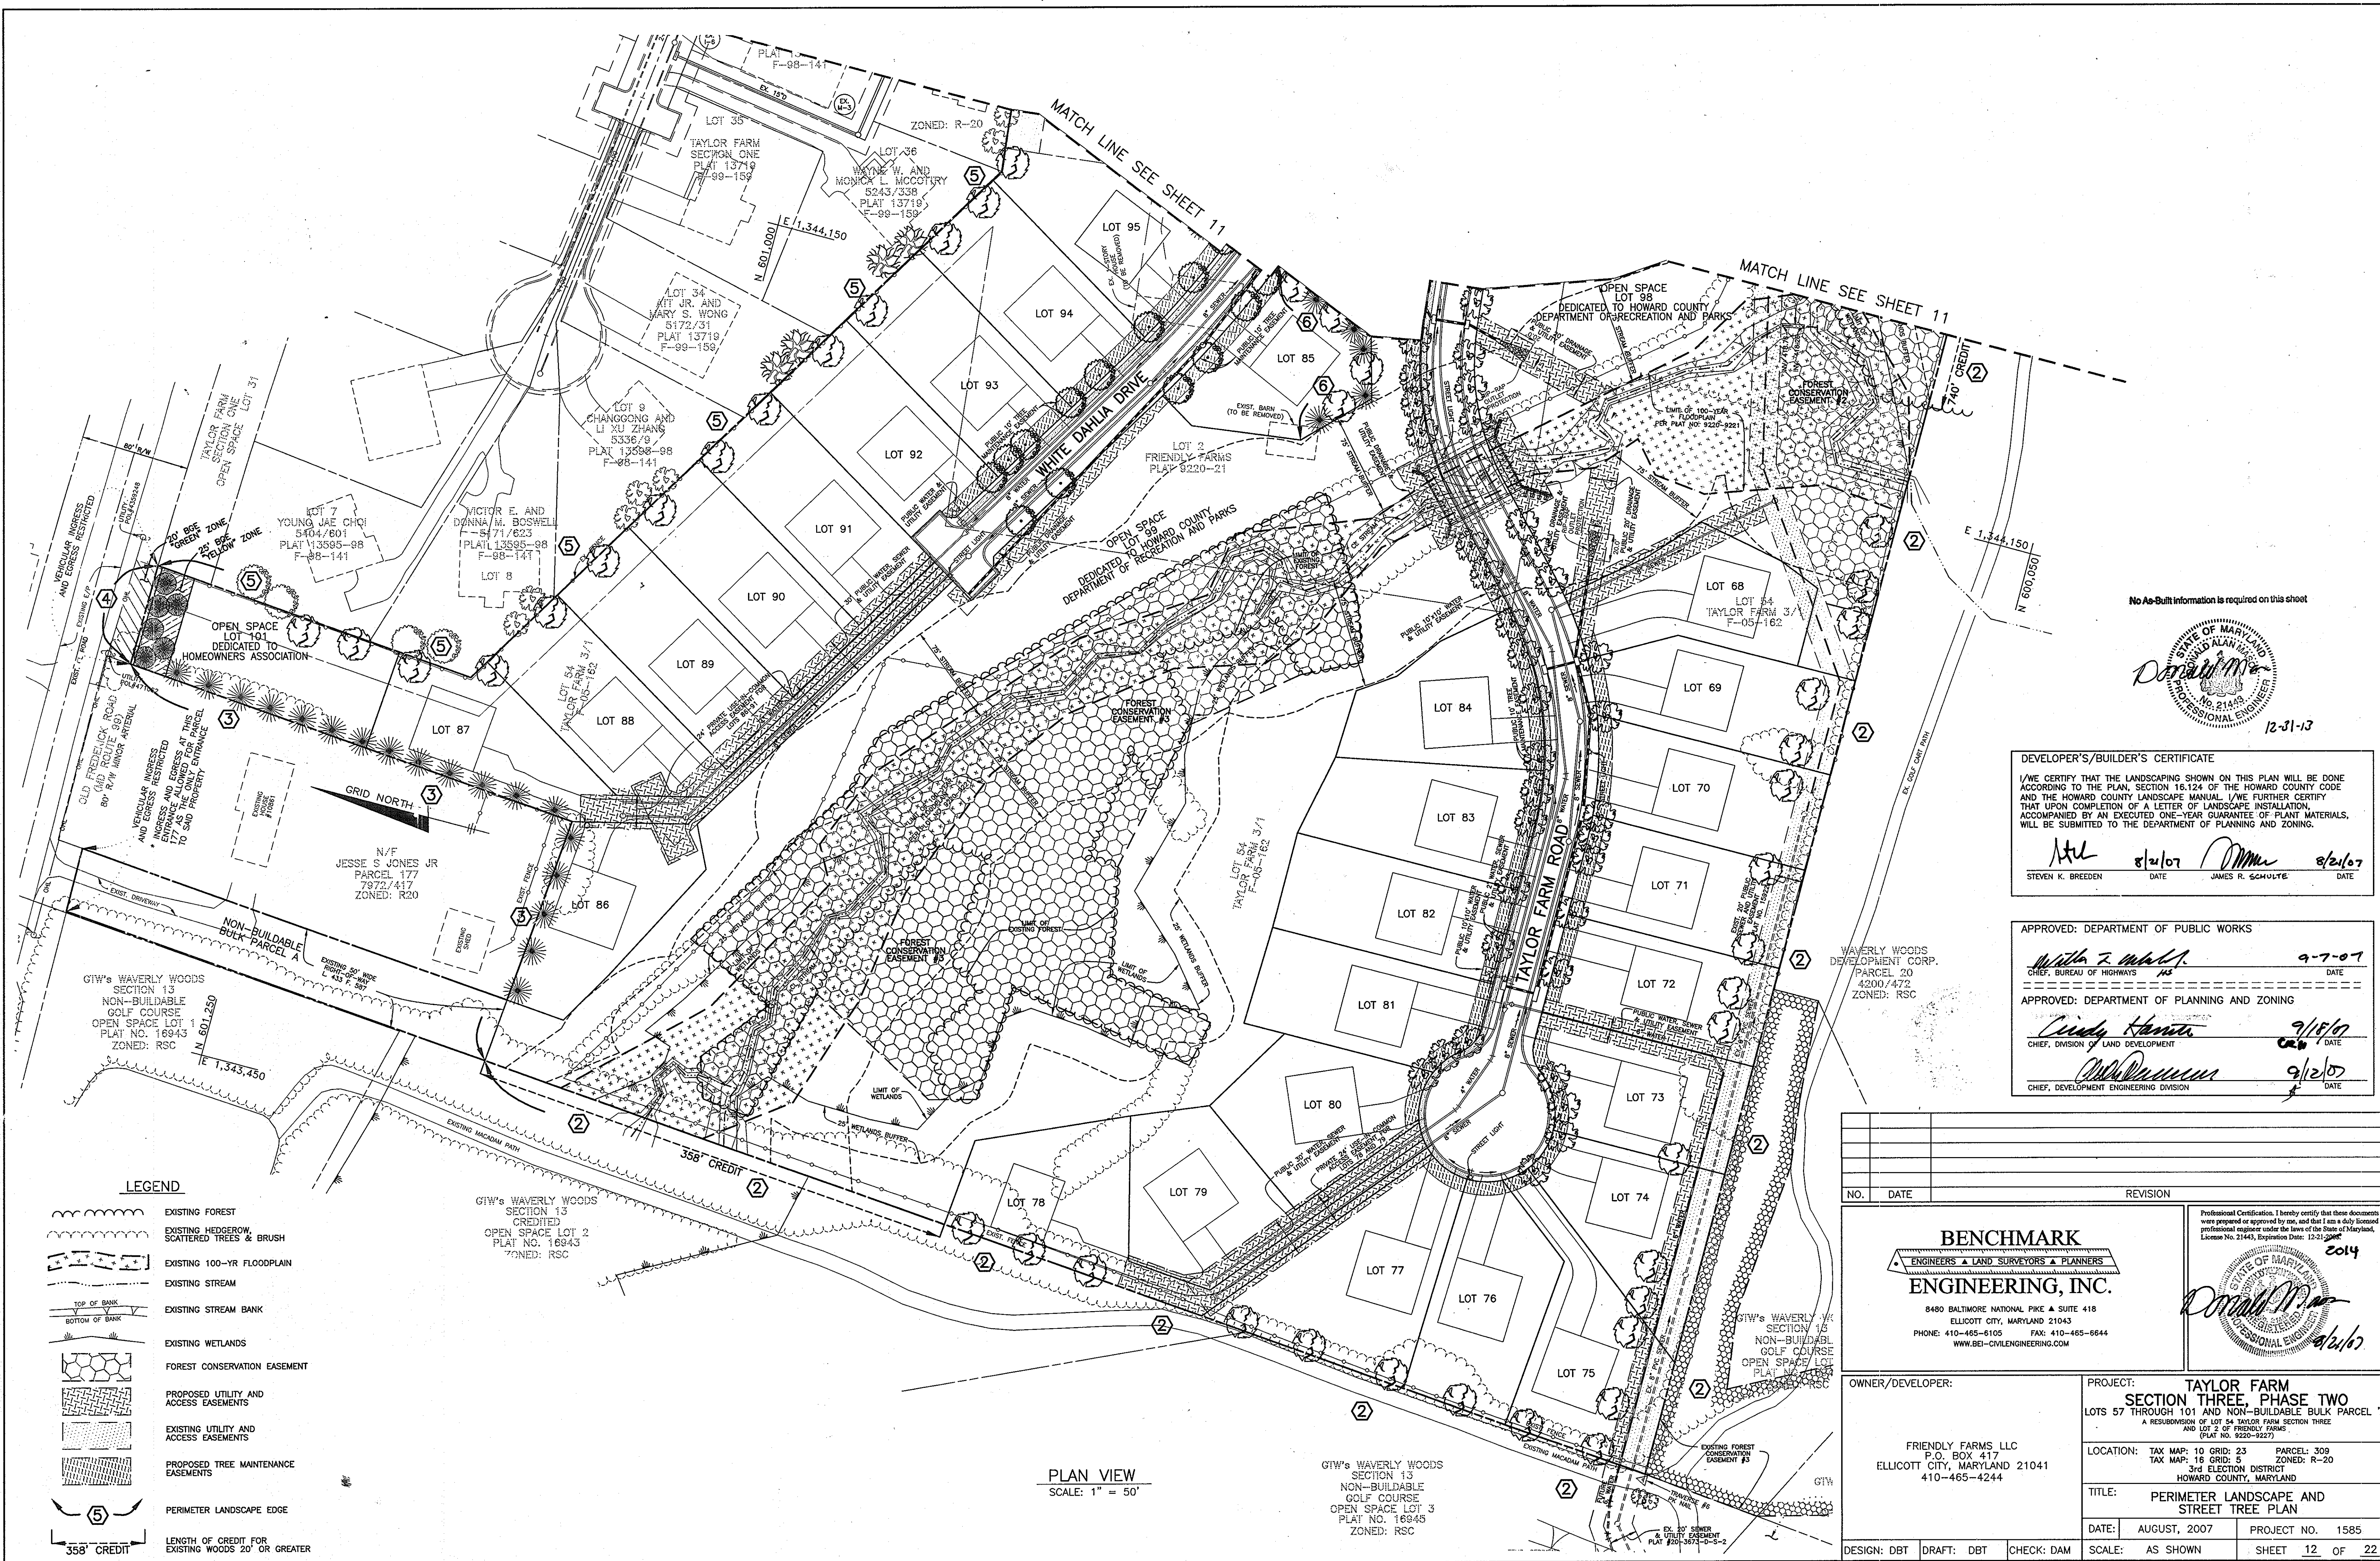


- LEGEND**
- EXISTING FOREST
 - EXISTING HEDGEROW, SCATTERED TREES & BRUSH
 - EXISTING 100-YR FLOODPLAIN
 - EXISTING STREAM
 - EXISTING STREAM BANK
 - EXISTING WETLANDS
 - FOREST CONSERVATION EASEMENT
 - PROPOSED UTILITY AND ACCESS EASEMENTS
 - EXISTING UTILITY AND ACCESS EASEMENTS
 - PROPOSED TREE MAINTENANCE EASEMENTS
 - PERIMETER LANDSCAPE EDGE
 - LENGTH OF CREDIT FOR EXISTING WOODS 20' OR GREATER

PLAN VIEW
SCALE: 1" = 50'

GIW's WAVERLY WOODS SECTION 13 NON-BUILDABLE GOLF COURSE OPEN SPACE LOT 3 PLAT NO. 16945 ZONED: RSC

No As-Built information is required on this sheet

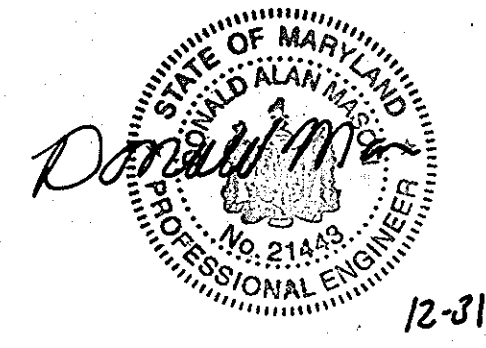

DEVELOPER'S/BUILDER'S CERTIFICATE

I/WE CERTIFY THAT THE LANDSCAPING SHOWN ON THIS PLAN WILL BE DONE ACCORDING TO THE PLAN, SECTION 16.124 OF THE HOWARD COUNTY CODE AND THE HOWARD COUNTY LANDSCAPE MANUAL. I/WE FURTHER CERTIFY THAT UPON COMPLETION OF A LETTER OF LANDSCAPE INSTALLATION, ACCOMPANIED BY AN EXECUTED ONE-YEAR GUARANTEE OF PLANT MATERIALS, WILL BE SUBMITTED TO THE DEPARTMENT OF PLANNING AND ZONING.

SKL 8/21/07 *JS* 8/21/07
STEVEN K. BREEDEN DATE JAMES R. SCHULTE DATE

APPROVED: DEPARTMENT OF PUBLIC WORKS

William Z. ... 9-7-07
CHIEF, BUREAU OF HIGHWAYS DATE

APPROVED: DEPARTMENT OF PLANNING AND ZONING

Cindy ... 9/18/07
CHIEF, DIVISION OF LAND DEVELOPMENT DATE

... 9/12/07
CHIEF, DEVELOPMENT ENGINEERING DIVISION DATE

NO.	DATE	REVISION



BENCHMARK ENGINEERING, INC.
ENGINEERS • LAND SURVEYORS • PLANNERS

8480 BALTIMORE NATIONAL PIKE & SUITE 418
ELLCOTT CITY, MARYLAND 21043
PHONE: 410-465-6105 FAX: 410-465-6644
WWW.BEI-CVLENGINEERING.COM

Professional Certification. I hereby certify that these documents were prepared or approved by me, and that I am a duly licensed professional engineer under the laws of the State of Maryland. License No. 21443, Expiration Date: 12-31-2014

Donald M. Schulte 8/21/07

OWNER/DEVELOPER: FRIENDLY FARMS LLC P.O. BOX 417 ELLCOTT CITY, MARYLAND 21041 410-465-4244	PROJECT: TAYLOR FARM SECTION THREE, PHASE TWO LOTS 57 THROUGH 101 AND NON-BUILDABLE BULK PARCEL 'A' A RESUBDIVISION OF LOT 54 TAYLOR FARM SECTION THREE AND LOT 2 OF FRIENDLY FARMS (PLAT NO. 9220-9227)
LOCATION: TAX MAP: 10 GRID: 23 PARCEL: 309 TAX MAP: 16 GRID: 5 ZONED: R-20 3rd ELECTION DISTRICT HOWARD COUNTY, MARYLAND	TITLE: PERIMETER LANDSCAPE AND STREET TREE PLAN
DATE: AUGUST, 2007 PROJECT NO. 1585	SCALE: AS SHOWN SHEET 12 OF 22
DESIGN: DBT DRAFT: DBT CHECK: DAM	

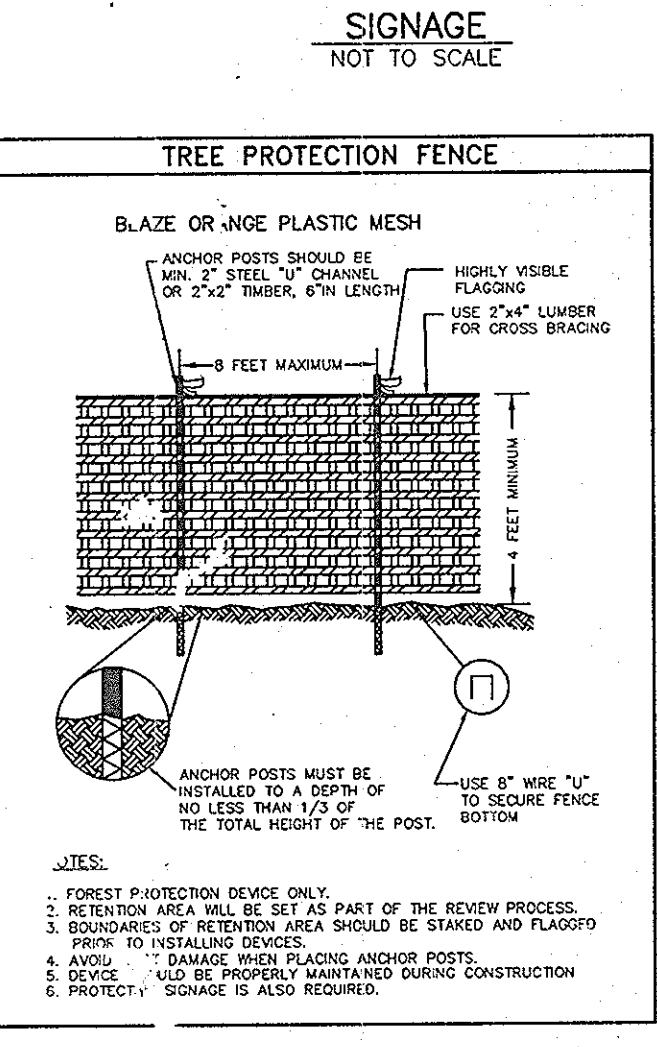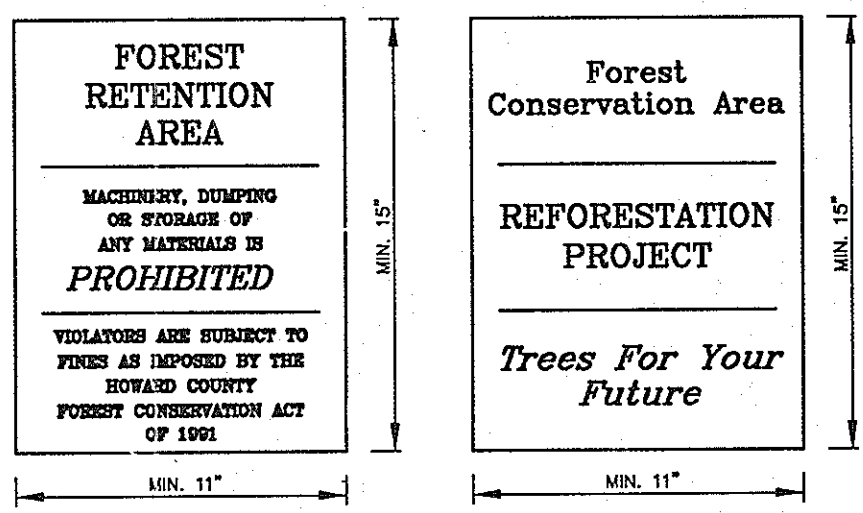

PLANTING NOTES:

- MULTIFLORA ROSE CONTROL MAY BE REQUIRED AS PART OF THIS PLANTING PLAN.
- BARBERD PLANT MATERIAL MAY BE USED TO OFFSET THE COST OF MULTIFLORA ROSE REMOVAL AND MAINTENANCE IF BARBERD MATERIAL IS USED IT MUST BE PLANTED IN MARCH - APRIL AND AN ANTI-DESICCANT GEL SHOULD BE UTILIZED TO PROTECT ROOT SYSTEMS. CONTAINER GROWN STOCK IS RECOMMENDED.
- PLANTS SHOULD BE FLAGGED TO AVOID LOCATION DURING MAINTENANCE. PLANTINGS SHOULD ALSO BE PLANTED IN A GRID PATTERN TO FACILITATE MAINTENANCE AND REMOVAL OF INVASIVE AND EXOTIC SPECIES.

MULTIFLORA ROSE CONTROL NOTE

MULTIFLORA ROSE IS PREVALENT IN CERTAIN AREAS TO BE AFFORESTED. PRIOR TO PLANTING ALL MULTIFLORA ROSE SHOULD BE REMOVED. REMOVAL OF THE ROSE MAY BE PERFORMED WITH MOWING AND HERBICIDE TREATMENTS. PHYSICAL REMOVAL OF ALL TOP GROWTH FOLLOWED BY A PERIODIC HERBICIDE TREATMENT OF STUMP SPROUTS IS RECOMMENDED. NATIVE TREE AND SHRUB SPECIES OCCURRING WITHIN THE ROSE THICKETS SHOULD BE RETAINED WHEREVER POSSIBLE. HERBICIDE TREATMENTS SHALL OCCUR ON 2 MONTH INTERVALS DURING THE FIRST GROWING SEASON AND ONCE EACH IN THE SPRING AND FALL FOR SUBSEQUENT YEARS. HERBICIDE USED SHALL BE MADE SPECIFICALLY TO ADDRESS WOODY PLANT MATERIAL AND SHALL BE APPLIED AS PER MANUFACTURERS SPECIFICATIONS. CARE SHOULD BE TAKEN NOT TO SPRAY PLANTED TREES OR NATURALLY OCCURRING NATIVE TREE/SHRUB SEEDLINGS. IT IS RECOMMENDED THAT INITIATION OF ROSE REMOVAL BEGIN AT LEAST SIX MONTHS PRIOR TO PLANTING.

PLANTING/SOIL SPECIFICATION:

- PLANTING OF NURSERY STOCK SHALL TAKE PLACE BETWEEN MARCH 15TH AND APRIL 30TH. CONTAINER STOCK MAY BE PLANTED BETWEEN SEPTEMBER 1ST AND OCTOBER 30TH.
- A TWO (2) INCH LAYER OF TOPSOIL SHALL BE SPREAD OVER ALL REFORESTATION AREAS IMPACTED BY SITE CHANGING TO ASSURE A SUITABLE PLANTING AREA. DISTURBED AREAS SHALL BE SEEDED AND STABILIZED AS PER GENERAL CONSTRUCTION PLAN FOR EROSION CONTROL. PLANTING AREAS NOT IMPACTED BY SITE CHANGING SHALL HAVE NO ADDITIONAL TOPSOIL APPLIED.
- ALL NURSERY PLANTING STOCK SHALL HAVE THEIR ROOT SYSTEMS DIPPED INTO AN ANTI-DESICCANT SOLUTION.
- PLANTS SHALL BE INSTALLED SO THAT THE TOP OF ROOT MASS IS LEVEL WITH THE TOP OF EXISTING GROUND SURFACE. PLANTS WITH SHALLOW ROOT SYSTEMS SHALL BE PLANTED AT A 1:1 RATIO OF PLANT HEIGHT TO 1 PART FINE SAND OR EQUIVALENT.
- FERTILIZER SHALL CONSIST OF A PROFORM 22-8-2, OR EQUIVALENT, APPLIED AS PER MANUFACTURERS SPECIFICATIONS.
- A TWO (2) INCH LAYER OF HARDWOOD MULCH SHALL BE PLACED OVER THE ROOT AREA OF ALL PLANTINGS.
- PLANT MATERIAL SHALL BE TRANSPORTED TO THE SITE IN A TARPED OR COVERED TRUCK. PLANTS SHALL BE KEPT MOIST PRIOR TO PLANTING.
- ALL NON-PLANTING DEBRIS ASSOCIATED WITH THE PLANTING OPERATION SHALL BE REMOVED FROM THE SITE.

SEQUENCE OF CONSTRUCTION

- PLANTS SHALL BE INSTALLED AS PER PLANT SCHEDULE AND PLANTING/SOIL SPECIFICATIONS FOR THE PROJECT.
- UPON COMPLETION OF THE PLANTING, SIGNAGE SHALL BE INSTALLED AS PER THE FOREST RETENTION AREA PROTECTION DEVICES SHOWN ON THE FOREST CONSERVATION PLAN.
- PLANTINGS SHALL BE MAINTAINED AND GUARANTEED IN ACCORDANCE WITH THE MAINTENANCE AND GUARANTEE REQUIREMENTS FOR PROJECT.

MAINTENANCE OF PLANTINGS

- MAINTENANCE OF ALL PLANTINGS SHALL LAST FOR A PERIOD OF 24 MONTHS.
- ALL PLANT MATERIAL SHALL BE WATERED TWICE A MONTH DURING THE 1ST GROWING SEASON. WATERING SHALL BE STOPPED PRIOR TO PLANTING.
- PROXIMATE EXISTING AND NEWLY PLANTED TREES SHALL BE MAINTAINED FROM REFORESTATION AREAS. OLD FIELD SUCCESSIONAL SPECIES WILL BE MONITORED AND MAINTAINED DURING THE GROWING SEASON FOR PLANTS WILL BE COMBINED AND MAINTAINED FOR TWO YEARS DURING THE GROWING SEASON FOR APPROPRIATE AGES. ALL PLANTS SHALL BE PRUNED FROM PLANTINGS.
- GUARANTEE REQUIREMENTS
- AFTER ONE GROWING SEASON, PLANT MATERIAL SHALL BE MAINTAINED AT 90% SURVIVAL THRESHOLD. A 75% SURVIVAL RATE OF PLANTINGS WILL BE MAINTAINED AT THE END OF THE 24 MONTH MAINTENANCE PERIOD. ALL PLANT MATERIAL BELOW THE 75% THRESHOLD WILL BE REPLACED AT THE BEGINNING OF THE NEXT GROWING SEASON. THE CONTRACTOR WILL NOT BE LIABLE FOR PLANT LOSS DUE TO THEFT OR VANDALISM. HOWEVER, DEVELOPER SHALL BE RELEASED FROM THE FOREST SURETY OBLIGATION.

SURETY FOR REFORESTATION


- THE DEVELOPER SHALL POST A SURETY BOND (LETTER OF CREDIT) TO ENSURE THAT REFORESTATION PLANTINGS ARE COMPLETED. UPON ACCEPTANCE OF THE PLANTINGS BY THE COUNTY, THE BOND SHALL BE RELEASED.

APPROVED: DEPARTMENT OF PUBLIC WORKS
 [Signature] 9-7-07
 CHIEF, BUREAU OF HIGHWAYS

APPROVED: DEPARTMENT OF PLANNING AND ZONING
 [Signature] 9/15/07
 CHIEF, DIVISION OF LAND DEVELOPMENT

[Signature] 9/16/07
 CHIEF, DEVELOPMENT ENGINEERING DIVISION

Eco-Science Professionals, Inc.
 CONSULTING
 P.O. Box 5006 Glen Arm, MD 21037 (410) 592-6752

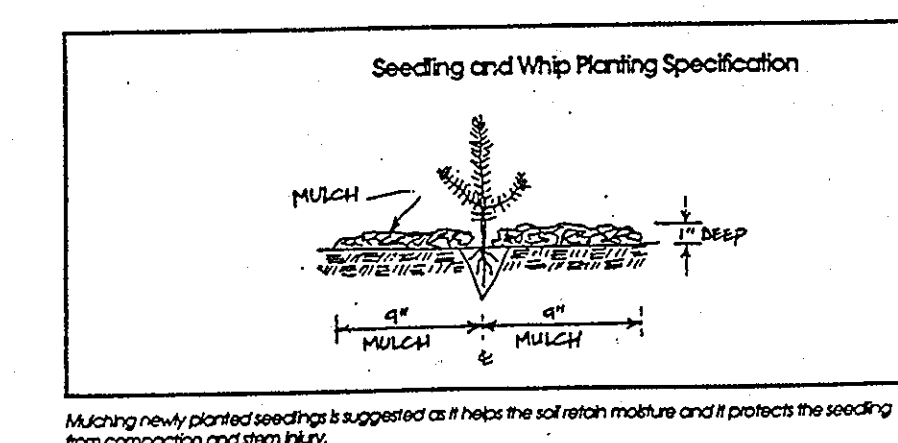


PLAN VIEW
 SCALE: 1" = 50'

FOREST CONSERVATION NOTES:

- ANY FOREST CONSERVATION EASEMENT (FCE) AREA SHOWN HEREON IS SUBJECT TO PROTECTIVE COVENANTS WHICH MAY BE FOUND IN THE LAND RECORDS OF HOWARD COUNTY WHICH RESTRICT THE DISTURBANCE AND USE OF THESE AREAS.
- THE FOREST CONSERVATION EASEMENTS HAVE BEEN ESTABLISHED TO FULFILL THE REQUIREMENTS OF SECTION 16.1200 OF THE HOWARD COUNTY CODE, FOREST CONSERVATION ACT. NO CLEARING, GRADING, OR CONSTRUCTION IS PERMITTED WITHIN THE FOREST CONSERVATION EASEMENTS; HOWEVER, FOREST MANAGEMENT PRACTICES AS DEFINED IN THE DEED OF FOREST CONSERVATION EASEMENT ARE ALLOWED.
- LIMITS OF DISTURBANCE SHALL BE RESTRICTED TO AREAS OUTSIDE THE LIMIT OF TEMPORARY FENCING OR THE FCE BOUNDARY, WHICHEVER IS GREATER.
- THERE SHALL BE NO CLEARING, GRADING, CONSTRUCTION OR DISTURBANCE OF VEGETATION IN THE FOREST CONSERVATION EASEMENT, EXCEPT AS PERMITTED BY HOWARD COUNTY DPZ.
- NO STOCKPILES, PARKING AREAS, EQUIPMENT CLEANING AREAS, ETC. SHALL OCCUR WITHIN AREAS DESIGNATED AS FOREST CONSERVATION EASEMENTS.
- TEMPORARY FENCING SHALL BE USED TO PROTECT FOREST RESOURCES DURING CONSTRUCTION. THE FENCING SHALL BE PLACED ALONG ALL FCE BOUNDARIES WHICH OCCUR WITHIN 15 FEET OF THE PROPOSED LIMITS OF DISTURBANCE.
- PERMANENT SIGNAGE SHALL BE PLACED 50'-100' APART ALONG THE BOUNDARIES OF ALL AREAS INCLUDED IN FOREST CONSERVATION EASEMENTS.
- PORTIONS OF THE SITE OCCURRING WITHIN THE 100-YEAR FLOODPLAIN ARE NOT INCLUDED AS PART OF THE NET TRACT AREA OF THE SITE. AREAS OF FLOODPLAIN FOREST OCCURRING WITHIN THE LIMITS OF A FOREST CONSERVATION EASEMENT WILL BE PROTECTED BY THE EASEMENT RESTRICTIONS BUT HAVE NOT BEEN CREDITED TOWARD THE PROJECTS FCE OBLIGATIONS.
- THE TOTAL FOREST CONSERVATION OBLIGATION AMOUNT OF 3.14 ACRES SHALL BE MET BY THE RETENTION OF 1.87 AC. OF NET TRACT AREA FOREST WITHIN A FOREST CONSERVATION EASEMENT (1.76 AC. ON-SITE AND 0.11 AC. CREDITED FROM FCE #1 IN TAYLOR FARM SECT. 3 PHASE 1, F-05-162) AND THE ON-SITE AFFORESTATION OF 1.27 AC. WITHIN A FOREST CONSERVATION EASEMENT. FINANCIAL SURETY FOR THE REQUIRED FOREST CONSERVATION HAS BEEN POSTED AS PART OF THE DPW DEVELOPER'S AGREEMENT IN THE AMOUNT OF \$42,993.72 (\$15,333.12 FOR RETENTION OF 76,665.6 S.F. OF FOREST AND \$27,660.6 FOR THE PLANTING OF 55,321.2 S.F. OF FOREST). SURETY FOR THE 0.11 AC. OF RETENTION IN FCE #1 HAS BEEN POSTED AS PART OF THE DEVELOPER'S AGREEMENT FOR F-05-162.
- THE FOREST CONSERVATION WATERSHED FOR THIS PROJECT IS THE PATAPSCO RIVER LOWER BRANCH #2130906.
- THERE ARE NO RARE, THREATENED OR ENDANGERED SPECIES LOCATED ON THIS SITE. THERE ARE NO SPECIMEN OR CHAMPION TREES LOCATED ON THIS SITE TO THE BEST OF OUR KNOWLEDGE, THERE ARE NO HISTORIC STRUCTURES LOCATED ON THIS SITE.
- THE PROTECTIVE SIGNAGE SHALL STAY ON-SITE IN PERPETUITY.

FOR BEARINGS AND DISTANCES OF THE FOREST CONSERVATION EASEMENTS SEE RECORDED PLAT.

LEGEND

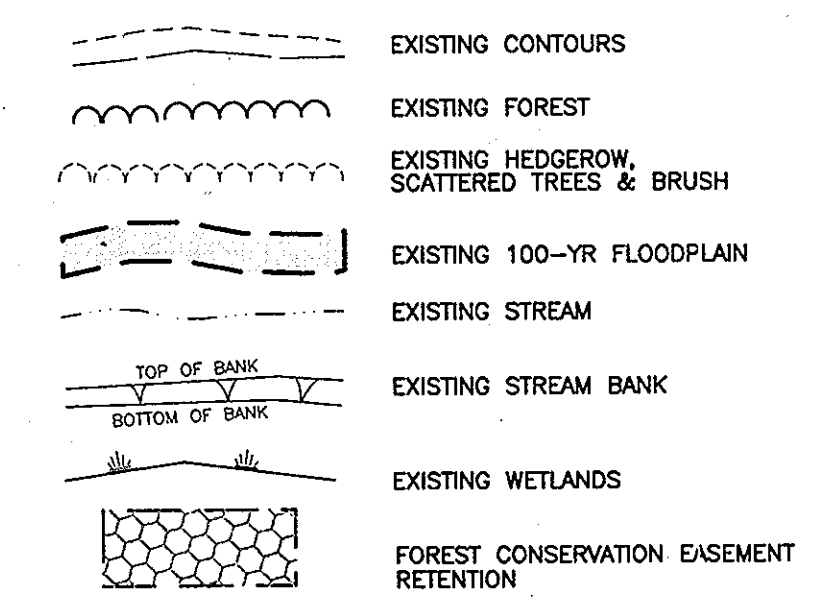

FOREST CONSERVATION WORKSHEET
 VERSION 1.0

NET TRACT AREA:

A. Total tract area	23.30
B. Area within 100 year floodplain	2.37
C. Area to remain in agricultural production	0.00
D. Net tract area	20.93

LAND USE CATEGORY: (from table 3.2.1, page 40, Manual)

Input the number "1" under the appropriate land use zoning and limit to only one entry.

ARA	MDR	IDA	HDR	MPD	CIA
0	0	0	1	0	0

E. Afforestation Threshold 15% x D = 3.14
 F. Conservation Threshold 20% x D = 4.19

EXISTING FOREST COVER:

G. Existing forest cover (excluding floodplain)	1.87
H. Area of forest above afforestation threshold	0.00
I. Area of forest above conservation threshold	0.00

BREAK EVEN POINT:

J. Forest retention above threshold with no mitigation	0.00
K. Clearing permitted without mitigation	0.00

PROPOSED FOREST CLEARING:

L. Total area of forest to be cleared	0.00
M. Total area of forest to be retained	1.87

PLANTING REQUIREMENTS:

N. Reforestation for clearing above conservation threshold	0.00
P. Reforestation for clearing below conservation threshold	0.00
O. Credit for retention above conservation threshold	0.00
R. Total reforestation required	0.00
S. Total afforestation required	1.27
T. Total reforestation and afforestation required	1.27

* 1.76 AC. ON SITE AND 0.11 AC. CREDITED IN FCE #1 IN TAYLOR FARM SECT. 3 PHASE 1 (F-05-162).

FCE ACREAGE CHART

EASEMENT	AREA IN HIGH PRIORITY BUFFERS	RETENTION CREDITED	RETENTION NON-CREDITED (IN FLOODPLAIN)	PLANTING	TOTAL EASEMENT AREA
2	1.95 AC.	0.77 AC.	0.45 AC.	0.87 AC.	2.09 AC.
3	2.11 AC.	0.99 AC.	0.73 AC.	0.40 AC.	2.12 AC.
TOTALS	4.06 AC.	1.76 AC.	1.18 AC.	1.27 AC.	4.21 AC.



No As-Built information is required on this sheet

NO.	DATE	REVISION


BENCHMARK ENGINEERING, INC.
 ENGINEERS & LAND SURVEYORS & PLANNERS
 8480 BALTIMORE NATIONAL PIKE A SUITE 418
 ELLICOTT CITY, MARYLAND 21043
 PHONE: 410-465-6105 FAX: 410-465-6644
 WWW.BE-ENGLANDENGINEERING.COM

Professional Certification: I hereby certify that these documents were prepared or approved by me, and that I am a duly licensed professional engineer under the laws of the State of Maryland. License No. 21443, Expiration Date: 12-31-2014

12/31/13

OWNER/DEVELOPER: FRIENDLY FARMS LLC P.O. BOX 417 ELLICOTT CITY, MARYLAND 21041 410-465-4244	PROJECT: TAYLOR FARM SECTION THREE, PHASE TWO LOTS 57 THROUGH 101 AND NON-BUILDABLE BULK PARCEL 'A' A RESUBDIVISION OF LOT 54 TAYLOR FARM SECTION THREE AND LOT 2 OF FRIENDLY FARMS (PLAT NO. 9220-9227)
LOCATION: TAX MAP: 10 GRID: 23 PARCEL: 309 TAX MAP: 16 GRID: 5 ZONED: R-20 WARD ELECTION DISTRICT: HOWARD COUNTY, MARYLAND	TITLE: FOREST CONSERVATION PLAN
DATE: AUGUST, 2007 PROJECT NO. 1585	SCALE: AS SHOWN SHEET 13 OF 22

AS-BUILT F-07-051

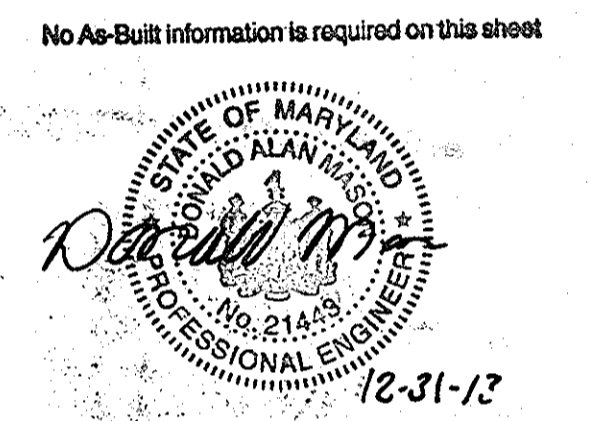

LEGEND

	EXISTING CONTOURS
	EXISTING FOREST
	EXISTING HEDGEROW, SCATTERED TREES & BRUSH
	EXISTING 100-YR FLOODPLAIN
	EXISTING STREAM
	EXISTING STREAM BANK
	EXISTING WETLANDS
	FOREST CONSERVATION EASEMENT RETENTION

NO.	DATE	REVISION

BENCHMARK ENGINEERING, INC.
 ENGINEERS • LAND SURVEYORS • PLANNERS
 8480 BALTIMORE NATIONAL PIKE & SUITE 418
 ELLICOTT CITY, MARYLAND 21043
 PHONE: 410-465-6105 FAX: 410-465-6644
 WWW.BCM-ENGINEERING.COM

Professional Certification, I hereby certify that these documents were prepared or approved by me, and that I am a duly licensed professional engineer under the laws of the State of Maryland, License No. 21443, Expiration Date: 12-31-2016

OWNER/DEVELOPER: FRIENDLY FARMS LLC P.O. BOX 417 ELLCOTT CITY, MARYLAND 21043 410-465-4244	PROJECT: TAYLOR FARM SECTION THREE, PHASE TWO LOTS 57 THROUGH 101 AND NON-BUILDABLE BULK PARCEL 'A' A RESUBDIVISION OF LOT 54 TAYLOR FARM SECTION THREE AND LOT 2 OF FRIENDLY FARMS (PLAT NO. 9220-9221)
LOCATION: TAX MAP: 10 GRID: 23 PARCEL: 309 TAX MAP: 18 GRID: 5 ZONED: R-20 3rd ELECTION DISTRICT HOWARD COUNTY, MARYLAND	TITLE: FOREST CONSERVATION PLAN
DATE: AUGUST, 2007	PROJECT NO. 1585
DESIGN: DBT	DRAFT: DBT
CHECK: DAM	SCALE: AS SHOWN
SHEET 14 OF 22	

APPROVED: DEPARTMENT OF PUBLIC WORKS
Walter M. ... 9-7-07
 CHIEF, BUREAU OF HIGHWAYS

APPROVED: DEPARTMENT OF PLANNING AND ZONING
Cindy Hama 9/15/07
 CHIEF, DIVISION OF LAND DEVELOPMENT

Alan ... 9/21/07
 CHIEF, DEVELOPMENT ENGINEERING DIVISION

FOR BEARINGS AND DISTANCES OF THE FOREST CONSERVATION EASEMENTS SEE RECORDED PLAT.

Eco-Science Professionals, Inc.
 CONSULTING ECOLOGISTS
 P.O. BOX 5056 GAITHERSBURG, MD 20878 (410) 592-6152

MD DNR Professional Seal
John ... 9/21/07
 CONSULTANT

PLAN VIEW
 SCALE: 1" = 50'

GIW's WAVERLY WOODS SECTION 13
 NON-BUILDABLE GOLF COURSE
 OPEN SPACE LOT 3
 PLAT NO. 16843
 ZONED: RSC

Installation Drawings Sheet Index	
CT1	TITLE SHEET & GENERAL NOTES
CT2	BRIDGE PLAN & DETAIL
CT3	FOUNDATION PLAN
CT4	FOOTING SECTION & DETAILS
CT5	ELEVATIONS
CT6	SECTION & DETAILS
CT7	SPECIFICATIONS
CT8	SPECIFICATIONS

TAYLOR FARM SECTION THREE, PHASE TWO

NOTES

GENERAL NOTES:

- This bridge has been designed for general site conditions. The project engineer shall be responsible for the structure's suitability to the existing site conditions and for the hydraulic evaluation -- including scour and confirmation of soil conditions.
- Prior to construction, contractor must verify all elevations shown through the engineer.
- Only CONTECH Bridge Solutions Inc. the CON/SPAN® approved precaster in Maryland may provide the structure designed in accordance with these plans.
- The use of another precast structure with the design assumptions used for the CON/SPAN® structure may lead to serious design errors. Use of any other precast structure with this design and drawings voids any certification of this design and warranty. CONTECH Bridge Solutions Inc. assumes no liability for design of any alternate or similar type structures.
- Alternate structures may be considered, provided that signed and sealed design drawings (and calculations) are submitted to the engineer 2 weeks prior to the bid date for review and approval.
- Proposed alternates to a CON/SPAN® Bridge System must submit at least two (2) independently verified full scale load tests that confirm the proposed design methodology of the three sided/arch structure(s). The proposed alternate, upon satisfactory confirmation of design methodology, may be considered an acceptable alternate.


DESIGN DATA

Design Loading:
 Bridge Units: HS25-44 + Maryland Legal Loads
 Headwalls: Earth Pressure Only
 Wingwalls: Earth Pressure Only
 Design Fill Height: 2'-0" min. to 6'-0" max. from top of crown to top of pavement.
 Design Method: Load factor per AASHTO Specification
 Net allowable soil bearing pressure: 6000 PSF *
 Gross allowable soil bearing pressure: 6000 PSF *


*Foundation excavation and subgrade preparation shall be in accordance with the geotechnical report for this project prepared by Hills-Carnes Engineering Associates, Inc. dated 9/28/06.

MATERIALS

Precast units shall be constructed and installed in accordance with CON/SPAN® Specifications. Concrete for Footings shall have a minimum compressive strength of 4000 psi. Reinforcing steel for footings shall conform to ASTM A615 or A996-Grade 60.

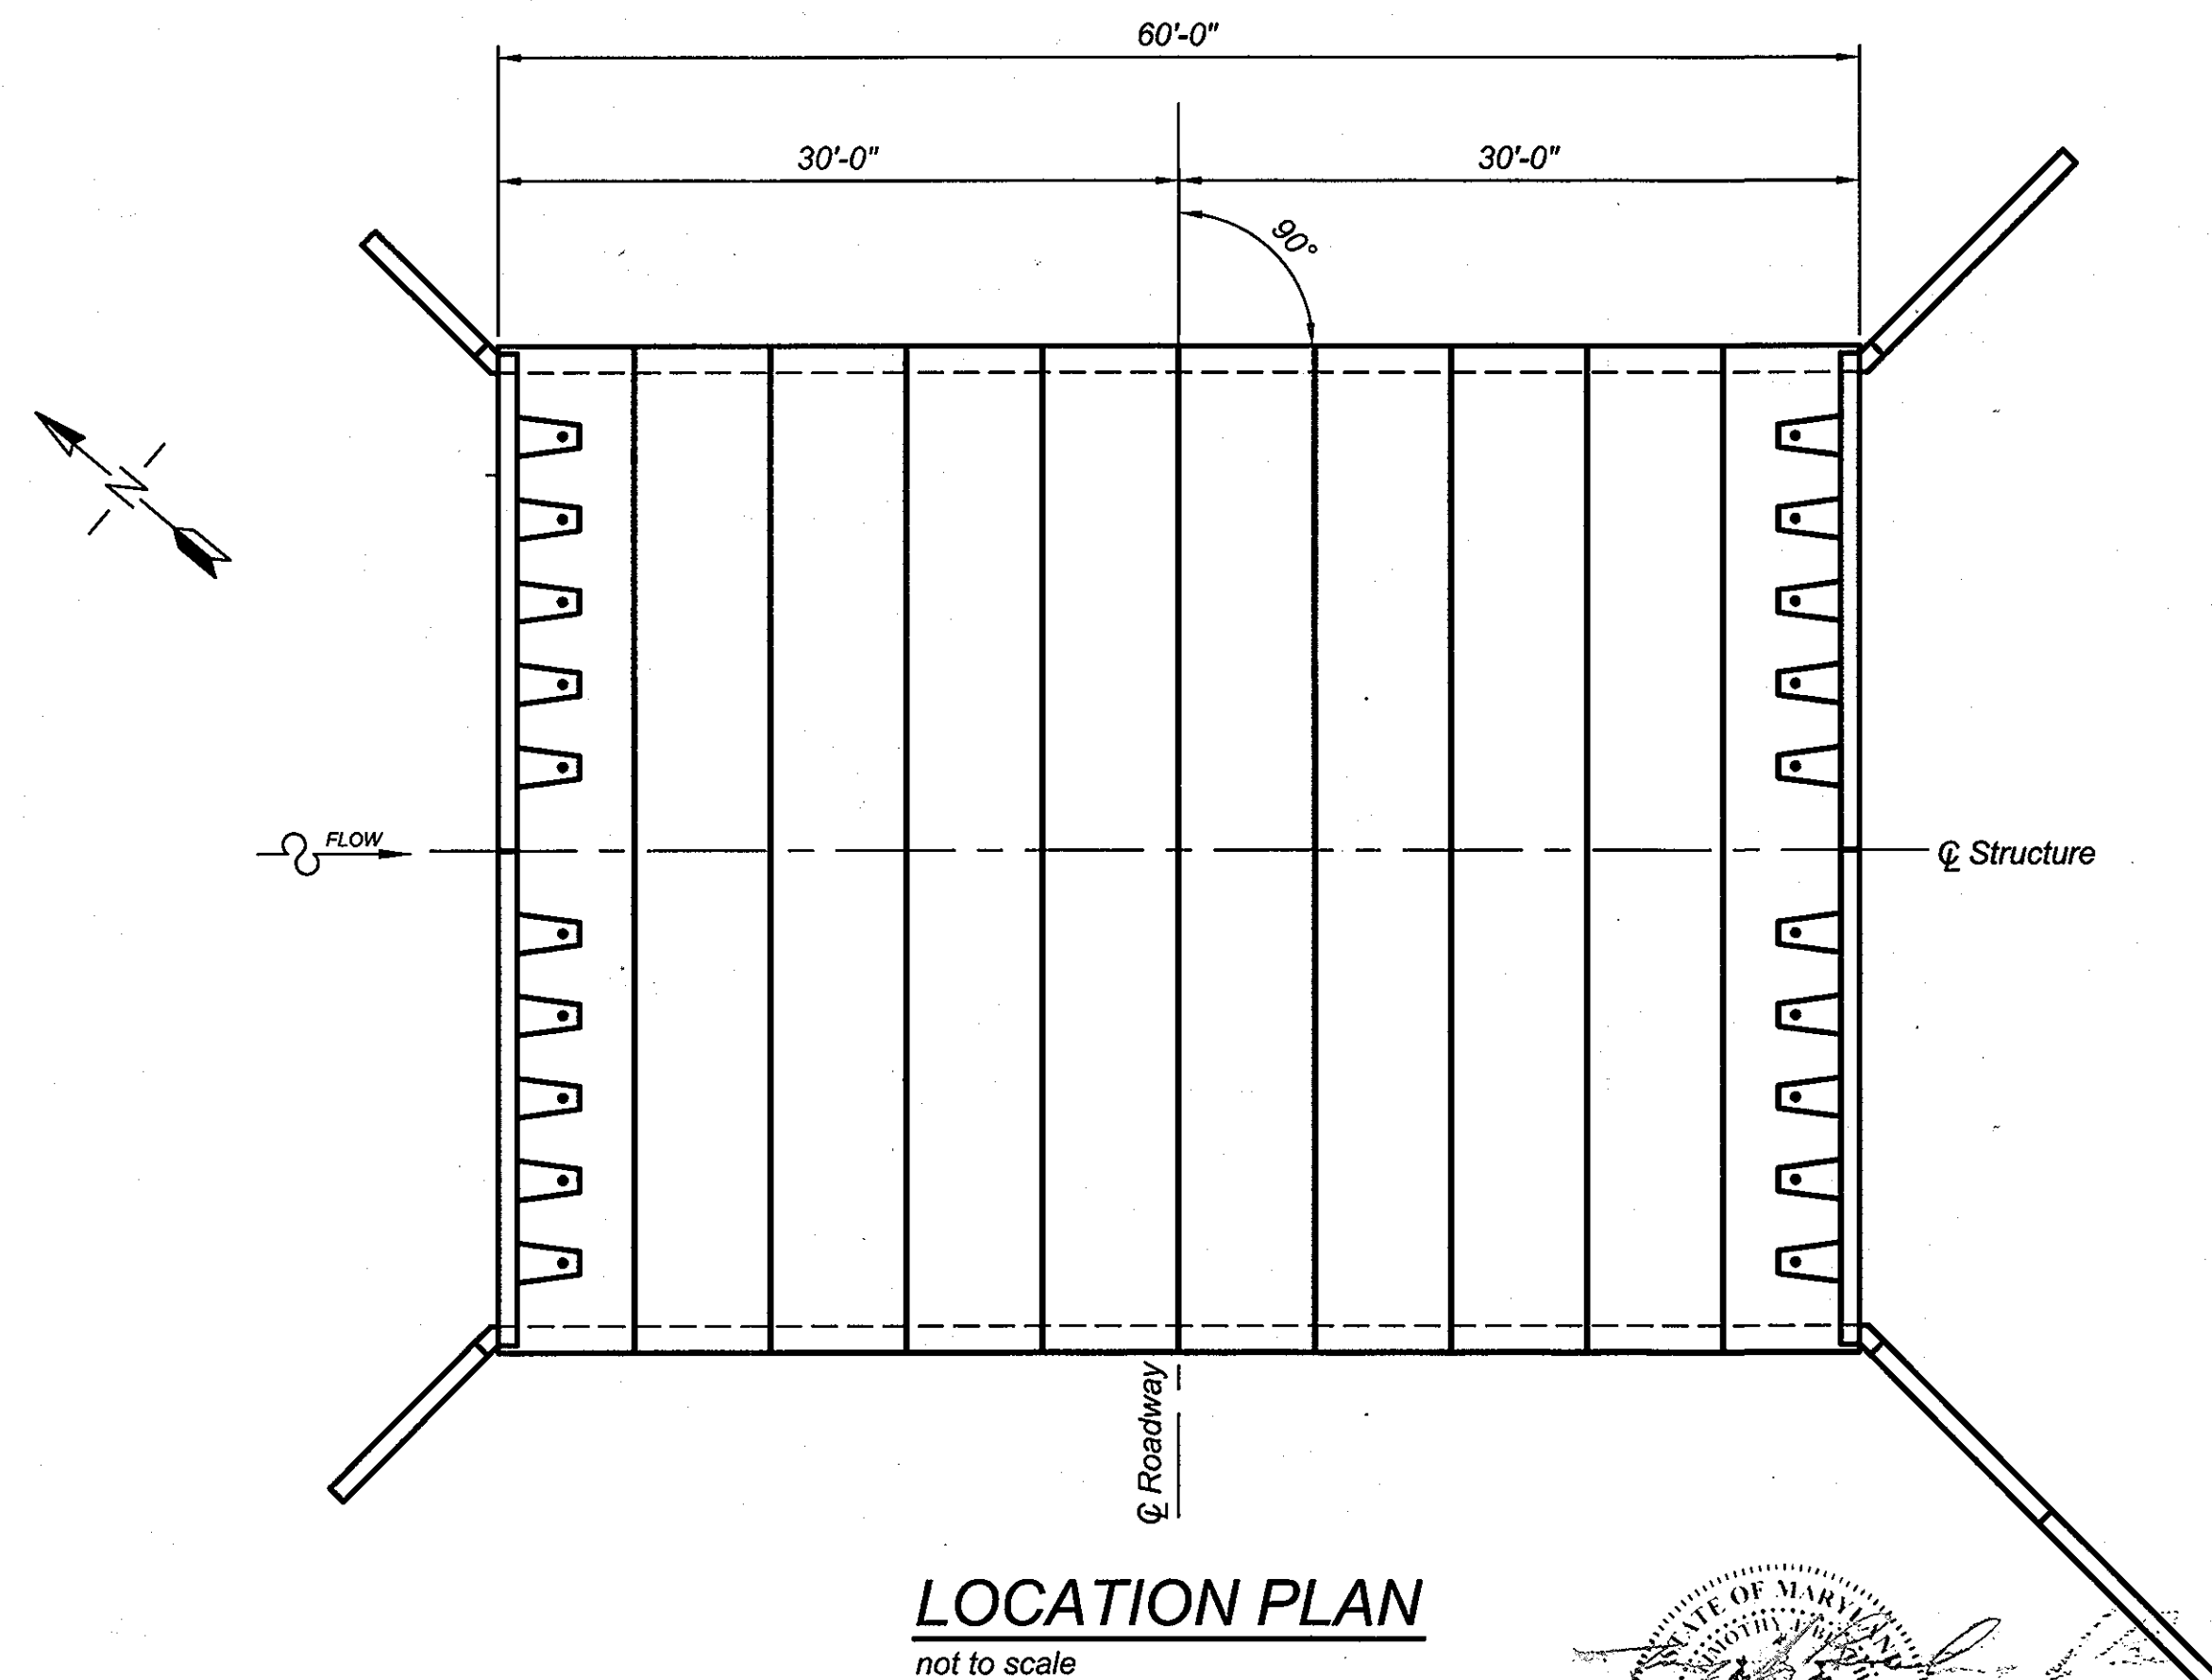

LOCATION PLAN
not to scale

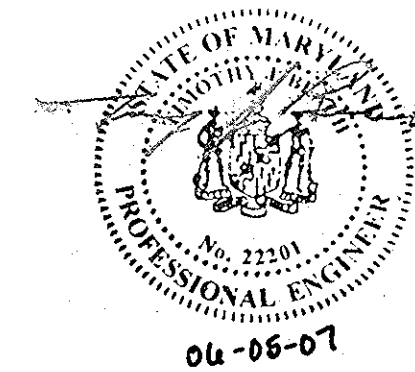

Professional Certification. I hereby certify that these documents were prepared or approved by me, and that I am a duly licensed professional engineer under the laws of the State of Maryland.
 License No. 21443 Expiration Date: 12-31-13

APPROVED: DEPARTMENT OF PUBLIC WORKS
 [Signature] 7-20-07
 CHIEF, BUREAU OF HIGHWAYS
 APPROVED: DEPARTMENT OF PLANNING AND ZONING
 [Signature] 9/15/07
 CHIEF, DIVISION OF LAND DEVELOPMENT
 [Signature] 2/24/07
 CHIEF, DEVELOPMENT ENGINEERING DIVISION

NO.	DATE	REVISION

BENCHMARK
 ENGINEERS & LAND SURVEYORS & PLANNERS
ENGINEERING, INC.
 8480 BALTIMORE NATIONAL PIKE & SUITE 418
 ELLICOTT CITY, MARYLAND 21043
 PHONE: 410-465-6105 FAX: 410-465-6644
 WWW.BE-CVLENGINEERING.COM

OWNER/DEVELOPER: FRIENDLY FARMS LLC
 P.O. BOX 417
 ELLICOTT CITY, MARYLAND 21041
 410-465-4244

PROJECT: TAYLOR FARM SECTION THREE, PHASE TWO
 LOTS 57 THROUGH 101 AND NON-BUILDABLE BULK PARCEL 'A' A RESUBDIVISION OF LOT 84 TAYLOR FARM SECTION THREE AND LOT 2 OF FRIENDLY FARMS (PLAT NO. 8220-0277)

LOCATION: TAX MAP: 10 GRID: 23 PARCEL: 308
 TAX MAP: 16 GRID: 5 ZONED: R-20
 3rd ELECTION DISTRICT
 HOWARD COUNTY, MARYLAND

TITLE: CON/SPAN BRIDGE
 TITLE SHEET & GENERAL NOTES

DATE: JULY, 2007 PROJECT NO. 1585

SCALE: AS SHOWN SHEET 15 OF 22

NOTICE
 © 2007. The design and information shown on this drawing is provided as a service to the project owner, engineer and contractor by CONTECH Bridge Solutions Inc. No part of this drawing may be used, reproduced, or modified in any manner without the prior written authorization of CONTECH Bridge Solutions Inc. Any such use, reproduction, or modification of this drawing is done at the user's own risk and the user agrees to indemnify, defend and hold harmless CONTECH Bridge Solutions Inc. from and against any and all claims, liability, and expense, including, but not limited to, reasonable attorney's fees, arising from such use, reproduction or modification.

If discrepancies between the supplied information and actual field conditions are encountered as site work progresses, these discrepancies must be reported to CONTECH Bridge Solutions Inc., immediately for re-evaluation of the design. CONTECH Bridge Solutions Inc. accepts no liability for designs based on inaccurate information supplied by others.

Company:

8430 University Executive Park Drive
 Suite 695
 Charlotte, North Carolina 28262






704-548-8420
 704-548-8586 fax
 800-526-3999

Sheet Title: TITLE SHEET & GENERAL NOTES

Project Status: APPROVED FOR CONSTRUCTION

Designed: MRP Project No. 15086
 Drawn: RPU
 Checked: LNM Sheet No. CT1
 Date: 4/12/07

CONTECH Bridge Solutions Inc. - System:

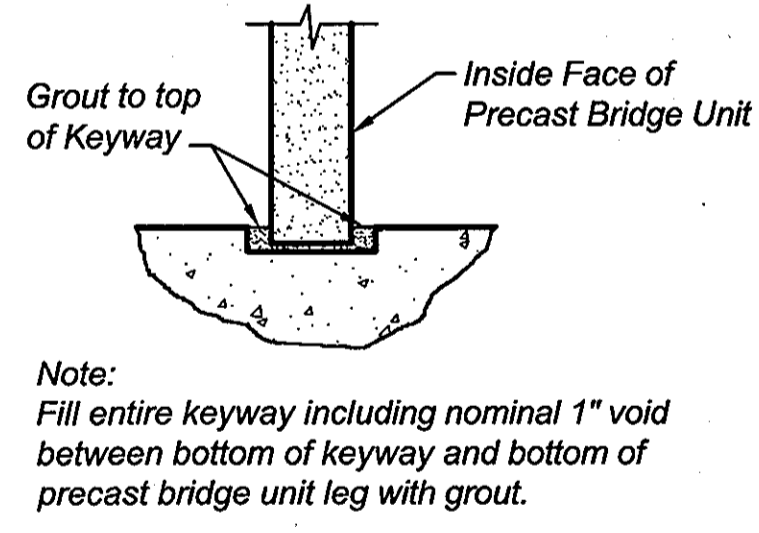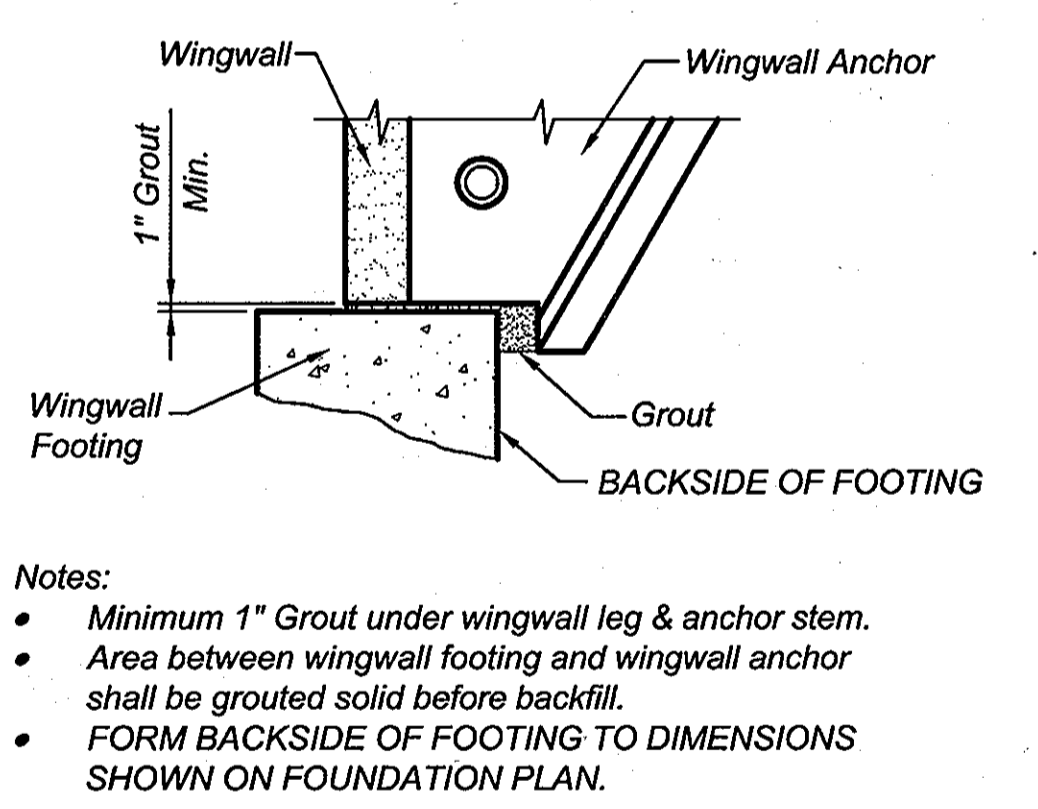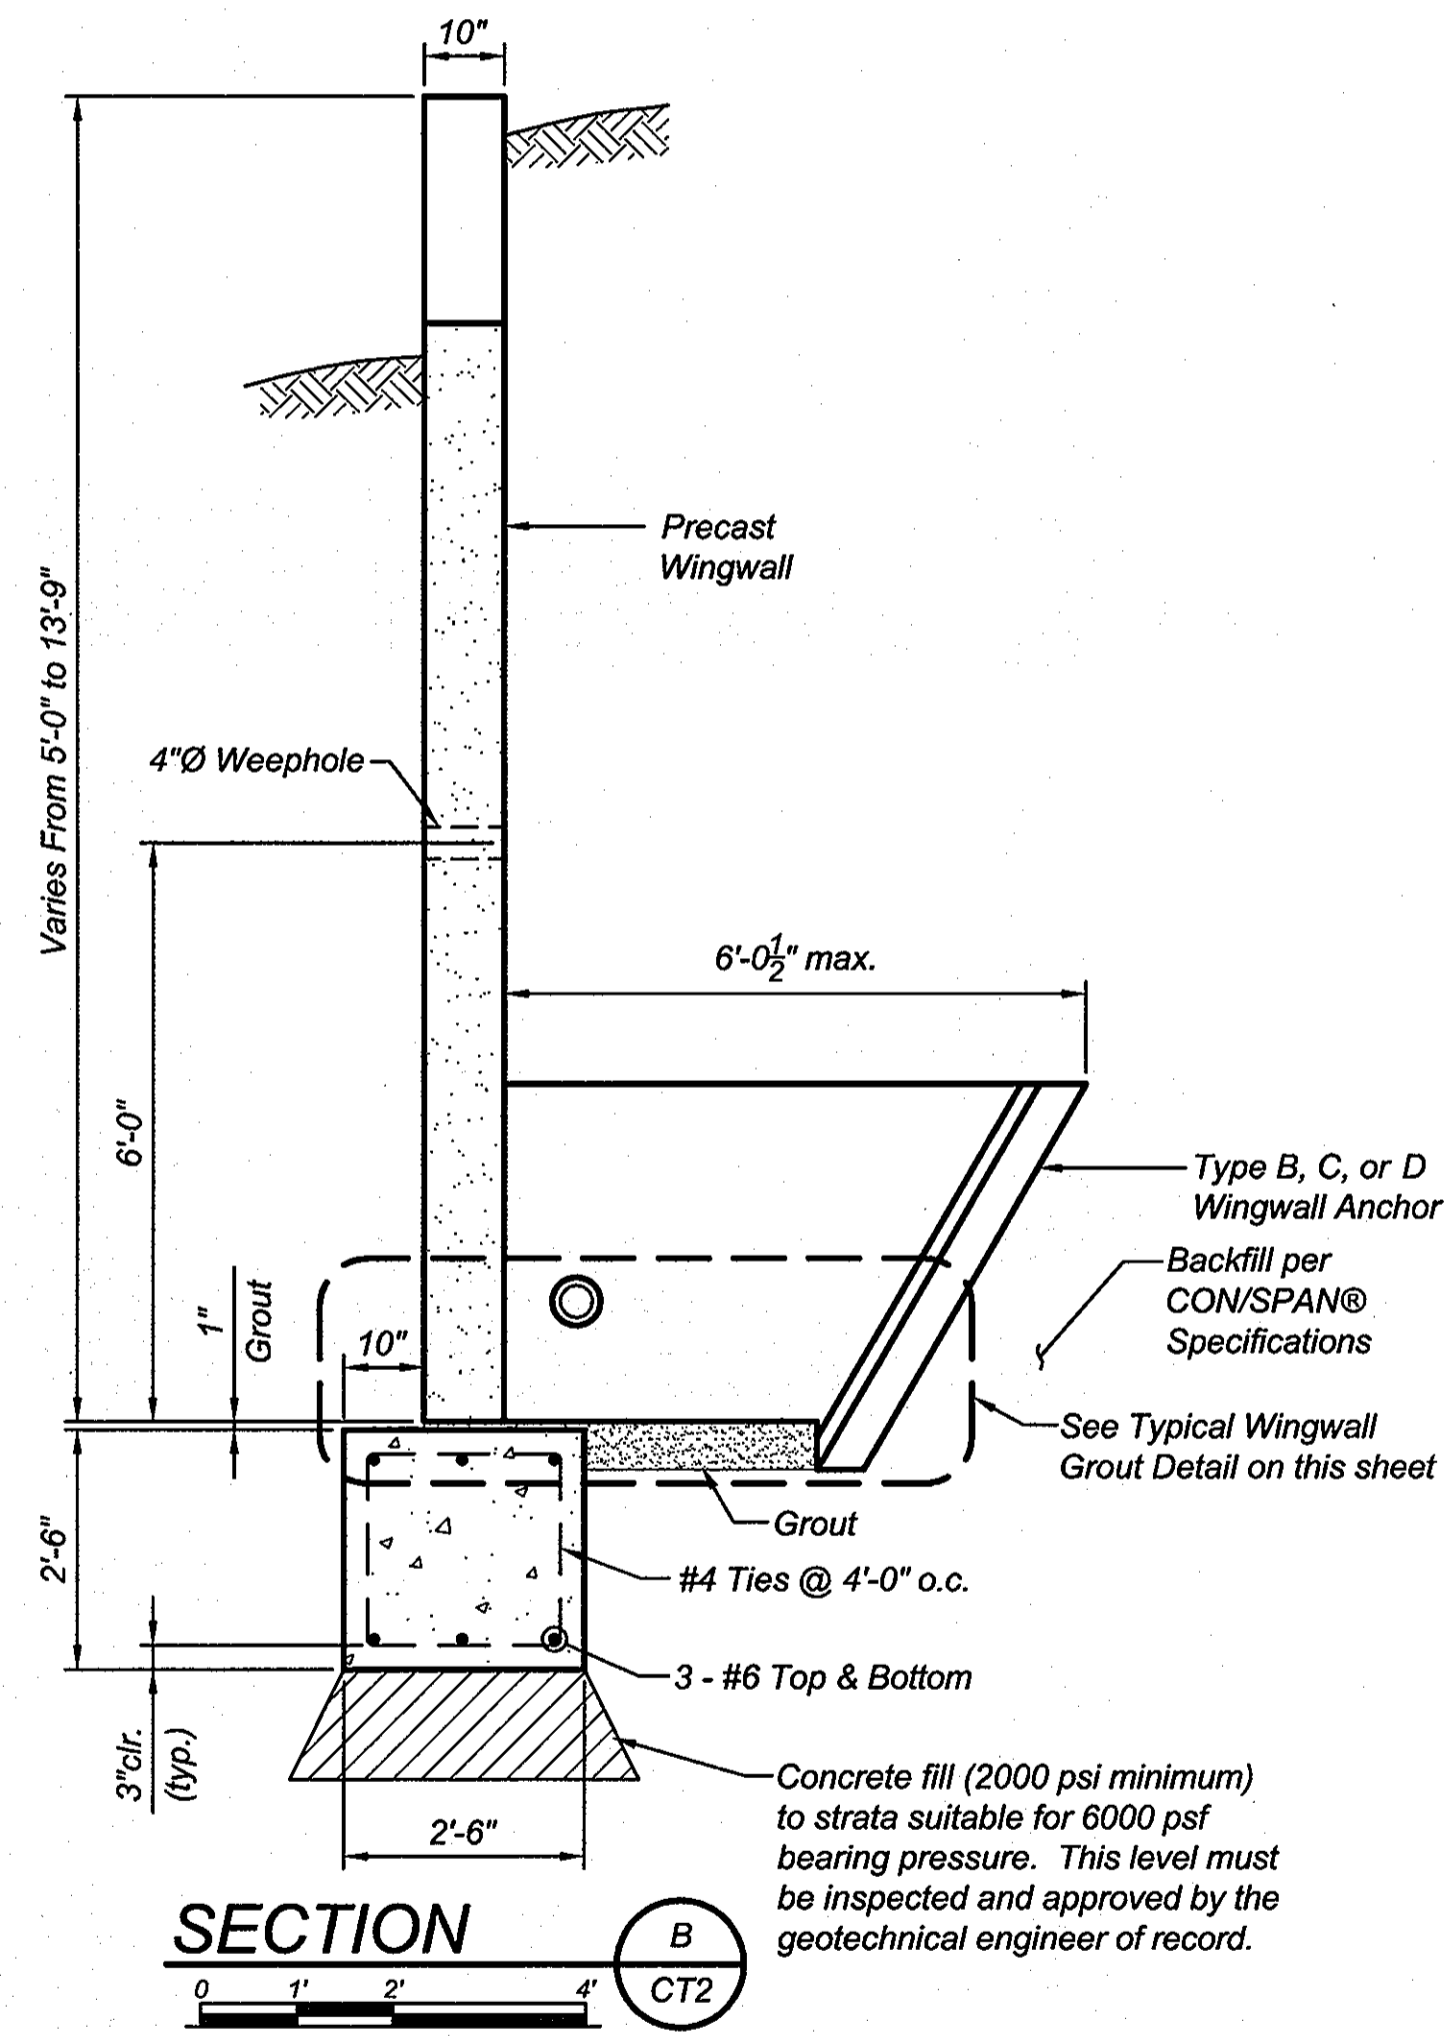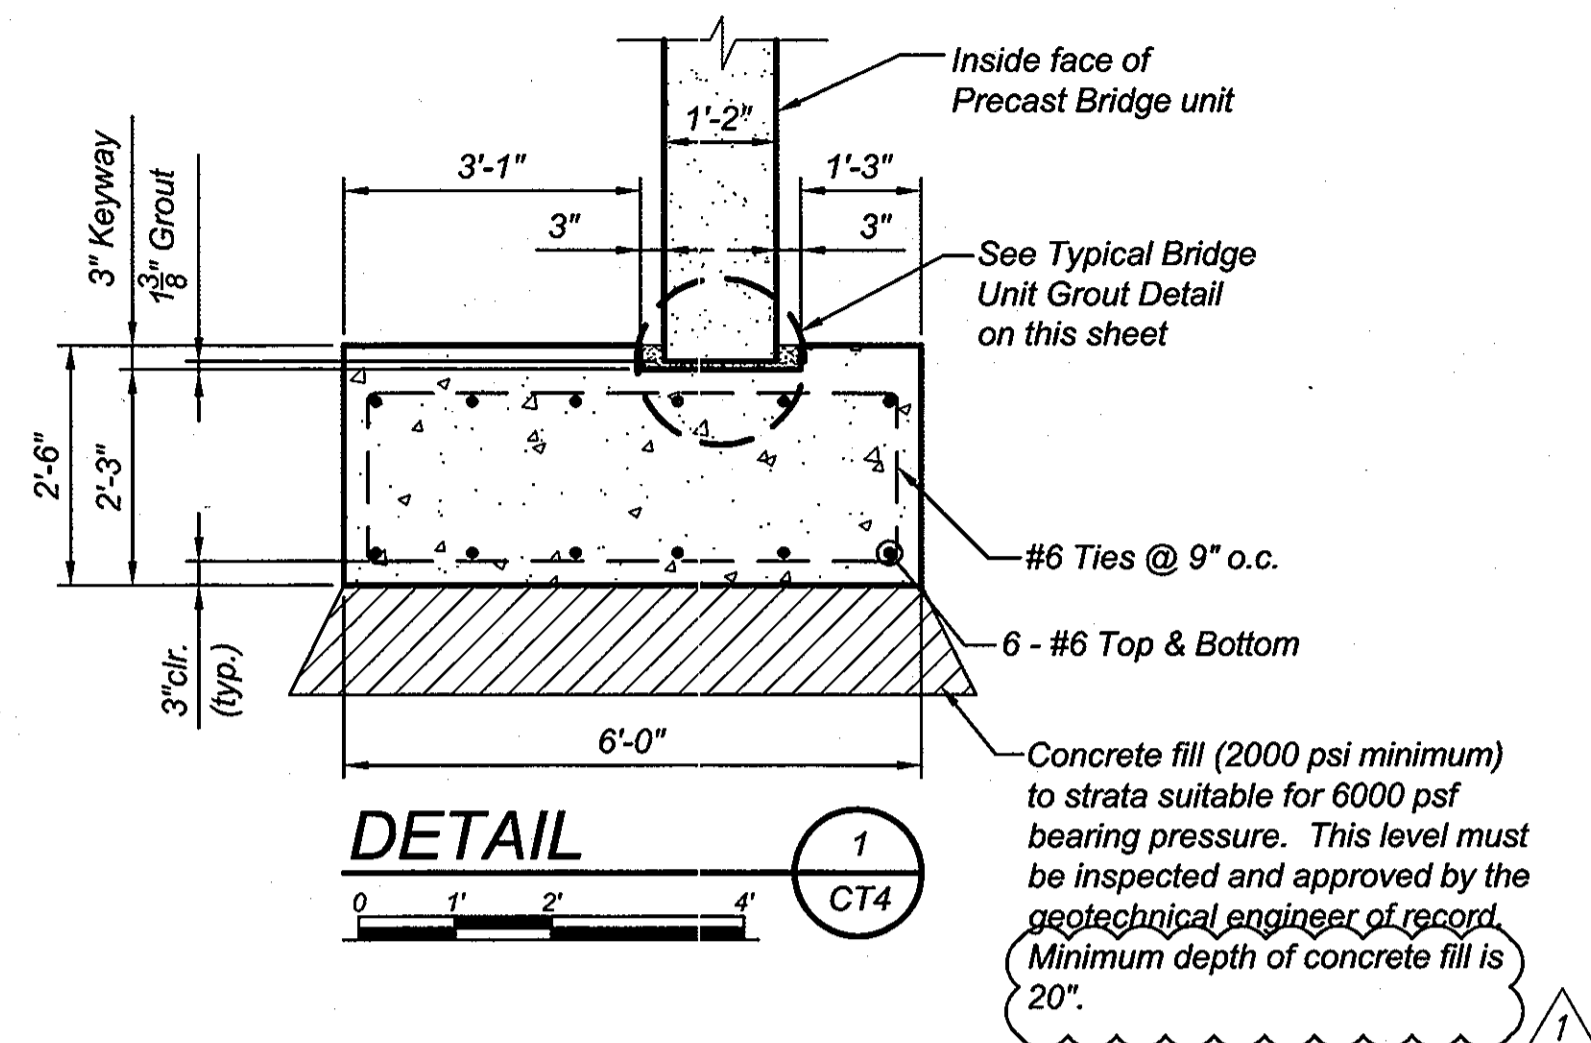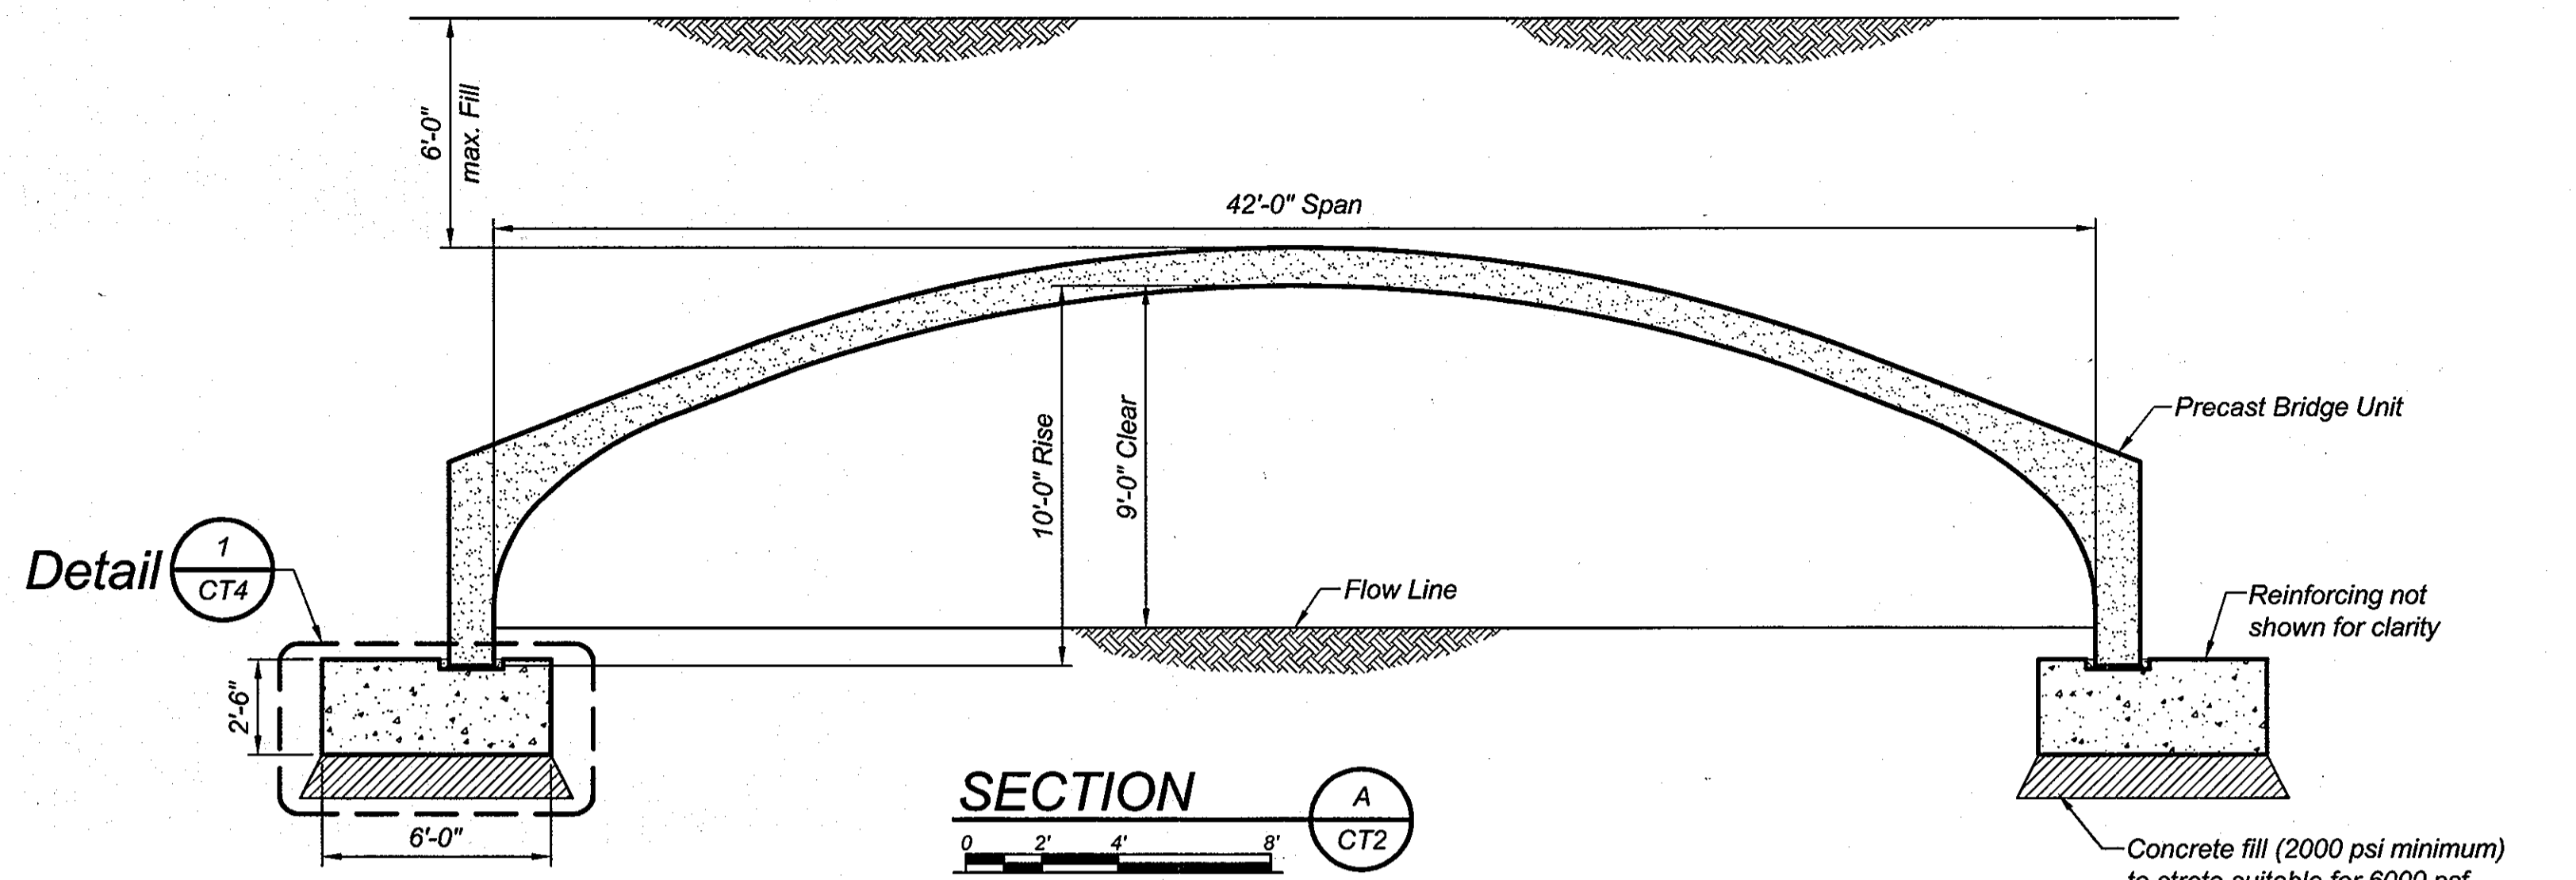

AS-BUILT CERTIFICATION
I hereby certify, by my seal, that the facilities shown on this plan were constructed as shown on this AS-BUILT plan.
Donald Mason, P.E. No. 21443 Date 12-31-13



Professional Certification: I hereby certify that these documents were prepared by approved by me, and that I am a duly licensed professional engineer under the laws of the State of Maryland.
License No. 21443 Expiration Date: 12-21-14

APPROVED: DEPARTMENT OF PUBLIC WORKS
W. Z. ... 7-20-07
CHIEF, BUREAU OF HIGHWAYS
APPROVED: DEPARTMENT OF PLANNING AND ZONING
C. ... 9/18/07
CHIEF, DIVISION OF LAND DEVELOPMENT
C. ... 7/24/07
CHIEF, DEVELOPMENT ENGINEERING DIVISION

NO.	DATE	REVISION
1	5/14/07	Minimum depth of concrete fill specification per engineer's comments



CON/SPAN®
BRIDGE SYSTEMS

BENCHMARK
ENGINEERS • LAND SURVEYORS • PLANNERS
ENGINEERING, INC.
8480 BALTIMORE NATIONAL PIKE SUITE 418
ELLCOTT CITY, MARYLAND 21043
PHONE: 410-465-6105 FAX: 410-465-6644
WWW.BEI-CVLENGINEERING.COM

NOTICE
© 2007. The design and information shown on this drawing is provided as a service to the project owner, engineer and contractor by CONTECH Bridge Solutions Inc. No part of this drawing may be used, reproduced, or modified in any manner without the prior written authorization of CONTECH Bridge Solutions Inc. Any such use, reproduction, or modification of this drawing is done at the user's own risk and the user agrees to indemnify, defend and hold harmless CONTECH Bridge Solutions Inc. from and against any and all claims, liability, and expense, including, but not limited to, reasonable attorney's fees, arising from such use, reproduction or modification.
If discrepancies between the supplied information and actual field conditions are encountered as site work progresses, these discrepancies must be reported to CONTECH Bridge Solutions Inc., immediately for re-evaluation of the design. CONTECH Bridge Solutions Inc. accepts no liability for designs based on inaccurate information supplied by others.

CONTECH
BRIDGE SOLUTIONS INC.

8430 University Executive Park Drive
Suite 695
Charlotte, North Carolina 28262
704-548-8420
704-548-8586 fax
800-526-3999

FOOTING SECTION & DETAILS
HOWARD COUNTY MARYLAND

TAYLOR FARM SECTION THREE, PHASE TWO


APPROVED FOR CONSTRUCTION
Designed: MRP Project No. 15086
Drawn: RPU
Checked: LNM Sheet No. CT4
Date: 4/12/07

OWNER/DEVELOPER: FRIENDLY FARMS LLC
P.O. BOX 417
ELLCOTT CITY, MARYLAND 21041
410-465-4244



PROJECT: TAYLOR FARM SECTION THREE, PHASE TWO
LOTS 57 THROUGH 101 AND NON-BUILDABLE BULK PARCEL 'A' A RESUBDIVISION OF LOT 84 TAYLOR FARM SECTION THREE AND LOT 2 OF FRIENDLY FARMS (PLAT NO. 8220-0227)

LOCATION: TAX MAP: 10 GRID: 23 PARCEL: 309
TAX MAP: 16 GRID: 5 ZONED: R-20
3rd ELECTION DISTRICT
HOWARD COUNTY, MARYLAND


TITLE: CON/SPAN BRIDGE FOOTING SECTION & DETAILS
DATE: JULY, 2007 PROJECT NO. 1585
SCALE: AS SHOWN SHEET 18 OF 22

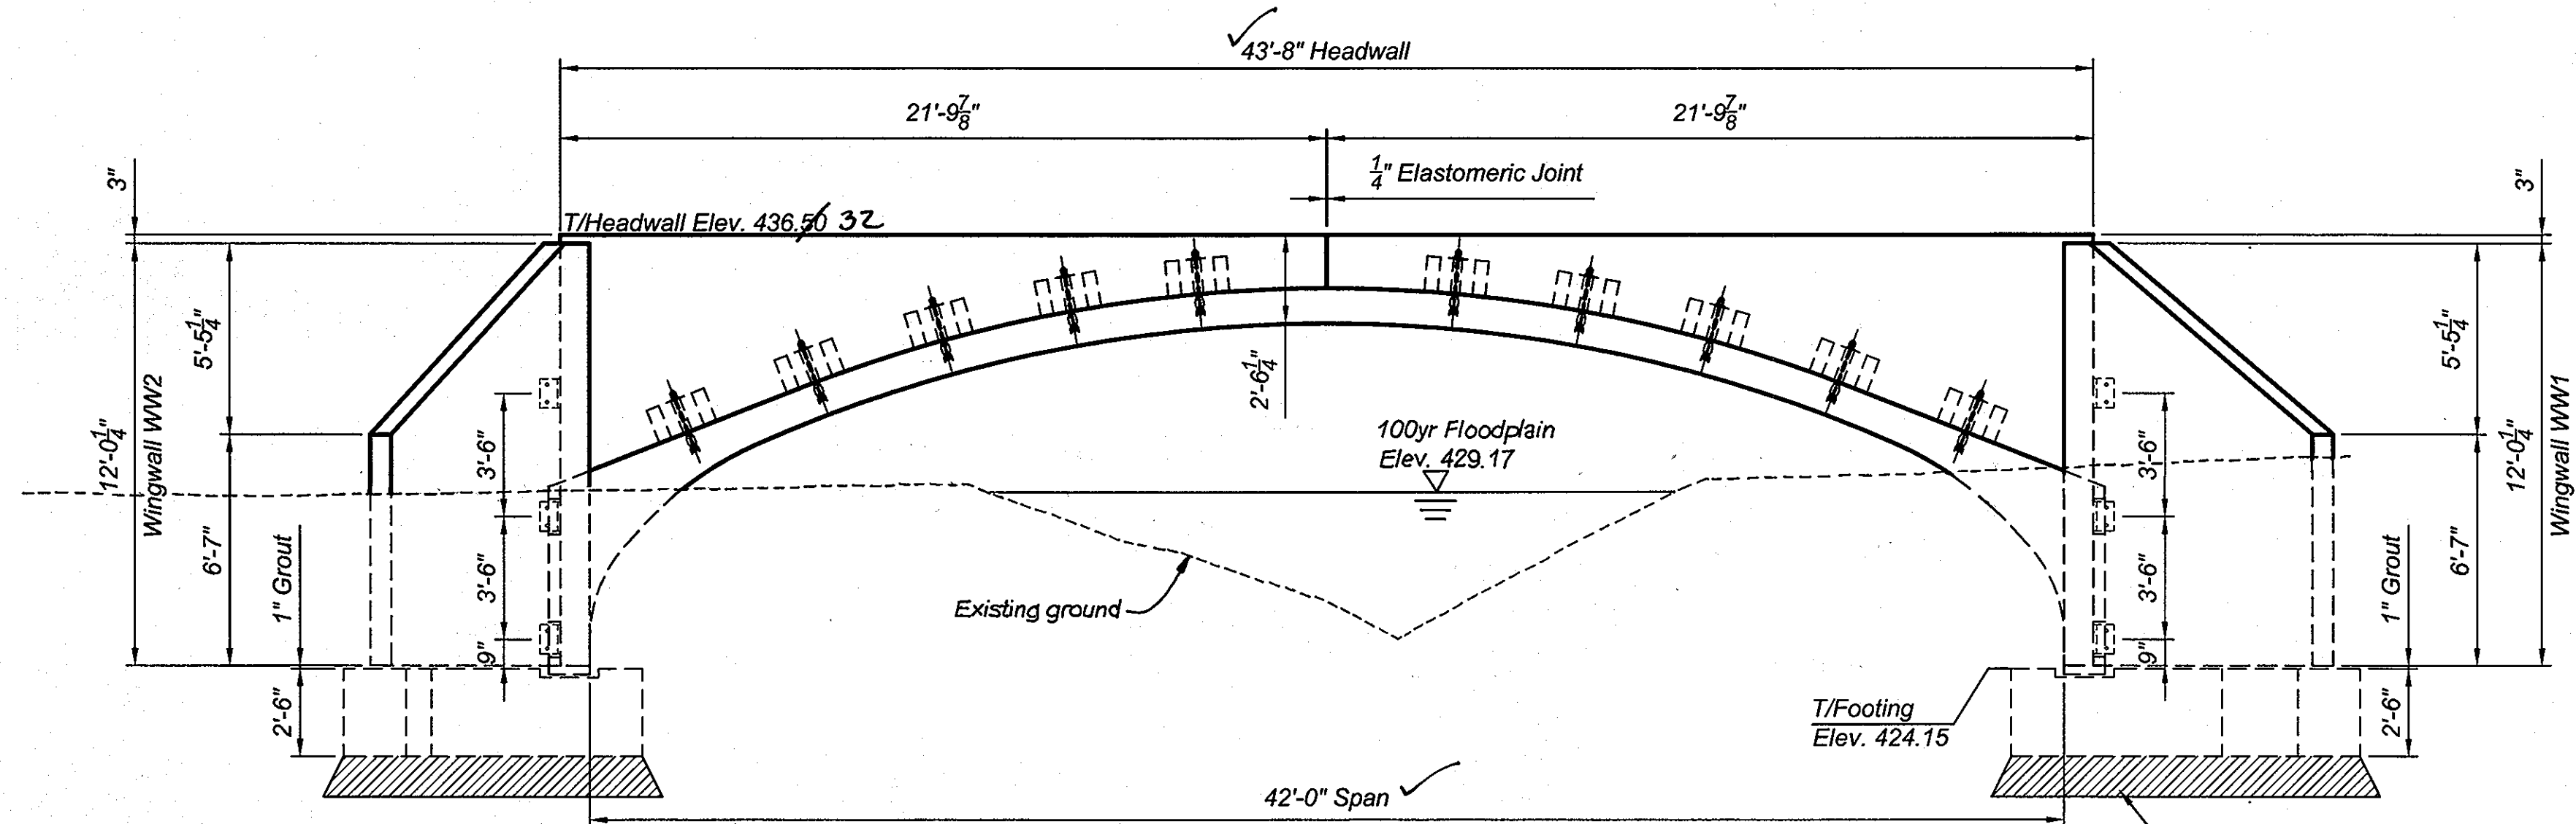

UPSTREAM ELEVATION

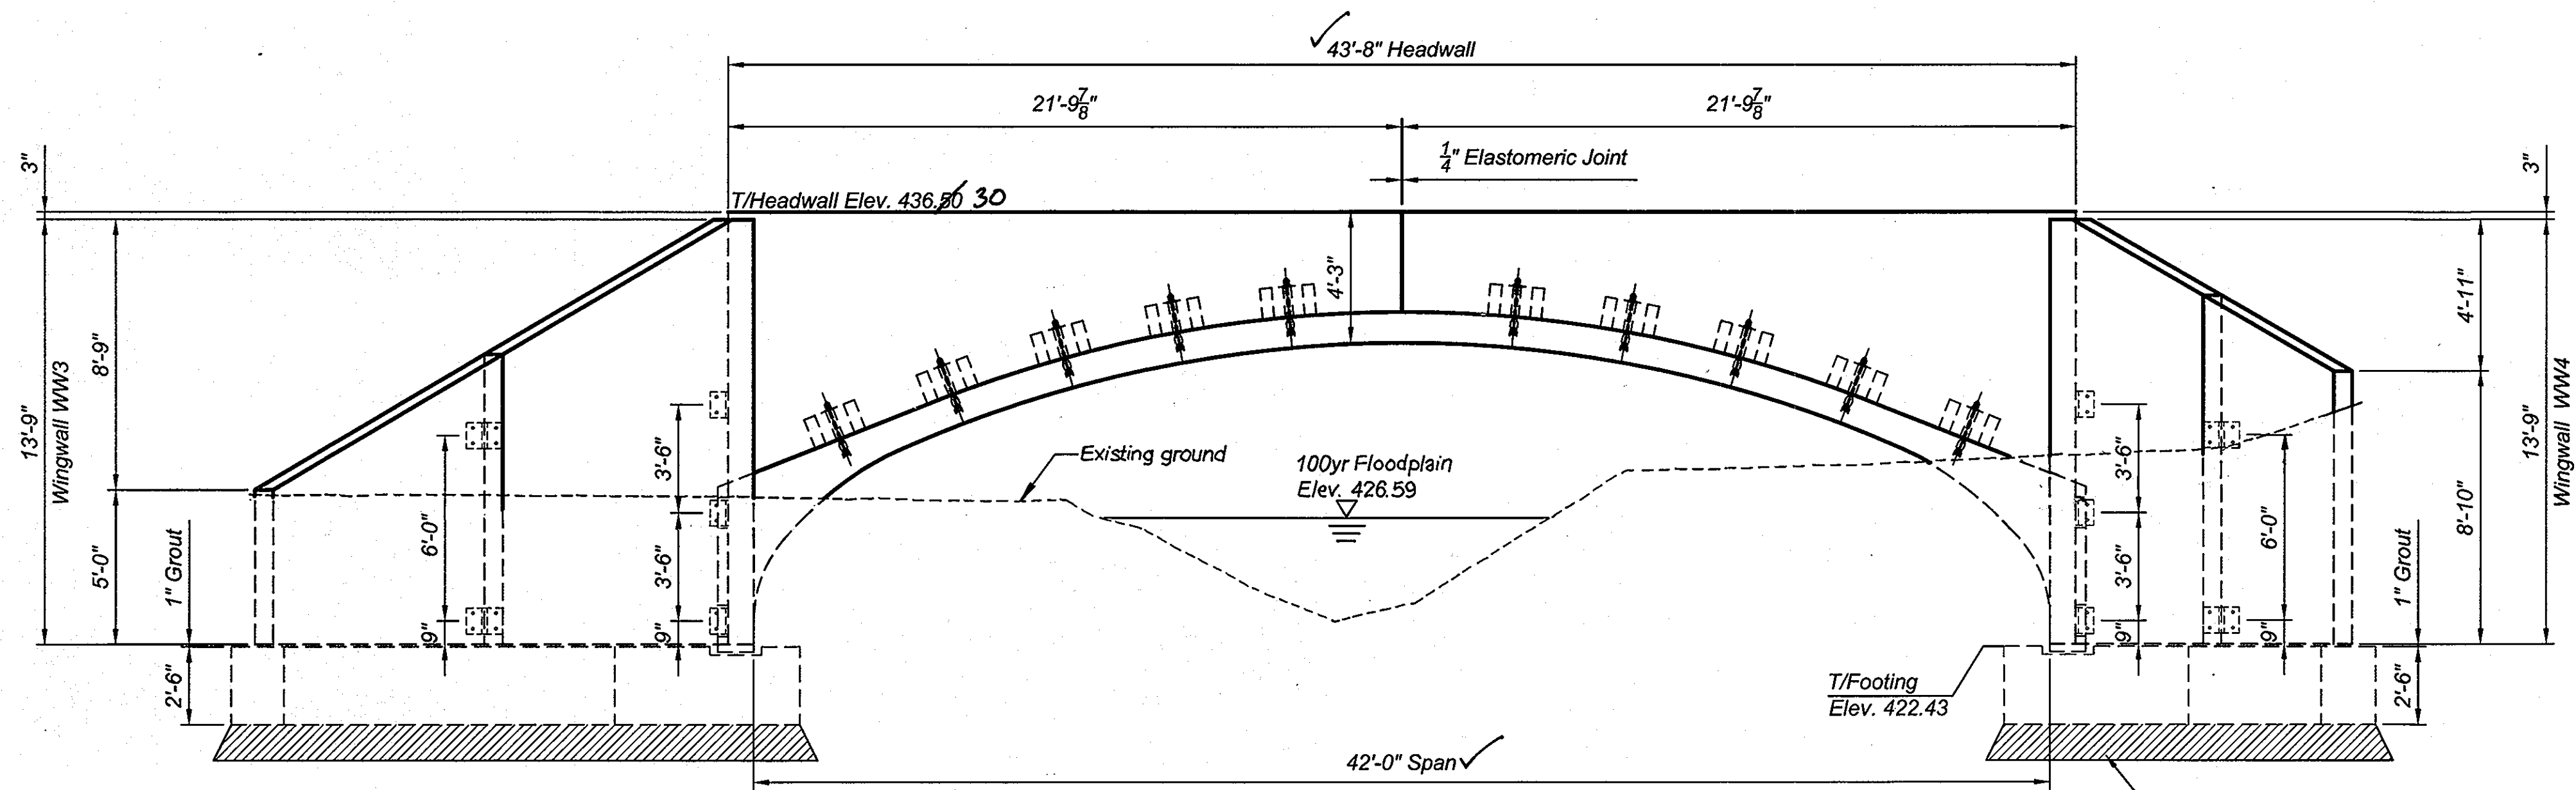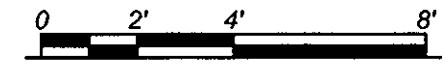

DOWNSTREAM ELEVATION

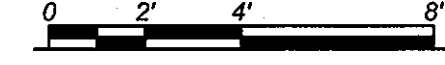


AS-BUILT CERTIFICATION
I hereby certify, by my seal, that the facilities shown on this plan were constructed as shown on this AS-BUILT plan.
Donald Mason, P.E. No. 21443 Date 12-31-13



Professional Certification. I hereby certify that these documents were prepared or approved by me, and that I am a duly licensed professional engineer under the laws of the State of Maryland.
License No. 21443 Expiration Date: 12-21-14

APPROVED: DEPARTMENT OF PUBLIC WORKS
Walter J. ... 7-20-07
CHIEF, BUREAU OF HIGHWAYS
APPROVED: DEPARTMENT OF PLANNING AND ZONING
Andy Hamster 9/15/07
CHIEF, DIVISION OF LAND DEVELOPMENT
... 7/24/05
CHIEF, DEVELOPMENT ENGINEERING DIVISION

NO.	DATE	REVISION
1	5/14/07	Minimum depth of concrete fill specification per engineer's comments

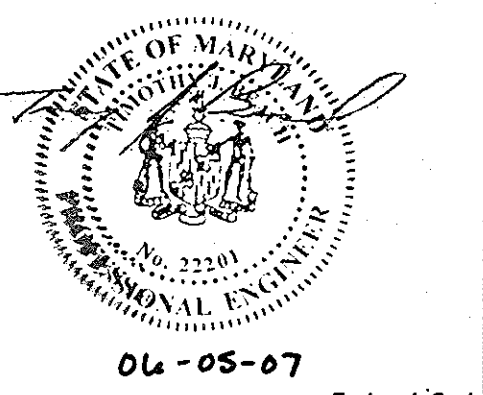

CONTECH Bridge Solutions Inc. - System

BENCHMARK ENGINEERING, INC.
ENGINEERS • LAND SURVEYORS • PLANNERS
8480 BALTIMORE NATIONAL PIKE & SUITE 418
ELLCOTT CITY, MARYLAND 21043
PHONE: 410-465-6105 FAX: 410-465-6644
WWW.BEI-CVLENGINEERING.COM

NOTICE
© 2007. The design and information shown on this drawing is provided as a service to the project owner, engineer and contractor by CONTECH Bridge Solutions Inc. No part of this drawing may be used, reproduced, or modified in any manner without the prior written authorization of CONTECH Bridge Solutions Inc. Any such use, reproduction, or modification of this drawing is done at the user's own risk and the user agrees to indemnify, defend and hold harmless CONTECH Bridge Solutions Inc. from and against any and all claims, liability, and expense, including, but not limited to, reasonable attorney's fees, arising from such use, reproduction or modification.
If discrepancies between the supplied information and actual field conditions are encountered as site work progresses, these discrepancies must be reported to CONTECH Bridge Solutions Inc., immediately for re-evaluation of the design. CONTECH Bridge Solutions Inc. accepts no liability for designs based on inaccurate information supplied by others.

Company:
CONTECH BRIDGE SOLUTIONS INC.
8430 University Executive Park Drive Suite 695
Charlotte, North Carolina 28262
704-548-8420
704-548-8586 fax
800-526-3999

Project Status:
APPROVED: FOR CONSTRUCTION

Project No. 15086
Sheet No. CT5
Date 4/12/07

OWNER/DEVELOPER: FRIENDLY FARMS LLC
P.O. BOX 417
ELLCOTT CITY, MARYLAND 21041
410-465-4244


PROJECT: TAYLOR FARM SECTION THREE, PHASE TWO
LOTS 57 THROUGH 101 AND NON-BUILDABLE BULK PARCEL 'A' A RECONFIGURATION OF LOT 84 TAYLOR FARM SECTION THREE AND LOT 3 OF FRIENDLY FARMS (PLAT NO. 6229-6227)

LOCATION: TAX MAP: 10 GRID: 23 PARCEL: 308
TAX MAP: 18 GRID: 5 ZONE: R-20
3rd ELECTION DISTRICT
HOWARD COUNTY, MARYLAND


TITLE: CON/SPAN BRIDGE ELEVATIONS

DATE: JULY, 2007 PROJECT NO. 1585
SCALE: AS SHOWN SHEET 19 OF 22




DESIGN: DRAFT: CHECK: AS-BUILT

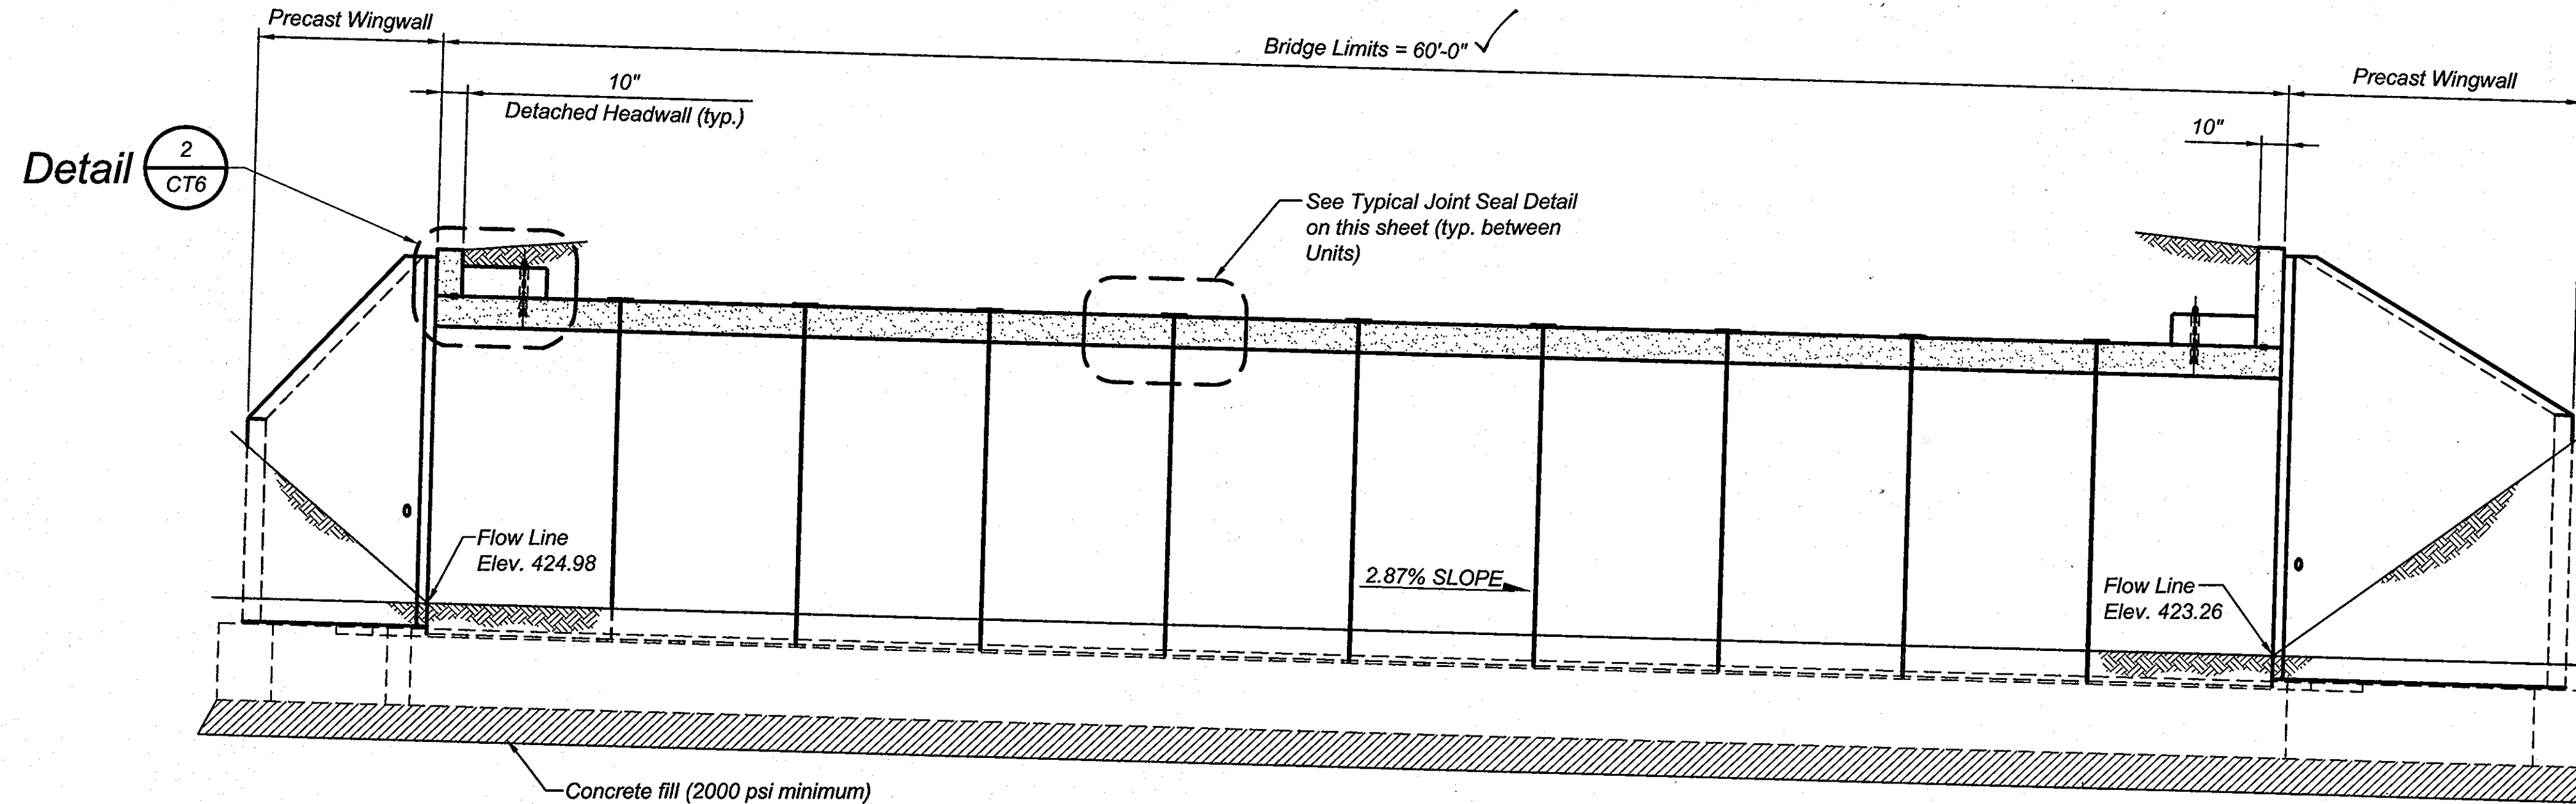


Concrete fill (2000 psi minimum) to strata suitable for 6000 psf bearing pressure. This level must be inspected and approved by the geotechnical engineer of record. Minimum depth of concrete fill is 20".

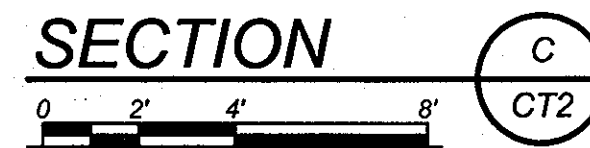



*Note: Foundation Slope to be continuous through Wingwall Footings

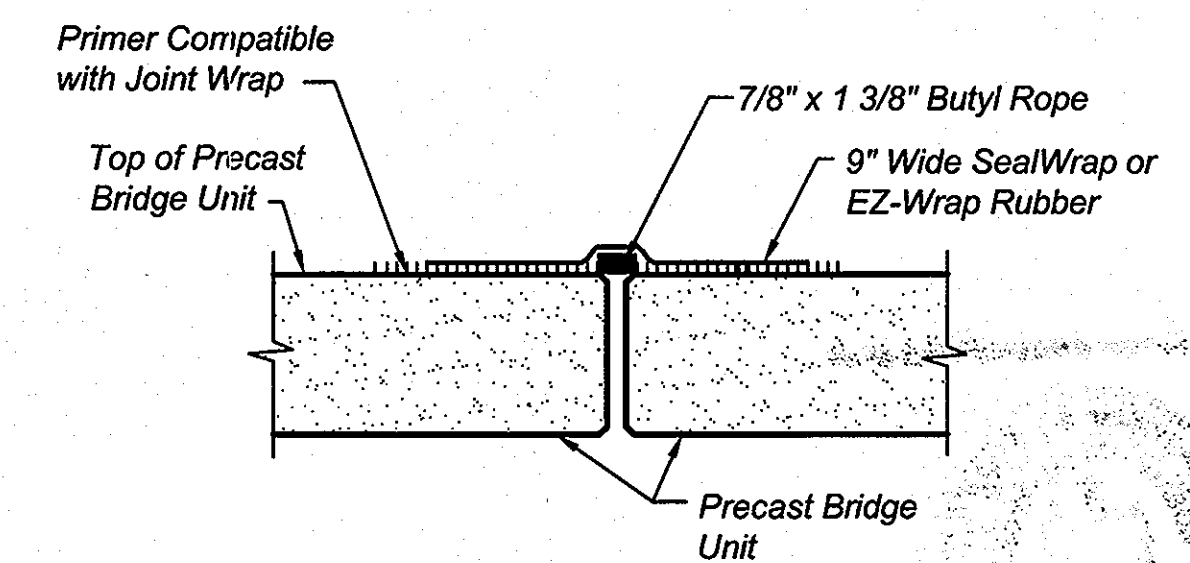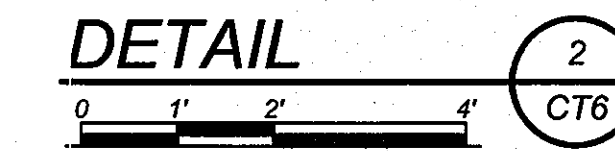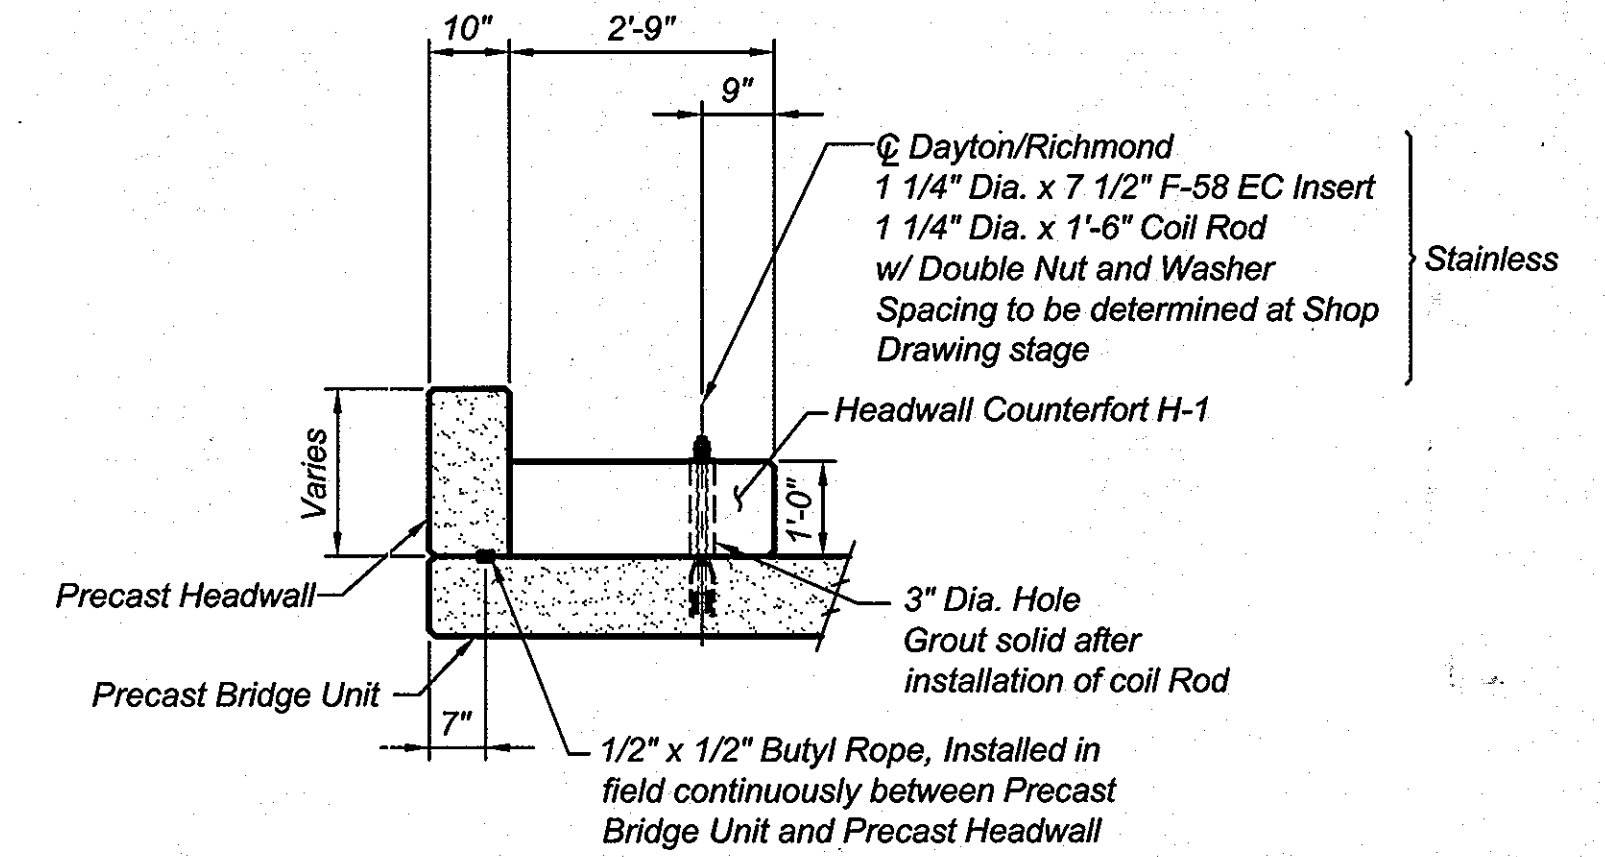



TYPICAL JOINT SEAL DETAIL
not to scale

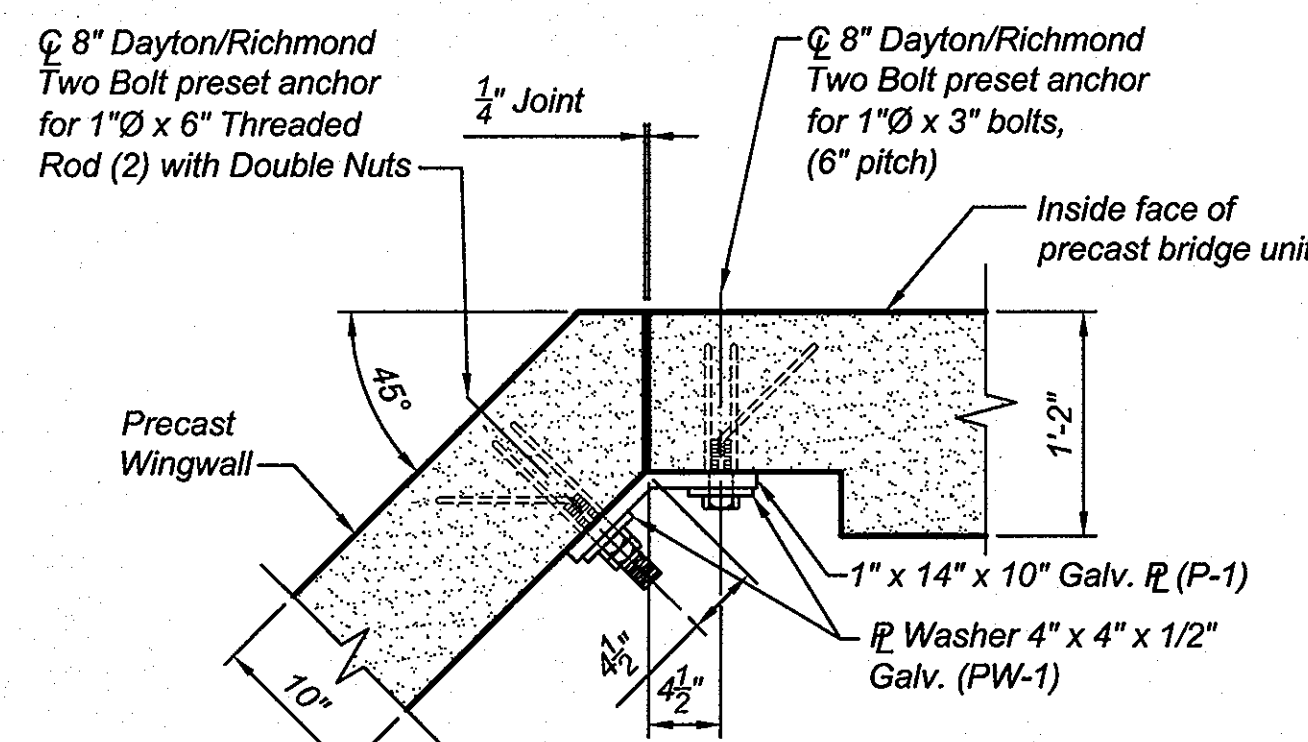

Note: Connection P's (P-1) must be positioned with small Ø holes toward precast bridge unit

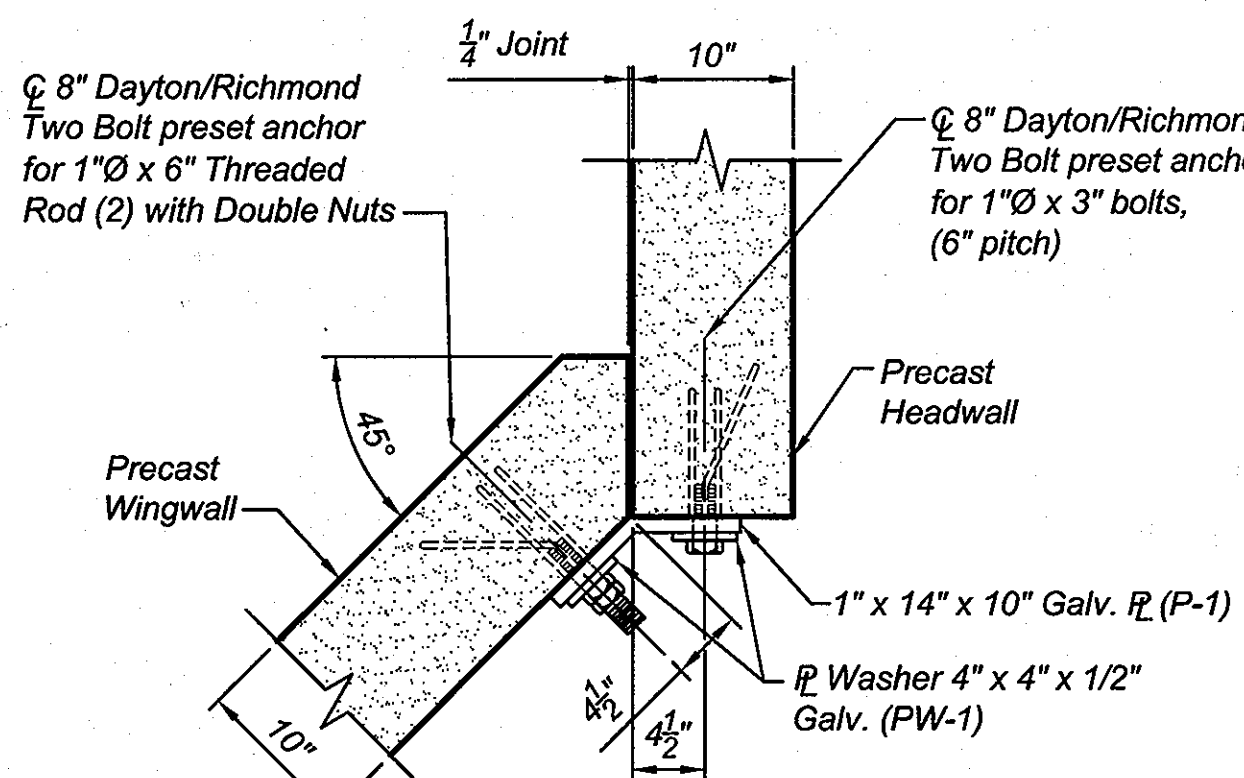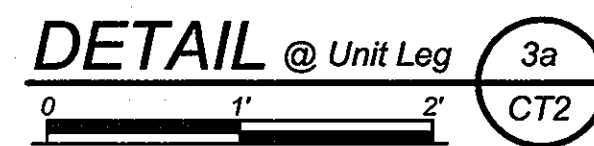


Note: Connection P's (P-1) must be positioned with small Ø holes toward precast headwall

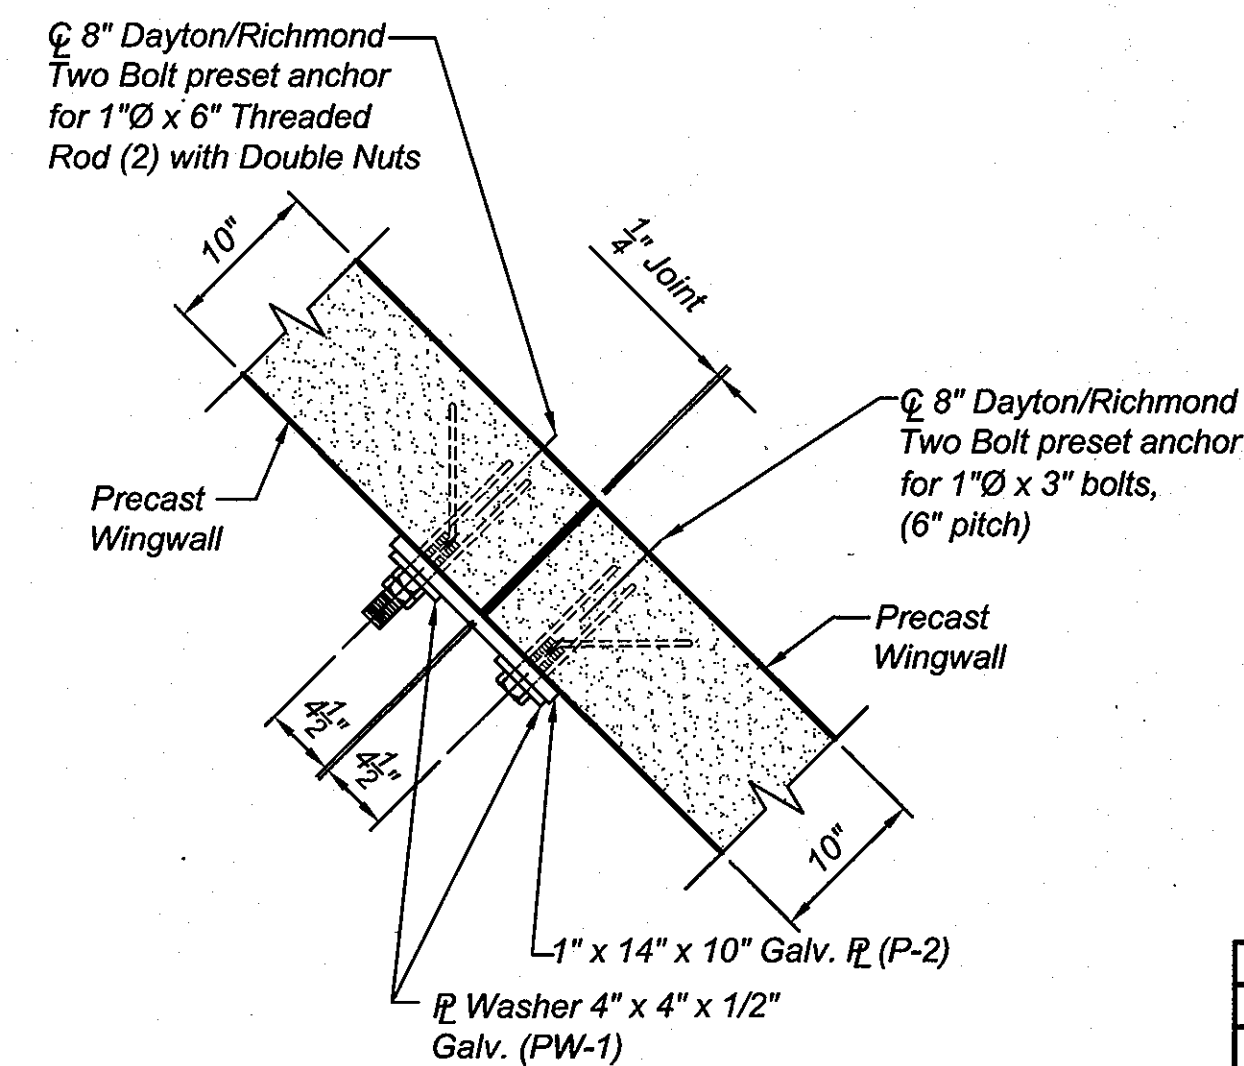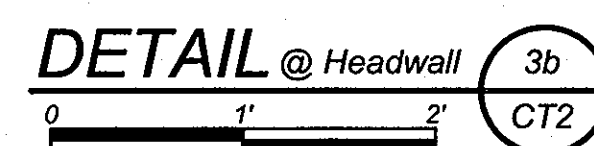


APPROVED: DEPARTMENT OF PUBLIC WORKS	7-20-07
WILLIAM J. MULLER CHIEF, BUREAU OF HIGHWAYS	DATE
APPROVED: DEPARTMENT OF PLANNING AND ZONING	9/15/07
WENDY HENRIKSON CHIEF, DIVISION OF LAND DEVELOPMENT	DATE
APPROVED: DEPARTMENT OF ENGINEERING	2/24/07
CHIEF, DEVELOPMENT ENGINEERING DIVISION	DATE

NO.	DATE	REVISION
1	5/14/07	Minimum depth of concrete fill specification per engineer's comments

AS-BUILT CERTIFICATION
I hereby certify, by my seal, that the facilities shown on this plan were constructed as shown on this AS-BUILT plan.
Donald Mason, P.E. No. 21443 Date 12-31-13

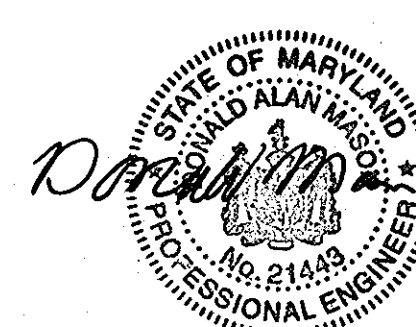

Professional Certification. I hereby certify that these documents were prepared or approved by me, and that I am a duly licensed professional engineer under the laws of the State of Maryland.
License No. 21443 Expiration Date: 12-21-14

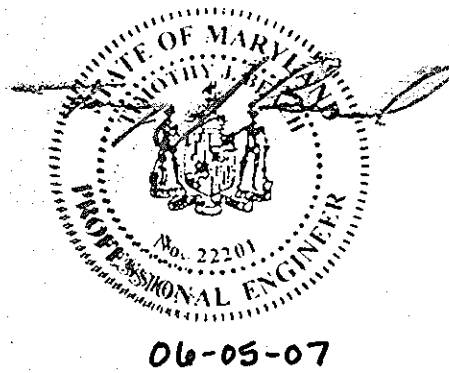

CONSPAN® BRIDGE SYSTEMS
Engineer's Seal

BENCHMARK
ENGINEERS & LAND SURVEYORS & PLANNERS
ENGINEERING, INC.
8480 BALTIMORE NATIONAL PIKE & SUITE 418
ELLCOTT CITY, MARYLAND 21043
PHONE: 410-465-8105 FAX: 410-465-8644
WWW.BEI-CVLENGINEERING.COM

NOTICE
© 2007. The design and information shown on this drawing is provided as a service to the project owner, engineer and contractor by CONTECH Bridge Solutions Inc. No part of this drawing may be used, reproduced, or modified in any manner without the prior written authorization of CONTECH Bridge Solutions Inc. Any such use, reproduction, or modification of this drawing is done at the user's own risk and the user agrees to indemnify, defend and hold harmless CONTECH Bridge Solutions Inc. from and against any and all claims, liability, and expense, including, but not limited to, reasonable attorney's fees, arising from such use, reproduction or modification.

If discrepancies between the supplied information and actual field conditions are encountered as site work progresses, these discrepancies must be reported to CONTECH Bridge Solutions Inc., immediately for re-evaluation of the design. CONTECH Bridge Solutions Inc. accepts no liability for designs based on inaccurate information supplied by others.

CONTECH
BRIDGE SOLUTIONS INC.
8430 University Executive Park Drive
Suite 695
Charlotte, North Carolina 28262
704-548-8420
704-548-8586 fax
800-526-3999

SECTION & DETAILS
TAYLOR FARM
SECTION THREE, PHASE TWO
HOWARD COUNTY MARYLAND

APPROVED: FOR CONSTRUCTION
Designed: MRP
Drawn: RPU
Checked: LNM
Date: 4/12/07
Project No.: 15086
Sheet No.: CT6

OWNER/DEVELOPER: FRIENDLY FARMS LLC
P.O. BOX 417
ELLCOTT CITY, MARYLAND 21041
410-465-4244

PROJECT: TAYLOR FARM SECTION THREE, PHASE TWO
LOTS 57 THROUGH 101 AND NON-BUILDABLE BULK PARCEL 'A'
A RESUBDIVISION OF LOT 84 TAYLOR FARM SECTION THREE AND LOT 2 OF PRECIOUS FARMS (PLAT NO. 8229-6227)

LOCATION: TAX MAP: 10 GRID: 23 PARCEL: 309
TAX MAP: 18 GRID: 5 ZONING: R-20
3rd ELECTION DISTRICT
HOWARD COUNTY, MARYLAND

TITLE: CON/SPAN BRIDGE SECTION & DETAILS

DATE: JULY, 2007 PROJECT NO. 1585

DESIGN: DRAFT: CHECK: SCALE: AS SHOWN SHEET 20 OF 22

SPECIFICATIONS FOR MANUFACTURE AND INSTALLATION OF CON/SPAN® BRIDGE SYSTEMS

1. DESCRIPTION

This work shall consist of constructing a CON/SPAN® bridge in accordance with these specifications and in reasonably close conformity with the lines, grades, design and dimensions shown on the plans or as established by the Engineer. In situations where two or more specifications apply to this work, the most stringent requirements shall govern.

2. TYPES

Precast reinforced concrete CON/SPAN® bridge units manufactured in accordance with this specification shall be designated by span and rise. Precast reinforced concrete CON/SPAN® wingwalls and headwalls manufactured in accordance with this specification shall be designated by length, height, and deflection angle.

3. MATERIALS - CONCRETE

The concrete for the culverts shall be air-entrained when installed in areas subject to freeze-thaw conditions, composed of portland cement, fine and coarse aggregates, admixtures and water. Air-entrained concrete shall contain 6 ± 2 percent air. The air entraining admixture shall conform to AASHTO M154.

- 3.1 Portland Cement - Shall conform to the requirements of ASTM Specifications C150-Type I, Type II, or Type III cement.
- 3.2 Coarse Aggregate - Shall consist of stone having a maximum size of 1 inch. Aggregate shall meet requirements for ASTM C33.
- 3.3 Water Reducing Admixture - The manufacturer may submit for approval by the Engineer, a water-reducing admixture for the purpose of increasing workability and reducing the water requirement for the concrete.
- 3.4 Calcium Chloride - The addition to the mix of calcium chloride or admixtures containing calcium chloride will not be permitted.

4. MATERIALS - STEEL REINFORCEMENT AND HARDWARE

All reinforcing steel for the culverts shall be fabricated and placed in accordance with the detailed shop drawings submitted by the manufacturer.

- 4.1 Steel Reinforcement - Reinforcement shall consist of welded wire fabric conforming to ASTM Specification A 185 or A 497, or deformed billet steel bars conforming to ASTM Specification A 615, Grade 60. Longitudinal distribution reinforcement may consist of welded wire fabric or deformed billet-steel bars.
- 4.2 Hardware: Bolts and threaded rods for wingwall connections shall conform to ASTM A 307. Nuts shall conform to AASHTO M 292 (ASTM A 194) Grade 2H. All bolts, threaded rods and nuts used in wingwall connections shall be mechanically zinc coated in accordance with ASTM B 695 Class 50.

Structural Steel for wingwall connection plates and plate washers shall conform to AASHTO M 270 (ASTM A 709) Grade 36 and shall be hot dip galvanized as per AASHTO M 111 (ASTM A 123).

Inserts for wingwalls shall be 1" diameter Two-Bolt Preset Wingwall Anchors as manufactured by Dayton/Richmond Concrete Accessories, Miamisburg, Ohio, (800) 745-3700.

Ferrule Loop Inserts shall be F-64 Ferrule Loop Inserts as manufactured by Dayton/Richmond Concrete Accessories, Miamisburg, Ohio, (800) 745-3700.

Hook Bolts used in attached headwall connections shall be ASTM A 307.

Inserts for detached headwall connections shall be AISI Type 304 stainless steel, F-58 Expanded Coil inserts as manufactured by Dayton/Richmond Concrete Accessories, Miamisburg, Ohio, (800) 745-3700. Coil rods and nuts used in headwall connections shall be AISI Type 304 stainless steel. Washers used in headwall connections shall be either AISI Type 304 stainless steel plate washers or AASHTO M 270 (ASTM A 709) Grade 36 plate washers hot dip galvanized as per AASHTO M 111 (ASTM A 153).

Reinforcing bar splices shall be made using the Dowel Bar Splicer System as manufactured by Dayton/Richmond Concrete Accessories, Miamisburg, Ohio, (800) 745-3700, and shall consist of the Dowel Bar Splicer (DB-SAE) and Dowel-In (DI).

5. MANUFACTURE

- 5.1 Mixture - The aggregates, cement and water shall be proportioned and mixed in a batch mixer to produce a homogeneous concrete meeting the strength requirements of this specification. The proportion of portland cement in the mixture shall not be less than 564 pounds (6 sacks) per cubic yard of concrete.
- 5.2 Curing - The precast concrete culvert units shall be cured for a sufficient length of time so that the concrete will develop the specified compressive strength in 28 days or less. Any one of the following methods of curing or combinations thereof shall be used:
 - 5.2.1 Steam Curing - The culverts may be low pressure, steam cured by a system that will maintain a moist atmosphere.
 - 5.2.2 Water Curing - The culverts may be water cured by any method that will keep the sections moist.
 - 5.2.3 Membrane Curing - A sealing membrane conforming to the requirements of ASTM Specification C 309 may be applied and shall be left intact until the required concrete compressive strength is attained. The concrete temperature at the time of application shall be within ± 10 degrees F of the atmospheric temperature. All surfaces shall be kept moist prior to the application of the compounds and shall be damp when the compound is applied.
- 5.3 Forms - The forms used in manufacture shall be sufficiently rigid and accurate to maintain the culvert dimensions within the permissible variations given in Section 7 of these specifications. All casting surfaces shall be of a smooth material.
- 5.4 Handling - Handling devices or holes shall be permitted in each culvert for the purpose of handling and setting.
- 5.5 Storage - The precast elements shall be stored in such a manner to prevent cracking or damage. The units shall not be moved until the concrete compressive strength has reached a minimum of 2500 psi, and they shall not be stored in an upright position until the concrete compressive strength is a minimum of 4,000 psi.

6. DESIGN

- 6.1 The precast element dimension and reinforcement details shall be as prescribed in the plan and the shop drawings provided by the manufacturer, subject to the provisions of Section 7, below. The minimum concrete compressive strength shall be as shown on the shop drawings. The minimum steel yield strength shall be 60,000 psi, unless otherwise noted on the shop drawings.
- 6.2 The precast elements are designed in accordance with the "Standard Specifications for Highway Bridges" 17th Edition, adopted by the American Association of State Highway and Transportation Officials, 2002. A minimum of one foot of cover above the crown of the bridge units is required in the installed condition. (Unless noted otherwise on the shop drawings and designed accordingly.)
- 6.3 Placement of Reinforcement in Precast Bridge Units - The cover of concrete over the outside circumferential reinforcement shall be 2 inches minimum. The cover of concrete over the inside circumferential reinforcement shall be 1 1/2 inches minimum, unless otherwise noted on the shop drawings. The clear distance of the end circumferential wires shall not be less than one inch nor more than two inches from the ends of each section. Reinforcement shall be assembled utilizing single or multiple layers of welded wire fabric (not to exceed 3 layers), supplemented with a single layer of deformed billet-steel bars, when necessary. Welded wire fabric shall be composed of circumferential and longitudinal wires meeting the spacing requirements of 6.6, below, and shall contain sufficient longitudinal wires extending through the bridge unit to maintain the shape and position of the reinforcement. Longitudinal distribution reinforcement may be welded wire fabric or deformed billet-steel bars and shall meet the spacing requirements of 6.6, below. The ends of the longitudinal distribution reinforcement shall be not more than 3 inches and not less than 1 1/2 inches from the ends of the bridge unit.
- 6.4 Placement of Reinforcement for Precast Wingwalls and Headwalls - The cover of concrete over the longitudinal and transverse reinforcement shall be 2 inches minimum. The clear distance from the end of each precast element to the end transverse reinforcing steel shall not be less than one inch nor more than two inches. Reinforcement shall be assembled utilizing a single layer of welded wire fabric, or a single layer of deformed billet-steel bars. Welded wire fabric shall be composed of transverse and longitudinal wires meeting the spacing requirements of 6.7, below, and shall contain sufficient longitudinal wires extending through the element to maintain the shape and position of the reinforcement. Longitudinal reinforcement may be welded wire fabric or deformed billet-steel bars and shall meet the spacing requirements of 6.7, below. The ends of the longitudinal reinforcement shall be not more than 3 inches and not less than 1 1/2 inches from the ends of the walls.
- 6.5 Bending of Reinforcement for Precast Bridge Units - The outside and inside circumferential reinforcing steel for the corners of the bridge shall be bent to such an angle that is approximately equal to the configuration of the bridge's outside corner.

- 6.6 Laps, Welds, and Spacing for Precast Bridge Units - Tension splices in the circumferential reinforcement shall be made by lapping. Laps may be tack welded together for assembly purposes. For smooth welded wire fabric, the overlap shall meet the requirements of AASHTO 8.30.2 and 8.32.6. For deformed welded wire fabric, the overlap shall meet the requirements of AASHTO 8.30.1 and 8.32.5. The overlap of welded wire fabric shall be measured between the outer most longitudinal wires of each fabric sheet. For deformed billet-steel bars, the overlap shall meet the requirements of AASHTO 8.25. For splices other than tension splices, the overlap shall be a minimum of 12" for welded wire fabric or deformed billet-steel bars. The spacing center to center of the circumferential wires in a wire fabric sheet shall be not less than 2 inches nor more than 4 inches. The spacing center to center of the longitudinal wires shall not be more than 8 inches. The spacing center to center of the longitudinal distribution steel for either line of reinforcing in the top slab shall be not more than 16 inches.
- 6.7 Laps, Welds, and Spacing for Precast Wingwalls and Headwalls - Splices in the reinforcement shall be made by lapping. Laps may be tack welded together for assembly purposes. For smooth welded wire fabric, the overlap shall meet the requirements of AASHTO 8.30.2 and 8.32.6. For deformed welded wire fabric, the overlap shall meet the requirements of AASHTO 8.30.1 and 8.32.5. For deformed billet-steel bars, the overlap shall meet the requirements of AASHTO 8.25. The spacing center-to-center of the wires in a wire fabric sheet shall be not less than 2 inches nor more than 8 inches.

7. PERMISSIBLE VARIATIONS

- 7.1 Bridge Units
 - 7.1.1 Internal Dimensions - The internal dimension shall vary not more than 1% from the design dimensions nor more than 1-1/2 inches whichever is less. The haunch dimensions shall vary not more than 3/4 inch from the design dimension.
 - 7.1.2 Slab and Wall Thickness - The slab and wall thickness shall not be less than that shown in the design by more than 1/4 inch. A thickness more than that required in the design shall not be cause for rejection.
 - 7.1.3 Length of Opposite Surfaces - Variations in laying lengths of two opposite surfaces of the bridge unit shall not be more than 1/2 inch in any section, except where beveled ends for laying of curves are specified by the purchaser.
 - 7.1.4 Length of Section - The underrun in length of a section shall not be more than 1/2 inch in any bridge unit.
 - 7.1.5 Position of Reinforcement - The maximum variation in position of the reinforcement shall be ± 1/2 inch. In no case shall the cover over the reinforcement be less than 1 1/2 inches for the outside circumferential steel or be less than 1 inch for the inside circumferential steel as measured to the external or internal surface of the bridge. These tolerances or cover requirements do not apply to mating surfaces of the joints.
 - 7.1.6 Area of Reinforcement - The areas of steel reinforcement shall be the design steel areas as shown in the manufacturer's shop drawings. Steel areas greater than those required shall not be cause for rejection. The permissible variation in diameter of any reinforcement shall conform to the tolerances prescribed in the ASTM Specification for that type of reinforcement.
- 7.2 Wingwalls and Headwalls
 - 7.2.1 Wall Thickness - The wall thickness shall not vary from that shown in the design by more than 1/2 inch.
 - 7.2.2 Length/Height of Wall sections - The length and height of the wall shall not vary from that shown in the design by more than 1/2 inch.
 - 7.2.3 Position of Reinforcement - The maximum variation in the position of the reinforcement shall be ± 1/2 inch. In no case shall the cover over the reinforcement be less than 1 1/2 inches.
 - 7.2.4 Size of Reinforcement - The permissible variation in diameter of any reinforcing shall conform to the tolerances prescribed in the ASTM Specification for that type of reinforcing. Steel area greater than that required shall not be cause for rejection.

8. TESTING AND INSPECTION

- 8.1 Type of Test Specimen - Concrete compressive strength shall be determined from compression tests made on cylinders or cores. For cylinder testing, a minimum of 4 cylinders shall be taken during each production run. For core testing, one core shall be cut from each of 3 precast elements selected at random from each production group. A production group shall be defined as 15 or fewer bridge units (of a particular size), wingwalls or headwalls in a continuous production run. For each continuous production run, each production group or fraction thereof shall be considered separately for the purpose of testing and acceptance. A production run shall be considered continuous if not interrupted for more than 3 consecutive days.
- 8.2 Compression Testing - Cylinders shall be made and tested as prescribed by the ASTM C 39 Specification. Cores shall be obtained and tested for compressive strength in accordance with the provisions of the ASTM C497 Specification.
- 8.3 Acceptability of Cylinder Tests - When the average compressive strength of all cylinders tested is equal to or greater than the design compressive strength, and not more than 10% of the cylinders tested have a compressive strength less than the design concrete strength, and no cylinder tested has a compressive strength less than 80% of the design compressive strength, then the lot shall be accepted. When the compressive strength of the cylinders tested does not conform to this acceptance criteria, the acceptability of the lot may be determined as described in section 8.4, below.
- 8.4 Acceptability of Core Tests - The compressive strength of the concrete in each production group as defined in 8.1 is acceptable when the average core test strength is equal to or greater than the design concrete strength. When the compressive strength of the core tested is less than the design concrete strength, the precast element from which that core was taken may be re-cored. When the compressive strength of the re-core is equal to or greater than the design concrete strength, the compressive strength of the concrete in that production group is acceptable.
 - 8.4.1 When the compressive strength of any re-core is less than the design concrete strength, the precast element from which that core was taken shall be rejected. Two precast elements from the remainder of the group shall be selected at random and one core shall be taken from each. If the compressive strength of both cores is equal to or greater than the design concrete strength, the compressive strength of the remainder of that group is acceptable. If the compressive strength of either of the two cores tested is less than the design concrete strength, the remainder of the group shall be rejected or, at the option of the manufacturer, each precast element of the remainder of the group shall be cored and accepted individually, and any of these elements that have cores with less than the design concrete strength shall be rejected.
 - 8.4.2 Plugging Core Holes - The core holes shall be plugged and sealed by the manufacturer in a manner such that the elements will meet all of the test requirements of this specification. Precast elements so sealed shall be considered satisfactory for use.
 - 8.4.3 Test Equipment - Every manufacturer furnishing culverts under this specification shall furnish all facilities and personnel necessary to carryout the test required.

9. JOINTS

The bridge units shall be produced with flat butt ends. The ends of the bridge units shall be such that when the sections are laid together they will make a continuous line of with a smooth interior free of appreciable irregularities, all compatible with the permissible variations in Section 7, above. The joint width shall not exceed 3/4 inches.

10. WORKMANSHIP AND FINISH

The bridge units, wingwalls, and headwalls shall be substantially free of fractures. The ends of the bridge units shall be normal to the walls and centerline of the bridge section, within the limits of the variations given in section 7, above, except where beveled ends are specified. The faces of the wingwalls and headwalls shall be parallel to each other, within the limits of variations given in section 7, above. The surface of the precast elements shall be a smooth steel form or troweled surface. Trapped air pockets causing surface defects shall be considered as part of a smooth, steel form finish.

11. REPAIRS

Precast elements may be repaired, if necessary, because of imperfections in manufacture or handling damage and will be acceptable if, in the opinion of the purchaser, the repairs are sound, properly finished and cured, and the repaired section conforms to the requirements of this specification.

12. INSPECTION

The quality of materials, the process of manufacture, and the finished culverts shall be subject to inspection by the purchaser.

13. REJECTION

The precast elements shall be subject to rejection on account of any of the specification requirements. Individual precast elements may be rejected because of any of the following:

- 13.1 Fractures or cracks passing through the wall, except for a single end crack that does not exceed one half the thickness of the wall.
- 13.2 Defects that indicate proportioning, mixing, and molding not in compliance with Section 5 of these specifications.
- 13.3 Honeycombed or open texture.
- 13.4 Damaged ends, where such damage would prevent making a satisfactory joint.

14. MARKING

Each bridge unit shall be clearly marked by waterproof paint. The following shall be shown on the inside of the vertical leg of the bridge section:

- Bridge Span X Bridge Rise
- Date of Manufacture
- Name or trademark of the manufacturer

No As-Built Information is required on this sheet



Professional Certification. I hereby certify that these documents were prepared or approved by me, and that I am a duly licensed professional engineer under the laws of the State of Maryland.
License No. 21443, Expiration Date: 12-31-17

APPROVED: DEPARTMENT OF PUBLIC WORKS	
<i>Walter J. Hall</i>	7-20-07
CHIEF, BUREAU OF HIGHWAYS	DATE
APPROVED: DEPARTMENT OF PLANNING AND ZONING	
<i>Wanda Hantz</i>	9/17/07
CHIEF, DIVISION OF LAND DEVELOPMENT	DATE
<i>David Williams</i>	7/24/07
CHIEF, DEVELOPMENT ENGINEERING DIVISION	DATE

NO.	DATE	REVISION

BENCHMARK
ENGINEERS & LAND SURVEYORS & PLANNERS
ENGINEERING, INC.

8480 BALTIMORE NATIONAL PIKE & SUITE 418
ELLCOTT CITY, MARYLAND 21043
PHONE: 410-465-6105 FAX: 410-465-6644
WWW.BEI-CIVLENGINEERING.COM

OWNER/DEVELOPER:	FRIENDLY FARMS LLC P.O. BOX 417 ELLCOTT CITY, MARYLAND 21041 410-465-4244
PROJECT:	TAYLOR FARM SECTION THREE, PHASE TWO LOTS 57 THROUGH 101 AND NON-BUILDABLE BULK PARCEL 'A' A REVISION OF LOT 57 TO BE 200' FROM SECTION THREE AND LOT 2 OF PREVIOUS PLAN (PLAN NO. 2000-4622)
LOCATION:	TAX MAP: 10 GRD: 23 PARCEL: 309 ZONING: R-20 3rd ELECTION DISTRICT HOWARD COUNTY, MARYLAND
TITLE:	CON/SPAN BRIDGE SPECIFICATIONS
DATE:	JULY, 2007
PROJECT NO.:	1585
DESIGN:	DRAFT: CHECK:
SCALE:	AS SHOWN
SHEET:	21 OF 22

NOTICE
© 2007. The design and information shown on this drawing is provided as a service to the project owner, engineer and contractor by CONTECH Bridge Solutions Inc. No part of this drawing may be used, reproduced, or modified in any manner without the prior written authorization of CONTECH Bridge Solutions Inc. Any such use, reproduction, or modification of this drawing is done at the user's own risk and the user agrees to indemnify, defend and hold harmless CONTECH Bridge Solutions Inc. from and against any and all claims, liability, and expense, including, but not limited to, reasonable attorney's fees, arising from such use, reproduction or modification.
If discrepancies between the supplied information and actual field conditions are encountered as site work progresses, these discrepancies must be reported to CONTECH Bridge Solutions Inc. immediately for re-evaluation of the design. CONTECH Bridge Solutions Inc. accepts no liability for designs based on inaccurate information supplied by others.

CONTECH
BRIDGE SOLUTIONS INC.

8430 University Executive Park Drive
Suite 695
Charlotte, North Carolina 28262

704-548-8420
704-548-8586 fax
800-526-3999

CONTECH
BRIDGE SOLUTIONS INC. - System

CON/SPAN
BRIDGE SYSTEMS


Project Status: **APPROVED FOR CONSTRUCTION**

Designed	MRP	Project No.
Drawn	RPU	15086
Checked	LNM	Sheet No.
Date	4/12/07	CT7

Sheet Title: **SPECIFICATIONS**

HOWARD COUNTY MARYLAND

TAYLOR FARM SECTION THREE, PHASE TWO

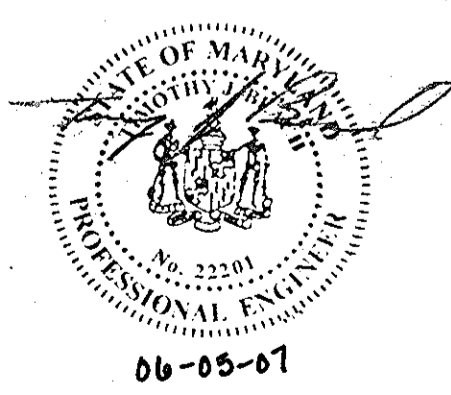

SPECIFICATIONS FOR MANUFACTURE AND INSTALLATION OF CON/SPAN® BRIDGE SYSTEMS (CONT'D)

15. CONSTRUCTION REQUIREMENTS

15.1 Footings - The bridge units and wingwalls shall be installed on either precast or cast-in-place concrete footings. The design size and elevation of the footings shall be as determined by the Engineer. A three inch deep keyway shall be formed in the top surface of the bridge footing three inches clear of the inside and outside faces of the bridge units, unless specified otherwise on the plans. No keyway is required in the wingwall footings, unless otherwise specified on the plans. The footings shall be given a smooth float finish and shall reach a compressive strength of 2,000 psi before placement of the bridge and wingwall elements. The completed footing surface shall be constructed in accordance with grades shown on the plans. When tested with a 10 foot straight edge, the surface shall not vary more than 1/4 inch in 10 feet. If a precast concrete footing is used, the contractor shall prepare a 4 inch thick base layer of compacted granular material the full width of the footing prior to placing the precast footing.

15.2 Placement of the Bridge Units, Wingwalls and Headwalls - The bridge units, wingwalls and headwalls shall be placed as shown on the Engineer's plan drawings. Special care shall be taken in setting the elements to the true line and grade. The bridge units and wingwalls shall be set on 6" x 6" masonite or steel shims. A minimum gap of 1/2 inch shall be provided between the footing and the bottom of the bridge's vertical legs or the wingwall. The gap shall be filled with cement grout (Portland cement and water or cement mortar composed of Portland cement, sand and water) with a minimum 28-day compressive strength of 3000 psi. If units have been set with temporary ties (cables, bars, etc.) grout must attain a minimum compressive strength of 1500 psi before ties may be removed.

15.3 External Protection of Joints - The butt joint made by two adjoining bridge units shall be covered with a 7/8" x 1 3/8" preformed bituminous joint sealant and a minimum of a 9 inch wide joint wrap. The surface shall be free of dirt before applying the joint material. A primer compatible with the joint wrap to be used shall be applied for a minimum width of nine inches on each side of the joint. The external wrap shall be either EZ-WRAP RUBBER by PRESS-SEAL GASKET CORPORATION, SEAL WRAP by MAR MAC MANUFACTURING CO. INC. or approved equal. The joint shall be covered continuously from the bottom of one bridge section leg, across the top of the arch and to the opposite bridge section leg. Any laps that result in the joint wrap shall be a minimum of six inches long with the overlap running downhill.

In addition to the joints between bridge units, the joint between the end bridge unit and the headwall shall also be sealed as described above. If precast wingwalls are used, the joint between the end bridge unit and the wingwall shall be sealed with a 2'-0" strip of filter fabric. Also, if lift holes are formed in the arch units, they shall be primed and covered with a 9" x 9" square of joint wrap.

During the backfilling operation, care shall be taken to keep the joint wrap in its proper location over the joint.

15.4 Backfill - Backfill shall be considered as all replaced excavation and new embankment adjacent to the CON/SPAN® bridge units, wingwalls, and headwalls. The project construction and material specifications which include the specifications for excavation for structures and roadway excavation and embankment construction, shall apply except as modified in this section.

No backfill shall be placed against any structural elements until they have been approved by the Engineer.

Backfill against a waterproofed surface shall be placed carefully to avoid damage to the waterproofing material.

Mechanical tampers or approved compacting equipment shall be used to compact all backfill and embankment immediately adjacent to each side and over the top of each bridge unit until it is covered to a minimum depth of one foot, unless the design fill height is less than 1'-0". The backfill within the Critical Backfill Zone (shown in the diagrams below) shall be placed in lifts of eight inches or less (loose depth). Heavy compaction equipment shall not be operated in this area or over the bridge until it is covered to a depth of one foot, unless the design fill height is less than 1'-0".

Lightweight dozers and graders may be operated over bridge units having one foot of compacted cover, but heavy earth moving equipment (larger than a D-4 Dozer weighing in excess of 12 tons and having track pressures of eight psi or greater) shall require two feet of cover unless the design cover is less than two feet. In no case shall equipment operating in excess of the design load (HS20 or HS25) be permitted over the bridge units unless approved by CON/SPAN®.

Any additional fill and subsequent excavation required to provide this minimum cover shall be made at no additional cost to the project.

As a precaution against introducing unbalanced stresses in the bridge, when placing backfill at no time shall the difference between the heights of fill on opposite sides of the bridge exceed 2'.

Backfill in front of wingwalls shall be carried to ground lines shown in the plans.

For fill heights over 12 feet, no backfilling may begin until a backfill compaction testing plan has been coordinated with and approved by CON/SPAN® Bridge Systems. Cost of the backfill compaction testing shall be included in the cost of the precast units. This included cost applies only to projects with fill heights over 12 feet (as measured from top crown of arch to finished grade).

16. QUALITY ASSURANCE

The Precaster shall demonstrate adherence to the standards set forth in the NPCA Quality Control Manual. The Precaster shall meet either Section 16.1 or 16.2.

16.1 Certification: The Precaster shall be certified by the Precast/Prestressed Concrete Institute Plant Certification Program or the National Precast Concrete Association's Plant Certification Program prior to and during production of the products covered by this specification.

16.2 Qualifications, Testing and Inspection

16.2.1 The Precaster shall have been in the business of producing precast concrete products similar to those specified for a minimum of three years. He shall maintain a permanent quality control department or retain an independent testing agency on a continuing basis. The agency shall issue a report, certified by a licensed engineer, detailing the ability of the Precaster to produce quality products consistent with industry standards.


16.2.2 The Precaster shall show that the following tests are performed in accordance with the ASTM standards indicated. Tests shall be performed for each 150 cubic yards of concrete placed, but not less frequently than once per production run, as defined in §8 of these specifications.

16.2.2.1 Air Content: C231 or C173

16.2.2.2 Compressive Strength: C39, C497


16.2.3 The Precaster shall provide documentation demonstrating compliance with this section to CON/SPAN® Bridge Systems at regular intervals or upon request.

16.2.4 The Owner may place an inspector in the plant when the products covered by this specification are being manufactured.

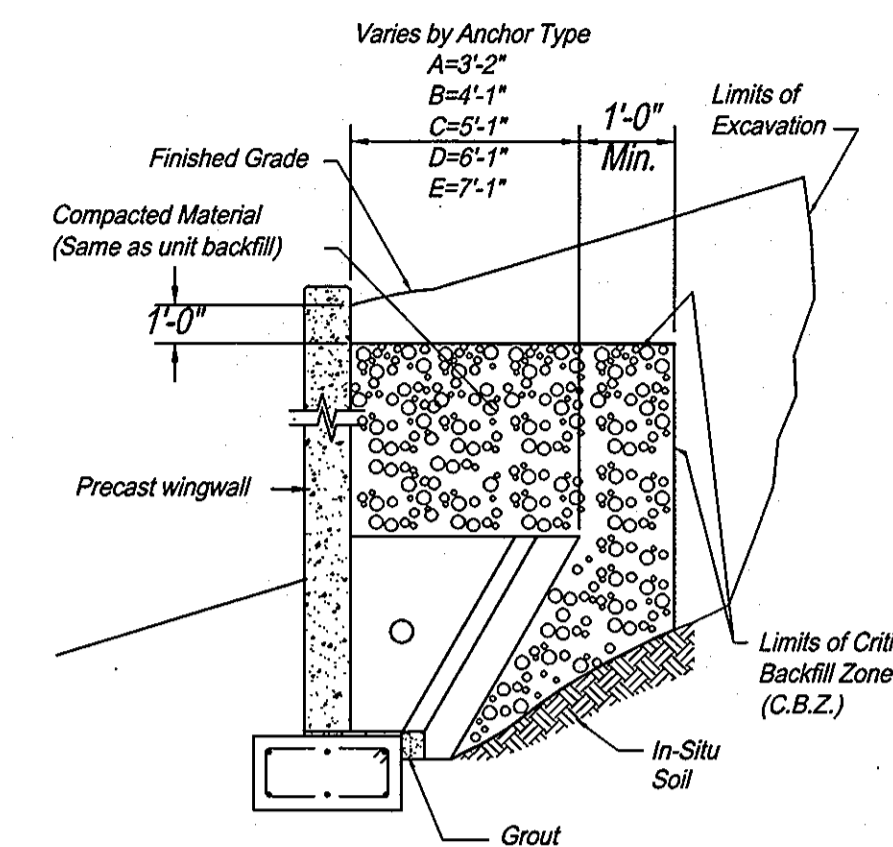

WINGWALL BACKFILL REQUIREMENTS

Group Classification	BACKFILL DESCRIPTION (AASHTO M 145-91)							
	A-1-a	A-1-b	A-3	A-2-4	A-2-5	A-2-6	A-2-7	A-4
Sieve Analysis, Percent Passing (100% Passing 3" Sieve)								
No. 10	50 max.							
No. 40	30 max.	50 max.	51 min.					
No. 200	15 max.	25 max.	10 max.	35 max.	35 max.	35 max.	35 max.	36 min.
Characteristics of Fraction Passing No. 40								
Liquid Limit				40 max.	41 min.	40 max.	41 min.	40 max.
Plasticity Index	6 max.		N.P.	10 max.	10 max.	11 min.	11 min.	10 max.
Usual Types of Significant Constituent Materials	Gravel & Sand		Sand	Silty or Clayey Gravel and Sand			Silty Soils	
General Rating as Subgrade				Excellent to Good			Fair to Poor	

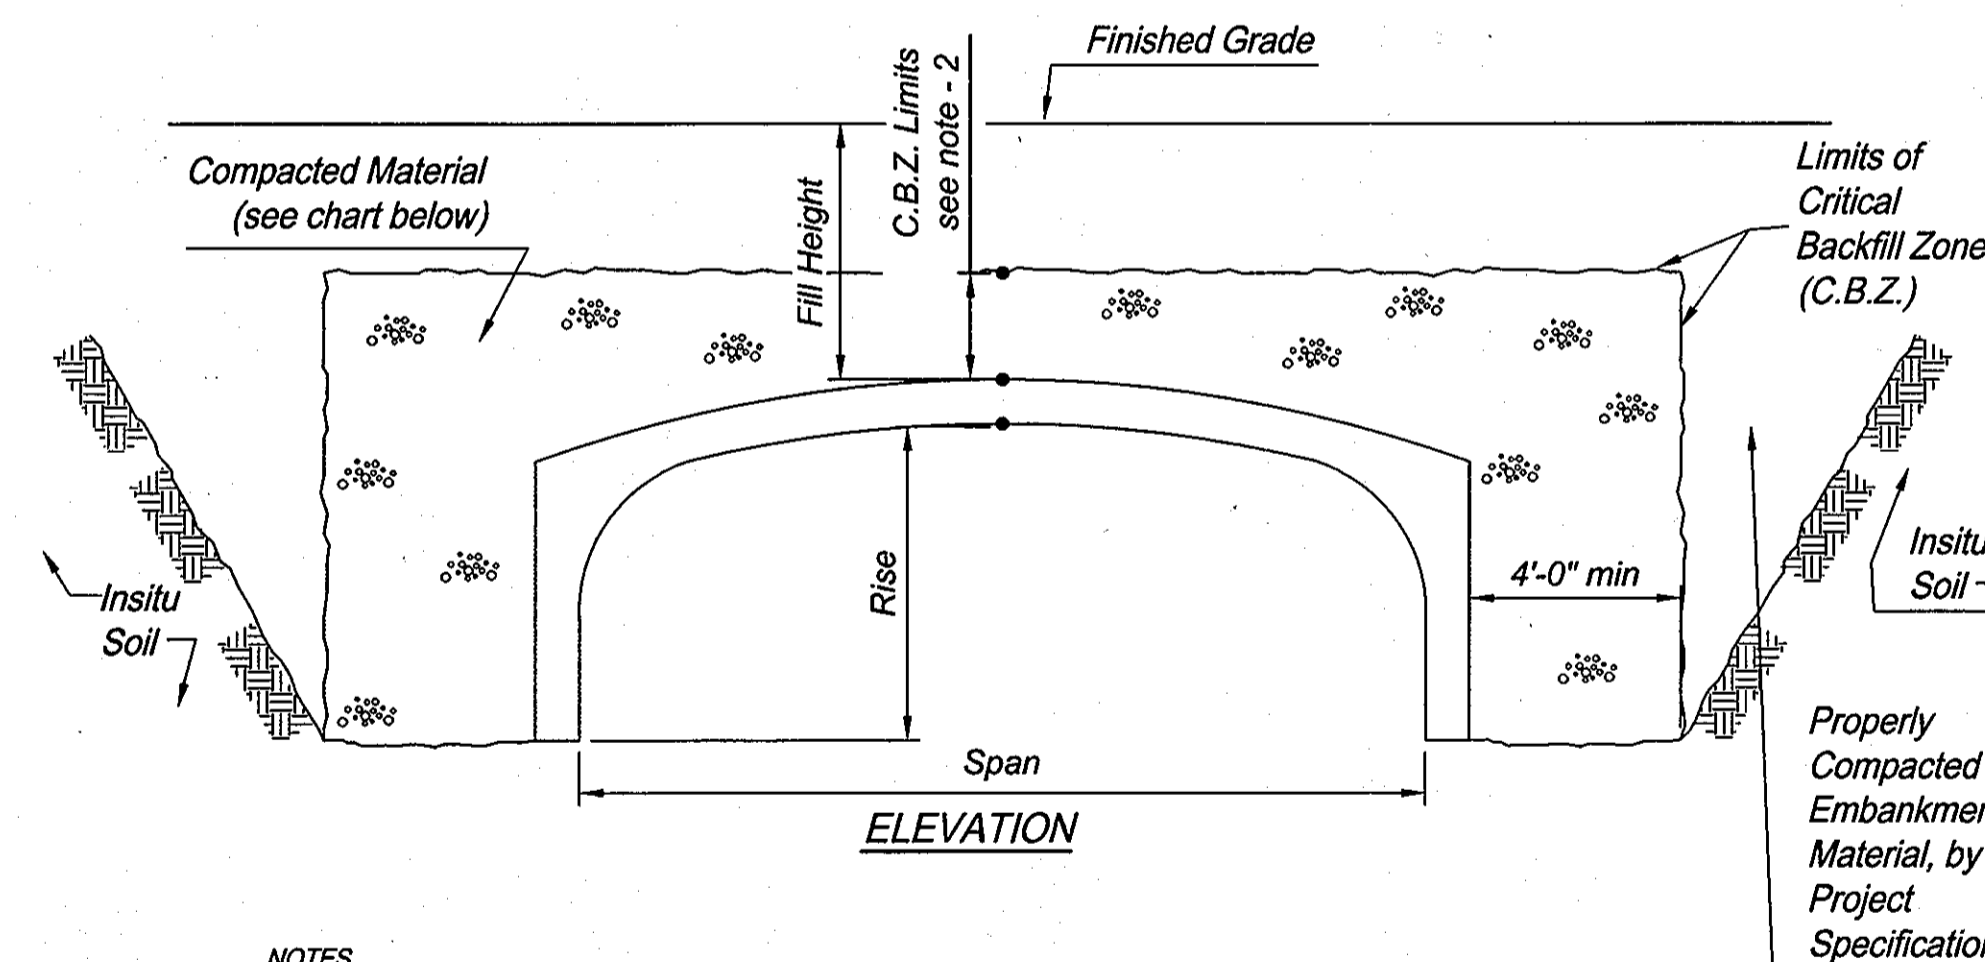


NOTES
 1. SEE CON/SPAN® SPECIFICATIONS SECTION 15.4 FOR BACKFILL SPECIFICATIONS.
 2. FOR FILL HEIGHTS GREATER THAN 2'-0", C.B.Z. LIMIT SHALL BE 2'-0" ABOVE ARCH CROWN. FOR FILL HEIGHTS LESS THAN 2'-0", THE FINISHED GRADE SHALL BE THE BOUNDARY LINE FOR THE C.B.Z.
 3. BACKFILLING OPERATIONS WITHIN THE C.B.Z. SHALL BE PERFORMED IN LIFTS OF 8" OR LESS (LOOSE DEPTH).
 4. MAXIMUM DRY DENSITY SHALL BE DETERMINED BY AASHTO T-99 OR OTHER APPROVED METHODS.
 5. BACKFILL SHALL BE COMPACTED IN LAYERS UNTIL THE DENSITY IS NOT LESS THAN 95% OF THE MAXIMUM DRY DENSITY.

SPAN	FILL HEIGHT	ACCEPTABLE MATERIAL INSIDE C.B.Z.	ACCEPTABLE MATERIAL OUTSIDE C.B.Z.
≤ 24'-0"	≥ 12'-0"	A1, A3	**
≤ 24'-0"	< 12'-0"	A1, A2, A3, A4	**
> 24'-0"	ALL	A1, A3	**

** EMBANKMENT MATERIAL PER PROJECT SPECIFICATIONS

BACKFILL REQUIREMENTS

REVISED 9/3/03 SPEC4.DWG
 REVISED 1/15/02 SPEC4.DWG
 REVISED 6/12/01 SPEC3.DWG
 REVISED 7/21/00 SPEC3.DWG
 REVISED 7/14/97 SPEC1.DWG
 REVISED 4/4/96 SPEC1.DWG
 REVISED 3/5/96 SPEC1.DWG
 REVISED 11/14/94 SPEC1.DWG
 REVISED 5/25/94 SPEC1.DWG
 REVISED 9/10/93 SPEC1.DWG

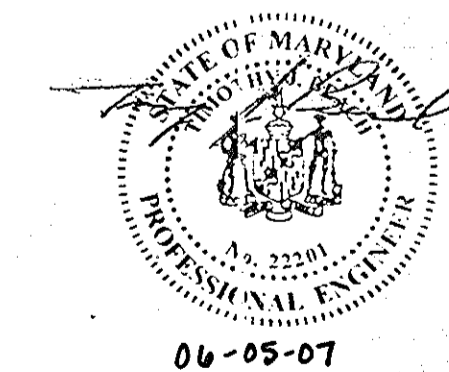

06-05-07
 Engineer's Seal



No As-Built information is required on this sheet



Professional Certification. I hereby certify that these documents were prepared or approved by me, and that I am a duly licensed professional engineer under the laws of the State of Maryland.
 License No. 21443, Expiration Date 12-21-14

APPROVED: DEPARTMENT OF PUBLIC WORKS
 With: Z. [Signature] 7-20-07
 CHIEF, BUREAU OF HIGHWAYS DATE

APPROVED: DEPARTMENT OF PLANNING AND ZONING
 Cindy [Signature] 9/15/07
 CHIEF, DIVISION OF LAND DEVELOPMENT DATE

[Signature] 7/29/07
 CHIEF, DEVELOPMENT ENGINEERING DIVISION DATE

NO.	DATE	REVISION

BENCHMARK ENGINEERING, INC.
 ENGINEERS • LAND SURVEYORS • PLANNERS
 8480 BALTIMORE NATIONAL PIKE • SUITE 418
 ELLICOTT CITY, MARYLAND 21043
 PHONE: 410-465-8105 FAX: 410-465-8644
 WWW.BEI-CIVLENGINEERING.COM

OWNER/DEVELOPER: FRIENDLY FARMS LLC
 P.O. BOX 417
 ELLICOTT CITY, MARYLAND 21041
 410-465-4244

PROJECT: TAYLOR FARM SECTION THREE, PHASE TWO
 LOTS 57 THROUGH 101 AND NON-BUILDABLE BULK PARCEL 'A' A RECONFIGURATION OF LOT 54 TAYLOR FARM SECTION THREE AND LOT 2 OF PREVIOUS PARCEL (PLAT NO. 8229-6527)

LOCATION: TAX MAP: 10 GRID: 23 PARCEL: 309
 TAX MAP: 18 GRID: 5 ZONING: R-20
 3rd ELECTION DISTRICT
 HOWARD COUNTY, MARYLAND

TITLE: CON/SPAN BRIDGE SPECIFICATIONS

DATE: JULY, 2007 PROJECT NO. 1585

DESIGN: DRAFT: CHECK: SCALE: AS SHOWN SHEET 22 OF 22

NOTICE
 © 2007, The design and information shown on this drawing is provided as a service to the project owner, engineer and contractor by CONTECH Bridge Solutions Inc. No part of this drawing may be used, reproduced, or modified in any manner without the prior written authorization of CONTECH Bridge Solutions Inc. Any such use, reproduction, or modification of this drawing is done at the user's own risk and the user agrees to indemnify, defend and hold harmless CONTECH Bridge Solutions Inc. from and against any and all claims, liability, and expense, including, but not limited to, reasonable attorney's fees, arising from such use, reproduction or modification.

If discrepancies between the supplied information and actual field conditions are encountered as site work progresses, these discrepancies must be reported to CONTECH Bridge Solutions Inc., immediately for re-evaluation of the design. CONTECH Bridge Solutions Inc. accepts no liability for designs based on inaccurate information supplied by others.

Company: **CONTECH BRIDGE SOLUTIONS INC.**

8430 University Executive Park Drive Suite 695
 Charlotte, North Carolina 28262

704-548-8420
 704-548-8586 fax
 800-526-3999

Sheet Title: **SPECIFICATIONS**

Project Status: **APPROVED FOR CONSTRUCTION**

Designed: MRP Project No. 15086
 Drawn: RPU
 Checked: LNM Sheet No. CT8
 Date: 4/12/07

HOWARD COUNTY MARYLAND

TAYLOR FARM SECTION THREE, PHASE TWO