

SHEET INDEX	
NO	DESCRIPTION
1	TITLE SHEET
2	EXISTING CONDITIONS PLAN AND SOILS MAP
3	FINAL GRADING AND SEDIMENT CONTROL PLAN
4	FINAL GRADING AND SEDIMENT CONTROL PLAN
5	SEDIMENT AND EROSION CONTROL NOTES AND DETAILS
6	LANDSCAPE PLAN AND NOTES
7	LANDSCAPE NOTES AND DETAILS
8	FOREST STAND DELINEATION PLAN
9	FOREST STAND DELINEATION NOTES AND TABULATIONS
10	FINAL FOREST CONSERVATION PLAN, NOTES AND DETAILS
11	FINAL FOREST CONSERVATION PLAN
12	FINAL FOREST CONSERVATION NOTES
13	ROAD PROFILE
14	SIGHT DISTANCE
15	INFILTRATION TRENCH DETAILS

**GENERAL NOTES**

- ALL CONSTRUCTION SHALL BE IN ACCORDANCE WITH THE LATEST STANDARDS AND SPECIFICATIONS OF HOWARD COUNTY PLUS MSHA STANDARDS AND SPECIFICATIONS, IF APPLICABLE.
- THE CONTRACTOR SHALL NOTIFY THE DEPARTMENT OF PUBLIC WORKS/BUREAU OF ENGINEERING/ CONSTRUCTION INSPECTION DIVISION AT (410) 313-1880 AT LEAST FIVE (5) WORKING DAYS PRIOR TO THE START OF WORK.
- THE CONTRACTOR SHALL NOTIFY "MISS UTILITY" AT 1-800-257-7777 AT LEAST 48 HOURS PRIOR TO ANY EXCAVATION WORK BEING DONE.
- TRAFFIC CONTROL DEVICES, MARKINGS, AND SIGNING SHALL BE IN ACCORDANCE WITH THE LATEST EDITION OF THE MANUAL ON UNIFORM TRAFFIC CONTROL DEVICES (MUTCD). ALL STREET AND REGULATORY SIGNS SHALL BE IN PLACE PRIOR TO THE PLACEMENT OF ANY ASPHALT.
- ALL PLAN DIMENSIONS ARE TO EDGE OF PAVEMENT UNLESS OTHERWISE NOTED.
- THE EXISTING TOPOGRAPHY IS TAKEN FROM FIELD RUN SURVEY WITH MAXIMUM TWO FOOT CONTOUR INTERVALS PREPARED BY PATTON HARRIS RUST & ASSOCIATES DATED JUNE 2006.
- THE COORDINATES SHOWN HEREON ARE BASED UPON THE HOWARD COUNTY GEODETIC CONTROL WHICH IS BASED UPON THE MARYLAND STATE PLANE COORDINATE SYSTEM. HOWARD COUNTY MONUMENT NOS. 291A AND 291D WERE USED FOR THIS PROJECT.
- WATER IS PRIVATE.
- SEWER IS PRIVATE.
- THE STORMWATER MANAGEMENT FOR THIS SITE IS PROVIDED IN ONE INFILTRATION TRENCH FOR BOTH WATER QUALITY VOLUME AND RECHARGE VOLUME. CHANNEL PROTECTION VOLUME IS NOT REQUIRED FOR THIS SITE. THE INFILTRATION TRENCH IS A STRUCTURAL PRACTICE, AND WILL BE PRIVATELY MAINTAINED.
- APPROXIMATE LOCATION OF EXISTING UTILITIES ARE SHOWN. THE CONTRACTOR SHALL TAKE ALL NECESSARY PRECAUTIONS TO PROTECT THE EXISTING UTILITIES AND MAINTAIN UNINTERRUPTED SERVICE. ANY DAMAGE INCURRED DUE TO CONTRACTOR'S OPERATION SHALL BE REPAIRED IMMEDIATELY AT THE CONTRACTOR'S EXPENSE. EXISTING UTILITIES ARE SHOWN BASED ON THE BEST AVAILABLE INFORMATION.
- THE 100-YEAR FLOODPLAIN HAS BEEN SHOWN HEREON BASED ON FIRM MAP # 24044, PANEL 0027.
- THE BOUNDARY SURVEY FOR THIS PROJECT WAS PREPARED BY PATTON HARRIS RUST & ASSOCIATES DATED JUNE 2006.
- SUBJECT PROPERTY ZONED RC-DEO PER THE 02-02-04 COMPREHENSIVE ZONING PLAN AND THE "COMP LITE" ZONING AMENDMENTS EFFECTIVE 07-28-06.
- ALL ELEVATIONS SHOWN ARE BASED ON THE U.S.C. AND G.S. MEAN SEA LEVEL DATUM, 1929.
- THE CONTRACTOR SHALL TEST PIT EXISTING UTILITIES AT LEAST (5) DAYS BEFORE STARTING WORK SHOWN ON THESE DRAWINGS.
- CONTRACTOR IS SOLELY RESPONSIBLE FOR CONSTRUCTION MEANS, METHODS, TECHNIQUES, SEQUENCES, PROCEDURES, AND SAFETY PRECAUTIONS AND PROGRAMS.
- PIPE SHALL NOT BE INSTALLED BY THE CONTRACTOR UNTIL THE LENGTH CALLED FOR AT EACH STATION HAS BEEN APPROVED BY THE ENGINEER IN THE FIELD.
- NO PIPE SHALL BE LAID UNTIL LINES OF EXCAVATION HAVE BEEN BROUGHT WITHIN 6" OF FINISHED GRADE
- ALL PIPE ELEVATIONS SHOWN ARE INVERT ELEVATIONS.
- PROFILE STATIONS SHALL BE ADJUSTED AS NECESSARY TO CONFORM TO PLAN DIMENSIONS.
- ALL FILL AREAS WITHIN ROADWAY AND UNDER STRUCTURES TO BE COMPACTED TO A MINIMUM OF 95% COMPACTION OF AASHTO T180.
- ALL LIGHTING IS TO BE DIRECTED/REFLECTED AWAY FROM ADJACENT PUBLIC ROADS AND RESIDENTIALLY ZONED PROPERTIES, AND BE IN ACCORDANCE WITH SECTION 134 OF THE HOWARD COUNTY ZONING REGULATIONS. LIGHT TRESPASS ONTO ADJOINING PROPERTIES SHALL BE LIMITED TO 0.1 FOOT CANDLES.
- THERE IS ONE EXISTING PERMANENT STRUCTURE AND THREE BARN ON-SITE. THE EXISTING BARN (CIRCA 1973) WILL BE REMOVED. THE HOUSE (BUILT IN 1973) WILL REMAIN.
- GRADING, REMOVAL OF VEGETATIVE COVER AND TREES AND PAVING ARE NOT PERMITTED IN WETLANDS, STREAMS, WETLAND BUFFERS, STREAM BUFFERS, FLOODPLAIN, FOREST CONSERVATION AREAS, OR STEEP SLOPES.
- BASED ON AVAILABLE COUNTY MAPS AND RECORDS, THERE ARE NO HISTORIC STRUCTURES OR KNOWN CEMETERIES LOCATED ON THE SUBJECT PROPERTY.
- THIS PLAN WAS PREPARED IN ACCORDANCE WITH THE PROVISIONS OF SECTION 16.124 OF THE HOWARD COUNTY CODE AND THE LANDSCAPE MANUAL. FINANCIAL SURETY FOR THE REQUIRED LANDSCAPING WILL BE ADDRESSED WITH THE REQUIRED GRADING PERMIT/BUILDING PERMIT IN THE AMOUNT OF \$ 8,600.00 FOR 28 SHADE TREES, 0 ORNAMENTAL TREES, 8 EVERGREEN TREES, AND 0 SHRUBS.
- LOT 1 IS EXEMPT FROM THE OPEN SPACE FEE BECAUSE IT CONTAINS AN EXISTING HOME. LOT 2 WILL BE REQUIRED TO PAY A FEE-IN-LIEU OF \$1,500.00 FOR OPEN SPACE.
- EXISTING USE IN COMMON DRIVEWAY IS TO REMAIN AND BE WIDENED TO AN ULTIMATE WIDTH OF 18'.
- FOR FLAG OR PIPE STEM LOTS, REFUSE COLLECTION, SNOW REMOVAL AND ROAD MAINTENANCE ARE PROVIDED TO THE JUNCTION OF THE FLAG OR PIPE STEM AND THE ROAD RIGHT-OF-WAY LINE ONLY AND NOT ONTO THE FLAG OR PIPE STEM LOT DRIVEWAY.
- VEHICULAR EGRESS AND INGRESS (VIER) IS RESTRICTED ALONG HOMEWOOD ROAD WEST OF THE EXISTING DRIVEWAY.
- A USE-IN-COMMON MAINTENANCE AGREEMENT WILL BE RECORDED CONCURRENTLY WITH THIS PLAN.
- THIS AREA DESIGNATES A PRIVATE SEWAGE DISPOSAL EASEMENT OF AT LEAST 10,000 SQUARE FEET AS REQUIRED BY THE MARYLAND DEPARTMENT OF THE ENVIRONMENT FOR INDIVIDUAL SEWAGE DISPOSAL. IMPROVEMENTS OF ANY NATURE IN THIS AREA ARE RESTRICTED. THESE EASEMENTS SHALL BECOME NULL AND VOID UPON CONNECTION TO A PUBLIC SEWERAGE SYSTEM. THE COUNTY HEALTH OFFICER SHALL HAVE THE AUTHORITY TO GRANT ADJUSTMENTS TO THE PRIVATE SEWAGE EASEMENT. RECORDEMENT OF A REVISED SEWAGE EASEMENT SHALL NOT BE NECESSARY.
- PERC HOLES SHOWN HEREON HAVE BEEN FIELD LOCATED BY PHRA IN JANUARY 30TH, 2007.
- PERC DENOTES PASSING PERC TEST.
- PERC DENOTES FAILED PERC TEST.
- WELLS AND SEPTIC SYSTEMS WITHIN 100 FEET OF THE PROPERTY BOUNDARY HAVE BEEN SHOWN TO THE BEST OF OUR KNOWLEDGE AND INFORMATION FROM AVAILABLE COUNTY RECORDS.
- THE LOTS SHOWN HEREON COMPLY WITH THE MINIMUM OWNERSHIP WIDTH AND LOT AREA AS REQUIRED BY THE MARYLAND DEPARTMENT OF THE ENVIRONMENT AND HOWARD COUNTY.
- PERC DENOTES WELL (NOT TO SCALE)
- STEEP SLOPES (25% OR GREATER) ARE LOCATED ON SITE AS SHOWN.
- ALL WELLS TO BE DRILLED PRIOR TO FINAL PLAT RECORDEMENT.
- DRIVEWAYS SHALL BE PROVIDED PRIOR TO THE ISSUANCE OF A USE AND OCCUPANCY PERMIT FOR ANY NEW DWELLINGS TO INSURE SAFE ACCESS FOR FIRE AND EMERGENCY VEHICLES PER THE FOLLOWING MINIMUM REQUIREMENTS:
  - WIDTH - 12' (16' SERVING MORE THAN ONE RESIDENCE);
  - SURFACE - 6" OF COMPACTED CRUSHER RUN BASE WITH TAR AND CHIP COATING (1/2" MIN.);
  - GEOMETRY - MAX. 15% GRADE, MAX. 10% GRADE CHANGE AND MIN. 45' TURNING RADIUS;
  - STRUCTURES (CULVERTS/ BRIDGES) - CAPABLE OF SUPPORTING 25 GROSS TONS (H25 LOADING);
  - DRAINAGE ELEMENTS - CAPABLE OF SAFELY PASSING 100 YEAR FLOOD WITH NO MORE THAN 1 FOOT DEPTH OVER DRIVEWAY SURFACE;
  - MAINTENANCE - SUFFICIENT TO INSURE ALL WEATHER USE.

# FINAL PLAN

# HOMEWOOD FARM


## LOTS 1 & 2

## 3RD ELECTION DISTRICT


## HOWARD COUNTY, MARYLAND

**AREA TABULATION CHART**

EXISTING ZONING:	RC-DEO
GROSS AREA OF SITE:	14.83 ACRES (646,203 SF)
AREA IN 100 YEAR FLOODPLAIN:	0.13 ACRES
AREA OF STEEP SLOPES:	0.33 ACRES (14,314 SF)
NET TRACT AREA:	14.37 ACRES
AREA OF RIGHT-OF-WAY DEDICATION:	0.28 ACRES
AREA OF PROPOSED BUILDABLE LOTS:	13.86 ACRES
AREA OF REQUIRED OPEN SPACE:	LOT 1 IS EXEMPT FROM OPEN SPACE FEE BECAUSE IT CONTAINS AN EXISTING HOME. LOT 2 REQUIRES A FEE-IN-LIEU OF \$1,500
LIMIT OF DISTURBED AREA:	1.56 ACRES
NUMBER OF BUILDABLE LOTS:	2 LOTS
NUMBER OF BUILDABLE PRESERVATION PARCELS:	0
NUMBER OF NON-BUILDABLE PARCELS:	1
NUMBER OF OPEN SPACE LOTS:	0
PROPOSED WATER AND SEWER:	PRIVATE WELL AND SEPTIC
EXISTING USES:	EXISTING HOME, HORSEFARM, AND WOODS
PROPOSED USES:	2 SINGLE FAMILY DETACHED RESIDENTIAL LOTS

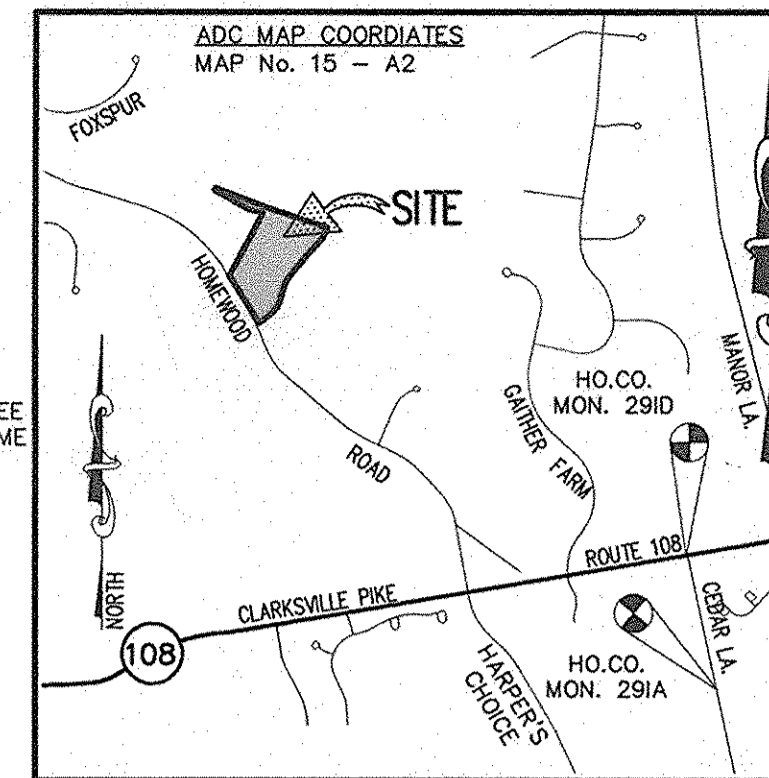

VICINITY MAP  
SCALE: 1" = 2000'

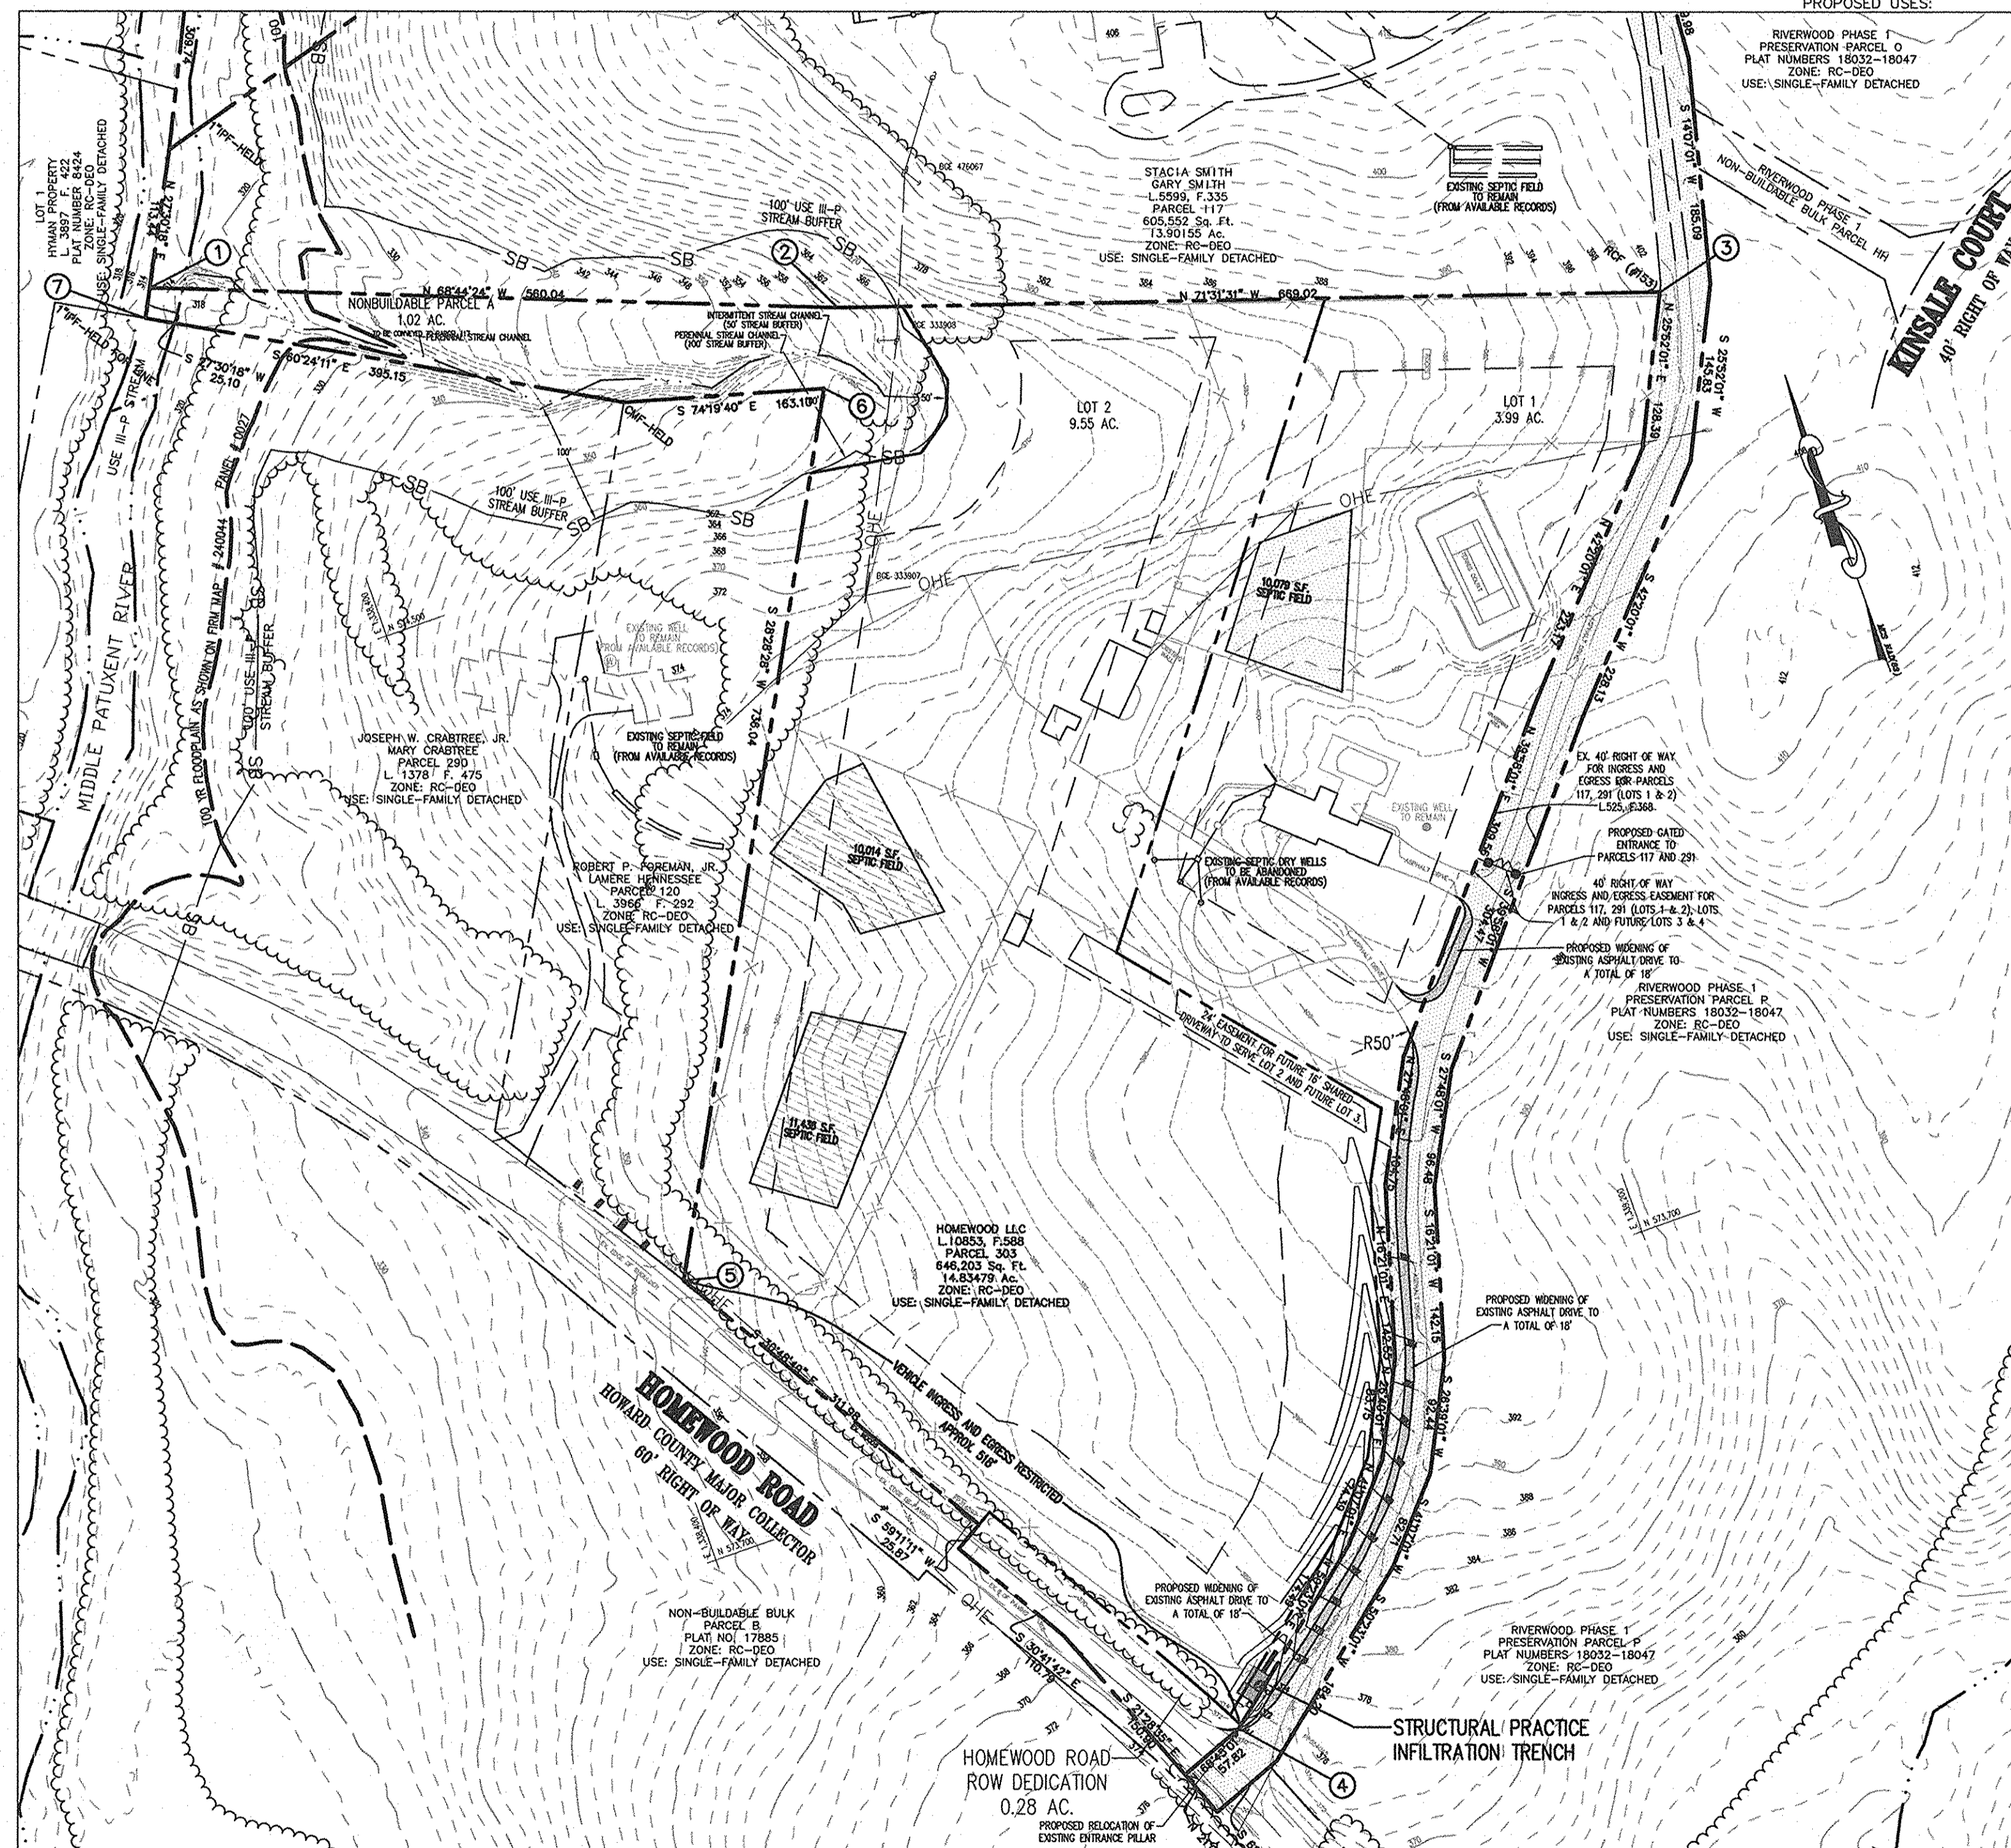

**WP-07-079 CONDITIONS OF APPROVAL:**

- THE DEVELOPER SHALL BE RESPONSIBLE FOR THE PREPARATION OF A USE-IN-COMMON DRIVEWAY MAINTENANCE AGREEMENT FOR THE EXISTING 40' WIDE RIGHT-OF-WAY SERVING PARCEL 117, PARCEL 291, AND NEW LOTS 1, 3, & 4. THIS MAINTENANCE DOCUMENT MAY BE RECORDED PRIOR TO, OR CONCURRENTLY WITH THE RECORDEMENT OF THE PLATS CREATING LOTS 1, 3, & 4 FROM PARCEL 303. IN ADDITION, A SEPARATE MAINTENANCE AGREEMENT WILL BE REQUIRED FOR THE 24' WIDE SHARED ACCESS EASEMENT (DESIGNED TO SERVE LOTS 3 AND 4 ONLY) WHICH WILL BE CREATED ON THE FORTHCOMING PLAT CREATING LOTS 1 & 2. THIS MAINTENANCE AGREEMENT WILL BE RECORDED WITH THE PLAT CREATING LOTS 3 & 4. (4/13/07)
- BY RECORD PLAT, THE DEVELOPER SHALL CREATE A 24' WIDE SHARED ACCESS EASEMENT FOR LOTS 3 AND 4. WITHIN THIS SHARED ACCESS, A 16' USE-IN-COMMON DRIVEWAY (MEETING DESIGN MANUAL STANDARDS) SHALL BE CONSTRUCTED. THE USE-IN-COMMON CREATED FOR LOTS 3 AND 4 WILL JOIN WITH THE IMPROVED 16' DRIVEWAY LOCATED WITHIN THE CONFINES OF THE 40' RIGHT-OF-WAY. (4/13/07)
- THE DEVELOPER SHALL IMPROVE THE EXISTING DRIVEWAY (CONTAINED WITHIN THE EXISTING 40' RIGHT-OF-WAY) TO 18' FROM HOMEWOOD ROAD TO THE LAST ACCESS POINT FOR PROPOSED LOT 1. (4/13/07)
- PLAN DETAILS FOR THE PROPOSED GATE SHOWING PROVISIONS FOR EMERGENCY ACCESS SHALL BE PROVIDED TO DEPARTMENT OF FIRE AND RESCUE SERVICES AND APPROVED BY THAT DEPARTMENT PRIOR TO THE RECORDEMENT OF THE PLAT CREATING LOTS 1 & 2. (4/13/07)
- THE DEVELOPER SHALL COMPLY WITH THE PREVIOUSLY FORWARDED COMMENTS FROM THE DEPARTMENT OF FIRE AND RESCUE SERVICES (DATED 2/14/07) REGARDING ADDRESS SIGNAGE AND DRIVEWAY TURNING RADIUS. (4/13/07)
- ON THE FORTHCOMING PLAT WHICH WILL CREATE LOTS 1 AND 2, NOTE ALL OF THE FRONTAGE ALONG HOMEWOOD ROAD AS "VEHICULAR INGRESS AND EGRESS RESTRICTED." CLEARLY NOTE THAT ALL ACCESS IS TO BE DERIVED VIA PARCEL 117. (4/13/07)
- BULK PARCEL A SHALL BE DESIGNATED AS NON-BUILDABLE PARCEL A WITH F-07-187. (6/22/07)
- NON-BUILDABLE PARCEL A WILL BE ENCUMBERED BY A FOREST CONSERVATION EASEMENT IN ITS ENTIRETY, ENCOMPASSING EXISTING FOREST AND FLOODPLAIN. (6/22/07)
- NON-BUILDABLE PARCEL A SHALL BE CONVEYED TO THE OWNERS OF ADJOINING PARCEL 117 IMMEDIATELY FOLLOWING THE RECORDEMENT OF THE PENDING PLAT (F-07-187). BE ADVISED THAT THIS NON-BUILDABLE 1,0191-ACRE PARCEL WILL BE A SEPARATE ENTITY FROM PARCEL 117 AND MAY ONLY BE MERGED WITH THAT PARCEL THROUGH THE RECORDEMENT OF A SUBDIVISION PLAT. (6/22/07)
- BULK PARCEL A SHALL BE DESIGNATED AS NON-BUILDABLE PARCEL A WITH F-07-187 AND F-07-213. (9/10/07)
- A PLAT OF EASEMENT FOR THE PARCELS PROVIDING FOR OFF-SITE FOREST CONSERVATION (INCLUDING PARCEL 291, PARCELS/LOTS 1 & 2) WILL NEED TO BE SUBMITTED. THIS PLAT MUST BE RECORDED PRIOR TO OR CONCURRENTLY WITH F-07-187. (9/10/07)

**LEGEND**

PROPERTY LINE	[Symbol]
EXISTING TREELINE	[Symbol]
PROPOSED TREELINE	[Symbol]
PROPOSED LOT LINE	[Symbol]
EXISTING SOILS	[Symbol]
EX. STREAM AND BUFFER	[Symbol]
EX. 100-YEAR FLOODPLAIN	[Symbol]
EXISTING CONTOURS	[Symbol]
PROPOSED CONTOURS	[Symbol]
EXISTING BUILDING	[Symbol]
PROPOSED BUILDING	[Symbol]
EXISTING WELL	[Symbol]
PROPOSED WELL	[Symbol]
PROPOSED SEPTIC AREA	[Symbol]
EXISTING SEPTIC AREA	[Symbol]
EX. OVERHEAD POWER LINE	[Symbol]

APPROVED : HOWARD COUNTY DEPARTMENT OF PLANNING AND ZONING.


DIRECTOR: [Signature] DATE: 2/8/08  
 CHIEF, DEVELOPMENT ENGINEERING DIVISION J.V. DATE: 2/8/08  
 CHIEF, DIVISION OF LAND DEVELOPMENT DATE: 2/8/08

OWNER:  
 HOMEWOOD L.L.C.  
 GARY B. SMITH  
 11362 HOMEWOOD ROAD  
 ELLICOTT CITY  
 MARYLAND 21042  
 410-964-0260

PROJECT: **HOMEWOOD FARM (MURPHY PROPERTY)**  
 AREA: TAX MAP 29 PARCELS 303, 117, 291  
 3RD ELECTION DISTRICT ZONED RC-DEO  
 HOWARD COUNTY, MARYLAND

TITLE: **TITLE SHEET**  
 Patton Harris Rust & Associates, pc  
 Engineers, Surveyors, Planners, Landscape Architects.  
 8818 Centre Park Drive  
 Columbia, MD 21045  
 T 410.997.8900  
 F 410.997.9282

DESIGNED BY : PHRA  
 DRAWN BY: JML  
 PROJECT NO : 14520-1-0  
 DATE : JANUARY 21, 2008  
 SCALE : AS SHOWN  
 DRAWING NO. 1 OF 15

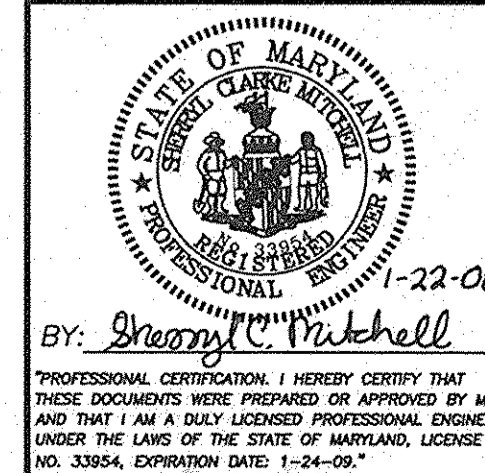

**PLAN**  
SCALE: 1" = 100'


MINIMUM LOT SIZE CHART			
LOT NO.	MIN. LOT SIZE	PIPESTEM AREA	GROSS AREA
1	173,699	6,347	167,352
2	427,159	0	427,159

ALL AREAS SHOWN ABOVE ARE IN SQUARE FEET

**BENCH MARK**  
 HOWARD COUNTY CONTROL STATION 0608  
 N 609,143.487  
 E 1,270,776.502  
 ELEV. 855.46  
 HOWARD COUNTY CONTROL STATION 06CA  
 N 610,135.318  
 E 1,272,833.911  
 ELEV. 815.20

**COORDINATE LIST**


1	N 574,832.07	E 1,338,313.80
2	N 574,629.01	E 1,338,313.72
3	N 574,417.00	E 1,339,470.26
4	N 573,427.66	E 1,338,755.20
5	N 573,923.59	E 1,338,451.91
6	N 574,570.59	E 1,338,802.83
7	N 574,809.81	E 1,338,902.21

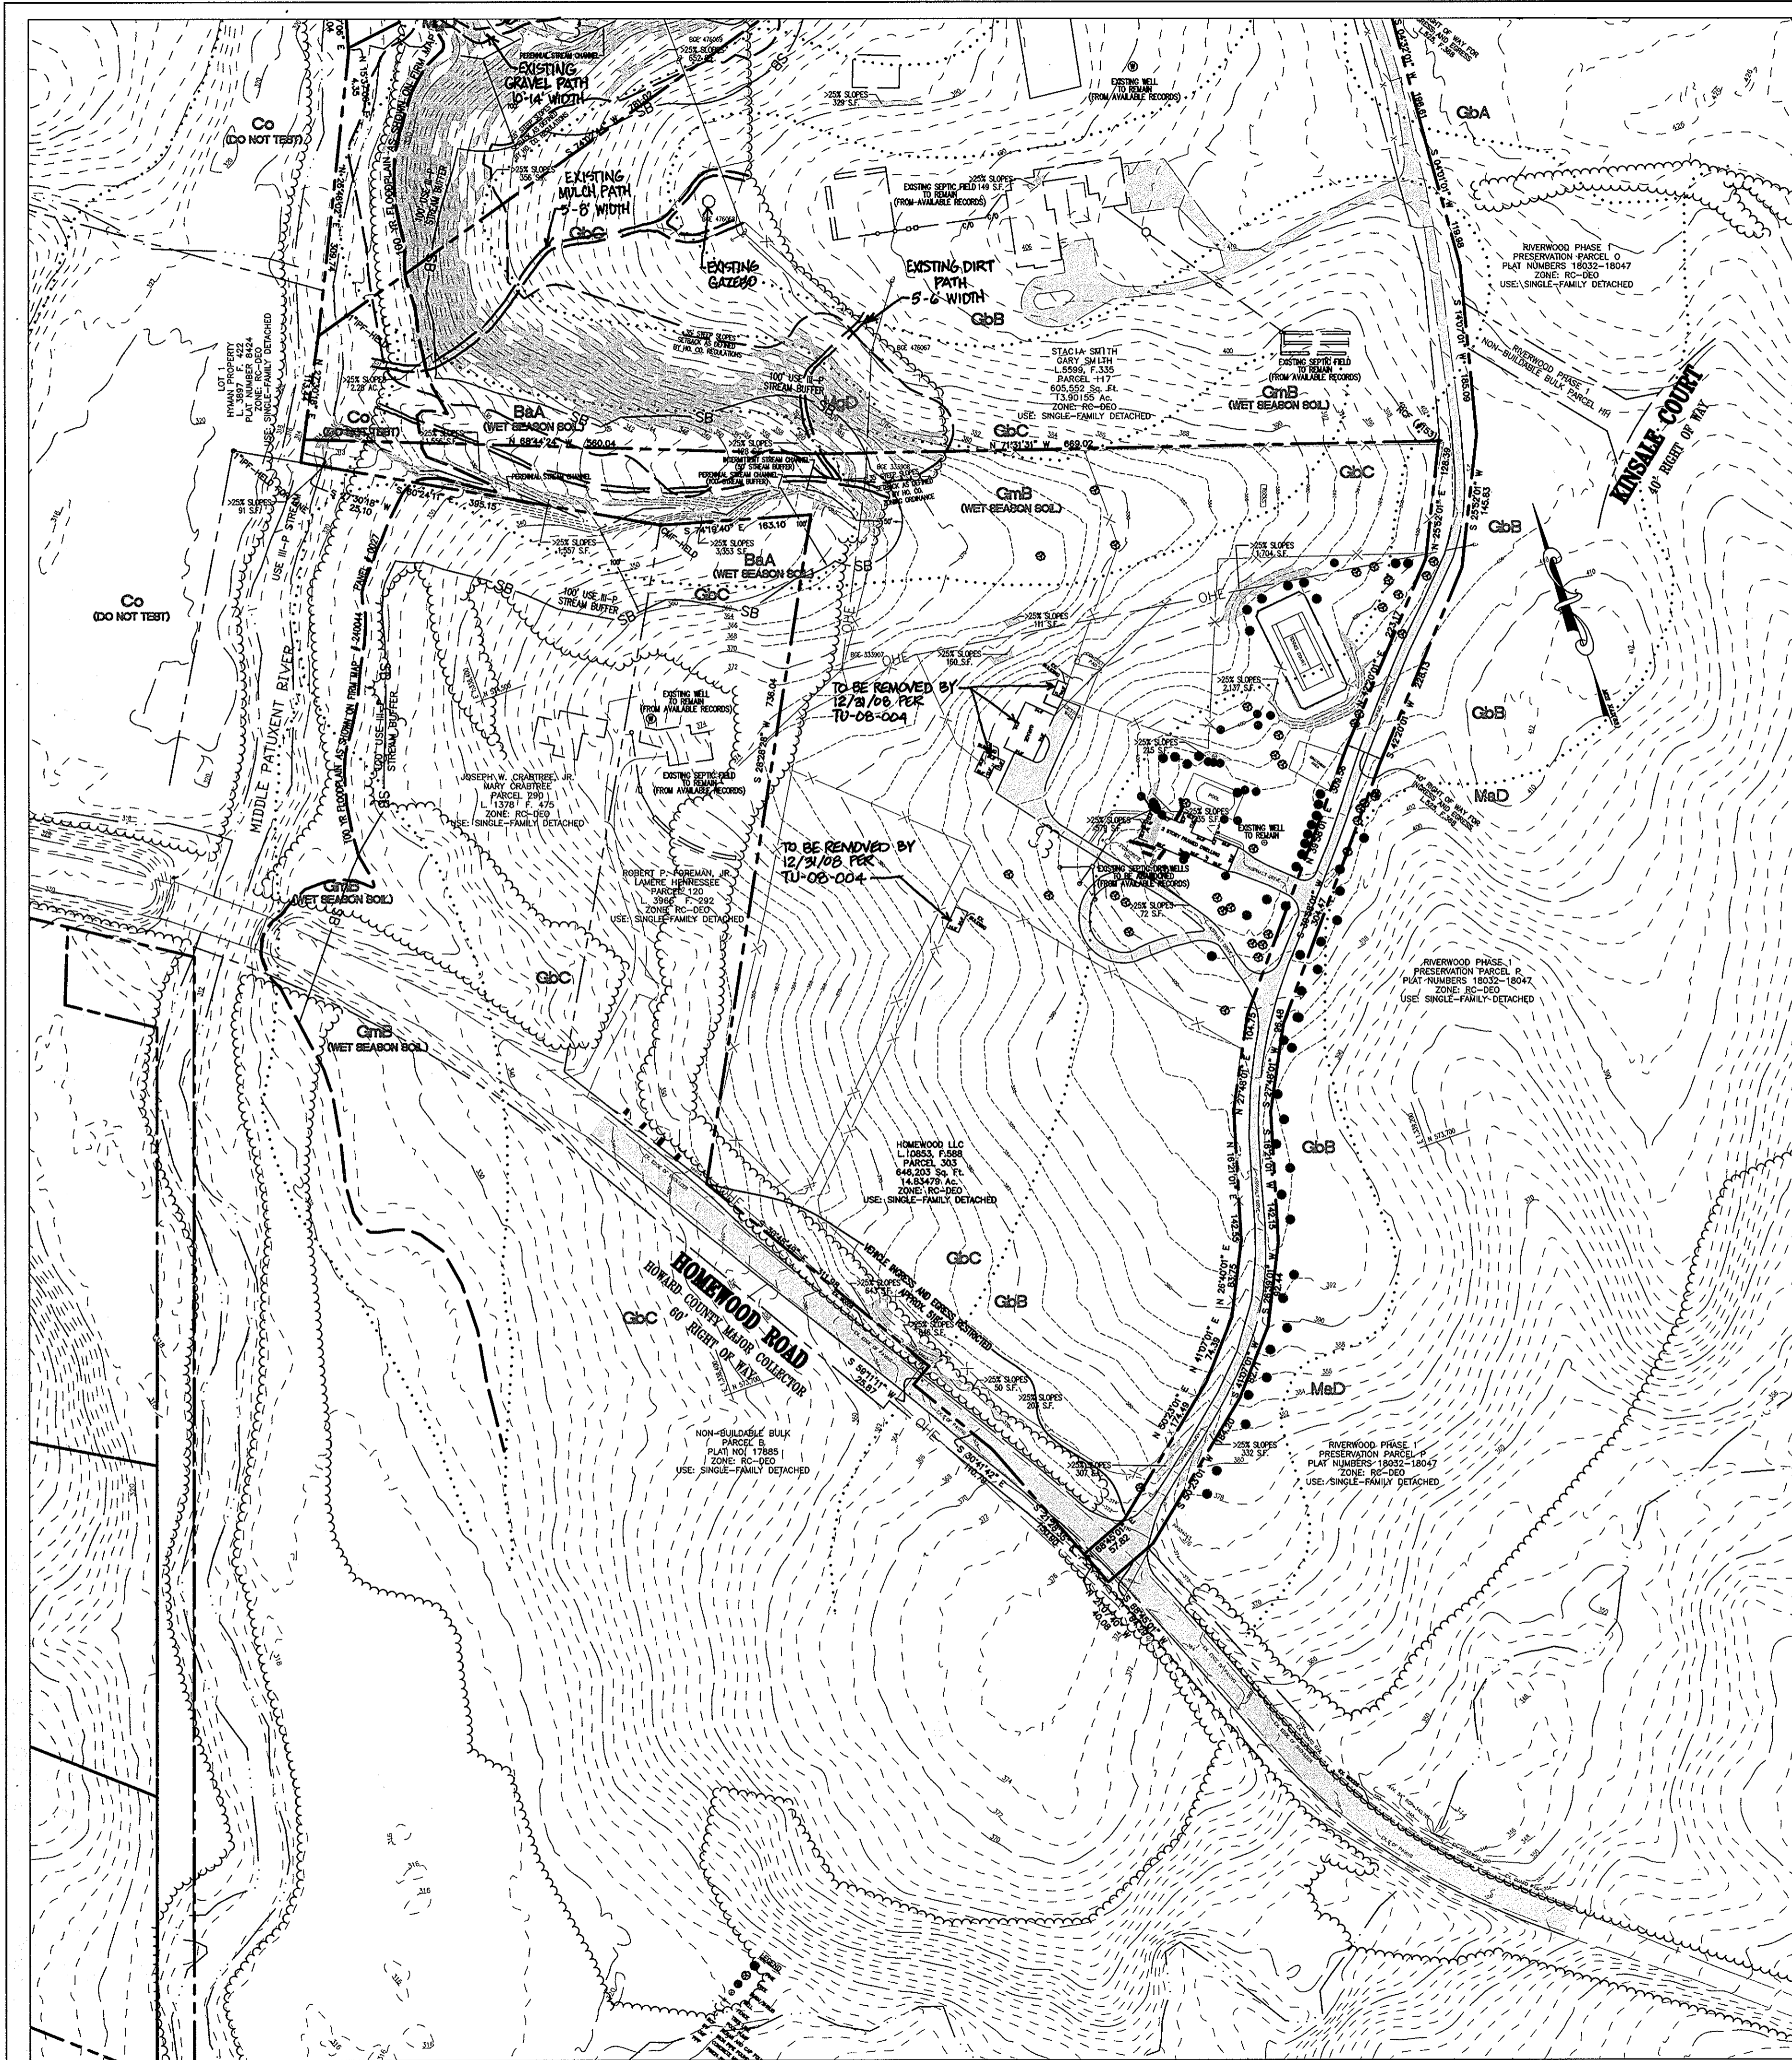

**SOILS CHART**

MAP SYMBOL	NAME	STRUCTURAL LIMITATIONS	EROSION HAZARD	HYDRIC	SLOPE (%)
BaA	Baile silt loam	Dwellings w/ Basements	Severe: high water table	Severe	Y 0-3
Co	Codorus and Habers silt loams	Severe: flood hazard	Severe	N	0-3
GbB	Gladstone loam	Moderate	Moderate	N	3-8
GbC	Gladstone loam	Moderate	Moderate	N	8-15

SOURCE: SOIL INFORMATION TAKEN FROM USDA-NRCS WEBSITE.

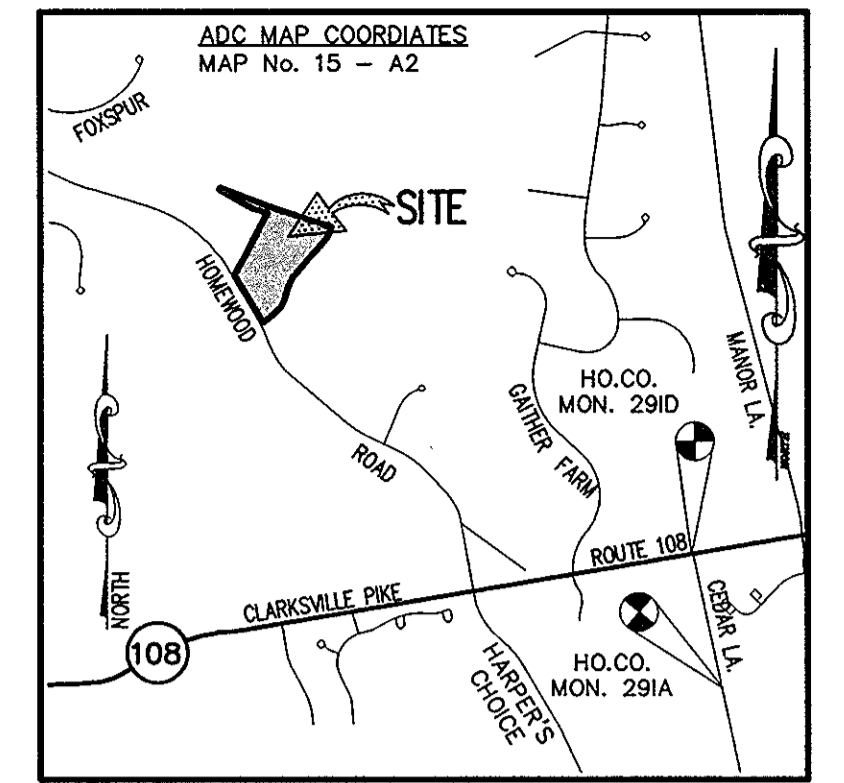

VICINITY MAP  
SCALE: 1" = 2000'

**LEGEND**

- PROPERTY LINE
- EXISTING TREELINE
- WETLANDS AND 25' BUFFER
- EX. STREAM AND BUFFER
- EX. 100-YEAR FLOODPLAIN
- EXISTING CONTOURS
- EXISTING BUILDING
- SLOPES: 15-25%
- SLOPES: > 25%
- EXISTING SOILS
- PASSED PERC TEST
- FAILED PERC TEST
- EXISTING WELL
- EXISTING SEPTIC AREA
- EX. OVERHEAD POWER LINE

APPROVED: HOWARD COUNTY DEPARTMENT OF PLANNING AND ZONING.

DIRECTOR: *John D. ...* DATE: 2/8/08  
 CHIEF, DEVELOPMENT ENGINEERING DIVISION  
 CHIEF, DIVISION OF LAND DEVELOPMENT DATE: 2/8/08

6/16/08 | REDLINE REVISION TO SHOW PATHS AND TRAILS

DATE NO. REVISION

OWNER:  
 HOMEWOOD L.L.C.  
 GARY B. SMITH  
 11362 HOMEWOOD ROAD  
 ELLICOTT CITY  
 MARYLAND 21042  
 410-964-0260


PROJECT: **HOMEWOOD FARM**  
(MURPHY PROPERTY)

AREA: TAX MAP 29 PARCELS 303, 117, 291  
 3RD ELECTION DISTRICT ZONED RC-DEO  
 HOWARD COUNTY, MARYLAND


TITLE: **EXISTING CONDITIONS PLAN AND SOILS MAP**

Patton Harris Rust & Associates, pc  
 Engineers, Surveyors, Planners, Landscape Architects.  
**PHRA**  
 8818 Centre Park Drive  
 Columbia, MD 21045  
 T 410.997.8900  
 F 410.997.9282

DESIGNED BY: PHRA  
 DRAWN BY: JML  
 PROJECT NO.: 14520-1-0  
 DATE: JANUARY 21, 2008  
 SCALE: 1" = 100'  
 DRAWING NO. 2 OF 15

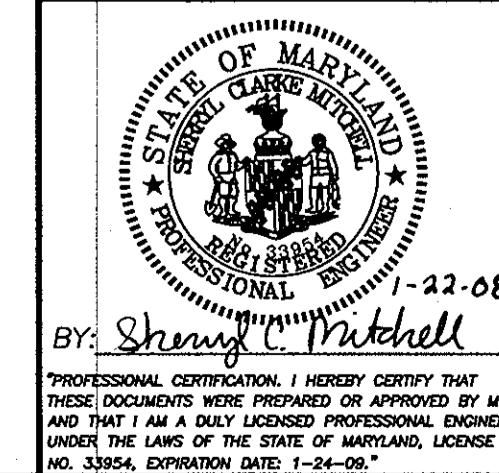

PROFESSIONAL CERTIFICATION: I HEREBY CERTIFY THAT THESE DOCUMENTS WERE PREPARED OR APPROVED BY ME, AND THAT I AM A DULY LICENSED PROFESSIONAL ENGINEER UNDER THE LAWS OF THE STATE OF MARYLAND, LICENSE NO. 33524, EXPIRES DATE: 1-22-08

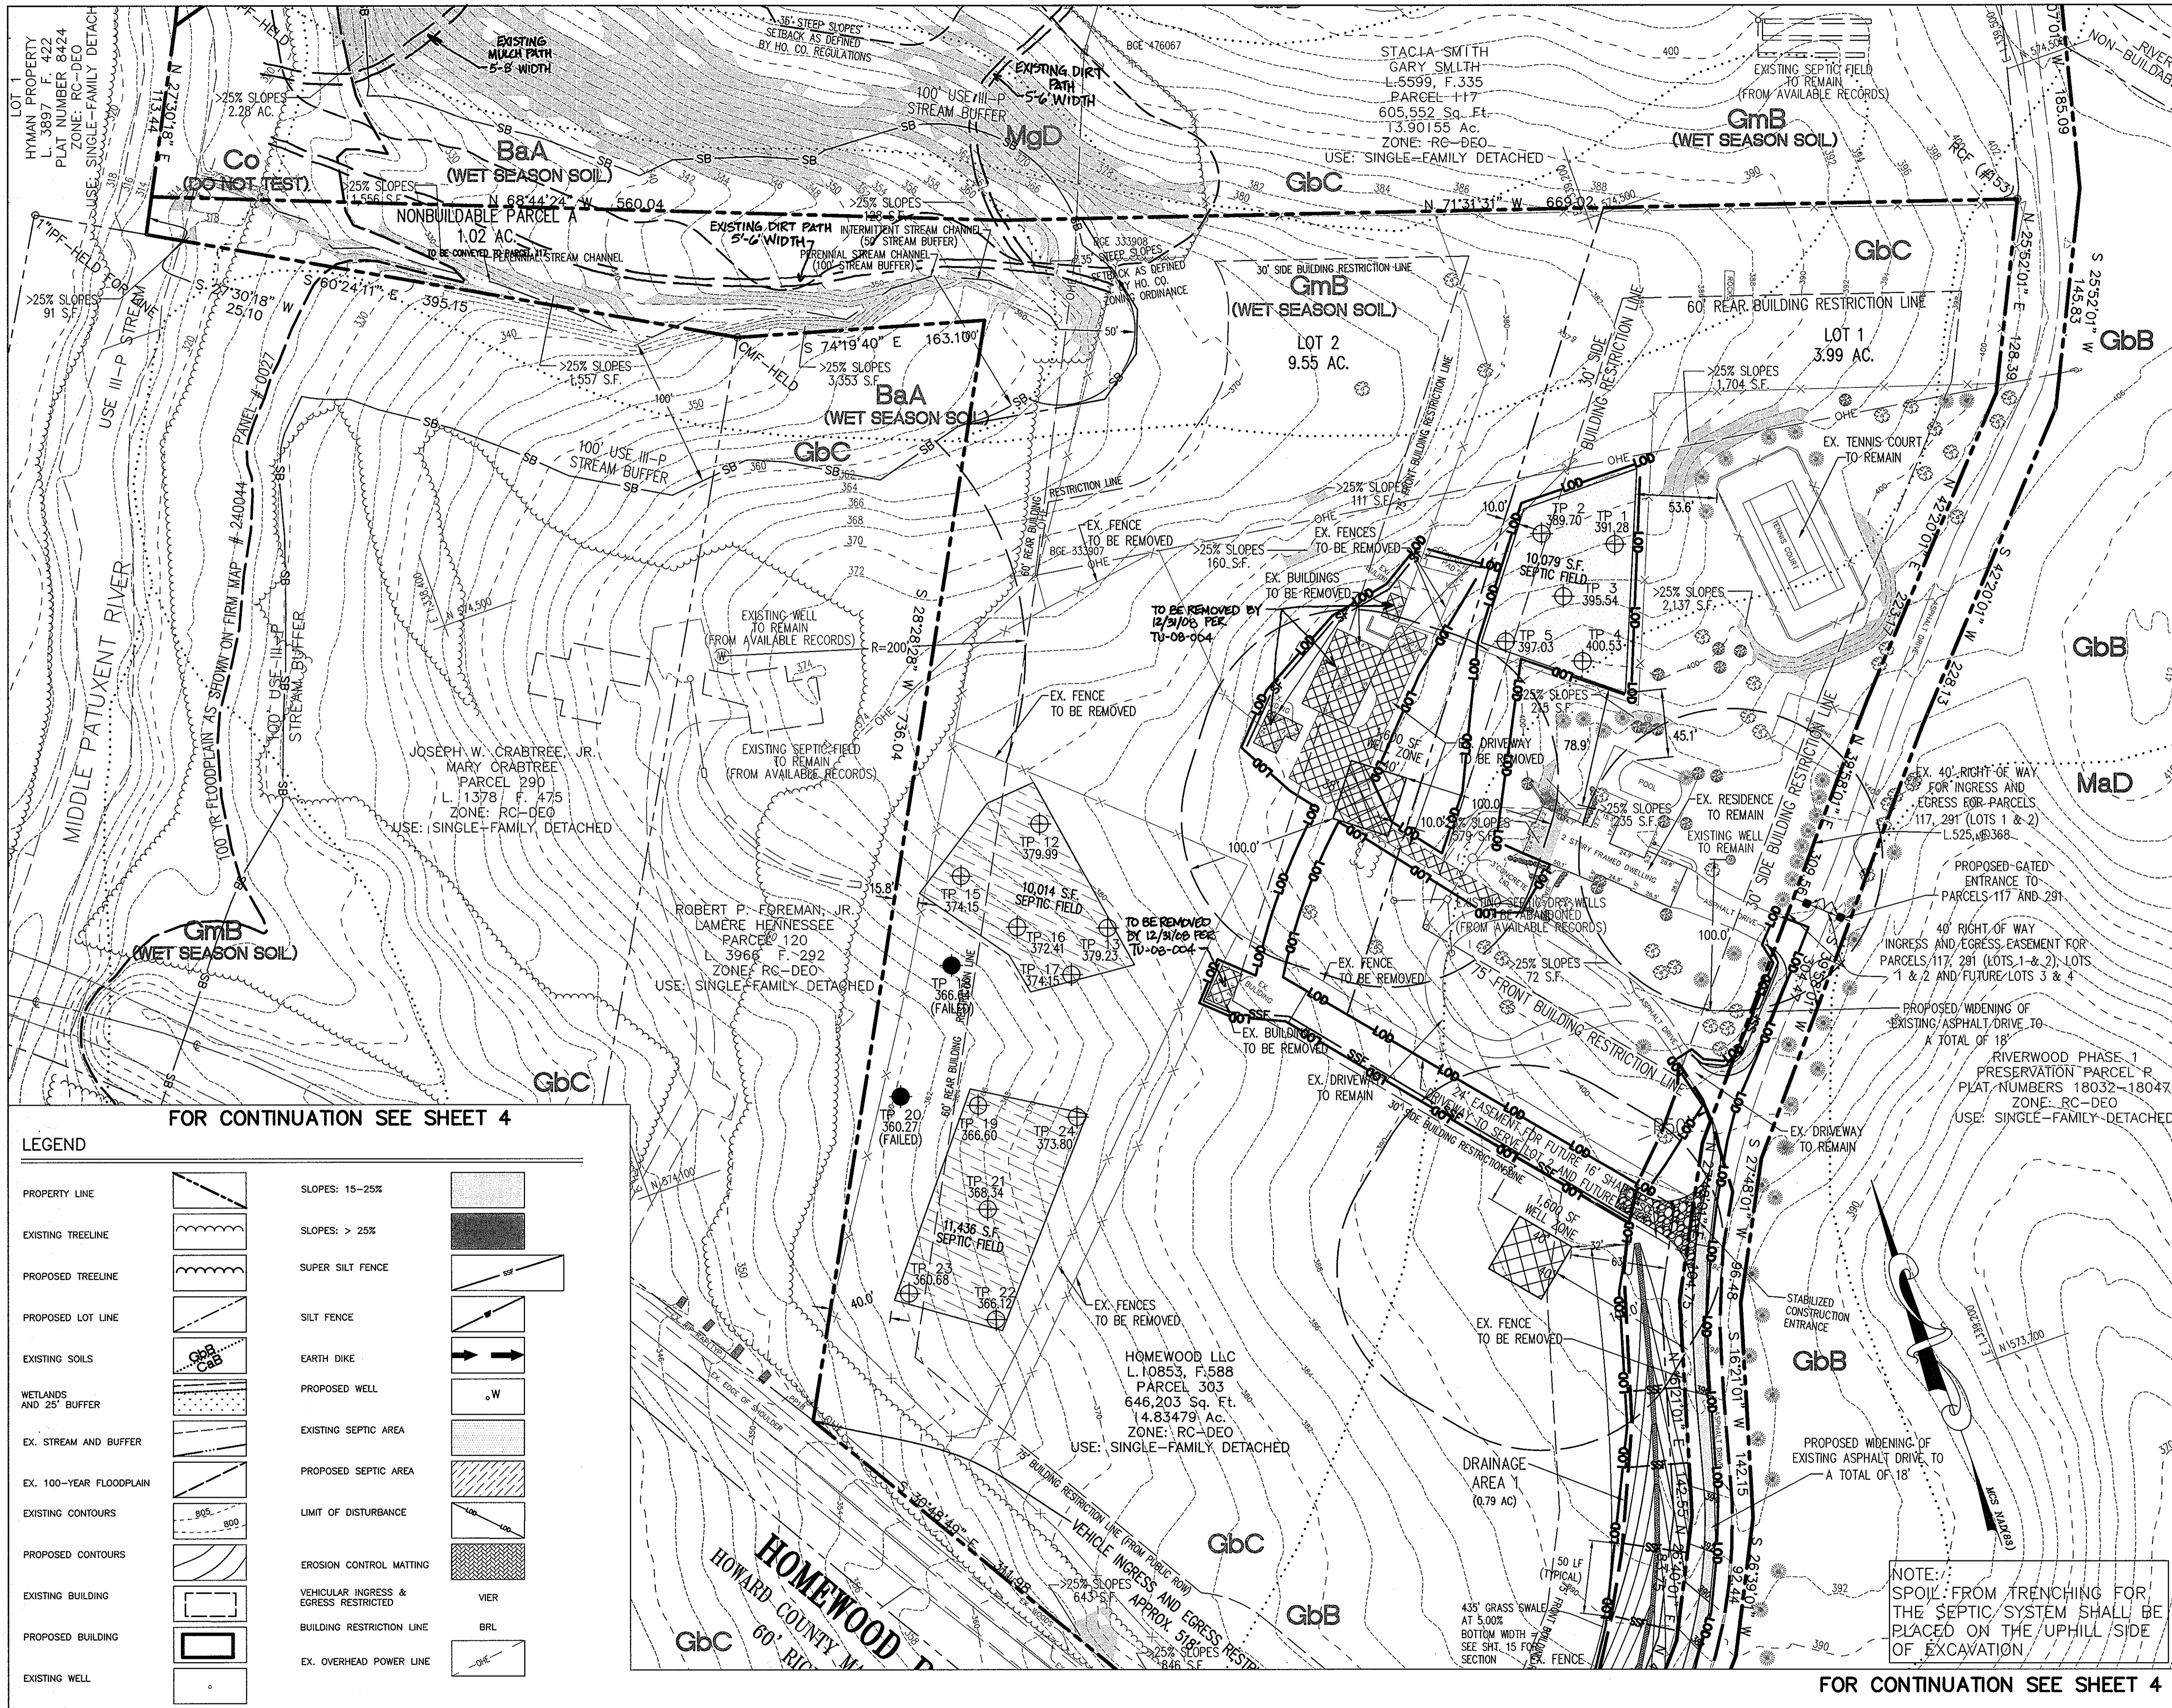

BY THE DEVELOPER :

I/WE CERTIFY THAT ALL DEVELOPMENT AND CONSTRUCTION WILL BE DONE ACCORDING TO THIS PLAN, AND THAT ANY RESPONSIBLE PERSONNEL INVOLVED IN THE CONSTRUCTION PROJECT WILL HAVE A CERTIFICATE OF ATTENDANCE AT A DEPARTMENT OF THE ENVIRONMENT APPROVED TRAINING PROGRAM FOR THE CONTROL OF SEDIMENT AND EROSION BEFORE BEGINNING THE PROJECT. I ALSO AUTHORIZE PERIODIC ON-SITE INSPECTIONS BY THE HOWARD SOIL CONSERVATION DISTRICT.

*Ka-Ma-Jon* 1/23/08  
 DEVELOPER DATE

BY THE ENGINEER :

I CERTIFY THAT THIS PLAN FOR EROSION AND SEDIMENT CONTROL REPRESENTS A PRACTICAL AND WORKABLE PLAN BASED ON MY PERSONAL KNOWLEDGE OF THE SITE CONDITIONS AND THAT IT WAS PREPARED IN ACCORDANCE WITH THE REQUIREMENTS OF THE HOWARD SOIL CONSERVATION DISTRICT.

*Sherryl C. Mitchell* 1-22-08  
 ENGINEER DATE

THESE PLANS HAVE BEEN REVIEWED FOR THE HOWARD SOIL CONSERVATION DISTRICT AND MEET THE TECHNICAL REQUIREMENTS FOR SOIL EROSION AND SEDIMENT CONTROL.

*[Signature]*  
 NATURAL RESOURCES CONSERVATION SERVICE DATE

THIS DEVELOPMENT PLAN IS APPROVED FOR SOIL EROSION AND SEDIMENT CONTROL BY THE HOWARD SOIL CONSERVATION DISTRICT.

*John R. Roberts* 1/31/08  
 HOWARD SOIL CONSERVATION DISTRICT DATE

APPROVED : HOWARD COUNTY DEPARTMENT OF PLANNING AND ZONING.

*[Signature]* 2/8/08  
 CHIEF, DEVELOPMENT ENGINEERING DIVISION DATE

*[Signature]* 2/8/08  
 CHIEF, DIVISION OF LAND DEVELOPMENT DATE

6/16/08 I REDLINE REMAIN TO SHOW PATHS AND TRAILS

DATE	NO.	REVISION

OWNER:  
 HOMEWOOD L.L.C.  
 GARY B. SMITH  
 11362 HOMEWOOD ROAD  
 ELLICOTT CITY  
 MARYLAND 21042  
 410-964-0260

PROJECT: **HOMEWOOD FARM**  
 (MURPHY PROPERTY)

AREA: TAX MAP 29 PARCELS 303, 117, 291  
 3RD ELECTION DISTRICT ZONED RC-DEO  
 HOWARD COUNTY, MARYLAND

TITLE: **FINAL GRADING AND SEDIMENT CONTROL PLAN**

Patton Harris Rust & Associates, PC  
 Engineers, Surveyors, Planners, Landscape Architects,  
 8818 Centre Park Drive  
 Columbia, MD 21045  
 T 410.997.8900  
 F 410.997.9282

DESIGNED BY: PDK  
 DRAWN BY: PDK  
 PROJECT NO: 14520-1-0  
 C200ESC.DWG  
 DATE: JANUARY 21, 2008  
 SCALE: 1"=50'  
 DRAWING NO. 3 OF 15


STATE OF MARYLAND  
 PROFESSIONAL ENGINEER  
 SHERRYL C. MITCHELL  
 1-22-08  
 PROFESSIONAL CERTIFICATION: I HEREBY CERTIFY THAT THESE DOCUMENTS WERE PREPARED OR APPROVED BY ME, AND THAT I AM A DULY LICENSED PROFESSIONAL ENGINEER UNDER THE LAWS OF THE STATE OF MARYLAND, LICENSE NO. 33864, EXPIRATION DATE: 1-24-09.

NOTE: SPOIL FROM TRENCHING FOR THE SEPTIC SYSTEM SHALL BE PLACED ON THE UPHILL SIDE OF EXCAVATION

FOR CONTINUATION SEE SHEET 4

FOR CONTINUATION SEE SHEET 3

FOR CONTINUATION SEE SHEET 3

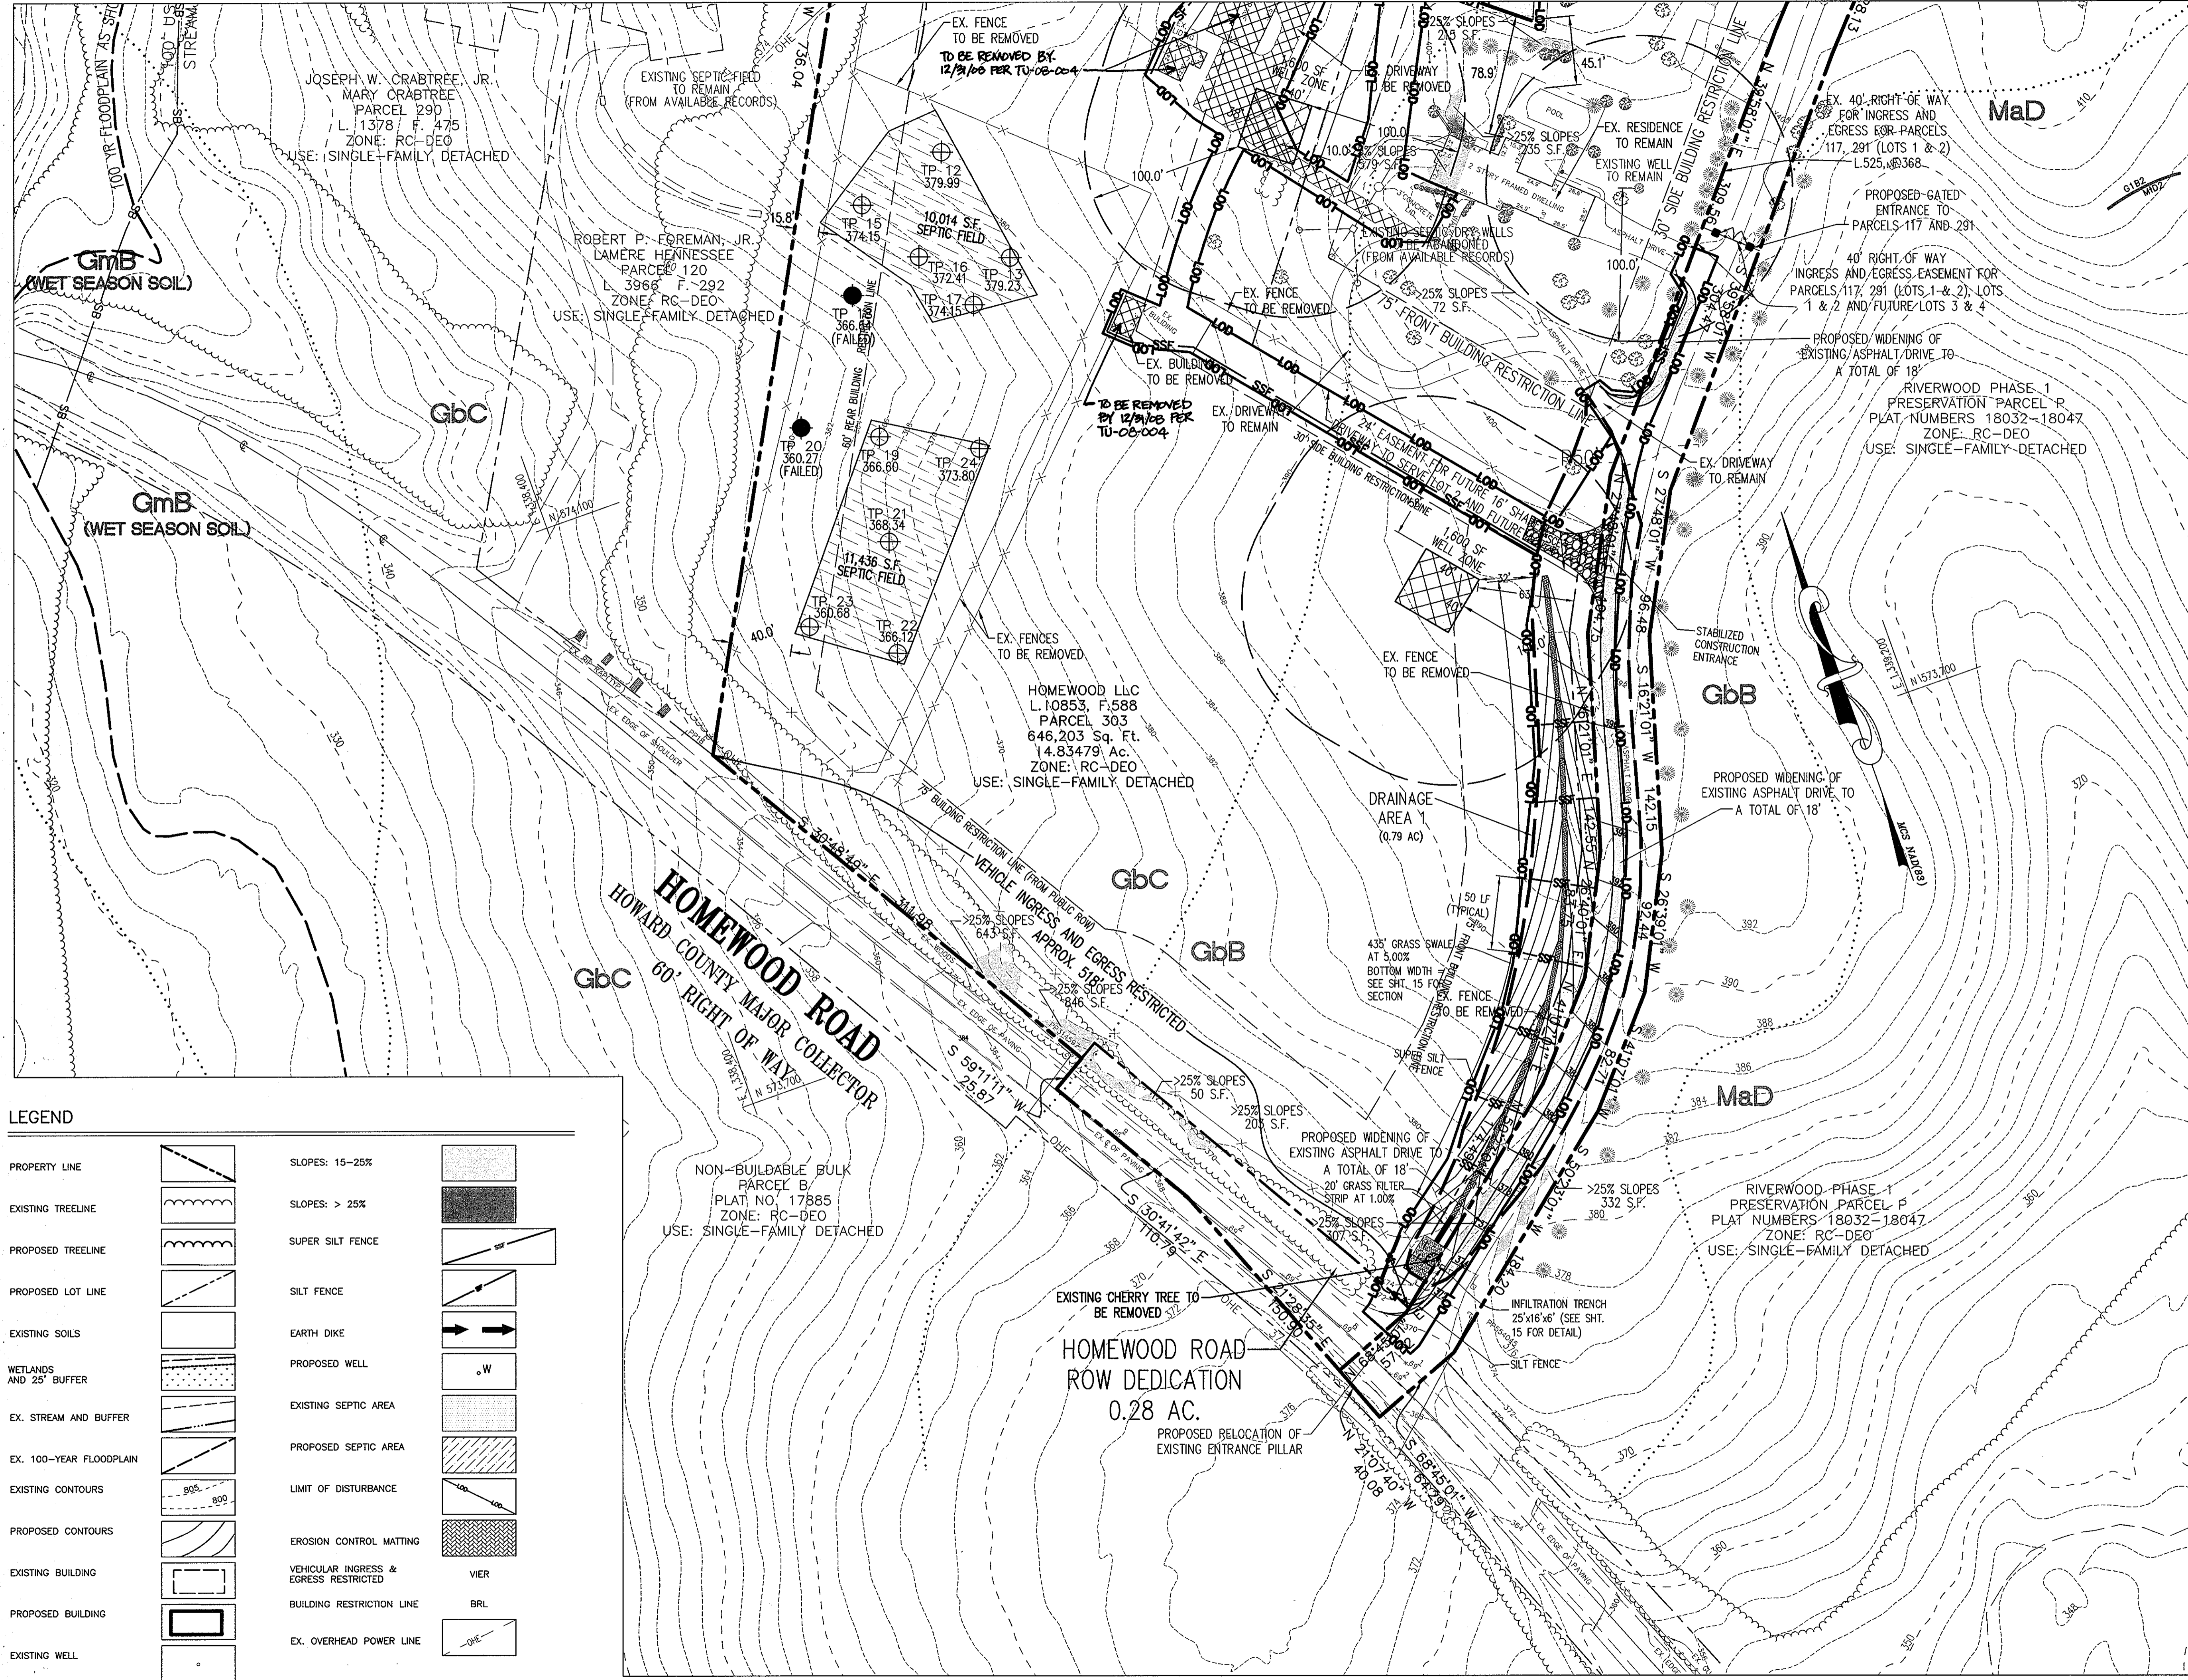

NOTE:  
SPOIL FROM TRENCHING FOR THE SEPTIC SYSTEM SHALL BE PLACED ON THE UPHILL SIDE OF EXCAVATION

BY THE DEVELOPER :  
I/WE CERTIFY THAT ALL DEVELOPMENT AND CONSTRUCTION WILL BE DONE ACCORDING TO THIS PLAN, AND THAT ANY RESPONSIBLE PERSONNEL INVOLVED IN THE CONSTRUCTION PROJECT WILL HAVE A CERTIFICATE OF ATTENDANCE AT A DEPARTMENT OF THE ENVIRONMENT APPROVED TRAINING PROGRAM FOR THE CONTROL OF SEDIMENT AND EROSION BEFORE BEGINNING THE PROJECT. I ALSO AUTHORIZE PERIODIC ON-SITE INSPECTIONS BY THE HOWARD SOIL CONSERVATION DISTRICT.  
*Ken M... 1/23/08*  
DEVELOPER DATE

BY THE ENGINEER :  
I CERTIFY THAT THIS PLAN FOR EROSION AND SEDIMENT CONTROL REPRESENTS A PRACTICAL AND WORKABLE PLAN BASED ON MY PERSONAL KNOWLEDGE OF THE SITE CONDITIONS AND THAT IT WAS PREPARED IN ACCORDANCE WITH THE REQUIREMENTS OF THE HOWARD SOIL CONSERVATION DISTRICT.  
*Sherry C. Mitchell 1-22-08*  
ENGINEER DATE

THESE PLANS HAVE BEEN REVIEWED FOR THE HOWARD SOIL CONSERVATION DISTRICT AND MEET THE TECHNICAL REQUIREMENTS FOR SOIL EROSION AND SEDIMENT CONTROL.  
*[Signature]*  
NATURAL RESOURCES CONSERVATION SERVICE DATE

THIS DEVELOPMENT PLAN IS APPROVED FOR SOIL EROSION AND SEDIMENT CONTROL BY THE HOWARD SOIL CONSERVATION DISTRICT.  
*John R. Rhoads 1/31/08*  
HOWARD SOIL CONSERVATION DISTRICT DATE

APPROVED : HOWARD COUNTY DEPARTMENT OF PLANNING AND ZONING.

*[Signature]* 2/6/08  
CHIEF, DEVELOPMENT ENGINEERING DIVISION DATE  
*[Signature]* 2/6/08  
CHIEF, DIVISION OF LAND DEVELOPMENT DATE

6/16/08 | REDLINE REVISION TO SHOW PATHS AND TRAILS

DATE NO.	REVISION

OWNER:  
HOMEWOOD L.L.C.  
GARY B. SMITH  
11362 HOMEWOOD ROAD  
ELLCOTT CITY  
MARYLAND 21042  
410-964-0260

PROJECT  
**HOMEWOOD FARM**  
(MURPHY PROPERTY)

AREA TAX MAP 29 PARCELS 303, 117, 291  
3RD ELECTION DISTRICT ZONED RC-DEO  
HOWARD COUNTY, MARYLAND

TITLE  
**FINAL GRADING AND SEDIMENT CONTROL PLAN**


Patton Harris Rust & Associates, pc  
Engineers, Surveyors, Planners, Landscape Architects.  
8818 Centre Park Drive  
Columbia, MD 21045  
T 410.997.8900  
F 410.997.9282

DESIGNED BY : PDK  
DRAWN BY: PDK  
PROJECT NO : 14520-1-0  
DATE : JANUARY 21, 2008  
SCALE : 1"=50'  
DRAWING NO. 4 OF 15

LEGEND

PROPERTY LINE		SLOPES: 15-25%	
EXISTING TREELINE		SLOPES: > 25%	
PROPOSED TREELINE		SUPER SILT FENCE	
PROPOSED LOT LINE		SILT FENCE	
EXISTING SOILS		EARTH DIKE	
WETLANDS AND 25' BUFFER		PROPOSED WELL	
EX. STREAM AND BUFFER		EXISTING SEPTIC AREA	
EX. 100-YEAR FLOODPLAIN		PROPOSED SEPTIC AREA	
EXISTING CONTOURS		LIMIT OF DISTURBANCE	
PROPOSED CONTOURS		EROSION CONTROL MATTING	
EXISTING BUILDING		VEHICULAR INGRESS & EGRESS RESTRICTED	
PROPOSED BUILDING		BUILDING RESTRICTION LINE	
EXISTING WELL		EX. OVERHEAD POWER LINE	

**DETAIL 24 - STABILIZED CONSTRUCTION ENTRANCE**

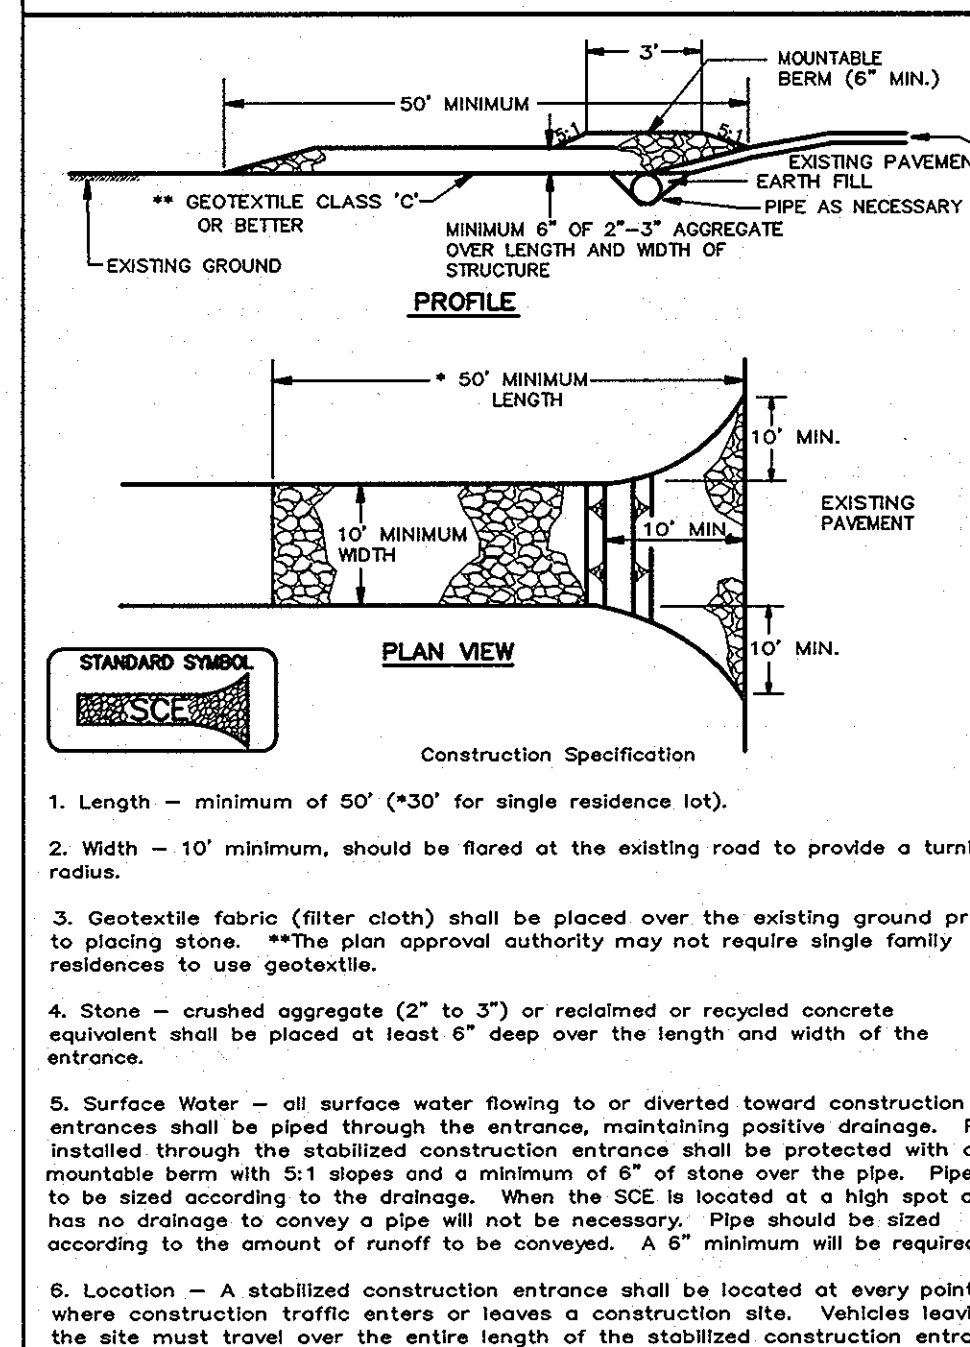


Construction Specification

- 1. Length - minimum of 50' (\*30' for single residence lot).
- 2. Width - 10' minimum, should be flared at the existing road to provide a turning radius.
- 3. Geotextile fabric (filter cloth) shall be placed over the existing ground prior to placing stone. The plan approval authority may not require single family residences to use geotextile.
- 4. Stone - crushed aggregate (2" to 3") or reclaimed or recycled concrete equivalent shall be placed at least 6" deep over the length and width of the entrance.
- 5. Surface Water - all surface water flowing to or diverted toward construction entrances shall be piped through the entrance, maintaining positive drainage. Pipe installed through the stabilized construction entrance shall be protected with a moundside berm with 5:1 slopes and a minimum of 6" of stone over the pipe. Pipe has to be sized according to the drainage. When the SCE is located at a high spot and has no drainage to convey a pipe will not be necessary. Pipe should be sized according to the amount of runoff to be conveyed. A 6" minimum will be required.
- 6. Location - A stabilized construction entrance shall be located at every point where construction traffic enters or leaves a construction site. Vehicles leaving the site must travel over the entire length of the stabilized construction entrance.

U.S. DEPARTMENT OF AGRICULTURE SOIL CONSERVATION SERVICE PAGE E-17-3 MARYLAND DEPARTMENT OF ENVIRONMENT WATER MANAGEMENT ADMINISTRATION

**DETAIL 30 - EROSION CONTROL MATTING**

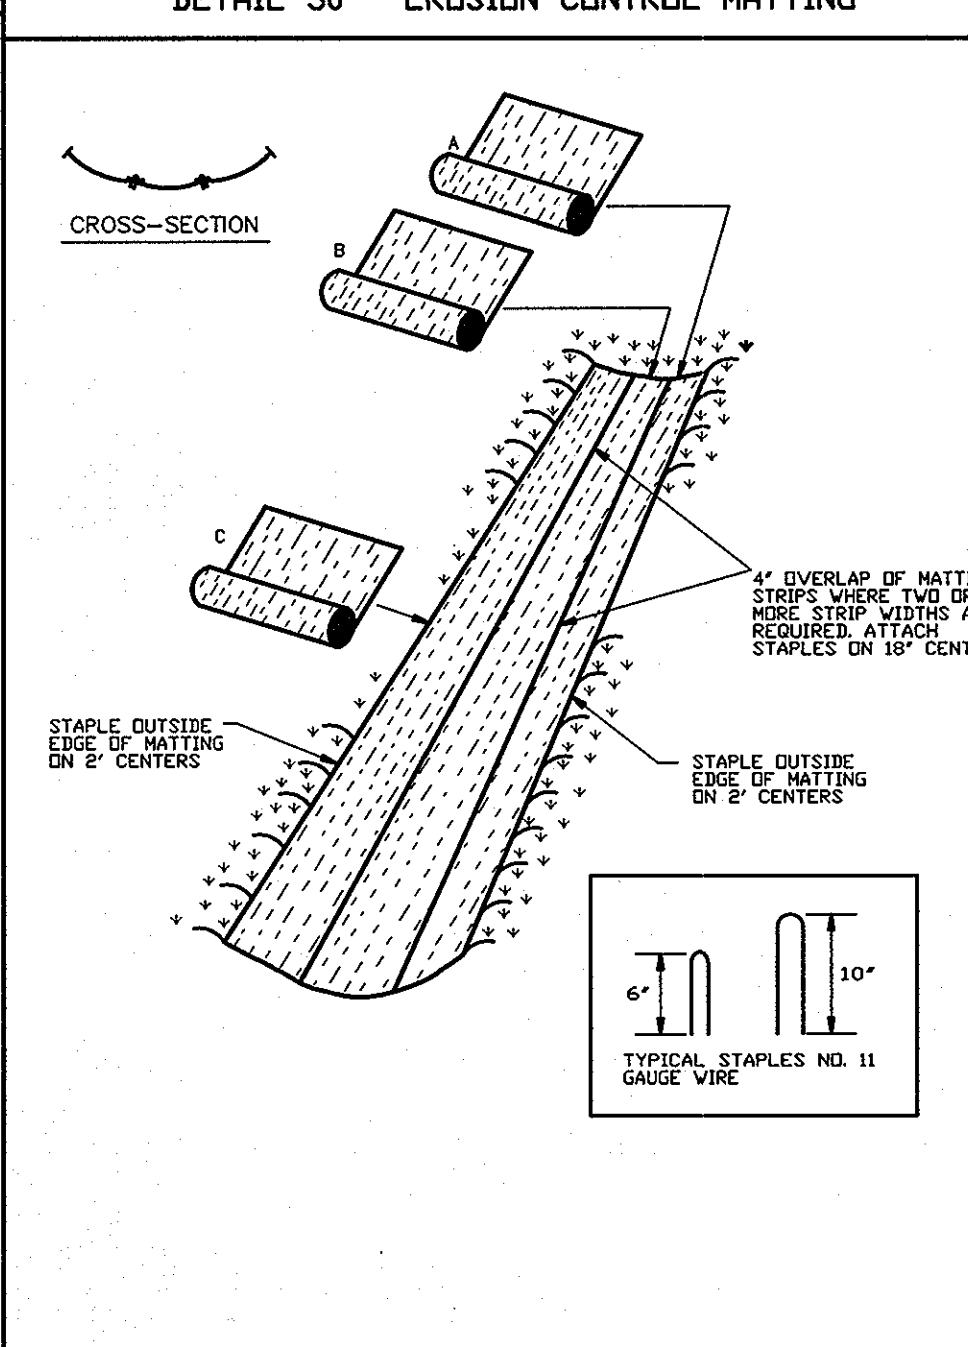


Construction Specification

- 1. Length - minimum of 50' (\*30' for single residence lot).
- 2. Width - 10' minimum, should be flared at the existing road to provide a turning radius.
- 3. Geotextile fabric (filter cloth) shall be placed over the existing ground prior to placing stone. The plan approval authority may not require single family residences to use geotextile.
- 4. Stone - crushed aggregate (2" to 3") or reclaimed or recycled concrete equivalent shall be placed at least 6" deep over the length and width of the entrance.
- 5. Surface Water - all surface water flowing to or diverted toward construction entrances shall be piped through the entrance, maintaining positive drainage. Pipe installed through the stabilized construction entrance shall be protected with a moundside berm with 5:1 slopes and a minimum of 6" of stone over the pipe. Pipe has to be sized according to the drainage. When the SCE is located at a high spot and has no drainage to convey a pipe will not be necessary. Pipe should be sized according to the amount of runoff to be conveyed. A 6" minimum will be required.
- 6. Location - A stabilized construction entrance shall be located at every point where construction traffic enters or leaves a construction site. Vehicles leaving the site must travel over the entire length of the stabilized construction entrance.

U.S. DEPARTMENT OF AGRICULTURE SOIL CONSERVATION SERVICE PAGE E-17-3 MARYLAND DEPARTMENT OF ENVIRONMENT WATER MANAGEMENT ADMINISTRATION

**DETAIL 33 - SUPER SILT FENCE**

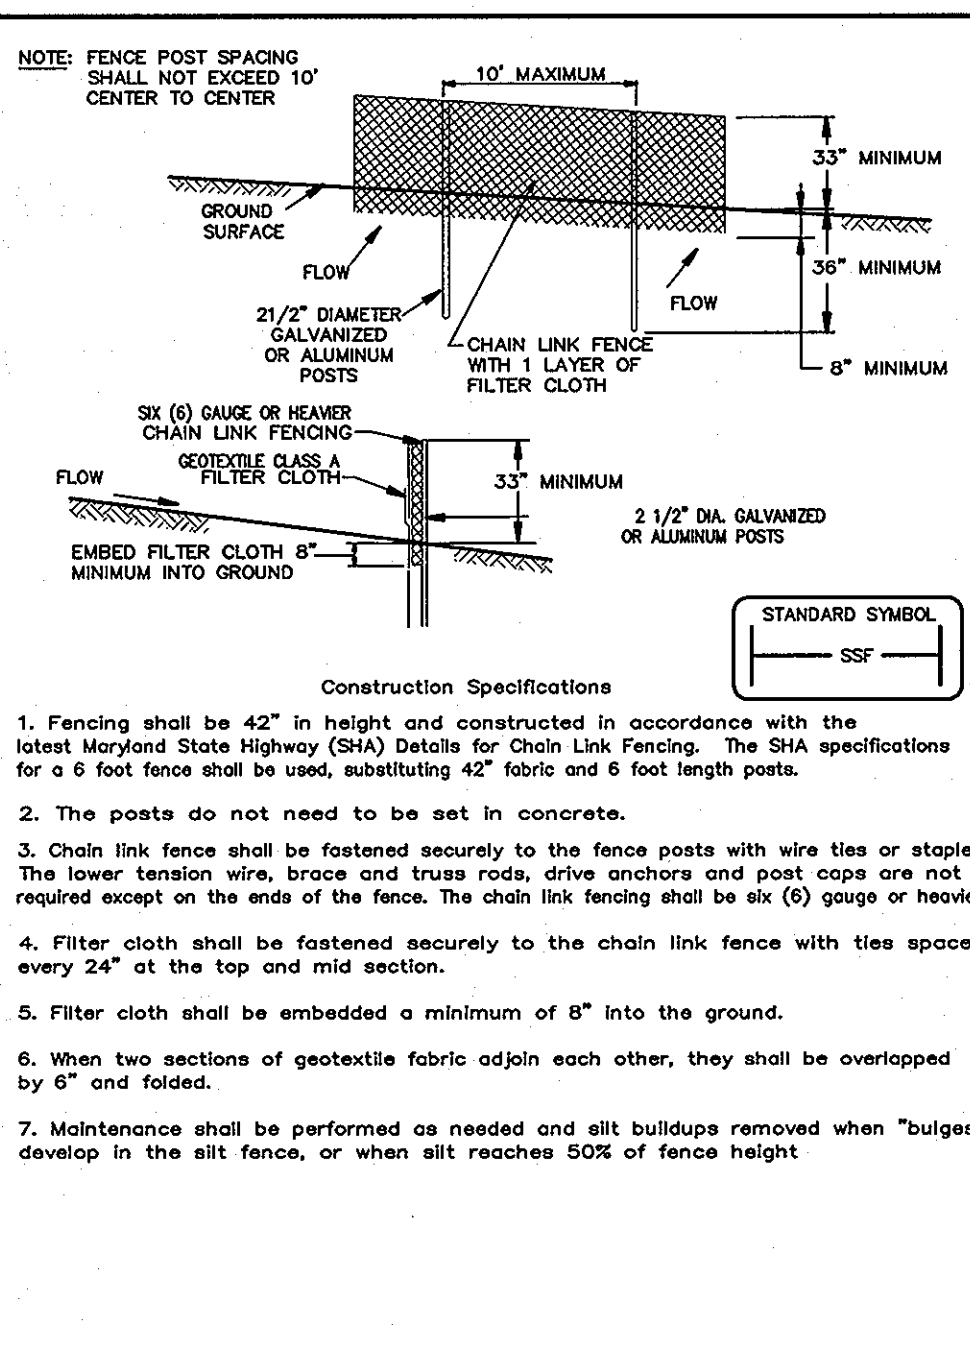


Construction Specifications

- 1. Fencing shall be 42" in height and constructed in accordance with the latest Maryland State Highway (SHA) details for Chain Link Fencing. The SHA specifications for a 6 foot fence shall be used, substituting 42" fabric and 6 foot length posts.
- 2. The posts do not need to be set in concrete.
- 3. Chain link fence shall be fastened securely to the fence posts with wire ties or staples. The lower tension wire, brace and truss rods, drive anchors and post caps are not required except on the ends of the fence. The chain link fencing shall be six (6) gauge or heavier.
- 4. Filter cloth shall be fastened securely to the chain link fence with ties spaced every 24" at the top and mid section.
- 5. Filter cloth shall be embedded a minimum of 8" into the ground.
- 6. When two sections of geotextile fabric adjoin each other, they shall be overlapped by 6" and folded.
- 7. Maintenance shall be performed as needed and silt buildups removed when "bulges" develop in the silt fence, or when silt reaches 50% of fence height.


U.S. DEPARTMENT OF AGRICULTURE SOIL CONSERVATION SERVICE PAGE H-26-3 MARYLAND DEPARTMENT OF ENVIRONMENT WATER MANAGEMENT ADMINISTRATION

**STABILIZED CONSTRUCTION ENTRANCE**

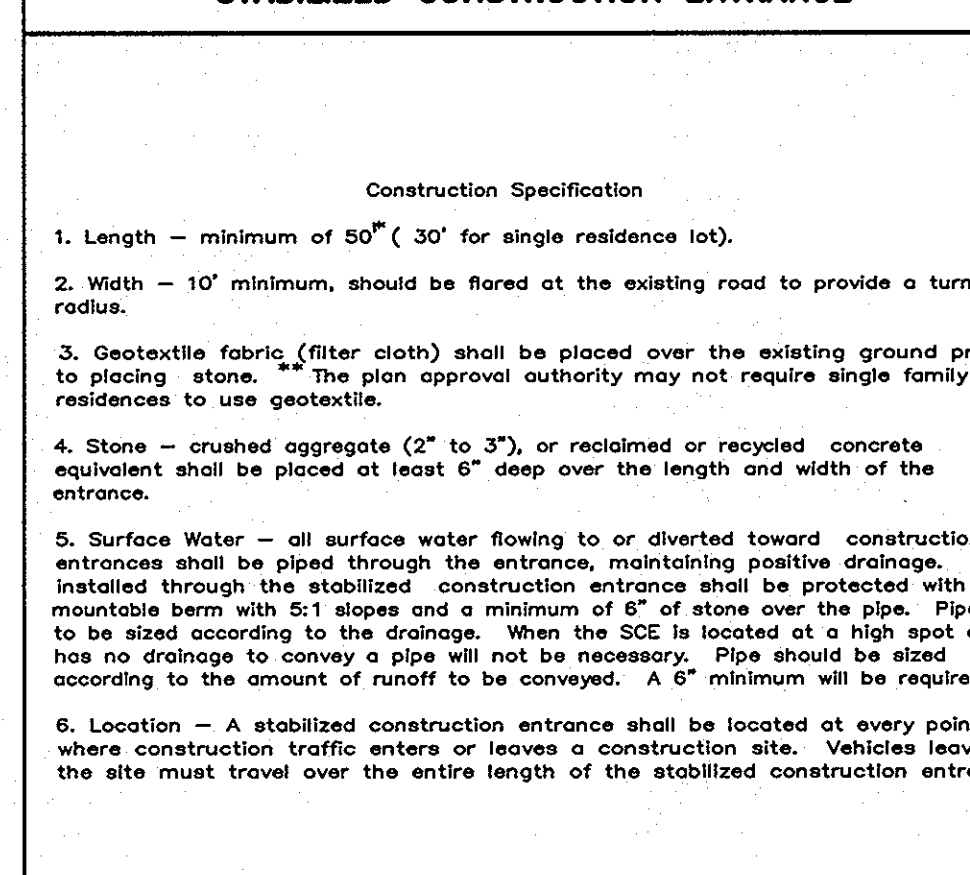

U.S. DEPARTMENT OF AGRICULTURE SOIL CONSERVATION SERVICE PAGE E-17-3 MARYLAND DEPARTMENT OF ENVIRONMENT WATER MANAGEMENT ADMINISTRATION

**DETAIL 22 - SILT FENCE**

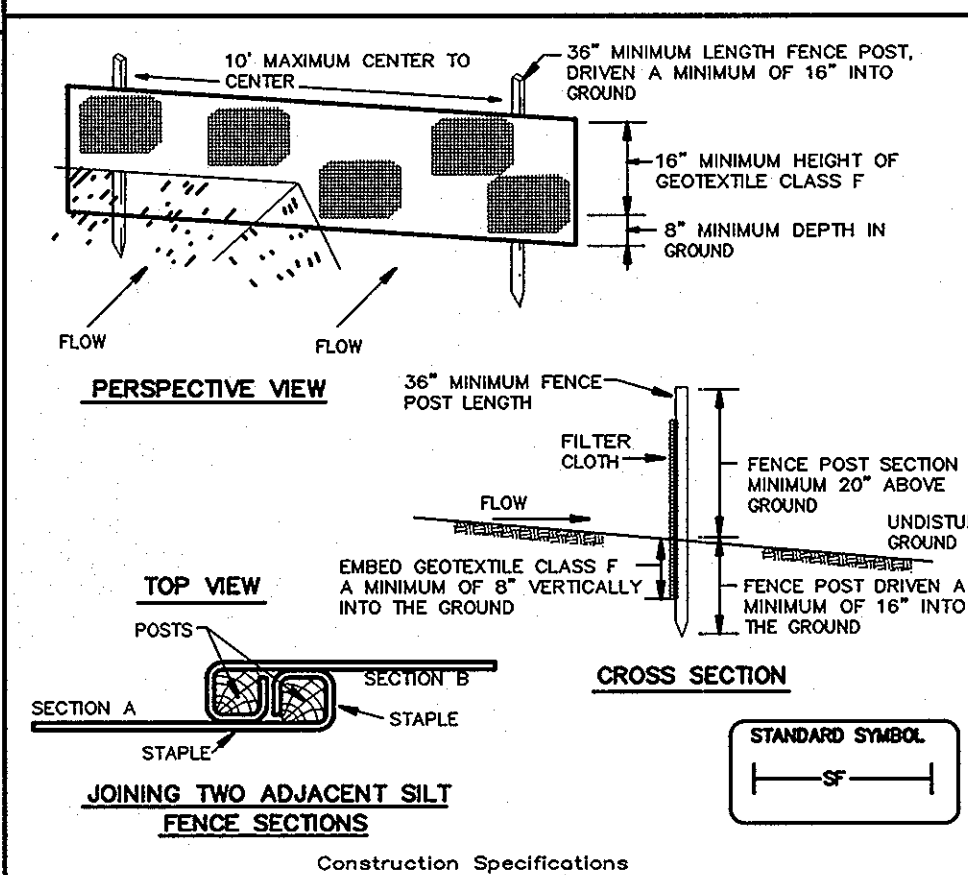

Construction Specifications

- 1. Fence posts shall be a minimum of 36" long driven 16" minimum into the ground. Wood posts shall be 1 1/2" x 1 1/2" square (minimum) cut, or 1 3/4" diameter (minimum) round and shall be of sound quality hardwood. Steel posts will be standard T or U section weighting not less than 1.00 pound per linear foot.
- 2. Geotextile shall be fastened securely to each fence post with wire ties or staples at top and mid-section and shall meet the following requirements for Geotextile Class F:
- 3. Where ends of geotextile fabric come together, they shall be overlapped, folded and stapled to prevent sediment bypass.
- 4. Silt Fence shall be inspected after each rainfall event and maintained when bulges occur or when sediment accumulation reached 50% of the fabric height.

U.S. DEPARTMENT OF AGRICULTURE SOIL CONSERVATION SERVICE PAGE E-15-3 MARYLAND DEPARTMENT OF ENVIRONMENT WATER MANAGEMENT ADMINISTRATION

**SUPER SILT FENCE**

Design Criteria

Slope	Slope Steepness	Slope Length (maximum)	Silt Fence Length (maximum)
0 - 10%	0 - 1:1	Unlimited	Unlimited
10 - 20%	1:1 - 5:1	200 feet	1,500 feet
20 - 33%	5:1 - 3:1	100 feet	1,000 feet
33 - 50%	3:1 - 2:1	100 feet	500 feet
50% +	2:1 +	50 feet	250 feet

U.S. DEPARTMENT OF AGRICULTURE SOIL CONSERVATION SERVICE PAGE H-26-3A MARYLAND DEPARTMENT OF ENVIRONMENT WATER MANAGEMENT ADMINISTRATION

**21.0 STANDARD AND SPECIFICATIONS FOR TOPSOIL**

**Definition**  
Placement of topsoil over a prepared subsoil prior to establishment of permanent vegetation.

**Purpose**  
To provide a suitable soil medium for vegetative growth. Soils of concern have low moisture content, low nutrient levels, low pH, materials toxic to plants, and/or unacceptable soil gradation.

**Conditions Where Practice Applies**

- The texture of the exposed subsoil parent material is not adequate to produce vegetative growth.
- The soil material is so shallow that the rooting zone is not deep enough to support plants or furnish continuing supplies of moisture and plant nutrients.
- The original soil to be vegetated contains material toxic to plant growth.
- The soil is so acidic that treatment with limestone is not feasible.

**Construction and Material Specifications**

- Topsoil salvaged from the existing site may be used provided that it meets the standards as set forth in these specifications. Typically, the depth of topsoil to be salvaged for a given soil type can be found in the representative soil profile section in the Soil Survey published by USDA-SCS in cooperation with Maryland Agricultural Experiment Station.
- Topsoil Specifications - Soil to be used as topsoil must meet the following:
  - Topsoil shall be a loam, sandy loam, clay loam, silt loam, sandy clay loam, loamy sand. Other soils may be used if recommended by an agronomist or soil scientist and approved by the appropriate approval authority. Regardless, topsoil shall not be a mixture of contrasting textured subsoils and shall contain less than 5% by volume of cinders, stones, slag, coarse fragments, gravel, sticks, rocks, trash, or other materials larger than 1 1/2" in diameter.
  - Topsoil must be free of plants or plant parts such as Bermuda grass, quackgrass, Johnsongrass, nutsedge, poison ivy, thistle, or others as specified.
  - Where subsoil is either highly acidic or composed of heavy clays, ground limestone shall be spread at the rate of 4-8 tons/acre (200-400 pounds per 1,000 square feet) prior to the placement of topsoil. Lime shall be distributed uniformly over designated areas and worked into the soil in conjunction with tillage operations as described in the following procedures.

**Construction and Material Specifications**

- For sites having disturbed areas over 5 acres:
  - Place topsoil (if required) and apply soil amendments as specified in 20.0 Vegetative Stabilization - Section I - Vegetative Stabilization Methods and Materials.
- For sites having disturbed areas over 5 acres:
  - On soil meeting Topsoil specifications, obtain test results dictating fertilizer and lime amendments required to bring the soil into compliance with the following:
    - pH for topsoil shall be between 6.0 and 7.5. If the tested soil demonstrates a pH of less than 6.0, sufficient lime shall be prescribed to raise the pH to 6.5 or higher.
    - Organic content of topsoil shall be not less than 1.5 percent by weight.
    - Topsoil having soluble salt content greater than 500 parts per million shall not be used.
    - No soil or seed shall be placed on soil which has been treated with soil sterilants or chemicals used for weed control until sufficient time has elapsed (14 days min.) to permit dissipation of phytotoxic materials.
  - Topsoil substitutes to be approved, as recommended by a qualified agronomist or soil scientist and approved by the appropriate approval authority may be used in lieu of natural topsoil.
- Topsoil Application
  - When topsoiling, maintain needed erosion and sediment control practices such as diversions, Grade Stabilization Structures, Earth Dikes, Slope Silt Fence and Sediment Traps and Basins.
  - Grades on the areas to be topsoiled, which have been previously established, shall be maintained, albeit 4" - 8" higher in elevation.
  - Topsoil shall be uniformly distributed in a 4" - 8" layer and lightly compacted to a minimum thickness of 4". Spreading shall be performed in such a manner that sodding or seeding can proceed with a minimum of additional soil preparation and tillage. Any irregularities in the surface resulting from topsoiling or other operations shall be corrected in order to prevent the formation of depressions or water pockets.
  - Topsoil shall not be placed while the topsoil or subsoil is in a frozen or muddy condition, when the subsoil is excessively wet or in a condition that may otherwise be detrimental to proper grading and seedbed preparation.

**Alternative for Permanent Seeding - instead of applying the full amounts of lime and commercial fertilizer, composted sludge and amendments may be applied as specified below.**

- Composted Sludge Material for use as a soil conditioner for sites having disturbed areas over 5 acres shall be tested to prescribe amendments and for site having disturbed areas over 5 acres shall conform to the following requirements:
  - Composted sludge shall be supplied by, or originate from, a person or persons that are permitted (at the time of application of the compost) by the Maryland Department of the Environment under COMAR 28.04.06.
  - Composted sludge shall contain at least 1 percent nitrogen, 1.5 percent phosphorus, and 0.2 percent potassium, and have a pH of 7.0 to 8.0. If compost does not meet these requirements, the appropriate constituents must be added to meet the requirements prior to use.
  - Composted sludge shall be applied at a rate of 1 ton/1,000 square feet.
  - Composted sludge shall be amended with a potassium fertilizer applied at the rate of 4 lb/1,000 square feet, and 1/3 the normal lime application rate.

References: Guidelines Specifications, Soil Preparation and Sodding, MD-VA, Pub. #1, Cooperative Extension Service, University of Maryland and Virginia Polytechnic Institute, Revised 1973.

**30.0 - DUST CONTROL**

**DEFINITION**  
CONTROLLING DUST BLOWING AND MOVEMENT ON CONSTRUCTION SITES AND ROADS.

**PURPOSE**  
TO PREVENT BLOWING AND MOVEMENT OF DUST FROM EXPOSED SOIL SURFACES, REDUCE ON AND OFF-SITE DAMAGE, HEALTH HAZARDS, AND IMPROVE TRAFFIC SAFETY.

**CONDITIONS WHERE PRACTICE APPLIES**  
THIS PRACTICE IS APPLICABLE TO AREAS SUBJECT TO DUST BLOWING AND MOVEMENT WHERE ON OFF-SITE DAMAGE IS LIKELY WITHOUT TREATMENT.

**SPECIFICATIONS**

**TEMPORARY METHODS**

- MULCHES - SEE STANDARDS FOR VEGETATIVE STABILIZATION WITH MULCHES ONLY. MULCH SHOULD BE GRATED OR TACKED TO PREVENT BLOWING.
- VEGETATIVE COVER - SEE STANDARDS FOR TEMPORARY VEGETATIVE COVER.
- TILLAGE - TO ROUGHEN SURFACE AND BRING CLDS TO THE SURFACE, THIS IS AN EMERGENCY MEASURE WHICH SHOULD BE USED BEFORE SOIL BLOWING STARTS, BEGIN PLOWING ON WINDWARD SIDE OF SITE. CHISEL-TYPE PLOWS SPACED ABOUT 12' APART, SPRING-TOOTHED HARROWS, AND SIMILAR PLOWS ARE EXAMPLES OF EQUIPMENT WHICH MAY PRODUCE THE DESIRED EFFECT.
- IRRIGATION - THIS IS GENERALLY DONE AS AN EMERGENCY TREATMENT. SITE IS SPRINKLED WITH WATER UNTIL THE SURFACE IS MOIST. REPEAT AS NEEDED. AT NO TIME SHOULD THE SITE BE IRRIGATED TO THE POINT THAT RUNOFF BEGINS TO FLOW.
- BARRIERS - SOLID BOARD FENCES, SILT FENCES, SNOW FENCES, BURLAP FENCES, STRAW BALEs, AND SIMILAR MATERIAL CAN BE USED TO CONTROL AIR CURRENTS AND SOIL BLOWING. BARRIERS PLACED AT RIGHT ANGLES TO PREVAILING CURRENTS AT INTERVALS OF ABOUT 10 TIMES THEIR HEIGHT ARE EFFECTIVE IN CONTROLLING SOIL BLOWING.
- CALCIUM CHLORIDE - APPLY AT RATES THAT WILL KEEP SURFACE MOIST. MAY NEED RETREATMENT.

**PERMANENT METHODS**

- PERMANENT VEGETATION - SEE STANDARDS FOR PERMANENT VEGETATIVE COVER. AND PERMANENT STABILIZATION WITH SOIL EXISTING TREES OR LARGE SHRUBS MAY PROVIDE VALUABLE PROTECTION IF USED IN PLACE OF MULCH.
- TOPSOILING - COVERING WITH LESS ERODIBLE SOIL MATERIALS. SEE STANDARDS FOR TOPSOILING.
- STONE - COVER SURFACE WITH CRUSHED STONE OR COARSE GRAVEL.

**REFERENCES**

- AGRICULTURE HANDBOOK 346, WIND EROSION FORCES IN THE UNITED STATES AND THEIR USES IN PREDICTING SOIL LOSS.
- AGRICULTURE INFORMATION BULLETIN 354, HOW TO CONTROL WIND EROSION, USDA-ARS.

U.S. DEPARTMENT OF AGRICULTURE SOIL CONSERVATION SERVICE PAGE R-39-1 MARYLAND DEPARTMENT OF ENVIRONMENT WATER MANAGEMENT ADMINISTRATION

**SEQUENCE OF CONSTRUCTION**

- BEFORE APPLYING FOR GRADING PERMIT, GET THE NECESSARY AUTHORIZATION FROM THE UTILITY COMPANIES FOR DEMOLITION ON SITE. DISCARD THE EXISTING UTILITIES ON SITE IF NOT TO BE REUSED.
- APPLY FOR AND OBTAIN ALL NECESSARY PERMITS REQUIRED FOR THE DEMOLITION OF THE EXISTING STRUCTURES.
- OBTAIN GRADING PERMIT.
- INSTALL STABILIZED CONSTRUCTION ENTRANCE, SILT FENCE, AND SWALE. CONTRACTOR IS TO STABILIZE SWALE IMMEDIATELY, INSTALL SUPER SILT FENCE IN SWALE AS SHOWN ON PLAN.
- CONSTRUCT PROPOSED DRIVEWAY SO THAT EXISTING DRIVE IS WIDENED TO A TOTAL WIDTH OF 18 FEET.
- INSTALL PROPOSED SEPTIC SYSTEM. WORK SHOULD BE COMPLETED AND STABILIZED WITHIN ONE DAY. IF NOT, THEN CONTRACTOR SHALL TAKE MEASURES TO STABILIZE THIS AREA UNTIL WORK IS COMPLETED.
- PERFORM FINE GRADING AND LANDSCAPING. CONTRACTOR TO PROVIDE DUST CONTROL AS NECESSARY AND AS DIRECTED BY THE INSPECTOR.
- APPLY TOPSOIL AND STABILIZE DISTURBED AREAS IN ACCORDANCE WITH PERMANENT SEEDING NOTES.
- INSTALL INFILTRATION TRENCH WHEN SITE HAS BEEN COMPLETELY STABILIZED, INSTALL PER NOTES ON SHEET 15.
- WITH PERMISSION OF COUNTY SEDIMENT CONTROL INSPECTOR, REMOVE ALL REMAINING SEDIMENT CONTROL DEVICES AND STABILIZE ANY REMAINING DISTURBED AREAS IN ACCORDANCE WITH PERMANENT SEEDING NOTES.

**TEMPORARY SEEDING NOTES**

Apply to graded or cleared areas likely to be redistributed where a short-term vegetative cover is needed.

**Seedbed Preparation** - Loosen upper three inches of soil by raking, tilling or other acceptable means before seeding, if not previously loosened.

**Soil Amendments** - Apply 600 lbs. per acre 10-10-10 fertilizer (14 lbs. per 1000 sq.ft.).

**Seeding** - For periods March 1 thru April 30 and from August 15 thru November 15, seed with 80 lbs. per acre 3:1 or better, (3:1 lbs. per 1000 sq.ft.). For the period May 1 thru July 31, seed with 50 lbs. per acre Kentucky 31 Tall Fescue per acre and 2 lbs. per acre (0.05 lbs. per 1000 sq.ft.) of weeping lovegrass. During the period October 15 thru February 28, protect site by applying 2 tons per acre of well-anchored straw mulch and seed as soon as possible in the spring, or use sod.

**Mulching** - Apply 1-1/2 to 2 tons per acre (70 to 90 lbs. per 1000 sq.ft.) of unfertilized straw immediately after seeding. Anchor mulch immediately after application using mulch anchoring tool or 2/8 gal. per acre (5 gal. per 1000 sq.ft.) of emulsified asphalt on flat areas. On slopes, 8" or higher, use 3/4 gal. per acre (3 gal. per 1000 sq.ft.) for anchoring.

Refer to the 1994 MARYLAND STANDARDS AND SPECIFICATIONS FOR SOIL EROSION AND SEDIMENT CONTROL, for rate and methods not covered.

**STANDARD SEDIMENT CONTROL NOTES**

- A MINIMUM OF 48 HOURS NOTICE MUST BE GIVEN TO THE HOWARD COUNTY DEPARTMENT OF INSPECTIONS, LICENSES AND PERMITS, SEDIMENT CONTROL DIVISION PRIOR TO THE START OF ANY CONSTRUCTION (313-1855).
- ALL VEGETATIVE AND STRUCTURAL PRACTICES ARE TO BE INSTALLED ACCORDING TO THE PROVISIONS OF THIS PLAN AND ARE TO BE IN CONFORMANCE WITH THE 1994 MARYLAND STANDARDS AND SPECIFICATIONS FOR SOIL EROSION AND SEDIMENT CONTROL AND REVISIONS THERETO.
- FOLLOWING INITIAL SOIL DISTURBANCE OR RE-DISTURBANCE, PERMANENT OR TEMPORARY STABILIZATION SHALL BE COMPLETED WITHIN: A) 7 CALENDAR DAYS FOR ALL PERIMETER SEDIMENT CONTROL STRUCTURES, DIKES, PERMETER SLOPES, AND ALL SLOPES STEEPER THAN 3:1; B) 14 DAYS AS TO ALL OTHER DISTURBED OR GRADED AREAS ON THE PROJECT SITE.
- ALL SEDIMENT TRAPS/BASINS MUST BE FENCED AND WARNING SIGNS POSTED AROUND THE PERIMETER IN ACCORDANCE WITH VOL. 1, CHAPTER 7, OF THE HOWARD COUNTY DESIGN MANUAL, STORM DRAINAGE.
- ALL DISTURBED AREAS MUST BE STABILIZED WITHIN THE TIME PERIOD SPECIFIED ABOVE IN ACCORDANCE WITH THE 1994 MARYLAND STANDARDS AND SPECIFICATIONS FOR SOIL EROSION AND SEDIMENT CONTROL FOR PERMANENT SEEDING, SOD, TEMPORARY SEEDING AND MULCHING (SEC. G.); TEMPORARY STABILIZATION WITH MULCH ALONE SHALL ONLY BE DONE WHEN RECOMMENDED SEEDING DATES DO NOT ALLOW FOR PROPER GERMINATION AND ESTABLISHED OF GRASSES.
- ALL SEDIMENT CONTROL STRUCTURES ARE TO REMAIN IN PLACE AND ARE TO BE MAINTAINED IN OPERATIVE CONDITION UNTIL PERMISSION FOR THEIR REMOVAL HAS BEEN OBTAINED FROM THE HOWARD COUNTY SEDIMENT CONTROL INSPECTOR.
- SITE ANALYSIS:**  
TOTAL AREA OF SITE 14.83 ACRES  
AREA DISTURBED 1.791 ACRES  
AREA TO BE ROOFED OR PAVED 0.857 ACRES  
AREA TO BE VEGETATIVELY STABILIZED 14,150 ACRES  
TOTAL CUT 1930 CY  
TOTAL FILL 0 CY  
OFFSITE WASTE AREA LOCATION TO HAVE ACTIVE GRADING PERMIT.  
\*QUANTITIES ARE FOR COUNTY FEE PURPOSES ONLY. CONTRACTOR IS RESPONSIBLE FOR VERIFICATION OF ACTUAL QUANTITIES.
- ANY SEDIMENT CONTROL PRACTICE WHICH IS DISTURBED BY GRADING ACTIVITY FOR PLACEMENT OF UTILITIES MUST BE REPAIRED ON THE SAME DAY OF DISTURBANCE.
- ADDITIONAL SEDIMENT CONTROLS MUST BE PROVIDED, IF DEEMED NECESSARY BY THE HOWARD COUNTY SEDIMENT CONTROL INSPECTOR.
- ON ALL SITES WITH DISTURBED AREAS IN EXCESS OF 2 ACRES, APPROVAL OF THE INSPECTION AGENCY SHALL BE REQUESTED UPON COMPLETION OF INSTALLATION OF PERIMETER EROSION AND SEDIMENT CONTROLS, BUT BEFORE PROCEEDING WITH ANY OTHER EARTH DISTURBANCE OR GRADING, OTHER BUILDING OR GRADING INSPECTION APPROVALS MAY NOT BE AUTHORIZED UNTIL THIS INITIAL APPROVAL BY THE INSPECTION AGENCY IS MADE.
- TRENCHES FOR THE CONSTRUCTION OF UTILITIES IS LIMITED TO THREE PIPE LENGTHS OR THAT WHICH SHALL BE BACK-FILLED AND STABILIZED WITHIN ONE WORKING DAY, WHICHEVER IS SHORTER.
- SITE GRADING WILL BEGIN ONLY AFTER ALL PERIMETER SEDIMENT CONTROL MEASURES HAVE BEEN INSTALLED AND ARE IN A FUNCTIONING CONDITION.
- SEDIMENT WILL BE REMOVED FROM TRAPS WHEN ITS DEPTH REACHES CLEAN OUT ELEVATION SHOWN ON THE PLANS.
- CUT AND FILL QUANTITIES PROVIDED UNDER SITE ANALYSIS DO NOT REPRESENT BID QUANTITIES. THESE QUANTITIES DO NOT DISTINGUISH BETWEEN TOPSOIL, STRUCTURAL FILL OR EMBANKMENT MATERIAL, NOR DO THEY REFLECT CONSIDERATION OF UNDERCUTTING OR REMOVAL OF UNSUITABLE MATERIAL. THE CONTRACTOR SHALL FAMILIARIZE HIMSELF WITH SITE CONDITIONS WHICH MAY AFFECT THE WORK.

U.S. DEPARTMENT OF AGRICULTURE SOIL CONSERVATION SERVICE PAGE H-26-3A MARYLAND DEPARTMENT OF ENVIRONMENT WATER MANAGEMENT ADMINISTRATION

BY THE DEVELOPER :

I/WE CERTIFY THAT ALL DEVELOPMENT AND CONSTRUCTION WILL BE DONE ACCORDING TO THIS PLAN, AND THAT ANY RESPONSIBLE PERSONNEL INVOLVED IN THE CONSTRUCTION PROJECT WILL HAVE A CERTIFICATE OF ATTENDANCE AT A DEPARTMENT OF THE ENVIRONMENT APPROVED TRAINING PROGRAM FOR THE CONTROL OF SEDIMENT AND EROSION BEFORE BEGINNING THE PROJECT. I ALSO AUTHORIZE PERIODIC ON-SITE INSPECTIONS BY THE HOWARD SOIL CONSERVATION DISTRICT.

*Tom McLean* 1/23/08  
DEVELOPER DATE

BY THE ENGINEER :

I CERTIFY THAT THIS PLAN FOR EROSION AND SEDIMENT CONTROL REPRESENTS A PRACTICAL AND WORKABLE PLAN BASED ON MY PERSONAL KNOWLEDGE OF THE SITE CONDITIONS AND THAT IT WAS PREPARED IN ACCORDANCE WITH THE REQUIREMENTS OF THE HOWARD SOIL CONSERVATION DISTRICT.

*Shirley C. Mitchell* 1-22-08  
ENGINEER DATE

THESE PLANS HAVE BEEN REVIEWED FOR THE HOWARD SOIL CONSERVATION DISTRICT AND MEET THE TECHNICAL REQUIREMENTS FOR SOIL EROSION AND SEDIMENT CONTROL.

*John R. Robertson* 1/21/09  
HOWARD SOIL CONSERVATION DISTRICT DATE

THIS DEVELOPMENT PLAN IS APPROVED FOR SOIL EROSION AND SEDIMENT CONTROL BY THE HOWARD SOIL CONSERVATION DISTRICT.

*John R. Robertson* 1/21/09  
HOWARD SOIL CONSERVATION DISTRICT DATE

APPROVED : HOWARD COUNTY DEPARTMENT OF PLANNING AND ZONING.

*William W. ...* 2/8/08  
CHIEF, DEVELOPMENT ENGINEERING DIVISION DATE

*Conde ...* 2/8/08  
CHIEF, DIVISION OF LAND DEVELOPMENT DATE

OWNER: HOMEWOOD L.L.C. GARY B. SMITH 11362 HOMEWOOD ROAD ELLICOTT CITY MARYLAND 21042 410-964-0260

PROJECT: HOMEWOOD FARM (MURPHY PROPERTY)

AREA: TAX MAP 29 PARCELS 303, 117, 291 3RD ELECTION DISTRICT ZONED RC-DEO HOWARD COUNTY, MARYLAND


TITLE: FINAL GRADING AND SEDIMENT CONTROL PLAN

Patton Harris Rust & Associates, pc  
Engineers, Surveyors, Planners, Landscape Architects.  
8818 Centre Park Drive  
Columbia, MD 21045  
T 410.997.8900  
F 410.997.9282


DESIGNED BY : PDK  
DRAWN BY: PDK  
PROJECT NO. 14520-1-0  
DATE : JANUARY 21, 2008  
SCALE : NTS  
DRAWING NO. 5 OF 15

P:\PROJ\14520-1\PLANS-107\070612.DWG



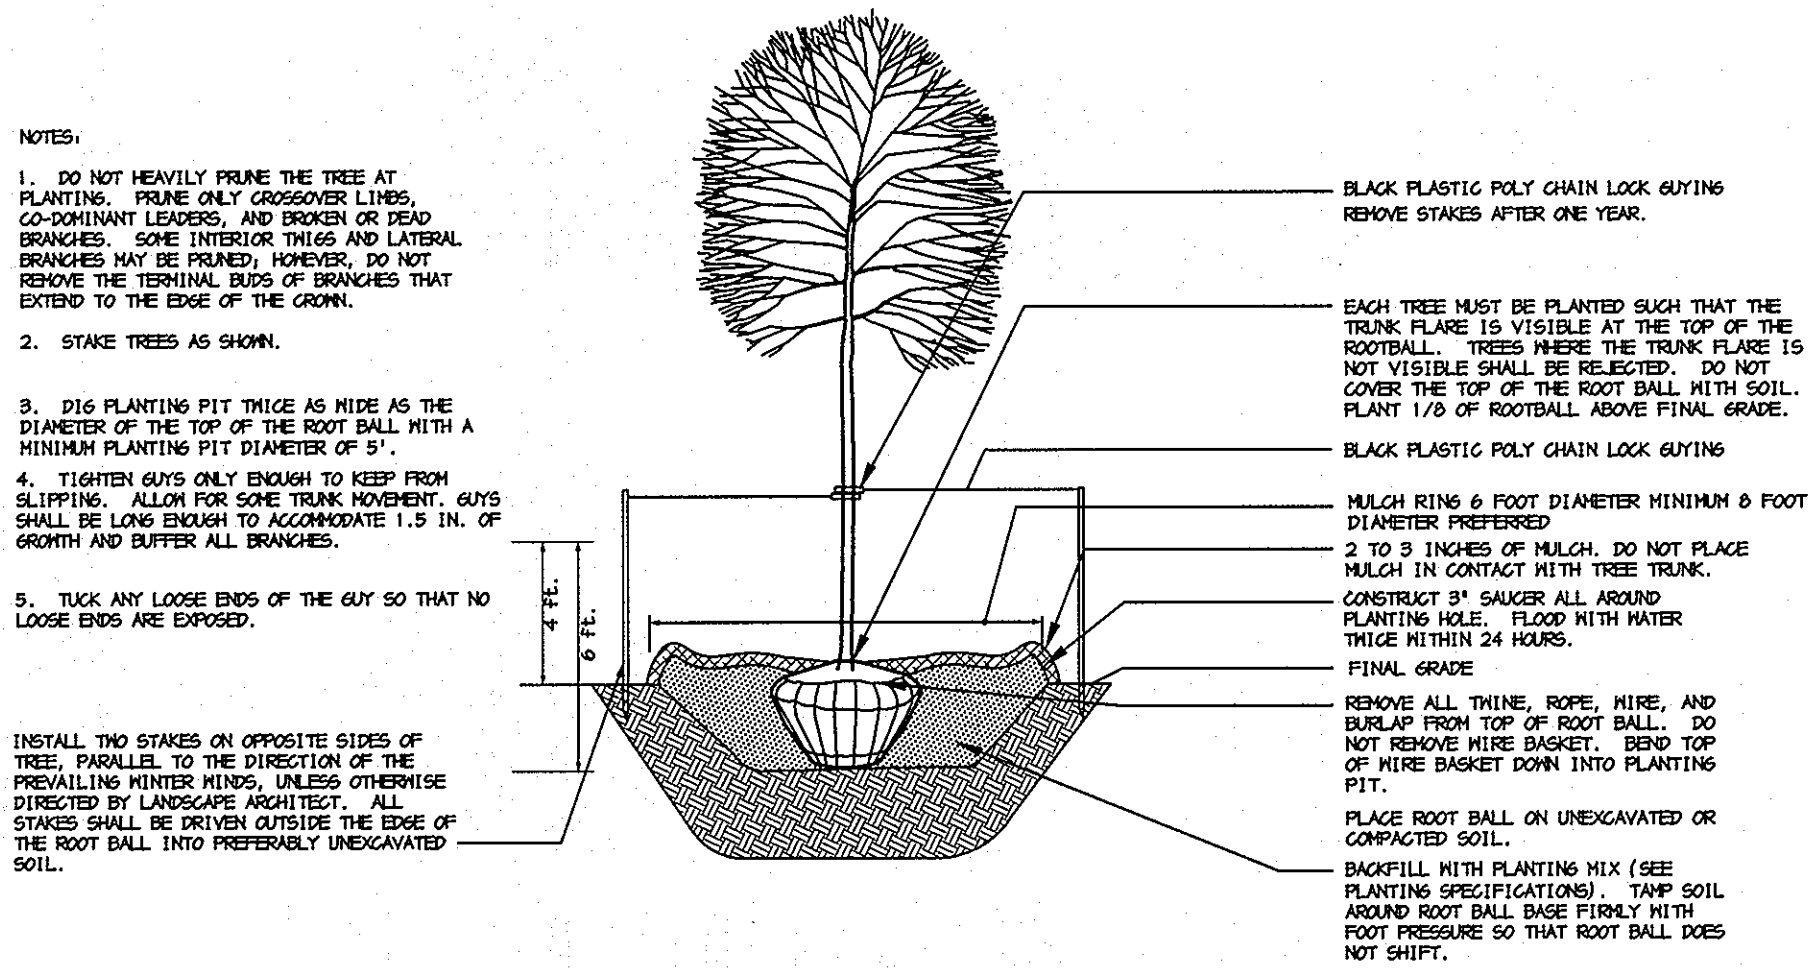

DECIDUOUS B&B TREE PLANTING DETAIL (TREES 3" CAL. OR SMALLER)  
NOT TO SCALE

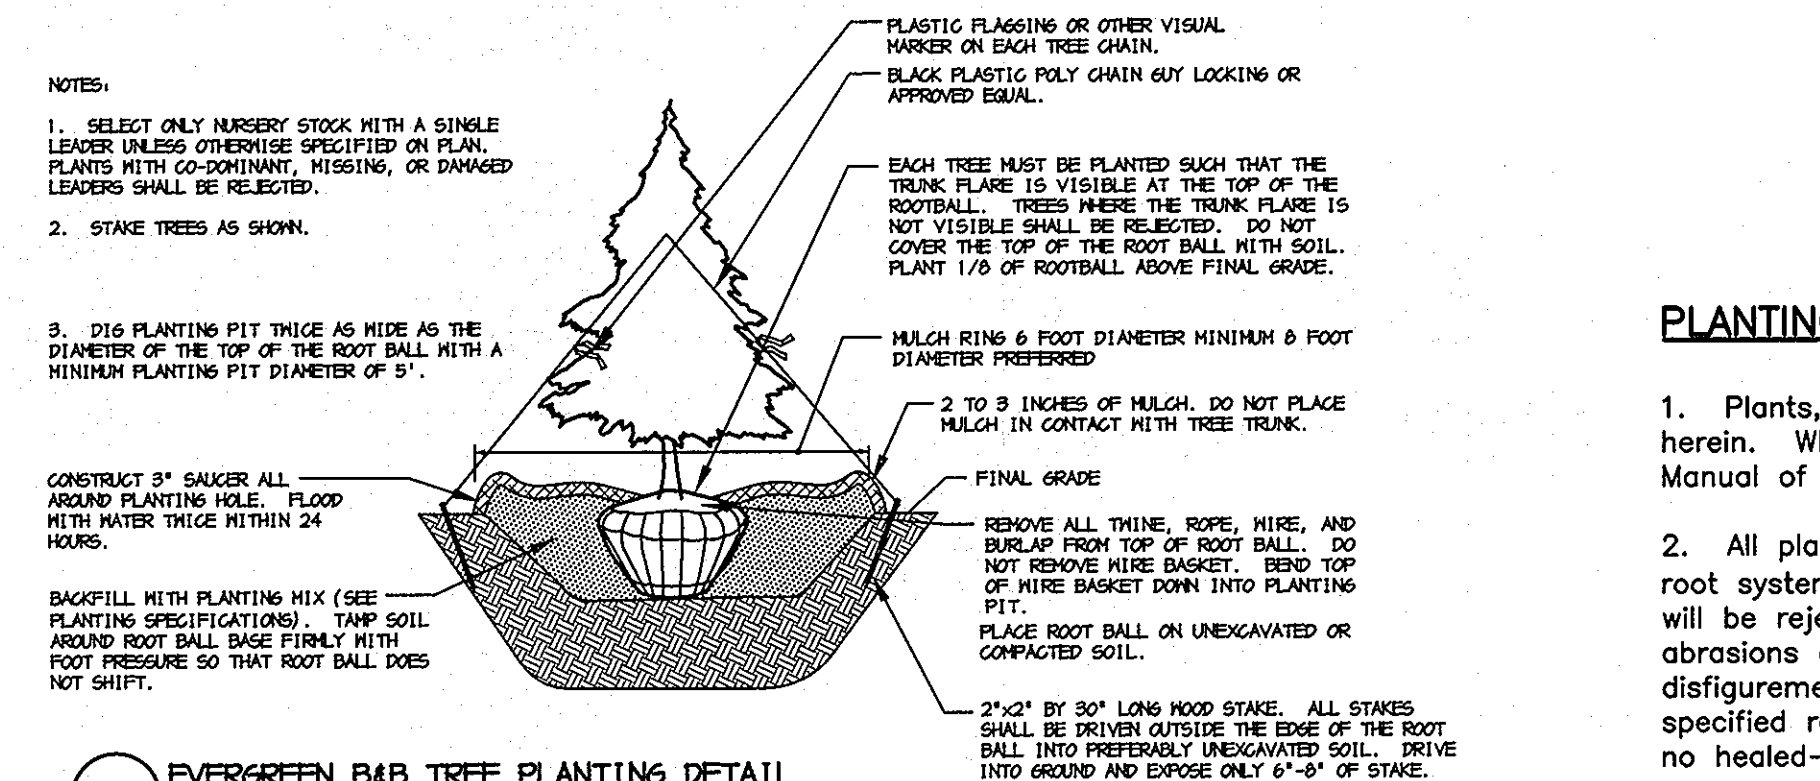

EVERGREEN B&B TREE PLANTING DETAIL  
NOT TO SCALE

PERIMETER	ADJACENT TO PERIMETER PROPERTIES			ADJACENT TO ROADWAYS
	1	2	3	4
LANDSCAPE TYPE	A	A	A	B
LINEAR FEET OF ROADWAY FRONTAGE/ PERIMETER	670' ±	832' ±	1,259' ±	590' ±
CREDIT FOR EXISTING VEGETATION (YES/NO LINEAR FEET) (DESCRIBE BELOW IF NEEDED)	YES 123' (2)	YES 313' (3)	YES 19 SHADE TREES	YES 277' (3)
CREDIT FOR WALL, FENCE, BERM OR DRIVE AISLE (YES/NO/LINEAR FEET)	NO	NO	NO	NO
LINEAR FEET REMAINING	547' ±	519' ±	1,259' ±	313' ±
NUMBER OF PLANTS REQUIRED				
SHADE TREES	10	9	21	7
EVERGREEN TREES	0	0	0	0
SHRUBS	0	0	0	0
NUMBER OF PLANTS PROVIDED				
SHADE TREES	10	9	2 (4)	7
EVERGREEN TREES	0	0	0	0
SMALL FLOWERING TREES	0	0	0	0
SHRUBS	0	0	0	0

- SCHEDULE 'A' NOTES:**
- REGULATIONS DO NOT REQUIRE LANDSCAPE EDGES, BUFFERING, OR SCREENING BETWEEN INTERNAL LOTS OR PARCELS WITHIN THE SAME DEVELOPMENT. (PAGE 17 OF THE HO. CO. LANDSCAPE MANUAL)
  - SUBSTITUTION NOTES PERIMETER 1:**  
123' OF EXISTING FOREST ALONG PERIMETER WILL COUNT AS CREDIT
  - SUBSTITUTION NOTES PERIMETER 2:**  
313' OF EXISTING FOREST ALONG PERIMETER WILL COUNT AS CREDIT
  - SUBSTITUTION NOTES PERIMETER 3:**  
12 EXISTING TREES WILL COUNT AS CREDIT FOR 12 REQUIRED SHADE TREES  
14 EXISTING EVERGREEN TREES WILL COUNT AS CREDIT FOR 7 REQUIRED SHADE TREES
  - SUBSTITUTION NOTES PERIMETER 4:**  
277' OF EXISTING FOREST ALONG PERIMETER WILL COUNT AS CREDIT

**PLANTING SPECIFICATIONS**

- Plants, related material, and operations shall meet the detailed description, as given on the plans and as described herein. Where discrepancies exist between Standards & Guidelines referenced within these specifications and the Landscape Manual of the applicable jurisdiction, the latter takes precedence.
- All plant material, unless otherwise specified, that is not nursery grown, uniformly branched, does not have a vigorous root system, and does not conform to the most recent edition of the American Association of Nurserymen (AAN) Standards will be rejected. Plant material that is not healthy, vigorous, free from defects, decay, disfiguring roots, unsound injuries, abrasions of the bark, plant disease, insect pest eggs, borers and all forms of insect infestations or objectionable disfigurements will be rejected. Plant material that is weak or which has been cut back from larger grades to meet specified requirements will be rejected. Trees with forked leaders will be rejected. All B & B plants shall be freshly dug; no healed-in plants or plants from cold storage will be accepted.
- Unless otherwise specified, all general conditions, planting operations, details and planting specifications shall conform to the most recent edition of the "Landscape Specification Guidelines by the Landscape Contractors Association of MD, DC, & VA", (hereinafter "Landscape Guidelines") approved by the Landscape Contractors Association of Metropolitan Washington and the Potomac Chapter of the American Society of Landscape Architects.
- Contractor shall guarantee all plant material for a period of one year after date of acceptance in accordance with the appropriate section on the Landscape Guidelines. Contractor's attention is directed to the maintenance requirements found within the one year specifications including watering and replacement of specified plant material.
- Contractor shall be responsible for notifying all relevant and appropriate utility companies, utility contractors, and "Miss Utility" a minimum of 48 hours prior to the beginning of any work. Contractor may make minor adjustments in spacing and location of plant material to avoid conflicts with utilities. Major changes will require the approval of the landscape architect. Damage to existing structure and utilities shall be repaired at the expense of the Contractor.
- Protection of existing vegetation to remain shall be accomplished via the temporary installation of 4 foot high snow fence at the drip line, see detail.
- Contractor is responsible for installing all material in the proper planting season for each plant type. All planting is to be completed within growing season of completion of site construction. Do not plant Pinus strobus or Xcupressacyparis leylandii between November 15 and March 15. Landscape plants are not to be installed before site is graded to final grade.
- Contractor to regrade, fine grade, sod, hydroseed and straw mulch all areas disturbed by their work.
- Bid shall be based on actual site conditions. No extra payment shall be made for work arising from actual site conditions differing from those indicated on drawings and specifications.
- Plant quantities are provided for the convenience of the contractor only. If discrepancies exist between quantities shown on plan and those shown on the plant list, the quantities on the plan take precedence. Where discrepancies on the plan exist between the symbols and the callout leader, the number of symbols take precedence.
- All shrubs and groundcover areas shall be planted in continuous planting beds, prepared as specified, unless otherwise indicated on plans. (See Specification 13). Beds to be mulched with minimum 2" and maximum 3" of composted, double-shredded hardwood mulch throughout.
- Positive drainage shall be maintained on planting beds (minimum 2 percent slope).
- Bed preparation shall be as follows: Till into a minimum depth of 6" 1 yard of Compro or Leafgro per 200 SF of planting bed, and 1 yard of topsoil per 100 SF of bed. Add 3 lbs of standard 5-10-5 fertilizer per cubic yard of planting mix and till. Ericaceous plants (Azaleas, Rhododendrons, etc.); top dress after planting with iron sulfate or comparable product according to package directions. Taxus baccata 'Repandens' (English weeping yews): Top dress after planting with 1/4 to 1/2 cup lime each.
- Planting mix: For trees not in a prepared bed, mix 50% Compro or Leafgro with 50% soil from tree hole to use as backfill, see tree planting detail.
- Weed & insect control: Incorporate a pre-emergent herbicide into the planting bed following recommended rates on the label. For tree planting, apply a pre-emergent on top of soil and root ball before mulching. Caution: For areas to be planted with a ground cover, be sure to carefully check the chemical used to assure its adaptability to the specific groundcover to be treated. Maintain the mulch weed-free for the extent of the warranty period. Under no circumstances is a pesticide containing chlorpyrifos to be used as a means of pest control.
- Water: All plant material planted shall be watered thoroughly the day of planting. All plant material not yet planted shall be properly protected from drying out until planted. At a minimum, water unplanted plant material daily and as necessary to avoid desiccation.
- Pruning: Do not heavily prune trees and shrubs at planting. Prune only broken, dead, or diseased branches.
- All areas within contract limits disturbed during or prior to construction not designated to receive plants and mulch shall be fine graded, grass seed planted, and covered with straw mulch.

**GENERAL NOTES:**

- THIS PLAN HAS BEEN PREPARED IN ACCORDANCE WITH THE PROVISIONS OF SECTION 16.124 OF THE HOWARD COUNTY CODE AND THE LANDSCAPE MANUAL.
- A LANDSCAPE SURETY OF \$9,600.00 WILL NEED TO BE POSTED WITH THE GRADING PERMIT FOR LOT 2.  
28 SHADE TREES @ \$300 = 8,400  
0 ORNAMENTAL TREES @ \$150 = 0  
8 EVERGREEN TREES @ \$150 = 1,200  
0 SHRUBS @ \$30 = 0
- THIS PLAN IS FOR LANDSCAPING PURPOSES ONLY.
- CONTRACTOR IS SOLELY RESPONSIBLE FOR CONSTRUCTION MEANS, METHODS, TECHNIQUES, SEQUENCES, PROCEDURES, AND SAFETY PRECAUTIONS AND PROGRAMS.
- ALL MATERIAL SELECTED SHALL BE EQUAL TO OR BETTER THAN THE REQUIREMENTS OF THE "USA STANDARD FOR NURSERY STOCK", LATEST EDITION, AS PUBLISHED BY THE AMERICAN ASSOCIATION OF NURSERYMEN.
- ALL MATERIAL SHALL BE PLANTED IN ACCORDANCE WITH THE MINIMUM STANDARDS CITED IN THE LATEST EDITION OF "LANDSCAPE SPECIFICATION GUIDELINES" PUBLISHED BY THE LANDSCAPE CONTRACTORS ASSOCIATION.
- AT THE TIME OF INSTALLATION, ALL SHRUBS AND OTHER PLANTINGS SHALL BE OF THE PROPER HEIGHT AND/OR SPREAD REQUIREMENTS IN ACCORDANCE WITH THIS PLAN AND THE HOWARD COUNTY LANDSCAPE MANUAL.
- NO SUBSTITUTIONS OR RELOCATION OF PLANTS MAY BE MADE WITHOUT PRIOR APPROVAL FROM THE DEPARTMENT OF PLANNING AND ZONING OF HOWARD COUNTY. ANY DEVIATION FROM THIS LANDSCAPE PLAN WILL RESULT IN A REQUIREMENT FOR SUBMITTAL OF AN OFFICIAL "REDLINE REVISION" TO THE SITE DEVELOPMENT PLAN(S) AND/OR DENIAL IN THE RELEASE OF LANDSCAPE SURETY.
- PERIMETER LANDSCAPE OBLIGATIONS WILL BE FULFILLED BY A COMBINATION OF NEW PLANTINGS AND PRESERVATION OF EXISTING VEGETATION.
- SHOULD ANY TREE DESIGNATED FOR PRESERVATION, FOR WHICH LANDSCAPING CREDIT IS GIVEN, DIE PRIOR TO RELEASE OF BONDS, THE OWNER WILL BE REQUIRED TO REPLACE THE TREE WITH THE EQUIVALENT SPECIES OR WITH A TREE WHICH WILL OBTAIN THE SAME HEIGHT, SPREAD AND GROWTH CHARACTERISTICS. THE REPLACEMENT TREE MUST BE A MINIMUM OF 3 INCHES IN CALIPER AND INSTALLED AS REQUIRED IN THE LANDSCAPE MANUAL.
- DEVELOPER/BUILDER IS RESPONSIBLE FOR INSTALLATION OF PERIMETER LANDSCAPING. NO INTERNAL LANDSCAPING IS REQUIRED WITH THIS DEVELOPMENT.

APPROVED : HOWARD COUNTY DEPARTMENT OF PLANNING AND ZONING.

DIRECTOR: *[Signature]* DATE: 2/10/08

CHIEF, DEVELOPMENT ENGINEERING DIVISION

CHIEF, DIVISION OF LAND DEVELOPMENT: *[Signature]* DATE: 2/10/08

DATE	NO.	REVISION

OWNER: HOMEWOOD L.L.C. GARY B. SMITH 11362 HOMEWOOD ROAD ELLICOTT CITY MARYLAND 21042 410-964-0260

PROJECT: HOMEWOOD FARM (MURPHY PROPERTY)

AREA: TAX MAP 29 PARCELS 303, 117, 291 3RD ELECTION DISTRICT ZONED RC-DEO HOWARD COUNTY, MARYLAND



TITLE: FINAL LANDSCAPE NOTES AND DETAILS

Patton Harris Rust & Associates, pc  
Engineers. Surveyors. Planners. Landscape Architects.  
8818 Centre Park Drive  
Columbia, MD 21045  
T 410.997.8900  
F 410.997.9282

DESIGNED BY: JML  
DRAWN BY: JML  
PROJECT NO: 14520-1-0  
DATE: JANUARY 21, 2008  
SCALE: NTS  
DRAWING NO. 7 OF 15

STATE OF MARYLAND  
787  
JAMES R. WOLFENBUTER  
COMMISSIONER OF PLANNING AND ZONING

PROJECT: 14520-1-0 PLANS F-07 LANDSCAPE NOTES

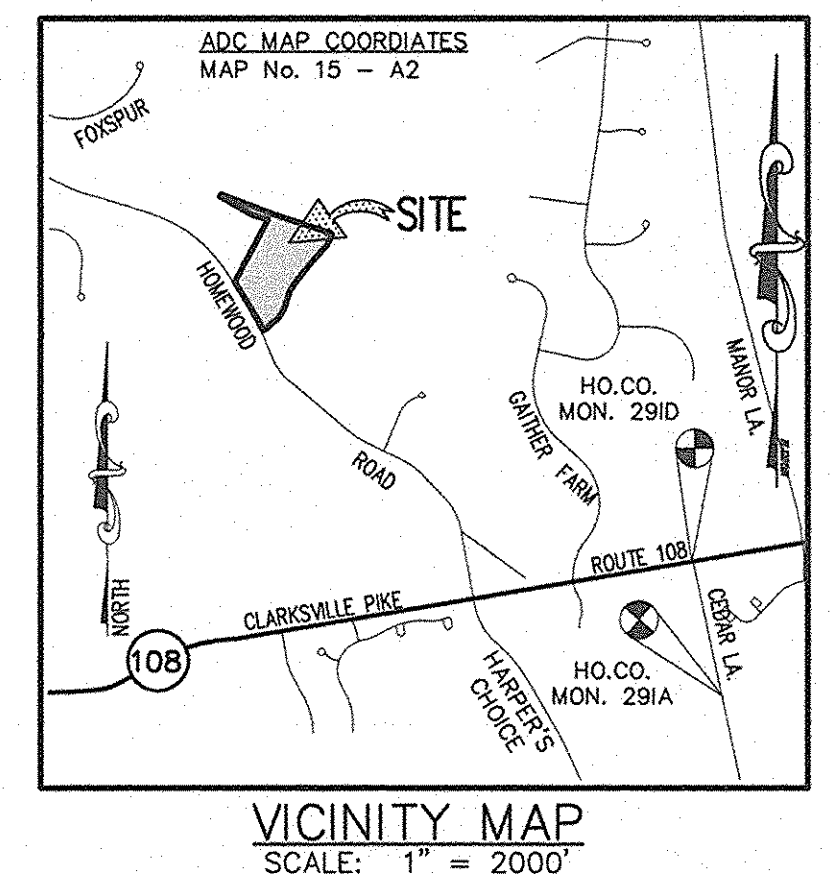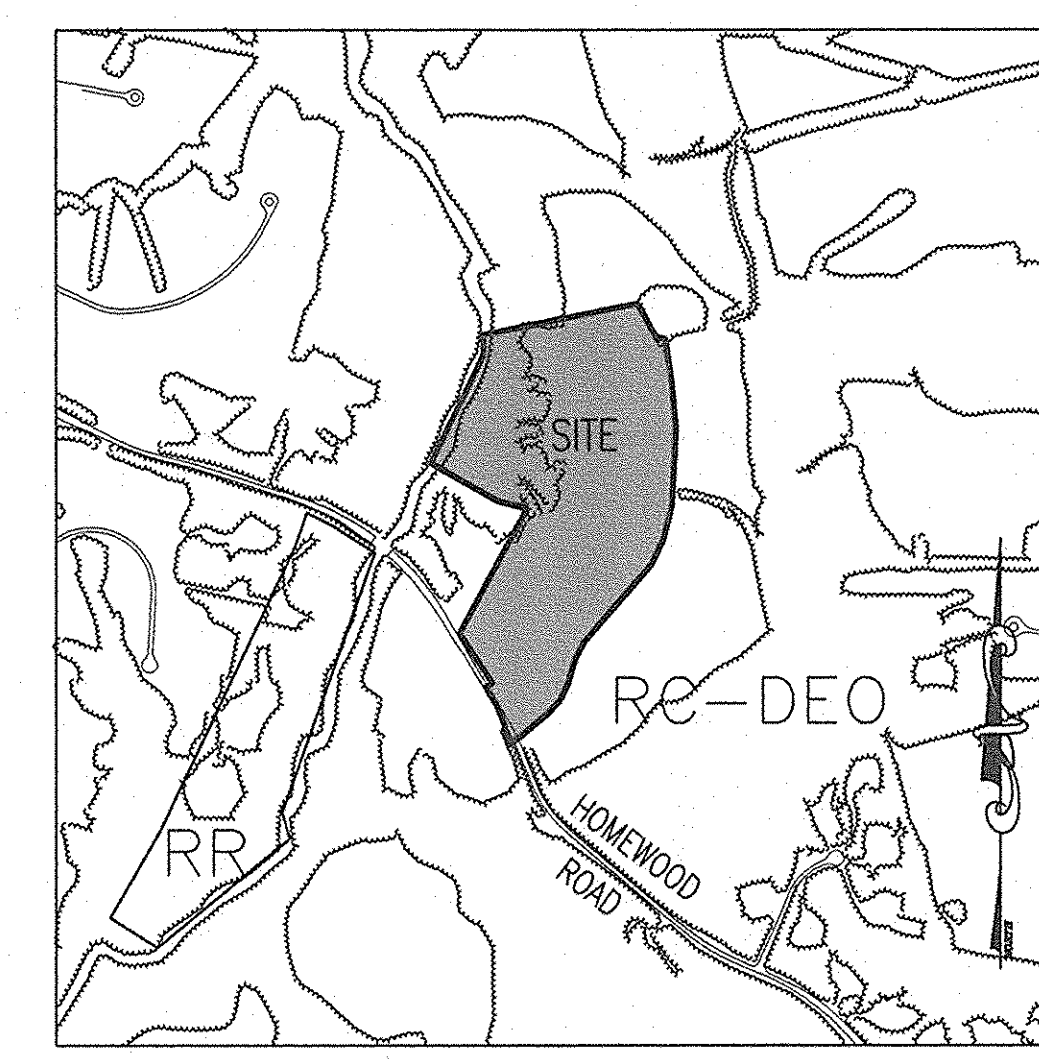

**LEGEND**

	PROPERTY LINE		EXISTING BUILDING
	EXISTING TREELINE		EXISTING WELL
	FEMA 100 YEAR FLOODPLAIN		PROPOSED WELL
	EXISTING SOILS		OPEN FIELD
	STREAM AND BUFFER		FOREST STAND
	EXISTING CONTOURS		HEDGEROW
	WET SEASON SOILS TEST		STEEP SLOPES > 25%
	NO TEST SOILS		SPECIMEN TREE LOCATION

APPROVED : HOWARD COUNTY DEPARTMENT OF PLANNING AND ZONING.

DIRECTOR	DATE
<i>[Signature]</i>	2/8/08
CHIEF, DEVELOPMENT ENGINEERING DIVISION	DATE
<i>[Signature]</i>	2/8/08
CHIEF, DIVISION OF LAND DEVELOPMENT	DATE

DATE	NO.	REVISION

OWNER:

HOMWOOD L.L.C.  
GARY B. SMITH  
11362 HOMWOOD ROAD  
ELLCOTT CITY  
MARYLAND 21042  
410-964-0260

PROJECT: **HOMWOOD FARM (MURPHY PROPERTY)**

AREA: TAX MAP 29 PARCELS 303, 117, 291  
3RD ELECTION DISTRICT ZONED RC-DEO  
HOWARD COUNTY, MARYLAND

TITLE: **FOREST STAND DELINEATION PLAN**

Patton Harris Rust & Associates, pc  
Engineers, Surveyors, Planners, Landscape Architects.  
8818 Centre Park Drive  
Columbia, MD 21045  
T 410.997.8900  
F 410.997.9282

**PHRA**

DESIGNED BY : JML
DRAWN BY : JML
PROJECT NO : 14520-1-0
DATE : JANUARY 21, 2008
SCALE : 1"=100'
DRAWING NO. 8 OF 15

*[Signature]* 1/22/08



SPECIMEN TREE CHART			
KEY	SPECIES	SIZE	CONDITION
1	TULIP POPLAR ( <i>Liriodendron tulipifera</i> )	30"	GOOD
2	WHITE OAK ( <i>Quercus alba</i> )	34"	GOOD
3	TULIP POPLAR ( <i>Liriodendron tulipifera</i> )	46"	DEAD
4	TULIP POPLAR ( <i>Liriodendron tulipifera</i> )	48"	GOOD
5	TULIP POPLAR ( <i>Liriodendron tulipifera</i> )	42"	GOOD
6	TULIP POPLAR ( <i>Liriodendron tulipifera</i> )	50"	GOOD
7	AMERICAN ELM ( <i>Ulmus</i> )	43"	GOOD
8	TULIP POPLAR ( <i>Liriodendron tulipifera</i> )	33"	GOOD
9	TULIP POPLAR ( <i>Liriodendron tulipifera</i> )	31"	GOOD
10	BLACK WALNUT ( <i>Juglans nigra</i> )	35"	GOOD
11	BITTERNUT HICKORY ( <i>Carya cordiformis</i> )	30"	GOOD
12	WHITE OAK ( <i>Quercus alba</i> )	31"	GOOD
13	WHITE OAK ( <i>Quercus alba</i> )	31"	GOOD
14	WHITE OAK ( <i>Quercus alba</i> )	47"	GOOD
15	AMERICAN BEECH ( <i>Fagus grandifolia</i> )	48"	GOOD
16	NORWAY SPRUCE ( <i>Picea abies</i> )	31"	GOOD
17	WHITE OAK ( <i>Quercus alba</i> )	42"	GOOD
18	TULIP POPLAR ( <i>Liriodendron tulipifera</i> )	32"	GOOD
19	BITTERNUT HICKORY ( <i>Carya cordiformis</i> )	32"	GOOD
20	AMERICAN BEECH ( <i>Fagus grandifolia</i> )	50"	GOOD
21	WHITE OAK ( <i>Quercus alba</i> )	39"	GOOD
22	WHITE OAK ( <i>Quercus alba</i> )	32"	GOOD
23	WHITE OAK ( <i>Quercus alba</i> )	43"	GOOD
24	TULIP POPLAR ( <i>Liriodendron tulipifera</i> )	54"	GOOD
25	BLACK WALNUT ( <i>Juglans nigra</i> )	34"	GOOD
26	WHITE OAK ( <i>Quercus alba</i> )	30"	GOOD
27	BLACK WALNUT ( <i>Juglans nigra</i> )	33"	GOOD
28	BLACK WALNUT ( <i>Juglans nigra</i> )	36"	GOOD
29	TULIP POPLAR ( <i>Liriodendron tulipifera</i> )	30"	GOOD
30	TULIP POPLAR ( <i>Liriodendron tulipifera</i> )	33"	GOOD
31	TULIP POPLAR ( <i>Liriodendron tulipifera</i> )	39"	GOOD
32	TULIP POPLAR ( <i>Liriodendron tulipifera</i> )	48"	GOOD
33	TULIP POPLAR ( <i>Liriodendron tulipifera</i> )	36"	GOOD
34	WHITE OAK ( <i>Quercus alba</i> )	35"	GOOD
35	RED OAK ( <i>Quercus rubra</i> )	37"	GOOD
36	TULIP POPLAR ( <i>Liriodendron tulipifera</i> )	41"	GOOD
37	TULIP POPLAR ( <i>Liriodendron tulipifera</i> )	33"	GOOD
38	TULIP POPLAR ( <i>Liriodendron tulipifera</i> )	30"	GOOD
39	TULIP POPLAR ( <i>Liriodendron tulipifera</i> )	30"	GOOD
40	WHITE OAK ( <i>Quercus alba</i> )	39"	GOOD
41	WHITE OAK ( <i>Quercus alba</i> )	30"	GOOD
42	WHITE OAK ( <i>Quercus alba</i> )	39"	GOOD
43	TULIP POPLAR ( <i>Liriodendron tulipifera</i> )	32"	GOOD
44	TULIP POPLAR ( <i>Liriodendron tulipifera</i> )	44"	GOOD
45	TULIP POPLAR ( <i>Liriodendron tulipifera</i> )	41"	GOOD
46	TULIP POPLAR ( <i>Liriodendron tulipifera</i> )	30"	GOOD
47	TULIP POPLAR ( <i>Liriodendron tulipifera</i> )	30"	GOOD
48	TULIP POPLAR ( <i>Liriodendron tulipifera</i> )	30"	GOOD
49	WHITE OAK ( <i>Quercus alba</i> )	30"	GOOD

KEY	SPECIES	SIZE	CONDITION
50	TULIP POPLAR ( <i>Liriodendron tulipifera</i> )	39"	GOOD
51	TULIP POPLAR ( <i>Liriodendron tulipifera</i> )	36"	GOOD
52	TULIP POPLAR ( <i>Liriodendron tulipifera</i> )	33"	GOOD
53	WHITE OAK ( <i>Quercus alba</i> )	31"	GOOD
54	RED OAK ( <i>Quercus rubra</i> )	30"	GOOD
55	TULIP POPLAR ( <i>Liriodendron tulipifera</i> )	33"	GOOD
56	RED OAK ( <i>Quercus rubra</i> )	32"	GOOD
57	SYCAMORE ( <i>Platanus occidentalis</i> )	32"	GOOD
58	TULIP POPLAR ( <i>Liriodendron tulipifera</i> )	33"	GOOD
59	WHITE OAK ( <i>Quercus alba</i> )	31"	GOOD
60	AMERICAN BEECH ( <i>Fagus grandifolia</i> )	32"	GOOD
61	AMERICAN BEECH ( <i>Fagus grandifolia</i> )	36"	GOOD
62	RED OAK ( <i>Quercus rubra</i> )	32"	GOOD
63	RED OAK ( <i>Quercus rubra</i> )	38"	GOOD
64	TULIP POPLAR ( <i>Liriodendron tulipifera</i> )	35"	GOOD
65	TULIP POPLAR ( <i>Liriodendron tulipifera</i> )	36"	GOOD
66	WHITE OAK ( <i>Quercus alba</i> )	30"	GOOD
67	RED OAK ( <i>Quercus rubra</i> )	57"	GOOD
68	AMERICAN BEECH ( <i>Fagus grandifolia</i> )	34"	GOOD
69	WHITE OAK ( <i>Quercus alba</i> )	43"	GOOD
70	TULIP POPLAR ( <i>Liriodendron tulipifera</i> )	35"	GOOD
71	TULIP POPLAR ( <i>Liriodendron tulipifera</i> )	31"	GOOD
72	TULIP POPLAR ( <i>Liriodendron tulipifera</i> )	32"	GOOD
73	TULIP POPLAR ( <i>Liriodendron tulipifera</i> )	35"	GOOD
74	TULIP POPLAR ( <i>Liriodendron tulipifera</i> )	30"	GOOD
75	TULIP POPLAR ( <i>Liriodendron tulipifera</i> )	36"	GOOD
76	WHITE OAK ( <i>Quercus alba</i> )	37"	GOOD
77	WHITE OAK ( <i>Quercus alba</i> )	32"	GOOD
78	WHITE OAK ( <i>Quercus alba</i> )	33"	GOOD
79	TULIP POPLAR ( <i>Liriodendron tulipifera</i> )	30"	GOOD
80	TULIP POPLAR ( <i>Liriodendron tulipifera</i> )	42"	GOOD
81	TULIP POPLAR ( <i>Liriodendron tulipifera</i> )	33"	GOOD
82	WHITE OAK ( <i>Quercus alba</i> )	45"	GOOD
83	AMERICAN BEECH ( <i>Fagus grandifolia</i> )	34"	GOOD
84	TULIP POPLAR ( <i>Liriodendron tulipifera</i> )	32"	GOOD
85	TULIP POPLAR ( <i>Liriodendron tulipifera</i> )	69"	GOOD
86	AMERICAN BEECH ( <i>Fagus grandifolia</i> )	35"	GOOD
87	AMERICAN BEECH ( <i>Fagus grandifolia</i> )	34"	GOOD
88	AMERICAN BEECH ( <i>Fagus grandifolia</i> )	30"	GOOD
89	RED MAPLE ( <i>Acer rubrum</i> )	33"	GOOD
90	TULIP POPLAR ( <i>Liriodendron tulipifera</i> )	36"	GOOD
91	RED MAPLE ( <i>Acer rubrum</i> )	46"	GOOD
92	BLACK WALNUT ( <i>Juglans nigra</i> )	31"	GOOD
93	BLACK WALNUT ( <i>Juglans nigra</i> )	37"	GOOD
94	GREEN ASH ( <i>Fraxinus pennsylvanica</i> )	44"	GOOD
95	BITTERNUT HICKORY ( <i>Carya cordiformis</i> )	36"	GOOD
96	TULIP POPLAR ( <i>Liriodendron tulipifera</i> )	61"	GOOD
97	RED MAPLE ( <i>Acer rubrum</i> )	35"	GOOD
98	WHITE OAK ( <i>Quercus alba</i> )	35"	GOOD

SOILS CHART					
MAP SYMBOL	NAME	STRUCTURAL LIMITATIONS	EROSION HAZARD	HYDRIC	SLOPE (%)
BaA	Balle silt loam	Severe: high water table	Severe	Y	0-3
Co	Codorus and Hatboro silt loams	Severe: flood hazard	Severe	N	0-3
GbA	Gladstone loam	Moderate	Moderate	N	0-3
GbB	Gladstone loam	Moderate	Moderate	N	3-8
GbC	Gladstone loam	Moderate	Moderate	N	8-15
GmB	Glenville silt loam	Moderate: impeded drainage	Moderate	Y	3-8
MgD	Manor-Bannertown sandy loams	Severe: slopes	Severe	N	15-25
MgF	Manor-Bannertown sandy loams	Severe: slopes	-	N	25-65

SOURCE: SOIL INFORMATION TAKEN FROM USDA-NRCS WEBSITE.

**GENERAL NOTES**

- THE SITE IS LOCATED AT 11380 HOMEWOOD ROAD, ELLICOTT CITY, MD 21042. THE SITE CONSISTS OF 4 PARCELS (PARCEL 117, PARCEL 1 OF PARCEL 291, PARCEL 2 OF PARCEL 291 & PARCEL 303) WHICH EQUAL A TOTAL OF 40.364 ACRES.
- BOUNDARY AND TOPOGRAPHIC INFORMATION IS PROVIDED BY HOWARD COUNTY GIS DATA AND PHRA FIELD SURVEY CONDUCTED IN JULY, 2006.
- THE SOILS ON SITE ARE BALLE SILT LOAM (0-3% SLOPES) - BaA, CODORUS AND HATBORO SILT LOAMS (0-3% SLOPES) - Co, GLADSTONE LOAM (0-3% SLOPES) - GbA, GLADSTONE LOAM (3-8% SLOPES) - GbB, GLADSTONE LOAM (8-15% SLOPES) - GbC, GLENVILLE SILT LOAM (3-8% SLOPES) - GmB, MANOR-BANNERTOWN SANDY LOAM (15-25% SLOPES) - MgD, MANOR-BANNERTOWN SANDY LOAM (25-65% SLOPES) - MgF ACCORDING TO THE SOIL SURVEY FOR HOWARD COUNTY, MARYLAND. THIS SITE CONTAINS SOILS WITH POSSIBLE HYDRIC INCLUSIONS, BALLE SILT LOAM (BaA) AND GLENVILLE SILT LOAM (GmB).
- THE SITE IS ZONED RC-DEO (RURAL CONSERVATION-DENSITY EXCHANGE OPTION). CURRENT USE OF THE SITE IS RESIDENTIAL.
- THIS SITE IS LOCATED IN THE MIDDLE PATUJENT RIVER WATERSHED (2131106). THIS SITE IS LOCATED IN A USE II-P WATERSHED ACCORDING TO INFORMATION AVAILABLE FROM THE CODE OF MARYLAND REGULATIONS (COMAR) 26.08.02.08 "STREAM SEGMENT DESIGNATIONS". THE APPROPRIATE 100' STREAM BUFFER HAS BEEN SHOWN AS REQUIRED IN THE HOWARD COUNTY SUBDIVISION AND LAND DEVELOPMENT REGULATIONS SECTION 16.116 "PROTECTION OF WETLANDS, STREAMS, AND STEEP SLOPES".
- ONE STREAM IS LOCATED ON THE SITE AND IS IDENTIFIED AS A USE II-P STREAM ACCORDING TO INFORMATION AVAILABLE FROM THE CODE OF MARYLAND REGULATIONS (COMAR) 26.08.02.08 "STREAM SEGMENT DESIGNATIONS". THE STREAM IS LOCATED IN THE WESTERN BOUNDARY OF THE SITE EXTENDING TO THE SOUTHWEST CORNER FLOWING OFF-SITE. A FLOODPLAIN IS LOCATED ON THE SITE AS SHOWN BY FEMA FIRM MAP 240044-0227C.
- EXISTING FOREST CONSISTS OF 1 STAND AND 1 HEDGEROW AS SHOWN. TREES GREATER THAN 30" IN DIAMETER WERE OBSERVED WITHIN THE PROPERTY BOUNDARY AND ARE SHOWN.
- FIELD WORK FOR THIS INVENTORY WAS CONDUCTED ON JANUARY 30, 2007 BY JAY M. LOFTUS, PLANNER AND JONATHAN S. NORMAN, PLANNER OF PATTON HARRIS RUST & ASSOCIATES, PC UNDER THE SUPERVISION OF PETER J. STONE, RLA AND SCOTT R. WOLFORD, RLA OF PATTON HARRIS RUST & ASSOCIATES, PC.
- THERE ARE NO KNOWN CEMETERIES OR BURIAL PLOTS LOCATED ON THE SITE, ACCORDING TO THE HOWARD COUNTY CEMETERIES INVENTORY.
- NO RARE, THREATENED OR ENDANGERED PLANTS OR ANIMALS OR CRITICAL HABITATS WERE OBSERVED IN THE FIELD AS STATED IN A LETTER RECEIVED FROM THE MARYLAND DNR.
- 98 SPECIMEN TREES (30" IN DIAMETER) HAVE BEEN IDENTIFIED AND MEASURED AS SHOWN ON THIS PLAN. NONE OF THE SPECIMEN TREES WILL NEED TO BE REMOVED DUE TO THE PROPOSED DEVELOPMENT ON THE SITE.
- THE MAJORITY OF THE PLAN HAS BEEN PREPARED USING PHRA-A FIELD RUN TOPOGRAPHY. SPECIMEN TREE LOCATIONS WERE FIELD APPROXIMATED.
- NO HISTORIC FEATURES ARE LOCATED ON-SITE.
- FOREST STAND 1 CONTAINS 7.34 ACRES OF FOREST ON-SITE, WHILE THE STAND IS PART OF CONTIGUOUS FOREST THAT EXTENDS FOR A TOTAL OF THREE HUNDRED AND EIGHTY-THREE (383) ACRES OFF-SITE.
- NO WETLANDS ARE LOCATED ON THE SITE.
- NO CRITICAL HABITATS OF RARE, THREATENED OR ENDANGERED SPECIES WERE OBSERVED.
- NO TREES, SHRUBS, OR PLANTS IDENTIFIED AS RARE, THREATENED OR ENDANGERED SPECIES WERE OBSERVED.
- THERE ARE FOUR EXISTING STRUCTURES ON THE SITE AS SHOWN. THE HOUSE WILL REMAIN, THE THREE BARNES WILL BE REMOVED. NO ADDITIONAL STRUCTURES ARE PROPOSED WITH THIS PLAN.
- THE FSD, DATED JULY, 2006, HAS BEEN PREPARED BY PATTON HARRIS RUST & ASSOCIATES IN CONJUNCTION WITH THESE PLANS.
- THE HOWARD COUNTY FOREST CONSERVATION MANUAL SUPERCEDES ANY DISCREPANCIES BETWEEN THE MANUAL AND THESE PLANS.
- THIS PROJECT COMPLIES WITH THE REQUIREMENTS OF SECTION 16.1200 OF THE HOWARD COUNTY CODE FOR FOREST CONSERVATION.
- THE FOREST CONSERVATION EASEMENT HAS BEEN ESTABLISHED TO FULFILL THE REQUIREMENTS OF SECTION 16.1200 OF THE HOWARD COUNTY CODE. NO CLEARING, GRADING, OR CONSTRUCTION IS PERMITTED WITHIN THE FOREST CONSERVATION EASEMENT, HOWEVER, FOREST MANAGEMENT PRACTICES AS DEFINED IN THE DEED OF FOREST CONSERVATION EASEMENT ARE ALLOWED.

PLANT COMMUNITY SUMMARY			
SYMBOL	COMMUNITY	AREA	PRIORITY RETENTION
F1	FOREST	7.34 Ac.±	HIGH
H1	HEDGEROW	0.38 Ac.±	LOW

AREA CHART	
AREA	ACRES
TOTAL TRACT AREA	40.36
EXISTING FOREST	7.34
EXISTING HEDGEROW	0.38
LAND WITHIN STREAM BUFFERS	5.13
LAND WITHIN STREAMBED	1.46
LAND WITHIN FLOODPLAIN	1.63
FOREST WITHIN STREAM BUFFERS	3.62
FOREST WITHIN STREAMBED	0
FOREST WITHIN FLOODPLAIN	0.64

APPROVED : HOWARD COUNTY DEPARTMENT OF PLANNING AND ZONING.

DIRECTOR: *[Signature]* DATE: 2/18/08

CHIEF, DEVELOPMENT ENGINEERING DIVISION

CHIEF, DIVISION OF LAND DEVELOPMENT: *[Signature]* DATE: 2/18/08

DATE NO. REVISION

OWNER: HOMEWOOD L.L.C. GARY B. SMITH 11362 HOMEWOOD ROAD ELLICOTT CITY MARYLAND 21042 410-964-0260

PROJECT: HOMEWOOD FARM (MURPHY PROPERTY)

AREA TAX MAP 29 PARCELS 303, 117, 291 3RD ELECTION DISTRICT ZONED RC-DEO HOWARD COUNTY, MARYLAND


TITLE: FOREST STAND DELINEATION PLAN

Patton Harris Rust & Associates, pc  
Engineers, Surveyors, Planners, Landscape Architects.  
8818 Centre Park Drive  
Columbia, MD 21045  
T 410.997.8900  
F 410.997.9282

DESIGNED BY: JML  
DRAWN BY: JML  
PROJECT NO.: 14520-1-0  
DATE: JANUARY 21, 2008  
SCALE: N.T.S.  
DRAWING NO. 9 OF 15

STATE OF MARYLAND  
DEPT. R. WOLFORD  
COMMISSIONER OF LAND RESOURCES

Project 14520-1-09-07-PLANS (2008)02.DWG

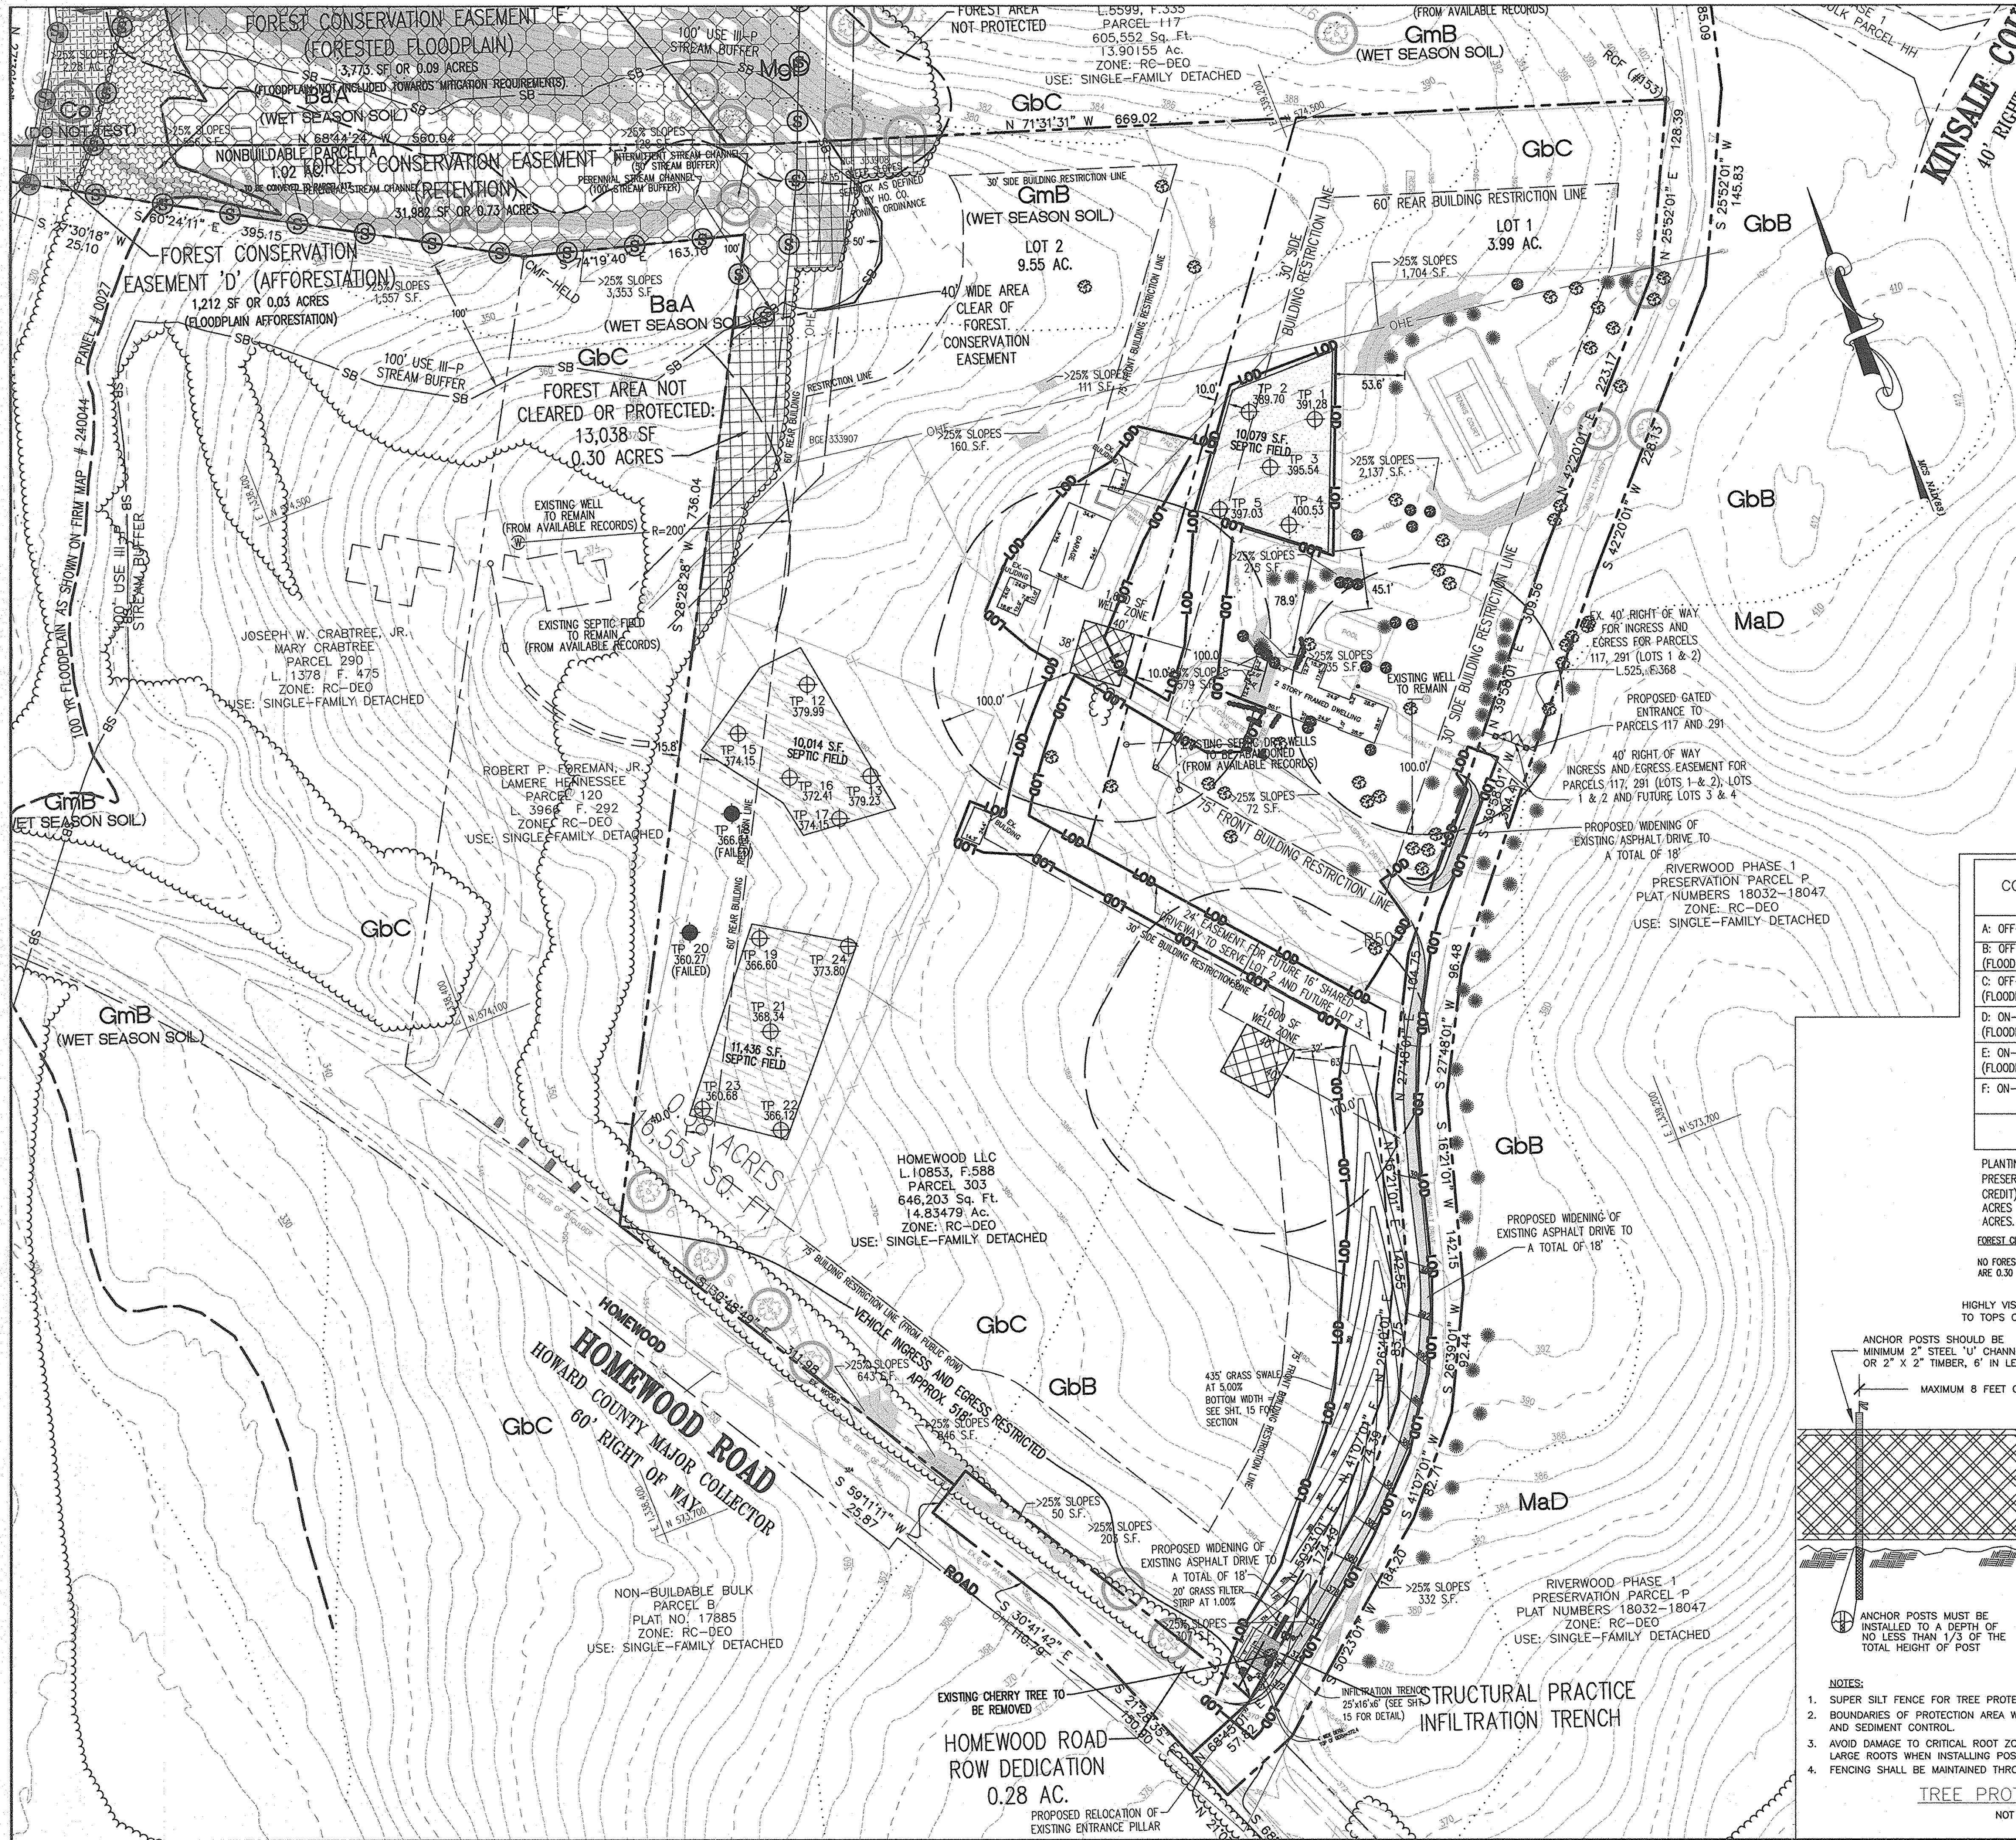


**LEGEND**

- PROPERTY LINE
- EXISTING TREELINE
- PROPOSED LOT LINE
- EX. STREAM AND BUFFER
- EX. 100-YEAR FLOODPLAIN
- EXISTING CONTOURS
- PROPOSED CONTOURS
- EXISTING BUILDING
- PROPOSED BUILDING
- LIMIT OF DISTURBANCE
- FOREST RETENTION SIGNAGE
- REFORESTATION SIGNAGE
- FOREST CONSERVATION AREA
- SPECIMEN TREES
- SLOPES: > 25%
- EXISTING SOILS
- EX. OVERHEAD POWER LINE

**STREAM BUFFER CONSERVATION CHART**

ACREAGE OF STREAM BUFFER CONSERVED	3.62 AC ±
WIDTH OF STREAM BUFFER CONSERVED	200' (PERENNIAL-USE III) 100' (INTERMITTENT)
LENGTH OF STREAM BUFFER CONSERVED	1,600±

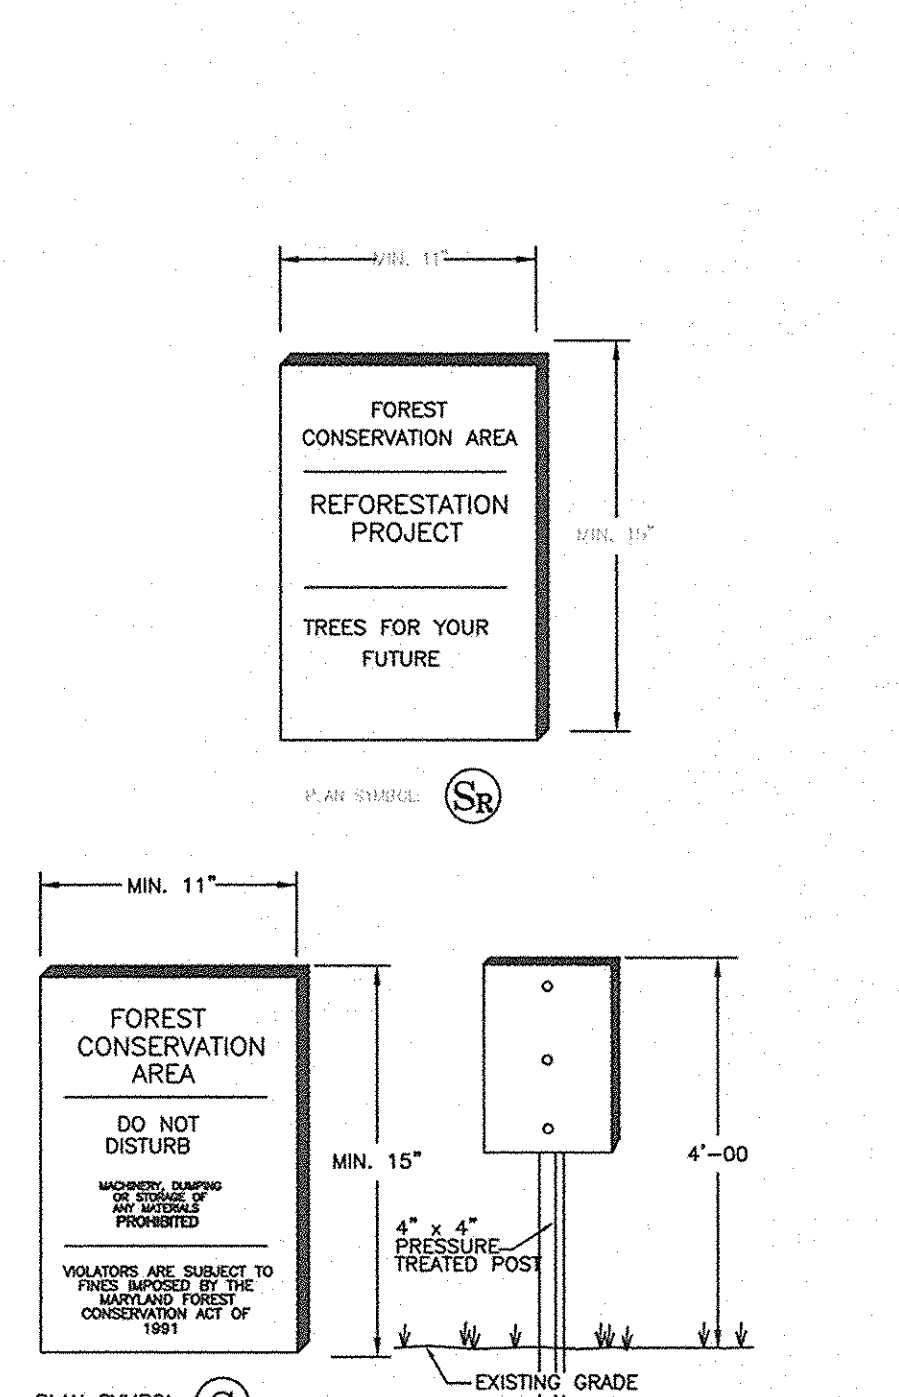


**FOREST CONSERVATION EASEMENT**

FOREST CONSERVATION EASEMENT	AREA (IN ACRES)
A: OFF-SITE RETENTION (FLOODPLAIN)	4.66 AC
B: OFF-SITE RETENTION (FLOODPLAIN)	0.52 AC
C: OFF-SITE AFFORESTATION (FLOODPLAIN)	0.16 AC
D: ON-SITE AFFORESTATION (FLOODPLAIN)	0.03 AC
E: ON-SITE RETENTION (FLOODPLAIN)	0.09 AC
F: ON-SITE RETENTION (FLOODPLAIN)	0.73 AC
<b>TOTAL</b>	<b>6.19 AC</b>

PLANTING REQUIREMENTS OF 2.50 ACRES ARE MET BY PRESERVATION OF 4.66 ACRES OF OFF-SITE FOREST (2.33 ACRES CREDIT), AND BY AFFORESTATION WITHIN THE FLOODPLAIN OF 0.16 ACRES OFF-SITE AND 0.03 ACRES ON-SITE FOR A TOTAL OF 2.52 ACRES.

**FOREST CLEARING JUSTIFICATION:**  
NO FOREST WILL BE CLEARED IN ORDER TO DEVELOP THE SITE. ADDITIONALLY, THERE ARE 0.30 ACRES OF FOREST WHICH ARE NOT CLEARED OR PROTECTED WITH THIS PLAN.

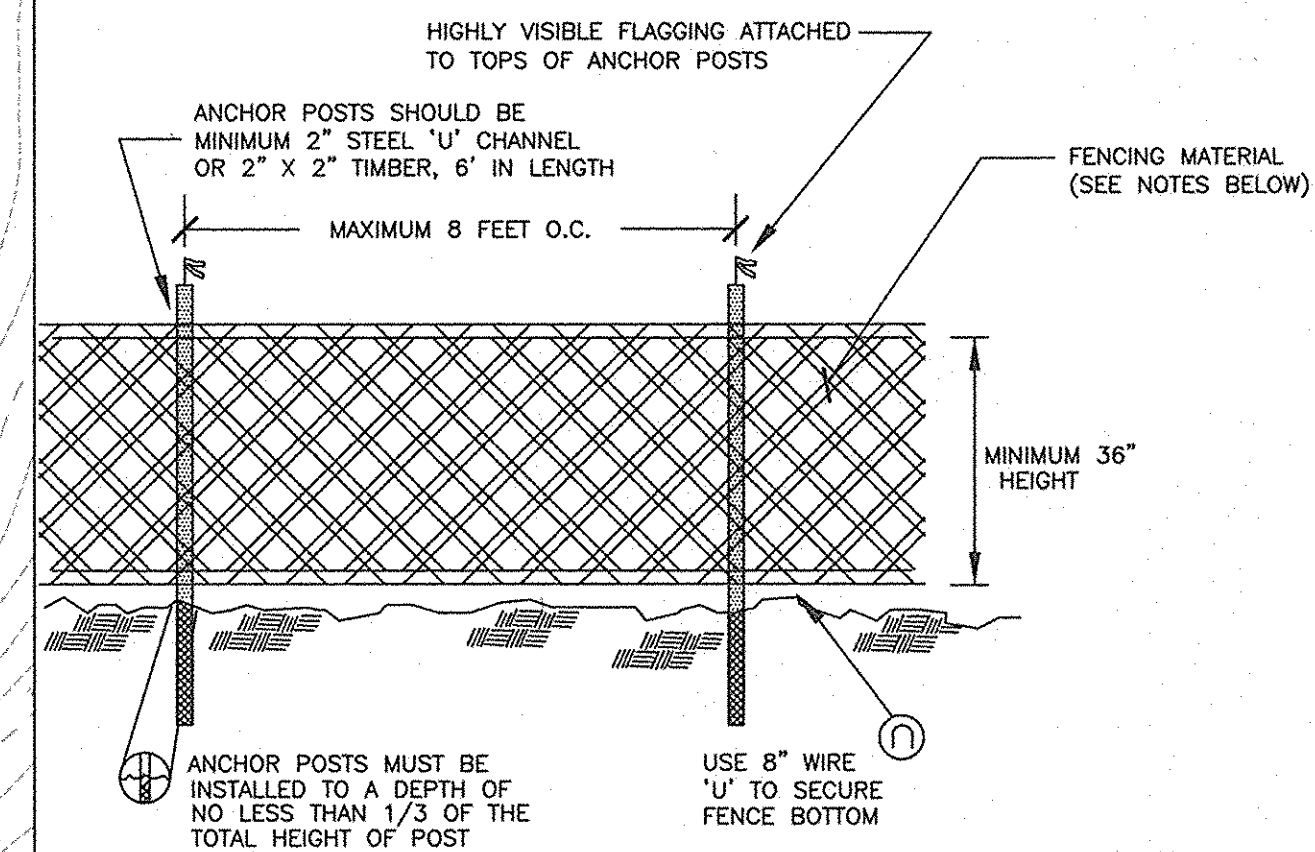

- NOTES:**
- SUPER SILT FENCE FOR TREE PROTECTION DEVICE, ONLY.
  - BOUNDARIES OF PROTECTION AREA WILL BE ESTABLISHED PRIOR TO GRADING AND SEDIMENT CONTROL.
  - AVOID DAMAGE TO CRITICAL ROOT ZONE. DO NOT DAMAGE OR SEVERE LARGE ROOTS WHEN INSTALLING POSTS.
  - FENCING SHALL BE MAINTAINED THROUGHOUT CONSTRUCTION.
- TREE PROTECTION FENCING**  
NOT TO SCALE

**APPROVED:** HOWARD COUNTY DEPARTMENT OF PLANNING AND ZONING.

DATE: 2/9/08  
DATE: 2/6/08

**OWNER:** HOMEWOOD L.L.C. GARY B. SMITH  
11362 HOMEWOOD ROAD ELLICOTT CITY MARYLAND 21042 410-964-0260

**PROJECT:** HOMEWOOD FARM (MURPHY PROPERTY)

**AREA:** TAX MAP 29 PARCELS 303, 117, 291  
3RD ELECTION DISTRICT ZONED RC-DEO  
HOWARD COUNTY, MARYLAND

**TITLE:** FINAL FOREST CONSERVATION PLAN, NOTES AND DETAILS

Patton Harris Rust & Associates, pc  
Engineers, Surveyors, Planners, Landscape Architects.  
8818 Centre Park Drive  
Columbia, MD 21045  
T 410.997.8900  
F 410.997.9282

**DESIGNED BY:** LNB  
**DRAWN BY:** JL  
**PROJECT NO.:** 14520-1-0  
**DATE:** JANUARY 21, 2008  
**SCALE:** 1" = 60'  
**DRAWING NO.:** 10 OF 15



**LEGEND**

PROPERTY LINE	[Symbol]
EXISTING TREELINE	[Symbol]
PROPOSED LOT LINE	[Symbol]
EX. STREAM AND BUFFER	[Symbol]
EX. 100-YEAR FLOODPLAIN	[Symbol]
EXISTING CONTOURS	[Symbol]
PROPOSED CONTOURS	[Symbol]
EXISTING BUILDING	[Symbol]
PROPOSED BUILDING	[Symbol]
LIMIT OF DISTURBANCE	[Symbol]
FOREST RETENTION SIGNAGE	[Symbol]
FOREST RETENTION SIGNAGE	[Symbol]
FOREST CONSERVATION AREA	[Symbol]
SPECIMEN TREES	[Symbol]
SLOPES: > 25%	[Symbol]
EXISTING SOILS	[Symbol]
EX. OVERHEAD POWER LINE	[Symbol]

**STREAM BUFFER CONSERVATION CHART**

ACREAGE OF STREAM BUFFER CONSERVED	3.62 AC ±
WIDTH OF STREAM BUFFER CONSERVED	200' (PERENNIAL-USE III) 100' (INTERMITTENT)
LENGTH OF STREAM BUFFER CONSERVED	1,600' ±

**FOREST CONSERVATION PROGRAM**

- I. OBJECTIVE:**  
IT IS THE OBJECTIVE OF THE FOREST CONSERVATION PLAN OF THE HOMEWOOD FARM TO RETAIN ENVIRONMENTAL INTEGRITY BY PRESERVING EXISTING WOODED AREAS.
- II. PRESERVATION:**  
FOREST PRESERVATION AREAS SHALL BE PERMANENTLY PROTECTED BY FOREST CONSERVATION EASEMENTS.
- III. GENERAL CONSTRUCTION NOTE:**  
THERE WILL BE NO STAGING OR STORING OF EQUIPMENT WITHIN THE LIMIT OF DISTURBANCE.
- IV. POST CONSTRUCTION MANAGEMENT PRACTICE:**  
A TWO-YEAR POSTED CONSTRUCTION AND MANAGEMENT PROGRAM TO ENSURE FOREST HEALTH IS REQUIRED AND INCLUDES THE FOLLOWING:
- 1- MAINTENANCE OF SIGNS, FENCES, AND TREE PROTECTION DEVICES TO
  - 2- PREVENT UNWARRANTED INTRUSION AND DAMAGE.
  - 3- CAREFUL REMOVAL OF ALL TEMPORARY STRUCTURES AFTER CONSTRUCTION.
  - 4- ROUTINE INSPECTIONS OF FOREST CONSERVATION EASEMENTS.

**FOREST CONSERVATION EASEMENT AREA (IN ACRES)**

A: OFF-SITE RETENTION (FLOODPLAIN)	4.66 AC
B: OFF-SITE RETENTION (FLOODPLAIN)	0.52 AC
C: OFF-SITE AFFORESTATION (FLOODPLAIN)	0.16 AC
D: ON-SITE AFFORESTATION (FLOODPLAIN)	0.03 AC
E: ON-SITE RETENTION (FLOODPLAIN)	0.09 AC
F: ON-SITE RETENTION	0.73 AC
<b>TOTAL</b>	<b>6.19 AC</b>

PLANTING REQUIREMENTS OF 2.50 ACRES ARE MET BY PRESERVATION OF 4.66 ACRES OF OFF-SITE FOREST (2.33 ACRES CREDIT), AND BY AFFORESTATION WITHIN THE FLOODPLAIN OF 0.16 ACRES OFF-SITE AND 0.03 ACRES ON-SITE FOR A TOTAL OF 2.52 ACRES.

**FOREST CLEARING JUSTIFICATION:**  
NO FOREST WILL BE CLEARED IN ORDER TO DEVELOP THE SITE. ADDITIONALLY, THERE ARE 0.30 ACRES OF FOREST WHICH ARE NOT CLEARED OR PROTECTED WITH THIS PLAN.

APPROVED: HOWARD COUNTY DEPARTMENT OF PLANNING AND ZONING.


**DIRECTOR** [Signature] **DATE** 3/8/08  
**CHIEF, DEVELOPMENT ENGINEERING DIVISION**  
**CHIEF, DIVISION OF LAND DEVELOPMENT** [Signature] **DATE** 3/8/08

**DATE NO.** [ ] **REVISION** [ ]  
**OWNER:** HOMEWOOD L.L.C.  
 GARY B. SMITH  
 11362 HOMEWOOD ROAD  
 ELLICOTT CITY  
 MARYLAND 21042  
 410-964-0260

**PROJECT** HOMEWOOD FARM (MURPHY PROPERTY)  
**AREA** TAX MAP 29 PARCELS 303, 117, 291  
 3RD ELECTION DISTRICT ZONED RC-DEO  
 HOWARD COUNTY, MARYLAND

**TITLE** FINAL FOREST CONSERVATION PLAN, NOTES AND DETAILS  
**Patton Harris Rust & Associates, pc**  
 Engineers, Surveyors, Planners, Landscape Architects.  
 8818 Centre Park Drive  
 Columbia, MD 21045  
 T 410.997.8900  
 F 410.997.9282

**DESIGNED BY:** LNB  
**DRAWN BY:** JL  
**PROJECT NO.:** 14520-1-0  
**DATE:** JANUARY 21, 2008  
**SCALE:** 1" = 60'  
**DRAWING NO.:** 11 OF 15

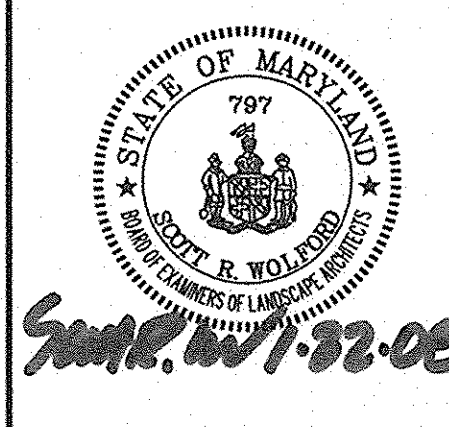


KEY	SPECIES	SIZE	CONDITION
1	TULIP POPLAR ( <i>Liriodendron tulipifera</i> )	30"	GOOD
2	WHITE OAK ( <i>Quercus alba</i> )	34"	GOOD
3	TULIP POPLAR ( <i>Liriodendron tulipifera</i> )	48"	DEAD
4	TULIP POPLAR ( <i>Liriodendron tulipifera</i> )	48"	GOOD
5	TULIP POPLAR ( <i>Liriodendron tulipifera</i> )	42"	GOOD
6	TULIP POPLAR ( <i>Liriodendron tulipifera</i> )	50"	GOOD
7	AMERICAN ELM ( <i>Ulmus</i> )	43"	GOOD
8	TULIP POPLAR ( <i>Liriodendron tulipifera</i> )	33"	GOOD
9	TULIP POPLAR ( <i>Liriodendron tulipifera</i> )	31"	GOOD
10	BLACK WALNUT ( <i>Juglans nigra</i> )	35"	GOOD
11	BITTERNUT HICKORY ( <i>Carya cordiformis</i> )	30"	GOOD
12	WHITE OAK ( <i>Quercus alba</i> )	31"	GOOD
13	WHITE OAK ( <i>Quercus alba</i> )	31"	GOOD
14	WHITE OAK ( <i>Quercus alba</i> )	47"	GOOD
15	AMERICAN BEECH ( <i>Fagus grandifolia</i> )	48"	GOOD
16	NORWAY SPRUCE ( <i>Picea abies</i> )	31"	GOOD
17	WHITE OAK ( <i>Quercus alba</i> )	42"	GOOD
18	TULIP POPLAR ( <i>Liriodendron tulipifera</i> )	32"	GOOD
19	BITTERNUT HICKORY ( <i>Carya cordiformis</i> )	32"	GOOD
20	AMERICAN BEECH ( <i>Fagus grandifolia</i> )	50"	GOOD
21	WHITE OAK ( <i>Quercus alba</i> )	38"	GOOD
22	WHITE OAK ( <i>Quercus alba</i> )	32"	GOOD
23	WHITE OAK ( <i>Quercus alba</i> )	43"	GOOD
24	TULIP POPLAR ( <i>Liriodendron tulipifera</i> )	54"	GOOD
25	BLACK WALNUT ( <i>Juglans nigra</i> )	34"	GOOD
26	WHITE OAK ( <i>Quercus alba</i> )	30"	GOOD
27	BLACK WALNUT ( <i>Juglans nigra</i> )	33"	GOOD
28	BLACK WALNUT ( <i>Juglans nigra</i> )	36"	GOOD
29	TULIP POPLAR ( <i>Liriodendron tulipifera</i> )	30"	GOOD
30	TULIP POPLAR ( <i>Liriodendron tulipifera</i> )	33"	GOOD
31	TULIP POPLAR ( <i>Liriodendron tulipifera</i> )	39"	GOOD
32	TULIP POPLAR ( <i>Liriodendron tulipifera</i> )	48"	GOOD
33	TULIP POPLAR ( <i>Liriodendron tulipifera</i> )	38"	GOOD
34	WHITE OAK ( <i>Quercus alba</i> )	35"	GOOD
35	RED OAK ( <i>Quercus rubra</i> )	37"	GOOD
36	TULIP POPLAR ( <i>Liriodendron tulipifera</i> )	41"	GOOD
37	TULIP POPLAR ( <i>Liriodendron tulipifera</i> )	33"	GOOD
38	TULIP POPLAR ( <i>Liriodendron tulipifera</i> )	30"	GOOD
39	TULIP POPLAR ( <i>Liriodendron tulipifera</i> )	30"	GOOD
40	WHITE OAK ( <i>Quercus alba</i> )	39"	GOOD
41	WHITE OAK ( <i>Quercus alba</i> )	30"	GOOD
42	WHITE OAK ( <i>Quercus alba</i> )	39"	GOOD
43	TULIP POPLAR ( <i>Liriodendron tulipifera</i> )	32"	GOOD
44	TULIP POPLAR ( <i>Liriodendron tulipifera</i> )	44"	GOOD
45	TULIP POPLAR ( <i>Liriodendron tulipifera</i> )	41"	GOOD
46	TULIP POPLAR ( <i>Liriodendron tulipifera</i> )	30"	GOOD
47	TULIP POPLAR ( <i>Liriodendron tulipifera</i> )	30"	GOOD
48	TULIP POPLAR ( <i>Liriodendron tulipifera</i> )	30"	GOOD
49	WHITE OAK ( <i>Quercus alba</i> )	30"	GOOD

KEY	SPECIES	SIZE	CONDITION
50	TULIP POPLAR ( <i>Liriodendron tulipifera</i> )	39"	GOOD
51	TULIP POPLAR ( <i>Liriodendron tulipifera</i> )	36"	GOOD
52	TULIP POPLAR ( <i>Liriodendron tulipifera</i> )	33"	GOOD
53	WHITE OAK ( <i>Quercus alba</i> )	31"	GOOD
54	RED OAK ( <i>Quercus rubra</i> )	30"	GOOD
55	TULIP POPLAR ( <i>Liriodendron tulipifera</i> )	33"	GOOD
56	RED OAK ( <i>Quercus rubra</i> )	32"	GOOD
57	SYCAMORE ( <i>Picotaria occidentalis</i> )	32"	GOOD
58	TULIP POPLAR ( <i>Liriodendron tulipifera</i> )	33"	GOOD
59	WHITE OAK ( <i>Quercus alba</i> )	31"	GOOD
60	AMERICAN BEECH ( <i>Fagus grandifolia</i> )	32"	GOOD
61	AMERICAN BEECH ( <i>Fagus grandifolia</i> )	36"	GOOD
62	RED OAK ( <i>Quercus rubra</i> )	32"	GOOD
63	RED OAK ( <i>Quercus rubra</i> )	38"	GOOD
64	TULIP POPLAR ( <i>Liriodendron tulipifera</i> )	35"	GOOD
65	TULIP POPLAR ( <i>Liriodendron tulipifera</i> )	36"	GOOD
66	WHITE OAK ( <i>Quercus alba</i> )	30"	GOOD
67	RED OAK ( <i>Quercus rubra</i> )	57"	GOOD
68	AMERICAN BEECH ( <i>Fagus grandifolia</i> )	34"	GOOD
69	WHITE OAK ( <i>Quercus alba</i> )	43"	GOOD
70	TULIP POPLAR ( <i>Liriodendron tulipifera</i> )	35"	GOOD
71	TULIP POPLAR ( <i>Liriodendron tulipifera</i> )	31"	GOOD
72	TULIP POPLAR ( <i>Liriodendron tulipifera</i> )	32"	GOOD
73	TULIP POPLAR ( <i>Liriodendron tulipifera</i> )	35"	GOOD
74	TULIP POPLAR ( <i>Liriodendron tulipifera</i> )	30"	GOOD
75	TULIP POPLAR ( <i>Liriodendron tulipifera</i> )	36"	GOOD
76	WHITE OAK ( <i>Quercus alba</i> )	37"	GOOD
77	WHITE OAK ( <i>Quercus alba</i> )	32"	GOOD
78	WHITE OAK ( <i>Quercus alba</i> )	33"	GOOD
79	TULIP POPLAR ( <i>Liriodendron tulipifera</i> )	30"	GOOD
80	TULIP POPLAR ( <i>Liriodendron tulipifera</i> )	42"	GOOD
81	TULIP POPLAR ( <i>Liriodendron tulipifera</i> )	33"	GOOD
82	WHITE OAK ( <i>Quercus alba</i> )	45"	GOOD
83	AMERICAN BEECH ( <i>Fagus grandifolia</i> )	34"	GOOD
84	TULIP POPLAR ( <i>Liriodendron tulipifera</i> )	32"	GOOD
85	TULIP POPLAR ( <i>Liriodendron tulipifera</i> )	69"	GOOD
86	AMERICAN BEECH ( <i>Fagus grandifolia</i> )	35"	GOOD
87	AMERICAN BEECH ( <i>Fagus grandifolia</i> )	34"	GOOD
88	AMERICAN BEECH ( <i>Fagus grandifolia</i> )	30"	GOOD
89	RED MAPLE ( <i>Acer rubrum</i> )	33"	GOOD
90	TULIP POPLAR ( <i>Liriodendron tulipifera</i> )	36"	GOOD
91	RED MAPLE ( <i>Acer rubrum</i> )	46"	GOOD
92	BLACK WALNUT ( <i>Juglans nigra</i> )	31"	GOOD
93	BLACK WALNUT ( <i>Juglans nigra</i> )	37"	GOOD
94	GREEN ASH ( <i>Fraxinus pennsylvanica</i> )	44"	GOOD
95	BITTERNUT HICKORY ( <i>Carya cordiformis</i> )	36"	GOOD
96	TULIP POPLAR ( <i>Liriodendron tulipifera</i> )	61"	GOOD
97	RED MAPLE ( <i>Acer rubrum</i> )	35"	GOOD
98	WHITE OAK ( <i>Quercus alba</i> )	35"	GOOD

**SEQUENCE OF OPERATIONS**

- PRE-CONSTRUCTION SITE PREPARATION**
- FIELD STAKE LIMITS OF DISTURBANCE (L.O.D.) AT 25' INTERVALS.
  - REVIEW L.O.D. IN FIELD AND ADJUST IF PRACTICAL.
  - INSTALL TREE PROTECTION FENCE AT THE L.O.D. AND IMPLEMENT TREE PROTECTION METHODS AS SHOWN.
  - CLEAR AND GRUB AS NECESSARY TO FACILITATE ROOT PRUNING TO A DEPTH OF 2-3 FEET WITHIN THE LIMITS OF THE PROPOSED FOREST RETENTION AREA AND AROUND SPECIMEN TREES TO BE SAVED. CLEAR REMAINING TREES IN A WAY THAT "SAVE TREES" ARE NOT DISTURBED. GRUB STUMPS 12" IN DIAMETER AND LARGER THAT ARE WITHIN 25' OF THE L.O.D.
  - PRUNE AND FERTILIZE DESIRABLE "EDGE TREES" AS PER CONSULTING ARBORISTS' RECOMMENDATIONS AND DETAILS PROVIDED ON THIS SHEET.
  - THERE SHALL BE NO STAGING, STORAGE, OR STOCKPILING OF MATERIALS WITHIN THE NONTIDAL WETLANDS OR 25' NONTIDAL WETLANDS BUFFER, OR OUTSIDE OF THE L.O.D.
  - REMOVE OR TREAT WITH AN ACCEPTABLE METHOD, NOXIOUS PLANT MATERIAL SUCH AS MULTIFLORA ROSE, TEARHAWK, AND JOHNSON GRASS BEFORE INSTALLING REFORESTATION PLANTS.
  - INSTALL TREE PROTECTION SIGNAGE.
  - STABILIZE ANY DISTURBED AREAS USING THE SPECIFIED STABILIZATION MIXTURE WHICH ALLOWS FOR NATURAL REVEGETATION OF FOREST COMMUNITIES.

- FOREST CONSERVATION SEQUENCE OF OPERATIONS**
- Prior to beginning any grading operations on this site or on a respective lot, there may be a preconstruction meeting held at the site which is to include the Contractor and representatives from Patton Harris Rust & Associates, Inc. (PHRA). The Howard County Department of Planning and Zoning (DPZ) and the owner will be notified by the Contractor as to the time and place of the field meeting, should they wish to send a representative. The purpose of this meeting will be to review the approved FDP and to field verify the correct Limits of Disturbance (L.O.D.).
  - The Limits of Disturbance (L.O.D.) pertinent to the preservation of wooded areas shall be staked in the field with final adjustments being made as necessary to insure adequate protection of the Critical Root Zone of trees designated for retention. Stakes to be used shall be those specified for the "TREE PROTECTION DEVICE" to which approved protective material will be attached. Alternate means of defining the L.O.D. may be used if approved by the DPZ.
  - All forest retention areas shall be protected by highly visible, well anchored temporary protection devices (see detail), which shall be securely in place prior to any clearing or grading operations.
  - Grading operations or other construction operations which could dislodge or otherwise damage the protective device shall be avoided along the edges of the L.O.D. lines if possible. Any protective devices which are damaged during site construction operations shall be properly repaired immediately by the Contractor.
  - After site grading, utility access road, and driveway construction have been completed, all trees adjacent to the L.O.D. line shall be inspected for indications of crown die-back (summer indicator), damage within respective critical root zones or any dead wood or other conditions which might be hazardous to pedestrians, utilities, lines vehicular access ways or parked vehicles.
  - Should there be evidence of any damage to tree trunks, branches or the critical root zone of trees within the protected areas, or to isolated specimen trees to be preserved, the damage shall be examined within a period of two (2) days from the date of observation by a licensed tree care professional. Exposed roots should be covered immediately to a depth of 6 - 8 inches with soil, preferably mixed with 50% peat moss or leaf mold.
  - Remove damaged, dead or dying trees or limbs only if the trees or limbs pose an immediate safety hazard to buildings, utility lines, vehicles, or access drives or pedestrian areas. Trees designated for pruning or removal shall be pruned or removed using equipment and methods which will not damage or destroy adjacent large trees or understorey trees or shrubs designated for retention.
  - All temporary forest protection devices will be carefully removed after all general construction, necessary tree surgery, removal of debris, etc. regarding and reseeded of sediment and erosion control disturbance have been completed and acceptance and approval of the work and site conditions have been given by the DPZ.

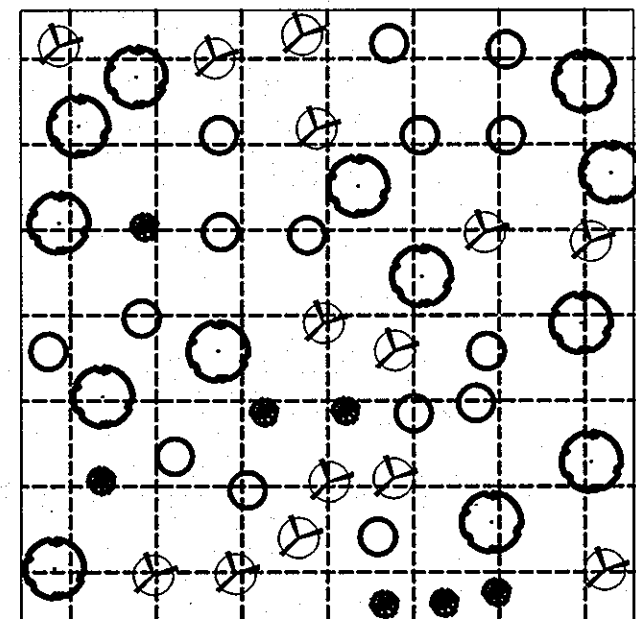


- KEY**
- TREES
  - TREE SPECIES 'A'
  - TREE SPECIES 'B'
  - TREE SPECIES 'C'
  - TREE SPECIES 'D'
  - TREE SPECIES 'E'
- NOTES**
- RANDOMLY LOCATE GROUPS OF PLANT SPECIES, TAKING CARE NOT TO PLANT IN SUCCESSION MORE THAN 4 OF THE SAME SPECIES.
  - THIS DETAIL PROVIDES A HYPOTHETICAL GRAPHIC DEPICTION OF A PROPOSED LAYOUT FOR INDE DIFFERENT TREE SPECIES (A-E). IT IS NOT MEANT TO BE FOLLOWED EXACTLY. THE PURPOSE IS TO ACHIEVE THE APPEARANCE OF RANDOM SPACING.
  - SEE PLANT LIST FOR ACTUAL NUMBER OF PLANT SPECIES. SEE PLANT LIST FOR ON-CENTER SPACING REQUIREMENTS.

**RANDOM PLANTING LAYOUT DETAIL**

**NOT TO SCALE**

RANDOMLY SPACE NEW TREE & SHRUB INSTALLATIONS TO ALLOW NO MORE THAN (5) 1" CALIBER TREES OF ANY PARTICULAR SPECIES TO BE PLANTED IN SUCCESSION. USE SUGGESTED SPACING AS A GENERAL GUIDE. TAKE CARE NOT TO PLANT IN PERFECT ROWS OR GRIDS.

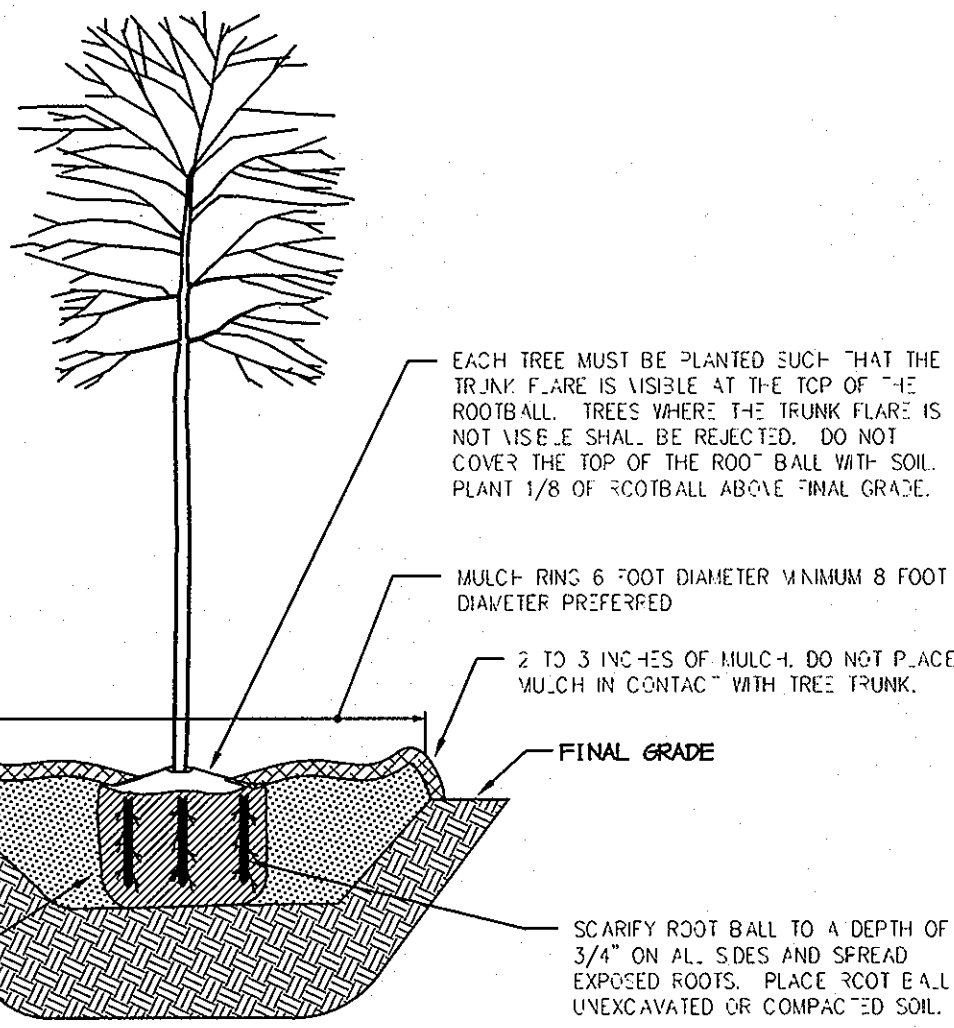

- NOTES**
- DO NOT HEAVILY PRUNE THE TREE AT PLANTING. PRUNE ONLY CROSSOVER LIMBS, CO-DOMINANT LEADERS, AND BROKEN OR DEAD BRANCHES. SOME INTERIOR THIGS AND LATERAL BRANCHES MAY BE PRUNED; HOWEVER, DO NOT REMOVE THE TERMINAL BUDS OF BRANCHES THAT EXTEND TO THE EDGE OF THE CROWN.
  - STAKE TREES AS SHOWN ON BAB DETAIL.


3. DIG PLANTING PIT TWO AND A HALF TIMES AS NICE AS THE DIAMETER OF THE CONTAINER WITH A MINIMUM PLANTING PIT DIAMETER OF 30".

4. REMOVE CONTAINER JUST BEFORE PLANTING. INSPECT HEALTH OF ROOTS. REJECT MATERIAL WITH UNHEALTHY OR INSUFFICIENT ROOTS.

BACKFILL WITH PLANTING MIX (SEE PLANTING SPECIFICATIONS) TAMP SOIL AROUND ROOT BALL BASE FIRMLY WITH FOOT PRESSURE SO THAT ROOT BALL DOES NOT SHIFT.


**CONTAINERIZED TREE PLANTING DETAIL**

NOT TO SCALE

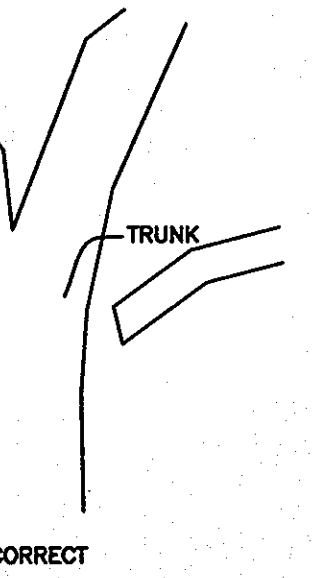

**TREE PRUNING METHOD AT BRANCH COLLAR**

- NOTES**
- ALL TREES REQUIRING PRUNING SHALL BE PRUNED AS SHOWN. BRANCHES SHALL NOT BE PRUNED BACK TO TRUNK. PRUNE ONLY BACK TO BRANCH COLLAR.

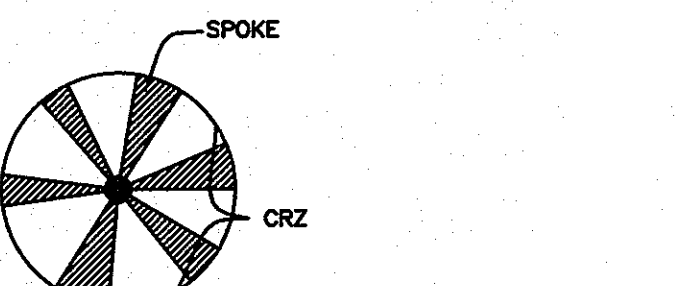

**RADIAL TRENCHING METHOD**

- NOTES**
- USING AIRSPADE, EXCAVATE SPOKES. REMOVE SPOILS AND BACKFILL WITH LEAF COMPOST OR EQUIVALENT.

**SOIL FRACTURING WITH GRO-GUN**

- NOTES**
- USING AIRSPADE, INSTALL PILOT HOLES 4-6" DEEP 8" ON CENTER THROUGHOUT CRITICAL ROOT ZONE (CRZ).
  - USING 105 CFM COMPRESSOR AND GRO-GUN, SEND BURST OF AIR TO PILOT HOLE.
  - APPLY LEAF COMPOST OF EQUAL 2" THICK.
  - SOIL DRENCH AREA WITHIN CRZ.

**Howard County Forest Conservation Worksheet**

Project Name: **11380 Homewood Road**  
 County File #: **F-07-187**  
 Date: **December 5, 2007**

**Net Tract Area**

- A. Total Tract Area
- B. Other Deductions
- C. Net Tract Area Net Tract Area = (A-B-C)

**Land Use Category: Medium Density Residential**  
 Afforestation Threshold (Net Tract Area X .20%)  
 Conservation Threshold (Net Tract Area X .25%)

**Existing Forest Cover**

- F. Existing Forest Cover within the Net Tract Area
- G. Area of Forest Above Conservation Threshold
- H. If the Existing Forest Cover (F) is greater than Conservation Threshold (G), then G = Existing Forest Cover (F) - Conservation Threshold (E); Otherwise G = 0

**Break Even Point**

Break Even (Amount of forest that must be retained so that no mitigation is required)

- (1) If the area of forest above the Conservation Threshold (G) is greater than zero, then H = (0.2 X the area of forest above Conservation Threshold (G)) + the Conservation Threshold (E)
- (2) If the area of forest above the Conservation Threshold (G) is equal to zero, then H = Existing Forest Cover (F)

**Forest Clearing Permitted Without Mitigation**

I = Existing Forest Cover (F) - Break Even Point (H)

**Proposed Forest Clearing**

- J. Total Area of Forest to be Cleared
- K. Total Area of Forest to be Retained
- L. K = Existing Forest Cover (F) - forest to be cleared (J)

**Planting Requirements**

If the Total Area of Forest to be Cleared (K) is at or above the Break Even Point (H), no planting is required and no further calculations are necessary (L=0, M=0, N=0, P=0); If not, calculate the planting requirement below:

**Reforestation for Clearing Above the Conservation Threshold**

- (1) If the total area of forest to be retained (K) is greater than the Conservation Threshold (E), then L = the area of forest to be cleared (J) X 0.25; or (2) If the forest to be retained (K) is less than or equal to the Conservation Threshold (E), then L = area of forest above Conservation Threshold (G) X 0.25

**Reforestation for Clearing Below the Conservation Threshold**

- (1) If Existing Forest Cover (F) is greater than Conservation Threshold (E) and the forest to be retained (K) is less than or equal to the Conservation Threshold (E), then M = 2.0 X (the Conservation Threshold (E) - the forest to be retained (K))
- (2) If Existing Forest (F) is less than or equal to the Conservation Threshold (E), then M = 2.0 X Forest to be cleared (J)

**Credit for Retention Above the Conservation Threshold**

If the area of forest to be retained (K) is greater than the Conservation Threshold (E), then N = K - E

**Total Reforestation Required P = L + M - N**

**Total Afforestation Required**

Q = the Afforestation Threshold (D) - the Existing Forest Cover (F)

**Total Planting Requirement R = P + Q**

**PLANTING SPECIFICATIONS**

**AFFORESTATION OR REFORESTATION MAINTENANCE AND REPLACEMENT REQUIREMENTS**

A two year (24) month maintenance and replacement warranty period is required for all newly planted materials. The maintenance and replacement warranty period shall commence upon the date of the written acceptance by the Owner of the planted areas. A written warranty will be delivered to the Owner upon acceptance of the planted areas. Maintenance and replacement shall be provided by the Contractor responsible for the initial planting operations and related work. All landscape plant material included as forest conservation credits shall be covered under this maintenance and replacement warranty period.

**I. MAINTENANCE:**

The Contractor shall field check the newly planted area(s) and shall provide the following maintenance items in accordance with the following schedule which shall begin after the completion and acceptance of the initial Afforestation or Reforestation planting.

**II. MAINTENANCE ITEMS:**

- Watering: Watering of all newly planted materials once per week as weather permits during the entire initial growing season. Following the initial growing season, watering shall be done on an "as needed" basis depending on the frequency of natural rainfall. During the months of July and August and periods of severe drought, all newly planted materials shall be watered thoroughly once every week. Watering shall be done deeply and slowly using an open end hose or watering probe, at low pressure, allowing the water to be absorbed into the soil until thoroughly saturated. The watered area shall include the whole root zone as the tree becomes more established.
- Fertilizing: Fertilizing shall be applied only after the soil has been tested to determine its needs. Organic fertilizer should be applied in accordance with the amounts recommended in the soil analysis report. No fertilizing of newly planted trees shall be done within the first growing season after initial planting. Following the first growing season, apply fertilizer as recommended either in late fall or early spring.
- Supplemental Mulch: To control undesirable vegetation adjacent to the newly planted materials and to prevent tree roots from drying out, additional mulch shall be placed over the existing mulch field where required. Carefully remove any invasive plants (including the root system) within the mulch fields. Do not damage trees in any way during removal of invasive plants or remaining operations.
- Pruning: Remove dead, diseased, dying and broken branches from all plant materials. Pruning shall be done cleanly leaving no ragged ends.

**III. REPLACEMENT OF DEAD OR DYING MATERIALS:**

- Replacement: Any plant materials which are 25% dead or more shall be replaced during the appropriate spring or fall planting seasons in accordance with the methods indicated in the Planting Specifications. A tree shall be considered dead when the main leader has died back.
- All replacements shall be plants of the same genus, species and size as specified on the plant list.

3. Contractor shall schedule an inspection of the Afforestation or Reforestation area(s) by a qualified representative of the DPZ and by the qualified professional who prepared the plan, at the beginning and at the end of the growing season to observe any problems, monitor survival rate and specify necessary remedial actions needed to correct existing problems. The inspection should focus on the following items when determining survival potential:

- (a) Vigor and threat of competing vegetation
- (b) Plant structure
- (c) Growth rate
- (d) Crown development
- (e) Trunk conditions and health

**IV. PLANT CONDITION CHECK SHEETS**

The Contractor shall maintain accurate records on appropriate field data check sheets which shall include all conditions observed relative to the health and potential survival of the plant materials. Such check sheets shall be completed during each scheduled maintenance session during the 24 month management and maintenance program. One copy of the check sheets shall be sent to the Client, one copy to PHRA, and one copy shall be sent to the Howard County Department of Planning and Zoning.

**V. SURVIVAL REQUIREMENT:**

The survival rate for Afforestation and Reforestation areas shall be a minimum of seventy-five percent (75%) of the total number of trees required to be planted per acre under the approved plan.

**VI. INSPECTION/CERTIFICATION SCHEDULE:**

The Contractor shall submit with his bid, a schedule for the work which shall include inspections by PHRA at the conclusion of installation and at the start and conclusion of each growing season during the two-year warranty period.

**VII. PENALTY FOR VIOLATION:**

A site inspection by the Contractor and a representative of PHRA shall take place at the end of the 24 month management and maintenance agreement period. The Contractor shall contact PHRA at least one (1) month in advance of such inspection for coordination. If the survival rate of the Afforestation or Reforestation area(s) falls below the established survival requirements by the end of the 24-month management and maintenance agreement, the remaining amount of the cash bond or other surety may be subject to forfeiture, or other penalties may be imposed.


**AFFORESTATION PLANTING LIST**

*QTY	SCIENTIFIC/COMMON NAME	SIZE	ROOT	REMARKS
8	ACER RUBRUM / RED MAPLE			
7	PLATANUS OCCIDENTALIS / SYCAMORE			
8	QUERCUS PALUSTRIS / PIN OAK	1" CAL.	CONT.	FULL CROWN PLANT 15" O.C.
8	FRAXINUS PENNSYLVANICA / GREEN ASH			
7	ULMUS RUBRA / SLIPPERY ELM			

\*NOTE: CALCULATIONS FOR 1" CAL. PLANTS IS BASED ON 200 PLANTS PER ACRE. AFFORESTATION AREA= 0.19 AC TOTAL PLANTING REQUIREMENT= 0.19 AC X 200 PLANTS/AC= 38 SHADE TREES


**GENERAL NOTES:**

- THE SITE IS LOCATED AT 11380 HOMEWOOD ROAD, ELLICOTT CITY, MD 21042. THE SITE CONSISTS OF 4 PARCELS (PARCEL 117, PARCEL 1 OF PARCEL 291, PARCEL 2 OF PARCEL 291 & PARCEL 303) WHICH EQUAL A TOTAL OF 40.364 ACRES.
- BOUNDARY AND TOPOGRAPHIC INFORMATION IS PROVIDED BY HOWARD COUNTY GIS DATA AND PHRA FIELD SURVEY CONDUCTED IN JULY, 2006.
- THE SOILS ON SITE ARE BAILE SILT LOAM (0-3% SLOPES) - BaA, COORUS AND HOTOBRO SILT LOAMS (0-3% SLOPES) - Co, GLADSTONE LOAM (0-3% SLOPES) - GbA, GLADSTONE LOAM (8-15% SLOPES) - GbC, GLENVILLE SILT LOAM (3-8% SLOPES) - GbB, MANOR-BANNERTOWN SANDY LOAM (15-25% SLOPES) - MbA, MANOR-BANNERTOWN SANDY LOAM (25-55% SLOPES) - MbF APPROPRIATE 100' STREAM BUFFER HAS BEEN SHOWN AS REQUIRED IN THE HOWARD COUNTY SUBDIVISION AND LAND DEVELOPMENT REGULATIONS SECTION 16.116 "PROTECTION OF WETLANDS, STREAMS, AND STEEP

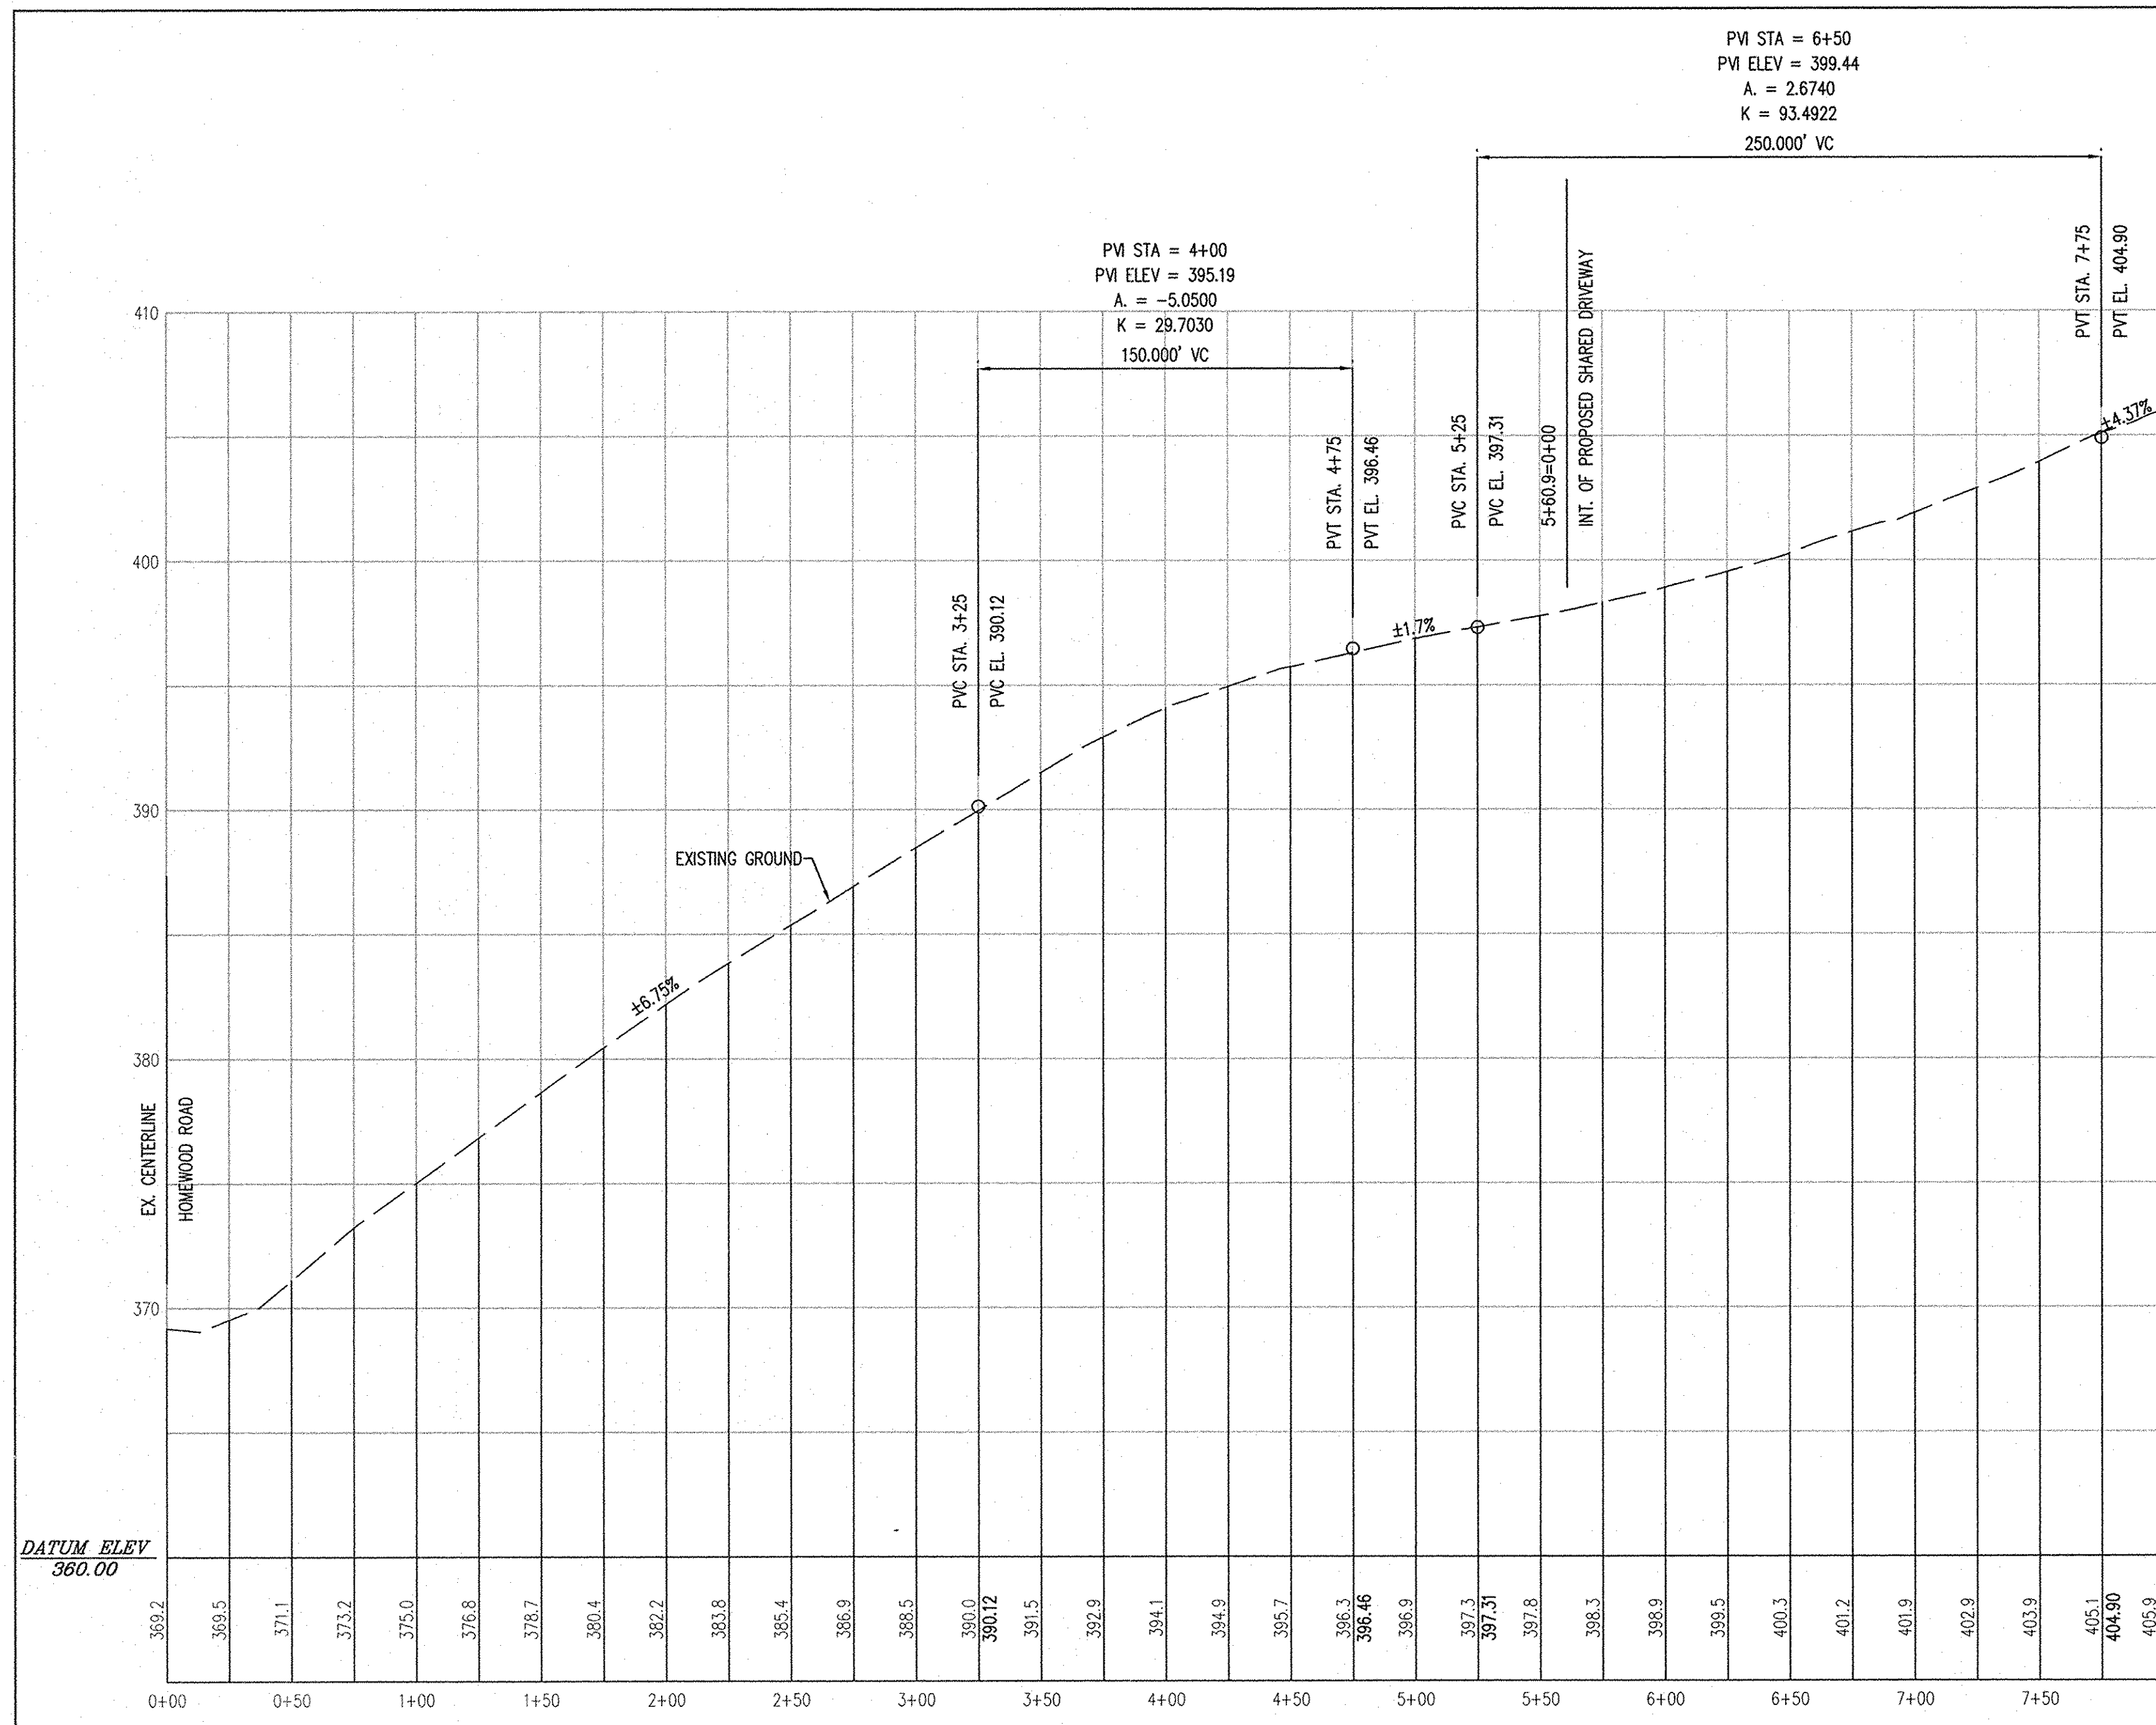

EXISTING GROUND CENTERLINE PROFILE FOR EXISTING USE IN COMMON DRIVEWAY

PAVEMENT DESIGN  
PAVEMENT DESIGN SHALL COMPLY WITH  
GEOTECHNICAL REPORT RECOMMENDATIONS  
(GEOTECHNICAL REPORT BY OTHERS)

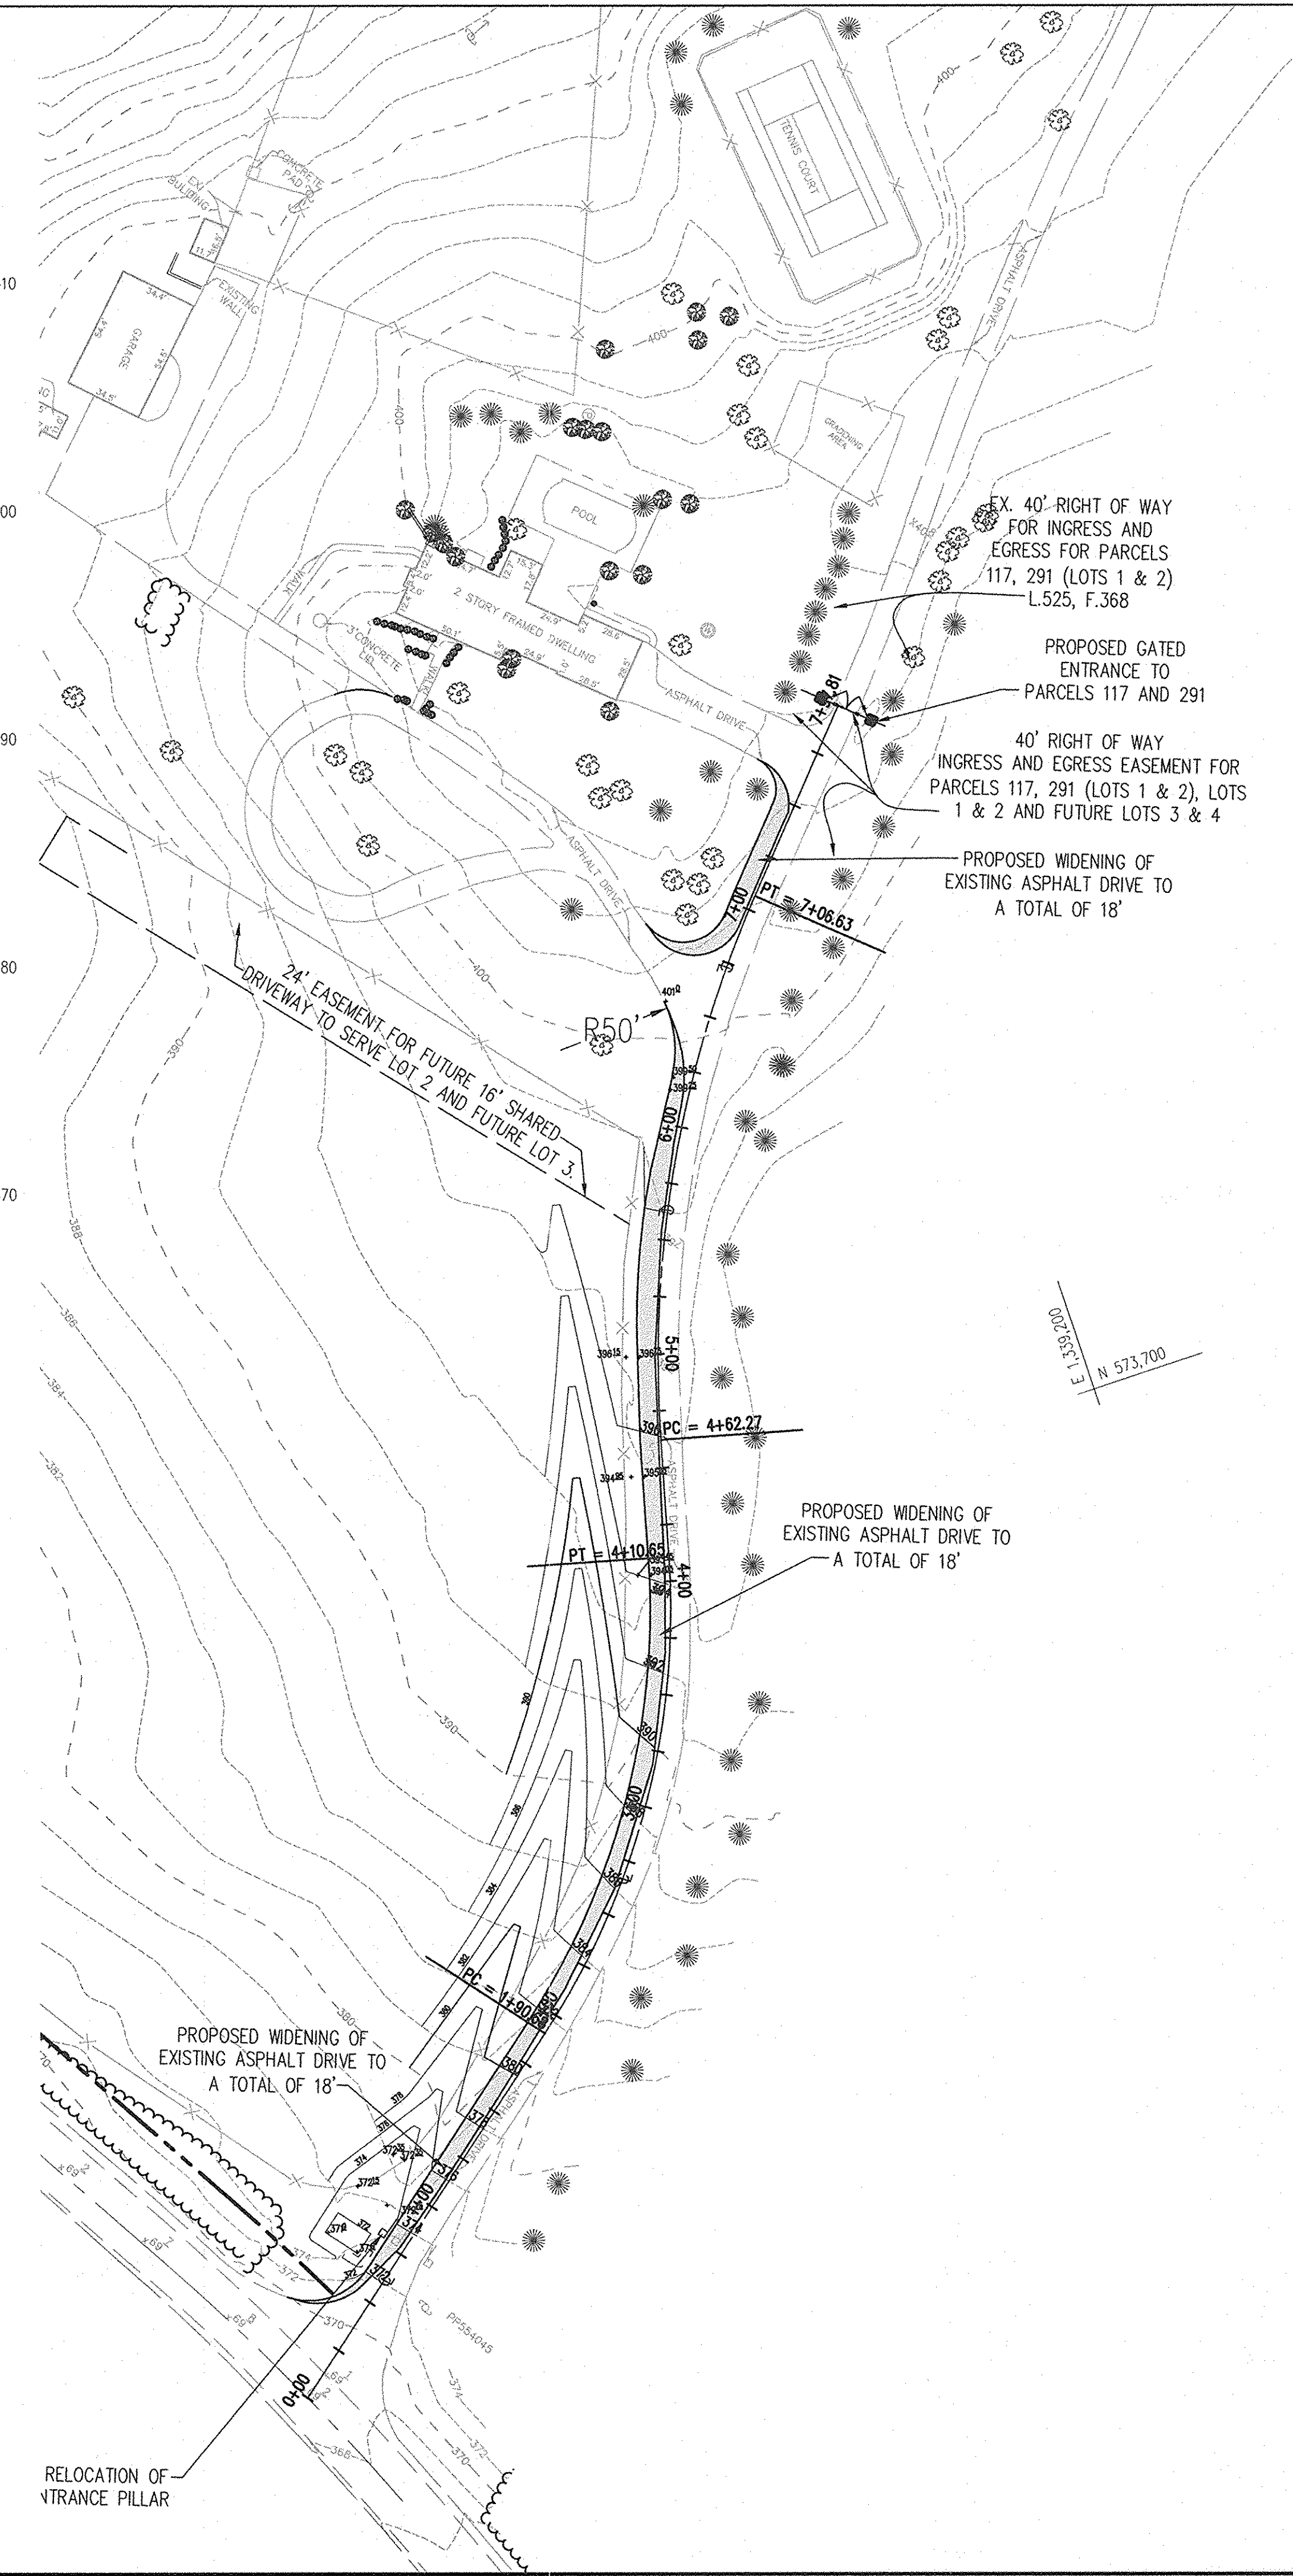

APPROVED : HOWARD COUNTY DEPARTMENT OF PLANNING AND ZONING.

DIRECTOR	DATE
<i>[Signature]</i>	2/9/08
CHIEF, DEVELOPMENT ENGINEERING DIVISION	J.T. DATE
<i>[Signature]</i>	2/8/08
CHIEF, DIVISION OF LAND DEVELOPMENT	DATE

DATE	NO.	REVISION

OWNER:  
HOMEWOOD L.L.C.  
GARY B. SMITH  
11362 HOMEWOOD ROAD  
ELLCOTT CITY  
MARYLAND 21042  
410-964-0260

PROJECT  
**HOMEWOOD FARM**  
(MURPHY PROPERTY)

AREA TAX MAP 29 PARCELS 303, 117, 291  
3RD ELECTION DISTRICT ZONED RC-DEO  
HOWARD COUNTY, MARYLAND

TITLE  
**ROAD PROFILE**

Patton Harris Rust & Associates, pc  
Engineers, Surveyors, Planners, Landscape Architects.  
PHRA  
8818 Centre Park Drive  
Columbia, MD 21045  
T 410.997.8900  
F 410.997.9282

DESIGNED BY : PHRA  
DRAWN BY: JML  
PROJECT NO : 14520-1-0  
DATE : JANUARY 21, 2008  
SCALE : 1"=50'  
DRAWING NO. 13 OF 15

BY: *[Signature]*  
PROFESSIONAL CERTIFICATION: I HEREBY CERTIFY THAT THESE DOCUMENTS WERE PREPARED OR APPROVED BY ME, AND THAT I AM A FULLY LICENSED PROFESSIONAL ENGINEER UNDER THE LAWS OF THE STATE OF MARYLAND, LICENSE NO. 33354, EXPIRATION DATE: 1-24-08

**INTERSECTION SIGHT DISTANCE**

EXISTING 2 LANE MAJOR COLLECTOR


OBSERVED SPEED ON HOMEWOOD ROAD = 46 & 47 MPH

BASED ON FIGURE 2.17 OF DESIGN MANUAL VOL. III (SIGHT DISTANCES HAVE BEEN INTERPOLATED FOR 46 & 47 MPH)

	DL	DR
CROSS	N/A	N/A
LEFT TURN	510'	700'
RIGHT TURN	692'	N/A


SINCE EXISTING ROAD HAS -3% GRADE TO THE RIGHT AND -3% GRADE TO THE LEFT, THE GRADE ADJUSTMENT FACTORS MUST BE USED.

	DL	DR
CROSS	N/A	N/A
LEFT TURN	510'x0.6=306'	700'x0.6=420' (CONTROL)
RIGHT TURN	692'x0.6=415' (CONTROL)	N/A

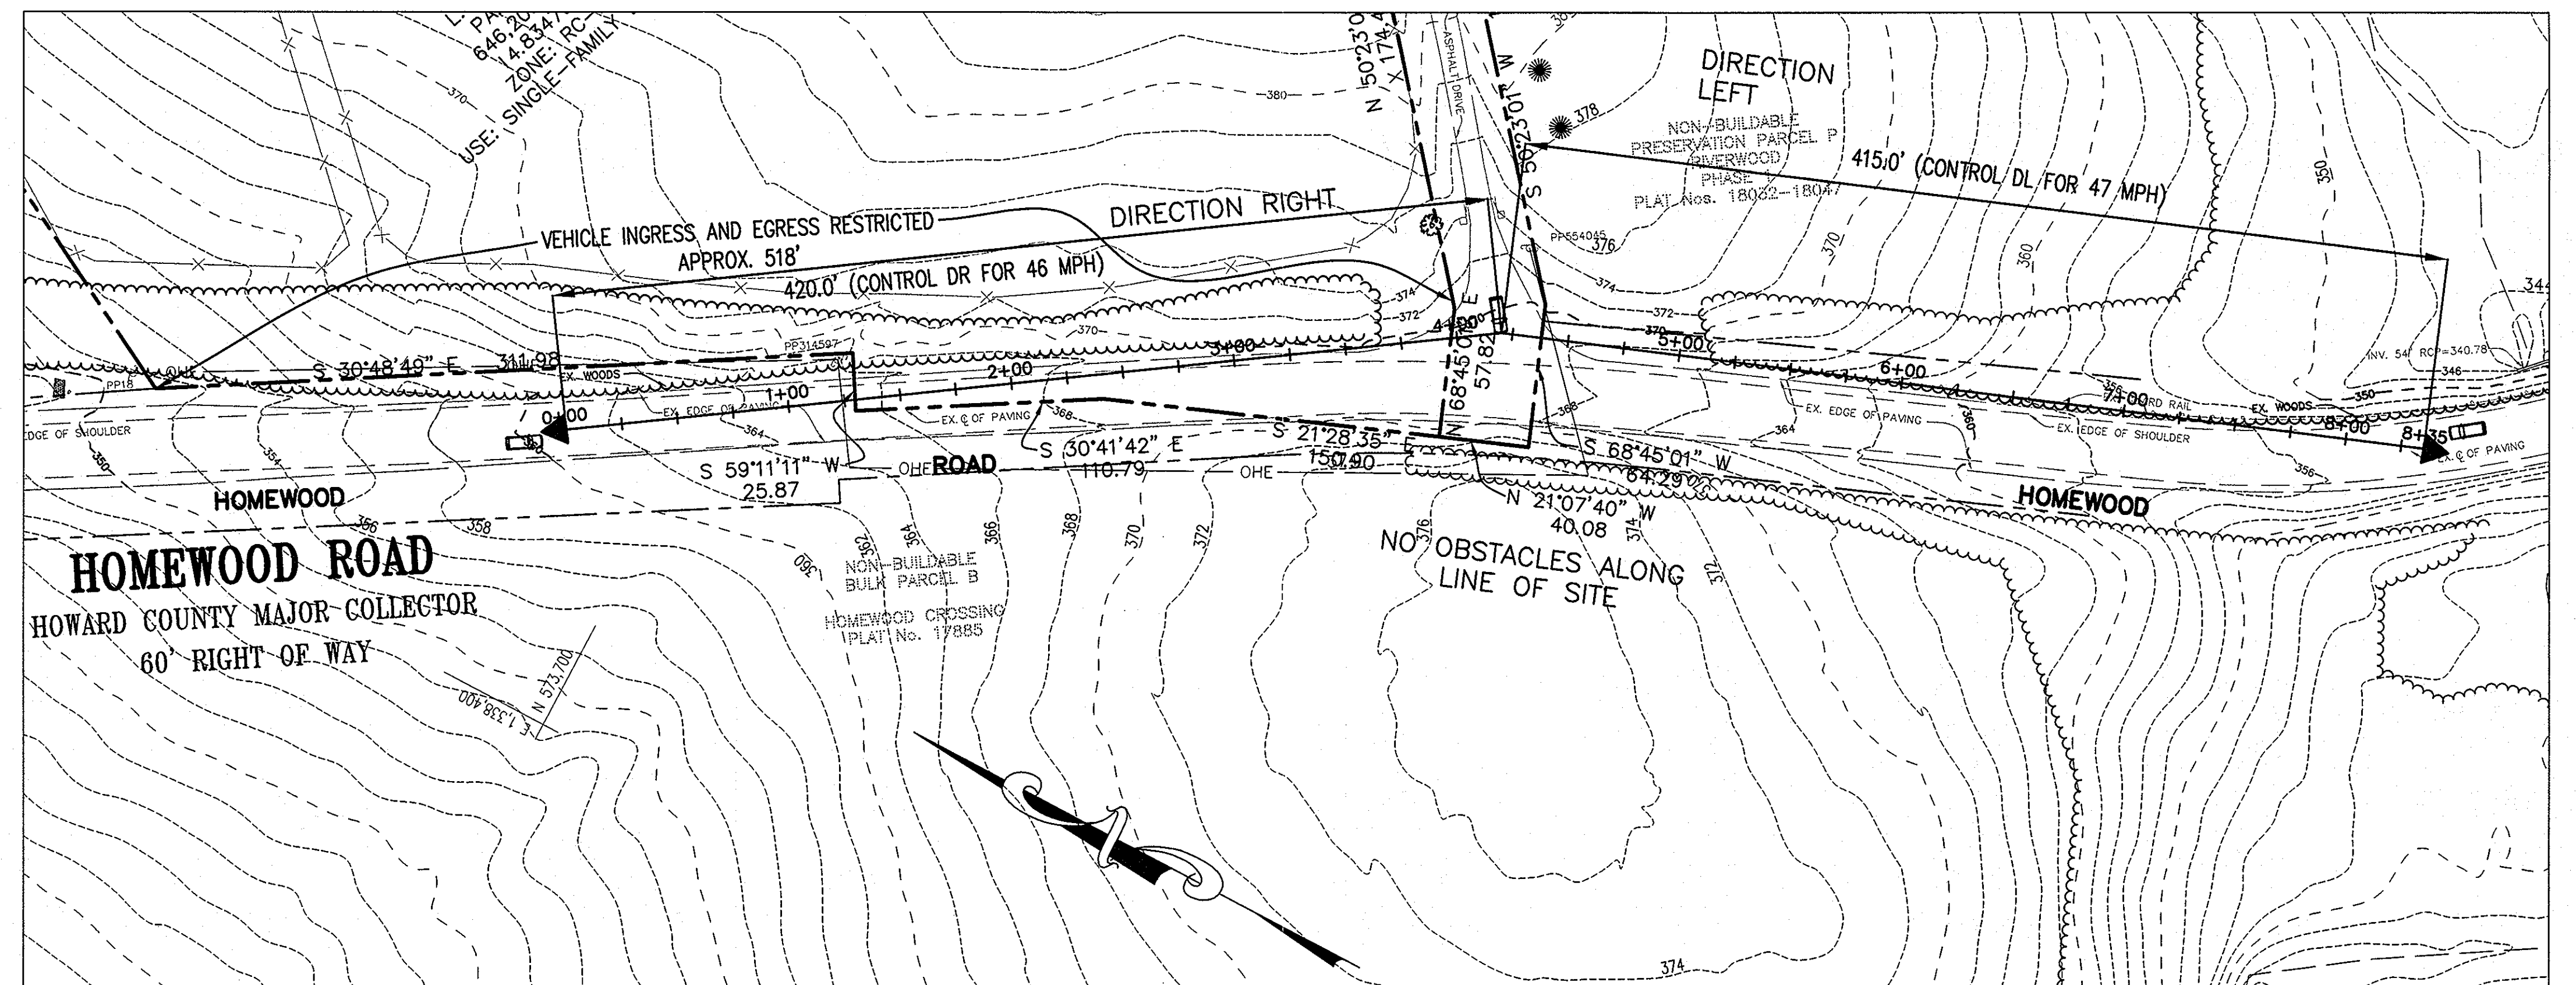

**GENERAL NOTES**

- BOUNDARY INFORMATION OBTAINED FROM HOWARD COUNTY G.I.S. TOPOGRAPHICAL INFORMATION OBTAINED FROM PATTON, HARRIS, RUST & ASSOCIATES, PC SURVEY CREW.
- THIS ANALYSIS CONDUCTED WITH BENEFIT OF A SPEED STUDY CONDUCTED BY TRAFFIC CONCEPTS, INC.

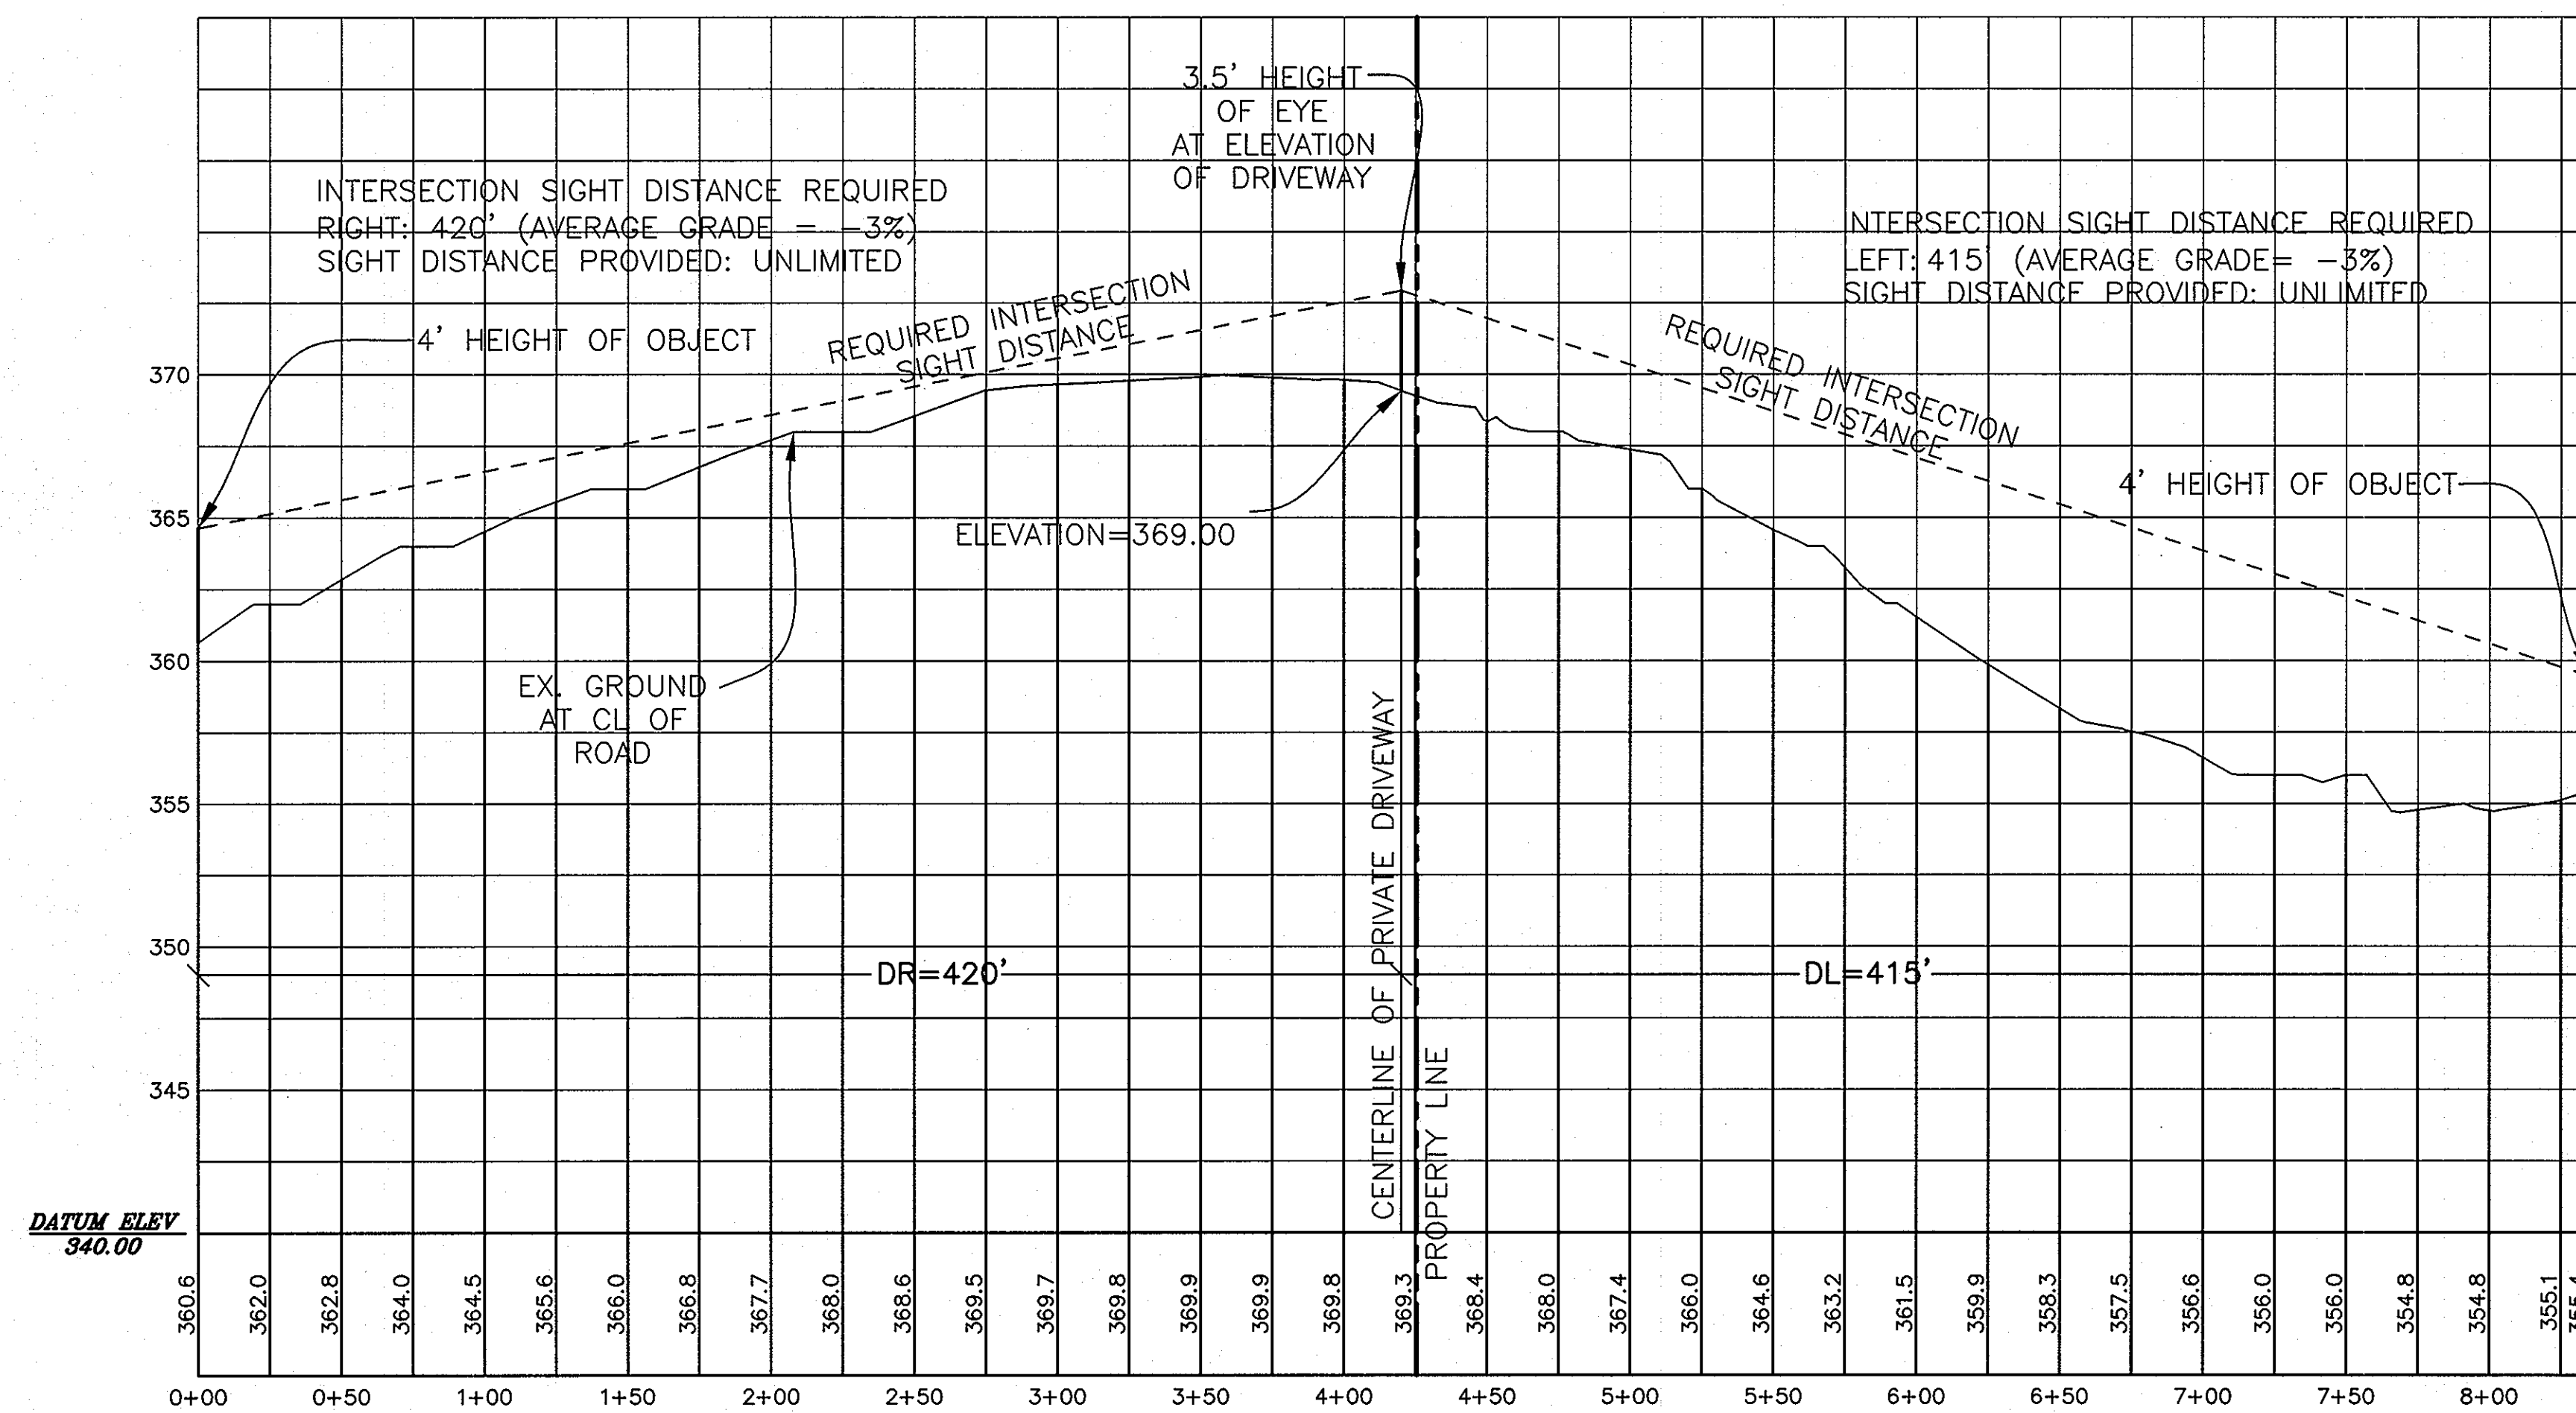

**INTERSECTION SIGHT DISTANCE HOMEWOOD ROAD  
46 MPH (DISTANCE RIGHT) & 47 MPH (DISTANCE LEFT)**

SCALE: HORIZONTAL 1" = 50'  
VERTICAL 1" = 5'

APPROVED : HOWARD COUNTY DEPARTMENT OF PLANNING AND ZONING.

DIRECTOR: *[Signature]* DATE: 2/16/08  
 CHIEF, DEVELOPMENT ENGINEERING DIVISION

CHIEF, DIVISION OF LAND DEVELOPMENT: *[Signature]* DATE: 2/16/08

DATE NO. REVISION

OWNER: HOMEWOOD L.L.C.  
 GARY B. SMITH  
 11362 HOMEWOOD ROAD  
 ELLICOTT CITY  
 MARYLAND 21042  
 410-964-0260

PROJECT: HOMEWOOD FARM (MURPHY PROPERTY)


AREA: TAX MAP 29 PARCELS 303, 117, 291  
 3RD ELECTION DISTRICT  
 ZONED RC-DEO  
 HOWARD COUNTY, MARYLAND

TITLE: SIGHT DISTANCE PLAN


Patton Harris Rust & Associates, pc  
 Engineers, Surveyors, Planners, Landscape Architects.  
 8818 Centre Park Drive  
 Columbia, MD 21045  
 T 410.997.8900  
 F 410.997.9282

DESIGNED BY : JML  
 DRAWN BY: JML  
 PROJECT NO : 14520-1-0  
 DATE : JANUARY 21, 2008  
 SCALE : 1" = 50'  
 DRAWING NO. 14 OF 15


BY: *[Signature]* 1-22-08  
 PROFESSIONAL ENGINEER  
 STATE OF MARYLAND  
 PROFESSIONAL ENGINEERING BOARD  
 NO. 33854, EXPIRATION DATE: 1-24-09

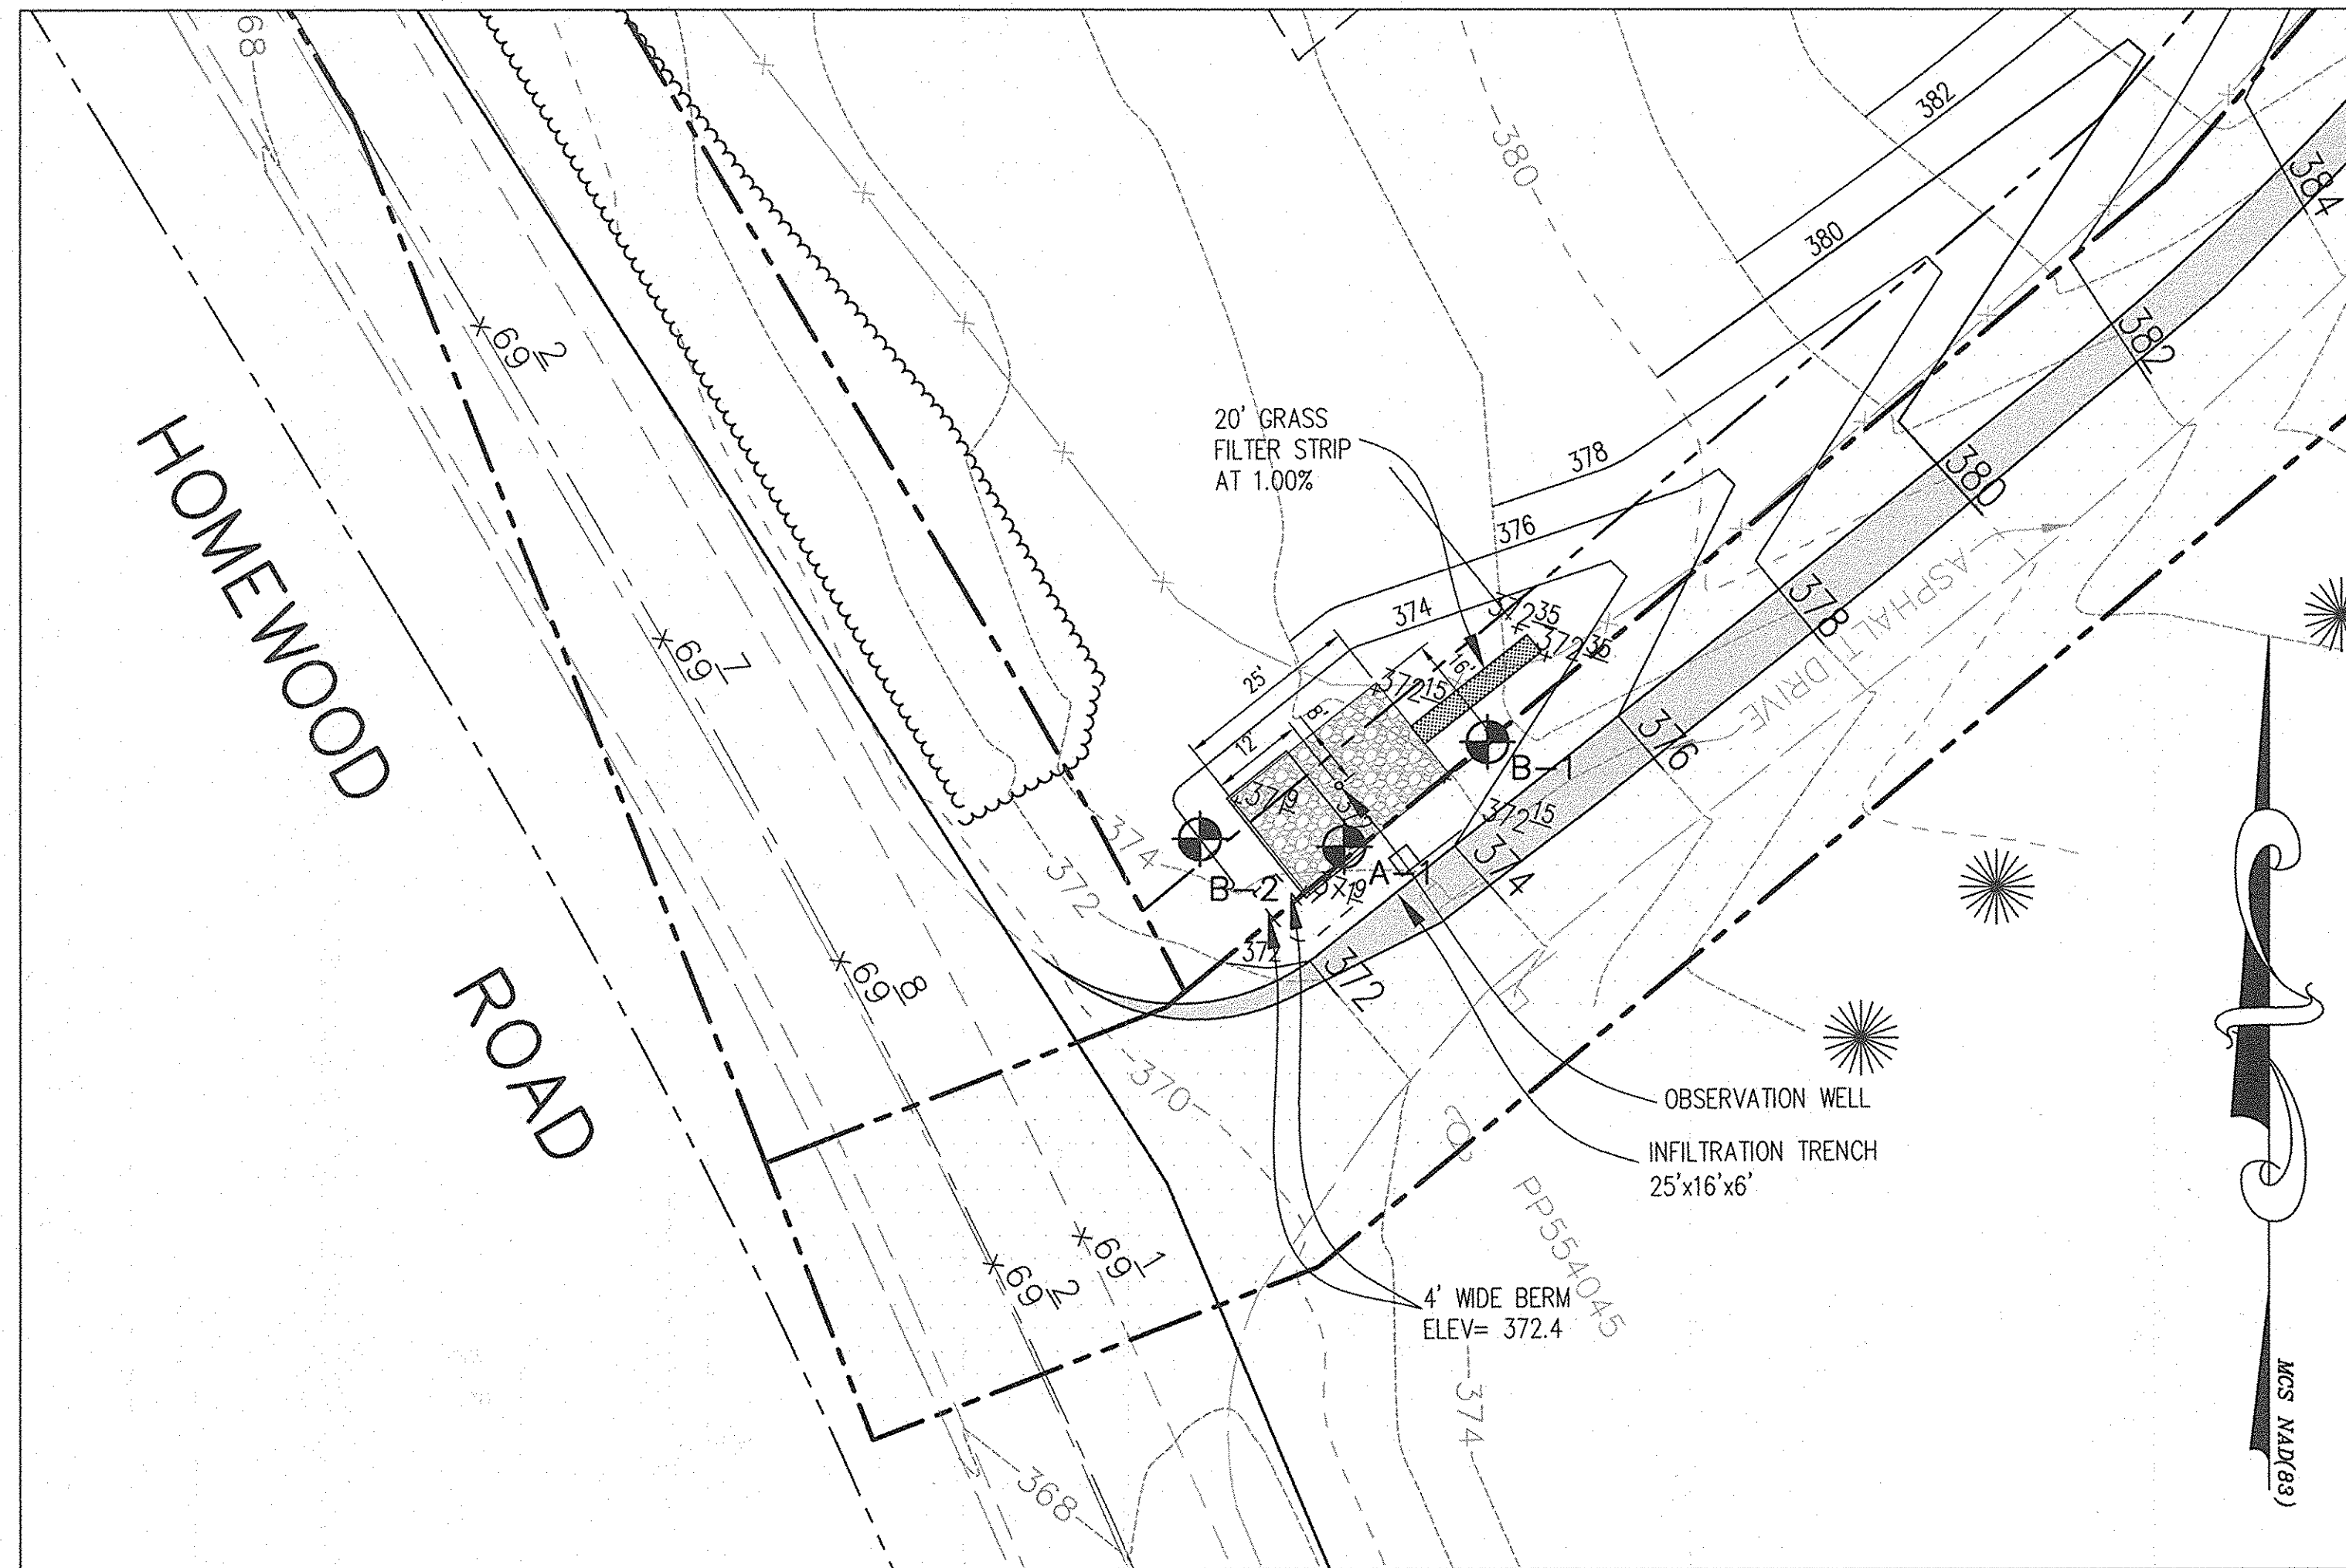


**PLAN VIEW INFILTRATION TRENCH**  
SCALE: 1"=20'

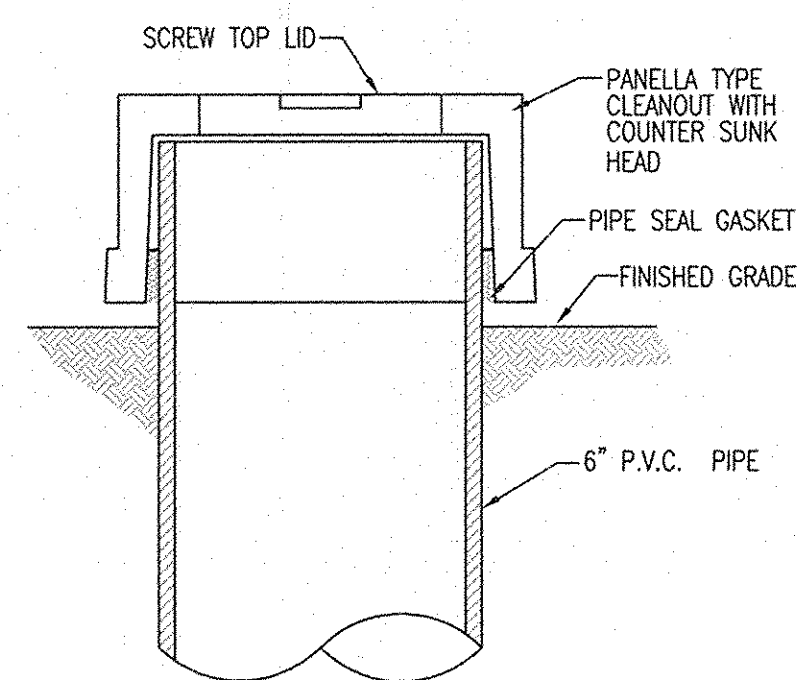

**OBSERVATION WELL CAP**  
(NOT TO SCALE)

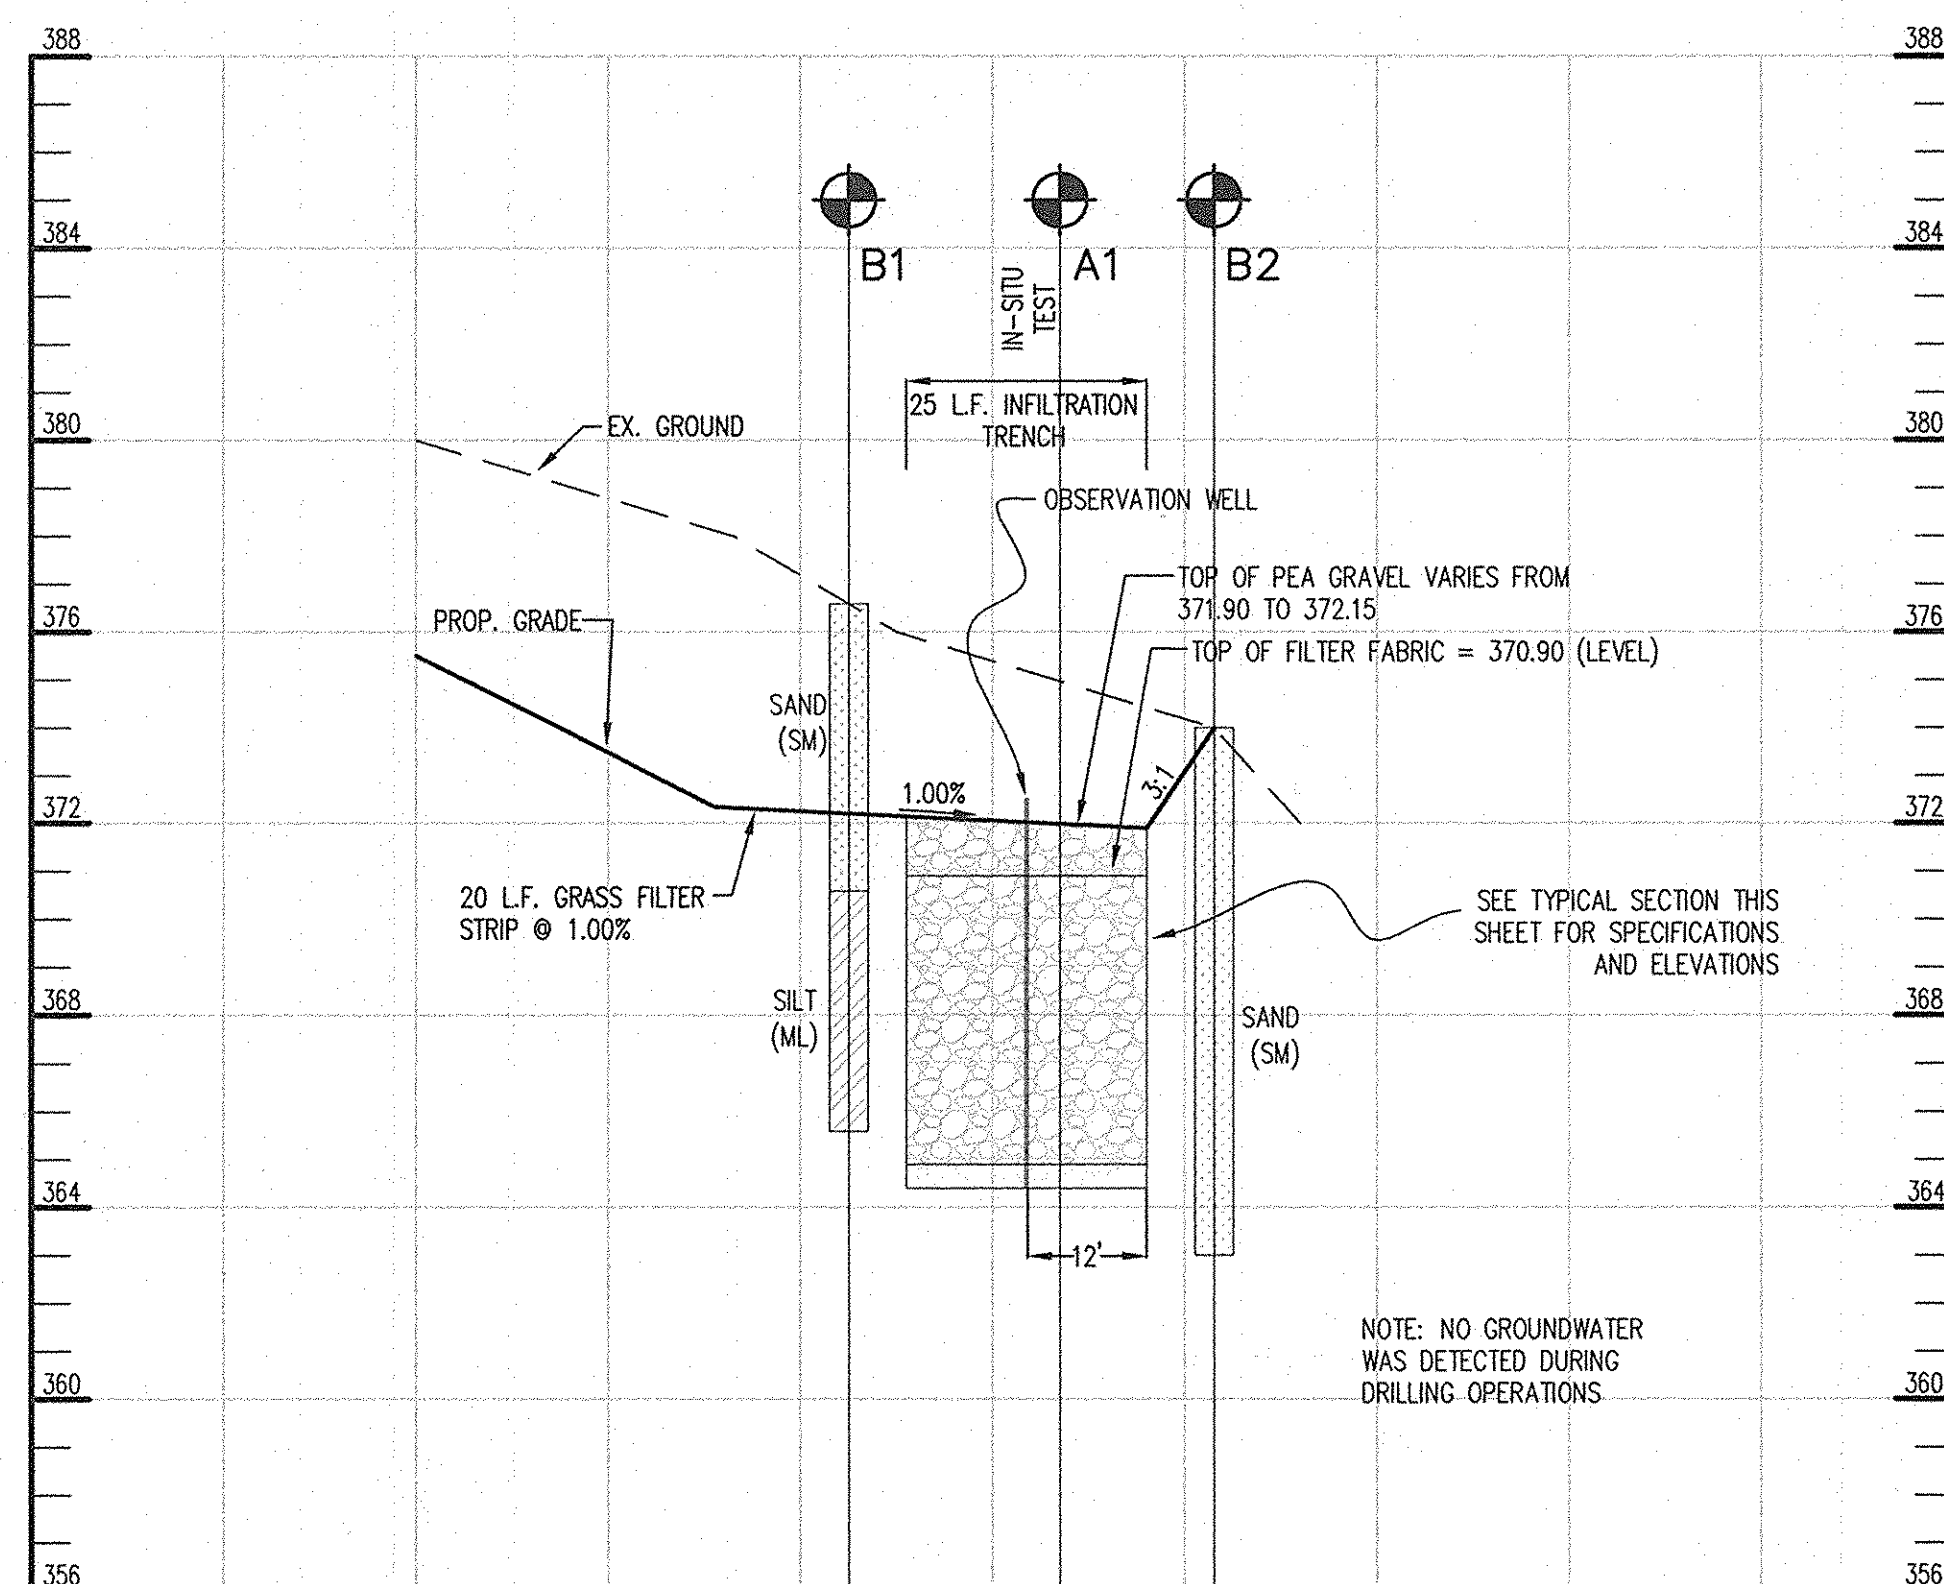

**INFILTRATION TRENCH PROFILE**  
SCALE: HOR: 1"=20'  
VERT: 1"=4'

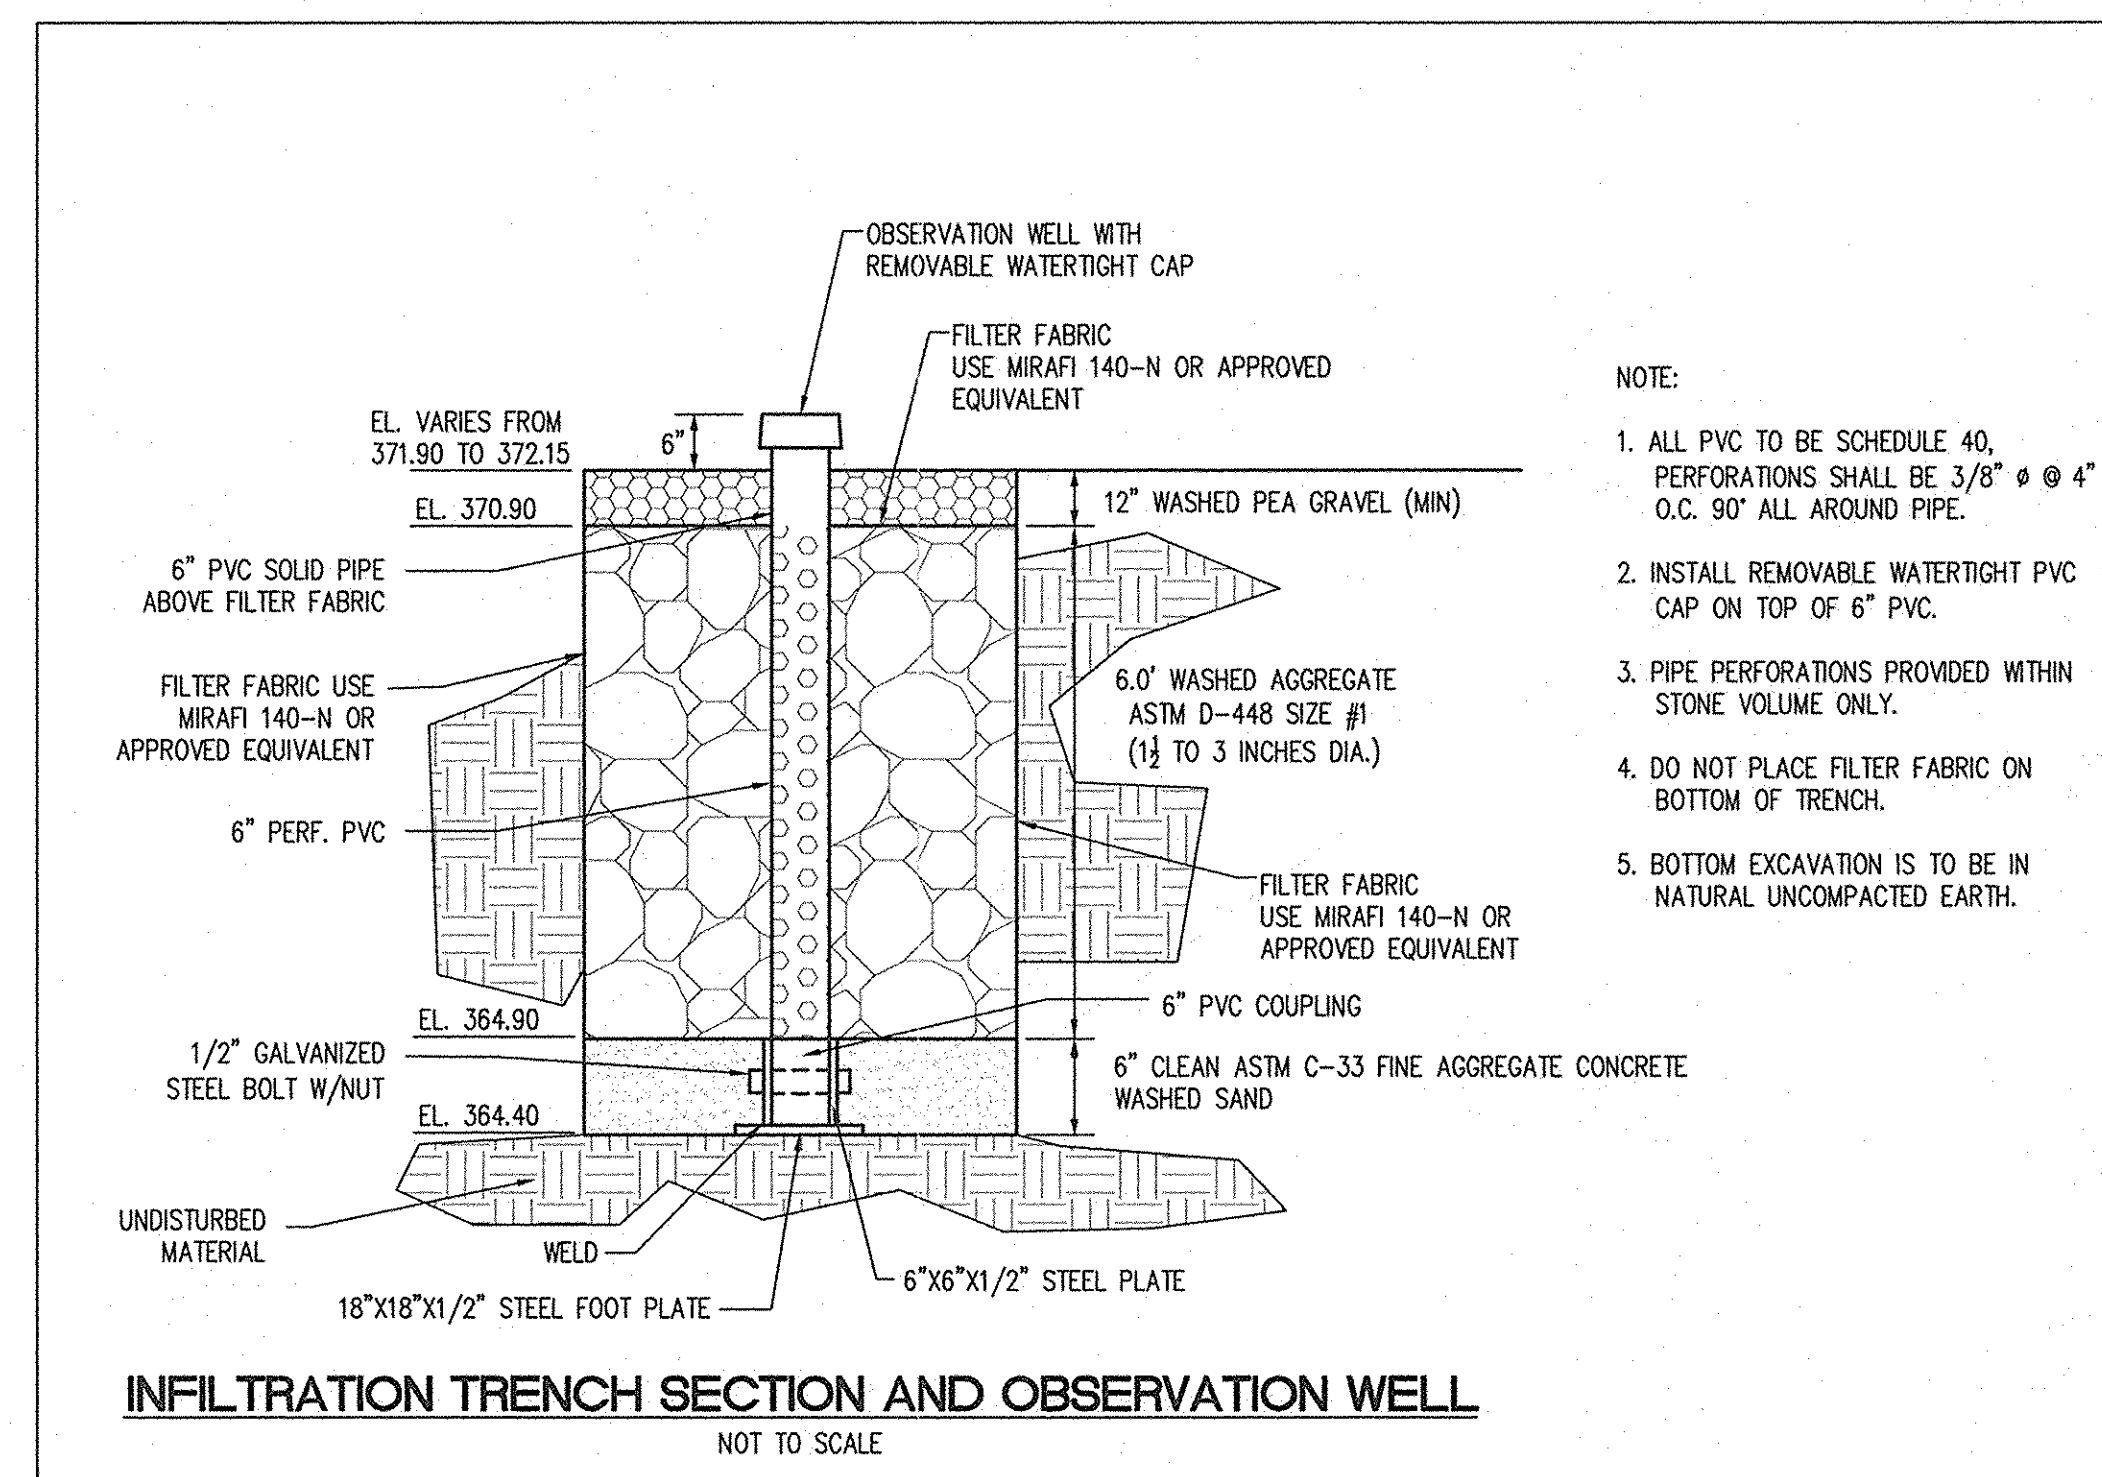

**INFILTRATION TRENCH SECTION AND OBSERVATION WELL**  
NOT TO SCALE

**INFILTRATION TRENCH SPECIFICATIONS**

**Construction Specifications**


- Timing**  
An infiltration trench may not be constructed or placed in service until all of the contributing drainage area has been stabilized and approved by the responsible inspector.
- Trench Preparation**  
Excavate the trench to the design dimensions. Excavated materials shall be placed away from the trench sides in order to prevent fabric puncturing or tearing during subsequent installation procedures. The side walls of the trench shall be roughened where sheared and sealed by heavy equipment. The trench wall shall be battered to maintain stability during construction. The bottom dimensions and stone depth shall be as specified.
- Fabric Laydown**  
The filter fabric roll must be cut to the proper width prior to installation. The cut width must include sufficient material to conform to trench perimeter irregularities and for a 6-inch minimum top overlap. Stones or other anchoring objects should be placed on the fabric at the edge of the trench to keep the line trench open during windy periods. When overlaps are required between rolls, the upstream roll should lap a minimum of 2 feet over the downstream roll in order to provide a shingled effect. The overlap ensures fabric continuity or to ensure that the fabric conforms to the excavation surface during aggregate placement and compaction. Filter cloth to be Mirafi 140-N or approved equivalent along the sides and top of the infiltration trench. Do not place any filter material on the bottom of the trench.
- Stone Aggregate, Sand Placement and Compaction**  
Trench shall be filled with 1.5-3.0 inch diameter washed stone meeting ASTM D448, size No. 1. The stone aggregate should be placed in lifts and compacted using plate compactors. As a rule of thumb, a maximum loose lift thickness of 12 inches is recommended. The compaction process ensures fabric conformity to the excavation sides, thereby reducing the potential for soil piping, fabric clogging, and settlement problems. The bottom of the trench shall be graded flat (0 Ft/Ft). Provide a 6" layer of clean washed sand (meeting ASTM C-33 fine aggregate concrete sand specifications) on the bottom of the trench. Manufactured sand is not allowed.
- Overlapping and Covering**  
Following the stone aggregate placement, the filter fabric shall be folded over the stone aggregate to form a 6" minimum longitudinal lap. The pea gravel shall be placed over the lap at sufficient intervals to maintain the lap during the subsequent backfilling.
- Contamination**  
Care shall be exercised to prevent natural or fill soils from intermixing with the stone aggregate. All contaminated stone aggregate shall be removed and replaced with uncontaminated stone aggregate. When a stone capping is specified, the stone capping shall be cleaned and free of all soil and fines.
- Voids Behind Fabric**  
Voids can be created between the fabric and excavation sides and shall be avoided. Removing boulders or other obstacles from the trench walls is one source of such voids. Natural soils should be placed in these voids at the most convenient time during construction to ensure fabric conformity to the excavation sides. Soil piping, fabric clogging, and possible surface subsidence will be avoided by the remedial process.
- Unstable Excavation Sides**  
Vertically excavated walls may be difficult to maintain in areas where the soil moisture is high or where soft cohesive or cohesionless soils predominate. These conditions may require laying back of the side slopes to maintain stability; trapezoidal rather than rectangular cross sections may result.
- Traffic Control**  
Heavy equipment and traffic shall be restricted from traveling over the recharge areas to minimize compaction of the soil.
- Observation Well**  
An Observation Well using 6 inch diameter perforated pvc pipe, schedule 40 shall be placed in each infiltration trench. The well shall be located in the longitudinal center of the trench and is to be capped using a threaded pvc fitting and a vandal proof sewer cap. The pipe shall have a plastic collar with ribs to prevent rotation when removing the cap. When soil capping is specified, the observation well shall be constructed of perforated pipe within the No. 2 stone sand non-perforated pipe through the soil capping. The depth of the well at the time of installation will be clearly marked on the well cap.

**Maintenance**

Infiltration trenches shall be designed to minimize maintenance. However, it is recognized that all infiltration facilities are subject to clogging by sediment, oil, grease, grill and other debris. Consequently, a monitoring observation well is required for all recharge structures.

The observation well shall be monitored periodically. For the first year after completion of construction, the well should be monitored on a quarterly basis and after every large storm. It is recommended that a log book be maintained indicating that rate at which the facility dewater after large storms and the depth of the well for each observation. Once the performance characteristics of the structure have been verified, the monitoring schedule can be reduced to an annual basis, unless the performance data indicate that a more frequent schedule is required.

Sediment build-up in the top foot of stone aggregates or the surface inlet should be monitored on the same schedule as the observation well. Sediment deposited shall not be allowed to build up to the point where it will reduce the rate of recharge into the trench.

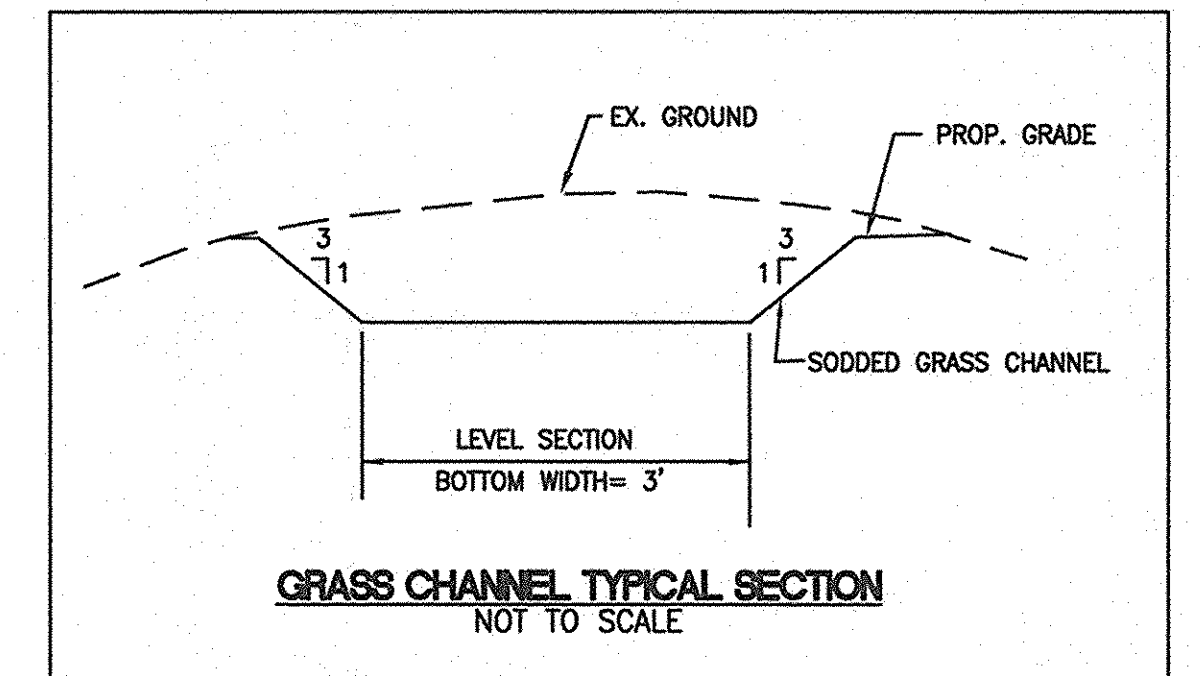

**GRASS CHANNEL TYPICAL SECTION**  
NOT TO SCALE

APPROVED : HOWARD COUNTY DEPARTMENT OF PLANNING AND ZONING.

DIRECTOR: *David DeMunn* DATE: 2/8/08  
CHIEF, DEVELOPMENT ENGINEERING DIVISION  
CHIEF, DIVISION OF LAND DEVELOPMENT: *Carly Hunt* DATE: 2/8/08

DATE NO. REVISION

OWNER: HOMEWOOD L.L.C.  
GARY B. SMITH  
11362 HOMEWOOD ROAD  
ELLCOTT CITY  
MARYLAND 21042  
410-964-0260

PROJECT: **HOMEWOOD FARM**  
(MURPHY PROPERTY)  
AREA: TAX MAP 29 PARCELS 303, 117, 291  
3RD ELECTION DISTRICT ZONED RC-DEO  
HOWARD COUNTY, MARYLAND

TITLE: **INFILTRATION TRENCH DETAILS**

Patton Harris Rust & Associates, pc  
Engineers, Surveyors, Planners, Landscape Architects.  
8818 Centre Park Drive  
Columbia, MD 21045  
T 410.997.8900  
F 410.997.9282

DESIGNED BY : SM  
DRAWN BY : DJK  
PROJECT NO : 14520-1-0  
DATE : JANUARY 21, 2008  
SCALE : 1"=50'  
DRAWING NO. 15 OF 15

