

SHEET INDEX

SHEET No.	TITLE SHEET
1	TITLE SHEET
2	VICTORY LANE - PLAN AND PROFILE
3	STREET TREE, GRADING AND SEDIMENT CONTROL PLAN
4	STREET TREE, GRADING AND SEDIMENT CONTROL PLAN
5	LANDSCAPE PLAN
6	ROADWAY DETAILS
7	STORM DRAIN PROFILES & STRUCTURE SCHEDULE
8	STORMWATER MANAGEMENT PROFILES AND DETAILS - BMP#1
9	STORMWATER MANAGEMENT PROFILES AND DETAILS - BMP#1
10	SEDIMENT CONTROL NOTES
11	SEDIMENT CONTROL DETAILS
12	STORM DRAIN DRAINAGE AREA MAP
13	SOIL BORINGS
14	FOREST CONSERVATION PLAN
15	STONE RESERVOIR PROFILE & DETAILS

**FINAL ROAD CONSTRUCTION,
GRADING AND STORMWATER MANAGEMENT PLAN**

MERIWETHER FARM

SECTION TWO

PHASE ONE

**BUILDABLE LOTS 1 THRU 10, NON-BUILDABLE PRESERVATION
PARCELS 'C' & 'D' AND BUILDABLE BULK PARCEL 'E'**

**(A RESUBDIVISION OF BUILDABLE BULK PARCEL 'A', MERIWETHER FARM,
SECTION TWO, F-08-198)**

ZONING: RC-DEO

TAX MAP No. 21 GRID No. 15, 16, 21 & 22 PARCEL No. 28

APPROVED: DEPARTMENT OF PUBLIC WORKS
W. J. Mall 1-12-09
 CHIEF, BUREAU OF HIGHWAYS DATE

APPROVED: DEPARTMENT OF PLANNING AND ZONING
Cindy Hamstra 1/22/09
 CHIEF, DIVISION OF LAND DEVELOPMENT DATE

Chad Ward 1/26/09
 CHIEF, DEVELOPMENT ENGINEERING DIVISION DATE


- GENERAL NOTES:**
- ALL CONSTRUCTION SHALL BE IN ACCORDANCE WITH THE LATEST STANDARDS AND SPECIFICATIONS OF HOWARD COUNTY PLUS MSHA STANDARDS AND SPECIFICATIONS IF APPLICABLE.
 - THE CONTRACTOR SHALL NOTIFY THE DEPARTMENT OF PUBLIC WORKS, BUREAU OF ENGINEERING, CONSTRUCTION INSPECTION DIVISION AT 1801 35-3800 AT LEAST 15 WORKING DAYS PRIOR TO THE START OF WORK.
 - THE CONTRACTOR SHALL NOTIFY "985 UTILITY" AT 1-800-257-7777 AT LEAST 48 HOURS PRIOR TO ANY EXCAVATION WORK BEING DONE.
 - TRAFFIC CONTROL DEVICES, MARKINGS AND SIGNING SHALL BE IN ACCORDANCE WITH THE LATEST EDITION OF THE MANUAL OF UNIFORM TRAFFIC CONTROL DEVICES (MUTCD). ALL REGULATORY SIGNS SHALL BE IN PLACE PRIOR TO THE PLACEMENT OF ANY ASPHALT.
 - THE COORDINATES SHOWN HEREON ARE BASED UPON THE HOWARD COUNTY GEODETIC CONTROL WHICH IS BASED UPON THE MARYLAND STATE PLANE COORDINATE SYSTEM. HORIZONTAL AND VERTICAL CONTROL DATUM IS BASED ON HOWARD COUNTY GEODETIC CONTROL STATIONS.
 HOWARD COUNTY MONUMENT NO. 21 EA N 582715.1493 ELEV. = 450.292
 N 100495.9996 E 1300868.4443 ELEV. = 476.653
 E 1300868.4443
 - THE TRAFFIC STUDY FOR THIS PROJECT WAS PREPARED BY MASS GROUP DATED NOVEMBER, 2006 AND WAS APPROVED UNDER SP-07-007.
 - BACKGROUND INFORMATION:
 A. SUBDIVISION NAME: MERIWETHER FARM
 B. TAX MAP NO.: 21
 C. PARCEL NO.: 28
 D. ZONING: RC-DEO
 E. ELECTION DISTRICT: FOURTH
 F. TOTAL TRACT AREA: 177,862 AC+ (BULK PARCEL 'A', PLAT NO. 3), ORIGINAL TRACT AREA = 183,068 AC+
 G. NET AREA = 103,068 - 6.79 (FLOODPLAIN) - 3.81 (STEEP SLOPES OUTSIDE FLOODPLAIN) = 172,478 AC+
 H. AREA OF STEEP SLOPES 2% AND GREATER = 6.79 AC+ TOTAL 15.81 AC+ OUTSIDE FLOODPLAIN
 I. NO. OF BUILDABLE LOTS: 10
 J. NO. OF NON-BUILDABLE PRESERVATION PARCELS: 2
 K. NO. OF BUILDABLE BULK PARCELS: 1
 L. AREA OF BUILDABLE LOTS: 10,650 AC+
 M. AREA OF NON-BUILDABLE PRESERVATION PARCELS: 2,761 AC+
 N. AREA OF BUILDABLE BULK PARCELS: 182,992 AC+
 O. TOTAL AREA OF ROADWAY TO BE DEDICATED: 1,139 AC+
 P. AREA OF FLOODPLAIN: 6,79 AC+
 - NO CONVEYANCES EXIST WITHIN THIS SUBDIVISION.
 - ALL FILL AREAS WITHIN ROADWAYS AND UNDER STRUCTURES SHALL BE COMPACTED TO A MINIMUM OF 95% COMPACTION OF ASPHALT T-80.
 - PLAN SUBJECT TO PRELIMINARY FILE NO.: SP-07-009, F-08-198 & WP-09-043
 - THE PROPOSED WATER AND SEWER SYSTEMS SHALL BE PRIVATE.
 - THE SUBJECT PROPERTY IS LOCATED OUTSIDE OF THE METROPOLITAN DISTRICT.
 - TOPOGRAPHIC CONTOURS BASED ON AERIAL BY HARFORD AERIAL SURVEYS, INC., DATED APRIL 6, 2004.
 - THE LOTS SHOWN HEREON COMPLY WITH THE MINIMUM OWNERSHIP WIDTH AND LOT AREA AS REQUIRED BY THE MARYLAND STATE DEPARTMENT OF THE ENVIRONMENT.
 - BOUNDARY OUTLINE BASED ON FIELD RUM SURVEY PERFORMED BY FISHER, COLLINS & CARTER, INC. DATED JUNE 15, 2005.
 - SUBJECT PROPERTY ZONED RC-DEO PER THE 2004 ZONING REGULATIONS AND THE COMPLETE ZONING AMENDMENTS DATED 7/28/06.
 - THIS SUBDIVISION PLAN IS SUBJECT TO THE AMENDED FIFTH EDITION OF THE SUBDIVISION AND LAND DEVELOPMENT REGULATIONS AND THE 2004 ZONING REGULATIONS PER COUNCIL BILL NO. 45-2003 AND THE ZONING REGULATIONS AS AMENDED BY COUNCIL BILL NO. 75-2003. DEVELOPMENT OR CONSTRUCTION ON THESE LOTS OR PARCELS MUST COMPLY WITH SETBACK AND BUFFER REGULATIONS IN EFFECT AT THE TIME OF SUBMISSION OF A BUILDING OR GRADING PERMIT APPLICATION.
 - THESE ARE AREAS OF STEEP SLOPES (2% OR GREATER) LOCATED ON THIS PROPERTY AS DEFINED BY THE HOWARD COUNTY SUBDIVISION AND LAND DEVELOPMENT REGULATIONS, SECTION 81.06B. THESE AREAS ARE LOCATED WITHIN THE PRESERVATION PARCELS AND NOT ON THE RESIDENTIAL LOTS.
 - STORMWATER MANAGEMENT WILL BE PROVIDED IN ACCORDANCE WITH HOWARD COUNTY AND MARYLAND 2705 SPECIFICATIONS. THE PROPOSED STORMWATER MANAGEMENT FOR THIS SITE IS CHANNEL PROTECTION AND WATER QUALITY AND IS PROVIDED IN THE FOLLOWING FACILITIES:
 a. BMP #1 IS A MICRO-POOL EXTENDED DETENTION POND AND IS PRIVATELY OWNED BY HOA AND JOINTLY MAINTAINED BY HOA, AND HOWARD COUNTY, LOCATED ON NON-BUILDABLE PRESERVATION PARCEL 'D'.
 b. BMP #2, 3 & 4 ARE AGE LEVEL SPREADERS, PRIVATELY OWNED AND MAINTAINED BY HOMEOWNERS, LOCATED ON OR NEAR LOTS 1, 5 & 6 RESPECTIVELY.
 - THE NON-CRITICAL FLOODPLAIN STUDY FOR THIS PROJECT WAS PREPARED BY FISHER, COLLINS & CARTER, INC. DATED NOVEMBER, 2006, AND SUPERSEDED WITH INFORMATION OBTAINED FROM HUDCO CAPITAL PROJECT 01-075 AND WAS APPROVED UNDER SP-07-007.
 - AS PER SECTION 104.F.6 OF THE ZONING REGULATIONS, ONLY ONE EASEMENT HOLDER IS REQUIRED FOR PRESERVATION PARCELS DESIGNED SOLELY FOR SMH FACILITIES OR COMMUNITY SEWERAGE DISPOSAL SYSTEMS.
 A. NON-BUILDABLE PRESERVATION PARCEL 'C'
 B. NON-BUILDABLE PRESERVATION PARCEL 'D'
 EASEMENT HOLDERS: HOWARD COUNTY, MARYLAND & EASEMENT HOLDER: HOWARD COUNTY, MARYLAND
 USE: ENVIRONMENTAL PROTECTION (E.C.) USE: S.M.H.
 - NO CLEARING, GRADING OR CONSTRUCTION IS PERMITTED WITHIN THE WETLANDS, STREAM, FOREST CONSERVATION EASEMENT OR THEIR REQUIRED BUFFERS.
 - THE GEOTECHNICAL REPORT FOR THIS PROJECT WAS PREPARED BY PENNIPAN & BROWN DATED NOVEMBER, 2006.
 - THE FOREST STAND DELINEATION AND WETLAND DELINEATION FOR THIS PROJECT WAS PREPARED BY ECO-SCIENCE PROFESSIONALS, INC. DATED NOVEMBER, 2006 AND WAS APPROVED UNDER SP-07-007.
 - THE FOREST CONSERVATION REQUIREMENTS PER SECTION 81.020 OF THE HOWARD COUNTY CODE AND THE FOREST CONSERVATION MANUAL FOR MERIWETHER FARM, SECTION TWO, PHASE ONE SUBDIVISION WILL BE FULFILLED BY PROVIDING A TOTAL OF ON-SITE RETENTION OF 14,249 ACRES OF FOREST AND 8173 ACRES OF ON-SITE PLANTING.
 A. TOTAL FOREST RETENTION OBLIGATION FOR MERIWETHER FARM, SECTION TWO = 301 ACRES.
 B. REQUIRED FOREST RETENTION OBLIGATION FOR MERIWETHER FARM, SECTION TWO, PHASE ONE = 6.40 ACRES.
 C01 AC. OF TOTAL RETENTION/77 TOTAL DU. = 0.040 AC/DU. X 10 DU. = 0.40 AC.
 C. PROVIDED FOREST RETENTION CONSERVATION EASEMENT FOR MERIWETHER FARM, SECTION TWO, PHASE ONE = 14,249 AC.
 D. REQUIRED FOREST REFORESTATION OBLIGATION FOR MERIWETHER FARM, SECTION TWO, PHASE ONE = 4.55 AC.
 C24 AC. OF TOTAL REFORESTATION/77 TOTAL DU. = 0.405 AC/DU. X 10 DU. = 4.05 AC.
 E. PROVIDED FOREST REFORESTATION CONSERVATION EASEMENT FOR MERIWETHER FARM, SECTION TWO, PHASE ONE = 8173 AC.
 F. FOREST CONSERVATION SURETY AMOUNT REQUIRED IS \$302,146.00 (14,249 AC. X \$43,560 X \$0.20 = \$124,130) + \$0.373 X \$43,560 X \$0.50 = \$81,016.00 AND SHALL BE PROVIDED WITH THE DEVELOPER'S AGREEMENT.
 - THE LANDSCAPE SURETY IN THE AMOUNT OF \$335,000 FOR PERIMETER LANDSCAPE REQUIREMENTS (79 SHADE TREES AND 63 EVERGREEN TREES) OF SECTION 81.01 OF THE HOWARD COUNTY CODE AND LANDSCAPE MANUAL IS POSTED WITH THE DEVELOPER'S AGREEMENT FOR THIS SUBDIVISION.
 - FINANCIAL SURETY FOR THE 44 REQUIRED STREET TREES SHALL BE POSTED AS PART OF THE DEVELOPER'S AGREEMENT IN THE AMOUNT OF \$43,560.
 - ALL EXISTING WELLS AND SEPTIC FIELDS WITHIN 100 FEET OF SUBJECT PROPERTY HAVE BEEN SHOWN.
 - SIGN POSTS ALL SIGN POST USED FOR TRAFFIC CONTROL SIGNS INSTALLED IN THE COUNTY RIGHT-OF-WAY SHALL BE MOUNTED ON A 2" GALVANIZED STEEL, PERFORATED SQUARE TUBE POST IN GAUGE) INSERTED INTO A 2-1/2" GALVANIZED STEEL, PERFORATED SQUARE SLEEVE (2 GAUGES) - 3" GALVANIZED STEEL POLE CAP SHALL BE MOUNTED ON TOP OF EACH POST.
 - DRIVEWAY (S) SHALL BE PROVIDED PRIOR TO RESIDENTIAL OCCUPANCY TO ENSURE SAFE ACCESS FOR FIRE AND EMERGENCY VEHICLES PER THE FOLLOWING MINIMUM REQUIREMENTS:
 A) WIDTH = 12 FEET OR FEET SERVING MORE THAN ONE RESIDENCE)
 B) SURFACE = SIX (6) INCHES OF COMPACTED CRUSHED RUN BASE WITH TAR AND CHIP COATING
 C) GEOMETRY - MAXIMUM 1% GRADE MAXIMUM 15' TURNING RADIUS
 D) STRUCTURES (CULVERTS/BRIDGES) CAPABLE OF SUPPORTING 25,000 LB. TONS LOADING
 E) DRAINAGE ELEMENTS CAPABLE OF SAFELY PASSING 100 YEAR FLOOD WITH NO MORE THAN 1' FOOT DEPTH OVER DRIVEWAY SURFACE
 F) STRUCTURE CLEARANCES - MINIMUM 12 FEET
 G) MAINTENANCE - SUFFICIENT TO ENSURE ALL WEATHER USE.
 - GROUND WATER APPROPRIATION PERMIT SHALL BE ISSUED PRIOR TO SUBMISSION OF RECORD PLAT FOR SIGNATURE.
 - ALL WELLS TO BE DRILLED PRIOR TO FINAL PLAT APPROVAL. IT IS THE DEVELOPER'S RESPONSIBILITY TO SCHEDULE THE WELL DRILLING PRIOR TO FINAL PLAT SUBMISSION. IT WILL NOT BE CONSIDERED "GOVERNMENT DELAY" IF THE WELL DRILLING HOLDS UP THE HEALTH DEPARTMENT SIGNATURE OF THE RECORD PLAT.
 - THERE IS AN EXISTING DWELLING(STRUCTURE) ON BUILDABLE BULK PARCEL 'E' TO REMAIN. NO NEW BUILDINGS, EXTENSIONS OR ADDITIONS TO THE EXISTING DWELLING ARE TO BE CONSTRUCTED AT A DISTANCE LESS THAN THE ZONING REGULATION REQUIREMENTS.
 - ALL EXISTING WELLS, BUILDINGS AND SEPTIC SYSTEMS WHICH ARE TO BE REMOVED SHALL BE REMOVED PRIOR TO FINAL PLAT SIGNATURE.
 - THIS AREA DESIGNATES A PRIVATE SEWAGE EASEMENT OF AT LEAST 10,000 SQUARE FEET AS REQUIRED BY THE MARYLAND STATE DEPARTMENT OF THE ENVIRONMENT FOR INDIVIDUAL SEWAGE DISPOSAL (SCDAR 26.030). IMPROVEMENTS OF ANY NATURE IN THIS AREA ARE RESTRICTED UNTIL PUBLIC SEWAGE IS AVAILABLE. THESE EASEMENTS SHALL BECOME NULL AND VOID UPON CONNECTION TO A PUBLIC SEWAGE SYSTEM. THE COUNTY HEALTH OFFICER SHALL HAVE THE AUTHORITY TO GRANT VARIANCES FOR ENCROACHMENTS INTO THE PRIVATE SEWAGE EASEMENT. RECORDATION OF A PRIVATE SEWAGE EASEMENT SHALL NOT BE NECESSARY.
 - THIS PLAN IS SUBJECT TO WAIVER PETITION WP-09-043 WHICH WAS APPROVED ON OCTOBER 23, 2008 BY HOWARD COUNTY DEVELOPMENT ENGINEERING DIVISION FROM SECTION 81.02 OF THE HOWARD COUNTY SUBDIVISION AND LAND DEVELOPMENT REGULATIONS TO ALLOW FOR THE PHASING OF FOREST CONSERVATION AREA FOR THIS PROJECT WITH THE FOLLOWING CONDITIONS:
 1. THE WAIVER PETITION APPROVAL APPLIES ONLY TO THE TEMPORARY DEFERRAL FOR ESTABLISHING THE FOREST CONSERVATION EASEMENTS FOR THIS SUBDIVISION BASED ON THE APPROPRIATE SCHEDULE FOR THIS PROJECT. EACH SUBSEQUENT PHASE OF DEVELOPMENT MUST ESTABLISH A PROPORTIONATE AREA OF FOREST CONSERVATION EASEMENTS AND PROVIDE THE NECESSARY AREA OF FOREST RETENTION AND AFForestation PLANTING AS REQUIRED BY THE FOREST CONSERVATION WORKSHEET FOR THIS PROJECT TO SATISFY ITS OBLIGATION. THE ENTIRE AREA OF FOREST CONSERVATION OBLIGATION MUST BE PROVIDED WITH THE PROCESS AND RECORDING OF THE LAST PHASE OF DEVELOPMENT FOR THIS PROJECT.
 2. THE APPLICANT/DEVELOPER MUST CONTINUE PROCESSING THE SUBDIVISION PLANS FOR MERIWETHER FARM AND MUST ALL APPLICABLE PROCESSING DEADLINE DATES IN ACCORDANCE WITH THE APPROVED APPG PHASING SCHEDULE.

ROADWAY INFORMATION CHART


ROAD NAME	CLASSIFICATION	DESIGN SPEED	R/W WIDTH
VICTORY LANE	PUBLIC ACCESS PLACE	25 MPH	50'

TRAFFIC CONTROL SIGNS

ROAD NAME	CENTERLINE STA.	OFFSET	POSTED SIGN	SIGN CODE
VICTORY LANE	0+25	16' L	STOP	RS-1
VICTORY LANE	2+10	11' R	SPEED LIMIT 25	RS-1

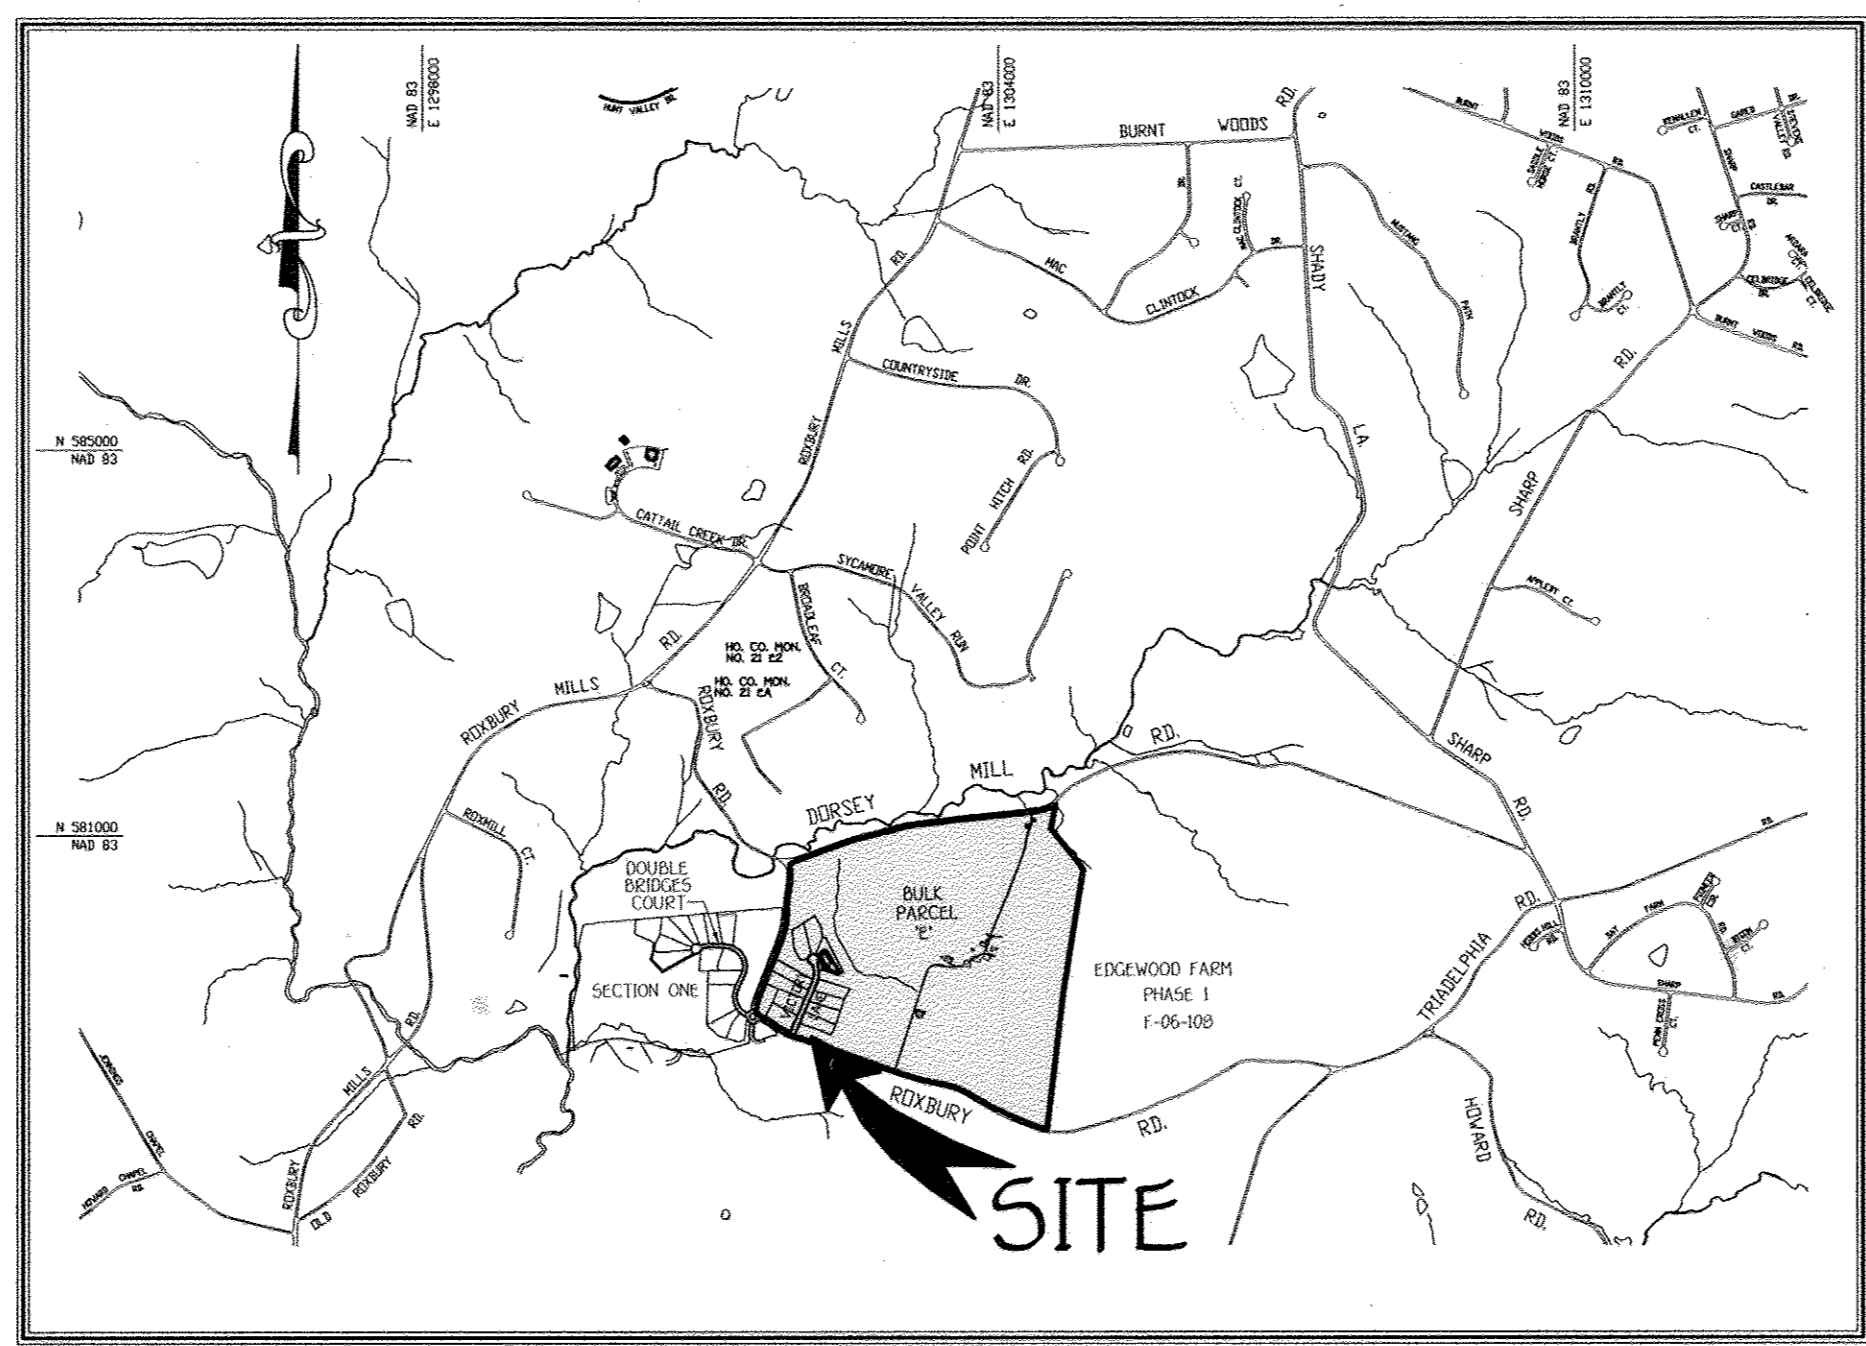

**FOURTH ELECTION DISTRICT
HOWARD COUNTY, MARYLAND**

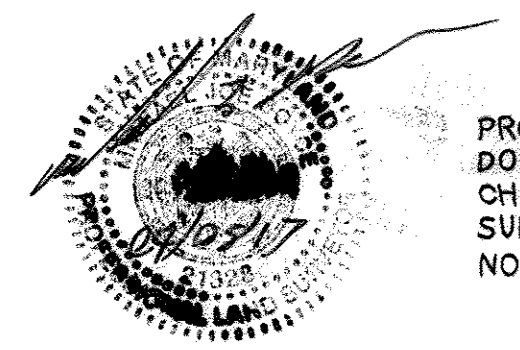

PROFESSIONAL CERTIFICATION: I HEREBY CERTIFY THAT THESE DOCUMENTS WERE PREPARED BY ME OR UNDER MY RESPONSIBLE CHARGE, AND THAT I AM A DULY LICENSED PROFESSIONAL LAND SURVEYOR UNDER THE LAWS OF THE STATE OF MARYLAND, LICENSE NO. 21328, EXPIRATION DATE 1/08/19.

NO.	REVISIONS	DATE
2	REVISED SWM LOTS 1, 5 & 6	2/28/17
1	REVISED OWNER AND DEVELOPER AND REVISIONS TO PARCELS 'C' & 'D'	11/9/11

FISHER, COLLINS & CARTER, INC.
 CIVIL ENGINEERING CONSULTANTS & LAND SURVEYORS
 CENTRAL SQUARE OFFICE PARK - 10222 BALTIMORE NATIONAL PIKE
 ELICOTT CITY, MARYLAND 21042
 (410) 461-2055

RIGHT-OF-WAY PINS SET

POINT#	NORTHING	EASTING
810	678007.90450	1507883.44230
821	678041.34770	1507929.02630
862	678036.16230	150815.09870
863	678027.06740	150818.07300
864	678469.47980	1502022.82310
865	678444.74420	1502046.79850
866	678600.38350	1502048.74320
867	678682.07800	1502111.00200
868	678660.57940	1502108.23400
869	678440.47040	1502098.68060
870	678007.03410	1501808.56100
871	678036.63650	1501878.31550

FOR ESE CONSULTANTS, INC.

PHASING TABULATION

PHASE	ALLOCATION YEAR	No. OF LOTS
ONE	2010	10
TWO	2011	36 AND 1 BUILDABLE PRESERVATION PARCEL = 37

OWNER
 MERIWETHER FARM II, LLC
 c/o SECOND GOODER, LLC
 10715 CHATELIER DRIVE
 SUITE 350
 COLUMBIA, MARYLAND 21044
 PH: (410) 977-7501
 ATTN: MR. ROBERT G. GOODER, JR.

DEVELOPER
 TOLL BROTHERS, INC.
 MARYLAND DIVISION
 7104 COLUMBIAN ANTWAY DRIVE
 SUITE 200
 COLUMBIA, MARYLAND 21046
 PH: (410) 977-7501
 ATTN: MR. JEFF DEBICOLI

DENSITY TABULATIONS

- ORIGINAL BASE DENSITY IS BASED ON ORIGINAL TRACT AREA OF 183,068 ACRES INCLUDING DORSEY MILL ROAD AND ROXBURY ROAD DEDICATED RIGHT-OF-WAY SEE F-08-198
- BASE DENSITY: 183,068 ACRES / 4,225 = 43.07 UNITS OR 43 SINGLE FAMILY DETACHED HOMES
- 43 LOTS (14-46) = 183,068 - (49,52 AC. LOT AREA - 10.89 AC. ROAD R/W - 10.82 AC. NON-BUILDABLE PARCELS) = 112,638 AC.
- 112,638 AC. FOR PRESERVATION PARCEL 'A' / 25 AC. = 4 BONUS UNITS.
- BONUS UNITS ARE LOTS 1, 2, 3 & BUILDABLE PRESERVATION PARCEL 'A'
- MAXIMUM DENSITY: 183,068 ACRES - 6.79 AC. FLOODPLAIN - 3.81 AC. STEEP SLOPES / 2 = 85,239 UNITS OR 85 SINGLE FAMILY DETACHED HOMES
- TOTAL NUMBER OF PROPOSED DWELLING UNITS = 47
 a. PHASE ONE - 10 BUILDABLE LOTS
 b. PHASE TWO - 36 BUILDABLE LOTS AND 1 BUILDABLE PRESERVATION PARCEL
- PRESERVATION EASEMENT TABULATION FOR SECTION TWO, PHASE ONE:
 A. TOTAL PRESERVATION EASEMENT OBLIGATION = 42.80 ACRES
 10 LOTS X 4.28 AC. / LOT = 42.80 ACRES
 B. PRESERVATION EASEMENT REQUIRED = 29.82 ACRES
 CITAL PRESERVATION AREA - LOT 1066 - VICTORY LANE AREA - ROAD DEDICATION (PLAT NO. 11-50 AC. = 11,000 AC. - 11,992 AC. - 4,479 AC. = 29,822 ACRES)
 C. PRESERVATION EASEMENT PROVIDED = 29,822 ACRES
 (NON-BUILDABLE PRESERVATION PARCELS 'C' & 'D' AND PRESERVATION EASEMENT #1) (1,066 AC. + 1,977 AC. + 23,410 ACRES)






Professional Engineer I hereby certify that these documents were prepared by me, and that I am a duly Licensed Professional Engineer under the laws of the State of Maryland, License No. 20748, Expiration Date 2-22-09.

**TITLE SHEET
MERIWETHER FARM
SECTION TWO
PHASE ONE
BUILDABLE LOTS 1 THRU 10, NON-BUILDABLE PRESERVATION
PARCELS 'C' & 'D' AND BUILDABLE BULK PARCEL 'E'**
 (A RESUBDIVISION OF BUILDABLE BULK PARCEL 'A', MERIWETHER FARM,
SECTION TWO, F-08-198)

ZONED: RC-DEO
 PARCEL No. 28 GRID No. 15, 16, 21 & 22
 FOURTH ELECTION DISTRICT
 HOWARD COUNTY, MARYLAND
 SCALE: AS SHOWN
 DATE: DECEMBER, 2008
 SHEET 1 OF 15


ASBUILT

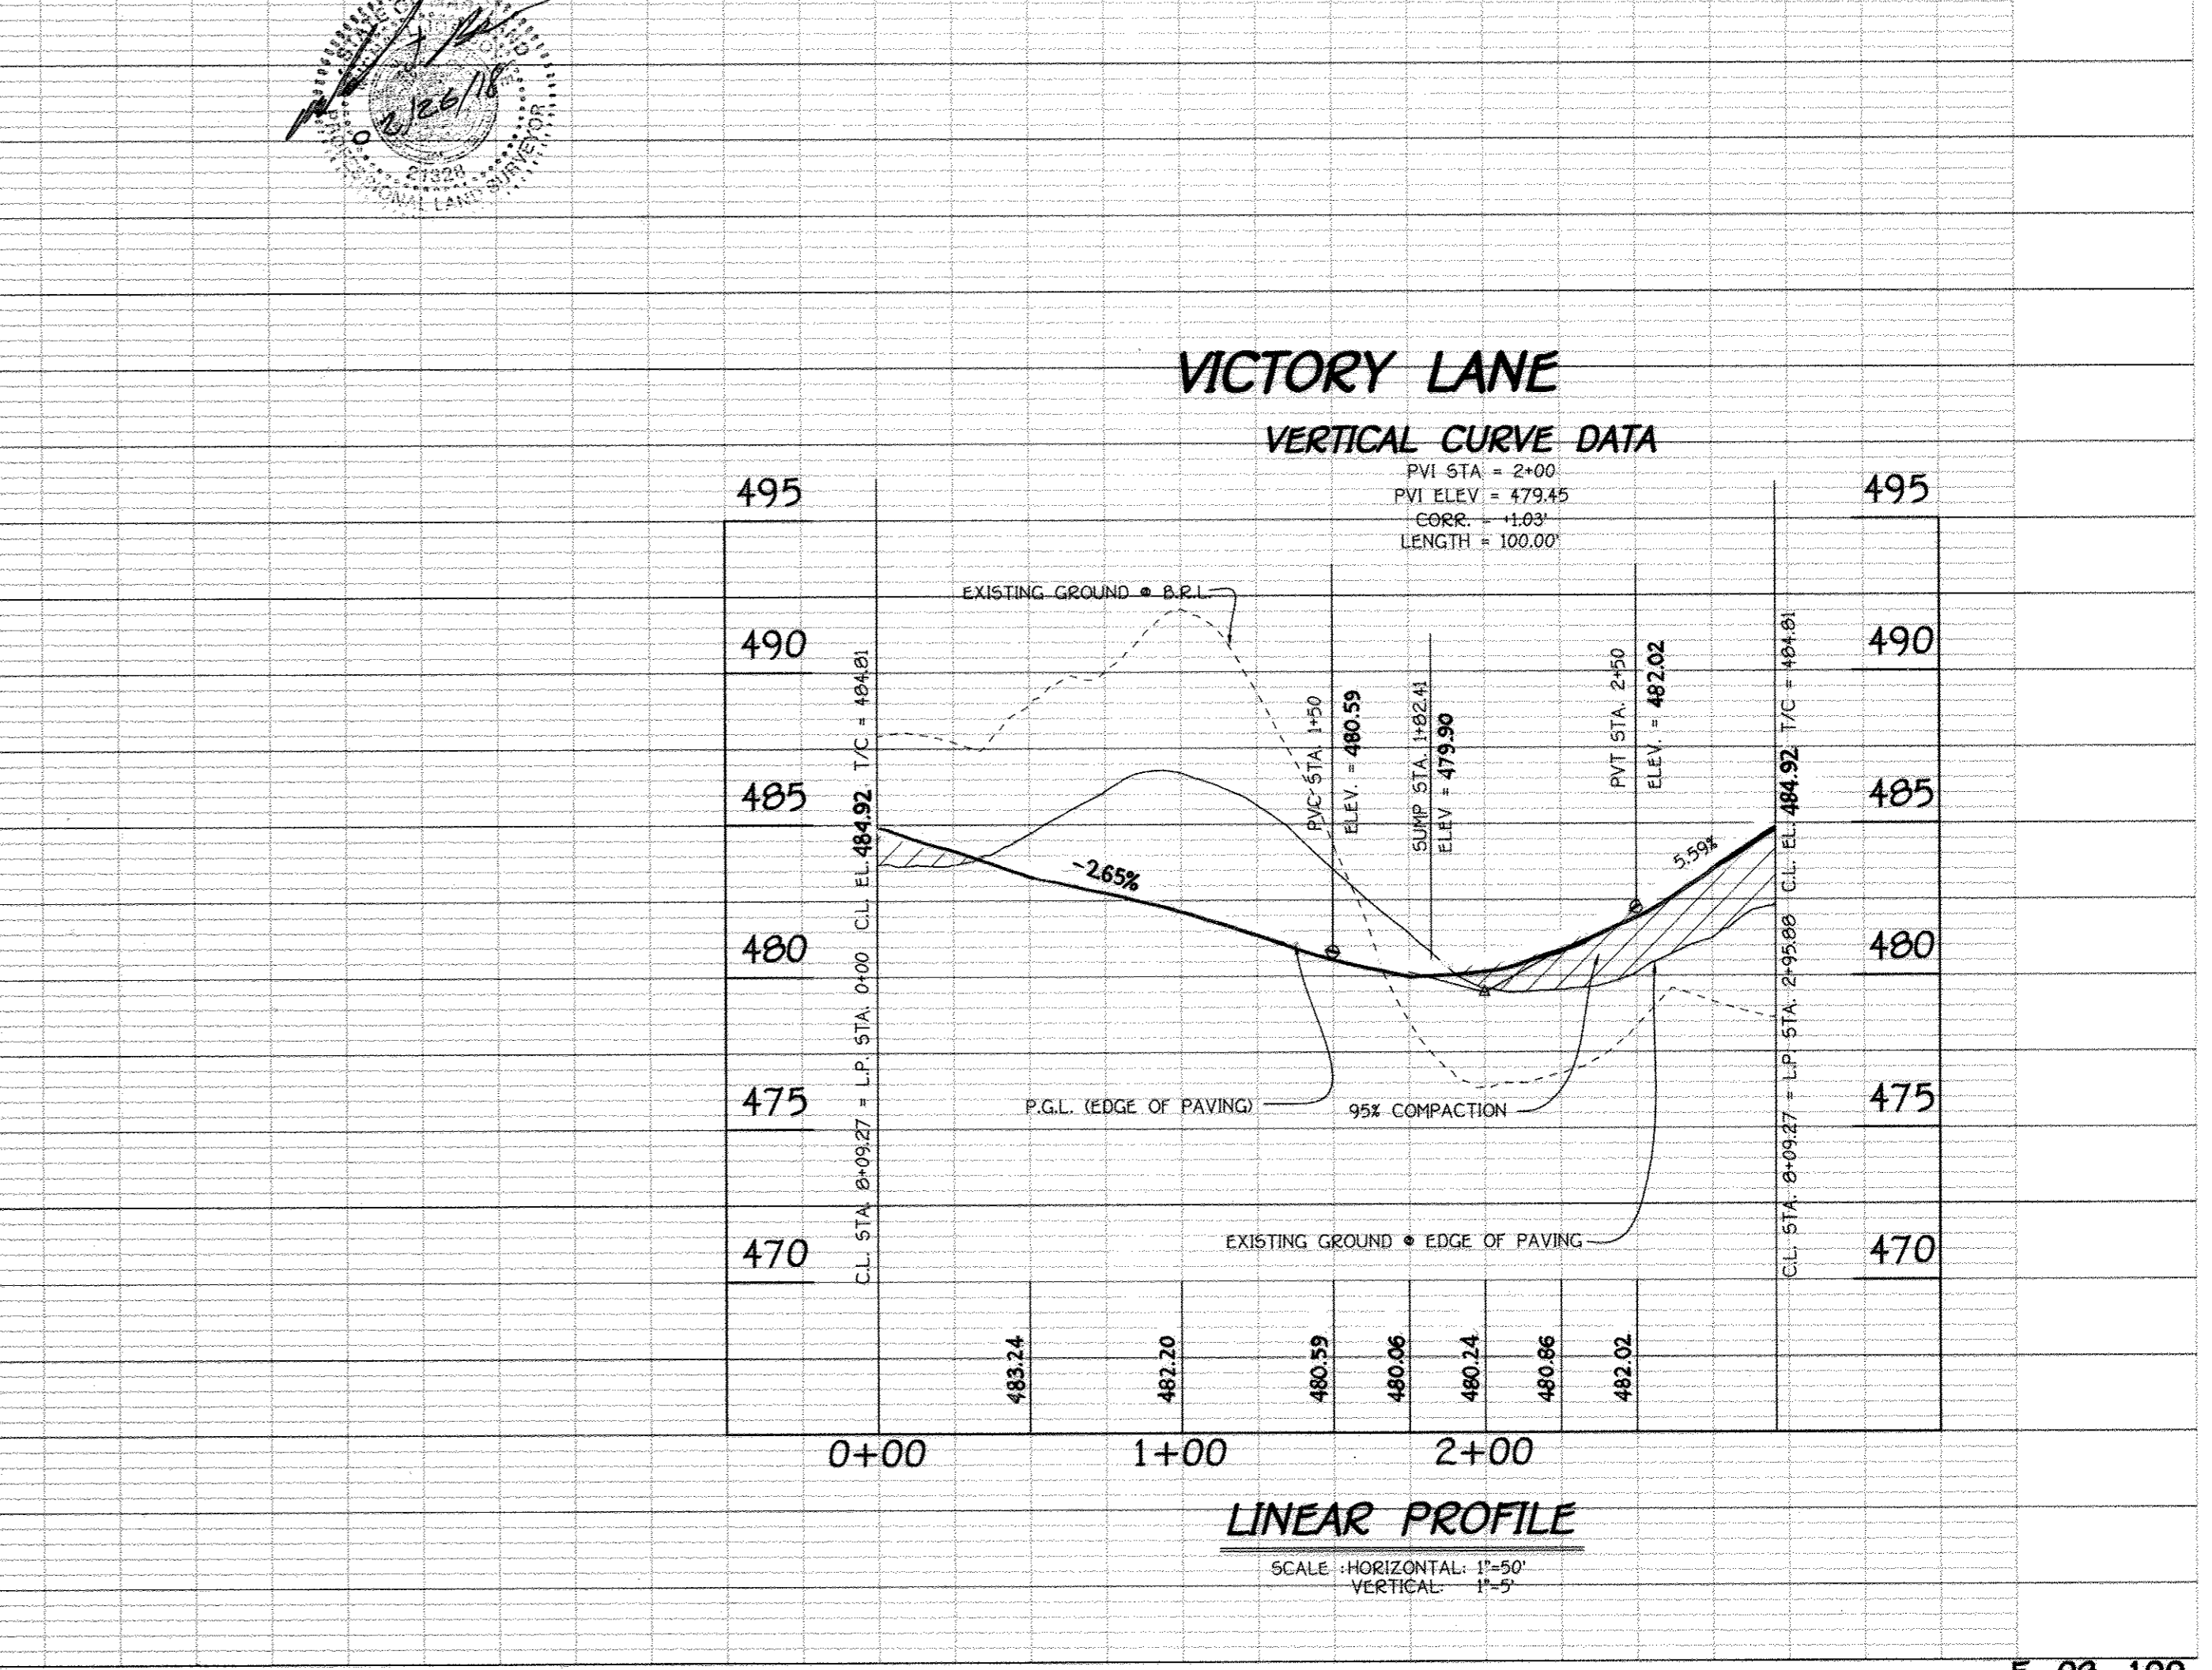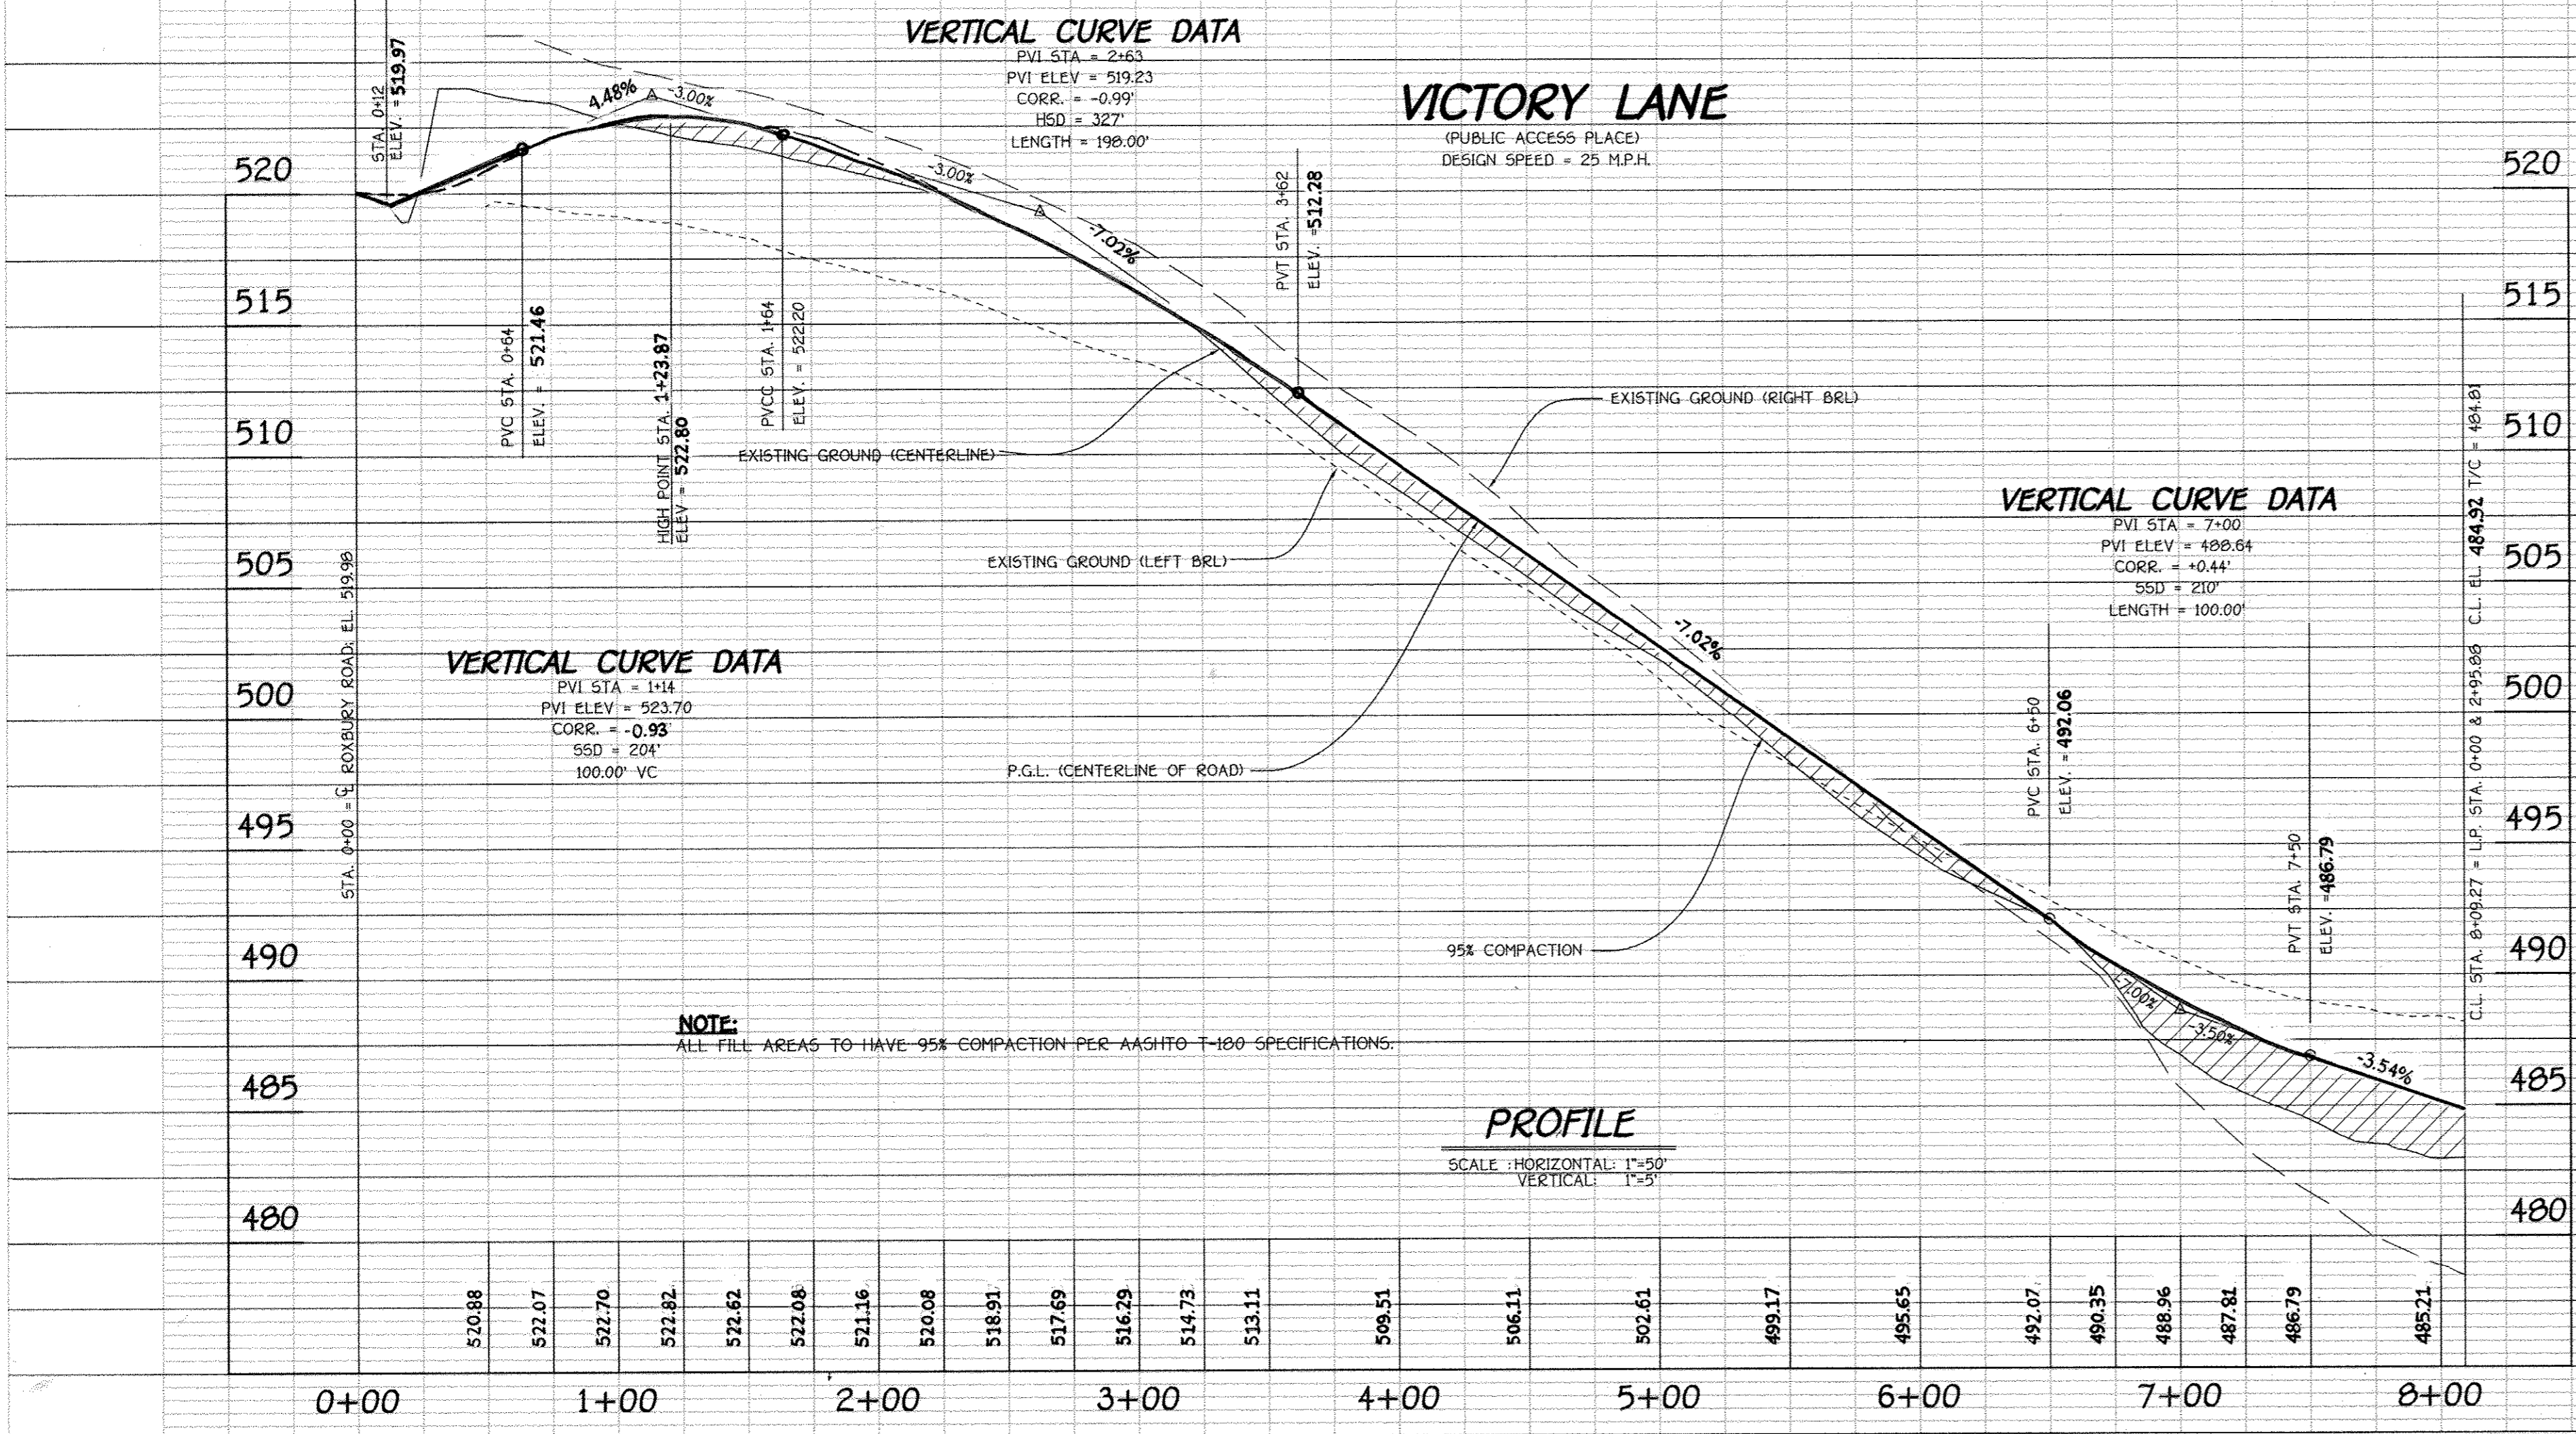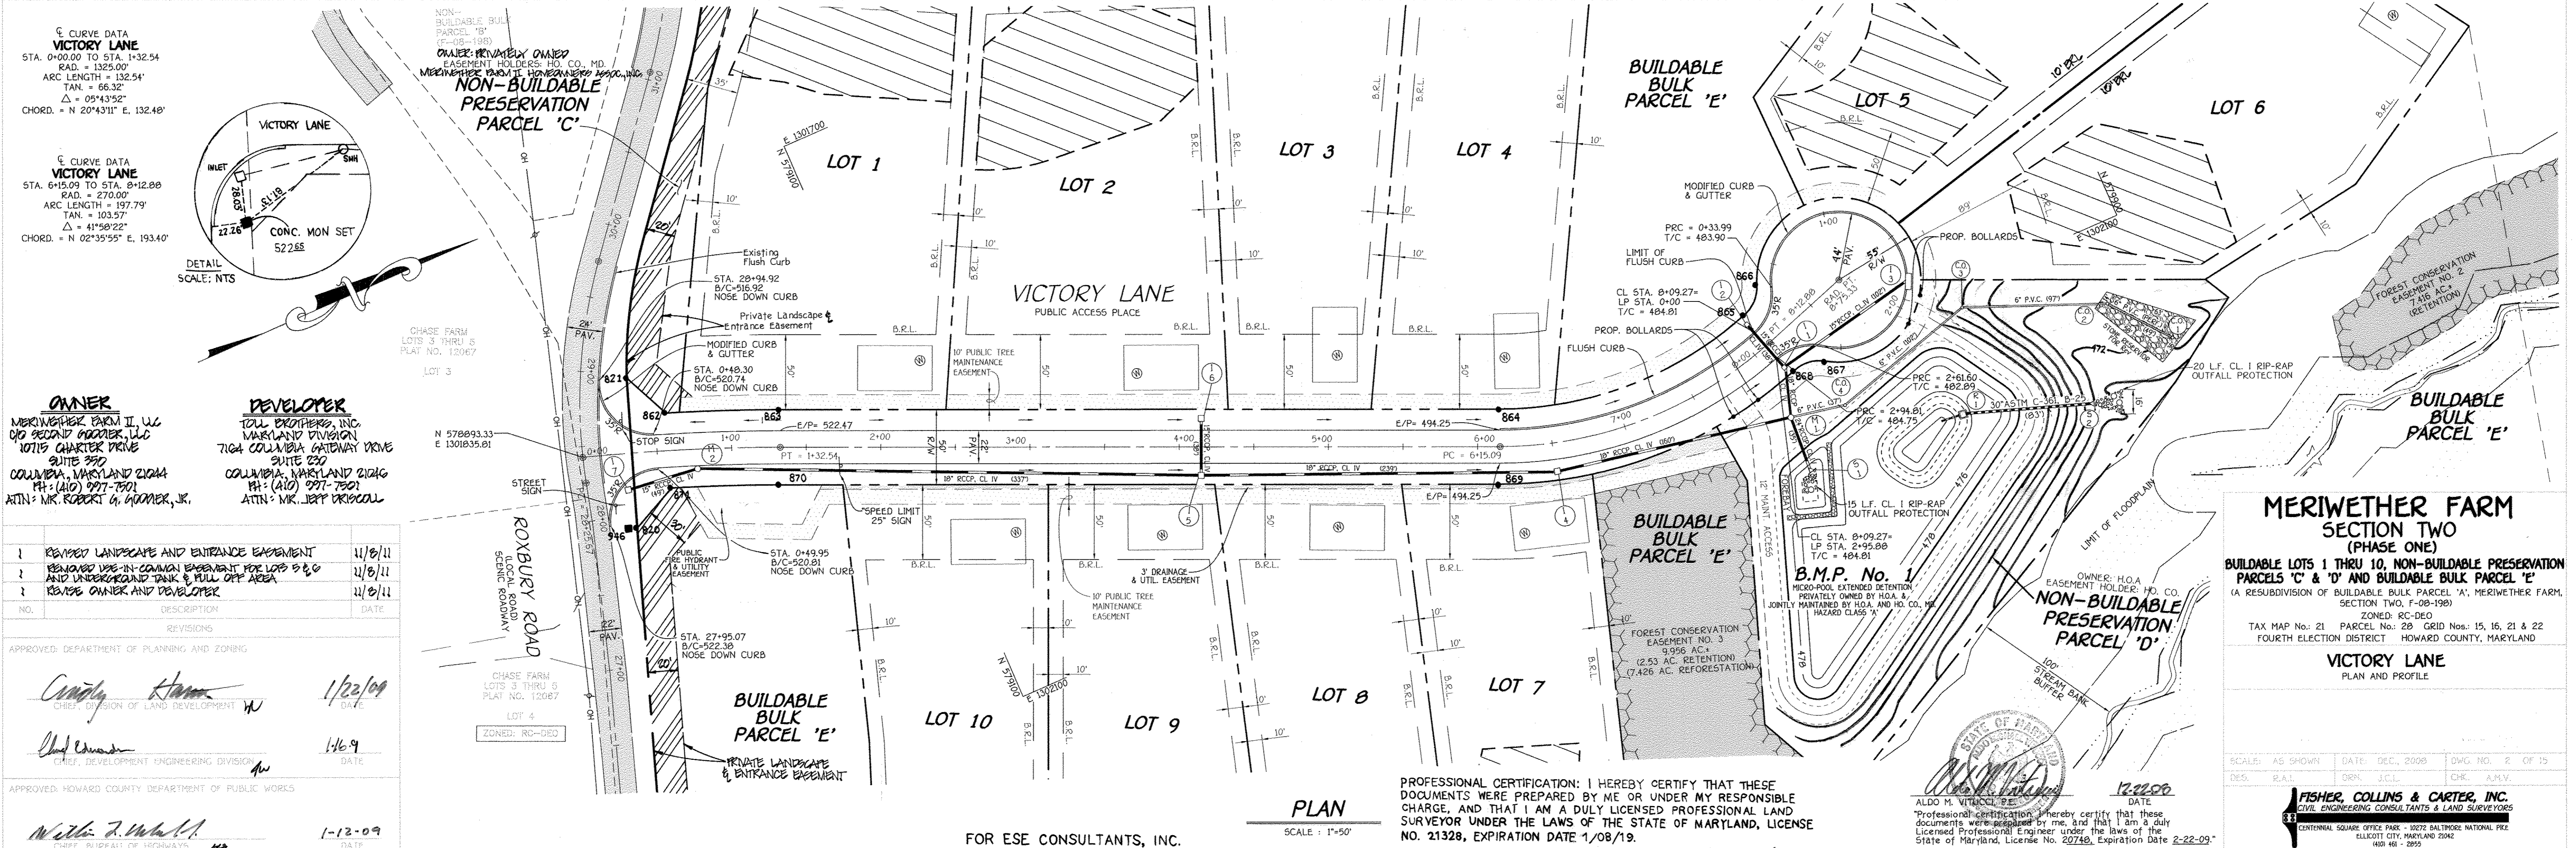

STREET TREE SCHEDULE				
SYMBOL	QTY.	BOTANICAL AND COMMON NAME	SIZE	COMMENTS
	075.33 x 2 / 40 = 43.77 44 TREES	PRUNUS SARGENTII SARGENT CHERRY	2 1/2"-3" CAL.	40' APART ON PUBLIC R/W

NOTE: STREET TREE TYPES ARE ONLY A RECOMMENDATION AND MAY BE SUBSTITUTED WITH A COUNTY ACCEPTED EQUIVALENT FROM THE HOWARD COUNTY LANDSCAPE MANUAL. FINANCIAL SURETY FOR THE 44 REQUIRED STREET TREES HAS BEEN POSTED AS PART OF THE DEVELOPER'S AGREEMENT IN THE AMOUNT OF \$13,200.00

LEVEL SPREADING DEVICE SUMMARY					
L.S. NO.	TRENCH LENGTH	TRENCH WIDTH & DEPTH	WQV VOLUME REQUIRED	WQV VOLUME PROVIDED	CREST ELEVATION
BMP 2	105'	-	- CU. FT.	- CU. FT.	513.0
BMP 3	58'	-	- CU. FT.	- CU. FT.	480.0
BMP 4	48'	108"	- CU. FT.	- CU. FT.	478.0 473.0

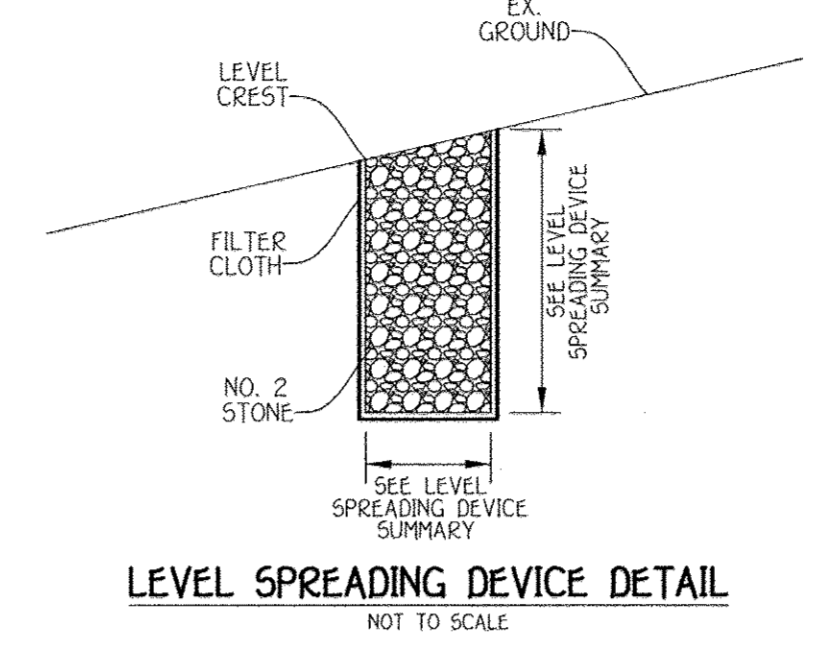

By The Developer:
 I/We Certify that All Development And/Or Construction Will Be Done According To These Plans, And That Any Responsible Personnel Involved In The Construction Project Will Have A Certificate Of Attendance At A Department Of The Environment Approved Training Program For The Control Of Sediment And Erosion Before Beginning The Project. I Shall Engage A Registered Professional Engineer To Supervise Pond Construction And Provide The Howard Soil Conservation District With An "As-Built" Plan Of The Pond Within 30 Days Of Completion. I Also Authorize Periodic On-Site Inspections By The Howard Soil Conservation District.

Signature of Developer: *Robert Goodwin* Date: 12-22-08
 Printed Name Of Developer: Robert Goodwin

By The Engineer:
 I Certify That This Plan For Pond Construction, Erosion And Sediment Control Represents A Practical And Workable Plan Based On My Personal Knowledge Of The Site Conditions. This Plan Was Prepared In Accordance With The Requirements Of The Howard Soil Conservation District. I Have Advised The Developer That He/She Must Engage A Registered Professional Engineer To Supervise Pond Construction And Provide The Howard Soil Conservation District With An "As-Built" Plan Of The Pond Within 30 Days Of Completion.

Signature of Engineer: *[Signature]* Date: 12-22-08
 Printed Name Of Engineer: [Name]

These Plans For Small Pond Construction, Soil Erosion And Sediment Control Meet The Requirements Of The Howard Soil Conservation District.

Signature of Public Works: *[Signature]* Date: 1/6/09
 Printed Name Of Public Works: [Name]
 Chief, Bureau of Highways

Signature of Planning and Zoning: *[Signature]* Date: 1/23/09
 Printed Name Of Planning and Zoning: [Name]
 Chief, Development Engineering Division


AS-BUILT CERTIFICATION
 I Herby Certify That The Facility Shown On This Plan Was Constructed As Shown On The "As-Built" Plans And Meets The Approved Plans And Specifications.

Signature: _____ P.E. No. _____
 Date: _____


Certify Means To State Or Declare A Professional Opinion Based Upon Onsite Inspections And Material Tests Which Are Conducted During Construction. The Onsite Inspections And Material Tests Are Those Inspections And Tests Deemed Sufficient And Appropriate Commonly Accepted Engineering Standards. Certify Does Not Mean Or Imply A Guarantee By The Engineer Nor Does An Engineer's Certification Relieve Any Other Party From Meeting Requirements Imposed By Contract, Employment, Or Other Means, Including Meeting Commonly Accepted Industry Practices.

NOTE:
 CONTRACTOR SHALL REMOVE ANY AND ALL JUNK, DEBRIS AND TRASH FROM WITHIN THE FLOODPLAIN, BUFFERS AND PRESERVATION PARCELS.

- LEGEND**
- S/SF—S/SF—S/SF— SUPER-SILT FENCE
 - SF—SF—SF— SILT FENCE
 - S.C.E. STABILIZED CONSTRUCTION ENTRANCE
 - EARTH DIKE
 - L.O.D. DENOTES LIMITS OF DISTURBANCE
 - E.C.M. DENOTES EROSION CONTROL MATTING
 - DENOTES SLOPES 25% OR GREATER
 - DENOTES SLOPES 15% TO 24.99%

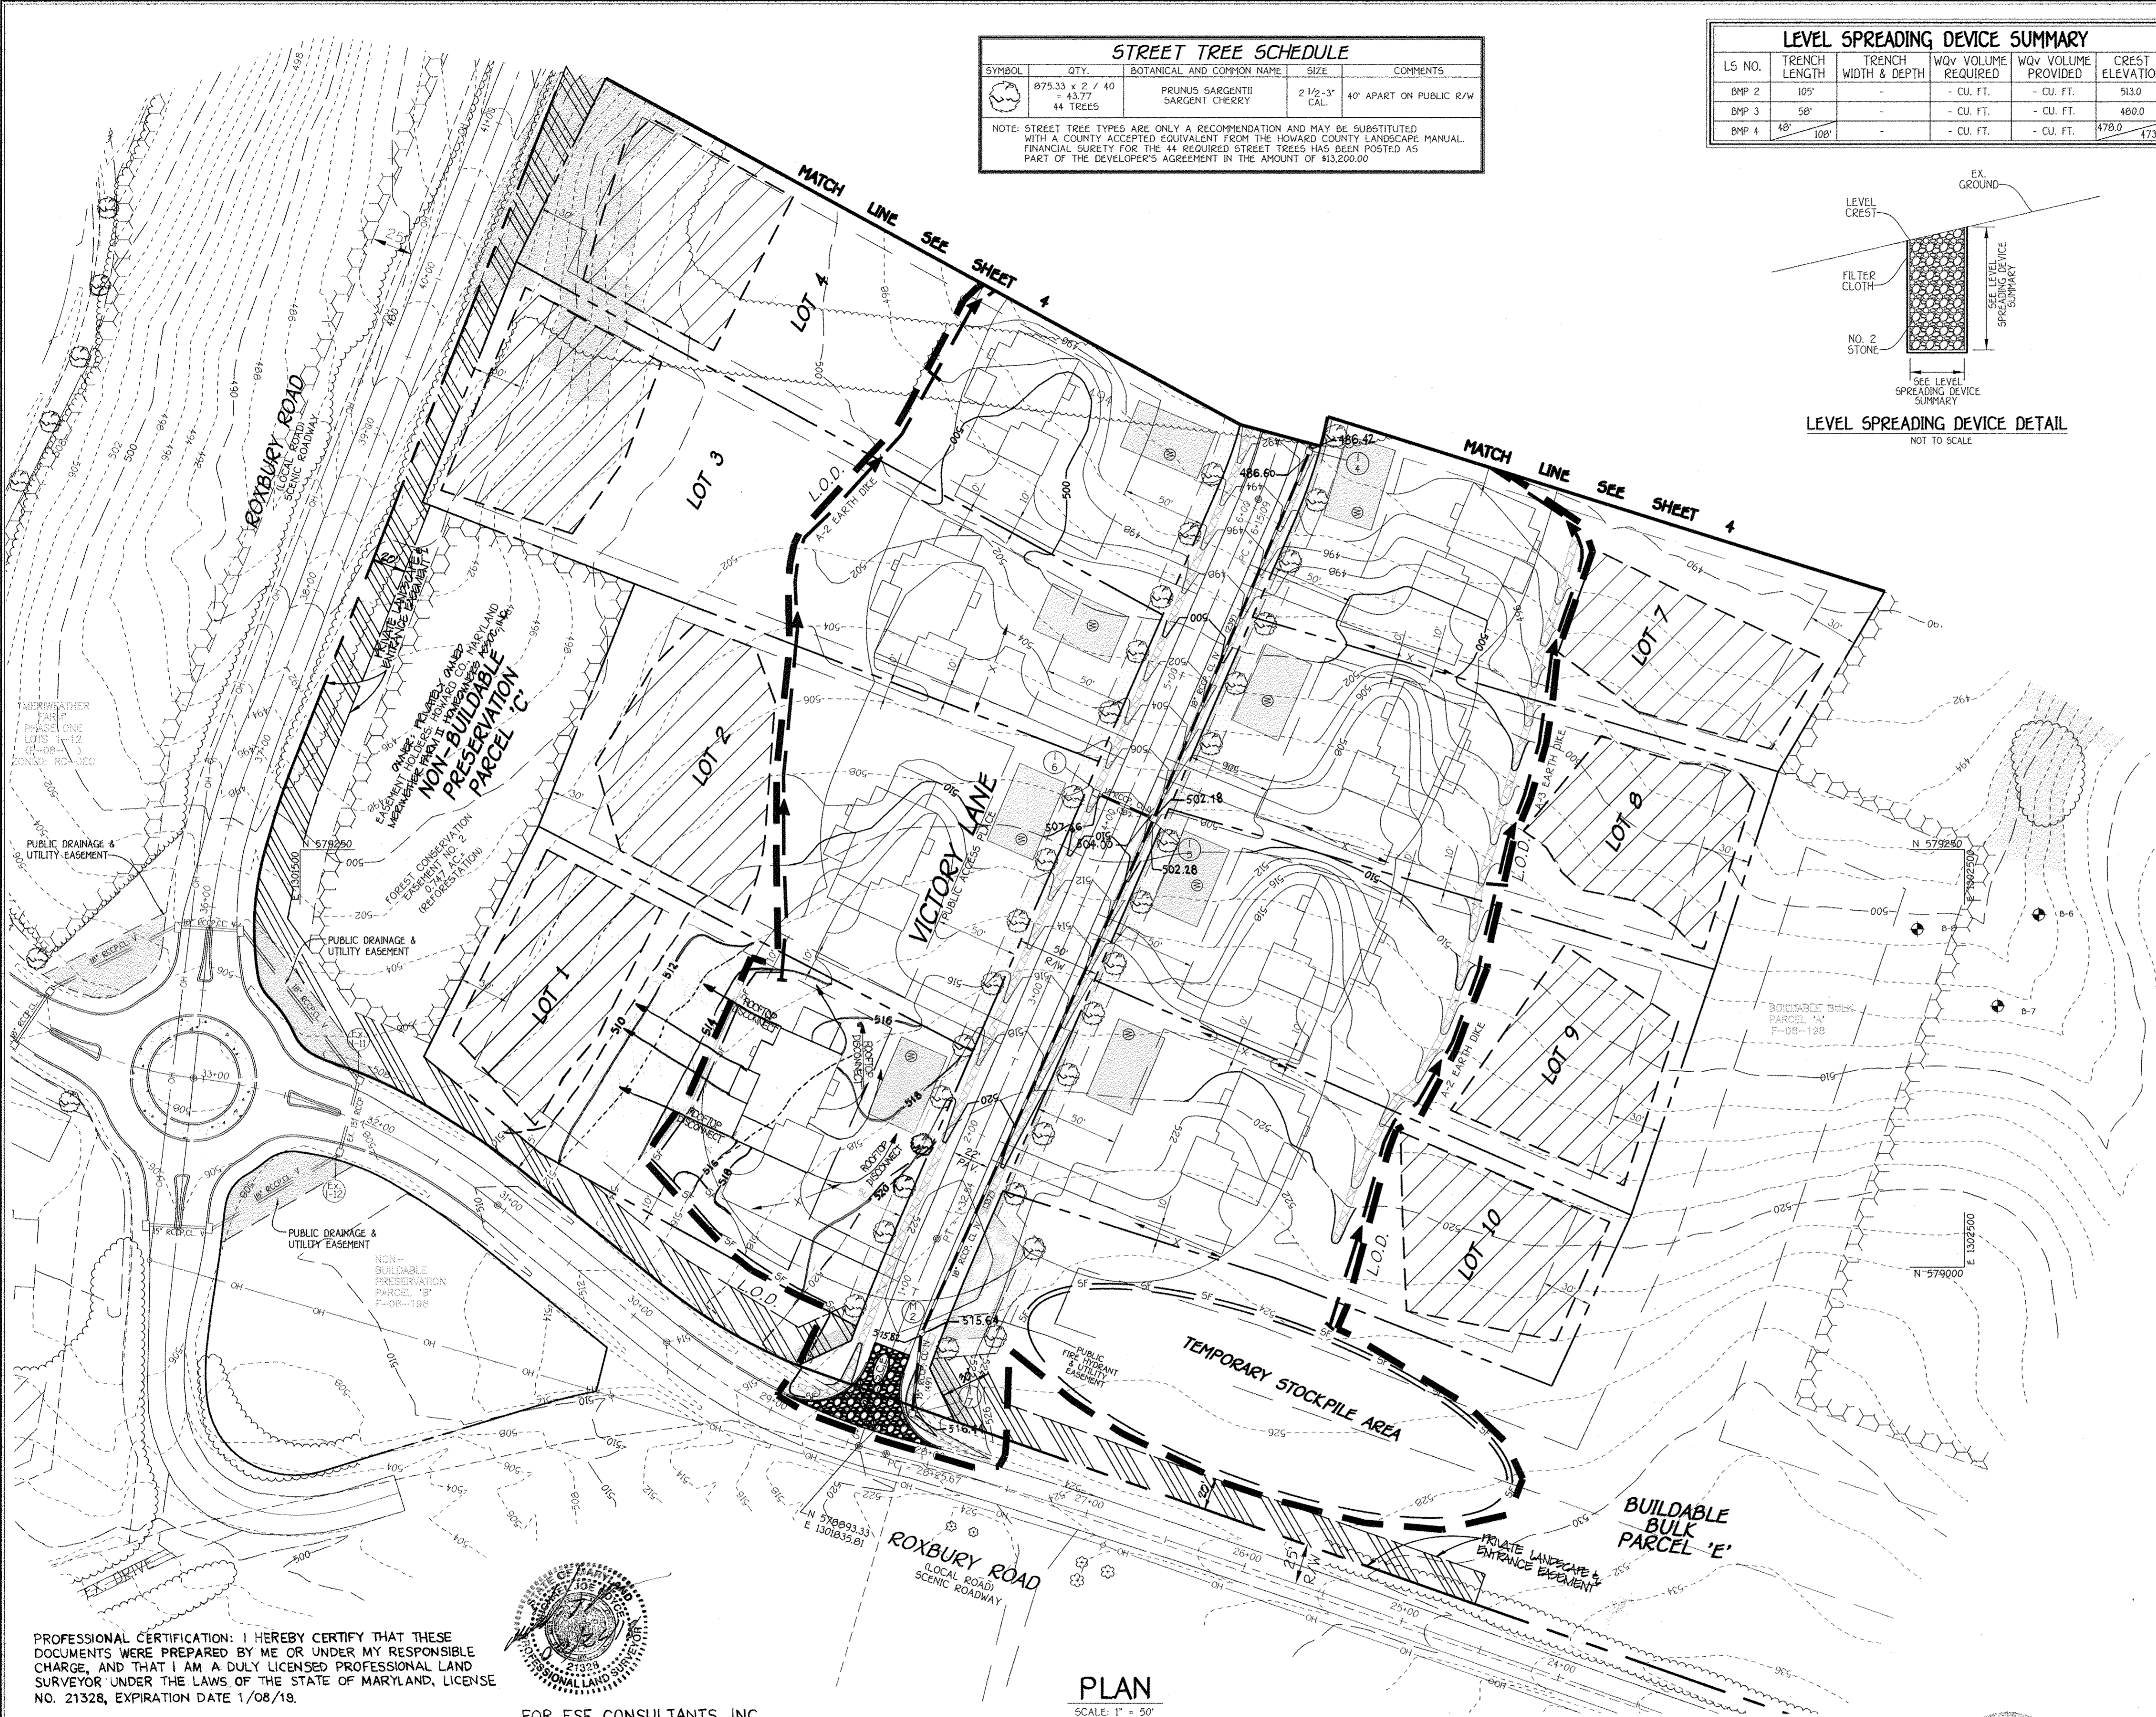

PROFESSIONAL CERTIFICATION: I HEREBY CERTIFY THAT THESE DOCUMENTS WERE PREPARED BY ME OR UNDER MY RESPONSIBLE CHARGE, AND THAT I AM A DULY LICENSED PROFESSIONAL LAND SURVEYOR UNDER THE LAWS OF THE STATE OF MARYLAND, LICENSE NO. 21328, EXPIRATION DATE 1/08/19.

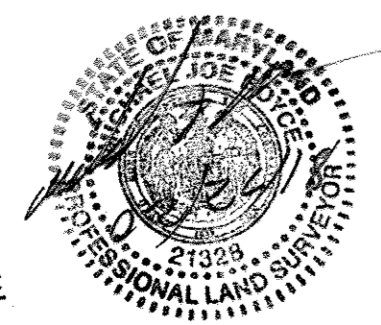

FOR ESE CONSULTANTS, INC.


PLAN
 SCALE: 1" = 50'

NO.	DESCRIPTION	REVISIONS
2	REVISED SWM ON LOTS 1, 5 & 6	2/28/17
1	REVISED LANDSCAPE AND ENTRANCE EMBELEM	11/0/11
1	REMOVED USE-IN-COMMON EMBELEM FOR LOTS 5 & 6 AND UNDERGROUND TANK & FILL OFF AREA	11/0/11
1	REVISE OWNER AND DEVELOPER	11/0/11

FISHER, COLLINS & CARTER, INC.
 CIVIL ENGINEERING CONSULTANTS & LAND SURVEYORS
 CENTRAL SQUARE OFFICE PARK - 10272 BALTIMORE NATIONAL PIKE
 ELLICOTT CITY, MARYLAND 21042
 (410) 461-3900


OWNER
 MERIWETHER FARM II, LLC
 C/O ROBERT GOODWIN, LLC
 10715 CHATEAU DRIVE
 SUITE 300
 COLUMBIA, MARYLAND 21044
 PH: (410) 297-7501
 ATTN: MR. ROBERT G. GOODWIN, JR.

DEVELOPER
 TOWL BROTHERS, INC.
 MARLAND DIVISION
 7104 COLUMBIA ANTWERP DRIVE
 SUITE 230
 COLUMBIA, MARYLAND 21044
 PH: (410) 297-7501
 ATTN: MR. JEFF DRISCOLL

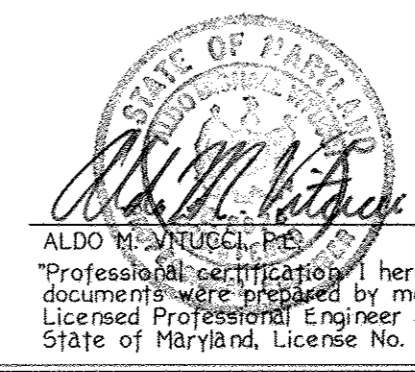

ALDO M. VITELLO, P.E.
 I hereby certify that these documents were prepared by me, and that I am a duly Licensed Professional Engineer under the laws of the State of Maryland, License No. 20740, Expiration Date 2-22-09.

Date: 12-22-08

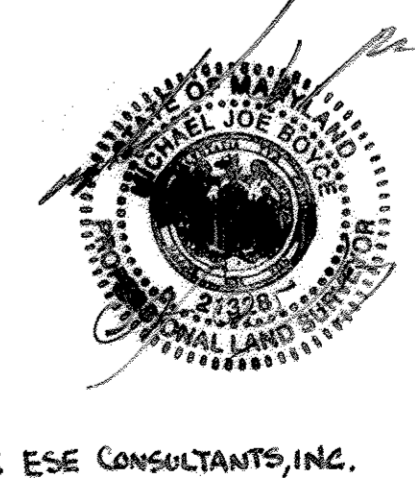


FOR ESE CONSULTANTS, INC.

STREET TREE, GRADING & SEDIMENT CONTROL PLAN
MERIWETHER FARM
SECTION TWO
PHASE ONE
BUILDABLE LOTS 1 THRU 10, NON-BUILDABLE PRESERVATION PARCELS 'C' & 'D' AND BUILDABLE BULK PARCEL 'E'
 (A RESUBDIVISION OF BUILDABLE BULK PARCEL 'A', MERIWETHER FARM, SECTION TWO, F-08-198)

TAX MAP NO. 21 PARCEL NO. 28 GRID NOS: 15, 16, 21 & 22
 ZONED: RC-DC
 FOURTH ELECTION DISTRICT
 HOWARD COUNTY, MARYLAND
 SCALE: AS SHOWN
 DATE: DECEMBER, 2008
 SHEET 3 OF 15

ASBUILT

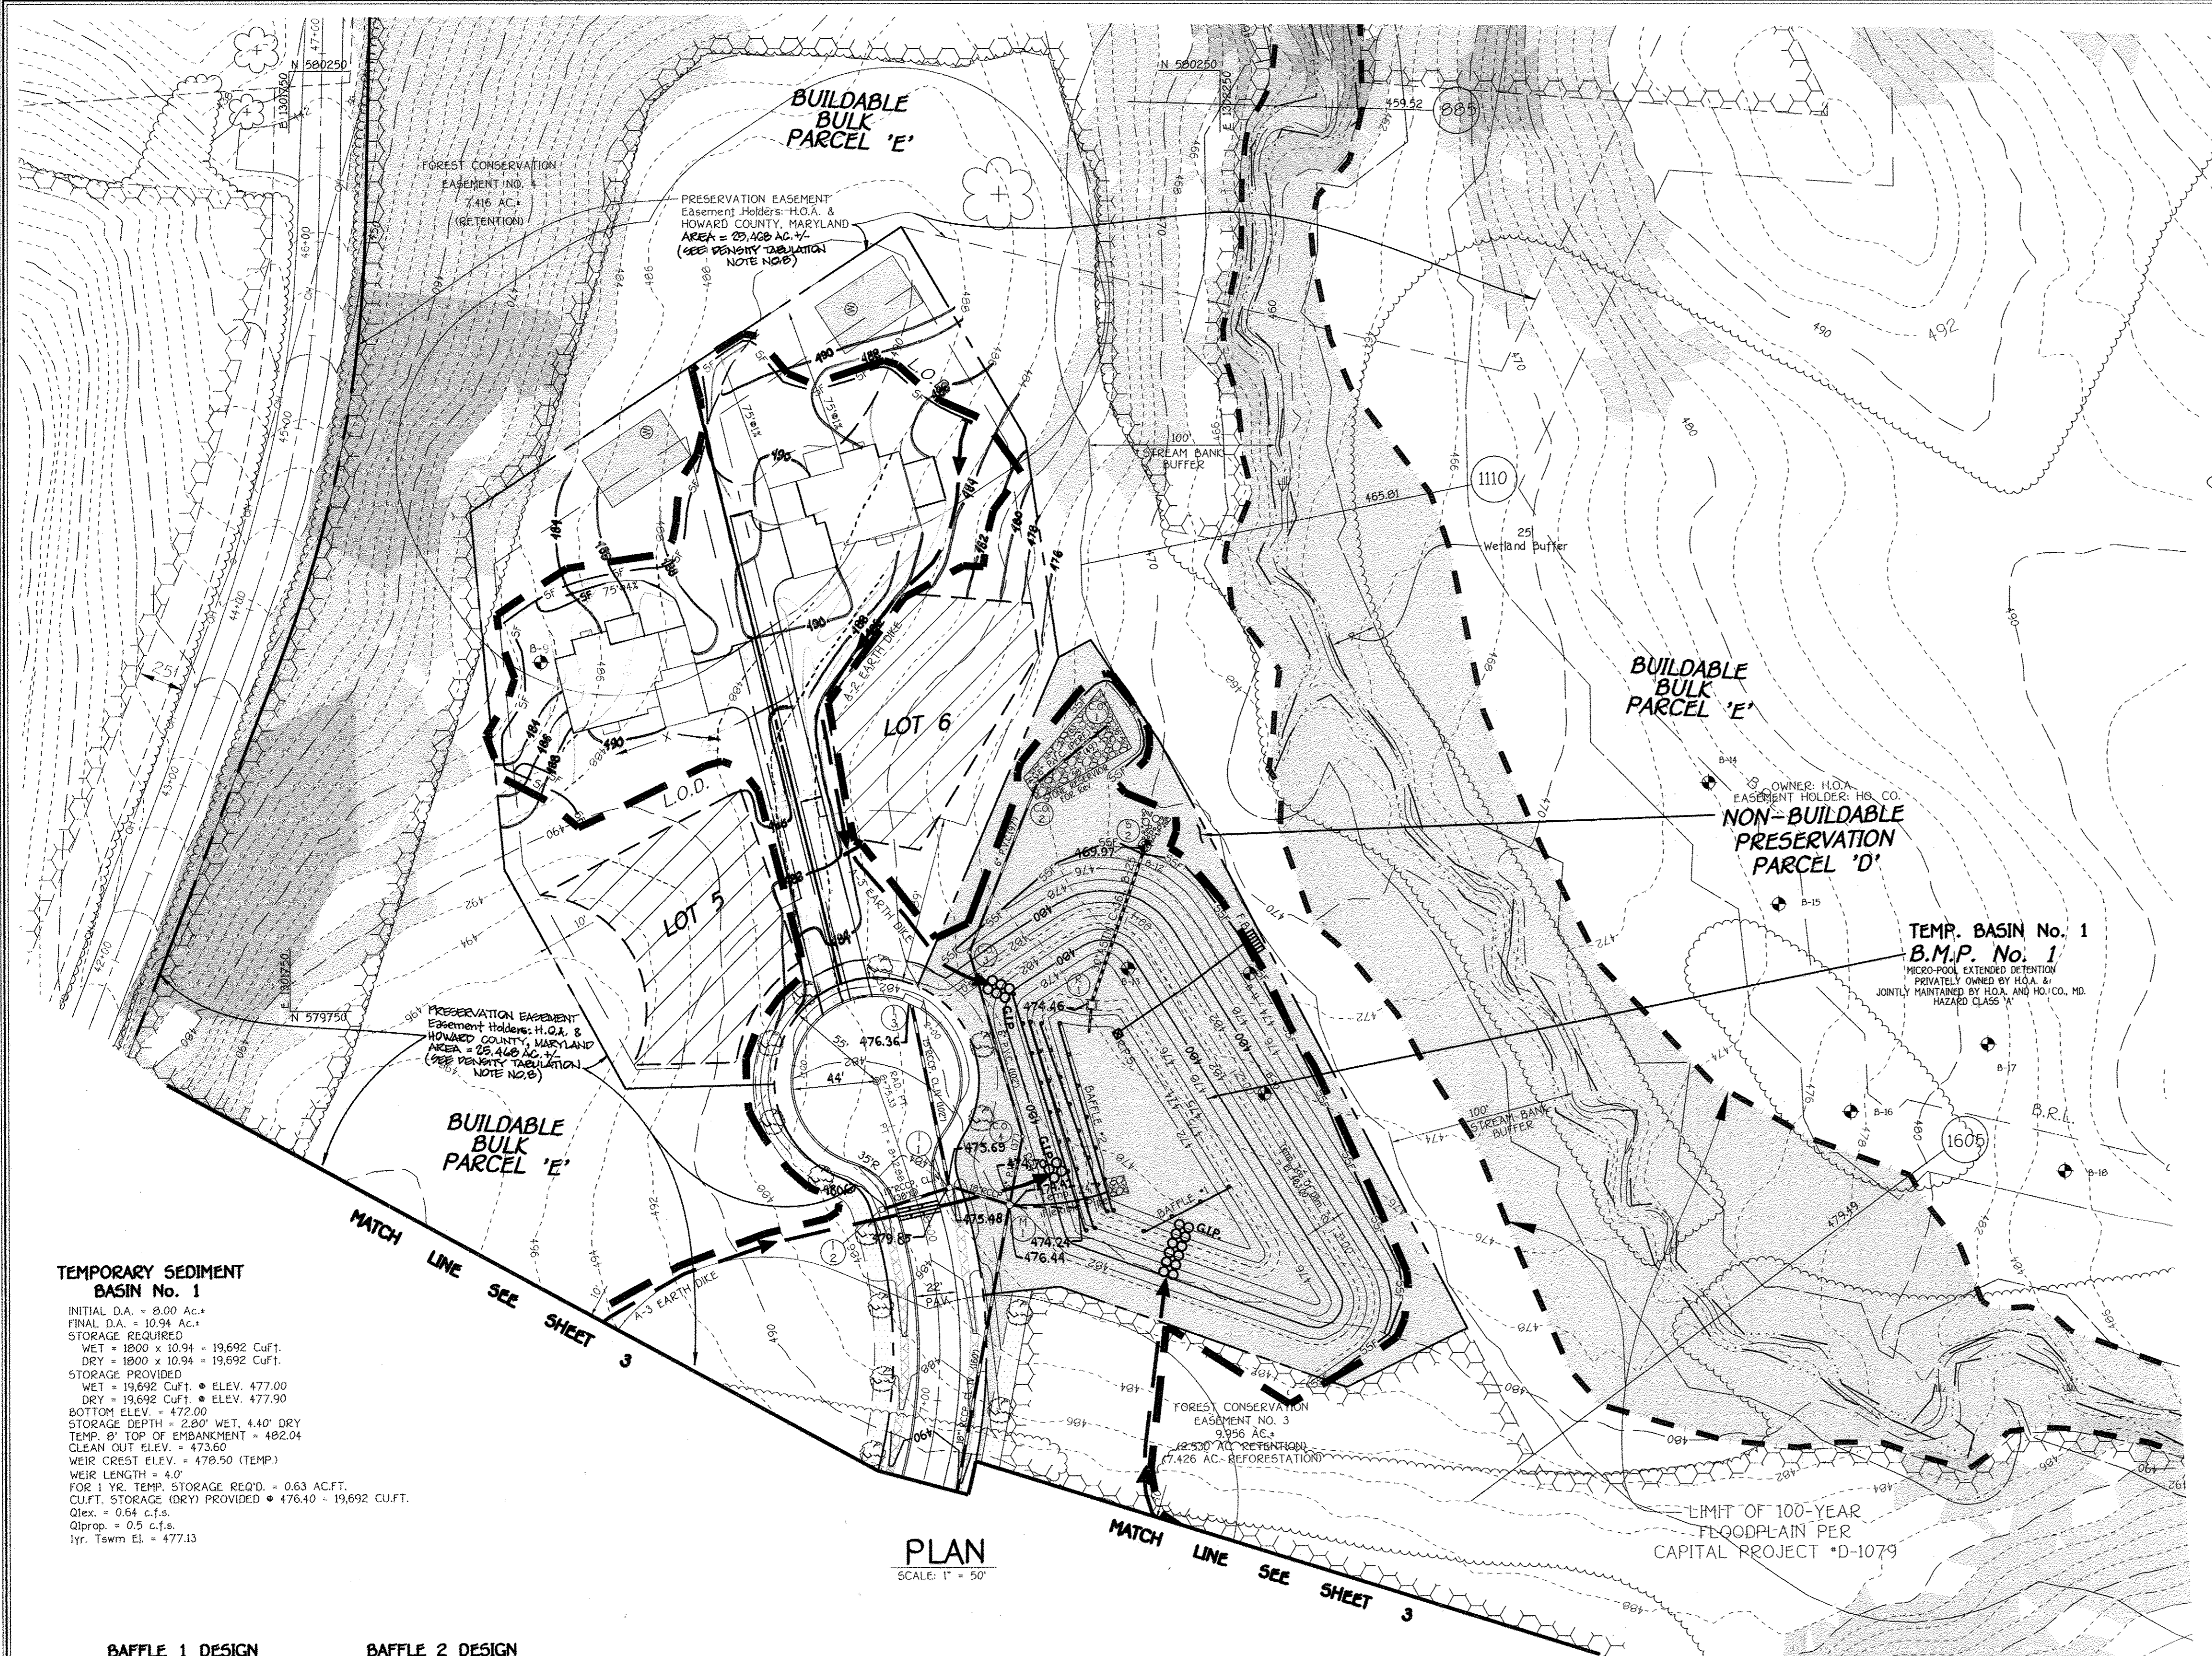

LEGEND

---Sf---Sf---Sf---	SUPER-SILT FENCE
---Sf---Sf---	SILT FENCE
[Symbol]	S.C.E.
[Symbol]	STABILIZED CONSTRUCTION ENTRANCE
[Symbol]	EARTH DIKE
[Symbol]	LOC.
[Symbol]	DENOTES LIMITS OF DISTURBANCE
[Symbol]	E.C.M.
[Symbol]	DENOTES EROSION CONTROL MATTING
[Symbol]	DENOTES SLOPES 25% OR GREATER
[Symbol]	DENOTES SLOPES 15% TO 24.9%
[Symbol]	STREAM
[Symbol]	WETLANDS
[Symbol]	FLOODPLAIN

By The Developer:
 I/We Certify That All Development And/Or Construction Will Be Done According To These Plans, And That Any Responsible Personnel Involved In The Construction Project Will Have A Certificate Of Attendance At A Department Of The Environment Approved Training Program For The Control Of Sediment And Erosion Before Beginning The Project. I Shall Engage A Registered Professional Engineer To Supervise Pond Construction And Provide The Howard Soil Conservation District With An "As-Built" Plan Of The Pond Within 30 Days Of Completion. I Also Will Provide On-Site Inspections By The Howard Soil Conservation District.

Signature: *Robert Goodier* Date: 12-22-08
 Printed Name Of Developer: Robert Goodier

By The Engineer:
 I Certify That This Plan For Pond Construction, Erosion And Sediment Control Represents A Practical And Workable Plan Based On My Personal Knowledge Of The Site Conditions. This Plan Was Prepared In Accordance With The Requirements Of The Howard Soil Conservation District. I Have Notified The Developer That He/She Must Engage A Registered Professional Engineer To Supervise Pond Construction And Provide The Howard Soil Conservation District With An "As-Built" Plan Of The Pond Within 30 Days Of Completion.

Signature: *Aldo M. Vitucci* Date: 12-22-08
 Printed Name Of Engineer: Aldo M. Vitucci

These Plans For Small Pond Construction, Soil Erosion And Sediment Control Meet The Requirements Of The Howard Soil Conservation District.

Signature: *Jeffrey J. DeScol* Date: 1/6/09
 Printed Name Of Engineer: Jeffrey J. DeScol
 Howard Soil Conservation District

Approved Department Of Public Works
 Signature: *William J. Mahoney* Date: 1-12-09
 Chief, Bureau Of Highways

Approved Department Of Planning And Zoning
 Signature: *Wendy J. Hannon* Date: 1/22/09
 Chief, Division Of Land Development

Signature: *David C. ...* Date: 1/16/09
 Chief, Development Engineering Division

TEMPORARY SEDIMENT BASIN No. 1
 INITIAL D.A. = 8.00 Ac.
 FINAL D.A. = 10.94 Ac.
 STORAGE REQUIRED
 WET = 1800 x 10.94 = 19,692 Cuft.
 DRY = 1800 x 10.94 = 19,692 Cuft.
 STORAGE PROVIDED
 WET = 19,692 Cuft. @ ELEV. 477.00
 DRY = 19,692 Cuft. @ ELEV. 477.90
 BOTTOM ELEV. = 472.00
 STORAGE DEPTH = 2.90' WET, 4.40' DRY
 TEMP. OF TOP OF EMBANKMENT = 482.04
 CLEAN OUT ELEV. = 473.60
 WEIR CREST ELEV. = 478.50 (TEMP.)
 WEIR LENGTH = 4.0'
 FOR 1 YR. TEMP. STORAGE REQ'D = 0.63 ACFT.
 CUFT. STORAGE (DRY) PROVIDED @ 476.40 = 19,692 CUFT.
 Qmax = 0.64 c.f.s.
 Qprop = 0.5 c.f.s.
 1/yr. Town El. = 477.13

BAFFLE 1 DESIGN
 D = 152'
 A = 8385
 We = A/D = 8385/152 = 55.2'
 Le = 45' + 120' = 165'
 Le/We = 165/55.2 = 2.9 > 2 .. OK

BAFFLE 2 DESIGN
 D = 36'
 A = 8385
 We = A/D = 8385/36 = 233'
 Le = 114' + 108' + 104' + 15' = 481'
 Le/We = 481/233 = 2.06 > 2 .. OK



NOTE:
 CONTRACTOR SHALL REMOVE ANY AND ALL JUNK, DEBRIS AND TRASH FROM WITHIN THE FLOODPLAIN, BUFFERS AND PRESERVATION PARCELS.

FOR ESE CONSULTANTS, INC.



PROFESSIONAL CERTIFICATION: I HEREBY CERTIFY THAT THESE DOCUMENTS WERE PREPARED BY ME OR UNDER MY RESPONSIBLE CHARGE, AND THAT I AM A DULY LICENSED PROFESSIONAL LAND SURVEYOR UNDER THE LAWS OF THE STATE OF MARYLAND, LICENSE NO. 21328, EXPIRATION DATE 1/08/19.


PROFESSIONAL CERTIFICATION: I HEREBY CERTIFY THAT THESE DOCUMENTS WERE PREPARED BY ME OR UNDER MY RESPONSIBLE CHARGE, AND THAT I AM A DULY LICENSED PROFESSIONAL LAND SURVEYOR UNDER THE LAWS OF THE STATE OF MARYLAND, LICENSE NO. 21328, EXPIRATION DATE 1/08/19.

FOR ESE CONSULTANTS, INC.

NO.	DESCRIPTION	REVISIONS
2	REVISED SWM ON LOTS 1, 5 & 6	2/23/11
1	REVISED USE-IN-COMMON EASEMENT FOR LOTS 5 & 6	11/8/11
1	REVISE OWNER AND DEVELOPER	11/8/11

OWNER
 MERIWETHER FARM II, LLC
 C/O ROBERT GOODIER, LLC
 10715 GARDNER DRIVE
 SUITE 250
 COLUMBIA, MARYLAND 21044
 PH: (410) 997-7501
 ATTN: MR. ROBERT G. GOODIER, JR.

DEVELOPER
 TOLL BROTHERS, INC.
 MARYLAND DIVISION
 7104 COLUMBIA GARDENWAY DRIVE
 SUITE 250
 COLUMBIA, MARYLAND 21044
 PH: (410) 997-7501
 ATTN: MR. JEFF DESCOL

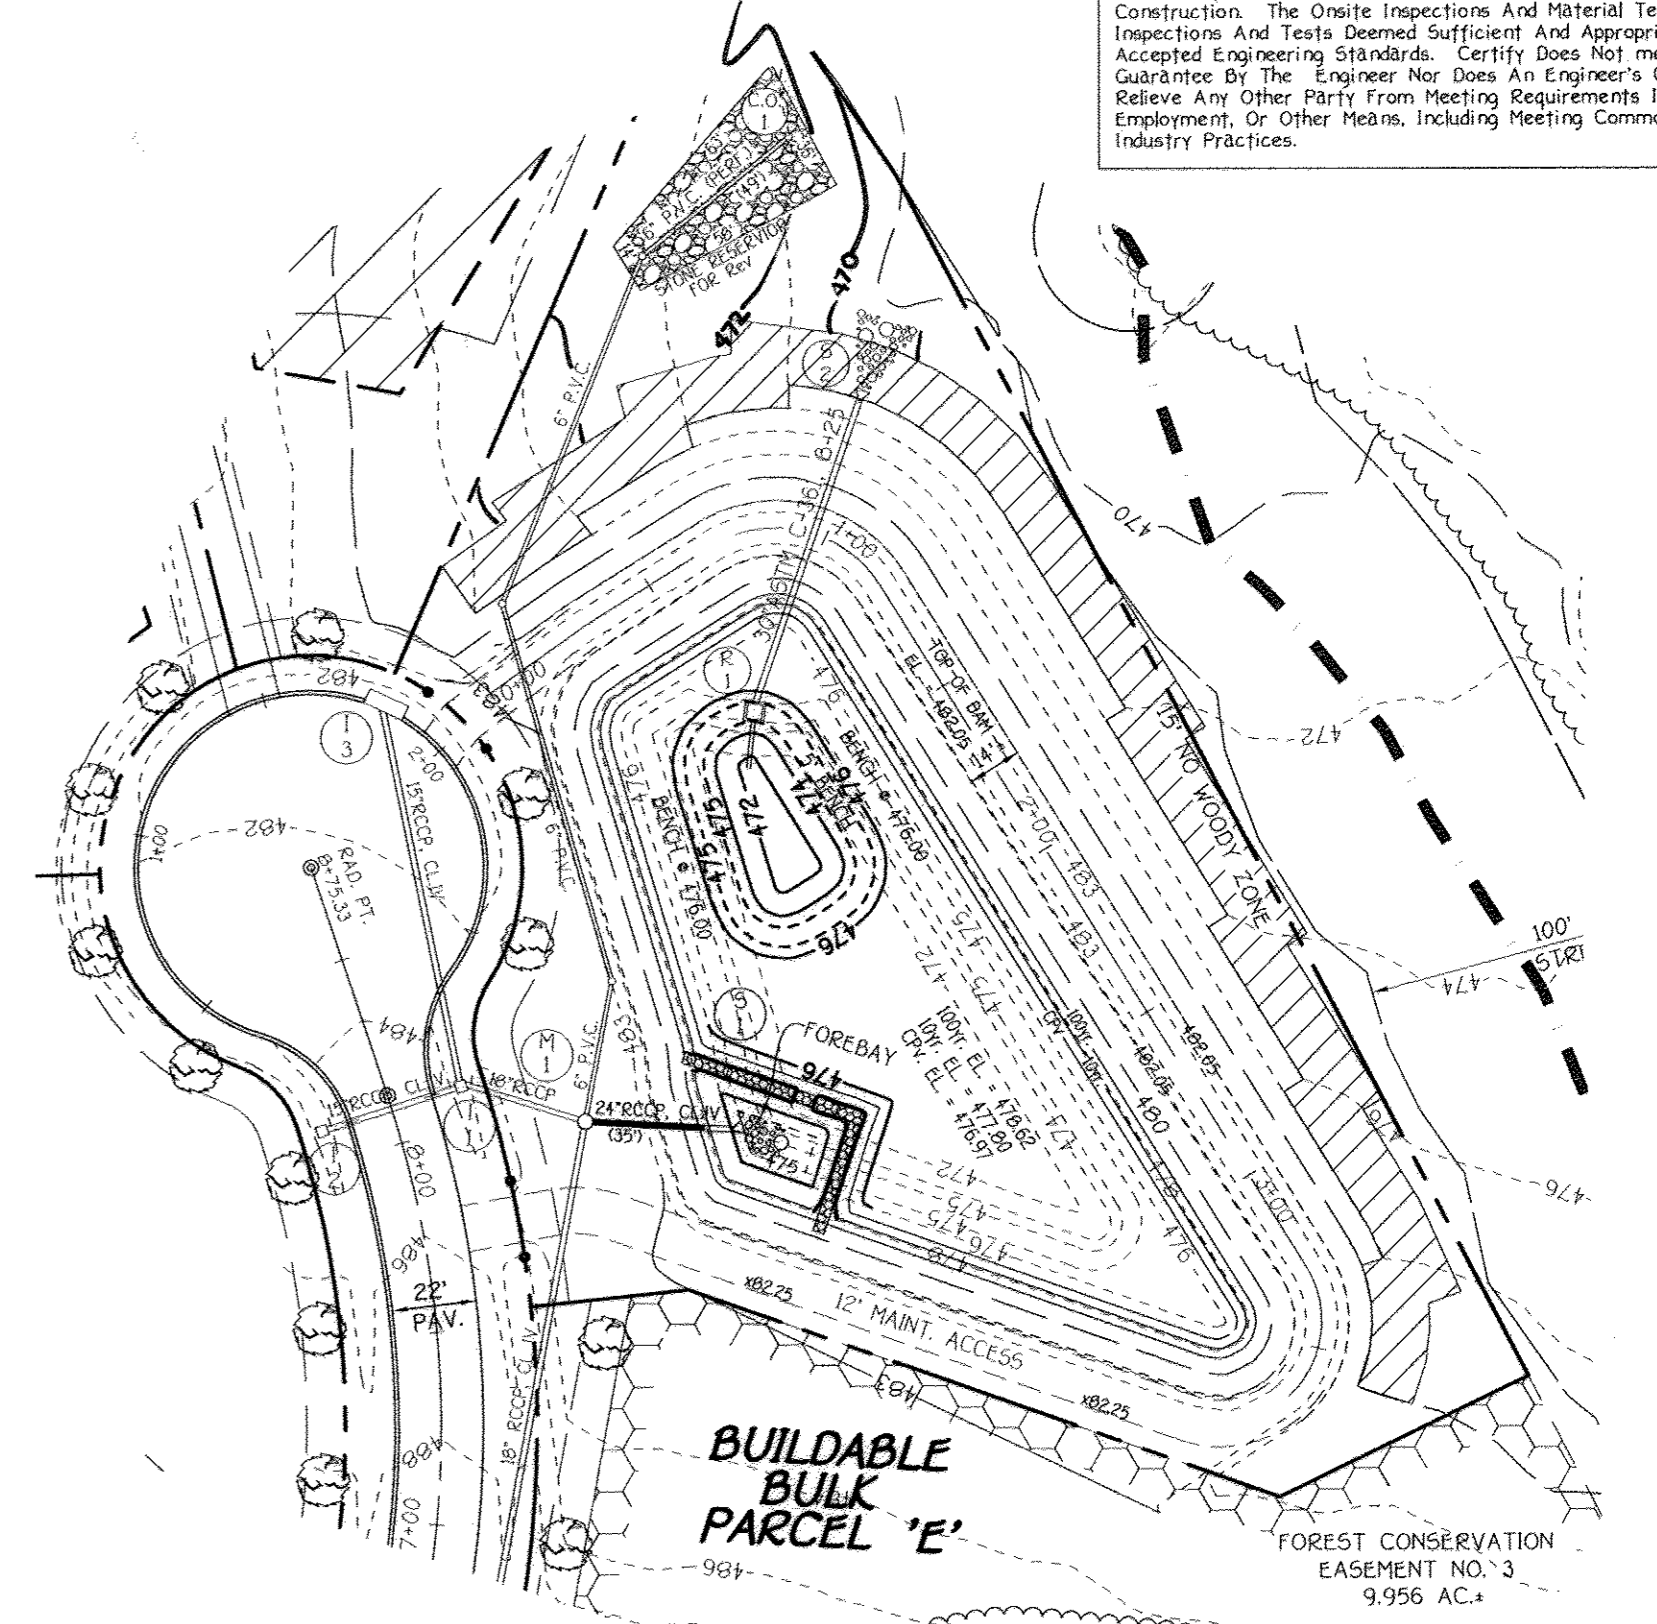

FINAL GRADING PLAN
 B.M.P. No. 1
 SCALE: 1" = 50'


STREET TREE, GRADING & SEDIMENT CONTROL PLAN
MERIWETHER FARM
SECTION TWO
PHASE ONE
 BUILDABLE LOTS 1 THRU 10, NON-BUILDABLE PRESERVATION PARCELS 'C' & 'D', AND BUILDABLE BULK PARCEL 'E'
 (A RESUBDIVISION OF BUILDABLE BULK PARCEL 'A', MERIWETHER FARM, SECTION TWO, F-08-198)

ZONED: RC-DEO
 TAX MAP NO: 21
 PARCEL NO: 29
 GRID NOS: 15, 16, 21 & 22
 FOURTH ELECTION DISTRICT
 HOWARD COUNTY, MARYLAND
 SCALE: AS SHOWN
 DATE: DECEMBER, 2008
 SHEET 4 OF 15

ASBUILT



PROFESSIONAL CERTIFICATION: I HEREBY CERTIFY THAT THESE DOCUMENTS WERE PREPARED BY ME OR UNDER MY RESPONSIBLE CHARGE, AND THAT I AM A DULY LICENSED PROFESSIONAL LAND SURVEYOR UNDER THE LAWS OF THE STATE OF MARYLAND, LICENSE NO. 20748, EXPIRATION DATE 2-22-09.

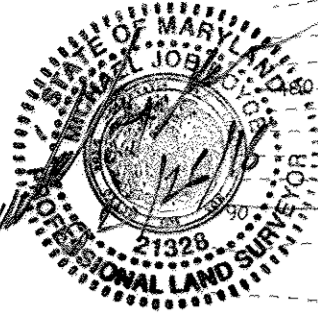

FOR ESE CONSULTANTS, INC.

PROFESSIONAL CERTIFICATION: I HEREBY CERTIFY THAT THESE DOCUMENTS WERE PREPARED BY ME OR UNDER MY RESPONSIBLE CHARGE, AND THAT I AM A DULY LICENSED PROFESSIONAL LAND SURVEYOR UNDER THE LAWS OF THE STATE OF MARYLAND, LICENSE NO. 21326, EXPIRATION DATE 1/08/19.

LANDSCAPE DEVELOPER'S CERTIFICATE

I/We certify that the landscaping shown on this plan will be done according to the plan, Section 16124 of the Howard County Code and the Howard County Landscape Manual. I/We further certify that upon completion a certification of landscape installation accompanied by an executed one year guarantee of plant materials will be submitted to the Department of Planning and Zoning.

Name: [Signature] Date: 12-22-08

"At the time of plant installation, all trees listed and approved on the landscape plan, shall comply with the proper height requirement in accordance with the Howard County Landscape Manual. In addition, no substitutions or relocations of the required plantings may be made without prior review and approval from the Department of Planning and Zoning. Any deviations from the approved Landscape Plan may result in denial or delay in the release of landscape survey until such time as all required materials are planted and/or revisions are made to the road drawing plans."

"The Owner, tenants and/or their agents shall be responsible for maintenance of the required perimeter landscaping. All plant materials shall be maintained in good growing condition, and when necessary, replaced with new materials to ensure continued compliance with applicable regulations. All the other required landscaping shall be permanently maintained in good condition, and when necessary, repaired or replaced."


Approved Department of Public Works: [Signature] 1-12-09 Date
Approved Department of Planning and Zoning: [Signature] 1/22/09 Date
[Signature] 1/17 Date
Chief, Development Engineering Division

SCHEDULE A - PERIMETER LANDSCAPING table with columns: PERIMETER, CATEGORY, LANDSCAPE TYPE, LINEAR FEET OF ROADWAY FRONTAGE, CREDIT FOR EXISTING VEGETATION, CREDIT FOR WALL, FENCE OR BERM, NUMBER OF PLANTS REQUIRED (SHADE TREES, EVERGREEN TREES, SHRUBS).



PLANT LIST table with columns: SYMBOL, QTY., BOTANICAL AND COMMON NAME, SIZE.

This plan has been prepared in accordance with the provision of Section 16124 of the Howard County Code and Landscape Manual. Financial surety for the required 81 shade and 70 evergreen trees will be posted as part of the Developer's Agreement in the amount of \$34,800.00.

SCHEDULE D STORMWATER MANAGEMENT AREA LANDSCAPING table with columns: LINEAR FEET OF TYPE 'B' PERIMETER, NUMBER OF TREES REQUIRED (SHADE TREES, EVERGREEN TREES), CREDIT FOR EXISTING VEGETATION, CREDIT FOR OTHER LANDSCAPING, NUMBER OF TREES PROVIDED (SHADE TREES, EVERGREEN TREES).

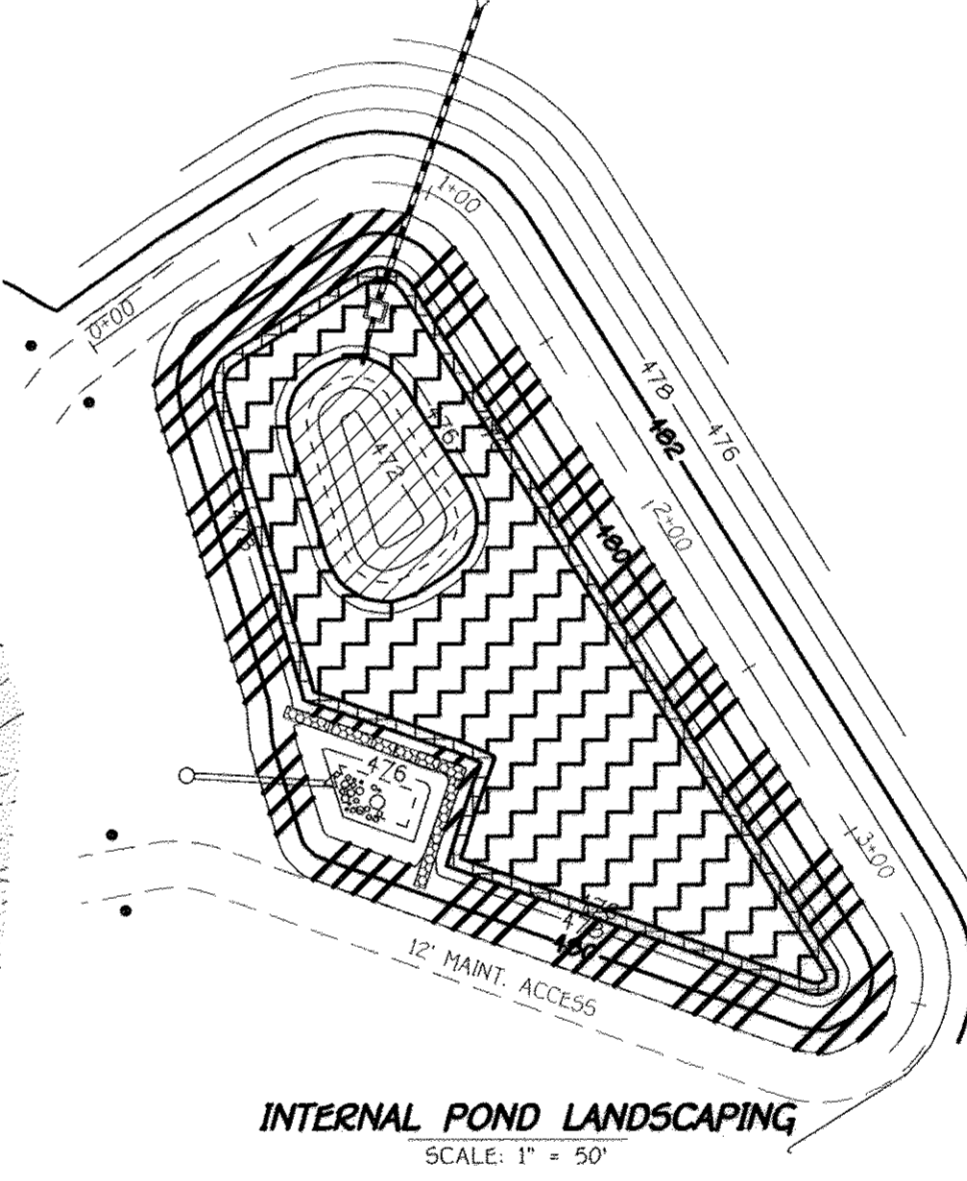


INTERNAL LANDSCAPING S.W.M. PONDS table with columns: ZONE, DESCRIPTION, BMP NO. 1, ELEVATION.

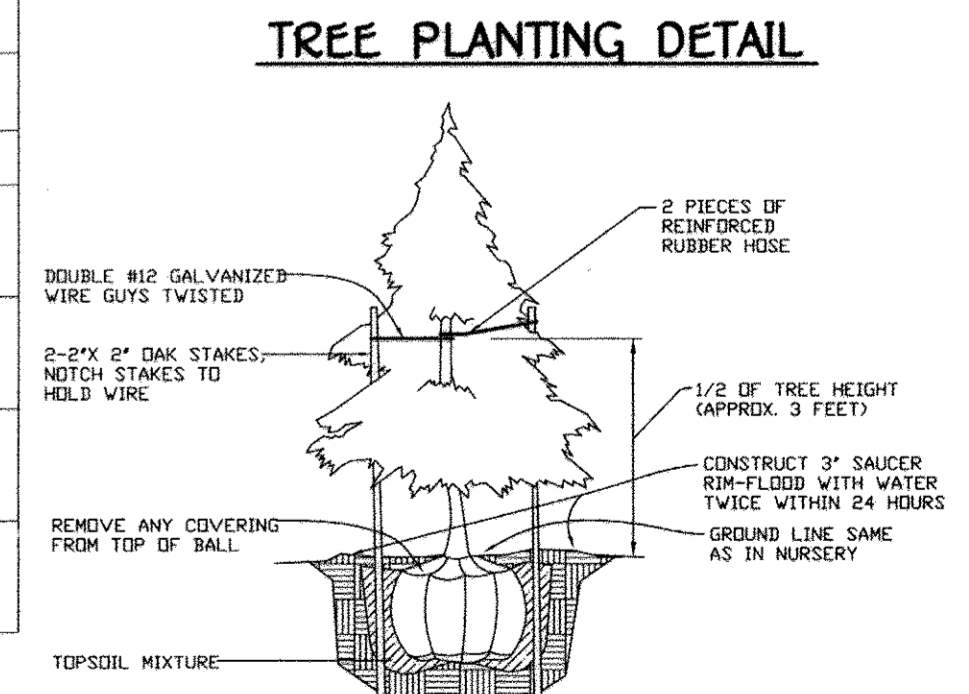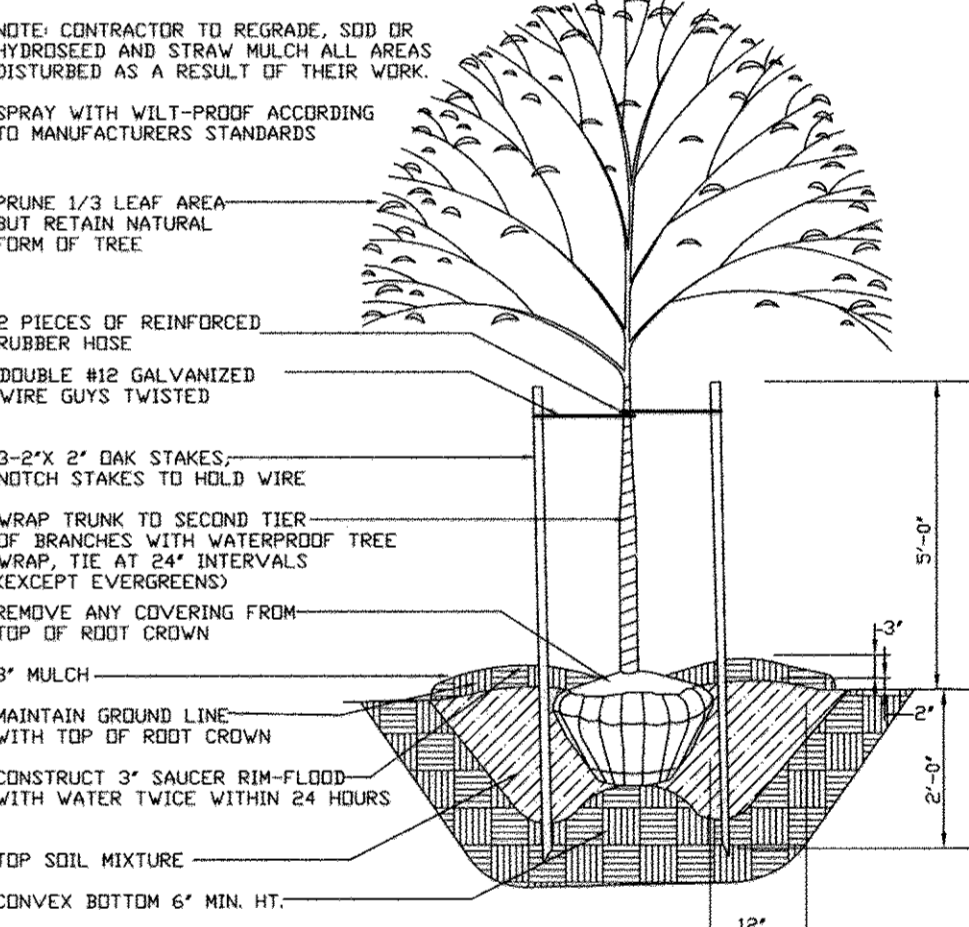

Revision table with columns: NO., DESCRIPTION, DATE.

PLAN SCALE: 1" = 60'

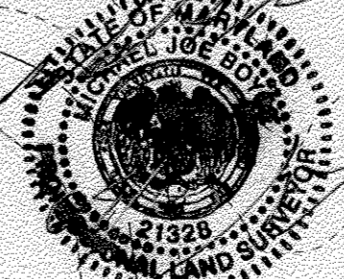

PROFESSIONAL CERTIFICATION: I HEREBY CERTIFY THAT THESE DOCUMENTS WERE PREPARED BY ME OR UNDER MY RESPONSIBLE CHARGE, AND THAT I AM A DULY LICENSED PROFESSIONAL LAND SURVEYOR UNDER THE LAWS OF THE STATE OF MARYLAND, LICENSE NO. 21326, EXPIRATION DATE 1/08/19.

OWNER: MERIWETHER FARM II, LLC
DEVELOPER: TOLL BROTHERS, INC.
COLUMBIA, MARYLAND 21044
ATTN: MR. ROBERT G. GOODIER, JR.

Professional certification: I hereby certify that these documents were prepared by me, and that I am a duly licensed Professional Engineer under the laws of the State of Maryland, License No. 20748, Expiration Date 2-22-09.

LANDSCAPE PLAN MERIWETHER FARM SECTION TWO PHASE ONE BUILDABLE LOTS 1 THRU 10, NON-BUILDABLE PRESERVATION PARCELS 'C' & 'D' AND BUILDABLE BULK PARCEL 'E' (A RESUBDIVISION OF BUILDABLE BULK PARCEL 'A', MERIWETHER FARM, SECTION TWO, F-08-198) TAX MAP NO. 21 PARCEL NO. 28 GRID Nos.: 15, 16, 21 & 22 FOURTH ELECTION DISTRICT HOWARD COUNTY, MARYLAND SCALE: AS SHOWN DATE: DECEMBER, 2008 SHEET 5 OF 15 ASBUILT

FISHER, COLLINS & CARTER, INC. CIVIL ENGINEERING CONSULTANTS & LAND SURVEYORS

12/20/10 10:05 AM PHASE TWO FINAL SHEET 5 LANDSCAPE PLAN.dwg, 12/19/2008 8:48:26 AM, jsm

NOTIFICATIONS FOR UNDERGROUND WATER TANKS AND FIRE PROTECTION

1.1 Scope
The construction of underground tanks for fire protection in accordance with Howard County Code, Title 17 and this specification is part of a program designed to improve level of protection from fires in residential and commercial properties. These specifications, along with associated documents, provides the information necessary for the construction and placement of fire protection tanks used for this purpose.





1.2 Purpose
The purpose of this specification is to provide the technical information required for the construction of underground water storage tanks in accordance with Howard County Maryland, Title 17 and all data therein referenced.

2. Underground tanks
2.1 Materials for a static water supply tank
2.1.1 Tanks shall be constructed of single-wall fiberglass per approved manufacturer's specifications.
2.1.2 The manufacturer shall provide a 30-year warranty, against defects in material for the tank system, to the purchaser of the tank and their successors, and assigns.
2.2 Details
2.2.1 The tank system shall include a device for holding the tank in position against flotation. This configuration shall be supplied by the tank manufacturer as part of the tank package. Installation shall be in accordance with the manufacturer's recommendations.
2.2.2 The tank shall include a removable access cover at grade (marked), at least 48" in diameter, to allow entry for maintenance and inspection of the inside of the tank. The access ladder shall be securely mounted to the tank. The cover shall be properly sealed and locked.
2.2.3 A permanent fitting of 4 inch thick concrete shall be placed over the tank, and shall extend to all fittings. Refer to tank drawings for concrete specifications.
2.2.4 Fittings
2.2.4.1 One draft connection shall consist of a 6 inch diameter galvanized or ductile iron pipe. The draft connection shall terminate in a dual threaded hydrant female connection with plug or cap. A PVC draft pipe with an anti-vortex plate shall be installed inside the tank by the manufacturer. The draft connection allows fire department pumper to connect and remove water from the tank at the specified rate of flow (flow draft connection shall be painted "Fire Engine Rest").
2.2.4.2 One combination vent/fill indicator shall consist of an 8 inch diameter PVC pipe which allows visual inspection of the tank water level, as well as preventing the required amount of venting to the tank.
2.2.4.3 One fill connection shall consist of a 4 inch diameter galvanized steel pipe, with a Samesse connection with two, two and one half inch (2-1/2") connection and one 4" Street connection. The fitting shall be angled downward 30 degrees to reduce hose and fitting strain during filling operations.
2.2.4.4 All pipe joints above the slab shall be flanged.
2.2.5 Any features not included in this specification, as well as any special circumstances such as single-tank design shall be evaluated and approved during design phase and before any construction is started.
2.2.6 The standard tank drawing, Fire Suppression Water Storage, 30,000 Gallon defines the requirements for a 1 to 30,000 gallon 10 foot diameter tank installation. Tank sizes other than 30,000 gallons may require additional drawings to be provided to fit the requirements for a particular site. Drawing Fire Suppression Water Storage, 12,000 Gallon defines the general requirements for construction of 10-foot diameter tanks, and shall be used accordingly. Supplemental drawings shall be reviewed and approved by the Fire Official prior to construction of any needed items.

2.3 Installation
2.3.1 All tanks shall be installed per the manufacturer's requirements.
2.3.2 Location and orientation of the tank shall be determined during site plan or preliminary subdivision plan layout, as approved by the Fire Official.
2.3.3 The installing contractor shall be responsible for obtaining all necessary permits for work and for scheduling required inspections.
2.3.4 The fittings shall be placed as follows:
2.3.4.1 The draft connection shall be located at least 12 inches from the edge of the abutting surface or curb line. This allows for a 12" section of suction sleeve to be used for drafting. The draft connection opening shall be turned facing directly toward the road surface.
2.3.4.2 Total elevation from the bottom of the draft pipe to the centerline of the draft connection shall not exceed 10 feet zero inches. This dimension shall be minimized as much as possible to reduce head loss, while maintaining correct depth of cover over tank, per manufacturer's specifications.
2.3.4.3 The draft connection shall be fixed at a height of 18 inches above finished grade of the pull off pad, to the centerline of the piping.
2.3.4.4 The fill connection shall be fixed at a height of 18 inches above finished grade of the pull off pad, to the centerline of the piping.
2.3.5 Excavation shall be performed per applicable regulations. The excavation shall be backfilled with a material per manufacturer's specifications. In designs in which the draft pipe is placed on the tank end, the fill shall be in place in advance toward the draft connection end.
2.4 Testing and acceptance
2.4.1 The tank shall be operable with a rated flow fire flow of 1000 gallons per minute (GPM) minimum using a fire department pumper operating under normal conditions.
2.4.2 A pressure test shall be performed prior to installation of the tank, per manufacturer's specifications.
2.4.3 A pressure test shall be performed after the tank is installed and covered at a minimum pressure of 5 psi (pounds per square inch) and held for a 24 hour period as determined by the Fire Official, or per manufacturer's specifications.

2.4.4 An operational test shall be performed when construction is completed, in accordance with the approved procedures. The test shall be conducted by the Fire Department and the contractor. When testing has been completed, the installer shall be limited to firefighting operations and routine test. The Fire Department shall be responsible for subsequent refilling to full capacity within 12 hours after using water from the tank.
2.4.5 Final approval will be in written notification in writing by the Fire Official.
2.5 Accessibility and surrounding features
2.5.1 A pull-off shall be constructed per Appendix 53, Driveway/Access/Truck Access, unless otherwise specified. Requirements for each site will be evaluated and approved by the Fire Official prior to start of work. Details shall be indicated on the subdivision plan as applicable.
2.5.2 No obstructions shall impede access to tank fittings. The facility shall remain accessible on a year-round basis.
2.5.2.1 Landscaping, shrubs, and trees shall be trimmed away from fittings. Obstructing branches shall be trimmed away at a minimum of 30 feet overhead. Grass and weeds shall be kept as needed.
2.5.3 Protective devices shall be used as applicable to prevent damage to fittings and to provide safety to operators. These include, but are not limited to the following:
a. bollards
b. concrete curbs
c. concrete nose down curbs
d. concrete dry hydrant
e. concrete fire department use only
2.5.4 A "NO PARKING" sign shall be posted which clearly identifies tank full capacity and identification number. An identification number shall be assigned by the Fire Department and the sign shall be placed on all major roads including the collector and driveway to tank with in a 2,500 foot radius.
2.5.5 An approved NO PARKING sign shall be provided and attached to a metal post.
2.5.6 All fittings above grade shall be painted with exterior-grade enamel. Color shall follow otherwise specified.

3. References
3.1 Publications
3.1.1 NFPA 963 - Standard for Fire Hose Srews Threads
3.1.2 NFPA 1642 - Standard for Water Supplies for Suburban and Rural Fire Protection
3.1.3 NFPA 241 - Standard for Fire Protection in Placed Building Groups
3.2 Other referenced documents
3.2.1 The Code of Public Local Laws and Ordinances of Howard County Maryland, Chapter 102
3.2.2 Underground Tanks & Dry Fire Hydrants Maintenance and Inspection, Chief Greg Cook / Regional Fire Protection Committee, 2008
3.3 Other
3.3.1 Drawing, Pull-off Tank Access

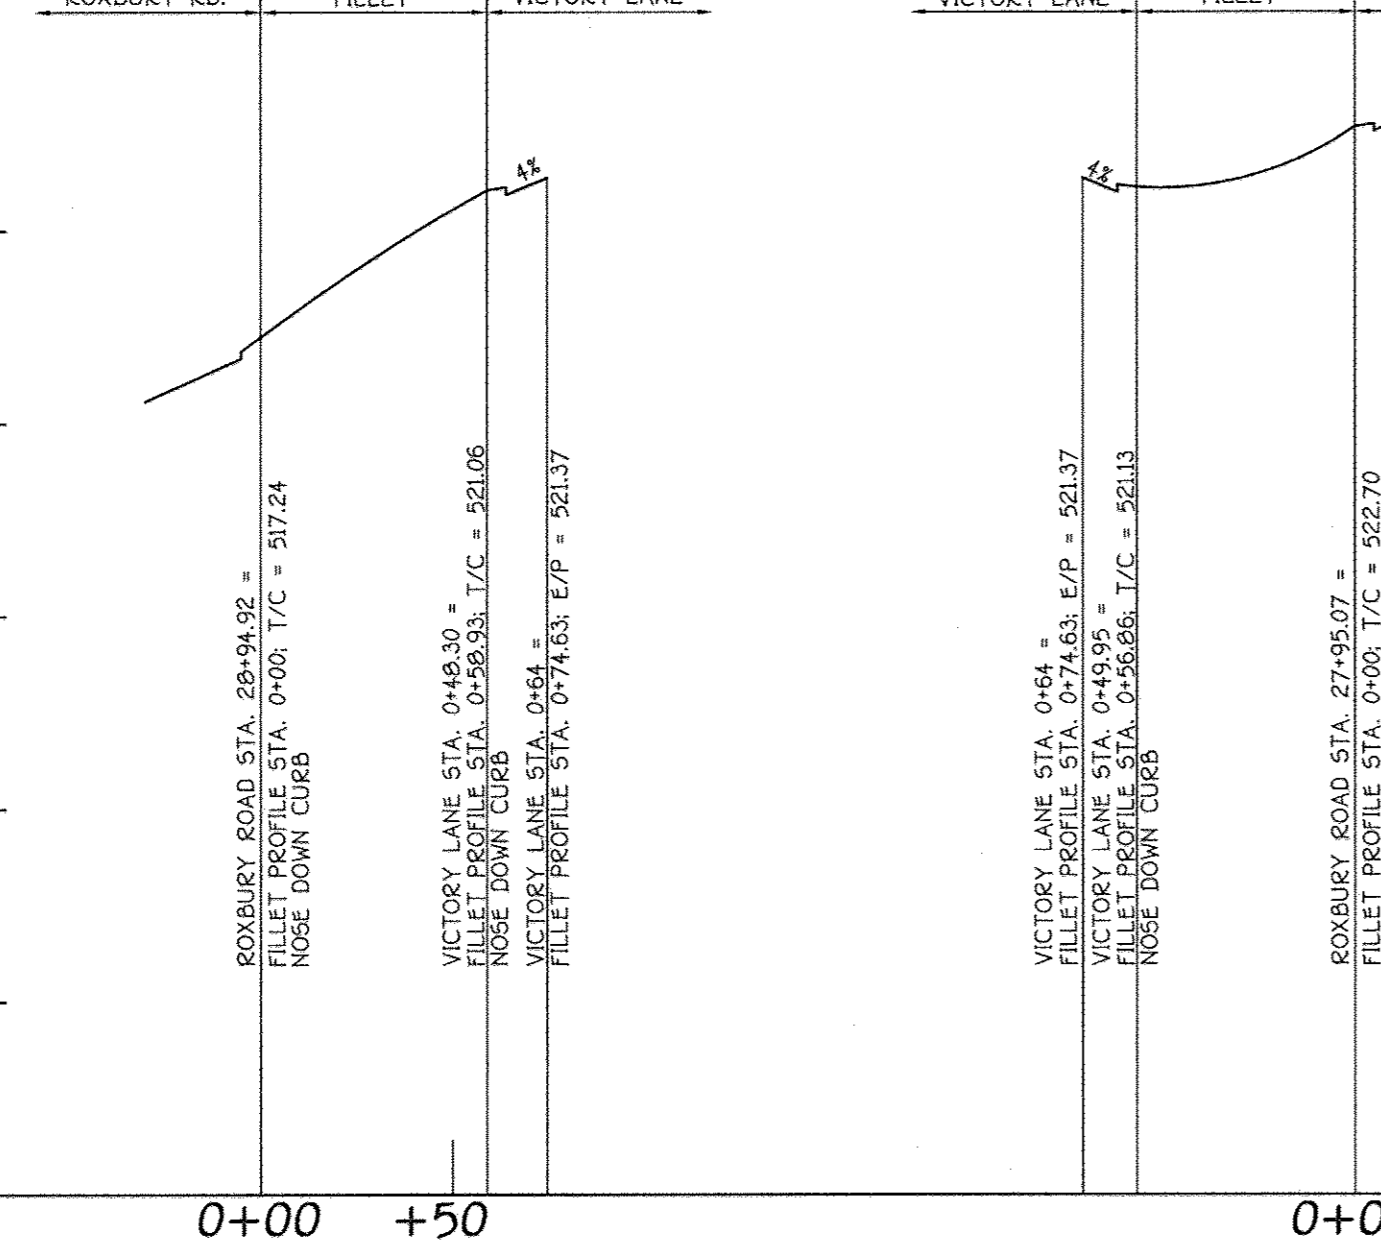
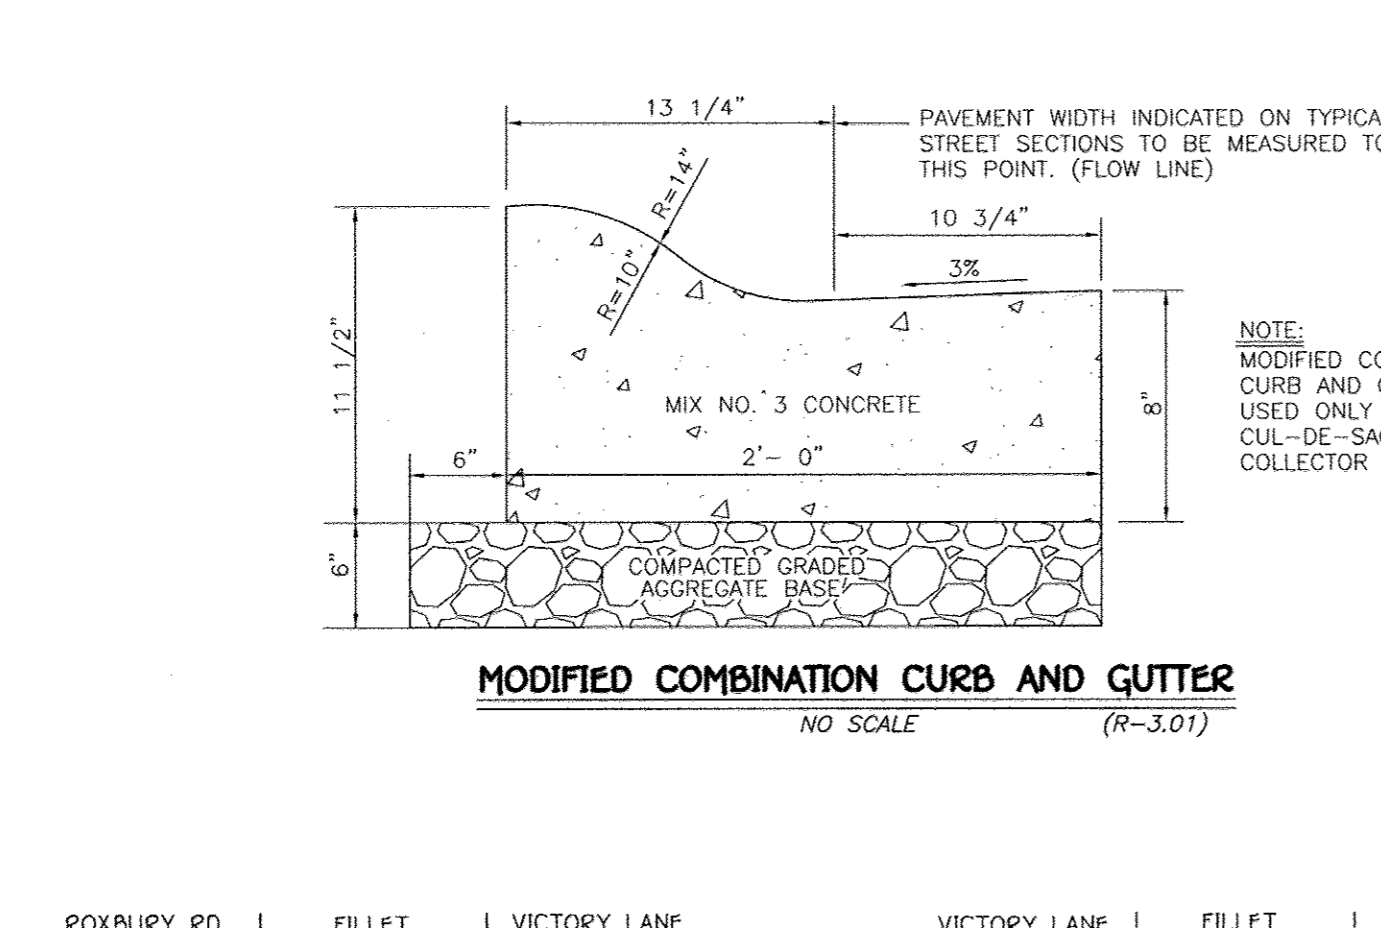
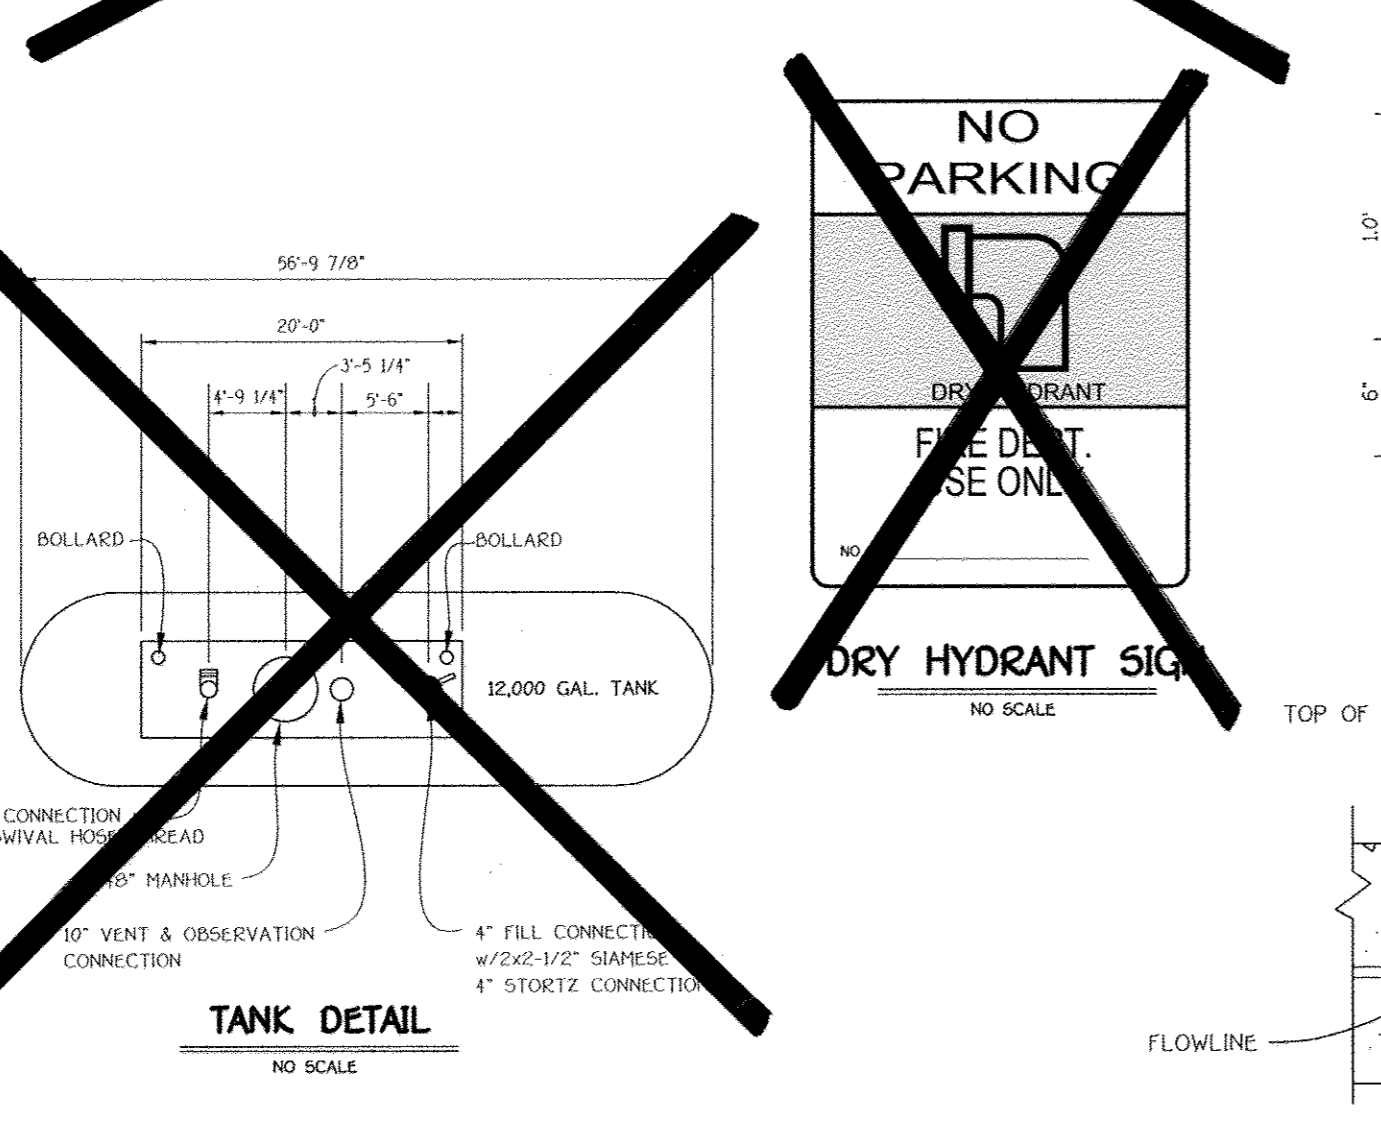
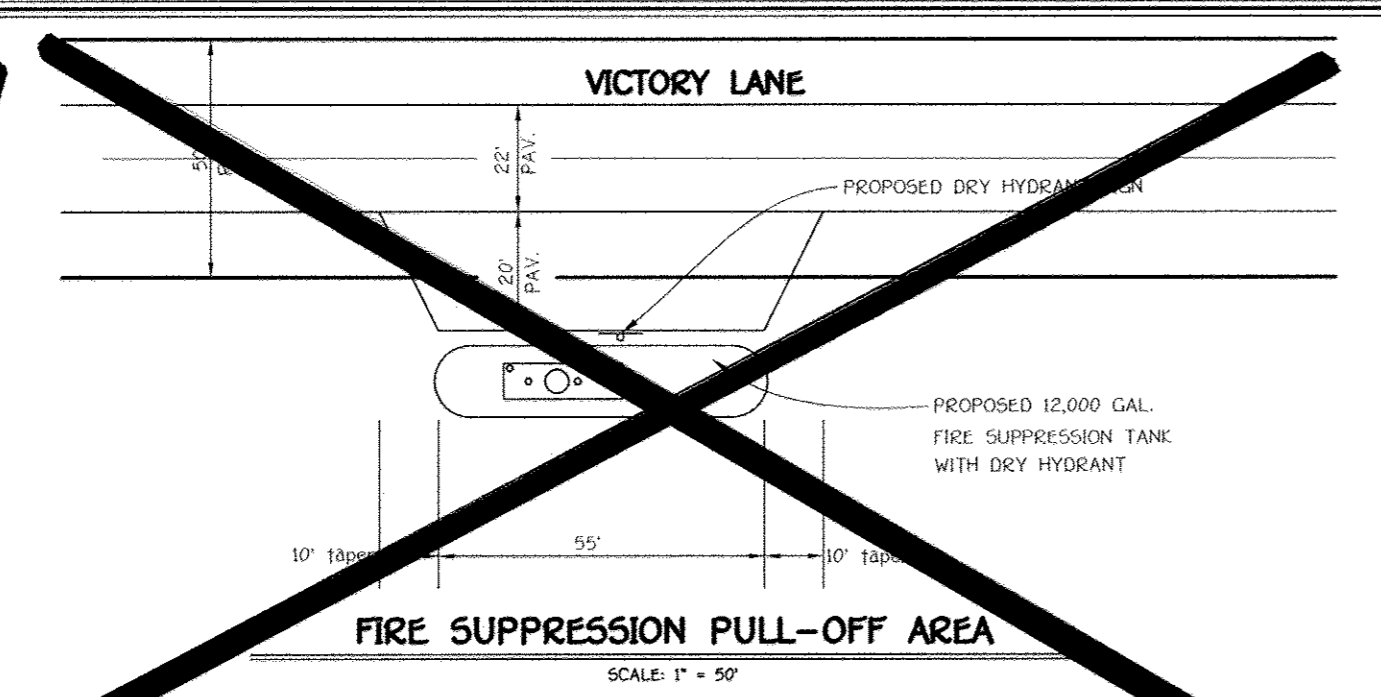


FILLET PROFILES

SCALE: HORIZONTAL: 1"=50'
VERTICAL: 1"=5'

NO.	DESCRIPTION	DATE
1	REMOVED UNDERGROUND FIRE TANK & PULL OFF AREA	11/8/11
1	REMOVE OWNER AND DEVELOPER	11/8/11


SECTION NUMBER	ROAD AND STREET CLASSIFICATION	CALIFORNIA BEARING RATIO (CBR)					
		3 TO <5	5 TO <7	>7	3 TO <5	5 TO <7	>7
P-2	PARKING DRIVE AISLES: RESIDENTIAL AND NON-RESIDENTIAL WITH NO MORE THAN 10 HEAVY TRUCKS PER DAY LOCAL ROADS: ACCESS PLACE, ACCESS STREET CUL-DE-SACS: RESIDENTIAL	PAVEMENT MATERIAL (INCHES)		MIN HMA WITH GAB		HMA WITH CONSTANT GAB	
		HMA SUPERPAVE FINAL SURFACE 9.5 MM, PG 64-22, LEVEL 1 (ESAL)		1.5	1.5	1.5	1.5
		HMA SUPERPAVE INTERMEDIATE SURFACE 9.5 MM, PG 64-22, LEVEL 1 (ESAL)		1.0	1.0	1.0	1.0
		HMA SUPERPAVE BASE 19.0 MM, PG 64-22, LEVEL 1 (ESAL)		2.0	2.0	2.0	2.0
GRADED AGGREGATE BASE (GAB)		0.0	4.0	3.0	4.0	4.0	

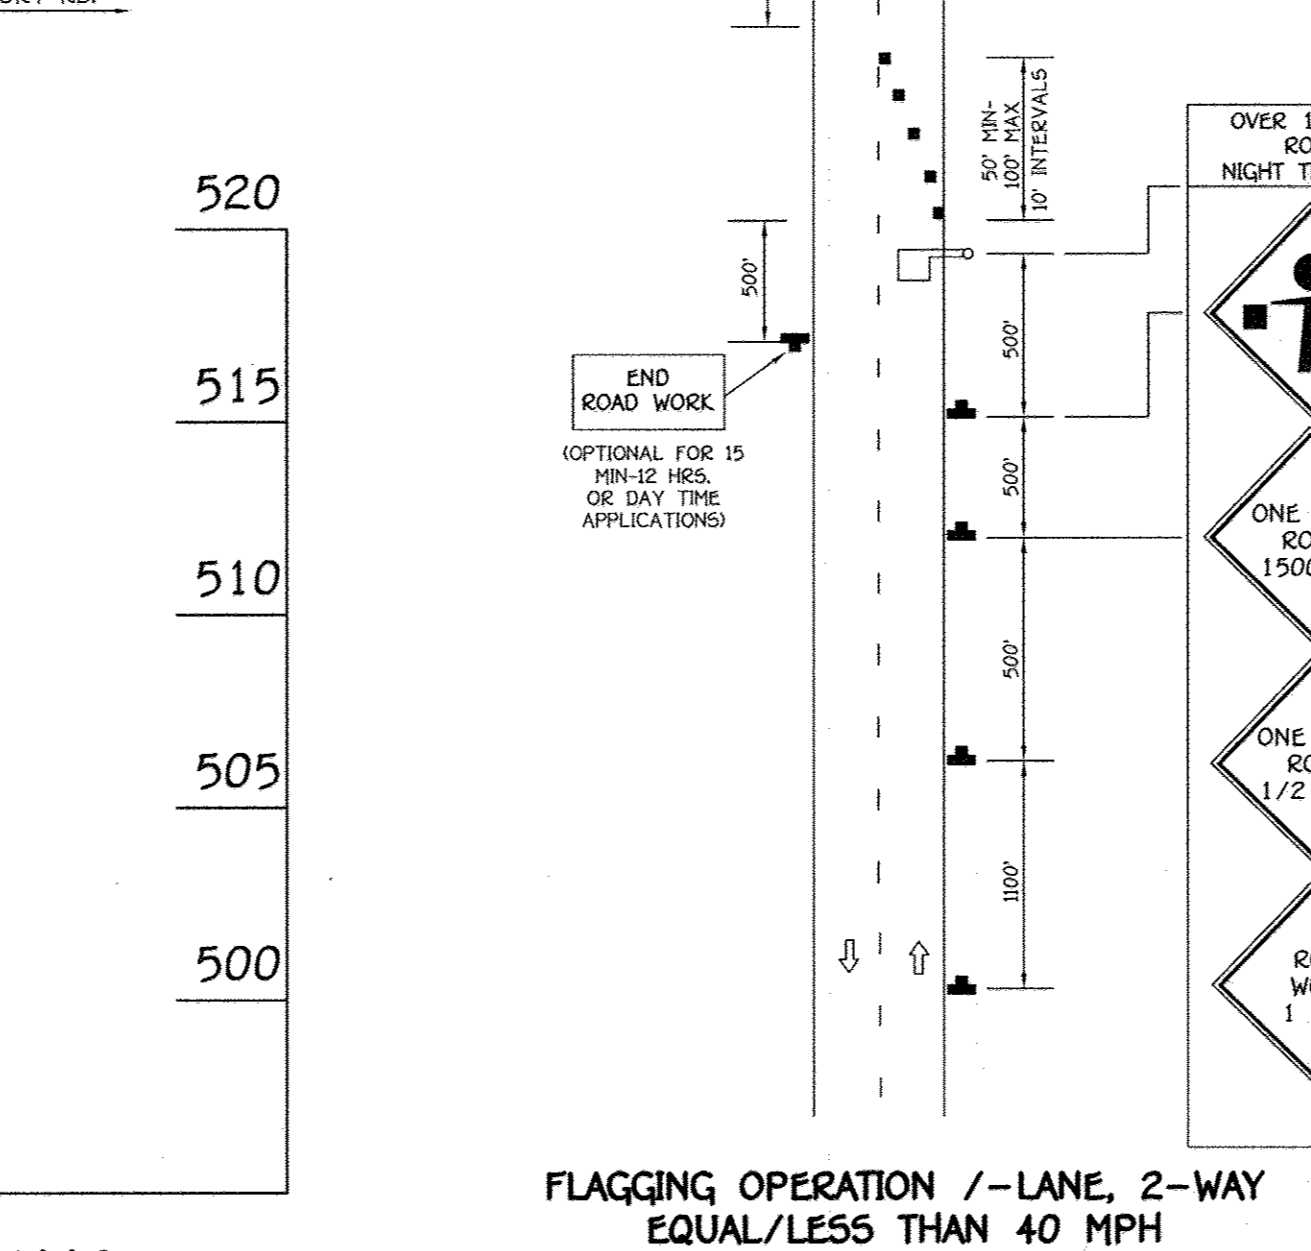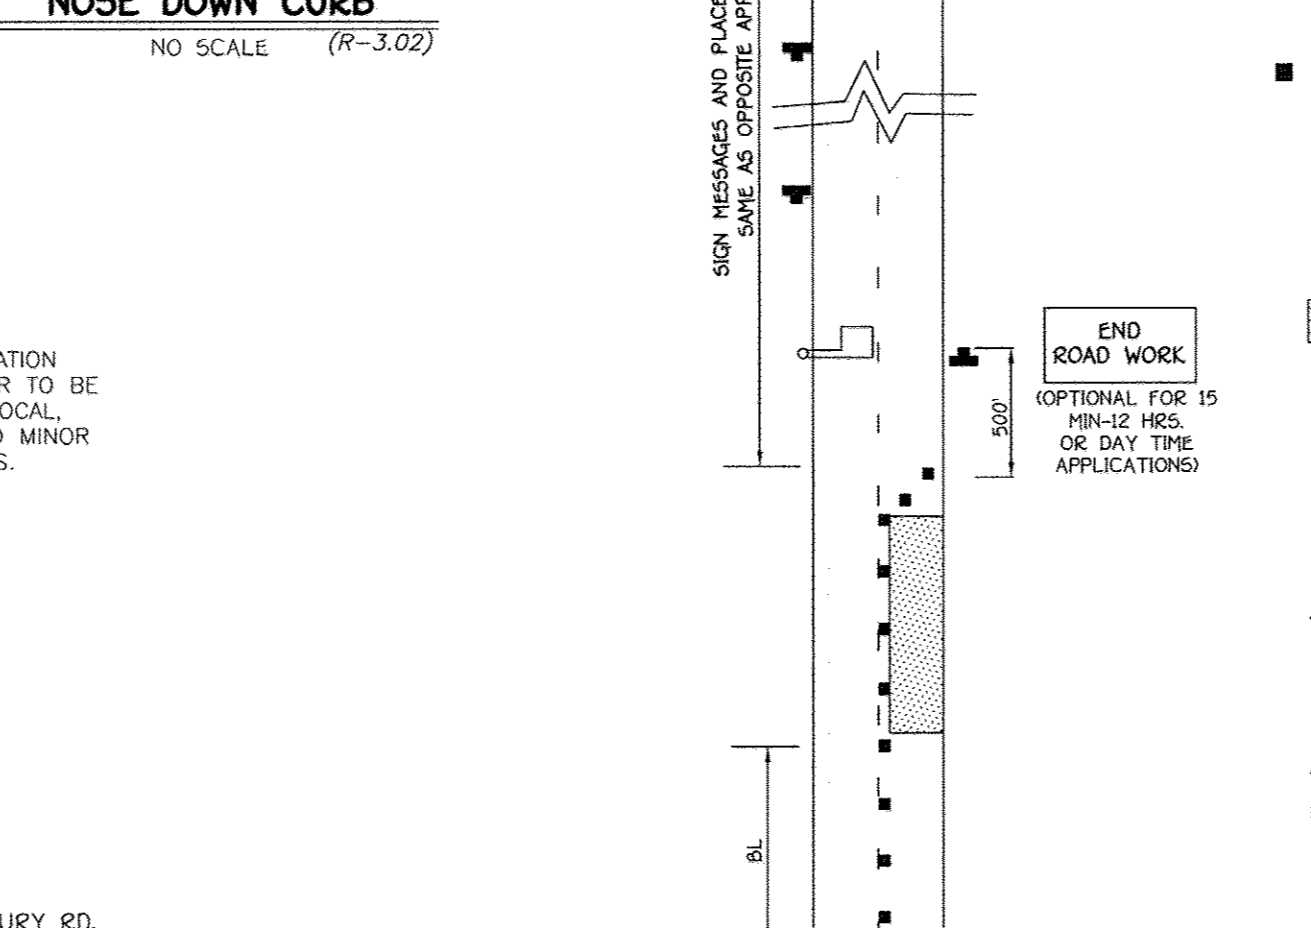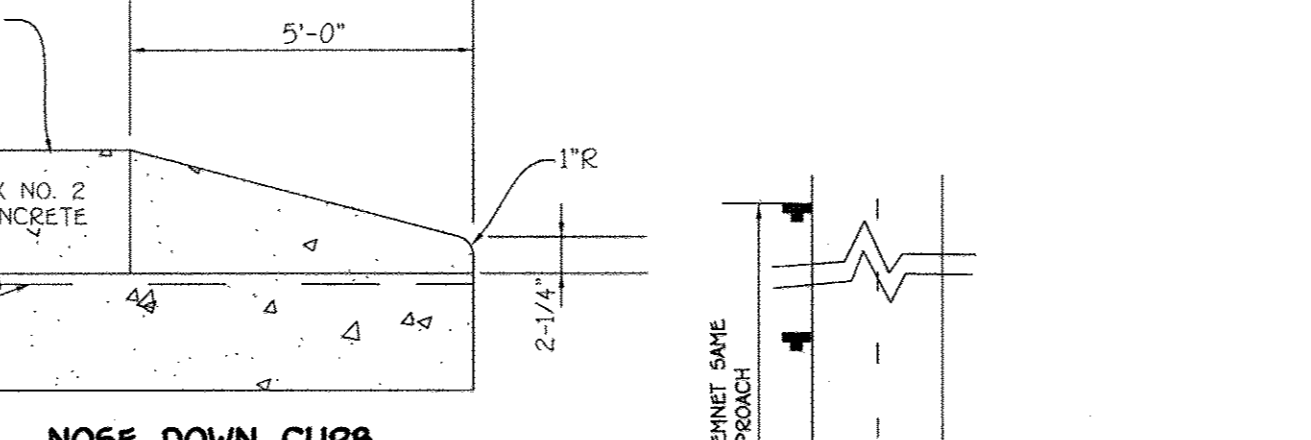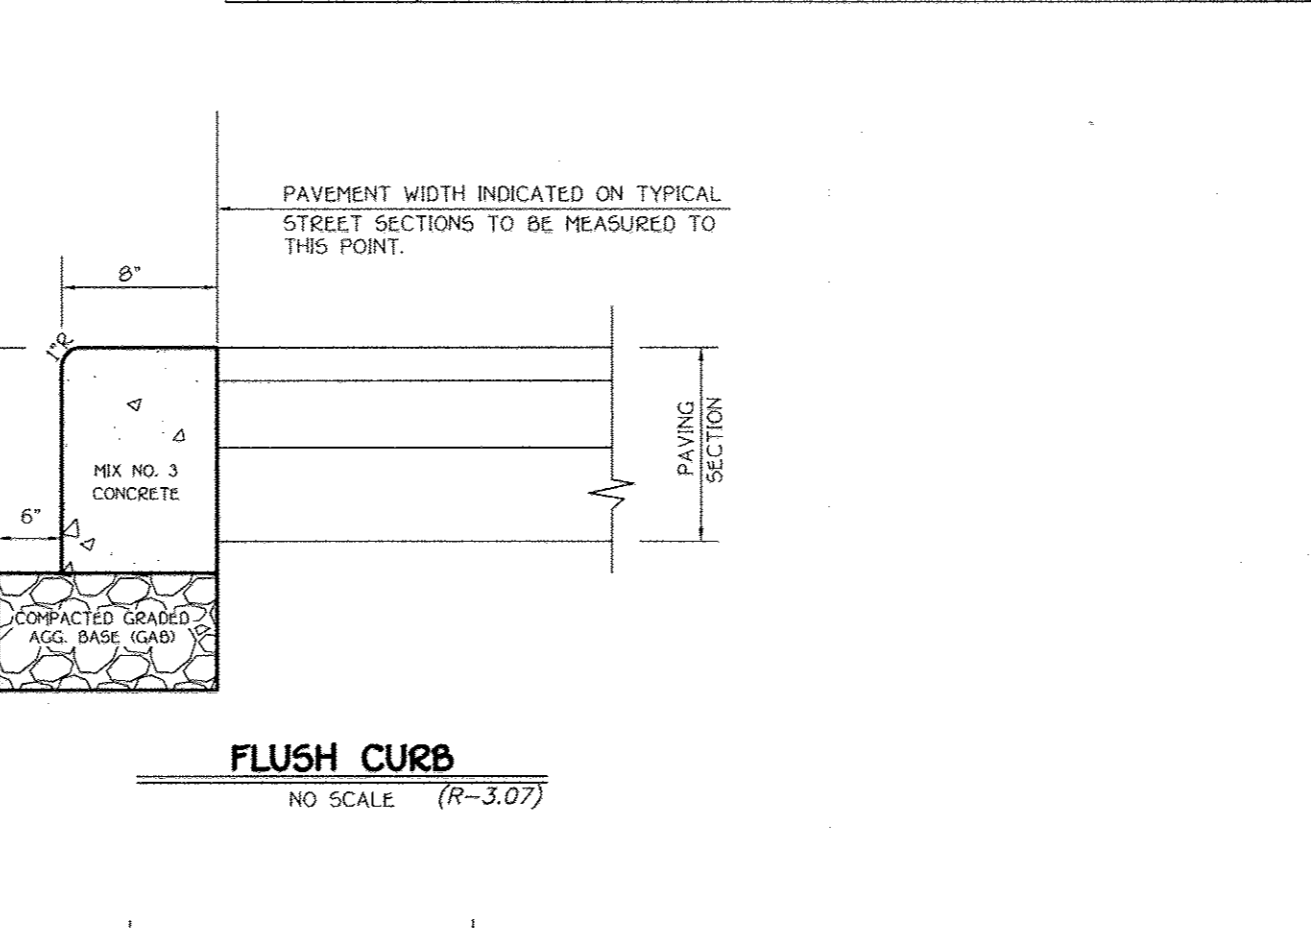

OWNER
MERIWETHER FARM II, LLC
C/O SECOND GOODER, LLC
10718 CHARTER DRIVE
SUITE 350
COLUMBIA, MARYLAND 21044
PH: (410) 997-7501
ATTN: MR. ROBERT G. GOODER, JR.



DEVELOPER
TOLL BROTHERS, INC.
MARYLAND DIVISION
716 COLUMBIA GATEWAY DRIVE
SUITE 230
COLUMBIA, MARYLAND 21046
PH: (410) 997-7501
ATTN: MR. JEFF BRACON

SECTION NUMBER	ROAD AND STREET CLASSIFICATION	CALIFORNIA BEARING RATIO (CBR)					
		3 TO <5	5 TO <7	>7	3 TO <5	5 TO <7	>7
P-2	PARKING DRIVE AISLES: RESIDENTIAL AND NON-RESIDENTIAL WITH NO MORE THAN 10 HEAVY TRUCKS PER DAY LOCAL ROADS: ACCESS PLACE, ACCESS STREET CUL-DE-SACS: RESIDENTIAL	PAVEMENT MATERIAL (INCHES)		MIN HMA WITH GAB		HMA WITH CONSTANT GAB	
		HMA SUPERPAVE FINAL SURFACE 9.5 MM, PG 64-22, LEVEL 1 (ESAL)		1.5	1.5	1.5	1.5
		HMA SUPERPAVE INTERMEDIATE SURFACE 9.5 MM, PG 64-22, LEVEL 1 (ESAL)		1.0	1.0	1.0	1.0
		HMA SUPERPAVE BASE 19.0 MM, PG 64-22, LEVEL 1 (ESAL)		2.0	2.0	2.0	2.0
GRADED AGGREGATE BASE (GAB)		0.0	4.0	3.0	4.0	4.0	

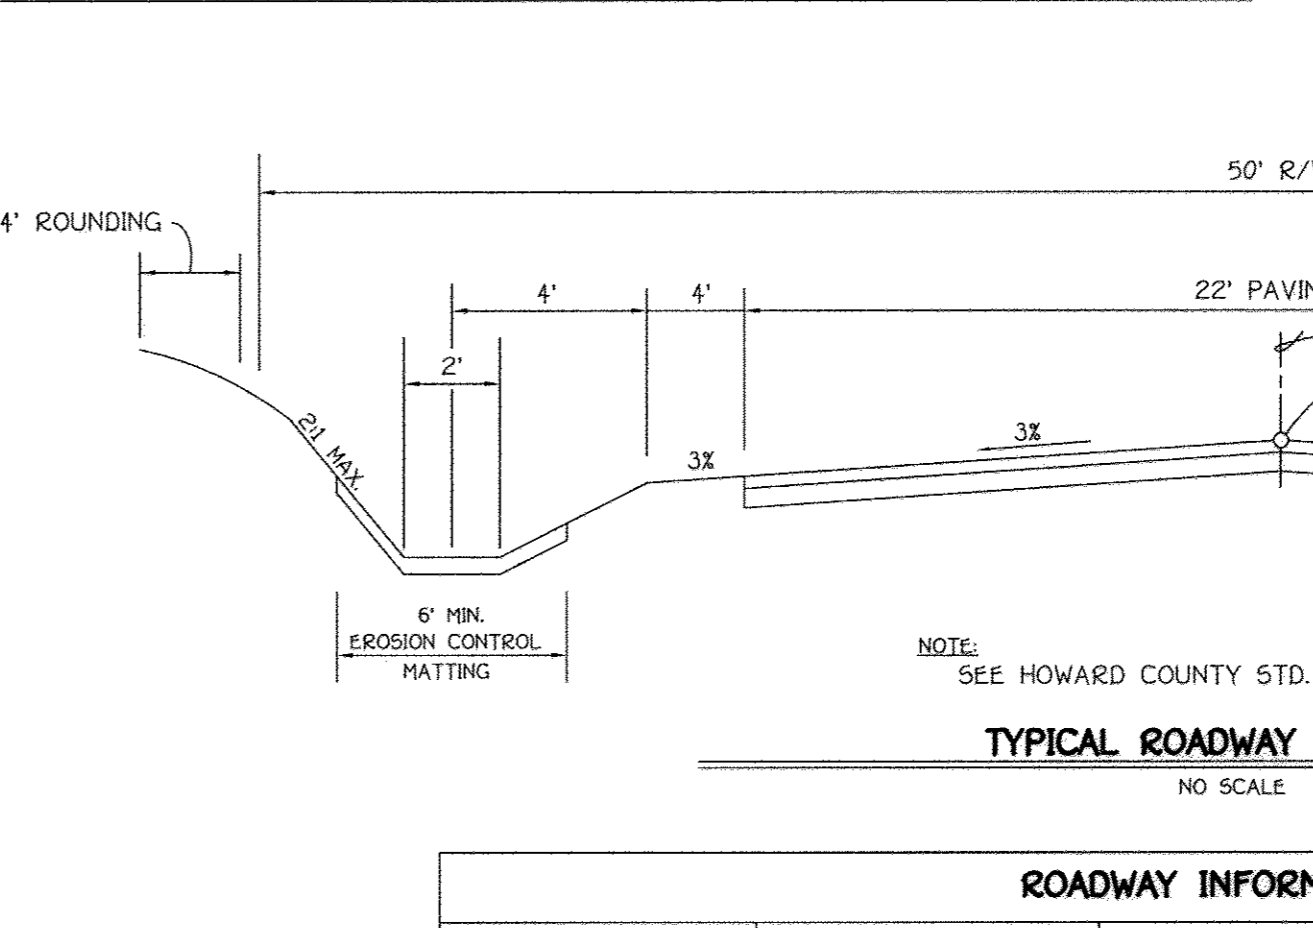

ROADWAY INFORMATION CHART

ROAD NAME	CLASSIFICATION	DESIGN SPEED	ZONING	STATION LIMITS	PAVING SECTION
VICTORY LANE	PUBLIC ACCESS PLACE	25 MPH	RC-DEO	0+00 TO 0+75.33	P-2

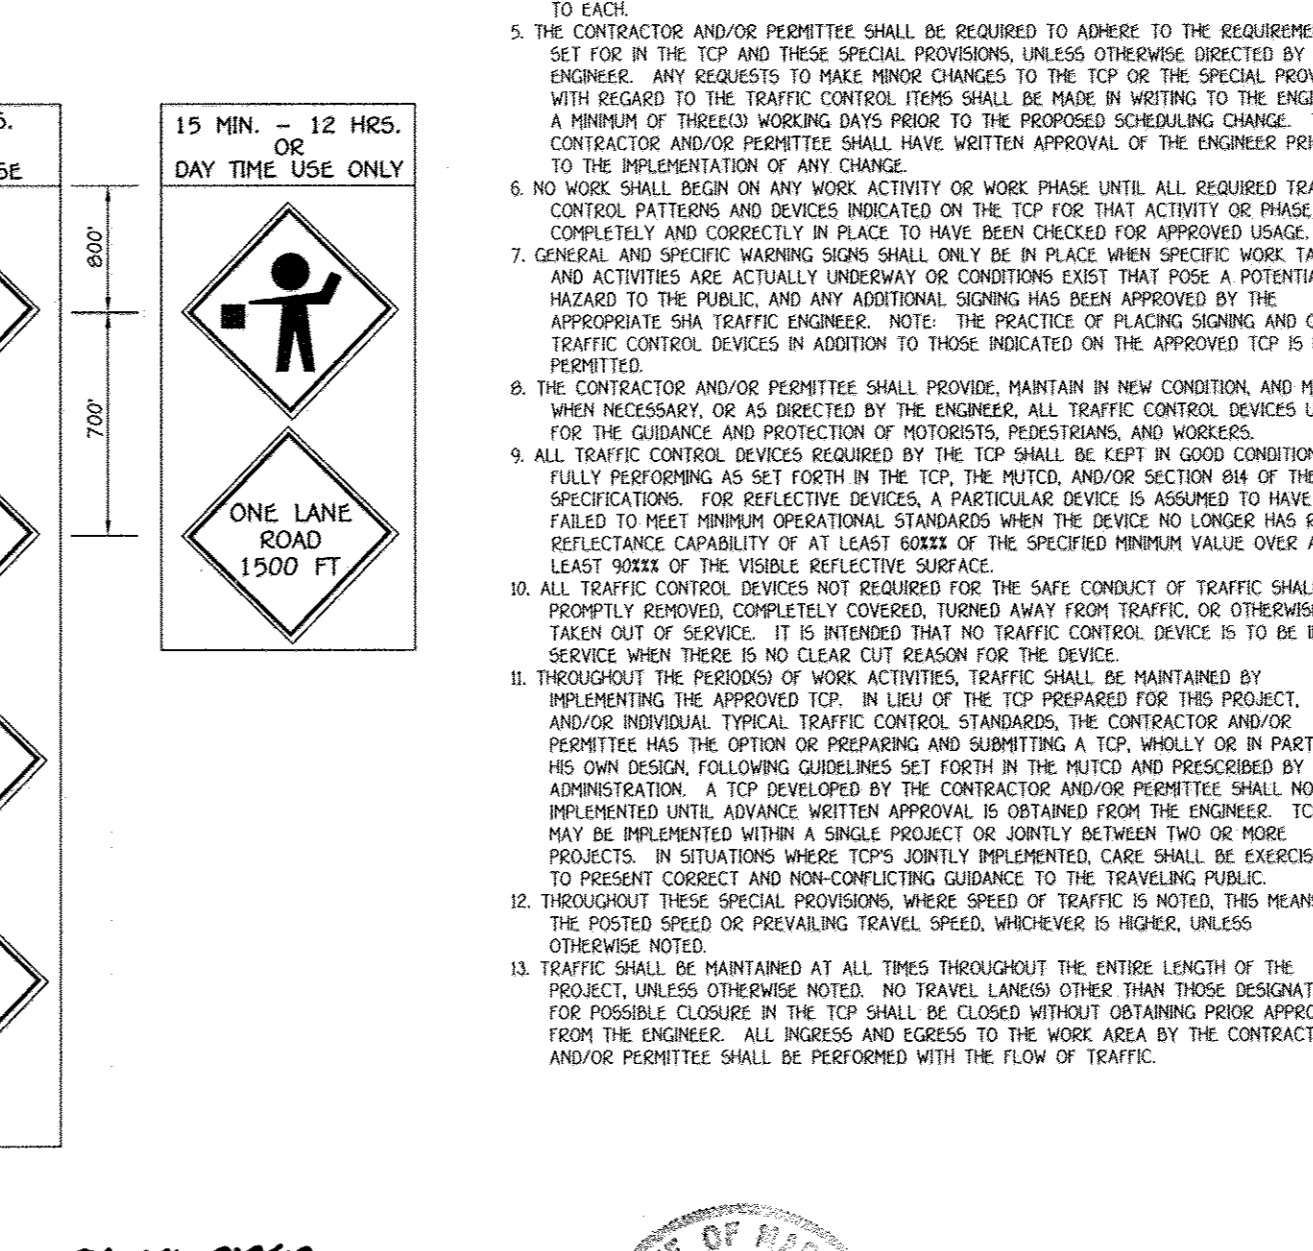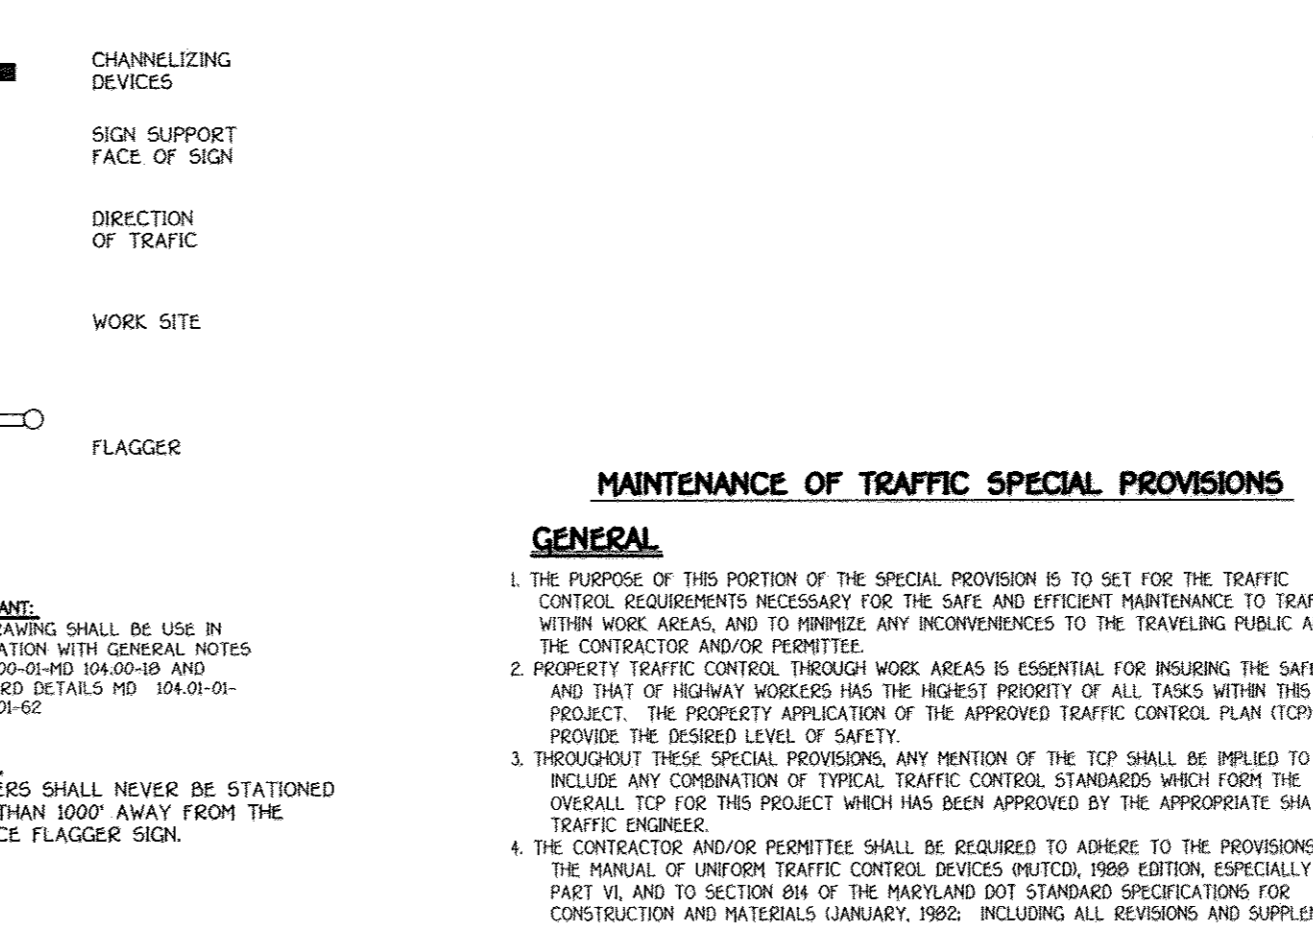

APPROVED: DEPARTMENT OF PUBLIC WORKS
WILLIAM Z. WILSON
CHIEF, BUREAU OF HIGHWAYS
1-12-09 DATE

APPROVED: DEPARTMENT OF PLANNING AND ZONING
CINDY HART
CHIEF, DIVISION OF LAND DEVELOPMENT
1/22/09 DATE

APPROVED: DEVELOPMENT ENGINEERING DIVISION
CHAD EDWARDS
CHIEF, DEVELOPMENT ENGINEERING DIVISION
1/16/09 DATE

NOTE:
ALL FILL AREAS TO HAVE 95% COMPACTION PER AASHTO T-180 SPECIFICATIONS.

IMPORTANT:
THIS DRAWING SHALL BE USED IN COMBINATION WITH GENERAL NOTES NO. 104.00-01-MD 104.00-02-MD 104.00-03-MD 104.00-464-MD 104.00-4

STRUCTURE SCHEDULE

STRUCTURE NO.	TOP ELEVATION	INV. IN	INV. OUT	LOCATION	STATION	OFFSET	TYPE	REMARKS
I-1	THROAT = 483.86	479.85	475.48	VICTORY LANE	8+09.27	19.0' R	'K' INLET	D - 4.12 w/D - 4.13
I-2	THROAT = 483.89	---	480.67	VICTORY LANE	8+09.27	19.0' L	'K' INLET	D - 4.12 w/D - 4.13
I-3	TOP = 480.37	---	476.36	VICTORY LANE	L.P. 1+02.41	---	A-10	D - 4.01
I-4	THROAT = 491.37	486.60	486.42	VICTORY LANE	6+51	19.0' R	'K' INLET	D - 4.12 w/D - 4.13
I-5	THROAT = 507.83	504.45, 502.28	502.18	VICTORY LANE	4+15	19.0' R	'K' INLET	D - 4.12 w/D - 4.13
I-6	THROAT = 507.66	---	504.45	VICTORY LANE	4+15	19.0' L	'K' INLET	D - 4.12 w/D - 4.13
I-7	THROAT = 520.93	---	516.44	VICTORY LANE	0+29	24.5' R	'K' INLET	D - 4.12 w/D - 4.13
M-1	TOP = 483.92	476.44	474.42	VICTORY LANE	7+93	47.5' R	STD. MANHOLE	G - 5.12
M-2	TOP = 521.64	515.82	515.64	VICTORY LANE	0+77	13.0' R	STD. MANHOLE	G - 5.12
S-1	TOP = 476.24	474.24	---	VICTORY LANE	7+85	82.0' R	CONC. END SECTION	D - 5.51
S-2	TOP = 471.94	469.94	---	N 579,846.11 E 1,302,212.55	---	---	CONC. END SECTION	D - 5.51
R-1	TOP = 480.92	471.70	471.50	N 579,766.50 E 1,302,189.21	---	---	CONCRETE RISER	SEE SHEET B

PROVIDE STD. MANHOLE STEPS

PROVIDE STD. MANHOLE STEPS


APPROVED: DEPARTMENT OF PUBLIC WORKS
William J. Marshall 1-12-09
 CHIEF, BUREAU OF HIGHWAYS

APPROVED: DEPARTMENT OF PLANNING AND ZONING
Chris Homan 1/22/09
 CHIEF, DIVISION OF LAND DEVELOPMENT

David R. Johnson 1-16-9
 CHIEF, DEVELOPMENT ENGINEERING DIVISION

DRIVEWAY CULVERT DATA




LOT	SLOPE (%)	Q10 (cfs)	PIPE SIZE
1	N/A HIGHPOINT	CREST	NO PIPE
2	5.02	8.20	12"
3	7.00	9.60	12"
4	7.00	9.60	12"
5 & 6	N/A SUMP	SUMP	NO PIPE
7	7.00	9.60	12"
8	7.00	9.60	12"
9	6.75	9.45	12"
10	3.82	7.00	12"

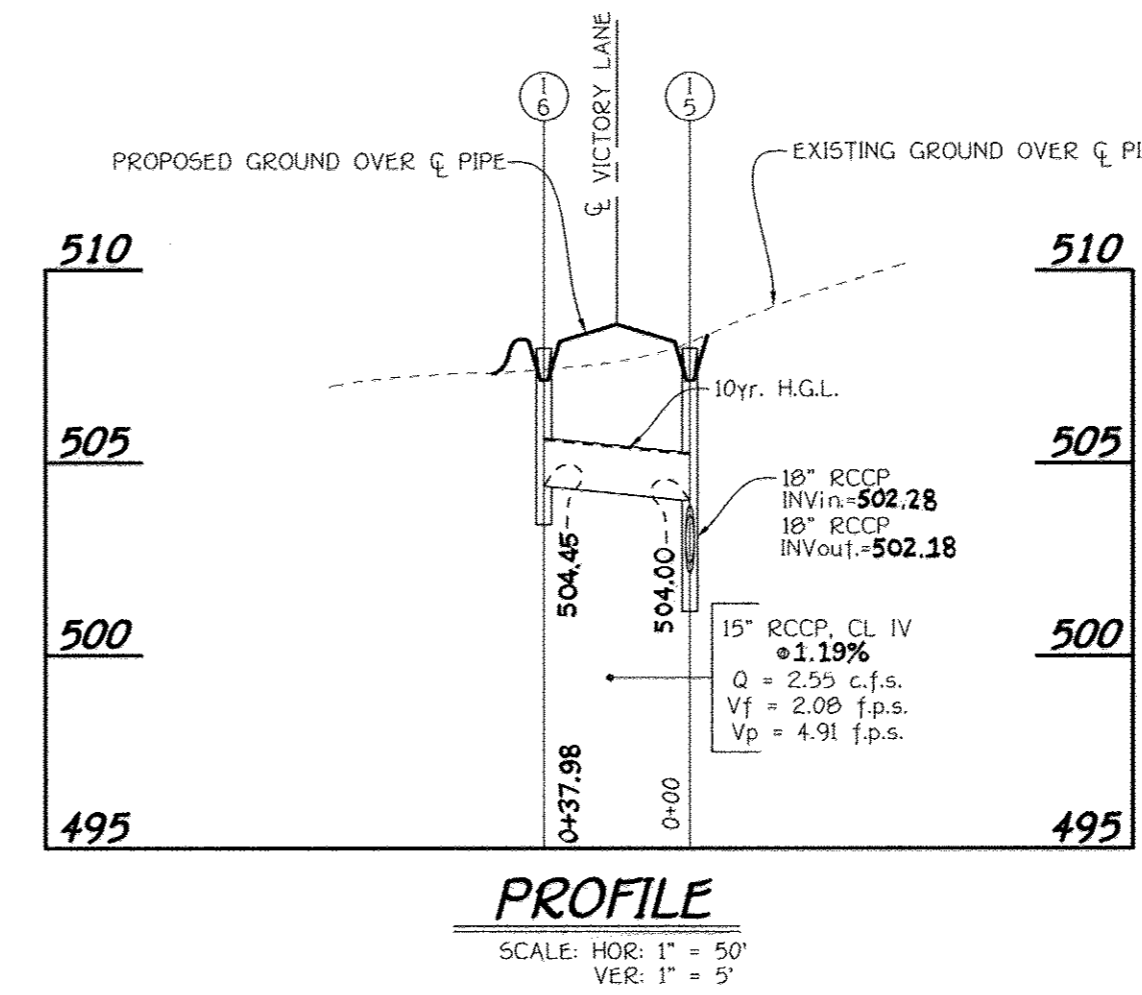

PIPE SCHEDULE

SIZE	CLASS	LENGTH
15"	RCCP, CL. V	227'
18"	RCCP, CL. IV	774'
24"	RCCP, CL. IV	35'
30"	ASTM C-361 B-25	83'
6"	D.I.P. POND DRAIN	7'
6"	PVC, SCH. 40	171'
6"	PERFORATED PVC, SCH. 40	62'

NOTE: RCCP, CL. IV PIPE MAY BE SUBSTITUTED WITH HDPE PIPE.

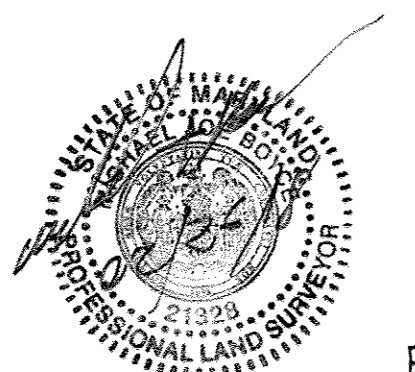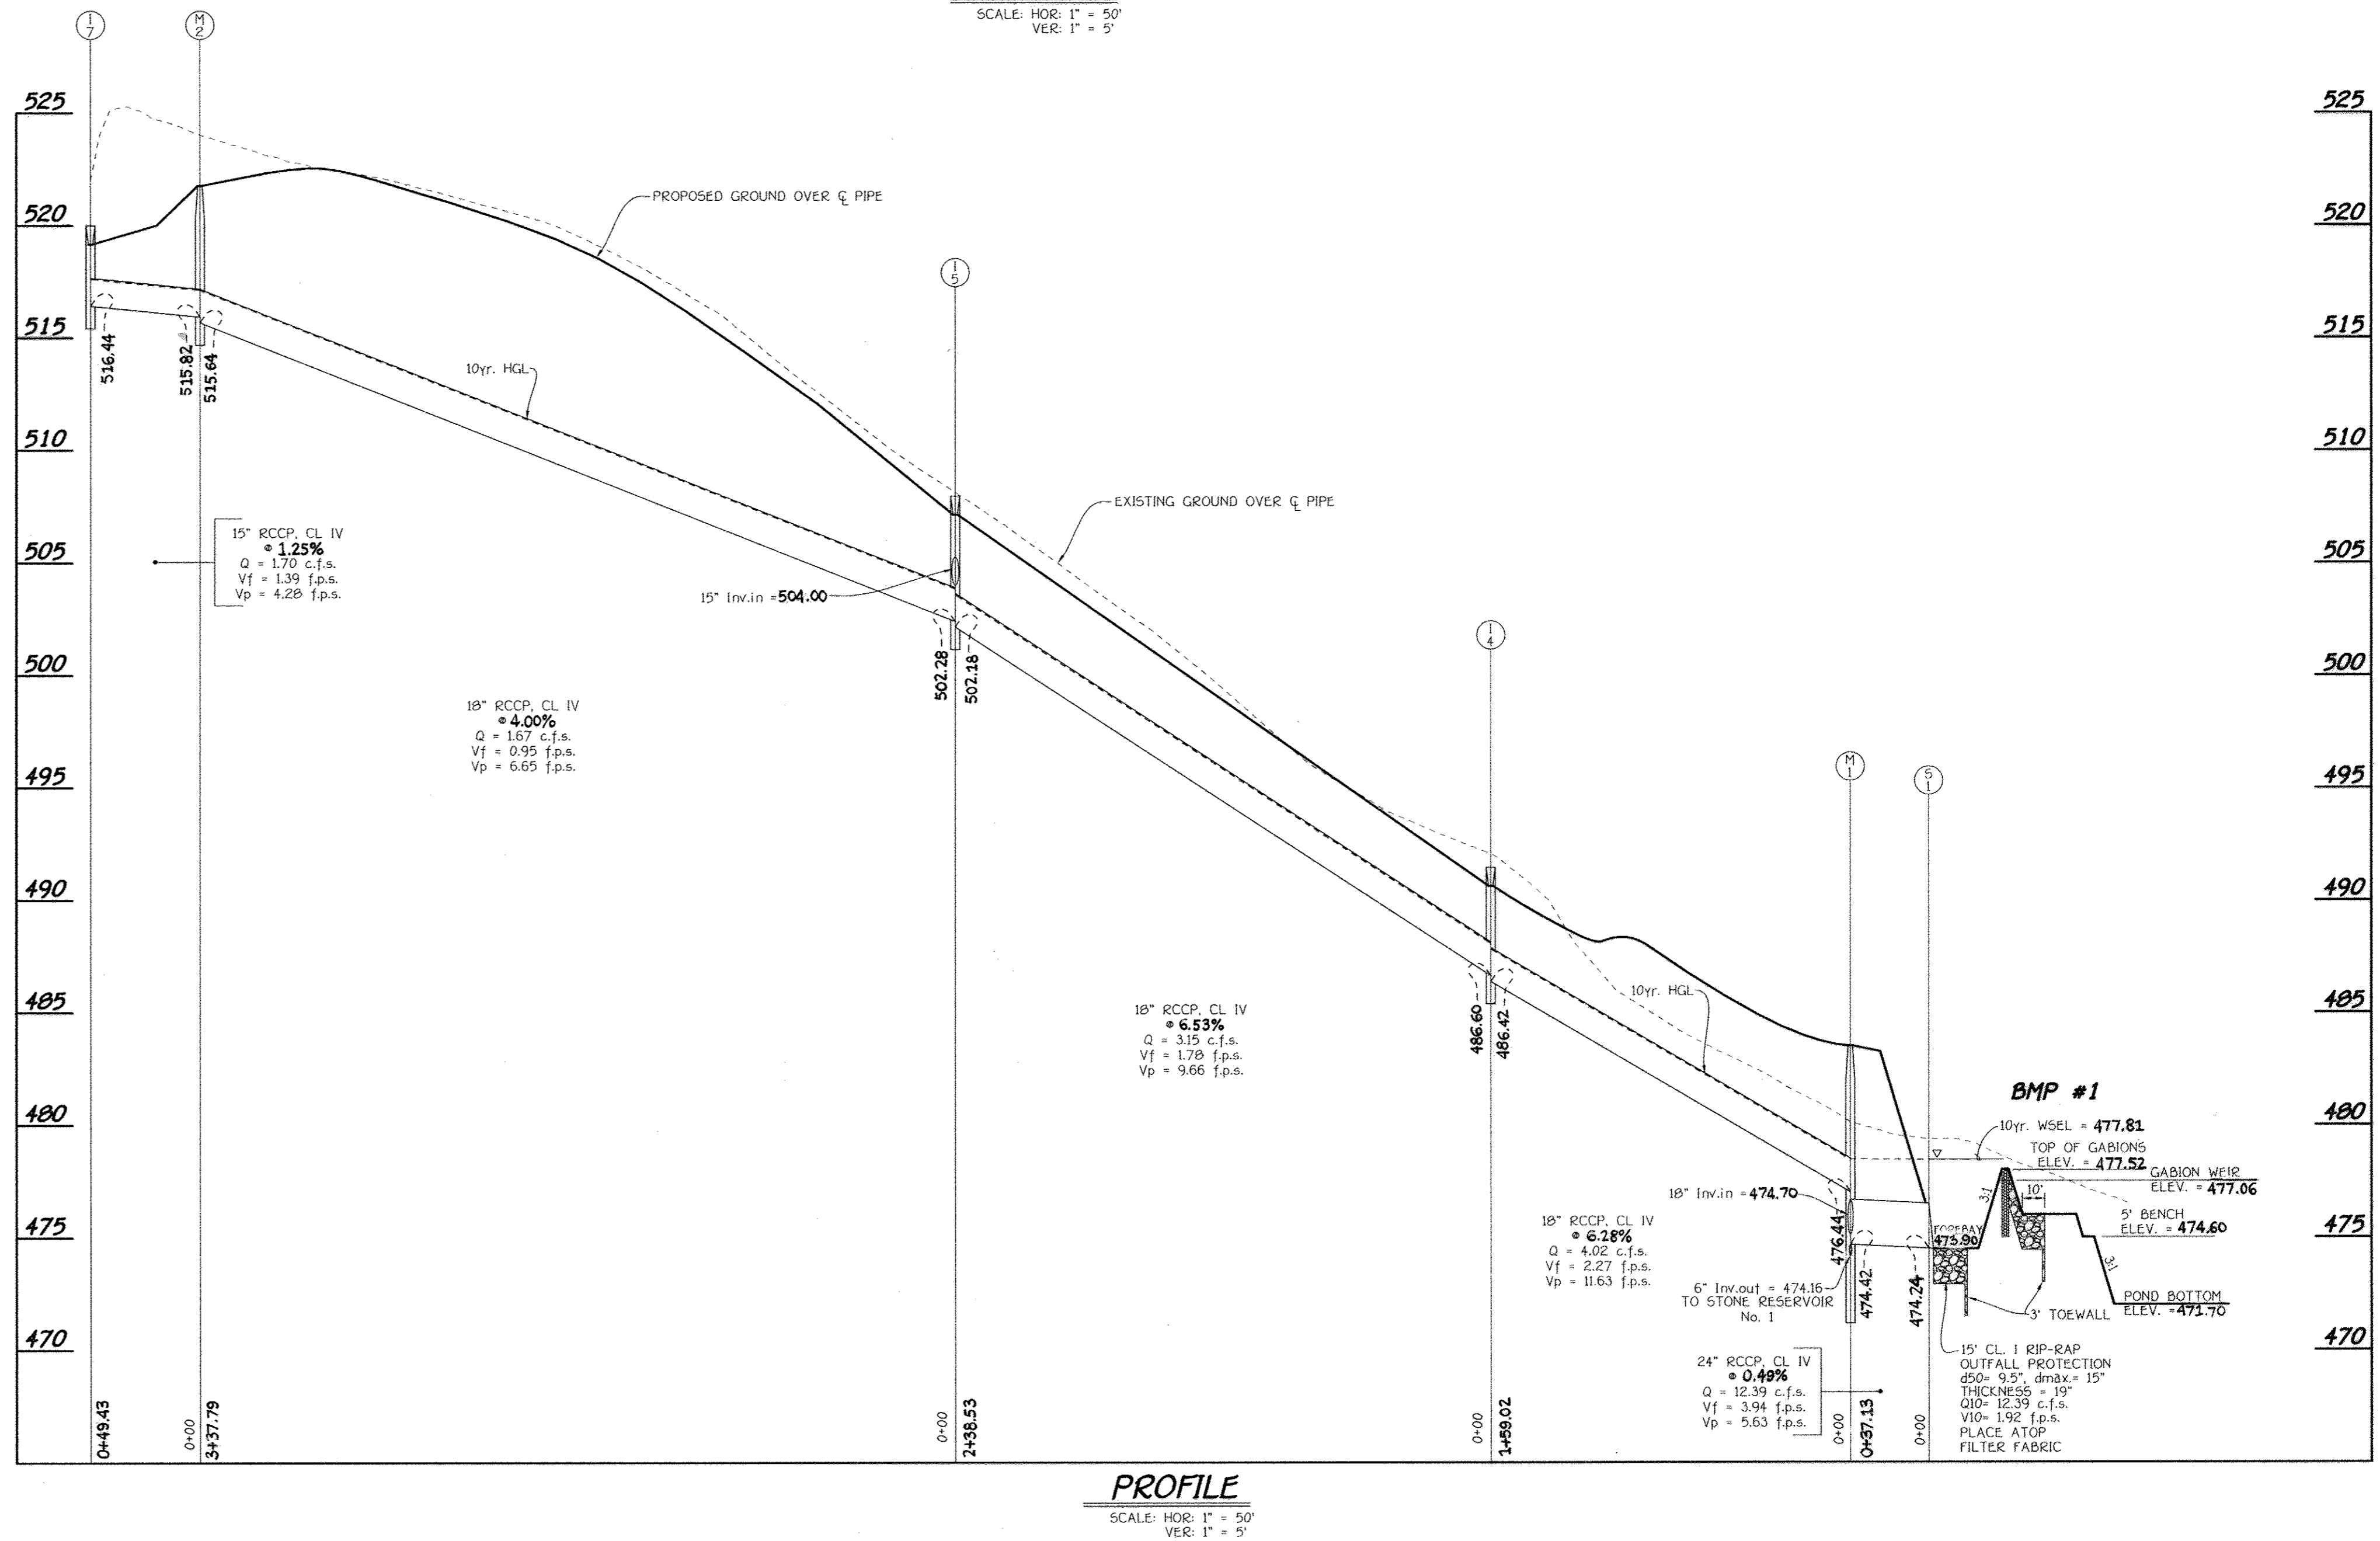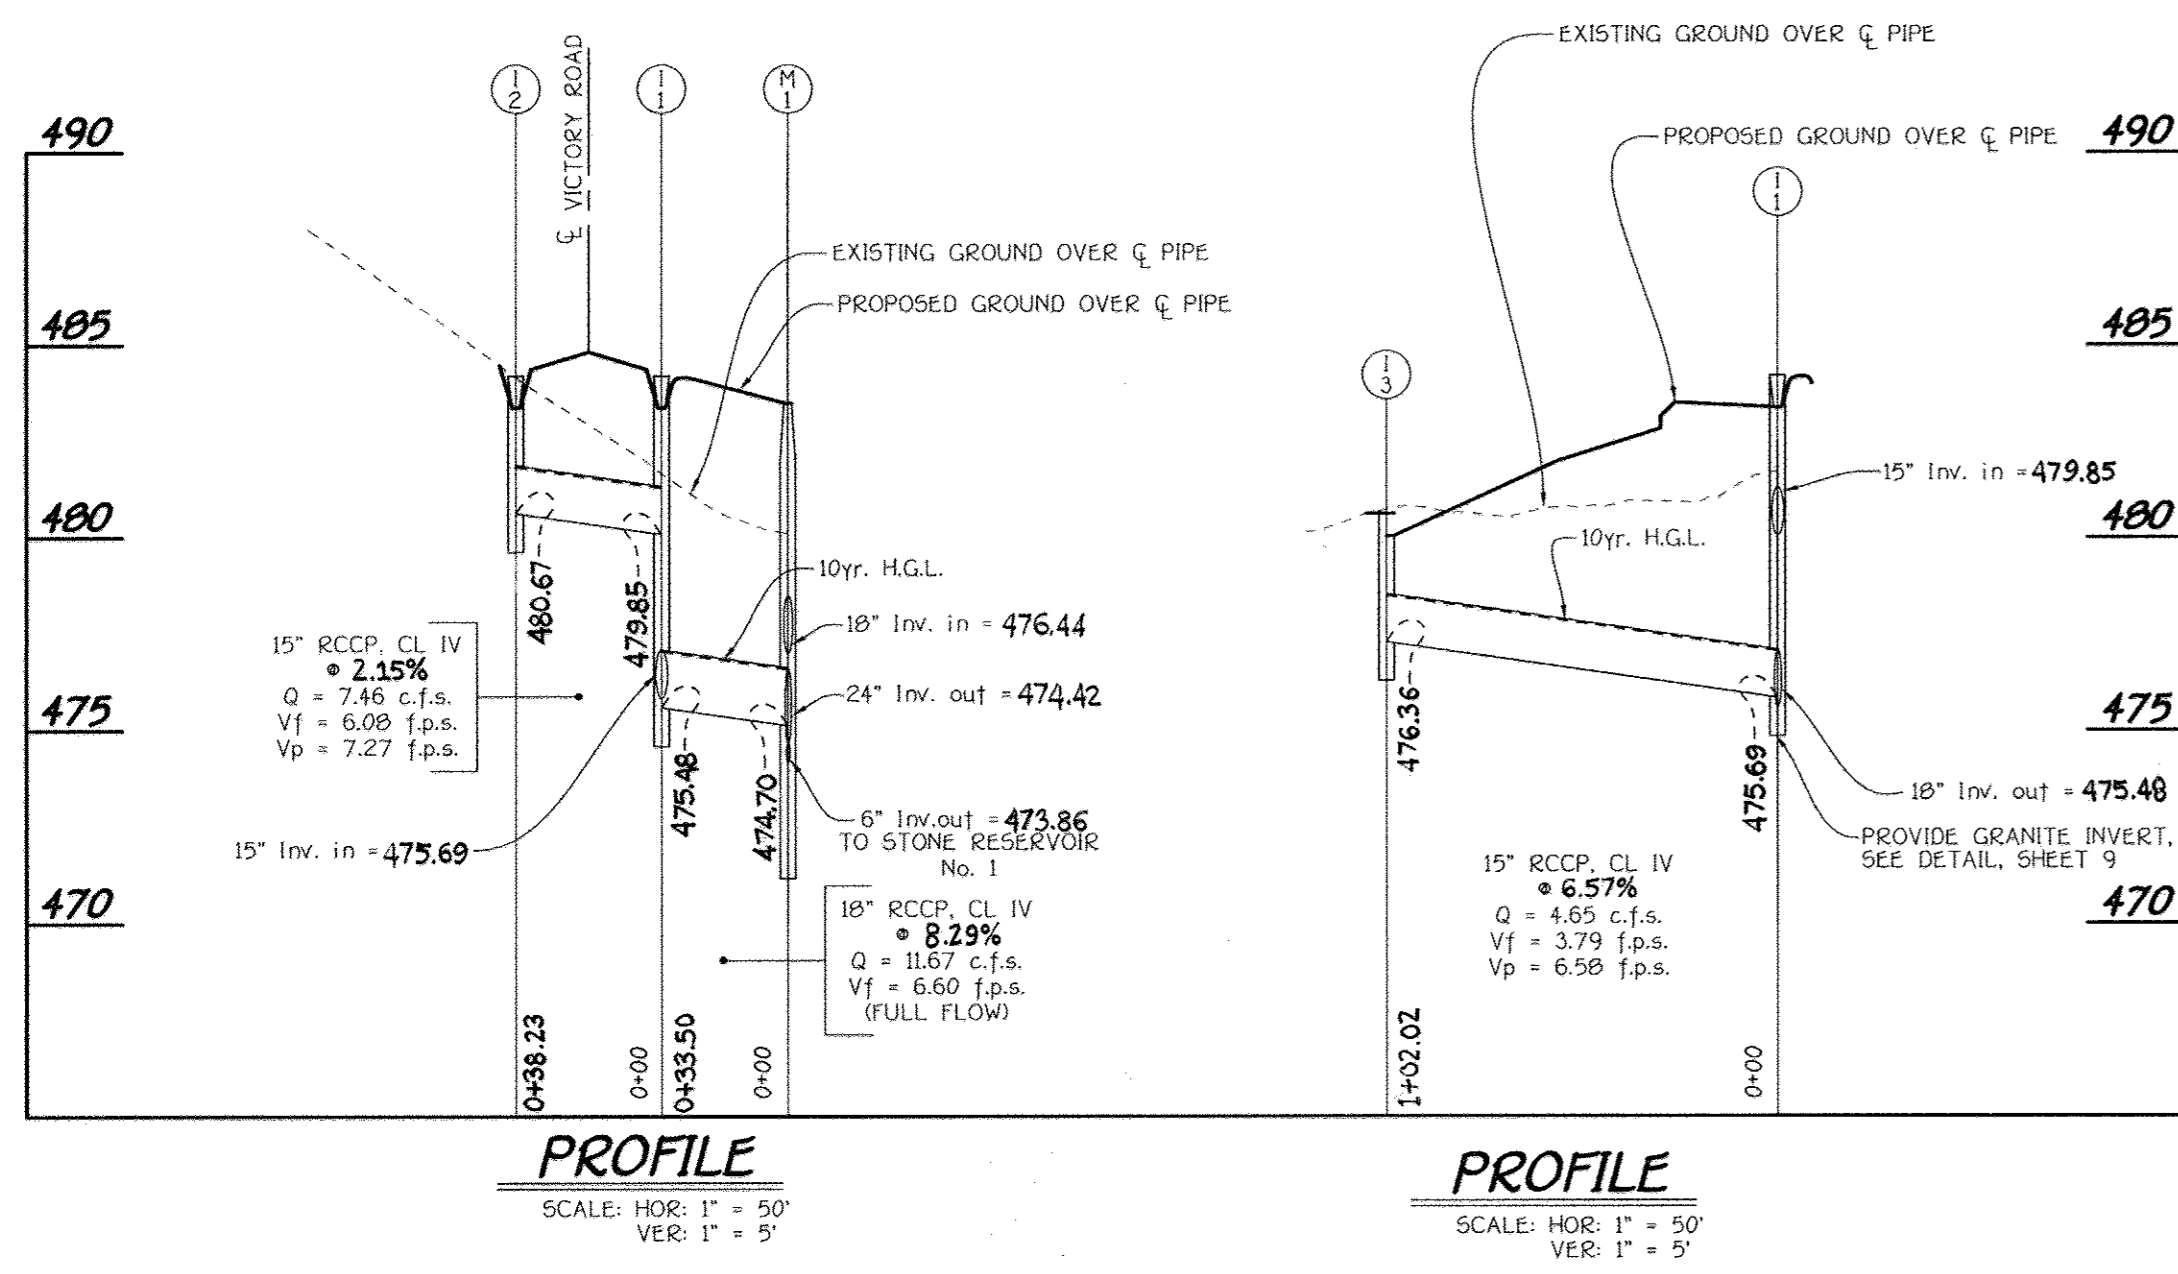

FOR ESE CONSULTANTS, INC.

PROFESSIONAL CERTIFICATION: I HEREBY CERTIFY THAT THESE DOCUMENTS WERE PREPARED BY ME OR UNDER MY RESPONSIBLE CHARGE, AND THAT I AM A DULY LICENSED PROFESSIONAL LAND SURVEYOR UNDER THE LAWS OF THE STATE OF MARYLAND, LICENSE NO. 21328, EXPIRATION DATE 1/08/19.

FISHER, COLLINS & CARTER, INC.
 CIVIL ENGINEERING CONSULTANTS & LAND SURVEYORS
 CENTRAL SQUARE OFFICE PARK - 10272 BALTIMORE NATIONAL FIVE
 ELLEOTT CITY, MARYLAND 21042
 (410) 461-2925

NO.	REVISION	DATE
1	REVISE OWNER AND DEVELOPER	11/8/11
	DESCRIPTION	
	REVISIONS	

OWNER
 MERIWETHER FARM II, LLC
 C/O GOODER, LLC
 10715 CHATEAU DRIVE
 SUITE 350
 COLUMBIA, MARYLAND 21044
 PH: (410) 997-7501
 ATTN: MR. ROBERT A. GOODER, JR.










DEVELOPER
 TOLL BROTHERS, INC.
 MARYLAND DIVISION
 7164 COLUMBIA GATEWAY DRIVE
 SUITE 230
 COLUMBIA, MARYLAND 21046
 PH: (410) 997-7501
 ATTN: MR. JEFF DRISCOLL



ALDO R. STUCCO, P.E.
 DATE: 12-22-08
 "Professional Certification" I hereby certify that these documents were prepared by me, and that I am a duly Licensed Professional Engineer under the laws of the State of Maryland, License No. 20740, Expiration Date 2-22-09.

STORM DRAIN PROFILES
MERIWETHER FARM
SECTION TWO
PHASE ONE
BUILDABLE LOTS 1 THRU 10, NON-BUILDABLE PRESERVATION PARCELS 'C' & 'D' AND BUILDABLE BULK PARCEL 'E'
 (A RESUBDIVISION OF BUILDABLE BULK PARCEL 'A', MERIWETHER FARM, SECTION TWO, F-08-198)
 ZONED: RC-DEO
 PARCEL No: 29 GRID Nos.: 15, 16, 21 & 22
 FOURTH ELECTION DISTRICT
 HOWARD COUNTY, MARYLAND
 SCALE: AS SHOWN
 DATE: DECEMBER, 2008
 SHEET 7 OF 15

ASBUILT

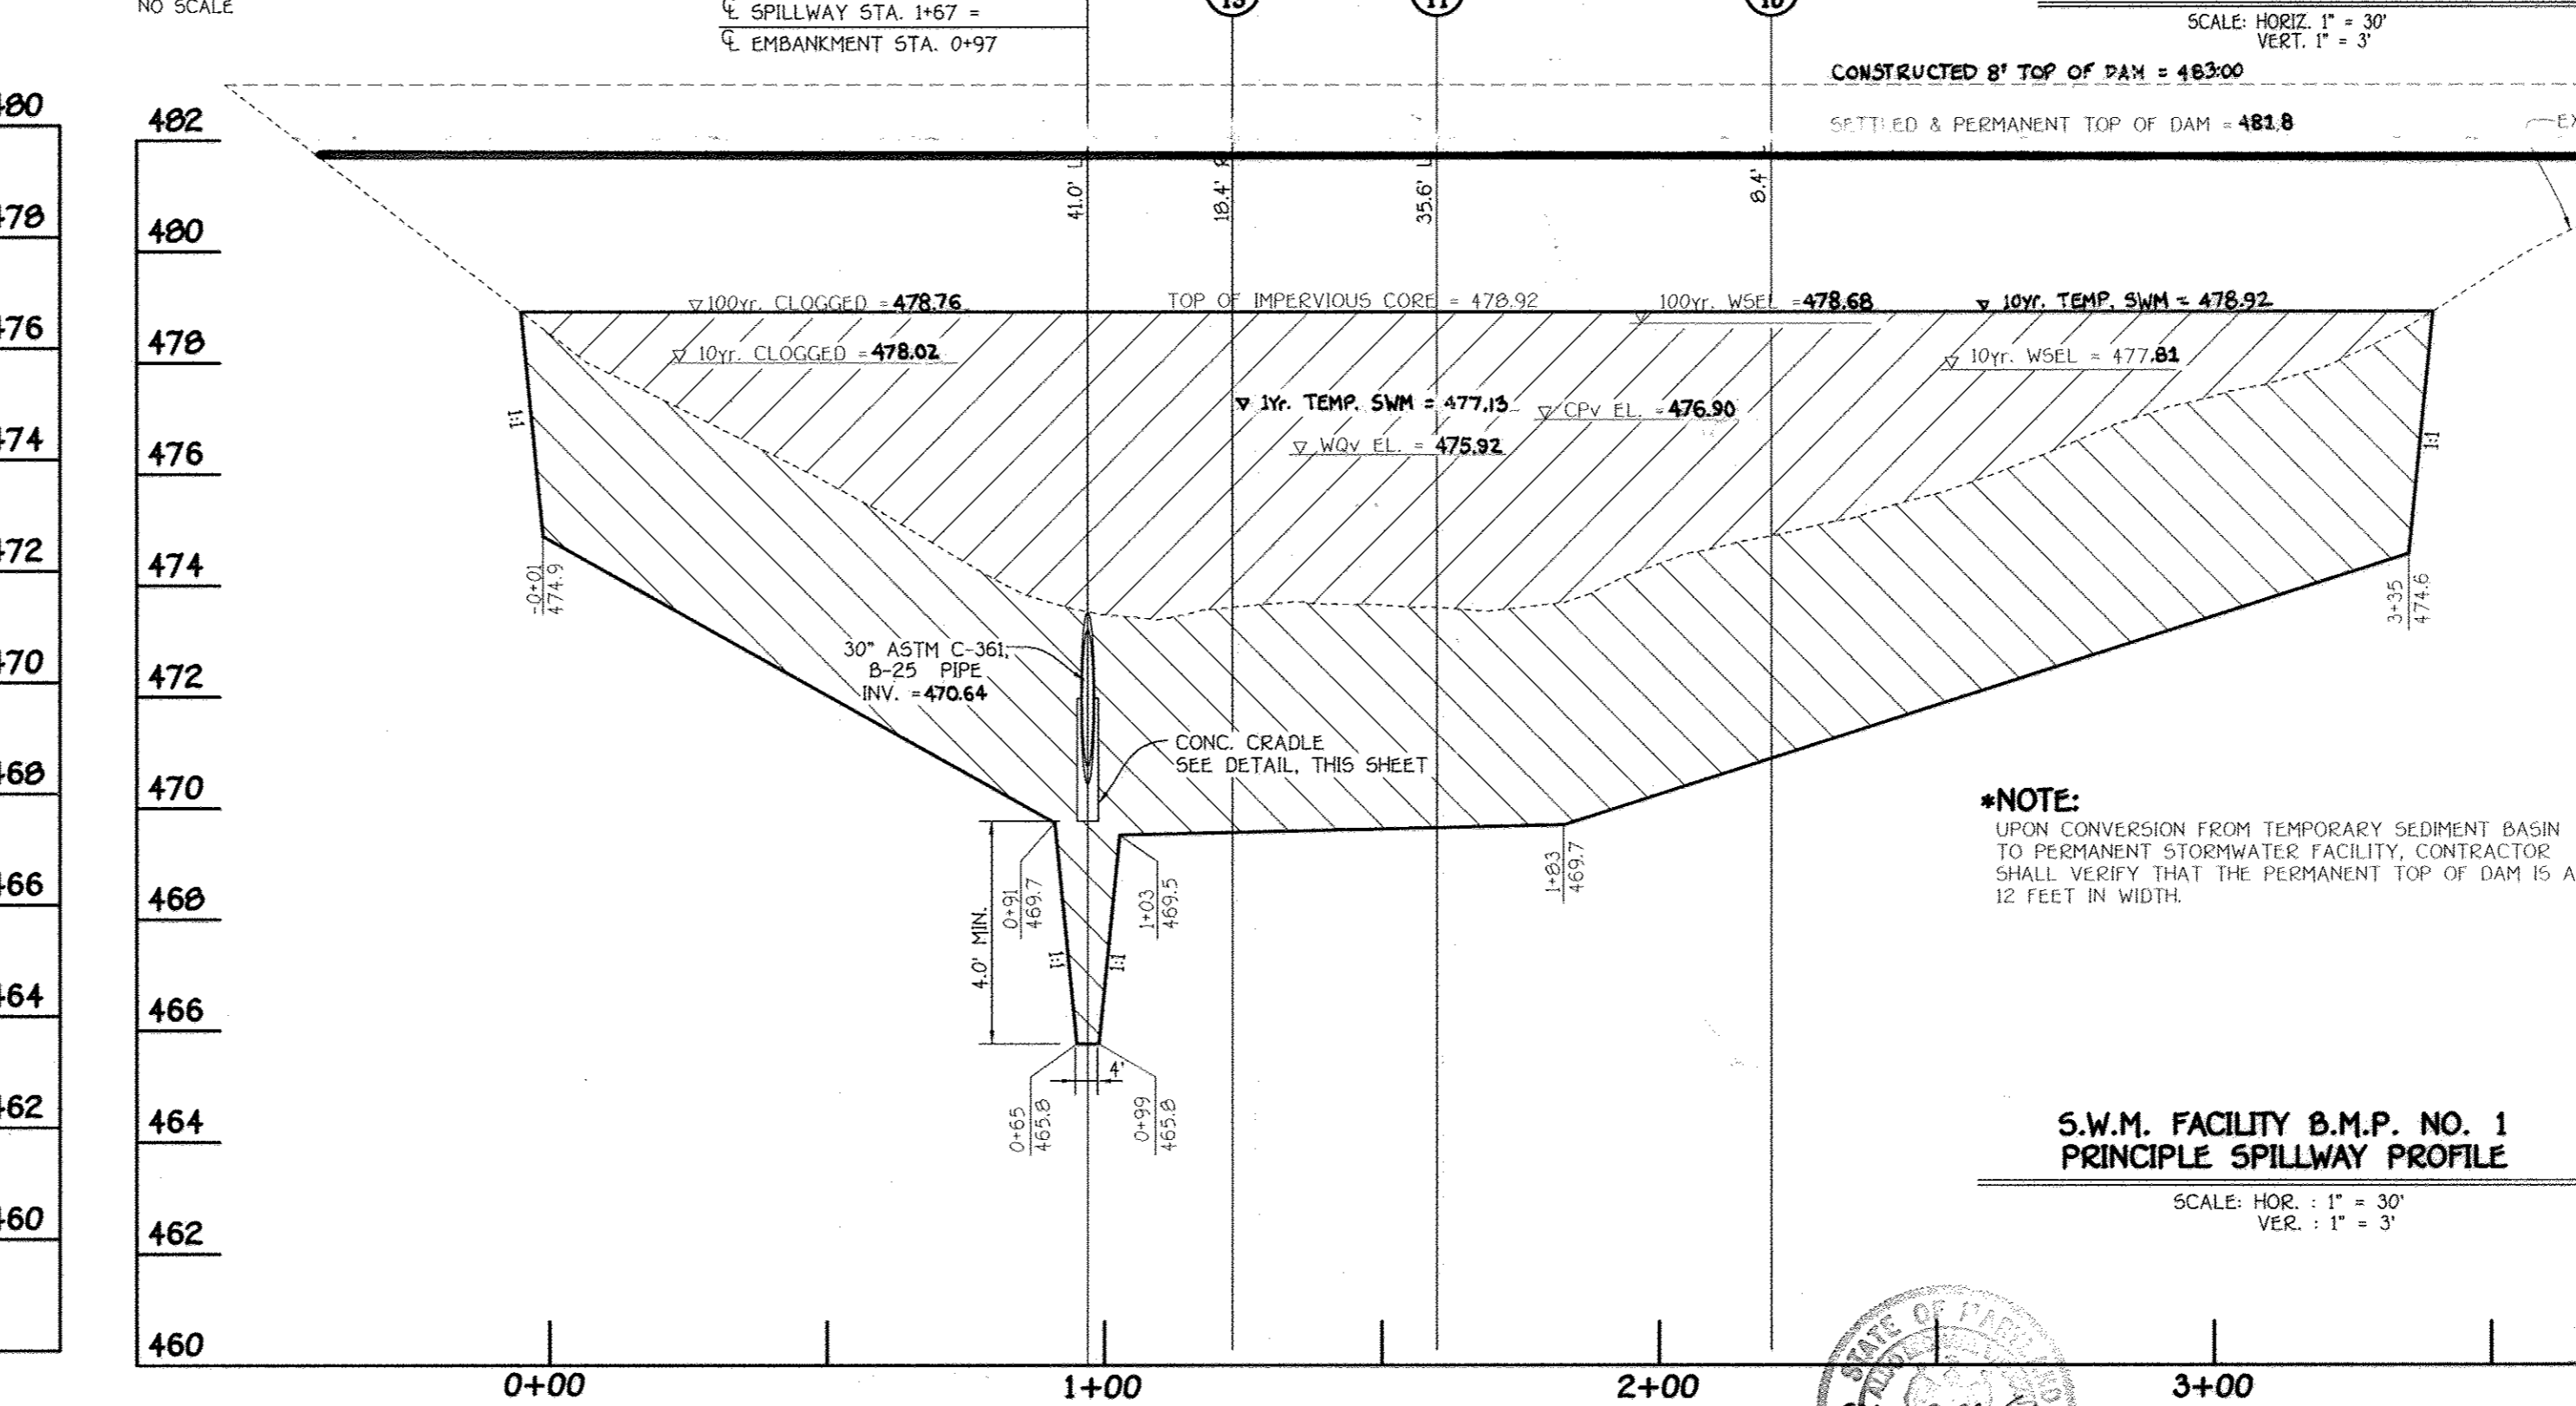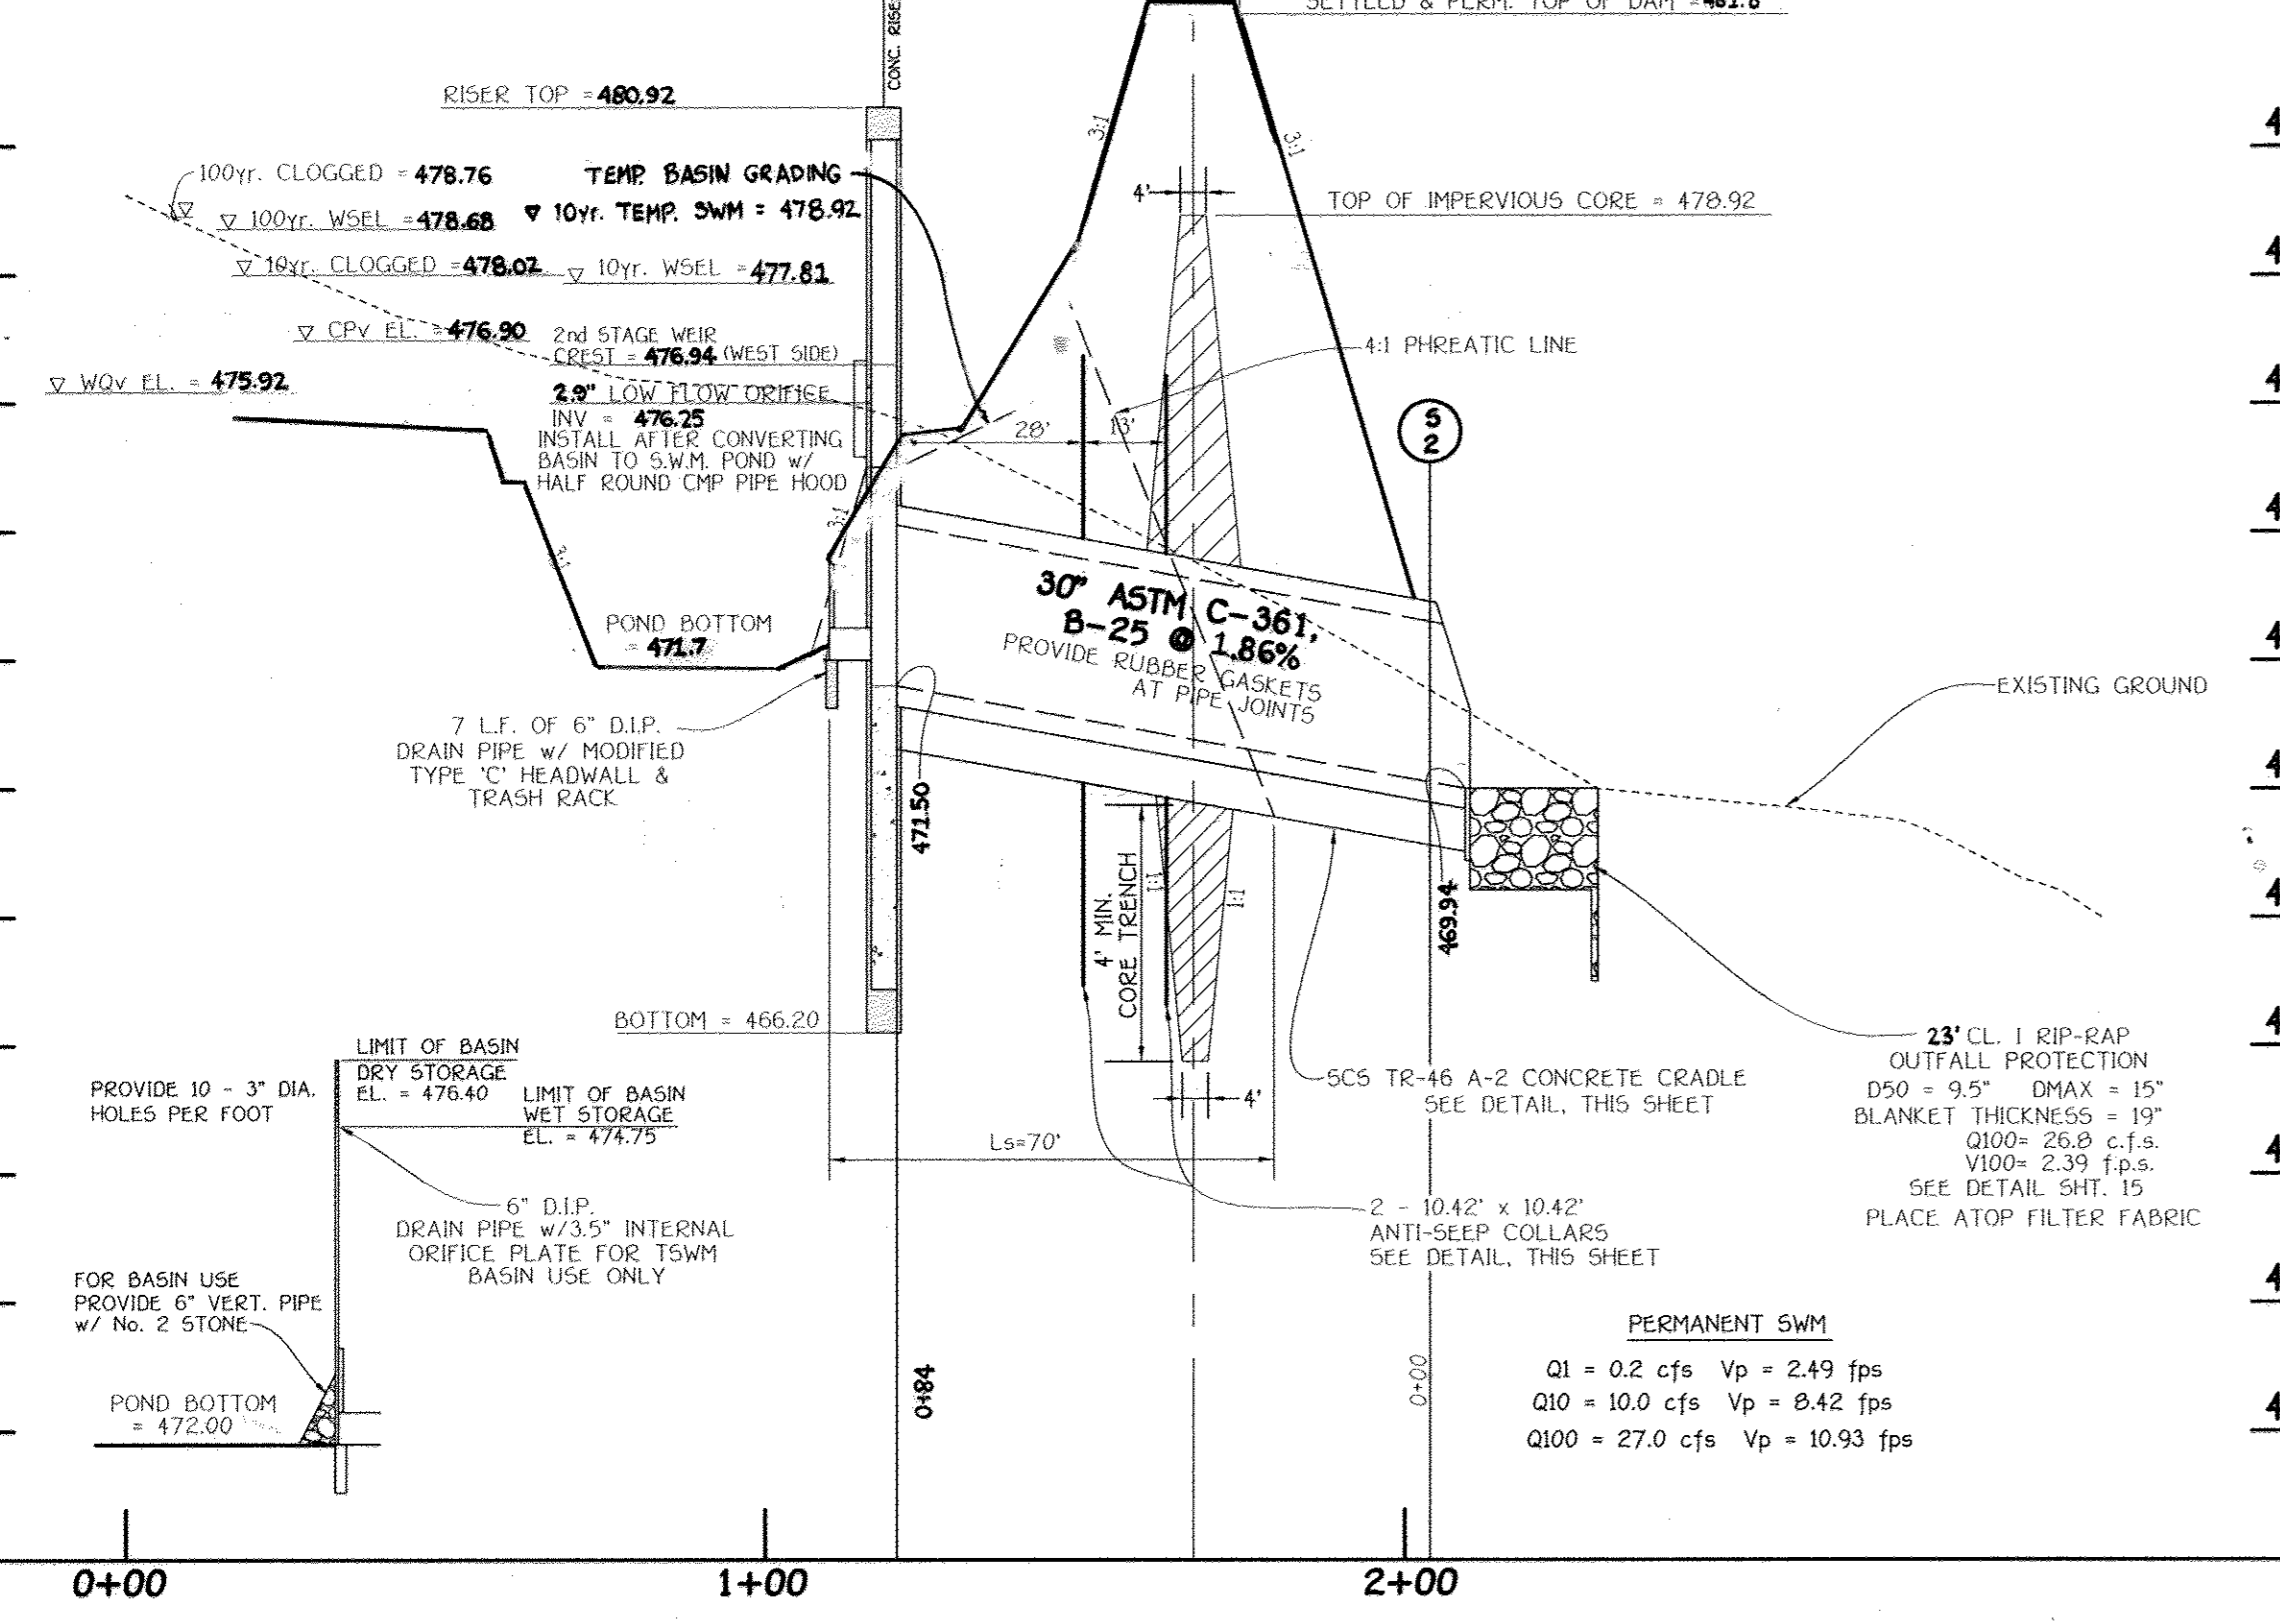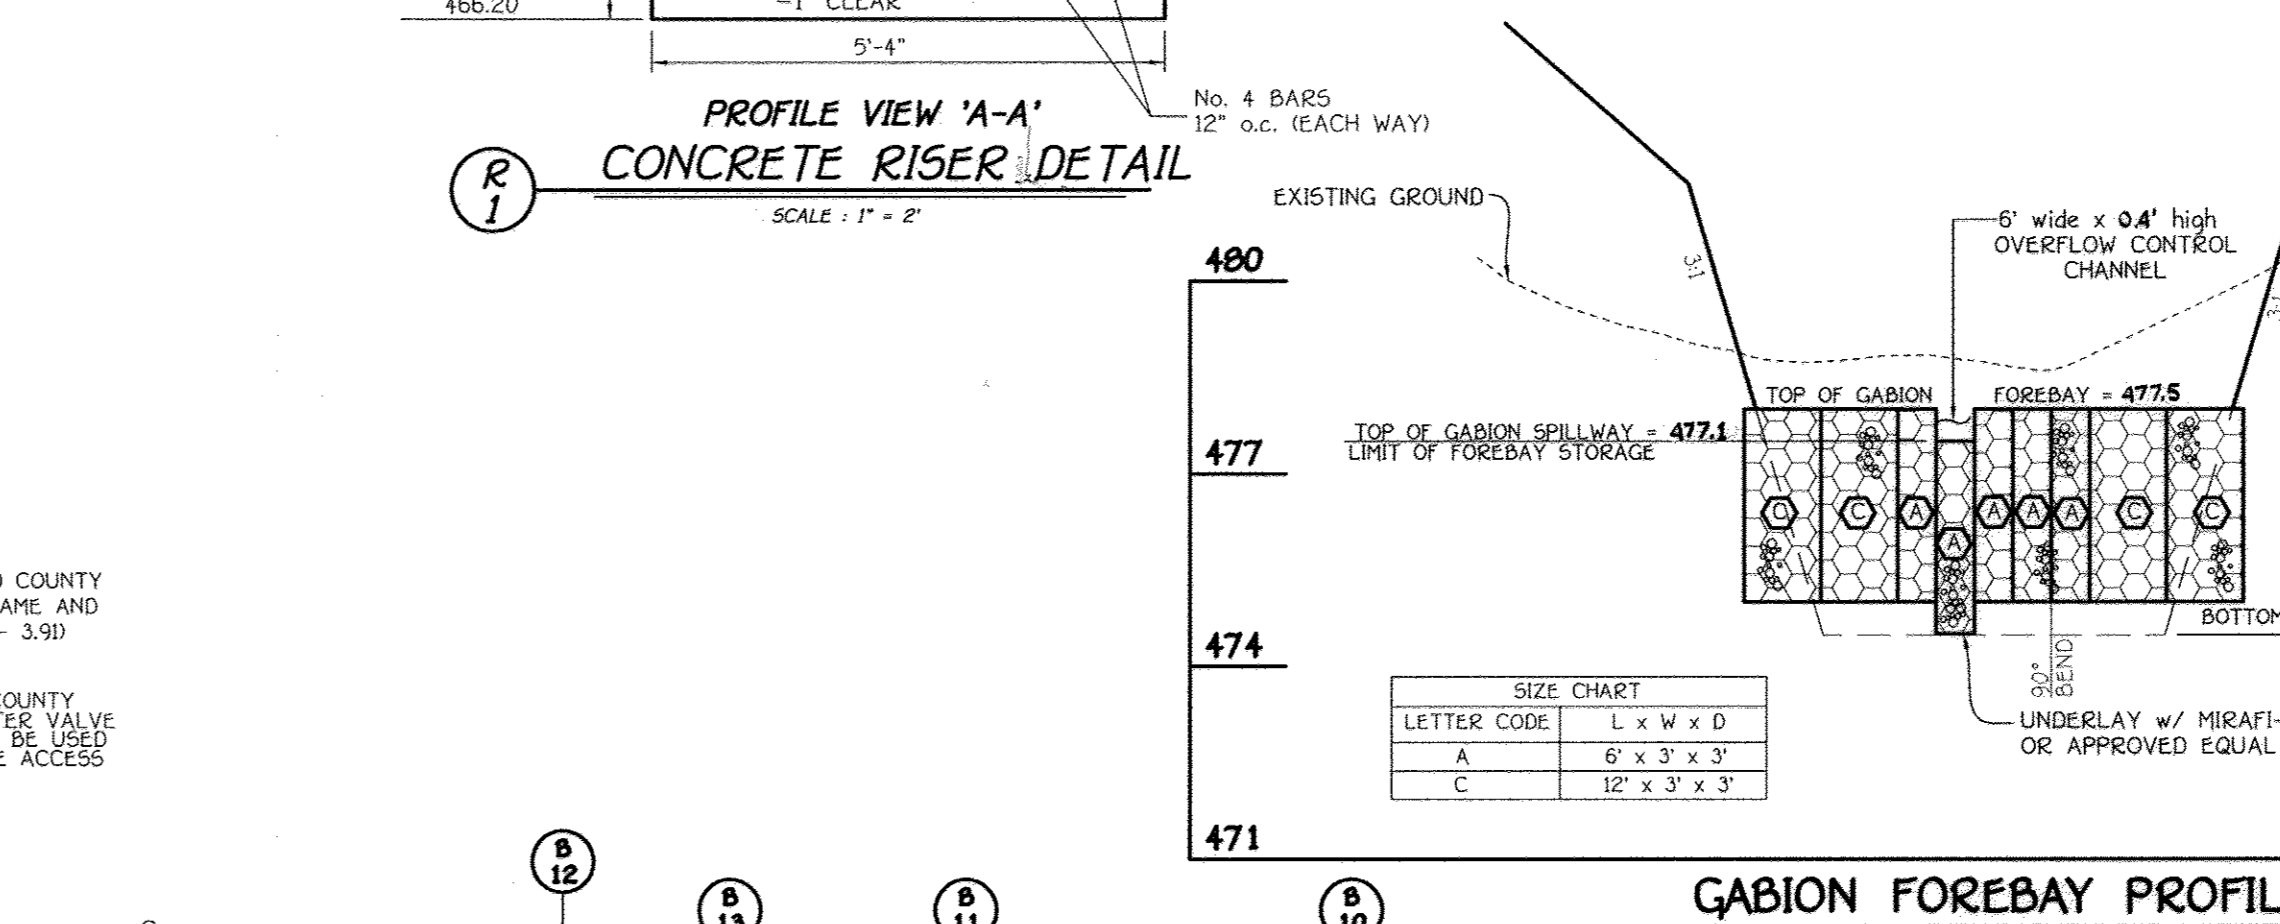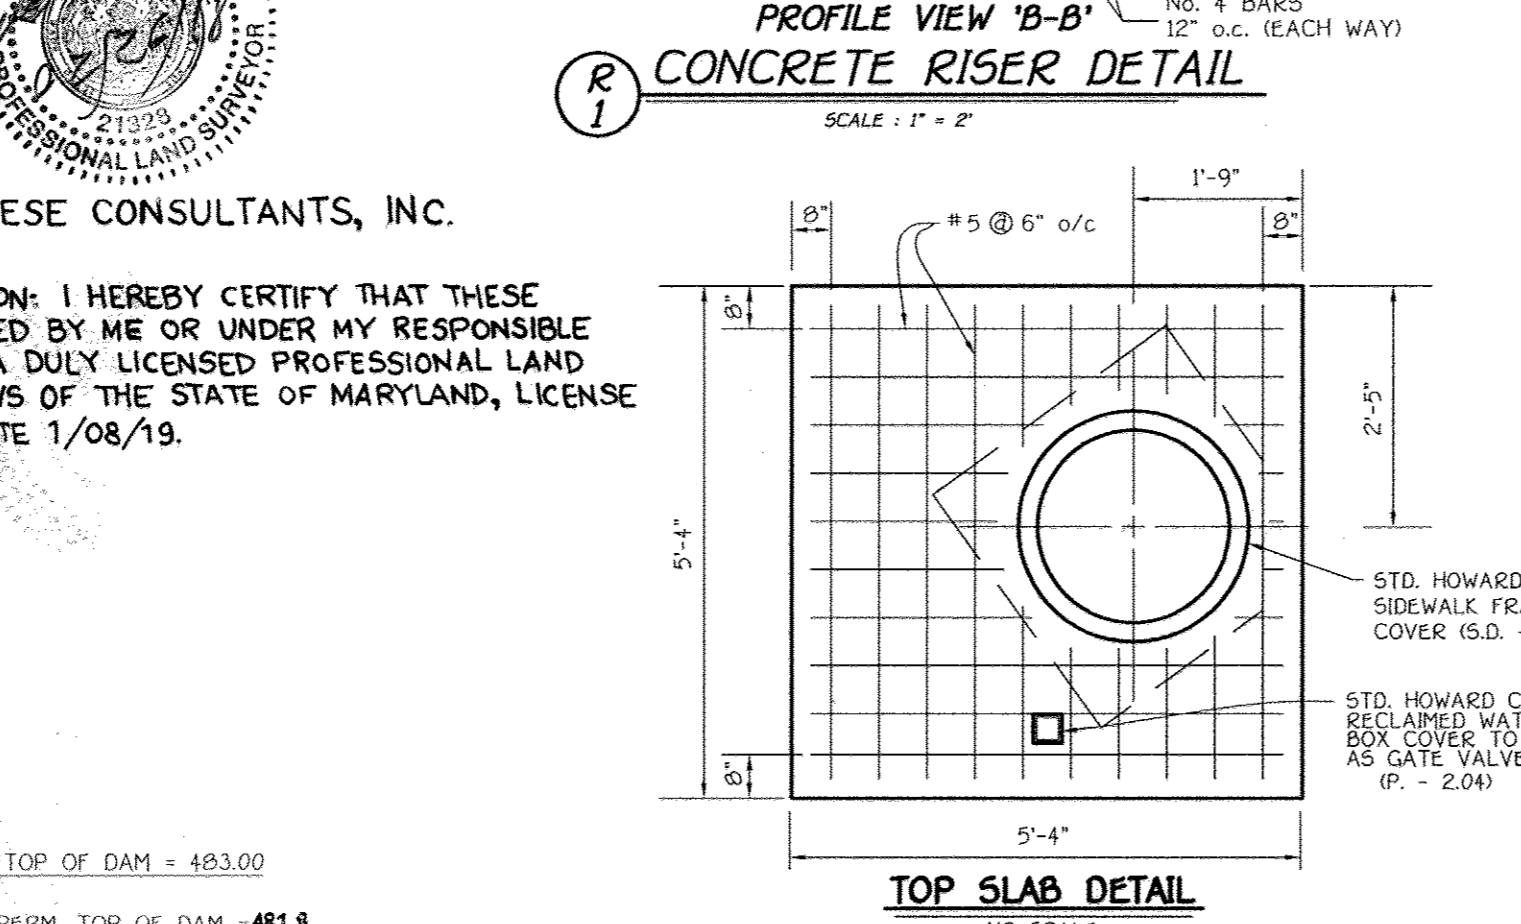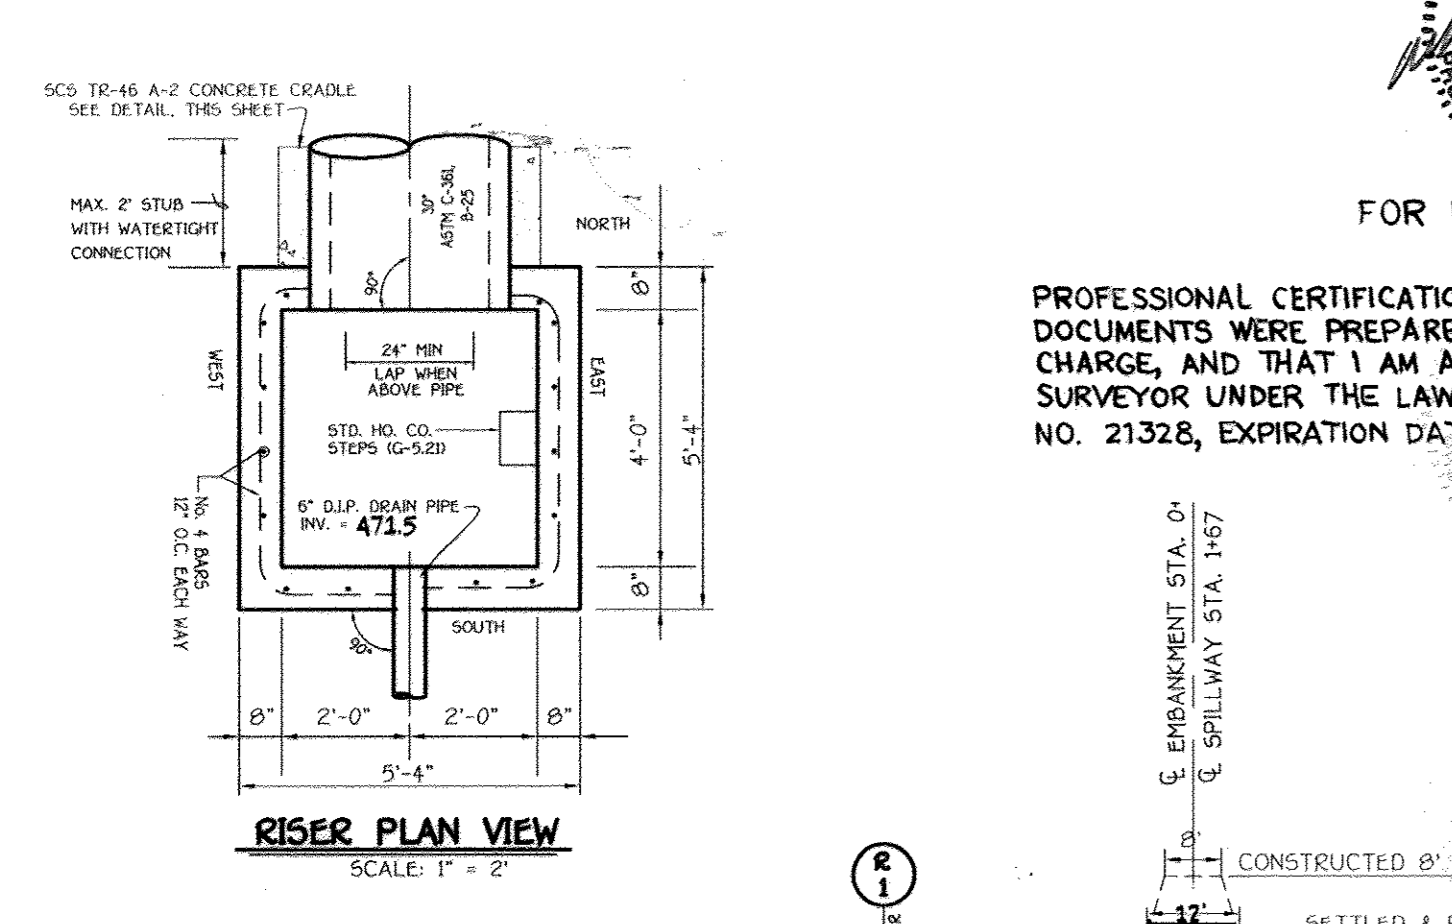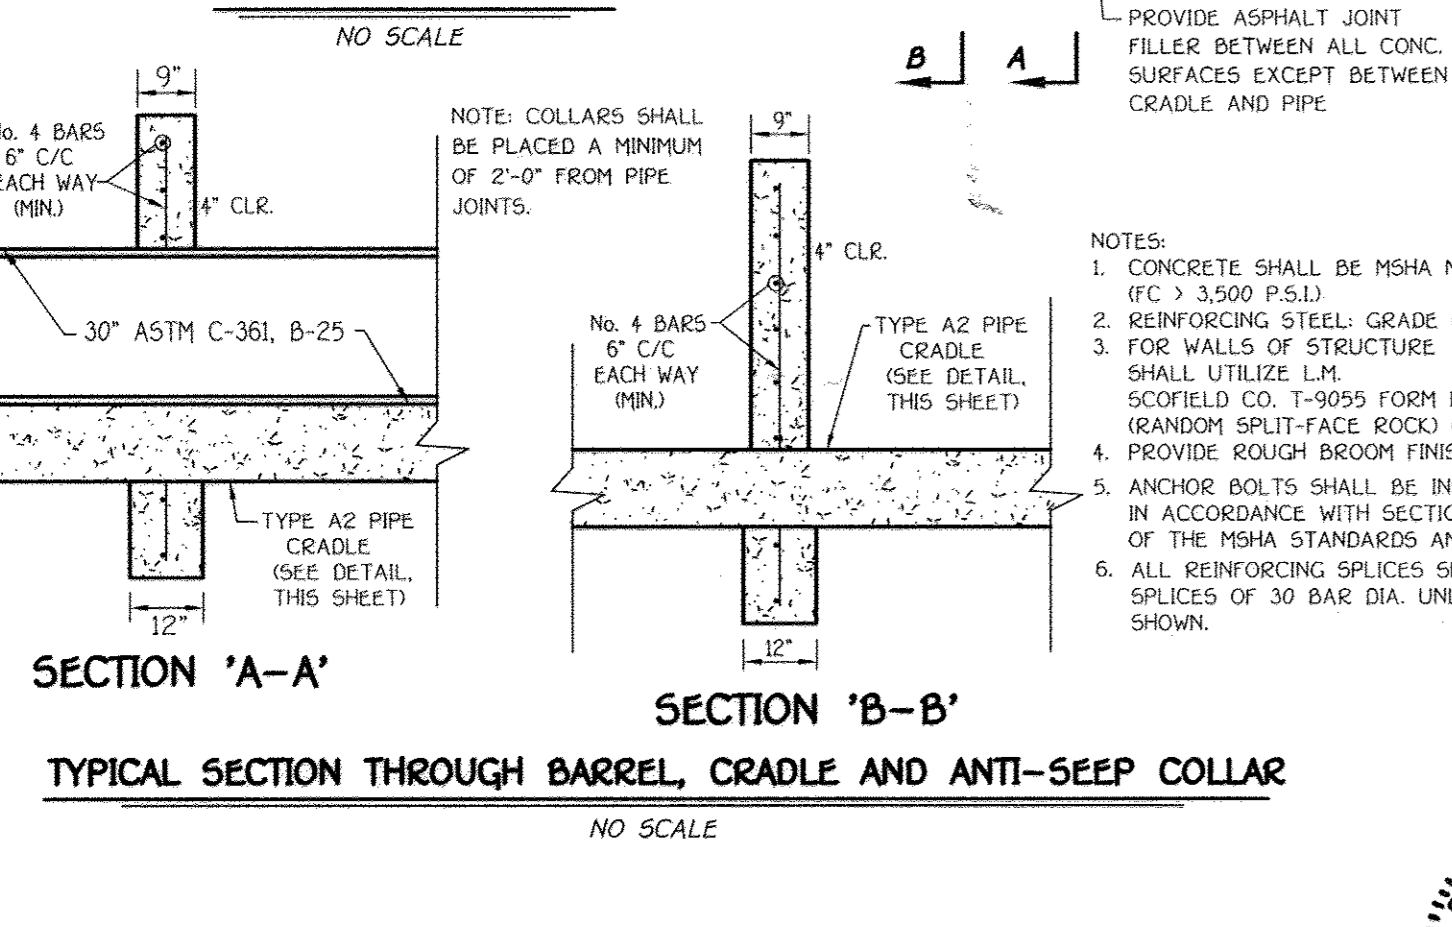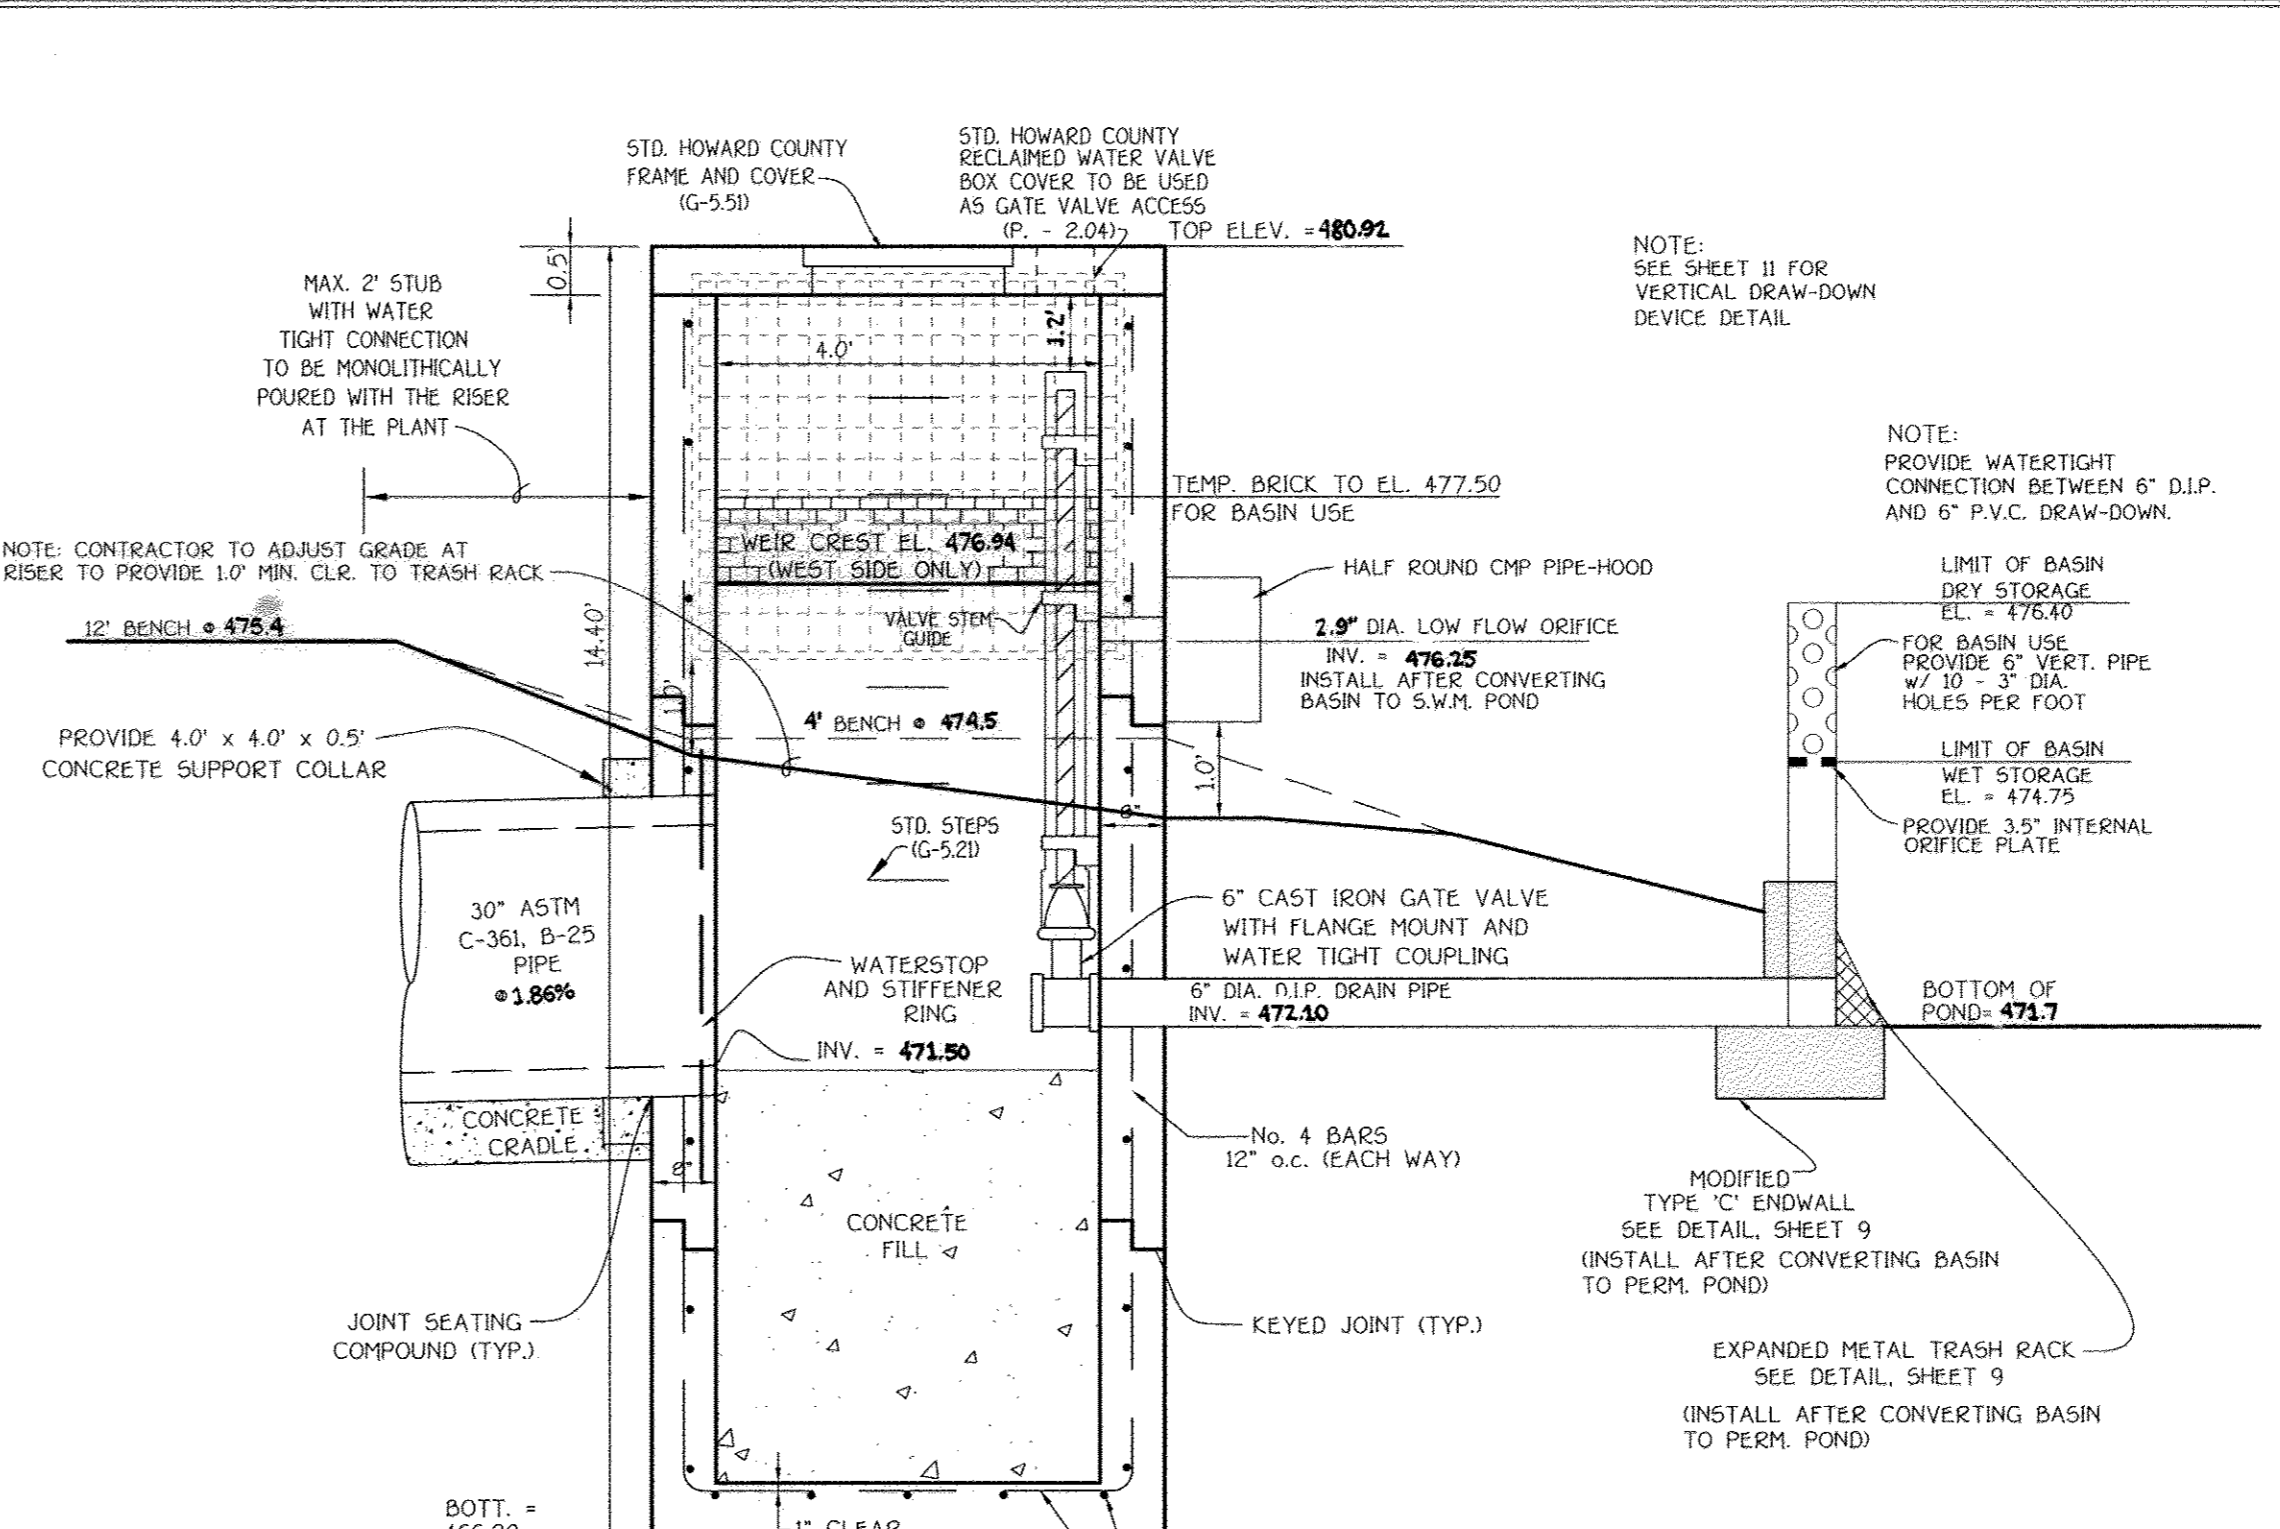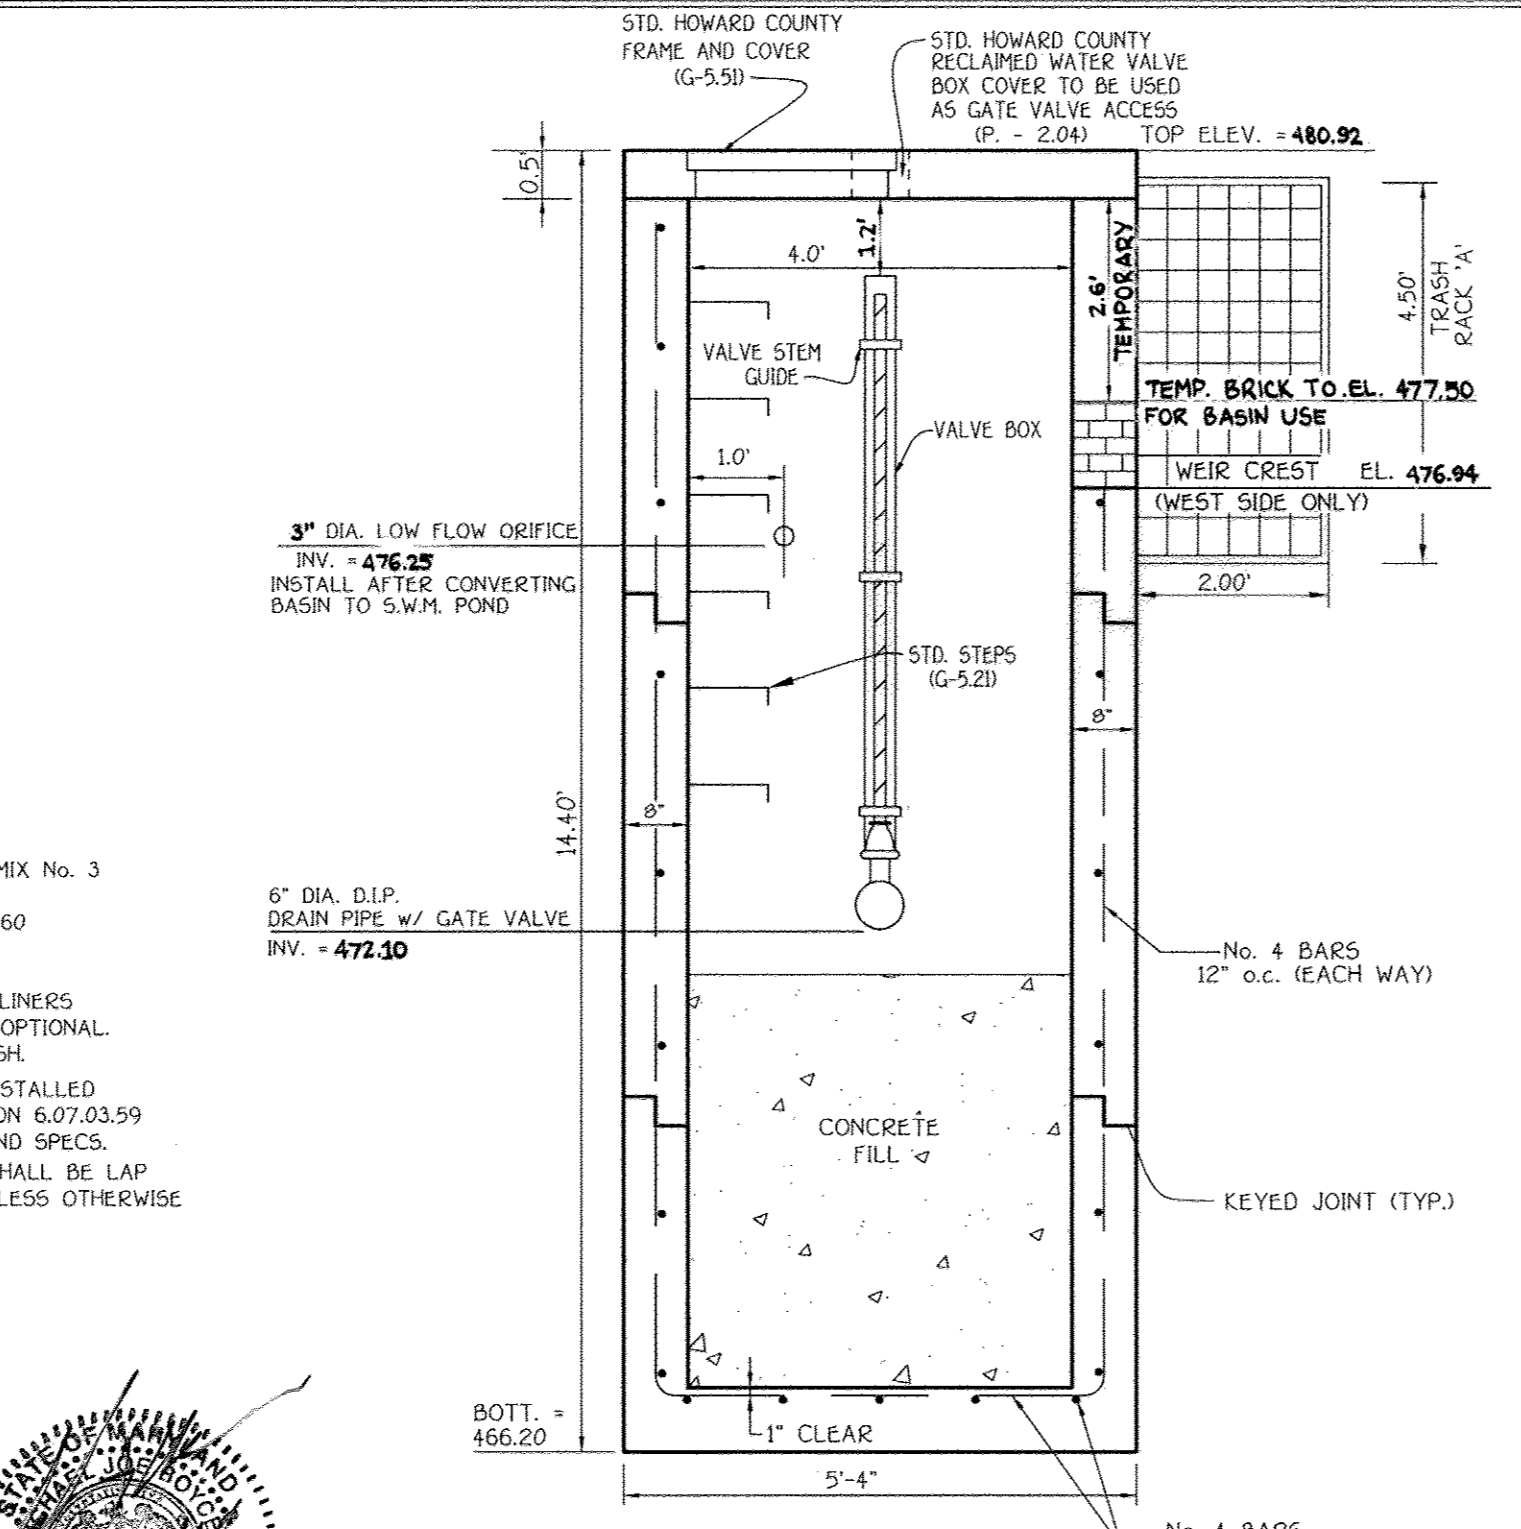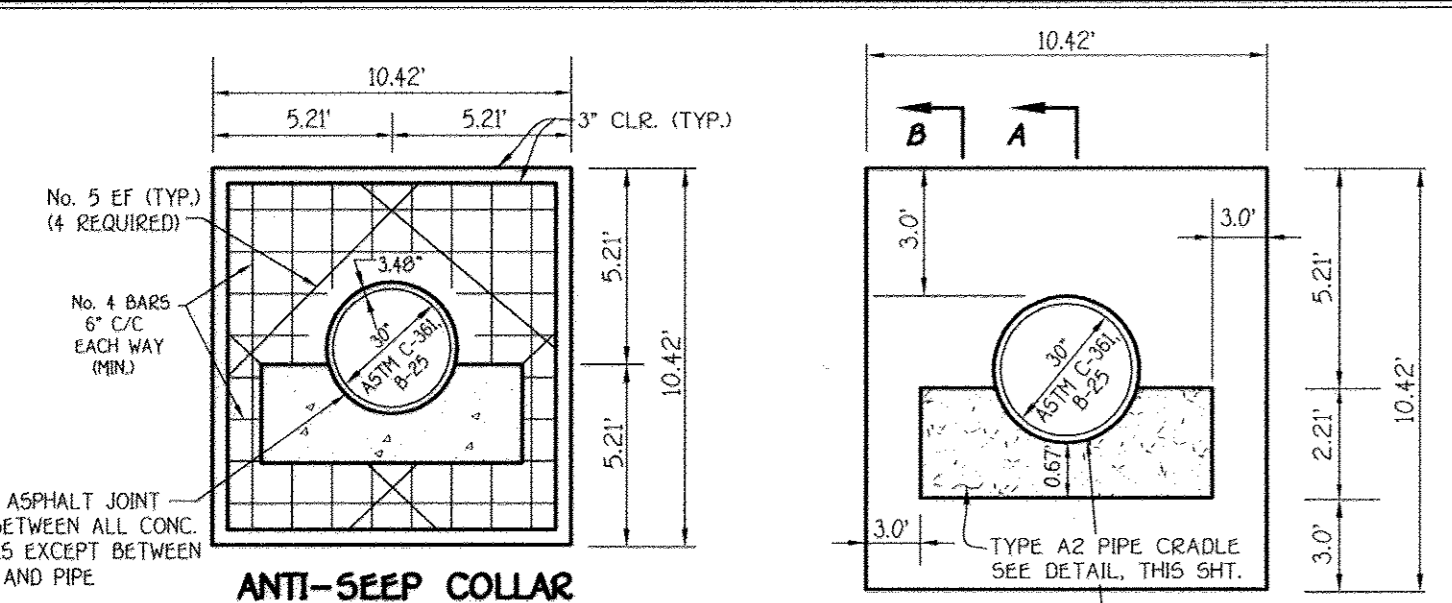

By The Developer:
I/We Certify That All Development And/Or Construction Will Be Done According To These Plans. And That Any Responsible Personnel Involved In The Construction Project Will Have A Certificate Of Attendance At A Department Of The Environment Approved Training Program For The Control Of Sediment And Erosion Before Beginning The Project. I Shall Engage A Registered Professional Engineer To Supervise Pond Construction And Provide The Howard Soil Conservation District With An "As-Built" Plan Of The Pond Within 30 Days Of Completion. I Also Authorize Periodic On-Site Inspections By The Howard Soil Conservation District.

Signature of Developer: *Robert Goodier* 12-22-09 Date
Printed Name of Developer: Robert Goodier

By The Engineer:
I Certify That This Plan For Pond Construction, Erosion And Sediment Control Represents A Practical And Workable Plan Based On My Personal Knowledge Of The Site Conditions. This Plan Was Prepared In Accordance With The Requirements Of The Howard Soil Conservation District. I Have Notified The District That He/She Must Engage A Registered Professional Engineer To Supervise Pond Construction And Provide The Howard Soil Conservation District With An "As-Built" Plan Of The Pond Within 30 Days Of Completion.

Signature of Engineer: *Robert Goodier* 12-22-09 Date
Printed Name of Engineer: Robert Goodier

These Plans For Small Pond Construction, Soil Erosion And Sediment Control Meet The Requirements Of The Howard Soil Conservation District.

Signature of Public Works: *William R. Wald* 1-12-09 Date
Printed Name of Public Works: William R. Wald
Chief, Bureau Of Highways

Signature of Planning And Zoning: *Cindy Hamer* 1/22/09 Date
Printed Name of Planning And Zoning: Cindy Hamer
Chief, Division Of Land Development

Signature of Development Engineering Division: *Chad Edwards* 1/16/09 Date
Printed Name of Development Engineering Division: Chad Edwards
Chief, Development Engineering Division

AS-BUILT CERTIFICATION
I Herby Certify That The Facility Shown On This Plan Was Constructed As Shown On The "As-Built" Plans And Meets The Approved Plans And Specifications.

Signature: _____ P.E. No. _____ Date: _____

Certify Means To State Or Declare A Professional Opinion Based Upon Onsite Inspections And Material Tests Which Are Conducted During Construction. The Onsite Inspections And Material Tests Are Those Inspections And Tests Deemed Sufficient And Appropriate Commonly Accepted Engineering Standards. Certify Does Not Mean Or Imply A Guarantee By The Engineer Nor Does An Engineer's Certification Relieve Any Other Party From Meeting Requirements Imposed By Contract, Employment, Or Other Means, Including Meeting Requirements Accepted

NOTE: CONCR. CRADLE TO BE POURED DIRECTLY AGAINST EARTH BANKS. IF BOTTOM OF TRENCH IS WIDER THAN THE CRADLE, SLOPING SIDES (FRAMED) SHALL BE USED.

SC5 TR-46 A-2 CONCRETE CRADLE
NO SCALE

OWNER
MERIWETHER FARM II, LLC
C/O SECOND GOODIER, LLC
10715 CHATEAU DRIVE
SUITE 300
COLUMBIA, MARYLAND 21046
PH: (410) 997-7501
ATTN: MR. ROBERT A. GOODIER, JR.

DEVELOPER
TOLL BROTHERS, INC.
MARYLAND DIVISION
7104 COLUMBIA GATEWAY DRIVE
SUITE 200
COLUMBIA, MARYLAND 21046
PH: (410) 997-7501
ATTN: MR. JEFF DEBACOLL

STORMWATER MANAGEMENT NOTES & DETAILS
MERIWETHER FARM
SECTION TWO
PHASE ONE
BUILDABLE LOTS 1 THRU 10, NON-BUILDABLE PRESERVATION PARCELS 'C' & 'D' AND BUILDABLE BULK PARCEL 'E'
(A RESUBDIVISION OF BUILDABLE BULK PARCEL 'A', MERIWETHER FARM, SECTION TWO, F-08-198)

TAX MAP NO. 21 PARCEL NO. 28 GRID NOs. 15, 16, 21 & 22
FOURTH ELECTION DISTRICT
HOWARD COUNTY, MARYLAND
SCALE: AS SHOWN
DATE: DECEMBER, 2008
SHEET 8 OF 15

ASBUILT

FISHER, COLLINS & CARTER, INC.
CIVIL ENGINEERING CONSULTANTS & LAND SURVEYORS
CENTRAL SQUARE OFFICE PARK - 10272 BALDWIN NATIONAL PIKE
ELICOTT CITY, MARYLAND 21042
(410) 461-2900

S.W.M. FACILITY B.M.P. NO. 1
PRINCIPLE SPILLWAY PROFILE
SCALE: HOR. 1" = 30'
VER. 1" = 3'

NO.	REVISION	DATE
1	REVISE OWNER AND DEVELOPER	11/9/11

Professional Certification I hereby certify that these documents were prepared by me, and that I am a duly Licensed Professional Engineer under the laws of the State of Maryland, License No. 20748, Expiration Date 2-22-09.

Robert Goodier
12/22/09
DATE

STORM WATER MANAGEMENT POND CONSTRUCTION SPECIFICATIONS

These specifications are appropriate to all ponds within the scope of the Standard for practice MD-378. All references to ASTM and AASHTO specifications apply to the most recent version.

Site Preparation

Areas designated for borrow areas, embankment, and structural works shall be cleared, grubbed and stripped of topsoil. All trees, vegetation, roots and other objectionable material shall be removed. Channel banks and sharp breaks shall be sloped to no steeper than 1:1. All trees shall be cleared and grubbed within 15 feet of the toe of the embankment.

Areas to be covered by the reservoir will be cleared of all trees, brush, logs, fences, rubbish and other objectionable material unless otherwise designated on the plans. Trees, brush, and stumps shall be cut approximately level with the ground surface. For dry stormwater management ponds, a minimum of a 25-foot radius around the inlet structure shall be cleared.

All cleared and grubbed material shall be disposed of outside and below the limits of the dam and reservoir as directed by the owner or his representative. When specified, a sufficient quantity of topsoil will be stockpiled in a suitable location for use on the embankment and other designated areas.

EARTH FILL

Material - The fill material shall be taken from approved designated borrow areas. It shall be free of roots, stumps, wood, rubbish, stones greater than 6", frozen or other objectionable materials. Fill material for the center of the embankment, and cut off trench shall conform to Unified Soil Classification CC, SC, GC or CL and shall have at least 30% passing the #200 sieve. Consideration may be given to the use of other materials in the embankment if designed by a geotechnical engineer. Such special design must have construction supervised by a geotechnical engineer. Material used in the outer shell of the embankment must have the capability to support vegetation of the quality required to prevent erosion of the embankment.

Placement - Areas on which fill is to be placed shall be scarified prior to placement of fill. Fill materials shall be placed in maximum 8-inch thick (before compaction) layers which are to be continuous over the entire length of the fill. The most permeable borrow material shall be placed in the downstream portions of the embankment. The principal spillway must be installed concurrently with fill placement and not excavated into the embankment.

Compaction - The movement of the hauling and spreading equipment over the fill shall be controlled so that the entire surface of each lift shall be traversed by not less than one tread track of heavy equipment or compaction shall be achieved by a minimum of four complete passes of a sheepsfoot, rubber tired or vibrator roller. Fill material shall contain sufficient moisture such that the required degree of compaction will be obtained with the equipment used. The fill material shall contain sufficient moisture so that if formed into a ball it will not crumble, yet not be so wet that water can be squeezed out.

When required by the reviewing agency the minimum required density shall not be less than 95% of maximum dry density with a moisture content within +2% of the optimum. Each layer of fill shall be compacted as necessary to obtain that density, and is to be certified by the Engineer at the time of construction. All compaction is to be determined by AASHTO Method T-99 (Standard Proctor).

Cut Off Trench - The cutoff trench shall be excavated into embankment material along or parallel to the centerline of the embankment as shown on the plans. The bottom width of the trench shall be covered by the equipment used for excavation with the minimum width being four feet. The depth shall be at least four feet below existing grade or as shown on the plans. The side slopes of the trench shall be 1 to 1 or flatter. The backfill shall be compacted with construction equipment, rollers, or hand tampers to assure maximum density and minimum permeability.

Embankment Core - The core shall be parallel to the centerline of the embankment as shown on the plans. The top width of the core shall be a minimum of four feet. The height shall extend up to at least the 10 year water elevation or as shown on the plans. The side slopes shall be 1 to 1 or flatter. The core shall be compacted with construction equipment, rollers, or hand tampers to assure maximum density and minimum permeability. In addition, the core shall be placed concurrently with the outer shell of the embankment.

Structure Backfill

Backfill adjacent to pipes or structures shall be of the type and quality conforming to that specified for the adjoining fill material. The fill shall be placed in horizontal layers not to exceed four inches in thickness and compacted by hand tampers or other manually directed compaction equipment. The material needs to fill completely all spaces under and adjacent to the pipe. At no time during the backfilling operation shall driven equipment be allowed to operate closer than four feet, measured horizontally, to any part of a structure. Under no circumstances shall equipment be driven over any part of a concrete structure or pipe, unless there is a compacted fill of 24" or greater over the structure or pipe.

Structure backfill may be flowable fill meeting the requirements of Maryland Department of Transportation, State Highway Administration Standard Specifications for Construction and Materials, Section 313 as modified. The mixture shall have a 100-200 psi, 28 day unconfined compressive strength. The flowable fill shall have a minimum pH of 4.0 and a minimum resistivity of 2,000 ohm-cm. Material shall be placed such that a minimum of 6" (measured perpendicular to the outside of the pipe) of flowable fill shall be under (bedding), over and, on the sides of the pipe. It only needs to extend up to the spring line for rigid conduits. Average slump of the fill shall be 7" to assure flowability of the material. Adequate measures shall be taken (sand bags, etc) to prevent flooding the pipe. When using flowable fill all metal pipe shall be bituminous coated. Any adjoining soil fill shall be placed in horizontal layers not to exceed four inches in thickness and compacted by hand tampers or other manually directed compaction equipment. The material shall completely fill all voids adjacent to the flowable fill zone. At no time during the backfilling operation shall driven equipment be allowed to operate closer than four feet, measured horizontally, to any part of a structure. Under no circumstances shall equipment be driven over any part of a structure or pipe unless there is a compacted fill of 24" or greater over the structure or pipe. Backfill material outside the structural backfill (flowable fill) zone shall be of the type and quality conforming to the specified for the core of the embankment or other embankment materials.

Pipe Conduits

All pipes shall be circular in cross section.

Corrugated Metal Pipe - All of the following criteria shall apply for corrugated metal pipe:

1. Materials - (Polymer Coated steel pipe) - Steel pipes with polymeric coatings shall have a minimum coating thickness of 0.01 inch (100 mil) on both sides of the pipe. This pipe and its appearance shall conform to the requirements of AASHTO Specifications M-245 & M-246 with watertight coupling bands or flanges.

Materials - (Aluminum Coated Steel Pipe) - This pipe and its appearance shall conform to the requirements of AASHTO Specification M-274 with watertight coupling bands or flanges. Aluminum Coated Steel Pipe, when used with flowable fill or when soil and/or water conditions warrant the need for increased durability, shall be fully bituminous coated per requirements of AASHTO Specification M-190 Type A. Any aluminum coating damaged or otherwise removed shall be replaced with cold applied bituminous coating compound. Aluminum surfaces that are to be in contact with concrete shall be painted with one coat of zinc chromate primer or two coats of asphalt.

Materials - (Aluminum Pipe) - This pipe and its appearance shall conform to the requirements of AASHTO Specification M-196 or M-221 with watertight coupling bands or flanges. Aluminum Pipe, when used with flowable fill or when soil and/or water conditions warrant for increased durability, shall be fully bituminous coated per requirements of AASHTO Specification M-190 Type A. Aluminum surfaces that are to be in contact with concrete shall be painted with one coat of zinc chromate primer or two coats of asphalt. Hot dip galvanized bolts may be used for connections. The pH of the surrounding soils shall be between 4 and 9.

2. Coupling bands, anti-seep collars, end sections, etc., must be composed of the same material and coatings as the pipe. Metals must be insulated from dissimilar materials with use of rubber or plastic insulating materials at least 2/16 inch in thickness.

3. Connections - All connections with pipes must be completely watertight. The drain pipe or barrel connection to the riser shall be welded all around when the pipe and riser are metal. Anti-seep collars shall be connected to the pipe in such a manner as to be completely watertight. Simple bands are not considered to be watertight.

FISHER, COLLINS & CARTER, INC.
CIVIL ENGINEERING CONSULTANTS & LAND SURVEYORS
CENTRAL SQUARE OFFICE PARK - 10722 BALTIMORE NATIONAL PIKE
ELLSWORTH, MARYLAND 21114
(410) 461-2855






OPERATION AND MAINTENANCE SCHEDULE FOR PRIVATELY OWNED AND JOINTLY MAINTAINED STORMWATER MANAGEMENT FACILITIES FOR BMP POND #1 & UNDERGROUND STONE RESERVOIR

ROUTINE MAINTENANCE

- Facility shall be inspected annually and after major storms. Inspections shall be performed during wet weather to determine if the pond is functioning properly.
- Top and side slopes of the embankment shall be mowed a minimum of two (2) times a year, once in June and once in September. Other side slopes and maintenance access should be mowed as needed.
- Debris and litter shall be removed during regular mowing operations and as needed.
- Visible signs of erosion in the pond as well as the rip-rap or gabion outlet area shall be repaired as soon as it is noticed.
- The off-line storm drain (M-1 to CO-1) and underground reservoir shall be inspected annually and after major storms.

NON-ROUTINE MAINTENANCE




- Structural components of the pond such as the dam, the riser, and the pipes shall be repaired upon the detection of any damage. The components shall be inspected during routine maintenance operations.
- Sediment shall be removed from the pond, and forebay, no later than when the capacity of the pond or forebay, is half full of sediment, or, when deemed necessary for aesthetic reasons, upon approval from the Department of Public Works.

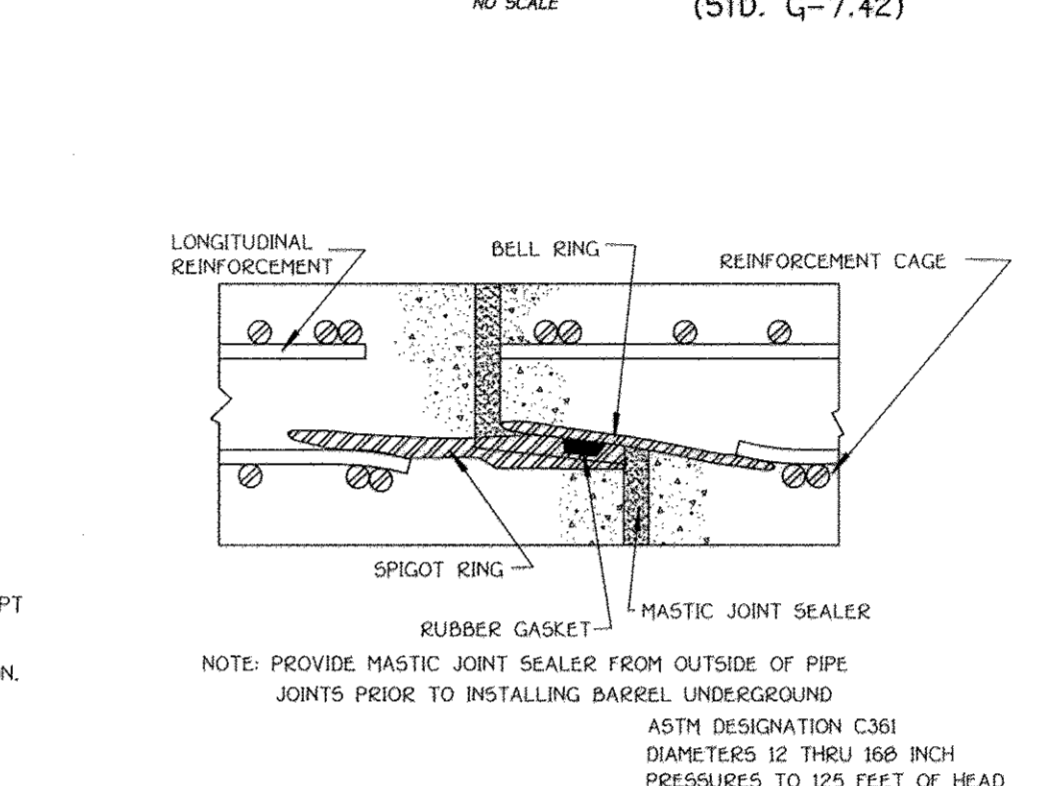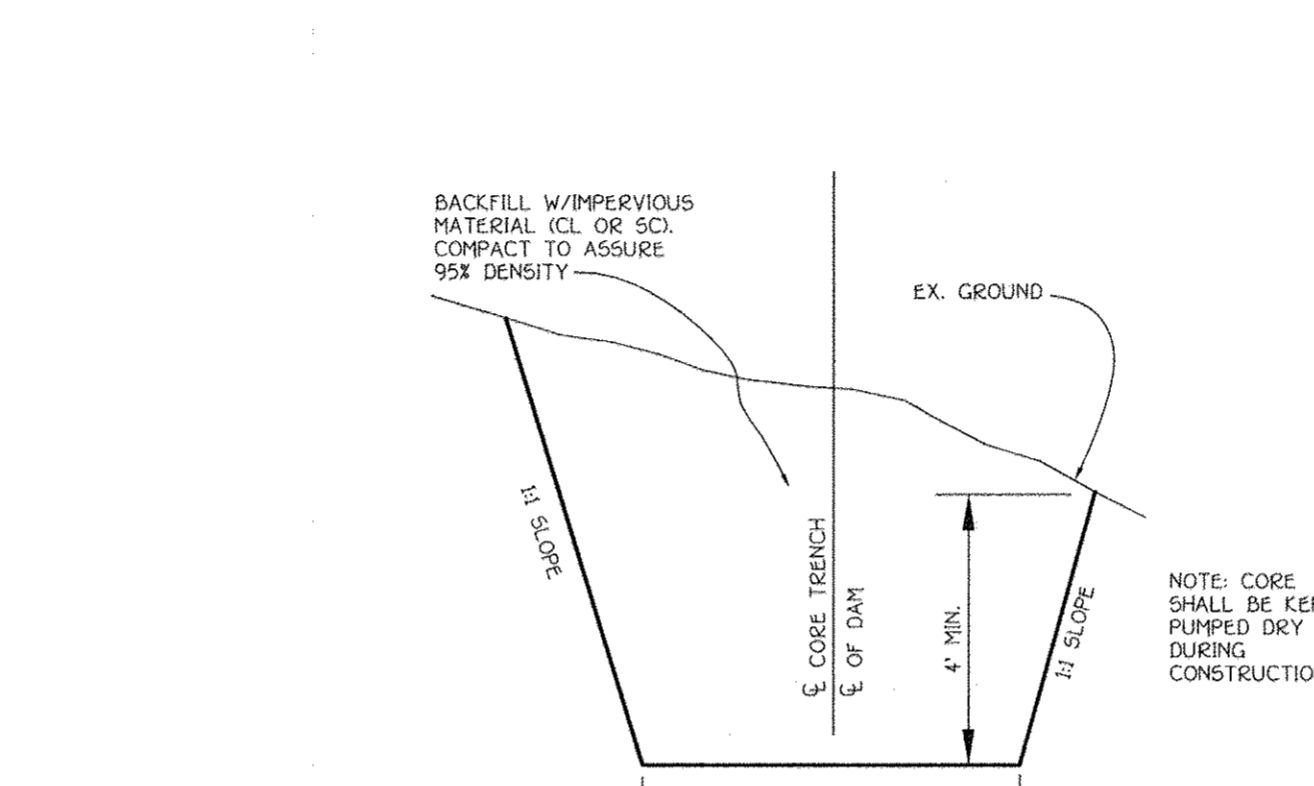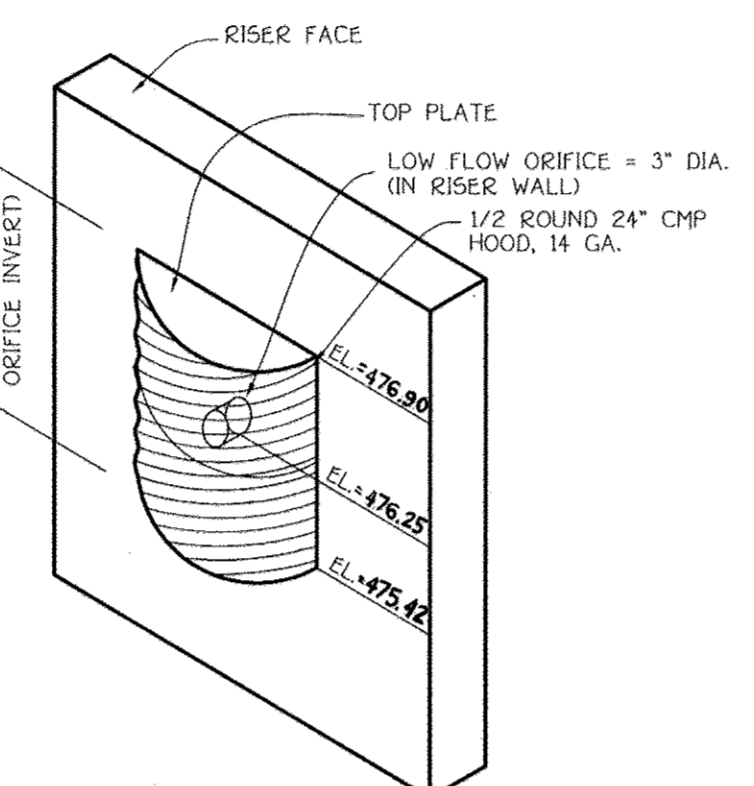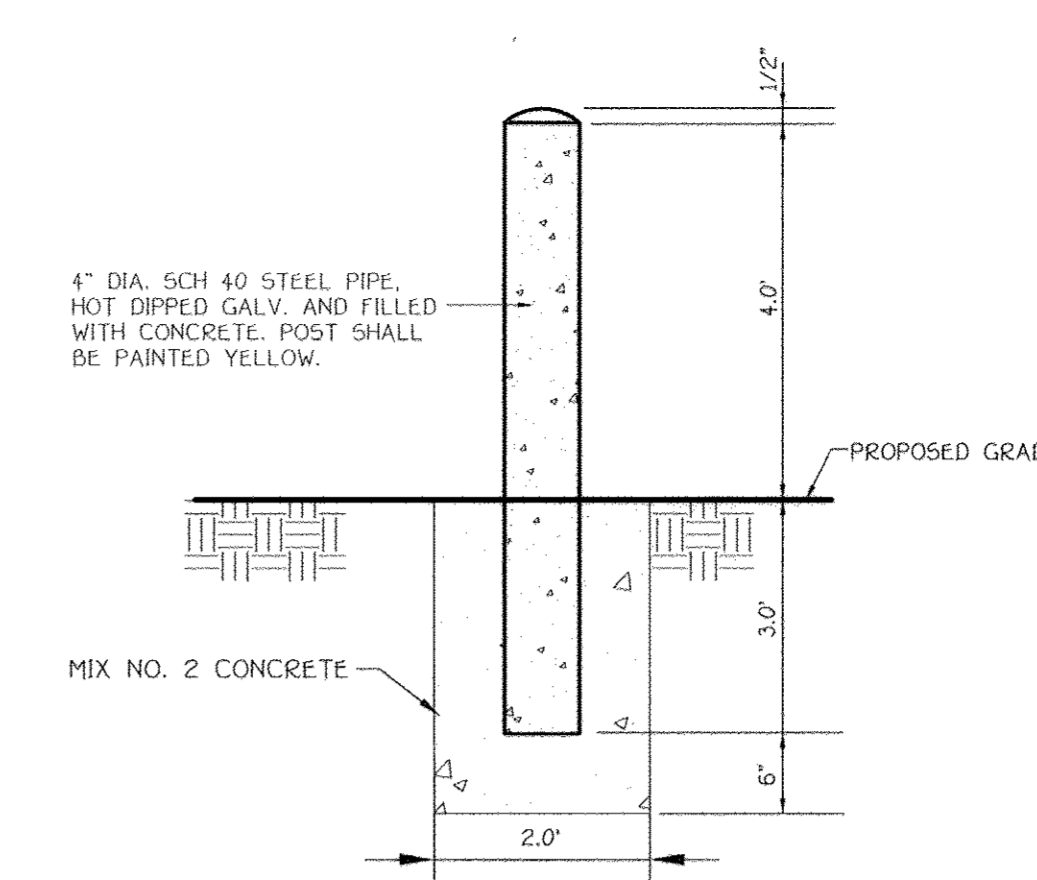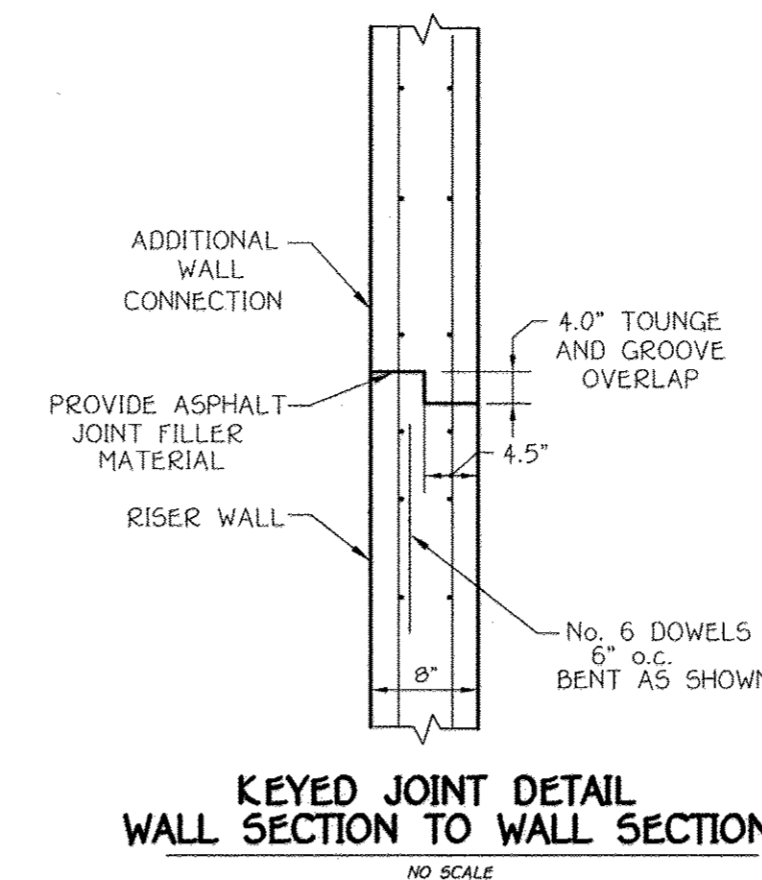

FISHER, COLLINS & CARTER, INC.
CIVIL ENGINEERING CONSULTANTS & LAND SURVEYORS
CENTRAL SQUARE OFFICE PARK - 10722 BALTIMORE NATIONAL PIKE
ELLSWORTH, MARYLAND 21114
(410) 461-2855



FOR ESE CONSULTANTS, INC.
PROFESSIONAL CERTIFICATION: I HEREBY CERTIFY THAT THESE DOCUMENTS WERE PREPARED BY ME OR UNDER MY RESPONSIBLE CHARGE, AND THAT I AM A DULY LICENSED PROFESSIONAL LAND SURVEYOR UNDER THE LAWS OF THE STATE OF MARYLAND, LICENSE NO. 21328, EXPIRATION DATE 1/08/19.

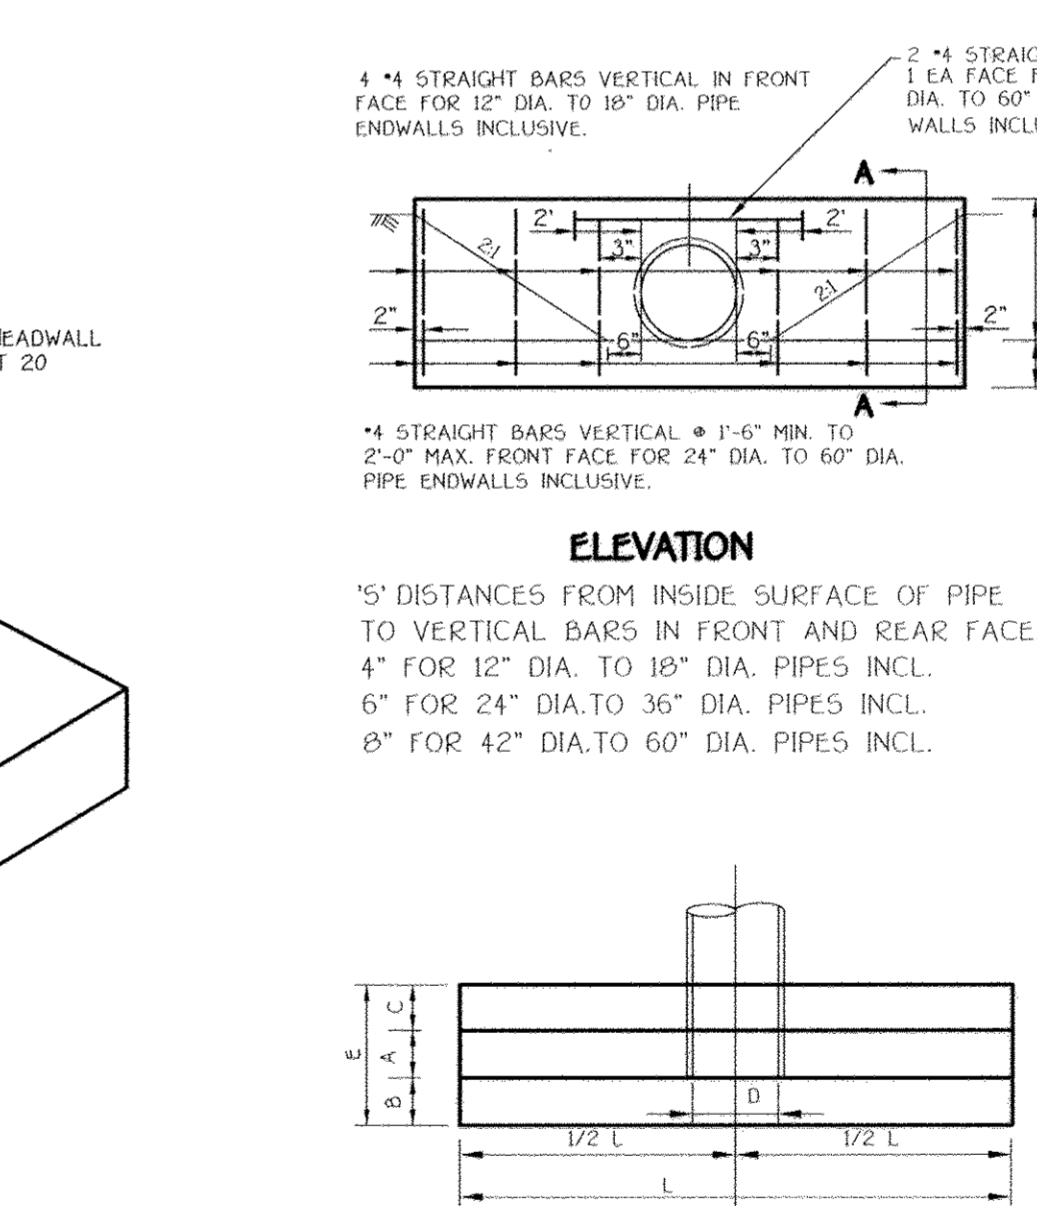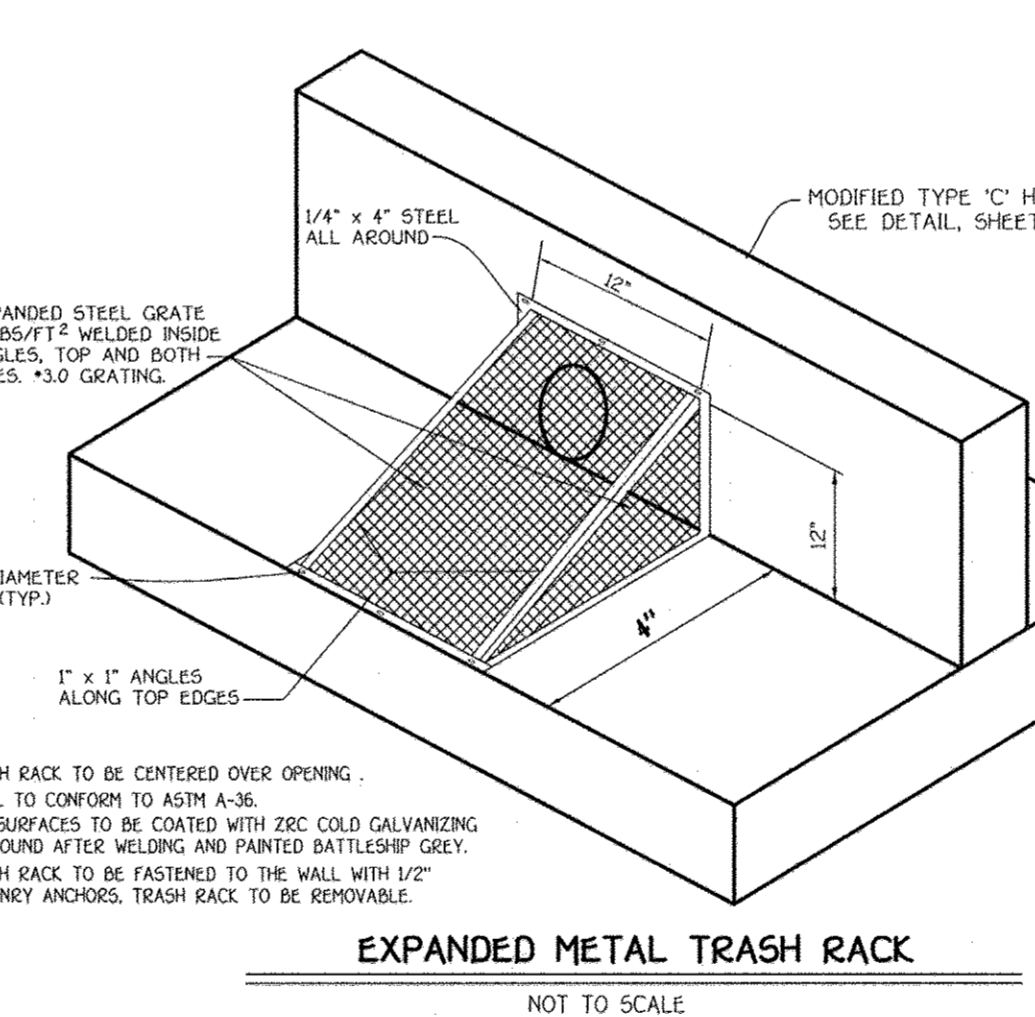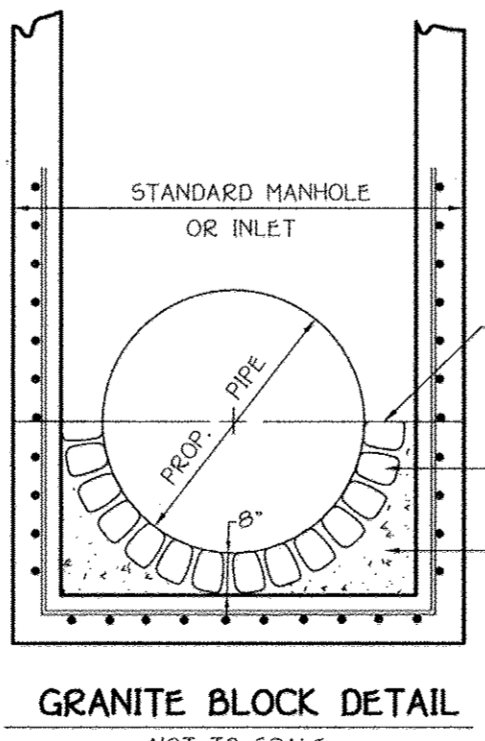

OPENINGS	D	AREA	A	B	C	E	F	H	L	VOLUME	STEE
	IN.	SQ.FT.								CONC.	LBS.
	6"	0.79	9"	6"	6"	1'-9"	9"	1'-6"	5'-5"	0.6j	38

MODIFIED TYPE 'C' ENDWALL
NO SCALE

By The Developer:
I/We Certify That All Development And/Or Construction Will Be Done According To These Plans, And That Any Responsible Personnel Involved In The Construction Project Will Have A Certificate Of Attendance At A Department Of The Environment Approved Training Program For The Control Of Sediment And Erosion Before Beginning The Project. I Shall Engage A Registered Professional Engineer To Supervise Pond Construction And Provide The Howard Soil Conservation District With An "As-Built" Plan Of The Pond Within 30 Days Of Completion. I Also Authorize Periodic On-site Inspections By The Howard Soil Conservation District.

Signature Of Developer: Robert Goodier
Date: 12-22-08

Printed Name Of Developer: Robert Goodier

By The Engineer:
I Certify That This Plan For Pond Construction, Erosion And Sediment Control Represents A Practical And Workable Plan Based On My Personal Knowledge Of The Site Conditions. This Plan Was Prepared In Accordance With The Requirements Of The Howard Soil Conservation District. I Have Notified The Developer That He/She Must Engage A Registered Professional Engineer To Supervise Pond Construction And Provide The Howard Soil Conservation District With An "As-Built" Plan Of The Pond Within 30 Days Of Completion.

Signature Of Engineer: Aldo M. Vitucci
Date: 12/22/08

Printed Name Of Engineer: Aldo M. Vitucci

These Plans For Small Pond Construction, Soil Erosion And Sediment Control Meet The Requirements Of The Howard Soil Conservation District.

Signature: [Signature]
Date: 1/4/09

Howard Soil Conservation District

Approved: Department Of Public Works
Signature: [Signature]
Date: 1-12-09

Approved: Department Of Planning And Zoning
Signature: [Signature]
Date: 1/22/09

Signature: [Signature]
Date: 1-16-9

AS-BUILT CERTIFICATION
I Herby Certify That The Facility Shown On This Plan Was Constructed As Shown On The "As-Built" Plans And Meets The Approved Plans And Specifications.

Signature: _____ P.E. No. _____
Date: _____

Certify Means To State Or Declare A Professional Opinion Based Upon On-site Inspections And Material Tests Which Are Conducted During Construction. The On-site Inspections And Material Tests Are Those Inspections And Tests Deemed Sufficient And Appropriate Commonly Accepted Engineering Standards. Certify Does Not Mean Or Imply A Guarantee By The Engineer Nor Does An Engineer's Certification Relieve Any Other Party From Meeting Requirements Imposed By Contract, Employment, Or Other Means, Including Meeting Commonly Accepted Industry Practices.

REINFORCING: DEFORMED STEEL BARS (1/2" DIA.)
CHAMFER: ALL EXPOSED EDGES 1"x 1" OR AS DIRECTED.
CONC. SHALL BE S.H.A. A. MIX NO. 2.


SECTION TWO
PHASE ONE
BUILDABLE LOTS 1 THRU 10, NON-BUILDABLE PRESERVATION PARCELS 'C' & 'D' AND BUILDABLE BULK PARCEL 'E'
(A RESUBDIVISION OF BUILDABLE BULK PARCEL 'A', MERIWETHER FARM SECTION TWO, F-08-19B)
ZONED: RC-DEO
PARCEL NO: 28 GRID Nos: 15, 16, 21 & 22
FIRST ELECTION DISTRICT HOWARD COUNTY, MARYLAND
SCALE: AS SHOWN
DATE: DECEMBER, 2008
SHEET 9 OF 15

ASBUILT
F-08-199

NO.	REVISION	DATE
1	REVISE OWNER AND DEVELOPER	11/0/11

OWNER
MERIWETHER FARM II, LLC
C/O ROBERT GOODIER, LLC
10715 CHAMBER DRIVE
SUITE 350
COLUMBIA, MARYLAND 21044
PH: (410) 997-7501
ATTN: MR. ROBERT G. GOODIER, JR.

DEVELOPER
TOLL BROTHERS, INC.
MARYLAND DIVISION
7164 COLUMBIA GATEWAY DRIVE
SUITE 230
COLUMBIA, MARYLAND 21046
PH: (410) 997-7501
ATTN: MR. JEFF DISCOW

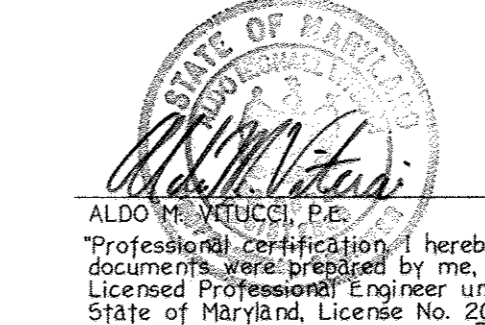

Signature: [Signature]
Date: 12/22/08
Professional certification I hereby certify that these documents were prepared by me, and that I am a duly Licensed Professional Engineer under the laws of the State of Maryland, License No. 20748, Expiration Date 2-22-09.

ENGINEER'S CERTIFICATE
I hereby certify that this Plan for Erosion and Sediment Control Represents a Practical and Workable Plan Based On My Personal Knowledge of the Site Conditions And That It Was Prepared In Accordance With the Requirements of the Howard Soil Conservation District.

DEVELOPER'S CERTIFICATE
I/We Certify That All Development And Construction Will Be Done According To This Plan Of Development And Plan For Erosion And Sediment Control And That All Responsible Personnel Involved In The Construction Project Will Have A Certificate Of Attendance At A Department Of Natural Resources' Approved Training Program For The Control Of Sediment And Erosion Before Beginning The Project. I Also Authorize Periodic On-Site Inspections By The Howard Soil Conservation District Or Their Authorized Agents As Are Deemed Necessary.

Signature of Engineer: [Signature] Date: 12-22-06
Signature of Developer: [Signature] Date: 12-22-06
Approved: This Development Is Approved For Erosion And Sediment Control By The Howard Soil Conservation District. Date: 1/6/09
Approved: Department Of Planning And Zoning Date: 1/6/09
Chief, Division Of Land Development Date: 1/6/09
Approved: Howard County Department Of Public Works Date: 1-12-09
Chief, Bureau Of Highways

20.0 STANDARDS AND SPECIFICATIONS
VEGETATIVE STABILIZATION
DEFINITION: Using vegetation as cover for barren soil to protect it from forces that cause erosion.
PURPOSE: Vegetative stabilization specifications are used to promote the establishment of vegetation on exposed soil. When soil is stabilized with vegetation, the soil is less likely to erode and more likely to allow infiltration of rainfall, thereby reducing sediment loads and run-off to downstream areas, and improving wildlife habitat and visual resources.

CONDITIONS WHERE PRACTICE APPLIES
This practice shall be used on denuded areas as specified on the plans and may be used on highly erodible or critically eroding areas. This specification is divided into Temporary Seeding, to quickly establish vegetative cover for short duration (Up to one year), and Permanent Seeding, for long term vegetative cover. Examples of applicable areas for Temporary Seeding are temporary soil stockpiling and construction phases, earth dikes, etc. and for Permanent Seeding are lawns, dams, cut and fill slopes and other areas at final grade, former stockpile and staging areas, etc.

VEGETATIVE STABILIZATION METHODS AND MATERIALS
I. Site Preparation
a. Install erosion and sediment control structures (either temporary or permanent) such as diversions, grade stabilization structures, berms, waterways, or sediment control basins.
b. Perform all grading operations at right angles to the slope. Final grading and sloping is not usually necessary for temporary seeding.
c. Schedule required soil tests to determine soil amendment composition and application rates for sites having disturbed area over 5 acres.
d. Soil Amendments (Fertilizer and Lime Specifications)
i. Soil tests must be performed to determine the exact ratios and application rates for both lime and fertilizer on sites having disturbed areas over 5 acres. Soil analysis may be performed by the University of Maryland or a recognized commercial laboratory. Soil samples taken for engineering purposes may also be used for chemical analyses.
ii. Fertilizers shall be uniform in composition, free flowing and suitable for accurate application by approved equipment. Manure may be substituted for fertilizer with prior approval from the appropriate approval authority. Fertilizers shall be delivered to the site in bags labeled according to the applicable state fertilizer laws and shall bear the name, trade name or trademark and warranty of the product.
iii. Lime materials shall be ground limestone hydrated or burnt lime may be substituted which contains at least 50% total oxides calcium oxide plus magnesium oxide. Limestone shall be ground to such fineness that at least 20% will pass through a #20 mesh sieve and 90-100% will pass through a #50 mesh sieve.
iv. Incorporate lime and fertilizer into the top 3-5" of soil by diking or other suitable means.

II. Permanent Seeding
a. Minimum soil conditions required for permanent vegetative establishment:
1. Soil pH shall be between 6.0 and 7.0.
2. Soluble salts shall be less than 500 parts per million (ppm).
3. The soil shall contain less than 40% clay, but enough fine grained material (0.075 sill plus clay) to provide the capacity to hold a moderate amount of moisture. An exception is if loess or silt loess is to be planted, then a sandy silt (50% silt plus clay) would be acceptable.
4. Soil shall contain 1.5% minimum organic matter by weight.
5. Soil must contain sufficient pore space to permit adequate root penetration.
6. If these conditions cannot be met by soils on site, additional topsoil is required in accordance with Section 21 Standards and Specification for Topsoil.
b. Areas previously graded in conformance with the drawings shall be maintained in a true and even grade, then scarified or otherwise loosened to a depth of 3-5" to permit bonding of the topsoil to the surface area and to create horizontal erosion check slots to prevent topsoil from sliding down a slope.
c. Apply soil amendments as per soil test or as included on the plans.
d. Mix soil amendments into the top 3-5" of soil by diking or other suitable means. Lawns should be raked to smooth the surface, remove large objects like stones and branches, and ready the area for seed and application. Where site conditions will not permit permanent seeded preparation, loosen surface soil by dragging with a heavy chain or other equipment equipped with a double flange harrow deeper than 2" and apply by hydroseeding at any one time. Do not use burnt or hydrated lime when hydroseeding.
e. Seed and fertilizer shall be mixed on site and seeding shall be done immediately and without interruption.

III. Dry Seeding
This includes use of conventional drop or broadcast spreaders.
a. Seed spreader shall be incorporated into the subsoil at the rates prescribed on the Temporary or Permanent Seeding Summaries or Tables 265 or 26. The seeded area shall then be rolled with a weighted roller to provide good seed to soil contact.
b. Where practical, seed should be applied in two directions perpendicular to each other. Apply half the seeding rate in each direction.
c. Drill or Outdragger Seeding: Mechanized seeders that apply and cover seed with soil.
d. Outdragger seeders are required to bury the seed in such a fashion as to provide at least 1/4 inch of soil covering. Seeded must be firm after planting.
e. Where practical, seed should be applied in two directions perpendicular to each other. Apply half the seeding rate in each direction.
f. Mulch Specifications (in order of preference)
i. Straw shall consist of threshed wheat, rye or oat straw, reasonable bright in color, and shall not be moist, mold, caked, decayed, or excessively dusty and shall be free of noxious weed seeds and other plant material.
ii. Wood Cellulose Fiber Mulch (WCFF)
a. WCFF shall consist of specially prepared wood cellulose processed into a uniform fibrous physical state.
b. WCFF shall be dried green or contain a green dye in the package that will provide an appropriate color to facilitate visual inspection of the uniform spread slurry.
c. WCFF, including dye, shall contain no germination or growth inhibiting factors.
d. WCFF materials shall be manufactured and processed such a manner that the wood cellulose fiber will remain in uniform suspension in water under agitation and will blend with seed, fertilizer, and other additives to form a homogeneous slurry.
e. The mulch material shall form a blotter-like ground cover, on application, having moisture absorption and percolation properties and shall cover and hold grass seed in contact with the soil without inhibiting the growth of the grass seedlings.
f. WCFF material shall contain no elements or compounds at concentration levels that will be detrimental.
g. WCFF must conform to the following physical requirements: fiber length to approximately 17 mm., diameter between 1 mm. and 1.5 mm., pH of 6.5, ash content of 1.6% maximum and water holding capacity of 50% minimum.
h. Note: Only organic mulch should be used in areas where one species of grass is desired.

IV. Mowing Seeded Areas
Mulch shall be applied to all seeded areas immediately after seeding.
a. If grading of the seeding season, mulch should be applied as prescribed in this section and maintained until the seeding season returns and seeding can be performed in accordance with these specifications.
b. When straw mulch is used, it shall be spread over all seeded areas at the rate of 2 tons/acre. Mulch shall be applied to a uniform loose depth of between 1" and 2". Mulch applied shall achieve a uniform distribution and depth so that the soil surface is not exposed. If a mulch anchoring tool is to be used, the rate should be increased to 2.5 tons/acre.
c. Wood cellulose fiber used as a mulch shall be applied at a net dry weight of 1,500 lbs. per acre. The wood cellulose fiber shall be mixed with water, and the mixture shall contain a maximum of 50 lbs. of wood cellulose fiber per 100 gallons of water.
d. Securing Straw Mulch (Mulch Anchoring): Mulch anchoring shall be performed immediately following mulch application to minimize loss by wind or water. This may be done by one of the following methods listed by preference, depending upon size of area and erosion hazard:
i. A mulch anchoring tool is a tractor drawn implement designed to punch and anchor mulch into the soil surface a minimum of two (2) inches. This practice is most effective on large areas, but is limited to flatter slopes where equipment can operate safely.
ii. Wind practice should be used on the contour, possible.
iii. When a wind practice is used, the fiber binder shall be applied at a rate of 100 lbs./acre. The fiber binder shall be mixed with water and applied to the mulch. The mixture shall contain a maximum of 50 pounds of wood cellulose fiber per 100 gallons of water.
iv. Application of liquid binders should be heavier at the edges where wind catches much, such as in valleys and crests of banks. The remainder of area should be spaced, uniform after binder application. Synthetic binders, such as acrylic, latex (water), DACK-70, Petro-Terra 11x, Terra Track AK or other approved equal may be used at rates recommended by the manufacturer to anchor mulch.
v. Lightweight plastic netting may be staped over the mulch according to manufacturer's recommendations. Netting is usually installed in rows 4' to 15' feet wide and 300 to 3,000 feet long.

V. Incremental Stabilization - Cut Slopes
a. All cut slopes shall be dressed, prepared, seeded and mulched as the work progresses. Slopes shall be excavated and stabilized in equal increments not to exceed 15'.
b. Construction sequence (Refer to Figure 3 below):
i. Excavate and stabilize all temporary swales, side ditches, or berms that will be used to convey runoff from the excavation.
ii. Perform Phase 1 excavation, dress, and stabilize.
iii. Perform Phase 2 excavation, dress and stabilize.
iv. Perform final phase excavation, dress and stabilize. Overseed previously seeded areas as necessary.
c. Once excavation has begun the operation should be continuous from grubbing through the completion of grading and placement of topsoil (if required) and permanent seed and mulch. Any interruptions in the operation of completing the operation of the seeding season will necessitate the application of temporary stabilization.
d. Incremental Stabilization of Embankments - Fill Slopes
i. Embankments shall be constructed in lifts as prescribed on the plans.
ii. Slopes shall be stabilized immediately when the vertical height of the multiple lifts reaches 15', or when the grading operation ceases as prescribed on the plans.
iii. At the end of each day, temporary berms and pipe slope drains should be constructed along the top edge of the embankment to intercept surface runoff and convey it down the slope in a non-eroding manner to a sediment trapping device.
iv. Refer to Figure 4 (below):
a. Excavate and stabilize all temporary swales, side ditches, or berms that will be used to convey runoff from the fill. Construct slope fill fence on low side of fill as shown in Figure 5, unless other methods shown on the plans address this area.
b. Place Phase 1 embankment, dress and stabilize.
c. Place Phase 2 embankment, dress and stabilize.
d. Place final phase embankment, dress and stabilize. Overseed previously seeded areas as necessary.

VI. Topsoil Stabilization
a. Once the placement of fill has begun the operation should be continuous from grubbing through the completion of grading and placement of topsoil (if required) and permanent seed and mulch. Any interruptions in the operation of completing the operation of the seeding season will necessitate the application of temporary stabilization.

Table with 3 columns: No., REVERSE OWNER AND DEVELOPER, and REVISIONS. Includes a table for 'Micro-pool Surface Area Tabulation Summary' with columns for Location & Drainage Area, Required Min. Surface Area, and Proposed Surface Area.

Signature of Engineer: [Signature] Date: 12-22-06
Signature of Developer: [Signature] Date: 12-22-06
Approved: This Development Is Approved For Erosion And Sediment Control By The Howard Soil Conservation District. Date: 1/6/09
Approved: Department Of Planning And Zoning Date: 1/6/09
Chief, Division Of Land Development Date: 1/6/09
Approved: Howard County Department Of Public Works Date: 1-12-09
Chief, Bureau Of Highways

SECTION 2 - TEMPORARY SEEDING
Vegetation - Annual grass or grain used to provide cover on disturbed areas for up to 12 months. For longer duration of vegetative cover, Permanent Seeding is required.
A. Seed mixtures - Temporary Seeding
i. Select one or more of the species or mixtures listed in Table 26 for the appropriate Plant Hardness Zone (from Figure 5) and enter them in the Temporary Seeding Summary below, along with application rates, seeding dates and seeding depths. If this summary is not put on the plans and completed, then Table 26 must be put on the plans.
ii. For sites having soil tests performed, the rates shown on this table shall be deleted and the rates recommended by the testing agency shall be written in. Soil tests are not required for Temporary Seeding.

Table for Temporary Seeding with columns: No., Species, Application Rate (lb/acc), Seeding Dates, Seeding Depth, Fertilizer Rate (0-10-10), and Lime Rate (0-0-0/1000).

SECTION 3 - PERMANENT SEEDING
Seeding grasses and legumes to establish ground cover for a minimum of one year on disturbed areas generally receiving low maintenance.
A. Seed mixtures - Permanent Seeding
i. Select one or more of the species or mixtures listed in Table 25 for the appropriate Plant Hardness Zone (from Figure 5) and enter them in the Permanent Seeding Summary below, along with application rates and seeding dates. Seeding depths can be estimated using Table 26. If this summary is not put on the construction plans and completed, then Table 25 must be put on the plans. Additional planting specifications for exceptional sites such as shorelines, streambanks, or dunes or for special purposes such as wildlife or aesthetic treatment may be found in USDA-SCS Technical Field Office Guide, Section 342 - Critical Area Planting For special lawn maintenance areas, see Sections IV Soil and V Turfgrass.

Table for Permanent Seeding with columns: No., Species, Application Rate (lb/acc), Seeding Dates, Seeding Depth, Fertilizer Rate (N, P205, K2O), and Lime Rate.

II. For areas receiving low maintenance, apply urea-form fertilizer (46-0-0) at 1 1/2 lbs/1000 sq. ft. (50 lb/acc), in addition to the above soil amendments shown in the table below, to be performed at the time of seeding.
III. For sites having disturbed area over 5 acres, the rates shown on this table shall be deleted and the rates recommended by the soil testing agency shall be written in.
IV. For areas receiving low maintenance, apply urea-form fertilizer (46-0-0) at 1 1/2 lbs/1000 sq. ft. (50 lb/acc), in addition to the above soil amendments shown in the table below, to be performed at the time of seeding.

SUMMARY TABLE #1: The following is a summary of the peak discharges from each of the drainage areas and study points. Table with columns: Study Point, One-Year Storm (cfs), Ten-Year Storm (cfs), 100-Year Storm (cfs).

Table with columns: Study Point, One-Year Storm (cfs), Ten-Year Storm (cfs), 100-Year Storm (cfs). Includes cumulative totals for various study points.

Table with columns: Location & Drainage Area, Required Min. Surface Area, Proposed Surface Area. Includes a table for 'Micro-pool Surface Area Tabulation Summary'.

Signature of Engineer: [Signature] Date: 12-22-06
Signature of Developer: [Signature] Date: 12-22-06
Approved: This Development Is Approved For Erosion And Sediment Control By The Howard Soil Conservation District. Date: 1/6/09
Approved: Department Of Planning And Zoning Date: 1/6/09
Chief, Division Of Land Development Date: 1/6/09
Approved: Howard County Department Of Public Works Date: 1-12-09
Chief, Bureau Of Highways

TOPSOIL NOTES
Definition: Placement of topsoil over a prepared subsoil prior to establishment of permanent vegetation.
Purpose: To provide a suitable soil medium for vegetative growth. Soils of concern have low moisture content, low nutrient levels, low pH materials, toxic to plants, and/or unacceptable soil gradation.
Conditions Where Practice Applies:
I. This practice is limited to areas having 21 or flatter slopes where:
a. The texture of the exposed subsoil/parent material is not adequate to produce vegetative growth.
b. The soil material is so shallow that the rooting zone is not deep enough to support plants or furnish continuing supplies of moisture and plant nutrients.
c. The original soil to be vegetated contains material toxic to plant growth.
d. The soil is so acidic that treatment with limestone is not feasible.

II. For the purpose of these Standards and Specifications, areas having slopes steeper than 2:1 require special consideration and design for adequate stabilization. Areas having slopes steeper than 2:1 shall have the appropriate stabilization shown on the plans.
Construction and Material Specifications
I. Topsoil salvaged from the existing site may be used provided that it meets the standards as set forth in these specifications. Topsoil, the depth of topsoil to be salvaged for a given soil type can be found in the representative soil profile section in the Soil Survey published by USDA-SCS in cooperation with Maryland Agricultural Experimental Station.
II. Topsoil Specifications - Soil to be used as topsoil must meet the following:
i. Topsoil shall be a loam, sandy loam, clay loam, silt loam, sandy clay loam, loamy sand. Other soils may be used if recommended by a geonomist or soil scientist approved by the appropriate approval authority. Regardless, topsoil shall not be a mixture of contrasting textured subsoils and shall contain less than 1% by volume of larger stones, gravel, clastic fragments, gravel, corks, roots, trash, or other materials larger than 1/2" in diameter.
ii. Topsoil must be free of plants or plant parts such as bermuda grass, quackgrass, Johnsrass, nutcase, poison ivy, thistle, or other as specified.
iii. Where the subsoil is either highly acidic or composed of heavy clays, ground limestone shall be spread at the rate of 4-8 tons/acre (200-400 pounds per 1,000 square feet) prior to the placement of topsoil. Lime shall be distributed uniformly by volume spreader or worked into the soil in conjunction with tillage operations as described in the following procedures.

III. For sites having disturbed areas over 5 acres:
a. pH for topsoil shall be between 6.0 and 7.5. If the tested soil demonstrates a pH of less than 6.0, sufficient lime shall be prescribed to raise the pH to 6.5 or higher.
b. Organic content of topsoil shall be not less than 1.5 percent by weight.
c. Topsoil having silt/clay content greater than 500 parts per million shall not be used.
d. No soil or seed shall be placed on soil which has been treated with soil sterilants or chemicals used for weed control until sufficient time has elapsed (14 days min) to permit dissipation of phytotoxic materials.
IV. pH for topsoil (if required) and apply soil amendments as specified in 20.0 Vegetative Stabilization - Section 1 - Vegetative Stabilization Methods and Materials.
V. Topsoil Application
i. When topsoiling, maintain needed erosion and sediment control practices such as diversions, grade stabilization structures, berms, and sediment traps and basins.
ii. Grades on the areas to be topsoiled, which have been previously established, shall be maintained, albeit 4" - 6" higher in elevation.
iii. Topsoil shall be uniformly distributed in a 4" - 6" layer and lightly compacted to a minimum thickness of 4". Spreading shall be performed in such a manner that sodding or seeding can proceed with a minimum of additional soil preparation and tillage. Any irregularities in the surface resulting from topsoiling or other operations shall be corrected in order to prevent the formation of depressions or water pockets.
iv. Topsoil shall not be placed while the topsoil is in a frozen or mud condition, when the subsoil is excessively wet or in a condition that may otherwise be detrimental to proper grading and seeded preparation.

VI. Alternative for Permanent Seeding - Instead of applying the full amounts of lime and commercial fertilizer, composted sludge and amendments may be applied as specified below:
a. Composted Sludge Material for use as a soil conditioner for sites having disturbed areas over 5 acres shall be tested to prescribe amendments and for sites having disturbed areas over 5 acres shall conform to the following requirements:
i. Composted sludge shall be supplied by, or originate from, a person or persons that are permitted (at the time of application of the compost) by the Maryland Department of the Environment.
ii. Composted sludge shall contain at least 1 percent nitrogen, 1.5 percent phosphorus, and 0.2 percent potassium and have a pH of 6.0 to 8.0. Appropriate amendments shall be required. The appropriate amendments must be added to meet the requirements prior to use.
iii. Composted sludge shall be applied at a rate of 1 ton/1,000 square feet.
iv. Composted sludge shall be amended with a potassium fertilizer applied at the rate of 4 lb/1,000 square feet, and 1/2 the normal lime application rate.
References: Guideline Specifications, Soil Preparation and Seeding, MD-VA, Pub. # Cooperative Extension Service, University of Maryland and Virginia Polytechnic Institutes, Revised 1973.

SUMMARY TABLE #2: The following is a summary of the Recharge, WQv, and CP Requirements. Table with columns: Area, Recharge Vol. for Entire Site (BMP), WQv, and CP.

Signature of Engineer: [Signature] Date: 12-22-06
Signature of Developer: [Signature] Date: 12-22-06
Approved: This Development Is Approved For Erosion And Sediment Control By The Howard Soil Conservation District. Date: 1/6/09
Approved: Department Of Planning And Zoning Date: 1/6/09
Chief, Division Of Land Development Date: 1/6/09
Approved: Howard County Department Of Public Works Date: 1-12-09
Chief, Bureau Of Highways

SEDIMENT CONTROL NOTES
I. A MINIMUM OF 48 HOURS NOTICE MUST BE GIVEN TO THE HOWARD COUNTY DEPARTMENT OF INSPECTIONS, LICENSES AND PERMITS, SEDIMENT CONTROL DIVISION PRIOR TO THE START OF ANY CONSTRUCTION (3:30-10:30).
II. ALL VEGETATIVE AND STRUCTURAL PRACTICES ARE TO BE INSTALLED ACCORDING TO THE PROVISIONS OF THIS PLAN AND ARE TO BE IN CONFORMANCE WITH THE MOST CURRENT MARYLAND STANDARDS AND SPECIFICATIONS FOR SOIL EROSION AND SEDIMENT CONTROL AND REVISIONS THERETO.
III. FOLLOWING INITIAL SOIL DISTURBANCE OR RE-DISTURBANCE, PERMANENT OR TEMPORARY STABILIZATION SHALL BE COMPLETED WITHIN: a) 7 CALENDAR DAYS FOR ALL PERIMETER SEDIMENT CONTROL STRUCTURES, DICES, PERIMETER SLOPES AND ALL SLOPES STEEPER THAN 3:1, b) 14 DAYS AS TO ALL OTHER DISTURBED OR GRADED AREAS ON THE SITE.
IV. ALL SEDIMENT TRAPS/BASINS SHOULD BE FENCED AND WARNING SIGNS POSTED AROUND THEIR PERIMETER IN ACCORDANCE WITH VOL. 1, CHAPTER 12 OF THE HOWARD COUNTY DESIGN MANUAL, STORM DRAINAGE.
V. ALL DISTURBED AREAS MUST BE STABILIZED WITHIN THE TIME PERIOD SPECIFIED ABOVE IN ACCORDANCE WITH THE 1994 MARYLAND STANDARDS AND SPECIFICATIONS FOR SOIL EROSION AND SEDIMENT CONTROL FOR PERMANENT SEEDING (SEC. 501, 500 (SEC. 5A), TEMPORARY SEEDING (SEC. 502, 500) AND MULCHING (SEC. 502, TEMPORARY STABILIZATION WITH MULCH ALONE CAN ONLY BE DONE WHEN RECOMMENDED SEEDING DATES DO NOT ALLOW FOR PROPER GERMINATION AND ESTABLISHMENT OF GRASSES.
VI. ALL SEDIMENT CONTROL STRUCTURES ARE TO REMAIN IN PLACE AND ARE TO BE MAINTAINED IN OPERATIVE CONDITION UNTIL PERMISSION FOR THEIR REMOVAL HAS BEEN OBTAINED FROM THE HOWARD COUNTY SEDIMENT CONTROL INSPECTOR.
VII. SITE ANALYSIS:
a. TOTAL AREA OF SITE: 177,782 ACRES
b. AREA DISTURBED: 929 ACRES
c. AREA TO BE ROOFED OR PAVED: 159 ACRES
d. AREA TO BE VEGETATIVELY STABILIZED: 770 ACRES
e. TOTAL CUT: 10,000 CU.YDS.
f. TOTAL FILL: 10,000 CU.YDS.
VIII. ANY SEDIMENT CONTROL PRACTICE WHICH IS DISTURBED BY GRADING ACTIVITY FOR PLACEMENT OF UTILITIES MUST BE REPAIRED ON THE SAME DAY OF DISTURBANCE.
IX. ADDITIONAL SEDIMENT CONTROLS MUST BE PROVIDED, IF DEEMED NECESSARY BY THE HOWARD COUNTY SEDIMENT CONTROL INSPECTOR.
X. ON ALL SITES WITH DISTURBED AREAS IN EXCESS OF 2 ACRES, APPROVAL OF THE INSPECTION AGENCY SHALL BE REQUESTED UNDER COMPLETION OF INSTALLATION OF PERIMETER EROSION AND SEDIMENT CONTROLS, BUT BEFORE CONSTRUCTION OF ANY OTHER EARTH DISTURBANCE OR GRADING. OTHER BUILDING OR GRADING INSPECTION APPROVALS MAY NOT BE AUTHORIZED UNTIL THIS INITIAL APPROVAL BY THE INSPECTION AGENCY IS MADE.
XI. TRENCHES FOR THE CONSTRUCTION OF UTILITIES IS LIMITED TO THREE PIPE LENGTHS OR THAT WHICH SHALL BE BACK-FILLED AND STABILIZED WITH ONE WORKING DAY, WHICHEVER IS SHORTER.

SEQUENCE OF CONSTRUCTION
1. OBTAIN GRADING PERMIT. 7 DAYS
2. INSTALL SEDIMENT CONTROL ASSOCIATED WITH SUBDIVISION AND 'A' CONSTRUCTION. 2 DAYS
3. INSTALL STONE CONSTRUCTION ENTRANCE FOR THE SUBDIVISION CONSTRUCTION. INSTALL THE TREE PROTECTION FENCE AND NEEDED SILT FENCE AND SEDIMENT BASIN 'A'. 10 DAYS
4. OBTAIN PERMISSION FROM THE SEDIMENT CONTROL INSPECTOR PRIOR TO PROCEEDING WITH CONSTRUCTION. 1 DAY
5. INSTALL PROPOSED EARTH DIKES TO DRAIN TO BASINS AND GRADE ROAD 'A' TO SUBGRADE. 6 DAYS
6. INSTALL REMAINING SILT FENCE FOR STOCKPILE AREAS AND THE REMAINING STORM DRAIN SYSTEM TO BE USED FOR SEDIMENT CONTROL. 5 DAYS
7. INSTALL BASE COURSE OF PAVING FOR ROAD 'A'. 2 DAYS
8. INSTALL PROPOSED CUTTER FOR SUBDIVISION ALONG ROAD 'A' AS SHOWN ON THE PLANS. 5 DAYS
9. INSTALL FINAL COURSE OF PAVING FOR ROAD 'A' AND STABILIZE ANY REMAINING DISTURBANCES WITH TEMPORARY SEEDING. 4 DAYS
10. FINE GRADE THE LOTS AS INDICATED ON THE PLAN INSTALL PERMANENT SEEDING. 2 DAYS
11. OBTAIN PERMISSION FROM THE SEDIMENT CONTROL INSPECTOR PRIOR TO PROCEEDING WITH CONSTRUCTION. 1 DAY
12. CONVERT THE SEDIMENT CONTROL BASIN 'A' TO PERMANENT SWM POND CONDITION FOR POND 'A' SEE PLAN. 2 DAYS
13. REMOVE SEDIMENT EROSION CONTROL DEVICES AND TREE PROTECTION FENCE AS SHOWN ON THE PLAN UNDER APPROVAL FROM THE SEDIMENT CONTROL INSPECTOR. 2 DAYS
14. CONTRACTOR SHALL REMOVE ANY AND ALL JUNK, DEBRIS AND TRASH FROM WITHIN THE FLOORPLAN, BUFFERS AND PRESERVATION PARCELS.

SEDIMENT CONTROL NOTES
MERIWETHER FARM
SECTION TWO
PHASE TWO
BUILDABLE LOTS 1 THRU 10, NON-BUILDABLE PRESERVATION PARCELS 'C' & 'D' AND BUILDABLE BULK PARCEL 'E'
(A RESUBDIVISION OF BUILDABLE BULK PARCEL 'A', MERIWETHER FARM, SECTION TWO, F-08-198)
ZONED RC-DE0
PARCEL No.: 28 GRID Nos.: 15, 16, 21 & 22
FOURTH ELECTION DISTRICT
HOWARD COUNTY, MARYLAND
SCALE: AS SHOWN
DATE: DECEMBER, 2008
SHEET 10 OF 15

SUMMARY TABLE #2: The following is a summary of the Recharge, WQv, and CP Requirements. Table with columns: Area, Recharge Vol. for Entire Site (BMP), WQv, and CP.

Signature of Engineer: [Signature] Date: 12-22-06
Signature of Developer: [Signature] Date: 12-22-06
Approved: This Development Is Approved For Erosion And Sediment Control By The Howard Soil Conservation District. Date: 1/6/09
Approved: Department Of Planning And Zoning Date: 1/6/09
Chief, Division Of Land Development Date: 1/6/09
Approved: Howard County Department Of Public Works Date: 1-12-09
Chief, Bureau Of Highways

ENGINEER'S CERTIFICATE
 I hereby certify that this Plan for Erosion and Sediment Control Represents a Practical and Workable Plan Based on My Personal Knowledge of the Site Conditions and That It Was Prepared in Accordance with the Requirements of the Howard Soil Conservation District.

Signature of Engineer: *[Signature]* Date: 12-22-08

DEVELOPER'S CERTIFICATE
 I/We certify that All Development and Construction Will be Done According to This Plan of Development and Plan for Erosion and Sediment Control and That All Responsible Personnel Involved in the Construction Project Will Have a Certificate of Attendance at a Department of Natural Resources Approved Training Program for the Control of Sediment and Erosion Before Beginning the Project. I also Authorize Periodic On-Site Inspection by the Howard Soil Conservation District or Their Authorized Agents, as Are Deemed Necessary.









Signature of Developer: *[Signature]* Date: 12-22-08

Approved: This Development is Approved for Erosion and Sediment Control by the Howard Soil Conservation District.
 Signature: *[Signature]* Date: 1/4/09

Approved: Department of Planning and Zoning
 Chief, Division of Land Development: *[Signature]* Date: 1-16-09

Approved: Howard County Department of Public Works
 Chief, Development Engineering Division: *[Signature]* Date: 1-12-09

Approved: Bureau of Highways
 Chief: *[Signature]* Date: 1-12-09

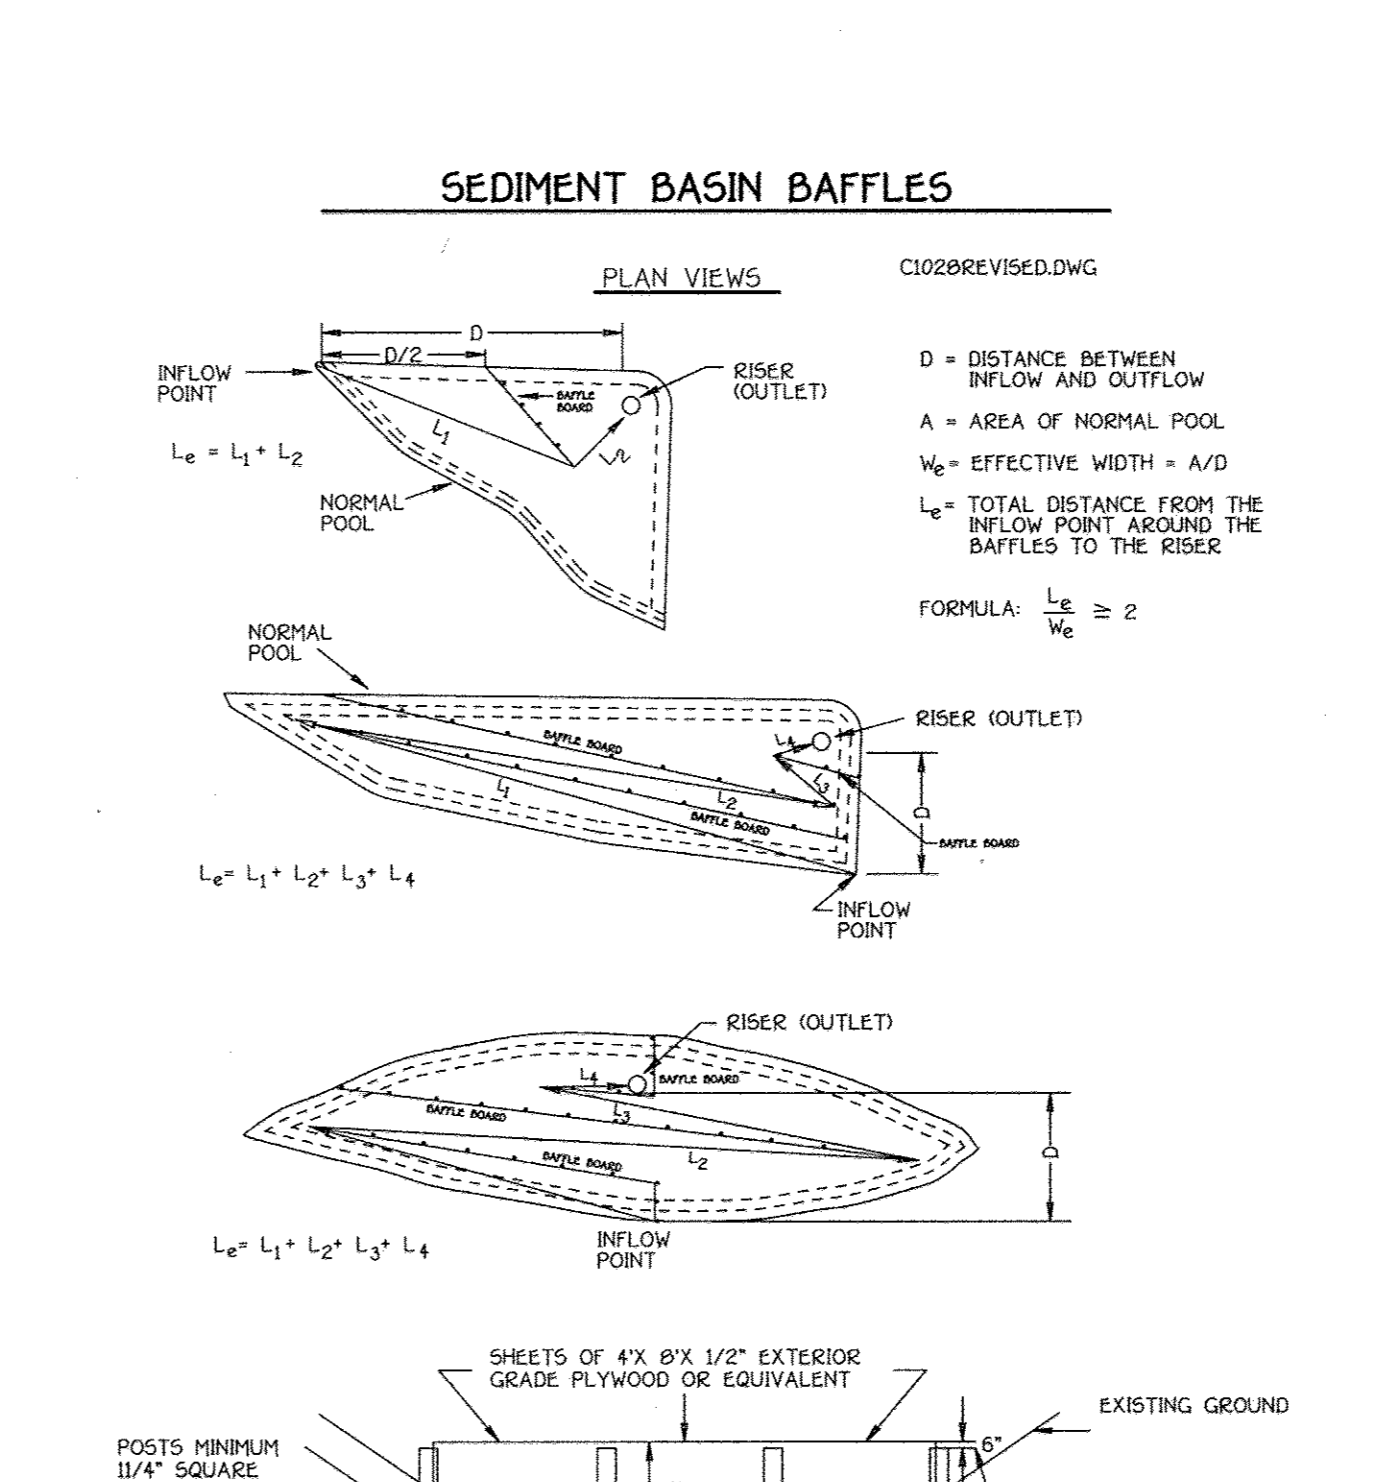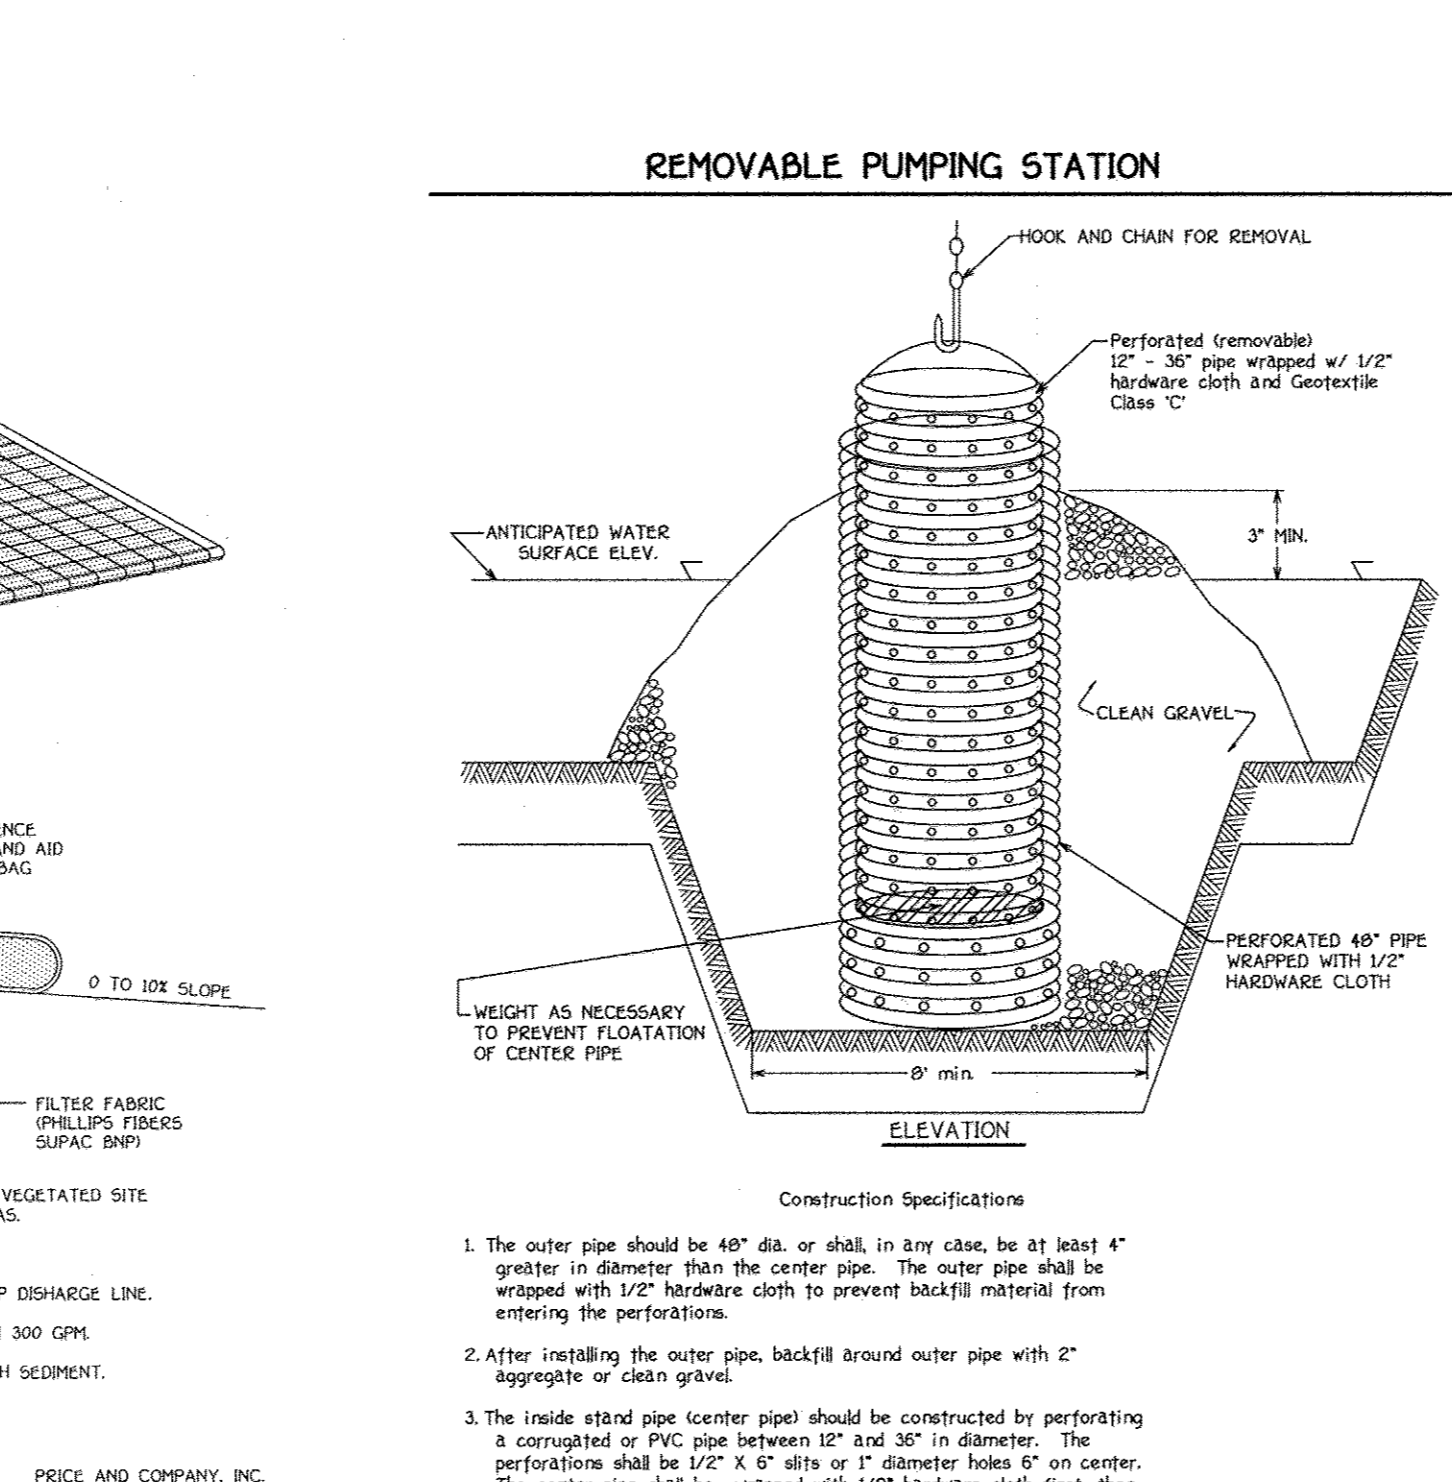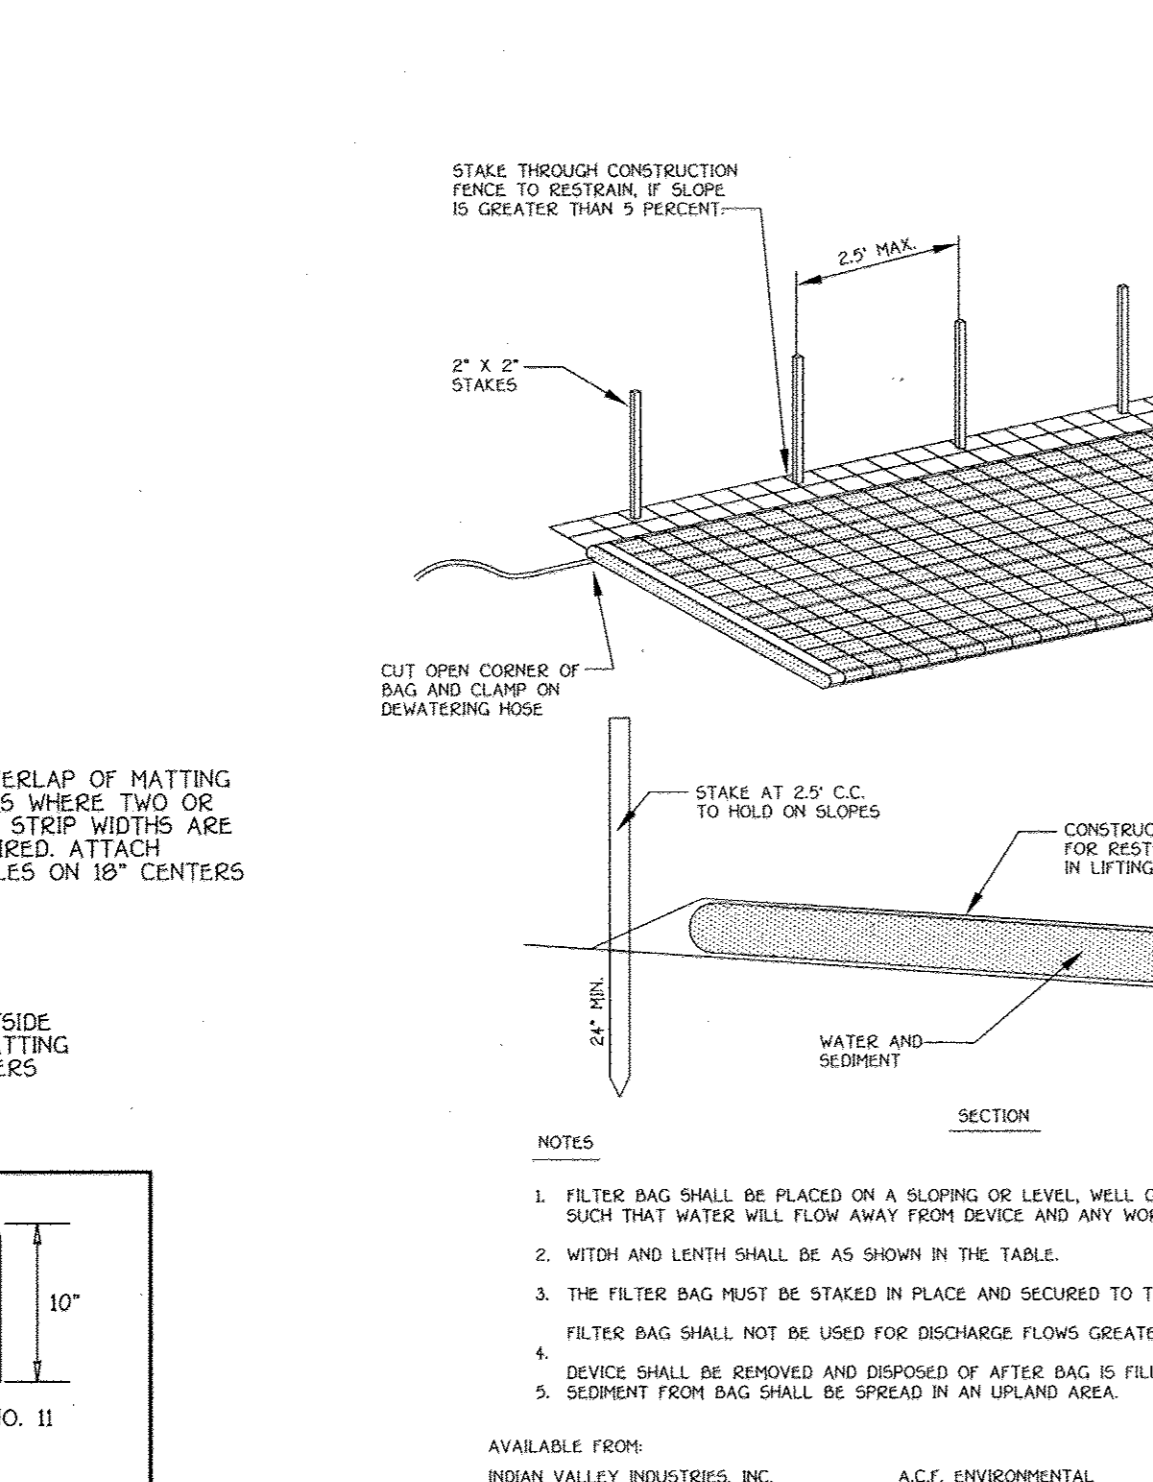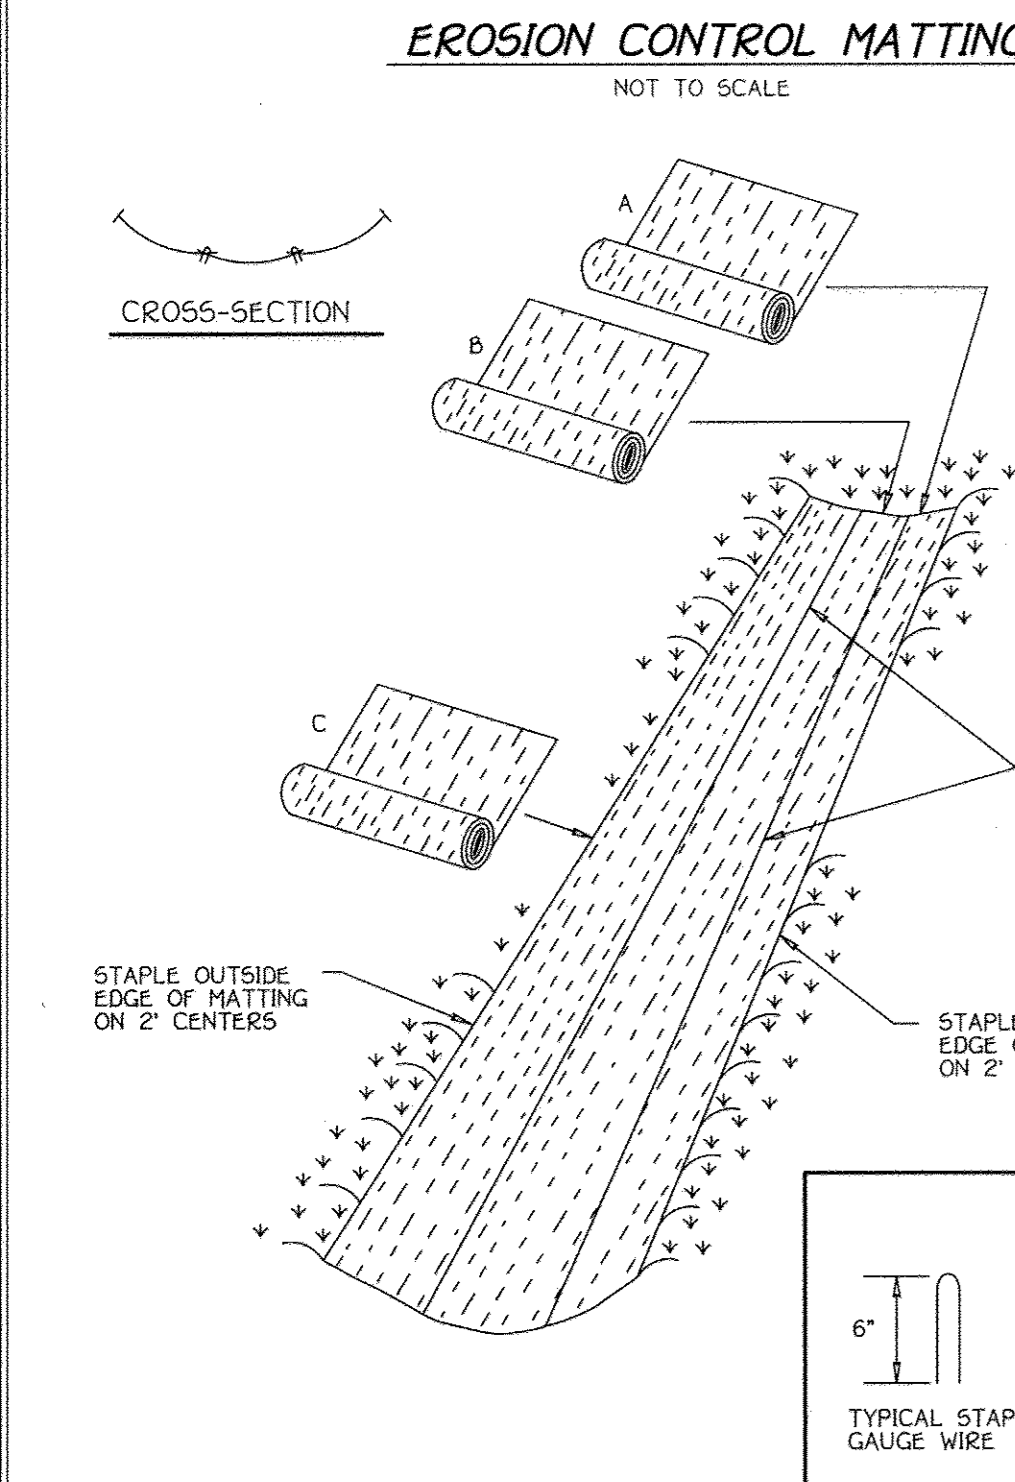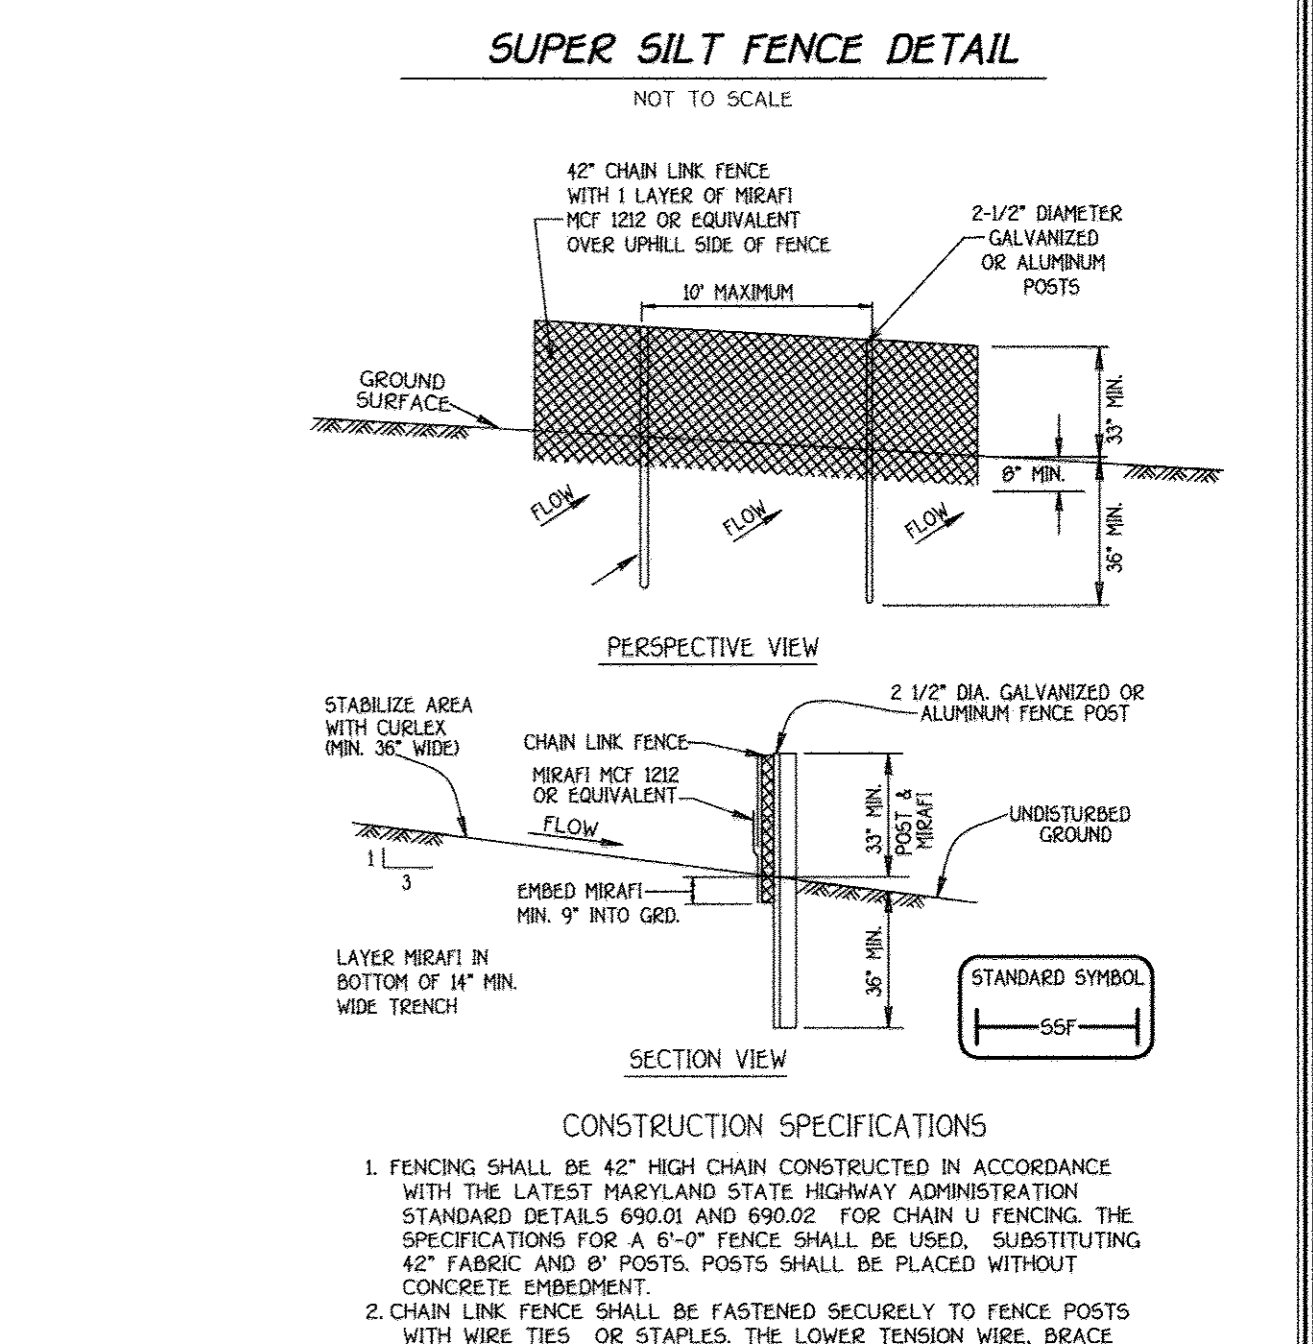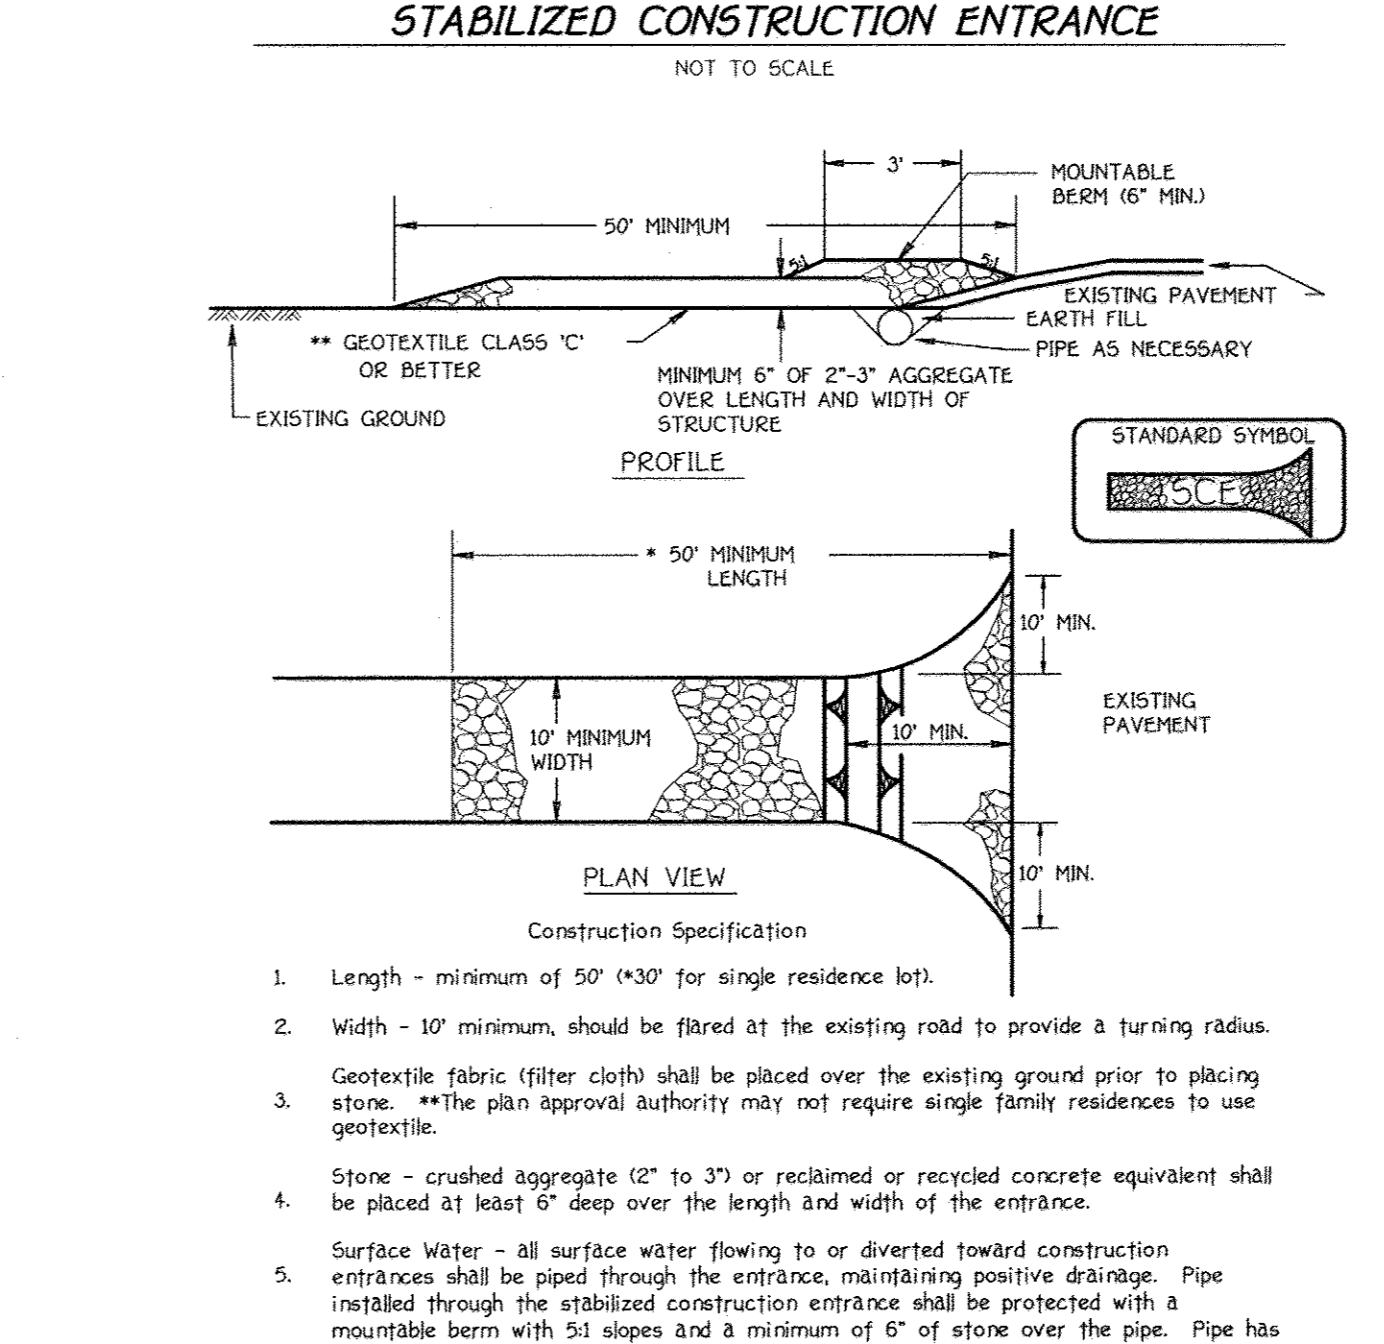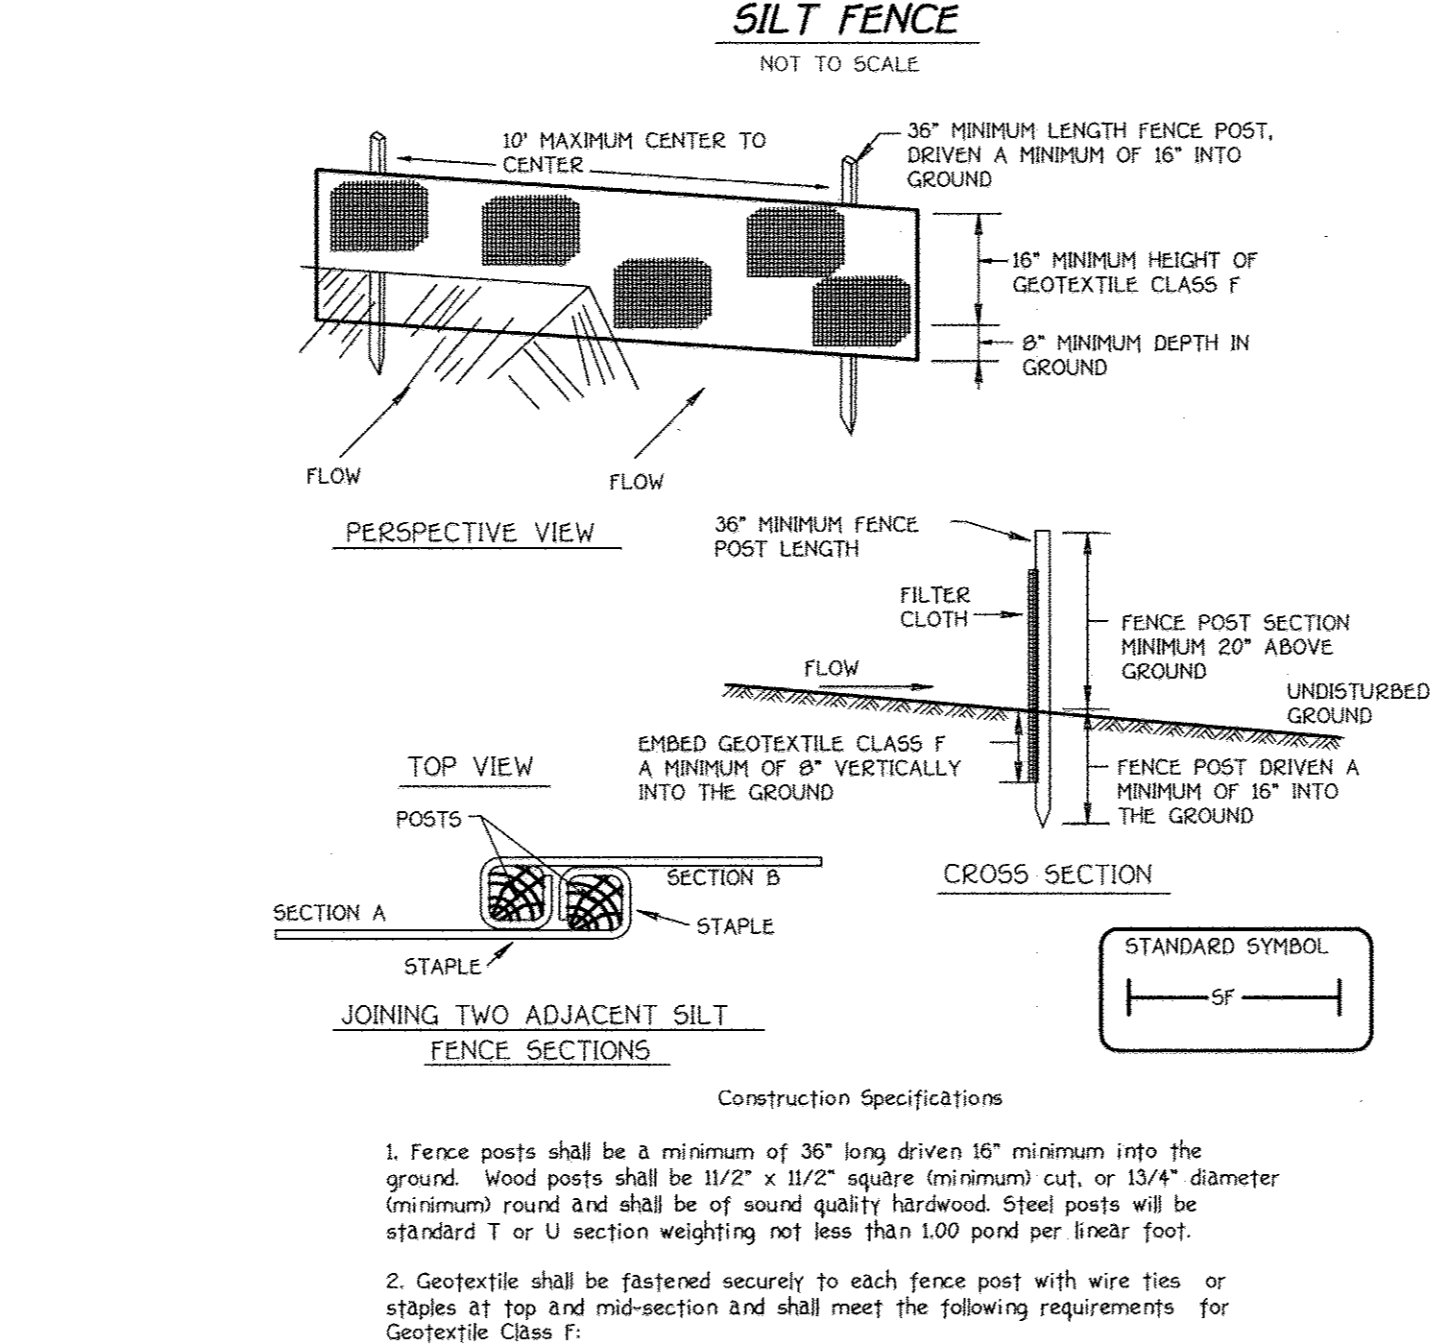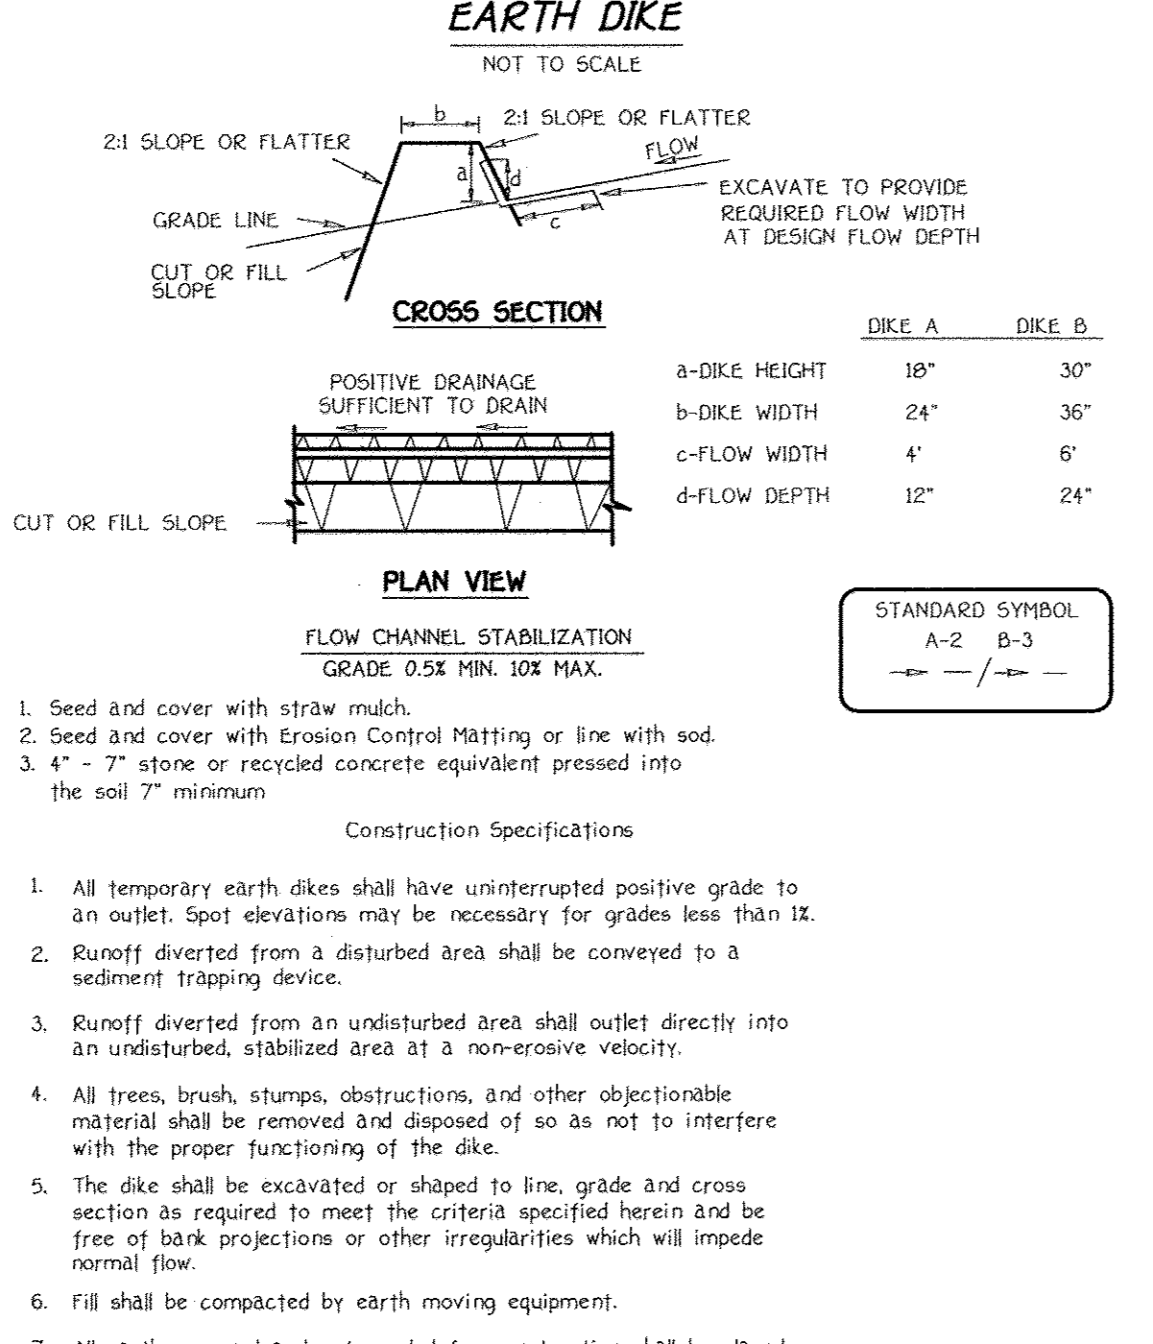

FISHER, COLLINS & CARTER, INC.
 CIVIL ENGINEERING CONSULTANTS & LAND SURVEYORS
 CENTRAL SQUARE OFFICE PARK - 3072 BALTIMORE NATIONAL PIKE
 ELICOTT CITY, MARYLAND 21042
 (410) 861-2000

FILTER BAG DETAIL
 NOT TO SCALE

NO.	REVISIONS	DATE
1	REMOVE OWNER AND DEVELOPER	11/8/11

OWNER
 MERIWETHER FARM II, LLC
 C/O BRADY GOODIER, LLC
 10715 CHARBEE DRIVE
 SUITE 350
 COLUMBIA, MARYLAND 21044
 PH: (410) 997-7501
 ATTN: MR. ROBERT A. GOODIER, JR.

DEVELOPER
 TOLL BROTHERS, INC.
 MARYLAND DIVISION
 7164 COLUMBIA AVENUE DRIVE
 SUITE 230
 COLUMBIA, MARYLAND 21046
 PH: (410) 997-7501
 ATTN: MR. JEFF DRISCOLL

SEDIMENT CONTROL DETAILS
MERIWETHER FARM
SECTION TWO
PHASE ONE
BUILDABLE LOTS 1 THRU 10, NON-BUILDABLE PRESERVATION
PARCELS 'C' & 'D' AND BUILDABLE BULK PARCEL 'E'
 (A RESUBDIVISION OF BUILDABLE BULK PARCEL 'A', MERIWETHER FARM, SECTION TWO, F-08-198)

Professional Engineer I hereby certify that these documents were prepared by me, and that I am a duly Licensed Professional Engineer under the laws of the State of Maryland, License No. 20748, Expiration Date 2-22-09.

Signature: *[Signature]* Date: 12-22-08

Professional Engineer License No. 20748, Expiration Date 2-22-09.

SEDIMENT CONTROL DETAILS
MERIWETHER FARM
SECTION TWO
PHASE ONE
BUILDABLE LOTS 1 THRU 10, NON-BUILDABLE PRESERVATION
PARCELS 'C' & 'D' AND BUILDABLE BULK PARCEL 'E'
 (A RESUBDIVISION OF BUILDABLE BULK PARCEL 'A', MERIWETHER FARM, SECTION TWO, F-08-198)

ZONED: RC-DCO
 PARCEL No. 28 GRID NOS: 15, 16, 21 & 22
 FOURTH ELECTION DISTRICT
 HOWARD COUNTY, MARYLAND
 SCALE: AS SHOWN
 DATE: DECEMBER, 2008
 SHEET 11 OF 15

TAX MAP No.: 21

Approved Department of Public Works
 Chief, Bureau of Highways
 Date: 1-12-09

Approved Department of Planning and Zoning
 Chief, Division of Land Development
 Date: 1/23/09


Chief, Development Engineering Division
 Date: 1-16-9

DRAINAGE AREA DATA				
STRUCTURE NO.	DRAINAGE AREA	AREA	'C'	ZONED
I-1	A	0.08 acres	0.61	RC-DEO
I-2	B	2.90 acres	0.39	RC-DEO
I-3	C	1.51 acres	0.41	RC-DEO
I-4	D	0.51 acres	0.43	RC-DEO
I-5	E	1.20 acres	0.39	RC-DEO
I-6	F	0.14 acres	0.61	RC-DEO
I-7	G	0.37 acres	0.61	RC-DEO



FOR ESE CONSULTANTS, INC.

PROFESSIONAL CERTIFICATION: I HEREBY CERTIFY THAT THESE DOCUMENTS WERE PREPARED BY ME OR UNDER MY RESPONSIBLE CHARGE, AND THAT I AM A DULY LICENSED PROFESSIONAL LAND SURVEYOR UNDER THE LAWS OF THE STATE OF MARYLAND, LICENSE NO. 21328, EXPIRATION DATE 1/08/19.

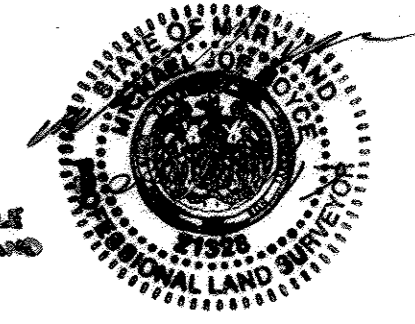

FOR ESE CONSULTANTS, INC.


PROFESSIONAL CERTIFICATION: I HEREBY CERTIFY THAT THESE DOCUMENTS WERE PREPARED BY ME OR UNDER MY RESPONSIBLE CHARGE, AND THAT I AM A DULY LICENSED PROFESSIONAL LAND SURVEYOR UNDER THE LAWS OF THE STATE OF MARYLAND, LICENSE NO. 21328, EXPIRATION DATE 1/08/19.

NO.	DESCRIPTION	DATE
2	REVISED SWM ON LOTS 1, 5 & 6	2/28/17
1	REVISE LANDSCAPE AND ENTRANCE EASEMENT	11/9/11
1	REVISED USE IN COMMON EASEMENT FOR LOTS 5 & 6 AND UNDERGROUND TANK & FILL OFF AREA	11/9/11
1	REVISE OWNER AND DEVELOPER	11/9/11


STORM DRAIN DRAINAGE AREA MAP
MERIWETHER FARM
SECTION TWO
PHASE ONE
BUILDABLE LOTS 1 THRU 10, NON-BUILDABLE PRESERVATION PARCELS 'C' & 'D' AND BUILDABLE BULK PARCEL 'E'
 (A RESUBDIVISION OF BUILDABLE BULK PARCEL 'A', MERIWETHER FARM, SECTION TWO, F-08-198)
 ZONED: RC-DEO
 TAX MAP NO. 21 PARCEL NO. 29 GRID NOS. 15, 16, 21 & 22
 FOURTH ELECTION DISTRICT
 HOWARD COUNTY, MARYLAND
 SCALE: AS SHOWN
 DATE: DECEMBER, 2008
 SHEET 12 OF 15

ASBUILT

F-08-199

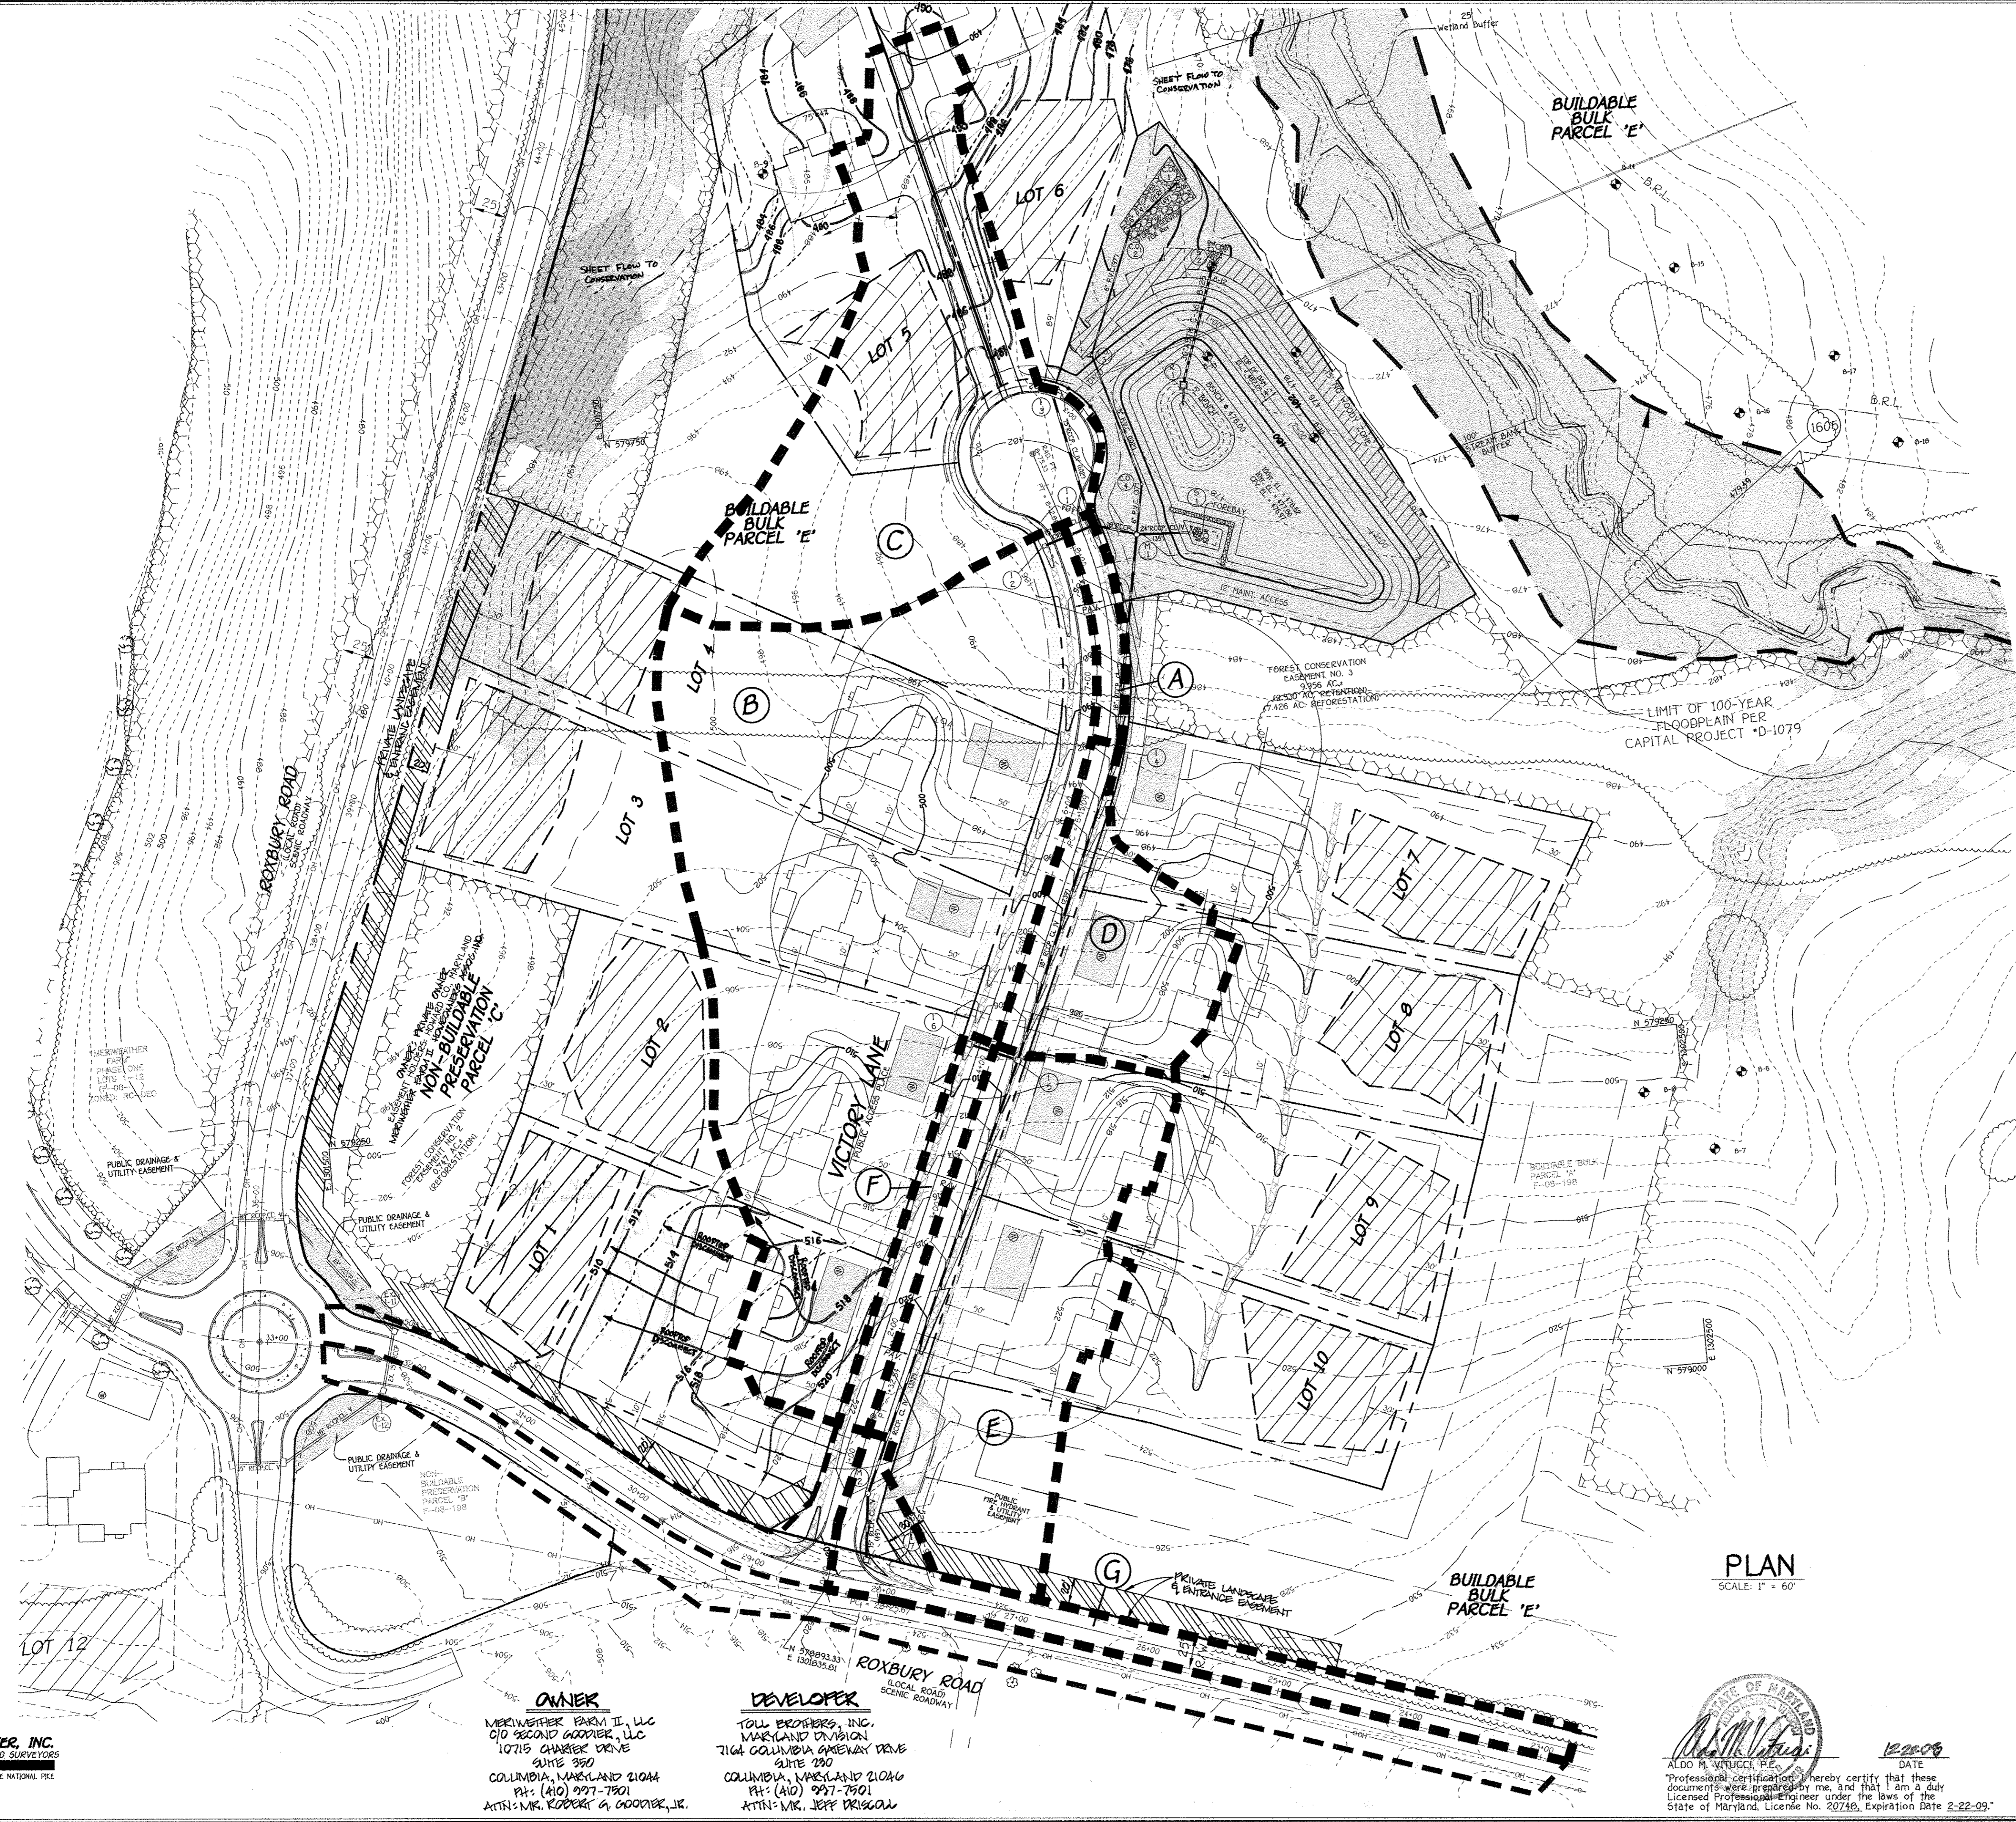

PLAN
 SCALE: 1" = 60'

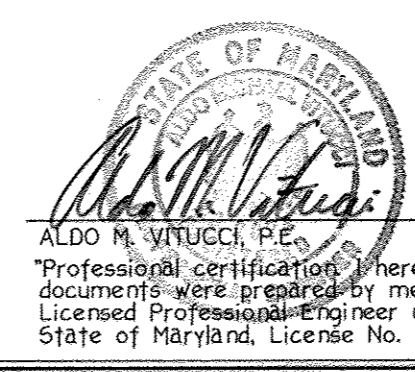

ALDO M. VIUCCI, P.E.
 DATE: 12-28-08
 PROFESSIONAL CERTIFICATION: I HEREBY CERTIFY THAT THESE DOCUMENTS WERE PREPARED BY ME, AND THAT I AM A DULY LICENSED PROFESSIONAL ENGINEER UNDER THE LAWS OF THE STATE OF MARYLAND, LICENSE NO. 20748, EXPIRATION DATE 2-22-09.





FISHER, COLLINS & CARTER, INC.
 CIVIL ENGINEERING CONSULTANTS & LAND SURVEYORS
 CENTENAL SQUARE OFFICE PARK - 10272 BALTIMORE NATIONAL PIKE
 ELLICOTT CITY, MARYLAND 21042
 (410) 461-2000

OWNER
 MERIWETHER FARM II, LLC
 C/O SECOND GOODRICK, LLC
 10715 CHAMBER DRIVE
 SUITE 350
 COLUMBIA, MARYLAND 21044
 PH: (410) 997-7501
 ATTN: MR. ROBERT A. GOODRICK, JR.

DEVELOPER
 TOLL BROTHERS, INC.
 MARYLAND DIVISION
 7164 COLUMBIA GATEWAY DRIVE
 SUITE 200
 COLUMBIA, MARYLAND 21046
 PH: (410) 997-7501
 ATTN: MR. JEFF DRISCOLL

I:\2004\04055\PHASE TWO FINALS\SHEET 12.DWG 12/19/2008 9:03:30 AM James

APPROVED: DEPARTMENT OF PUBLIC WORKS
 WILLIAM Z. ... 1-12-09
 CHIEF, BUREAU OF HIGHWAYS
 APPROVED: DEPARTMENT OF PLANNING AND ZONING
 ... 1/22/09
 CHIEF, DIVISION OF LAND DEVELOPMENT
 ... 1-16-9
 CHIEF, DEVELOPMENT ENGINEERING DIVISION

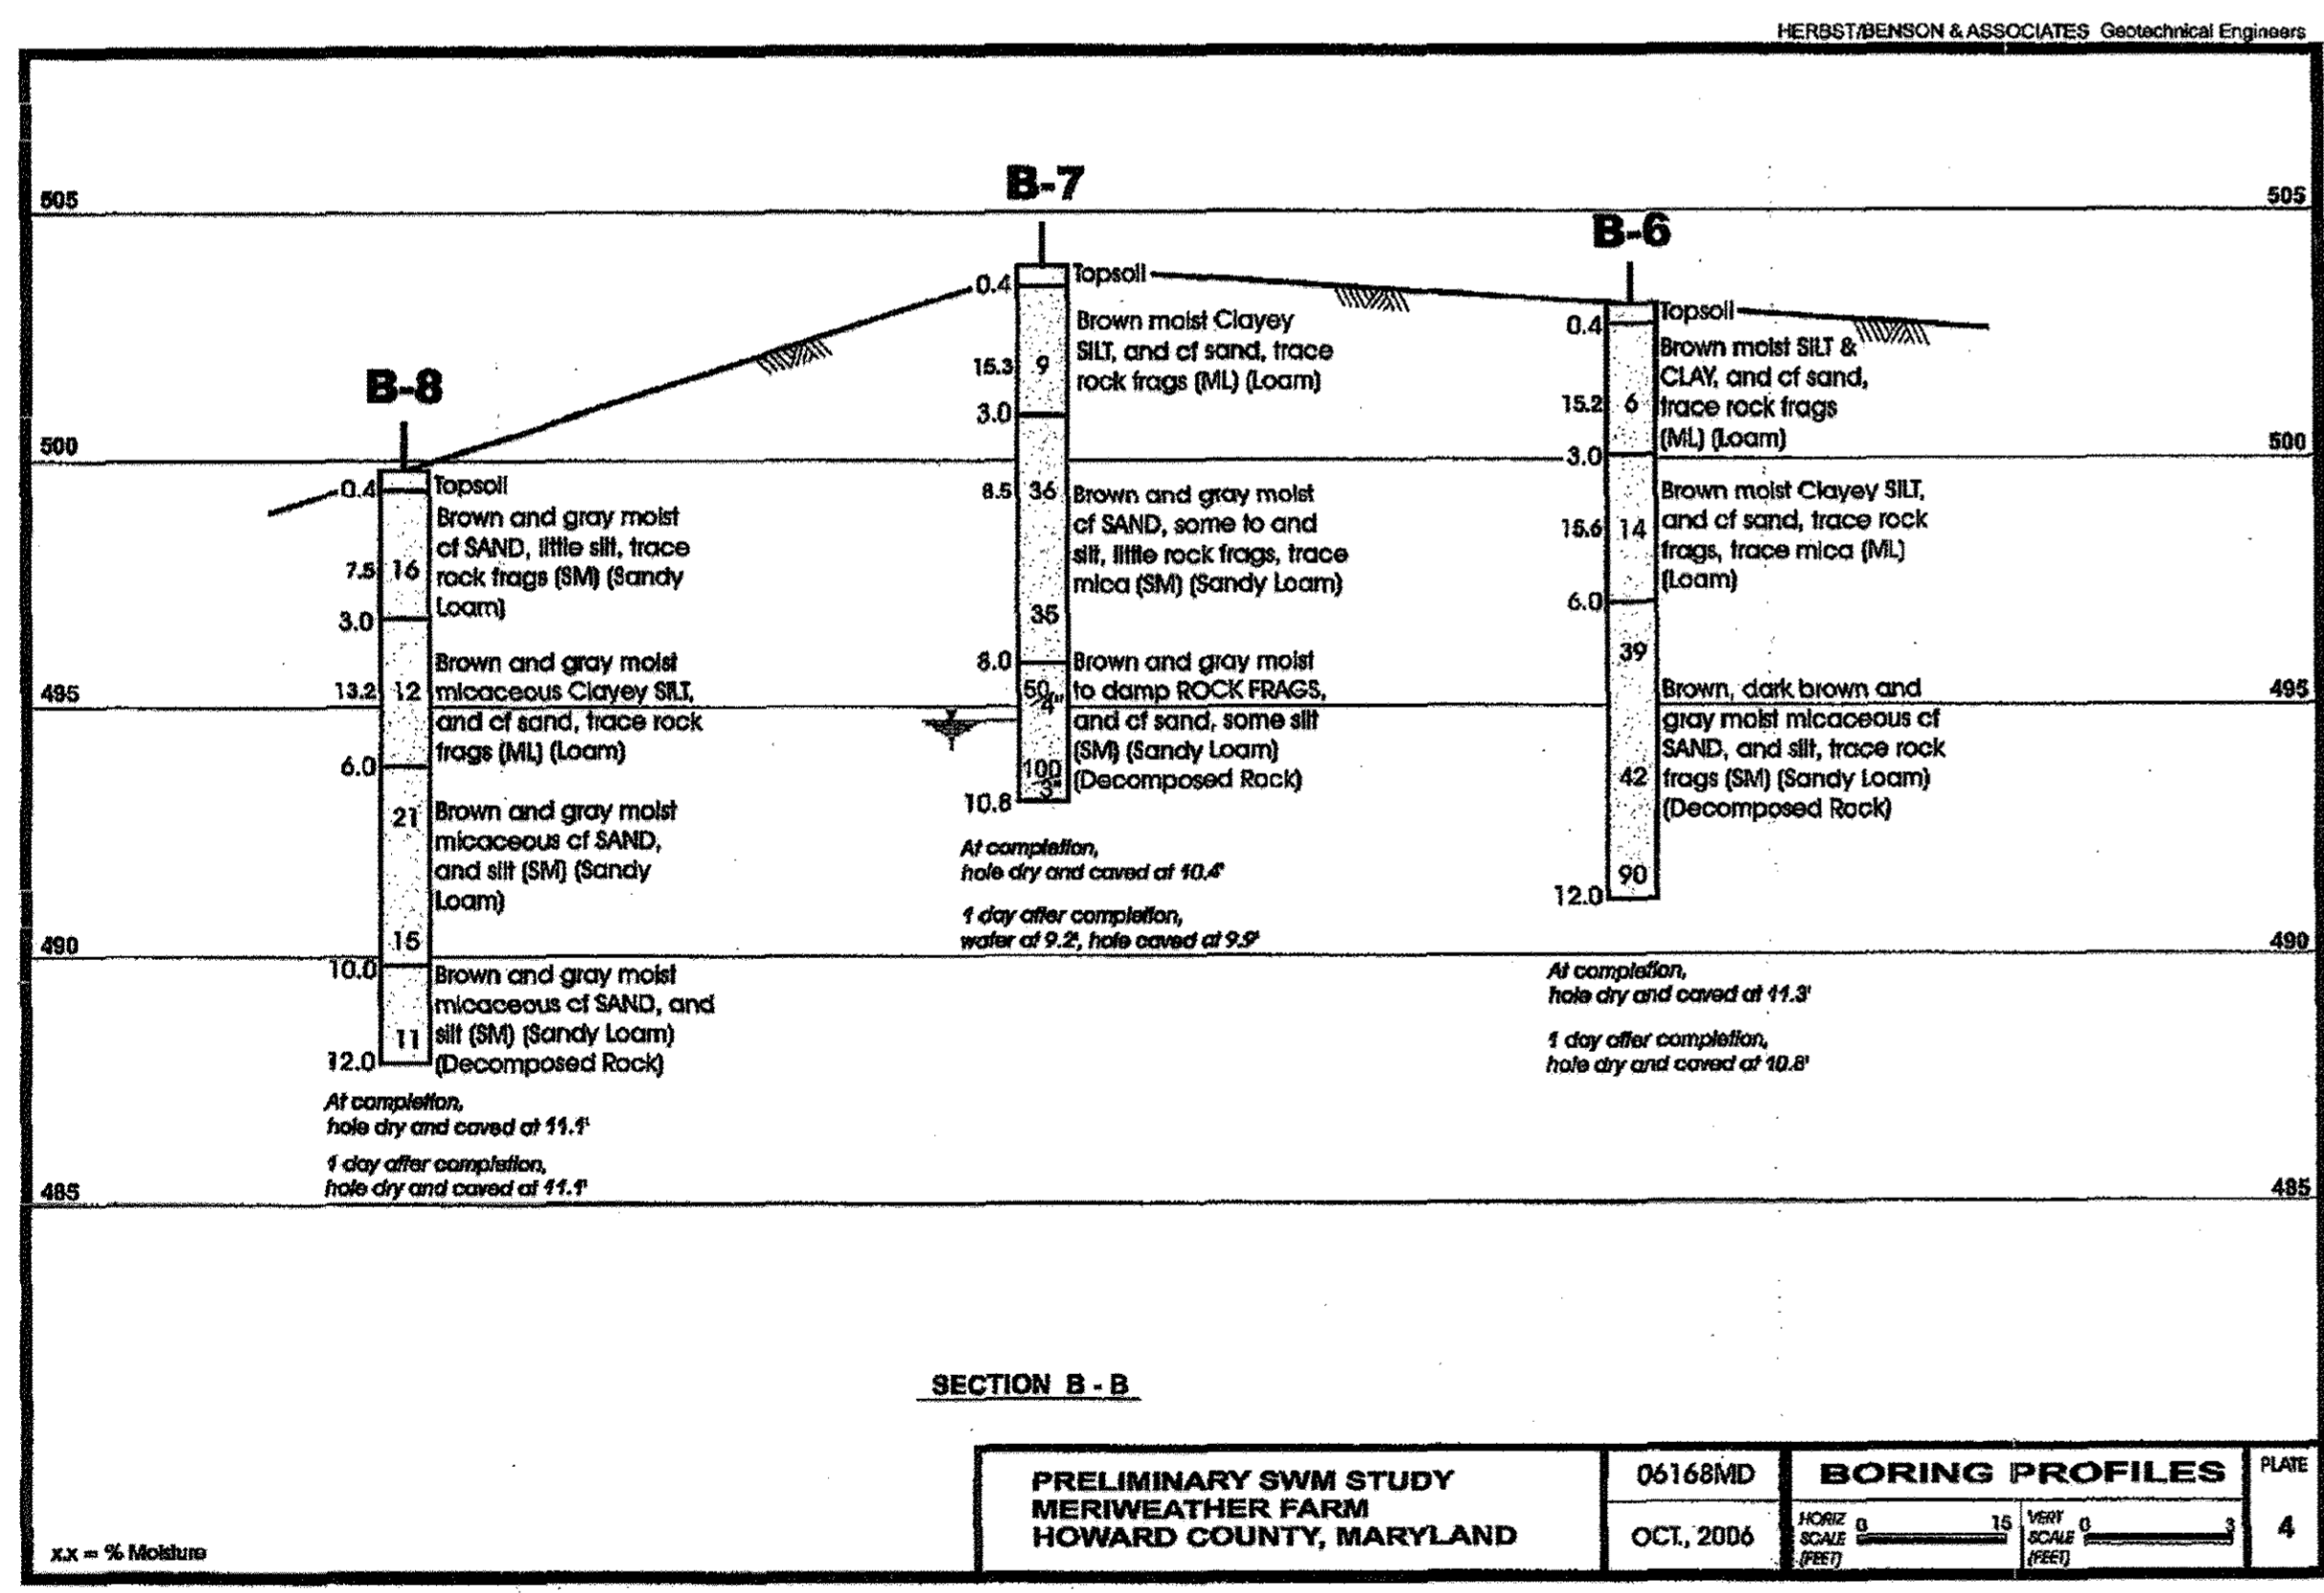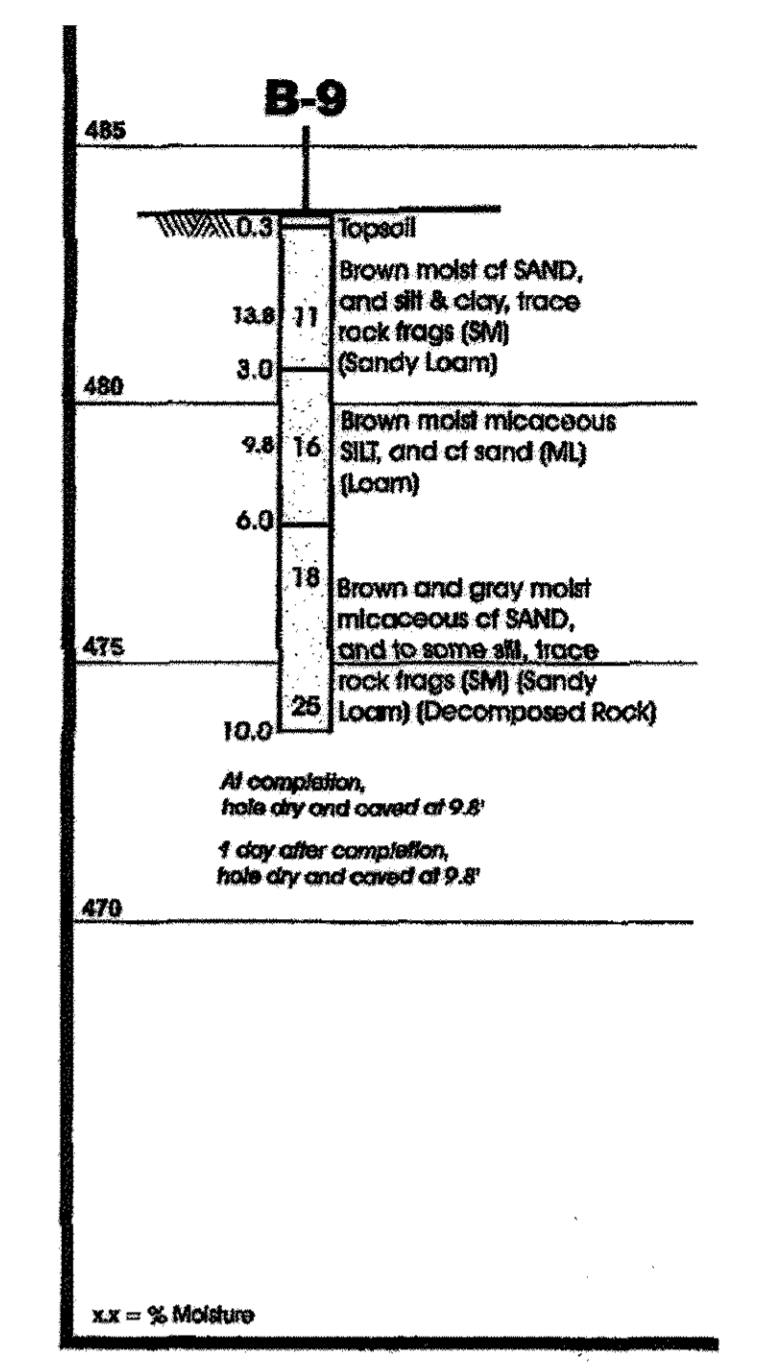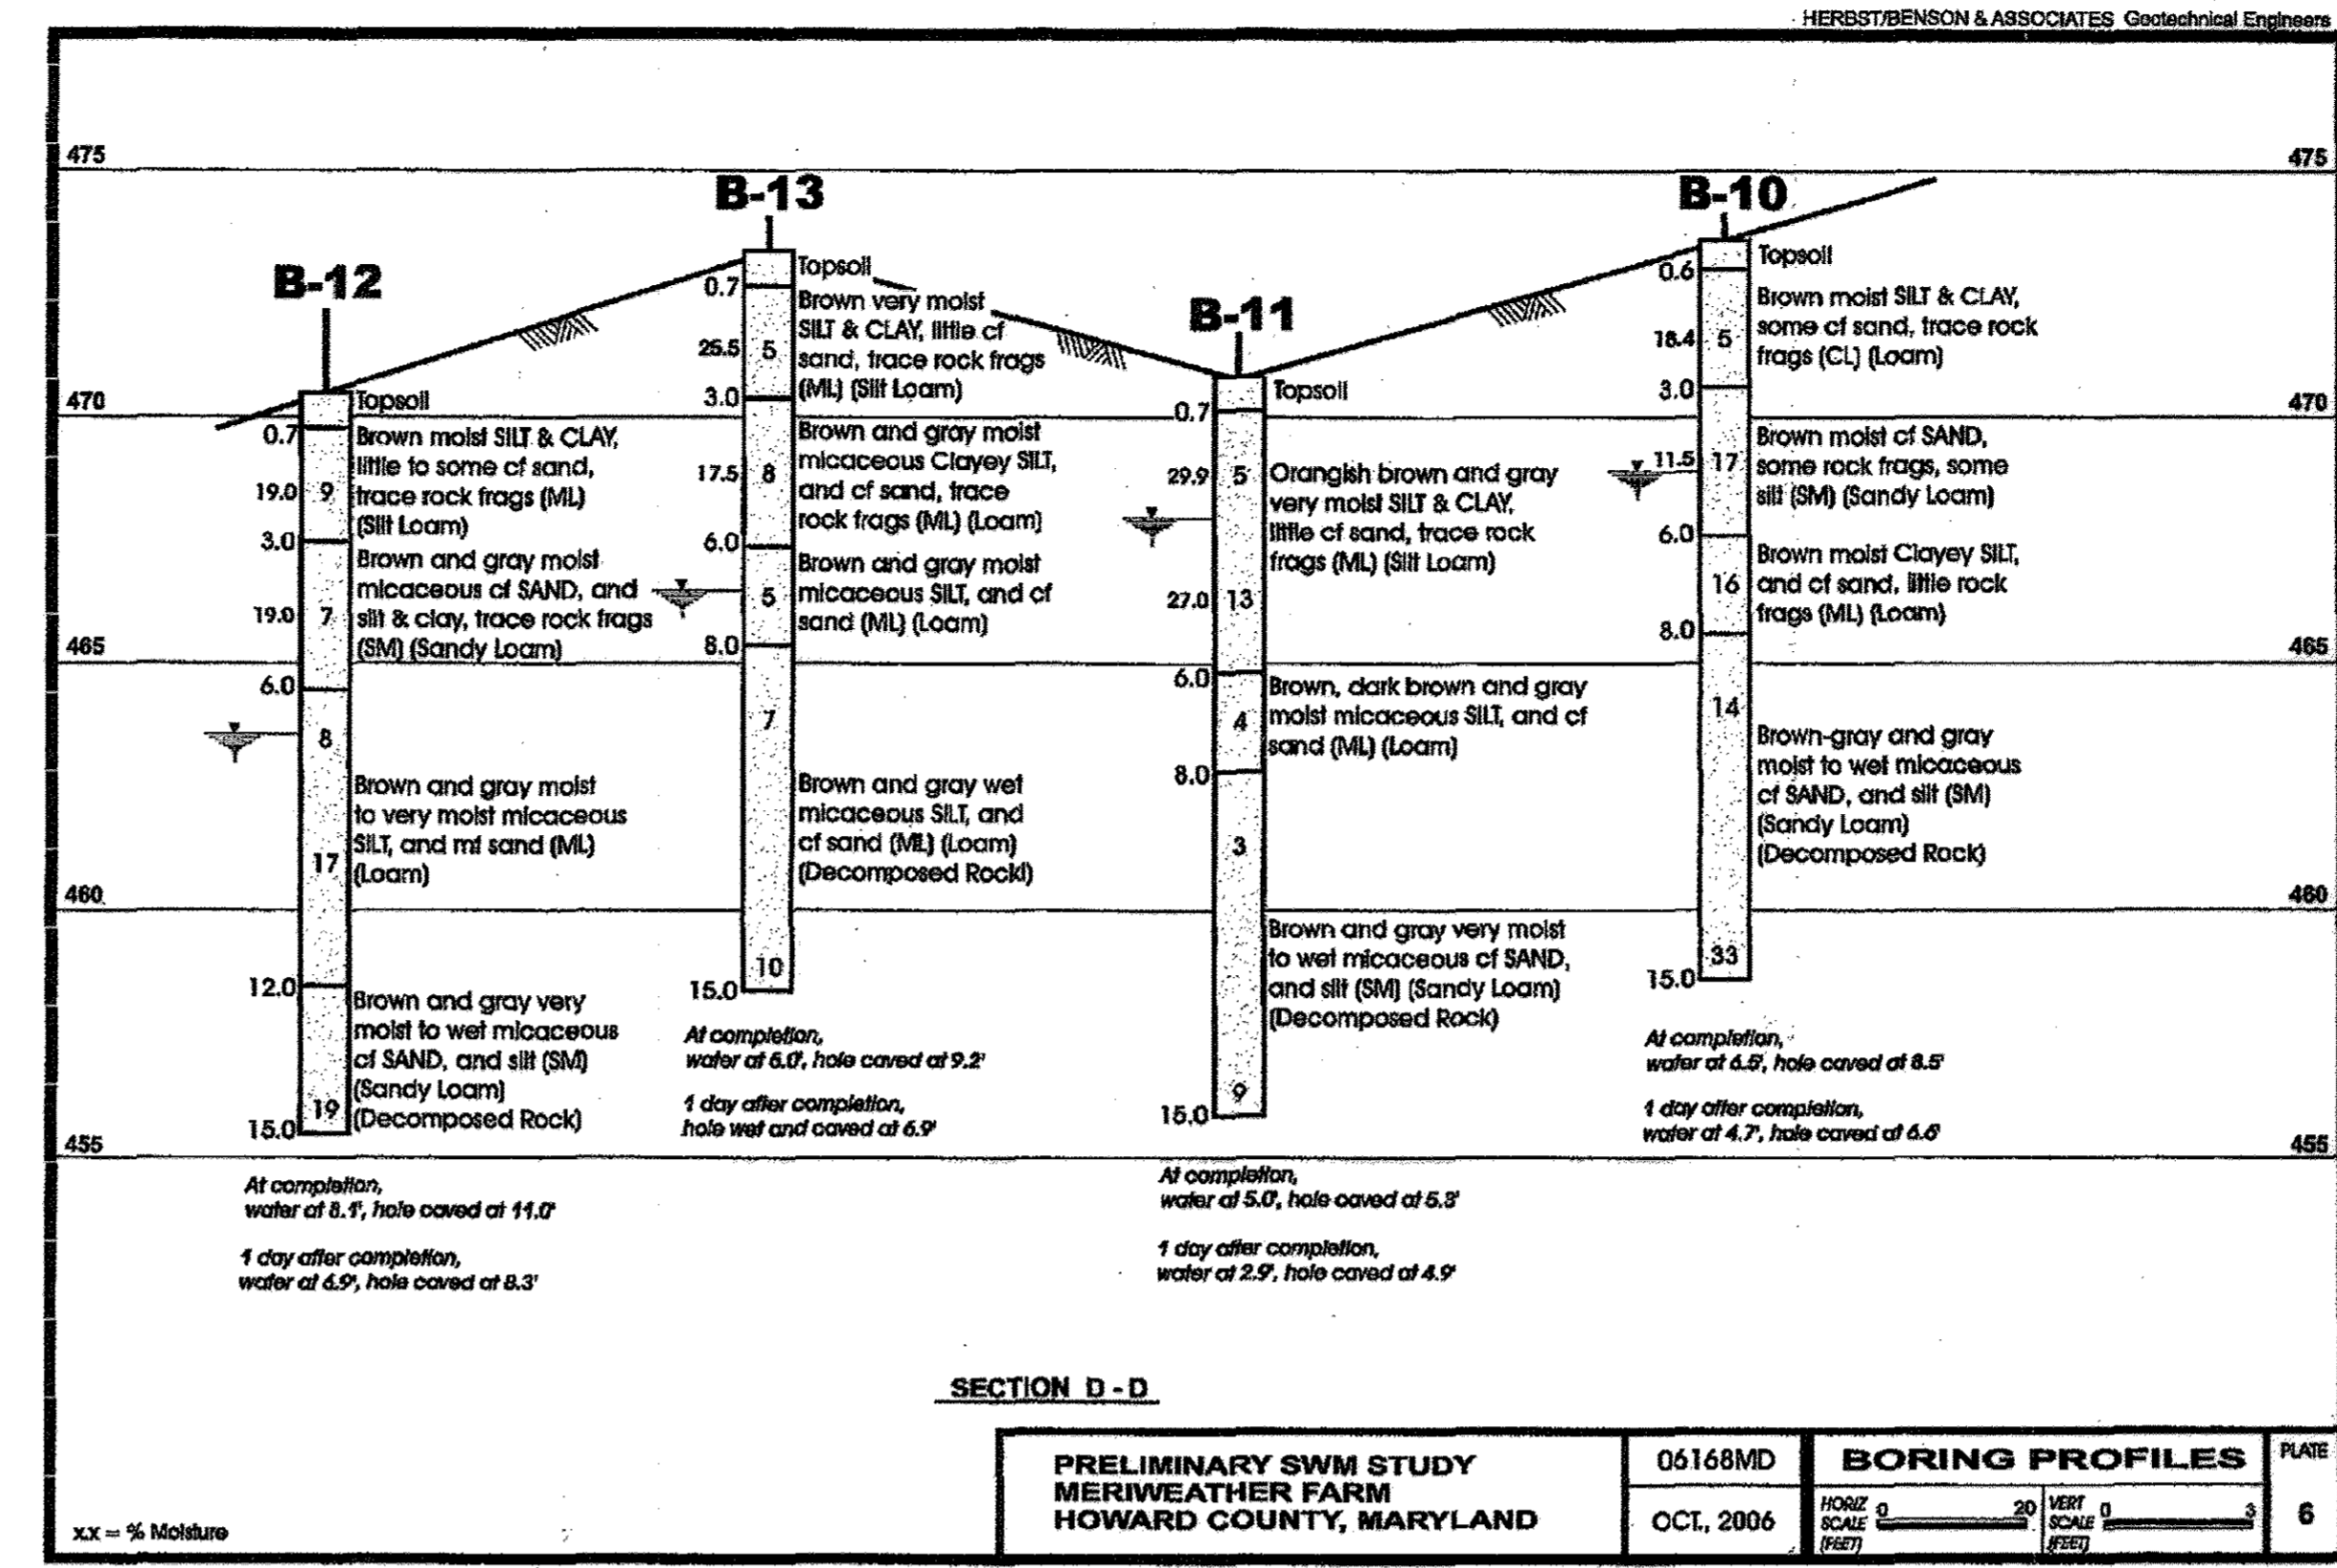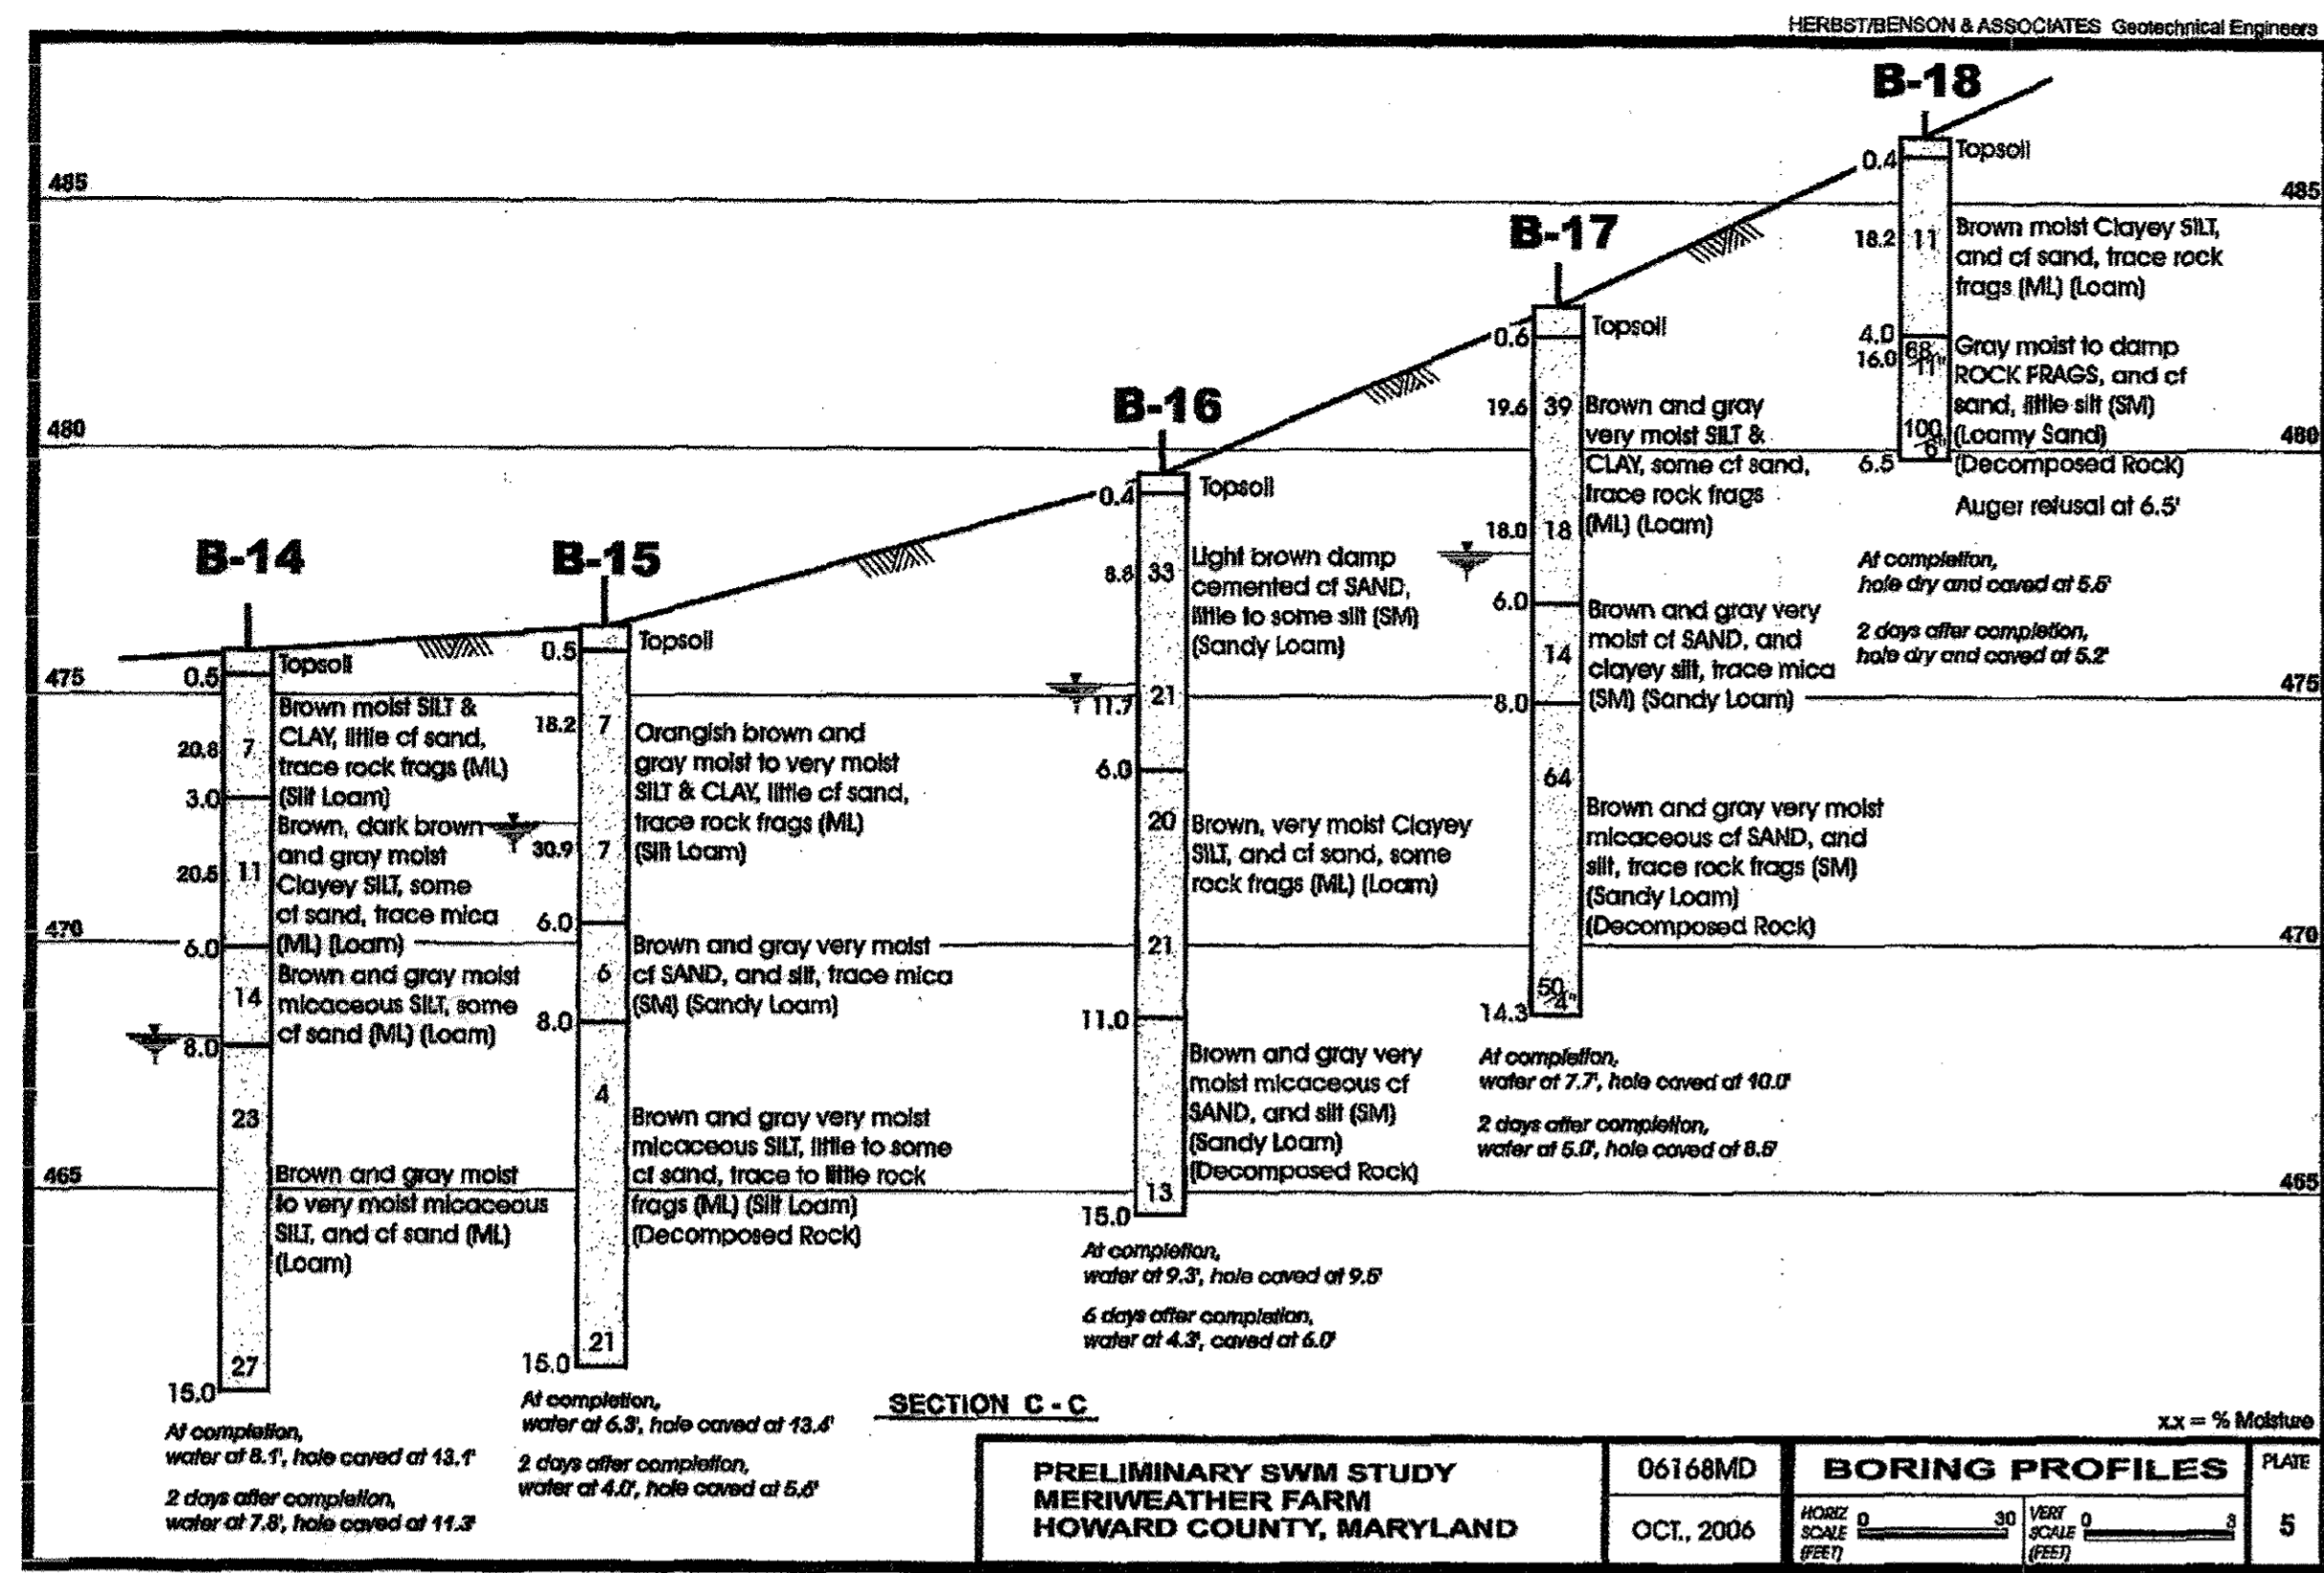

FISHER, COLLINS & CARTER, INC.
 CIVIL ENGINEERING CONSULTANTS & LAND SURVEYORS
 CENTRAL SQUARE OFFICE PARK - 10272 BALTIMORE NATIONAL PIKE
 ELLETTT CITY, MARYLAND 21042
 410.461.2955

1	RENAME OWNER AND DEVELOPER	11/8/11
NO.	DESCRIPTION	
	REVISIONS	

OWNER
 MERIWETHER FARM II, LLC
 C/O SECOND GOODER, LLC
 10715 CHARTER DRIVE
 SUITE 350
 COLUMBIA, MARYLAND 21044
 PH: (410) 997-7501
 ATTN: MR. ROBERT G. GOODER, JR.

DEVELOPER
 TOLL BROTHERS, INC.
 MARYLAND DIVISION
 7164 COLUMBIA GATEWAY DRIVE
 SUITE 230
 COLUMBIA, MARYLAND 21046
 PH: (410) 997-7501
 ATTN: MR. JEFF DRISCOLL

ALDO M. VITTORELLI
 1022-09
 DATE
 "Professional certification I hereby certify that these documents were prepared by me, and that I am a duly Licensed Professional Engineer under the laws of the State of Maryland, License No. 20748, Expiration Date 2-22-09."

**SOIL BORINGS
 MERIWETHER FARM
 SECTION TWO
 PHASE ONE
 BUILDABLE LOTS 1 THRU 10, NON-BUILDABLE PRESERVATION
 PARCELS 'C' & 'D' AND BUILDABLE BULK PARCEL 'E'**
 (A RESUBDIVISION OF BUILDABLE BULK PARCEL 'A', MERIWETHER FARM,
 SECTION TWO, F-08-198)
 ZONED: RC-060
 PARCEL No.: 29 GRID Nos.: 15, 16, 21 & 22
 FOURTH ELECTION DISTRICT
 HOWARD COUNTY, MARYLAND
 SCALE: AS SHOWN
 DATE: DECEMBER, 2008
 SHEET 13 OF 15

2	Revised SMM on Lots 1, 5 & 6	2/28/17
1	REMOVE USE-IN-COMM EASEMENT FOR LOTS 5 & 6 AND UNDERGROUND TANK & PUMP OUT AREA	11/8/11
1	RENAME OWNER AND DEVELOPER	11/8/11
NO	REVISIONS	DATE


FOR ESE CONSULTANTS, INC.
 PROFESSIONAL CERTIFICATION: I HEREBY CERTIFY THAT THESE DOCUMENTS WERE PREPARED BY ME OR UNDER MY RESPONSIBLE CHARGE AND THAT I AM A DULY LICENSED PROFESSIONAL LAND SURVEYOR UNDER THE LAWS OF THE STATE OF MARYLAND, LICENSE NO. 21328, EXPIRATION DATE 1/08/19.

FCR - 3 - 2,426 Acres
 Plantings Required 350 WHPS/ACRE = 860 WHPS
 Plantings Provided 100 - 1" CAL. TREES & 227 WHPS

Qty	Species	Size	Spacing	Total FCA Units
25	Acer rubrum - Red maple	1" cal.	15' x 15'	10
25	Liriodendron tulipifera - Tulip poplar **	1" cal.	15' x 15'	10
25	Platanus occidentalis - Sycamore	1" cal.	15' x 15'	10
25	Quercus alba - White oak **	1" cal.	15' x 15'	10
350	Total 1" caliper trees = 35 units/acre FCA unit credit			350
350	Acer rubrum - Red maple	2-3" whp	15' x 15'	1050
350	Diosteros virginiana - Persimmon **	2-3" whp	15' x 15'	1050
300	Liriodendron tulipifera - Tulip poplar **	2-3" whp	15' x 15'	900
300	Nyssa sylvatica - Black gum	2-3" whp	15' x 15'	900
250	Platanus occidentalis - Sycamore Prunus	2-3" whp	15' x 15'	750
250	serotina - Black cherry **	2-3" whp	15' x 15'	750
225	Quercus alba - White oak	2-3" whp	15' x 15'	675
200	Ulmus rubra - Sluggery Elm Vitumnus	2-3" whp	15' x 15'	600
200	prunifolium - Blackhaw **	2-3" whp	15' x 15'	600
2425	Total whp plantings = 2 units/acre = FCA unit credit			4950
	Total Unit Credit			5200

FCR - 2 - 0.747 Acres
 Plantings Required 350 WHPS/ACRE = 262 WHPS
 Plantings Provided 20 - 1" CAL. TREES & 227 WHPS


Qty	Species	Size	Spacing	Total FCA Units
5	Acer rubrum - Red maple	1" cal.	15' x 15'	2
5	Liriodendron tulipifera - Tulip poplar **	1" cal.	15' x 15'	2
5	Platanus occidentalis - Sycamore	1" cal.	15' x 15'	2
5	Quercus alba - White oak **	1" cal.	15' x 15'	2
30	Total 1" caliper trees = 30 units/acre FCA unit credit			70
30	Acer rubrum - Red maple	2-3" whp	15' x 15'	90
27	Diosteros virginiana - Persimmon **	2-3" whp	15' x 15'	81
30	Liriodendron tulipifera - Tulip poplar **	2-3" whp	15' x 15'	90
25	Nyssa sylvatica - Black gum	2-3" whp	15' x 15'	75
20	Platanus occidentalis - Sycamore Prunus	2-3" whp	15' x 15'	60
20	serotina - Black cherry **	2-3" whp	15' x 15'	60
20	Quercus alba - White oak	2-3" whp	15' x 15'	60
20	Ulmus rubra - Sluggery Elm Vitumnus	2-3" whp	15' x 15'	60
15	prunifolium - Blackhaw **	2-3" whp	15' x 15'	45
227	Total whp plantings = 2 units/acre = FCA unit credit			494
	Total Unit Credit			524

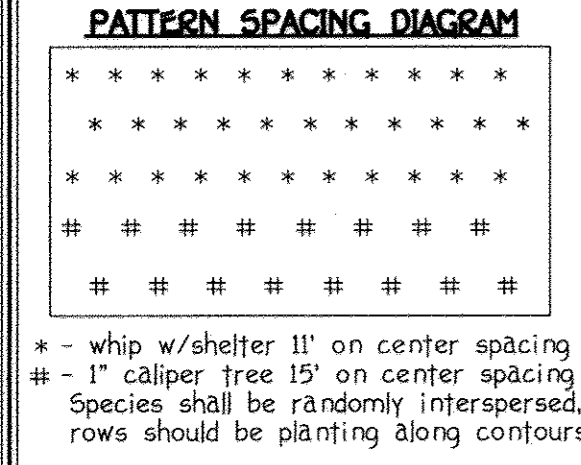

FOREST CONSERVATION EASEMENT NO. 2
 0.747 AC. ±
 (REFORESTATION)

Eco-Science Professionals, Inc.
 CONSULTING ECOLOGISTS
 MD DNR Qualified Professional
 USACOE Wetland Delineator
 Certification # WDCP93MD08100448
 J. Canoles 12/14/08
 JOHN P. CANOLES

FISHER, COLLINS & CARTER, INC.
 CIVIL ENGINEERING CONSULTANTS & LAND SURVEYORS
 CENTRAL SQUARE OFFICE PARK - 10775 BAL THORNE NATIONAL FEE
 ELICOTT CITY, MARYLAND 21042
 410-481-2955

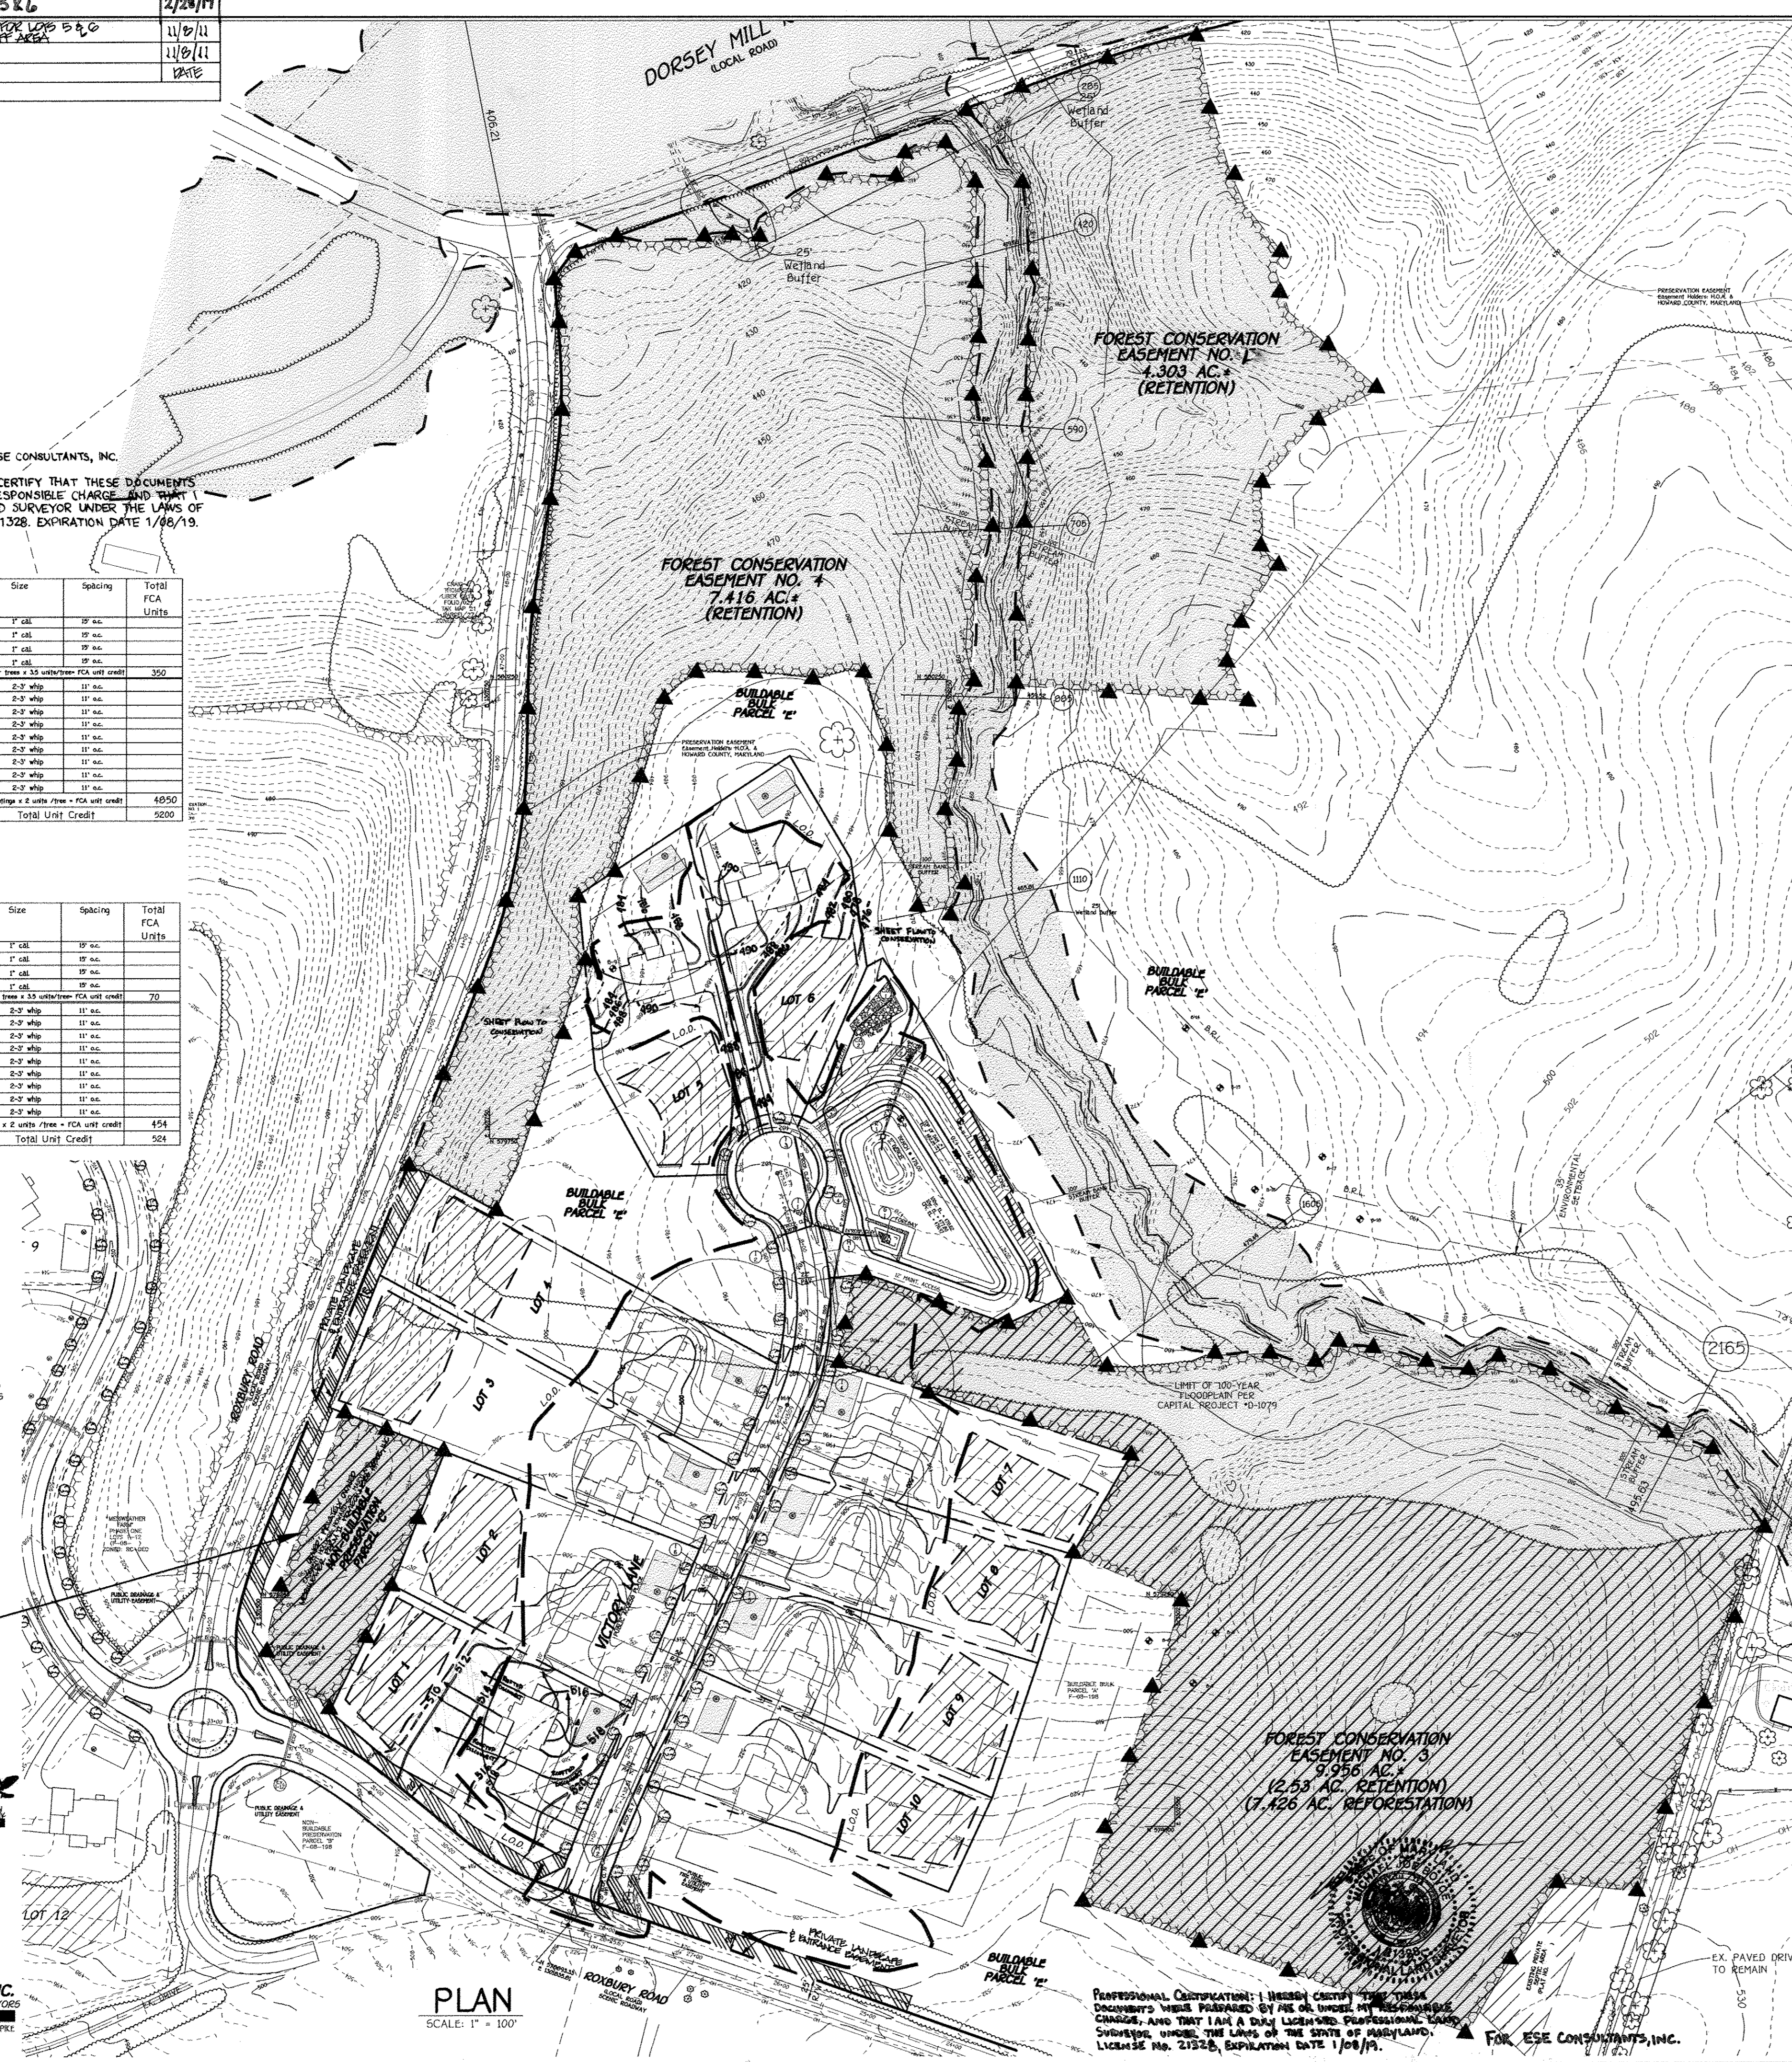

Planting/Soil Specifications

- Installation of bare-root plants shall take place between March 15 - April 20. B&B/Container stock March 15 - May 30 or September 15 - November 15. Fall planting of B&B stock is not recommended.
- Disturbed areas shall be seeded and established as per general construction plan for project. Planting areas not impacted by site grading shall have no additional topsoil installed.
- Bare-root plants shall be installed so that the top of root mass is level with the top of existing grade. Stems shall be dug in an anti-desiccant gel prior to planting. Backfill in the planting pits shall consist of 3 parts existing soil to 1 part pine fines or equivalent.
- Fertilizer shall consist of Agriform 22-0-2, or equivalent, applied as per manufacturer's specifications, for woody plants. Herbaceous plants shall be fertilized with Osmocote 0-6-12.
- Plant material shall be transported to the site in a tarped or covered truck. Plants shall be kept moist prior to planting.
- All non-organic debris associated with the planting operation shall be removed from the site by the contractor.

Sequence of Construction

- Sediment control shall be installed in accordance with general construction plan for site.
- Plants shall be installed as per Plant Schedule and the Planting/Soil Specifications for the project.
- Upon completion of the planting, signage shall be installed as shown.
- Plantings shall be maintained and guaranteed in accordance with the Maintenance and Guarantee requirements for project.

Maintenance of Plantings

- Maintenance of plantings shall last for a period of 2 years.
- Plantings must receive 2 gallons of water, either through precipitation or watering, weekly during the last growing season, as needed. During second growing season, once a month during May-September, if needed.
- Invasive species and noxious weeds will be removed, as required, from planting areas mechanically and/or with limited herbicide application (see groundcover note where appropriate). Old field successional species will be retained.
- Plants will be examined a minimum two times during the growing season for serious plant pests and diseases. Serious problems will be treated with the appropriate agent.
- Dead branches will be pruned from plantings.

Guarantee Requirements

- A 75 percent survival rate of forestation plantings will be required at the end of 2 growing seasons. All plant material below the 75 percent threshold will be replaced at the beginning of the next growing season. Wild trees arising from natural regeneration may be counted up to 50 percent towards the total survival number if they are healthy, native species of at least 12 inches tall.

Surety for Forestation

The Forest Conservation Requirements Per Section 16.1200 of the Howard County Code And The Forest Conservation Manual For Meriwether Farm, Section Two, Phase One Subdivision will be Fulfilled by Providing A Total Of Onsite Retention Of 14,249 Acres Of Forest And 8,172 Acres Of Onsite Planting.

- Total Forest Retention Obligation For Meriwether Farm, Section Two - 301 Acres.
- Required Forest Retention Obligation For Meriwether Farm, Section Two, Phase One - 640 Acres.
- 301 Ac. Of Total Retention/7 Total Du = 636.42 Ac./Du. X 10 Du = 6,364 Ac.
- Provided Forest Retention Conservation Easement For Meriwether Farm, Section Two, Phase One = 14,249 Ac.
- Required Forest Retention Obligation For Meriwether Farm, Section Two, Phase One = 455 Ac.
- 455 Ac. Of Total Retention/7 Total Du = 65.0 Ac./Du. X 10 Du = 650 Ac.
- Provided Forest Retention Conservation Easement For Meriwether Farm, Section Two, Phase One = 8,172 Ac.

F. The Forest Conservation Surety Amount Required is \$302,146.00 And Shall be Provided With The Developer's Agreement.

Planting Notes

When possible, plants shall be installed within 24 hours of delivery. If installation cannot be performed within this time frame, plants stock shall be watered and protected from desiccation.

Application of herbicide, Round-up or equivalent, may be used to reduce plant competition from old field successional growth at the time of installation. Having re-plantation of herbicide, or a combination thereof, may be used to control unwanted competing vegetation.

Planting shall be installed within one year or two growing seasons of subdivision approval. Plantings shall be installed in accordance with the time schedule included in Note 1 of the planting/seedling specifications.

FCP NOTES

- ANY FOREST CONSERVATION EASEMENT (FCE) AREA SHOWN HEREON IS SUBJECT TO PROTECTIVE COVENANTS WHICH ARE FOUND IN THE LAND RECORDS OF HOWARD COUNTY WHICH RESTRICT THE DISTURBANCE AND USE OF THESE AREAS.
- THE FOREST CONSERVATION EASEMENTS HAVE BEEN ESTABLISHED TO FULFILL THE REQUIREMENTS OF SECTION 16.1200 OF THE HOWARD COUNTY CODE, FOREST CONSERVATION ACT, NO CLEARING, GRADING, OR CONSTRUCTION IS PERMITTED WITHIN THE FOREST CONSERVATION EASEMENTS, HOWEVER, FOREST MANAGEMENT PRACTICES AS DEFINED IN THE DEED OF FOREST CONSERVATION EASEMENT ARE ALLOWED.
- FORESTED AREAS OCCURRING OUTSIDE OF THE FCE SHALL NOT BE CONSIDERED PART OF THE FCE AND SHALL NOT BE SUBJECT TO PROTECTIVE LAND COVENANTS.
- LISTS OF DISTURBANCE SHALL BE RESTRICTED TO AREAS OUTSIDE THE LIMIT OF TEMPORARY FENCING OR THE FCE BOUNDARY, WHICHEVER IS GREATER.
- THERE SHALL BE NO CLEARING, GRADING, CONSTRUCTION OR DISTURBANCE OF VEGETATION IN THE FOREST CONSERVATION EASEMENT, EXCEPT AS PERMITTED BY HOWARD COUNTY DEED.
- NO STOCKPILES, PARKING AREAS, EQUIPMENT CLEANING AREAS, ETC. SHALL OCCUR WITHIN AREAS DESIGNATED AS FOREST CONSERVATION EASEMENTS.
- TEMPORARY FENCING SHALL BE USED TO PROTECT FOREST RESOURCES DURING CONSTRUCTION THE FENCING SHALL BE PLACED ALONG ALL FCE BOUNDARIES WHICH OCCUR WITHIN 15 FEET OF THE PROPOSED LISTS OF DISTURBANCE.
- PERMANENT STORAGE SHALL BE PLACED 50' - 100' APART ALONG BOUNDARIES OF ALL AREAS INCLUDED IN FOREST CONSERVATION EASEMENTS.

Approved Department of Public Works
 Chief, Bureau of Highways
 1-12-09
 Date

Approved Department of Planning and Zoning
 Chief, Division of Land Development
 1/22/09
 Date


Chief, Development Engineering Division
 1-16-09
 Date

FOREST CONSERVATION WORKSHEET

NET TRACT AREA	ACRES
A. TOTAL TRACT AREA	282.56
B. DEDUCTING CRITICAL AREA AREA RESTRICTED BY LOCAL OR PROGRAM	6.78
C. NET TRACT AREA - NET TRACT AREA - TOTAL TRACT (A) - DEDUCTING (B)	175.78
LAND USE CATEGORY: RESUB DIVISION	
D. AFFORESTATION THRESHOLD NET TRACT AREA (C) x 20%	35.16
E. CONSERVATION THRESHOLD NET TRACT AREA (C) x 25%	43.95
EXISTING FOREST COVER	
F. EXISTING FOREST COVER WITHIN THE NET TRACT AREA	48.0
G. AREA OF FOREST ABOVE CONSERVATION THRESHOLD	0
H. IF THE EXISTING FOREST COVER (F) IS GREATER THAN THE CONSERVATION THRESHOLD (E), THEN G = F - E. OTHERWISE G = 0.	0
BREAK-EVEN POINT	
I. BREAK-EVEN POINT AMOUNT OF FOREST THAT MUST BE RETAINED SO THAT NO NETGATION IS REQUIRED	48.0
J. IF THE AREA OF FOREST ABOVE CONSERVATION THRESHOLD (G) IS GREATER THAN 0, THEN H - I = J. OTHERWISE J = 0.	0
K. IF J = 0 - THE AREA OF FOREST ABOVE CONSERVATION THRESHOLD (G) IS EQUAL TO 0, THEN CONSERVATION THRESHOLD (E).	0
L. IF THE AREA OF FOREST ABOVE CONSERVATION THRESHOLD (G) IS EQUAL TO 0, THEN J = 0. OTHERWISE FOREST COVER (F).	0
FOREST CLEARING REQUIRED WITHOUT NETGATION	
M. FOREST CLEARING REQUIRED WITHOUT NETGATION	0
N. EXISTING FOREST COVER (F) - BREAK-EVEN POINT (H)	0
PROPOSED FOREST CLEARING	
O. TOTAL AREA OF FOREST TO BE CLEARED	107
P. TOTAL AREA OF FOREST TO BE CLEARED	107
Q. EXISTING FOREST COVER (F) - FOREST TO BE CLEARED (O)	0
PLANTING REQUIREMENTS	
R. IF THE TOTAL AREA OF FOREST TO BE RETAINED (K) IS AT OR ABOVE THE BREAK-EVEN POINT (H), NO NETGATION IS REQUIRED AND NO FURTHER CALCULATIONS ARE NECESSARY. L.H.G., M.H.G., P.H.G., Q.H.G.	0
S. OTHERWISE, CALCULATE THE PLANTING REQUIREMENTS AS FOLLOWS:	0
T. REFORESTATION FOR CLEARING ABOVE THE CONSERVATION THRESHOLD	0
U. IF THE TOTAL AREA OF FOREST TO BE RETAINED (K) IS GREATER THAN THE CONSERVATION THRESHOLD (E), THEN L - THE AREA OF FOREST TO BE CLEARED (O) IS GREATER THAN 0.	0
V. IF THE FOREST TO BE RETAINED (K) IS LESS THAN OR EQUAL TO THE CONSERVATION THRESHOLD (E), THEN L - THE AREA OF FOREST ABOVE CONSERVATION THRESHOLD (G) x 0.25.	0
W. IF THE FOREST TO BE RETAINED (K) IS LESS THAN OR EQUAL TO THE CONSERVATION THRESHOLD (E), THEN L - THE AREA OF FOREST ABOVE CONSERVATION THRESHOLD (G) x 0.25.	0
X. TOTAL REFORESTATION REQUIRED (T) + L - M.	214
Y. TOTAL REFORESTATION REQUIRED	214
Z. EXISTING FOREST COVER (F) IS LESS THAN OR EQUAL TO THE CONSERVATION THRESHOLD (E), THEN M - 2.0 x FOREST TO BE CLEARED (O).	0
AA. CREDIT FOR REDUCTION ABOVE THE CONSERVATION THRESHOLD	0
AB. IF THE AREA OF FOREST TO BE RETAINED (K) IS GREATER THAN THE CONSERVATION THRESHOLD (E), THEN N - E - E. OTHERWISE N = 0.	0
AC. TOTAL REFORESTATION REQUIRED (Y) + L - M.	214
AD. TOTAL REFORESTATION REQUIRED	214
AE. EXISTING FOREST COVER (F) IS LESS THAN OR EQUAL TO THE AFFORESTATION THRESHOLD (D), THEN 0.	0
AF. AFFORESTATION THRESHOLD (D) - EXISTING FOREST COVER (F)	0
AG. TOTAL PLANTING REQUIREMENT (AC) + P - Q.	214

OWNER
 MERIWETHER FARM II, LLC
 C/O SECOND OWNER, LLC
 10715 CHAMBER DRIVE
 SUITE 350
 COLUMBIA, MARYLAND 21046
 PH: (410) 997-7501
 ATTN: MR. ROBERT G. COOPER, JR.

DEVELOPER
 TOLL BROTHERS, INC.
 MARYLAND DIVISION
 7124 COLUMBIA GATEWAY DRIVE
 SUITE 230
 COLUMBIA, MARYLAND 21046
 PH: (410) 997-7501
 ATTN: MR. JEFF BRIGGS

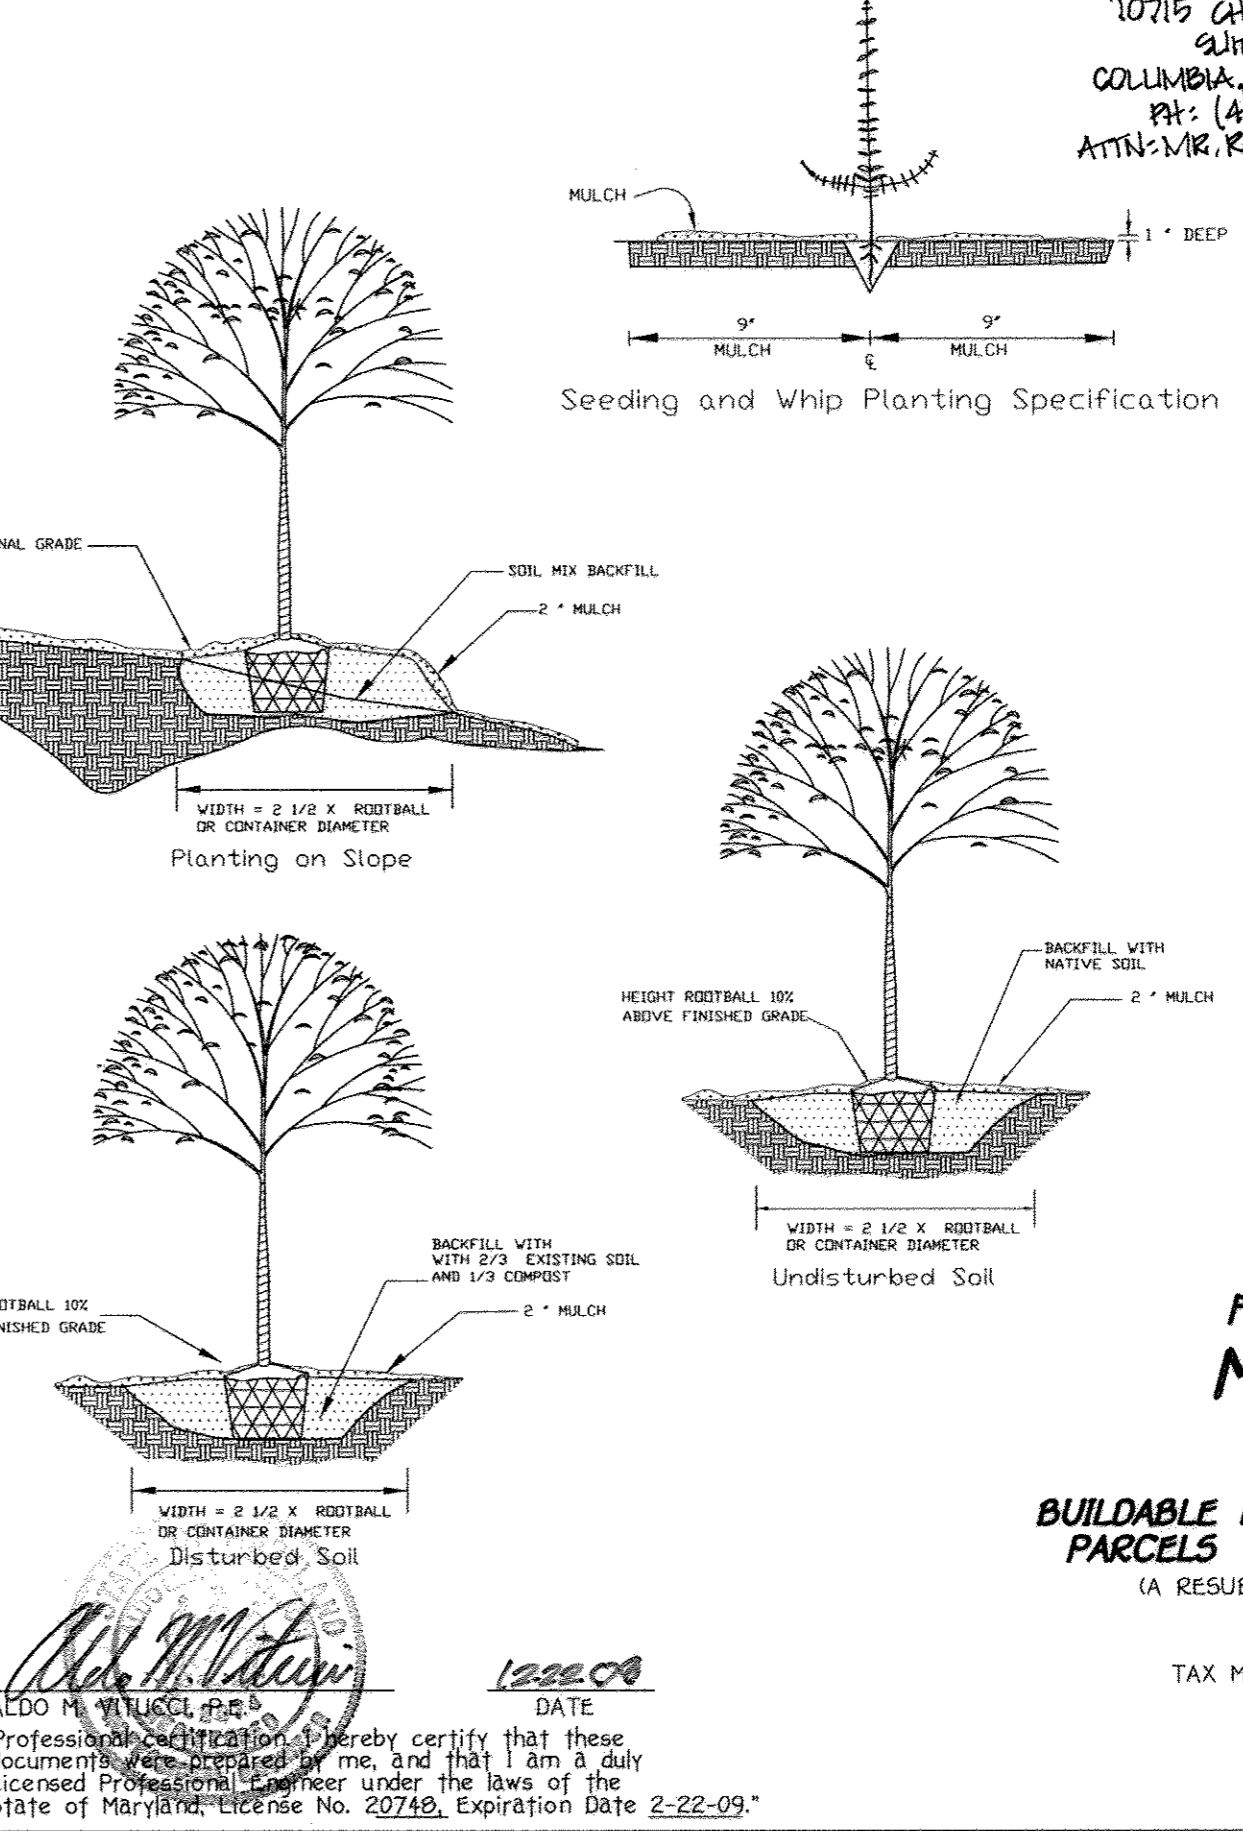

PROFESSIONAL CERTIFICATION: I HEREBY CERTIFY THAT THESE DOCUMENTS WERE PREPARED BY ME OR UNDER MY RESPONSIBLE CHARGE, AND THAT I AM A DULY LICENSED PROFESSIONAL LAND SURVEYOR UNDER THE LAWS OF THE STATE OF MARYLAND, LICENSE NO. 21328, EXPIRATION DATE 1/08/19.




FOR ESE CONSULTANTS, INC.

I:\3001\0456\img\PHASE TWO FINALS\SHEET 14 FOREST CON PLAN.dwg, 12/19/2008 9:24:50 AM, jmm


APPROVED: DEPARTMENT OF PUBLIC WORKS
William F. Caldwell 1-12-09
 CHIEF, BUREAU OF HIGHWAYS DATE

APPROVED: DEPARTMENT OF PLANNING AND ZONING
Cindy Hamer 1/22/09
 CHIEF, DIVISION OF LAND DEVELOPMENT DATE

Chad Edwards 1-16-9
 CHIEF, DEVELOPMENT ENGINEERING DIVISION DATE

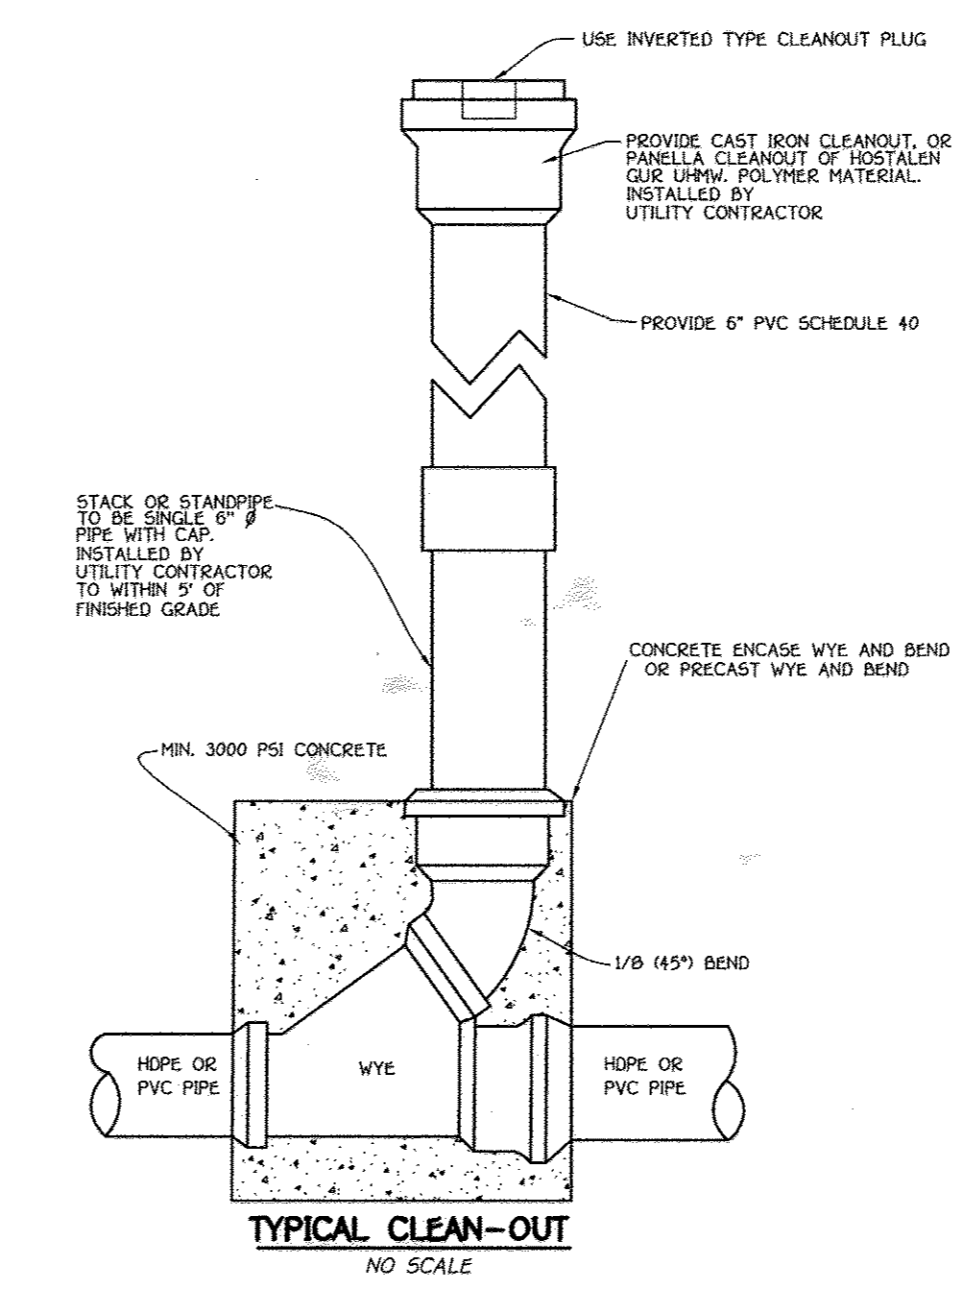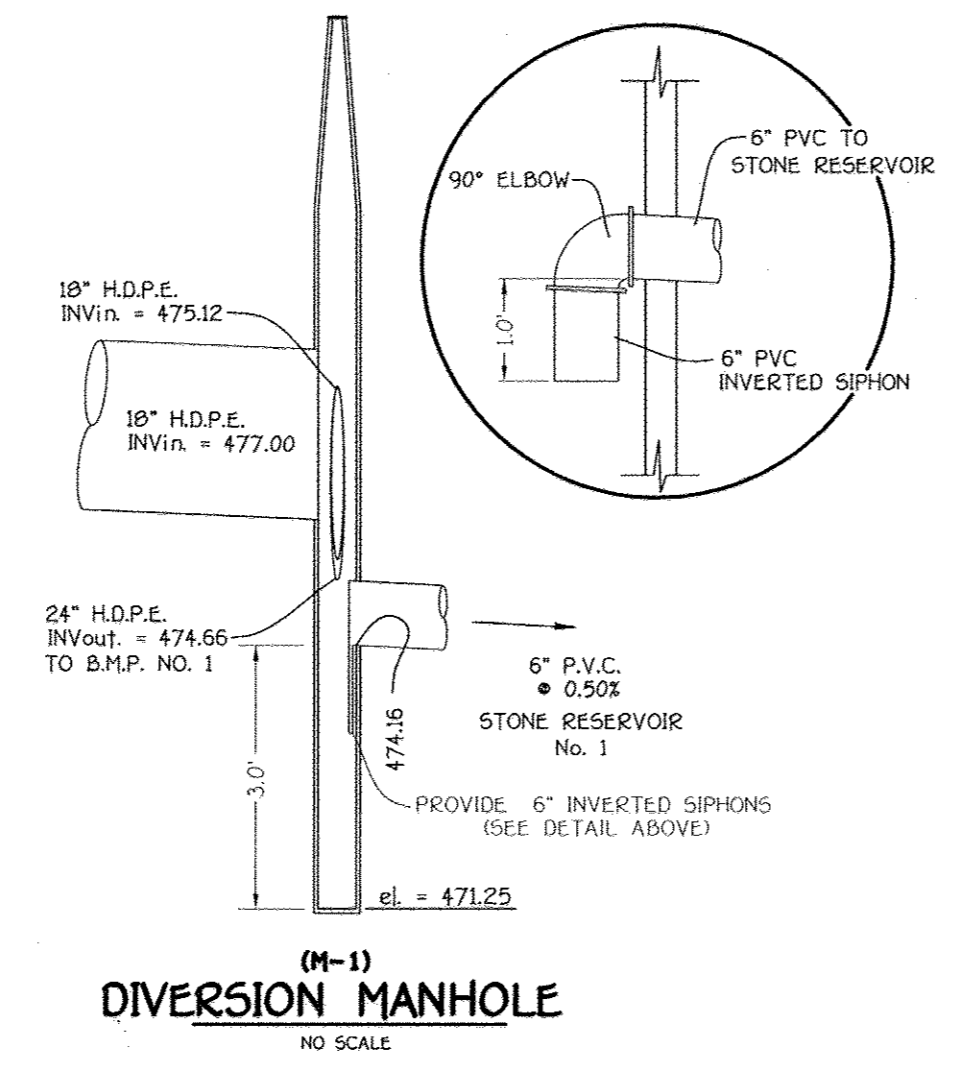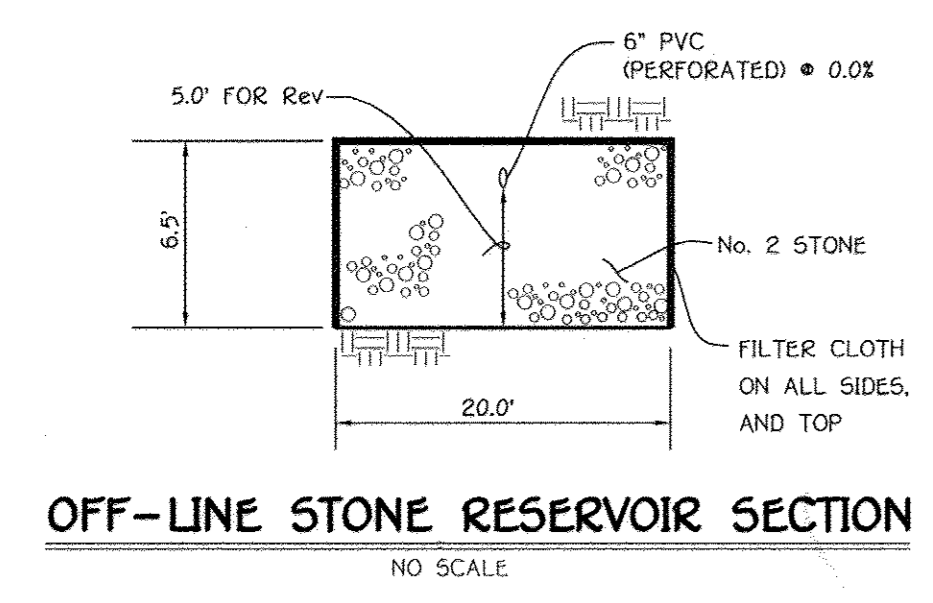


CLEAN-OUT SCHEDULE					
STRUCTURE NO.	TOP ELEVATION	INVERT	LOCATION		REMARKS
			NORTH	EAST	
C.O.-1	473.30	470.11	N 579,903.37	E 1,302,189.85	SEE DETAIL THIS SHEET
C.O.-2	474.40	470.11	N 579,870.47	E 1,302,151.61	SEE DETAIL THIS SHEET
C.O.-3	479.0	471.77	N 579,790.26	E 1,302,114.86	SEE DETAIL THIS SHEET
C.O.-4	483.0	473.53	N 579,682.20	E 1,302,143.08	SEE DETAIL THIS SHEET

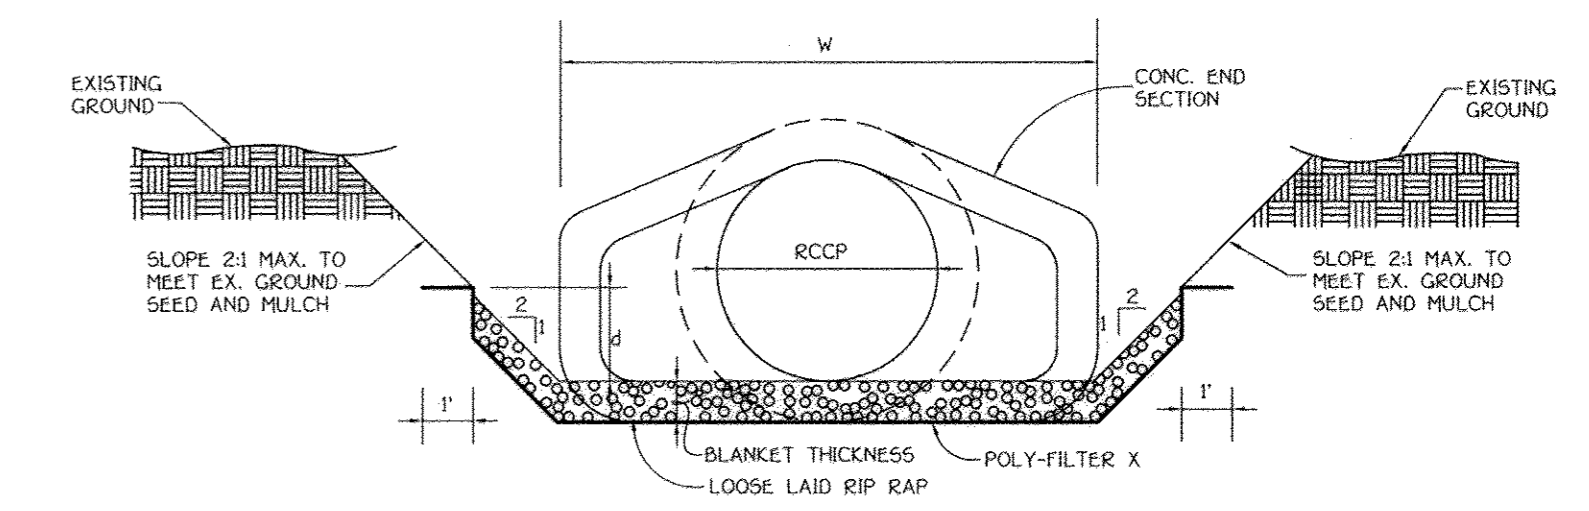

RIP-RAP CHANNEL DESIGN DATA													
STRUCTURE	AREA	WETTED PERIMETER	R	R 2/3	S	S 1/2	W	d	N	V10 (f.p.s.)	Q10 (c.f.s.)	RIIP-RAP SIZE D ₅₀ D _{max}	BLANKET THICKNESS
S-1	6.48	10.40	0.6231	0.7284	0.0050	0.0707	7.0'	0.76'	0.04	1.92	12.39	9.5" 15"	19"
S-2	11.22	12.92	0.8684	0.9098	0.0050	0.0707	8.0'	1.10'	0.04	* 2.39	* 26.8	9.5" 15"	19"

* - DENOTES 100-YEAR Q DESIGN

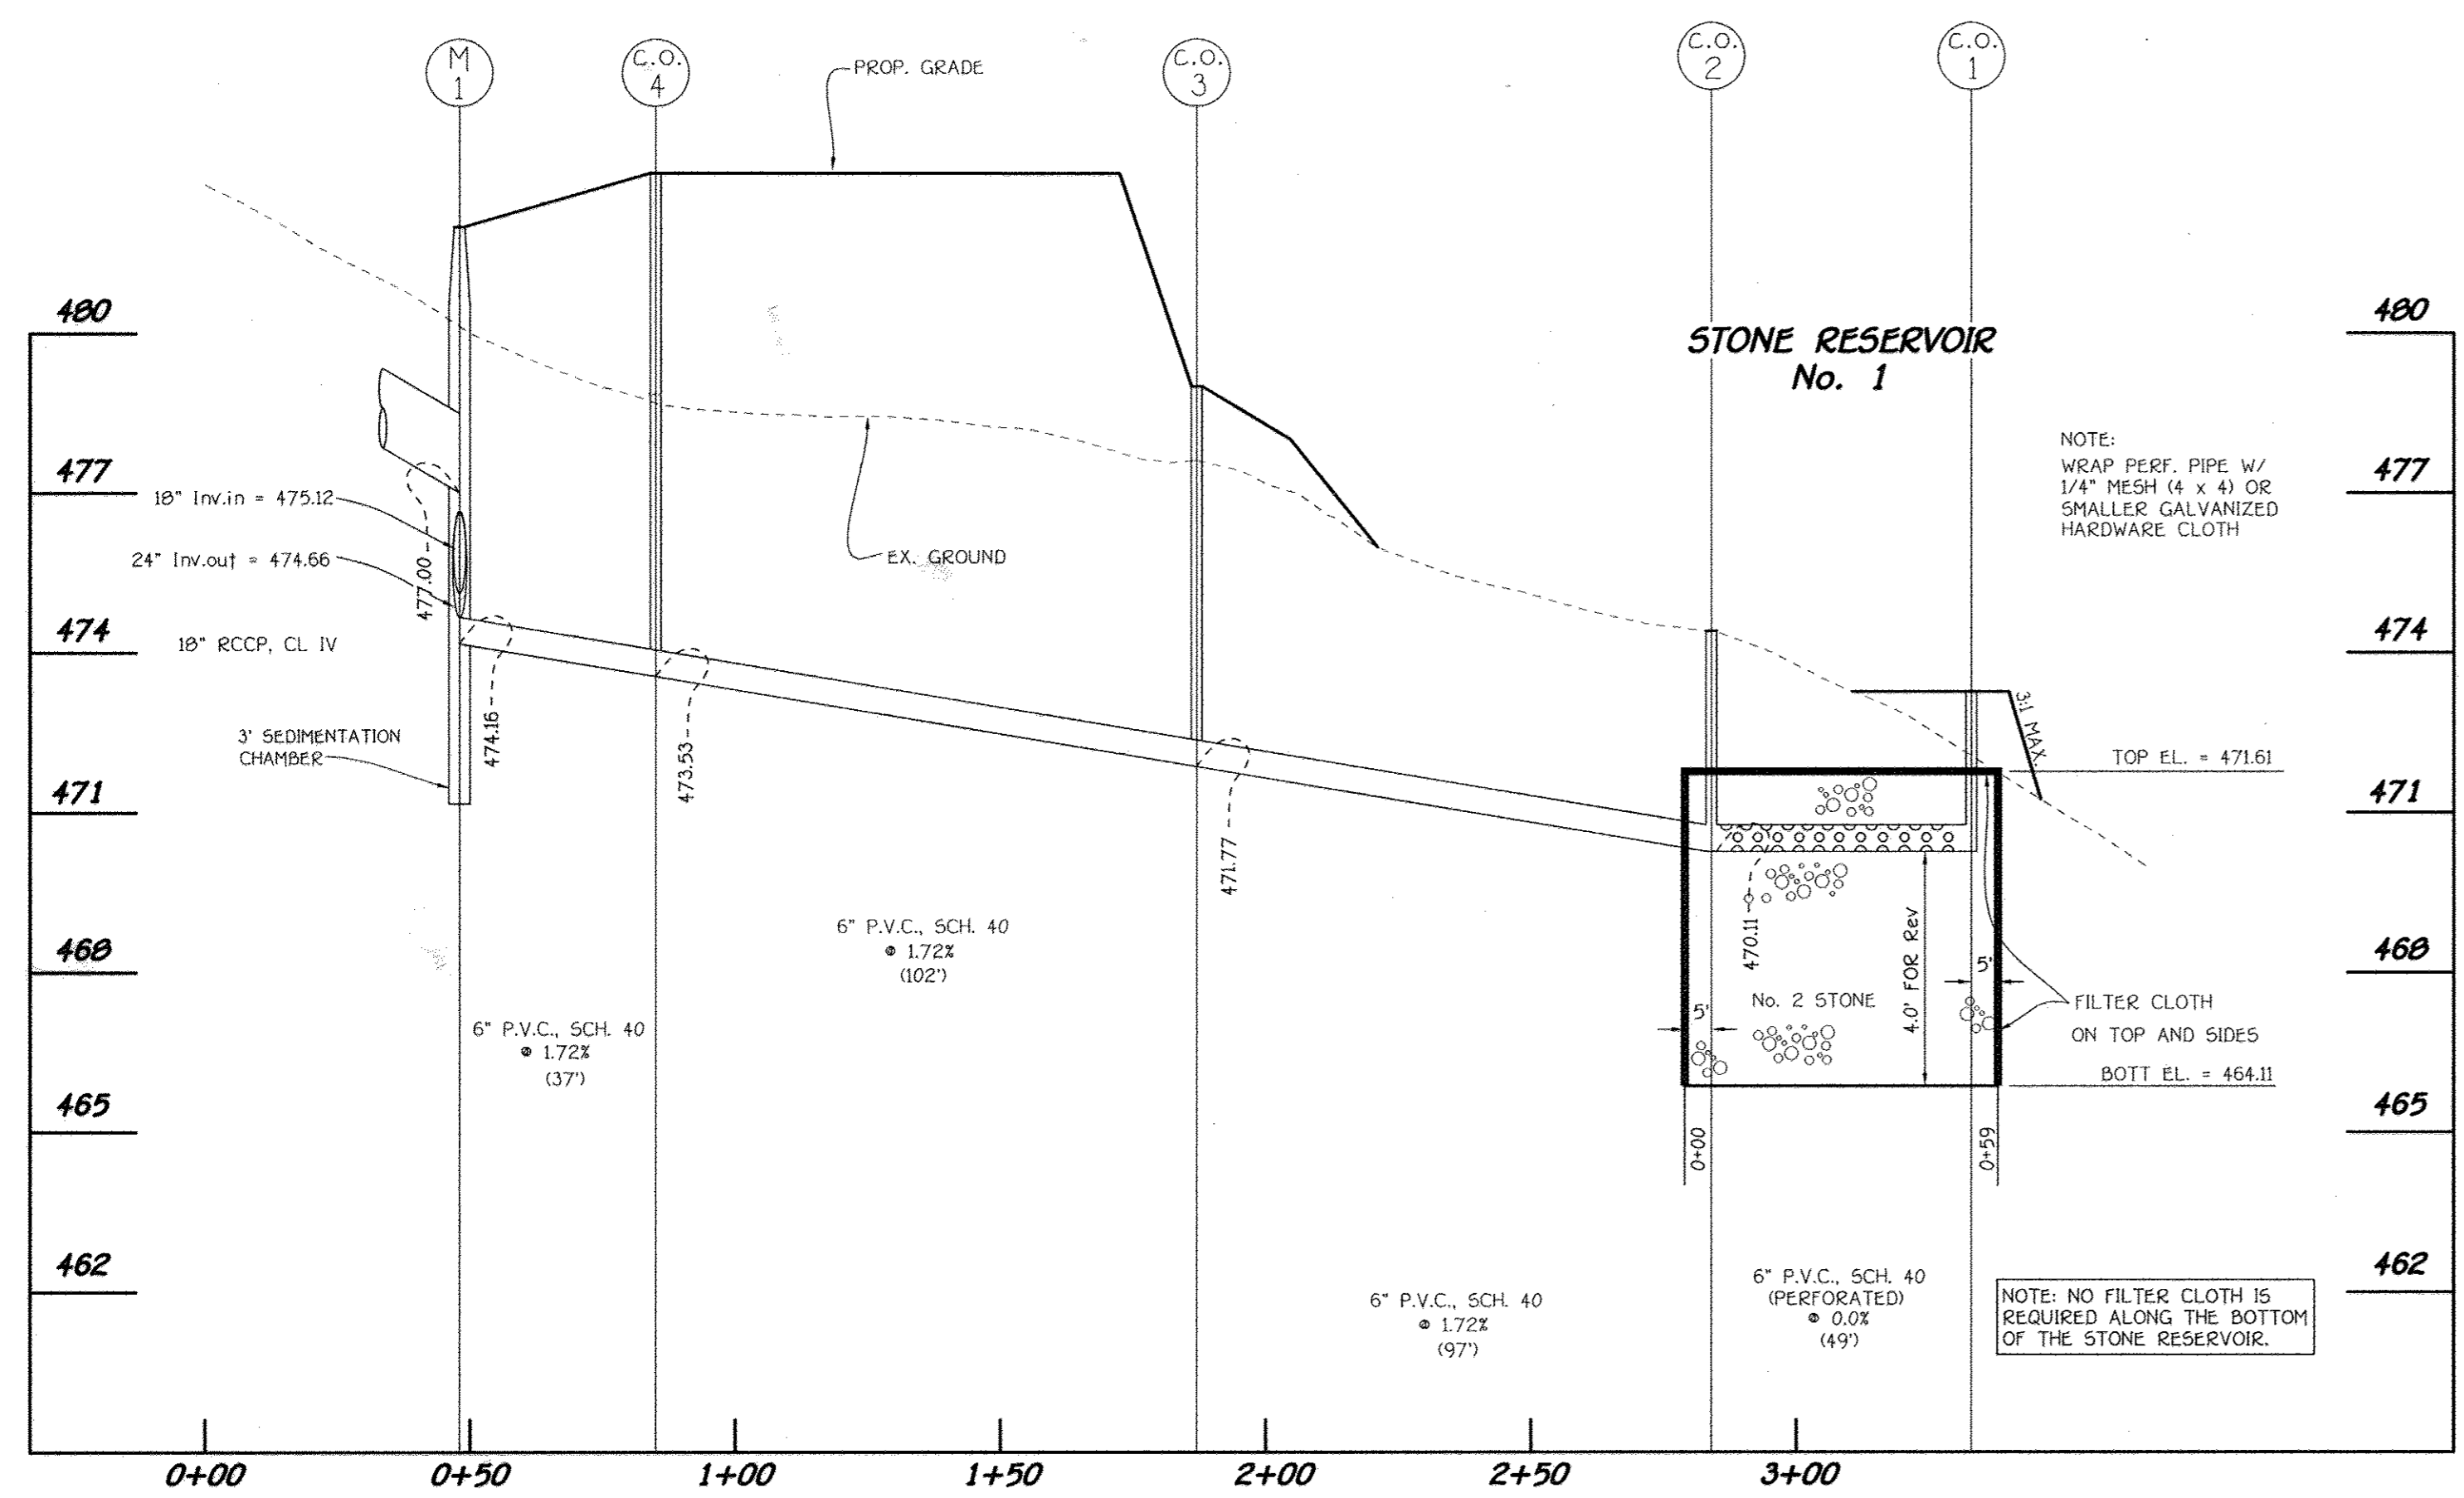

OFF-LINE STONE RESERVOIRS FOR Rev REQUIREMENT
 SCALE: HOR. : 1" = 30'
 VER. : 1" = 5'

CONSTRUCTION SPECIFICATIONS FOR RIP-RAP OUTFALLS

- The subgrade for the filter, riprap or gabion shall be prepared to the required lines and grades. Any fill required in the subgrade shall be compacted to a density of approximately that of the surrounding undisturbed material.
- The rock or gravel shall conform to the specified grading limits when installed respectively in the riprap or filter.
- Filter cloth shall be protected from punching, cutting or tearing. Any damage other than an occasional small hole shall be repaired by placing another piece of cloth over the damaged part or by completely replacing the cloth. All overlaps whether for repairs or for joining two pieces of cloth shall be a minimum of one foot.
- Stone for the riprap or gabion outlets may be placed by equipment. Both shall be constructed to the full course thickness in one operation and in such a manner as to avoid displacement of underlying materials. The stone for riprap or gabion outlets shall be delivered and placed in a manner that will insure that it is reasonably homogeneous with the smaller stones and spalls filling the voids between the larger stones. Riprap shall be placed in a manner to prevent damage to the filter blanket or filter cloth. Hand placement will be required to the extent necessary to prevent damage to the permanent works.

**STONE RESERVOIR PROFILE & DETAILS
 MERIWETHER FARM
 SECTION TWO
 PHASE ONE
 BUILDABLE LOTS 1 THRU 10, NON-BUILDABLE PRESERVATION
 PARCELS 'C' & 'D' AND BUILDABLE BULK PARCEL 'E'**

FISHER, COLLINS & CARTER, INC.
 CIVIL ENGINEERING CONSULTANTS & LAND SURVEYORS
 CENTENNIAL SQUARE OFFICE PARK - 10272 BALTIMORE NATIONAL PARK
 ELLICOTT CITY, MARYLAND 21042
 (410) 461-2395

NO.	REVISIONS	DATE
1	REVISE OWNER AND DEVELOPER	11/10/11

OWNER
 MERIWETHER FARM II, LLC
 610 SECOND ADDICKER, LLC
 10719 CHASER DRIVE
 SUITE 350
 COLUMBIA, MARYLAND 21044
 PH: (410) 997-7501
 ATTN: MR. ROBERT G. GOODER, JR.

DEVELOPER
 TOLL BROTHERS, INC.
 MARYLAND DIVISION
 7104 COLUMBIA WAREHOUSE DRIVE
 SUITE 830
 COLUMBIA, MARYLAND 21046
 PH: (410) 997-7501
 ATTN: MR. JEFF BRACOU

STATE OF MARYLAND
 ALDO H. VITKUCI, P.E.
 Professional Engineer
 I hereby certify that these documents were prepared by me, and that I am a duly Licensed Professional Engineer under the laws of the State of Maryland, License No. 50748, Expiration Date 2-22-09.

DATE: 12/01/08

TAX MAP No.: 21
 ZONED: RC-DEO
 PARCEL No.: 28 GRID No.: 15, 16, 21 & 22
 FOURTH ELECTION DISTRICT
 HOWARD COUNTY, MARYLAND
 SCALE: AS SHOWN
 DATE: DECEMBER, 2008
 SHEET 15 OF 15