


# ROAD CONSTRUCTION PLANS BONNIE BRANCH WOODS LOTS 1-15 AND OPEN SPACE LOTS 16-22 SECOND ELECTION DISTRICT HOWARD COUNTY, MARYLAND

## SHEET INDEX

COVER SHEET	1
ROAD PLAN AND PROFILES	2
FINAL GRADING AND SEDIMENT CONTROL PLAN	3
SEDIMENT CONTROL NOTES AND DETAILS	4
STORM DRAIN DRAINAGE AREA MAP	5
STORM DRAIN PROFILES	6
SWM END SEDIMENT BASIN PLANS, PROFILES AND DETAILS	7
SWM DETAILS	8
SWM SPECIFICATION AND SOIL BORRINGS	9
LANDSCAPING AND FOREST CONSERVATION PLAN	10
FOREST CONSERVATION NOTES AND DETAILS	11
CULVERT SOIL BORINGS AND PAVEMENT MARKING DETAILS	12
MISCELLANEOUS DETAILS	13
BOTTOMLESS CULVERT DETAILS	14
BOTTOMLESS CULVERT DETAILS	15
BOTTOMLESS CULVERT DETAILS	16
BOTTOMLESS CULVERT DETAILS	17
BOTTOMLESS CULVERT DETAILS	18
BOTTOMLESS CULVERT DETAILS AND SPECIFICATIONS	19
BOTTOMLESS CULVERT DETAILS AND SPECIFICATIONS	20
TITLE SHEET/INDEX (ARCH FOOTING)	21
PLAN PROFILES AND DETAILS (ARCH FOOTING)	22
SPECIFICATIONS (ARCH FOOTING)	23
SPECIFICATIONS CONTINUED (ARCH FOOTING)	24

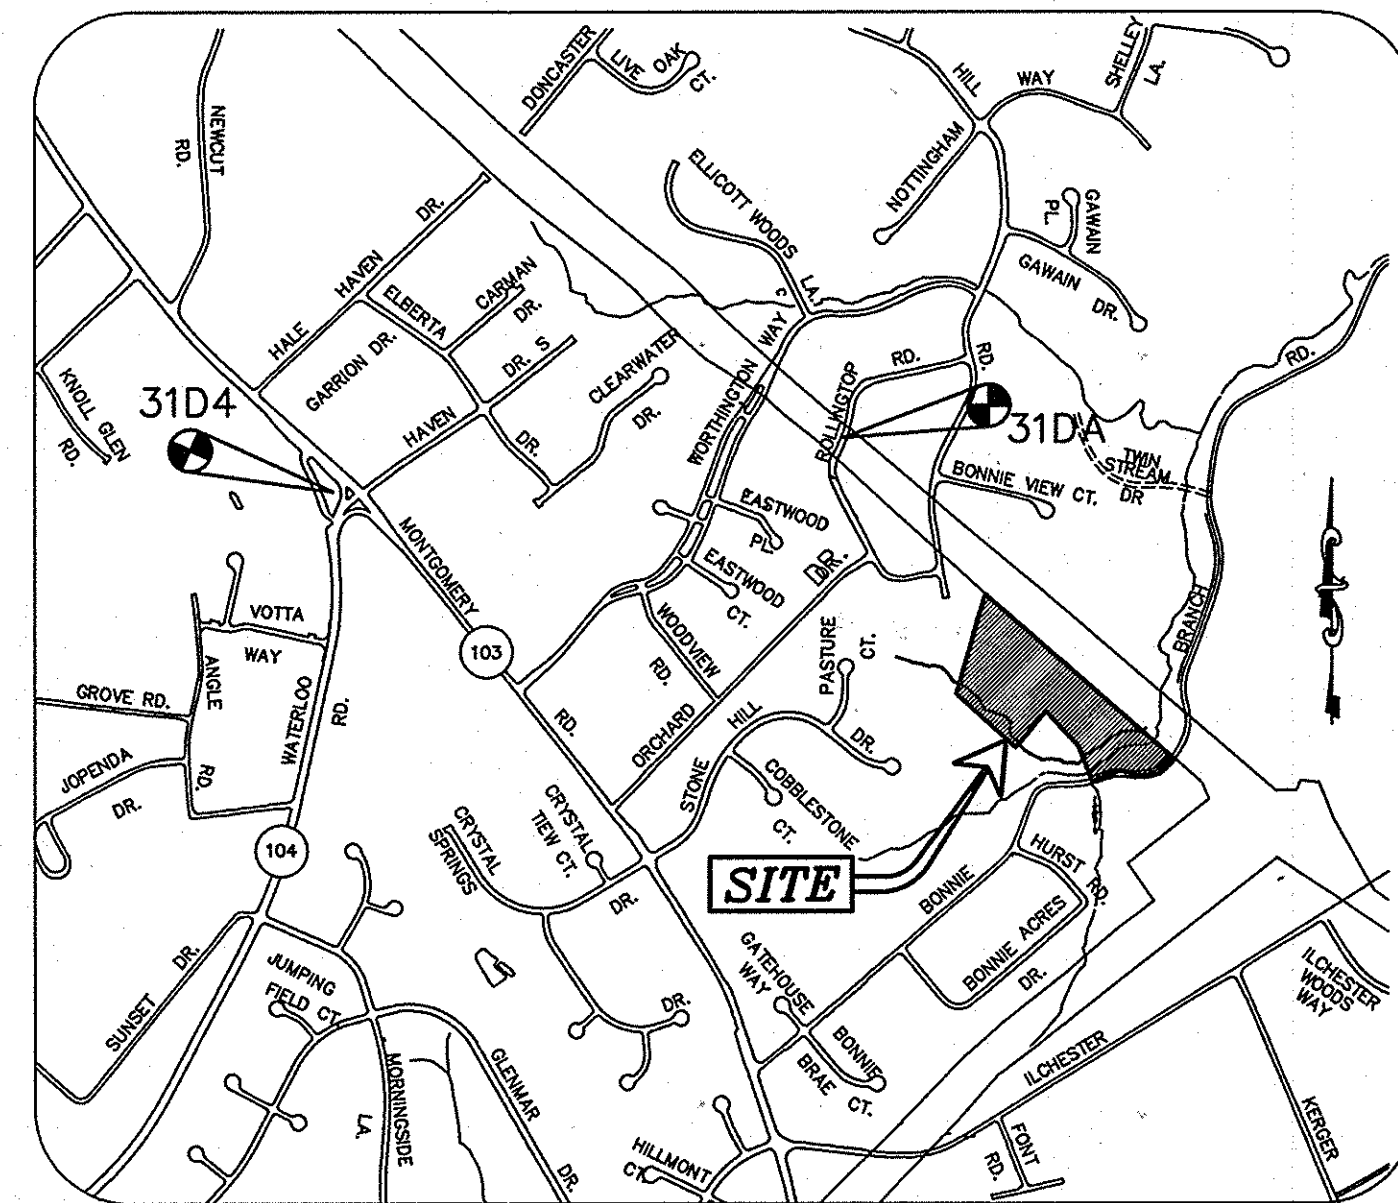

**VICINITY MAP**

SCALE: 1" = 2000'  
ADC MAP 4936 (D4)

### LEGEND

- SLOPES GREATER THAN 25%
- 15% TO 25% SLOPES
- FLOODPLAIN
- WETLANDS
- FOREST CONSERVATION EASEMENT (RETENTION)
- FOREST CONSERVATION (AFFORESTATION)
- EXISTING TREE LINE
- LIMIT OF DISTURBANCE
- SUPER SILT FENCE
- TREE PROTECTION FENCE
- DENOTES FOREST CONSERVATION SIGNAGE
- DENOTES PERIMETER LANDSCAPE EDGE
- DENOTES CURB TRANSITION
- AREA DEDICATED TO HO.CO. FOR PURPOSE OF PUBLIC ROAD
- NON-CREDITED OPEN SPACE
- RECREATIONAL OPEN SPACE
- PUBLIC WATER AND SEWER EASEMENT
- PRIVATE USE-IN-COMMON ACCESS EASEMENT

### GENERAL NOTES:

- ALL CONSTRUCTION SHALL BE IN ACCORDANCE WITH THE LATEST STANDARDS AND SPECIFICATIONS OF HOWARD COUNTY.
- THE CONTRACTOR SHALL NOTIFY THE DEPARTMENT OF PUBLIC WORKS/ BUREAU OF ENGINEERING/ CONSTRUCTION INSPECTION DIVISION AT (410)313-1880 AT LEAST FIVE (5) WORKING DAYS PRIOR TO THE START OF WORK.
- THE CONTRACTOR SHALL NOTIFY "MISS UTILITY" AT 1-800-257-7777 AT LEAST 48 HOURS PRIOR TO ANY EXCAVATION WORK BEING DONE.
- TRAFFIC CONTROL DEVICES, MARKINGS AND SIGNING SHALL BE IN ACCORDANCE WITH THE LATEST EDITION OF THE MANUAL OF UNIFORM TRAFFIC CONTROL DEVICES (MUTCD).
- STREET LIGHT PLACEMENT AND THE TYPE OF FIXTURE AND POLE SHALL BE IN ACCORDANCE WITH THE HOWARD COUNTY DESIGN MANUAL, VOLUME III (2006) SECTION 5.5.A.  
A MINIMUM SPACING OF 20' SHALL BE MAINTAINED BETWEEN ANY STREET LIGHT AND ANY STREET TREE.
- THE STREET LIGHT LOCATIONS AND TYPES OF LIGHTS SHOWN ON SHEETS 2 & 3 ARE AS FOLLOWS:  
- 150-WATT HPS VAPOR PREMIER POST TOP FIXTURE MOUNTED ON A 14-FOOT BLACK FIBERGLASS POLE, STATION 0+24, 20' RIGHT (CORNER OF GOOD MEMORY LANE AND BONNIE BRANCH ROAD).  
- 100-WATT HPS VAPOR "PREMIER" POST TOP FIXTURE ON A 14' BLACK FIBERGLASS POLE AT GOOD MEMORY LANE STATION 2+43, 15' LEFT, STATION 5+90, 21' RIGHT, LP STATION 0+75, 3' BACK.
- THE EXISTING TOPOGRAPHY IS TAKEN FROM AERIAL SURVEY WITH MAXIMUM TWO FOOT CONTOUR INTERVALS PREPARED BY WINGS TOPOGRAPHY INC. DATED JUNE 2008.
- COORDINATES SHOWN HEREON ARE BASED UPON HOWARD COUNTY GEODETIC CONTROL WHICH IS BASED UPON MARYLAND STATE PLANE COORDINATE SYSTEM. HOWARD COUNTY MONUMENT NOS. 31DA AND 31D4 WERE USED FOR THIS PROJECT.  
STA. No. 31D4 N 571,700.693 E 1,369,606.348 ELEV. 494.421  
STA. No. 31DA N 571,982.686 E 1,372,145.055 ELEV. 481.585
- WATER IS PUBLIC. CONTRACT NO. 14-4594-D.
- SEWER IS PUBLIC. CONTRACT NO. 14-4594-D.
- STORMWATER MANAGEMENT IS PROVIDED BY THREE (3) SAND-FILTER FACILITIES, MULTIPLE ON-LOT RAINGARDENS, ONE (1) INFILTRATION TRENCH AND A DRY DETENTION POND IN ACCORDANCE WITH THE 2000 MARYLAND STORMWATER DESIGN MANUAL. DRY DETENTION POND WILL BE JOINTLY MAINTAINED WITH HOWARD COUNTY.
- EXISTING UTILITIES SHOWN HEREON ARE BASED ON AERIAL SURVEY PREPARED BY WINGS INC. TOPOGRAPHY DATED JUNE 2008, AS-BUILT PLANS AND VERIFIED IN THE FIELD.
- THE FLOODPLAIN STUDY FOR THIS PROJECT WAS PREPARED BY MILDENBERG, BOENDER AND ASSOCIATES, INC. DATED, AUGUST 2008.
- FOREST STAND AND WETLANDS DELINEATION PREPARED BY HILLIS-CARNES ENGINEERING ASSOCIATES, INC. DATED JUNE 2008, UPDATED ON DECEMBER 2008.
- APFO ROAD TEST PREPARED BY TRAFFIC GROUP, DATED NOVEMBER 2008, AND APPROVED ON MAY 18, 2009, UNDER SP-09-002.
- PROJECT BACKGROUND:**  
TAX MAP : 31 PARCEL : 101 ; GRID: 9 AND 15.  
ELECTION DISTRICT : SECOND  
ZONING : R-20  
DEED REFERENCE : 6911/243  
ADDRESS : 5036 BONNIE BRANCH RD., ELLICOTT CITY, MD 21043
- AREA TABULATION**  
GROSS AREA OF PROPERTY TRACT: 9.88 AC±  
AREA OF FLOODPLAIN: 0.88 AC±  
NUMBER OF BUILDABLE LOTS PROPOSED: 15 LOTS  
MINIMUM LOT AREA ALLOWED: 12,000 S.F.  
AREA OF PROPOSED LOTS: 4.22 AC±  
AREA OF NON-CREDITED OPEN SPACE PROVIDED: 4.0% = 3.95 AC±  
AREA OF OPEN SPACE PROVIDED: 4.11 AC±  
AREA OF CREDITED OPEN SPACE PROVIDED: 4.04 AC± (41.2%)  
AREA OF NON-CREDITED OPEN SPACE PROVIDED: 0.07 AC±  
AREA OF REC. OPEN SPACE PROVIDED: 200 SQ.FT./LOT = 3,000 SQ.FT.  
AREA OF REC. OPEN SPACE PROVIDED: 4,500 SQ.FT.  
AREA OF PUBLIC ROAD DEDICATION: 11,237 SQ.FT. (0.26 AC±)  
AREA OF PUBLIC ROAD ROW: 96,192 SQ.FT. (1.29 AC±)
- NO HISTORIC STRUCTURES, CEMETERIES, OR GRAVE SITES EXIST ON-SITE. SITE IS ADJACENT TO A DESIGNATED SCENIC ROAD.
- SOIL DELINEATION IS BASED ON HOWARD COUNTY SOIL SURVEY MAP, PAGE 23.
- THE FOREST CONSERVATION OBLIGATIONS PER SECTION 16.1202 OF THE HOWARD COUNTY CODE AND FOREST CONSERVATION ACT FOR THIS SUBDIVISION HAVE BEEN FULFILLED BY PROVIDING RETENTION OF 2.08 ACRES OF FOREST, AFFORESTATION OF 0.42 ACRES AND FEE-IN-LIEU OF 0.40 ACRES.  
FINANCIAL SURETY FOR THE ON-SITE RETENTION FOR THE AMOUNT OF \$18,121.00, AND AFFORESTATION FOR THE AMOUNT OF \$9,148.00, FOR A TOTAL OF \$27,269.00 WILL BE POSTED AS PART OF DEVELOPERS AGREEMENT.  
0.40 ACRES OF REQUIRED FOREST CONSERVATION WILL BE ADDRESSED VIA FEE-IN-LIEU IN THE AMOUNT OF \$13,068.00
- ALL EXISTING STRUCTURES ARE TO BE REMOVED UNLESS OTHERWISE NOTED.
- AGE OF THE EXISTING STRUCTURES ARE ESTIMATED.
- THIS PLAN HAS BEEN PREPARED IN ACCORDANCE WITH THE PROVISIONS OF SECTION 16.124 OF THE HOWARD COUNTY CODE AND THE LANDSCAPE MANUAL.
- FINANCIAL SURETY FOR THE REQUIRED LANDSCAPING IS TO BE POSTED FOR 44 SHADE AND 29 EVERGREEN TREES IN THE AMOUNT OF \$17,550.00 AS PART OF THE DPW DEVELOPERS AGREEMENT.
- DUE TO EXTENSIVE ENVIRONMENTAL FEATURES AND ASSOCIATED REQUIRED BUFFERS, FUTURE SUBDIVISION OF PARCEL 102 WOULD BE NON-EXISTENT OR EXTREMELY LIMITED AND ACCESS TO THE PARCEL THROUGH THE PROPOSED PETERSON PROPERTY SUBDIVISION IS NOT REQUIRED.
- SUBJECT PROPERTY IS ZONED R-20 PER THE 2/2/04 COMPREHENSIVE ZONING PLAN AND PER THE COMP LITE ZONING REGULATION AMENDMENTS EFFECTIVE 7/28/06.
- DRIVEWAYS SHALL BE PROVIDED PRIOR TO RESIDENTIAL OCCUPANCY TO ENSURE SAFE ACCESS FOR FIRE AND EMERGENCY VEHICLES PER THE FOLLOWING MINIMUM REQUIREMENTS:  
A) WIDTH - 12 FEET (16 FEET SERVING MORE THAN ONE RESIDENT).  
B) SURFACE - 6 INCHES OF COMPACTED CRUSHER RUN BASE WITH TAR AND CHIP COATING (1.5" MIN).  
C) GEOMETRY - MAX. 14% GRADE, MAX. 10% GRADE CHANGE AND MIN. OF 45 FOOT TURNING RADIUS.  
D) STRUCTURES (CULVERTS/BRIDGES) - CAPABLE OF SUPPORTING 25 GROSS TONS (H25 LOADING).  
E) DRAINAGE ELEMENTS - CAPABLE OF SAFELY PASSING 100 YEAR FLOOD PLAIN WITH NO MORE THAN 1 FOOT OF DEPTH OVER DRIVEWAY SURFACE.  
F) STRUCTURE CLEARANCES - MINIMUM 12 INCHES  
G) MAINTENANCE - SUFFICIENT TO ENSURE ALL WEATHER USE.
- NO GRADING, REMOVAL OF VEGETATIVE COVER OF TREES, PAVING AND NEW STRUCTURES SHALL BE PERMITTED WITHIN LIMITS OF WETLANDS, STREAMS OR THEIR REQUIRED BUFFERS, FLOODPLAIN AND FOREST CONSERVATION EASEMENT AREAS, EXCEPT AS DETERMINED TO BE NECESSARY DISTURBANCE.
- FOR FLAG OR PIPE STEM LOTS, REFUSE COLLECTION, SNOW REMOVAL AND ROAD MAINTENANCE ARE PROVIDED TO THE JUNCTION OF THE FLAG OR PIPE STEM AND THE ROAD RIGHT OF WAY LINE AND NOT ONTO THE FLAG OR PIPE STEM LOT DRIVEWAY.
- ROAD CONSTRUCTION, STORMWATER MANAGEMENT OUTFALL AND LOCATIONS OF WATER AND SEWER MAINS HAVE BEEN DETERMINED AS NECESSARY DISTURBANCE, AND HAVE BEEN APPROVED UNDER SP-09-002.
- FOREST CONSERVATION EASEMENT AREA MUST BE DEVOID OF TRASH, DEBRIS, STRUCTURES, FENCING, ETC. IT IS DEVELOPERS RESPONSIBILITY TO KEEP FCE AREA CLEAN OF DEBRIS AND ENCROACHMENT FOR 2 YEAR MAINTENANCE PERIOD.
- USE HOWARD COUNTY STANDARD R-3.01 MODIFIED CURB AND GUTTER, UNLESS OTHERWISE NOTED.
- ALL SIGN POSTS USED FOR TRAFFIC CONTROL SIGNS INSTALLED IN THE COUNTY RIGHT-OF-WAY SHALL BE MOUNTED ON A 2" GALVANIZED STEEL PERFORATED, SQUARE TUBE POST (14 GAUGE), INSERTED INTO A 2-1/2" GALVANIZED STEEL PERFORATED SQUARE TUBE SLEEVE (12 GAUGE) - 3' LONG. A GALVANIZED STEEL POLE CAP SHALL BE MOUNTED ON TOP OF EACH POST.
- THE TRAFFIC CONTROL SIGN LOCATIONS AND TYPES SHOWN ARE AS FOLLOWS:  
- R1-1 "STOP" SIGN AT STA. 0+40, LEFT  
- R2-1 "SPEED LIMIT" SIGN AT STA. 1+25, RIGHT  
- W3-1 "STOP AHEAD" WARNING SIGN AT STA. 3+30, LEFT
- MDE PERMIT TRACKING #: 200863162.
- ENTIRE OPEN SPACE LOT 21 IS SUBJECT TO PUBLIC SWM & UTILITY EASEMENT.

BY THE DEVELOPER:  
I, THE DEVELOPER, CERTIFY THAT ALL DEVELOPMENT AND/OR CONSTRUCTION WILL BE DONE ACCORDING TO THESE PLANS, AND THAT ANY RESPONSIBLE PERSONNEL INVOLVED IN THE CONSTRUCTION PROJECT WILL HAVE A CERTIFICATE OF ATTENDANCE AT A DEPARTMENT OF THE ENVIRONMENT APPROVED TRAINING PROGRAM FOR THE CONTROL OF SEDIMENT AND EROSION BEFORE BEGINNING THE PROJECT. I SHALL ENGAGE A REGISTERED PROFESSIONAL ENGINEER TO SUPERVISE POND CONSTRUCTION AND PROVIDE THE HOWARD SOIL CONSERVATION DISTRICT WITH AN "AS-BUILT" PLAN OF THE POND WITHIN 30 DAYS OF COMPLETION. I ALSO AUTHORIZE PERIODIC ON-SITE INSPECTIONS BY THE HOWARD SOIL CONSERVATION DISTRICT.

*John Douglas Cashmere* 5/16/10  
SIGNATURE OF DEVELOPER DATE  
JOHN DOUGLAS CASHMERE  
PRINTED NAME OF DEVELOPER

BY THE ENGINEER:  
I CERTIFY THAT THIS PLAN FOR POND CONSTRUCTION, EROSION AND SEDIMENT CONTROL REPRESENTS A PRACTICAL AND WORKABLE PLAN BASED ON MY PERSONAL KNOWLEDGE OF THE SITE CONDITIONS. THIS PLAN WAS PREPARED IN ACCORDANCE WITH THE REQUIREMENTS OF THE HOWARD SOIL CONSERVATION DISTRICT. I HAVE NOTIFIED THE DEVELOPER THAT HE/SHE MUST ENGAGE A REGISTERED PROFESSIONAL ENGINEER TO SUPERVISE POND CONSTRUCTION AND PROVIDE THE HOWARD SOIL CONSERVATION DISTRICT WITH AN "AS-BUILT" PLAN OF THE POND WITHIN 30 DAYS OF COMPLETION.

*R. Jacob Hymat* 5/16/10  
SIGNATURE OF ENGINEER DATE  
R. JACOB HYMAT  
PRINTED NAME OF ENGINEER

THIS DEVELOPMENT PLAN IS APPROVED FOR SOIL EROSION AND SEDIMENT CONTROL BY THE HOWARD SOIL CONSERVATION DISTRICT.

*Howard Soil Conservation District* 5/19/10  
HOWARD SOIL CONSERVATION DISTRICT DATE

APPROVED: DEPARTMENT OF PUBLIC WORKS

*Chief Bureau of Planning* 6-11-10  
CHIEF BUREAU OF PLANNING DATE

APPROVED: DEPARTMENT OF PLANNING AND ZONING


*Chief, Division of Land Development* 6/22/10  
CHIEF, DIVISION OF LAND DEVELOPMENT DATE

*Chief, Development Engineering Division* 6/22/10  
CHIEF, DEVELOPMENT ENGINEERING DIVISION DATE

I HEREBY CERTIFY THAT THESE DOCUMENTS WERE PREPARED OR APPROVED BY ME AND THAT I AM A DULY LICENSED PROFESSIONAL ENGINEER UNDER THE LAWS OF THE STATE OF MARYLAND, LICENSE NO. 17942, EXP DATE 9/3/10.



I hereby certify that the facility shown on this plan was constructed as shown on the "As-Built" plans and meets with the approved plans and specifications.

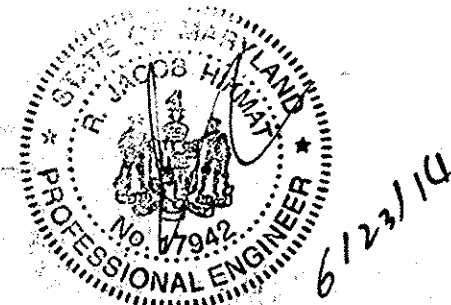

date	MAY 2010	engineering	MMM	approval	RIH
project	08-007	illustration	MMM	scale	1" = 50'

AS-BUILT

**BONNIE BRANCH WOODS**

TAX MAP: 31 PARCEL: 101 HOWARD COUNTY, MARYLAND

SECOND ELECTION DISTRICT COVER SHEET

**MILDENBERG, BOENDER & ASSOC., INC.**

Engineers Planners Surveyors

6800 Deeptrap Road, Suite 150, Elkridge, Maryland 21075  
(410) 997-0298 Fax: (410) 997-0298


**OWNER/DEVELOPER**

BONNIE BRANCH WOODS INC.  
C/O MILDENBERG, BOENDER AND ASSOC., INC.  
6800 DEERTRAP ROAD, SUITE 150  
ELKRIDGE, MARYLAND 21075  
410-997-0296

1 of 24

F-10-042









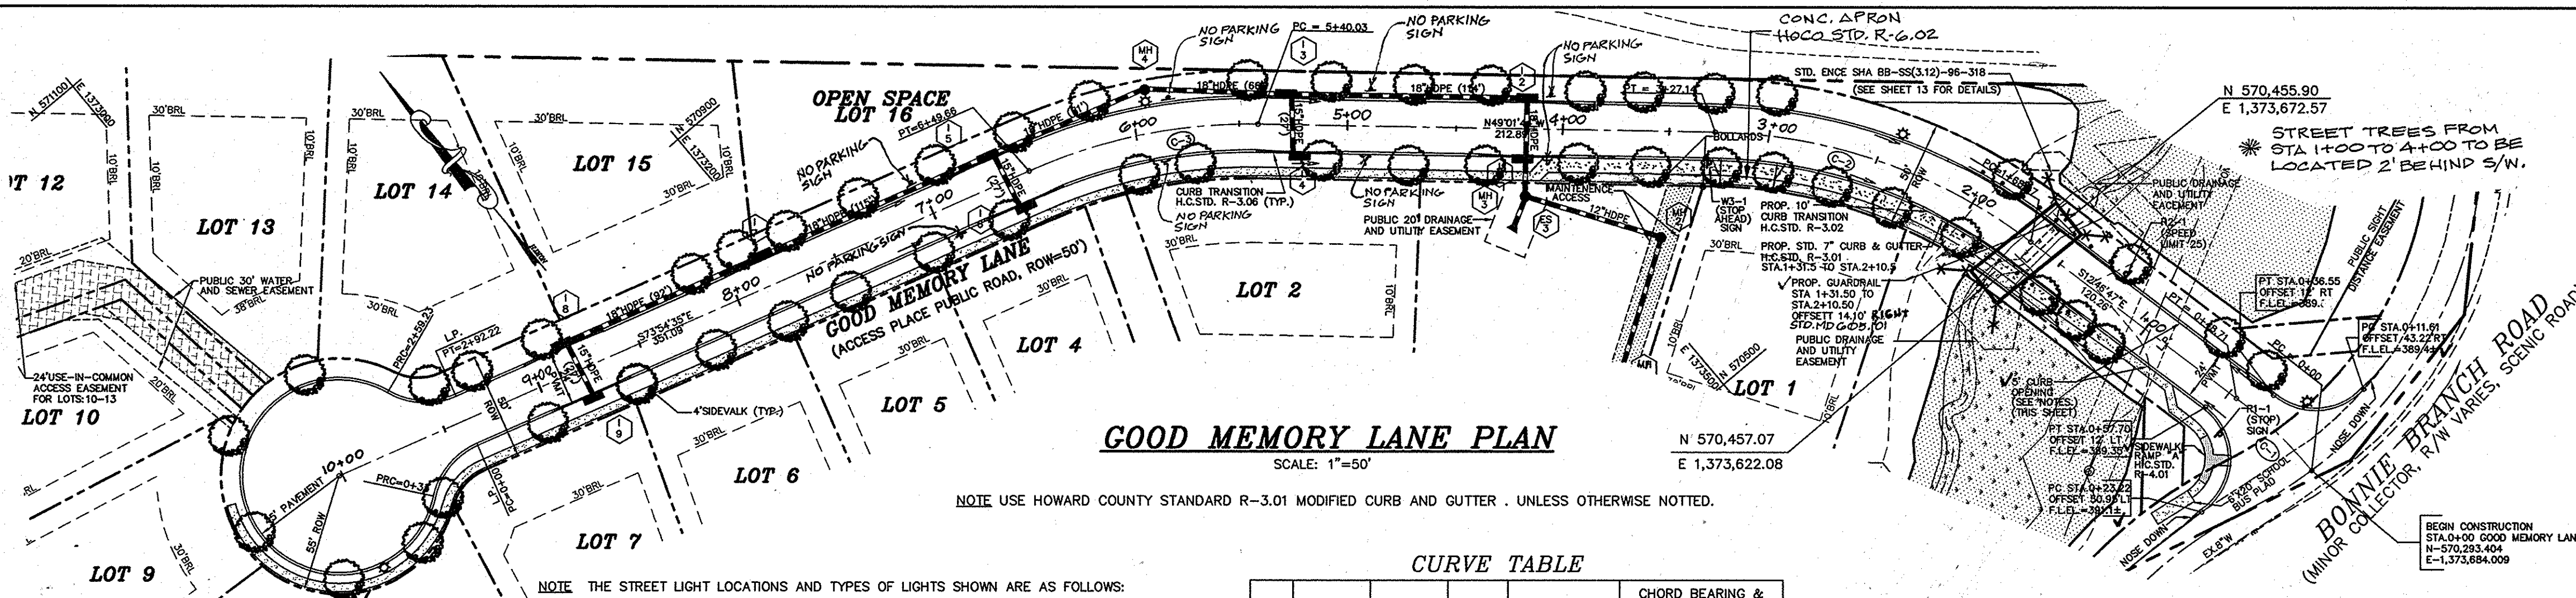


**CURVE TABLE**

CURVE	RADIUS	LENGTH	TANGENT	DELTA	CHORD BEARING & DISTANCE
C1	210.00	48.71	24.47	131°28'	N06°08'03"W 48.61
C2	250.00	158.17	81.83	36°14'57"	N30°54'19"W 155.45
C3	250.00	109.63	55.71	25°07'28"	N61°35'28"W 108.75

NOTE: THE TRAFFIC CONTROL SIGN LOCATIONS AND TYPES SHOWN ARE AS FOLLOWS:  
 - R-1 "STOP" SIGN AT STA. 0+40, LEFT  
 - R-2 "SPEED LIMIT" SIGN AT STA. 1+25, RIGHT  
 - W-3 "STOP AHEAD" WARNING SIGN AT STA. 3+30, LEFT

NOTE: NO TREES SHALL BE PLANTED FROM STOP SIGN LOCATION (STA.0+44, LT) TO STA. 0+84, LT.

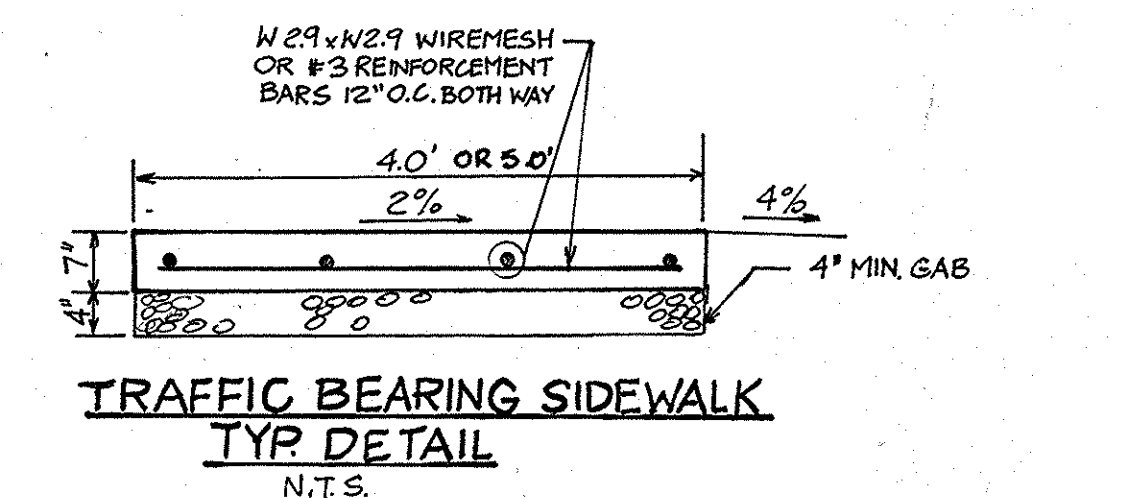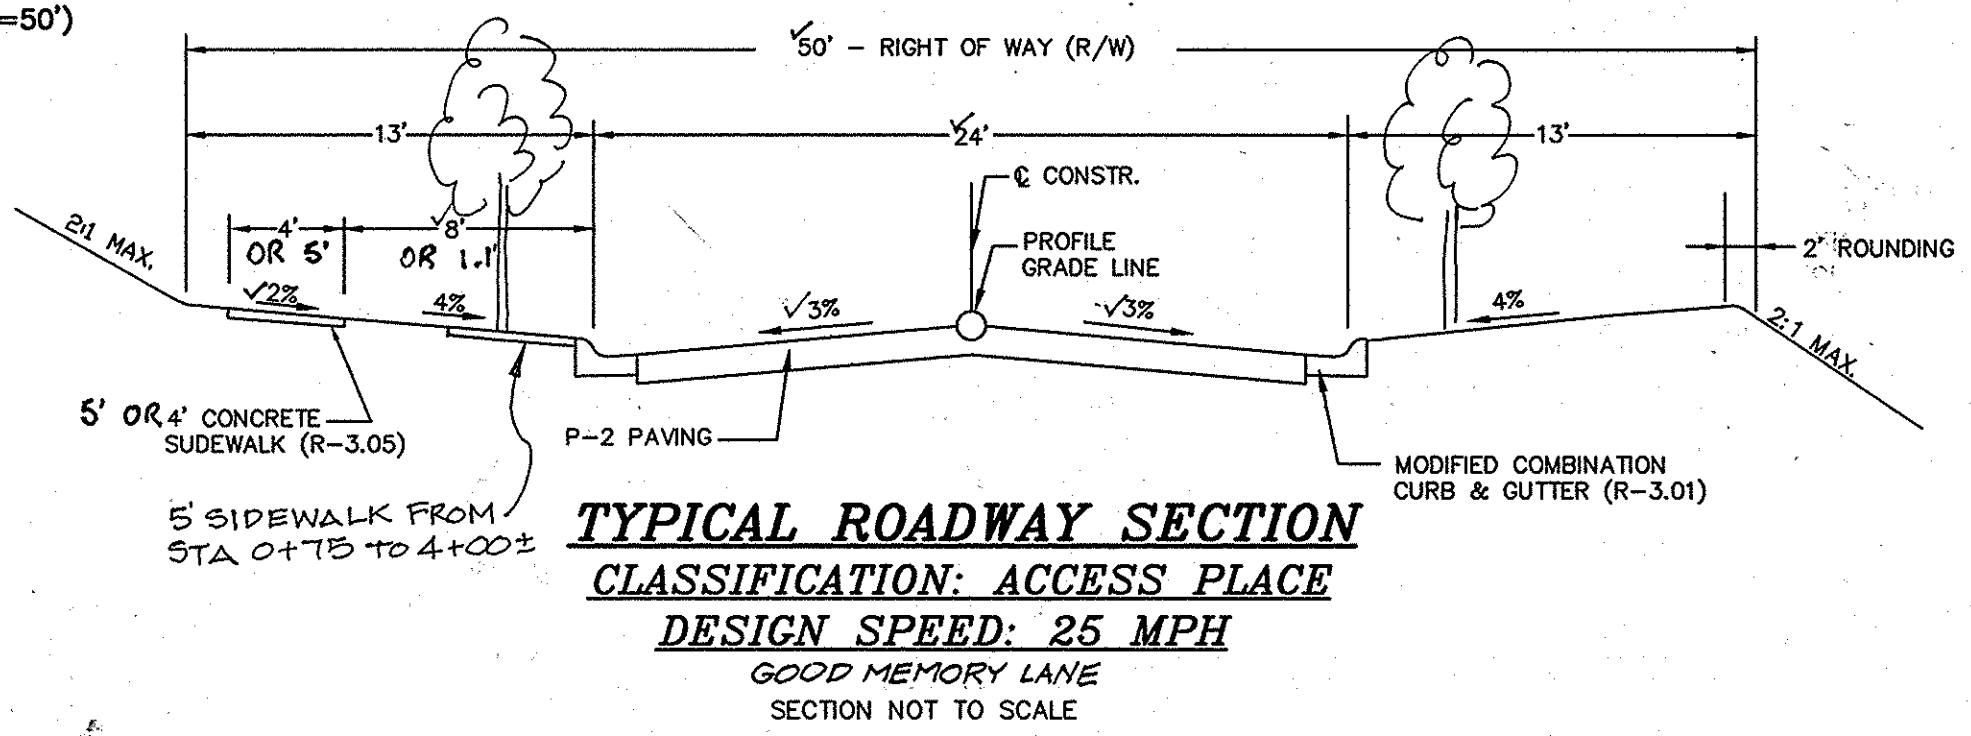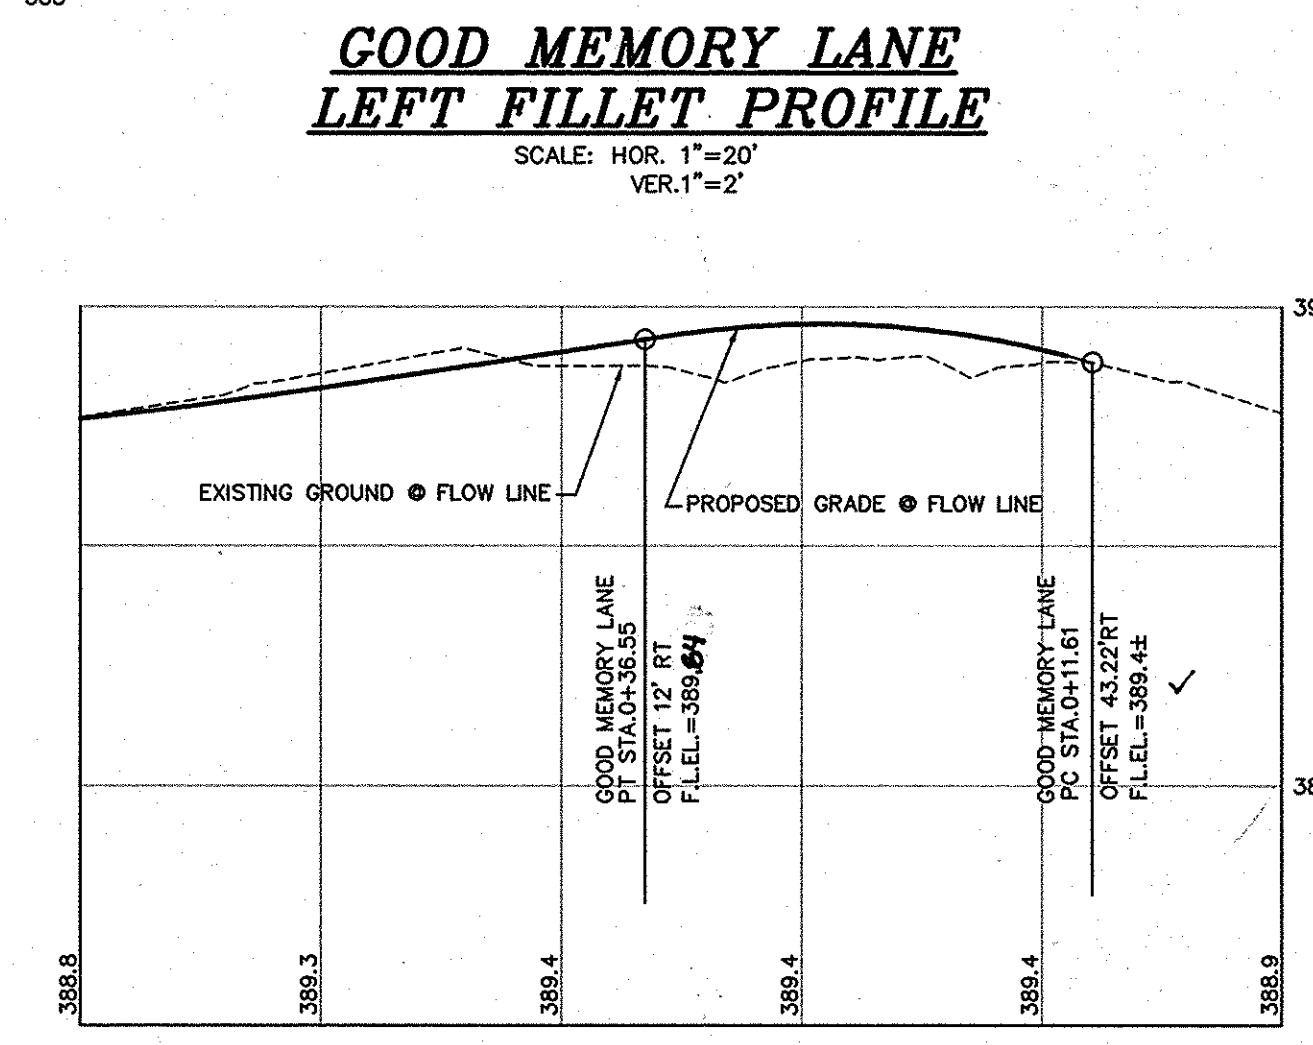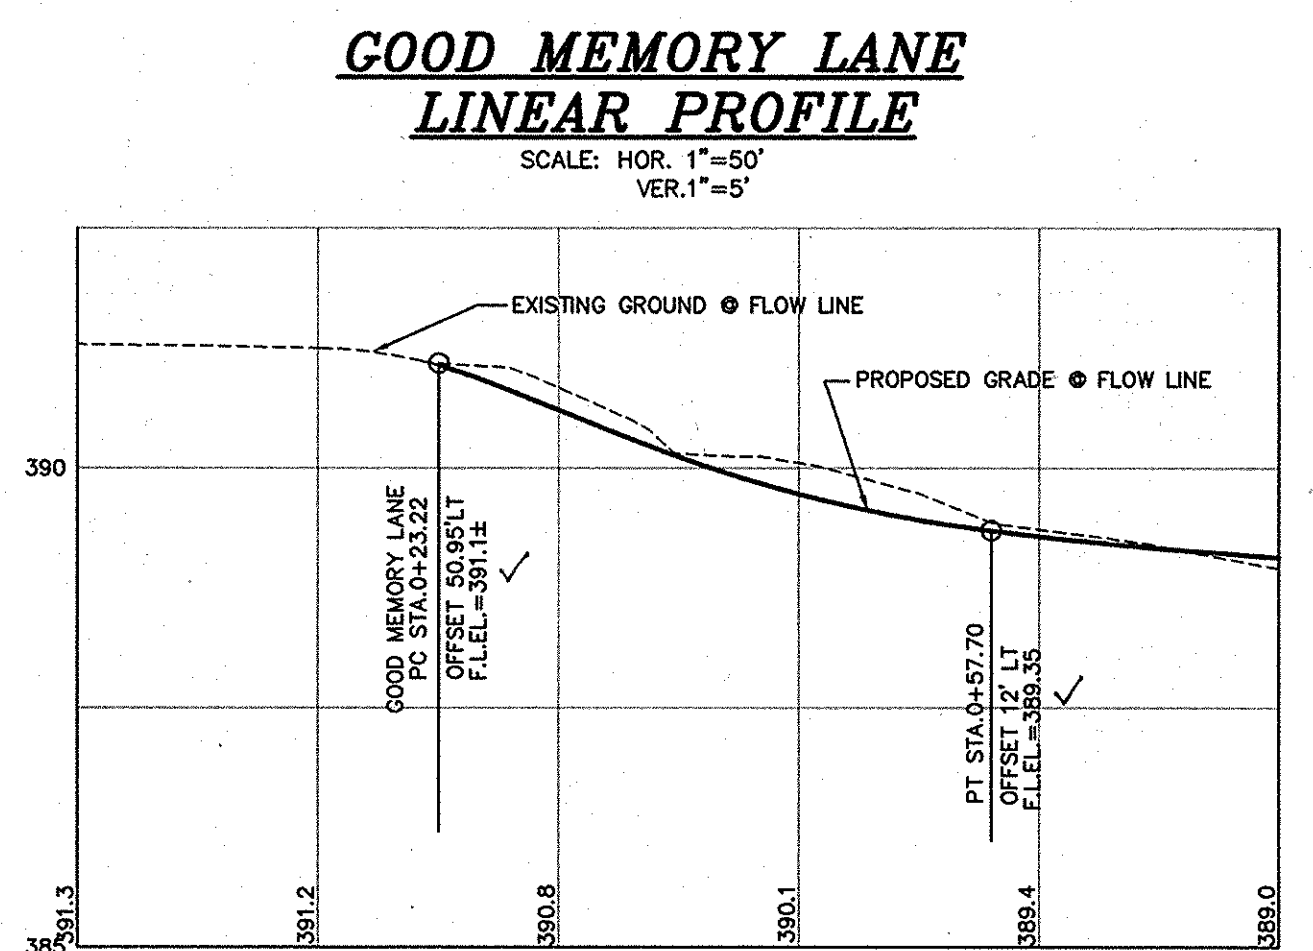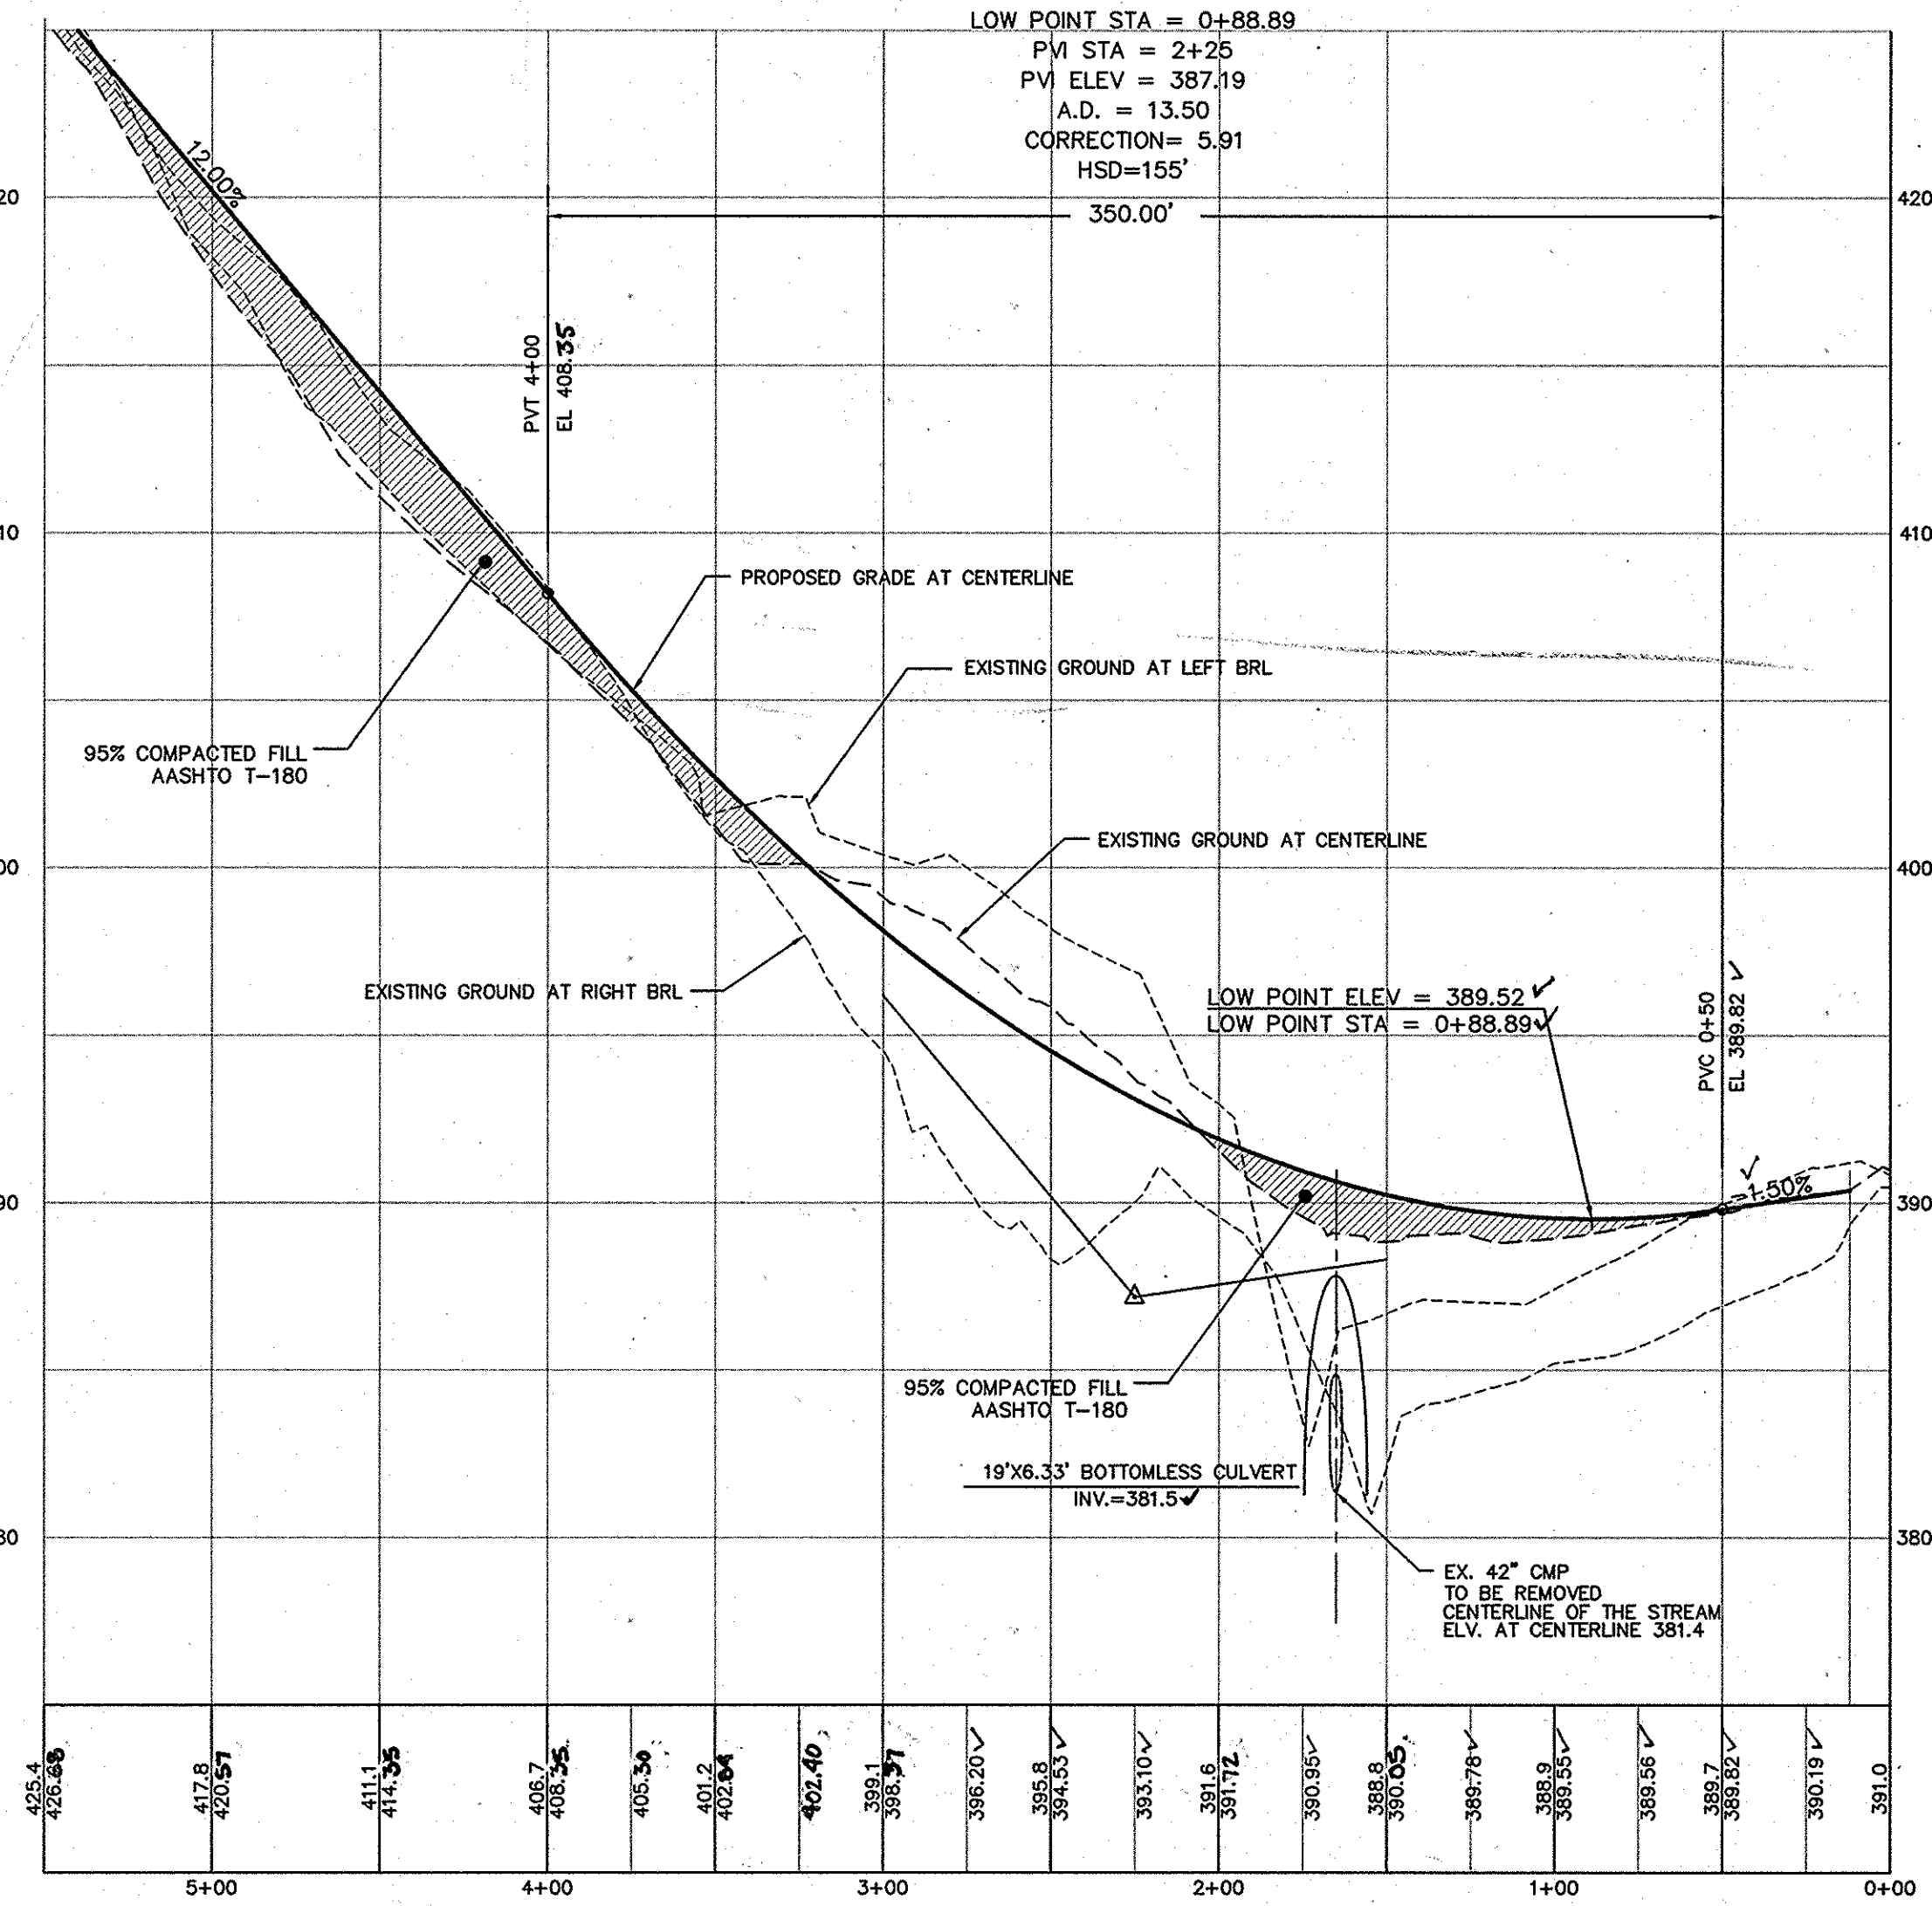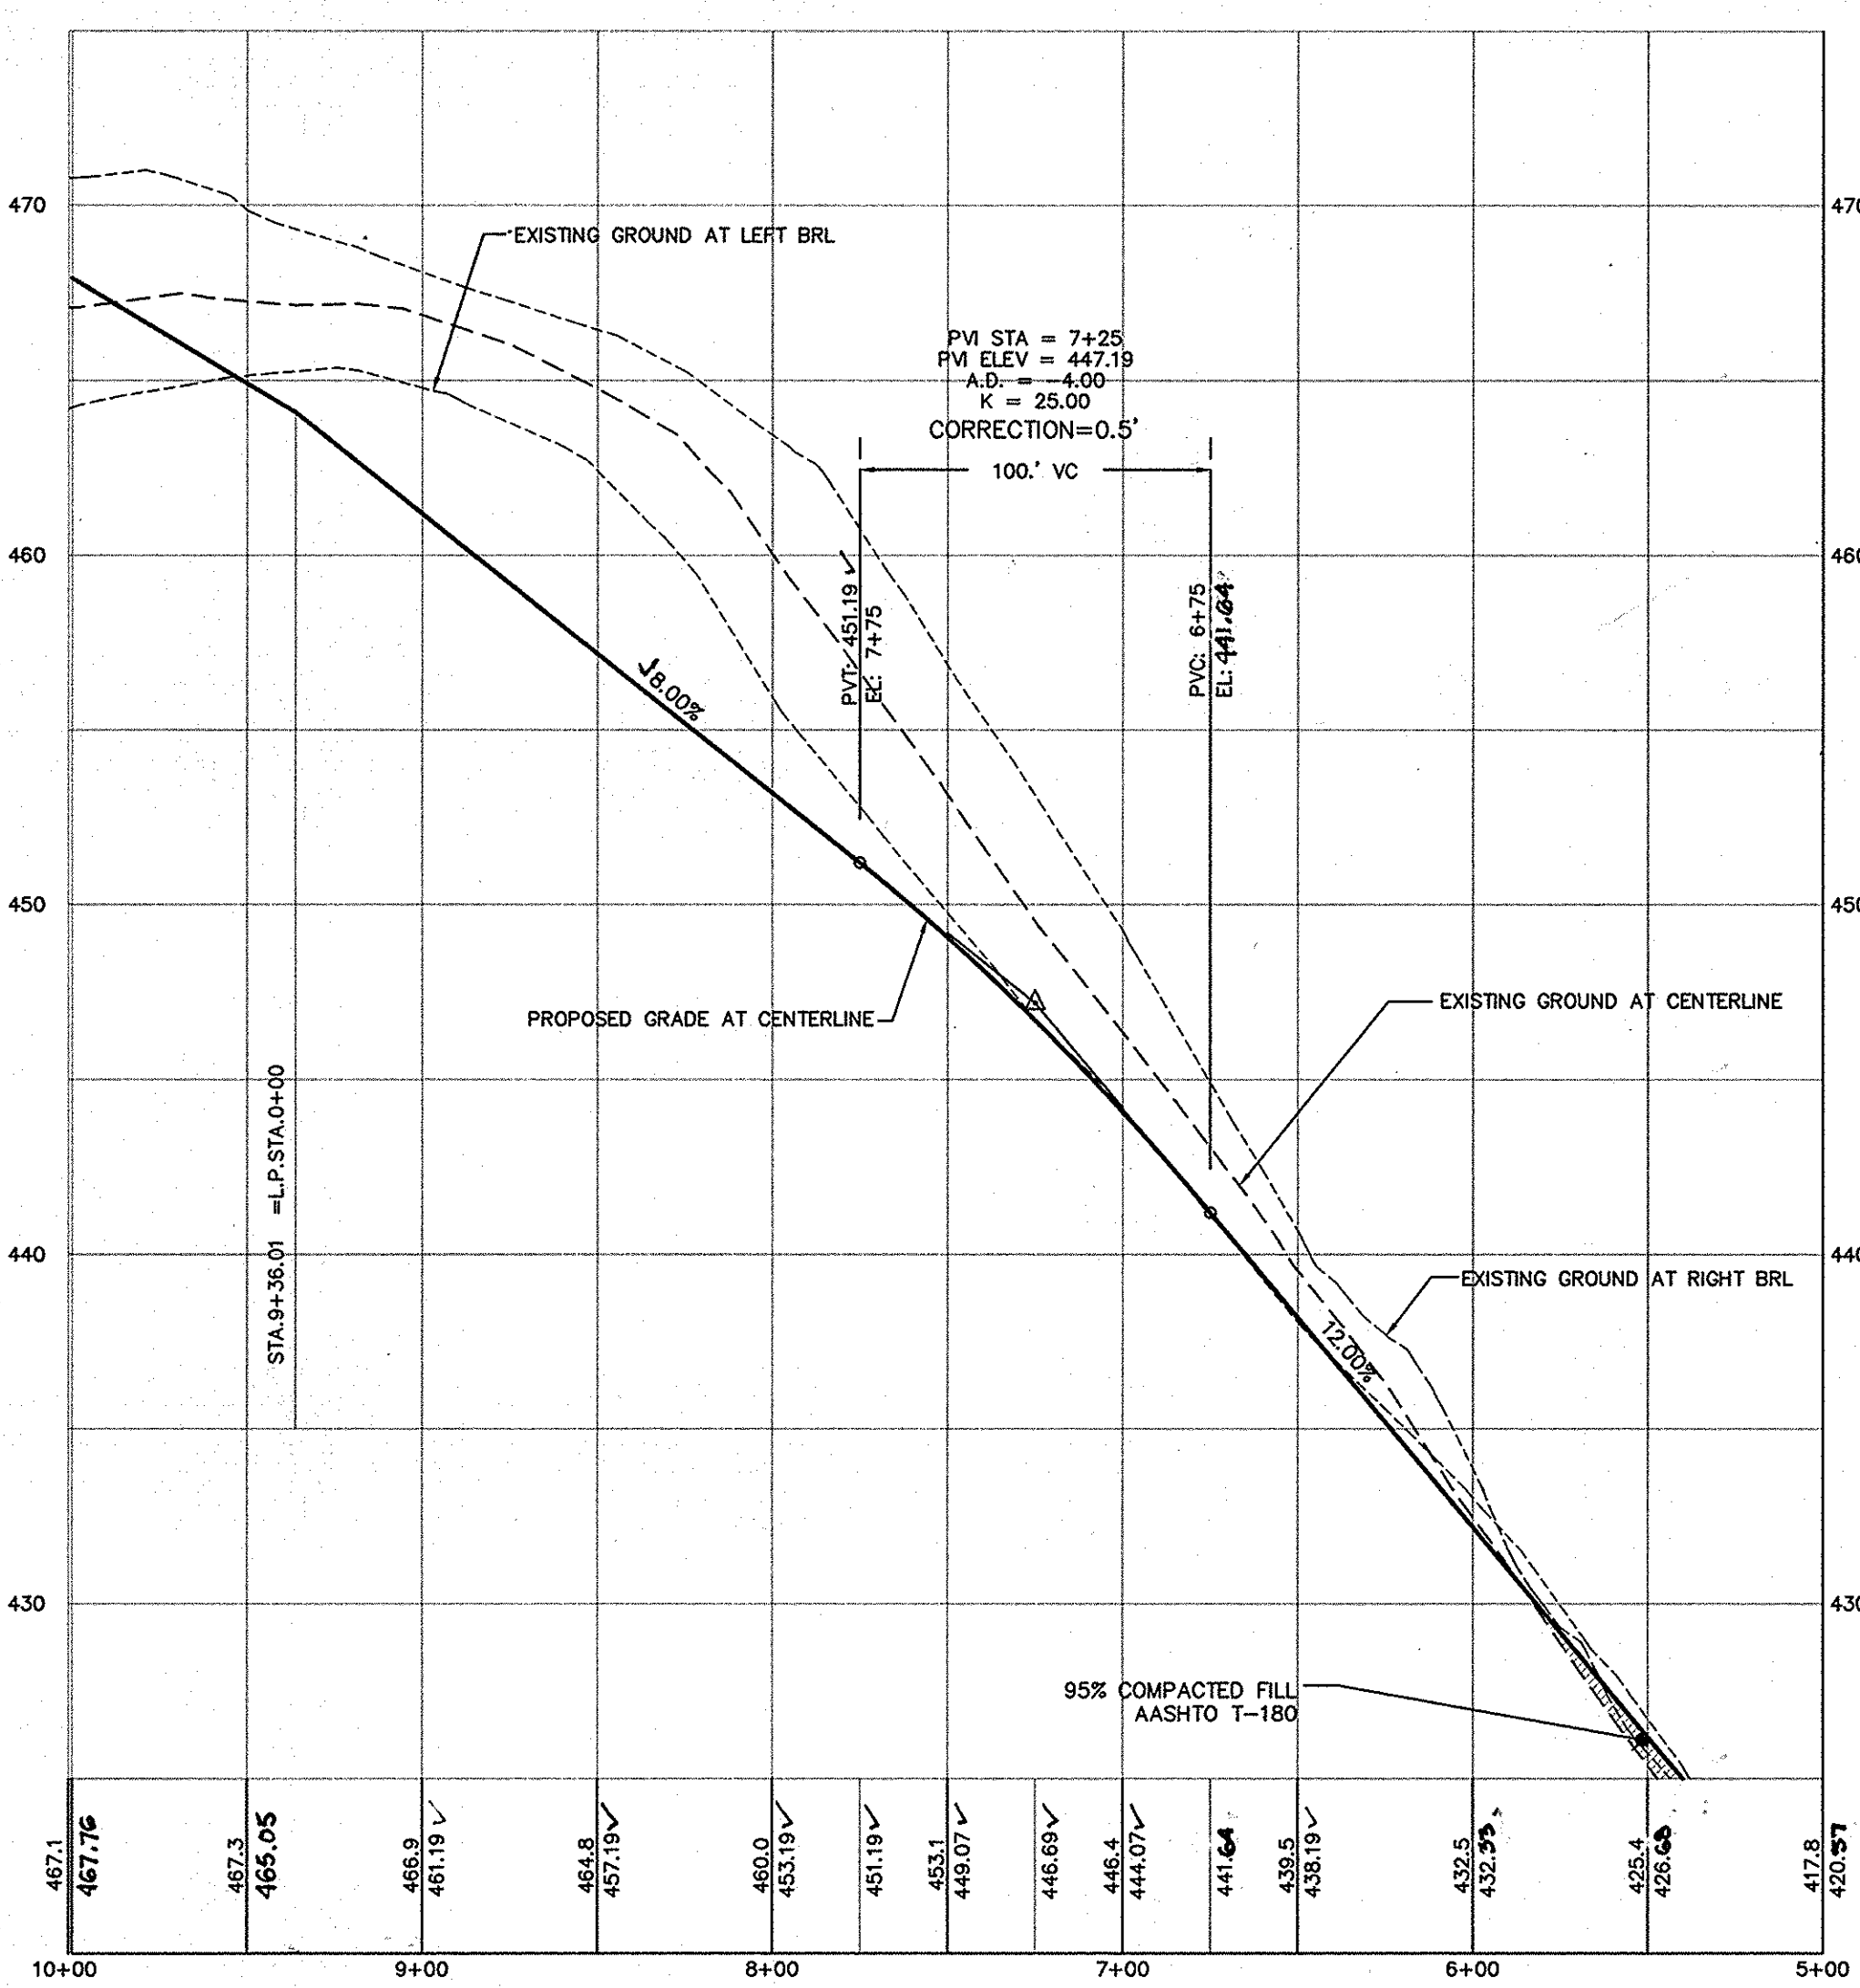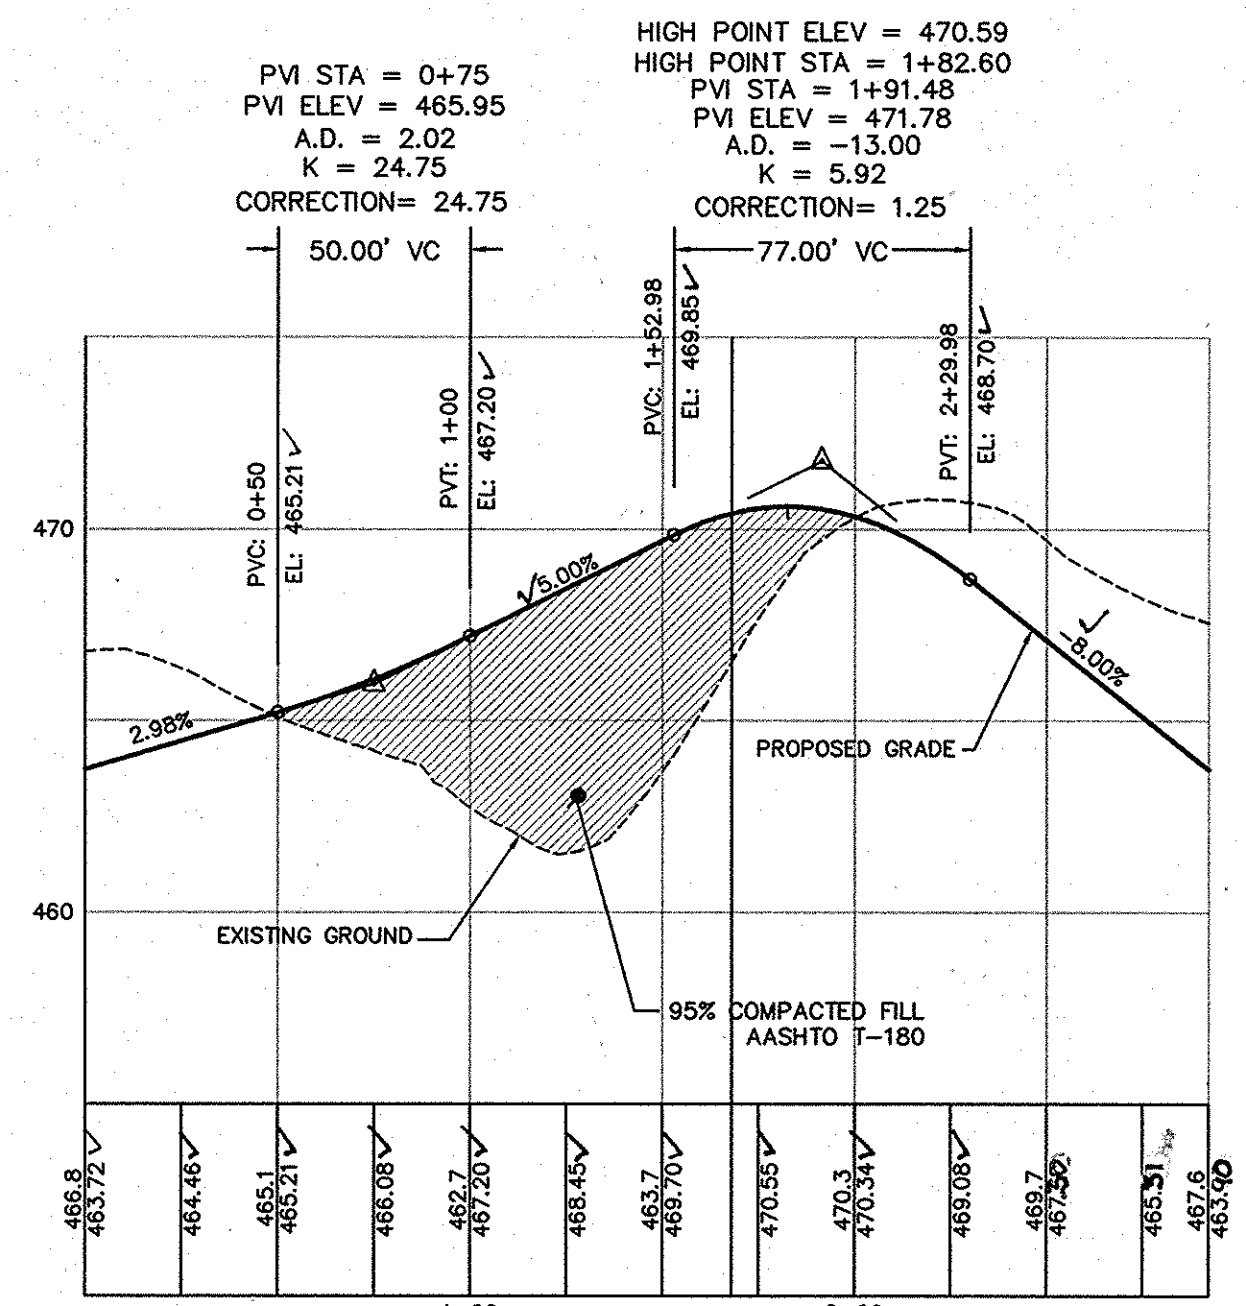

**OWNER/DEVELOPER**  
BONNIE BRANCH WOODS INC.  
C/O MILDENBERG, BOENDER AND ASSOC., INC.  
6800 DEERPATH ROAD, SUITE 150  
ELKRIE, MARYLAND 21075  
410-997-0296

FILE: 08-007.DWG; FINAL; FINAL; R-20.DWG

I HEREBY CERTIFY THAT THESE DOCUMENTS WERE PREPARED OR APPROVED BY ME AND THAT I AM A DULY LICENSED PROFESSIONAL ENGINEER UNDER THE LAWS OF THE STATE OF MARYLAND, LICENSE NO. 17942, EXP DATE 9/3/10.


I hereby certify that the facility shown on this plan was constructed as shown on the 'As-Built' plans and meets with the approved plans and specifications.

APPROVED: DEPARTMENT OF PUBLIC WORKS  
 [Signature] 6-11-10  
 CHIEF BUREAU OF HIGHWAYS

APPROVED: DEPARTMENT OF PLANNING AND ZONING  
 [Signature] 6/22/10  
 CHIEF, DIVISION OF LAND DEVELOPMENT

APPROVED: [Signature] 6/18/10  
 CHIEF, DEVELOPMENT ENGINEERING DIVISION

STATE OF MARYLAND  
 PROFESSIONAL ENGINEER  
 [Signature] 6/23/14

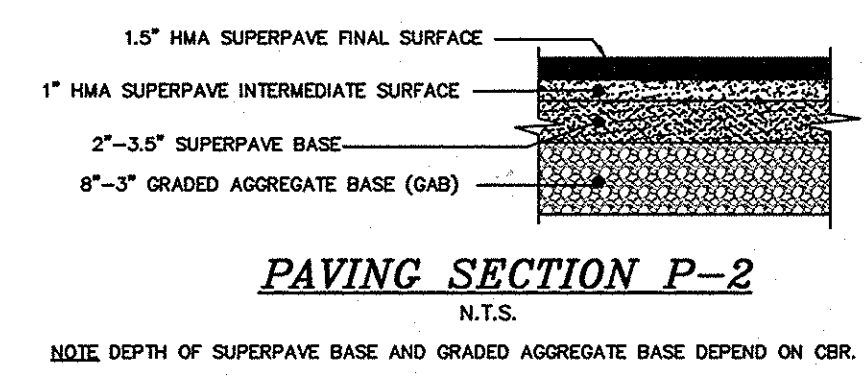

**MILDENBERG, BOENDER & ASSOC., INC.**  
 Surveyors, Planners, Engineers  
 6800 DEERPATH ROAD, SUITE 150, ELKRIE, MARYLAND 21075  
 (410) 997-0296


**BONNIE BRANCH WOODS**  
 AS-BUILT  
 TAX MAP: 31 PARCEL: 101  
 HOWARD COUNTY, MARYLAND  
 SECOND ELECTION DISTRICT  
 ROAD PLAN AND PROFILES

Project: 08-007  
 date: MAY 2010  
 illustration: MAM  
 scale: MAM  
 description: APP 5' S/W NOTE FOR AFRON ST. TREES  
 date: 6/17/14  
 no.: 1  
 approval: AS SHOWN

2 OF 24  
 F-10-042



NOTE: ENTIRE OPEN SPACE LOT 21 IS SUBJECT TO PUBLIC SHM & UTILITY EASEMENT

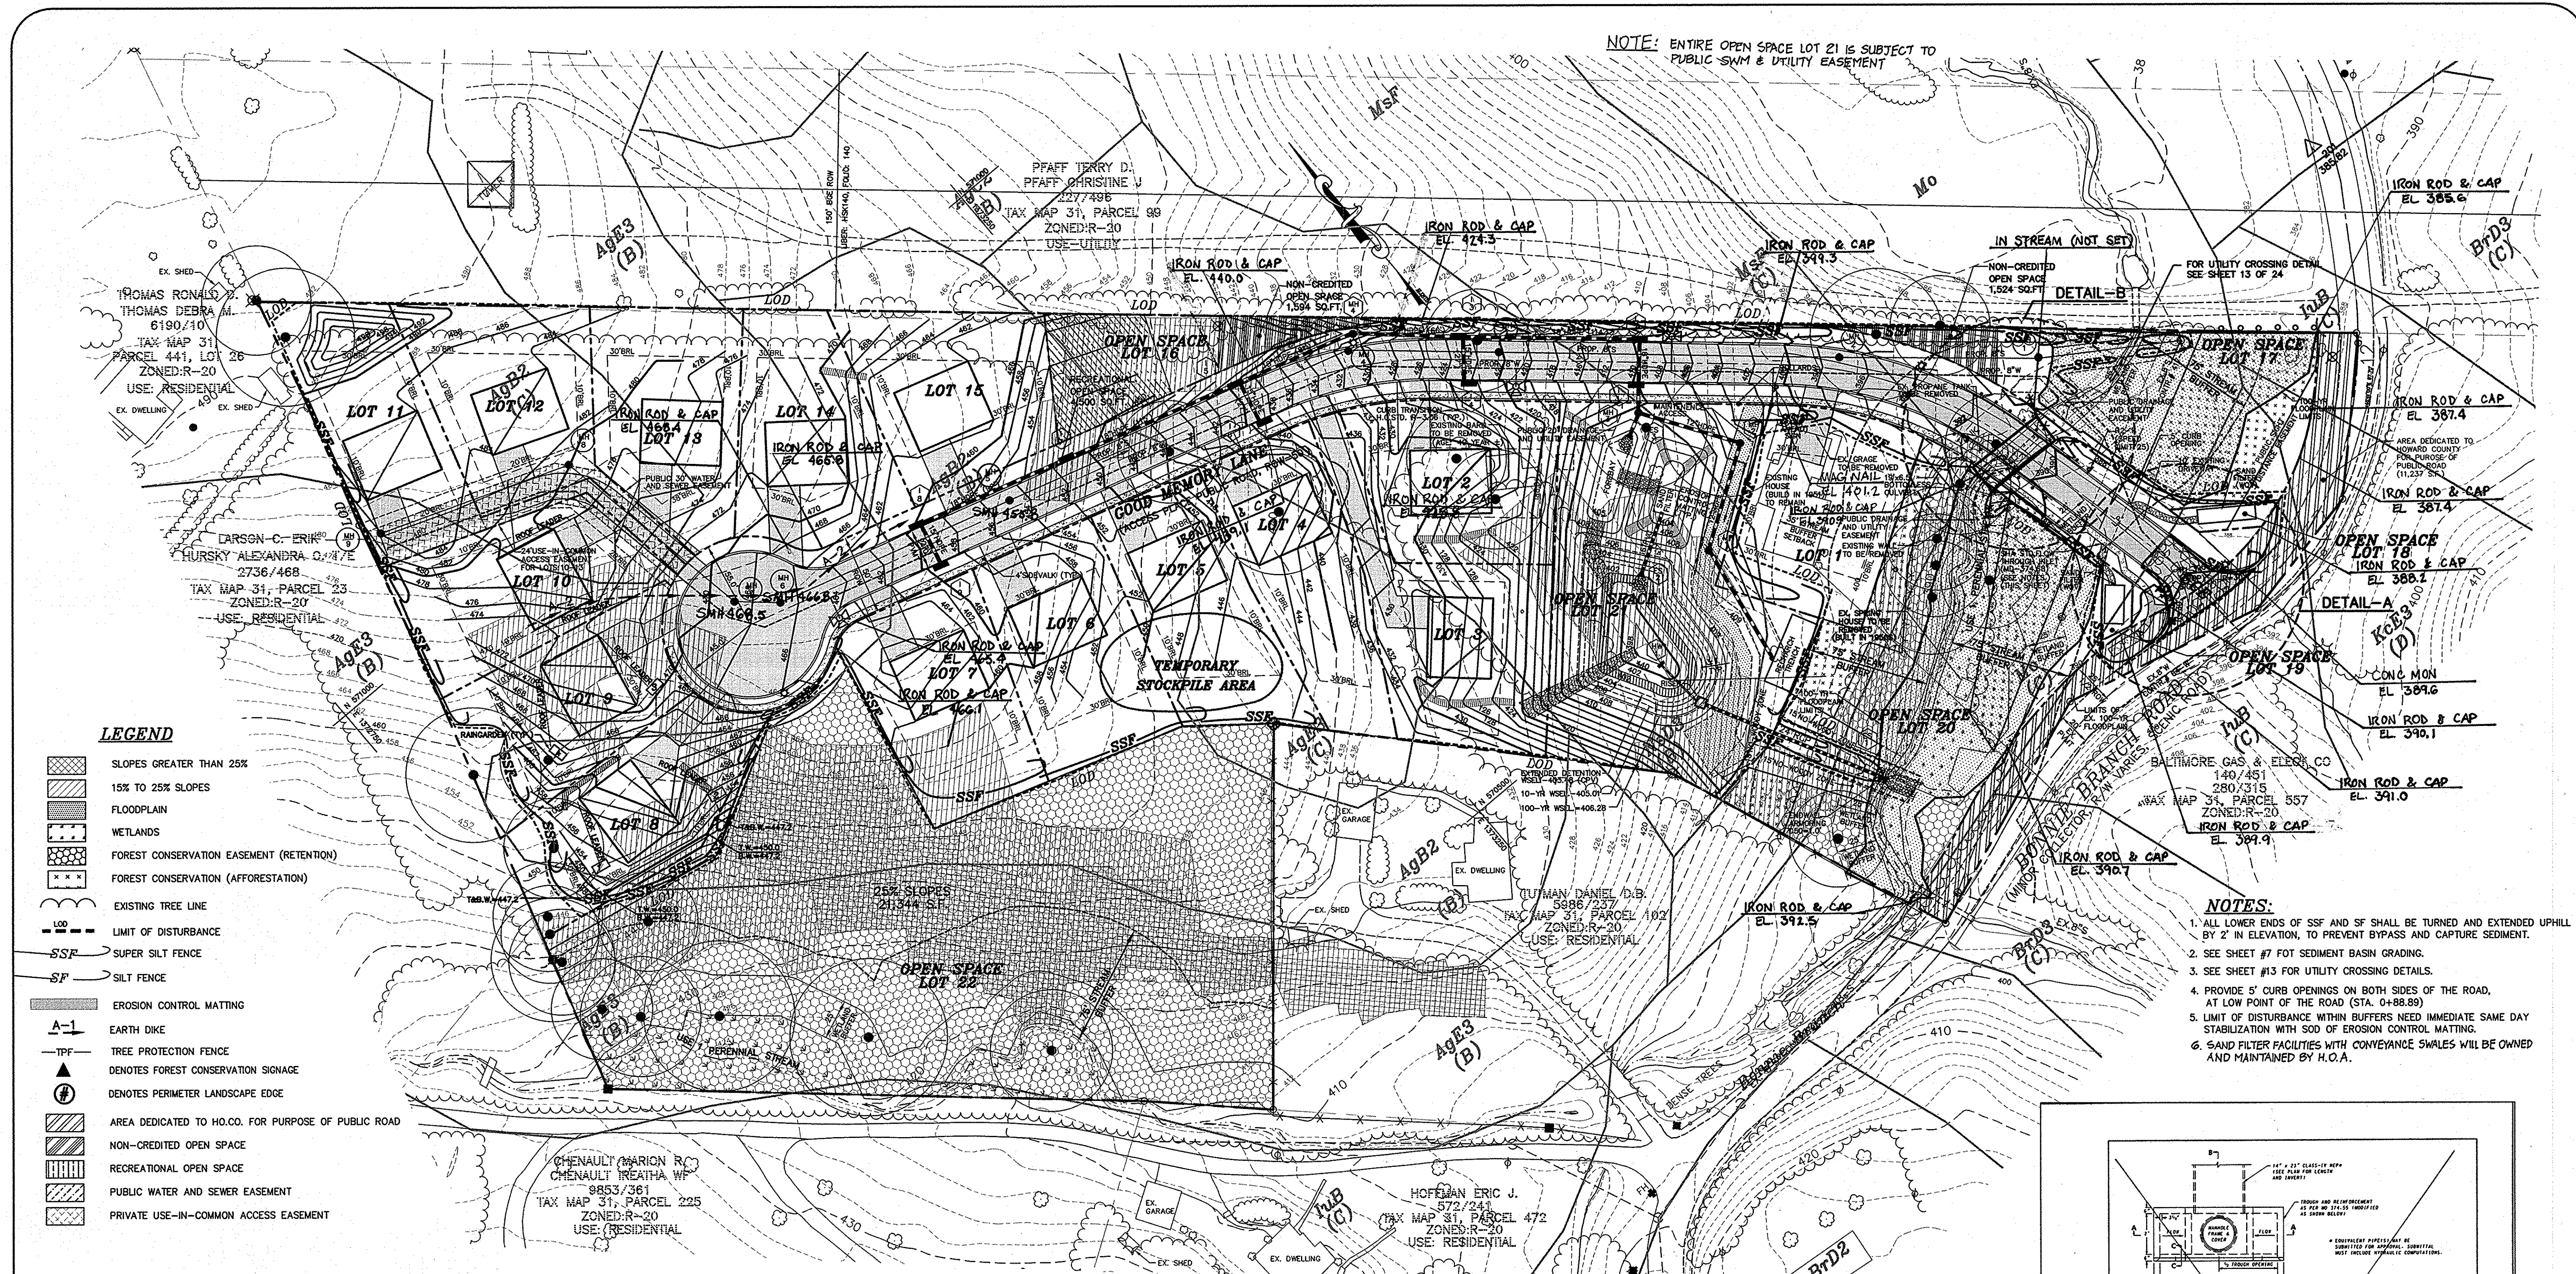

**LEGEND**

- SLOPES GREATER THAN 25%
- 15% TO 25% SLOPES
- FLOODPLAIN
- WETLANDS
- FOREST CONSERVATION EASEMENT (RETENTION)
- FOREST CONSERVATION (AFFORESTATION)
- EXISTING TREE LINE
- LIMIT OF DISTURBANCE
- SUPER SILT FENCE
- SILT FENCE
- EROSION CONTROL MATTING
- EARTH DIKE
- TREE PROTECTION FENCE
- DENOTES FOREST CONSERVATION SIGNAGE
- DENOTES PERIMETER LANDSCAPE EDGE
- AREA DEDICATED TO HO.CO. FOR PURPOSE OF PUBLIC ROAD
- NON-CREDITED OPEN SPACE
- RECREATIONAL OPEN SPACE
- PUBLIC WATER AND SEWER EASEMENT
- PRIVATE USE-IN-COMMON ACCESS EASEMENT

**NOTES:**

1. ALL LOWER ENDS OF SSF AND SF SHALL BE TURNED AND EXTENDED UPHILL BY 2' IN ELEVATION, TO PREVENT BYPASS AND CAPTURE SEDIMENT.
2. SEE SHEET #7 FOR SEDIMENT BASIN GRADING.
3. SEE SHEET #13 FOR UTILITY CROSSING DETAILS.
4. PROVIDE 5' CURB OPENINGS ON BOTH SIDES OF THE ROAD, AT LOW POINT OF THE ROAD (STA. 0+88.89).
5. LIMIT OF DISTURBANCE WITHIN BUFFERS NEED IMMEDIATE SAME DAY STABILIZATION WITH SOD OF EROSION CONTROL MATTING.
6. SAND FILTER FACILITIES WITH CONVEYANCE SWALES WILL BE OWNED AND MAINTAINED BY H.O.A.

BY THE DEVELOPER:  
 I/WE CERTIFY THAT ALL DEVELOPMENT AND/OR CONSTRUCTION WILL BE DONE ACCORDING TO THESE PLANS, AND THAT ANY RESPONSIBLE PERSONNEL INVOLVED IN THE CONSTRUCTION PROJECT WILL HAVE A CERTIFICATE OF ATTENDANCE AT A DEPARTMENT OF THE ENVIRONMENT APPROVED TRAINING PROGRAM FOR THE CONTROL OF SEDIMENT AND EROSION BEFORE BEGINNING THE PROJECT. I SHALL ENGAGE A REGISTERED PROFESSIONAL ENGINEER TO SUPERVISE POND CONSTRUCTION AND PROVIDE THE HOWARD SOIL CONSERVATION DISTRICT WITH AN "AS-BUILT" PLAN OF THE POND WITHIN 30 DAYS OF COMPLETION. I ALSO AUTHORIZE PERIODIC ON-SITE INSPECTIONS BY THE HOWARD SOIL CONSERVATION DISTRICT.  
 Signature: *John Douglas Cashmere* DATE: 5/6/10  
 PRINTED NAME OF DEVELOPER: JOHN DOUGLAS CASHMERE

BY THE ENGINEER:  
 I CERTIFY THAT THIS PLAN FOR POND CONSTRUCTION, EROSION AND SEDIMENT CONTROL REPRESENTS A PRACTICAL AND WORKABLE PLAN BASED ON MY PERSONAL KNOWLEDGE OF THE SITE CONDITIONS. THIS PLAN WAS PREPARED IN ACCORDANCE WITH THE REQUIREMENTS OF THE HOWARD SOIL CONSERVATION DISTRICT. I HAVE NOTICED THE DEVELOPER THAT HE/MUST ENGAGE A REGISTERED PROFESSIONAL ENGINEER TO SUPERVISE POND CONSTRUCTION AND PROVIDE THE HOWARD SOIL CONSERVATION DISTRICT WITH AN "AS-BUILT" PLAN OF THE POND WITHIN 30 DAYS OF COMPLETION.  
 Signature: *R. Jacob Hixmat* DATE: 5/16/10  
 PRINTED NAME OF ENGINEER: R. JACOB HIXMAT

APPROVED: DEPARTMENT OF PUBLIC WORKS  
 Signature: *W. R. Marshall* DATE: 6-11-10  
 CHIEF BUREAU OF HIGHWAYS

APPROVED: DEPARTMENT OF PLANNING AND ZONING  
 Signature: *West Shulz* DATE: 6/22/10  
 CHIEF, DIVISION OF LAND DEVELOPMENT


APPROVED: DEPARTMENT OF ENGINEERING DIVISION  
 Signature: *John P. ...* DATE: 6/16/10  
 CHIEF, DEVELOPMENT ENGINEERING DIVISION

SOIL TYPE	HYDRO	K-VALUE	WOODLAND SUITABILITY GROUP	NATIVE VEGETATION
Ag2 (B) AURA GRAVELLY LOAM 1-5% SLOPES, MODERATELY ERODED	NO	0.43	12	OAKS AND OTHER UPLAND HARDWOODS
Ag3 (B) AURA GRAVELLY LOAM 10-30% SLOPES, SEVERELY ERODED	NO	0.43	17	OAKS AND OTHER UPLAND HARDWOODS
Brd2 (B) BRANDWINE LOAM 15-25% SLOPES, MODERATELY ERODED	NO	0.24	41	OAKS AND OTHER UPLAND HARDWOODS
Lub (C) LUKA LOAM, LOCAL ALLUVIUM 1-5% SLOPES	YES	0.37	4	MIXED HARDWOODS WATER TOLERANT
Kc2 (C) KELLY CLAY LOAM 15-30% SLOPES, SEVERELY ERODED	NO	0.32	34	MIXED HARDWOODS MAINLY WHITE OAKS
Mo (C) MIXED ALLUVIAL LAND	NO	0.43	2	MIXED HARDWOODS MAINLY OAKS
Mac (C) MONTALO AND RELAY VERY STONY SILT LOAMS 15-30% SLOPES	NO	0.32	32	MIXED HARDWOODS MAINLY OAKS
Md (C) MONTGOMERY SILT LOAM 15-30% SLOPES, SEVERELY ERODED	NO	0.28	31	MIXED HARDWOODS MAINLY OAKS


STATE OF MARYLAND  
 PROFESSIONAL ENGINEER  
 No. 17942  
 6/23/14

I hereby certify that the facility shown on this plan was constructed as shown on the "As-Built" plans and meets with the approved plans and specifications.


TRAFFIC BEARING SIDEWALK STA. 0+50 TO STA. 1+00 (SEE DET. ON SHEET 2)

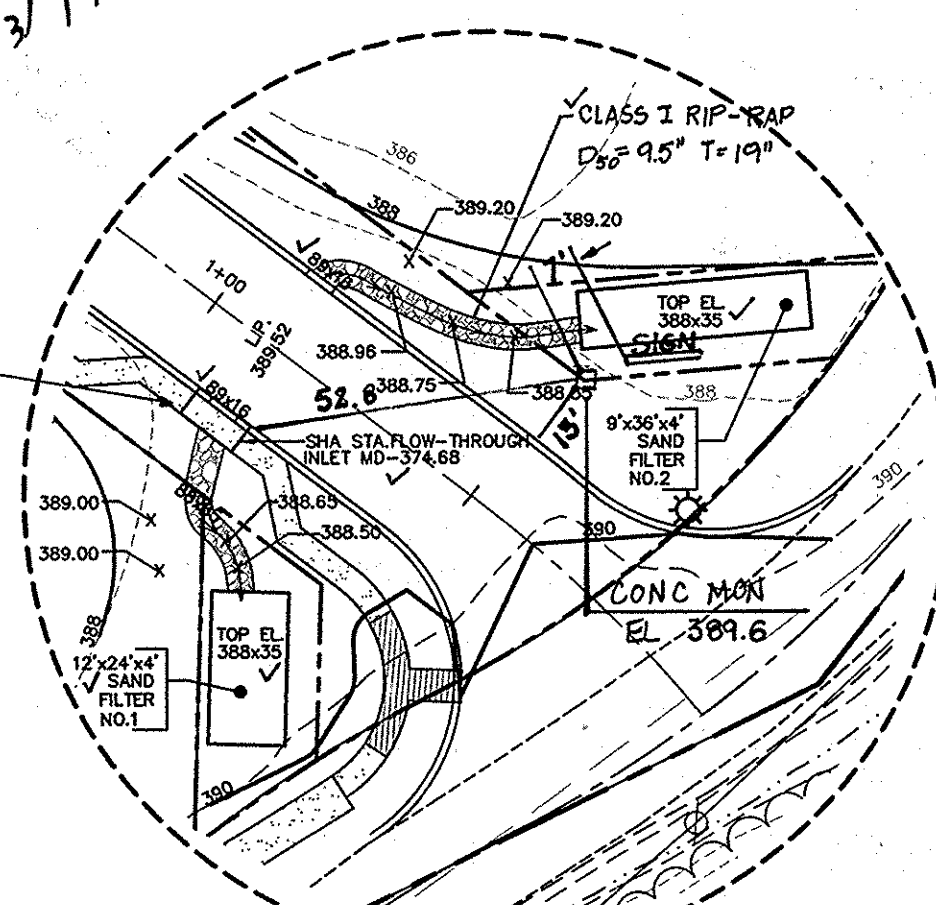

**SAND FILTER TYP. DETAIL**  
 SCALE: 1"=5'

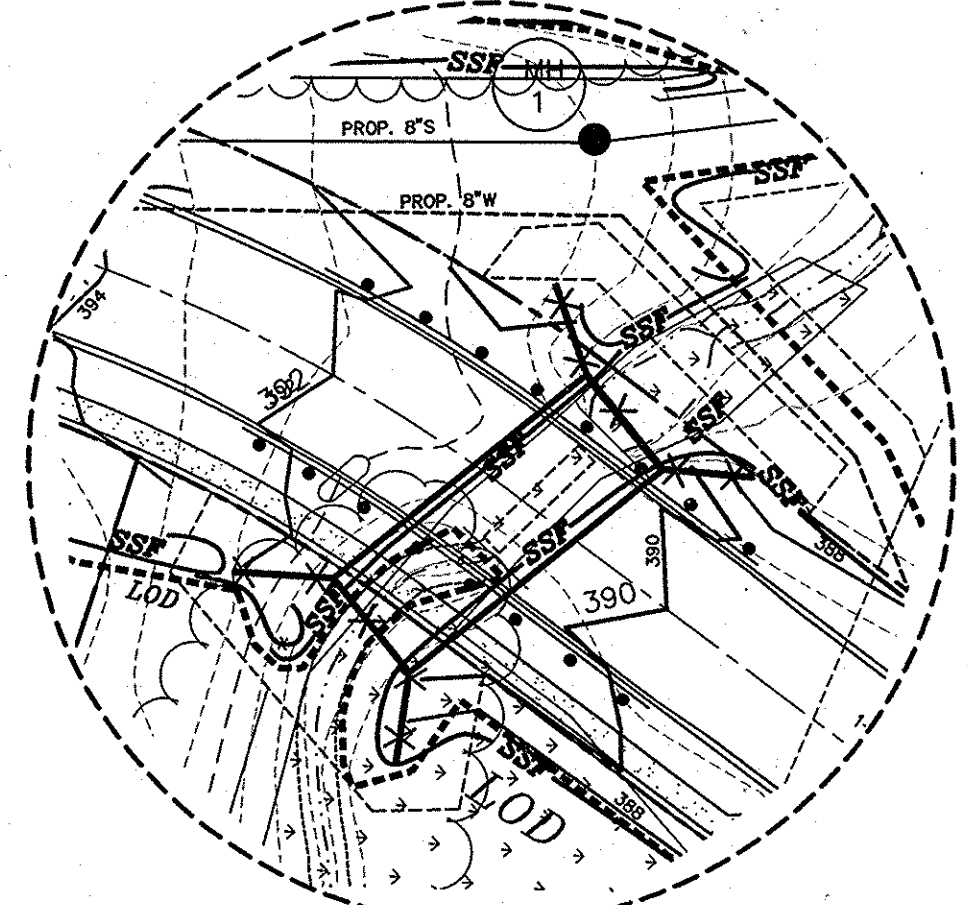

**SEDIMENT CONTROL DETAIL-B**  
 SCALE: 1"=30'

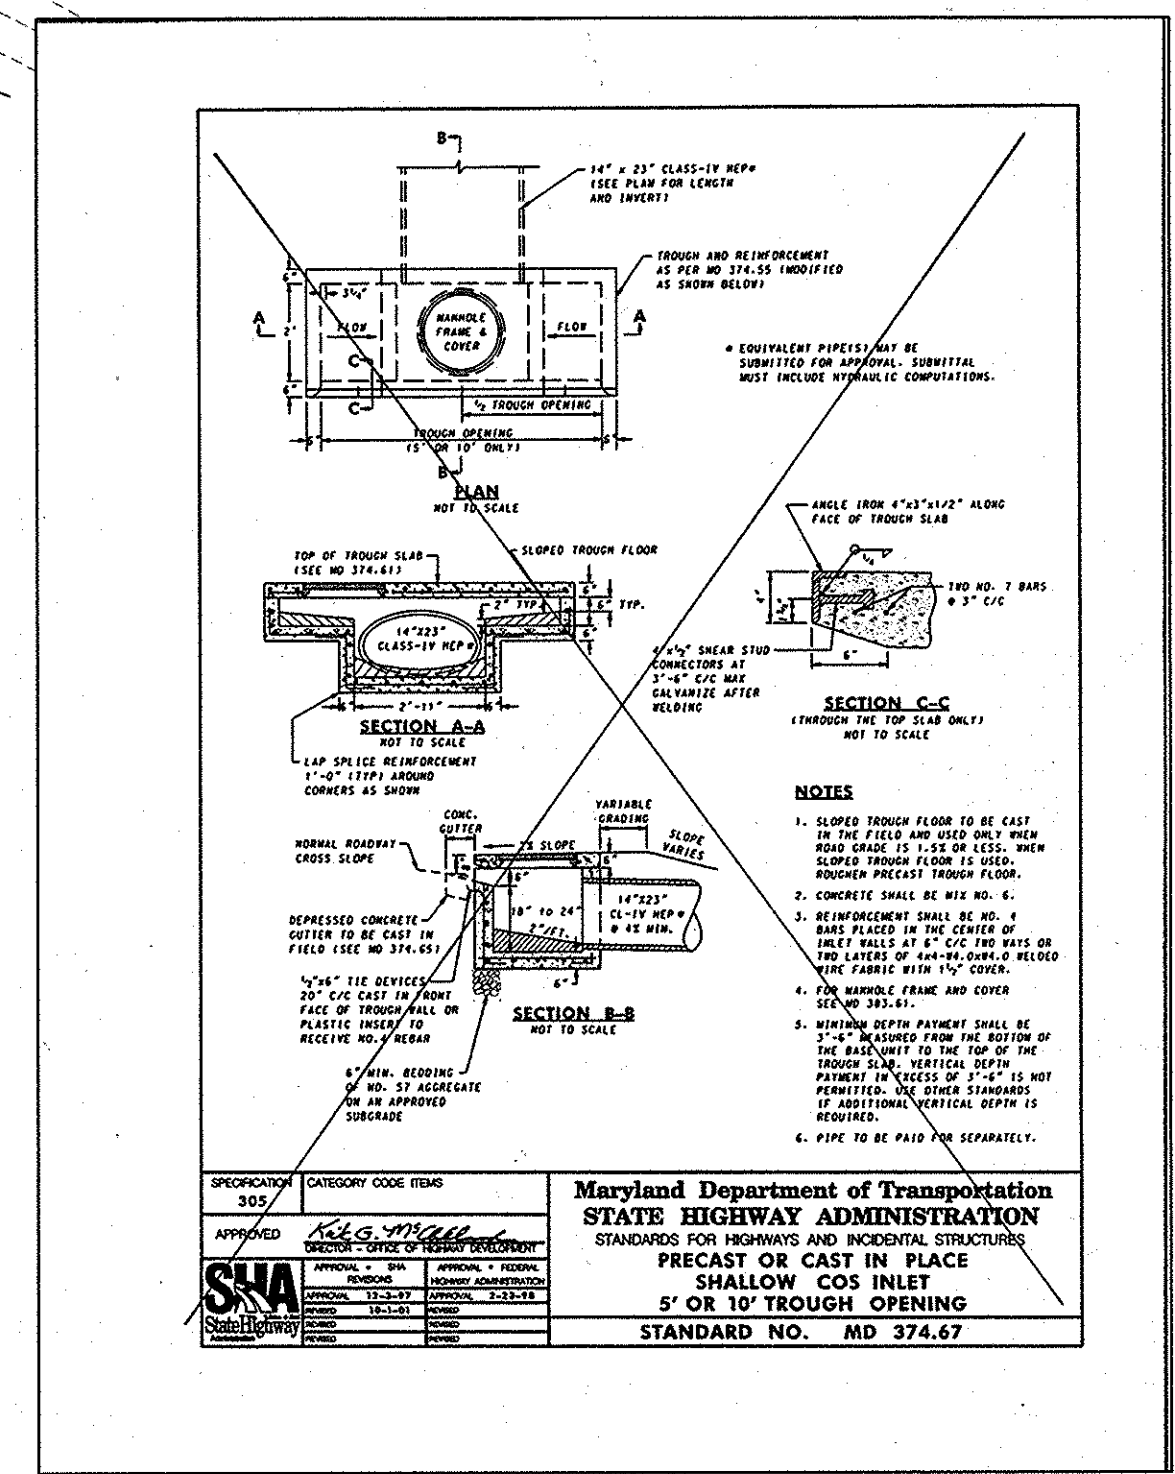

**OWNER/DEVELOPER**  
 BONNIE BRANCH WOODS INC.  
 C/O MILDENBERG, BOENDER AND ASSOC., INC.  
 6800 DEEPWATER ROAD, SUITE 150  
 ELKBRIDGE, MARYLAND 21075  
 410-997-0286



HOWARD SOIL CONSERVATION DISTRICT

PERMANENT SEEDING NOTES

APPLY TO GRADED OR CLEARED AREAS NOT SUBJECT TO IMMEDIATE FURTHER DISTURBANCE WHERE A PERMANENT LONG-TERM VEGETATIVE COVER IS NEEDED.

SEEDING PREPARATION: LOOSEN UPPER THREE INCHES OF SOIL BY RAKING, DISKING OR OTHER ACCEPTABLE MEANS BEFORE SEEDING, IF NOT PREVIOUSLY LOOSENED.

SOIL AMENDMENTS: IN LIEU OF SOIL TEST RECOMMENDATIONS, USE ONE OF THE FOLLOWING SCHEDULES: 1) PREFERRED - APPLY 2 TONS PER ACRE...

TEMPORARY SEEDING NOTES

APPLY TO GRADED OR CLEARED AREAS LIKELY TO BE REDISTURBED THROUGH A SHORT-TERM VEGETATIVE COVER IS NEEDED.

SEEDING PREPARATION: LOOSEN UPPER THREE INCHES OF SOIL BY RAKING, DISKING OR OTHER ACCEPTABLE MEANS BEFORE SEEDING, FOR NOT PREVIOUSLY LOOSENED.


STANDARD SEDIMENT CONTROL NOTES

- 1) A MINIMUM OF 48 HOURS NOTICE MUST BE GIVEN TO THE HOWARD COUNTY DEPARTMENT OF INSPECTIONS, LICENSES AND PERMITS, SEDIMENT CONTROL DIVISION PRIOR TO THE START OF ANY CONSTRUCTION...

BY THE DEVELOPER: I HEREBY CERTIFY THAT ALL DEVELOPMENT AND/OR CONSTRUCTION WILL BE DONE ACCORDING TO THESE PLANS, AND THAT ANY RESPONSIBLE PERSONNEL INVOLVED IN THE CONSTRUCTION PROJECT WILL HAVE A CERTIFICATE OF ATTENDANCE AT A DEPARTMENT OF THE ENVIRONMENT APPROVED TRAINING PROGRAM FOR THE CONTROL OF SEDIMENT AND EROSION BEFORE BEGINNING THE PROJECT...

BY THE ENGINEER: I CERTIFY THAT THIS PLAN FOR POND CONSTRUCTION, EROSION AND SEDIMENT CONTROL REPRESENTS A PRACTICAL AND WORKABLE PLAN BASED ON MY PERSONAL KNOWLEDGE OF THE SITE CONDITIONS AND THAT THIS PLAN WAS PREPARED IN ACCORDANCE WITH THE REQUIREMENTS OF THE HOWARD SOIL CONSERVATION DISTRICT...

I HEREBY CERTIFY THAT THESE DOCUMENTS WERE PREPARED OR APPROVED BY ME AND THAT I AM A DULY LICENSED PROFESSIONAL ENGINEER UNDER THE LAWS OF THE STATE OF MARYLAND, LICENSE NO. 17942, EXP DATE 9/3/10.

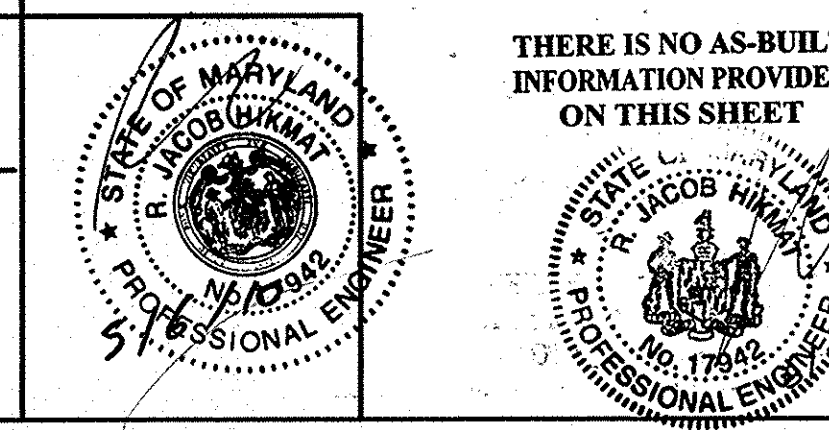

STANDARD AND SPECIFICATIONS FOR TOPSOIL

DEFINITION: PLACEMENT OF TOPSOIL OVER A PREPARED SUBSOIL PRIOR TO ESTABLISHMENT OF PERMANENT VEGETATION. PURPOSE: TO PROVIDE A SUITABLE SOIL MEDIUM FOR VEGETATIVE GROWTH...

CONDITIONS WHERE PRACTICE APPLIES: 1. THIS PRACTICE IS LIMITED TO AREAS HAVING 2:1 OR FLATTER SLOPES... 2. THE TEXTURE OF THE EXPOSED SUBSOIL/PARENT MATERIAL IS NOT ADEQUATE TO PRODUCE VEGETATIVE GROWTH...

CONSTRUCTION AND MATERIAL SPECIFICATIONS: 1. TOPSOIL SALVAGED FROM THE EXISTING SITE MAY BE USED PROVIDED THAT IT MEETS THE STANDARDS AS SET FORTH IN THIS SPECIFICATION...

2. TOPSOIL MUST BE FREE OF PLANTS OR PLANT PARTS SUCH AS BERMUDA GRASS, QUACKGRASS, JOHNSONSON GRASS, NUTSEDGE, POISON HLY, THISTLE, OR OTHERS AS SPECIFIED. 3. WHERE THE SUBSOIL IS EITHER HIGHLY ACIDIC OR COMPOSED OF HEAVY CLAYS, GROUND LIMESTONE SHALL BE SPREAD AT THE RATE OF 4-8 TONS PER ACRE...

ALTERNATIVE FOR PERMANENT SEEDING - INSTEAD OF APPLYING THE FULL AMOUNTS OF LIME AND COMMERICAL FERTILIZER, COMPOSTED SLUDGE AND AMENDMENTS MAY BE APPLIED AS SPECIFIED BELOW: 1. COMPOSTED SLUDGE MATERIAL FOR USE AS A SOIL CONDITIONER FOR SITES HAVING DISTURBED AREAS OVER 5 ACRES...

REFERENCES: GUIDELINE SPECIFICATIONS, SOIL PREPARATION AND SODDING, MD-VIA, PUB. #1, COOPERATIVE EXTENSION SERVICE, UNIVERSITY OF MARYLAND AND VIRGINIA POLYTECHNIC INSTITUTES. REVISED 1973.

TEMPORARY DUST CONTROL MEASURES

- 1. MULCHES - SEE STANDARDS FOR VEGETATIVE STABILIZATION WITH MULCHES ONLY. MULCH SHOULD BE CRIMPED OR TACKED TO PREVENT BLOWING. 2. VEGETATIVE COVER - SEE STANDARDS FOR TEMPORARY VEGETATIVE COVER.

EROSION AND SEDIMENT CONTROL NOTES FOR UTILITY CONSTRUCTION

- 1. ALL SEDIMENT CONTROL OPERATIONS ARE TO BE DONE IN ACCORDANCE WITH SECTION 219 OF THE HOWARD COUNTY VOLUME IV DESIGN MANUAL AND THE STANDARDS AND SPECIFICATIONS FOR SEDIMENT CONTROL IN DEVELOPING AREAS.

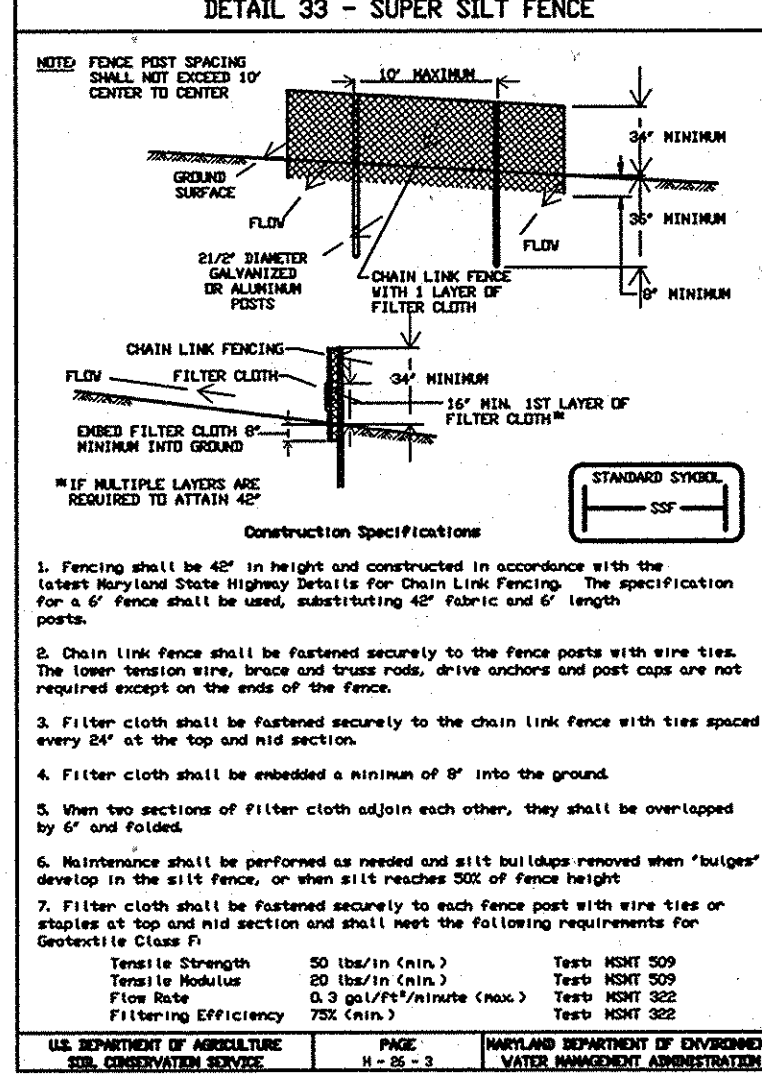


Table with columns: Slope, Slope Steepness, Slope Length (Maximum), Silt Fence Length (Maximum). Rows include slopes from 0-10% to 30%+.





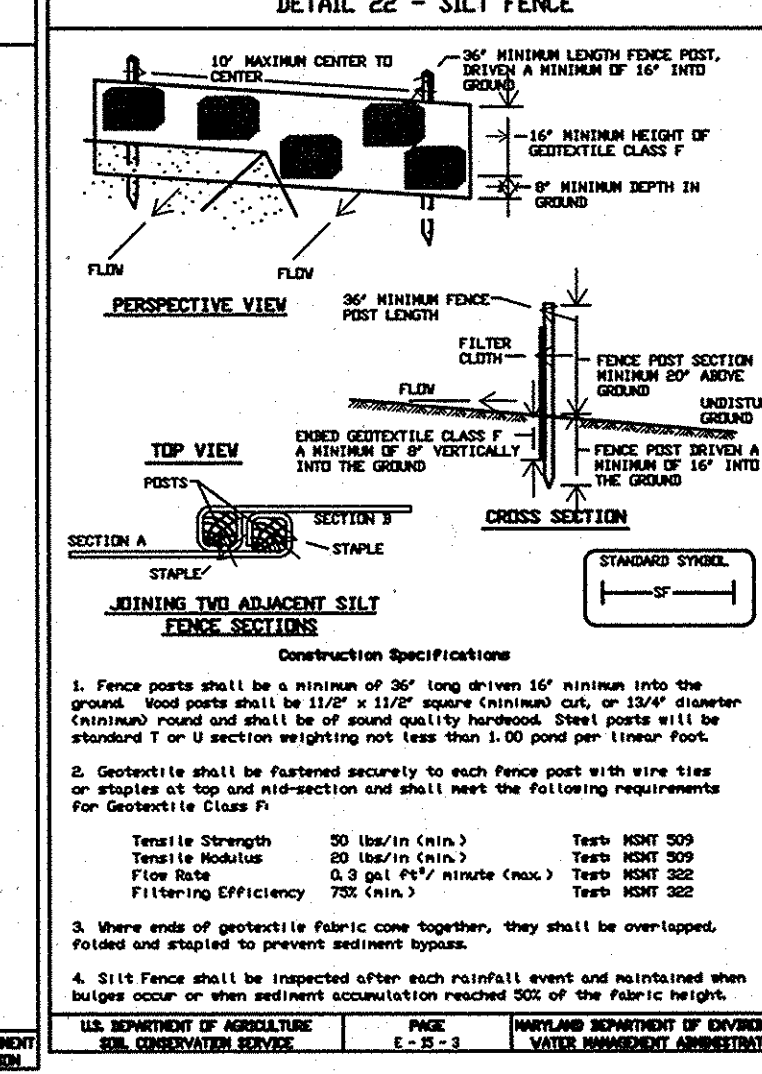


Table with columns: Slope Steepness, Slope Length, Silt Fence Length. Rows include slopes from 5:1 to 1:1 and 1:1 and steeper.

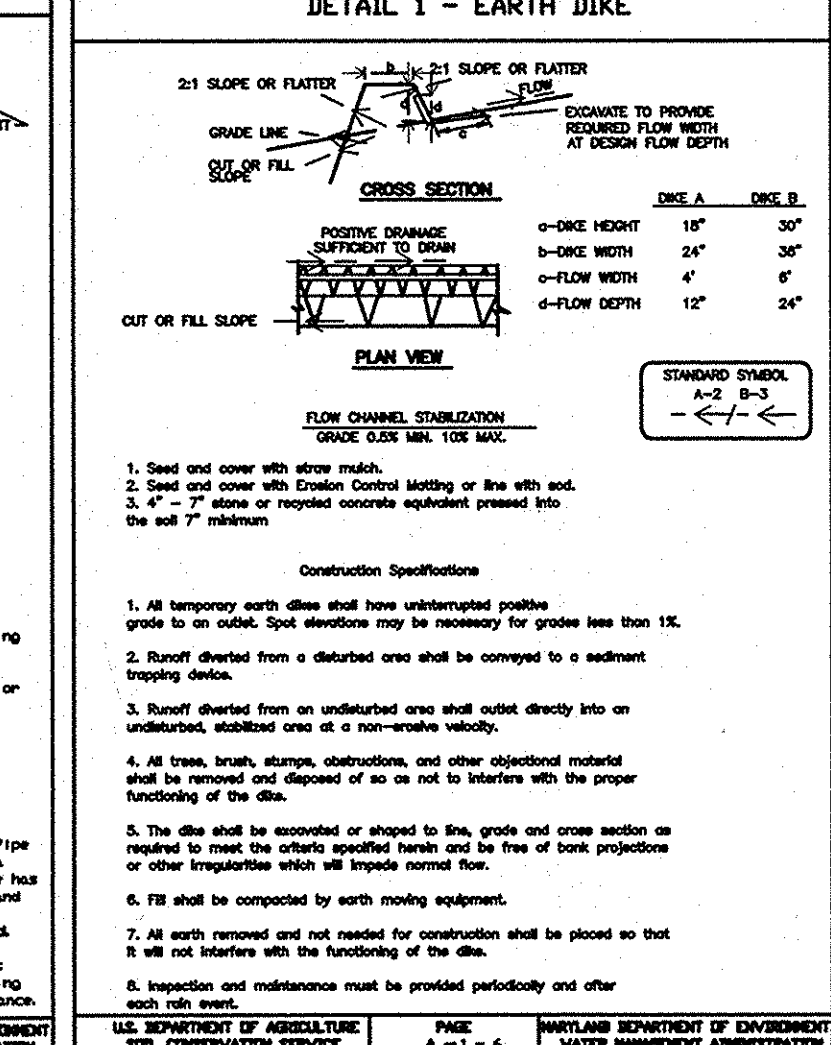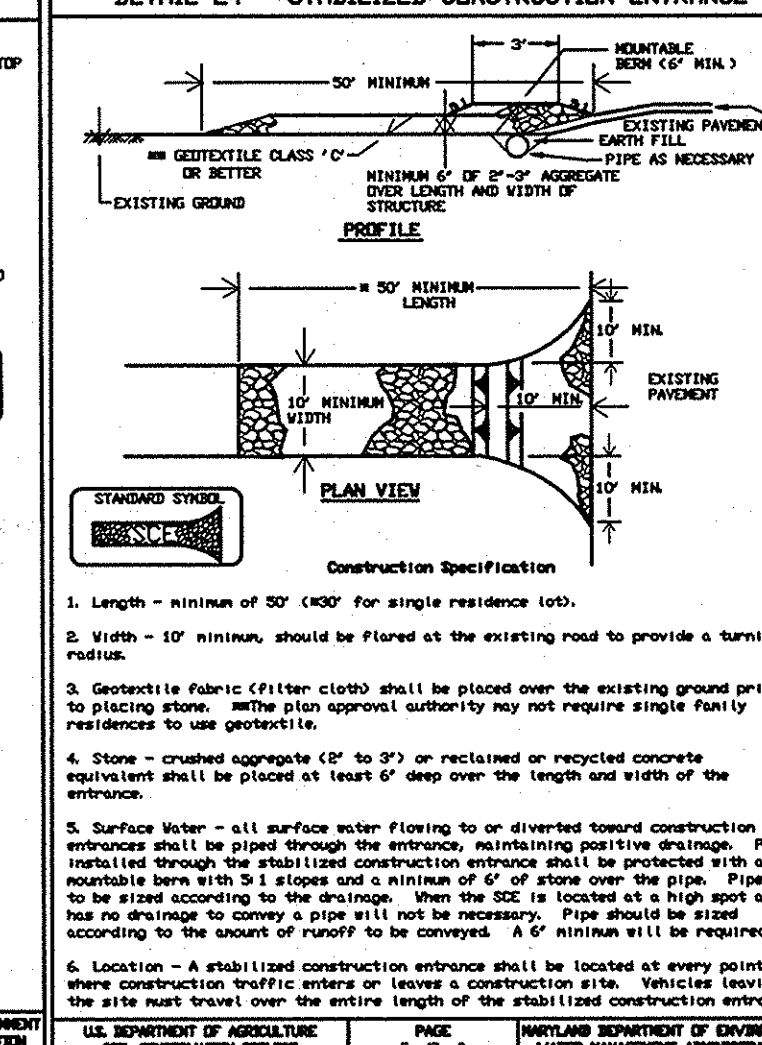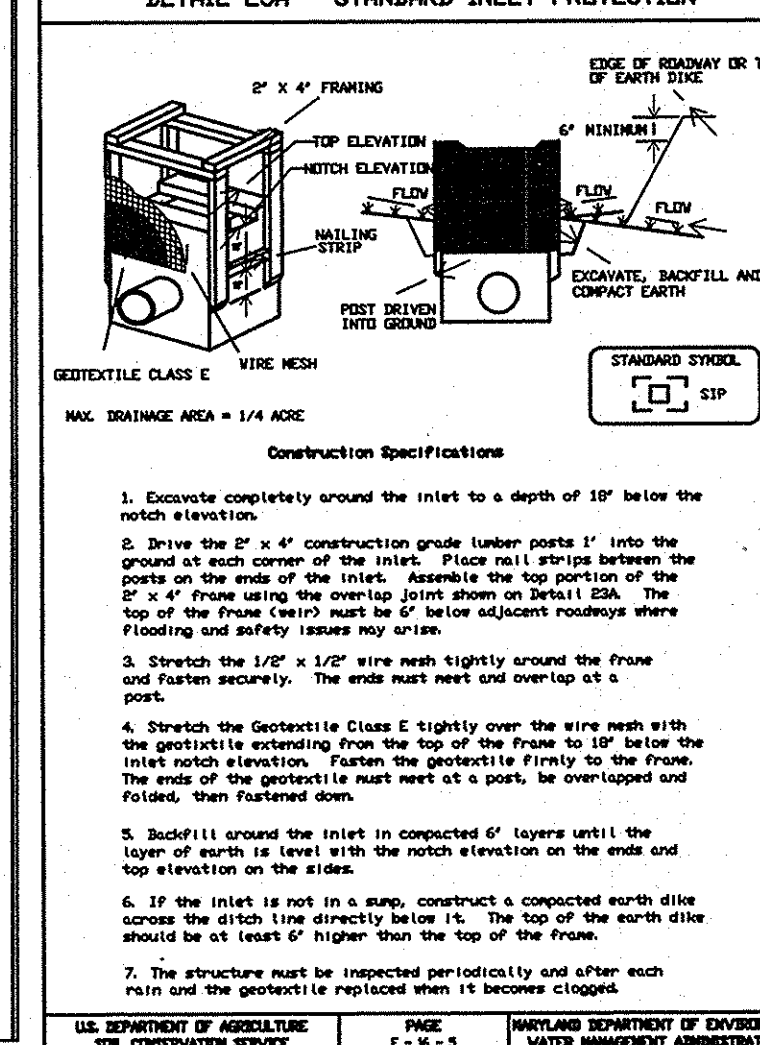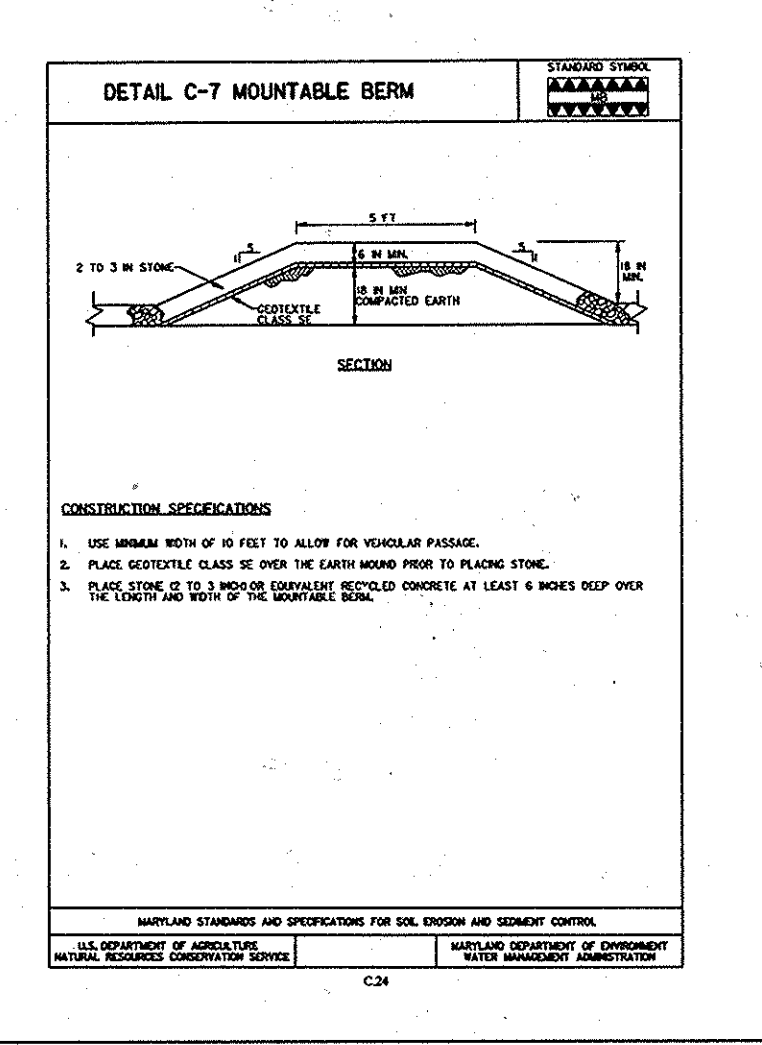

BEST MANAGEMENT PRACTICES FOR WORKING IN NONTIDAL WETLANDS, WETLAND BUFFERS, WATERWAYS AND 100-YEAR FLOODPLAINS


- 1. NO EXCESS FILL, CONSTRUCTION MATERIAL, OR DEBRIS SHALL BE STOCKPILED OR STORED IN NONTIDAL WETLANDS, NONTIDAL WETLAND BUFFERS, WATERWAYS OR 100-YEAR FLOODPLAIN.

SEQUENCE OF CONSTRUCTION

- 1. OBTAIN GRADING PERMIT. 2. CONSTRUCT STABILIZED CONSTRUCTION ENTRANCES, WITH MOUNTABLE BEAM, AT LOCATIONS SHOWN. (1 DAY)

AS-BUILT BONNIE BRANCH WOODS SECOND ELECTION DISTRICT HOWARD COUNTY, MARYLAND. MILDENBERG, BOENDER & ASSOC., INC. 6800 Deerpath Road, Suite 150, Elkridge, Maryland 21075 (410) 997-0288 Fax. 4 OF 24 F-10-042



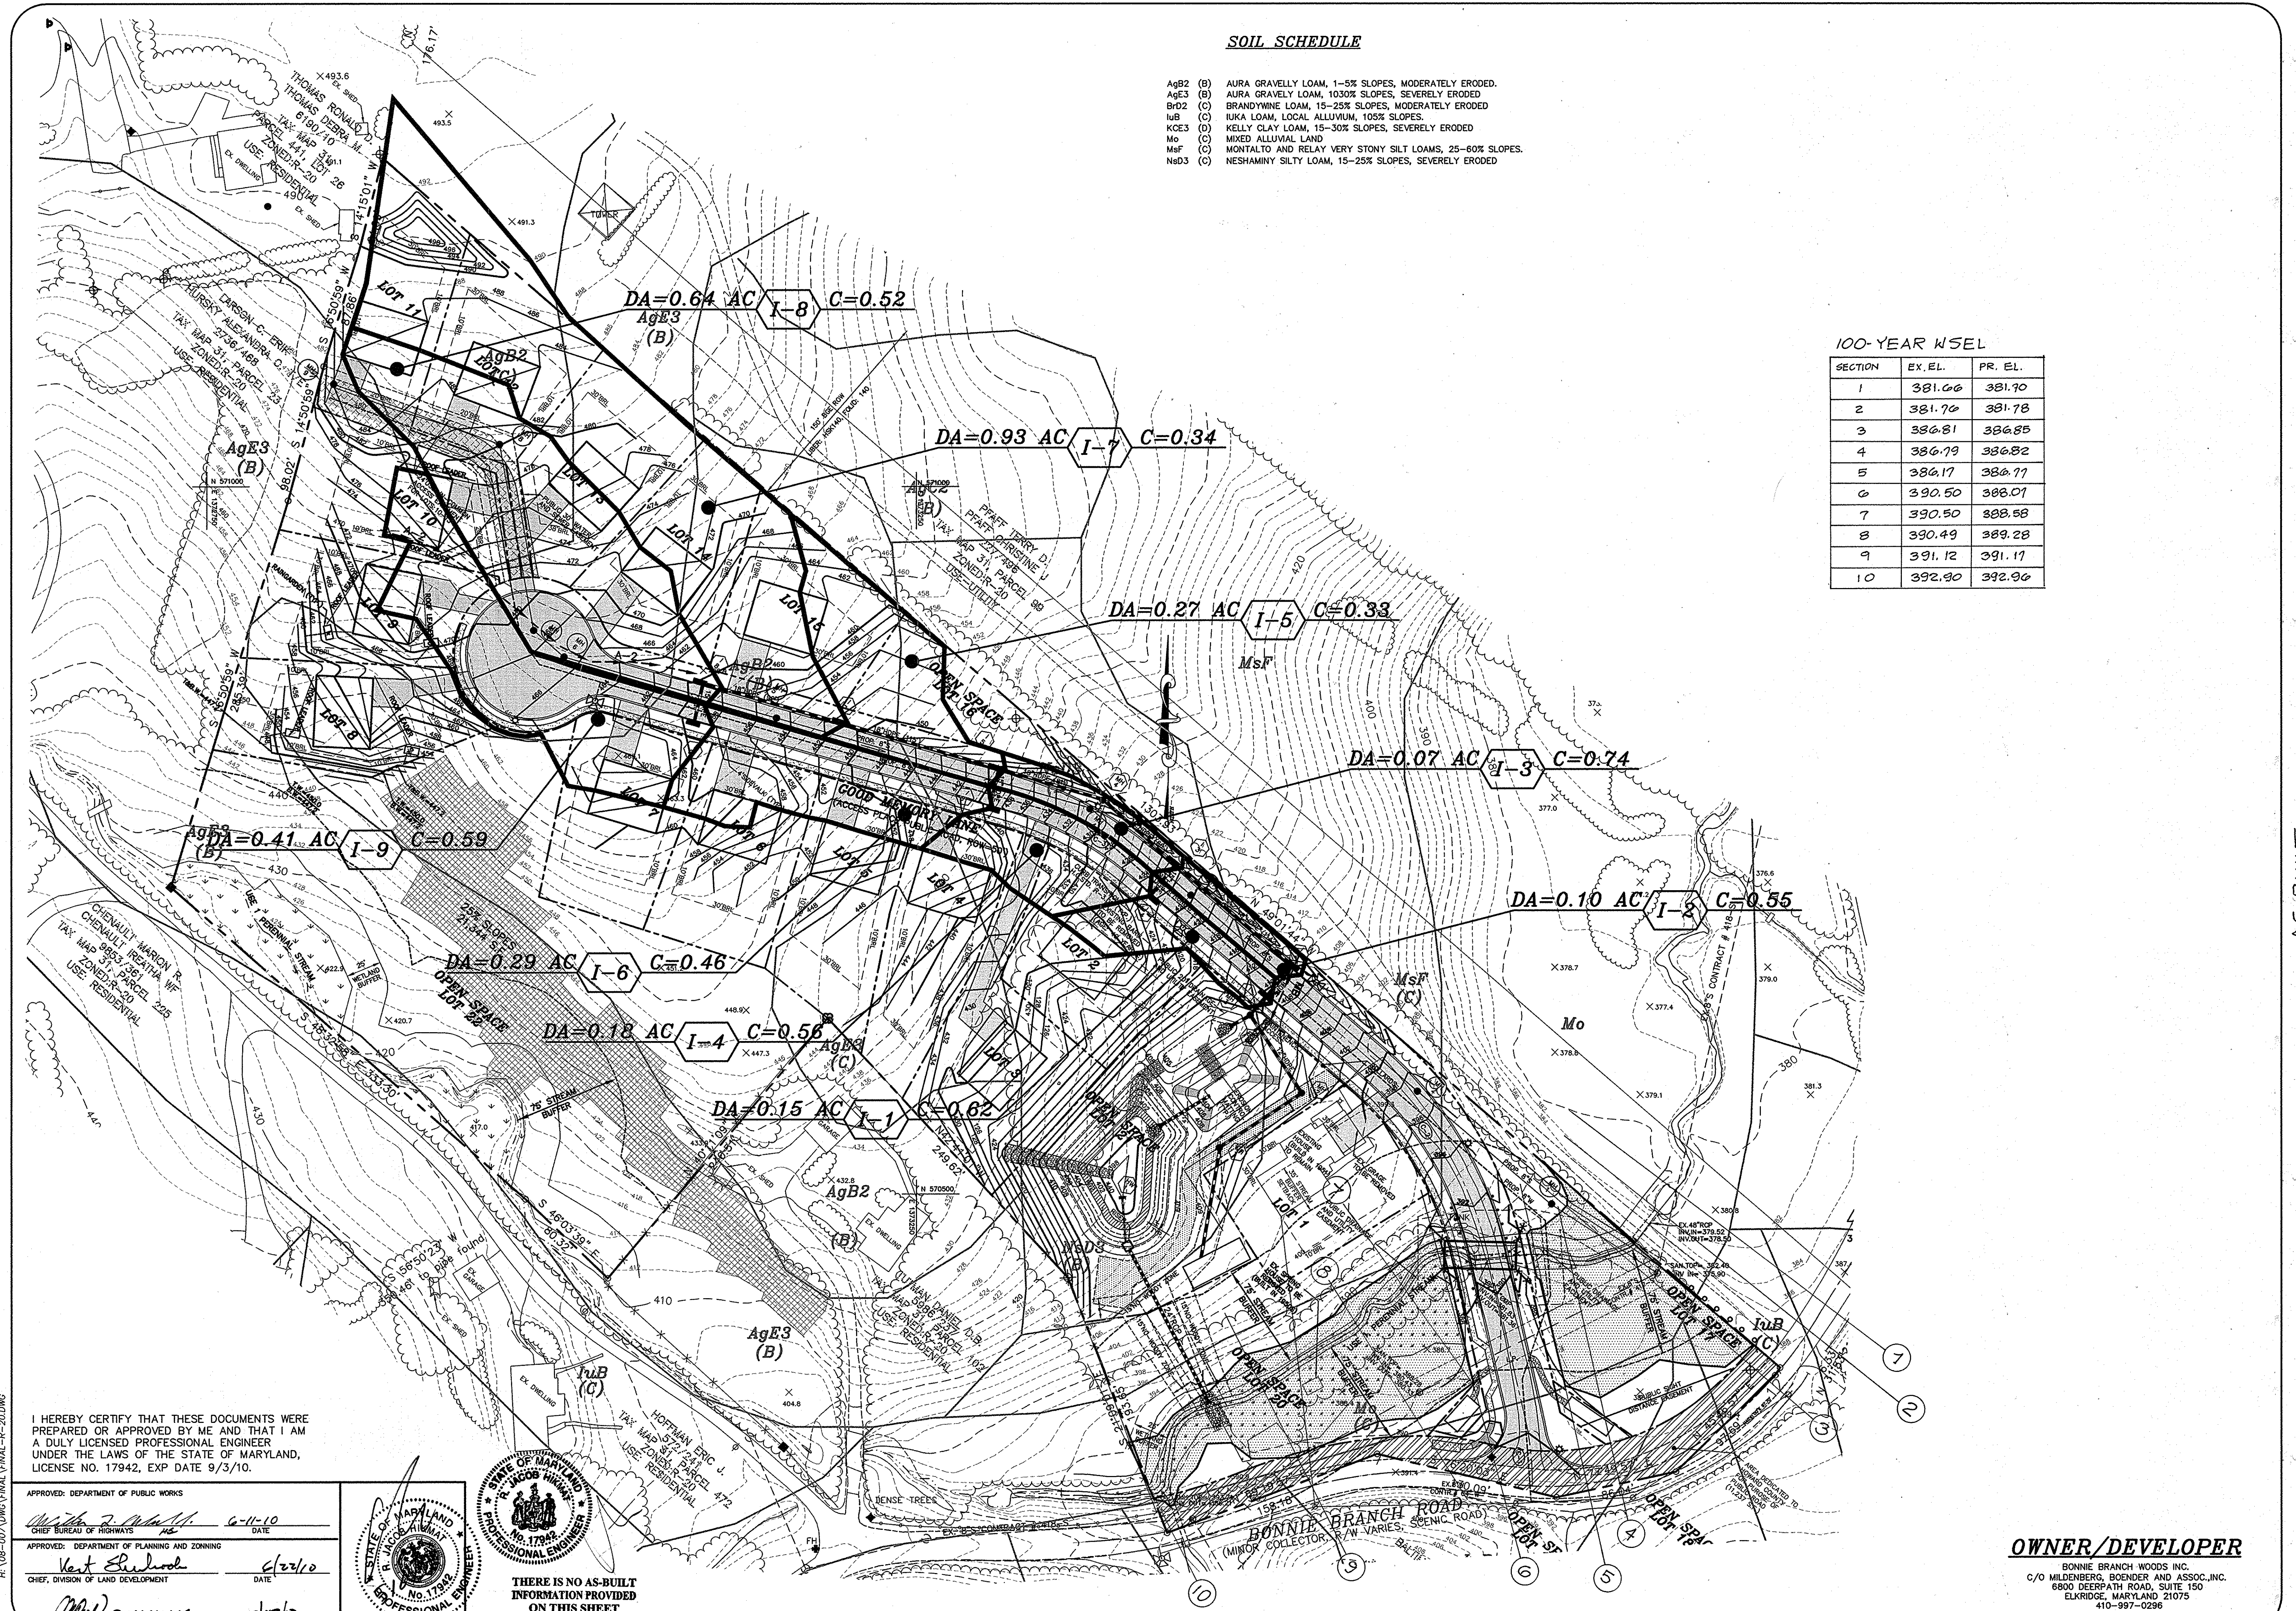

**SOIL SCHEDULE**

- AgB2 (B) AURA GRAVELLY LOAM, 1-5% SLOPES, MODERATELY ERODED.
- AgE3 (B) AURA GRAVELLY LOAM, 10-30% SLOPES, SEVERELY ERODED
- BrD2 (C) BRANDYME LOAM, 15-25% SLOPES, MODERATELY ERODED
- InB (C) IUKA LOAM, LOCAL ALLUVIUM, 10% SLOPES.
- KCE3 (D) KELLY CLAY LOAM, 15-30% SLOPES, SEVERELY ERODED
- Mo (C) MIXED ALLUVIAL LAND
- MsR (C) MONTALTO AND RELAY VERY STONY SILT LOAMS, 25-60% SLOPES.
- NsD3 (C) NESHAMINY SILTY LOAM, 15-25% SLOPES, SEVERELY ERODED

**100-YEAR WSEL**

SECTION	EX. EL.	PR. EL.
1	381.66	381.70
2	381.76	381.78
3	386.81	386.85
4	386.79	386.82
5	386.17	386.77
6	390.50	388.01
7	390.50	388.58
8	390.49	388.28
9	391.12	391.17
10	392.90	392.96

I HEREBY CERTIFY THAT THESE DOCUMENTS WERE PREPARED OR APPROVED BY ME AND THAT I AM A DULY LICENSED PROFESSIONAL ENGINEER UNDER THE LAWS OF THE STATE OF MARYLAND, LICENSE NO. 17942, EXP DATE 9/3/10.

APPROVED: DEPARTMENT OF PUBLIC WORKS  
 CHIEF BUREAU OF HIGHWAYS  
 DATE: 6-11-10

APPROVED: DEPARTMENT OF PLANNING AND ZONING  
 CHIEF, DIVISION OF LAND DEVELOPMENT  
 DATE: 6/22/10

APPROVED: DEVELOPMENT ENGINEERING DIVISION  
 DATE: 6/18/10



THERE IS NO AS-BUILT INFORMATION PROVIDED ON THIS SHEET

**OWNER/DEVELOPER**  
 BONNIE BRANCH WOODS INC.  
 C/O MILDENBERG, BOENDER AND ASSOC., INC.  
 6800 DEERPATH ROAD, SUITE 150  
 ELKRIDGE, MARYLAND 21075  
 410-997-0296


date	MAY 2010	engineering	MMM	approval	RIH
project	08-007	illustration	MMM	scale	1"=50'

no.	description	revisions	date


AS-BUILT  
**BONNIE BRANCH WOODS**  
 TAX MAP: 31 PARCEL 101 HOWARD COUNTY, MARYLAND  
 SECOND ELECTION DISTRICT  
**STORM DRAIN DRAINAGE AREA MAP**

**MILDENBERG, BOENDER & ASSOC., INC.**  
 Engineers Planners Surveyors  
 6800 Deerpath Road, Suite 150, Elkridge, Maryland 21075  
 (410) 997-0296 Fax (410) 997-0288 Fax




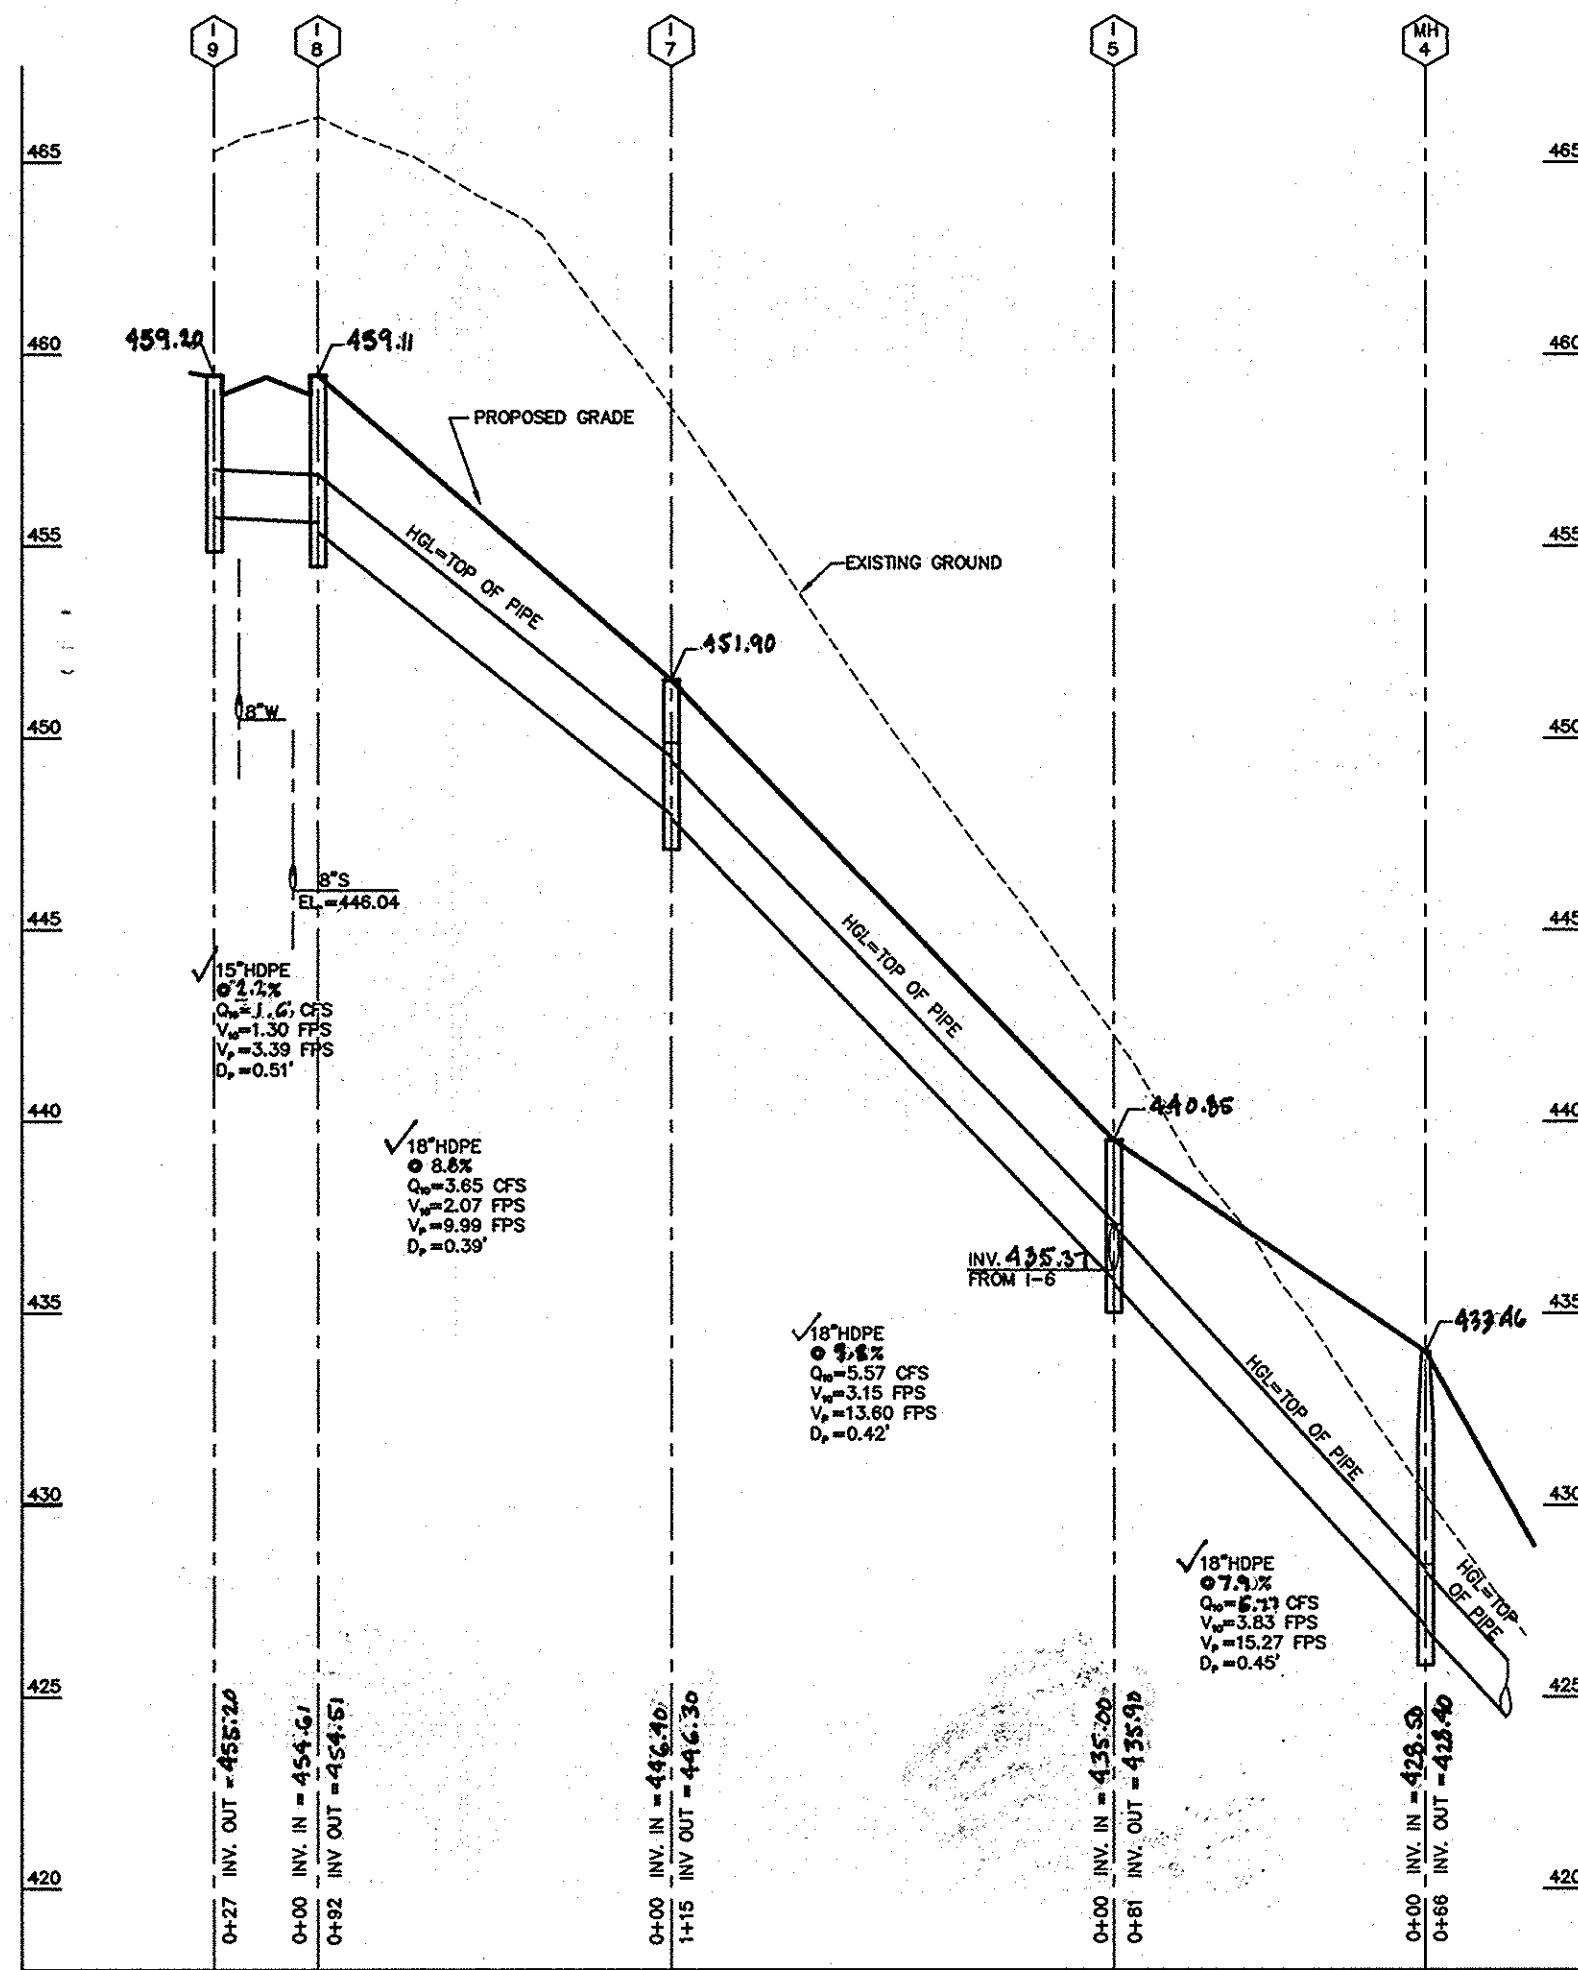


**STORM DRAIN PROFILE  
1-5 TO MH-4**  
SCALE: HOR. 1"=50'  
VER. 1"=5'

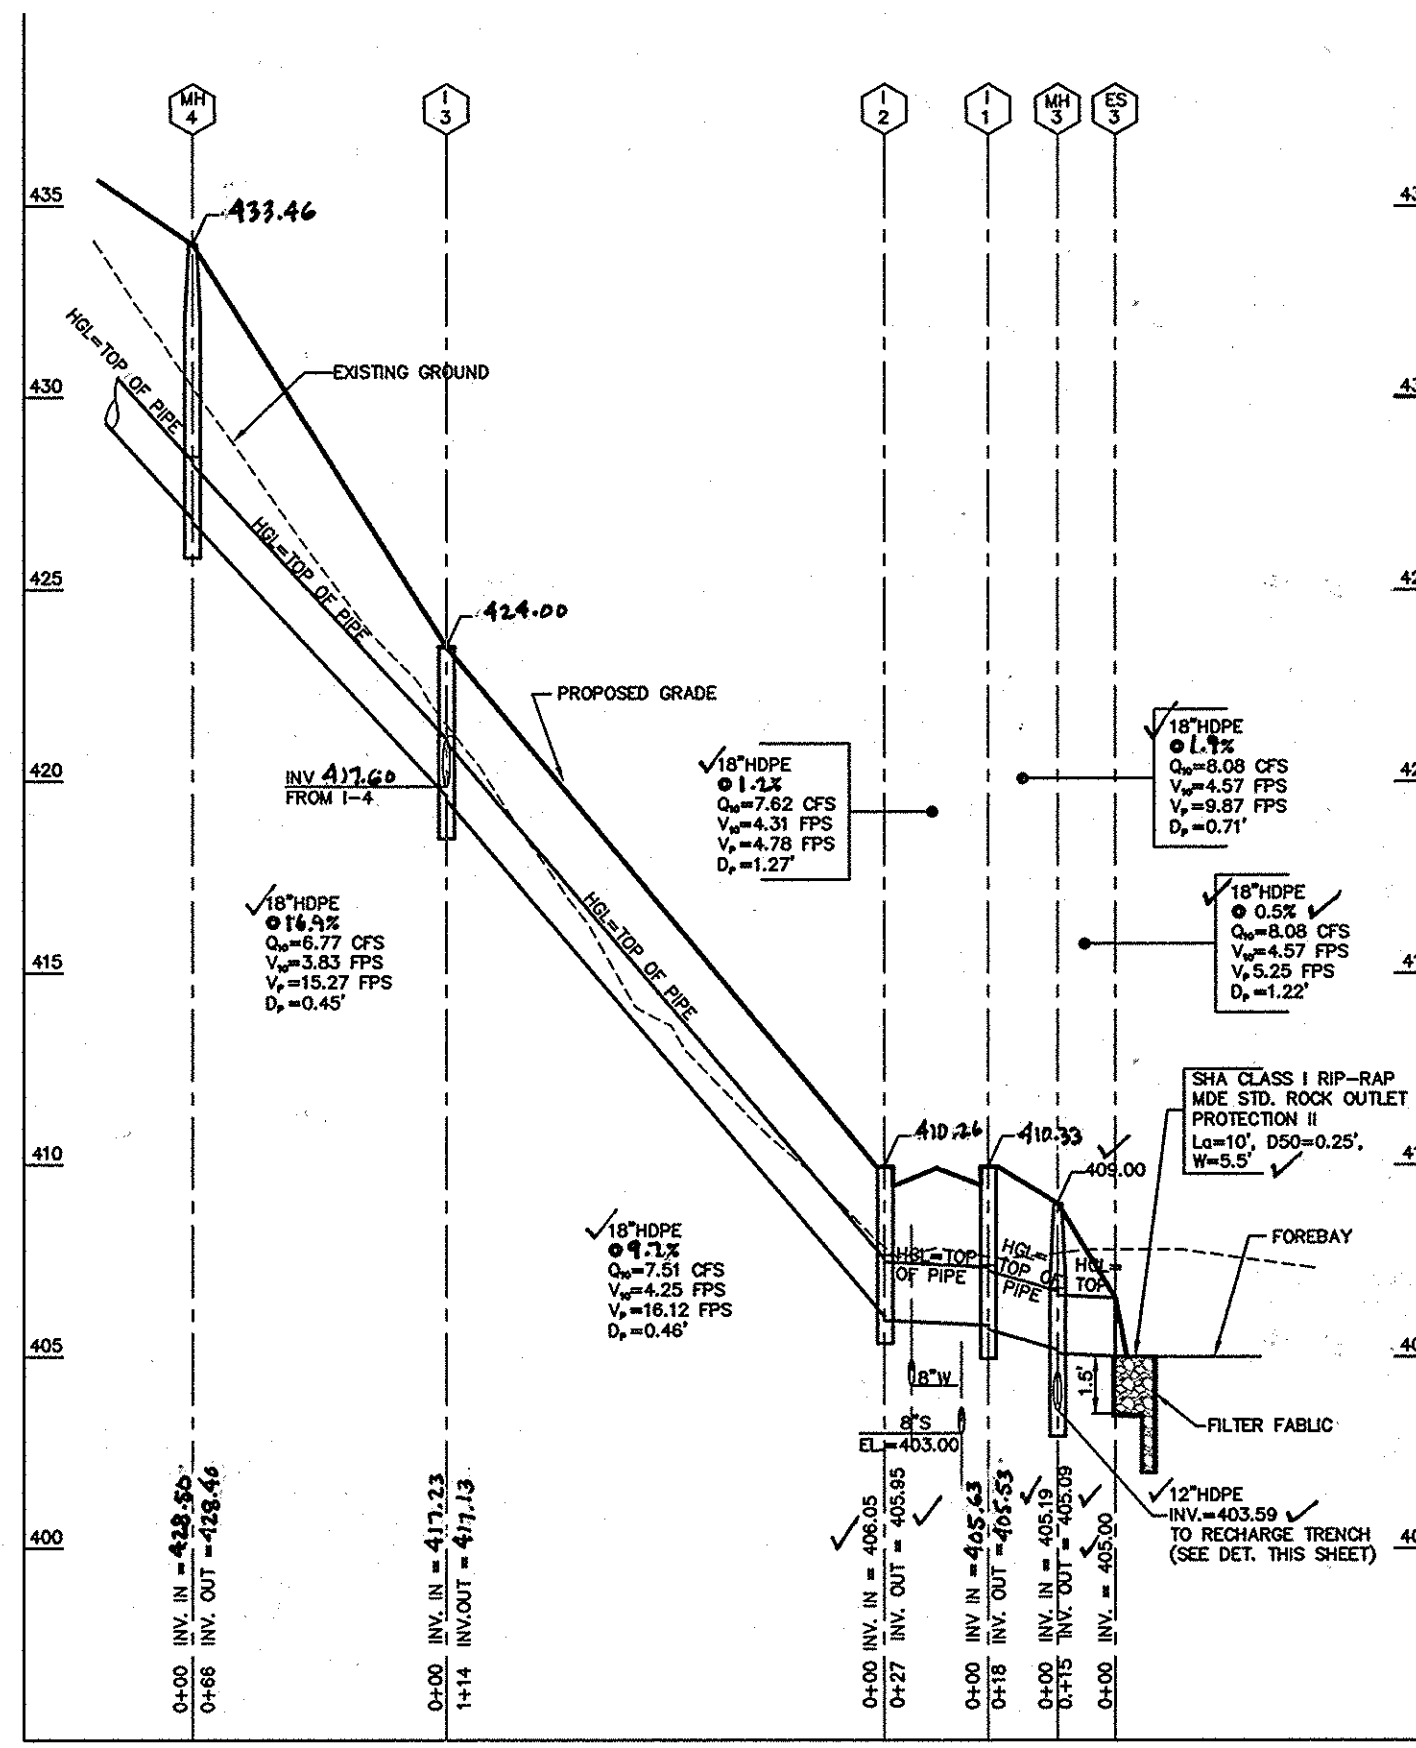


**STORM DRAIN PROFILE  
MH-4 TO EI-1**  
SCALE: HOR. 1"=50'  
VER. 1"=5'

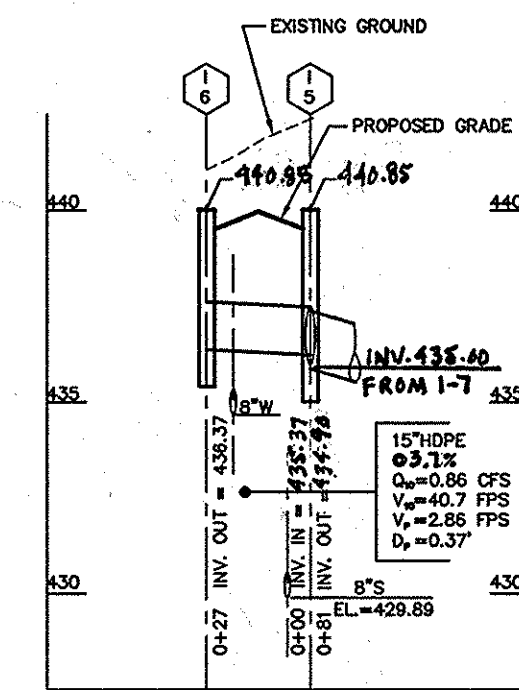

**STORM DRAIN PROFILE  
1-6 TO 1-5**  
SCALE: HOR. 1"=50'  
VER. 1"=5'

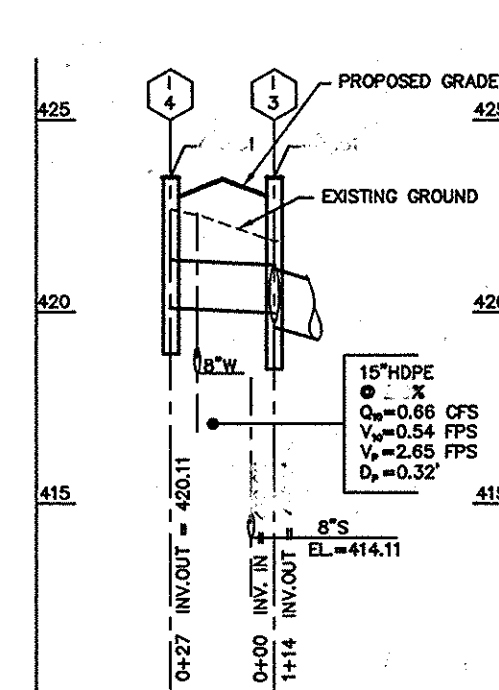


**STORM DRAIN PROFILE  
1-4 TO 1-3**  
SCALE: HOR. 1"=50'  
VER. 1"=5'

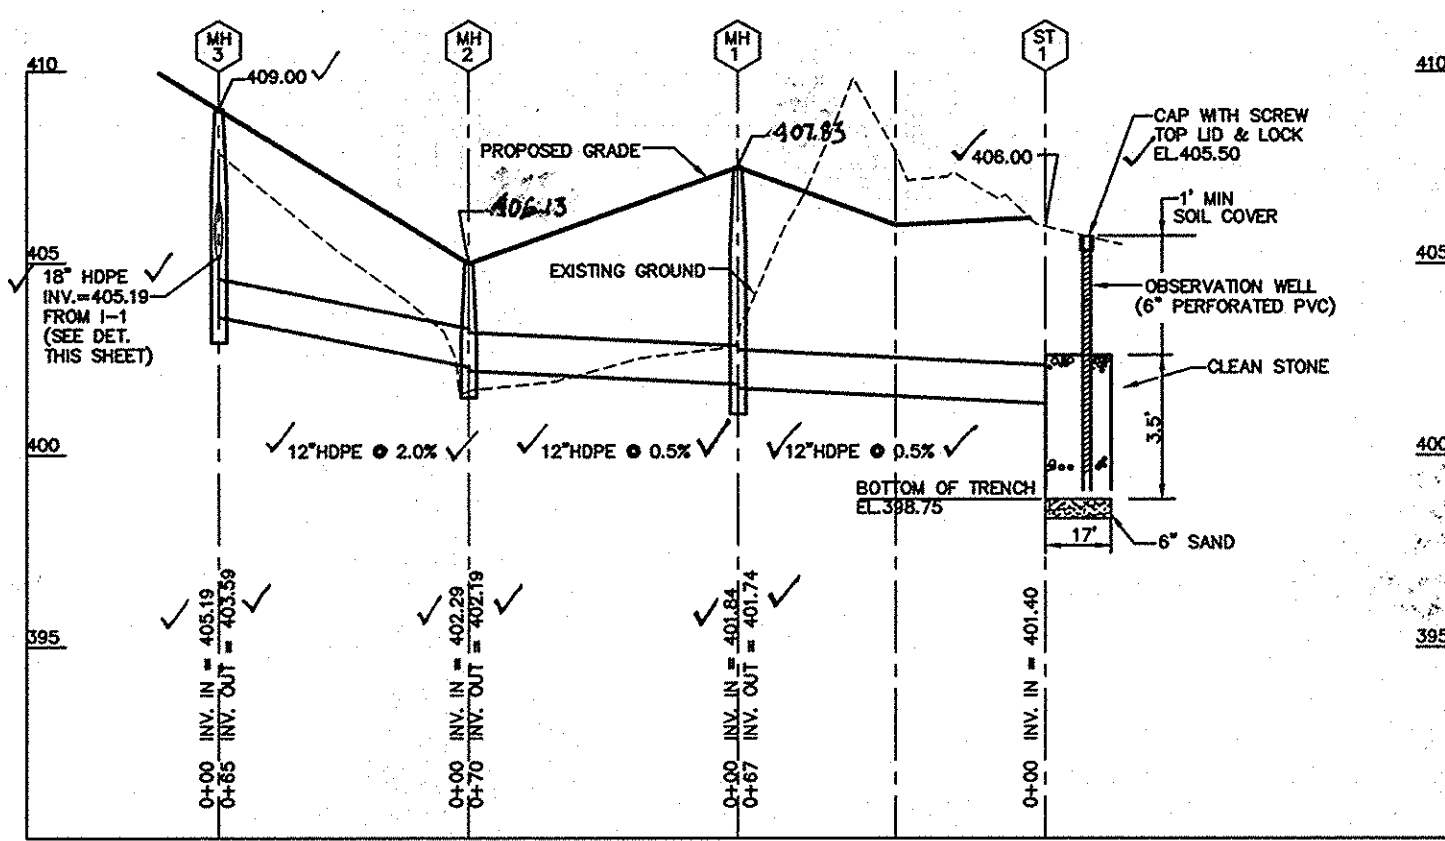


**STORM DRAIN PROFILE  
MH-3 TO ST-1**  
SCALE: HOR. 1"=50'  
VER. 1"=5'

NOTE: STORM DRAIN FROM MH-3 TO ST-1 AND STONE RECHARGE TRENCH SHALL BE OWNED AND MAINTAIN BY HOA.

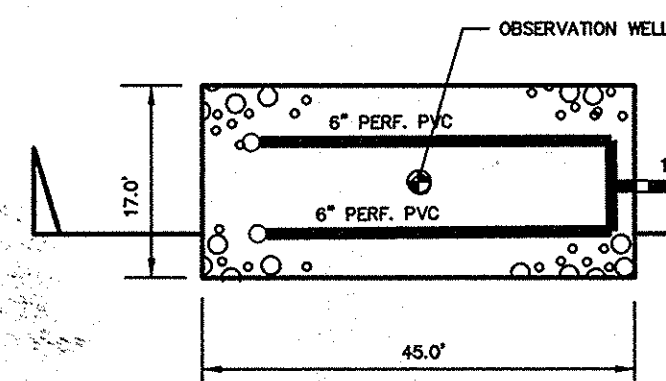

**STONE RECHARGE TRENCH**

- 1) FILTER FABRIC (CLASS C) TOP AND ALL SIDES EXCEPT BOTTOM
- 2) AGGREGATE SIZE 1.5" TO 3" MINIMUM WITH NO FINES
- 3) CAP ALL ENDS OF PIPE
- 4) USE SCHEDULE SDR 35 OR 40
- 5) PERFORATIONS 3/8" DIAMETER. TERMINATE PERFORATIONS A MINIMUM 1' FROM END OF TRENCH
- 6) GRASSES OF THE FESCUE FAMILY SHOULD BE PLANTED AROUND OBSERVATION WELL

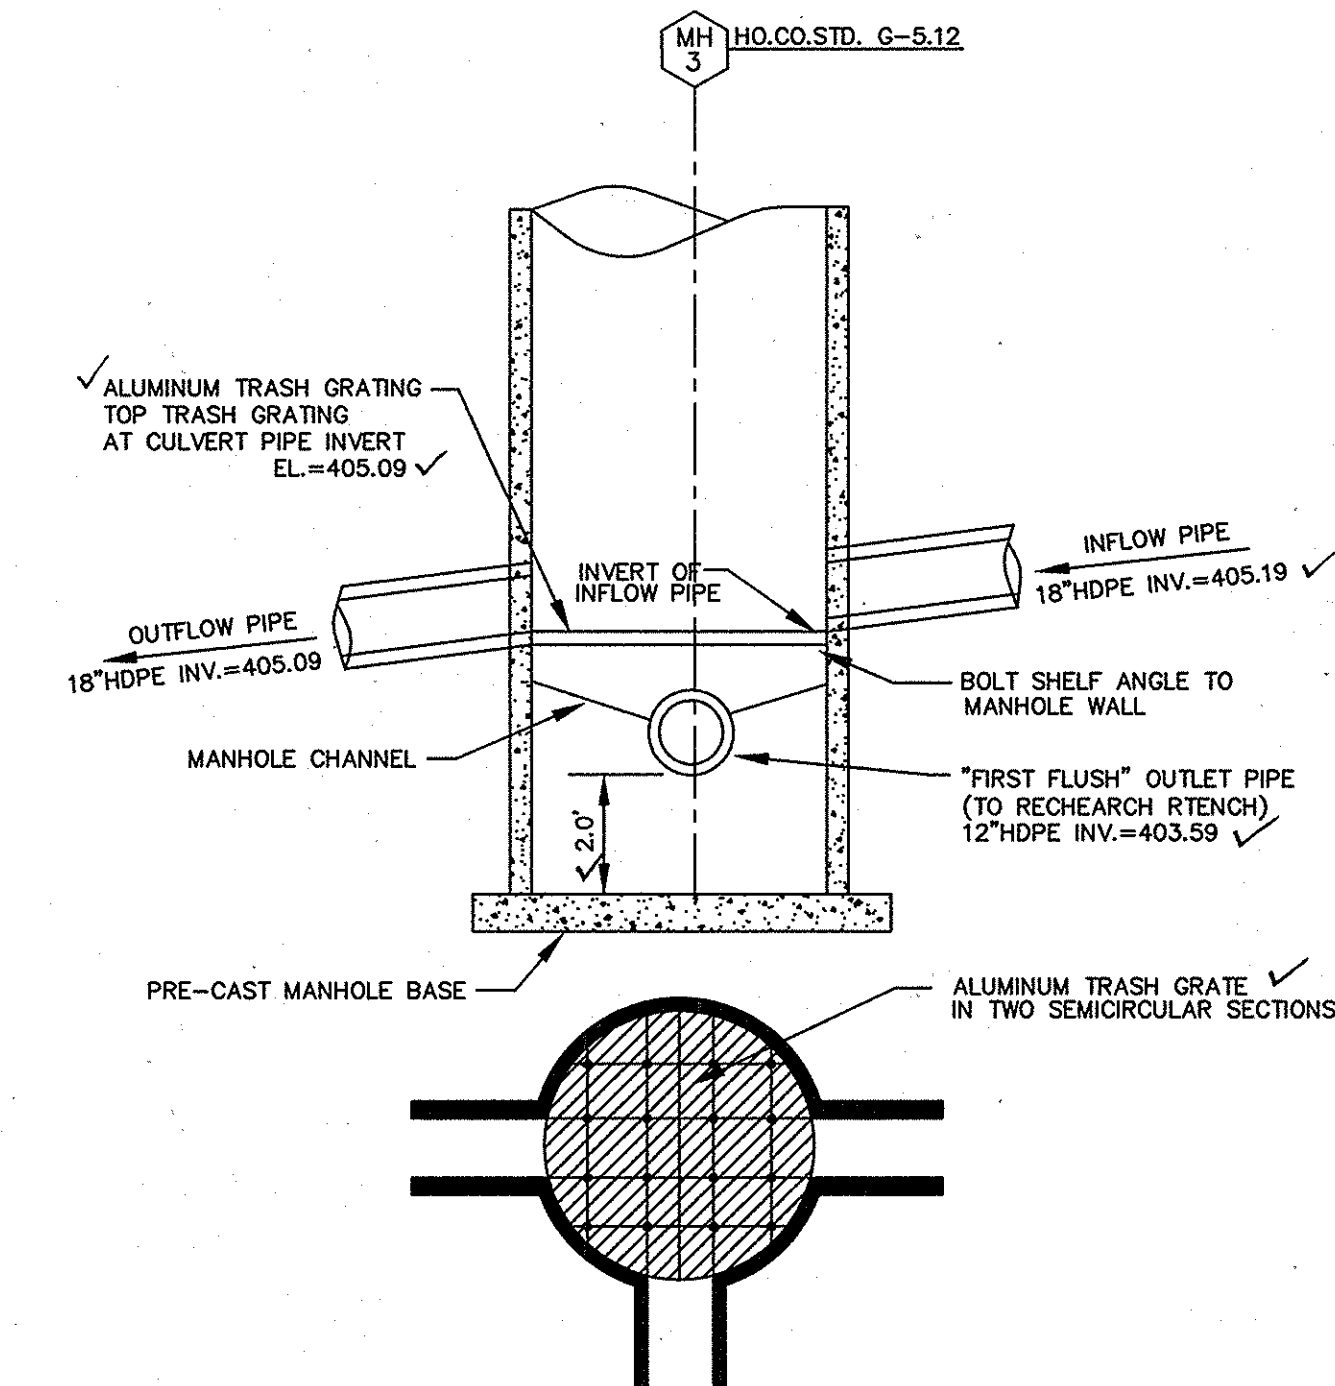

**DIVERSION MANHOLE #3 DETAIL**  
NTS

**STRUCTURE SCHEDULE**

NO.	LOCATION*	TOP**	INV. IN	INV. OUT	COMMENTS
EW-1	N 570,497.0 E 1,373,395.4	-	-	398.00 ✓	END WALL TYPE C (HO.CO.STD. D-5-21)
ES-1	N 570,356.7 E 1,373,454.0	-	-	367.50	END SECTION (HO.CO.STD. D-5.51)
ES-2	N 570,546.4 E 1,373,520.4	-	-	402.00 ✓	6" PVC END SECTION
ES-3	N 570,318.9 E 1,373,473.5	-	-	405.00 ✓	18" HDPE END SECTION
I-1	GOOD MEMORY LANE STA.4+15.0 OFFSET 12.52 LT.	410.53	406.63	406.53	INLET TYPE A-10 (HO. CO. STD D-4.03)
I-2	GOOD MEMORY LANE STA.4+15.0 OFFSET 12.52 RT.	410.26	406.05 ✓	405.95 ✓	INLET TYPE A-10 (HO. CO. STD D-4.03)
I-3	GOOD MEMORY LANE STA.5+28.0 OFFSET 12.52 RT.	424.00	417.65	417.33	INLET TYPE A-10 (HO. CO. STD D-4.03)
I-4	GOOD MEMORY LANE STA.5+28.0 OFFSET 12.52 LT.	424.00	-	420.11	INLET TYPE A-10 (HO. CO. STD D-4.03)
I-5	GOOD MEMORY LANE STA.6-65.5 OFFSET 12.52 RT.	440.85	438.31	434.90	INLET TYPE A-10 (HO. CO. STD D-4.03)
I-6	GOOD MEMORY LANE STA.6-65.5 OFFSET 12.52 LT.	440.85	-	436.90	INLET TYPE A-10 (HO. CO. STD D-4.03)
I-7	GOOD MEMORY LANE STA.7-80.5 OFFSET 12.52 RT.	451.90	446.40	446.30	INLET TYPE A-10 (HO. CO. STD D-4.03)
I-8	GOOD MEMORY LANE STA.8+71.0 OFFSET 12.52 RT.	459.11	454.61	454.51	INLET TYPE A-10 (HO. CO. STD D-4.03)
I-9	GOOD MEMORY LANE STA.8+71.0 OFFSET 12.52 LT.	459.20	-	455.20	INLET TYPE A-10 (HO. CO. STD D-4.03)
MH-1	N 470,513.4 E 1,373,439.1	401.84 ✓	401.74 ✓	401.74 ✓	MH (HO. CO. STD G 5.12)
MH-2	N 570,571.2 E 1,373,521.5	406.13	402.29 ✓	402.19 ✓	MH (HO. CO. STD G 5.12)
MH-3	N 570,626.4 E 1,373,485.4	409.00 ✓	405.19 ✓	405.09 ✓	MH (HO. CO. STD G 5.12)
MH-4	GOOD MEMORY LANE STA.5+89.0 OFFSET 12.52 RT.	433.46	428.50	428.40	MH (HO. CO. STD G 5.12)

\* STATIONS GIVEN TO CENTERLINE FACE OF INLET AT TOP OF CURB FOR INLETS LOCATED WITHIN THE ROAD RIGHT-OF-WAY. STATIONS FOR YARD INLETS TO CL OF INLET. LOCATION OF MANHOLES IS TO CL OF MANHOLE COVER. END SECTION GIVEN TO THE CENTERLINE OF PIPE AT THE CONNECTION OF THE STORM DRAIN PIPE TO THE END SECTION.  
\*\* ELEVATIONS MEASURED TO CENTER OF ALL INLETS.

**PIPE SCHEDULE**


QUANTITY	PIPE SIZE
214	12" HDPE
289	15" HDPE
428	18" HDPE
85	6" PERFORATE PVC

I HEREBY CERTIFY THAT THESE DOCUMENTS WERE PREPARED OR APPROVED BY ME AND THAT I AM A DULY LICENSED PROFESSIONAL ENGINEER UNDER THE LAWS OF THE STATE OF MARYLAND, LICENSE NO. 17942, EXP DATE 9/3/10.

APPROVED: DEPARTMENT OF PUBLIC WORKS  
*William J. Mahall* 6-11-10  
CHIEF BUREAU OF HIGHWAYS DATE

APPROVED: DEPARTMENT OF PLANNING AND ZONING  
*Robert J. ...* 6/22/10  
CHIEF, DIVISION OF LAND DEVELOPMENT DATE

*William J. Mahall* 6/18/10  
CHIEF, DEVELOPMENT ENGINEERING DIVISION DATE

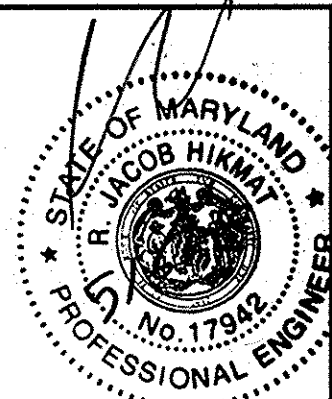

I hereby certify that the facility shown on this plan was constructed as shown on the 'As-Built' plans and meets with the approved plans and specifications.



**OWNER/DEVELOPER**

BONNIE BRANCH WOODS INC.  
C/O MILDENBERG, BOENDER AND ASSOC., INC.  
6800 DEERPATH ROAD, SUITE 150  
ELK RIDGE, MARYLAND 21075  
410-997-0296

AS-BUILT


**BONNIE BRANCH WOODS**  
TAX MAP: 31 PARCEL 101  
SECOND ELECTION DISTRICT HOWARD COUNTY, MARYLAND  
STORM DRAIN PROFILES

**MILDENBERG, BOENDER & ASSOC., INC.**  
Engineers Planners Surveyors  
6800 Deerpath Road, Suite 150, Elkridge, Maryland 21075  
(410) 997-0296 Fax

PROJECT: 08-007  
DATE: MAY 2010  
ILLUSTRATION: MMM  
SCALE: 1"=50'  
APPROVAL: RHH

6 OF 24  
F-10-042



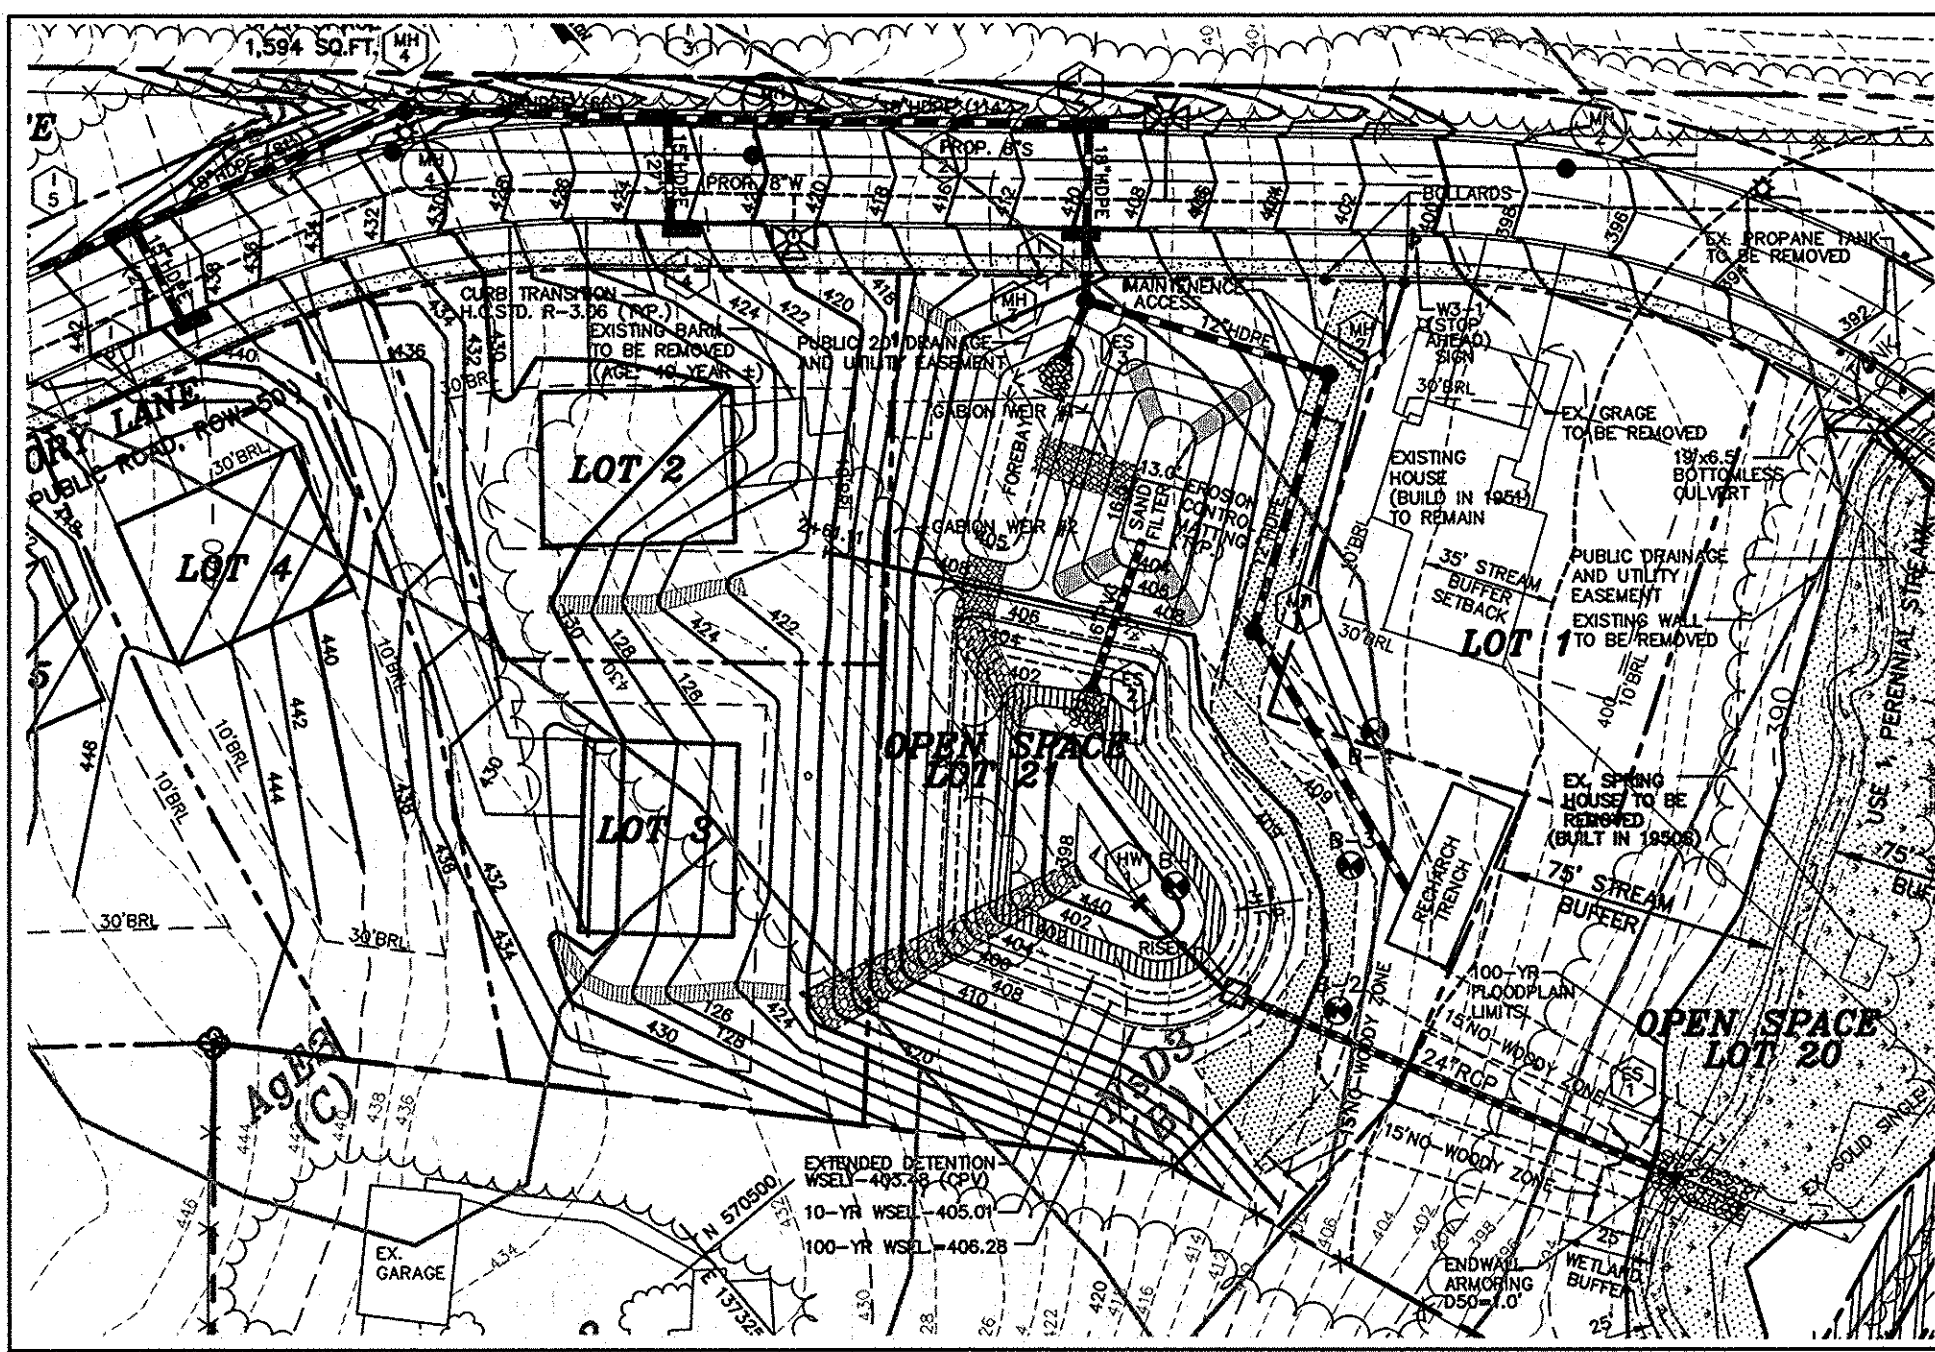


**STORMWATER MANAGEMENT PLAN**  
SCALE: 1"=50'



**POND DATA:**

HAZARD CLASSIFICATION:	"A"
F-1 SAND FILTER, EXTENDED DETENTION	
DRAINAGE AREA:	5.65 AC
PROPOSED R/OH:	72
PROPOSED Tc:	0.26
SAND FILTER AREA (WQV):	200 S.F.
EXTENDED DETENTION WSEL:	403.48
10-YR CLOGGED Q:	10.79 CFS
10-YR CLOGGED WSEL:	405.36
10-YR Q:	6.04 CFS
10-YR WSEL:	405.01
100-YR Q:	18.88 CFS
100-YR WSEL:	406.28
W <sub>AV</sub> REQUIRED:	4,182 C.F.
W <sub>AV</sub> PROVIDED:	4,182 C.F.
REV. REQUIRED:	1,179 C.F.
REV. PROVIDED:	1,179 C.F.
MAINTENANCE:	JOINTLY MAINTAINED
OWNERSHIP:	PRIVATE


**TOP SLAB DETAIL**  
SCALE: 1"=5'

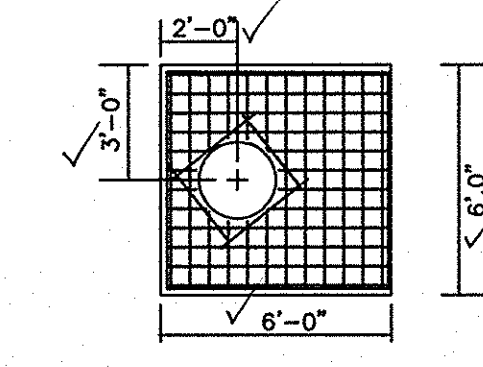


**ELEVATION OF TRASH RACK**  
SCALE: 1"=5'

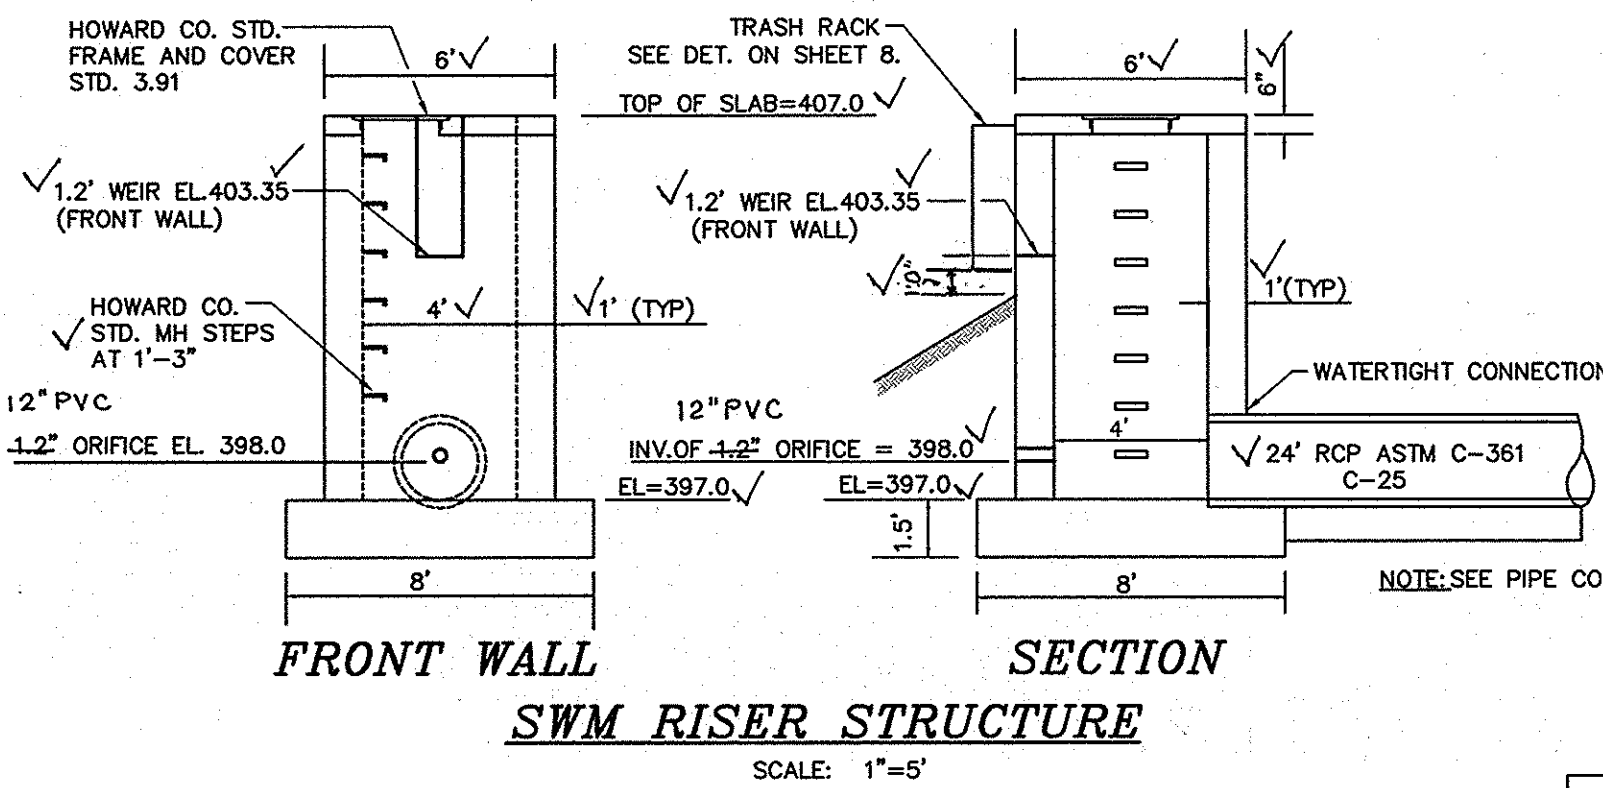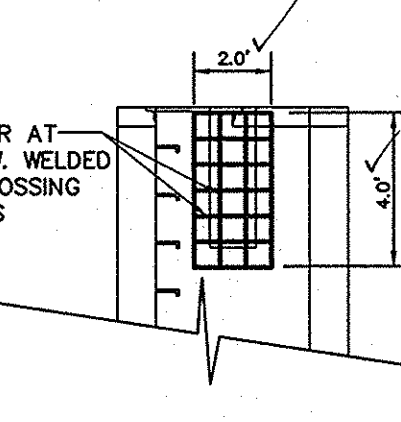


**FRONT WALL SECTION SWM RISER STRUCTURE**  
SCALE: 1"=5'

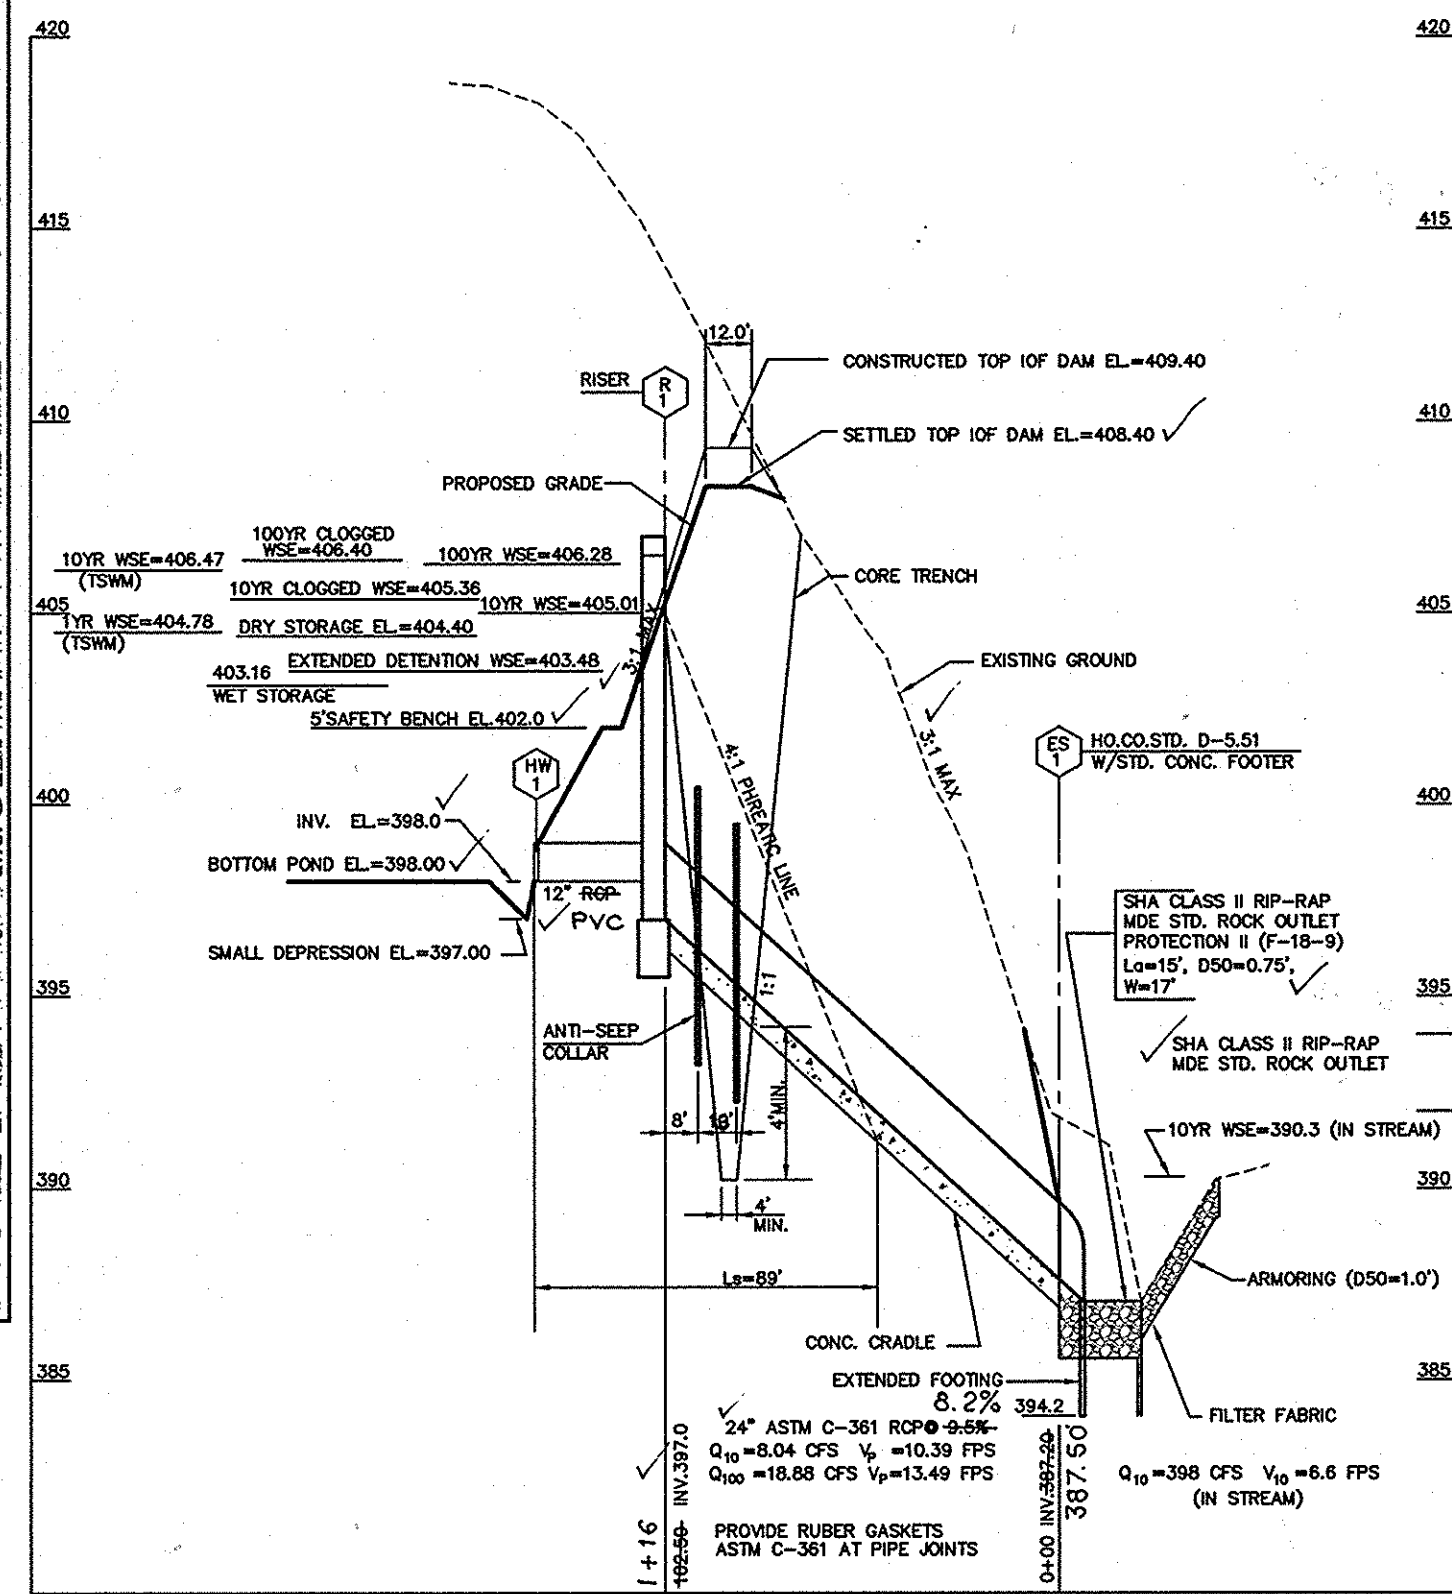


**PRINCIPLE SPILLWAY PROFILE**  
SCALE: HOR. 1"=30' VER. 1"=5'

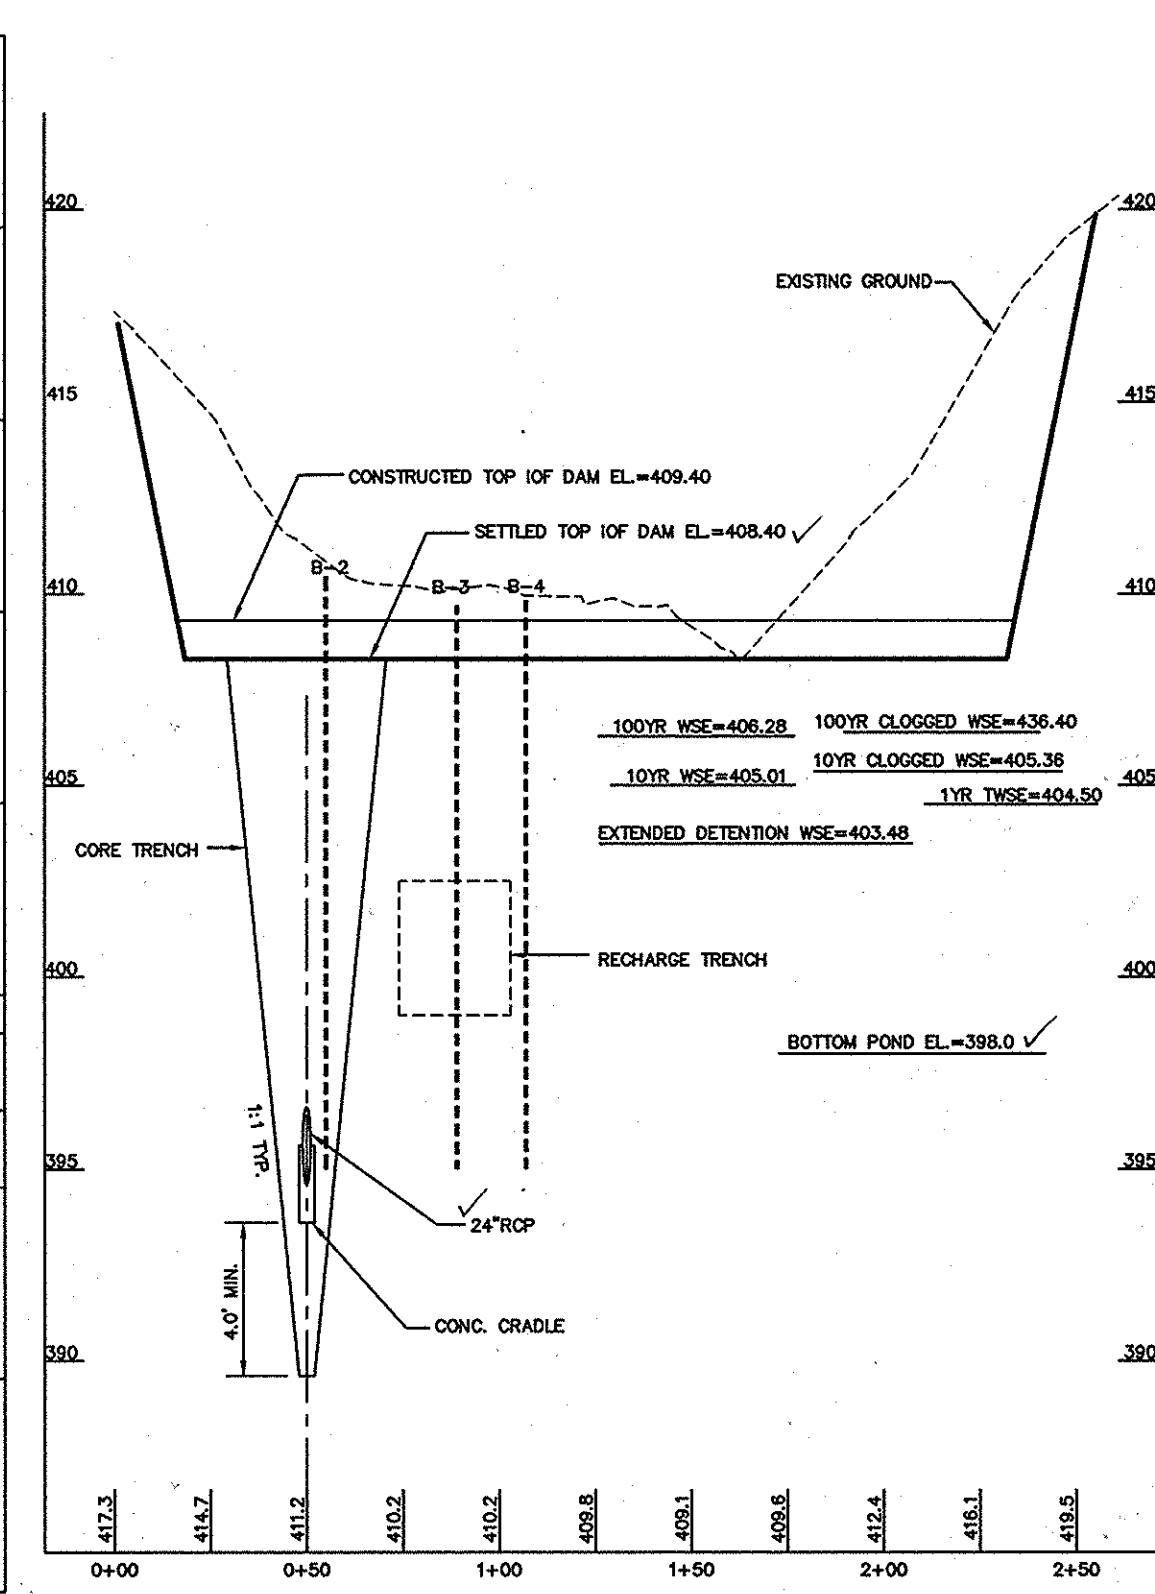


**CENTERLINE DAM PROFILE**  
SCALE: HOR. 1"=50' VER. 1"=5'

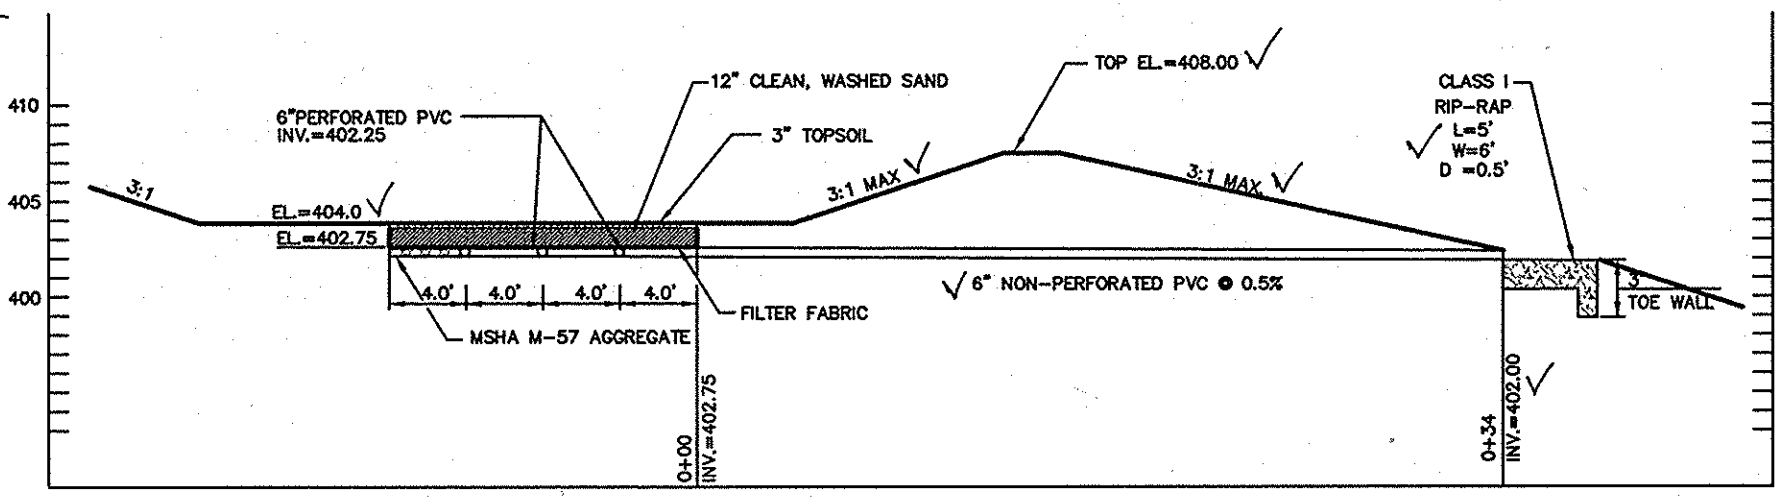


**SAND FILTER PROFILE**  
SCALE: 1"=10'

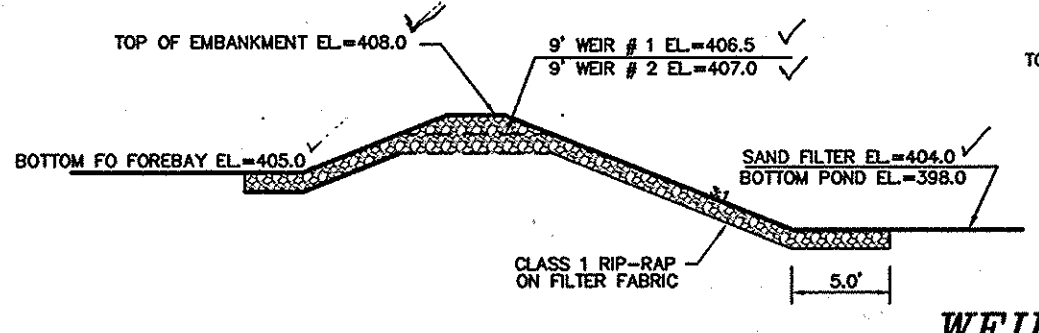


**WEIR DETAIL**  
SCALE: 1"=10'

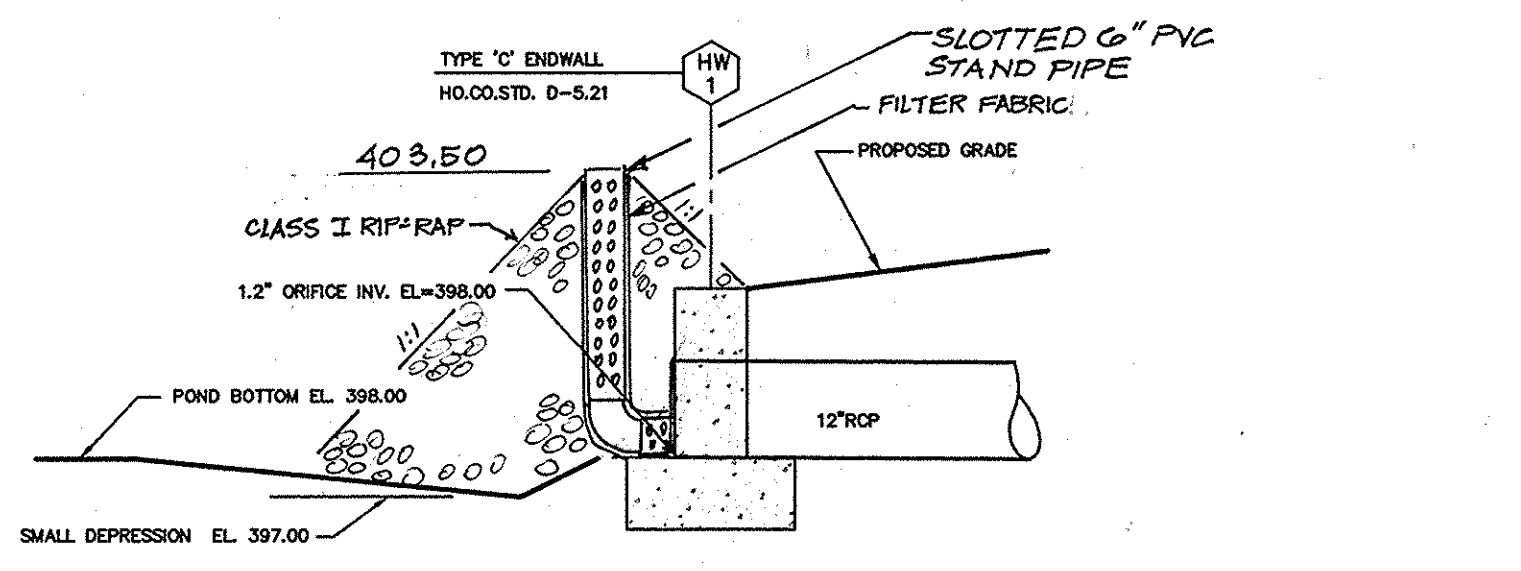


**HEAD WALL DETAIL**  
SCALE: 1"=2'

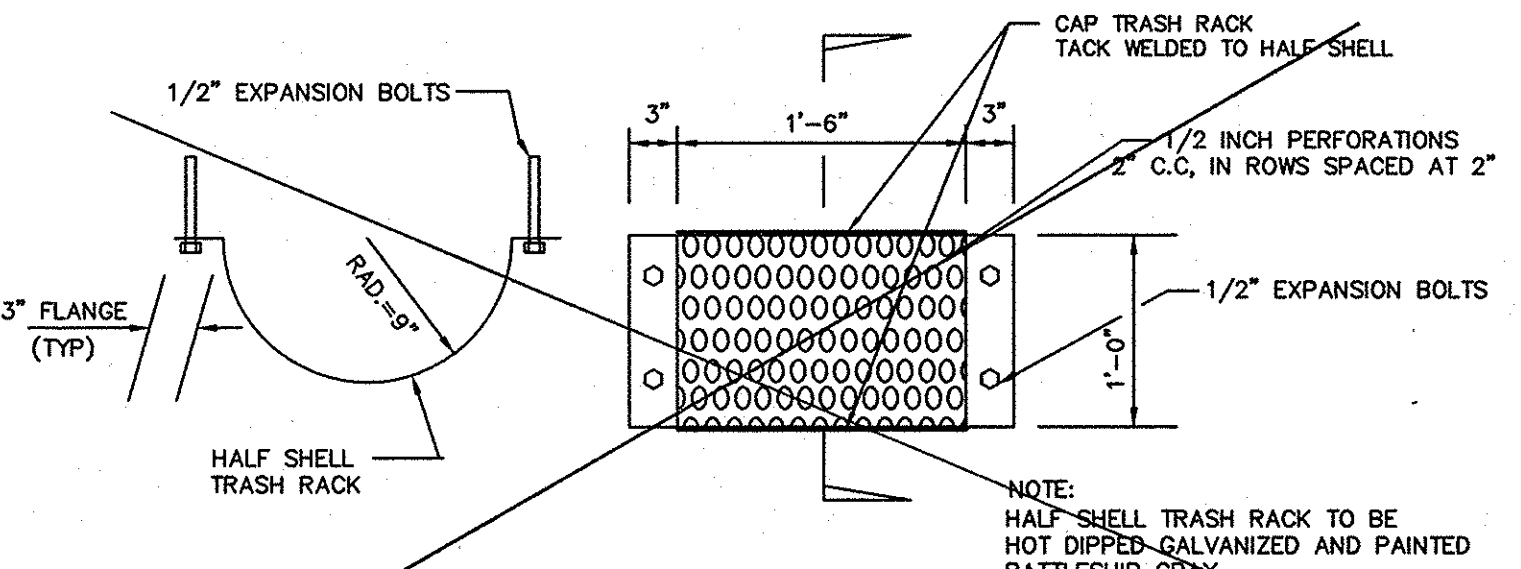

**HALF SHELL TRASH RACK**  
SCALE: 1"=1'

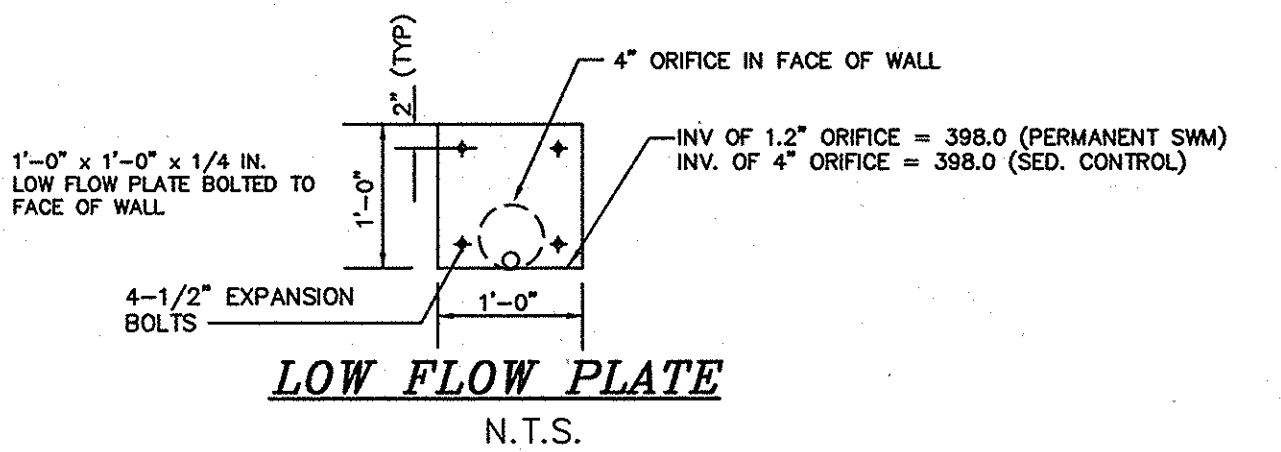


**LOW FLOW PLATE**  
N.T.S.

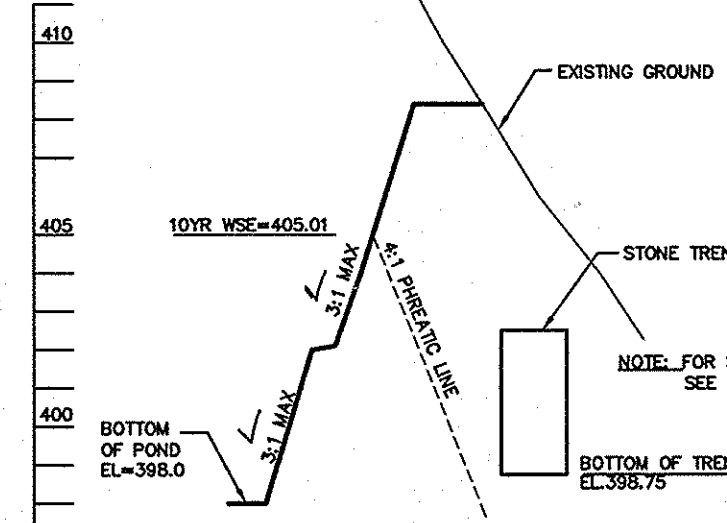


**EMBANKMENT AND STONE TRENCH SECTION**  
SCALE: HOR. 1"=50' VER. 1"=5'

**SEDIMENT BASIN #1: SCHEDULE**


EXISTING DRAINAGE AREA =	4.20 AC.
PROPOSED DRAINAGE AREA =	5.55 AC.
STORAGE REQUIRED =	19,980 CU. FT.
STORAGE PROVIDED =	19,980 @ EL. 404.4
BARREL SIZE =	24" RCP
BARREL SIZE =	24" RCP
DEPTH BELOW OUTLET EL. =	5.16'
EMBANKMENT EL. =	408.40
OUTLET ELEV. =	403.16
CLEANOUT ELEV. =	402.32
BOTTOM ELEV. =	398.0
BOTTOM DIMENSIONS =	17.5'x19.5'x30.0'
EXISTING Q <sub>2</sub> =	1.42 CFS
PROPOSED Q <sub>2</sub> =	14.6 CFS

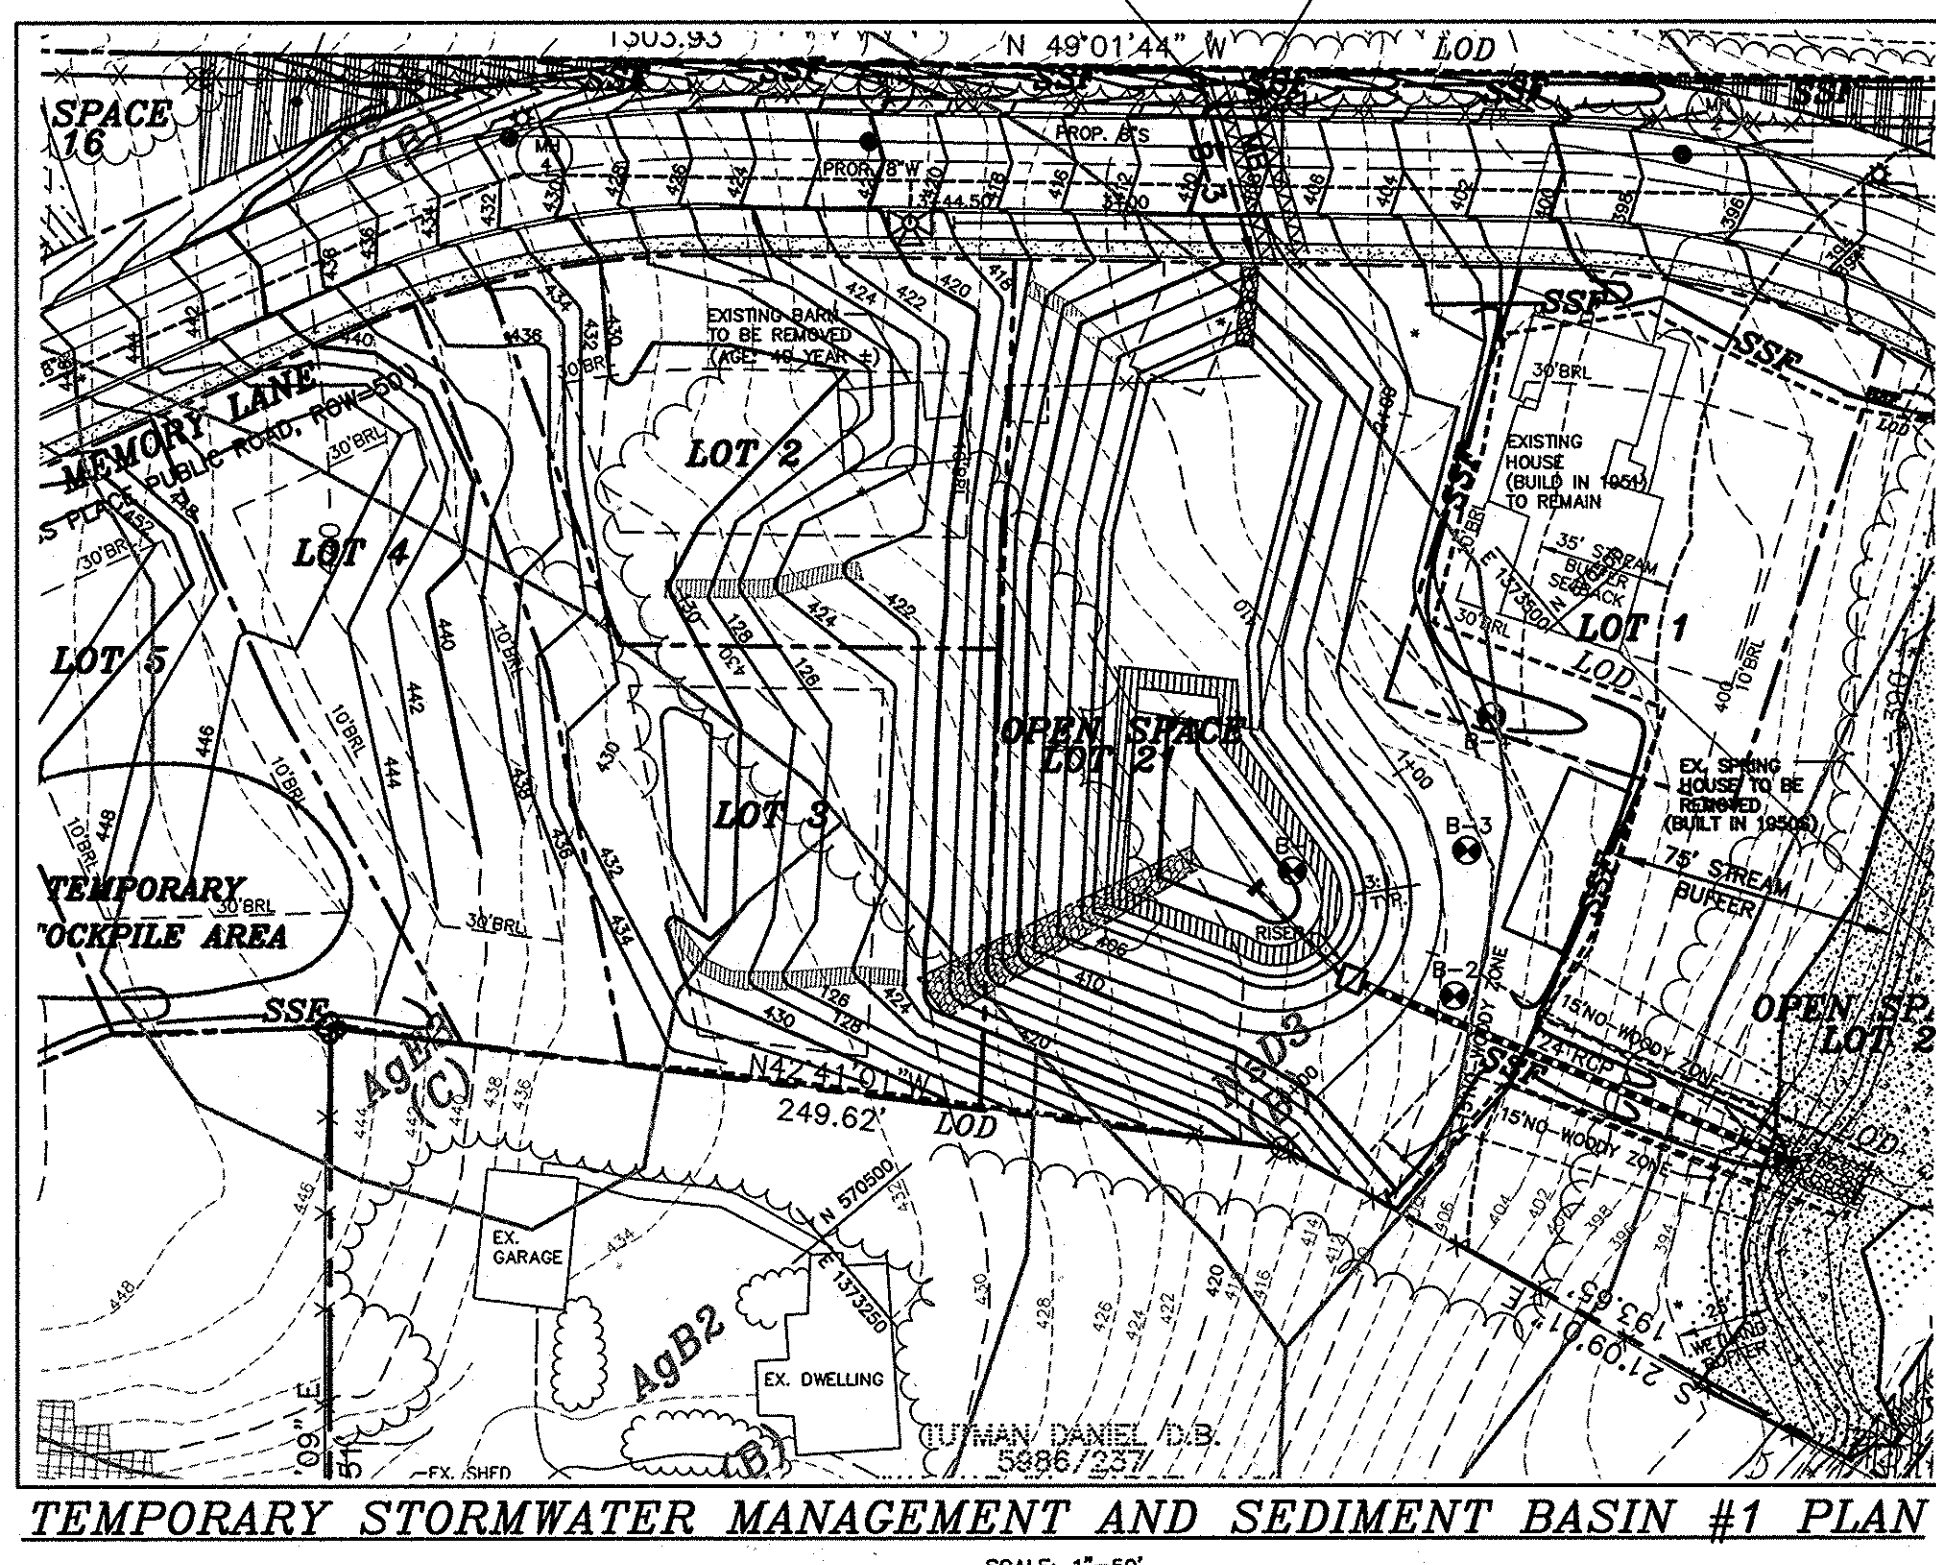

**TEMPORARY STORMWATER MANAGEMENT AND SEDIMENT BASIN #1 PLAN**  
SCALE: 1"=50'

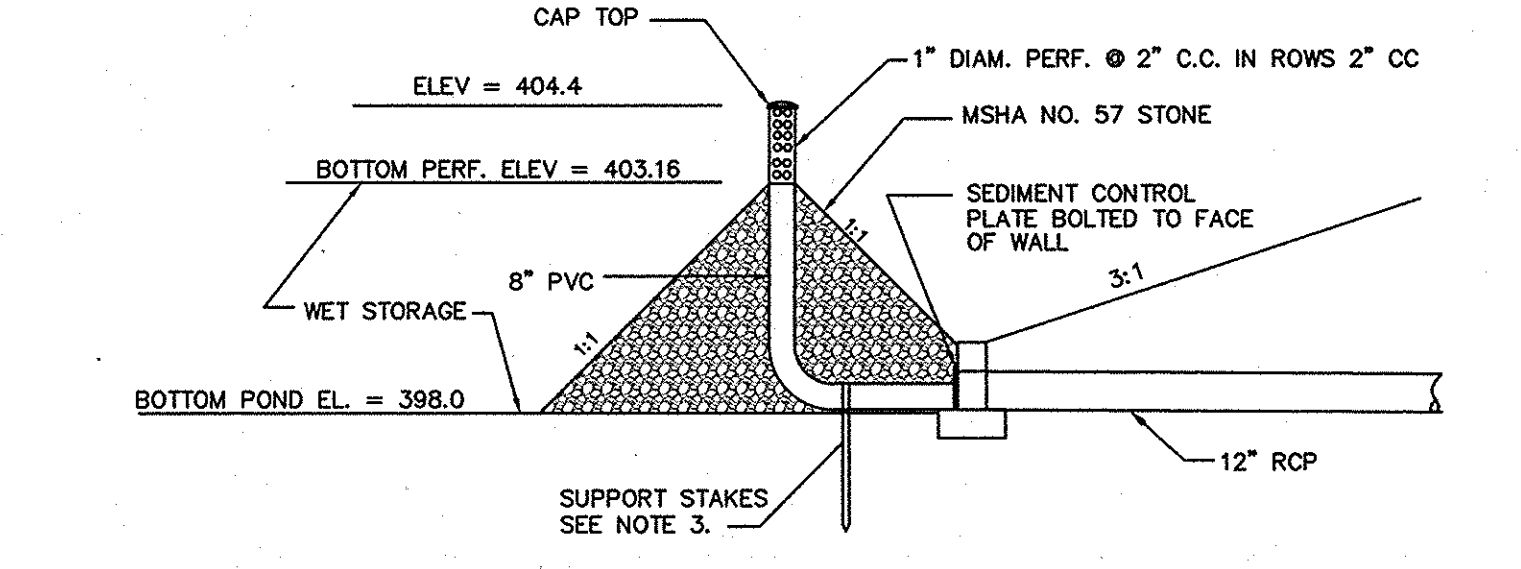

**TEMPORARY DEWATERING STANDPIPE**  
SCALE: 1"=5'

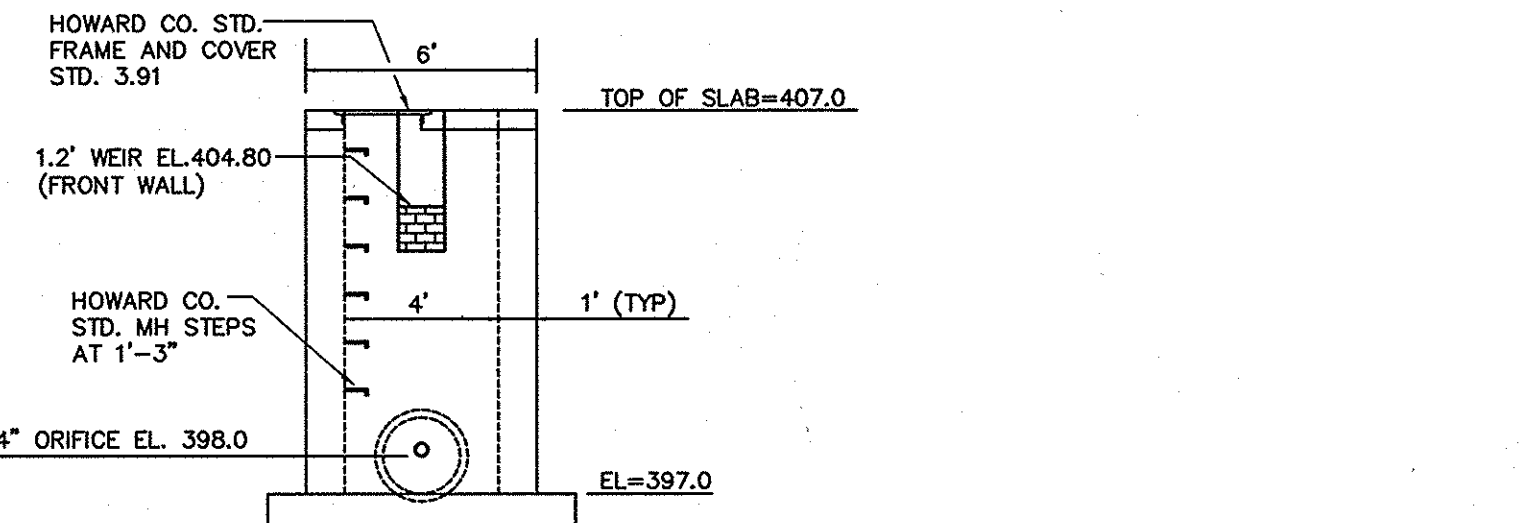

**TSWM BLOCKING DETAIL**  
SCALE: 1"=5'

**OWNER/DEVELOPER**

BONNIE BRANCH WOODS INC.  
C/O MILDENBERG, BOENDER AND ASSOC., INC.  
6800 DEERPATH ROAD, SUITE 150  
ELK RIDGE, MARYLAND 21075  
410-997-0296

BY THE DEVELOPER:  
I/WE CERTIFY THAT ALL DEVELOPMENT AND/OR CONSTRUCTION WILL BE DONE ACCORDING TO THESE PLANS, AND THAT ANY RESPONSIBLE PERSONNEL INVOLVED IN THE CONSTRUCTION PROJECT WILL HAVE A CERTIFICATE OF ATTENDANCE AT A DEPARTMENT OF THE ENVIRONMENT APPROVED TRAINING PROGRAM FOR THE CONTROL OF SEDIMENT AND EROSION BEFORE BEGINNING THE PROJECT. I SHALL ENGAGE A REGISTERED PROFESSIONAL ENGINEER TO SUPERVISE POND CONSTRUCTION AND PROVIDE THE HOWARD SOIL CONSERVATION DISTRICT WITH AN "AS-BUILT" PLAN OF THE POND WITHIN 30 DAYS OF COMPLETION. I ALSO AUTHORIZE PERIODIC ON-SITE INSPECTIONS BY THE HOWARD SOIL CONSERVATION DISTRICT.

Signature: *John Douglas Cashmere*  
DATE: 5/16/10

Signature of Developer: *John Douglas Cashmere*  
PRINTED NAME OF DEVELOPER

BY THE ENGINEER:  
I CERTIFY THAT THIS PLAN FOR POND CONSTRUCTION, EROSION AND SEDIMENT CONTROL REPRESENTS A PRACTICAL AND WORKABLE PLAN BASED ON MY PERSONAL KNOWLEDGE OF THE SITE CONDITIONS. THIS PLAN WAS PREPARED IN ACCORDANCE WITH THE REQUIREMENTS OF THE HOWARD SOIL CONSERVATION DISTRICT. I HAVE NOTIFIED THE DEVELOPER THAT THE LIGHT ENGINEER A REGISTERED PROFESSIONAL ENGINEER TO SUPERVISE POND CONSTRUCTION AND PROVIDE THE HOWARD SOIL CONSERVATION DISTRICT WITH AN "AS-BUILT" PLAN OF THE POND WITHIN 30 DAYS OF COMPLETION.

Signature of Engineer: *R. Jacob Hixmat*  
DATE: 5/16/10


Signature of Engineer: *R. Jacob Hixmat*  
PRINTED NAME OF ENGINEER

THIS DEVELOPMENT PLAN IS APPROVED FOR SOIL EROSION AND SEDIMENT CONTROL BY THE HOWARD SOIL CONSERVATION DISTRICT.

Signature: *R. Jacob Hixmat*  
DATE: 5/19/10

Signature: *R. Jacob Hixmat*  
DATE: 6/22/10

Signature: *R. Jacob Hixmat*  
DATE: 6/10/10

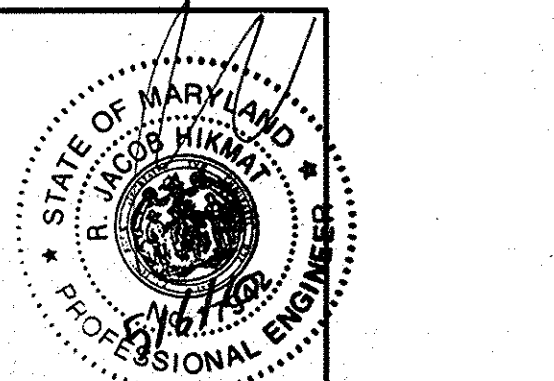

AS-BUILT

BONNIE BRANCH WOODS

TAX MAP: 31 PARCEL 101

HOWARD COUNTY, MARYLAND

SECOND ELECTION DISTRICT

SWM AND SEDIMENT BASIN PLANS, PROFILES AND DETAILS

MILDENBERG, BOENDER & ASSOC., INC.


Engineers, Surveyors, Planners

6800 DEERPATH ROAD, SUITE 150, ELK RIDGE, MARYLAND 21075  
(410) 997-0296 Fax


7 OF 24

F-10-042




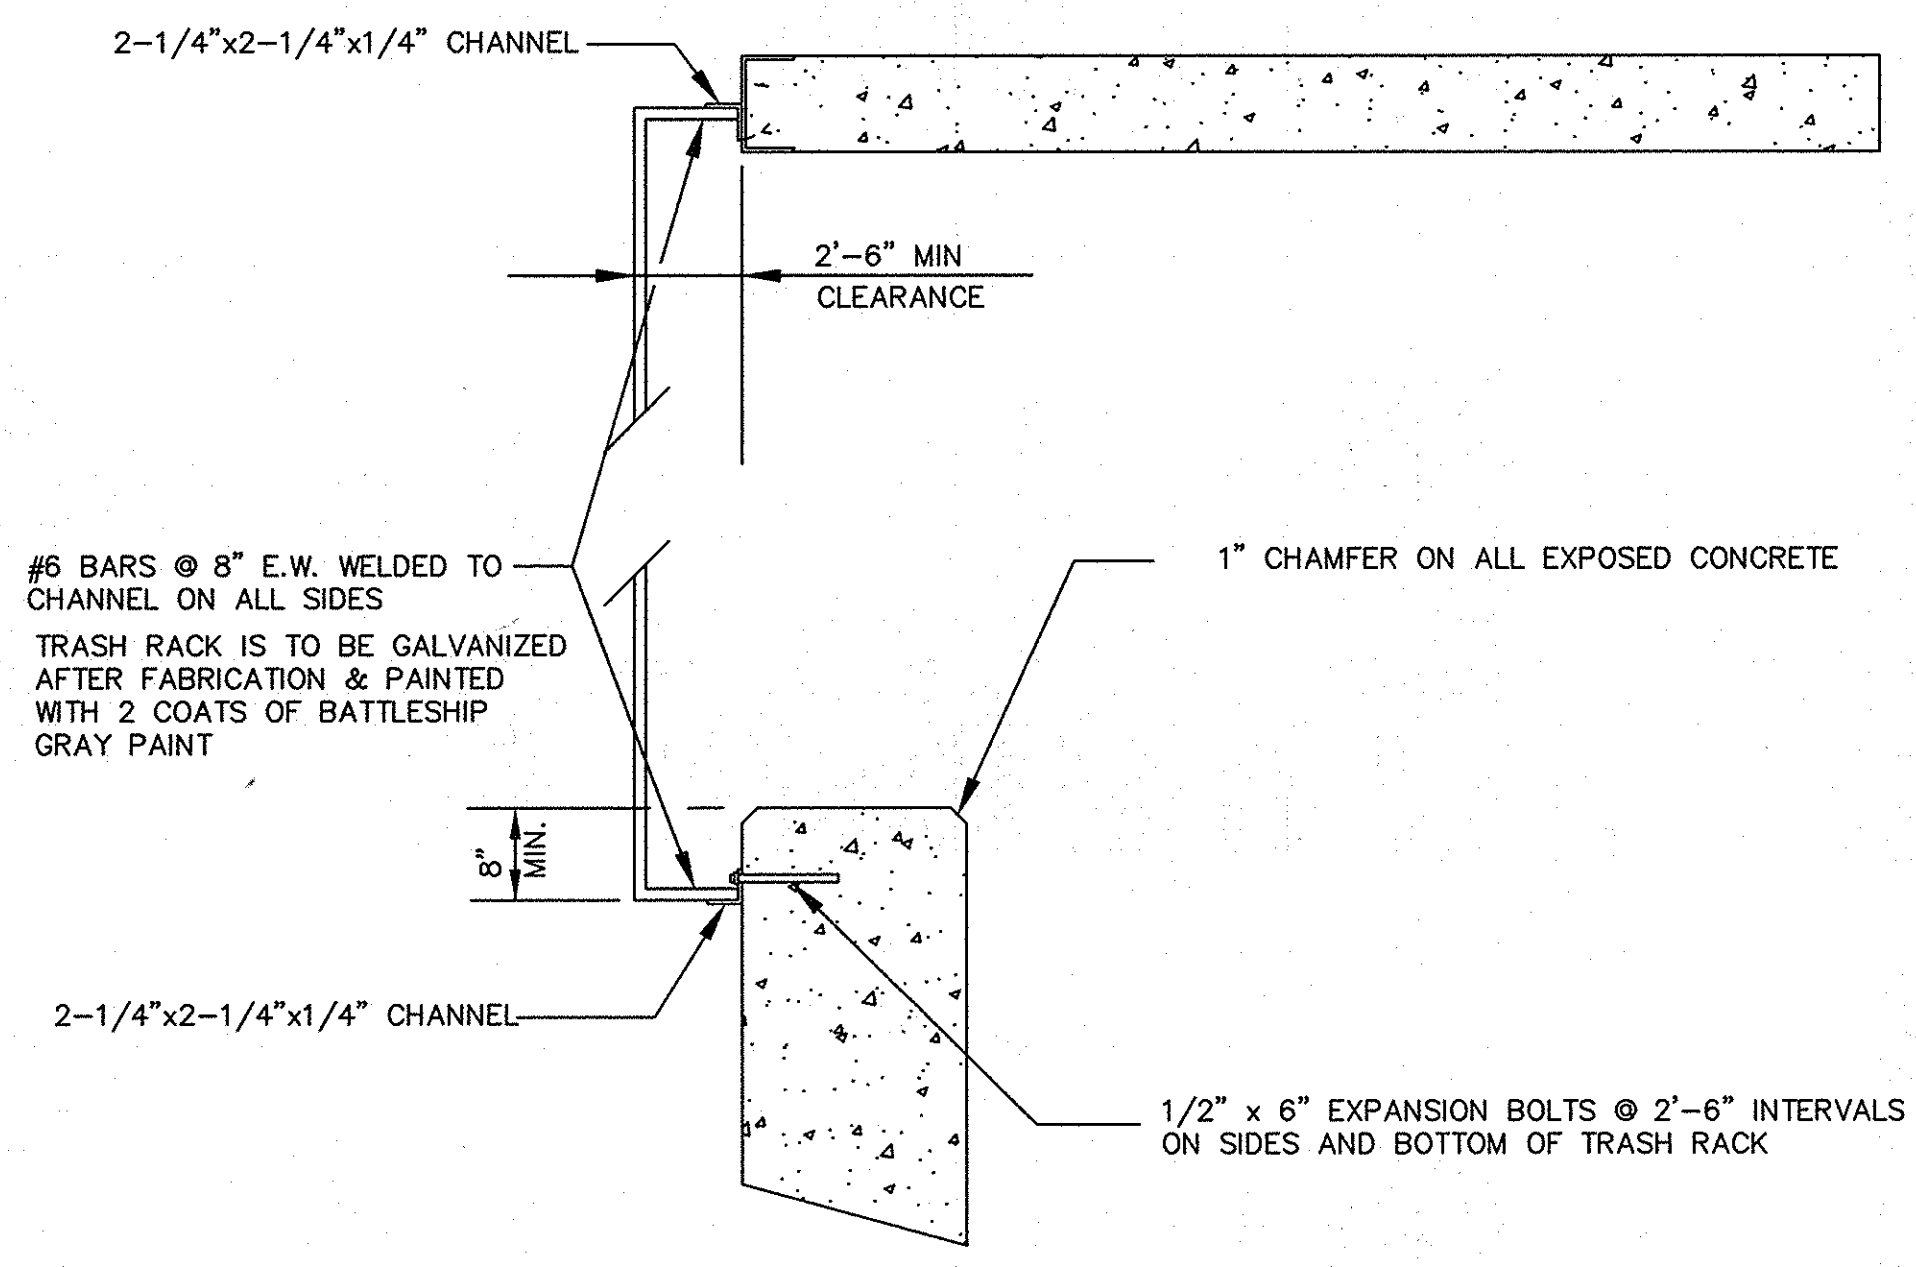


**TRASH RACK DETAIL**  
N.T.S.

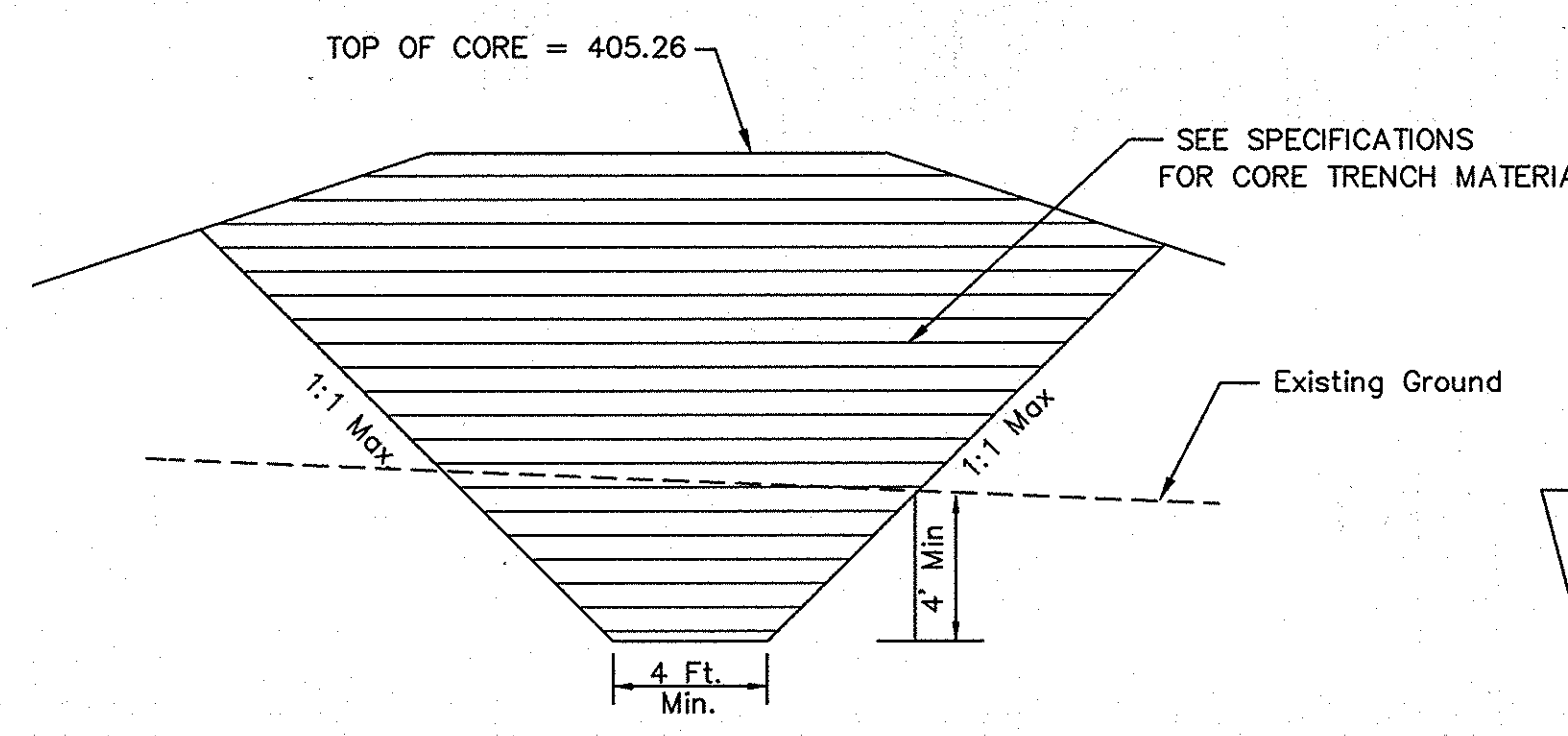


**CORE TRENCH DETAIL**  
N.T.S.

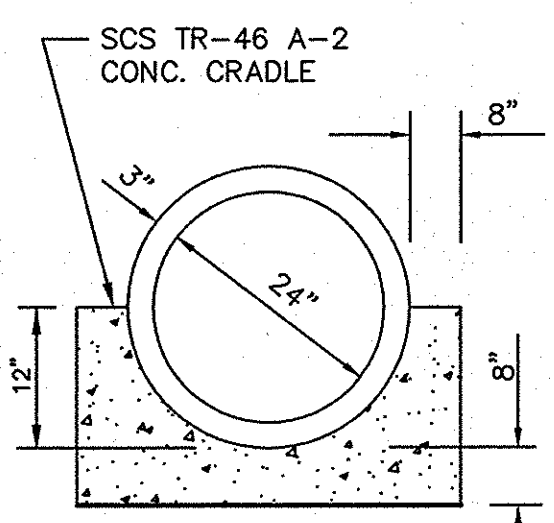


**DETAIL OF CONCRETE CRADLE**  
N.T.S.

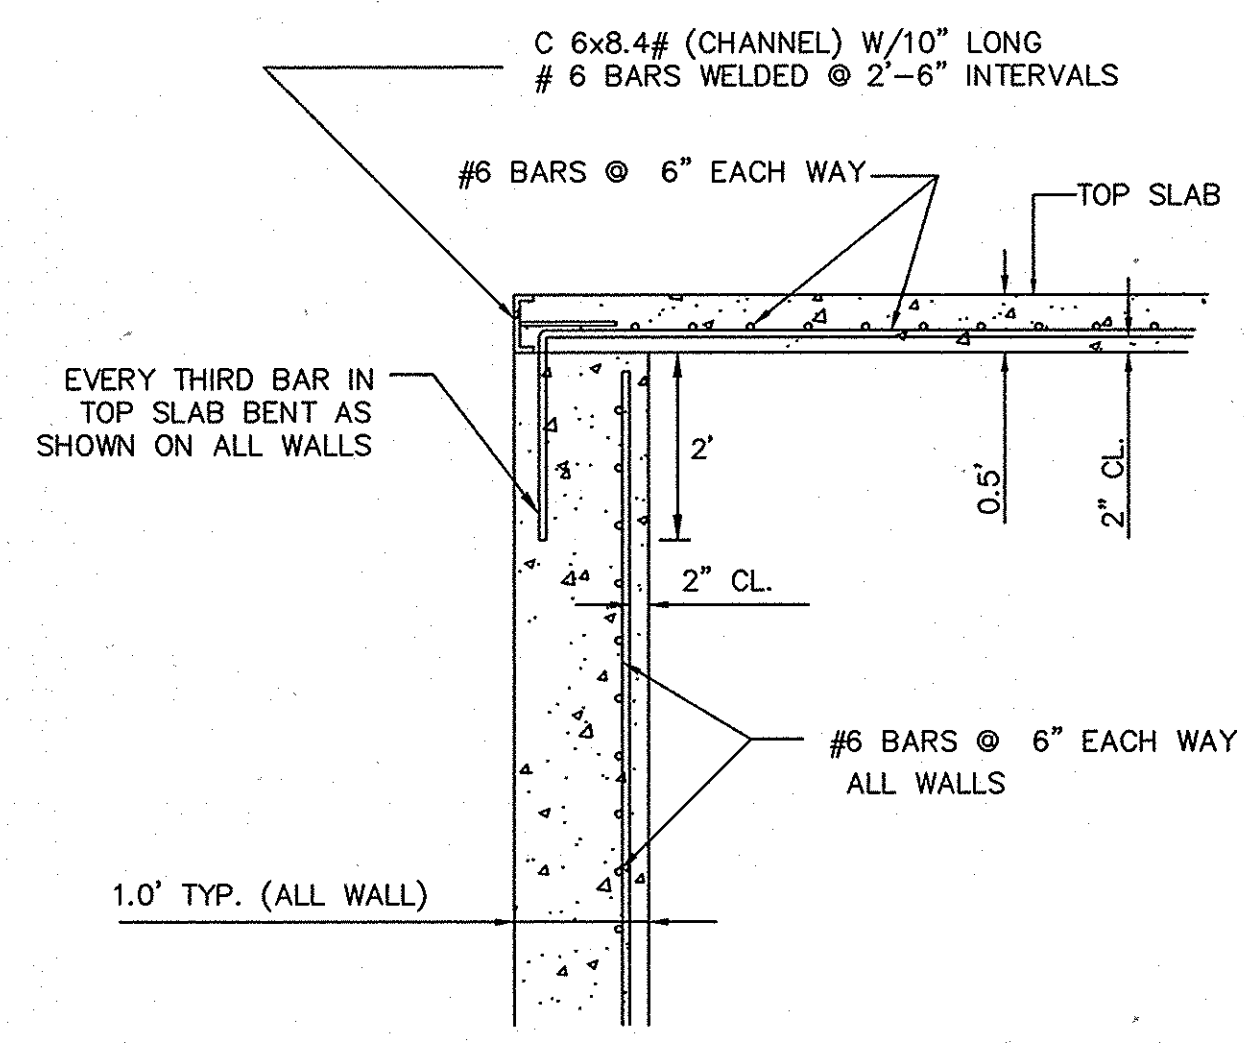


**REINFORCEMENT DETAIL**  
N.T.S.

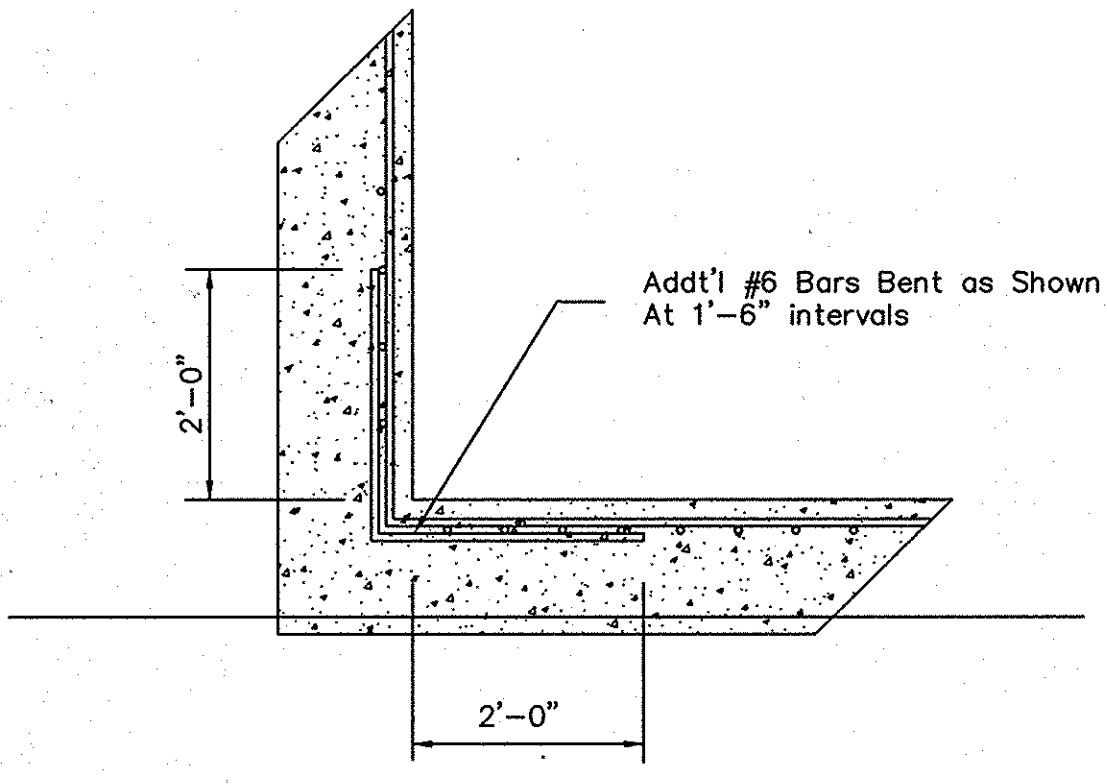


**CORNER TREATMENT DETAIL**  
N.T.S.

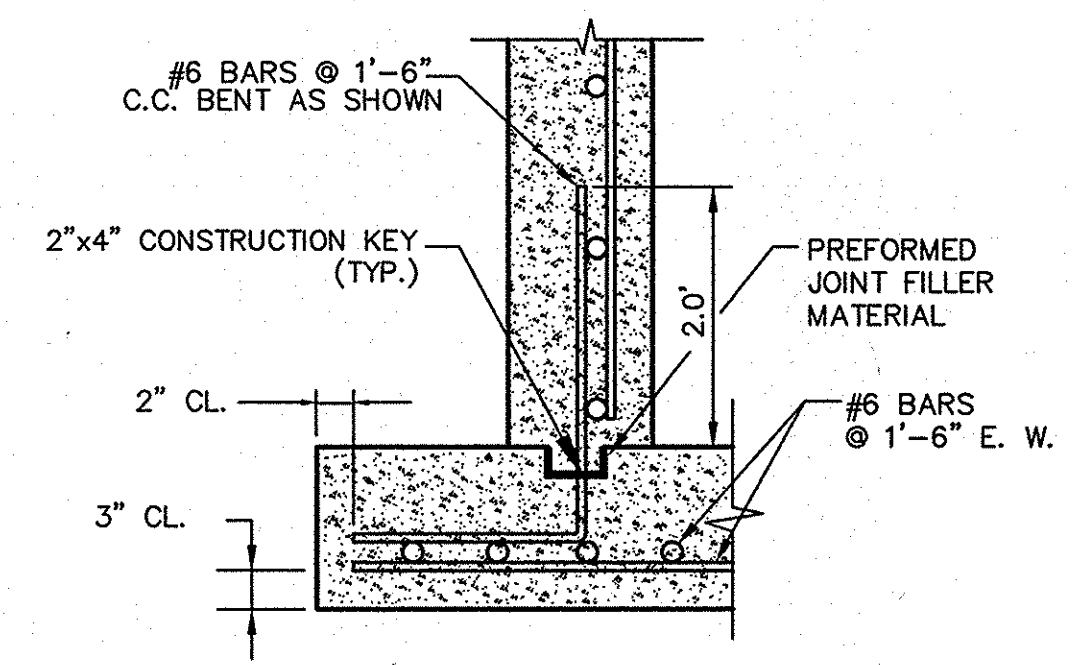


**WALL TO BOTTOM SLAB CONNECTION DETAIL**  
N.T.S.

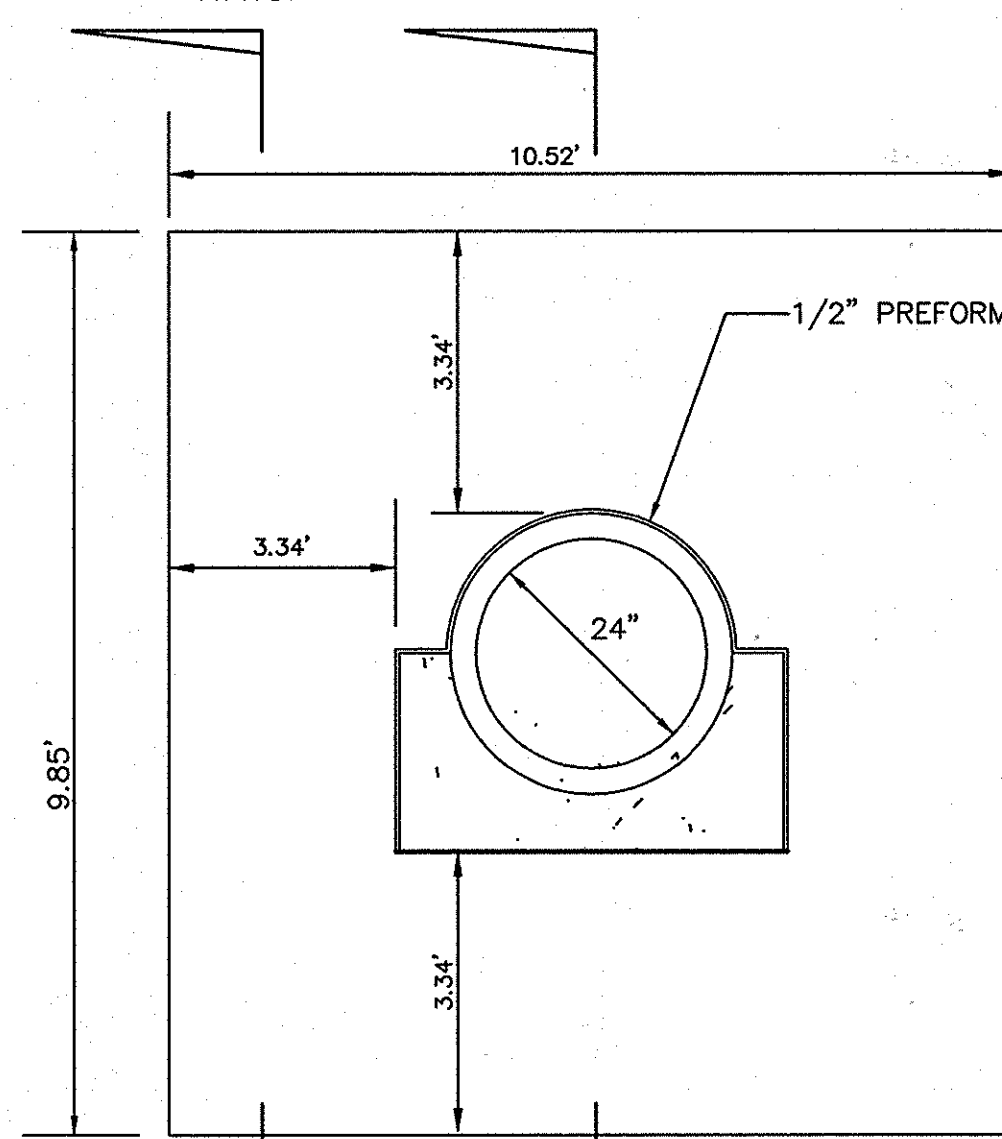

**ANTI-SEEP COLLAR DETAIL**  
N.T.S.

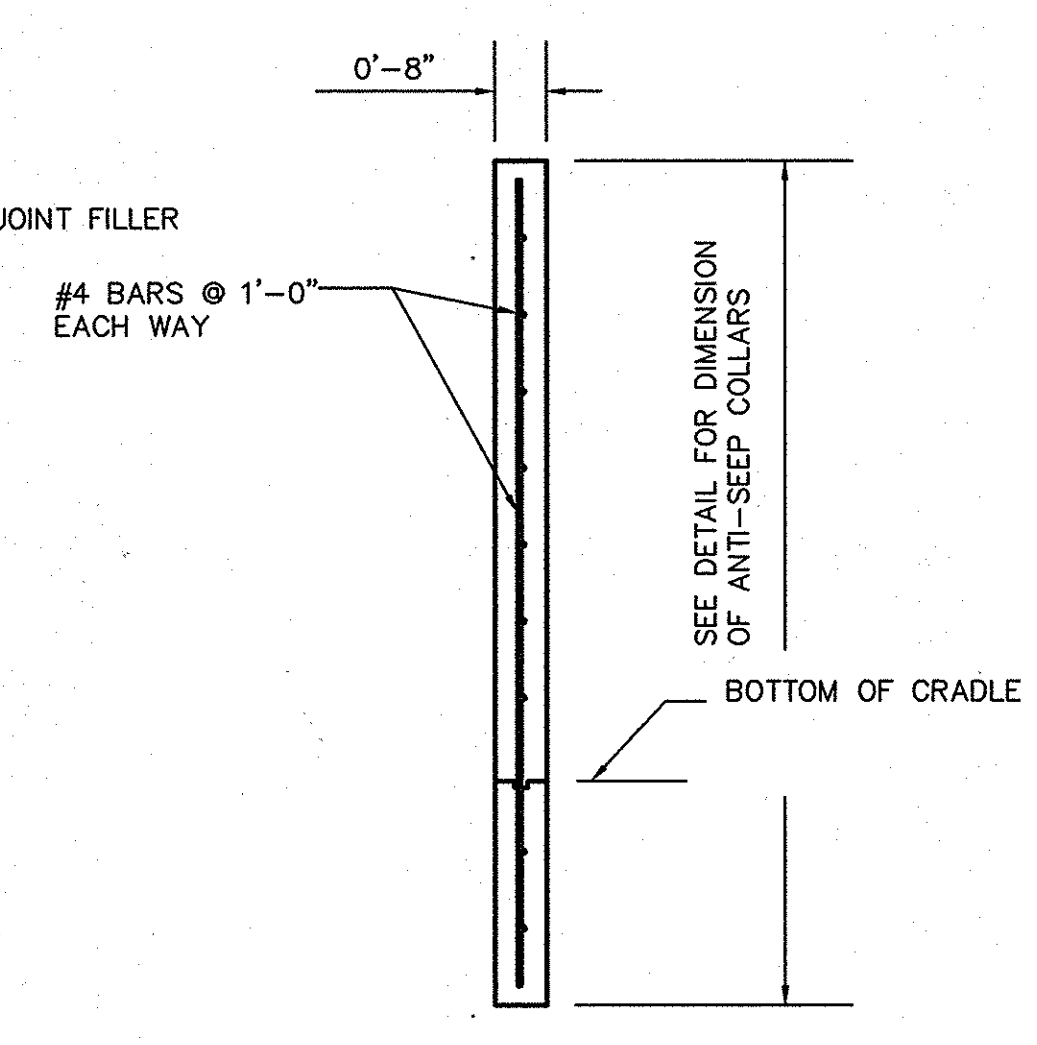

**SECTION 1**  
N.T.S.

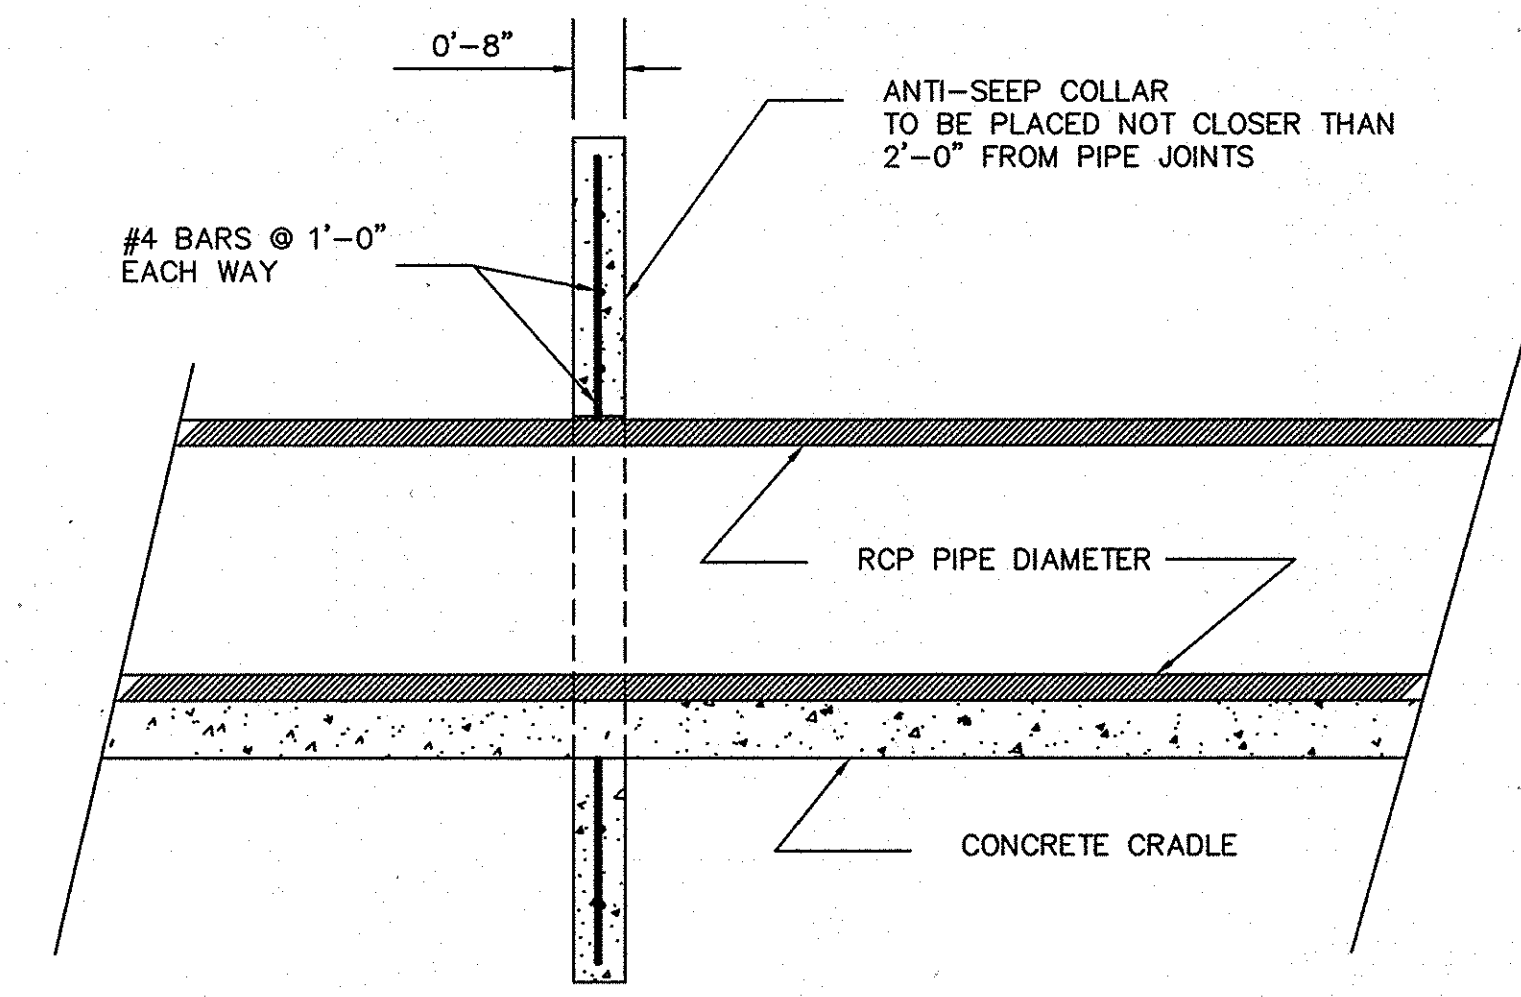

**SECTION 2**  
N.T.S.

BY THE DEVELOPER:  
I, WE CERTIFY THAT ALL DEVELOPMENT AND/OR CONSTRUCTION WILL BE DONE ACCORDING TO THESE PLANS, AND THAT ANY RESPONSIBLE PERSONNEL INVOLVED IN THE CONSTRUCTION PROJECT WILL HAVE A CERTIFICATE OF ATTENDANCE AT A DEPARTMENT OF THE ENVIRONMENT APPROVED TRAINING PROGRAM FOR THE CONTROL OF SEDIMENT AND EROSION BEFORE BEGINNING THE PROJECT. I SHALL ENGAGE A REGISTERED PROFESSIONAL ENGINEER TO SUPERVISE POND CONSTRUCTION AND PROVIDE THE HOWARD SOIL CONSERVATION DISTRICT WITH AN "AS-BUILT" PLAN OF THE POND WITHIN 30 DAYS OF COMPLETION. I ALSO AUTHORIZE PERIODIC ON-SITE INSPECTIONS BY THE HOWARD SOIL CONSERVATION DISTRICT.

Signature: *John Douglas Cashmere* DATE: 5/6/10  
PRINTED NAME OF DEVELOPER: JOHN DOUGLAS CASHMERE

BY THE ENGINEER:  
I CERTIFY THAT THIS PLAN FOR POND CONSTRUCTION, EROSION AND SEDIMENT CONTROL REPRESENTS A PRACTICAL AND WORKABLE PLAN BASED ON MY PERSONAL KNOWLEDGE OF THE SITE CONDITIONS. THIS PLAN WAS PREPARED IN ACCORDANCE WITH THE REQUIREMENTS OF THE HOWARD SOIL CONSERVATION DISTRICT. I HAVE NOTIFIED THE DEVELOPER THAT HE/MUST ENGAGE A REGISTERED PROFESSIONAL ENGINEER TO SUPERVISE POND CONSTRUCTION AND PROVIDE THE HOWARD SOIL CONSERVATION DISTRICT WITH AN "AS-BUILT" PLAN OF THE POND WITHIN 30 DAYS OF COMPLETION.


Signature: *R. Jacob Hikmat* DATE: 5/16/10  
PRINTED NAME OF ENGINEER: R. JACOB HIKMAT

APPROVED: DEPARTMENT OF PUBLIC WORKS  
Signature: *John J. ...* DATE: 6-11-10  
CHIEF BUREAU OF HIGHWAYS


APPROVED: DEPARTMENT OF PLANNING AND ZONING  
Signature: *Robert ...* DATE: 6/22/10  
CHIEF, DIVISION OF LAND DEVELOPMENT

APPROVED: DEPARTMENT OF ENGINEERING  
Signature: *Michael ...* DATE: 6/10/10  
CHIEF, DEVELOPMENT ENGINEERING DIVISION

I hereby certify that the facility shown on this plan was constructed as shown on the "As-Built" plans and meets with the approved plans and specifications.

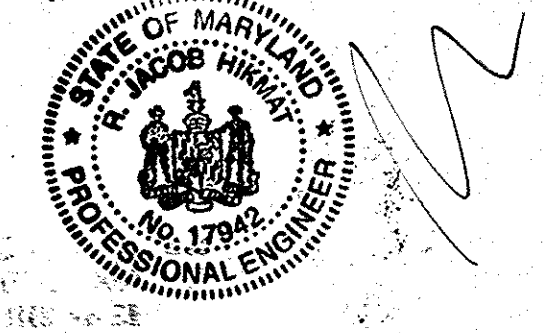


I HEREBY CERTIFY THAT THESE DOCUMENTS WERE PREPARED OR APPROVED BY ME AND THAT I AM A DULY LICENSED PROFESSIONAL ENGINEER UNDER THE LAWS OF THE STATE OF MARYLAND, LICENSE NO. 17942, EXP DATE 9/3/10.

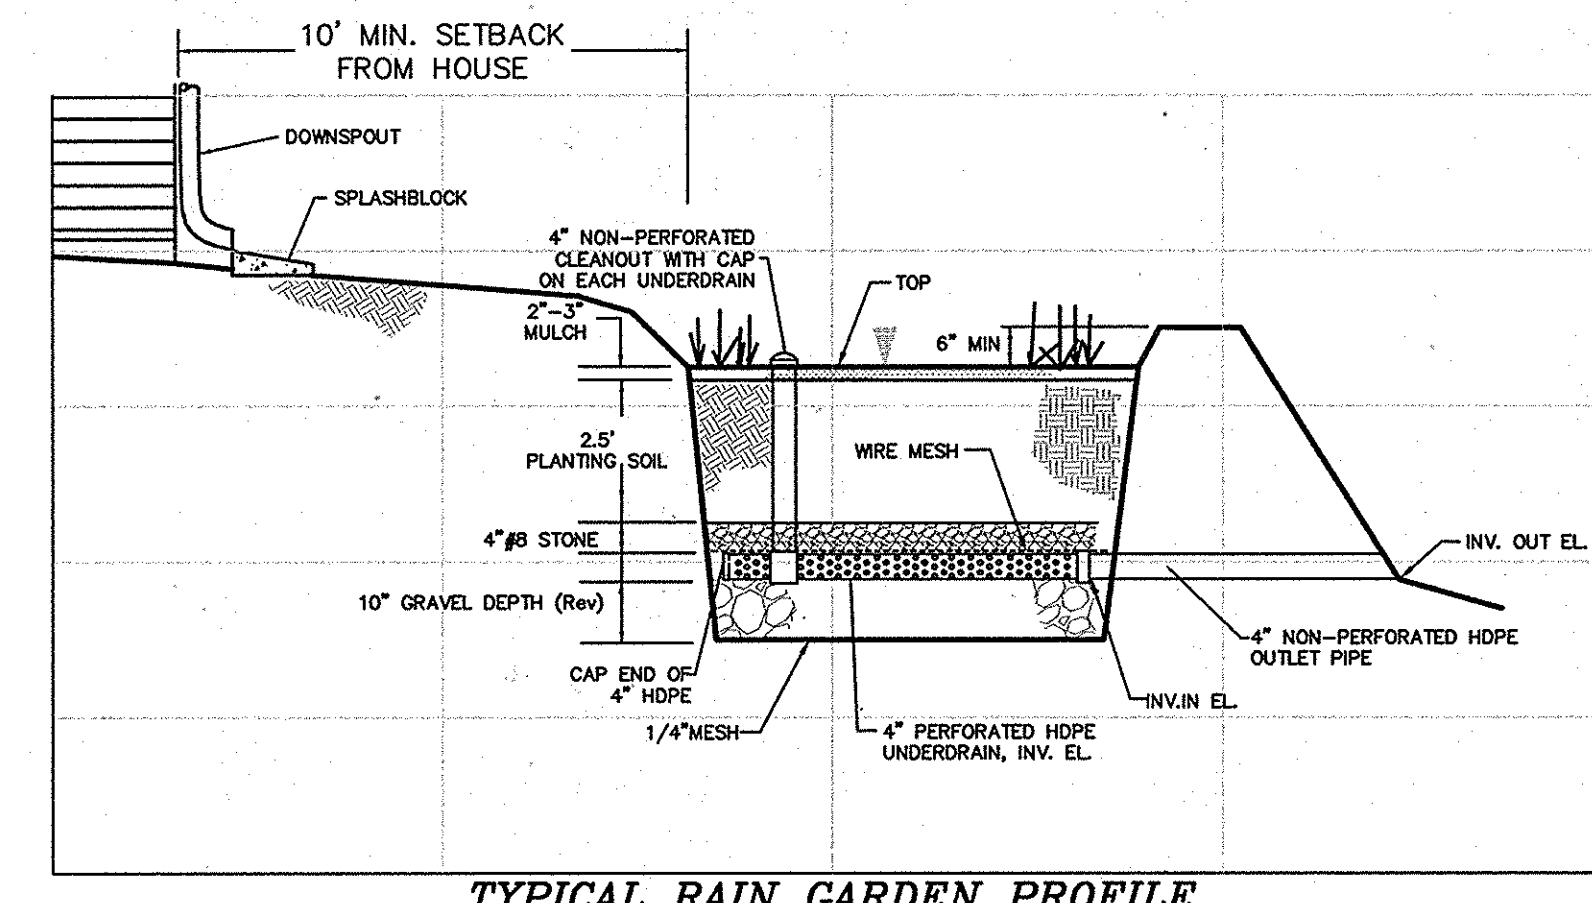

**TYPICAL RAIN GARDEN PROFILE**

NOTE: FINAL DESIGN OF THE RAIN GARDENS WILL BE PROVIDED AT SDP STAGE.

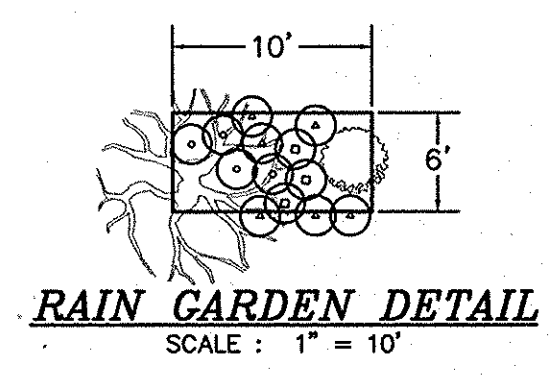

**PLANT LIST**

QUANTITY	SYMBOL	BOTANICAL NAME	COMMON NAME	SIZE
1	☐	PLATANUS OCCIDENTALIS	AMERICAN SYCAMORE	2-1/2" - 3" CAL.
1	○	ILEX GLABRA	INK BERRY	2 - 3' HT.
6	○	LOBELIA SIPHILITICA	GREAT BLUE LOBELIA	1 GAL. CONTAINER
4	○	ONOCLEA SENSIBILIS	SENSITIVE FERN	1 GAL. CONTAINER
3	○	ASTER NOVAE-ANGLIAE	NEW ENGLAND ASTER	1 GAL. CONTAINER

TOTAL: 13 PERENNIALS, 1 SHRUB, 1 TREE (PER EACH RAIN GARDEN)

**OWNER/DEVELOPER**  
BONNIE BRANCH WOODS INC.  
C/O MILDENBERG, BOENDER AND ASSOC., INC.  
6800 DEERPATH ROAD, SUITE 150  
ELK RIDGE, MARYLAND 21075  
410-997-0296

AS-BUILT

**BONNIE BRANCH WOODS**  
TAX MAP: 31 PARCEL 101 HOWARD COUNTY, MARYLAND  
SECOND ELECTION DISTRICT SWM DETAILS

**MILDENBERG, BOENDER & ASSOC., INC.**  
Engineers, Surveyors, Planners  
6800 Deerpath Road, Suite 150, Elkridge, Maryland 21075  
(410) 997-0296 Fax: (410) 997-0296


Project: 08-007  
Date: MAY 2010  
Illustration: MMM  
Scale: AS SHOWN  
Approval: AS SHOWN  
Revisions: AS SHOWN

8 of 24  
F-10-042







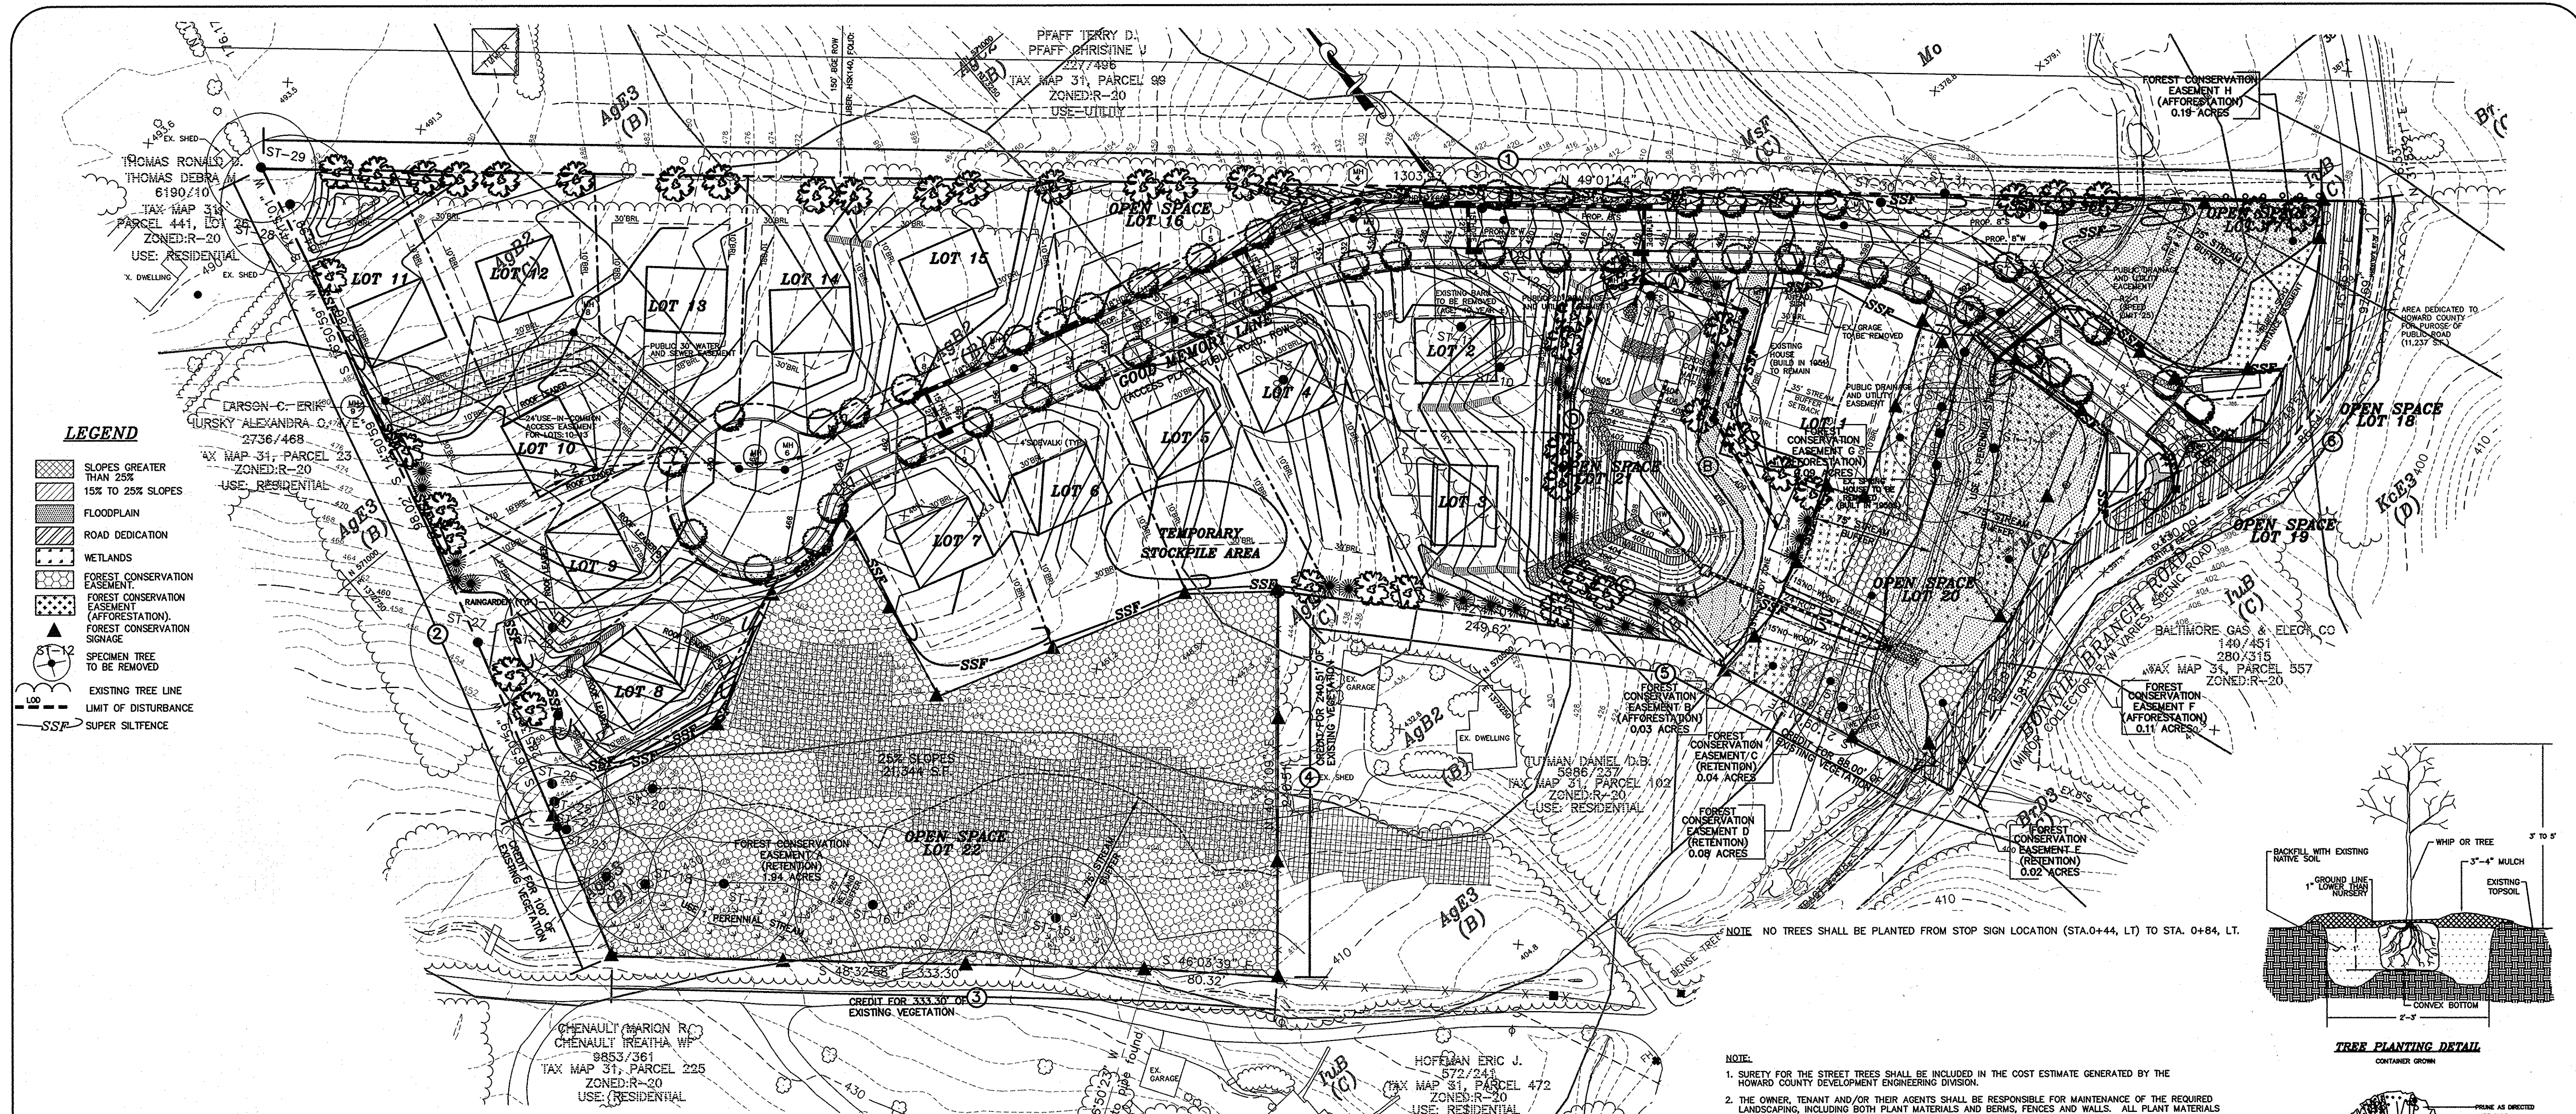

- LEGEND**
- SLOPES GREATER THAN 25%
  - 15% TO 25% SLOPES
  - FLOODPLAIN
  - ROAD DEDICATION
  - WETLANDS
  - FOREST CONSERVATION EASEMENT
  - FOREST CONSERVATION EASEMENT (AFFORESTATION)
  - FOREST CONSERVATION SIGNAGE
  - SPECIMEN TREE TO BE REMOVED
  - EXISTING TREE LINE
  - LIMIT OF DISTURBANCE
  - SSP SUPER SILTENCE

**SCHEDULE A : PERIMETER LANDSCAPED EDGE**

CATEGORY	ADJACENT TO PERIMETER PROPERTIES					ADJACENT TO ROADWAYS	TOTAL
	A (PERIMETER 1)	A (PERIMETER 2)	A (PERIMETER 3)	A (PERIMETER 4)	A (PERIMETER 5)	B (PERIMETER 6)	
LANDSCAPE TYPE	1278 LF	536.26' LF	333.30 LF	240.51 LF	418 LF	485 LF	
CREDIT FOR EXISTING VEGETATION (YES, NO, LINEAR FEET)	NO	YES, 100 LF.	YES, 333.30 LF.	YES, 240.51 LF.	YES, 88.00 LF.	N/A	
CREDIT FOR WALL FENCE, OR BERM (YES, NO, LINEAR FEET)	NO	NO	NO	NO	NO	N/A	
NUMBER OF PLANTS REQUIRED	21 SHADE TREES 0 EVERGREEN TREES 0 SHRUBS	7 SHADE TREE 0 EVERGREEN TREES 0 SHRUBS	0 SHADE TREES 0 EVERGREEN TREES 0 SHRUBS	0 SHADE TREES 0 EVERGREEN TREES 0 SHRUBS	6 SHADE TREES 0 EVERGREEN TREES 0 SHRUBS	0 SHADE TREES 0 EVERGREEN TREES 0 SHRUBS	34 SHADE TREES 0 EVERGREEN TREES 0 SHRUBS
NUMBER OF PLANTS PROVIDED	21 SHADE TREES 0 EVERGREEN TREES 0 SHRUBS	7 SHADE TREE 5 EVERGREEN TREES 0 SHRUBS	0 SHADE TREES 0 EVERGREEN TREES 0 SHRUBS	0 SHADE TREES 0 EVERGREEN TREES 0 SHRUBS	4 SHADE TREES 9 EVERGREEN TREES 0 SHRUBS	0 SHADE TREES 0 EVERGREEN TREES 0 SHRUBS	32 SHADE TREES 14 0 SHRUBS

\* TWO (2) SHADE TREES HAVE BEEN SUBSTITUTED WITH FOUR (4) EVERGREEN TREES, IN ADDITION, 5 EVERGREEN TREES ARE PROPOSED TO PROVIDE YEAR-LONG SCREENING ALONG THE PERIMETER 6.

**PERIMETER LANDSCAPE PLANTING SCHEDULE**

QUANTITY	SYMBOL	BOTANICAL NAME	COMMON NAME	SIZE
32		ACER SACCHARUM 'GREEN MOUNTAIN'	GREEN MOUNTAIN SUGAR MAPLE OR EQUIVALENT	2 1/2" - 3" CAL
14		PINUS THUNBERGIANA	JAPANESE BLACK PINE OR EQUIVALENT	
<b>TOTAL</b>				
46 TREES (32 SHADE TREES, 14 EVERGREENS)				

**STREET TREE PLANTING SCHEDULE**

QUANTITY	SYMBOL	BOTANICAL NAME	COMMON NAME	SIZE
50		Prunus sargentii	Sargent Cherry	2 1/2" - 3" CAL
<b>TOTAL</b>				
50 STREET TREES				

**STREET TREE CALCULATIONS**


GOOD MEMORY LANE - 2000 / 40 = 50  
 TOTAL TREES REQUIRED = 50 TREES  
 TOTAL TREES PROVIDED = 50 TREES

**SCHEDULE B : STORMWATER MANAGEMENT AREA LANDSCAPING**


LINEAR FEET OF PERIMETER	(A) 557 LF
CREDIT FOR EXISTING VEGETATION (NO, YES AND LINEAR FEET)	N/A
CREDIT FOR OTHER LANDSCAPING (NO, YES AND LINEAR FEET)	N/A
NUMBER OF TREES REQUIRED	12 SHADE TREES 15 EVERGREEN TREES

**STORMWATER MANAGEMENT AREA PLANTING SCHEDULE**

QUANTITY	SYMBOL	BOTANICAL NAME	COMMON NAME	SIZE
12		ACER SACCHARUM 'GREEN MOUNTAIN'	GREEN MOUNTAIN SUGAR MAPLE OR EQUIVALENT	2 1/2" - 3" CAL 6" - 8" HT.
15		PINUS THUNBERGIANA	JAPANESE BLACK PINE OR EQUIVALENT	6" - 8" HT.
<b>TOTAL</b>				
27 TREES (12 SHADE TREES, 14 EVERGREENS)				

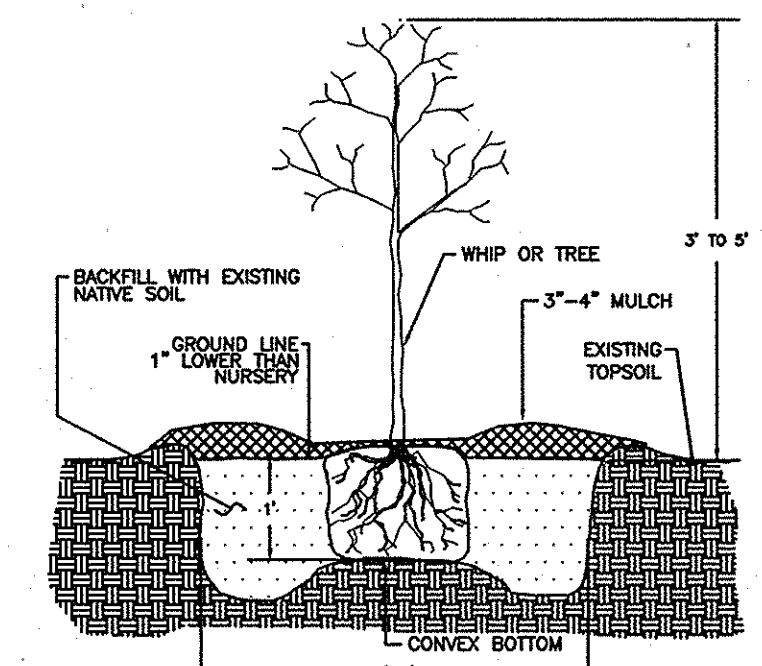

**TYPICAL DECIDUOUS TREE PLANTING DETAIL**

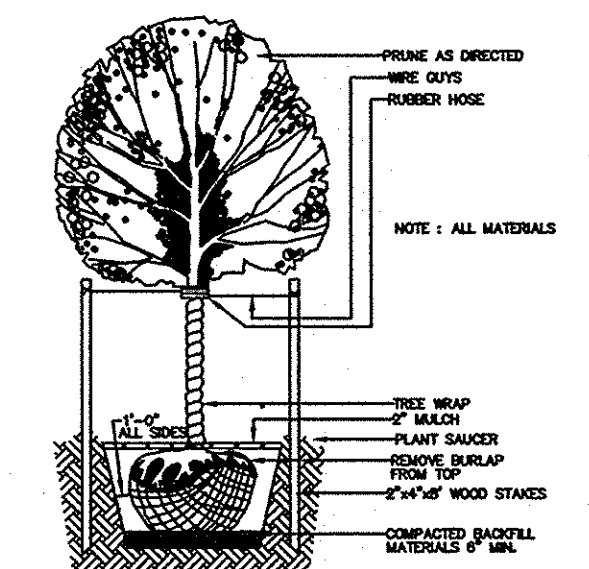


**TYPICAL EVERGREEN TREE PLANTING DETAIL**

**DEVELOPER'S/OWNER'S CERTIFICATE**  
 I/WE CERTIFY THAT THE LANDSCAPING SHOWN ON THIS PLAN WILL BE DONE IN ACCORDANCE TO THE PLAN, SECTION 16.124 OF THE HOWARD COUNTY CODE AND THE HOWARD COUNTY LANDSCAPE MANUAL. I/WE FURTHER CERTIFY THAT UPON COMPLETION A CERTIFICATION OF LANDSCAPE INSTALLATION, ACCOMPANIED BY AN EXECUTED ONE YEAR GUARANTEE OF PLANT MATERIALS, WILL BE SUBMITTED TO THE DEPARTMENT OF PLANNING AND ZONING.

*[Signature]* 5/16/10  
 NAME DATE

I HEREBY CERTIFY THAT THESE DOCUMENTS WERE PREPARED OR APPROVED BY ME AND THAT I AM A DULY LICENSED PROFESSIONAL ENGINEER UNDER THE LAWS OF THE STATE OF MARYLAND, LICENSE NO. 17942, EXP DATE 9/3/10.

I hereby certify that the facility shown on this plan was constructed as shown on the 'As-Built' plan and meets with the approved plans and specifications.

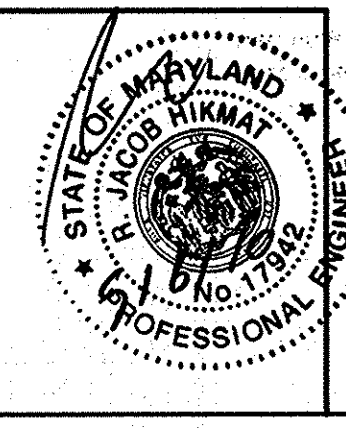

APPROVED: DEPARTMENT OF PUBLIC WORKS  
*[Signature]* 6-11-10  
 CHIEF BUREAU OF HIGHWAYS DATE

APPROVED: DEPARTMENT OF PLANNING AND ZONING  
*[Signature]* 6/22/10  
 CHIEF, DIVISION OF LAND DEVELOPMENT DATE

APPROVED: *[Signature]* 6/16/10  
 CHIEF, DEVELOPMENT ENGINEERING DIVISION DATE

project	08-007	date	MAY 2010
illustration	MMM	engineering	MMM
scale	1"=60'	approval	MMM
revisions		description	

no.	date	description

AS-BUILT  
**BONNIE BRANCH WOODS**  
 TAX MAP 31, PARCEL 101  
 SECOND ELECTION DISTRICT  
 HOWARD COUNTY, MARYLAND  
**LANDSCAPING AND FOREST CONSERVATION PLAN**

**MILDENBERG, BOENDER & ASSOC., INC.**  
 Engineers Planners Surveyors  
 6800 Deerpath Road, Suite 150, Elkridge, Maryland 21075  
 (410) 997-0288 Fax: (410) 997-0288 Fax

**OWNER/DEVELOPER**

BONNIE BRANCH WOODS INC.  
 C/O MILDENBERG, BOENDER AND ASSOC. INC.  
 6800 DEERPATH ROAD, SUITE 150  
 ELK RIDGE, MARYLAND 21075  
 410-997-0286



PLANTING SPECIFICATIONS AND NOTES

- 1. PROTECTION FENCING AND SILT FENCES FOR SEDIMENT AND EROSION CONTROL ARE TO BE INSTALLED AS A FIRST ORDER OF BUSINESS. SEE PLAN FOR LOCATIONS.

- 2. DISTURBANCE OF SOILS SHOULD BE LIMITED TO THE PLANTING FIELD FOR EACH PLANT. AS SHOWN ON THE PLANS, A PLANTING FIELD OF RADIUS = 5 X DIAMETER OF THE ROOT BALL OR CONTAINER IS RECOMMENDED.

- 3. SOIL MIX FOR ALL PLANTS EXCEPT EPICACEOUS MATERIAL SOIL MIX SHALL CONSIST OF EXISTING NATIVE TOPSOIL MIXTURE AT EACH PLANTING LOCATION INTO WHICH THE CONTRACTOR SHALL THOROUGHLY INCORPORATE 25% BY VOLUME OF COMPOSTED SLUDGE.

- 4. SOIL MIX FOR EPICACEOUS MATERIAL SOIL MIX SHALL CONSIST OF EXISTING NATIVE TOPSOIL MIXTURE AT EACH PLANTING LOCATION INTO WHICH THE CONTRACTOR SHALL THOROUGHLY INCORPORATE 25% BY VOLUME OF COMPOSTED SLUDGE.

- 5. ALL MIXING IN 3 AND 4 SHALL BE LIMITED TO CONTAINER GROWN OR BALL AND BURLAP STOCK ONLY AND CONFINED TO THE PLANTING FIELD AND IMMEDIATE ADJACENT SOIL SURFACE AREA AND SHALL BE DONE TO THE SATISFACTION OF THE DESIGN TEAM OR ENGINEER.

- 6. PLANT STORAGE AND INSPECTION

- 7. FOR CONTAINER GROWN NURSERY STOCK, PLANTING SHOULD OCCUR WITHIN 2 WEEKS AFTER DELIVERY TO THE SITE.

- 8. FOR BALL AND BURLAP NURSERY STOCK, PLANTING SHOULD OCCUR WITHIN THREE DAYS AFTER DELIVERY TO THE SITE.

- 9. PLANTING STOCK SHOULD BE INSPECTED PRIOR TO PLANTING. PLANTS NOT CONFORMING TO STANDARD NURSERYMAN SPECIFICATIONS FOR SIZE, FORM, WOOD, ROOTS, TRUNK WOUNDS, INSECTS AND DISEASE SHOULD BE REPLACED.

- 10. UNTIL PLANTED, ALL PLANT STOCK SHALL BE KEPT IN A SHADED, COOL AND MOISTIFIED ENVIRONMENT.

- 11. PLANT INSTALLATION

- 12. THE PLANTING FIELD SHOULD BE PREPARED AS SPECIFIED (SEE DETAIL). NATIVE STOCKED SOILS SHOULD BE USED FOR SOIL MIX AND BACKFILL FOR PLANTING FIELD. AFTER PLANT INSTALLATION, GRADE SOILS EVENLY OVER THE PLANTING FIELD AND COVER WITH AT LEAST 4 INCHES OF MULCH. WATER GENEROUSLY TO SETTLE SOIL AND BACKFILLED AREAS.

- 13. PLANTING FIELD DIAMETERS SHOULD BE REDUCED OR PLANTING FIELD MOVED IF IT APPEARS THAT EXCESSIVE EXISTING ROOT DAMAGE MAY OCCUR DURING DIGGING OPERATION NEAR EXISTING FOREST.

- 14. CARE SHALL BE TAKEN WHEN DIGGING PLANTING FIELDS NOT TO CHOP THRU LARGER EXISTING ROOTS FROM EXISTING MATURE TREES. IF ROOTS GREATER THAN 1/2 INCH ARE ENCOUNTERED PLEASE TRY TO DIG AROUND THEM AS MUCH AS POSSIBLE TO MINIMIZE IMPACT TO EXISTING TREES. THEY WERE HERE FIRST.

- 15. CONTAINER GROWN STOCK SHOULD BE REMOVED FROM THE CONTAINER AND ROOTS GENTLY LOOSENED FROM THE SOIL. IF THE ROOTS ENIRCLE THE ROOT BALL, SUBSTITUTION IS STRONGLY RECOMMENDED. J-SHAPED OR KINKED ROOT SYSTEMS SHOULD ALSO BE NOTED. ROOTS MAY NOT BE TRIMMED ON SITE, DUE TO THE INCREASED CHANCES OF SOIL BORNE DISEASE.

- 16. FOR BALL AND BURLAP STOCK, PLACE TREE IN PREPARED PLANTING FIELD AND REMOVE ANY STUMP OR ROOT BALL. THEN FEEL BACK BURLAP TO BASE OF ROOT BALL AND COVER ENTIRE ROOT BALL WITH TOPSOIL MIXTURE INDICATED ABOVE AND WATER GENEROUSLY.

- 17. FOR TREES PLANTED IN AFFORESTATION AREA, CONTRACTOR SHALL EVENLY DISPERSE SPECIES IN GROUPS OF TWO (2) TO FOUR (4), PER SPECIES, OVER THE ENTIRE DESIGNATED AREA TO BE PLANTED WHILE MAINTAINING AN AVERAGE RANDOM SPACING OF INDIVIDUAL TREES AT PROPER SPACING INDICATED ON PLANT LIST.

- 1. DO NOT FERTILIZE NEWLY PLANTED TREES WITHIN THE FIRST GROWING SEASON AFTER PLANTING. DOING SO MAY CAUSE A SPURT OF CANOPY GROWTH WHICH THE ROOTS CANNOT SUPPORT AND ADDITIONAL STOCK TO THE ALREADY DISTURBED PLANT.

- 2. NOTHING SHOULD BE ADDED TO THE SOIL WITHOUT TESTING IT FIRST TO DETERMINE ITS NEEDS.

- 3. IF AND WHEN IT IS TIME TO FERTILIZE, ORGANIC FERTILIZERS ARE PREFERRED TO SYNTHETIC FERTILIZERS. BONE MEAL OR SEAWEED BASED PRODUCTS ARE AVAILABLE COMMERCIALY AND ARE RECOMMENDED. THEY HAVE THE ABILITY TO SUPPLY NUTRIENTS TO THE PLANT AS NEEDED WHILE MINIMIZING THE RISK OF EXCESS NUTRIENTS ENTERING THE FOREST SYSTEM AND WATER SUPPLY.

- 4. ANNUAL MAINTENANCE DURING THE GROWING SEASON, FOR A THREE YEAR PERIOD.

- 5. ASSESS TREE MORTALITY OF PLANTING STOCK, REMOVE AND REPLACE ANY DEAD OR DISEASED PLANTINGS.

- 6. VOLUNTEER SEEDING OF NATIVE LOCAL AND ENDEMIC VEGETATION IS TO BE EXPECTED. DO NOT DISCOURAGE THIS EFFORT UNLESS IT IS NEARLY EFFECTING THE PLANTED STOCK.

- 7. REMOVE THROUGH MANUAL MEANS (SURROUNDING, PULLING, CUTTING) AGGRESSIVE, INVASIVE SPECIES AND ALL HERBACEOUS VEGETATION WITHIN A 3-FOOT RADIUS SURROUNDING THE PLANTED WOODY NURSERY STOCK.

- 8. REMOVE AND DISPOSE OF MAN-MADE TRASH, INCLUDING ITEMS CONTAINED WITHIN ENTIRE PLANTING AREA. DO NOT REMOVE DOWN AND DEAD MATERIAL, NATURALLY OCCURRING OR ACCUMULATING, UNLESS IT IS SMOTHERING PLANTING STOCK.

- 9. A 75 PERCENT SURVIVAL OF PLANTED STOCK MUST BE ACHIEVED AT THE END OF THE 24 MONTH MANAGEMENT PERIOD. IF NOT, ADDITIONAL PLANTINGS MAY BE REQUIRED TO ACHIEVE THIS GOAL.

- 10. ALL FOREST CONSERVATION ACTIVITIES SHALL BE DONE UNDER THE DIRECT SUPERVISION OF SOMEONE FROM THE DESIGN TEAM OR OTHER QUALIFIED PROFESSIONAL AS DETERMINED BY THE REQUIREMENTS OF COMAR 08.19.08.01 AND THE MARYLAND DEPARTMENT OF NATURAL RESOURCES, PUBLIC LANDS AND FORESTRY DIVISION.

- 11. STANDARD SPECIMEN TREE NON-DISTURBANCE NOTE: "THERE SHALL BE NO CLEARING, GRADING, CONSTRUCTION, SOIL COMPACTION OR EXCAVATION, INTRODUCTION OF TOXIC CHEMICALS OR OTHER DISTURBANCES DETRIMENTAL TO THE LIVE SPECIMEN TREES OR CRITICAL ROOT ZONES FOR THESE TREES EXCEPT AS PERMITTED BY HOWARD COUNTY"

- 12. CONSTRUCTION PERIOD PROTECTION AND MANAGEMENT PROGRAM

- 1. ALL FOREST RETENTION AREAS AND ISOLATED POTENTIAL SPECIMEN TREES SHALL BE TEMPORARILY PROTECTED BY WELL ANCHORED, BLAZE ORANGE PLASTIC MESH FENCING AND SIGNAGE AS INDICATED ON THE PLANS. THE DEVICES SHALL BE INSTALLED ALONG THE FOREST RETENTION BOUNDARY AND AROUND ISOLATED POTENTIAL SPECIMEN TREES PRIOR TO ANY LAND CLEARING, GRADING, OR GRADING ACTIVITIES.

- 2. BLAZE ORANGE PLASTIC MESH FENCING SHALL BE INSTALLED ALONG THE FOREST RETENTION BOUNDARY WHERE THERE IS NO SUPER SILT FENCE PROVIDED. AFTER THE NEXT TWO YEARS MAY REQUIRE WATERING ONLY A FEW TIMES A YEAR DURING SHARPLY DRY WINTERS. AFTER THAT PERIOD, TREES SHOULD ONLY NEED WATER IN SEVERE DROUGHTS. ANY WATERING PLAN SHOULD COMPENSATE FOR RECENT RAINFALL PATTERNS.

- 3. THE FOREST PROTECTION DEVICES SHALL BE INSTALLED SUCH THAT THE ENTIRE DRY MATTER OF ALL TREES WITHIN THE RETENTION AREA NOT OTHERWISE PROTECTED WILL BE WITHIN FOREST PROTECTION DEVICES. IT IS UNDERSTOOD THAT THE INSTALLATION OF THE FENCING IN THIS MANNER WILL CREATE AN ESCAPE ROUTE.

- 4. ALL PROTECTION DEVICES SHALL BE MAINTAINED THROUGHOUT CONSTRUCTION. ALL DEVICES SHALL REMAIN IN PLACE UNTIL ALL CONSTRUCTION HAS CEASED IN THE IMMEDIATE VICINITY.

- 5. ATTACHMENT OF SIGNS, OR ANY OTHER OBJECTS TO TREES IS PROHIBITED. NO EQUIPMENT, MACHINERY, VEHICLES, MATERIALS OR EXCESSIVE PEDESTRIAN TRAFFIC SHALL BE ALLOWED WITHIN THE PROTECTED AREAS.

- 6. INSTALLATION AND MAINTENANCE OF PROTECTIVE FENCING AND SIGNAGE SHALL BE THE RESPONSIBILITY OF THE GENERAL CONTRACTOR. THE GENERAL CONTRACTOR SHALL TAKE THE UTMOST CARE TO PROTECT TREE ROOT SYSTEMS DURING ALL CONSTRUCTION ACTIVITIES. TREE ROOT SYSTEMS SHALL BE PROTECTED FROM SMOTHERING, FLOODING, EXCESSIVE WETTING FROM DE-WATERING OPERATIONS, OFF-SITE RUN OFF, SPILLAGE AND DRAINING OF MATERIALS THAT MAY BE HARMFUL TO TREES.

- 7. THE GENERAL CONTRACTOR SHALL PREVENT PARKING OF CONSTRUCTION VEHICLES AND EQUIPMENT, AND THE STORING OF BUILDING SUPPLIES OR STOCKPILING OF EARTH WITHIN FOREST CONSERVATION EASEMENTS. REMOVAL OF TOPSOIL OR ROOT MAT WITHIN THE TREE PRESERVATION AREA SHALL BE PROHIBITED.

- 8. THE GENERAL CONTRACTOR SHALL BE RESPONSIBLE FOR ANY TREES DAMAGED OR DESTROYED WITHIN THE FOREST CONSERVATION EASEMENTS. ROOT PRUNING SHALL BE USED AT THE LIMIT OF DISTURBANCE OR LIMIT OF GRADING WITHIN AND ADJACENT TO ALL FORESTED AREAS. PLEASE REFER TO ROOT PRUNING DETAIL THIS SHEET.

- 9. PRE-CONSTRUCTION MEETING

- 10. AFTER THE BOUNDARIES OF THE FOREST RETENTION AREAS HAVE BEEN FIELD LOCATED AND MARKED, AND AFTER THE FOREST PROTECTION DEVICES HAVE BEEN INSTALLED, BUT BEFORE ANY OTHER DISTURBANCE HAS TAKEN PLACE ON SITE, A PRE-CONSTRUCTION MEETING SHALL TAKE PLACE ON SITE. THE DEVELOPER, CONTRACTOR OR PROJECT MANAGER, AND HOWARD COUNTY INSPECTORS SHALL ATTEND. THE PURPOSE OF THIS MEETING WILL BE:

- 11. TO IDENTIFY THE LOCATIONS OF THE FOREST RETENTION AREAS, SPECIMEN TREES WITHIN 50 FEET OF THE LIMIT OF DISTURBANCE, LIMITS OF CONSTRUCTION, EMPLOYEE PARKING AREAS AND EQUIPMENT STAGING AREAS.

- 12. INSPECT ALL FLAGGED BOUNDARIES AND PROTECTION DEVICES, MAKE ALL NECESSARY ADJUSTMENTS.

- 13. ASSIGN RESPONSIBILITIES AS APPROPRIATE AND DISCUSS PENALTIES.

- 14. CONSTRUCTION MONITORING

- 15. THE SITE SHALL BE INSPECTED PERIODICALLY DURING THE CONSTRUCTION PHASE OF THE PROJECT. A QUALIFIED PROFESSIONAL SHALL BE RESPONSIBLE FOR IDENTIFYING DAMAGE TO PROTECTED FOREST AREAS OR INDIVIDUAL TREES WHICH MAY HAVE BEEN CAUSED BY CONSTRUCTION ACTIVITIES. SUCH AS SOIL COMPACTION, TREE KILLS, TRUNK WOUNDS, LIMB INJURY, OR STRESS CAUSED BY FLOODING OR DROUGHT CONDITIONS.

- 16. ANY SUCH DAMAGE THAT MAY OCCUR SHALL BE REMEDIATED IMMEDIATELY USING APPROPRIATE MEASURES. SEVERE PROBLEMS MAY REQUIRE CONSULTATION WITH A PROFESSIONAL ARBORIST.

- 17. THE CONSTRUCTION PROCEDURE SHALL NOT DAMAGE AREAS OUTSIDE OF THE LIMIT OF DISTURBANCE AS DESIGNATED ON THE PLANS. ANY DAMAGE TO BE RESTORED BY THE CONTRACTOR AT HIS EXPENSE AND TO THE SATISFACTION OF THE DESIGN TEAM OR ENGINEER.

- 18. CONSTRUCTION MONITORING

- 19. THE SITE SHALL BE INSPECTED PERIODICALLY DURING THE CONSTRUCTION PHASE OF THE PROJECT. A QUALIFIED PROFESSIONAL SHALL BE RESPONSIBLE FOR IDENTIFYING DAMAGE TO PROTECTED FOREST AREAS OR INDIVIDUAL TREES WHICH MAY HAVE BEEN CAUSED BY CONSTRUCTION ACTIVITIES. SUCH AS SOIL COMPACTION, TREE KILLS, TRUNK WOUNDS, LIMB INJURY, OR STRESS CAUSED BY FLOODING OR DROUGHT CONDITIONS.

- 20. ANY SUCH DAMAGE THAT MAY OCCUR SHALL BE REMEDIATED IMMEDIATELY USING APPROPRIATE MEASURES. SEVERE PROBLEMS MAY REQUIRE CONSULTATION WITH A PROFESSIONAL ARBORIST.

- 21. THE CONSTRUCTION PROCEDURE SHALL NOT DAMAGE AREAS OUTSIDE OF THE LIMIT OF DISTURBANCE AS DESIGNATED ON THE PLANS. ANY DAMAGE TO BE RESTORED BY THE CONTRACTOR AT HIS EXPENSE AND TO THE SATISFACTION OF THE DESIGN TEAM OR ENGINEER.

- 22. CONSTRUCTION MONITORING

- 23. THE SITE SHALL BE INSPECTED PERIODICALLY DURING THE CONSTRUCTION PHASE OF THE PROJECT. A QUALIFIED PROFESSIONAL SHALL BE RESPONSIBLE FOR IDENTIFYING DAMAGE TO PROTECTED FOREST AREAS OR INDIVIDUAL TREES WHICH MAY HAVE BEEN CAUSED BY CONSTRUCTION ACTIVITIES. SUCH AS SOIL COMPACTION, TREE KILLS, TRUNK WOUNDS, LIMB INJURY, OR STRESS CAUSED BY FLOODING OR DROUGHT CONDITIONS.

- 24. ANY SUCH DAMAGE THAT MAY OCCUR SHALL BE REMEDIATED IMMEDIATELY USING APPROPRIATE MEASURES. SEVERE PROBLEMS MAY REQUIRE CONSULTATION WITH A PROFESSIONAL ARBORIST.

- 25. THE CONSTRUCTION PROCEDURE SHALL NOT DAMAGE AREAS OUTSIDE OF THE LIMIT OF DISTURBANCE AS DESIGNATED ON THE PLANS. ANY DAMAGE TO BE RESTORED BY THE CONTRACTOR AT HIS EXPENSE AND TO THE SATISFACTION OF THE DESIGN TEAM OR ENGINEER.

- 26. CONSTRUCTION MONITORING

- 27. THE SITE SHALL BE INSPECTED PERIODICALLY DURING THE CONSTRUCTION PHASE OF THE PROJECT. A QUALIFIED PROFESSIONAL SHALL BE RESPONSIBLE FOR IDENTIFYING DAMAGE TO PROTECTED FOREST AREAS OR INDIVIDUAL TREES WHICH MAY HAVE BEEN CAUSED BY CONSTRUCTION ACTIVITIES. SUCH AS SOIL COMPACTION, TREE KILLS, TRUNK WOUNDS, LIMB INJURY, OR STRESS CAUSED BY FLOODING OR DROUGHT CONDITIONS.

- 28. ANY SUCH DAMAGE THAT MAY OCCUR SHALL BE REMEDIATED IMMEDIATELY USING APPROPRIATE MEASURES. SEVERE PROBLEMS MAY REQUIRE CONSULTATION WITH A PROFESSIONAL ARBORIST.

FOREST CONSERVATION WORKSHEET

NET TRACT AREA:
A. Total tract area = 9.88
B. Area within 100 year floodplain & overhead transmission line = 0.88
C. Area to remain in agricultural production = 0.00
D. Net tract area = 9.00

LAND USE CATEGORY:
Input the number "1" under the appropriate land use zoning, and limit to only one entry.
ARA MDR IDA HDR MPD CIA
0 0 0 1 0 0

E. Afforestation Threshold = 15% x D = 1.35
F. Conservation Threshold = 20% x D = 1.80

EXISTING FOREST COVER:
G. Existing forest cover (excluding floodplain) = 6.47
H. Area of forest above afforestation threshold = 5.12
I. Area of forest above conservation threshold = 4.67

BREAK EVEN POINT:
J. Forest retention above threshold with no mitigation = 2.73
K. Clearing permitted without mitigation = 3.74


PROPOSED FOREST CLEARING:
L. Total area of forest to be cleared = 4.39
M. Total area of forest to be retained = 2.08

PLANTING REQUIREMENTS:
N. Reforestation for clearing above conservation threshold = 1.10
P. Reforestation for clearing below conservation threshold = 0.00
Q. Credit for retention above conservation threshold = 0.28
R. Total reforestation required = 0.82
S. Total afforestation required = 0.00
T. Total reforestation and afforestation required = 0.82

Total reforestation and afforestation provided = 0.42
0.40 ACRES OF REQUIRED FOREST CONSERVATION WILL BE ADDRESSED VIA FEE-IN-LIEU IN THE AMOUNT OF \$13,068


I HEREBY CERTIFY THAT THESE DOCUMENTS WERE PREPARED OR APPROVED BY ME AND THAT I AM A DULY LICENSED PROFESSIONAL ENGINEER UNDER THE LAWS OF THE STATE OF MARYLAND, LICENSE NO. 17942, EXP DATE 9/3/10.

APPROVED: DEPARTMENT OF PUBLIC WORKS
M. J. ... 6-11-10
APPROVED: DEPARTMENT OF PLANNING AND ZONING
K. ... 6/23/10
APPROVED: CHIEF, DEVELOPMENT ENGINEERING DIVISION
M. ... 6/23/10

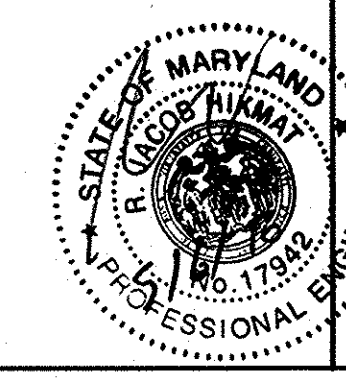

MD DNR QUALIFIED PROFESSIONAL
Mashid ... 5/6/10
MASHID TRINCA



THERE IS NO AS-BUILT INFORMATION SHOWN ON THIS SHEET

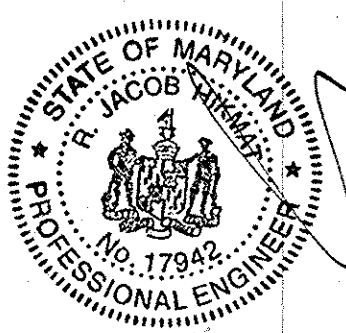

NOTES:



- 1. THIS PLAN HAS BEEN PREPARED IN ACCORDANCE WITH THE PROVISIONS OF SECTION 16.124 OF THE HOWARD COUNTY CODE AND THE LANDSCAPE MANUAL.
2. FINANCIAL SURETY FOR THE REQUIRED LANDSCAPING IS TO BE POSTED FOR .44 SHADE AND 29 EVERGREEN TREES IN THE AMOUNT OF \$17,550.00 AS PART OF THE DWP DEVELOPERS AGREEMENT.
3. THE FOREST CONSERVATION REQUIREMENTS PER SECTION 16.1202 OF THE HOWARD COUNTY CODE FOR FOREST CONSERVATION BY RETENTION OF 2.08 ACRES OF FOREST, AFFORESTATION OF 0.42 ACRES AND FEE-IN-LIEU OF 0.40 ACRES, FINANCIAL SURETY FOR THE ON-SITE RETENTION FOR THE AMOUNT OF \$ 18,121.00, AND AFFORESTATION FOR THE AMOUNT OF \$ 9,148.00 FOR A TOTAL OF \$ 27,269.00 WILL BE POSTED AS PART OF THE DEVELOPERS AGREEMENT.
4. NO CLEARING, GRADING OR CONSTRUCTION IS PERMITTED WITHIN THE FOREST CONSERVATION EASEMENT; HOWEVER FOREST MANAGEMENT PRACTICES AS DEFINED IN THE DEED OF FOREST CONSERVATION EASEMENT ARE ALLOWED.
5. 0.40 ACRES OF REQUIRED FOREST CONSERVATION WILL BE ADDRESSED VIA FEE-IN-LIEU IN THE AMOUNT OF \$13,068.00
6. SIGNAGE SHALL BE PLACED FOR PERPETUITY
7. THE OWNER, TENANT AND/OR THEIR AGENTS SHALL BE RESPONSIBLE FOR MAINTENANCE OF THE REQUIRED LANDSCAPING, INCLUDING BOTH PLANT MATERIALS AND BIRMS, FENCES AND WALLS. ALL PLANT MATERIALS SHALL BE MAINTAINED IN GOOD GROWING CONDITION, AND WHEN NECESSARY, REPLACED WITH NEW MATERIALS TO ENSURE CONTINUED COMPLIANCE WITH APPLICABLE REGULATIONS. ALL OTHER REQUIRED LANDSCAPING SHALL BE PERMANENTLY MAINTAINED IN GOOD CONDITION AND WHEN NECESSARY, REPAIRED OR REPLACED AT THE TIME OF INSTALLMENT. ALL SHRUBS AND OTHER PLANTINGS HEREWITH LISTED AND APPROVED FOR THIS SITE, SHALL BE OF THE PROPER HEIGHT REQUIREMENTS IN ACCORDANCE WITH THE HOWARD COUNTY LANDSCAPING MANUAL. IN ADDITION, NO SUBSTITUTIONS OR RELOCATION OF REQUIRED PLANTINGS MAY BE MADE WITHOUT PRIOR REVIEW AND APPROVAL FROM THE DEPARTMENT OF PLANNING AND ZONING. ANY DEVIATION FROM THIS APPROVED LANDSCAPE PLAN MAY RESULT IN DENIAL OR DELAY IN THE RELEASE OF LANDSCAPE SURETY UNTIL SUCH TIME AS ALL REQUIRED MATERIALS ARE PLANTED AND/OR REVISIONS ARE MADE TO APPLICABLE PLANS AND CERTIFICATES.
8. PROPOSED TREE LINE IS COINCIDENT WITH THE LIMIT OF THE FOREST CONSERVATION EASEMENT.

- NOTE:
1. NO RARE, THREATENED OR ENDANGERED SPECIES AND THEIR HABITATS WERE OBSERVED ON THE PROPERTY.
2. SURROUNDING LAND USE IS MEDIUM DENSITY RESIDENTIAL AND FOREST.
3. SUBJECT PROPERTY IS IN PATAPSCO RIVER NORTH BRANCH WATER SHED, NO. 2139006.
4. NO HISTORIC STRUCTURES, CEMETERIES, RARE, THREATENED OR ENDANGERED SPECIES AND THEIR HABITATS EXIST ON-SITE.

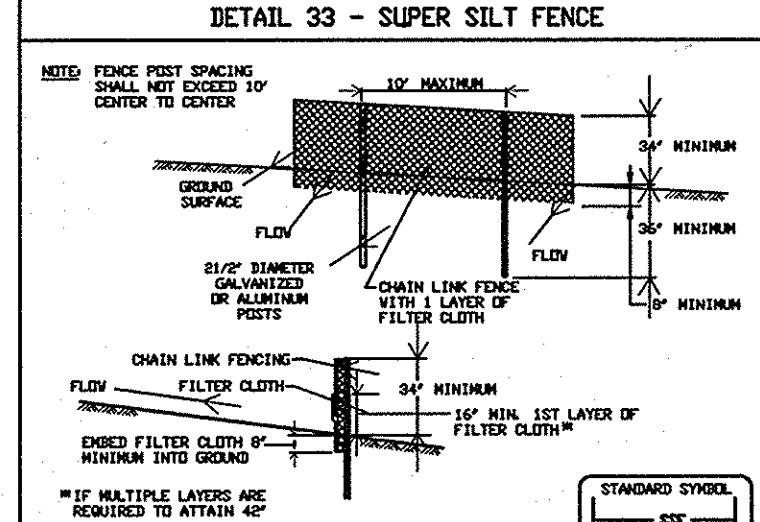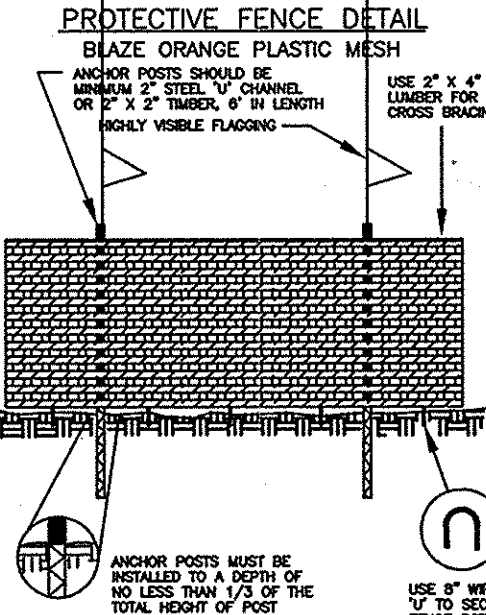


AFFORESTATION PLANT LISTS

Table with columns: QTY, SPECIES, SHADE, MOIST, WET, MIN.D.C., SIZE & TOL, RESUME STATUS, SPACING REMARKS. Lists plants like Acer rubrum, Red Maple, Liriodendron tulipifera, Nyssa sylvatica, Fagus grandifolia, American Beech.

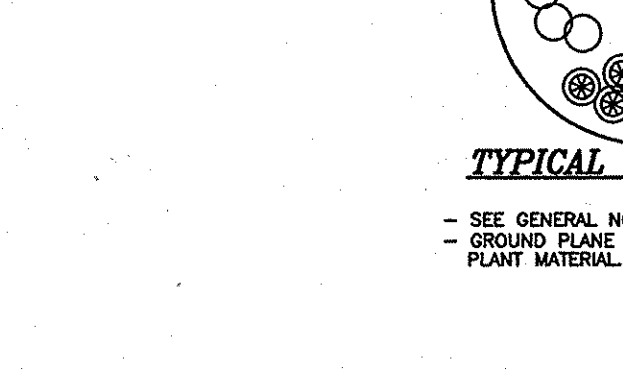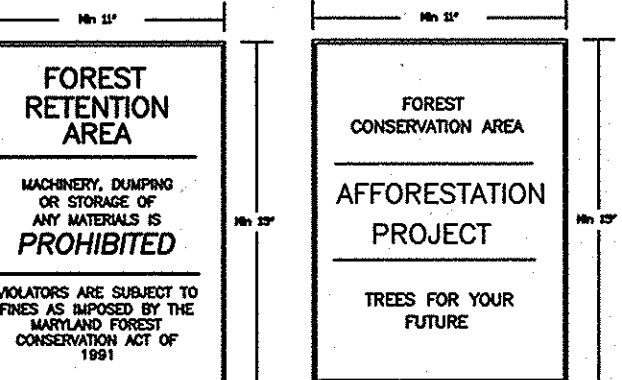

SIGNAGE DETAILS

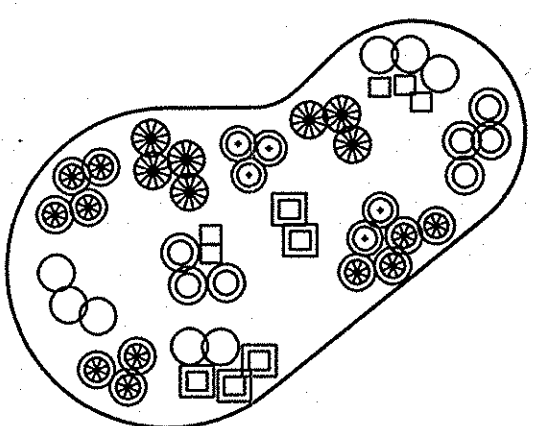

TYPICAL TREE PLANTING PLAN NOT TO SCALE

project date MAY 2010
08-007 illustration engineering
MMM scale approval
MMM date
1"=60' RJH

description revisions
no.

AS-BUILT
BONNIE BRANCH WOODS
TAX MAP: 31 PARCEL 101
HOWARD COUNTY, MARYLAND
SECOND ELECTION DISTRICT
FOREST CONSERVATION NOTES AND DETAILS

MILDENBERG, BOENDER & ASSOC., INC.
Engineers Planners Surveyors
6800 Deerpath Road, Suite 150, Elkridge, Maryland 21075
(410) 997-0288 Fax.

OWNER/DEVELOPER

BONNIE BRANCH WOODS INC.
C/O MILDENBERG, BOENDER AND ASSOC., INC.
6800 DEERPATH ROAD, SUITE 150
ELKRIDGE, MARYLAND 21075
410-997-0286







**MGWC 4.2: UTILITY CROSSING**


**Temporary In-stream Construction**

**DESCRIPTION**  
The work should consist of installing erosion control devices in and adjacent to the construction of utility crossings.


**INSTALLATION GUIDELINES**  
All erosion and sediment control devices, including dewatering basins, should be implemented as the first order of business according to a plan approved by the WMA or local authority. (See the 1994 Maryland Standards and Specifications for Soil Erosion and Sediment Control). The proposed construction sequence is as follows (refer to Detail 4.2):

1. The contractor should ensure that a continuous perimeter control barrier is in place to minimize the amount of pollutants entering the flow. A diversion pipe as shown in MGWC 1.4, Diversion Pipe or other measure should be installed and sandbag or stone barriers as shown in MGWC 1.5, Sandbag/Stone Diversion should be constructed according to specifications to divert the streamflow.
2. Excavated topsoil and subsoil should be kept separate, placed on the upland side of the excavation, and placed in their natural order.
3. All construction should take place during stream low flows. The length of construction time should be limited to a maximum of 5 consecutive days for each crossing.
4. All utility crossings should be placed a minimum of 3 feet (1 meter) behind the stream bed unless an alternative section is specifically approved by the WMA. For instances where a 3-foot cover is not viable, two alternate stabilization options are given in the Detail 4.2. A low flow channel shall be constructed through all riprap placements across the stream bed.
5. The stream should be diverted by an approved temporary stream diversion, the construction area should be dewatered, and any disturbed banks should be stabilized. The contractor may elect to construct the utility crossing in two stages. In this case, a WMA approved flow barrier may be constructed to keep the construction area dry.
6. Once the crossing is completed, the diversion should be removed from upstream to downstream. Sediment control devices, including perimeter erosion control, are to remain in place until all disturbed areas are stabilized in accordance with an approved sediment and erosion control plan and the inspection authority approves their removal.

**Maryland's Guidelines To Waterway Construction  
DETAIL 4.2(a): UTILITY CROSSING**

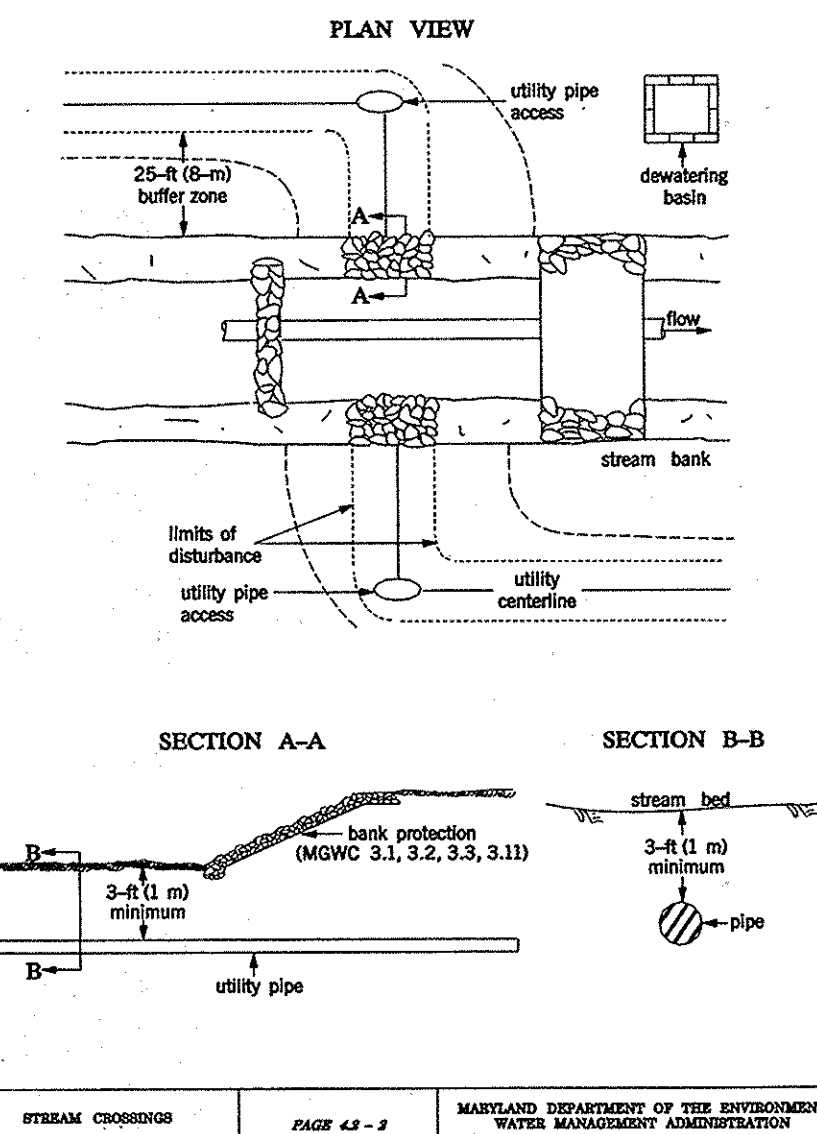

**Maryland's Guidelines To Waterway Construction  
DETAIL 1.2: PUMP-AROUND PRACTICE**

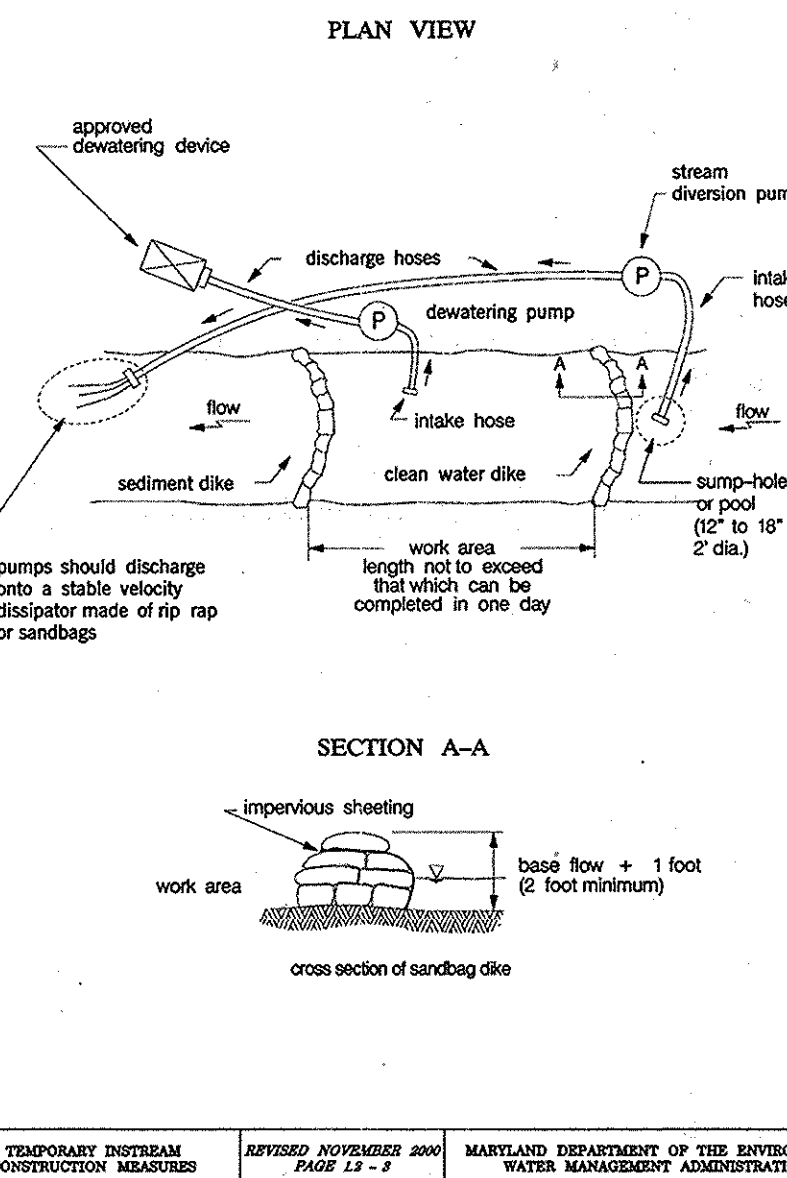

**MGWC 1.2: PUMP-AROUND PRACTICE**

**Temporary measures for dewatering in-channel construction sites**

**DESCRIPTION**  
The work should consist of installing a temporary pump around and supporting measures to divert flow around in-stream construction sites.

**IMPLEMENTATION REQUIREMENTS**  
Sediment control measures, pump-around practices, and associated channel and bank construction should be completed in the following sequence (refer to Detail 1.2):

1. Construction activities including the installation of erosion and sediment control measures should not begin until all necessary assessments and/or right-of-way have been acquired. All existing utilities should be marked in the field prior to construction. The contractor is responsible for any damage to existing utilities that may result from construction and should repair the damage at his/her own expense or the county's or utility company's satisfaction.
2. The contractor should notify the Maryland Department of the Environment or WMA sediment control inspector at least 5 days before beginning construction. Additionally, the contractor should inform the local environmental protection and resource management inspection and enforcement division and the provider of local utilities a minimum of 48 hours before starting construction.
3. The contractor should conduct a pre-construction meeting on site with the WMA sediment control inspector, the county project manager, and the engineer to review limits of disturbance, erosion and sediment control requirements, and the sequence of construction. The contractor should stake out all limits of disturbance prior to the pre-construction meeting so they may be reviewed. The participants will also designate the contractor's staging areas and flag areas within the limits of disturbance which will be removed for construction access. Trees should not be removed within the limits of disturbance without approval from the WMA or local authority.
4. Construction should not begin until all sediment and erosion control measures have been installed and approved by the engineer and the sediment control inspector. The contractor should stay within the limits of the disturbance as shown on the plans and minimize disturbance within the work area whenever possible.
5. Upon installation of all sediment control measures and approval by the sediment control inspector and the local environmental protection and resource management inspection and enforcement division, the contractor should begin work at the upstream section and proceed downstream beginning with the establishment of stabilized construction entrances. In some cases, work may begin downstream if appropriate. The sequence of construction must be followed unless the contractor gets written approval for deviations from the WMA or local authority. The contractor should only begin work in an area which can be completed by the end of the day including grading adjacent to the channel. At the end of each work day, the work area must be stabilized and the pump around removed from the channel. Work should not be conducted in the channel during rain events.
6. Sandbag dikes should be situated at the upstream and downstream ends of the work area as shown on the plans, and stream flow should be pumped around the work area. The pump should discharge onto a stable velocity dissipater made of riprap or sandbags.




**MGWC 1.2: PUMP-AROUND PRACTICE**

**Temporary measures for dewatering in-channel construction sites**

**DESCRIPTION**  
Water from the work area should be pumped to a sediment filtering measure such as a dewatering basin, sediment bag, or other approved source. The measure should be located such that the water drains back into the channel below the downstream sandbag dike.

8. Traversing a channel reach with equipment within the work area where no work is proposed should be avoided. If equipment has to traverse such a reach for access to another area, then timber mats or similar measures should be used to minimize disturbance to the channel. Temporary stream crossings should be used only when necessary and only where noted on the plans or specified. (See Section 4, Stream Crossings, Maryland Guidelines to Waterway Construction).
9. All stream restoration measures should be installed as indicated by the plans and all banks graded in accordance with the grading plans and typical cross-sections. All grading must be stabilized at the end of each day with seed and mulch or seed and matting as specified on the plans.
10. After an area is completed and stabilized, the clean water dike should be removed. After the first sediment flush, a new clean water dike should be established upstream from the old sediment dike. Finally, upon establishment of a new sediment dike below the old one, the old sediment dike should be removed.
11. A pump around must be installed on any tributary or storm drain outfall which contributes baseflow to the work area. This should be accomplished by locating a sandbag dike at the downstream end of the tributary or storm drain outfall and pumping the stream flow around the work area. This water should discharge onto the same velocity dissipater used for the main stem pump around.
12. If a tributary is to be restored, construction should take place on the tributary before work on the main stem reaches the tributary confluence. Construction in the tributary, including pump around practices, should follow the same sequence as for the main stem of the river or stream. When construction on the tributary is completed, work on the main stem should resume. Water from the tributary should continue to be pumped around the work area in the main stem.
13. The contractor is responsible for providing access to and maintaining all erosion and sediment control devices until the sediment control inspector approves their removal.
14. After construction, all disturbed areas should be regraded and revegetated as per the planting plan.

**MDE DETAILS**

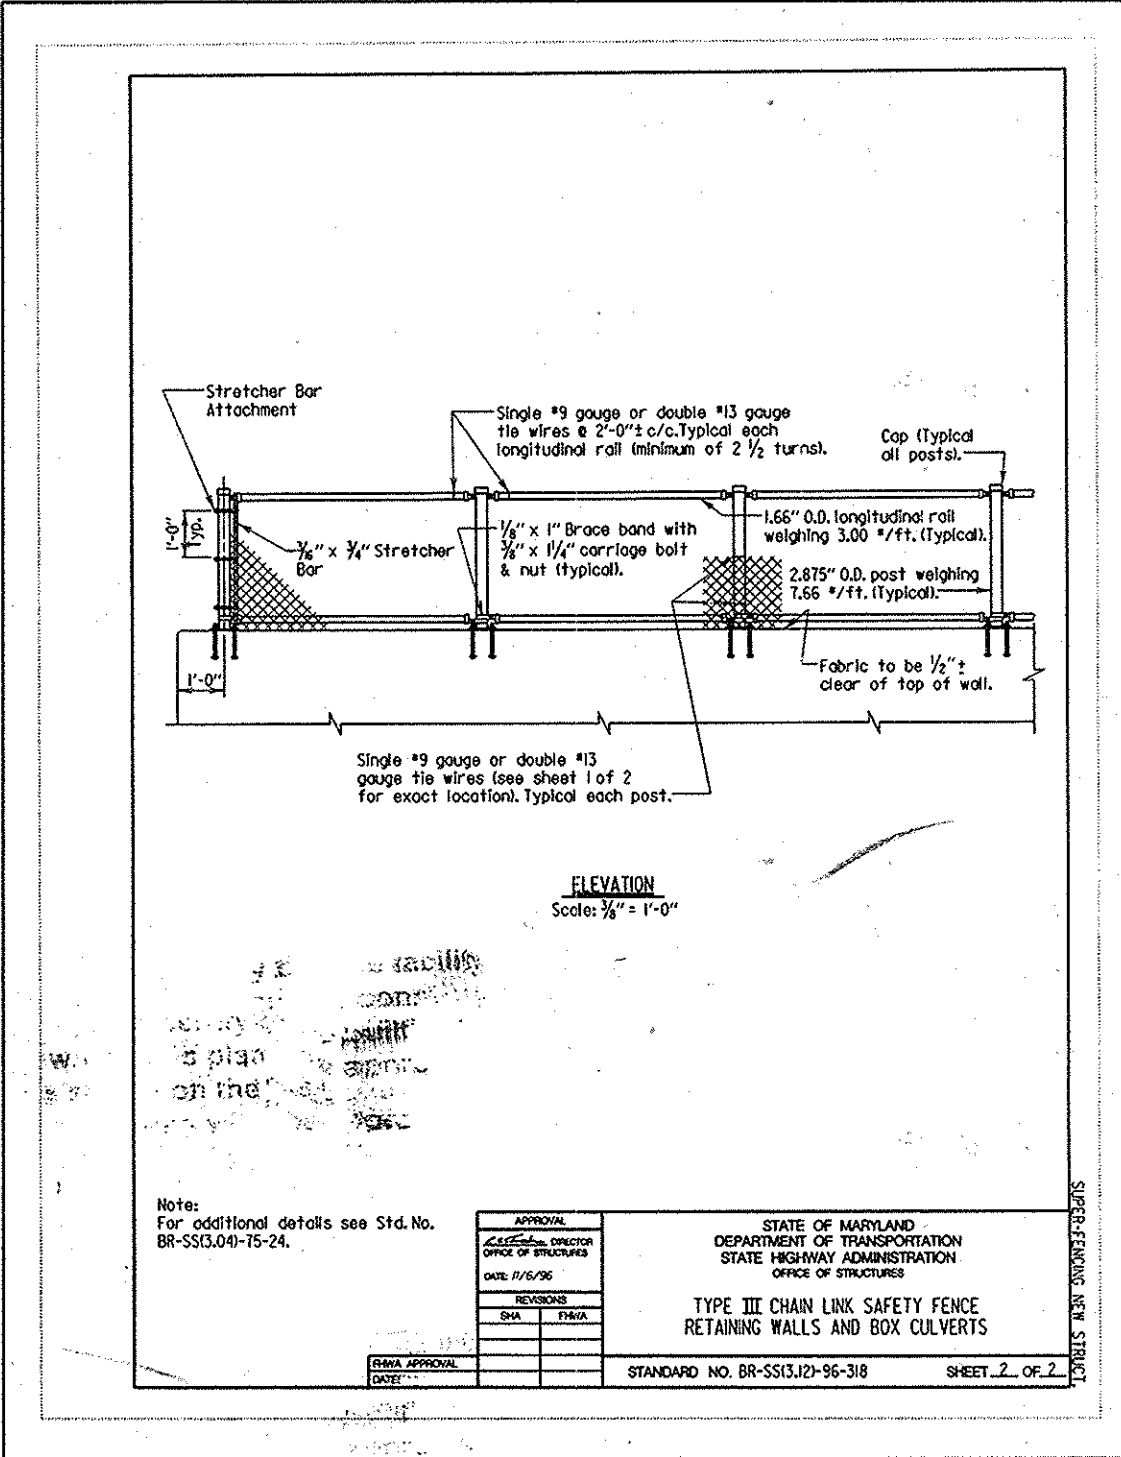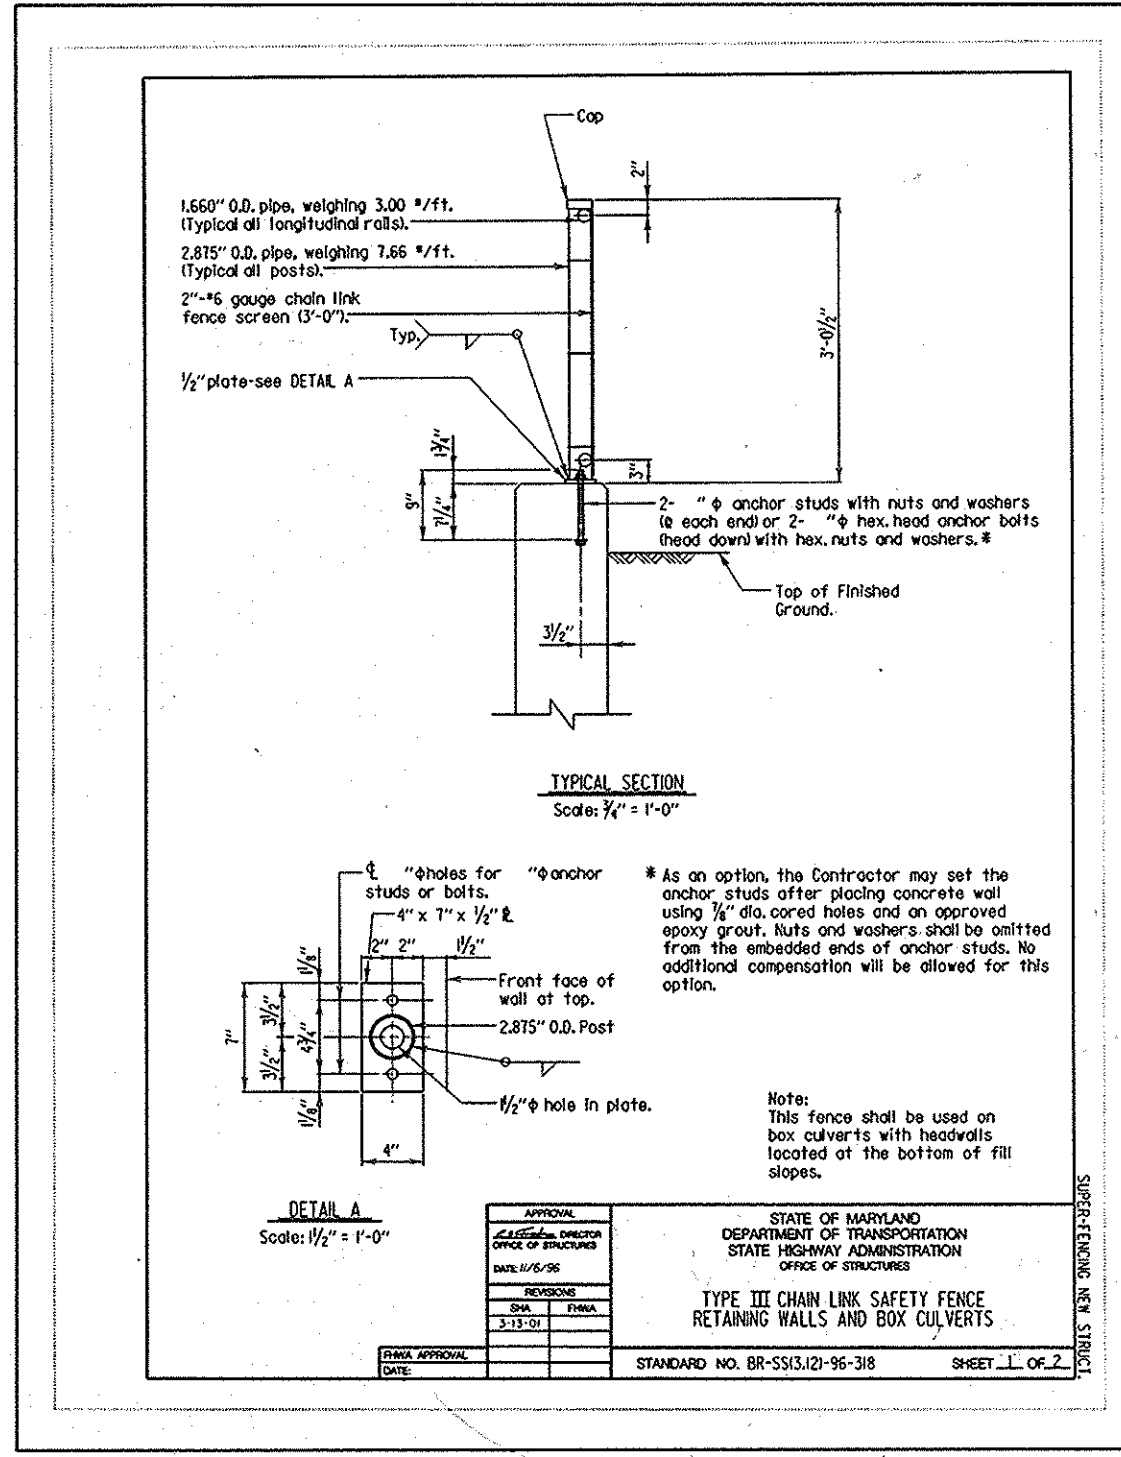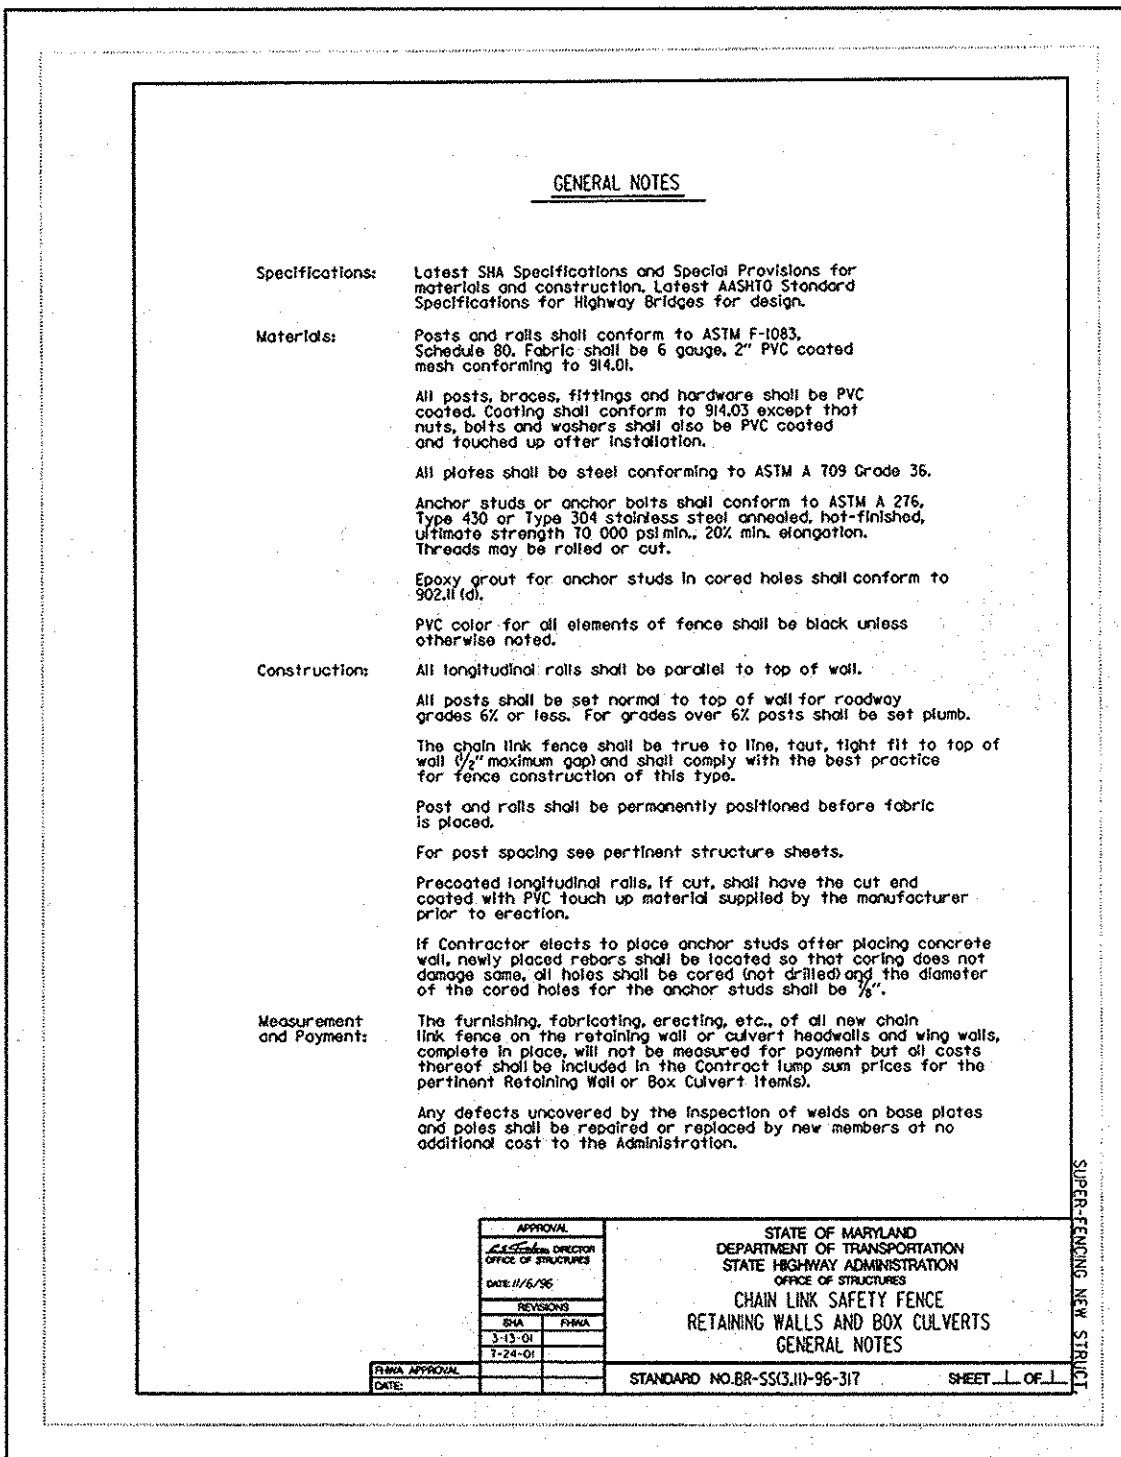


**MD. SHA DETAILS**

THERE IS NO AS-BUILT INFORMATION PROVIDED ON THIS SHEET

APPROVED: DEPARTMENT OF PUBLIC WORKS  
 [Signature] 6-11-10  
 CHIEF BUREAU OF HIGHWAYS  
 APPROVED: DEPARTMENT OF PLANNING AND ZONING  
 [Signature] 6/22/10  
 CHIEF, DIVISION OF LAND DEVELOPMENT  
 APPROVED: [Signature] 6/16/10  
 CHIEF, DEVELOPMENT ENGINEERING DIVISION

STATE OF MARYLAND  
 DEPARTMENT OF TRANSPORTATION  
 STATE HIGHWAY ADMINISTRATION  
 OFFICE OF STRUCTURES  
 CHAIN LINK SAFETY FENCE  
 RETAINING WALLS AND BOX CULVERTS  
 GENERAL NOTES  
 STANDARD NO. BR-SS3.02-96-37 SHEET 2 OF 2

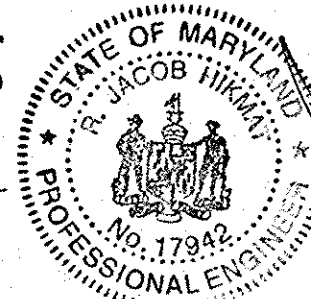

I HEREBY CERTIFY THAT THESE DOCUMENTS WERE PREPARED OR APPROVED BY ME AND THAT I AM A DULY LICENSED PROFESSIONAL ENGINEER UNDER THE LAWS OF THE STATE OF MARYLAND, LICENSE NO. 17942, EXP DATE 9/3/10.

**OWNER/DEVELOPER**

BONNIE BRANCH WOODS, INC.  
 C/O MILDENBERG, BOENDER AND ASSOC., INC.  
 6800 DEERPATH ROAD, SUITE 150  
 ELK RIDGE, MARYLAND 21075  
 410-997-0296

project	date	approval
06-007	MAY 2010	MMM
illustration	engineering	MMM
scale		AS SHOWN
no.		AS SHOWN

description	date
revisions	

AS-BUILT  
**BONNIE BRANCH WOODS**  
 SECOND ELECTION DISTRICT  
 TAX MAP: 31 PARCEL 101  
 HOWARD COUNTY, MARYLAND  
 MISCELLANEOUS DETAILS

**MILDENBERG, BOENDER & ASSOC., INC.**  
 Engineers Planners Surveyors  
 6800 Deerpath Road, Suite 150, Elkridge, Maryland 21075  
 (410) 997-0296 Fax



**NOTES**

**GENERAL NOTES:**

1. THIS BRIDGE HAS BEEN DESIGNED FOR GENERAL SITE CONDITIONS. THE PROJECT ENGINEER SHALL BE RESPONSIBLE FOR THE STRUCTURE'S SUITABILITY TO THE EXISTING SITE CONDITIONS AND FOR THE HYDRAULIC EVALUATION - INCLUDING SCOUR AND CONFIRMATION OF SOIL CONDITIONS.
2. PRIOR TO CONSTRUCTION, CONTRACTOR MUST VERIFY ALL ELEVATIONS SHOWN THROUGH THE ENGINEER.
3. ONLY CONTECH BRIDGE SOLUTIONS INC. THE CON/SPAN® APPROVED PRECASTER IN MARYLAND MAY PROVIDE THE STRUCTURE DESIGNED IN ACCORDANCE WITH THESE PLANS.
4. THE USE OF ANOTHER PRECAST STRUCTURE WITH THE DESIGN ASSUMPTIONS USED FOR THE CON/SPAN® STRUCTURE MAY LEAD TO SERIOUS DESIGN ERRORS. USE OF ANY OTHER PRECAST STRUCTURE WITH THIS DESIGN AND DRAWINGS VOIDS ANY CERTIFICATION OF THIS DESIGN AND WARRANTY. CONTECH BRIDGE SOLUTIONS INC. ASSUMES NO LIABILITY FOR DESIGN OF ANY ALTERNATE OR SIMILAR TYPE STRUCTURES.
5. ALTERNATE STRUCTURES MAY BE CONSIDERED, PROVIDED THAT SIGNED AND SEALED DESIGN DRAWINGS (AND CALCULATIONS) ARE SUBMITTED TO THE ENGINEER 2 WEEKS PRIOR TO THE BID DATE FOR REVIEW AND APPROVAL.

# BONNIE BRANCH WOODS HOWARD COUNTY, MARYLAND

**DESIGN DATA**

**DESIGN LOADING:**



HEADWALLS: EARTH PRESSURE + LIVE LOAD SURCHARGE  
 WINGWALLS: EARTH PRESSURE ONLY  
 HEADWALL DESIGN FILL HEIGHT: 1'-6" MIN. FROM TOP OF CORRUGATED STRUCTURE TO BOTTOM OF FLEXIBLE PAVEMENT/  
 2'-0" MAX. FROM TOP OF CORRUGATED STRUCTURE TO TOP OF ROADWAY

DESIGN METHOD: LOAD FACTOR PER AASHTO SPECIFICATION  
 NET ALLOWABLE SOIL BEARING PRESSURE: 2500 PSF \*  
 GROSS ALLOWABLE SOIL BEARING PRESSURE: 2500 PSF \*

\*FOUNDATION EXCAVATION AND SUBGRADE PREPARATION SHALL BE IN ACCORDANCE WITH THE GEOTECHNICAL REPORT FOR THIS PROJECT PREPARED BY HILLIS-CARNES DATED OCTOBER 13, 2009.

**MATERIALS**

PRECAST UNITS SHALL BE CONSTRUCTED AND INSTALLED IN ACCORDANCE WITH CON/SPAN® SPECIFICATIONS. CONCRETE FOR FOOTINGS SHALL HAVE A MINIMUM COMPRESSIVE STRENGTH OF 4000 PSI. REINFORCING STEEL FOR FOOTINGS SHALL CONFORM TO ASTM A615 OR A996-GRADE 60.

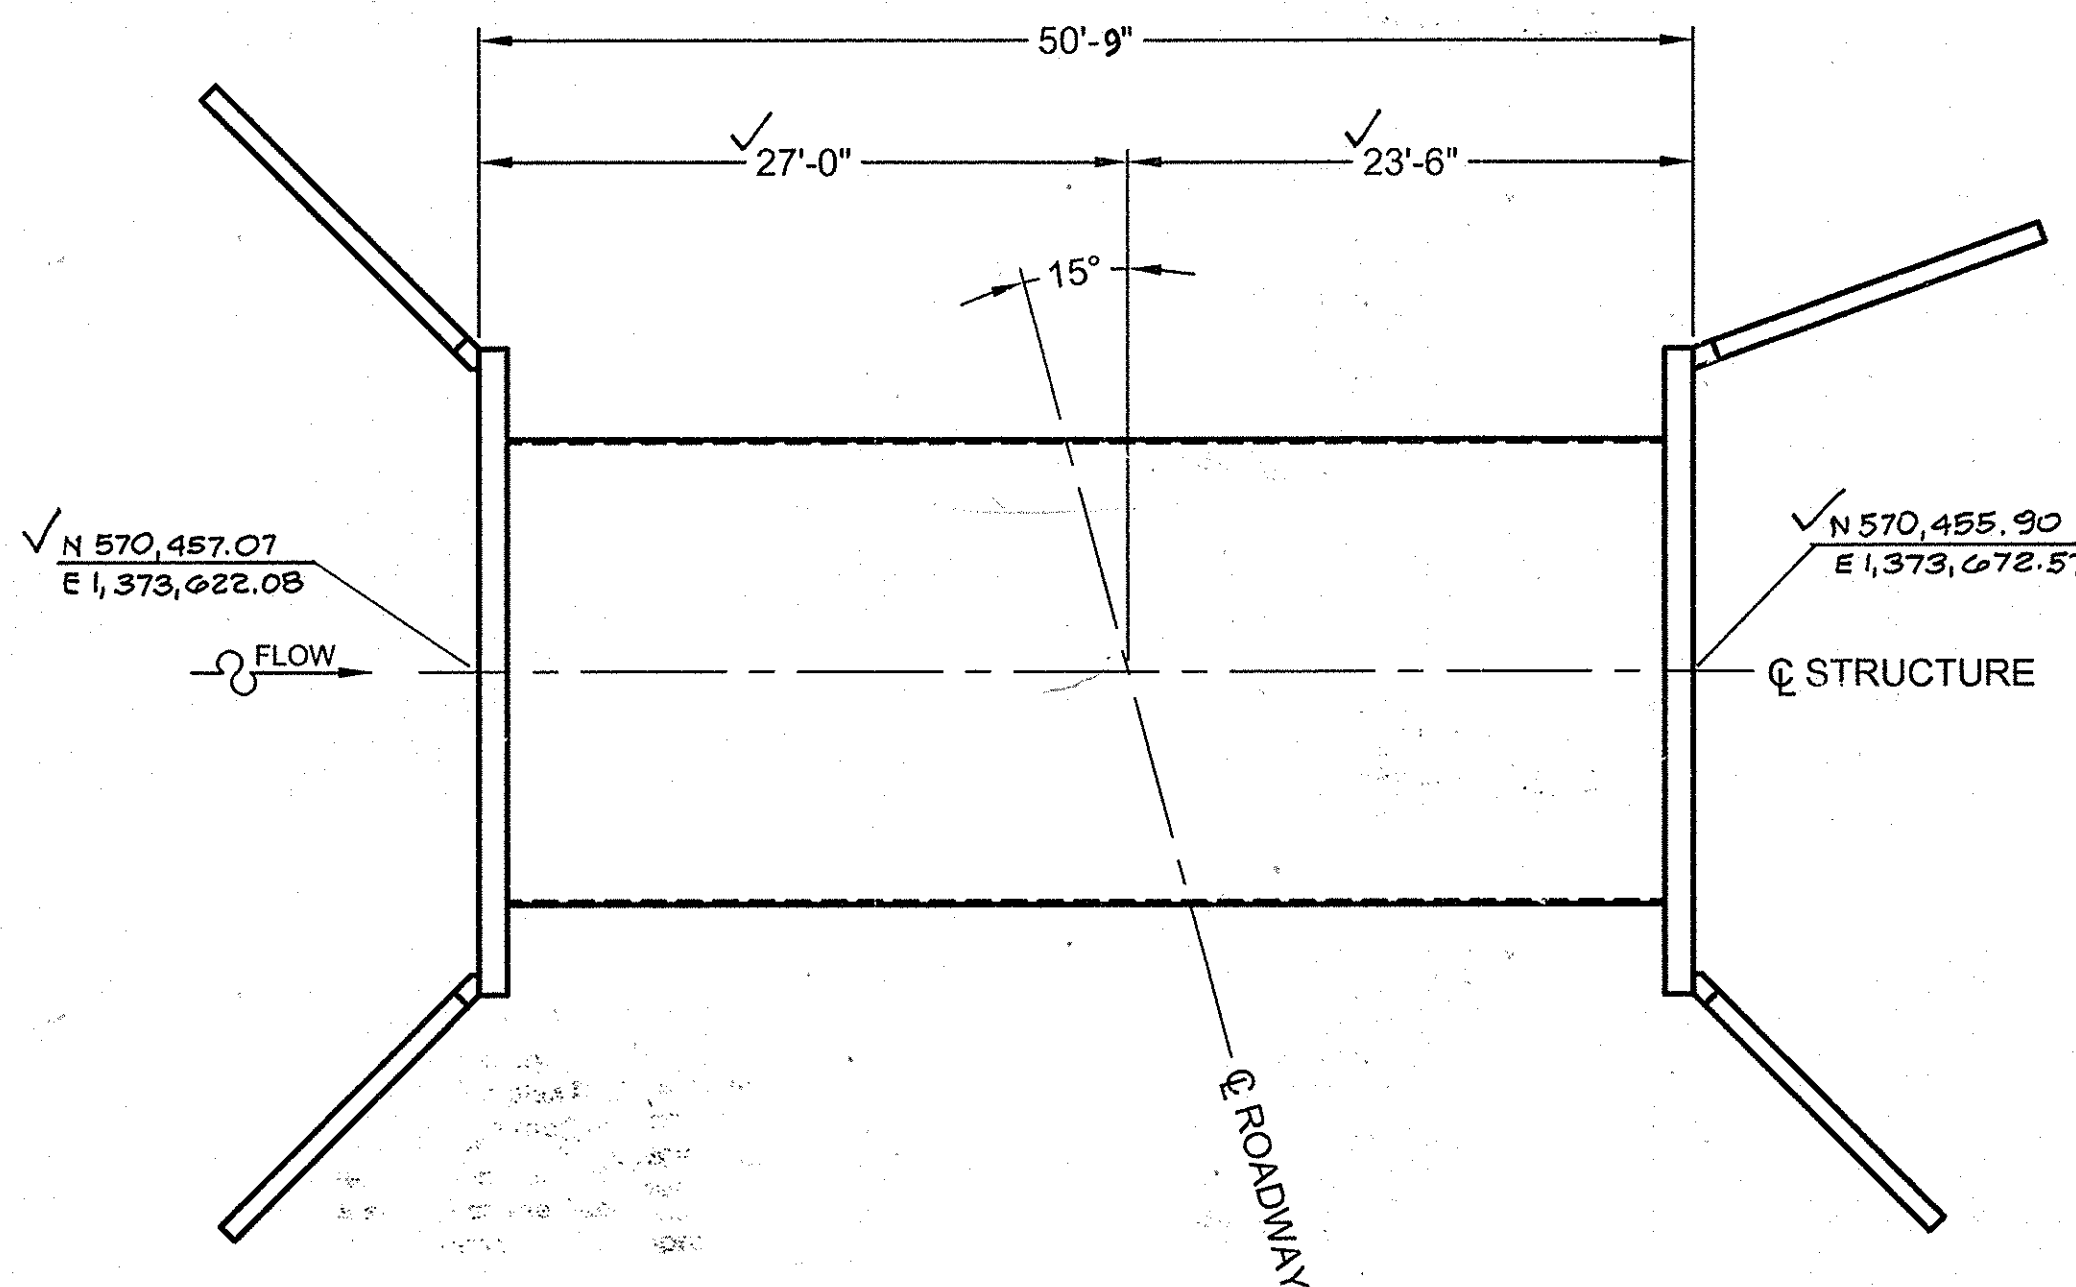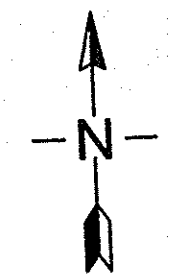


NOTE:  
WINGWALL & HEADWALL PRECAST UNITS & FOUNDATIONS DESIGNED BY CONTECH

NOTE:  
BRIDGE AND BRIDGE FOUNDATION DESIGNED BY CBC ENGINEERS

PROFESSIONAL CERTIFICATION: I HEREBY CERTIFY THAT THESE DOCUMENTS WERE PREPARED OR APPROVED BY ME, AND THAT I AM A DULY LICENSED PROFESSIONAL ENGINEER UNDER THE LAWS OF THE STATE OF MARYLAND, LICENSE NO. 36225, EXPIRATION DATE: 8/19/2010.

**LOCATION PLAN**

NOT TO SCALE

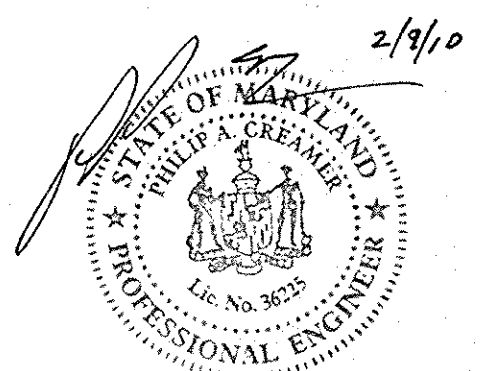

I:\MERCURY\PROJECTS\ACTIVE\402195\402195-1\MULTI-PLATE\DRAWINGS\CONTRACT\PRE-402195-001-CS-CO.N.B.DWG 2/9/2010 11:28 AM

APPROVED: DEPARTMENT OF PUBLIC WORKS  
*[Signature]* 6-11-10  
 CHIEF BUREAU OF HIGHWAYS DATE


APPROVED: DEPARTMENT OF PLANNING AND ZONING  
*[Signature]* 6/22/10  
 CHIEF, DIVISION OF LAND DEVELOPMENT DATE

APPROVED: DEVELOPMENT ENGINEERING DIVISION  
*[Signature]* 6/10/10  
 CHIEF, DEVELOPMENT ENGINEERING DIVISION DATE

I hereby certify that the facility shown on this plan was constructed as shown on the 'As-Built' plans and meets with the approved plans and specifications.



I hereby certify that the facility shown on this plan was constructed as shown on the 'As-Built' plans and meets with the approved plans and specifications.

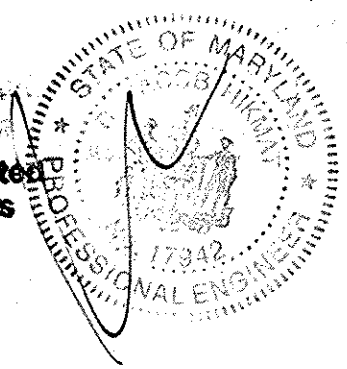

The design and information shown on this drawing is provided as a service to the project owner, engineer and contractor by CONTECH Construction Products Inc. or one of its affiliated companies ("CONTECH"). Neither this drawing, nor any part thereof, may be used, reproduced or modified in any manner without the prior written consent of CONTECH. Failure to comply is done at the user's own risk and CONTECH expressly disclaims any liability or responsibility for such use.

If discrepancies between the supplied information upon which the drawing is based and actual field conditions are encountered as site work progresses, these discrepancies must be reported to CONTECH immediately for re-evaluation of the design. CONTECH accepts no liability for designs based on missing, incomplete or inaccurate information supplied by others.

MARK	DATE	REVISION DESCRIPTION	BY
JMF	2/8/2010	NO CHANGES ON THIS SHEET	JMF

**CONTECH**  
 CONSTRUCTION PRODUCTS INC.  
 www.contech-cpi.com  
 9025 Centre Pointe Dr., Suite 400, West Chester, OH 45069  
 800-338-1122 513-645-7000 513-645-7993 FAX



**CON/SPAN**  
 BRIDGE SYSTEMS  
 CONTECH  
 CONTRACT  
 DRAWING

BONNIE BRANCH WOODS  
 AS-BUILT  
 HOWARD COUNTY, MARYLAND


PROJECT No.: 402195	SEQ. No.: 001	DATE: 11/13/2009
DESIGNED: JMF	DRAWN: ZWM	
CHECKED: DMR	APPROVED: PAC	
SHEET NO.: 14 OF 24 CT1 OF CT7		

F-10-042




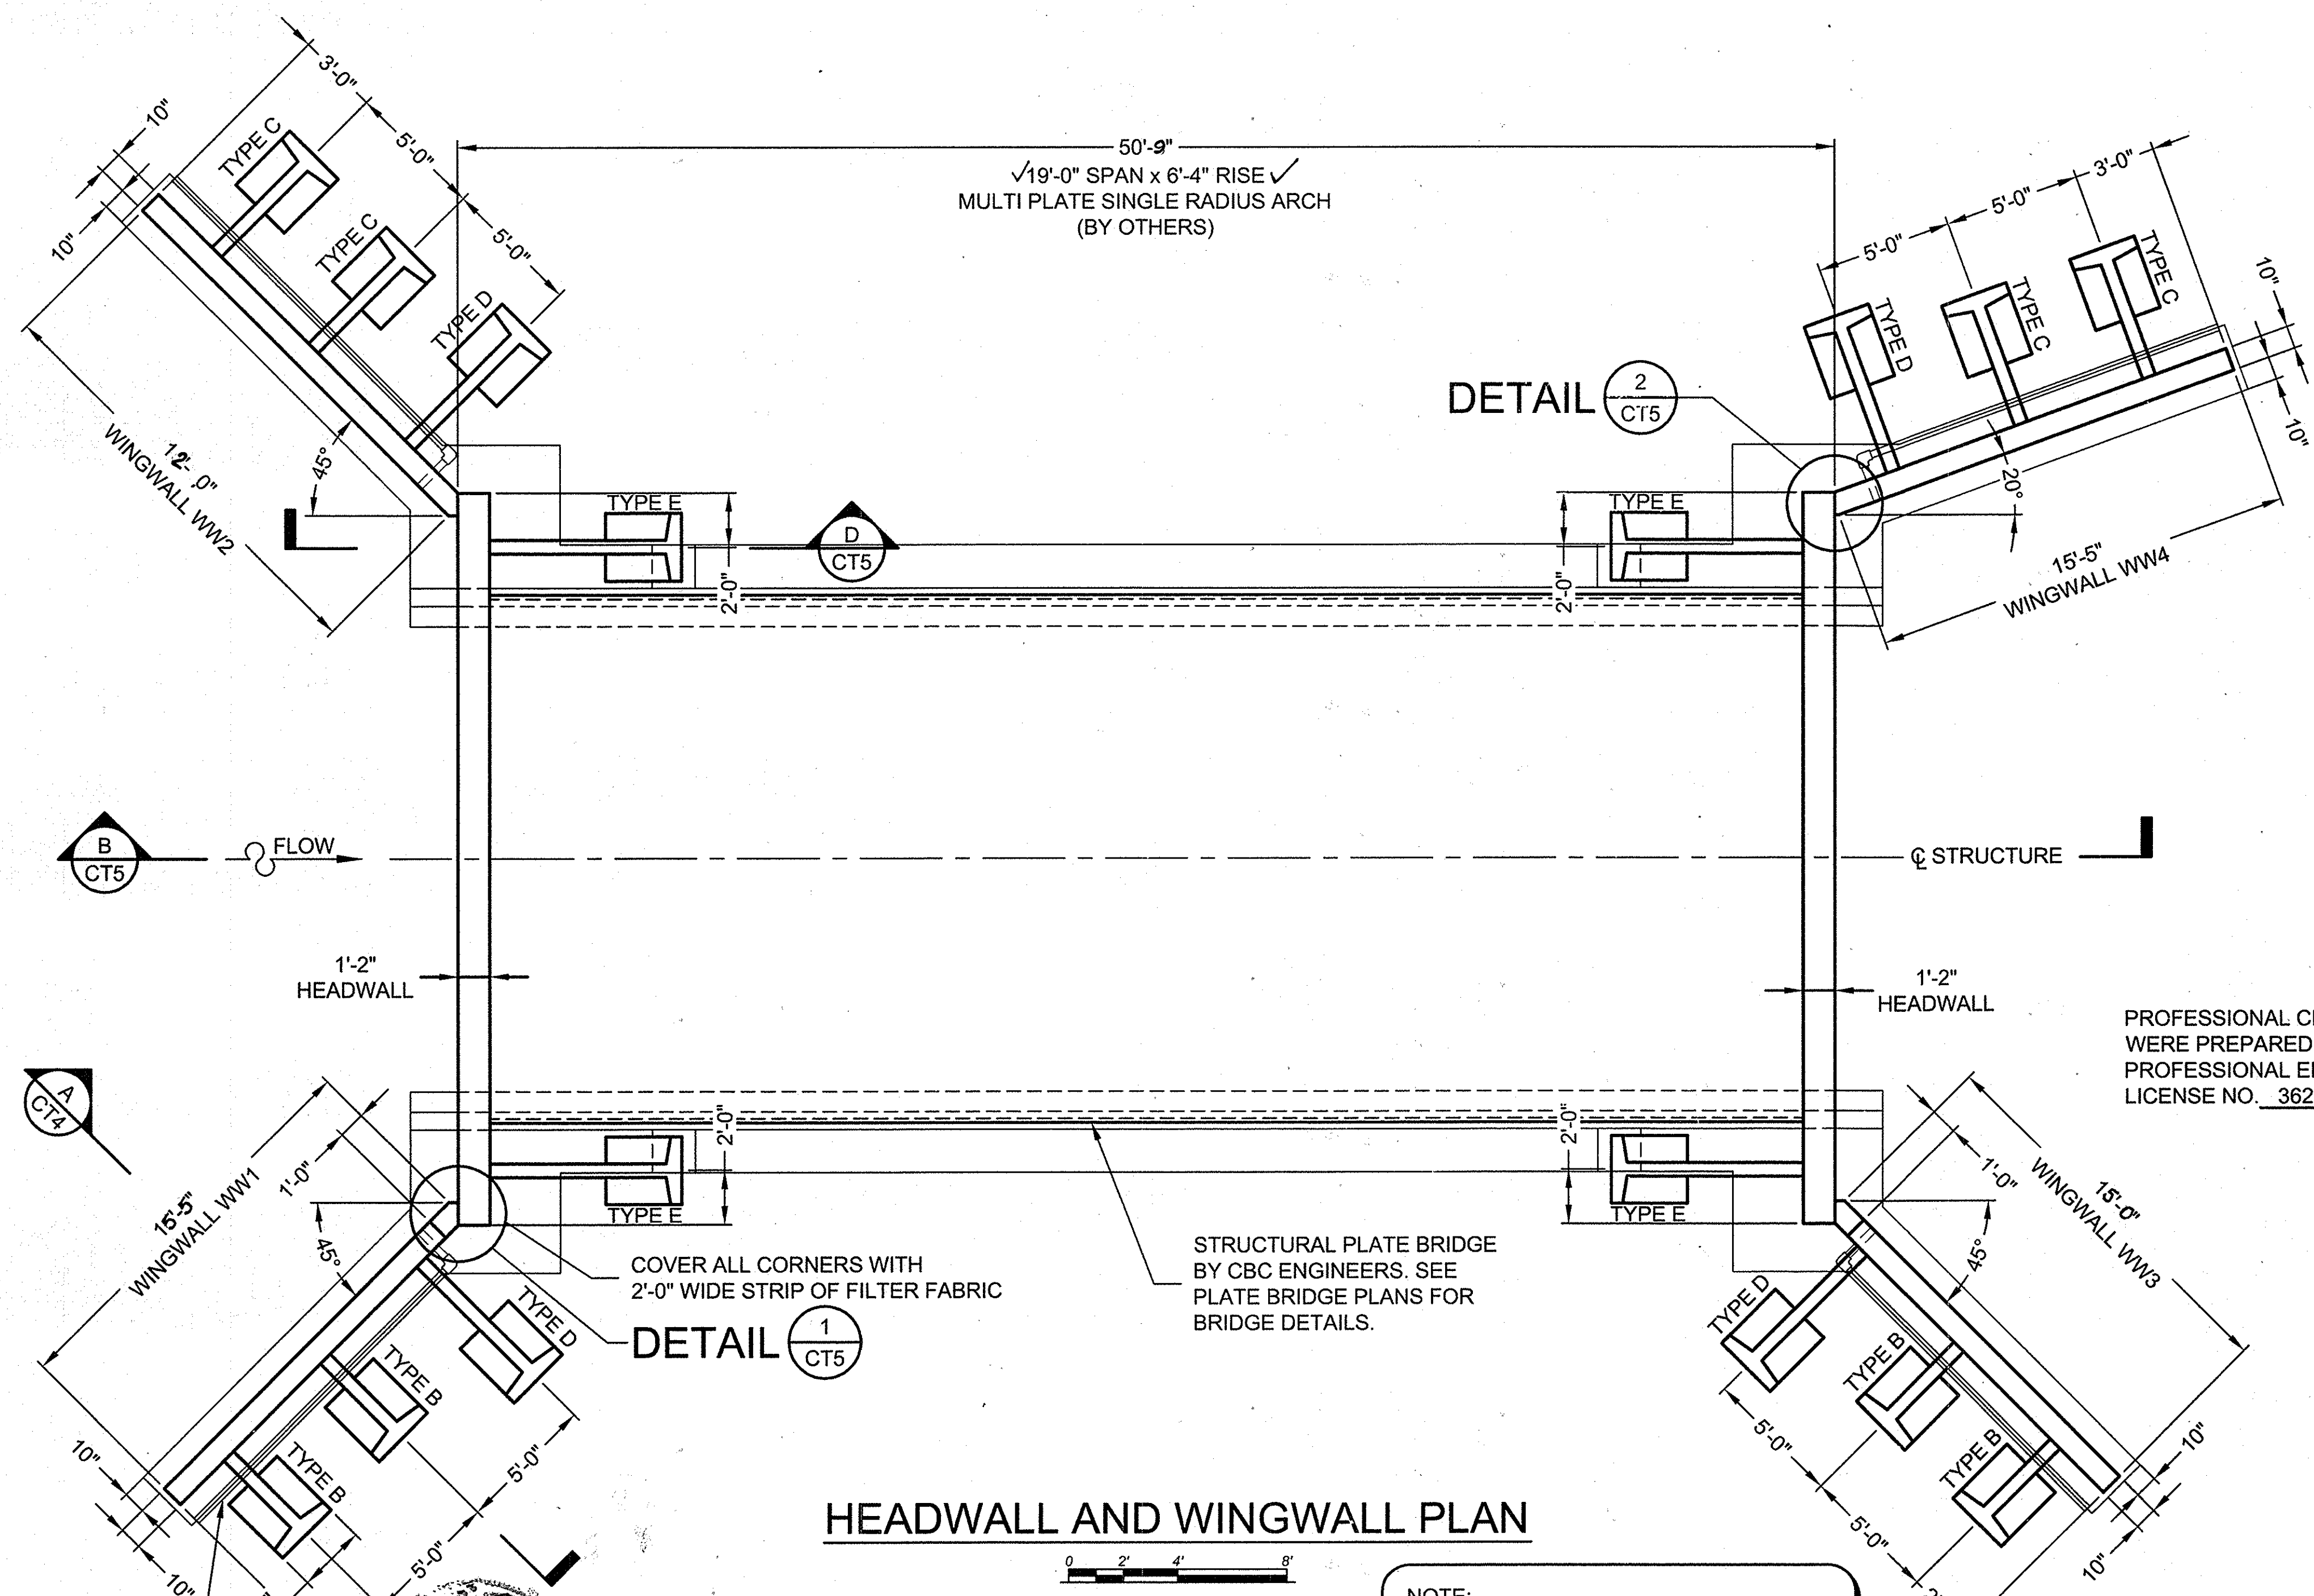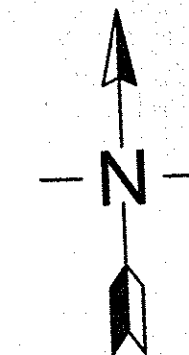

### HEADWALL AND WINGWALL PLAN

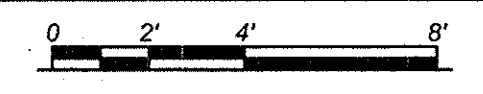


PROFESSIONAL CERTIFICATION: I HEREBY CERTIFY THAT THESE DOCUMENTS WERE PREPARED OR APPROVED BY ME, AND THAT I AM A DULY LICENSED PROFESSIONAL ENGINEER UNDER THE LAWS OF THE STATE OF MARYLAND, LICENSE NO. 36225, EXPIRATION DATE: 8/19/2010

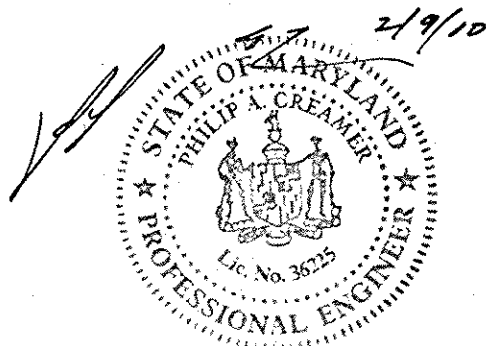

NOTE:  
WINGWALL & HEADWALL PRECAST UNITS & FOUNDATIONS DESIGNED BY CONTECH

NOTE:  
BRIDGE AND BRIDGE FOUNDATION DESIGNED BY CBC ENGINEERS

I hereby certify that the facility shown on this plan was constructed as shown on the 'As-Built' plans and meets with the approved plans and specifications.

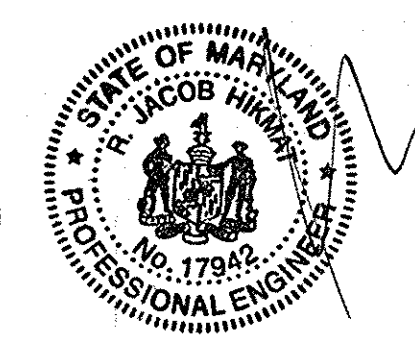

APPROVED: DEPARTMENT OF PUBLIC WORKS  
*[Signature]* 6-11-10  
 CHIEF, BUREAU OF HIGHWAYS

APPROVED:  
*[Signature]* 6/22/10  
 CHIEF, DIVISION OF LAND DEVELOPMENT

APPROVED:  
*[Signature]* 6/18/10  
 CHIEF, DEVELOPMENT ENGINEERING DIVISION

The design and information shown on this drawing is provided as a service to the project owner, engineer and contractor by CONTECH Construction Products Inc. or one of its affiliated companies ('CONTECH'). Neither this drawing, nor any part thereof, may be used, reproduced or modified in any manner without the prior written consent of CONTECH. Failure to comply is done at the user's own risk and CONTECH expressly disclaims any liability or responsibility for such use.

If discrepancies between the supplied information upon which the drawing is based and actual field conditions are encountered as site work progresses, these discrepancies must be reported to CONTECH immediately for re-evaluation of the design. CONTECH accepts no liability for designs based on missing, incomplete or inaccurate information supplied by others.

MARK	DATE	REVISION DESCRIPTION	BY
JMF	2/8/2010	NO CHANGES ON THIS SHEET	JMF

**CONTECH**  
 CONSTRUCTION PRODUCTS INC.  
 www.contech-cpi.com

9025 Centre Pointe Dr., Suite 400, West Chester, OH 45069  
 800-338-1122 513-645-7000 513-645-7993 FAX

**CONSPAN**  
 BRIDGE SYSTEMS

CONTECH  
 CONTRACT  
 DRAWING



BONNIE BRANCH WOODS  
 AS-BUILT  
 HOWARD COUNTY, MARYLAND

PROJECT No.: 402195	SEQ. No.: 001	DATE: 11/13/2009
DESIGNED: JMF	DRAWN: ZWM	
CHECKED: DMR	APPROVED: PAC	
SHEET NO.: 15 OF 24		
CT2 OF CT7		

F-10-042

I:\MEL\PROJECTS\ACTIVE\402195\1-MULTI-PLATE\DRAWINGS\CONTRACT\PRE-402195-001-CS-COM-8.DWG 2/8/2010 11:30 AM



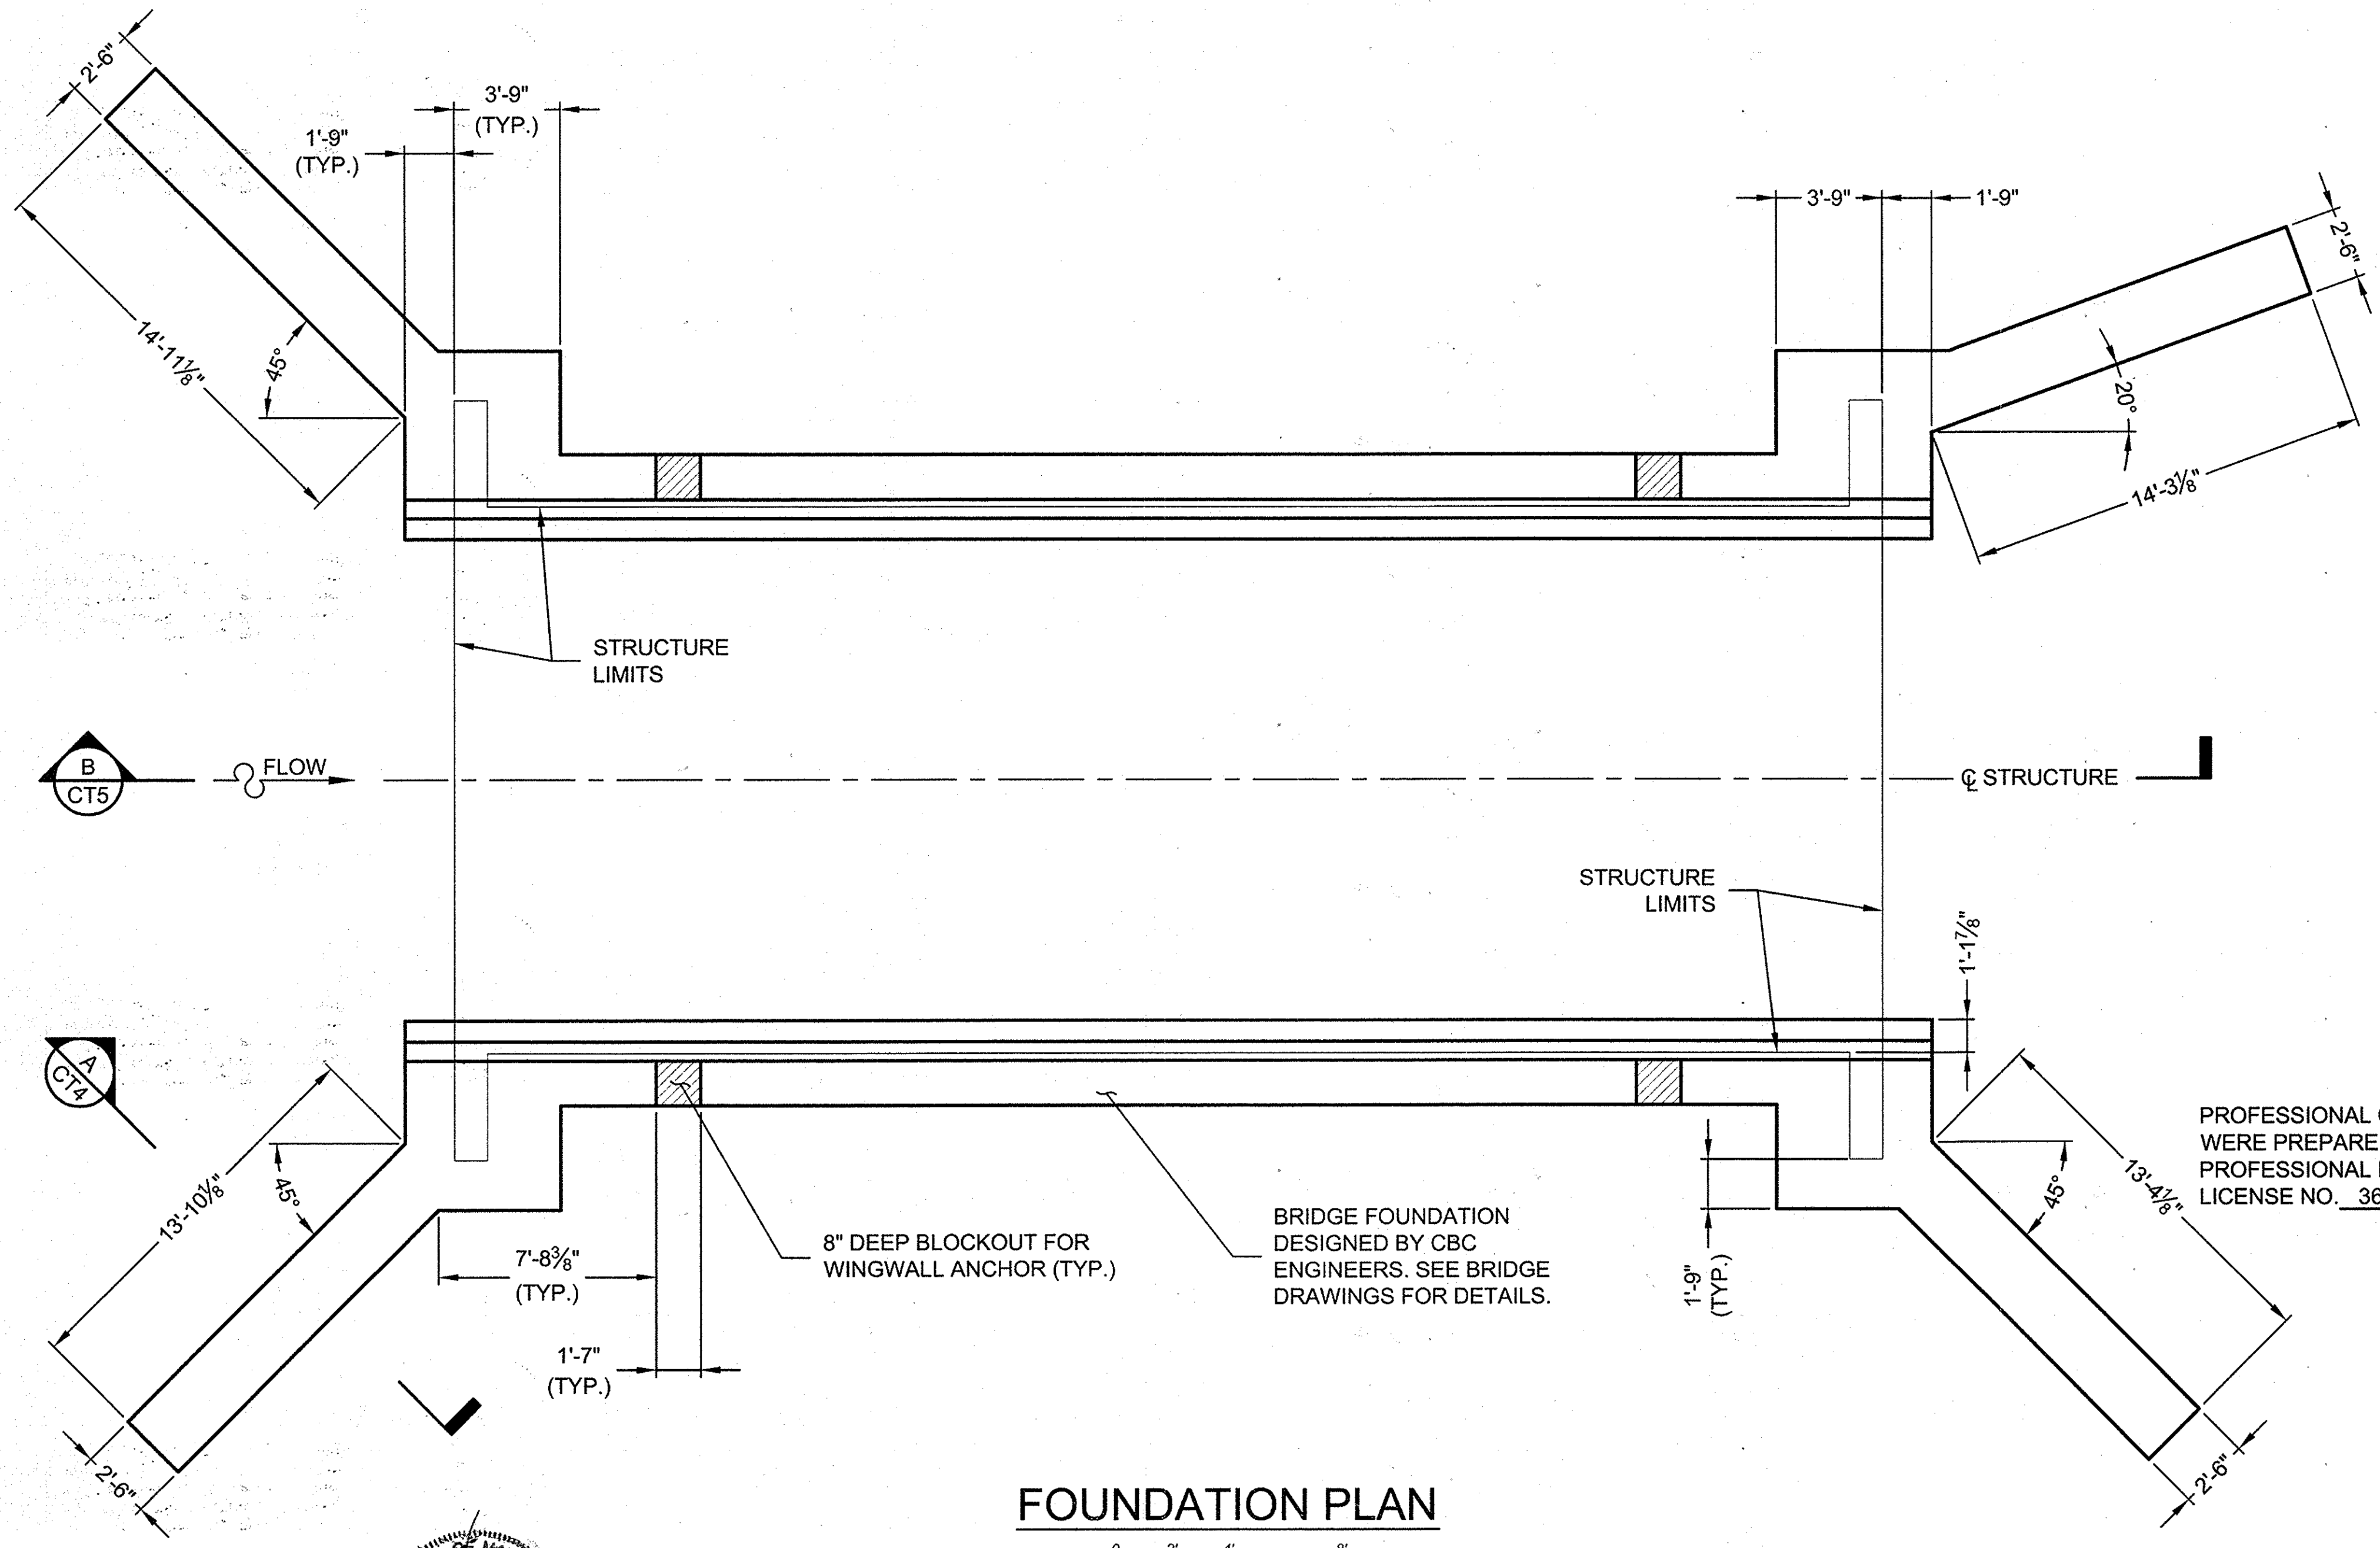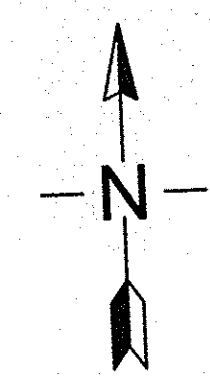


NOTE:  
WINGWALL & HEADWALL PRECAST UNITS  
& FOUNDATIONS DESIGNED BY CONTECH



NOTE:  
BRIDGE AND BRIDGE FOUNDATION  
DESIGNED BY CBC ENGINEERS

PROFESSIONAL CERTIFICATION: I HEREBY CERTIFY THAT THESE DOCUMENTS  
WERE PREPARED OR APPROVED BY ME, AND THAT I AM A DULY LICENSED  
PROFESSIONAL ENGINEER UNDER THE LAWS OF THE STATE OF MARYLAND,  
LICENSE NO. 36225, EXPIRATION DATE: 8/19/2010

**FOUNDATION PLAN**

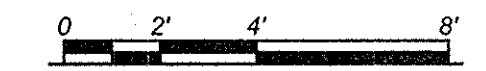

I hereby certify that the facility  
shown on this plan was constructed  
as shown on the "As-Built" plans  
and meets with the approved  
plans and specifications.

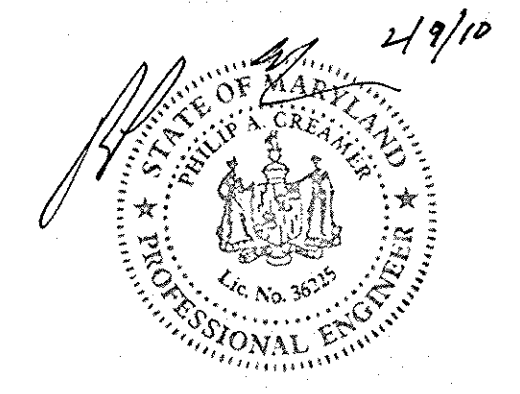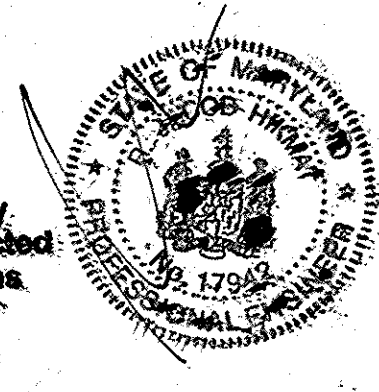

APPROVED: DEPARTMENT OF PUBLIC WORKS  
*[Signature]* 6-11-10  
CHIEF, BUREAU OF HIGHWAYS DATE

APPROVED: DEPARTMENT OF PLANNING AND ZONING  
*[Signature]* 6/22/10  
CHIEF, DIVISION OF LAND DEVELOPMENT DATE

*[Signature]* 6/22/10  
CHIEF, DEVELOPMENT ENGINEERING DIVISION DATE

The design and information shown on this drawing is provided as a service to the project owner, engineer and contractor by CONTECH Construction Products Inc. or one of its affiliated companies ("CONTECH"). Neither this drawing, nor any part thereof, may be used, reproduced or modified in any manner without the prior written consent of CONTECH. Failure to comply is done at the user's own risk and CONTECH expressly disclaims any liability or responsibility for such use.

If discrepancies between the supplied information upon which the drawing is based and actual field conditions are encountered as site work progresses, these discrepancies must be reported to CONTECH immediately for re-evaluation of the design. CONTECH accepts no liability for designs based on missing, incomplete or inaccurate information supplied by others.

MARK	DATE	REVISION DESCRIPTION	BY
JMF	2/8/2010	NO CHANGES ON THIS SHEET	JMF

**CONTECH**  
CONSTRUCTION PRODUCTS INC.  
www.contech-cpi.com

9025 Centre Pointe Dr., Suite 400, West Chester, OH 45069  
800-338-1122 513-645-7000 513-645-7993 FAX

**CONSPAN**  
BRIDGE SYSTEMS

CONTECH  
CONTRACT  
DRAWING


BONNIE BRANCH WOODS  
AS-BUILT  
HOWARD COUNTY, MARYLAND

PROJECT No.: 402195	SEQ. No.: 001	DATE: 11/13/2009
DESIGNED: JMF	DRAWN: ZWM	
CHECKED: DMR	APPROVED: PAC	
SHEET NO.: 10 OF 24 CT3 OF CT7		

F-10-042

I:\MERLIN\PROJECTS\ACTIVE\10040402\10040402-1\MULTI-PLAN\DRAWINGS\CONTRACT\PRE-402195-001-CS-COM-B.DWG 2/8/2010 11:30 AM




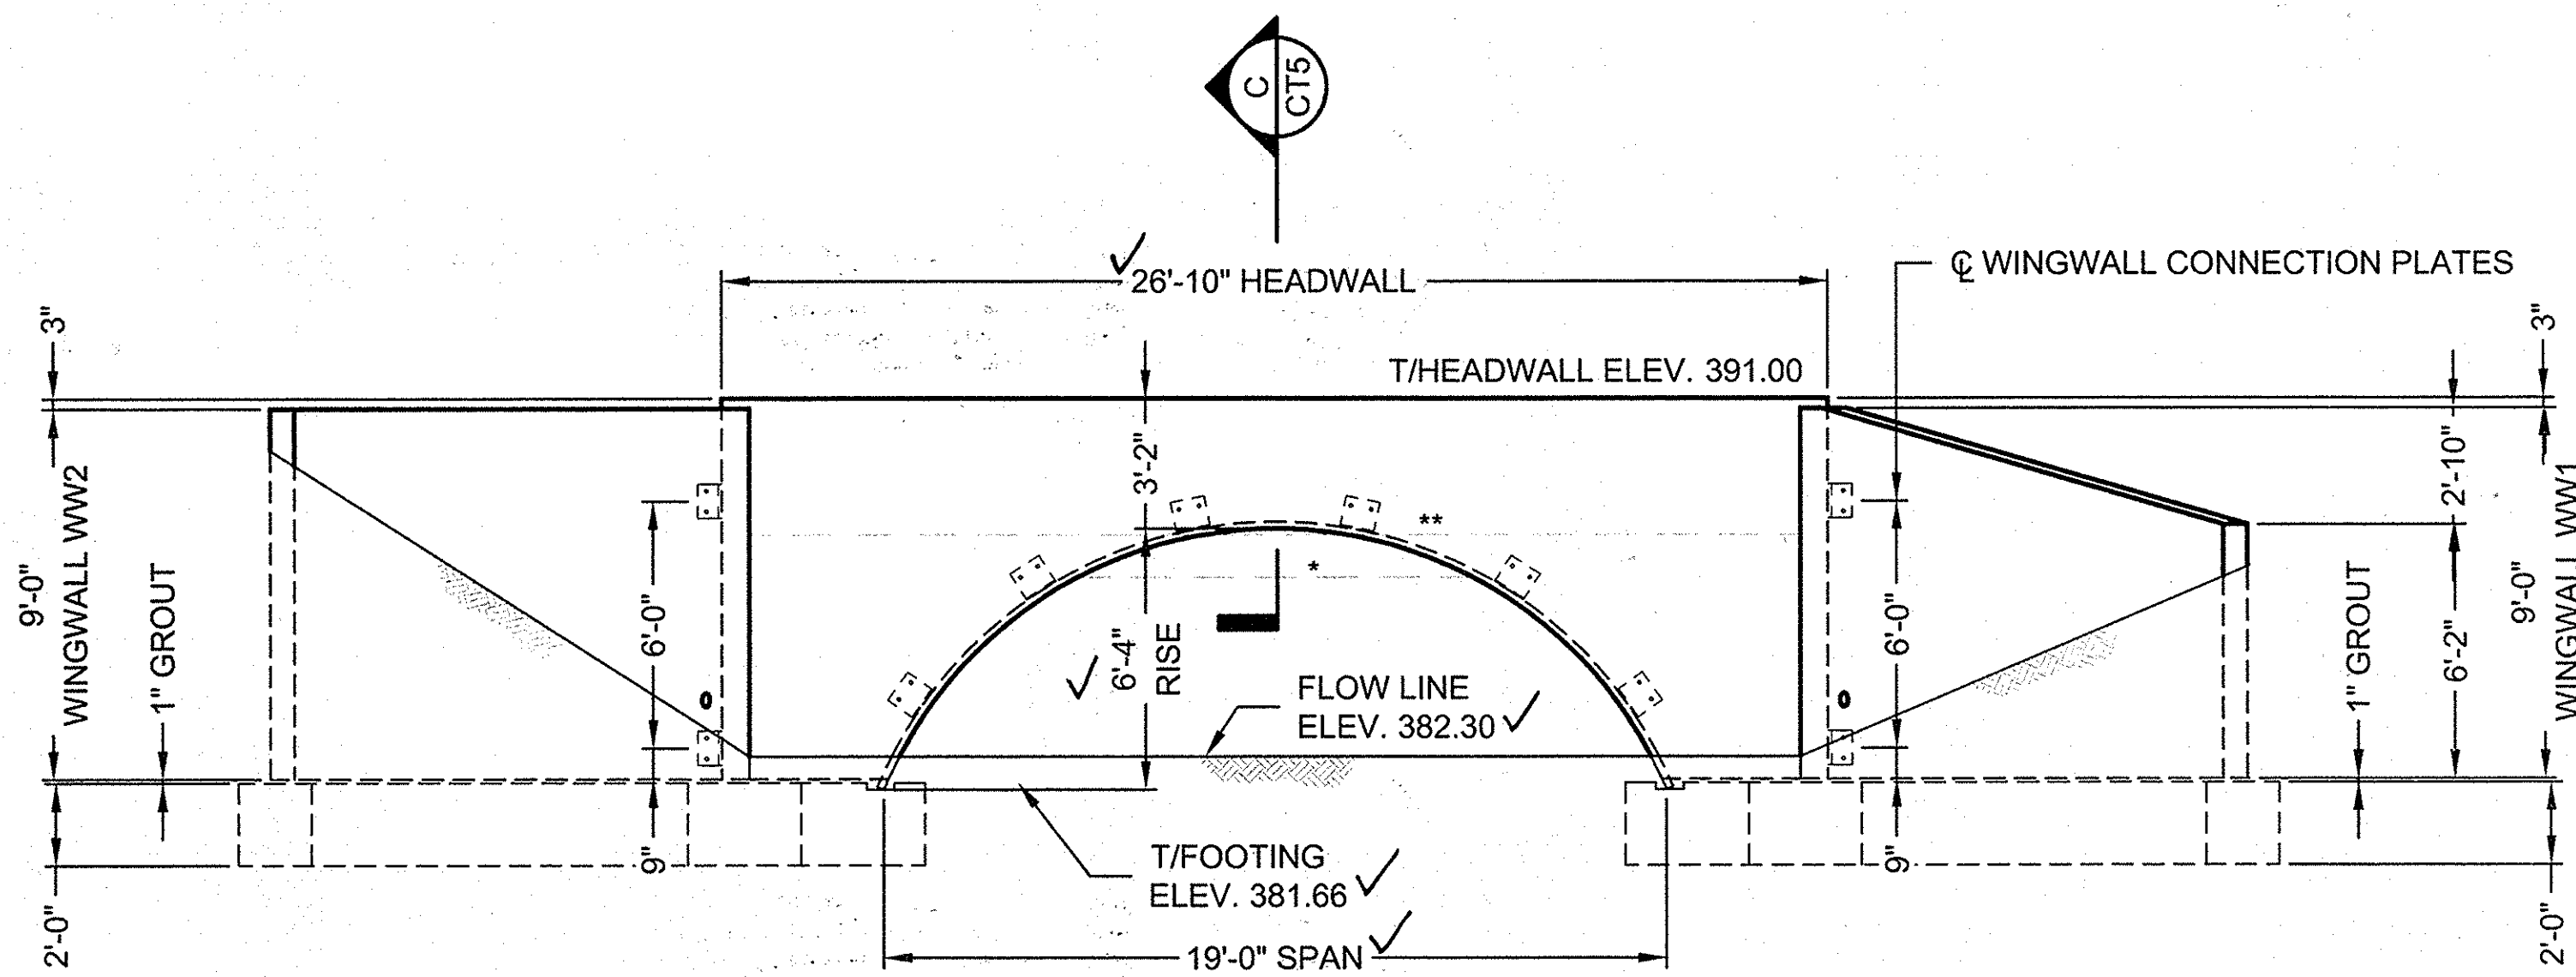


**UPSTREAM END ELEVATION**

\* 25 YEAR WATER LEVEL = 386.64; VELOCITY 8.49 CFS  
 \*\* 100 YEAR FLOOD ELEVATION = 387.68  
 (INFORMATION PROVIDED BY OTHERS)

NOTE:  
 BRIDGE AND BRIDGE FOUNDATION  
 DESIGNED BY CBC ENGINEERS

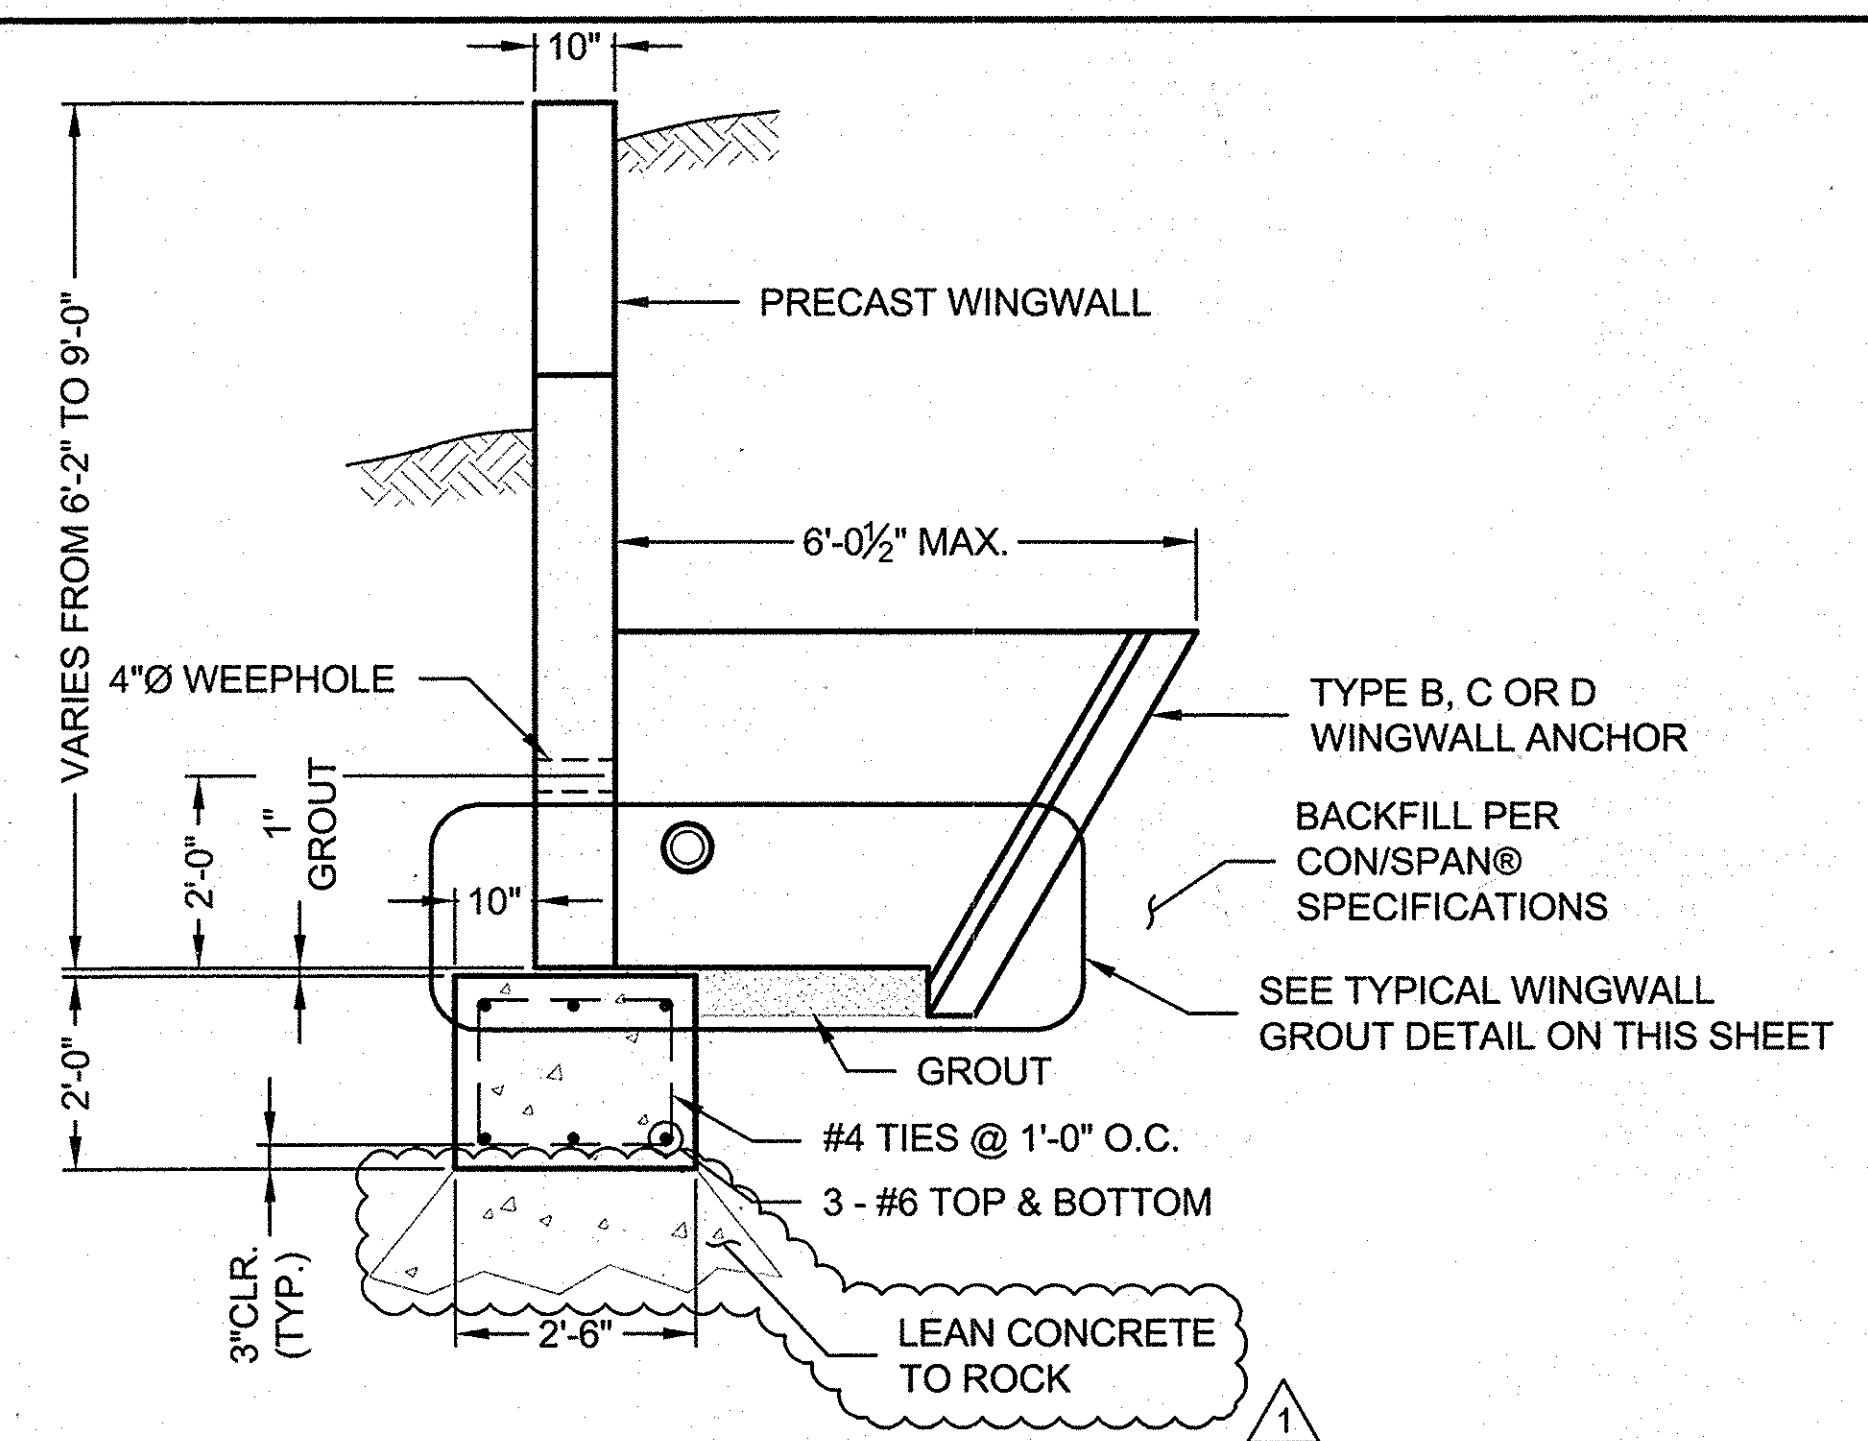


**SECTION A**

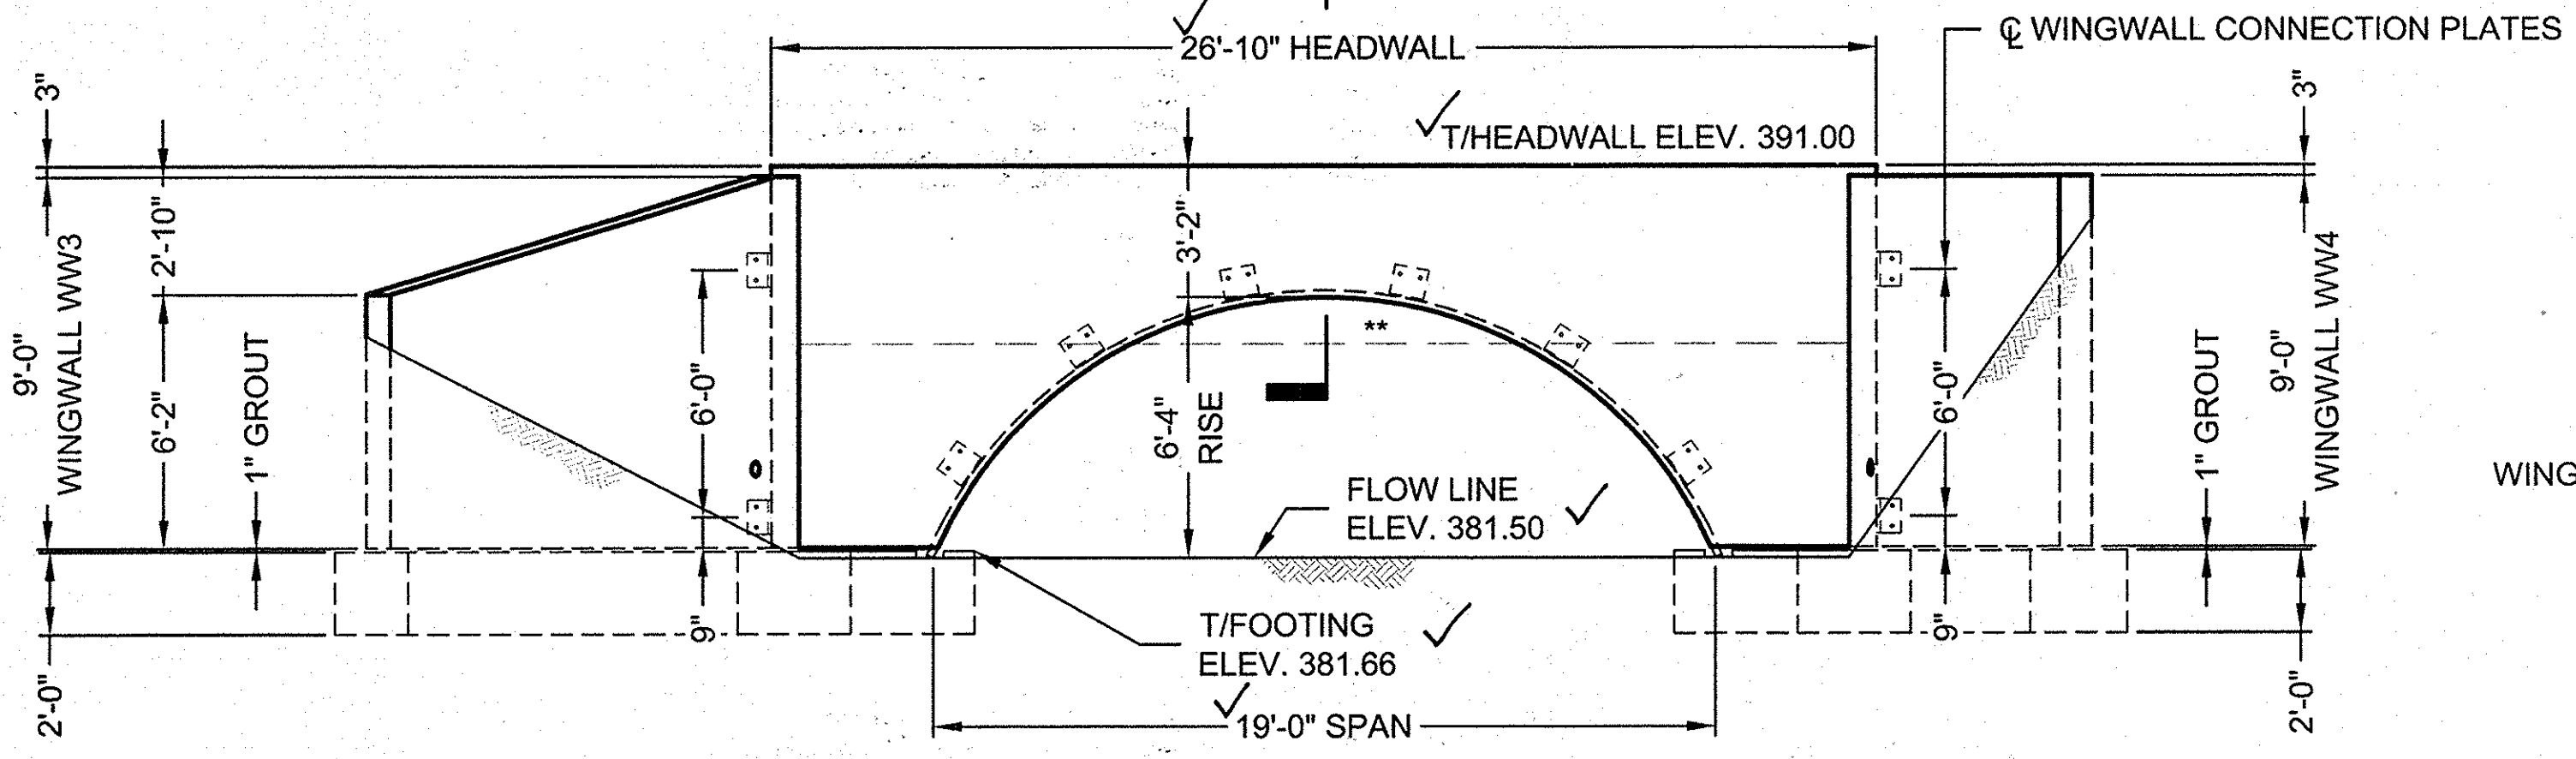

**DOWNSTREAM END ELEVATION**


\*\* 100 YEAR FLOOD ELEVATION = 386.70  
 (INFORMATION PROVIDED BY OTHERS)

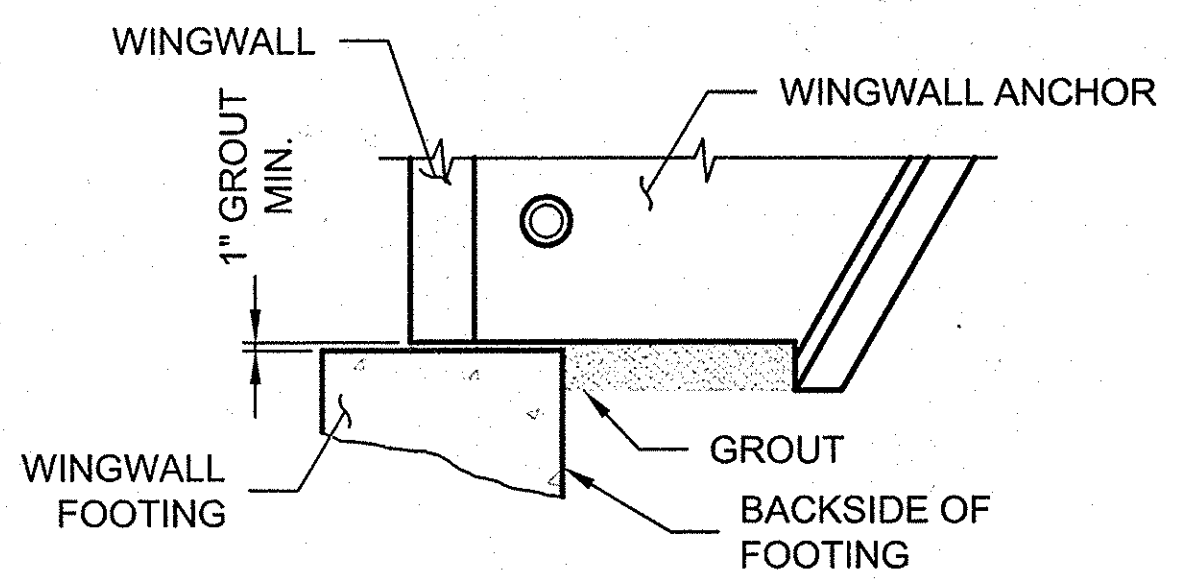

**TYPICAL WINGWALL GROUT DETAIL**  
 NOT TO SCALE

- NOTES:
- MINIMUM 1" GROUT UNDER WINGWALL LEG & ANCHOR STEM.
  - AREA BETWEEN WINGWALL FOOTING AND WINGWALL ANCHOR SHALL BE GROUTED SOLID BEFORE BACKFILL.
  - FORM BACKSIDE OF FOOTING TO DIMENSIONS SHOWN ON FOUNDATION PLAN.

PROFESSIONAL CERTIFICATION: I HEREBY CERTIFY THAT THESE DOCUMENTS WERE PREPARED OR APPROVED BY ME, AND THAT I AM A DULY LICENSED PROFESSIONAL ENGINEER UNDER THE LAWS OF THE STATE OF MARYLAND, LICENSE NO. 36225, EXPIRATION DATE: 8/19/2010

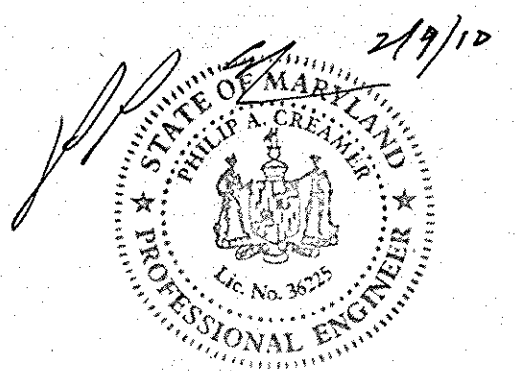


APPROVED: DEPARTMENT OF PUBLIC WORKS  
*[Signature]* 6-11-10  
 CHIEF, BUREAU OF HIGHWAYS

APPROVED: DEPARTMENT OF PLANNING AND ZONING  
*[Signature]* 6/22/10  
 CHIEF, DIVISION OF LAND DEVELOPMENT

*[Signature]* 6/18/10  
 CHIEF, DEVELOPMENT ENGINEERING DIVISION

I hereby certify that the facility shown on this plan was constructed as shown on the "As-Built" plans and meets with the approved plans and specifications.

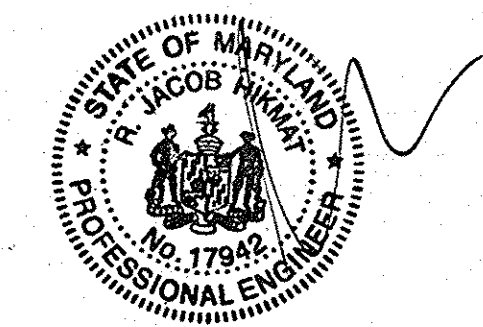

The design and information shown on this drawing is provided as a service to the project owner, engineer and contractor by CONTECH Construction Products Inc. or one of its affiliated companies ("CONTECH"). Neither this drawing, nor any part thereof, may be used, reproduced or modified in any manner without the prior written consent of CONTECH. Failure to comply is done at the user's own risk and CONTECH expressly disclaims any liability or responsibility for such use.

If discrepancies between the supplied information upon which the drawing is based and actual field conditions are encountered as site work progresses, these discrepancies must be reported to CONTECH immediately for re-evaluation of the design. CONTECH accepts no liability for designs based on missing, incomplete or inaccurate information supplied by others.

MARK	DATE	REVISION DESCRIPTION	BY
JMF	2/8/2010	REVISED PER REVIEW COMMENTS	JMF

**CONTECH**  
 CONSTRUCTION PRODUCTS INC.  
 www.contech-cpi.com

9025 Centre Pointe Dr., Suite 400, West Chester, OH 45069  
 800-338-1122 513-645-7000 513-645-7993 FAX

**CONSPAN**  
 BRIDGE SYSTEMS


CONTECH  
 CONTRACT  
 DRAWING

BONNIE BRANCH WOODS  
 AS-BUILT  
 HOWARD COUNTY, MARYLAND


PROJECT No.: 402195	SEQ. No.: 001	DATE: 11/13/2009
DESIGNED: JMF	DRAWN: ZWM	
CHECKED: DMR	APPROVED: PAC	
SHEET NO.: 17 OF 24		
CT4 OF CT7		
F-10-042		

I:\MEL\PROJECTS\ACTIVE\402195\402195-1\MULTI-PLATE\DRAWINGS\CONTRACT\PRE-402195-01-CS-CON-B.DWG 2/8/2010 11:30 AM



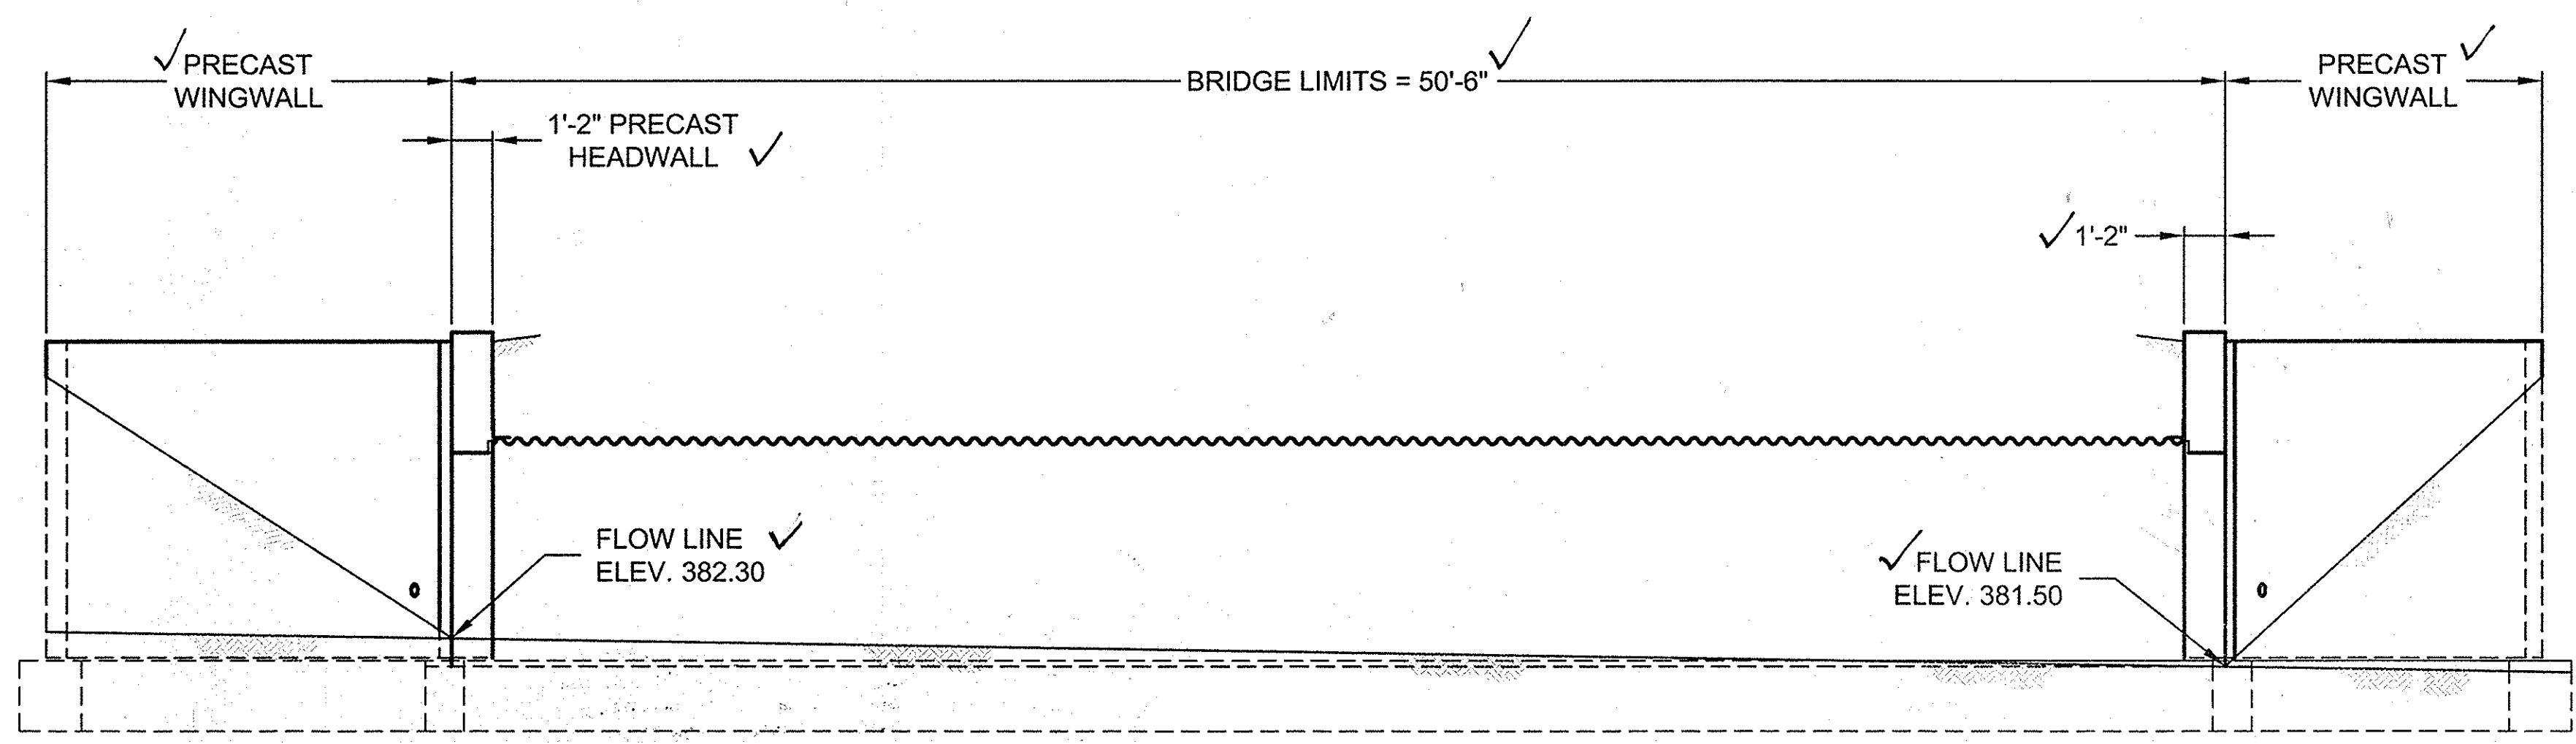


**SECTION B**  
CT2

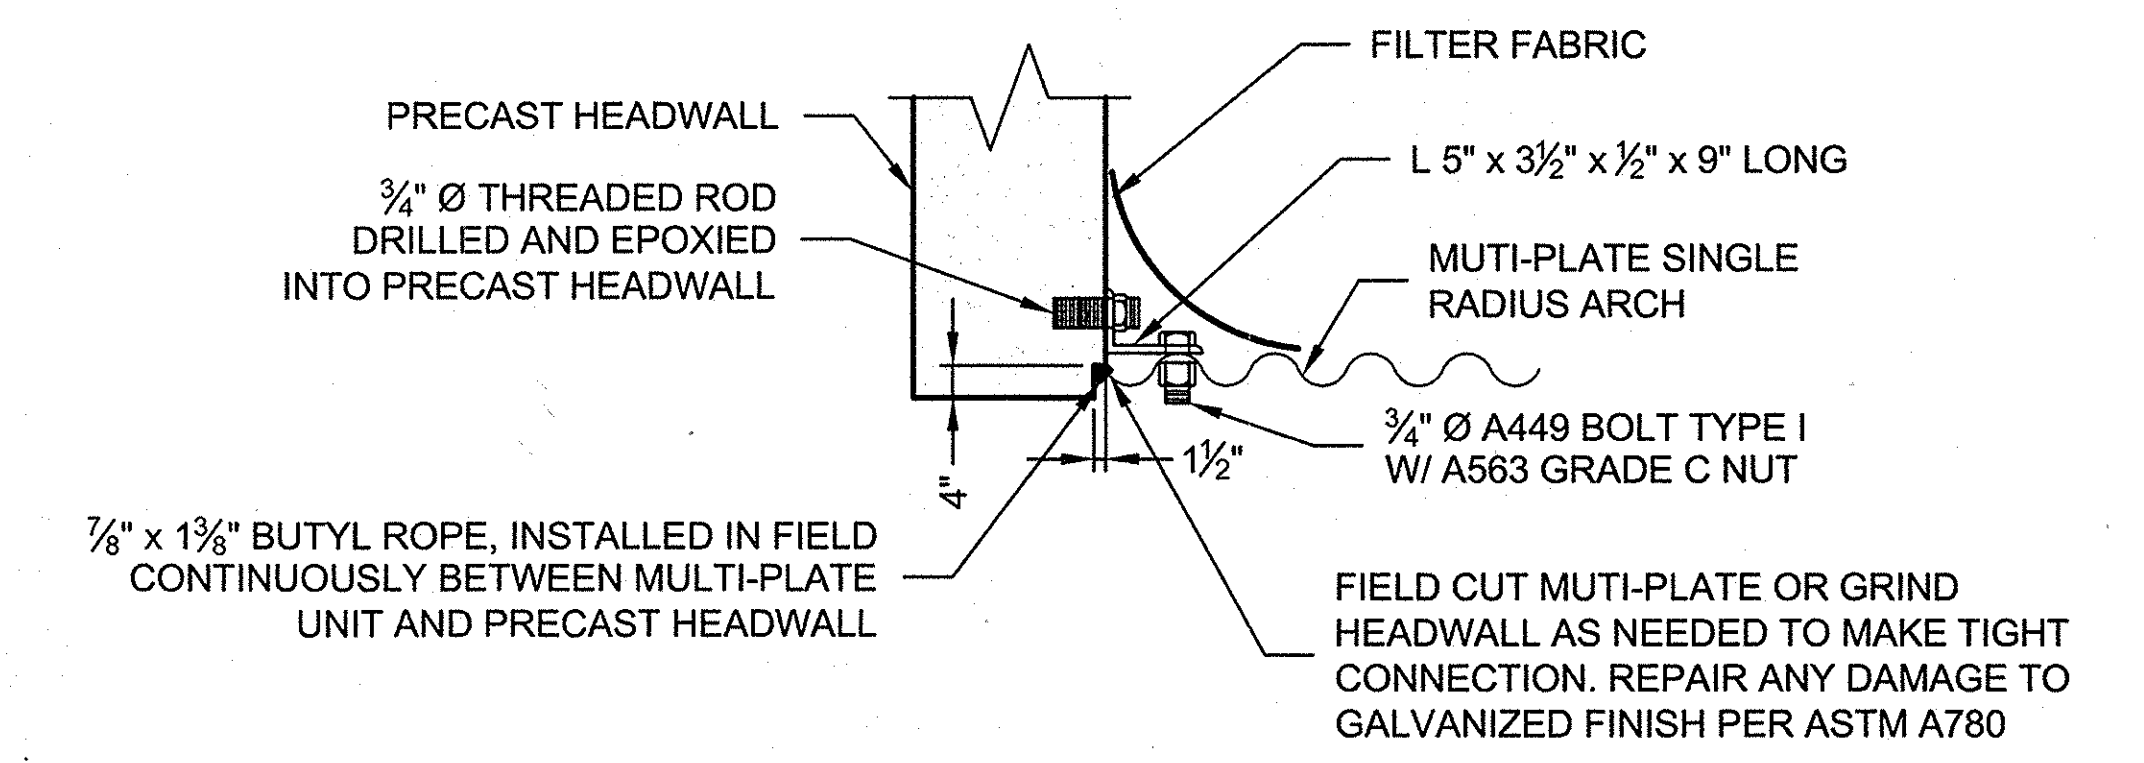


**SECTION C**  
NOT TO SCALE  
CT4


NOTE:  
BRIDGE AND BRIDGE FOUNDATION  
DESIGNED BY CBC ENGINEERS

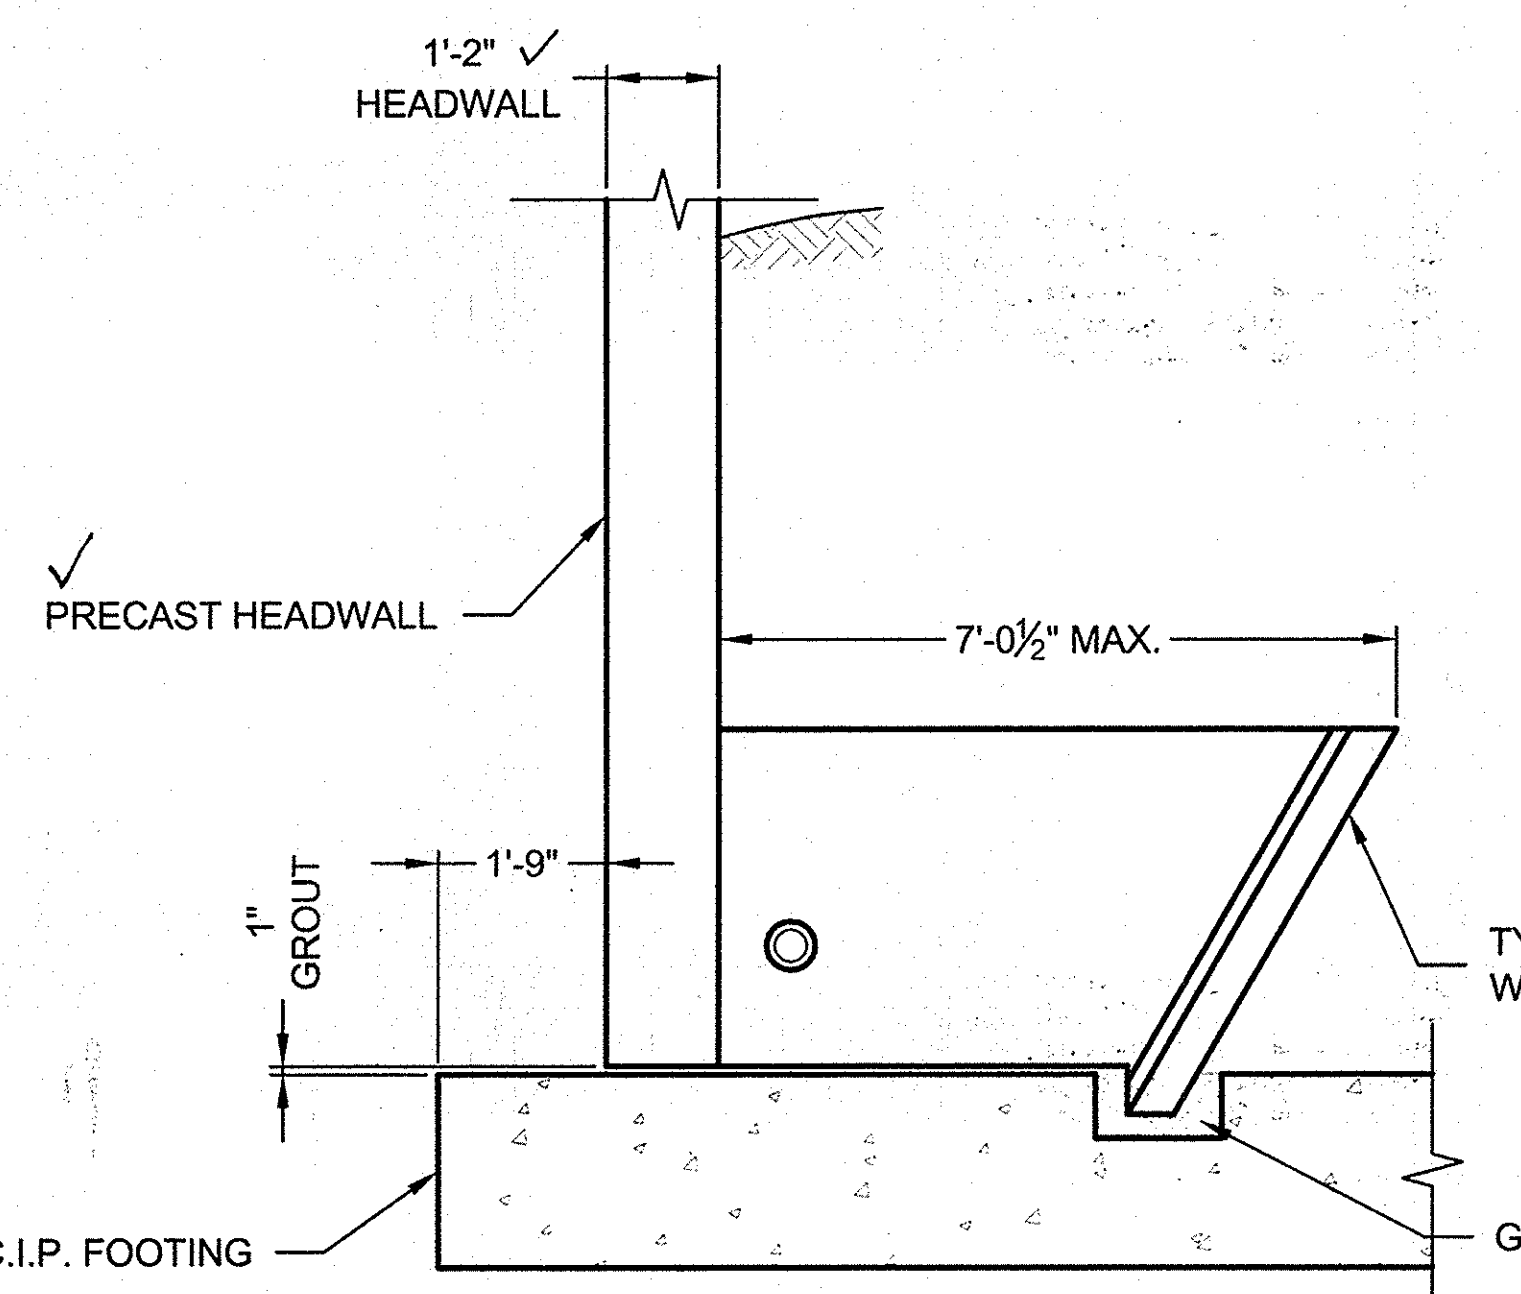

**SECTION D**  
CT2

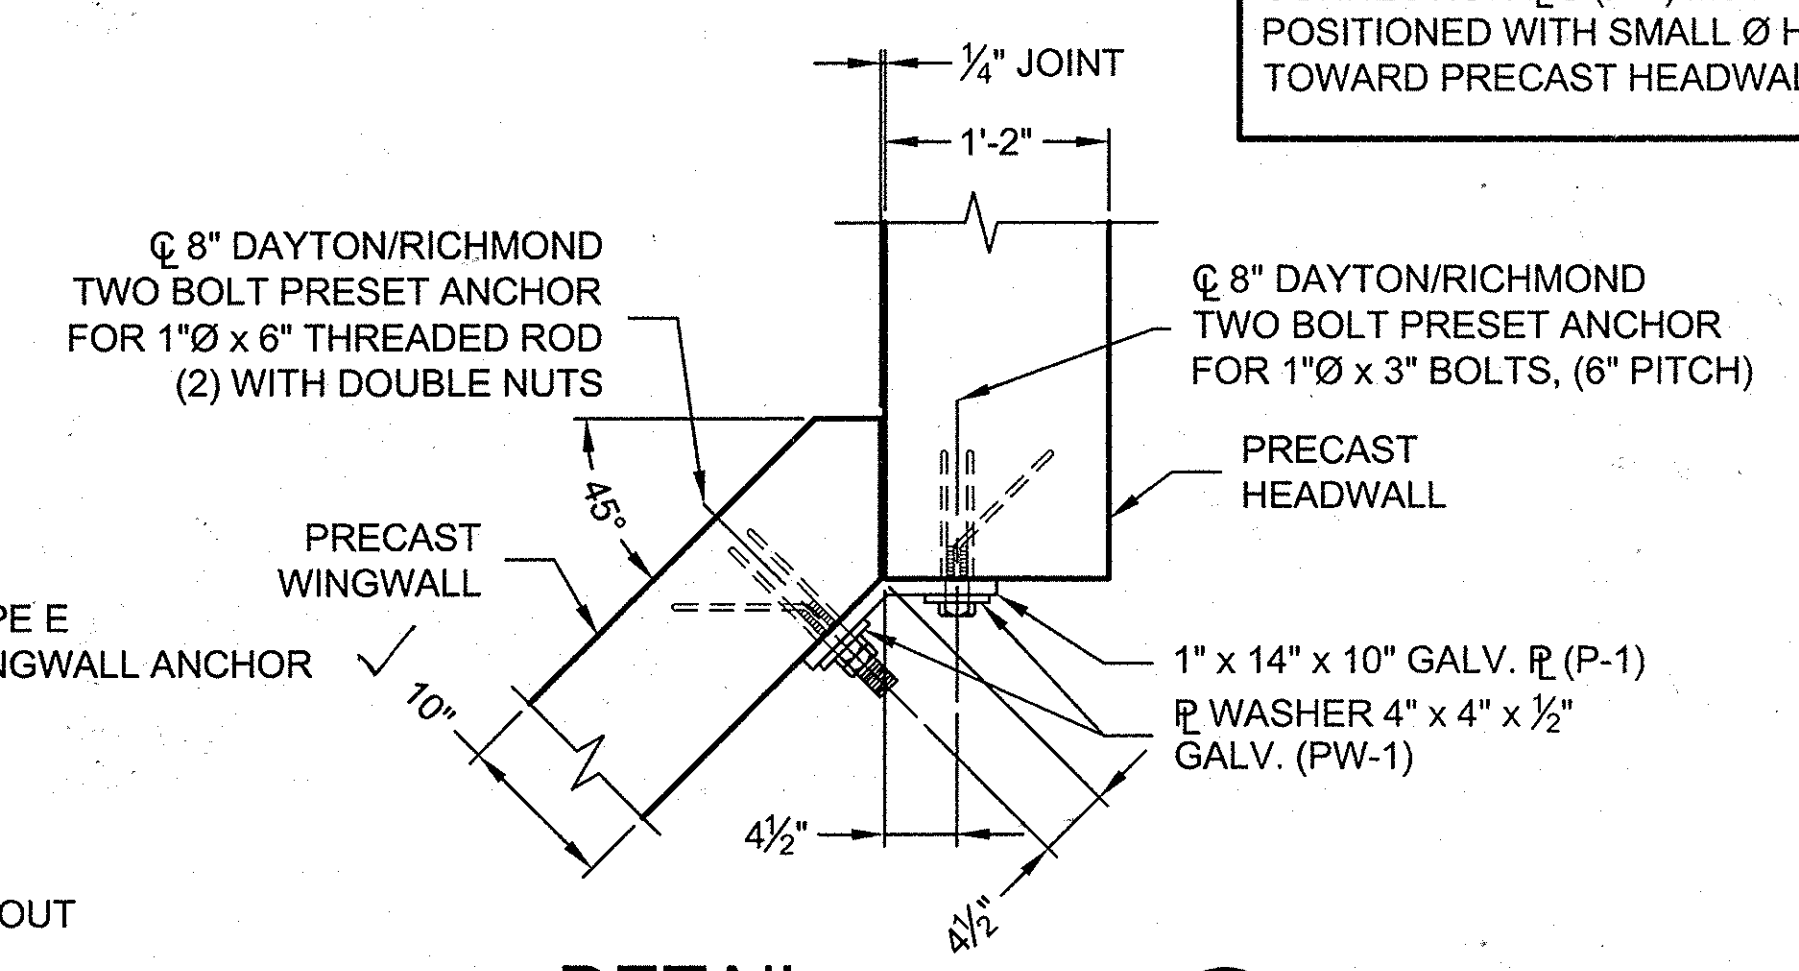

**DETAIL 1**  
CT2

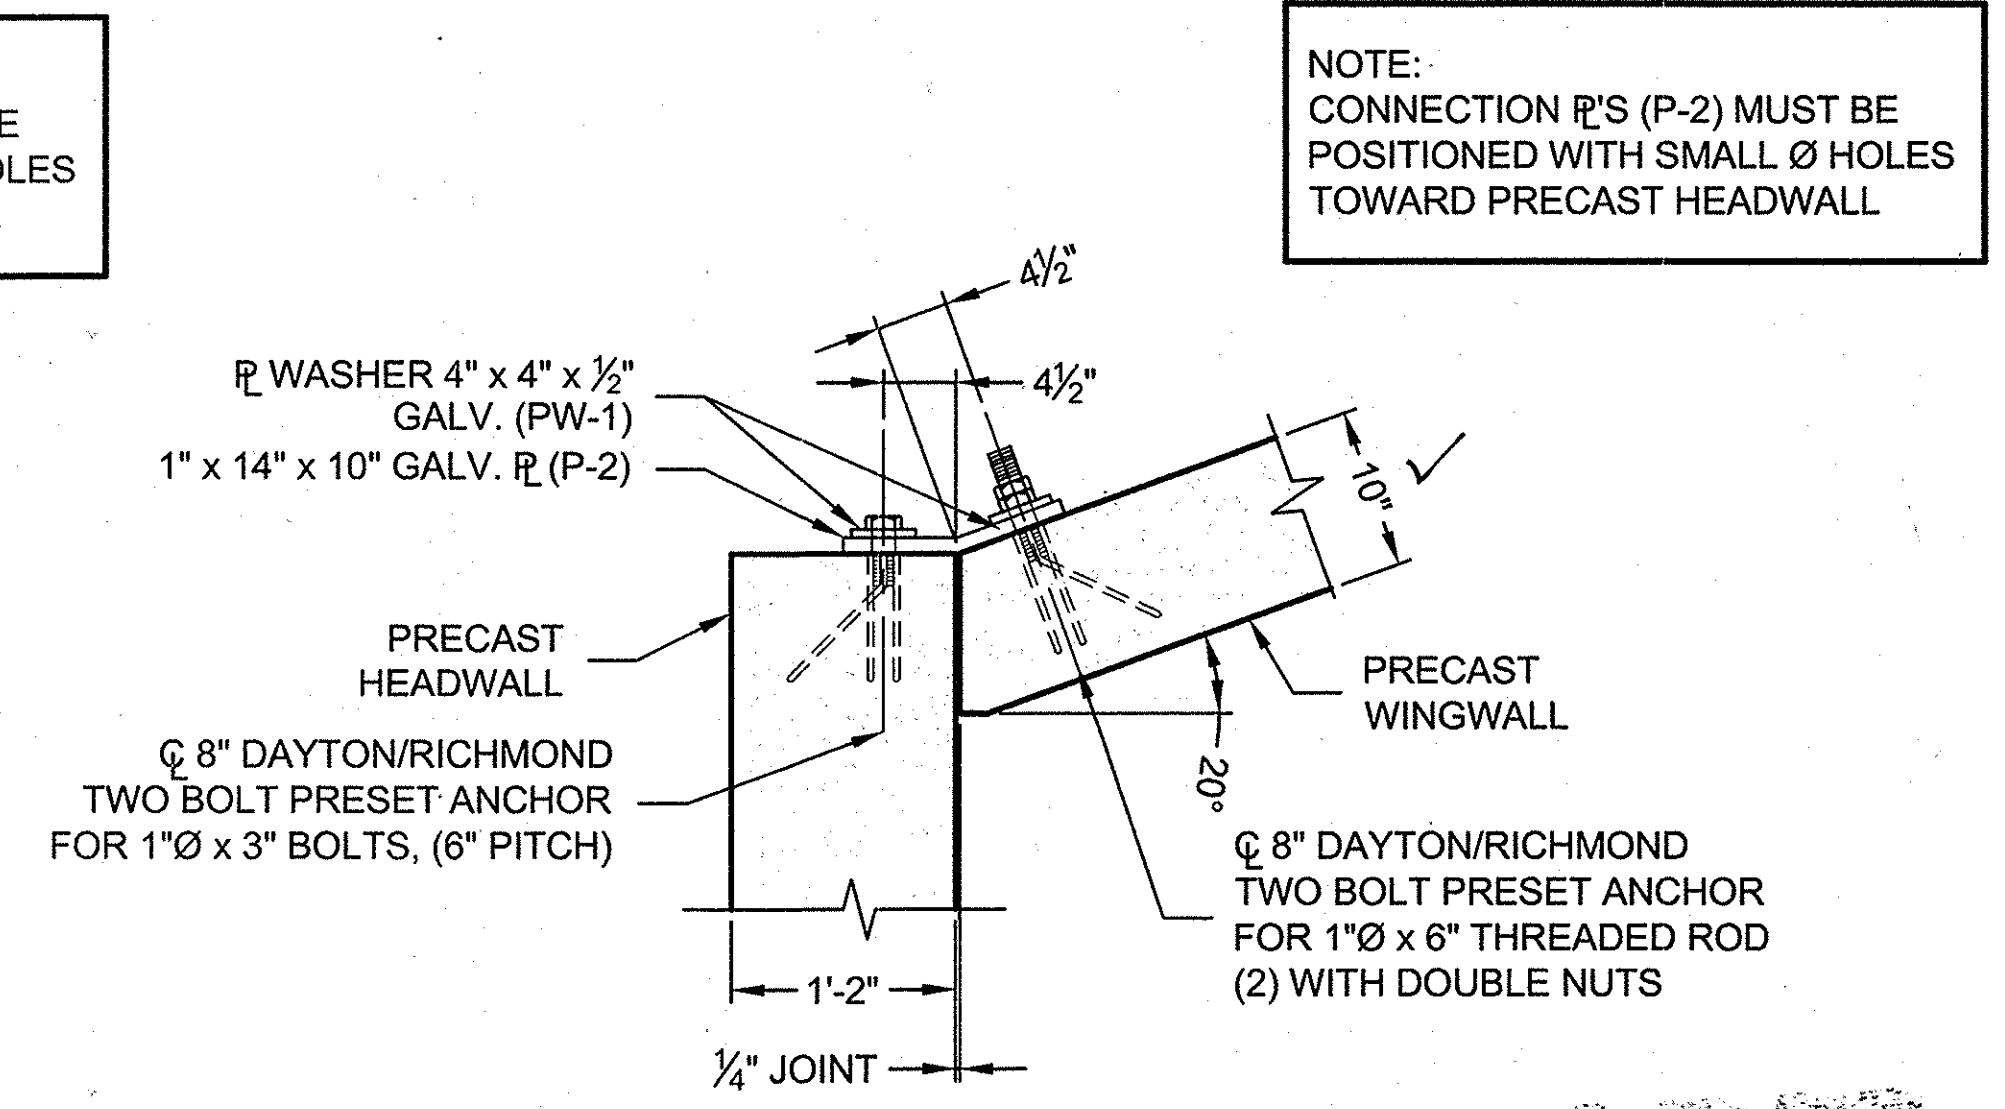

**DETAIL 2**  
CT2

NOTE:  
CONNECTION P'S (P-1) MUST BE  
POSITIONED WITH SMALL Ø HOLES  
TOWARD PRECAST HEADWALL

NOTE:  
CONNECTION P'S (P-2) MUST BE  
POSITIONED WITH SMALL Ø HOLES  
TOWARD PRECAST HEADWALL


I:\MRL\PROJECTS\ACTIVE\102100402\1051-1\MULTI-PLATE\DRAWINGS\CONTRACT\PRE-402195-001-CS-COIN-B.DWG 2/8/2010 11:30 AM

APPROVED: DEPARTMENT OF PUBLIC WORKS  
*[Signature]* DATE *[Date]*  
CHIEF, BUREAU OF HIGHWAYS

APPROVED: DEPARTMENT OF PLANNING AND ZONING  
*[Signature]* DATE *[Date]*  
CHIEF, DIVISION OF LAND DEVELOPMENT

*[Signature]* DATE *[Date]*  
CHIEF, DEVELOPMENT ENGINEERING DIVISION

I hereby certify that the facility shown on this plan was constructed as shown on the 'As-Built' plans and meets with the approved plans and specifications.

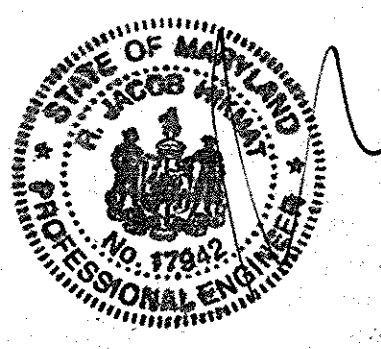

PROFESSIONAL CERTIFICATION: I HEREBY CERTIFY THAT THESE DOCUMENTS WERE PREPARED OR APPROVED BY ME, AND THAT I AM A DULY LICENSED PROFESSIONAL ENGINEER UNDER THE LAWS OF THE STATE OF MARYLAND, LICENSE NO. 36225, EXPIRATION DATE: 8/19/2010.

MARK	DATE	REVISION DESCRIPTION	BY
JMF	2/8/2010	NO CHANGES ON THIS SHEET	JMF

**CONTECH**  
CONSTRUCTION PRODUCTS INC.  
www.contech-cpi.com  
9025 Centre Pointe Dr., Suite 400, West Chester, OH 45069  
800-338-1122 513-645-7000 513-645-7993 FAX

**CONSPAN**  
BRIDGE SYSTEMS  
CONTECH  
CONTRACT  
DRAWING

BONNIE BRANCH WOODS  
AS-BUILT  
HOWARD COUNTY, MARYLAND

PROJECT No.: 402195	SEQ. No.: 001	DATE: 11/13/2009
DESIGNED: JMF	DRAWN: ZWM	
CHECKED: DMR	APPROVED: PAC	
SHEET NO.: 18 OF 24 CT5 OF CT7		



F-10-042



# SPECIFICATIONS FOR MANUFACTURE AND INSTALLATION OF CON/SPAN® BRIDGE SYSTEMS

## 1. DESCRIPTION

1.1. TYPE - THIS WORK SHALL CONSIST OF FURNISHING AND CONSTRUCTING A CON/SPAN® BRIDGE SYSTEM IN ACCORDANCE WITH THESE SPECIFICATIONS AND IN REASONABLY CLOSE CONFORMITY WITH THE LINES, GRADES, DESIGN AND DIMENSIONS SHOWN ON THE PLANS OR AS ESTABLISHED BY THE ENGINEER. IN SITUATIONS WHERE TWO OR MORE SPECIFICATIONS APPLY TO THIS WORK, THE MOST STRINGENT REQUIREMENTS SHALL GOVERN.

1.2. DESIGNATION - PRECAST REINFORCED CONCRETE CON/SPAN® BRIDGE UNITS MANUFACTURED IN ACCORDANCE WITH THIS SPECIFICATION SHALL BE DESIGNATED BY SPAN AND RISE. PRECAST REINFORCED CONCRETE WINGWALLS AND HEADWALLS MANUFACTURED IN ACCORDANCE WITH THIS SPECIFICATION SHALL BE DESIGNATED BY LENGTH, HEIGHT, AND DEFLECTION ANGLE.

## 2. DESIGN

2.1. SPECIFICATIONS - THE PRECAST ELEMENTS ARE DESIGNED IN ACCORDANCE WITH THE "STANDARD SPECIFICATIONS FOR HIGHWAY BRIDGES" 17TH EDITION, ADOPTED BY THE AMERICAN ASSOCIATION OF STATE HIGHWAY AND TRANSPORTATION OFFICIALS, 2002. A MINIMUM OF ONE FOOT OF COVER ABOVE THE CROWN OF THE BRIDGE UNITS IS REQUIRED IN THE INSTALLED CONDITION. (UNLESS NOTED OTHERWISE ON THE SHOP DRAWINGS AND DESIGNED ACCORDINGLY.)

## 3. MATERIALS

3.1. CONCRETE - THE CONCRETE FOR THE PRECAST ELEMENTS SHALL BE AIR-ENTRAINED WHEN INSTALLED IN AREAS SUBJECT TO FREEZE-THAW CONDITIONS, COMPOSED OF PORTLAND CEMENT, FINE AND COARSE AGGREGATES, ADMIXTURES AND WATER. AIR-ENTRAINED CONCRETE SHALL CONTAIN 6 ± 2 PERCENT AIR. THE AIR-ENTRAINING ADMIXTURE SHALL CONFORM TO AASHTO M154. THE MINIMUM CONCRETE COMPRESSIVE STRENGTH SHALL BE AS SHOWN ON THE SHOP DRAWINGS.

3.1.1. PORTLAND CEMENT - SHALL CONFORM TO THE REQUIREMENTS OF ASTM SPECIFICATIONS C150-TYPE I, TYPE II, OR TYPE III CEMENT.

3.1.2. COARSE AGGREGATE - SHALL CONSIST OF STONE HAVING A MAXIMUM SIZE OF 1 INCH. AGGREGATE SHALL MEET REQUIREMENTS FOR ASTM C33.

3.1.3. WATER REDUCING ADMIXTURE - THE MANUFACTURER MAY SUBMIT, FOR APPROVAL BY THE ENGINEER, A WATER-REDUCING ADMIXTURE FOR THE PURPOSE OF INCREASING WORKABILITY AND REDUCING THE WATER REQUIREMENT FOR THE CONCRETE.

3.1.4. CALCIUM CHLORIDE - THE ADDITION TO THE MIX OF CALCIUM CHLORIDE OR ADMIXTURES CONTAINING CALCIUM CHLORIDE WILL NOT BE PERMITTED.

3.1.5. MIXTURE - THE AGGREGATES, CEMENT AND WATER SHALL BE PROPORTIONED AND MIXED IN A BATCH MIXER TO PRODUCE A HOMOGENEOUS CONCRETE MEETING THE STRENGTH REQUIREMENTS OF THIS SPECIFICATION. THE PROPORTION OF PORTLAND CEMENT IN THE MIXTURE SHALL NOT BE LESS THAN 864 POUNDS (6 SACKS) PER CUBIC YARD OF CONCRETE.

## 3.2. STEEL REINFORCEMENT

3.2.1. THE MINIMUM STEEL YIELD STRENGTH SHALL BE 60,000 PSI, UNLESS OTHERWISE NOTED ON THE SHOP DRAWINGS.

3.2.2. ALL REINFORCING STEEL FOR THE PRECAST ELEMENTS SHALL BE FABRICATED AND PLACED IN ACCORDANCE WITH THE DETAILED SHOP DRAWINGS SUBMITTED BY THE MANUFACTURER.

3.2.3. REINFORCEMENT SHALL CONSIST OF WELDED WIRE FABRIC CONFORMING TO ASTM SPECIFICATION A 185 OR A 497, OR DEFORMED BILLET STEEL BARS CONFORMING TO ASTM SPECIFICATION A 615, GRADE 60. LONGITUDINAL DISTRIBUTION REINFORCEMENT MAY CONSIST OF WELDED WIRE FABRIC OR DEFORMED BILLET-STEEL BARS.

## 3.3. STEEL HARDWARE

3.3.1. BOLTS AND THREADED RODS FOR WINGWALL CONNECTIONS SHALL CONFORM TO ASTM A 307. NUTS SHALL CONFORM TO AASHTO M292 (ASTM A194) GRADE 2H. ALL BOLTS, THREADED RODS AND NUTS USED IN WINGWALL CONNECTIONS SHALL BE MECHANICALLY ZINC COATED IN ACCORDANCE WITH ASTM B695 CLASS 50.

3.3.2. STRUCTURAL STEEL FOR WINGWALL CONNECTION PLATES AND PLATE WASHERS SHALL CONFORM TO AASHTO M 270 (ASTM A 709) GRADE 36 AND SHALL BE HOT DIP GALVANIZED AS PER AASHTO M111 (ASTM A123).

3.3.3. INSERTS FOR WINGWALLS SHALL BE 1" DIAMETER TWO-BOLT PRESET WINGWALL ANCHORS AS MANUFACTURED BY DAYTON/RICHMOND CONCRETE ACCESSORIES, MIAMISBURG, OHIO, (800) 745-3700.

3.3.4. FERRULE LOOP INSERTS SHALL BE F-64 FERRULE LOOP INSERTS AS MANUFACTURED BY DAYTON/RICHMOND CONCRETE ACCESSORIES, MIAMISBURG, OHIO, (800) 745-3700.

3.3.5. HOOK BOLTS USED IN ATTACHED HEADWALL CONNECTIONS SHALL BE ASTM A307.

3.3.6. INSERTS FOR DETACHED HEADWALL CONNECTIONS SHALL BE AISI TYPE 304 STAINLESS STEEL, F-58 EXPANDED COIL INSERTS AS MANUFACTURED BY DAYTON/RICHMOND CONCRETE ACCESSORIES, MIAMISBURG, OHIO, (800) 745-3700. COIL RODS AND NUTS USED IN HEADWALL CONNECTIONS SHALL BE AISI TYPE 304 STAINLESS STEEL. WASHERS USED IN HEADWALL CONNECTIONS SHALL BE EITHER AISI TYPE 304 STAINLESS STEEL PLATE WASHERS

OR AASHTO M270 (ASTM A709) GRADE 36 PLATE WASHERS HOT DIP GALVANIZED AS PER AASHTO M111 (ASTM A123).

3.3.7. REINFORCING BAR SPLICES SHALL BE MADE USING THE DOWEL BAR SPICER SYSTEM AS MANUFACTURED BY DAYTON/RICHMOND CONCRETE ACCESSORIES, MIAMISBURG, OHIO, (800) 745-3700, AND SHALL CONSIST OF THE DOWEL BAR SPICER (DB-SAE) AND DOWEL-IN (DI).

## 4. MANUFACTURE OF PRECAST ELEMENTS - SUBJECT TO THE PROVISIONS OF SECTION 5, BELOW, THE PRECAST ELEMENT DIMENSION AND REINFORCEMENT DETAILS SHALL BE AS PRESCRIBED IN THE PLAN AND SHOP DRAWINGS PROVIDED BY THE MANUFACTURER.

4.1. FORMS - THE FORMS USED IN MANUFACTURE SHALL BE SUFFICIENTLY RIGID AND ACCURATE TO MAINTAIN THE REQUIRED PRECAST ELEMENT DIMENSIONS WITHIN THE PERMISSIBLE VARIATIONS GIVEN IN SECTION 5 OF THESE SPECIFICATIONS. ALL CASTING SURFACES SHALL BE OF A SMOOTH MATERIAL.

## 4.2. PLACEMENT OF REINFORCEMENT

4.2.1. PLACEMENT OF REINFORCEMENT IN PRECAST BRIDGE UNITS - THE COVER OF CONCRETE OVER THE OUTSIDE CIRCUMFERENTIAL REINFORCEMENT SHALL BE 2" MINIMUM. THE COVER OF CONCRETE OVER THE INSIDE CIRCUMFERENTIAL REINFORCEMENT SHALL BE 1 1/2" MINIMUM, UNLESS OTHERWISE NOTED ON THE SHOP DRAWINGS. THE CLEAR DISTANCE OF THE END CIRCUMFERENTIAL WIRES SHALL NOT BE LESS THAN 1" NOR MORE THAN 2" FROM THE ENDS OF EACH SECTION. REINFORCEMENT SHALL BE ASSEMBLED UTILIZING SINGLE OR MULTIPLE LAYERS OF WELDED WIRE FABRIC (NOT TO EXCEED 3 LAYERS), SUPPLEMENTED WITH A SINGLE LAYER OF DEFORMED BILLET-STEEL BARS, WHEN NECESSARY. WELDED WIRE FABRIC SHALL BE COMPOSED OF CIRCUMFERENTIAL AND LONGITUDINAL WIRES MEETING THE SPACING REQUIREMENTS OF 4.3, BELOW, AND SHALL CONTAIN SUFFICIENT LONGITUDINAL WIRES EXTENDING THROUGH THE BRIDGE UNIT TO MAINTAIN THE SHAPE AND POSITION OF THE REINFORCEMENT. LONGITUDINAL DISTRIBUTION REINFORCEMENT MAY BE WELDED WIRE FABRIC OR DEFORMED BILLET-STEEL BARS AND SHALL MEET THE SPACING REQUIREMENTS OF 4.3, BELOW. THE ENDS OF THE LONGITUDINAL DISTRIBUTION REINFORCEMENT SHALL BE NOT MORE THAN 3" AND NOT LESS THAN 1 1/2" FROM THE ENDS OF THE BRIDGE UNIT.

4.2.2. BENDING OF REINFORCEMENT FOR PRECAST BRIDGE UNITS - THE OUTSIDE AND INSIDE CIRCUMFERENTIAL REINFORCING STEEL FOR THE CORNERS OF THE BRIDGE SHALL BE BENT TO SUCH AN ANGLE THAT IS APPROXIMATELY EQUAL TO THE CONFIGURATION OF THE BRIDGE'S OUTSIDE CORNER.

4.2.3. PLACEMENT OF REINFORCEMENT FOR PRECAST WINGWALLS AND HEADWALLS - THE COVER OF CONCRETE OVER THE LONGITUDINAL AND TRANSVERSE REINFORCEMENT SHALL BE 2" MINIMUM. THE CLEAR DISTANCE FROM THE END OF EACH PRECAST ELEMENT TO THE END OF REINFORCING STEEL SHALL NOT BE LESS THAN 1/2" NOR MORE THAN 3". REINFORCEMENT SHALL BE ASSEMBLED UTILIZING A SINGLE LAYER OF WELDED WIRE FABRIC, OR A SINGLE LAYER OF DEFORMED BILLET-STEEL BARS. WELDED WIRE FABRIC SHALL BE COMPOSED OF TRANSVERSE AND LONGITUDINAL WIRES MEETING THE SPACING REQUIREMENTS OF 4.3, BELOW, AND SHALL CONTAIN SUFFICIENT LONGITUDINAL WIRES EXTENDING THROUGH THE ELEMENT TO MAINTAIN THE SHAPE AND POSITION OF THE REINFORCEMENT. LONGITUDINAL REINFORCEMENT MAY BE WELDED WIRE FABRIC OR DEFORMED BILLET-STEEL BARS AND SHALL MEET THE SPACING REQUIREMENTS OF 4.3, BELOW.

4.2.4. BENDING OF REINFORCEMENT FOR PRECAST BRIDGE UNITS - THE OUTSIDE AND INSIDE CIRCUMFERENTIAL REINFORCING STEEL FOR THE CORNERS OF THE BRIDGE SHALL BE BENT TO SUCH AN ANGLE THAT IS APPROXIMATELY EQUAL TO THE CONFIGURATION OF THE BRIDGE'S OUTSIDE CORNER.

4.2.5. PLACEMENT OF REINFORCEMENT FOR PRECAST WINGWALLS AND HEADWALLS - THE COVER OF CONCRETE OVER THE LONGITUDINAL AND TRANSVERSE REINFORCEMENT SHALL BE 2" MINIMUM. THE CLEAR DISTANCE FROM THE END OF EACH PRECAST ELEMENT TO THE END OF REINFORCING STEEL SHALL NOT BE LESS THAN 1/2" NOR MORE THAN 3". REINFORCEMENT SHALL BE ASSEMBLED UTILIZING A SINGLE LAYER OF WELDED WIRE FABRIC, OR A SINGLE LAYER OF DEFORMED BILLET-STEEL BARS. WELDED WIRE FABRIC SHALL BE COMPOSED OF TRANSVERSE AND LONGITUDINAL WIRES MEETING THE SPACING REQUIREMENTS OF 4.3, BELOW, AND SHALL CONTAIN SUFFICIENT LONGITUDINAL WIRES EXTENDING THROUGH THE ELEMENT TO MAINTAIN THE SHAPE AND POSITION OF THE REINFORCEMENT. LONGITUDINAL REINFORCEMENT MAY BE WELDED WIRE FABRIC OR DEFORMED BILLET-STEEL BARS AND SHALL MEET THE SPACING REQUIREMENTS OF 4.3, BELOW.

4.2.6. BENDING OF REINFORCEMENT FOR PRECAST BRIDGE UNITS - THE OUTSIDE AND INSIDE CIRCUMFERENTIAL REINFORCING STEEL FOR THE CORNERS OF THE BRIDGE SHALL BE BENT TO SUCH AN ANGLE THAT IS APPROXIMATELY EQUAL TO THE CONFIGURATION OF THE BRIDGE'S OUTSIDE CORNER.

4.2.7. PLACEMENT OF REINFORCEMENT FOR PRECAST WINGWALLS AND HEADWALLS - THE COVER OF CONCRETE OVER THE LONGITUDINAL AND TRANSVERSE REINFORCEMENT SHALL BE 2" MINIMUM. THE CLEAR DISTANCE FROM THE END OF EACH PRECAST ELEMENT TO THE END OF REINFORCING STEEL SHALL NOT BE LESS THAN 1/2" NOR MORE THAN 3". REINFORCEMENT SHALL BE ASSEMBLED UTILIZING A SINGLE LAYER OF WELDED WIRE FABRIC, OR A SINGLE LAYER OF DEFORMED BILLET-STEEL BARS. WELDED WIRE FABRIC SHALL BE COMPOSED OF TRANSVERSE AND LONGITUDINAL WIRES MEETING THE SPACING REQUIREMENTS OF 4.3, BELOW, AND SHALL CONTAIN SUFFICIENT LONGITUDINAL WIRES EXTENDING THROUGH THE ELEMENT TO MAINTAIN THE SHAPE AND POSITION OF THE REINFORCEMENT. LONGITUDINAL REINFORCEMENT MAY BE WELDED WIRE FABRIC OR DEFORMED BILLET-STEEL BARS AND SHALL MEET THE SPACING REQUIREMENTS OF 4.3, BELOW.

4.2.8. BENDING OF REINFORCEMENT FOR PRECAST BRIDGE UNITS - THE OUTSIDE AND INSIDE CIRCUMFERENTIAL REINFORCING STEEL FOR THE CORNERS OF THE BRIDGE SHALL BE BENT TO SUCH AN ANGLE THAT IS APPROXIMATELY EQUAL TO THE CONFIGURATION OF THE BRIDGE'S OUTSIDE CORNER.

4.2.9. PLACEMENT OF REINFORCEMENT FOR PRECAST WINGWALLS AND HEADWALLS - THE COVER OF CONCRETE OVER THE LONGITUDINAL AND TRANSVERSE REINFORCEMENT SHALL BE 2" MINIMUM. THE CLEAR DISTANCE FROM THE END OF EACH PRECAST ELEMENT TO THE END OF REINFORCING STEEL SHALL NOT BE LESS THAN 1/2" NOR MORE THAN 3". REINFORCEMENT SHALL BE ASSEMBLED UTILIZING A SINGLE LAYER OF WELDED WIRE FABRIC, OR A SINGLE LAYER OF DEFORMED BILLET-STEEL BARS. WELDED WIRE FABRIC SHALL BE COMPOSED OF TRANSVERSE AND LONGITUDINAL WIRES MEETING THE SPACING REQUIREMENTS OF 4.3, BELOW, AND SHALL CONTAIN SUFFICIENT LONGITUDINAL WIRES EXTENDING THROUGH THE ELEMENT TO MAINTAIN THE SHAPE AND POSITION OF THE REINFORCEMENT. LONGITUDINAL REINFORCEMENT MAY BE WELDED WIRE FABRIC OR DEFORMED BILLET-STEEL BARS AND SHALL MEET THE SPACING REQUIREMENTS OF 4.3, BELOW.

4.2.10. BENDING OF REINFORCEMENT FOR PRECAST BRIDGE UNITS - THE OUTSIDE AND INSIDE CIRCUMFERENTIAL REINFORCING STEEL FOR THE CORNERS OF THE BRIDGE SHALL BE BENT TO SUCH AN ANGLE THAT IS APPROXIMATELY EQUAL TO THE CONFIGURATION OF THE BRIDGE'S OUTSIDE CORNER.

4.2.11. PLACEMENT OF REINFORCEMENT FOR PRECAST WINGWALLS AND HEADWALLS - THE COVER OF CONCRETE OVER THE LONGITUDINAL AND TRANSVERSE REINFORCEMENT SHALL BE 2" MINIMUM. THE CLEAR DISTANCE FROM THE END OF EACH PRECAST ELEMENT TO THE END OF REINFORCING STEEL SHALL NOT BE LESS THAN 1/2" NOR MORE THAN 3". REINFORCEMENT SHALL BE ASSEMBLED UTILIZING A SINGLE LAYER OF WELDED WIRE FABRIC, OR A SINGLE LAYER OF DEFORMED BILLET-STEEL BARS. WELDED WIRE FABRIC SHALL BE COMPOSED OF TRANSVERSE AND LONGITUDINAL WIRES MEETING THE SPACING REQUIREMENTS OF 4.3, BELOW, AND SHALL CONTAIN SUFFICIENT LONGITUDINAL WIRES EXTENDING THROUGH THE ELEMENT TO MAINTAIN THE SHAPE AND POSITION OF THE REINFORCEMENT. LONGITUDINAL REINFORCEMENT MAY BE WELDED WIRE FABRIC OR DEFORMED BILLET-STEEL BARS AND SHALL MEET THE SPACING REQUIREMENTS OF 4.3, BELOW.

4.2.12. BENDING OF REINFORCEMENT FOR PRECAST BRIDGE UNITS - THE OUTSIDE AND INSIDE CIRCUMFERENTIAL REINFORCING STEEL FOR THE CORNERS OF THE BRIDGE SHALL BE BENT TO SUCH AN ANGLE THAT IS APPROXIMATELY EQUAL TO THE CONFIGURATION OF THE BRIDGE'S OUTSIDE CORNER.

4.2.13. PLACEMENT OF REINFORCEMENT FOR PRECAST WINGWALLS AND HEADWALLS - THE COVER OF CONCRETE OVER THE LONGITUDINAL AND TRANSVERSE REINFORCEMENT SHALL BE 2" MINIMUM. THE CLEAR DISTANCE FROM THE END OF EACH PRECAST ELEMENT TO THE END OF REINFORCING STEEL SHALL NOT BE LESS THAN 1/2" NOR MORE THAN 3". REINFORCEMENT SHALL BE ASSEMBLED UTILIZING A SINGLE LAYER OF WELDED WIRE FABRIC, OR A SINGLE LAYER OF DEFORMED BILLET-STEEL BARS. WELDED WIRE FABRIC SHALL BE COMPOSED OF TRANSVERSE AND LONGITUDINAL WIRES MEETING THE SPACING REQUIREMENTS OF 4.3, BELOW, AND SHALL CONTAIN SUFFICIENT LONGITUDINAL WIRES EXTENDING THROUGH THE ELEMENT TO MAINTAIN THE SHAPE AND POSITION OF THE REINFORCEMENT. LONGITUDINAL REINFORCEMENT MAY BE WELDED WIRE FABRIC OR DEFORMED BILLET-STEEL BARS AND SHALL MEET THE SPACING REQUIREMENTS OF 4.3, BELOW.

4.2.14. BENDING OF REINFORCEMENT FOR PRECAST BRIDGE UNITS - THE OUTSIDE AND INSIDE CIRCUMFERENTIAL REINFORCING STEEL FOR THE CORNERS OF THE BRIDGE SHALL BE BENT TO SUCH AN ANGLE THAT IS APPROXIMATELY EQUAL TO THE CONFIGURATION OF THE BRIDGE'S OUTSIDE CORNER.

4.2.15. PLACEMENT OF REINFORCEMENT FOR PRECAST WINGWALLS AND HEADWALLS - THE COVER OF CONCRETE OVER THE LONGITUDINAL AND TRANSVERSE REINFORCEMENT SHALL BE 2" MINIMUM. THE CLEAR DISTANCE FROM THE END OF EACH PRECAST ELEMENT TO THE END OF REINFORCING STEEL SHALL NOT BE LESS THAN 1/2" NOR MORE THAN 3". REINFORCEMENT SHALL BE ASSEMBLED UTILIZING A SINGLE LAYER OF WELDED WIRE FABRIC, OR A SINGLE LAYER OF DEFORMED BILLET-STEEL BARS. WELDED WIRE FABRIC SHALL BE COMPOSED OF TRANSVERSE AND LONGITUDINAL WIRES MEETING THE SPACING REQUIREMENTS OF 4.3, BELOW, AND SHALL CONTAIN SUFFICIENT LONGITUDINAL WIRES EXTENDING THROUGH THE ELEMENT TO MAINTAIN THE SHAPE AND POSITION OF THE REINFORCEMENT. LONGITUDINAL REINFORCEMENT MAY BE WELDED WIRE FABRIC OR DEFORMED BILLET-STEEL BARS AND SHALL MEET THE SPACING REQUIREMENTS OF 4.3, BELOW.

4.2.16. BENDING OF REINFORCEMENT FOR PRECAST BRIDGE UNITS - THE OUTSIDE AND INSIDE CIRCUMFERENTIAL REINFORCING STEEL FOR THE CORNERS OF THE BRIDGE SHALL BE BENT TO SUCH AN ANGLE THAT IS APPROXIMATELY EQUAL TO THE CONFIGURATION OF THE BRIDGE'S OUTSIDE CORNER.

4.2.17. PLACEMENT OF REINFORCEMENT FOR PRECAST WINGWALLS AND HEADWALLS - THE COVER OF CONCRETE OVER THE LONGITUDINAL AND TRANSVERSE REINFORCEMENT SHALL BE 2" MINIMUM. THE CLEAR DISTANCE FROM THE END OF EACH PRECAST ELEMENT TO THE END OF REINFORCING STEEL SHALL NOT BE LESS THAN 1/2" NOR MORE THAN 3". REINFORCEMENT SHALL BE ASSEMBLED UTILIZING A SINGLE LAYER OF WELDED WIRE FABRIC, OR A SINGLE LAYER OF DEFORMED BILLET-STEEL BARS. WELDED WIRE FABRIC SHALL BE COMPOSED OF TRANSVERSE AND LONGITUDINAL WIRES MEETING THE SPACING REQUIREMENTS OF 4.3, BELOW, AND SHALL CONTAIN SUFFICIENT LONGITUDINAL WIRES EXTENDING THROUGH THE ELEMENT TO MAINTAIN THE SHAPE AND POSITION OF THE REINFORCEMENT. LONGITUDINAL REINFORCEMENT MAY BE WELDED WIRE FABRIC OR DEFORMED BILLET-STEEL BARS AND SHALL MEET THE SPACING REQUIREMENTS OF 4.3, BELOW.

4.2.18. BENDING OF REINFORCEMENT FOR PRECAST BRIDGE UNITS - THE OUTSIDE AND INSIDE CIRCUMFERENTIAL REINFORCING STEEL FOR THE CORNERS OF THE BRIDGE SHALL BE BENT TO SUCH AN ANGLE THAT IS APPROXIMATELY EQUAL TO THE CONFIGURATION OF THE BRIDGE'S OUTSIDE CORNER.

4.2.19. PLACEMENT OF REINFORCEMENT FOR PRECAST WINGWALLS AND HEADWALLS - THE COVER OF CONCRETE OVER THE LONGITUDINAL AND TRANSVERSE REINFORCEMENT SHALL BE 2" MINIMUM. THE CLEAR DISTANCE FROM THE END OF EACH PRECAST ELEMENT TO THE END OF REINFORCING STEEL SHALL NOT BE LESS THAN 1/2" NOR MORE THAN 3". REINFORCEMENT SHALL BE ASSEMBLED UTILIZING A SINGLE LAYER OF WELDED WIRE FABRIC, OR A SINGLE LAYER OF DEFORMED BILLET-STEEL BARS. WELDED WIRE FABRIC SHALL BE COMPOSED OF TRANSVERSE AND LONGITUDINAL WIRES MEETING THE SPACING REQUIREMENTS OF 4.3, BELOW, AND SHALL CONTAIN SUFFICIENT LONGITUDINAL WIRES EXTENDING THROUGH THE ELEMENT TO MAINTAIN THE SHAPE AND POSITION OF THE REINFORCEMENT. LONGITUDINAL REINFORCEMENT MAY BE WELDED WIRE FABRIC OR DEFORMED BILLET-STEEL BARS AND SHALL MEET THE SPACING REQUIREMENTS OF 4.3, BELOW.

MEET THE REQUIREMENTS OF AASHTO 8.30.1 AND 8.32.5. FOR DEFORMED BILLET-STEEL BARS, THE OVERLAP SHALL MEET THE REQUIREMENTS OF AASHTO 8.25. THE SPACING CENTER-TO-CENTER OF THE WIRES IN A WIRE FABRIC SHEET SHALL BE NOT LESS THAN 2" NOR MORE THAN 8".

4.4. CURING - THE PRECAST CONCRETE ELEMENTS SHALL BE CURED FOR A SUFFICIENT LENGTH OF TIME SO THAT THE CONCRETE WILL DEVELOP THE SPECIFIED COMPRESSIVE STRENGTH IN 28 DAYS OR LESS. ANY ONE OF THE FOLLOWING METHODS OF CURING OR COMBINATIONS THERE OF SHALL BE USED:

4.4.1. STEAM CURING - THE PRECAST ELEMENTS MAY BE LOW-PRESSURE STEAM CURED BY A SYSTEM THAT WILL MAINTAIN A MOIST ATMOSPHERE.

4.4.2. WATER CURING - THE PRECAST ELEMENTS MAY BE WATER CURED BY ANY METHOD THAT WILL KEEP THE SECTIONS MOIST.

4.4.3. MEMBRANE CURING - A SEALING MEMBRANE CONFORMING TO THE REQUIREMENTS OF ASTM SPECIFICATION C309 MAY BE APPLIED AND SHALL BE LEFT INTACT UNTIL THE REQUIRED CONCRETE COMPRESSIVE STRENGTH IS ATTAINED. THE CONCRETE TEMPERATURE AT THE TIME OF STRENGTH IS ATTAINED. THE CONCRETE TEMPERATURE AT THE TIME OF APPLICATION SHALL BE WITHIN +/- 10 DEGREES F OF THE ATMOSPHERIC TEMPERATURE. ALL SURFACES SHALL BE KEPT MOIST PRIOR TO THE APPLICATION OF THE COMPOUNDS AND SHALL BE DAMP WHEN THE COMPOUND IS APPLIED.

4.5. STORAGE, HANDLING & DELIVERY

4.5.1. STORAGE - PRECAST CONCRETE BRIDGE ELEMENTS SHALL BE LIFTED AND STORED IN "AS-CAST" POSITION. PRECAST CONCRETE HEADWALL AND WINGWALL UNITS ARE CAST, STORED AND SHIPPED IN A FLAT POSITION. THE PRECAST ELEMENTS SHALL BE STORED IN SUCH A MANNER TO PREVENT CRACKING OR DAMAGE. STORE ELEMENTS USING TIMBER SUPPORTS AS APPROPRIATE. THE UNITS SHALL NOT BE MOVED UNTIL THE CONCRETE COMPRESSIVE STRENGTH HAS REACHED A MINIMUM OF 2500 PSI, AND THEY SHALL NOT BE STORED IN AN UPRIGHT POSITION.

4.5.2. HANDLING - HANDLING DEVICES SHALL BE PERMITTED IN EACH PRECAST ELEMENT FOR THE PURPOSE OF HANDLING AND SETTING. SPREADER BEAMS MAY BE REQUIRED FOR THE LIFTING OF PRECAST CONCRETE BRIDGE ELEMENTS TO PRECLUDE DAMAGE FROM BENDING OR TORSION FORCES.

4.5.3. DELIVERY - PRECAST CONCRETE ELEMENTS MUST NOT BE SHIPPED UNTIL THE CONCRETE HAS ATTAINED THE SPECIFIED DESIGN COMPRESSIVE STRENGTH, OR AS DIRECTED BY THE DESIGN ENGINEER. PRECAST CONCRETE ELEMENTS MAY BE UNLOADED AND PLACED ON THE GROUND AT THE SITE UNTIL INSTALLED. STORE ELEMENTS USING TIMBER SUPPORTS AS APPROPRIATE.

4.6. QUALITY ASSURANCE - THE PRECASTER SHALL DEMONSTRATE ADHERENCE TO THE STANDARDS SET FORTH IN THE NPCA QUALITY CONTROL MANUAL. THE PRECASTER SHALL MEET EITHER SECTION 4.7.1 OR 4.7.2.

4.6.1. CERTIFICATION - THE PRECASTER SHALL BE CERTIFIED BY THE PRECAST/PRESTRESSED CONCRETE INSTITUTE PLANT CERTIFICATION PROGRAM OR THE NATIONAL PRECAST CONCRETE ASSOCIATION'S PLANT CERTIFICATION PROGRAM PRIOR TO AND DURING PRODUCTION OF THE PRODUCTS COVERED BY THIS SPECIFICATION.

4.6.2. QUALIFICATIONS, TESTING AND INSPECTION

4.6.2.1. THE PRECASTER SHALL HAVE BEEN IN THE BUSINESS OF PRODUCING PRECAST CONCRETE PRODUCTS SIMILAR TO THOSE SPECIFIED FOR A MINIMUM OF THREE YEARS. HE SHALL MAINTAIN A PERMANENT QUALITY CONTROL DEPARTMENT OR RETAIN AN INDEPENDENT TESTING AGENCY ON A CONTINUING BASIS. THE AGENCY SHALL ISSUE A REPORT, CERTIFIED BY A LICENSED ENGINEER, DETAILING THE ABILITY OF THE PRECASTER TO PRODUCE QUALITY PRODUCTS CONSISTENT WITH INDUSTRY STANDARDS.

4.6.2.2. THE PRECASTER SHALL SHOW THAT THE FOLLOWING TESTS ARE PERFORMED IN ACCORDANCE WITH THE ASTM STANDARDS INDICATED. TESTS SHALL BE PERFORMED AS INDICATED IN SECTION 6 OF THESE SPECIFICATIONS.

4.6.2.2.1. AIR CONTENT: C231 OR C173

4.6.2.2.2. COMPRESSIVE STRENGTH: C31, C39, C497

4.6.2.3. THE PRECASTER SHALL PROVIDE DOCUMENTATION DEMONSTRATING COMPLIANCE WITH THIS SECTION TO CONTECH® BRIDGE SOLUTIONS AT REGULAR INTERVALS OR UPON REQUEST.

4.6.2.4. THE OWNER MAY PLACE AN INSPECTOR IN THE PLANT WHEN THE PRODUCTS COVERED BY THIS SPECIFICATION ARE BEING MANUFACTURED.

4.6.3. DOCUMENTATION - THE PRECASTER SHALL SUBMIT PRECAST PRODUCTION REPORTS TO CONTECH® BRIDGE SOLUTIONS AS REQUIRED.

5. PERMISSIBLE VARIATIONS

5.1. WINGWALLS & HEADWALLS

5.1.1. WALL THICKNESS - THE WALL THICKNESS SHALL NOT VARY FROM THAT SHOWN IN THE DESIGN BY MORE THAN 1/2".

5.1.2. LENGTH/HEIGHT OF WALL SECTIONS - THE LENGTH AND HEIGHT OF THE WALL SHALL NOT VARY FROM THAT SHOWN IN THE DESIGN BY MORE THAN 1/2".

5.1.3. POSITION OF REINFORCEMENT - THE MAXIMUM VARIATION IN THE POSITION OF THE REINFORCEMENT SHALL BE ± 1/2" IN NO CASE SHALL THE COVER OVER THE REINFORCEMENT

BE LESS THAN 1/2".

5.1.4. SIZE OF REINFORCEMENT - THE PERMISSIBLE VARIATION IN DIAMETER OF ANY REINFORCING SHALL CONFORM TO THE TOLERANCES PRESCRIBED IN THE ASTM SPECIFICATION FOR THAT TYPE OF REINFORCING. STEEL AREA GREATER THAN THAT REQUIRED SHALL NOT BE CAUSE FOR REJECTION.

6. TESTING/INSPECTION

6.1. TESTING

6.1.1. TYPE OF TEST SPECIMEN - CONCRETE COMPRESSIVE STRENGTH SHALL BE DETERMINED FROM COMPRESSION TESTS MADE ON CYLINDERS OR CORES. FOR CYLINDER TESTING, A MINIMUM OF 3 CYLINDERS SHALL BE TAKEN FOR EACH LOT OF BRIDGE ELEMENTS. (A LOT IS DEFINED AS THE PRECAST ELEMENTS MADE USING THE SAME CONCRETE MIX DURING A SINGLE DAY'S PRODUCTION.) FOR CORE TESTING, ONE CORE SHALL BE CUT FROM EACH OF 3 PRECAST ELEMENTS SELECTED AT RANDOM FROM EACH GROUP OF 15 OR FEWER ELEMENTS MADE USING A SINGLE CONCRETE MIX IN THE SAME DAY'S PRODUCTION. EACH LOT SHALL BE CONSIDERED SEPARATELY FOR THE PURPOSE OF TESTING AND ACCEPTANCE.

6.1.2. COMPRESSION TESTING - CYLINDERS SHALL BE MADE AND TESTED AS PRESCRIBED BY THE ASTM C39 SPECIFICATION. CORES SHALL BE OBTAINED AND TESTED FOR COMPRESSIVE STRENGTH IN ACCORDANCE WITH THE PROVISIONS OF THE ASTM C42 SPECIFICATION.

6.1.3. ACCEPTABILITY OF CYLINDER TESTS - WHEN THE AVERAGE COMPRESSIVE STRENGTH OF ALL CYLINDERS TESTED IS EQUAL TO OR GREATER THAN THE DESIGN COMPRESSIVE STRENGTH, AND NOT MORE THAN 10% OF THE CYLINDERS TESTED HAVE A COMPRESSIVE STRENGTH LESS THAN THE DESIGN CONCRETE STRENGTH, AND NO CYLINDER TESTED HAS A COMPRESSIVE STRENGTH LESS THAN 80% OF THE DESIGN COMPRESSIVE STRENGTH, THEN THE LOT SHALL BE ACCEPTED. WHEN THE COMPRESSIVE STRENGTH OF THE CYLINDERS TESTED DOES NOT CONFORM TO THESE ACCEPTANCE CRITERIA, THE ACCEPTABILITY OF THE LOT MAY BE DETERMINED AS DESCRIBED IN SECTION 6.1.4, BELOW.

6.1.4. ACCEPTABILITY OF CORE TESTS - THE COMPRESSIVE STRENGTH OF THE CONCRETE IN A LOT IS ACCEPTABLE WHEN THE AVERAGE CORE TEST STRENGTH IS EQUAL TO OR GREATER THAN THE DESIGN CONCRETE STRENGTH. WHEN THE COMPRESSIVE STRENGTH OF A CORE TESTED IS LESS THAN THE DESIGN CONCRETE STRENGTH, THE PRECAST ELEMENT FROM WHICH THAT CORE WAS TAKEN MAY BE RE-CORED. WHEN THE COMPRESSIVE STRENGTH OF THE RE-CORE IS EQUAL TO OR GREATER THAN THE DESIGN CONCRETE STRENGTH, THE COMPRESSIVE STRENGTH OF THE CONCRETE IN THAT LOT IS ACCEPTABLE.

6.1.4.1. WHEN THE COMPRESSIVE STRENGTH OF ANY RECORE IS LESS THAN THE DESIGN CONCRETE STRENGTH, THE PRECAST ELEMENT FROM WHICH THAT CORE WAS TAKEN SHALL BE REJECTED. TWO PRECAST ELEMENTS FROM THE REMAINDER OF THE LOT SHALL BE SELECTED AT RANDOM AND ONE CORE SHALL BE TAKEN FROM EACH. IF THE COMPRESSIVE STRENGTH OF BOTH CORES IS EQUAL TO OR GREATER THAN THE DESIGN CONCRETE STRENGTH, THE COMPRESSIVE STRENGTH OF THE REMAINDER OF THAT GROUP IS ACCEPTABLE. IF THE COMPRESSIVE STRENGTH OF EITHER OF THE TWO CORES TESTED IS LESS THAN THE DESIGN CONCRETE STRENGTH, THE REMAINDER OF THE GROUP SHALL BE REJECTED OR, AT THE OPTION OF THE MANUFACTURER, EACH PRECAST ELEMENT OF THE REMAINDER OF THE GROUP SHALL BE CORED AND ACCEPTED INDIVIDUALLY, AND ANY OF THESE ELEMENTS THAT HAVE CORES WITH LESS THAN THE DESIGN CONCRETE STRENGTH SHALL BE REJECTED.

6.1.4.2. TEST EQUIPMENT - EVERY MANUFACTURER FURNISHING PRECAST ELEMENTS UNDER THIS SPECIFICATION SHALL FURNISH ALL FACILITIES AND PERSONNEL NECESSARY TO CARRY OUT THE TEST REQUIRED.

6.2. INSPECTION - THE QUALITY OF MATERIALS, THE PROCESS OF MANUFACTURE, AND THE FINISHED PRECAST ELEMENTS SHALL BE SUBJECT TO INSPECTION BY THE PURCHASER.

7. JOINTS

THE BRIDGE UNITS SHALL BE PRODUCED WITH FLAT BUTT ENDS. THE ENDS OF THE BRIDGE UNITS SHALL BE SUCH THAT WHEN THE SECTIONS ARE LAID TOGETHER THEY WILL MAKE A CONTINUOUS LINE WITH A SMOOTH INTERIOR FREE OF APPRECIABLE IRREGULARITIES, ALL COMPATIBLE WITH THE PERMISSIBLE VARIATIONS IN SECTION 5, ABOVE. THE JOINT WIDTH BETWEEN ADJACENT PRECAST UNITS SHALL NOT EXCEED 3/4".

8. WORKMANSHIP/ FINISH

THE BRIDGE UNITS, WINGWALLS, AND HEADWALLS SHALL BE SUBSTANTIALLY FREE OF FRACTURES. THE ENDS OF THE BRIDGE UNITS SHALL BE NORMAL TO THE WALLS AND CENTERLINE OF THE BRIDGE SECTION, WITHIN THE LIMITS OF THE VARIATIONS GIVEN IN

SECTION 5, ABOVE, EXCEPT WHERE BEVELED ENDS ARE SPECIFIED. THE FACES OF THE WINGWALLS AND HEADWALLS SHALL BE PARALLEL TO EACH OTHER, WITHIN THE LIMITS OF VARIATIONS GIVEN IN SECTION 5, ABOVE. THE SURFACE OF THE PRECAST ELEMENTS SHALL BE A SMOOTH STEEL FORM OR TROWELED SURFACE. TRAPPED AIR POCKETS CAUSING SURFACE DEFECTS SHALL BE CONSIDERED AS PART OF A SMOOTH, STEEL FORM FINISH.

9. REPAIRS

PRECAST ELEMENTS MAY BE REPAIRED, IF NECESSARY, BECAUSE OF IMPERFECTIONS IN MANUFACTURE OR HANDLING DAMAGE AND WILL BE ACCEPTABLE IF, IN THE OPINION OF THE PURCHASER, THE REPAIRS ARE SOUND, PROPERLY FINISHED AND CURED, AND THE REPAIRED SECTION CONFORMS TO THE REQUIREMENTS OF THIS SPECIFICATION.

10. REJECTION

THE PRECAST ELEMENTS SHALL BE SUBJECT TO REJECTION ON ACCOUNT OF ANY OF THE SPECIFICATION REQUIREMENTS. INDIVIDUAL PRECAST ELEMENTS MAY BE REJECTED BECAUSE OF ANY OF THE FOLLOWING:

10.1. FRACTURES OR CRACKS PASSING THROUGH THE WALL, EXCEPT FOR A SINGLE END CRACK THAT DOES NOT EXCEED ONE HALF THE THICKNESS OF THE WALL.

10.2. DEFECTS THAT INDICATE PROPORTIONING, MIXING, AND MOLDING NOT IN COMPLIANCE WITH SECTION 4 OF THESE SPECIFICATIONS.

10.3. HONEYCOMBED OR OPEN TEXTURE.

10.4. DAMAGED ENDS, WHERE SUCH DAMAGE WOULD PREVENT MAKING A SATISFACTORY JOINT.

11. MARKING

EACH BRIDGE UNIT SHALL BE CLEARLY MARKED BY WATERPROOF PAINT. THE FOLLOWING SHALL BE SHOWN ON THE INSIDE OF THE VERTICAL LEG OF THE BRIDGE SECTION:

BRIDGE SPAN x BRIDGE RISE

DATE OF MANUFACTURE

NAME OR TRADEMARK OF THE MANUFACTURER

PROFESSIONAL CERTIFICATION: I HEREBY CERTIFY THAT THESE DOCUMENTS WERE PREPARED OR APPROVED BY ME, AND THAT I AM A DULY LICENSED PROFESSIONAL ENGINEER UNDER THE LAWS OF THE STATE OF MARYLAND, LICENSE NO. 36225, EXPIRATION DATE: 8/19/2010.

THERE IS NO AS-BUILT INFORMATION PROVIDED ON THIS SHEET.

APPROVED: DEPARTMENT OF PUBLIC WORKS

APPROVED: DEPARTMENT OF PLANNING AND ZONING

PROJECT No.: 402195

SEQ. No.: 001

DATE: 11/13/2009

DESIGNED: JMF

DRAWN: ZWM

CHECKED: DMR

APPROVED: PAC

SHEET NO.: 19 OF 24

CT6 OF CT7

F-10-042

The design and information shown on this drawing is provided as a service to the project owner, engineer and contractor by CONTECH Construction Products Inc. or one of its affiliated companies ("CONTECH"). Neither this drawing, nor any part thereof, may be used, reproduced or modified in any manner without the prior written consent of CONTECH. Failure to comply is done at the user's own risk and CONTECH expressly disclaims any liability or responsibility for such use.

MARK	DATE	REVISION DESCRIPTION	BY
JMF	2/8/2010	NO CHANGES ON THIS SHEET	JMF

**CONTECH®**  
CONSTRUCTION PRODUCTS INC.  
www.contech-cpi.com

9025 Centre Pointe Dr., Suite








# CONTECH CONSTRUCTION PRODUCTS, INC. DESIGN OF FOOTINGS, BACKFILL SPECIFICATIONS AND SCOUR ANALYSIS FOR A 19' x 6'-4" MULTI-PLATE ARCH; BONNIE BRANCH WOODS HOWARD COUNTY, MARYLAND

INDEX	
1.	TITLE SHEET/INDEX
2.	PLAN, PROFILE AND DETAILS
3.	SPECIFICATIONS
4.	SPECIFICATIONS CONTINUED


THERE IS NO AS-BUILT  
INFORMATION PROVIDED  
ON THIS SHEET

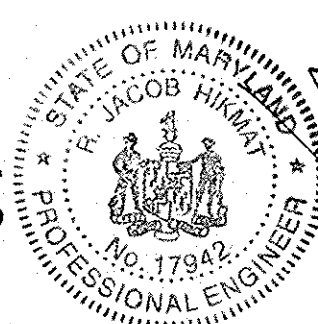

APPROVED: DEPARTMENT OF PUBLIC WORKS  
*[Signature]* 6-11-10  
CHIEF, BUREAU OF HIGHWAYS DATE

APPROVED: DEPARTMENT OF PLANNING AND ZONING  
*[Signature]* 6-22-10  
CHIEF, DIVISION OF LAND DEVELOPMENT DATE

APPROVED: DEPARTMENT OF ENGINEERING  
*[Signature]* 6-10-10  
CHIEF, DEVELOPMENT ENGINEERING DIVISION DATE

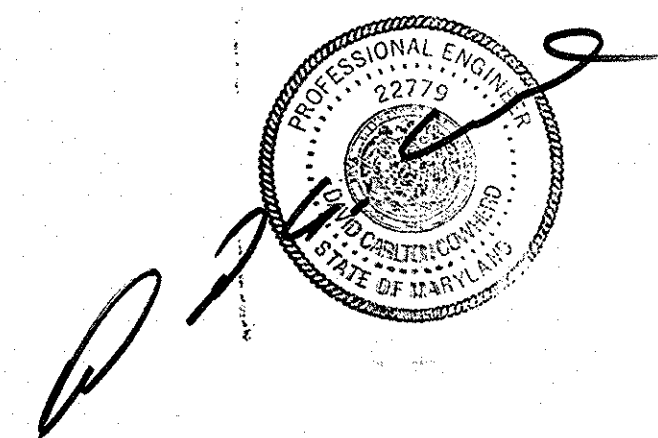

1	2/17/10	DJH	REVISION 1						
<b>CBC ENGINEERS</b> DAYTON, OHIO									
<b>TITLE SHEET / INDEX</b>									
Drawn By	JBE	Date	11/17/09	CONTECH CONSTRUCTION PRODUCTS, INC. DESIGN OF FOOTINGS, BACKFILL SPECIFICATIONS AND SCOUR ANALYSIS FOR A 19' x 6'-4" MULTI-PLATE ARCH; BONNIE BRANCH WOODS HOWARD COUNTY, MARYLAND					
Approved By		Date							
Scale	GRAPHIC	Project No.	CBC-11035	Rev.	1	Sheet	21 OF 24	1 OF 4	

AS-BUILT







I - GENERAL

1.0 STANDARDS AND DEFINITIONS

- 1.1 STANDARDS - All standards refer to latest edition unless otherwise noted.
- 1.1.1 ASTM D-698-70 (Method C) "Standard Test Methods for Moisture, Density Relations of Soils and Soil Aggregate Mixtures Using 5.5-lb (2.5 kg.) Rammer and 12-inch (305-mm) Drop".
- 1.1.2 ASTM D-2922 "Standard Test Method for Density of Soil and Soil Aggregate in Place by Nuclear methods (Shallow Depth)".
- 1.1.3 ASTM D-1556 "Standard Test Method for Density of Soil in place by the Sand-Cone Method".
- 1.1.4 ASTM D-1557 "Standard Test Method for Laboratory Compaction Characteristics of Soil Using Modified Effort".
- 1.1.5 All construction and materials shall be in accordance with the latest AASHTO and Maryland DOT standards.
- 1.2 DEFINITIONS
- 1.2.1 Owner - In these specifications the word "Owner" shall mean Duckett's Ridge, LLC, Columbia, Maryland.
- 1.2.2 Engineer - In these specifications the word "Engineer" shall mean the Owner designated engineer.
- 1.2.3 Design Engineer - In these specifications the words "Design Engineer" shall mean CBC Engineers and Associates, Ltd.
- 1.2.4 Contractor - In these specifications the word "Contractor" shall mean the firm or corporation undertaking the execution of any work under the terms of these specifications.
- 1.2.5 Approved - In these specifications the word "approved" shall refer to the approval of the Engineer or his designated representative.
- 1.2.6 As Directed - In these specifications the words "as directed" shall refer to the directions to the Contractor from the Owner or his designated representative.

2.0 GENERAL CONDITIONS

- 2.1 The Contractor shall furnish all labor, material and equipment and perform all work and services except those set out and furnished by the Owner, necessary to complete in a satisfactory manner the site preparation, excavation, filling, compaction, grading as shown on the plans and as described therein.
- This work shall consist of all mobilization clearing and grading, grubbing, stripping, removal of existing material unless otherwise stated, preparation of the land to be filled, filling of the land, spreading and compaction of the fill, and all subsidiary work necessary to complete the grading of the cut and fill areas to conform with the lines, grades, slopes, and specifications.
- This work is to be accomplished under the observation of the Owner or his designated representative.
- 2.2 Prior to bidding the work, the Contractor shall examine, investigate and inspect the construction site as to the nature and location of the work, and the general and local conditions at the construction site, including, without limitation, the character of surface or subsurface conditions and obstacles to be encountered on and around the construction site; and shall make such additional investigation as he may deem necessary for the planning and proper execution of the work.
- If conditions other than those indicated are discovered by the Contractor, the Owner should be notified immediately. The material which the Contractor believes to be a changed condition should not be disturbed so that the owner can investigate the condition.
- 2.3 The construction shall be performed under the direction of an experienced engineer who is familiar with the design plan.

II - FOOTINGS

1.0 EXCAVATION FOR FOOTINGS

- 1.1 Footing excavation shall consist of the removal of all material, of whatever nature, necessary for the construction of foundations.
- 1.2 It shall be the responsibility of the Contractor to identify and relocate all existing utilities which conflict with the proposed footing locations shown on the plan. The Contractor must call the appropriate utility company at least 48 hours before any excavation to request exact field location of utilities, and coordinate removal and installation of all utilities with the respective utility company.
- 1.3 The side of all excavations shall be cut to prevent sliding or caving of the material above the footings.
- 1.4 Excavated material shall be disposed in accordance with the plan established by the Engineer.
- 1.5 The footings are designed for an allowable bearing capacity of 4,000 psf on lean concrete (fc = 2,000 psi) placed directly on competent rock with an allowable bearing capacity of 5,000 psf. These values and the presence of rock shall be verified in the field before construction. The dimensions of the lean concrete shall be as shown on the drawings.

2.0 CONCRETE FOOTING DIMENSIONS

The footings shall be reinforced in accordance with the construction drawings.

III - MULTI-PLATE ARCH

1.0 GENERAL

- 1.1 This work shall consist of furnishing, fabricating, and installation of a Multi-Plate arch culvert in conformance with these specifications, the manufacturer provisions, and the details shown on the plans.
- 1.2 The contractor shall verify the actual location of all utilities in the field before beginning any work that could be impacted by these utilities.
- 1.3 Contractor must notify/contact all utility companies to determine exact locations of existing utilities prior to commencing any work on this contract.
- 1.4 Contractor shall coordinate construction with work done by others adjacent to or within the contract limits.

2.0 DIMENSIONS

- 2.1 The proposed structure shall be a MULTI-PLATE arch with the following dimensions:

Span: 19'-0"  
Rise: 6'-4"  
Gage: 10 (0.140")

- 2.2 All plan dimensions on the contract drawings are measured in a true horizontal plan unless otherwise noted.

- 2.3 All dimensions, locations, and elevations of existing structures shown on the contract drawings shall be verified by the contractor in the field.

3.0 DESIGN CRITERIA

All design, except where noted, conforms to the applicable sections of the current AASHTO Standard Specifications for Highway Bridges.

4.0 WORKMANSHIP AND INSPECTIONS

All metal piping materials shall conform to the workmanship and inspection requirements of AASHTO M36 and M167.

5.0 MATERIALS AND DIMENSIONS

- 5.1 Steel structural plate arches shall conform to the requirements of AASHTO M167.
- 5.2 Bolts and nuts shall meet the provisions of ASTM A-449 and ASTM A-563, Grade C, respectively, and shall be galvanized in accordance with the requirements of ASTM A-153, Class C.

6.0 INSTALLATION

ASSEMBLY. The Structure shall be assembled in accordance with the Manufacturer's instructions. All plates shall be unloading and handled with reasonable care. Plates shall not be rolled or dragged over gravel rock and shall be prevented from striking rock or other hard objects during placement in trench or on bedding.

The Structure shall be placed in the footing starting at the downstream end. Structures with circumferential seams shall be installed with their inside circumferential sheet laps pointing downstream.

IV - CONCRETE

1.0 CODES AND STANDARDS

- 1.1 Reinforced concrete for the structural footings shall conform to the requirements of AASHTO Standard Specifications for Highway Bridges, Division II - Construction, Section 8, "Concrete Structures", for Class A concrete, having a minimum compressive strength of 4,000 psi.

2.0 STANDARDS FOR MATERIALS

- 2.1 Portland Cement - Conforming to ASTM Specification C-150, Type I or II.
- 2.2 Water - The water shall be drinkable, clean free from injurious amounts of oils, acids, alkalis, organic materials, or deleterious substances.
- 2.3 Aggregates - Fine and coarse aggregates shall conform to current ASTM Specification C-33 "Specification for Concrete Aggregates" except that local aggregates which have been shown by tests and by actual service to produce satisfactory qualities may be used when approved by the Engineer.
- 2.4 Submittals - Test data and/or certifications to the Owner shall be furnished upon request.

3.0 PROPORTIONING OF CONCRETE

3.1 COMPOSITION

- 3.1.1 The concrete shall be composed of cement, fine aggregate, coarse aggregate and water.
- 3.1.2 The concrete shall be homogeneous, readily placeable and uniformly workable and shall be proportioned in accordance with ACI-211.1.
- 3.1.3 Proportions shall be established on the basis of field experience with the materials to be employed. The amount of water used shall not exceed the maximum 0.49 water/cement ratio, and shall be reduced as necessary to produce concrete of the specified consistency at the time of placement.
- 3.1.4 An air-entraining admixture, conforming to the requirements of ASTM C260, shall be used in all concrete furnished under this contract. The quantity of admixture shall be such as to produce an air content in the freshly mixed concrete of 6 percent plus or minus 1 percent as determined in accordance with ASTM C231 or C173.

- 3.2 Qualities Required - As indicated in the table below:

TABLE IV-1  
QUALITIES REQUIRED

ITEM	QUALITY REQUIRED
AASHTO Class	A
Type of Cement	I or II
Compressive Strength $f_c$ @ 28 days	4,000 psi
Slump, inches	2 - 4 in.

- 3.3 Maximum Size of Coarse Aggregates - Maximum size of coarse aggregates shall not be larger than 38 mm (1 1/2 inches).

- 3.4 Rate of Hardening of Concrete - Concrete mix shall be adjusted to produce the required rate of hardening for varied climatic conditions:

Under 40°F Ambient Temperature - Accelerate calcium chloride at 2% is acceptable when used within the recommendations of ACI-306R "Cold Weather Concreting." Admixtures containing chloride ion in excess of 1% by weight of admixture shall not be used in reinforced concrete.

4.0 MIXING AND PLACING

- 4.1 Equipment - Ready Mix Concrete shall be used and shall conform to the "Specifications for Ready-Mix Concrete," ASTM C-94. Approval is required prior to using job mixed concrete.
- 4.2 Preparation - All work shall be in accordance with ACI-304, "Recommended Practice for Measuring, Mixing, Transporting and Placing Concrete." All construction debris and extraneous matter shall be removed from within the forms. Concrete shall be placed on clean surfaces, free from water. Concrete that has to be dropped four (4) feet or more shall be placed through a tremie.
- 4.3 All concrete shall be consolidated by internal mechanical vibration immediately after placement. Vibrators shall be of a size appropriate for the work, capable of transmitting vibration to concrete at frequencies of not less than 4,500 impulses per minute.

5.0 FORM WORK

- 5.1 Forms shall be of wood, steel or other approved material and shall be set and held true to the dimensions, lines and grades of the structure prior to and during the placement of concrete.
- 5.2 Forms shall not be removed until the concrete has sufficient strength to prevent concrete damage and/or drainage.

6.0 CURING



- 6.1 Fresh concrete shall be protected from rains, flowing water and mechanical injury for a period of four (4) days.

APPROVED: DEPARTMENT OF PUBLIC WORKS  
*[Signature]* 6-11-10  
 CHIEF, BUREAU OF HIGHWAYS DATE

APPROVED: DEPARTMENT OF PLANNING AND ZONING  
*[Signature]* 6/22/10  
 CHIEF, DIVISION OF LAND DEVELOPMENT DATE

APPROVED: ENGINEERING DIVISION  
*[Signature]* 6/18/10  
 CHIEF, DEVELOPMENT ENGINEERING DIVISION DATE

THERE IS NO AS-BUILT  
 INFORMATION PROVIDED  
 ON THIS SHEET

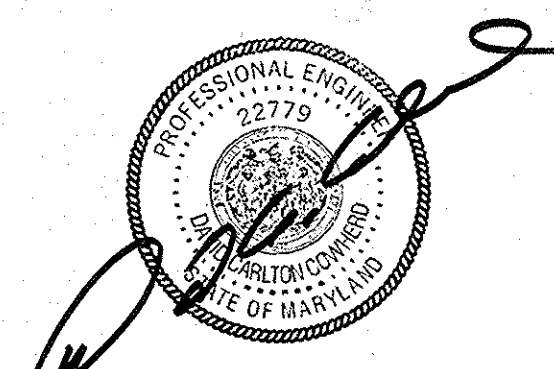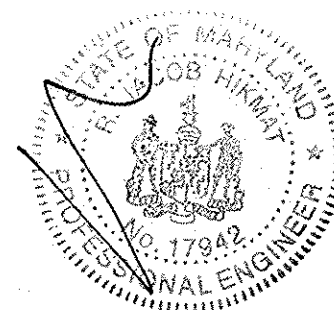

1	2/17/10	DJH	REVISION 1
<b>SPECIFICATIONS</b>			
Drawn By	Date	CONTECH CONSTRUCTION PRODUCTS, INC. DESIGN OF FOOTINGS, BACKFILL SPECIFICATIONS AND SCOUR ANALYSIS	
JBE	11/17/09	FOR A 19' x 6'-4" MULTI-PLATE ARCH, BONNIE BRANCH WOODS HOWARD COUNTY, MARYLAND	
Approved By	Date	Project No.	Rev. Sheet
		CBC-11035	1 23 OF 24 3 OF 4
Scale	GRAPHIC		

AS-BUILT



**7.0 REINFORCING STEEL**

**7.1 MATERIAL**

7.1.1 All reinforcing bars shall be deformed bars (ASTM-A615) Grade 60.

**7.2 BENDING AND SPLICING**

7.2.1 Bar reinforcement shall be cut and bent to the shapes shown on the plans. Fabrication tolerances shall be in accordance with ACI 315. All bars shall be bent cold, unless otherwise permitted.

7.2.2 All reinforcement shall be furnished in the full lengths indicated on the plans unless otherwise permitted. Except for splices shown on the plans and splices for No. 5 or smaller bars, splicing of bars will not be permitted without written approval. Splices shall be staggered as far as possible.

7.2.3 In lapped splices, the bars shall be placed and wired in such a manner as to maintain the minimum distance to the surface of the concrete shown on the plans.

7.2.4 Substitution of different size bars will be permitted only when authorized by the engineer. The substituted bars shall have an area equivalent to the design area, or larger.

**7.3 PLACING AND FASTENING**

7.3.1 Steel reinforcement shall be accurately placed as shown on the plans and firmly held in position during the placing and setting of concrete. Bars shall be tied at all intersections around the perimeter of each mat and at not less than 2 foot centers or at every intersection, whichever is greater, elsewhere. Welding of cross bars (tack welding) will not be permitted for assembly of reinforcement.

7.3.2 Reinforcing steel shall be supported in its proper position by use of mortar blocks, wire bar supports, supplementary bars or other approved devices. Such devices shall be of such height and placed at sufficiently frequent intervals so as to maintain the distance between the reinforcing and the formed surface or the top surface within 1/4 inch of that indicated on the plans.

**V - SELECT BACKFILL SPECIFICATIONS**

**1.0 GENERAL CONDITIONS**

1.1 The contractor shall furnish all labor, materials, and equipment, and perform all work and services necessary to complete in a satisfactory manner the site preparation, excavation, filling, compaction and grading as shown on the plans and as described therein.

1.2 This work shall consist of all clearing and grading, removal of existing structures unless otherwise stated, preparation of the land to be filled, spreading and compaction of the fill, and all subsidiary work necessary to complete the grading of the cut and fill areas to conform with the lines, grades, slopes, and specifications.

1.3 This work is to be accomplished under the constant and continuous supervision of the Owner or his designated representative.

**2.0 SUBSURFACE CONDITIONS**

2.1 The Contractor shall examine, investigate and inspect the construction site as to the nature and location of the work, and the general and local conditions at the construction site, including, without limitation, the character of surface or subsurface conditions and obstacles to be encountered on and around the construction site; and shall make such additional investigation as he may deem necessary for the planning and proper execution of the work.

2.2 If conditions other than those indicated are discovered by the Contractor, the Owner should be notified immediately. The material which the Contractor believes to be a changed condition should not be disturbed so that the Owner can investigate the condition.

**3.0 SITE PREPARATION**

3.1 Within the specified areas, all debris, existing stockpile material, and structures scheduled for demolition shall be removed and disposed of.

3.2 Any rubbish, organic and other objectionable soils, and other deleterious material, shall be disposed of off the site, or as directed by the Owner or his designated representative if on site disposal is provided. In no case shall such objectionable material be allowed in, or under the fill.

3.3 Prior to the addition of fill, any required undercuts shall be made and the original ground shall be compacted to the project specifications as outlined below. Special attention shall be given to the proposed fill area at this time. If wet spots, spongy conditions, or ground water seepage is found, corrective measures must be taken before the placement of fill.

**4.0 FORMATION OF FILL AREAS**

**4.1 SELECT BACKFILL**

4.1.1 Select backfill shall be placed to a minimum distance of 3 feet horizontally, as measured from the springline of the structure, and to the bottom of the flexible pavement above the crown of the structure as shown on the construction drawings.

**5.0 MINIMUM BACKFILL REQUIREMENTS**

**5.1 MATERIAL**

A granular type of material shall be used around and over the structure. This select structural backfill material shall conform to AASHTO Specification AASHTO M-145 A-1 or A-2 and the following requirements. Maximum particle size shall not exceed 3 inches.

TABLE V-1  
BACKFILL REQUIREMENTS

AASHTO M-145 - TABLE 2 (MODIFIED)*				
GROUP CLASSIFICATION	A-1		A-2 (Modified)	
	A-1-a	A-1-b	A-2-4	A-2-5
Sieve Analysis, Percent Passing				
No. 10 (2.00 mm)	50 max.	--	--	--
No. 40 (0.425 mm)	30 max.	50 max.	--	--
No. 100 (.150 mm)	--	--	50 max.	50 max.
No. 200 (0.075 mm)	15 max.	25 max.	20 max.	20 max.
CHARACTERISTICS OF FRACTION PASSING NO. 40 (0.425 mm)				
Liquid Limit	--	--	40 max.	41 min.
Plasticity Index	6 max.		10 max.	10 max.
USUAL TYPES OF SIGNIFICANT CONSTITUENT MATERIALS	Stone Fragments, Gravel and Sand		Silty or Clayey Gravel and Sand	

\*Modified to be more select than M-145.

Additional Backfill Material Requirements:

- Backfill must be well-graded material. Open-graded or gap-graded materials are not allowed.
- Fine beach sands, windblown sands, stream deposited sands exhibiting fine, rounded particles and typically classified by AASHTO M-145 as A-3 materials are not allowed.
- On-site mixing or blending to achieve specified gradation is not allowed.
- The maximum particle size shall not exceed 3 inches.
- The stone particles shall be angular and not rounded.
- The backfill should have a Los Angeles Abrasion Test loss no greater than 50%. Other backfill materials which provide equivalent long term structural properties in the environmental conditions expected (saturation, freeze-thaw, etc.) may be used. Such materials shall be approved only after thorough investigation and testing by a soils engineer.

**5.2 BACKFILL LIMITS**

The required width of the structural backfill shall be 3 feet minimum outside the springline and to the bottom of the flexible pavement over the top of the structure.

**5.3 BACKFILL PLACEMENT**

Approved backfill material shall be placed in horizontal, uniform layers not exceeding 8" in thickness, before compaction, and shall be brought up uniformly on both sides of the structure. Each layer of backfill shall be compacted to a relative density of not less than 90%, modified Proctor per AASHTO Test Method No. T-180. Field density tests of compacted backfill shall be made at regular intervals during backfill.

Contractors should plan to have a D4 (approximately 20,000 lbs.) or similar weight tracked dozer to place and grade backfill immediately alongside and above the structure until minimum cover level is reached. Lightweight vibratory plate or roller type compaction equipment must be used to compact the backfill in these zones. Use of heavier equipment and/or rubber tired equipment such as scrapers, graders and front end loaders are prohibited inside the select fill envelope zone until appropriate minimum cover height has been obtained.

**6.0 SLOPE RATIO AND STORM WATER RUN-OFF**

Protected slopes shall not be greater than 3.0 (horizontal) to one (1) (vertical) in both cut and fill, and storm water shall not be drained over the slopes.

**7.0 GRADING**

The Contractor shall furnish, operate, and maintain such equipment as is necessary to construct uniform layers, and control smoothness of grade for maximum compaction and drainage.

**8.0 COMPACTING**

8.1 The compaction equipment shall be approved equipment of such design, weight, and quantity to obtain the required density in accordance with these specifications, without distorting the structure.


8.2 During backfill, only small tracked vehicles (D-4 or smaller) shall be near the structure as fill progresses above the crown and to finished grade. The contractor is cautioned that the minimum cover may need to be increased to handle temporary construction vehicle loads (larger than a D-4).

8.3 The Owner shall be responsible for providing all necessary field testing to verify that the provisions of these specifications are met.


APPROVED: DEPARTMENT OF PUBLIC WORKS  
*W. R. Smith* 6-11-10  
 CHIEF, BUREAU OF HIGHWAYS DATE

APPROVED: DEPARTMENT OF PLANNING AND ZONING  
*Kent Selbach* 6/22/10  
 CHIEF, DIVISION OF LAND DEVELOPMENT DATE

*W. J. ...* 6/10/10  
 CHIEF, DEVELOPMENT ENGINEERING DIVISION DATE

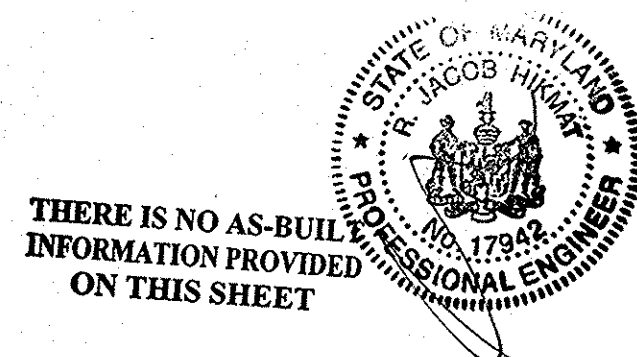

THERE IS NO AS-BUILT INFORMATION PROVIDED ON THIS SHEET

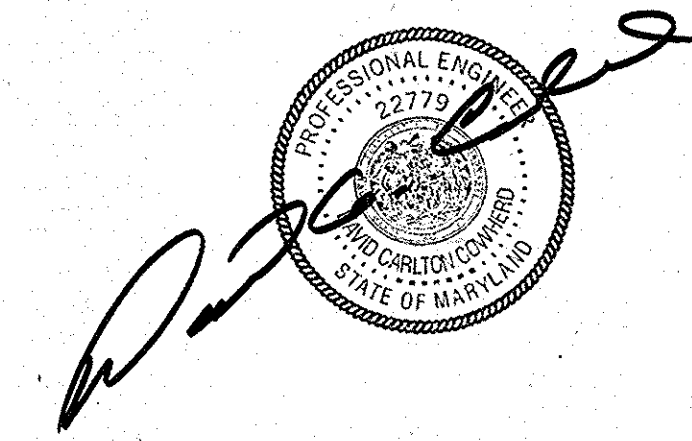

1	2/17/10	DJH	REVISION 1
<b>SPECIFICATIONS CONTINUED</b>			
Drawn By	Date	CONTECH CONSTRUCTION PRODUCTS, INC. DESIGN OF FOOTINGS, BACKFILL SPECIFICATIONS AND SCOUR ANALYSIS	
JBE	11/17/09	FOR A 19' x 8'-4" MULTI-PLATE ARCH; BONNIE BRANCH WOODS HOWARD COUNTY, MARYLAND	
Approved By	Date	Project No.	Rev.
		CBC-11035	1
Scale	Sheet	24 OF 24 4 OF 4	
GRAPHIC			

AS-BUILT