

FINAL ROAD CONSTRUCTION PLANS

WESTLAND FARM ESTATES


LOTS 3 THRU 14 & OPEN SPACE LOT 15

TAX MAP No. 45 GRID No. 5 PARCEL No. 28
 FIFTH ELECTION DISTRICT HOWARD COUNTY, MARYLAND

SHEET INDEX	
SHEET NO.	DESCRIPTION
1	TITLE SHEET
2	DEMOLITION PLAN
3	WESTLAND COURT PLAN AND PROFILE
4	ACCELERATION/DECELERATION LANE CROSS SECTIONS
5	LANDSCAPE & FOREST CONSERVATION PLAN
6	LANDSCAPE & FOREST CONSERVATION PLAN
7	LANDSCAPE & FOREST CONSERVATION PLAN
8	LANDSCAPE & FOREST CONSERVATION PLAN
9	GRADING AND EROSION & SEDIMENT CONTROL PLAN
10	GRADING AND EROSION & SEDIMENT CONTROL PLAN
11	GRADING AND EROSION & SEDIMENT CONTROL PLAN
12	GRADING AND EROSION & SEDIMENT CONTROL PLAN
13	STORM DRAIN DRAINAGE AREA MAP
14	STORM DRAIN PROFILES
15	STORMWATER MANAGEMENT NOTES & DETAILS
16	LANDSCAPE & FOREST CONSERVATION NOTES & DETAILS
17	SEDIMENT & EROSION CONTROL NOTES & DETAILS
18	POND UPGRADE DETAILS & SPECIFICATIONS
19	POND UPGRADE DETAILS & SPECIFICATIONS

Minimum Lot Size Chart			
Lot No.	Gross Area	Pipestem Area	Minimum Lot Size
5	3.039 Ac.±	0.035 Ac.±	3,004 Ac.±
6	3.070 Ac.±	0.057 Ac.±	3,013 Ac.±
7	3.087 Ac.±	0.087 Ac.±	3,000 Ac.±
8	5.132 Ac.±	0.059 Ac.±	5,073 Ac.±
10	3.164 Ac.±	0.152 Ac.±	3,012 Ac.±



SPECIMEN TREE TABLE				
KEY	SPECIES	SIZE (DBH)	CRZ (FT RADIUS)	COMMENTS
SP1	BLACK WALNUT	30"	45'	TO BE RETAINED
SP2	SYCAMORE	50"	75'	TO BE REMOVED
SP3	SYCAMORE	62"	93'	TO BE REMOVED
SP4	TULIP POPLAR	30"	45'	TO BE REMOVED
SP5	NORWAY MAPLE	30"	45'	TO BE RETAINED

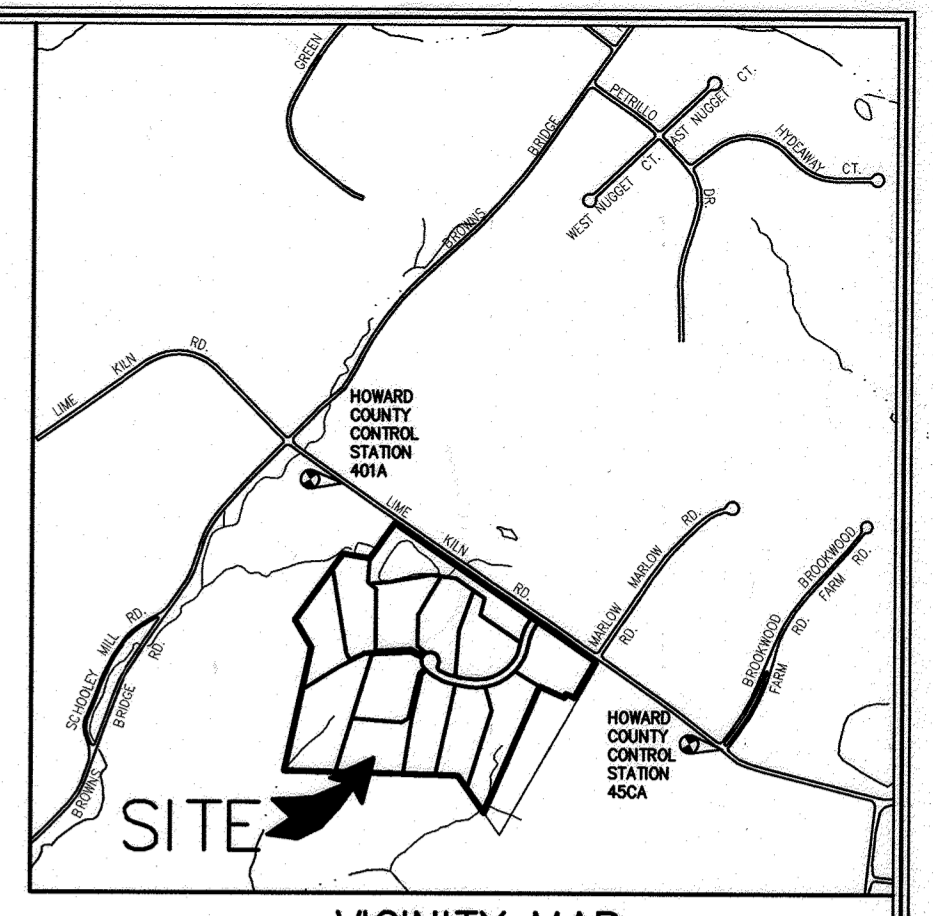

STORMWATER MANAGEMENT SUMMARY			
AREA ID.	ESDv REQUIRED CU.FT.	ESDv PROVIDED CU.FT.	REMARKS
SITE	17,093	18,761	NON-ROOFTOP DISCONNECTIONS (N-2), DRY WELLS (M-5), MICRO-BIORETENTION (M-6), GRASS SWALE (M-8) & BIORETENTION (F-6)
TOTAL	17,093	18,761	

STORMWATER MANAGEMENT PRACTICES				
LOT NO.	DISCONNECTION OF ROOFTOP RUNOFF (N-1) Y/N, NUMBER	DISCONNECTION OF NON-ROOFTOP RUNOFF (N-2) Y/N	DRY WELLS (M-5) Y/N, NUMBER	MICRO-BIORETENTION (M-6) Y/N, NUMBER
3	NO	YES	YES, FOUR (4)	NO
4	NO	YES	YES, FOUR (4)	NO
5	NO	YES	NO	YES, ONE (1)
6	NO	YES	YES, FOUR (4)	NO
7	NO	NO	NO	YES, ONE (1)
8	NO	YES	YES, FOUR (4)	NO
9	NO	YES	YES, FOUR (4)	NO
10	NO	YES	NO	YES, ONE (1)
11	NO	YES	YES, FOUR (4)	NO
12	NO	YES	YES, FOUR (4)	NO
13	NO	YES	YES, FOUR (4)	NO
14	NO	YES	YES, FOUR (4)	NO
15	NO	NO	NO	YES, ONE (1)

NO.	REVISION	DATE
1	REVISE THIS SHEET TO SHOW LOT 15, SHEETS 7 & 11	12/17/15
2	ADD INLET, MANA, AROUND HOUSE ON LOT 6, SHEETS 6 & 10	11/11/15
3	REVISE THIS SHEET LOT 12 - SHEETS 5, 7 & 15	5/6/15
4	REVISE THIS SHEET LOT 7 AND CHANGING DRAINAGE TO ROAD CONTROL	5/6/15
5	REVISE THIS SHEET TO SHOW AROUND HOUSE ON LOT 6, SHEETS 6 & 10	5/6/15
6	REVISE THIS SHEET TO SHOW AROUND HOUSE ON LOT 6, SHEETS 6 & 10	11/17/15
7	REVISE THIS SHEET TO SHOW AROUND HOUSE ON LOT 6, SHEETS 6 & 10	9/3/15
8	REVISE THIS SHEET TO SHOW AROUND HOUSE ON LOT 6, SHEETS 6 & 10	12/17/15

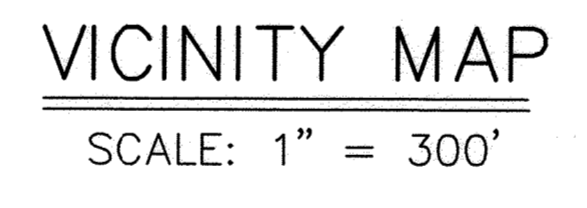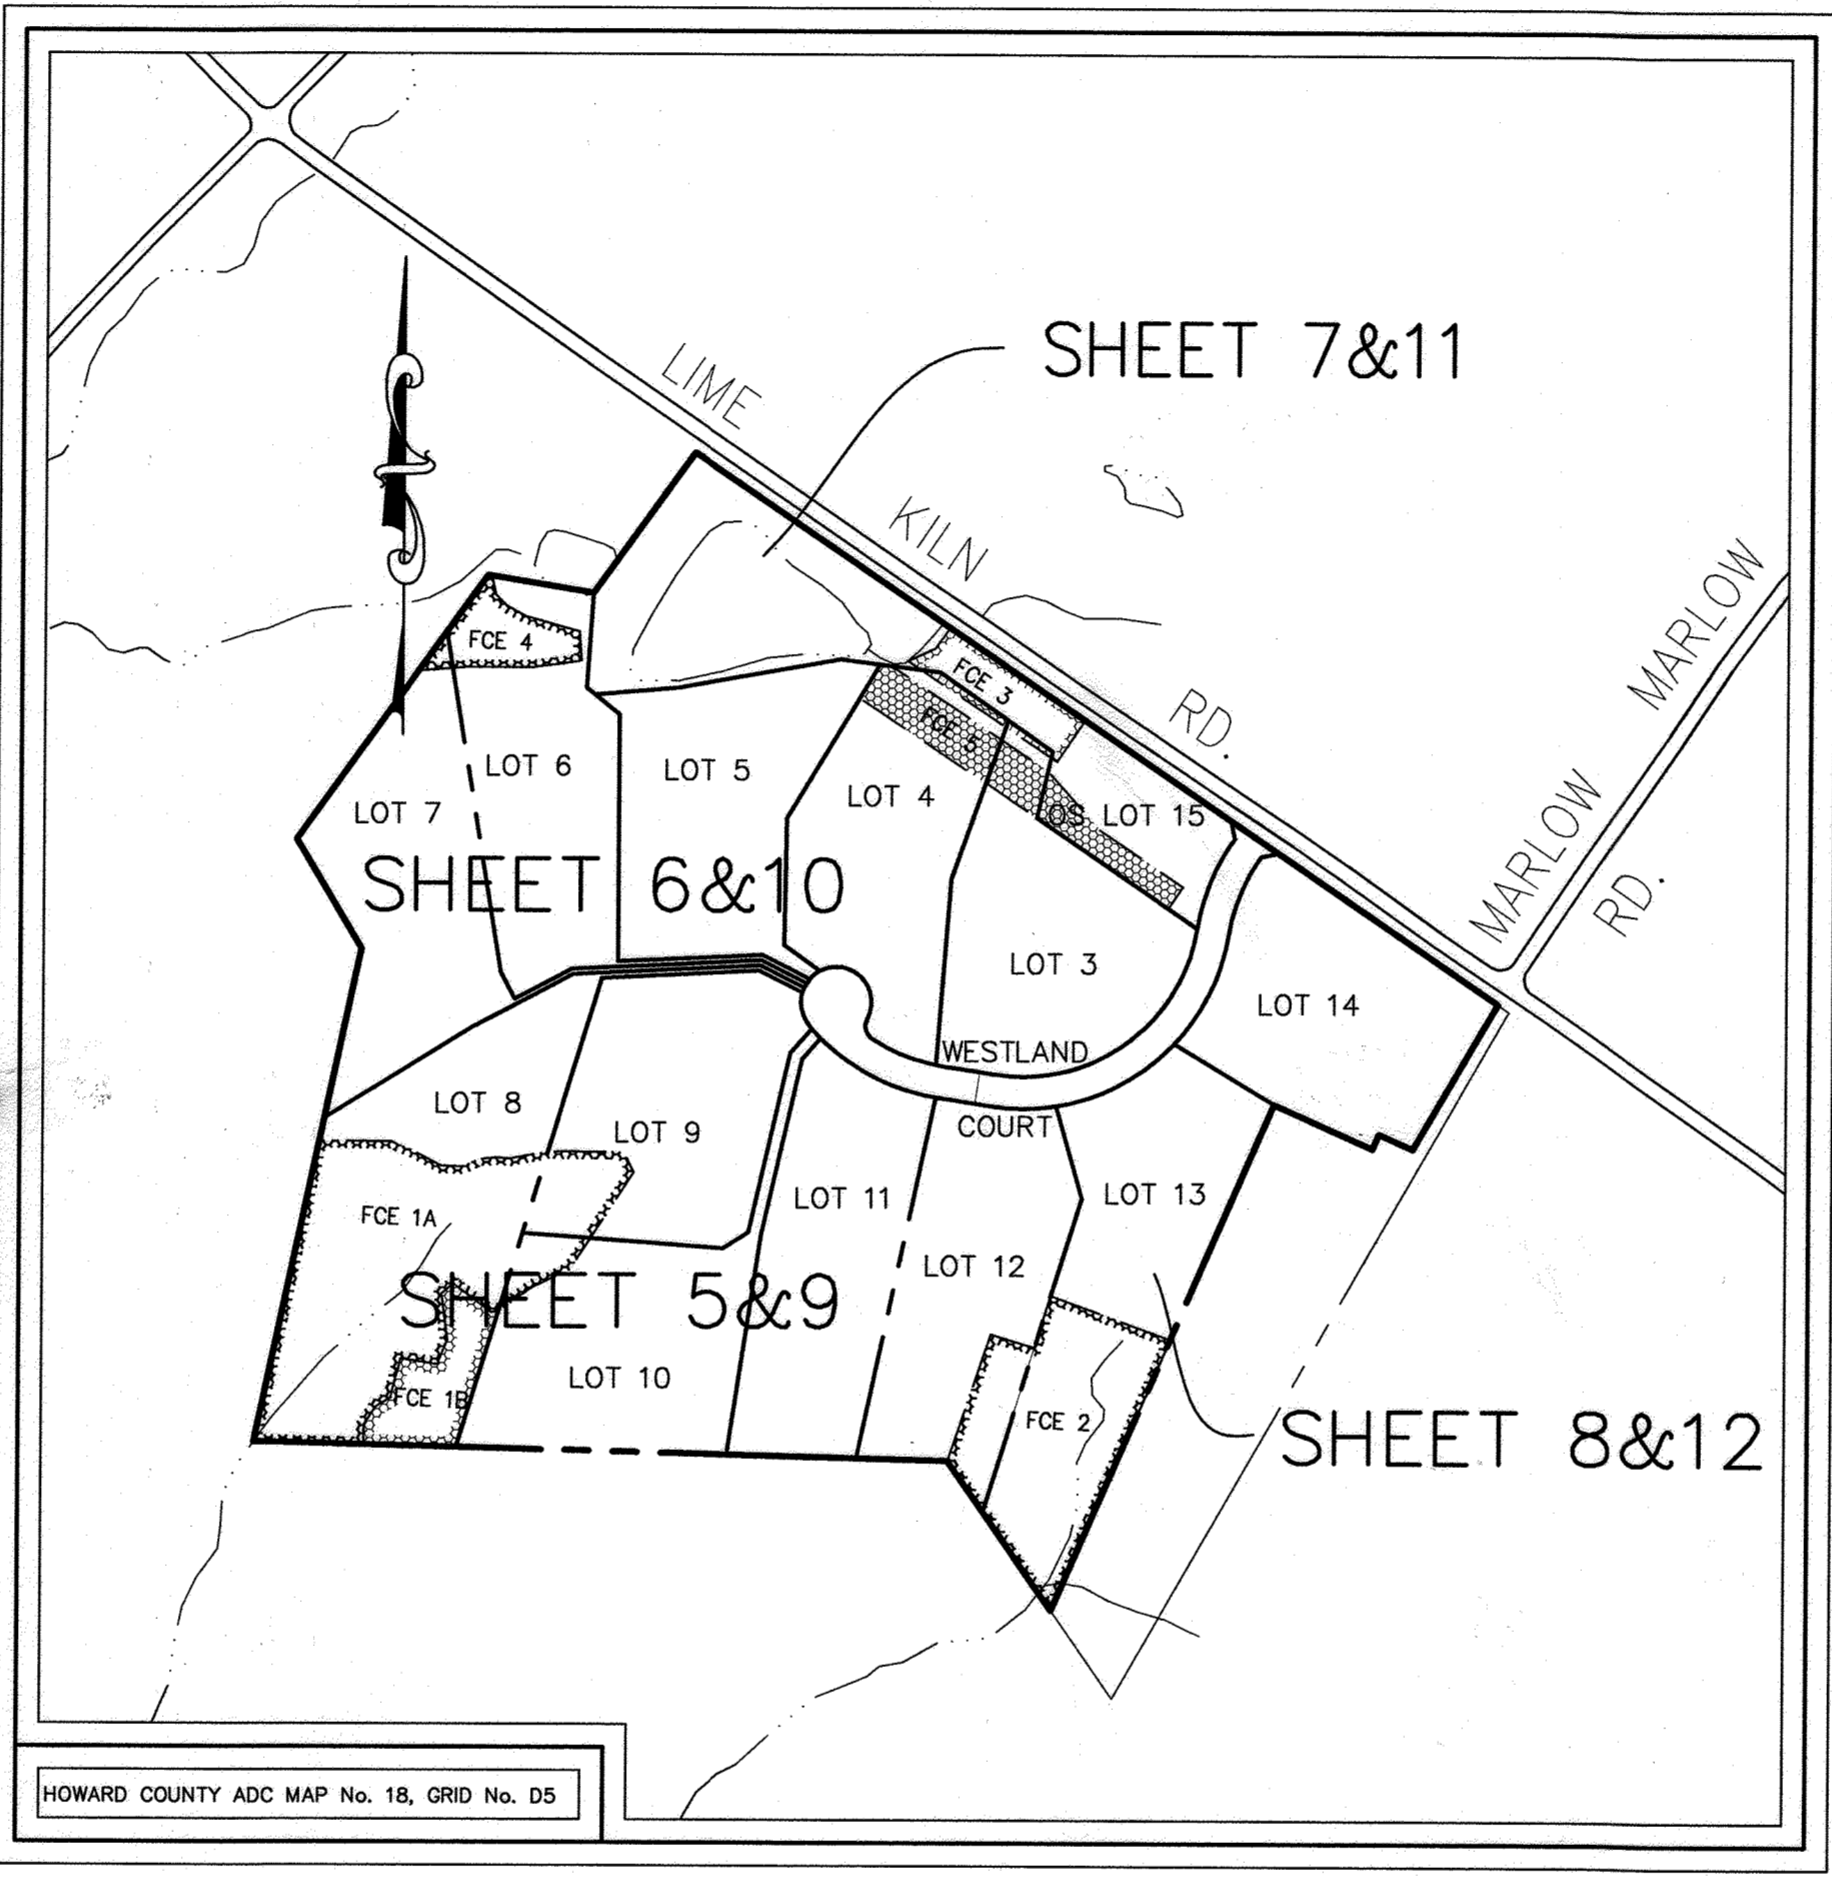


SITE ANALYSIS DATA CHART

- A. TOTAL AREA OF THIS SUBMISSION = 45.28 AC.±
- B. LIMIT OF DISTURBED AREA = 16.20 AC.±
- C. PRESENT ZONING DESIGNATION = RR-DEO (PER 10/06/2013 COMPREHENSIVE ZONING PLAN)
- D. PROPOSED USE: RESIDENTIAL
- E. REQUIRED PARKING: 2.5 SPACES PER LOT X 11 LOTS = 28 SPACES. PROPOSED PARKING: 44 SPACES (4 SPACES PER LOT)
- F. TOTAL AREA OF FLOODPLAIN LOCATED ON-SITE = 3.00 AC.±
- G. TOTAL AREA OF SLOPES IN EXCESS OF 15% = 11.15 AC.± (1.96 AC. IS 25% OR GREATER)
- H. TOTAL AREA OF WETLANDS (INCLUDING BUFFER) = 0.00 AC.
- I. TOTAL AREA OF EXISTING FOREST = 8.30 AC.±
- J. TOTAL GREEN OPEN AREA = 42.43 AC.±
- K. TOTAL IMPERVIOUS AREA = 2.85 AC.±
- L. AREA OF ERODIBLE SOILS = 6.34 AC.±
- M. AREA OF ROAD DEDICATION = 0.00 AC.
- N. AREA OF O.S. (PROVIDED; BUT NOT REQUIRED): 4.33 AC.
- O. O.S.FEE-IN-LIEU OF \$1,500.00 PER LOT WILL BE PROVIDED.

SOILS LEGEND

SOIL	NAME	CLASS	K FACTOR
Beb	Benevola silt loam, 3 to 8 percent slopes	C	0.43
Ggb	Glenelig loam, 3 to 8 percent slopes	B	0.28
Ggc	Glenelig loam, 8 to 15 percent slopes	B	0.28
Gmb	Glenville silt loam, 3 to 8 percent slopes	C	0.43
Mac	Manor loam, 8 to 15 percent slopes	B	0.28
Mad	Manor loam, 15 to 25 percent slopes	B	0.28
Mkf	Manor-brinklow Complex, 25 to 65 percent slopes, very rocky	B	0.32
Whb	Wiltshire silt loam, 3 to 8 percent slopes	C	0.20

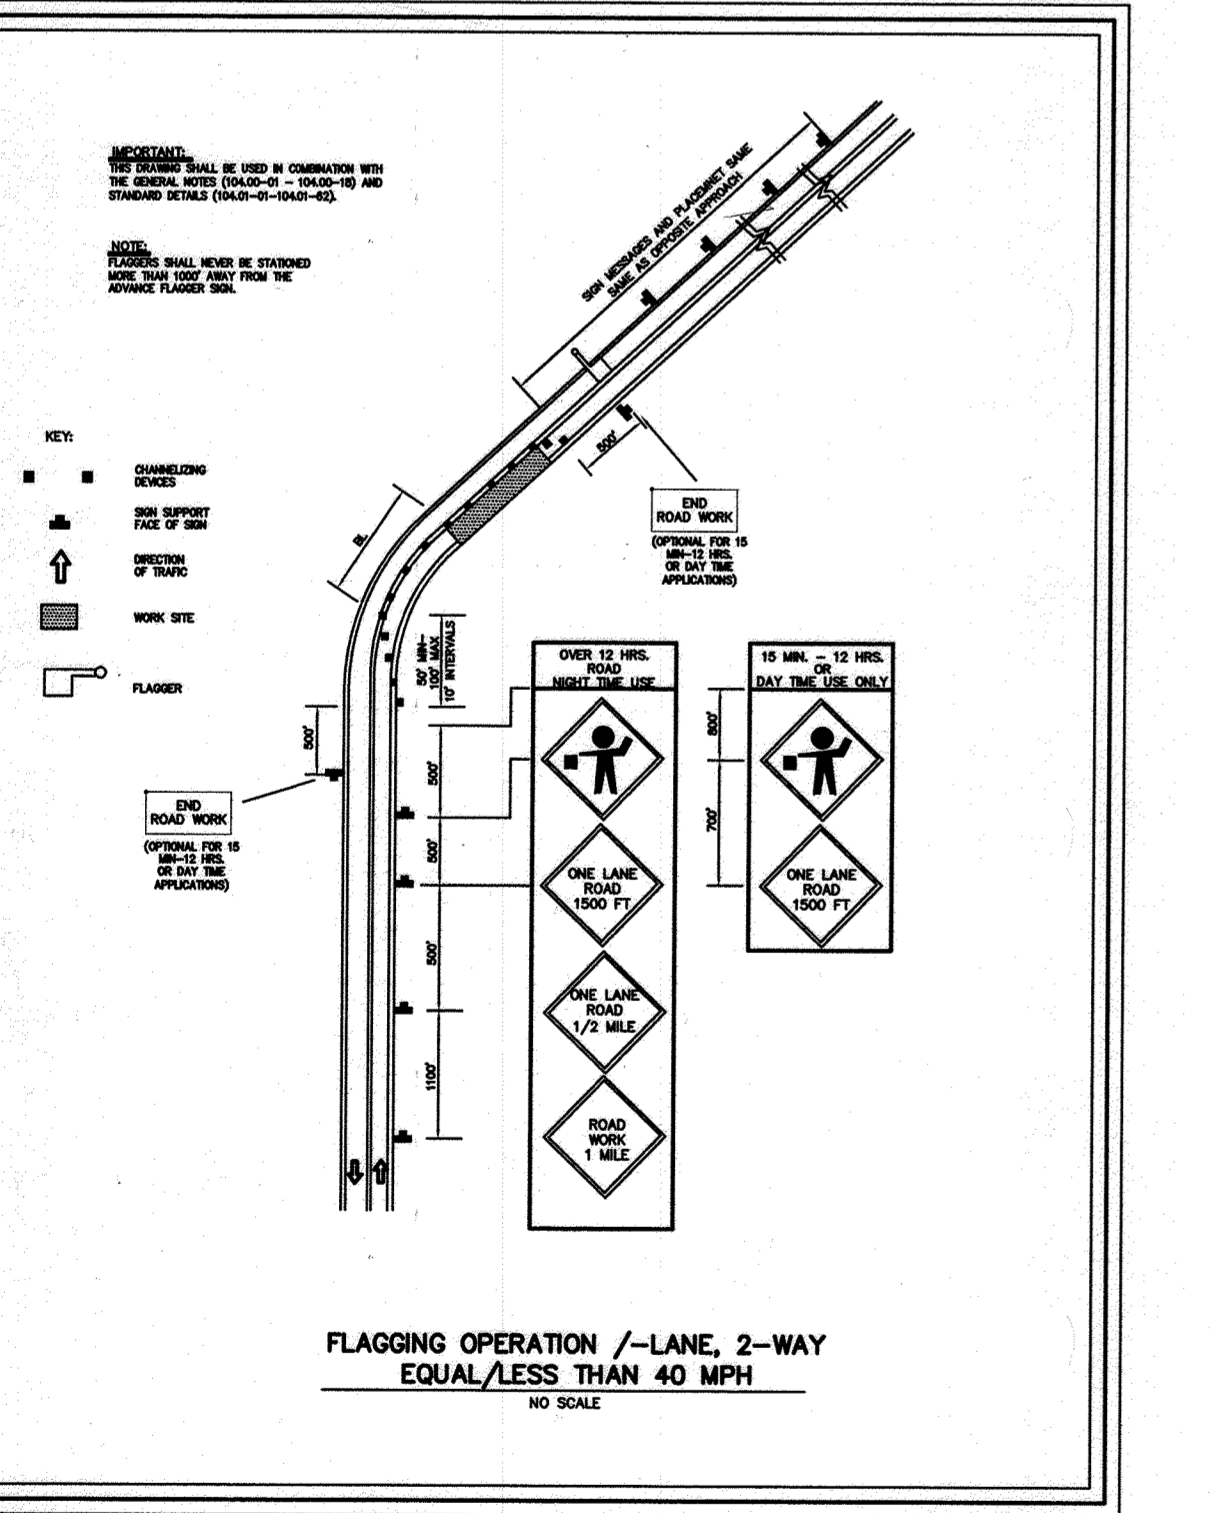

OWNERS
LIME KILN, LLC
12549 LIME KILN ROAD
FULTON, MARYLAND 20759-0460
410-792-2922

DEVELOPER
WILLIAMSBURG GROUP, LLC
C/O BOB CORRETT
5485 HARPERS FARM ROAD, SUITE 200
COLUMBIA, MARYLAND 21044
410-997-8800

APPROVED: DEPARTMENT OF PUBLIC WORKS
[Signature] DATE: 2/22/2016

APPROVED: DEPARTMENT OF PLANNING AND ZONING
[Signature] DATE: 6-21-16


APPROVED: DEVELOPMENT ENGINEERING DIVISION
[Signature] DATE: 3-2-16

FISHER, COLLINS & CARTER, INC.
CIVIL ENGINEERING CONSULTANTS & LAND SURVEYORS
CENTENAL SQUARE OFFICE PARK - 10272 BALTIMORE NATIONAL PIKE
ELICOTT CITY, MARYLAND 21042
(410) 461-2855

PROFESSIONAL CERTIFICATION

I HEREBY CERTIFY THAT THESE DOCUMENTS WERE PREPARED OR APPROVED BY ME AND THAT I AM A DULY LICENSED PROFESSIONAL ENGINEER UNDER THE LAWS OF THE STATE OF MARYLAND, LICENSE NO. 38386, EXPIRATION DATE: 01/12/2016.

[Signature] DATE: 12/9/15

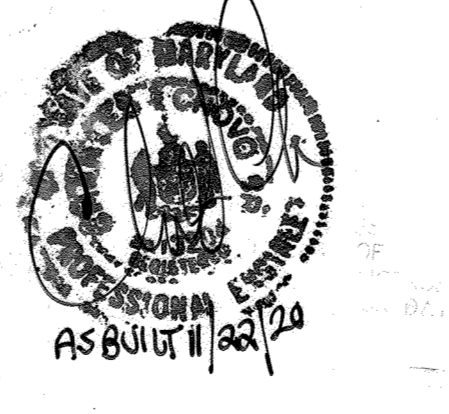


LEGEND	
SYMBOL	DESCRIPTION
---412---	EXISTING 2' CONTOURS
---410---	EXISTING 10' CONTOURS
Ggb	SOILS LINES AND TYPE
Ggc	EXISTING TREELINE
15% to 24.9% STEEP SLOPES	
25% AND GREATER STEEP SLOPES	
100 YEAR PUBLIC FLOODPLAIN, DRAINAGE AND UTILITY EASEMENT	
STREAM BANK BUFFER	
EXISTING CENTERLINE OF STREAM	
ST1	SPECIMEN TREE
PROPOSED FOREST CONSERVATION EASEMENT	
TPF	TREE PROTECTIVE FENCING
---482---	PROPOSED CONTOUR
+362.5	SPOT ELEVATION
LOD	LIMITS OF DISTURBANCE
---	PROPOSED TREELINE
PROPOSED PAVING	
544	BORING (PERC) TEST HOLE
SF	SILT FENCE
EDM	EROSION CONTROL MATTING
SSF	SUPER SILT FENCE
---	DIVERSION FENCE
---	STABILIZES CONSTRUCTION ENTRANCE
---	DRAINAGE AREA DIVIDE


54. ON MAY 5, 2015 THE PLANNING DIRECTOR APPROVED A WAIVER (WP-15-126) TO SECTION 16.1005(O)(7) AND (10) REQUIRING THE RETENTION OF SPECIMEN TREES AS A PRIORITY TO REMOVE 3 OF 5 SPECIMEN TREES. APPROVAL TO THE REQUESTED WAIVERS IS SUBJECT TO THE FOLLOWING CONDITIONS:
 - (1) APPROVAL IS GIVEN FOR THE REMOVAL OF 3 SPECIMEN TREES IDENTIFIED AS: 50" (SPECIMEN TREE NO. 2) AND 62" (SPECIMEN TREE NO. 3) SYCAMORE TREES AND 30" (SPECIMEN TREE NO. 4) TULIP POPLAR. REMOVAL OF THE THREE (3) SPECIMEN TREES WILL REQUIRE MITIGATION WITH THE PLANTING OF THE THREE (3) NEW NATIVE SHADE TREES WITH A MINIMUM CALIPER SIZE OF 2.5" @ 3' MITIGATED TREES SHALL BE OF SIMILAR SPECIES, BE SHOWN ON THE LANDSCAPE PLAN SHEET OF THE ROAD CONSTRUCTION / SUPPLEMENTAL PLANS AND BONDED WITH THE LANDSCAPE OBLIGATION.
55. ON SEPTEMBER 14, 2009, THE PLANNING DIRECTOR APPROVED A REQUEST TO WAIVE SECTION 16.120(B)(4)(ii) REQUIRING LOT DIMENSIONS TO GENERALLY NOT EXCEED 3:1 LOT DEPTH TO LOT WIDTH RATIO (LOTS 11 & 12), SECTION 16.1005(O)(10) REQUIRING THE LOCATIONS OF SPECIMEN TREES AND THEIR BUFFERS AND FOREST CONSERVATION EASEMENTS TO BE LOCATED ON LOTS 10 ACRES OR GREATER IN SIZE AND SECTION 16.132(A)(2)(i) REQUIRING THAT IF LAND IS OWNED ON ONLY ONE SIDE OF A LOCAL OR MAJOR COLLECTOR ROAD, THE DEVELOPER SHALL CONSTRUCT ONE SIDE OF THE ROAD UP TO ONE-HALF OF THE FULL DESIGNATED PAVEMENT WIDTH OR CONTRIBUTE TO THE COUNTY FUNDS NECESSARY TO DO CONSTRUCTION SUBJECT TO THE FOLLOWING CONDITIONS:
 - (1) A 30' BUILDING RESTRICTION LINE FROM THE STREAM BANK BUFFERS, FLOODPLAIN LIMITS AND FOREST CONSERVATION EASEMENTS SHALL BE DELINEATED AND LABELED ON THE FINAL PLAN.
 - (2) NO GRADING, REMOVAL OF VEGETATIVE COVER AND TREES, PAVING AND NEW STRUCTURES SHALL BE PERMITTED IN THE STREAMS, STREAM BANK BUFFERS, FLOODPLAIN AREA OR FOREST CONSERVATION EASEMENTS.
56. ON JANUARY 8, 2013, THE PLANNING DIRECTOR APPROVED A WAIVER (WP-13-076) TO SECTION 16.144(K) REQUIRING SUBMISSION OF THE FINAL PLANS FOR WESTLAND FARM ESTATES, PHASE II, BETWEEN JULY 1, 2012 TO NOVEMBER 1, 2012 (SP-09-011), A ONE YEAR EXTENSION WAS APPROVED SUBJECT TO THE FOLLOWING CONDITIONS:
 - (1) THE FINAL PLAN FOR PHASE II SHALL BE SUBMITTED BETWEEN JULY 1, 2013 TO NOVEMBER 1, 2013.
 - (2) SUBMISSION TO THE DEVELOPMENT ENGINEERING DIVISION OF AN ENVIRONMENTAL CONCEPT PLAN (ECP) - BASED ON NEW STORMWATER MANAGEMENT REGULATIONS FOR REVIEW A MINIMUM OF 30 DAYS PRIOR TO JULY 1, 2013 (ON OR BEFORE JUNE 1, 2013).
 - (3) THE FINAL PLAN FOR PHASE II OF WESTLAND FARM ESTATES (SP-09-011) SHALL BE DESIGNED IN ACCORDANCE WITH THE NEW STORMWATER MANAGEMENT REGULATIONS AND SHALL ADDRESS ALL ECP COMMENTS AS APPLICABLE.
57. ON SEPTEMBER 28, 2014 THE PLANNING DIRECTOR APPROVED A WAIVER (WP-15-023) TO SECTION 16.144(G) TO REACTIVATE SP-09-011 AND SECTION 16.144(K) REQUIRING SUBMISSION OF FINAL PLANS FOR PHASE II BETWEEN JULY 1, 2013 TO NOVEMBER 1, 2013 (SP-09-011) TO EXTEND THE DEADLINE BY SIX MONTHS FROM THE WAIVER PETITION APPROVAL LETTER. APPROVAL TO THE REQUESTED WAIVERS IS SUBJECT TO THE FOLLOWING CONDITIONS:
 - (1) THE PRELIMINARY EROSION CONTROL PLAN, SP-09-011, IS REACTIVATED AND A SIX MONTH EXTENSION FROM THE DATE OF THIS WAIVER PETITION APPROVAL LETTER (ON OR BEFORE MARCH 28, 2015) IS GRANTED FOR THE SUBMISSION OF THE FINAL PLAN FOR PHASE II.
 - (2) SUBMISSION TO THE DEVELOPMENT ENGINEERING DIVISION OF AN ENVIRONMENTAL CONCEPT PLAN (ECP) BASED ON NEW STORMWATER MANAGEMENT REGULATIONS WITHIN 45 DAYS FROM THE DATE OF THE WAIVER PETITION APPROVAL LETTER (ON OR BEFORE NOVEMBER 10, 2014).
 - (3) THE FINAL PLAN MUST COMPLY WITH ALL CURRENT COUNTY AND STATE REGULATIONS IN EFFECT AT THE TIME OF SUBMISSION (INCLUDING MODERATE INCOME HOUSING UNIT REQUIREMENTS).
 - (4) THE FINAL PLAN FOR PHASE II OF WESTLAND FARM ESTATES (SP-09-011) SHALL BE DESIGNED IN ACCORDANCE WITH THE NEW STORMWATER MANAGEMENT REGULATIONS AND SHALL ADDRESS ALL ECP COMMENTS AS APPLICABLE.
 - (5) A NEW APFO TRAFFIC STUDY MAY BE REQUIRED WITH THE FINAL PLAN SUBMISSION. PLEASE VERIFY WITH THE DEVELOPMENT ENGINEERING DIVISION.
58. SECTION 16.121 OF THE SUBDIVISION REGULATIONS REQUIRE A \$1,500.00 PER LOT FEE-IN-LIEU OF OPEN SPACE FOR NON-CLUSTER SUBDIVISIONS IN THE RR ZONING DISTRICT. THE DEVELOPER WILL PAY THE FEE-IN-LIEU, BUT IS ALSO CREATING A BONUS OPEN SPACE LOT TO ACCOMMODATE A STORM WATER MANAGEMENT FACILITY FOR THIS SUBDIVISION. A FEE-IN-LIEU IN THE AMOUNT OF \$1,500 WILL BE PAID.
59. A FLOODPLAIN STUDY WAS PREPARED BY FISHER, COLLINS & CARTER, INC. DATED SEPTEMBER, 2009 AND APPROVED ON NOVEMBER 4, 2009 WITH SP-09-011. ARTICLES OF INCORPORATION FOR THE WESTLAND FARM ESTATES HOMEOWNERS ASSOCIATION, INC. WILL BE FILED WITH THE MARYLAND STATE DEPARTMENT OF ASSESSMENTS AND TAXATION PRIOR TO THE RECORDATION OF THE FINAL PLAN.
60. OPEN SPACE LOT 15 IS OWNED AND MAINTAINED BY THE WESTLAND FARM ESTATES HOMEOWNERS ASSOCIATION, INC.
61. THIS SUBDIVISION IS WITHIN THE GROWTH TIER III.
62. THE PRIVATE USE-IN-COMMON ACCESS EASEMENT AND MAINTENANCE AGREEMENT FOR SHARED DRIVEWAYS IS RECORDED SIMULTANEOUSLY WITH THE PLAT. DECLARATION OF COVENANTS AND RESTRICTIONS FOR THE HOMEOWNERS ASSOCIATION ARE TO BE RECORDED SIMULTANEOUSLY WITH THE PLAT. THE HOA SHALL BE RESPONSIBLE FOR THE MAINTENANCE AND UPKEEP OF THE EXISTING POND.
63. EXISTING UTILITIES ARE BASED ON FIELD LOCATION OF UTILITIES ARE BASED ON AVAILABLE COUNTY RECORDS.
64. THE FOLLOWING SHALL BE NOTED REGARDING TRAFFIC CONTROL SIGNS IN THE COUNTY RIGHT-OF-WAY:
 - (A) THE R1-1 (STOP) SIGN (STA 0+58.6, 0/15' LEFT), R2-1 (25 MPH) SPEED SIGN (STA 0+85.6, 0/5' 15' RIGHT), AND THE STREET NAME SIGN (SNS) ASSEMBLY FOR THIS DEVELOPMENT MUST BE INSTALLED BEFORE THE BASE PAVING IS COMPLETED.
 - (B) THE TRAFFIC CONTROL DEVICE LOCATIONS SHOWN ON THE PLANS ARE APPROXIMATE AND MUST BE FIELD APPROVED BY HOWARD COUNTY TRAFFIC DIVISION (410)-313-2425 PRIOR TO INSTALLATION OF ANY OF THE TRAFFIC CONTROL DEVICES.
 - (C) ALL TRAFFIC CONTROL DEVICES AND THEIR LOCATIONS SHALL BE IN ACCORDANCE WITH THE LATEST EDITION OF THE MARYLAND MANUAL ON UNIFORM TRAFFIC CONTROL DEVICES (MUTCD). ALL SIGN POSTS USED FOR TRAFFIC CONTROL SIGNS INSTALLED IN THE COUNTY RIGHT-OF-WAY SHALL BE MOUNTED ON A 2" GALVANIZED STEEL SUPPORTER (GALVANIZED SQUARE TUBE) WITH AN ANCHOR BOLT (1/4 GAUGE) INSERTED INTO A 2-1/2" GALVANIZED STEEL PERFORATED SQUARE TUBE SLEEVE (12 GAUGE) - 3' LONG. THE ANCHOR SHALL NOT EXTEND MORE THAN TWO QUARTER HOLES ABOVE GROUND LEVEL. A GALVANIZED STEEL POLE CAP SHALL BE MOUNTED ON TOP OF EACH POST.
 - (D) A PRIVATE RANGE OF ADDRESS SIGN SHALL BE FABRICATED AND INSTALLED BY HOWARD COUNTY BUREAU OF HIGHWAYS AT THE DEVELOPERS/OWNERS EXPENSE. CONTACT HOWARD COUNTY TRAFFIC DIVISION AT 410-313-2430 FOR DETAILS AND COST ESTIMATE.
65. THE CONTRACTOR SHALL NOTIFY THE DEPARTMENT OF PUBLIC WORKS / BUREAU OF ENGINEERING / CONSTRUCTION INSPECTION DIVISION AT (410) 313-1880 AT LEAST (3) WORKING DAYS PRIOR TO THE START OF WORK.
66. THE CONTRACTOR SHALL NOTIFY "MISS UTILITY" AT 1-800-257-7777 AT LEAST 48 HOURS PRIOR TO ANY EXCAVATION WORK BEING DONE.
67. TRAFFIC CONTROL DEVICES, WARNINGS, AND SIGNING SHALL BE IN ACCORDANCE WITH THE LATEST EDITION OF THE MANUAL OF UNIFORM TRAFFIC CONTROL DEVICES (MUTCD). ALL STREET AND ROAD NAMES SHALL BE IN PLACE PRIOR TO THE LAYMENT OF ANY ASPHALT.
68. ALL CONSTRUCTION SHALL BE IN ACCORDANCE WITH THE LATEST STANDARDS AND SPECIFICATIONS OF HOWARD COUNTY MSHA STANDARDS AND SPECIFICATIONS, IF APPLICABLE.
69. STANDARD SEDIMENT CONTROL PLAN MAY NOT BE UTILIZED TO OBTAIN GRADING PERMITS FOR THIS PROJECT.
70. DRIVEWAYS SHALL BE PROVIDED PRIOR TO RESIDENTIAL OCCUPANCY TO ENSURE SAFE ACCESS FOR FIRE AND EMERGENCY VEHICLES PER THE FOLLOWING (MINIMUM) REQUIREMENTS:
 - a) WIDTH - 12 FEET (16 FEET SERVING MORE THAN ONE RESIDENCE).
 - b) SURFACE - SIX (6) INCHES OF COMPACTED CRUSHER RUN BASE WITH TAR AND CHIP COATING (1-1/2" MINIMUM).
 - c) GEOMETRY - MAXIMUM 15% GRADE CHANGE AND 45-FOOT TURNING RADII.
 - d) STRUCTURES (CULVERTS/BRIDGES) - CAPABLE OF SUPPORTING 25 GROSS TONS (125-LADING).
 - e) DRAINAGE ELEMENTS - CAPABLE OF SAFELY PASSING 100 YEAR FLOOD WITH NO MORE THAN 1 FOOT DEPTH OVER SURFACE.
 - f) STRUCTURE CLEARANCES - MINIMUM 12 FEET.
 - g) MAINTENANCE - SUFFICIENT TO ENSURE ALL WEATHER USE.
71. SECTION 16.121 OF THE SUBDIVISION REGULATIONS REQUIRE A \$1,500.00 PER LOT FEE-IN-LIEU OF OPEN SPACE FOR NON-CLUSTER SUBDIVISIONS IN THE RR ZONING DISTRICT. THE DEVELOPER WILL PAY THE FEE-IN-LIEU, BUT IS ALSO CREATING A BONUS OPEN SPACE LOT TO ACCOMMODATE A STORM WATER MANAGEMENT FACILITY FOR THIS SUBDIVISION.
72. BEE HAS REVIEWED AND APPROVED LANDSCAPE PLANTINGS ALONG LIME KILN ROAD.
73. IT WAS DETERMINED THAT THE PREVIOUSLY RECORDED 100' STREAM BANK BUFFER CAN BE REDUCED TO 75' ON PLAT 3 OF 3 IN ACCORDANCE WITH THE WATERSHED MAP.

TITLE SHEET
WESTLAND FARM ESTATES
 LOTS 3 THRU 14 AND OPEN SPACE LOT 15
 ZONED RR-DEO
 TAX MAP No. 45 GRID No. 5 PARCEL No. 28
 FIFTH ELECTION DISTRICT HOWARD COUNTY, MARYLAND
 SCALE: AS SHOWN DATE: DECEMBER, 2015
 SHEET 1 OF 19

LEGEND			
SYMBOL	DESCRIPTION	SYMBOL	DESCRIPTION
	EXISTING 2' CONTOURS		PROPOSED CONTOUR
	EXISTING 10' CONTOURS		SPOT ELEVATION
	SOILS LINES AND TYPE		LIMITS OF DISTURBANCE
	EXISTING TREELINE		PROPOSED TREELINE
	15% TO 24.9% STEEP SLOPES		PROPOSED PAVING
	25% AND GREATER STEEP SLOPES		BORING (PERC) TEST HOLE
	100 YEAR PUBLIC FLOODPLAIN, DRAINAGE AND UTILITY EASEMENT		SILT FENCE
	STREAM BANK BUFFER		EROSION CONTROL MATTING
	EXISTING CENTERLINE OF STREAM		SUPER SILT FENCE
	SPECIMEN TREE		DIVERSION FENCE
	PROPOSED FOREST CONSERVATION EASEMENT		STABILIZES CONSTRUCTION ENTRANCE
	STRUCTURES AND PAVING TO BE REMOVED		DRAINAGE AREA DIVIDE

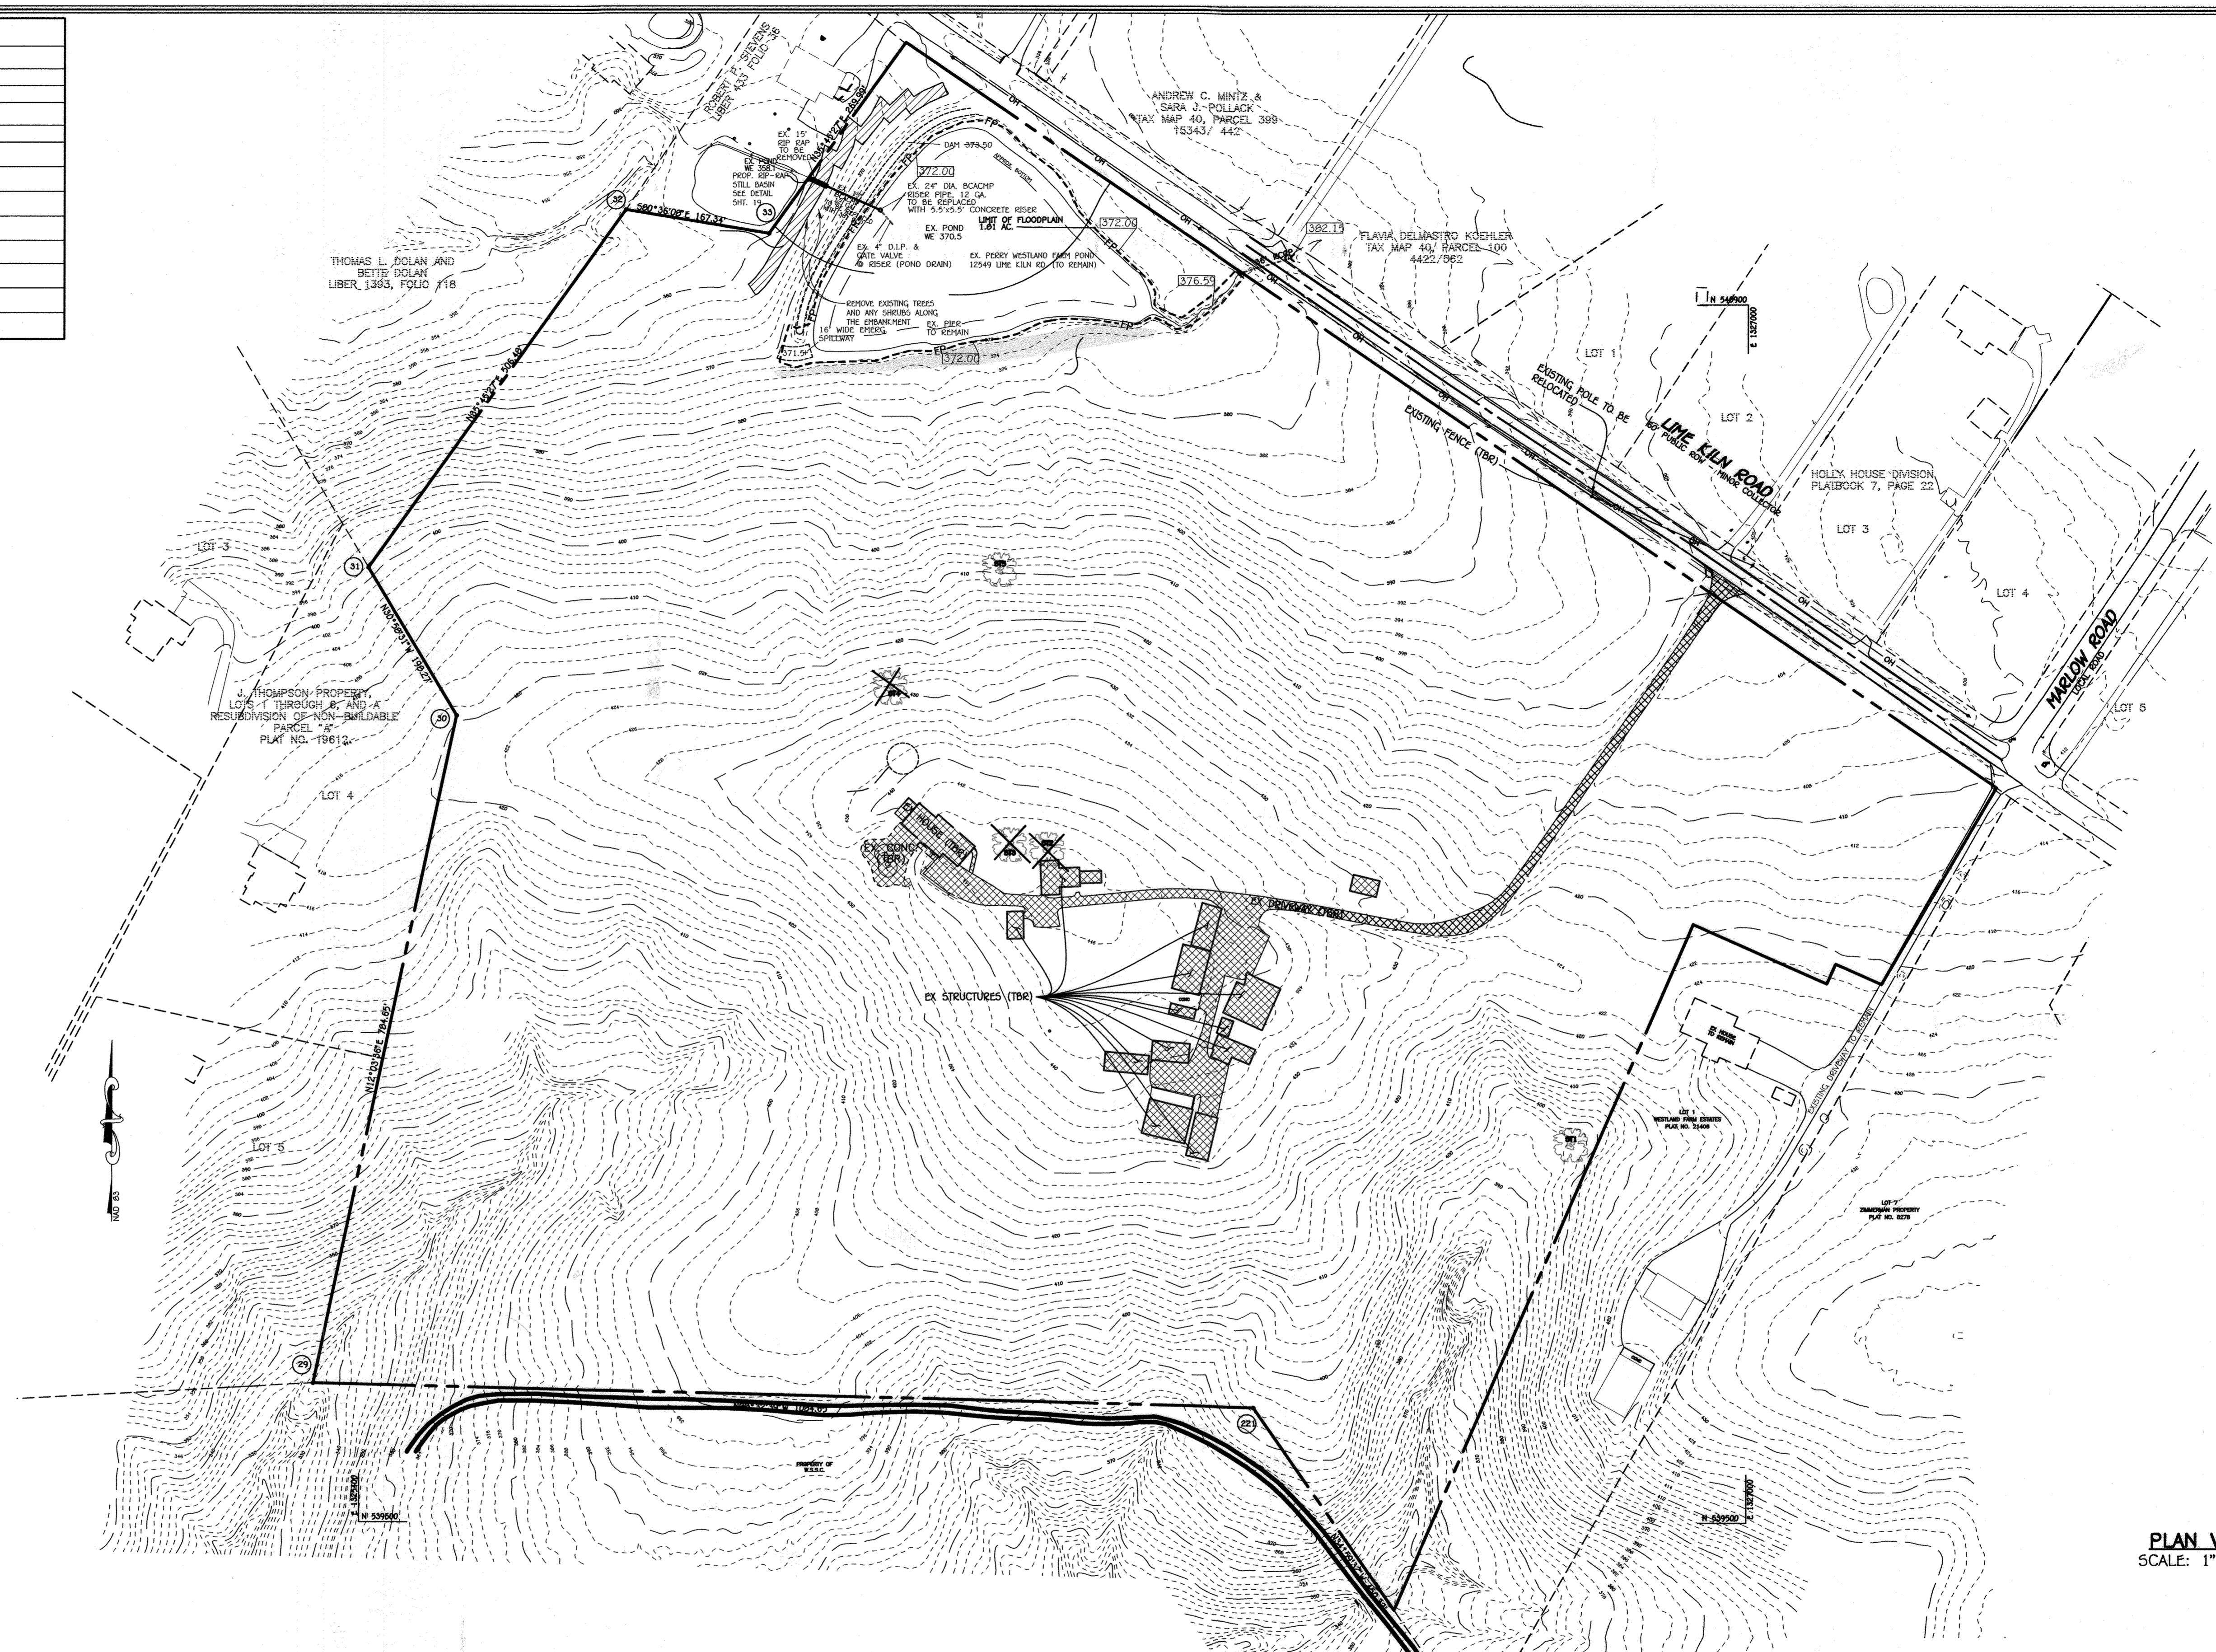

PLAN VIEW
SCALE: 1" = 100'

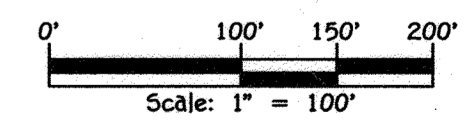

APPROVED: DEPARTMENT OF PUBLIC WORKS
Mreunin 2/22/2016
CHIEF, BUREAU OF HIGHWAYS DATE

APPROVED: DEPARTMENT OF PLANNING AND ZONING
Kat Shivers 6.21.16
CHIEF, DIVISION OF LAND DEVELOPMENT DATE

Ch. Ch... 3.2.16
CHIEF, DEVELOPMENT ENGINEERING DIVISION DATE

OWNERS
LIME KILN, LLC
12549 LIME KILN ROAD
FULTON, MARYLAND 20779-0460
410-792-2922

AND
PERRY C. WESTLAND, JR.
12549 LIME KILN ROAD
FULTON, MARYLAND 20779-0460
410-792-2922

DEVELOPER
WILLIAMSBURG GROUP, LLC
C/O BOB CORRETT
5405 HARRISS FARM ROAD, SUITE 200
COLUMBIA, MARYLAND 21044
410-997-0800

FISHER, COLLINS & CARTER, INC.
CIVIL ENGINEERING CONSULTANTS & LAND SURVEYORS
CONTINENTAL SQUARE OFFICE PARK - 10272 BALTIMORE NATIONAL Pk.
ELLSWORTH CITY, MARYLAND 21042
(410) 481-2295

AS-BUILT CERTIFICATION FOR
Note: There is no "AS BUILT" information provided on this sheet.

Charles Cronok 11/22/20
P.E. #13204 Date

PROFESSIONAL CERTIFICATION
I HEREBY CERTIFY THAT THESE DOCUMENTS WERE PREPARED OR APPROVED BY ME AND THAT I AM A DULY LICENSED PROFESSIONAL ENGINEER UNDER THE LAWS OF THE STATE OF MARYLAND, LICENSE NO. 36386, EXPIRATION DATE: 01/12/2016.

Ambram Janta 12/21/15
Signature Of Professional Engineer DATE

DEMOLITION PLAN
WESTLAND FARM ESTATES
LOTS 3 THRU 14 AND OPEN SPACE LOT 15
ZONED RR-DEO
TAX MAP No. 45 GRID No. 5 PARCEL No. 28
FIFTH ELECTION DISTRICT HOWARD COUNTY, MARYLAND
SCALE: AS SHOWN DATE: DECEMBER, 2015
SHEET 2 OF 19

F-15-038

THERE IS NO "AS-BUILT" INFORMATION PROVIDED ON THIS SHEET

13/2005/05062.dwg/Print/05062 Base Plan new.dwg SHEET 2, 12/22/2015 2:42:45 PM, 1:1



ROADWAY INFORMATION CHART

ROAD NAME	CLASSIFICATION	DESIGN SPEED	ZONING	STATION LIMITS	PAVING SECTION
WESTLAND COURT	PUBLIC ACCESS PLACE	25 M.P.H.	RR-DEO	0+00 TO 8+75.73	P-2



PLAN VIEW
SCALE: 1" = 50'

SECTION NUMBER	ROAD AND STREET CLASSIFICATION	CALIFORNIA BEARING RATIO (CBR)	3 TO <5		5 TO <7		>7	
			MIN	HMA WITH GAB	MIN	HMA WITH CONSTANT GAB	MIN	HMA WITH CONSTANT GAB
P-2	PARKING DRIVE AISLES: RESIDENTIAL AND NON-RESIDENTIAL WITH NO MORE THAN 10 HEAVY TRUCKS PER DAY LOCAL ROADS: ACCESS PLACE, ACCESS STREET CUL-DE-SACS: RESIDENTIAL	HMA SUPERPAVE FINAL SURFACE 9.5 MM, PG 64-22, LEVEL 1 (ESAL) HMA SUPERPAVE INTERMEDIATE SURFACE 9.5 MM, PG 64-22, LEVEL 1 (ESAL) HMA SUPERPAVE BASE 19.0 MM, PG 64-22, LEVEL 1 (ESAL) GRADED AGGREGATE BASE (GAB)	1.5	1.5	1.5	1.5	1.5	1.5
			1.0	1.0	1.0	1.0	1.0	1.0
			2.0	2.0	2.0	3.5	2.0	2.0
			8.0	4.0	3.0	4.0	4.0	4.0

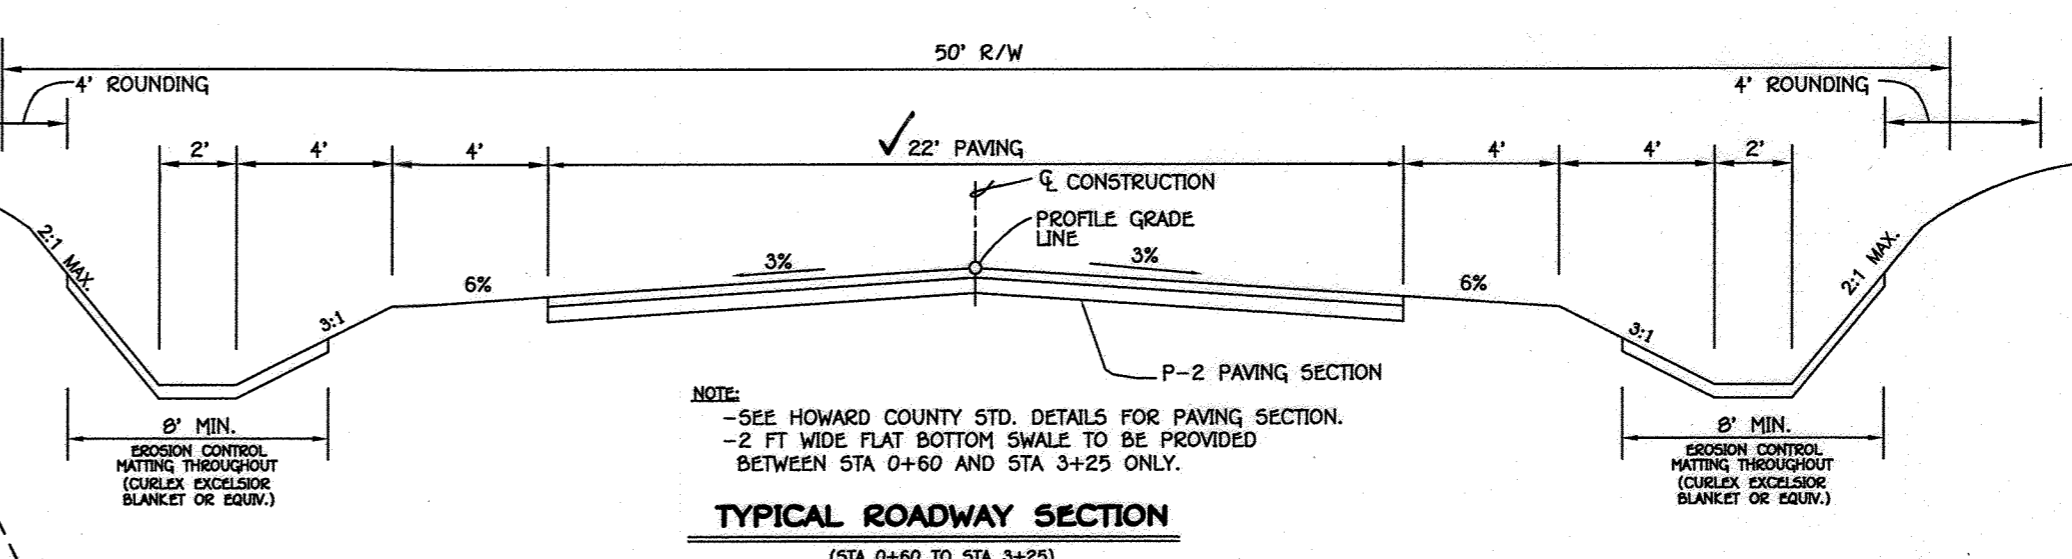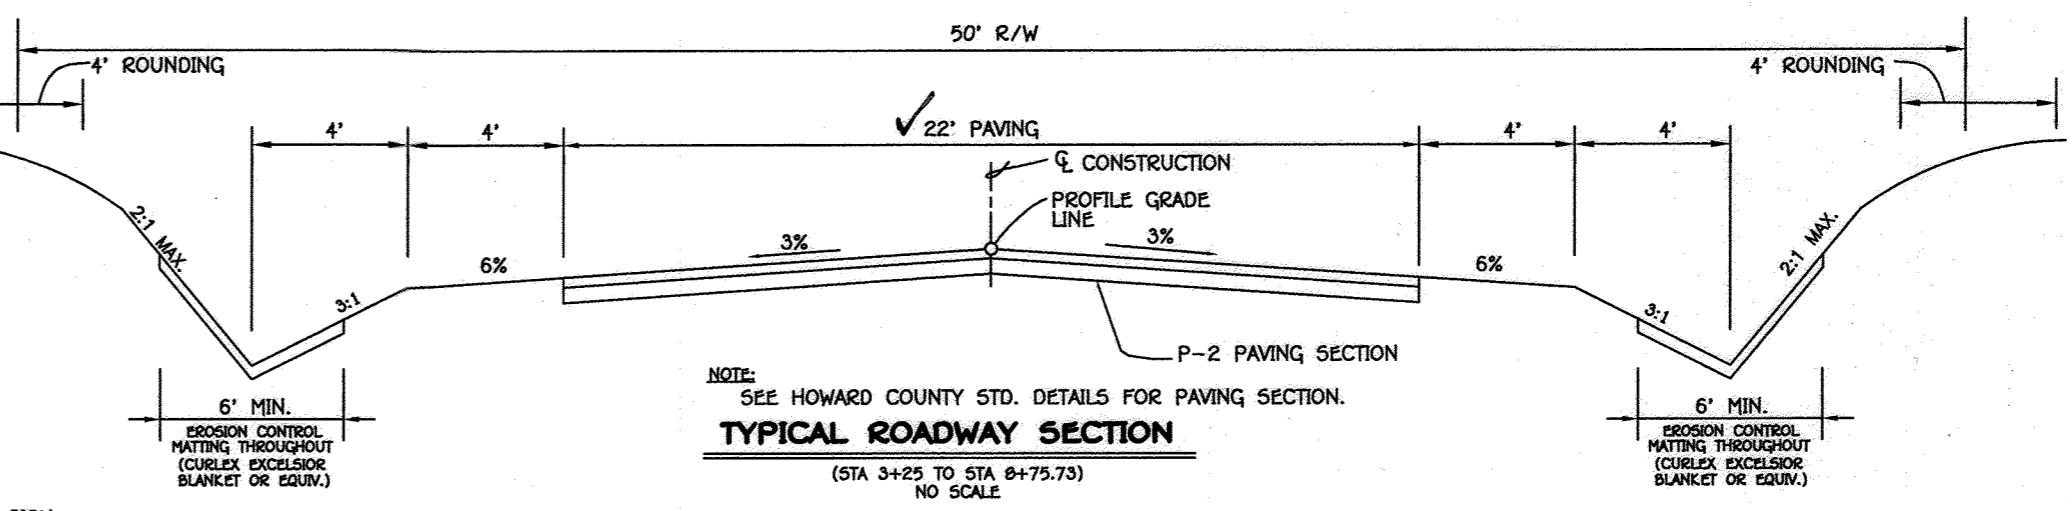

STREET LIGHTS TABLE

ROAD NAME	SECTION & OFFSET	TYPE
WESTLAND COURT	0+75 TO 1+5	LED 100 COLONIAL POST TOP
WESTLAND COURT	3+75 TO 15' LEFT	LED 100 COLONIAL POST TOP
WESTLAND COURT	7+44.81 15' RIGHT	LED 100 COLONIAL POST TOP
WESTLAND COURT	1+15H 2' LEFT	LED 100 COLONIAL POST TOP

CENTERLINE CURVE DATA

ROAD NAME	STA. TO STA.	RADIUS	LENGTH	DELTA
WESTLAND COURT	0+42.99 - 1+94.07	300.00'	131.08'	25°02'03"
WESTLAND COURT	1+94.07 - 6+64.54	300.00'	470.47'	89°51'12"
WESTLAND COURT	7+44.81 - 9+26.54	320.00'	181.73'	32°32'21"

PROFESSIONAL CERTIFICATION
I HEREBY CERTIFY THAT THESE DOCUMENTS WERE PREPARED OR APPROVED BY ME AND THAT I AM A DULY LICENSED PROFESSIONAL ENGINEER UNDER THE LAWS OF THE STATE OF MARYLAND, LICENSE NO. 38386, EXPIRATION DATE: 01/12/2016.

Anthony J. White 2/18/16
Signature of Professional Engineer DATE



REVISIONS

DATE	DESCRIPTION
11/16/16	ADD STREET LIGHTS & STREET LIGHTS TABLE

APPROVED: DEPARTMENT OF PUBLIC WORKS
 CHIEF, BUREAU OF HIGHWAYS: *2/18/2016* DATE
 APPROVED: DEPARTMENT OF PLANNING AND ZONING
 CHIEF, DIVISION OF LAND DEVELOPMENT: *6-21-16* DATE
 CHIEF, DEVELOPMENT ENGINEERING DIVISION: *3-2-16* DATE

WESTLAND FARM ESTATES
 LOTS 3 THRU 14 AND OPEN SPACE LOT 15
 ZONED RR-DEO
 TAX MAP No. 45 GRID No. 5 PARCEL No. 28
 FIFTH ELECTION DISTRICT HOWARD COUNTY, MARYLAND

WESTLAND COURT
 PLAN AND PROFILE




OWNERS
 LIME KILN, LLC
 12549 LIME KILN ROAD
 FULTON, MARYLAND 20779-0460
 410-792-2322

AND
 PERRY C. WESTLAND, JR.
 12549 LIME KILN ROAD
 FULTON, MARYLAND 20779-0460
 410-792-2322

DEVELOPER
 WILLIAMSBURG GROUP, LLC
 C/O BOB CORRETT
 5485 HARRIS FARM ROAD, SUITE 200
 COLUMBIA, MARYLAND 21044
 410-997-8800


SCALE: AS SHOWN DATE: DECEMBER, 2015 DWG. NO. 3 OF 18
 DES. SJT DRN. SJT CHK. -

FISHER, COLLINS & CARTER, INC.
 CIVIL ENGINEERING CONSULTANTS & LAND SURVEYORS
 CENTENNIAL SQUARE OFFICE PARK - 10272 BALDORNE NATIONAL FREE
 ELLICOTT CITY, MARYLAND 21042
 (410) 461-2895

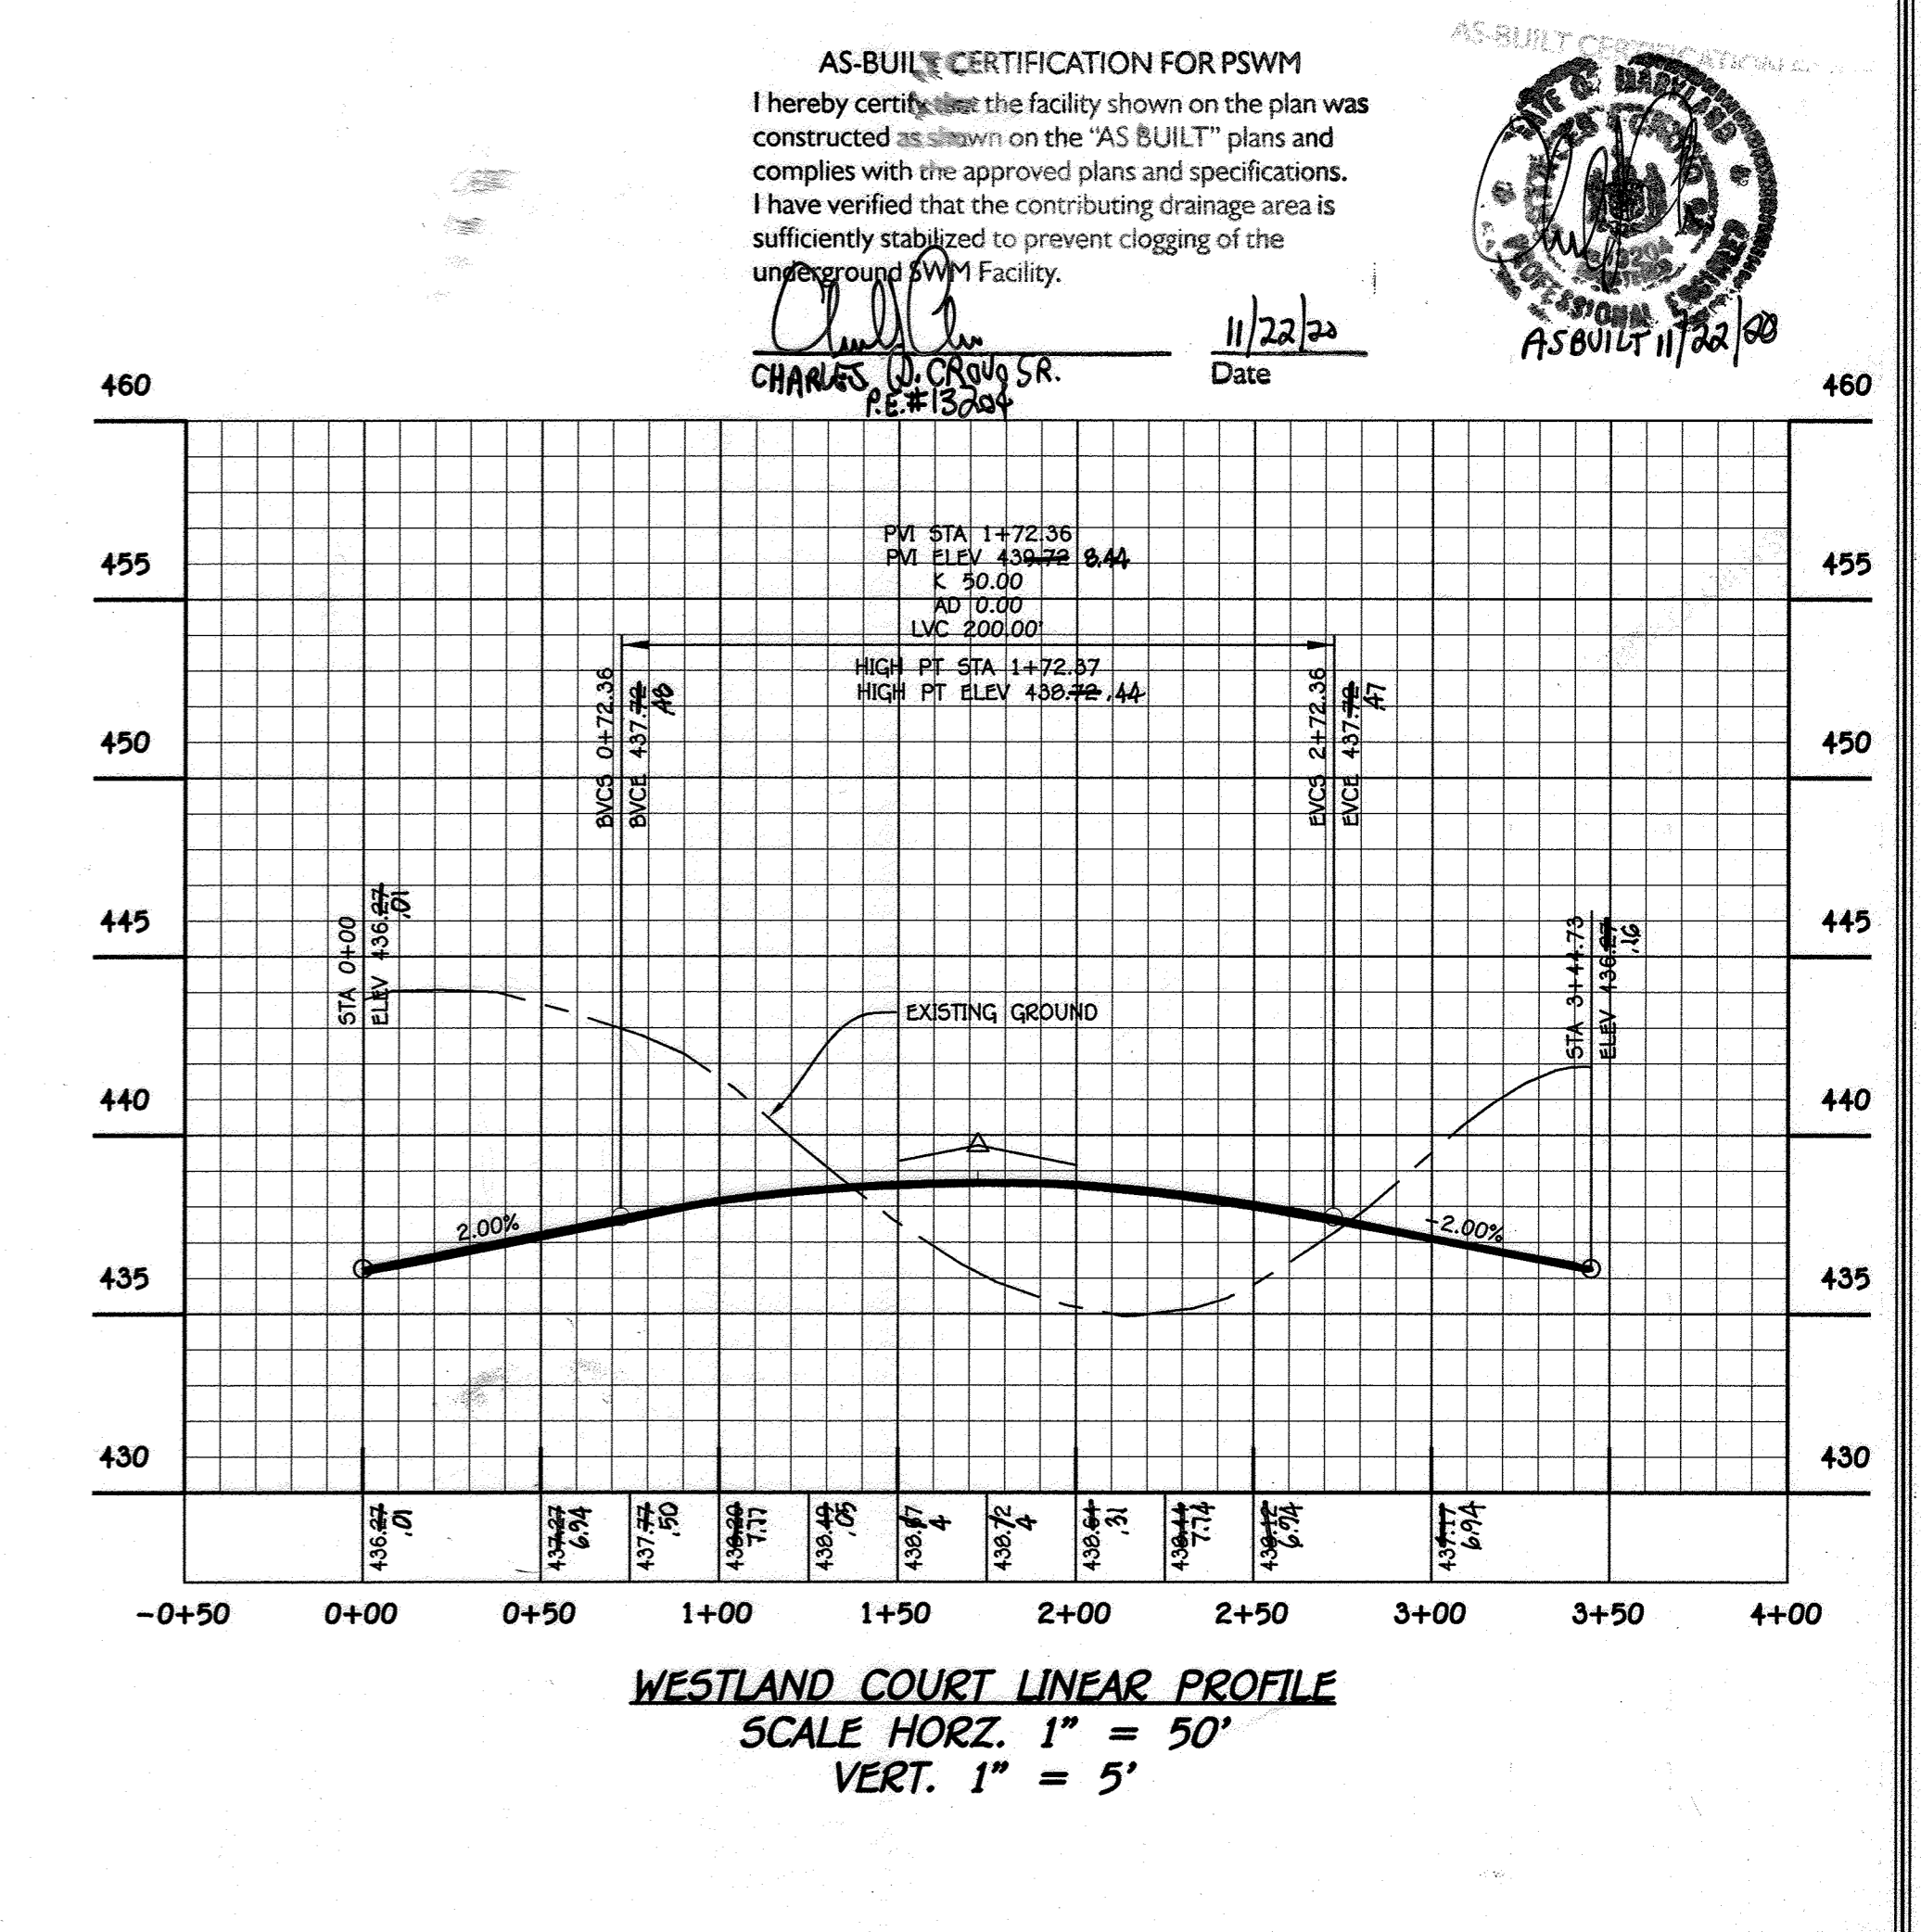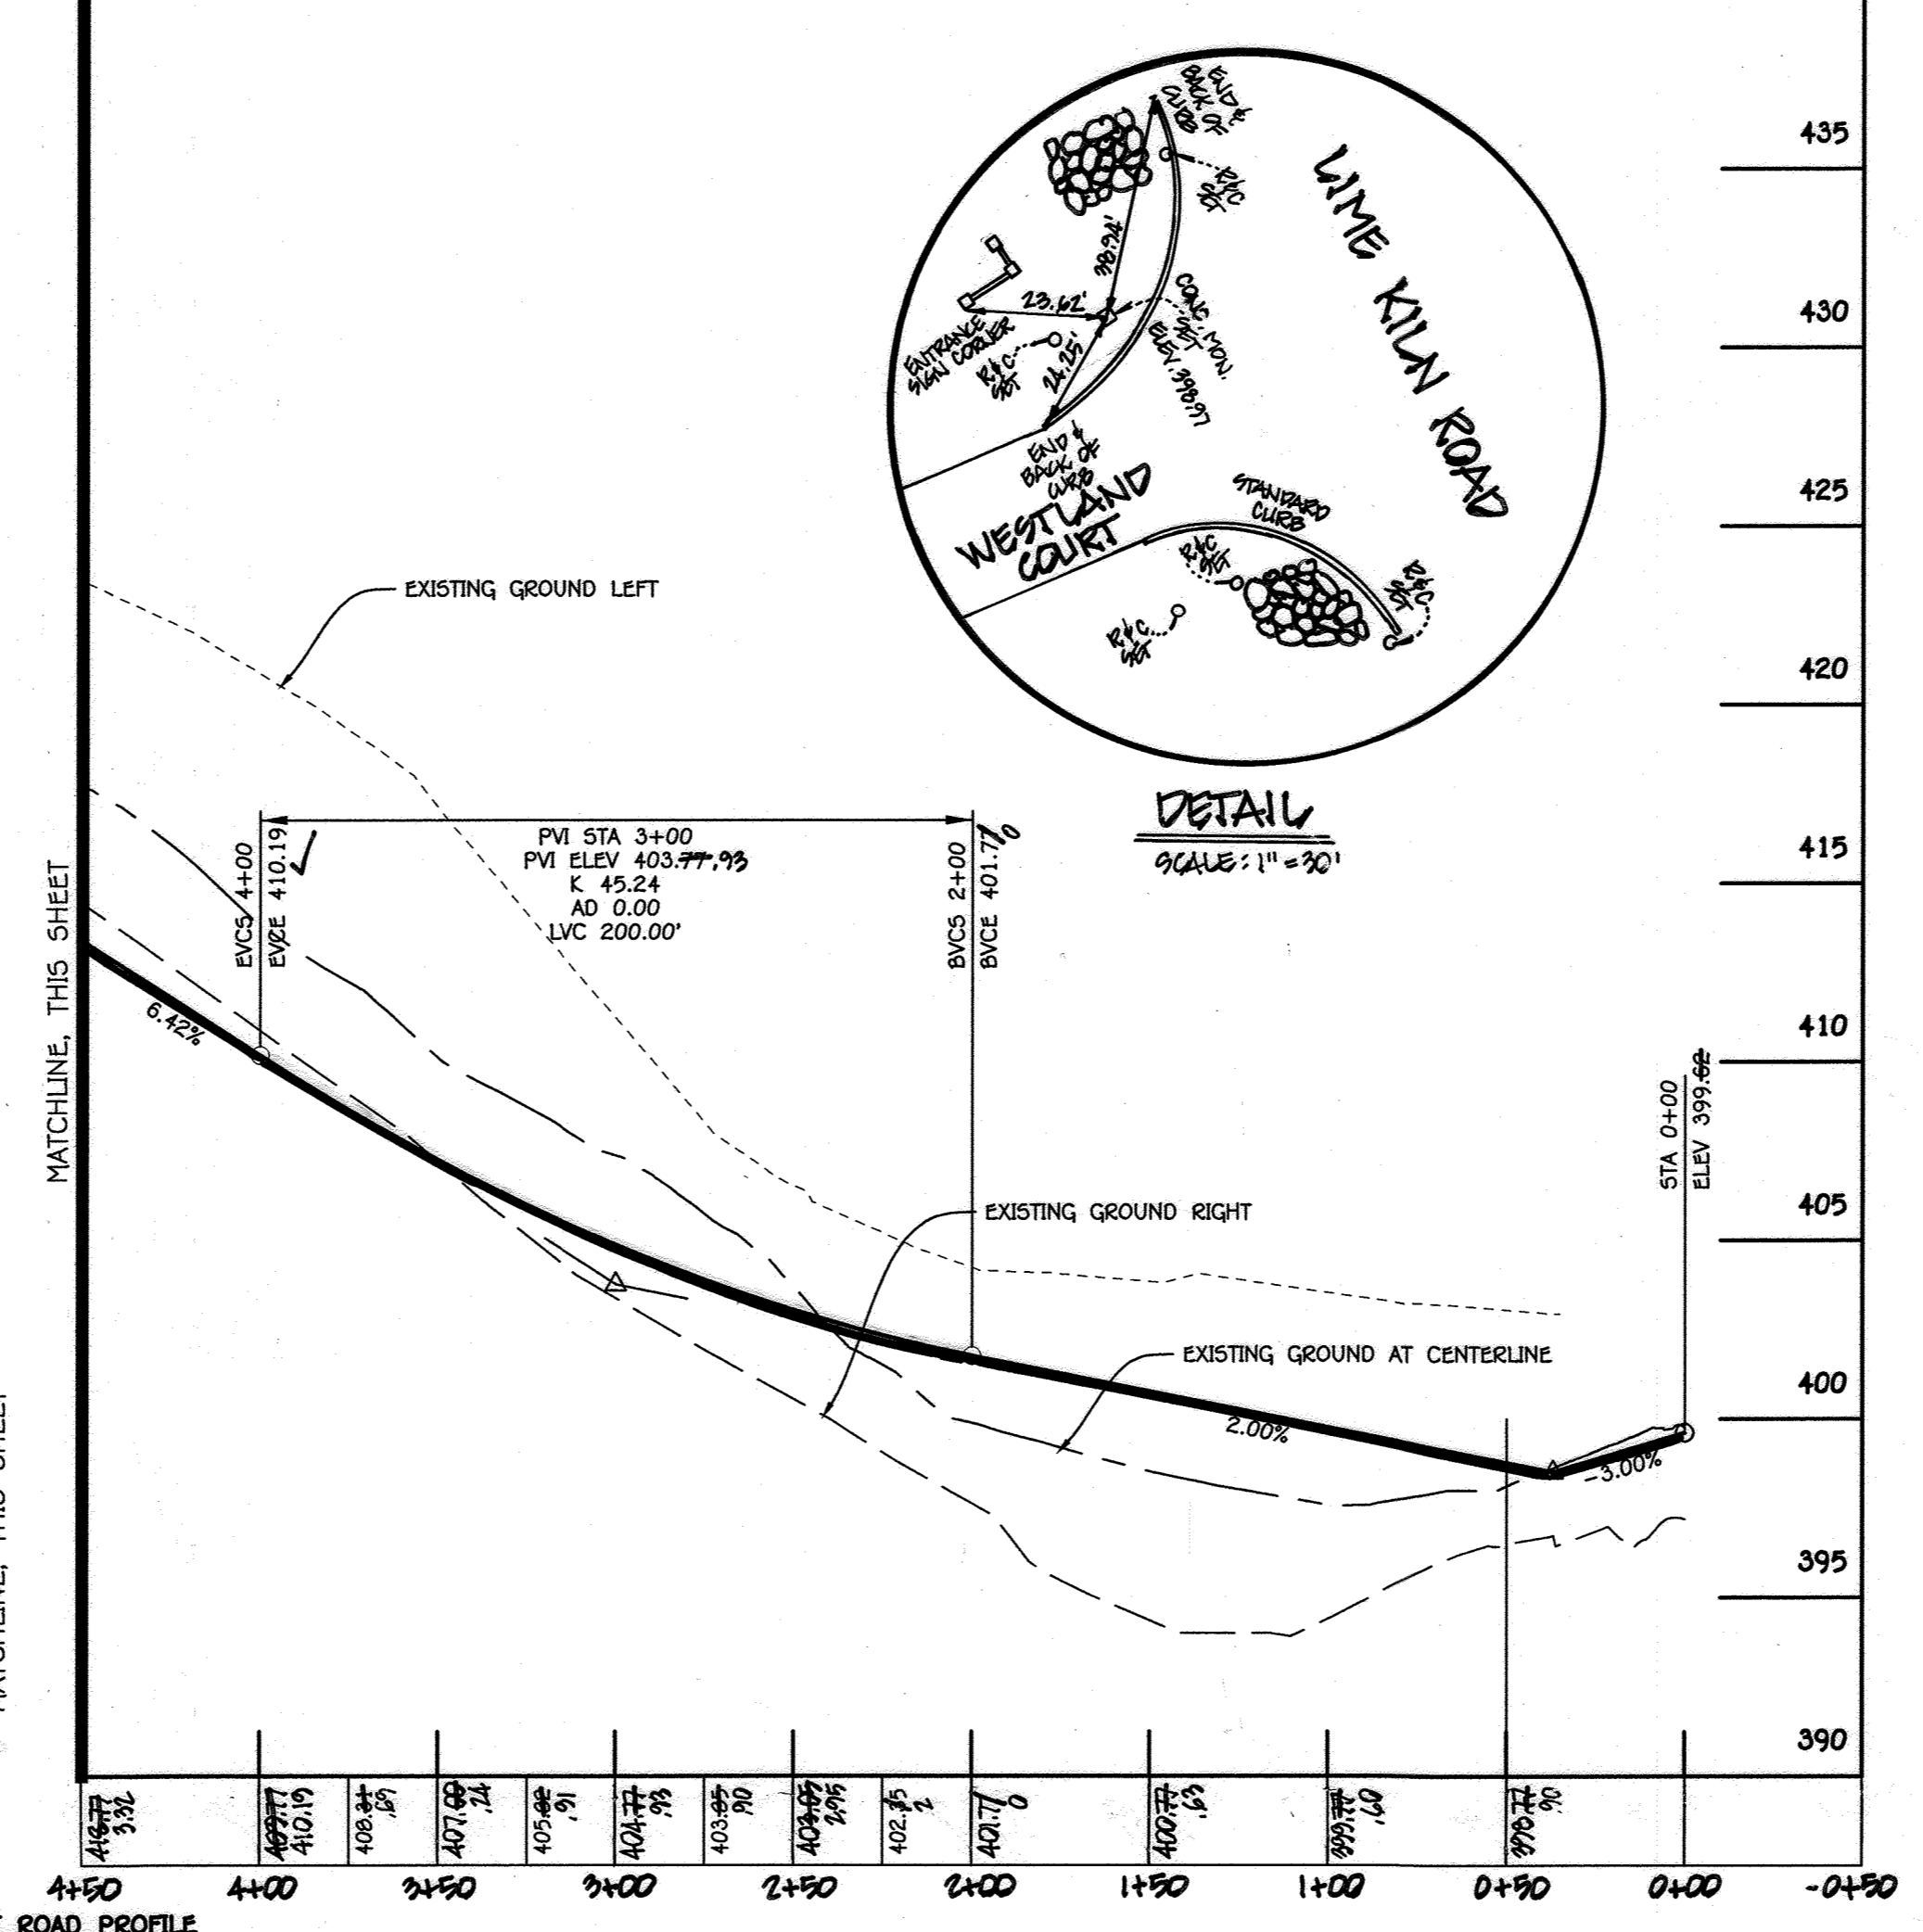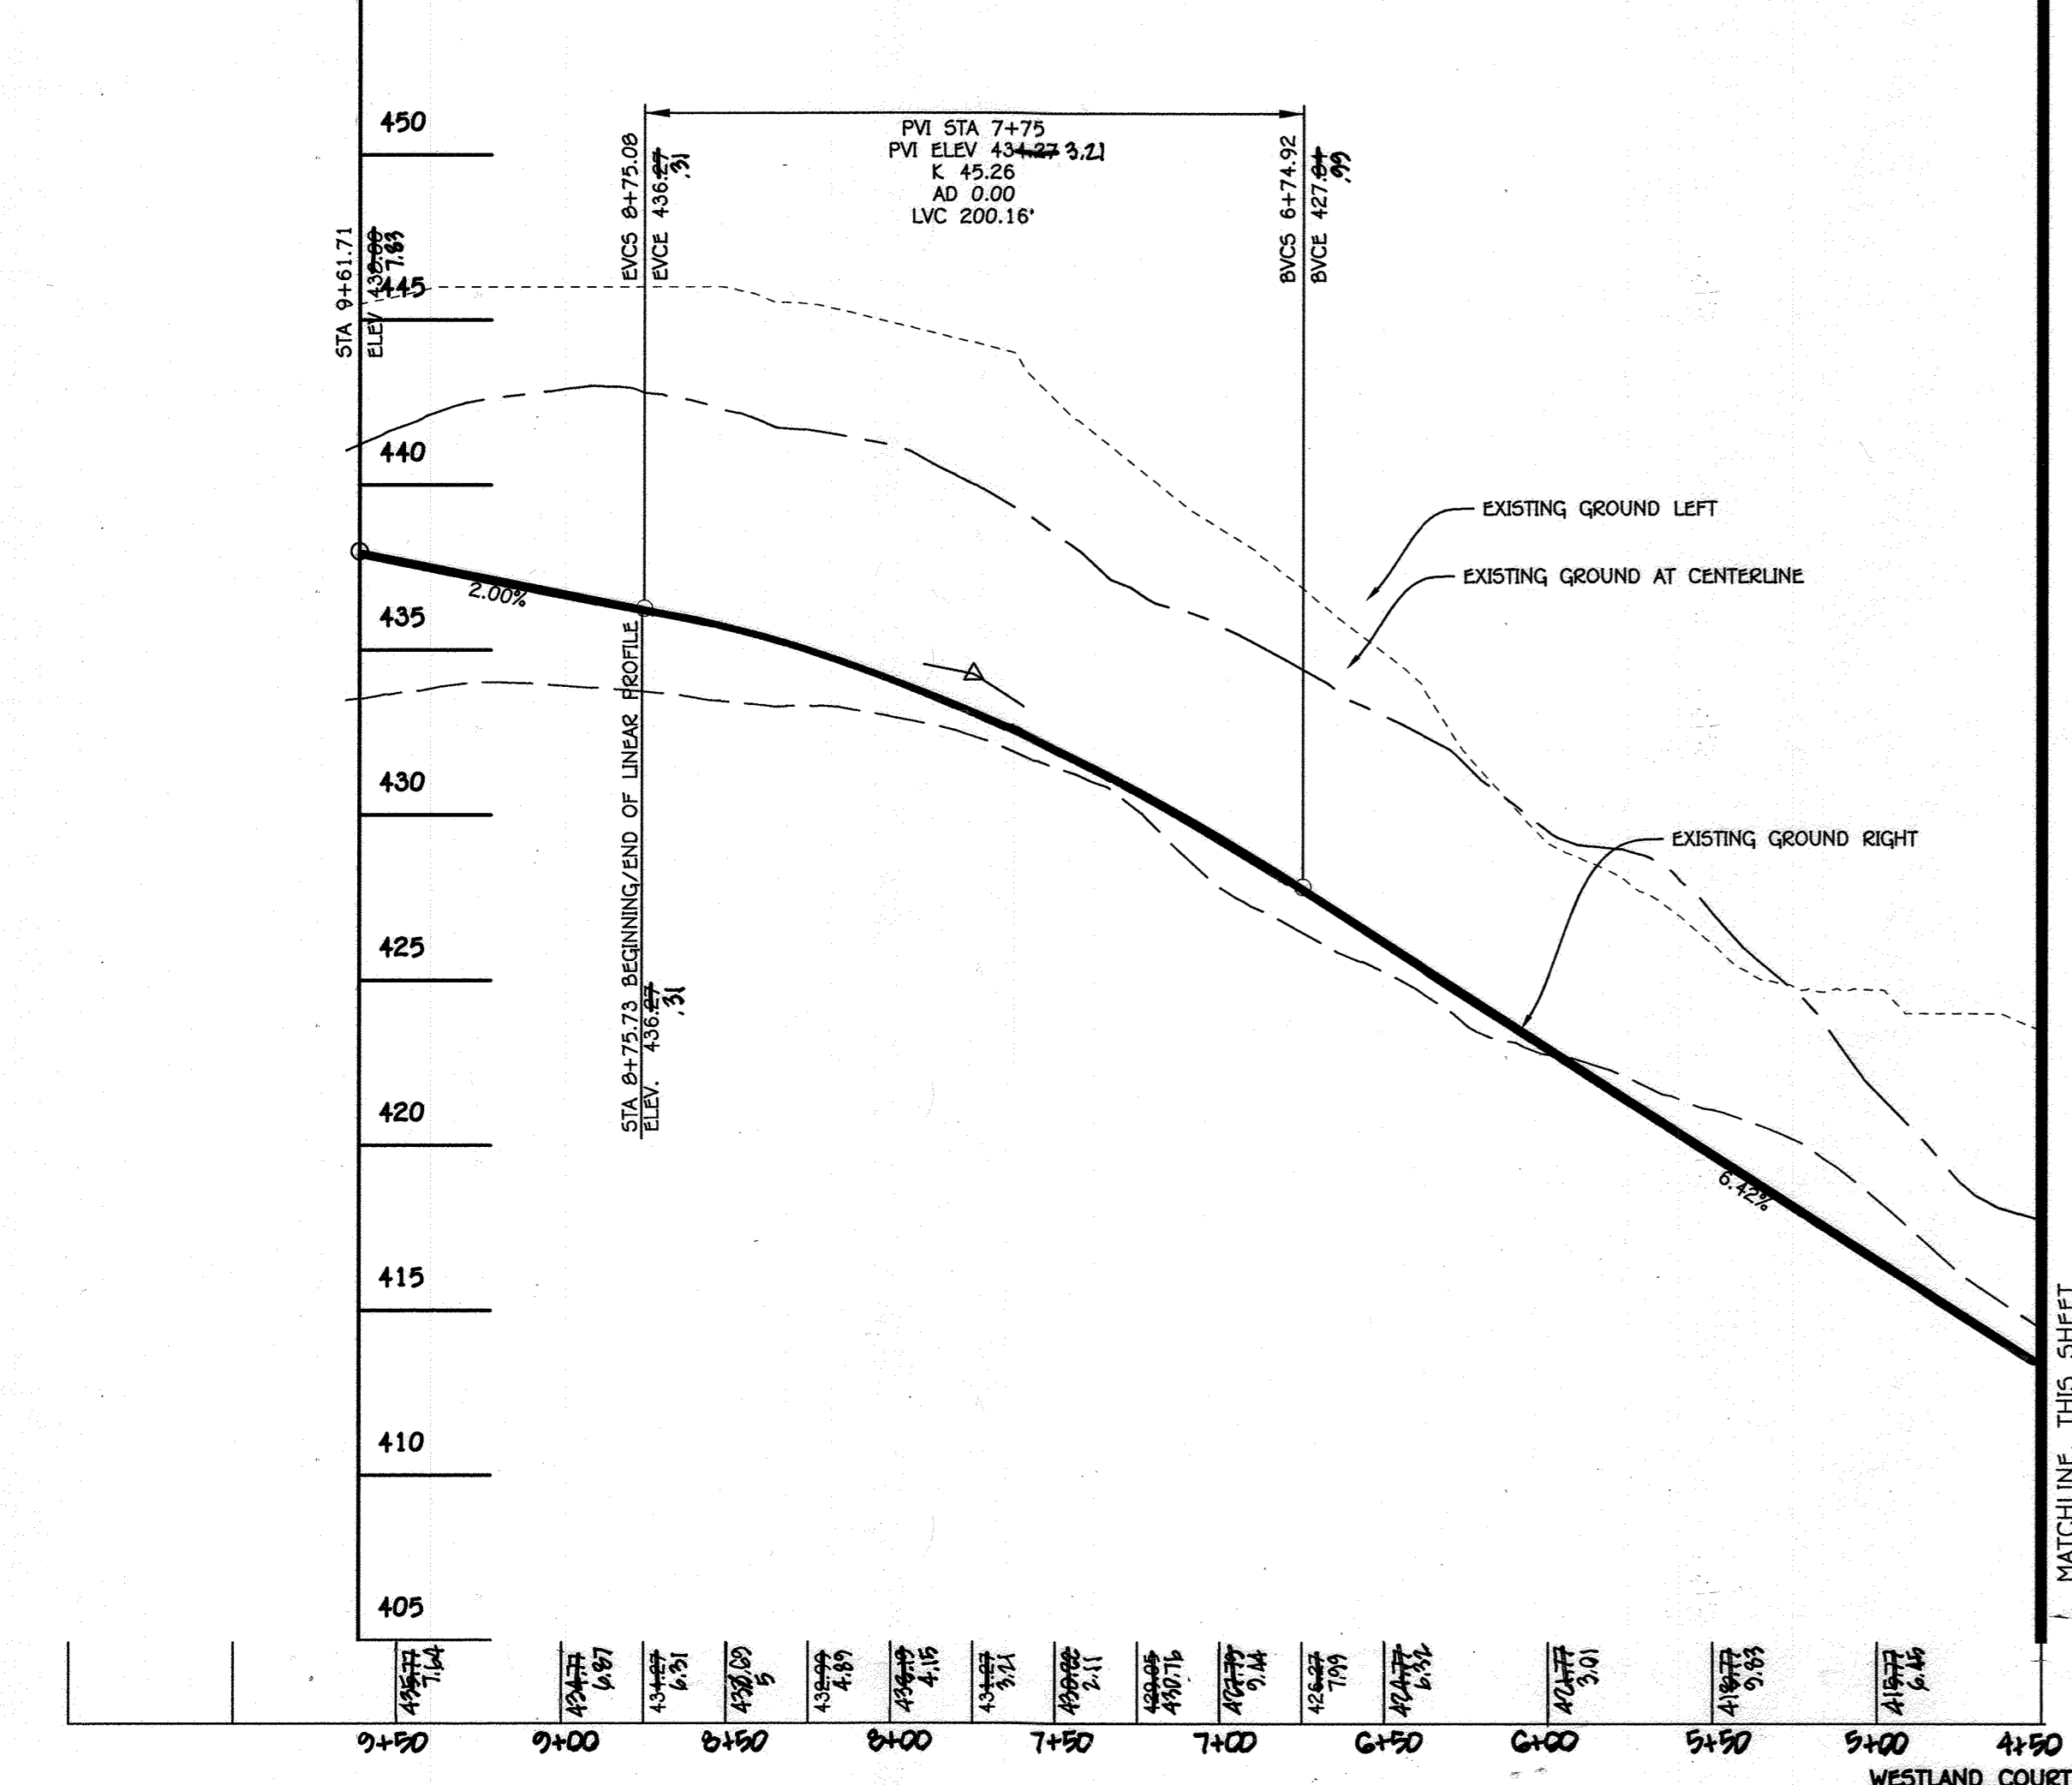


AS-BUILT CERTIFICATION FOR PSWM
 I hereby certify that the facility shown on the plan was constructed as shown on the "AS BUILT" plans and specifications. I have verified that the contributing drainage area is sufficiently stabilized to prevent clogging of the underground SWM Facility.

Charles J. Collins Sr. 11/22/20
 CHARLES J. COLLINS SR. Date
 P.E. #15204












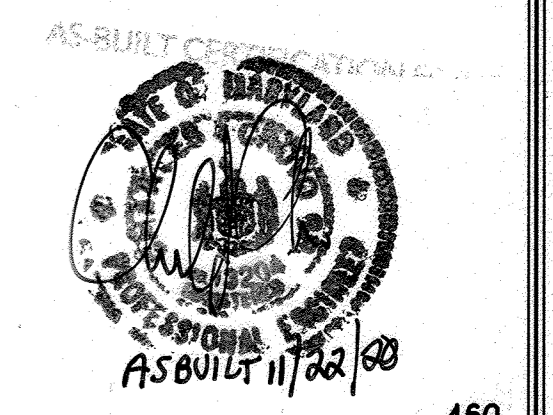


SECTION NUMBER	ROAD AND STREET CLASSIFICATION	CALIFORNIA BEARING RATIO (CBR)					
		3 TO <5	5 TO <7	≥7	3 TO <5	5 TO <7	≥7
P-3	PARKING DRIVE ASIDES RESIDENTIAL AND NON-RESIDENTIAL WITH NO MORE THAN 10 HEAVY TRUCKS PER DAY LOCAL ROADS: ACCESS PLACE, ACCESS STREET CUL-DE-SACS: RESIDENTIAL MINOR COLLECTORS: RESIDENTIAL	PAVEMENT MATERIAL (INCHES)					
		HMA SUPERPAVE FINAL SURFACE 9.5 MM, PG 64-22, LEVEL 1 (ESAL)					
		HMA SUPERPAVE INTERMEDIATE SURFACE 9.5 MM, PG 64-22, LEVEL 1 (ESAL)					
		HMA SUPERPAVE BASE 19.0 MM, PG 64-22, LEVEL 1 (ESAL)					
		GRADED AGGREGATE BASE (GAB)					
		MIN HMA WITH GAB			HMA WITH CONSTANT GAB		



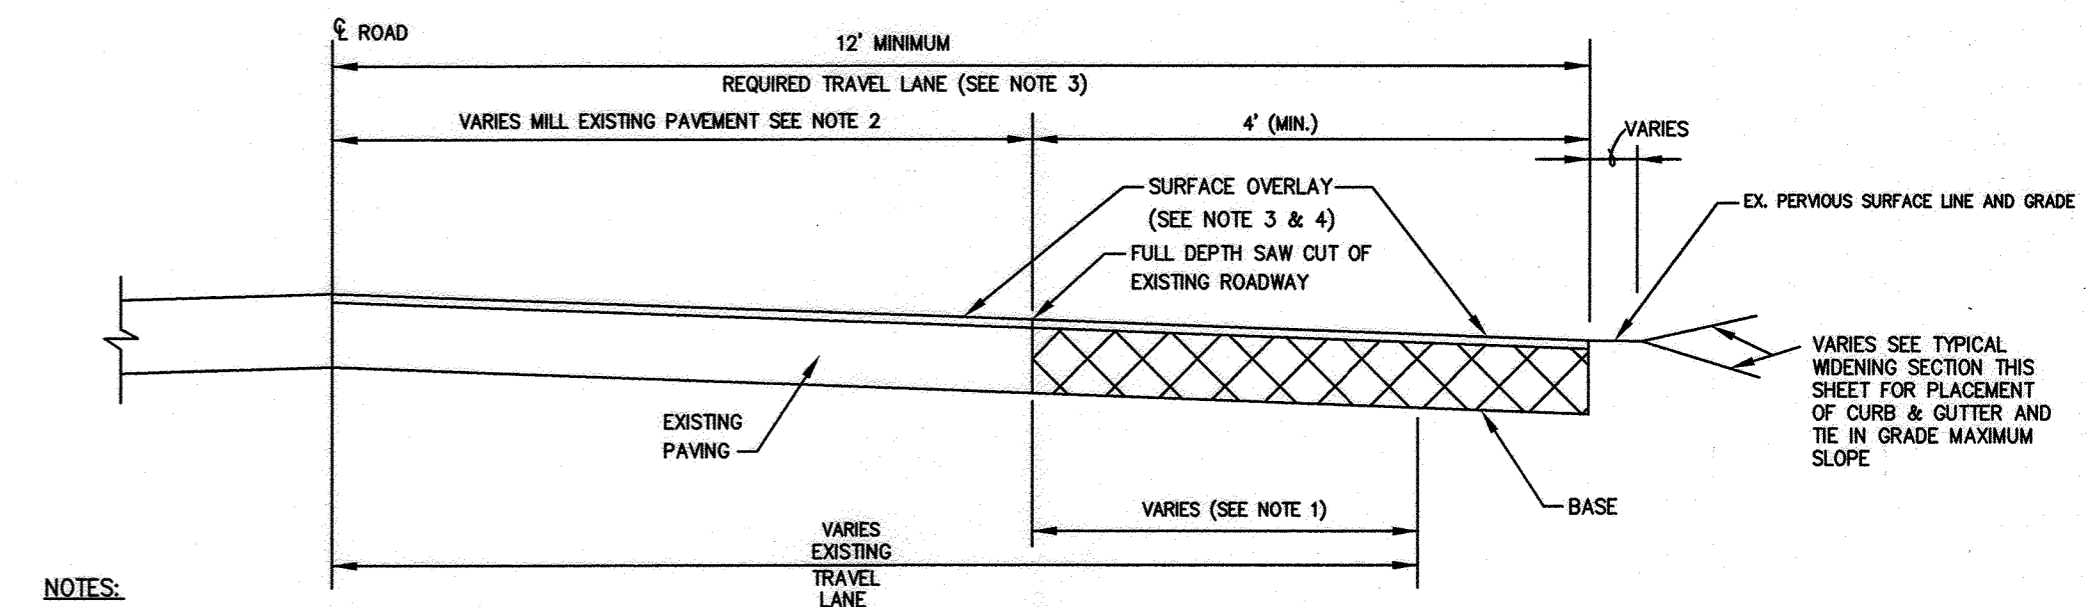


- NOTES:
- WHEN EXISTING TRAVEL LANE IS LESS THAN THE REQUIRED 12' LANE CONTRACTOR SHALL REMOVE A MINIMUM OF 1" FULL DEPTH OF THE EXISTING ROADWAY. IF CURB AND GUTTER IS INSTALLED, PROVIDE A MINIMUM OF 4" OF WIDENING FROM FACE OF GUTTER PAN.
 - THE EXISTING PAVEMENT TO BE RESURFACED SHALL BE MILLED AT DEPTH OF 1 1/2" (MINIMUM).
 - THE RESURFACING SHALL BE PLACED TO THE CENTERLINE OF THE ROADWAY (UPON COMPLETION OF INSTALLATION OF WATER MAIN).
 - RESURFACING COURSE TO BE EQUAL TO THE SURFACE COURSE OF THE TYPICAL PAVEMENT SECTION.

EXISTING ROADWAY WIDENING STRIP (R-1.08)
NO SCALE

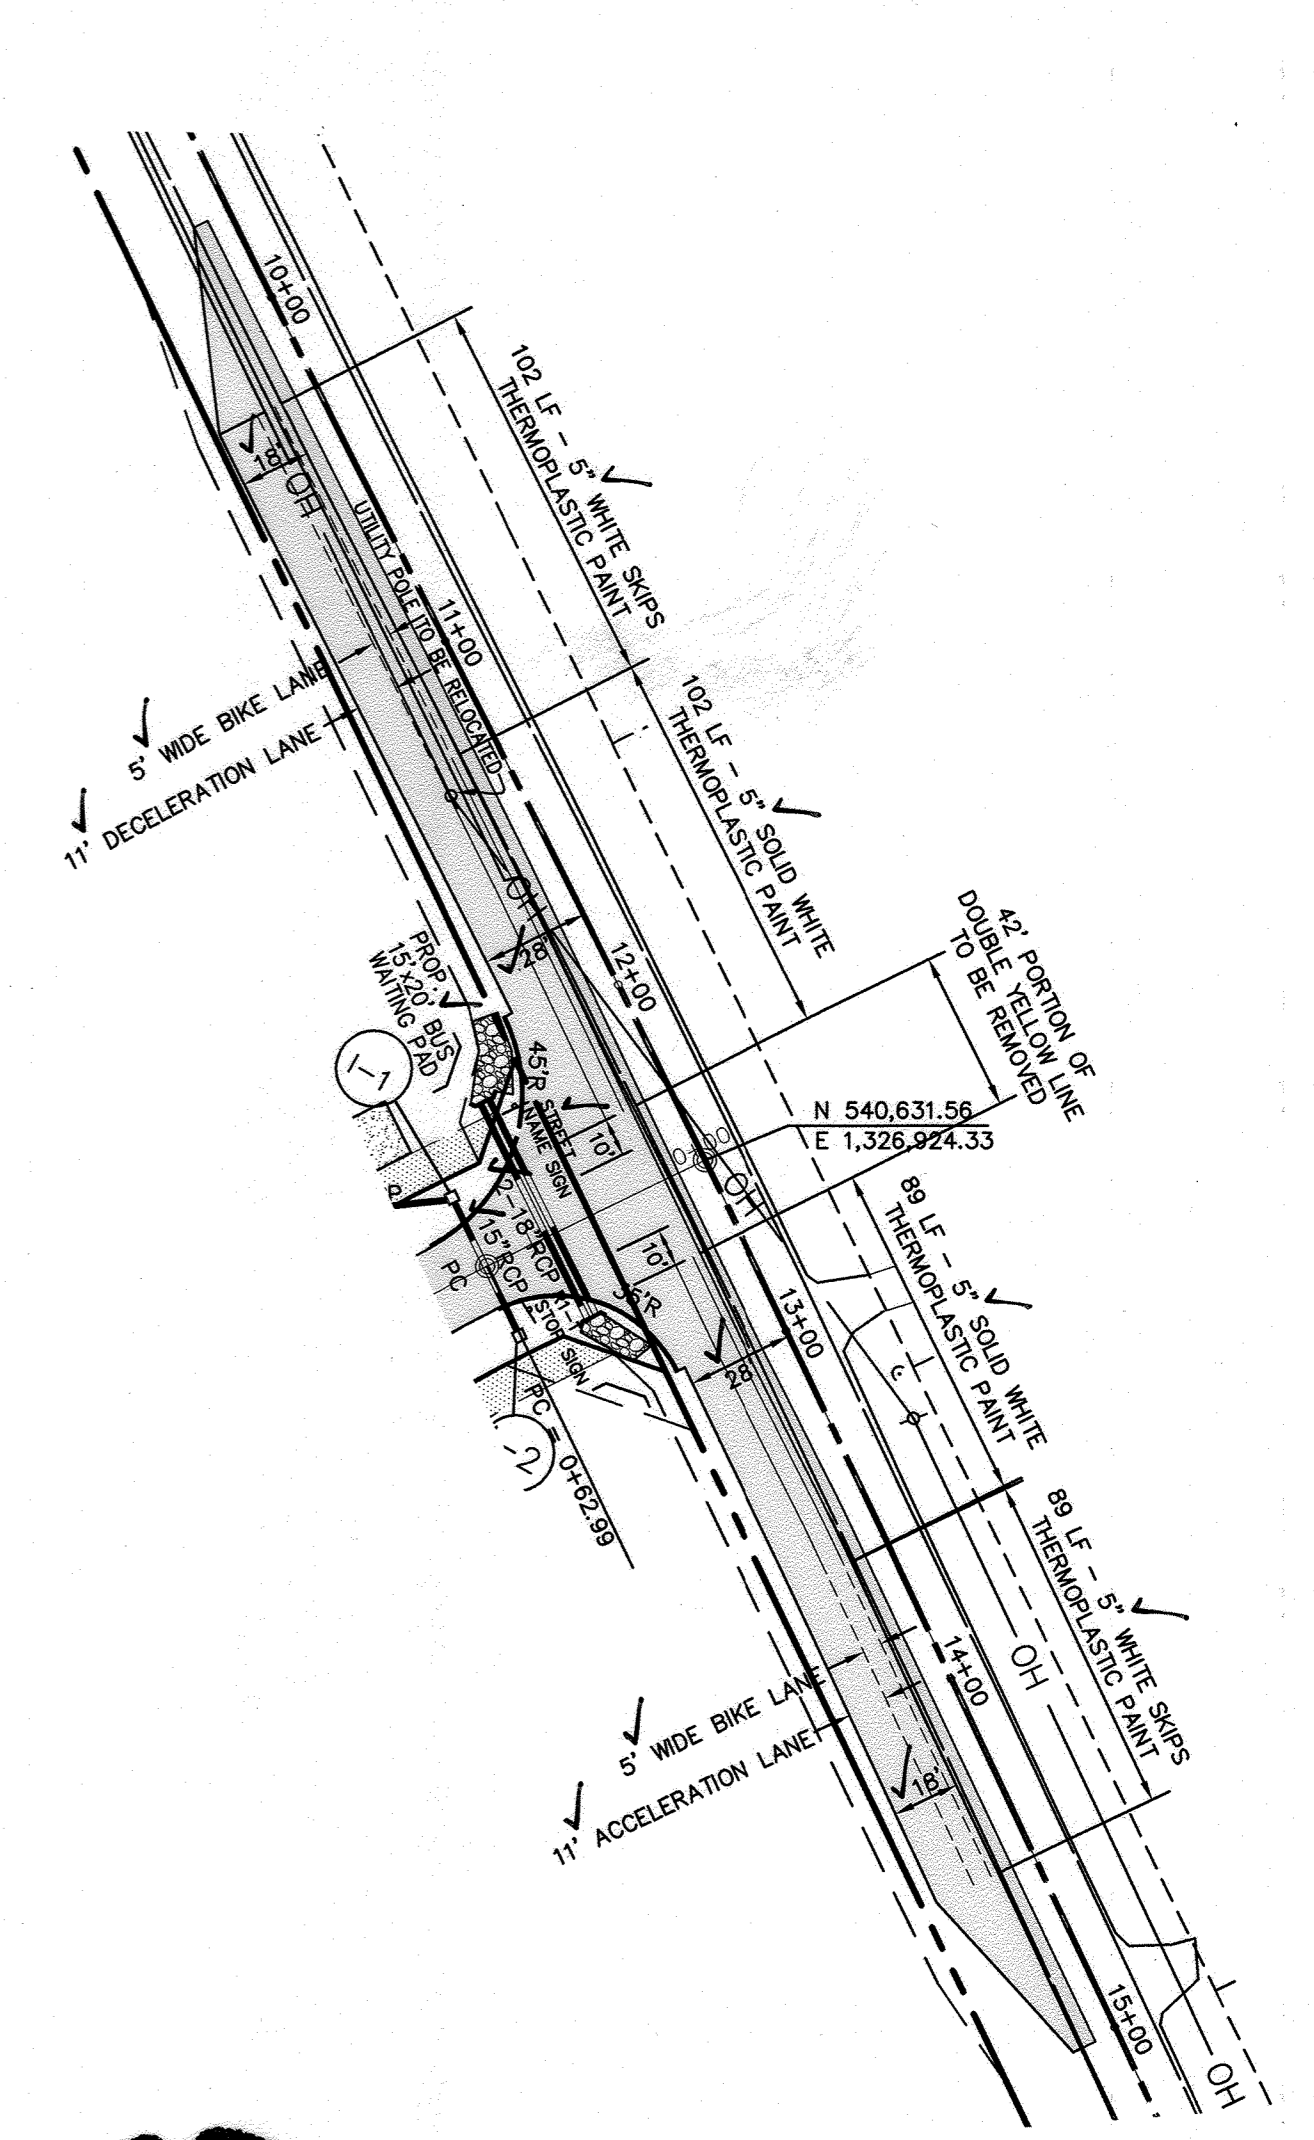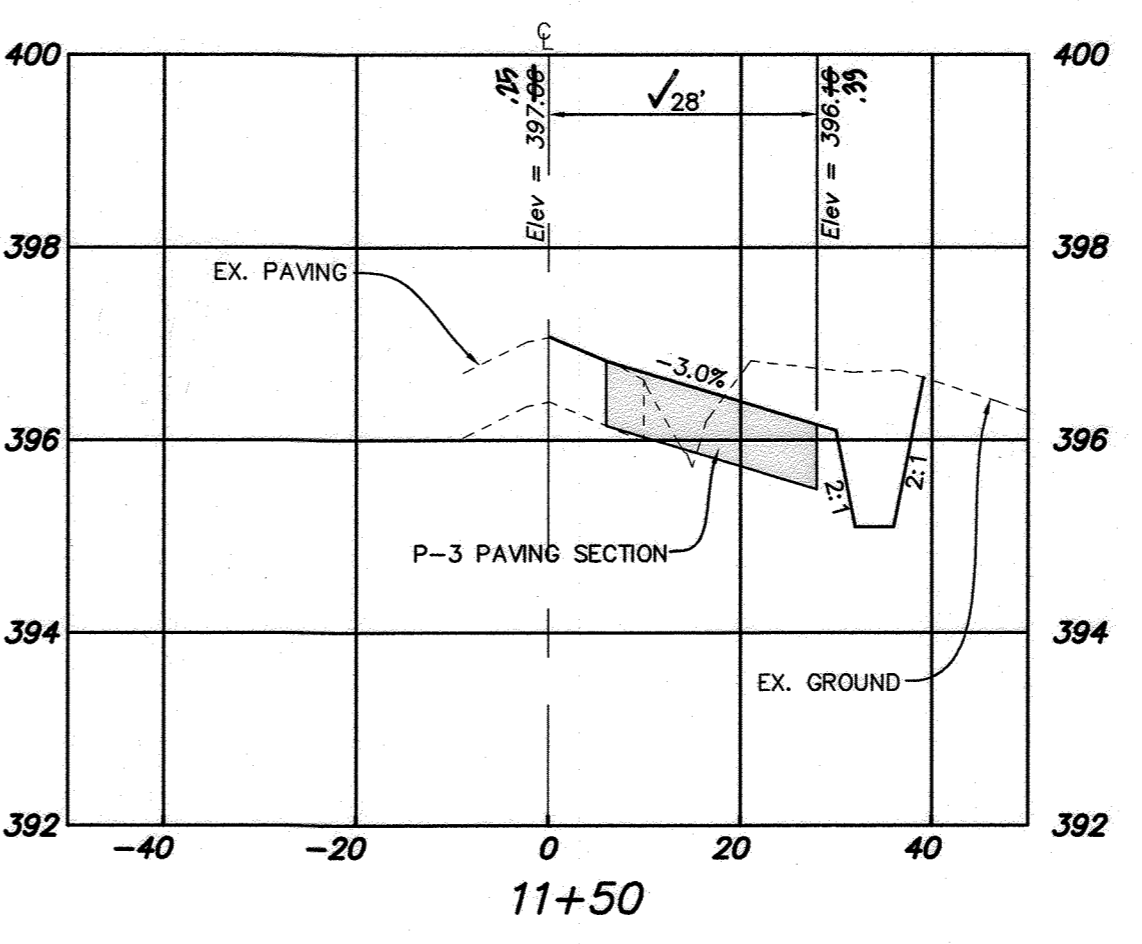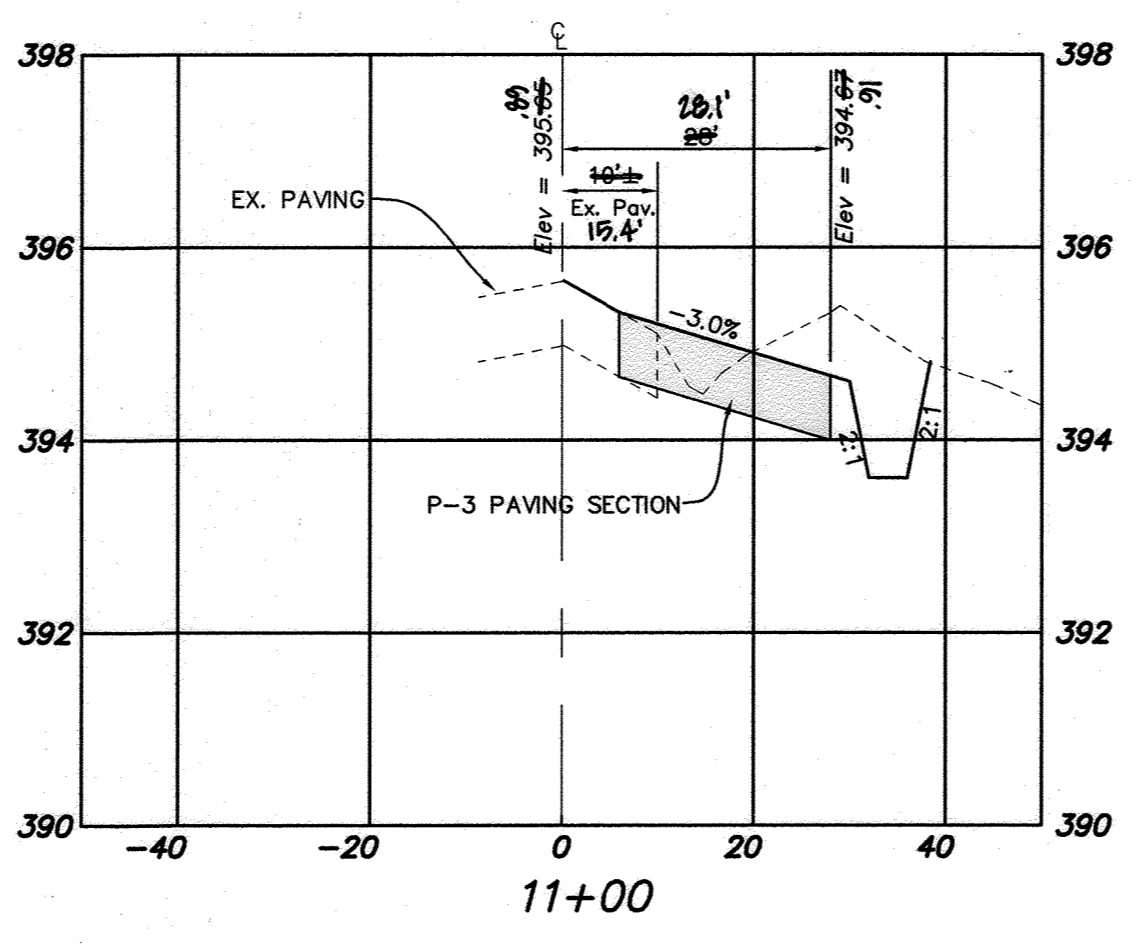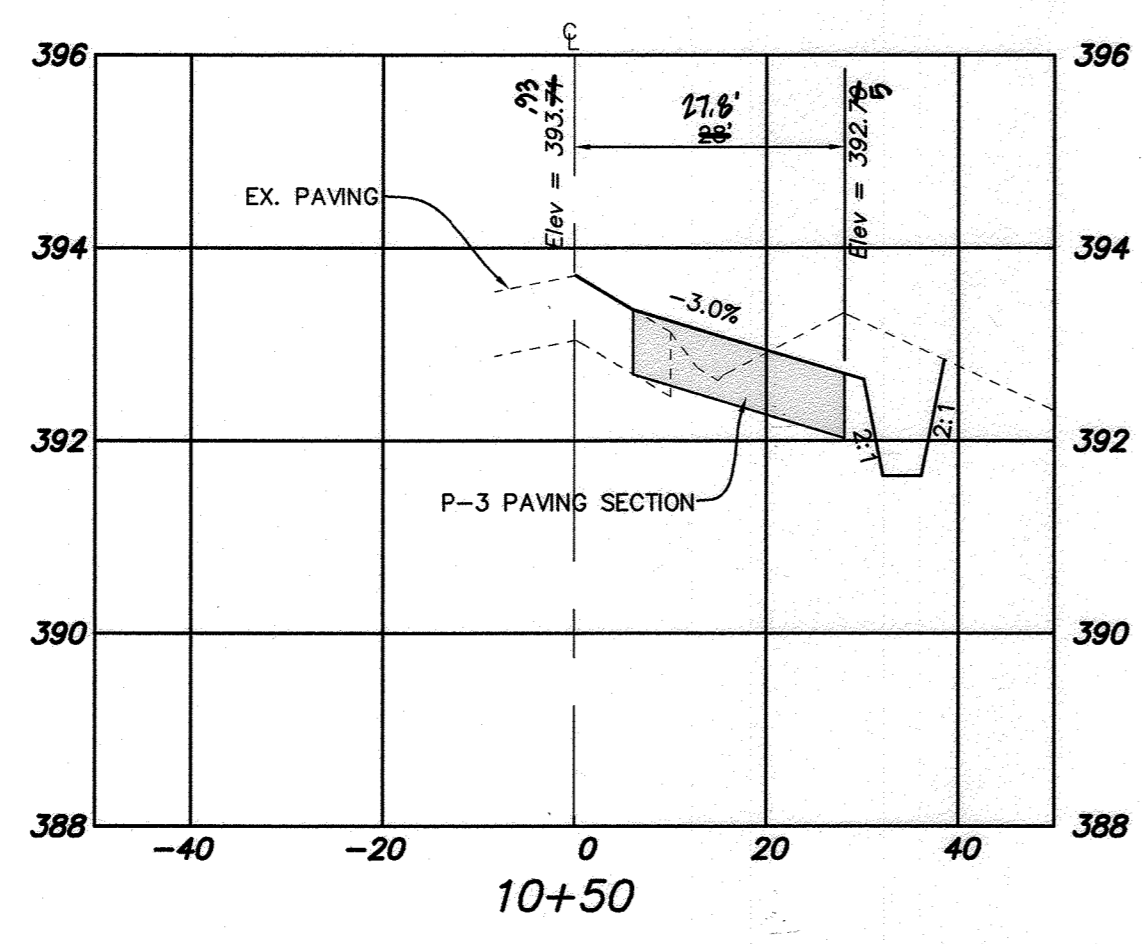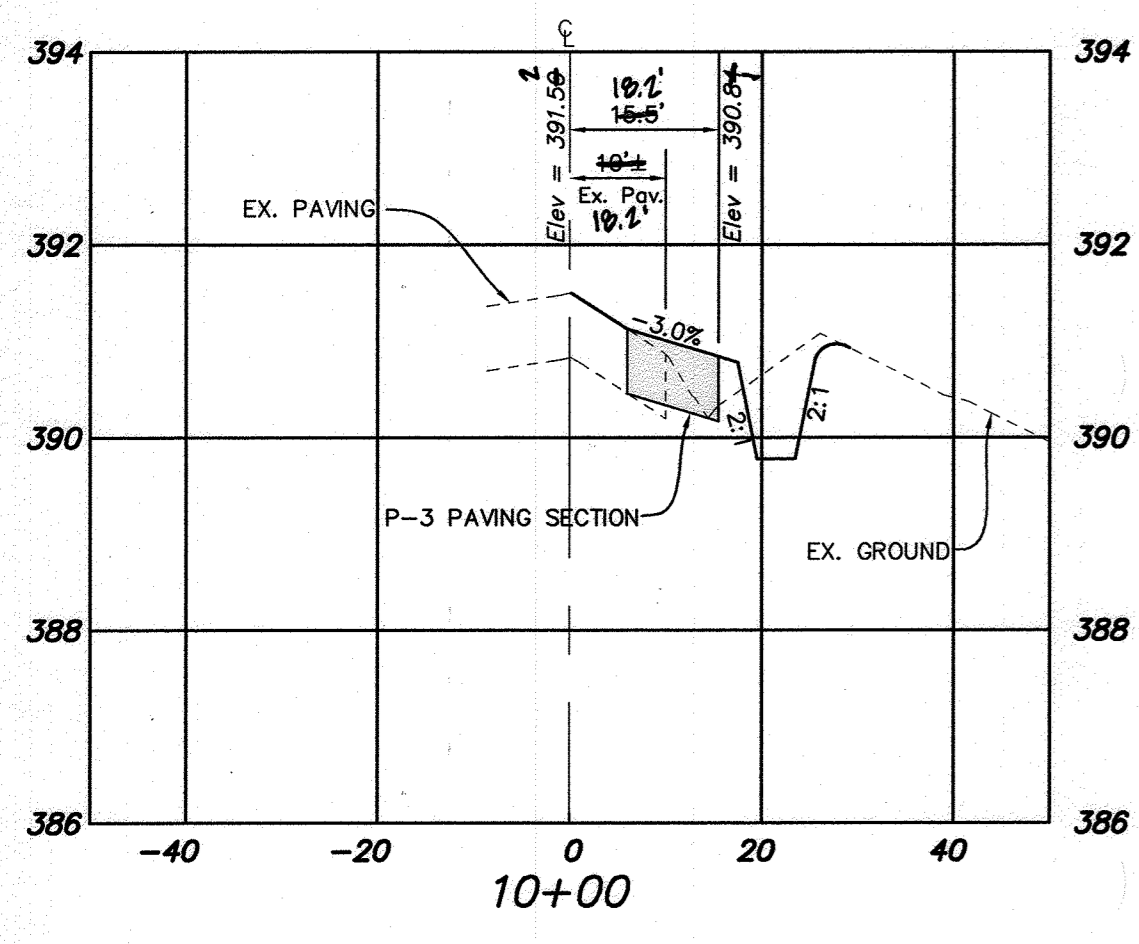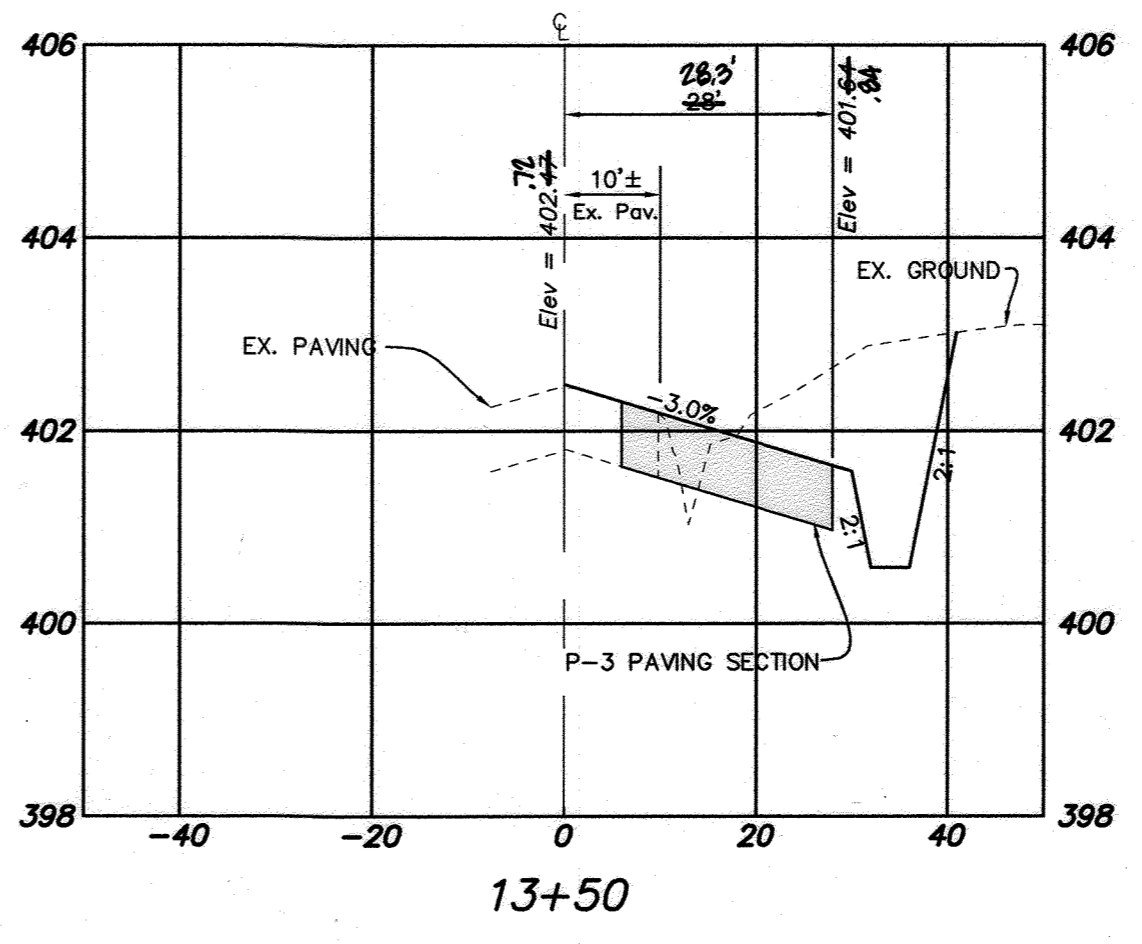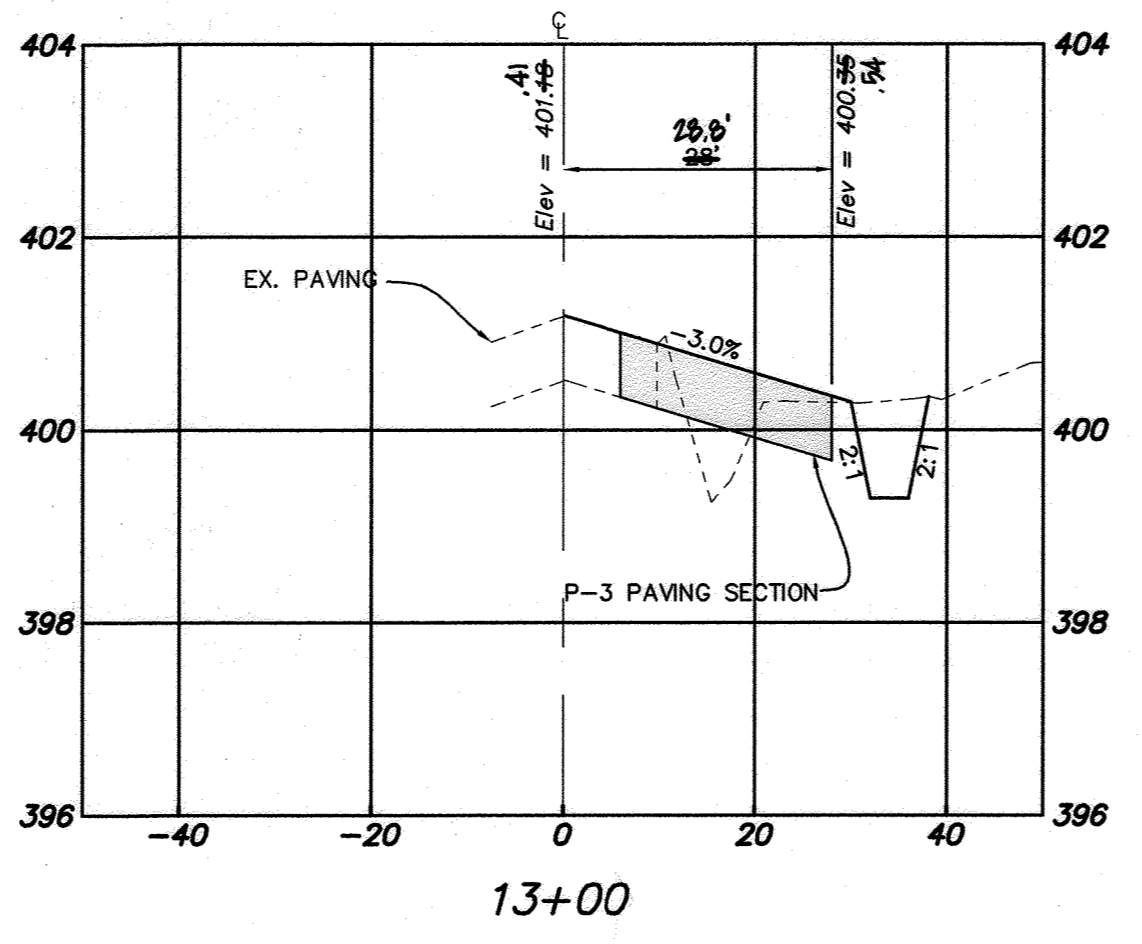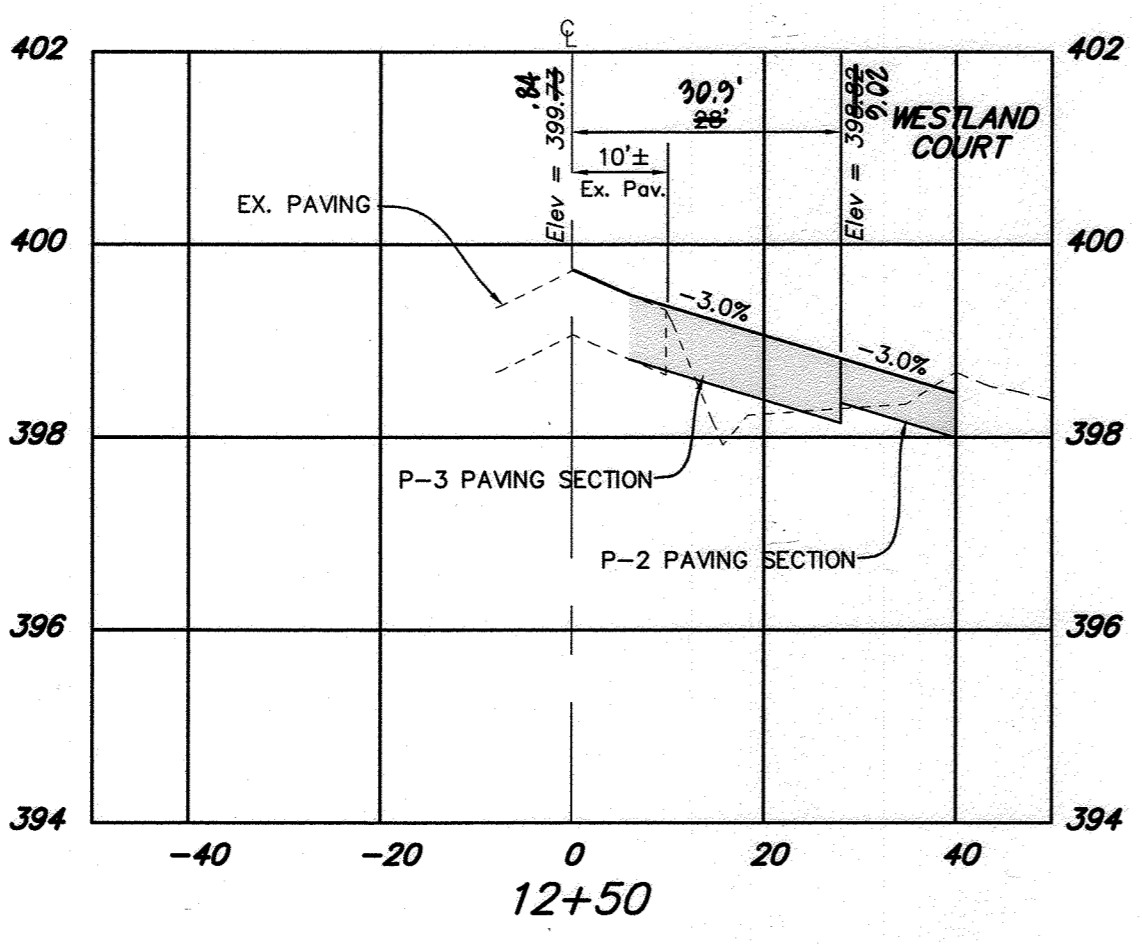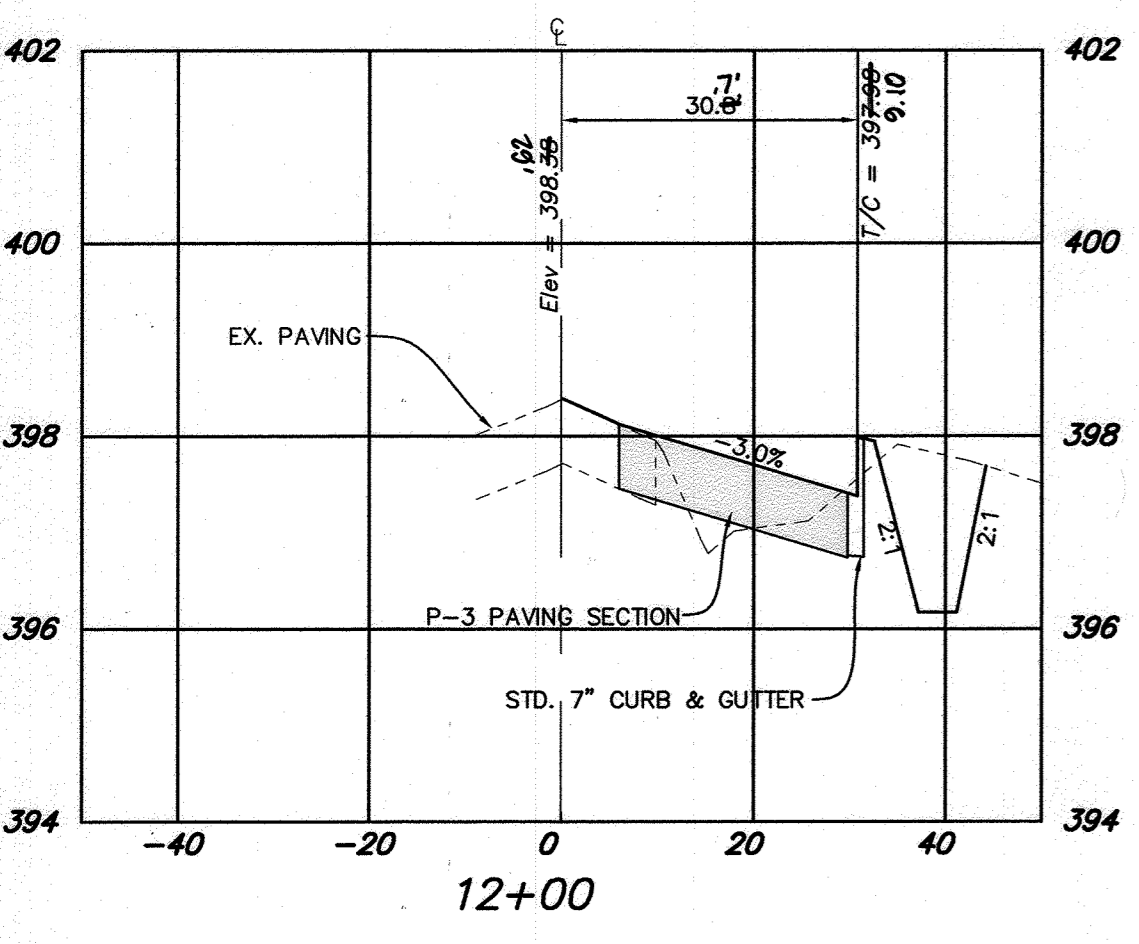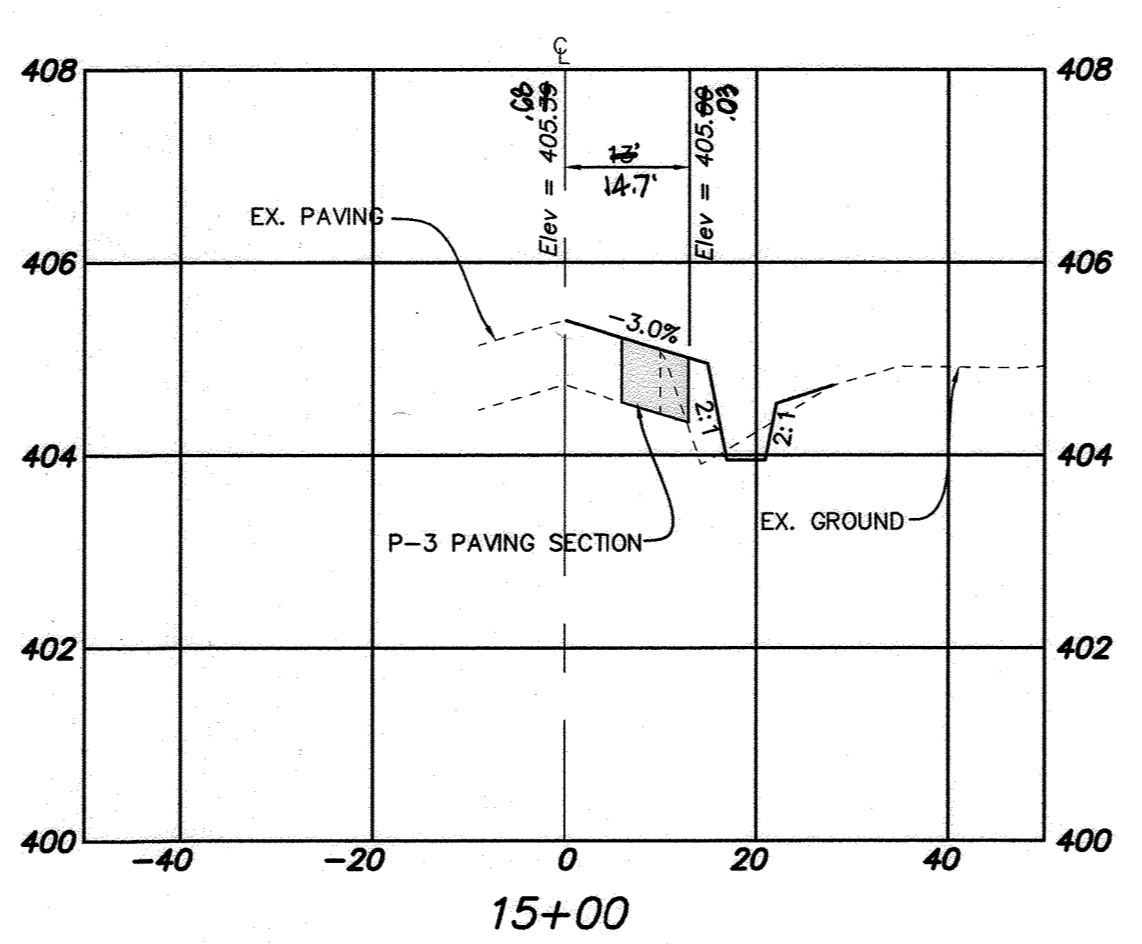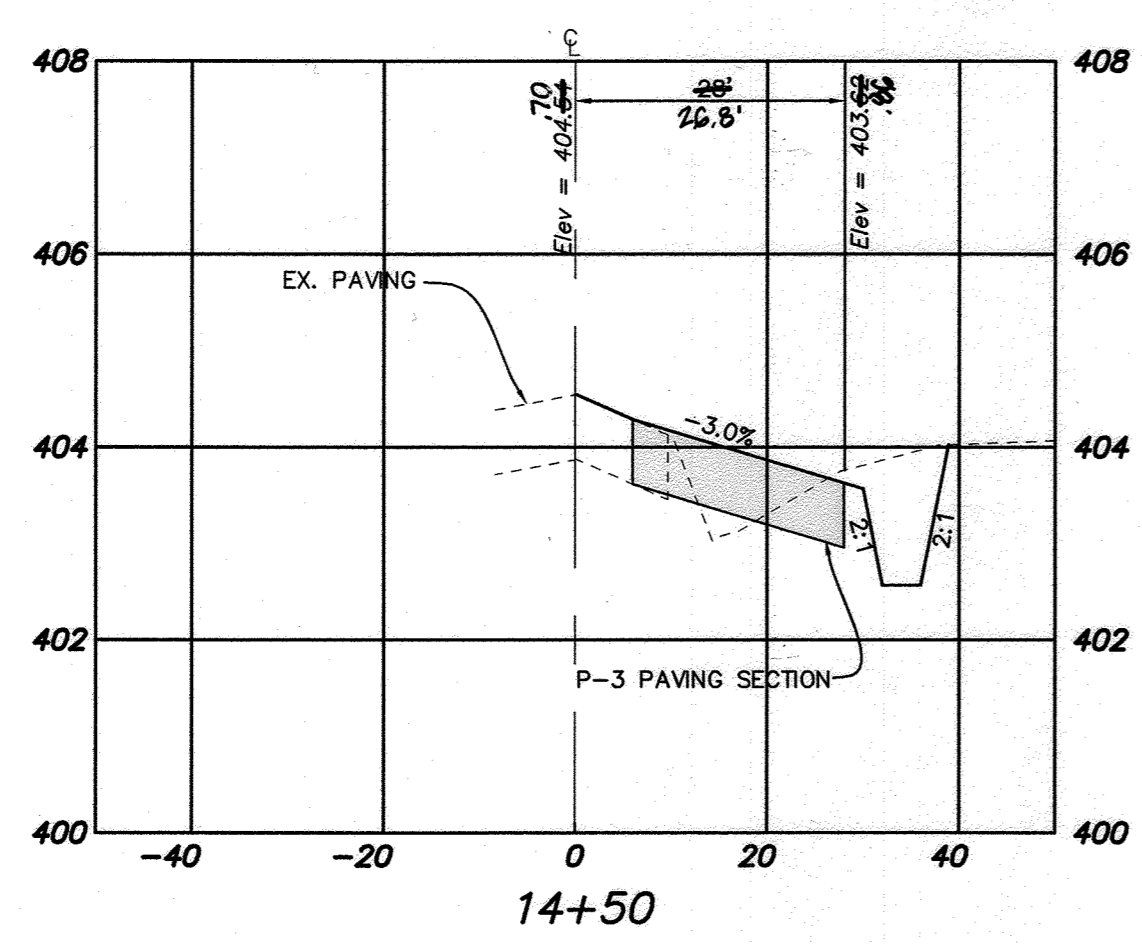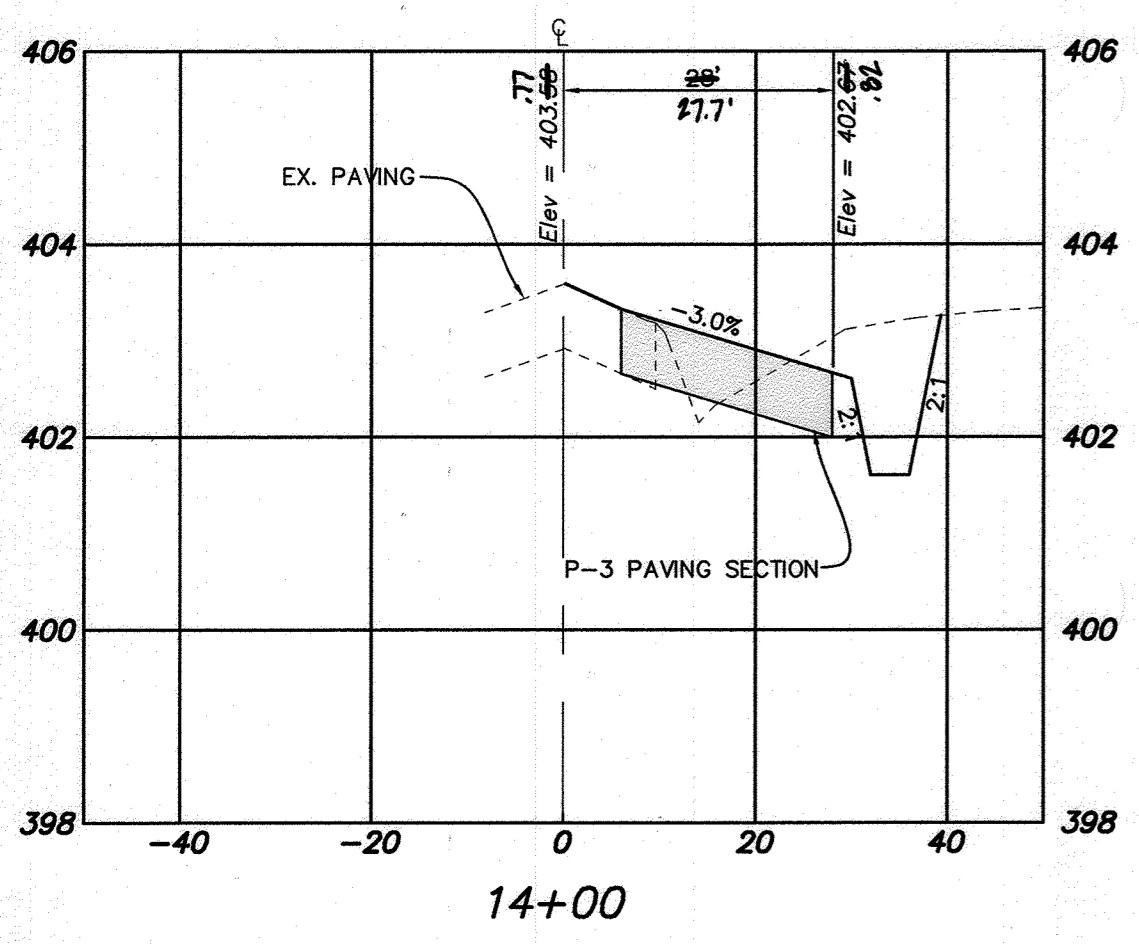

ACCELERATION / DECELERATION & BIKE LANE STRIPING
(LIME KILN ROAD)
SCALE: 1" = 50'

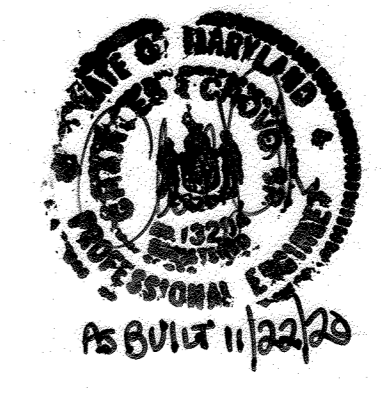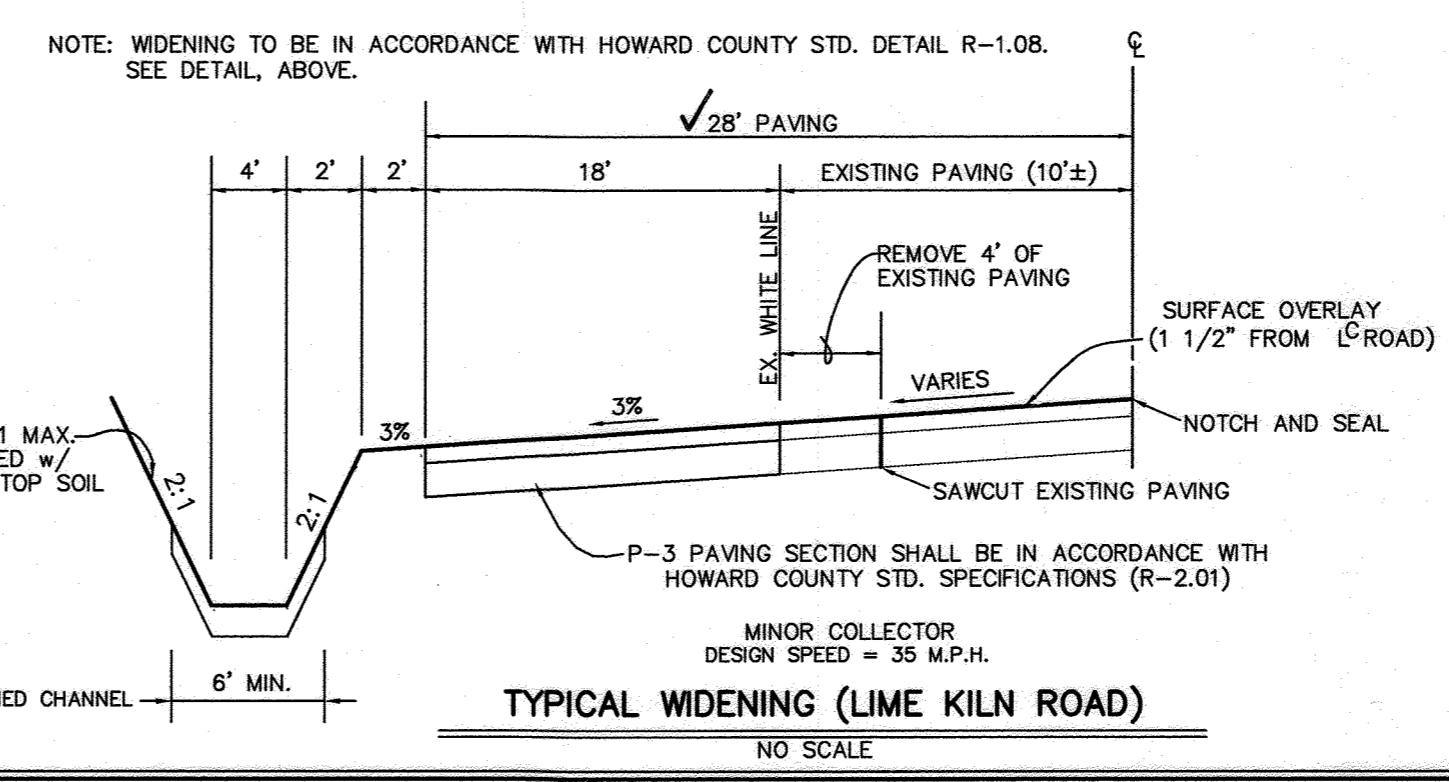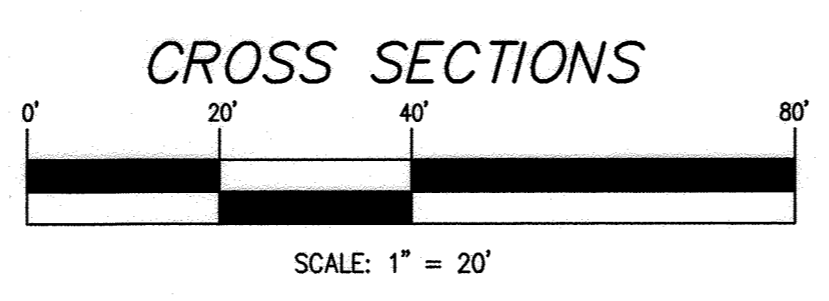

ACCELERATION/DECELERATION LANE CROSS SECTIONS
WESTLAND FARM ESTATES
LOTS 3 THRU 14 AND OPEN SPACE LOT 15
ZONED RR-DEO
TAX MAP No. 45 GRID No. 5 PARCEL No. 28
FIFTH ELECTION DISTRICT HOWARD COUNTY, MARYLAND
SCALE: AS SHOWN DATE: DECEMBER, 2015
SHEET 4 OF 19

APPROVED: DEPARTMENT OF PUBLIC WORKS
Melvin 2/22/2016
CHIEF, BUREAU OF HIGHWAYS DATE

APPROVED: DEPARTMENT OF PLANNING AND ZONING
Victor 6-21-16
CHIEF, DIVISION OF LAND DEVELOPMENT DATE

Chad 3-2-16
CHIEF, DEVELOPMENT ENGINEERING DIVISION DATE

OWNERS
LIME KILN, LLC
12549 LINE KILN ROAD
FULTON, MARYLAND 20759-0460
410-792-2922

DEVELOPER
WILLIAMSBURG GROUP, LLC
C/O BOB CORBETT
5485 HARPERS FARM ROAD, SUITE 200
COLUMBIA, MARYLAND 21044
410-997-8800

AND
PERRY C. WESTLAND, JR.
12549 LINE KILN ROAD
FULTON, MARYLAND 20759-0460
410-792-2922

FISHER, COLLINS & CARTER, INC.
CIVIL ENGINEERING CONSULTANTS & LAND SURVEYORS
CENTENNIAL SQUARE OFFICE PARK - 10272 BALTIMORE NATIONAL PIKE
ELLICOTT CITY, MARYLAND 21042
(410) 461-2855

PROFESSIONAL CERTIFICATION
I HEREBY CERTIFY THAT THESE DOCUMENTS WERE PREPARED OR APPROVED BY ME AND THAT I AM A DULY LICENSED PROFESSIONAL ENGINEER UNDER THE LAWS OF THE STATE OF MARYLAND, LICENSE NO. 38386, EXPIRATION DATE: 01/12/2016.

Stephen J. White 12/9/15
Signature Of Professional Engineer DATE




NO.	REVISION	DATE
1	REVISE LOCATION OF POND ON LOTS 9 & 4 AND REVISE PROPOSED TREE LINE ON LOTS 6 & 7	6/2/17
2	REVISE HUB & CATCH LOT 9, FROM OPEN BOX TO RUTLEDGE	9/1/18
3	REVISE HUB & CATCH LOT 10, FROM OPEN BOX TO WELLINGTON	8/3/18
4	REVISE HUB & CATCH LOT 8, FROM OPEN BOX TO RUTLEDGE	11/7/18
5	REVISE HUB & CATCH LOT 12, FROM OPEN BOX TO RUTLEDGE	9/19/19
6	REVISE LOCATION OF 6 TREES ON LOT 10	12/7/23

LEGEND			
SYMBOL	DESCRIPTION	SYMBOL	DESCRIPTION
- - - 412	EXISTING 2' CONTOURS	- - - 400	PROPOSED CONTOUR
- - - 410	EXISTING 10' CONTOURS	+362.5	SPOT ELEVATION
GgB	SOILS LINES AND TYPE	LOD	LIMITS OF DISTURBANCE
- - - 400	EXISTING TREE LINE	- - - 400	PROPOSED TREE LINE
- - - 400	15% TO 24.9% STEEP SLOPES	- - - 400	PROPOSED PAVING
- - - 400	25% AND GREATER STEEP SLOPES	544	BORING (PERC) TEST HOLE
- - - 400	100 YEAR PUBLIC FLOODPLAIN, DRAINAGE AND UTILITY EASEMENT	5F	SILT FENCE
- - - 400	STREAM BANK BUFFER	ECM	EROSION CONTROL MATTING
- - - 400	EXISTING CENTERLINE OF STREAM	55F	SUPER SILT FENCE
ST1	SPECIMEN TREE	DF	DIVERSION FENCE
- - - 400	PROPOSED FOREST CONSERVATION EASEMENT	- - - 400	STABILIZES CONSTRUCTION ENTRANCE
TPF	TREE PROTECTIVE FENCING	- - - 400	DRAINAGE AREA DIVIDE



PLAN VIEW
SCALE: 1" = 50'

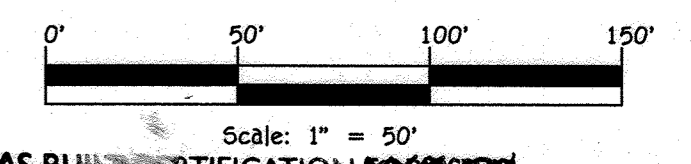

NOTE:
THIS PLAN IS TO BE USED FOR INDIVIDUAL DRIVEWAYS AND HOME CONSTRUCTION ALONG WITH ROAD AND SIDEWALK MANAGEMENT CONSTRUCTION.

APPROVED: DEPARTMENT OF PUBLIC WORKS
[Signature] 2/27/2016 DATE
CHIEF, BUREAU OF HIGHWAYS

APPROVED: DEPARTMENT OF PLANNING AND ZONING
[Signature] 6-21-16 DATE
CHIEF, DIVISION OF LAND DEVELOPMENT

[Signature] 3-2-16 DATE
CHIEF, DEVELOPMENT ENGINEERING DIVISION

OWNERS
LIME KILN, LLC
12549 LIME KILN ROAD
FULTON, MARYLAND 20779-0460
410-792-2922

DEVELOPER
WILLIAMSBURG GROUP, LLC
C/O BOB CORBETT
5405 HARRIS FARM ROAD, SUITE 200
COLUMBIA, MARYLAND 21044
410-997-8800

FISHER, COLLINS & CARTER, INC.
CIVIL ENGINEERING CONSULTANTS & LAND SURVEYORS
CENTRAL SQUARE OFFICE PARK - 10272 BALTIMORE NATIONAL PIKE
ELLSWORTH CITY, MARYLAND 21042
(410) 461-2895

PROFESSIONAL CERTIFICATION
I HEREBY CERTIFY THAT THESE DOCUMENTS WERE PREPARED OR APPROVED BY ME AND THAT I AM A DULY LICENSED PROFESSIONAL ENGINEER UNDER THE LAWS OF THE STATE OF MARYLAND, LICENSE NO. 36386, EXPIRATION DATE: 01/12/2016.

[Signature] 2/8/16 DATE
Signature of Professional Engineer



DEVELOPER'S / BUILDER'S CERTIFICATE
I/WE CERTIFY THAT THE LANDSCAPING SHOWN ON THIS PLAN WILL BE DONE ACCORDING TO THE PLAN, SECTION 16.124 OF THE HOWARD COUNTY CODE AND THE HOWARD COUNTY LANDSCAPE MANUAL. I/WE FURTHER CERTIFY THAT UPON COMPLETION, A LETTER OF LANDSCAPE INSTALLATION ACCOMPANIED BY AN EXECUTED ONE YEAR GUARANTEE OF PLANT MATERIALS WILL BE SUBMITTED TO THE DEPARTMENT OF PLANNING AND ZONING.

[Signature] 2-8-16 DATE
NAME Bob Corbett

SOIL	NAME	CLASS	K FACTOR
BeB	Benevolat silt loam, 3 to 8 percent slopes	C	0.43
GgB	Glenelg loam, 3 to 8 percent slopes	B	0.28
GgC	Glenelg loam, 8 to 15 percent slopes	B	0.28
GmB	Glenville silt loam, 3 to 8 percent slopes	C	0.43
MaC	Manor loam, 8 to 15 percent slopes	B	0.28
MaD	Manor loam, 15 to 25 percent slopes	B	0.28
MkF	Manor-Brinklow Complex, 25 to 65 percent slopes, very rocky	B	0.32
WhB	Wiltshire silt loam, 3 to 8 percent slopes	C	0.20


LANDSCAPE & FOREST CONSERVATION PLAN
WESTLAND FARM ESTATES
LOTS 3 THRU 14 AND OPEN SPACE LOT 15
ZONED RR-DEO
TAX MAP No. 45 GRID No. 5 PARCEL No. 28
FIFTH ELECTION DISTRICT HOWARD COUNTY, MARYLAND
SCALE: AS SHOWN DATE: DECEMBER, 2015
SHEET 5 OF 19

AS-BUILT CERTIFICATION
Note: There is no "AS-BUILT" information provided on this sheet.
[Signature] 11/22/20
CHARLES W. CORBETT, P.E. 11/22/20 Date

THERE IS NO "AS-BUILT" INFORMATION PROVIDED ON THIS SHEET

LEGEND		LEGEND	
SYMBOL	DESCRIPTION	SYMBOL	DESCRIPTION
---412---	EXISTING 2' CONTOURS	---	PROPOSED CONTOUR
---410---	EXISTING 10' CONTOURS	+362.5	SPOT ELEVATION
---	SOILS LINES AND TYPE	---	LIMITS OF DISTURBANCE
---	EXISTING TREELINE	---	PROPOSED TREELINE
---	15% TO 24.9% STEEP SLOPES	---	PROPOSED PAWING
---	25% AND GREATER STEEP SLOPES	544	BORING (PERC) TEST HOLE
---	100 YEAR PUBLIC FLOODPLAIN, DRAINAGE AND UTILITY EASEMENT	---	SILT FENCE
---	STREAM BANK BUFFER	---	EROSION CONTROL MATTING
---	EXISTING CENTERLINE OF STREAM	---	SUPER SILT FENCE
---	SPECIMEN TREE	---	DIVERSION FENCE
---	PROPOSED FOREST CONSERVATION EASEMENT	---	STABILIZES CONSTRUCTION ENTRANCE
---	TREE PROTECTIVE FENCING	---	DRAINAGE AREA DIVIDE

SOILS LEGEND			
SOIL	NAME	CLASS	K FACTOR
BeB	Benevola silt loam, 3 to 8 percent slopes	C	0.43
GgB	Glenelg loam, 3 to 8 percent slopes	B	0.28
GgC	Glenelg loam, 8 to 15 percent slopes	B	0.28
GmB	Glenville silt loam, 3 to 8 percent slopes	C	0.43
MaC	Manor loam, 8 to 15 percent slopes	B	0.28
MaD	Manor loam, 15 to 25 percent slopes	B	0.28
MkF	Manor-Brinklow Complex, 25 to 65 percent slopes, very rocky	B	0.32
WhB	Wilshire silt loam, 3 to 8 percent slopes	C	0.20

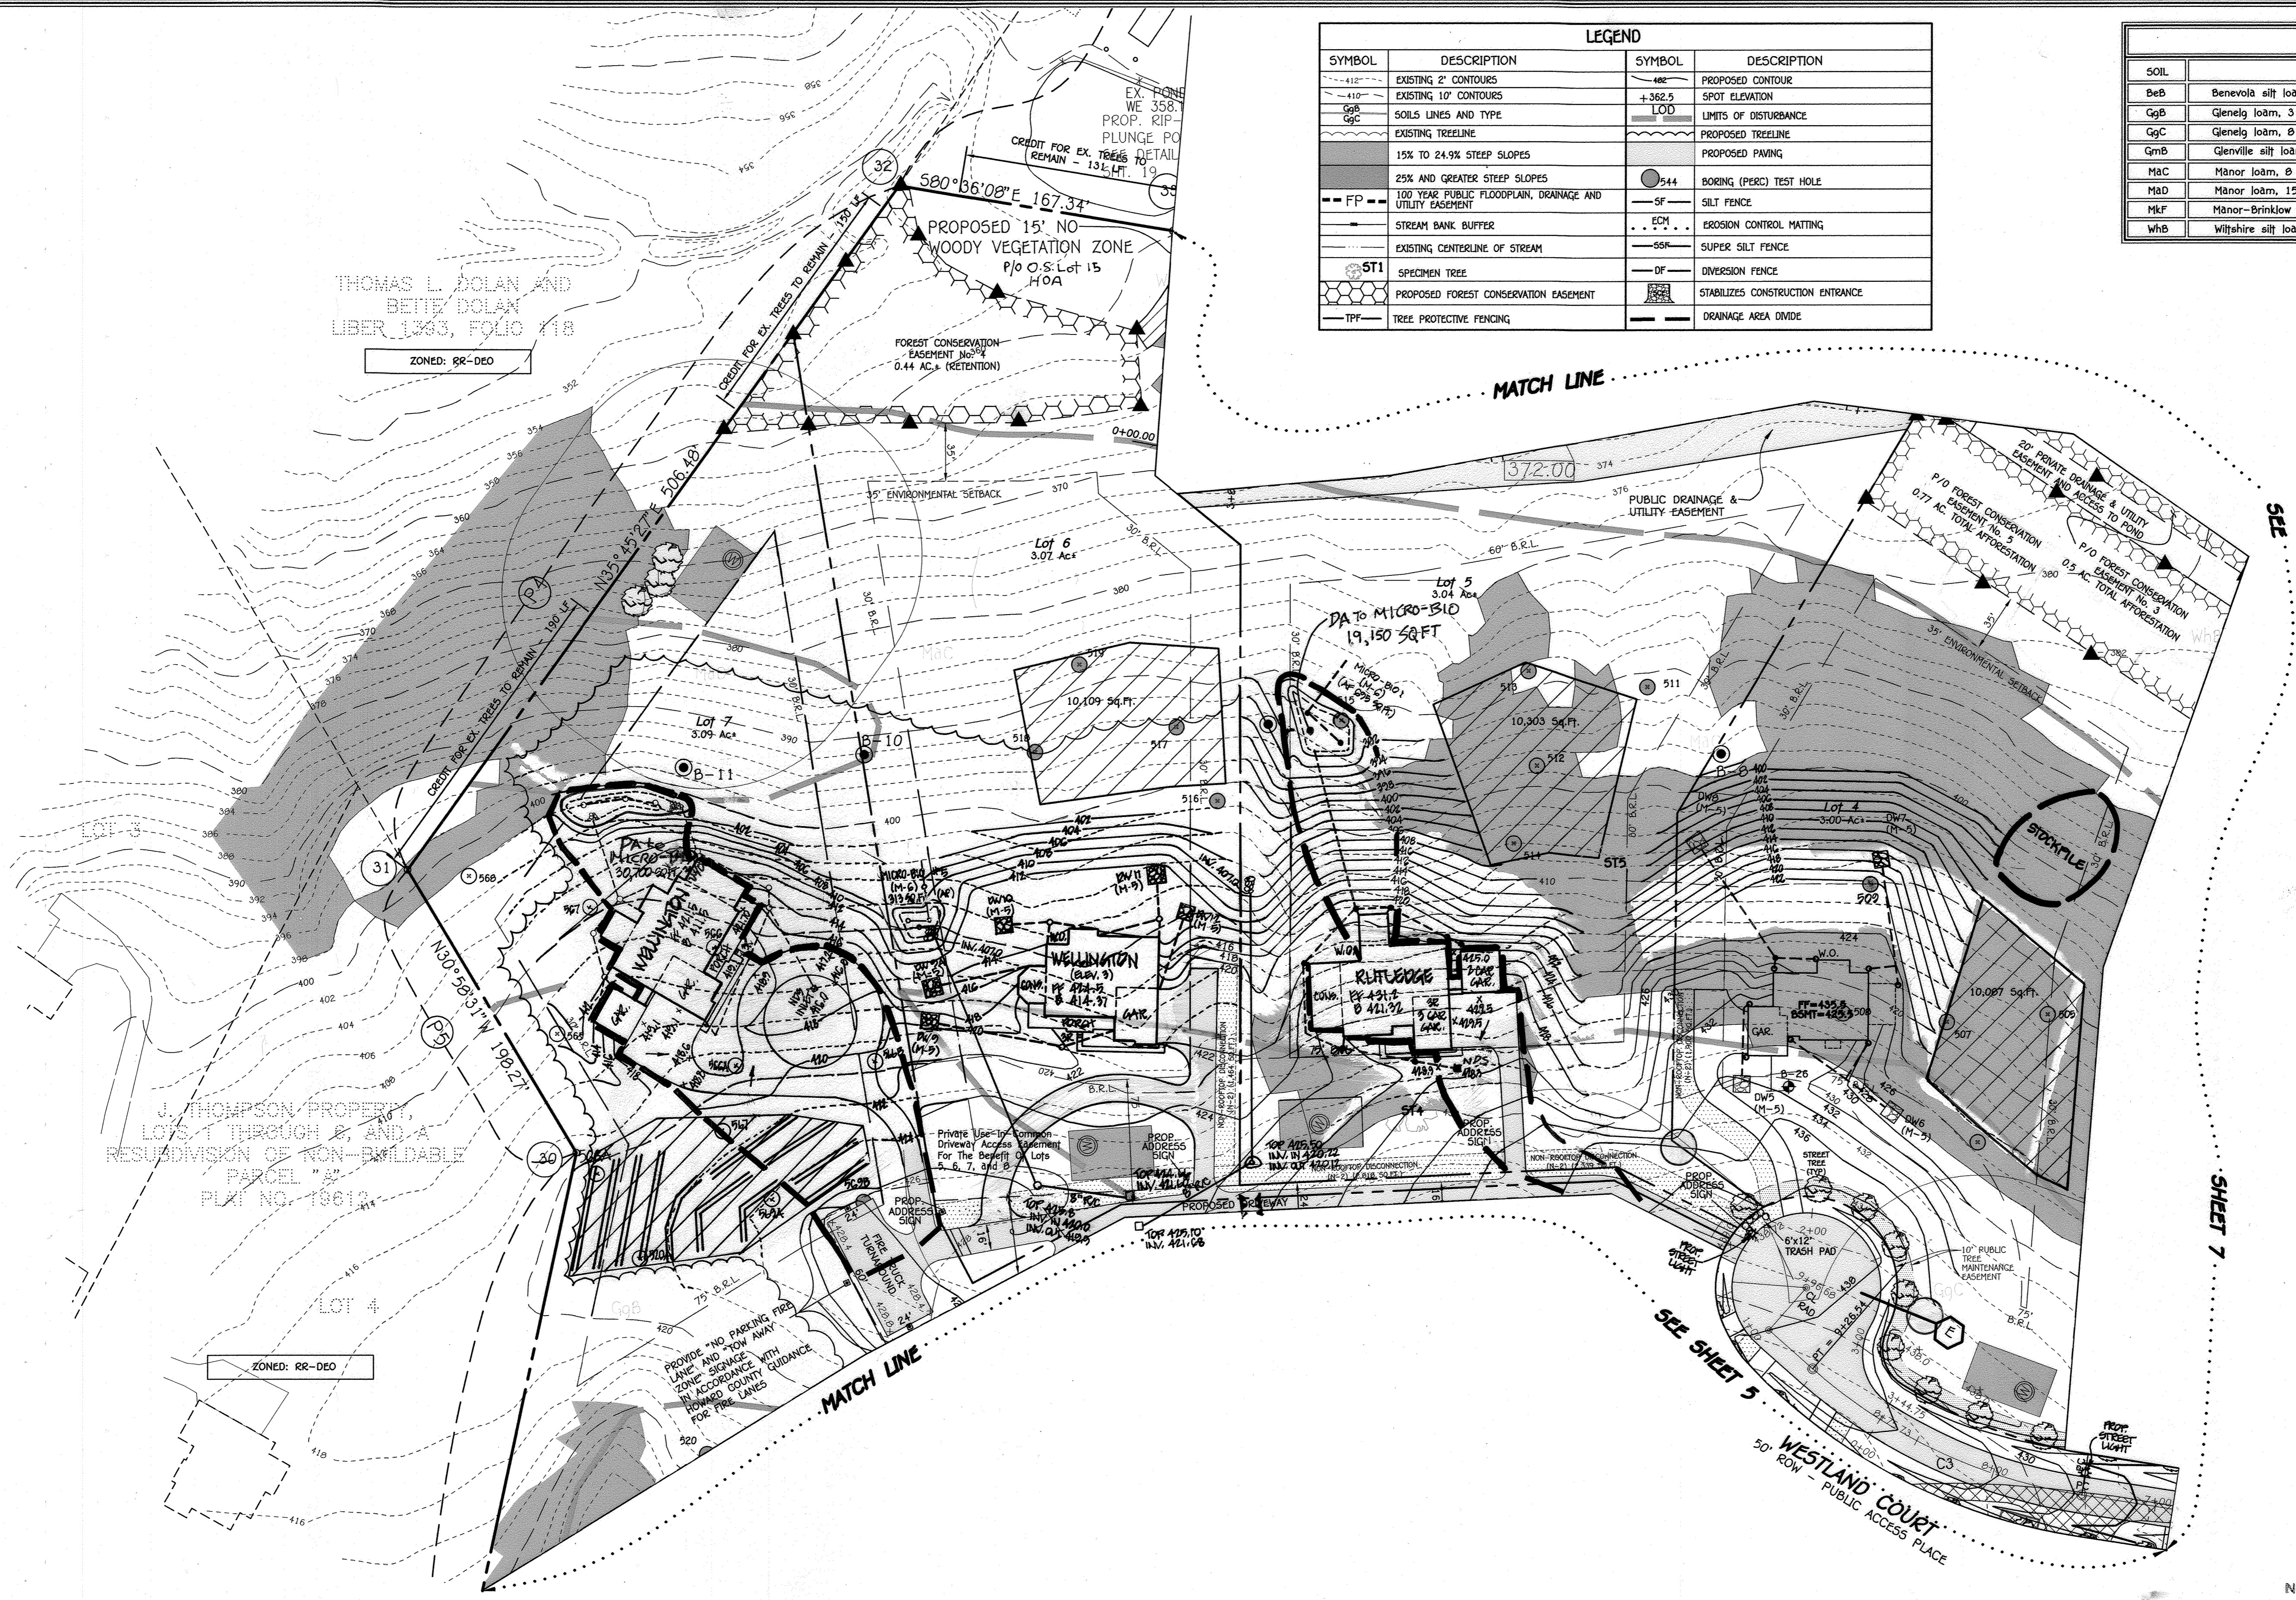

THOMAS L. DOLAN AND BETTE DOLAN
LIBER 1343, FOLIO 118
ZONED: RR-DEO

J. THOMPSON PROPERTY,
LOTS 1 THROUGH 8, AND A
RESUBDIVISION OF NON-BUILDABLE
PARCEL 22
PLAT NO. 19613
ZONED: RR-DEO

NOTE:
THIS PLAN IS TO BE USED FOR INDIVIDUAL
DRIVEWAYS AND HOUSE CONSTRUCTION ALONG
WITH ROAD & STORMWATER MANAGEMENT CONSTRUCTION.

APPROVED: DEPARTMENT OF PUBLIC WORKS
M. Meunier 2/22/2016
CHIEF, BUREAU OF HIGHWAYS
APPROVED: DEPARTMENT OF PLANNING AND ZONING
K. Salas 6-21-16
CHIEF, DIVISION OF LAND DEVELOPMENT
D. Edman 3-2-16
CHIEF, DEVELOPMENT ENGINEERING DIVISION

OWNERS
LIME KILN, LLC
12549 LIME KILN ROAD
FULTON, MARYLAND 20759-0460
410-792-2922
AND
PERRY C. WESTLAND, JR.
12549 LIME KILN ROAD
FULTON, MARYLAND 20759-0460
410-792-2922

DEVELOPER
WILLIAMSBURG GROUP, LLC
C/O BOB CORBETT
5485 HARPERS FARM ROAD, SUITE 200
COLUMBIA, MARYLAND 21044
410-997-8000

FISHER, COLLINS & CARTER, INC.
CENTENAL SQUARE OFFICE PARK - 10722 BALDORNE NATIONAL PIKE
ELLSWORTH CITY, MARYLAND 21042
(410) 461-2895

PROFESSIONAL CERTIFICATION
I HEREBY CERTIFY THAT THESE DOCUMENTS WERE PREPARED OR APPROVED BY ME
AND THAT I AM A DULY LICENSED PROFESSIONAL ENGINEER UNDER THE LAWS OF
THE STATE OF MARYLAND, LICENSE NO. 38386, EXPIRATION DATE: 01/12/2016.
Meunier 2/8/16
Signature of Professional Engineer DATE



DEVELOPER'S / BUILDER'S CERTIFICATE
I/WE CERTIFY THAT THE LANDSCAPING SHOWN ON THIS PLAN WILL BE DONE ACCORDING TO THE
PLAN, SECTION 16.124 OF THE HOWARD COUNTY CODE AND THE HOWARD COUNTY LANDSCAPE
MANUAL. I/WE FURTHER CERTIFY THAT UPON COMPLETION, A LETTER OF LANDSCAPE INSTALLATION
ACCOMPANIED BY AN EXECUTED ONE YEAR GUARANTEE OF PLANT MATERIALS WILL BE SUBMITTED
TO THE DEPARTMENT OF PLANNING AND ZONING.
NAME: _____ DATE: 2-8-16


DATE	REVISION
10/17/10	REVISE HOG CREEK & DRIVEWAY LOTS 9, TO EXISTENCE
11/18/10	ADD INLETS, PIPING, AROUND HOUSE, LOT 6
9/6/10	REVISE THE SITE LOT 7, ADD CIRCULAR DRIVEWAY, PROPOSED DRIVEWAY & DRIVEWAY AREA TO LOT 7
9/20/10	REVISE HOUSE DRIVEWAY, GRADING, SEWAGE CONTROLS & DRAINAGE AREAS LOT 7
9/2/10	REVISE THE 2' AND 4' DEEP BOX TO WELLINGTON DRIVE & ADD 2' DEEP DRIVEWAY TO LOT 7
6/6/17	REVISE DRIVEWAY ON LOT 4 & REVISED PROPOSED TREELINE ON LOT 4 & 15
11/16/16	ADD PROPOSED GRADING FOR A POND ON LOT 4 & ADD STREET LIGHT POSITION

PLAN VIEW
SCALE: 1" = 50'
0' 50' 100' 150'
Scale: 1" = 50'

AS-BUILT CERTIFICATION
Note: There is no "AS-BUILT" information
provided on this sheet.
[Signature] 11/22/20
DATE

LANDSCAPE & FOREST CONSERVATION PLAN
WESTLAND FARM ESTATES
LOTS 3 THRU 14 AND OPEN SPACE LOT 15
ZONED RR-DEO
TAX MAP No. 45 GRID No. 5 PARCEL No. 28
FIFTH ELECTION DISTRICT HOWARD COUNTY, MARYLAND
SCALE: AS SHOWN DATE: DECEMBER, 2015
SHEET 6 OF 19

THERE IS NO "AS-BUILT" INFORMATION PROVIDED ON THIS SHEET

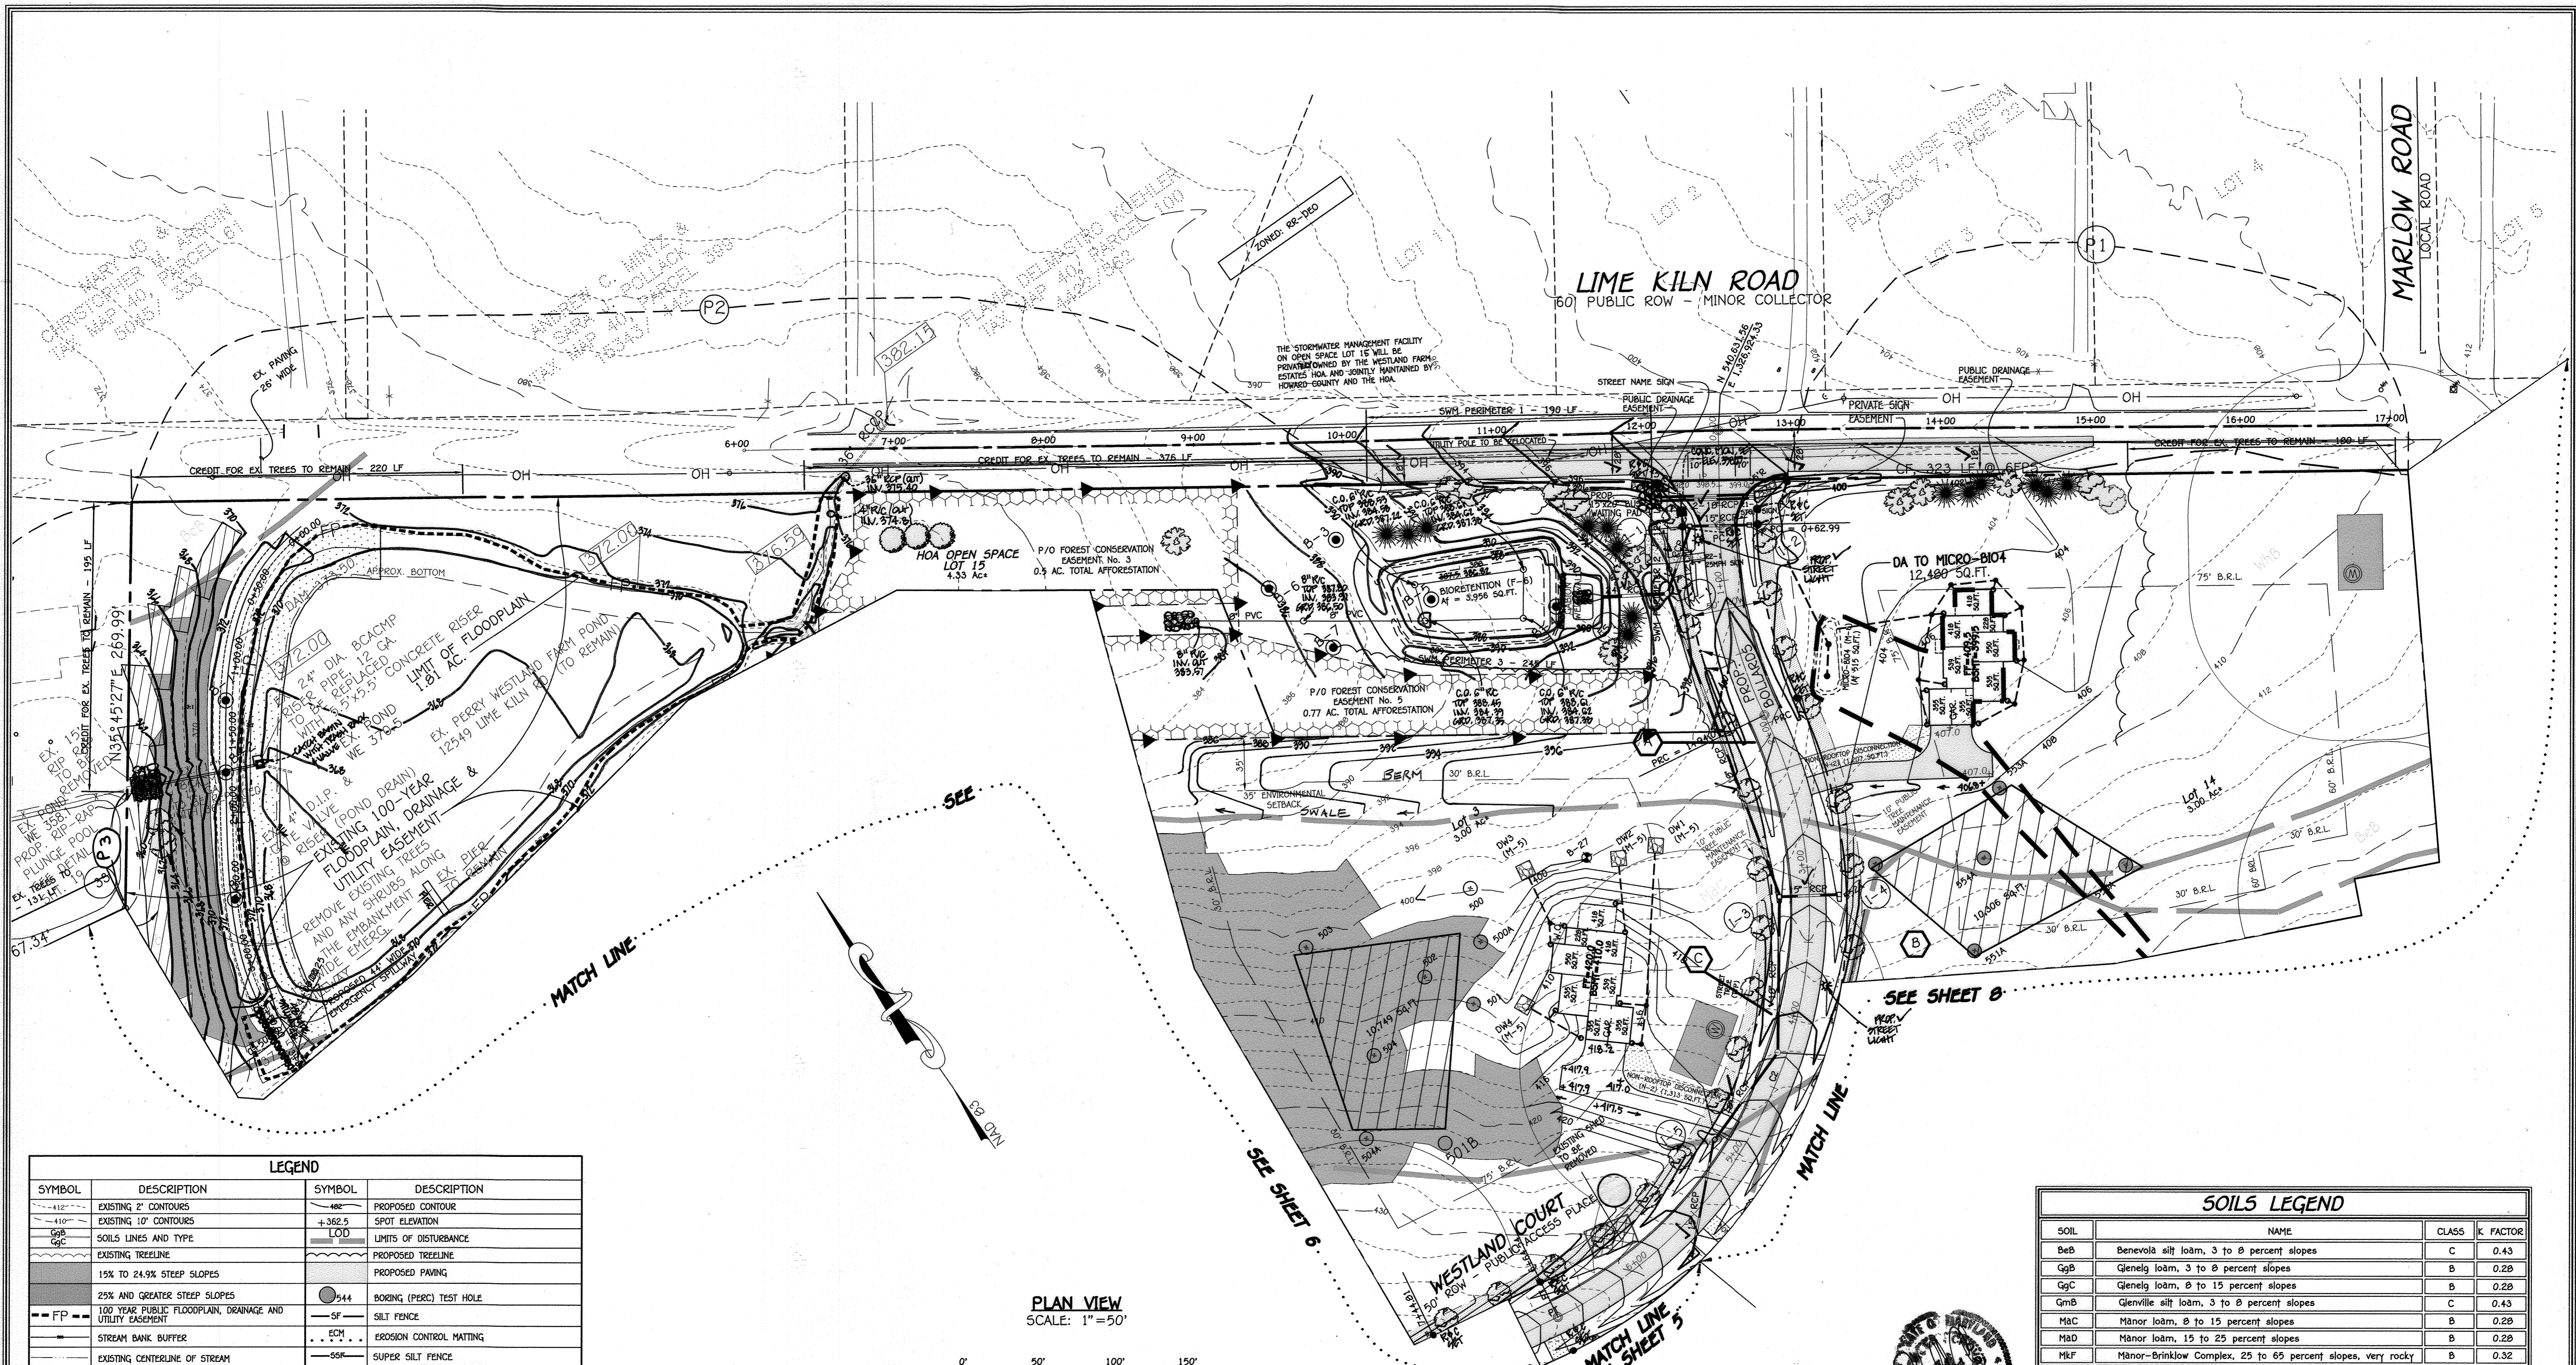


LEGEND

SYMBOL	DESCRIPTION	SYMBOL	DESCRIPTION
---412---	EXISTING 2' CONTOURS	---406---	PROPOSED CONTOUR
---410---	EXISTING 10' CONTOURS	+362.5	SPOT ELEVATION
GgB	SOILS LINES AND TYPE	LOD	LIMITS OF DISTURBANCE
GgC		---	PROPOSED TREETRUELINE
---	EXISTING TREETRUELINE	---	PROPOSED PAVING
15% TO 24.9% STEEP SLOPES		⊙44	BORING (PERC) TEST HOLE
25% AND GREATER STEEP SLOPES		---SF---	SILT FENCE
100 YEAR PUBLIC FLOODPLAIN, DRAINAGE AND UTILITY EASEMENT		---ECH---	EROSION CONTROL MATTING
STREAM BANK BUFFER		---SSC---	SUPER SILT FENCE
EXISTING CENTERLINE OF STREAM		---DF---	DIVERSION FENCE
ST1	SPECIMEN TREE	---	STABILIZES CONSTRUCTION ENTRANCE
---	PROPOSED FOREST CONSERVATION EASEMENT	---	PROPOSED AREA FOR CLAY LAYER IN EX. POND
---	TREE PROTECTIVE FENCING		

SOILS LEGEND

SOIL	NAME	CLASS	K FACTOR
BeB	Benevola silt loam, 3 to 8 percent slopes	C	0.43
GgB	Glenelg loam, 3 to 8 percent slopes	B	0.28
GgC	Glenelg loam, 8 to 15 percent slopes	B	0.28
GmB	Glenville silt loam, 3 to 8 percent slopes	C	0.43
MaC	Manor loam, 8 to 15 percent slopes	B	0.28
MaD	Manor loam, 15 to 25 percent slopes	B	0.28
MkF	Manor-Brinklow Complex, 25 to 65 percent slopes, very rocky	B	0.32
WhB	Wiltshire silt loam, 3 to 8 percent slopes	C	0.20

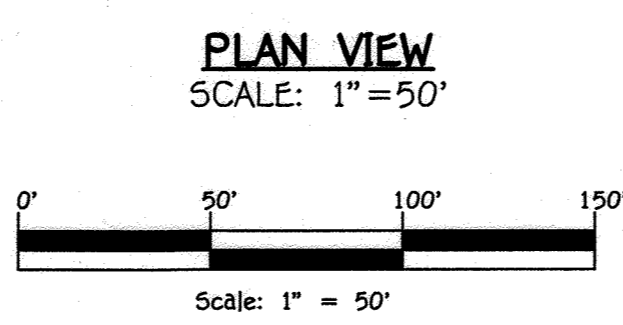

NOTE:
THIS PLAN IS TO BE USED FOR INDIVIDUAL DRIVEWAYS AND HOUSE CONSTRUCTION ALONG WITH ROAD & STORMWATER MANAGEMENT CONSTRUCTION.

APPROVED: DEPARTMENT OF PUBLIC WORKS
[Signature] 2/8/2016
 CHIEF, BUREAU OF HIGHWAYS DATE

APPROVED: DEPARTMENT OF PLANNING AND ZONING
[Signature] 6-21-16
 CHIEF, DIVISION OF LAND DEVELOPMENT DATE

[Signature] 3-2-16
 CHIEF, DEVELOPMENT ENGINEERING DIVISION DATE

OWNERS
 LIME KILN, LLC
 12549 LIME KILN ROAD
 FULTON, MARYLAND 20799-0460
 410-792-2922

AND

PERRY C. WESTLAND, JR.
 12549 LIME KILN ROAD
 FULTON, MARYLAND 20799-0460
 410-792-2922

DEVELOPER
 WILLIAMSBURG GROUP, LLC
 C/O BOB CORBETT
 5485 HARRIS FARM ROAD, SUITE 200
 COLUMBIA, MARYLAND 21044
 410-997-8800


PROFESSIONAL CERTIFICATION
 I HEREBY CERTIFY THAT THESE DOCUMENTS WERE PREPARED OR APPROVED BY ME AND THAT I AM A DULY LICENSED PROFESSIONAL ENGINEER UNDER THE LAWS OF THE STATE OF MARYLAND, LICENSE NO. 38386, EXPIRATION DATE: 01/12/2016.

[Signature] 2/8/16
 Signature of Professional Engineer DATE



DEVELOPER'S / BUILDER'S CERTIFICATE
 I/WE CERTIFY THAT THE LANDSCAPE SHOWN ON THIS PLAN WILL BE DONE ACCORDING TO THE PLAN, SECTION 16.124 OF THE HOWARD COUNTY CODE AND THE HOWARD COUNTY LANDSCAPE MANUAL. I/WE FURTHER CERTIFY THAT UPON COMPLETION, A LETTER OF LANDSCAPE INSTALLATION ACCOMPANIED BY AN EXECUTED ONE-YEAR GUARANTEE OF PLANT MATERIALS WILL BE SUBMITTED TO THE DEPARTMENT OF PLANNING AND ZONING.

[Signature] 2-8-16
 NAME DATE

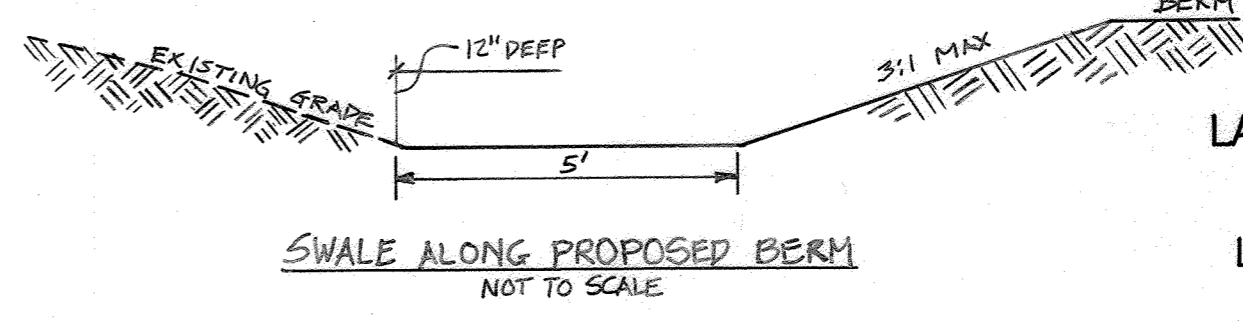


6/5/17 REWARD GRADING OF BERM AT REAR OF LOT 3
 11/16/16 AND PROPOSED GRADING FOR A BERM ON LOT 3 & AND STREET LIGHT REVISION

LANDSCAPE & FOREST CONSERVATION PLAN
WESTLAND FARM ESTATES
 LOTS 3 THRU 14 AND OPEN SPACE LOT 15
 ZONED RR-DEO
 TAX MAP No. 45 GRID No. 5 PARCEL No. 28
 FIFTH ELECTION DISTRICT HOWARD COUNTY, MARYLAND
 SCALE: AS SHOWN DATE: DECEMBER, 2015
 SHEET 7 OF 19

F-15-038
 "AS-BUILT"




SOILS LEGEND			
SOIL	NAME	CLASS	K FACTOR
BeB	Benevola silt loam, 3 to 8 percent slopes	C	0.43
GgB	Glenelg loam, 3 to 8 percent slopes	B	0.28
GgC	Glenelg loam, 8 to 15 percent slopes	B	0.28
GmB	Glenville silt loam, 3 to 8 percent slopes	C	0.43
MaC	Manor loam, 8 to 15 percent slopes	B	0.28
MaD	Manor loam, 15 to 25 percent slopes	B	0.28
MkF	Manor-Brinklow Complex, 25 to 65 percent slopes, very rocky	B	0.32
WhB	Wiltshire silt loam, 3 to 8 percent slopes	C	0.20

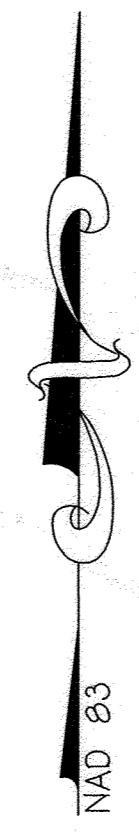

LEGEND			
SYMBOL	DESCRIPTION	SYMBOL	DESCRIPTION
---412---	EXISTING 2' CONTOURS	---412---	PROPOSED CONTOUR
---410---	EXISTING 10' CONTOURS	+362.5	SPOT ELEVATION
GgB	SOILS LINES AND TYPE	LOD	LIMITS OF DISTURBANCE
---	EXISTING TREELINE	---	PROPOSED TREELINE
---	15% TO 24.9% STEEP SLOPES	---	PROPOSED PAVING
---	25% AND GREATER STEEP SLOPES	544	BORING (PERC) TEST HOLE
FP	100 YEAR PUBLIC FLOODPLAIN, DRAINAGE AND UTILITY EASEMENT	SF	SILT FENCE
---	STREAM BANK BUFFER	---	EROSION CONTROL MATTING
---	EXISTING CENTERLINE OF STREAM	---	SUPER SILT FENCE
ST1	SPECIMEN TREE	DF	DIVERSION FENCE
---	PROPOSED FOREST CONSERVATION EASEMENT	---	STABILIZES CONSTRUCTION ENTRANCE
TPF	TREE PROTECTIVE FENCING		

PLAN VIEW
SCALE: 1" = 50'

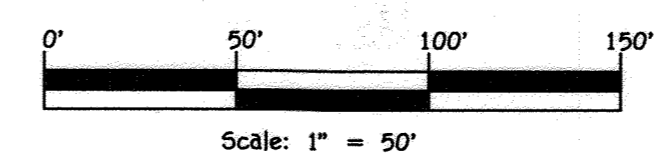

APPROVED: DEPARTMENT OF PUBLIC WORKS
[Signature] 2/22/2016
 CHIEF, BUREAU OF HIGHWAYS DATE

APPROVED: DEPARTMENT OF PLANNING AND ZONING
[Signature] 6-21-16
 CHIEF, DIVISION OF LAND DEVELOPMENT DATE

[Signature] 3-2-16
 CHIEF, DEVELOPMENT ENGINEERING DIVISION DATE

OWNERS
 LIME KILN, LLC
 12549 LIME KILN ROAD
 FULTON, MARYLAND 20759-0460
 410-792-2922

AND
 PERRY C. WESTLAND, JR.
 12549 LIME KILN ROAD
 FULTON, MARYLAND 20759-0460
 410-792-2922

DEVELOPER
 WILLIAMSBURG GROUP, LLC
 C/O BOB CORBETT
 5405 HARPER'S FARM ROAD, SUITE 200
 COLUMBIA, MARYLAND 21044
 410-997-0800

FISHER, COLLINS & CARTER, INC.
 CIVIL ENGINEERING CONSULTANTS & LAND SURVEYORS
 CENTONIAL SQUARE OFFICE PARK - 10272 BALTIMORE NATIONAL PIKE
 ELICOTT CITY, MARYLAND 21042
 410-461-2292

PROFESSIONAL CERTIFICATION
 I HEREBY CERTIFY THAT THESE DOCUMENTS WERE PREPARED OR APPROVED BY ME AND THAT I AM A DULY LICENSED PROFESSIONAL ENGINEER UNDER THE LAWS OF THE STATE OF MARYLAND, LICENSE NO. 30386, EXPIRATION DATE: 01/12/2016.
[Signature] 12/2/15
 Signature of Professional Engineer DATE



DEVELOPER'S / BUILDER'S CERTIFICATE
 I/WE CERTIFY THAT THE LANDSCAPING SHOWN ON THIS PLAN WILL BE DONE ACCORDING TO THE PLAN, SECTION 16.124 OF THE HOWARD COUNTY CODE AND THE HOWARD COUNTY LANDSCAPE MANUAL. I/WE FURTHER CERTIFY THAT UPON COMPLETION, A LETTER OF LANDSCAPE INSTALLATION ACCOMPANIED BY AN EXECUTED ONE YEAR GUARANTEE OF PLANT MATERIALS WILL BE SUBMITTED TO THE DEPARTMENT OF PLANNING AND ZONING.
[Signature] 1-4-16
 NAME DATE

AS-BUILT CERTIFICATION
 Note: There is no "AS BUILT" information provided on this sheet.
[Signature] 11/22/20
 DATE


12/17/19
 DATE

LANDSCAPE & FOREST CONSERVATION PLAN
WESTLAND FARM ESTATES
 LOTS 3 THRU 14 AND OPEN SPACE LOT 15
 ZONED RR-DEO
 TAX MAP No. 45 GRID No. 5 PARCEL No. 28
 FIFTH ELECTION DISTRICT HOWARD COUNTY, MARYLAND
 SCALE: AS SHOWN DATE: DECEMBER, 2015
 SHEET 8 OF 19
 F-15-038

THERE IS NO "AS-BUILT" INFORMATION PROVIDED ON THIS SHEET

LEGEND			
SYMBOL	DESCRIPTION	SYMBOL	DESCRIPTION
---412---	EXISTING 2' CONTOURS	---482---	PROPOSED CONTOUR
---410---	EXISTING 10' CONTOURS	+362.5	SPOT ELEVATION
---	SOILS LINES AND TYPE	---	LIMITS OF DISTURBANCE
---	EXISTING TREELINE	---	PROPOSED TREELINE
---	15% TO 24.9% STEEP SLOPES	---	PROPOSED PAVING
---	25% AND GREATER STEEP SLOPES	544	BORING (PERC) TEST HOLE
---	100 YEAR PUBLIC FLOODPLAIN, DRAINAGE AND UTILITY EASEMENT	SF	SILT FENCE
---	STREAM BANK BUFFER	ECM	EROSION CONTROL MATTING
---	EXISTING CENTERLINE OF STREAM	SSS	SUPER SILT FENCE
ST1	SPECIMEN TREE	DF	DIVERSION FENCE
---	PROPOSED FOREST CONSERVATION EASEMENT	---	STABILIZES CONSTRUCTION ENTRANCE
---	TREE PROTECTIVE FENCING	---	DRAINAGE AREA DIVIDE


SOILS LEGEND			
SOIL	NAME	CLASS	K FACTOR
BeB	Benevola silt loam, 3 to 8 percent slopes	C	0.43
GgB	Gleniel loam, 3 to 8 percent slopes	B	0.28
GgC	Gleniel loam, 8 to 15 percent slopes	B	0.28
GmB	Glenville silt loam, 3 to 8 percent slopes	C	0.43
MaC	Manor loam, 8 to 15 percent slopes	B	0.28
MaD	Manor loam, 15 to 25 percent slopes	B	0.28
MkF	Manor-Brinklow Complex, 25 to 65 percent slopes, very rocky	B	0.32
WhB	Wiltshire silt loam, 3 to 8 percent slopes	C	0.20

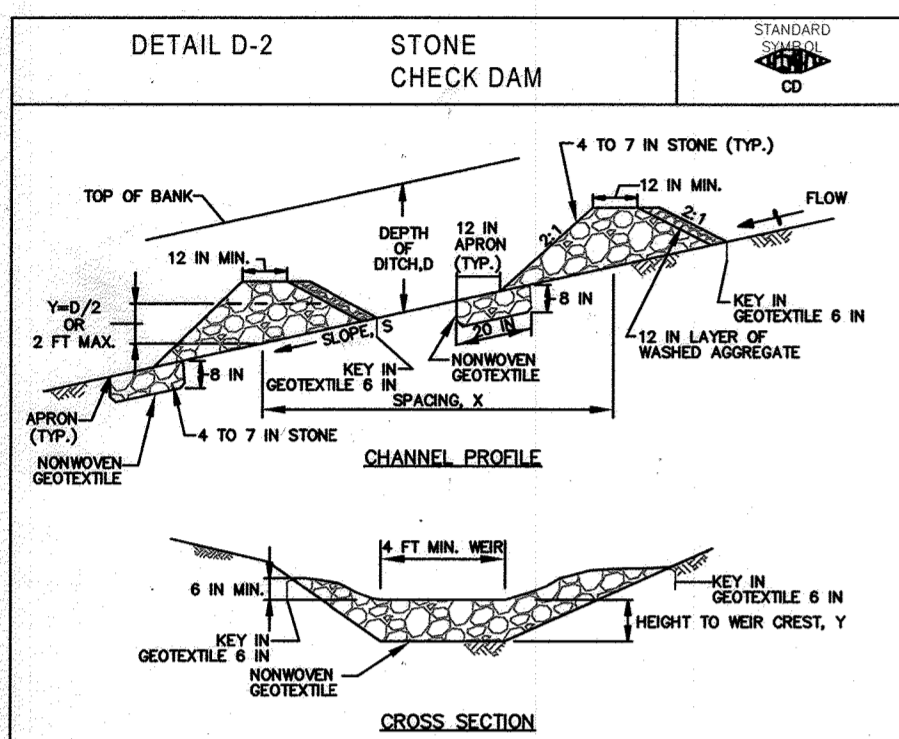

CONSTRUCTION SPECIFICATIONS

- PREPARE SWALES IN ACCORDANCE WITH THE CONSTRUCTION SPECIFICATIONS DESCRIBED IN SECTION C-2, STANDARDS AND SPECIFICATIONS FOR TEMPORARY SWALE, OR AS SPECIFIED ON PLAN.
- PLACE NONWOVEN GEOTEXTILE, AS SPECIFIED IN SECTION H-1 MATERIALS, UNDER THE BOTTOM AND SIDES OF THE DAM PRIOR TO PLACEMENT OF STONE. CONSTRUCT THE CHECK DAM WITH WASHED 4 TO 7 INCH STONE OR EQUIVALENT RECYCLED CONCRETE (WITHOUT REBAR) WITH SLOPE SIDES OF 2:1 OR FLATTER AND A MINIMUM TOP WIDTH OF 12 INCHES. PLACE THE STONE SO THAT IT COMPLETELY COVERS THE WIDTH OF THE CHANNEL AND CHANNEL BANKS FROM THE WEIR SO THAT TOP OF THE OUTLET CREST IS APPROXIMATELY 6 INCHES LOWER THAN THE OUTER EDGES. LINE THE UPSTREAM FACE OF THE DAM WITH A 1 FOOT THICK LAYER OF WASHED AGGREGATE (3/4 TO 1 1/2 INCH).
- SET THE HEIGHT FOR THE WEIR CREST EQUAL TO ONE-HALF THE DEPTH OF THE CHANNEL OR DITCH TO AVOID SCOUR. THE MAXIMUM HEIGHT OF THE WEIR CREST MUST NOT EXCEED 2.0 FEET.
- REMOVE ACCUMULATED SEDIMENT WHEN IT REACHES ONE-HALF OF THE HEIGHT OF THE WEIR CREST. MAINTAIN LINE, GRADE, AND CROSS SECTION.

MARYLAND STANDARDS AND SPECIFICATIONS FOR SOIL EROSION AND SEDIMENT CONTROL
U.S. DEPARTMENT OF AGRICULTURE NATIONAL RESOURCES CONSERVATION SERVICE, 2011

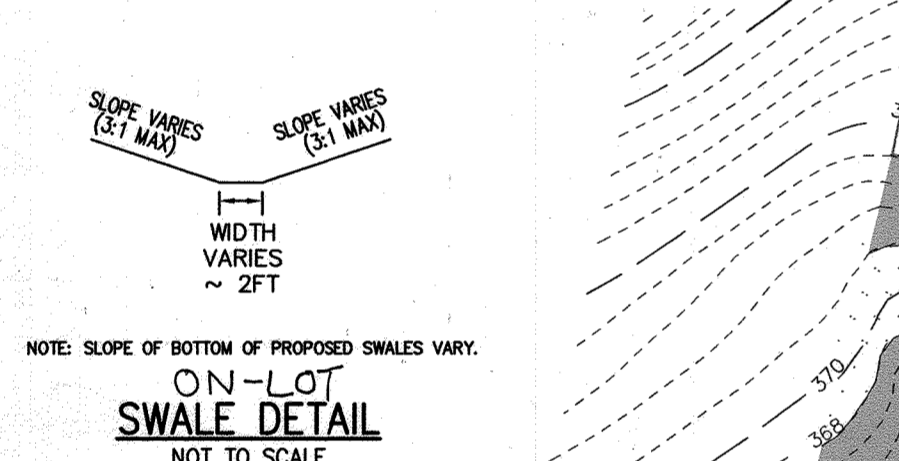

DATE	REVISION
5/16/10	REVISED HERE & AREA LOT 16, FROM GEN. BOX TO RUTLEDGE
11/7/10	REVISED HERE & AREA LOT 9, FROM GEN. BOX TO RUTLEDGE
9/9/10	REVISED HERE & AREA LOT 10, FROM GEN. BOX TO WELLINGTON
9/11/10	REVISED HERE & AREA LOT 9, FROM GEN. BOX TO RUTLEDGE
6/6/17	REVISED DESIGN OF DAM ON LOTS 3 & 4 AND REVISED PROPOSED TREELINE ON LOT 17

THIS DEVELOPMENT IS APPROVED FOR SOIL EROSION AND SEDIMENT CONTROL BY THE HOWARD SOIL CONSERVATION DISTRICT.

APPROVED: *John L. Robertson* 12/16/15
HOWARD SOIL CONSERVATION DISTRICT

APPROVED: DEPARTMENT OF PUBLIC WORKS
Meunier 2/22/2016
CHIEF, BUREAU OF HIGHWAYS

APPROVED: DEPARTMENT OF PLANNING AND ZONING
Katsheloh 6-21-16
CHIEF, DIVISION OF LAND DEVELOPMENT

Chad Eshen 3-2-16
CHIEF, DEVELOPMENT ENGINEERING DIVISION

OWNERS
LIME KILN, LLC
12549 LIME KILN ROAD
FULTON, MARYLAND 20779-0460
410-792-2922

DEVELOPER
WILLIAMSBURG GROUP, LLC
C/O BOB CORBETT
5485 HARRIS FARM ROAD, SUITE 200
COLUMBIA, MARYLAND 21044
410-997-8800

AND
PERRY C. WESTLAND, JR.
12549 LIME KILN ROAD
FULTON, MARYLAND 20779-0460
410-792-2922

FISHER, COLLINS & CARTER, INC.
CIVIL ENGINEERING CONSULTANTS & LAND SURVEYORS
CENTENNIAL SQUARE OFFICE PARK - 10272 BALTIMORE NATIONAL PIKE
ELICOTT CITY, MARYLAND 21042
(410) 461-2855

PROFESSIONAL CERTIFICATION
I HEREBY CERTIFY THAT THESE DOCUMENTS WERE PREPARED OR APPROVED BY ME AND THAT I AM A DULY LICENSED PROFESSIONAL ENGINEER UNDER THE LAWS OF THE STATE OF MARYLAND, LICENSE NO. 363366, EXPIRATION DATE: 01/12/2016.

Stephanie Lutz 12/9/15
Signature of Professional Engineer DATE

ENGINEER'S CERTIFICATE
I/WE CERTIFY THAT THIS PLAN FOR EROSION AND SEDIMENT CONTROL REPRESENTS A PRACTICAL AND WORKABLE PLAN BASED ON MY PERSONAL KNOWLEDGE OF THE SITE CONDITIONS AND THAT IT WAS PREPARED IN ACCORDANCE WITH THE REQUIREMENTS OF THE HOWARD SOIL CONSERVATION DISTRICT.

Stephanie Lutz 12/9/15
SIGNATURE OF ENGINEER DATE

DRAINAGE AREA TO TEMPORARY STONE OUTLET STRUCTURE (TSOS)
0.37 ACRES
737 CY STORAGE
TOP = 410 (687 SQ.FT.)
BOTTOM = 408 (199 SQ.FT.)

BUILDER/DEVELOPER'S CERTIFICATE
I/WE CERTIFY THAT ALL DEVELOPMENT AND CONSTRUCTION WILL BE DONE ACCORDING TO THIS PLAN, FOR SEDIMENT AND EROSION CONTROL AND THAT ANY RESPONSIBLE PERSONNEL INVOLVED IN THE CONSTRUCTION PROJECT WILL HAVE A CERTIFICATE OF ATTENDANCE AT A DEPARTMENT OF THE ENVIRONMENT APPROVED TRAINING PROGRAM FOR THE CONTROL OF SEDIMENT AND EROSION BEFORE BEGINNING THE PROJECT. I ALSO AUTHORIZE PERIODIC ON-SITE INSPECTION BY THE HOWARD SOIL CONSERVATION DISTRICT.

[Signature] 1-4-16
SIGNATURE OF DEVELOPER DATE

AS-BUILT CERTIFICATION
Note: There is no "AS BUILT" information provided on this sheet.

[Signature] 1/22/16
Date

GRADING AND EROSION & SEDIMENT CONTROL PLAN
WESTLAND FARM ESTATES
LOTS 3 THRU 14 AND OPEN SPACE LOT 15
ZONED RR-DEO
TAX MAP No. 45 GRID No. 5 PARCEL No. 28
FIFTH ELECTION DISTRICT HOWARD COUNTY, MARYLAND
SCALE: AS SHOWN DATE: DECEMBER, 2015
SHEET 9 OF 19

PLAN VIEW
SCALE: 1"=50'

Scale: 1" = 50'

0' 50' 100' 150'

NAD 83


F-15-038

THERE IS NO "AS-BUILT" INFORMATION PROVIDED ON THIS SHEET

DETAIL E-9-2 AT-GRADE INLET PROTECTION

STANDARD SYMBOL
AGIP

MAXIMUM DRAINAGE AREA = 1 ACRE

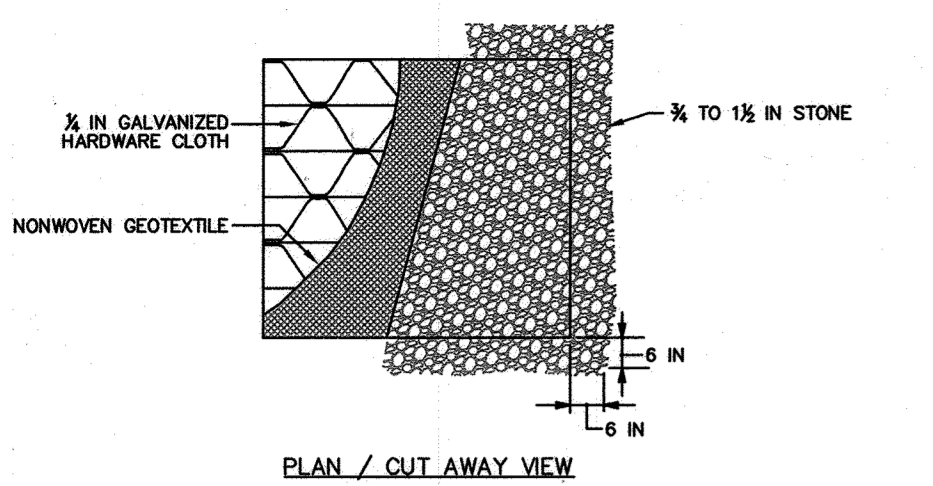

DRAINAGE AREA TO TEMPORARY STONE OUTLET STRUCTURE (TSOS)
0.50 ACRES
923 CY STORAGE
TOP = 409 (125 SQ.FT.)
BOTTOM = 412 (520 SQ.FT.)

DRAINAGE AREA TO TEMPORARY STONE OUTLET STRUCTURE (TSOS)
0.10 ACRES
912 CY STORAGE
TOP = 404.75 (882 SQ.FT.)
BOTTOM = 402.75 (572 SQ.FT.)

CONSTRUCTION SPECIFICATIONS

- USE NONWOVEN GEOTEXTILE AS SPECIFIED IN SECTION H-1 MATERIALS.
- LIFT GRATE AND WRAP WITH NONWOVEN GEOTEXTILE TO COMPLETELY COVER ALL OPENINGS. SECURE WITH WIRE TIES AND SET GRATE BACK IN PLACE.
- PLACE CLEAN 3/4 TO 1 1/2 INCH STONE OR EQUIVALENT RECYCLED CONCRETE 6 INCHES THICK ON THE GRATE.
- STORM DRAIN INLET PROTECTION REQUIRES FREQUENT MAINTENANCE. REMOVE ACCUMULATED SEDIMENT AFTER EACH RAIN EVENT TO MAINTAIN FUNCTION AND AVOID PREMATURE CLOGGING. IF INLET PROTECTION DOES NOT COMPLETELY DRAIN WITHIN 24 HOURS AFTER A STORM EVENT, IT IS CLOGGED. WHEN THIS OCCURS, REMOVE ACCUMULATED SEDIMENT AND CLEAN, OR REPLACE GEOTEXTILE AND STONE.

MARYLAND STANDARDS AND SPECIFICATIONS FOR SOIL EROSION AND SEDIMENT CONTROL
U.S. DEPARTMENT OF AGRICULTURE NATURAL RESOURCES CONSERVATION SERVICE 2011 MARYLAND DEPARTMENT OF ENVIRONMENT AND WATER MANAGEMENT ADMINISTRATION

10/21/17	REVISE HSE, SAND & DRAINAGE, LOT 9, TO REVISE
11/16/19	ADD INLET, PAVING, AROUND HOME, LOT 6
8/6/19	REVISE HSE, GRADING, AND CHECKER DRIVEWAY, SEDIMENT CONTROL
11/5/18	EXPAND LOD WEST OF PROP. HOUSE ON LOT 7
9/20/18	REVISE HOUSE DRIVEWAY, GRADING, + SEDIMENT CONTROLS - LOT 7
8/2/18	REVISE HSE & SAND FROM HSE BOX, TO WELLINGTON & 950, CORNER LOT 6
6/9/17	REVISED GRADING OF BEAM ON LOT 4 & REVISED LOD ON LOTS 6 & 7
11/16/16	ADD PROPOSED GRADING, HSE & BEAM ON LOT 3, PROPOSED ON LOT 4, AND REVISE HSE BOX FROM LOT 3, SAND, SAND, AND SAND
DATE	REVISION

BUILDER/DEVELOPER'S CERTIFICATE

"I/WE CERTIFY THAT ALL DEVELOPMENT AND CONSTRUCTION WILL BE DONE ACCORDING TO THIS PLAN, FOR SEDIMENT AND EROSION CONTROL, AND THAT ANY RESPONSIBLE PERSONNEL INVOLVED IN THE CONSTRUCTION PROJECT WILL HAVE A CERTIFICATE OF ATTENDANCE AT A DEPARTMENT OF THE ENVIRONMENT APPROVED TRAINING PROGRAM FOR THE CONTROL OF SEDIMENT AND EROSION BEFORE BEGINNING THE PROJECT. I ALSO AUTHORIZE PERIODIC ON-SITE INSPECTION BY THE HOWARD SOIL CONSERVATION DISTRICT."

Signature of Developer: [Signature] DATE: 2-1-16

ENGINEER'S CERTIFICATE

"I/WE CERTIFY THAT THIS PLAN FOR EROSION AND SEDIMENT CONTROL REPRESENTS A PRACTICAL AND WORKABLE PLAN BASED ON MY PERSONAL KNOWLEDGE OF THE SITE CONDITIONS AND THAT IT WAS PREPARED IN ACCORDANCE WITH THE REQUIREMENTS OF THE HOWARD SOIL CONSERVATION DISTRICT."

Signature of Engineer: [Signature] DATE: 1/29/16

THIS DEVELOPMENT IS APPROVED FOR SOIL EROSION AND SEDIMENT CONTROL BY THE HOWARD SOIL CONSERVATION DISTRICT.
APPROVED: [Signature] DATE: 2/2/16

APPROVED, DEPARTMENT OF PUBLIC WORKS
CHIEF, BUREAU OF HIGHWAYS DATE: 2/22/2016

APPROVED, DEPARTMENT OF PLANNING AND ZONING
CHIEF, DIVISION OF LAND DEVELOPMENT DATE: 6-21-16

CHIEF, DEVELOPMENT ENGINEERING DIVISION DATE: 3-2-16

FISHER, COLLINS & CARTER, INC.
CIVIL ENGINEERING, CONSULTANTS & LAND SURVEYORS
CENTRAL SQUARE OFFICE PARK - 10272 BALTIMORE NATIONAL PIKE
ELICOTT CITY, MARYLAND 21042
(410) 461-2895

OWNERS
LIME KILN, LLC
12549 LIME KILN ROAD
FULTON, MARYLAND 20799-0460
410-792-2922

DEVELOPER
WILLIAMSBURG GROUP, LLC
C/O BOB CORRETT
5495 HARBERS FARM ROAD, SUITE 200
COLUMBIA, MARYLAND 21044
410-997-8800

AND
PERRY C. WESTLAND, JR.
12549 LIME KILN ROAD
FULTON, MARYLAND 20799-0460
410-792-2922

PROFESSIONAL CERTIFICATION



I HEREBY CERTIFY THAT THESE DOCUMENTS WERE PREPARED OR APPROVED BY ME AND THAT I AM A DULY LICENSED PROFESSIONAL ENGINEER UNDER THE LAWS OF THE STATE OF MARYLAND, LICENSE NO. 38386, EXPIRATION DATE: 01/12/2016.

Signature of Professional Engineer: [Signature] DATE: 1/29/16



LEGEND		LEGEND	
SYMBOL	DESCRIPTION	SYMBOL	DESCRIPTION
-412-	EXISTING 2' CONTOURS	-482-	PROPOSED CONTOUR
-410-	EXISTING 10' CONTOURS	+362.5	SPOT ELEVATION
GgB	SOILS LINES AND TYPE	LOD	LIMITS OF DISTURBANCE
-	EXISTING TREELINE	-	PROPOSED TREELINE
15% TO 24.9% STEEP SLOPES		244	BORING (PERC) TEST HOLE
25% AND GREATER STEEP SLOPES		5F	SILT FENCE
100 YEAR PUBLIC FLOODPLAIN, DRAINAGE AND UTILITY EASEMENT		ECM	EROSION CONTROL MATING
STREAM BANK BUFFER		55F	SUPER SILT FENCE
EXISTING CENTERLINE OF STREAM		DF	DIVERSION FENCE
ST1	SPECIMEN TREE	-	STABILIZES CONSTRUCTION ENTRANCE
-	PROPOSED FOREST CONSERVATION EASEMENT	-	DRAINAGE AREA DIVIDE
TPF	TREE PROTECTIVE FENCING		

SOILS LEGEND			
SOIL	NAME	CLASS	K FACTOR
BeB	Benevola silt loam, 3 to 8 percent slopes	C	0.43
GgB	Glenelg loam, 3 to 8 percent slopes	B	0.28
GgC	Glenelg loam, 8 to 15 percent slopes	B	0.28
GmB	Glenville silt loam, 3 to 8 percent slopes	C	0.43
MaC	Manor loam, 8 to 15 percent slopes	B	0.28
MaD	Manor loam, 15 to 25 percent slopes	B	0.28
MkF	Manor-Brinklow Complex, 25 to 65 percent slopes, very rocky	B	0.32
WhB	Wiltshire silt loam, 3 to 8 percent slopes	C	0.20

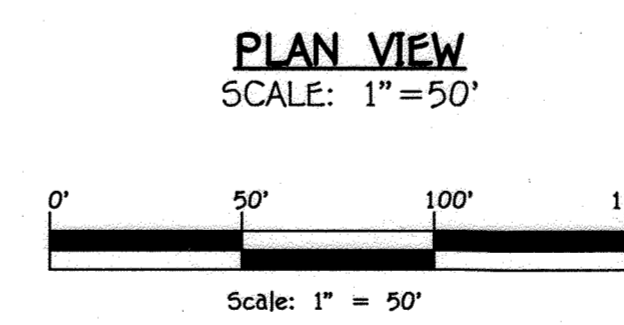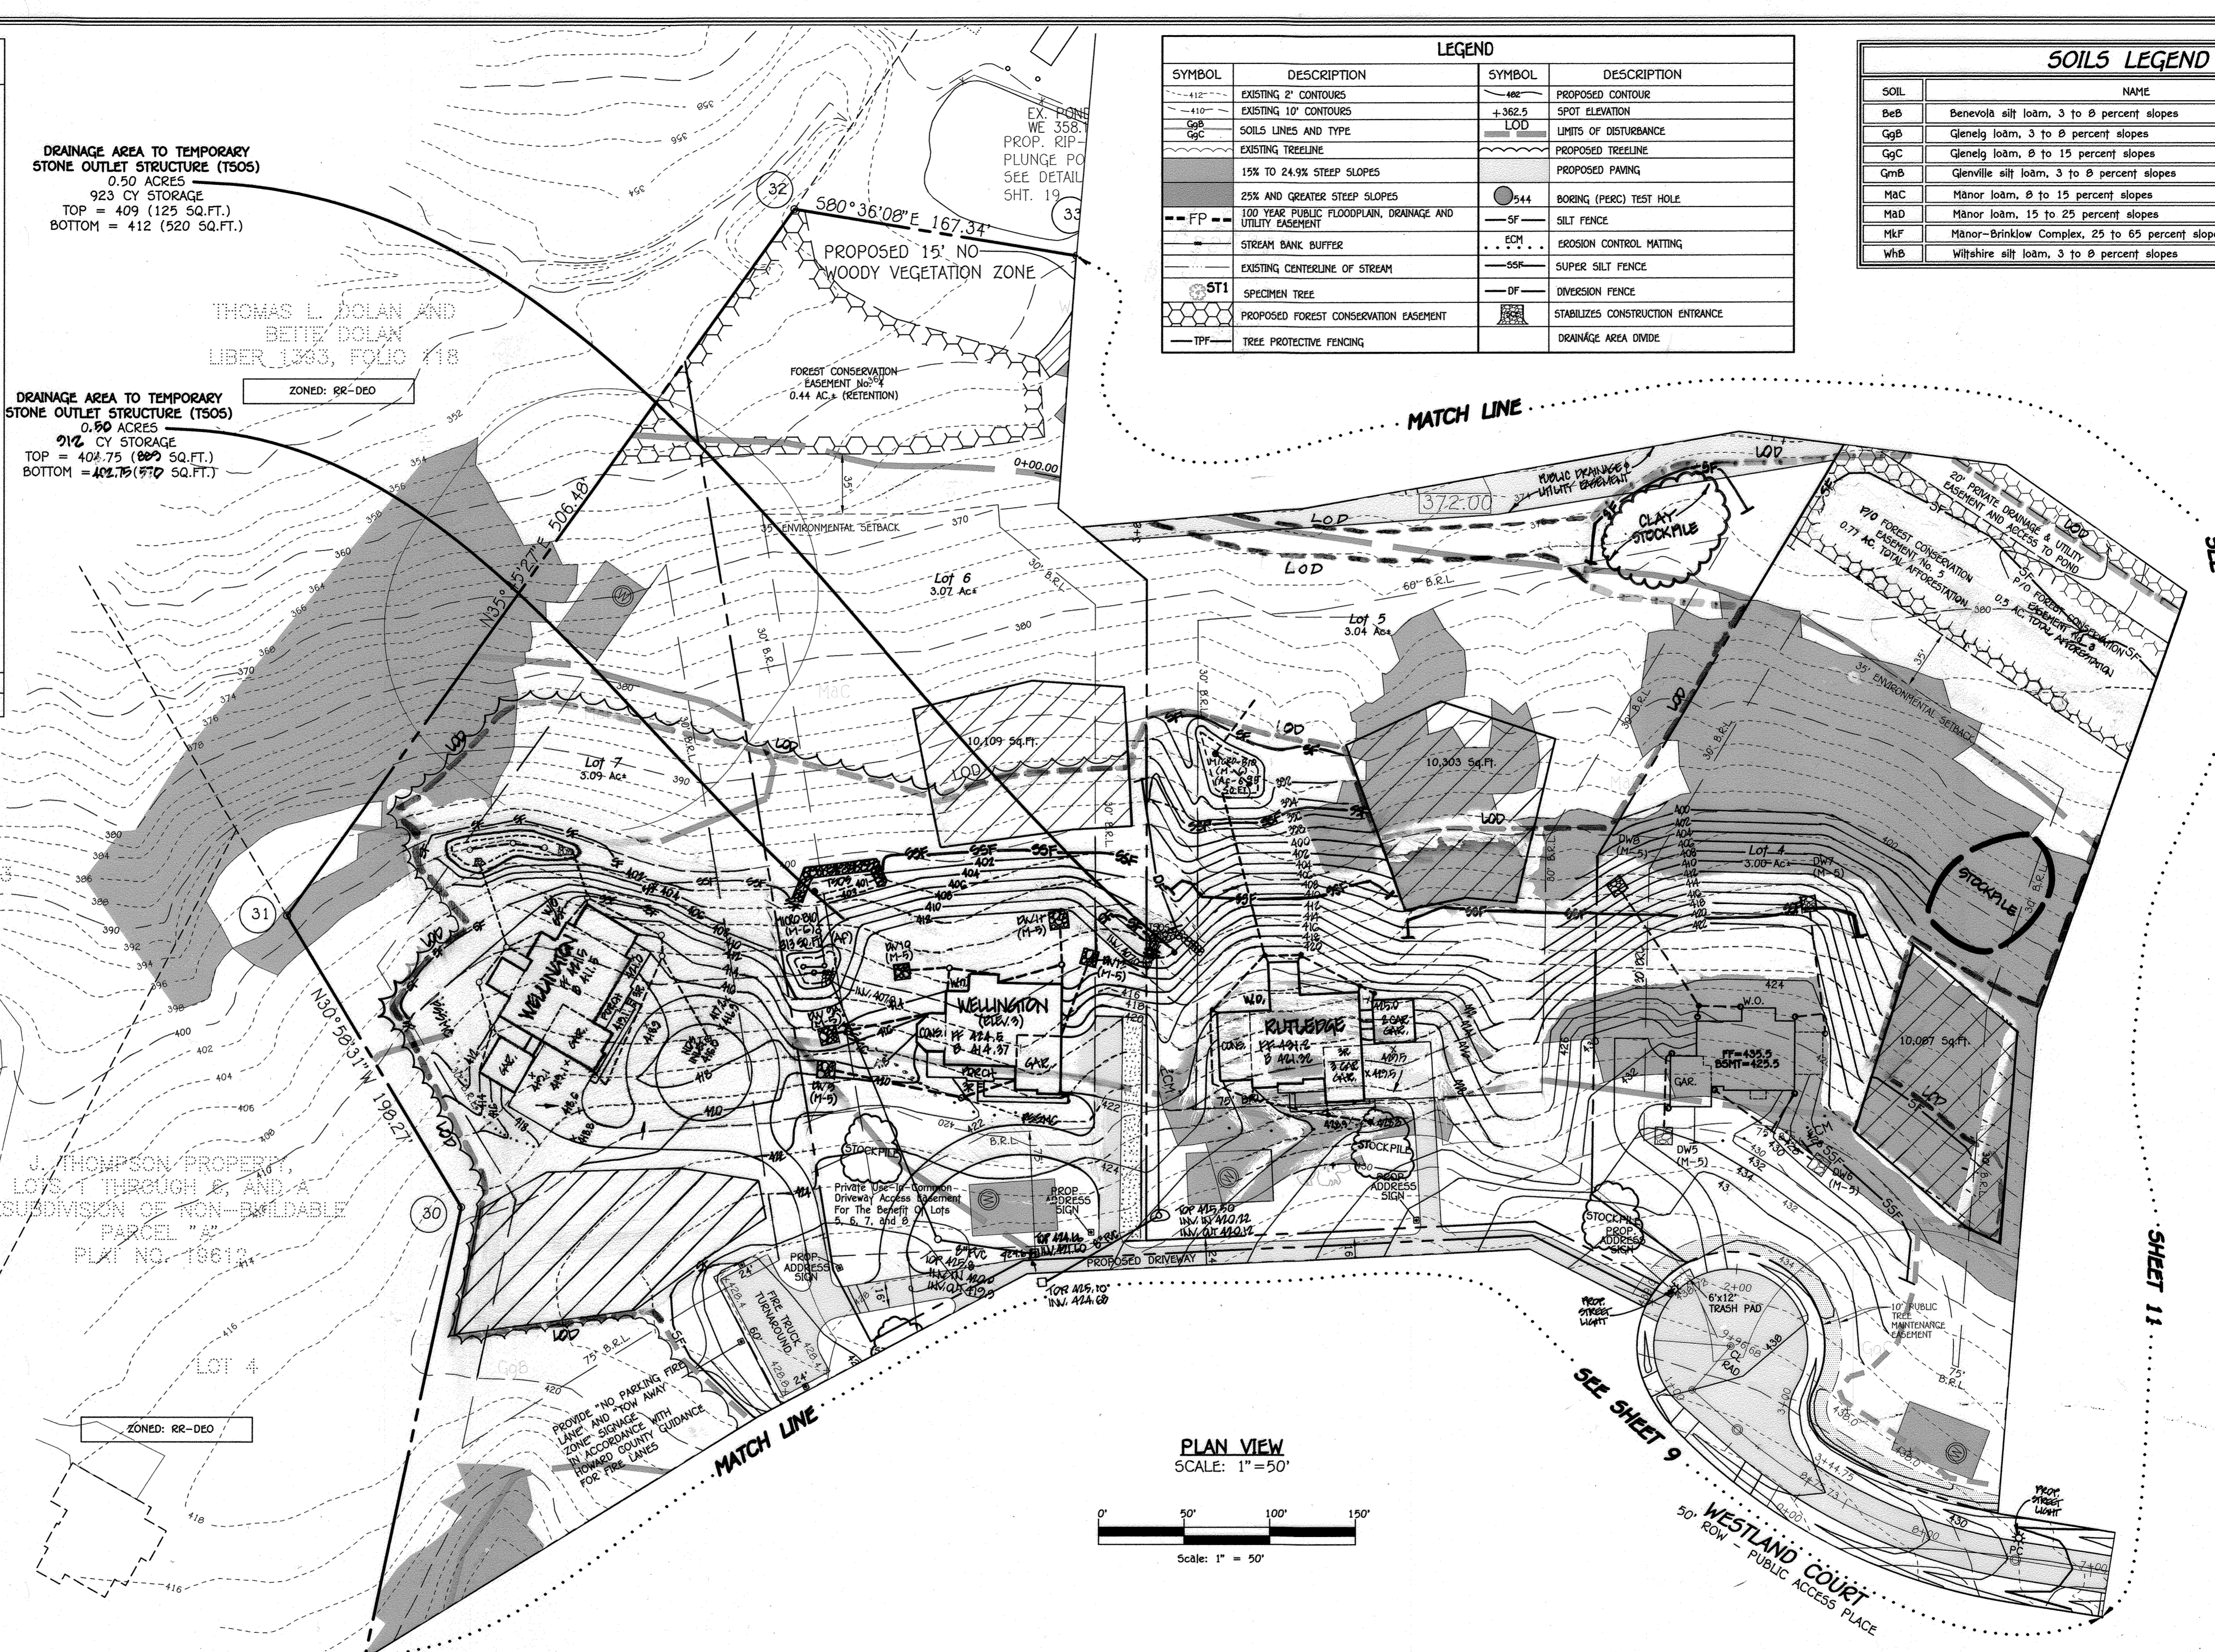


*PAVING SHALL BEGIN AT CUL-DE-SAC END OF WESTLAND COURT AND WORK TOWARD LIME KILN ROAD.


GRADING AND EROSION & SEDIMENT CONTROL PLAN
WESTLAND FARM ESTATES
LOTS 3 THRU 14 AND OPEN SPACE LOT 15
ZONED RR-DEO
TAX MAP No. 45 GRID No. 5 PARCEL No. 28
FIFTH ELECTION DISTRICT HOWARD COUNTY, MARYLAND
SCALE: AS SHOWN DATE: DECEMBER, 2015
SHEET 10 OF 19

RESULT CERTIFICATION FOR PAVING
Note: There is no "AS-BUILT" information provided on this sheet.
Signature: [Signature] DATE: 1/29/16
CHARLES J. CROOKS, P.E. #13204

THERE IS NO "AS-BUILT" INFORMATION PROVIDED ON THIS SHEET

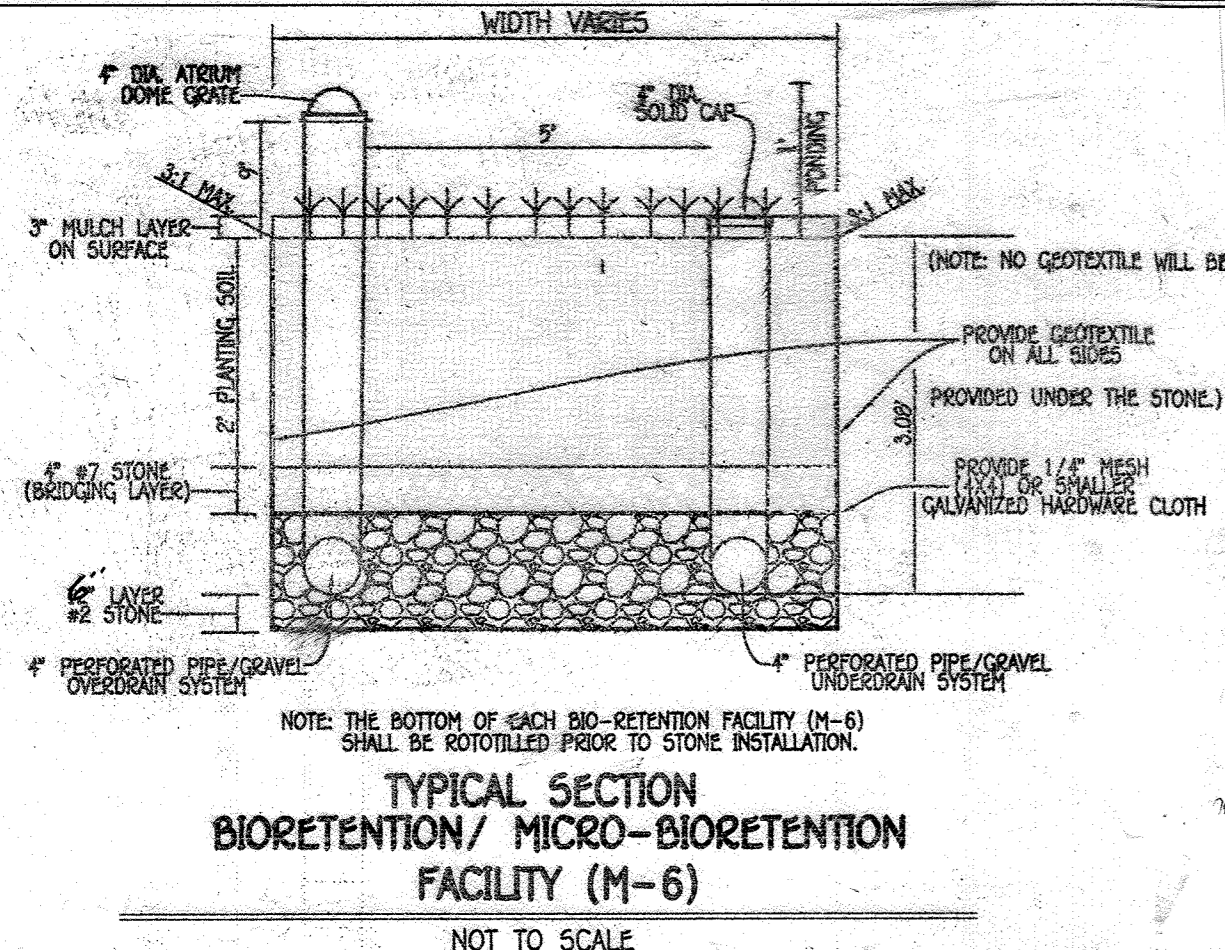

STORMWATER MANAGEMENT PRACTICES							
AREA ID	LOCATION	ADDRESS	DRAINAGE AREA SF.	% IMPERVIOUS	ESDV REQUIRED CUFT.	ESDV PROVIDED CUFT.	BIO-RETENTION (Y/N)
MB #1	LOT 14	12505 WESTLAND CT	20,576	14%	870	1162	Y

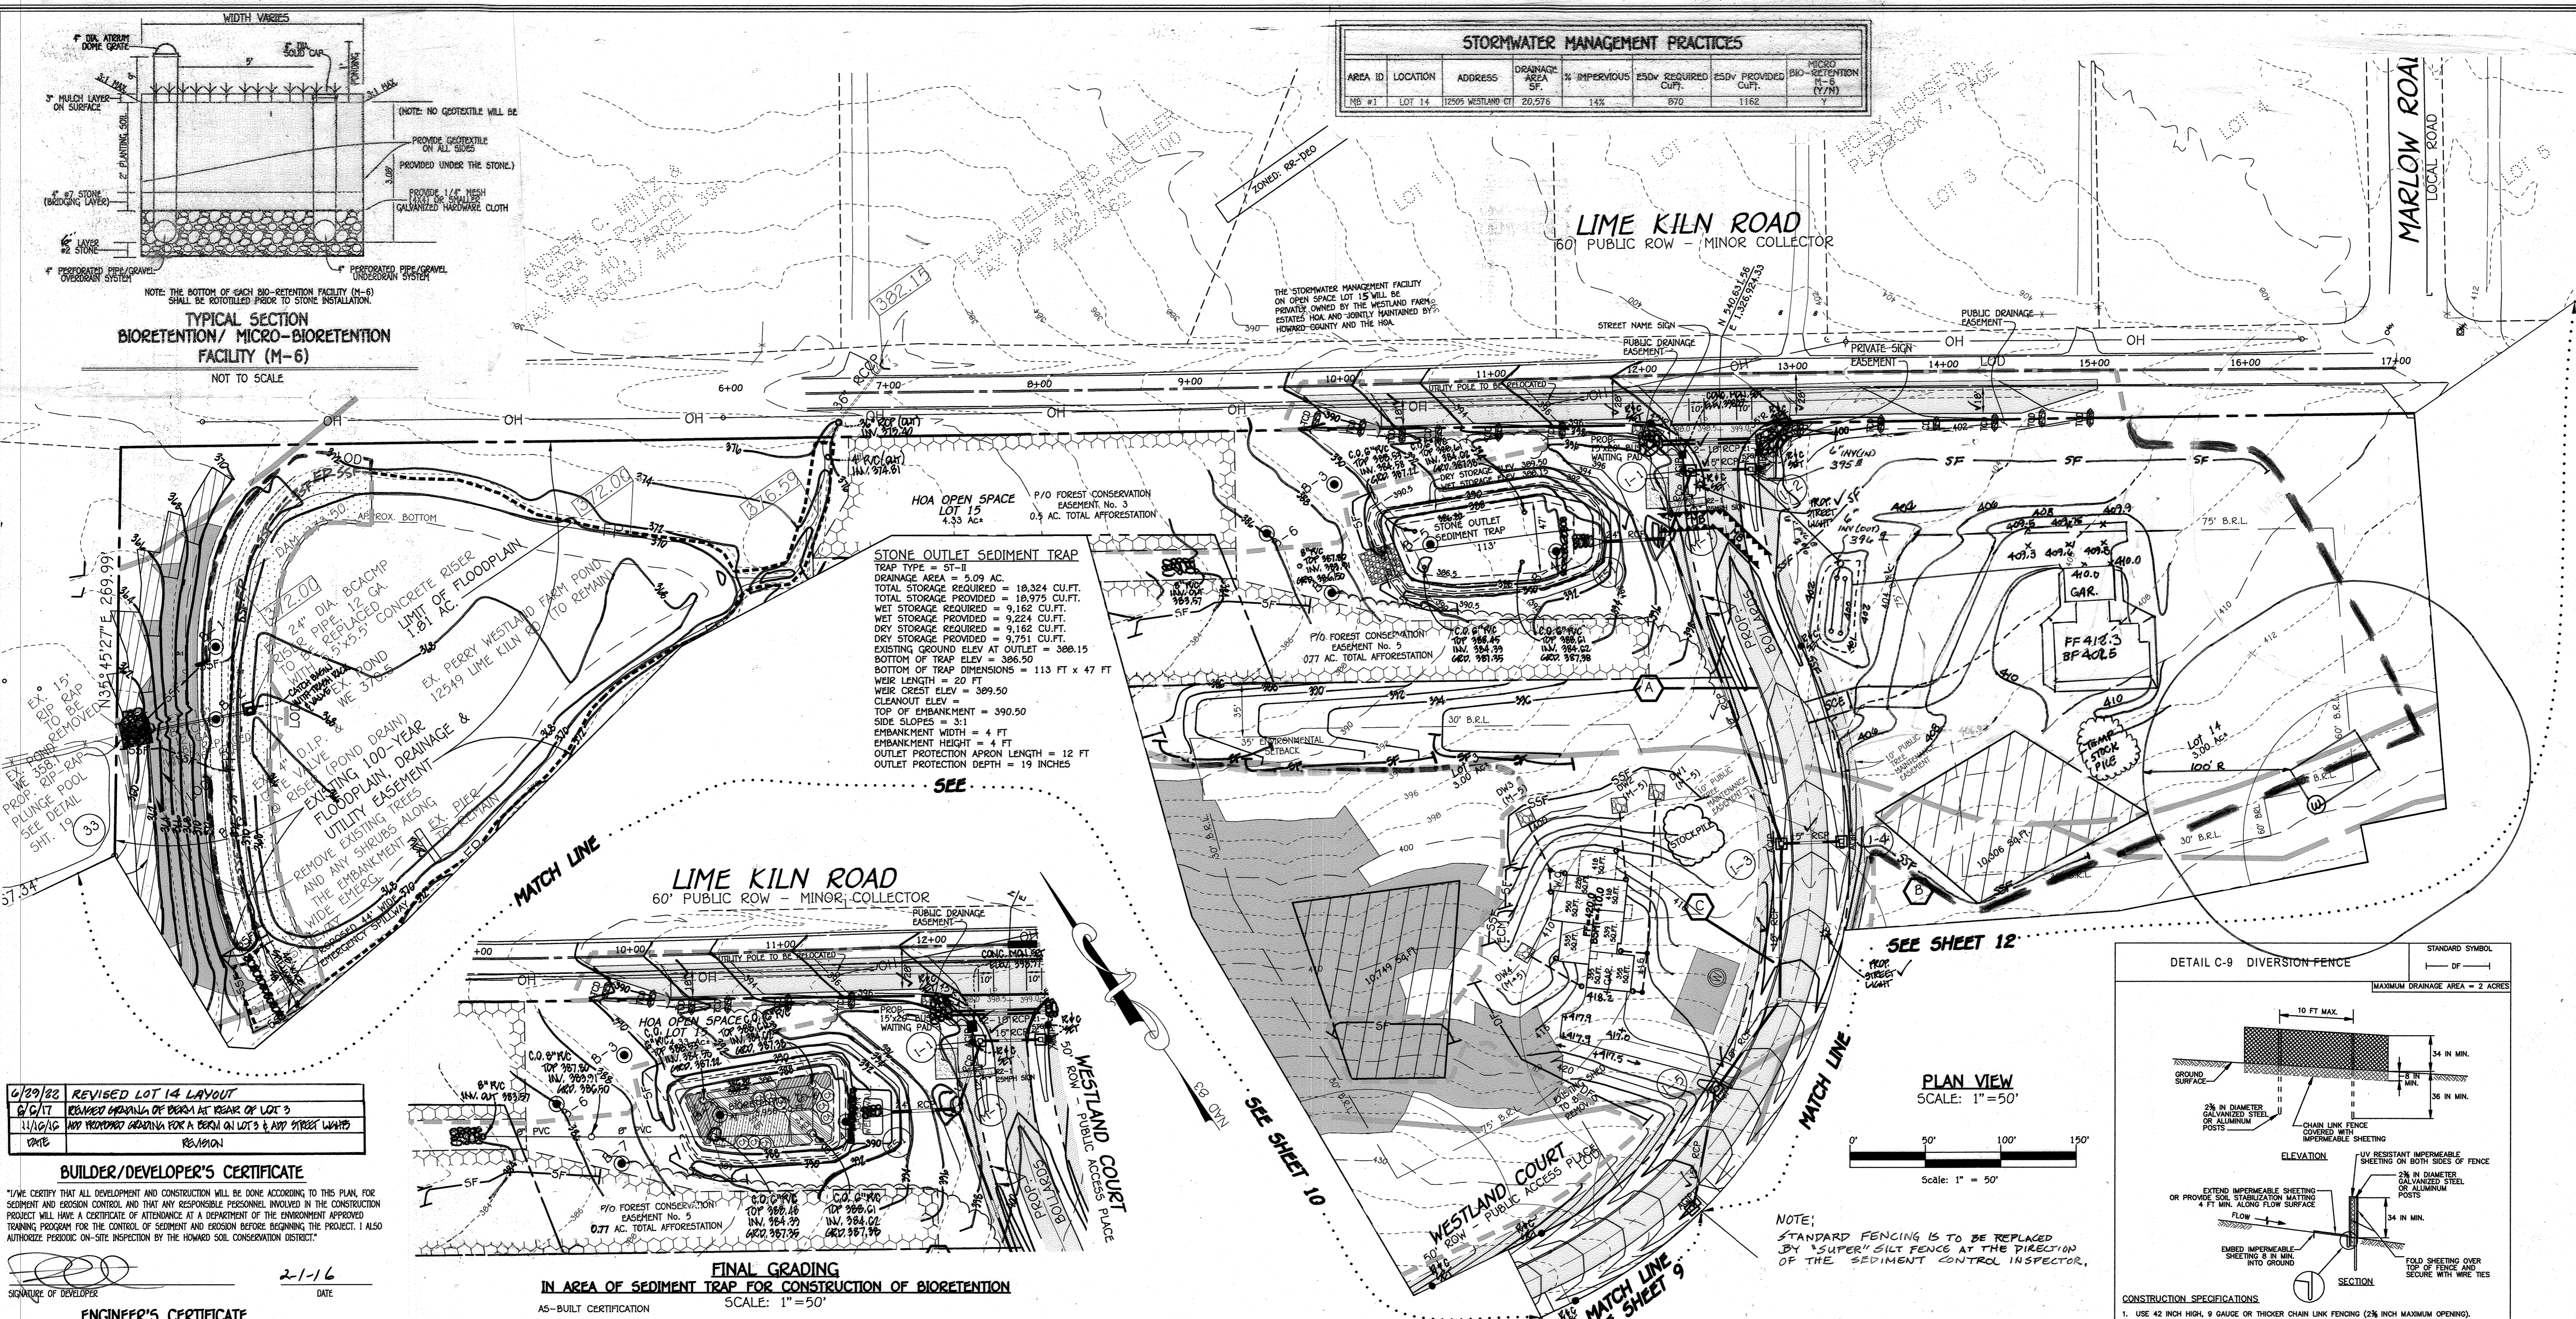

STONE OUTLET SEDIMENT TRAP
 TRAP TYPE = ST-II
 DRAINAGE AREA = 5.09 AC.
 TOTAL STORAGE REQUIRED = 10,324 CU.FT.
 TOTAL STORAGE PROVIDED = 10,975 CU.FT.
 WET STORAGE REQUIRED = 9,162 CU.FT.
 WET STORAGE PROVIDED = 9,224 CU.FT.
 DRY STORAGE REQUIRED = 9,162 CU.FT.
 DRY STORAGE PROVIDED = 9,751 CU.FT.
 EXISTING GROUND ELEV AT OUTLET = 388.15
 BOTTOM OF TRAP ELEV = 386.50
 BOTTOM OF TRAP DIMENSIONS = 113 FT x 47 FT
 WEIR LENGTH = 20 FT
 WEIR CREST ELEV = 389.50
 CLEANOUT ELEV =
 TOP OF EMBANKMENT = 390.50
 SIDE SLOPES = 3:1
 EMBANKMENT WIDTH = 4 FT
 EMBANKMENT HEIGHT = 4 FT
 OUTLET PROTECTION APRON LENGTH = 12 FT
 OUTLET PROTECTION DEPTH = 19 INCHES

6/29/22	REVISED LOT 14 LAYOUT
6/17/17	REMOVED HEADLAND OF BEAMA AT REAR OF LOT 3
11/10/16	ADD PROPOSED GRADING FOR A BEAMA ON LOT 3 & ADJ STREET LIGHTS
DATE	REVISION

BUILDER/DEVELOPER'S CERTIFICATE
 I/WE CERTIFY THAT ALL DEVELOPMENT AND CONSTRUCTION WILL BE DONE ACCORDING TO THIS PLAN FOR SEDIMENT AND EROSION CONTROL AND THAT ANY RESPONSIBLE PERSONNEL INVOLVED IN THE CONSTRUCTION PROJECT WILL HAVE A CERTIFICATE OF ATTENDANCE AT A DEPARTMENT OF THE ENVIRONMENT APPROVED TRAINING PROGRAM FOR THE CONTROL OF SEDIMENT AND EROSION BEFORE BEGINNING THE PROJECT. I ALSO AUTHORIZE PERIODIC ON-SITE INSPECTION BY THE HOWARD SOIL CONSERVATION DISTRICT.

Signature of Developer: [Signature] DATE: 2-1-16

ENGINEER'S CERTIFICATE
 I HEREBY CERTIFY THAT THIS PLAN FOR EROSION AND SEDIMENT CONTROL REPRESENTS A PRACTICAL AND WORKABLE PLAN BASED ON MY PERSONAL KNOWLEDGE OF THE SITE CONDITIONS AND THAT IT WAS PREPARED IN ACCORDANCE WITH THE REQUIREMENTS OF THE HOWARD SOIL CONSERVATION DISTRICT.

Signature of Engineer: [Signature] DATE: 1/29/16

APPROVED: DEPARTMENT OF PUBLIC WORKS
 CHIEF, BUREAU OF HIGHWAYS
 DATE: 2/22/2016

APPROVED: DEPARTMENT OF PLANNING AND ZONING
 CHIEF, DIVISION OF LAND DEVELOPMENT
 DATE: 6-21-16

CHIEF, DEVELOPMENT ENGINEERING DIVISION
 DATE: 3-2-16

FINAL GRADING IN AREA OF SEDIMENT TRAP FOR CONSTRUCTION OF BIORETENTION
 AS-BUILT CERTIFICATION SCALE: 1"=50'

OWNERS
 LIME KILN, LLC
 12549 LIME KILN ROAD
 FULTON, MARYLAND 20799-0460
 410-792-2922

DEVELOPER
 WILLIAMSBURG GROUP, LLC
 C/O BOB CORBETT
 5485 HARBERS FARM ROAD, SUITE 200
 COLUMBIA, MARYLAND 21044
 410-997-8800


FISHER, COLLINS & CARTER, INC.
 CIVIL ENGINEERING CONSULTANTS & LAND SURVEYORS
 CONTINENTAL SQUARE OFFICE PARK - 10272 BALDORNE NATIONAL PIKE
 SUITE 201 CITY, MARYLAND 21042
 (410) 461-2895

SOIL	NAME	CLASS	K FACTOR
BeB	Benevola silt loam, 3 to 8 percent slopes	C	0.43
GgB	Glenelg loam, 3 to 8 percent slopes	B	0.28
GgC	Glenelg loam, 8 to 15 percent slopes	B	0.28
GmB	Glenville silt loam, 3 to 8 percent slopes	C	0.43
MaC	Manor loam, 8 to 15 percent slopes	B	0.28
MaD	Manor loam, 15 to 25 percent slopes	B	0.28
MkF	Manor-Brinklow Complex, 25 to 65 percent slopes, very rocky	B	0.32
WhB	Wiltshire silt loam, 3 to 8 percent slopes	C	0.20

PROFESSIONAL CERTIFICATION
 I HEREBY CERTIFY THAT THESE DOCUMENTS WERE PREPARED OR APPROVED BY ME AND THAT I AM A DULY LICENSED PROFESSIONAL ENGINEER UNDER THE LAWS OF THE STATE OF MARYLAND, LICENSE NO. 38396, EXPIRATION DATE: 01/12/2016.

Signature of Professional Engineer: [Signature] DATE: 1/29/16

LEGEND		LEGEND	
SYMBOL	DESCRIPTION	SYMBOL	DESCRIPTION
---412---	EXISTING 2' CONTOURS	---466---	PROPOSED CONTOUR
---410---	EXISTING 10' CONTOURS	+362.5	SPOT ELEVATION
GgB	SOILS LINES AND TYPE	LOD	LIMITS OF DISTURBANCE
GgC		---	PROPOSED TREELINE
---	EXISTING TREELINE	---	PROPOSED PAVING
---	15% TO 24.9% STEEP SLOPES	944	BORING (PERC) TEST HOLE
---	25% AND GREATER STEEP SLOPES	SF	SILT FENCE
---	100 YEAR PUBLIC FLOODPLAIN, DRAINAGE AND UTILITY EASEMENT	ECM	EROSION CONTROL MATTING
---	STREAM BANK BUFFER	SSR	SUPER SILT FENCE
---	EXISTING CENTERLINE OF STREAM	DF	DIVERSION FENCE
ST1	SPECIMEN TREE	---	STABILIZES CONSTRUCTION ENTRANCE
---	PROPOSED FOREST CONSERVATION EASEMENT	---	DRAINAGE AREA DIVIDE
---	TPF	---	

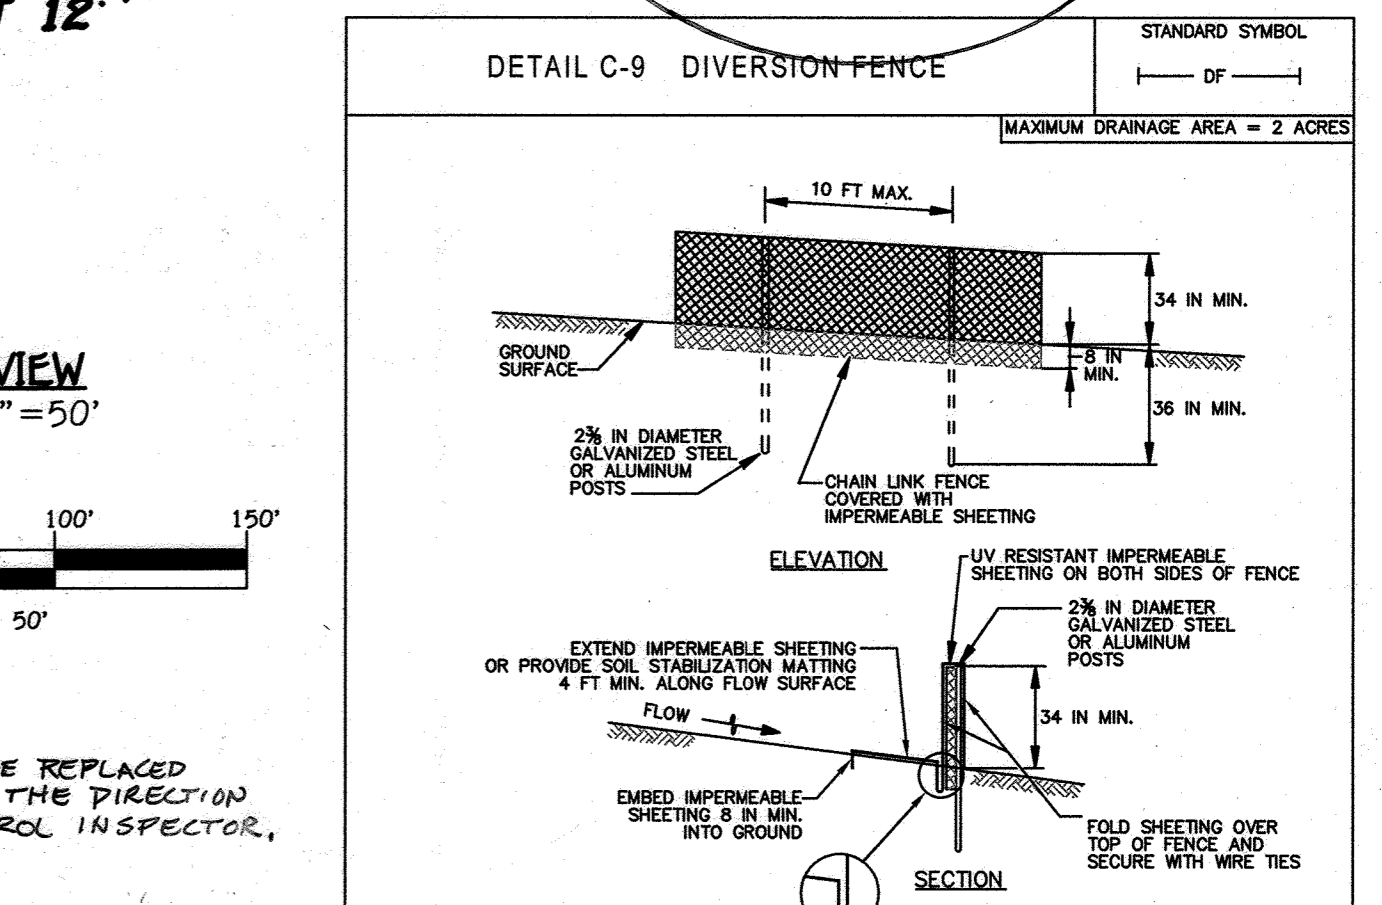

- CONSTRUCTION SPECIFICATIONS**
- USE 42 INCH HIGH, 9 GAUGE OR THICKER CHAIN LINK FENCING (2 1/2 INCH MAXIMUM OPENING).
 - USE 2 1/2 INCH DIAMETER GALVANIZED STEEL POSTS OF 0.095 INCH WALL THICKNESS AND SIX FOOT LENGTH SPACED NO FURTHER THAN 10 FEET APART. THE POSTS DO NOT NEED TO BE SET IN CONCRETE.
 - FASTEN CHAIN LINK FENCE SECURELY TO THE FENCE POSTS WITH WIRE TIES.
 - SECURE 10 MIL OR THICKER UV RESISTANT IMPERMEABLE SHEETING TO CHAIN LINK FENCE WITH TIES SPACED EVERY 24 INCHES AT TOP, MID SECTION, AND BELOW GROUND SURFACE.
 - EXTEND SHEETING A MINIMUM OF 4 FEET ALONG FLOW SURFACE AND ENDED END A MINIMUM OF 8 INCHES INTO GROUND. SOIL STABILIZATION MATTING MAY BE USED IN LIEU OF IMPERMEABLE SHEETING ALONG FLOW SURFACE.
 - WHEN TWO SECTIONS OF SHEETING ADJOIN EACH OTHER, OVERLAP BY 6 INCHES AND FOLD WITH SEAM FACING DOWNWARD.
 - KEEP FLOW SURFACE ALONG DIVERSION FENCE AND POINT OF DISCHARGE FREE OF EROSION. REMOVE ACCUMULATED SEDIMENT AND DEBRIS. MAINTAIN POSITIVE DRAINAGE. REPLACE IMPERMEABLE SHEETING IF TORN IF UNDERMINING OCCURS, REINSTATE FENCE.
- MARYLAND STANDARDS AND SPECIFICATIONS FOR SOIL EROSION AND SEDIMENT CONTROL
 U.S. DEPARTMENT OF AGRICULTURE
 NATURAL RESOURCES CONSERVATION SERVICE 2011 MARYLAND DEPARTMENT OF ENVIRONMENT AND WATER MANAGEMENT ADMINISTRATION

GRADING AND EROSION & SEDIMENT CONTROL PLAN
WESTLAND FARM ESTATES
 LOTS 3 THRU 14 AND OPEN SPACE LOT 15
 ZONED RR-DEO
 TAX MAP No. 45 GRID No. 5 PARCEL No. 28
 FIFTH ELECTION DISTRICT HOWARD COUNTY, MARYLAND
 SCALE: AS SHOWN DATE: DECEMBER, 2015
 SHEET 11 OF 19

NOTE:

1. THIS PLAN IS TO BE USED FOR INDIVIDUAL DRIVEWAYS AND HOUSE CONSTRUCTION ALONG WITH ROAD & STORMWATER MANAGEMENT CONSTRUCTION.
2. STANDARD FENCING IS TO BE REPLACED BY "SUPER" SILT FENCE AT THE DIRECTION OF THE SEDIMENT CONTROL INSPECTOR.

SOILS LEGEND			
SOIL	NAME	CLASS	K FACTOR
BaB	Benevola silt loam, 3 to 8 percent slopes	C	0.43
GgB	Glenelg loam, 3 to 8 percent slopes	B	0.28
GgC	Glenelg loam, 8 to 15 percent slopes	B	0.28
GmB	Glenville silt loam, 3 to 8 percent slopes	C	0.43
MaC	Manor loam, 8 to 15 percent slopes	B	0.28
MaD	Manor loam, 15 to 25 percent slopes	B	0.28
MkF	Manor-Brinklow Complex, 25 to 65 percent slopes, very rocky	B	0.32
WhB	Wiltshire silt loam, 3 to 8 percent slopes	C	0.20



BUILDER/DEVELOPER'S CERTIFICATE

"I/WE CERTIFY THAT ALL DEVELOPMENT AND CONSTRUCTION WILL BE DONE ACCORDING TO THIS PLAN, FOR SEDIMENT AND EROSION CONTROL AND THAT ANY RESPONSIBLE PERSONNEL INVOLVED IN THE CONSTRUCTION PROJECT WILL HAVE A CERTIFICATE OF ATTENDANCE AT A DEPARTMENT OF THE ENVIRONMENT APPROVED TRAINING PROGRAM FOR THE CONTROL OF SEDIMENT AND EROSION BEFORE BEGINNING THE PROJECT. I ALSO AUTHORIZE PERIODIC ON-SITE INSPECTION BY THE HOWARD SOIL CONSERVATION DISTRICT."

Signature of Developer: [Signature] DATE: 1-1-16

ENGINEER'S CERTIFICATE

"I/WE CERTIFY THAT THIS PLAN FOR EROSION AND SEDIMENT CONTROL REPRESENTS A PRACTICAL AND WORKABLE PLAN BASED ON MY PERSONAL KNOWLEDGE OF THE SITE CONDITIONS AND THAT IT WAS PREPARED IN ACCORDANCE WITH THE REQUIREMENTS OF THE HOWARD SOIL CONSERVATION DISTRICT."

Signature of Engineer: [Signature] DATE: 12/9/15

THIS DEVELOPMENT IS APPROVED FOR SOIL EROSION AND SEDIMENT CONTROL BY THE HOWARD SOIL CONSERVATION DISTRICT.

APPROVED: [Signature] DATE: 12/10/15
HOWARD SOIL CONSERVATION DISTRICT

APPROVED: DEPARTMENT OF PUBLIC WORKS
[Signature] DATE: 2/22/2016
CHIEF, BUREAU OF HIGHWAYS

APPROVED: DEPARTMENT OF PLANNING AND ZONING
[Signature] DATE: 6-21-16
CHIEF, DIVISION OF LAND DEVELOPMENT

[Signature] DATE: 3-2-16
CHIEF, DEVELOPMENT ENGINEERING DIVISION

OWNERS
LIME KILN, LLC
12549 LIME KILN ROAD
FULTON, MARYLAND 20759-0460
410-792-2922

DEVELOPER
WILLIAMSBURG GROUP, LLC
C/O BOB CORBETT
5485 HARRIS FARM ROAD, SUITE 200
COLUMBIA, MARYLAND 21044
410-997-8800


FISHER, COLLINS & CARTER, INC.
CIVIL ENGINEERING CONSULTANTS & LAND SURVEYORS
CENTENNIAL SQUARE OFFICE PARK - 10272 BALTIMORE NATIONAL PIKE
ELLSWORTH CITY, MARYLAND 21042
(410) 461-2855

PROFESSIONAL CERTIFICATION
I HEREBY CERTIFY THAT THESE DOCUMENTS WERE PREPARED OR APPROVED BY ME AND THAT I AM A DULY LICENSED PROFESSIONAL ENGINEER UNDER THE LAWS OF THE STATE OF MARYLAND, LICENSE NO. 38396, EXPIRATION DATE: 01/12/2016.
Signature of Professional Engineer: [Signature] DATE: 12/9/15



DATE	REVISION
12/17/15	REVISE HOPE, ROAD & DRIVEWAY, LOT 13
6/6/17	REVISE NOTES.
	REVISION

PLAN VIEW
SCALE: 1"=50'

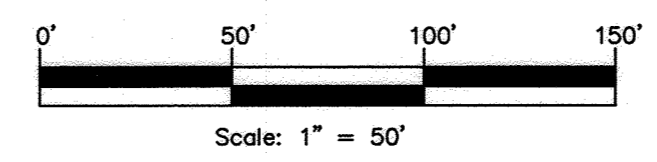


LEGEND			
SYMBOL	DESCRIPTION	SYMBOL	DESCRIPTION
-412-	EXISTING 2' CONTOURS	-482-	PROPOSED CONTOUR
-410-	EXISTING 10' CONTOURS	+362.5	SPOT ELEVATION
GgB GgC	SOILS LINES AND TYPE	LOD	LIMITS OF DISTURBANCE
-	EXISTING TREELINE	-	PROPOSED TREELINE
-	15% TO 24.9% STEEP SLOPES	-	PROPOSED PAVING
-	25% AND GREATER STEEP SLOPES	544	BORING (PERC) TEST HOLE
FP	100 YEAR PUBLIC FLOODPLAIN, DRAINAGE AND UTILITY EASEMENT	SF	SILT FENCE
-	STREAM BANK BUFFER	ECM	EROSION CONTROL MATTING
-	EXISTING CENTERLINE OF STREAM	SSF	SUPER SILT FENCE
ST1	SPECIMEN TREE	DF	DIVERSION FENCE
-	PROPOSED FOREST CONSERVATION EASEMENT	-	STABILIZES CONSTRUCTION ENTRANCE
TPF	TREE PROTECTIVE FENCING	-	DRAINAGE AREA DIVIDE

GRADING AND EROSION & SEDIMENT CONTROL PLAN
WESTLAND FARM ESTATES
LOTS 3 THRU 14 AND OPEN SPACE LOT 15
ZONED RR-DEO
TAX MAP No. 45 GRID No. 5 PARCEL No. 28
FIFTH ELECTION DISTRICT HOWARD COUNTY, MARYLAND
SCALE: AS SHOWN DATE: DECEMBER, 2015
SHEET 12 OF 19

THERE IS NO "AS-BUILT" INFORMATION PROVIDED ON THIS SHEET

INLET DRAINAGE AREA INFORMATION				
DRAINAGE AREA	INLET #	Tc	C	AREA
A	I-1	10 MIN.	0.87	0.19 AC.
B	I-2	10 MIN.	0.34	1.38 AC.
C	I-3	10 MIN.	0.73	0.13 AC.
D	I-4	10 MIN.	0.38	0.79 AC.
E	I-5	10 MIN.	0.69	0.49 AC.
F	I-6	10 MIN.	0.36	1.62 AC.

LIME KILN ROAD
60' PUBLIC ROW - MINOR COLLECTOR

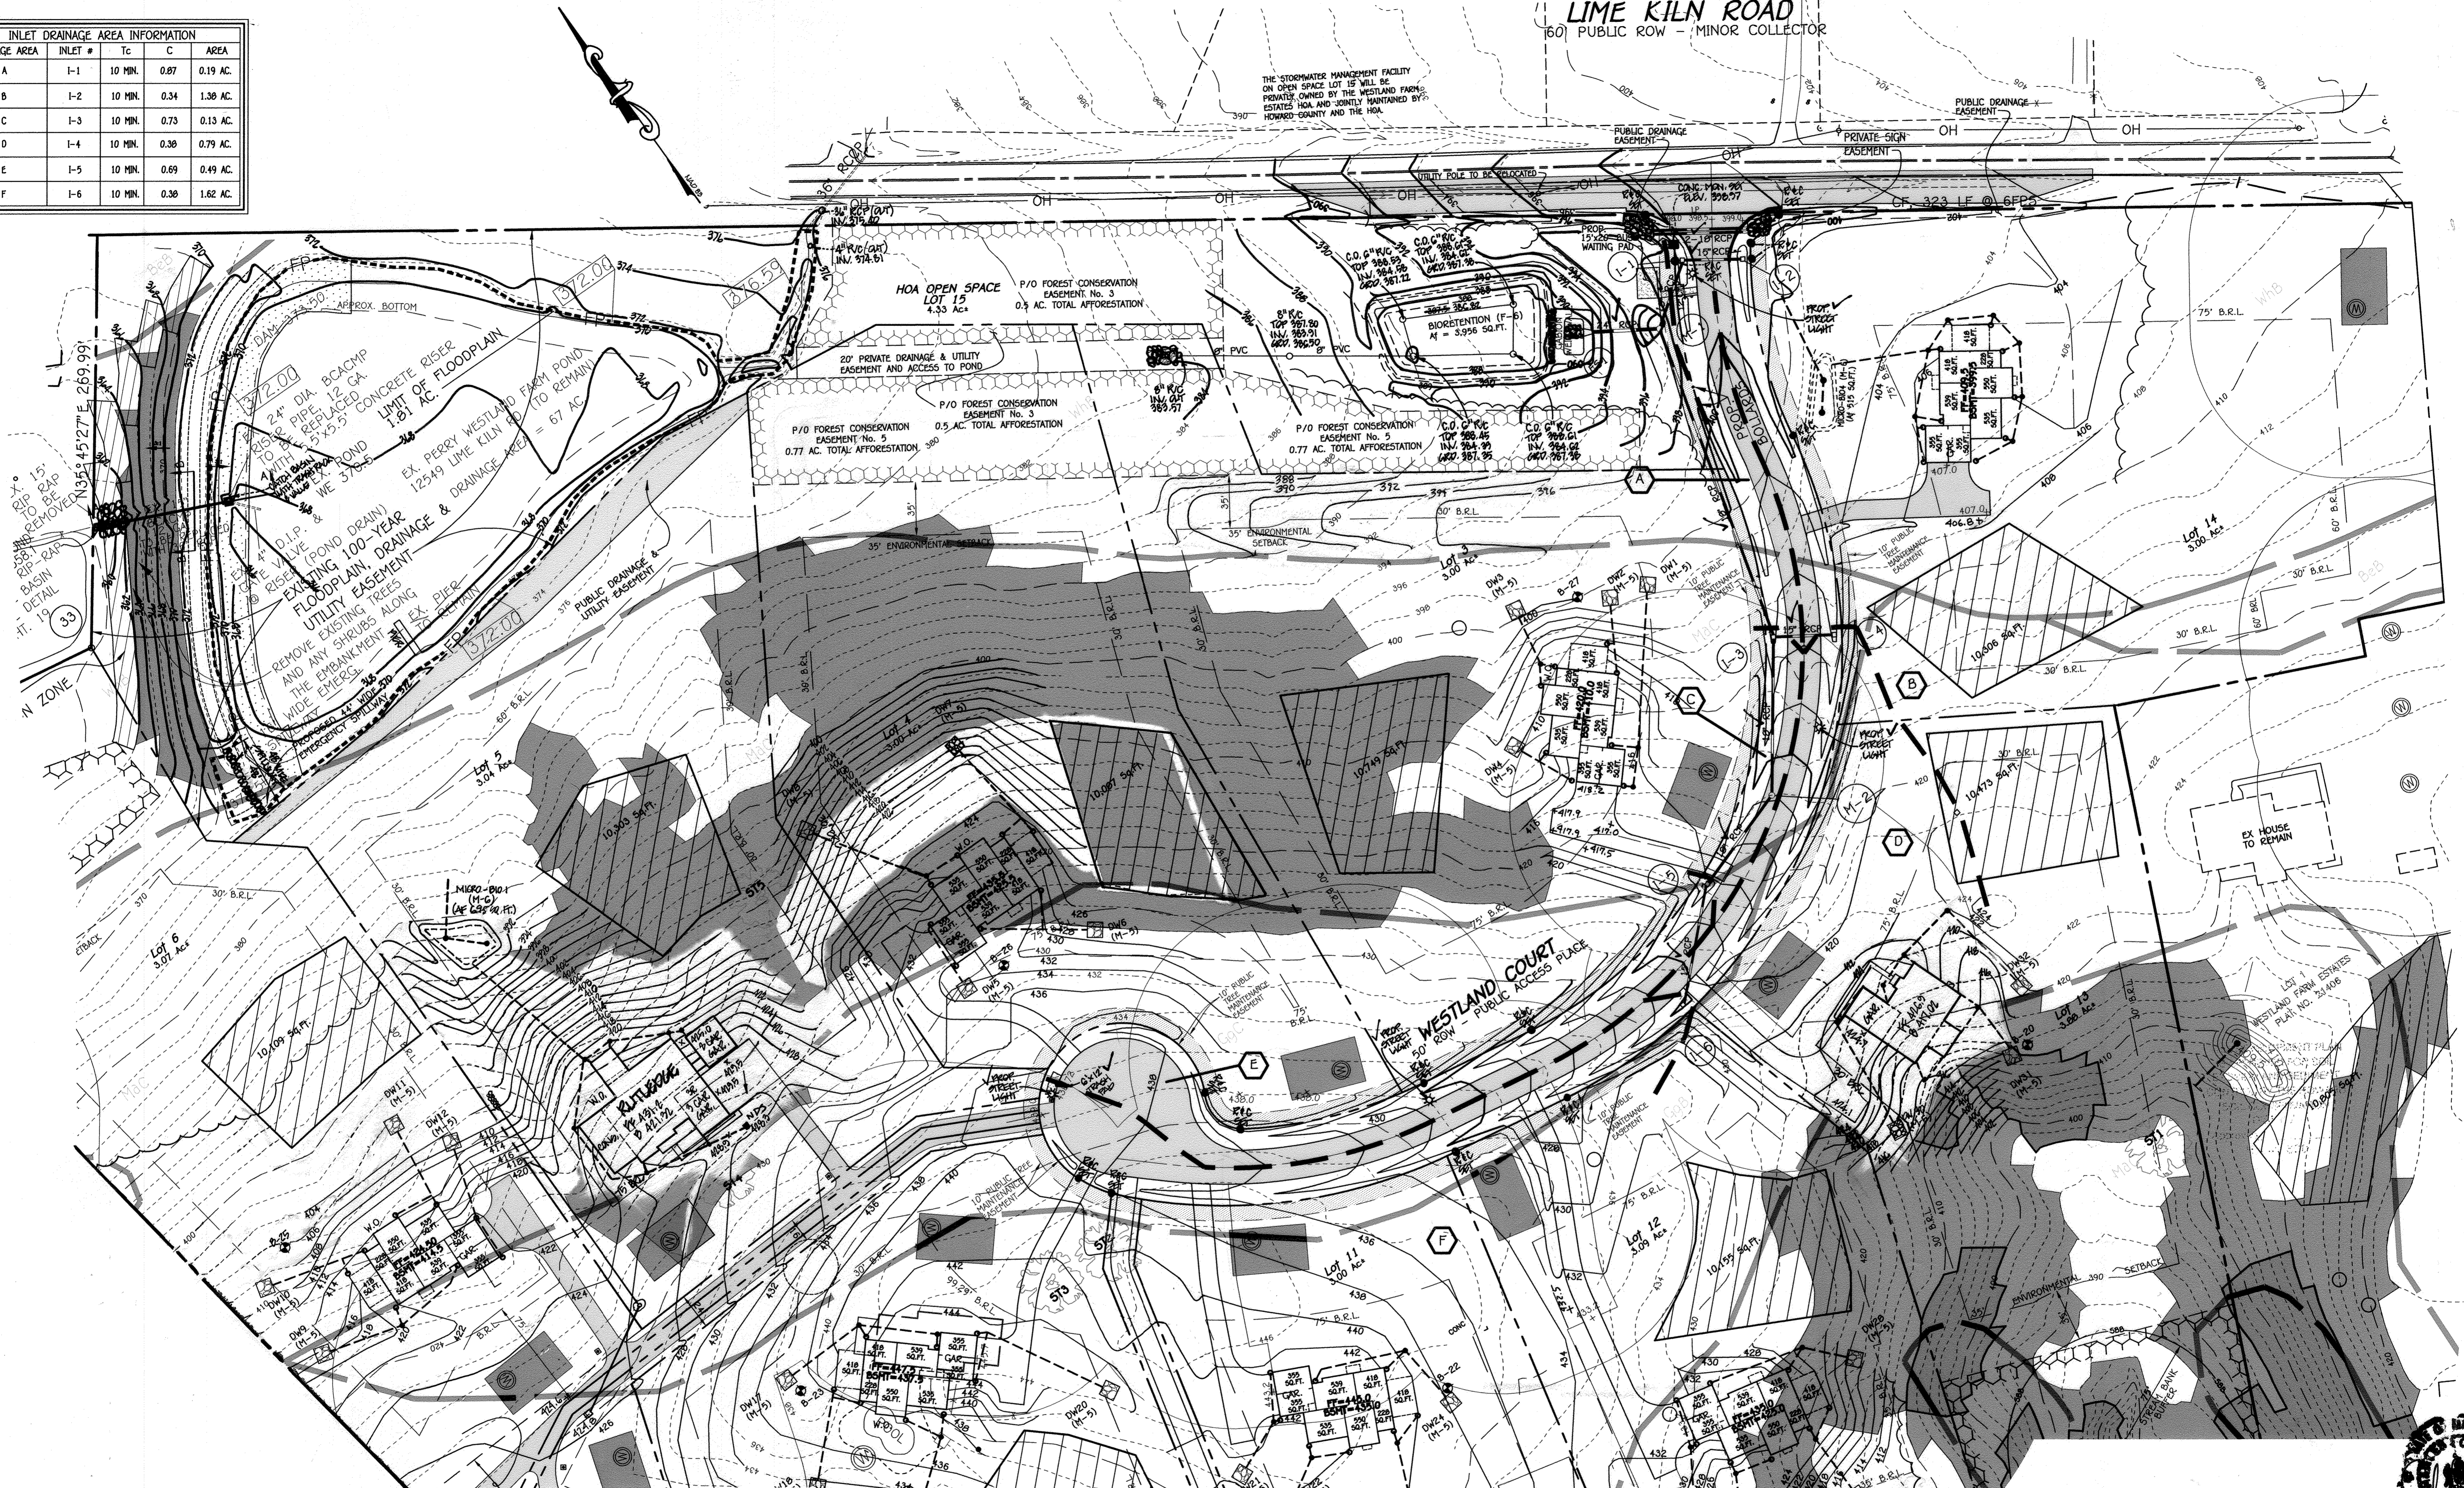

APPROVED: DEPARTMENT OF PUBLIC WORKS
Moumin
 CHIEF, BUREAU OF HIGHWAYS
 DATE: 2/22/2016

APPROVED: DEPARTMENT OF PLANNING AND ZONING
Kate Schuler
 CHIEF, DIVISION OF LAND DEVELOPMENT
 DATE: 6-21-16

Chick
 CHIEF, DEVELOPMENT ENGINEERING DIVISION
 DATE: 3-2-16

OWNERS
 LIME KILN, LLC
 12549 LIME KILN ROAD
 FULTON, MARYLAND 20759-0460
 410-792-2922

DEVELOPER
 WILLIAMSBURG GROUP, LLC
 C/O BOB CORBETT
 5485 HARBERS FARM ROAD, SUITE 200
 COLUMBIA, MARYLAND 21044
 410-997-8600

PERRY C. WESTLAND, JR.
 12549 LIME KILN ROAD
 FULTON, MARYLAND 20759-0460
 410-792-2922

PROFESSIONAL CERTIFICATION
 I HEREBY CERTIFY THAT THESE DOCUMENTS WERE PREPARED OR APPROVED BY ME AND THAT I AM A DULY LICENSED PROFESSIONAL ENGINEER UNDER THE LAWS OF THE STATE OF MARYLAND, LICENSE NO. 38366, EXPIRATION DATE: 01/12/2016.


Stephen Lutz 12/2/15
 Signature Of Professional Engineer DATE




FISHER, COLLINS & CARTER, INC.
 CIVIL ENGINEERING CONSULTANTS & LAND SURVEYORS
 CONTINENTAL SQUARE OFFICE PARK - 10272 BALTIMORE NATIONAL PIKE
 ELICOTT CITY, MARYLAND 21042
 (410) 461-2855

DATE	REVISION
12/17/19	REMOVE VARIOUS EASEMENTS & REVISIONS, LOTS 15 & 19
5/6/19	REVISIONS LOT 7
9/6/17	REVISIONS DRAINAGE OF BIORETENTION LOTS 5 & 6 AND REMOVED PROPOSED BIORETENTION ON LOT 8 & 7
11/16/16	ADD PROPOSED CHANGING FOR A DEEM ON LOTS 3, 4 & ADD STREET LIGHTS

STORM DRAIN DRAINAGE AREA MAP
 WESTLAND FARM ESTATES
 LOTS 3 THRU 14 AND OPEN SPACE LOT 15
 ZONED RR-DEO
 TAX MAP No. 45 GRID No. 5 PARCEL No. 28
 FIFTH ELECTION DISTRICT HOWARD COUNTY, MARYLAND
 SCALE: 1" = 50' DATE: DECEMBER, 2015
 SHEET 13 OF 19

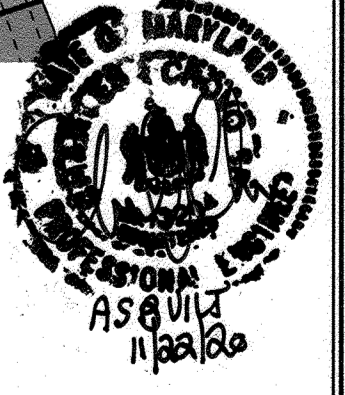


F-15-038
 "AS-BUILT"

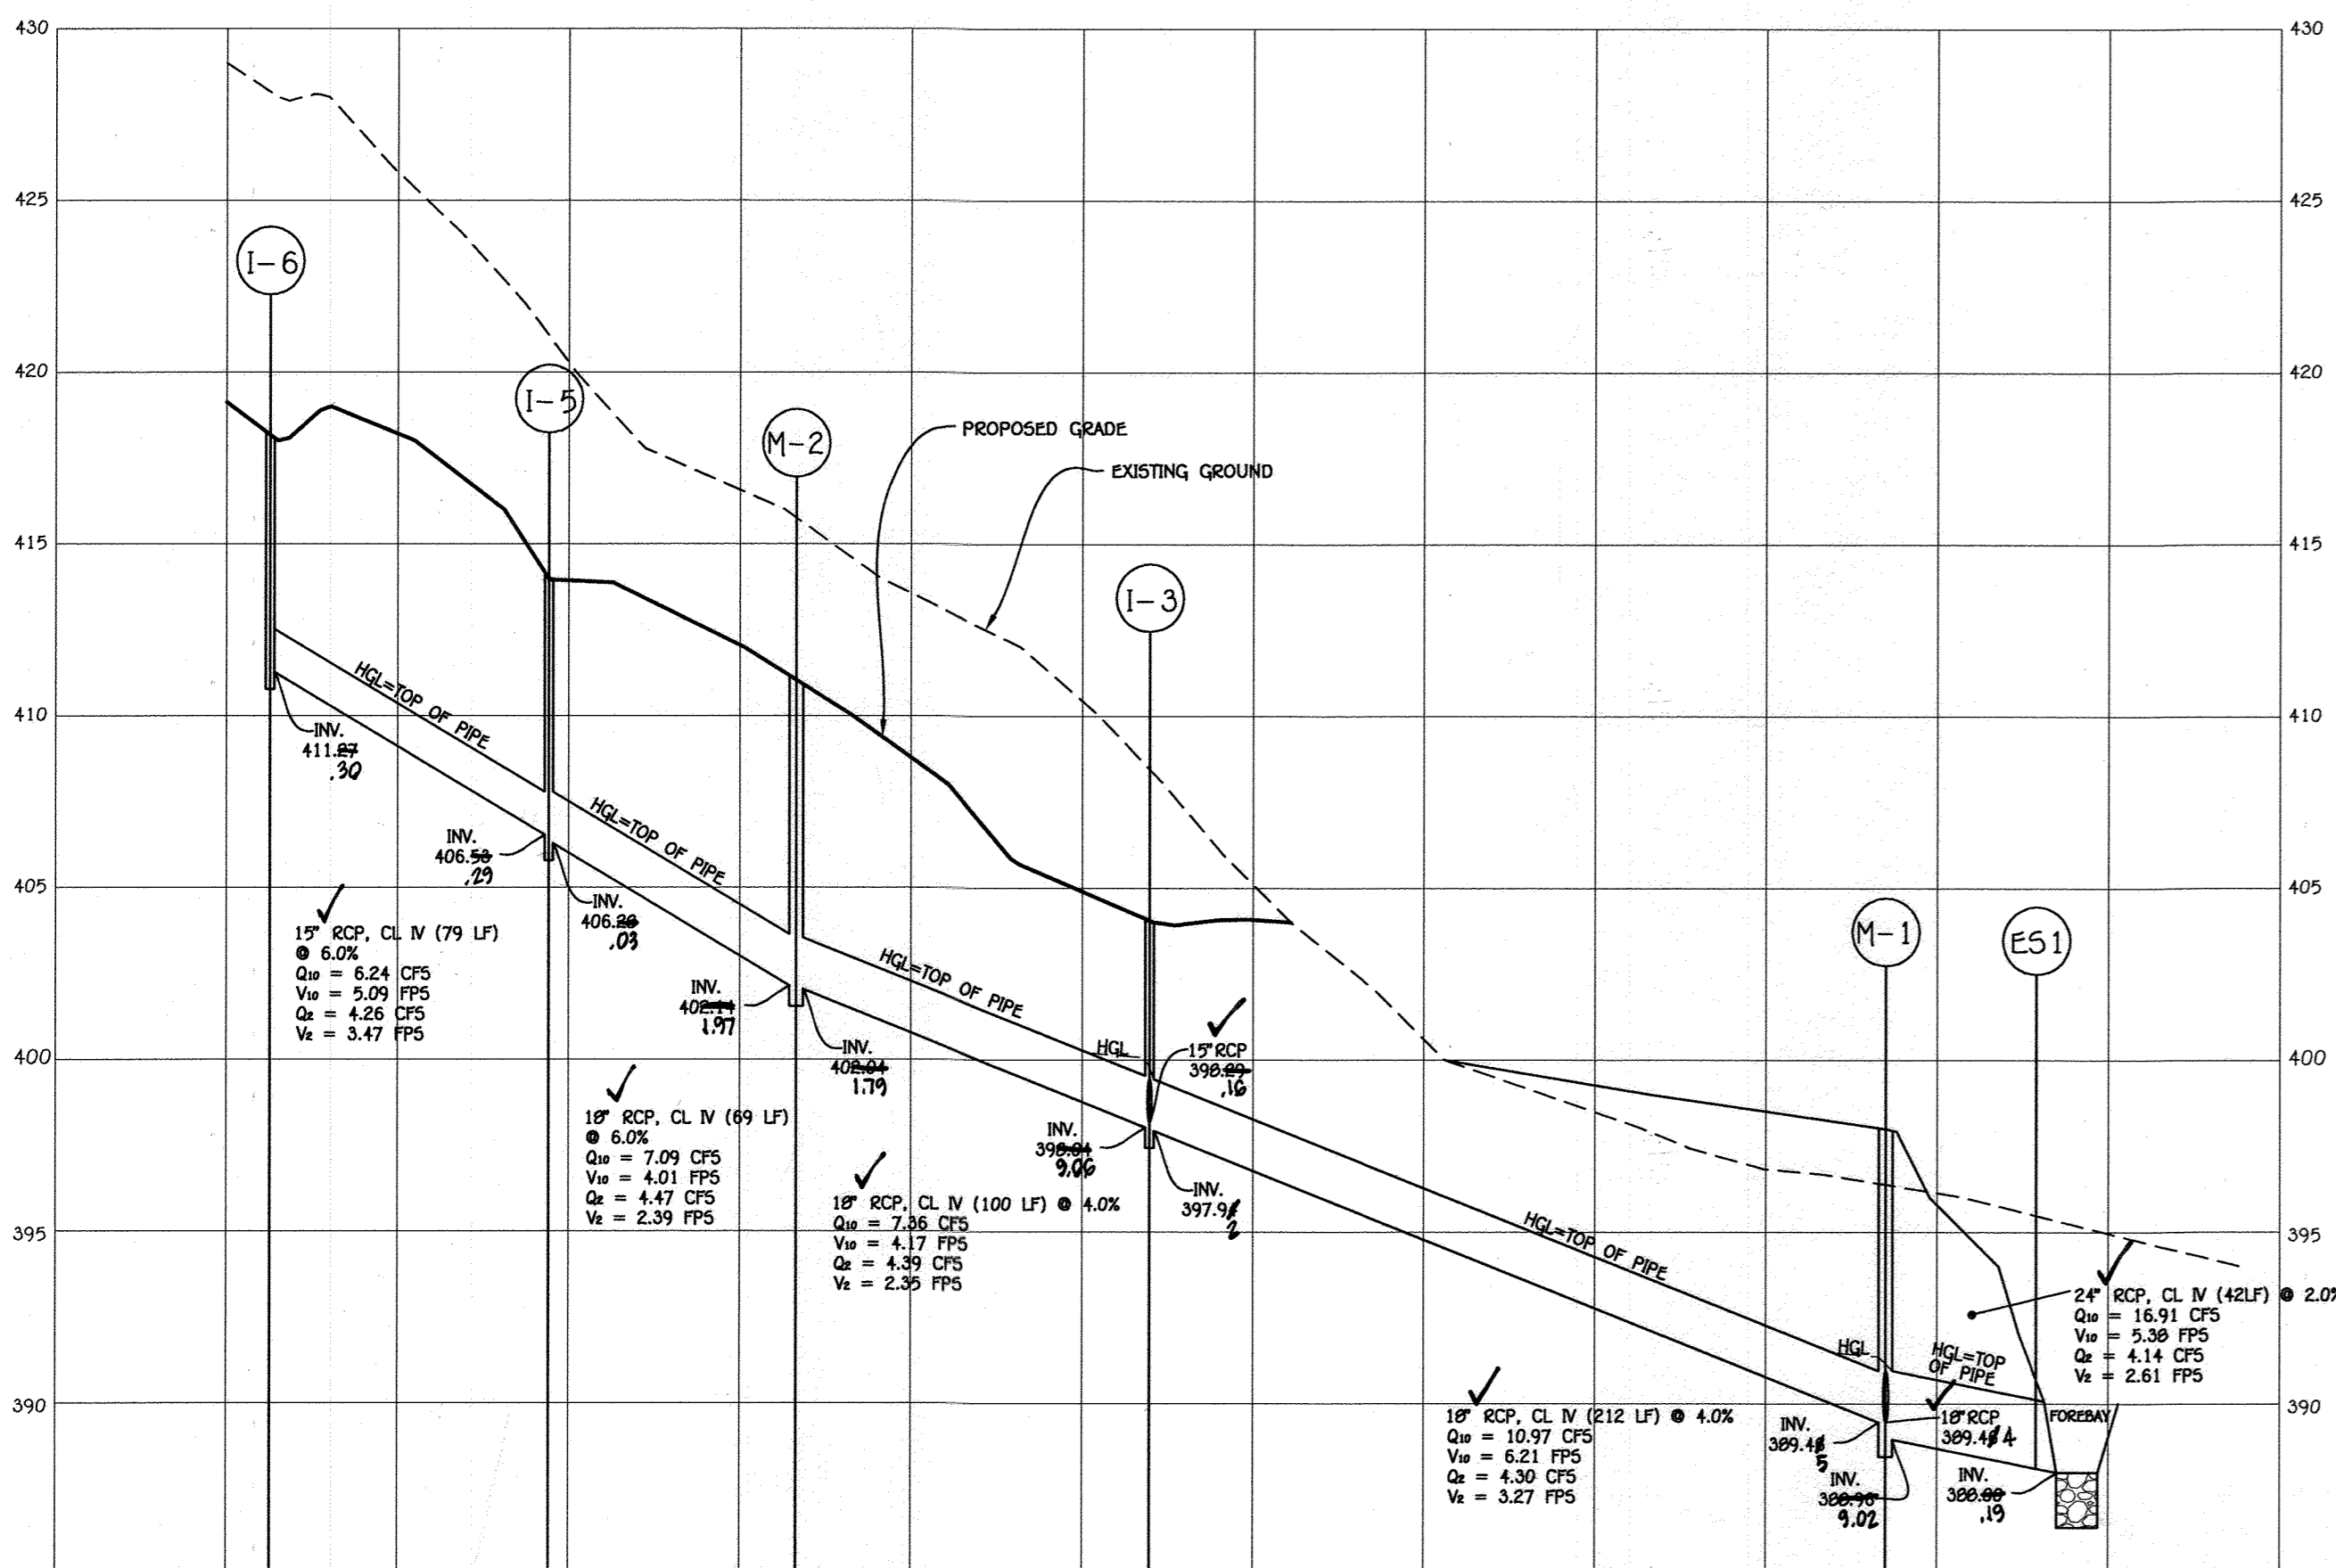

STORM DRAIN PROFILE FROM I-6 TO ES1

HORIZONTAL SCALE: 1"=50'
VERTICAL SCALE: 1"=5'

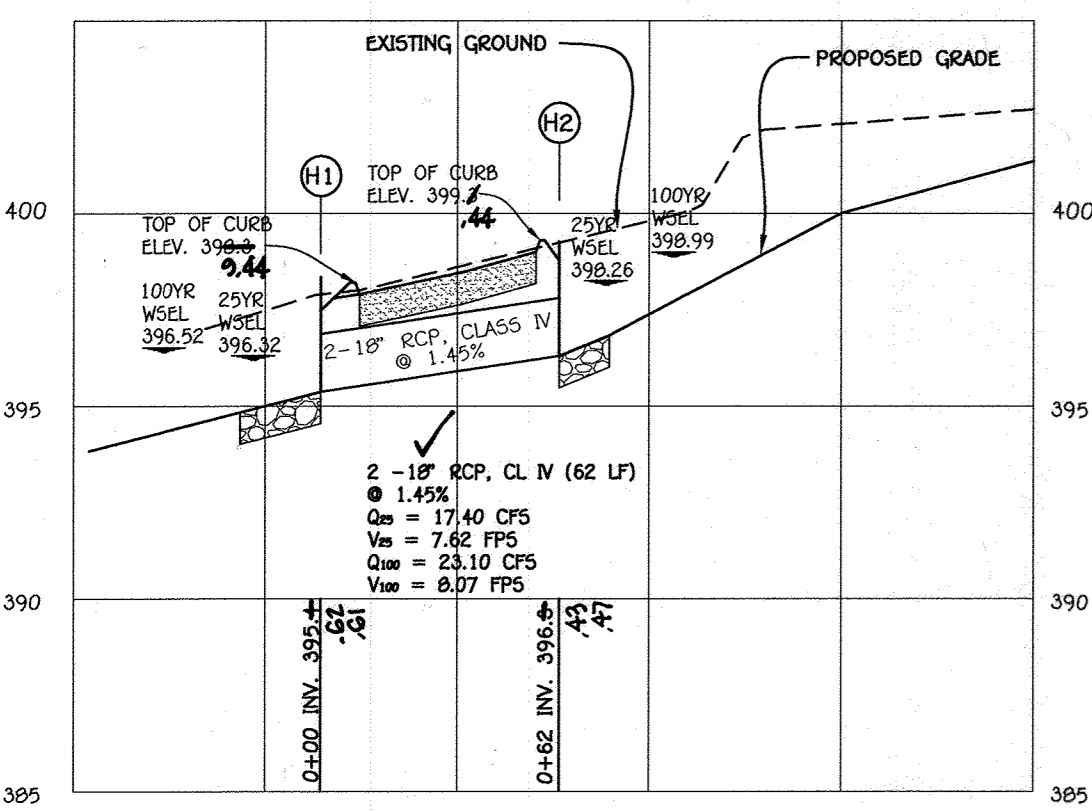


CULVERT

HORIZONTAL SCALE: 1"=50'
VERTICAL SCALE: 1"=5'


PIPE SCHEDULE - WESTLAND COURT		
TYPE	SIZE	QUANTITY
RCP, CL IV	15'	154 LF
RCP, CL IV	18'	549 LF
RCP, CL IV	24'	42 LF

PIPE SCHEDULE - BIORETENTION 5		
TYPE	SIZE	QUANTITY
PVC, SCHEDULE 40, PERFORATED	6"	180 LF
PVC, SCHEDULE 40, SOLID	8"	147 LF

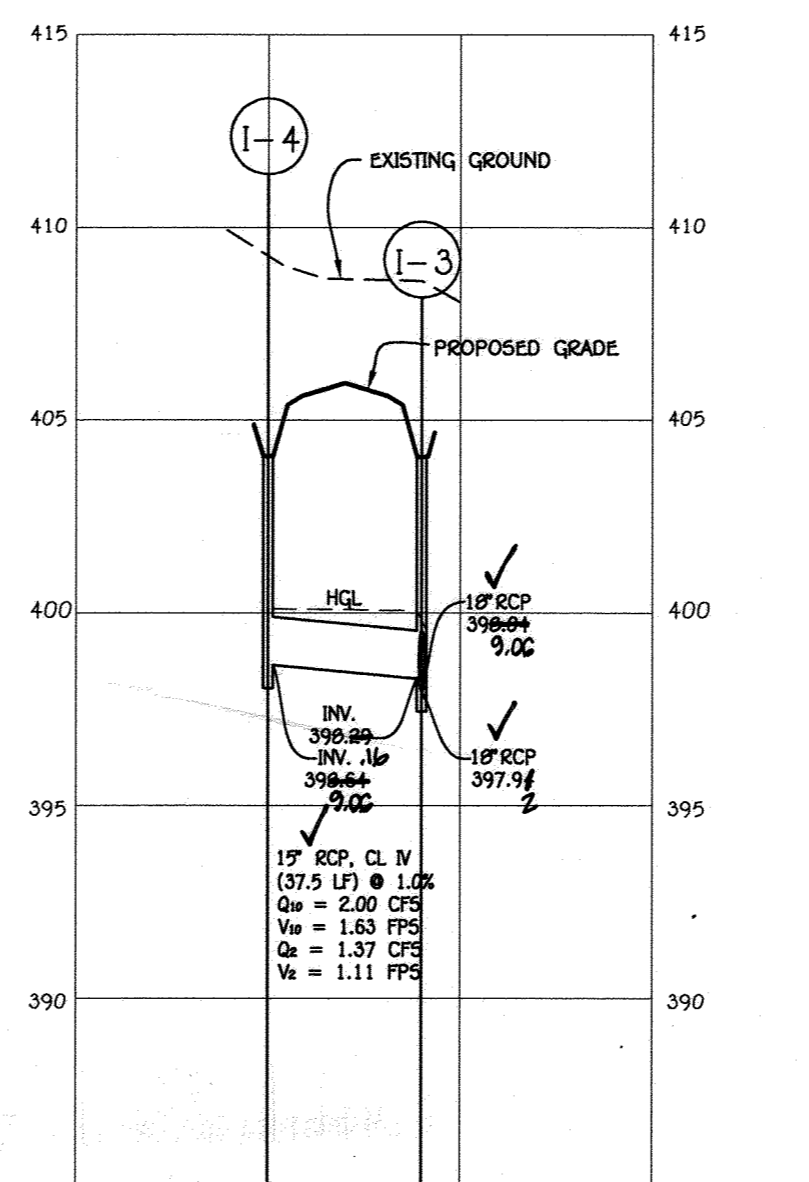

STORM DRAIN PROFILE FROM I-4 TO I-3

VERTICAL SCALE: 1"=5'

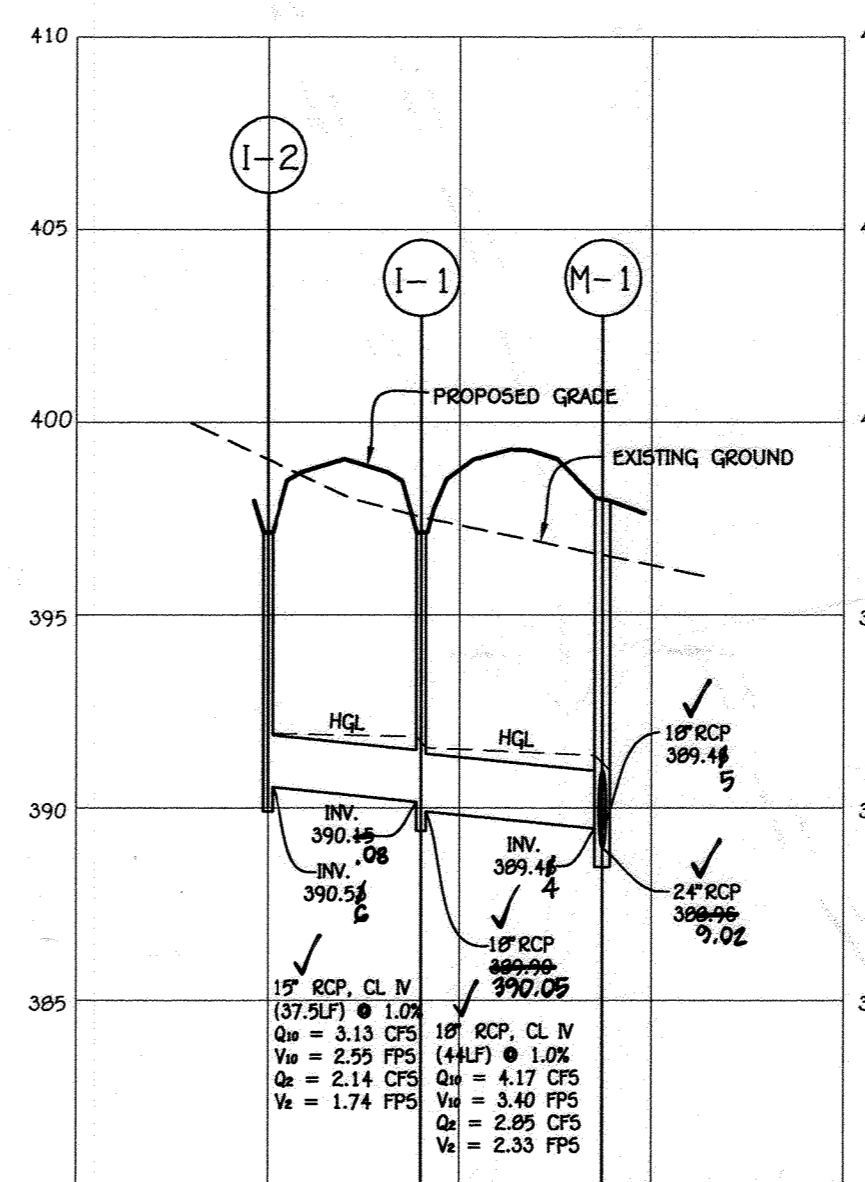


STORM DRAIN PROFILE FROM I-2 TO M-1

HORIZONTAL SCALE: 1"=50'
VERTICAL SCALE: 1"=5'

STRUCTURE SCHEDULE

STRUCTURE NO.	TOP ELEVATION	INVIN	INV.OUT	LOCATION	TYPE	REMARKS
I-6	418.88.10	-----	411.89.30	WESTLAND CT STA 5+72.273 14' LT 19.5	YARD ✓	D-4.14
I-5	413.98.06	406.58.29	406.88.03	WESTLAND CT STA 4+102.24 14' RT 19.5	YARD ✓	D-4.14
I-4	411.19.403.10	-----	398.64.9.06	WESTLAND CT STA 3+18.00 20' LT 20.1	YARD ✓	D-4.14
I-3	403.66.77	398.88.16	397.9.4.2	WESTLAND CT STA 3+18.00 20' LT 20.1	YARD ✓	D-4.14
I-2	397.1.8.6	-----	390.5.8.2	WESTLAND CT STA 0+63.86 20' RT 19.7	YARD ✓	D-4.14
I-1	397.45.91	390.45.08	389.98.390.05	WESTLAND CT STA 0+63.86 20' RT 19.7	YARD ✓	D-4.14
M-2	411.19.70	408.1.1.97	408.0.1.79	WESTLAND CT STA 4+26.76 6' RT 9.0	MANHOLE ✓	G-5.12
M-1	398.0.7.2	389.1.8.4	389.0.6.9.02	WESTLAND CT STA 1+02.38.1' RT 20.4	MANHOLE ✓	G-5.12
ES1 (PRIVATELY OWNED & MAINTAINED)	-----	-----	389.0.0.368.19	WESTLAND CT STA 0+99.54 20' RT 19.7	24" RCP END SECTION ✓	D-5.51
H2	TW 399.88.91	47 398.88.43	-----	WESTLAND CT STA 0+46.57 23.89' LT 19.7	TYPE "A" HEADWALL (DOUBLE WIDTH TO ACCOMMODATE DUAL PIPES) ✓	D-5.11
H1	TW 398.48.04	-----	47 395.48.01	WESTLAND CT STA 0+42.55 23.89' RT 19.7	TYPE "A" HEADWALL (DOUBLE WIDTH TO ACCOMMODATE DUAL PIPES) ✓	D-5.11

NOTE: LOCATION OF YARD INLETS AND MANHOLES IS TO CENTER OF STRUCTURE. LOCATION OF END SECTION IS TO JUNCTION WITH PIPE. LOCATION OF HEADWALL IS TO MIDDLE OF WALL BETWEEN DUAL PIPES AT JUNCTION WITH PIPE.

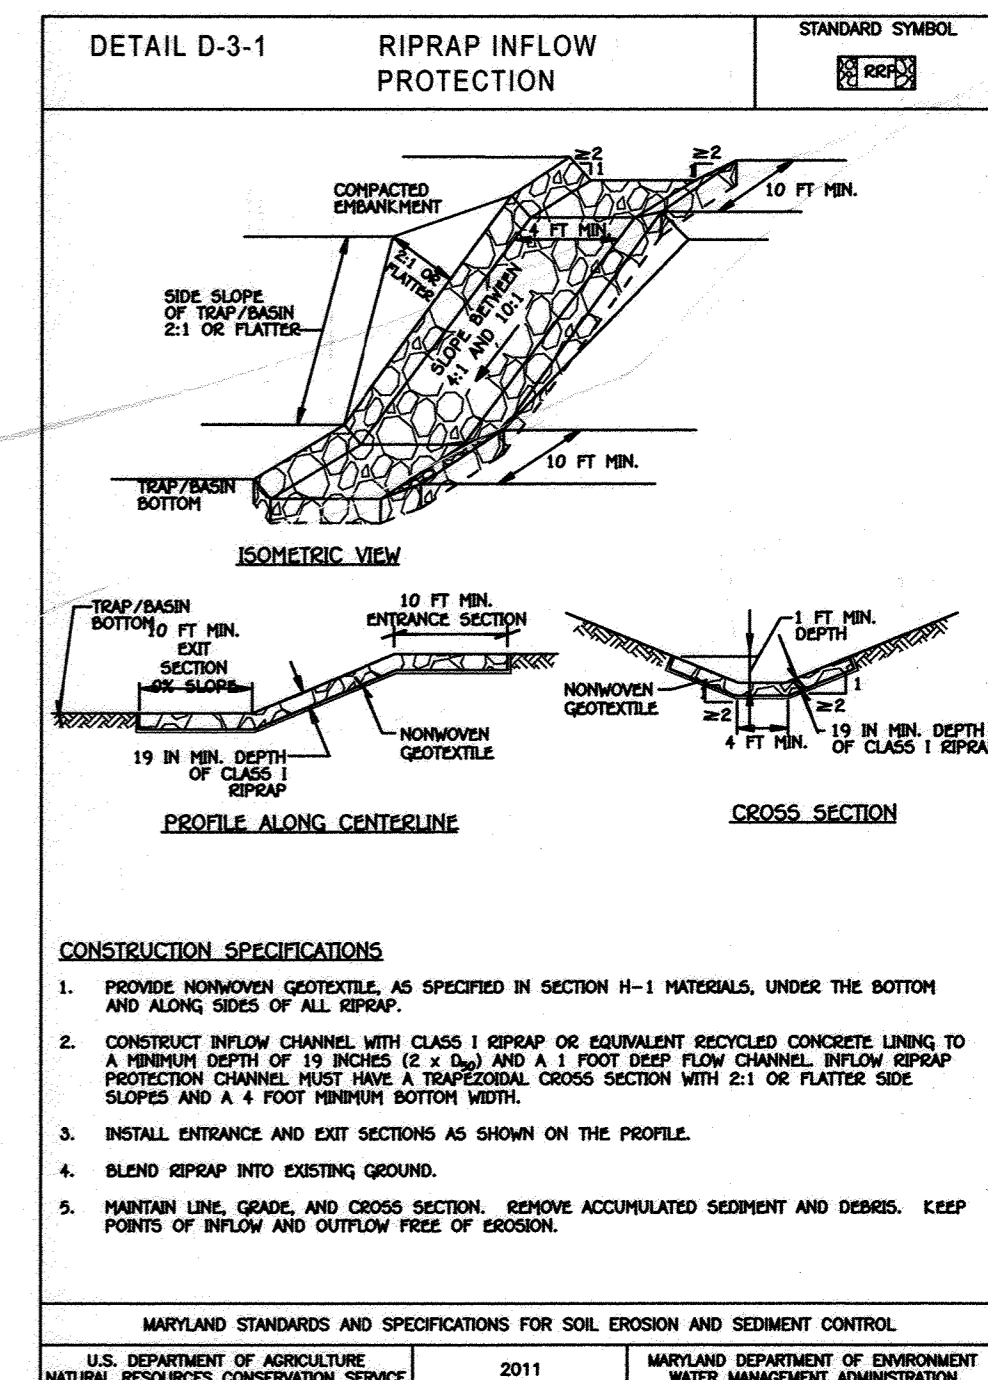

THIS DEVELOPMENT PLAN IS APPROVED FOR SOIL EROSION AND SEDIMENT CONTROL BY THE HOWARD SOIL CONSERVATION DISTRICT.
Approved: *[Signature]*
Hard SGD
2/17/16

APPROVED: DEPARTMENT OF PUBLIC WORKS
[Signature] 2/22/2016
CHIEF, BUREAU OF HIGHWAYS
APPROVED: DEPARTMENT OF PLANNING AND ZONING
[Signature] 6-21-16
CHIEF, DIVISION OF LAND DEVELOPMENT
[Signature] 2-2-16
CHIEF, DEVELOPMENT ENGINEERING DIVISION

OWNERS
LIME KILN, LLC
12549 LIME KILN ROAD
FULTON, MARYLAND 20759-0460
410-792-2922
AND
PERRY C. WESTLAND, JR.
12549 LIME KILN ROAD
FULTON, MARYLAND 20759-0460
410-792-2922
FISHER, COLLINS & CARTER, INC.
CIVIL ENGINEERING CONSULTANTS & LAND SURVEYORS
CONTINENTAL SQUARE OFFICE PARK - 10222 BALTIMORE NATIONAL PIKE
ELLSWORTH CITY, MARYLAND 21042
(410) 461 - 2895

DEVELOPER
WILLIAMSBURG GROUP, LLC
C/O BOB CORBETT
5485 HADSPER FARM ROAD, SUITE 200
COLUMBIA, MARYLAND 21044
410-997-8800

PROFESSIONAL CERTIFICATION
I HEREBY CERTIFY THAT THESE DOCUMENTS WERE PREPARED OR APPROVED BY ME AND THAT I AM A DULY LICENSED PROFESSIONAL ENGINEER UNDER THE LAWS OF THE STATE OF MARYLAND, LICENSE NO. 38386, EXPIRATION DATE: 01/12/2016.
[Signature] 12/2/15
Signature Of Professional Engineer DATE





STORM DRAIN PROFILES
WESTLAND FARM ESTATES
LOTS 3 THRU 14 AND OPEN SPACE LOT 15
ZONED RR-DEO
TAX MAP No. 45 GRID No. 5 PARCEL No. 28
FIFTH ELECTION DISTRICT HOWARD COUNTY, MARYLAND
SCALE: AS SHOWN DATE: DECEMBER, 2015
SHEET 14 OF 19

Table B.4. Materials Specifications for Micro-Bioretenion, Rain Gardens & Landscape Infiltration


Material	Specification	Size	Notes
Plantings	see Appendix A Table A.4	n/a	plantings are site-specific
Planting soil (2" to 4" deep)	loamy sand 60-65% compost 35-40% or sandy loam 50% coarse sand 30% compost 40%		USDA soil types loamy sand or sandy loam; clay content <5%
Organic Content	Min. 10% by dry weight (ASTM D 2574)		
Mulch	shredded hardwood		aged 6 months, minimum
Pea gravel diaphragm	pea gravel: ASTM-D-440	No. 8 or No. 9 (1/8" to 3/8")	
Curtain drain	ornamental stone: washed cobble	stone: 2" to 5"	
Geotextile		n/a	PE Type 1 nonwoven
Gravel (underdrains and infiltration berms)	ASHTO M-43	No. 57 or No. Aggregate (3/8" to 3/4")	
Underdrain piping	1" 750, Type PS 2B or ASHTO M-27B	4" to 6" rigid schedule 40 PVC or SDR35	slotted or perforated pipe: 3/8" pert. @ 6" on center, 4 holes per row, minimum of 3" of gravel over pipes; not necessary underneath pipes. Perforated pipe shall be wrapped with 1/4 inch galvanized hardware cloth
Poured in place concrete (if required)	MSHA Mix No. 3; f = 3500 psi at 28 days, normal weight, air-entrained, reinforcing to meet ASTM-A-639-02	n/a	on-site testing of poured-in-place concrete required: 28 day strength and slump test; all concrete design (cast-in-place or pre-cast) not using previously approved state or local standards requires design engineer sealed and approved by a professional structural engineer licensed in the state of Maryland - design to include meeting ACI Code 308.3-09, vertical loading D1-10 or H-20; allowable horizontal loading (based on soil pressure); and analysis of potential cracking
Sand	ASHTO M-6 or ASTM-C-33	0.02" to 0.04"	sand substitutions such as Diabase and Gneiss (ASHTO) #10 are not acceptable. No silicium carbonated or dolomitic sand substitutions are acceptable. No "rock dust" can be used for sand.

OPERATION & MAINTENANCE SCHEDULE FOR PRIVATELY OWNED AND MAINTAINED, DISCONNECTION OF ROOFTOP RUNOFF (N-1) DISCONNECTION OF NONROOFTOP RUNOFF (N-2)

1. MAINTENANCE OF AREAS RECEIVING DISCONNECTION RUNOFF IS GENERALLY NO DIFFERENT THAN THAT REQUIRED FOR OTHER LAWN OR LANDSCAPED AREAS. THE AREAS RECEIVING RUNOFF SHOULD BE PROTECTED FROM FUTURE COMPACTON OR DEVELOPMENT OF IMPERVIOUS AREA IN COMMERCIAL AREAS FOOT TRAFFIC SHOULD BE DISCOURAGED AS WELL.

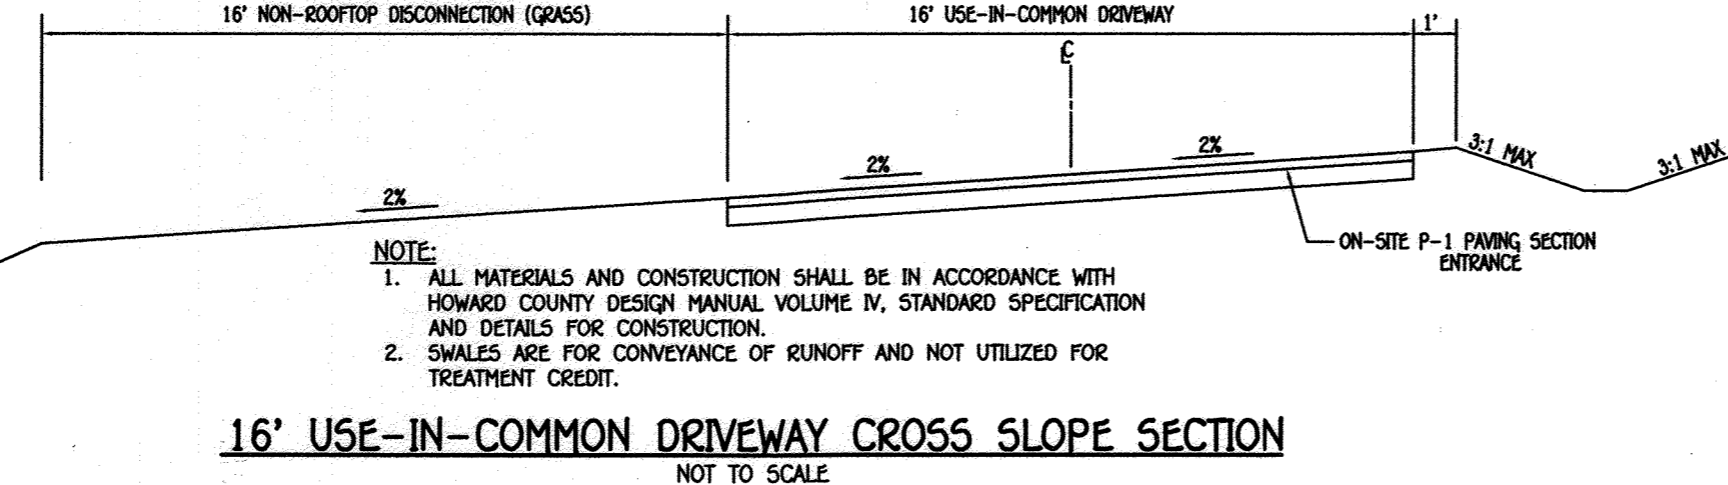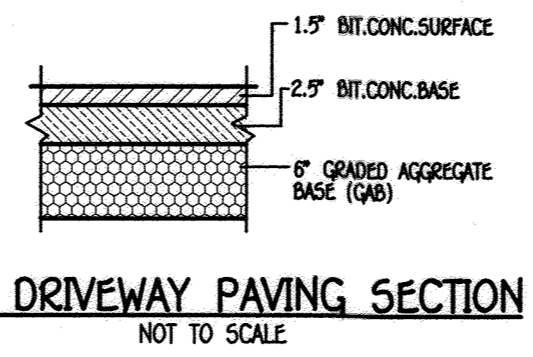

NOTE:
1. ALL MATERIALS AND CONSTRUCTION SHALL BE IN ACCORDANCE WITH HOWARD COUNTY DESIGN MANUAL VOLUME IV, STANDARD SPECIFICATION AND DETAILS FOR CONSTRUCTION.
2. SWALES ARE FOR CONVEYANCE OF RUNOFF AND NOT UTILIZED FOR TREATMENT CREDIT.

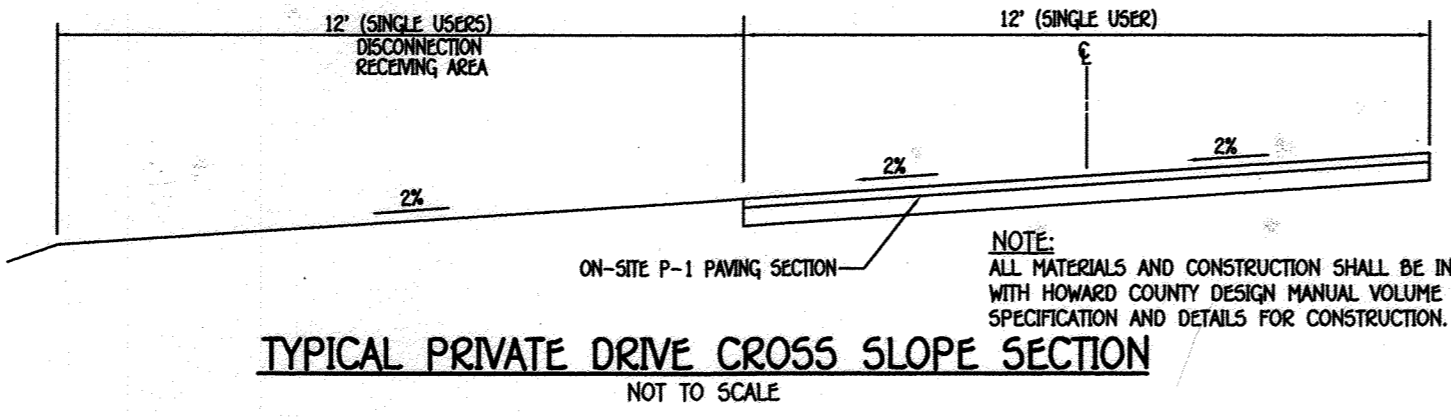


NOTE:
ALL MATERIALS AND CONSTRUCTION SHALL BE IN ACCORDANCE WITH HOWARD COUNTY DESIGN MANUAL VOLUME IV, STANDARD SPECIFICATION AND DETAILS FOR CONSTRUCTION.

BIORETENTION FILTER	MICRO-BIORETENTION								
	A	B	C	D	E	F	G	H	I
1	394.00	394.00	393.00	392.75	390.75	390.50	390.00	389.00	389.75
2	400.00	400.00	399.00	398.75	396.75	396.50	396.00	395.00	395.75
3	400.50	400.50	399.50	399.25	397.25	397.00	396.50	395.50	396.25
4	403.50	403.50	403.25	403.00	401.00	400.75	400.25	399.25	400.00
5	406.00	406.00	405.00	404.75	402.75	402.50	402.00	401.00	401.75



MICRO-BIORETENTION PLANT MATERIAL					
MICRO-BIO 1 QUANTITY	MICRO-BIO 2 QUANTITY	MICRO-BIO 3 QUANTITY	MICRO-BIO 4 QUANTITY	NAME	MAXIMUM SPACING (FT.)
60	60	55	50	MIXED PERENNIALS	1.5 TO 3.0 FT.
3	3	1	1	SILKY DOGWOOD	PLANT AWAY FROM INFLOW LOCATION

OPERATION & MAINTENANCE SCHEDULE FOR MICRO-BIORETENTION (M-6)

- THE OWNER SHALL MAINTAIN THE PLANT MATERIAL, MULCH LAYER AND SOIL LAYER ANNUALLY. MAINTENANCE OF MULCH AND SOIL IS LIMITED TO CORRECTING AREAS OF EROSION OR WASH OUT. ANY MULCH REPLACEMENT SHALL BE DONE IN THE SPRING. PLANT MATERIAL SHALL BE CHECKED FOR DISEASE AND INSECT INFESTATION AND MAINTENANCE WILL ADDRESS DEAD MATERIAL AND PRUNING. ACCEPTABLE REPLACEMENT PLANT MATERIAL IS LISTED TO THE FOLLOWING: 2000 MARYLAND STORMWATER DESIGN MANUAL VOLUME II, TABLE A.4.1 AND 2.
- THE OWNER SHALL PERFORM A PLANT IN THE SPRING AND IN THE FALL OF EACH YEAR. DURING THE INSPECTION, THE OWNER SHALL REMOVE DEAD AND DISEASED VEGETATION CONSIDERED BEYOND TREATMENT. REPLACE DEAD PLANT MATERIAL WITH ACCEPTABLE REPLACEMENT PLANT MATERIAL. TREAT DISEASED TREES AND SHRUBS AND REPLACE ALL DEFICIENT STAKES AND WIRES.
- THE OWNER SHALL INSPECT THE MULCH EACH SPRING. THE MULCH SHALL BE REPLACED EVERY TWO TO THREE YEARS. THE PREVIOUS MULCH LAYER SHALL BE REMOVED BEFORE THE NEW LAYER IS APPLIED.
- THE OWNER SHALL CORRECT SOIL EROSION ON AN AS NEEDED BASIS, WITH A MINIMUM OF ONCE PER MONTH AND AFTER EACH HEAVY STORM.

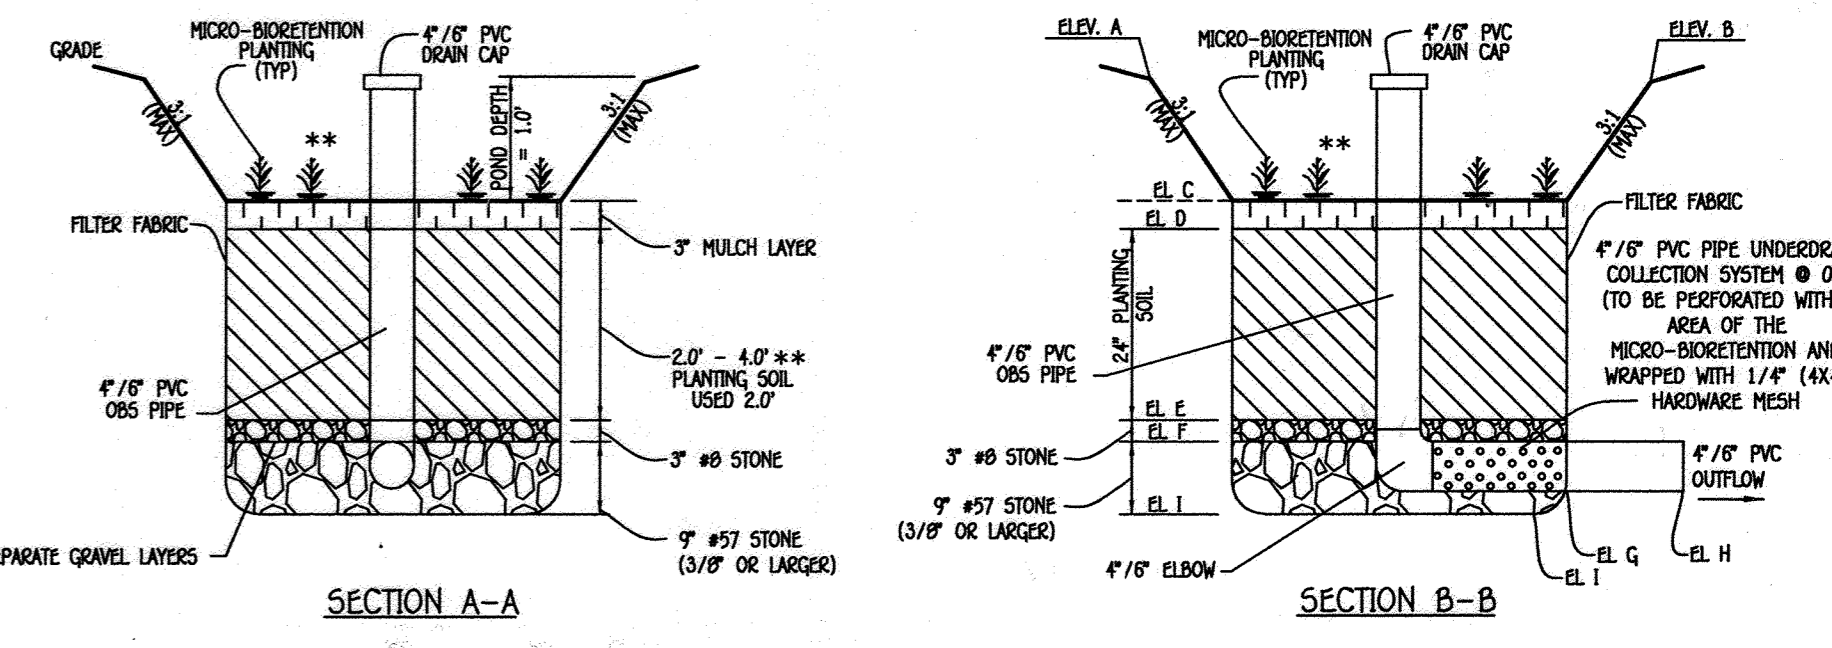


MICRO-BIORETENTION DETAIL (M-6)

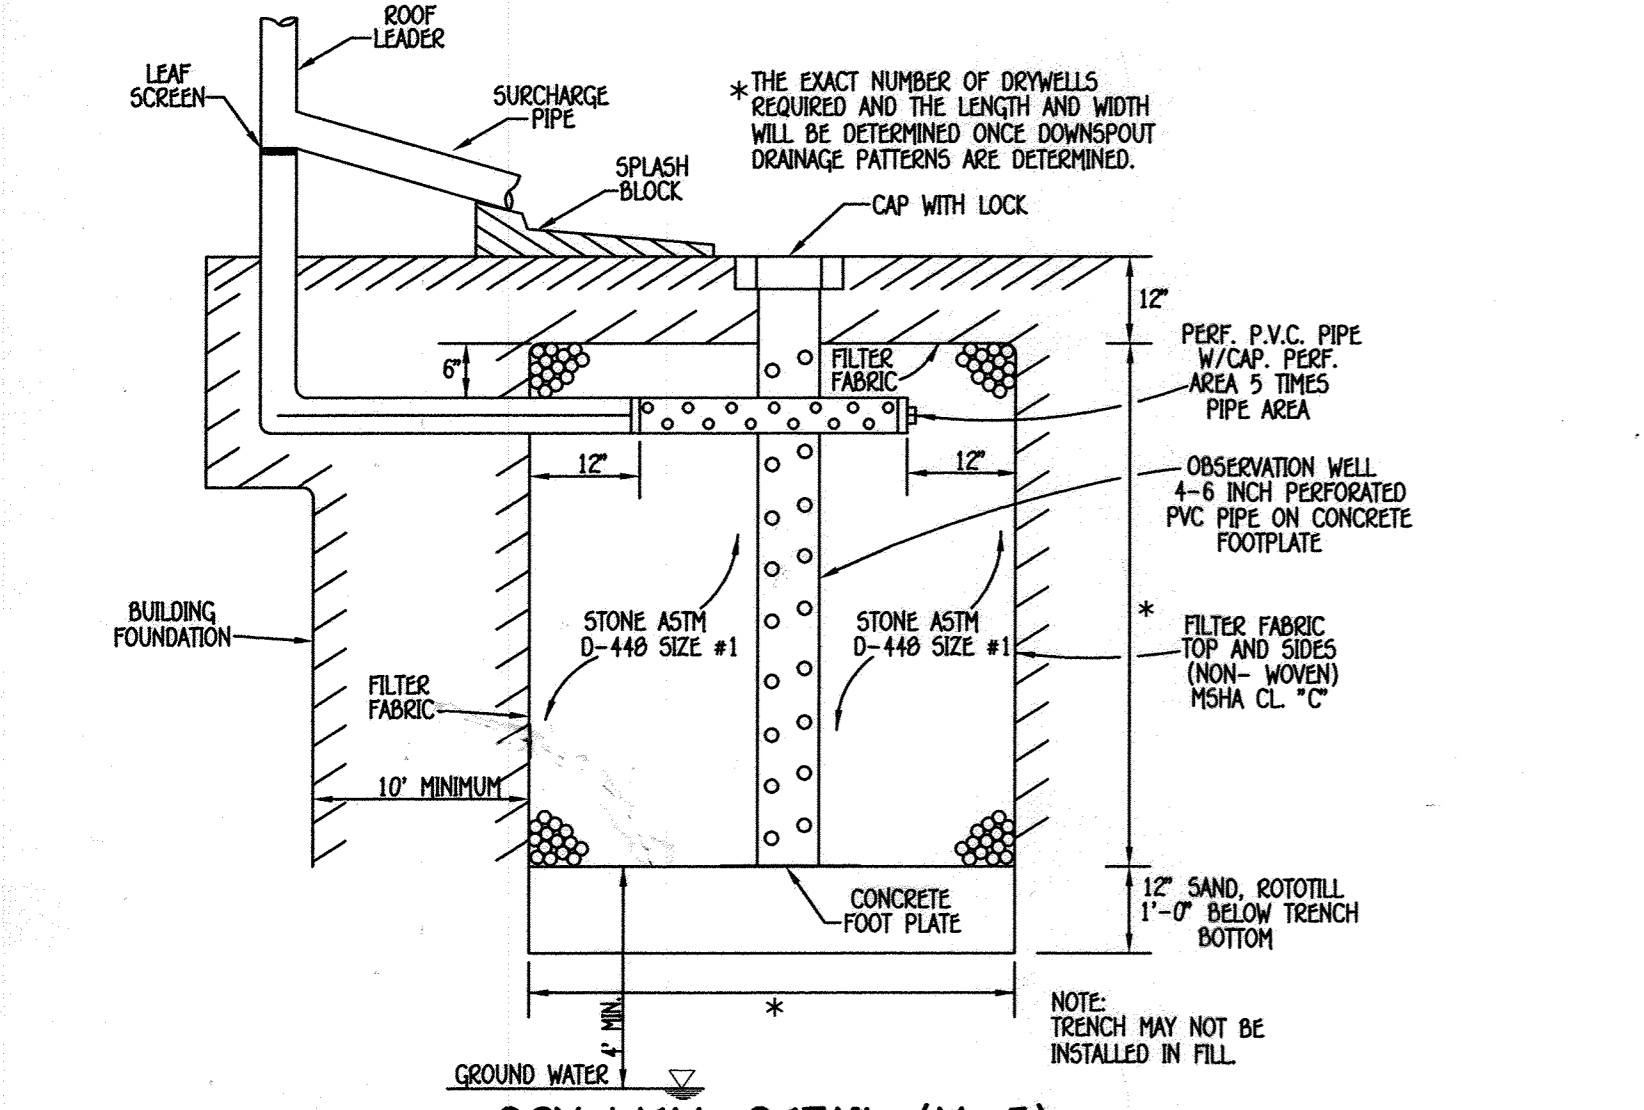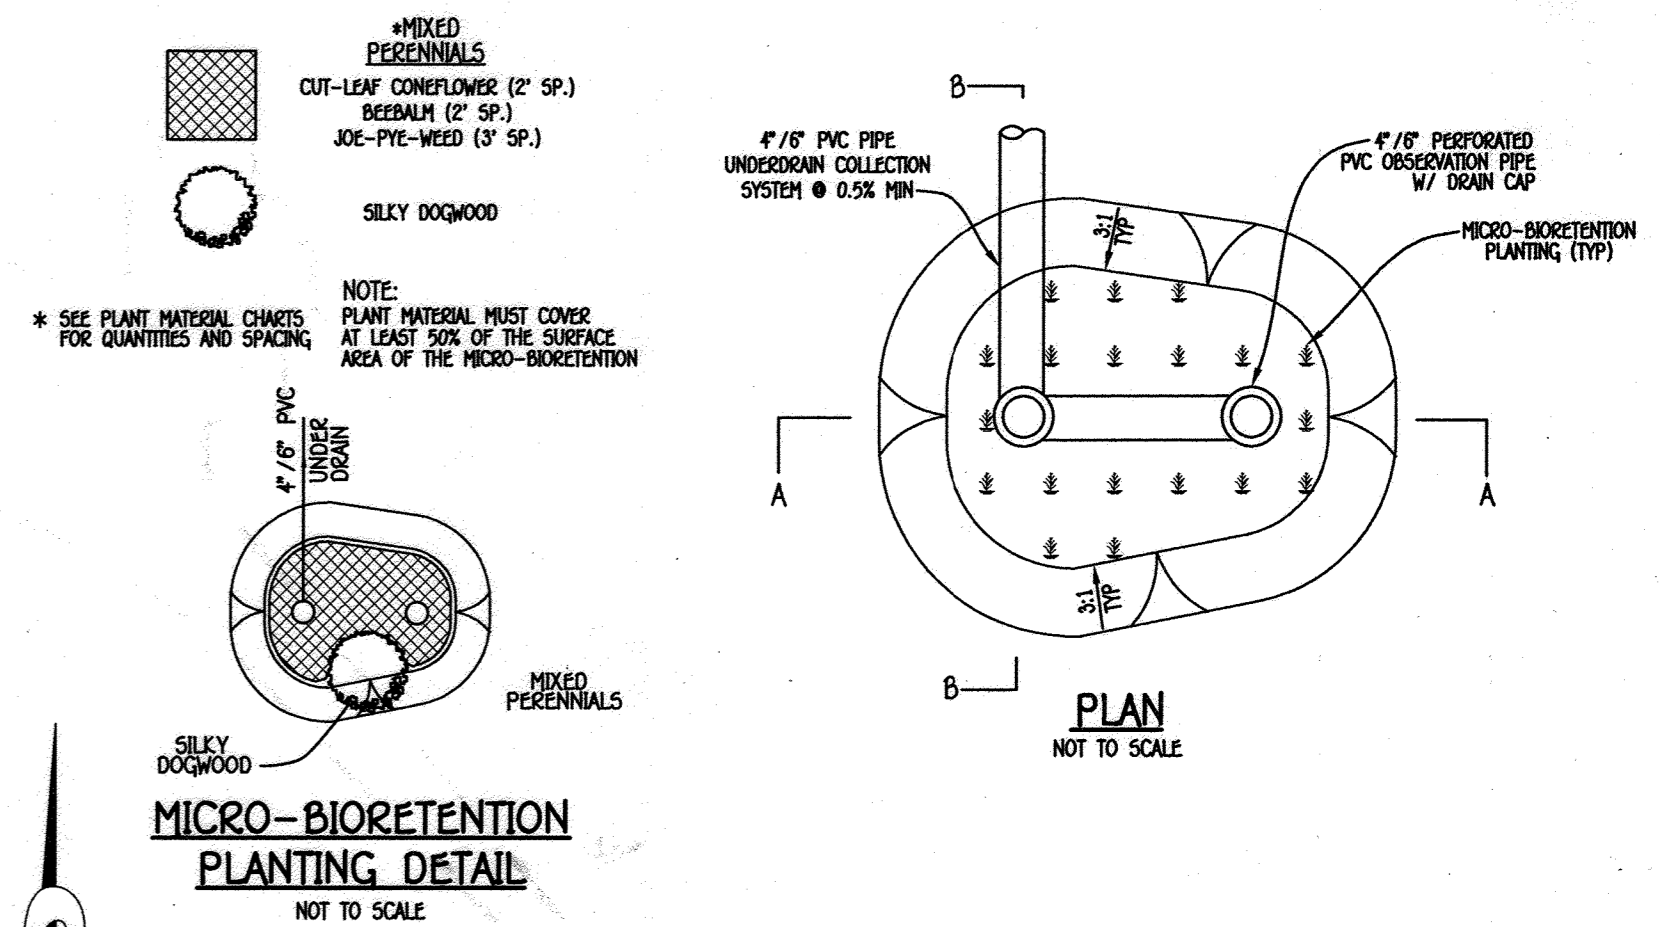



STORMWATER MANAGEMENT NOTES

- STORMWATER MANAGEMENT IS PROVIDED IN ACCORDANCE WITH WITH CHAPTER 5, "ENVIRONMENTAL SITE DESIGN" OF THE 2007 MARYLAND STORMWATER MANAGEMENT DESIGN MANUAL, EFFECTIVE MAY 4, 2010.
- MAXIMUM CONTRIBUTING ROOF TOP AREA TO EACH DOWNSPOUT SHALL BE 1,000 SQ. FT. OR LESS.
- DRYWELLS SHALL BE PROVIDED AT LOCATIONS WHERE THE LENGTH OF DISCONNECTION IS LESS THAN 75' AT 5% SLOPE. THE SIZE AND CONSTRUCTION OF THE DRYWELL SHALL BE IN ACCORDANCE WITH THE DETAIL SHOWN ON THIS SHEET.
- FINAL GRADING IS SHOWN ON THIS SITE DEVELOPMENT PLAN.

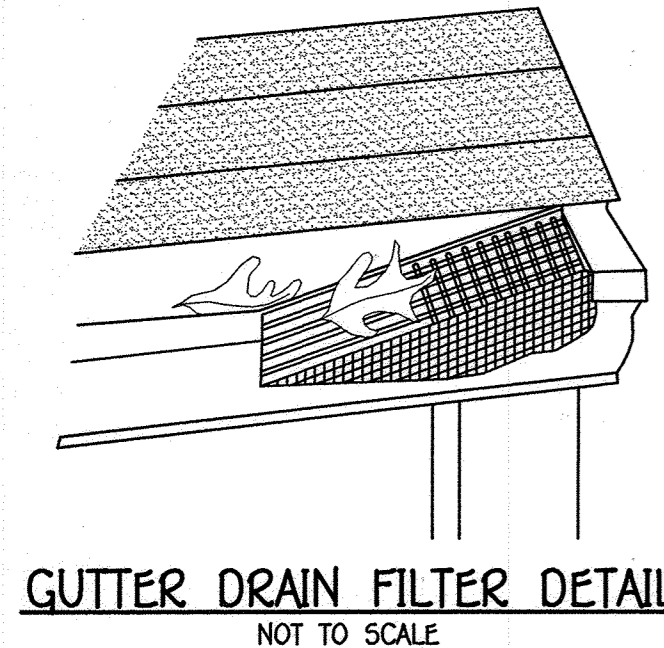

DRYWELL NO.	AREA OF ROOF PER DOWN SPOUT	VOLUME REQUIRED	VOLUME PROVIDED	AREA OF TREATMENT	L	W	D
DW1	894 SQ. FT.	72 C.F.	77 C.F.	100%	8'	8'	3'
DW2	836 SQ. FT.	71 C.F.	77 C.F.	100%	8'	8'	3'
DW3	778 SQ. FT.	67 C.F.	77 C.F.	100%	8'	8'	3'
DW4	890 SQ. FT.	71 C.F.	77 C.F.	100%	8'	8'	3'
DW5	710 SQ. FT.	57 C.F.	77 C.F.	100%	8'	8'	3'
DW6	957 SQ. FT.	76 C.F.	77 C.F.	100%	8'	8'	3'
DW7	646 SQ. FT.	52 C.F.	77 C.F.	100%	8'	8'	3'
DW8	1,085 SQ. FT.	86 C.F.	102 C.F.	100%	8'	8'	4'
DW9	957 SQ. FT.	76 C.F.	77 C.F.	100%	8'	8'	3'
DW10	646 SQ. FT.	52 C.F.	77 C.F.	100%	8'	8'	3'
DW11	1,085 SQ. FT.	86 C.F.	102 C.F.	100%	8'	8'	4'
DW12	710 SQ. FT.	57 C.F.	77 C.F.	100%	8'	8'	3'
DW13	906 SQ. FT.	72 C.F.	77 C.F.	100%	8'	8'	3'
DW14	1,078 SQ. FT.	86 C.F.	87 C.F.	100%	8'	8'	3'
DW15	992 SQ. FT.	76 C.F.	77 C.F.	100%	8'	8'	3'
DW16	1,012 SQ. FT.	81 C.F.	87 C.F.	100%	8'	8'	3'
DW17	957 SQ. FT.	76 C.F.	77 C.F.	100%	8'	8'	3'
DW18	646 SQ. FT.	52 C.F.	77 C.F.	100%	8'	8'	3'
DW19	1,085 SQ. FT.	86 C.F.	102 C.F.	100%	8'	8'	4'
DW20	710 SQ. FT.	57 C.F.	77 C.F.	100%	8'	8'	3'
DW21	710 SQ. FT.	57 C.F.	77 C.F.	100%	8'	8'	3'
DW22	1,085 SQ. FT.	86 C.F.	102 C.F.	100%	8'	8'	4'
DW23	646 SQ. FT.	52 C.F.	77 C.F.	100%	8'	8'	3'
DW24	957 SQ. FT.	76 C.F.	77 C.F.	100%	8'	8'	3'
DW25	361 SQ. FT.	29 C.F.	77 C.F.	100%	8'	8'	3'
DW26	952 SQ. FT.	76 C.F.	77 C.F.	100%	8'	8'	3'
DW27	572 SQ. FT.	46 C.F.	77 C.F.	100%	8'	8'	3'
DW27A	585 SQ. FT.	47 C.F.	77 C.F.	100%	8'	8'	3'
DW28	867 SQ. FT.	69 C.F.	77 C.F.	100%	8'	8'	3'
DW28A	769 SQ. FT.	61 C.F.	77 C.F.	100%	8'	8'	3'
DW29	710 SQ. FT.	57 C.F.	77 C.F.	100%	8'	8'	3'
DW30	1,085 SQ. FT.	86 C.F.	102 C.F.	100%	8'	8'	4'
DW31	646 SQ. FT.	52 C.F.	77 C.F.	100%	8'	8'	3'
DW32	957 SQ. FT.	76 C.F.	77 C.F.	100%	8'	8'	3'

* AREA OF TREATMENT EXCEEDS THAT REQUIRED.

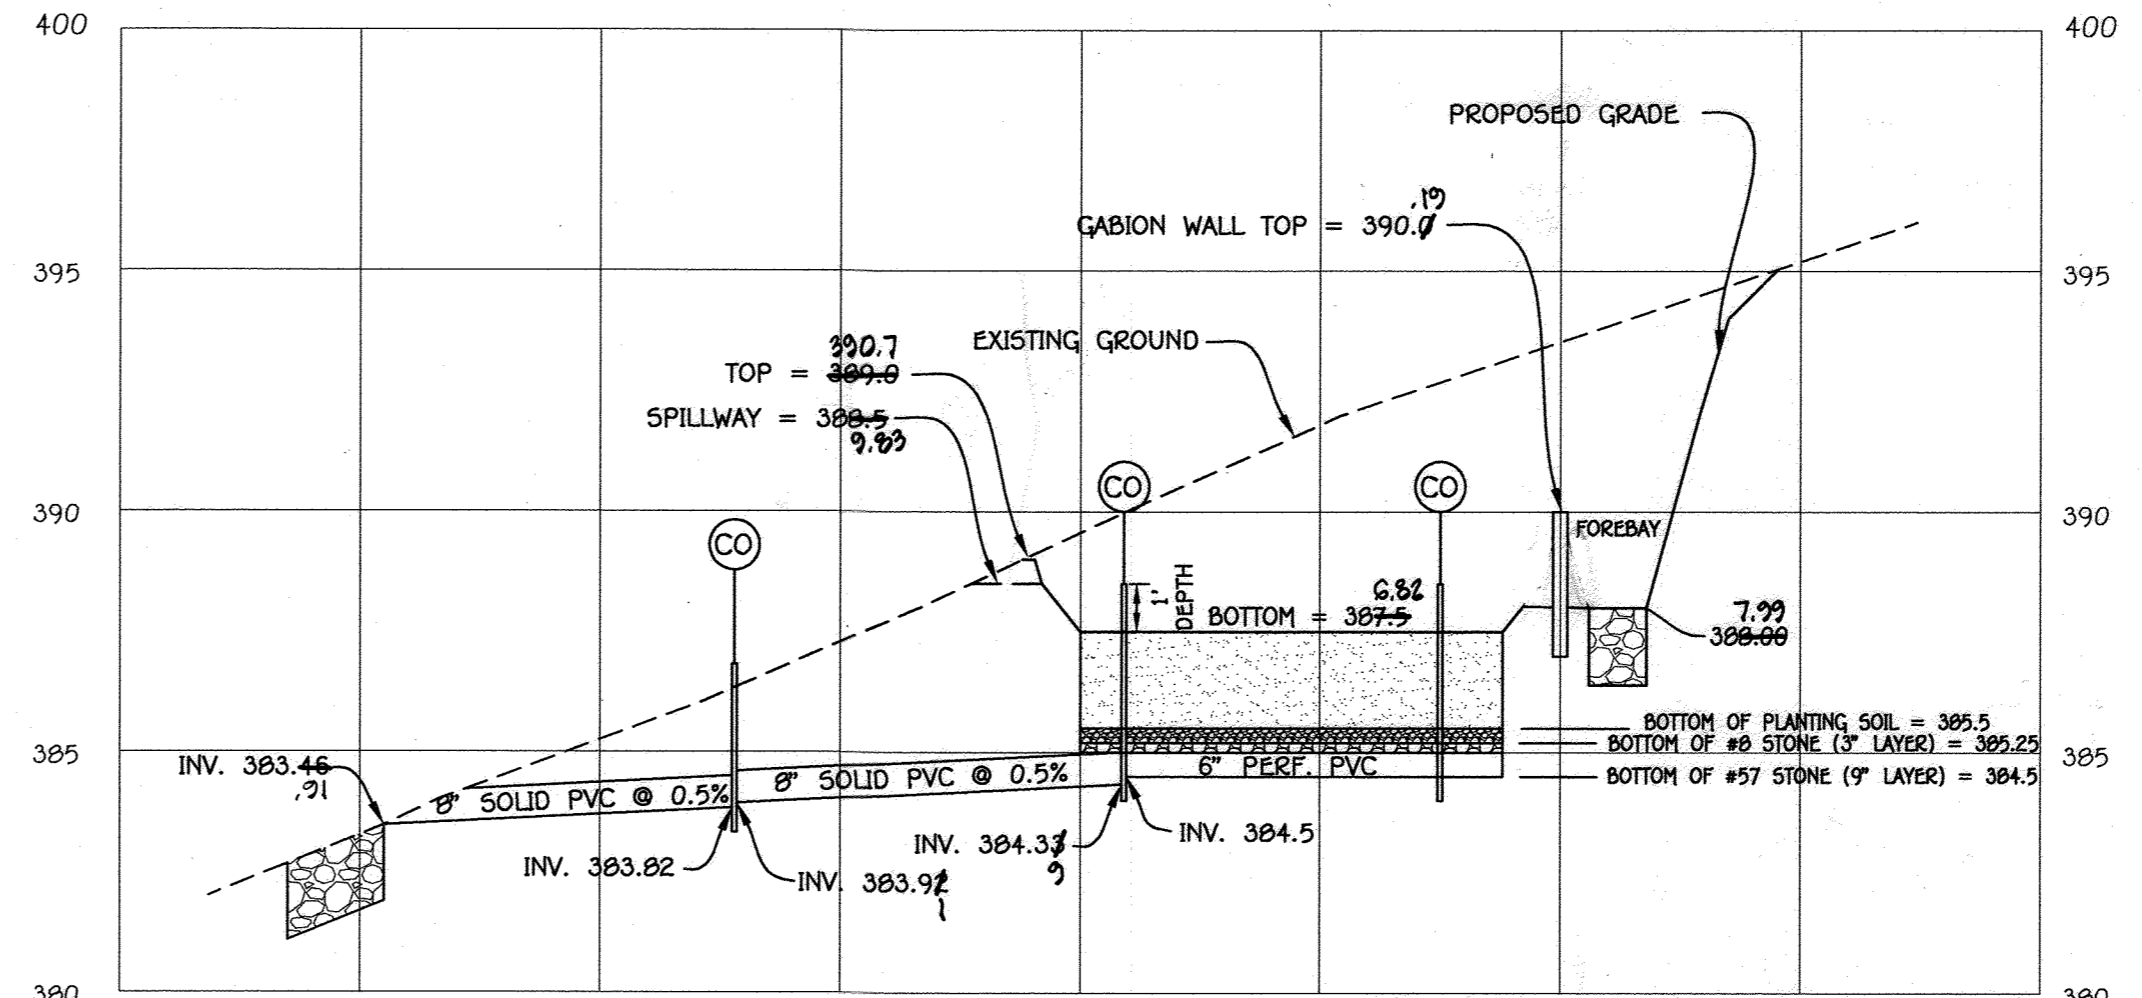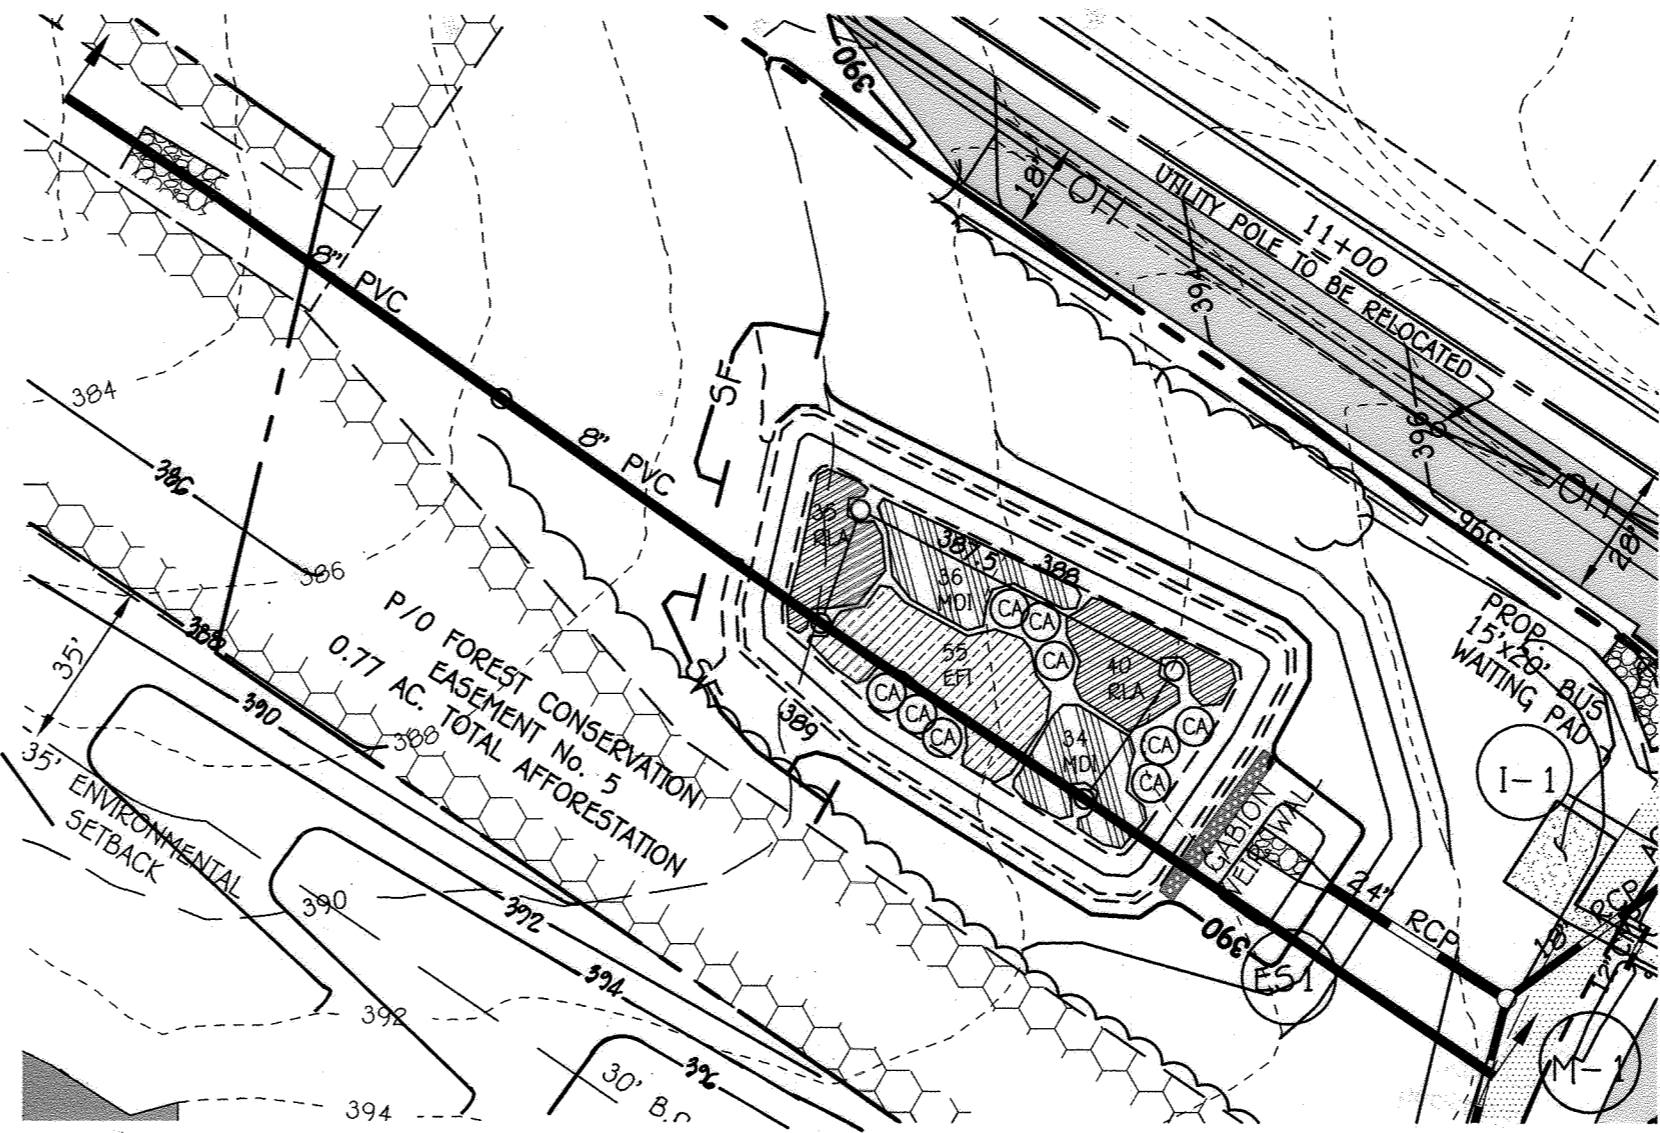

AS-BUILT CERTIFICATION FOR PSWM
I hereby certify that the facility shown on the plan was constructed as shown on the "AS BUILT" plans and specifications. I have verified that the contributing drainage area is sufficiently stabilized to prevent clogging of the underground SWM Facility.
Charles J. ...
Date: 11/24/15

BIORETENTION PLANT LIST			
SYMBOL	QTY.	BOTANICAL AND COMMON NAME	SIZE SPACING
(P)	55	EUTROCIUM FISTULOSUM	BARE ROOT OR PLUG 3' SPACING
(M)	70	MONARDA DIDYMA	BARE ROOT OR PLUG 2' SPACING
(C)	9	CORNUS AMOMUM	B&B OR CONT. 6'-8' SPACING

11/7/10 REVISE DRY WELL CHART (DOWNSPOUTS)
5/4/10 REVISE MICRO-BIORETENTION CHART
11/16/16 ADD PROPOSED GRADING FOR A BEAM ON LOT 3

APPROVED: DEPARTMENT OF PUBLIC WORKS
Chief, Bureau of Highways
2/22/2016

APPROVED: DEPARTMENT OF PLANNING AND ZONING
Chief, Division of Land Development
6-21-16

APPROVED: DEPARTMENT OF PLANNING AND ZONING
Chief, Development Engineering Division
3-2-16

OWNERS
LIME KILN, LLC
12549 LIME KILN ROAD
FULTON, MARYLAND 20799-0460
410-792-2922

DEVELOPER
WILLIAMSBURG GROUP, LLC
C/O BOB CORRETT
5485 HARPERS FARM ROAD, SUITE 200
COLUMBIA, MARYLAND 21044
410-997-8800

FISHER, COLLINS & CARTER, INC.
CIVIL ENGINEERING CONSULTANTS & LAND SURVEYORS
CONTINENTAL SQUARE OFFICE PARK - 10272 BALTIMORE NATIONAL PIKE
ELLSWORTH CITY, MARYLAND 21042
(410) 461-2895

PROFESSIONAL CERTIFICATION
I HEREBY CERTIFY THAT THESE DOCUMENTS WERE PREPARED OR APPROVED BY ME AND THAT I AM A DULY LICENSED PROFESSIONAL ENGINEER UNDER THE LAWS OF THE STATE OF MARYLAND, LICENSE NO. 36386, EXPIRATION DATE: 01/12/2016.
Signature: Stephen J. ...
Date: 12/4/15



STORMWATER MANAGEMENT NOTES & DETAILS
WESTLAND FARM ESTATES
LOTS 3 THRU 14 AND OPEN SPACE LOT 15
ZONED RR-DEO
TAX MAP No. 45 GRID No. 5 PARCEL No. 28
FIFTH ELECTION DISTRICT HOWARD COUNTY, MARYLAND
SCALE: AS SHOWN DATE: DECEMBER, 2015
SHEET 15 OF 19

SOIL PREPARATION, TOPSOILING AND SOIL AMENDMENTS (B-4-2)

A. Soil Preparation

- Temporary Stabilization
 - Seedbed preparation consists of loosening soil to a depth of 3 to 5 inches by means of suitable agricultural or construction equipment, such as disc harrows or chain plows or rippers mounted on construction equipment. After the soil is loosened it must be allowed to settle into the roughened condition. Slopes 2:1 or flatter are to be tracked with ridges running parallel to the contour of the slope.
 - Apply fertilizer and lime as prescribed on the plans.
- Permanent Stabilization
 - A soil test is required for any earth disturbance of 5 acres or more. The minimum soil conditions required for permanent vegetative establishment are:
 - Soil pH between 6.0 and 7.0
 - Soil contains less than 100 parts per million (ppm)
 - Soil contains less than 40 percent clay but enough fine grained material (greater than 30 percent silt plus clay) to provide the capacity to hold a moderate amount of moisture. An exception: if loess/lam will be planted a sandy soil (less than 30 percent silt plus clay) may be accepted.
 - Soil contains 1.5 percent minimum organic matter by weight.
 - Soil contains sufficient pore space to permit adequate root penetration.
 - Application of amendments or topsoil is required if on-site soils do not meet the above conditions.
 - Graded areas must be maintained in a true and even grade as specified on the approved plan, then scrippled or otherwise loosened to a depth of 3 to 5 inches.
 - Apply soil amendments as specified on the approved plan or as indicated by the results of a soil test.
 - Mix soil amendments into the top 3 to 5 inches of soil by disking or other suitable means. Stake lawn areas to smooth the surface, remove large objects like stones and branches, and ready the area for seed application. Loosen surface soil by dragging with a heavy chain or other equipment to roughen the surface where site conditions will permit. Minimum seedbed preparation, track slopes 2:1 or flatter with tracked equipment leaving the soil in an irregular condition with ridges running parallel to the contour of the slope. Leave the top 1 to 3 inches of soil loose and friable, seedbed loosening may be unnecessary on newly disturbed areas.

B. Topsoiling

- Topsoil is placed over prepared subsoil prior to establishment of permanent vegetation. The purpose is to provide a suitable soil medium for vegetative growth. Soils of concern have low moisture content, low nutrient levels, low pH, materials toxic to plants, and/or unacceptable soil gradation.
- Topsoil salvaged from an existing site may be used provided it meets the standards as set forth in these specifications. Typically, the depth of topsoil to be salvaged for a given soil can be found in the representative soil profile section in the USA-NRCS.
- Topsoiling is limited to areas having 2:1 or flatter slopes where:
 - The texture of the exposed subsoil/parent material is not adequate to produce vegetative growth.
 - The soil material is so shallow that the rooting zone is not deep enough to support plants or furnish continuing supplies of moisture and plant nutrients.
 - The original soil to be vegetated contains material toxic to plant growth.
 - The soil is so acidic that treatment with limestone is not feasible.
- Areas having slopes steeper than 2:1 require special consideration and design.
- Topsoil Specifications: Topsoil to be used as topsoil must meet the following criteria:
 - Topsoil must be a loam, sandy loam, clay loam, silt loam, sandy clay loam, or loamy sand. Other soils may be used if recommended by an agronomist or soil scientist and approved by the appropriate approval authority. Topsoil must not be a mixture of contrasting textured subsoils and must contain less than 5 percent by volume of cinders, stones, slag, coarse pebbles, rocks, or other materials larger than 1 1/2 inches in diameter.
 - Topsoil must be free of noxious plants or plant parts such as Bermuda grass, quack grass, Johnson grass, nut sedge, poison ivy, thistle, or others as specified.
 - Topsoil substitutes or amendments, as recommended by a qualified agronomist or soil scientist and approved by the appropriate approval authority, may be used in lieu of natural topsoil.
- Areas having slopes steeper than 2:1 require special consideration and design.
- Topsoil Specifications: Topsoil to be used as topsoil must meet the following criteria:
 - Topsoil must be a loam, sandy loam, clay loam, silt loam, sandy clay loam, or loamy sand. Other soils may be used if recommended by an agronomist or soil scientist and approved by the appropriate approval authority. Topsoil must not be a mixture of contrasting textured subsoils and must contain less than 5 percent by volume of cinders, stones, slag, coarse pebbles, rocks, or other materials larger than 1 1/2 inches in diameter.
 - Topsoil must be free of noxious plants or plant parts such as Bermuda grass, quack grass, Johnson grass, nut sedge, poison ivy, thistle, or others as specified.
 - Topsoil substitutes or amendments, as recommended by a qualified agronomist or soil scientist and approved by the appropriate approval authority, may be used in lieu of natural topsoil.
- Topsoil Application
 - Erosion and sediment control practices must be maintained when applying topsoil.
 - Uniformly distribute topsoil in a 5 to 8 inch layer and lightly compact to a minimum thickness of 4 inches. Spreading is to be performed in a uniform manner in the direction of the slope. Topsoil shall be placed in the direction of the slope and fillage. Any irregularities in the surface resulting from topsoiling or other operations must be corrected in order to prevent the formation of depressions or water pockets.
 - Topsoil must not be placed if the topsoil or subsoil is in a frozen or muddy condition, when the subsoil is excessively wet or in a condition that may otherwise be detrimental to proper grading and seedbed preparation.

C. Soil Amendments (Fertilizer and Lime Specifications)

- Soil tests must be performed to determine the exact ratios and application rates for both lime and fertilizer on sites having disturbed areas of 5 acres or more. Soil analysis may be performed by a recognized private or commercial laboratory. Soil samples taken for engineering purposes may also be used for chemical analysis.
- Fertilizers must be uniform in composition, free flowing and suitable for accurate application by appropriate equipment. Manure may be substituted for fertilizer with prior approval from the appropriate approval authority. Fertilizers must all be delivered to the site fully baled according to the applicable laws and must bear the name, trade name or trademark and warranty of the producer.
- Lime materials must be ground limestone (hydrated or burnt lime may be substituted except when hydroseeding) which contains at least 90 percent total oxides (calcium oxide plus magnesium oxide). Limestone must be ground to such fineness that at least 50 percent will pass through a #100 mesh sieve and 90 to 100 percent will pass through a #20 mesh sieve.
- Lime and fertilizer are to be evenly distributed and incorporated into the top 3 to 5 inches of soil by disking or other suitable means.
- Where the subsoil is either highly acidic or composed of heavy clays, spread ground limestone at the rate of 4 to 8 tons/acre (2000 to 4000 lbs/acre) on soils with a pH of 5.5 or lower.

BUILDER/DEVELOPER'S CERTIFICATE

"I/We Certify That All Development And/Or Construction Will Be Done According To These Plans, And That All Construction In Accordance With The Construction Plans Will Have A Certificate of Attendance At A Department Of The Environment Approved Training Program For The Control Of Sediment And Erosion Before Beginning The Project. I Shall Engage A Registered Professional Engineer To Supervise Pond Construction And Provide The Howard Soil Conservation District With An "As-Built" Plan Of The Pond Within 30 Days Of Completion. I Also Authorize Periodic On-Site Inspections By The Howard Soil Conservation District."

SIGNATURE OF DEVELOPER

DATE: 2-1-16

ENGINEER'S CERTIFICATE

"I Certify That This Plan For Pond Construction, Erosion And Sediment Control Represents A Practical And Workable Plan Based On My Personal Knowledge Of The Site Conditions. This Plan Was Prepared In Accordance With The Requirements Of The Howard Soil Conservation District. I Have Notified The Developer That He/She Must Engage A Registered Professional Engineer To Supervise Pond Construction And Provide The Howard Soil Conservation District With An "As-Built" Plan Of The Pond Within 30 Days Of Completion."

SIGNATURE OF ENGINEER
Hyppolite Linte
DATE: 1/29/16

B-4-3 STANDARDS AND SPECIFICATIONS FOR SEEDING AND MULCHING

The application of seed and mulch to establish vegetative cover.

Purpose:
To protect disturbed soils from erosion during and at the end of construction.

Conditions Where Practice Applies:
To the surface of all perimeter controls, slopes, and any disturbed area not under active grading.

Criteria:

- Seeding
 - All seed must meet the requirement of the Maryland Seed Law. All seed must be subject to re-testing by a recognized seed laboratory. All seed used must have been tested within the 6 months immediately preceding the date of sowing such material on any project. Refer to Table B.4 regarding the quality of seed. Seed tags must be available upon request to the inspector to verify type of seed and seeding rate.
 - Mulch alone may be applied between the fall and spring seeding dates only if the ground is frozen. The appropriate seeding mixture must be applied when the ground thaws.
 - Inoculants: The inoculant for treating legume seed in the seed mixtures must be a pure culture of nitrogen fixing bacteria prepared specifically for the species. Inoculants must be stored in dry conditions. Add fresh inoculants as directed on the package. Use four times the recommended rate when hydroseeding. Note: it is very important to keep inoculants as cool as possible upon use. Temperatures above 75 to 80 degrees Fahrenheit can weaken bacteria and make the inoculant less effective.
 - Seed or seed mix must be placed on soil which has been treated with soil sterilants or chemicals used for weed control until sufficient time has elapsed (14 days min.) to permit dissipation of phytotoxic materials.
- Application
 - Dry Seeding: This includes use of conventional drop or broadcast spreaders.
 - Inoculate seeds into the soil at the rates prescribed on Temporary Seeding Table B.1, Permanent Seeding Table B.3, or site-specific seeding summaries.
 - Apply seed in two directions, perpendicular to each other. Apply half the seeding rate in each direction. Roll the seeded area with weighted roller to provide good seed to soil contact.
 - Drill or Cultipacker Seeding: Mechanized seeders that apply and cover seed with soil.
 - Cultipacker seeders are required to bury the seed in such a fashion as to provide at least 1/4 inch of soil covering. Seeded area must be firm after planting.
 - Apply seed in two directions, perpendicular to each other. Apply half the seeding rate in each direction.
 - Hydroseeding: Apply seed uniformly with hydroseeder (slurry includes seed and fertilizer).
 - If fertilizer is being applied at the time of seeding, the application rates should not exceed the following: nitrogen, 100 pounds per acre total of soluble nitrogen P O (phosphorus), 200 pounds per acre; K O (potassium), 500 pounds per acre.
 - Hydroseeding: Use only ground agricultural limestone (up to 3 tons per acre) may be applied by hydroseeding. Normally, not more than 2 tons are applied by hydroseeding at any one time. Do not use burnt or hydrated lime when hydroseeding.
 - Mix seed and fertilizer, and seed immediately and without interruption.
 - When hydroseeding do not incorporate seed into the soil.
- Mulch Materials (in order of preference)
 - Straw consisting of thoroughly threshed wheat, rye, oat, or barley and reasonably bright in color. Straw is to be free of noxious weeds as specified in the Maryland Seed Law and not musty, moldy, caked, decayed, or excessively dirty. Note: Use only sterile straw in areas where one species of grass is desired.
 - Wood Cellulose Fiber Mulch (WCFM) consisting of specially prepared wood cellulose processed into a uniform fibrous physical entity.
 - WCFM is to be dyed green or contain a green dye in the package that will provide an appropriate color to facilitate visual inspection of the uniformly spread slurry.
 - WCFM, including dye, must contain no germination or growth inhibiting factors.
 - WCFM materials are to be manufactured and processed in such a manner that the wood cellulose fiber mulch will remain in uniform suspension in water under agitation and will blend with seed, fertilizer, and other additives to form a homogeneous slurry. The mulch material must form a firm enough to support 10 percent of the seed of the seed.
 - Seed must not be harvested or transplanted when moisture content (excessively dry wet) may adversely affect germination.
 - Seed must be harvested, delivered, and installed within a period of 36 hours. Seed not transplanted within this period must be approved by an agronomist or soil scientist prior to its installation.
 - During periods of excessively high temperature or in areas having dry ground, lightly irrigate the subsoil immediately prior to laying the sod.
 - At the first week of sod with subsequent rows placed parallel to it and tightly wedged against each other. Stagger joint joints to promote more uniform growth and strength. Ensure that soil is not stretched or overworked and that all joints are pulled tight in order to prevent voids which would cause air drying of the sod.
 - Wherever possible, lay sod with the long edges parallel to the contour and with staggering joints. Roll and tamp, jog or otherwise secure the sod and to prevent slippage on slopes. Ensure solid contact exists between sod roots and the underlying soil surface.
 - Water the sod immediately following rolling and tamping until the underside of the new sod pad and the surface below the sod are thoroughly wet. Complete the operations of laying, tamping, and irrigating for any piece of sod within eight hours.
- Soil Installation
 - During periods of excessively high temperature or in areas having dry ground, lightly irrigate the subsoil immediately prior to laying the sod.
 - At the first week of sod with subsequent rows placed parallel to it and tightly wedged against each other. Stagger joint joints to promote more uniform growth and strength. Ensure that soil is not stretched or overworked and that all joints are pulled tight in order to prevent voids which would cause air drying of the sod.
 - Wherever possible, lay sod with the long edges parallel to the contour and with staggering joints. Roll and tamp, jog or otherwise secure the sod and to prevent slippage on slopes. Ensure solid contact exists between sod roots and the underlying soil surface.
 - Water the sod immediately following rolling and tamping until the underside of the new sod pad and the surface below the sod are thoroughly wet. Complete the operations of laying, tamping, and irrigating for any piece of sod within eight hours.

- Cultivars Seeding Rate: 1.5 to 2.0 pounds per 1000 square feet. Choose a minimum of three Kentucky bluegrass cultivars with each ranging from 10 to 35 percent of the total mixture by weight.
- Kentucky Bluegrass/Perennial Rye: Full Sun Mixture: For use in full sun areas where rapid establishment is necessary and when turf will receive moderate to intensive maintenance. Certified Perennial Rye/Cultivated Kentucky Bluegrass Seeding Rate: 2 pounds per 1000 square feet. Choose a minimum of three Kentucky bluegrass cultivars with each ranging from 10 to 35 percent of the total mixture by weight.
- Tall Fescue/Cultivated Kentucky Bluegrass: Full Sun Mixture: For use in drought prone areas and/or for areas receiving low to medium maintenance in full sun to moderate shade conditions. Certified Tall Fescue/Cultivated Kentucky Bluegrass Seeding Rate: 3 pounds per 1000 square feet. Choose a minimum of three Kentucky bluegrass cultivars with each ranging from 10 to 35 percent of the total mixture by weight.
- Shade Mixture: For use in shaded areas where rapid establishment is necessary and when turf will receive moderate to intensive maintenance. Certified Kentucky Bluegrass/Cultivated Kentucky Bluegrass Seeding Rate: 2 pounds per 1000 square feet. Choose a minimum of three Kentucky bluegrass cultivars with each ranging from 10 to 35 percent of the total mixture by weight.

Notes: Select turfgrass varieties from those listed in the most current University of Maryland Publication, Agronomy Memo #77, "Turfgrass Cultivar Recommendations for Maryland"

Choose certified material. Certified material is the best guarantee of cultivar purity. The certification program of the Maryland Department of Agriculture, Turf and Seed Section, provides a reliable means of consumer protection and assures the public generally of the purity of its seed.

Hardiness Zone (from Figure B.3):	Seeding Dates	Seeding Depth	Fertilizer Rate (10-20-20)				Lime Rate
			N	P ₂ O ₅	K ₂ O		
No. Species	Application Rate (lb/acre)	Mar. 1-May 15 Aug. 15-Oct. 15	1 1/4"-1 1/2" in.	45 lb. per acre (10 lb/1000 sq ft)	90 lb/acre (2 lb/1000 sq ft)	90 lb/acre (2 lb/1000 sq ft)	2 tons/acre (90 lb/1000 sq ft)
B	TALL FESCUE	100					

B. Sod: To provide quick cover on disturbed areas (2:1 grade or flatter).

- General Specifications
 - Class of turfgrass sod must be Maryland Seed Certified. Sod labels must be made available to the job foreman and inspector.
 - Sod must be machine cut at a uniform soil thickness to 3/4 inch, plus or minus 1/4 inch, at the time of cutting. Turfgrass sods must contain no germination or growth inhibiting factors.
 - Standard size sections of sod must be strong enough to support their own weight and retain their size and composition during the much material must form a firm enough to support 10 percent of the seed.
 - Sod must not be harvested or transplanted when moisture content (excessively dry wet) may adversely affect germination.
 - Seed must be harvested, delivered, and installed within a period of 36 hours. Seed not transplanted within this period must be approved by an agronomist or soil scientist prior to its installation.
- Soil Installation
 - During periods of excessively high temperature or in areas having dry ground, lightly irrigate the subsoil immediately prior to laying the sod.
 - At the first week of sod with subsequent rows placed parallel to it and tightly wedged against each other. Stagger joint joints to promote more uniform growth and strength. Ensure that soil is not stretched or overworked and that all joints are pulled tight in order to prevent voids which would cause air drying of the sod.
 - Wherever possible, lay sod with the long edges parallel to the contour and with staggering joints. Roll and tamp, jog or otherwise secure the sod and to prevent slippage on slopes. Ensure solid contact exists between sod roots and the underlying soil surface.
 - Water the sod immediately following rolling and tamping until the underside of the new sod pad and the surface below the sod are thoroughly wet. Complete the operations of laying, tamping, and irrigating for any piece of sod within eight hours.
- Soil Maintenance
 - In the absence of adequate rainfall, water daily during the first week or as often and sufficiently as necessary to maintain moist soil to a depth of 4 inches. Water sod during the heat of the day to prevent wilting.
 - After the first week, watering is required as necessary to maintain adequate moisture content.
 - No concrete safety, if used on sloping land, this practice should follow the contour.

B-4-4 STANDARDS AND SPECIFICATIONS FOR STOCKPILE AREAS

- A mound or pile of soil protected by appropriate designed erosion and sediment control measures.
 - To provide a designated location for the temporary storage of soil that controls the potential for erosion, sedimentation, and changes to drainage patterns.
- Conditions Where Practice Applies
 - Stockpile areas are utilized when it is necessary to salvage and store soil for later use.
 - The stockpile location and all related sediment control practices must be clearly indicated on the erosion and sediment control plan.
 - The topsoil of the stockpile must be covered to accommodate anticipated erosion and based on a slope ratio no steeper than 2:1. Benching must be provided in accordance with Section B-3 Land Grading.
 - Ranoff from the stockpile area must drain to a suitable sediment practice.
 - Access to the stockpile must be provided at all times.
 - Clear water runoff into the stockpile area must be minimized by use of a diversion device such as an earth dam, temporary swale or diversion fence. Provisions must be made for discharging concentrated flow in a non-erosive manner.
 - Where water concentrates along the toe of the stockpile, an appropriate erosion/sediment control practice must be used to intercept the discharge.
 - Stockpiles must be stabilized in accordance with the 3/7 day stabilization requirement set by Standard B-4-1 Incremental Stabilization and Standard B-3 Temporary Stabilization.
 - If the stockpile is located on an impervious surface, a liner should be provided below the stockpile to facilitate cleaning. Stockpiles containing contaminated material are prohibited.
- Maintenance
 - The stockpile area must continuously meet the requirements for Adequate Vegetative Establishment in accordance with Section B-4 Vegetative Stabilization.
 - Slope areas must be maintained at no steeper than a 2:1 slope. The stockpile area must be kept free of erosion. If the vertical height of a stockpile exceeds 20 feet for 2:1 slopes, 30 feet for 3:1 slopes, or 40 feet for 4:1 slopes, benching must be provided in accordance with Section B-3 Land Grading.

HOWARD SOIL CONSERVATION DISTRICT (HSCD) STANDARD SEDIMENT CONTROL NOTES

- A pre-construction meeting must occur with the Howard County Department of Public Works, Construction Inspection Division (CID), 410-313-1955 after the future ID and project area has been established in the field. A minimum of 40 hour notice to CID must be given at the following stages:
 - Prior to the start of earth disturbance.
 - Upon completion of the installation of perimeter erosion and sediment controls, but before proceeding with any other earth disturbance or grading.
 - Prior to the start of another phase of construction or opening of another grading unit.
 - Prior to the removal or modification of sediment control practice.
- Other grading or grading installation approvals may not be authorized until this initial approval by the inspection agency is made. Other related state and federal permits shall be referenced, to ensure coordination and to avoid conflicts with this plan.
- All vegetative and structural practices to be installed according to the provisions of this plan and are to be in conformance with the 2011 MARYLAND STANDARDS AND SPECIFICATIONS FOR SOIL EROSION AND SEDIMENT CONTROL, and revisions thereto.
- Following initial soil disturbance or re-disturbance, permanent or temporary stabilization is required within three (3) calendar days as to the surface of all perimeter controls, dikes, swales, ditches, sediment slopes, and all slopes steeper than 3 horizontal to 1 vertical (3:1); and seven (7) calendar days as to all other disturbed areas on the project site except for those areas under active grading.
- All disturbed areas must be established within the time period specified above in accordance with the 2011 MARYLAND STANDARDS AND SPECIFICATIONS FOR SOIL EROSION AND SEDIMENT CONTROL, for topsoil (Sec. B-4-2), permanent seeding (Sec. B-4-3), temporary seeding (Sec. B-4-3), and mulching (Sec. B-4-3). Temporary stabilization with mulch alone can only be applied between the fall and spring seeding dates in the Permanent Seeding Summary (Sec. B-4-3). Specifications shall be enforced in areas with >15% cut and/or fill. Stockpiles (Sec. B-4-4) in excess of 20 ft. must be benched with stable outlet. All concentrated flow, steep slopes, and highly erodible areas shall meet soil establishment meeting (Sec. B-4-3).
- All sediment control structures are to remain in place, and are to be maintained in operative condition until permission for their removal has been obtained from the CID.
- Site Analysis:

Total Area of Site:	42.28	Acres
Area Disturbed:	19.13	Acres
Area to be roofed or paved:	2.95	Acres
Area to be vegetatively established:	10.29	Acres
Total Cut:	97,000	Cu. Yds.
Total Fill:	31,000	Cu. Yds.
- Off-site water/borrow area location: N/A
- Any sediment control practice which is disturbed by grading activity for placement of utilities must be repaired on the same day of disturbance. Erosion/sediment control practice which is disturbed by utility construction shall be repaired by the contractor weekly; and the next day after each rain event. A storm report by the contractor, made available upon request, is part of every inspection and should include:
 - Inspection date
 - Inspection time (routine, pre-storm event, during rain event)
 - Name and title of inspector
 - Inspection information (current conditions as well as time and amount of last recorded precipitation)
 - Brief description of project status (e.g., pre-completion and/or current activities)
 - Evidence of sediment discharges
 - Identification of erosion control practice
 - Identification of sediment controls that require maintenance
 - Identification of non-eroded areas and/or areas requiring maintenance
 - Compliance status regarding the sequence of construction and stabilization requirements
 - Photographs
 - Monitors/inspections
 - Maintenance and/or corrective action performed
- Trenches for the construction of utilities is limited to three pipe lengths or that which can and shall be back-filled and stabilized by the end of each workday, whichever is shorter. Any major changes or revisions to the plan or sequence of construction must be reviewed and approved by the HSCD prior to proceeding with construction. Minor revisions may be allowed by the CID per the list of HSCD-approved field changes.
- Disturbance shall not occur below the L.O.C. A project is to be sequenced so that grading activities begin on a grading unit (maximum acreage of 25 ac. per grading unit) at a time. Work may proceed to a subsequent grading unit when at least 50 percent of the disturbed area in the preceding grading unit has been stabilized and the L.O.C. is in place. Utilities (other than water and sanitary sewers) shall be installed in a trench in a sediment basin or other approved catchment device.
- Topsoil shall be stabilized and preserved on-site for redistribution onto final grade.
- All Silt Fence and Super Silt Fence shall be placed on the contour, and be indicated at 25 minimum intervals, with lower ends oriented uphill by 2 in elevation. Trenches channels must not be disturbed during the following restricted time periods (inclusive):
 - Use I and II: March 1 - June 15
 - Use III: June 15 - October 31
 - Use IV and V: March 1 - May 31
- A copy of this plan, the 2011 MARYLAND STANDARDS AND SPECIFICATIONS FOR SOIL EROSION AND SEDIMENT CONTROL, and associated permits shall be on-site and available to the site at all times.


DETAIL C-8 MOUNTABLE BERM
 ISOMETRIC VIEW
 CONSTRUCTION SPECIFICATIONS:
 1. USE MINIMUM WIDTH OF 10 FEET TO ALLOW FOR WIDENING PAVEMENT.
 2. PLACE NONWOVEN GEOTEXTILE AS SPECIFIED IN SECTION H-1 MATERIALS OVER THE EXISTING ROAD TO PROTECT PAVEMENT FROM PLACING STONE.
 3. PLACE 2 TO 3 INCH STONE OR EQUIVALENT RECYCLED CONCRETE AT LEAST 4 INCHES DEEP OVER THE ENTIRE SURFACE OF THE BERM.
 4. MAINTAIN LINE, GRADE AND CROSS SECTION OF BERM TO MATCH EXISTING CONDITIONS. CONSTRUCT BERM TO BE PROPERLY DIMENSIONED, REMOVE ACCUMULATED SEDIMENT AND GRASS, MAINTAIN POSITIVE DRAINAGE.
 5. MAINTAIN POSITIVE DRAINAGE.
 6. MAINTAIN POSITIVE DRAINAGE.
DETAIL E-1 SILT FENCE
 ISOMETRIC VIEW
 CONSTRUCTION SPECIFICATIONS:
 1. USE WOOD POSTS 2x4 OR 2x6 IN DIAMETER SQUARE END OF SOUND QUALITY WOODWORK NOT LESS THAN 1 1/2 INCHES THICK FOR UPRIGHTS AND AT LEAST 1 1/2 INCHES THICK FOR RAILS.
 2. USE 3/4 INCH DIAMETER GALVANIZED STEEL PIPES 1/4 INCH MINIMUM IN DIAMETER AND 6 FEET APART.
 3. USE 1/2 INCH DIAMETER GALVANIZED STEEL PIPES 1/4 INCH MINIMUM IN DIAMETER AND 6 FEET APART.
 4. PROVIDE MANUFACTURER CERTIFICATION TO THE INSPECTOR/DEPARTMENT AUTHORITY SHOWING THAT GEOTEXTILE MEETS REQUIREMENTS OF SECTION H-1 MATERIALS.
 5. UNLESS OTHERWISE SPECIFIED, THE GEOTEXTILE SHALL BE A NONWOVEN GEOTEXTILE.
 6. EROSION CONTROL SYSTEM SHALL BE INSTALLED ON THE RAIL FENCE AND AT THE ENDS OF THE RAIL FENCE.
 7. EXTEND BOTH ENDS OF THE RAIL FENCE A MINIMUM OF FIVE HORIZONTAL FEET UPRIGHT AT 90 DEGREES TO THE MAIN FENCE ALIGNMENT TO PREVENT SHARP POINTS FROM FORMING AT THE ENDS OF THE RAIL FENCE.
 8. PROVIDE MANUFACTURER CERTIFICATION TO THE INSPECTOR/DEPARTMENT AUTHORITY SHOWING THAT GEOTEXTILE MEETS REQUIREMENTS OF SECTION H-1 MATERIALS.
 9. UNLESS OTHERWISE SPECIFIED, THE GEOTEXTILE SHALL BE A NONWOVEN GEOTEXTILE.
 10. EROSION CONTROL SYSTEM SHALL BE INSTALLED ON THE RAIL FENCE AND AT THE ENDS OF THE RAIL FENCE.
 11. EXTEND BOTH ENDS OF THE RAIL FENCE A MINIMUM OF FIVE HORIZONTAL FEET UPRIGHT AT 90 DEGREES TO THE MAIN FENCE ALIGNMENT TO PREVENT SHARP POINTS FROM FORMING AT THE ENDS OF THE RAIL FENCE.
 12. PROVIDE MANUFACTURER CERTIFICATION TO THE INSPECTOR/DEPARTMENT AUTHORITY SHOWING THAT GEOTEXTILE MEETS REQUIREMENTS OF SECTION H-1 MATERIALS.
 13. UNLESS OTHERWISE SPECIFIED, THE GEOTEXTILE SHALL BE A NONWOVEN GEOTEXTILE.
 14. EROSION CONTROL SYSTEM SHALL BE INSTALLED ON THE RAIL FENCE AND AT THE ENDS OF THE RAIL FENCE.
 15. EXTEND BOTH ENDS OF THE RAIL FENCE A MINIMUM OF FIVE HORIZONTAL FEET UPRIGHT AT 90 DEGREES TO THE MAIN FENCE ALIGNMENT TO PREVENT SHARP POINTS FROM FORMING AT THE ENDS OF THE RAIL FENCE.
 16. PROVIDE MANUFACTURER CERTIFICATION TO THE INSPECTOR/DEPARTMENT AUTHORITY SHOWING THAT GEOTEXTILE MEETS REQUIREMENTS OF SECTION H-1 MATERIALS.
 17. UNLESS OTHERWISE SPECIFIED, THE GEOTEXTILE SHALL BE A NONWOVEN GEOTEXTILE.
 18. EROSION CONTROL SYSTEM SHALL BE INSTALLED ON THE RAIL FENCE AND AT THE ENDS OF THE RAIL FENCE.
 19. EXTEND BOTH ENDS OF THE RAIL FENCE A MINIMUM OF FIVE HORIZONTAL FEET UPRIGHT AT 90 DEGREES TO THE MAIN FENCE ALIGNMENT TO PREVENT SHARP POINTS FROM FORMING AT THE ENDS OF THE RAIL FENCE.
 20. PROVIDE MANUFACTURER CERTIFICATION TO THE INSPECTOR/DEPARTMENT AUTHORITY SHOWING THAT GEOTEXTILE MEETS REQUIREMENTS OF SECTION H-1 MATERIALS.


DETAIL G-1-2 STONERIPRAP OUTLET SEDIMENT TRAP S-T-1
 ISOMETRIC VIEW
 CONSTRUCTION SPECIFICATIONS:
 1. CONSTRUCT TRAP IN SUCH A MANNER THAT EROSION AND WATER POLLUTION ARE AVOIDED.
 2. CLEAR GRADE AND STRIP ANY VEGETATION AND ROOT MAT FROM THE AREA UNDER THE EMBANKMENT AND TRAP BOTTOM.
 3. USE WELL SORTED, FREE OF ROOTS, WOODY VEGETATION, OVERGROWN STONES, ROCKS, ORGANIC MATERIAL, OR OTHER OBJECTIONABLE MATERIAL FOR THE EMBANKMENT.
 4. CONSTRUCT TOP OF EMBANKMENT 1 FOOT MINIMUM ABOVE MEAN HIGH WREST, COMPACT THE EMBANKMENT BY TRAVELING WITH EQUIPMENT WEIGHING 15,000 LB OR MORE.
 5. MAINTAIN ALL CUT AND FILL SLOPES AT 1:1 OR SHALLOWER.
 6. PLACE NONWOVEN GEOTEXTILE AS SPECIFIED IN SECTION H-1 MATERIALS, OVER THE BOTTOM AND SLOPE OF OUTLET AND PRIOR PRIOR TO PLACEMENT OF RIPRAP. OVERLAP SECTIONS OF GEOTEXTILE TO PROVIDE A MINIMUM OF 6 INCHES OF OVERLAP AT JOINTS. MAINTAIN POSITIVE DRAINAGE AT ALL JOINTS.
 7. MAINTAIN POSITIVE DRAINAGE AT ALL JOINTS.
 8. MAINTAIN POSITIVE DRAINAGE AT ALL JOINTS.
SEDIMENT CONTROL NOTES & DETAILS
WESTLAND FARM ESTATES
 LOTS 3 THRU 14 AND OPEN SPACE LOT 15
 ZONED RR-DEO
 TAX MAP No. 45 GRID No. 28
 FIFTH ELECTION DISTRICT HOWARD COUNTY, MARYLAND
 SCALE: AS SHOWN DATE: DECEMBER, 2015
 SHEET 17 OF 19


AS-BUILT CERTIFICATION INFORMATION
 Note: There is no "AS-BUILT" information provided on this sheet.
 PROJECT NO: 111016
 DATE: 1/29/16
 ENGINEER: [Signature]

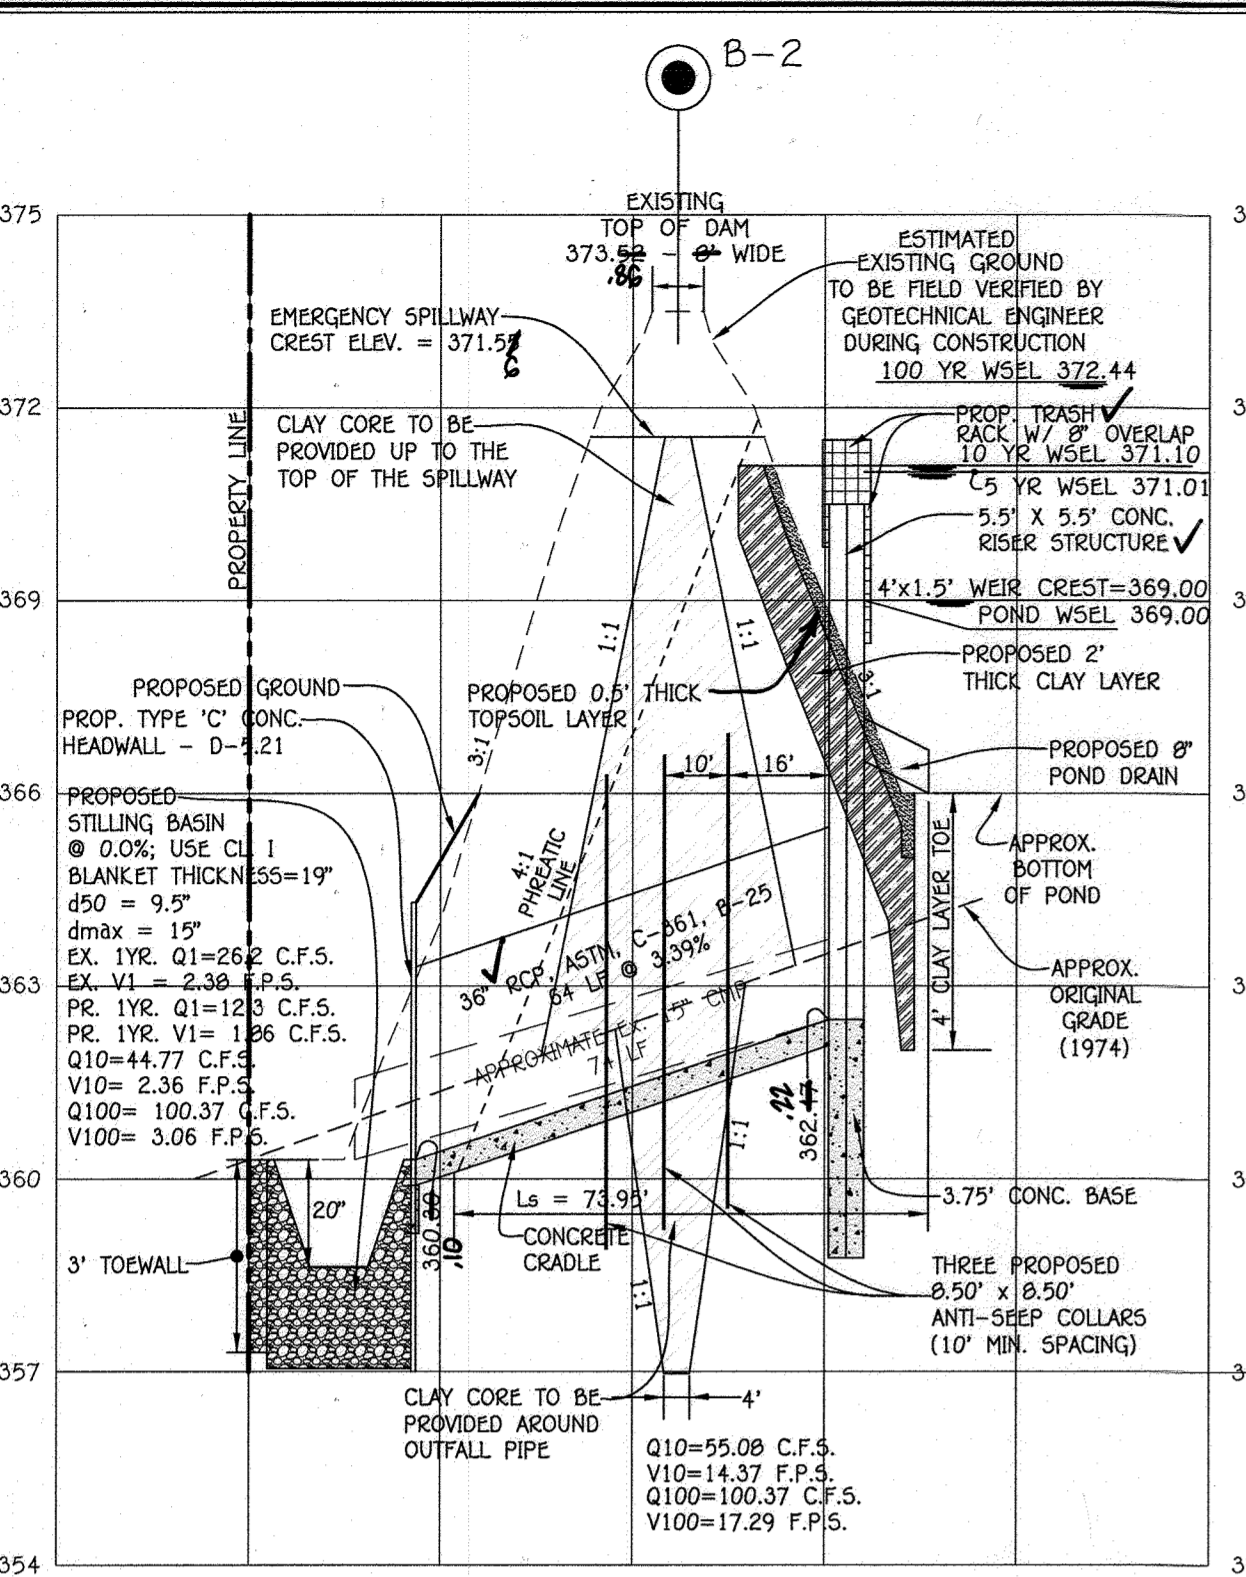


SECTION A-A THRU EXISTING POND DAM
 HORIZONTAL SCALE: 1"=30'
 VERTICAL SCALE: 1"=5'

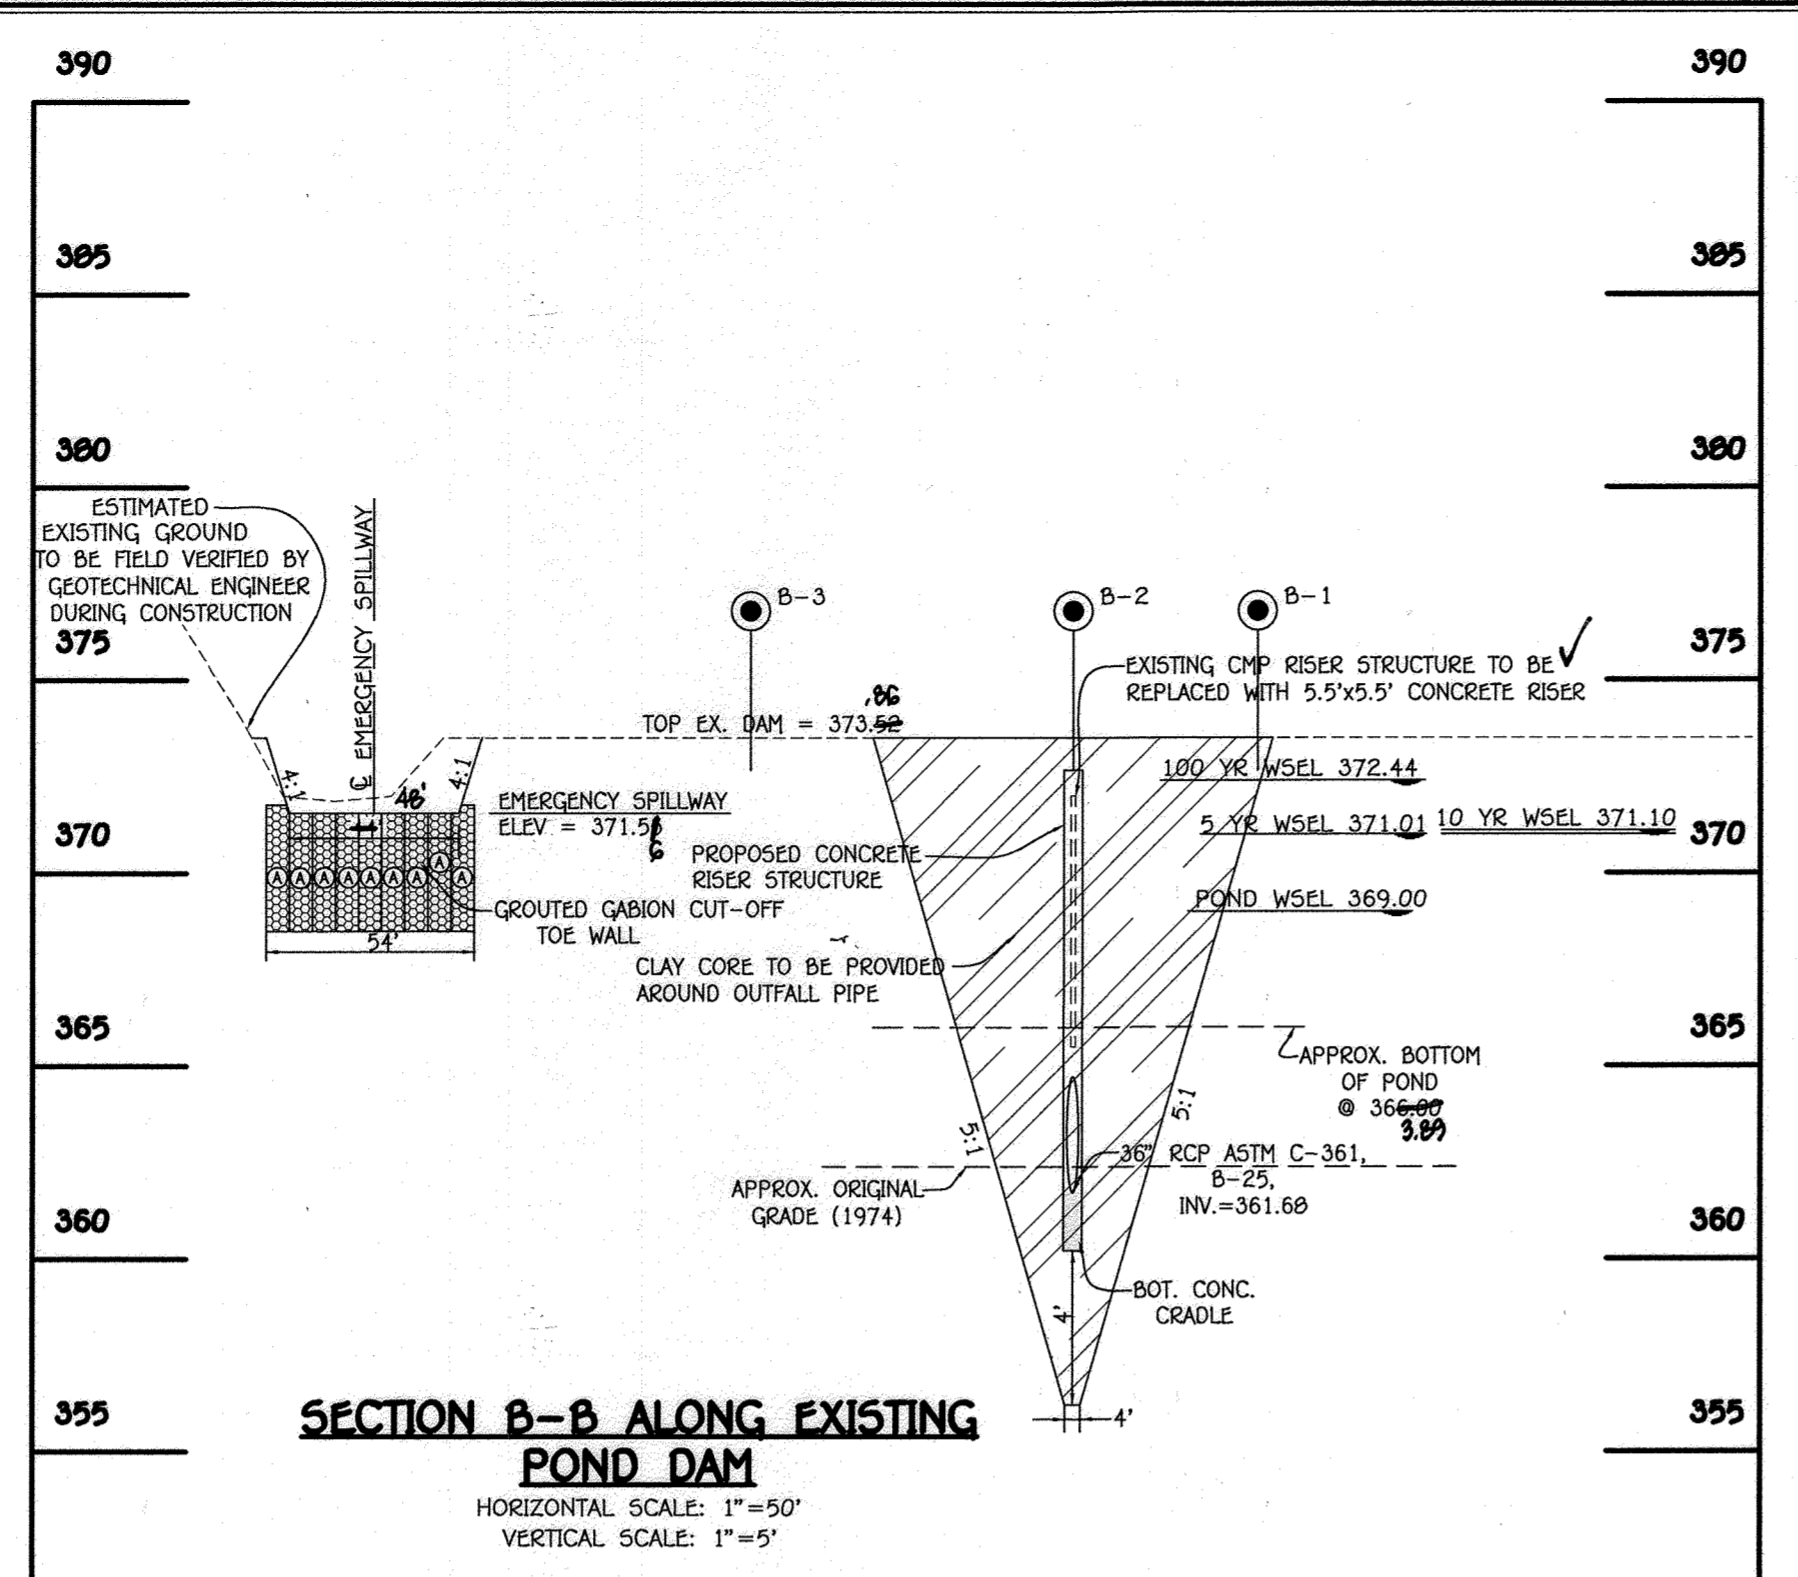


SECTION B-B ALONG EXISTING POND DAM
 HORIZONTAL SCALE: 1"=50'
 VERTICAL SCALE: 1"=5'

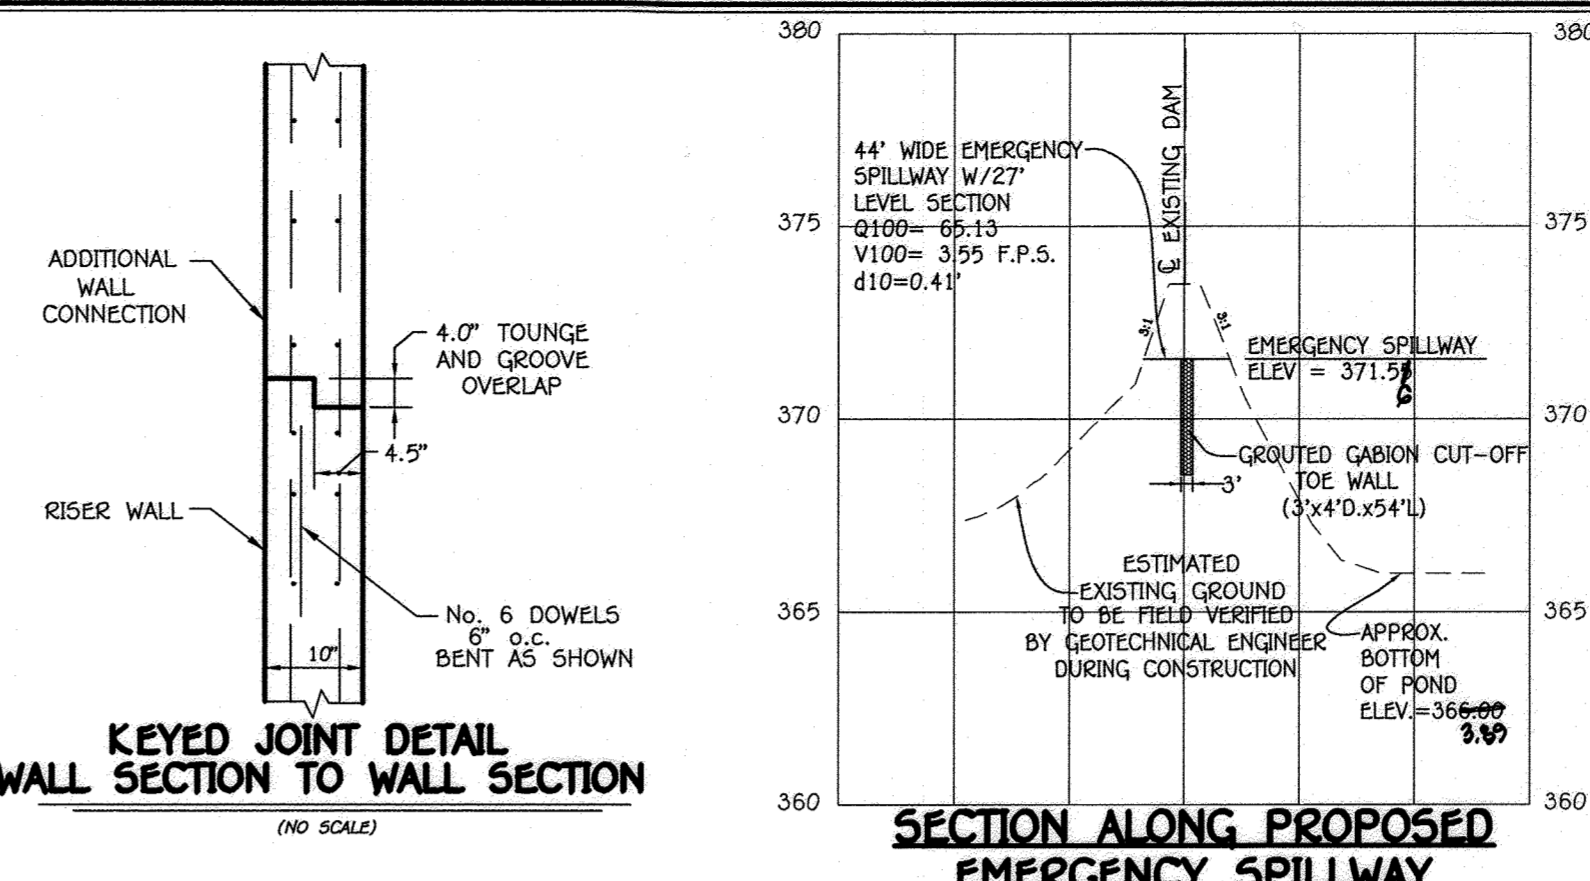


KEYED JOINT DETAIL WALL SECTION TO WALL SECTION
 (NO SCALE)

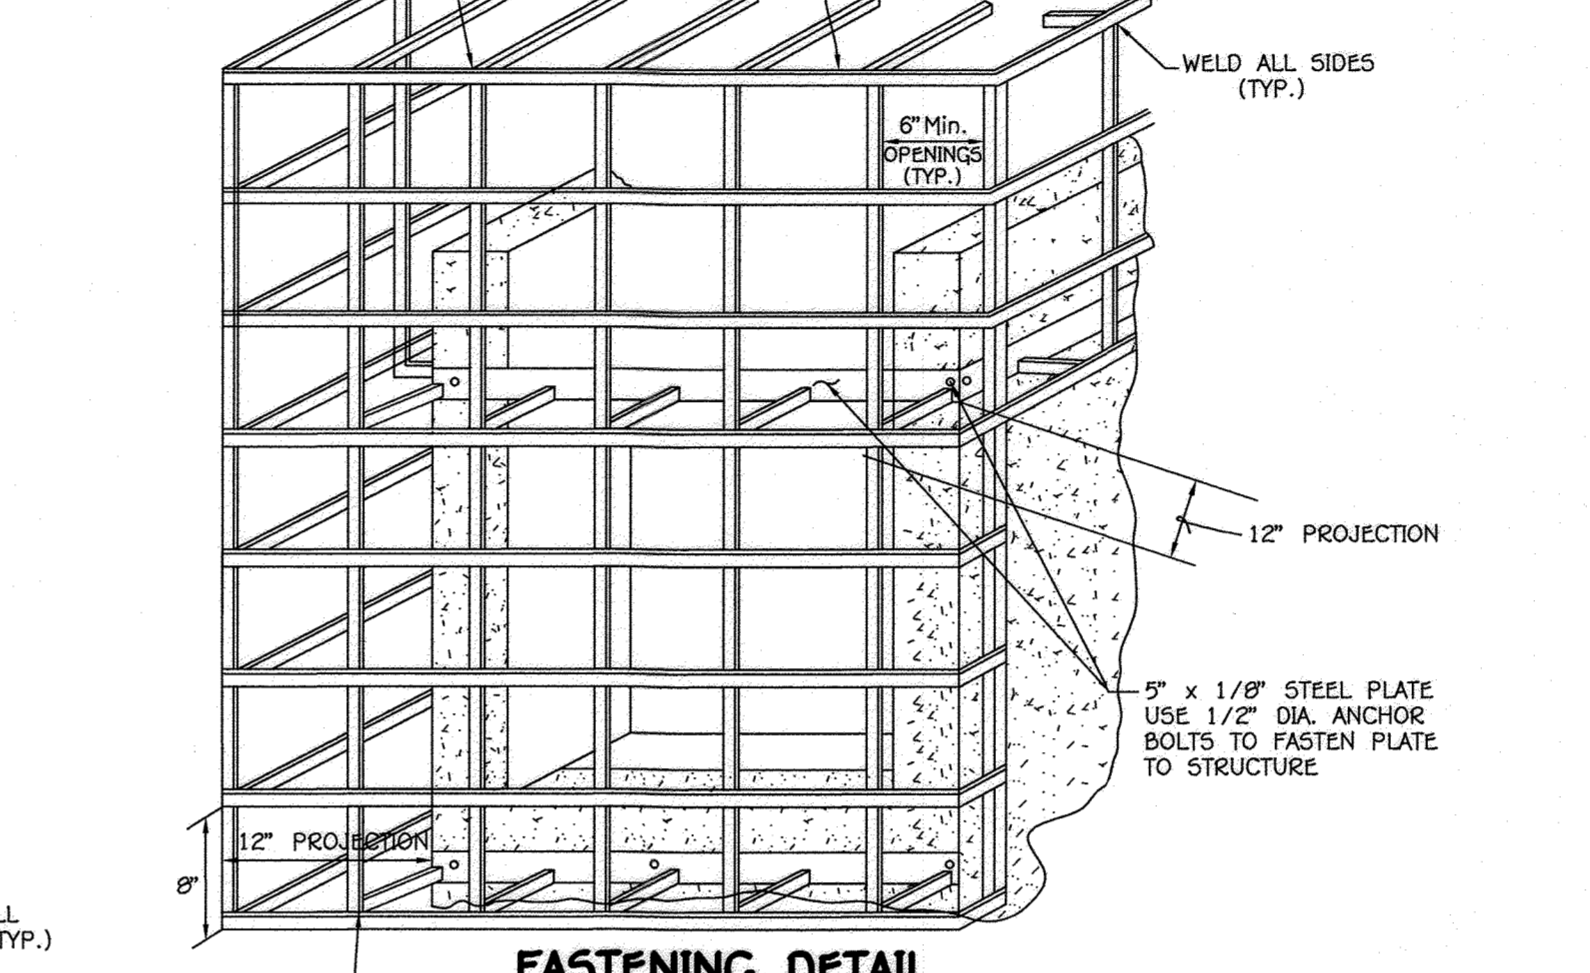


SECTION ALONG PROPOSED EMERGENCY SPILLWAY
 HORIZONTAL SCALE: 1"=50'
 VERTICAL SCALE: 1"=5'

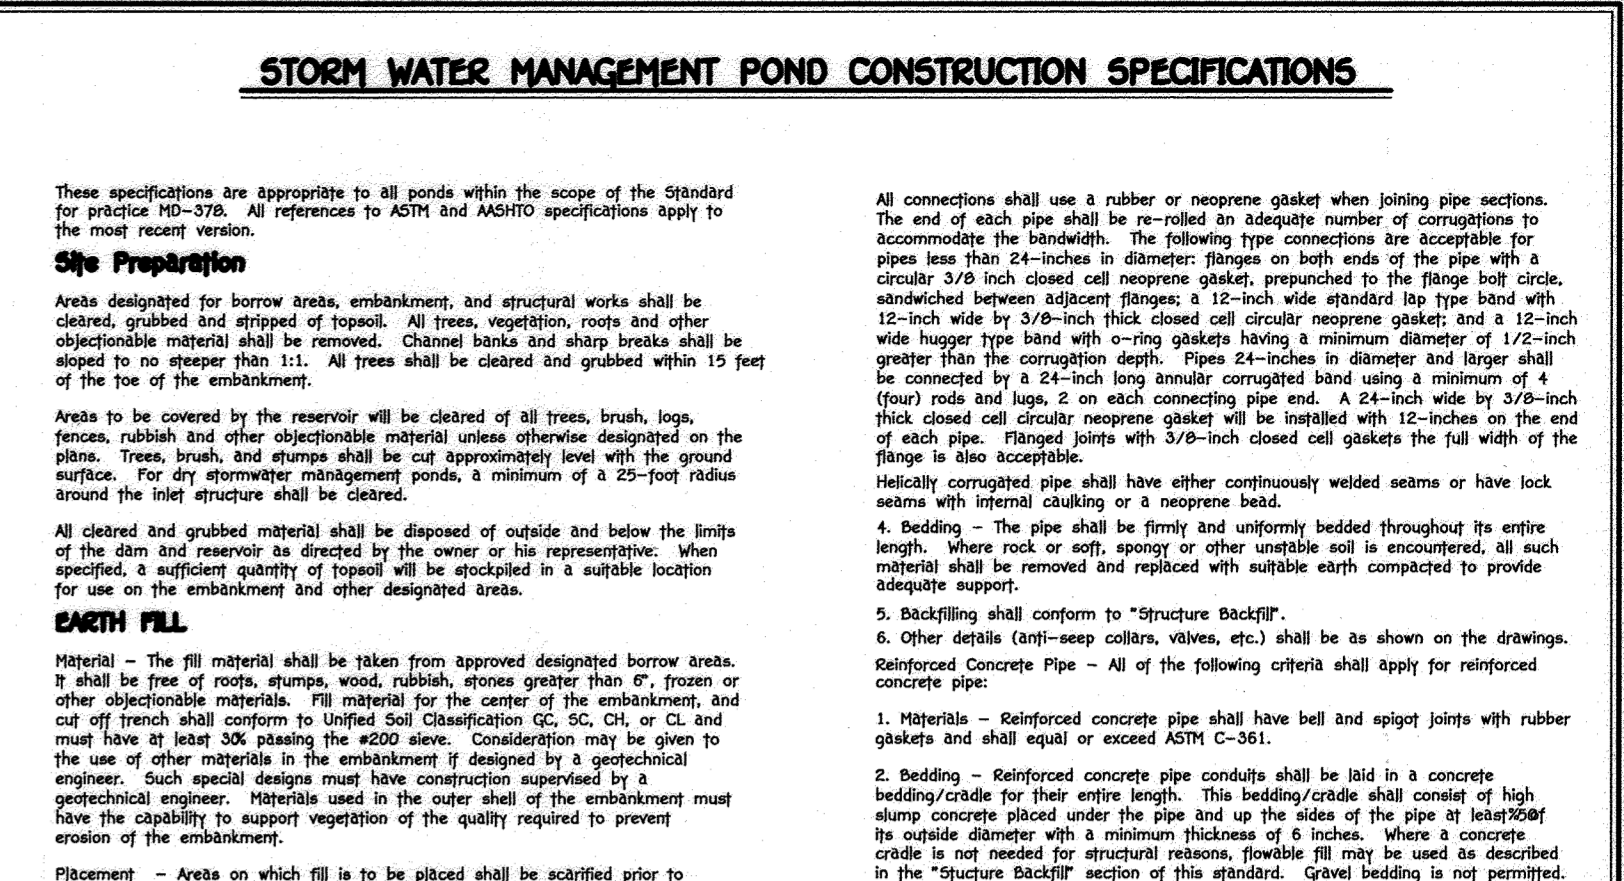


STORM WATER MANAGEMENT POND CONSTRUCTION SPECIFICATIONS

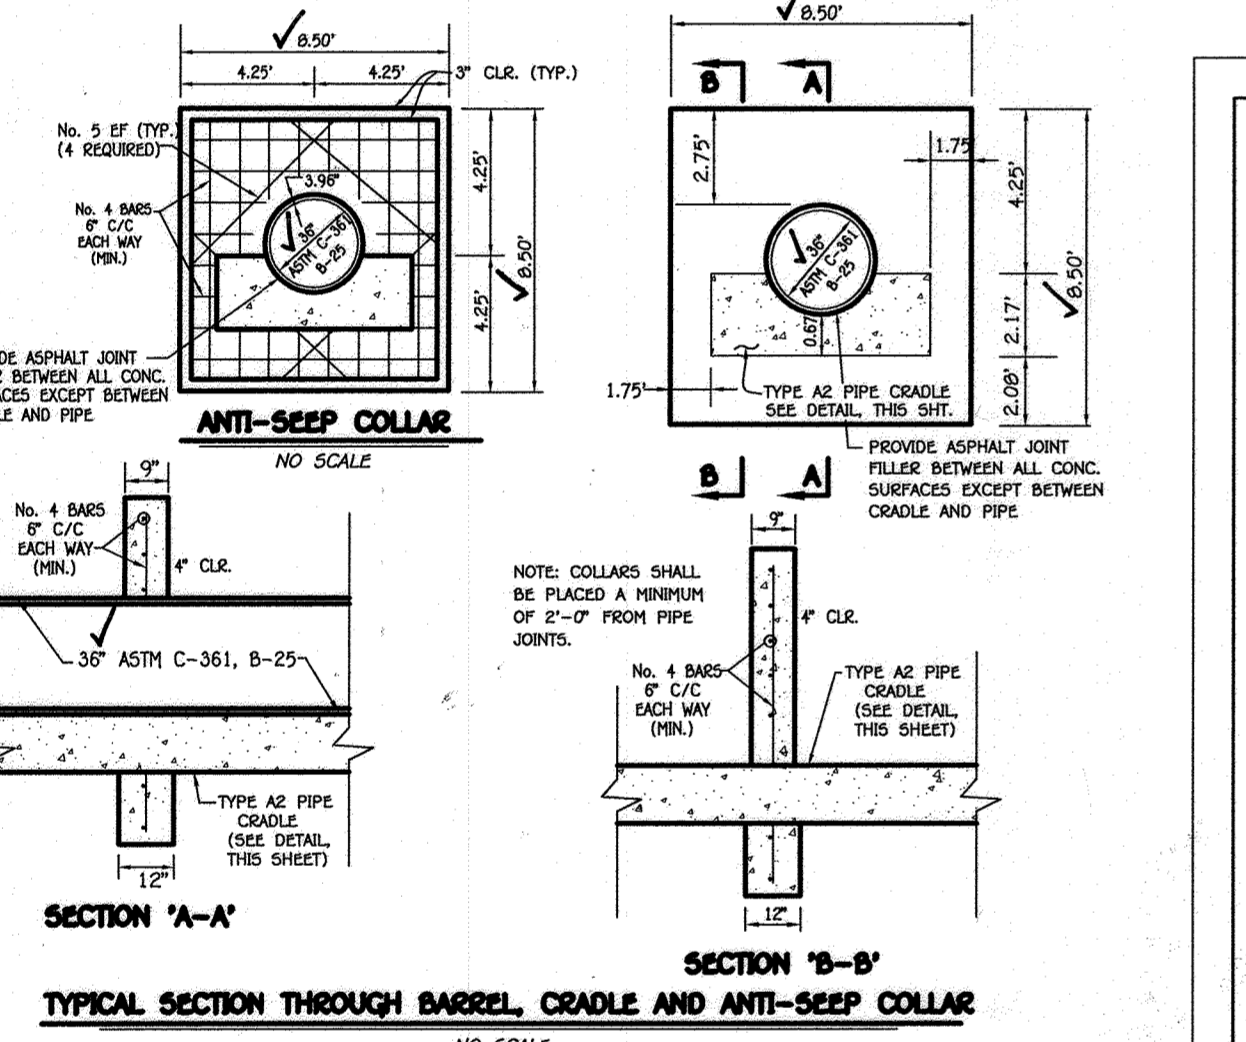

SECTION A-A' and SECTION B-B'
 TYPICAL SECTION THROUGH BARREL, CRADLE AND ANTI-SEEP COLLAR
 NO SCALE

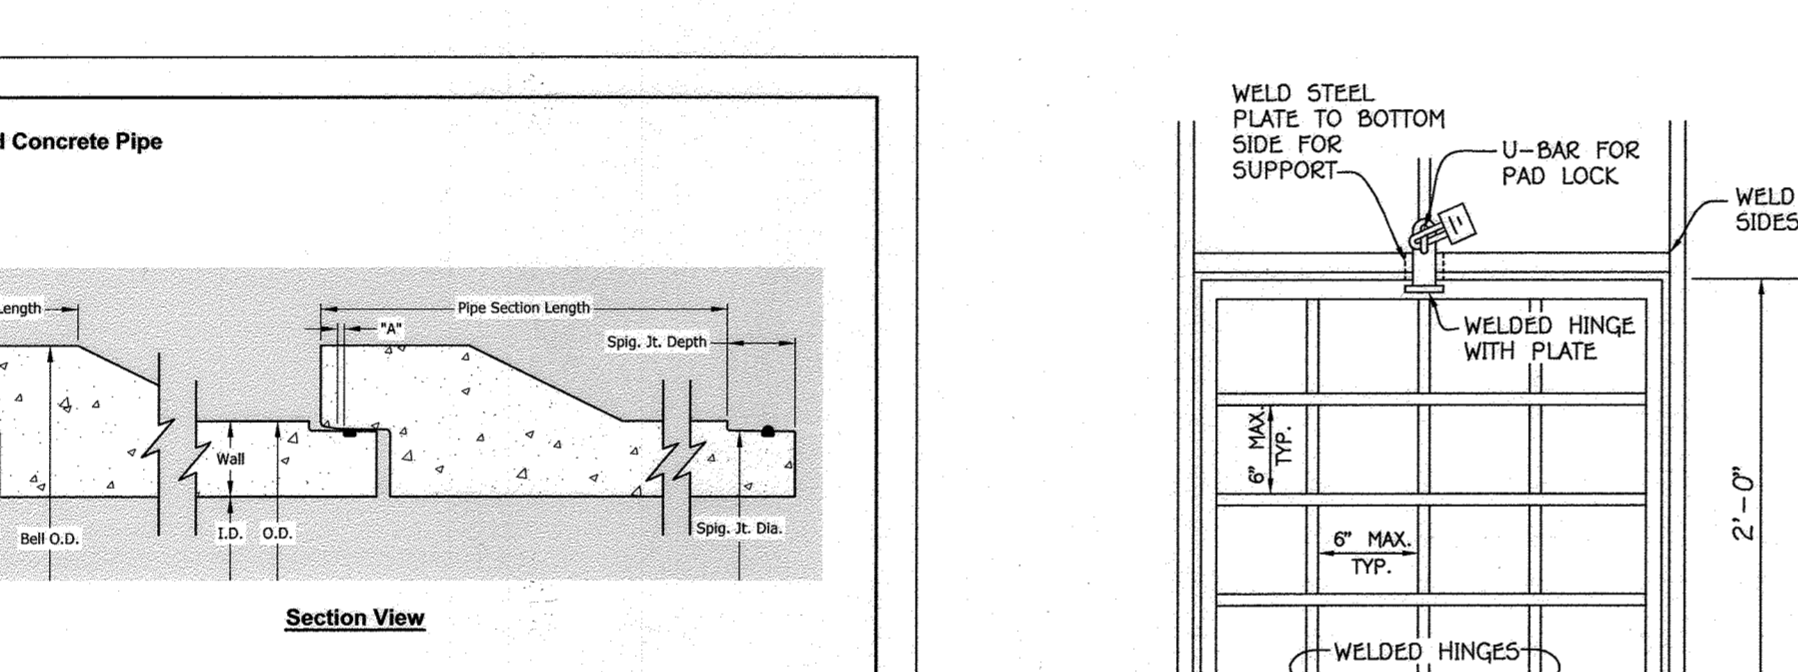

Basic Dimensions											
ID	Section	Nominal	Wall	Spig. J.	"A"	Bell	Bell	Approx			
Pipe	Length	Length	Thickness	J. Dia.	Depth	Dia.	O.D.	Lgth.	WT.	WT.	WT.
15	8	20.14	2.50	19.18	3.34	1.14	24.18	5.14	170		
18	8	23.12	2.34	22.58	3.34	1.14	27.58	5.14	210		
21	8	27	3	25.78	3.34	1.14	31.58	5.38	270		
24	8	31.12	3.34	29.38	3.78	1.38	35.58	5.34	370		
27	8	35	4	32.78	3.78	1.38	39.58	5.78	450		
30	8	38.12	4.14	35.18	3.78	1.38	43.18	6.18	550		
36	8	45.12	4.34	42.18	3.78	1.38	51.316	6.38	690		
42	8	51.14	4.58	50	4.58	1.12	58.12	7.18	820		
48	8	58.14	5.18	57	4.34	1.58	65.14	7.14	1030		

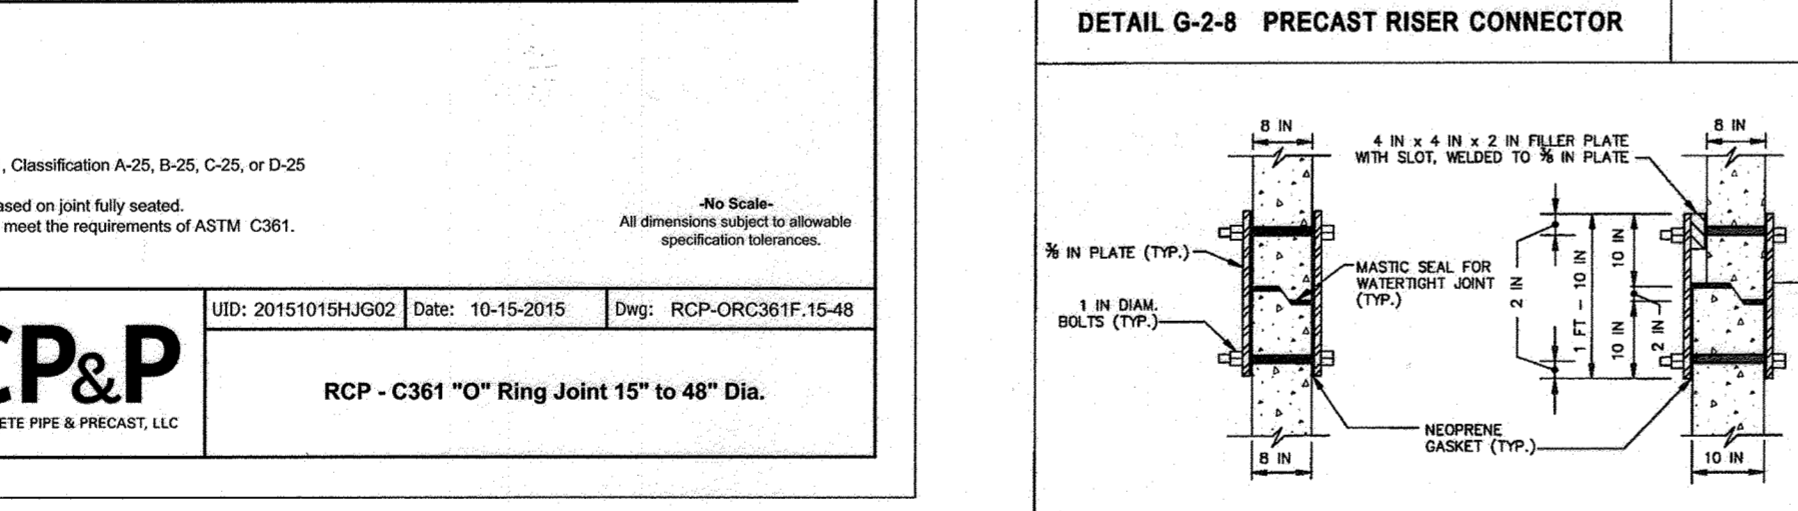

FASTENING DETAIL and OPENING DETAIL
 NO SCALE

BUILDER/DEVELOPER'S CERTIFICATE
 "I/We Certify That All Development And/Or Construction Will be Done According to These Plans, And That Any Responsible Personnel Involved in The Construction Project Will Have A Certificate of Attendance At A Department of the Environment Approved Training Program For The Control of Sediment And Erosion Before Beginning The Project. I shall Engage A Registered Professional Engineer To Supervise Pond Construction And Provide The Howard Soil Conservation District With An "As-Built" Plan of The Pond Within 30 Days of Completion. I Also Authorize Periodic On-Site Inspections By The Howard Soil Conservation District."

Signature: [Signature] DATE: 5-26-16

ENGINEER'S CERTIFICATE
 "I Certify That This Plan For Pond Construction, Erosion And Sediment Control Represents A Practical And Workable Plan Based On My Personal Knowledge Of The Site Conditions. This Plan Was Prepared In Accordance With The Requirements of The Howard Soil Conservation District. I Have Notified The Developer That He/She Must Engage A Registered Professional Engineer To Supervise Pond Construction And Provide The Howard Soil Conservation District With An "As-Built" Plan of The Pond Within 30 Days of Completion."

Signature: [Signature] DATE: 5/26/16

OCP&P CONCRETE PIPE & PRECAST, LLC
 RCP - C361 "O" Ring Joint 15" to 48" Dia.

OWNERS
 LINE KILN, LLC
 12549 LIME KILN ROAD
 FULTON, MARYLAND 20779-0460
 410-792-2922

DEVELOPER
 WILLIAMS/BOG GROUP, LLC
 C/O BOB CORBETT
 5465 HARGREYS FARM ROAD, SUITE 200
 COLUMBIA, MARYLAND 21044
 410-997-8000


PROFESSIONAL CERTIFICATION
 I HEREBY CERTIFY THAT THESE DOCUMENTS WERE PREPARED OR APPROVED BY ME AND THAT I AM A DULY LICENSED PROFESSIONAL ENGINEER UNDER THE LAWS OF THE STATE OF MARYLAND, LICENSE NO. 38386, EXPIRATION DATE: 01/12/2016.

Signature: [Signature] DATE: 5/26/16


CONSTRUCTION SPECIFICATIONS

- FABRICATE PLATE CONNECTORS FROM STAINLESS STEEL CONFORMING TO ASTM A666-72, GRADE A OR B.
- USE TYPE 304 STAINLESS STEEL FOR BOLTS.
- REMOVE CONCRETES AT CENTERLINE OF EACH PRECAST BOX FACE, FOR MANHOLES PROVIDE FOUR PLATES SPACED AT 90°.


U.S. DEPARTMENT OF AGRICULTURE NATURAL RESOURCES CONSERVATION SERVICE 2011
 MARYLAND DEPARTMENT OF ENVIRONMENT WATER MANAGEMENT ADMINISTRATION G-50

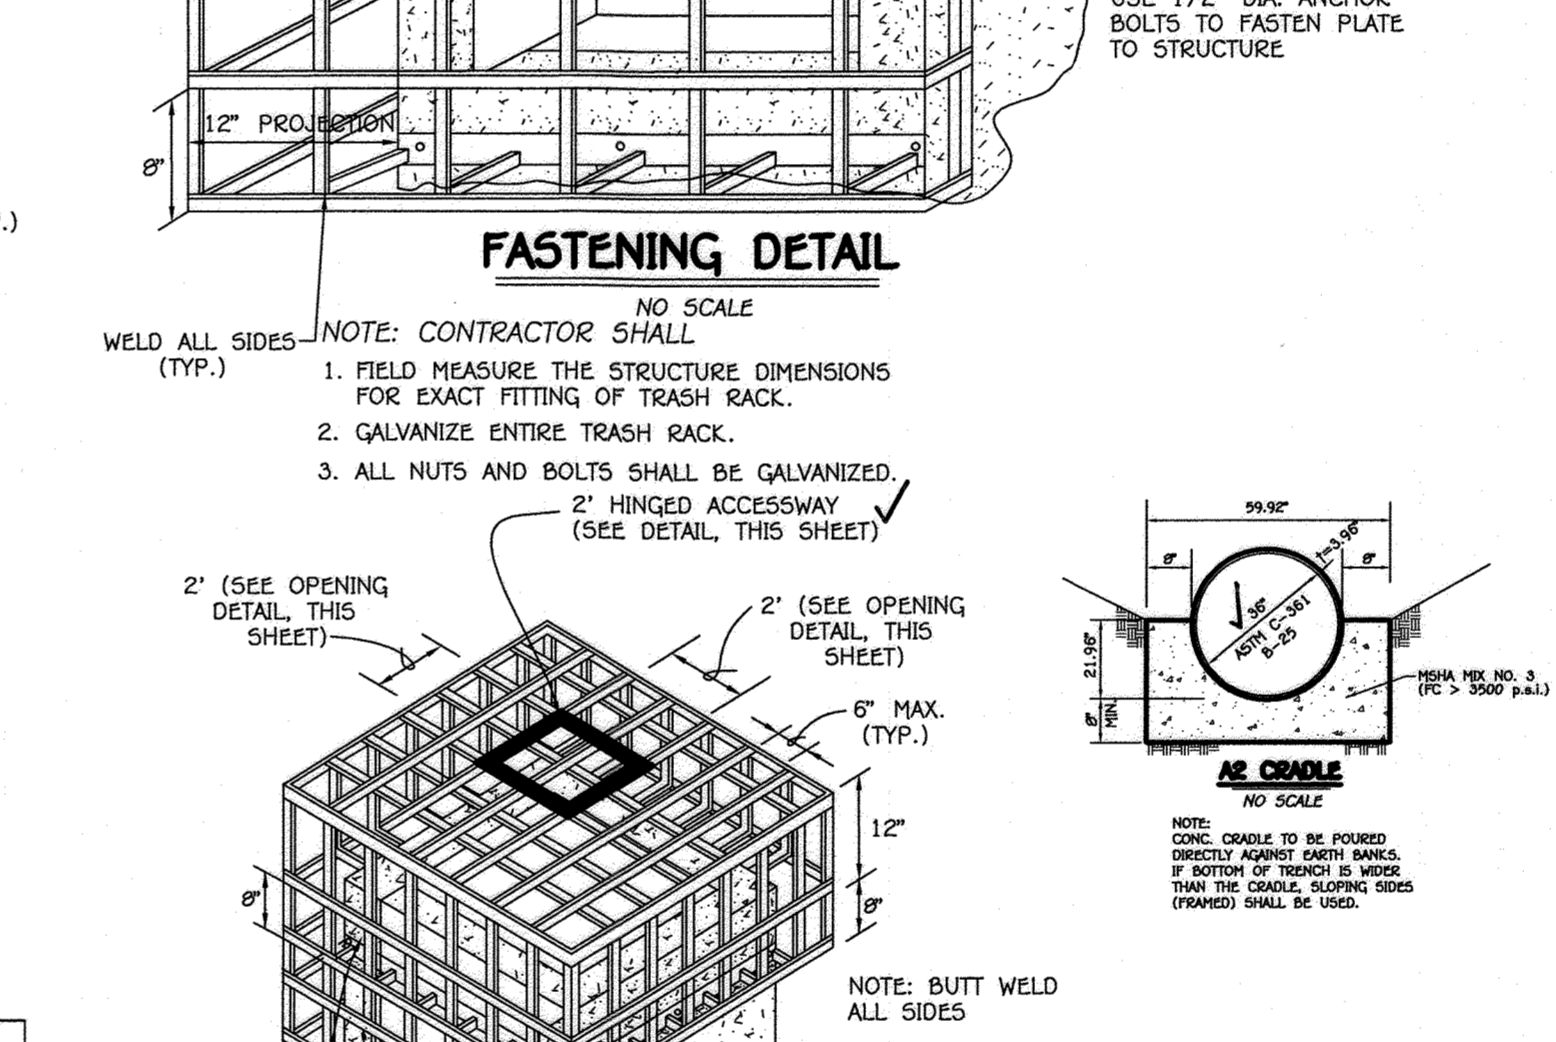


TRASH RACK FOR POND OPERATION
 NO SCALE

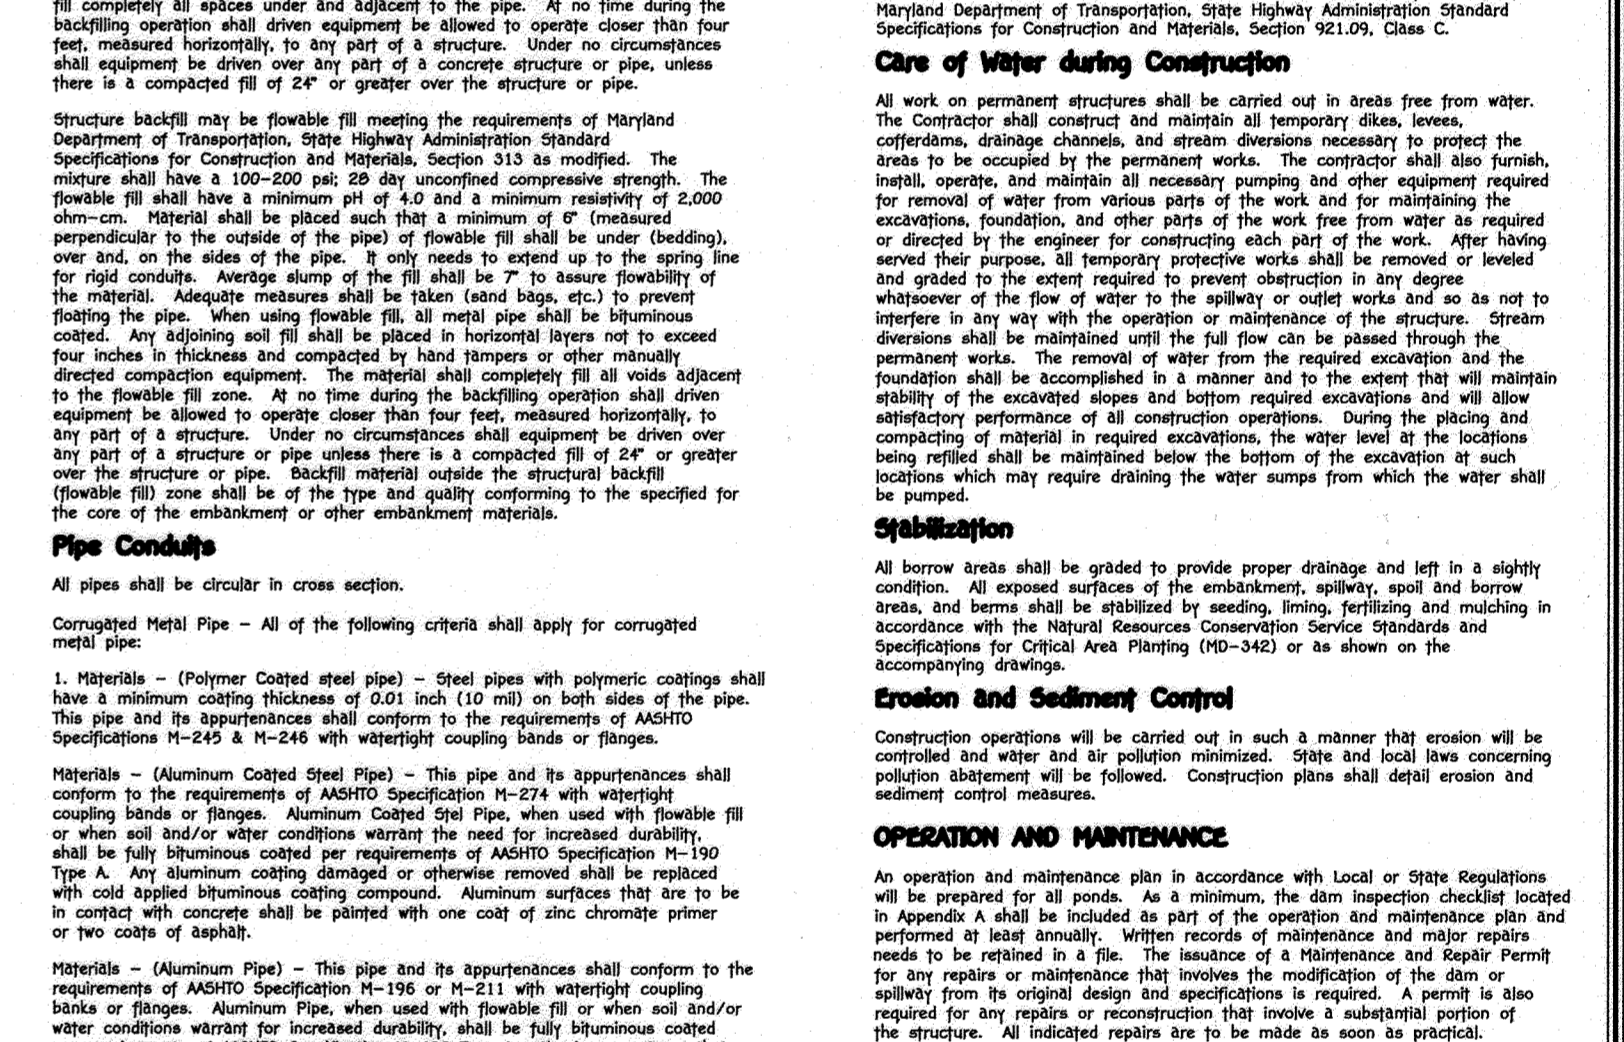

GABION BASKETS (MACCAFFERTY GABIONS OR APPROVED EQUAL)
 DESIGNATION: DIMENSIONS (A) 6'W x 3'H x 3'D




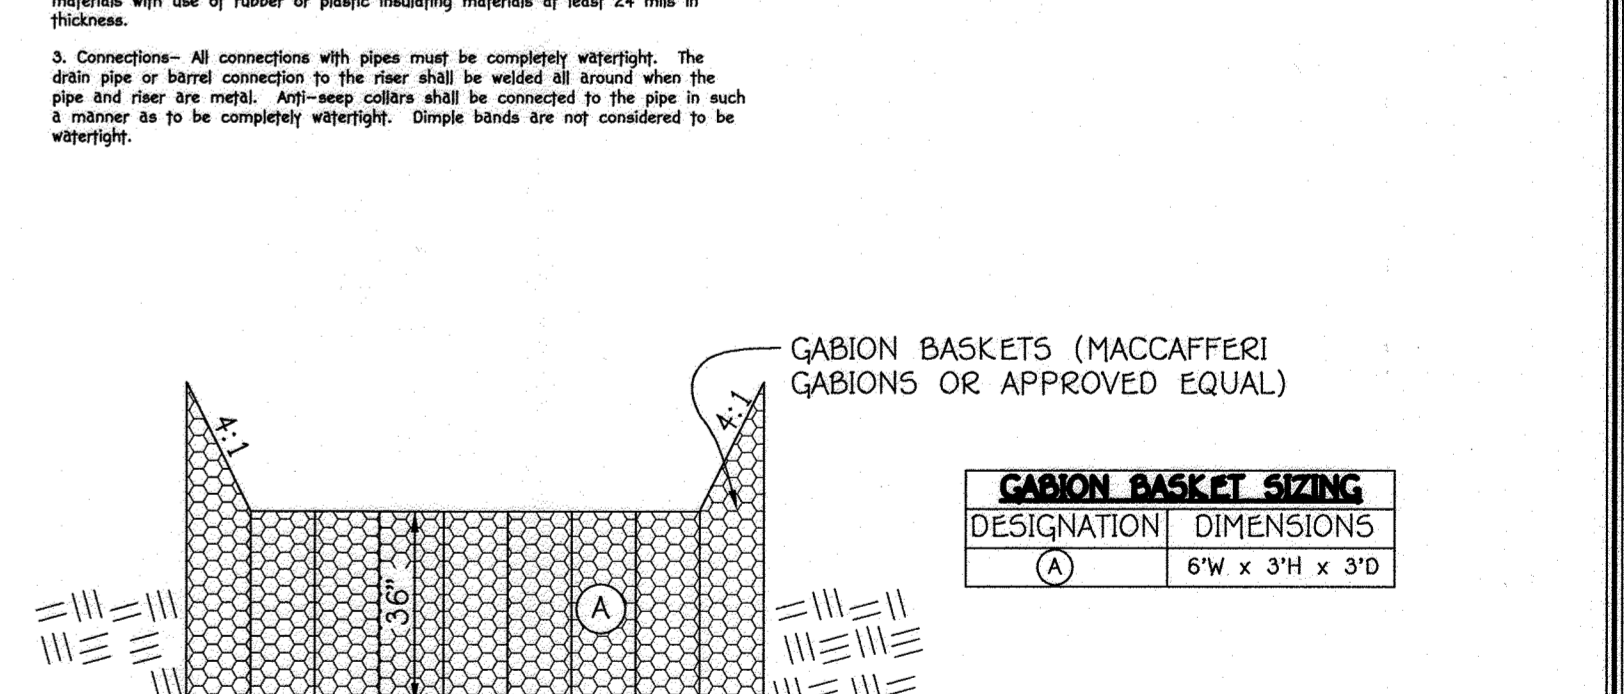


GABION BASKET DETAIL FOR EMERGENCY SPILLWAY TOE WALL
 SCALE: NOT TO SCALE

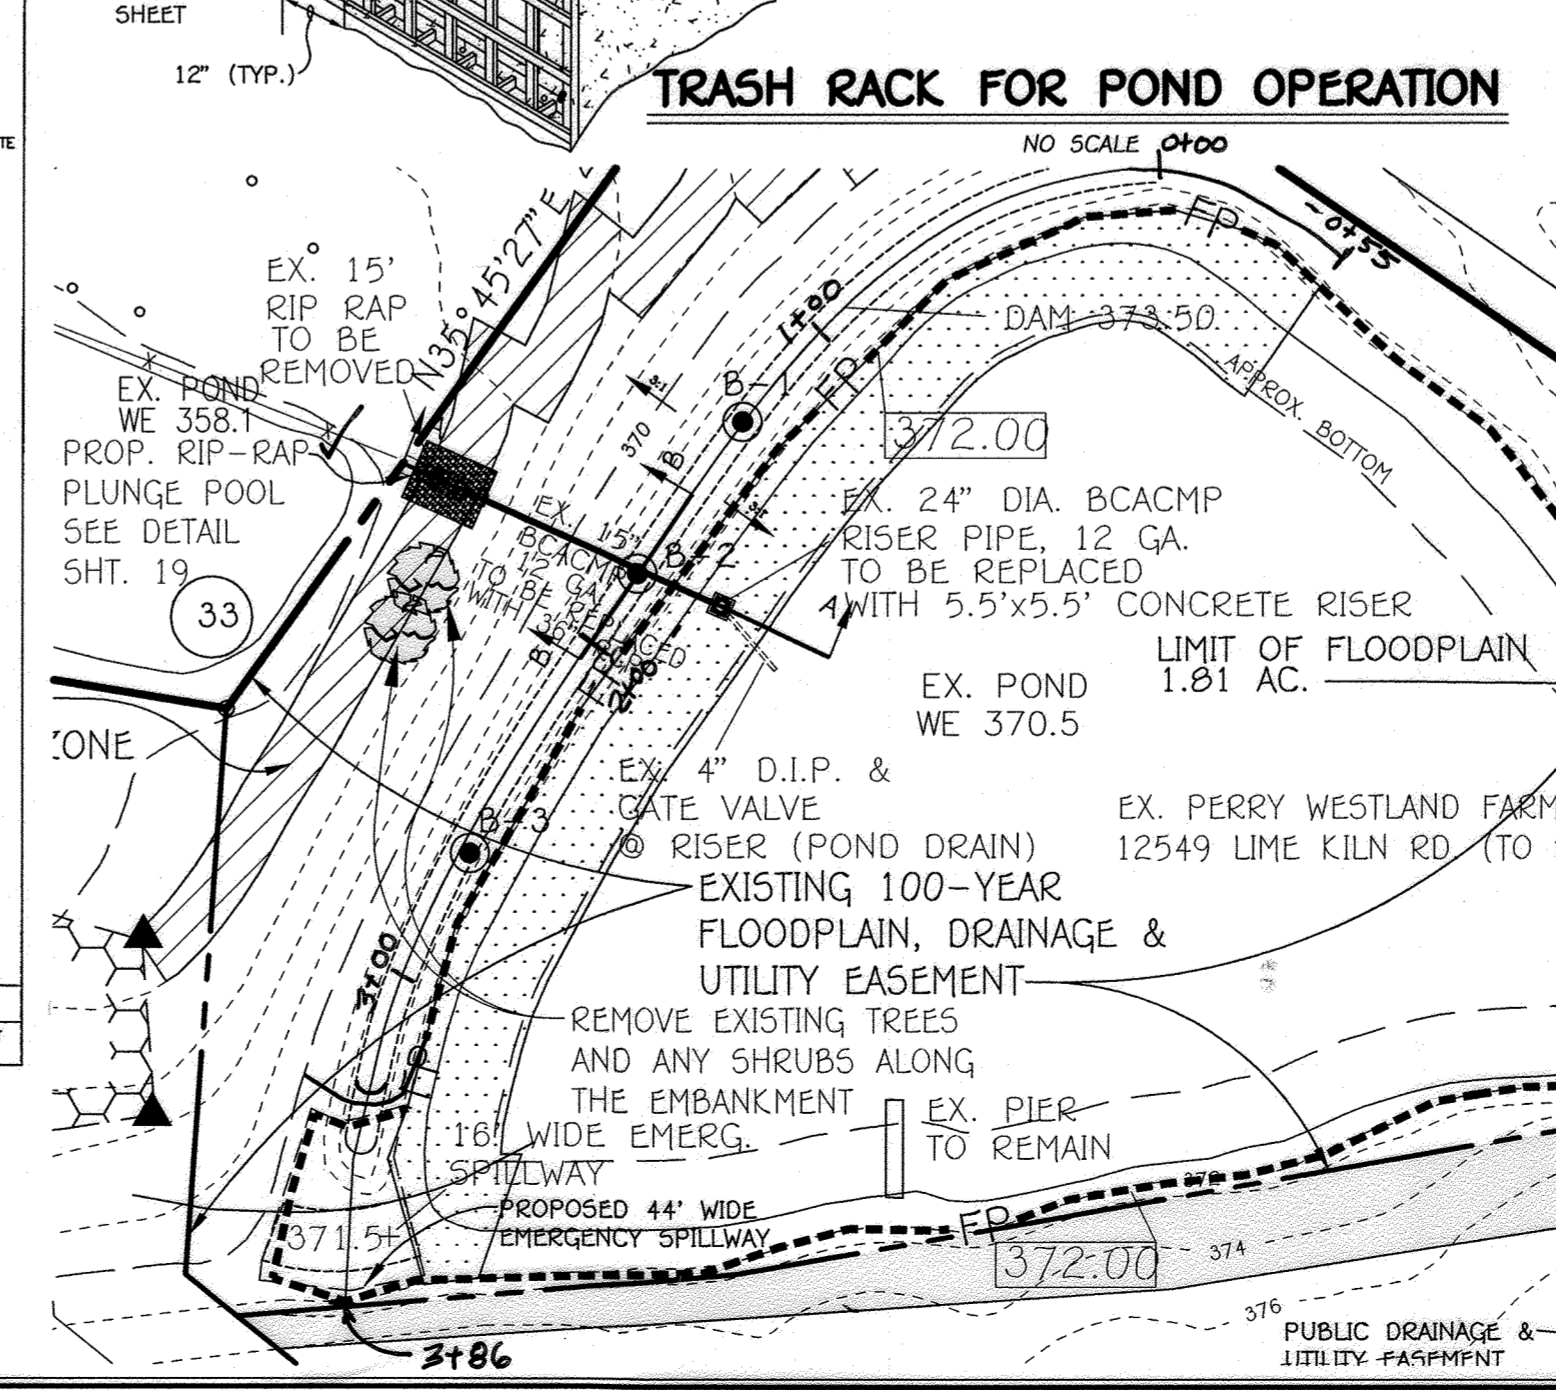

POND UPGRADE DETAILS & SPECIFICATIONS WESTLAND FARM ESTATES
 LOTS 3 THRU 14 AND OPEN SPACE LOT 15
 ZONED RR-DEO
 TAX MAP NO. 45 GRID NO. 5 PARCEL NO. 28
 FIFTH ELECTION DISTRICT HOWARD COUNTY, MARYLAND
 SCALE: AS SHOWN DATE: MAY, 2016
 SHEET 18 OF 19
 EX. POND PLAN VIEW SCALE: 1"=50'

POND UPGRADE DETAILS & SPECIFICATIONS WESTLAND FARM ESTATES
 LOTS 3 THRU 14 AND OPEN SPACE LOT 15
 ZONED RR-DEO
 TAX MAP NO. 45 GRID NO. 5 PARCEL NO. 28
 FIFTH ELECTION DISTRICT HOWARD COUNTY, MARYLAND
 SCALE: AS SHOWN DATE: MAY, 2016
 SHEET 18 OF 19

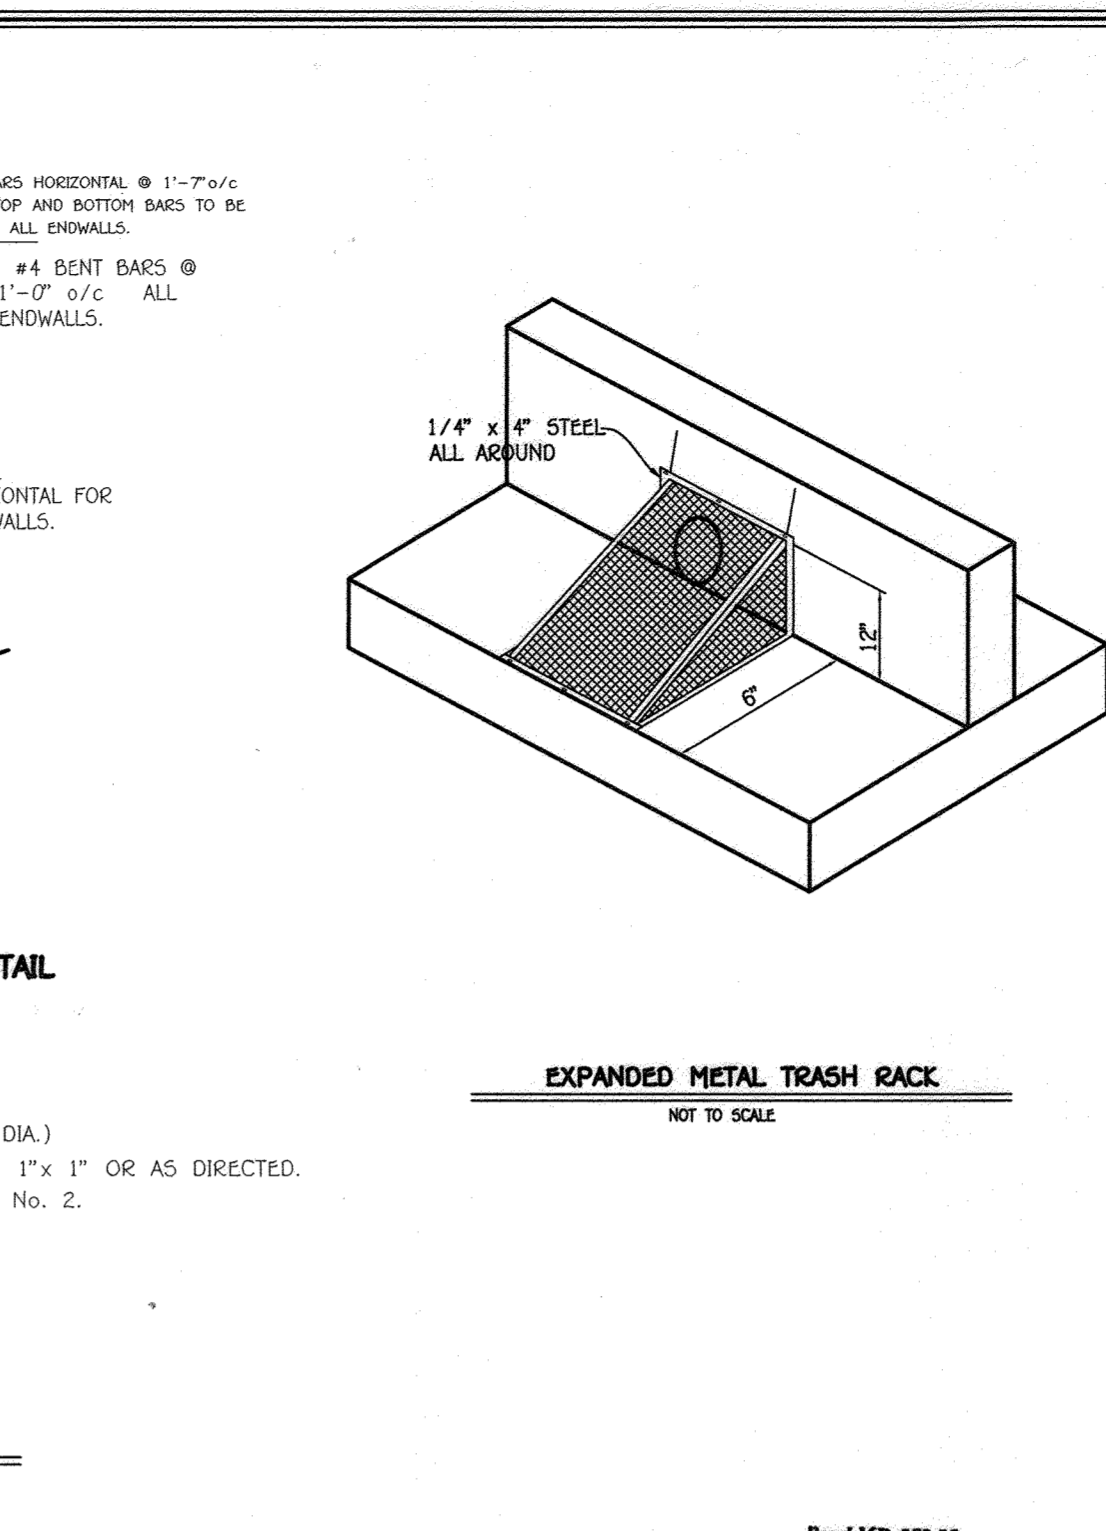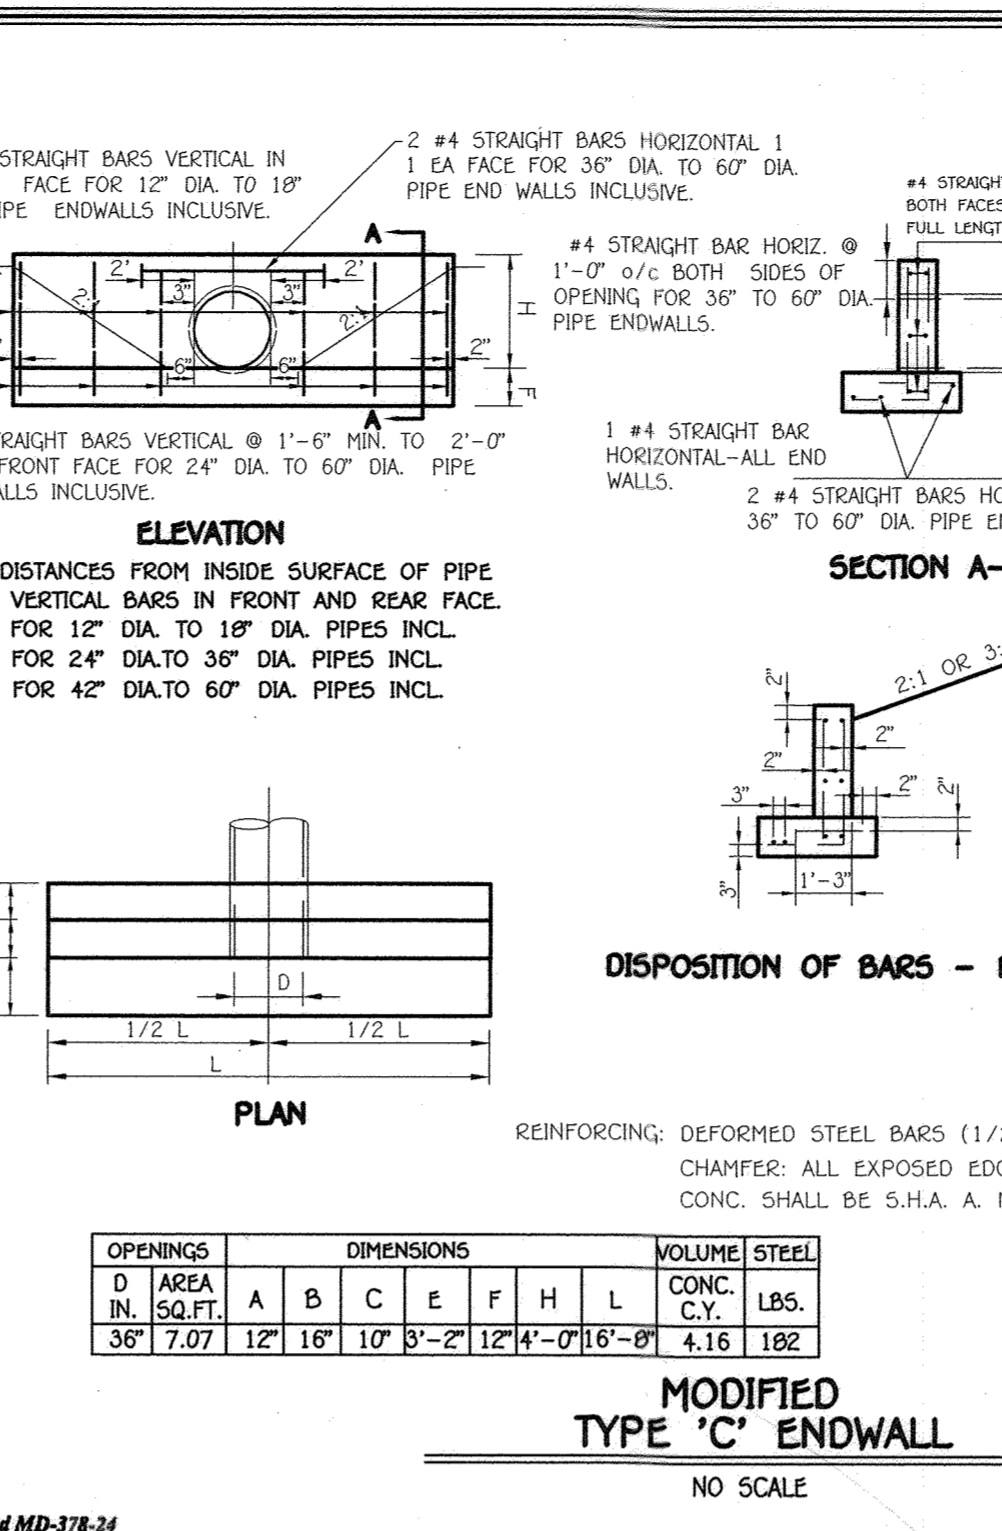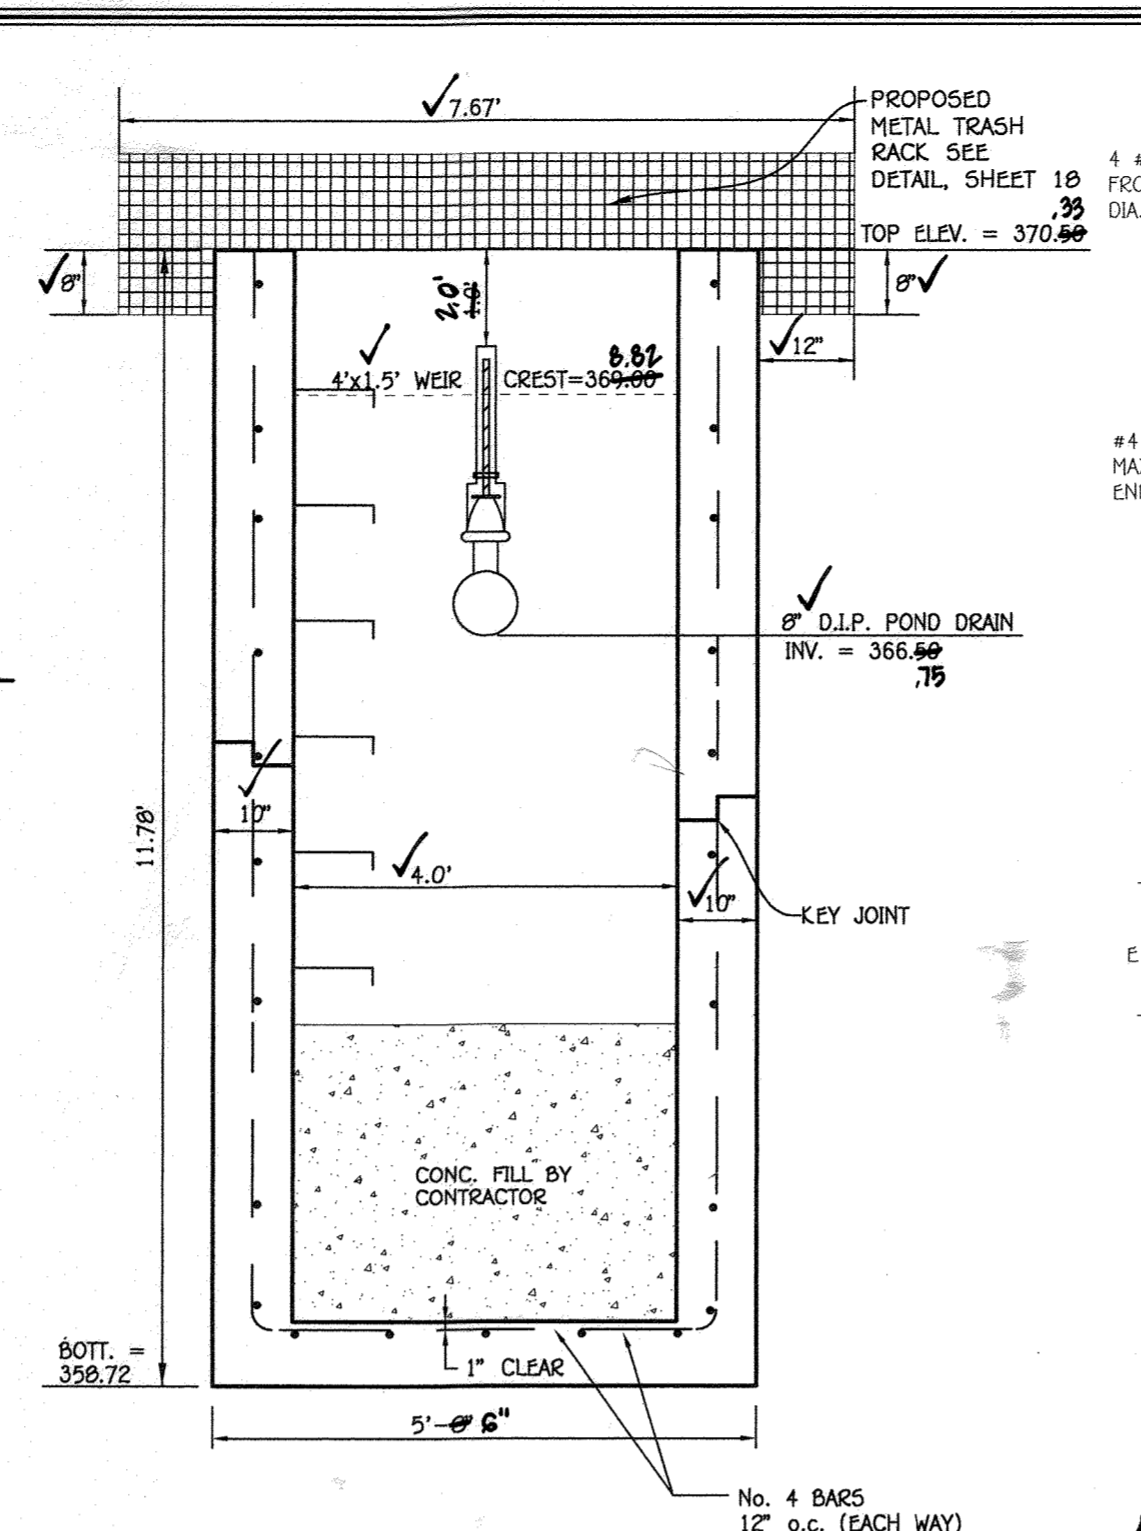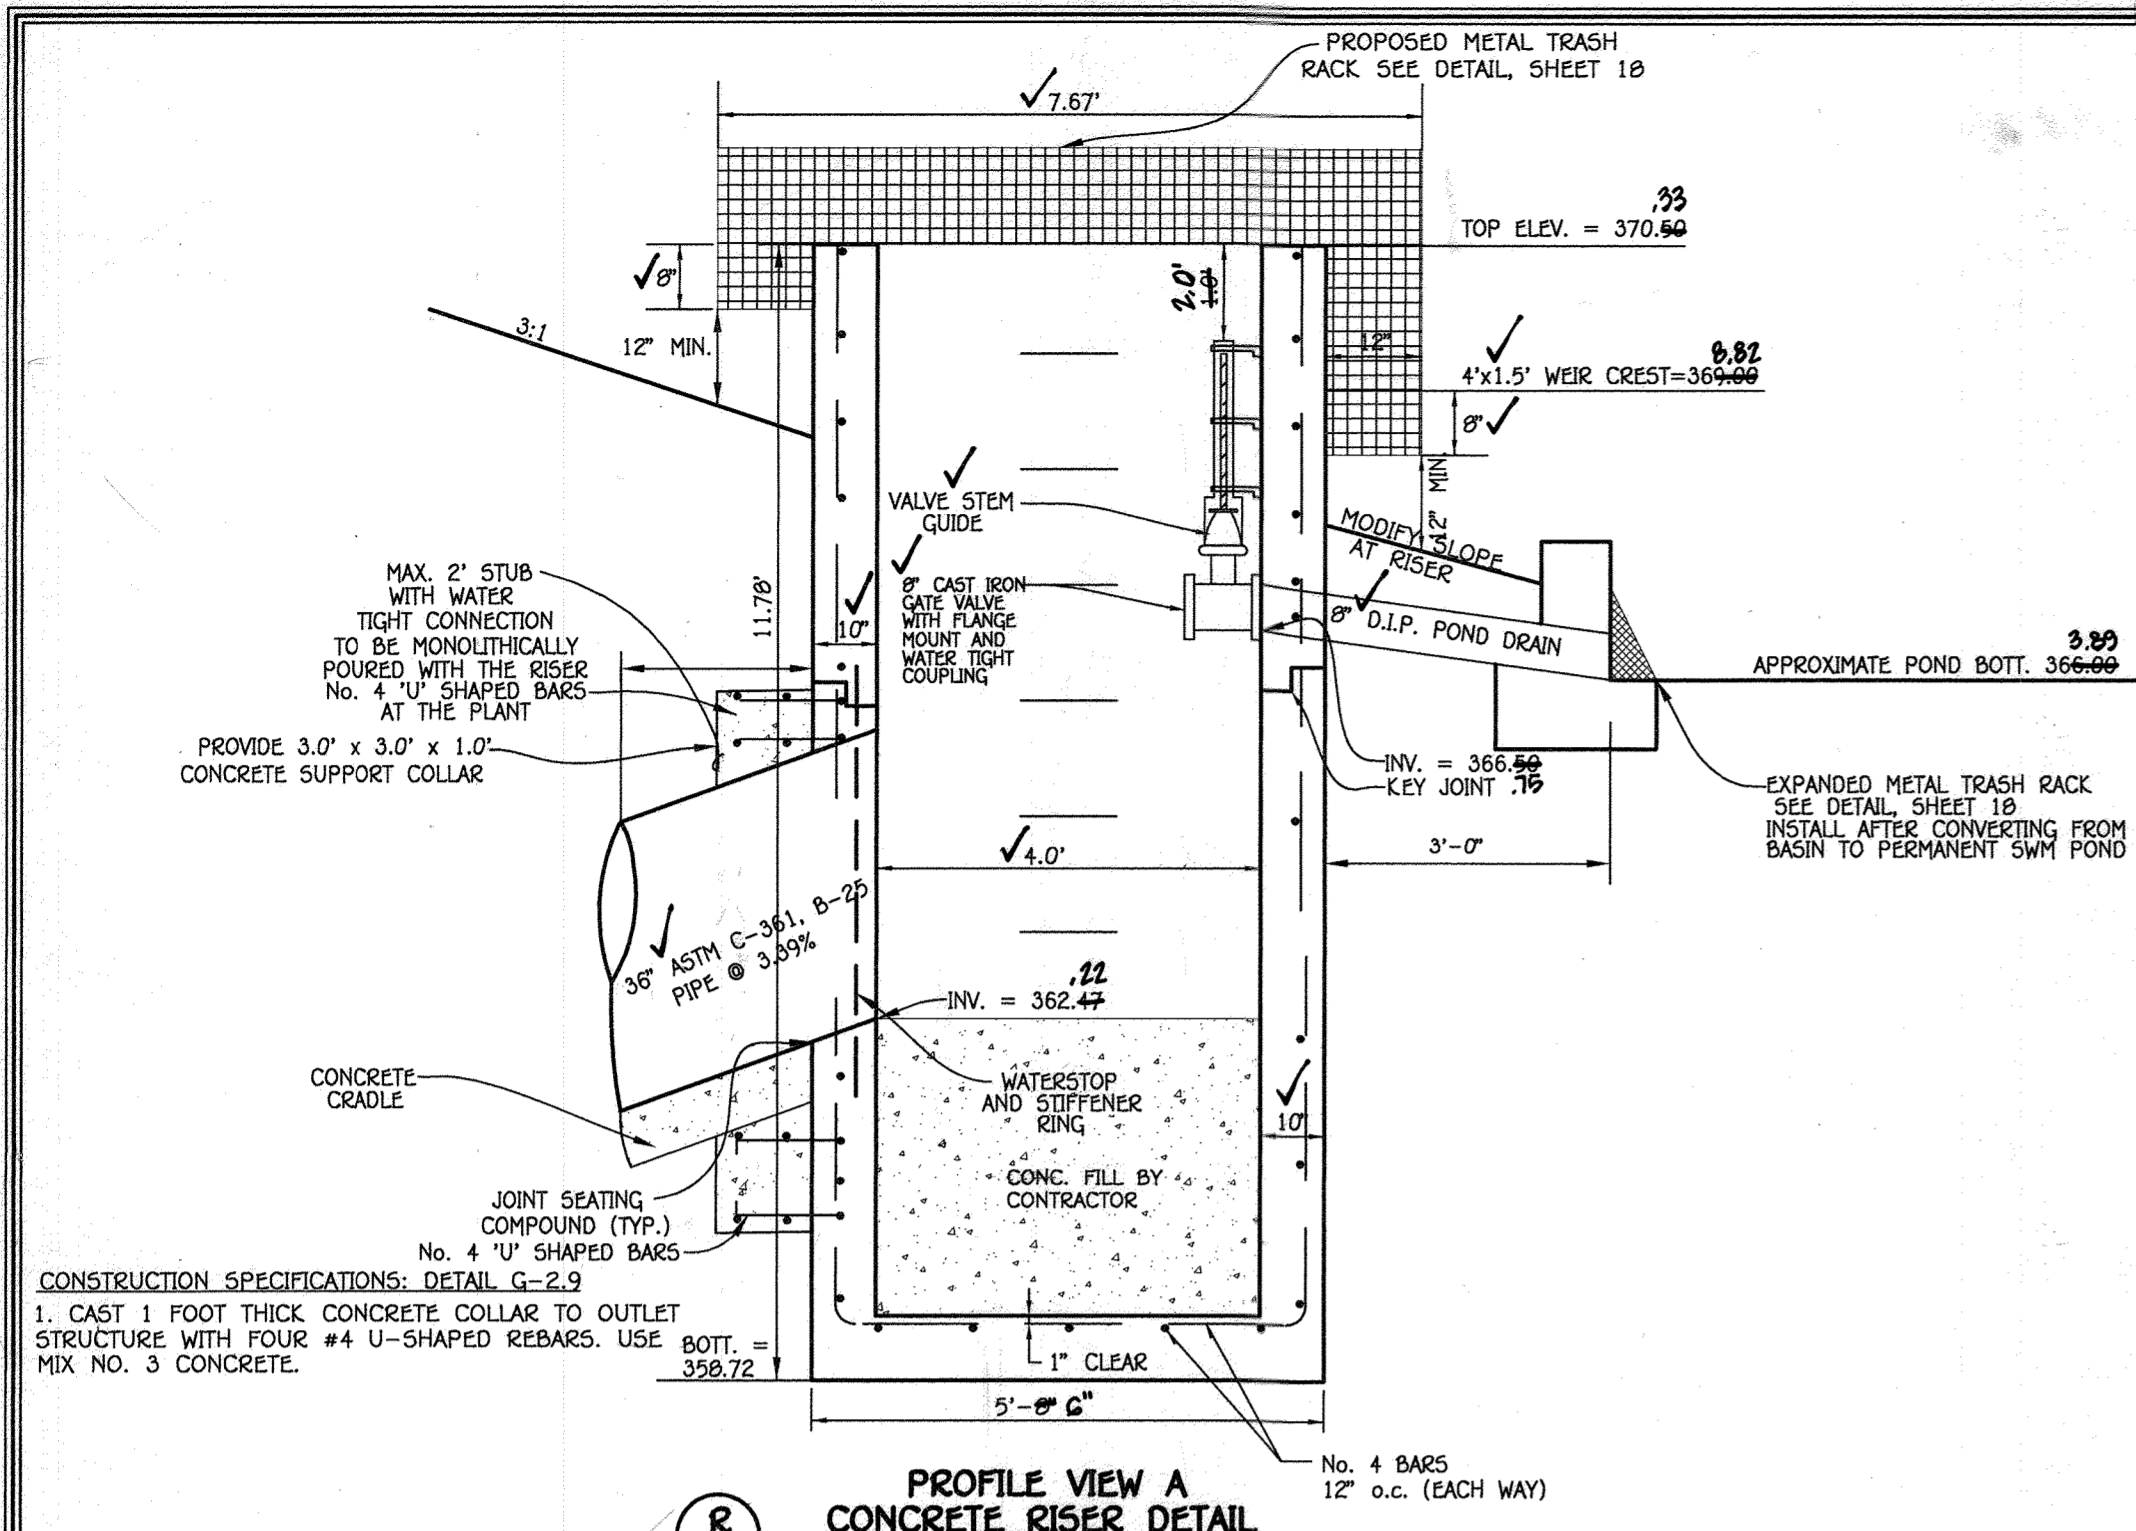

DETAIL G-2-9 PROJECTION COLLAR

CONSTRUCTION SPECIFICATIONS
1. CAST 1 FOOT THICK CONCRETE COLLAR TO OUTLET STRUCTURE WITH FOUR #4 U-SHAPED REBARS.

MARYLAND STANDARDS AND SPECIFICATIONS FOR SOIL EROSION AND SEDIMENT CONTROL
U.S. DEPARTMENT OF AGRICULTURE
NATURAL RESOURCES CONSERVATION SERVICE 2011 MARYLAND DEPARTMENT OF ENVIRONMENT WATER MANAGEMENT ADMINISTRATION

EXISTING POND OPERATION AND MAINTENANCE NOTES:

- ROUTINE MAINTENANCE**
- Facility shall be inspected annually and after major storms. Inspections shall be performed during wet weather to determine if the pond is functioning properly.
 - Top and side slopes of the embankment shall be mowed a minimum of two (2) times a year, once in June and once in September. Other side slopes and maintenance access should be mowed as needed.
 - Debris and litter shall be removed during regular mowing operations and as needed.
 - Visible signs of erosion in the pond as well as the rip-rap or gabion outlet area shall be repaired as soon as it is noticed.
- NON-ROUTINE MAINTENANCE**
- Structural components of the pond such as the dam, the riser, and the pipes shall be repaired upon the detection of any damage. The components shall be inspected during routine maintenance operations.
 - Sediment shall be removed from the pond, and forebay, no later than when the capacity of the pond or forebay is half full of sediment, or, when deemed necessary for aesthetic reasons, upon approval from the Department of Public Works.

AS-BUILT CERTIFICATION

I HEREBY CERTIFY THAT THE FACILITY SHOWN ON THIS PLAN WAS CONSTRUCTED AS SHOWN ON THE "AS-BUILT" PLANS AND MEETS THE APPROVED PLANS AND SPECIFICATIONS.

CERTIFY MEANS TO STATE OR DECLARE A PROFESSIONAL OPINION BASED UPON ON-SITE INSPECTIONS AND MATERIAL TESTS WHICH ARE CONDUCTED DURING CONSTRUCTION. THE ON-SITE INSPECTIONS AND MATERIAL TESTS ARE THOSE INSPECTIONS AND TESTS DEEMED SUFFICIENT AND APPROPRIATE BY COMMONLY ACCEPTED ENGINEERING STANDARDS. CERTIFY DOES NOT MEAN OR IMPLY A GUARANTEE BY THE ENGINEER NOR DOES AN ENGINEER'S CERTIFICATION RELIEVE ANY OTHER PARTY FROM MEETING REQUIREMENTS IMPOSED BY CONTRACT, EMPLOYMENT, OR OTHER MEANS, INCLUDING MEETING COMMONLY ACCEPTED INDUSTRY PRACTICES.

BUILDER/DEVELOPER'S CERTIFICATE

"I/We Certify That All Development And/Or Construction Will Be Done According To These Plans, And That Any Responsible Personnel Involved In The Construction Project Will Have A Certificate Of Attendance At A Department Of The Environment Approved Training Program For The Control Of Sediment And Erosion Before Beginning The Project. I Shall Engage A Registered Professional Engineer To Supervise Pond Construction And Provide The Howard Soil Conservation District With An "As-Built" Plan Of The Pond Within 30 Days Of Completion. I Also Authorize Periodic On-Site Inspections By The Howard Soil Conservation District."

SIGNATURE OF DEVELOPER: [Signature] DATE: 5-26-16

ENGINEER'S CERTIFICATE

"I Certify That This Plan For Pond Construction, Erosion And Sediment Control Represents A Practical And Workable Plan Based On My Personal Knowledge Of The Site Conditions. This Plan Was Prepared In Accordance With The Requirements Of The Howard Soil Conservation District. I Have Notified The Developer That He/She Must Engage A Registered Professional Engineer To Supervise Pond Construction And Provide The Howard Soil Conservation District With An "As-Built" Plan Of The Pond Within 30 Days Of Completion."

SIGNATURE OF ENGINEER: [Signature] DATE: 5/24/16

These Plans For Small Pond Construction, Soil Erosion And Sediment Control Meet The Requirements Of The Howard Soil Conservation District.

APPROVED: DEPARTMENT OF PUBLIC WORKS
[Signature] DATE: 6-21-16
CHIEF, BUREAU OF HIGHWAYS

APPROVED: DEPARTMENT OF PLANNING AND ZONING
[Signature] DATE: 6-21-16
CHIEF, DIVISION OF LAND DEVELOPMENT

APPROVED: DEPARTMENT OF PUBLIC WORKS
[Signature] DATE: 6-1-16
CHIEF, DEVELOPMENT ENGINEERING DIVISION

OWNERS
LINE ELEM. LLC
12549 LINE ELEM ROAD
FULTON, MARYLAND 20799-0460
410-792-2922

DEVELOPER
WILLIAMSBURG GROUP, LLC
C/O BOB CORRETT
5405 HARBERS FARM ROAD, SUITE 200
COLUMBIA, MARYLAND 21044
410-997-0800

AND
PERRY C. WESTLAND, JR.
12549 LINE ELEM ROAD
FULTON, MARYLAND 20799-0460
410-792-2922

PROFESSIONAL CERTIFICATION

I HEREBY CERTIFY THAT THESE DOCUMENTS WERE PREPARED OR APPROVED BY ME AND THAT I AM A DULY LICENSED PROFESSIONAL ENGINEER UNDER THE LAWS OF THE STATE OF MARYLAND, LICENSE NO. 30386, EXPIRATION DATE: 01/12/2016.

[Signature] DATE: 5/26/16

DAM INSPECTION CHECKLIST

To help the dam owner perform periodic safety inspections of the structure, a checklist is provided. Each item of the checklist should be completed. Repair is required when obvious problems are observed. Monitoring is recommended if there is potential for a problem to occur in the future. Investigation is necessary if the reason for the observed problem is not obvious.

A brief description should be made of any noted irregularities, needed maintenance, or problems. Abbreviations and short descriptions are recommended. Space at the bottom of the form should be used for any items not listed.

DAM WESTLAND FARM DATE: 4 AUG 15 (REV 20 SEP 15)
WEATHER: SUNNY
POOL LEVEL:

Item	Comments	Y	N	U	U
1. CREST					
a. Visual settlement					
b. Displacement					
c. Cracking					
2. UPSTREAM SLOPE					
a. Erosion					
b. Ground cover in good condition					
c. Trees, shrubs, or other woody vegetation					
d. Longitudinal/perforated cracks					
e. Adequate riprap protection					
f. Stone deterioration					
g. Settlements, depressions, or bulges?					
3. DOWNSTREAM SLOPE					
a. Erosion					
b. Ground cover in good condition					
c. Trees, shrubs, or other woody vegetation					
d. Longitudinal/perforated cracks					
e. Stone protection adequate					
f. Settlements, depressions, or bulges?					
g. Soft spots or boggy areas?					
h. Movement at or beyond toe?					
i. Seepage at toe?					
4. CHANNELS AND CONTROL					
a. Internal drains flow?					
b. Seepage at toe?					
c. Does seepage contain fines?					

WESTLAND FARM POND RECONSTRUCTION SUMMARY

As part of the Westland Farm development project we were required to address the Howard Soil Conservation District's requirement that all existing Farm Ponds within any developed property be either removed and the stream restored to pre-existing conditions or upgrade the Pond to meet today's current MDE-370 Pond Specifications (Year 2000). This requirement is also a product of the MDE Dam Safety Division program to help upgrade older failing ponds for safety concerns.

Consideration was given to the removal of the dam embankment however this would have resulted in an increase of stream flow runoff on the downstream properties not seen since the original farm pond was constructed in the 1970's. The Developer opted for reconstruction of the pond. For consistency, the height of the dam embankment and volume of water being stored were kept the same from the existing pond to this new embankment design. This design approach will allow for similar release rates as best can be obtained using the current MD-370 Pond Specifications.

MD-370 Table #1 Hydraulic Criteria for Ponds:
Class "A" Structure, Drainage Area < 100 acres, Height < 15', Water Surface Area < 12 acres in size
Principal Spillway Capacity (per Notes 5 and 5C5) for Urban Pond is the 5-year storm event.
Emergency Spillway Capacity is the 100-year storm event with one-foot of freeboard. The 5-year storm must be routed thru the Principal Spillway.

MD-370 Table #2:
For Height of Dam between 11-feet and 14-feet use a minimum top of dam width = 8-feet

MD-370 SUMMARY TABLE:
Existing Condition: 5-Year Storm Event: Inflow=65.38 c.f.s.; Outflow=53.7 c.f.s. @ elev.371.94.
100-Year Storm Event: Inflow=237.18 c.f.s.; Outflow=185.50 @ elev.373.23.
Proposed Condition: 5-Year Storm Event: Inflow=65.38 c.f.s.; Outflow=36.76 c.f.s. @ elev.371.01.
100-Year Storm Event: Inflow=237.18 c.f.s.; Outflow=173.68 @ elev.372.44.

Summary:
In summary, the reconstruction of the Dam embankment was designed to maintain the existing height and storage volume of the old original dam while meeting the current design standards of the MD-370 Pond Specifications. In addition to the 5-year and 10-year design storm events other storms were evaluated for water surface storage elevations and relationships to various weir elevations. The smaller 1 and 2-year storm events were evaluated since they are more common and found to match the existing discharge and storage volumes very well. The design criteria used is the best available method that protects downstream properties and also keeps the pond in compliance with the MD-370 regulations.

INSPECTION CHECKLIST - PAGE 2



INSPECTED BY: M. Johnson DATE: 4 AUG 15 REV: 20 SEP 15

Item	Comments	Y	N	U	U
5. AMBUSH CONTACTS					
a. Erosion					
b. Differential movement?					
c. Cracks?					
d. Seepage?					
e. Adequate erosion protection for ditch?					
6. INLET STRUCTURE Concrete or Metal Pipe (circle one)					
a. Seepage into structure?					
b. Debris or obstruction?					
c. If concrete, do surface show:					
1. Spalling?					
2. Cracking?					
3. Erosion?					
4. Sealing?					
5. Covered reinforcement?					
6. Other?					
d. If metal, do surface show:					
1. Displacement or offset?					
2. Protective coating deficient?					
3. Misalignment or split seams?					
e. Do the joints show:					
1. Displacement or offset?					
2. Loss of joint material?					
3. Leakage?					
f. Are the trash racks:					
1. Broken or bent?					
2. Corroded or rusted?					
3. Obstructed?					
4. Operational?					
5. Sluice/Drain gates:					
1. Broken or bent?					
2. Corroded or rusted?					
3. Locked?					
4. Not seated correctly?					
5. Periodically maintained?					
6. Operational?					

INSPECTION CHECKLIST - PAGE 3

INSPECTED BY: M. Johnson DATE: 4 AUG 15 REV: 20 SEP 15

Item	Comments	Y	N	U	U
7. PRINCIPAL SPILLWAY PIPE Concrete or Metal Pipe (circle one)					
a. Seepage into contact?	UNABLE TO ACCESS				
b. Debris present?					
c. Do concrete surfaces show:					
1. Spalling?					
2. Cracking?					
3. Erosion?					
4. Sealing?					
5. Exposed reinforcement?					
6. Other?					
d. Do the joints show:					
1. Displacement or offset?					
2. Loss of joint material?					
3. Leakage?					
e. Is reinforced masonry:					
1. Underdraining the outlet?					
2. Eroding the embankment?					
3. Displacing riprap?					
4. Encouraging the plunge pool?					
f. Tailwater elevation and flow condition:					
8. STILLING BASIN/POOL Riprap or Concrete (circle one)					
a. If concrete, condition of surfaces?					
b. Deterioration or displacement of joints?					
c. Outlet channel obstructed?					
d. In reinforced masonry:					
1. Underdraining the outlet?					
2. Eroding the embankment?					
3. Displacing riprap?					
4. Encouraging the plunge pool?					
e. Tailwater elevation and flow condition:					
9. EMBANKMENT					
a. Is the channel:					
1. Eroding or backingout?					
2. Obstructed?					
b. Trees or shrubs in the channel?					
c. Seepage present?					
d. Soft spots or boggy areas?					
e. Channel slopes eroding or sloughing?					
f. Adequate riprap protection for ditch?					
10. RESERVOIR					
a. High water mark?					
b. Erosion/slides into pool area?					
c. Embankment deterioration?					
d. Floating debris present?					
e. Adequate riprap protection for ditch?					

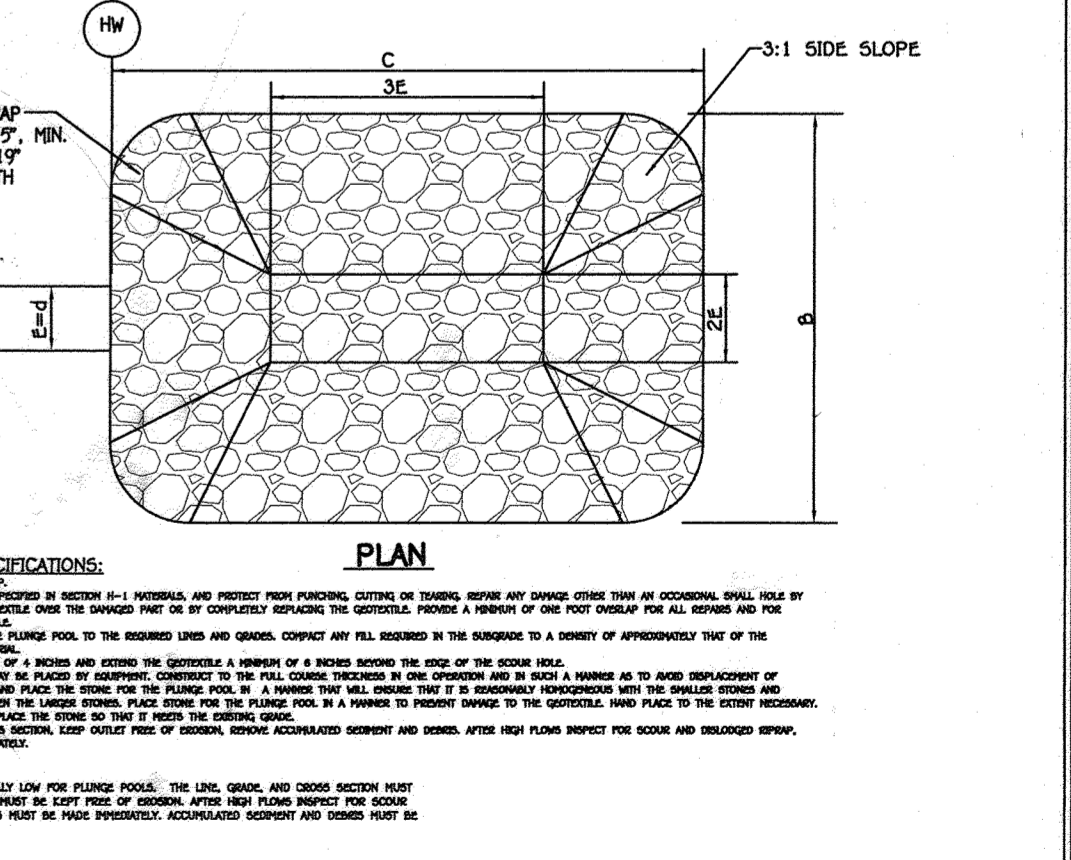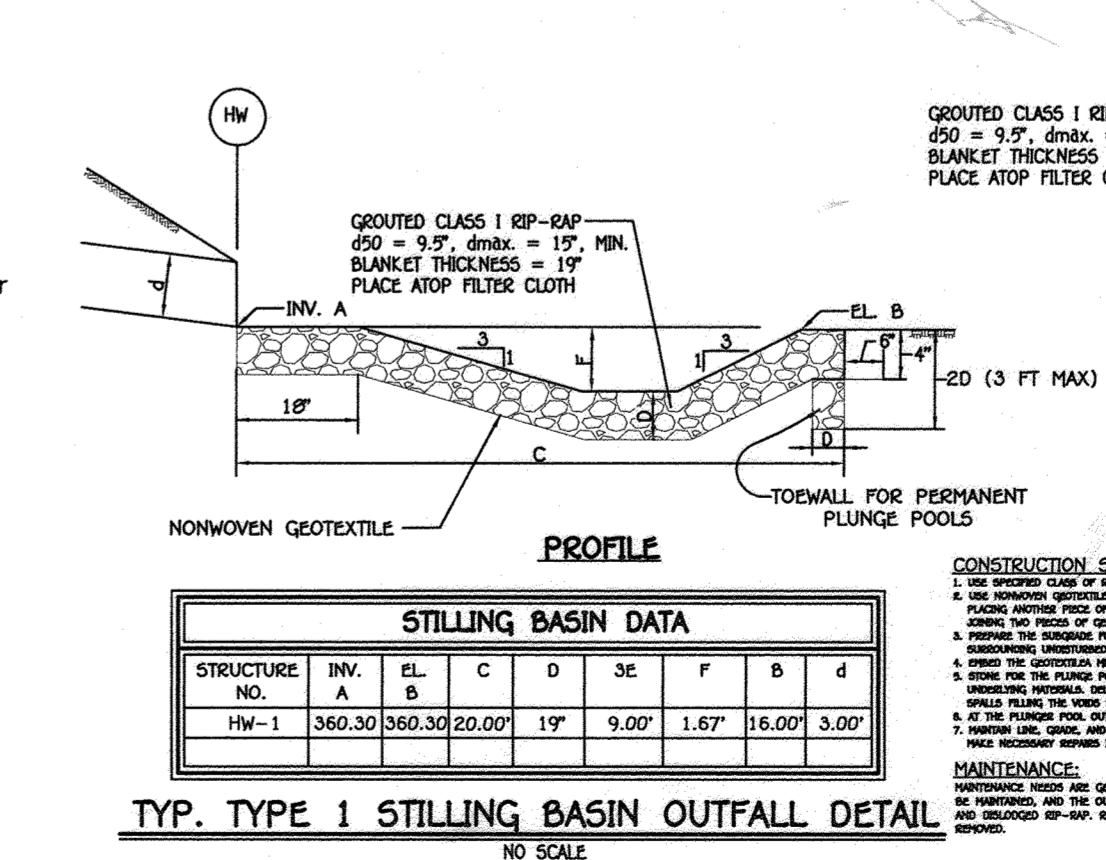

POND UPGRADE DETAILS & SPECIFICATIONS
WESTLAND FARM ESTATES
LOTS 3 THRU 14 AND OPEN SPACE LOT 15
ZONED RR-DEO
TAX MAP No. 45 GRID No. 5 PARCEL No. 28
FIFTH ELECTION DISTRICT HOWARD COUNTY, MARYLAND
SCALE: AS SHOWN DATE: MAY, 2016
SHEET 19 OF 19