

SHEET INDEX

NO	TITLE
1	COVER SHEET
2	ROAD PLAN, PROFILE, TYPICAL SECTION AND SOIL BORING LOGS
3	GRADING AND SEDIMENT CONTROL PLAN
4	SEDIMENT CONTROL NOTES AND DETAILS
5	SOILS, DRAINAGE AREA MAP AND STORM DRAIN PROFILES AND DETAILS
6	STORMWATER MANAGEMENT PLAN AND DETAILS
7	FINAL LANDSCAPING AND FOREST CONSERVATION PLAN

MINIMUM LOT SIZE CHART

LOT NO.	GROSS AREA	PIPESTEM AREA	MINIMUM LOT SIZE
2	12,684 SQ.FT.	562 SQ.FT.	12,122 SQ.FT.
3	17,594 SQ.FT.	283 SQ.FT.	17,341 SQ.FT.
4	13,077 SQ.FT.	1,043 SQ.FT.	12,034 SQ.FT.
5	13,239 SQ.FT.	1,239 SQ.FT.	12,000 SQ.FT.
6	13,540 SQ.FT.	1,540 SQ.FT.	12,000 SQ.FT.
7	13,292 SQ.FT.	1,292 SQ.FT.	12,000 SQ.FT.
8	12,774 SQ.FT.	394 SQ.FT.	12,080 SQ.FT.
0/5 9	7,836 SQ.FT.	1,653 SQ.FT.	6,183 SQ.FT.

LEGEND

	EXISTING DRIVEWAY TO BE REMOVED		EARTH DIKE
	PROPOSED PAVEMENT		DIVERSION FENCE
	AREA OF WETLANDS		SILT FENCE
	100 YR. FLOODPLAIN		SUPER SILT FENCE
	PR. 8" SEWER MAIN		LIMIT OF DISTURBANCE
	PR. MANHOLE		LIMIT OF DRAINAGE AREA
	PR. 8" WATER MAIN		SOIL BORING
	PR. STORM DRAIN PIPE		STABILIZED CONSTRUCTION ENTRANCE
	PR. STORM DRAIN INLET		MICRO-BIORETENSION NUMBER
			EXISTING TREE


FINAL ROAD CONSTRUCTION PLAN

ELKDALE GLENN PROPERTY

LOTS 1 THRU 8, AND OPEN SPACE LOTS 9 & 10 AND NON-BUILDABLE BULK PARCEL "A"

FIRST ELECTION DISTRICT

HOWARD COUNTY, MARYLAND

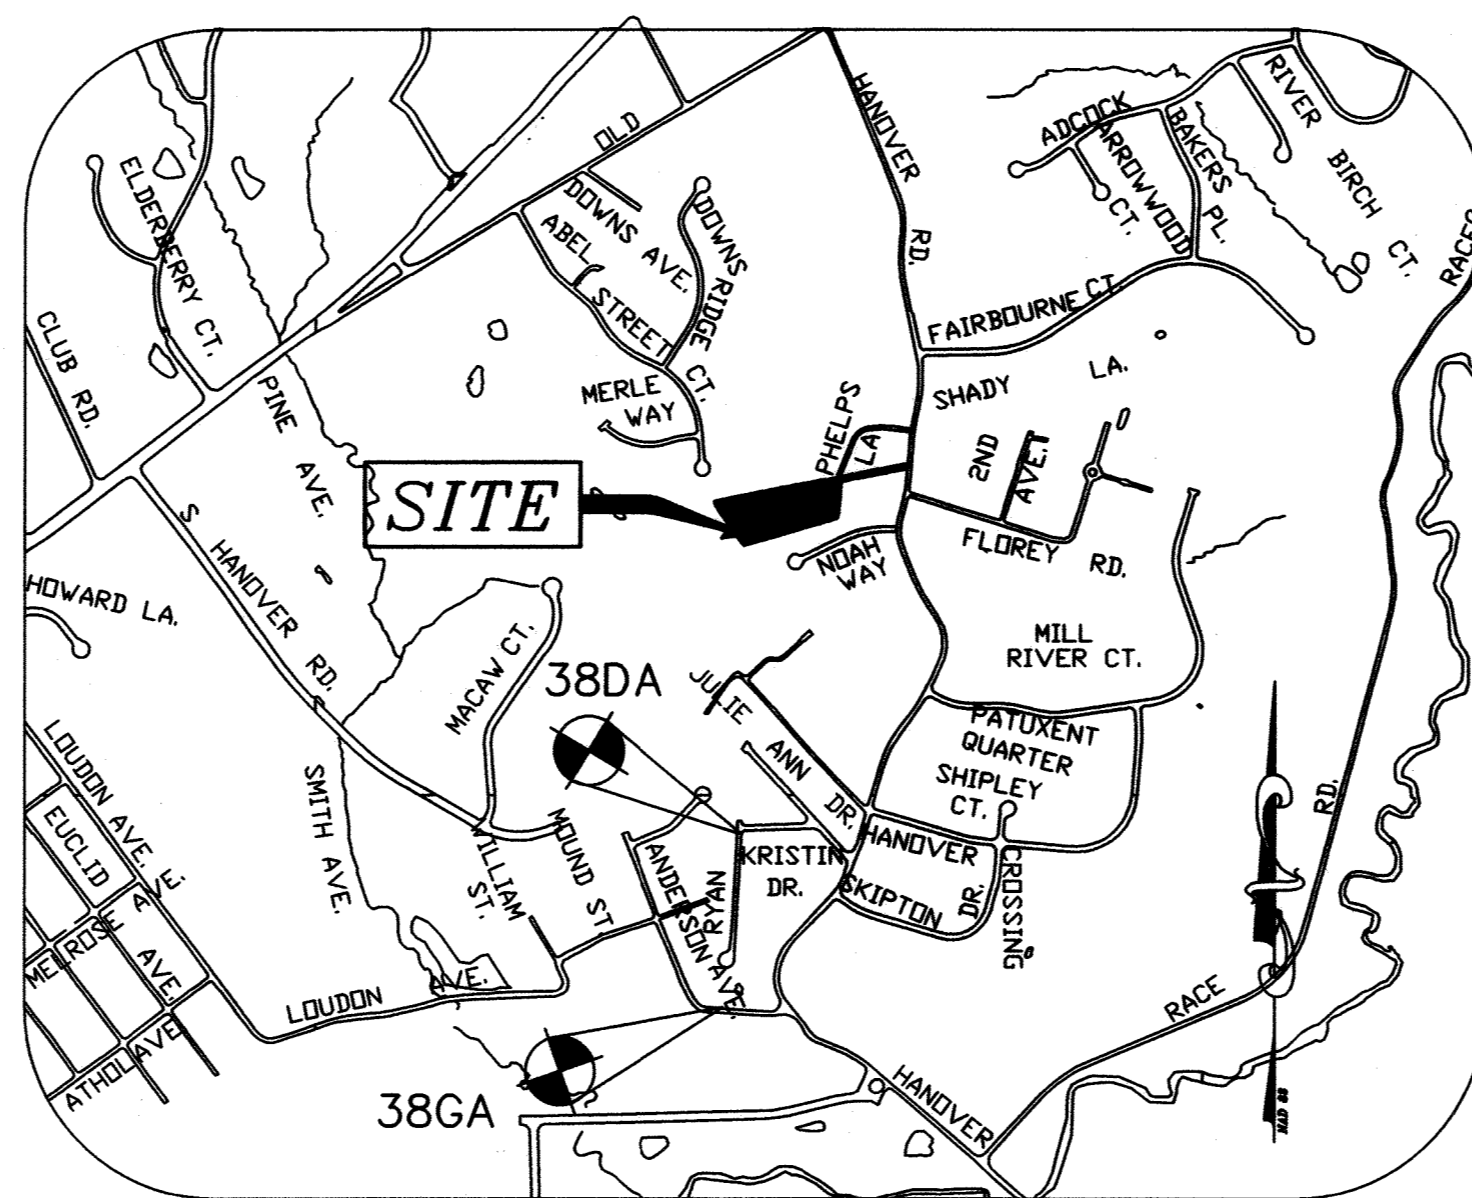

VICINITY MAP

SCALE: 1"=1000'
ADC MAP: 35 GRID: E-4

GENERAL NOTES:

- THIS SUBJECT PROPERTY IS ZONED R-12 PER THE OCTOBER 6, 2013 COMPREHENSIVE ZONING PLAN.
- THE PROJECT IS IN CONFORMANCE WITH THE LATEST HOWARD COUNTY STANDARDS UNLESS WAIVERS HAVE BEEN APPROVED.
- TOPOGRAPHY WITHIN 200' OF SITE BOUNDARY SHOWN HEREON IS BASED ON FIELD RUN SURVEY PERFORMED BY MILDENBERG, BOENDER & ASSOC., INC. ON OR ABOUT FEBRUARY 2016. OTHER TOPOGRAPHY SHOWN IS BASED ON HOWARD COUNTY GIS.
- BOUNDARY SHOWN HEREON IS BASED ON A FIELD RUN MONUMENTED BOUNDARY SURVEY PERFORMED ON OR ABOUT FEBRUARY, 2016 BY MILDENBERG, BOENDER & ASSOC. INC.
- COORDINATES BASED ON NAD '83 (HORIZONTAL) AND NAVD '86 (VERTICAL) MARYLAND COORDINATE SYSTEM AS PROJECTED BY HOWARD COUNTY GEODETIC CONTROL STATIONS
STA. No. 38GA N 555,897.324 E 1N390,132.094 ELEV. 80.85
STA. No. 38DA N 556,796.309 E 1,390,221.433 ELEV. 126.15
- SITE AREA TABULATION:**
TOTAL AREA: 3.26 AC±
AREA OF 100 YEAR FLOODPLAIN: 0.14 AC±
TOTAL NET AREA: 3.12 AC±
MINIMUM LOT SIZE PROPOSED: 12,000 SQ.F.
NUMBER OF BUILDABLE LOTS: 8
NUMBER OF OPEN SPACE LOTS: 2
TYPE OF PROPOSED UNIT: SFD
AREA OF BUILDABLE LOTS: 2.50 AC±
AREA OF ROAD ROW: 0.15 AC±
AREA OF OPEN SPACE REQUIRED: (8%) 0.26 AC±
AREA OF OPEN SPACE PROVIDED: (14.4%) 0.46 AC±
- WATER IS PUBLIC.
- SEWER IS PUBLIC.
- STORMWATER MANAGEMENT IS PROVIDED BY M-6 MICRO-BIORETENTION FACILITIES IN ACCORDANCE WITH THE 2007 MARYLAND STORMWATER DESIGN MANUAL.
- FLOODPLAIN EXISTS ON SITE AND WAS DELINEATED BASED ON RECORDED PLATS NO. 13062 AND 18903.
- WETLANDS, STREAM AND ITS BUFFER EXIST ON SITE AS CERTIFIED IN THE WETLAND REPORT PREPARED BY ECO-SCIENCE PROFESSIONALS, INC. IN FEBRUARY 2016.
- FOREST STAND DELINEATION PERFORMED BY ECO-SCIENCE PROFESSIONALS, INC. IN FEBRUARY, 2016. THERE ARE FOREST RESOURCES OR SPECIMEN TREES ON THE PROPERTY.
- FOREST CONSERVATION OBLIGATIONS IN ACCORDANCE WITH SECTION 16.1200 OF THE HOWARD COUNTY CODE AND FOREST CONSERVATION ACT FOR THIS SUBDIVISION WILL BE FULFILLED BY OFF-SITE CONSERVATION ESMT FOR LOCATIONS OF RESTORATION AT MILDENBERG WOODS (11025). NO CLEARING, GRADING OR CONSTRUCTION IS PERMITTED WITHIN THE FOREST CONSERVATION ESMT. HOWEVER, FOREST MANAGEMENT PRACTICES AS DEFINED IN THE DEED OF FOREST CONSERVATION ESMT ARE ALLOWED.
- STREET LIGHT PLACEMENT AND THE TYPE OF FIXTURES AND POLES SHALL BE IN ACCORDANCE WITH THE HOWARD COUNTY DESIGN MANUAL, VOLUME III (2006), SECTION 5.5.A. A MINIMUM OF 20' SHALL BE MAINTAINED BETWEEN ANY STREET LIGHT AND ANY TREE.
- PER SECTION 16.121(c) OF THE HOWARD COUNTY SUBDIVISION AND LAND USE REGULATIONS, OPEN SPACE FOR THIS SUBDIVISION HAS BEEN PROVIDED THROUGH THE CREATION OF OPEN SPACE LOTS 9 AND 10.
- A PRE-SUBMISSION COMMUNITY MEETING FOR THIS PROJECT WAS HELD ON DECEMBER 21, 2015 AT 6:00 PM AT THE ELKDALE LIBRARY.
- THIS DEVELOPMENT PLAN IS SUBJECT TO THE AMENDED FIFTH EDITION OF THE SUBDIVISION AND LAND DEVELOPMENT REGULATIONS PER COUNCIL BILL 45-2003 AND THE ZONING REGULATIONS AS AMENDED BY COUNCIL BILL 75-2003. DEVELOPMENT OR CONSTRUCTION ON LOTS MUST COMPLY WITH SETBACK AND BUFFER REGULATIONS IN EFFECT AT THE TIME OF SUBMISSION OF THE BUILDING / GRADING PERMIT.
- EXISTING DWELLING LOCATED ON LOT 3 IS TO REMAIN. ALL OTHER EXISTING STRUCTURES ARE TO BE REMOVED.
- APFO ROAD TEST IS NOT REQUIRED. THERE IS NO INTERSECTION OF MAJOR COLLECTOR ROADS (OR HIGHER ROAD CLASSIFICATION) WITHIN 1.5 MILE FROM THE ENTRANCE TO THIS SUBDIVISION.
- NOISE STUDY IS NOT REQUIRED FOR THIS PROJECT.
- NO HISTORIC STRUCTURES, CEMETERIES, OR GRAVE SITES EXIST ON-SITE.
- SITE IS NOT ADJACENT TO A DESIGNATED SCENIC ROAD.
- ALL NEW LOTS/RESIDENTIAL UNITS IN THIS SUBDIVISION ARE SUBJECT TO THE MIHU FEE-IN-LIEU REQUIREMENT THAT IS TO BE CALCULATED AND PAID TO THE DEPARTMENT OF INSPECTIONS, LICENSES AND PERMITS AT THE TIME OF BUILDING PERMIT ISSUANCE BY THE PERMIT APPLICANT.
- NO STEEP SLOPES EXIST ON-SITE.
- THE SEPTIC SYSTEM MUST BE PROPERLY ABANDONED WITH DOCUMENTATION SENT TO THE HEALTH DEPARTMENT PRIOR TO HEALTH DEPARTMENT SIGNATURE OF THE FINAL RECORD PLAT.
- A PRIVATE RANGE OF ADDRESS SIGN ASSEMBLY SHALL BE FABRICATED AND INSTALLED BY HOWARD COUNTY BUREAU OF HIGHWAYS AT THE DEVELOPERS/OWNERS EXPENSE. CONTACT HOWARD COUNTY TRAFFIC DIVISION AT 410-313-2430 FOR DETAILS AND COST ESTIMATES.
- THE PROPERTY FALLS WITHIN THE BW AIRPORT HEIGHT RESTRICTION AREA.
- OPEN SPACE LOT 10 IS TO BE DEDICATED TO HOWARD COUNTY DEPARTMENT OF RECREATION AND PARKS.
- THIS PROPERTY IS SUBJECT TO THE DESIGN MANUAL WAIVER, VOLUME III, SECTION 1.1.D.2, TO ALLOW 8 DWELLING UNITS ON ONE USE-IN-COMMON DRIVEWAY. WAIVER WAS DENIED ON MARCH 17, 2017 WITH THE RECOMMENDATION TO PROVIDE SECOND USE IN COMMON DRIVEWAY ACCESSED FROM THE SIDE LEG OF THE TEE-TURNAROUND.
- THIS PLAN HAS BEEN PREPARED IN ACCORDANCE WITH THE PROVISIONS OF SECTION 16.124 OF THE HOWARD COUNTY CODE AND THE LANDSCAPE MANUAL.
- FINANCIAL SURETY FOR THE REQUIRED LANDSCAPING IN THE AMOUNT OF \$11,100.00 (20 SHADE TREES, 34 EVERGREEN TREES) WILL BE POSTED AT THE SITE DEVELOPMENT STAGE.
- A SURETY IN THE AMOUNT OF \$ 2,100 FOR (7 SHADE TREES) PUBLIC STREET TREES WILL BE ADDRESSED UNDER DED'S COST ESTIMATE.
- THE CONTRACTOR SHALL NOTIFY "MISS UTILITY" AT 1-800-257-7777 AT LEAST 48 HOURS PRIOR TO ANY EXCAVATION WORK BEING DONE.
- ALL CONSTRUCTION SHALL BE IN ACCORDANCE WITH THE LATEST STANDARDS AND SPECIFICATIONS OF HOWARD COUNTY PLUS MSHA STANDARDS AND SPECIFICATIONS IF APPLICABLE.
- THE CONTRACTOR SHALL NOTIFY THE DEPARTMENT OF PUBLIC WORKS / BUREAU OF ENGINEERING, CONSTRUCTION INSPECTION DIVISION AT (410)313-1880 AT LEAST FIVE (5) WORKING DAYS PRIOR TO THE START OF WORK.
- THIS PROPERTY IS LOCATED WITHIN THE BW AIRPORT ZONING DISTRICT. MAA PERMIT NO 17-220, WAS ISSUED ON NOVEMBER 09, 2017.
- ALL STORM DRAINS, MICRO-BIODES AND RAIN GARDENS FACILITIES SHALL BE PRIVATELY OWNED AND MAINTAINED.

SWM PRACTICES CHART

LOT NO.	BIO-RETENTION (M-6) (NUMBER)	RAIN GARDEN (M-7) (NUMBER)
1	0	0
2	0	1
3	0	0
4	0	1
5	0	1
6	0	1
7	0	1
8	0	1
9	1	0
10	0	0

ENGINEER'S CERTIFICATE
I CERTIFY THAT THIS PLAN FOR EROSION AND SEDIMENT CONTROL REPRESENTS A PRACTICAL AND WORKABLE PLAN BASED ON MY PERSONAL KNOWLEDGE OF THE SITE CONDITIONS AND THAT IT WAS PREPARED IN ACCORDANCE WITH THE REQUIREMENTS OF THE HOWARD SOIL CONSERVATION DISTRICT.

1/16/18
DATE

R. JACOB HIKMAT, P.E.
PRINTED NAME OF ENGINEER

DEVELOPERS CERTIFICATE
I CERTIFY THAT ALL DEVELOPMENT AND CONSTRUCTION WILL BE DONE ACCORDING TO THIS PLAN, AND THAT ANY RESPONSIBLE PERSONNEL INVOLVED IN THE CONSTRUCTION PROJECT WILL HAVE A CERTIFICATE OF ATTENDANCE AT A DEPARTMENT OF THE ENVIRONMENT APPROVED TRAINING PROGRAM FOR THE CONTROL OF SEDIMENT AND EROSION BEFORE BEGINNING THE PROJECT. HOWARD SOIL CONSERVATION DISTRICT IS AUTHORIZED TO CONDUCT PERIODIC ON-SITE INSPECTION.

01/18/18
DATE

W.M. SCOT GODFREY
PRINTED NAME OF DEVELOPER

THIS DEVELOPMENT PLAN IS APPROVED FOR SOIL EROSION AND SEDIMENT CONTROL BY THE HOWARD SOIL CONSERVATION DISTRICT.



1/31/18
DATE

APPROVED: DEPARTMENT OF PUBLIC WORKS
2/6/2018
DATE

APPROVED: DEPARTMENT OF PLANNING AND ZONING
2-26-18
DATE

3-14-18
DATE

THERE IS NO AS-BUILT INFORMATION PROVIDED ON THIS SHEET

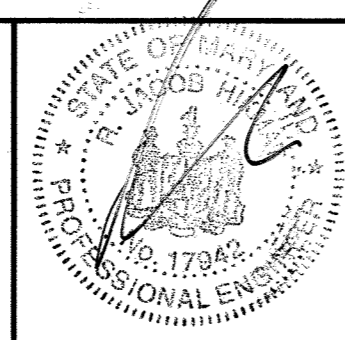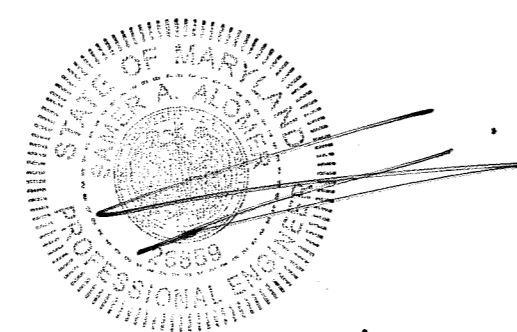

OWNER / DEVELOPER


HARMONY BUILDERS INC
4228 COLUMBIA ROAD
ELLICOTT CITY, MD 21042
410-461-0833

date	JAN. 2018
project	15-011
illustration	MMM
scale	1"=50'
approval	MMM
initials	RJH



date	JAN 2018
description	AS BUILT INFO ADDED
revisions	1
no.	2

ELKDALE GLENN PROPERTY
 LOTS 1-8, OPEN SPACE LOTS 9 & 10 AND NON-BUILDABLE BULK PARCEL "A"
 TAX MAP 38, GRID 15, PARCEL 871
 FIRST ELECTION DISTRICT
 HOWARD COUNTY, MARYLAND
 COVER SHEET

MILDENBERG, BOENDER & ASSOC., INC.
 Engineers Planners Surveyors
 7350-B Grace Drive, Columbia, Maryland 21044
 (410) 997-0286 Tel. (410) 997-0286 Fax

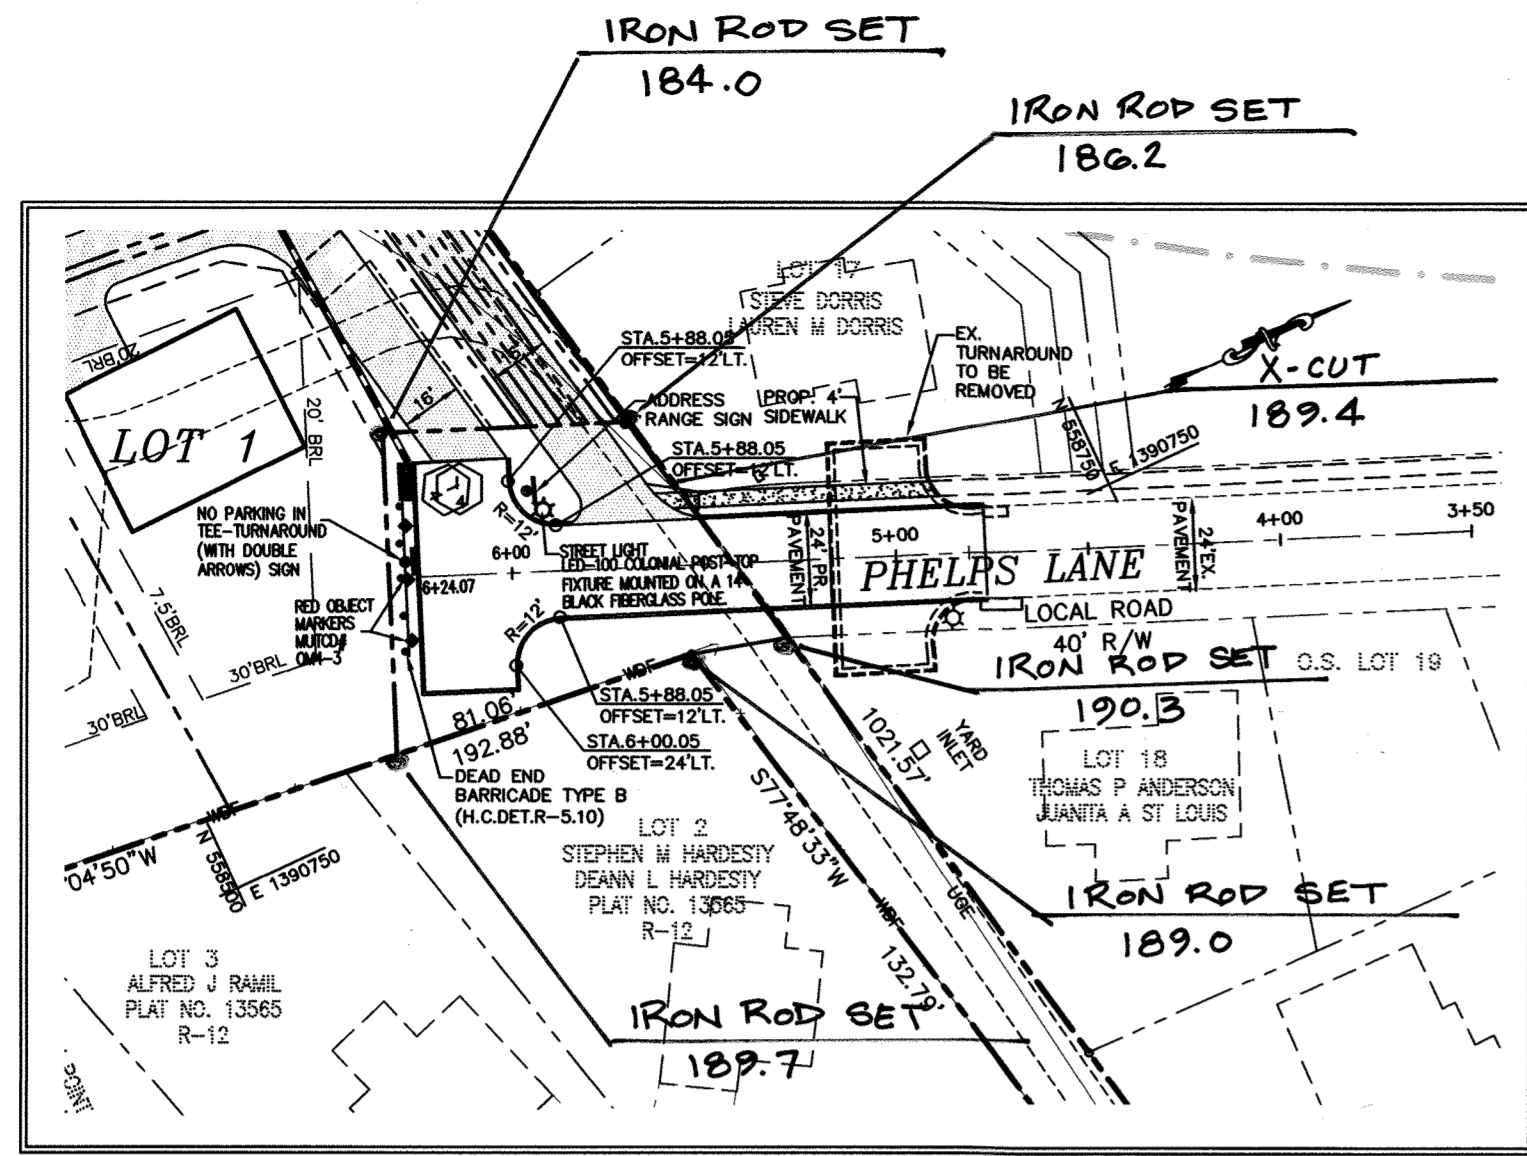


PHELPS LANE EXTENSION PLAN
GRAPHIC SCALE

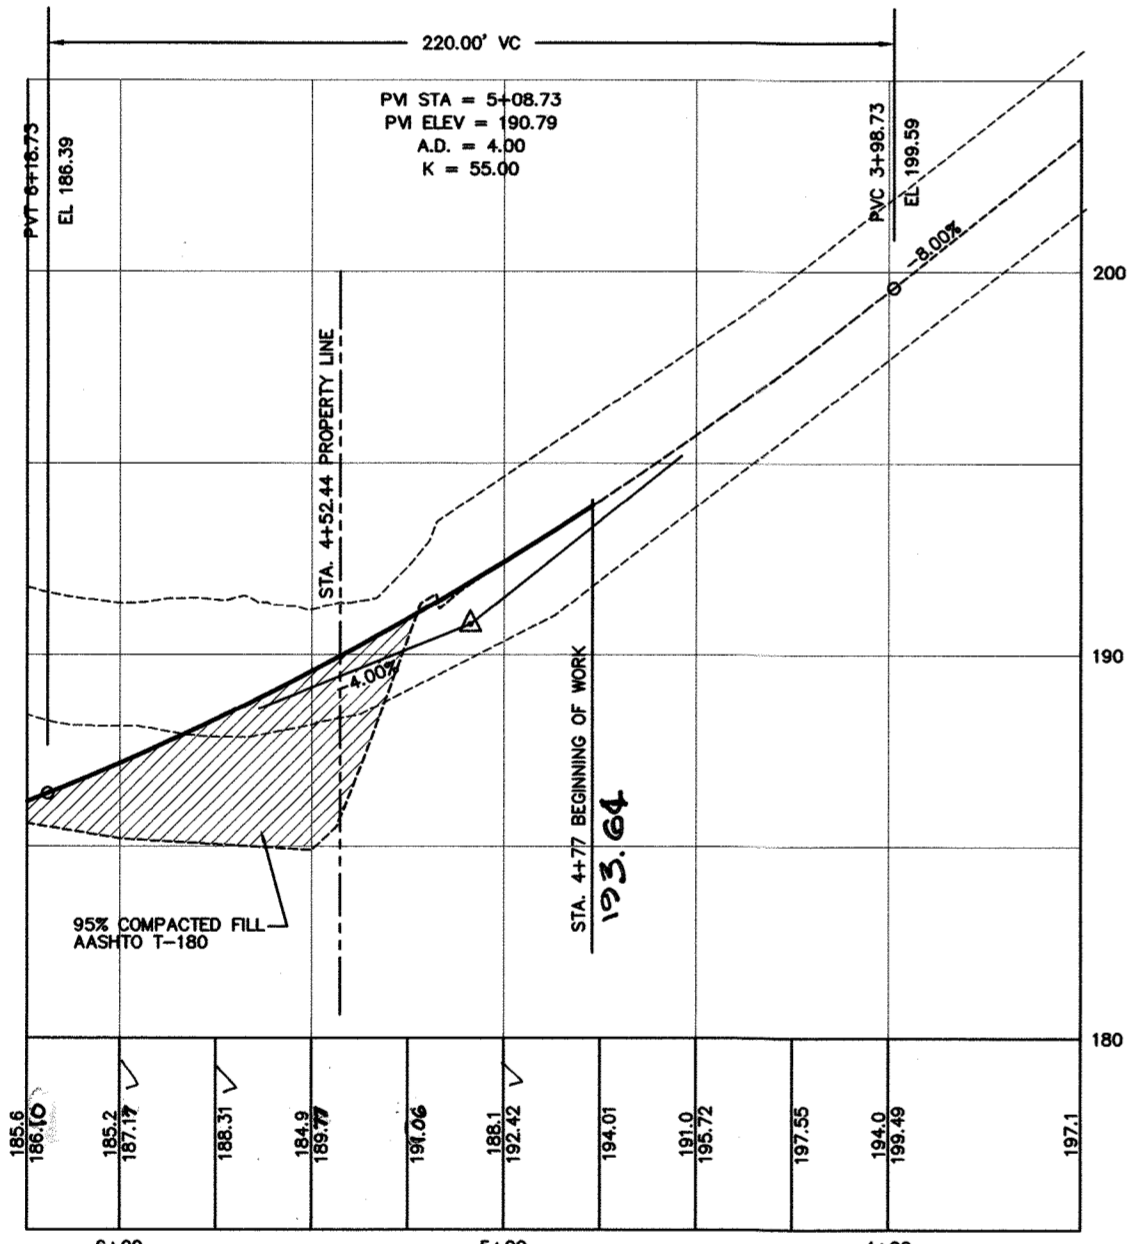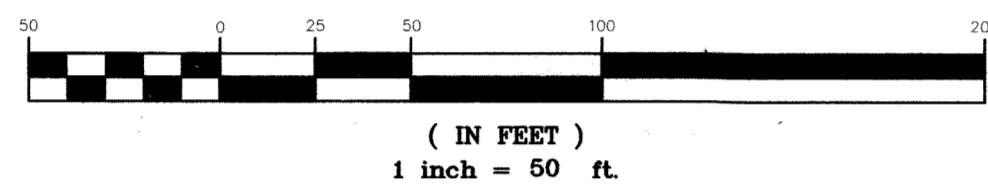


PHELPS LANE EXTENSION PROFILE

SCALE: HOR. 1"=50'
VER. 1"=5'

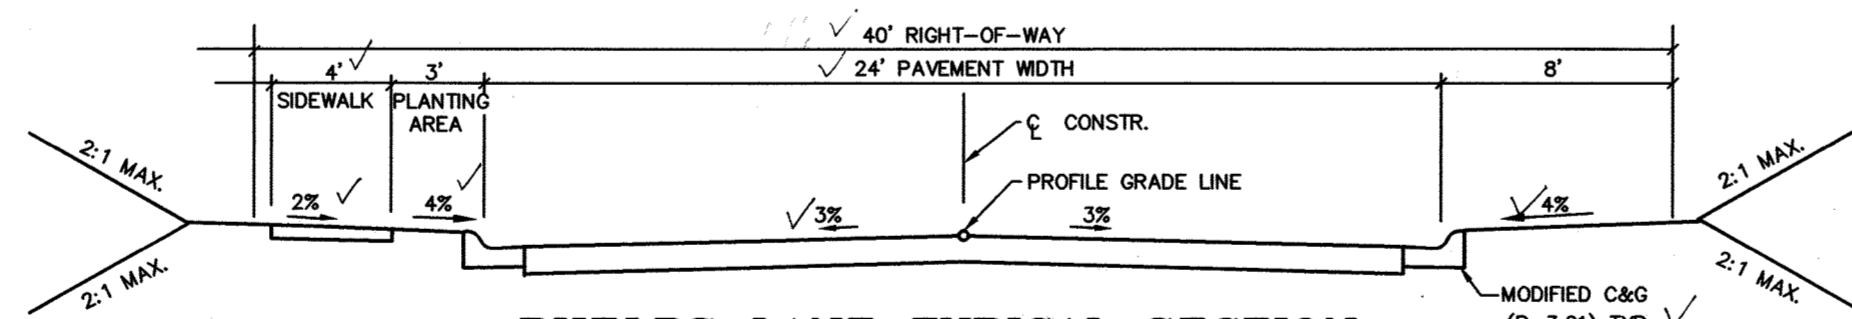

PHELPS LANE TYPICAL SECTION


CLASSIFICATION: ACCESS STREET
DESIGN SPEED: 25 MPH
HO.CO.STD.R-1.02
N.T.S.

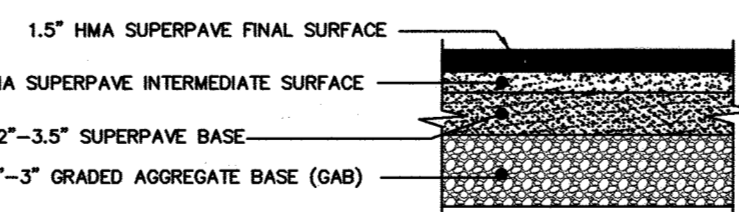

PAVING SECTION P-2


NOTE: DEPTH OF SUPERPAVE BASE AND GRADED AGGREGATE BASE DEPEND ON CBR.

I hereby certify that the facility shown on this plan was constructed as shown on the 'As-Built' plans and meets with the approved plans and specifications.

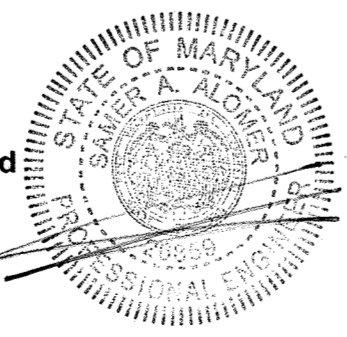

OWNER
HARMONY BUILDERS INC
4228 COLUMBIA ROAD
ELLCOTT CITY, MD 21042
410-461-0833

I HEREBY CERTIFY THAT THESE DOCUMENTS WERE PREPARED OR APPROVED BY ME AND THAT I AM A DULY LICENSED PROFESSIONAL ENGINEER UNDER THE LAWS OF THE STATE OF MARYLAND, LICENSE NO. 17942, EXP DATE 09/03/18

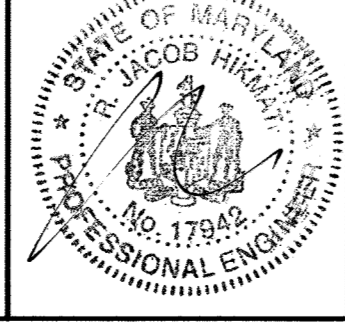

R. JACOB HIKMAT P.E. DATE: 1/16/18

APPROVED: DEPARTMENT OF PUBLIC WORKS

M. M. M. 2/16/2018
CHIEF, BUREAU OF HIGHWAYS

APPROVED: DEPARTMENT OF PLANNING AND ZONING

J. M. 2-28-17
CHIEF, DEVELOPMENT ENGINEERING DIVISION

J. M. 3-14-18
CHIEF, DIVISION OF LAND DEVELOPMENT

R. JACOB HIKMAT P.E. DATE: 1/16/18

P:\2004\15-011\DWG\FINAL\FINAL.DWG

GEOTECHNICAL CONSULTANTS, INC.
P.O. Box 2071
Columbia, MD 21045-2071
Phone: (410) 381-5330
Fax: (410) 381-1064
e-mail: mouzir54@yahoo.com

PROJECT: Mounir Abovazhah, MSCE, PE
CONSULTANTS: Edward De Santis, Eng. C.E., PE + Dr. Karim Tarfaoui, Ph.D., PE

December 4, 2016

Mildenberg, Boender & Associates, Inc.
7350-B Grace Drive
Columbia, Maryland 21044

Attn: Ms. Maya M. Mildenberg
Vice President

Re: Limited Subsurface Exploration
Proposed Development
Greene Property
6200 Hanover Road, Hanover
Howard County, Maryland
Tax Map 38, Grid 15, Parcel 871
GEAT Project No. G-246

Dear Ms. Mildenberg:

On November 26th, 2016, GEAT Consultants, Inc. utilized a truck mounted B-47 drilling rig to bore six (6) soil borings (B-1 through B-6) to depths ranging from 4 ft to 10 ft below existing site grades at the locations shown on the attached Borings Location Map. The purpose of the study was to evaluate the presence/absence of bedrock and local groundwater at the locations shown, within the depths explored. The number, location, and depth of the borings were determined by others and the borings were staked-out in the field by others.

Our field observations are summarized in Table 1 below:

Boring No.	Depth to Groundwater (ft)	Depth to Anger Refusal (ft)	Boring Termination Depth (ft)	Remarks
B-1	N/A	N/A	8.0	
B-2	N/A	N/A	6.5	
B-3	N/A	N/A	4.0	
B-4	N/A	N/A	6.0	
B-5	N/A	N/A	10.0	
B-6	N/A	N/A	6.5	


Note: All depths are below existing site grades

It should be noted that the actual level of groundwater and the amount and level of perched water should be anticipated to fluctuate through the year, depending on variations in precipitation, surface run-off, infiltration, site topography, drainage, and other factors not evident at the time of our exploration. GEAT can not be responsible for changes in groundwater conditions at the site due to seasonal variations and changes caused by other factors such as grading operations at the site. It should also be noted that soil descriptions listed in the boring logs were based on visual classification and no laboratory testing was performed.

GEAT appreciates the opportunity to provide this geotechnical engineering service to you. Should you have any questions regarding this letter report, or require additional services, please feel free to contact our office.

Sincerely,

GEAT Consultants, Inc.

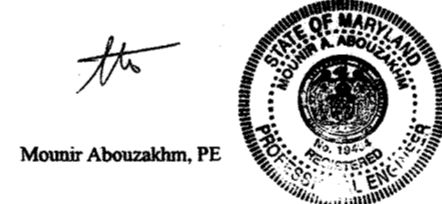

Mounir Abovazhah, PE

LOG OF BORING

Project Name: Greene Property
Client: Mildenberg, Boender & Associates, Inc.
Proj. Location: 6200 Hanover Road, Hanover, MD 21046

Sheet: 1 of 1
Boring No.: B-1
Project No.: G-246
Date: 11/26/16

Depth (ft)	Soil Description	Penetration (lb/ft)	Remarks
0.00	Topsoil, dark, medium dense to dense Silty SILT (SM), trace clay and gravel	15	Water on Rod Day
1.00		15	Water on Completion Day
2.00		15	Water on Completion Day
SB: Split Spore - "N" was encountered due to the presence of gravel
N: No. of blows required for a 140 lb. hammer dropping 30 in. to drive 2 in. C&G, 1.375 in. ID sampler a total of 18 inches in three (3) increments. The sum of the last two increments of penetration is termed as the standard penetration resistance, N.

LOG OF BORING

Project Name: Greene Property
Client: Mildenberg, Boender & Associates, Inc.
Proj. Location: 6200 Hanover Road, Hanover, MD 21046

Sheet: 1 of 1
Boring No.: B-2
Project No.: G-246
Date: 11/26/16

Depth (ft)	Soil Description	Penetration (lb/ft)	Remarks
0.00	Topsoil, dark, medium dense to dense Silty SILT (SM), trace clay and gravel	15	Water on Rod Day
1.00		15	Water on Completion Day
2.00		15	Water on Completion Day
SB: Split Spore - "N" was encountered due to the presence of gravel
N: No. of blows required for a 140 lb. hammer dropping 30 in. to drive 2 in. C&G, 1.375 in. ID sampler a total of 18 inches in three (3) increments. The sum of the last two increments of penetration is termed as the standard penetration resistance, N.

LOG OF BORING

Project Name: Greene Property
Client: Mildenberg, Boender & Associates, Inc.
Proj. Location: 6200 Hanover Road, Hanover, MD 21046

Sheet: 1 of 1
Boring No.: B-3
Project No.: G-246
Date: 11/26/16

Depth (ft)	Soil Description	Penetration (lb/ft)	Remarks
0.00	Topsoil, dark, medium dense to dense Silty SILT (SM), trace clay and gravel	15	Water on Rod Day
1.00		15	Water on Completion Day
2.00		15	Water on Completion Day
SB: Split Spore - "N" was encountered due to the presence of gravel
N: No. of blows required for a 140 lb. hammer dropping 30 in. to drive 2 in. C&G, 1.375 in. ID sampler a total of 18 inches in three (3) increments. The sum of the last two increments of penetration is termed as the standard penetration resistance, N.

SOIL BORING LOGS

LOG OF BORING

Project Name: Greene Property
Client: Mildenberg, Boender & Associates, Inc.
Proj. Location: 6200 Hanover Road, Hanover, MD 21046

Sheet: 1 of 1
Boring No.: B-4
Project No.: G-246
Date: 11/26/16

Depth (ft)	Soil Description	Penetration (lb/ft)	Remarks
0.00	Topsoil, dark, medium dense to dense Silty SILT (SM), trace clay and gravel	15	Water on Rod Day
1.00		15	Water on Completion Day
2.00		15	Water on Completion Day
SB: Split Spore - "N" was encountered due to the presence of gravel
N: No. of blows required for a 140 lb. hammer dropping 30 in. to drive 2 in. C&G, 1.375 in. ID sampler a total of 18 inches in three (3) increments. The sum of the last two increments of penetration is termed as the standard penetration resistance, N.

LOG OF BORING

Project Name: Greene Property
Client: Mildenberg, Boender & Associates, Inc.
Proj. Location: 6200 Hanover Road, Hanover, MD 21046

Sheet: 1 of 1
Boring No.: B-5
Project No.: G-246
Date: 11/26/16

Depth (ft)	Soil Description	Penetration (lb/ft)	Remarks
0.00	Topsoil, dark, medium dense to dense Silty SILT (SM), trace clay and gravel	15	Water on Rod Day
1.00		15	Water on Completion Day
2.00		15	Water on Completion Day
SB: Split Spore - "N" was encountered due to the presence of gravel
N: No. of blows required for a 140 lb. hammer dropping 30 in. to drive 2 in. C&G, 1.375 in. ID sampler a total of 18 inches in three (3) increments. The sum of the last two increments of penetration is termed as the standard penetration resistance, N.

LOG OF BORING

Project Name: Greene Property
Client: Mildenberg, Boender & Associates, Inc.
Proj. Location: 6200 Hanover Road, Hanover, MD 21046

Sheet: 1 of 1
Boring No.: B-6
Project No.: G-246
Date: 11/26/16

Depth (ft)	Soil Description	Penetration (lb/ft)	Remarks
0.00	Topsoil, dark, medium dense to dense Silty SILT (SM), trace clay and gravel	15	Water on Rod Day
1.00		15	Water on Completion Day
2.00		15	Water on Completion Day
SB: Split Spore - "N" was encountered due to the presence of gravel
N: No. of blows required for a 140 lb. hammer dropping 30 in. to drive 2 in. C&G, 1.375 in. ID sampler a total of 18 inches in three (3) increments. The sum of the last two increments of penetration is termed as the standard penetration resistance, N.

SOIL BORING LOGS


project: 15-011
date: JAN. 2018
illustration: MMM
scale: 1"=50'
revision: 1

AS-BUILT INFO: ADDRESS: description: date


ELKDALE GLENN PROPERTY
LOTS 1-8, OPEN SPACE LOTS 9 & 10 AND NON-BUILDABLE BULK PARCEL A
TAX MAP 38, GRID 15, PARCEL 871
FIRST ELECTION DISTRICT
HOWARD COUNTY, MARYLAND
ROAD PLAN, PROFILE, TYPICAL SECTION AND SOIL BORING LOGS

MILDENBERG, BOENDER & ASSOC., INC.
Engineers Planners Surveyors
7350-B Grace Drive, Columbia, Maryland 21044
(410) 997-0296 Tel. (410) 997-0298 Fax.

2 OF 7
F-17-107

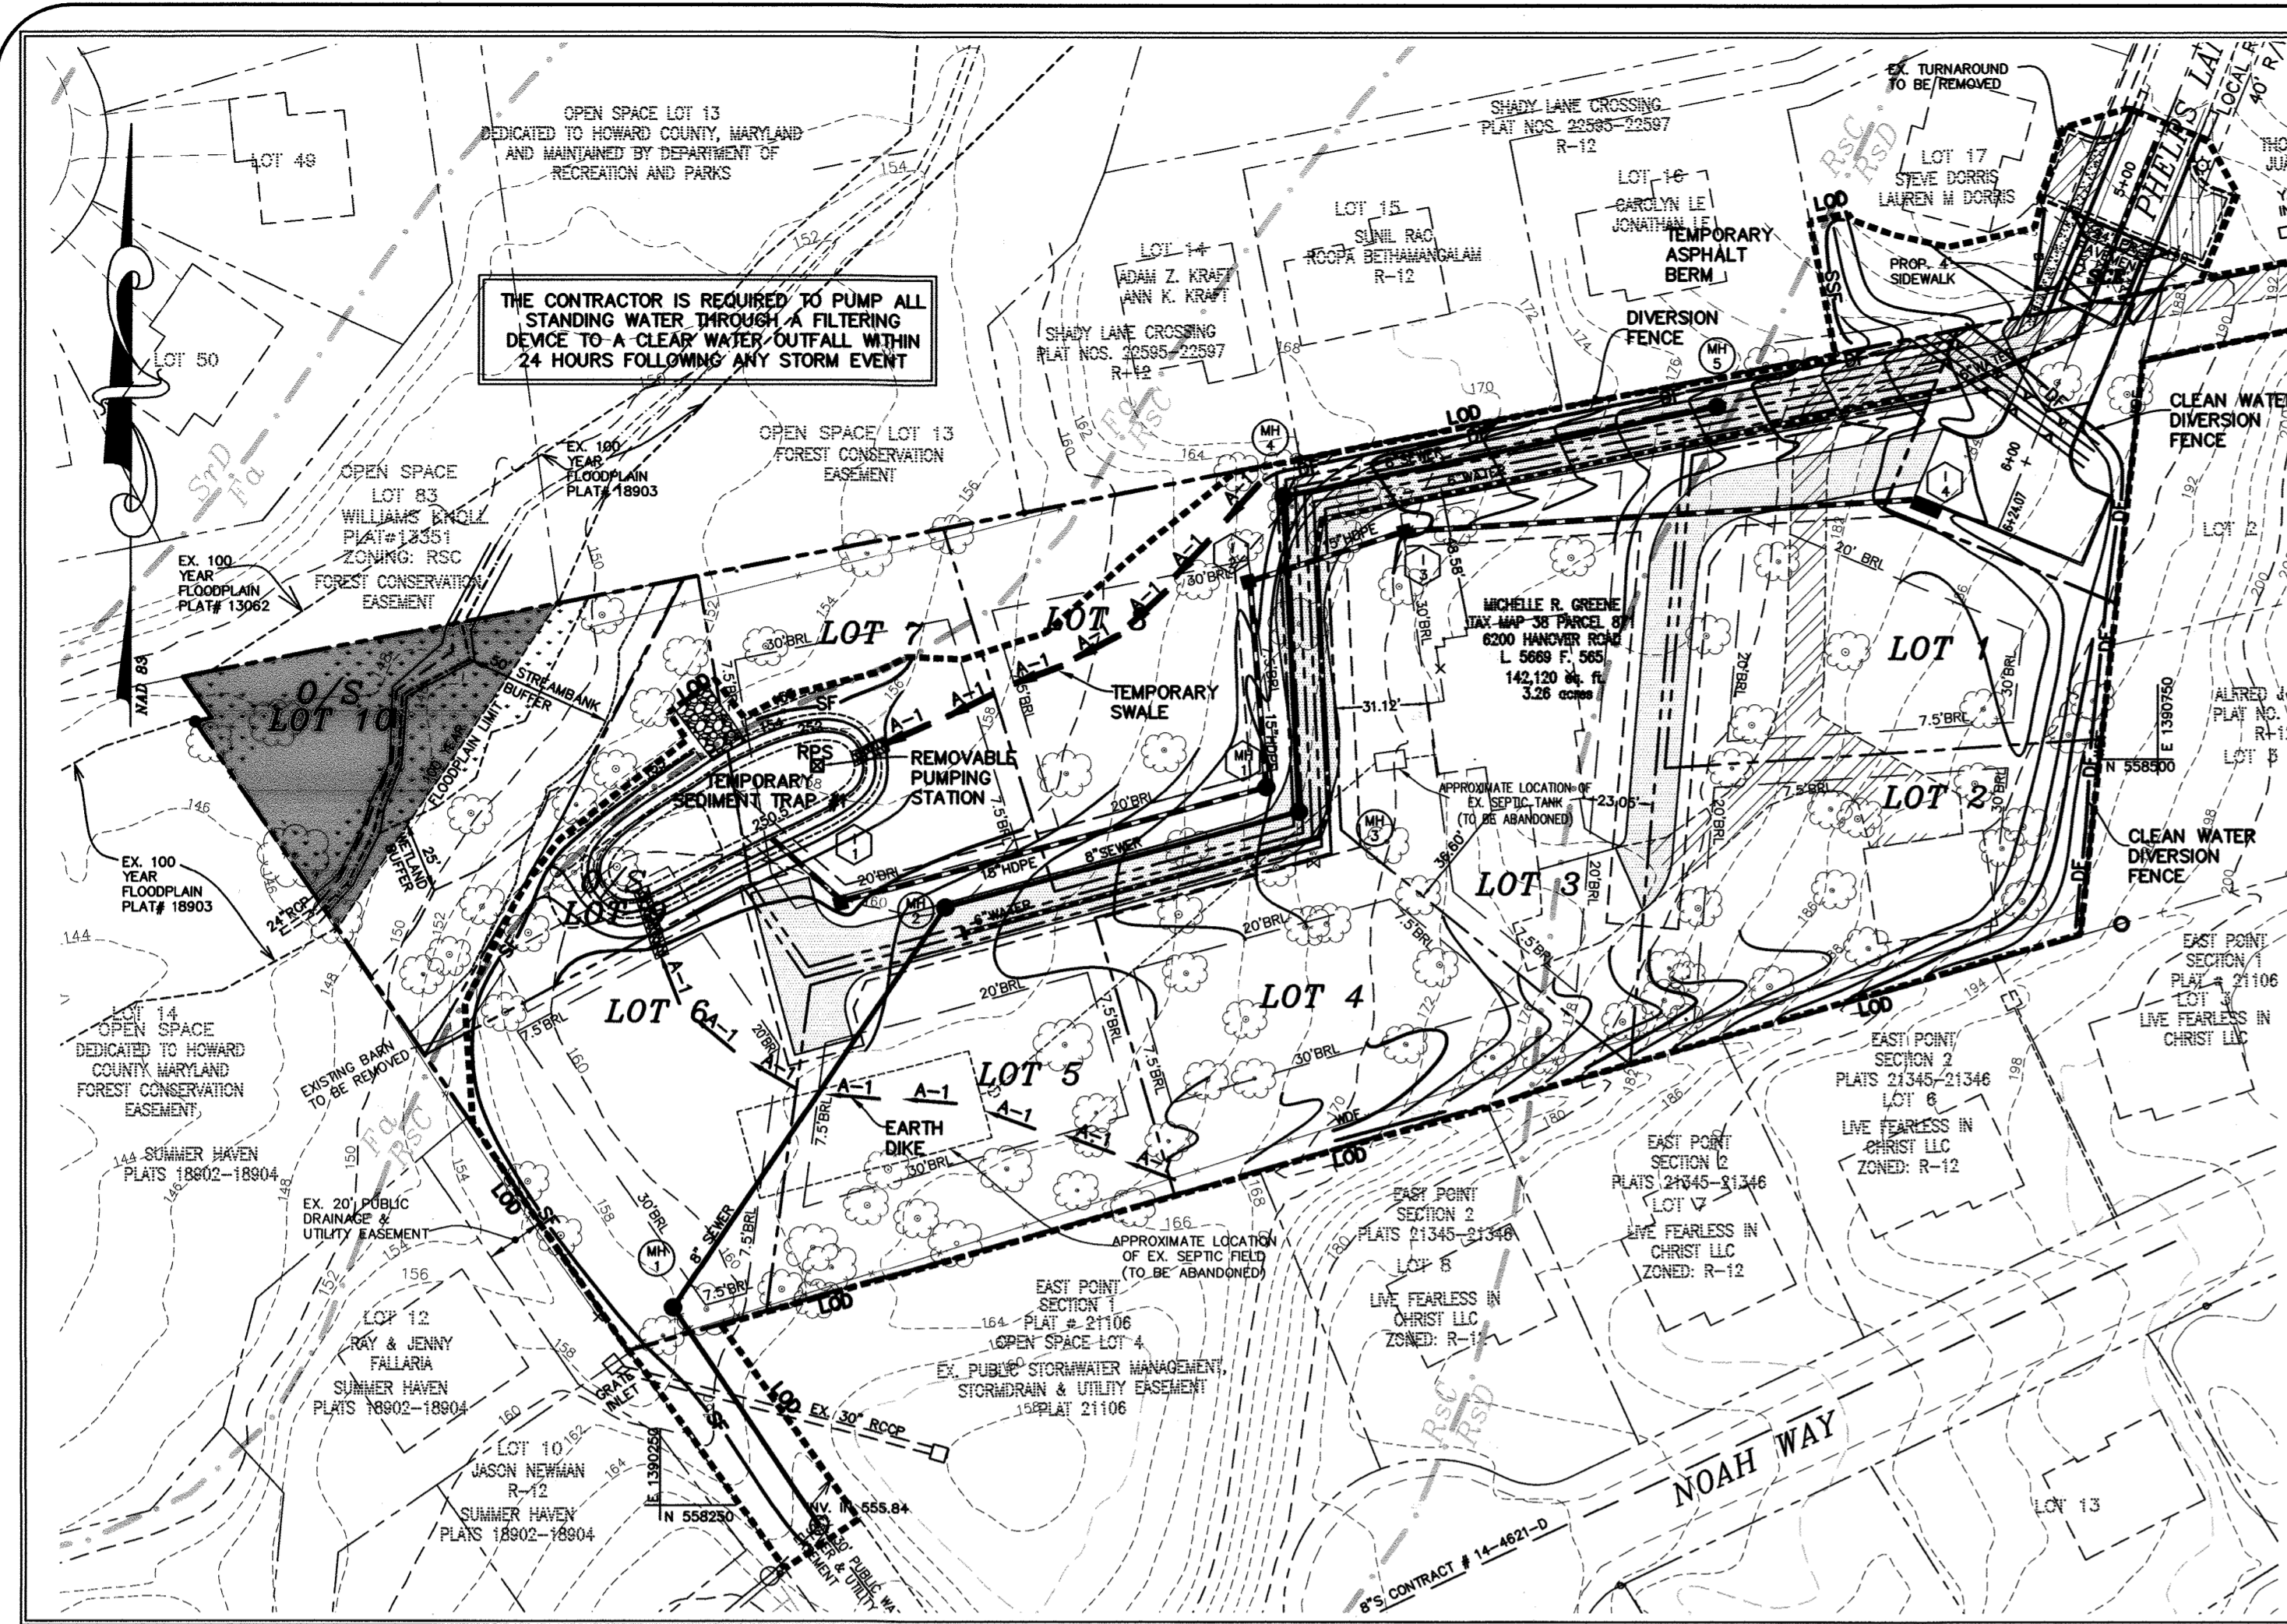

GRADING AND SEDIMENT CONTROL PLAN (FOR CONSTRUCTION OF ROADWAYS AND UTILITIES)
GRAPHIC SCALE

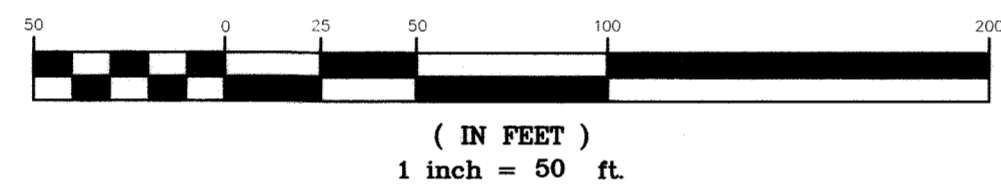

SOILS TABLE

SYMBOL	RATING	NAME	K FACTOR	MAP #
Fo	(D)	SASSAFRAS & CROOM SOILS, 10-15% SLOPES	.24	20
RsC	(C)	RUSSETT FINE SANDY LOAM, 5-10% SLOPES	.24	20
RsD	(C)	RUSSETT FINE SANDY LOAM, 10-15% SLOPES	.24	20
SfB	(B)	SASSAFRAS GRAVELLY SANDY LOAM, 2-5% SLOPES	.32	20
UcD	(D)	URBAN LAND-CHILLUM-BELVILLE COMPLEX, 5-15%	---	20

LEGEND

- EXISTING PAVEMENT TO BE REMOVED
- PROPOSED PAVEMENT
- AREA OF WETLANDS
- 100 YR. FLOODPLAIN
- PROPOSED SIDEWALK
- 8" SEWER MAIN
- PR. 8" STORM MAIN
- PR. MANHOLE
- PR. 8" WATER MAIN
- PR. STORM DRAIN PIPE
- PR. STORM DRAIN INLET
- EARTH DIKE
- DIVERSION FENCE
- SILT FENCE
- SUPER SILT FENCE
- LIMIT OF DISTURBANCE
- LIMIT OF DRAINAGE AREA
- STABILIZED CONSTRUCTION ENTRANCE
- MICRO-BIORETENATION NUMBER
- EXISTING TREE

ENGINEER'S CERTIFICATE
I CERTIFY THAT THIS PLAN FOR EROSION AND SEDIMENT CONTROL REPRESENTS A PRACTICAL AND WORKABLE PLAN BASED ON MY PERSONAL KNOWLEDGE OF THE SITE CONDITIONS AND THAT IT WAS PREPARED IN ACCORDANCE WITH THE REQUIREMENTS OF THE HOWARD SOIL CONSERVATION DISTRICT.

1/16/18
SIGNATURE OF ENGINEER
DATE
JACOB HIKMAT, P.E.
PRINTED NAME OF ENGINEER

DEVELOPER'S CERTIFICATE
I CERTIFY THAT ALL DEVELOPMENT AND CONSTRUCTION WILL BE DONE ACCORDING TO THIS PLAN, AND THAT ANY RESPONSIBLE PERSONNEL INVOLVED IN THE CONSTRUCTION PROJECT WILL HAVE A CERTIFICATE OF ATTENDANCE AT A DEPARTMENT OF THE ENVIRONMENT APPROVED TRAINING PROGRAM FOR THE CONTROL OF SEDIMENT AND EROSION BEFORE BEGINNING THE PROJECT. HOWARD SOIL CONSERVATION DISTRICT IS AUTHORIZED TO CONDUCT PERIODIC ON-SITE INSPECTION.

01/18/18
SIGNATURE OF DEVELOPER
DATE
Wm Scott Goodstrey
PRINTED NAME OF DEVELOPER

THIS DEVELOPMENT PLAN IS APPROVED FOR SOIL EROSION AND SEDIMENT CONTROL BY THE HOWARD SOIL CONSERVATION DISTRICT.

1/31/18
SIGNATURE OF HOWARD SOIL CONSERVATION DISTRICT
DATE

APPROVED: DEPARTMENT OF PUBLIC WORKS
CHIEF, BUREAU OF HIGHWAYS
DATE



APPROVED: DEPARTMENT OF PLANNING AND ZONING
CHIEF, DEVELOPMENT ENGINEERING DIVISION
DATE

3-14-18
CHIEF, DIVISION OF LAND DEVELOPMENT
DATE

OWNER
HARMONY BUILDERS INC
4228 COLUMBIA ROAD
ELLICOTT CITY, MD 21042
410-461-0833

I hereby certify that the facility shown on this plan was constructed as shown on the 'As-Built' plans and meets with the approved plans and specifications.

I HEREBY CERTIFY THAT THESE DOCUMENTS WERE PREPARED OR APPROVED BY ME AND THAT I AM A DULY LICENSED PROFESSIONAL ENGINEER UNDER THE LAWS OF THE STATE OF MARYLAND, LICENSE NO. 17942, EXP DATE 09/03/18
1/16/18
R. JACOB HIKMAT P.E.
DATE


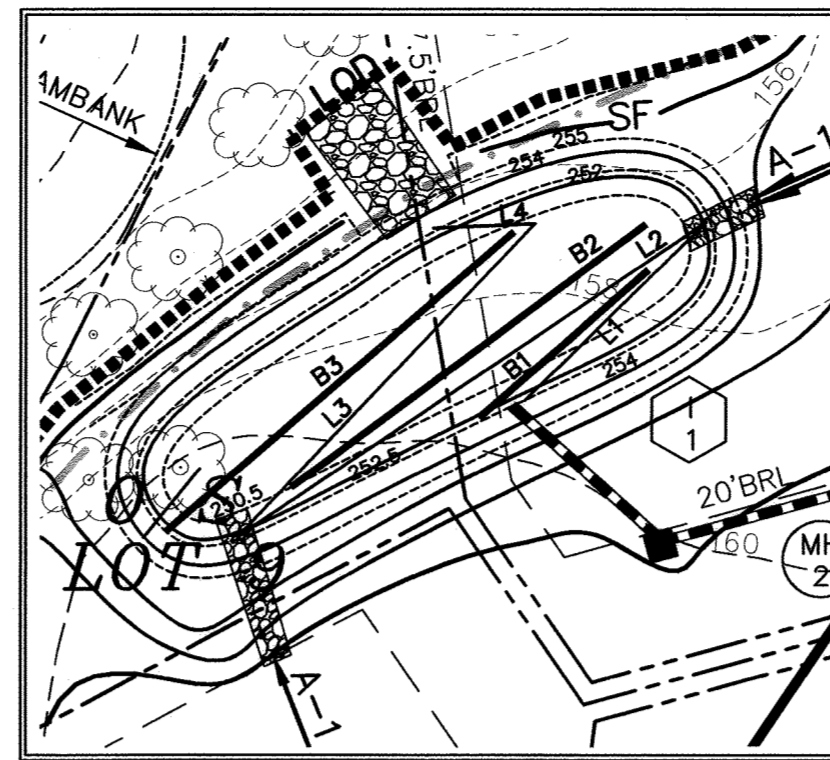
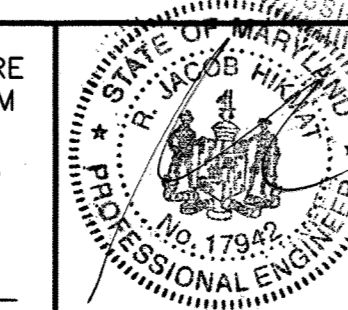


BAFFLE DETAIL
SCALE: 1"=30'


SEDIMENT TRAP #1 (ST 1)

DRAINAGE AREA: 2.00 AC.
TOTAL STORAGE REQUIRED: 7,200 C.F.
TOTAL STORAGE PROVIDED: 8,630 C.F.
WET STORAGE REQUIRED: 3,600 C.F.
WET STORAGE PROVIDED: 4,180 C.F.
DRY STORAGE REQUIRED: 3,600 C.F.
DRY STORAGE PROVIDED: 4,470 C.F.
WET POOL ELEVATION: 152.50
BOTTOM ELEVATION: 150.50
BOTTOM DIMENSIONS: 110'x27'
WEIR LENGTH: 10'
WEIR CREST ELEV.: 154.00
TOP OF EMBANKMENT ELEV.: 155.00
TOP OF EMBANKMENT WIDTH: 4'
SIDE SLOPE: 2:1
OUTLET PROTECTION LENGTH: 19'
OUTLET PROTECTION DEPTH: 19'

BAFFLE DESIGN
A-AREA OF WET POOL
A = 2,530 S.F.
D-DISTANCE BETWEEN INFLOW AND OUTFLOW
D=30' D=45' D=60'
We-EFFECTIVE WIDTH: A/D
We=84' We=50' We=42'
L=TOTAL DISTANCE: (We)(D)
L=168' L=112' L=84'
L=PROVIDED
L=140' L=87' L=68' L=16'
L=114' L=74' L=54' L=16'
L=134' L=84' L=64' L=16'
L=154' L=104' L=84' L=16'
B=35' B=45' B=72'

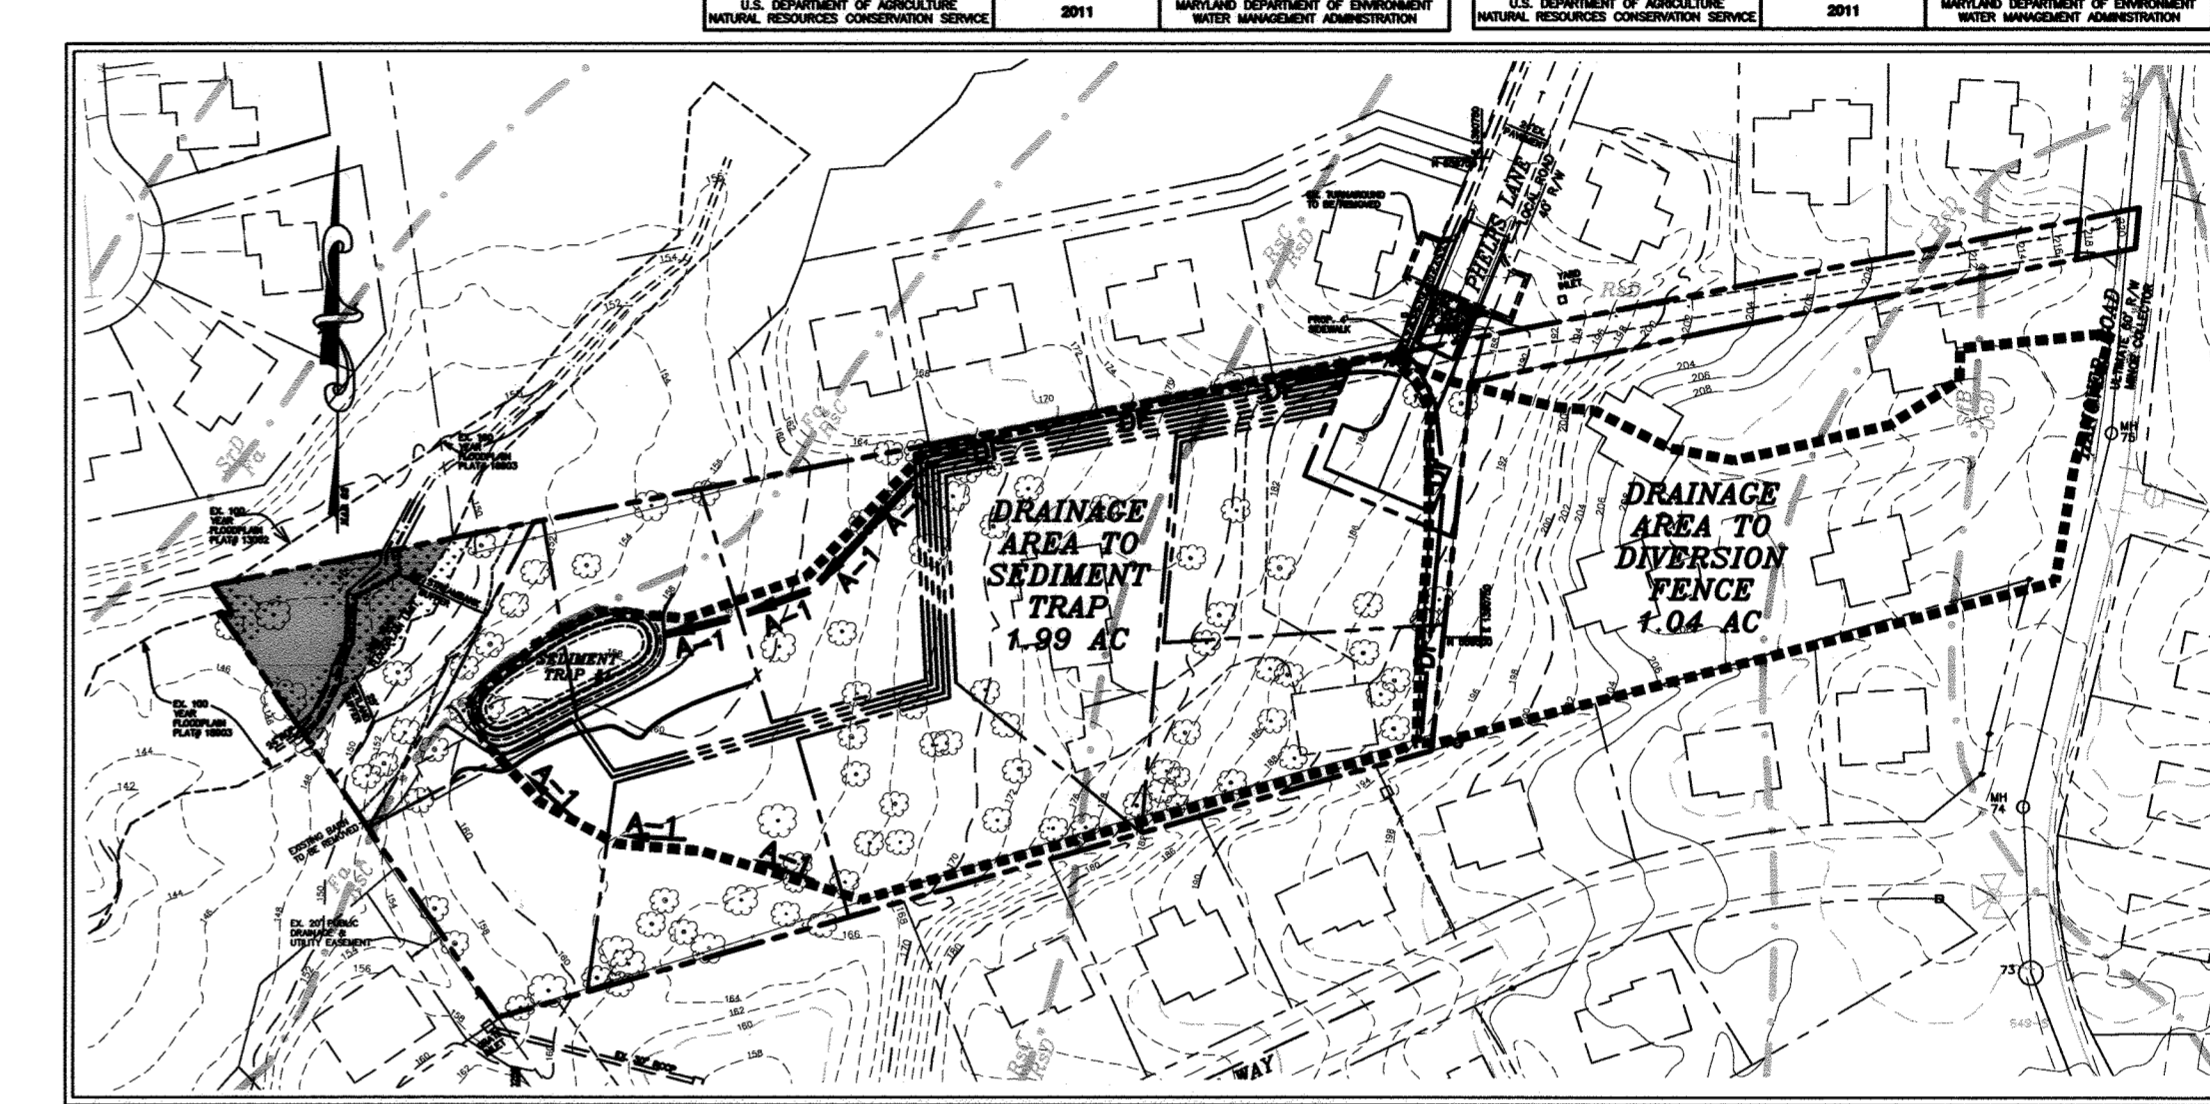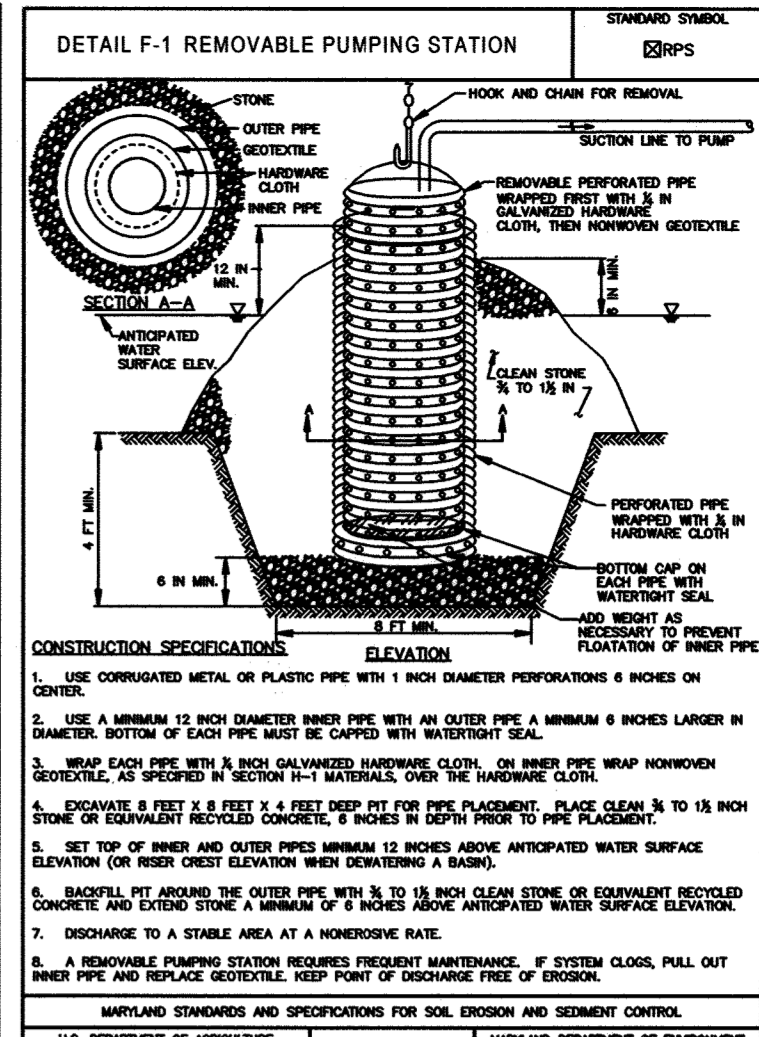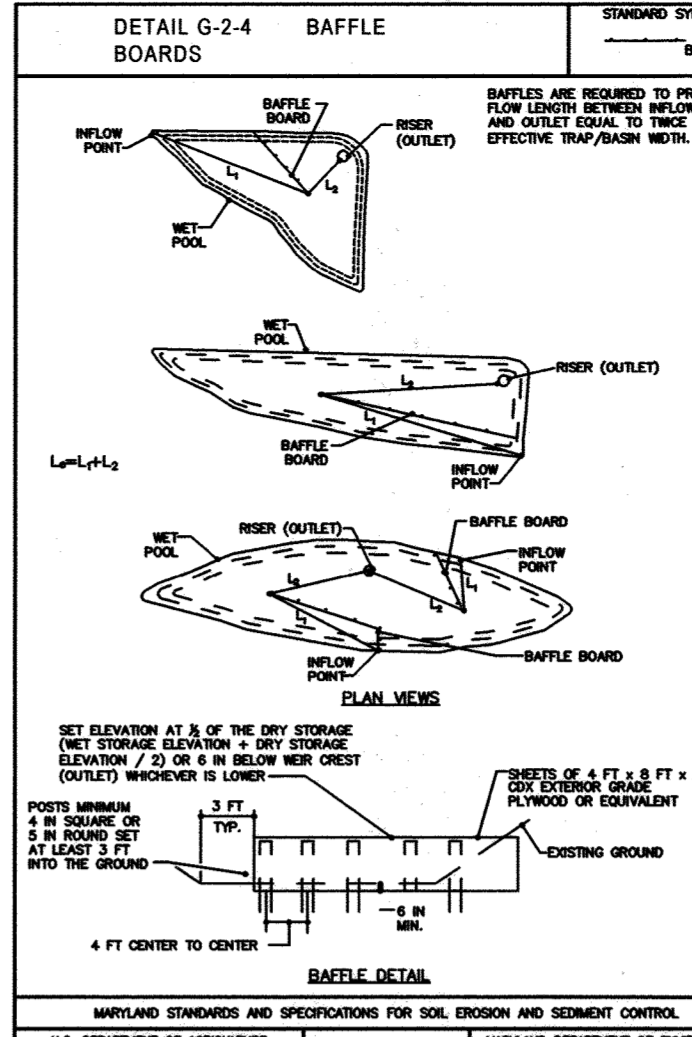

SEDIMENT CONTROLS DRAINAGE AREA MAP
SCALE: 1"=100'

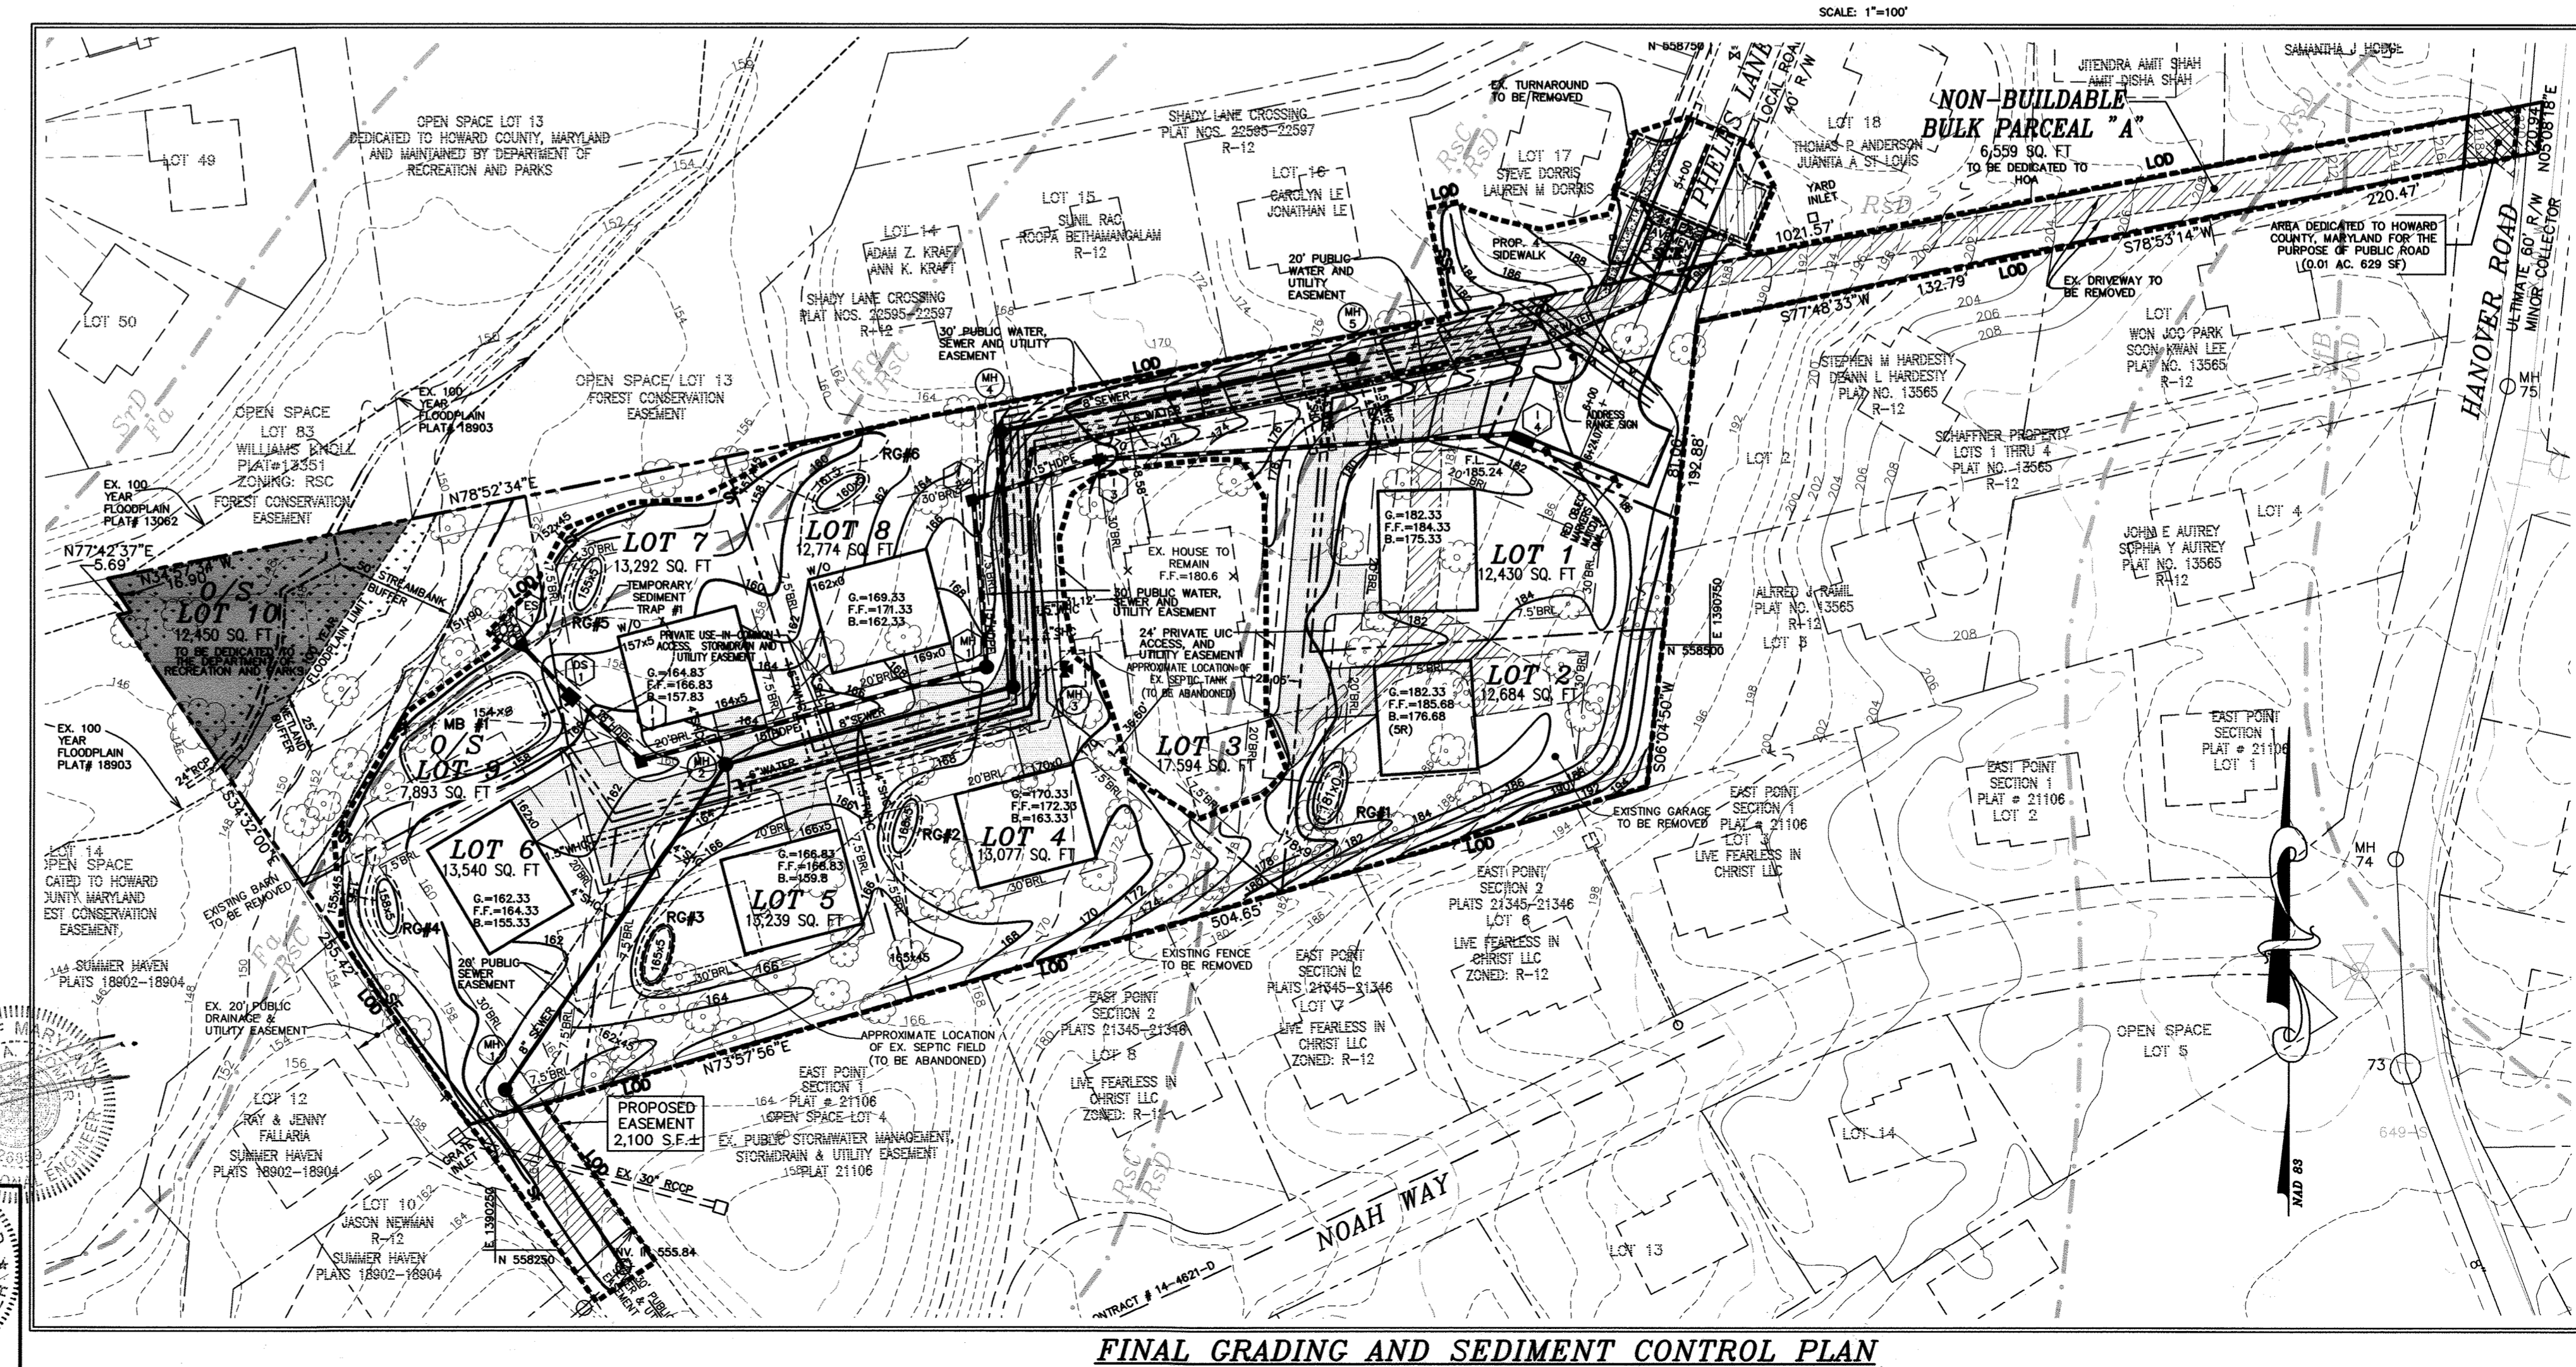

FINAL GRADING AND SEDIMENT CONTROL PLAN
SCALE: 1"=50'

project	15-011	date	JAN. 2018
illustration	MMM	approval	MMM
scale	1"=50'	date	JAN. 2018

description	AS-BUILT	date	JAN. 2018
revisions			

ELKDALE GLENN PROPERTY
LOTS 1-8, OPEN SPACE LOTS 9 & 10 AND NON-BUILDABLE BULK PARCEL A
TAX MAP 38, GRID 15, PARCEL 871
HOWARD COUNTY, MARYLAND
FIRST ELECTION DISTRICT
GRADING AND SEDIMENT CONTROL PLAN

MILDENBERG, BOENDER & ASSOC., INC.
Engineers Planners Surveyors
7380-B Grace Drive, Columbia, Maryland 21044
(410) 997-0236 Tel. (410) 997-0236 Fax

(B-4-2) STANDARDS AND SPECIFICATIONS FOR SOIL PREPARATION, TOPSOILING, AND SOIL AMENDMENTS

DEFINITION
THE PROCESS OF PREPARING THE SOILS TO SUSTAIN ADEQUATE VEGETATIVE STABILIZATION.
PURPOSE
TO PROVIDE A SUITABLE SOIL MEDIUM FOR VEGETATIVE GROWTH.
CONDITIONS WHERE PRACTICE APPLIES
WHERE VEGETATIVE STABILIZATION IS TO BE ESTABLISHED.

- CRITERIA**
- SOIL PREPARATION**
 - TEMPORARY STABILIZATION**
 - SEEDBED PREPARATION CONSISTS OF LOOSENING SOIL TO A DEPTH OF 3 TO 5 INCHES BY MEANS OF SUITABLE AGRICULTURAL OR CONSTRUCTION EQUIPMENT, SUCH AS DISC HARROWS OR CHISEL PLOWS OR TRIPPERS MOUNTED ON CONSTRUCTION EQUIPMENT. AFTER THE SOIL IS LOOSENED, IT MUST BE ROLLED OR GRADDED SMOOTH BUT LET THE TOUGHENED CONDITION. SLOPES 3:1 OR FLATTER ARE TO BE TRACKED WITH RIDGES RUNNING PARALLEL TO THE CONTOUR OF THE SLOPE.
 - APPLY FERTILIZER AND LIME AS SPECIFIED ON THE PLANS.
 - INCORPORATE LIME AND FERTILIZER INTO THE TOP 3 TO 5 INCHES OF SOIL BY DISKING OR OTHER SUITABLE MEANS.
 - PERMANENT STABILIZATION**
 - A SOIL TEST IS REQUIRED FOR ANY EARTH DISTURBANCE OF 5 ACRES OR MORE. THE MINIMUM SOIL CONDITIONS REQUIRED FOR PERMANENT VEGETATIVE ESTABLISHMENT ARE:
 - I. SOIL PH BETWEEN 6.0 AND 7.0.
 - II. SOLUBLE SALTS LESS THAN 500 PARTS PER MILLION (PPM).
 - III. SOIL CONTAINS LESS THAN 40% FINE GRAINED MATERIAL (GREATER THAN 30 PERCENT SILT PLUS CLAY) TO PROVIDE THE CAPACITY TO HOLD A MODERATE AMOUNT OF MOISTURE. AN EXCEPTION: IF LOVEGRASS WILL BE PLANTED, THEN A SANDY SOIL (LESS THAN 30 PERCENT SILT PLUS CLAY) WOULD BE ACCEPTABLE.
 - IV. SOIL CONTAINS 1.5 PERCENT MINIMUM ORGANIC MATTER BY WEIGHT.
 - SOIL CONTAINS SUFFICIENT PORE SPACE TO PERMIT ADEQUATE ROOT PENETRATION.
 - APPLICATION OF AMENDMENTS OR TOPSOIL IS REQUIRED IF ON-SITE SOILS DO NOT MEET THE ABOVE CONDITIONS.
 - GRADED AREAS MUST BE MAINTAINED IN A TRUE AND EVEN GRADE AS SPECIFIED ON THE APPROVED PLAN, THEN SCARIFIED OR DISKED TO A DEPTH OF 3 TO 5 INCHES.
 - APPLY SOIL AMENDMENTS AS SPECIFIED ON THE APPROVED PLAN OR AS INDICATED BY THE RESULTS OF SOIL TESTS.
 - SOIL AMENDMENTS INTO THE TOP 3 TO 5 INCHES OF SOIL BY DISKING OR OTHER SUITABLE MEANS. RAKE LAWN AREAS TO SMOOTH THE SURFACE, REMOVE LARGE OBJECTS LIKE STONES AND BRANCHES, AND READY THE AREA FOR SEED APPLICATION. LOOSEN SURFACE SOIL BY DRAGGING WITH A HEAVY CHAIN OR OTHER EQUIPMENT. REMOVE NORMAL WEEDS AND WEEDS THAT WOULD INHIBIT SEEDBED PREPARATION. TRACK SLOPES 3:1 OR FLATTER WITH TRACKED EQUIPMENT LEAVING THE SOIL IN AN IRREGULAR CONDITION WITH RIDGES RUNNING PARALLEL TO THE CONTOUR OF THE SLOPE. LEAVE THE TOP 3 TO 5 INCHES OF SOIL LOOSE AND FRAGILE. SEEDBED LOOSENING MAY BE UNNECESSARY ON NEWLY DISTURBED AREAS.

B. TOPSOILING

- TOPSOIL IS PLACED OVER PREPARED SUBSOIL PRIOR TO ESTABLISHMENT OF PERMANENT VEGETATION. THE PURPOSE IS TO PROVIDE A SUITABLE SOIL MEDIUM FOR VEGETATIVE GROWTH. SOILS OF CONCERN HAVE LOW MOISTURE CONTENT, LOW NUTRIENT LEVELS, LOW PH, MATERIALS TOXIC TO PLANTS, AND/OR UNACCEPTABLE SOIL GRADATION.
- TOPSOIL SALVAGED FROM AN EXISTING SITE MAY BE USED PROVIDED IT MEETS THE STANDARDS AS SET FORTH IN THESE SPECIFICATIONS. TYPICALLY, THE DEPTH OF TOPSOIL TO BE SALVAGED FOR A GIVEN SOIL TYPE CAN BE FOUND IN THE REPRESENTATIVE SOIL PROFILE SECTION IN THE SOIL SURVEY PUBLISHED BY USDA-NRCS.
- TOPSOILING IS LIMITED TO AREAS HAVING 2:1 OR FLATTER SLOPES WHERE:
a. THE TEXTURE OF THE EXPOSED SUBSOIL/PARENT MATERIAL IS NOT ADEQUATE TO PRODUCE VEGETATIVE GROWTH.
b. THE SOIL MATERIAL IS SO SHALLOW THAT THE ROOTING ZONE IS NOT DEEP ENOUGH TO SUPPORT PLANTS OR FURNISH CONTINUING SUPPLIES OF MOISTURE AND PLANT NUTRIENTS.
c. THE ORIGINAL SOIL TO BE VEGETATED CONTAINS MATERIAL TOXIC TO PLANT GROWTH.
d. THE SOIL IS SO AODIC THAT TREATMENT WITH LIMESTONE IS NOT FEASIBLE.
- AREAS HAVING SLOPES STEEPER THAN 2:1 REQUIRE SPECIAL CONSIDERATION AND DESIGN.
- TOPSOIL SPECIFICATIONS: SOIL TO BE USED AS TOPSOIL MUST MEET THE FOLLOWING CRITERIA:
a. TOPSOIL MUST BE A LOAM, SANDY LOAM, CLAY LOAM, SILT LOAM, SANDY CLAY LOAM, OR LOAMY SAND.
b. OTHER SOILS MAY BE USED IF RECOMMENDED BY AN AGRONOMIST OR SOIL SCIENTIST AND APPROVED BY THE APPROPRIATE APPROVAL AUTHORITY. TOPSOIL MUST NOT BE A MIXTURE OF CONTRASTING TEXTURED SUBSOILS AND MUST CONTAIN LESS THAN 5 PERCENT BY VOLUME OF CONKERS, STONES, SLAG, COARSE FRAGMENTS, GRASS ROOTS, TRASH, OR OTHER MATERIALS LARGER THAN 1 1/2 INCHES IN DIAMETER.
c. TOPSOIL MUST BE FREE OF NOXIOUS PLANTS OR PLANT PARTS SUCH AS BERMUDA GRASS, QUACK GRASS, JOHNSON GRASS, NUT SEDGE, POISON Ivy, THISTLE, OR OTHERS AS SPECIFIED.
d. TOPSOIL SUBSTITUTES OR AMENDMENTS AS RECOMMENDED BY A QUALIFIED AGRONOMIST OR SOIL SCIENTIST AND APPROVED BY THE APPROPRIATE APPROVAL AUTHORITY, MAY BE USED IN LIEU OF NATURAL TOPSOIL.
- TOPSOIL APPLICATION
a. EROSION AND SEDIMENT CONTROL PRACTICES MUST BE MAINTAINED WHEN APPLYING TOPSOIL.
b. UNIFORMLY DISTRIBUTE TOPSOIL IN A 5 TO 8 INCH LAYER AND LIGHTLY COMPACT TO A MINIMUM THICKNESS OF 4 INCHES. SPECIFICALLY, TOPSOILING MUST BE PERFORMED IN SUCH A MANNER THAT SOODING OR SEEDING CAN PROCEED WITH A MINIMUM OF ADDITIONAL SOIL PREPARATION AND TILLAGE. ANY IRREGULARITIES IN THE SURFACE RESULTING FROM TOPSOILING OR OTHER OPERATIONS MUST BE CORRECTED IN ORDER TO PREVENT DEPRESSIONS OR WATER POCKETS.
c. TOPSOIL MUST NOT BE PLACED IF THE TOPSOIL OR SUBSOIL IS IN A FROZEN OR MUDDY CONDITION, WHEN THE SUBSOIL IS EXCESSIVELY WET OR IN A CONDITION THAT MAY OTHERWISE BE DETRIMENTAL TO PROPER GRADING AND SEEDBED PREPARATION.

C. SOIL AMENDMENTS (FERTILIZER AND LIME SPECIFICATIONS)

- SOIL TESTS MUST BE PERFORMED TO DETERMINE THE EXACT RATIOS AND APPLICATION RATES FOR BOTH LIME AND FERTILIZER ON SITES HAVING DISTURBED AREAS OF 5 ACRES OR MORE. SOIL ANALYSIS MAY BE PERFORMED BY A RECOGNIZED PRIVATE OR COMMERCIAL LABORATORY. SOIL SAMPLES TAKEN FOR ENGINEERING PURPOSES MAY ALSO BE USED FOR CHEMICAL ANALYSES.
- FERTILIZERS MUST BE UNIFORM IN COMPOSITION, FINE FLOWING AND SUITABLE FOR ACCURATE APPLICATION BY APPROPRIATE EQUIPMENT. MANURE MAY BE SUBSTITUTED FOR FERTILIZER WITH PRIOR APPROVAL FROM THE APPROPRIATE APPROVAL AUTHORITY. FERTILIZERS MUST ALL BE DELIVERED TO THE SITE FULLY LABELED ACCORDING TO THE APPLICABLE LAWS AND MUST BEAR THE NAME, TRADE NAME OR TRADEMARK AND WARRANTY OF THE PRODUCER.
- LIME MATERIALS MUST BE GROUND LIMESTONE (HYDRATED OR BURNT LIME MAY BE SUBSTITUTED EXCEPT WHEN HYDROSEEDING) WITH A MINIMUM OF 90 PERCENT TOTAL OXIDES (CALCIUM OXIDE PLUS MAGNESIUM OXIDE). LIMESTONE MUST BE GROUND TO SUCH FINENESS THAT AT LEAST 50 PERCENT WILL PASS THROUGH A #100 MESH SIEVE AND 98 TO 100 PERCENT WILL PASS THROUGH A #20 MESH SIEVE.
- LIME AND FERTILIZER ARE TO BE EVENLY DISTRIBUTED AND INCORPORATED INTO THE TOP 3 TO 5 INCHES OF WHERE THE SUBSOIL IS EITHER HIGHLY ACIDIC OR COMPOSED OF HEAVY CLAYS, SPREAD GROUND LIMESTONE AT THE RATE OF 4 TO 8 TONS/ACRE (200-400 POUNDS PER 1,000 SQUARE FEET) PRIOR TO THE PLACEMENT OF TOPSOIL.

(B-4-3) STANDARDS AND SPECIFICATIONS FOR SEEDING AND MULCHING

DEFINITION
THE APPLICATION OF SEED AND MULCH TO ESTABLISH VEGETATIVE COVER.
PURPOSE
TO PROTECT DISTURBED SOILS FROM EROSION DURING AND AT THE END OF CONSTRUCTION.
CONDITIONS WHERE PRACTICE APPLIES
TO THE SURFACE OF ALL PERIMETER CONTROLS, SLOPES, AND ANY DISTURBED AREA NOT UNDER ACTIVE GRADING.

- CRITERIA**
- SEEDING**
 - 1. SPECIFICATIONS**
 - ALL SEED MUST MEET THE REQUIREMENTS OF THE MARYLAND STATE SEED LAW. ALL SEED MUST BE SUBJECT TO RE-TESTING BY A RECOGNIZED SEED LABORATORY. ALL SEED MUST HAVE BEEN TESTED WITHIN THE 6 MONTHS IMMEDIATELY PRECEDING THE DATE OF SOWING SUCH MATERIAL ON ANY PROJECT. REFER TO TABLE B.4 REGARDING THE QUALITY OF SEED. SEED MUST BE AVAILABLE UPON REQUEST TO THE INSPECTOR TO VERIFY TYPE OF SEED AND SEEDING RATE.
 - MULCH ALONE MAY BE APPLIED BETWEEN THE FALL AND SPRING SEEDING DATES ONLY IF THE GROUND IS FROZEN. THE APPROPRIATE SEEDING MIXTURE MUST BE USED WHEN THE GROUND THAW.
 - INOCULANTS: THE INOCULANT FOR TREATING LEGUME SEED IN THE SEED MIXTURES MUST BE A PURE CULTURE OF NITROGEN FIXING BACTERIA PREPARED SPECIFICALLY FOR THE SPECIES. INOCULANTS MUST NOT BE USED LATER THAN THE DATE INDICATED ON THE CONTAINER. ADD FRESH INOCULANTS AS DIRECTED ON THE PACKAGE. USE FOUR TIMES THE RECOMMENDED RATE WHEN HYDROSEEDING. NOTE: IT IS VERY IMPORTANT TO KEEP INOCULANT AS COOL AS POSSIBLE UNTIL USED. TEMPERATURES ABOVE 75 TO 80 DEGREES FAHRENHEIT CAN WEAKEN BACTERIA AND MAKE THE INOCULANT LESS EFFECTIVE.
 - SOD OR SEED MUST NOT BE PLACED ON SOIL WHICH HAS BEEN TREATED WITH SOIL STERILANTS OR CHEMICALS USED FOR WEED CONTROL UNTIL SUFFICIENT TIME HAS ELAPSED (14 DAYS MIN.) TO PERMIT DISSIPATION OF PHYTO-TOXIC MATERIALS.
 - 2. APPLICATION**
 - DRY SEEDING: THIS INCLUDES USE OF CONVENTIONAL DROP OR BROADCAST SPREADERS.
 - INCORPORATE SEED INTO THE SUBSOIL AT THE RATES PRESCRIBED ON TEMPORARY SEEDING TABLE B.1.
 - PERMANENT SEEDING TABLE B.3, OR SITE-SPECIFIC SEEDING SUMMARIES.
 - APPLY SEED IN TWO DIRECTIONS, PERPENDICULAR TO EACH OTHER. APPLY HALF THE SEEDING RATE IN EACH DIRECTION. ROLL THE SEEDED AREA WITH A WEIGHTED ROLLER TO PROVIDE GOOD SEED TO SOIL CONTACT.
 - DRILL OR CULTEPACER SEEDING: MECHANIZED SEEDERS THAT APPLY AND COVER SEED WITH SOIL.
 - CULTEPACER SEEDERS ARE REQUIRED TO BURY THE SEED IN SUCH A FASHION AS TO PROVIDE AT LEAST 1/4 INCH OF SOIL COVERING. SEEDBEDS MUST BE FIRM AFTER PLANTING.
 - APPLY SEED IN TWO DIRECTIONS, PERPENDICULAR TO EACH OTHER. APPLY HALF THE SEEDING RATE IN EACH DIRECTION.
 - HYDROSEEDING: APPLY SEED UNIFORMLY WITH HYDROSEEDER (SLURRY INCLUDES SEED AND FERTILIZER).
 - IF FERTILIZER IS BEING APPLIED AT THE TIME OF SEEDING, THE APPLICATION RATES SHOULD NOT EXCEED THE FOLLOWING: NITROGEN, 100 POUNDS PER ACRE; TOTAL SOLUBLE NITROGEN; P₂O₅ (PHOSPHORUS), 200 POUNDS PER ACRE; K₂O (POTASSIUM), 200 POUNDS PER ACRE.
 - LIME: USE ONLY GROUND AGRICULTURAL LIMESTONE (UP TO 3 TONS PER ACRE MAY BE APPLIED BY HYDROSEEDING). NORMALLY, NOT MORE THAN 2 TONS ARE APPLIED BY HYDROSEEDING AT ANY ONE TIME. DO NOT USE BURNT OR HYDRATED LIME WHEN HYDROSEEDING.
 - MIX SEED AND FERTILIZER ON SITE AND SEED IMMEDIATELY AND WITHOUT INTERRUPTION.
 - WHEN HYDROSEEDING DO NOT INCORPORATE SEED INTO THE SOIL.

B. MULCHING

- MULCH MATERIALS (IN ORDER OF PREFERENCE)
 - STRAW CONSISTING OF THOROUGHLY THRESHED WHEAT, RYE, OAT, OR BARLEY AND REASONABLY BRIGHT IN COLOR. STRAW IS TO BE FREE OF NOXIOUS WEED SEEDS AS SPECIFIED IN THE MARYLAND SEED LAW AND NOT MUSTY, MOLLY, CAKED, DECAYED, OR EXCESSIVELY DUSTY. NOTE: USE ONLY STERILE STRAW MULCH IN AREAS WHERE ONE SPECIES OF GRASS IS DESIRED.
 - WOOD CELLULOSE FIBER MULCH (WCFM) CONSISTING OF SPECIALLY PREPARED WOOD CELLULOSE PROCESSED INTO A UNIFORM FIBROUS PHYSICAL STATE.
 - WCFM IS TO BE DYE FREE OR CONTAIN A GREEN DYE IN THE PACKAGE THAT WILL PROVIDE AN APPROPRIATE COLOR TO FACILITATE VISUAL INSPECTION OF THE UNIFORMLY SPREAD SLURRY.
 - WCFM, INCLUDING DYE, MUST CONTAIN NO GERMINATION OR GROWTH INHIBITING FACTORS.
 - WCFM MATERIALS ARE TO BE UNIFORM IN SUCH A MANNER THAT THE WOOD CELLULOSE FIBER MULCH WILL REMAIN IN UNIFORM SUSPENSION IN WATER UNDER AGITATION AND WILL BLEND WITH SEED, FERTILIZER AND OTHER ADDITIVES TO FORM A HOMOGENEOUS SLURRY. THE MULCH MATERIAL MUST FORM A BLOTTER-LIKE GROUND COVER, ON APPLICATION, HAVING UNIFORM DISTRIBUTION AND PERCOLATION PROPERTIES AND MUST COVER AND HOLD GRASS SEED IN CONTACT WITH THE SOIL WITHOUT INHIBITING THE GROWTH OF THE GRASS SEEDLINGS.
 - WCFM MATERIALS MUST NOT CONTAIN ELEMENTS OR COMPOUNDS AT CONCENTRATION LEVELS THAT WILL BE PHYTO-TOXIC.
 - WCFM MUST CONFORM TO THE FOLLOWING PHYSICAL REQUIREMENTS: FIBER LENGTH OF APPROXIMATELY 10 MILLIMETERS (PH RANGE OF 4.0 TO 8.5, ASH CONTENT OF 1.6 PERCENT MAXIMUM AND WATER HOLDING CAPACITY OF 90 PERCENT MINIMUM).

2. APPLICATION

- APPLY MULCH TO ALL SEEDED AREAS IMMEDIATELY AFTER SEEDING.
 - WHEN STRAW MULCH IS USED, SPREAD IT OVER ALL SEEDED AREAS AT THE RATE OF 2 TONS PER ACRE TO A UNIFORM LOOSE DEPTH OF 1 TO 2 INCHES. APPLY MULCH TO ACHIEVE A UNIFORM DISTRIBUTION AND DEPTH SO THAT THE SOIL SURFACE IS NOT EXPOSED. WHEN USING A MULCH ANCHORING TOOL, INCREASE THE APPLICATION RATE TO 2.5 TONS PER ACRE.
 - WOOD CELLULOSE FIBER USED AS MULCH MUST BE APPLIED AT A NET DRY WEIGHT OF 1500 POUNDS PER ACRE. MIX THE WOOD CELLULOSE FIBER WITH WATER TO ATTAIN A MIXTURE WITH A MAXIMUM OF 50 POUNDS OF WOOD CELLULOSE FIBER PER 100 GALLONS OF WATER.
- ANCHORING
 - PERFORM MULCH ANCHORING IMMEDIATELY FOLLOWING APPLICATION OF MULCH TO MINIMIZE LOSS BY WIND OR WATER. THIS MAY BE DONE BY ONE OF THE FOLLOWING METHODS (LISTED BY PREFERENCE), DEPENDING UPON THE SIZE OF THE AREA AND EROSION HAZARD:
 - A MULCH ANCHORING TOOL HAVING AN ANCHORMENT DESIGNED TO PUNCH AND ANCHOR MULCH INTO THE SOIL SURFACE A MINIMUM OF 2 INCHES. THIS PRACTICE IS MOST EFFECTIVE ON LARGE AREAS, BUT IS LIMITED TO FLATTER SLOPES WHERE EQUIPMENT CAN OPERATE SAFELY. IF USED ON SLOPING LAND, THIS PRACTICE SHOULD BE LIMITED TO 10 PERCENT SLOPES.
 - WOOD CELLULOSE FIBER MAY BE USED FOR ANCHORING STRAW. APPLY THE FIBER BINDER AT A NET DRY WEIGHT OF 750 POUNDS PER ACRE. MIX THE WOOD CELLULOSE FIBER WITH WATER AT A MAXIMUM OF 50 POUNDS OF WOOD CELLULOSE FIBER PER 100 GALLONS OF WATER.
 - SYNTHETIC BINDERS SUCH AS ACRYLIC OILS (AGRO-TACK), DCA-70, PIRETRET, TERRA TAC II, TERRA TACKER OR OTHER APPROVED PRODUCTS PER 100 GALLONS OF WATER.
 - MANUFACTURER. APPLICATION OF LIQUID BINDERS NEEDS TO BE HEAVIER AT THE EDGES WHERE WIND CATCHES MULCH, SUCH AS IN VALLEYS AND ON CRESTS OF BANKS.
 - USE ASPHALT BINDERS USED AS MULCH MUST BE APPLIED AT A NET DRY WEIGHT OF 100 POUNDS PER ACRE. VETCH MULCH PLASTIC NETTING MAY BE STAPLED OVER THE MULCH ACCORDING TO MANUFACTURER RECOMMENDATIONS. NETTING IS USUALLY AVAILABLE IN ROLLS 4 TO 15 FEET WIDE AND 300 TO 3,000 FEET LONG.

(B-4-5) STANDARDS AND SPECIFICATIONS FOR PERMANENT STABILIZATION

DEFINITION
TO STABILIZE DISTURBED SOIL WITH PERMANENT VEGETATION.
PURPOSE
TO USE LONG-LIVED PERENNIAL GRASSES AND LEGUMES TO ESTABLISH PERMANENT GROUND COVER OF DISTURBED EXPOSED SOILS WHERE GROUND COVER IS NEEDED FOR 6 MONTHS OR MORE.

- CRITERIA**
- SEED MIXTURES**
 - 1. GENERAL USE**
 - SELECT ONE OR MORE OF THE SPECIES OR MIXTURES LISTED IN TABLE B.3 FOR THE APPROPRIATE PLANT HARDNESS ZONE (FROM FIGURE B.3) AND BASED IN THE SITE CONDITION OR PURPOSE. FOUND ON TABLE B.2. ENTER SELECTED MIXTURE(S), APPLICATION RATES, AND SEEDING DATES IN THE PERMANENT SEEDING SUMMARY.
 - ADDITIONAL PLANTING SPECIFICATIONS FOR EXCEPTIONAL SITES SUCH AS SHORELINES, STREAM BANKS, OR DICES OR FOR SPECIAL PURPOSES SUCH AS WILDLIFE OR AESTHETIC TREATMENT MAY BE FOUND IN USDA-NRCS TECHNICAL FIELD GUIDE, SECTION 342-CRITICAL AREA PLANTING.
 - FOR SITES HAVING DISTURBED AREA OVER 5 ACRES, USE AND SHOW RATES RECOMMENDED BY THE SOIL TESTING AGENCY.
 - FOR AREAS RECEIVING LOW MAINTENANCE, APPLY UREA FROM FERTILIZED (40-0-0) AT 3 1/2 POUNDS PER 1000 S.F. (150 POUNDS PER ACRE) AT THE TIME OF SEEDING IN ADDITION TO THE SOIL AMENDMENTS SHOWN IN THE PERMANENT SEEDING SUMMARY.
 - 2. TURFGRASS MIXTURES**
 - AREAS WHERE TURFGRASS MAY BE DESIRE INCLUDE LAWNS, PARKS, PLAYGROUNDS, AND COMMERCIAL SITES WHICH WILL RECEIVE A MEDIUM TO HIGH LEVEL OF MAINTENANCE.
 - SELECT ONE OR MORE OF THE SPECIES OR MIXTURES LISTED IN TABLE B.3. ENTER THE SEEDING CONDITIONS OR PURPOSE, ENTER SELECTED MIXTURE(S), APPLICATION RATES, AND SEEDING DATES IN THE PERMANENT SEEDING SUMMARY.
 - KENTUCKY BLUEGRASS: FULL SUN MIXTURE: FOR USE IN AREAS THAT RECEIVE INTENSIVE MAINTENANCE. BRIGATION REQUIRED IN THE AREAS OF CENTRAL MARYLAND AND EASTERN SHORE. RECOMMENDED CERTIFIED KENTUCKY BLUEGRASS SEEDING RATE: 1.5 TO 2.0 POUNDS PER 1000 S.F. CHOOSE A MINIMUM OF THREE KENTUCKY BLUEGRASS CULTIVARS WITH EACH RANGING FROM 10 TO 35 PERCENT OF THE TOTAL MIXTURE BY WEIGHT.
 - KENTUCKY BLUEGRASS/PERENIAL RYE: FULL SUN MIXTURE: FOR USE IN FULL SUN AREAS WHERE RAPID ESTABLISHMENT IS NECESSARY AND WHEN TURF WILL RECEIVE MEDIUM TO INTENSIVE MAINTENANCE. CERTIFIED PERENIAL RYEGRASS CULTIVARS/CERTIFIED KENTUCKY BLUEGRASS SEEDING RATE: 2 POUNDS MIXTURE PER 1000 S.F. CHOOSE A MINIMUM OF THREE KENTUCKY BLUEGRASS CULTIVARS WITH EACH RANGING FROM 10 TO 35 PERCENT OF THE TOTAL MIXTURE BY WEIGHT.
 - TALL FESCUE/KENTUCKY BLUEGRASS: FULL MIXTURE: FOR USE IN DROUGHT AREAS AND/OR FOR MIXTURE INCLUDING CERTIFIED TALL FESCUE CULTIVARS 65 TO 100 PERCENT, CERTIFIED KENTUCKY BLUEGRASS CULTIVARS 0 TO 5 PERCENT. SEEDING RATE: 5 TO 8 PERCENT PER 1000 S.F. ONE OR MORE CULTIVARS MAY BE BLENDED.
 - KENTUCKY BLUEGRASS/FINE SCUD: SEED MIXTURE: FOR USE IN AREAS WITH SHADE IN BLUEGRASS LAWNS. FOR ESTABLISHMENT IN HIGH QUALITY, INTENSIVELY MANAGED TURF AREA. MIXTURE INCLUDES: CERTIFIED KENTUCKY BLUEGRASS CULTIVARS 30 TO 40 PERCENT AND CERTIFIES FINE FESCUE AND 60 TO 70 PERCENT. SEEDING RATES 1 1/2 TO 3 POUNDS PER 1000 S.F.
 - 3. IDEAL TIMES OF SEEDING FOR TURF GRASS MIXTURE**
 - WESTERN MD: MARCH 15 TO JUNE 1, AUGUST 1 TO OCTOBER 1 (HARDNESS ZONES: 5B,6A)
 - CENTRAL MD: MARCH 15 TO MAY 15, AUGUST 15 TO OCTOBER 15 (HARDNESS ZONE: 6B)
 - SOUTHERN MD-EASTERN SHORE: MARCH 15 TO MAY 15, AUGUST 15 TO OCTOBER 15 (HARDNESS ZONE: 7A, 7B)
 - TILL AREAS TO RECEIVE SEED BY DISKING OR OTHER APPROVED METHODS TO A DEPTH OF 2 TO 4 INCHES. LEVEL AND RAKE THE AREAS TO PREPARE A PROPER SEEDBED. REMOVE STONE, AND DEBRIS OVER 1.5 INCHES IN DIAMETER. THE RESULTING SEEDBED SHOULD BE SMOOTH AND WITHOUT FUTURE MOVING OF GRASS WILL BE NO DIFFICULTY.
 - IF SOIL MOISTURE IS DEFICIENT, SUPPLY NEAR SEEDINGS WITH ADEQUATE WATER FOR PLANT GROWTH. WATERING SHOULD BE DONE EVERY 3 TO 4 DAYS DEPENDING ON SOIL TEXTURE UNTIL THEY ARE FIRMLY ESTABLISHED. THIS IS ESPECIALLY TRUE WHEN SEEDINGS ARE MADE LATE IN THE PLANTING SEASON, IN ABNORMALLY DRY OR HOT SEASON, OR ON ADVERSE SITES.

(B-4-8) STANDARDS AND SPECIFICATION FOR STOCKPILE AREA

DEFINITION
A MOUND OR PILE OF SOIL PROTECTED BY APPROPRIATELY DESIGNED EROSION AND SEDIMENT CONTROL MEASURES.
PURPOSE
TO PROVIDE A DESIGNATED LOCATION FOR THE TEMPORARY STORAGE OF SOIL THAT CONTROLS THE POTENTIAL FOR EROSION, SEDIMENTATION, AND CHANGES TO DRAINAGE PATTERNS.

CONDITIONS WHERE PRACTICE APPLIES
STOCKPILE AREAS ARE UTILIZED WHEN IT IS NECESSARY TO SALVAGE AND STORE SOIL FOR LATER USE.

- THE STOCKPILE LOCATION AND ALL RELATED SEDIMENT CONTROL PRACTICES MUST BE CLEARLY INDICATED ON THE EROSION AND SEDIMENT CONTROL PLAN.
- THE FOOTPRINT OF STOCKPILE MUST BE SIZED TO ACCOMMODATE THE ANTICIPATED VOLUME OF MATERIAL AND BASED ON A SIDE SLOPE RATIO NO STEEPER THAN 2:1. BENCHING MUST BE PROVIDED IN ACCORDANCE WITH SECTION B-3 LAND GRADING.
- RUNOFF FROM THE STOCKPILE AREA MUST DRAIN TO A SUITABLE SEDIMENT CONTROL PRACTICE.
- ACCESS THE STOCKPILE AREA FROM THE UPGRADE SIDE.
- CLEAR WATER RUNOFF INTO THE STOCKPILE AREA MUST BE MINIMIZED BY USE OF A DIVERSION DEVICE SUCH AS AN EARTH DIKE, TEMPORARY SWALE OR DIVERSION FENCE. PROMISIONS MUST BE MADE FOR DISCHARGING CONCENTRATED FLOW IN A NON-EROSIVE MANNER.
- WHERE RUNOFF CONCENTRATES ALONG THE TOE OF THE STOCKPILE FILL, AN APPROPRIATE EROSION/SEDIMENT CONTROL PRACTICE MUST BE USED TO INTERCEPT THE DISCHARGE.
- STOCKPILE MUST BE STABILIZED IN ACCORDANCE WITH THE 3/7 DAY STABILIZATION REQUIREMENT AS WELL AS APPROPRIATE PERMANENT STABILIZATION AND STANDARD B-4-1 INCENTRAL STABILIZATION AND STANDARD B-4-2 PERMANENT STABILIZATION.
- IF THE STOCKPILE IS LOCATED ON AN IMPERVIOUS SURFACE, A LINER SHOULD BE PROVIDED BELOW THE STOCKPILE TO FACILITATE CLEANUP. STOCKPILES CONTAINING CONTAMINATED MATERIAL MUST COVERED WITH IMPERMEABLE SHEETING.

THE STOCKPILE AREA MUST CONTINUOUSLY MEET THE REQUIREMENTS FOR ADEQUATE VEGETATIVE ESTABLISHMENT IN ACCORDANCE WITH SECTION B-4 VEGETATIVE STABILIZATION. SIDE SLOPES MUST BE MAINTAINED AT NO STEEPER THAN 2:1 RATIO. THE VERTICAL STORM DRAIN SYSTEM FROM I-1 TO I-4 AND DIVERSION PIPE TO THE TRAP, (10 DAYS)

(B-4-4) STANDARDS AND SPECIFICATIONS FOR TEMPORARY STABILIZATION

DEFINITION
TO STABILIZE DISTURBED SOIL WITH VEGETATION FOR UP TO 6 MONTHS.
PURPOSE
TO USE FAST GROWING VEGETATION THAT PROVIDES COVER ON DISTURB SOIL.


CONDITIONS WHERE PRACTICE APPLIES
EXPOSED SOILS WHERE GROUND COVER IS NEEDED FOR A PERIOD OF 6 MONTHS OR LESS. FOR LONGER DURATION OF TIME, PERMANENT STABILIZATION PRACTICES ARE REQUIRED.

- CRITERIA**
- SELECT ONE OR MORE OF THE SPECIES OR SEED MIXTURES LISTED IN TABLE B.1 FOR THE APPROPRIATE PLANT HARDNESS ZONE (FROM FIGURE B.3), AND ENTER THEM IN THE TEMPORARY SEEDING SUMMARY ALONG WITH APPLICATION RATES, SEEDING DATES AND SEEDING DEPTHS. IF THIS SUMMARY IS NOT PUT ON THE PLAN AND COMPLETED, THEN TABLE B-1 PLUS FERTILIZER AND LIME RATES MUST BE PUT ON THE PLAN.
 - FOR SITES HAVING SOIL TESTS PERFORMED, USE AND SHOW THE RECOMMENDED RATES BY THE TESTING AGENCY. SOIL TESTS ARE NOT REQUIRED FOR TEMPORARY SEEDING.
 - WHEN STABILIZATION IS REQUIRED OUTSIDE OF A SEEDING SEASON, APPLY SEED AND MULCH OR STRAW MULCH ALONE AS PRESCRIBED IN SECTION B-4-3.1.b, AND MAINTAIN UNTIL THE NEXT SEEDING SEASON.

SEQUENCE OF CONSTRUCTION

- OBTAIN GRADING PERMIT (1 DAY).
- PERFORM INITIAL GRADING AND GRADING AS NECESSARY FOR THE INSTALLATION OF PERIMETER CONTROLS (5 DAYS).
- CONSTRUCT STABILIZED CONSTRUCTION ENTRANCE AT LOCATION INDICATED (1 DAY)
- CONSTRUCT PERIMETER CONTROLS: SILT FENCES (SF), SUPER SILT FENCES (SSF), EARTH DIKE (A-1) DIVERSION FENCES (DF), TEMPORARY SWALE (A-1) AND SEDIMENT TRAP (S-T) AS SHOWN ON PLAN (6 DAYS)
- CLEAR AND GRUB SITE (2 DAYS)
- PERFORM INITIAL GRADING (7 DAYS)
- INSTALL STORM DRAIN SYSTEM FROM I-1 TO I-4 AND DIVERSION PIPE TO THE TRAP, (10 DAYS)
- INSTALL WATER AND SEWER SYSTEMS (14 DAYS)
- CONSTRUCT PUBLIC ROAD AND UIC DRIVEWAY, INSTALL TEMPORARY DIVERSION BEAM (14 DAYS)
- STABILIZE DISTURBED AREA (1 DAY)
- WITH THE APPROVAL OF SEDIMENT CONTROL INSPECTOR, CONVERT SEDIMENT TRAP INTO MICRO-BIORETENTION #6 (3 DAYS)
- WITH THE APPROVAL OF SEDIMENT CONTROL INSPECTOR, REMOVE EARTH DICES AND DIVERSION FENCES.
- COMPLETE FINE GRADING.
- STABILIZE ALL DISTURBED AREAS.
- LEAVE IN PLACE THE REMAINING SEDIMENT CONTROL DEVICES FOR FUTURE CONSTRUCTION OF THE HOUSES (SDP STAGE).

OWNER
HARMONY BUILDERS INC
4222 COLUMBIA ROAD
ELLICOTT CITY, MD 21042
410-461-0833

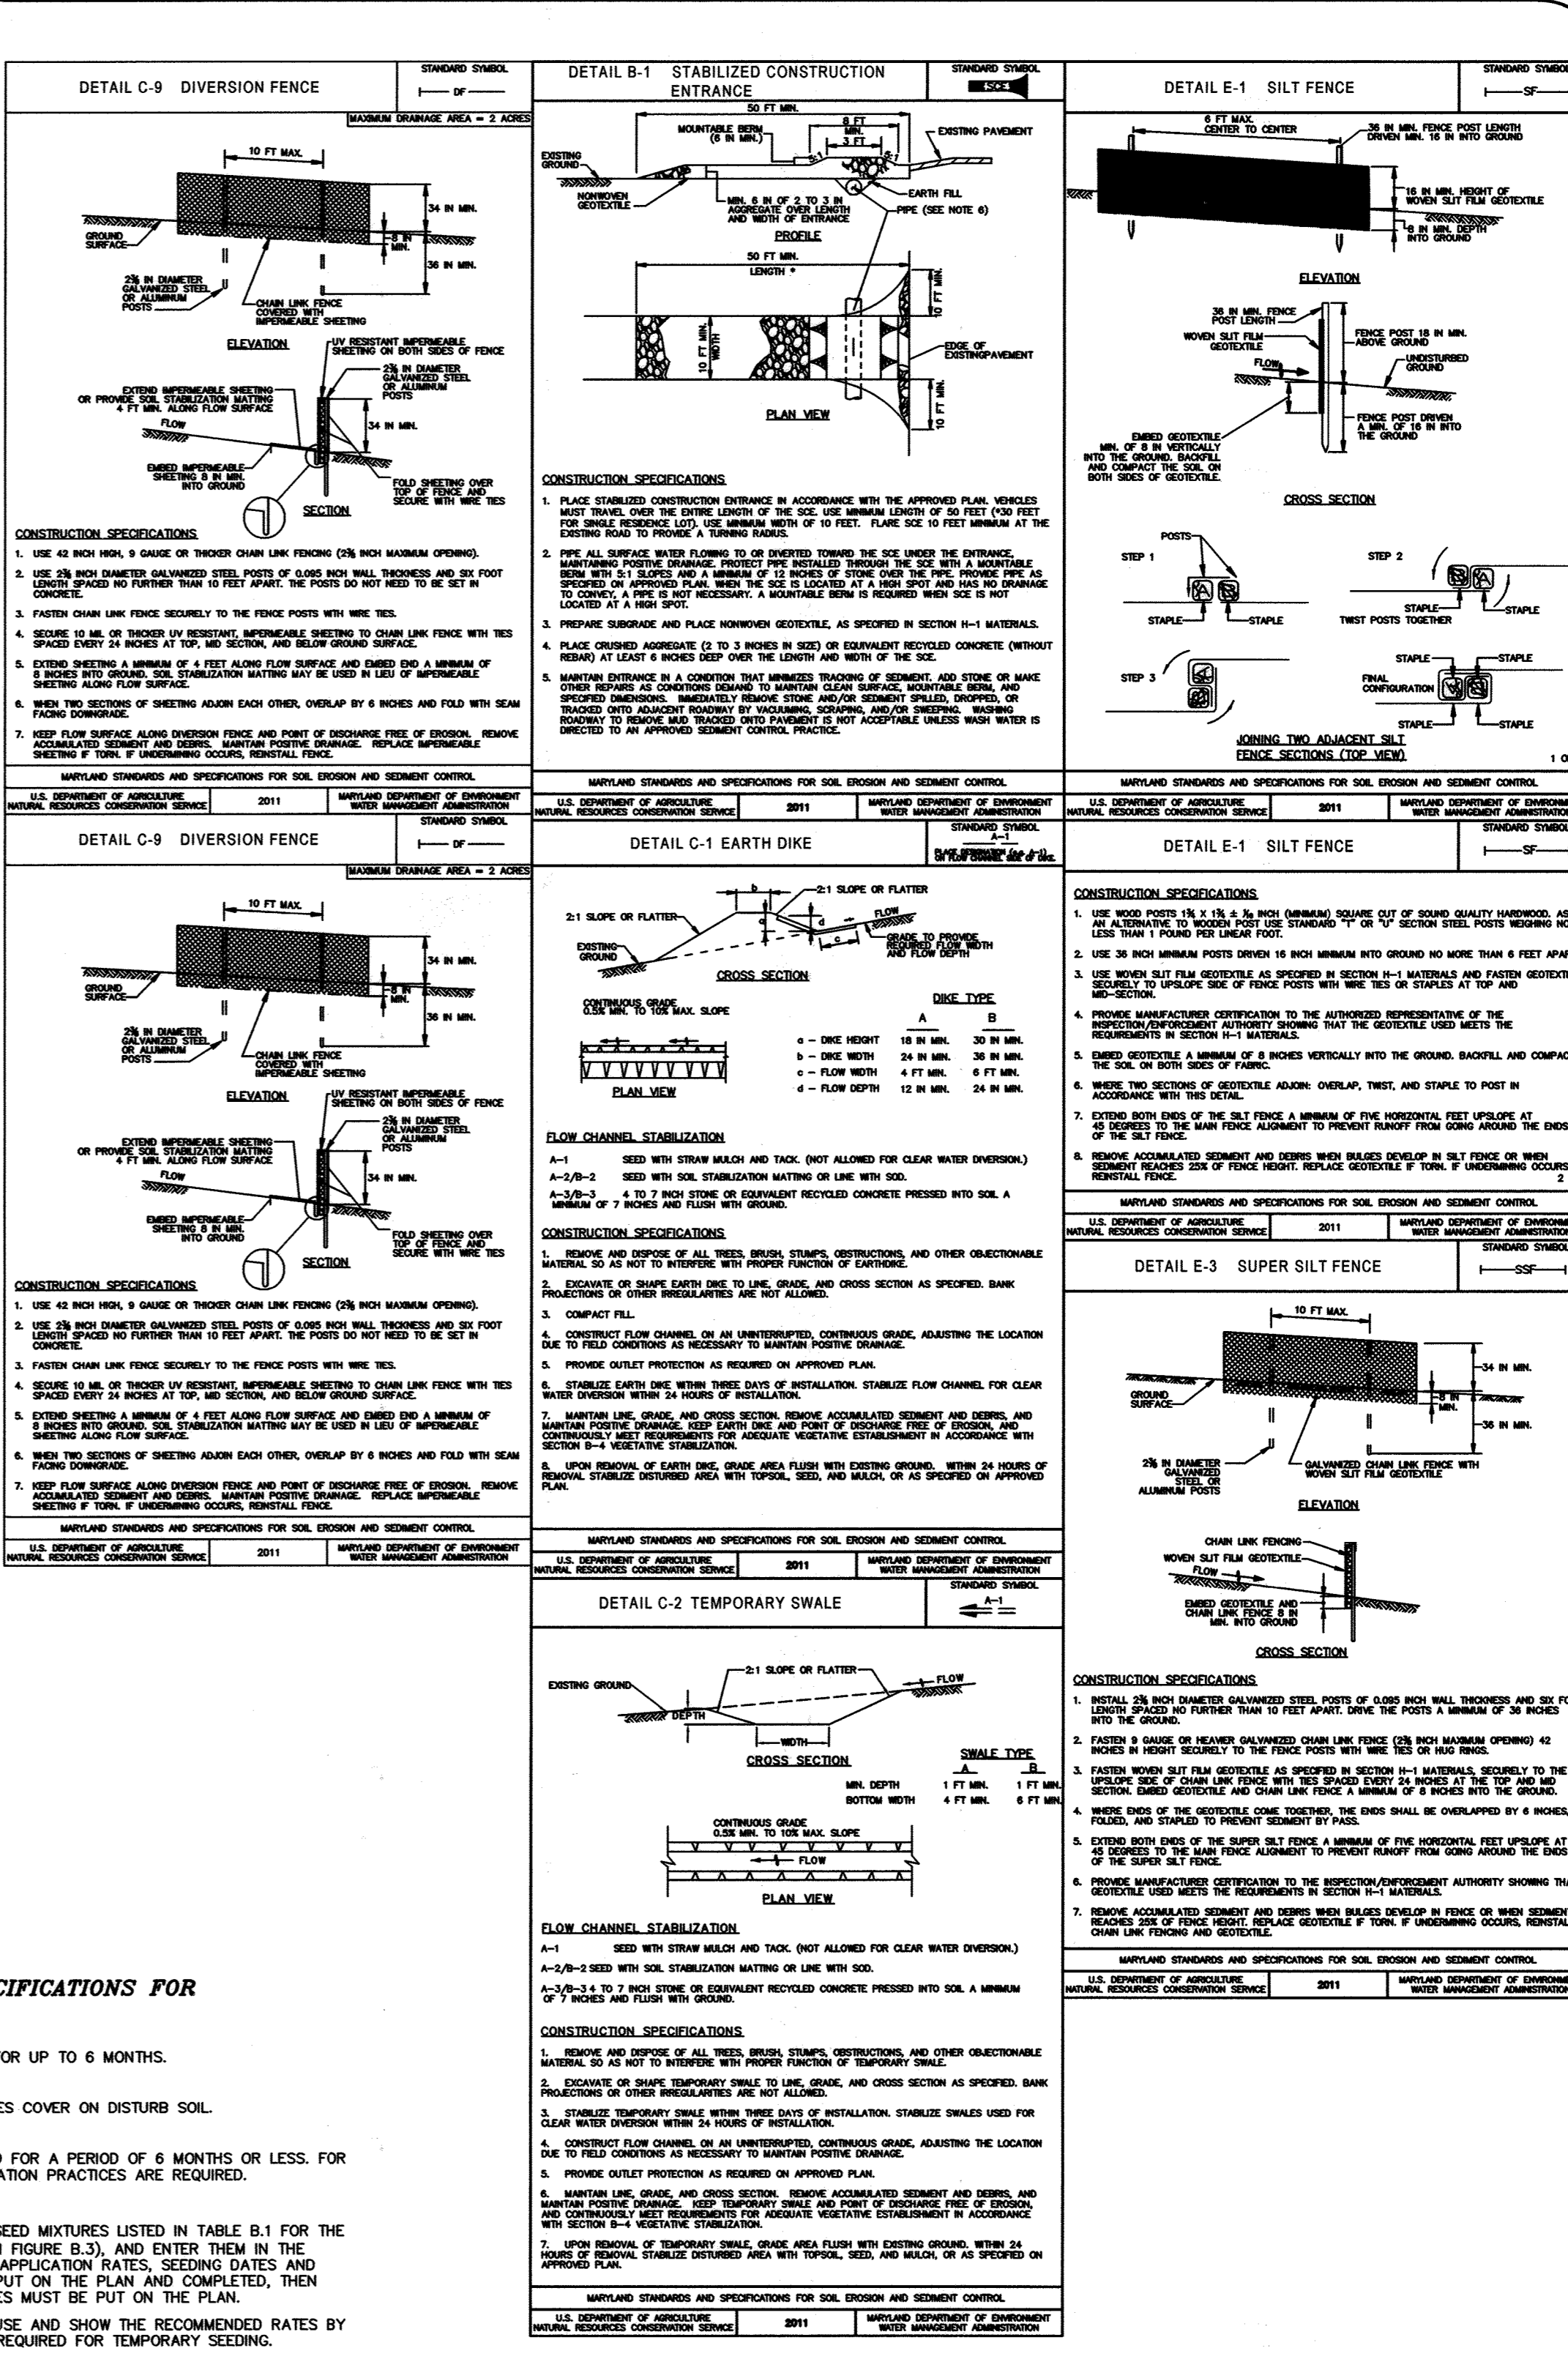

PLANT SPECIES	SEEDING RATE (LB/AC)	SEEDING DEPTH (INCHES)	RECOMMENDED SEEDING DATED BY PLANT HARDNESS ZONE			
			5B AND 6A	6B	7A AND 7B	
COOL SEASON GRASSES						
ANNUAL RYEGRASS (LOULIE PERENNIAL MIX)	40	1.0	MAR 15 TO MAY 31; AUG 1 TO OCT 15	MAR 1 TO MAY 15; AUG 1 TO OCT 15	FEB 15 TO APR 30; MAY 15 TO NOV 30	
BARLEY (HORDEUM VULGARE)	96	2.2	MAR 15 TO MAY 31; AUG 1 TO SEP 30	MAR 1 TO MAY 15; AUG 1 TO OCT 15	FEB 15 TO APR 30; MAY 15 TO NOV 30	
OATS (AVEENA SATIVA)	72	1.7	MAR 15 TO MAY 31; AUG 1 TO SEP 30	MAR 1 TO MAY 15; AUG 1 TO OCT 15	FEB 15 TO APR 30; MAY 15 TO NOV 30	
WHEAT (TRITICUM AESTIVUM)	120	2.8	MAR 15 TO MAY 31; AUG 1 TO SEP 30	MAR 1 TO MAY 15; AUG 1 TO OCT 15	FEB 15 TO APR 30; MAY 15 TO NOV 30	
CEREAL RYE (SECALE ITALICA)	112	2.8	MAR 15 TO MAY 31; AUG 1 TO OCT 31	MAR 1 TO MAY 15; AUG 1 TO OCT 15	FEB 15 TO APR 30; MAY 15 TO DEC 15	
WARM SEASON GRASSES						
FOXTAIL MILLET (SETARIA ITALICA)	30	0.7	JUN 1 TO JUL 31	MAY 16 TO JUL 31	MAY 1 TO AUG 14	
PEARL MILLET (PENISETUM GLAUCUM)	20	0.5	JUN 1 TO JUL 31	MAY 16 TO JUL 31	MAY 1 TO AUG 14	

NO.	SPECIES	APPLICATION RATE (LB/AC)	SEEDING DATES	SEEDING DEPTHS	FERTILIZER RATE (10-20-20)		LIME RATE
					N	P ₂ O ₅	
1	TALL FESCUE	100	MARCH 1-MAY 15 OCT 15-15	1/4"-1/2"	45 LBS. PER ACRE (1 LB./1000 SF)	90 LBS. PER ACRE (2 LB./1000 SF)	2 TONS / ACRE (90 LBS / 1000 SF)

MIXTURES 1, 4-7, 9, AND 10 FROM TABLE B.3 OF THE 2011 MARYLAND STANDARD AND SPECIFICATIONS FOR SOIL EROSION AND SEDIMENT CONTROL MAY BE USED.

ENGINEER'S CERTIFICATE

I CERTIFY THAT THIS PLAN FOR EROSION AND SEDIMENT CONTROL REPRESENTS A PRACTICAL AND WORKABLE PLAN BASED ON MY PERSONAL KNOWLEDGE OF THE SITE CONDITIONS AND THAT IT WAS PREPARED IN ACCORDANCE WITH THE REQUIREMENTS OF THE HOWARD SOIL CONSERVATION DISTRICT.

SIGNATURE OF ENGINEER: *R. JACOB HIKMAT* DATE: *11/6/18*

PRINTED NAME OF ENGINEER: R. JACOB HIKMAT, PE.

DEVELOPERS CERTIFICATE

I CERTIFY THAT ALL DEVELOPMENT AND CONSTRUCTION WILL BE DONE ACCORDING TO THIS PLAN, AND THAT ANY RESPONSIBLE PERSONNEL INVOLVED IN THE CONSTRUCTION PROJECT WILL HAVE A CERTIFICATE OF ATTENDANCE AT A DEPARTMENT OF THE ENVIRONMENT APPROVED TRAINING PROGRAM FOR THE CONTROL OF SEDIMENT AND EROSION BEFORE BEGINNING THE PROJECT. HOWARD SOIL CONSERVATION DISTRICT IS AUTHORIZED TO CONDUCT PERIODIC ON-SITE INSPECTION.

SIGNATURE OF DEVELOPER: *John Scott Bodstrey* DATE: *01/18/18*

PRINTED NAME OF DEVELOPER: John Scott Bodstrey

THIS DEVELOPMENT PLAN IS APPROVED FOR SOIL EROSION AND SEDIMENT CONTROL BY THE HOWARD SOIL CONSERVATION DISTRICT.

APPROVED: DEPARTMENT OF PLANNING AND ZONING
John R. Roberts DATE: *1/31/18*

APPROVED: DEPARTMENT OF PUBLIC WORKS
John R. Roberts DATE: *1/31/18*

APPROVED: DEPARTMENT OF PLANNING AND ZONING
John R. Roberts DATE: *2-28-18*



APPROVED: DEPARTMENT OF PLANNING AND ZONING
John R. Roberts DATE: *3-14-18*

STANDARD SEDIMENT CONTROL NOTES



- A PRE-CONSTRUCTION MEETING MUST OCCUR WITH THE HOWARD COUNTY DEPARTMENT OF PUBLIC WORKS, CONSTRUCTION INSPECTION DIVISION (CID), 410-313-1855 AFTER THE FUTURE LOO AND PROTECTED AREAS ARE MARKED CLEARLY IN THE FIELD. A MINIMUM OF 48 HOUR NOTICE TO CID MUST BE GIVEN AT THE FOLLOWING STAGES:
 - PRIOR TO THE START OF EARTH DISTURBANCE.
 - UPON COMPLETION OF THE INSTALLATION OF PERIMETER EROSION AND SEDIMENT CONTROLS, BUT BEFORE PROCEEDING WITH ANY OTHER EARTH DISTURBANCE OR GRADING.
 - PRIOR TO THE START OF ANOTHER PHASE OF CONSTRUCTION OR OPENING OF ANOTHER GRADING UNIT.
 - PRIOR TO THE REMOVAL OR MODIFICATION OF SEDIMENT CONTROL PRACTICES.
- OTHER BUILDING OR GRADING INSPECTION APPROVALS MAY NOT BE AUTHORIZED UNTIL THIS INITIAL APPROVAL BY THE INSPECTION AGENCY IS MADE. OTHER RELATED STATE AND FEDERAL PERMITS SHALL BE REFERENCED, TO ENSURE COORDINATION AND TO AVOID CONFLICTS WITH THIS PLAN.
- ALL VEGETATIVE AND STRUCTURAL PRACTICES ARE TO BE INSTALLED ACCORDING TO THE PROVISIONS OF THIS PLAN AND ARE TO BE IN CONFORMANCE WITH THE 2011 MARYLAND STANDARDS AND SPECIFICATIONS FOR SOIL EROSION AND SEDIMENT CONTROL, AND REVISIONS THERETO.
- FOLLOWING INITIAL SOIL DISTURBANCE OR RE-DISTURBANCE, PERMANENT OR TEMPORARY STABILIZATION IS REQUIRED WITHIN THREE (3) CALENDAR DAYS AS TO THE SURFACE OF ALL PERIMETER CONTROLS, DICES, SWALES, DITCHES, PERIMETER SLOPES, AND ALL SLOPES STEEPER THAN 3 HORIZONTAL TO 1 VERTICAL (3:1). AND SEVEN (7) CALENDAR DAYS AS TO ALL OTHER DISTURBED AREAS ON THE PROJECT SITE EXCEPT FOR THOSE AREAS UNDER ACTIVE GRADING.
- ALL DISTURBED AREAS MUST BE STABILIZED WITHIN THE TIME PERIOD SPECIFIED ABOVE IN ACCORDANCE WITH THE STANDARD AND SPECIFICATIONS FOR SOIL EROSION AND SEDIMENT CONTROL FOR TOPSOIL (SEC. B-4-2), PERMANENT SEEDING (SEC. B-4-5), TEMPORARY SEEDING (SEC. B-4-4) AND MULCHING (SEC. B-4-3). TEMPORARY STABILIZATION WITH MULCH ALONE CAN ONLY BE APPLIED BETWEEN THE FALL AND SPRING SEEDING DATES IF THE GROUND IS FROZEN. INCREMENTAL STABILIZATION (SEC. B-4-1) SPECIFICALLY DESIGNED FOR ENFORCED IN AREAS WITH 15% OR FLATTER SLOPES (SEC. B-4-8) IN EXCESS OF 20 FT. MUST BE BENCHMARK WITH STABLE OUTLET. ALL CONCENTRATED FLOW, STEEP SLOPE, AND HIGHLY ERODIBLE AREAS SHALL RECEIVE SOIL STABILIZATION MATTING (SEC. B-4-6).
- ALL SEDIMENT CONTROL STRUCTURES ARE TO REMAIN IN PLACE, AND ARE TO BE MAINTAINED IN OPERATIVE CONDITION UNTIL PERMISSION FOR THEIR REMOVAL HAS BEEN OBTAINED FROM THE CID.
- SITE ANALYSIS:
 - TOTAL AREA OF SITE: 3.28 ACRES
 - AREA TO BE GRADDED: 1.12 ACRES
 - AREA TO BE ROOFED OR PAVED: 0.76 ACRES
 - AREA TO BE VEGETATIVE STABILIZED: 2.36 ACRES
 - TOTAL CUT: 500 CU. YDS.
 - TOTAL FILL: 500 CU. YDS.
 - OFFSITE WASTE/BORROW AREA LOCATION: [Blank]
- WASH WATER FROM ANY EQUIPMENT, VEHICLES, WHEELS, PAVED, AND OTHER SOURCES MUST BE TREATED IN A SEDIMENT BASIN OR OTHER APPROVED WASHOUT STRUCTURE.
- TOPSOIL SHALL BE STOCKPILED AND PRESERVED ON-SITE FOR REDISTRIBUTION UNTIL FINAL GRADE.
- ALL SILT FENCE AND SUPER SILT FENCE SHALL BE PLACED ON-THE-CONTOUR, AND BE IMBERICATED AT 25' MINIMUM INTERVALS, WITH LOWER ENDS CURLED UPHILL BY 2' IN ELEVATION.
- STREAM CHANNELS MUST NOT BE DISTURBED DURING THE FOLLOWING RESTRICTED TIME PERIODS (INCLUSIVE):
 - USE I AND II: MARCH

SOILS TABLE

SYMBOL	RATING	NAME	K FACTOR	MAP #	COMMENTS
Fa	(D)	FALLSINGTON SANDY LOAM, 0-2% SLOPES.	.24	20	----
RaC	(C)	RUSSETT FINE SANDY LOAM, 5-10% SLOPES.	.24	20	----
RaD	(C)	RUSSETT FINE SANDY LOAM, 10-15% SLOPES.	.24	20	----
SfB	(B)	SASSAFRAS GRAVELLY SANDY LOAM, 2-5% SLOPES	.32	20	----
UcD	(D)	URBAN LAND-CHILLUM-BELTVILLE COMPLEX, 5-15%	.37	20	----

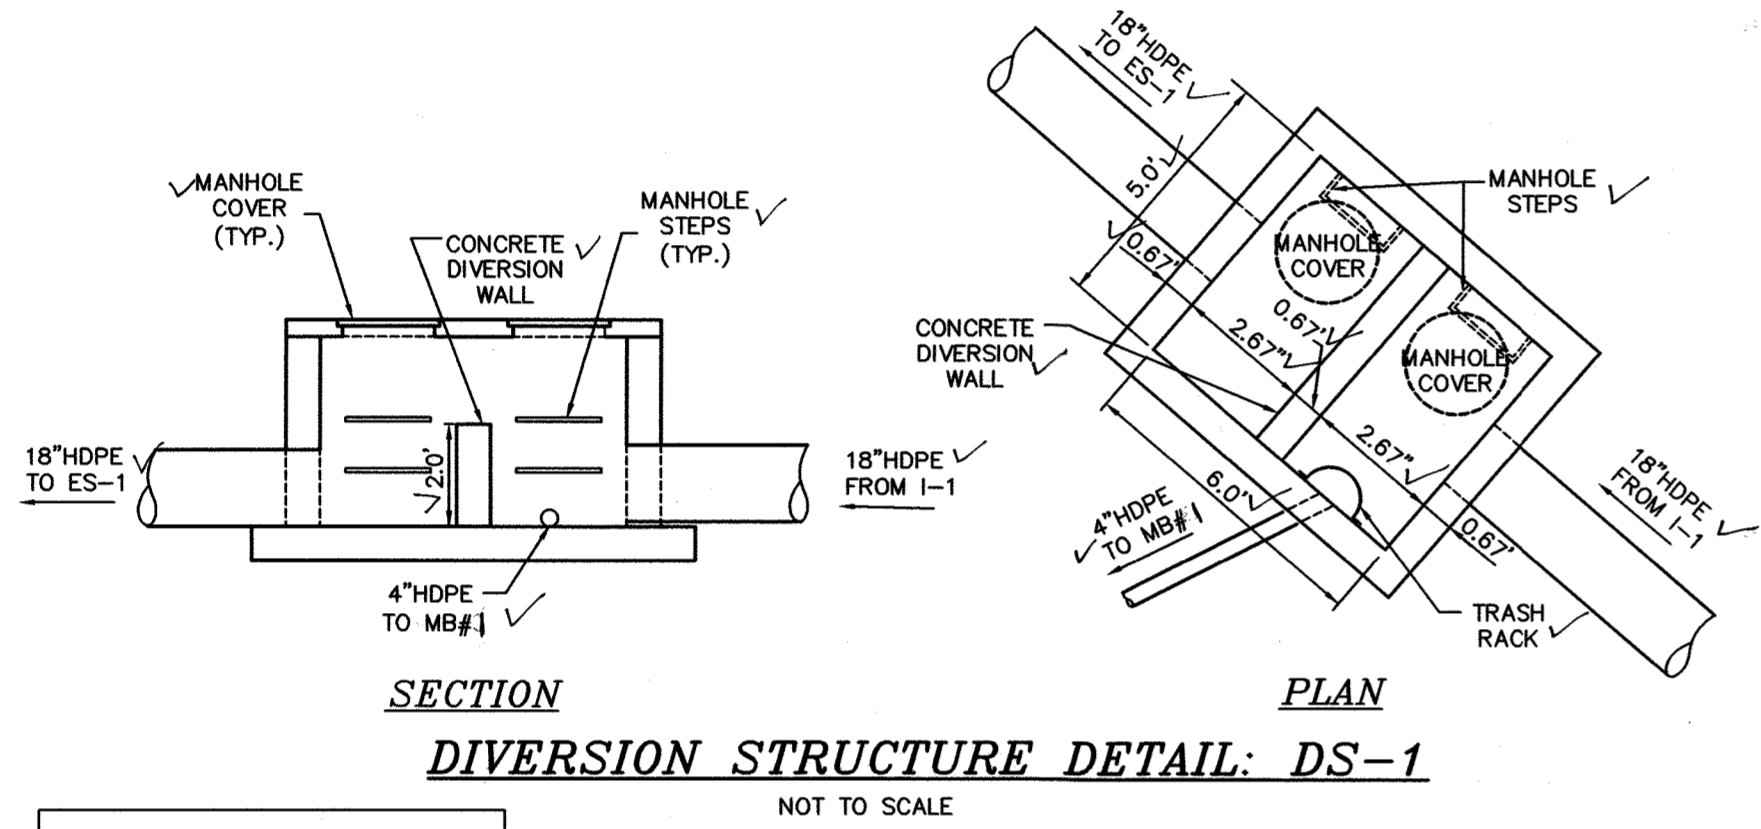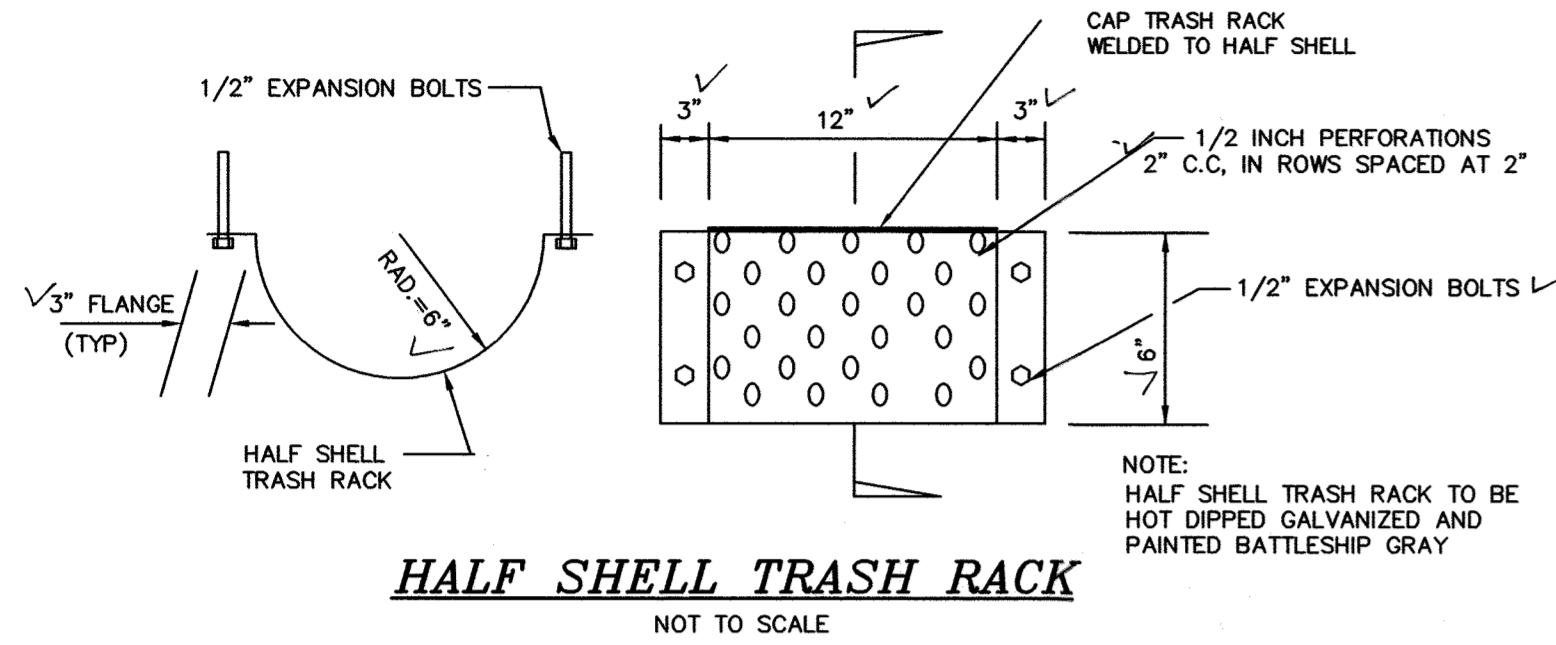

REINFORCEMENT FOR DIVERSION STRUCTURE SHALL BE IN ACCORDANCE WITH HOWARD COUNTY STD. D-4.02

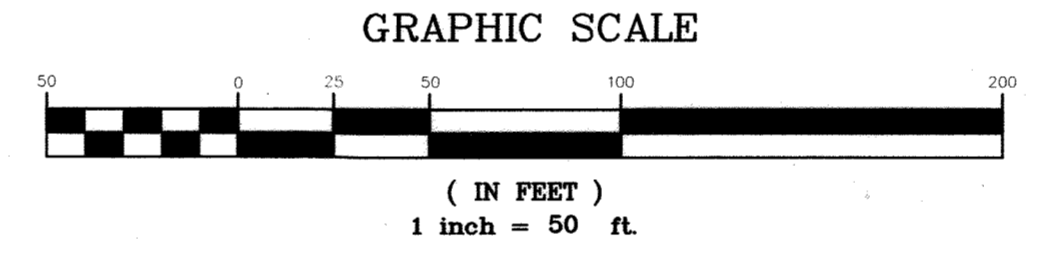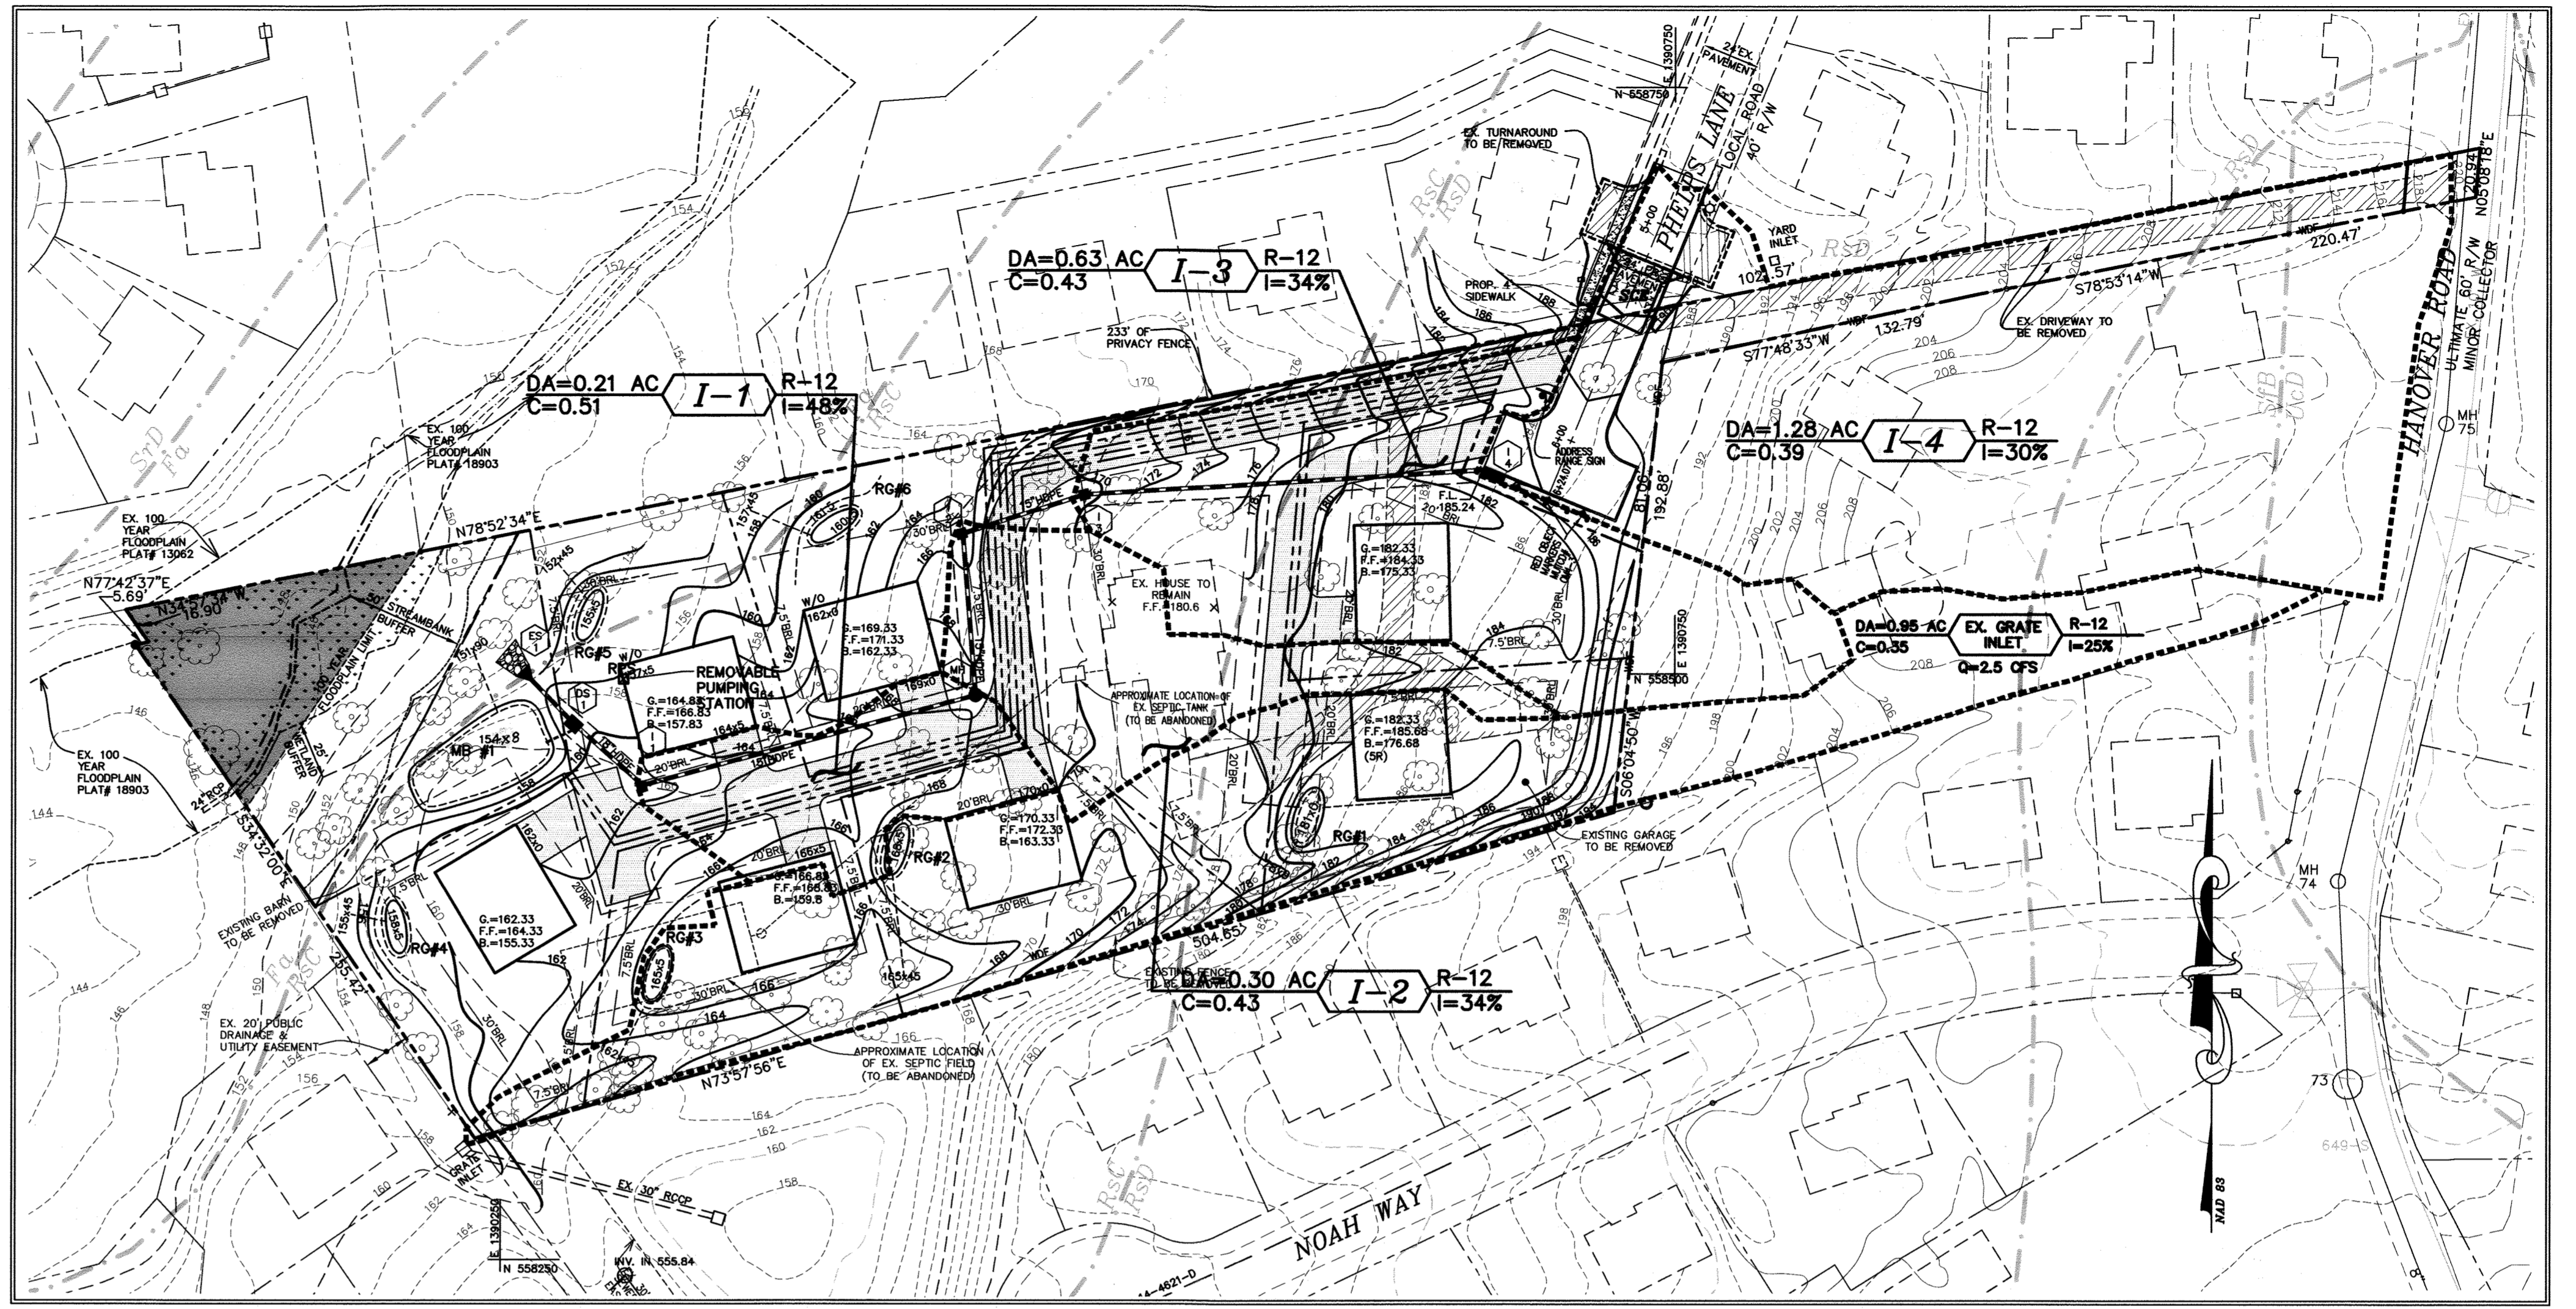

PIPE SCHEDULE

PIPE SIZE	QUANTITY
15" HDPE	296 LF.
18" HDPE	215 LF.

STRUCTURE SCHEDULE

NO.	LOCATION*	TOP**	INV. IN	INV. OUT	COMMENTS
ES-1	N 558,500.17 E 1,390,257.33	153.66	153.66	153.66	18" HDPE END SECTION
I-1	N 558,451.71 E 1,390,310.32	161.80	155.34	155.24	TYPE "S" INLET (HO. CO. STD D-4.22)
I-2	N 558,559.43 E 1,390,446.96	165.50	161.53	161.43	TYPE "S" INLET (HO. CO. STD D-4.22)
I-3	N 558,576.09 E 1,390,498.66	169.50	163.10	163.00	TYPE "S" INLET (HO. CO. STD D-4.22)
I-4	N 558,584.84 E 1,390,672.37	185.82	181.22	181.22	TYPE "A-10" INLET (HO. CO. STD D-4.03)
DS-1	N 558,478.29 E 1,390,281.03	159.00	158.90	154.95	DIVERSION STRUCTURE (SEE DET. THIS SHEET)
M-2	N 558,490.64 E 1,390,452.25	168.30	156.50	156.44	STANDARD MH (HO. CO. STD G-5.12)

- NOTES: 1. LOCATION GIVEN TO CENTER OF THE FACE OF CURB FOR INLETS LOCATED WITHIN THE ROAD RIGHT-OF-WAY.
2. STATIONS FOR YARD INLETS TO CENTER OF INLET.
3. LOCATION OF END SECTION GIVEN TO THE END END SECTION.
4. ELEVATIONS MEASURED TO CENTER OF ALL INLETS.



OWNER

HARMONY BUILDERS INC
4220 COLUMBIA ROAD
ELLCOTT CITY, MD 211042
410-461-0833

I HEREBY CERTIFY THAT THESE DOCUMENTS WERE PREPARED OR APPROVED BY ME AND THAT I AM A DULY LICENSED PROFESSIONAL ENGINEER UNDER THE LAWS OF THE STATE OF MARYLAND, LICENSE NO. 17942, EXP DATE 09/03/18



I hereby certify that the facility shown on this plan was constructed as shown on the 'As-Built' plans and meets with the approved plans and specifications.

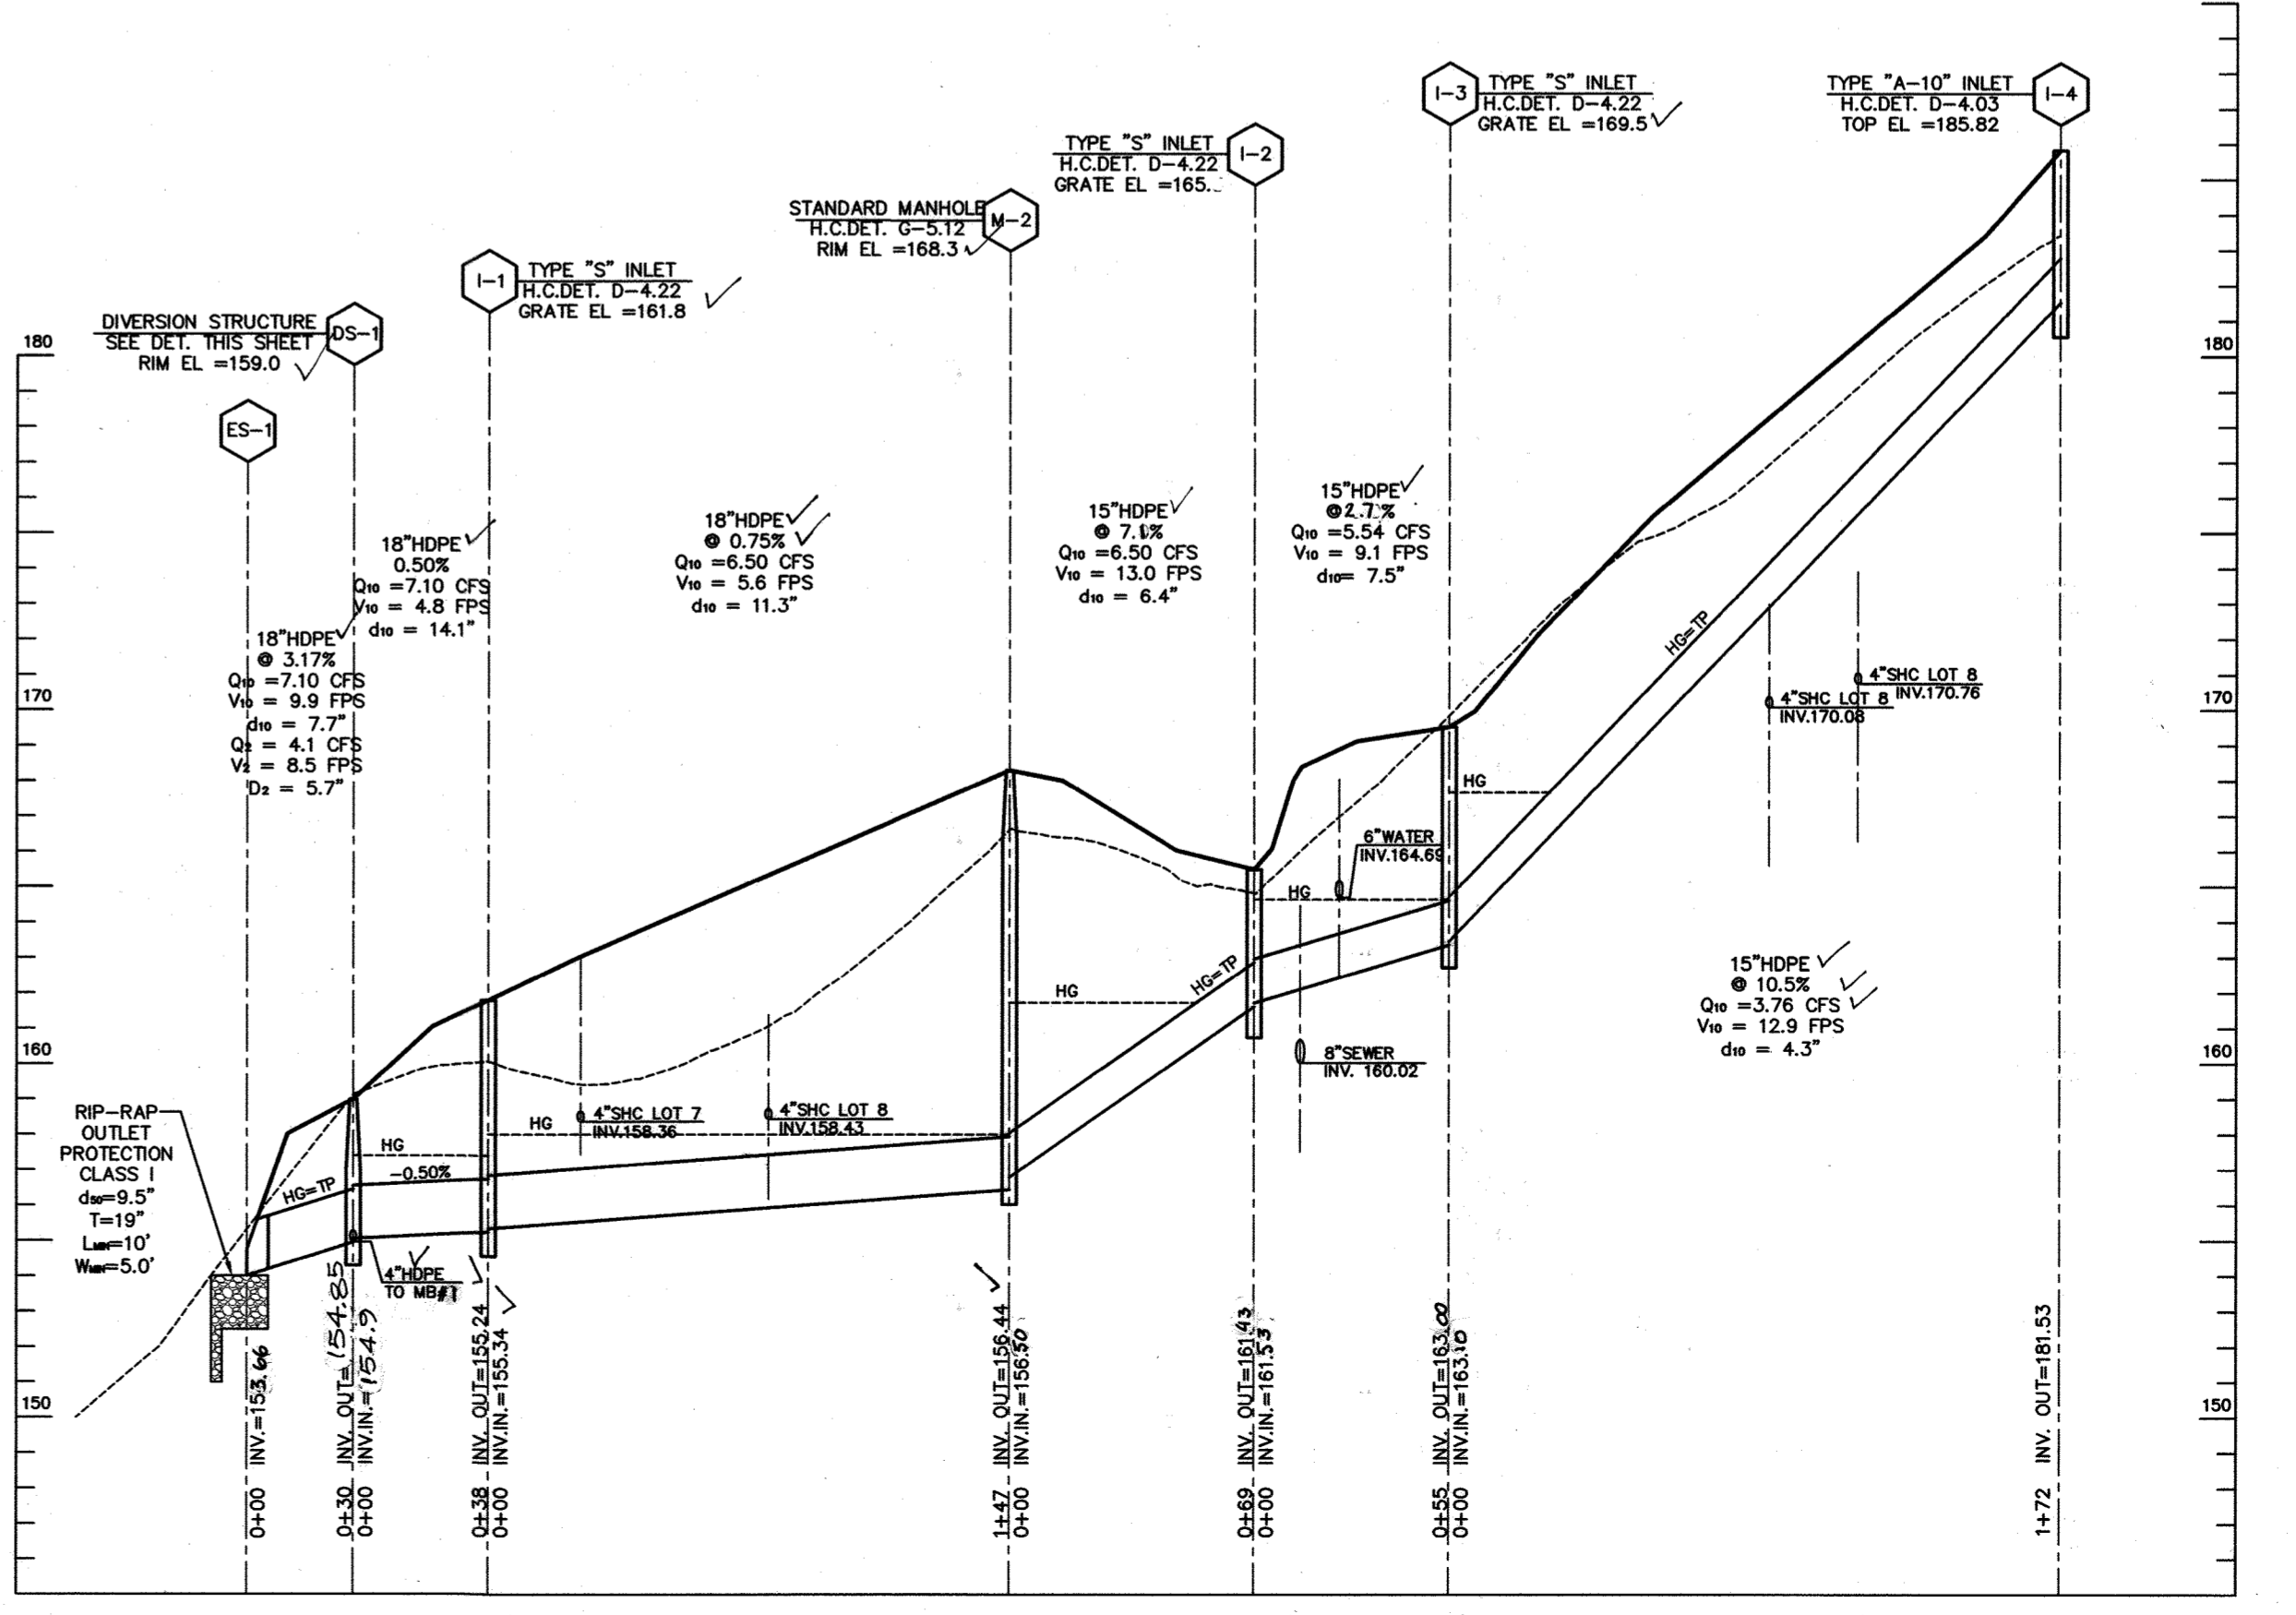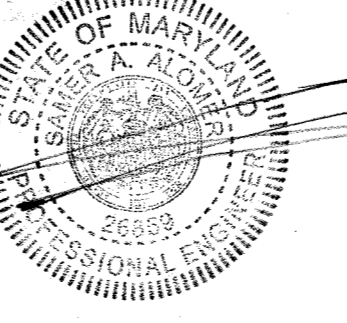

SCALE: HOR. 1"=50'
VER. 1"=5'

ENGINEER'S CERTIFICATE
I CERTIFY THAT THIS PLAN FOR EROSION AND SEDIMENT CONTROL REPRESENTS A PRACTICAL AND WORKABLE PLAN BASED ON MY PERSONAL KNOWLEDGE OF THE SITE CONDITIONS AND THAT IT WAS PREPARED IN ACCORDANCE WITH THE REQUIREMENTS OF THE HOWARD SOIL CONSERVATION DISTRICT.

1/16/18
DATE

R. JACOB HIKMAT, PE.
PRINTED NAME OF ENGINEER

DEVELOPERS CERTIFICATE
I CERTIFY THAT ALL DEVELOPMENT AND CONSTRUCTION WILL BE DONE ACCORDING TO THIS PLAN, AND THAT ANY RESPONSIBLE PERSONNEL INVOLVED IN THE CONSTRUCTION PROJECT WILL HAVE A CERTIFICATE OF ATTENDANCE AT A DEPARTMENT OF THE ENVIRONMENT APPROVED TRAINING PROGRAM FOR THE CONTROL OF SEDIMENT AND EROSION BEFORE BEGINNING THE PROJECT. HOWARD SOIL CONSERVATION DISTRICT IS AUTHORIZED TO CONDUCT PERIODIC ON-SITE INSPECTION.

01/18/18
DATE

Wm Scott Godfrey
PRINTED NAME OF DEVELOPER

THIS DEVELOPMENT PLAN IS APPROVED FOR SOIL EROSION AND SEDIMENT CONTROL BY THE HOWARD SOIL CONSERVATION DISTRICT.

1/31/18
DATE

APPROVED: DEPARTMENT OF PUBLIC WORKS
CHIEF, BUREAU OF HIGHWAYS

2/28/18
DATE

APPROVED: DEPARTMENT OF PLANNING AND ZONING
CHIEF, DEVELOPMENT ENGINEERING DIVISION

3-14-18
DATE

CHIEF, DIVISION OF LAND DEVELOPMENT

date	project	illustration	scale	description	revision
JAN. 2018	15-011	MM	1"=50'	approval	RH

ELKDALE GLENN PROPERTY
LOTS 1-8, OPEN SPACE LOTS 9 & 10 AND NON-BUILDABLE BULK PARCEL A
TAX MAP 38, GRID 15, PARCEL 871
FIRST ELECTION DISTRICT
HOWARD COUNTY, MARYLAND
SOILS AND DRAINAGE AREA MAP, STORM DRAIN PROFILES AND DETAILS




MILDENBERG, BOENDER & ASSOC., INC.
Engineers Surveyors Planners
7350-B Grace Drive, Columbia, Maryland 21044
(410) 997-0296 Tel. (410) 997-0296 Fax

LEGEND


- EXISTING DRIVEWAY TO BE REMOVED
- AREA OF WETLANDS
- 100 YR. FLOODPLAIN
- 8" SEWER
- PR. 8" SEWER MAIN
- PR. MANHOLE
- PR. 8" WATER MAIN
- PR. STORM DRAIN PIPE
- PR. STORM DRAIN INLET
- EXISTING TREE
- MICRO-BIORETENTION NUMBER
- IMPERVIOUS AREA TREATED BY MICRO-BIORETENTION #6 (M-6)
- IMPERVIOUS AREA TREATED BY MICRO-BIORETENTION #1-5 (M-6)
- DRAINAGE AREA LIMIT
- SOIL BORING LOCATION

SWM SUMMARY TABLE

LOT	SWM PRACTICE	ESD _v REQUIRED	ESD _v PROVIDED
2	RAIN GARDEN (M-7)	209 C.F.	260 C.F.
3	N/A	N/A	N/A
4	RAIN GARDEN (M-7)	209 C.F.	260 C.F.
5	RAIN GARDEN (M-7)	209 C.F.	260 C.F.
6	RAIN GARDEN (M-7)	209 C.F.	260 C.F.
7	RAIN GARDEN (M-7)	209 C.F.	260 C.F.
8	RAIN GARDEN (M-7)	209 C.F.	260 C.F.
1 & ROADWAYS	MICRO-BIORETENTION (M-6)	2,040 C.F.	2,152 C.F.
TOTAL		3,294 C.F.	3,712 C.F.

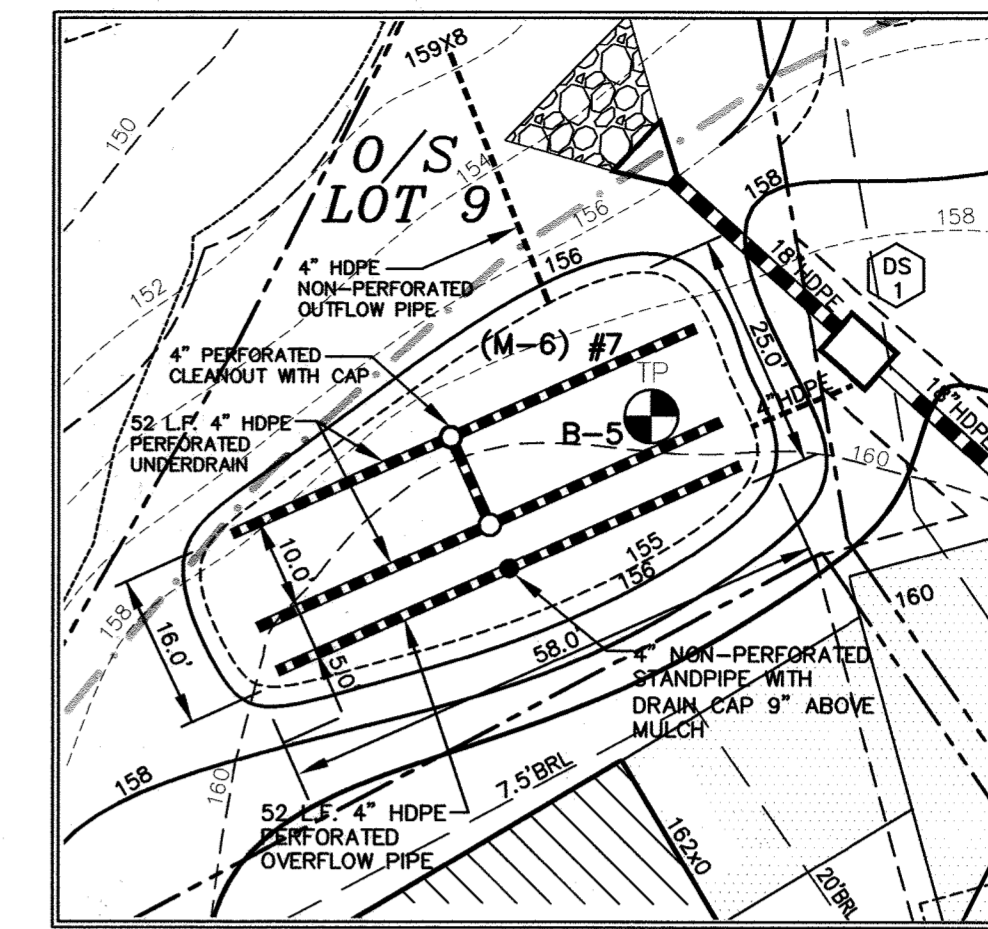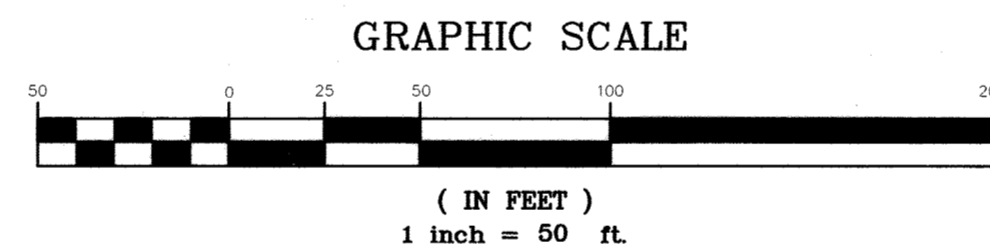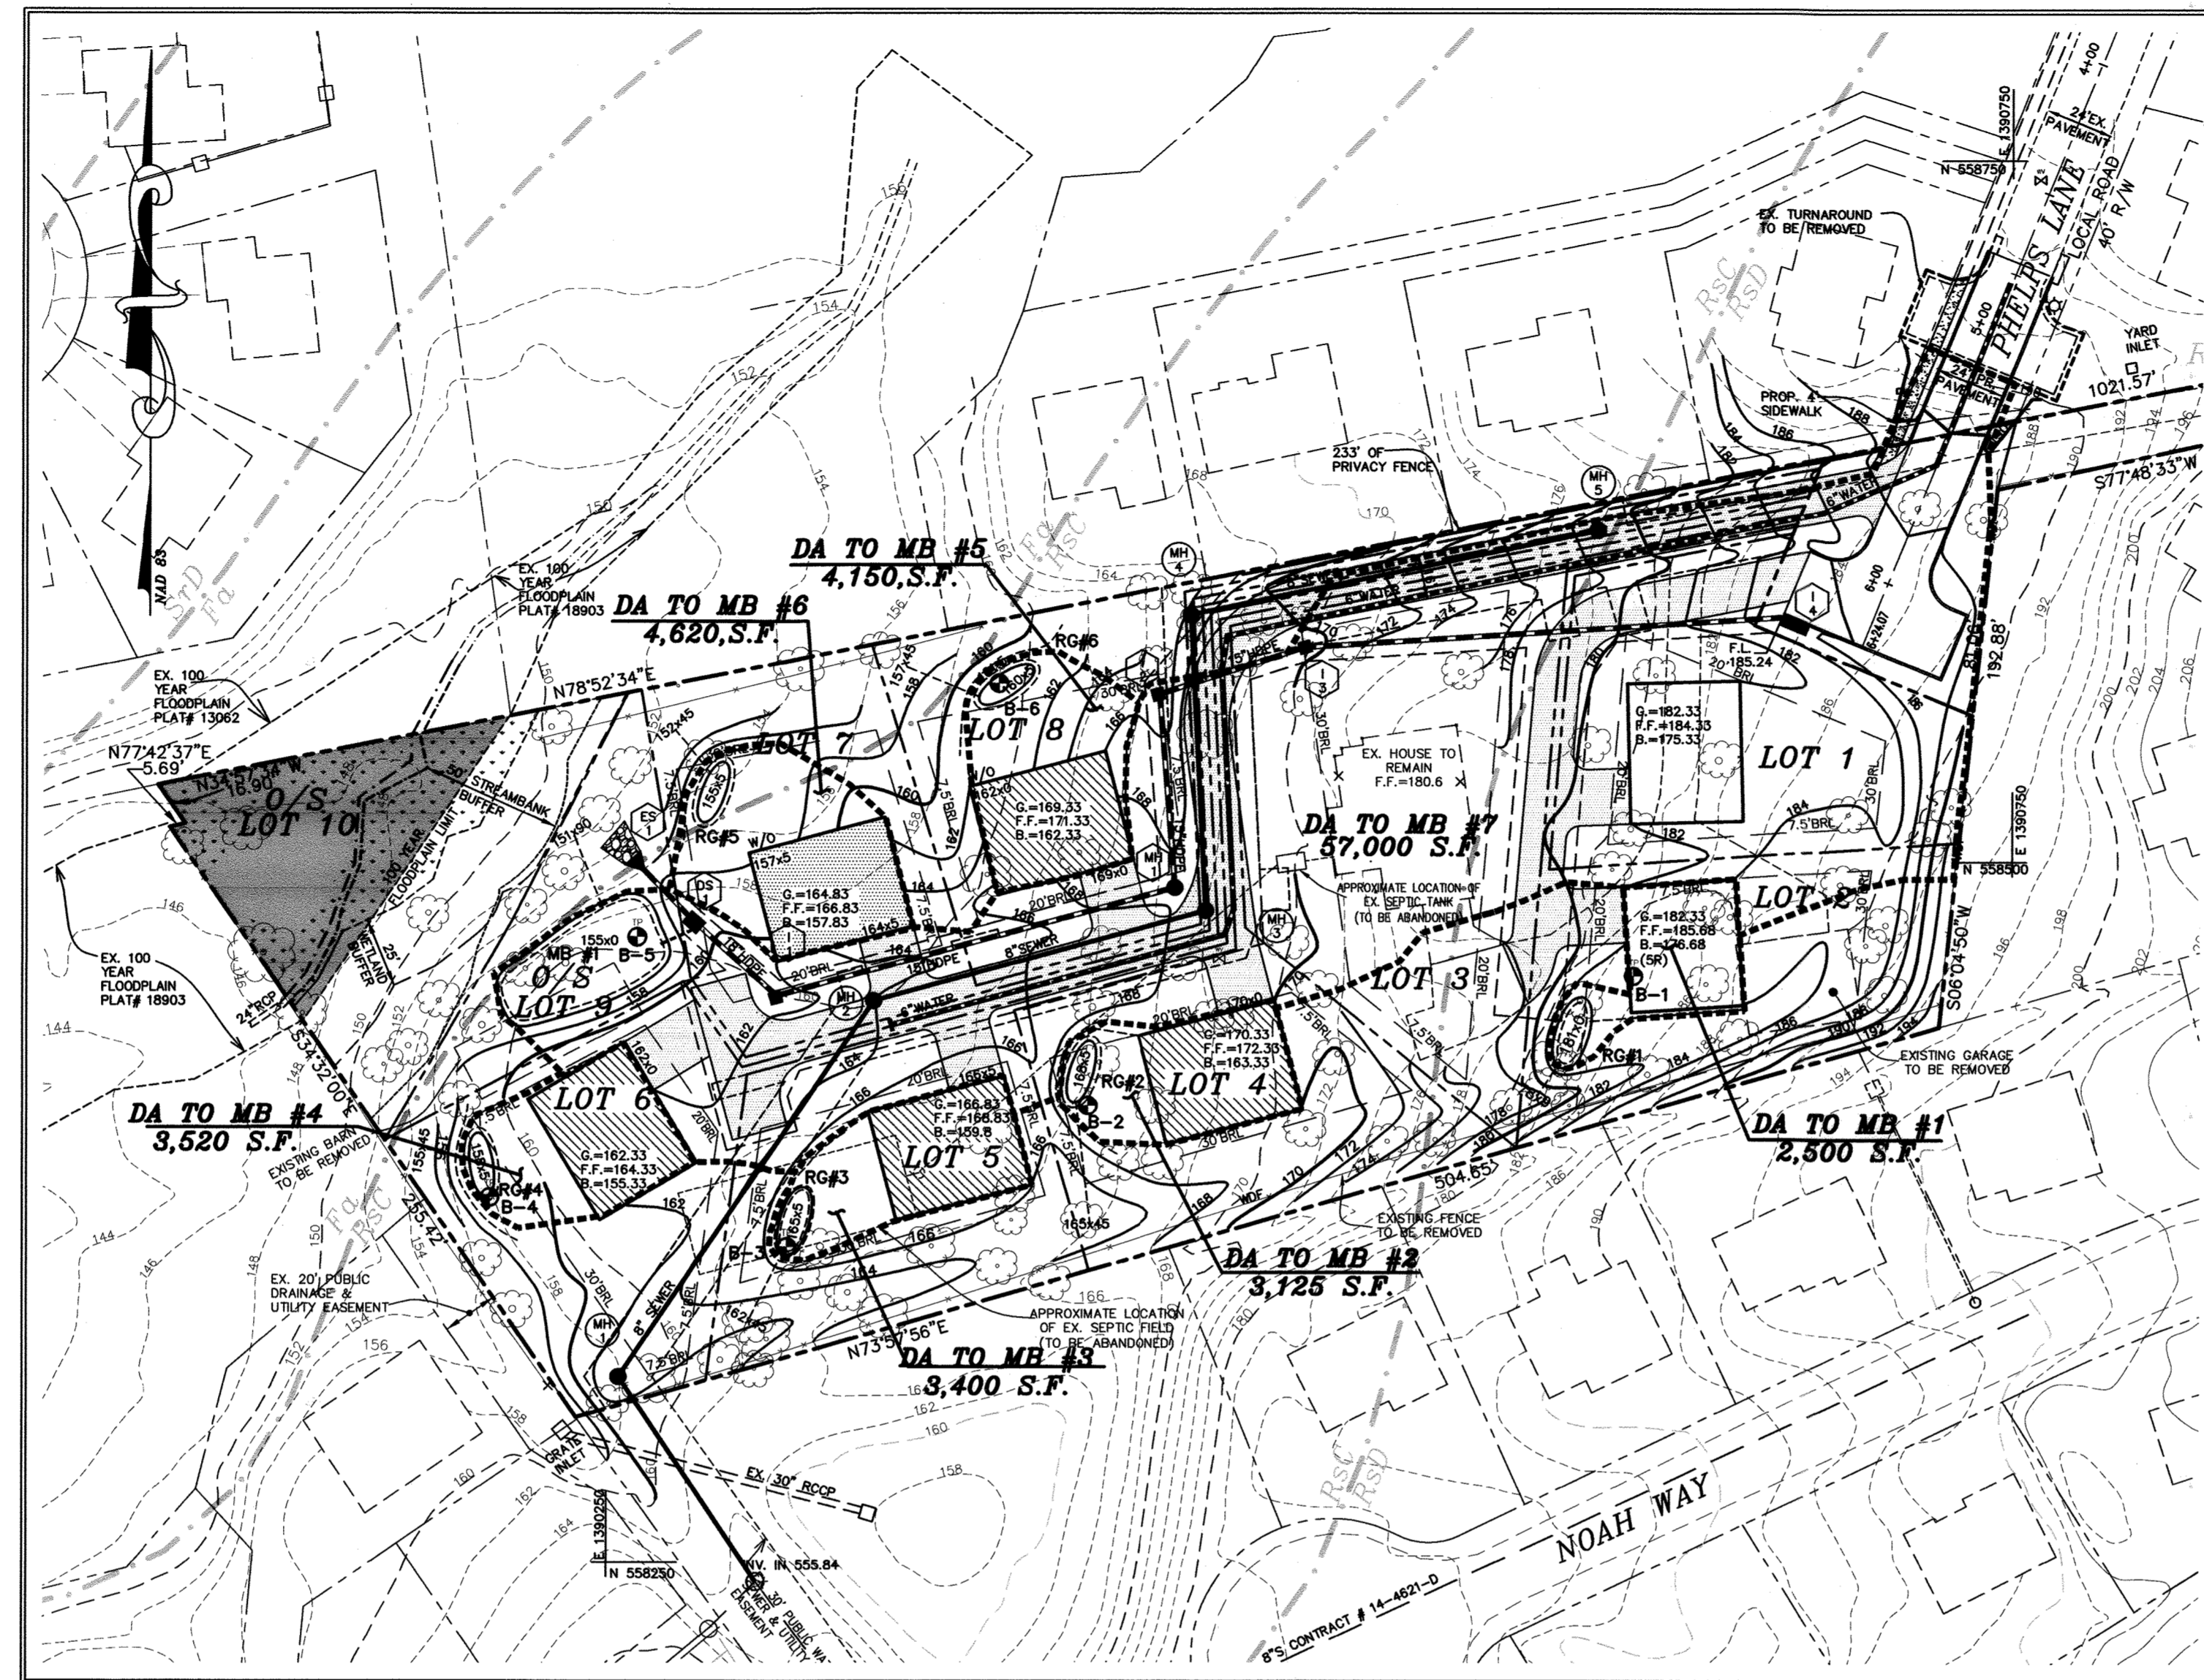

MICRO-BIORETENTION #1 (M-6) PLAN
SCALE: 1"=20'

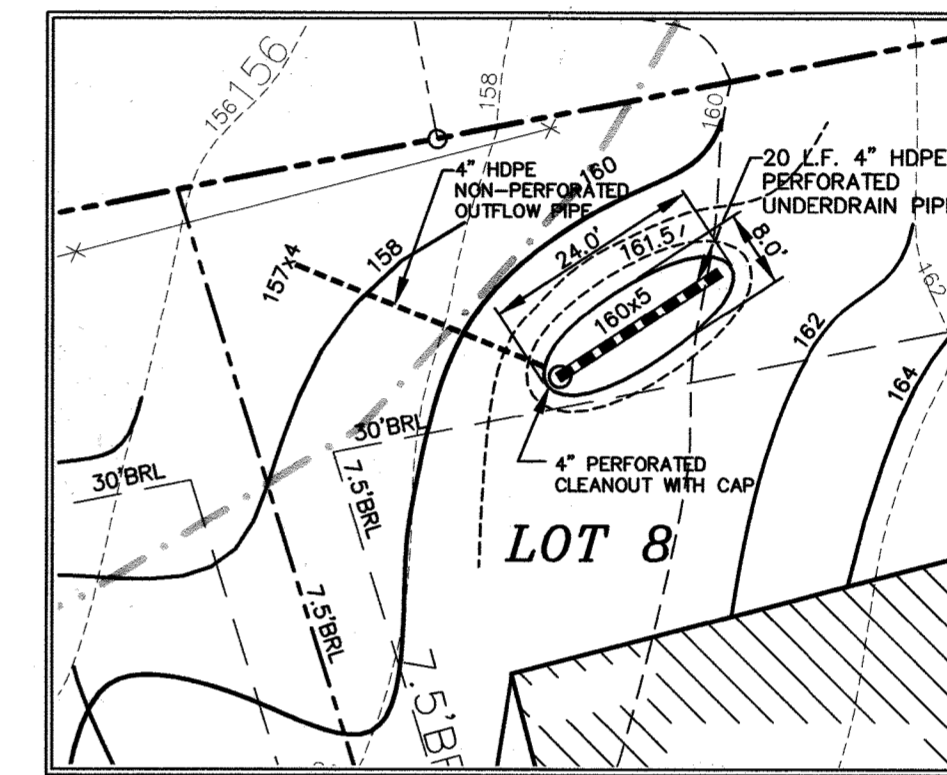

TYPICAL RAIN GARDEN (M-7) PLAN
SCALE: 1"=20'

OPERATION AND MAINTENANCE SCHEDULE FOR MICRO-BIORETENTION (M-6)

ANNUAL MAINTENANCE OF PLANT MATERIAL, MULCH LAYER AND SOIL LAYER IS REQUIRED. MAINTENANCE OF MULCH AND SOIL IS LIMITED TO CORRECTING AREAS OF EROSION OR WASH OUT. ANY MULCH REPLACEMENT SHALL BE DONE IN THE SPRING. PLANT MATERIAL SHALL BE CHECKED FOR DISEASE AND INSECT INFESTATION AND MAINTENANCE WILL ADDRESS DEAD MATERIAL AND PRUNING. ACCEPTABLE REPLACEMENT PLANT MATERIAL IS LIMITED TO THE FOLLOWING: 2000 MARYLAND STORMWATER DESIGN MANUAL VOLUME II, TABLE A.4.1 AND 2 AND MAX PLANTING MATERIAL LIST.

SCHEDULE OF PLANT INSPECTION WILL BE TWICE A YEAR IN SPRING AND FALL. THIS INSPECTION WILL INCLUDE REMOVAL OF DEAD AND DISEASED VEGETATION CONSIDERED BEYOND TREATMENT, TREATMENT OF ALL DISEASED TREES AND SHRUBS AND REPLACEMENT OF ALL DEFICIENT STAKES AND TREES.

MULCH SHALL BE INSPECTED EACH SPRING. REMOVE PREVIOUS MULCH LAYER BEFORE APPLYING NEW LAYER ONCE EVERY 2 TO 3 YEARS.


SOIL EROSION TO BE ADDRESSED ON AN AS NEEDED BASIS, WITH A MINIMUM OF ONCE PER MONTH AND AFTER HEAVY STORM EVENTS.

REMOVE AND REPLACE TOP FEW INCHES OF PLANTING MEDIA IF WATER PONDS FOR MORE THAN 24 HOURS FOLLOWING ANY STORM EVENT.

MICRO-BIORETENTION SCHEDULE

FACILITY	TOP EL.	TOP OF BERM	INV. IN	INV. OUT	AREA AT TOP EL.
*RG #1	181.00	182.00	178.08	177.90	150 SF
*RG #2	168.50	169.50	165.58	165.45	150 SF
*RG #3	165.50	166.50	162.58	162.45	150 SF
*RG #4	158.50	159.50	155.58	155.45	150 SF
*RG #5	155.5	156.5	152.58	152.45	150 SF
*RG #6	160.50	161.50	157.58	157.45	150 SF
*MB #1	154.75	156.00	152.08	151.90	1,430 SF

*RG#1 THRU RG#6 ARE ON-LOT STORMWATER MANAGEMENT FACILITIES AND ARE AS-BUILT ON THE GRADING CERTIFICATIONS FOR EACH LOT.

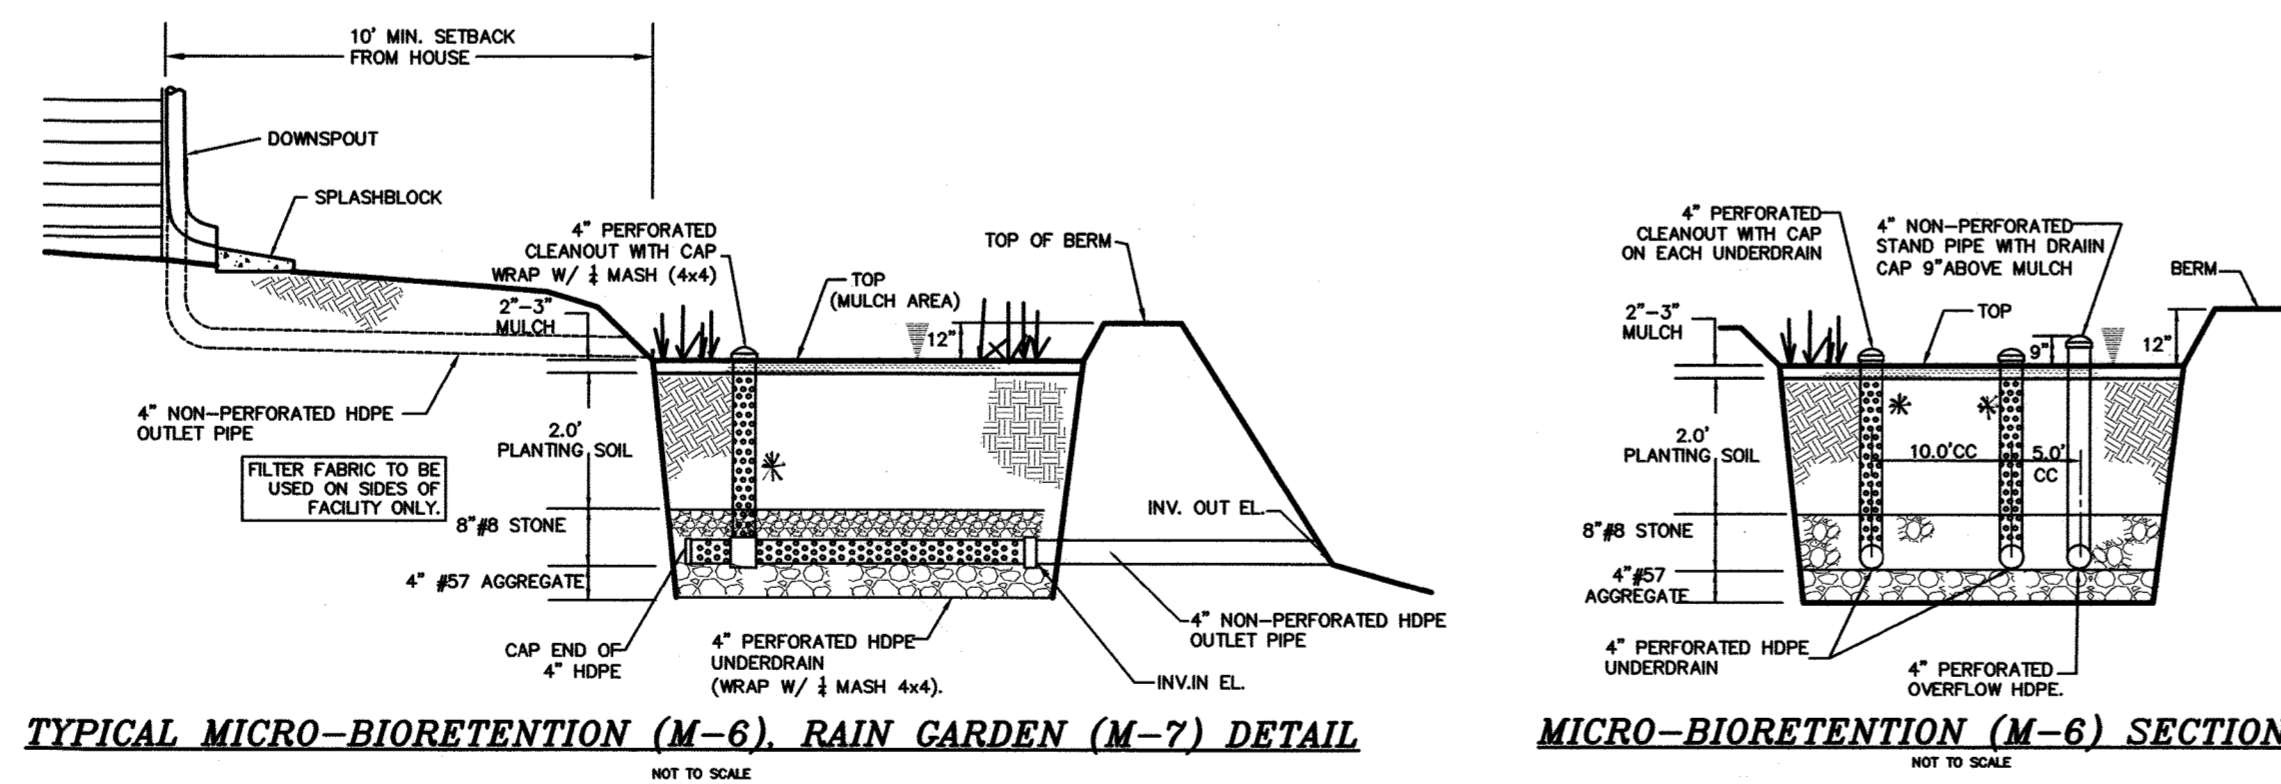

TYPICAL MICRO-BIORETENTION (M-6), RAIN GARDEN (M-7) DETAIL

MICRO-BIORETENTION (M-6) SECTION


*NO PERFORATIONS WITHIN THE SOIL MEDIA. USE SOLID PVC WITHIN THE SOIL MEDIA.

- MIXED PERENNIALS
- CUT-LEAF CONEFLOWER (1.5' SP.)
- BEEBALM (1.5' SP.)
- JOW-PYE-WEED (3' SP.) OR EQUIVALENT.
- MIXED PERENNIALS
- INK BERRY OR EQUIVALENT
- INK BERRY

NOTE: PLANT MATERIAL MUST COVER AT LEAST 50% OF THE SURFACE AREA OF THE MICRO-BIORETENTION

TYP. MICRO-BIORETENTION (M-6) DETAIL
SCALE: NTS

NOTE: PLANT MATERIAL MUST BE IN ACCORDANCE WITH AAA PLANTING MATERIAL LIST AND COVER AT LEAST 50% OF THE SURFACE AREA OF THE MICRO-BIORETENTION

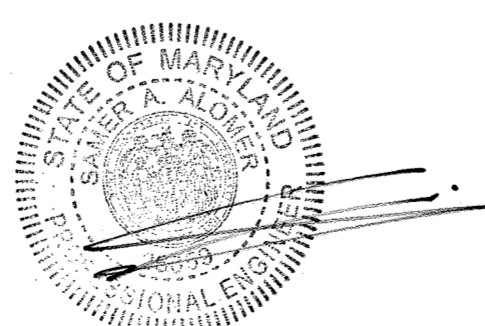

I hereby certify that the facility shown on this plan was constructed as shown on the 'As-Built' plans and meets with the approved plans and specifications.

ENGINEER'S CERTIFICATE
I CERTIFY THAT THIS PLAN FOR EROSION AND SEDIMENT CONTROL REPRESENTS A PRACTICAL AND WORKABLE PLAN BASED ON MY PERSONAL KNOWLEDGE OF THE SITE CONDITIONS AND THAT IT WAS PREPARED IN ACCORDANCE WITH THE REQUIREMENTS OF THE HOWARD SOIL CONSERVATION DISTRICT.
SIGNATURE OF ENGINEER: R. JACOB HIKMAT, PE. DATE: 1/16/18

DEVELOPERS CERTIFICATE
I CERTIFY THAT ALL DEVELOPMENT AND CONSTRUCTION WILL BE DONE ACCORDING TO THIS PLAN, AND THAT ANY RESPONSIBLE PERSONNEL INVOLVED IN THE CONSTRUCTION PROJECT WILL HAVE A CERTIFICATE OF ATTENDANCE AT A DEPARTMENT OF THE ENVIRONMENT APPROVED TRAINING PROGRAM FOR THE CONTROL OF SEDIMENT AND EROSION BEFORE BEGINNING THE PROJECT. HOWARD SOIL CONSERVATION DISTRICT IS AUTHORIZED TO CONDUCT PERIODIC ON-SITE INSPECTION.
SIGNATURE OF DEVELOPER: WM. SCOTT GODFREY. DATE: 01/18/18

APPROVED: DEPARTMENT OF PUBLIC WORKS
SIGNATURE: [Signature]. DATE: 1/31/18

APPROVED: DEPARTMENT OF PLANNING AND ZONING
SIGNATURE: [Signature]. DATE: 2/28/18

APPROVED: DEPARTMENT OF LAND DEVELOPMENT
SIGNATURE: [Signature]. DATE: 3/14/18

OWNER: HARMONY BUILDERS INC, 4228 COLUMBIA ROAD, ELLICOTT CITY, MD 21042, 410-461-0833

I HEREBY CERTIFY THAT THESE DOCUMENTS WERE PREPARED OR APPROVED BY ME AND THAT I AM A DULY LICENSED PROFESSIONAL ENGINEER UNDER THE LAWS OF THE STATE OF MARYLAND, LICENSE NO. 17942, EXP. DATE 09/03/18.

R. JACOB HIKMAT P.E. DATE: 1/16/18

Project	15-011	date	JAN. 2018
Illustration	MM	engineering	MM
scale	1"=50'	approval	RH

description	AS-BUILT / INF. ADDED	date	JAN 2018
revisions			

ELKDALE GLENN PROPERTY
LOTS 1-8, OPEN SPACE LOTS 9 & 10 AND NON-BUILDABLE BULK PARCEL A
TAX MAP 38, GRID 15, PARCEL 871
FIRST ELECTION DISTRICT
HOWARD COUNTY, MARYLAND
STORMWATER MANAGEMENT PLAN AND DETAILS

MILDENBERG, BOENDER & ASSOC., INC.
Engineers Planners Surveyors
7350-B Craco Drive, Columbia, Maryland 21044
(410) 997-0286 Tel. (410) 997-0286 Fax

