

SOILS LEGEND


SOIL	NAME	CLASS
Co	Codorus and Habero silt loams, 0 to 3 percent slopes	C
GmC	Glenville silt loam, 0 to 15 percent slopes	C
LeB	Legore silt loam, 3 to 8 percent slopes, stony	C
LeC	Legore silt loam, 8 to 15 percent slopes, stony	C
LoB	Legore-Montalto-Urban land complex, 0 to 8 percent slopes	B
LoC	Legore-Montalto-Urban land complex, 8 to 15 percent slopes	B
LrD	Legore-Relay gravelly loams, 15 to 25 percent slopes, very stony	B/C
LrF	Legore-Relay gravelly loams, 25 to 65 percent slopes, very stony	B/C
MnC	Manor loam, 0 to 15 percent slopes	B
UaF	Udorthens, Highway, 0 to 65 percent slopes	X
WcB	Waching silt loam, 3 to 8 percent slopes, stony	D

- TP — DENOTES TREE PROTECTION FENCE
- X DENOTES TREE TO BE REMOVED
- [Hatched Box] DENOTES UTILITY TO BE REMOVED

SPECIMEN TREE CHART

Key (ST-#)	Species	Size (in. dbh)	CRZ (feet radius)	Comments
*1	Red oak	38	57	
*2	Red oak	35	52.5	
3	Tulip poplar	34	51	
4	Black oak	35	52.5	fair, limb dieback noted
5	American beech	30	45	
6	Black walnut	34	51	
7	Tulip poplar	35	52.5	twin stems above breast height
*8	Tulip poplar	34	51	
9	Black oak	35	52.5	
*10	White oak	31	46.5	
*11	Tulip poplar	52	78	fair, limb dieback and heavy vine cover
12	American beech	34	51	
13	White oak	49.5	74.25	
**14	White oak	41	61.5	fair, heavily trimmed
15	White oak	36	54	
16	White oak	49	73.5	

* DENOTES: ST1, ST2, ST8, ST10, & ST11 ARE TO BE REMOVED.
 ** DENOTES ST14 TAKEN DOWN DUE TO HAZARD OF FALLING ON HOUSE.

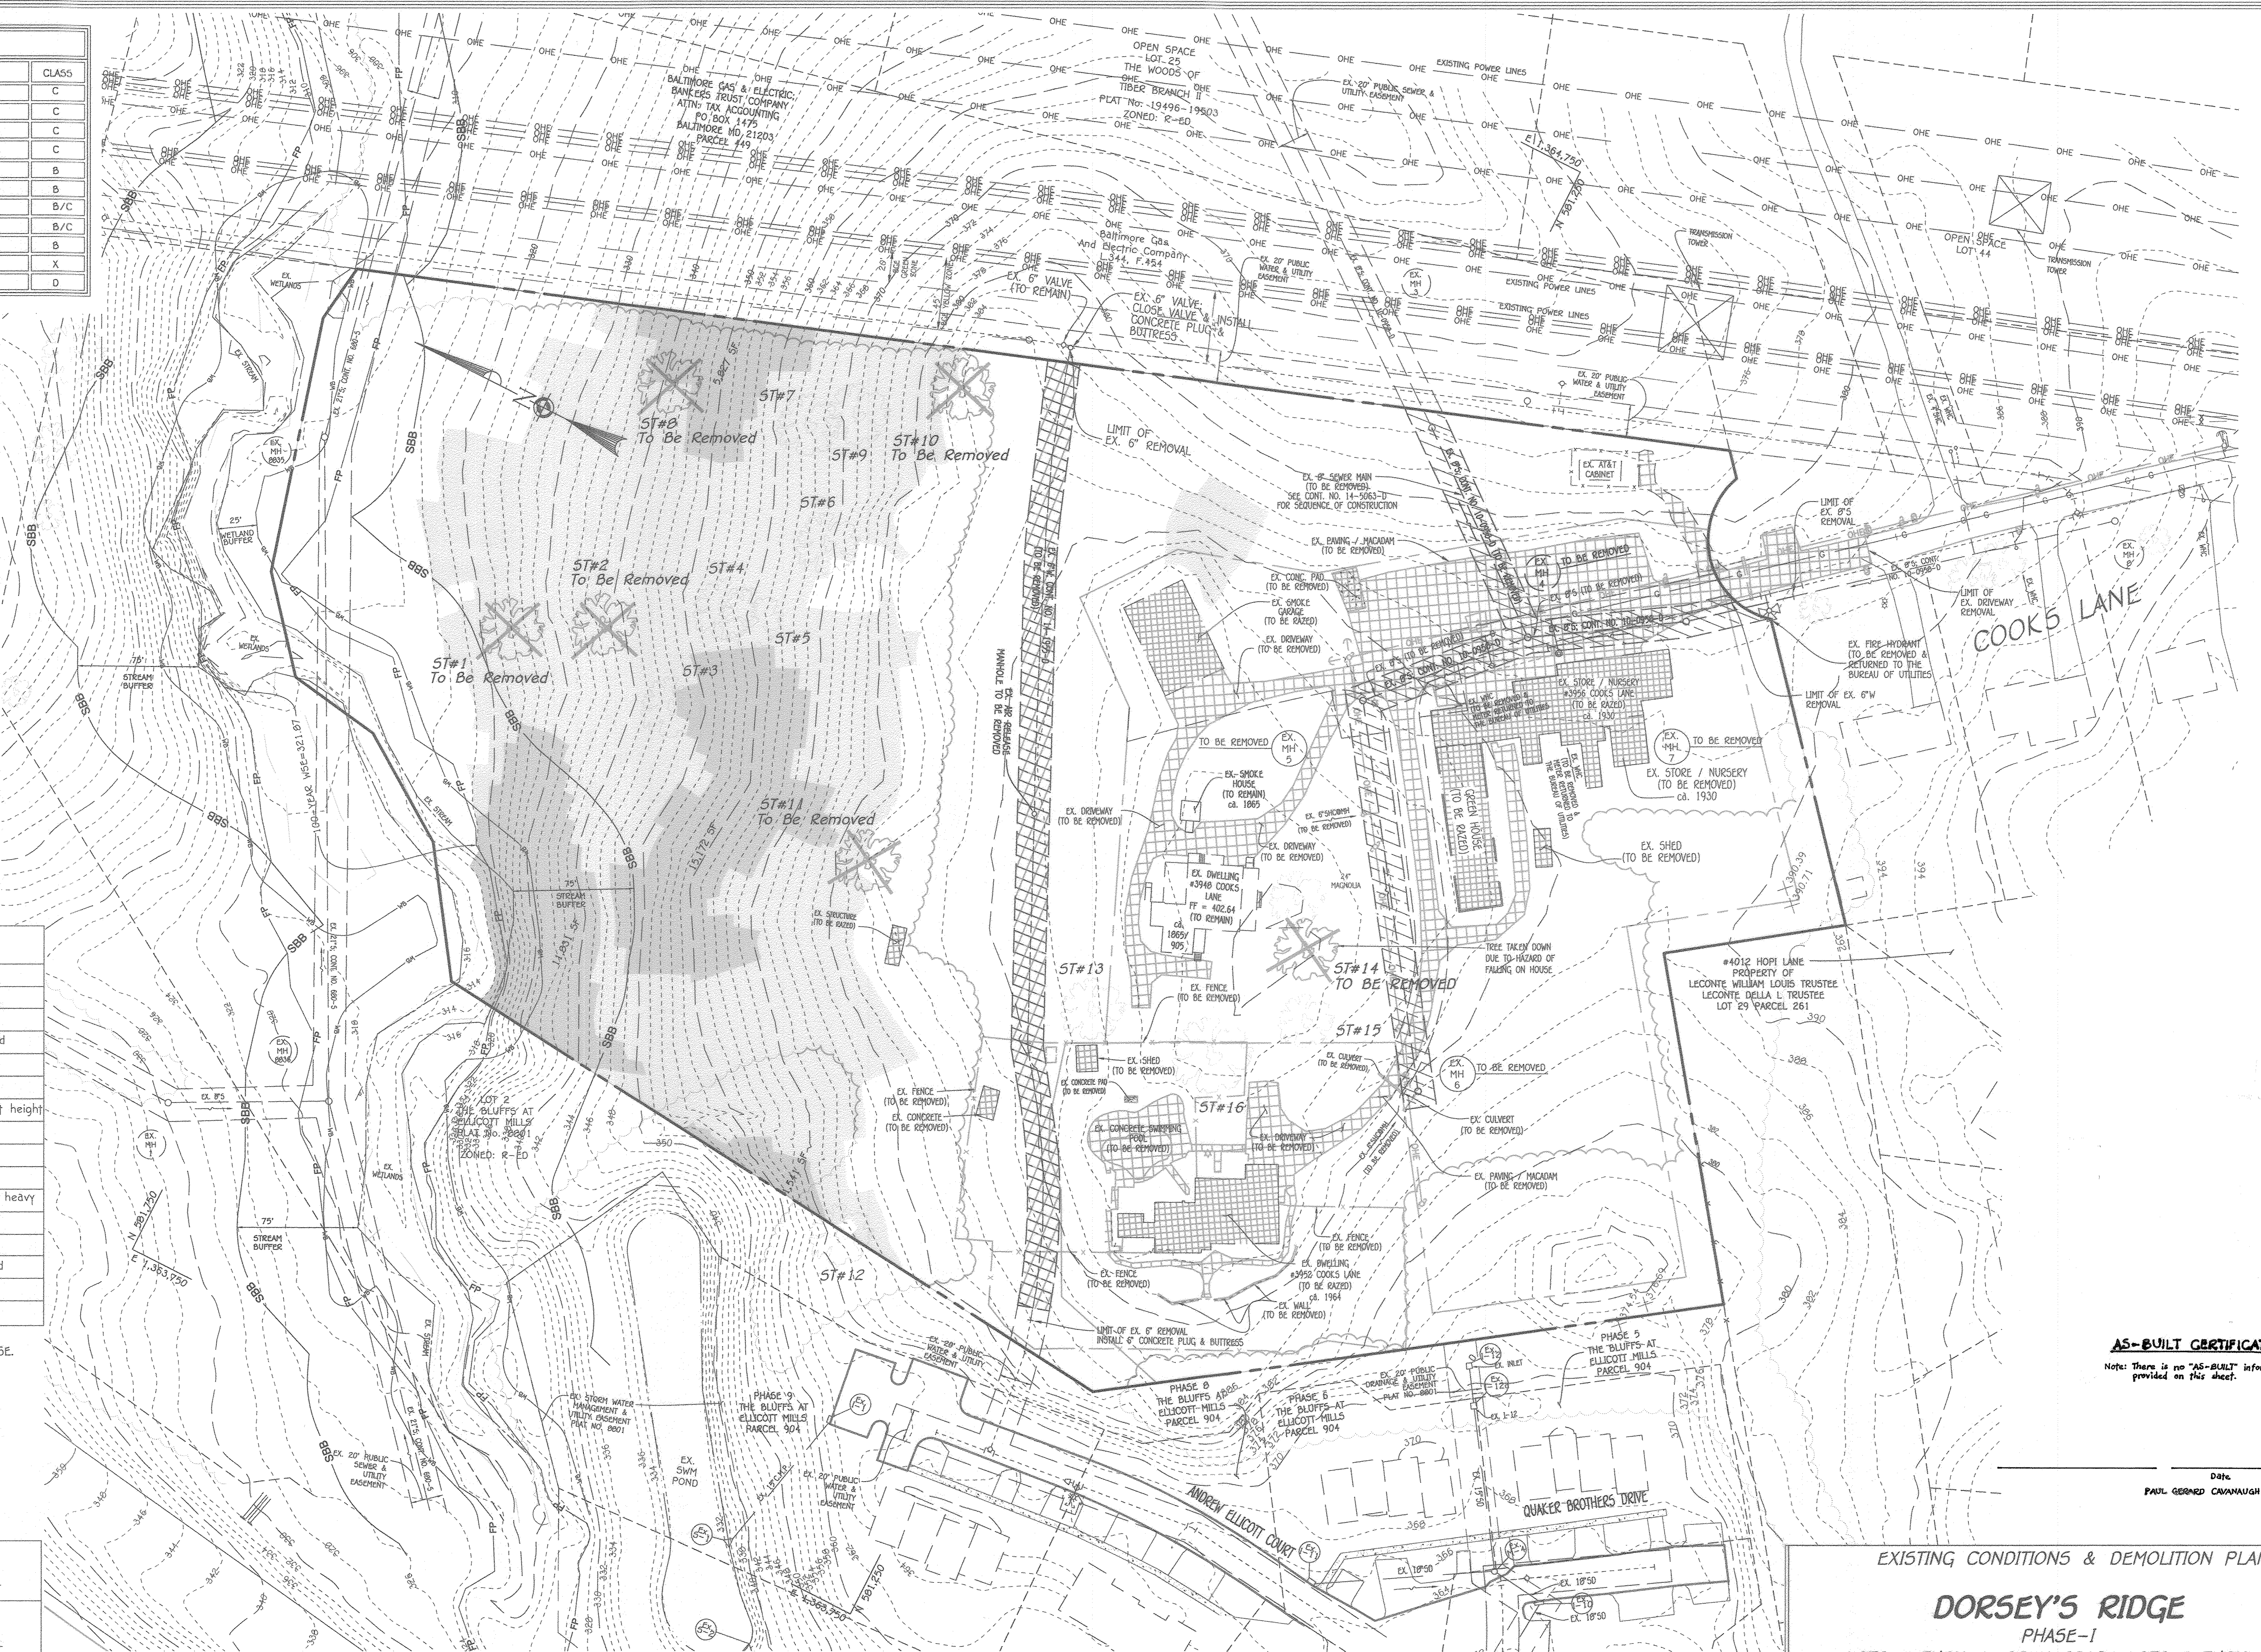


APPROVED: DEPARTMENT OF PUBLIC WORKS
 [Signature] 5/17/2020
 CHIEF, BUREAU OF HIGHWAYS MK DATE

APPROVED: DEPARTMENT OF PLANNING AND ZONING
 [Signature] 5-28-20
 CHIEF, DEVELOPMENT ENGINEERING DIVISION HSP DATE


NO.	REVISIONS DESCRIPTION	DATE

FISHER, COLLINS & CARTER, INC.
 CIVIL ENGINEERING CONSULTANTS & LAND SURVEYORS
 CENTENNIAL SQUARE OFFICE PARK - 10272 BALTIMORE NATIONAL PIKE
 ELLICOTT CITY, MARYLAND 21042
 (410) 461-2855

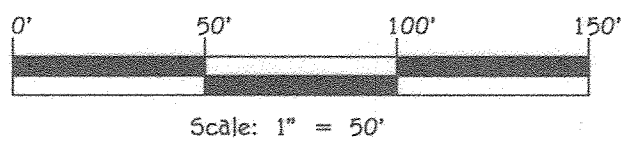

OWNER/DEVELOPER
 DORSEY'S RIDGE, LLC
 C/O DAVE WOSSNER
 308 MAGOTHY ROAD
 SEVERNA PARK, MD 21146
 410-461-0837

PROFESSIONAL CERTIFICATION
 I HEREBY CERTIFY THAT THESE DOCUMENTS WERE PREPARED OR APPROVED BY ME AND THAT I AM A DULY LICENSED PROFESSIONAL ENGINEER UNDER THE LAWS OF THE STATE OF MARYLAND, LICENSE NO. 20748, EXPIRATION DATE: 02/22/2021.
 [Signature] 5/27/2020
 Signature of Professional Engineer DATE

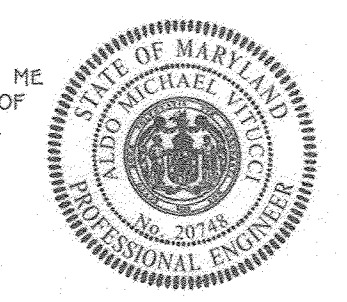

EXISTING CONDITIONS & DEMOLITION PLAN
DORSEY'S RIDGE
 PHASE-1
 LOTS 1 THRU 4, OPEN SPACE LOTS 5 THRU 8,
 & NON-BUILDABLE BULK PARCELS A THRU F
 'A RESUBDIVISION OF "WILHIDE PROPERTY, LOT 1, 2 & 3", PLAT NO. 18442
 ZONED: CEF-2
 TAX MAP NO.: 24 GRID NO.: 18 PARCEL NO.: 260 LOTS: 1 THRU 3
 SECOND ELECTION DISTRICT HOWARD COUNTY, MARYLAND
 SCALE: AS SHOWN DATE: MAY, 2020
 SHEET 2 OF 18

AS-BUILT CERTIFICATION
 Note: There is no "AS-BUILT" information provided on this sheet.

Date:
 PAUL GERARD CUMMINGS #27020

- ✕ DENOTES REBAR AND CAP SET (FCC #106)
- ✕ DENOTES X-MARK SET
- ⊗ DENOTES PK NAIL SET
- DENOTES CONCRETE MONUMENT SET

Centerline Curve Table

Curve #	Street	Length	Radius	Delta	Chord Length	Chord Bearing
C1	Dorseys Ridge Square	22.91'	100.00'	13°07'39"	22.86'	S 46°53'25.76" W
C2	Dorseys Ridge Square	81.68'	52.00'	90°00'00"	73.54'	N 81°32'44.75" W
C3	Dorseys Ridge Square	113.02'	400.00'	16°11'21"	112.65'	N 28°27'04.30" W
C4	Dorseys Ridge Square	80.20'	52.00'	88°21'57"	73.54'	N 23°49'34.82" E
C5	Cooks Lane	90.58'	100.00'	51°53'53"	87.51'	S 47°56'23.42" E
C6	Cooks Lane	65.18'	100.00'	37°20'35"	64.03'	S 55°13'02.53" E
C7	Cooks Lane	81.83'	250.00'	18°45'16"	81.47'	S 27°10'07.91" E

LEGEND

SYMBOL	DESCRIPTION	SYMBOL	DESCRIPTION
	PROPOSED CONTOURS		FOREST CONSERVATION EASEMENT
	PROPOSED STORM DRAIN		EXISTING WETLANDS & WETLAND BUFFER
	PROPOSED DRYWELL (M-5)		EXISTING FLOODPLAIN
	PROPOSED WATER LINE		EXISTING OVER HEAD POWER LINES
	PROPOSED SEWER LINE		EXISTING SEWER LINE
	LIMIT OF DISTURBANCE		EXISTING WATER LINE
	PROPOSED PAVING		PROPOSED STREET TREE
	PROPOSED SIDEWALKS		
	SPOT ELEVATION		
	FLOW ARROW		
	NON-CREDITED OPEN SPACE		NO PARKING SIGN
			NO PARKING SIGN ON LIGHT POLE

Centerline Line Table

Curve #	Street	Length	Bearing
L1	Cooks Lane	141.45'	S 21°59'27" E
L2	Cooks Lane	86.37'	S 36°32'45" E
L3	Cooks Lane	202.36'	S 40°24'40" E
L4	Dorseys Ridge Square	64.20'	S 40°19'36" W
L5	Dorseys Ridge Square	132.54'	S 53°27'15" W
L6	Dorseys Ridge Square	35.54'	N 36°32'45" W
L7	Dorseys Ridge Square	23.09'	N 20°21'24" W
L8	Dorseys Ridge Square	400.52'	N 68°00'33" E


AS-BUILT CERTIFICATION
 I hereby certify, by my seal, that to the best of my knowledge and belief that the facilities shown on this plan were constructed as shown on this "AS-BUILT" plan meet the approved plans and specifications.

Date
 PAUL GERARD CAVANAUGH


NO.	DESCRIPTION	DATE
1	REVERSE MAILBOX, PAVEMENT, CHANGES TO WATER, SEWER, STORM DRAIN, SWM, LOT LINES 30-40 COOKS LANE CURB & PROFILE	6/7/22
		3/1/22

APPROVED: DEPARTMENT OF PLANNING AND ZONING
 CHIEF, DIVISION OF LAND DEVELOPMENT
 DATE: 3/1/22

APPROVED: HOWARD COUNTY DEPARTMENT OF PUBLIC WORKS
 CHIEF, BUREAU OF HIGHWAYS
 DATE: 02/14/2022

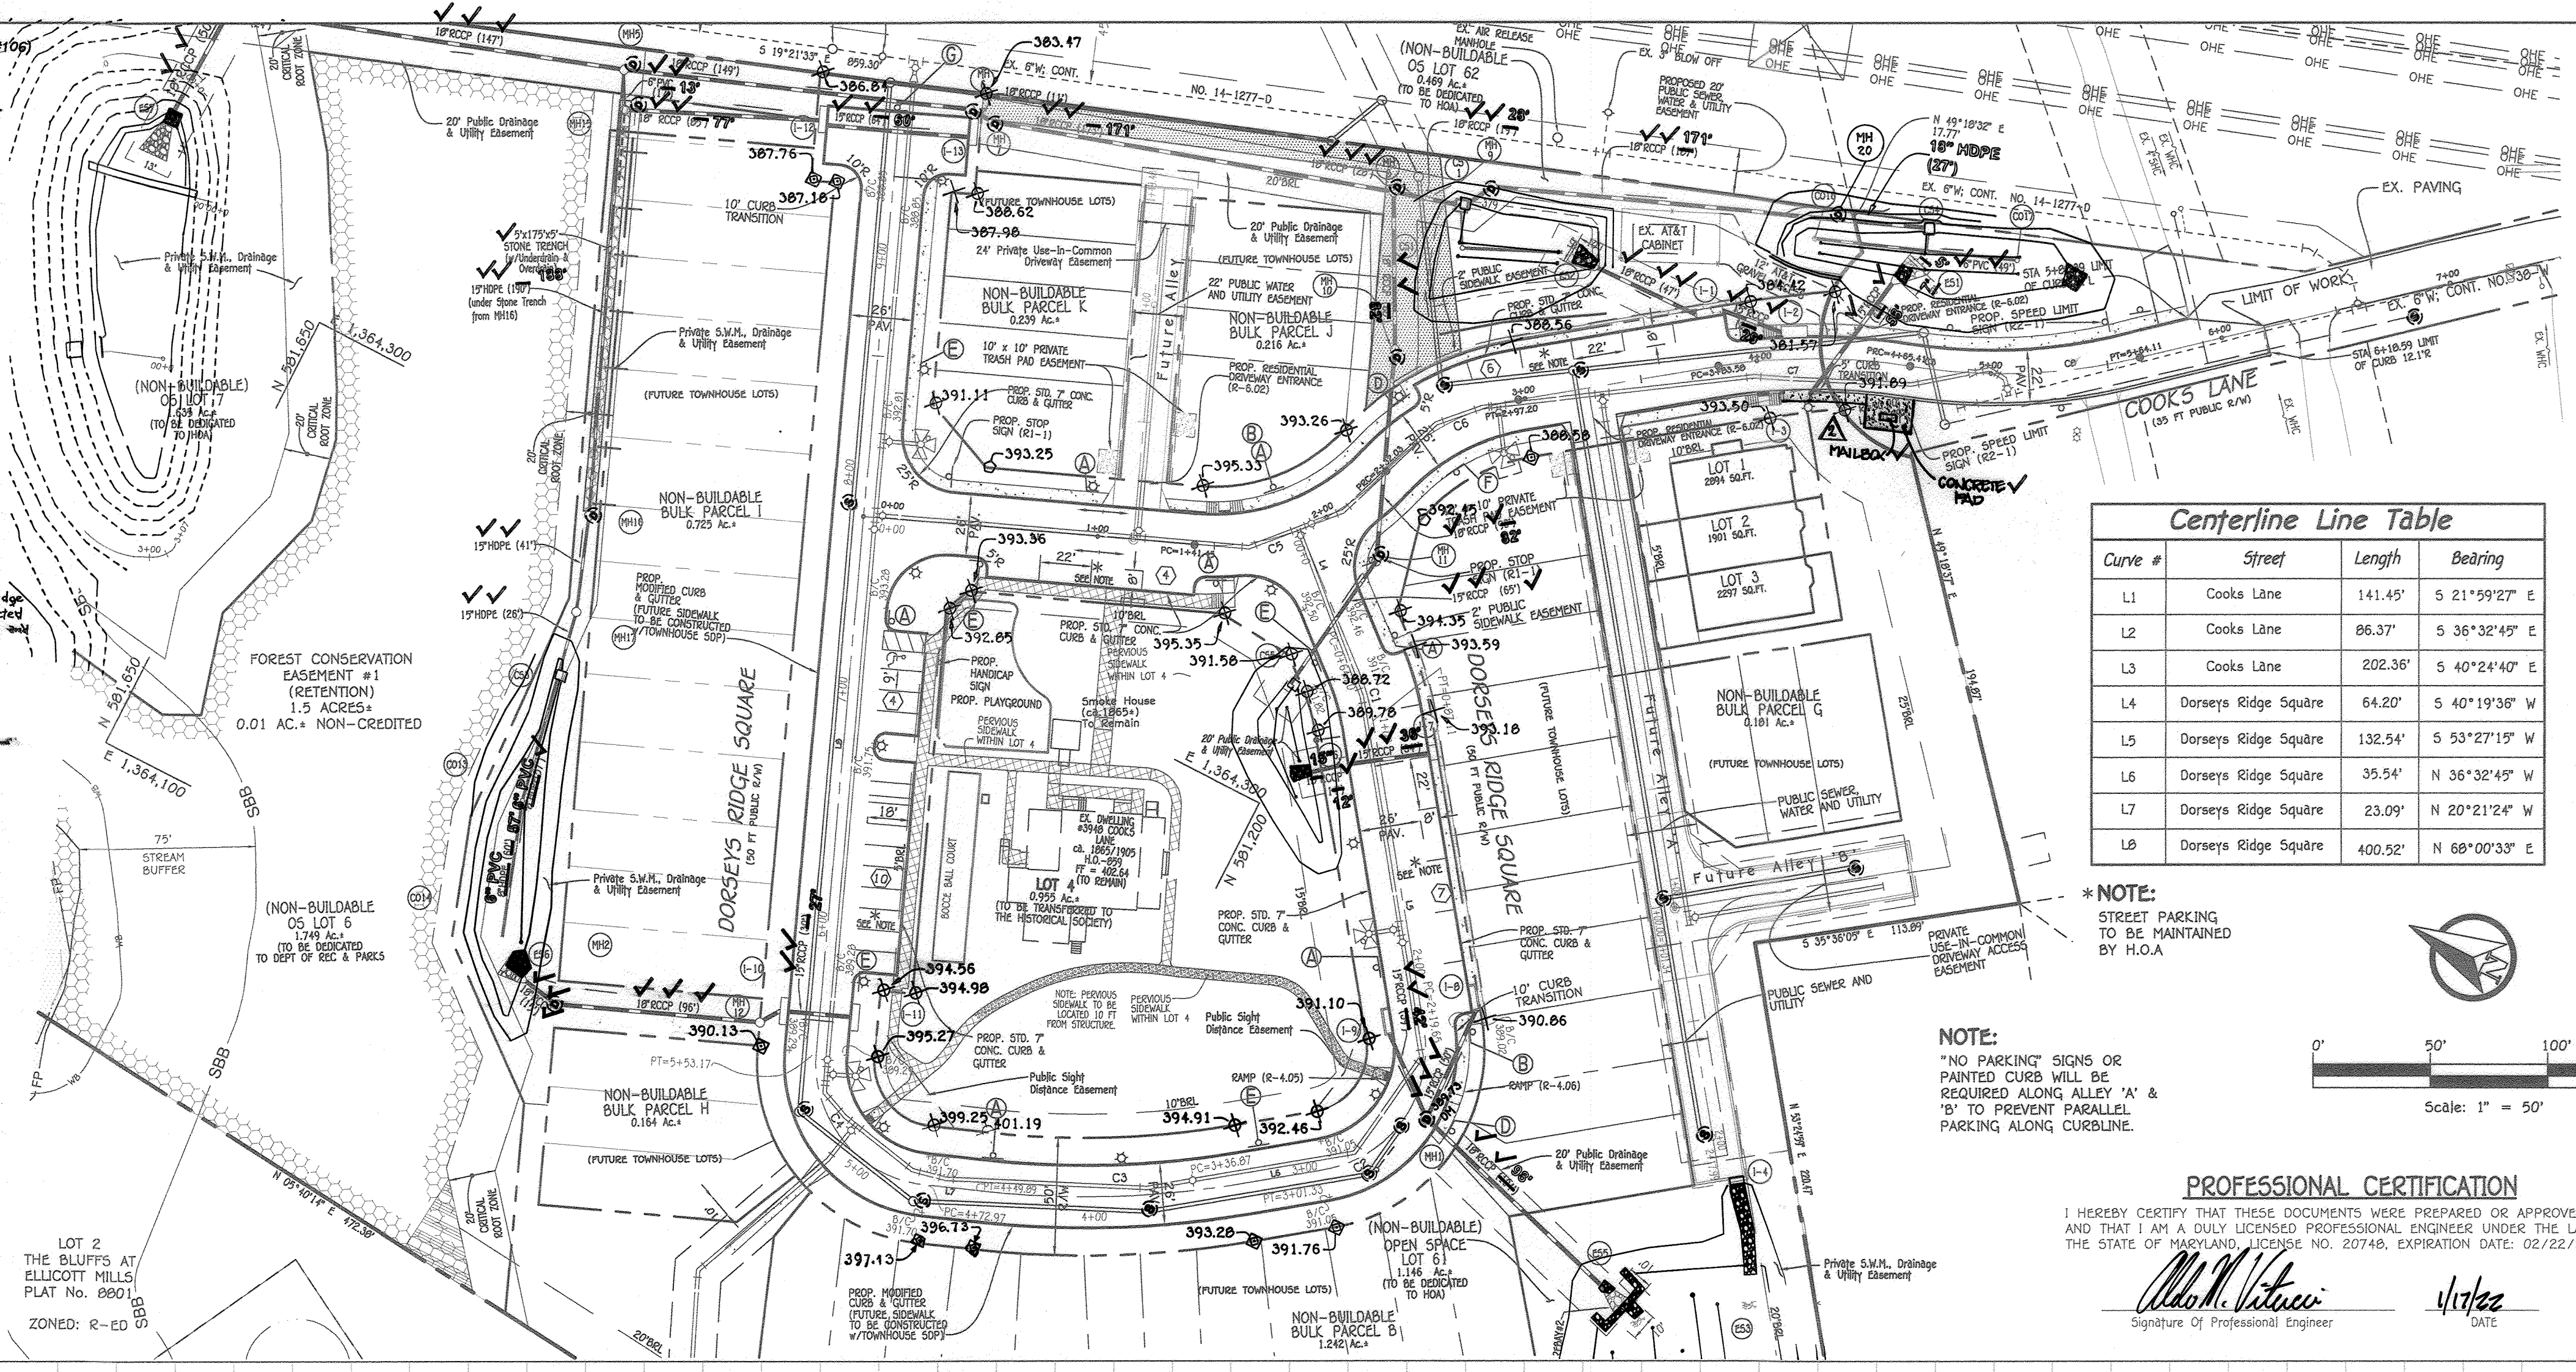

*NOTE:
 STREET PARKING TO BE MAINTAINED BY H.O.A.
 *NO PARKING SIGNS OR PAINTED CURBS WILL BE REQUIRED ALONG ALLEY 'A' & 'B' TO PREVENT PARALLEL PARKING ALONG CURBLINE.

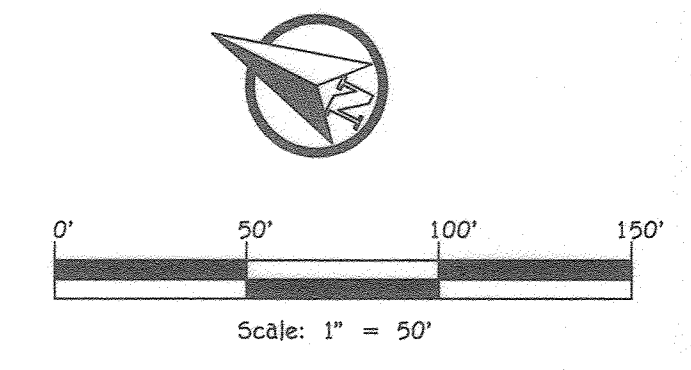

PROFESSIONAL CERTIFICATION
 I HEREBY CERTIFY THAT THESE DOCUMENTS WERE PREPARED OR APPROVED BY ME AND THAT I AM A DULY LICENSED PROFESSIONAL ENGINEER UNDER THE LAWS OF THE STATE OF MARYLAND, LICENSE NO. 20748, EXPIRATION DATE: 02/22/2023.
 Signature of Professional Engineer: [Signature]
 DATE: 1/1/22



REPLACEMENT SHEET (SEE LEGEND, SHEET 4.)


DORSEY'S RIDGE PHASE-1
 LOTS 1 THRU 4, OPEN SPACE LOTS 6,7,61,62 & NON-BUILDABLE BULK PARCELS B, G THRU K
 A Resubdivision of "Wildfire Property, Lot 1, 2 & 3", Plat No. 184442
 Zoned: CEF
 Tax Map No.: 24 Grid No.: 18 Parcel No.: 260 Lots: 1 thru 3
 Second Election District Howard County, Maryland



COOKS LANE DORSEYS RIDGE SQUARE
 ROAD PLAN AND PROFILE ROAD PLAN

OWNER/DEVELOPER
 DORSEYS RIDGE, LLC
 C/O DAVE WOESSNER
 308 MAGDOY ROAD
 SEVERNA PARK, MD 21146
 410-461-0837

SCALE: AS SHOWN DATE: DECEMBER, 2021 DWG. NO. 3 OF 18
 DES. S.J.T. DRN. J.C.L. CHK. F.J.M.




FISHER, COLLINS & CARTER, INC.
 CIVIL ENGINEERING CONSULTANTS & LAND SURVEYORS
 CENTRAL SQUARE OFFICE PARK - 16275 BALTIMORE NATIONAL PIKE
 ELLICOTT CITY, MARYLAND 21114
 (410) 461-2895

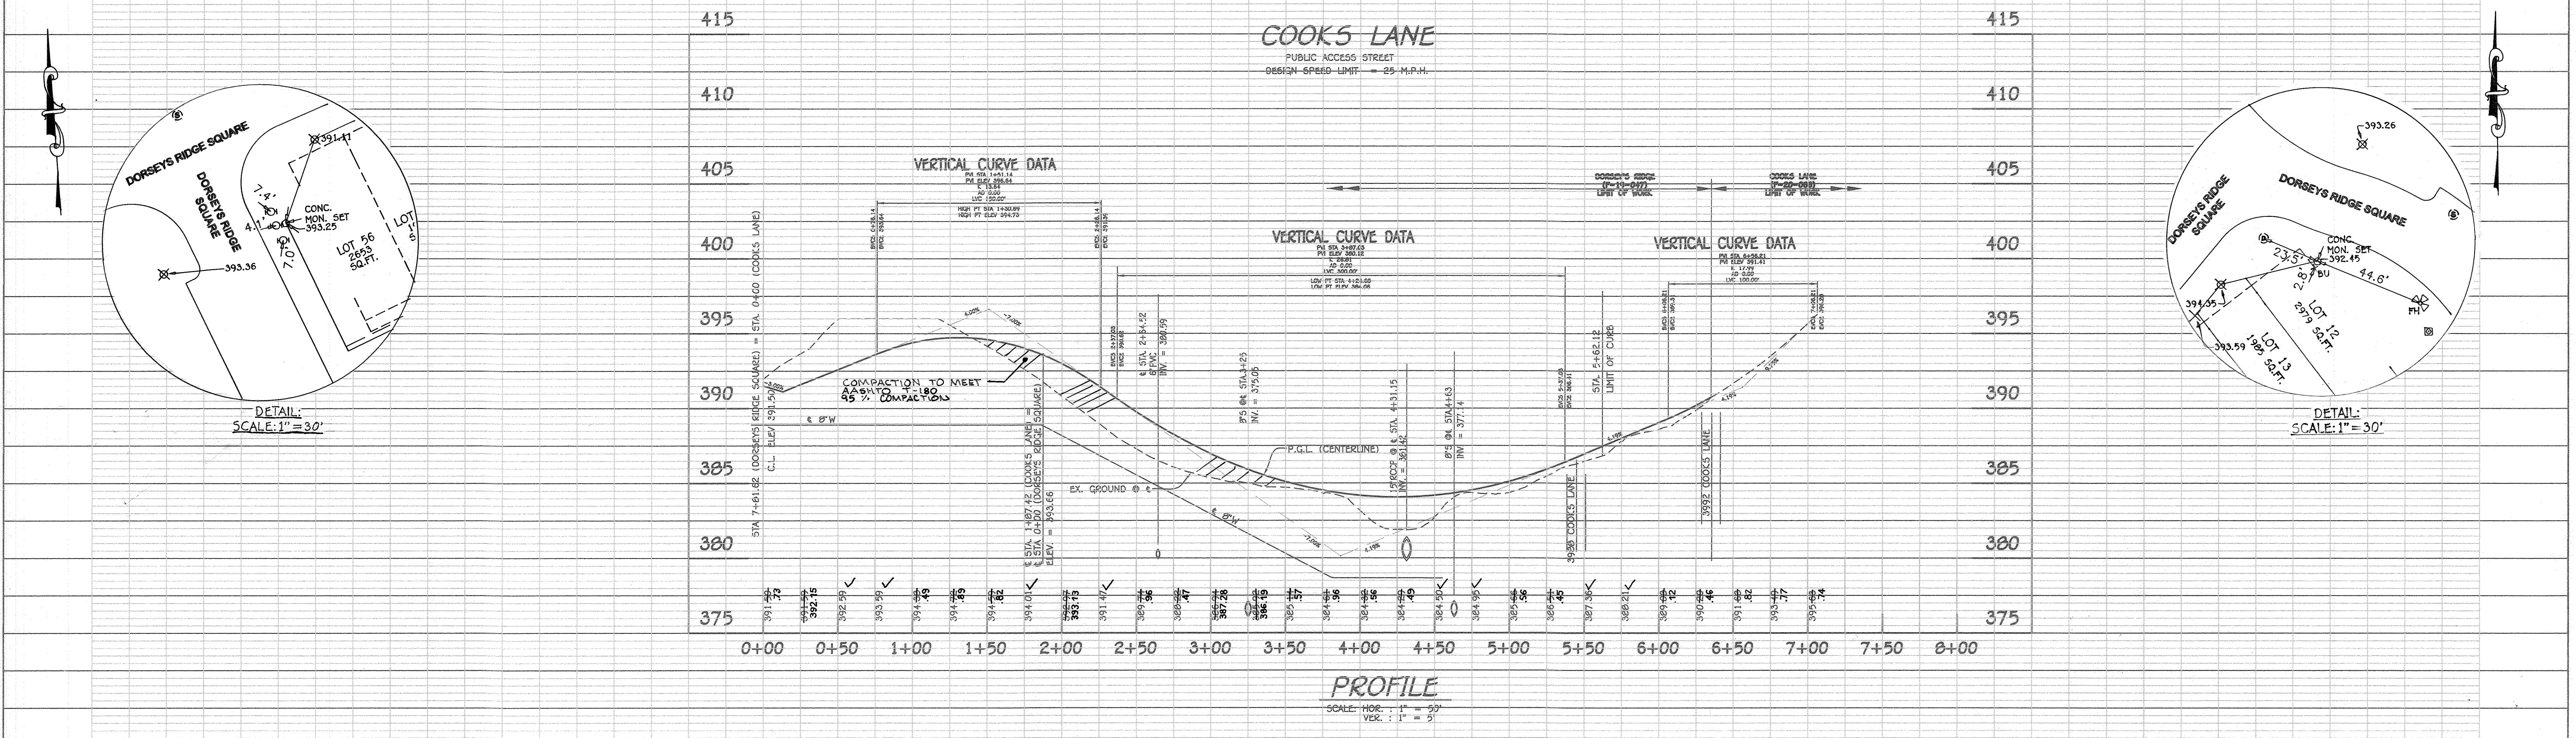

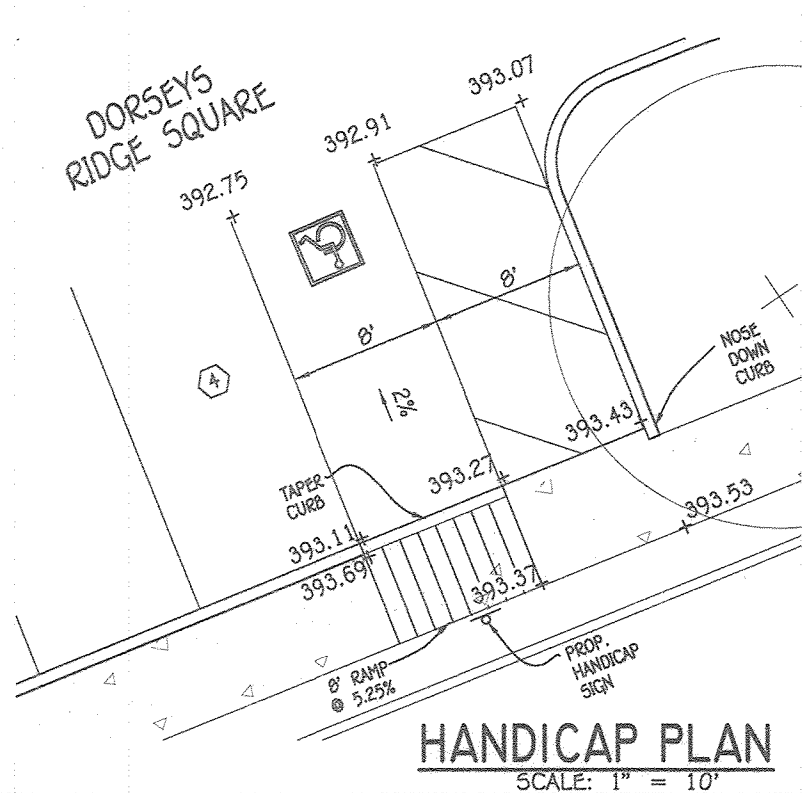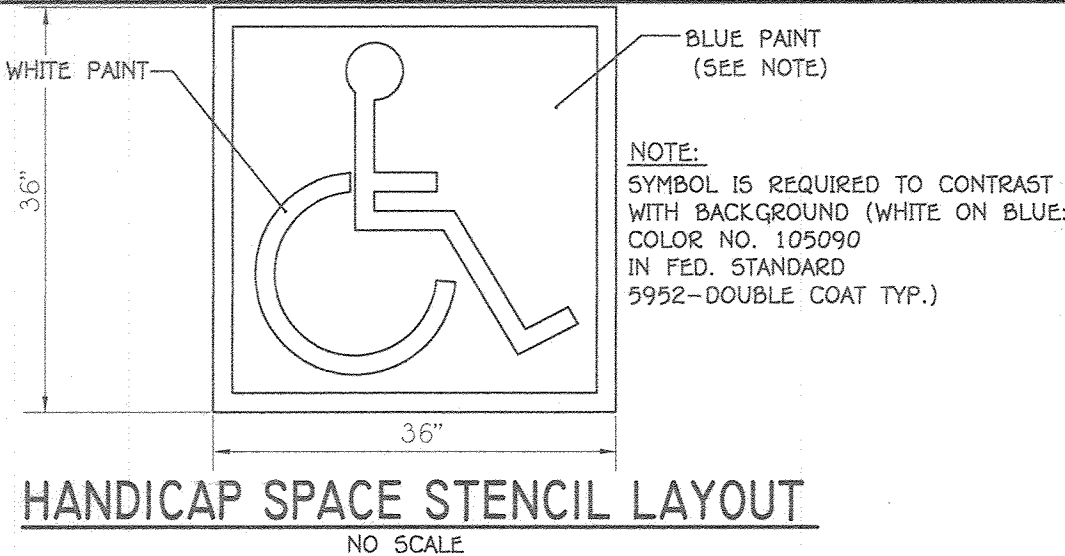


1	Changes to road profile	3/1/22
NO.	DESCRIPTION	DATE
REVISIONS		
APPROVED: DEPARTMENT OF PLANNING AND ZONING		
 CHIEF, DIVISION OF LAND DEVELOPMENT		3/3/22 DATE
 CHIEF, DEVELOPMENT ENGINEERING DIVISION		2-23-22 DATE
APPROVED: HOWARD COUNTY DEPARTMENT OF PUBLIC WORKS		
 CHIEF, BUREAU OF HIGHWAYS		02/14/2022 DATE

- GENERAL NOTES:**
1. SIGNS SHALL MEET DESIGN STANDARDS OF THE FEDERAL HIGHWAY ADMINISTRATION AND CONFORM TO THE STATE OF MARYLAND STANDARD HIGHWAY SIGN BOOKLET DETAIL R7-B.
 2. ONE SIGN IS REQUIRED PER SPACE PLACED AS SHOWN ON SITE IMPROVEMENT PLAN.
 3. SIGNS SHALL BE POLE MOUNTED WITH HOT DIPPED GALVANIZED COUNTY APPROVED PERFORATED CHANNEL POSTS W/TOP OF SIGNS 9'-1" ABOVE FINISHED GRADE OR AS INDICATED ON SITE DRAWINGS.
 4. SIGN SHALL BE ATTACHED TO FLANGED SIDE OF POST. POST SHALL EXTEND INTO GROUND 2'-6" MIN.
 5. COLORS: LEGEND AND BORDER-GREEN
SYMBOL-WHITE ON BLUE BACKGROUND
BACKGROUND-WHITE
 6. CONTRACTOR SHALL COORDINATE ARROW DIRECTION WITH LOCATION OF ADJACENT AISLE.

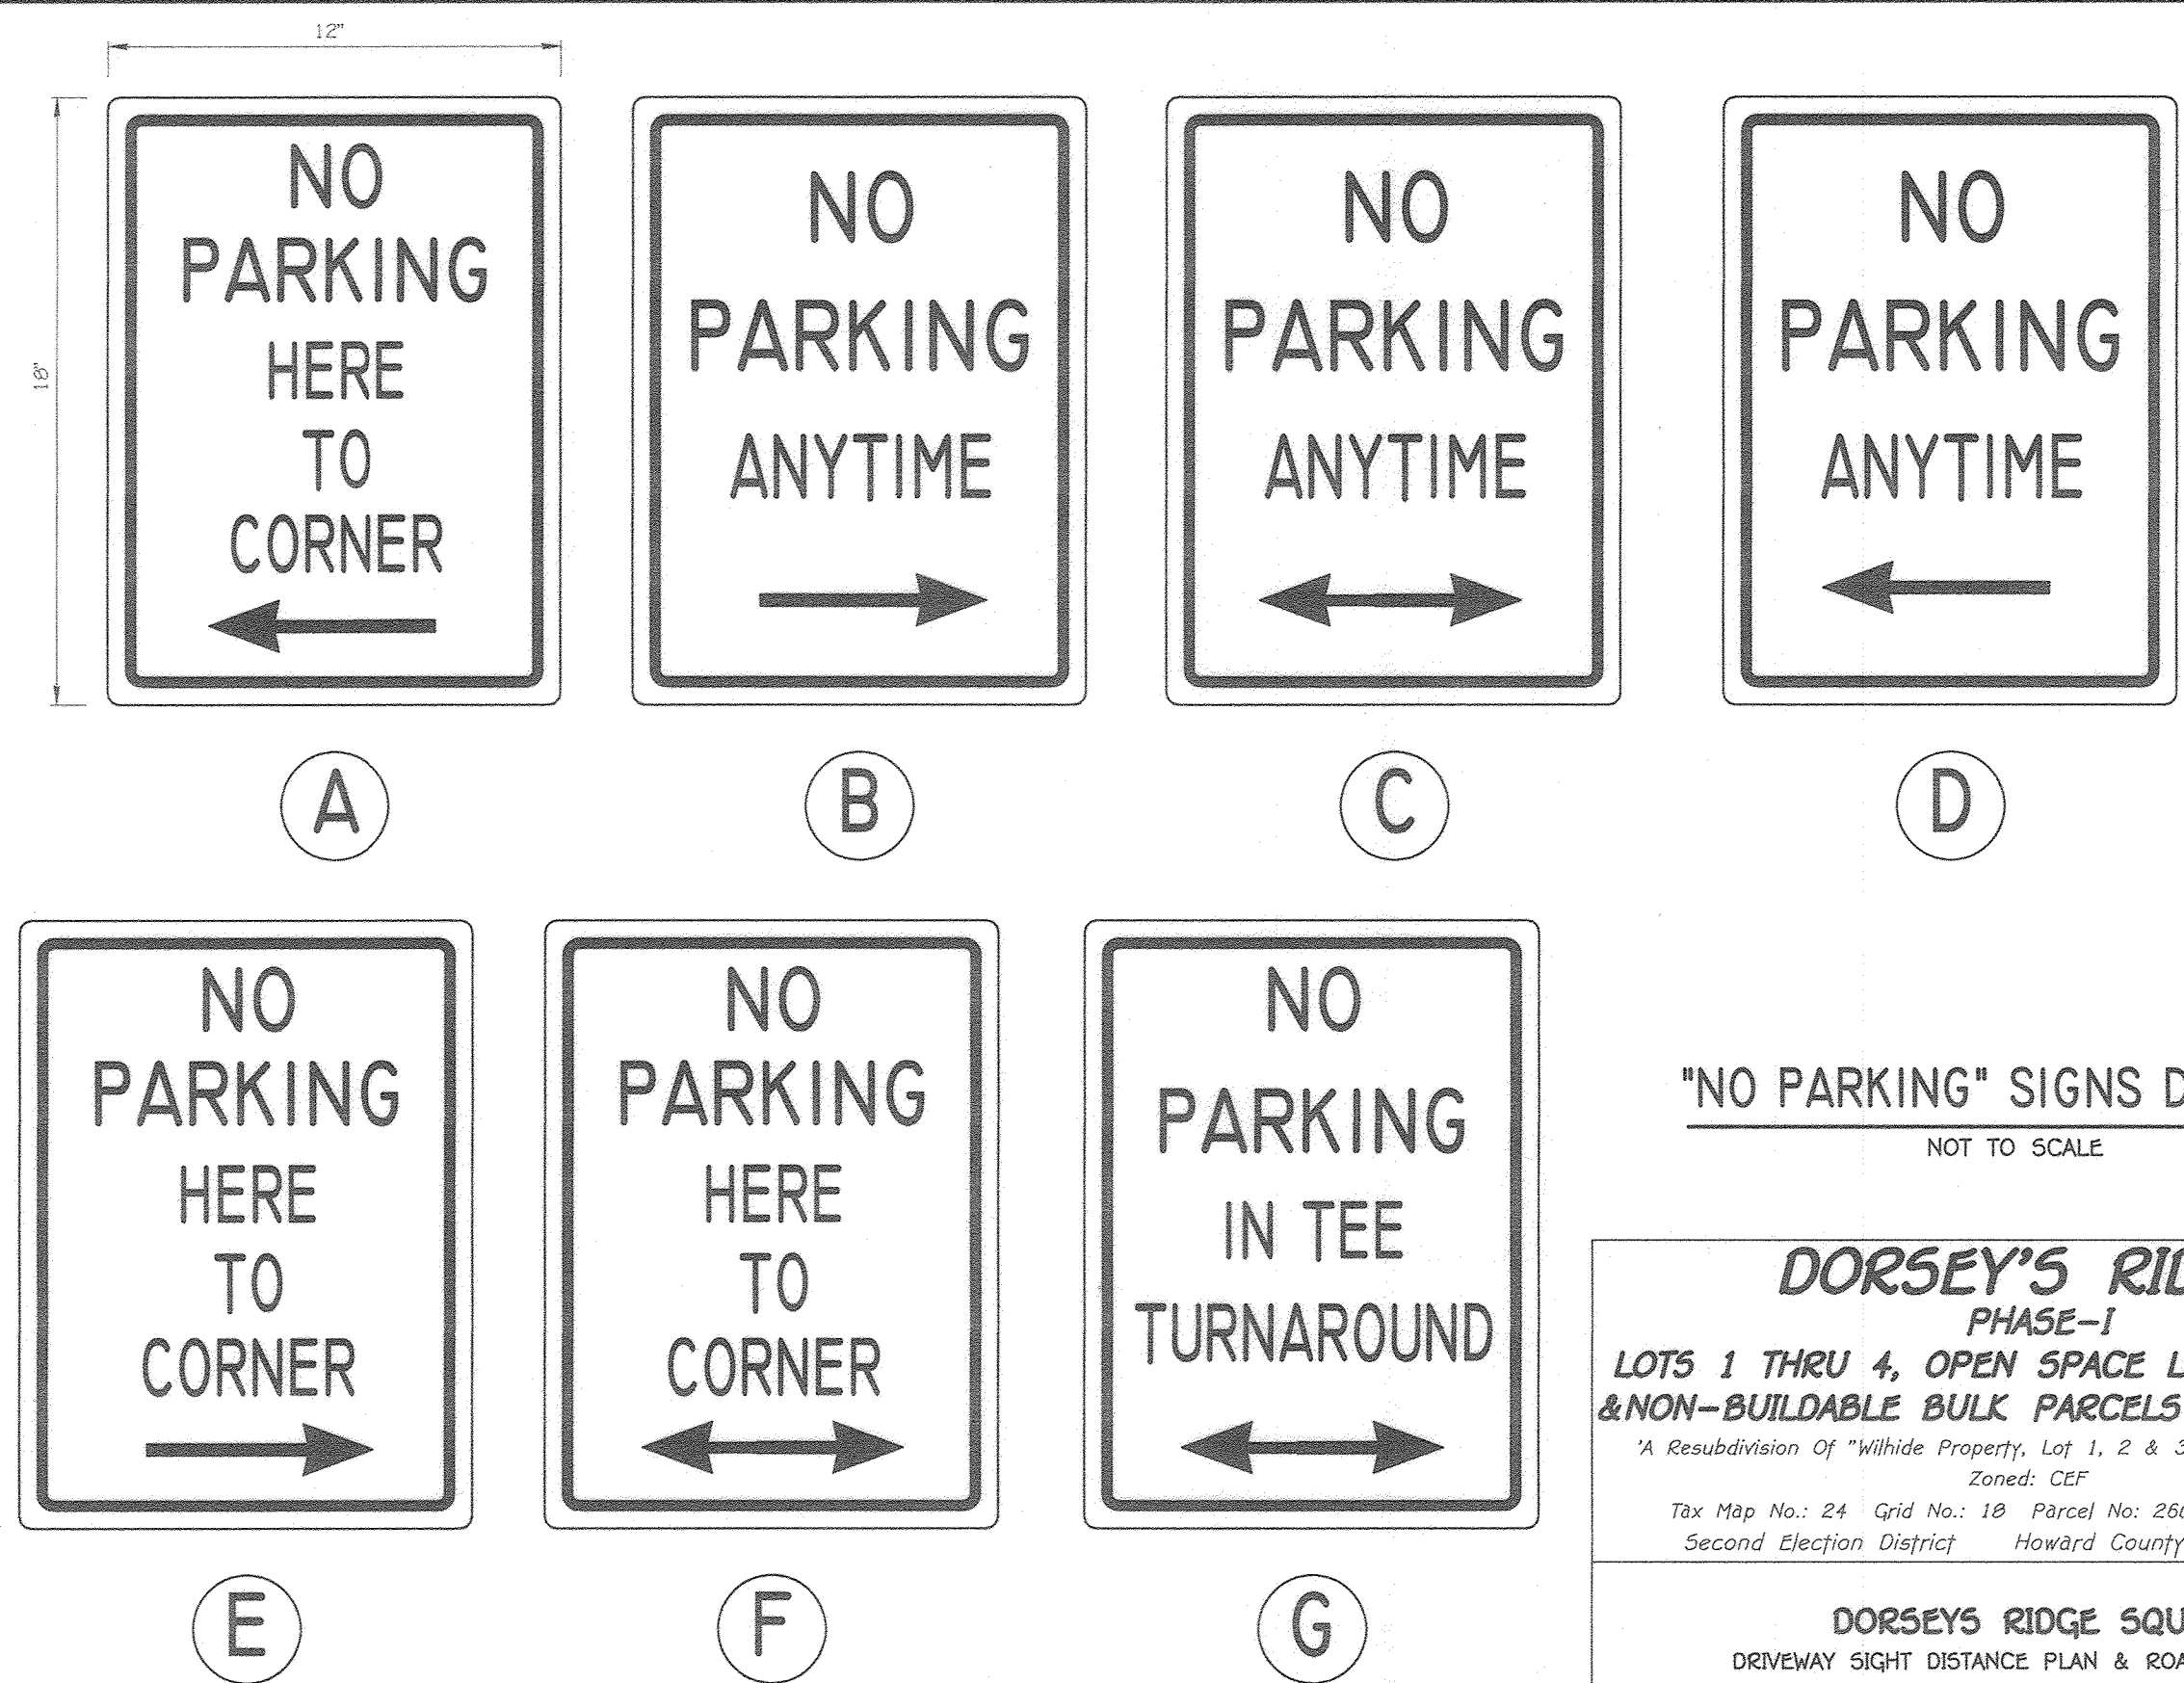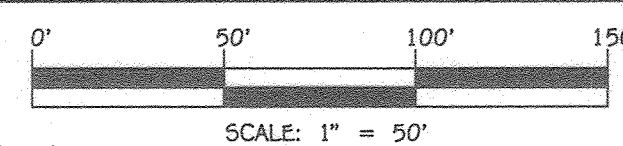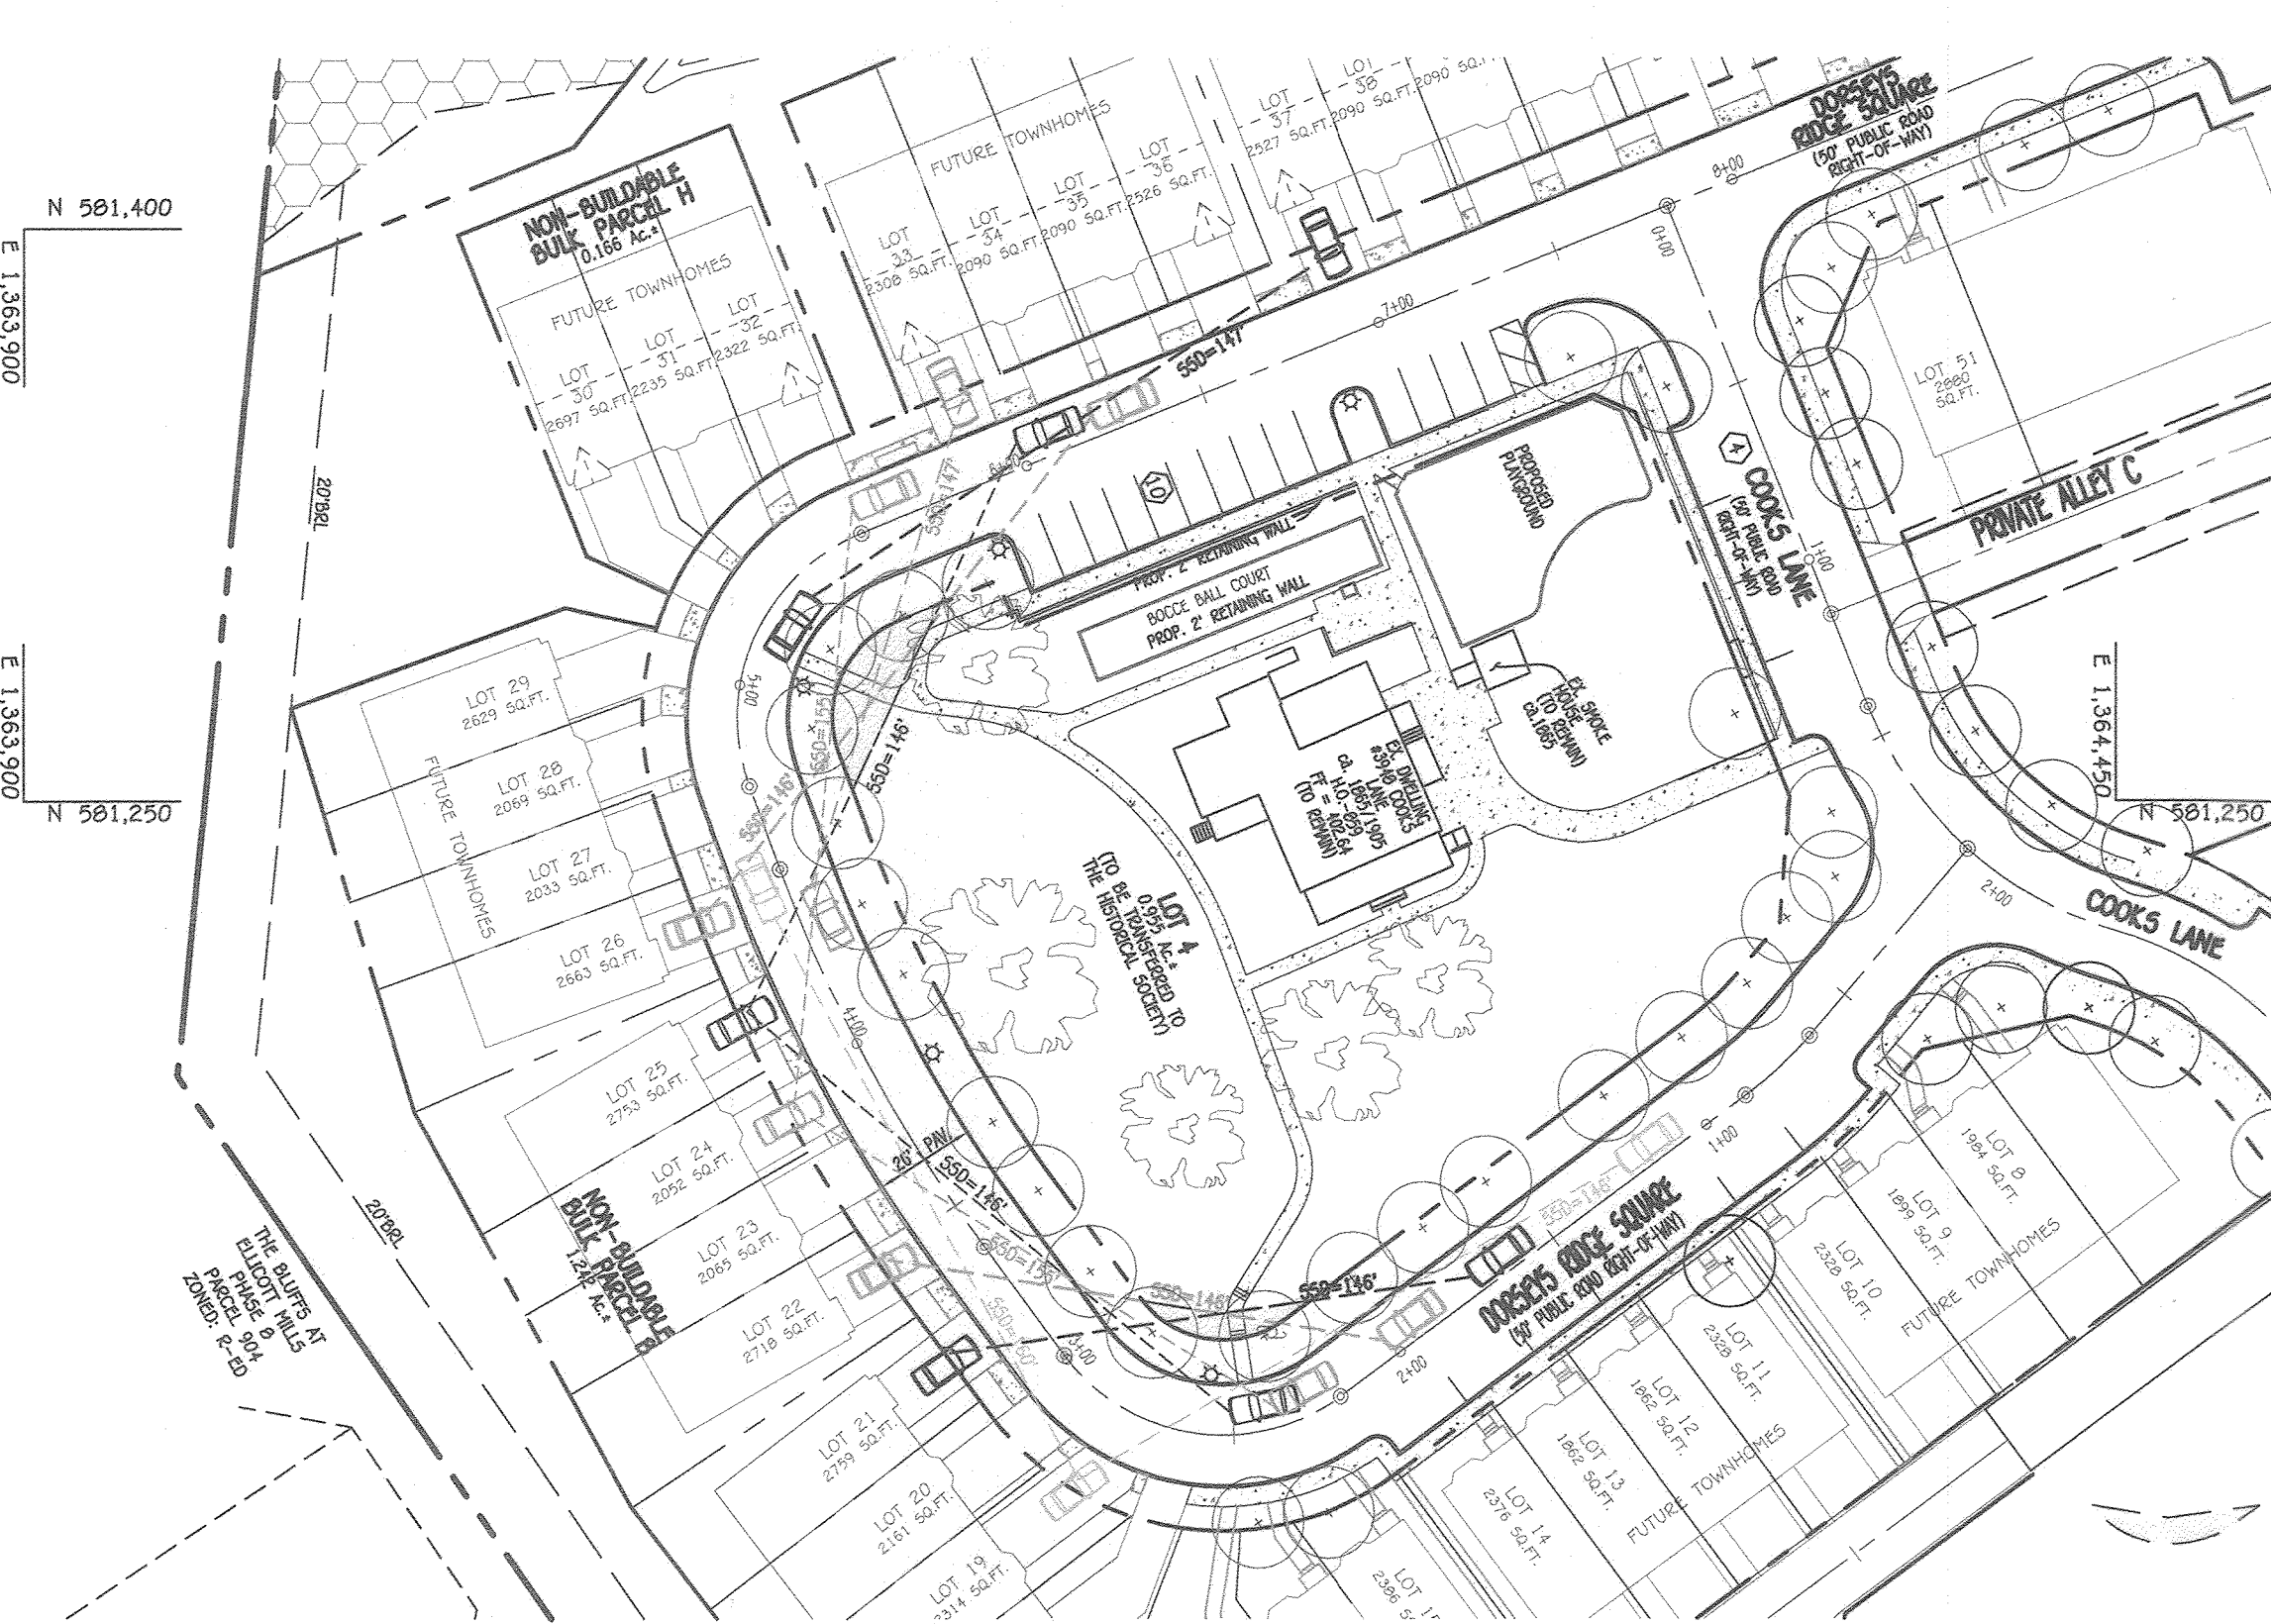

PROFESSIONAL CERTIFICATION
I HEREBY CERTIFY THAT THESE DOCUMENTS WERE PREPARED OR APPROVED BY ME AND THAT I AM A DULY LICENSED PROFESSIONAL ENGINEER UNDER THE LAWS OF THE STATE OF MARYLAND, LICENSE NO. 20740, EXPIRATION DATE: 02/22/2023.

Signature of Professional Engineer
Signature of Professional Engineer

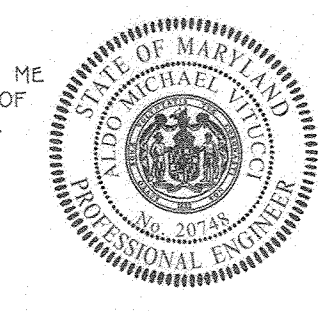

DORSEY'S RIDGE PHASE-1
LOTS 1 THRU 4, OPEN SPACE LOTS 6,7,61,62 & NON-BUILDABLE BULK PARCELS B, G THRU K

*A Resubdivision Of "Wildfire Property, Lot 1, 2 & 3", Plot No. 10442
Zoned: CEF
Tax Map No.: 24 Grid No.: 10 Parcel No.: 260 Lots: 1 Thru 3
Second Election District Howard County, Maryland

DORSEYS RIDGE SQUARE
DRIVEWAY SIGHT DISTANCE PLAN & ROAD PROFILE


OWNER/DEVELOPER
DORSEYS RIDGE, LLC
C/O DAVE WOESSNER
308 MAGDOY ROAD
SEVERNA PARK, MD 21146
410-461-0837

SCALE: AS SHOWN DATE: DECEMBER, 2021 DWG. NO. 4 OF 10
DES. S.J.T. DRN. J.C.L. CHK. F.J.M.

FISHER, COLLINS & CARTER, INC.
CIVIL ENGINEERING CONSULTANTS & LAND SURVEYORS
CENTENNIAL SQUARE OFFICE PARK - 10272 BALTIMORE NATIONAL PIKE
ELICOTT CITY, MARYLAND 21117
(410) 461-2892





DORSEYS RIDGE SQUARE

PUBLIC ACCESS STREET
DESIGN SPEED LIMIT = 25 M.P.H.

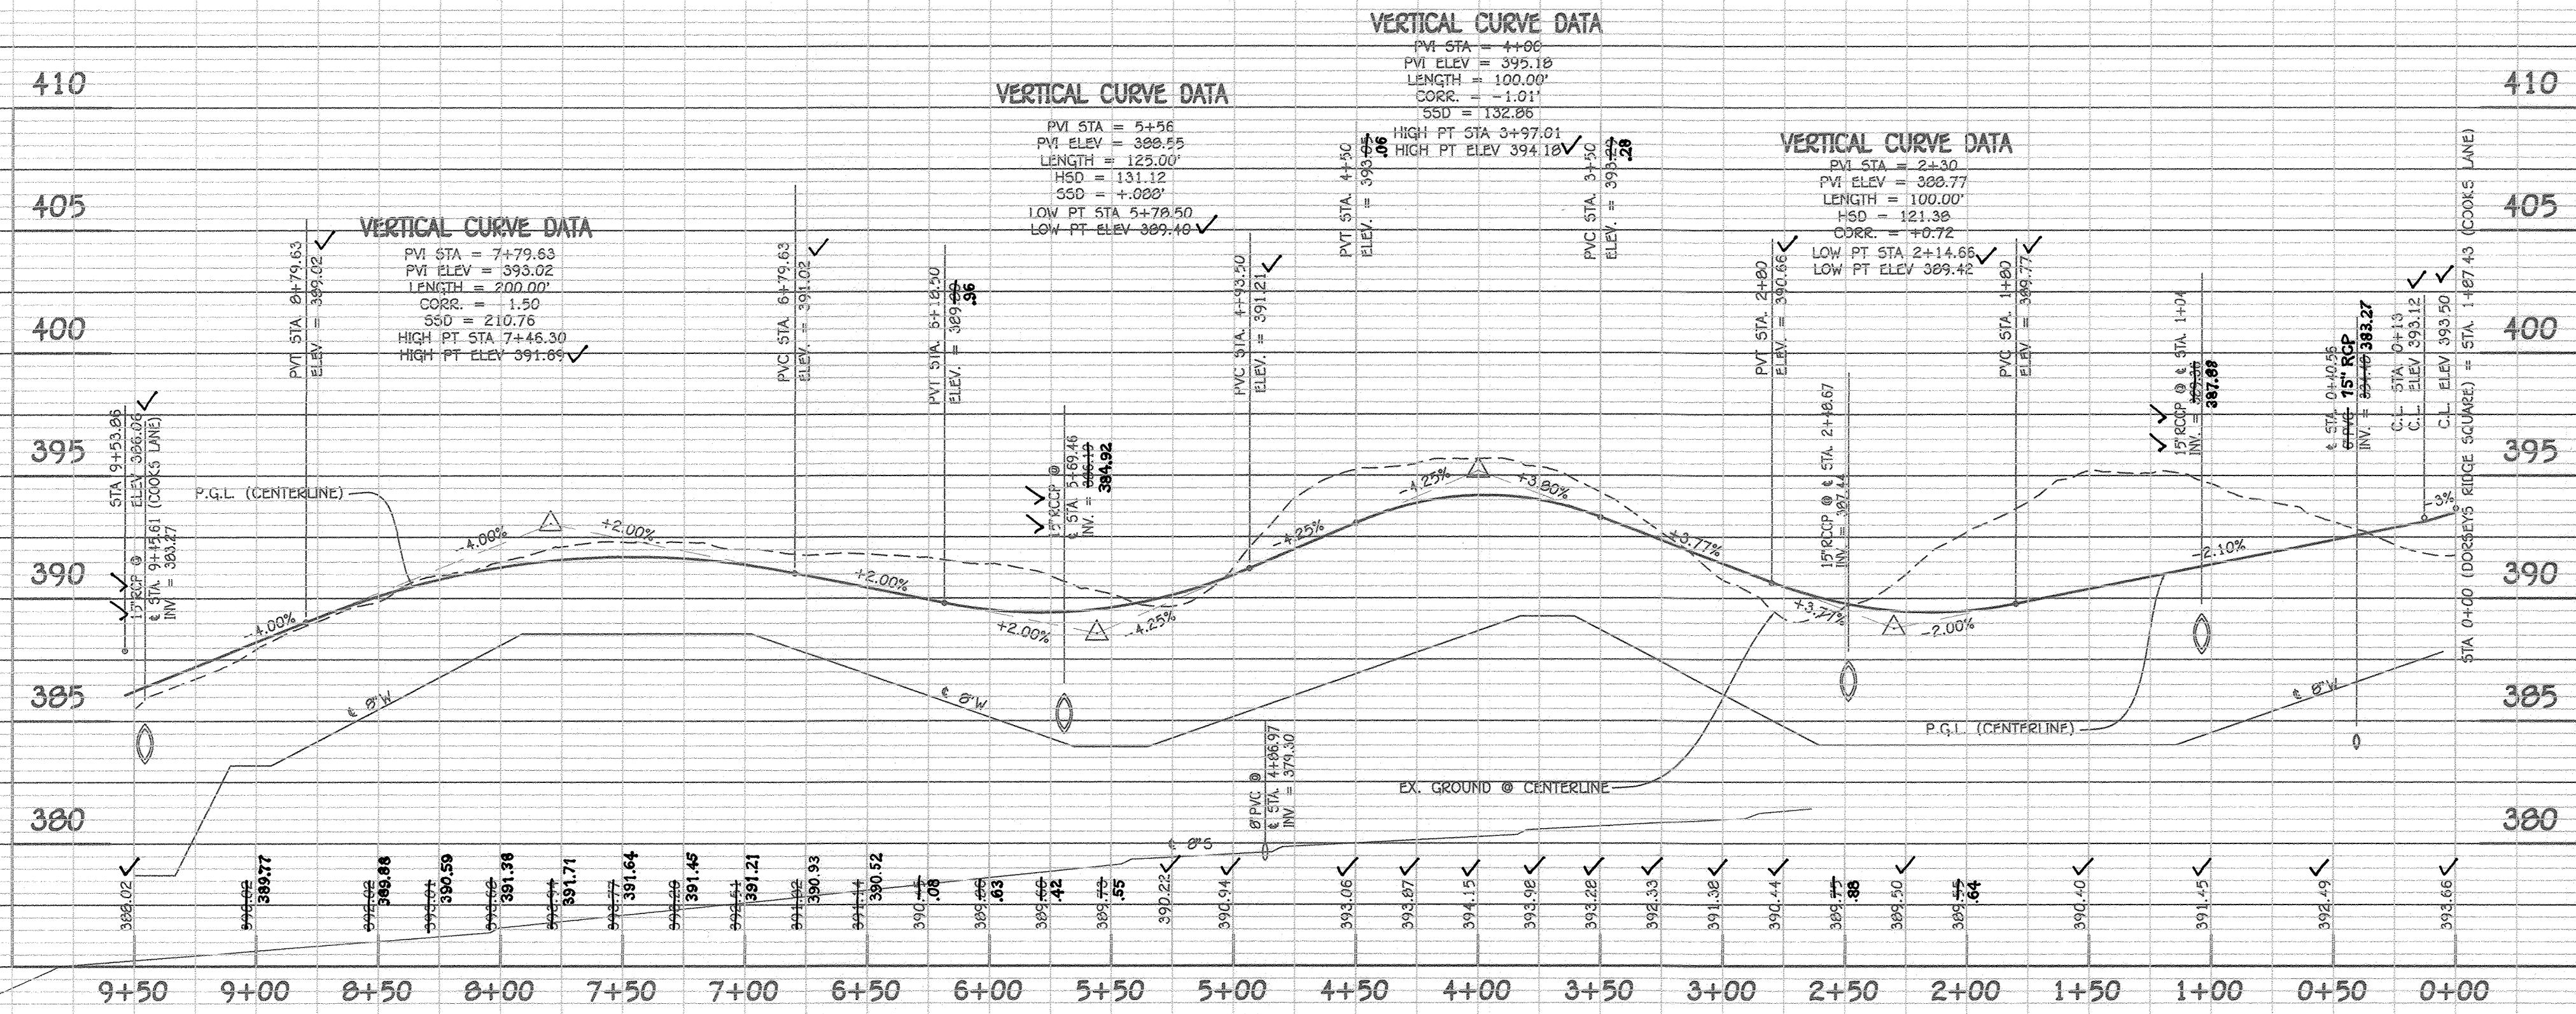


AS-BUILT CERTIFICATION
I hereby certify, by my seal, that to the best of my knowledge and belief that the facilities shown on the plan was constructed as shown on the "AS-BUILT" plan meet the approved plans and specifications.








Date
PAUL GERARD CAVANAUGH #27020

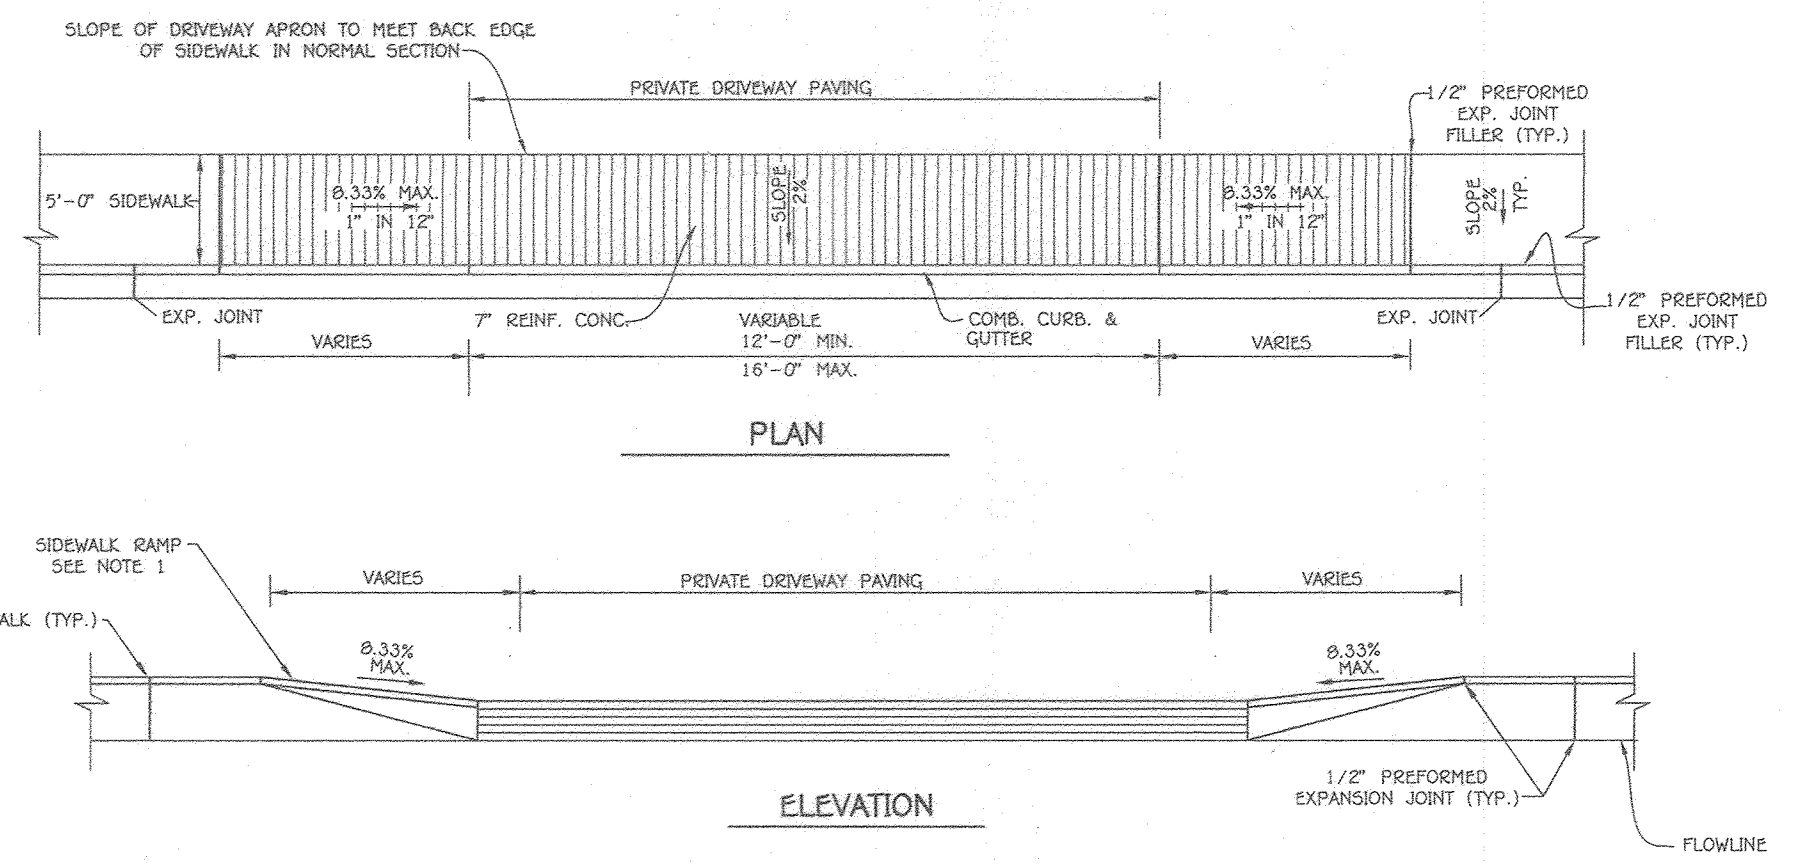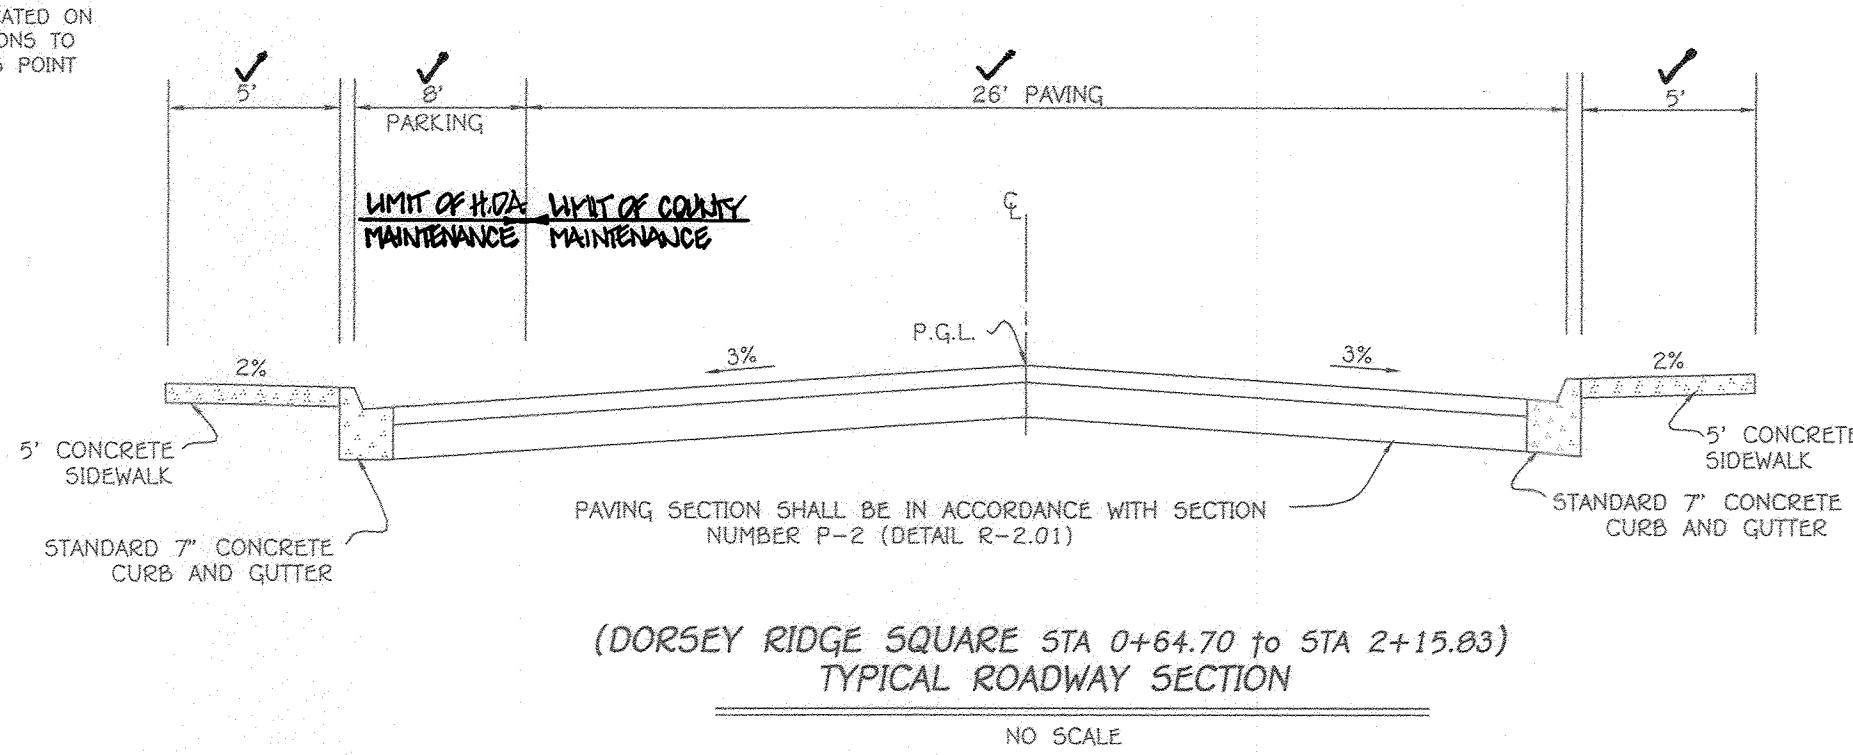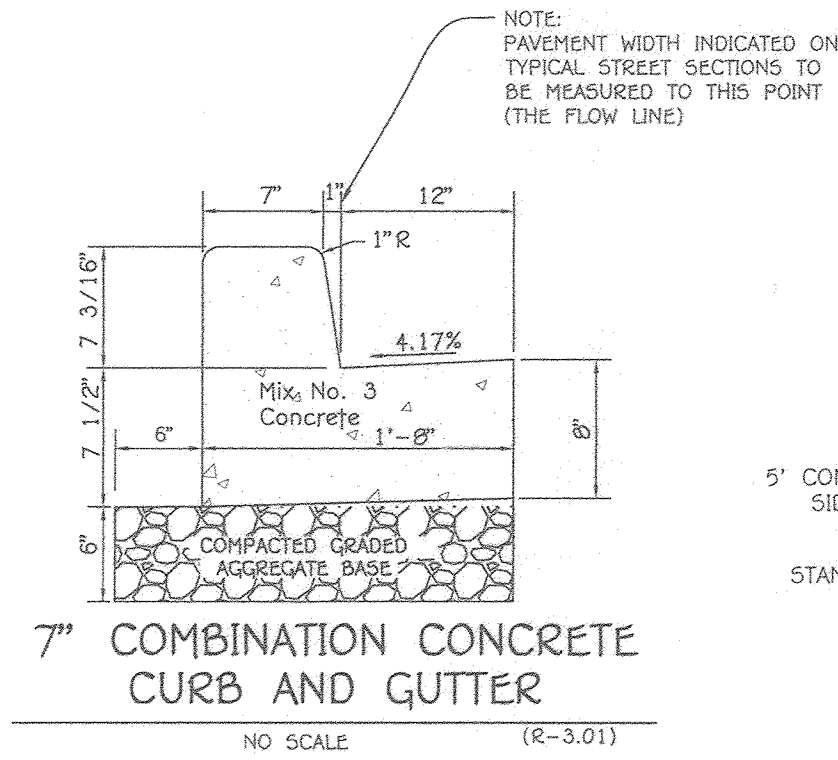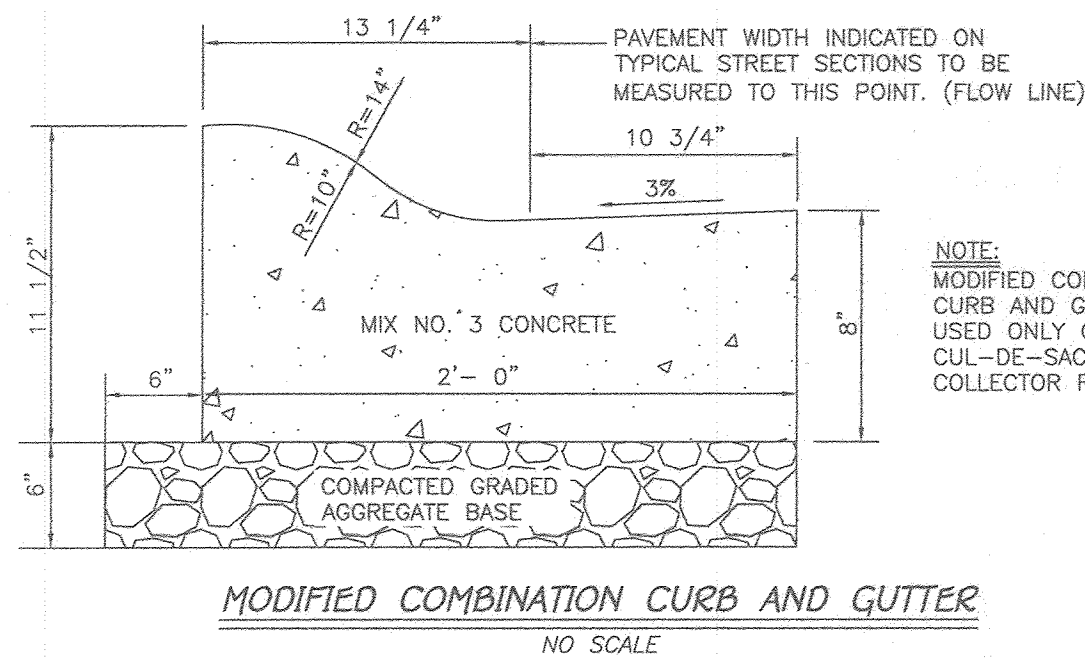

SECTION NUMBER	ROAD AND STREET CLASSIFICATION	CALIFORNIA BEARING RATIO (CBR)						
		3 TO <5	5 TO <7	≥7	3 TO <5	5 TO <7	≥7	
P-2	PARKING DRIVE AISLES: RESIDENTIAL AND NON-RESIDENTIAL WITH NO MORE THAN 10 HEAVY TRUCKS PER DAY LOCAL ROADS: ACCESS PLACE, ACCESS STREET CUL-DE-SACS: RESIDENTIAL	PAVEMENT MATERIAL (INCHES)		MIN HMA WITH GAB		HMA WITH CONSTANT GAB		
		HMA SUPERPAVE FINAL SURFACE 9.5 MM PG 64-22, LEVEL 1 (ESAL)		1.5	1.5	1.5	1.5	1.5
		HMA SUPERPAVE INTERMEDIATE SURFACE 9.5 MM PG 64-22, LEVEL 1 (ESAL)		1.0	1.0	1.0	1.0	1.0
		HMA SUPERPAVE BASE 19.0 MM PG 64-22, LEVEL 1 (ESAL)		2.0	2.0	2.0	3.5	2.0
		GRADED AGGREGATE BASE (GAB)		0.0	4.0	3.0	4.0	4.0

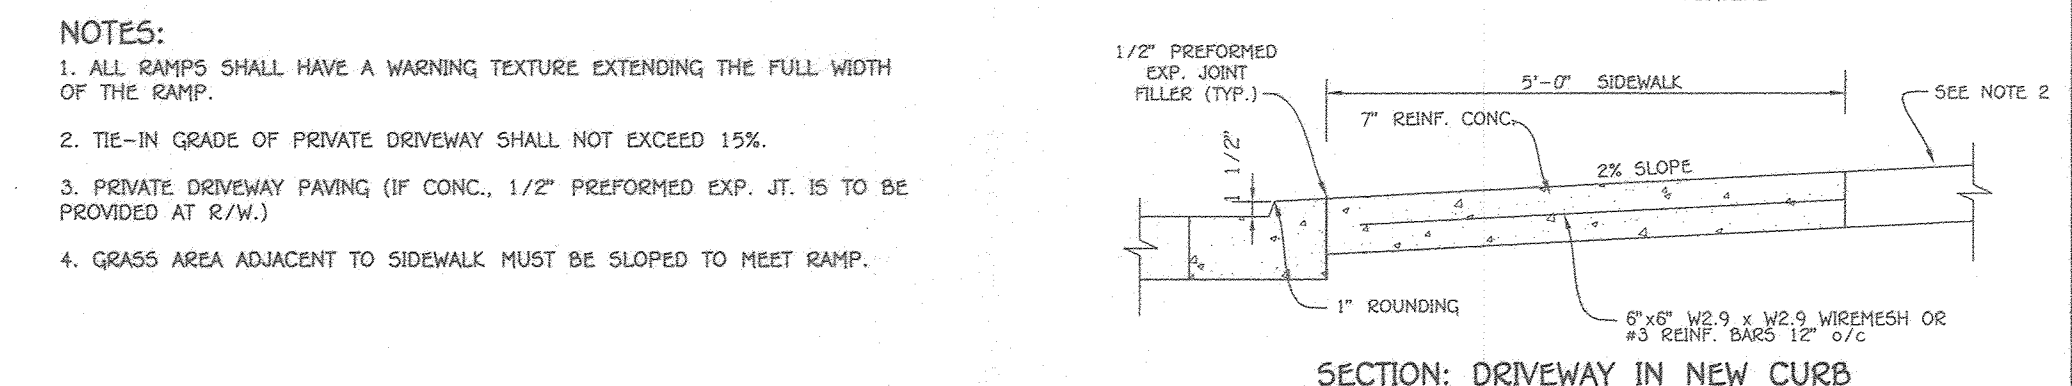

**RESIDENTIAL DRIVEWAY ENTRANCE
7\"/>**

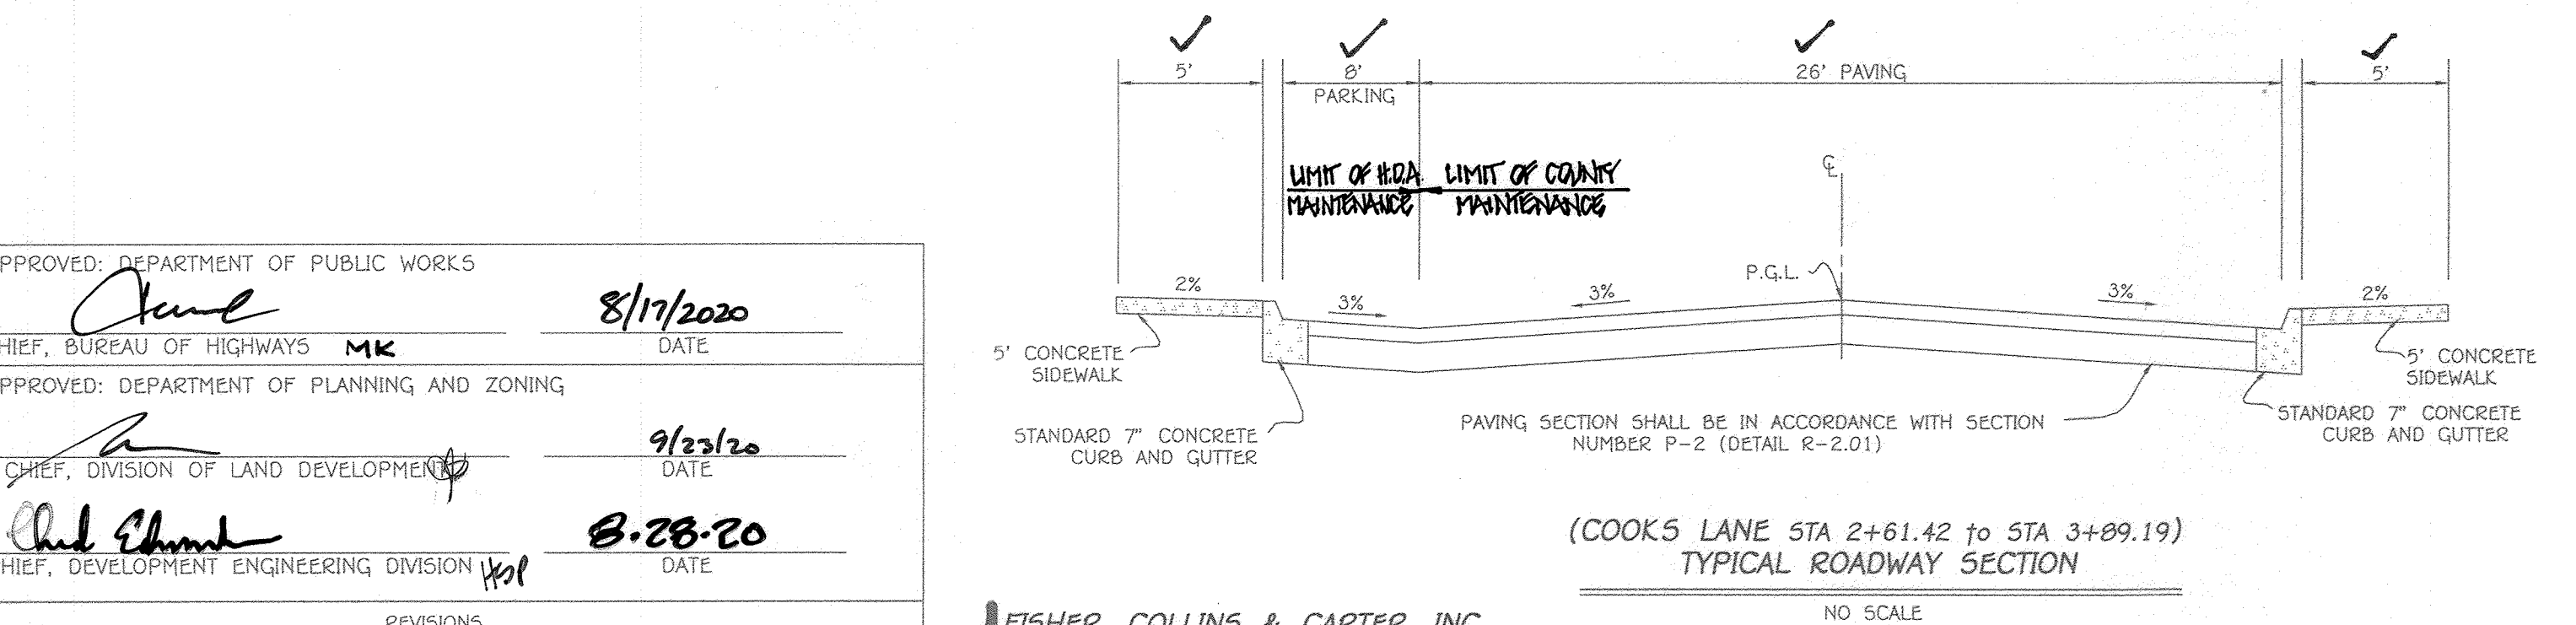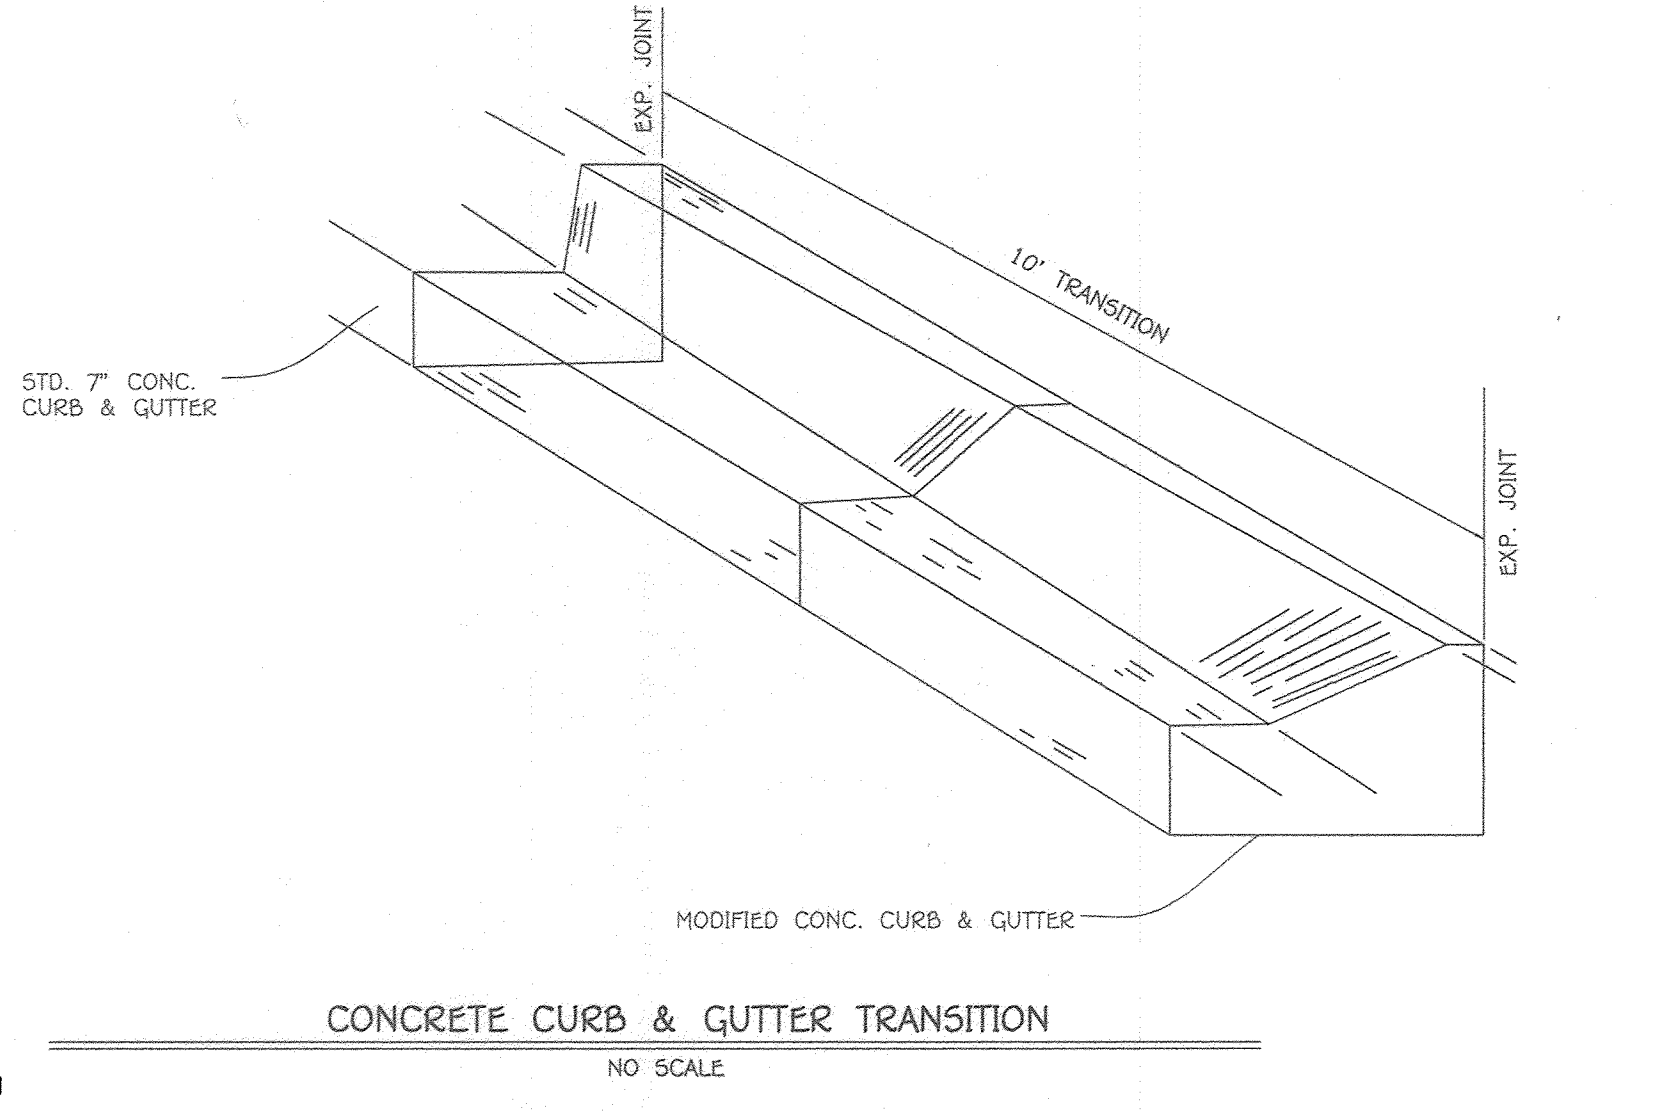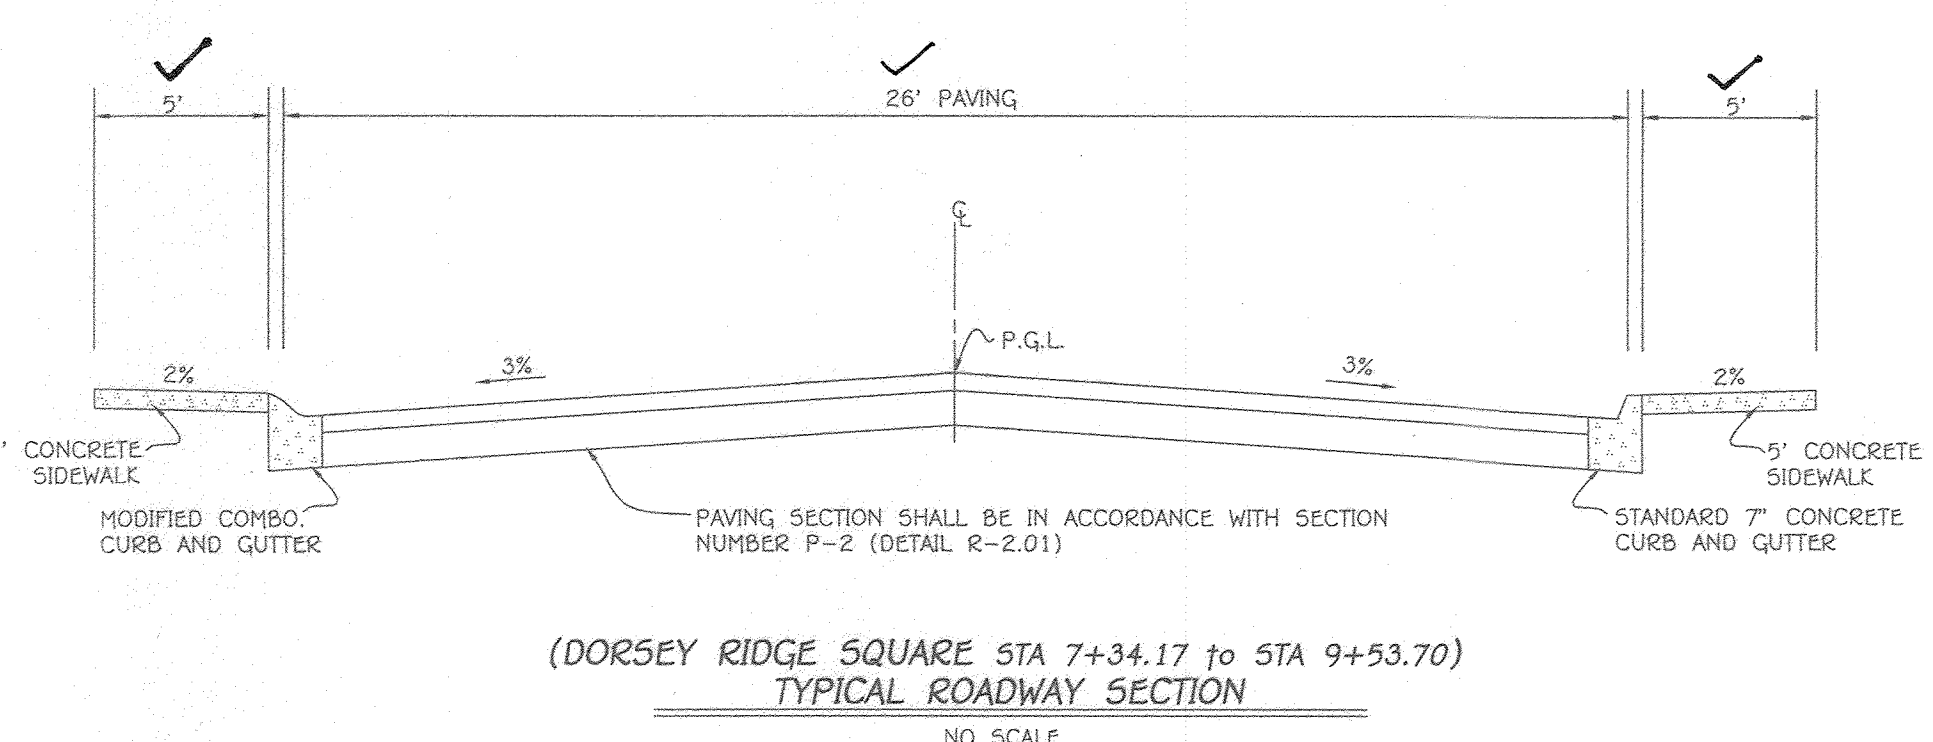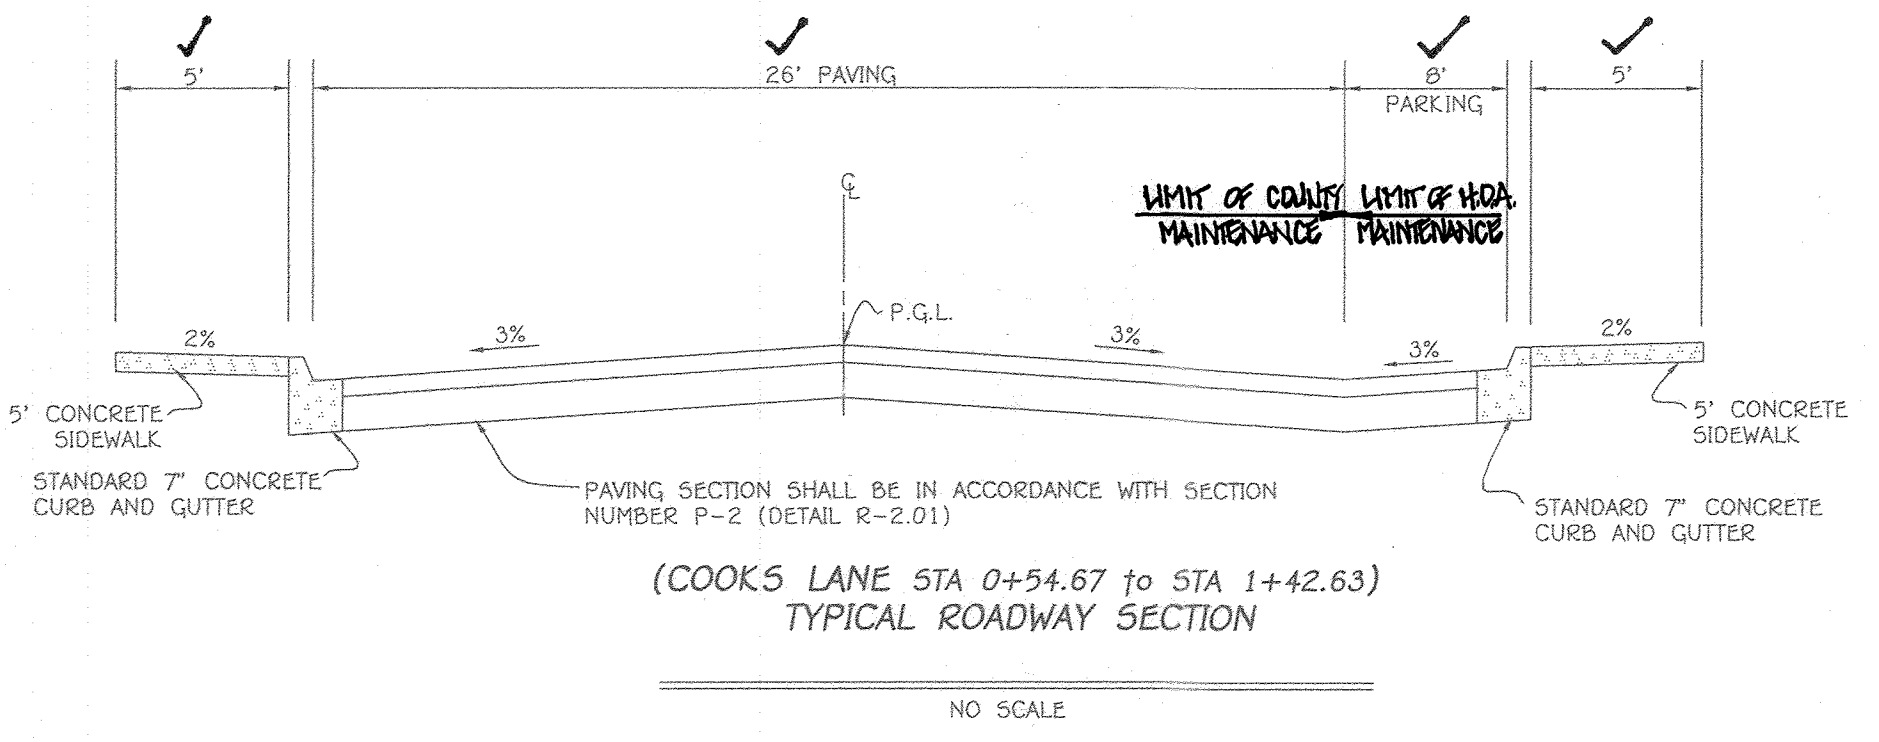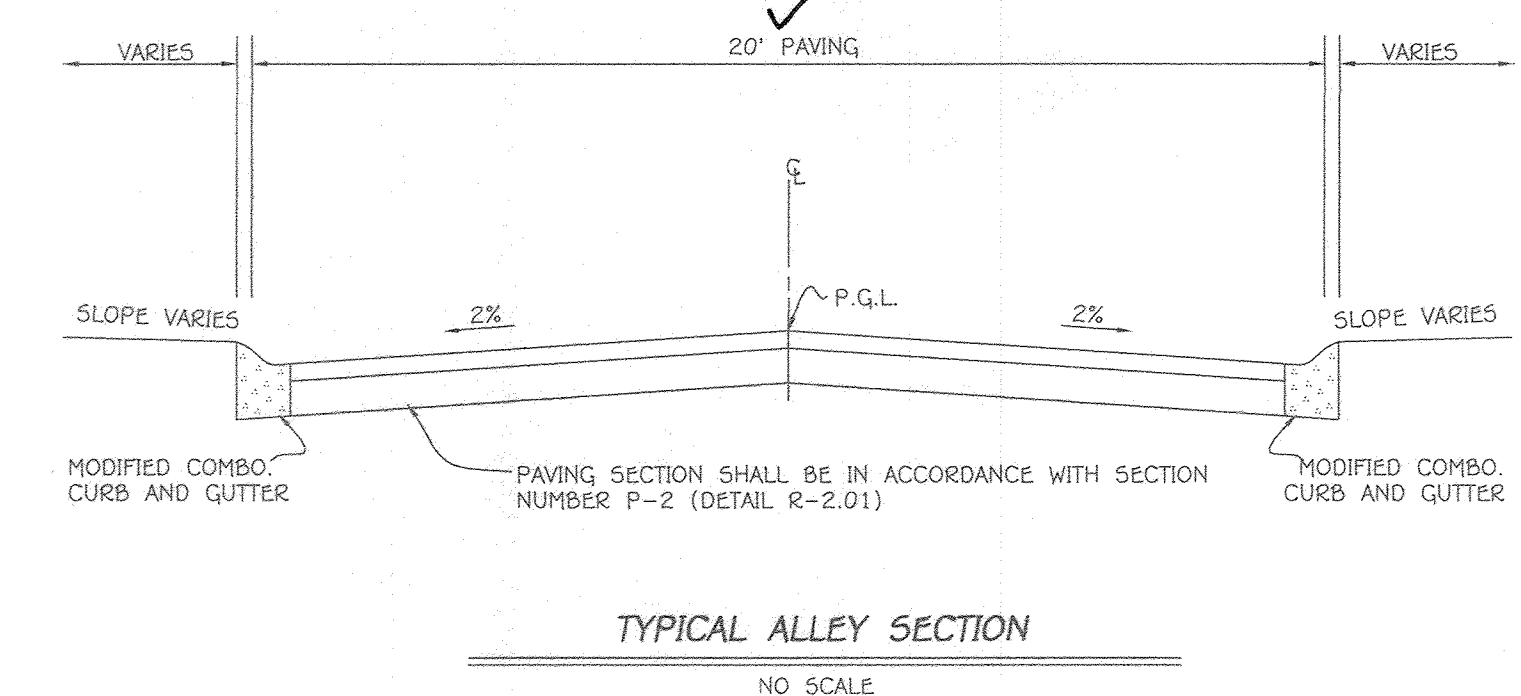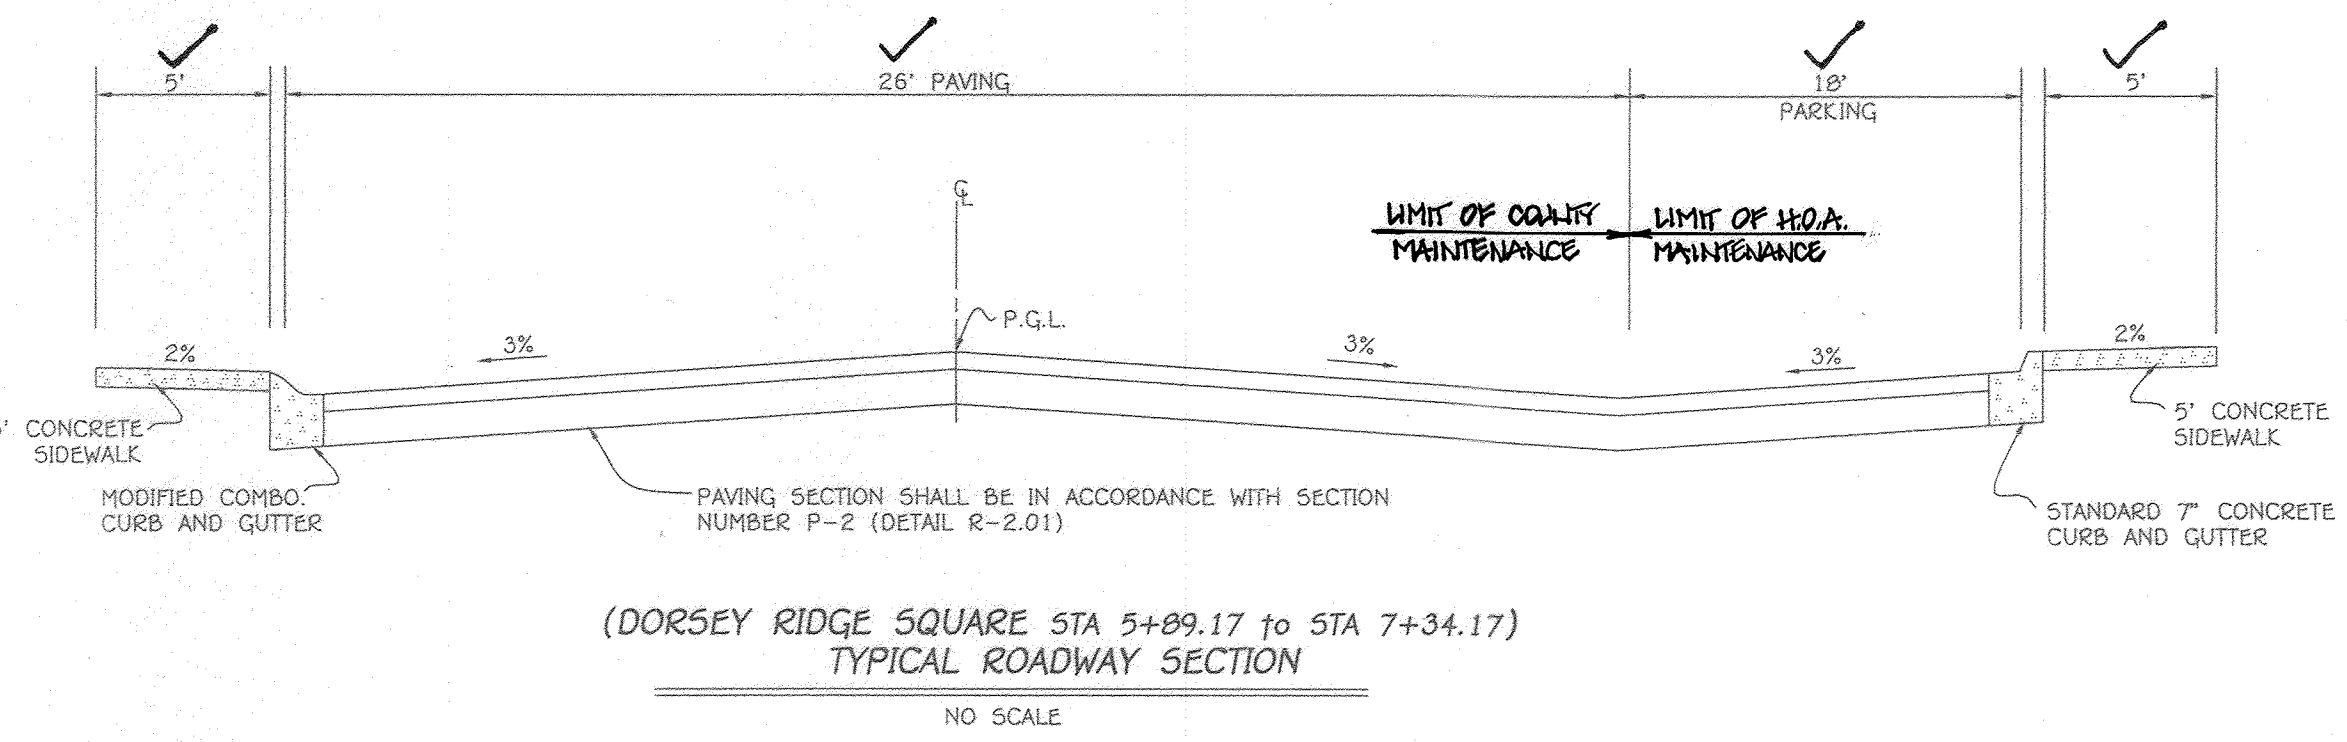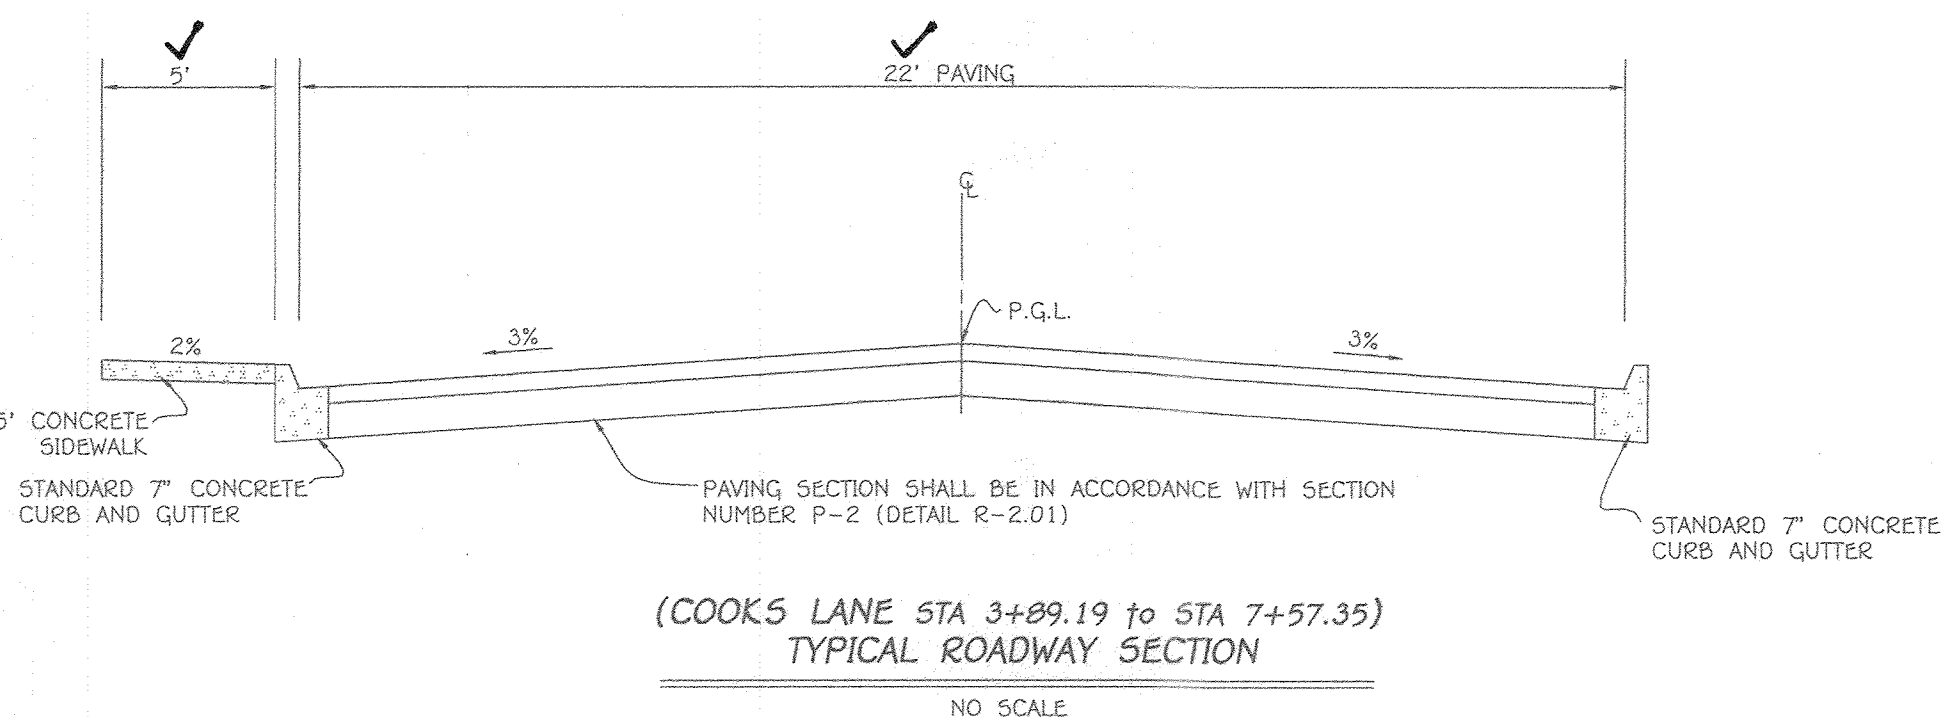


AS-BUILT CERTIFICATION
I hereby certify, by my seal, that to the best of my knowledge and belief that the facilities shown on the plan was constructed as shown on this "AS-BUILT" plan meet the approved plans and specifications.
Date: 5/21/2020
PAUL GERARD CAVANAUGH #27020


PROFESSIONAL CERTIFICATION
I HEREBY CERTIFY THAT THESE DOCUMENTS WERE PREPARED OR APPROVED BY ME AND THAT I AM A DULY LICENSED PROFESSIONAL ENGINEER UNDER THE LAWS OF THE STATE OF MARYLAND, LICENSE NO. 20748, EXPIRATION DATE: 02/22/2021.
Signature of Professional Engineer: Alfred M. Vitacek
DATE: 5/21/2020

ROADWAY DETAILS
DORSEY'S RIDGE
PHASE-1
LOTS 1 THRU 4, OPEN SPACE LOTS 5 THRU 8, & NON-BUILDABLE BULK PARCELS A THRU F
A RESUBDIVISION OF "WILHIDE PROPERTY, LOT 1, 2 & 3", PLAT NO. 10442
ZONED: CEF-R
TAX MAP NO.: 24 GRID NO.: 18 PARCEL NO.: 260 LOTS: 1 THRU 3
SECOND ELECTION DISTRICT HOWARD COUNTY, MARYLAND
SCALE: AS SHOWN DATE: MAY, 2020
SHEET 5 OF 10

FISHER, COLLINS & CARTER, INC.
CIVIL ENGINEERING CONSULTANTS & LAND SURVEYORS
CONTINENTAL SQUARE OFFICE PARK - 10272 BALTIMORE NATIONAL PIKE
ELICOTT CITY, MARYLAND 21042
(410) 461-2895

OWNER/DEVELOPER
DORSEY'S RIDGE, LLC
C/O DAVE WOODSNER
308 MAGDOOTHY ROAD
SEVERNA PARK, MD 21146
410-461-0837

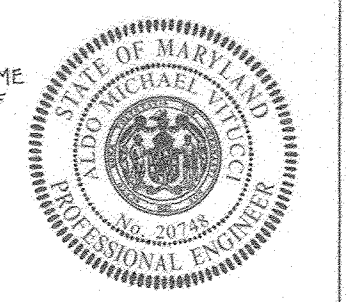

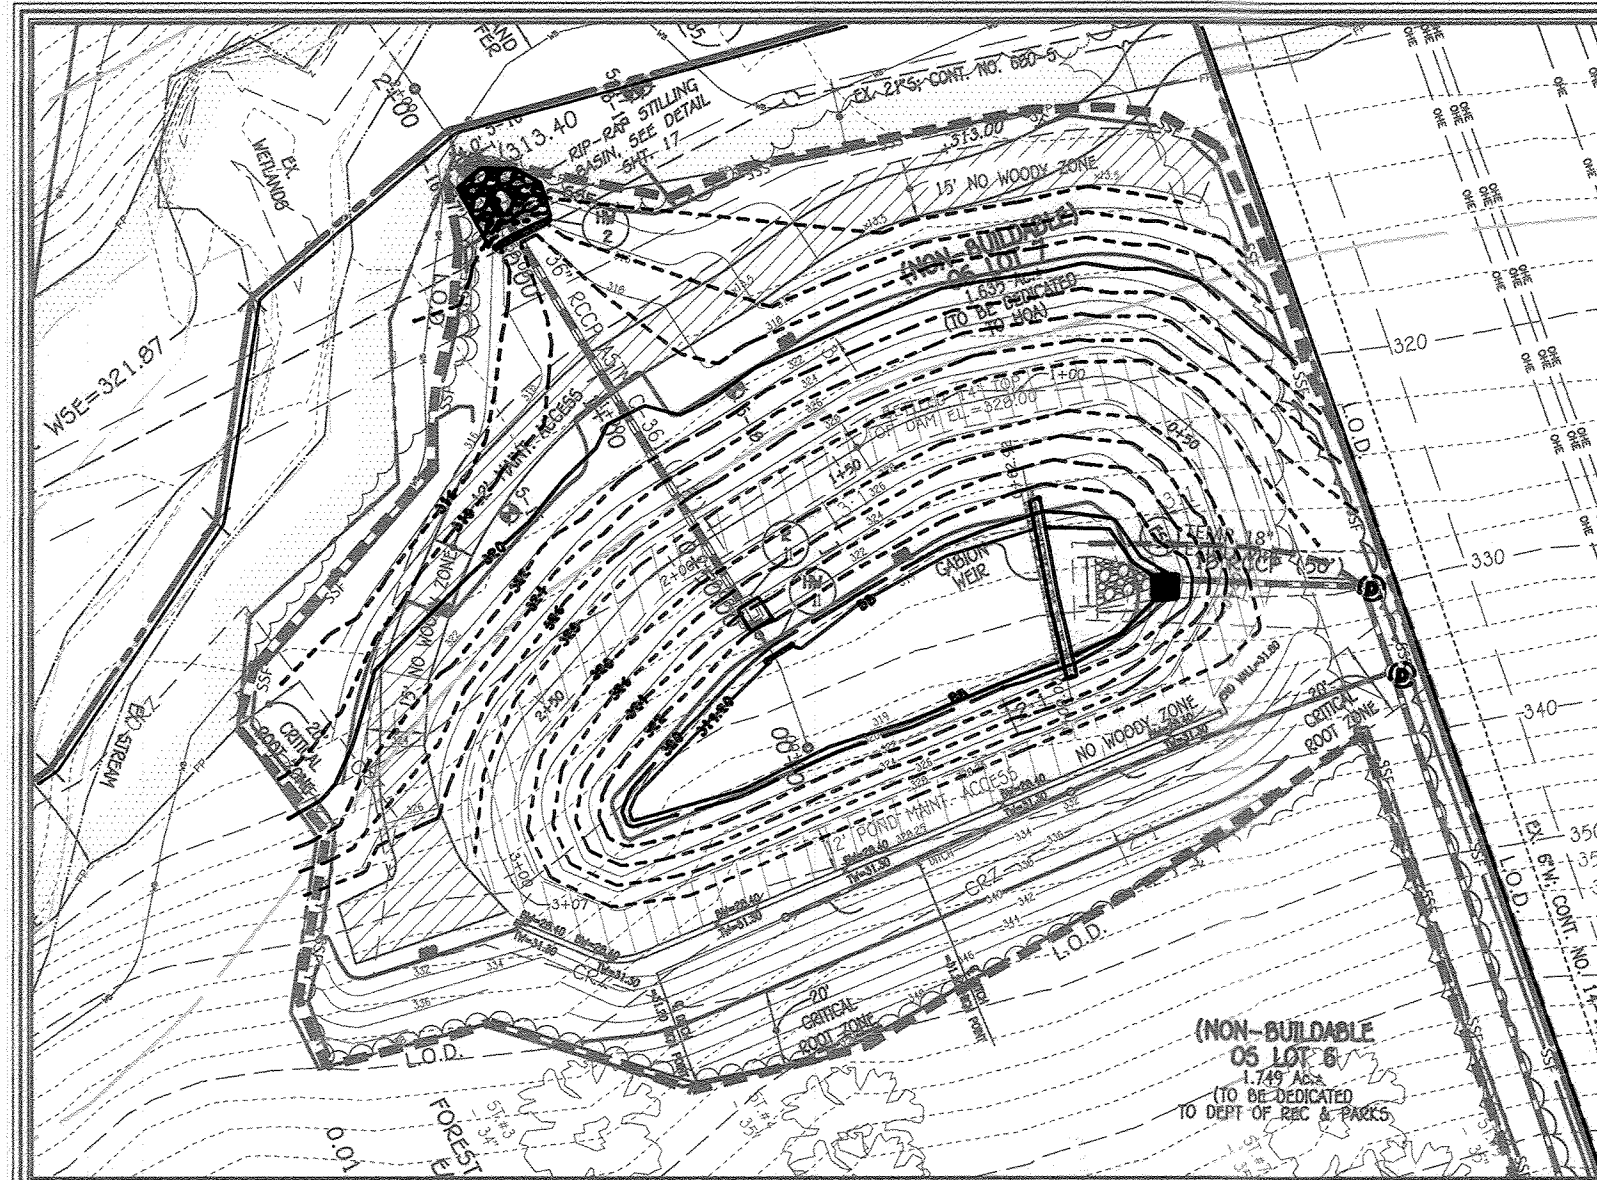


TEMPORARY SEDIMENT TRAP BASIN #1
 TRAP TYPE = SEDIMENT CONTROL BASIN
 EXISTING DRAINAGE AREA = 1.91 AC.
 PROPOSED DRAINAGE AREA = 7.31 AC.
 TOTAL STORAGE REQUIRED = 26,316 CU.FT.
 TOTAL STORAGE PROVIDED = 26,316 CU.FT.
 WET STORAGE REQUIRED = 13,158 CU.FT.
 WET STORAGE PROVIDED = 13,158 CU.FT.
 DRY STORAGE REQUIRED = 13,158 CU.FT.
 DRY STORAGE PROVIDED = 13,158 CU.FT.
 EXISTING GROUND ELEV. AT OUTLET = 317.00
 BOTTOM OF BASIN ELEV. = 319.00
 BOTTOM OF BASIN DIMENSIONS = 30 FT x 145 FT
 BARREL SIZE = 36"
 CREST OF DRAIN DOWN = 325.11
 WET CREST = (8" ROCK UP W/ER FOR TSWH) @ 325.25
 CLEANOUT ELEV. = 320.30
 TOP OF EMBANKMENT = 328.00
 SIDE SLOPES = 3:1 EMBANKMENT
 WIDTH = 14 FT (SETTLED)
 EMBANKMENT HEIGHT = 9.0 FT
 OUTLET PROTECTION APRON LENGTH = 18.5 FT OUTLET
 PROTECTION DEPTH = 19 INCHES
 PRE (EXISTING) Q1 = 0.45 C.F.S.
 POST (PROPOSED) Q1 = 0.80 C.F.S.

IMMEDIATELY STABILIZE THE OUTSIDE OF 55' & L.O.D. FOR CONSTRUCTION OF PLUNGE POOL. SEE DETAIL D-5.53


FINAL SWM POND PLAN @ SEDIMENT BASIN #1
 Scale: 1" = 50'

SEDIMENT CONTROL LEGEND

- SF Silt Fence
- SSF Super-Silt Fence
- S.C.E. Stabilized Construction Entrance
- L.O.D. Limit of Disturbance
- LI Standard Inlet Protection (Type 'A')
- SE Sediment Baffles
- ED Earth Dike
- Soil Type and Name
- Soil Stabilization Matting
- Slopes 15% - 24.9%
- Slopes 25% & Greater
- Removable Pumping Sta.
- Filter Bag

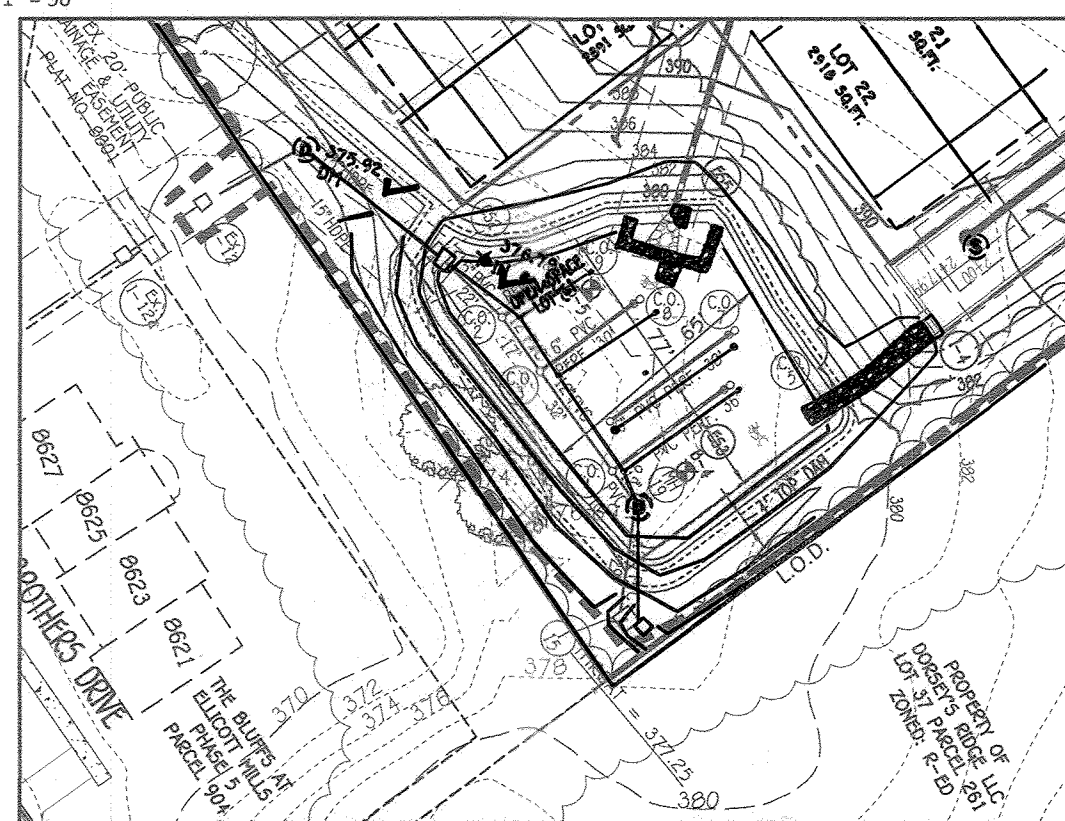

FINAL SWM POND PLAN @ TRAP #2
 Scale: 1" = 50'

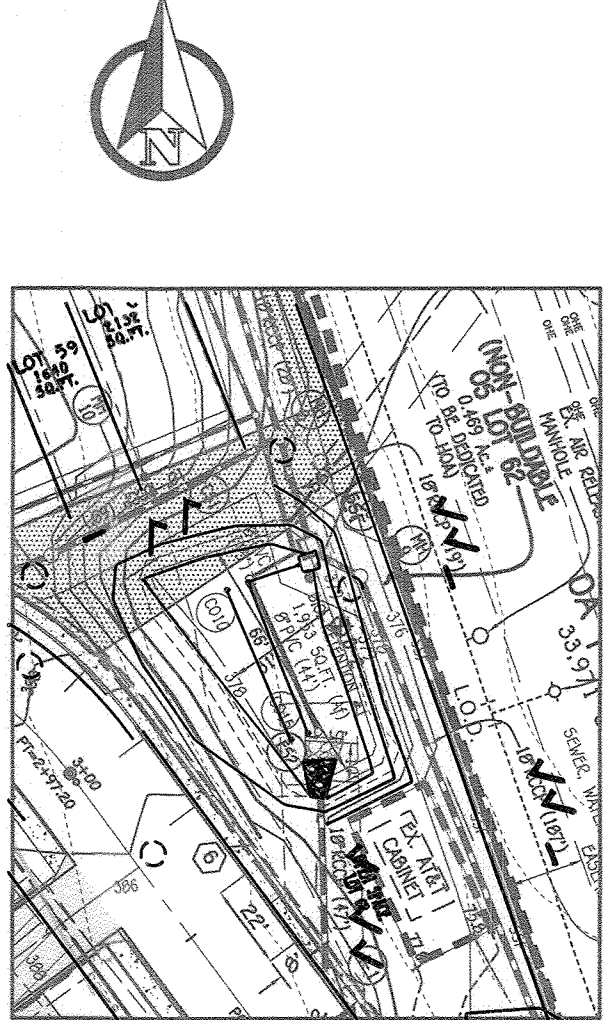


FINAL SWM POND PLAN @ TRAP #1
 Scale: 1" = 50'

SOILS LEGEND

SOIL	NAME	CLASS	C _w
Cs	Codorus and Hibbers silt loam, 0 to 3 percent slopes	C	0.37*
Cnc	Glenville silt loam, 0 to 15 percent slopes	C	0.37*
LaB	Lagore silt loam, 3 to 8 percent slopes, stony	C	0.28
LaC	Lagore silt loam, 8 to 15 percent slopes, stony	C	0.28
LoB	Lagore-Montalto-Urban land complex, 0 to 8 percent slopes	B	0.28
LcC	Lagore-Montalto-Urban land complex, 8 to 15 percent slopes	B	0.28
LcD	Lagore-Rally gravelly loam, 15 to 25 percent slopes, very stony	B/C	0.28
LcF	Lagore-Rally gravelly loam, 25 to 65 percent slopes, very stony	B/C	0.28
MaC	Manor loam, 8 to 15 percent slopes	B	0.24
UwF	Udorthents, highwater, 0 to 35 percent slopes	X	X
WcB	Witching silt loam, 3 to 8 percent slopes, stony	D	0.20

* DENOTES HIGHLY ERODIBLE SLOPES

FISHER, COLLINS & CARTER, INC.
 CIVIL ENGINEERING CONSULTANTS & LAND SURVEYORS
 CENTENNIAL SQUARE OFFICE PARK • 10272 BALDPORE NATIONAL PIKE
 ELICOTT CITY, MARYLAND 21042
 (410) 461-8999

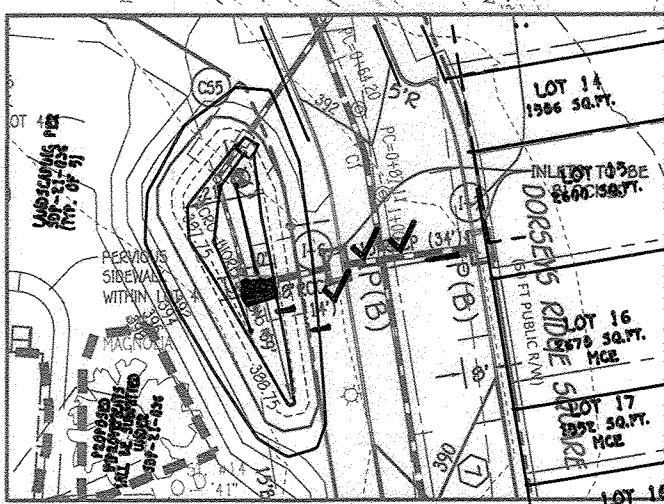

FINAL SWM POND PLAN MICRO-BIORETENTION POND 5
 Scale: 1" = 50'

AS-BUILT CERTIFICATION

I hereby certify, by my seal, that to the best of my knowledge and belief that the facilities shown on the plan was constructed as shown on this AS-BUILT plan meet the approved plans and specifications.

Date
 PAUL GERARD CAVANAUGH #27020

OWNER/DEVELOPER

DORSEYS RIDGE, LLC
 C/O DAVID WICKESHAVER
 308 MAGDOY ROAD
 SEVERNA PARK, MD 21146
 410-461-0837

PROFESSIONAL CERTIFICATION

I HEREBY CERTIFY THAT THESE DOCUMENTS WERE PREPARED OR APPROVED BY ME AND THAT I AM A DULY LICENSED PROFESSIONAL ENGINEER UNDER THE LAWS OF THE STATE OF MARYLAND, LICENSE NO. 20748, EXPIRATION DATE: 02/22/2023.

Signature of Professional Engineer
 DATE



GRADING & SEDIMENT CONTROL PLAN

REPLACEMENT SHEET
DORSEY'S RIDGE
 PHASE-1
 LOTS 1 THRU 4, OPEN SPACE LOTS 6,7,61,62,
 & NON-BUILDABLE BULK PARCELS B, G THRU K
 A RESUBDIVISION OF "MILHIDE PROPERTY, LOT 1, 2 & 3", PLAT NO. 18442
 ZONED: CEF-R
 TAX MAP NO.: 24 GRID NO.: 18 PARCEL NO: 260 LOTS: 1 THRU 3
 SECOND ELECTION DISTRICT HOWARD COUNTY, MARYLAND
 SCALE: AS SHOWN DATE: DECEMBER, 2021
 SHEET 6 OF 18

OWNER/DEVELOPER CERTIFICATION
 "I/We hereby certify that any clearing, grading construction, or development will be done pursuant to this approved erosion and sediment control plan, including inspecting and maintaining controls, and that the responsible person involved in the construction project will have a Certificate of Training at a Maryland Department of the Environment (MDE) approved training program for the control on erosion and sediment prior to beginning the project. I shall engage a Maryland registered professional engineer to supervise pond construction, and provide the Howard Soil Conservation District with an "As-Built" plan of the pond within 30 days of completion. I certify right-of-entry for periodic on-site evaluation by Howard County, the Howard Soil Conservation District and/or MDE."

David Woessner
 Owners/Developer's Signature
 DAVID WOESSNER
 Printed Name & Title
 11/17/2022
 Date

DESIGN CERTIFICATION
 "I hereby certify that this plan has been designed in accordance with current Maryland erosion and sediment control laws, regulation, and standards, that it represents a practical and workable plan based on my personal knowledge of the site, and that it was prepared in accordance with the requirements of the Howard Soil Conservation District. I have notified the Howard Soil Conservation District that he/she must engage a registered professional engineer to supervise construction and provide the Howard Soil Conservation District with an "As-Built" plan of the pond within 30 days of completion."
 Alexander Brantchi
 Design Engineer's Signature
 ALEXANDER BRANTCHI
 Printed Name & Title
 11/22/2022
 Date
 MD Registration No. 20749
 P.E., R.L.S., or R.L.A. (circle one)
 Approved: This Plan is Approved For Small Pond Construction and Soil Erosion And Sediment Control By The Howard Soil Conservation District.
 Alexander Brantchi
 Howard Soil Conservation District
 02/01/22
 Date

Approved: Department Of Planning And Zoning
 Chief, Division Of Land Development
 5/6/22
 Date
 Chief, Development Engineering Division
 2-22-22
 Date
 Approved: Howard County Department of Public Works
 Chief, Bureau Of Highways
 02/19/2022
 Date

REVISIONS

NO.	DESCRIPTION	DATE
1	REMOVE MAILBOX, PAV & SIDEWALK CHANGES TO WATER SCOUR, SHORNDRAIN, THE PROTECTIVE FENCE ONLY	07/22
2	Ed trap 1, cooks lane curb	3/1/22

SOIL PREPARATION, TOPSOILING AND SOIL AMENDMENTS (B-4-2)

- A. Soil Preparation
1. Temporary Stabilization
a. Seeded preparation consists of loosening soil to a depth of 3 to 3.5 inches by means of suitable agricultural or construction equipment...
b. Apply fertilizer and lime as prescribed on the plans.
c. Incorporate lime and fertilizer into the top 3 to 5 inches of soil by diskling or other suitable means.
d. A soil test is required for any earth disturbance of 5 acres or more.
e. Soil pH between 6.0 and 7.0.
f. Soluble salts less than 500 parts per million (ppm).
g. Soil contains less than 40 percent clay but enough fine grained material (greater than 30 percent silt plus clay) to provide the capacity to hold a moderate amount of moisture.
h. Soil contains less than 30 percent silt plus clay weight to be acceptable.
i. Soil contains sufficient pore space to permit adequate root penetration.
j. Application of amendments or topsoil is required if on-site soils do not meet the above conditions.
k. Graded areas must be maintained in a true and even grade as specified on the approved plan, then scarified or otherwise loosened to a depth of 3 to 5 inches.
l. Apply soil amendments as specified on the approved plan or as indicated by the results of a soil test.
m. Mix soil amendments into the top 3 to 5 inches of soil by diskling or other suitable means.
n. Smooth the surface, remove large objects like stones and branches, and ready the area for seed application.
o. Loosen surface soil by dragging with a heavy chain or other equipment to a depth of 3 to 5 inches.
p. Topsoil must not permit normal seeded separation.
q. Track slopes 3:1 or flatter with tracked equipment leaving the soil in an irregular condition with ridges running parallel to the contour of the slope.
r. Leave the top 1 to 3 inches of soil loose and friable.
s. Seeded broadcast may be unnecessary on newly disturbed areas.

- B. Topsoiling
1. Topsoil is placed over prepared subsoil prior to establishment of permanent vegetation.
2. Topsoil salvaged from an existing site may be used provided it meets the standards as set forth in these specifications.
3. Topsoiling is limited to areas having 2:1 or flatter slopes where:
a. The texture of the exposed subsoil/parent material is not adequate to produce vegetative growth.
b. The soil material is so shallow that the rooting zone is not deep enough to support plants or furnish containing supplies of moisture and plant nutrients.
c. The original soil to be vegetated contains material toxic to plant growth.
d. The soil is so acidic that treatment with limestone is not feasible.
e. Areas having slopes steeper than 2:1 require special consideration and design.
5. Topsoil Specifications: Topsoil to be used as topsoil must meet the following criteria:
a. Topsoil must be a loam, sandy loam, clay loam, silt loam, sandy clay loam, or loamy sand.
b. Topsoil must be free of noxious plants or plant parts such as Bermuda grass, quack grass, johnson grass, nuttall, poison ivy, thistle, or others as specified.
c. Topsoil substitutes or amendments, as recommended by a qualified agronomist or soil scientist and approved by the appropriate authority, may be used in lieu of natural topsoil.
6. Topsoil Application
a. Erosion and sediment control practices must be maintained when applying topsoil.
b. Uniformly distribute topsoil in a 5 to 8 inch layer and lightly compact to a minimum thickness of 4 inches.
c. Soil Amendments (Fertilizer and Lime Specifications)
1. Soil tests must be performed to determine the exact ratios and application rates for both lime and fertilizer on sites having disturbed areas of 5 acres or more.
2. Fertilizers must be uniform in composition, free flowing and suitable for accurate application by appropriate equipment.
3. Fertilizers must be substituted for fertilizer by prior approval from the appropriate authority.
4. Fertilizers must all be delivered to the site fully labeled according to the applicable laws and must bear the name, trade name or trademark and warranty of the producer.
5. Lime materials must be ground limestone (hydrated or burnt lime) may be substituted except when hydroseeding which contains at least 50 percent lime with at least a #100 mesh sieve and 98 to 100 percent will pass through a #20 mesh sieve.
6. Lime and fertilizer to be evenly distributed and incorporated into the top 3 to 5 inches of soil by diskling or other suitable means.
7. Where the subsoil is either highly acidic or composed of heavy clays, spread ground limestone at the rate of 4 to 10 tons/acre (100-400 pounds per 1,000 square feet) prior to the placement of topsoil.

TEMPORARY SEEDING NOTES (B-4-4)

- To stabilize disturbed soils with vegetation for up to 6 months.
Purpose
To use fast growing vegetation that provides cover on disturbed soils.
Conditions Where Practice Applies
Exposed soils where ground cover is needed for a period of 6 months or less.
Criteria
1. Select one or more of the species or seed mixtures listed in Table B.1 for the appropriate Plant Hardness Zone (from Figure B.3), and enter them in the Temporary Seeding Summary below along with application rates, seeding dates and seeding depths.
2. For sites having soil tests performed, use and show the recommended rates by the Testing Agency.
3. When stabilization is required outside of a seeding season, apply seed and mulch or straw mulch alone as prescribed in Section B-4-3.A.1.b and maintain until the next seeding season.
Temporary Seeding Summary
Table B.1: Temporary Seeding Summary
Table with columns: Hardiness Zone, Species, Application Rate (lb/ac), Seeding Dates, Seeding Depths, N, P2O5, K2O, Fertilizer Rate, Lime Rate.

Table B.1: Temporary Seeding Summary. Columns: Hardiness Zone, Species, Application Rate (lb/ac), Seeding Dates, Seeding Depths, N, P2O5, K2O, Fertilizer Rate, Lime Rate.

PERMANENT SEEDING NOTES (B-4-5)

- A. Seed Mixtures
1. General Use
a. Select one or more of the species or mixtures listed in Table B.3 for the appropriate Plant Hardness Zone (from Figure B.3) and based on the site condition or purpose found on Table B.2.
b. Additional planting specifications for exceptional sites such as shorelines, stream banks, or dunes or for special purposes such as wildlife or aesthetic treatment may be found in USDA-NRCS Technical Field Office Guide, Section 347 - Critical Area Planting.
c. For sites having disturbed areas over 5 acres, use and show the rates recommended by the soil testing agency.
d. For areas receiving low maintenance, apply area fertilizer (40-0-0) at 3 1/2 pounds per 1000 square feet (150 pounds per acre) at the time of seeding in addition to the seed mixtures shown in the Permanent Seeding Summary.
2. Turfgrass Mixtures
a. Areas where turfgrass may be desired include lawns, parks, playgrounds, and commercial sites which require a medium to high level of maintenance.
b. Select one or more of the species or mixtures listed below based on the site conditions or purpose.
c. For sites having disturbed areas over 5 acres, use and show the rates recommended by the soil testing agency.
3. Kentucky Bluegrass/Perennial Ryegrass: Full Sun Mixture: For use in areas that receive intensive management.
4. Kentucky Bluegrass/Perennial Ryegrass: Full Sun Mixture: For use in drought prone areas and/or for areas receiving low to medium management in full sun to medium shade.
5. Kentucky Bluegrass/Fine Fescue: Shade Mixture: For use in areas with shade in Bluegrass lawns.
6. Topsoil Application
a. Erosion and sediment control practices must be maintained when applying topsoil.
b. Uniformly distribute topsoil in a 5 to 8 inch layer and lightly compact to a minimum thickness of 4 inches.
c. Soil Amendments (Fertilizer and Lime Specifications)
1. Soil tests must be performed to determine the exact ratios and application rates for both lime and fertilizer on sites having disturbed areas of 5 acres or more.
2. Fertilizers must be uniform in composition, free flowing and suitable for accurate application by appropriate equipment.
3. Fertilizers must be substituted for fertilizer by prior approval from the appropriate authority.
4. Fertilizers must all be delivered to the site fully labeled according to the applicable laws and must bear the name, trade name or trademark and warranty of the producer.
5. Lime materials must be ground limestone (hydrated or burnt lime) may be substituted except when hydroseeding which contains at least 50 percent lime with at least a #100 mesh sieve and 98 to 100 percent will pass through a #20 mesh sieve.
6. Lime and fertilizer to be evenly distributed and incorporated into the top 3 to 5 inches of soil by diskling or other suitable means.
7. Where the subsoil is either highly acidic or composed of heavy clays, spread ground limestone at the rate of 4 to 10 tons/acre (100-400 pounds per 1,000 square feet) prior to the placement of topsoil.

B-4-1 STANDARDS AND SPECIFICATIONS FOR INCREMENTAL STABILIZATION

- Purpose
Establishment of vegetative cover on cut and fill slopes.
Conditions Where Practice Applies
To provide timely vegetative cover on cut and fill slopes as work progresses.
Criteria
1. Incremental Stabilization - Cut Slopes
a. Excavate and stabilize cut slopes in increments not to exceed 15 feet in height.
b. Prepare seeded and apply seed and mulch on all cut slopes as the work progresses.
c. Construction sequence example (Refer to Figure B.1):
1. Construct and stabilize all temporary swales or dikes that will be used to convey runoff around the excavation.
2. Perform Phase 1 excavation, prepare seeded, and stabilize.
3. Perform Phase 2 excavation, prepare seeded, and stabilize.
4. Perform Phase 3 excavation, prepare seeded, and stabilize.
5. Overseed previously seeded areas as necessary.
2. Application
a. Apply mulch to all seeded areas immediately after seeding.
b. When straw mulch is used, spread it over all seeded areas at the rate of 2 tons per acre to a uniform loose depth of 1 to 2 inches.
c. Wood cellulose fiber used as mulch must be applied to a net dry weight of 1500 pounds per acre.
d. Mix the wood cellulose fiber with water to attain a mixture with a maximum of 50 pounds of wood cellulose fiber per 100 gallons of water.
3. Anchoring
a. Perform mulch anchoring immediately following application of mulch to minimize loss by wind or water.
b. A mulch anchoring tool is a tractor drawn implement designed to such and anchor mulch into the soil surface to a minimum of 2 inches.
c. Wood cellulose fiber may be used for anchoring straw.
d. Synthetic binders such as Acrylic DLR (Ago-Tack), DCA-70, Patrosol, Terra Tex II, Terra Tack AR or other approved equal may be used.
e. Lightweight plastic netting may be applied over the mulch according to manufacturer recommendations.
f. Netting is usually available in rolls 4-15 feet wide and 300 to 3,000 feet long.

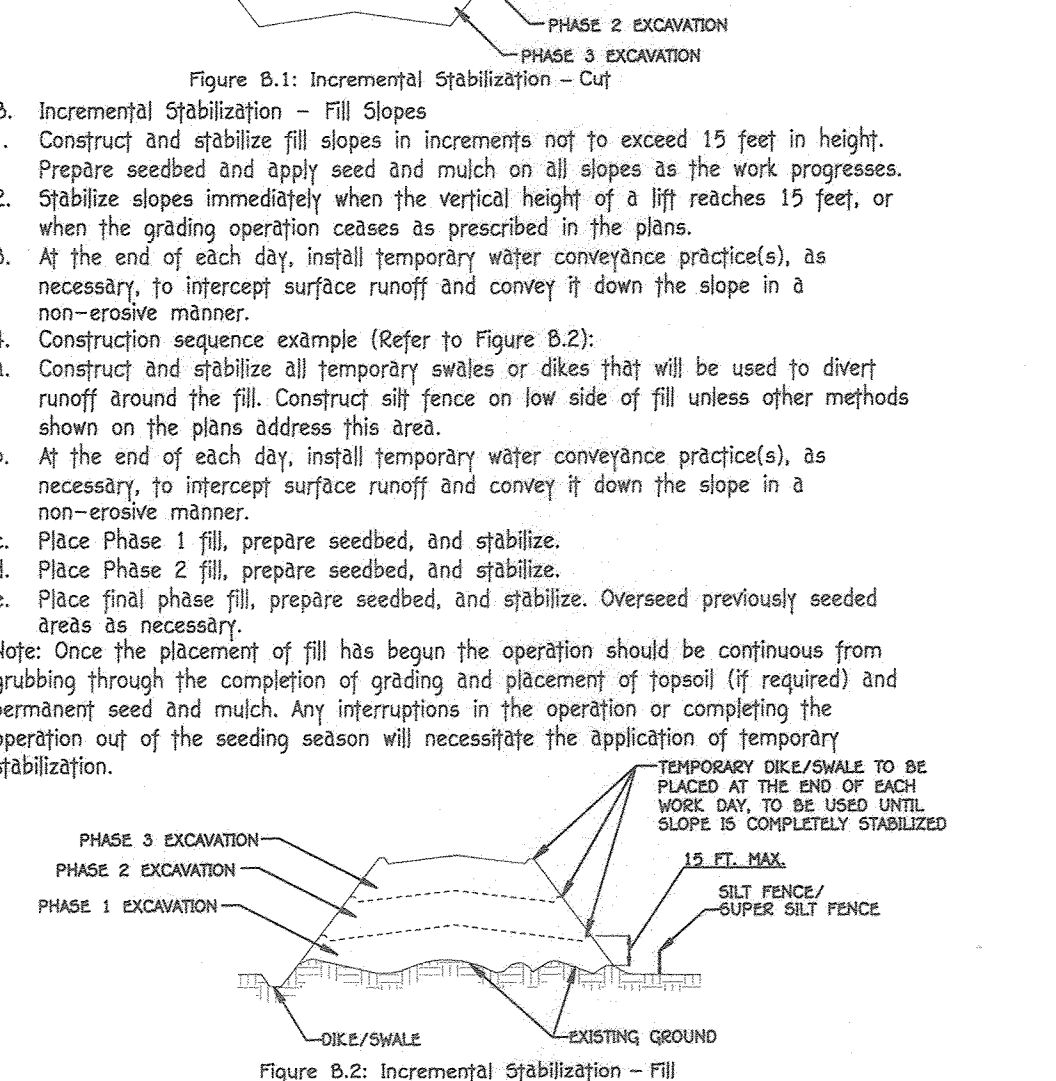


Figure B.1: Incremental Stabilization - Cut

STANDARD STABILIZATION NOTE

- FOLLOWING INITIAL SOIL DISTURANCE OR RE-DISTURBANCE, PERMANENT OR TEMPORARY STABILIZATION MUST BE COMPLETED WITHIN:
a) THREE (3) CALENDAR DAYS AS TO THE SURFACE OF ALL PERMETER DIKES, SWALES, DITCHES, PERMETER SLOPES AND ALL SLOPES STEEPER THAN 3 HORIZONTAL TO 1 VERTICAL (3:1); AND
b) SEVEN (7) CALENDAR DAYS AS TO ALL OTHER DISTURBED OR GRADED AREAS ON THE PROJECT SITE NOT UNDER ACTIVE GRADING.

STANDARDS AND SPECIFICATIONS FOR STOCKPILE AREAS (B-4-6)

- Purpose
To provide a designated location for the temporary storage of soil that controls the potential for erosion, sedimentation, and changes to drainage patterns.
Criteria
1. The stockpile location and all related sediment control practices must be clearly indicated on the erosion and sediment control plan.
2. The footprint of the stockpile must be sized to accommodate the anticipated volume of material and based on a side slope ratio no steeper than 2:1.
3. Runoff from the stockpile area must drain to a suitable sediment control practice.
4. Access the stockpile area from the upgrade side.
5. Clear water runoff into the stockpile area must be minimized by use of a diversion device such as an earth dike, temporary swale or diversion fence.
6. Where runoff concentrates along the slope of the stockpile, an appropriate erosion/sediment control practice must be used to intercept the vegetative cover.
7. Stockpiles must be stabilized in accordance with the 3/7 day stabilization requirement as well as Standards B-4-1 Incremental Stabilization and Standard B-4-2 Temporary Stabilization.
8. If the stockpile is located on an impervious surface, a liner should be provided below the stockpile to facilitate closure. Stockpiles containing contaminated material must be covered with impermeable sheeting.

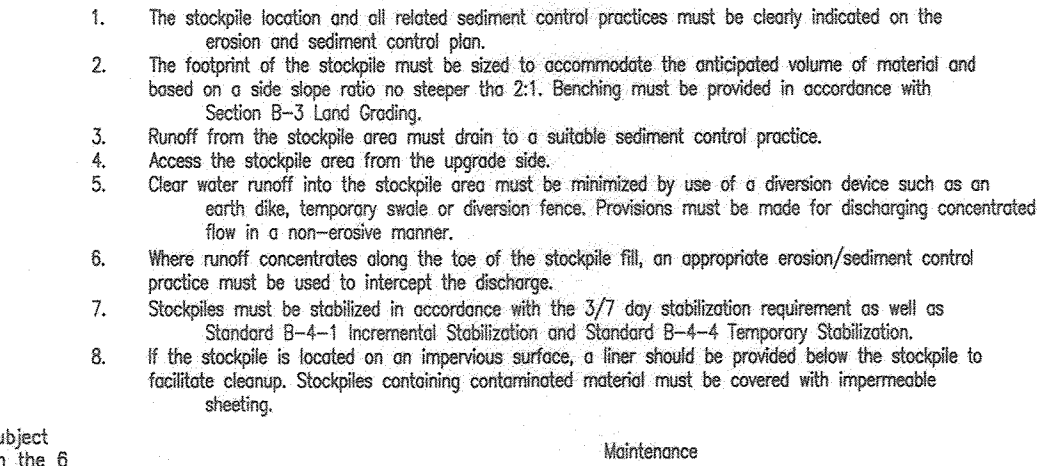


Figure B.2: Incremental Stabilization - Fill

AS-BUILT CERTIFICATION

I hereby certify that my seal, that is to the best of my knowledge and belief that the facilities shown on the plans were constructed as shown on this AS-BUILT plan meet the approved plans and specifications.

DAVID W. BESSNER, Owner/Developer Signature
PAUL GERARD CARNAVAUGH #27020, Date

FISHER, COLLINS & CARTER, INC. CIVIL ENGINEERING CONSULTANTS & LAND SURVEYORS. 10272 BALTIMORE NATIONAL PIKE, ELICOTT CITY, MARYLAND 21042. (410) 461-2955

- B. Mulching
1. Materials (in order of preference)
a. Straw consisting of thoroughly threshed wheat, rye, oat, or barley and reasonably bright in color.
b. Wood Cellulose Fiber Mulch (WCFM) consisting of specially prepared wood cellulose processed into uniform fibrous physical state.
c. WCFM is to be dyed green or contain a green dye in the package that will provide an appropriate color to facilitate visual inspection of the uniformly spread slurry.
d. WCFM, including dye, must contain no herbicide or growth inhibiting factors.
e. WCFM materials are to be manufactured and processed in such a manner that the wood cellulose fiber mulch will remain in uniform suspension in water under agitation and will blend with seeds, fertilizer and other additives to form a homogeneous slurry.
f. WCFM material must not contain elements or compounds at concentration levels that will be phytotoxic.
g. WCFM must conform to the following physical requirements: fiber length of approximately 10 millimeters, diameter approximately 1 millimeter, pH range of 4.0 to 8.5, ash content of 1.5 percent maximum and water holding capacity 90 percent minimum.
2. Application
a. Apply mulch to all seeded areas immediately after seeding.
b. When straw mulch is used, spread it over all seeded areas at the rate of 2 tons per acre to a uniform loose depth of 1 to 2 inches.
c. Wood cellulose fiber used as mulch must be applied to a net dry weight of 1500 pounds per acre.
d. Mix the wood cellulose fiber with water to attain a mixture with a maximum of 50 pounds of wood cellulose fiber per 100 gallons of water.
3. Anchoring
a. Perform mulch anchoring immediately following application of mulch to minimize loss by wind or water.
b. A mulch anchoring tool is a tractor drawn implement designed to such and anchor mulch into the soil surface to a minimum of 2 inches.
c. Wood cellulose fiber may be used for anchoring straw.
d. Synthetic binders such as Acrylic DLR (Ago-Tack), DCA-70, Patrosol, Terra Tex II, Terra Tack AR or other approved equal may be used.
e. Lightweight plastic netting may be applied over the mulch according to manufacturer recommendations.
f. Netting is usually available in rolls 4-15 feet wide and 300 to 3,000 feet long.

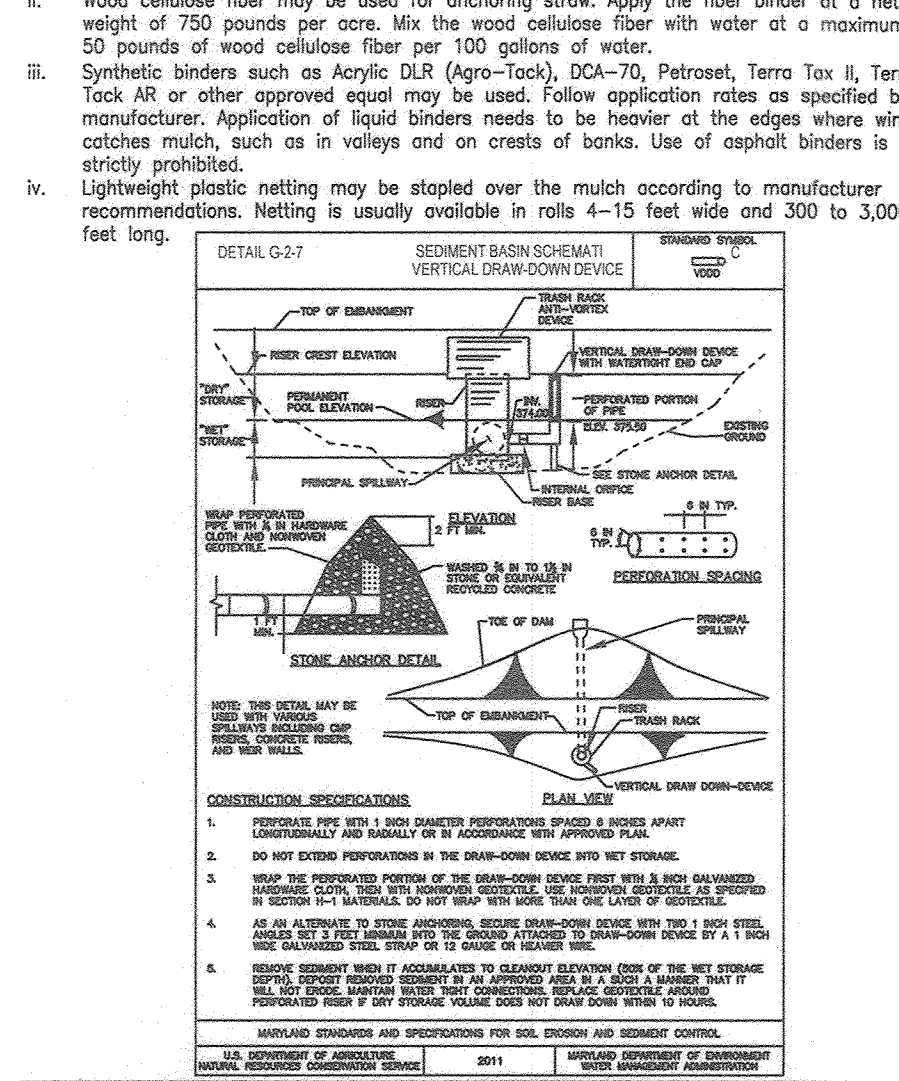


Figure B.3: Incremental Stabilization - Fill

STANDARD STABILIZATION NOTE

- FOLLOWING INITIAL SOIL DISTURANCE OR RE-DISTURBANCE, PERMANENT OR TEMPORARY STABILIZATION MUST BE COMPLETED WITHIN:
a) THREE (3) CALENDAR DAYS AS TO THE SURFACE OF ALL PERMETER DIKES, SWALES, DITCHES, PERMETER SLOPES AND ALL SLOPES STEEPER THAN 3 HORIZONTAL TO 1 VERTICAL (3:1); AND
b) SEVEN (7) CALENDAR DAYS AS TO ALL OTHER DISTURBED OR GRADED AREAS ON THE PROJECT SITE NOT UNDER ACTIVE GRADING.

STANDARDS AND SPECIFICATIONS FOR STOCKPILE AREAS (B-4-6)

- Purpose
To provide a designated location for the temporary storage of soil that controls the potential for erosion, sedimentation, and changes to drainage patterns.
Criteria
1. The stockpile location and all related sediment control practices must be clearly indicated on the erosion and sediment control plan.
2. The footprint of the stockpile must be sized to accommodate the anticipated volume of material and based on a side slope ratio no steeper than 2:1.
3. Runoff from the stockpile area must drain to a suitable sediment control practice.
4. Access the stockpile area from the upgrade side.
5. Clear water runoff into the stockpile area must be minimized by use of a diversion device such as an earth dike, temporary swale or diversion fence.
6. Where runoff concentrates along the slope of the stockpile, an appropriate erosion/sediment control practice must be used to intercept the vegetative cover.
7. Stockpiles must be stabilized in accordance with the 3/7 day stabilization requirement as well as Standards B-4-1 Incremental Stabilization and Standard B-4-2 Temporary Stabilization.
8. If the stockpile is located on an impervious surface, a liner should be provided below the stockpile to facilitate closure. Stockpiles containing contaminated material must be covered with impermeable sheeting.

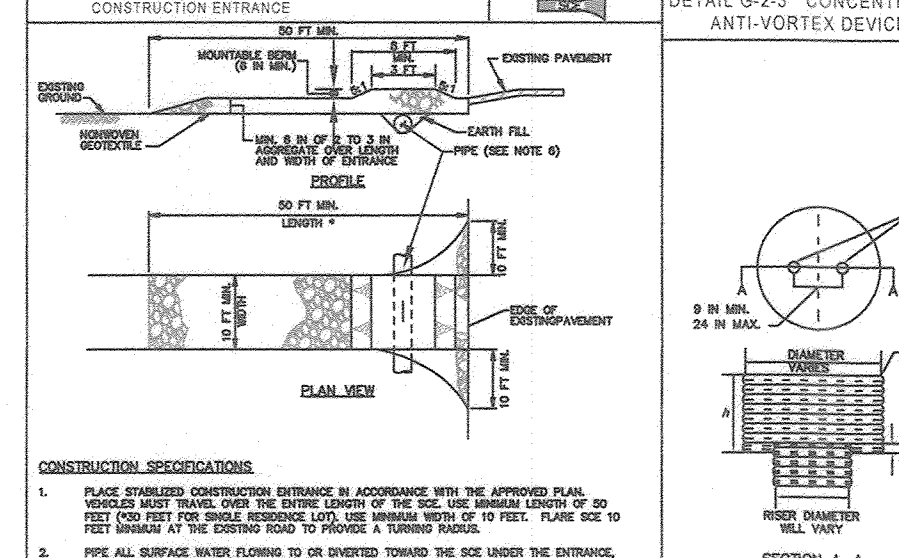


Figure B.4: Stockpile Area

AS-BUILT CERTIFICATION

I hereby certify that my seal, that is to the best of my knowledge and belief that the facilities shown on the plans were constructed as shown on this AS-BUILT plan meet the approved plans and specifications.

DAVID W. BESSNER, Owner/Developer Signature
PAUL GERARD CARNAVAUGH #27020, Date

FISHER, COLLINS & CARTER, INC. CIVIL ENGINEERING CONSULTANTS & LAND SURVEYORS. 10272 BALTIMORE NATIONAL PIKE, ELICOTT CITY, MARYLAND 21042. (410) 461-2955

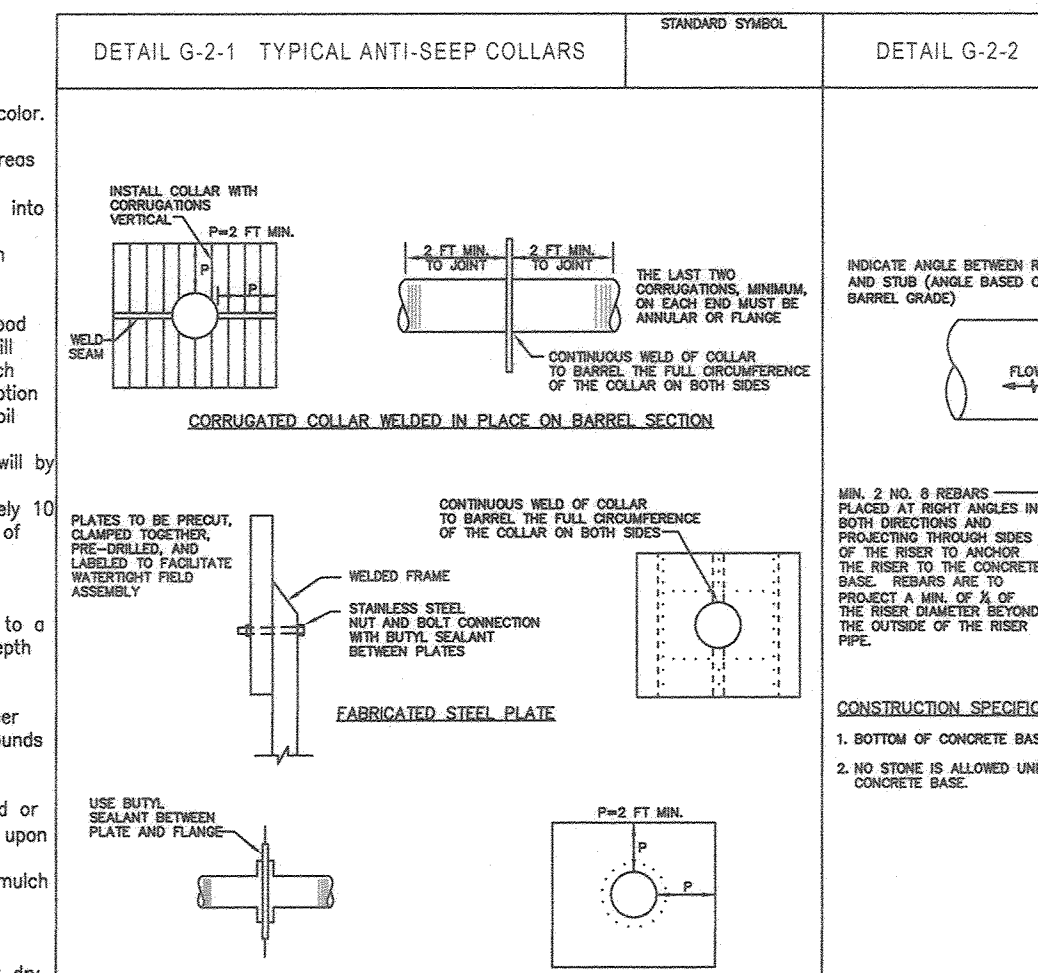


Figure B.5: Typical Anti-Seep Collars

HOWARD SOIL CONSERVATION DISTRICT (HSCD) STANDARD SEDIMENT CONTROL NOTES

- 1. A pre-construction meeting must occur with the Howard County Department of Public Works, Construction Inspection Department and the Howard County Department of Public Works, Construction Inspection Department.
2. Upon completion of the installation of perimeter erosion and sediment controls, but before proceeding with any other earth disturbance or grading.
3. Prior to the start of another phase of construction or opening of another grading unit, d. Prior to the removal or modification of sediment control practices.
4. Other grading or grading inspection activities may not be authorized until the inspection agency is notified.
5. All sediment control structures are to be installed according to the provisions of this plan and are to be in accordance with the 2011 MARLAND STANDARDS AND SPECIFICATIONS FOR SOIL EROSION AND SEDIMENT CONTROL.
6. All sediment control structures are to remain in place, and are to be maintained in operative condition until permanent removal has been obtained from the CDO.
7. Any sediment control practice which is disturbed by grading activity for placement of utilities must be repaired on the same day of disturbance.
8. Additional sediment control must be provided, if deemed necessary by the CDO. The site and all controls shall be inspected by the contractor weekly and the next day after each other such activities. A written report by the contractor, made available upon request, is part of every inspection and should include:
- Inspection date
- Name and title of inspector
- Inception time/Current conditions as well as time and amount of (if recorded precipitation)
- Brief description of project's status (e.g., percent complete) and/or current activities
- Location of sediment control practices
- Identification of plan deficiencies that require maintenance
- Identification of missing or improperly installed sediment controls
- Identification of missing or improperly installed sediment control practices
- Photographs
- Maintenance and/or corrective action performed
- Date and signature of inspector
9. Treatment for the construction of utilities is limited to those items for which the contractor shall be back-filled and stabilized by the end of each workday, whichever is shorter.
10. Any major changes or revisions to the plan or sequence of construction must be reviewed and approved by the CDO prior to proceeding with construction.
11. Disbursement shall not occur outside the L.O.D. A project is to be sequenced so that grading activities begin on one grading unit no less than 20 feet from the next step.
12. When grading activities begin on one grading unit, the next grading unit shall be established and approved by the HSCD.
13. Stream channels must not be disturbed during the following restricted time periods (inclusive):
- Use 1 and 2 from 1 June 15 - June 15
- Use 3 from 1 June 15 - Sept 30
- Use 4 and 5 from 1 April 30 - April 30
- Use 6 from 1 May 1 - May 31
14. A copy of this plan, the 2011 MARLAND STANDARDS AND SPECIFICATIONS FOR SOIL EROSION AND SEDIMENT CONTROL, associated permits, shall be on-site and available when the site is active.

DETAIL G-2-1 TYPICAL ANTI-SEEP COLLARS

DETAIL G-2-2 CORRUGATED RISER BASE

DETAIL G-2-3 CONCENTRIC TRASH RACK AND ANTI-VORTEX DEVICE

DETAIL G-2-4 CONCENTRIC TRASH RACK AND ANTI-VORTEX DEVICE

DETAIL G-2-5 CONCENTRIC TRASH RACK AND ANTI-VORTEX DEVICE

DETAIL G-2-6 CONCENTRIC TRASH RACK AND ANTI-VORTEX DEVICE

DETAIL G-2-7 CONCENTRIC TRASH RACK AND ANTI-VORTEX DEVICE

DETAIL G-2-8 CONCENTRIC TRASH RACK AND ANTI-VORTEX DEVICE

DETAIL G-2-9 CONCENTRIC TRASH RACK AND ANTI-VORTEX DEVICE

DETAIL G-2-10 CONCENTRIC TRASH RACK AND ANTI-VORTEX DEVICE

DETAIL G-2-11 CONCENTRIC TRASH RACK AND ANTI-VORTEX DEVICE

DETAIL G-2-12 CONCENTRIC TRASH RACK AND ANTI-VORTEX DEVICE

DETAIL G-2-13 CONCENTRIC TRASH RACK AND ANTI-VORTEX DEVICE

DETAIL G-2-14 CONCENTRIC TRASH RACK AND ANTI-VORTEX DEVICE

DETAIL G-2-15 CONCENTRIC TRASH RACK AND ANTI-VORTEX DEVICE

DETAIL G-2-16 CONCENTRIC TRASH RACK AND ANTI-VORTEX DEVICE

DETAIL G-2-17 CONCENTRIC TRASH RACK AND ANTI-VORTEX DEVICE

DETAIL G-2-18 CONCENTRIC TRASH RACK AND ANTI-VORTEX DEVICE

DETAIL G-2-19 CONCENTRIC TRASH RACK AND ANTI-VORTEX DEVICE

DETAIL G-2-20 CONCENTRIC TRASH RACK AND ANTI-VORTEX DEVICE

DETAIL G-2-21 CONCENTRIC TRASH RACK AND ANTI-VORTEX DEVICE

DETAIL G-2-22 CONCENTRIC TRASH RACK AND ANTI-VORTEX DEVICE

DETAIL G-2-23 CONCENTRIC TRASH RACK AND ANTI-VORTEX DEVICE

DETAIL G-2-24 CONCENTRIC TRASH RACK AND ANTI-VORTEX DEVICE

DETAIL G-2-25 CONCENTRIC TRASH RACK AND ANTI-VORTEX DEVICE

SEDIMENT AND EROSION CONTROL NOTES & DETAILS

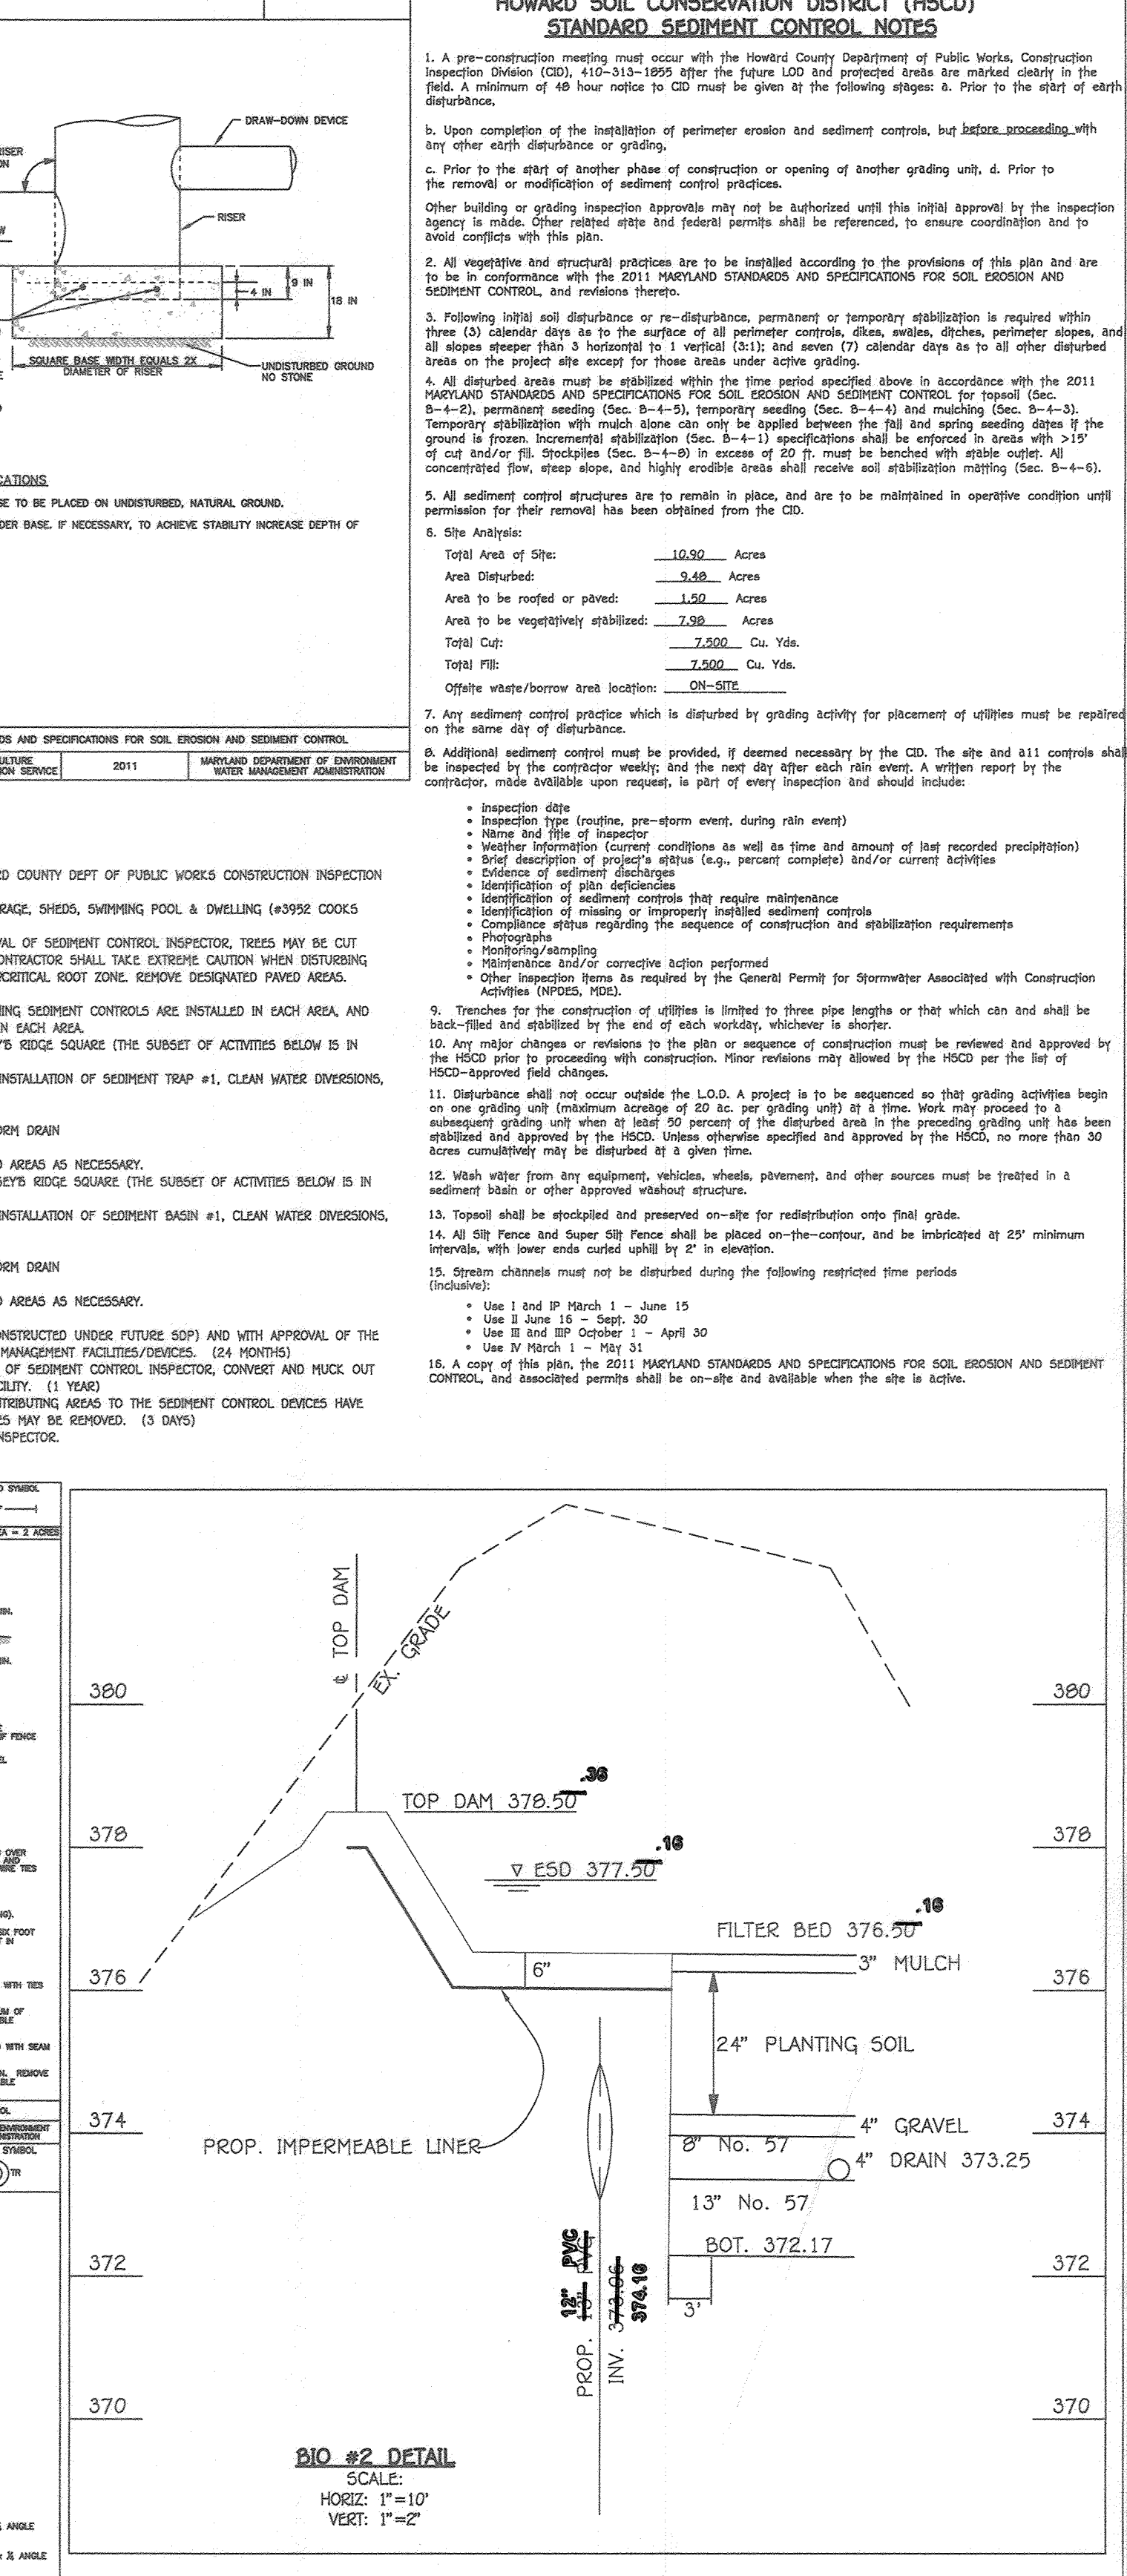


Figure B.6: Sediment and Erosion Control Notes & Details

PROFESSIONAL CERTIFICATION

I HEREBY CERTIFY THAT THESE DOCUMENTS WERE PREPARED OR APPROVED BY ME AND THAT I AM A FULLY LICENSED PROFESSIONAL ENGINEER UNDER THE LAWS OF THE STATE OF MARYLAND, LICENSE NO. 20740, EXPIRATION DATE: 02/22/2023.

DAVID W. BESSNER, Owner/Developer Signature
PAUL GERARD CARNAVAUGH #27020, Date

SEDIMENT AND EROSION CONTROL NOTES & DETAILS REPLACEMENT SHEET DORSEY'S RIDGE PHASE-1 LOTS 1 THRU 4, OPEN SPACE LOTS 6,7,61,62, & NON-BUILDABLE BULK PARCELS B, G THRU K. A RESUBDIVISION OF "MILHIDE PROPERTY, LOT 1, 2 & 3", PLAT NO. 18442 ZONED: CEF-R. TAX MAP NO.: 24 GRID NO.: 18 PARCEL NO.: 260 LOTS: 1 THRU 3 SECOND ELECTION DISTRICT HOWARD COUNTY, MARYLAND. SCALE: AS SHOWN DATE: DECEMBER, 2021 SHEET 7 OF 18

5.0 GEOTECHNICAL RECOMMENDATION
5.1 SITE PREPARATION
We have not been provided with a grading plan, but we asked to provide recommendations for the placement and compaction of engineered fill. The following recommendations are general comments for the satisfactory performance of the earthwork that may be involved to attain the planned grades for construction of the project.

- The site should be cleared and grubbed; all topsoil, vegetation, root-balls, and organic or other deleterious soils should be removed.
- Existing structures should be fully demolished - to include their foundations, retaining all underground utilities. Basement and utility excavations should be backfilled with well-compacted, engineered fill.
- Old fill soils beneath planned pavements should be undercut at least 2 ft.

Following stripping and removal of unsuitable soils, grading operations may proceed. Prior to any fill placement, the site should be observed by the Geotechnical Engineer or his qualified representative for proper stripping and preparation for receiving the fill.

Proof-rolling: Once the site has been cleared and the planned subgrade exposed, the exposed subgrade soils in building and paved areas should be carefully evaluated by the Geotechnical Engineer. Proof-rolling should be performed using heavy pneumatic tired equipment (such as loaded dump trucks). Soils that are observed to not deflect excessively under the moving load should be under-cut and replaced with compacted fill that meets the requirements listed below. All proof-rolling and under-cutting activities should be observed and evaluated by the Geotechnical Engineer and should be performed during periods of dry weather. If proof-rolling is not practical, Dynamic Cone Penetrometer tests (DCP) can be performed to evaluate the subgrade condition.

Earthwork: Effort should be made to keep building and pavement areas free of ponding water. Subgrade strength may be reduced if soils are exposed to construction traffic and increases in moisture content, possibly resulting in the need for under-cut excavations. Note that during periods of cold weather, frozen soils cannot be used as fill or backfill (and fill should not be placed on frozen ground).

During subgrade preparation and inspection, if under-cutting is needed at isolated locations, the following recommendations are intended for the satisfactory performance of the earthwork that may be needed to provide the planned grades for the proposed construction.

- Material satisfactory for controlled fill should include clean soil or bankrun sand and gravel (GW, GM, and SM). GC and SC materials may be used, provided that the density and the liquid limit and plasticity index of the finer fraction of the material satisfy the following requirements:
 - Maximum Dry Density (pcf) ≥ 105 pcf, standard Proctor
 - Liquid Limit (KL) ≤ 40
 - Plasticity Index ≤ 15 .

Some of the soils removed during the excavation processes previously discussed may be suitable for reuse.

- Highly plastic soils (MH and CH) should not be used in engineered fill. The fill materials should be free from topsoil, organics and rock fragments having a major dimension greater than 3 inches.
- The moisture content of the fill should be within plus or minus two (2%) percentage points of the optimum moisture content.
- Fill placement should be in maximum 8-inch thick, loose, horizontal lifts, compacted uniformly with suitable equipment.
- Rock fragments in the fill should be limited to maximum size of 3-inches. Larger particles should be well-distributed within the fill.
- To be considered well-compacted, Engineered Fill on the site should be compacted to at least ninety-five percent (95 percent) of the standard Proctor maximum dry density (MDD). Depending on project specifics, additional compactive effort may be required at specific locations. For example, structural fills (under and within 10 ft of buildings) might require compaction to 98 percent of the standard Proctor MDD.
- The compaction for the roadways and other paved areas will be governed by Maryland DOT requirements, or by local municipal requirements.

Limited Space Backfilling: Limited spaces are defined as areas where backfill operations are restricted to the use of small mechanical compaction equipment. Most deficiencies in compacted backfill around subsurface structures have occurred in limited spaces, where required densities are difficult to achieve because of restricted working room and where relatively low compaction effort is provided by the compaction equipment used.

All structural backfill, including that placed in limited spaces, must be systematically compacted to the project requirements, even if crushed aggregate is placed. Over-sized rock fragments should not be placed around pipes or other below-ground structures.

Proper placement and compaction of backfill around pipes, conduits and utility lines is often difficult and should be given special attention. Clearly defined project specifications for confined zone backfill compaction and sufficient field monitoring is essential in preventing problems associated with utility trench backfill settlement.

DESIGN CERTIFICATION

I hereby Certify That this Plan Has Been Designed In Accordance With Current Maryland Erosion And Sediment Control Laws, Regulations And Standards, That It Represents A Practical And Workable Plan Based On My Personal Knowledge Of The Site, And That It Was Prepared In Accordance With The Requirements Of The Howard Soil Conservation District.

Designer's Signature: *Alvo M. Vitucci* Date: *5/21/2020*
Printed Name: *Alvo M. Vitucci* Registration No. *MD 20746*
P.E. Registration No. *MD 20746* or G.L.A. (circle one)

OWNER/DEVELOPER CERTIFICATION

"I/We Certify That Any Clearing, Grading, Construction Or Development Will Be Done Pursuant To This Approved Erosion And Sediment Control Plan, Including Inspecting And Maintaining Controls, And That The Responsible Personnel Involved In The Construction Project Will Have A Certificate Of Training At A Maryland Department Of The Environment (MDE) Approved Training Program For The Control On Erosion And Sediment Prior To Beginning The Project. I Shall Engage A Maryland Registered Professional Engineer To Supervise Pond Construction, And Provide The Howard Soil Conservation District With An "As-Built" Plan Of The Pond Within 30 Days Of Completion. I Certify Right-of-entry For Periodic On-site Evaluation By Howard County, The Howard Soil Conservation District And/or MDE."

Owner's/Developer's Signature: *Alvo M. Vitucci* Date: *5/21/2020*

Printed Name & Title: *Alvo M. Vitucci*

Approved: *Spencer A. B... 6/17/20*
Howard Soil Conservation District

Approved: Department Of Planning And Zoning

Chief, Division Of Land Development Date: *6/15/20*

Chief, Development Engineering Division Date: *8-28-20*

Approved: Howard County Department Of Public Works

Chief, Bureau Of Highways Date: *8/17/2020*

NO.	REVISIONS DESCRIPTION	DATE
-----	-----------------------	------

Also, backfilling in limited access areas, such as in utility trenches and around below-grade structures, such as manholes, junction boxes, and curb inlets, should have a loose-lift thickness limited to 4 to 6 inches. A sufficient amount of testing or observation should be conducted to verify that proper compaction is achieved. In extremely tight spaces, use of alternate backfill materials, such as flowable fill, should be considered.

5.2 INFILTRATION OF STORMWATER

The 2007 Maryland Stormwater Design Manual with LID Practices, adopted for use by Howard County, requires a minimum infiltration rate of 1.02 inch/hour if infiltration practices are to be used. All of the tests indicated infiltration rates greater than 1.02 inch per hour. Based on these test results, well-constructed infiltration structures will likely provide good performance. Water quality improvements will be feasible through use of sand filters and other bio-retention methods that include provisions for underdrains to collect stormwater for subsequent disposal at approved locations.

5.3 STORMWATER POND

Borings S-15 to S-18 were drilled near the location of a planned stormwater pond embankment dam. Soils consisted of residual silt and clayey sands, with very stiff soils encountered at a depth of 5 ft in these four borings. Groundwater was encountered at depths of 3.75 to 6.8 ft in these four borings. Decomposed rock was encountered at a depth of 8.5 ft in Boring S-18.

The data developed during this study indicate that the subsurface soil and groundwater conditions are generally suitable for the construction of the proposed stormwater management facility. Any water and sediment laden soils that may collect during the excavations as a result of precipitation or near surface seepage should be removed prior to placement of reinforcement and structural concrete. If the concrete cannot be placed due to inclement weather conditions or any other unforeseen circumstances, then the bottoms of the foundation excavations should be protected by undercutting 3 inches and placing a 3-inch thick lean mix concrete work mat immediately upon approval of the excavation bottom and before placement of reinforcing steel.

5.3.1 General Embankment Design

Top widths and side slopes for the pond embankments should conform to the requirements of Code No. 378. Base on the plans provided to us, the propose embankment will have a height of about 8 ft. Actual conditions will need to be evaluated in the field at the time of construction.

5.3.2 Discharge Structures

Because of possible variations in subsurface conditions and related bearing capacity, the excavations for the discharge structure foundations should be observed and approved by the Geotechnical Engineer. Any water and sediment laden soils that may collect during the excavations as a result of precipitation or near surface seepage should be removed prior to placement of reinforcement and structural concrete. If the concrete cannot be placed due to inclement weather conditions or any other unforeseen circumstances, then the bottoms of the foundation excavations should be protected by undercutting 3 inches and placing a 3-inch thick lean mix concrete work mat immediately upon approval of the excavation bottom and before placement of reinforcing steel.

The Geotechnical Engineer should observe the conditions encountered. Backfill around and above the discharge structure foundations should satisfy the controlled fill requirements described in the previous Section 5.1 Site Preparation and Earthwork. Erosion (e.g., rip-rap or approved equivalent) protection should be provided.

5.3.3 Cutoff Trenches and Impervious Cores







Cut-off trenches and impervious cores must be provided since the planned pond will be constructed in a combination of cut and fill. The core trench for the proposed embankment should extend to a depth of at least 6 ft, into the very stiff soils found in our four borings (S-15 to S-18) at the embankment location. Provided below is general guidance regarding the provision of cut-off trenches and impervious cores.

The cutoff trenches should extend longitudinally the entire length of the pond embankment dam and should have minimum depths of 4 ft below the bottom levels of the ponds or below the bottom levels of the concrete cradles for the principal spillway pipes. The bottom widths of the cutoff trenches must accommodate the equipment used for construction and must not be less than 4ft. Side slopes for the cutoff trenches should be compacted to at least 90% of the maximum dry density and should extend from the bottom levels of the cutoff trenches up to the bottom levels of the ponds.

The impervious cores should extend longitudinally the entire length of the dam embankment. Vertically, the impervious cores should extend from the tops of the cutoff trenches up to the 10-year-storm water surface levels for the ponds. Side slopes for the impervious concrete cores should be 1H:1V or flatter. The cutoff trenches and impervious cores should be constructed of the materials discussed in previous Section 5.1. The materials should be compacted to at least ninety-five percent (95 percent) of the maximum dry density as established by the standard Proctor (ASTM D698) test methods at moisture contents

5.3.4 Principal Spillways
















Principal spillways typically consist of single 15-inch or larger diameter reinforced concrete pipes, conforming to the ASTM C-361 specification, with watertight, gasketed joints. The entire embedded lengths of the principal spillway pipes, beginning at the discharge structures, should be installed on concrete cradles, which should have a thickness of at least 6 inches and should extend up to the spring lines of the pipes. Seepage control shall be provided using filter and drainage diaphragms, designed in accordance with criteria outlined in Code No. 378. The final design should be reviewed by Specialized Engineering to determine if the design or our recommendations need to be revised since a preliminary design of the facility has not been provided.

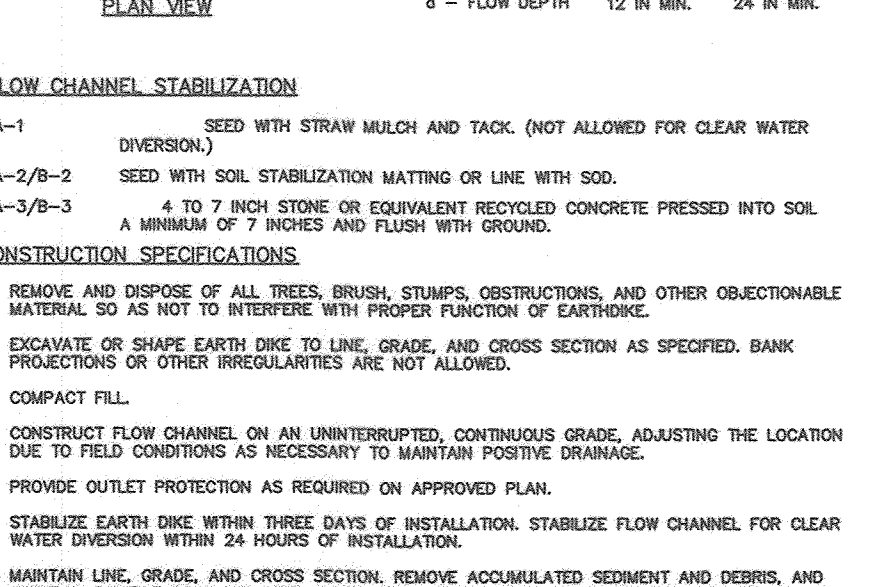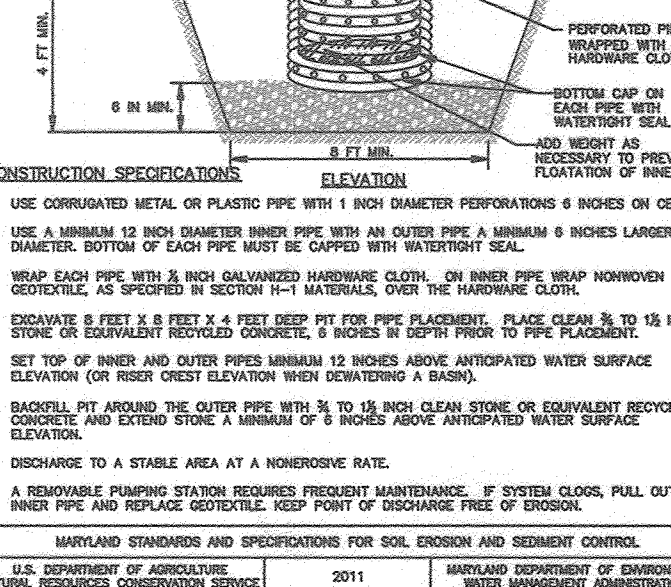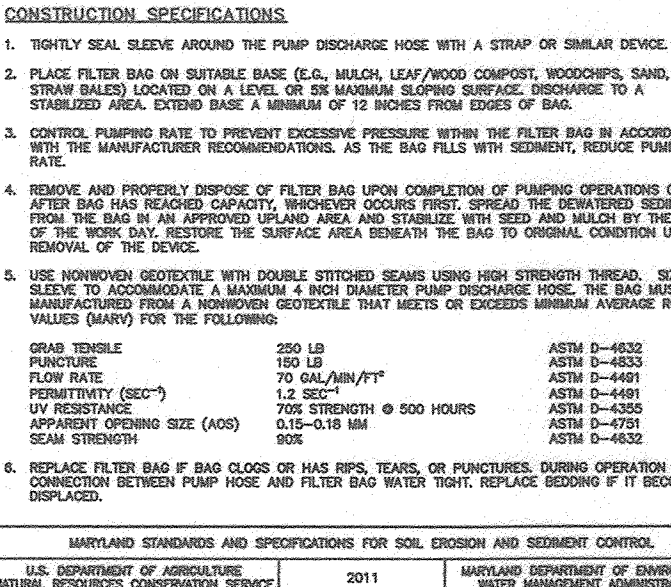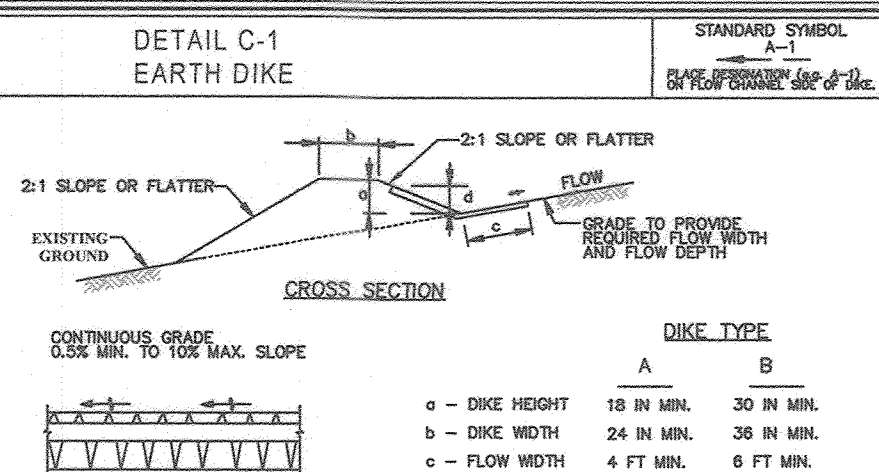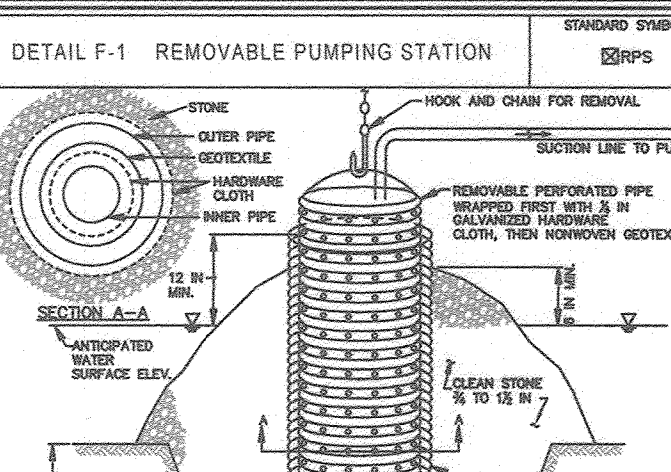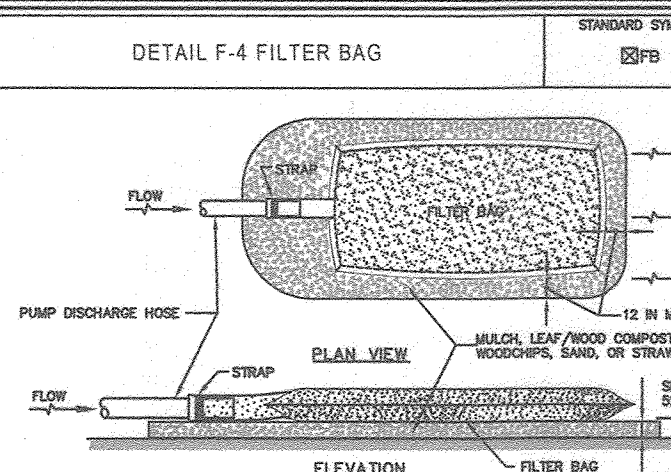

AS-BUILT CERTIFICATION

Note: There is no "AS-BUILT" information provided on this sheet.

DATE: PAUL GERARD CAVANAGH #27020

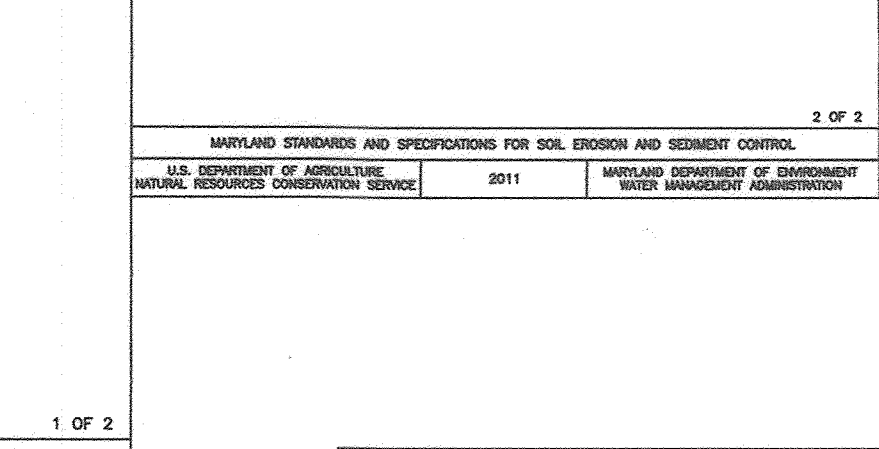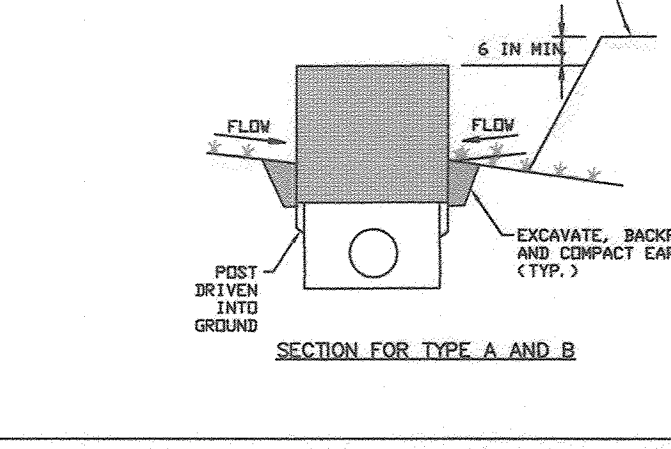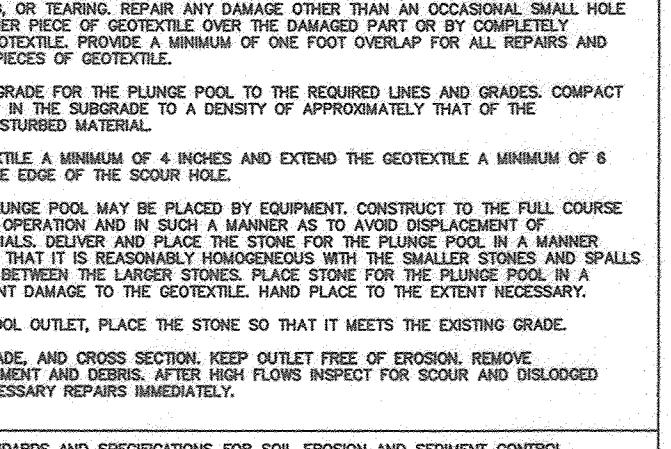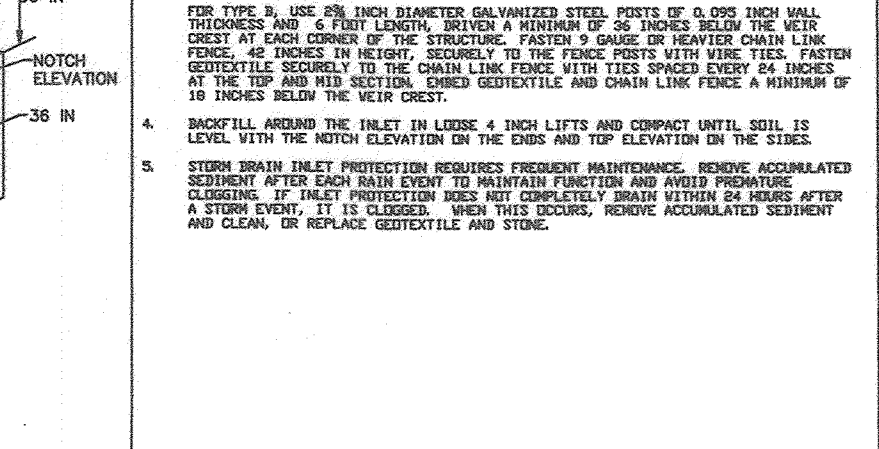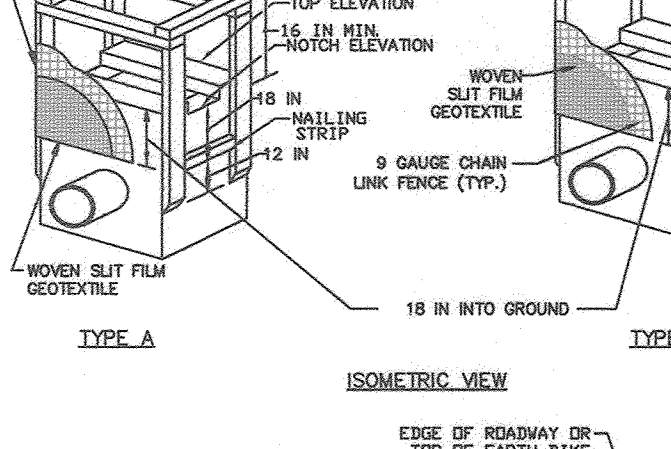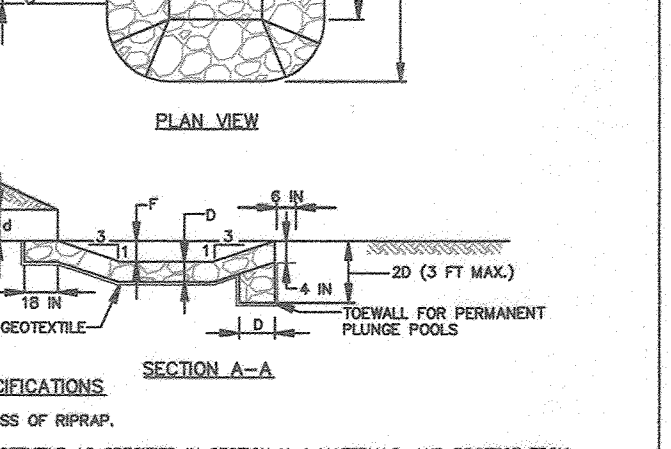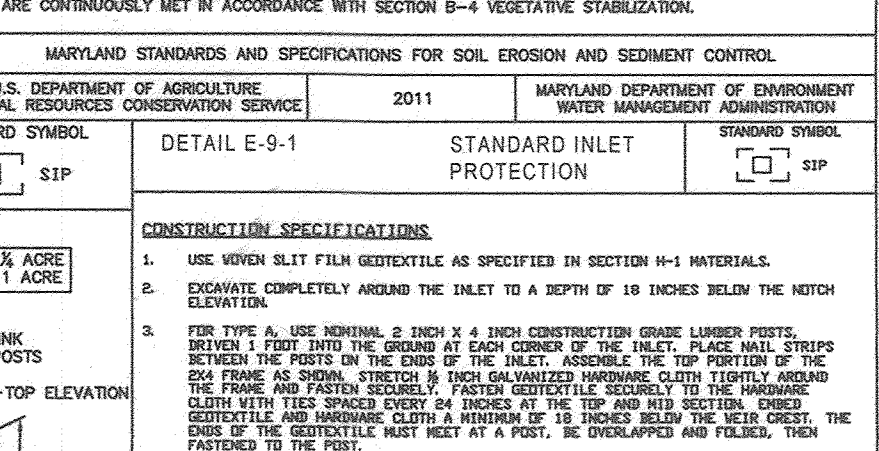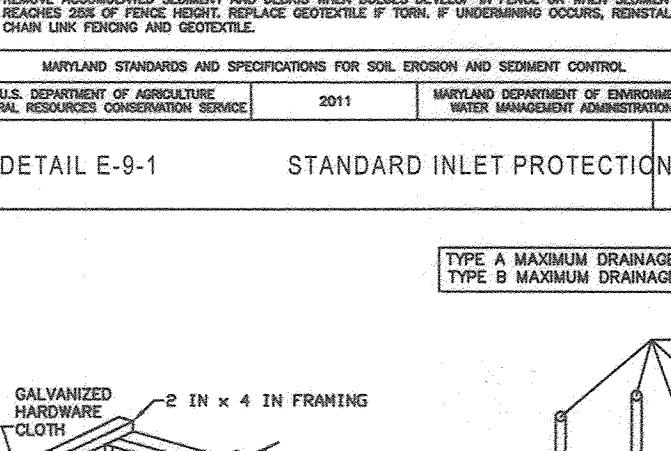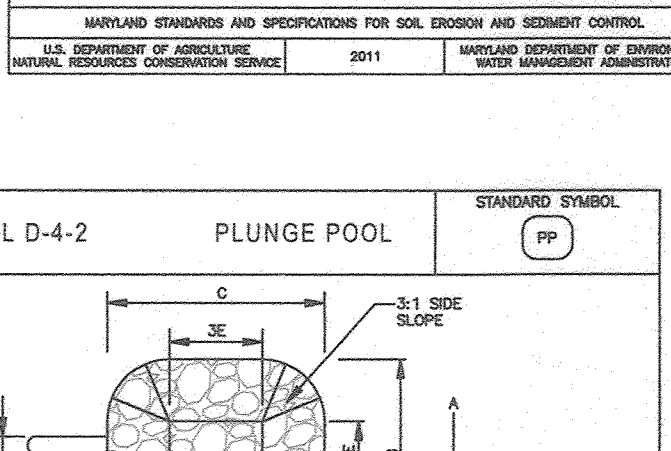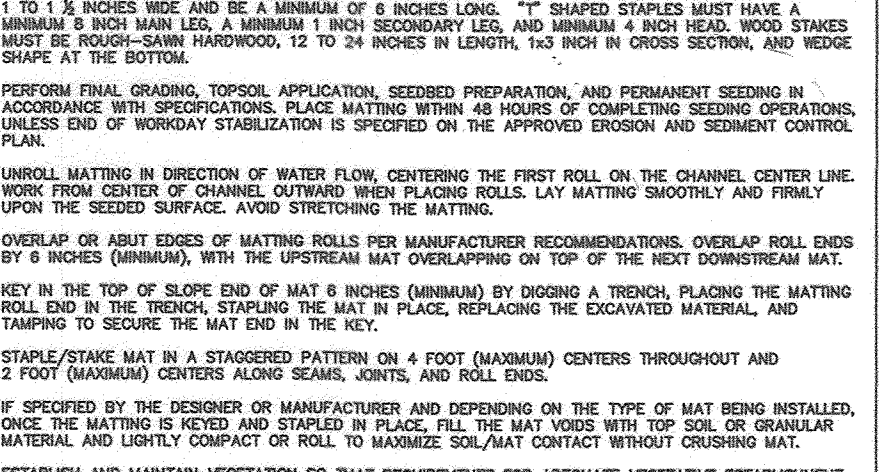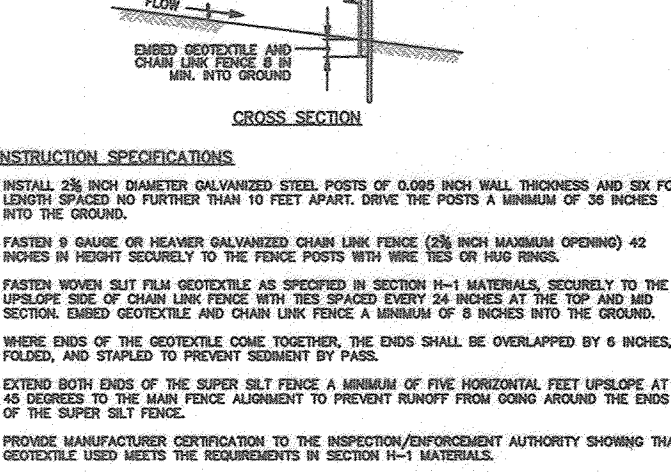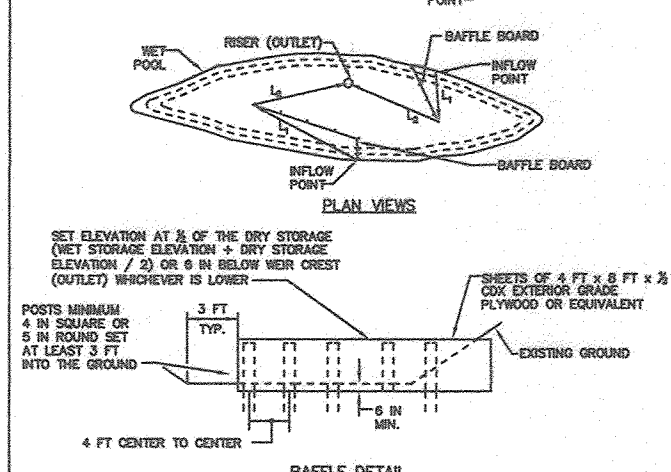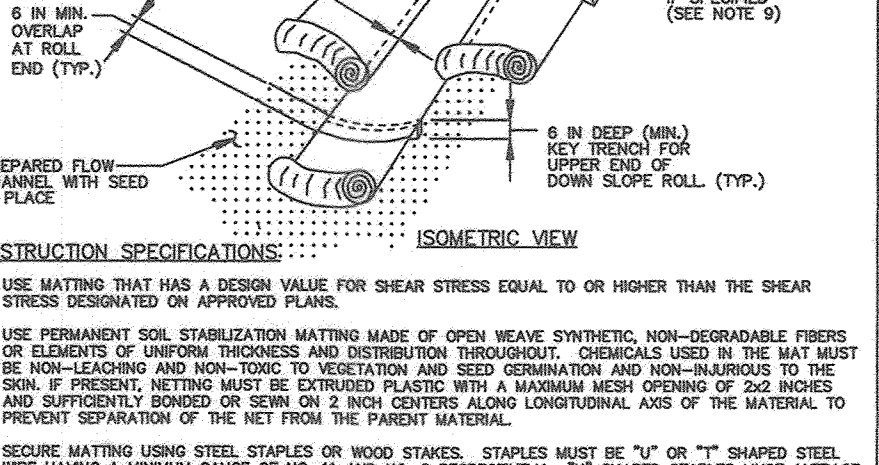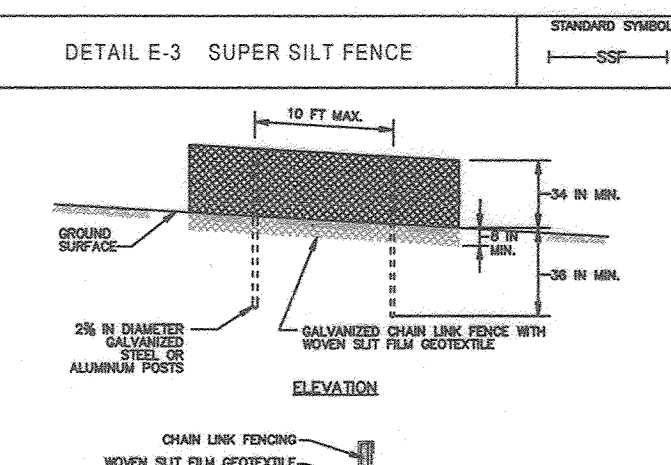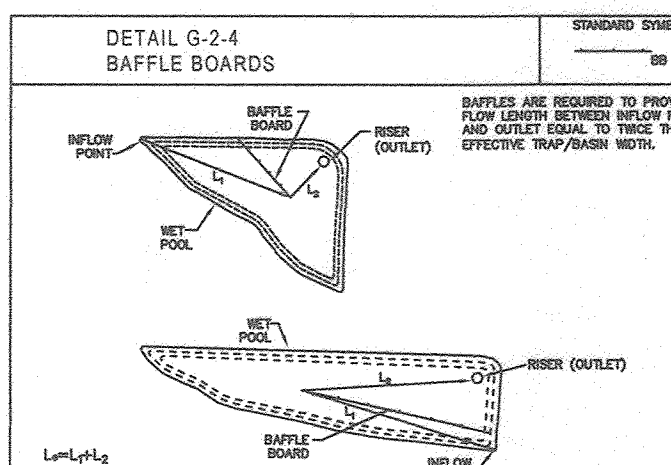

MD-378 STORM WATER MANAGEMENT POND CONSTRUCTION SPECIFICATIONS

These specifications are appropriate to all ponds within the scope of the Standard Practice MD-378. All references to ASH and ASHTO specifications apply to the most recent version.

Site Preparation

Areas designated for borrow areas, embankment, and structural works shall be cleared, grubbed and stripped of topsoil. All trees, vegetation, roots and other objectionable material shall be removed. Channel banks and sharp breaks shall be sloped to no steeper than 1:1. All trees shall be cleared and grubbed within 15 feet of the edge of the embankment.

Areas to be covered by the reservoir will be cleared of all trees, brush, logs, fences, rubbish and other objectionable material unless otherwise designated on the plans. Trees, brush, and stumps shall be cut approximately level with the ground surface. For dry stormwater management ponds, a minimum of a 25-foot radius around the structure shall be cleared.

EARTH FILL

Material - The fill material shall be taken from approved designated borrow areas. It shall be free of roots, stumps, wood, rubbish, stones greater than 6", frozen or other objectionable materials. Fill material for the center of the embankment, and for trench shall conform to Unified Soil Classification C.C., C.C., C.U., C.L., and C.U. and must have at least 30% passing the #20 sieve. Consideration may be given to the use of other materials in the embankment if designed by a geotechnical engineer. Such special designs must have construction supervised by a geotechnical engineer. Materials used in the outer shell of the embankment must have the capability to support vegetation of the quality required to prevent erosion of the embankment.

Placement - Areas on which fill is to be placed shall be scarified prior to placement of fill. Fill materials shall be placed in maximum 8-inch thick (before compaction) layers which are to be continuous over the entire length of the fill. The most permeable borrow material shall be placed in the downstream portions of the embankment. The principal spillway must be installed concurrently with fill placement and not excavated into the embankment.

Compaction - The movement of the hauling and spreading equipment over the fill shall be controlled so that the entire surface of each lift shall be traversed by the fill less than one tread track of heavy equipment or compaction shall be achieved by a minimum of four complete passes of a sheepfoot, roller, tread or vibrator. The equipment used shall provide sufficient moisture such that the required degree of compaction will be obtained with the equipment used. The fill material shall contain sufficient moisture so that if formed into a ball it will not crumble, yet not so wet that water can be squeezed out.

When required by the reviewing agency the minimum required density shall not be less than 95% of maximum dry density of the soil as determined by the optimum. Each layer of fill shall be compacted as necessary to obtain that density, and it is to be certified by the Engineer at the time of construction. All compaction is to be determined by AASHTO Method T-99 (Standard Proctor).

Cut Off Trench - The cutoff trench shall be excavated into impervious material below the dam and reservoir to the centerline of the embankment as shown on the drawings. The bottom width of the trench shall be governed by the equipment used for excavation, with the minimum width being four feet. The depth shall be at least four feet below existing grade and adjacent to the pipe. The side slopes of the trench shall be 1 to 1 or flatter. The backfill shall be compacted with construction equipment, rollers, or hand tampers to assure maximum density and minimum permeability.

Embankment Core - The core shall be parallel to the centerline of the embankment for the dam and reservoir as shown on the drawings. The core shall be a minimum of four feet. The height shall extend up to the 10 year water elevation or as shown on the plans. The side slopes shall be 1 to 1 or flatter. The core shall be compacted with construction equipment, rollers, or hand tampers to assure maximum density and minimum permeability. In addition, the core shall be placed concurrently with the outer shell of the embankment.

Structure Backfill

Backfill adjacent to pipes or structures shall be of the type and quality conforming to that specified for the adjoining fill material. The fill shall be placed in horizontal layers not to exceed four inches in thickness and compacted by hand tampers or other manually directed compaction equipment. The material needs to be placed in horizontal layers not to exceed four inches in thickness and compacted by hand tampers or other manually directed compaction equipment. The material needs to be placed in horizontal layers not to exceed four inches in thickness and compacted by hand tampers or other manually directed compaction equipment. The material needs to be placed in horizontal layers not to exceed four inches in thickness and compacted by hand tampers or other manually directed compaction equipment.

Structure Backfill

Backfill adjacent to pipes or structures shall be of the type and quality conforming to that specified for the adjoining fill material. The fill shall be placed in horizontal layers not to exceed four inches in thickness and compacted by hand tampers or other manually directed compaction equipment. The material needs to be placed in horizontal layers not to exceed four inches in thickness and compacted by hand tampers or other manually directed compaction equipment. The material needs to be placed in horizontal layers not to exceed four inches in thickness and compacted by hand tampers or other manually directed compaction equipment.

Structure Backfill

Backfill adjacent to pipes or structures shall be of the type and quality conforming to that specified for the adjoining fill material. The fill shall be placed in horizontal layers not to exceed four inches in thickness and compacted by hand tampers or other manually directed compaction equipment. The material needs to be placed in horizontal layers not to exceed four inches in thickness and compacted by hand tampers or other manually directed compaction equipment. The material needs to be placed in horizontal layers not to exceed four inches in thickness and compacted by hand tampers or other manually directed compaction equipment.

Pipe Conduits

All pipes shall be circular in cross section. Corrugated Metal Pipe - All of the following criteria shall apply for corrugated metal pipe:

1. Materials - (Polymer Coated steel pipe) - Steel pipes with polymer coatings shall have a minimum coating thickness of 0.01 inch (10 mil) on both sides of the pipe. This pipe and its fittings shall conform to the requirements of AASHTO Specifications M-245 & M-246 with watertight coupling bands or flanges.
2. Materials - (Aluminum Coated Steel Pipe) - This pipe and its appurtenances shall conform to the requirements of AASHTO Specification M-274 with watertight coupling bands or flanges. Aluminum Coated Steel Pipe, when used with flowable fill or when soil or water conditions warrant the need for increased durability, shall be fully bituminous coated per requirements of AASHTO Specification M-190 Type A. Any aluminum coating damaged or otherwise removed shall be replaced with cold applied bituminous coating compound. Aluminum surfaces that are to be in contact with concrete shall be painted with one coat of zinc chromate primer or two coats of asphalt. Hot dip galvanization is not permitted for connections. The pH of the surrounding soils shall be between 4 and 9.

Materials - (Aluminum Pipe) - This pipe and its appurtenances shall conform to the requirements of AASHTO Specification M-196 or M-211 with watertight coupling bands or flanges. Aluminum Pipe, when used with flowable fill or when soil or water conditions warrant the need for increased durability, shall be fully bituminous coated per requirements of AASHTO Specification M-190 Type A. Aluminum surfaces that are to be in contact with concrete shall be painted with one coat of zinc chromate primer or two coats of asphalt. Hot dip galvanization is not permitted for connections. The pH of the surrounding soils shall be between 4 and 9.

Coupling bands and anti-seep collars, and sections, etc. must be composed of the same material and coatings as the pipe. Metals must be insulated from dissimilar materials with use of rubber or plastic insulating materials at least 24 mils in thickness.

Connections - All connections with pipes must be completely watertight. The drain pipe or riser connection to riser shall be welded all around when the pipe and riser are metal. Anti-seep collars shall be connected to the pipe in such a manner as to be completely watertight. Dipmole bands are not considered to be watertight.

SEDIMENT & EROSION CONTROL NOTES & DETAILS

AND MD 378 SPECIFICATIONS

DORSEY'S RIDGE

PHASE-1

LOTS 1 THRU 4, OPEN SPACE LOTS 5 THRU 8, & NON-BUILDABLE BULK PARCELS A THRU F

A RESUBDIVISION OF "WILHIDE PROPERTY, LOT 1, 2 & 3", PLAT NO. 18442

ZONED: CEF-R

TAX MAP NO.: 24 GRD NO.: 18 PARCEL NO.: 260 LOTS: 1 THRU 3

SECOND ELECTION DISTRICT HOWARD COUNTY, MARYLAND

SCALE: AS SHOWN DATE: APRIL, 2020

SHEET 8 OF 18

PROFESSIONAL CERTIFICATION

I HEREBY CERTIFY THAT THESE DOCUMENTS WERE PREPARED OR APPROVED BY ME AND THAT I AM A DULY LICENSED PROFESSIONAL ENGINEER UNDER THE LAWS OF THE STATE OF MARYLAND, LICENSE NO. 20746, EXPIRATION DATE: 02/22/2021.

Signature of Professional Engineer: *Alvo M. Vitucci* Date: *5/21/2020*

SEVERAL PARK, MD 21146

410-461-0837

FISHER, COLLINS & CARTER, INC.

CENTRAL SQUARE OFFICE PARK - 10725 BALTIMORE PARKWAY, ELICOTT CITY, MARYLAND 21114
14100 431-2102

AS-BUILT CERTIFICATION

Note: There is no "AS-BUILT" information provided on this sheet.

PAUL GERARD CAVANAUGH #27020

LEGEND	
SYMBOL	DESCRIPTION
(Symbol)	EXISTING 2' & 10' CONTOURS
(Symbol)	PROPOSED CONTOURS
(Symbol)	EXISTING TREELINE
(Symbol)	PROPOSED TREELINE
(Symbol)	PROPOSED STORM DRAIN
(Symbol)	PROPOSED DRYWELL (M-5)
(Symbol)	PROPOSED WATER LINE
(Symbol)	PROPOSED SEWER LINE
(Symbol)	LIMIT OF DISTURBANCE
(Symbol)	PROPOSED PAVING
(Symbol)	PROPOSED SIDEWALKS
(Symbol)	SPOT ELEVATION
(Symbol)	FLOW ARROW
(Symbol)	EXISTING POWER POLE
(Symbol)	SPECIMEN TREE
(Symbol)	EXISTING TREES
(Symbol)	EXISTING TREES TO BE REMOVED
(Symbol)	NON-CREDITED OPEN SPACE
(Symbol)	FOREST CONSERVATION EASEMENT
(Symbol)	PROPOSED TREES
(Symbol)	PROPOSED SPECIMEN TREE REPLACEMENTS (STR)
(Symbol)	EXISTING WETLANDS & WETLAND BUFFER
(Symbol)	EXISTING FLOODPLAIN
(Symbol)	SWM POND - NO "WOODY" ZONE

SPECIMEN TREE CHART

Key (ST-#)	Species	Size (in dbh)	CRZ (feet radius)	Comments
*1	Red oak	30	57	
*2	Red oak	35	52.5	
3	Tulip poplar	34	51	
4	Black oak	35	52.5	fair, limb dieback noted
5	American beech	30	45	
6	Black walnut	34	51	
7	Tulip poplar	35	52.5	twin stems above breast height
*8	Tulip poplar	34	51	
9	Black oak	35	52.5	
*10	White oak	31	46.5	
*11	Tulip poplar	52	70	fair, limb dieback and heavy vine cover
12	American beech	34	51	
13	White oak	49.5	74.25	
**14	White oak	41	61.5	fair, heavily trimmed
15	White oak	36	54	
16	White oak	49	73.5	

* DENOTES: ST1, ST2, ST8, ST10, & ST11 ARE TO BE REMOVED.
 ** DENOTES ST14 TAKEN DOWN DUE TO HAZARD OF FALLING ON HOUSE.

LANDSCAPE DEVELOPER'S CERTIFICATE

I/We certify that the landscaping shown on this plan will be done according to the plan, Section 16.124 of the Howard County Code and the Howard County Landscape Manual. I/We further certify that upon completion a letter of landscape installation accompanied by an executed one year guarantee of plant materials will be submitted to the Department of Planning and Zoning.

Paul Gerard Cavanaugh 1/21/2022
 Name Date

NOTE: FOR GRADING/DISTURBANCE WITHIN BUFFERS REFER TO GENERAL NOTE 41 ON THE TITLE SHEET FOR APPROVAL OF WP-20-053 WITH CONDITIONS.

APPROVED: DEPARTMENT OF PUBLIC WORKS


Chris M. K... 02/19/2022
 CHIEF, BUREAU OF HIGHWAYS MK DATE

APPROVED: DEPARTMENT OF PLANNING AND ZONING


... 1/21/22
 CHIEF, DIVISION OF LAND DEVELOPMENT DATE

... 2-23-22
 CHIEF, DEVELOPMENT ENGINEERING DIVISION DATE

REVISIONS		
NO.	DESCRIPTION	DATE
1	REMOVE SIDEWALK, PAVEMENT, STORM DRAIN, MICRO-BIO POND 1, LOT 1 (02/20/22)	6/7/22
2	CHANGE WATER SEWER, STORM DRAIN, MICRO-BIO POND 1, LOT 1 (02/20/22)	3/1/22

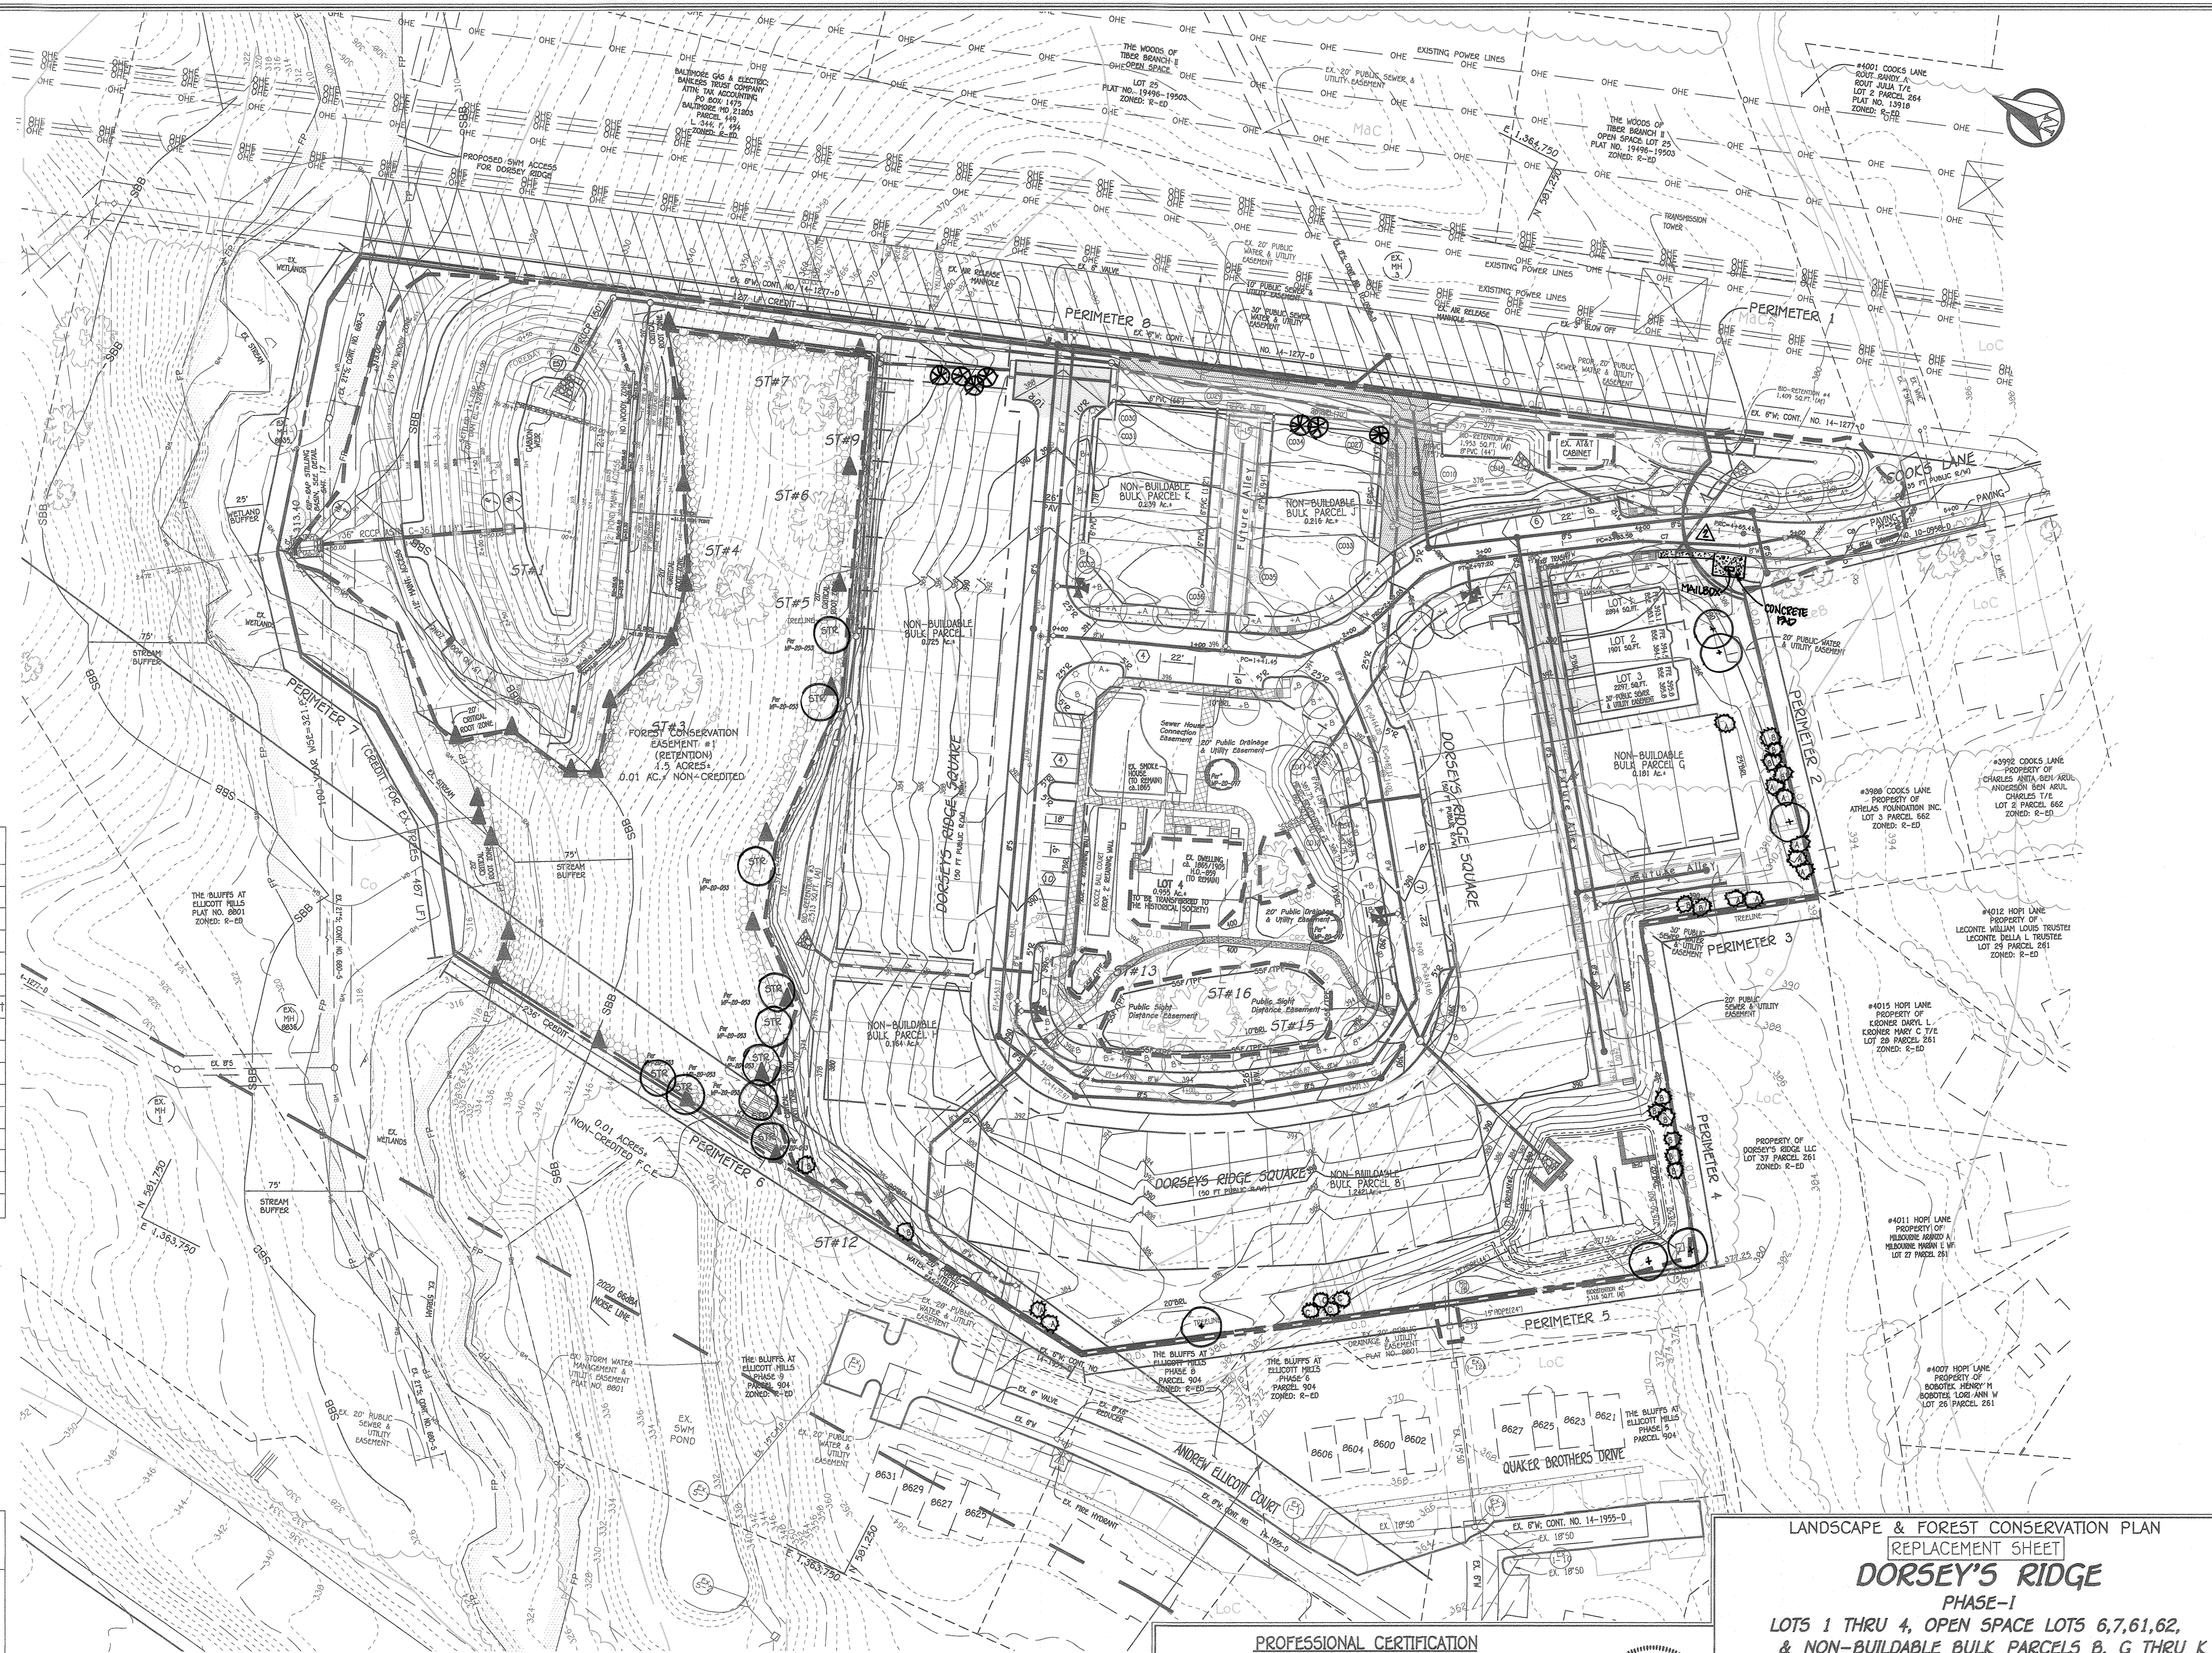

FISHER, COLLINS & CARTER, INC.
 CIVIL ENGINEERING CONSULTANTS & LAND SURVEYORS
 CENTRAL SQUARE OFFICE PARK - 10272 BALTIMORE NATIONAL PIKE
 ELICOTT CITY, MARYLAND 21042
 (410) 461-2995

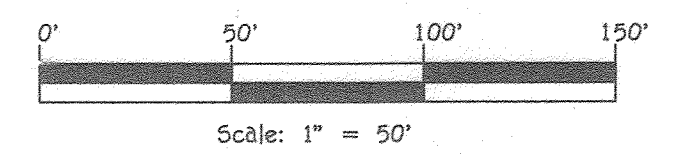

OWNER/DEVELOPER
 DORSEY'S RIDGE, LLC
 C/O DAVE WORSNER
 308 MAGOTHY ROAD
 SEVERNA PARK, MD 21146
 410-461-0837

PROFESSIONAL CERTIFICATION
 I HEREBY CERTIFY THAT THESE DOCUMENTS WERE PREPARED OR APPROVED BY ME AND THAT I AM A DULY LICENSED PROFESSIONAL ENGINEER UNDER THE LAWS OF THE STATE OF MARYLAND, LICENSE NO. 20748, EXPIRATION DATE: 02/22/2023.
Paul Gerard Cavanaugh 1/21/22
 SIGNATURE OF LICENSED PROFESSIONAL DATE



LANDSCAPE & FOREST CONSERVATION PLAN
REPLACEMENT SHEET
DORSEY'S RIDGE
 PHASE-1
 LOTS 1 THRU 4, OPEN SPACE LOTS 6,7,61,62,
 & NON-BUILDABLE BULK PARCELS B, G THRU K
 A RESUBDIVISION OF "MILHIDE PROPERTY, LOT 1, 2 & 3", PLAT NO. 18442
 ZONED: CEF-R
 TAX MAP NO.: 24 GRID NO.: 10 PARCEL NO.: 260 LOTS: 1 THRU 3
 SECOND ELECTION DISTRICT HOWARD COUNTY, MARYLAND
 SCALE: AS SHOWN DATE: DECEMBER, 2021
 SHEET 9 OF 18

THERE IS NO AS-BUILT INFORMATION ON THIS SHEET

FOREST PROTECTION GENERAL NOTES

- ALL FOREST RETENTION AREAS AND SPECIMEN TREES SHALL BE TEMPORARILY PROTECTED BY WELL ANCHORED BLAZE ORANGE PLASTIC MESH FENCING, AS NECESSARY, AND SIGNAGE AS INDICATED ON THE PLANS. THE DEVICES SHALL BE INSTALLED ALONG THE FOREST RETENTION BOUNDARY PRIOR TO ANY LAND CLEARING, GRUBBING, OR GRADING ACTIVITIES.
- THE FOREST PROTECTION DEVICES SHALL BE INSTALLED SUCH THAT THE CRITICAL ROOT ZONES OF ALL TREES WITHIN THE RETENTION AREA NOT OTHERWISE PROTECTED WILL BE WITHIN FOREST PROTECTION DEVICES, UNLESS ROOT PRUNING IS PROPOSED.
- ALL PROTECTION DEVICES SHALL BE MAINTAINED THROUGHOUT CONSTRUCTION, INCLUDING SILT FENCE BEING USED AS PROTECTIVE FENCING, ALL DEVICES SHALL REMAIN IN PLACE UNTIL ALL CONSTRUCTION HAS CEASED IN THE IMMEDIATE VICINITY.
- ATTACHMENT OF SIGNS, OR ANY OTHER OBJECTS TO TREES IS PROHIBITED. NO EQUIPMENT, MACHINERY, VEHICLES, MATERIALS OR EXCESSIVE PEDESTRIAN TRAFFIC SHALL BE ALLOWED WITHIN THESE PROTECTED AREAS.
- INSTALLATION AND MAINTENANCE OF PROTECTIVE FENCING AND SIGNAGE SHALL BE THE RESPONSIBILITY OF THE GENERAL CONTRACTOR. THE GENERAL CONTRACTOR SHALL TAKE THE UTMOST CARE TO PROTECT TREE ROOT SYSTEMS FOR SPECIMEN TREES AND FOREST CONSERVATION AREAS DURING ALL CONSTRUCTION ACTIVITIES. TREE ROOT SYSTEMS SHALL BE PROTECTED FROM SHOOTING, FLOODING, EXCESSIVE WETTING FROM DE-WATERING OPERATIONS, OFF-SITE RUN OFF, SPILLAGE AND DRAINING OF MATERIALS THAT MAY BE HARMFUL TO TREES.
- THE GENERAL CONTRACTOR SHALL PREVENT PARKING OF CONSTRUCTION VEHICLES AND EQUIPMENT, AND THE STORING OF BUILDING SUPPLIES OR STOCKPILING OF EARTH WITHIN FOREST CONSERVATION EASEMENTS.
- REMOVAL OF TOPSOIL OR ROOT MAT WITHIN THE TREE PRESERVATION AREA SHALL BE PROHIBITED.
- THE GENERAL CONTRACTOR SHALL BE HELD RESPONSIBLE FOR ANY TREES DAMAGED OR DESTROYED WITHIN THE FOREST CONSERVATION EASEMENTS.
- ROOT PRUNING SHALL BE USED AT THE LIMIT OF DISTURBANCE OR LIMIT OF GRADING WITHIN AND ADJACENT TO ALL PRESERVATION AREAS, AS NECESSARY.

- PRE-CONSTRUCTION MEETING**
- AFTER THE BOUNDARIES OF THE FOREST RETENTION AREAS HAVE BEEN FIELD LOCATED AND MARKED, AND AFTER THE FOREST PROTECTION DEVICES HAVE BEEN INSTALLED, BUT BEFORE ANY OTHER DISTURBANCE HAS TAKEN PLACE ON SITE, A PRE-CONSTRUCTION MEETING SHALL TAKE PLACE ON SITE. THE DEVELOPER, CONTRACTOR OR PROJECT MANAGER, AND HOWARD COUNTY INSPECTORS SHALL ATTEND. THE PURPOSE OF THIS MEETING WILL BE:
 - TO IDENTIFY THE LOCATIONS OF THE FOREST RETENTION AREAS, SPECIMEN TREES WITHIN 50 FEET OF THE LIMIT OF DISTURBANCE, LIMITS OF CONSTRUCTION, EMPLOYEE PARKING AREAS AND EQUIPMENT STAGING AREAS;
 - INSPECT ALL FLAGGED BOUNDARIES AND PROTECTION DEVICES;
 - MAKE ALL NECESSARY ADJUSTMENTS;
 - ASSIGN RESPONSIBILITIES AS APPROPRIATE AND DISCUSS PENALTIES.
 - SPECIMEN TREES ST-6, ST-7, ST-9, ST-13, ST-15, AND ST-16 MUST BE PROTECTED DURING CONSTRUCTION. AN REGISTERED ARBORIST MUST INSPECT THE TREES AND IMPLEMENT RECOMMENDATIONS FOR PROFESSIONAL PRUNING OF ROOTS AND FOLIAGE. ALL PRUNING MUST BE PERFORMED BY A MARYLAND LICENSED TREE EXPERT. TREE PROTECTION FENCING MUST BE INSTALLED AROUND THE ENTIRE PERIMETER OF SPECIMEN TREES ST-6, ST-7, ST-9, ST-13, ST-15 AND ST-16 TO THE GREATEST EXTENT POSSIBLE. (WHILE NOT DISTURBING PROPOSED FOREST CONSERVATION AREAS), TO PREVENT ROOT AND FOLIAGE DAMAGE DURING CONSTRUCTION.

- CONSTRUCTION MONITORING**
- THE SITE SHALL BE INSPECTED PERIODICALLY DURING THE CONSTRUCTION PHASE OF THE PROJECT. A QUALIFIED PROFESSIONAL SHALL BE RESPONSIBLE FOR IDENTIFYING DAMAGE TO PROTECTED FOREST AREAS OR INDIVIDUAL TREES WHICH MAY HAVE BEEN CAUSED BY CONSTRUCTION ACTIVITIES, SUCH AS SOIL COMPACTION, ROOT INJURY, TRUNK WOUNDS, LIMB INJURY, OR STRESS CAUSED BY FLOODING OR DROUGHT CONDITIONS.
 - ANY SUCH DAMAGE THAT MAY OCCUR SHALL BE REMEDIATED IMMEDIATELY USING APPROPRIATE MEASURES. SEVERE PROBLEMS MAY REQUIRE CONSULTATION WITH A MARYLAND LICENSED TREE EXPERT.
 - THE CONSTRUCTION PROCEDURE SHALL NOT DAMAGE AREAS OUTSIDE OF THE LIMITS OF DISTURBANCE AS DESIGNATED ON THE PLANS. ANY DAMAGE SHALL BE RESTORED BY THE CONTRACTOR AT HIS EXPENSE AND TO THE SATISFACTION OF THE DESIGN TEAM OR LANDSCAPE ARCHITECT.

MULTIFLORA ROSE CONTROL NOTE:


PRIOR TO PLANTING ALL MULTIFLORA ROSE WITHIN PLANTING AREAS SHALL BE REMOVED. Removal Of The Multiflora Rose May Be Performed With Mowing And Herbicide Treatments. Physical Removal Of All Top Growth Followed By A Periodic Herbicide Treatment Of Stump Sprouts Is Recommended. Native Tree And Shrub Species Occurring Within The Rose Thickets Should Be Retained Wherever Possible. Herbicide Treatments Shall Occur On Two (2) Month Intervals During The First Growing Season And Once In The Spring And Once In The Fall For Subsequent Years. Herbicide Used Shall Be Made Specifically To Address Woody Plant Material And Shall Be Applied As Per Manufacturers Specifications. Care Should Be Taken Not To Spray Planned Trees Or Naturally Occurring Native Tree And Shrub Seedlings. It Is Recommended That Initiation Of Rose Removal Begin At Least Six Months Prior To Planting So That New Growth Of Roses Is Able To Be More Successfully Managed.

Table B.4. Materials Specifications for Micro-Bioretenention, Rain Gardens & Landscape Infiltration


Material	Specification	Size	Notes
Plantings	see Appendix A, Table A.4	n/a	plantings are site-specific
Planting soil (2" to 4" deep)	loamy sand 60-65% compost 35-40% or sandy loam 30% coarse sand 30% compost 40%		USDA soil types loamy sand or sandy loam; clay content <5%
Organic Content	Min. 10% by dry weight (ASTM D 2974)		
Mulch	shredded hardwood		aged 6 months, minimum
Peak gravel/diaphragm	pea gravel; ASTM-D-449	No. 8 or No. 9 (1/8" to 3/8")	
Curtain drain	ornamental stone; washed cobbles	stone: 2" to 5"	
Geotextile		n/a	PE Type 1 nonwoven
Gravel (underdrains and infiltration berms)	AASHTO M-43	No. 57 or No. Aggregate (3/8" to 3/4")	
Underdrain piping	F 758, Type PS 28 or AASHTO M-279	4" to 6" rigid schedule 40 PVC or 50835	Slotted or perforated pipe, 3/8" pert. @ 6" on center, 4 holes per row; maximum of 3" of gravel over pipes; not necessary underdrain pipes. Perforated pipe shall be wrapped with 1/4 inch galvanized hardware cloth
Poured in place concrete (if required)	MHA Mix No. 3, f = 3500 psi at 28 days, normal weight, air-entrained; reinforcing to meet ASTM-615-50	n/a	on-site testing of poured-in-place concrete required: 28 day strength and slump test; all concrete design (cast-in-place or pre-cast) not using previously approved site or local standards requires design drawings sealed and approved by a professional structural engineer licensed in the State of Maryland - design to include meeting ACI Code 318.6/09, vertical loading (H-10 or H-20), allowable horizontal loading (based on soil pressure); and analysis of potential cracking
Sand	AASHTO-M-6 or ASTM-C-33	0.02" to 0.04"	Sand substitutions such as Silasand and Calstone (AASHTO #10 are not acceptable. No calcium carbonate or dolomitic sand substitutions are acceptable. No "rock dust" can be used for sand.

**FOREST CONSERVATION WORKSHEET
VERSION 1.0**


NET TRACT AREA	ACRES
A. TOTAL TRACT AREA	10.9
B. DEDUCTIONS (AREA WITHIN 100 YEAR FLOODPLAIN)	0.3
C. AREA TO REMAIN IN AGRICULTURAL PRODUCTION	0.0
D. NET TRACT AREA	10.6
LAND USE CATEGORY: HIGH DENSITY RESIDENTIAL	
E. AFFORESTATION THRESHOLD (NET TRACT AREA (C) x 15%)	1.6
F. CONSERVATION THRESHOLD (NET TRACT AREA (C) x 20%)	2.1
EXISTING FOREST COVER	
G. EXISTING FOREST COVER WITHIN THE NET TRACT AREA	3.3
H. AREA OF FOREST ABOVE AFFORESTATION THRESHOLD	1.7
I. AREA OF FOREST ABOVE CONSERVATION THRESHOLD	1.2
BREAK EVEN POINT	
J. FOREST RETENTION ABOVE THRESHOLD WITH NO MITIGATION	2.4
K. CLEARING PERMITTED WITHOUT MITIGATION	2.4
L. TOTAL AREA OF FOREST TO BE RETAINED	1.5
M. TOTAL AREA OF FOREST TO BE CLEARED	1.8
PLANTING REQUIREMENTS	
N. REFORESTATION FOR CLEARING ABOVE THE CONSERVATION THRESHOLD	0.3
O. REFORESTATION FOR CLEARING BELOW THE CONSERVATION THRESHOLD	1.3
P. CREDIT FOR RETENTION ABOVE THE CONSERVATION THRESHOLD	0
R. TOTAL REFORESTATION REQUIRED	1.6
S. TOTAL AFFORESTATION REQUIRED	0
T. TOTAL PLANTING REQUIREMENT	1.6

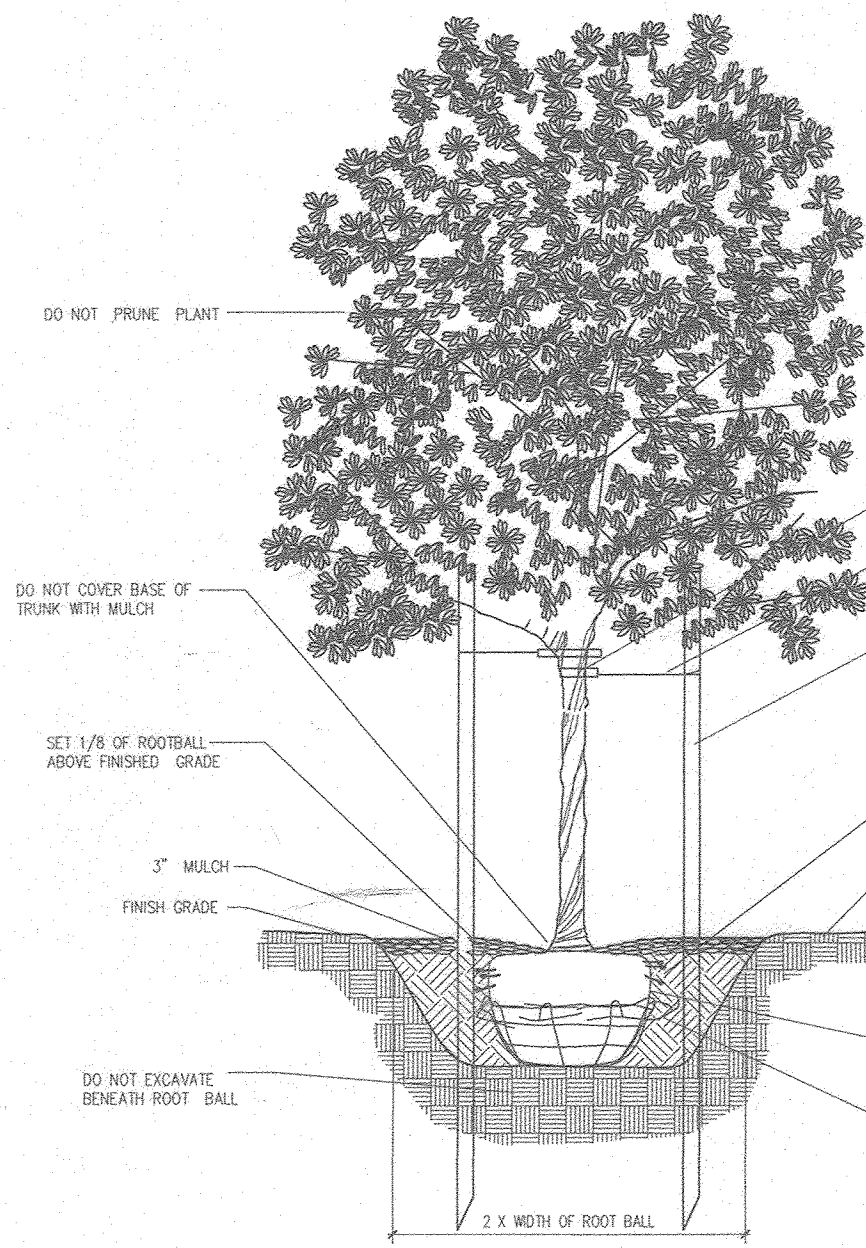


DECIDUOUS TREE - TYPICAL PLANTING DETAIL

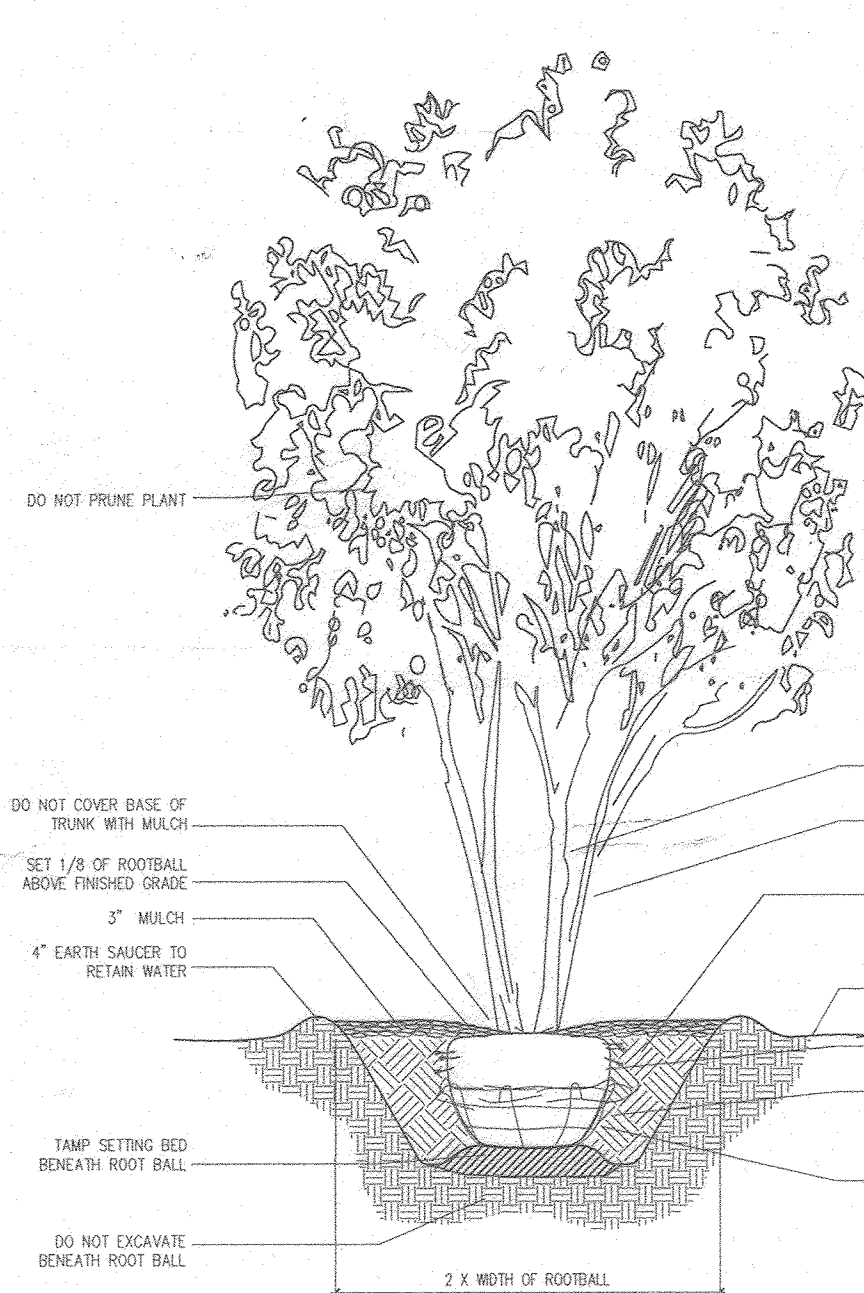


MULTISTEM TREE - TYPICAL PLANTING DETAIL

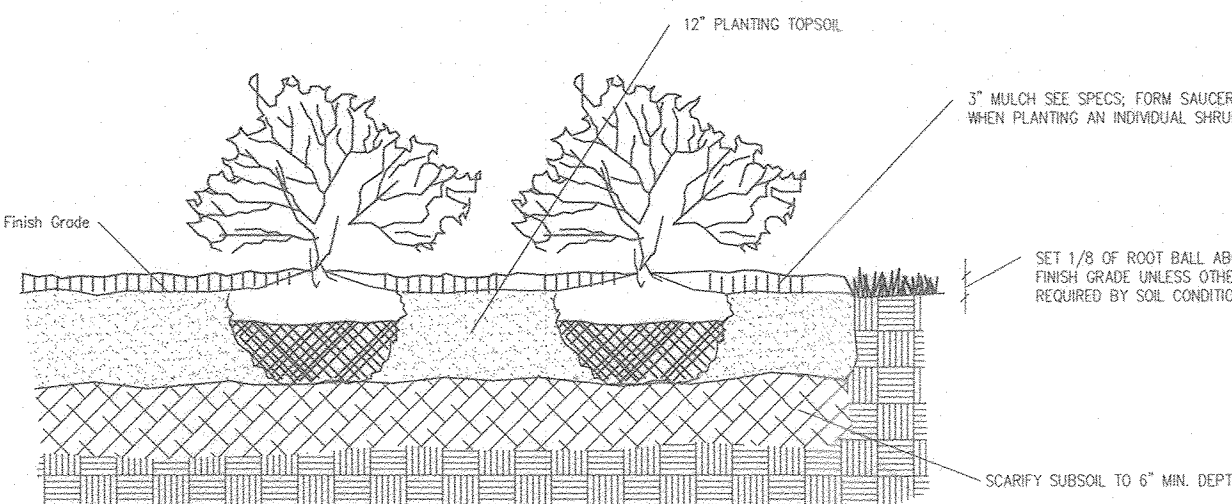

SHRUB AND HEDGEROW - TYPICAL PLANTING DETAIL

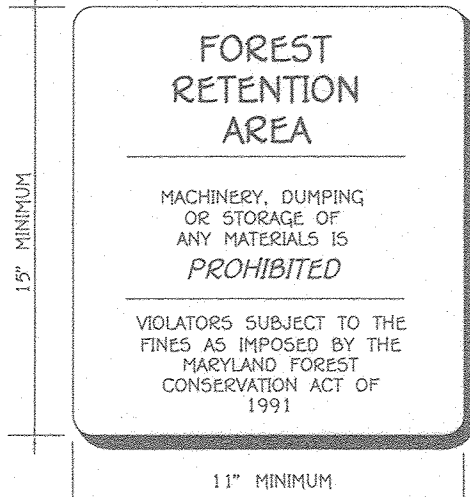

FOREST CONSERVATION SIGN DETAIL

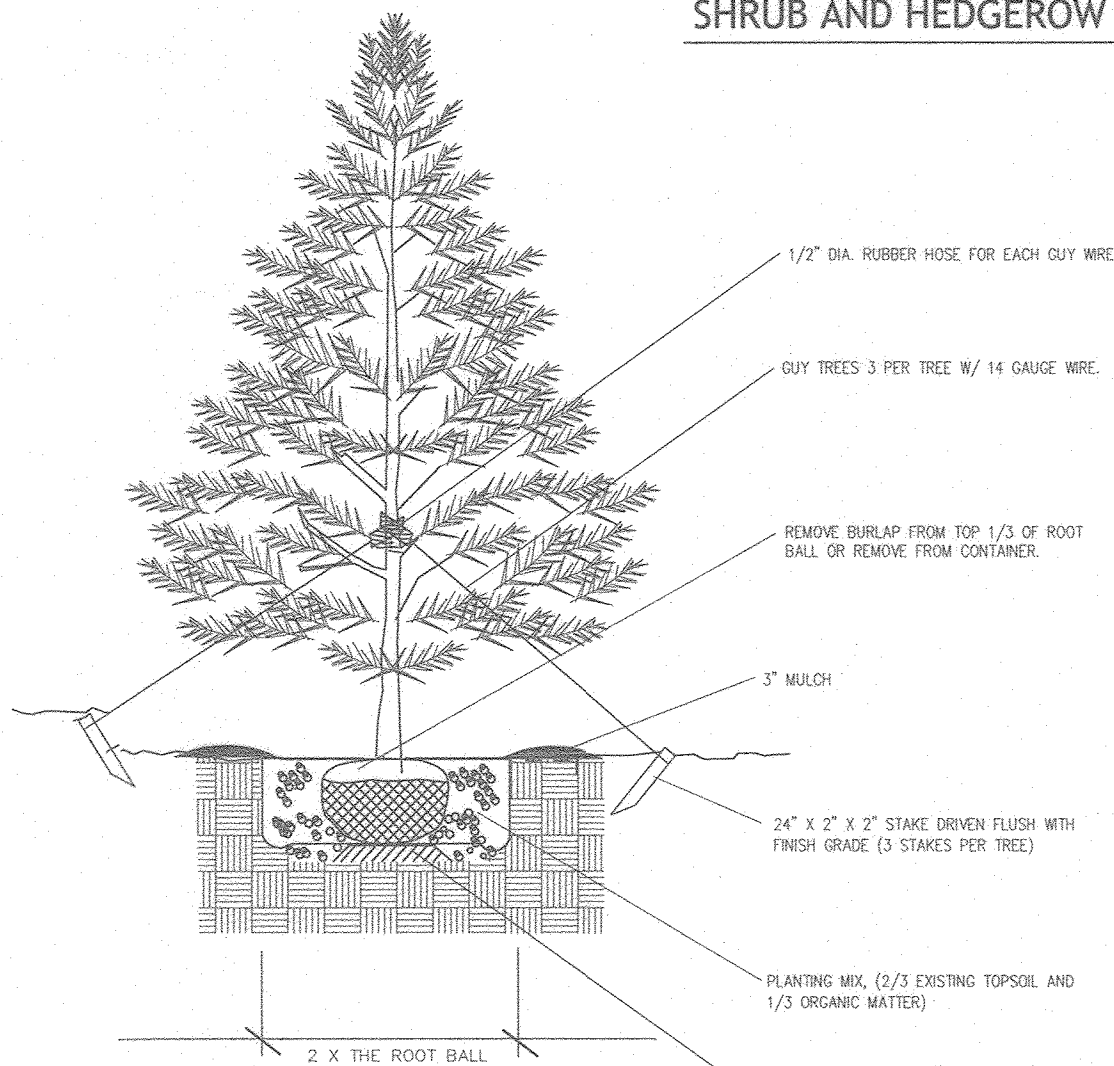

EVERGREEN TREE - TYPICAL PLANTING DETAIL

NOTES:

- THIS PLAN COMPLIES WITH THE REQUIREMENTS OF SECTION 16.1200 OF THE HOWARD COUNTY CODE FOR FOREST CONSERVATION BY THE ON-SITE RETENTION OF 1.48 ACRES OF FOREST. NO SURETY WILL BE REQUIRED FOR THE RETENTION. (1.47 ACRES CREDITED.) THE REMAINING REFORESTATION REQUIREMENT OF 1.6 ACRES WILL BE FULFILLED OFF-SITE PLANTING. SEE GENERAL NOTE #6, SHEET 1.
- THIS PLAN HAS BEEN PREPARED IN ACCORDANCE WITH THE PROVISIONS OF SECTION 16.124 OF THE HOWARD COUNTY CODE AND THE LANDSCAPE MANUAL. FINANCIAL SURETY FOR THE REQUIRED LANDSCAPING (32 SHADE TREES, 29 EVERGREEN TREES & 10 ORNAMENTAL TREES) WHICH INCLUDES THE MITIGATION TREES REQUIRED PER THE WP-17-084, WP-20-053 & WP-20-097, HAS BEEN POSTED AS PART OF THE DEVELOPER'S AGREEMENT IN THE AMOUNT OF \$15,300.00.
- THE DEPARTMENT OF PLANNING AND ZONING APPROVED THE REMOVAL OF SIX SPECIMEN TREES: ST-10 & ST-11 UNDER WP-17-084; ST-1, ST-2 & ST-8 UNDER WP-20-053 AND ST-14 UNDER WP-20-097. APPROVAL REQUIRES MITIGATION OF 12 SHADE TREES WHICH ARE INCLUDED IN THE LANDSCAPING REQUIREMENT.
- THIS PROJECT IS NOT SUBJECT TO C682-2019 BECAUSE THE SUBDIVISION RECEIVED PRELIMINARY PLAN APPROVAL PRIOR TO FEBRUARY 5, 2020.

PLANTING SPECIFICATIONS

- CLEAR & GRIP ALL PLANTING AREAS AS INDICATED ON THE DRAWINGS.
- PROVIDE PROTECTION FOR TREES, SHRUBS, AND PERENNIALS/GROUND COVERS THAT ARE TO BE PRESERVED.
- CONTRACTOR SHALL VERIFY THE CORRECT LOCATION OF ALL UNDERGROUND UTILITIES IN THE FIELD PRIOR TO INSTALLATION OF ANY PLANT MATERIALS.
- ALL PLANTING SHALL BE DONE AS PER PLANTING DETAILS AND SPECIFICATIONS.
- NO CHANGES SHALL BE MADE WITHOUT WRITTEN CONSENT OF THE OWNER OR LANDSCAPE ARCHITECT.
- PRIOR TO CONSTRUCTION OF PLANTING BEDS, THE CONTRACTOR SHALL STAKE OUT PLANTING BED LINES IN THE FIELD FOR REVIEW BY THE LANDSCAPE ARCHITECT. LANDSCAPE ARCHITECT SHALL MAKE ADJUSTMENTS IN THE FIELD AS NECESSARY. ALL FINAL PLANTING BED LOCATIONS ARE TO BE APPROVED BY THE LANDSCAPE ARCHITECT. FOR LAYOUT REVIEW, CONTRACTOR SHALL NOTIFY LANDSCAPE ARCHITECT A MINIMUM OF THREE DAYS IN ADVANCE.
- INSTALL ALL REQUIRED PLANTING AND LAWN SOILS AS PER DETAILS AND SPECIFICATIONS, AND ALL SHRUBS, GROUND COVERS, AND PERENNIALS SHALL BE PLANTED IN PLANTING BEDS PREPARED AS REQUIRED BY THE DETAILS AND SPECIFICATIONS.
- MAINTAIN POSITIVE DRAINAGE OUT OF PLANTING BEDS AT A MINIMUM 2% SLOPE AND MAINTAIN POSITIVE DRAINAGE OF ALL LAWN AREAS, UNLESS OTHERWISE NOTED ON DRAWINGS. ALL DIMENSIONS, AND EXISTING CONDITIONS SHALL BE VERIFIED BY THE CONTRACTOR ON SITE BEFORE CONSTRUCTION BEGINS. ANY DISCREPANCIES SHALL BE BROUGHT TO THE ATTENTION OF THE LANDSCAPE ARCHITECT OR OWNER.
- ALL PLANT BEDS SHALL BE CONTAINED WITH A SPACED EDGE UNLESS OTHERWISE NOTED ON DRAWINGS.
- IN THE EVENT OF A DISCREPANCY BETWEEN QUANTITIES SHOWN ON THE DRAWINGS AND QUANTITIES SHOWN ON THE PLANT LIST, THE QUANTITIES ON THE DRAWINGS SHALL APPLY. REPORT DISCREPANCIES TO THE LANDSCAPE ARCHITECT FOR CLARIFICATION PRIOR TO BIDDING.
- ALL PLANTS SHALL CONFORM TO THE SIZES GIVEN IN THE PLANT LIST AND SHALL BE NURSERY GROWN IN ACCORDANCE WITH THE "AMERICAN STANDARD FOR NURSERY STOCK" (ANSI Z60.1), LATEST EDITION.
- PLANTS SHALL BE LOCATED AS SHOWN ON THE DRAWINGS. PRIOR TO PLANTING, THE CONTRACTOR SHALL STAKE OUT THE LOCATIONS OF ALL PLANTS IN THE FIELD FOR REVIEW BY THE LANDSCAPE ARCHITECT. LANDSCAPE ARCHITECT SHALL MAKE ADJUSTMENTS IN THE FIELD AS NECESSARY. ALL FINAL PLANT LOCATIONS ARE TO BE APPROVED BY THE LANDSCAPE ARCHITECT. FOR LAYOUT REVIEW, CONTRACTOR SHALL NOTIFY LANDSCAPE ARCHITECT A MINIMUM OF THREE DAYS IN ADVANCE. PLANTS CANNOT BE INSTALLED WITHIN PUBLIC EASEMENTS WITHOUT PRIOR APPROVAL FROM THE DEPARTMENT OF PUBLIC WORKS.
- ALL DISTURBED AREAS SHALL BE FINE GRADED AND SEEDED OR SOODED, SEE PLAN FOR LOCATIONS.
- CONTRACTOR SHALL BE RESPONSIBLE FOR WATERING AND MAINTAINING ALL PLANTS DURING THE WARRANTY PERIOD; REFER TO SPECIFICATIONS.

AS-BUILT CERTIFICATION

Note: There is no "AS-BUILT" information provided on this sheet.

Date:

PAUL GERRARD CAVANAGH #27020

**STREET TREE LOCATION REQUIREMENTS
(per Ho. Co. Landscaping Manual)**

The following standards shall govern the placement of street trees in public rights-of-way:

When the distance between the curb and sidewalk is 6 feet or greater, trees shall be located within the right-of-way and shall be centered between the curb and the sidewalk.

When the distance between the curb and the sidewalk is less than 6 feet, and where trees are planted closer than 3 feet to the sidewalk, a biological root inhibitor barrier or physical container barrier shall be required.

When the distance between the curb and the sidewalk is less than 6 feet, trees may be planted 3 feet from the sidewalk in the direction away from the road. A 10 foot wide tree maintenance easement shall be required if the right-of-way is limited.

Trees shall be planted 6 feet behind the curb when there are no sidewalks.

Trees shall be placed a minimum of 30 feet from all signs and intersections when planted between sidewalk and curb, and be located with consideration of underground utilities and structures. Street trees may not be planted within 5 feet of a drain inlet structure, 5 feet of an open space access strip, or 10 feet of a driveway.

COOKS LANE - 1034 LF / 40 LF = 26 TREES REQUIRED
DORSEY SQUARE - 1802 LF / 40 LF = 45 TREES REQUIRED
TOTAL STREET TREES REQUIRED = 71

PROVIDED BY			STREET TREE SCHEDULE			
SOP-21-036	SOP-21-002	F-19-047	SYMBOL	BOTANICAL AND COMMON NAME	SIZE	COMMENTS
3	2	21	A	ACER RUBRUM 'RED SUNSET' (RED SUNSET RED MAPLE)	2.5\"/>	

TOTAL PROVIDED = 71
NOTE: 1. STREET TREE TYPES ARE ONLY A RECOMMENDATION AND MAY BE SUBSTITUTED WITH A COUNTY ACCEPTED EQUIVALENT FROM THE HOWARD COUNTY LANDSCAPE MANUAL.

LANDSCAPE DEVELOPER'S CERTIFICATE

I/We certify that the landscaping shown on this plan will be done according to the plan, Section 16.124 of the Howard County Code and the Howard County Landscape Manual. I/We further certify that upon completion a letter of landscape installation accompanied by an executed one year guarantee of plant materials will be submitted to the Department of Planning and Zoning.

Paul Gerrard Cavanagh
Name: Paul Gerrard Cavanagh
Date: 5/26/2020

LANDSCAPE & FOREST CONSERVATION NOTES & DETAILS

**DORSEY'S RIDGE
PHASE-1**

LOTS 1 THRU 4, OPEN SPACE LOTS 6,7,61,62 & NON-BUILDABLE BULK PARCELS B, G THRU K
A RESUBDIVISION OF "WILHIE PROPERTY, LOT 1, 2 & 3", PLAT NO. 18442
ZONED: CEF-R
TAX MAP NO.: 24 GRID NO.: 10 PARCEL NO.: 260 LOTS: 1 THRU 3
SECOND ELECTION DISTRICT HOWARD COUNTY, MARYLAND
SCALE: AS SHOWN DATE: MAY, 2020
SHEET 10 OF 18

APPROVED: DEPARTMENT OF PUBLIC WORKS
Frank 8/17/2020
CHIEF, BUREAU OF HIGHWAYS MK DATE

APPROVED: DEPARTMENT OF PLANNING AND ZONING
Paul 9/23/20
CHIEF, DIVISION OF LAND DEVELOPMENT DATE

APPROVED: DEVELOPMENT ENGINEERING DIVISION
Paul 8-28-20
CHIEF, DEVELOPMENT ENGINEERING DIVISION DATE

REVISIONS

NO.	DESCRIPTION	DATE

FISHER, COLLINS & CARTER, INC.
CIVIL ENGINEERING CONSULTANTS & LAND SURVEYORS
CENTENNIAL SQUARE OFFICE PARK - 10272 BALTIMORE NATIONAL PIKE
ELLSWORTH CITY, MARYLAND 21042
(410) 461 - 2895

SCHEDULE A - PERIMETER LANDSCAPE EDGE

PERIMETER	1	2	3	4	5	6	7	8	TOTAL
CATEGORY	ADJACENT TO ROADWAY	ADJACENT TO ROADWAY	ADJACENT TO PERIMETER PROPERTIES	ADJACENT TO PERIMETER PROPERTIES	ADJACENT TO PERIMETER PROPERTIES	ADJACENT TO PERIMETER PROPERTIES	ADJACENT TO PERIMETER PROPERTIES	ADJACENT TO PERIMETER PROPERTIES	
LANDSCAPE TYPE	N/A (FRONT)	N/A (FRONT)	C (ADJ TO SFD)	A (ADJ TO OS)	A (ADJ TO OS)	A (ADJ TO OS)	A (ADJ TO OS)	A (ADJ TO BGE ROW)	
LINEAR FEET OF PERIMETER	39 L.F.	37 L.F.	195 L.F.	114 L.F.	220 L.F.	395 L.F.	472 L.F.	859 L.F.	
CREDIT FOR EXISTING TREES (YES/NO, LENGTH)	N/A	N/A	N/A	N/A	N/A	N/A	YES, 236 L.F. (236 L.F. REMAINING)	YES, 487 L.F. (0 L.F. REMAINING)	
NUMBER OF PLANTS REQUIRED SHADE TREES/EVERGREENS	0	0	5/10 (195/40' = 4.9 OR 5) (195/20' = 9.75 OR 10)	(114/60' = 1.9 OR 2)	(220/60' = 3.7 OR 4)	(395/60' = 6.6 OR 7)	(472/60' = 7.9 OR 8)	(859/60' = 14.3 OR 15)	34 SHADE TREES 10 EVERGREENS
NUMBER OF PLANTS PROVIDED SHADE TREES SMALL/MEDIUM DECIDUOUS TREES/EVERGREENS	0	0	5 10	0 4	1 6	5 4	2 0	7 10	20 SHADE TREES 28 EVERGREENS/ 10 ORNAMENTAL TREES

NOTE: PERIMETER NO. 8 IS SUBJECT TO BGE 'RED' ZONE PLANTING CRITERIA. MITIGATION FOR SPECIMEN TREE REMOVAL UNDER WP-17-084, WP20-053, AND WP-20-097 HAS BEEN PROVIDED ON LOT 4 AND WITHIN THE FOREST CONSERVATION EASEMENT.

PROFESSIONAL CERTIFICATION

I HEREBY CERTIFY THAT THESE DOCUMENTS WERE PREPARED OR APPROVED BY ME AND THAT I AM A DULY LICENSED REGISTERED LANDSCAPE ARCHITECT UNDER THE LAWS OF THE STATE OF MARYLAND, LICENSE NO. 3038, EXPIRATION DATE: 04/17/2022.

Stephen J. Jurek 5/31/20
Signature of Registered Landscape Architect DATE



OWNER/DEVELOPER

DORSEY'S RIDGE, LLC
C/O DAVE WOESSNER
308 MAGOOTHY ROAD
SEVERNA PARK, MD 21146
410-461-0837

SYMBOL	DESCRIPTION
(Symbol)	EXISTING 2' & 10' CONTOURS
(Symbol)	PROPOSED CONTOURS
(Symbol)	EXISTING TREELINE
(Symbol)	PROPOSED TREELINE
(Symbol)	PROPOSED STORM DRAIN
(Symbol)	PROPOSED DRYWELL (M-5)
(Symbol)	PROPOSED WATER LINE
(Symbol)	PROPOSED SEWER LINE
(Symbol)	LIMIT OF DISTURBANCE
(Symbol)	PROPOSED PAVING
(Symbol)	PROPOSED SIDEWALKS
(Symbol)	SPOT ELEVATION
(Symbol)	FLOW ARROW
(Symbol)	EXISTING POWER POLE
(Symbol)	SPECIMEN TREE
(Symbol)	EXISTING TREES
(Symbol)	EXISTING TREES TO BE REMOVED
(Symbol)	NON-CREDITED OPEN SPACE
(Symbol)	FOREST CONSERVATION EASEMENT
(Symbol)	DEADLINE DIVIDE
(Symbol)	EXISTING OVER HEAD POWER LINES
(Symbol)	EXISTING SEWER LINE
(Symbol)	EXISTING WATER LINE
(Symbol)	EXISTING GAS LINE
(Symbol)	EXISTING WETLANDS & WETLAND BUFFER
(Symbol)	EXISTING FLOODPLAIN

SOILS LEGEND		
SOIL	NAME	CLASS
Co	Codorus and Hatboro silt loams, 0 to 3 percent slopes	C
LeB	Legore silt loam, 3 to 8 percent slopes, stony	C
LoC	Legore-Hatboro-Urban land complex, 8 to 15 percent slopes	B
LrT	Legore-Reley gravelly loams, 25 to 65 percent slopes, very stony	B/C
MAC	Manor loam, 8 to 15 percent slopes	B

DRY WELL CHART (FUTURE LOTS)							
DRYWELL NO.	AREA OF ROOF PER DRYWELL	VOLUME REQUIRED	VOLUME PROVIDED	AREA OF TREATMENT	L	W	D
LOT 30	600 SQ. FT.	82 C.F.	85 C.F.	100%*	7'	7'	5'
LOT 31	600 SQ. FT.	82 C.F.	85 C.F.	100%*	7'	7'	5'
LOT 32	600 SQ. FT.	82 C.F.	85 C.F.	100%*	7'	7'	5'
LOT 33	600 SQ. FT.	82 C.F.	85 C.F.	100%*	7'	7'	5'
LOT 34	600 SQ. FT.	82 C.F.	85 C.F.	100%*	7'	7'	5'
LOT 35	600 SQ. FT.	82 C.F.	85 C.F.	100%*	7'	7'	5'
LOT 36	600 SQ. FT.	82 C.F.	85 C.F.	100%*	7'	7'	5'
LOT 37	600 SQ. FT.	82 C.F.	85 C.F.	100%*	7'	7'	5'
LOT 38	600 SQ. FT.	82 C.F.	85 C.F.	100%*	7'	7'	5'
LOT 39	600 SQ. FT.	82 C.F.	85 C.F.	100%*	7'	7'	5'
LOT 40	600 SQ. FT.	82 C.F.	85 C.F.	100%*	7'	7'	5'
LOT 4(W)	719 SQ. FT.	103 C.F.	128 C.F.	100%*	8'	8'	5'
LOT 4(E)	616 SQ. FT.	80 C.F.	98 C.F.	100%*	7'	7'	5'
LOT 4(S)	244 SQ. FT.	35 C.F.	41 C.F.	100%*	4.5'	4.5'	5'

DRAINAGE AREA INFORMATION				
STRUCTURE NO.	AREA (ACRES)	C FACTOR	Tc	
I-1	0.14	0.95	10 MIN.	
I-2	0.12	0.90	10 MIN.	
I-3	2.41	0.40	10 MIN.	
I-4	0.56	0.18	10 MIN.	
I-6	0.14	0.48	10 MIN.	
I-7	0.09	0.86	10 MIN.	
I-8	0.56	0.87	10 MIN.	
I-9	0.37	0.43	10 MIN.	
I-10	0.58	0.81	10 MIN.	
I-11	0.74	0.47	10 MIN.	
I-12	0.22	0.87	10 MIN.	
I-13	0.12	0.87	10 MIN.	
I-14	0.15	0.74	10 MIN.	
I-15	1.74	0.23	10 MIN.	
CS-1	0.61	0.40	10 MIN.	
CS-2	0.30	0.15	10 MIN.	
CS-3	0.52	0.40	10 MIN.	
CS-4	0.61	0.15	10 MIN.	
CS-5	0.21	0.24	10 MIN.	


STORM DRAIN DRAINAGE AREA MAP
REPLACEMENT SHEET
DORSEY'S RIDGE
PHASE-1
LOTS 1 THRU 4, OPEN SPACE LOTS 6,7,61,62,
& NON-BUILDABLE BULK PARCELS B, G THRU K
 A RESUBDIVISION OF "WILDE PROPERTY, LOT 1, 2 & 3", PLAT NO. 18442 ZONED: CEF-R
 TAX MAP NO.: 24 GRID NO.: 18 PARCEL NO.: 260 LOTS: 1 THRU 3
 SECOND ELECTION DISTRICT HOWARD COUNTY, MARYLAND
 SCALE: AS SHOWN DATE: DECEMBER, 2021
 SHEET 11 OF 18

AS-BUILT CERTIFICATION
 Note: There is no "AS-BUILT" information provided on this sheet.

APPROVED: DEPARTMENT OF PUBLIC WORKS
 CHIEF, BUREAU OF HIGHWAYS MK 07/19/2022 DATE
 APPROVED: DEPARTMENT OF PLANNING AND ZONING
 CHIEF, DIVISION OF LAND DEVELOPMENT CP 7/19/22 DATE
 CHIEF, DEVELOPMENT ENGINEERING DIVISION MK 7/23/22 DATE

REVISIONS
 NO. DESCRIPTION DATE
 1 CHANGE WATER, SEWER, STORM DRAIN, SWM, UTILITIES 30-40, CHECK 7/19/22
 2 7/22


FISHER, COLLINS & CARTER, INC.
 CIVIL ENGINEERING CONSULTANTS & LAND SURVEYORS
 CENTENAL SQUARE OFFICE PARK - 10272 BALDORRE NATIONAL PIRE
 ELLICOTT CITY, MARYLAND 21142
 (410) 461-2855

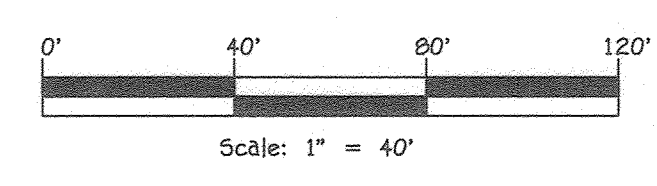



OWNER/DEVELOPER
 DORSEY'S RIDGE, LLC
 C/O DAVE WOLFSNER
 308 MAGOTHY ROAD
 SEVERNA PARK, MD 21146
 410-461-0837

PROFESSIONAL CERTIFICATION
 I HEREBY CERTIFY THAT THESE DOCUMENTS WERE PREPARED OR APPROVED BY ME AND THAT I AM A DULY LICENSED PROFESSIONAL ENGINEER UNDER THE LAWS OF THE STATE OF MARYLAND, LICENSE NO. 20748, EXPIRATION DATE: 02/22/2023.

Alfred M. Vitoreo
 Signature of Professional Engineer
 DATE: 7/22/22









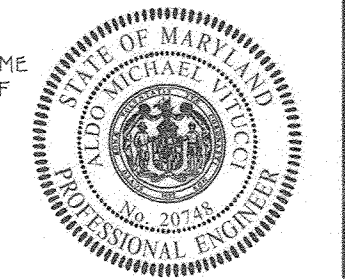


I:\2015\15000\DWG\Final\Final - Loop Road\Reclines\Final - Loop Road\Reclines\Recl-line 15000-3001-Sheet 11-14 Storm Drain & SWM details REVISED AUGUST 2020 - Recline.dwg, 1/14/2022 3:14:30 PM, Upstairs 1500.Mjlar.pcs

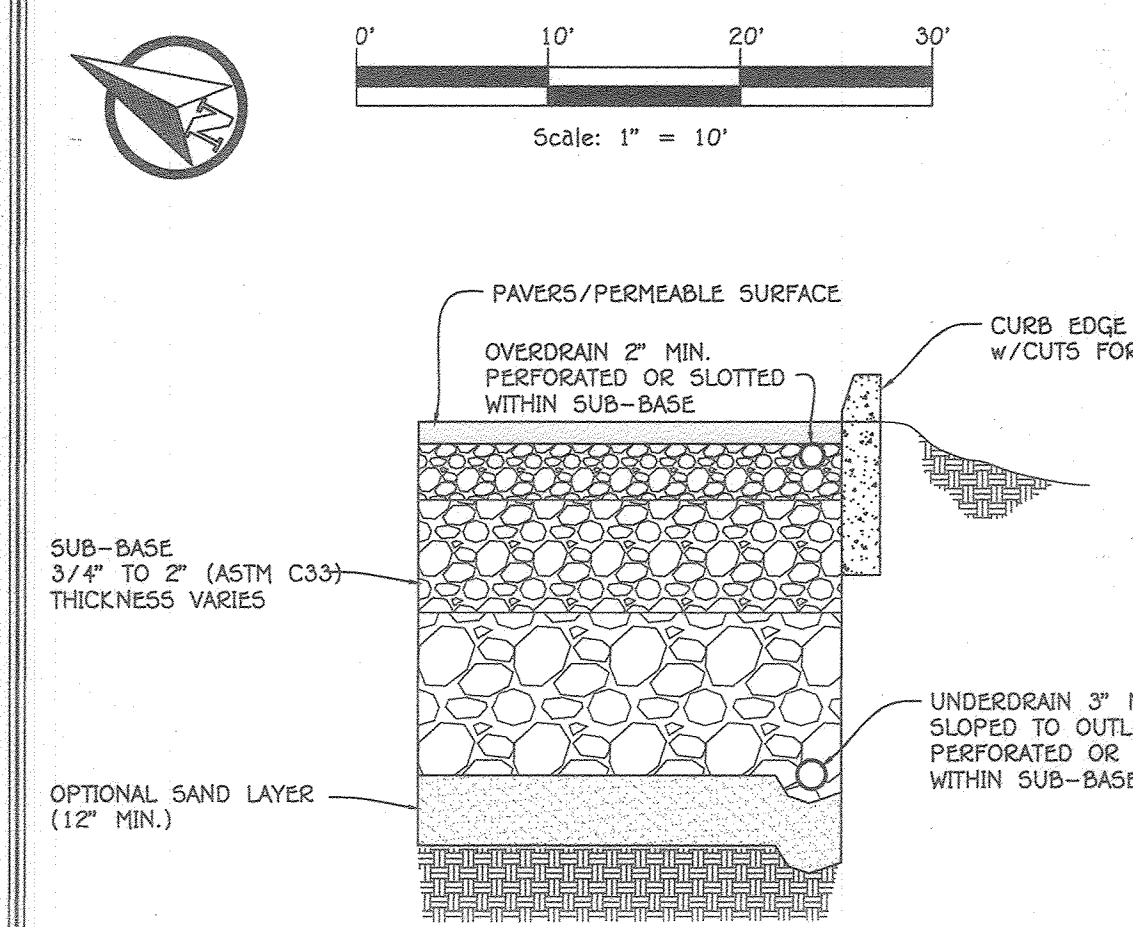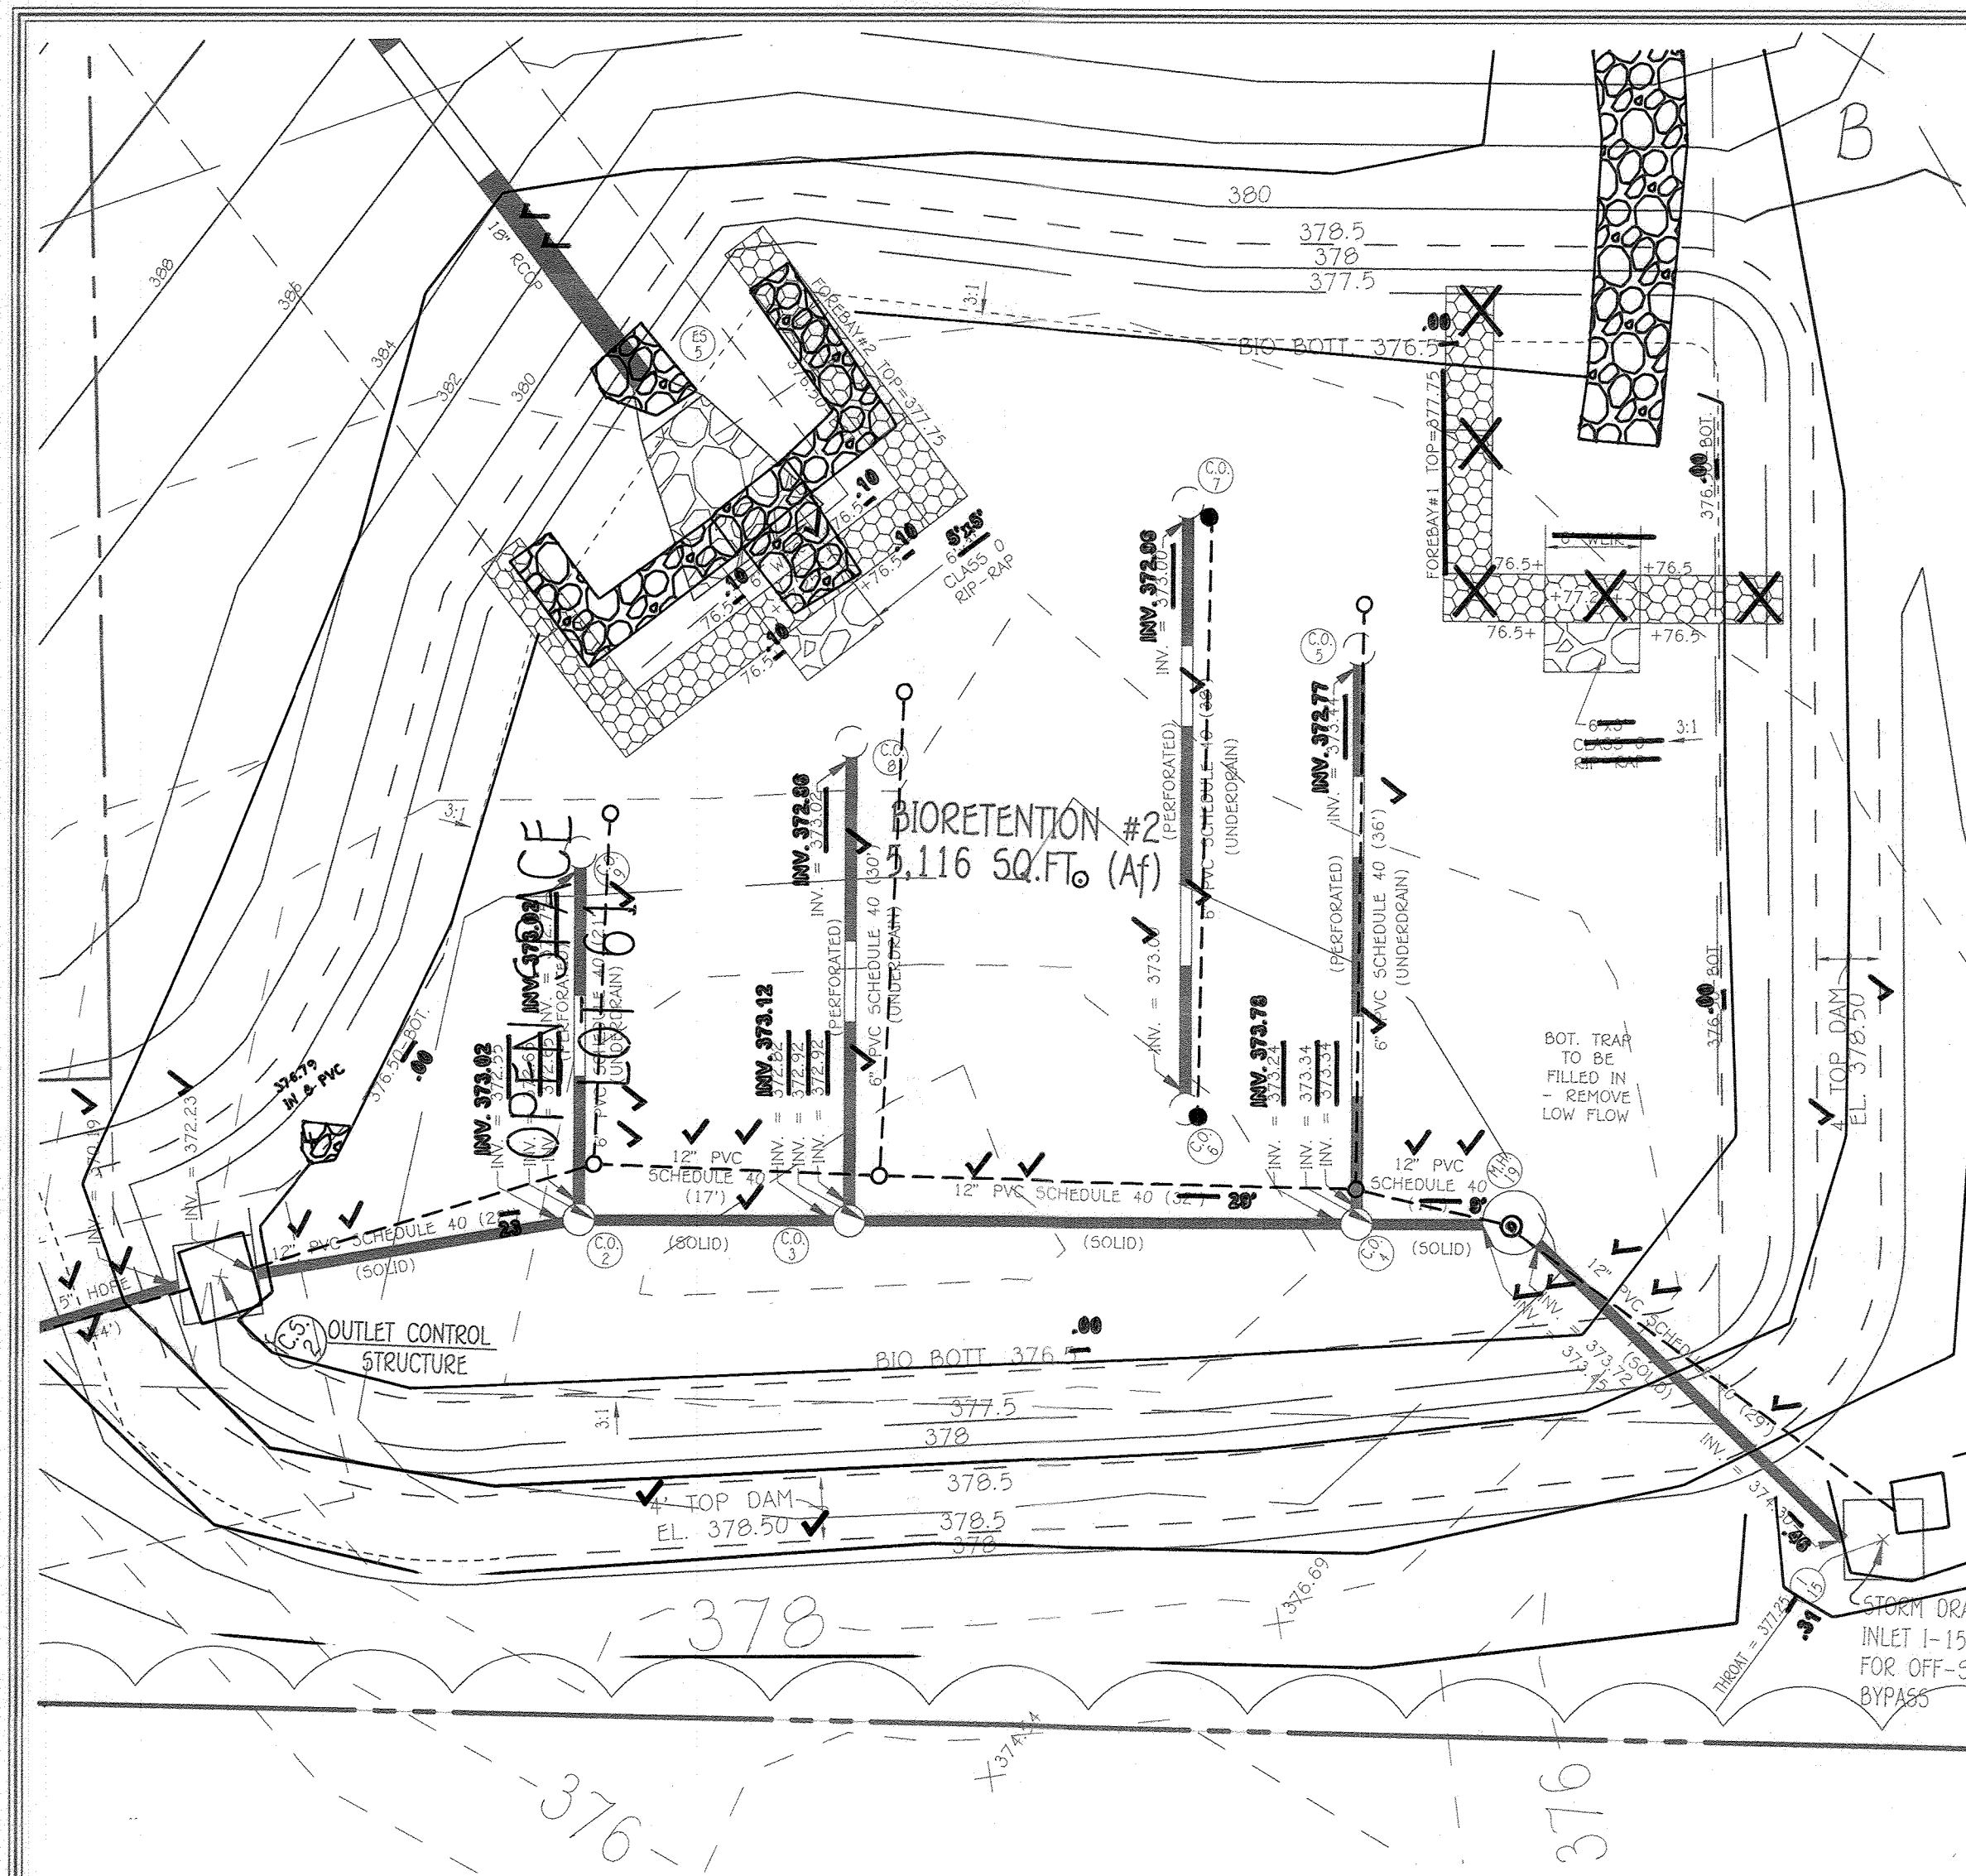

APPROVED: DEPARTMENT OF PUBLIC WORKS
 CHIEF, BUREAU OF HIGHWAYS MK 02/14/2022 DATE
 APPROVED: DEPARTMENT OF PLANNING AND ZONING
 CHIEF, DIVISION OF LAND DEVELOPMENT 02/14/2022 DATE
 CHIEF, DEVELOPMENT ENGINEERING DIVISION 2-23-22 DATE

NO.	DESCRIPTION	DATE
1	SWR drain profiles & structure schedule	2/1/22

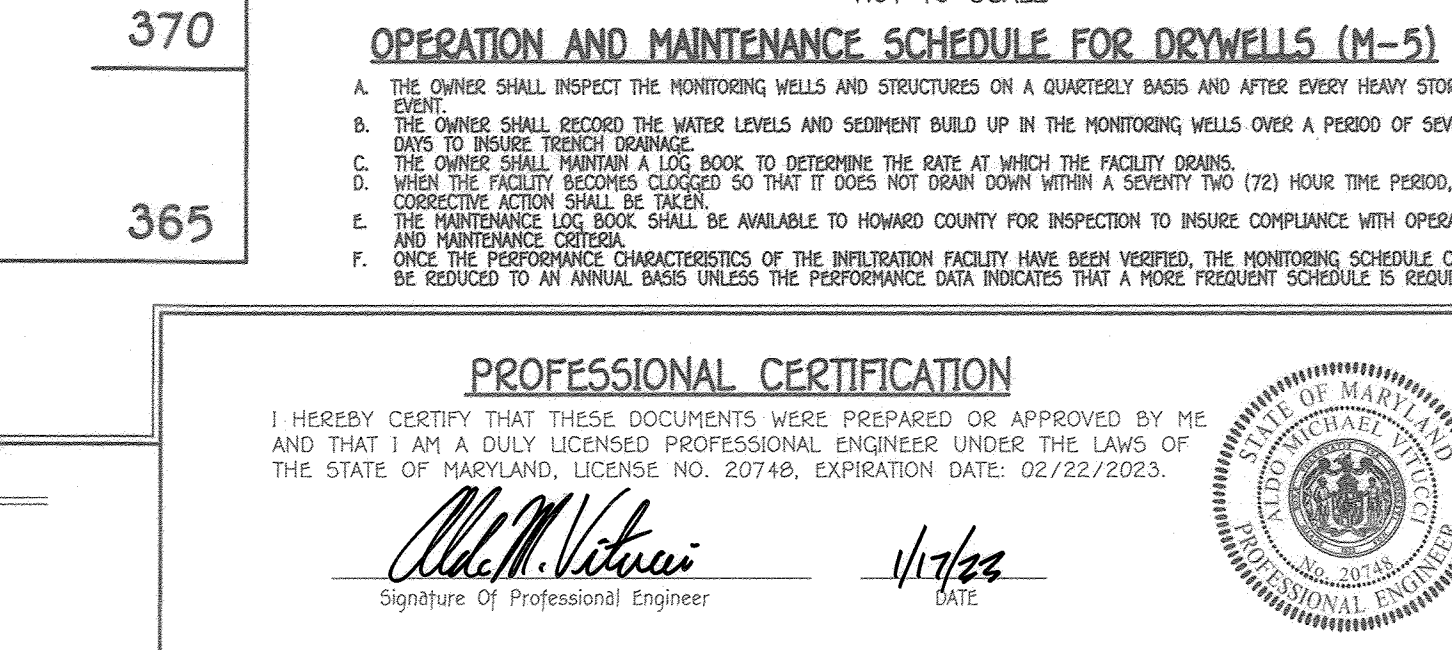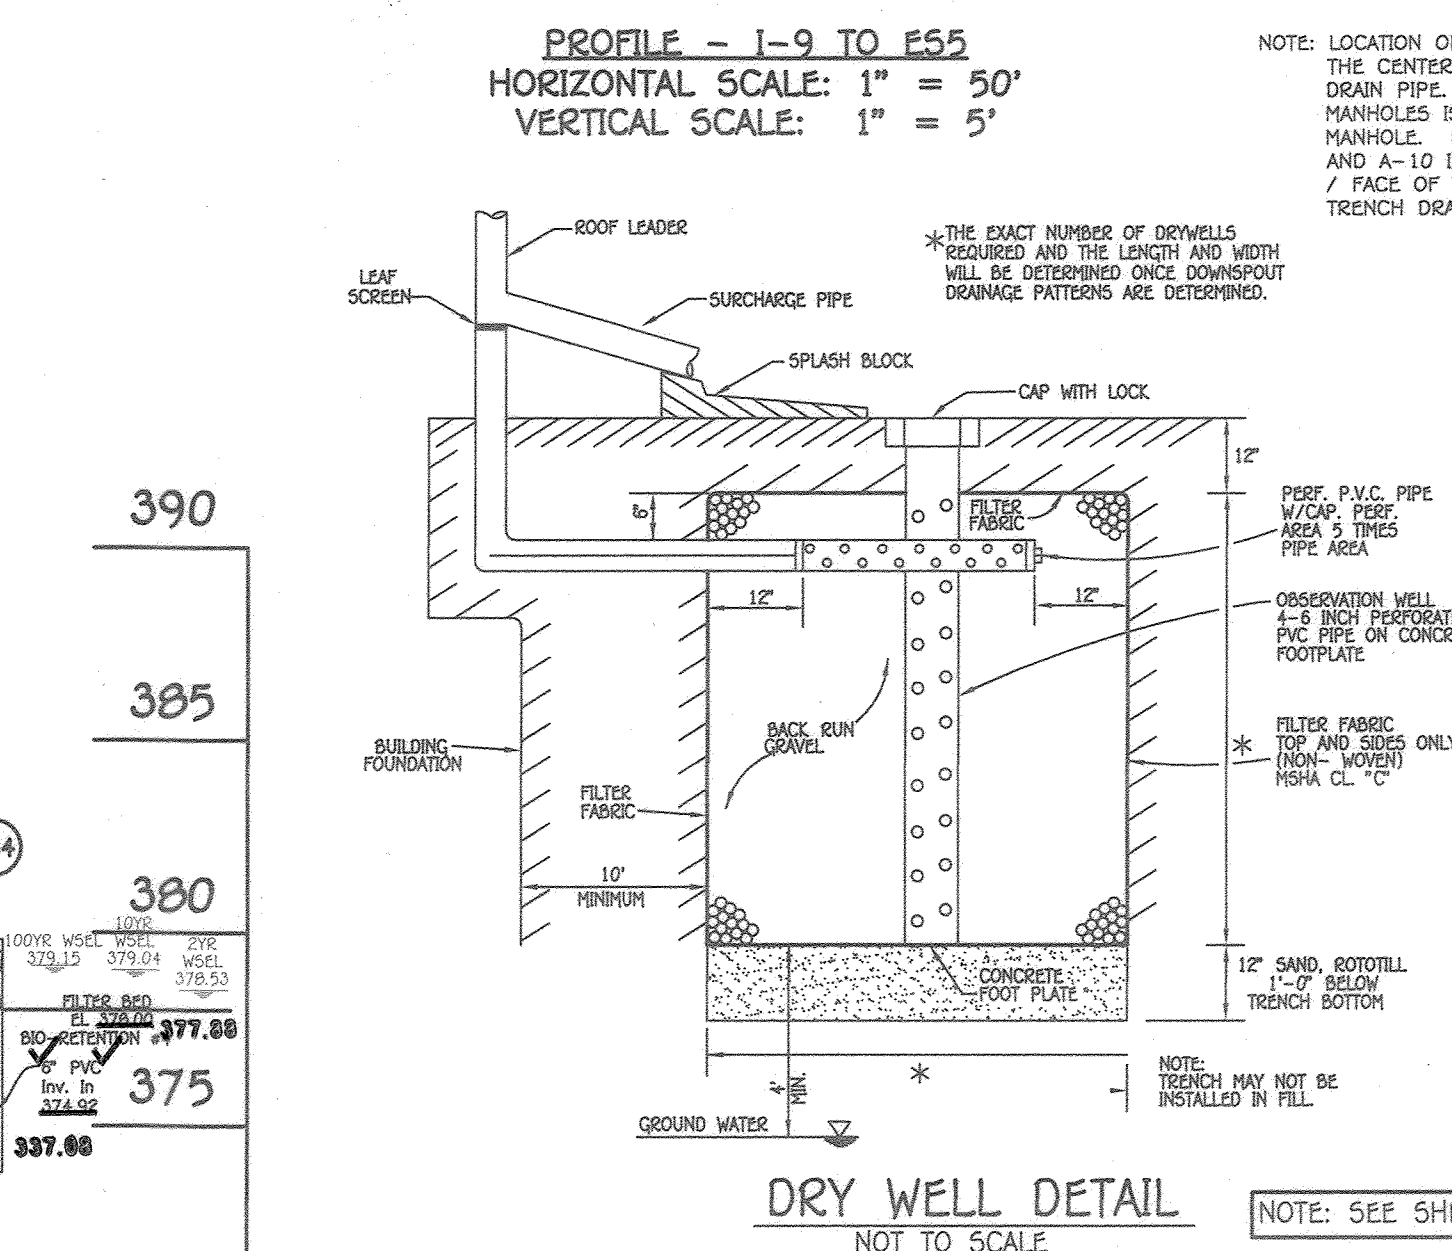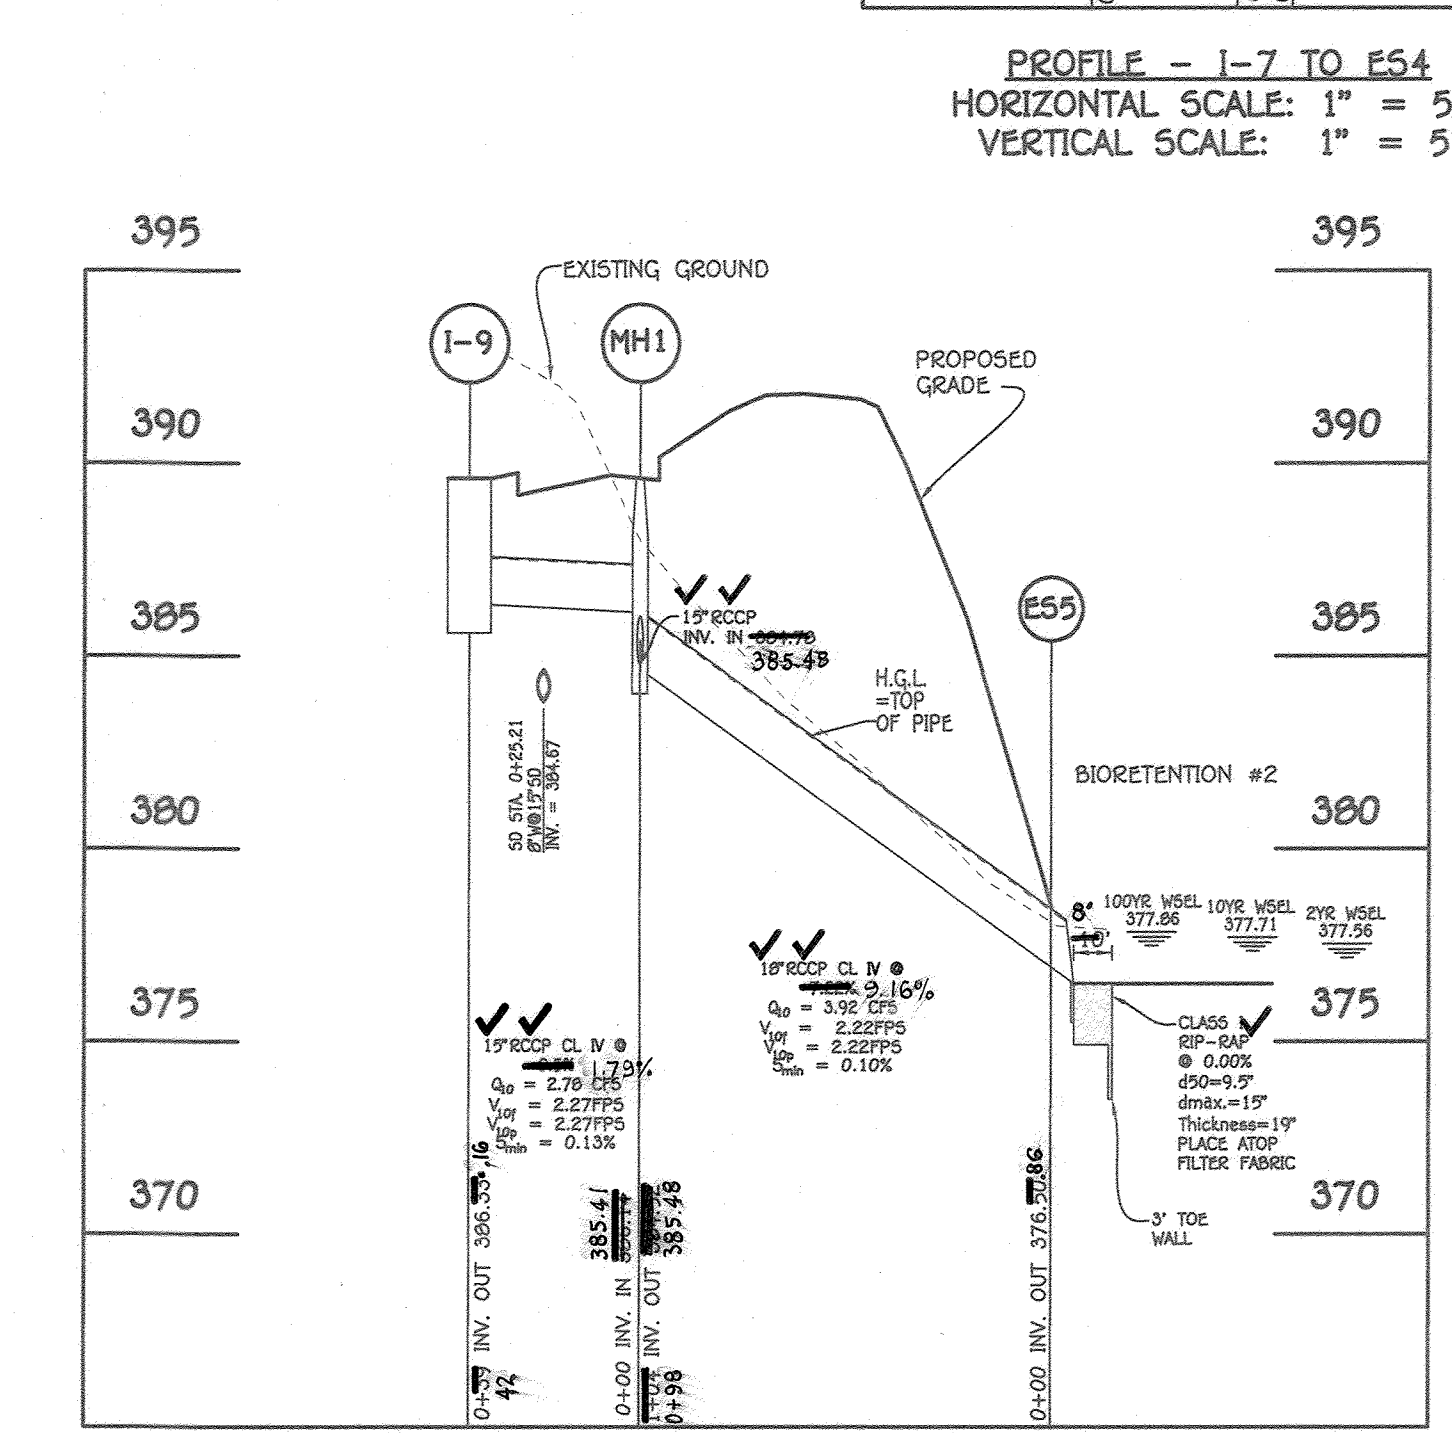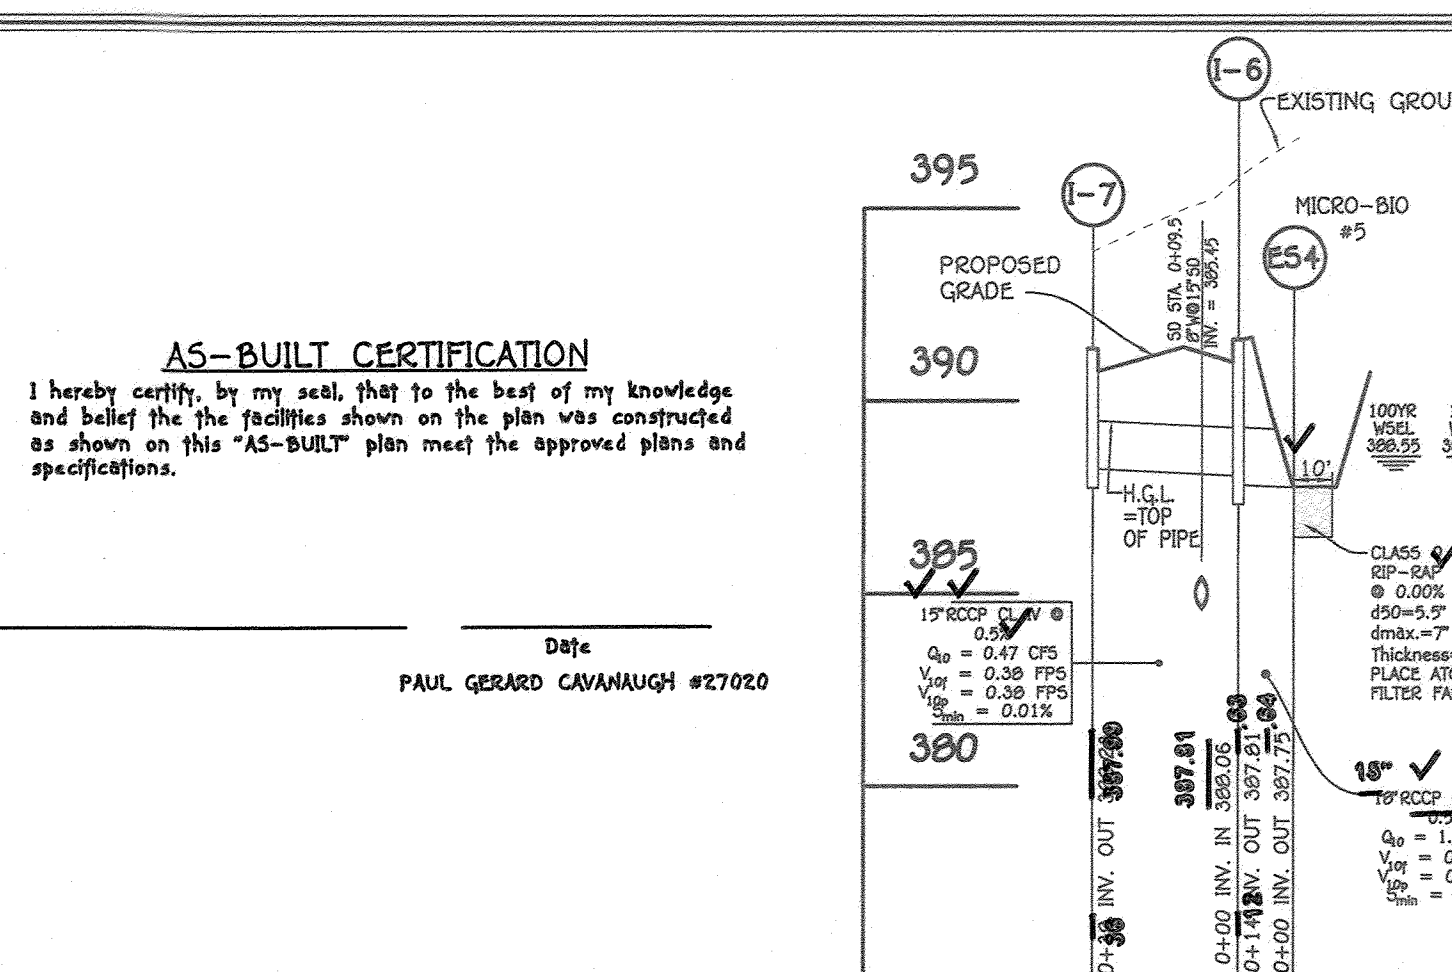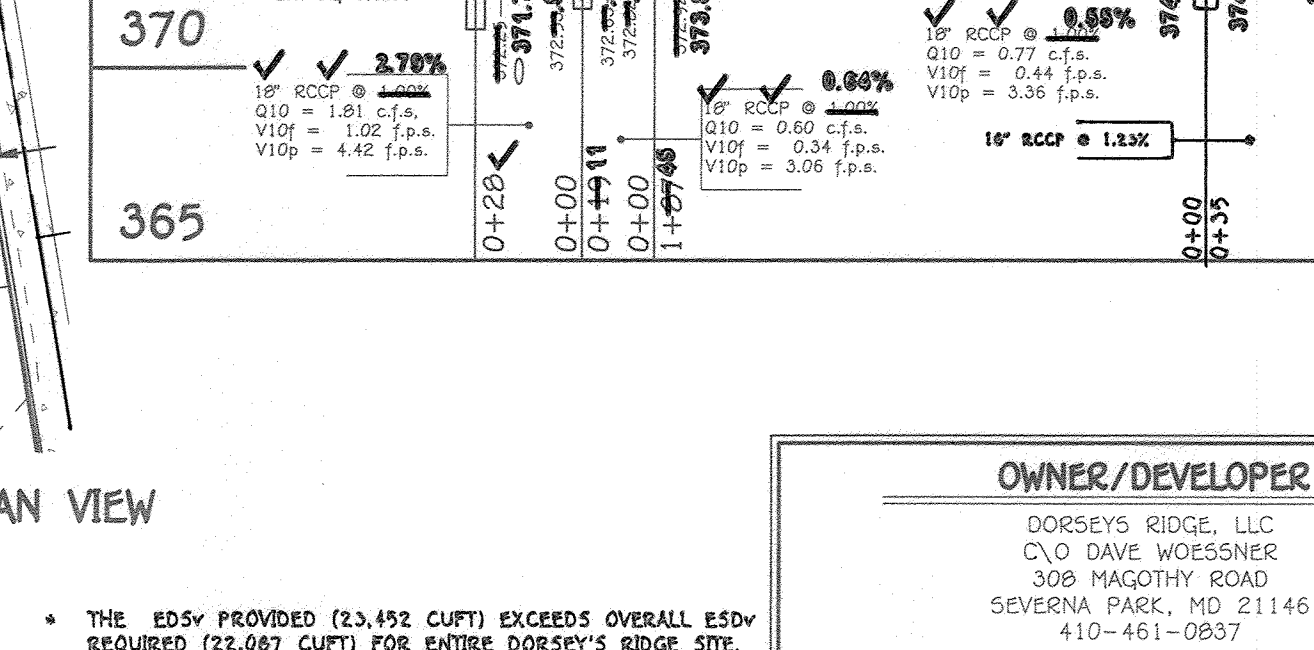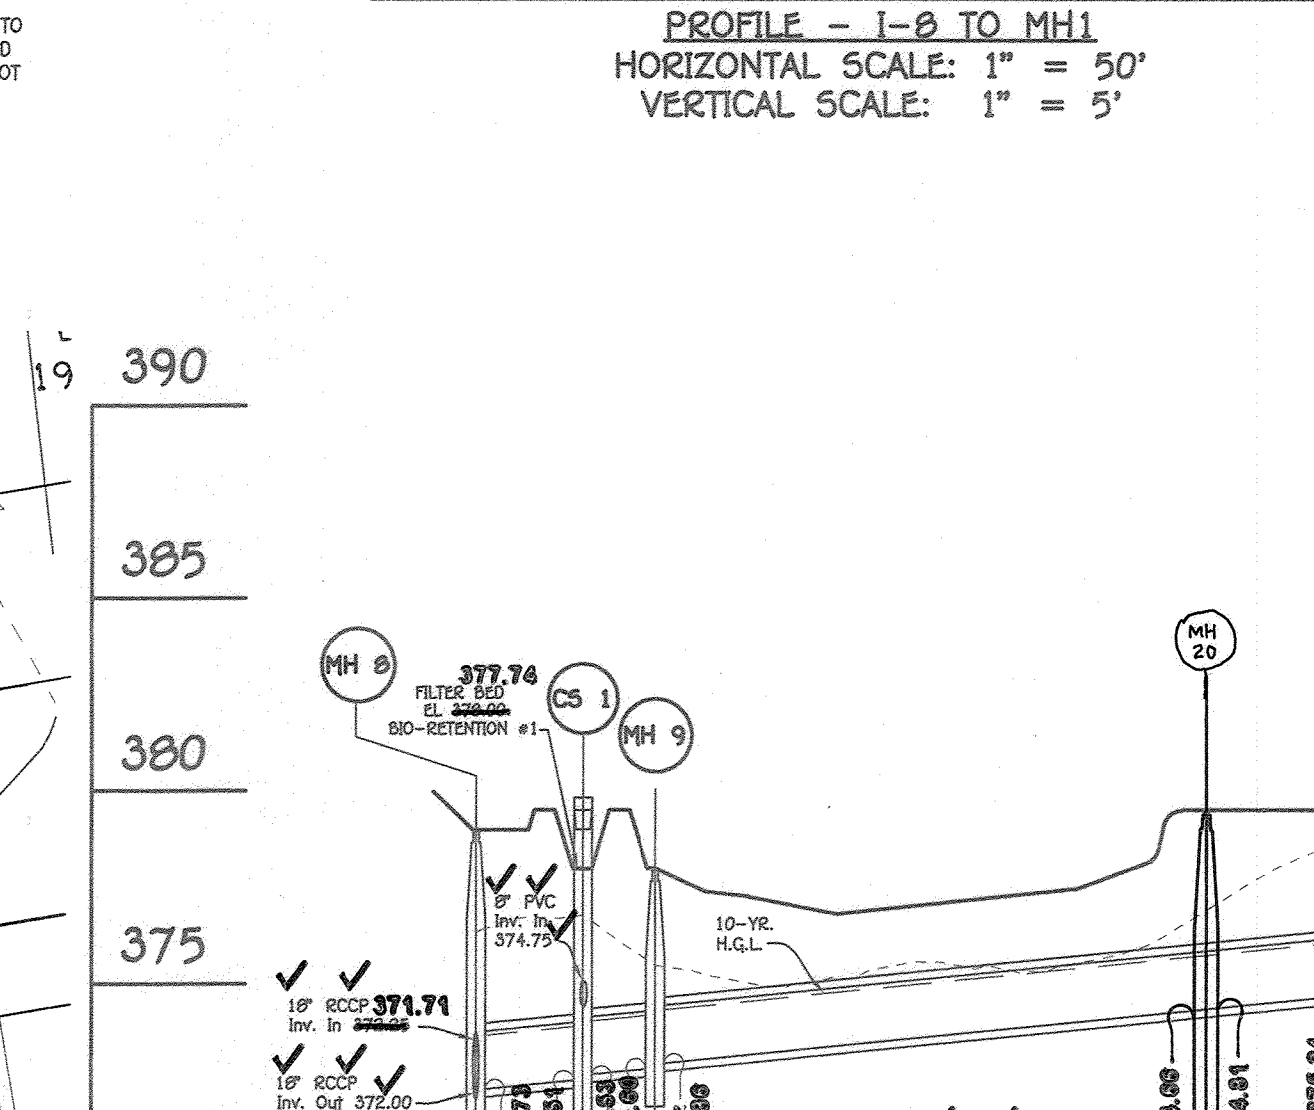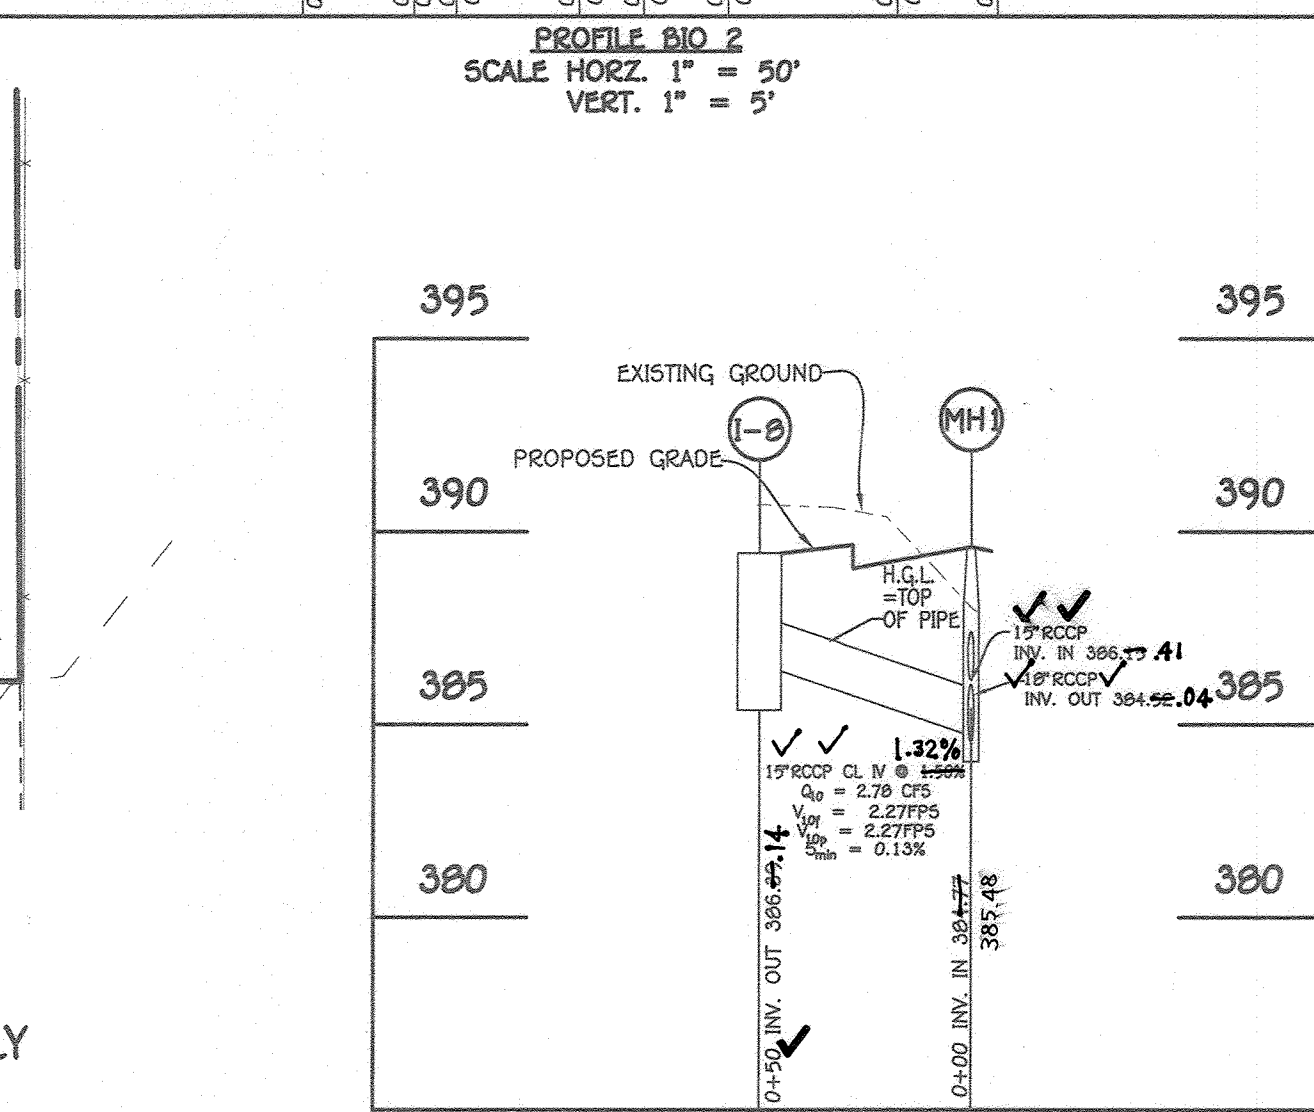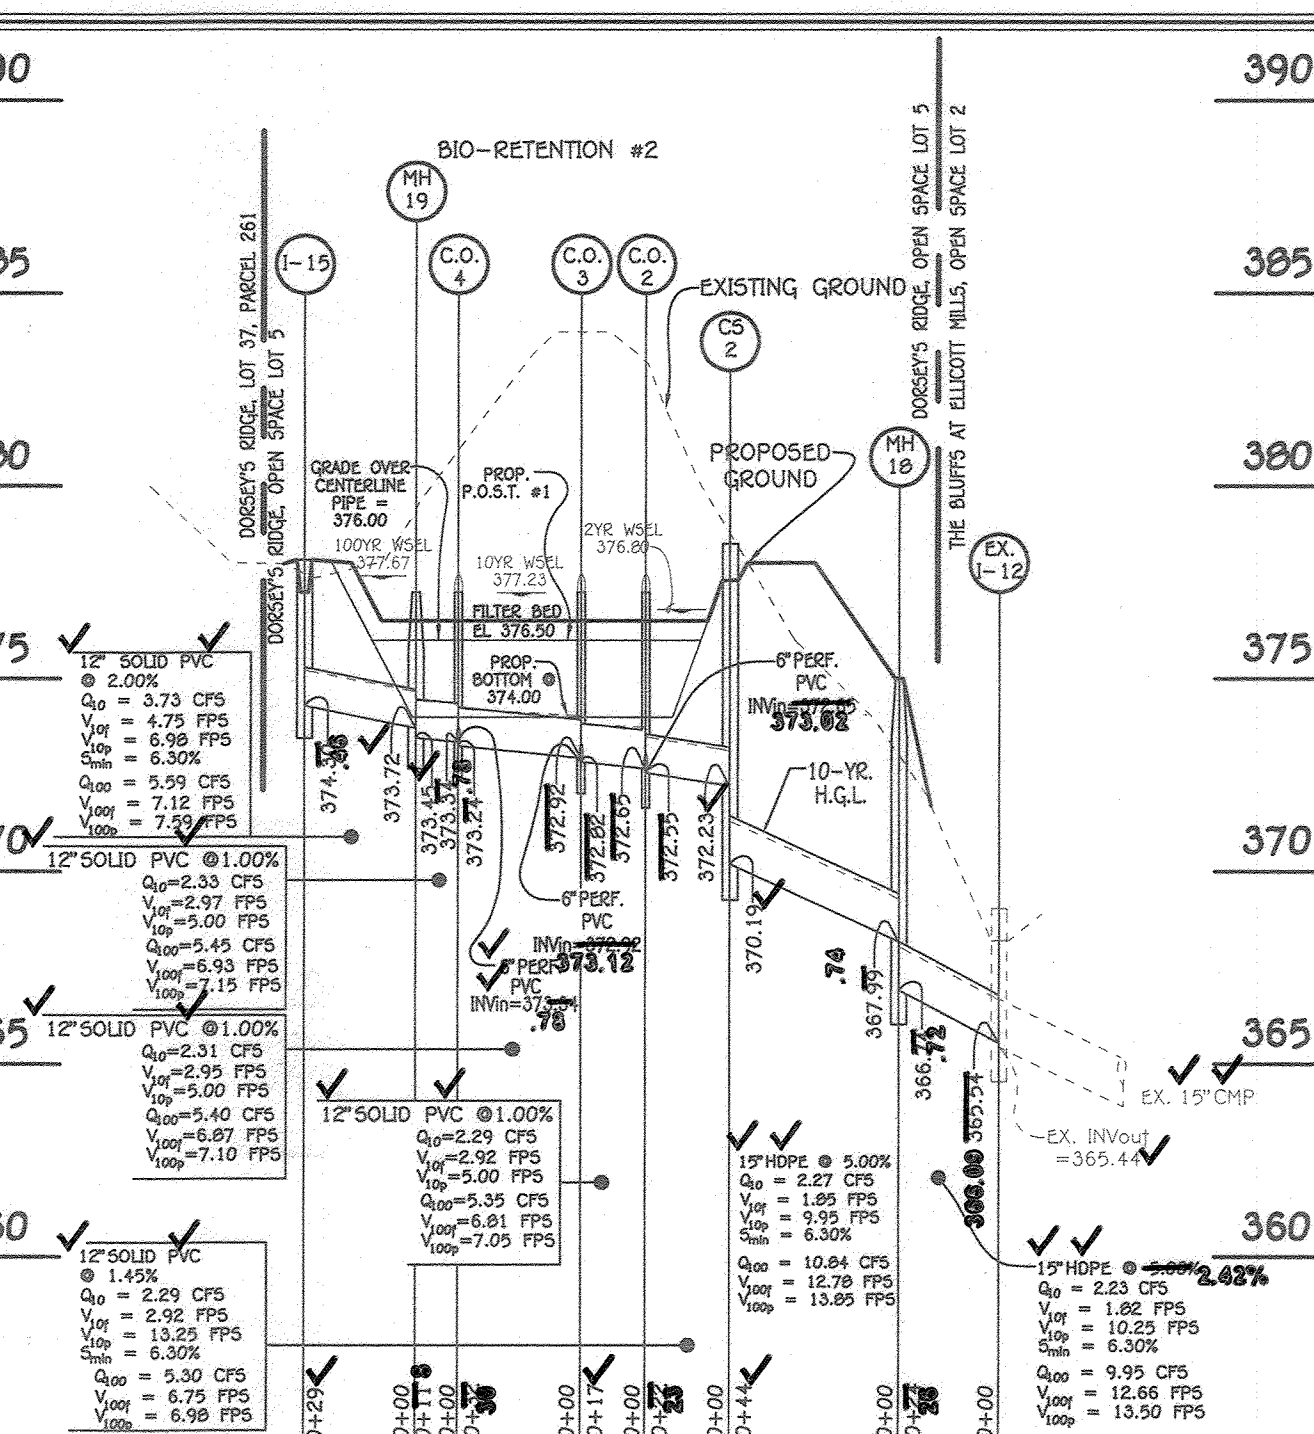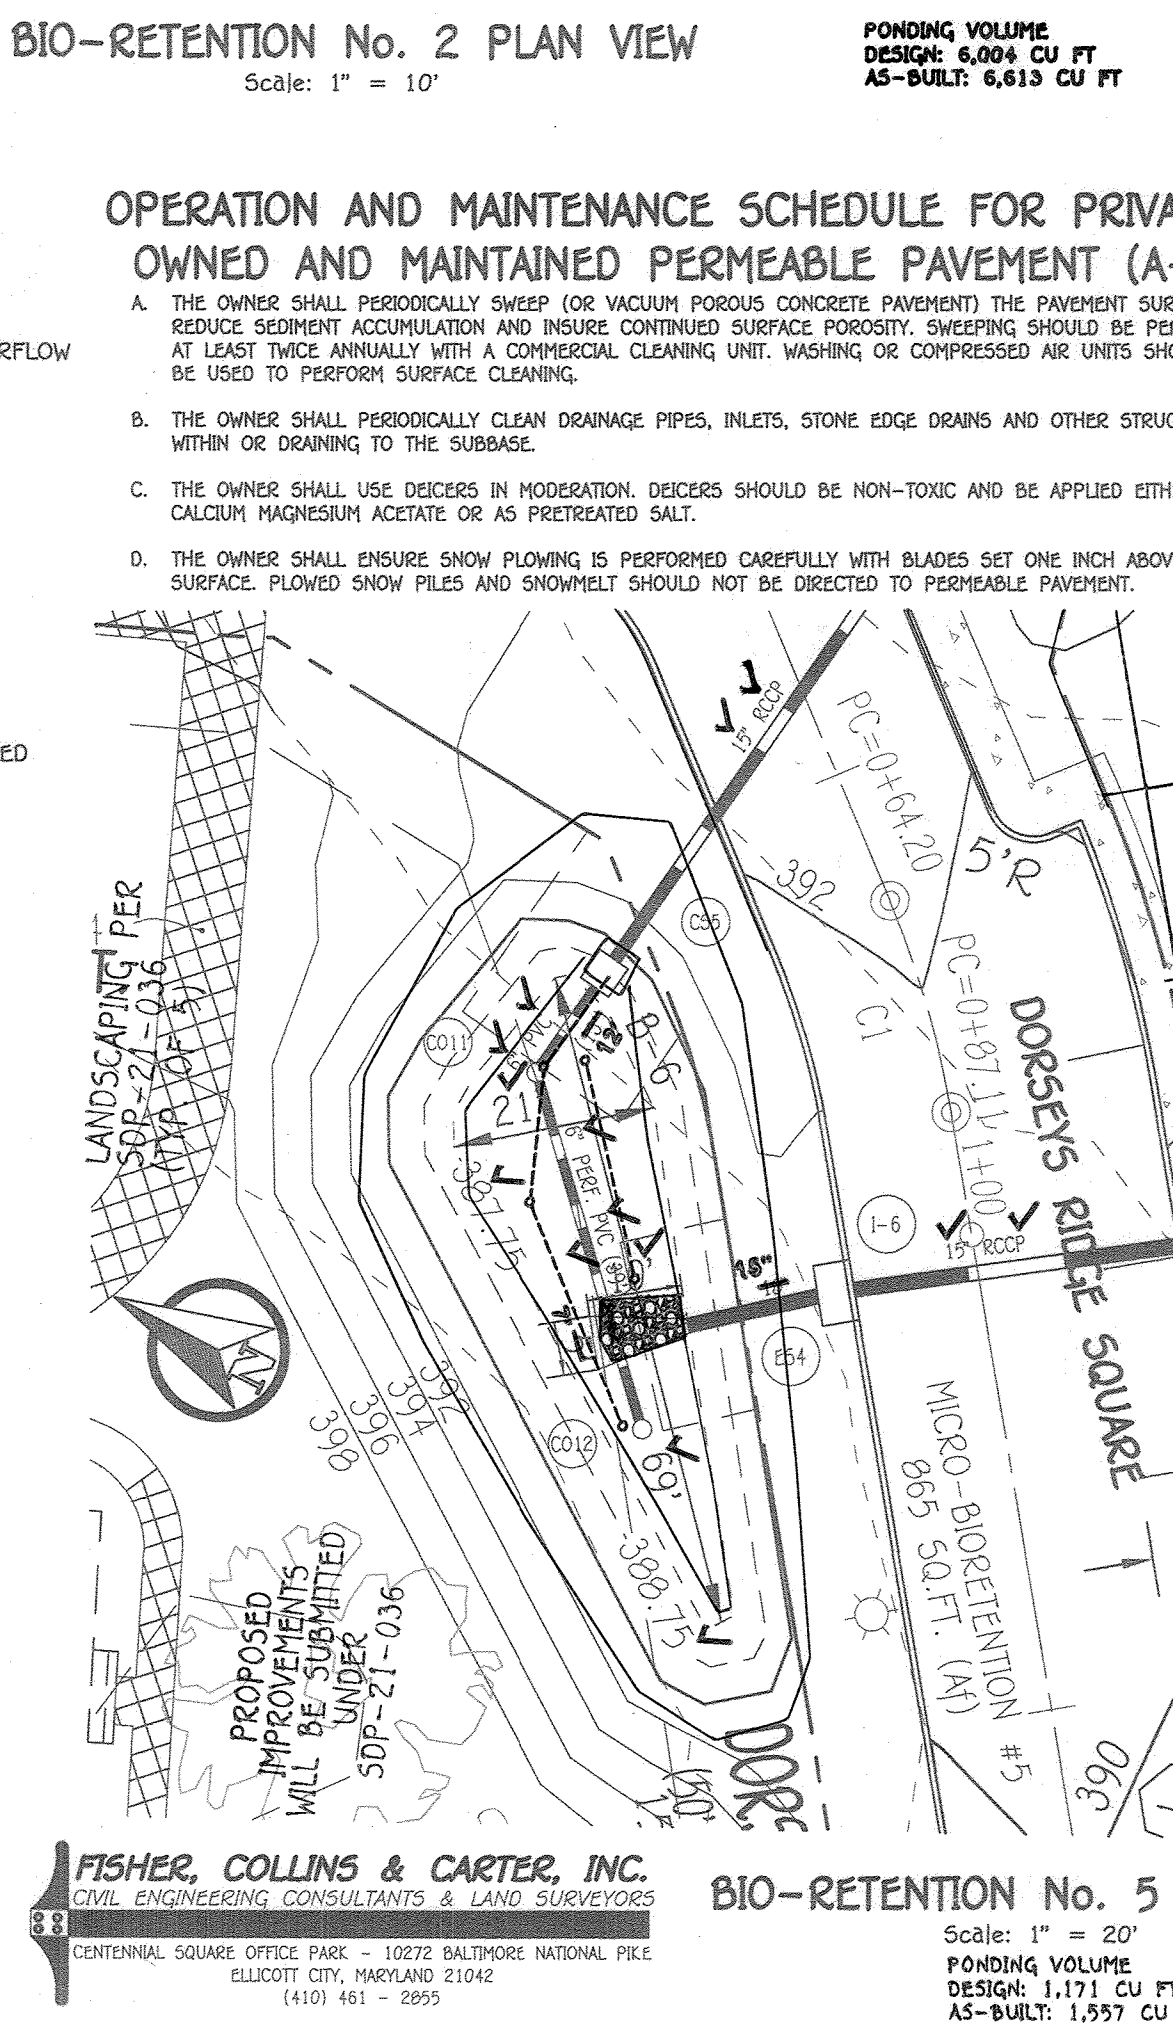

STR #	STATION & OFFSET OR COORDINATES	TOP ELEV	TYPE	INV IN	INV OUT
E51	N 981,060.422 E 1,364,618.861	---	CONC. END SECTION DTL D - 5.51	---	377.00 (18" RCCP)
E52	N 981,174.85 E 1,364,567.74	---	CONC. END SECTION DTL D - 5.51	---	378.00 (11) (18" RCCP) ✓
E53	N 981,266.39 E 1,364,567.74	---	CONC. END SECTION DTL D - 5.51	---	378.00 (11) (18" RCCP) ✓
E54	N 981,187.183 E 1,364,320.791	---	CONC. END SECTION DTL D - 5.51	---	387.66 64 (18" RCCP) ✓
E55	N 980,973.219 E 1,364,182.400	---	CONC. END SECTION DTL D - 5.51	---	376.66 (MH 1) (18" RCCP) ✓
E56	N 981,444.176 E 1,364,290.891	---	CONC. END SECTION DTL D - 5.51	---	372.00 (MH 2) (18" RCCP) ✓
E57	N 981,744.077 E 1,364,339.045	---	CONC. END SECTION DTL D - 5.51	---	319.15 (18" RCCP) ✓
MH1	STA 2+55.06 O/S 8.2' LT	389.65 7.3	5' STANDARD MH DTL G-5.13	385.66 (I-9) 19"	385.00 48 (18" RCCP) ✓
MH2	N 981,429.734 E 1,364,093.823	380.89	STANDARD MH DTL G-5.12	373.78 (MH-10)	373.47 16 (18" RCCP) ✓
MH3	DELETED	321.27	---	---	---
MH4	N 981,712.221 E 1,364,408.612	329.45	STANDARD MH DTL G-5.12	325.46 (MH 4A)	325.77 319.97 (18" RCCP) ✓
MH4A	N 981,722.409 E 1,364,408.190	335.75	STANDARD MH DTL G-5.12	329.46 (MH 5)	325.77 321.62 (18" RCCP) ✓
MH5	N 981,583.035 E 1,364,454.480	335.23	STANDARD MH DTL G-5.12	327.23 (MH 6)	327.23 58 (18" RCCP) ✓
MH6	N 981,443.898 E 1,364,506.29	385.77	STANDARD MH DTL G-5.12	369.66 (MH 7)	369.41 (18" RCCP) ✓
MH7	N 981,432.899 E 1,364,505.880	385.54	STANDARD MH DTL G-5.12	369.66 (MH 8)	369.24 (18" RCCP) ✓
MH8	N 981,573.098 E 1,364,526.554	379.98	STANDARD MH DTL G-5.12	372.00 (MH 10)	372.00 19 (18" RCCP) ✓
MH9	N 981,191.663 E 1,364,453.100	389.62	STANDARD MH DTL G-5.12	373.78 (MH 10)	372.66 60 (18" RCCP) ✓
MH10	N 981,243.413 E 1,364,572.209	388.08	STANDARD MH DTL G-5.12	381.05 (MH 11)	381.60 48 (18" RCCP) ✓
MH11	N 981,141.585 E 1,364,618.092	392.74	SHALLOW MH DTL G-5.12	386.77 (MH 12)	386.77 382.30 (18" RCCP) ✓
MH12	N 981,222.481 E 1,364,529.548	391.50	STANDARD MH DTL G-5.12	383.44 (MH 13)	383.44 383.44 (18" RCCP) ✓
MH13	N 981,191.663 E 1,364,453.100	389.62	STANDARD MH DTL G-5.12	381.05 (MH 11)	381.60 48 (18" RCCP) ✓
MH14	N 981,200.760 E 1,364,459.494	398.46	STANDARD MH DTL G-5.12	388.00 (MH 14)	388.00 388.00 (18" RCCP) ✓
MH15	N 981,574.986 E 1,364,439.528	379.93	STANDARD MH DTL G-5.12	372.00 (MH 15)	372.00 19 (18" RCCP) ✓
MH16	N 981,279.111 E 1,364,279.111	377.93	STANDARD MH DTL G-5.12	370.00 (MH 16)	367.06 (18" RCCP) ✓
MH17	N 981,496.43 E 1,364,242.42	376.8	STANDARD MH DTL G-5.12	367.70 (MH 17)	367.45 (18" RCCP) ✓
MH18	N 980,990.02 E 1,364,083.16	375.92	STANDARD MH DTL G-5.12	367.70 (MH 18)	367.45 (18" RCCP) ✓
MH19	N 980,990.57 E 1,364,170.20	377.75	STANDARD MH DTL G-5.12	373.72 (MH 19)	373.45 (18" RCCP) ✓
I-1	STA 1+03.57 O/S 10' RT	383.24	TYPE A-10 O/S 10' RT	379.45 (I-1)	379.45 30 (18" RCCP) ✓
I-2	STA 4+37.72 O/S 10' LT	383.52	TYPE A-10 O/S 10' LT	380.85 (I-2)	380.85 28 (18" RCCP) ✓
I-3	STA 3+83.57 O/S 21.1' RT	383.97	TYPE A-10 O/S 21.1' RT	380.85 (I-3)	380.85 28 (18" RCCP) ✓
I-4	N 980,947.108 E 1,364,250.788	376.38	TYPE A-5 DTL D-4.01	381.05 (I-4)	381.05 28 (18" RCCP) ✓
I-5	DELETED	---	---	---	---
I-6	STA 1+03.57 O/S 13' RT	391.22	TYPE A-5 DTL D-4.01	387.81 (I-6)	387.81 63 (18" RCCP) ✓
I-7	STA 1+03.57 O/S 13' LT	391.37	TYPE A-5 DTL D-4.01	387.81 (I-7)	387.81 63 (18" RCCP) ✓
I-8	STA 2+10.16 O/S 21' LT	388.61	TYPE A-10 DTL D-4.03	386.66 (I-8)	386.66 14 (18" RCCP) ✓
I-9	STA 2+15.95 O/S 13' RT	388.69	TYPE A-10 DTL D-4.03	386.66 (I-9)	386.66 14 (18" RCCP) ✓
I-10	STA 5+69.39 O/S 13' RT	388.78	TYPE A-10 DTL D-4.03	384.01 (I-10)	384.01 16 (18" RCCP) ✓
I-11	STA 5+69.39 O/S 13' RT	388.78	TYPE A-10 DTL D-4.03	384.01 (I-11)	384.01 16 (18" RCCP) ✓
I-12	STA 9+48.03 O/S 30' RT	389.59	TYPE A-10 DTL D-4.03	381.18 (I-12)	377.98 21 (18" RCCP) ✓
I-13	STA 9+48.03 O/S 30' RT	389.59	TYPE A-10 DTL D-4.03	381.18 (I-13)	377.98 21 (18" RCCP) ✓
I-14	N 981,352.999 (FUTURE)	389.90	TRENCH DRAIN NOS DURASLOPE	---	---
EX. INLET I-12	N 980,977.209 E 1,364,080.390	383.34	EX. INLET DTL D-4.39	386.09 (I-12)	386.09 46 (18" RCCP) ✓
I-15	N 980,887.89 E 1,364,188.03	377.89	TYPE D DTL D-4.39	374.88 (I-15)	374.88 46 (18" RCCP) ✓
CS1	N 981,236.45 E 1,364,545.39	379.51	CONCRETE FOOT PLATE	373.49 (P. PERFORATED PVC)	373.49 118 (18" RCCP) ✓
CS2	N 980,963.71 E 1,364,113.49	377.22	CONCRETE FOOT PLATE	372.23 (P. PERFORATED PVC)	372.23 118 (18" RCCP) ✓
CS3	N 981,491.37 E 1,364,514.90	378.79	CONCRETE FOOT PLATE	388.48 (P. PERFORATED PVC)	388.48 58 (18" RCCP) ✓
CS4	N 981,075.17 E 1,364,531.23	378.98	CONCRETE FOOT PLATE	375.05 (P. PERFORATED PVC)	375.05 58 (18" RCCP) ✓
CS5	N 981,211.52 E 1,364,349.43	388.80	CONCRETE FOOT PLATE	384.84 (P. PERFORATED PVC)	384.84 118 (18" RCCP) ✓
MH20	N 981,095.53 E 1,364,638.26	380.22	STANDARD MH DTL G-5.12	374.88 (MH 20)	374.88 16 (18" RCCP) ✓

*INLET TOP ELEVATIONS DENOTES THROAT ELEVATIONS WHERE APPLICABLE.

STORMWATER MANAGEMENT NOTES

- STORMWATER MANAGEMENT IS PROVIDED IN ACCORDANCE WITH CHAPTER 5 "ENVIRONMENTAL SITE DESIGN" OF THE 2007 MARYLAND STORMWATER MANAGEMENT DESIGN MANUAL.
- MAXIMUM CONTRIBUTING ROOF TOP AREA TO EACH DRYWELL SHALL BE 1,000 SQ. FT. OR LESS.
- DRYWELLS SHALL BE PROVIDED AT LOCATIONS WHERE THE LENGTH OF DISCONNECTION IS LESS THAN 75' AT 2% SLOPE AND CONSTRUCTION OF THE DRYWELL SHALL BE IN ACCORDANCE WITH THE DETAIL SHOWN ON THIS SHEET.
- FINAL GRADING IS SHOWN ON THE SITE DEVELOPMENT PLAN.

STORMWATER MANAGEMENT NOTES

STORM DRAIN & SWM PROFILES

DORSEY'S RIDGE

PHASE-1

LOTS 1 THRU 4, OPEN SPACE LOTS 6,7,61,62, & NON-BUILDABLE BULK PARCELS B, G THRU K

A RESUBDIVISION OF "MILHIDE PROPERTY, LOT 1, 2 & 3", PLAT NO. 18442


ZONED: CEF-R

TAX MAP NO.: 24 GRID NO.: 18 PARCEL NO.: 260 LOTS: 1 THRU 3

SECOND ELECTION DISTRICT HOWARD COUNTY, MARYLAND

SCALE: AS SHOWN DATE: DECEMBER, 2021

SHEET 12 OF 18

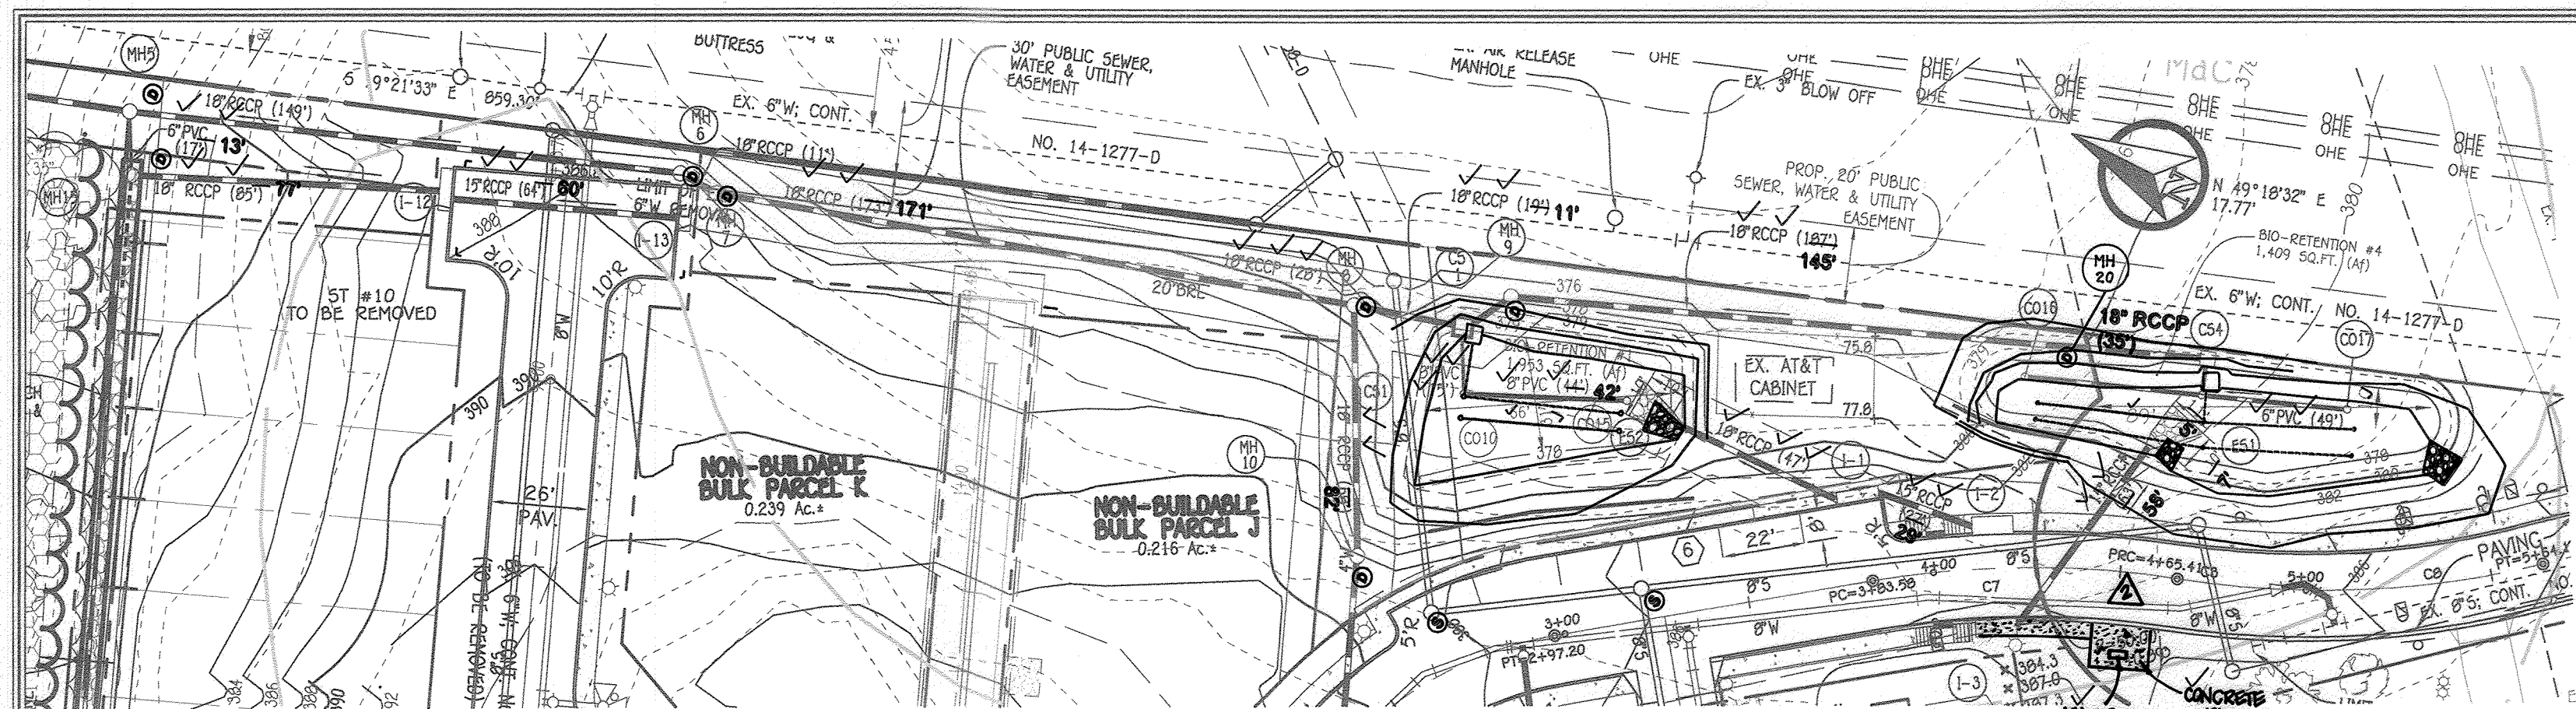


BIO-RETENTION No. 1 & 4 PLAN VIEW
Scale: 1" = 40'

PONDING VOLUME
DESIGN: 1,772 CU FT
AS-BUILT: 1,954 CU FT

PONDING VOLUME
DESIGN: 1,640 CU FT
AS-BUILT: 2,061 CU FT

THE ESDV PROVIDED (23,452 CUFT) EXCEEDS OVERALL ESDV REQUIRED (22,067 CUFT) FOR ENTIRE DORSEY'S RIDGE SITE.

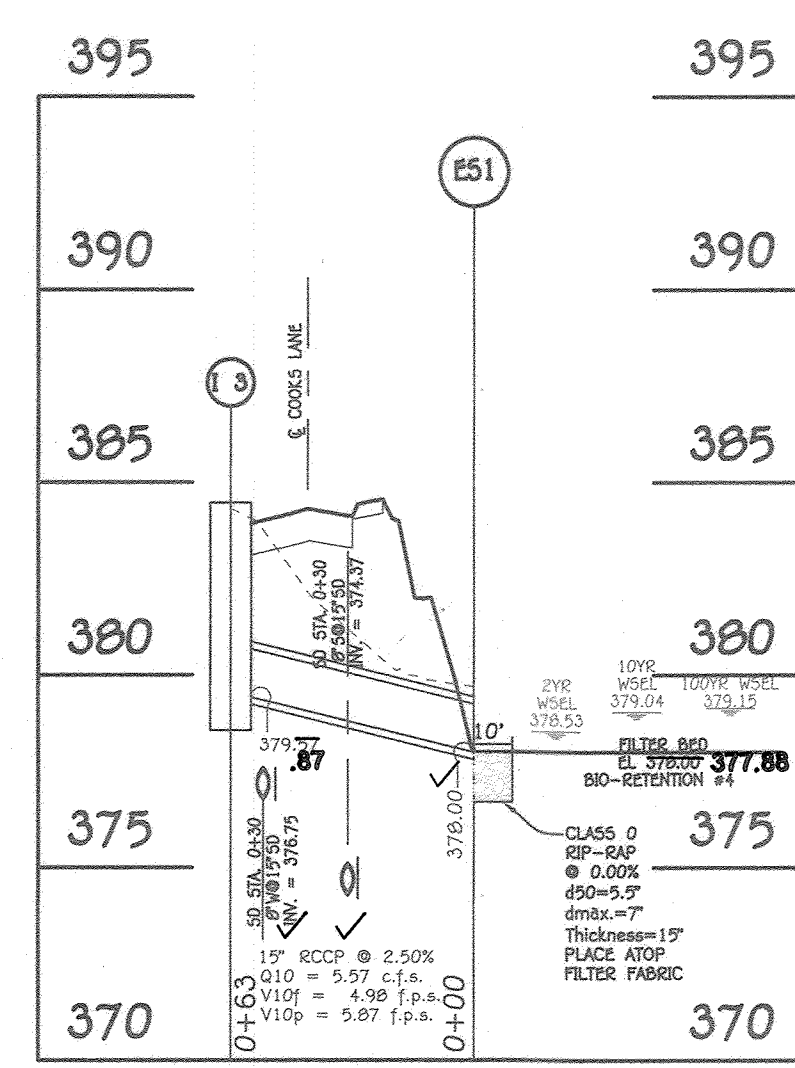

OPERATION AND MAINTENANCE SCHEDULE FOR MICRO BIO-RETENTION AREAS (M-6)

- The owner shall maintain the plant material, mulch layer and soil layer annually, maintenance of mulch and soil is limited to correcting areas of erosion or wash out. Any mulch replacement shall be done in the spring. Plant material shall be checked for disease and insect infestation and maintenance will address dead material and pruning. Acceptable replacement plant material is limited to the following: 2000 Maryland stormwater design manual volume II, table A.4.1 and 2.
- The owner shall perform a plant in the spring and in the fall each year, during the inspection, the owner shall remove dead and diseased vegetation considered beyond treatment, replace dead plant material with acceptable replacement plant material, treat diseased trees and shrubs and replace all deficient stakes and wires.
- The owner shall inspect the mulch each spring. The mulch shall be replaced every two to three years. The previous mulch layer shall be removed before the new layer is applied.
- The owner shall correct soil erosion on an as needed basis, with a minimum of once per month and after each heavy storm.

STORMWATER MANAGEMENT PIPE SCHEDULE

SIZE	TYPE	LENGTH
6"	PVC	31 L.F.
6"	PVC	5 L.F.
6"	PVC, PERFORATED	226 L.F.
6"	PVC, PERFORATED	153 L.F.
12"	PVC	60 L.F.


CLEANOUT STRUCTURE SCHEDULE

STR #	STATION & OFFSET OR COORDINATES	TOP ELEV	TYPE	INV IN	INV OUT
CO2	N 980,946.1226 E 1,364,135.5323	377.40 379.19	6" CLEANOUT	372.55 373.03	372.55 373.03
CO3	N 980,932.3408 E 1,364,145.4894	377.50 379.12	6" CLEANOUT	372.82 373.12	372.82 373.12
CO4	N 980,906.5368 E 1,364,164.2544	377.50 379.12	6" CLEANOUT	373.24 373.78	373.24 373.78
CO5	N 980,945.1286 E 1,364,176.4790	377.25 378.88	6" CLEANOUT	-	373.44 373.00
CO6	N 980,914.0726 E 1,364,162.9175	377.25 378.88	6" CLEANOUT	-	373.00 372.88
CO7	N 981,230.2325 E 1,364,248.9389	377.25 378.88	6" CLEANOUT	-	373.00 372.88
CO8	N 981,190.499 E 1,364,566.964	377.25 378.88	6" CLEANOUT	-	373.00 372.88
CO9	N 981,083.5119 E 1,364,633.9137	377.25 378.88	6" CLEANOUT	-	373.00 372.88
CO10	N 981,017.4423 E 1,364,651.7971	377.25 378.88	6" CLEANOUT	-	373.00 372.88
CO11	N 981,213.173 E 1,364,337.053	377.25 378.88	6" CLEANOUT	364.17 364.78	364.17 364.78
CO12	N 981,186.6081 E 1,364,309.0447	377.25 378.88	6" CLEANOUT	-	364.36 364.97
CO13	N 981,480.4823 E 1,364,158.4982	372.75 374.38	6" CLEANOUT	368.70 369.31	368.70 369.31
CO14	N 981,461.4316 E 1,364,102.1925	372.75 374.38	6" CLEANOUT	-	369.20 369.81
CO15	N 981,191.6602 E 1,364,569.6931	372.75 374.38	6" CLEANOUT	-	373.45 374.06
CO16	N 981,065.0117 E 1,364,630.7835	372.75 374.38	6" CLEANOUT	-	373.02 373.63
CO17	N 981,017.3422 E 1,364,653.1692	372.75 374.38	6" CLEANOUT	-	374.18 374.79

NOTE: * LOCATION OF 6" & 8" COs IS TO THE CENTER OF CLEANOUT CAP. LOCATION OF THE 48" HP MHs IS TO THE CENTER OF STRUCTURE.


Table B.4. Materials Specifications for Micro-Bioretention, Rain Gardens & Landscape Infiltration

Material	Specification	Size	Notes
Plantings	see Appendix A Table A.4	n/a	plantings are site-specific
Planting soil (2" to 4" deep)	loamy sand 60-65% composed 30-40% or sandy loam 30% coarse sand 30% composed 40%	n/a	USDA soil types loamy sand or sandy loam; clay content <5%
Organic Content	Mn, 10% by dry weight (ASTM D 2974)	n/a	
Mulch	shredded hardwood	n/a	aged 6 months, minimum
Peak gravel diameter	peak gravel: ASTM-D-448	No. 8 or No. 9 (1/8" to 3/8")	
Curbs/drain	environmental stone washed cobble	n/a	stone: 2" to 3"
Geotextile	AGS100 M-43	n/a	PE Type 1 nonwoven
Underdrain piping	7.750, Type II 20 or AGS100 M-278	4" to 6" rigid schedule 40 PVC or 20035	slotted or perforated pipe 3/8" per 6" on center. A hole per row, minimum of 2" of ground over pipe not necessary underdrain pipes. Perforated pipe shall be wrapped with 1/4 inch galvanized hardware cloth.
Found in place concrete (if required)	MHA Mix No. 3 f = 5500 psi of 28 days, nominal weight, air-entrained, conforming to meet ASTM-615-02	n/a	on-site testing of poured-in-place concrete required: 28 day strength and slump test; all concrete design (cast-in-place or pre-cast) not using previously approved forms or local standards requires design drawings sealed and approved by a professional structural engineer licensed in the State of Maryland - design to include meeting ACI 308.3R, vertical loading 10-10 or 10-20; allowable horizontal loading (based on soil pressure); and analysis of potential cracking.
Sand	AGS100 M-6 or ASTM-C-33	0.075" to 0.075"	sand substitutions such as Dribble and Gravelite (AGS100) are not acceptable. No calcium carbonate or dolomitic sand substitutions are acceptable. No "rock dust" can be used for sand.

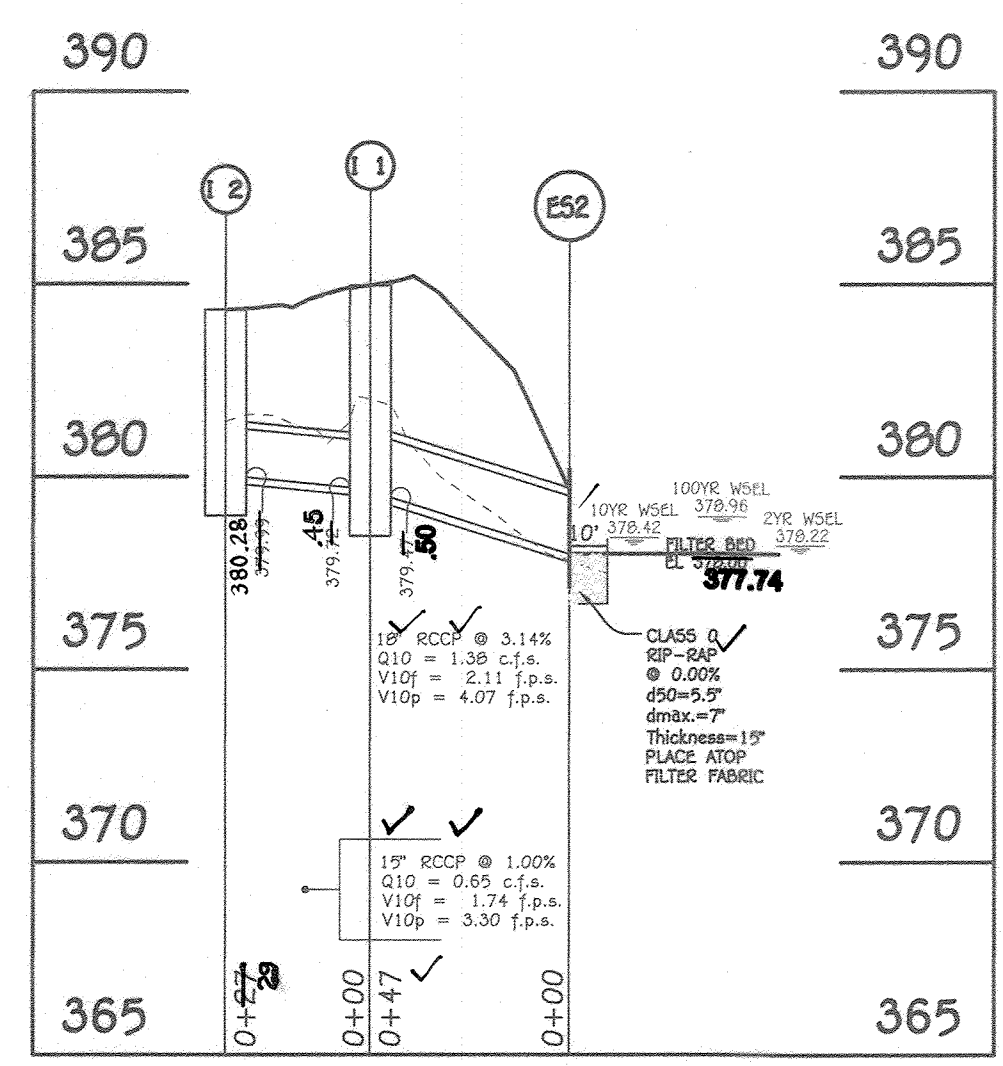

AS-BUILT CERTIFICATION
I hereby certify, by my seal, that to the best of my knowledge and belief that the facilities shown on the plan was constructed as shown on this "AS-BUILT" plan meet the approved plans and specifications.


Date
PAUL GERARD CAVANAUGH #27020

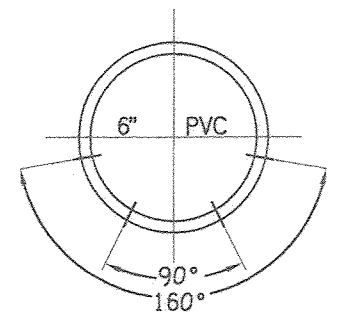

SCH 40 PVC PERFORATED UNDERDRAIN PIPE DETAIL FOR HORIZONTAL DRAIN PIPE
NO SCALE

STORM DRAIN PIPE SCHEDULE (ROADS & ALLEYS)

SIZE	TYPE	LENGTH
12"	HDPE	68 L.F.
15"	HDPE	371 L.F.
18"	HDPE	787 L.F.
15"	RCCP, CL IV	335 L.F.
18"	RCCP, CL IV	609 L.F.

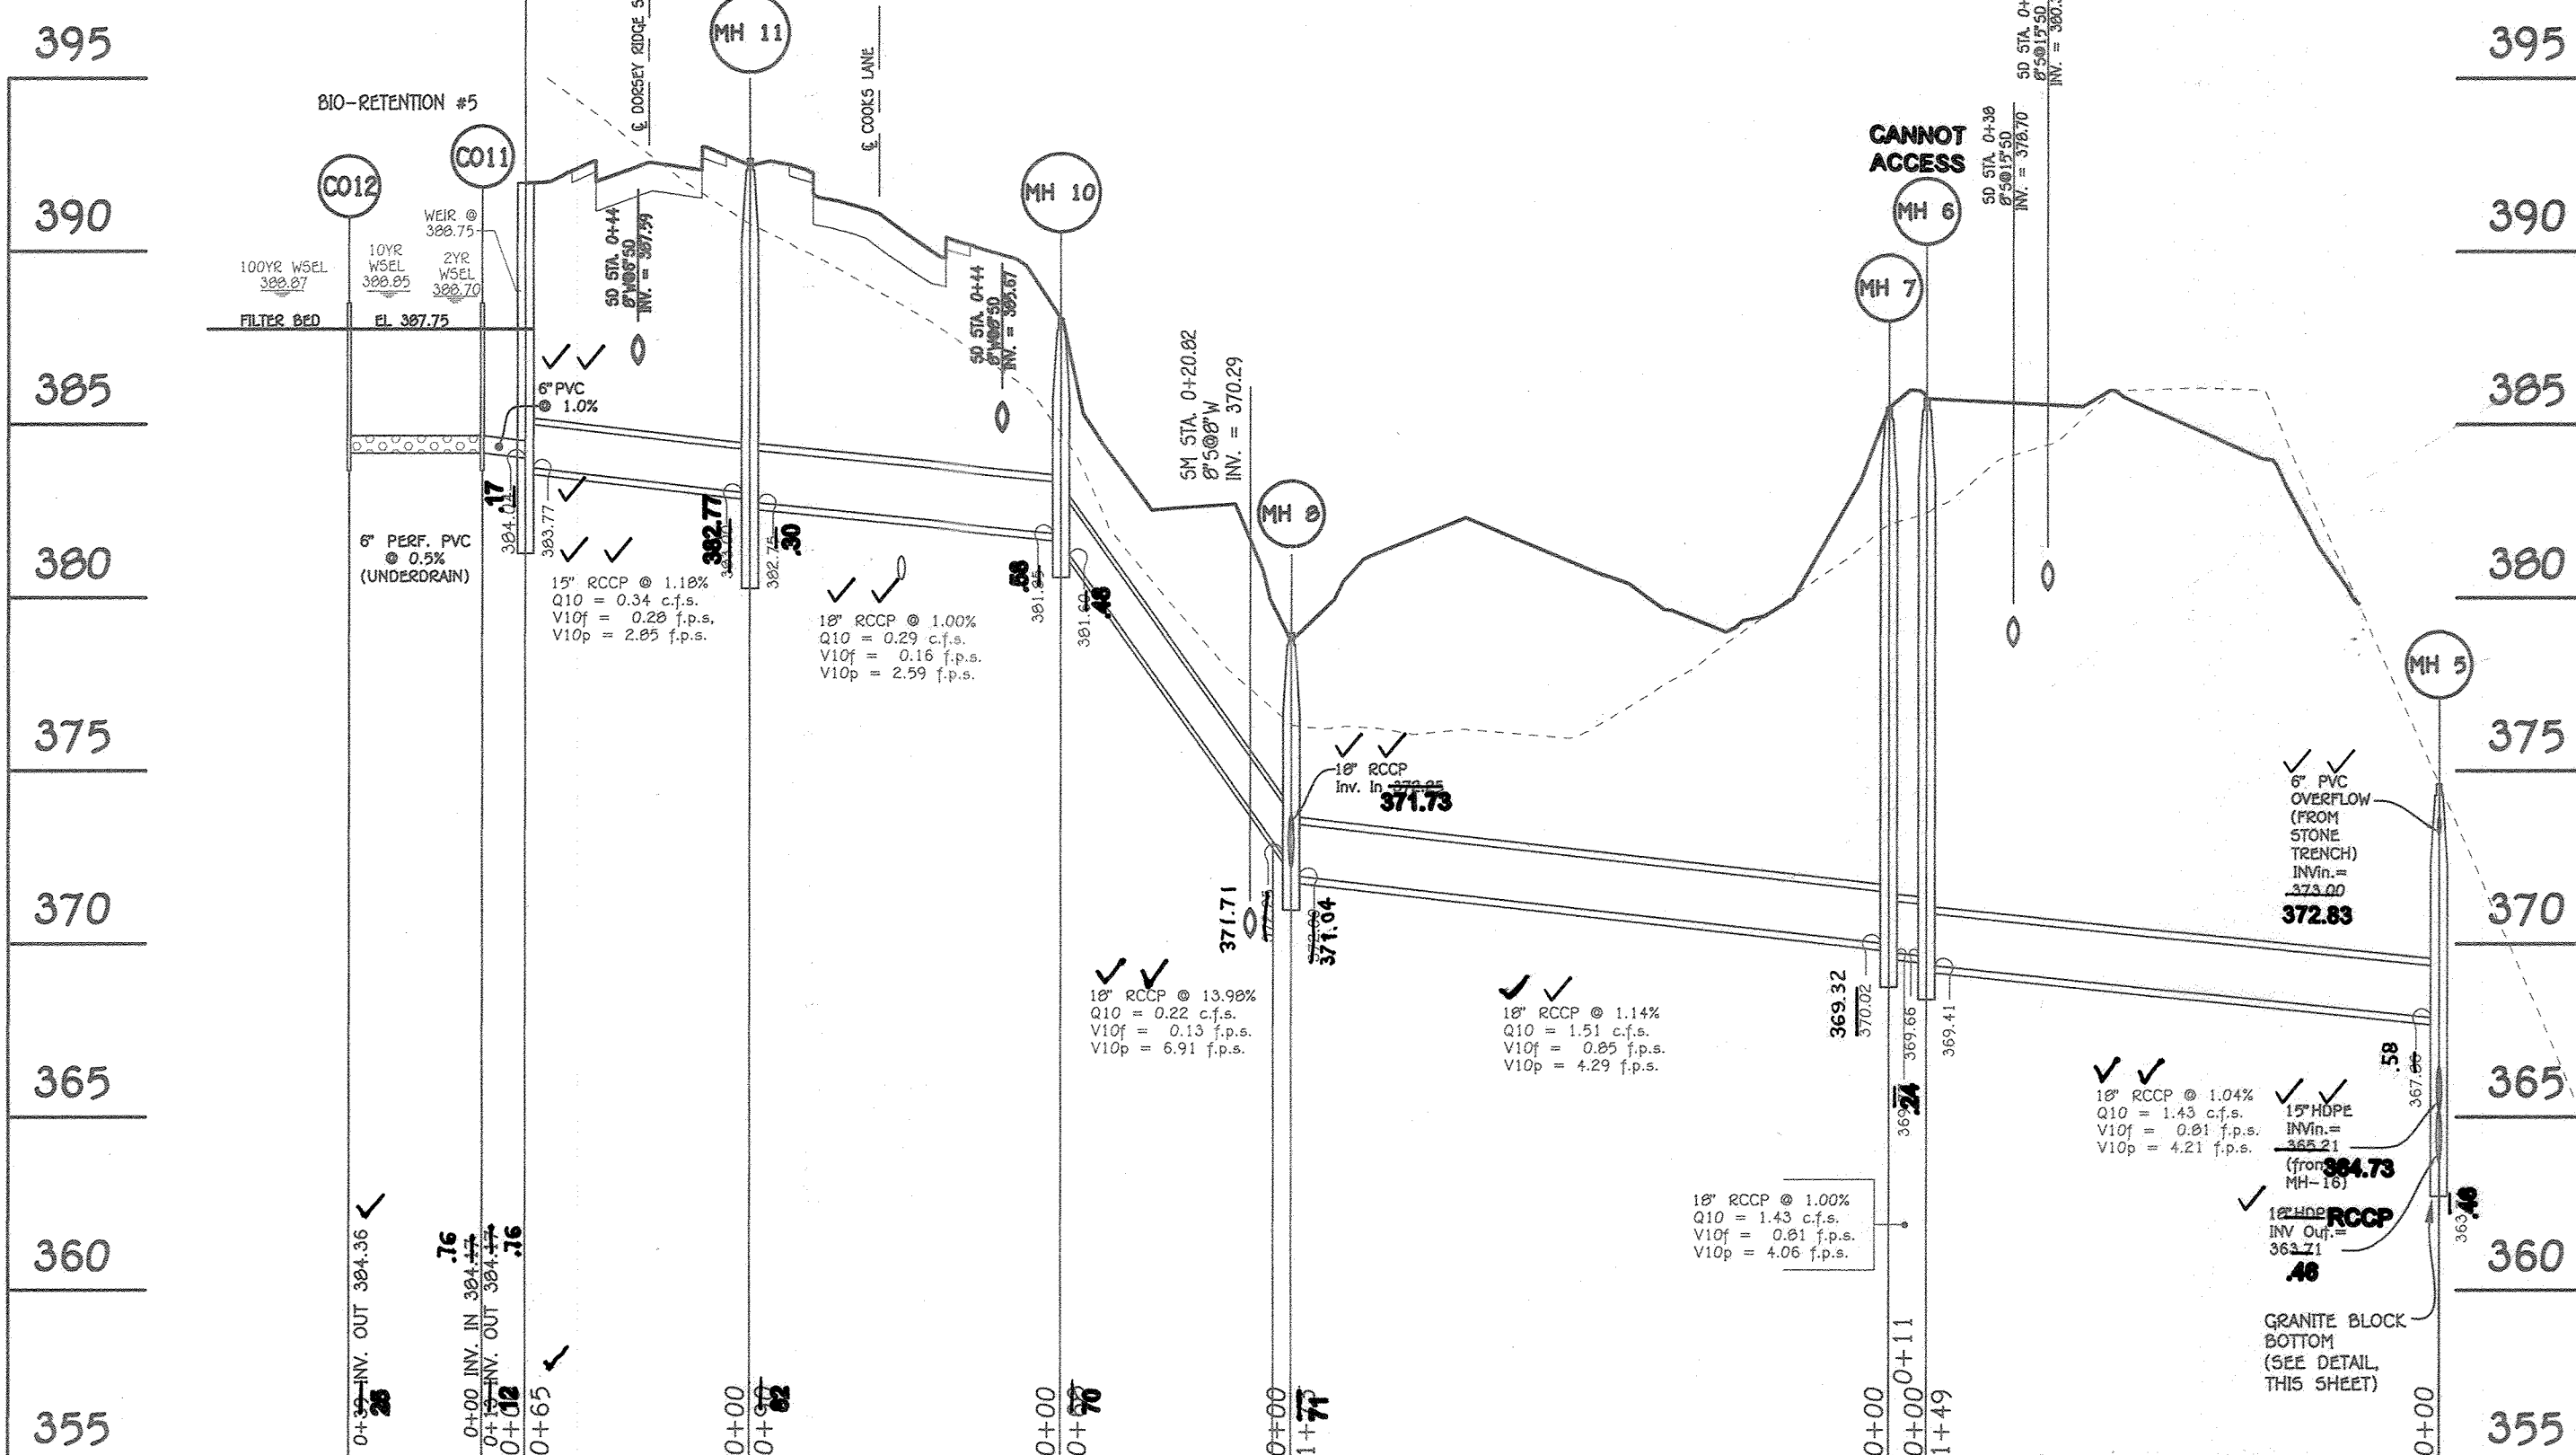

OPERATION AND MAINTENANCE SCHEDULE FOR BIO-RETENTION AREAS (F-6)

- The owner shall maintain the plant material, mulch layer and soil layer annually, maintenance of mulch and soil is limited to correcting areas of erosion or wash out. Any mulch replacement shall be done in the spring. Plant material shall be checked for disease and insect infestation and maintenance will address dead material and pruning. Acceptable replacement plant material is limited to the following: 2000 Maryland stormwater design manual volume II, table A.4.1 and 2.
- The owner shall perform a plant in the spring and in the fall each year, during the inspection, the owner shall remove dead and diseased vegetation considered beyond treatment, replace dead plant material with acceptable replacement plant material, treat diseased trees and shrubs and replace all deficient stakes and wires.
- The owner shall inspect the mulch each spring. The mulch shall be replaced every two to three years. The previous mulch layer shall be removed before the new layer is applied.
- The owner shall correct soil erosion on an as needed basis, with a minimum of once per month and after each heavy storm.


BIO-RETENTION #4 OPERATION AND MAINTENANCE SCHEDULE FOR PUBLICLY OWNED AND JOINTLY MAINTAINED STORMWATER MANAGEMENT FACILITIES

- ROUTINE MAINTENANCE - (HOWARD COUNTY)
- Factory shall be inspected annually and after major storms. Inspections shall be performed during wet weather to determine if the pond is functioning properly.
 - Top and side slopes of the embankment shall be moved a minimum of two (2) times a year, once in June and once in September. Other side slopes and maintenance access should be moved as needed.
 - Debris and litter shall be removed during regular mowing operations and as needed.
 - Visible signs of erosion in the pond as well as the rip-rap or gabion outlet area shall be repaired as soon as it is noticed.

NON-ROUTINE MAINTENANCE - (HOWARD COUNTY)


- Structural components of the pond such as the dam, the riser, and the pipes shall be repaired upon the detection of any damage. The components shall be inspected during routine maintenance operations.

FISHER, COLLINS & CARTER, INC.
CIVIL ENGINEERING CONSULTANTS & LAND SURVEYORS
CENTRAL SQUARE OFFICE PARK - 10272 BALTIMORE NATIONAL PIKE
ELICOTT CITY, MARYLAND 21042
(410) 461 - 2855

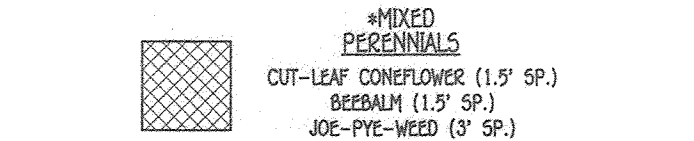

MIXED PERENNIALS
CUT-LEAF CONEFLOWER (1.5' SP.)
BEARBAM (1.5' SP.)
JOE-PRE-WED (3' SP.)
SILKY DOGWOOD

NOTE: PLANT MATERIAL MUST COVER AT LEAST 50% OF THE SURFACE AREA OF THE MICRO-BIORETENTION

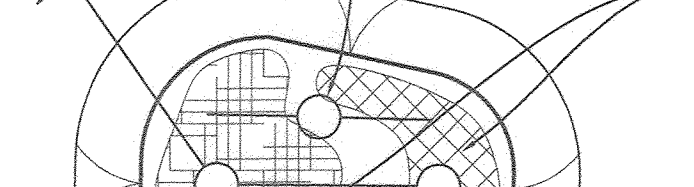

MIXED PERENNIALS
SILKY DOGWOOD

MICRO BIO / BIORETENTION PLANTING DETAIL
NOT TO SCALE

BIORETENTIONS

BIORETENTION FILTER	A	B	C	D	E	F	G	H	I
#1	379.00	378.00	377.00	376.75	374.75	374.45	374.45	373.00	372.37
#2	378.50	377.50	376.50	376.25	374.25	373.95	373.95	372.50	371.87
#3	374.00	373.00	372.00	371.75	369.75	369.45	369.45	368.00	367.37
#4	379.00	378.00	377.00	376.75	374.75	374.45	374.45	373.00	372.37
#5	390.00	388.75	387.50	387.25	385.25	384.95	384.95	383.50	382.87

NOTE: BIORETENTION #2 TOP OF DAM IS 378.50 (0.5 FOOT HIGHER TO PASS / CONTROL 100 YR STORM).

BIORETENTION PLANT MATERIAL

BIORETENTION 1 QUANTITY	BIORETENTION 2 QUANTITY	BIORETENTION 3 QUANTITY	BIORETENTION 4 QUANTITY	MICRO-BIO 5 QUANTITY	NAME	MAXIMUM SPACING (FT.)
110	340	130	95	80	MIXED PERENNIALS	1.5 TO 3.0 FT.
3	5	3	3	1	SILKY DOGWOOD	PLANT AWAY FROM INFLOW LOCATION

OWNER/DEVELOPER
DORSEY'S RIDGE, LLC
C/O DAVE WOODSNER
308 MAGDOY ROAD
SEVERNA PARK, MD 21146
410-461-0837






PROFESSIONAL CERTIFICATION

I HEREBY CERTIFY THAT THESE DOCUMENTS WERE PREPARED OR APPROVED BY ME AND THAT I AM A DULY LICENSED PROFESSIONAL ENGINEER UNDER THE LAWS OF THE STATE OF MARYLAND, LICENSE NO. 20748, EXPIRATION DATE: 02/22/2023.







STORM DRAIN & SWM PROFILES REPLACEMENT SHEET

DORSEY'S RIDGE
PHASE-1
LOTS 1 THRU 4, OPEN SPACE LOTS 6,7,61,62, & NON-BUILDABLE BULK PARCELS B, G THRU K
A RESUBDIVISION OF "WILHIE PROPERTY, LOT 1, 2 & 3", PLAT NO. 18442
ZONED: CEF-R
TAX MAP NO.: 24 GRID NO.: 18 PARCEL NO.: 260 LOTS: 1 THRU 3
SECOND ELECTION DISTRICT HOWARD COUNTY, MARYLAND
SCALE: AS SHOWN DATE: DECEMBER, 2021
SHEET 13 OF 18

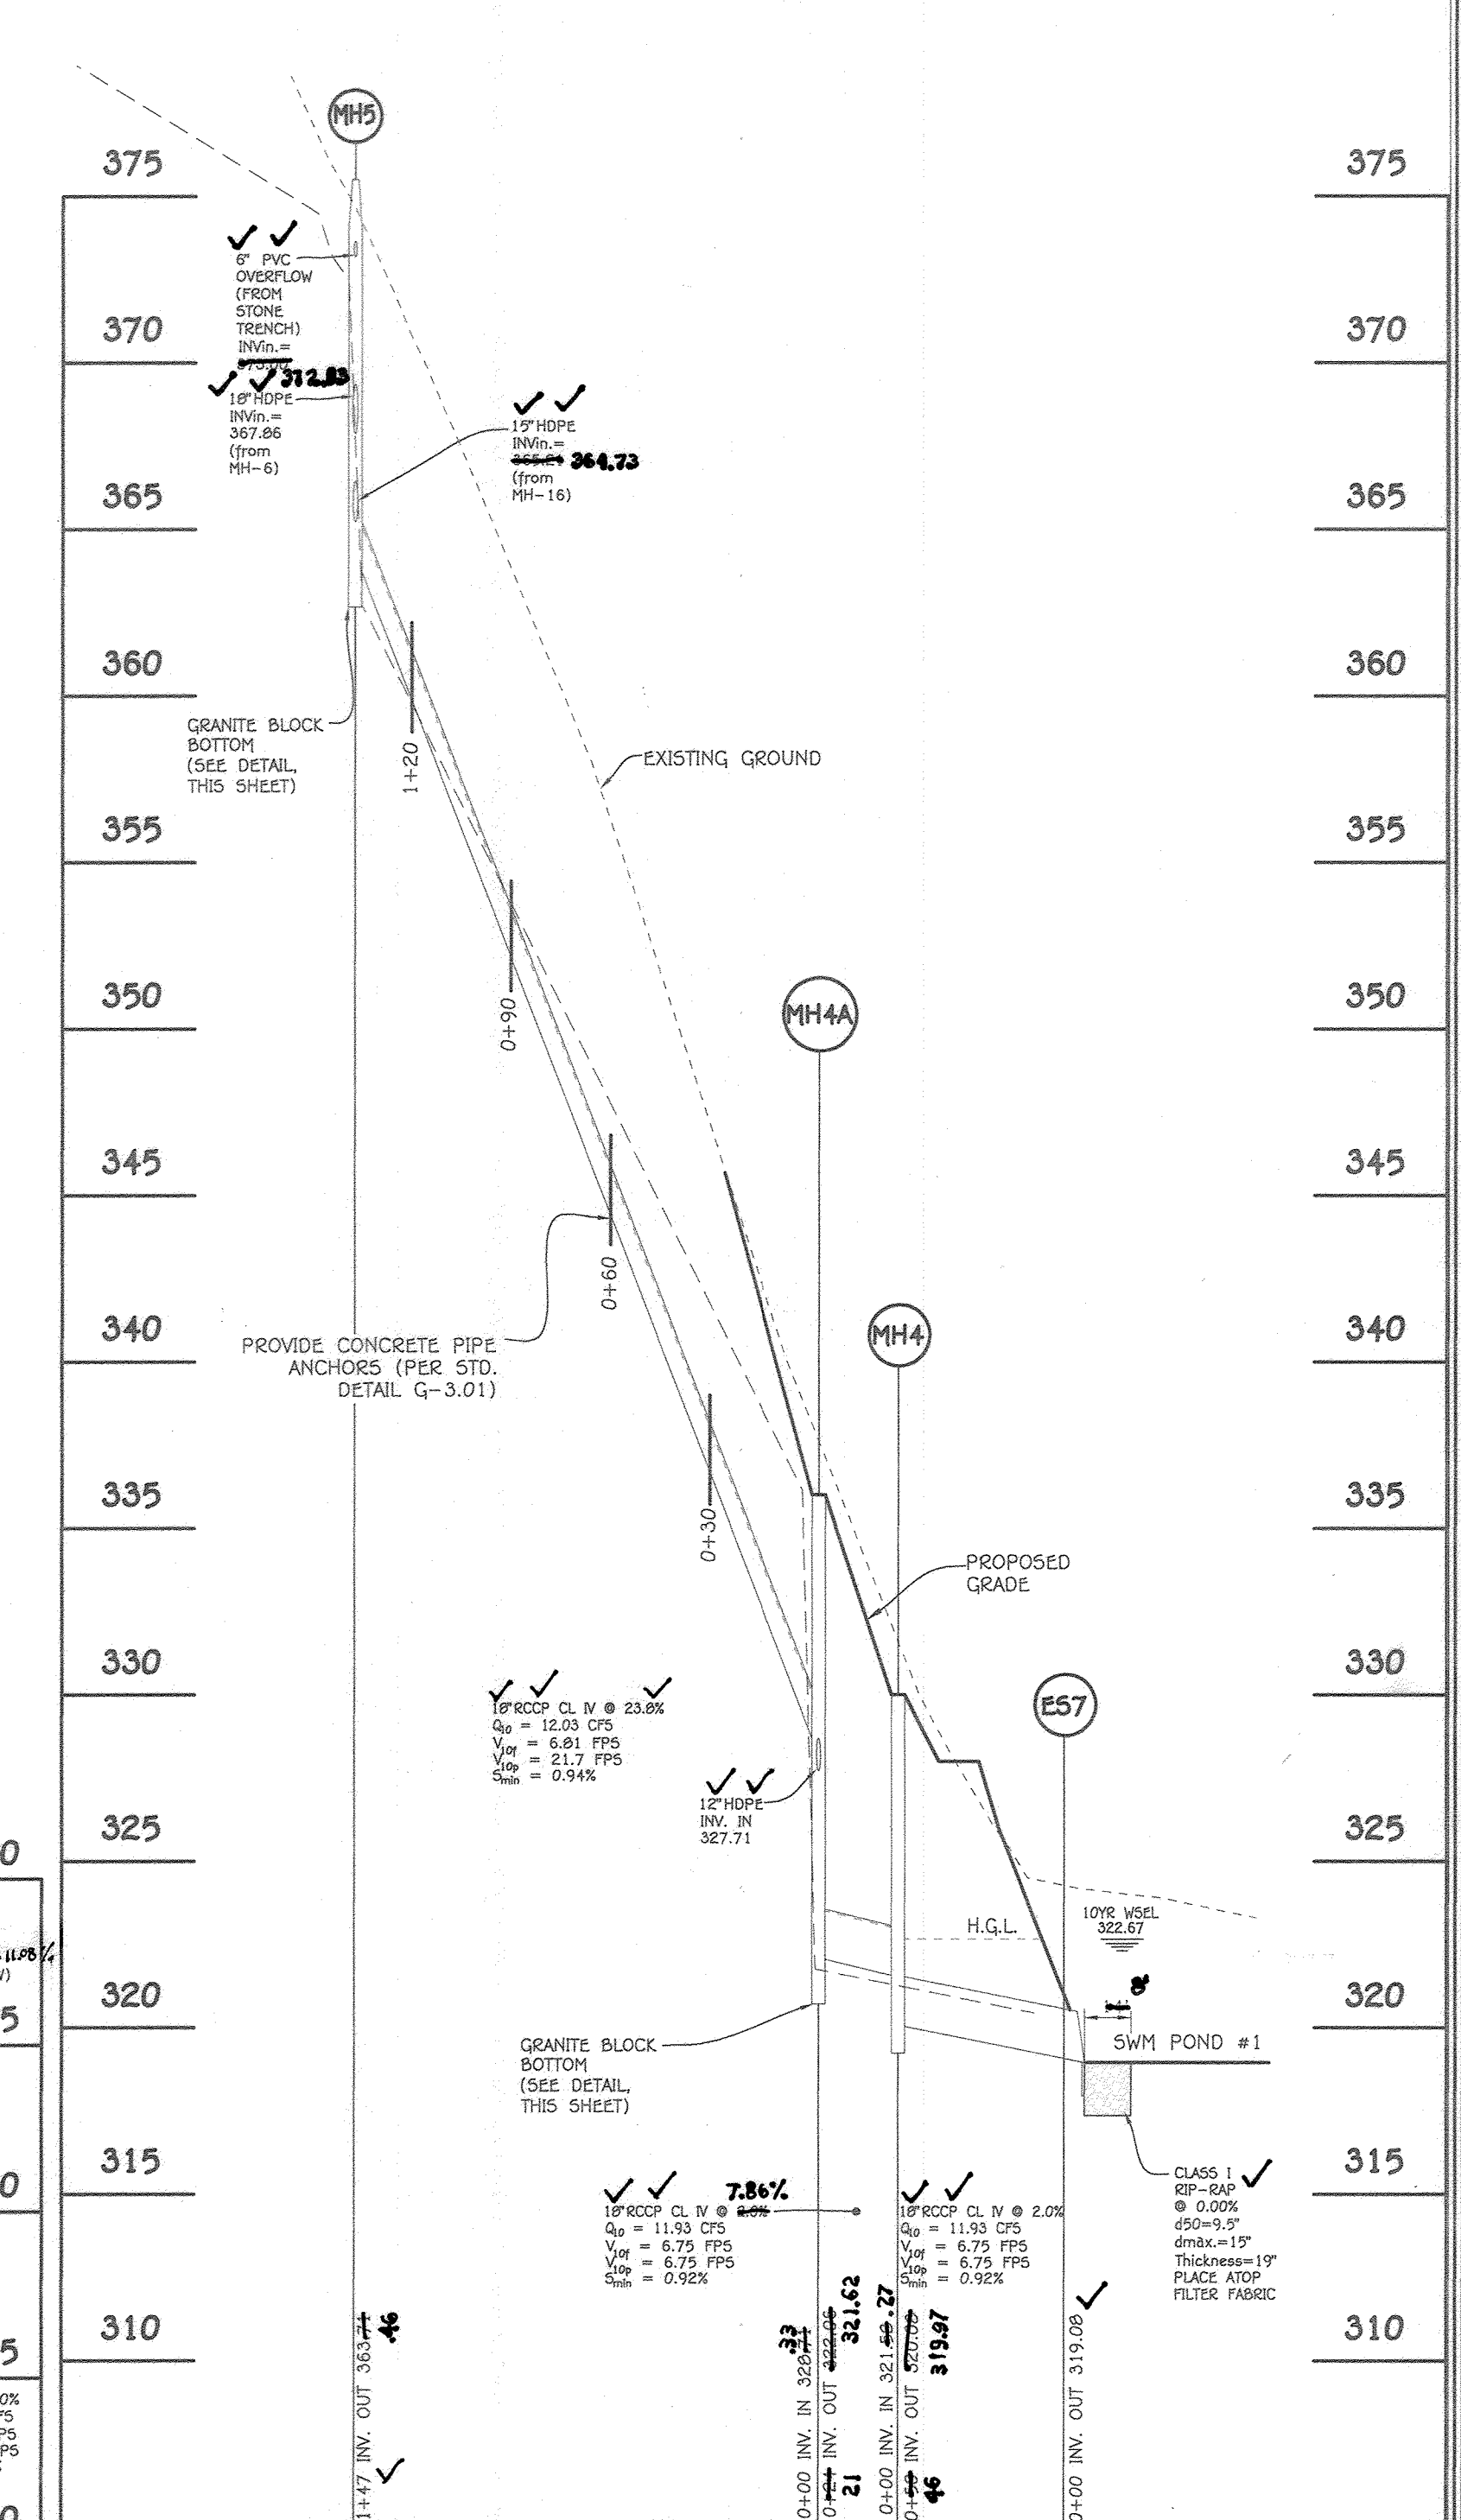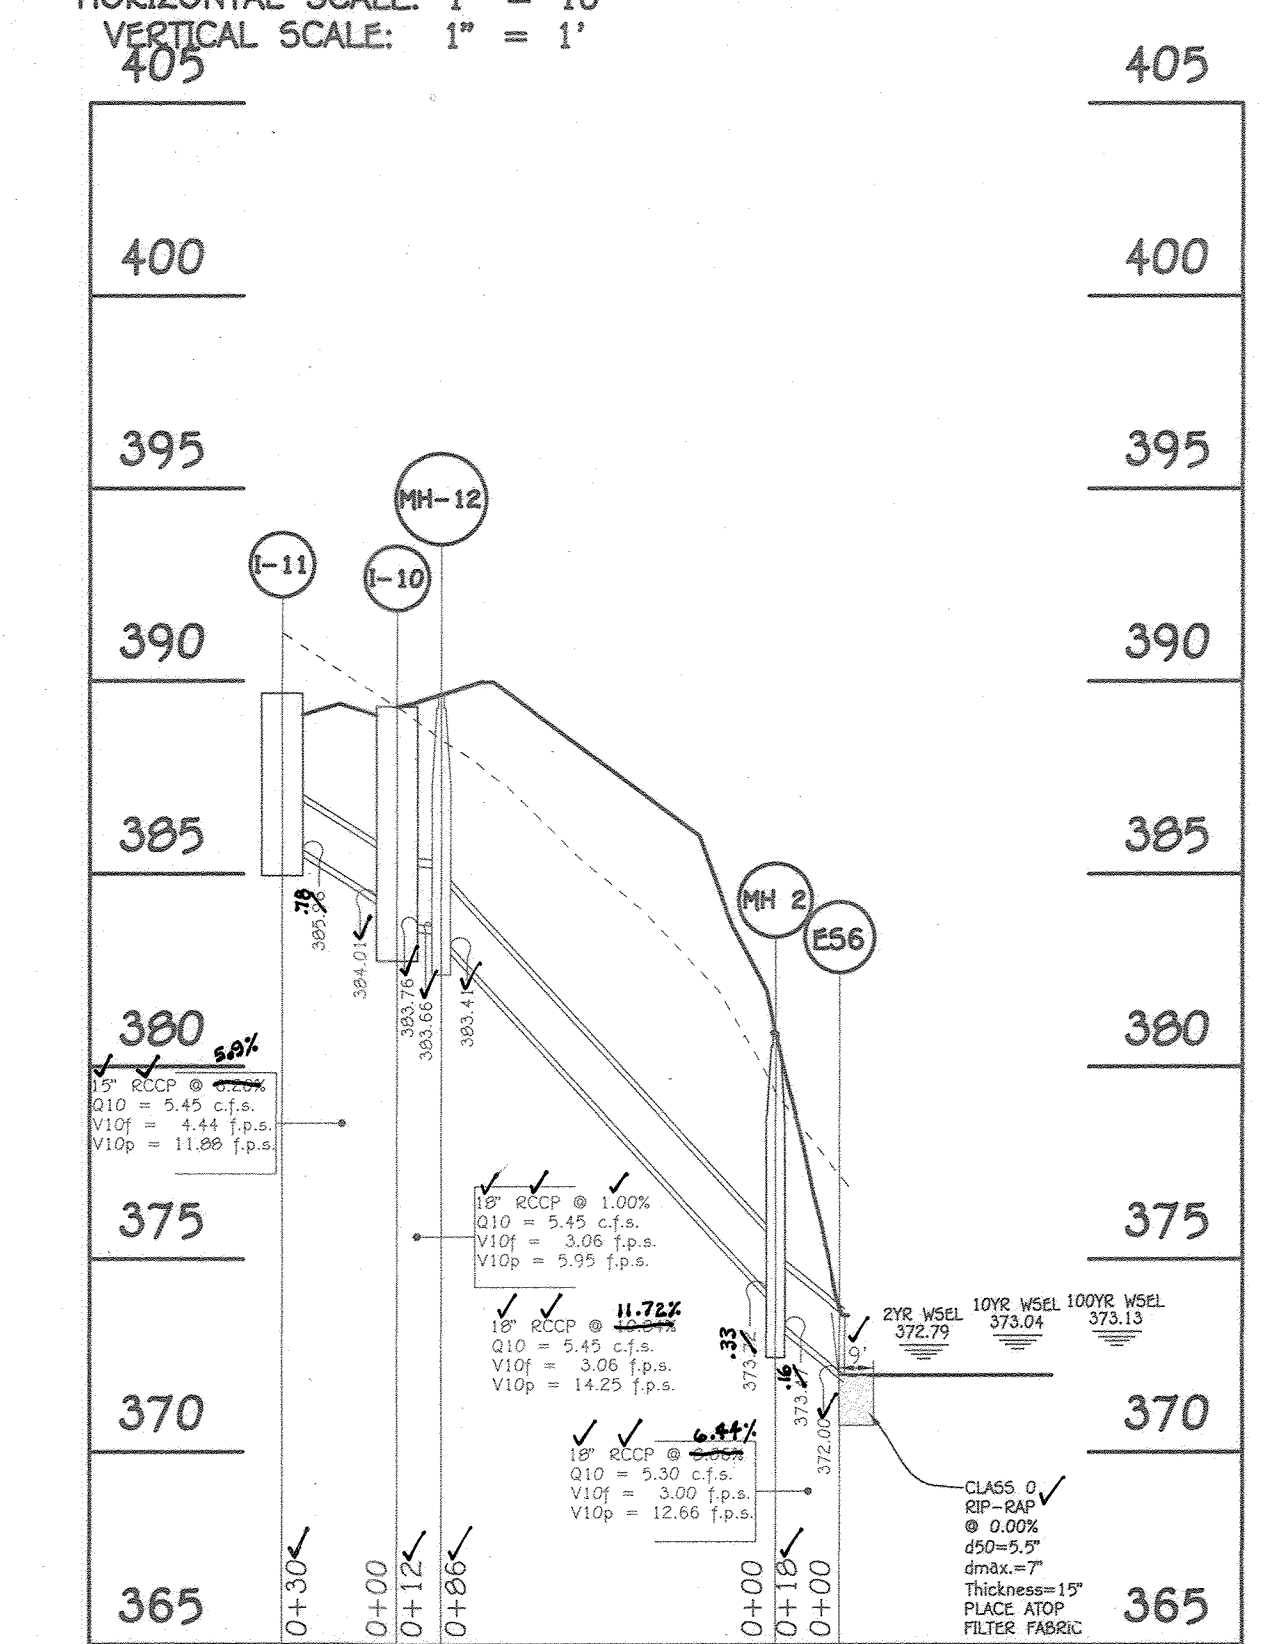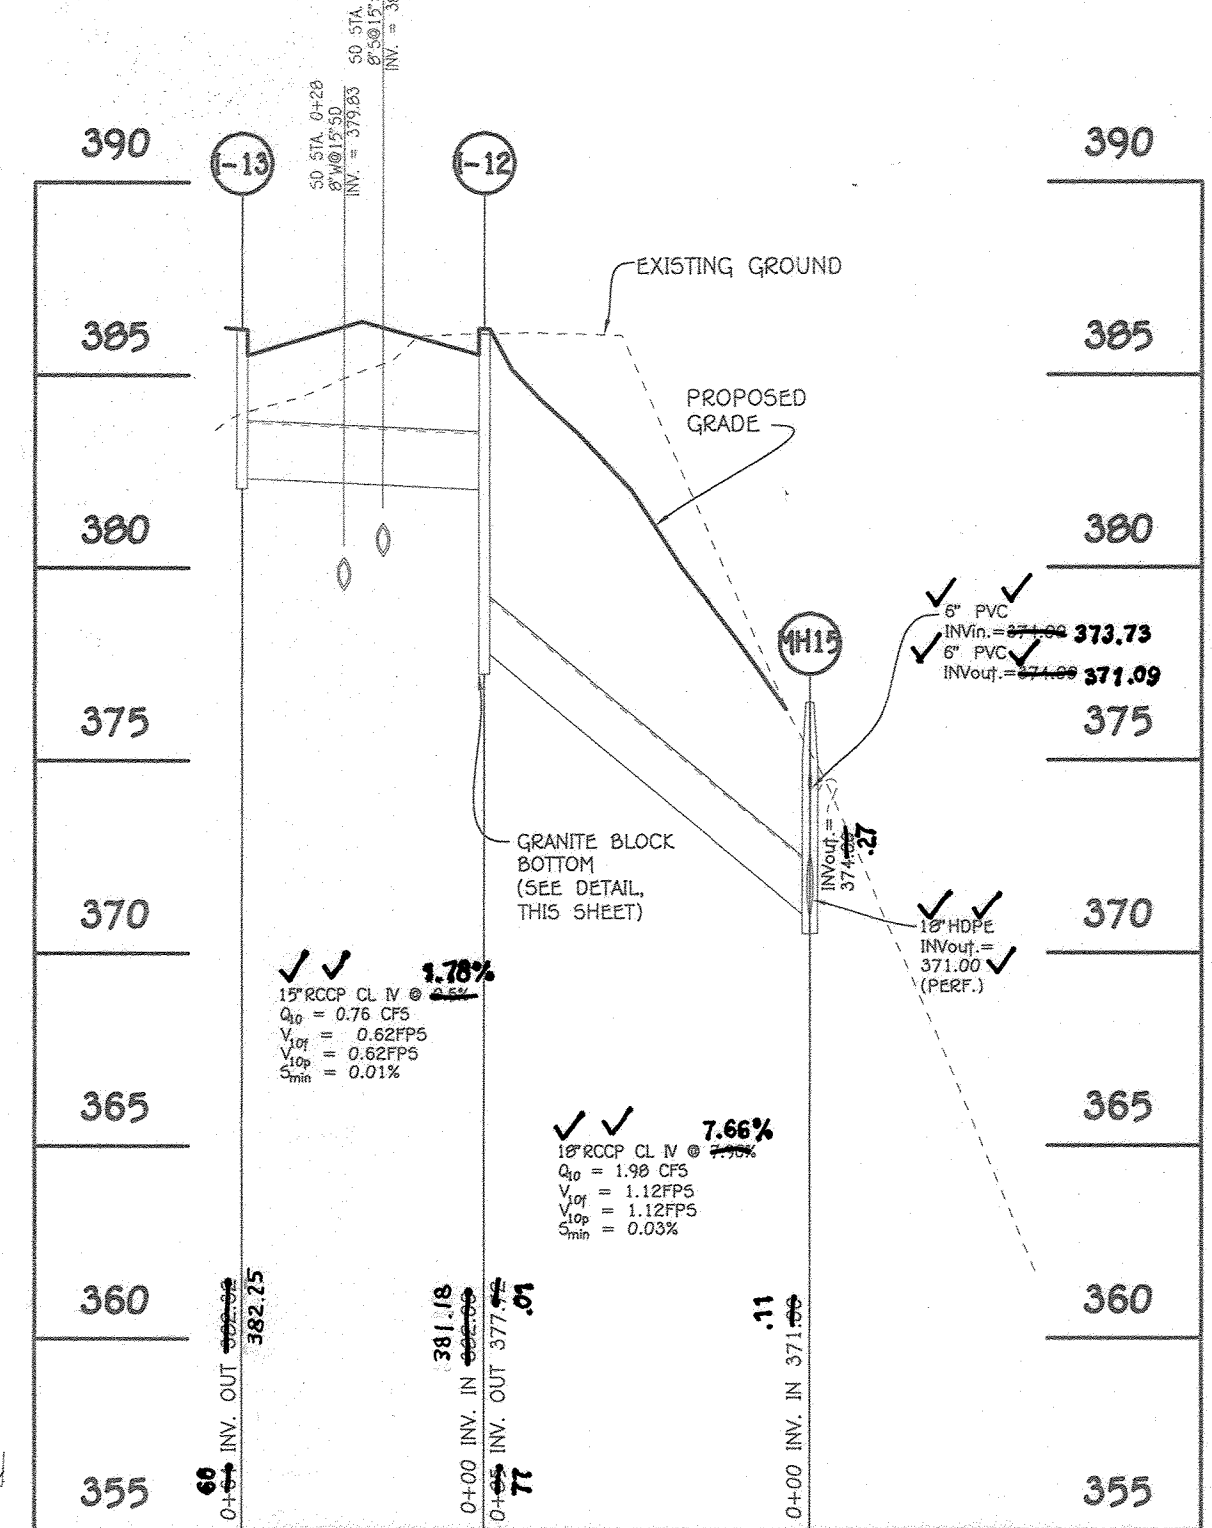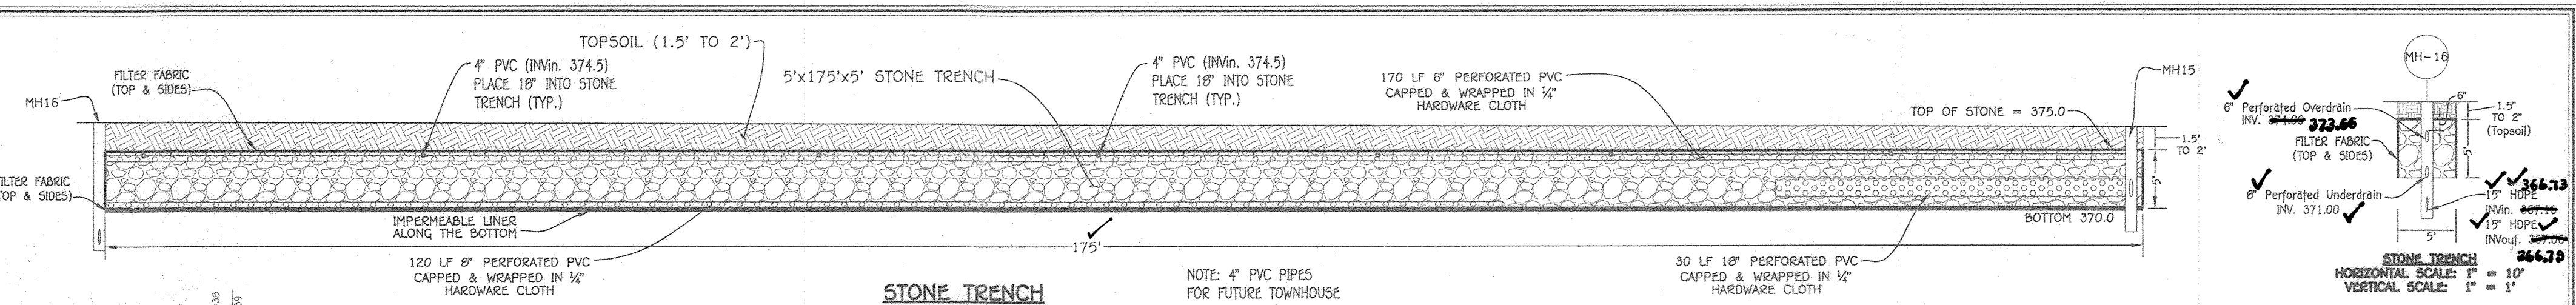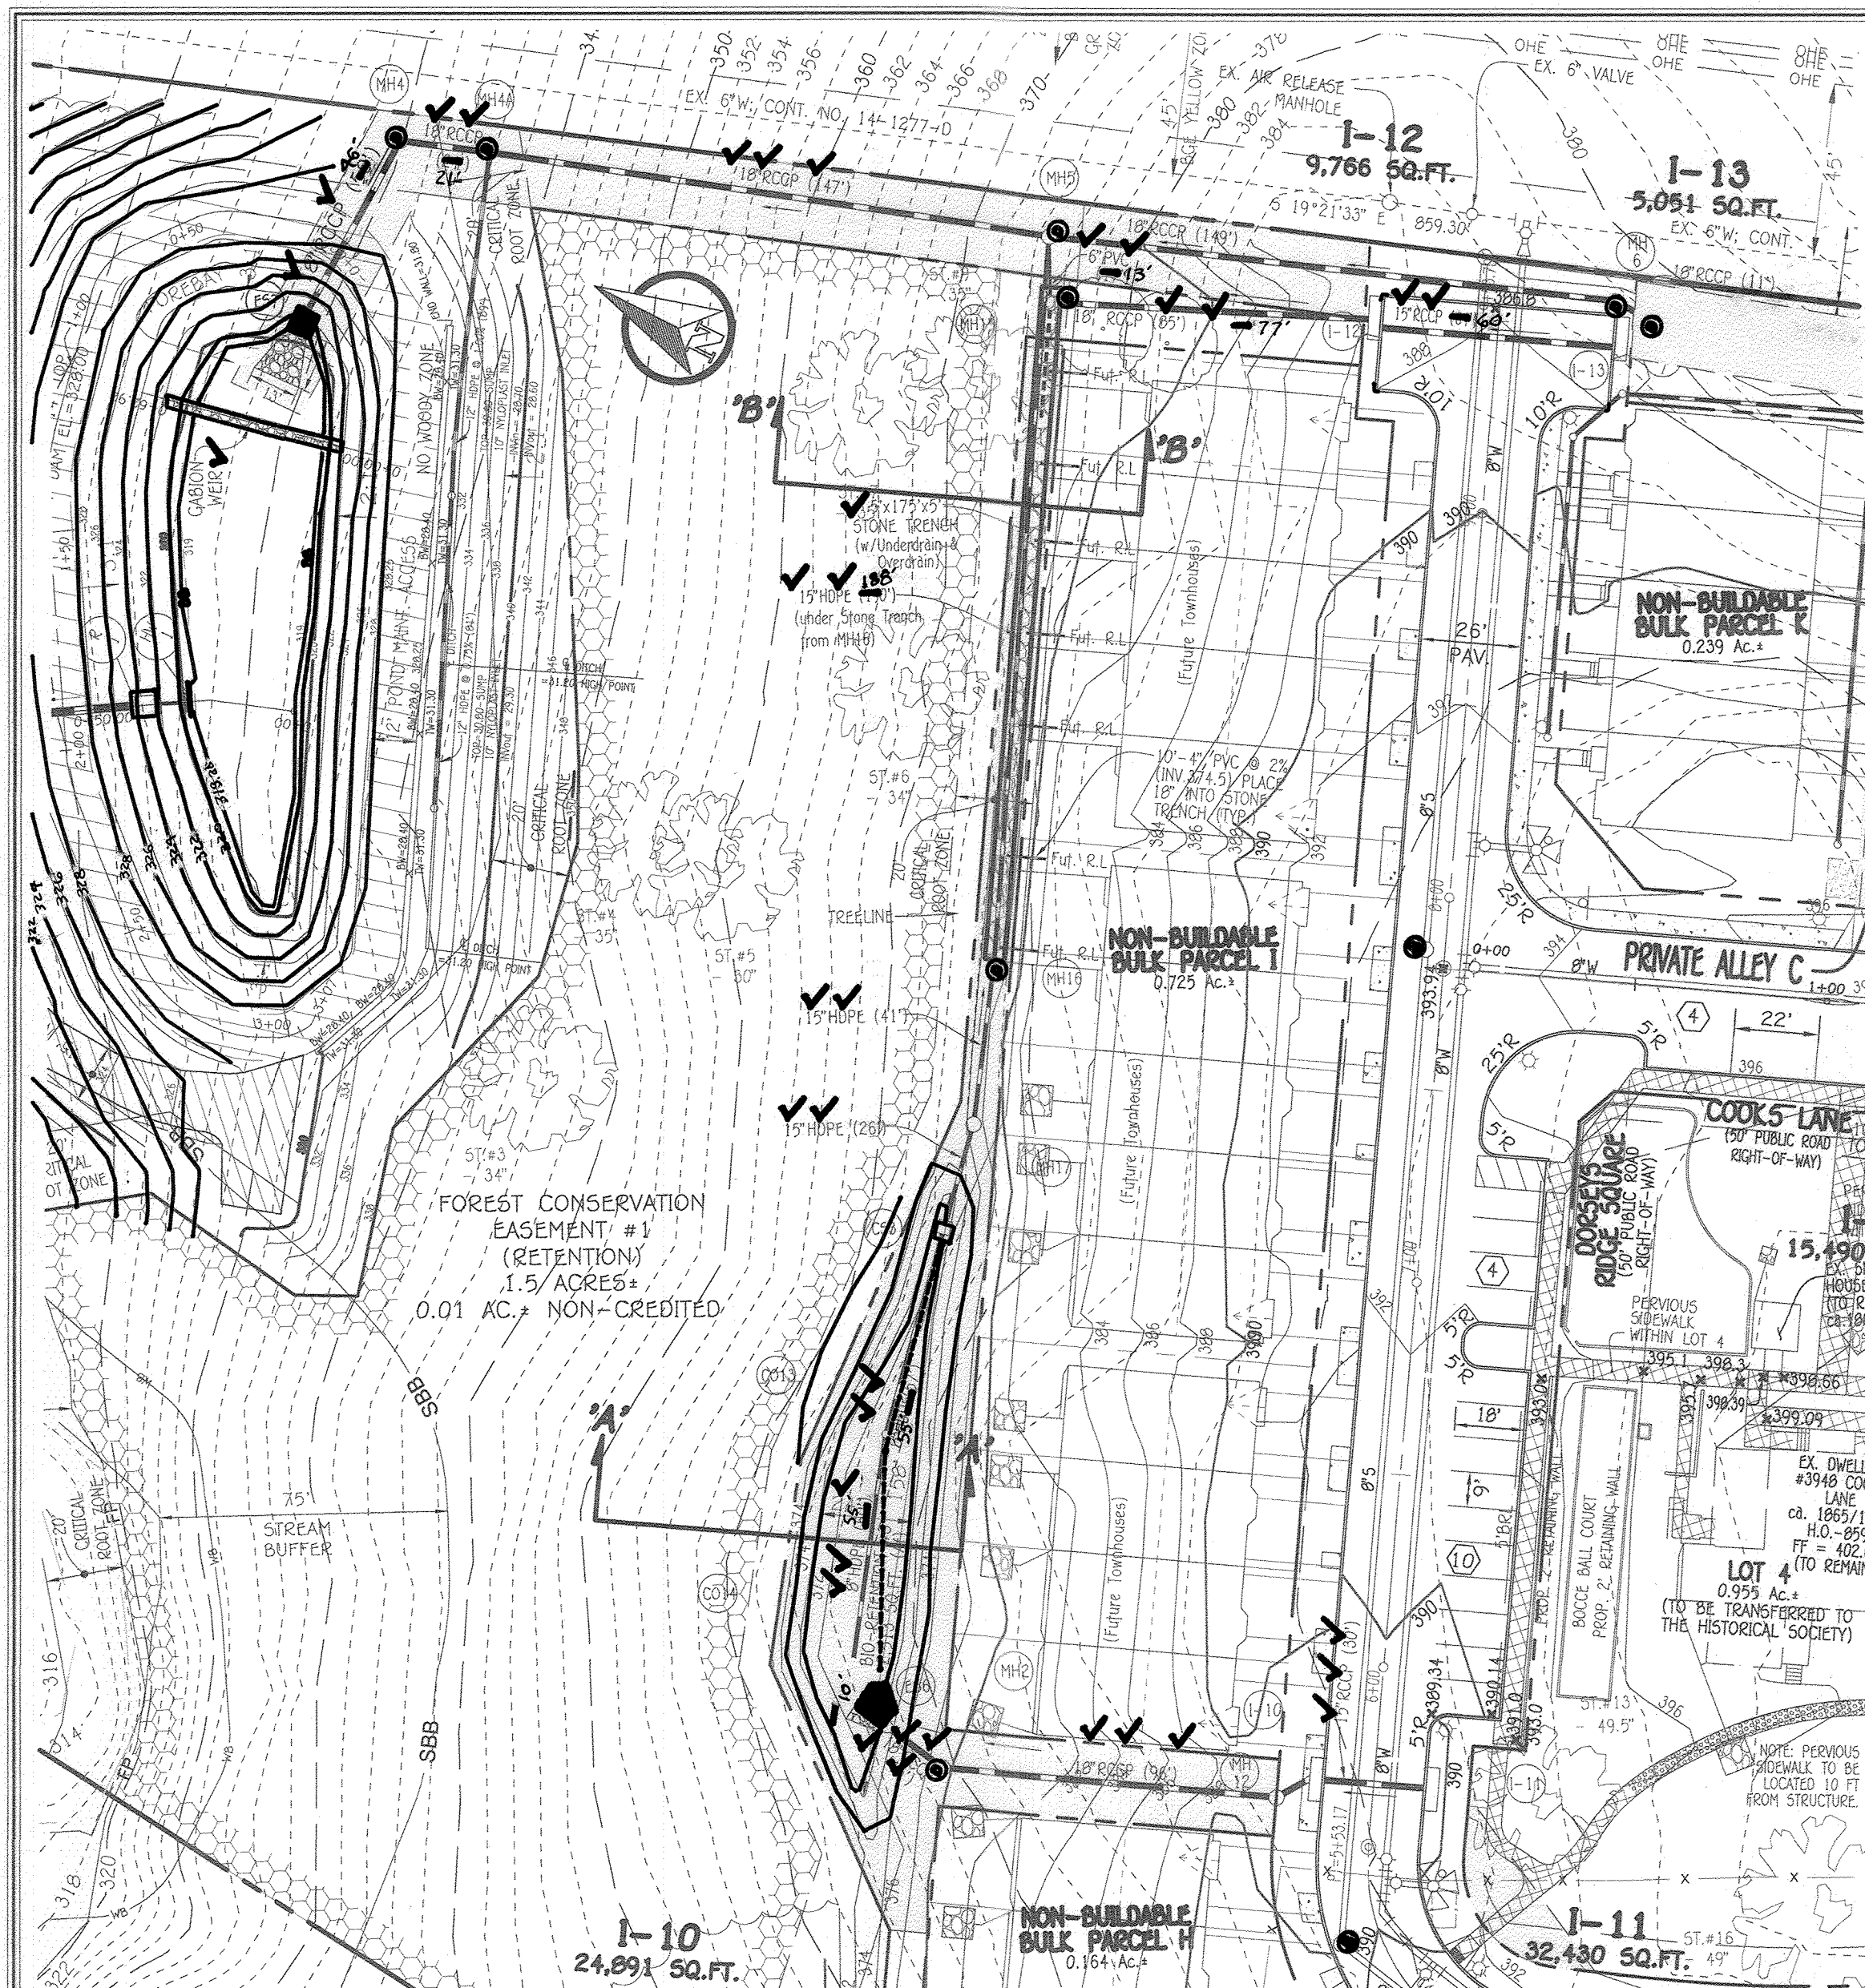

AS-BUILT CERTIFICATION
 I hereby certify, by my seal, that to the best of my knowledge and belief that the elevations shown on the plans was constructed as shown on this "AS-BUILT" plan meet the approved plans and specifications.

PROFILE - CO14 TO MH5
 HORIZONTAL SCALE: 1" = 50'
 VERTICAL SCALE: 1" = 5'

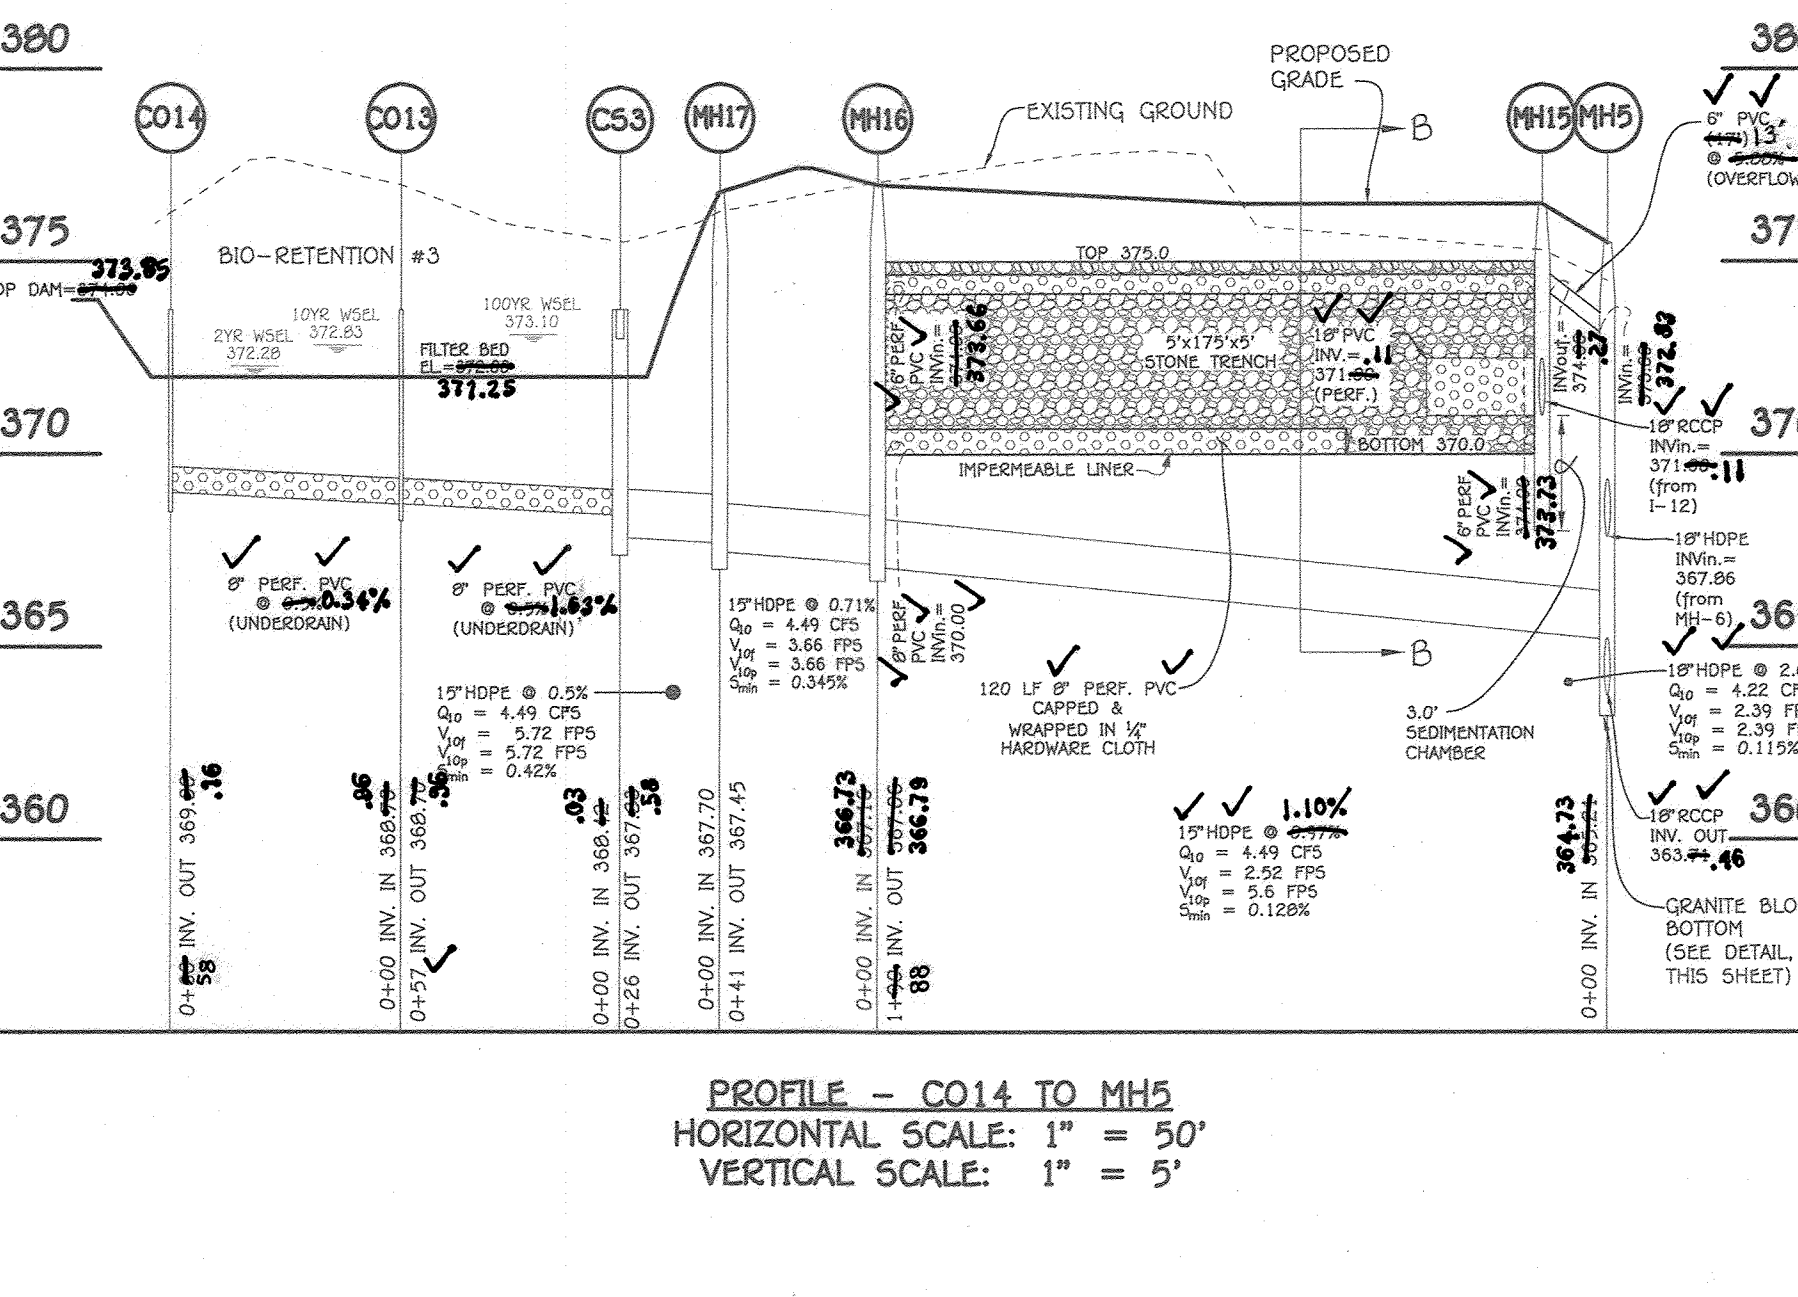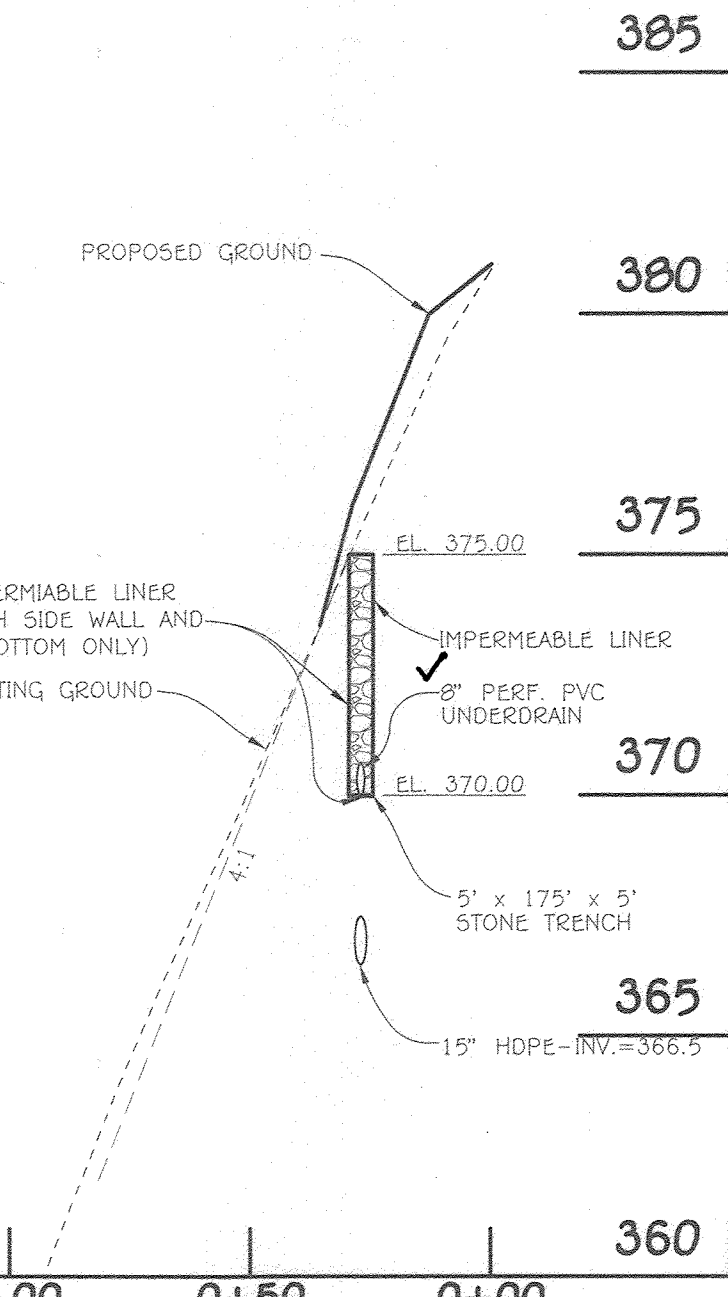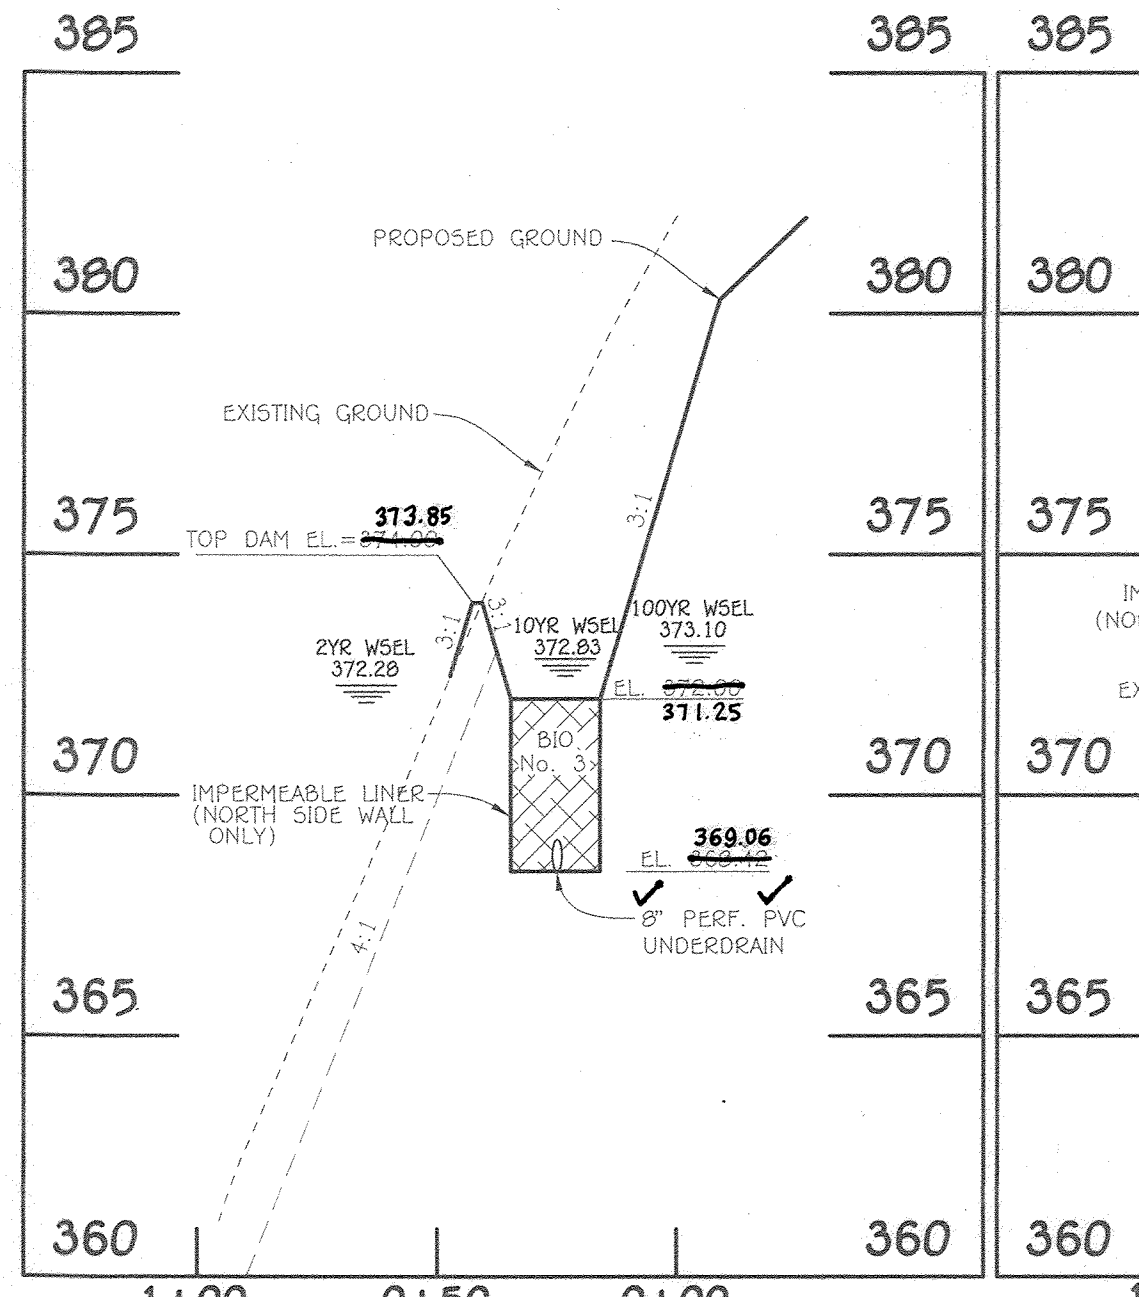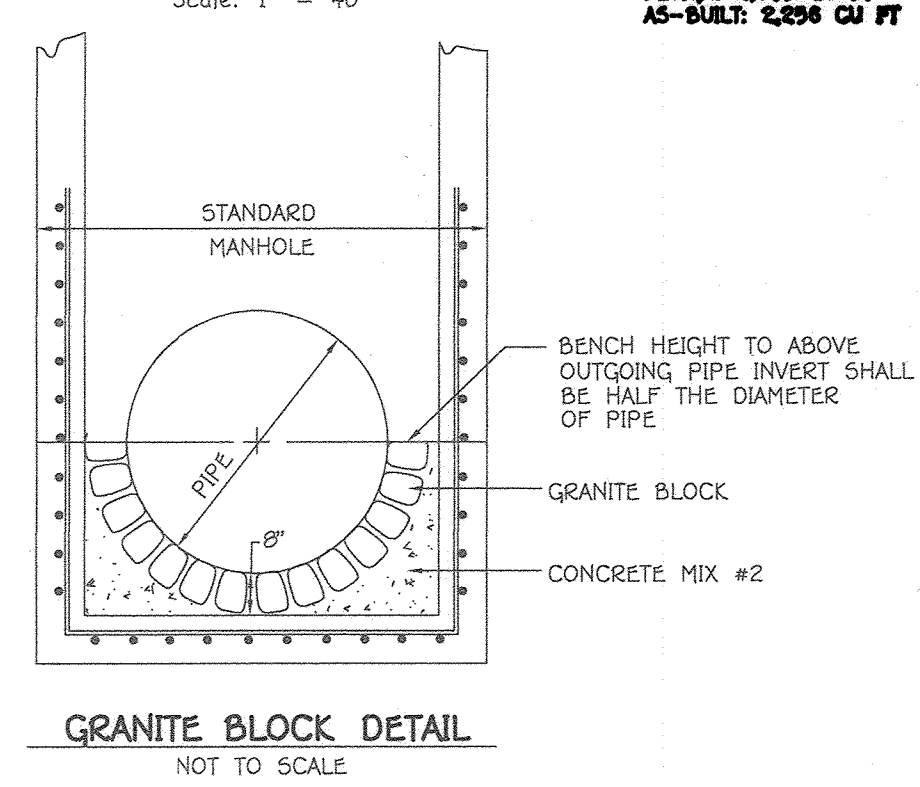

APPROVED: DEPARTMENT OF PUBLIC WORKS
 CHIEF, BUREAU OF HIGHWAYS MK 02/14/2022 DATE

APPROVED: DEPARTMENT OF PLANNING AND ZONING
 CHIEF, DIVISION OF LAND DEVELOPMENT 3/10/22 DATE

CHIEF, DEVELOPMENT ENGINEERING DIVISION HJK 2.23.22 DATE


NO.	REVISIONS	DATE
1	REMOVE SD PROFILES	

FISHER, COLLINS & CARTER, INC.
 CIVIL ENGINEERING CONSULTANTS & LAND SURVEYORS
 CENTENIAL SQUARE OFFICE PARK - 10232 BALTIMORE NATIONAL PIKE
 ELICOTT CITY, MARYLAND 21042
 (410) 461-2895

OWNER/DEVELOPER
 DORSEY'S RIDGE, LLC
 C/O DAVE WOESSNER
 308 MAGDOHY ROAD
 SEVERNA PARK, MD 21146
 410-461-0837

PROFESSIONAL CERTIFICATION
 I HEREBY CERTIFY THAT THESE DOCUMENTS WERE PREPARED OR APPROVED BY ME AND THAT I AM A DULY LICENSED PROFESSIONAL ENGINEER UNDER THE LAWS OF THE STATE OF MARYLAND, LICENSE NO. 20748, EXPIRATION DATE: 02/22/2023.

Alfred M. ...
 Signature Of Professional Engineer
 01/17/22 DATE

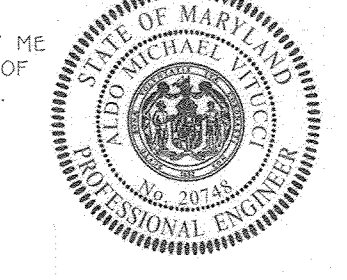

STORM DRAIN & SWM PROFILES
 REPLACEMENT SHEET
DORSEY'S RIDGE
 PHASE-1
 LOTS 1 THRU 4, OPEN SPACE LOTS 6,7,61,62,
 & NON-BUILDABLE BULK PARCELS B, G THRU K

A RESUBDIVISION OF "WILHIDE PROPERTY, LOT 1, 2 & 3", PLAT NO. 18442
 ZONED: CEF-R
 TAX MAP NO.: 24 GRID NO.: 10 PARCEL NO.: 260 LOTS: 1 THRU 3
 SECOND ELECTION DISTRICT HOWARD COUNTY, MARYLAND
 SCALE: AS SHOWN DATE: DECEMBER, 2021
 SHEET 14 OF 18

Infiltration and Filter System Construction Specifications

Infiltration and filter systems either take advantage of existing permeable soils or create a permeable medium such as sand for WC, and de v. In some instances where permeability is great, these facilities may be used for do its well. The most common systems include infiltration trenches, infiltration basins, sand filters, and organic filters.

When properly planted, vegetation will thrive and enhance the functioning of these systems. For example, pre-treatment buffers will trap sediments that often are bound with phosphorous and metals. Vegetation planted in the facility will aid in nutrient uptake and water storage. Additionally, plant roots will provide arteries for stormwater to permeate soil for groundwater recharge. Finally, successful plantings provide aesthetic value and wildlife habitat making these facilities more desirable to the public.

- Design Constraints:**
- > Planting buffer strips of at least 20 feet will cause sediments to settle out before reaching the facility, thereby reducing the possibility of clogging.
 - > Determine areas that will be saturated with water and water table depth so that appropriate plants may be selected (hydrology will be similar to bioretention facilities, see figure A.5 and Table A.4 for planting material guidance).
 - > Plants known to send down deep taproots should be avoided in systems where filter fabric is used as part of facility design.
 - > Test soil conditions to determine if soil amendments are necessary.
 - > Plants shall be located so that access is possible for structure maintenance.
 - > Stabilize heavy flow areas with erosion control mats or soil.
 - > Temporarily divert flows from seeded areas until vegetation is established.
 - > See Table A.5 for additional design considerations.

Bio-retention

Soil Bed Characteristics

The characteristics of the soil for the bioretention facility are perhaps as important as the facility location, size, and treatment volume. The soil must be permeable enough to allow runoff to filter through the media, while having characteristics suitable to promote and sustain a robust vegetative cover crop. In addition, much of the nutrient pollutant uptake (nitrogen and phosphorus) is accomplished through absorption and microbial activity within the soil profile. Therefore, soils must balance their chemical and physical properties to support biotic communities above and below ground.

The planting soil should be a sandy loam, loam sand, loam (USDA), or a loam/sand mix (should contain a minimum 35% to 60% sand, by volume). The clay content for these soils should be less than 25% by volume (Environmental Quality Resources (EQR), 1996; Engineering Technology Inc. and Biohabitats, Inc. (ETAB), 1993). Soils should fall within the SM, ML, SC classifications of the Unified Soil Classification System (USCS). A permeability of at least 1.0 feet per day (0.5 in/hr) is required (a conservative value of 0.5 feet per day is used for design). The soil should be free of stones, stumps, roots, or other woody material over 1" in diameter. Brush or roots from noxious weeds (e.g., Johnson Grass, Mugwort, Nutsedge, and Canada Thistle or other noxious weeds as specified under COMAR 15.08.01.05) should not be present in the soil. Placement of the planting soil should be in 12 to 18 lifts that are loosely compacted (tamped lightly with a backhoe bucket or traversed by dozer tracks). The specific characteristics are presented in Table A.3.

Table A.3 Planting Soil Characteristics

Parameter	Value
pH range	5.2 to 7.00
Organic matter	1.5 to 4.0% (by weight)
Magnesium	35 lbs. per acre, minimum
Phosphorus (phosphate - P2O5)	75 lbs. per acre, minimum
Potassium (potash - K2O)	85 lbs. per acre, minimum
Soluble salts	500 ppm
Clay	0 to 5%
Silt	30 to 55%
Sand	35 to 60%

Mulch Layer


The mulch layer plays an important role in the performance of the bioretention system. The mulch layer helps maintain soil moisture and avoids surface sealing, which reduces permeability. Mulch helps prevent erosion, and provides a microenvironment suitable for soil biota at the mulch/soil interface. It also serves as a pretreatment layer, trapping the finer sediments, which remain suspended after the primary pretreatment.

The mulch layer should be standard landscape style, single or double shredded hardwood mulch or chips. The mulch layer should be well aged (stockpiled or stored for at least 12 months), uniform in color, and free of other materials, such as weed seeds, soil, roots, etc. The mulch should be applied to a maximum depth of three inches. Grass clippings should not be used as mulch material.

Planting Guidance



Plant material selection should be based on the goal of simulating a terrestrial forested community of native species. Bioretention simulates an upland-species ecosystem. The community should be dominated by trees, but have a distinct community of understory trees, shrubs and herbaceous materials. By creating a diverse, dense plant cover, a bioretention facility will be able to treat stormwater runoff and withstand urban stresses from insects, disease, drought, temperature, wind, and exposure.

The proper selection and installation of plant materials is key to a successful system. There are essentially three zones within a bioretention facility (Figure A.5). The lowest elevation supports plant species adapted to standing and fluctuating water levels. The middle elevation supports plants that like drier soil conditions, but can still tolerate occasional inundation by water. The outer edge is the highest elevation and generally supports plants adapted to drier conditions. A sample of appropriate plant materials for bioretention facilities are included in Table A.4. The layout of plant material should be flexible, but should follow the general principles described in Table A.5. The objective is to have a system, which resembles a random and natural plant layout, while maintaining optimal conditions for plant establishment and growth. For a more extensive bioretention plan, consult ETAB, 1993 or Claytor and Schueler, 1997.

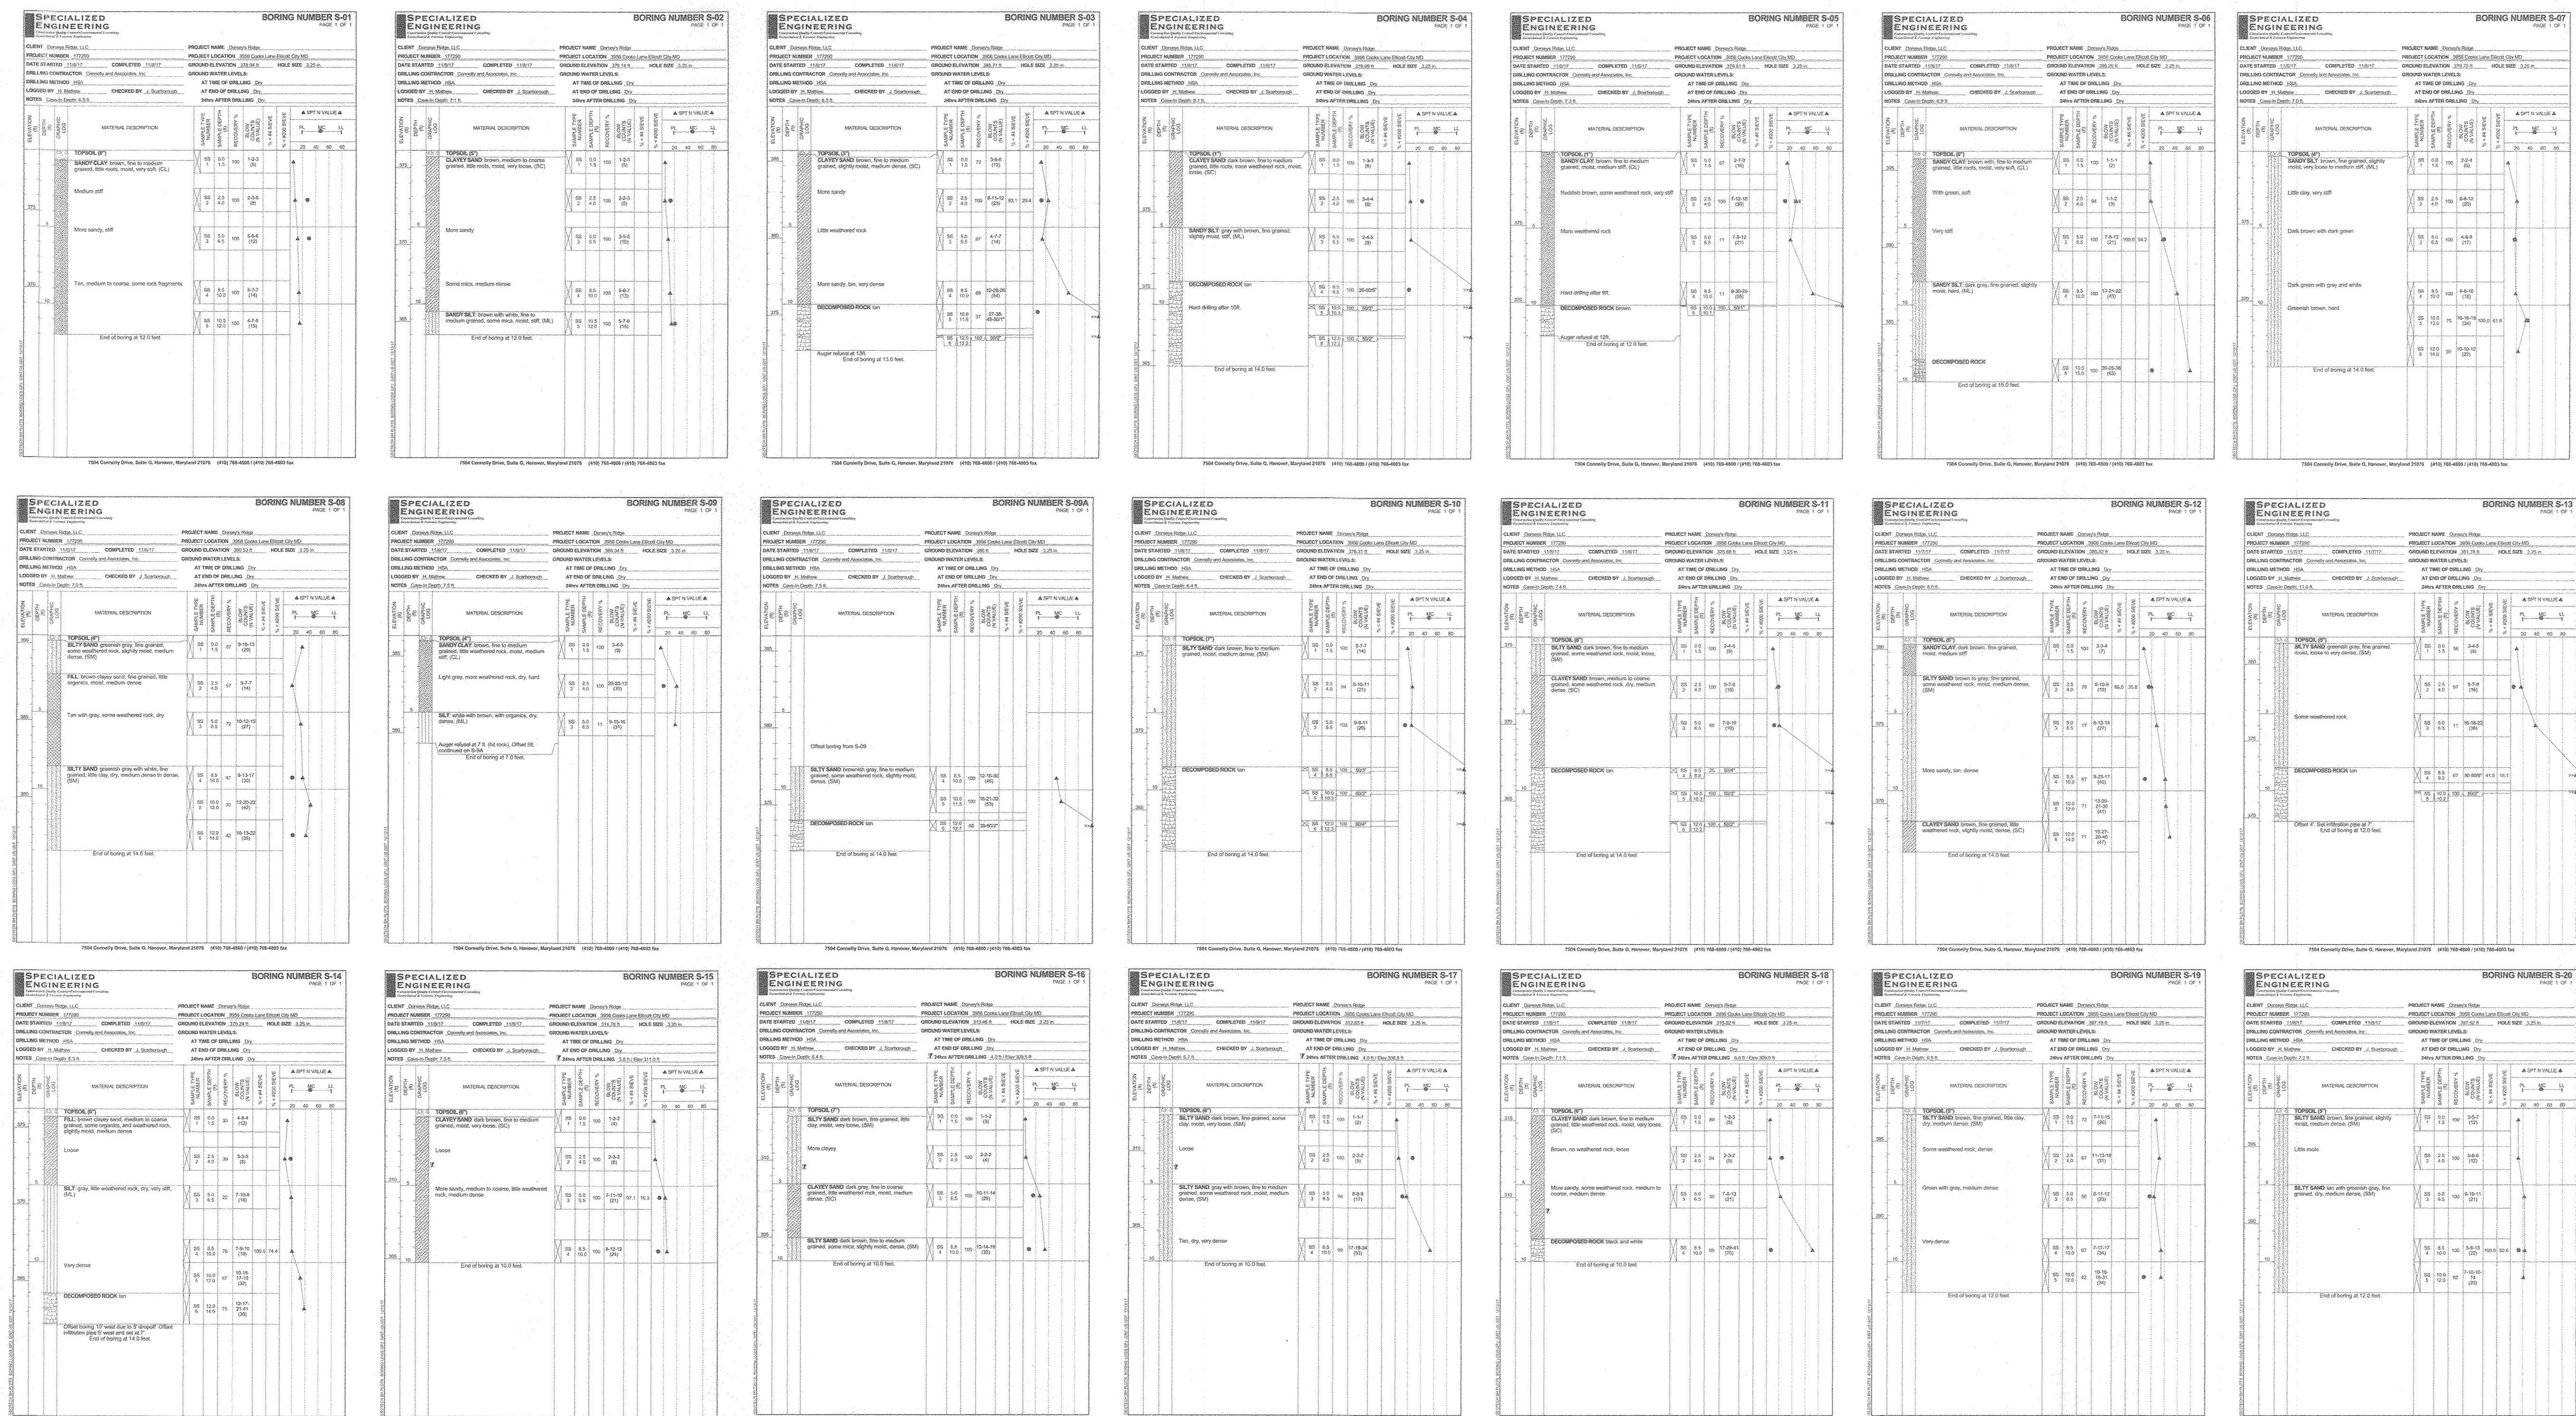

AS-BUILT CERTIFICATION

I hereby certify, by my seal, that to the best of my knowledge and belief that the facilities shown on the plan was constructed as shown on this "AS-BUILT" plan meet the approved plans and specifications.

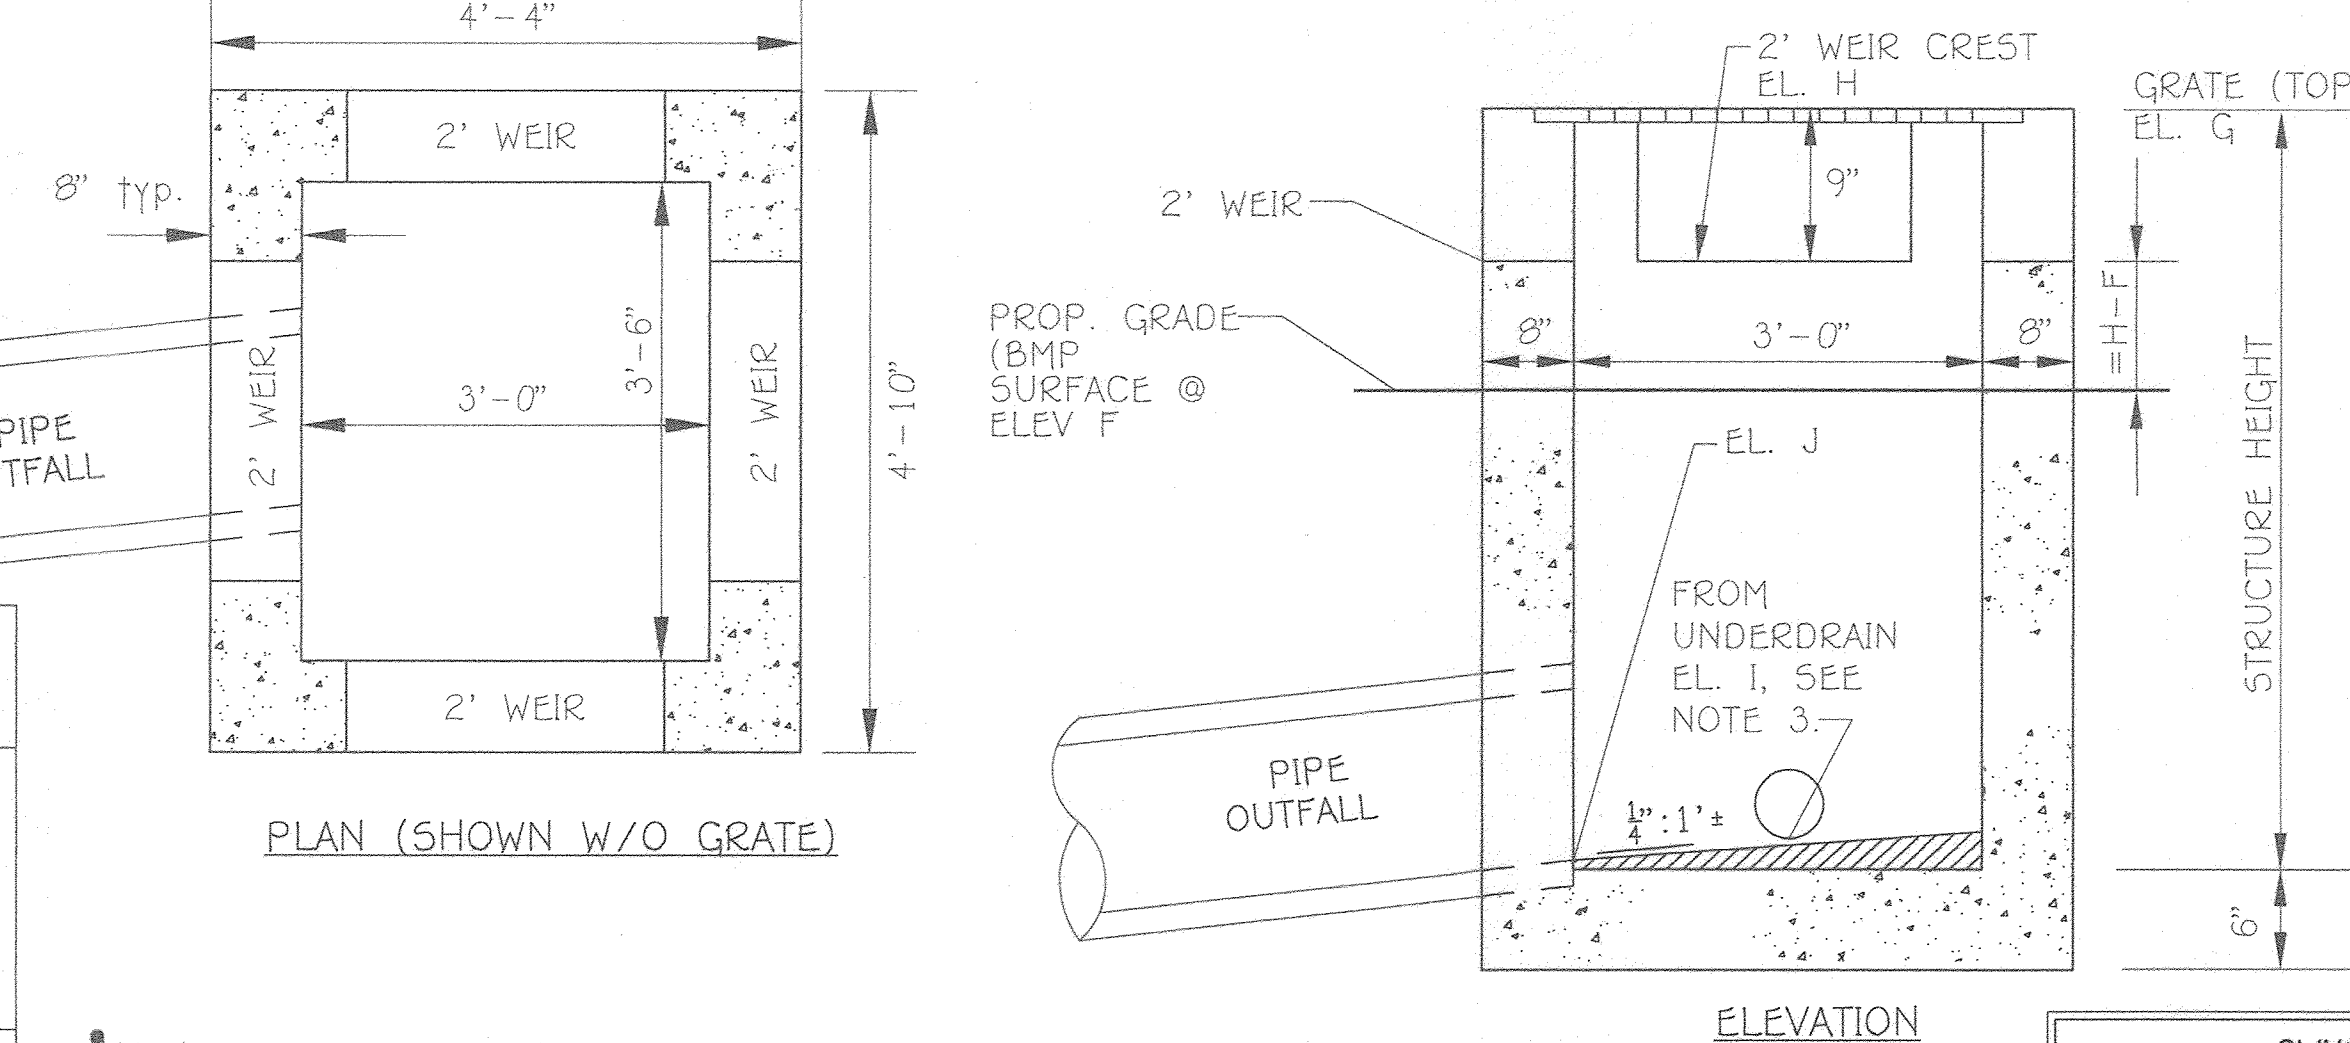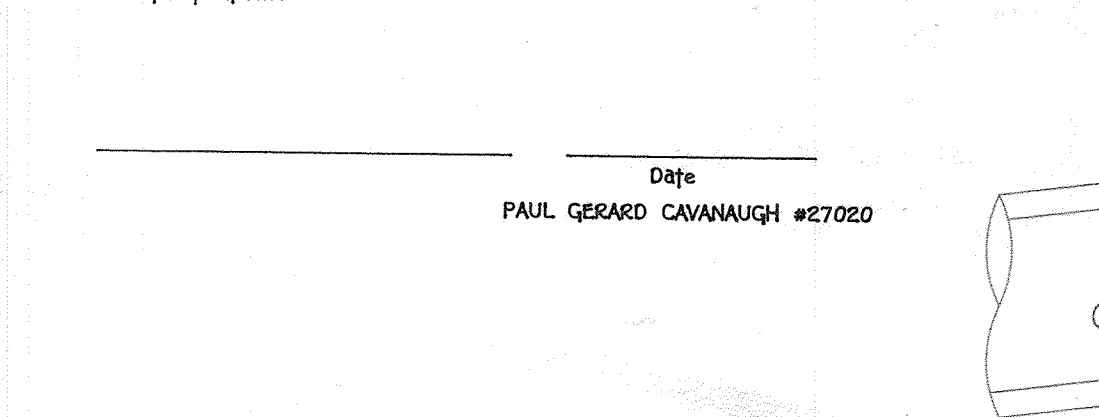

ELEVATION TABLE (BMP)

	C51	C52	C53	C54	C55
ELEV. F	377.40 .65	376.40 .00	371.25	377.00	387.40
ELEV. G	379.83	378.25	373.75 .52	379.74	389.50
ELEV. H	378.00	377.50 .20	372.80	379.00	388.75 .80
ELEV. I	373.45 374.75	372.23	368.40 .03	373.35 375.04	384.44 .17
ELEV. J	373.40 372.51	371.50	367.75 .58	373.65 375.24	383.77 .82

- NOTES:**
- SEE MSHA STD DETAIL MD-378.11 FOR DETAILS NOT SHOWN.
 - USE DOUBLE OPENING WITH NO CONCRETE GUTTER APPROACHES.
 - PIPE MAY ENTER INLET AT AN ANGLE TO MAINTAIN IN CENTER OF BMP. SEE PLAN FOR PIPE ENTRANCE WALL LOCATION.
 - SLOPE RISER INVERT 1/4" : 1" TOWARD OUTFALL WITH CONCRETE.
 - THIS STRUCTURE SHALL BE CONSTRUCTED WITH FOUR (4) 2' WIDE WEIR OPENINGS.

APPROVED: DEPARTMENT OF PUBLIC WORKS
 CHIEF, BUREAU OF HIGHWAYS
 DATE: 8/17/2020

APPROVED: DEPARTMENT OF PLANNING AND ZONING
 CHIEF, DIVISION OF LAND DEVELOPMENT
 DATE: 9/23/20

CHIEF, DEVELOPMENT ENGINEERING DIVISION
 DATE: 8/20/20

REVISIONS

NO.	DESCRIPTION	DATE

FISHER, COLLINS & CARTER, INC.
 CIVIL ENGINEERING CONSULTANTS & LAND SURVEYORS
 CENTRAL SQUARE OFFICE PARK - 10272 BALTOPPER NATIONAL PIKE
 ELLICOTT CITY, MARYLAND 21042
 (410) 461-2895

MODIFIED S-INLET TYPICAL SECTION FOR CONTROL STRUCTURES NTS

OWNER/DEVELOPER
 DORSEYS RIDGE, LLC
 C/O DAVE WOESSNER
 308 MAGDOY ROAD
 SEVENNA PARK, MD 21146
 410-461-0807

PROFESSIONAL CERTIFICATION


I HEREBY CERTIFY THAT THESE DOCUMENTS WERE PREPARED OR APPROVED BY ME AND THAT I AM A DULY LICENSED PROFESSIONAL ENGINEER UNDER THE LAWS OF THE STATE OF MARYLAND, LICENSE NO. 20748, EXPIRATION DATE: 02/22/2021.

Paul M. Vitucci
 Signature of Professional Engineer

Stefanese
 DATE

BORINGS AND SWM SPECIFICATIONS
DORSEY'S RIDGE
 PHASE-1
 LOTS 1 THRU 4, OPEN SPACE LOTS 5 THRU 8, & NON-BUILDABLE BULK PARCELS A THRU F
 A RESUBDIVISION OF "WILHIDE PROPERTY, LOT 1, 2 & 3", PLAT NO. 18442
 ZONED: CEF-R
 TAX MAP NO.: 24 GRID NO.: 18 PARCEL NO.: 260 LOTS: 1 THRU 3
 SECOND ELECTION DISTRICT HOWARD COUNTY, MARYLAND
 SCALE: AS SHOWN DATE: MAY, 2020
 SHEET 15 OF 18

LEGEND	
SYMBOL	DESCRIPTION
	PROPOSED CONTOURS
	PROPOSED STORM DRAIN
	PROPOSED DRYWELL (M-5)
	PROPOSED WATER LINE
	PROPOSED SEWER LINE
	LIMIT OF DISTURBANCE
	PROPOSED PAVING
	PROPOSED SIDEWALKS
	SPOT ELEVATION
	FLOW ARROW
	NON-CREDITED OPEN SPACE
	FOREST CONSERVATION EASEMENT
	FLOW ARROW
	EXISTING WETLANDS & WETLAND BUFFER
	EXISTING FLOODPLAIN
	EXISTING OVER HEAD POWER LINES
	EXISTING SEWER LINE
	EXISTING WATER LINE
	SOIL BORINGS
	SPECIMEN TREE
	EXISTING TREES

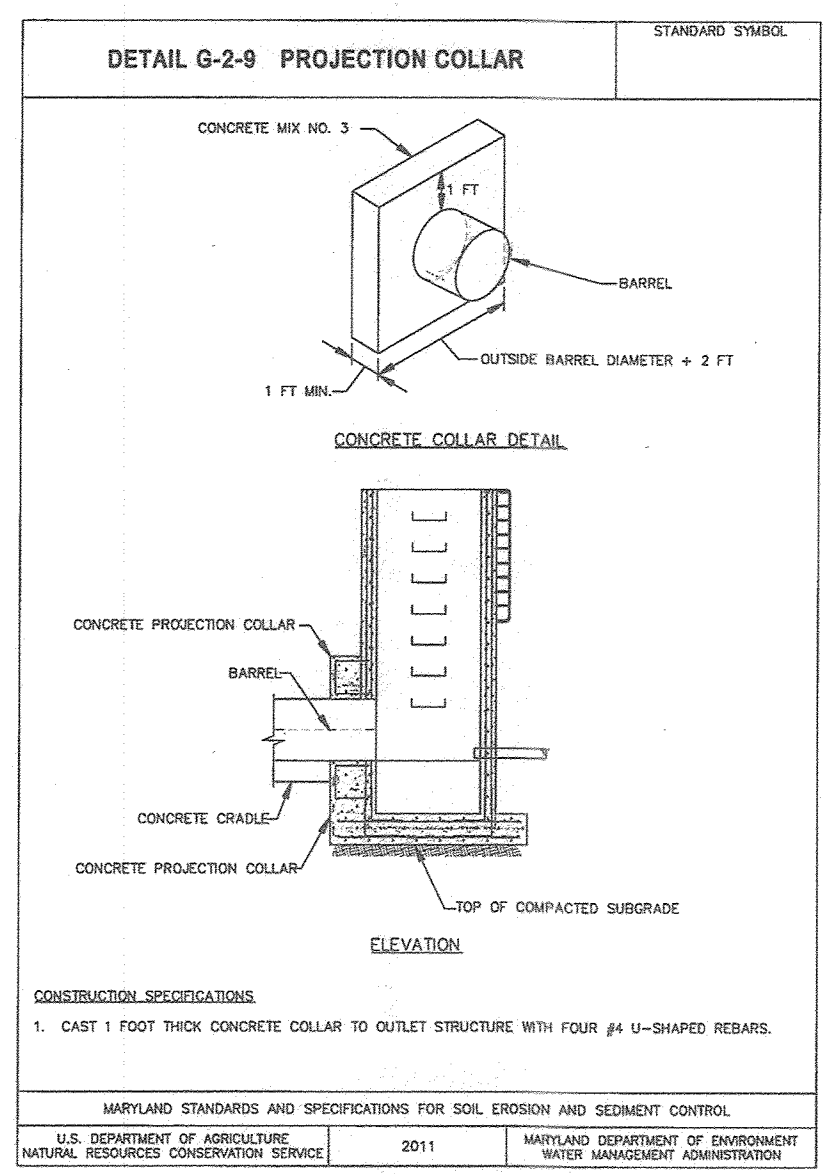

OPERATION AND MAINTENANCE SCHEDULE FOR PRIVATELY OWNED AND JOINTLY MAINTAINED STORMWATER MANAGEMENT FACILITIES

- ROUTINE MAINTENANCE - (HOA)**
- Facility shall be inspected annually and after major storms. Inspections shall be performed during wet weather to determine if the pond is functioning properly.
 - Top and side slopes of the embankment shall be mowed a minimum of two (2) times a year, once in June and once in September. Other side slopes and maintenance access should be mowed as needed.
 - Debris and litter shall be removed during regular mowing operations and as needed.
 - Visible signs of erosion in the pond as well as the rip-rap or gabion outlet area shall be repaired as soon as it is noticed.
- NON-ROUTINE MAINTENANCE - (HOWARD COUNTY)**
- Structural components of the pond such as the dam, the riser, and the pipes shall be repaired upon the detection of any damage. The components shall be inspected during routine maintenance operations.
 - Sediment shall be removed from the pond, and forebay, no later than when the capacity of the pond or forebay, is half full of sediment, or when deemed necessary for aesthetic reasons, upon approval from the Department of Public Works.

OWNER/DEVELOPER CERTIFICATION

"I/We hereby certify that any clearing, grading construction, or development will be done pursuant to this approved erosion and sediment control plan, including inspecting and maintaining controls, and that the responsible person involved in the construction project will have a Certificate of Training at a Maryland Department of the Environment (MDE) approved training program for the control on erosion and sediment prior to beginning the project. I shall engage a Maryland registered professional engineer to supervise pond construction, and provide the Howard Soil Conservation District with an "As-Built" plan of the pond within 30 days of completion. I certify right-of-entry for periodic on-site evaluation by Howard County, the Howard Soil Conservation District and/or MDE."

David Woessner
 Owners/Developer's Signature
DAVID WOESSNER
 Printed Name & Title
 9/8/2020
 Date

DESIGN CERTIFICATION

"I hereby certify that this plan has been designed in accordance with current Maryland erosion and sediment control laws, regulation, and standards, that it represents a practical and workable plan based on my personal knowledge of the site, and that it was prepared in accordance with the requirements of the Howard Soil Conservation District. I have notified the developer that he/she must engage a registered professional engineer to supervise construction and provide the Howard Soil Conservation District with an "As-Built" plan of the pond within 30 days of completion."


Paul Gerard Cavanaugh
 Designer's Signature
PAUL GERARD CAVANAUGH
 Printed Name & Title
 9/9/2020
 Date
 20746
 MD Registration No.
 Approved: This Plan For Small Pond Construction and Soil Erosion And Sediment Control By The Howard Soil Conservation District.
Paul Gerard Cavanaugh
 9/9/20
 Date
 Howard Soil Conservation District

PROFESSIONAL CERTIFICATION






"I hereby certify these documents were prepared or approved by me, and that I am a duly licensed professional engineer under the laws of the State of Maryland."

License Number: _____ Expiration Date: _____
 Approved: Department Of Planning And Zoning
 Chief, Division Of Land Development
 9/23/20
 Date
 Chief, Development Engineering Division
 9-23-20
 Date
 Approved: Howard County Department Of Public Works
 Chief, Bureau Of Highways
 9/21/2020
 Date

REVISIONS		
NO.	DESCRIPTION	DATE

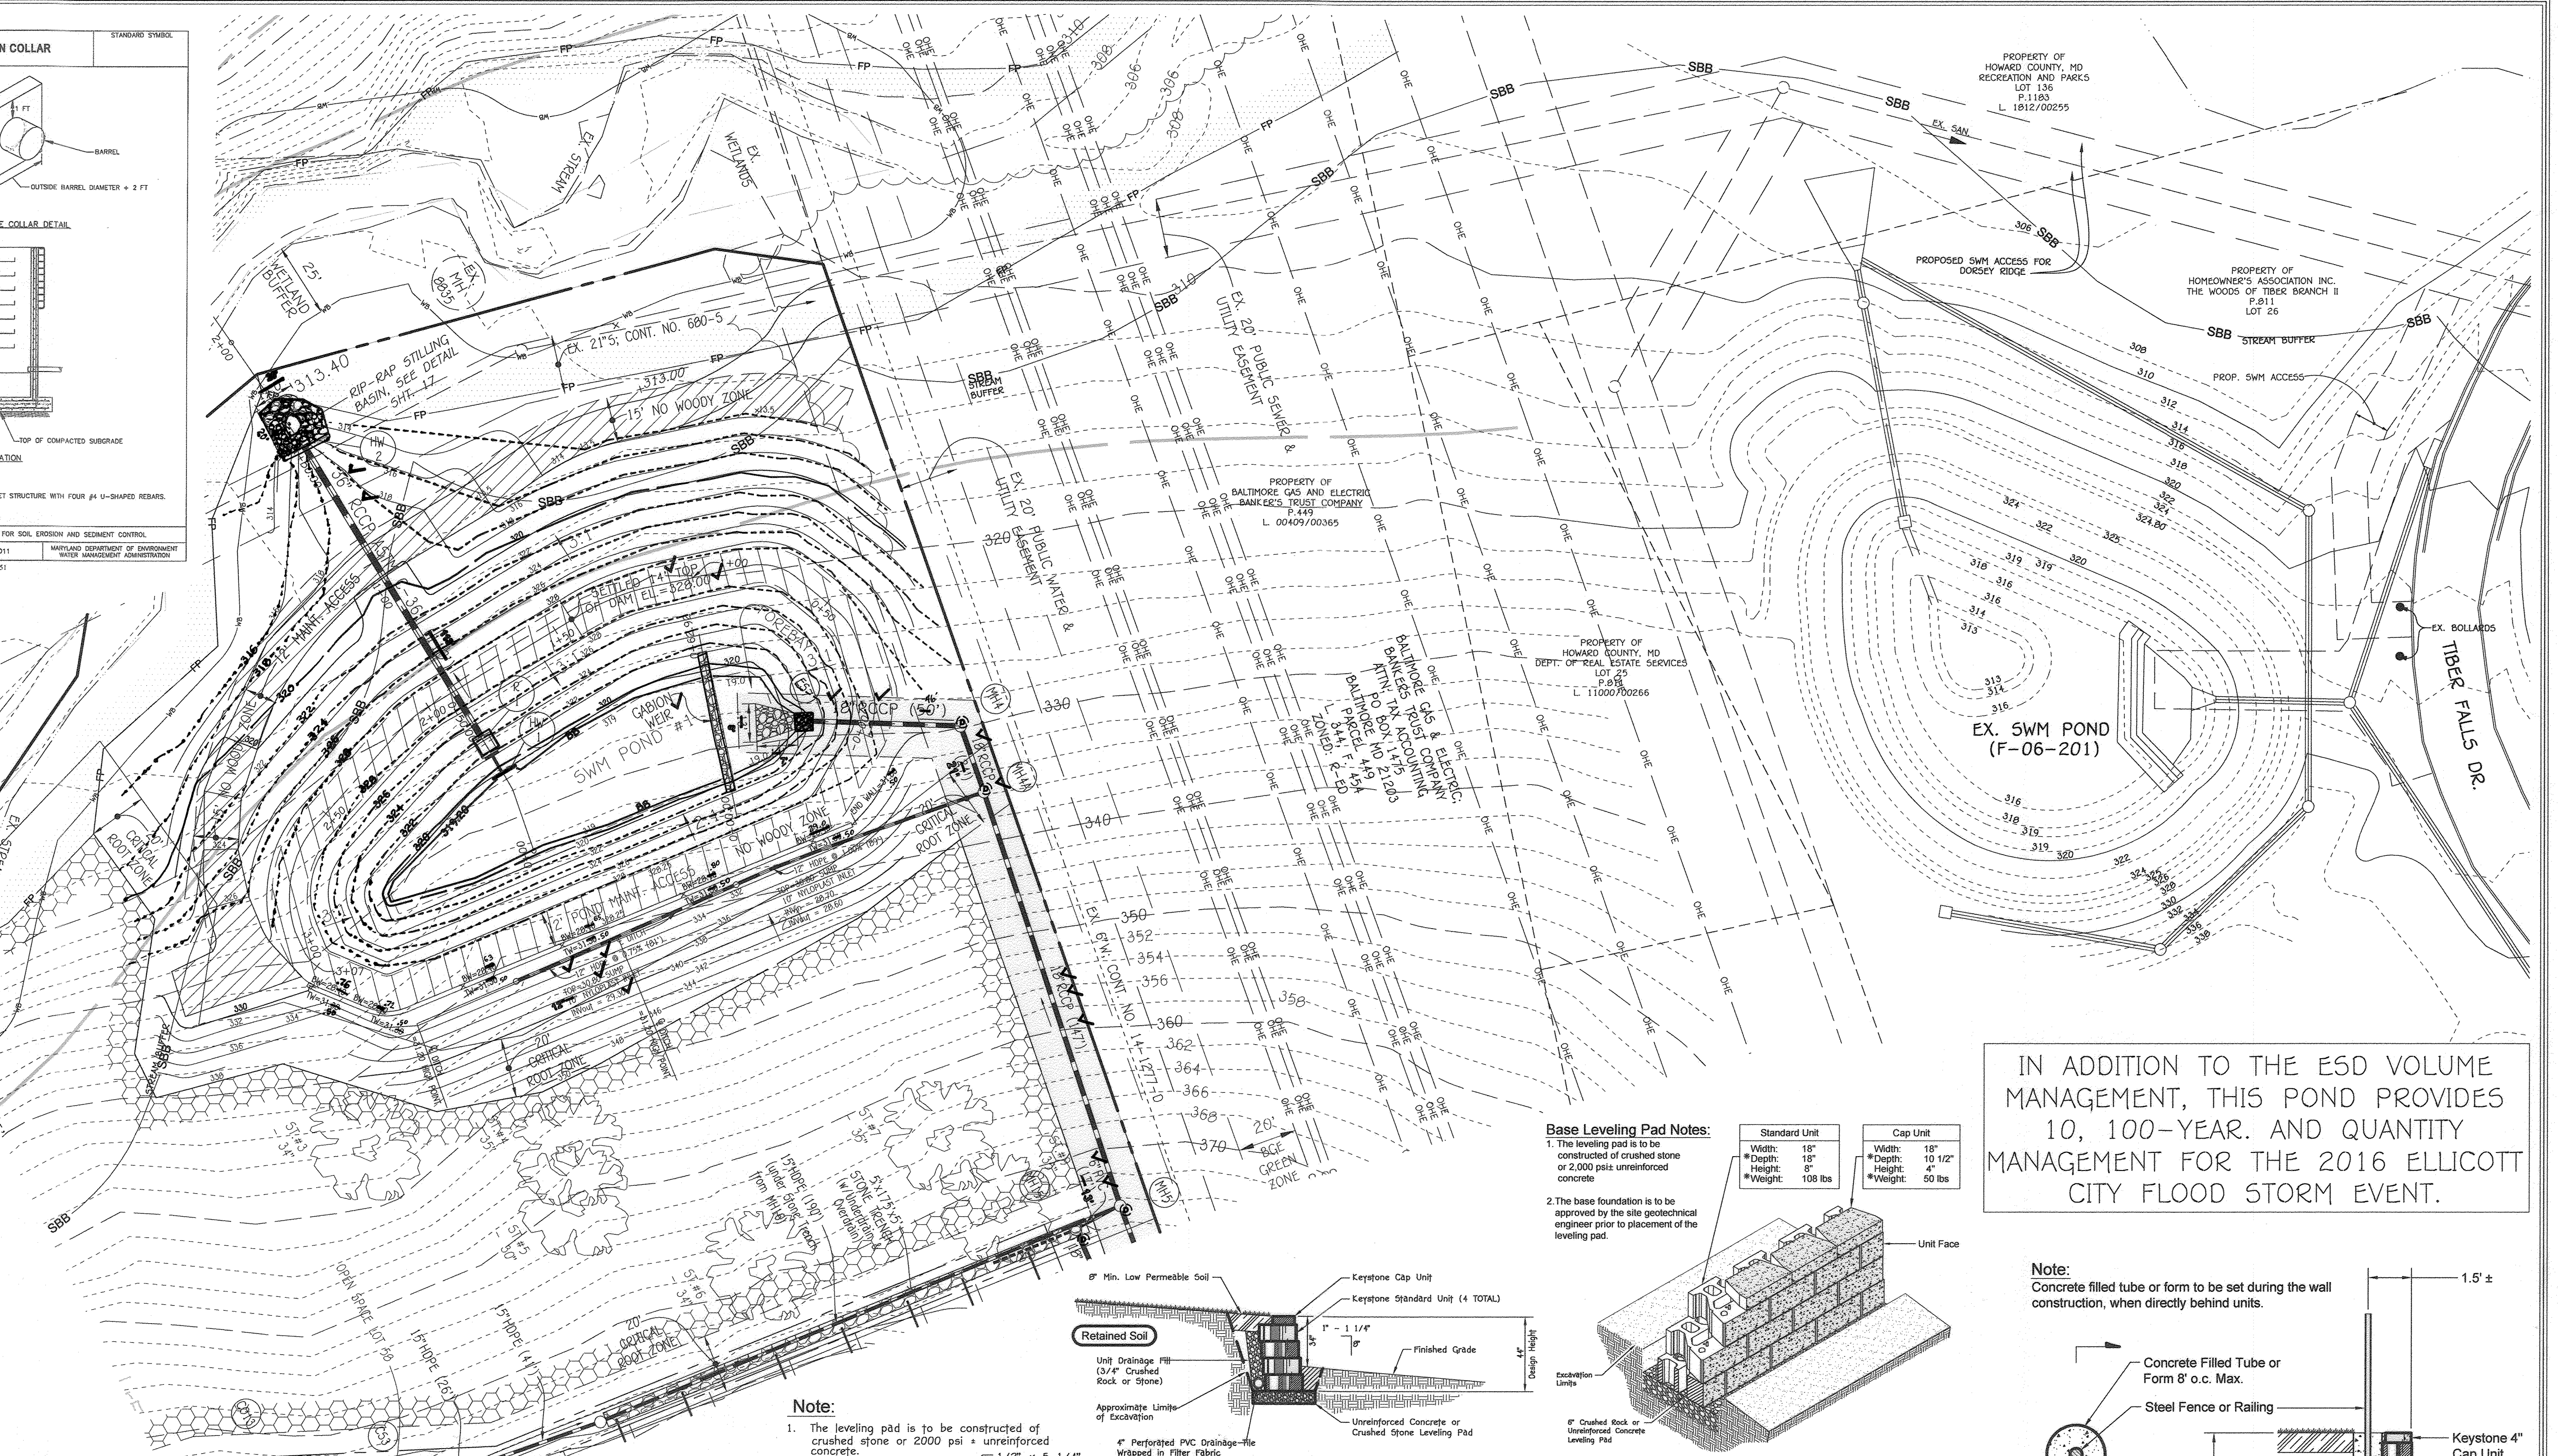


PLAN
 SCALE: 1"=30'

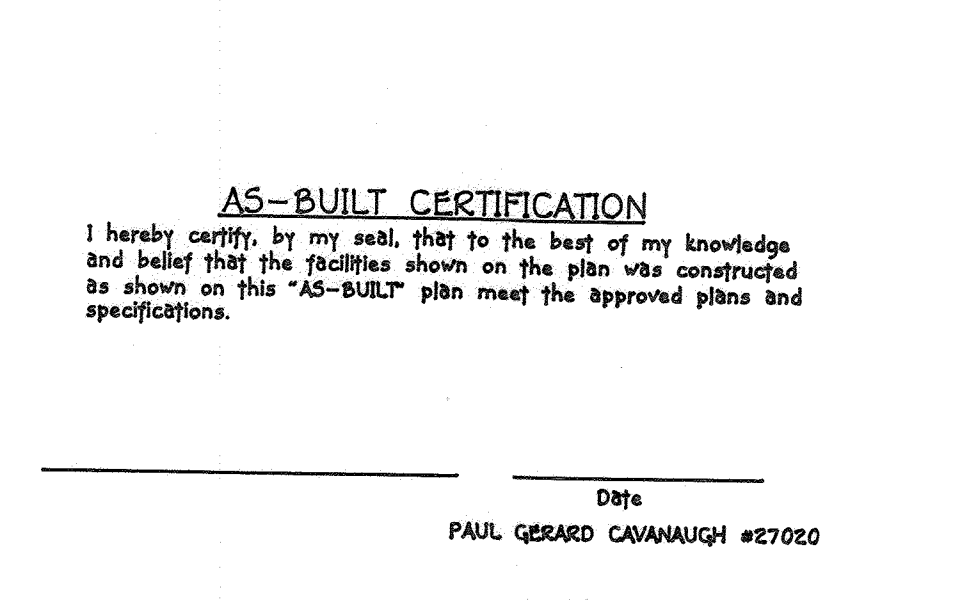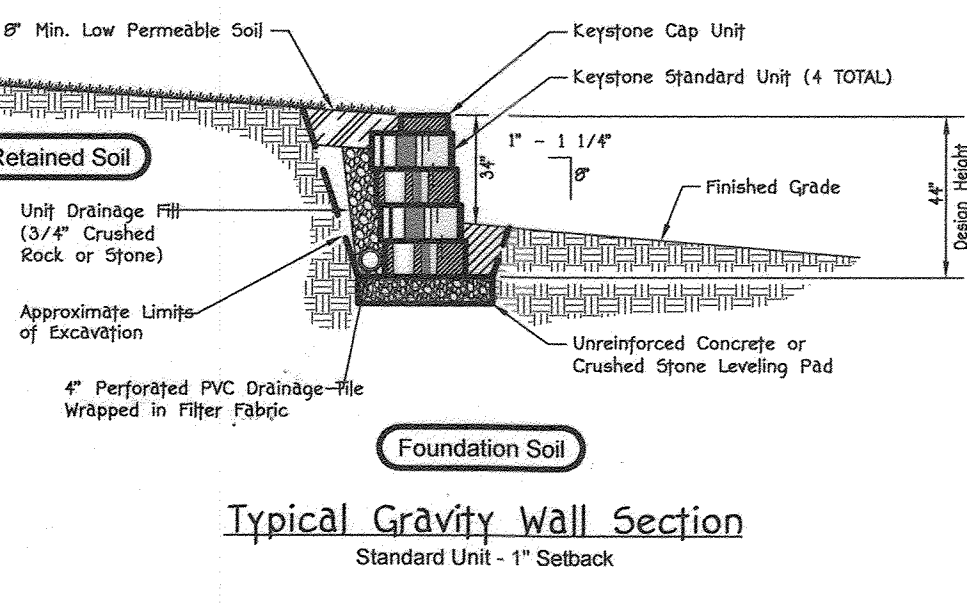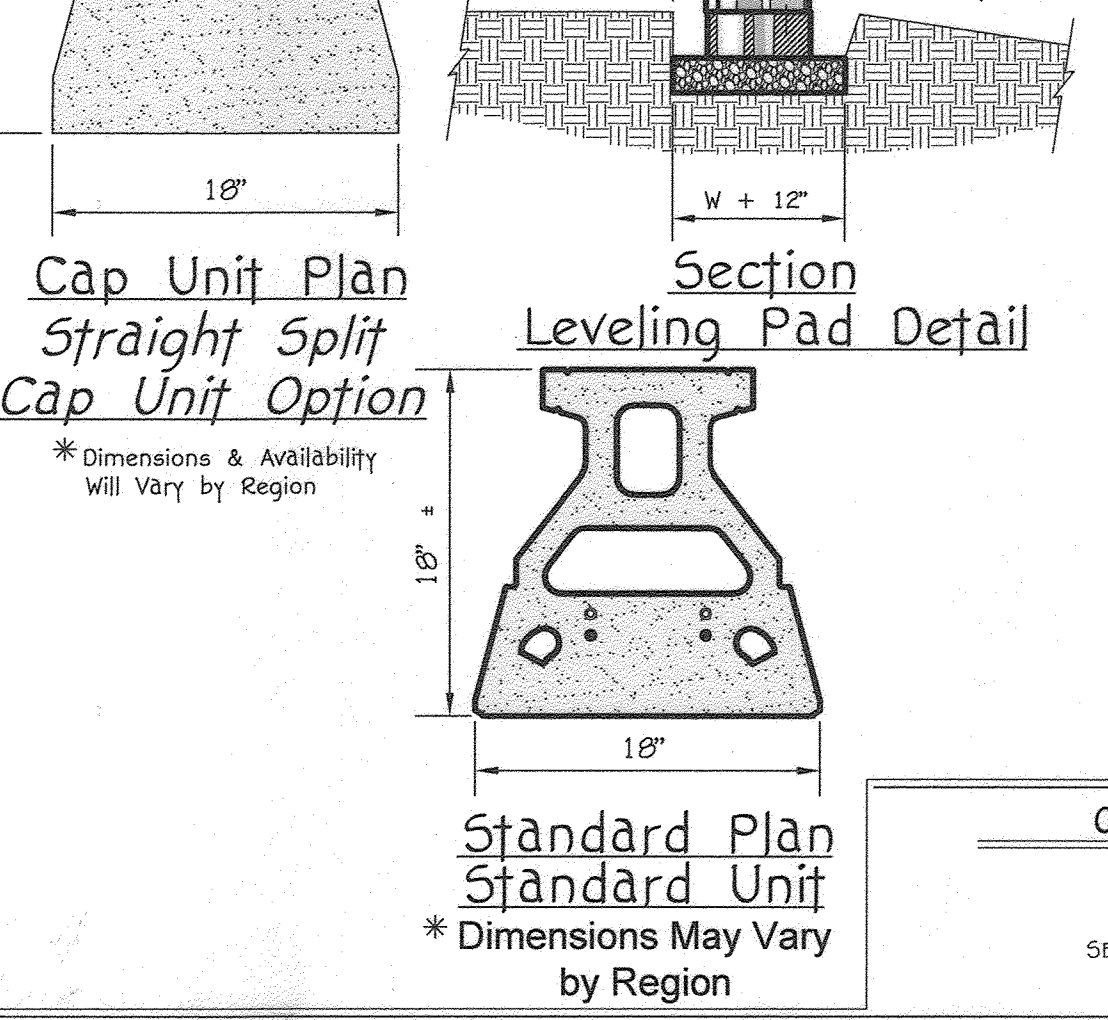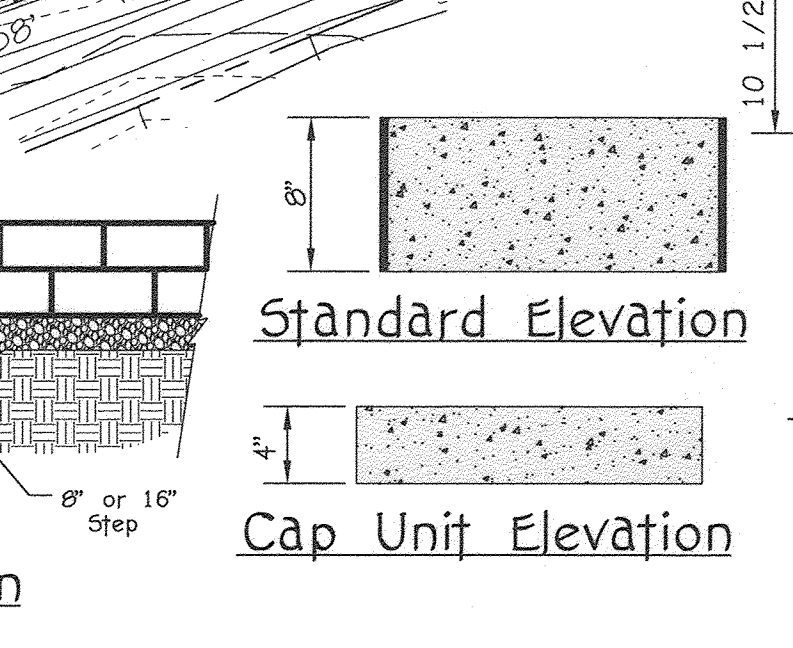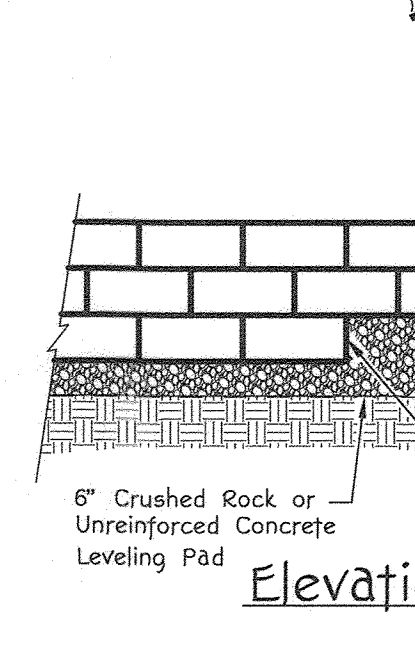

Base Leveling Pad Notes:


- The leveling pad is to be constructed of crushed stone or 2,000 psi unreinforced concrete.
- The base foundation is to be approved by the site geotechnical engineer prior to placement of the leveling pad.

Standard Unit	Cap Unit
*Width: 18"	*Width: 18"
*Depth: 18"	*Depth: 10 1/2"
*Height: 8"	*Height: 4"
*Weight: 108 lbs	*Weight: 60 lbs

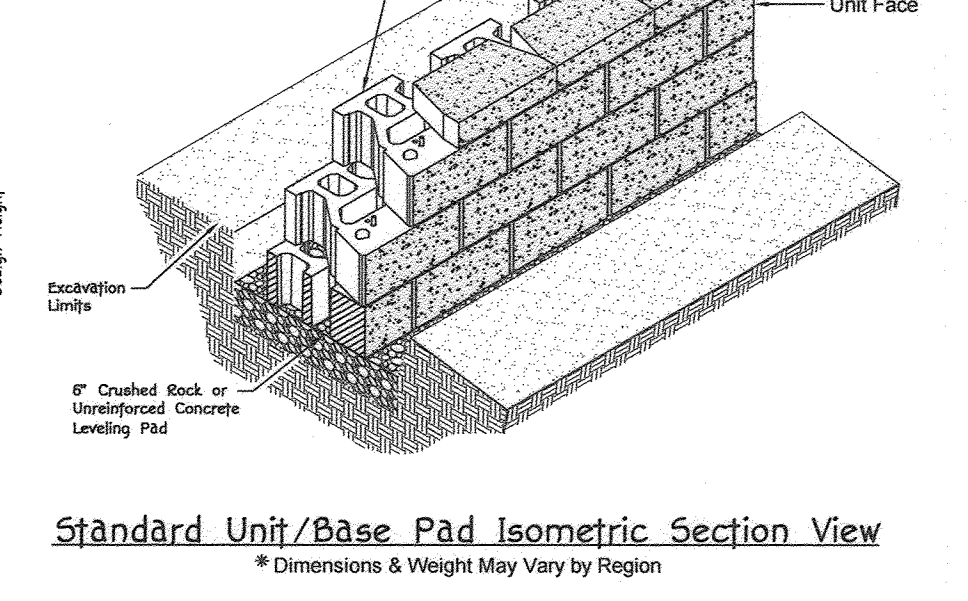

- Construction Notes:**
- Retaining walls shall only be constructed under the observation of a Registered Professional Engineer and a (INCEP, MACE, or equivalent) certified soils technician.
 - The required bearing pressure beneath the footing of the wall shall be verified in the field by a certified soils technician. Testing documentation shall be provided to the Howard County Inspector prior to the start of construction. The required test procedure shall be the Dynamic Cone Penetrometer Test ASTM D1585-99.
 - The suitability of fill material shall be confirmed by the onsite soils technician. Each eight (8) inch lift shall be compacted to a minimum of 95% Standard Proctor Density and the testing report shall be made available to the Howard County Inspector upon completion of construction.
 - For "CRITICAL" walls, one soil boring shall be required every 100' along the entire length of the wall. Copies of all boring reports shall be provided to the Howard County Inspector prior to the start of construction.
 - * THIS WALL IS NOT DESIGNED FOR SURCHARGE LOADS.

IN ADDITION TO THE ESD VOLUME MANAGEMENT, THIS POND PROVIDES 10, 100-YEAR, AND QUANTITY MANAGEMENT FOR THE 2016 ELLICOTT CITY FLOOD STORM EVENT.

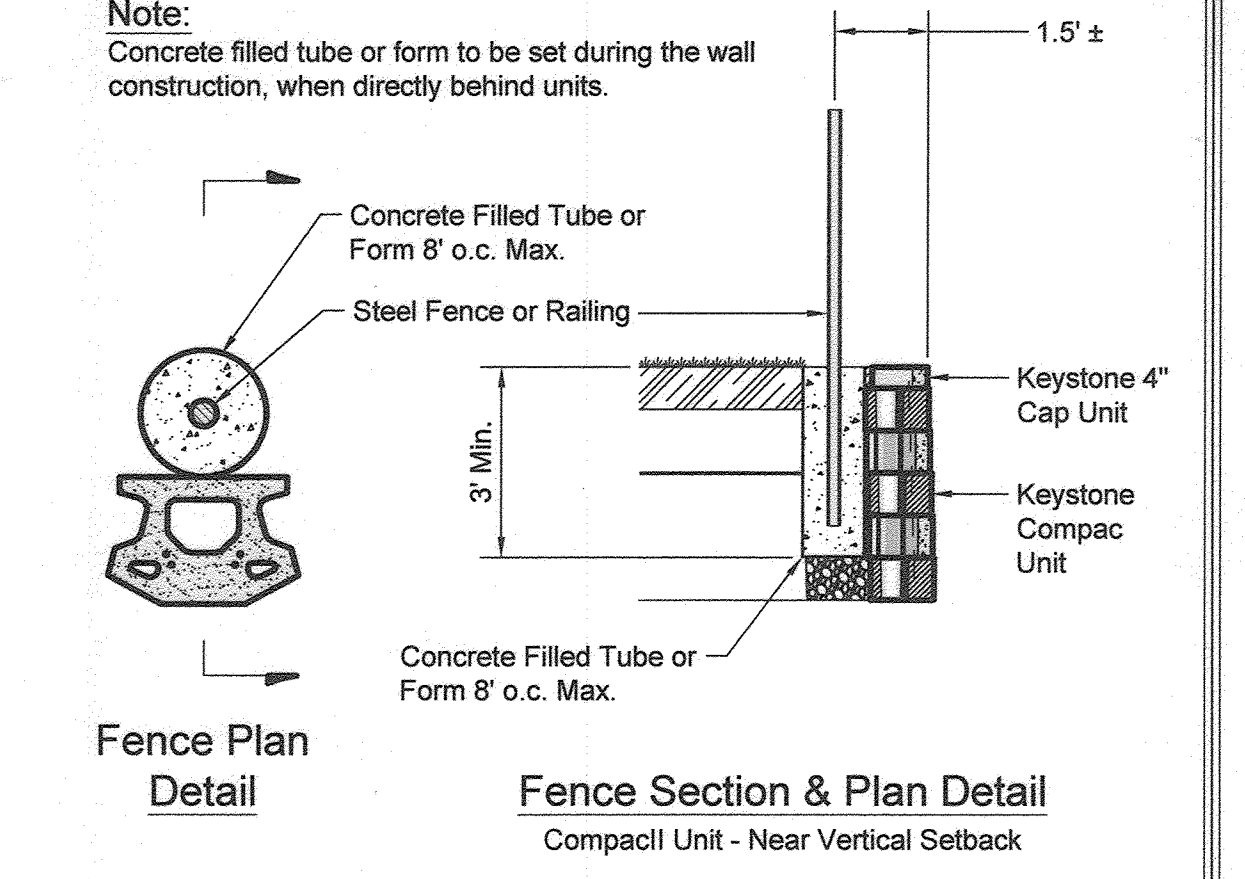

SWM NOTES AND DETAILS

DORSEY'S RIDGE

PHASE-1

LOTS 1 THRU 4, OPEN SPACE LOTS 5 THRU 8, & NON-BUILDABLE BULK PARCELS A THRU F

A RESUBDIVISION OF "MILHIDE PROPERTY, LOT 1, 2 & 3", PLAT NO. 10442 ZONED: CEF-R

TAX MAP NO.: 24 GRID NO.: 18 PARCEL NO.: 260 LOTS: 1 THRU 3

SECOND ELECTION DISTRICT HOWARD COUNTY, MARYLAND

SCALE: AS SHOWN DATE: MAY, 2020

SHEET 16 OF 18

PROFESSIONAL CERTIFICATION





I HEREBY CERTIFY THAT THESE DOCUMENTS WERE PREPARED OR APPROVED BY ME AND THAT I AM A DULY LICENSED PROFESSIONAL ENGINEER UNDER THE LAWS OF THE STATE OF MARYLAND, LICENSE NO. 20746, EXPIRATION DATE: 02/12/2021.

Paul Gerard Cavanaugh
 Signature Of Professional Engineer
 9/9/2020
 DATE



OWNER/DEVELOPER

DORSEY'S RIDGE, LLC
 C/O DAVE WOESSNER
 308 MAGDOY ROAD
 SEVERNA PARK, MD 21146
 410-461-0837

FISHER, COLLINS & CARTER, INC.
 CIVIL ENGINEERING, CONSULTANTS & LAND SURVEYORS
 CENTRAL SQUARE OFFICE PARK - 10272 BALTIMORE NATIONAL PIKE
 ELLICOTT CITY, MARYLAND 21142
 (410) 461-2999

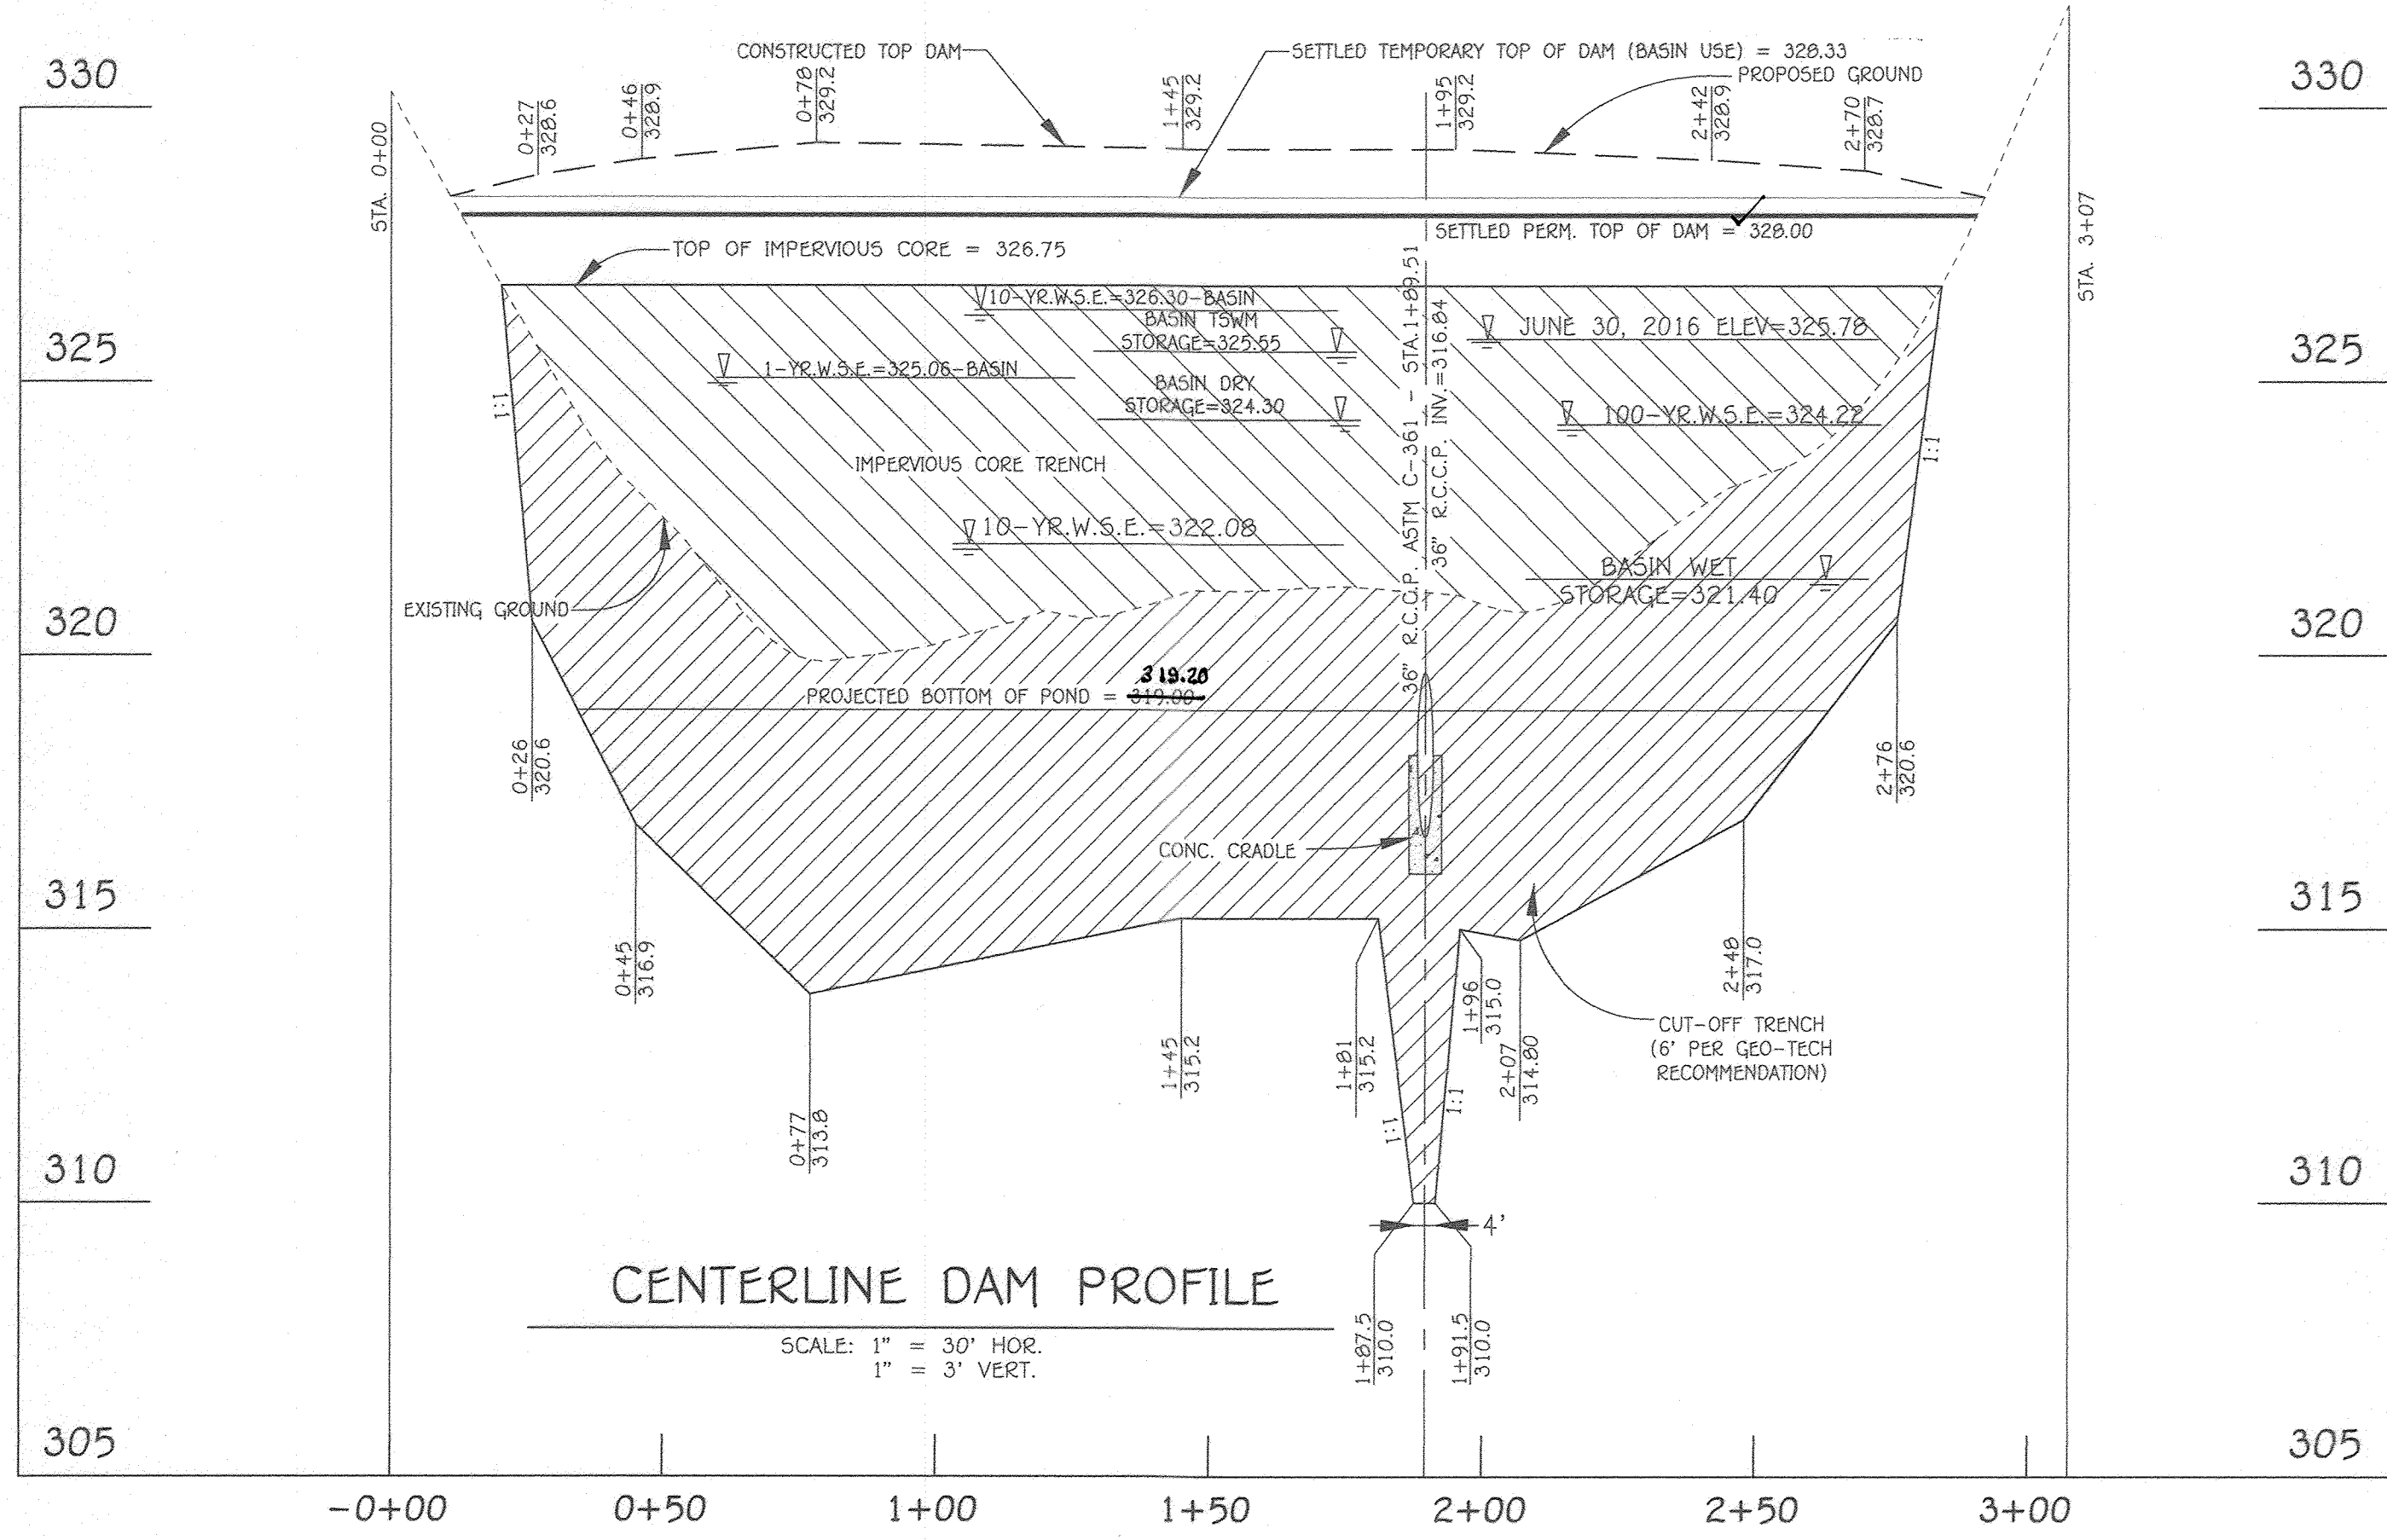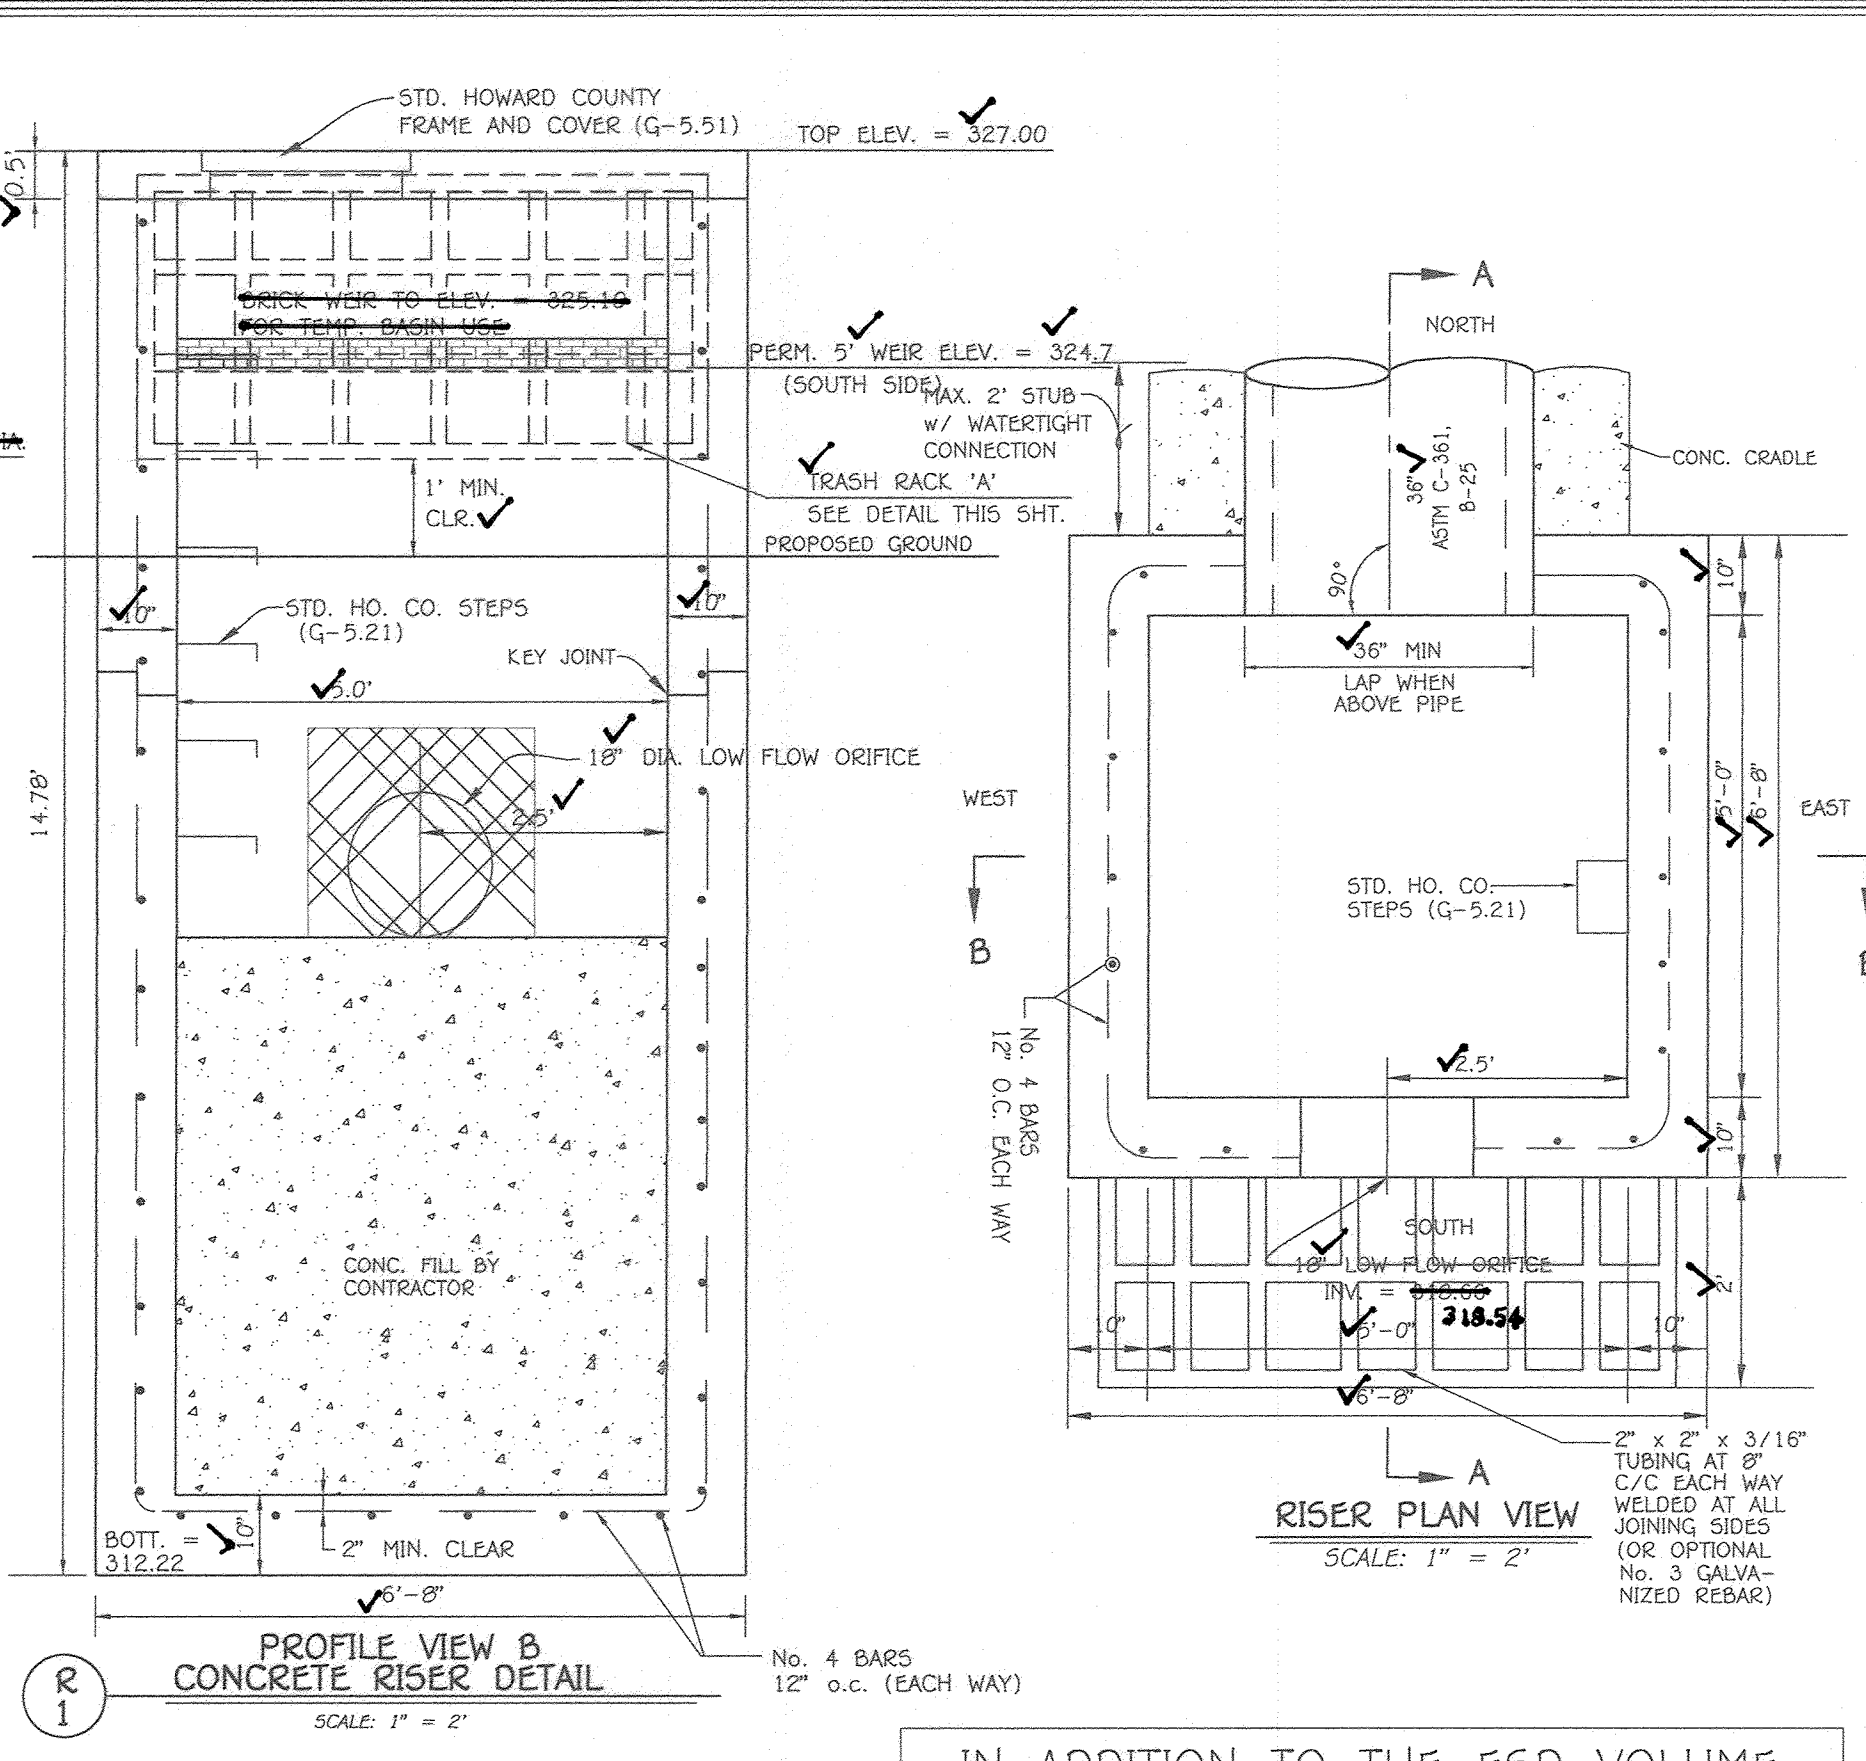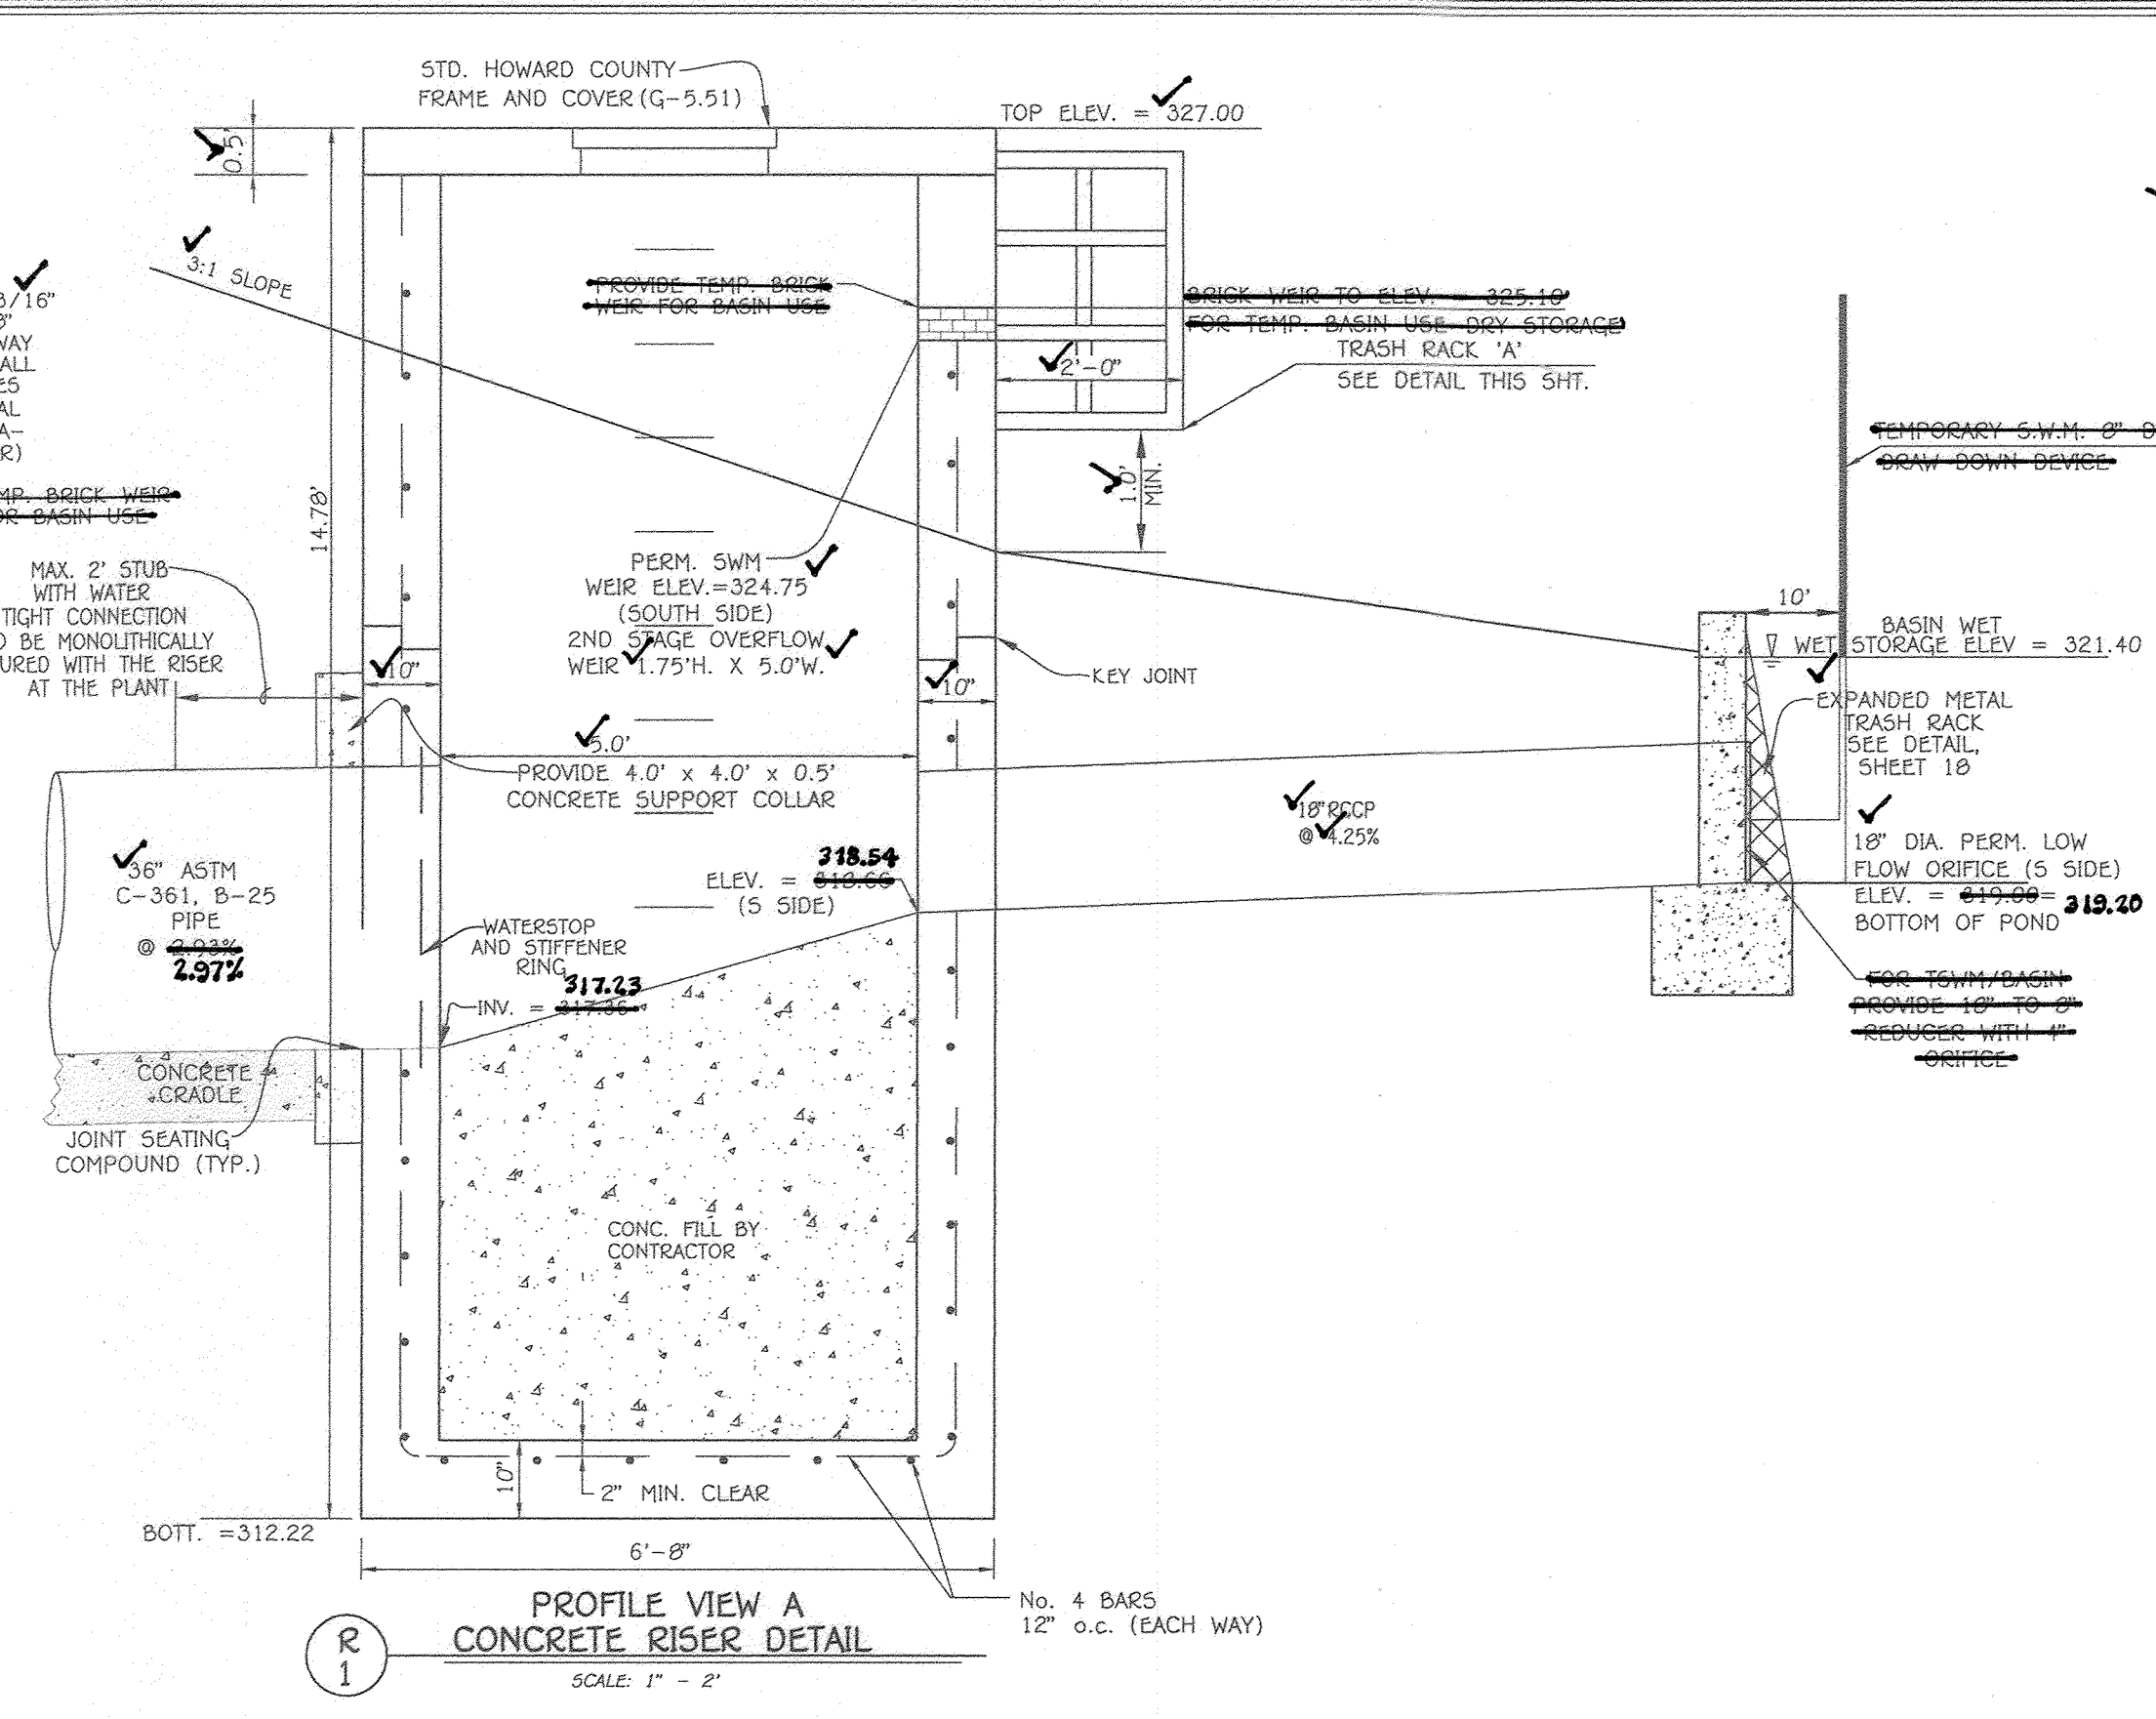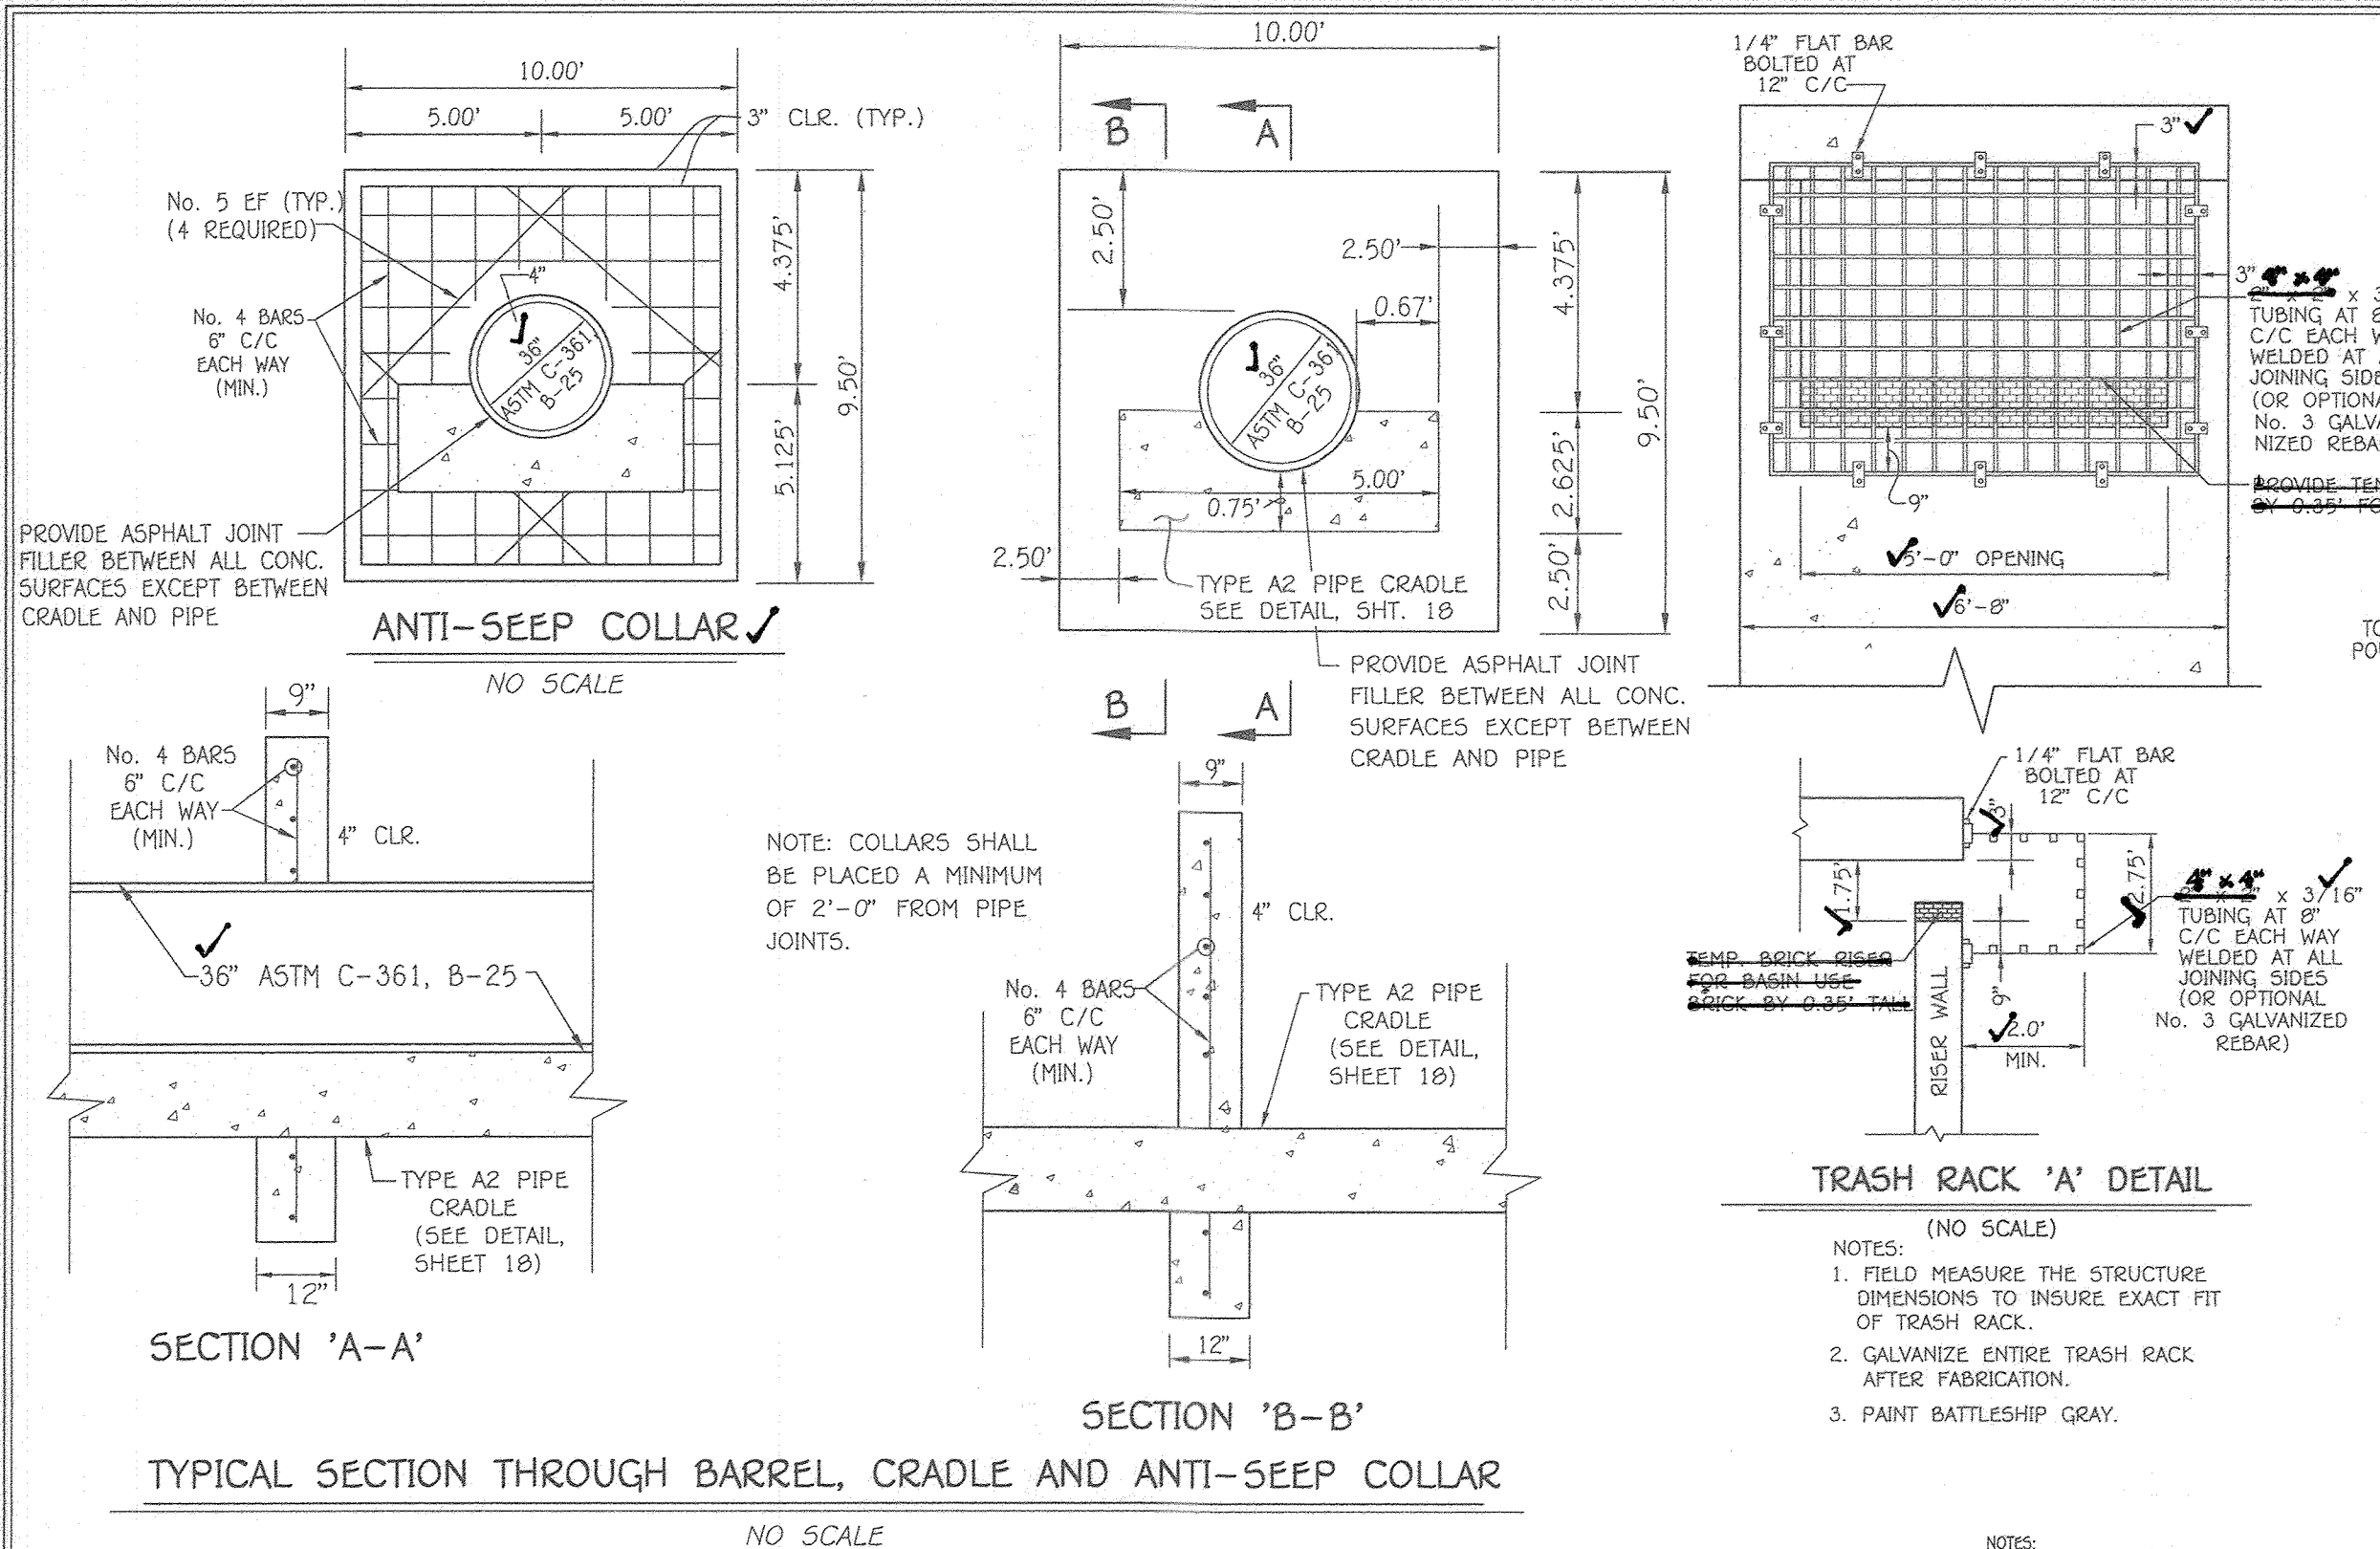

IN ADDITION TO THE ESD VOLUME MANAGEMENT, THIS POND PROVIDES 10, 100-YEAR AND QUANTITY MANAGEMENT FOR THE 2016 ELLICOTT CITY FLOOD STORM EVENT.

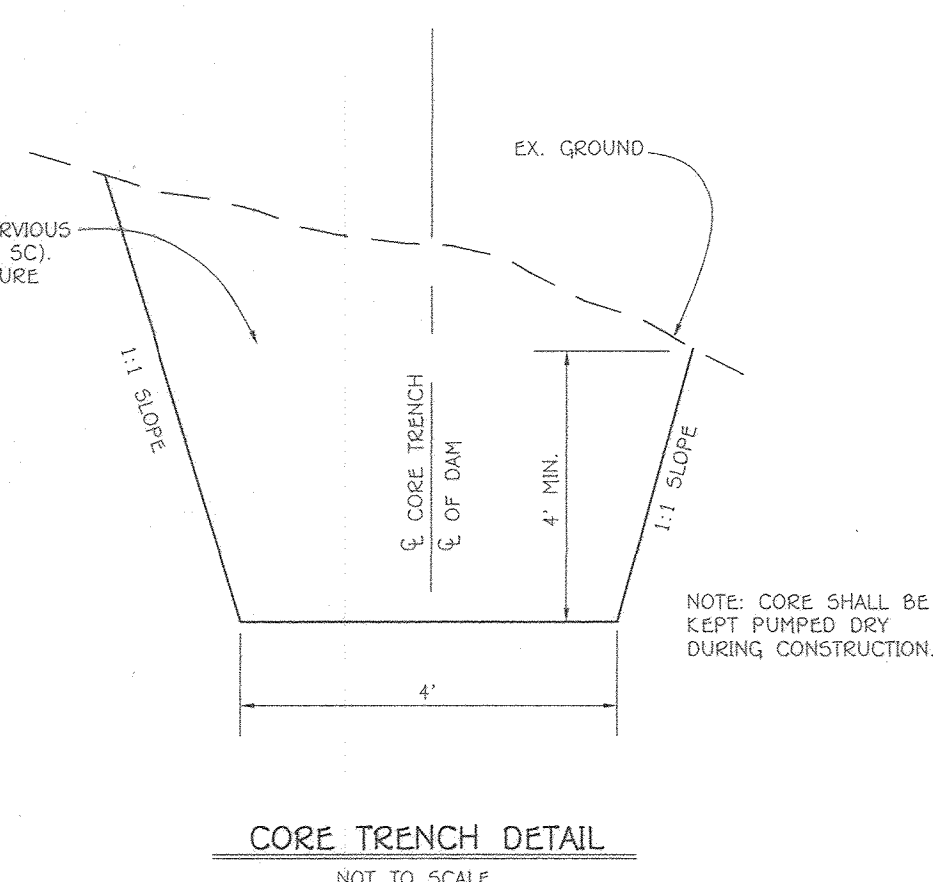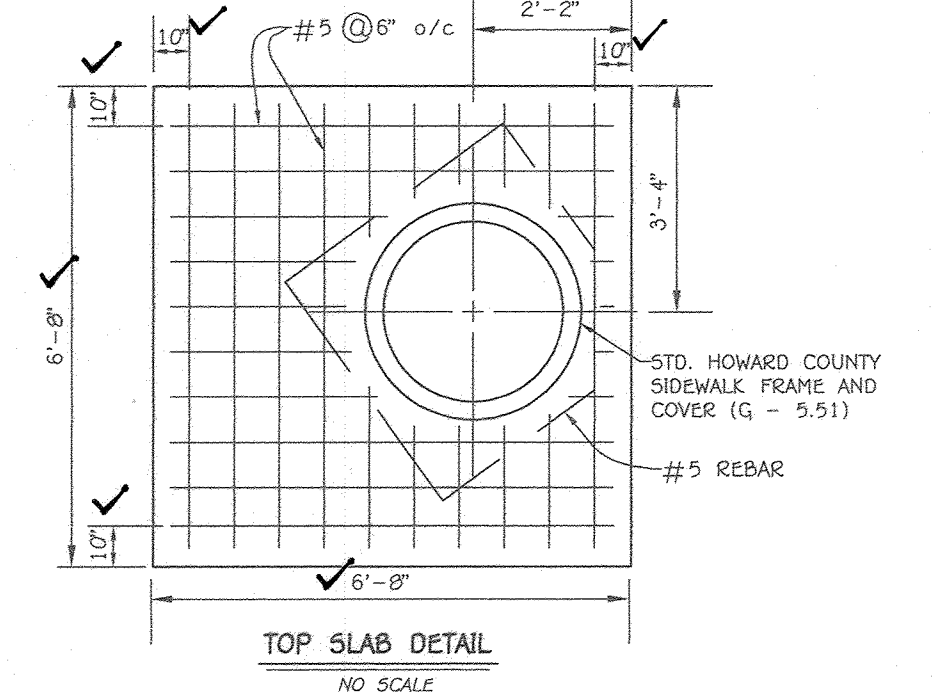

OWNER/DEVELOPER CERTIFICATION
"I/We hereby certify that any clearing, grading construction, or development will be done pursuant to this approved erosion and sediment control plan, including inspecting and maintaining controls, and that the responsible person involved in the construction project will have a Certificate of Training at a Maryland Department of the Environment (MDE) approved training program for the control on erosion and sediment prior to beginning the project. I shall engage a Maryland registered professional engineer to supervise pond construction, and provide the Howard Soil Conservation District with an "As-Built" plan of the pond within 30 days of completion. I certify right-of-entry for periodic on-site evaluation by Howard County, the Howard Soil Conservation District and/or MDC."

Owners/Developer's Signature: *David Woessner* Date: 5/26/2020
Printed Name & Title: DAVID WOESSNER

DESIGN CERTIFICATION
"I hereby certify that this plan has been designed in accordance with current Maryland erosion and sediment control laws, regulation, and standards, that it represents a practical and workable plan based on my personal knowledge of the site, and that it was prepared in accordance with the requirements of the Howard Soil Conservation District. I have notified the designee that he must engage a registered professional engineer to supervise the construction and provide the Howard Soil Conservation District with an "As-Built" plan of the pond within 30 days of completion."


Design Engineer's Signature: *Alpo M. Witten* Date: 5/27/2020
Printed Name: ALPO M. WITTEN, P.E. MD Registration No. 20748
Approved: This Plan is for Small Pond Construction and Soil Erosion and Sediment Control By The Howard Soil Conservation District.
Township Soil Conservation District: *Paul Selig* Date: 6/18/20

PROFESSIONAL CERTIFICATION
"I hereby certify these documents were prepared and approved by me, and that I am a duly licensed professional engineer under the laws of the State of Maryland."

Professional Engineer's Signature: *Alpo M. Witten* Date: 5/27/2020

Approved: Department Of Planning And Zoning
Chief, Division Of Land Development: *[Signature]* Date: 9/23/20
Chief, Development Engineering Division: *[Signature]* Date: 8/28/22
Approved: Howard County Department Of Public Works
Chief, Bureau Of Highways: *[Signature]* Date: 8/17/2020

NO.	REVISIONS	DATE

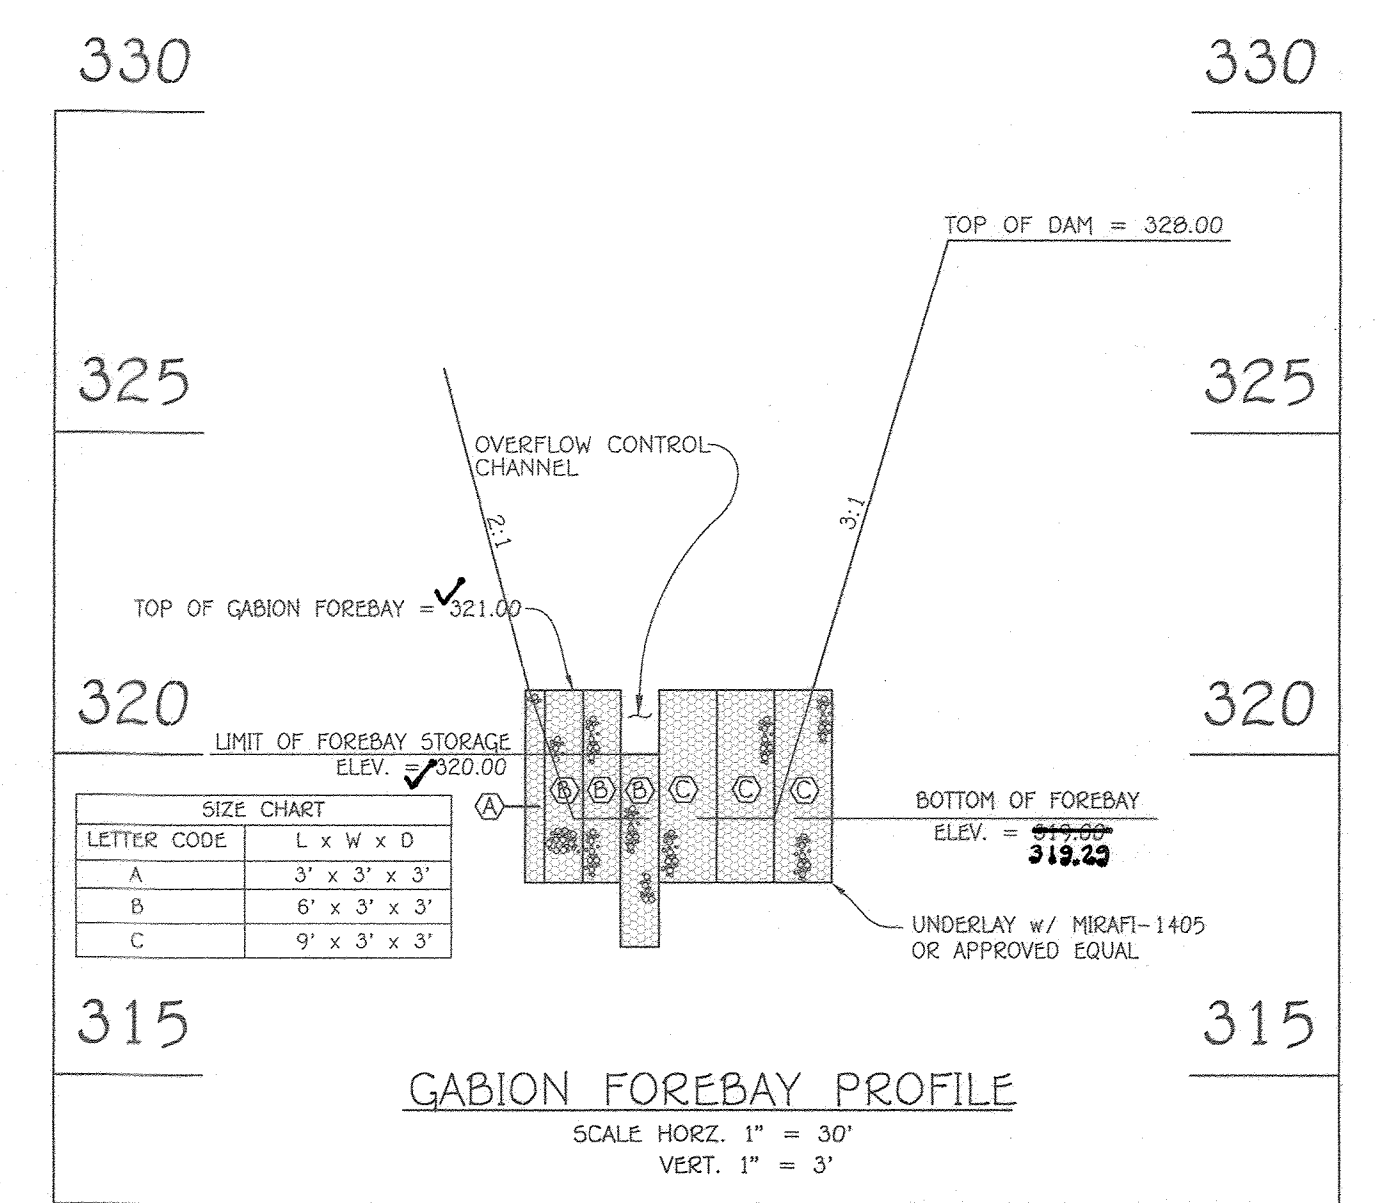

AS-BUILT CERTIFICATION
I hereby certify, by my seal, that to the best of my knowledge and belief that the facilities shown on this plan were constructed as shown on this "AS-BUILT" plan meet the approved plans and specifications.

Date: PAUL GEORGE CAVANUGH #27020

OWNER/DEVELOPER
DORSEY'S RIDGE, LLC
C/O DAVE WOESSNER
309 MAGDOOTH ROAD
SEVERNA PARK, MD 21146
410-461-0837



PROFESSIONAL CERTIFICATION
I HEREBY CERTIFY THAT THESE DOCUMENTS WERE PREPARED OR APPROVED BY ME AND THAT I AM A DULY LICENSED PROFESSIONAL ENGINEER UNDER THE LAWS OF THE STATE OF MARYLAND, LICENSE NO. 20748, EXPIRATION DATE: 02/22/2021.

Signature Of Professional Engineer: *Alpo M. Witten* Date: 5/27/2020

SWM NOTES AND DETAILS
DORSEY'S RIDGE
PHASE-I
LOTS 1 THRU 4, OPEN SPACE LOTS 5 THRU 8, & NON-BUILDABLE BULK PARCELS A THRU F
A RESUBDIVISION OF "WILHIDE PROPERTY, LOT 1, 2 & 3", PLAT NO. 18442
ZONED: CEF-R
TAX MAP NO.: 24 GRID NO.: 18 PARCEL NO.: 260 LOTS: 1 THRU 3
SECOND ELECTION DISTRICT HOWARD COUNTY, MARYLAND
SCALE: AS SHOWN DATE: MAY, 2020
SHEET 17 OF 18

DETAIL G-2-8 PRECAST RISER CONNECTOR

STANDARD SYMBOL

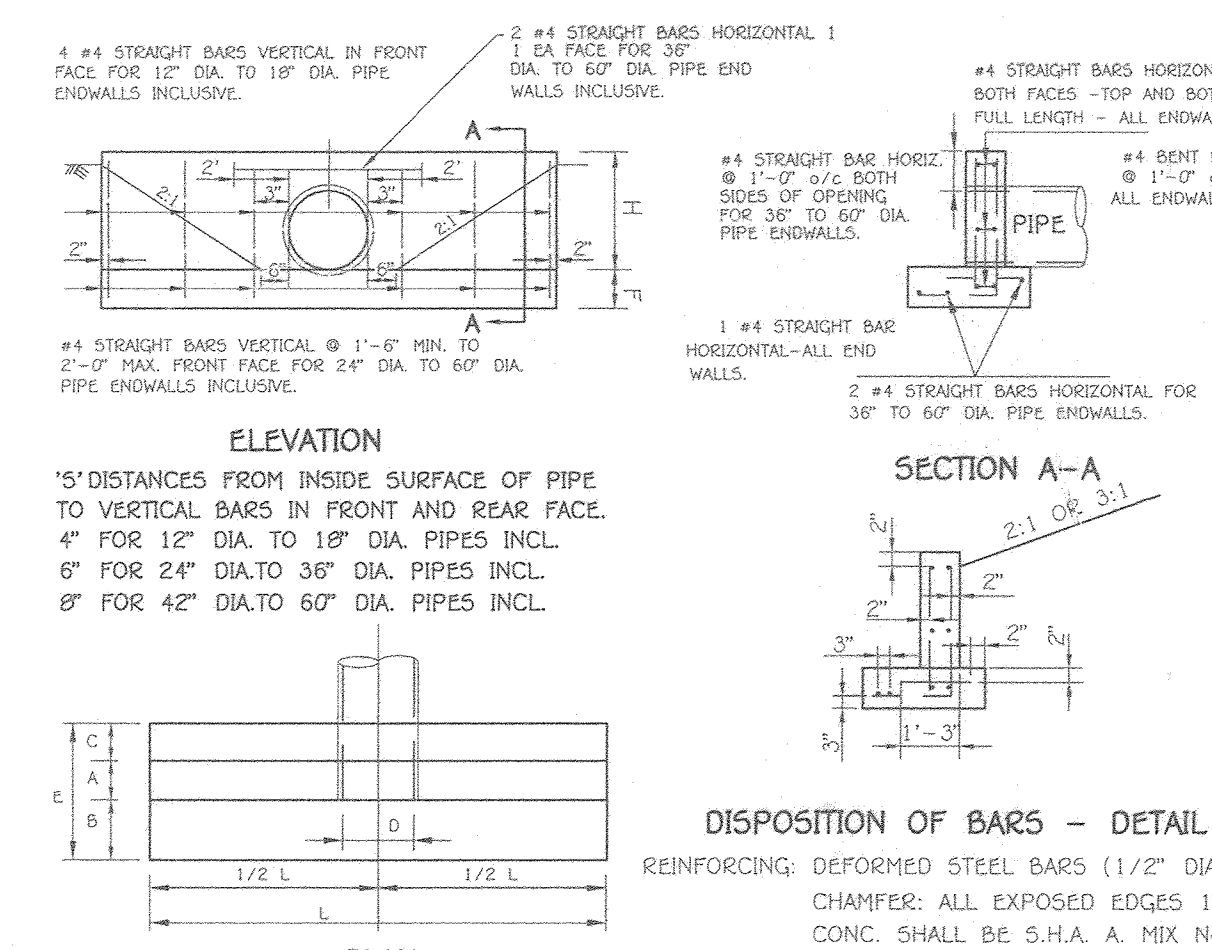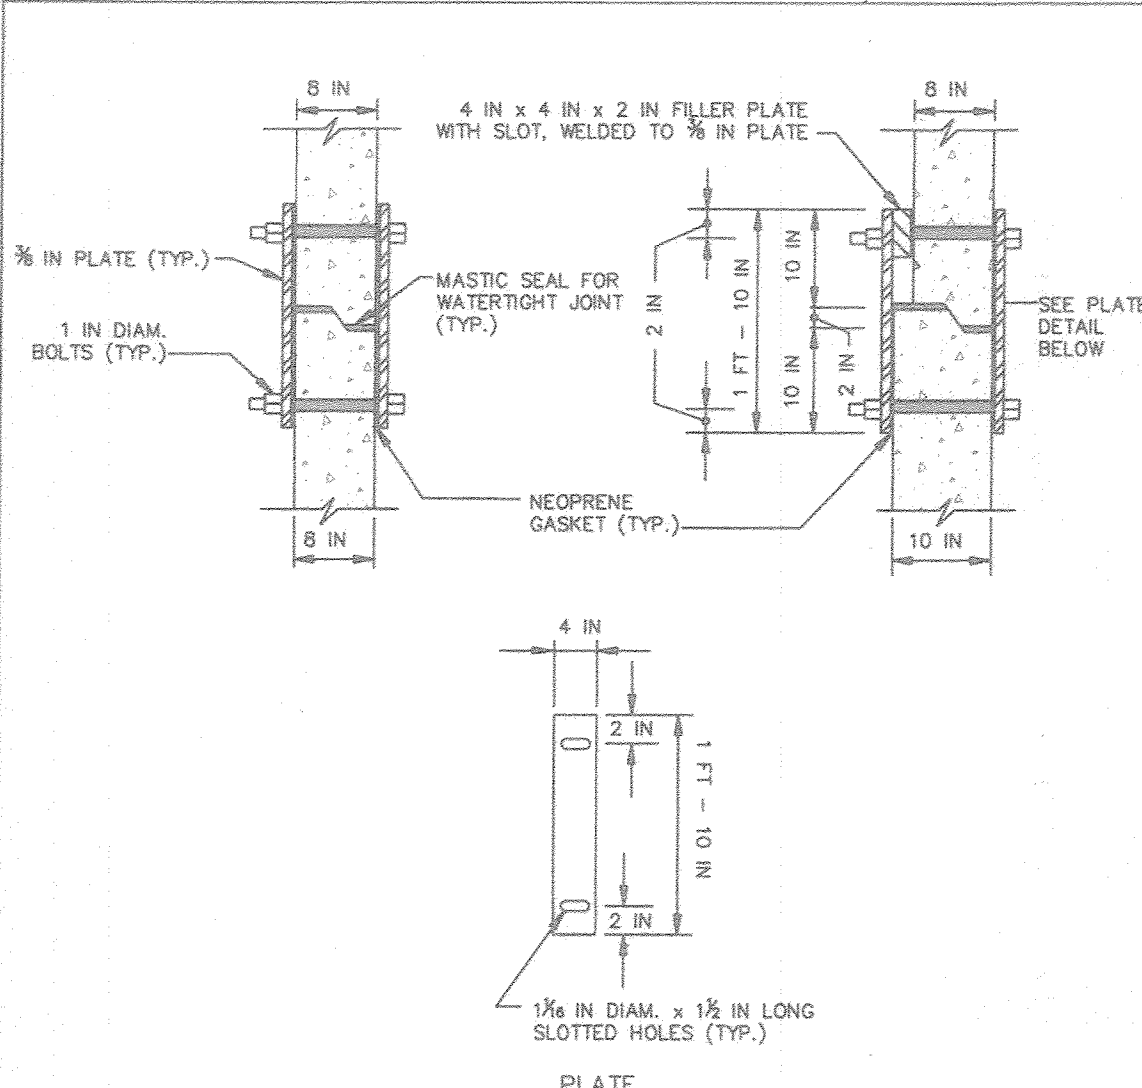

OPENINGS	DIMENSIONS								VOLUME CONC. C.Y.	STEEL LBS.
	D	A	B	C	E	F	H	L		
HW-1	18"	17"	9"	6"	1'-9"	9"	2'-3"	9'-0"	0.95	54
HW-2	36"	7.07'	12"	16"	10'	3'-2"	12'	4'-0"	4.16	182

- CONSTRUCTION SPECIFICATIONS**
- FABRICATE PLATE CONNECTORS FROM STAINLESS STEEL CONFORMING TO ASTM A666-72, GRADE A OR B.
 - USE TYPE 304 STAINLESS STEEL FOR BOLTS.
 - PROVIDE CONNECTORS AT CENTERLINE OF EACH PRECAST BOX FACE. FOR MANHOLES PROVIDE FOUR PLATES SPACED AT 90°.

MARYLAND STANDARDS AND SPECIFICATIONS FOR SOIL EROSION AND SEDIMENT CONTROL
 U.S. DEPARTMENT OF AGRICULTURE NATURAL RESOURCES CONSERVATION SERVICE 2011
 MARYLAND DEPARTMENT OF ENVIRONMENT WATER MANAGEMENT ADMINISTRATION

IN ADDITION TO THE ESD VOLUME MANAGEMENT, THIS POND PROVIDES 10, 100-YEAR AND QUANTITY MANAGEMENT FOR THE 2016 ELLICOTT CITY FLOOD STORM EVENT.

OWNER/DEVELOPER CERTIFICATION
 "I/we hereby certify that any clearing, grading construction, or development will be done pursuant to this approved erosion and sediment control plan, including inspecting and maintaining controls, and that the responsible person involved in the construction project will have a Certificate of Training at a Maryland Department of the Environment (MDE) approved training program for the control on erosion and sediment prior to beginning the project. I shall engage a Maryland registered professional engineer to supervise pond construction, and provide the Howard Soil Conservation District with an "As-Built" plan of the pond within 30 days of completion. I certify right-of-entry for periodic on-site evaluation by Howard County, Howard Soil Conservation District and/or MDE."

David Woessner
 5/26/2020

DESIGN CERTIFICATION
 "I hereby certify that this plan has been designed in accordance with current Maryland erosion and sediment control laws, regulations, and standards, that it represents a practical and workable plan based on my personal knowledge of the site, and that it was prepared in accordance with the requirements of the Howard Soil Conservation District. I have notified the owner that he/she must engage a registered professional engineer to supervise construction and provide the Howard Soil Conservation District with an "As-Built" plan of the pond within 30 days of completion."


Michael Vitale
 5/27/2020
 #20749
 MD Registration No. P.E., R.L.S., or R.L.A. (circle one)

PROFESSIONAL CERTIFICATION
 "I hereby certify that these documents were prepared or approved by me, and that I am a duly licensed professional engineer under the laws of the State of Maryland."
 Approved: Department of Planning And Zoning
 Chief, Division of Land Development
 Chief, Development Engineering Division
 Approved: Howard County Department of Public Works
 Chief, Bureau of Highways

REVISIONS

NO.	DESCRIPTION	DATE


TYPE 'C' ENDWALL

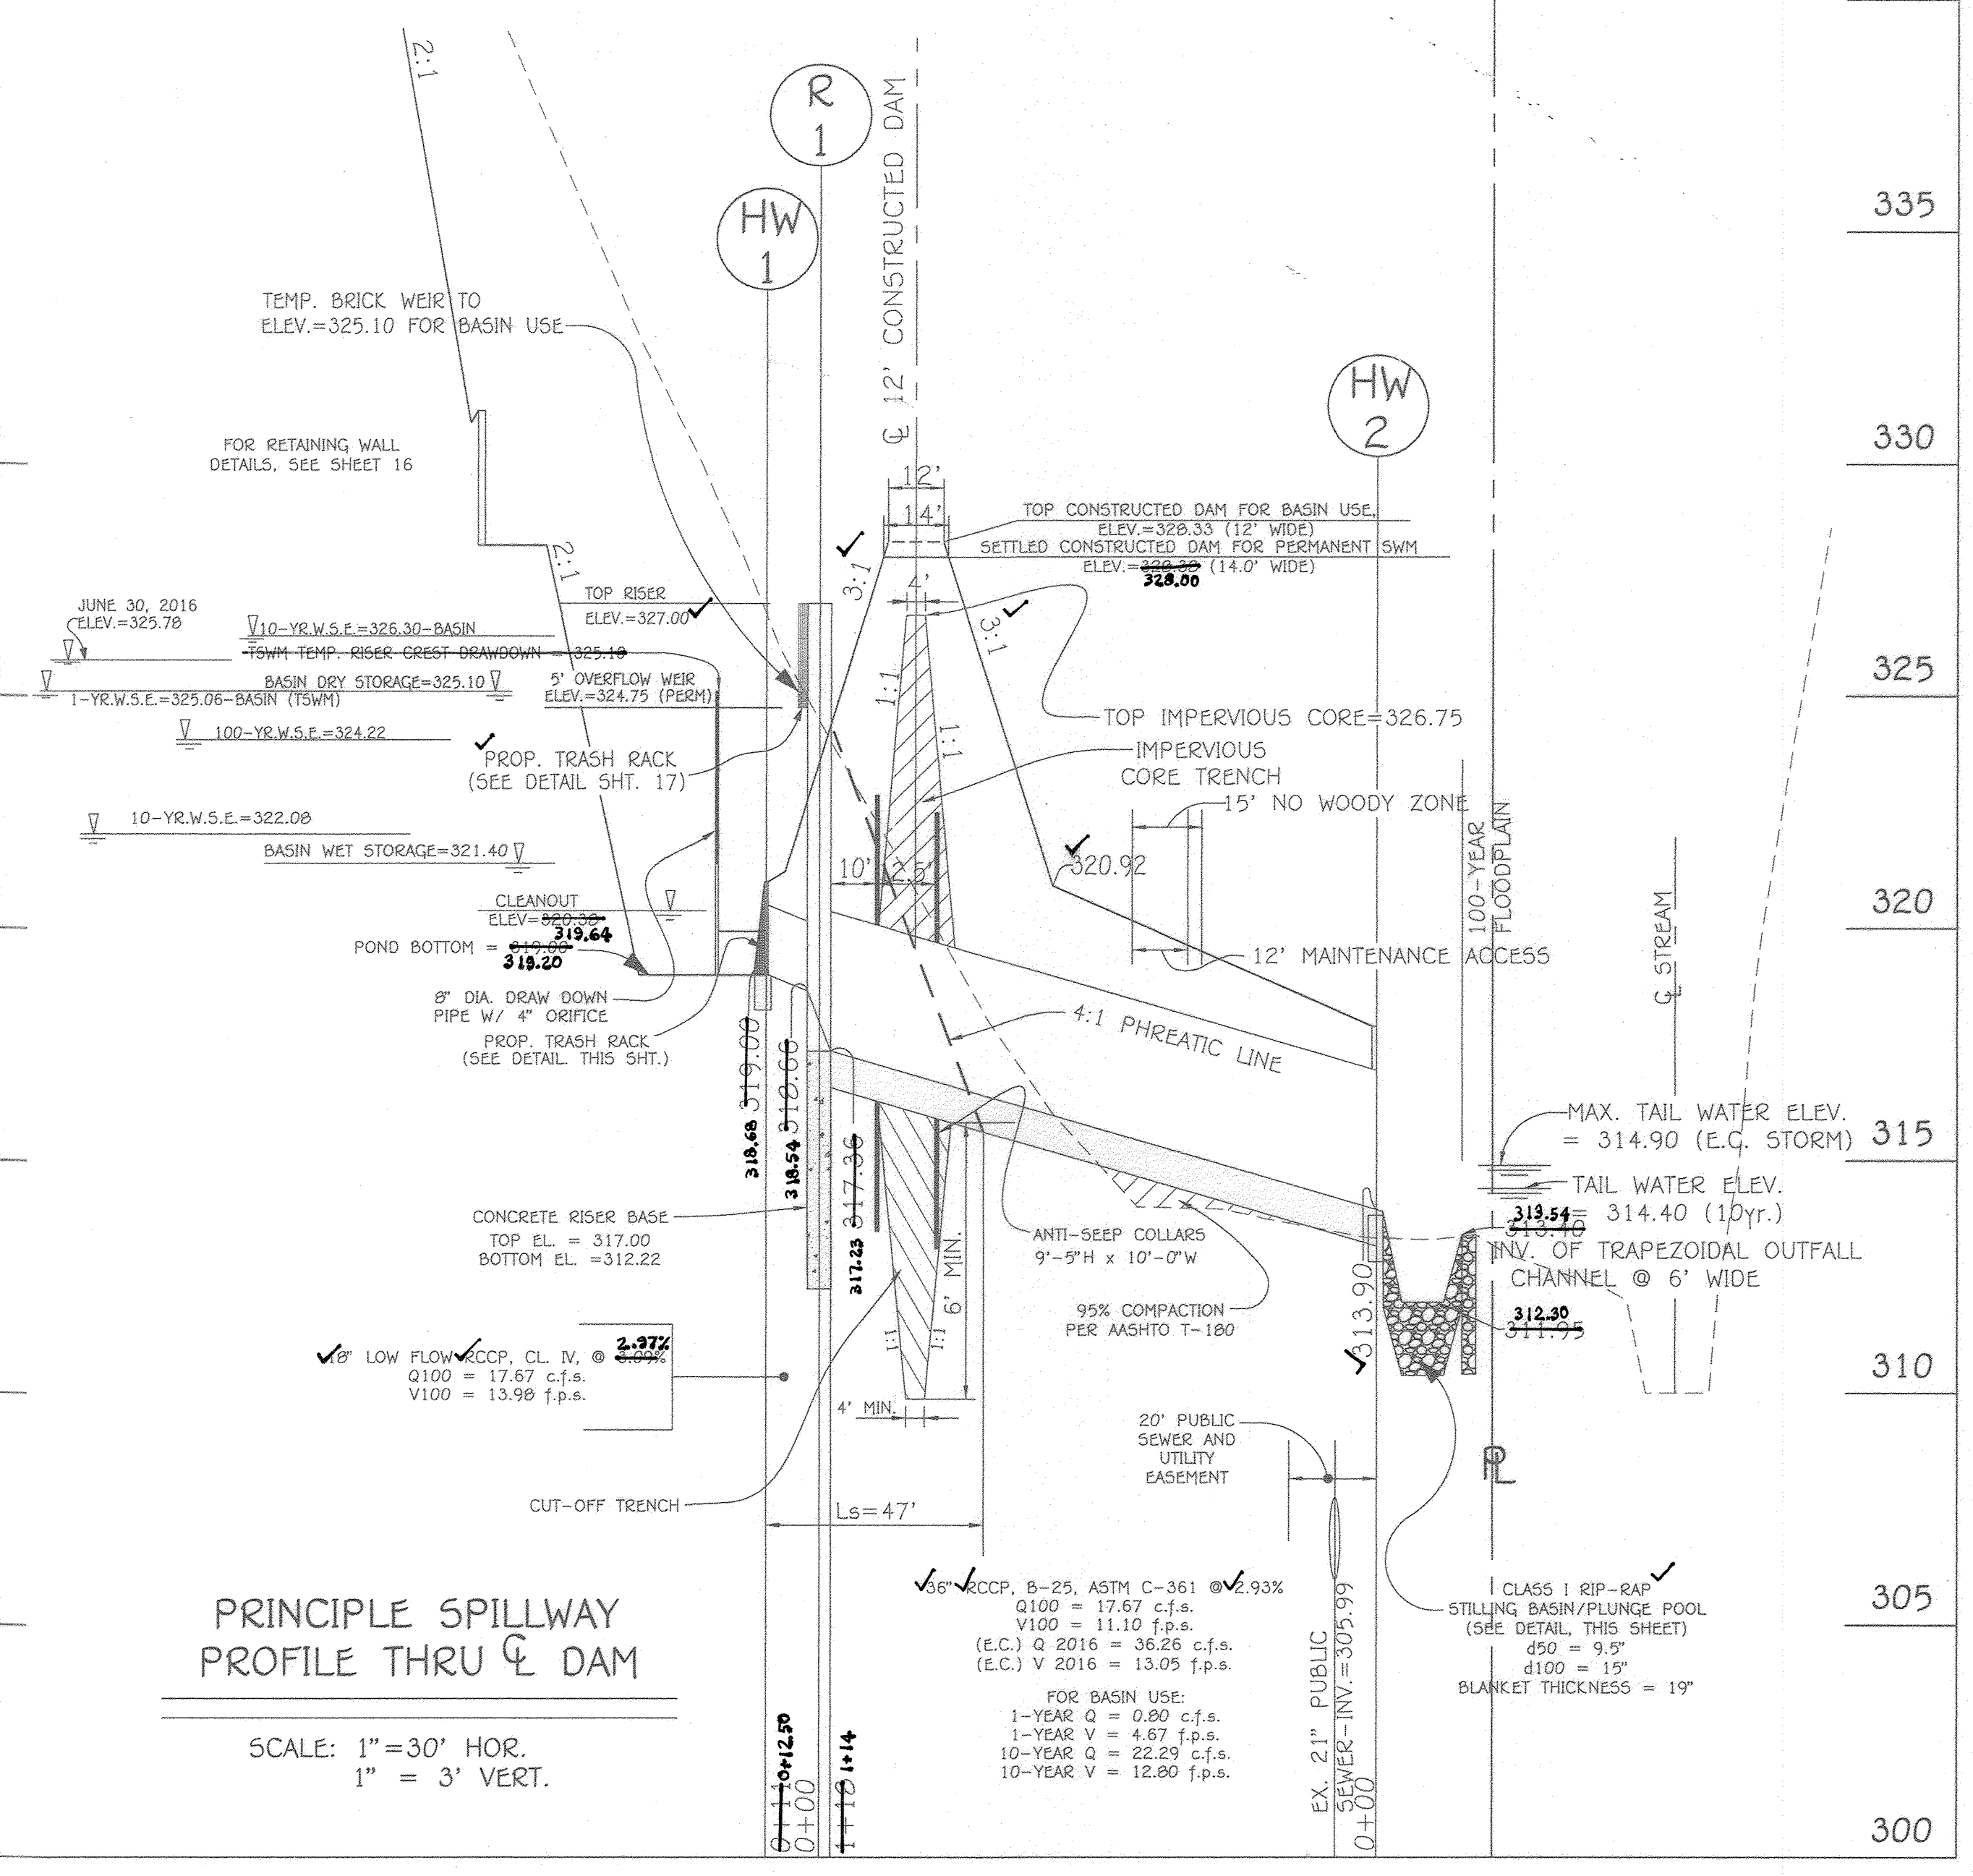

PRINCIPLE SPILLWAY PROFILE THRU & DAM

SCALE: 1" = 30' HOR.
 1" = 3' VERT.

FISHER, COLLINS & CARTER, INC.
 CIVIL ENGINEERING CONSULTANTS & LAND SURVEYORS
 CONFEDERAL SQUARE OFFICE PARK - 10272 BALTIMORE NATIONAL PIKE
 ELLICOTT CITY, MARYLAND 21142
 (410) 461-2855

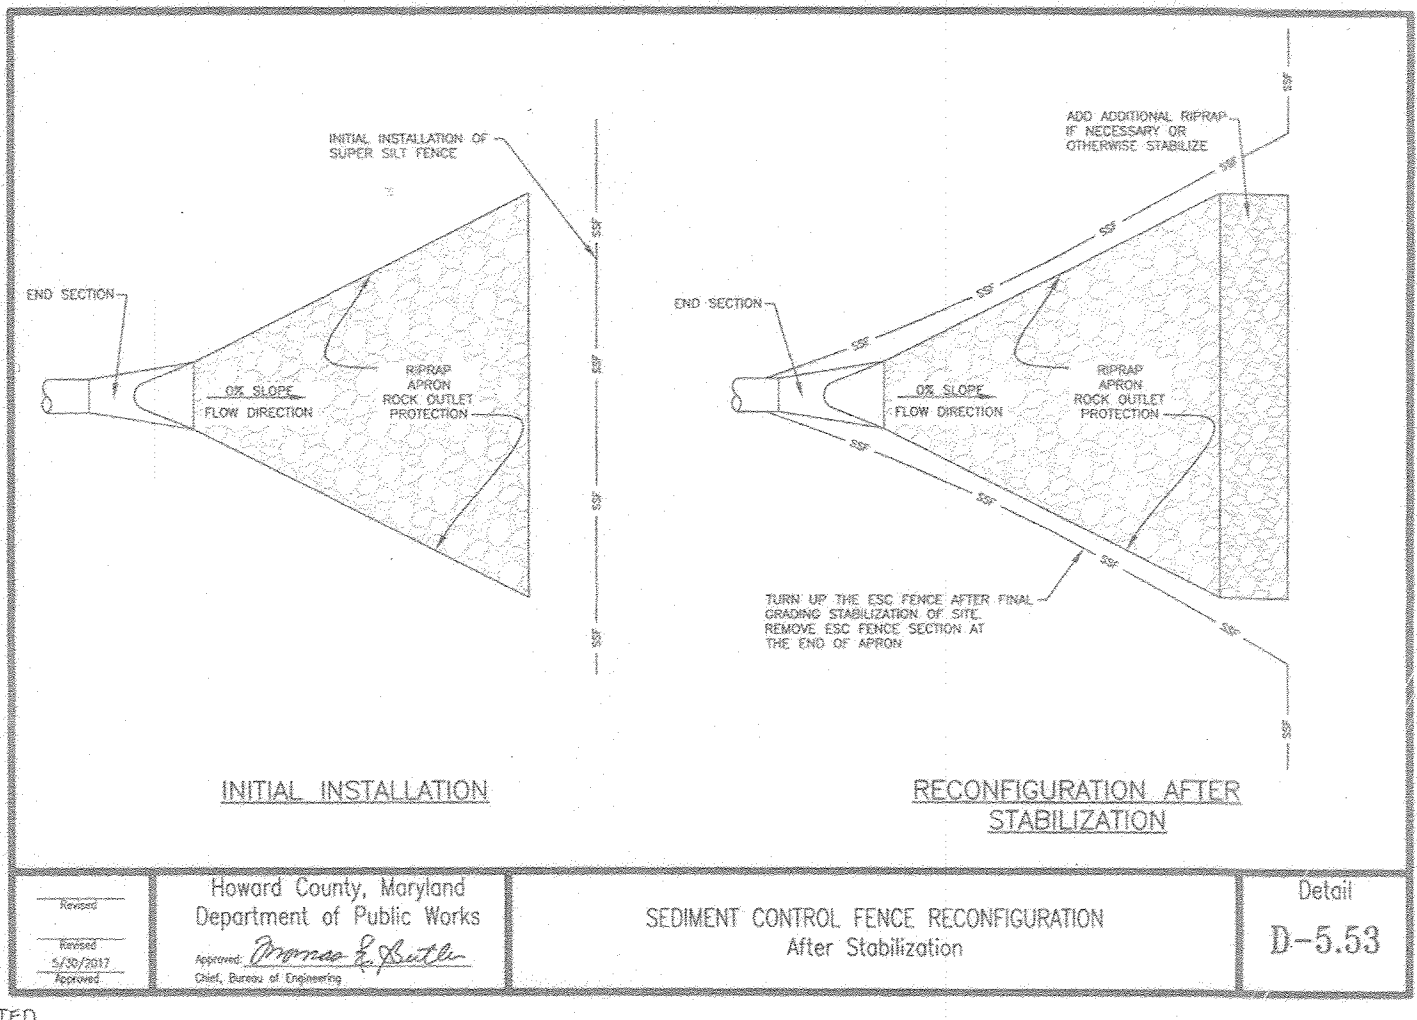


MARYLAND STANDARDS AND SPECIFICATIONS FOR SOIL EROSION AND SEDIMENT CONTROL
 U.S. DEPARTMENT OF AGRICULTURE NATURAL RESOURCES CONSERVATION SERVICE 2011
 MARYLAND DEPARTMENT OF ENVIRONMENT WATER MANAGEMENT ADMINISTRATION

OWNER/DEVELOPER
 DORSEY'S RIDGE, LLC
 C/O DAVE WOESSNER
 308 MAGOTHY ROAD
 SEVERNA PARK, MD 21146
 410-461-0837


DETAIL D-4-2 PLUNGE POOL

STANDARD SYMBOL

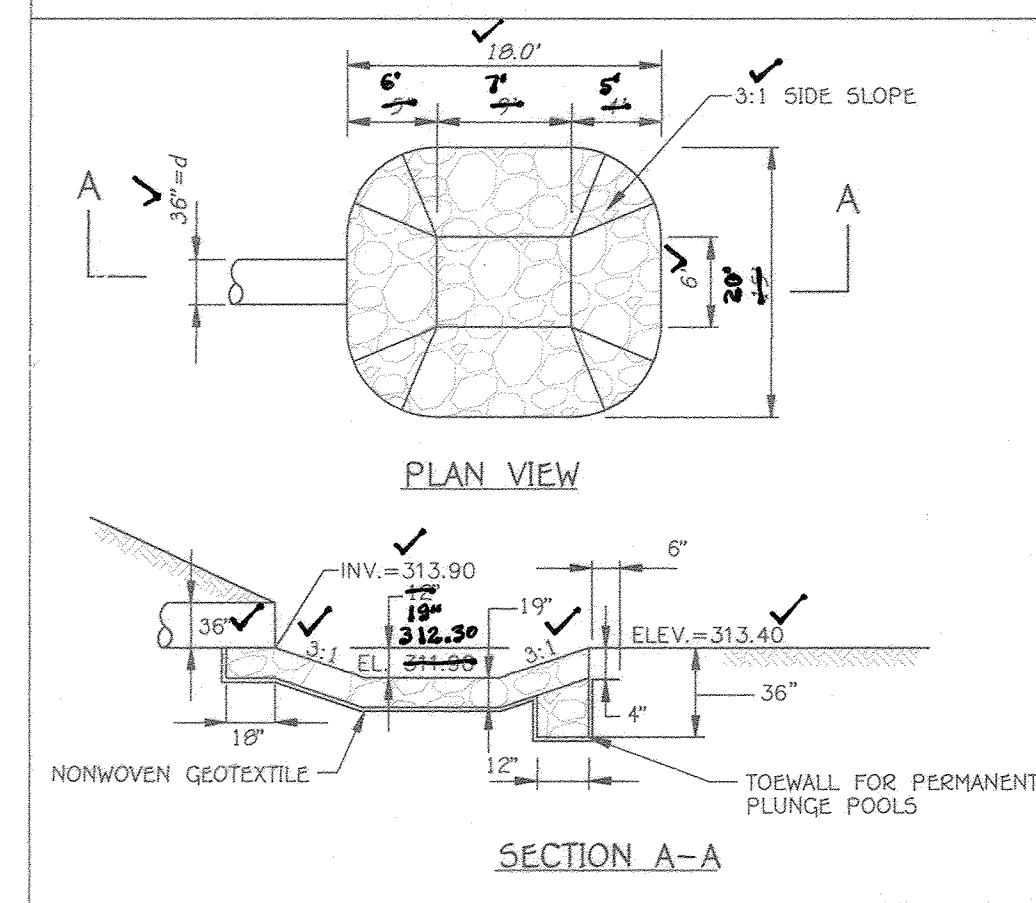

- CONSTRUCTION SPECIFICATIONS**
- USE CLASS 1 RIPRAP.
 - USE NONWOVEN GEOTEXTILE AS SPECIFIED IN SECTION H-1 MATERIALS, AND PROTECT FROM PUNCHING, CUTTING, OR TEARING. REPAIR ANY DAMAGE OTHER THAN AN OCCASIONAL SMALL HOLE BY PLACING ANOTHER PIECE OF GEOTEXTILE OVER THE DAMAGED PART OR BY COMPLETELY REPLACING THE GEOTEXTILE. PROVIDE A MINIMUM OF ONE FOOT OVERLAP FOR ALL REPAIRS AND FOR JOINING TWO PIECES OF GEOTEXTILE.
 - PREPARE THE SUBGRADE FOR THE PLUNGE POOL TO THE REQUIRED LINES AND GRADES. COMPACT ANY FILL REQUIRED IN THE SUBGRADE TO A DENSITY OF APPROXIMATELY THAT OF THE SURROUNDING UNDISTURBED MATERIAL.
 - EMBED THE GEOTEXTILE A MINIMUM OF 4 INCHES AND EXTEND THE GEOTEXTILE A MINIMUM OF 6 INCHES BEYOND THE EDGE OF THE SCOUR HOLE.
 - STONE FOR THE PLUNGE POOL MAY BE PLACED BY EQUIPMENT. CONSTRUCT TO THE FULL COURSE THICKNESS IN ONE OPERATION AND IN SUCH A MANNER AS TO AVOID DISPLACEMENT OF UNDERLYING MATERIALS. DELIVER AND PLACE THE STONE FOR THE PLUNGE POOL IN A MANNER THAT WILL ENSURE THAT IT IS REASONABLY HOMOGENEOUS WITH THE SMALLER STONES AND SPALLS FILLING THE VOIDS BETWEEN THE LARGER STONES. PLACE STONE FOR THE PLUNGE POOL IN A MANNER TO PREVENT DAMAGE TO THE GEOTEXTILE. HAND PLACE TO THE EXTENT NECESSARY.
 - AT THE PLUNGE POOL OUTLET, PLACE THE STONE SO THAT IT MEETS THE EXISTING GRADE.
 - MAINTAIN LINE, GRADE, AND CROSS SECTION. KEEP OUTLET FREE OF EROSION. REMOVE ACCUMULATED SEDIMENT AND DEBRIS. AFTER HIGH FLOWS INSPECT FOR SCOUR AND DISLODGED RIPRAP. MAKE NECESSARY REPAIRS IMMEDIATELY.

MARYLAND STANDARDS AND SPECIFICATIONS FOR SOIL EROSION AND SEDIMENT CONTROL
 U.S. DEPARTMENT OF AGRICULTURE NATURAL RESOURCES CONSERVATION SERVICE 2011
 MARYLAND DEPARTMENT OF ENVIRONMENT WATER MANAGEMENT ADMINISTRATION

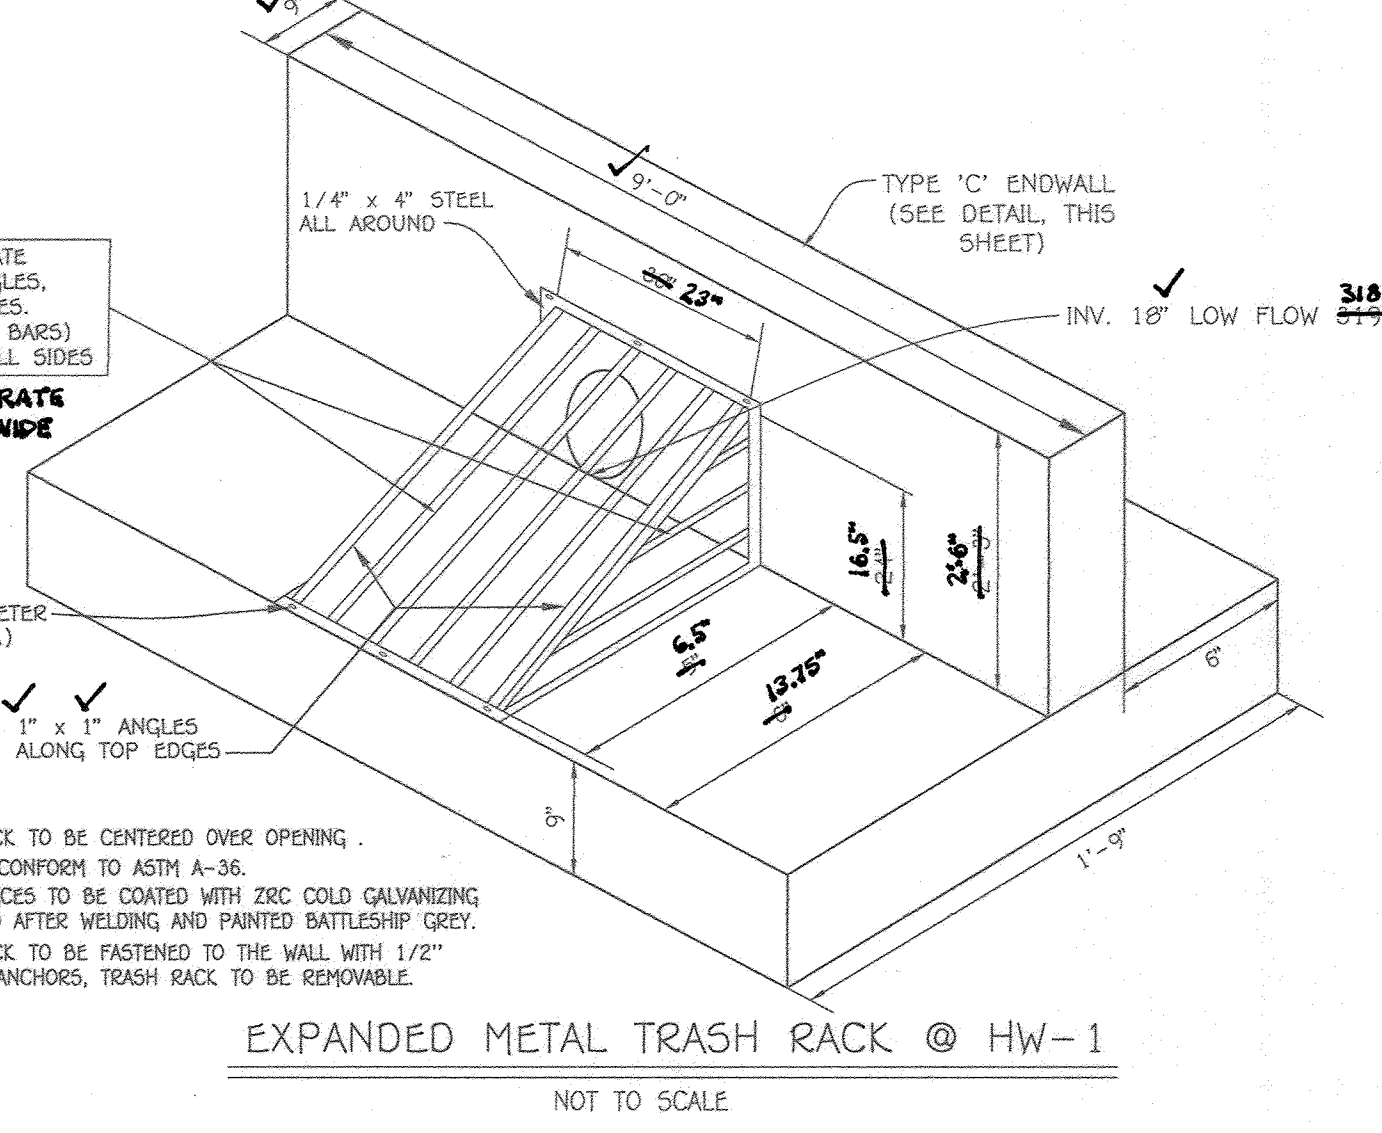


EXPANDED METAL TRASH RACK @ HW-1

- NOTES:**
- TRASH RACK TO BE CENTERED OVER OPENING.
 - STEEL TO CONFORM TO ASTM A-36.
 - ALL SURFACES TO BE COATED WITH ZINC COLD GALVANIZING COMPOUND AFTER WELDING AND PAINTED BATTLESHIP GREY.
 - TRASH RACK TO BE FASTENED TO THE WALL WITH 1/2" MASONRY ANCHORS, TRASH RACK TO BE REMOVABLE.


AS-BUILT CERTIFICATION
 I hereby certify, by my seal, that to the best of my knowledge and belief that the facilities shown on this plan were constructed as shown on this "AS-BUILT" plan, except the approved plans and specifications.

Paul Gerard Cavanaugh
 5/27/2020

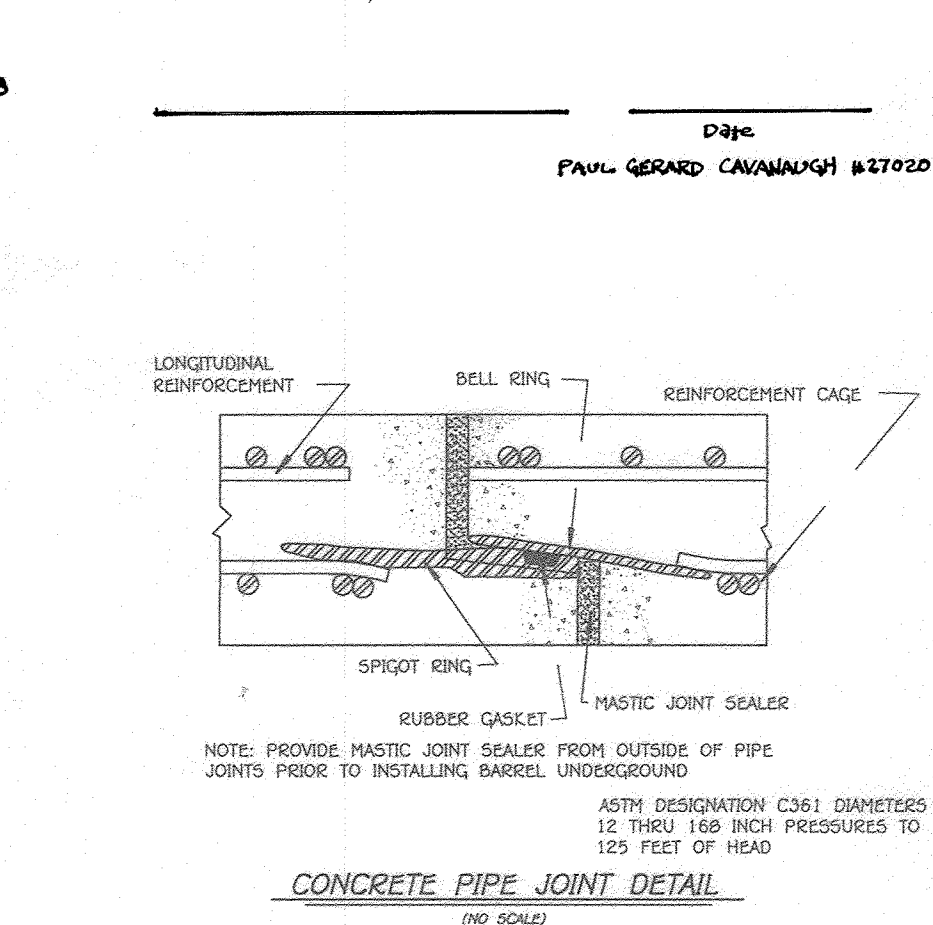

CONCRETE PIPE JOINT DETAIL


OPERATION AND MAINTENANCE
 An operation and maintenance plan in accordance with Local or State Regulations will be prepared for all ponds. As a minimum, the dam inspection checklist located in Appendix A shall be included as part of the operation and maintenance plan and performed at least annually. Written records of maintenance and major repairs needs to be retained in a file. The issuance of a Maintenance and Repair Permit for any repairs or maintenance that involves the modification of the dam or spillway from its original design and specifications is required. A permit is also required for any repairs or reconstruction that involve a substantial portion of the structure. All indicated repairs are to be made as soon as practical.

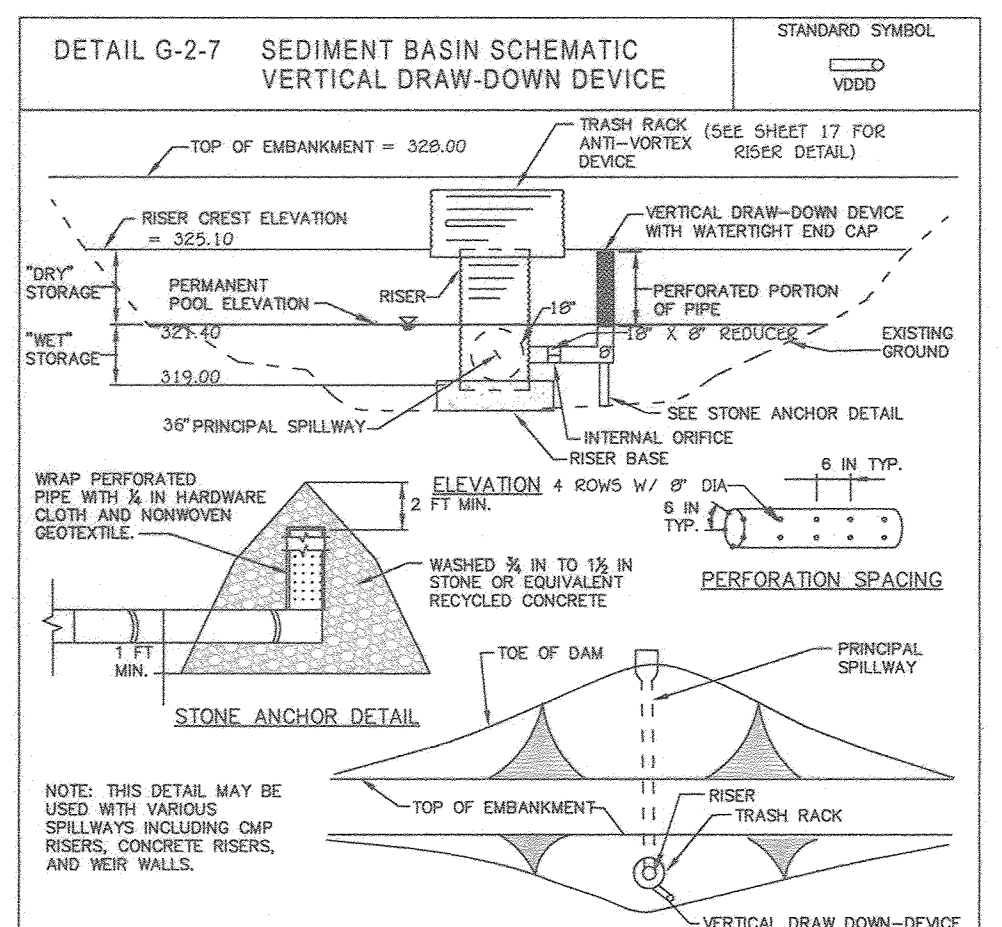

- CONSTRUCTION SPECIFICATIONS**
- PERFORATE PIPE WITH 1 INCH DIAMETER PERFORATIONS SPACED 6 INCHES APART LONGITUDINALLY AND RADIALLY OR IN ACCORDANCE WITH APPROVED PLAN.
 - DO NOT EXTEND PERFORATIONS IN THE DRAW-DOWN DEVICE INTO NET STORAGE.
 - WRAP THE PERFORATED PORTION OF THE DRAW-DOWN DEVICE FIRST WITH 1/8 INCH GALVANIZED HARDWARE CLOTH, THEN WITH NONWOVEN GEOTEXTILE. USE NONWOVEN GEOTEXTILE AS SPECIFIED IN SECTION H-1 MATERIALS. DO NOT WRAP WITH MORE THAN ONE LAYER OF GEOTEXTILE.
 - AS AN ALTERNATE TO STONE ANCHORING, SECURE DRAW-DOWN DEVICE WITH TWO 1 INCH STEEL ANCHORS SET 3 FEET MINIMUM INTO THE GROUND ATTACHED TO DRAW-DOWN DEVICE BY A 1 INCH RISE GALVANIZED STEEL STRAP OR 12 GAUGE OR HEAVIER WIRE.
 - REMOVE SEDIMENT WHEN IT ACCUMULATES TO CLEANOUT ELEVATION (SOIL OF THE NET STORAGE DEPTH). DEPOSIT REMOVED SEDIMENT IN AN APPROVED AREA IN A SUCH A MANNER THAT IT WILL NOT CROSS MAINTAIN WATER TIGHT CONNECTIONS. REPLACE GEOTEXTILE AROUND PERFORATED RISER IF DRY STORAGE VOLUME DOES NOT DRAW DOWN WITHIN 10 HOURS.

PROFESSIONAL CERTIFICATION
 I HEREBY CERTIFY THAT THESE DOCUMENTS WERE PREPARED OR APPROVED BY ME, AND THAT I AM A DULY LICENSED PROFESSIONAL ENGINEER UNDER THE LAWS OF THE STATE OF MARYLAND, LICENSE NO. 20748, EXPIRATION DATE: 02/22/2021.

Michael Vitale
 5/27/2020

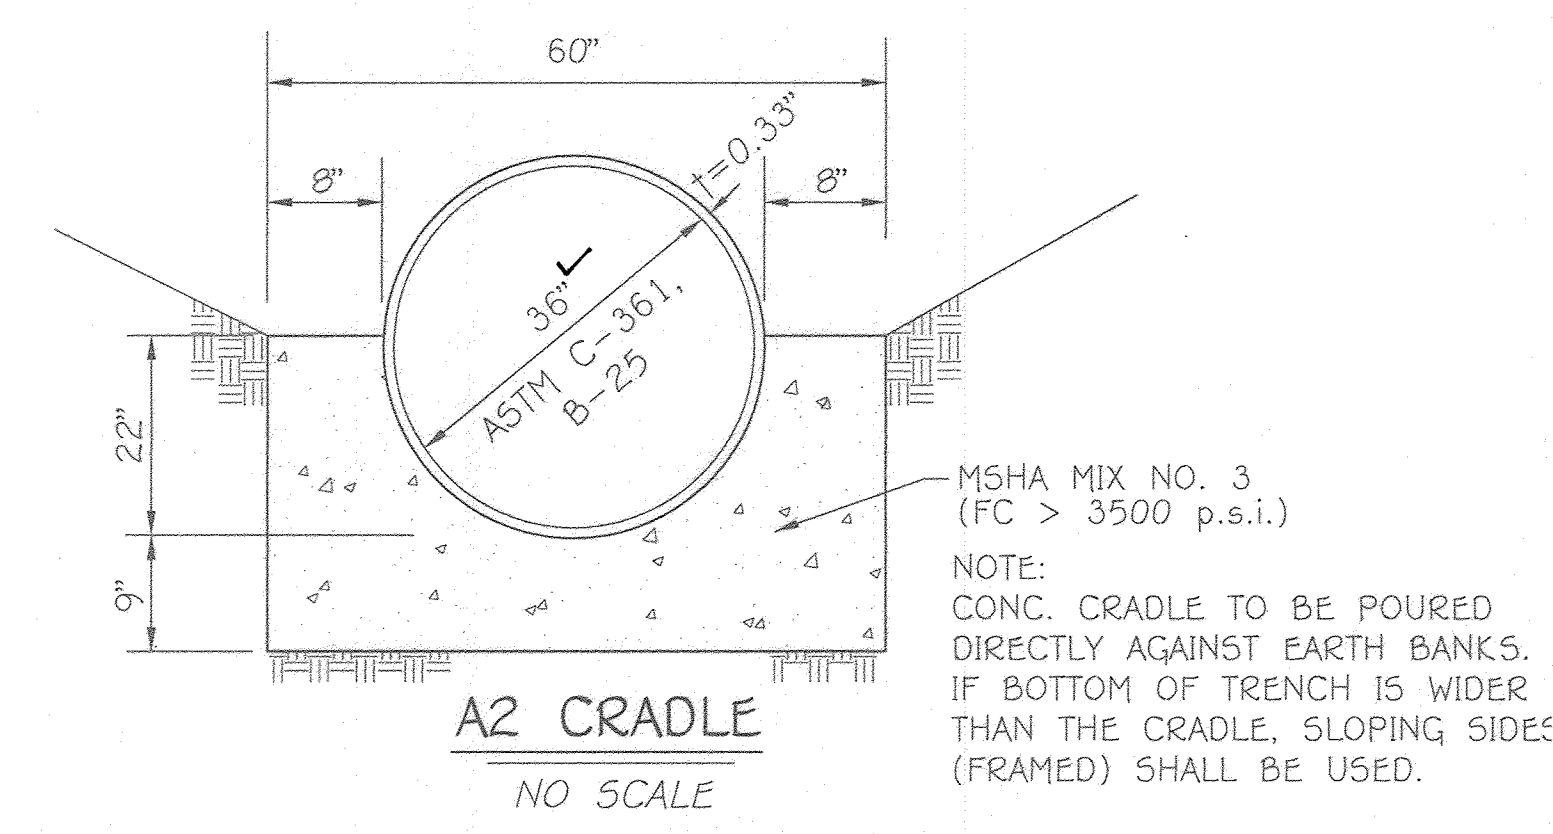

SWM NOTES AND DETAILS

DORSEY'S RIDGE
 PHASE-1
 LOTS 1 THRU 4, OPEN SPACE LOTS 5 THRU 8, & NON-BUILDABLE BULK PARCELS A THRU F
 A RESUBDIVISION OF "WILHIE PROPERTY, LOT 1, 2 & 3", PLAT NO. 18442
 ZONED: CEF-R
 TAX MAP NO.: 24 GRID NO.: 18 PARCEL NO.: 260 LOTS: 1 THRU 3
 SECOND ELECTION DISTRICT HOWARD COUNTY, MARYLAND
 SCALE: AS SHOWN DATE: MAY, 2020
 SHEET 18 OF 18