

SHEET INDEX	
SHEET No.	DESCRIPTION
1	TITLE SHEET
2	HERITAGE RIDGE ROAD - PLAN AND PROFILE
3	ROADWAY DETAILS
4-5	STREET TREE, GRADING AND SEDIMENT CONTROL PLAN
6-7	SEDIMENT CONTROL NOTES & DETAILS
8-9	LANDSCAPE PLAN
10	LANDSCAPE NOTES & DETAILS
11-17	STORMWATER MANAGEMENT NOTES AND DETAILS
18	PRIVATE STORMWATER MANAGEMENT DETAILS
19-20	STORM DRAIN PROFILES
21	STORM DRAIN DRAINAGE AREA MAP & SOILS MAP
22-23	SWM DRAINAGE AREA MAP
24	GRADING & SEDIMENT CONTROL PLAN


STORMWATER MANAGEMENT PRACTICES				
LOT No.	MICRO-BIO-RETENTION (M-8)	DRY WELL (M-9)	SOFTTOP DISCONNECTION (N-1)	NON-ROOFTOP DISCONNECTION (N-2)
24	-	3	-	-
25	-	3	-	-
26	-	3	-	YES
27	-	2	-	YES
28	-	2	-	YES
29	-	3	-	YES
30	-	3	-	-
31	-	3	-	YES
32	-	3	-	YES
33	-	3	-	YES
34	-	3	-	YES
35	-	3	-	YES
36	-	3	-	YES
37	-	2	-	YES
38	-	2	-	YES
39	-	2	-	YES
40	-	2	-	YES
41	-	2	-	YES
42	-	4	YES	YES
43	-	2	YES	YES
44	-	2	YES	YES

ROADWAY INFORMATION CHART				
ROAD NAME	CLASSIFICATION	DESIGN SPEED	POSTED SPEED LIMIT	R/W WIDTH
EMBERLYS WAY	PRIVATE USE-IN-COMMON	25 M.P.H.	---	36' EASE.
HERITAGE RIDGE ROAD	PUBLIC ACCESS STREET	30 M.P.H.	25 M.P.H.	50'

TRAFFIC CONTROL SIGNS				
ROAD NAME	CENTERLINE STA.	OFFSET	POSTED SIGN	SIGN CODE
KIMBERLYS WAY	0+20	13'L	STOP	R1-1

NOTE: SEE SHEET 2 FOR "NO PARKING" SIGN LOCATIONS ALONG HERITAGE RIDGE.
5 TOTAL (R7-1) & 4 TOTAL (R7-111)

AS-BUILT SURVEY NOTE:
THE INSTRUMENTS USED IN PERFORMING AS-BUILT SURVEY: 10 SECOND ROBOTIC TOTAL STATION & PRISM

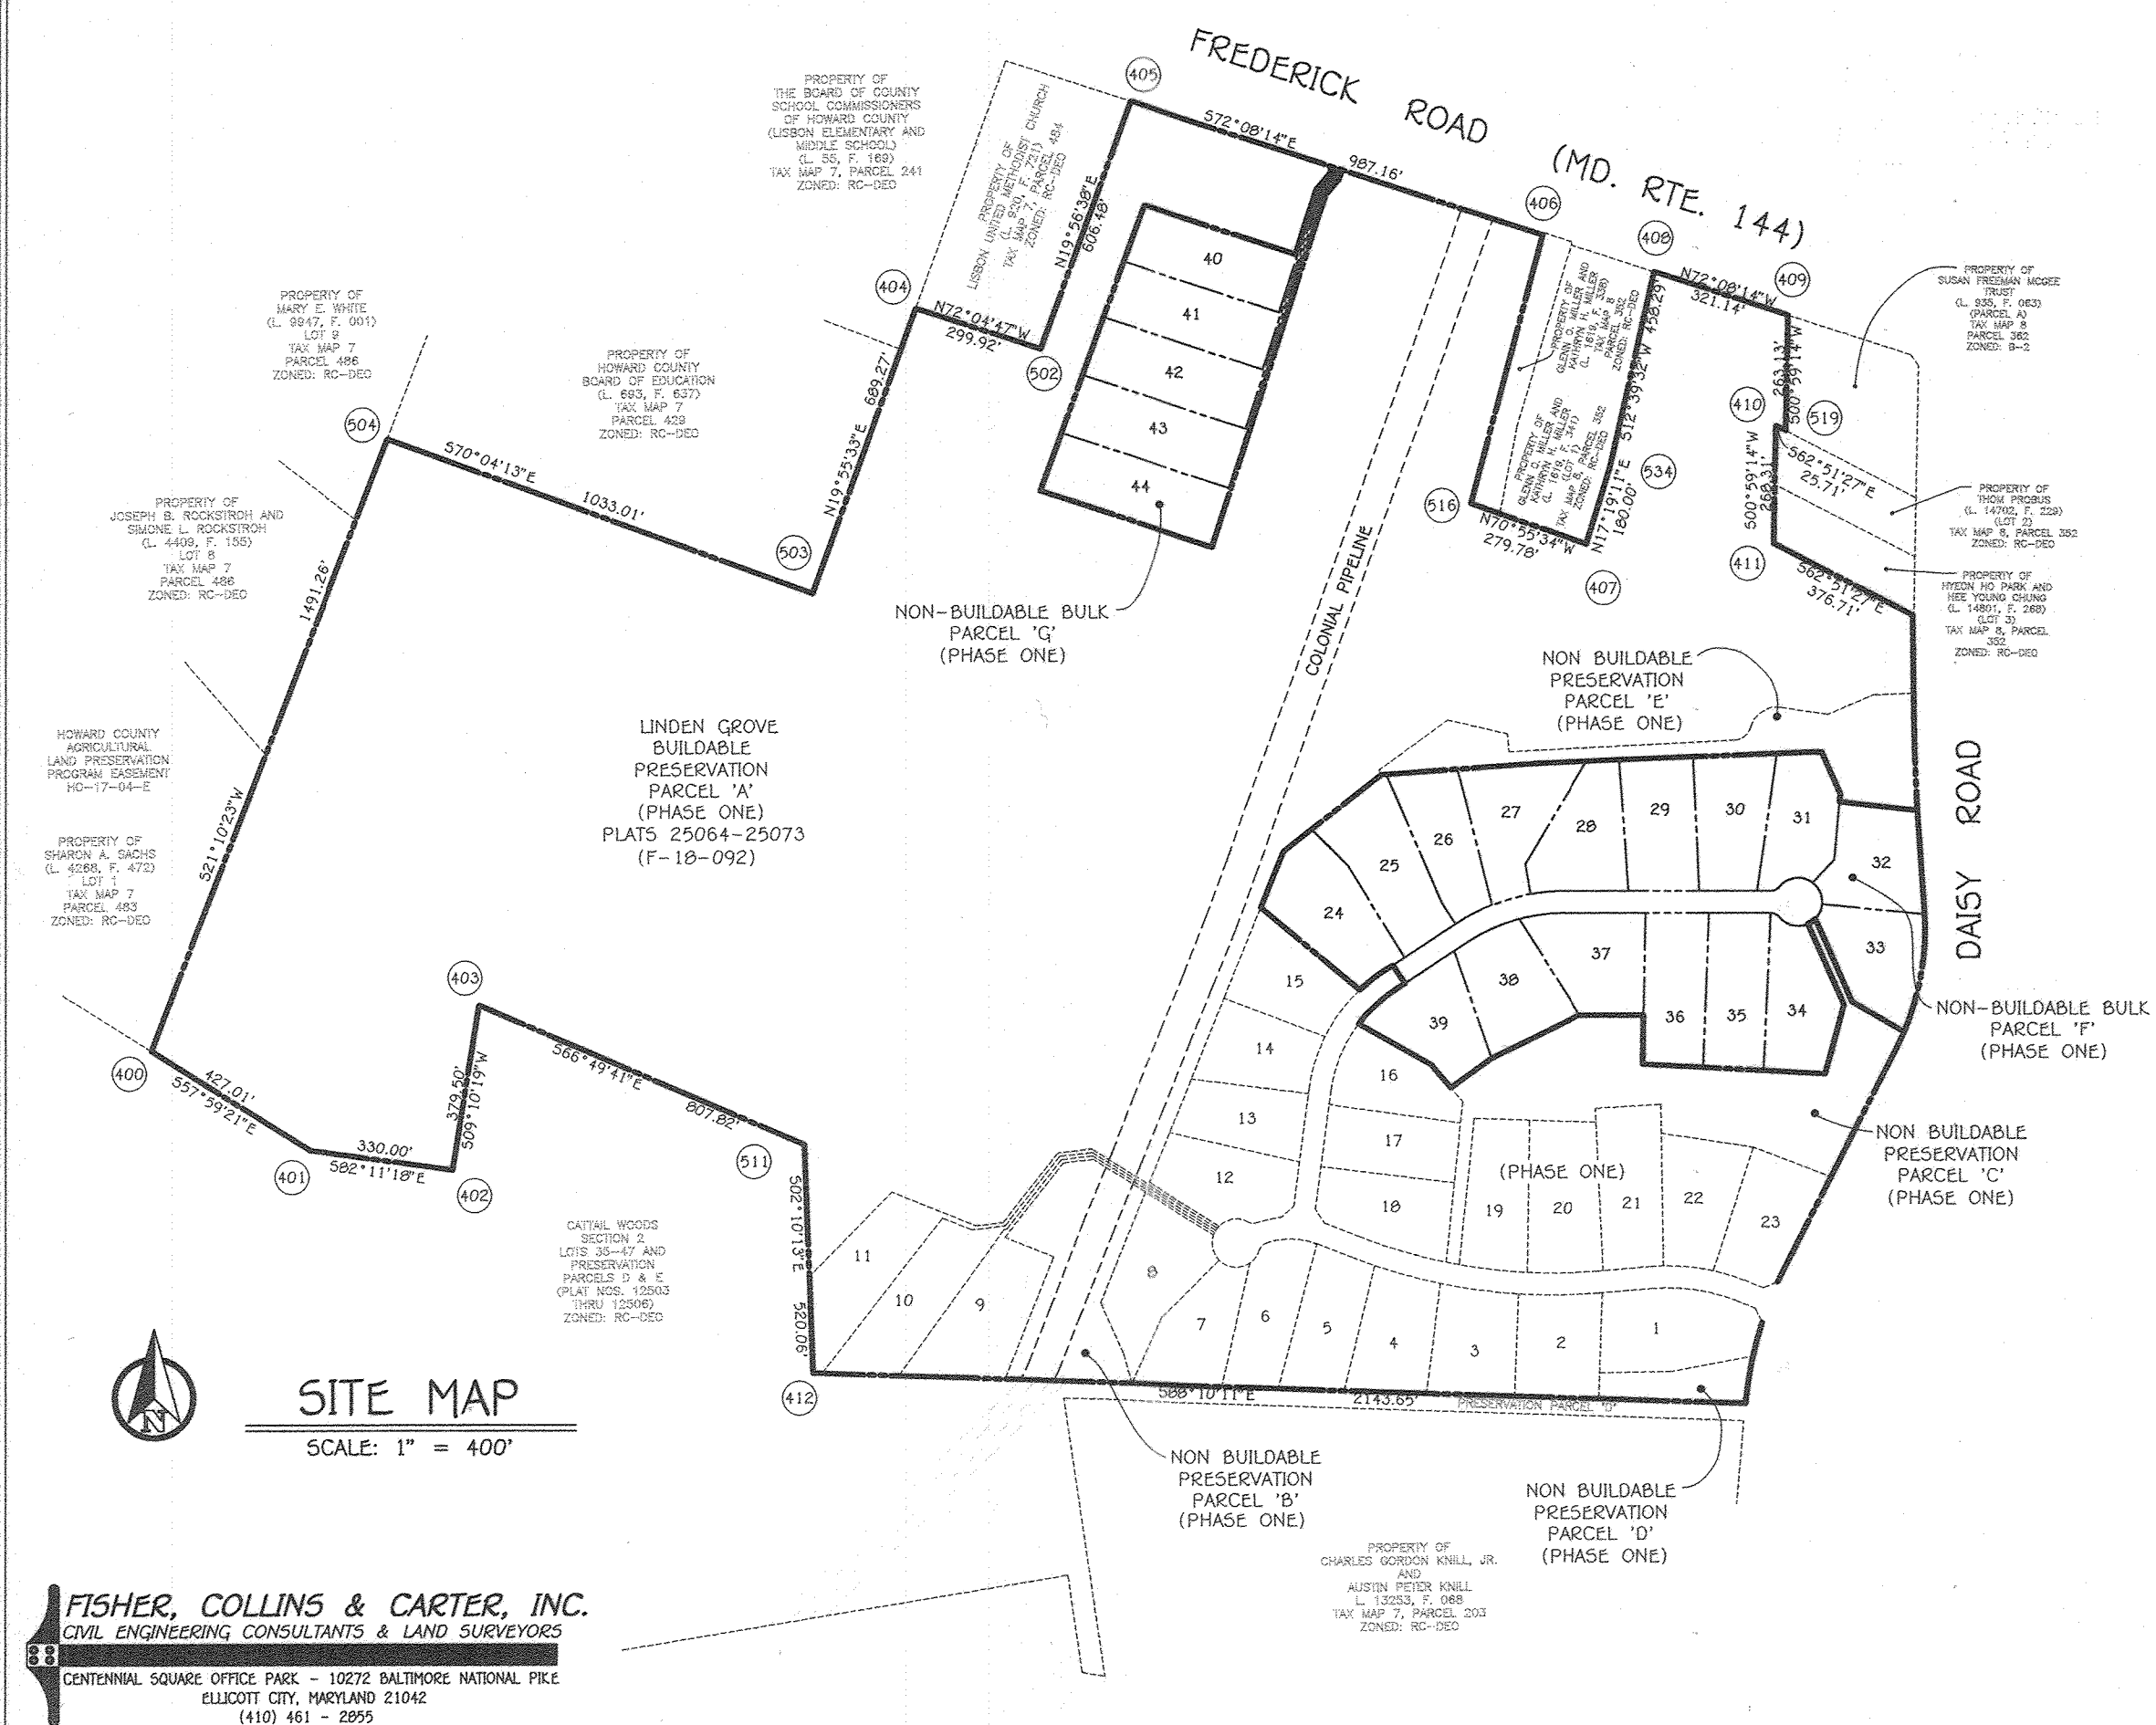

FINAL ROAD CONSTRUCTION, GRADING AND STORMWATER MANAGEMENT PLAN


LINDEN GROVE PHASE TWO

LOTS 24 THRU 44

(A Resubdivision of Non-Buildable Bulk Parcels 'F' & 'G', Recorded As "Linden Grove, Phase One, Lots 1 Thru 23, Buildable Preservation Parcel 'A', Non-Buildable Preservation Parcels 'B' Thru 'E' And Non-Buildable Bulk Parcels 'F' And 'G', Plat Nos. 25064 Thru 25073.)

ZONED: RC-DEO

TAX MAP No. 8 GRID No. 7 PARCEL No. 5


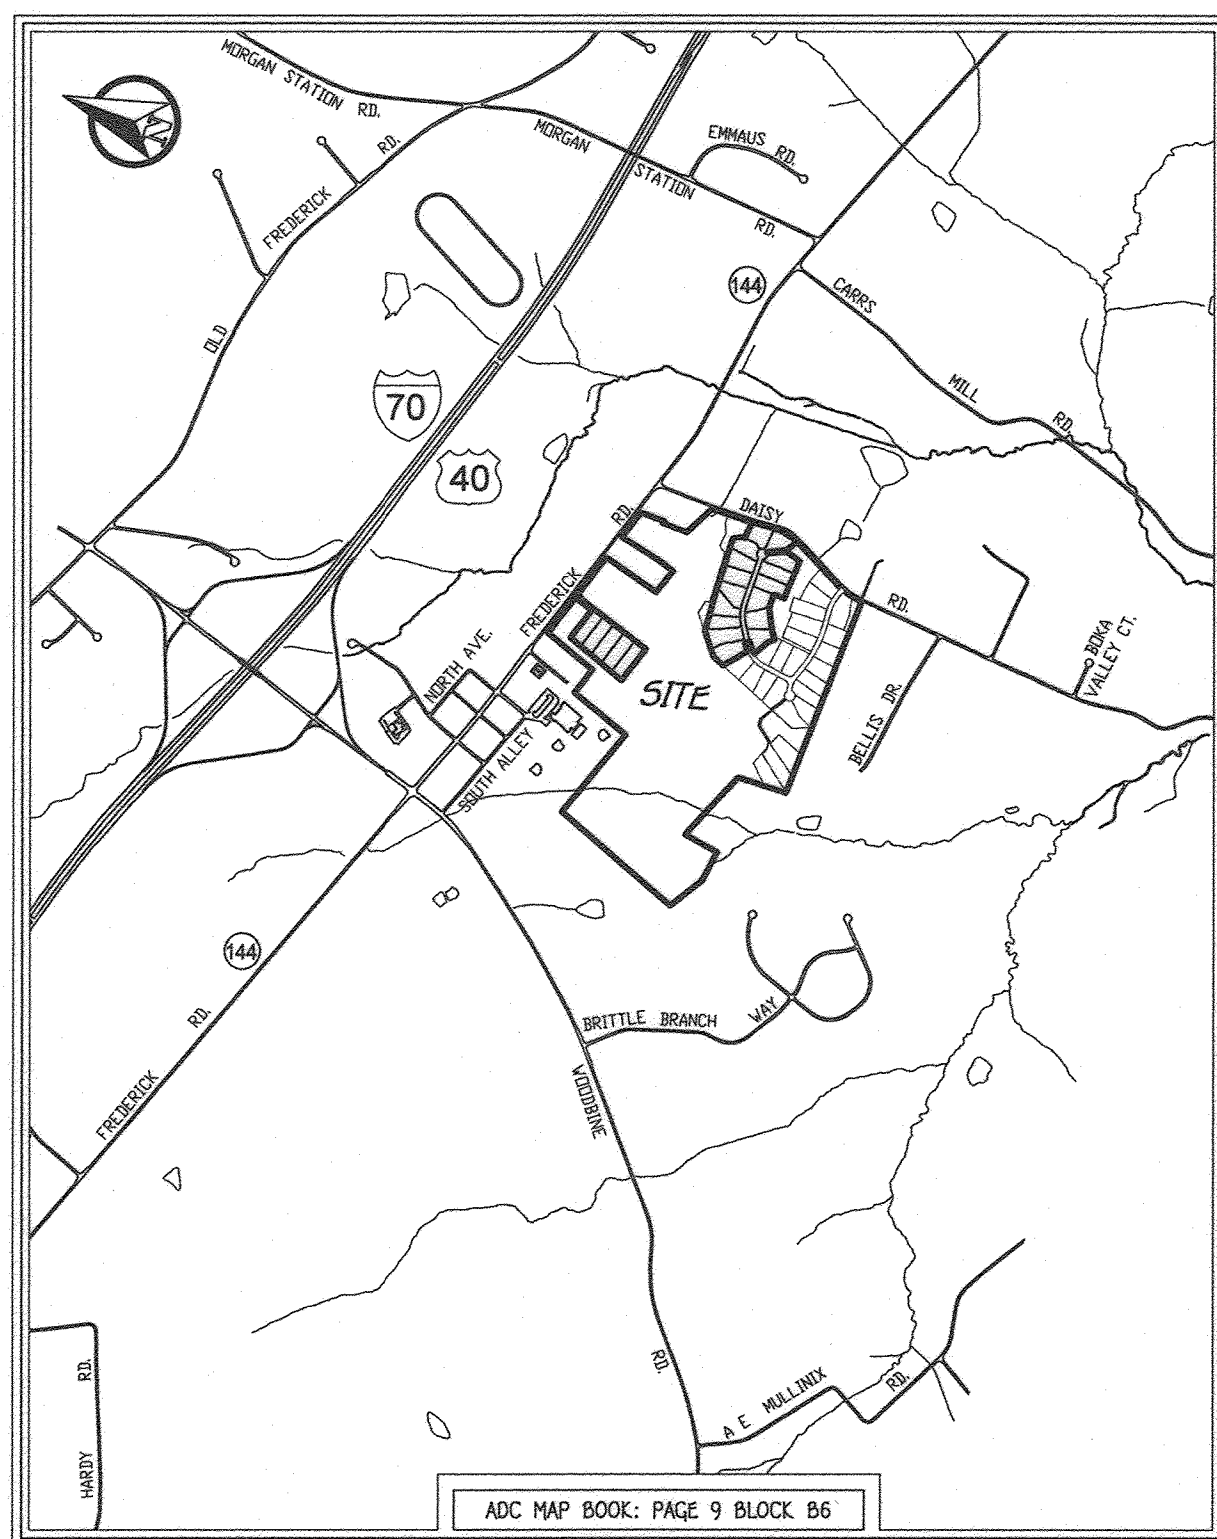


4th ELECTION DISTRICT HOWARD COUNTY, MARYLAND

DENSITY TABULATION (PHASE ONE & TWO)

- TRACT AREA = 176.680 ACRES
- FLOODPLAIN AREA = 6.204 ACRES
- STEEP SLOPES AREA = 0.60 ACRES
- NET TRACT AREA = 169.876 ACRES
- 176.680 AC. = 6.204 AC. = 0.80 AC.
- DENSITY ALLOWED BY MATTER OF RIGHT: 176.680 ACRES X 1 DWELLING UNIT/4.25 ACRES = 41.57 or 41 SINGLE FAMILY DETACHED UNITS.
- DENSITY ALLOWED WITH DENSITY EXCHANGE OPTION = 64 SINGLE FAMILY UNITS (1 DWELLING UNIT / 2.5 NET ACRES = 169.876 NET ACRES)
- TOTAL NUMBER OF PROPOSED DWELLING UNITS = 45 UNITS (23 UNITS IN PHASE ONE) (144 CLUSTER LOTS + 1 BUILDABLE PRESERVATION PARCEL)
- DEVELOPMENT RIGHTS WILL BE TRANSFERRED TO THIS SUBDIVISION PURSUANT TO THE DENSITY TRANSFER PROVISION OF SECTION 106.0 OF THE ZONING REGULATIONS FOR THIS PROPERTIES UNDERLYING RC ZONING DISTRICT.
- (45 PROPOSED DWELLING UNITS - 41 BASE DENSITY / RIGHT = 4 DEVELOPMENT RIGHTS ARE REQUIRED TO BE TRANSFERRED WITH THIS PHASE TWO SUBMISSION.

AS-BUILT SURVEY NOTE:
THE INSTRUMENTS USED IN PERFORMING AS-BUILT SURVEY: 10 SECOND ROBOTIC TOTAL STATION & PRISM

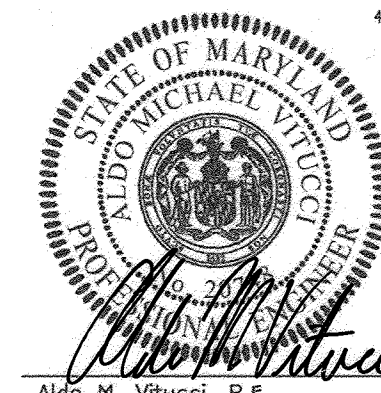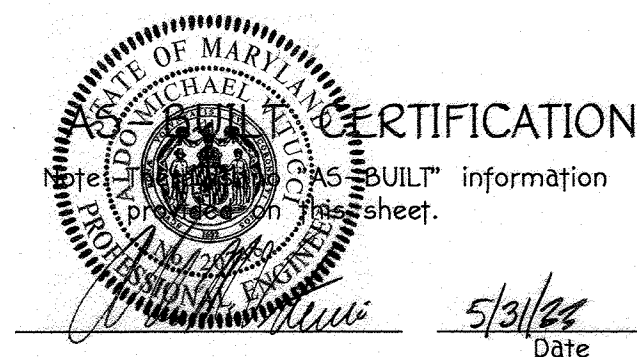

OWNER:
KIMBERLY/HERITAGE LLC
3425 HIRSELEY HILL ROAD
WOODBINE, MARYLAND 21797-7615
410-489-7900

DEVELOPER:
HERITAGE LAND DEVELOPMENT
15950 NORTH AVENUE
LISBON, MARYLAND 21765
410-489-7900

APPROVED: DEPARTMENT OF PUBLIC WORKS		
<i>[Signature]</i>	10/19/2020	
CHIEF, BUREAU OF HIGHWAYS MK	DATE	
APPROVED: DEPARTMENT OF PLANNING AND ZONING		
<i>[Signature]</i>	11/1/20	
CHIEF, DIVISION OF LAND DEVELOPMENT	DATE	
<i>[Signature]</i>	10/27/20	
CHIEF, DEVELOPMENT ENGINEERING DIVISION	DATE	
REVISIONS		
NO.	DESCRIPTION	DATE
1	To show type grading and SWM details	8/5/21

GENERAL NOTES:

- ALL CONSTRUCTION SHALL BE IN ACCORDANCE WITH THE LATEST STANDARDS AND SPECIFICATIONS OF HOWARD COUNTY PLUS MSHA STANDARDS AND SPECIFICATIONS IF APPLICABLE.
- THE CONTRACTOR SHALL NOTIFY THE DEPARTMENT OF PUBLIC WORKS, BUREAU OF ENGINEERING, CONSTRUCTION INSPECTION DIVISION AT (410) 313-1880 AT LEAST (5) WORKING DAYS PRIOR TO THE START OF WORK.
- THE CONTRACTOR SHALL NOTIFY "MISS UTILITY" AT 1-800-257-7777 AT LEAST 48 HOURS PRIOR TO ANY EXCAVATION WORK BEING DONE.
- TRAFFIC CONTROL DEVICES:
 - THE R-1 (STOP) SIGN AND THE STREET SIGN (S)S) ASSEMBLY FOR THIS DEVELOPMENT MUST BE INSTALLED BEFORE THE BASE FINISH IS COMPLETED.
 - ALL TRAFFIC CONTROL DEVICES AND THEIR LOCATIONS SHOWN ON THIS PLAN ARE APPROXIMATE AND MUST BE FIELD APPROVED BY HOWARD COUNTY TRAFFIC DIVISION (410-313-2430) PRIOR TO THE INSTALLATION OF ANY OF THE TRAFFIC CONTROL DEVICES.
 - ALL TRAFFIC CONTROL DEVICES AND THEIR LOCATIONS SHOWN ON THIS PLAN ARE APPROXIMATE AND MUST BE FIELD APPROVED BY HOWARD COUNTY TRAFFIC DIVISION (410-313-2430) PRIOR TO THE INSTALLATION OF ANY OF THE TRAFFIC CONTROL DEVICES.
 - ALL SIGN POSTS USED FOR TRAFFIC CONTROL SIGNS INSTALLED IN THE COUNTY RIGHT-OF-WAY SHALL BE MOUNTED ON A 2" GALVANIZED STEEL, PERFORATED (POLICE PUNCT), SQUARE TUBE POST (1 1/4" DIA) INSERTED INTO A 3" GALVANIZED STEEL, PERFORATED SQUARE TUBE (1 1/2" DIA) X 3' LONG. THE POSTER SHALL NOT EXCEED MORE THAN TWO "CLICK PUNCH" HOLES ABOVE LEVEL. A GALVANIZED STEEL POLE CAP SHALL BE MOUNTED ON TOP OF EACH POST.
- THE COORDINATES SHOWN HEREON ARE BASED UPON THE HOWARD COUNTY GEODETIC CONTROL WHICH IS BASED UPON THE MARYLAND STATE PLANNED CONTROL SYSTEM. HOWARD COUNTY HORIZONTAL AND VERTICAL DATUM IS BASED ON HOWARD COUNTY GEODETIC CONTROL STATIONS:

CONTROL STATION NO. 08 DA	N 606,534.18	E 1,299,700.92	CONTROL STATION NO. 08 CB	N 602,784.88	E 1,294,916.90
	ELEV. 554.636			ELEV. 570.387	
- THE TRAFFIC STUDY FOR THIS PROJECT WAS PREPARED BY PMS GROUP DATED APRIL 19, 2016 AND WAS APPROVED UNDER SP-17-003.
- BACKGROUND INFORMATION:
 - SUBDIVISION NAME: LINDEN GROVE
 - TAX MAP NO.: 8
 - ZONING: RC-DEO
 - ELECTION DISTRICT: FOURTH
 - TOTAL TRACT AREA: 176.680 AC. (PHASE ONE & TWO)
 - PHASE TWO AREA = 25.195 AC. (BULK PARCELS 'F' & 'G')
 - AREA OF STEEP SLOPES 20% AND GREATER = 0.60 AC. (PHASE TWO)
 - AREA OF BUILDABLE PRESERVATION PARCELS: 0 (PHASE TWO)
 - NO. OF BUILDABLE LOTS 21 (PHASE TWO)
 - NO. OF NON-BUILDABLE PRESERVATION PARCELS: 0 (PHASE TWO)
 - NO. OF NON-BUILDABLE BULK PARCELS: 0 (PHASE TWO)
 - AREA OF BUILDABLE LOTS: 24,901 AC. (PHASE TWO)
 - AREA OF BUILDABLE PRESERVATION PARCELS: 0.00 AC. (PHASE TWO)
 - AREA OF NON-BUILDABLE PRESERVATION PARCELS: 0.00 AC. (PHASE TWO)
 - TOTAL AREA OF ROADWAY TO BE RELOCATED: 1.254 AC. (PHASE TWO)
 - PREVIOUS FILE NOS.: ECP-17-019, SP-17-003, F-18-092, PB CASE NO.432, WP-18-001
 - AREA OF FLOODPLAIN: 0.00 AC. (PHASE TWO)
- TO THE BEST OF OUR KNOWLEDGE, NO CONFLICTS EXIST ON THE SUBJECT PROPERTY BASED ON A VISUAL OBSERVATION OR LISTED IN AVAILABLE HOWARD COUNTY CEMETERY INVENTORY MAP.
- ALL FILL AREAS WITHIN ROADWAYS AND UNDER STRUCTURES SHALL BE COMPACTED TO A MINIMUM OF 95% COMPACTION OF ASTM D-1557.
- PROPERTY ZONED RC-DEO PER 10/6/13 COMPREHENSIVE ZONING PLAN.
- IN ACCORDANCE WITH SECTION 104.0.F OF THE ZONING REGULATIONS AT LEAST 10% OF THE DWELLINGS IN EACH RC DEVELOPMENT SHALL BE MODERATE INCOME HOUSING UNITS.
- SOILS INFORMATION TAKEN FROM NCS WBS SOIL SURVEY.
- FLOODPLAIN INFORMATION TAKEN FROM NCS WBS SOIL SURVEY.
- PERMITS AND A WETLAND DELINEATION REPORT DATED DECEMBER, 2016 WAS PREPARED BY ECO-SCIENCE PROFESSIONALS, INC. AND WAS APPROVED UNDER SP-17-003.
- THESE ARE STEEP SLOPES OF 25% OR GREATER ON SITE OF 16.60 ACRES FROM PHASE 1. NO STEEP SLOPES OR WETLAND AREAS FROM PHASE 1 WILL BE DISTURBED WITH THIS F-PLAN.
- A BURN WITH ACCESSORY STRUCTURES MUST BE ON-SITE AND ASSESS PLANNED TO REPAIR.
- THE SITE IS ADJACENT TO TWO SCENIC ROADS (DAISY ROAD & FREDERICK ROAD). A SCENIC ROADS REPORT HAS BEEN PROVIDED BY FISHER, COLLINS & CARTER, INC. DATED 10/24/16.
- PRIVATE RANGE OF ADDRESS SIGN ASSEMBLIES SHALL BE FABRICATED AND INSTALLED BY HOWARD COUNTY BUREAU OF HIGHWAYS AT THE DEVELOPERS/OWNERS EXPENSE FOR THE TWO (2) USE-IN-COMMON DRIVEWAYS, ONE LOCATED AT THE CORNER OF ROAD 'A' AND ONE LOCATED OFF FREDERICK ROAD. CONTACT HOWARD COUNTY TRAFFIC DIVISION AT 410-313-5792 FOR DETAILS AND COST ESTIMATES.
- FOR FLAG OR FIRESTORM SERVICE COLLECTION, SNOW REMOVAL, AND ROAD MAINTENANCE ARE PROVIDED TO THE JUNCTION OF THE FLAG OR FIRESTORM AND ROAD RIGHT-OF-WAY LINE AND NOT TO THE PAVEMENT LOT DRIVEWAY.
- ARTICLES OF INCORPORATION FOR THE LINDEN GROVE HOMEOWNERS ASSOCIATION, INC. WILL BE FILED WITH THE STATE DEPARTMENT OF ASSESSMENTS AND TAXATION PRIOR TO REZONATION OF THE FINAL PLAN.
- ALL COSTS FOR WELL AND SEPTIC SYSTEMS WHICH ARE NOT UTILIZED BY THE LOT OWNER WILL BE ABANDONED PRIOR TO REZONATION OF THE FINAL PLAN.
- THIS AREA DESIGNATES A PRIVATE SEWERAGE AREA OF AT LEAST 10,000 SQUARE FEET AS REQUIRED BY THE MARYLAND STATE DEPARTMENT OF THE ENVIRONMENT FOR INDIVIDUAL SEWERAGE DISPOSAL. IMPROVEMENTS OF ANY NATURE IN THIS AREA ARE RESTRICTED UNTIL PUBLIC SEWERAGE IS AVAILABLE. THESE AREAS SHALL BECOME NULL AND VOID UPON CONNECTION TO A PUBLIC SEWERAGE SYSTEM. THE COUNTY HEALTH OFFICER SHALL HAVE THE AUTHORITY TO QUANTIFY ADJUSTMENTS TO THE PRIVATE SEWERAGE AREA. REZONATION OF A MODIFIED AREA SHALL NOT BE NECESSARY.
- THE LOTS SHOWN HEREON COMPLY WITH THE MINIMUM OWNERSHIP WIDTH AND LOT AREA AS REQUIRED BY THE MARYLAND STATE DEPARTMENT OF THE ENVIRONMENT.
- ANY CHANGES TO THE PRIVATE SEWERAGE AREA SHALL REQUIRE A REZONED PERMIT APPLICATION.
- NO GRADING, REMOVAL OF VEGETATIVE COVER OR TREES, PAVING AND NEW STRUCTURES SHALL BE PERMITTED WITHIN THE LOTS OF WETLANDS, STREAMS, OR OTHER REQUIRED BUFFERS, FLOODPLAIN AND FOREST CONSERVATION EASEMENT AREAS.
- THE 100 YEAR FLOODPLAIN DELINEATED ON THIS PLAN HAS BEEN DETERMINED TO BE "NOT CRITICAL" BASED ON A REPORT PREPARED BY FISHER, COLLINS & CARTER, INC. ON JANUARY 6, 2017.
- A PRE-SUBMISSION COMMUNITY MEETING WAS HELD AT THE GLENWOOD LIBRARY FOR THIS PROJECT ON 2/23/17 ASSOCIATED WITH SP-17-003.
- THE FOREST CONSERVATION EASEMENTS HAVE BEEN ESTABLISHED TO FULFILL THE REQUIREMENTS OF SECTION 16.12.00 OF THE HOWARD COUNTY CODE AND FOREST ACT. NO CLEARING, GRADING OR CONSTRUCTION IS PERMITTED WITHIN THE FOREST CONSERVATION EASEMENTS. HOWEVER, FOREST MANAGEMENT PRACTICES AS DEFINED IN THE FOREST CONSERVATION EASEMENT ARE ALLOWED. THE FOREST CONSERVATION REQUIREMENTS PER SECTION 16.12.00 OF THE HOWARD COUNTY CODE AND FOREST CONSERVATION MANUAL FOR THIS SUBDIVISION HAVE BEEN FULFILLED UNDER PHASE ONE (F-18-092).
- PERMITS AND LANDSCAPING FOR THIS DEVELOPMENT SHALL BE IN ACCORDANCE WITH SECTION 16.12.04 OF THE SUBDIVISION AND LAND DEVELOPMENT REGULATIONS AND LANDSCAPE MANUAL. FINANCIAL IN THE AMOUNT OF \$10,000.00 (10 X \$1000) HAS BEEN POSTED WITH THE DEVELOPERS AGREEMENT.
- THE PROJECT IS IN COMPLIANCE WITH THE LATEST HOWARD COUNTY STANDARDS UNLESS OTHERWISE SPECIFIED.
- THE EXISTING TOPOGRAPHY INFORMATION SHOWN IS BASED ON HOWARD COUNTY AERIAL CONTOURS AND SUPPLEMENTED WITH A FIELD KRM TOPOGRAPHIC SURVEY PERFORMED ON OR ABOUT 7/2/18 BY FISHER, COLLINS & CARTER, INC.
- BOUNDARY INFORMATION IS BASED ON A SURVEY PERFORMED ON OR ABOUT 11/11/14 BY FISHER, COLLINS & CARTER, INC.
- THIS PROPERTY IS NOT LOCATED WITHIN THE METROPOLITAN DISTRICT. PRIVATE WELL AND SEPTIC WILL BE UTILIZED FOR THIS PROJECT.
- STORM WATER MANAGEMENT IS IN ACCORDANCE WITH THE H.O.A. STORM WATER DESIGN MANUAL, VOLUMES I & II, REVISED 2009. STORMWATER MANAGEMENT IS BEING PROVIDED BY THE USE OF (1) ROBOTIC DISCONNECTION DEVICES, (2) NON-ROOFTOP DISCONNECTION DEVICES, (3) DRYWELLS, (4) SOFTTOP DISCONNECTION DEVICES AND (5) MICRO-BIO-RETENTION DEVICES.
- STORM WATER MANAGEMENT DEVICES LOCATED ON INDIVIDUAL LOTS WILL BE OWNED AND MAINTAINED BY THAT PARCELS LOT OWNER AND SUBJECT TO THE REQUIREMENTS OF THE H.O.A. STORM WATER DESIGN MANUAL. STORM WATER MANAGEMENT DEVICES LOCATED ON COMMON AREAS WILL BE JOINTLY OWNED AND JOINTLY MAINTAINED. COMMON AREAS LOCATED ON PARCELS WILL BE OWNED AND MAINTAINED BY THE H.O.A. SWM FACILITIES SERVING PUBLIC ROADS, BUT LOCATED ON PRIVATE LOTS WILL BE PRIVATELY OWNED AND JOINTLY MAINTAINED.
- A HOUSE STUDY IS NOT REQUIRED FOR THIS PROJECT.
- ALL WELLS MUST BE DRILLED PRIOR TO HOWARD COUNTY HEALTH DEPARTMENT SIGNATURE OF THE FINAL PLAN.
- A GROUNDWATER APPROPRIATIONS PERMIT MUST BE OBTAINED FROM THE MARYLAND DEPARTMENT OF THE ENVIRONMENT PRIOR TO HOWARD COUNTY HEALTH DEPARTMENT SIGNATURE OF THE FINAL PLAN. STATE WATER APPROPRIATION AND USE PERMIT NO. H00017020013.
- DRIVEWAY (S) SHALL BE PROVIDED PRIOR TO RESIDENTIAL OCCUPANCY TO ENSURE SAFE ACCESS FOR FIRE AND EMERGENCY VEHICLES PER THE FOLLOWING (MINIMUM) REQUIREMENTS:
 - WIDTH - 12 FEET (16 FEET SERVING MORE THAN ONE RESIDENCE)
 - FINISH - 4" MINIMUM OF COMPACTED GRANULAR FILL BASE WITH T&E AND CHIP CURB
 - GEOMETRY - MAXIMUM 1% GRADE, MAXIMUM 10% GRADE CHANGE AND MINIMUM OF 46' FOOT TURNING RADIUS
 - STRUCTURE CLEARANCE - CAPABLE OF SUPPORTING 25 TONS (TWO TRUCKS) LOADING
 - SPACING ELEMENTS - CAPABLE OF SAFELY PASSING 100 YEAR FLOOD WITH NO MORE THAN 1 FOOT DEPTH OVER DRIVEWAY SURFACE
 - MAINTENANCE - SUFFICIENT TO ENSURE ALL WEATHER USE
- THIS F-PLAN CANNOT BE USED FOR THE CONSTRUCTION OF HOUSES SINCE THE ACTUAL HOUSE TYPE AND THE REQUIRED SEPTIC CONTROL HAS NOT BEEN ESTABLISHED.
- THIS SUBDIVISION PLAN IS SUBJECT TO THE REQUIREMENTS OF SECTION 16.12.00 OF THE SUBDIVISION AND LAND DEVELOPMENT REGULATIONS AND THE 10-OR-13 ZONING REGULATIONS PER COUNCIL BILL NO. 32-2013. DEVELOPMENT OR CONSTRUCTION ON THESE LOTS MUST COMPLY WITH SETBACKS AND BUFFER REGULATIONS IN EFFECT AT THE TIME OF SUBMISSION OF A BUILDING OR GRADING PERMIT APPLICATION.
- THE CONCRETE PADS FOR REFUSE AND RECYCLING COLLECTION LOCATED WITHIN THE USE-IN-COMMON DRIVEWAY EASEMENTS FOR LOTS 40-44 WILL BE MAINTAINED BY THE OWNERS OF THESE LOTS PURSUANT TO THE DECLARATION OF RIGHT OF ACCESS AND MAINTENANCE OBLIGATION RECORDED AMONG THE LAND RECORDS OF HOWARD COUNTY ALONG WITH THE RECORDING OF THIS PLAN.
- IN ACCORDANCE WITH SECTION 104.0.F OF THE ZONING REGULATIONS AT LEAST 10% OF THE DWELLINGS IN EACH RC DEVELOPMENT SHALL BE MODERATE INCOME HOUSING UNITS. THIS PROJECT HAS ELECTED TO SATISFY THE M.I.H.U. REQUIREMENTS BY A FEE-IN-LIEU PAYMENT. THE EXECUTED M.I.H.U. AGREEMENT WILL BE RECORDED SIMULTANEOUSLY WITH THIS PLAN.
- SUBDIVISION IS SUBJECT TO 104.0.F OF THE ZONING REGULATIONS. AT LEAST 10% OF THE DWELLING UNITS SHALL BE MODERATE INCOME HOUSING UNITS (M.I.H.U.) OR AN ALTERNATIVE COMPLIANCE WILL BE PROVIDED. THE DEVELOPER SHALL EXECUTE A M.I.H.U. AGREEMENT WITH THE DEPARTMENT OF HOUSING TO INDICATE HOW THE M.I.H.U. REQUIREMENT WILL BE MET. THE M.I.H.U. AGREEMENT AND COVENANTS WILL BE RECORDED SIMULTANEOUSLY WITH THE ASSOCIATED PLAN IN THE LAND RECORDS OF HOWARD COUNTY, MARYLAND. THIS DEVELOPMENT WILL MEET MODERATE INCOME HOUSING UNIT (M.I.H.U.) TABULATIONS:

A. TOTAL M.I.H.U. REQUIRED = FOR PHASE ONE = PHASE TWO = 5 UNITS.
(23 LOTS X 1 BUILDABLE PRESERVATION PARCEL) = (11 LOTS) X 10% = 11 UNITS
(TOTAL M.I.H.U. PHASE ONE) = 11 UNITS
(5 UNITS - 3 UNITS = 2 UNITS)
- M.I.H.U. PROPOSED - DEVELOPER WILL PURSUE ALTERNATIVE COMPLIANCE BY PAYING A FEE-IN-LIEU TO HOWARD COUNTY HOUSING DEPARTMENT FOR THE UNITS REQUIRED BY THE DEPARTMENT.
- AN EXECUTED M.I.H.U. AGREEMENT WITH THE HOWARD COUNTY HOUSING DEPARTMENT HAS BEEN COMPLETED.
- THIS PROJECT IS SUBMITTABLE AS THE SUSTAINABLE GROWTH AND AGRICULTURE ACT OF 2012, MAP 6-3, AS APPROVED BY THE HOWARD COUNTY COUNCIL AS PART OF PLAN HOWARD 2030.
- THIS PLAN IS SUBJECT TO AN ALTERNATIVE COMPLIANCE (WP-18-001) WITH SECTION 16.116.5 - ACCESS RESTRICTIONS, RESTRICTING TWO POINTS OF ACCESS FROM A PRIVATE DRIVEWAY TO THE SUBDIVISION. THIS ALTERNATIVE COMPLIANCE WAS APPROVED BY THE HOWARD COUNTY PLANNING BOARD ON JANUARY 10, 2018 WITH THE FOLLOWING CONDITIONS:
 - THE SUBDIVISION SHALL COORDINATE THE DESIGN OF THE DRIVEWAYS FOR FUTURE LOTS 40-44 WITH THE FIRE DEPARTMENT TO ENSURE ADEQUATE VEHICLE TURNAROUND AND ACCESS MUST MEET ALL SHA ACCESS AND SIGHT DISTANCE REQUIREMENTS.
 - ANY NECESSARY PULLOVER AREAS AND WITH THE DEVELOPMENT ENGINEERING DIVISION AND STATE HIGHWAY ADMINISTRATION TO ENSURE ADEQUATE SITE DISTANCE. THE PROPOSED ACCESS MUST MEET ALL SHA ACCESS AND SIGHT DISTANCE REQUIREMENTS.
- THE PROPOSED 4' WIDE NATURE TRAIL LOCATED ON BUILDABLE PRESERVATION PARCEL 'A' WITH THE EXISTING FOREST CONSERVATION EASEMENT BEHIND LOTS 40-44 SHALL BE MAINTAINED BY THE HOMEOWNERS ASSOCIATION.

LINDEN GROVE PHASE TWO

LOTS 24 THRU 44

(A Resubdivision of Non-Buildable Bulk Parcels 'F' & 'G', Recorded As "Linden Grove, Phase One Lots 1 Thru 23, Buildable Preservation Parcel 'A', Non-Buildable Preservation Parcels 'B' Thru 'E' And Non-Buildable Bulk Parcels 'F' And 'G', Plat Nos. 25064 Thru 25073.)


ZONED: RC-DEO
TAX MAP No. 8 GRID No. 7 PARCEL No. 5
4TH ELECTION DISTRICT HOWARD COUNTY, MARYLAND
DATE: JUNE 16, 2020
SHEET 1 of 24

"AS-BUILT" F-20-019


CENTERLINE LINE TABLE		
Line #	Length	Direction
L6	202.93'	N56° 47' 38"E
L7	534.14'	S89° 59' 07"W

CENTERLINE CURVE TABLE				
Curve #	Delta	Arc Length	Radius	Chord Bearing
C5	033.1914	246.20'	425.00'	S73° 23' 23"W

NOTE:
SEE SHEET 12 FOR
MICRO BIO-RETENTION
(M-6) DETAIL PLANS.



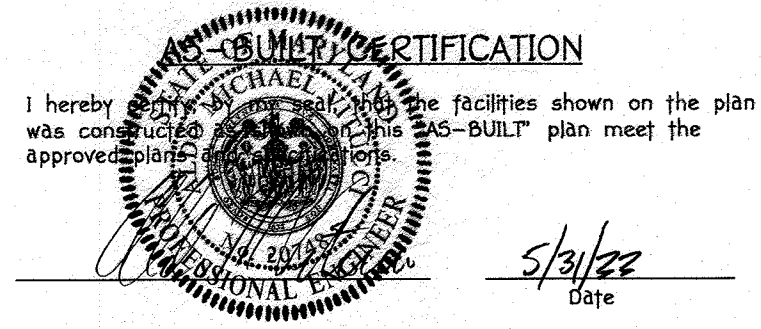


NO.	DESCRIPTION	DATE
	REVISIONS	
APPROVED: DEPARTMENT OF PLANNING AND ZONING		
	DATE	
	DATE	
APPROVED: HOWARD COUNTY DEPARTMENT OF PUBLIC WORKS		
	DATE	

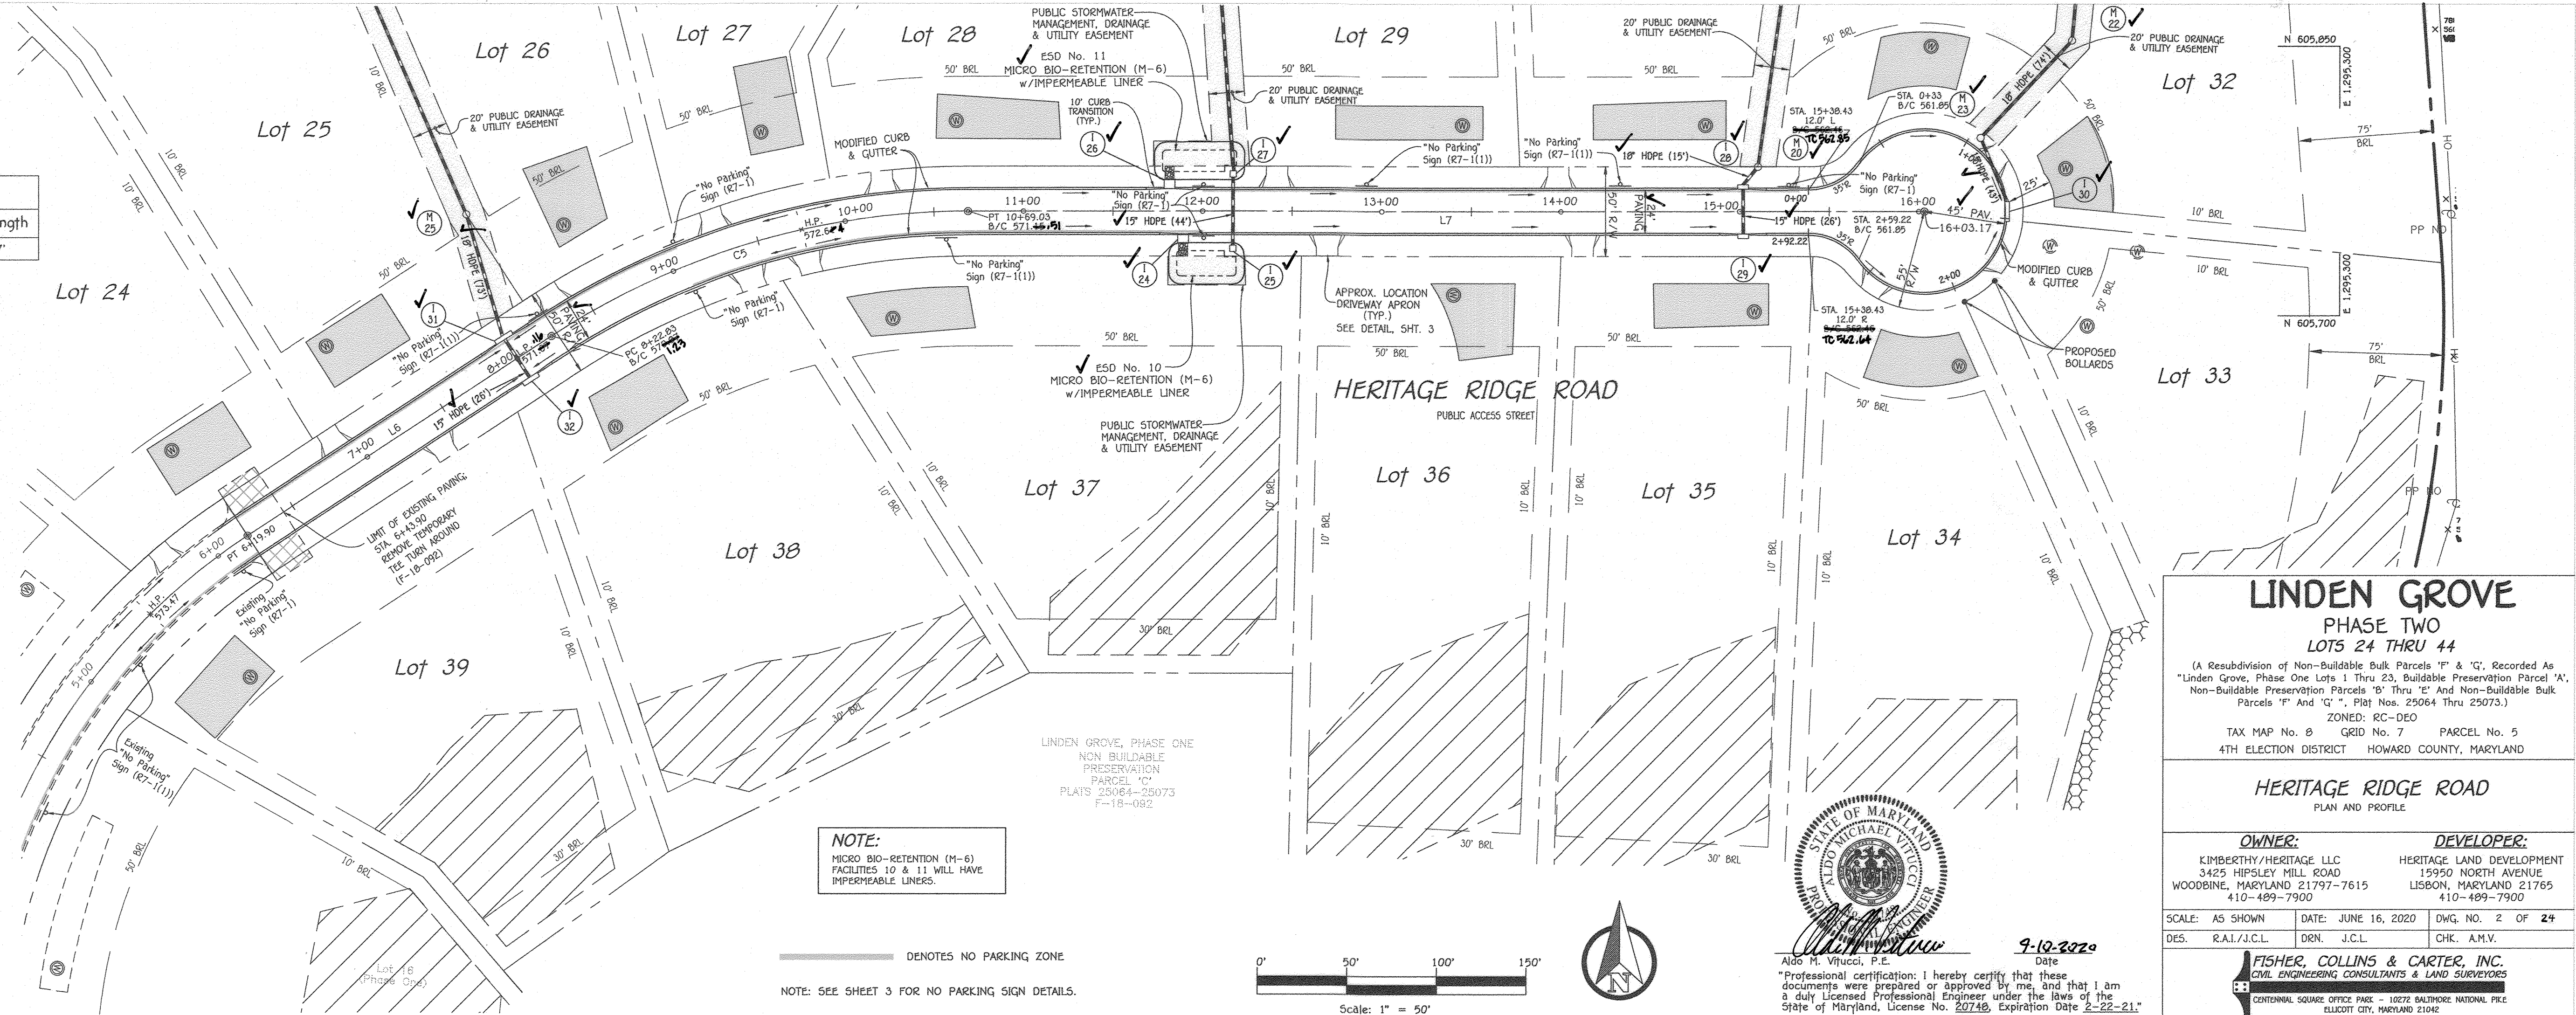

NOTE:
MICRO BIO-RETENTION (M-6)
FACILITIES 10 & 11 WILL HAVE
IMPERMEABLE LINERS.

— DENOTES NO PARKING ZONE
NOTE: SEE SHEET 3 FOR NO PARKING SIGN DETAILS.

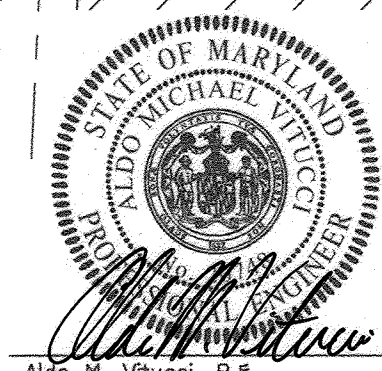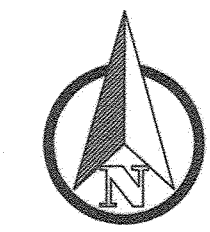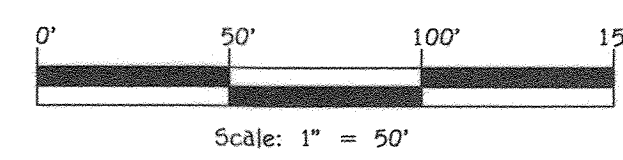

LINDEN GROVE
PHASE TWO
LOTS 24 THRU 44

(A Resubdivision of Non-Buildable Bulk Parcels "F" & "G", Recorded As "Linden Grove, Phase One Lots 1 Thru 23, Buildable Preservation Parcel "A", Non-Buildable Preservation Parcels "B" Thru "E", And Non-Buildable Bulk Parcels "F" And "G", Plat Nos. 25064 Thru 25073.)

ZONED: RC-DEO
TAX MAP No. 8 GRID No. 7 PARCEL No. 5
4TH ELECTION DISTRICT HOWARD COUNTY, MARYLAND

HERITAGE RIDGE ROAD
PLAN AND PROFILE


OWNER: KIMBERLY/HERITAGE LLC 3425 HIPPLEY MILL ROAD WOODBINE, MARYLAND 21797-7615 410-489-7900	DEVELOPER: HERITAGE LAND DEVELOPMENT 15950 NORTH AVENUE LISBON, MARYLAND 21765 410-489-7900
---	--

SCALE: AS SHOWN DATE: JUNE 16, 2020 DWG. NO. 2 OF 24
DES. R.A.L./J.C.L. DRN. J.C.L. CHK. A.M.V.


FISHER, COLLINS & CARTER, INC.
CIVIL ENGINEERING CONSULTANTS & LAND SURVEYORS
CENTENNIAL SQUARE OFFICE PARK - 10227 BALTIMORE NATIONAL PIKE
ELLCOTT CITY, MARYLAND 21114
(410) 481-2895


HERITAGE RIDGE ROAD

PUBLIC ACCESS STREET

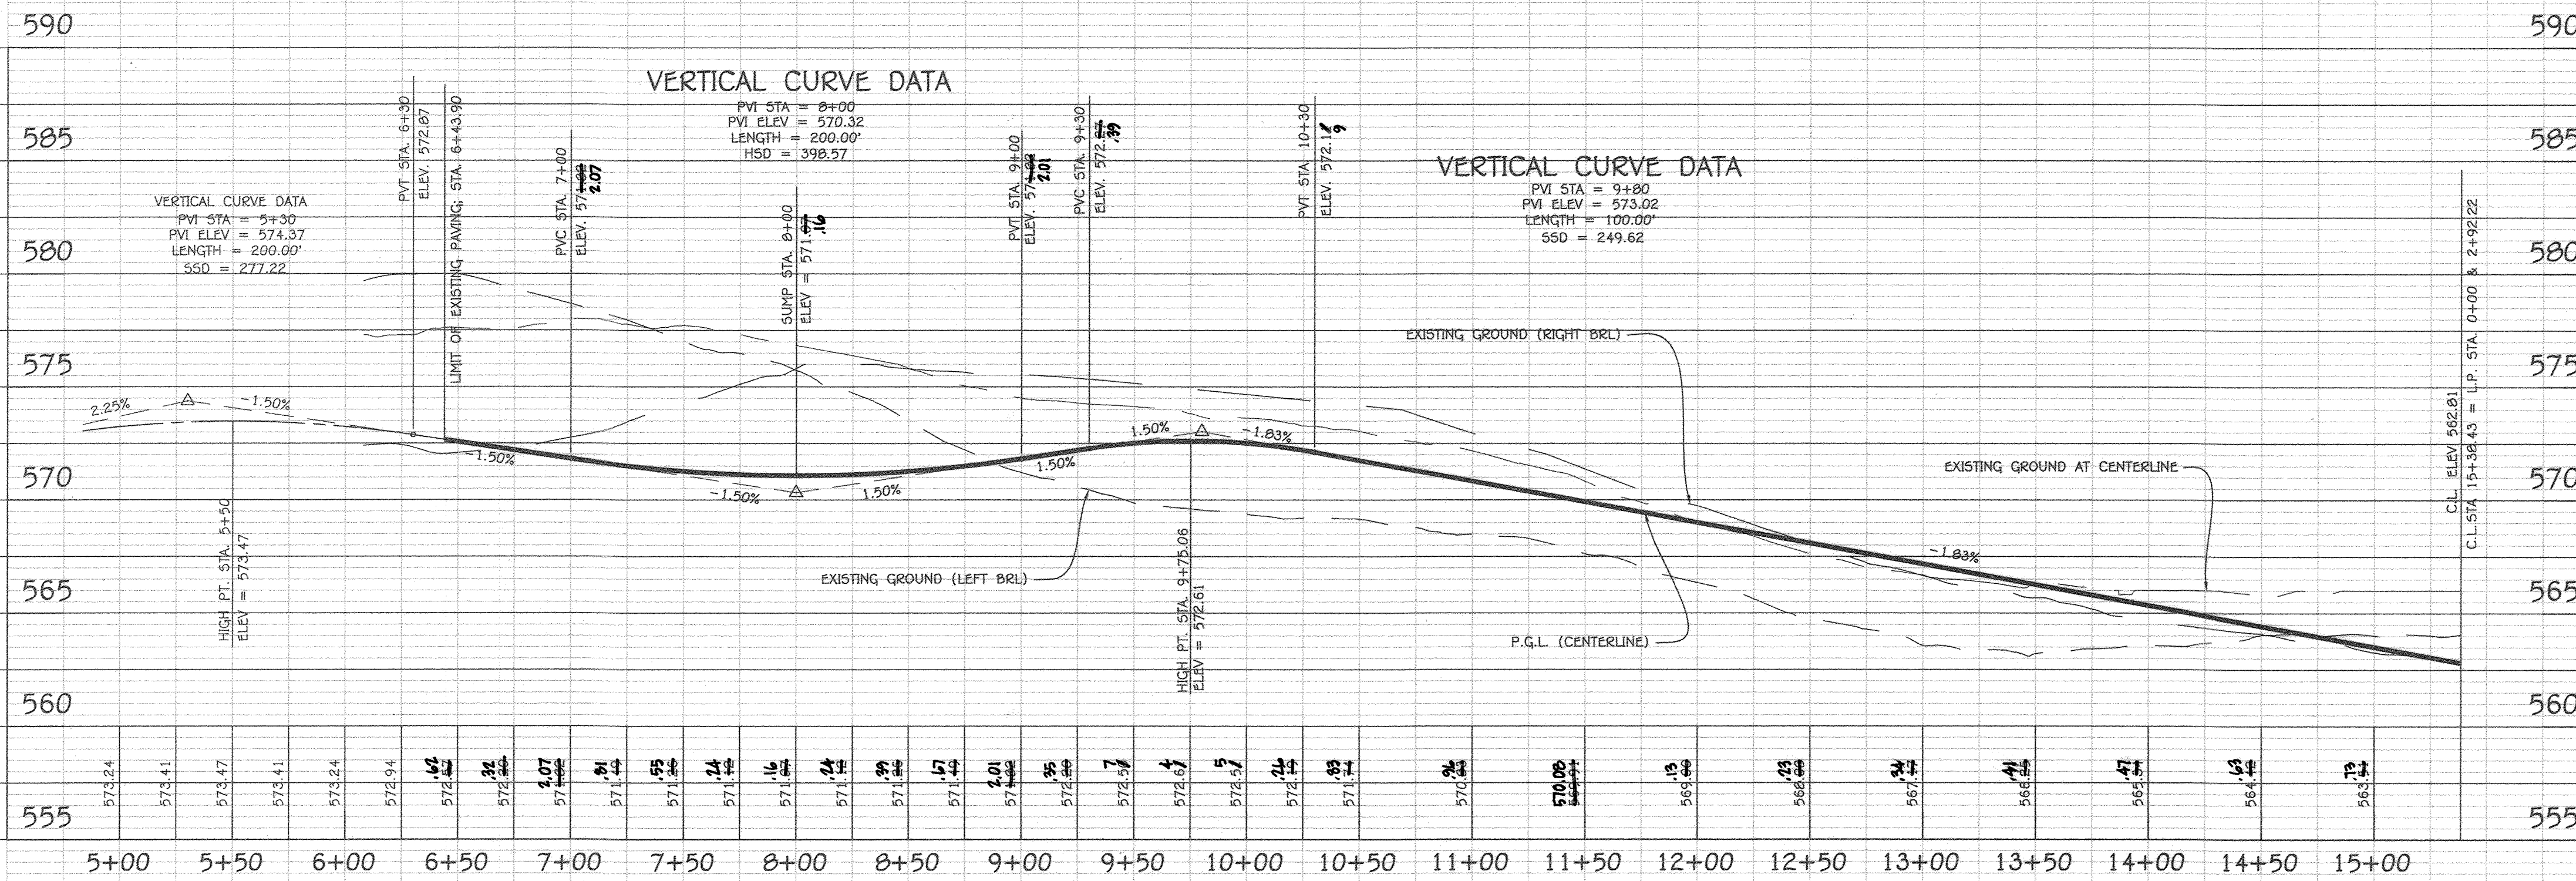


HERITAGE RIDGE ROAD

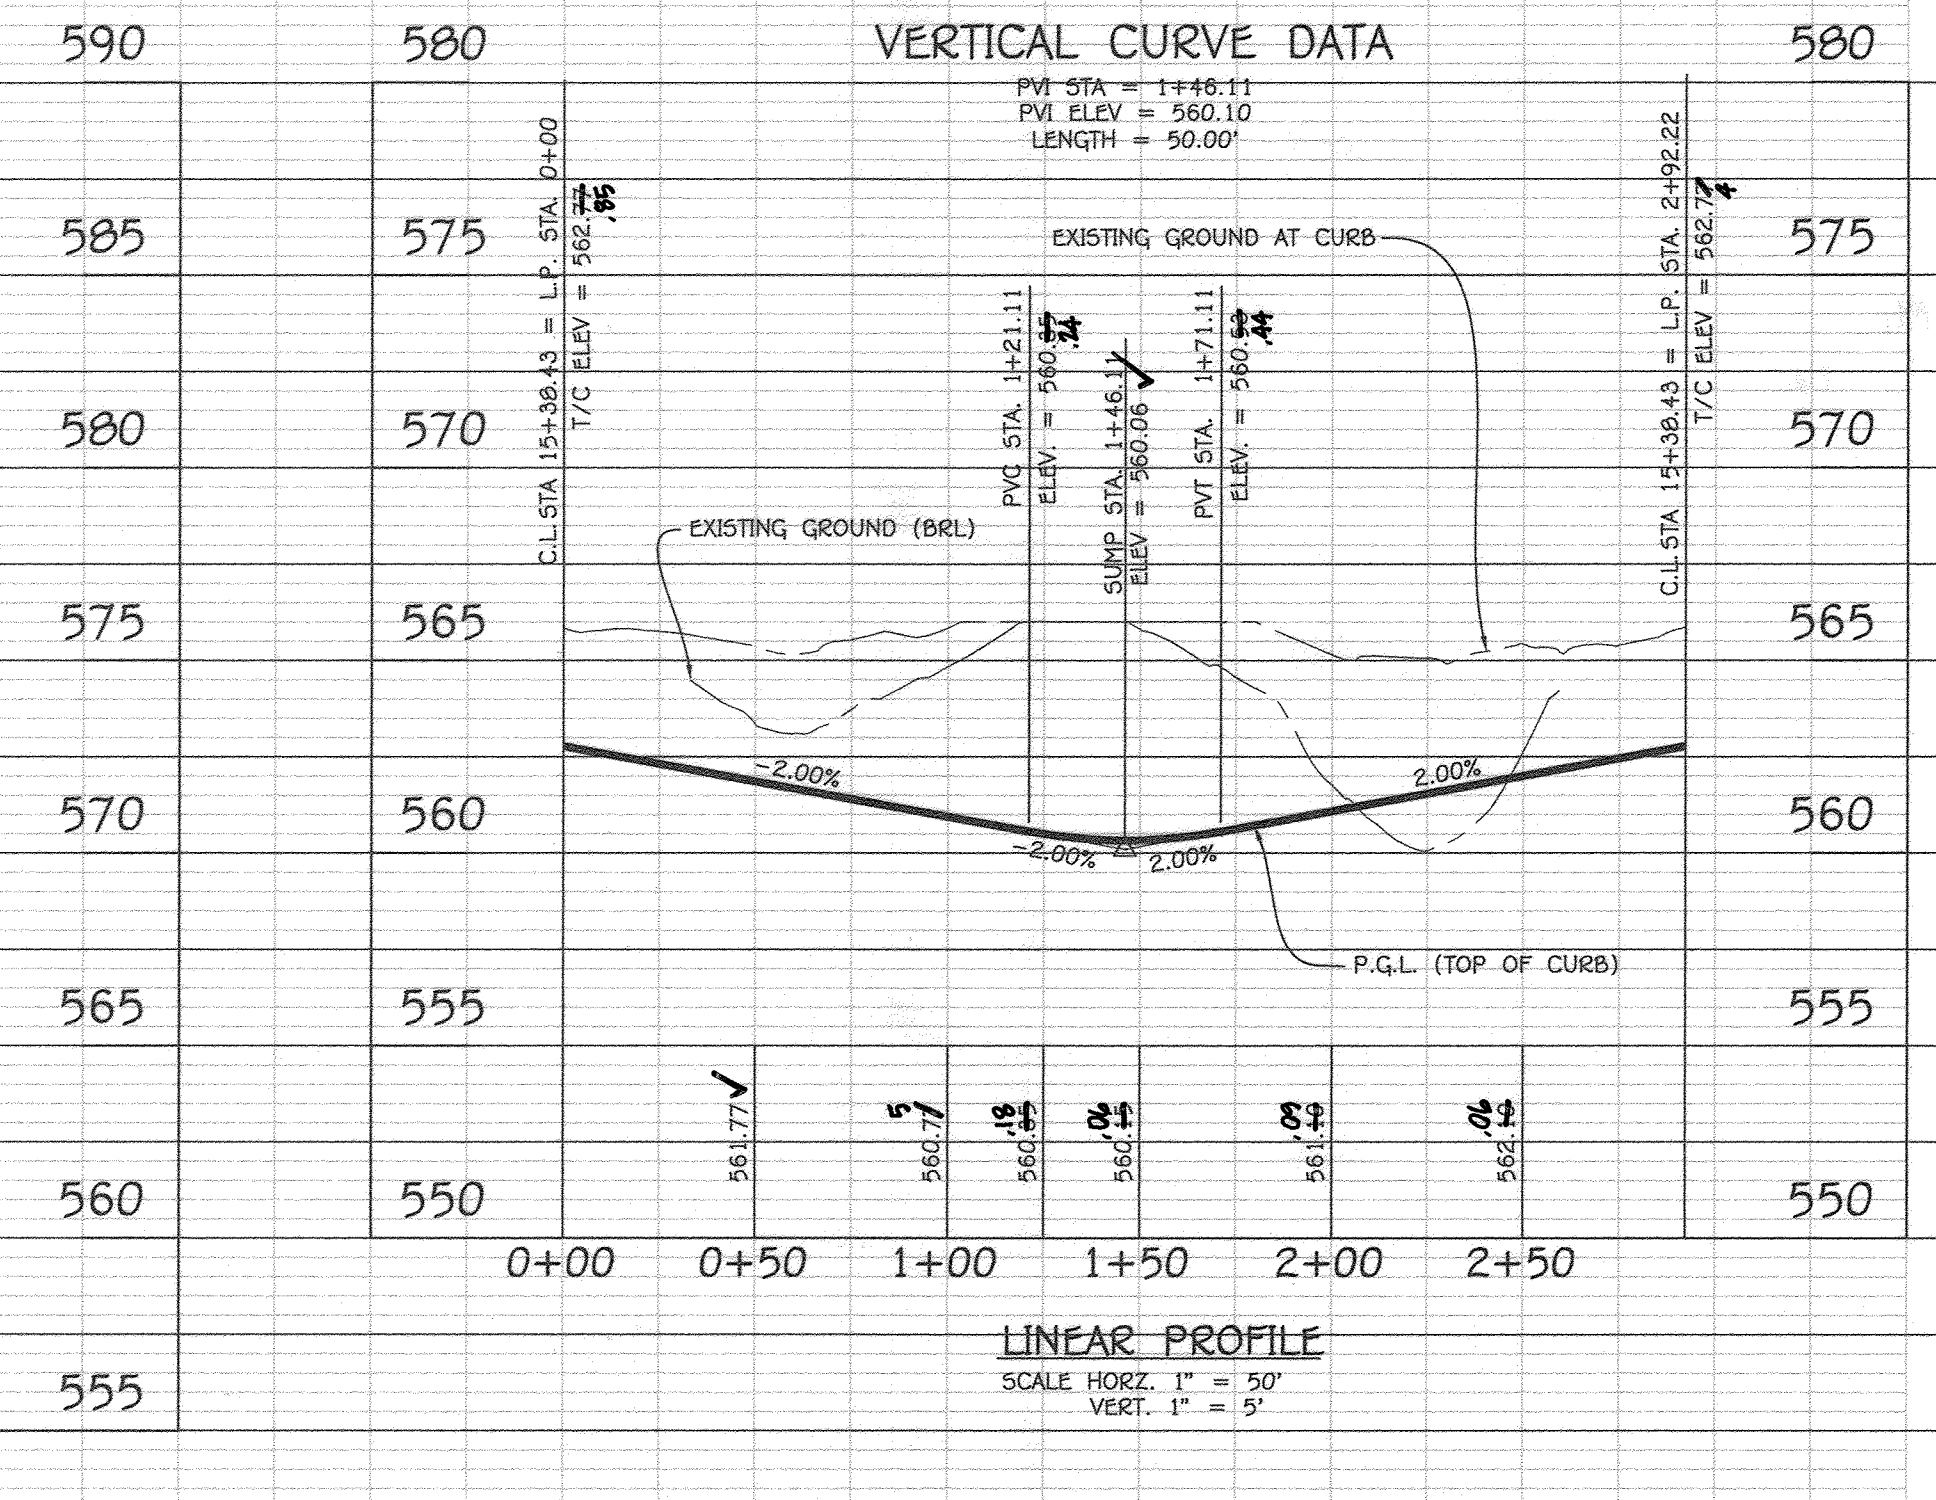

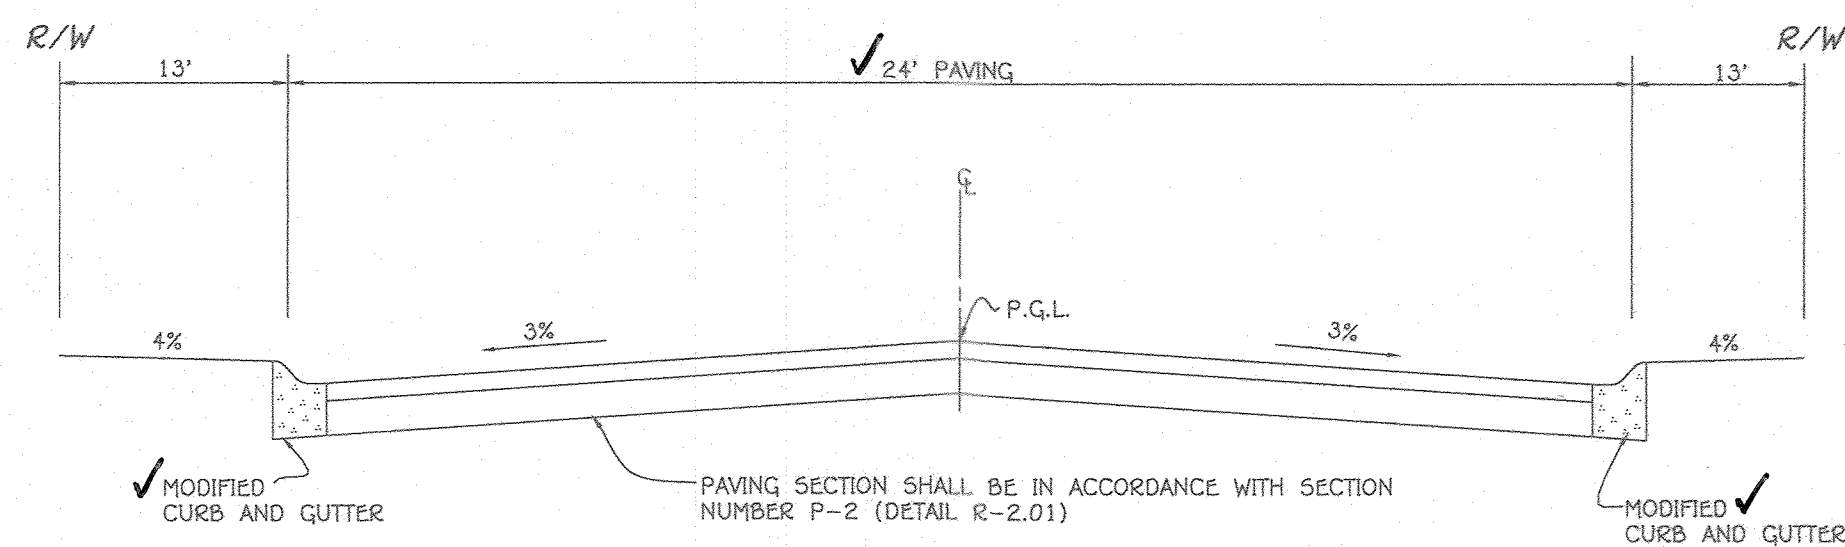


TYPICAL ROADWAY SECTION

NO SCALE

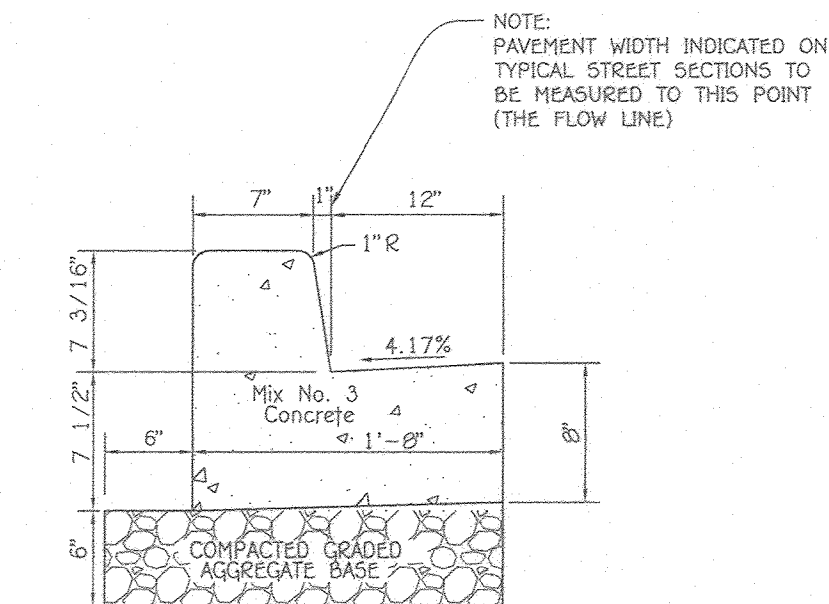

7" COMBINATION CONCRETE CURB AND GUTTER

NO SCALE (R-3.01)

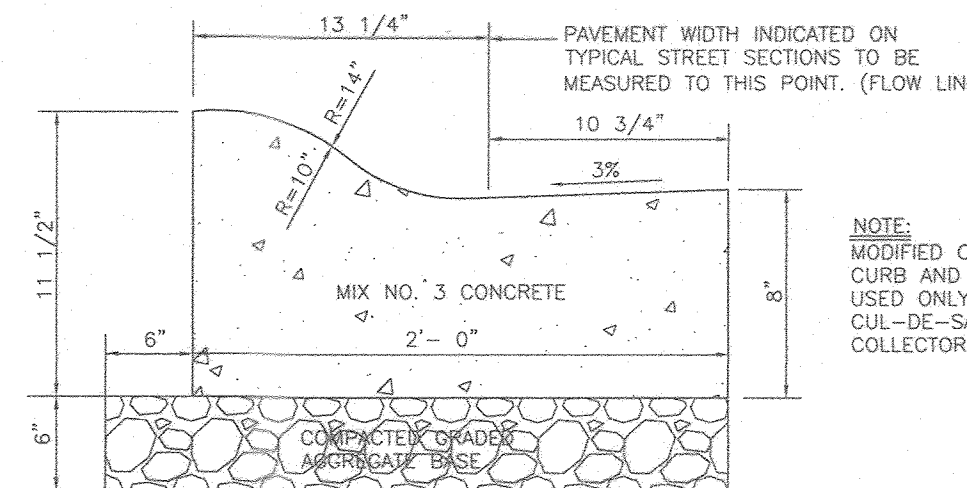

MODIFIED COMBINATION CURB AND GUTTER

NO SCALE


APPROVED: DEPARTMENT OF PUBLIC WORKS	8/17/2020	
CHIEF, BUREAU OF HIGHWAYS	DATE	
APPROVED: DEPARTMENT OF PLANNING AND ZONING	11/2/20	
CHIEF, DIVISION OF LAND DEVELOPMENT	DATE	
CHIEF, DEVELOPMENT ENGINEERING DIVISION	8-28-20	
DATE		
REVISIONS		
NO.	DESCRIPTION	DATE

ROADWAY INFORMATION CHART					
ROAD NAME	CLASSIFICATION	DESIGN SPEED	ZONING	STATION LIMITS	PAVING SECTION
HERITAGE RIDGE ROAD	PUBLIC ACCESS STREET	30 M.P.H.	RC-DEO	6+43.90 TO 16+03.17	P-2

SECTION NUMBER	ROAD AND STREET CLASSIFICATION	CALIFORNIA BEARING RATIO (CBR) (INCHES)					
		3 TO <5	5 TO <7	≥7	3 TO <5	5 TO <7	≥7
P-2	PARKING DRIVE ASIDES: RESIDENTIAL AND NON-RESIDENTIAL WITH NO MORE THAN 10 HEAVY TRUCKS PER DAY LOCAL ROADS: ACCESS PLACE, ACCESS STREET CUL-DE-SACS: RESIDENTIAL	PAVEMENT MATERIAL (INCHES)					
		HMA SUPERPAVE FINAL SURFACE 9.5 MM, PG 64-22, LEVEL 1 (ESAL)					
		HMA SUPERPAVE INTERMEDIATE SURFACE 9.5 MM, PG 64-22, LEVEL 1 (ESAL)					
		HMA SUPERPAVE BASE 19.0 MM, PG 64-22, LEVEL 1 (ESAL)					
		8.0	4.0	3.0	4.0	4.0	4.0


IMPORTANT:
THIS DRAWING SHALL BE USED IN COMBINATION WITH GENERAL NOTES (MD 104.00-01 THRU MD 104.00-18) AND STANDARD DETAILS (MD 104.01-01 THRU MD 104.01-62)

NOTE:
FLAGGERS SHALL NEVER BE STATIONED MORE THAN 1000' AWAY FROM THE ADVANCE FLAGGER SIGN.

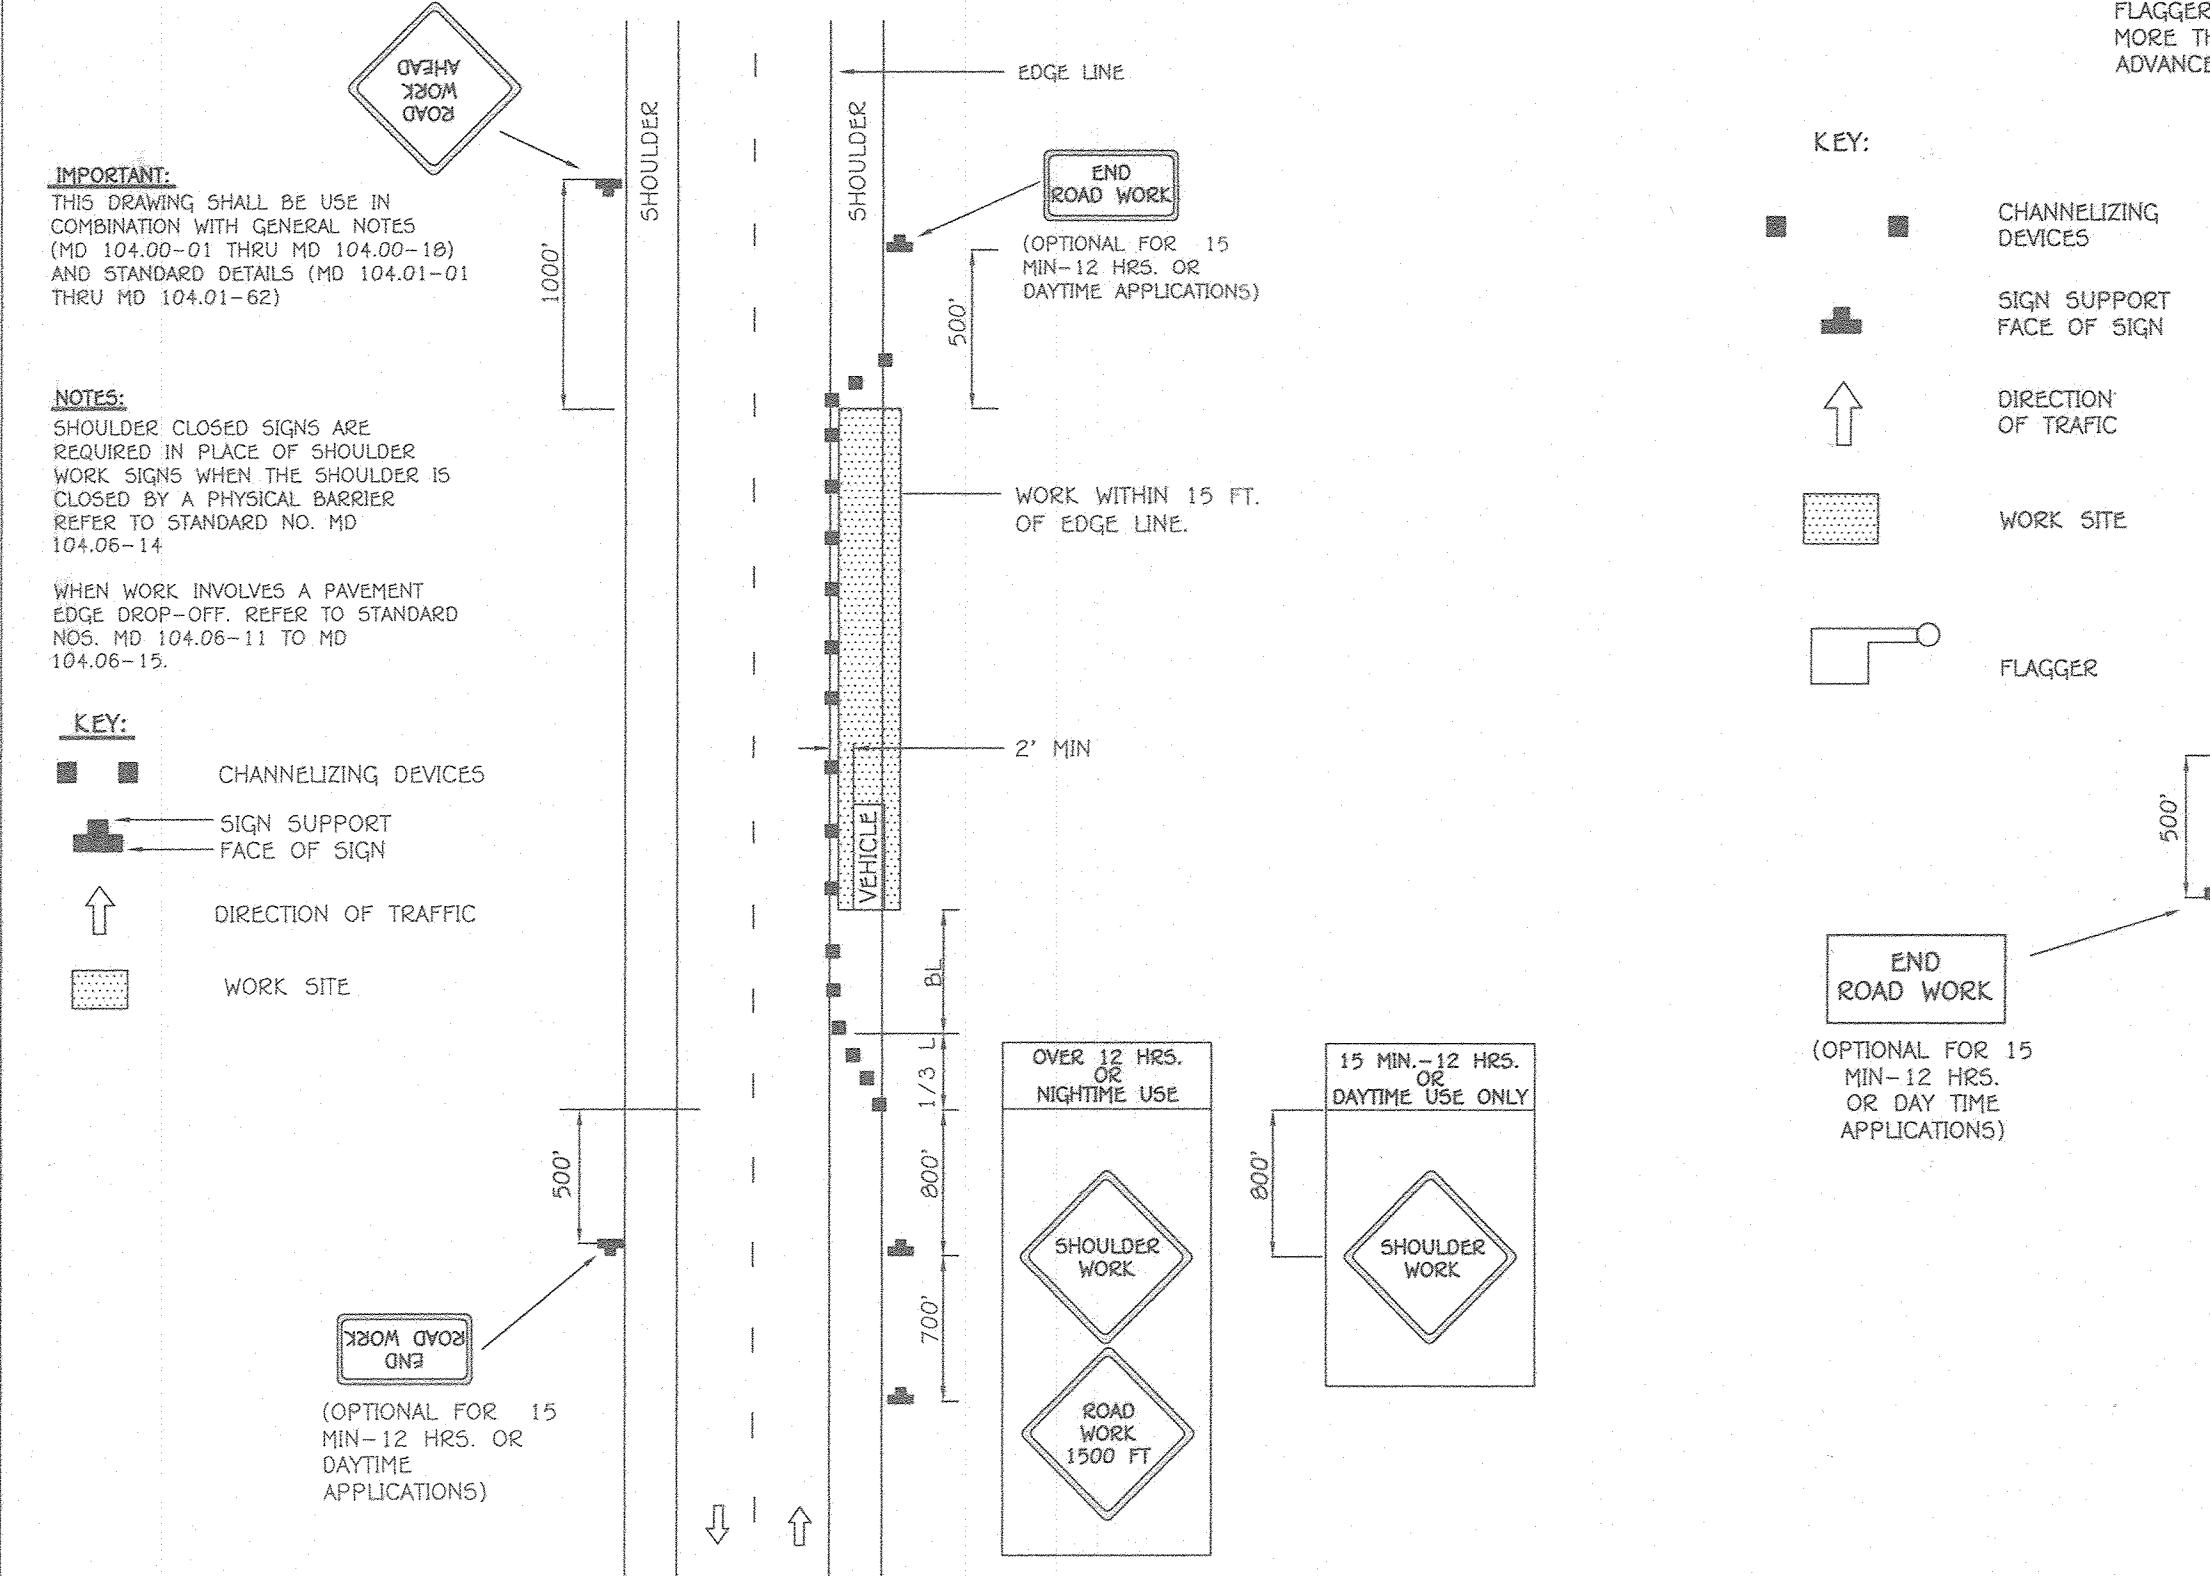


FOR FREDERICK ROAD - ROUTE 144
USE-IN-COMMON DRIVEWAY
INSTALLATION
SHOULDER WORK / 2-LANE, 2-WAY
EQL/LESS THAN 40 MPH

NO SCALE

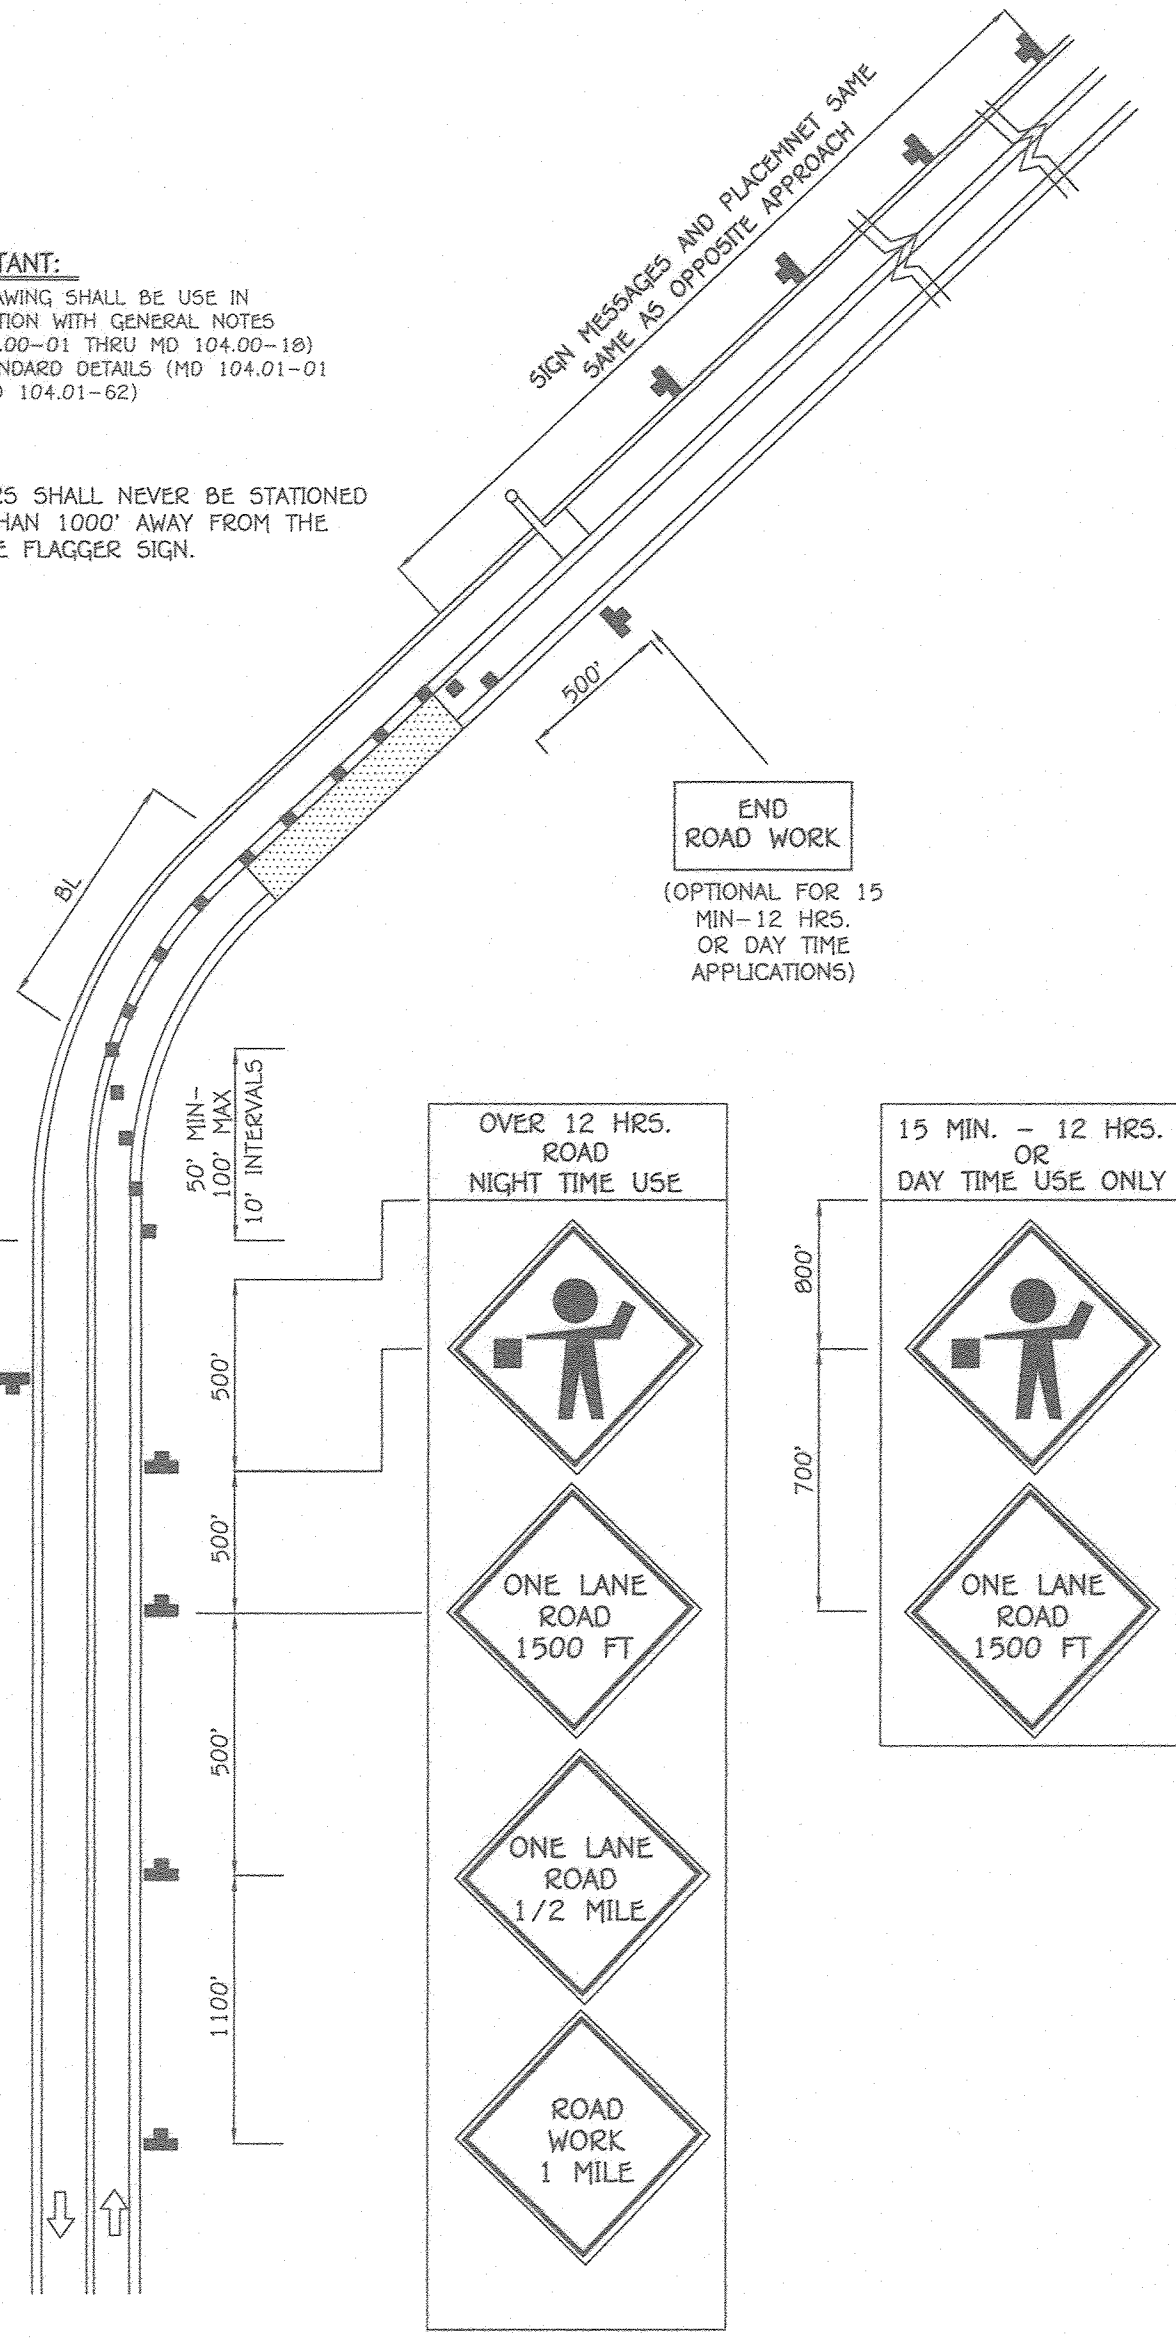

FLAGGING OPERATION / 1-LANE, 2-WAY
EQUAL/LESS THAN 40 MPH

NO SCALE

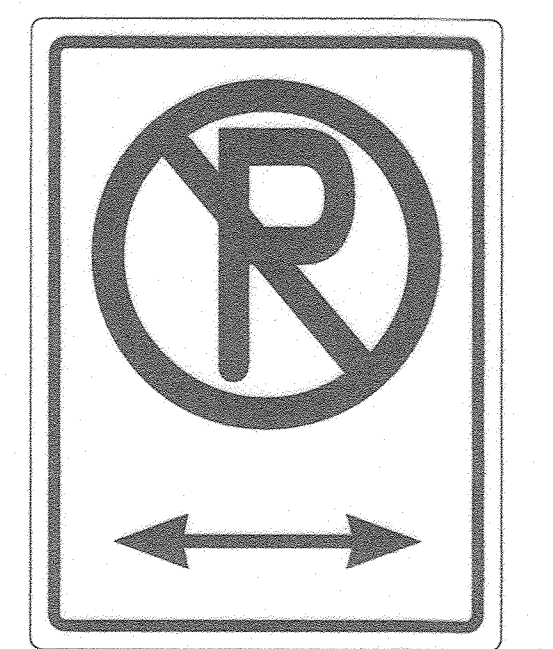


"R7-(I) NO PARKING" SIGN DETAIL

NOT TO SCALE




"R7-I NO PARKING" SIGN DETAIL

NOT TO SCALE

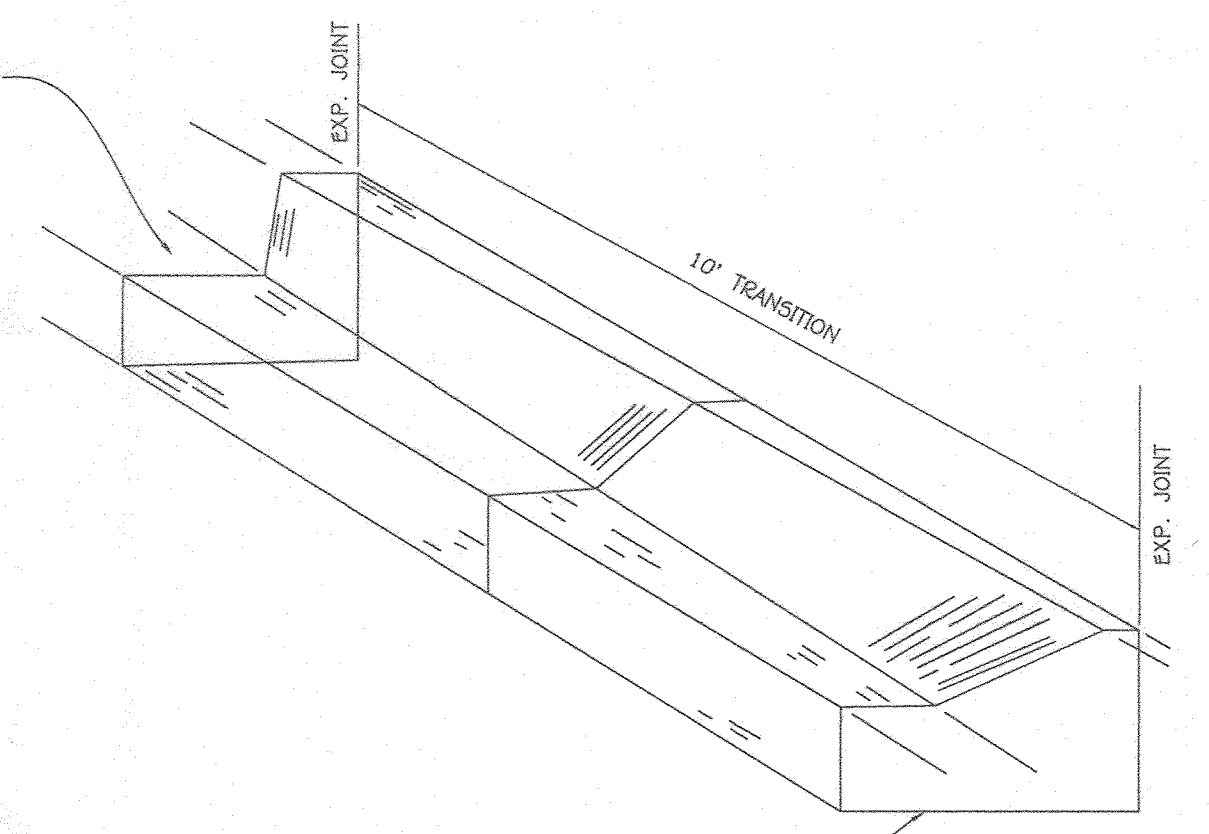

CONCRETE CURB & GUTTER TRANSITION

NO SCALE

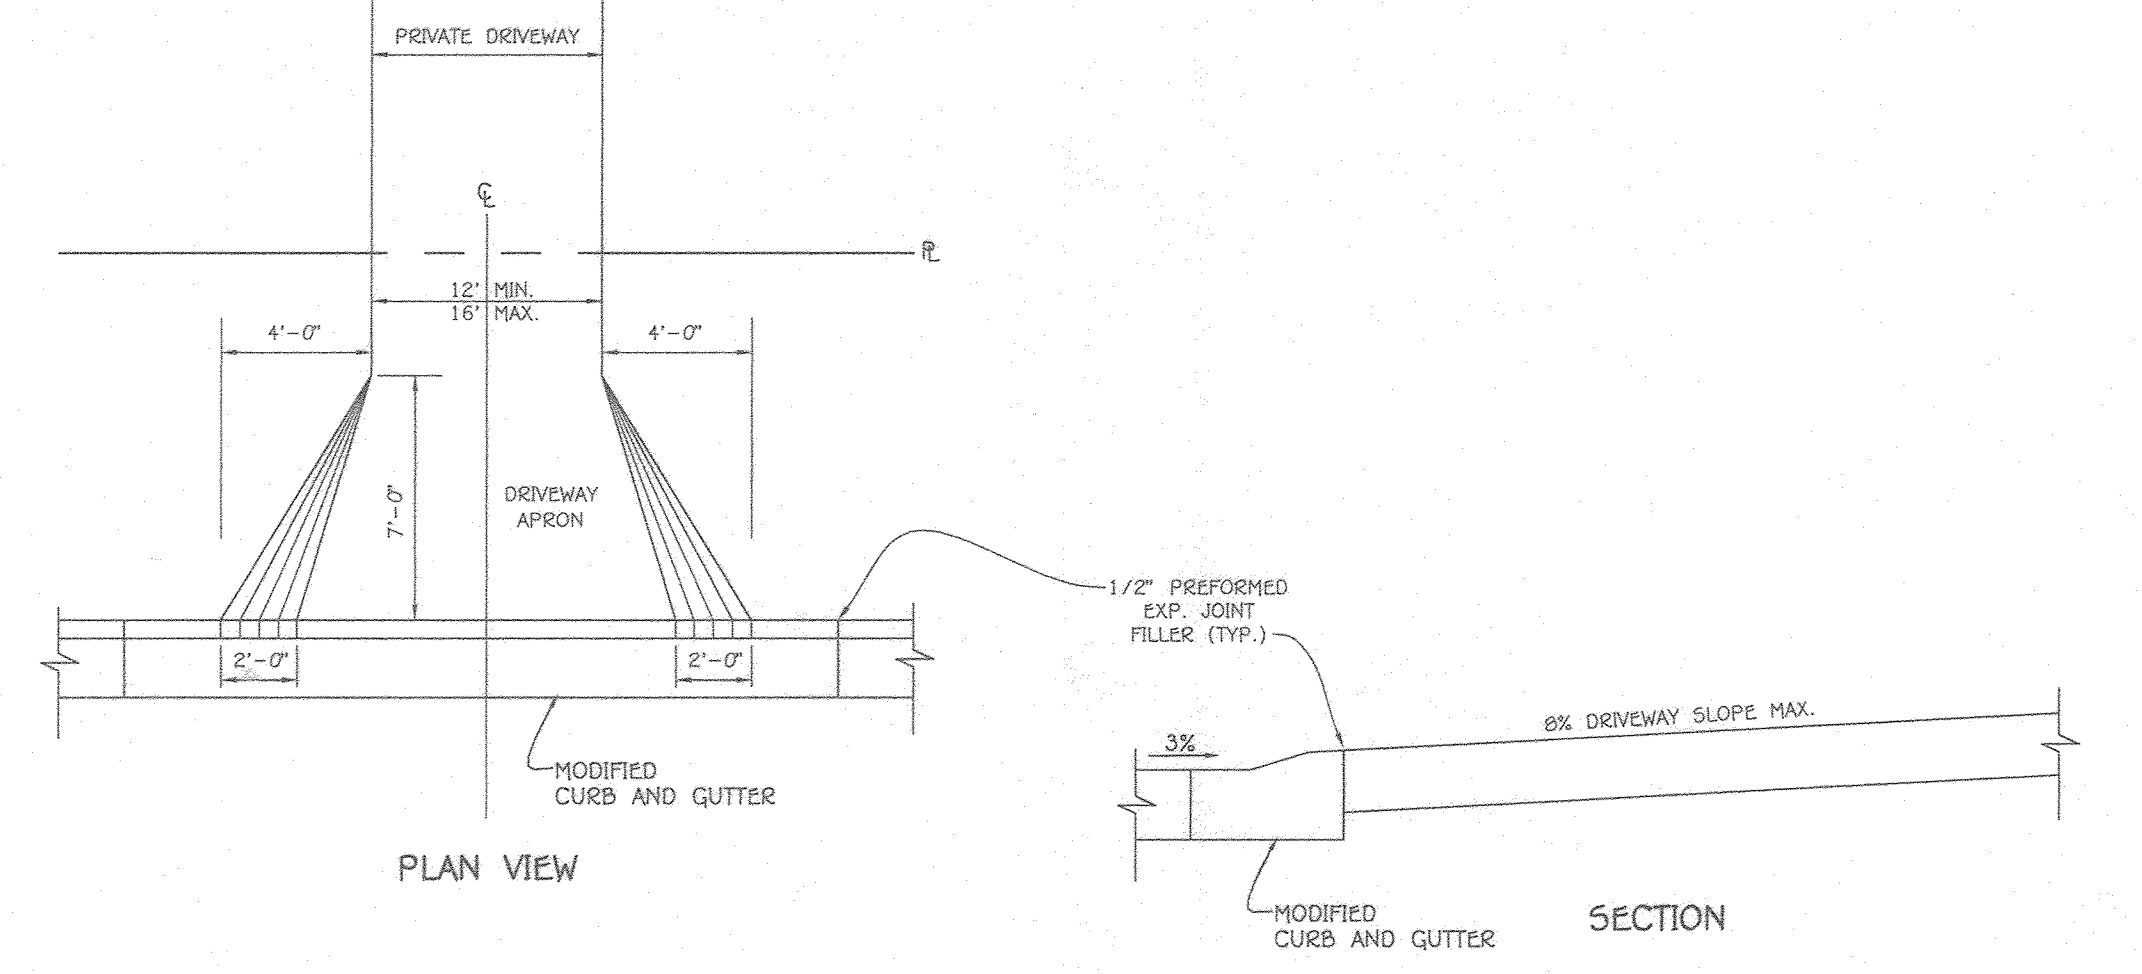


RESIDENTIAL DRIVEWAY ENTRANCE
MODIFIED COMBINATION CURB & GUTTER

NOT TO SCALE

NOTE: APPROX. LOCATION SHOWN ON SHEET 2 SUBJECT TO FINAL GRADING PERMIT PLAN.

AS-BUILT CERTIFICATION
I hereby certify that the facilities shown on the plan were constructed in accordance with the AS-BUILT plan and the approved specifications.

[Signature]
5/3/22
Date

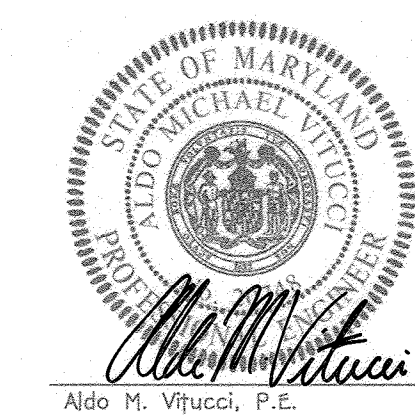

8/17/2020
Date

FISHER, COLLINS & CARTER, INC.
CIVIL ENGINEERING CONSULTANTS & LAND SURVEYORS
CENTRAL SQUARE OFFICE PARK - 10272 BALTIMORE NATIONAL FREE
GLIESTT CITY, MARYLAND 21042
(410) 461-2895

OWNER:
KIMBERLY/HERITAGE LLC
3425 HIPSLEY MILL ROAD
WOODBINE, MARYLAND 21797-7615
410-489-7900

DEVELOPER:
HERITAGE LAND DEVELOPMENT
15950 NORTH AVENUE
LISSON, MARYLAND 21765
410-489-7900

"Professional Certification: I hereby certify that these documents were prepared or approved by me, and that I am a duly Licensed Professional Engineer under the laws of the State of Maryland, License No. 20740, Expiration Date 2-22-21."

ROADWAY DETAILS & MOT PLAN
LINDEN GROVE
PHASE TWO
LOTS 24 THRU 44
(A Resubdivision of Non-Buildable Bulk Parcels 'P' & 'G', Recorded As 'Linden Grove, Phase One Lots 1 Thru 23, Buildable Preservation Parcel 'A', Non-Buildable Preservation Parcels 'S' Thru 'E' And Non-Buildable Bulk Parcels 'F' And 'V' - Plot Nos. 25044 Thru 25073.)
ZONED: RC-DEO
TAX MAP No. 8 GRID No. 7 PARCEL No. 5
4TH ELECTION DISTRICT HOWARD COUNTY, MARYLAND
DATE: JUNE 16, 2020
SHEET 3 of 24

"AS-BUILT" F-20-019

STONE/RIPRAP OUTLET SEDIMENT TRAP ST-II (F-18-092)		TRAP NO. 3	TRAP NO. 4
DRAINAGE AREA - INITIAL	3.28 AC.	1.93 AC.	---
DRAINAGE AREA - FINAL	4.34 AC.	2.92	---
TOTAL STORAGE REQUIRED	15,624 CF	9,072 CF	---
TOTAL STORAGE PROVIDED	31,899 CF	13,460 CF	---
WET STORAGE REQUIRED	7,812 CF	4,536 CF	---
WET STORAGE PROVIDED	7,812 CF	4,536 CF	---
DRY STORAGE REQUIRED	9,583 CF	4,792 CF	---
DRY STORAGE PROVIDED	9,583 CF	4,792 CF	---
EXISTING GROUND ELEVATION AT OUTLET (WET STORAGE ELEVATION)	548.25	562.30	---
TRAP BOTTOM ELEVATION	548.00	562.00	---
TRAP BOTTOM DIMENSIONS	80' x 40'	70' x 35'	---
WEIR LENGTH	22'	20'	---
WEIR CREST (DRY STORAGE) ELEVATION	548.30	563.95	---
CLEANOUT ELEVATION	547.00	562.75	---
TOP OF EMBANKMENT ELEVATION	552.00	566.00	---
SIDE SLOPE	2:1	2:1	---
EMBANKMENT TOP WIDTH	6.0'	6.0'	---
OUTLET PROTECTION - LENGTH	18'	30'	---
OUTLET PROTECTION - DEPTH	19"	19"	---

HOUSE CONSTRUCTION NOTES:

- THIS HOWARD (SCD) STANDARD SEDIMENT CONTROL PLAN MAY NOT BE USED TO OBTAIN PERMITS FOR HOUSE CONSTRUCTION FOR THIS PROJECT.
- HOUSES MAY NOT BE BUILT USING THIS DRAWING.

DESIGN CERTIFICATION

I hereby certify that the facilities shown on the plan were designed in accordance with the AS-BUILT plan meet the requirements of the Maryland Department of the Environment.

[Signature]
Date: 5/1/22

SEDIMENT CONTROL LEGEND

- SSF — SSF — SSF — SUPER-SILT FENCE
- SF — SF — SF — SILT FENCE
- STABILIZED CONSTRUCTION ENTRANCE
- S.I.P. (A) STANDARD INLET PROTECTION INLET TYPE 'A' OR 'B'
- L.O.D. LIMIT OF DISTURBANCE
- FUTURE LIMIT OF DISTURBANCE FOR SEPTIC SYSTEM INSTALL.
- R.P.S. REMOVABLE PUMPING STATION
- F.B. FILTER BAG
- TYPE A-2 EARTH DIKE
- 12' DISCONNECTION OF NON ROOF-TOP RUNOFF CREDIT. (TYPE N-2)

SEE SHEET 24 FOR DETAILS ON LOT SWM, GRADING AND HOUSE CONFIGURATIONS

DESIGN CERTIFICATION

I, the undersigned, being a duly Licensed Professional Engineer under the laws of the State of Maryland, License No. 20749, do hereby certify that the facilities shown on the plan were designed in accordance with the AS-BUILT plan meet the requirements of the Maryland Department of the Environment.

[Signature]
Date: 6/17/2020

[Signature]
Date: 20749

Printed Name: *[Name]*
RD Registration No. or E.L.S. or L.L.A. (circle one)

OWNER/DEVELOPER CERTIFICATION

I/We certify that any Clearing, Grading, Construction or Development will be Done Pursuant to This Approved Erosion and Sediment Control Plan, including Inspecting and Maintaining Controls And That the Responsible Personnel Involved in the Construction Project will Have a Certificate of Training At A Maryland Department of the Environment (MDE) Approved Training Program For The Control On Erosion and Sediment Prior To Beginning The Project. I Certify Right-of-entry For Periodic On-site Evaluation by Howard County, The Howard Soil Conservation District And/or MDE.

[Signature]
Date: 6/25/20

Printed Name & Title: *[Name], Manager*

Approved: This Plan is Approved for Soil Erosion and Sediment Control by Howard County Department of Planning and Zoning

[Signature] 7/29/20
Date: 11/2/20

Chief, Division of Land Development

[Signature] 8/28/20
Date: 8/28/20

Chief, Development Engineering Division

Approved: Howard County Department of Public Works

[Signature] 8/17/2020
Date: 8/17/2020

Chief, Bureau of Highways

NO. _____ DATE _____

REVISIONS


DESCRIPTION _____ DATE _____

NO. _____ DATE _____

DESCRIPTION _____ DATE _____

CONTRACTOR NOTES:

- CONTRACTOR SHALL REMOVE ANY AND ALL JUNK, DEBRIS AND TRASH FROM WITHIN THE FLOODPLAIN, STREAMS, WETLANDS & THEIR BUFFERS.
- SHOULD THE STOCKPILE EXCEED 15 FT. IN HEIGHT IT MUST BE BENCHED.
- EARTH DIKES CROSSING THE ROADWAYS ARE TO BE CONNECTED TO MACADAM BERMS AT THE DIRECTION OF THE SEDIMENT CONTROL INSPECTOR.
- ANY ROADSIDE SWALE OR DITCH LOCATED IN FILL SHALL BE COMPACTED TO 95% COMPACTION TO AVOID EROSION IN THESE AREAS.

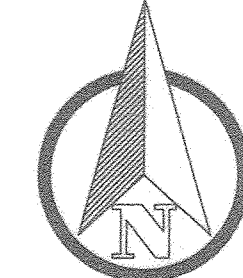

ROOFLEADER NOTE:

A OVERFLOW OUTFALL (SURCHARGE) SHALL BE PROVIDED AT EACH DOWNSPOUT PRIOR TO CONNECTION TO THE UNDERGROUND ROOFLEADER. SEE DETAIL SHEET 19.

GRADING & SEDIMENT CONTROL PLAN
LINDEN GROVE
PHASE TWO
LOTS 24 THRU 44

(A Re-subdivision of Non-Buildable Bulk Parcels 'F' & 'G', Recorded As 'Linden Grove, Phase One Lots 1 Thru 23, Buildable Preservation Parcel 'A', Non-Buildable Preservation Parcel 'B' Thru 'E' And Non-Buildable Bulk Parcel 'F' And 'G', Plat Nos. 25064 Thru 25073.)

ZONED: RC-DEO
GRID No. 7
PARCEL No. 5
TAX MAP No. 8
4TH ELECTION DISTRICT HOWARD COUNTY, MARYLAND
DATE: JUNE 16, 2020
SHEET 4 OF 24

FISHER, COLLINS & CARTER, INC.
CIVIL ENGINEERING CONSULTANTS & LAND SURVEYORS
CENTRAL SQUARE OFFICE PARK - 16272 BALDOR NATIONAL PARK
ELICOTT CITY, MARYLAND 21042
(410) 461 - 2099

OWNER:
KIMBERLY/HERITAGE LLC
3425 HIPSLEY MILL ROAD
WOODBINE, MARYLAND 21797-7615
410-499-7900

DEVELOPER:
HERITAGE LAND DEVELOPMENT
15950 NORTH AVENUE
LISBON, MARYLAND 21765
410-499-7900

[Signature] 6/17/2020
Date: 6/17/2020

Also known as: VUCCHI, P.E.
Professional Certification: I hereby certify that these documents were prepared or approved by me, and that I am a duly Licensed Professional Engineer under the laws of the State of Maryland, License No. 20749, expiration date 2-22-21.

SOIL PREPARATION, TOPSOILING AND SOIL AMENDMENTS (B-4-2)

A. Soil Preparation

- 1. Temporary Stabilization
a. Seeded preparation consists of loosening soil to a depth of 3 to 5 inches by means of suitable agricultural or construction equipment...

2. Permanent Stabilization

- a. A soil test is required for any earth disturbance of 5 acres or more. The minimum soil conditions required for permanent vegetative establishment are:
i. Soil pH between 6.0 and 7.0
ii. Soluble salts less than 500 parts per million (ppm)...

B. Topsoiling

- 1. Topsoil is prepared over prepared subsoil prior to establishment of permanent vegetation. The purpose is to provide a suitable soil medium for vegetative growth.
2. Topsoil obtained from an existing site may be used provided it meets the standards set forth in these specifications...

PERMANENT SEEDING NOTES (B-4-5)

A. Seed Mixtures

- 1. General Use
a. Select one or more of the species or mixtures listed in Table B.3 for the appropriate Plant Hardness Zone (from Figure B.3) and based on the site condition or purpose found on Table B.2. Enter selected mixtures, application rates, and seeding dates in the Permanent Seeding Summary...

2. Turfgrass Mixtures

- a. Areas where turfgrasses may be desired include lawns, parks, playgrounds, and commercial sites which will receive a medium to high level of maintenance.
b. Select one or more of the species or mixtures listed below based on the site conditions or purpose. Enter selected mixtures, application rates, and seeding dates in the Permanent Seeding Summary...

- i. Kentucky Bluegrass: Full Sun Mixture: For use in areas that receive intensive maintenance, irrigation required in the areas of central Maryland and Eastern Shore.
ii. Kentucky Bluegrass/Perennial Rye: Full Sun Mixture: For use in full sun areas where rapid establishment is necessary...

- iii. Tall Fescue/Kentucky Bluegrass: Full Sun Mixture: For use in areas with drought prone areas and/or for areas receiving low to medium maintenance in full sun to medium shade.
iv. Kentucky Bluegrass/Fine Fescue: Shade Mixture: For use in areas with shade in Bluegrass lawns...

- c. Ideal Times of Seeding for Turf Grass Mixtures Western MD: March 15 to June 1, August 1 to October 1 (Hardness Zone: 6b, 6a) Central MD: March 1 to May 15, August 15 to October 15 (Hardness Zone: 6b) Southern MD, Eastern Shore: March 1 to May 15, August 15 to October 15 (Hardness Zone: 7a, 7b)

- d. Till areas to receive seed by disking or other approved methods to a depth of 2 to 4 inches, level and rake the areas to prepare a proper seedbed. Remove stones and debris over 1 1/2 inches in diameter...

- e. If soil moisture is deficient, supply new seedlings with adequate water for plant growth (1 1/2 to 1 inch every 3 to 4 days depending on soil texture) until they are firmly established. This is especially true when seedlings are made late in the planting season...

Permanent Seeding Summary table with columns: Hardness Zone, Seed Mixture, Application Rate, Seeding Dates, Fertilizer Rate, Lime Rate.

STANDARD STABILIZATION NOTE
FOLLOWING INITIAL SOIL DISTURBANCE OR RE-DISTURBANCE, PERMANENT OR TEMPORARY STABILIZATION MUST BE COMPLETED WITHIN:
a.) THREE (3) CALENDAR DAYS AS TO THE SURFACE OF ALL PERIMETER DIKES, SWALES, DITCHES, PERIMETER SLOPES AND ALL SLOPES STEEPER THAN 3 HORIZONTAL TO 1 VERTICAL (3:1); AND
b.) SEVEN (7) CALENDAR DAYS AS TO ALL OTHER DISTURBED OR GRADED AREAS ON THE PROJECT SITE NOT UNDER ACTIVE GRADING.

STANDARDS AND SPECIFICATIONS FOR STOCKPILE AREA (B-4-6)

The mound or pile of soil protected by appropriately designed erosion and sediment control measures.

To provide a designated location for the temporary storage of soil that controls the potential for erosion, sedimentation, and changes to drainage patterns.

Stockpile areas are utilized when it is necessary to salvage and store soil for later use.

- 1. The stockpile location and all related sediment control practices must be clearly indicated on the erosion and sediment control plan.
2. The footprint of the stockpile must be sized to accommodate the anticipated volume of material and based on a side slope ratio no steeper than 2:1. Benching must be provided in accordance with Section B-3 Land Grading...

Maintenance
The stockpile area must continuously meet the requirements for Adequate Vegetative Establishment in accordance with Section B-4 Vegetative Stabilization. Side slopes must be maintained on no steeper than a 2:1 ratio. The stockpile area must be kept free of the vertical height of stockpile exceeds 20 feet for 2:1 slopes, 30 feet for 3:1 slopes, or 40 feet for 4:1 slopes...

STANDARDS AND SPECIFICATIONS FOR SEEDING AND MULCHING (B-4-3)

The application of seed and mulch to establish vegetative cover.

To protect disturbed soils from erosion during and at the end of construction.

To the surface of all perimeter controls, slopes, and any disturbed area not under active grading.

- A. Seeding
1. Specifications
a. All seed must meet the requirement of the Maryland State Seed Law. All seed must be subject to re-testing by a recognized seed laboratory...

- b. Mulch alone may be applied between the fall and spring seeding dates only if the ground is frozen. The appropriate seeding mixture must be applied between the ground thaws...

- 2. Application
a. Dry Seeding: This includes use of conventional grid or broadcast spreaders. Incorporate seed into the subsoil at the rates prescribed on Temporary Seeding Table B.1...

- b. Drill or Cultipacker Seeding: Mechanized seeders that apply and cover seed with soil. Cultipacker seeders are required to bury the seed in such a fashion as to provide at least 1/4 inch of soil covering...

- c. Hydroseeding: Apply seed uniformly with hydroseeder (slurry includes seed and fertilizer). If fertilizer is being applied at the time of seeding, the application rates should not exceed the following...

- d. Till areas to receive seed by disking or other approved methods to a depth of 2 to 4 inches, level and rake the areas to prepare a proper seedbed. Remove stones and debris over 1 1/2 inches in diameter...

- e. If soil moisture is deficient, supply new seedlings with adequate water for plant growth (1 1/2 to 1 inch every 3 to 4 days depending on soil texture) until they are firmly established. This is especially true when seedlings are made late in the planting season...

- B. Mulching
1. Mulch Materials (in order of preference)
a. Straw consisting of thoroughly threshed wheat, rye, oat, or barley and reasonably bright in color. Straw is to be free of noxious weed seeds as specified in the Maryland Seed Law...

- b. Wood Cellulose Fiber Mulch (WCFM) consisting of specially prepared wood cellulose processed into uniform fibrous physical sheets.
i. WCFM is to be dyed green or contain a green dye in the package that will provide an appropriate color to facilitate visual inspection of the uniformly spread slurry...

- ii. WCFM, including mulch, must contain no germination or growth inhibiting factors.
iii. WCFM materials are to be manufactured and processed in such a manner that the wood cellulose fiber mulch will remain in uniform suspension in water under agitation and will blend with water, fertilizer and other additives to form a homogeneous slurry...

- iv. WCFM material must not contain elements or compounds at concentration levels that will be phytotoxic.
v. WCFM must conform to the following physical requirements: fiber length of approximately 10 millimeters, diameter approximately 1 millimeter, pH range of 4.0 to 6.5, ash content of 1.6 percent maximum and water holding capacity of 90 percent minimum.

- 2. Application
a. Apply mulch to all seeded areas immediately after seeding.
b. When straw mulch is used, spread it over all seeded areas at the rate of 2 tons per acre to a uniform loose depth of 1 to 2 inches. Apply mulch to achieve a uniform distribution and depth so that the soil surface is not exposed. When using a mulch anchoring tool, increase the application rate to 2.5 tons per acre.

- c. Wood cellulose fiber used as mulch must be applied to a net dry weight of 1500 pounds per acre. Mix the wood cellulose fiber with water to obtain a mixture with a maximum of 50 pounds of wood cellulose fiber per 100 gallons of water.

- 3. Anchoring
a. Perform mulch anchoring immediately following application of mulch to minimize loss by wind or water. This may be done by one of the following methods (listed by preference), depending upon the size of the area and erosion hazard:
i. A mulch anchoring tool is a tractor draw implement designed to punch and anchor mulch into the soil surface a minimum of 2 inches. This practice is most effective on large areas, but is limited to flatter slopes where equipment can operate safely...

- ii. Wood cellulose fiber may be used for anchoring straw. Apply the fiber binder at a net dry weight of 750 pounds per acre. Mix the wood cellulose fiber with water at a maximum of 50 pounds of wood cellulose fiber per 100 gallons of water.

- iii. Synthetic binders such as Acrylic DLR (Agra-Tack), DDA-70, Petrosel, Terra Tax II, Terra Tack AR or other approved equal may be used. Follow application rates as specified by the manufacturer. Application of liquid binders needs to be heavier at the edges where wind catches mulch, such as in valleys and on crests of banks. Use of asphalt binders is strictly prohibited.

- iv. Lightweight plastic netting may be stapled over the mulch according to manufacturer recommendations. Netting is usually available in rolls 4-15 feet wide and 300 to 3,000 feet long.


B-4-1 STANDARDS AND SPECIFICATIONS FOR INCREMENTAL STABILIZATION

Establishment of vegetative cover on cut and fill slopes as work progresses.

To provide timely vegetative cover on cut and fill slopes as work progresses.

Any cut or fill slope greater than 15 feet in height. This practice also applies to stockpiles.


- 1. Excavate and stabilize cut slopes in increments not to exceed 15 feet in height. Prepare seedbed and apply seed and mulch on all cut slopes as the work progresses.
2. Construction sequence example (Refer to Figure B.1):
a. Construct and stabilize all temporary swales or dikes that will be used to convey runoff around the excavation.
b. Perform Phase 1 excavation, prepare seedbed, and stabilize.
c. Perform Phase 2 excavation, prepare seedbed, and stabilize. Overseed Phase 1 areas as necessary.
d. Perform final phase excavation, prepare seedbed, and stabilize. Overseed previously seeded areas as necessary.

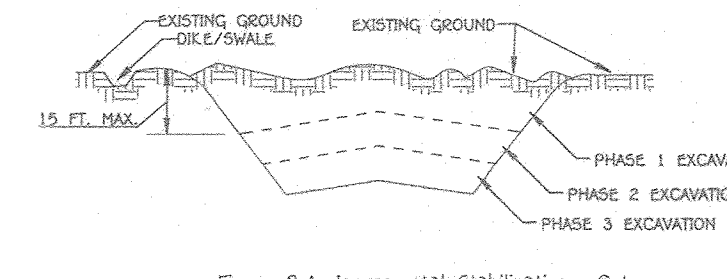

- B. Incremental Stabilization - Fill Slopes
1. Construct and stabilize fill slopes in increments not to exceed 15 feet in height. Prepare seedbed and apply seed and mulch on all slopes as the work progresses.
2. Stabilize slopes immediately when the vertical height of a fill reaches 15 feet, or when the grading operation ceases as prescribed in the plans.

- 3. At the end of each day, install temporary water conveyance practices, as necessary, to intercept surface runoff and convey it down the slope in a non-erosive manner.
4. Construction sequence example (Refer to Figure B.2):
a. Construct and stabilize all temporary swales or dikes that will be used to divert runoff around the fill. Construct silt fence on side of fill unless other methods shown on the plans stabilize this area.
b. At the end of each day, install temporary water conveyance practices, as necessary, to intercept surface runoff and convey it down the slope in a non-erosive manner.
c. Place Phase 1 fill, prepare seedbed, and stabilize.
d. Place Phase 2 fill, prepare seedbed, and stabilize.
e. Place final phase fill, prepare seedbed, and stabilize. Overseed previously seeded areas as necessary.

Note: Once the placement of fill has begun the operation should be continuous from grubbing through the completion of grading and placement of topsoil (if required) and permanent seed and mulch. Any interruptions in the operation or completing the operation out of the seeding season will necessitate the application of temporary stabilization.

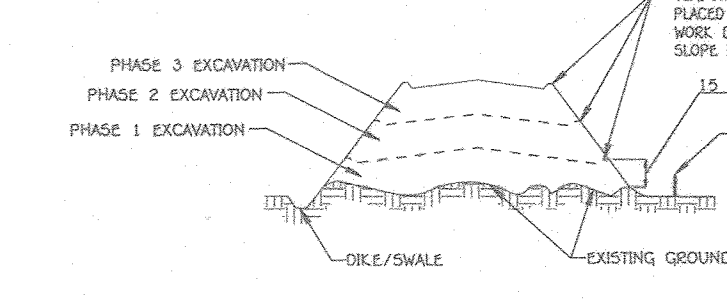

SEQUENCE OF CONSTRUCTION

- 1. OBTAIN A GRADING PERMIT. (2 WEEKS)
2. NOTIFY "MISS UTILITY" AT LEAST 48 HOURS BEFORE BEGINNING ANY WORK AT 1-800-257-7777. NOTIFY THE HOWARD COUNTY OFFICE OF CONSTRUCTION/INSPECTION AT 410-313-1330 AT LEAST 24 HOURS BEFORE STARTING WORK.
3. INSTALL THE STABILIZED CONSTRUCTION ENTRANCES. (1 DAY)
4. INSTALL SUPER SILT/FENCE AS SHOWN ON THE PLANS. (1 WEEK)
5. UPON COMPLETION OF THE SEDIMENT CONTROL INSTALLATION, RECEIVE PERMISSION FROM THE SEDIMENT CONTROL INSPECTOR PRIOR TO PROCEEDING.
6. CLEAR AND GRUB SITE (2 WEEKS)
7. GRADE PROPOSED ROADS & LOTS TO SUBGRADE, INSTALL THE STORM DRAIN INLETS, MANHOLES AND END SECTIONS. (3 WEEKS)
8. STABILIZE ALL SLOPES IMMEDIATELY UPON COMPLETION OF GRADING.
9. CONSTRUCT ROAD BASE COURSE. (3 WEEKS)
10. WHEN ALL CONTRIBUTING AREAS TO THE SEDIMENT CONTROL DEVICES HAVE BEEN STABILIZED AND WITH THE PERMISSION OF THE SEDIMENT CONTROL INSPECTOR, THE SEDIMENT CONTROL DEVICES MAY BE REMOVED AND/OR BACKFILLED AND THE REMAINING AREAS BROUGHT TO FINAL GRADE AND THE FINAL GWH FACILITIES CONSTRUCTED. STABILIZE ALL DISTURBED AREAS IN ACCORDANCE WITH PERMANENT SEEDING NOTES. (2 WEEKS)
11. NOTIFY HOWARD COUNTY OFFICE OF INSPECTIONS AND PERMITS FOR FINAL INSPECTION OF THE COMPLETED PROJECT. (1 WEEK)

NOTE: THE CONTRACTOR SHALL INSPECT AND PROVIDE NECESSARY MAINTENANCE ON ALL SEDIMENT AND EROSION CONTROL STRUCTURES SHOWN HEREON, AFTER EACH RAINFALL AND ON A DAILY BASIS.



DESIGN CERTIFICATION
I hereby certify that this plan has been designed in accordance with current Maryland Code, Regulations and Standards, that it is based on my personal knowledge of the site, and that it complies with the requirements of the Howard Soil Conservation District.
Signature: Timothy W. Feag, Manager
Date: 6/17/2020
Printed Name & Title: Timothy W. Feag, Manager
Approved: This Plan is Approved For Soil Erosion And Sediment Control By the Howard Soil Conservation District.
Signature: John A. Blunt, Director
Date: 7/29/20
Approved: Howard County Department of Public Works
Signature: [Signature]
Date: 8/17/2020

HOWARD SOIL CONSERVATION DISTRICT (HSCD) STANDARD SEDIMENT CONTROL NOTES

- 1. A pre-construction meeting must occur with the Howard County Department of Public Works, Construction Inspection Division (CID) 410-313-1399 after the latest of the following dates are met: a minimum of 14 days before notice to CID must be given at the following stages: a. Prior to the start of earth disturbance.
b. Upon completion of the installation of perimeter erosion and sediment controls, but any other before proceeding with earth disturbance or grading.
c. Prior to the start of another phase of construction or opening of another grading unit. d. Prior to the removal or modification of sediment control practices.
Other grading or grading inspection activities may not be authorized until this initial approval by the inspection agency is made. Other related state and federal permits shall be referenced, to ensure coordination and to avoid conflicts with this plan.
2. All vegetative and structural practices are to be installed according to the provisions of this plan and are to be in conformance with the 2011 MARYLAND STANDARDS AND SPECIFICATIONS FOR SOIL EROSION AND SEDIMENT CONTROL, and revisions thereto.
3. Following initial soil disturbance or re-disturbance, permanent or temporary stabilization is required within three (3) calendar days to the surface of all perimeter controls, dikes, swales, ditches, perimeter slopes, and all slopes steeper than 3 horizontal to 1 vertical (3:1); and seven (7) calendar days as to all other disturbed areas on the project site except for those areas under active grading.
4. All disturbed areas must be stabilized within the time period specified above in accordance with the 2011 MARYLAND STANDARDS AND SPECIFICATIONS FOR SOIL EROSION AND SEDIMENT CONTROL for topsoil (Sec. B-4-2), permanent seeding (Sec. B-4-5), temporary seeding (Sec. B-4-4) and mulching (Sec. B-4-3). Temporary stabilization with mulch alone can only be used between the fall and spring seeding dates if the ground is frozen. Incremental stabilization (Sec. B-4-1) applications shall be entered in areas with 1:1 cut and/or fill. Stockpiles (Sec. B-4-6) in excess of 20 ft. must be bonded with stable soil. All concentrated flow, steep slopes, and highly erodible areas shall receive soil stabilization matting (Sec. B-4-4).
5. All sediment control structures are to remain in place, and are to be maintained in operative condition until permission for their removal has been obtained from the CID.
6. Site Analysis:
Total Tract Area (Phase One & Two): 28,680 Acres
Total Area of This Plan: 28,152 Acres (Bulk Parcels "F" & "G")
Area Disturbed: 18,100 Acres
Area to be roofed or paved: 1.1 Acres
Area to be vegetatively established: 17.0 Acres
Total Cut: 11,200 Cu. Yds.
Total Fill: 3,600 Cu. Yds.
Off-site water/runoff area location: ON-SITE.
7. An sediment control practice which is disturbed by grading activity for placement of utilities must be repaired on the same day of disturbance.
8. Additional sediment control must be provided, if deemed necessary by the CID. The site and all controls shall be inspected by the contractor weekly; and the soil dry after each rain event. A written report by the contractor, made available upon request, is part of every inspection and should include:
• Inspection date
• Inspection type (routine, pre-storm event, during rain event)
• Name and title of inspector
• Weather information (current conditions as well as time and amount of last recorded precipitation)
• Brief description of current status (e.g., percent compliance) and/or current activities
• Evidence of sediment discharges
• Identification of site deficiencies
• Identification of sediment controls that require maintenance
• Identification of missing or improperly installed sediment controls
• Compliance status regarding the acquisition of construction and stabilization requirements
• Photographs
• Monitoring/drainage
• Maintenance and/or corrective action performed
• Other inspection items to be reported by the General Permit for Stormwater Associated with Construction Activities (NPDES, MDE).
9. Trenches for the construction of utilities are limited to three pipe lengths or that which can and shall be back-filled and stabilized by the end of each workday, whichever is shorter.
10. Any major changes or revisions to the plan or sequence of construction must be reviewed and approved by the HSCD prior to proceeding with construction. Minor revisions may be allowed by the CID per the list of HSCD-approved field changes.
11. Disturbance shall not occur outside the LOD. A project is to be sequenced so that grading activities begin on one grading unit (minimum acreage of 20 ac. per grading unit) at a time. Work may proceed to a subsequent grading unit when at least 50 percent of the disturbed area in the preceding grading unit has been stabilized and approved by the CID. Unless otherwise specified and approved by the CID, no more than 30 acres cumulatively may be disturbed at a given time.
12. Water from any equipment, vehicles, wheels, pavement, and other sources must be treated in a sediment basin or other approved without structure.
13. Topsoil shall be stockpiled and preserved on-site for redistribution onto final grades.
14. All 50' fence and Super Silt Fence shall be placed on-the-contour, and be installed at 25' minimum intervals, with lower ends curved until it is in position.
15. Stream channels must be disturbed during the following restricted time periods (include):
• Use I and II from March 1 - June 15
• Use III and IV from October 1 - April 30
• Use IV March 1 - May 31
16. A copy of this plan, the 2011 MARYLAND STANDARDS AND SPECIFICATIONS FOR SOIL EROSION AND SEDIMENT CONTROL, and associated permits shall be on-site and available when the site is active.

SEDIMENT AND EROSION CONTROL NOTES & DETAILS

LINDEN GROVE PHASE TWO LOTS 24 THRU 44
(A Resubdivision of Non-Buildable Bulk Parcels "F" & "G", Recorded As "Linden Grove, Phase One Lots 1 Thru 23, Buildable Preservation Parcel "A", Non-Buildable Preservation Parcels "B" Thru "E" And Non-Buildable Bulk Parcels "F" And "G", PWT No. 25064 From 25073.)
ZONED: RC-DEO
TAX MAP No. 6 GRID No. 7 PARCEL No. 5
4TH ELECTION DISTRICT HOWARD COUNTY, MARYLAND
DATE: JUNE 16, 2020
SHEET 6 of 24



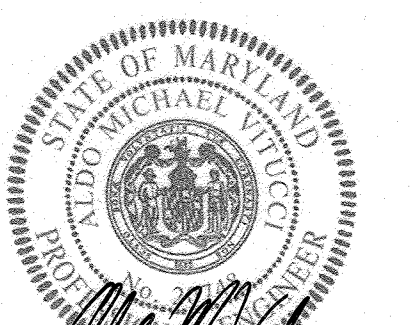
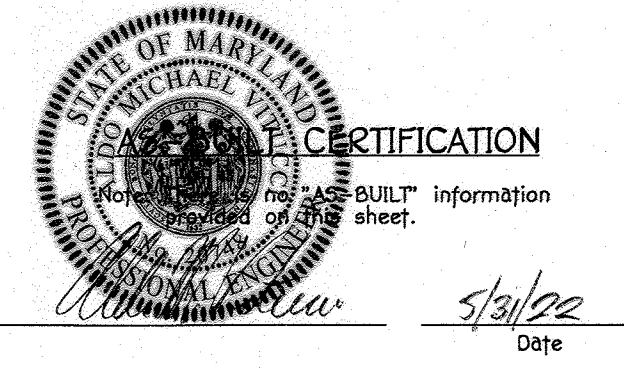


FISHER, COLLINS & CARTER, INC. CIVIL ENGINEERING CONSULTANTS & LAND SURVEYORS
CENTRAL SQUARE OFFICE: 1672 BALTIMORE NATIONAL PLACE BALTIMORE CITY, MARYLAND 21204 (410) 481-2895

OWNER: KIMBERLY/HERITAGE LLC
8425 HIGHLAY HILL ROAD WOODBINE, MARYLAND 21797-7615 410-489-7900
DEVELOPER: HERITAGE LAND DEVELOPMENT
15950 NORTH AVENUE LISBON, MARYLAND 21765 410-489-7900

Aldo M. Vitucci, P.E.
Professional Certification: I hereby certify that these documents were prepared or approved by me and that I am a duly Licensed Professional Engineer under the laws of the State of Maryland, License No. 20748, Expiration Date 2-22-21.

THERE IS NO "AS-BUILT" INFORMATION PROVIDED ON THIS SHEET F-20-019

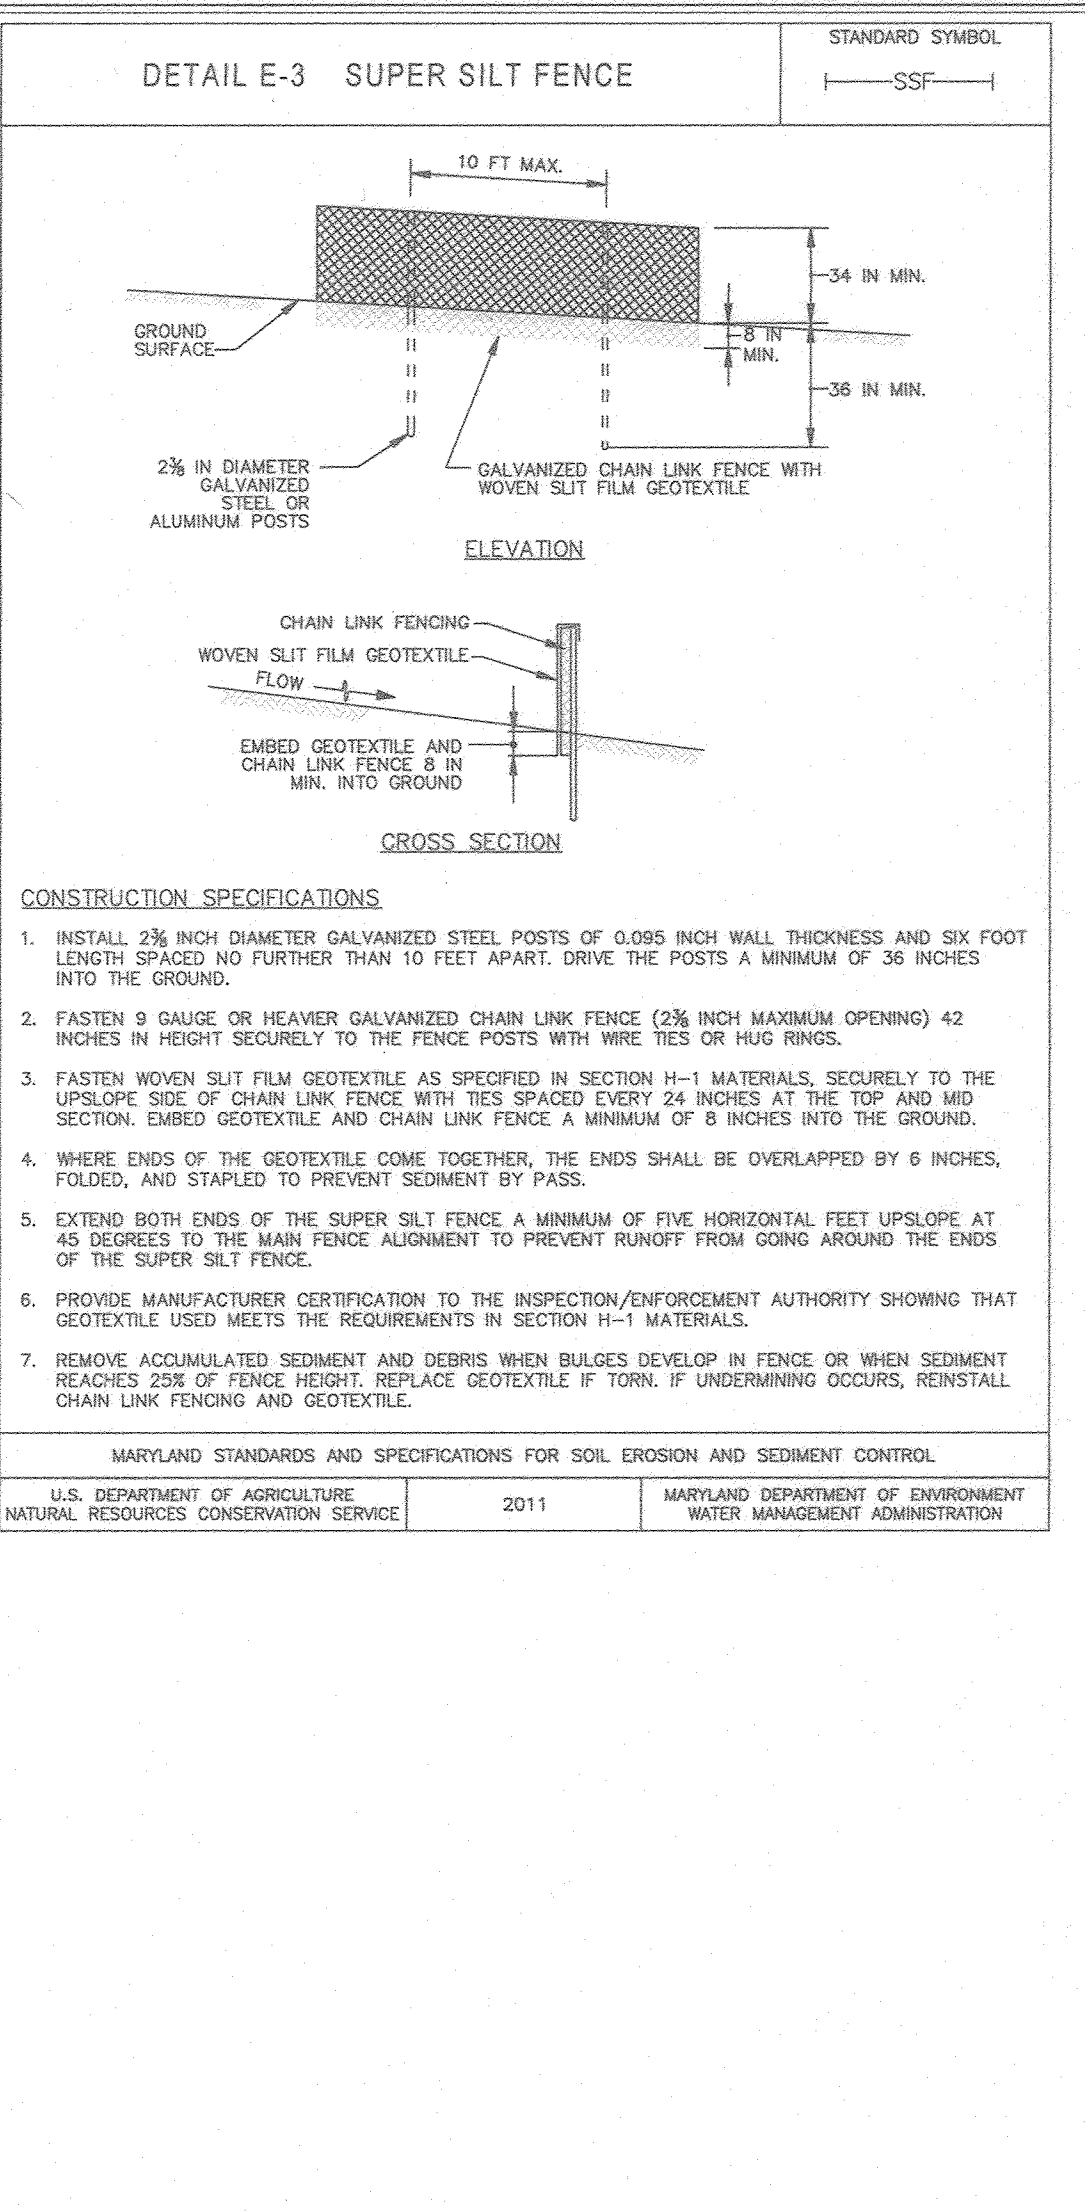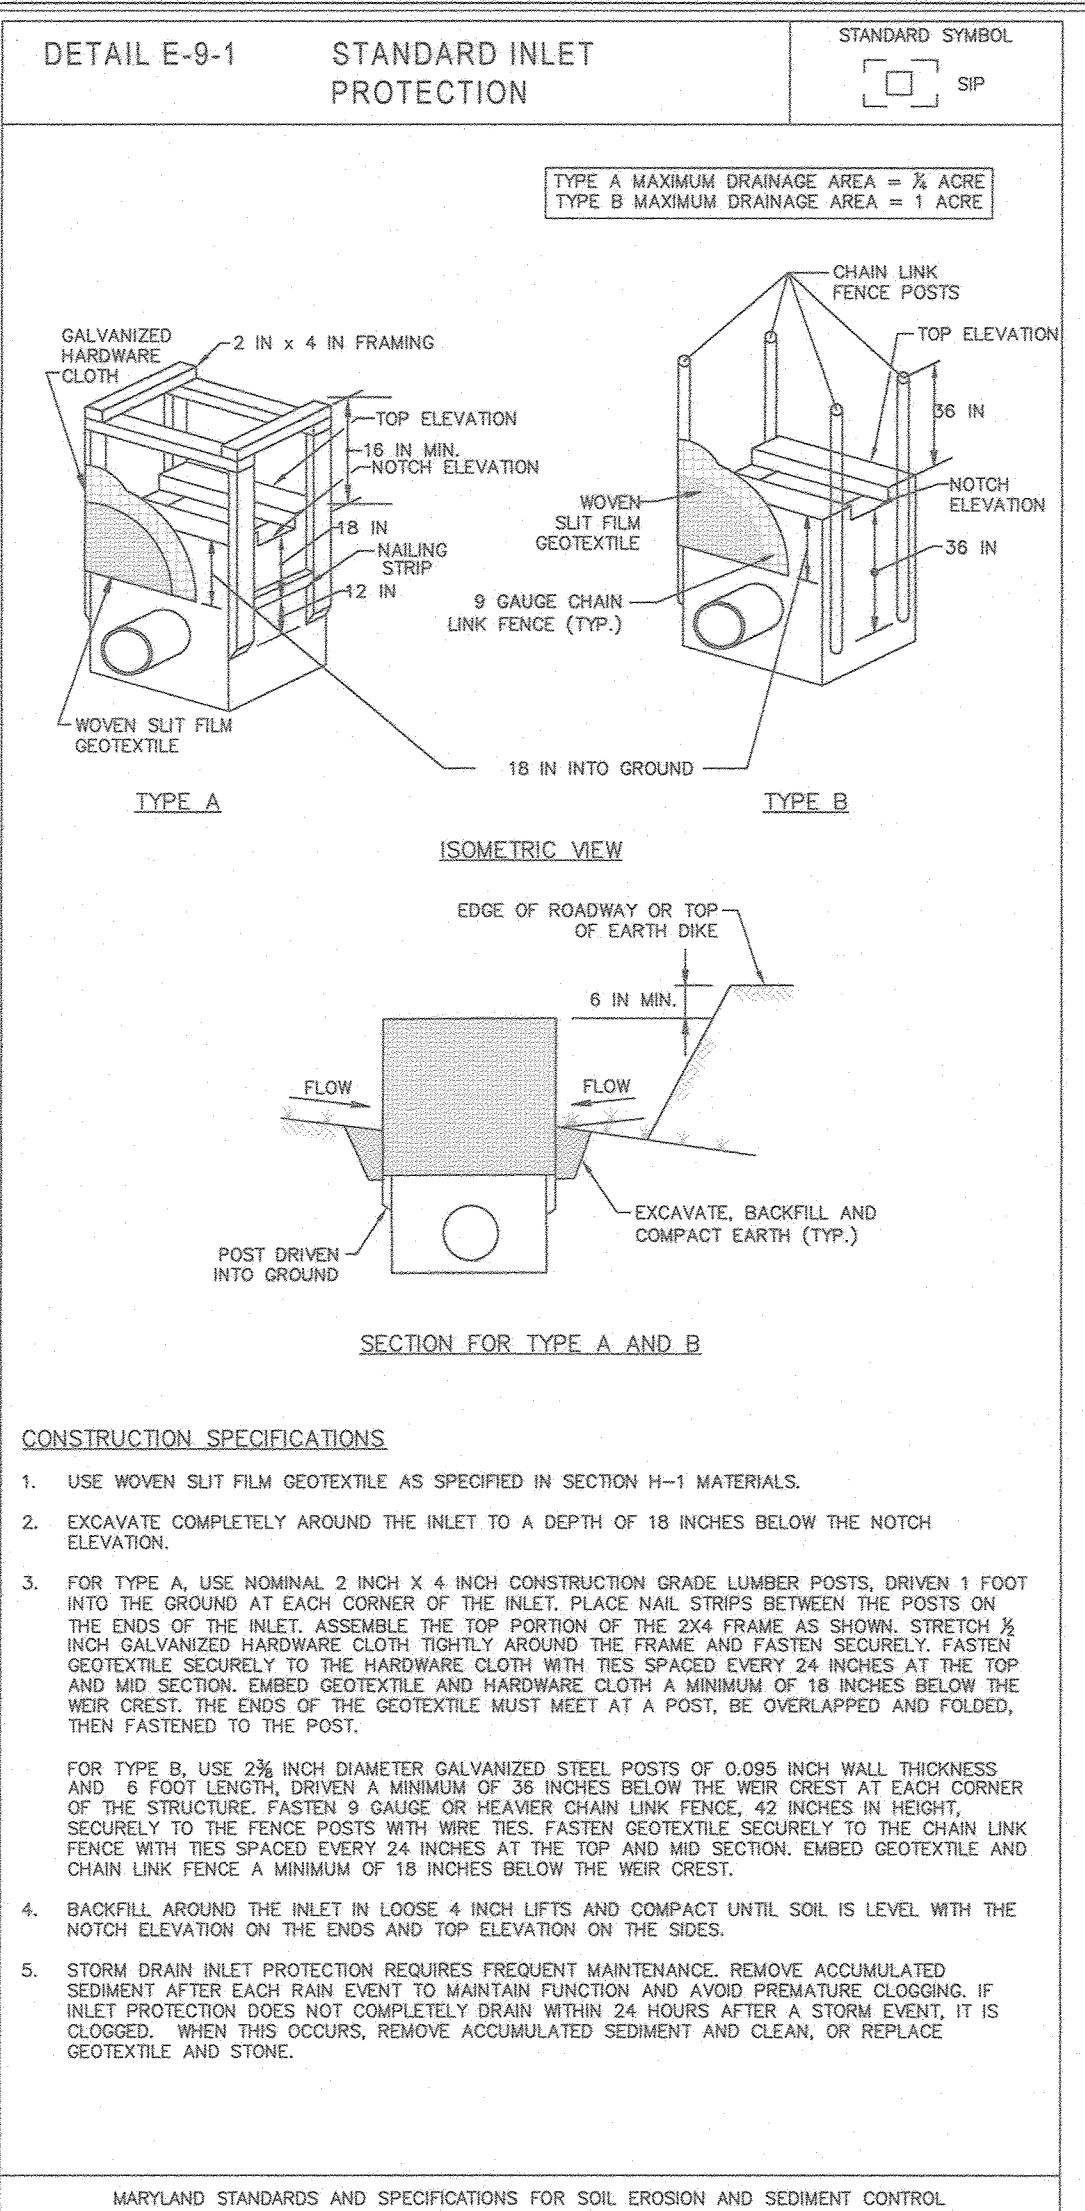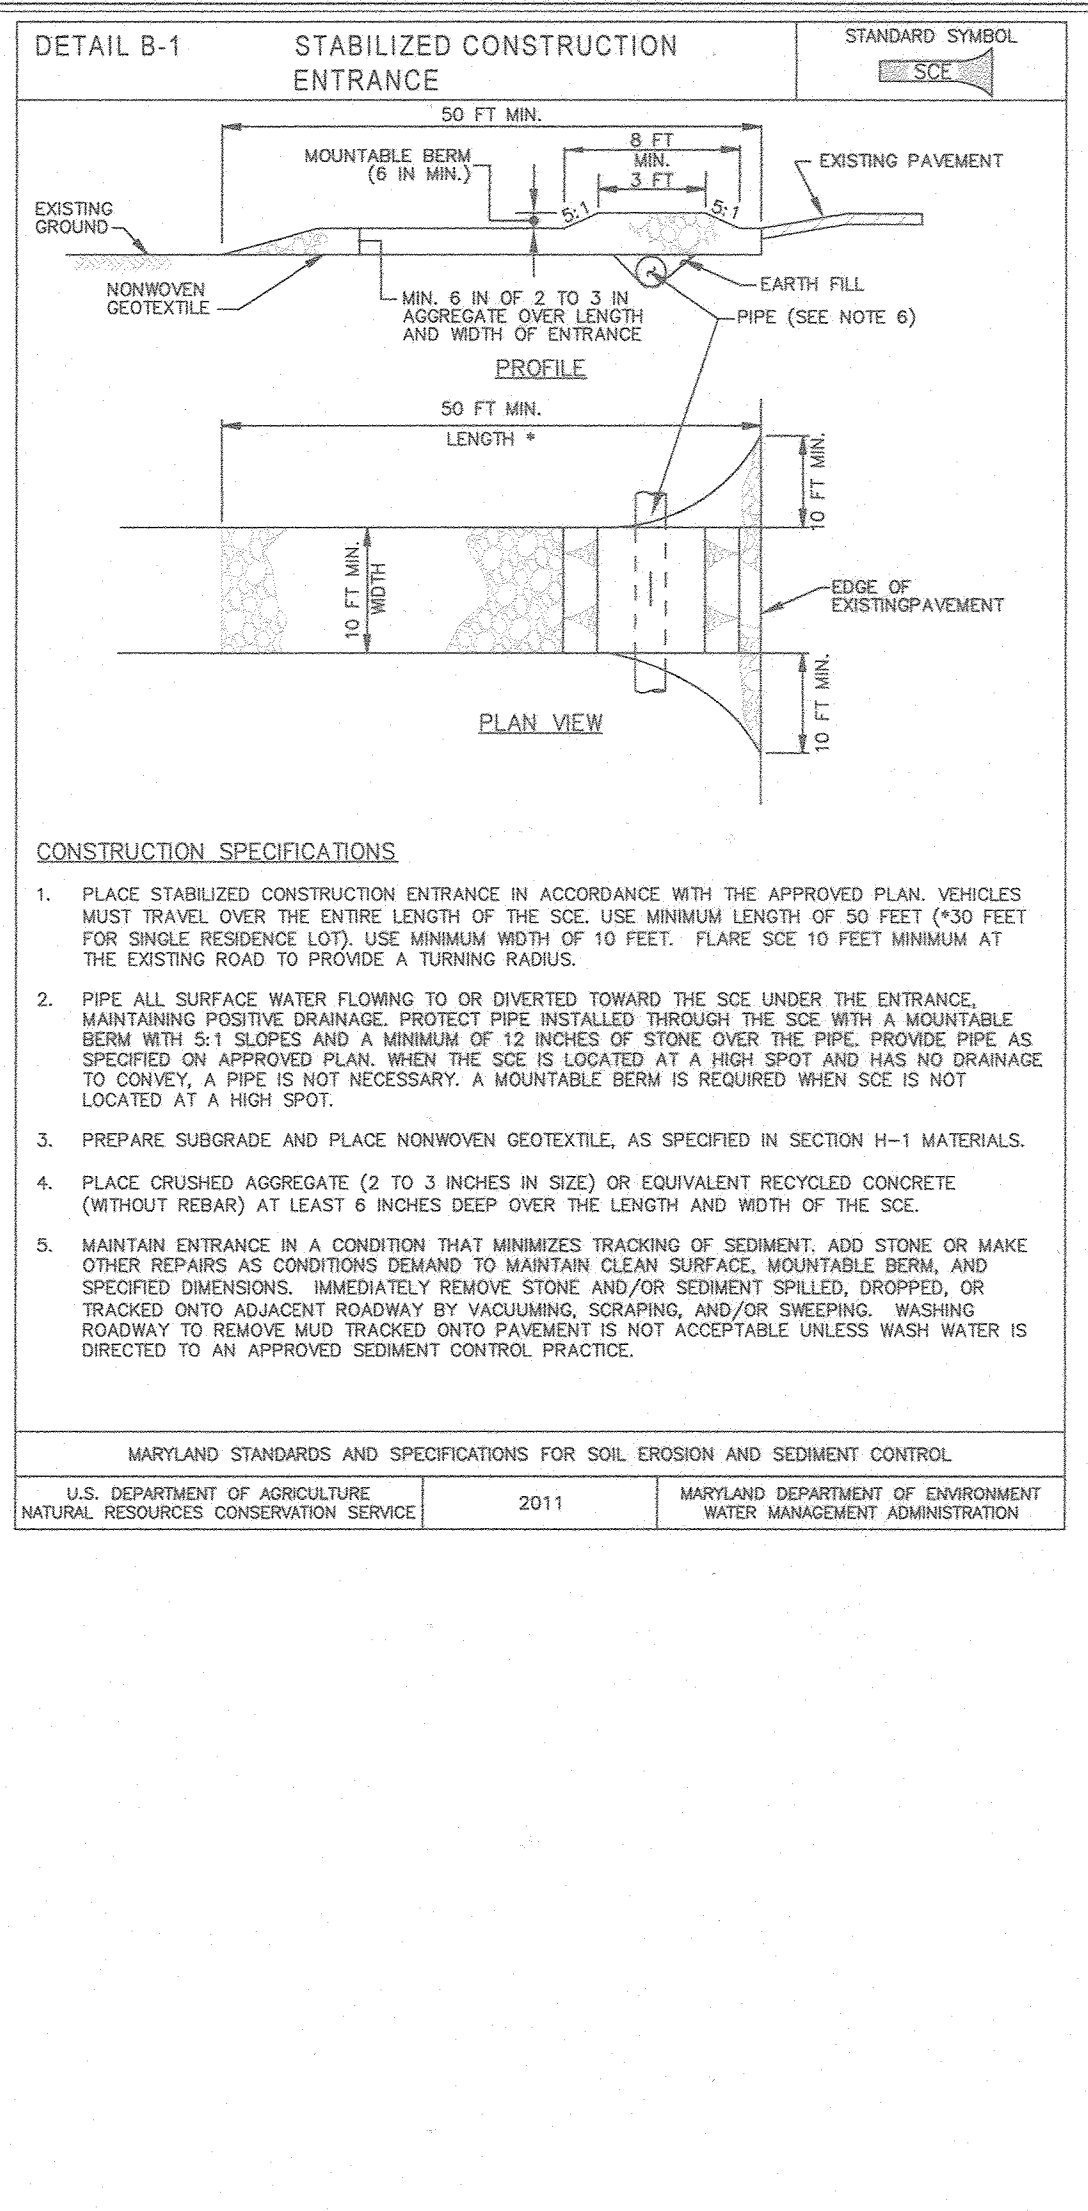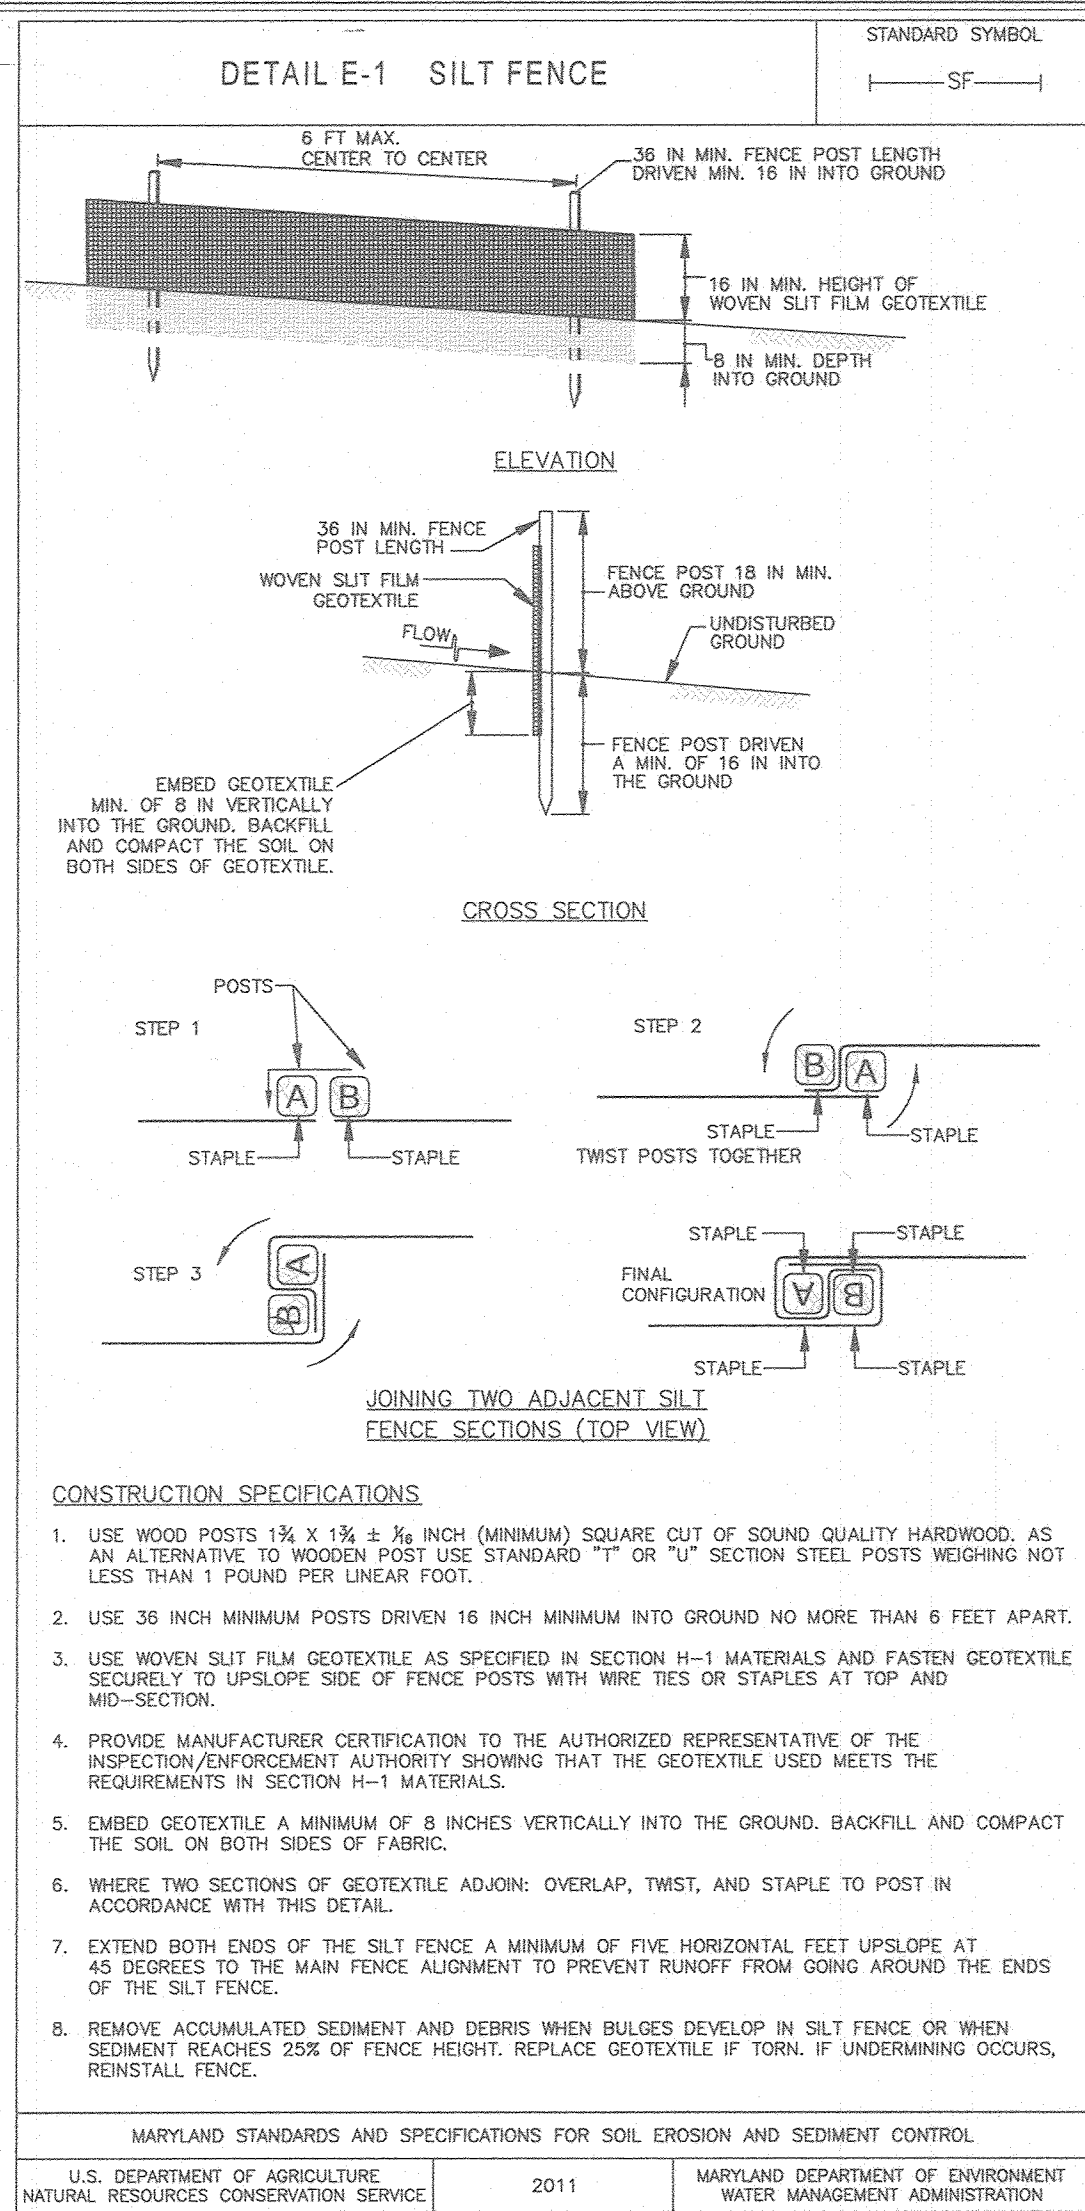

DESIGN CERTIFICATION

I hereby certify that this plan has been designed in accordance with current Maryland Erosion Laws, Regulations and Standards, that it represents an Erosion Control Plan Based on My Personal Knowledge of the Site, and that it complies with the Requirements of the Howard Soil Conservation District.

6/17/2020
Date
20749
Registration No.
K.C.S. or G.S.A. (circle one)

DEVELOPER CERTIFICATION

I/We Certify that Any Clearing, Grading, Construction or Development Will be Done Pursuant to This Approved Erosion and Sediment Control Plan, Including Inspecting and Maintaining Controls And That the Responsible Personnel Involved in the Construction Project Will Have a Certificate of Training at a Maryland Department of the Environment (MDE) Approved Training Program for the Control of Erosion and Sediment Prior to Beginning the Project. I Certify Right-of-entry For Periodic On-site Evaluation by Howard County, the Howard Soil Conservation District And/or MDE.



Timothy Peage
Owner's/Developer's Signature
6-25-20
Date
Timothy Peage, Manager
Printed Name & Title

Approved: This Plan is Approved For Soil Erosion and Sediment Control by the Howard Soil Conservation District
John R. Hunter
Howard Soil Conservation District
Approved: Department of Planning and Zoning

Chief, Division of Land Development
11/4/20
Date
Chief, Development Engineering Division
8/28/20
Date
Approved: Howard County Department of Public Works
Chief, Bureau of Highways
8/17/2020
Date

REVISIONS		
NO.	DESCRIPTION	DATE

MARYLAND STANDARDS AND SPECIFICATIONS FOR SOIL EROSION AND SEDIMENT CONTROL.
U.S. DEPARTMENT OF AGRICULTURE, NATURAL RESOURCES CONSERVATION SERVICE, 2011

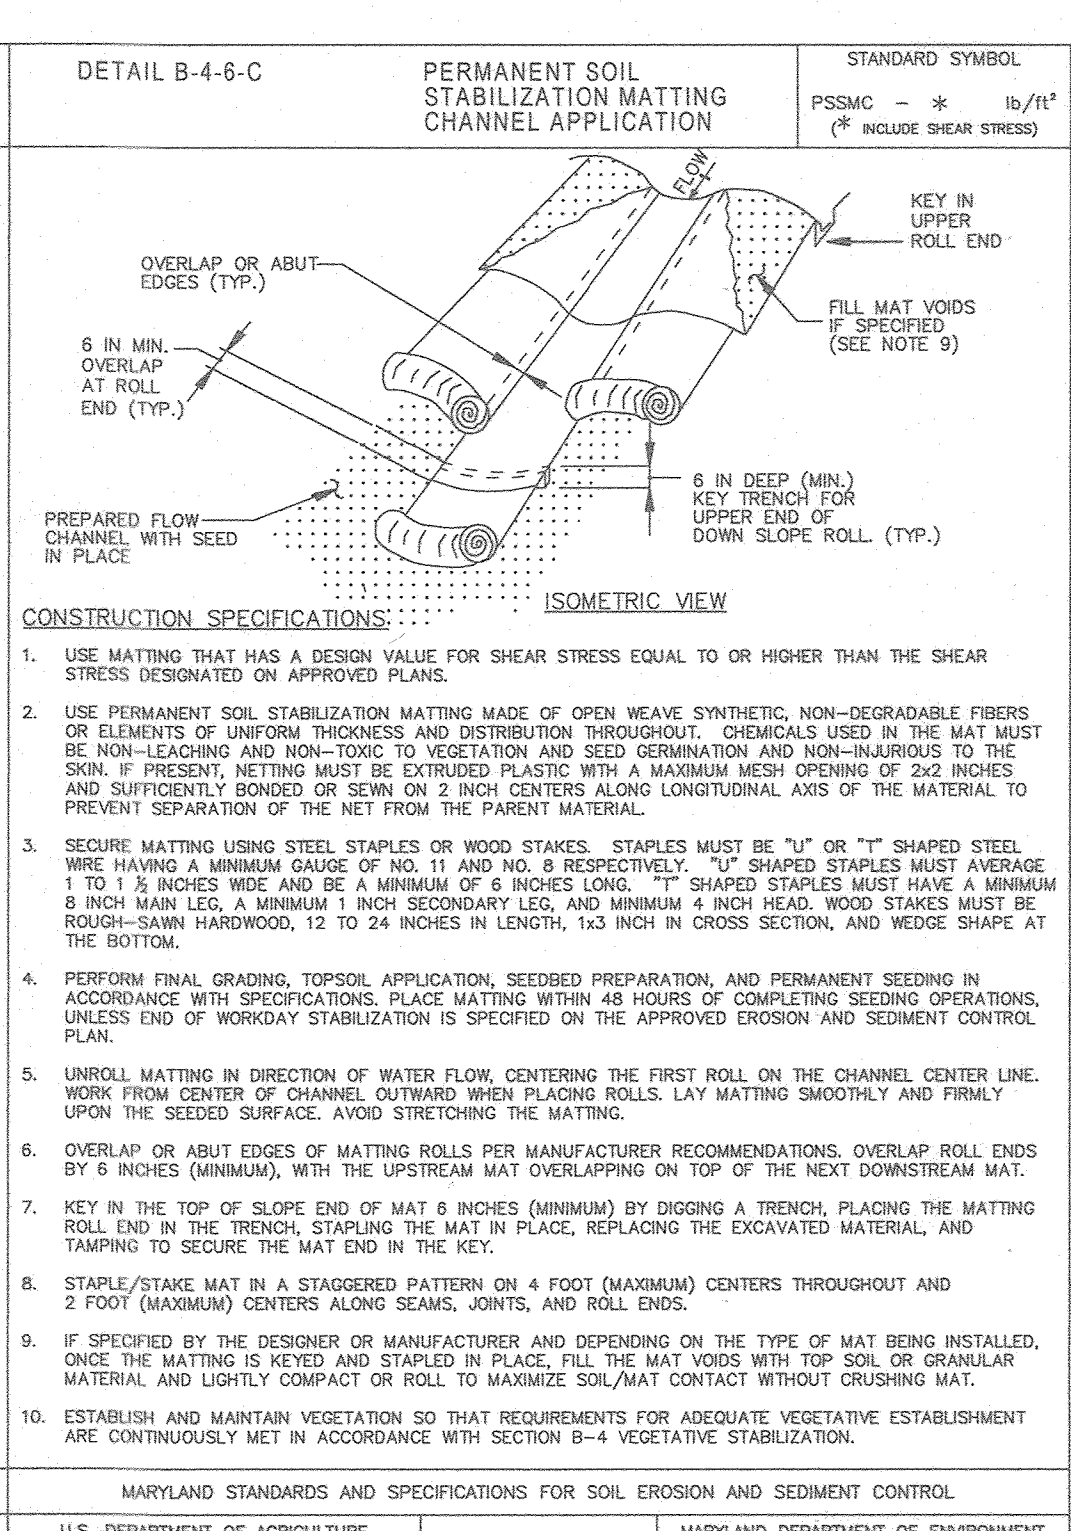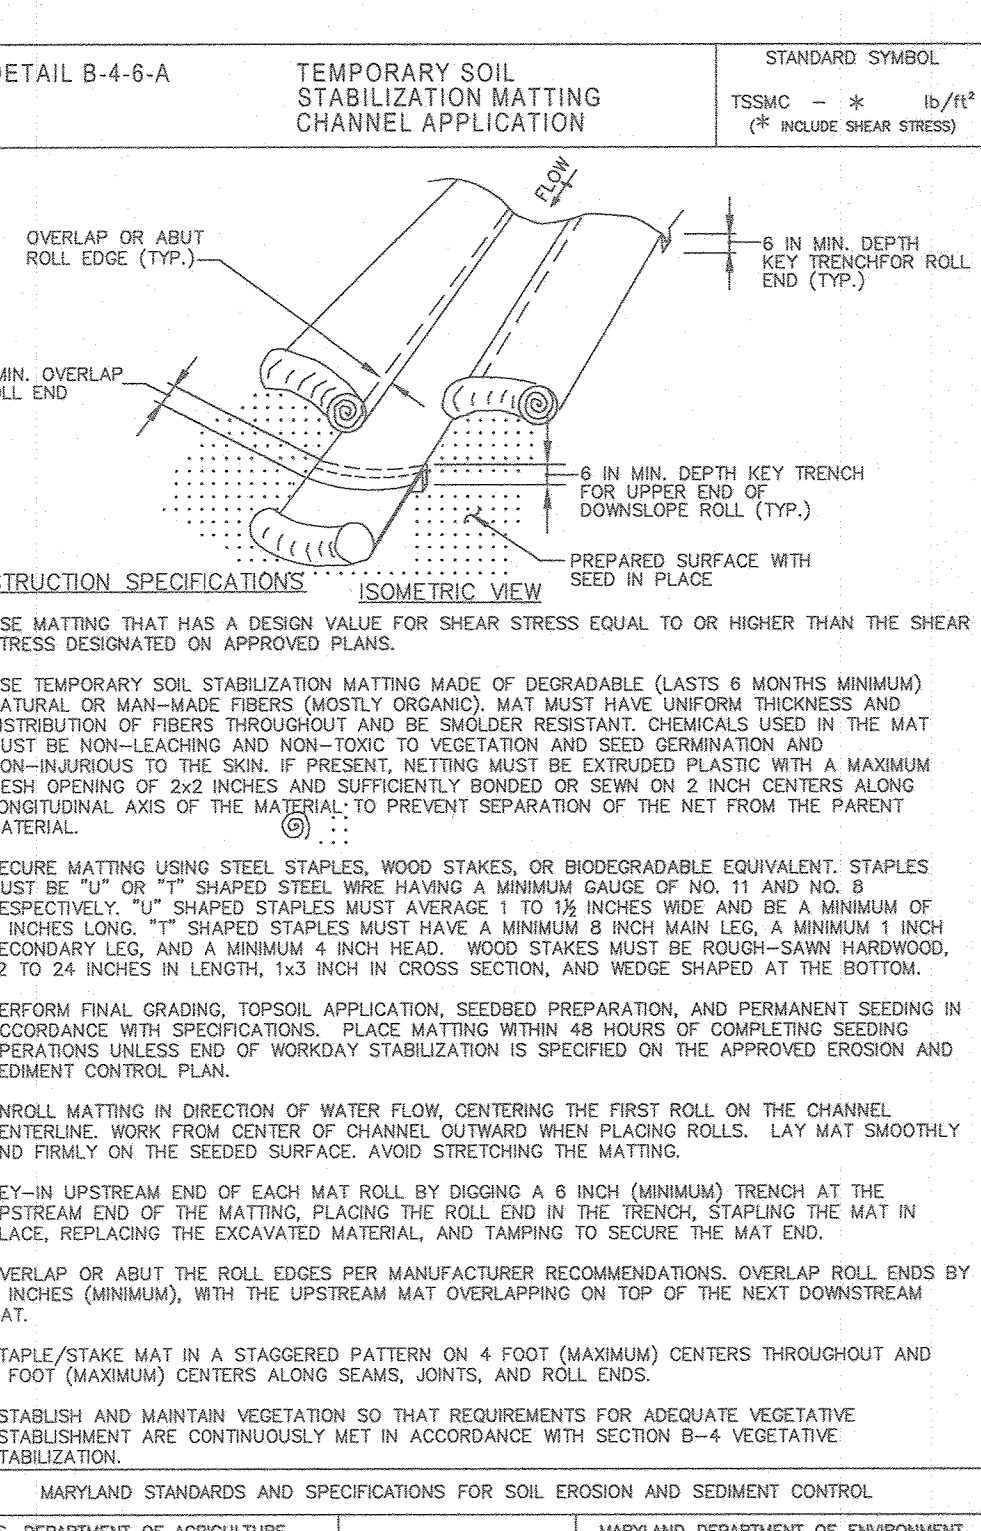

SHEAR STRESS COMPUTATIONS:

ECM#1:
DRAINAGE AREA = 0.14 AC.
% IMPERVIOUS: 2% (122 Sq.Ft.)
SOILS: 'B' SOILS- 100%
AVERAGE SLOPE = 9.89%
'C' FACTOR = 0.35 (RESIDENTIAL LOT)
WEIGHTED 'C' FACTOR = 0.35
TIME = 5.00 MINUTES MIN.
Q10 = 0.42 C.F.S.-Q=CIA, WHERE I10=0.5
BOTTOM WIDTH = 5'
SIDE SLOPE = 3:1
DEPTH OF SWALE = 1'
LENGTH OF SLOPE = 79'
V10 = 0.68 F.P.S.
DEPTH OF FLOW = 0.12'
WETTED PERIMETER = 5.53'
FLOW AREA = 0.62 SQ.FT.
R=A/WP = 0.62/5.53 = 0.1121

SHEAR STRESS: 0.69 lb./ft-2
SHEAR STRESS = Y x R x Sw
WHERE Y = WEIGHT DENSITY OF WATER
R = HYDRAULIC RADIUS
Sw = WATER SURFACE SLOPE FT/FT

ECM#1 = 62.4 x 0.1121 x 0.0909 = 0.69 lb/ft2
USE WOOD CELLULOSE FIBER.

ECM#2:
DRAINAGE AREA = 0.16 AC.
% IMPERVIOUS: 4% (279 Sq.Ft.)
SOILS: 'B' SOILS- 100%
AVERAGE SLOPE = 10.52%
'C' FACTOR = 0.35 (RESIDENTIAL LOT)
WEIGHTED 'C' FACTOR = 0.35
TIME = 5.00 MINUTES MIN.
Q10 = 0.48 C.F.S.-Q=CIA, WHERE I10=0.5
BOTTOM WIDTH = 5'
SIDE SLOPE = 3:1
DEPTH OF SWALE = 1'
LENGTH OF SLOPE = 122'
V10 = 0.75 F.P.S.
DEPTH OF FLOW = 0.12'
WETTED PERIMETER = 5.55'
FLOW AREA = 0.64 SQ.FT.
R=A/WP = 0.64/5.55 = 0.1153

SHEAR STRESS: 0.75 lb./ft-2
SHEAR STRESS = Y x R x Sw
WHERE Y = WEIGHT DENSITY OF WATER
R = HYDRAULIC RADIUS
Sw = WATER SURFACE SLOPE FT/FT

ECM#2 = 62.4 x 0.1153 x 0.1052 = 0.75 lb/ft2
USE WOOD CELLULOSE FIBER.

ECM#3:
DRAINAGE AREA = 0.17 AC.
% IMPERVIOUS: 7.8% (580 Sq.Ft.)
SOILS: 'B' SOILS- 100%
AVERAGE SLOPE = 1.53%
'C' FACTOR = 0.42 (RESIDENTIAL LOT)
WEIGHTED 'C' FACTOR = 0.42
TIME = 5.00 MINUTES MIN.
Q10 = 0.61 C.F.S.-Q=CIA, WHERE I10=0.5
BOTTOM WIDTH = 5'
SIDE SLOPE = 3:1
DEPTH OF SWALE = 1'
LENGTH OF SLOPE = 95'
V10 = 0.44 F.P.S.
DEPTH OF FLOW = 0.25'
WETTED PERIMETER = 6.12'
FLOW AREA = 1.37 SQ.FT.
R=A/WP = 1.37/6.12 = 0.2238

SHEAR STRESS: 0.21 lb./ft-2
SHEAR STRESS = Y x R x Sw
WHERE Y = WEIGHT DENSITY OF WATER
R = HYDRAULIC RADIUS
Sw = WATER SURFACE SLOPE FT/FT

ECM#3 = 62.4 x 0.2238 x 0.0153 = 0.21 lb/ft2
USE WOOD CELLULOSE FIBER.

STATE OF MARYLAND
MICHAEL B. WALKER
GOVERNOR
CERTIFICATION

I hereby certify that this plan has been designed in accordance with current Maryland Erosion Laws, Regulations and Standards, that it represents an Erosion Control Plan Based on My Personal Knowledge of the Site, and that it complies with the Requirements of the Howard Soil Conservation District.

6/17/2020
Date
20749
Registration No.
K.C.S. or G.S.A. (circle one)

DEVELOPER CERTIFICATION

I/We Certify that Any Clearing, Grading, Construction or Development Will be Done Pursuant to This Approved Erosion and Sediment Control Plan, Including Inspecting and Maintaining Controls And That the Responsible Personnel Involved in the Construction Project Will Have a Certificate of Training at a Maryland Department of the Environment (MDE) Approved Training Program for the Control of Erosion and Sediment Prior to Beginning the Project. I Certify Right-of-entry For Periodic On-site Evaluation by Howard County, the Howard Soil Conservation District And/or MDE.

John R. Hunter
Owner's/Developer's Signature
6-25-20
Date
John R. Hunter
Printed Name & Title

Approved: This Plan is Approved For Soil Erosion and Sediment Control by the Howard Soil Conservation District
John R. Hunter
Howard Soil Conservation District
Approved: Department of Planning and Zoning

Chief, Division of Land Development
11/4/20
Date
Chief, Development Engineering Division
8/28/20
Date
Approved: Howard County Department of Public Works
Chief, Bureau of Highways
8/17/2020
Date

SEDIMENT AND EROSION CONTROL NOTES & DETAILS

LINDEN GROVE PHASE TWO

LOTS 24 THRU 44

(A Resubdivision of Non-Buildable Bulk Parcels 'F' & 'G', Recorded As "Linden Grove, Phase One Lots 1 Thru 23, Buildable Preservation Parcel 'X', Non-Buildable Preservation Parcels 'B' Thru 'E' and Non-Buildable Bulk Parcels 'F' and 'G', Plot Nos. 25064 Thru 25073.)

ZONED: RC-DEO
TAX MAP NO. 8 GRID NO. 7 PARCEL NO. 5
4TH ELECTION DISTRICT HOWARD COUNTY, MARYLAND
DATE: JUNE 16, 2020
SHEET 7 of 24

FISHER, COLLINS & CARTER, INC.
CIVIL ENGINEERING CONSULTANTS & LAND SURVEYORS
CORONAL SQUARE OFFICE PARK - 16275 BURNING WOOD DRIVE
BLUDD CITY, MARYLAND 21042
(410) 461-8999

OWNER:
KIMBETH/HEDGEFACE LLC
3425 HIPLEYS MILL ROAD
WOODBINE, MARYLAND 21797-7615
410-489-7900

DEVELOPER:
HEDGEFACE LAND DEVELOPMENT
15950 NORTH AVENUE
LISBON, MARYLAND 21765
410-489-7900

STATE OF MARYLAND
MICHAEL B. WALKER
GOVERNOR
CERTIFICATION

I hereby certify that this plan has been designed in accordance with current Maryland Erosion Laws, Regulations and Standards, that it represents an Erosion Control Plan Based on My Personal Knowledge of the Site, and that it complies with the Requirements of the Howard Soil Conservation District.

6/17/2020
Date
20749
Registration No.
K.C.S. or G.S.A. (circle one)

DEVELOPER CERTIFICATION




I/We Certify that Any Clearing, Grading, Construction or Development Will be Done Pursuant to This Approved Erosion and Sediment Control Plan, Including Inspecting and Maintaining Controls And That the Responsible Personnel Involved in the Construction Project Will Have a Certificate of Training at a Maryland Department of the Environment (MDE) Approved Training Program for the Control of Erosion and Sediment Prior to Beginning the Project. I Certify Right-of-entry For Periodic On-site Evaluation by Howard County, the Howard Soil Conservation District And/or MDE.

John R. Hunter
Owner's/Developer's Signature
6-25-20
Date
John R. Hunter
Printed Name & Title

Approved: This Plan is Approved For Soil Erosion and Sediment Control by the Howard Soil Conservation District
John R. Hunter
Howard Soil Conservation District
Approved: Department of Planning and Zoning

Chief, Division of Land Development
11/4/20
Date
Chief, Development Engineering Division
8/28/20
Date
Approved: Howard County Department of Public Works
Chief, Bureau of Highways
8/17/2020
Date

THERE IS NO "AS-BUILT" INFORMATION PROVIDED ON THIS SHEET

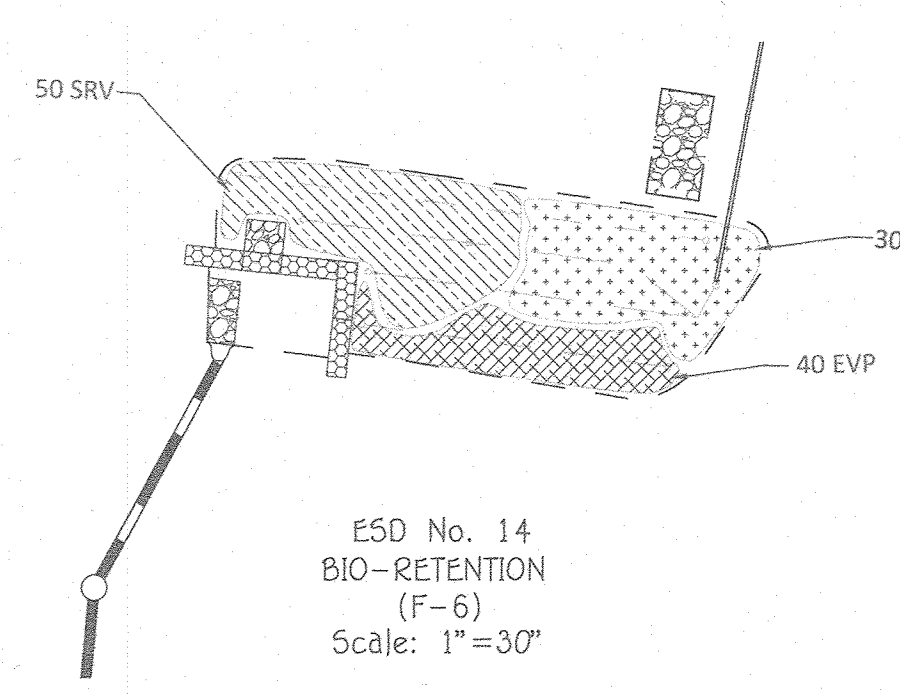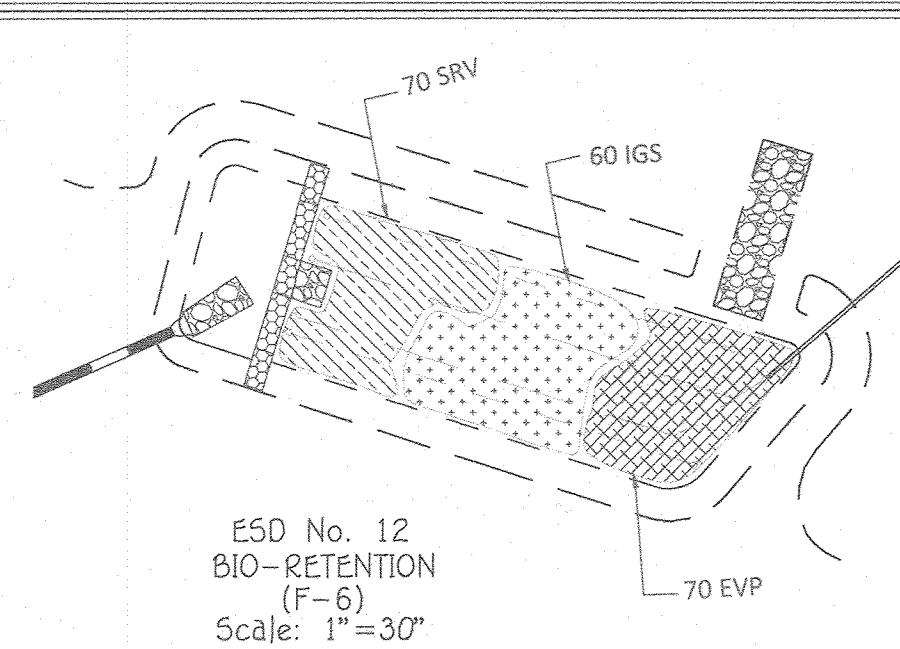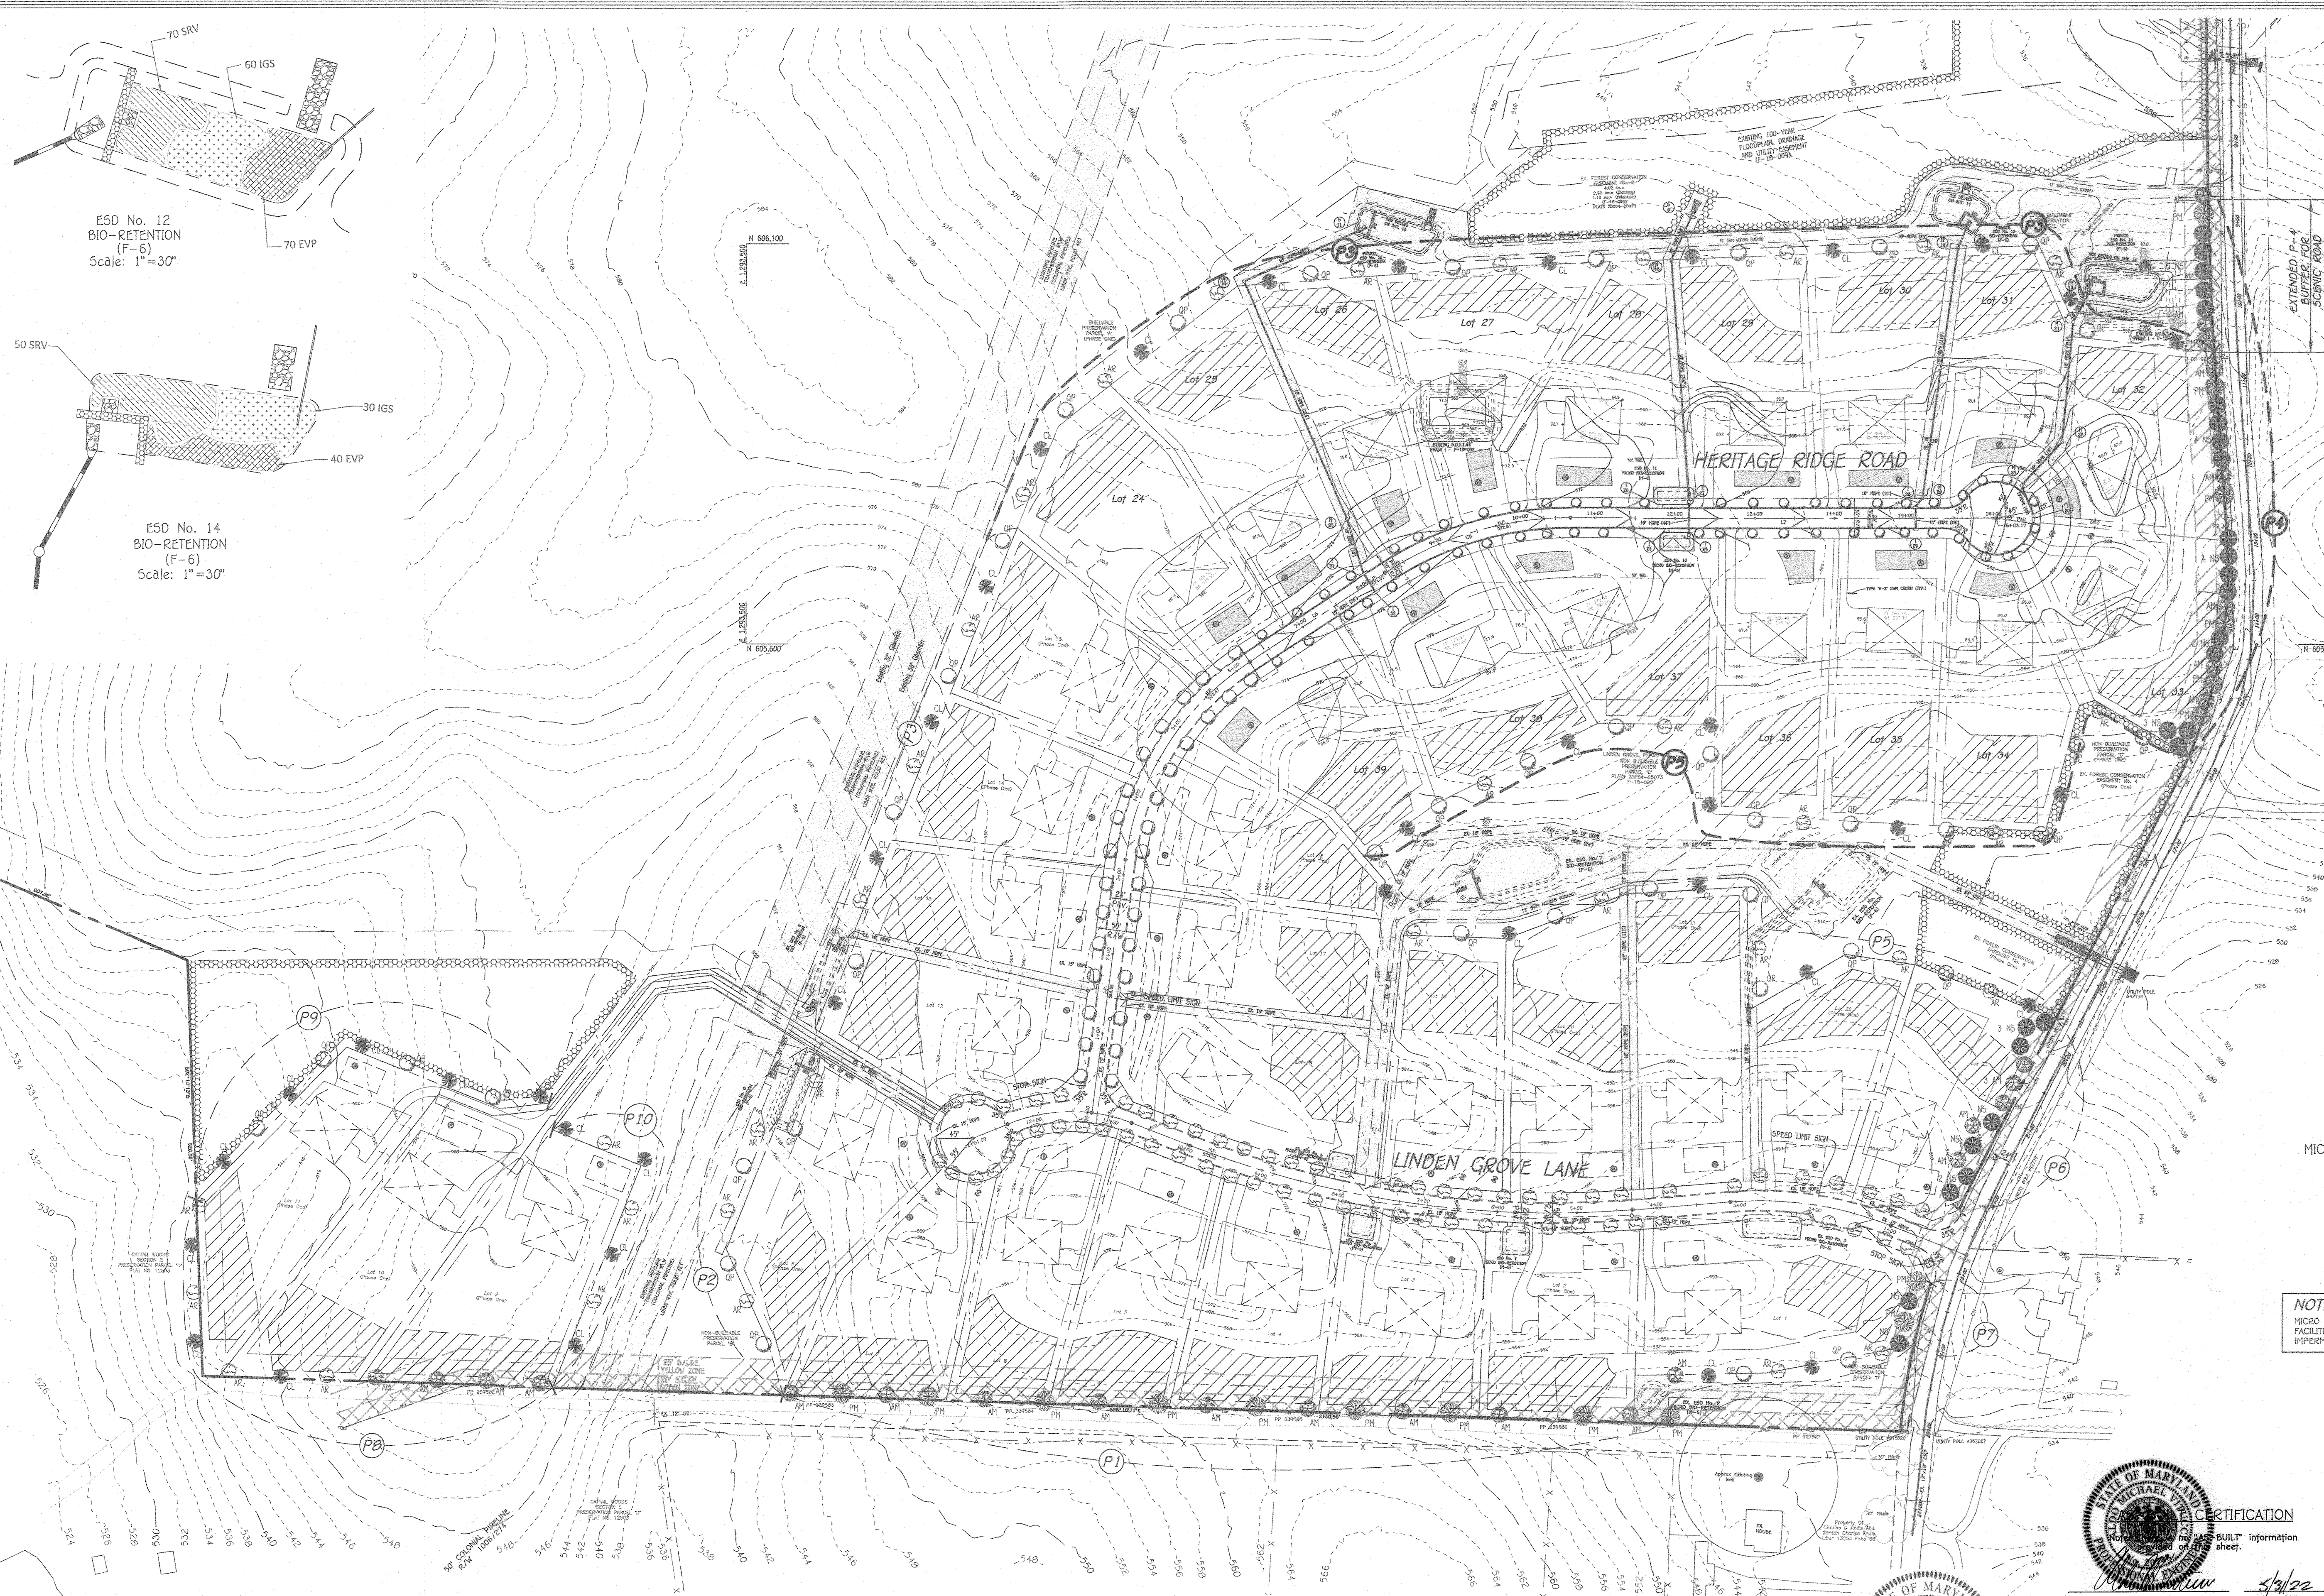

Approved: Department of Planning and Zoning

Chief, Division of Land Development *[Signature]* Date: **11/4/20**




Chief, Development Engineering Division *[Signature]* Date: **8/28/20**

Approved: Howard County Department of Public Works


Chief, Bureau of Highways *[Signature]* Date: **8/17/2020**

REVISIONS

NO.	DESCRIPTION	DATE

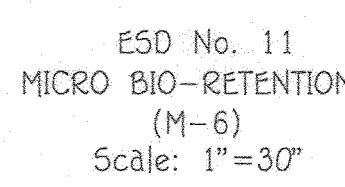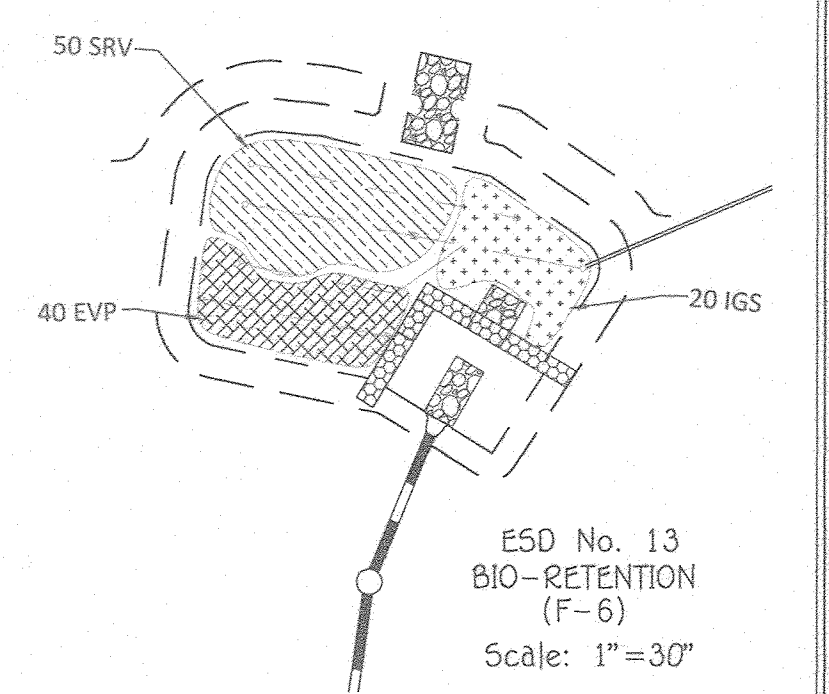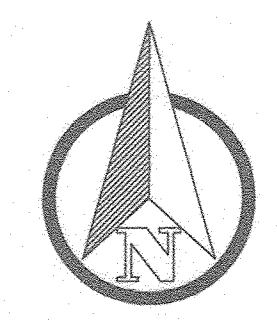

NOTE:
MICRO BIO-RETENTION (M-6)
FACILITIES 10 & 11 WILL HAVE
IMPERMEABLE LINERS.

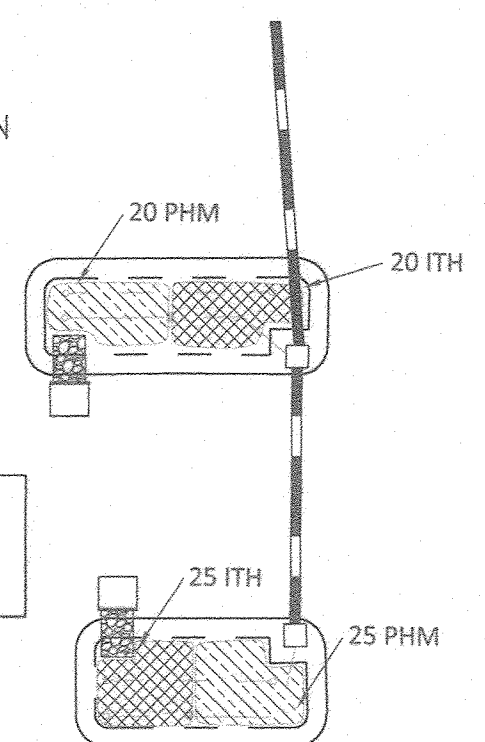


DEVELOPER'S / BUILDER'S CERTIFICATE

I/WE CERTIFY THAT THE LANDSCAPING SHOWN ON THIS PLAN WILL BE DONE ACCORDING TO THE PLAN, SECTION 16.124 OF THE HOWARD COUNTY CODE AND THE HOWARD COUNTY LANDSCAPE MANUAL. I/WE FURTHER CERTIFY THAT UPON COMPLETION, A LETTER OF LANDSCAPE INSTALLATION ACCOMPANIED BY AN EXECUTED ONE YEAR GUARANTEE OF PLANT MATERIALS WILL BE SUBMITTED TO THE DEPARTMENT OF PLANNING AND ZONING.

[Signature]
NAME: **Fisher & Feag**

6/25/20
DATE:

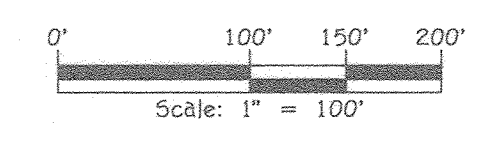


FISHER, COLLINS & CARTER, INC.
CIVIL ENGINEERING CONSULTANTS & LAND SURVEYORS


CENTRAL SQUARE OFFICE PARK - 18272 BALDORNE NATIONAL PIKE
ELICOTT CITY, MARYLAND 21042
(410) 461-1299

OWNER:
KIMBERLY/HERITAGE LLC
3425 HIPSLEY MILL ROAD
WOODBINE, MARYLAND 21797-7615
410-489-7900

DEVELOPER:
HERITAGE LAND DEVELOPMENT
15950 NORTH AVENUE
LISBON, MARYLAND 21765
410-489-7900

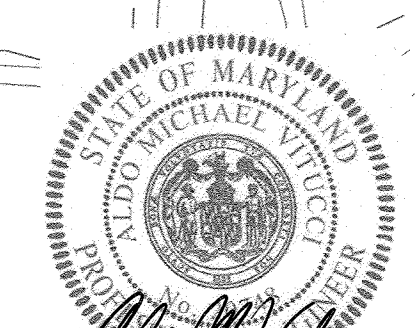

[Signature]
Also: M. Vitucci, P.E.
Professional Certification: I hereby certify that these documents were prepared or approved by me, and that I am a duly Licensed Professional Engineer under the laws of the State of Maryland, License No. 20748, Expiration Date 2-22-21.

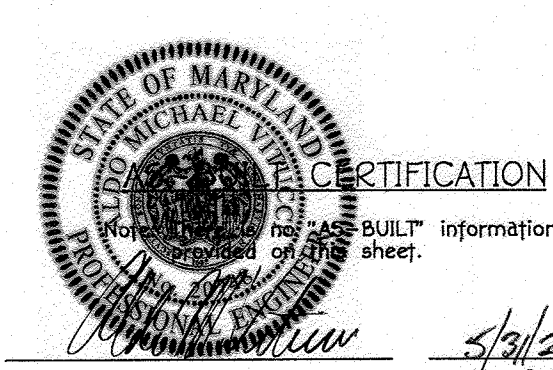

[Signature]
DATE: **6/17/2020**

LANDSCAPE PLAN
LINDEN GROVE
PHASE TWO
LOTS 24 THRU 44

(A Resubdivision of Non-Buildable Bulk Parcels "F" & "G", Recorded As "Linden Grove, Phase One Lots 1 Thru 23, Buildable Preservation Parcel "A", Non-Buildable Preservation Parcels "B" Thru "E" And Non-Buildable Bulk Parcels "F" And "G", Plat Nos. 25064 Thru 25073.)

ZONED: RC-DEO
TAX MAP No. 8 GRID No. 7 PARCEL No. 5
4TH ELECTION DISTRICT HOWARD COUNTY, MARYLAND
DATE: JUNE 16, 2020
SHEET 8 of 24

THERE IS NO "AS-BUILT" INFORMATION PROVIDED ON THIS SHEET F-20-019

Approved: Department Of Planning And Zoning



Chief, Division of Land Development *[Signature]* 7/16/20
Date

Chief, Engineering Division *[Signature]* 8/26/20
Date

Approved: Howard County Department of Public Works

Chief, Bureau of Highways *[Signature]* 8/17/2020
Date





REVISIONS		
NO.	DESCRIPTION	DATE

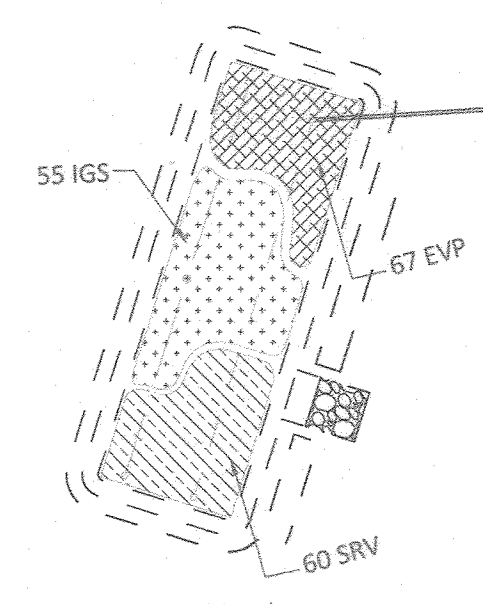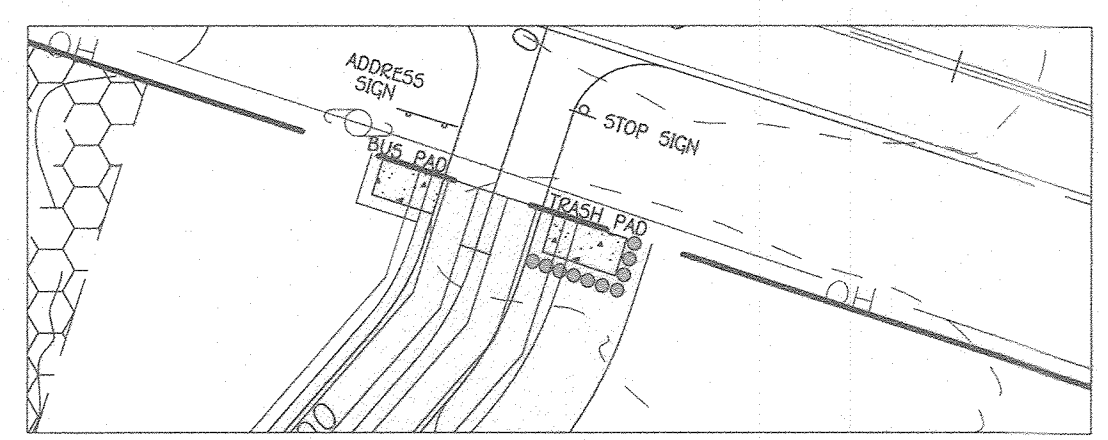

NOTE:
BIO-RETENTION (F-6)
FACILITY No. 15 WILL HAVE
AN IMPERMEABLE LINER.


NOTE: INTERSECTION SIGHT
DISTANCE (DR/DL) AND
STOPPING SIGHT DISTANCE
(SSD) LINES SHOWN WERE
APPROVED WITH SP-17-003.

NOTE:
BIO-RETENTION (F-6)
FACILITY No. 16 WILL HAVE
AN IMPERMEABLE LINER.

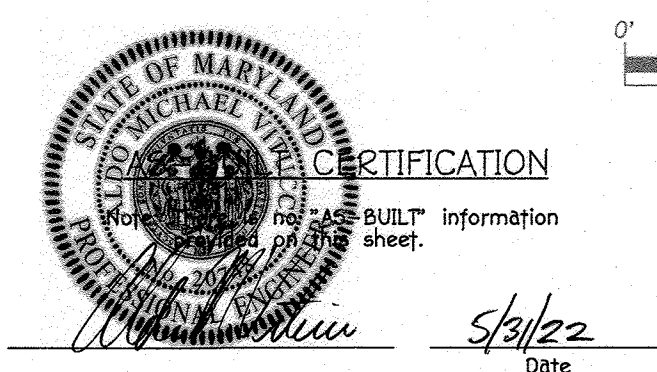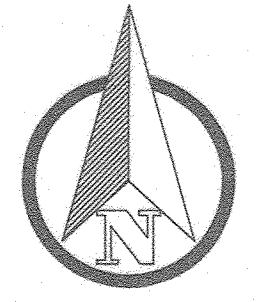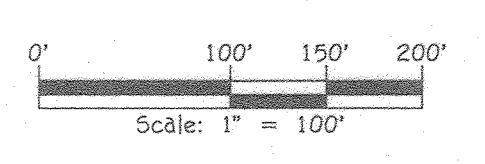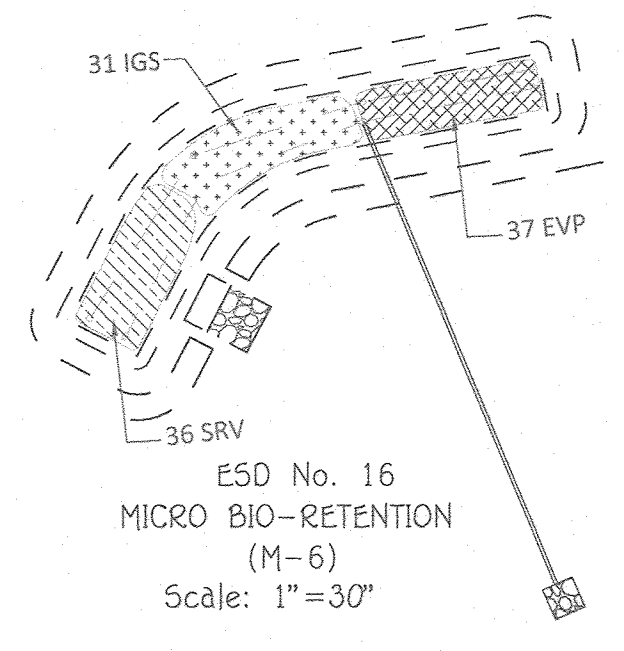

DEVELOPER'S / BUILDER'S CERTIFICATE
I/WE CERTIFY THAT THE LANDSCAPING SHOWN ON THIS PLAN WILL BE DONE ACCORDING TO THE PLAN, SECTION 16.124 OF THE HOWARD COUNTY CODE AND THE HOWARD COUNTY LANDSCAPE MANUAL. I/WE FURTHER CERTIFY THAT UPON COMPLETION, A LETTER OF LANDSCAPE INSTALLATION ACCOMPANIED BY AN EXECUTED ONE YEAR GUARANTEE OF PLANT MATERIALS WILL BE SUBMITTED TO THE DEPARTMENT OF PLANNING AND ZONING.

[Signature] DATE: 8/25/20

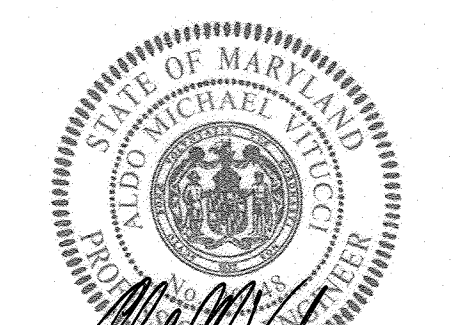

OWNER:
KIMBERLY/HERITAGE LLC
3425 HIPSLEY HILL ROAD
WOODBINE, MARYLAND 21797-7615
410-489-7900

DEVELOPER:
HERITAGE LAND DEVELOPMENT
15950 NORTH AVENUE
LISBON, MARYLAND 21765
410-489-7900

[Signature] 8/17/2020
Date
"Professional Certification: I hereby certify that these documents were prepared or approved by me, and that I am a duly Licensed Professional Engineer under the laws of the State of Maryland, License No. 20748, Expiration Date 2-22-21."

**LANDSCAPE PLAN
LINDEN GROVE
PHASE TWO
LOTS 24 THRU 44**

(A Resubdivision of Non-Buildable Bulk Parcels 'F' & 'G', Recorded As "Linden Grove, Phase One Lots 1 Thru 23, Buildable Preservation Parcel 'A', Non-Buildable Preservation Parcels 'B' Thru 'E' And Non-Buildable Bulk Parcels 'F' And 'G', Plot Nos. 25064 Thru 25073.)

ZONED: RC-DEO
GRID No. 7 PARCEL No. 5
TAX MAP No. B
4TH ELECTION DISTRICT HOWARD COUNTY, MARYLAND
DATE: JUNE 16, 2020
SHEET 9 of 24

FISHER, COLLINS & CARTER, INC.
CIVIL ENGINEERING CONSULTANTS & LAND SURVEYORS
CENTENAL SQUARE OFFICE PARK - 10272 BALTIMORE NATIONAL FREE
ELLSWORTH CITY, MARYLAND 21042
(410) 481-2895

Approved: Department Of Planning And Zoning

Chief, Division Of Land Development 11/6/20
Date

Chief, Development Engineering Division 8-28-20
Date

Approved: Howard County Department Of Public Works
Chief, Bureau Of Highways MK 8/17/2020
Date

NO.	DESCRIPTION	DATE

TRASH/RECYCLE PAD LANDSCAPING	
LINEAR FEET OF PERIMETER	LOTS 40-44 PAD: 24 L.F.
NUMBER OF SHRUBS PROVIDED:	10


- NOTES: 1. THE TRASH/RECYCLE PAD LANDSCAPING WILL BE MAINTAINED BY THE USERS OF THE PRIVATE USE-IN-COMMON MAINTENANCE AGREEMENT.
2. THE LANDSCAPING SHALL BE INSTALLED AROUND THE PERIMETER OF THE PAD EXCLUDING THE SIDE ADJACENT TO THE PUBLIC ROAD RIGHT-OF-WAY.

STREET TREE SCHEDULE				
QTY. REQ'D.	QTY. PROV'D.	SIZE	BOTANICAL AND COMMON NAME	COMMENTS
TOTAL ROW LENGTH = 1603' 3206'/40 = 80.15 80 TREES	50 TREES (Phase Two)	2 1/2 - 3" CAL.	PRUNUS SARGENTI SARGENT CHERRY	40' APART ON PUBLIC R/W (HERITAGE RIDGE)


NOTE: FINAL PLACEMENT OF STREET TREES WILL OCCUR IN THE FIELD AND BE PLACED A MINIMUM OF 30 FEET FROM ALL SIGNS AND INTERSECTIONS WHEN PLANTED BETWEEN SIDEWALK AND CURB, BE LOCATED WITHIN CONSIDERATION OF UNDERGROUND UTILITIES AND STRUCTURES AND MAINTAIN A MINIMUM 5 FEET DISTANCE ON CENTER FROM A DRAIN INLET STRUCTURE, 5 FEET FROM AN OPEN SPACE ACCESS STRIP AND 10 FEET AWAY FROM A DRIVEWAY.

SCHEDULE 'A' - PERIMETER LANDSCAPE EDGE							
PERIMETER	P-3	P-4	P-5	P-11	P-12	P-13	P-14
CATEGORY	Adjacent to Preservation Parcel	Adjacent to Roadway	Adjacent to Preservation Parcel	Adjacent to Roadway	Adjacent to Preservation Parcel	Adjacent to Preservation Parcel	Adjacent to Preservation Parcel
LANDSCAPE TYPE	A	B	A	B	A	A	A
LINEAR FEET OF ROADWAY FRONTAGE/PERIMETER	2406.2' (total) 1731.2' (Phase Two)	700.6'	2350.4' (total) 1201.4' (Phase Two)	355.9'	702.3'	306.4'	702.5'
CREDIT FOR EXISTING VEGETATION (YES, NO LINEAR FEET) (DESCRIBE BELOW IF NEEDED)	-	-	-	-	-	-	-
CREDIT FOR WALL, FENCE OR BERM (YES, NO LINEAR FEET) (DESCRIBE BELOW IF NEEDED)	-	-	-	-	-	-	-
NUMBER OF PLANTS REQUIRED	40 (total)	14	39 (total)	7	12	6	12
SHADE TREES	-	10	-	9	-	-	-
EVERGREEN TREES	-	-	-	-	-	-	-
SHRUBS	-	-	-	-	-	-	-
NUMBER OF PLANTS PROVIDED	29	14	21	7	12	6	12
SHADE TREES	-	10	-	9	-	-	-
EVERGREEN TREES	-	-	-	-	-	-	-
SHRUBS	-	-	-	-	-	-	-


* 11 Planted in Phase One * 19 Planted in Phase One

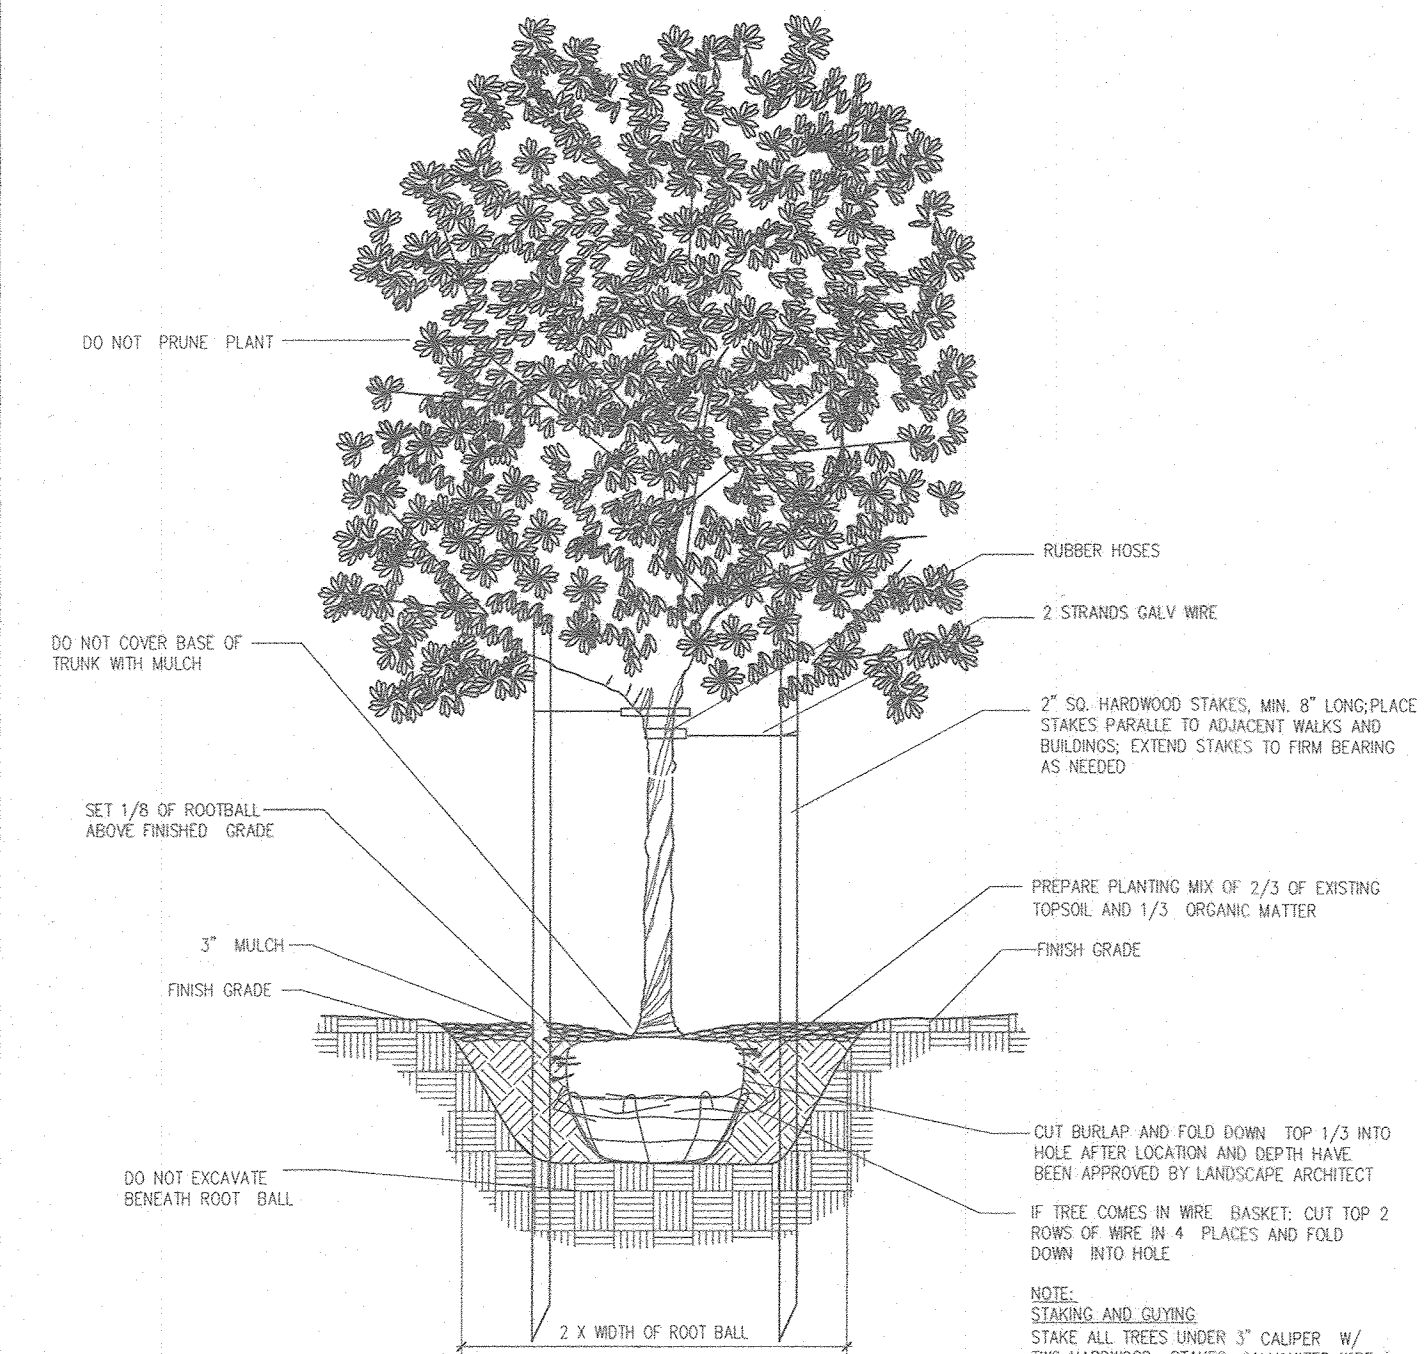

DECIDUOUS TREE - TYPICAL PLANTING DETAIL

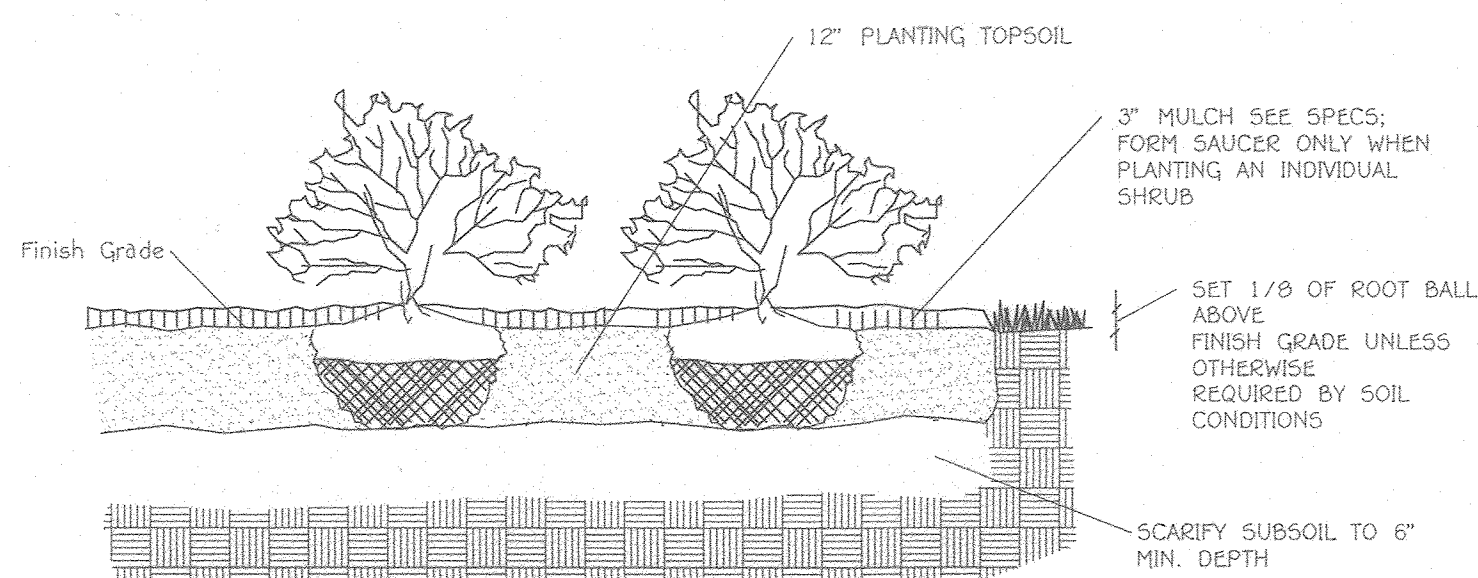

SHRUB AND HEDGEROW - TYPICAL PLANTING DETAIL

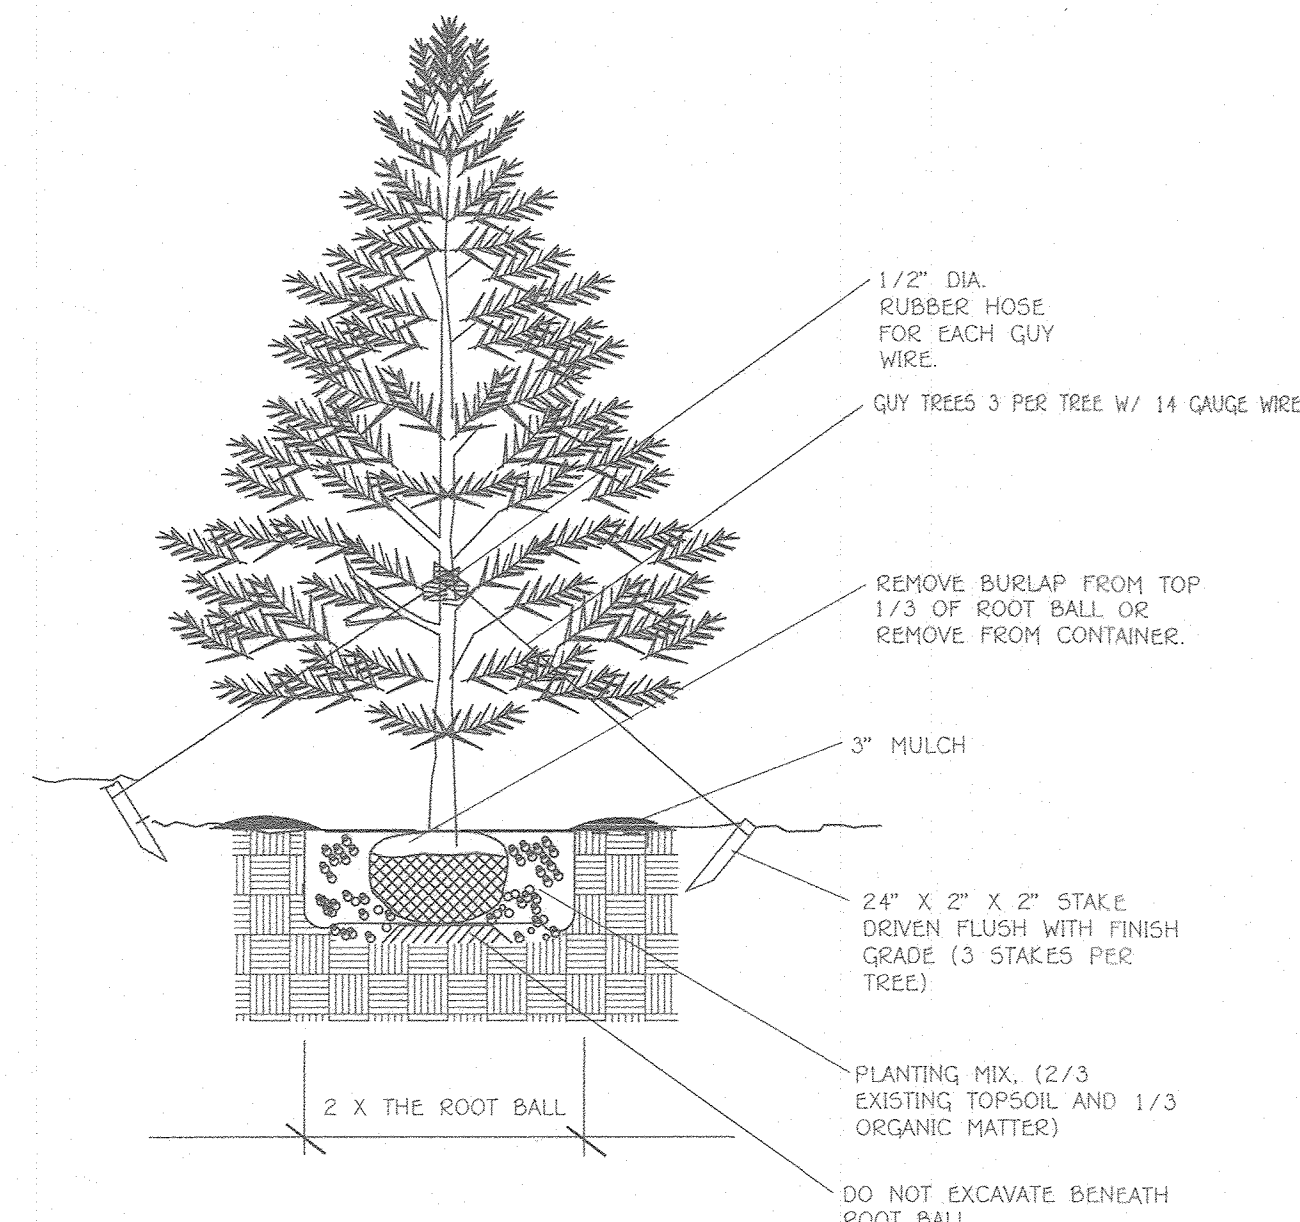

EVERGREEN TREE - TYPICAL PLANTING DETAIL

PLANTING SPECIFICATIONS

- CLEAR & GRUB ALL PLANTING AREAS AS INDICATED ON THE DRAWINGS.
- PROVIDE PROTECTION FOR TREES, SHRUBS, AND PERENNIALS/GROUND COVERS THAT ARE TO BE PRESERVED.
- CONTRACTOR SHALL VERIFY THE CORRECT LOCATION OF ALL UNDERGROUND UTILITIES IN THE FIELD PRIOR TO INSTALLATION OF ANY PLANT MATERIALS.
- ALL PLANTING SHALL BE DONE AS PER PLANTING DETAILS AND SPECIFICATIONS.
- NO CHANGES SHALL BE MADE WITHOUT WRITTEN CONSENT OF THE OWNER OR LANDSCAPE ARCHITECT.
- PRIOR TO CONSTRUCTION OF PLANTING BEDS, THE CONTRACTOR SHALL STAKE OUT PLANTING BED LINES IN THE FIELD FOR REVIEW BY THE LANDSCAPE ARCHITECT. LANDSCAPE ARCHITECT SHALL MAKE ADJUSTMENTS IN THE FIELD AS NECESSARY. ALL FINAL PLANTING BED LOCATIONS ARE TO BE APPROVED BY THE LANDSCAPE ARCHITECT. FOR LAYOUT REVIEW, CONTRACTOR SHALL NOTIFY LANDSCAPE ARCHITECT A MINIMUM OF THREE DAYS IN ADVANCE.
- INSTALL ALL REQUIRED PLANTING AND LAWN SOILS AS PER DETAILS AND SPECIFICATIONS, AND ALL SHRUBS, GROUND COVERS, AND PERENNIALS SHALL BE PLANTED IN PLANTING BEDS PREPARED AS REQUIRED BY THE DETAILS AND SPECIFICATIONS.
- MAINTAIN POSITIVE DRAINAGE OUT OF PLANTING BEDS AT A MINIMUM 2% SLOPE AND MAINTAIN POSITIVE DRAINAGE OF ALL LAWN AREAS, UNLESS OTHERWISE NOTED ON DRAWINGS. ALL GRADES, DIMENSIONS, AND EXISTING CONDITIONS SHALL BE VERIFIED BY THE CONTRACTOR ON SITE BEFORE CONSTRUCTION BEGINS. ANY DISCREPANCIES SHALL BE BROUGHT TO THE ATTENTION OF THE LANDSCAPE ARCHITECT OR OWNER.
- ALL PLANT BEDS SHALL BE CONTAINED WITH A SPADED EDGE UNLESS OTHERWISE NOTED ON DRAWINGS.
- IN THE EVENT OF A DISCREPANCY BETWEEN QUANTITIES SHOWN ON THE DRAWINGS AND QUANTITIES SHOWN ON THE PLANT LIST, THE QUANTITIES ON THE DRAWINGS SHALL APPLY. REPORT DISCREPANCIES TO THE LANDSCAPE ARCHITECT FOR CLARIFICATION PRIOR TO BIDDING.
- ALL PLANTS SHALL CONFORM TO THE SIZES GIVEN IN THE PLANT LIST AND SHALL BE NURSERY GROWN IN ACCORDANCE WITH THE "AMERICAN STANDARD FOR NURSERY STOCK" (ANSI Z60.1), LATEST EDITION.
- PLANTS SHALL BE LOCATED AS SHOWN ON THE DRAWINGS. PRIOR TO PLANTING, THE CONTRACTOR SHALL STAKE OUT THE LOCATIONS OF ALL PLANTS IN THE FIELD FOR REVIEW BY THE LANDSCAPE ARCHITECT. LANDSCAPE ARCHITECT SHALL MAKE ADJUSTMENTS IN THE FIELD AS NECESSARY. ALL FINAL PLANT LOCATIONS ARE TO BE APPROVED BY THE LANDSCAPE ARCHITECT. FOR LAYOUT REVIEW, CONTRACTOR SHALL NOTIFY LANDSCAPE ARCHITECT A MINIMUM OF THREE DAYS IN ADVANCE.
- ALL DISTURBED AREAS SHALL BE FINE GRADED AND SEEDED OR SOODED; SEE PLAN FOR LOCATIONS.
- CONTRACTOR SHALL BE RESPONSIBLE FOR WATERING AND MAINTAINING ALL PLANTS DURING THE WARRANTY PERIOD; REFER TO SPECIFICATIONS.

DEVELOPER'S / BUILDER'S CERTIFICATE

I/WE CERTIFY THAT THE LANDSCAPING SHOWN ON THIS PLAN WILL BE DONE ACCORDING TO THE PLAN, SECTION 16.124 OF THE HOWARD COUNTY CODE AND THE HOWARD COUNTY LANDSCAPE MANUAL. I/WE FURTHER CERTIFY THAT UPON COMPLETION, A LETTER OF LANDSCAPE INSTALLATION ACCOMPANIED BY AN EXECUTED ONE YEAR GUARANTEE OF PLANT MATERIALS WILL BE SUBMITTED TO THE DEPARTMENT OF PLANNING AND ZONING.

NAME: [Signature] DATE: 6-25-20



OWNER: KIMBERLY/HERITAGE LLC
3425 HIPSLEY HILL ROAD
WOODBINE, MARYLAND 21797-7615
410-489-7900

DEVELOPER: HERITAGE LAND DEVELOPMENT
15950 NORTH AVENUE
LISBON, MARYLAND 21765
410-489-7900

PERIMETER PLANT LIST FOR SCHEDULE 'A' - PERIMETER LANDSCAPE EDGE TRASH/RECYCLE PAD LANDSCAPING			
SYMBOL	QTY.	BOTANICAL AND COMMON NAME	SIZE
AR	34	ACER RUBRUM 'OCTOBER GLORY' RED MAPLE	2 1/2-3" CAL.
QP	25	QUERCUS PALUSTRIS PIN OAK	2 1/2-3" CAL.
CL	20	CLADRASTIS LUTEA YELLOWWOOD	2 1/2-3" CAL.
AM	7	* ACER GINNALA AMUR MAPLE	2 1/2-3" CAL.
PM	7	* ACER QUESUM PAPERBARK MAPLE	2 1/2-3" CAL.
NS	10	* LLEX 'NELLIE R. STEVENS' NELLIE R. STEVENS HOLLY	5' - 6' HT.
PS	9	PINUS STROBUS EASTERN WHITE PINE	6'-8' HT.
	10	PRUNUS LAUROCEASUS 'SCHIPPAENSIS'/ SKIP CHERRY/LAUREL	18"-24" SPREAD

* DENOTES APPROVED TREE TO BE PLANTED UNDER OR WITHIN 20' OF OVERHEAD LINES

ESD PLANTS					
211	IGS	Ilex glabra 'Shamrock' Inkberry	24"-30" HT.	Cont.	40" o.c./Male Cultivar
284	EVP	Eupatorium dubium 'Little Joe' Dwarf Joe-Pye Weed	#1	Cont.	24" O.C.
45	ITH	Itea virginica 'Little Henry' Dwarf Virginia Sweetspire	24"-30" ht.	Cont.	36" O.C.
45	PHM	Panicum virgatum 'Heavy Metal' Heavy Metal Switchgrass	#1	Cont.	36" O.C.
296	SRV	Solidago Rugosa Goldenrod	#1	Cont.	18" O.C.

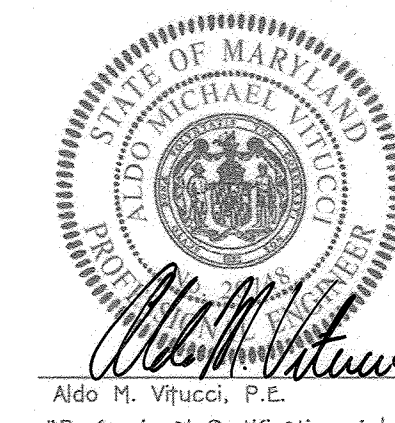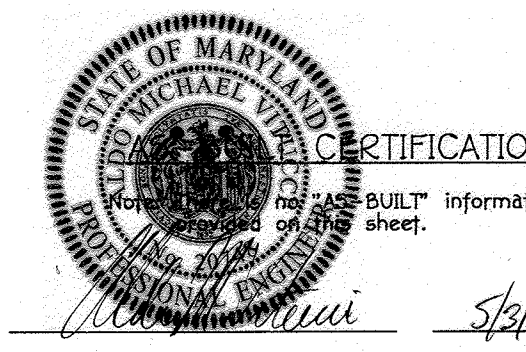

*Professional Certification: I hereby certify that these documents were prepared or approved by me, and that I am a duly Licensed Professional Engineer under the laws of the State of Maryland, License No. 20740, Expiration Date 2-22-21.

LANDSCAPE NOTES & DETAILS
LINDEN GROVE
PHASE TWO
LOTS 24 THRU 44

(A Resubdivision of Non-Buildable Bulk Parcels 'P' & 'G', Recorded As "Linden Grove, Phase One Lots 1 Thru 23, Buildable Preservation Parcel 'A', Non-Buildable Preservation Parcels 'B' Thru 'E' And Non-Buildable Bulk Parcels 'F' And 'C', Plot Nos. 25064 Thru 25073.)

TAX MAP No. 8 GRID No. 7 PARCEL No. 5
4TH ELECTION DISTRICT HOWARD COUNTY, MARYLAND
DATE: JUNE 16, 2020
SHEET 10 OF 24

Infiltration and Filter System Construction Specifications

Infiltration and filter systems either take advantage of existing permeable soils or create a permeable medium such as sand for WC, and Re v. In some instances where permeability is great, these facilities may be used for Qp as well. The most common systems include infiltration trenches, infiltration basins, sand filters, and organic filters.

When properly planted, vegetation will thrive and enhance the functioning of these systems. For example, pre-treatment buffers will trap sediments that often are bound with phosphorus and metals. Vegetation planted in the facility will aid in nutrient uptake and water storage. Additionally, plant roots will provide arteries for stormwater to permeate soil for groundwater recharge. Finally, successful plantings provide aesthetic value and wildlife habitat making these facilities more desirable to the public.

Design Constraints:

- > Planting buffer strips of at least 20 feet will cause sediments to settle out before reaching the facility, thereby reducing the possibility of clogging.
- > Determine areas that will be saturated with water and water table depth so that appropriate plants may be selected (hydrology will be similar to bioretention facilities, see Figure A.5 and Table A.4 for planting material guidance).
- > Plants known to send down deep taproots should be avoided in systems where filter fabric is used as part of facility design.
- > Test soil conditions to determine if soil amendments are necessary.
- > Plants shall be located so that access is possible for structure maintenance.
- > Stabilize heavy flow areas with erosion control mats or sod.
- > Temporarily divert flows from seeded areas until vegetation is established.
- > See Table A.5 for additional design considerations.

Bio-retention

Soil Bed Characteristics

The characteristics of the soil for the bioretention facility are perhaps as important as the facility location, size, and treatment volume. The soil must be permeable enough to allow runoff to filter through the media, while having characteristics suitable to promote and sustain a robust vegetative cover crop. In addition, much of the nutrient pollutant uptake (nitrogen and phosphorus) is accomplished through absorption and microbial activity within the soil profile. Therefore, soils must balance their chemical and physical properties to support biotic communities above and below ground.

The planting soil should be a sandy loam, loamy sand, loam (USDA), or a loam/sand mix (should contain a minimum 35 to 60% sand, by volume). The clay content for these soils should be less than 25% by volume (Environmental Quality Resources (EQR), 1996; Engineering Technology Inc. and Biohabitats, Inc. (ETAB), 1993). Soils should fall within the SM, ML, SC classifications or the Unified Soil Classification System (USCS). A permeability of at least 1.0 feet per day (0.5"/hr) is required (a conservative value of 0.5 feet per day is used for design). The soil should be free of stones, stumps, roots, or other woody material over 1" in diameter. Brush or seeds from noxious weeds (e.g., Johnson Grass, Mugwort, Nutsedge, and Canada Thistle or other noxious weeds as specified under COMAR 15.08.01.05) should not be present in the soils. Placement of the planting soil should be in 12 to 18 lifts that are loosely compacted (tamped lightly with a backhoe bucket or traversed by dozer tracks). The specific characteristics are presented in Table A.3.

Table A.3 Planting Soil Characteristics

Parameter	Value
pH range	5.2 to 7.00
Organic matter	1.5 to 4.0% (by weight)
Magnesium	35 lbs. per acre, minimum
Phosphorus (phosphate - P2O5)	75 lbs. per acre, minimum
Potassium (potash - K2O)	85 lbs. per acre, minimum
Soluble salts	500 ppm
Clay	0 to 5%
Silt	30 to 55%
Sand	35 to 60%

Mulch Layer

The mulch layer plays an important role in the performance of the bioretention system. The mulch layer helps maintain soil moisture and avoids surface sealing, which reduces permeability. Mulch helps prevent erosion, and provides a microenvironment suitable for soil biota at the mulch/soil interface. It also serves as a pretreatment layer, trapping the finer sediments, which remain suspended after the primary pretreatment.

The mulch layer should be standard landscape style, single or double shredded hardwood mulch or chips. The mulch layer should be well aged (stockpiled or stored for at least 12 months), uniform in color, and free of other materials, such as weed seeds, soil, roots, etc. The mulch should be applied to a maximum depth of three inches. Grass clippings should not be used as a mulch material.

Planting Guidance

Plant material selection should be based on the goal of simulating a terrestrial forested community of native species. Bioretention simulates an upland-species ecosystem. The community should be dominated by trees, but have a distinct community of understory trees, shrubs and herbaceous materials. By creating a diverse, dense plant cover, a bioretention facility will be able to treat stormwater runoff and withstand urban stresses from insects, disease, drought, temperature, wind, and exposure.

The proper selection and installation of plant materials is key to a successful system. There are essentially three zones within a bioretention facility (Figure A.5). The lowest elevation supports plant species adapted to standing and fluctuating water levels. The middle elevation supports plants that like drier soil conditions, but can still tolerate occasional inundation by water. The outer edge is the highest elevation and generally supports plants adapted to drier conditions. A sample of appropriate plant materials for bioretention facilities are included in Table A.4. The layout of plant material should be flexible, but should follow the general principals described in Table A.5. The objective is to have a system, which resembles a random, and natural plant layout, while maintaining optimal conditions for plant establishment and growth. For a more extensive bioretention plan, consult ETAB, 1993 or Clayton and Schueler, 1997.

B.4.C Specifications for Micro-Bioretention. Rain Gardens, Landscape Infiltration & Infiltration Berms

1. Material Specifications

The allowable materials to be used in these practices are detailed in Table B.4.1.

2. Filtering Media or Planting Soil

The soil shall be a uniform mix, free of stones, stumps, roots or other similar objects larger than two inches. No other materials or substances shall be mixed or dumped within the micro-bioretention practice that may be harmful to plant growth, or prove a hindrance to the planting or maintenance operations. The planting soil shall be free of Bermuda grass, Quackgrass, Johnson grass, or other noxious weeds as specified under COMAR 15.08.01.05.

The planting soil shall be tested and shall meet the following criteria:

Soil Component - Loamy Sand or Sandy Loam (USDA Soil Textural Classification)

Organic Content - Minimum 10% by dry weight (ASTM D 2974). In general, this can be met with a mixture of loamy sand (60%-65%) and compost (35% to 40%) or sandy loam (30%), coarse sand (30%), and compost (40%).

Clay Content - Media shall have a clay content of less than 5%.

pH Range - Should be between 5.5 - 7.0. Amendments (e.g., lime, iron sulfate plus sulfur) may be mixed into the soil to increase or decrease pH.

There shall be at least one soil test per project. Each test shall consist of both the standard soil test for pH, and additional tests of organic matter, and soluble salts. A textural analysis is required from the site stockpiled topsoil. If topsoil is imported, then a texture analysis shall be performed for each location where the topsoil was excavated.

3. Compaction

It is very important to minimize compaction of both the base of bioretention practices and the required backfill. When possible, use excavation hoses to remove original soil. If practices are excavated using a loader, the contractor should use wide track or marsh track equipment, or light equipment with turf type tires. Use of equipment with narrow tracks or narrow tires, rubber tires with large lugs, or high-pressure tires will cause excessive compaction resulting in reduced infiltration rates and is not acceptable. Compaction will significantly contribute to design failure.

Compaction can be alleviated at the base of the bioretention facility by using a primary tilling operation such as a chisel plow, ripper, or subsoiler. These tilling operations are to restructure the soil profile through the 12 inch completion zone. Substitute methods must be approved by the engineer. Rototillers typically do not till deep enough to reduce the effects of compaction from heavy equipment.

Rototill 2 to 3 inches of sand into the base of the bioretention facility before backfilling the optional sand layer. Pump any ponded water before preparing (rototilling) base. When backfilling the topsoil over the sand layer, first place 3 to 4 inches of topsoil over the sand, then rototill the sand/topsoil to create a gradation zone. Backfill the remainder of the topsoil to final grade.

When backfilling the bioretention facility, place soil in lifts 12" to 18". Do not use heavy equipment within the bioretention basin. Heavy equipment can be used around the perimeter of the basin to supply soils and sand. Grade bioretention materials with light equipment such as a compact loader or a dozer/loader with marsh tracks.

4. Plant Material

Recommended plant material for micro-bioretention practices can be found in Appendix A, Section A.2.3.

5. Plant Installation

Compost is a better organic material source, is less likely to float, and should be placed in the invert and other low areas. Mulch should be placed in surrounding to a uniform thickness of 2" to 3". Shredded or chipped hardwood mulch is the only accepted mulch. Fine mulch and wood chips will float and move to the perimeter of the bioretention area during a storm event and are not acceptable. Shredded mulch must be well aged (6 to 12 months) for acceptance.

Rootstock of the plant material shall be kept moist during transport and on-site storage. The plant root ball should be planted so 1/8 th of the ball is above final grade surface. The diameter of the planting pit shall be at least six inches larger than the diameter of the planting ball. Set and maintain the plant straight during the entire planting process. Thoroughly water ground bed cover after installation.

Trees shall be braced using 2" by 2" stakes only as necessary and for the first growing season only. Stakes are to be equally spaced on the outside of the tree ball. Grasses and legume seeds should be drilled into the soil to a depth of at least one inch. Grass and legume plugs shall be planted following the non-grass ground cover planting specifications.

The topsoil specifications provide enough organic material to adequately supply nutrients from natural cycling. The primary function of the bioretention structure is to improve water quality. Adding fertilizers, pesticides, or other chemicals is not the goal. Only add fertilizer if wood chips or mulch are used to amend the soil. Rototill urea fertilizer at a rate of 2 pounds per 1000 square feet.

6. Underdrains

Underdrains should meet the following criteria:

Pipe - Should be 4 to 6 diameter, slotted or perforated rigid plastic pipe (ASTM F 796, Type PS 28, or AASHTO-M-278) in a gravel layer. The preferred material is slotted, 4" rigid pipe (e.g., PVC or HDPE).

Perforations - If perforated pipe is used, perforations should be 3/8" diameter located 6 center with a minimum of four holes per row. Pipe shall be wrapped with a 1/4" (No. 4 or 4x) galvanized hardware cloth.

Gravel - The gravel layer (No. 57 stone preferred) shall be at least 3" thick above and below the underdrain.

The main collector pipe shall be at a minimum 0.5% slope.


A rigid, non-perforated observation well must be provided (one per every 1,000 square feet) to provide a clean-out port and monitor performance of the filter.

A 4" layer of pea gravel (1/8" to 3/8" stone) shall be located between the filter media and underdrain to prevent migration of fines into the underdrain. This layer may be considered part of the filter bed when bed thickness exceeds 24".

The main collector pipe for underdrain systems shall be constructed at a minimum slope of 0.5%. Observation wells and/or clean-out pipes must be provided (one minimum per every 1000 square feet of surface area).

7. Miscellaneous

These practices may not be constructed until all contributing drainage area has been stabilized.

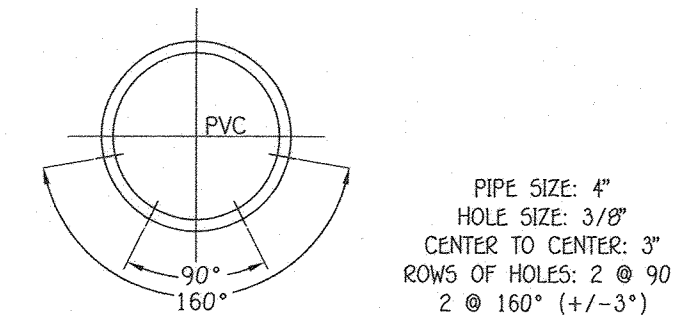

Sch 40 Pvc Perforated Underdrain Pipe Detail For Horizontal Drain Pipe
NO SCALE

NOTES:

UNDERDRAIN PIPE SHALL BE 4" DIAMETER, SLOTTED OR PERFORATED RIGID PLASTIC PIPE (ASTM F 796, TYPE PS 28 OR AASHTO-M-278) IN A GRAVEL LAYER. THE PREFERRED MATERIAL IS SLOTTED 4" RIGID PIPE (E.G., PVC OR HDPE).

PERFORATIONS SHALL BE 3/8" DIAMETER LOCATED 6" ON CENTER WITH A MINIMUM OF FOUR HOLES PER ROW. PIPE SHALL BE WRAPPED WITH A 1/4" (NO. 4 OR 4 X 4) GALVANIZED HARDWARE CLOTH.

GRAVEL LAYER SHALL BE (NO. 57 STONE PREFERRED) AT LEAST 3" THICK ABOVE AND BELOW THE UNDERDRAIN.

THE MAIN COLLECTOR PIPE SHALL BE AT A MINIMUM 0.5% SLOPE.

A RIGID, NON PERFORATED OBSERVATION WELL MUST BE PROVIDED (ONE PER EVERY 1,000 SQ.FT.) TO PROVIDE A CLEANOUT PORT AND MONITOR PERFORMANCE OF THE FILTER.

A 4" LAYER OF PEA GRAVEL (1/8" TO 3/8" STONE) SHALL BE LOCATED BETWEEN THE FILTER MEDIA AND UNDERDRAIN TO PREVENT MIGRATION OF FINES INTO THE UNDERDRAIN. THIS LAYER MAY BE CONSIDERED PART OF THE FILTER BED WHEN BED THICKNESS EXCEEDS 24".

AS-BUILT VERIFICATION FOR PSWM

I hereby certify that the work shown on the plan was constructed in accordance with the approved plans and complies with the approved specifications. I have verified the construction and the work is sufficiently stabilized to prevent clogging of the facility.

[Signature]
5/3/22
Date

Operation And Maintenance Schedule For Homeowners Association Owned & Maintained Bio-Retention Areas (M-6)

- The owner shall maintain the plant material, mulch layer and soil layer annually, maintenance of mulch and soil is limited to correcting areas of erosion or wash out. Any mulch replacement shall be done in the spring. Plant material shall be checked for disease and insect infestation and maintenance will address dead material and pruning. Acceptable replacement plant material is limited to the following: 2000 Maryland stormwater design manual volume II, table A.4.1 and 2.
- The owner shall perform a plant in the spring and in the fall each year. During the inspection, the owner shall remove dead and diseased vegetation considered beyond treatment, replace dead plant material with acceptable replacement plant material. Treat diseased trees and shrubs and replace all deficient stakes and wires.
- The owner shall inspect the mulch each spring. The mulch shall be replaced every two to three years. The previous mulch layer shall be removed before the new layer is applied.
- The owner shall correct soil erosion on an as needed basis, with a minimum of once per month and after each heavy storm.
- The owner shall maintain all observation wells, clean-outs and perforated underdrains.
- Filter material must be replaced when water remains on the surface of the filter bed for more than 24 hours following a 1 or 2 year storm event or more than 48 hours following a 10 year storm event.

Approved: Department Of Planning And Zoning


Chief, Division Of Land Development *[Signature]* 11/2/20
Date

Chief, Development Engineering Division *[Signature]* 10/22/20
Date


Approved: Howard County Department Of Public Works

Chief, Bureau Of Highways MKK 10/19/2020
Date


REVISIONS	
NO.	DATE

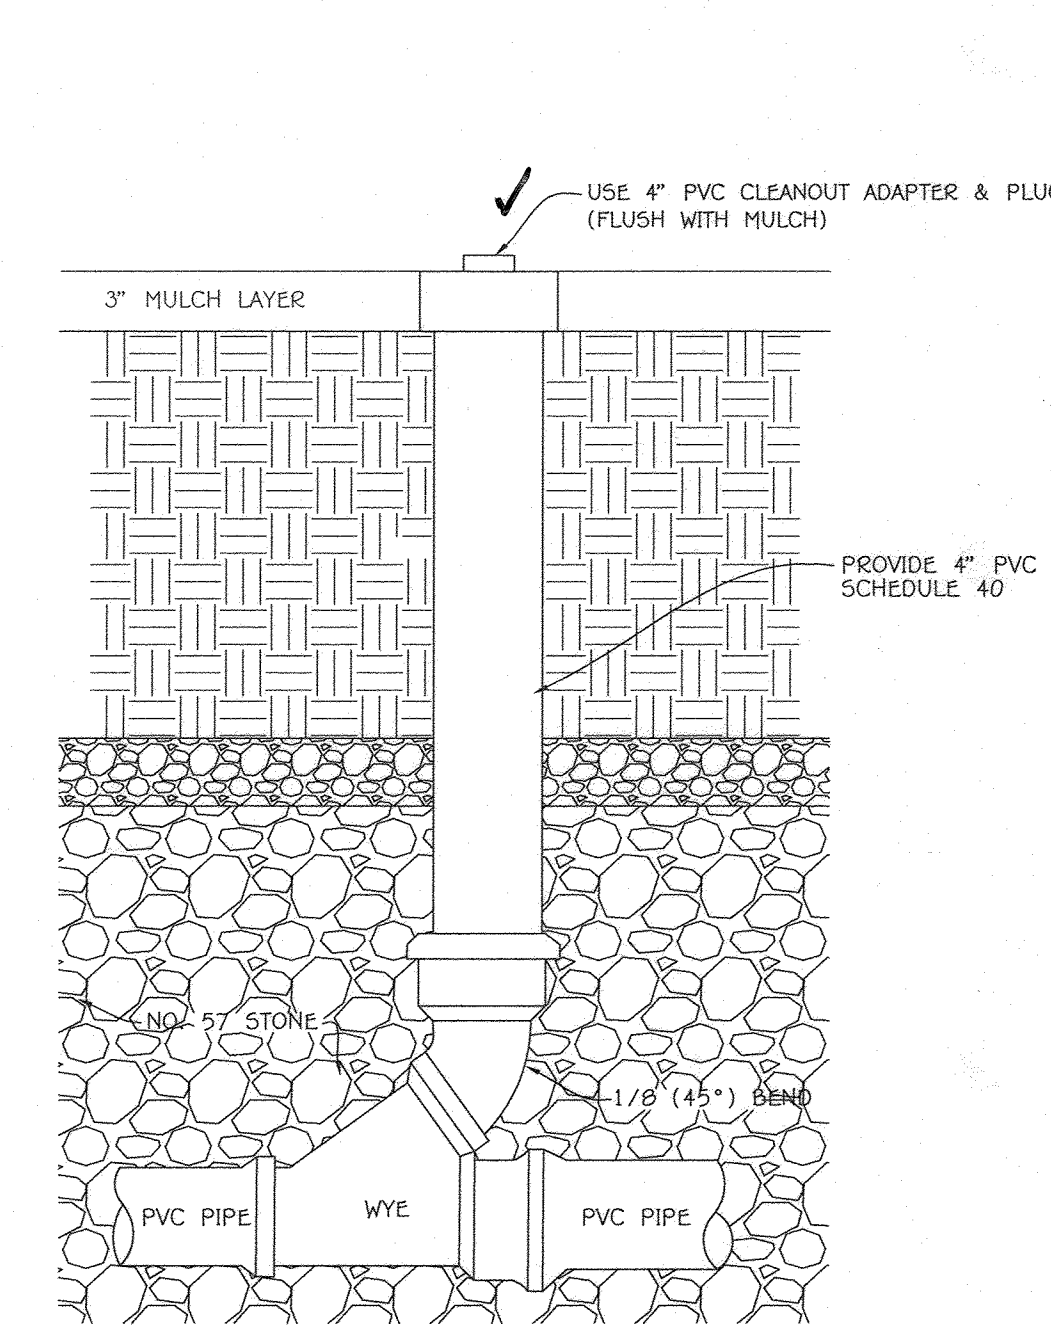


Typical Clean-Out Detail (4" Underdrain to Outfall Or Inlet)
NO SCALE

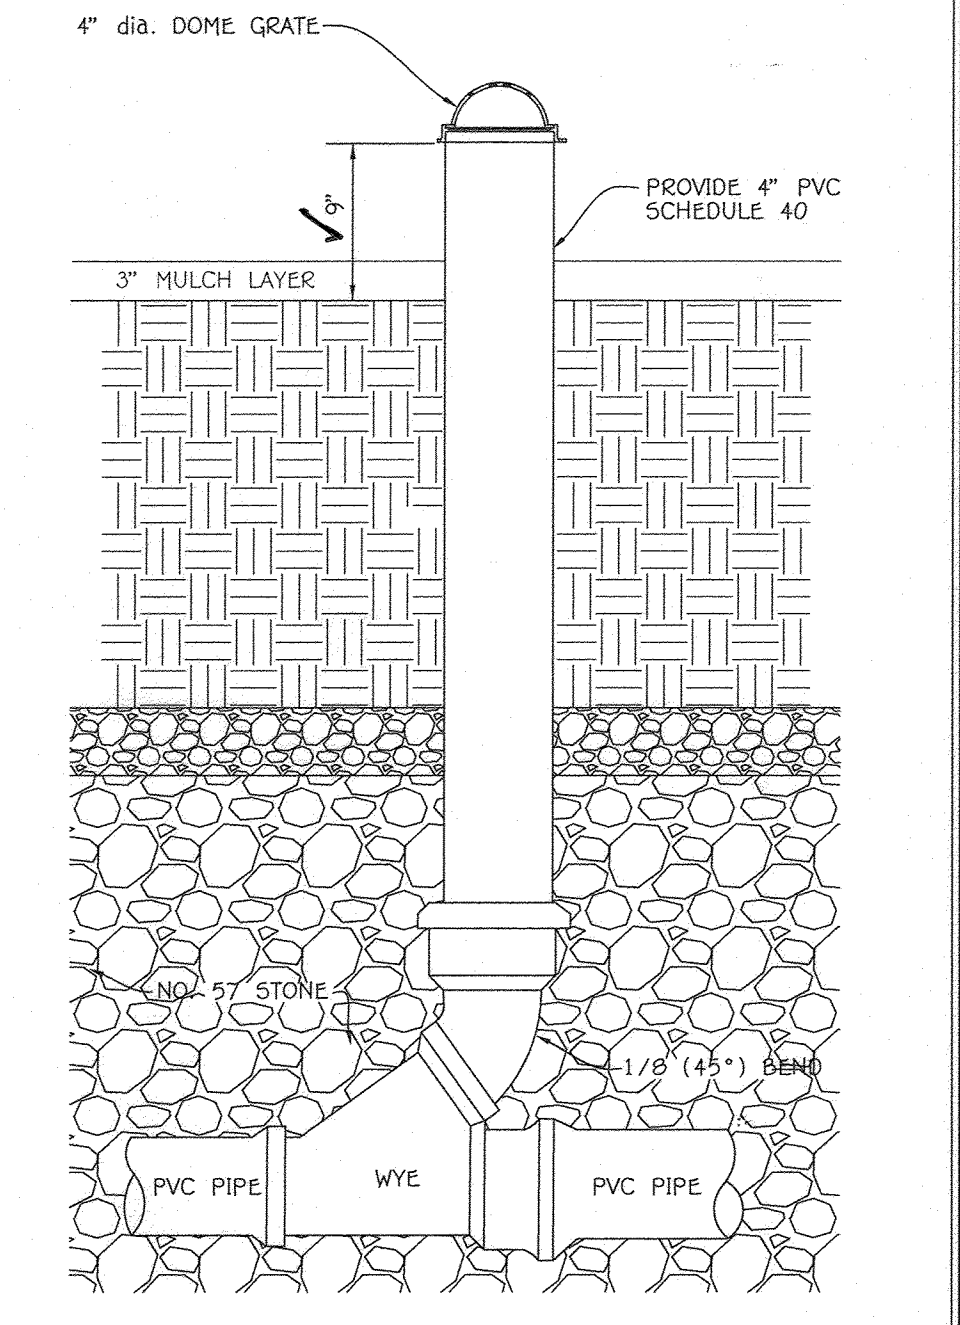


Typical Clean-Out Detail (4" Distribution Pipe)
NO SCALE

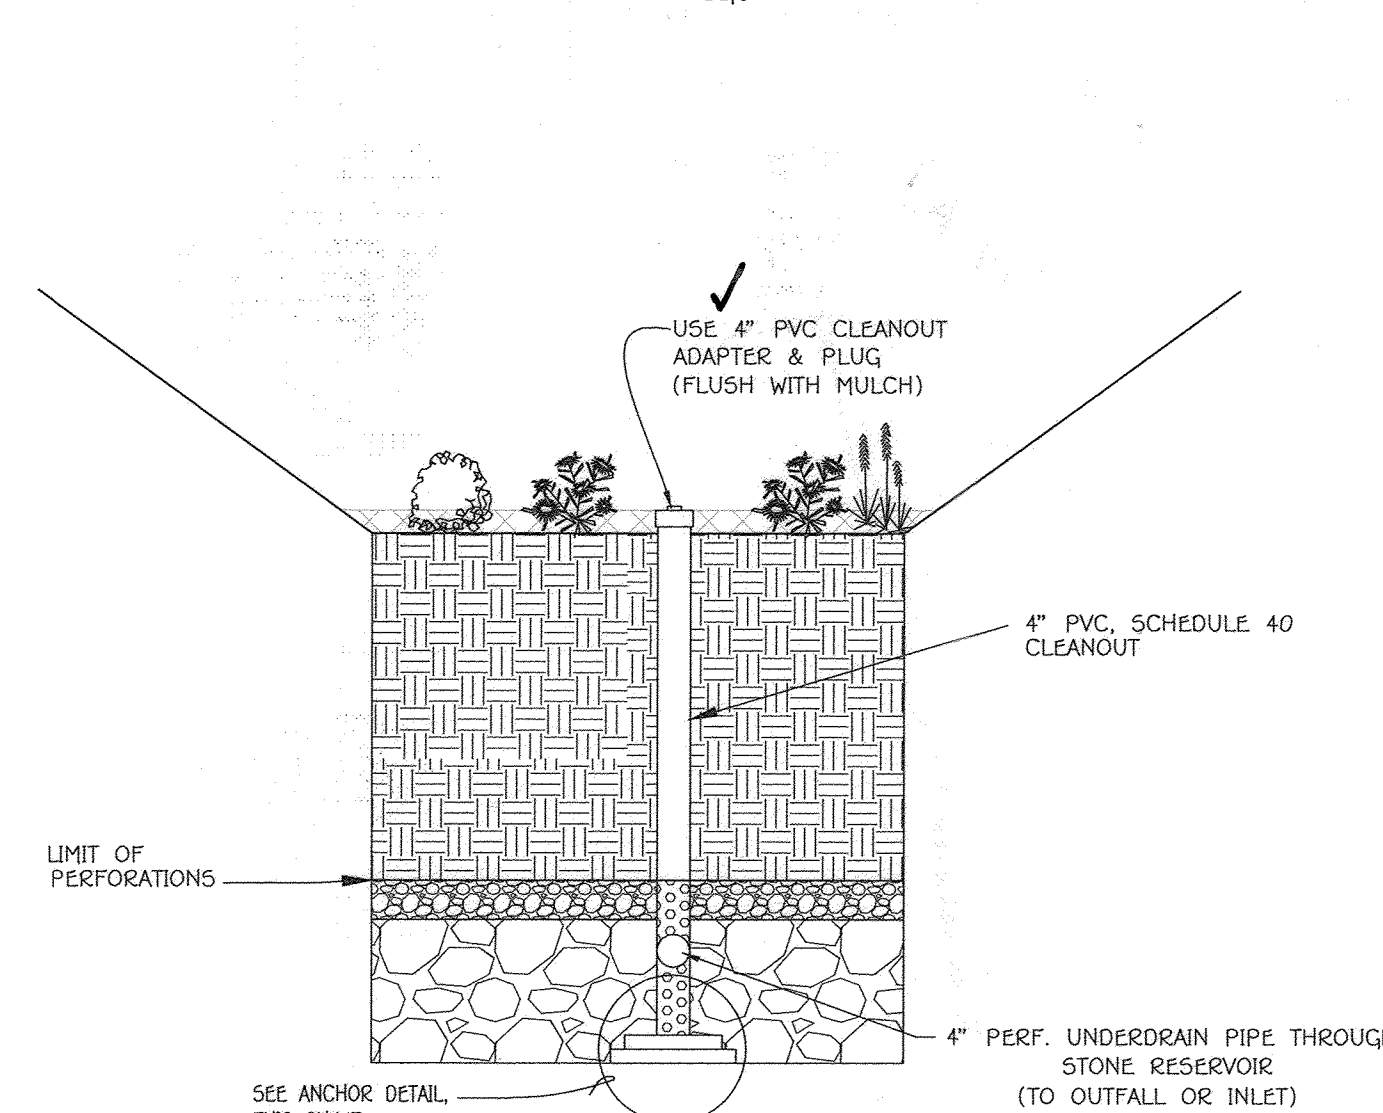

Section @ Observation Well Location
NO SCALE

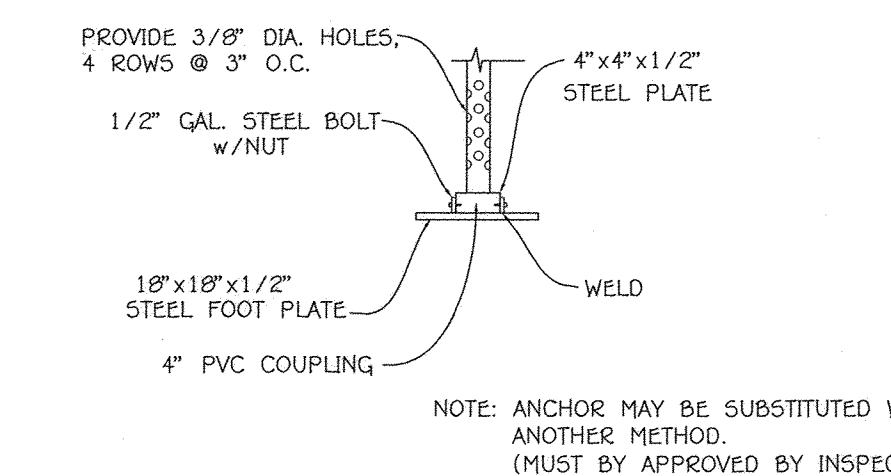


Anchor Detail
NO SCALE

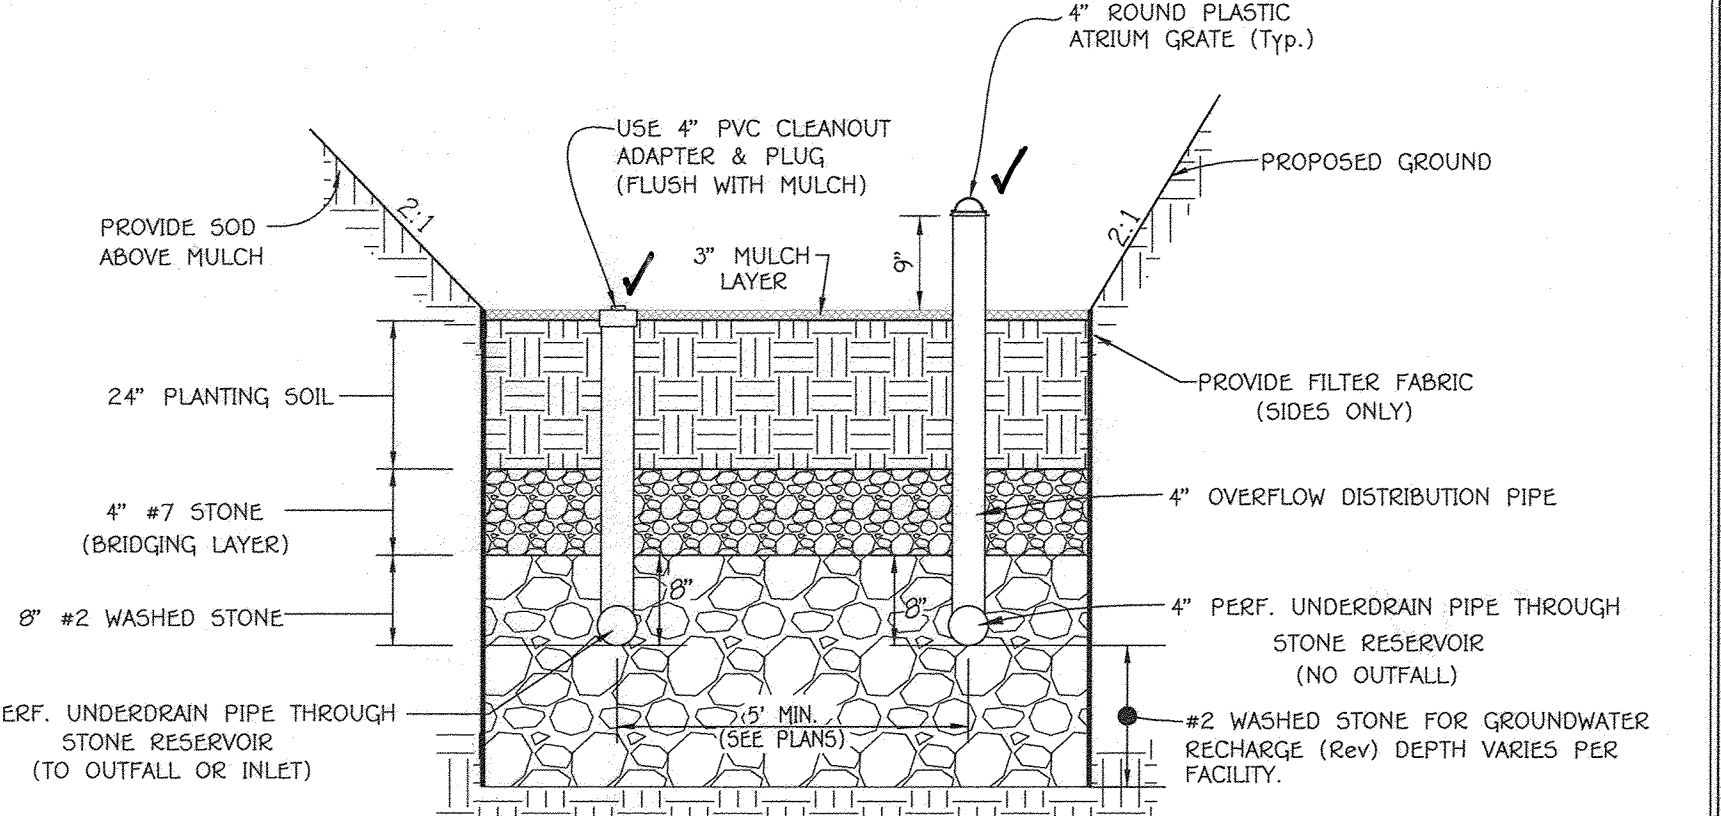

Bio-Retention (F-6) Section With 4" Overflow Distribution Pipe
NO SCALE

STORMWATER MANAGEMENT COUNTY MAINTENANCE NOTE

ALL STORMWATER MANAGEMENT FACILITIES WILL BE PRIVATELY OWNED AND MAINTAINED BY THE HOMEOWNER'S ASSOCIATION. THE STREET TREES, PERFORATED UNDERDRAINS, FEEDERS, PLANTINGS AND SWALES WILL ALSO BE PRIVATELY OWNED AND MAINTAINED BY THE H.O.A. HOWARD COUNTY WILL ONLY MAINTAIN THE INLET STRUCTURE WITHIN THE MICRO BIO-RETENTION FACILITIES ADJACENT TO THE PUBLIC RIGHT-OF-WAY (E50 No. 10 & E50 No. 11).

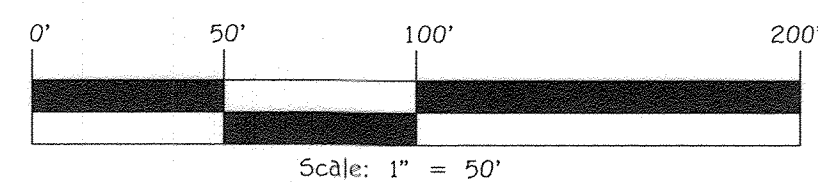

FISHER, COLLINS & CARTER, INC.
CIVIL ENGINEERING CONSULTANTS & LAND SURVEYORS
CENTRAL SQUARE OFFICE PARK - 16272 BALTIMORE NATIONAL PIKE
SUITE 201, GAITHERSBURG, MARYLAND 20878
(410) 461-2899

OWNER:
KIMBETH/HEDGEFACE LLC
3425 HIPSLEY MILL ROAD
WOODBINE, MARYLAND 21797-7615
410-489-7900

DEVELOPER:
HEGFACE LAND DEVELOPMENT
15950 NORTH AVENUE
LISBON, MARYLAND 21765
410-489-7900



Aldo H. Vitucci, P.E.
9/6/2020
Date
"Professional Certification: I hereby certify that these documents were prepared or approved by me, and that I am a duly Licensed Professional Engineer under the laws of the State of Maryland, License No. 20748, Expiration Date 2-22-21."

Stormwater Management Notes And Details (Bio-Retention)


LINDEN GROVE PHASE TWO LOTS 24 THRU 44

(A Resubdivision of Non-Buildable Bulk Parcels "F" & "G", Recorded As "Linden Grove, Phase One, Lots 1 Thru 23, Buildable Preservation Parcel "A", Non-Buildable Preservation Parcels "B" Thru "E" And Non-Buildable Bulk Parcels "F" And "G", Plat Nos. 25064 Thru 25073.)


ZONED: RC-DEO
TAX MAP No. 8 GRID No. 7 PARCEL No. 5
4TH ELECTION DISTRICT HOWARD COUNTY, MARYLAND
DATE: JUNE 16, 2020
SHEET 11 of 24

"AS-BUILT" F-20-019

Approved: Department Of Planning And Zoning		
Chief, Division Of Land Development	<i>[Signature]</i>	11/2/20
		Date
Chief, Development Engineering Division	<i>[Signature]</i>	10/22/20
		Date
Approved: Howard County Department Of Public Works		
Chief, Bureau Of Highways	<i>[Signature]</i>	10/19/2020
		Date
REVISIONS		
NO.	DESCRIPTION	DATE

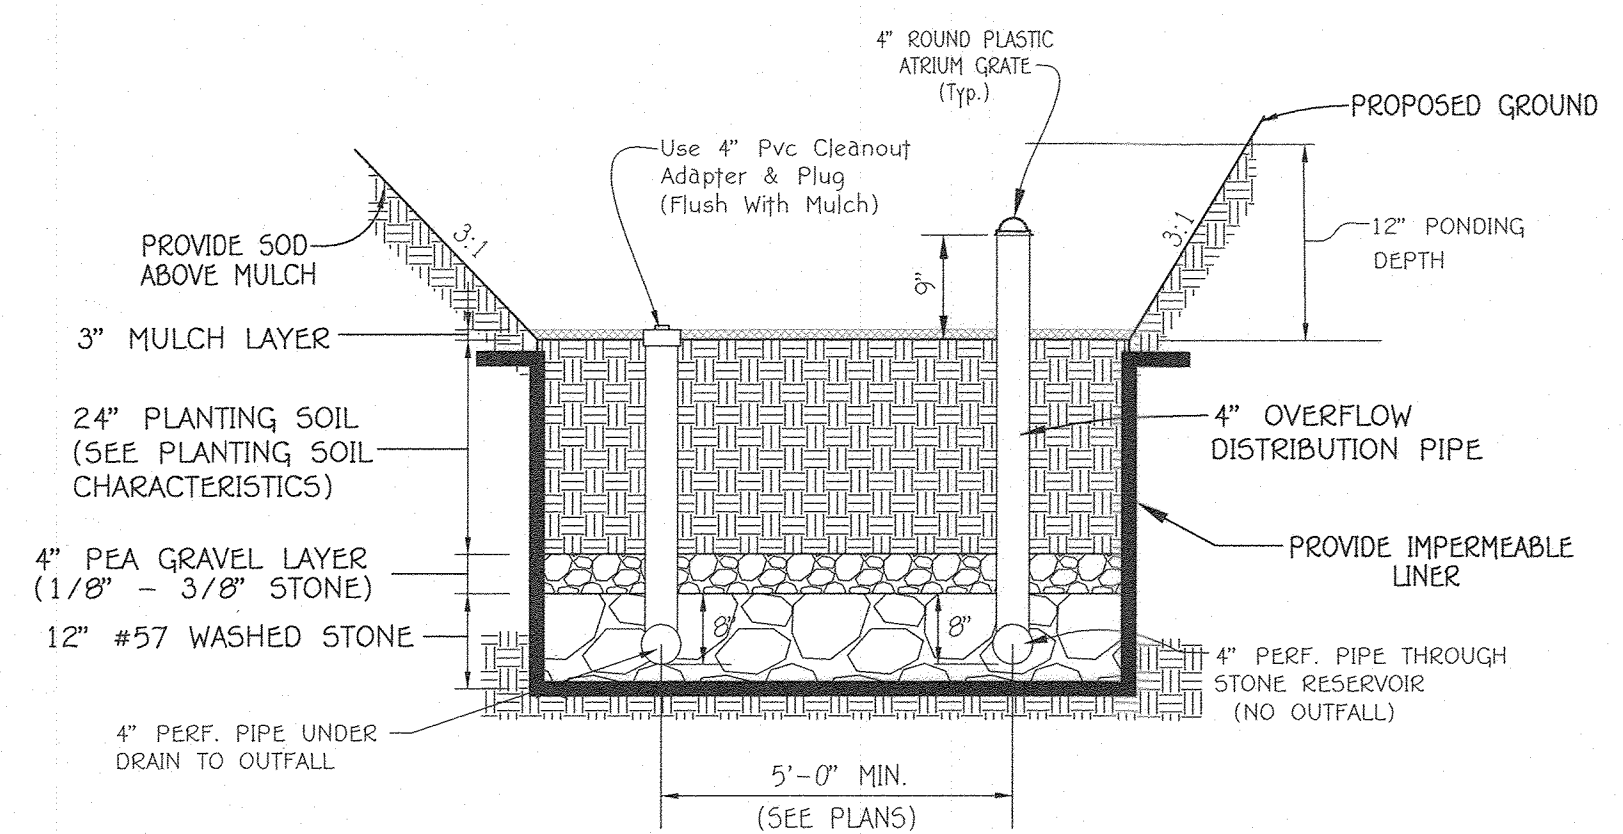


(FOR Nos. 10 & 11)
**MICRO BIO-RETENTION SECTION
 WITH 4" OVERFLOW DISTRIBUTION PIPE**
 NO SCALE

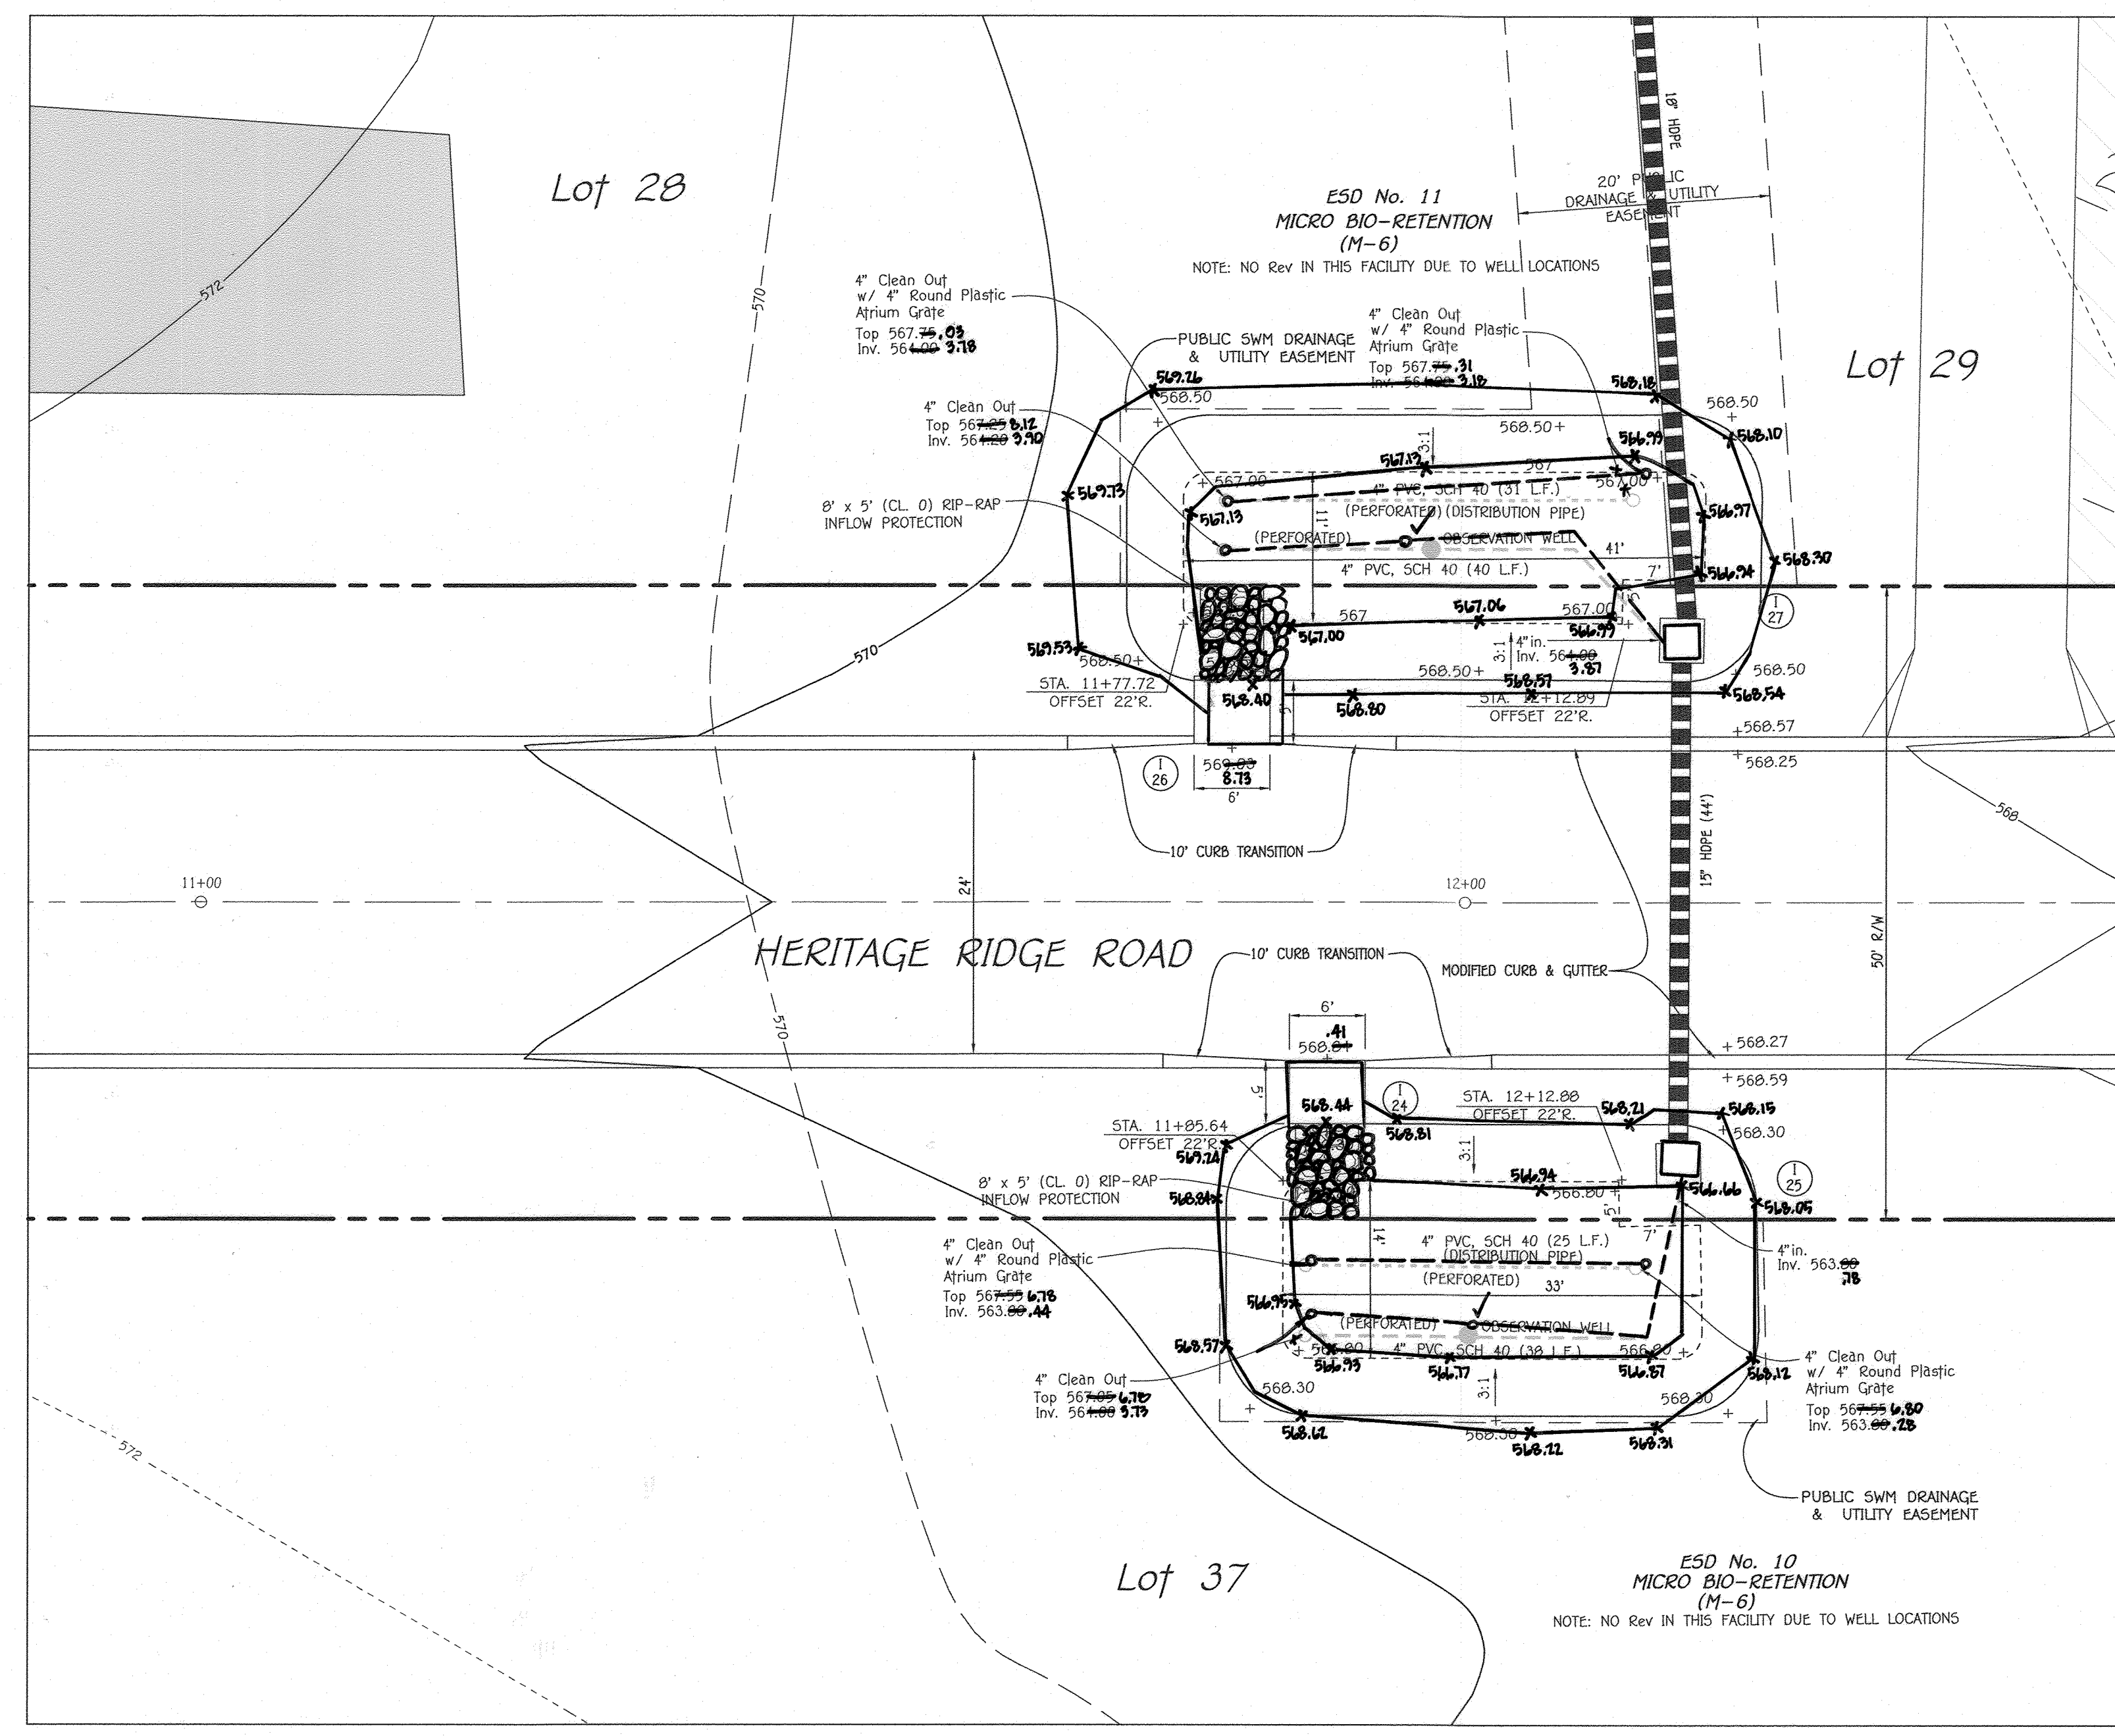

STORMWATER MANAGEMENT MAINTENANCE NOTE
 ALL STORMWATER MANAGEMENT FACILITIES WILL BE PRIVATELY OWNED AND MAINTAINED BY THE LINDEN GROVE HOMEOWNERS ASSOCIATION. THE STREET TREES, PLANTINGS WITHIN THE BIO-RETENTION, PERFORATED UNDERDRAINS, FEEDERS AND SWALES WILL ALSO BE PRIVATELY OWNED AND MAINTAINED BY THE LINDEN GROVE HOMEOWNERS ASSOCIATION. HOWARD COUNTY WILL ONLY MAINTAIN THE INLET STRUCTURE WITHIN THE MICRO BIO-RETENTION FACILITIES ADJACENT TO THE PUBLIC RIGHT-OF-WAY.

AS-BUILT CERTIFICATION FOR PSWM
 I hereby certify that the information shown on the plan was constructed in accordance with the approved plans and complies with the approved specifications. I have verified the contributing drainage area and the structure is sufficiently stabilized to prevent clogging of the inlet structure and SWM facility.
[Signature]
 Date: 5/3/22


**PROPOSED MICRO BIO-RETENTION (M-6)
 ESD Nos. 10 & 11 PLAN VIEW**
 SCALE: 1" = 10'

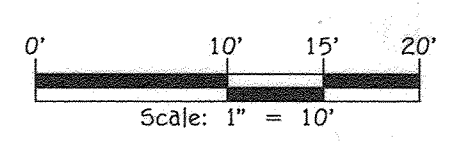

FISHER, COLLINS & CARTER, INC.
 CIVIL ENGINEERING CONSULTANTS & LAND SURVEYORS
 CENTENNIAL SQUARE OFFICE PARK - 10272 BALTIMORE NATIONAL PIKE
 ELLICOTT CITY, MARYLAND 21042
 (410) 461-2295

OWNER:
 KIMBERLY/HERITAGE LLC
 3425 HIPSLEY MILL ROAD
 WOODBINE, MARYLAND 21797-7615
 410-489-7900



DEVELOPER:
 HERITAGE LAND DEVELOPMENT
 15950 NORTH AVENUE
 LISBON, MARYLAND 21765
 410-489-7900

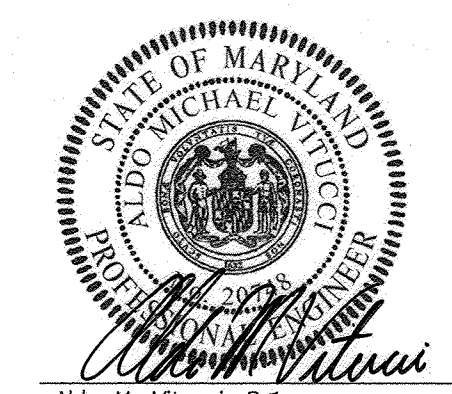




[Signature]
 Aldo M. Vuceli, P.E.
 "Professional Certification: I hereby certify that these documents were prepared or approved by me, and that I am a duly Licensed Professional Engineer under the laws of the State of Maryland, License No. 20748, Expiration Date 2-22-21."
 Date: 9/6/2020

**Stormwater Management
 Plan Views
 LINDEN GROVE
 PHASE TWO
 LOTS 24 THRU 44**
 (A Re subdivision of Non-Buildable Bulk Parcels "F" & "G", Recorded As "Linden Grove, Phase One Lots 1 Thru 23, Buildable Preservation Parcel "A", Non-Buildable Preservation Parcels "B" Thru "E" And Non-Buildable Bulk Parcels "F" And "G", Plat Nos. 25064 Thru 25073.)
 ZONED: RC-DEO
 TAX MAP No. 8 GRID No. 7 PARCEL No. 5
 4TH ELECTION DISTRICT HOWARD COUNTY, MARYLAND
 DATE: JUNE 16, 2020
 SHEET 12 OF 24

Approved: Department of Planning And Zoning		
Chief, Division of Land Development	11/2/20 Date	
Chief, Development Engineering Division	10/22/20 Date	
Approved: Howard County Department of Public Works		
Chief, Bureau of Highways	10/19/2020 Date	
REVISIONS		
NO.	DESCRIPTION	DATE

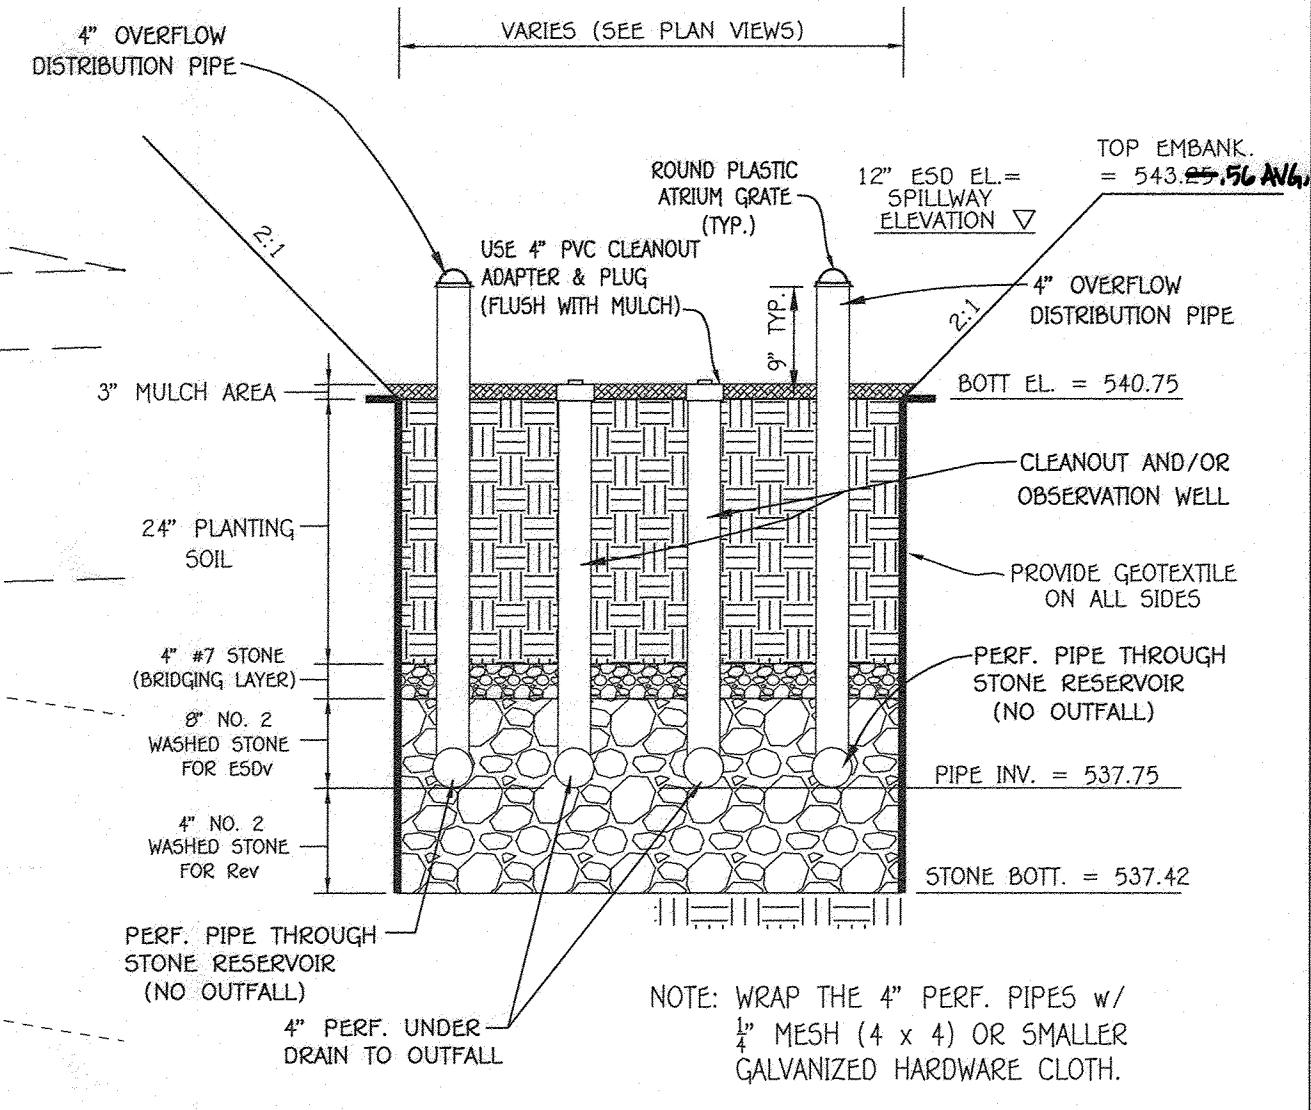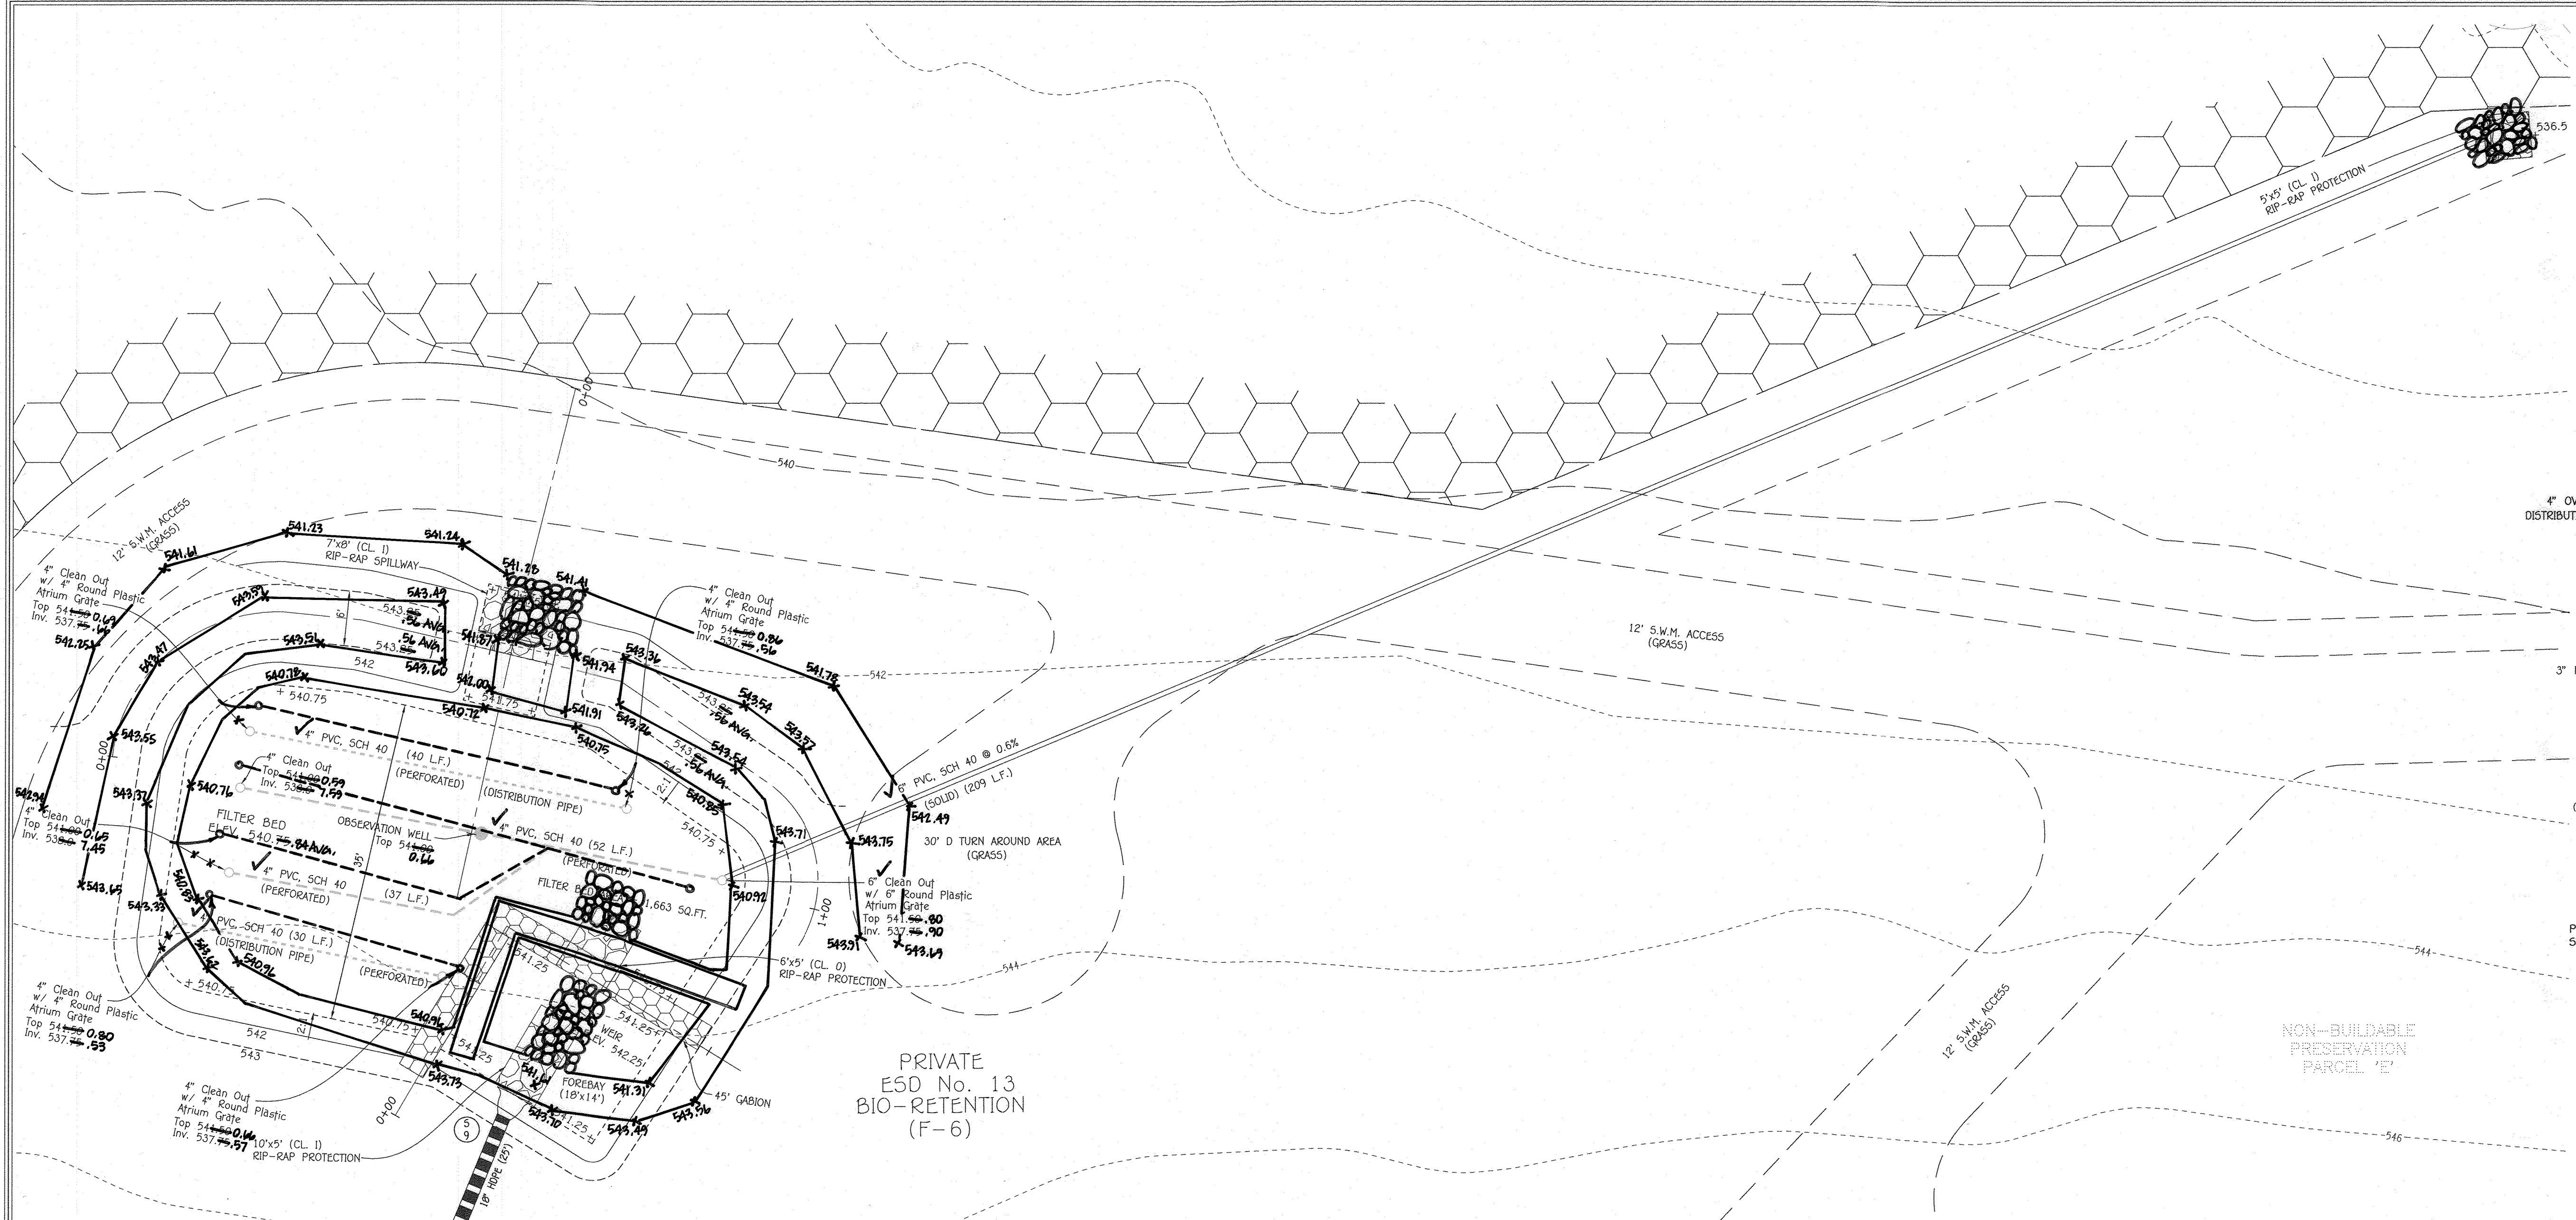

**PROPOSED BIO-RETENTION (F-6)
ESD No. 13 PLAN VIEW**
SCALE: 1" = 10'

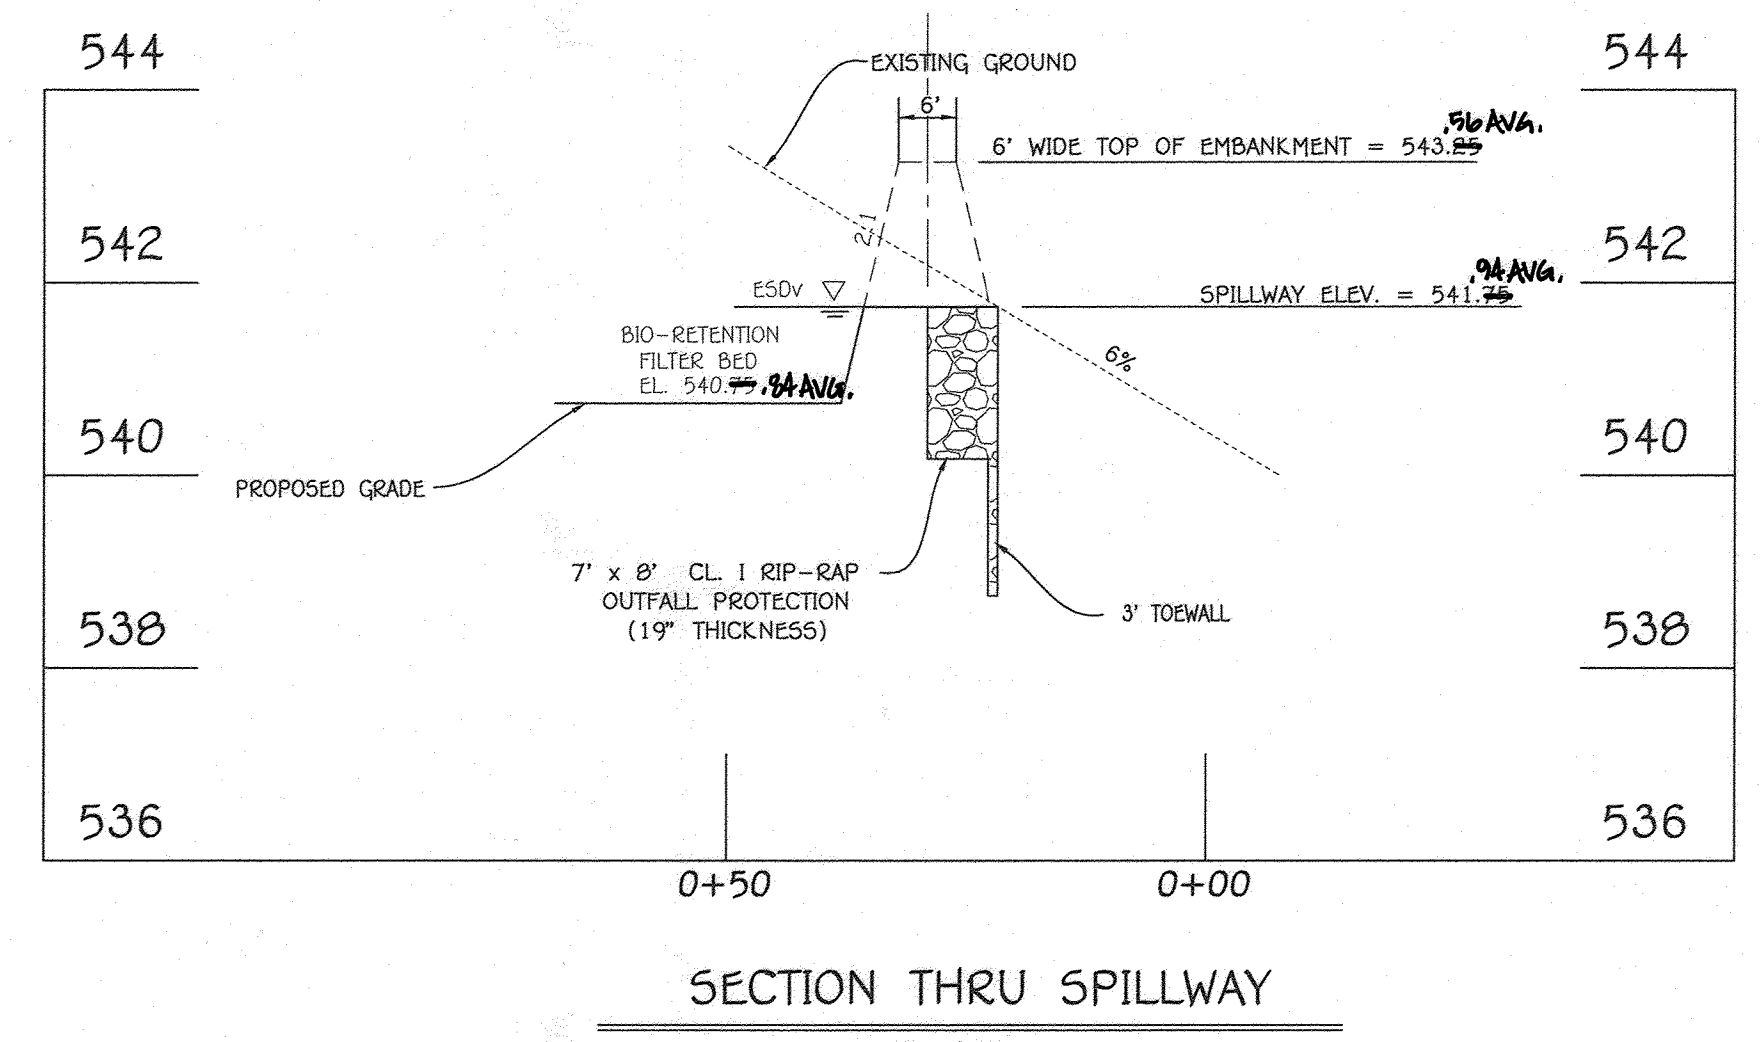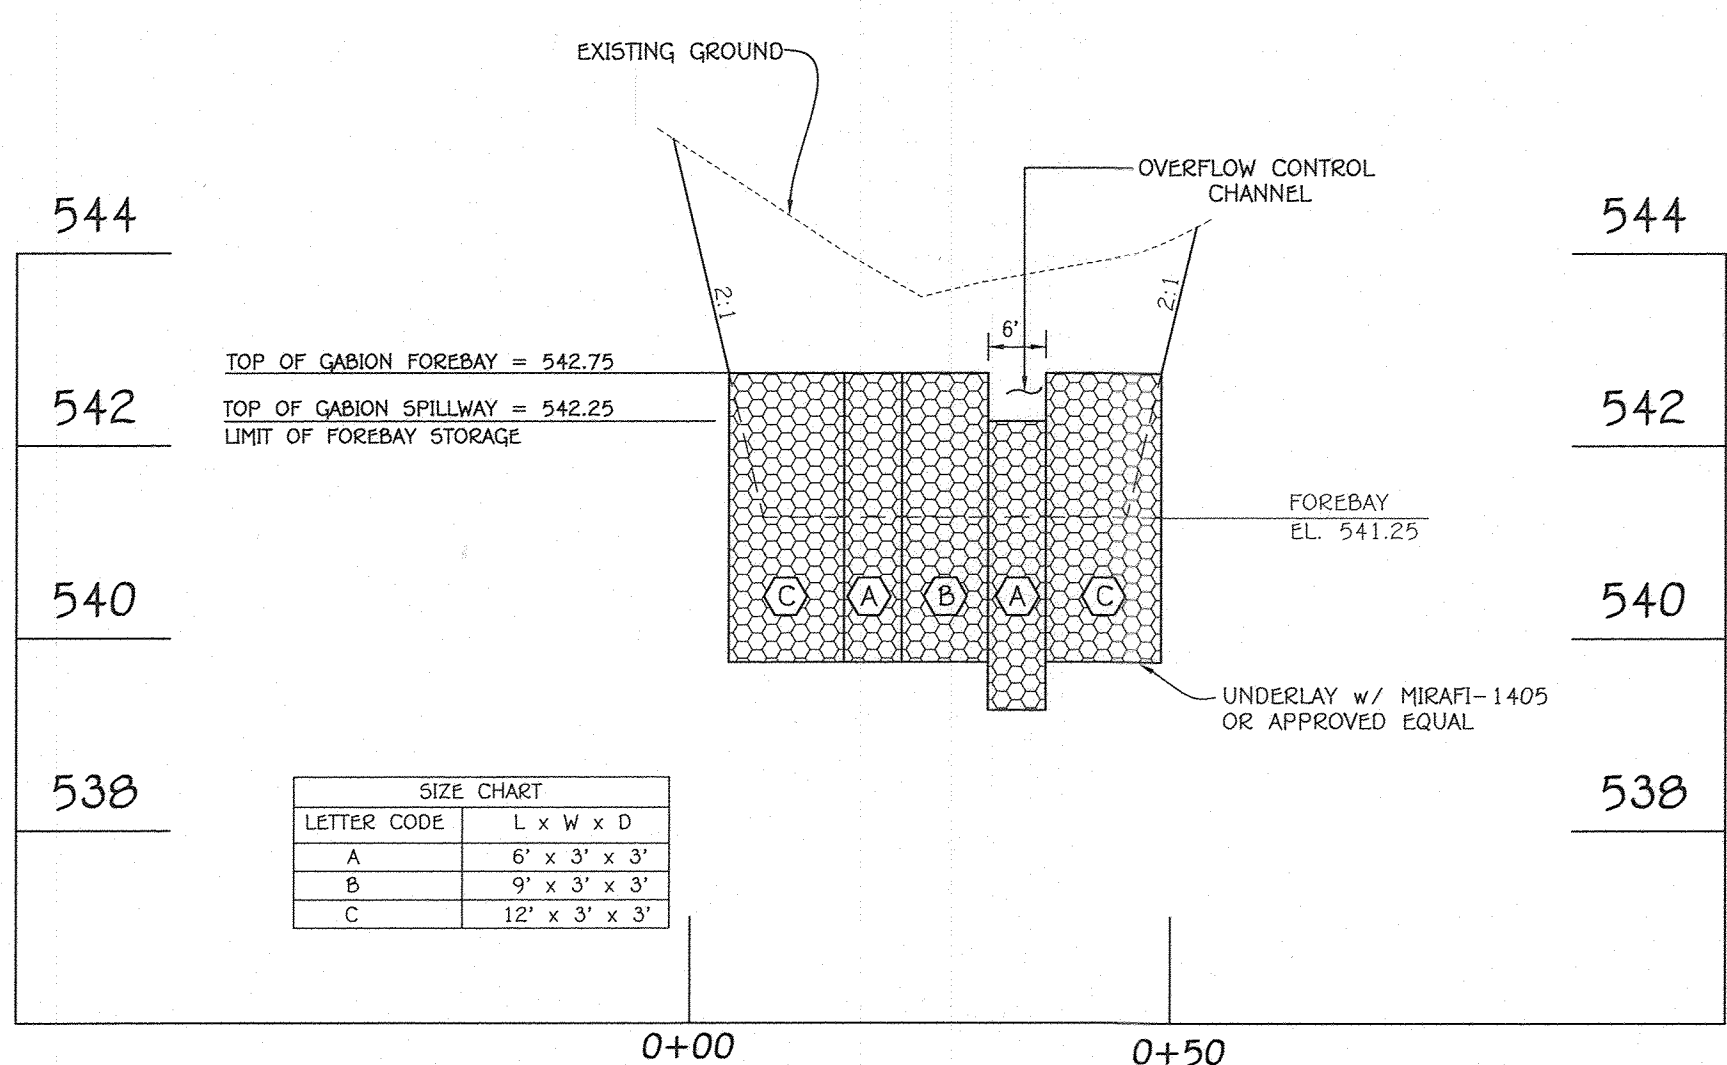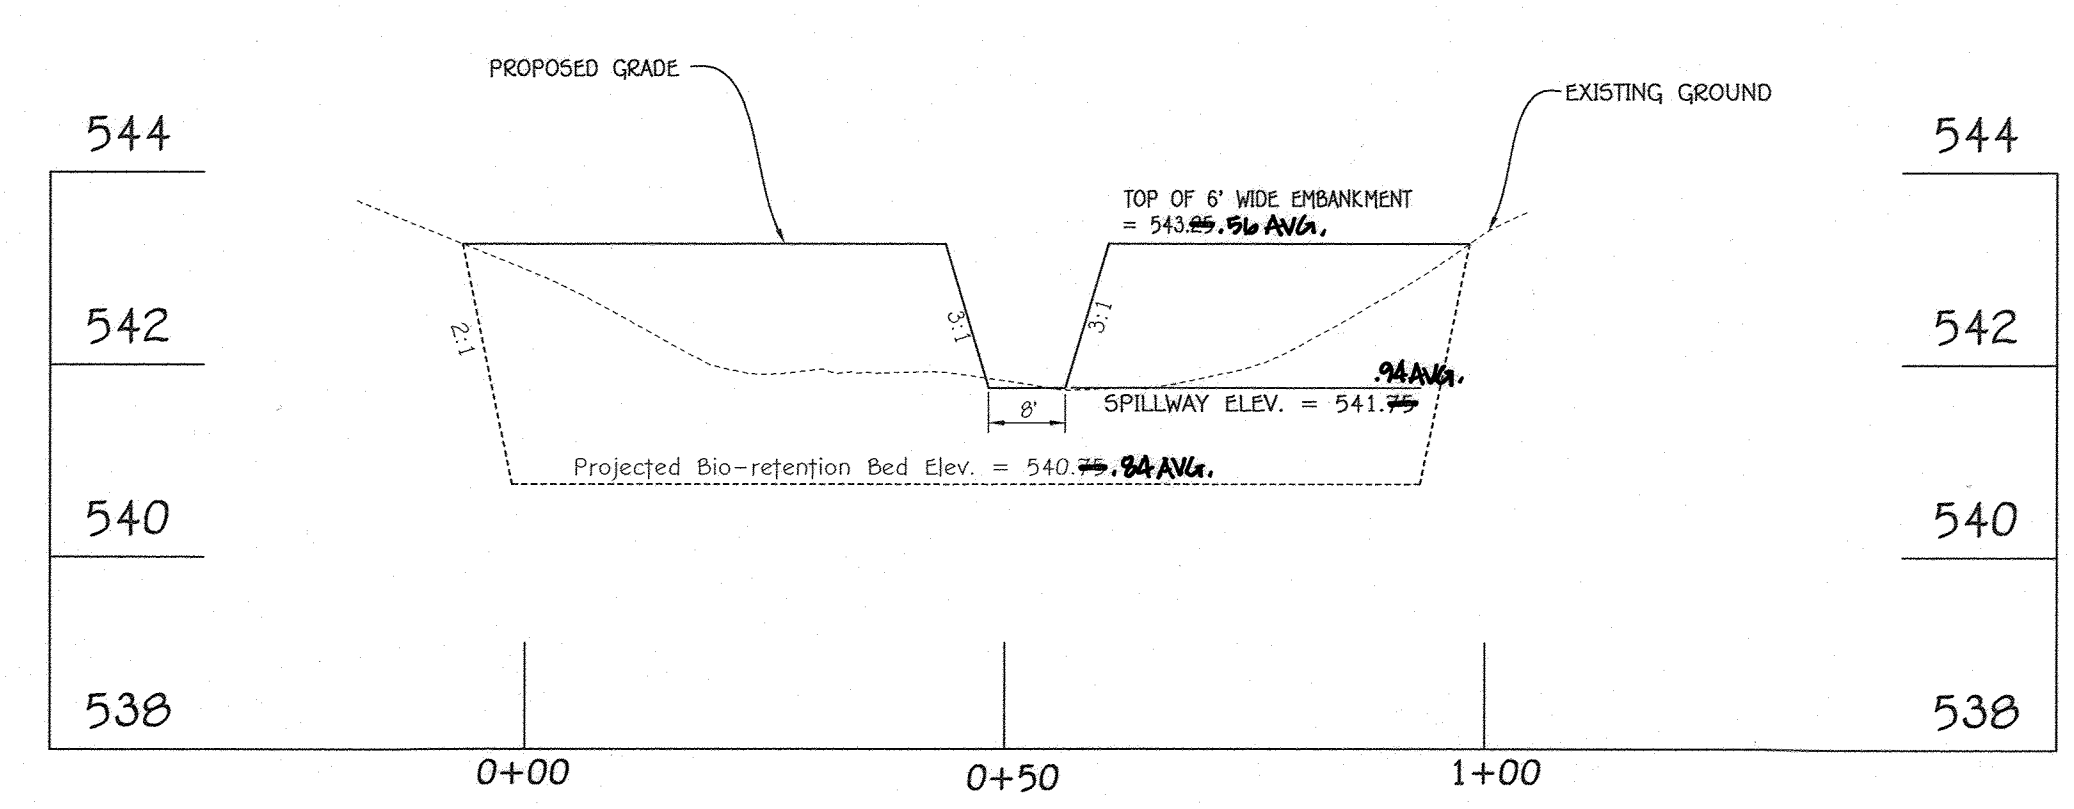

AS-BUILT VERIFICATION FOR P5WM
 I hereby certify that the construction on the plan was constructed in accordance with the approved plans and complies with the specifications. I have verified the contribution of the bio-retention area to the stormwater management system.

[Signature]
 Date: 5/31/22

PROFILE ALONG TOP OF EMBANKMENT
 SCALE: HORIZ. 1" = 20'
 VERT. 1" = 2'

GABION FOREBAY PROFILE
 SCALE: HORIZ. 1" = 20'
 VERT. 1" = 2'

**Stormwater Management
Plan Views**
**LINDEN GROVE
PHASE TWO
LOTS 24 THRU 44**
 (A Resubdivision of Non-Buildable Bulk Parcels 'F' & 'G', Recorded As 'Linden Grove, Phase One Lots 1 Thru 23, Buildable Preservation Parcel 'A', Non-Buildable Preservation Parcels 'B' Thru 'C' And Non-Buildable Bulk Parcels 'F' And 'G', Plat Nos. 25064 Thru 25073.)

ZONED: RC-DEO
 TAX MAP No. 8 GRID No. 7 PARCEL No. 5
 4TH ELECTION DISTRICT HOWARD COUNTY, MARYLAND
 DATE: JUNE 16, 2020
 SHEET 14 of 24





Aldo M. Vitucci, P.E.
 Date: 9/2/2020
 "Professional Certification: I hereby certify that these documents were prepared or approved by me, and that I am a duly Licensed Professional Engineer under the laws of the State of Maryland, License No. 20748, Expiration Date 2-22-21."

OWNER:
 KIMBERLY/HERITAGE LLC
 3425 HIPSLEY HILL ROAD
 WOODBINE, MARYLAND 21797-7615
 410-489-7900

DEVELOPER:
 HERITAGE LAND DEVELOPMENT
 15950 NORTH AVENUE
 LUSKON, MARYLAND 21765
 410-489-7900

FISHER, COLLINS & CARTER, INC.
 CIVIL ENGINEERING CONSULTANTS & LAND SURVEYORS
 CENTENNIAL SQUARE OFFICE PARK - 10272 BALTIMORE NATIONAL PIKE
 ELICOTT CITY, MARYLAND 21042
 (410) 461-2895



Approved: Department of Planning and Zoning		
Chief, Division of Land Development	11/2/20 Date	
Chief, Development Engineering Division	10/22/20 Date	
Approved: Howard County Department of Public Works		
Chief, Bureau of Highways	10/19/2020 Date	
REVISIONS		
NO.	DESCRIPTION	DATE

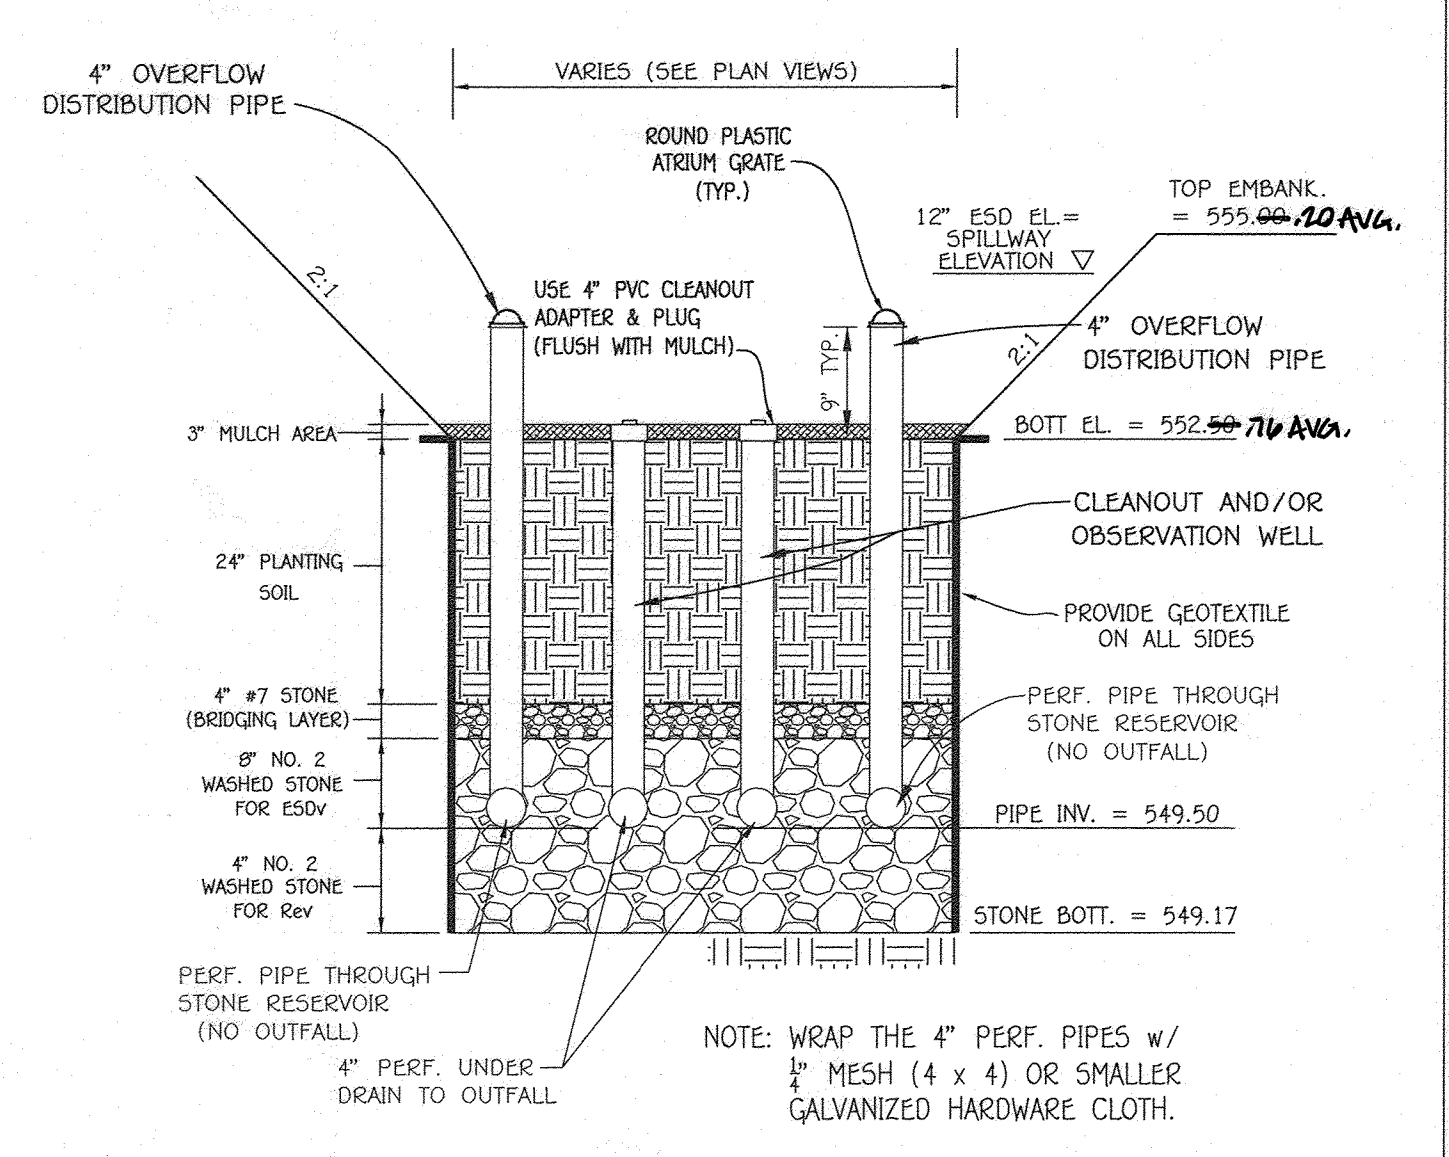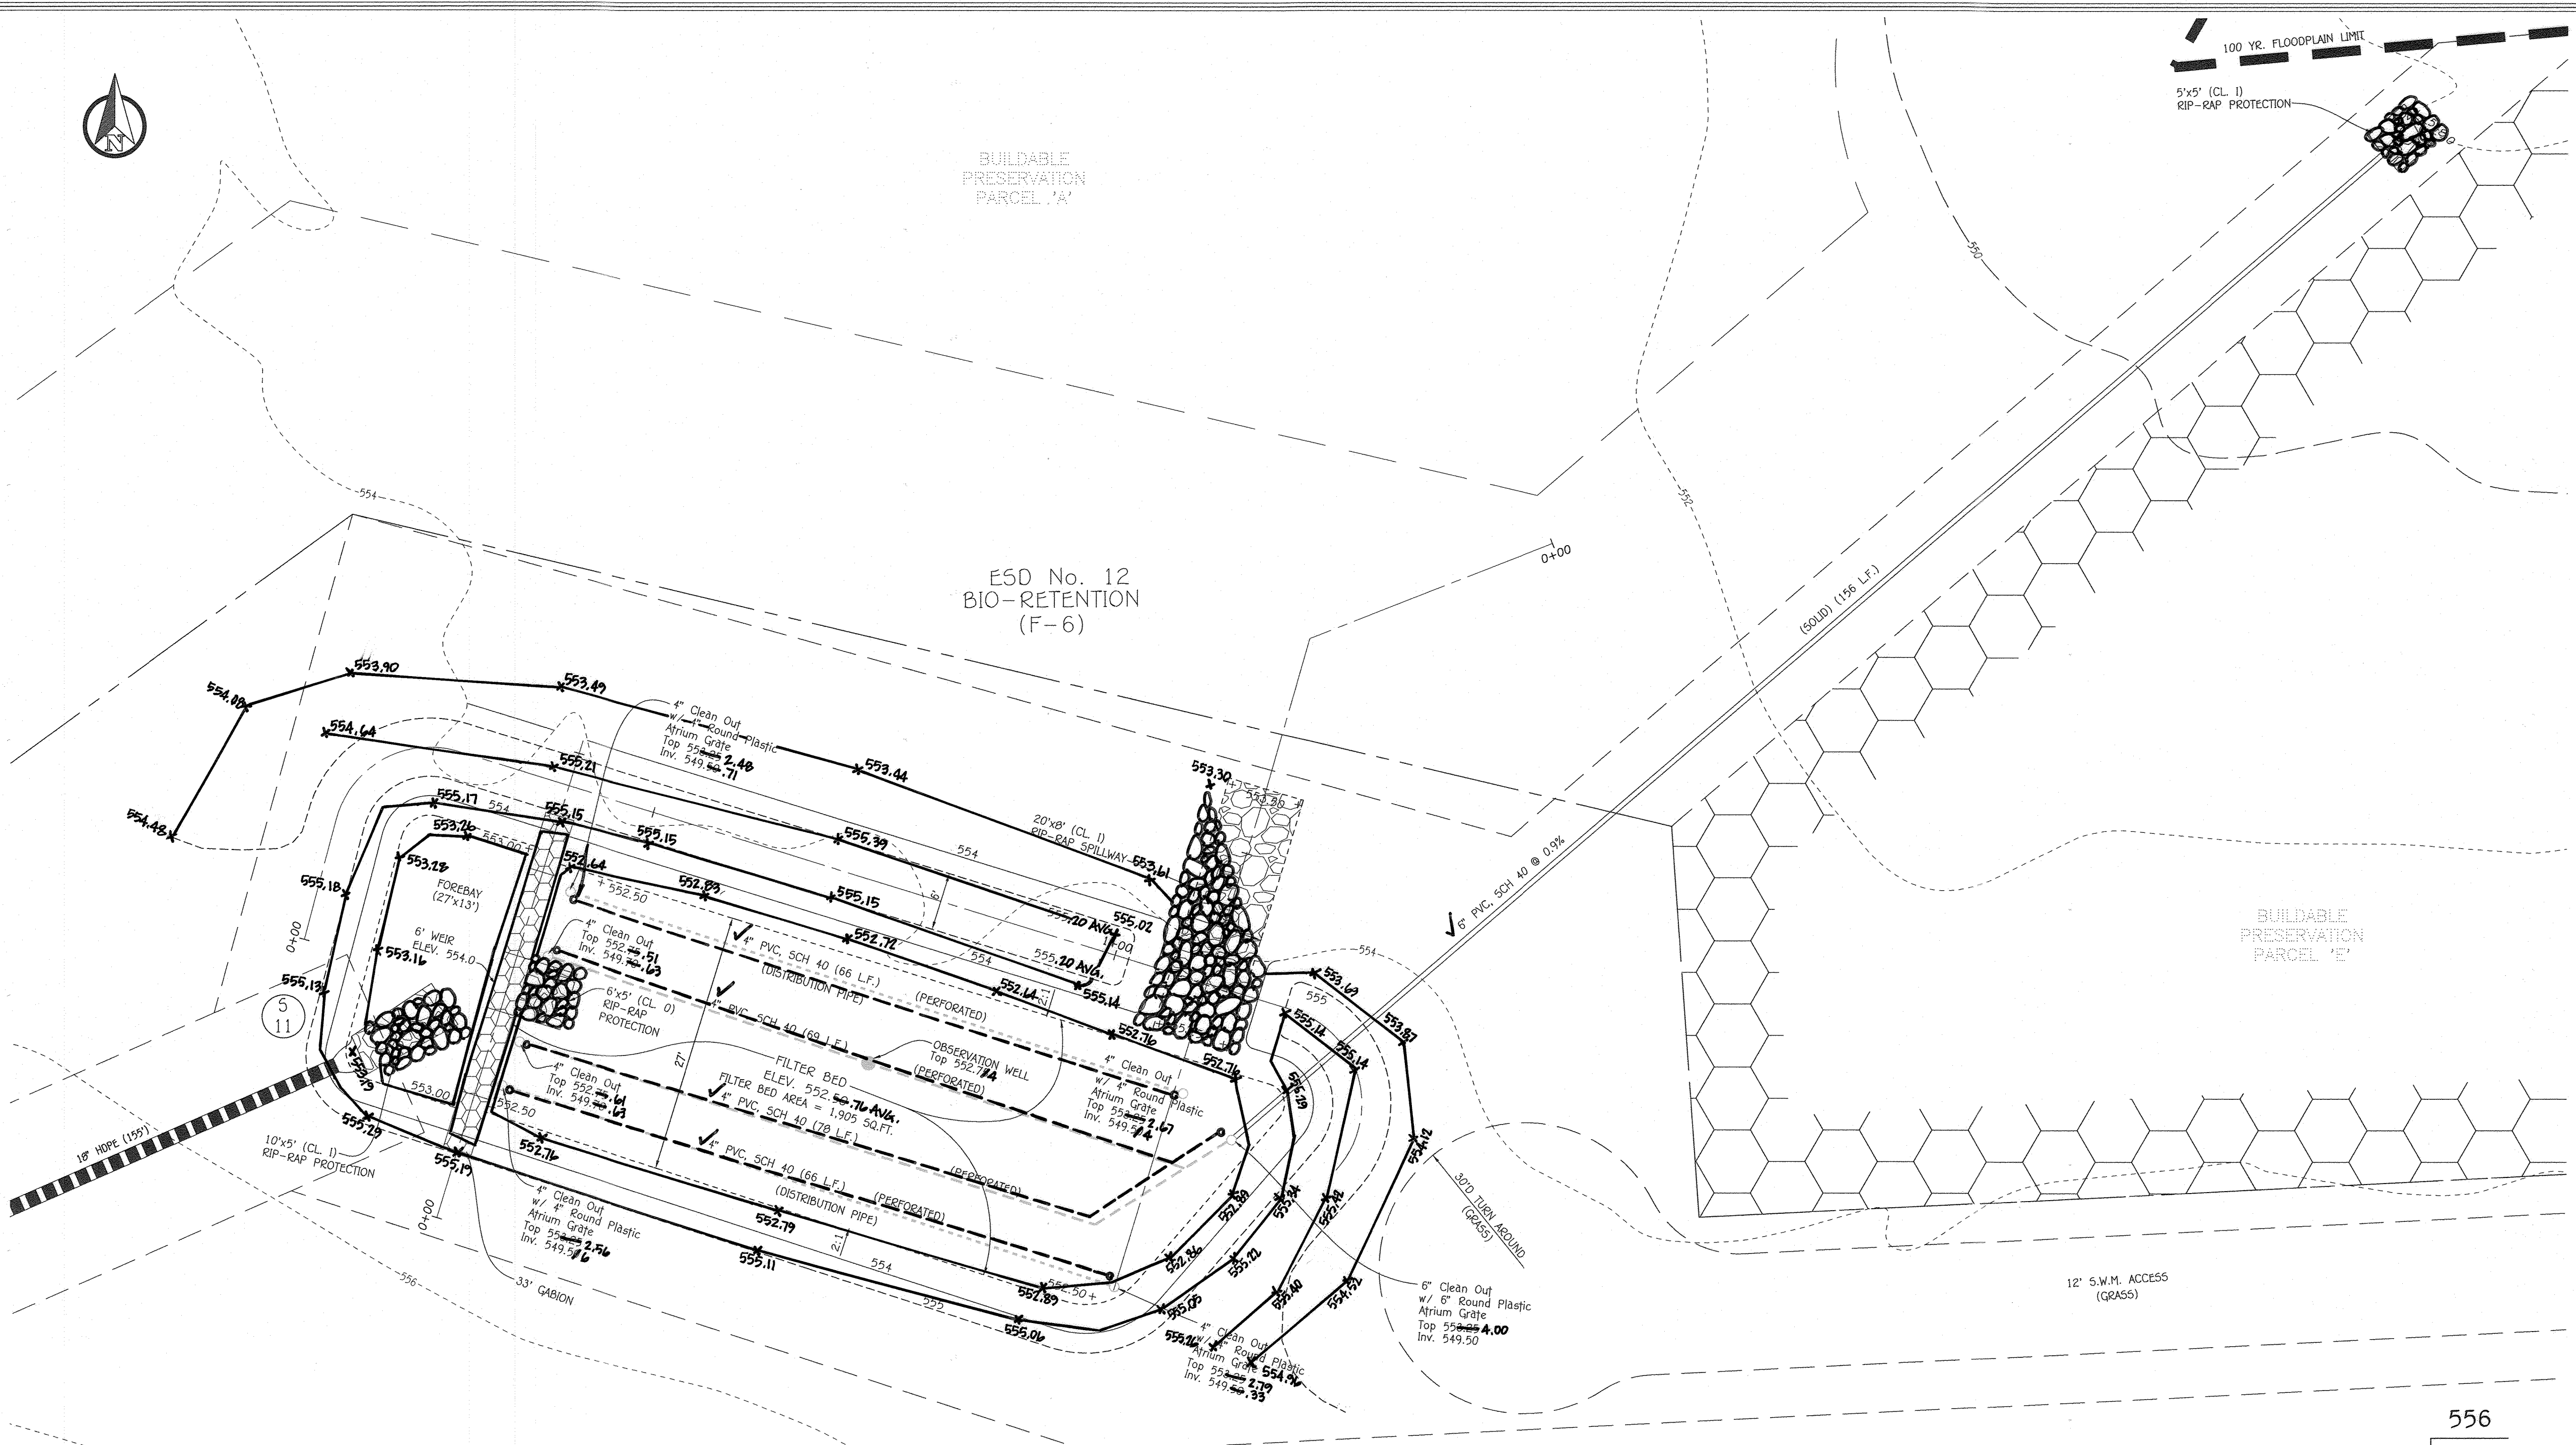


BIO-RETENTION SECTION (F-6) (ESD #12)
NO SCALE

AS-BUILT CERTIFICATION FOR PSWM
I hereby certify that the work shown on the plan was constructed in accordance with the approved plans and specifications. I have verified the contributing discharge to prevent clogging of the facility.
Date: 5/9/22


PROPOSED BIO-RETENTION (F-6)-PRIVATE
ESD No. 12 PLAN VIEW
SCALE: 1" = 10'

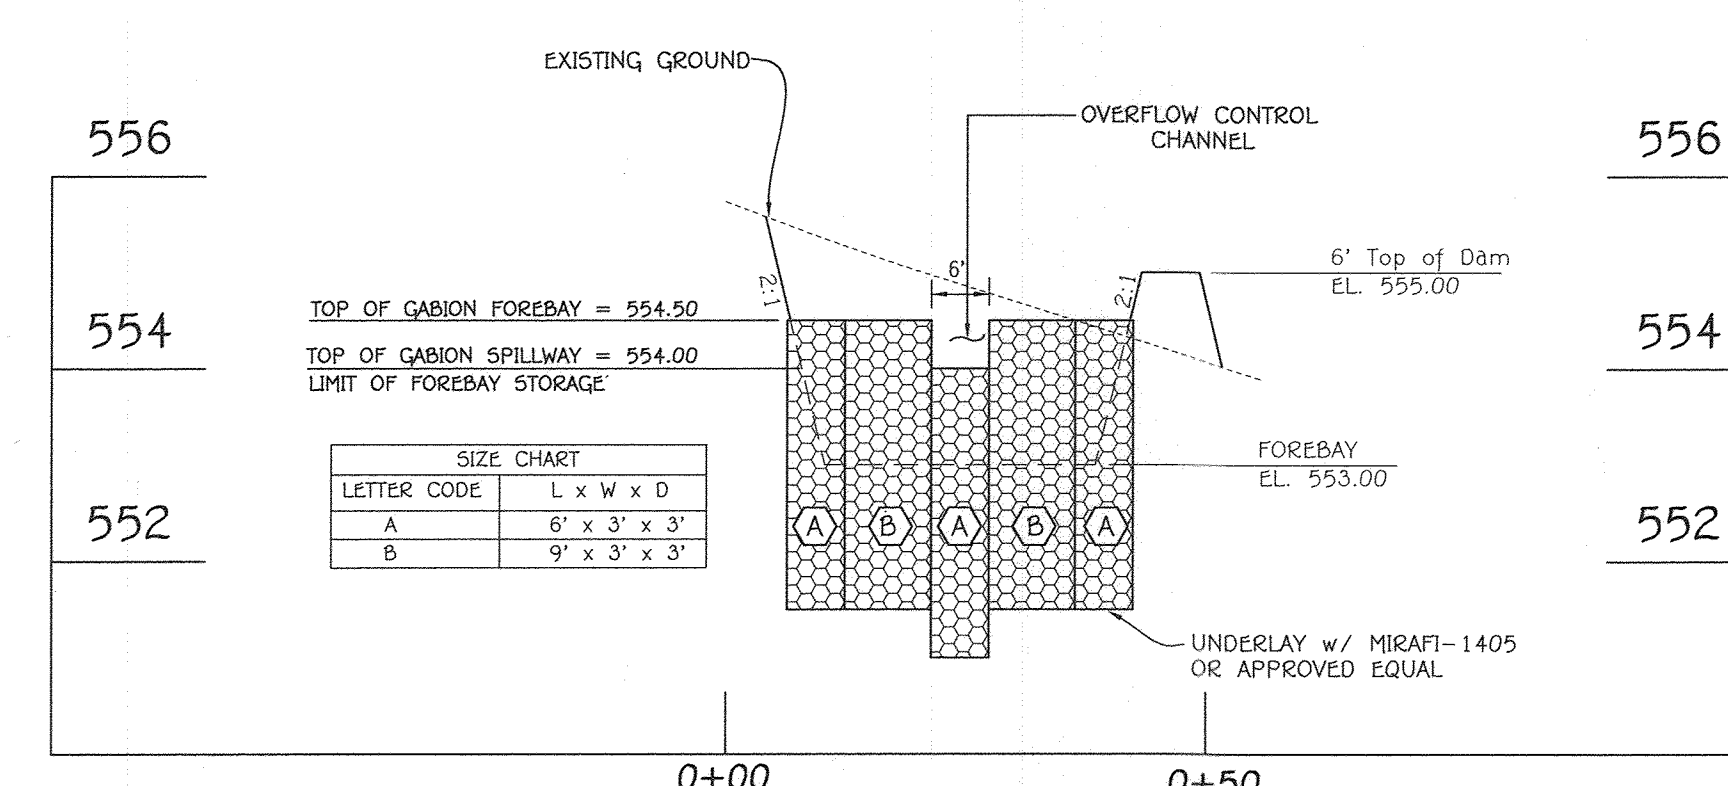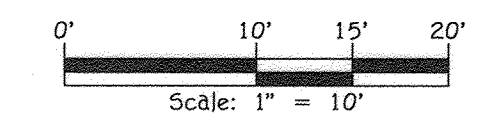

GABION FOREBAY PROFILE
SCALE: HORIZ. 1" = 20'
VERT. 1" = 2'

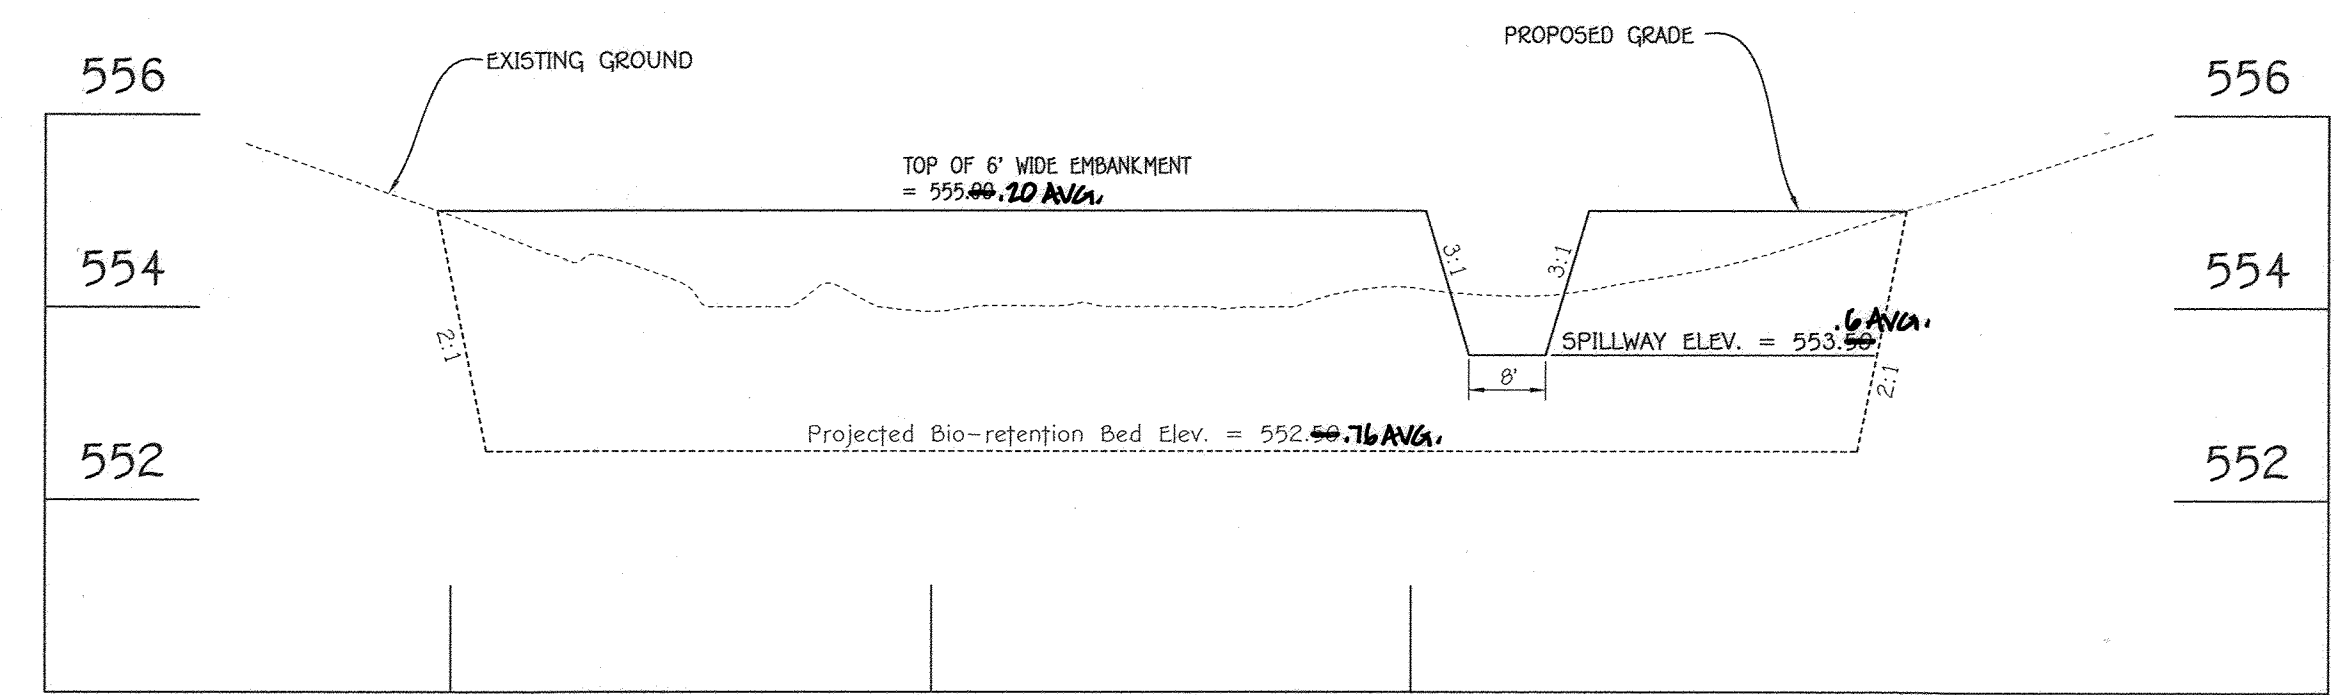

PROFILE ALONG TOP OF EMBANKMENT
SCALE: HORIZ. 1" = 20'
VERT. 1" = 2'

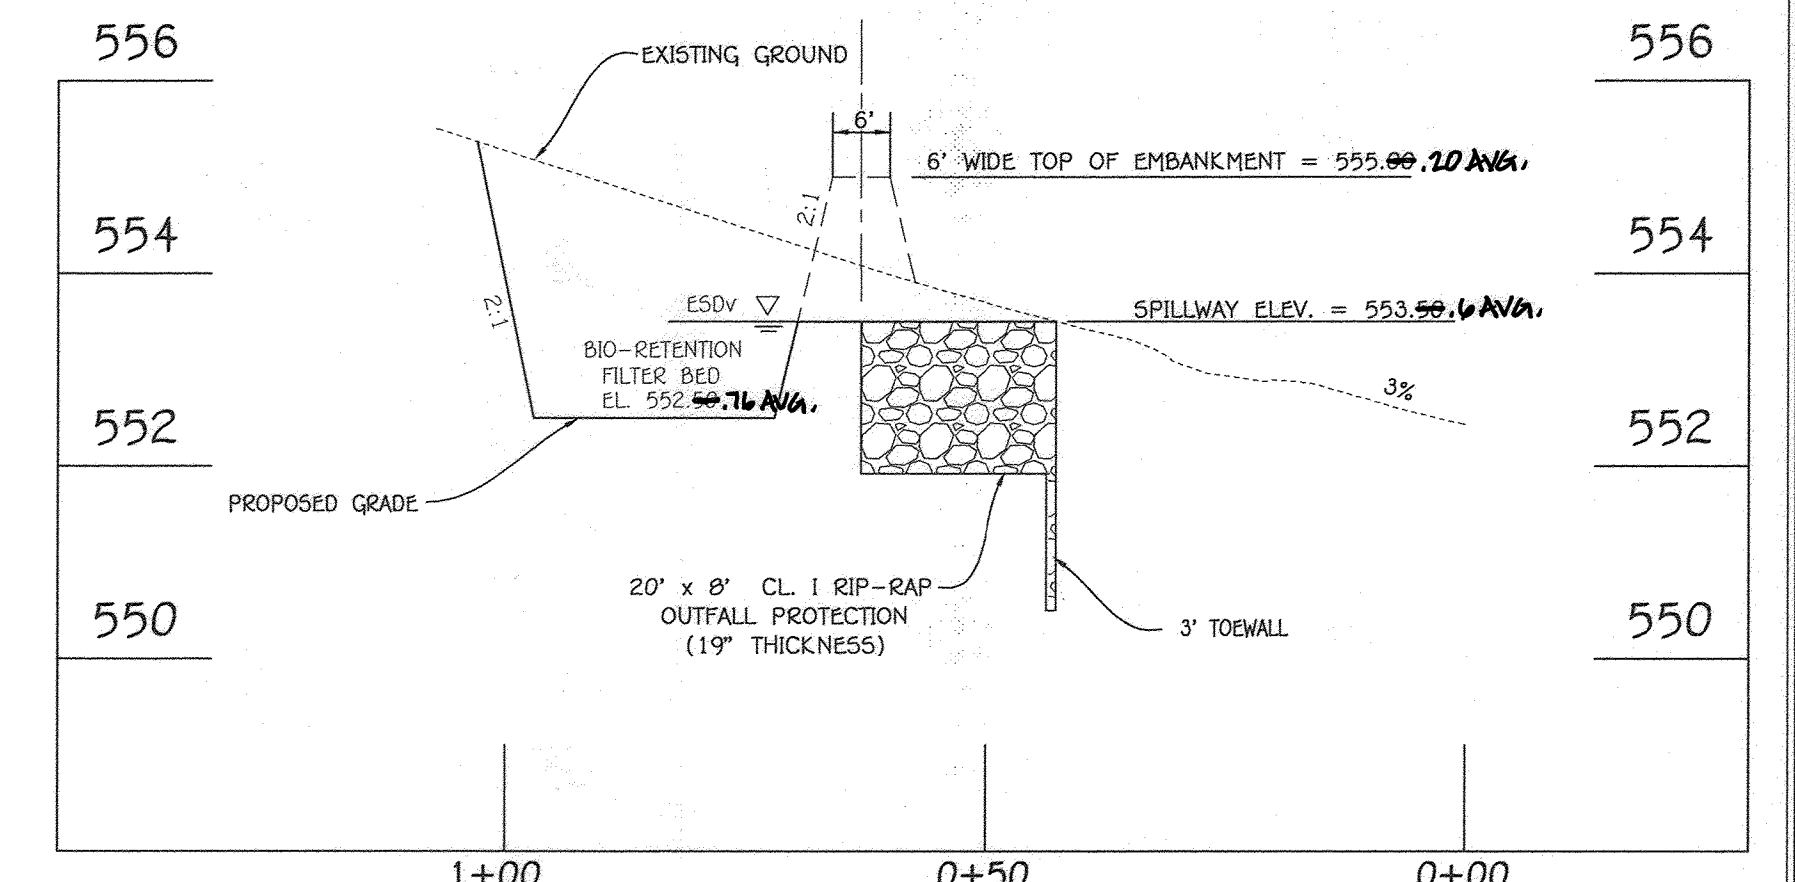


SECTION THRU SPILLWAY
SCALE: HORIZ. 1" = 20'
VERT. 1" = 2'

Stormwater Management
Plan Views
LINDEN GROVE
PHASE TWO
LOTS 24 THRU 44

(A Resubdivision of Non-Buildable Bulk Parcels 'F' & 'G', Recorded As "Linden Grove, Phase One Lots 1 Thru 23, Buildable Preservation Parcel 'A', Non-Buildable Preservation Parcels 'B' Thru 'E' And Non-Buildable Bulk Parcels 'F' And 'G' ". Plat Nos. 25064 Thru 25073.)

ZONED: RC-DEO
TAX MAP No. 8 GRID No. 7 PARCEL No. 5
4TH ELECTION DISTRICT HOWARD COUNTY, MARYLAND
DATE: JUNE 16, 2020
SHEET 15 OF 24

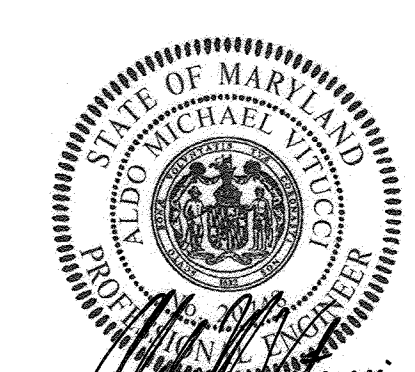



Aldo M. Vitiello, P.E.
Professional Certification: I hereby certify that these documents were prepared or approved by me, and that I am a duly Licensed Professional Engineer under the laws of the State of Maryland, License No. 20748, Expiration Date 2-22-21.

OWNER:
KIMBERLY HERITAGE LLC
3425 HIPSLEY MILL ROAD
WOODBINE, MARYLAND 21797-7615
410-489-7900

DEVELOPER:
HERITAGE LAND DEVELOPMENT
15950 NORTH AVENUE
LISBON, MARYLAND 21765
410-489-7900

FISHER, COLLINS & CARTER, INC.
CIVIL ENGINEERING CONSULTANTS & LAND SURVEYORS
CENTRAL SQUARES OFFICE PARK - 10772 BALDWIN NATIONAL PARK
ELLICOTT CITY, MARYLAND 21042
(410) 461-2299

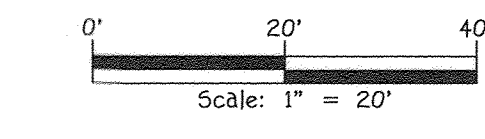

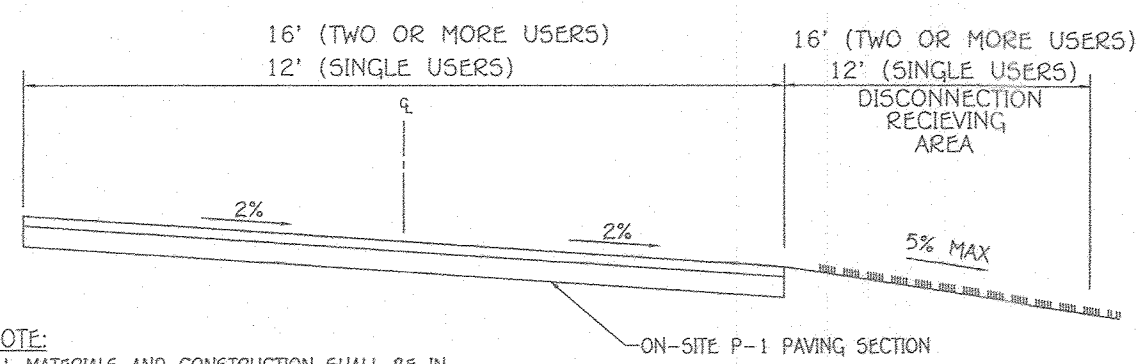


NOTE:
ALL MATERIALS AND CONSTRUCTION SHALL BE IN ACCORDANCE WITH HOWARD COUNTY DESIGN MANUAL VOLUME IV, STANDARD SPECIFICATION AND DETAILS FOR CONSTRUCTION.


Typical Private Drive Cross Slope Section
NOT TO SCALE

Operation & Maintenance Schedule For Privately Owned And Maintained Disconnection Of Nonrooftop Runoff (N-2)

1. Maintenance Of Areas Receiving Disconnection Runoff Is Generally No Different Than That Required For Other Lawn Or Landscaped Areas. The Areas Receiving Runoff Should Be Protected From Future Compaction Or Development Of Impervious Area. In Commercial Areas, Foot Traffic Should Be Discouraged As Well.

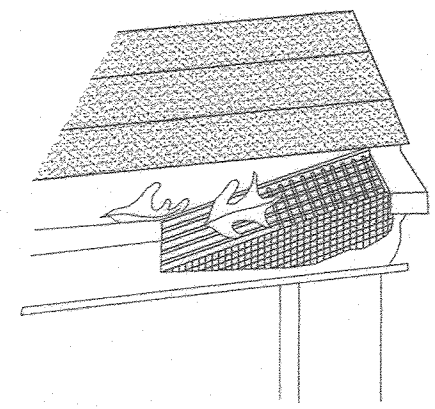

GUTTER DRAIN FILTER DETAIL
NOT TO SCALE


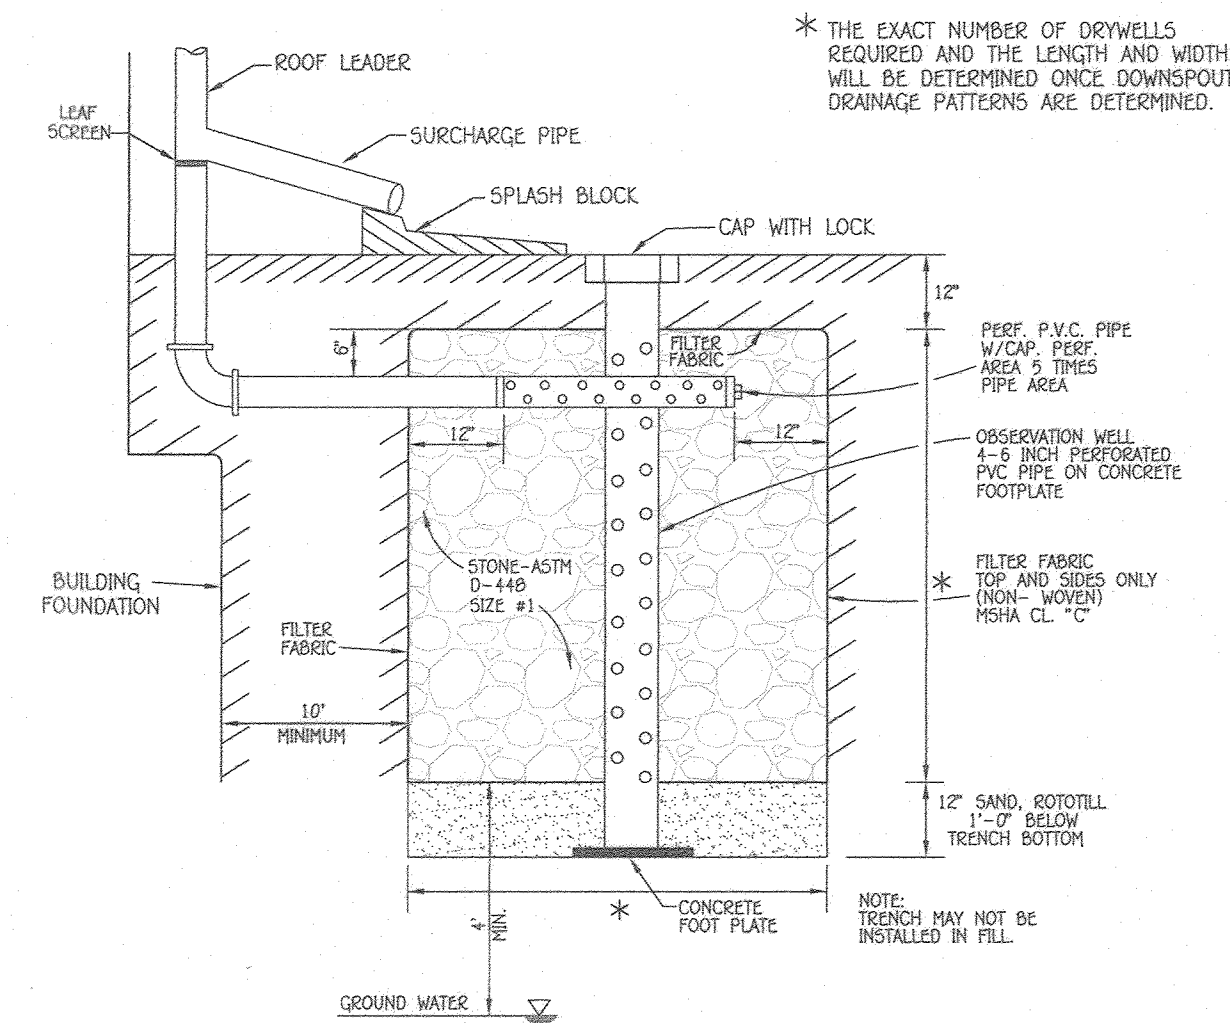


DRYWELL (M-5)

OPERATION AND MAINTENANCE SCHEDULE FOR DRYWELLS (M-5)

- THE OWNER SHALL INSPECT THE MONITORING WELLS AND STRUCTURES ON A QUARTERLY BASIS AND AFTER EVERY HEAVY STORM EVENT.
- THE OWNER SHALL RECORD THE WATER LEVELS AND SEDIMENT BUILD UP IN THE MONITORING WELLS OVER A PERIOD OF SEVERAL DAYS TO INSURE TRENCH DRAINAGE.
- THE OWNER SHALL MAINTAIN A LOG BOOK TO DETERMINE THE RATE AT WHICH THE FACILITY DRAINS.
- WHEN THE FACILITY BECOMES CLOGGED SO THAT IT DOES NOT DRAIN WITHIN A SEVENTY TWO (72) HOUR TIME PERIOD, CORRECTIVE ACTION SHALL BE TAKEN.
- THE MAINTENANCE LOG BOOK SHALL BE AVAILABLE TO HOWARD COUNTY FOR INSPECTION TO INSURE COMPLIANCE WITH OPERATION AND MAINTENANCE CRITERIA.
- ONCE THE PERFORMANCE CHARACTERISTICS OF THE INFILTRATION FACILITY HAVE BEEN VERIFIED, THE MONITORING SCHEDULE CAN BE REDUCED TO AN ANNUAL BASIS UNLESS THE PERFORMANCE DATA INDICATES THAT A MORE FREQUENT SCHEDULE IS REQUIRED.

APPROVED: DEPARTMENT OF PUBLIC WORKS		8/17/2020
CHIEF, BUREAU OF HIGHWAYS	DATE	
APPROVED: DEPARTMENT OF PLANNING AND ZONING		
CHIEF, DIVISION OF LAND DEVELOPMENT	DATE	11/2/20
CHIEF, DEVELOPMENT ENGINEERING DIVISION	DATE	8/28/20
REVISIONS		
NO.	DESCRIPTION	DATE

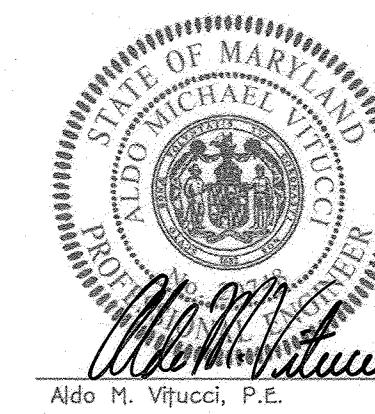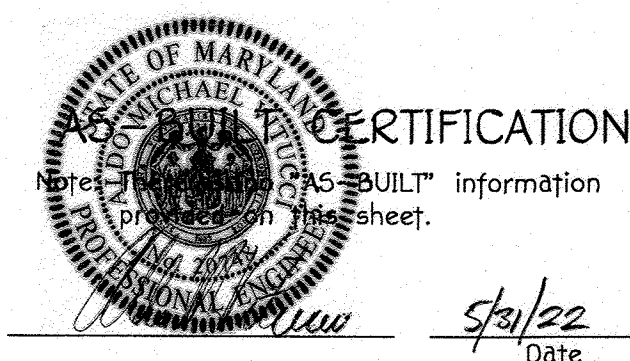

PRIVATE STORMWATER MANAGEMENT NOTES AND DETAILS


LINDEN GROVE PHASE TWO

LOTS 24 THRU 44

(A Resubdivision of Non-Buildable Bulk Parcels 'F' & 'G', Recorded As 'Linden Grove, Phase One Lots 1 Thru 23, Buildable Preservation Parcel 'A', Non-Buildable Preservation Parcels 'B' Thru 'E' And Non-Buildable Bulk Parcels 'F' And 'G', Plot Nos. 25064 Thru 25073.)

ZONED: RC-DEO
TAX MAP No. 8 GRID No. 7 PARCEL No. 5
4TH ELECTION DISTRICT HOWARD COUNTY, MARYLAND
DATE: JUNE 16, 2020
SHEET 18 of 24

FISHER, COLLINS & CARTER, INC.
CIVIL ENGINEERING CONSULTANTS & LAND SURVEYORS
CENTENNIAL SQUARE OFFICE PARK - 16272 BALTIMORE NATIONAL PIKE
ELLSWORTH CITY, MARYLAND 21042
(410) 461-2895

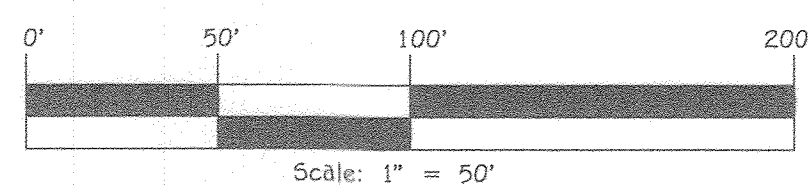

OWNER:
KIMBERETHY/HERITAGE LLC
3425 HIPPOLEY MILL ROAD
WOODBINE, MARYLAND 21797-7615
410-489-7900

DEVELOPER:
HERITAGE LAND DEVELOPMENT
15950 NORTH AVENUE
USDON, MARYLAND 21765
410-489-7900

Professional Certification: I hereby certify that these documents were prepared or approved by me, and that I am a duly Licensed Professional Engineer under the laws of the State of Maryland, License No. 20748, Expiration Date 2-22-21.

STRUCTURE SCHEDULE

STRUCTURE NO.	TOP ELEVATION	INV. IN	INV. OUT	ROAD NAME	ROAD STA.	OFFSET	TYPE	REMARKS
I-24	569.46	---	---	HERITAGE RIDGE ROAD	11+09.13	12.43' R	COG/COS OPENING	MD - 374.60
I-25	567.71	563.20 (4")	562.27 (15")	HERITAGE RIDGE ROAD	12+16.90	21.7' R	'S' INLET	D - 4.22
I-26	569.56	---	---	HERITAGE RIDGE ROAD	11+01.56	12.43' L	COG/COS OPENING	MD - 374.60
I-27	569.70	564.19 (15")	561.23 (18")	HERITAGE RIDGE ROAD	12+17.13	21.7' L	'S' INLET	D - 4.22
I-28	563.75	559.24 (15")	559.24 (18")	HERITAGE RIDGE ROAD	15+01.92	12.4' L	A-10	D - 4.03
I-29	563.72	---	562.21 (15")	HERITAGE RIDGE ROAD	15+01.95	12.4' R	A-10	D - 4.03
I-30	560.06	---	555.25 (15")	HERITAGE RIDGE ROAD	L.P. 1+46.12	---	A-10	D - 4.03
I-31	571.00	566.49 (15")	567.12 (18")	HERITAGE RIDGE ROAD	7+99.96	12.5' L	A-10	D - 4.03
I-32	571.00	---	567.52 (15")	HERITAGE RIDGE ROAD	7+99.96	12.5' L	A-10	D - 4.03
M-18	555.50	551.24 (18")	551.24 (18")	N 606,003.15 E 1,294,659.74	---	---	4' DIA. MANHOLE	G - 5.12
M-19	547.00	541.00 (18")	541.00 (18")	N 606,003.15 E 1,295,011.50	---	---	4' DIA. MANHOLE	G - 5.12
M-20	564.00	559.24 (18")	559.24 (18")	HERITAGE RIDGE ROAD	15+10.19	25' L	4' DIA. MANHOLE	G - 5.12
M-21	556.00	549.24 (18")	549.24 (18")	N 606,003.15 E 1,295,161.47	---	---	4' DIA. MANHOLE	G - 5.12
M-22	564.40	554.24 (18")	553.20 (18")	N 605,853.27 E 1,295,151.98	---	---	4' DIA. MANHOLE	G - 5.12
M-23	560.60	555.24 (15")	554.20 (18")	HERITAGE RIDGE ROAD	L.P. 1+04.17	6.5' L	4' DIA. MANHOLE	G - 5.12
M-24	560.70	555.24 (18")	555.24 (18")	N 606,053.11 E 1,294,121.33	---	---	4' DIA. MANHOLE	G - 5.12
M-25	576.00	566.24 (18")	566.24 (18")	HERITAGE RIDGE ROAD	0+20.00	02.7' L	4' DIA. MANHOLE	G - 5.12
S-8	552.00	550.80 (18")	---	N 606,111.11 E 1,294,681.11	---	---	FLARED END SECTION	***
S-9	548.00	541.00 (18")	---	N 606,111.11 E 1,295,021.11	---	---	FLARED END SECTION	***
S-10	550.00	543.00 (18")	---	N 606,039.07 E 1,295,101.07	---	---	FLARED END SECTION	***
S-11	554.00	553.00 (18")	---	N 606,111.11 E 1,294,261.11	---	---	FLARED END SECTION	***

***- A.D.S. FLARED END SECTION OR EQUAL

NOTE: TOP ELEVATION FOR THE COG/COS OPENING AND A-10 INLETS IS THE TOP OF CURB ELEVATION.

PIPE SCHEDULE

SIZE	CLASS	LENGTH
4"	PVC SCH. 40 (PERFORATED)	020'
6"	PVC SCH. 40 (SOLID)	798'
6"	PVC SCH. 40 (PERFORATED)	149'
15"	HOPE	139'
18"	HOPE	1,532'

APPROVED: DEPARTMENT OF PUBLIC WORKS


CHIEF, BUREAU OF HIGHWAYS *MK* 8/17/2020 DATE

APPROVED: DEPARTMENT OF PLANNING AND ZONING


CHIEF, DIVISION OF LAND DEVELOPMENT *11/2/20* DATE

CHIEF, DEVELOPMENT ENGINEERING DIVISION *8/28/20* DATE

REVISIONS		
NO.	DESCRIPTION	DATE

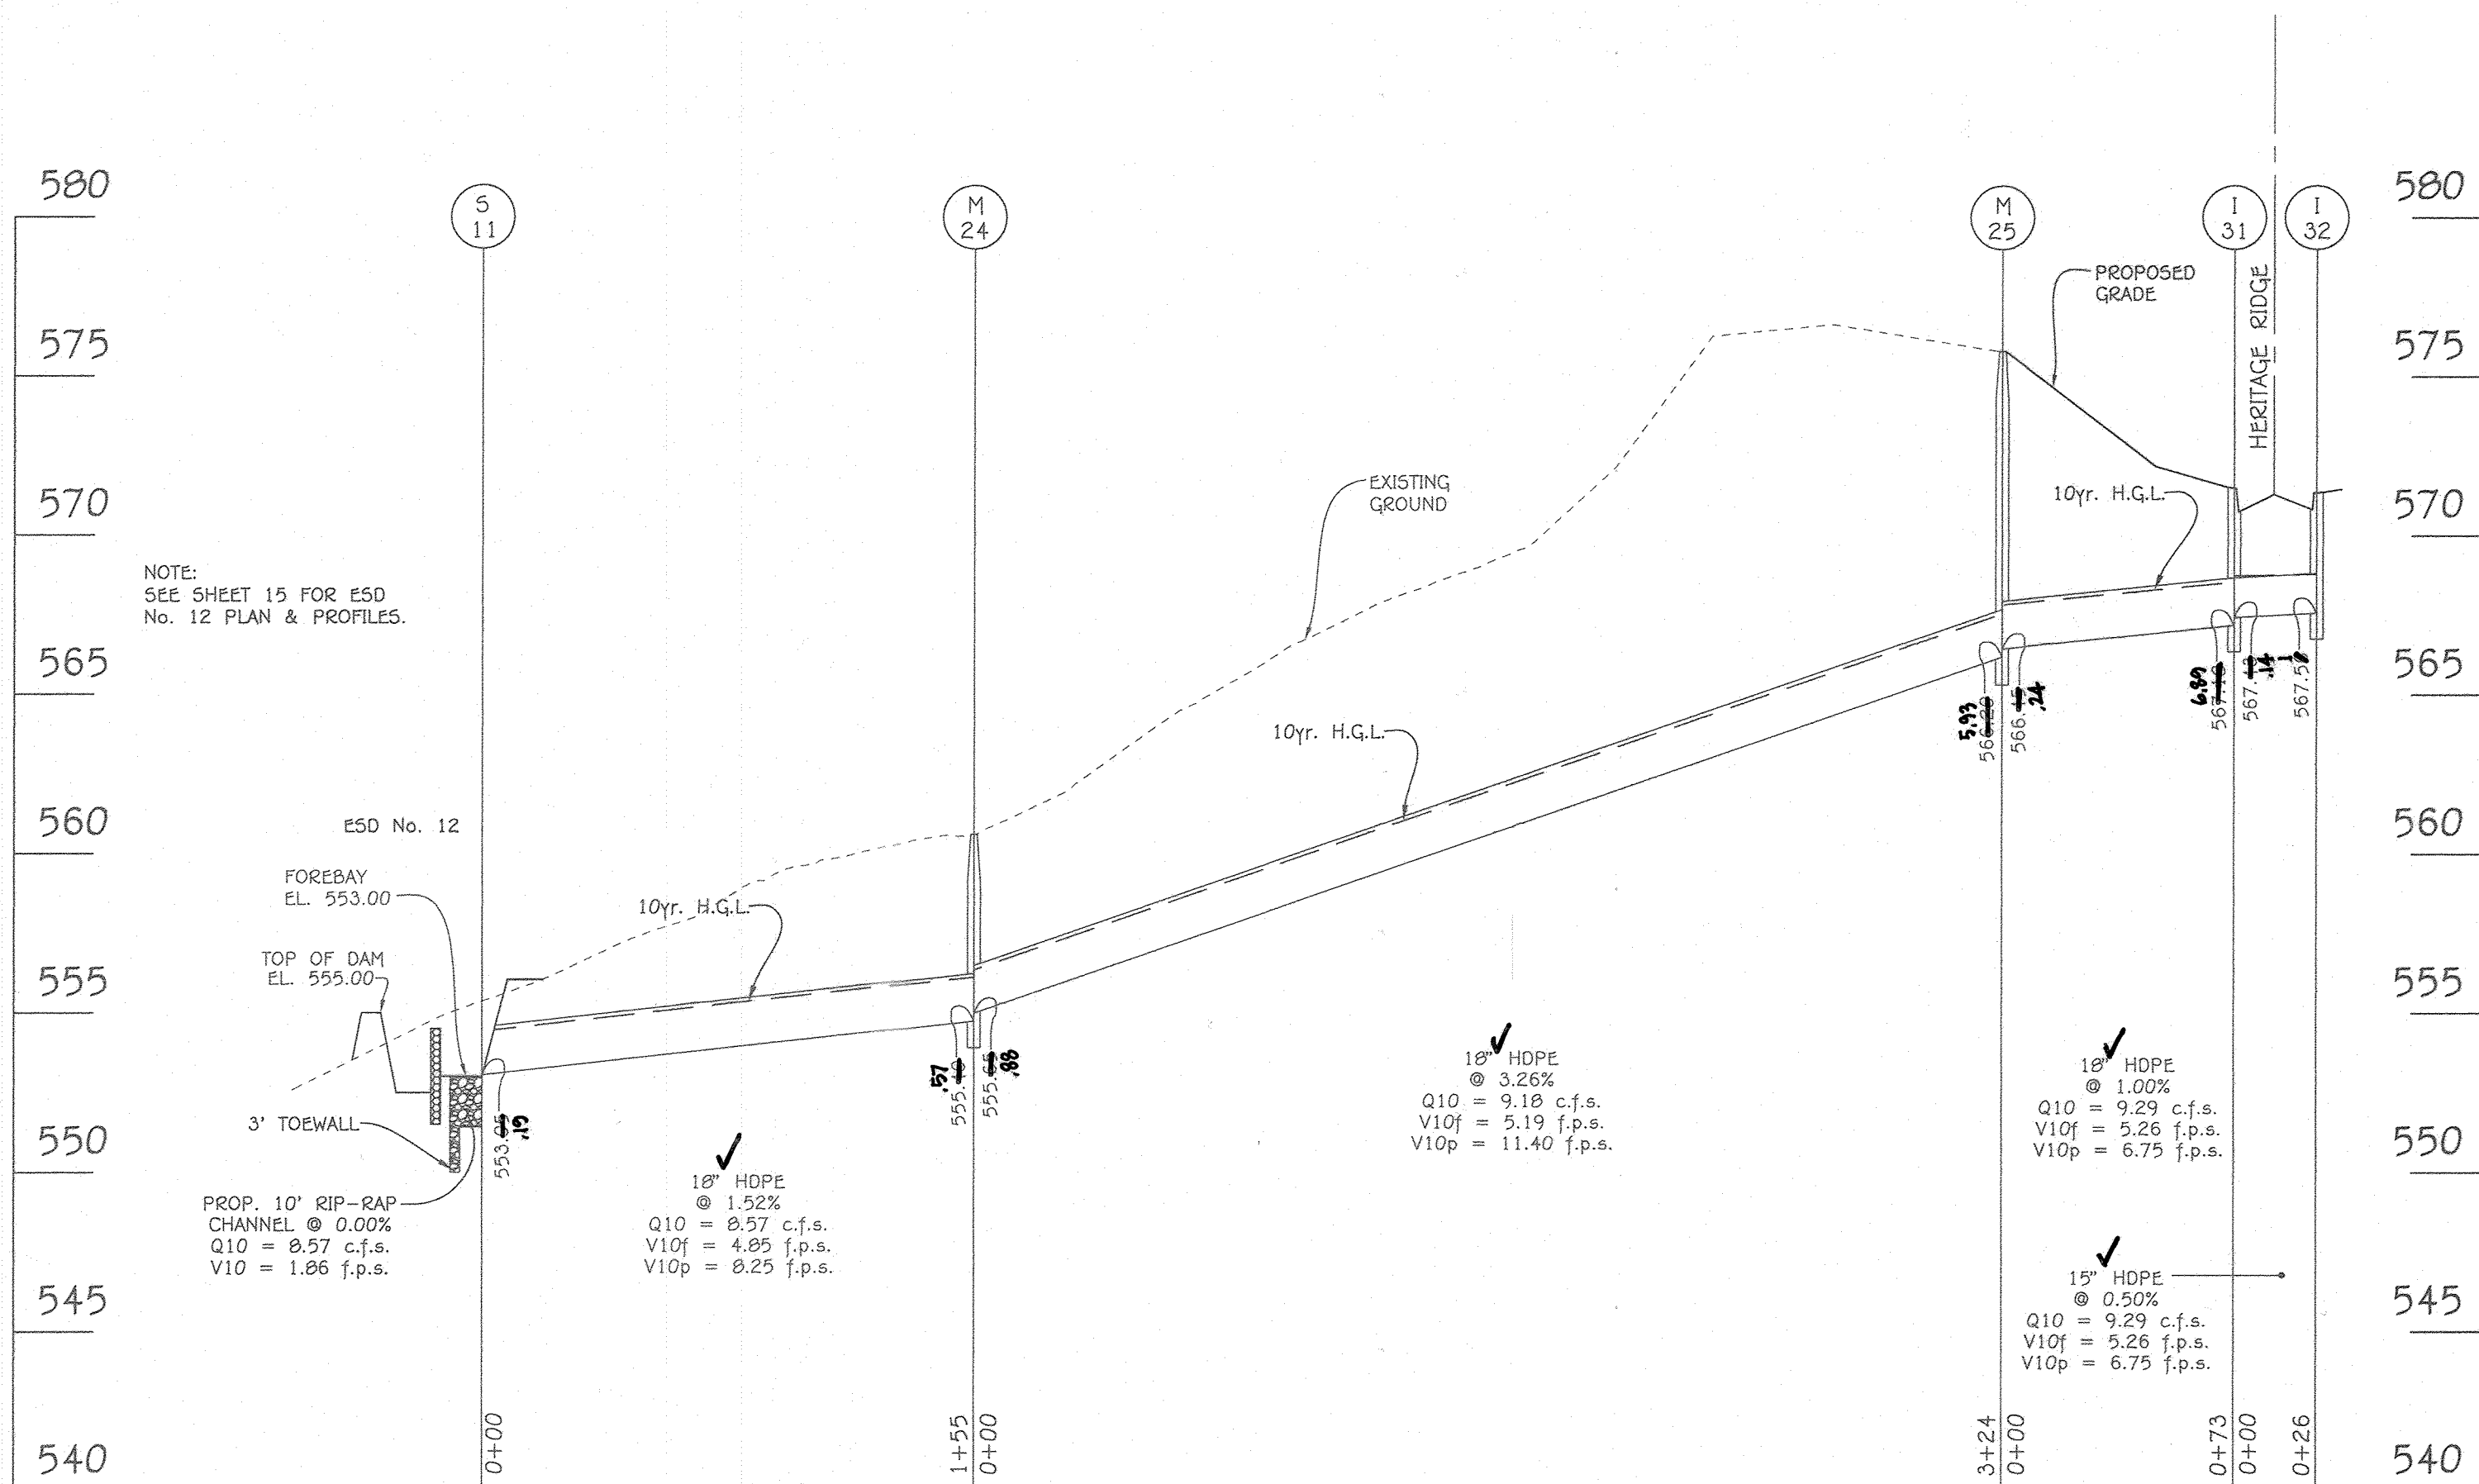


PROFILE
SCALE HORZ. 1"=50'
VERT. 1"=5'

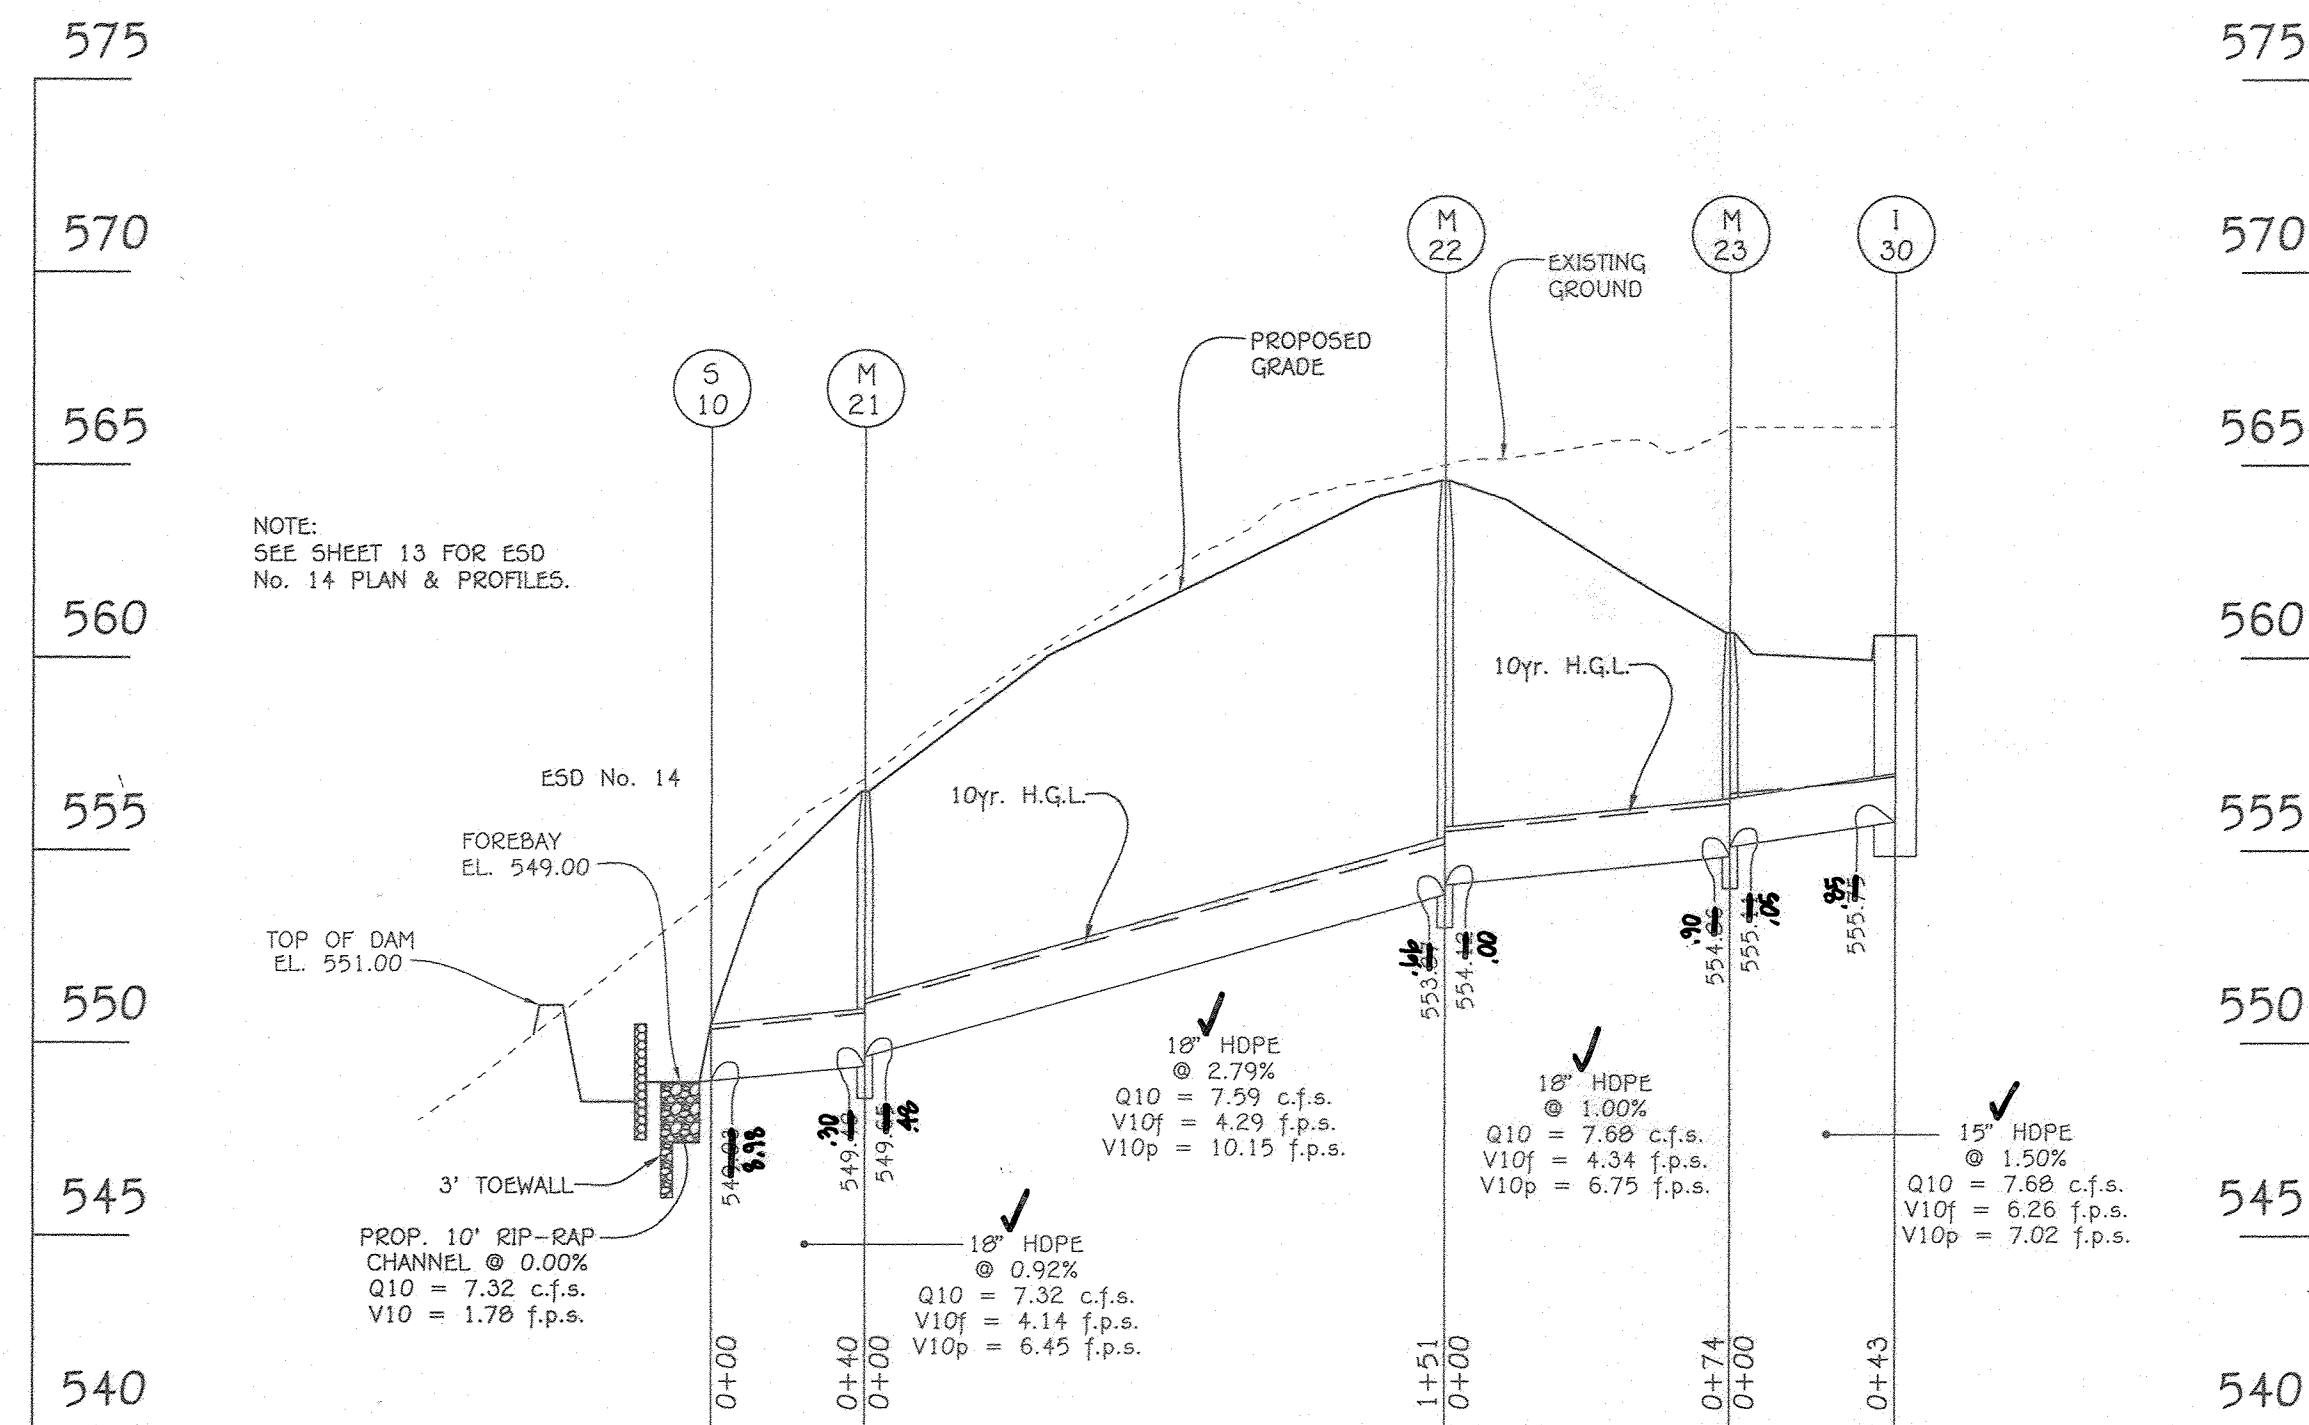

PROFILE
SCALE HORZ. 1"=50'
VERT. 1"=5'

AS-BUILT CERTIFICATION
I hereby certify that the information shown on the plan was constructed in accordance with the approved plans and specifications.

[Signature] 5/3/22
Date

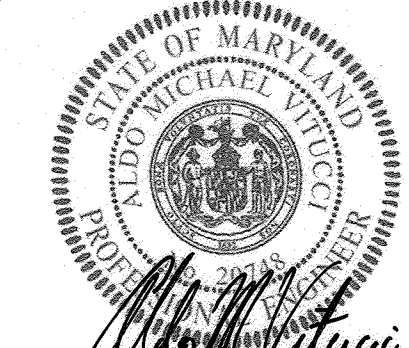

Aldo M. Vitucci, P.E.
"Professional Certification: I hereby certify that these documents were prepared or approved by me, and that I am a duly Licensed Professional Engineer under the laws of the State of Maryland, License No. 20748, Expiration Date 2-22-21."

STORM DRAIN PROFILES
LINDEN GROVE
PHASE TWO
LOTS 24 THRU 44

(A Resubdivision of Non-Buildable Bulk Parcels 'I' & 'G', Recorded As "Linden Grove, Phase One Lots 1 Thru 23, Buildable Preservation Parcel 'A', Non-Buildable Preservation Parcels 'B' Thru 'E' And Non-Buildable Bulk Parcels 'I' And 'G'", Plat Nos. 25064 Thru 25073.)


ZONED: RC-DEO
TAX MAP No. 8 GRID No. 7 PARCEL No. 5
4TH ELECTION DISTRICT HOWARD COUNTY, MARYLAND
DATE: JUNE 16, 2020
SHEET 19 OF 24

STONE/RIPRAP OUTLET SEDIMENT TRAP ST-II (F-18-092)		
TRAP NO.	STRAP NO.	4
DRAINAGE AREA - INITIAL	3.28 AC.	1.93 AC.
DRAINAGE AREA - INTERIM	---	---
DRAINAGE AREA - FINAL	4.34 AC.	2.52
TOTAL STORAGE REQUIRED	15,624 CF	9,072 CF
TOTAL STORAGE PROVIDED	31,899 CF	13,160 CF
WET STORAGE REQUIRED	7,812 CF	4,536 CF
WET STORAGE PROVIDED	7,812 CF	4,536 CF
DRY STORAGE REQUIRED	7,812 CF	4,536 CF
DRY STORAGE PROVIDED	7,812 CF	4,536 CF
EXISTING GROUND ELEVATION AT OUTLET	548.25	562.30
TRAP BOTTOM ELEVATION	548.00	562.00
TRAP TOP ELEVATION	66' x 40'	70' x 35'
WEIR LENGTH	22'	20'
WEIR CREST (DRY STORAGE) ELEVATION	548.30	563.55
CLEANOUT ELEVATION	547.00	562.75
TOP OF EMBANKMENT ELEVATION	552.00	566.00
SIDE SLOPE	2:1	2:1
EMBANKMENT TOP WIDTH	6.0'	6.0'
OUTLET PROTECTION - LENGTH	18'	30'
OUTLET PROTECTION - DEPTH	19'	19'

HOUSE CONSTRUCTION NOTES:


- THIS HOWARD (SCD) STANDARD SEDIMENT CONTROL PLAN MAY NOT BE USED TO OBTAIN PERMITS FOR HOUSE CONSTRUCTION FOR THIS PROJECT.
- HOUSES MAY NOT BE BUILT USING THIS DRAWING.

PROFESSIONAL CERTIFICATION: I HEREBY CERTIFY THAT THESE DOCUMENTS WERE PREPARED BY ME OR UNDER MY RESPONSIBLE CHARGE, AND THAT I AM A DULY LICENSED PROFESSIONAL LAND SURVEYOR UNDER THE LAWS OF MARYLAND, LICENSE NO. 21328, EXPIRATION DATE 10/23.

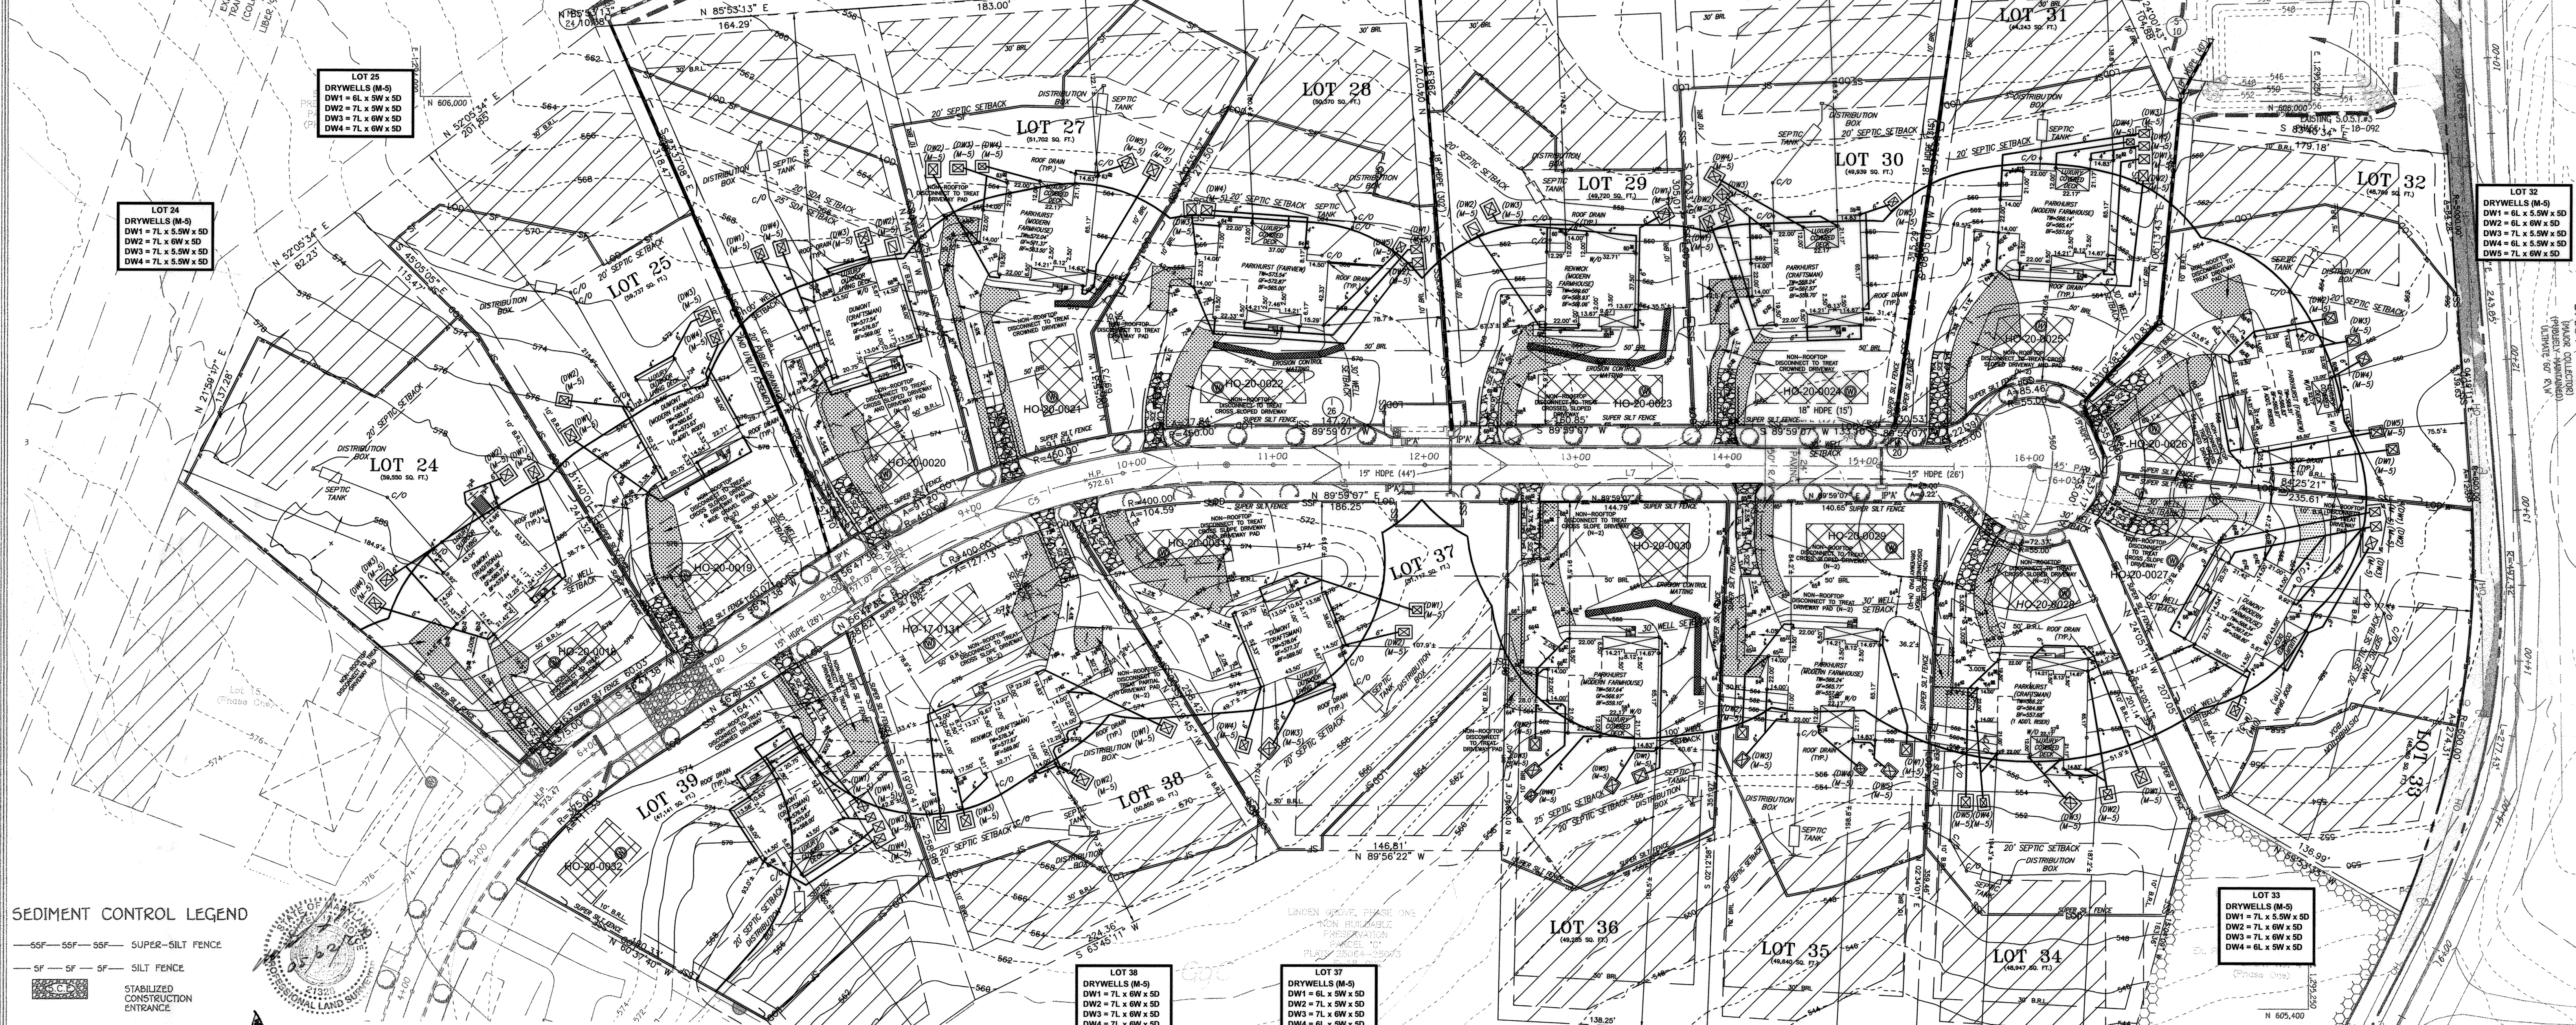

SEDIMENT CONTROL LEGEND

- SSP-SSP-SSP SUPER-SILT FENCE
- SF-SF-SF SILT FENCE
- STABILIZED CONSTRUCTION ENTRANCE
- S.I.P. (A) STANDARD INLET PROTECTION INLET TYPE 'A' or 'B'
- L.O.D. LIMIT OF DISTURBANCE
- FUTURE LIMIT OF DISTURBANCE FOR SEPTIC SYSTEM INSTALL.
- R.P.S. REMOVABLE PUMPING STATION
- F.B. FILTER BAG
- TYPE A-2 EARTH DIKE
- 12' DISCONNECTION OF NON ROOF-TOP RUNOFF CREDIT. (TYPE N-2)

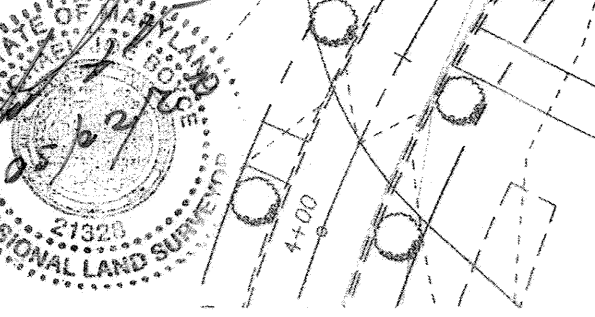

APPROVED: DEPARTMENT OF PLANNING AND ZONING

DATE: 03/22

APPROVED: HOWARD COUNTY DEPARTMENT OF PUBLIC WORKS

DATE: 6/5/22

APPROVED: HOWARD SOIL CONSERVATION DISTRICT

DATE: 06/09/2022

DATE: 06/21/22




PROFESSIONAL CERTIFICATION

DATE: 05/02/22

NO.	REVISIONS DESCRIPTION	DATE
1	LOTS 24 & 39 REVISIONS	07/15/2021
2	LOTS 27-30 REVISIONS	10/05/2021
3	LOT 33 REVISIONS	10/16/2021
4	LOTS 28 AND 30 REVISIONS	03/15/2022
5	LOTS 29 AND 33 REVISIONS	05/02/2022

CONTRACTOR NOTES:

- CONTRACTOR SHALL REMOVE ANY AND ALL JUNK, DEBRIS AND TRASH FROM WITHIN THE FLOODPLAIN, STREAMS, WETLANDS & THEIR BUFFERS.
- SHOULD THE STOCKPILE EXCEED 15 FT. IN HEIGHT IT MUST BE BENCHED.
- EARTH DIKES CROSSING THE ROADWAYS ARE TO BE CONNECTED TO MACADAM BERMS AT THE DIRECTION OF THE SEDIMENT CONTROL INSPECTOR.
- ANY ROADSIDE SWALE OR DITCH LOCATED IN FILL SHALL BE COMPACTED TO 95% COMPACTION TO AVOID EROSION IN THESE AREAS.

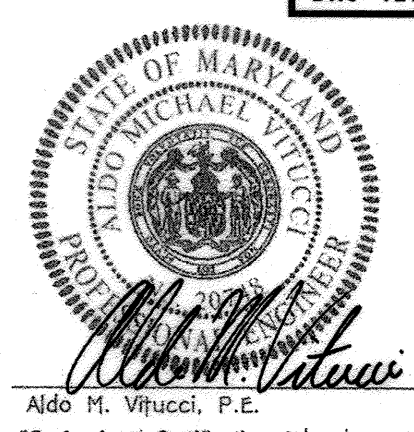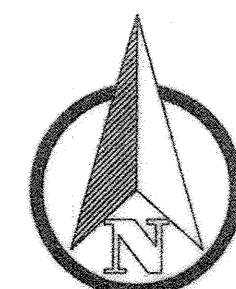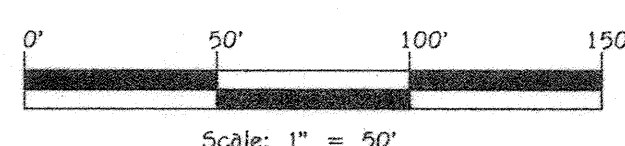

ROOFLEADER NOTE:

A OVERFLOW GUTTER (SURCHARGE) SHALL BE PROVIDED AT EACH DOWNSPOUT PRIOR TO CONNECTION TO THE UNDERGROUND ROOFLEADER. SEE DETAIL SHEET 1B.

NEW SHEET *REVISED*



GROWING & SEDIMENT CONTROL PLAN
LINDEN GROVE
 PHASE TWO
 LOTS 24 THRU 44

(A Resubdivision of Non-Buildable Bulk Parcels 'F' & 'G', Recorded As 'Linden Grove, Phase One Lots 1 Thru 23, Buildable Preservation Parcel 'A', Non-Buildable Preservation Parcels 'B' Thru 'E' And Non-Buildable Bulk Parcels 'F' And 'G', - Plat No. 25064 Thru 25073.)


TAX MAP NO. 8 ZONED: RC-250 PARCEL NO. 5
 4TH ELECTION DISTRICT HOWARD COUNTY, MARYLAND

DATE: 6/17/2022
 SHEET 24 OF 24
 SHEET 4 OF 24

APPROVED: DEPARTMENT OF PUBLIC WORKS		
<i>Chase</i>	8/17/2020	DATE
CHIEF, BUREAU OF HIGHWAYS MK		
APPROVED: DEPARTMENT OF PLANNING AND ZONING		
<i>[Signature]</i>	11/16/20	DATE
CHIEF, DIVISION OF LAND DEVELOPMENT		
<i>[Signature]</i>	8/28/20	DATE
CHIEF, DEVELOPMENT ENGINEERING DIVISION		
REVISIONS		
NO.	DESCRIPTION	DATE

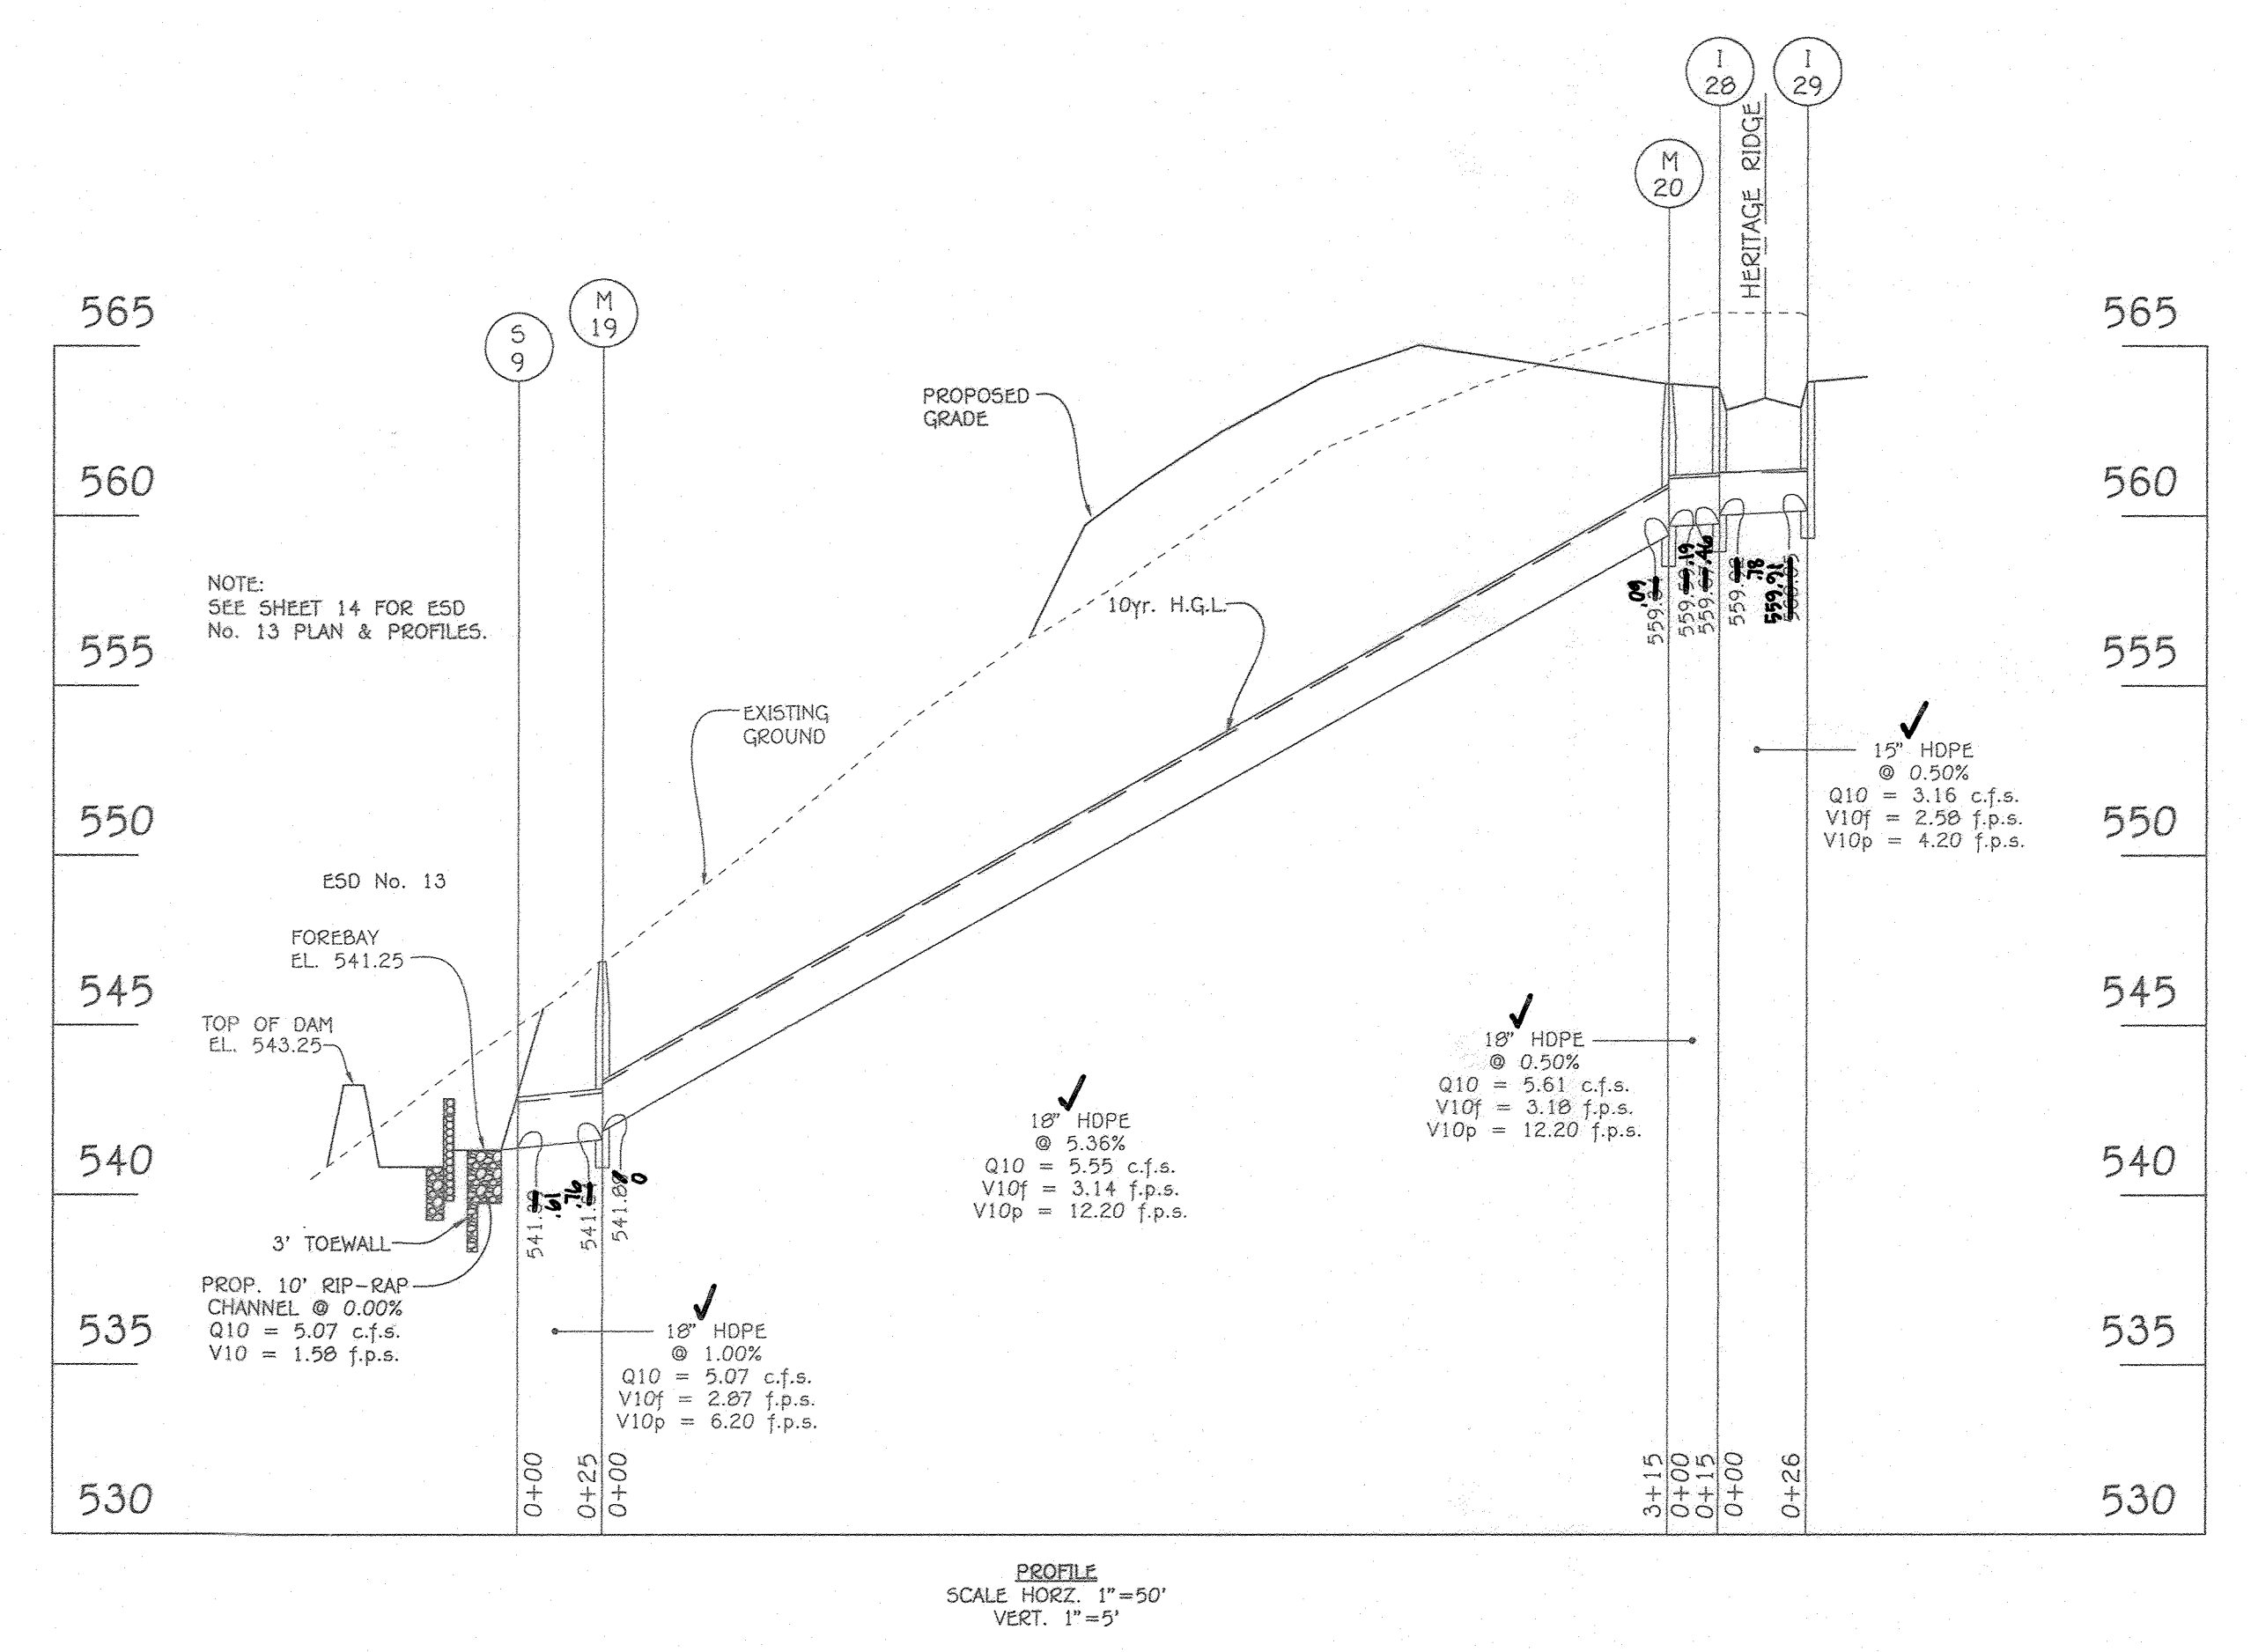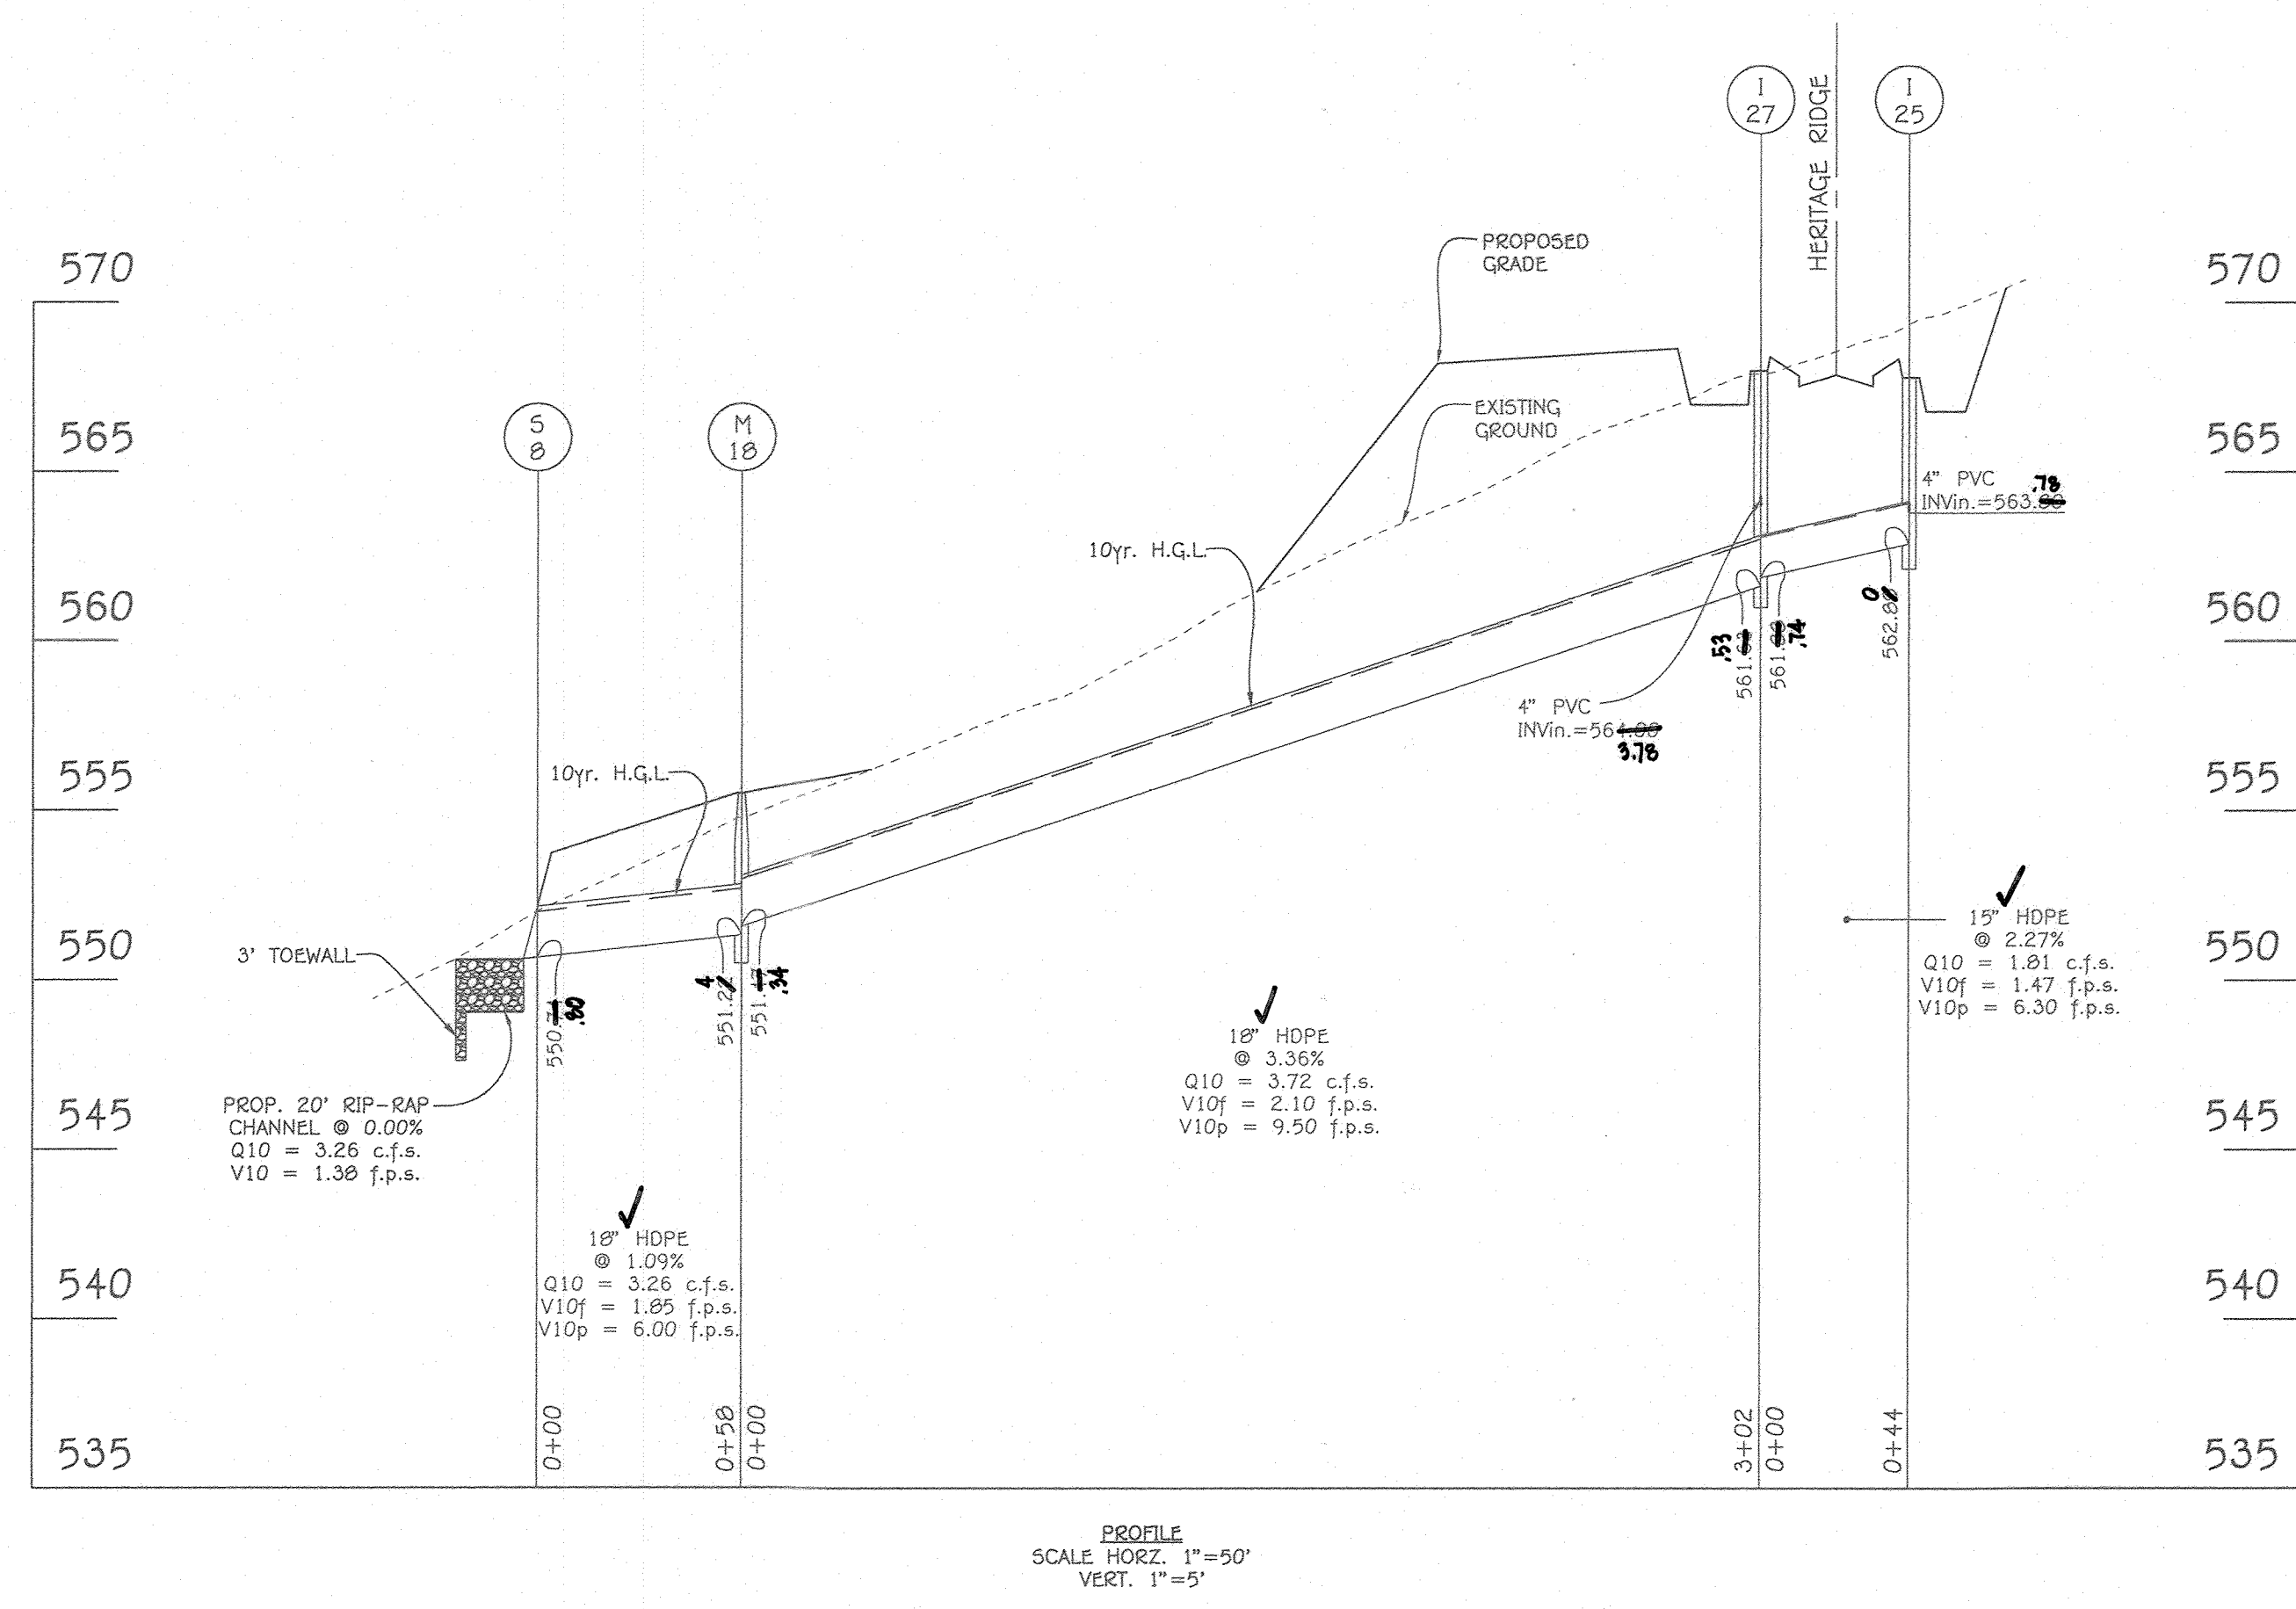

AGENCY CERTIFICATION
 I hereby certify that the information shown on the plan was constructed in accordance with the approved plans and specifications.
[Signature]
 Date: 5/31/22

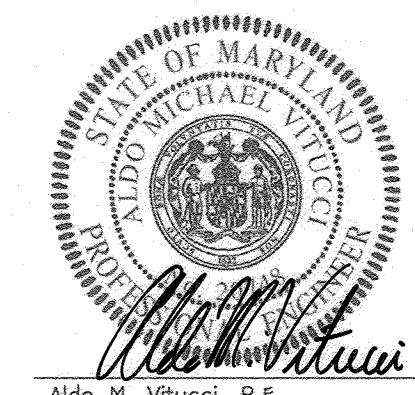


Aldo M. Vitucci, P.E.
 Date: 8/17/2020
 "Professional Certification: I hereby certify that these documents were prepared or approved by me, and that I am a duly Licensed Professional Engineer under the laws of the State of Maryland. License No. 20748. Expiration Date 2-22-21."

STORM DRAIN PROFILES
LINDEN GROVE
 PHASE TWO
 LOTS 24 THRU 44
 (A Resubdivision of Non-Buildable Bulk Parcels 'F' & 'G', Recorded As 'Linden Grove, Phase One Lots 1 Thru 23, Buildable Preservation Parcel 'A', Non-Buildable Preservation Parcels 'B' Thru 'I', And Non-Buildable Bulk Parcels 'F' And 'G', Plot Nos. 25064 Thru 25073.)
 ZONED: RC-DEO
 TAX MAP No. 8 GRID No. 7 PARCEL No. 5
 4TH ELECTION DISTRICT HOWARD COUNTY, MARYLAND
 DATE: JUNE 16, 2020
 SHEET 20 of 24





FISHER, COLLINS & CARTER, INC.
 CIVIL ENGINEERING CONSULTANTS & LAND SURVEYORS
 CENTENNIAL SQUARE OFFICE PARK - 10272 BALTIMORE NATIONAL PIKE
 ELICOTT CITY, MARYLAND 21042
 410) 461 - 2929

OWNER:
 KIMBERTHY/HERITAGE LLC
 3425 HIPSLEY MILL ROAD
 WOODBINE, MARYLAND 21797-7615
 410-489-7900

DEVELOPER:
 HERITAGE LAND DEVELOPMENT
 15950 NORTH AVENUE
 LISBON, MARYLAND 21765
 410-489-7900

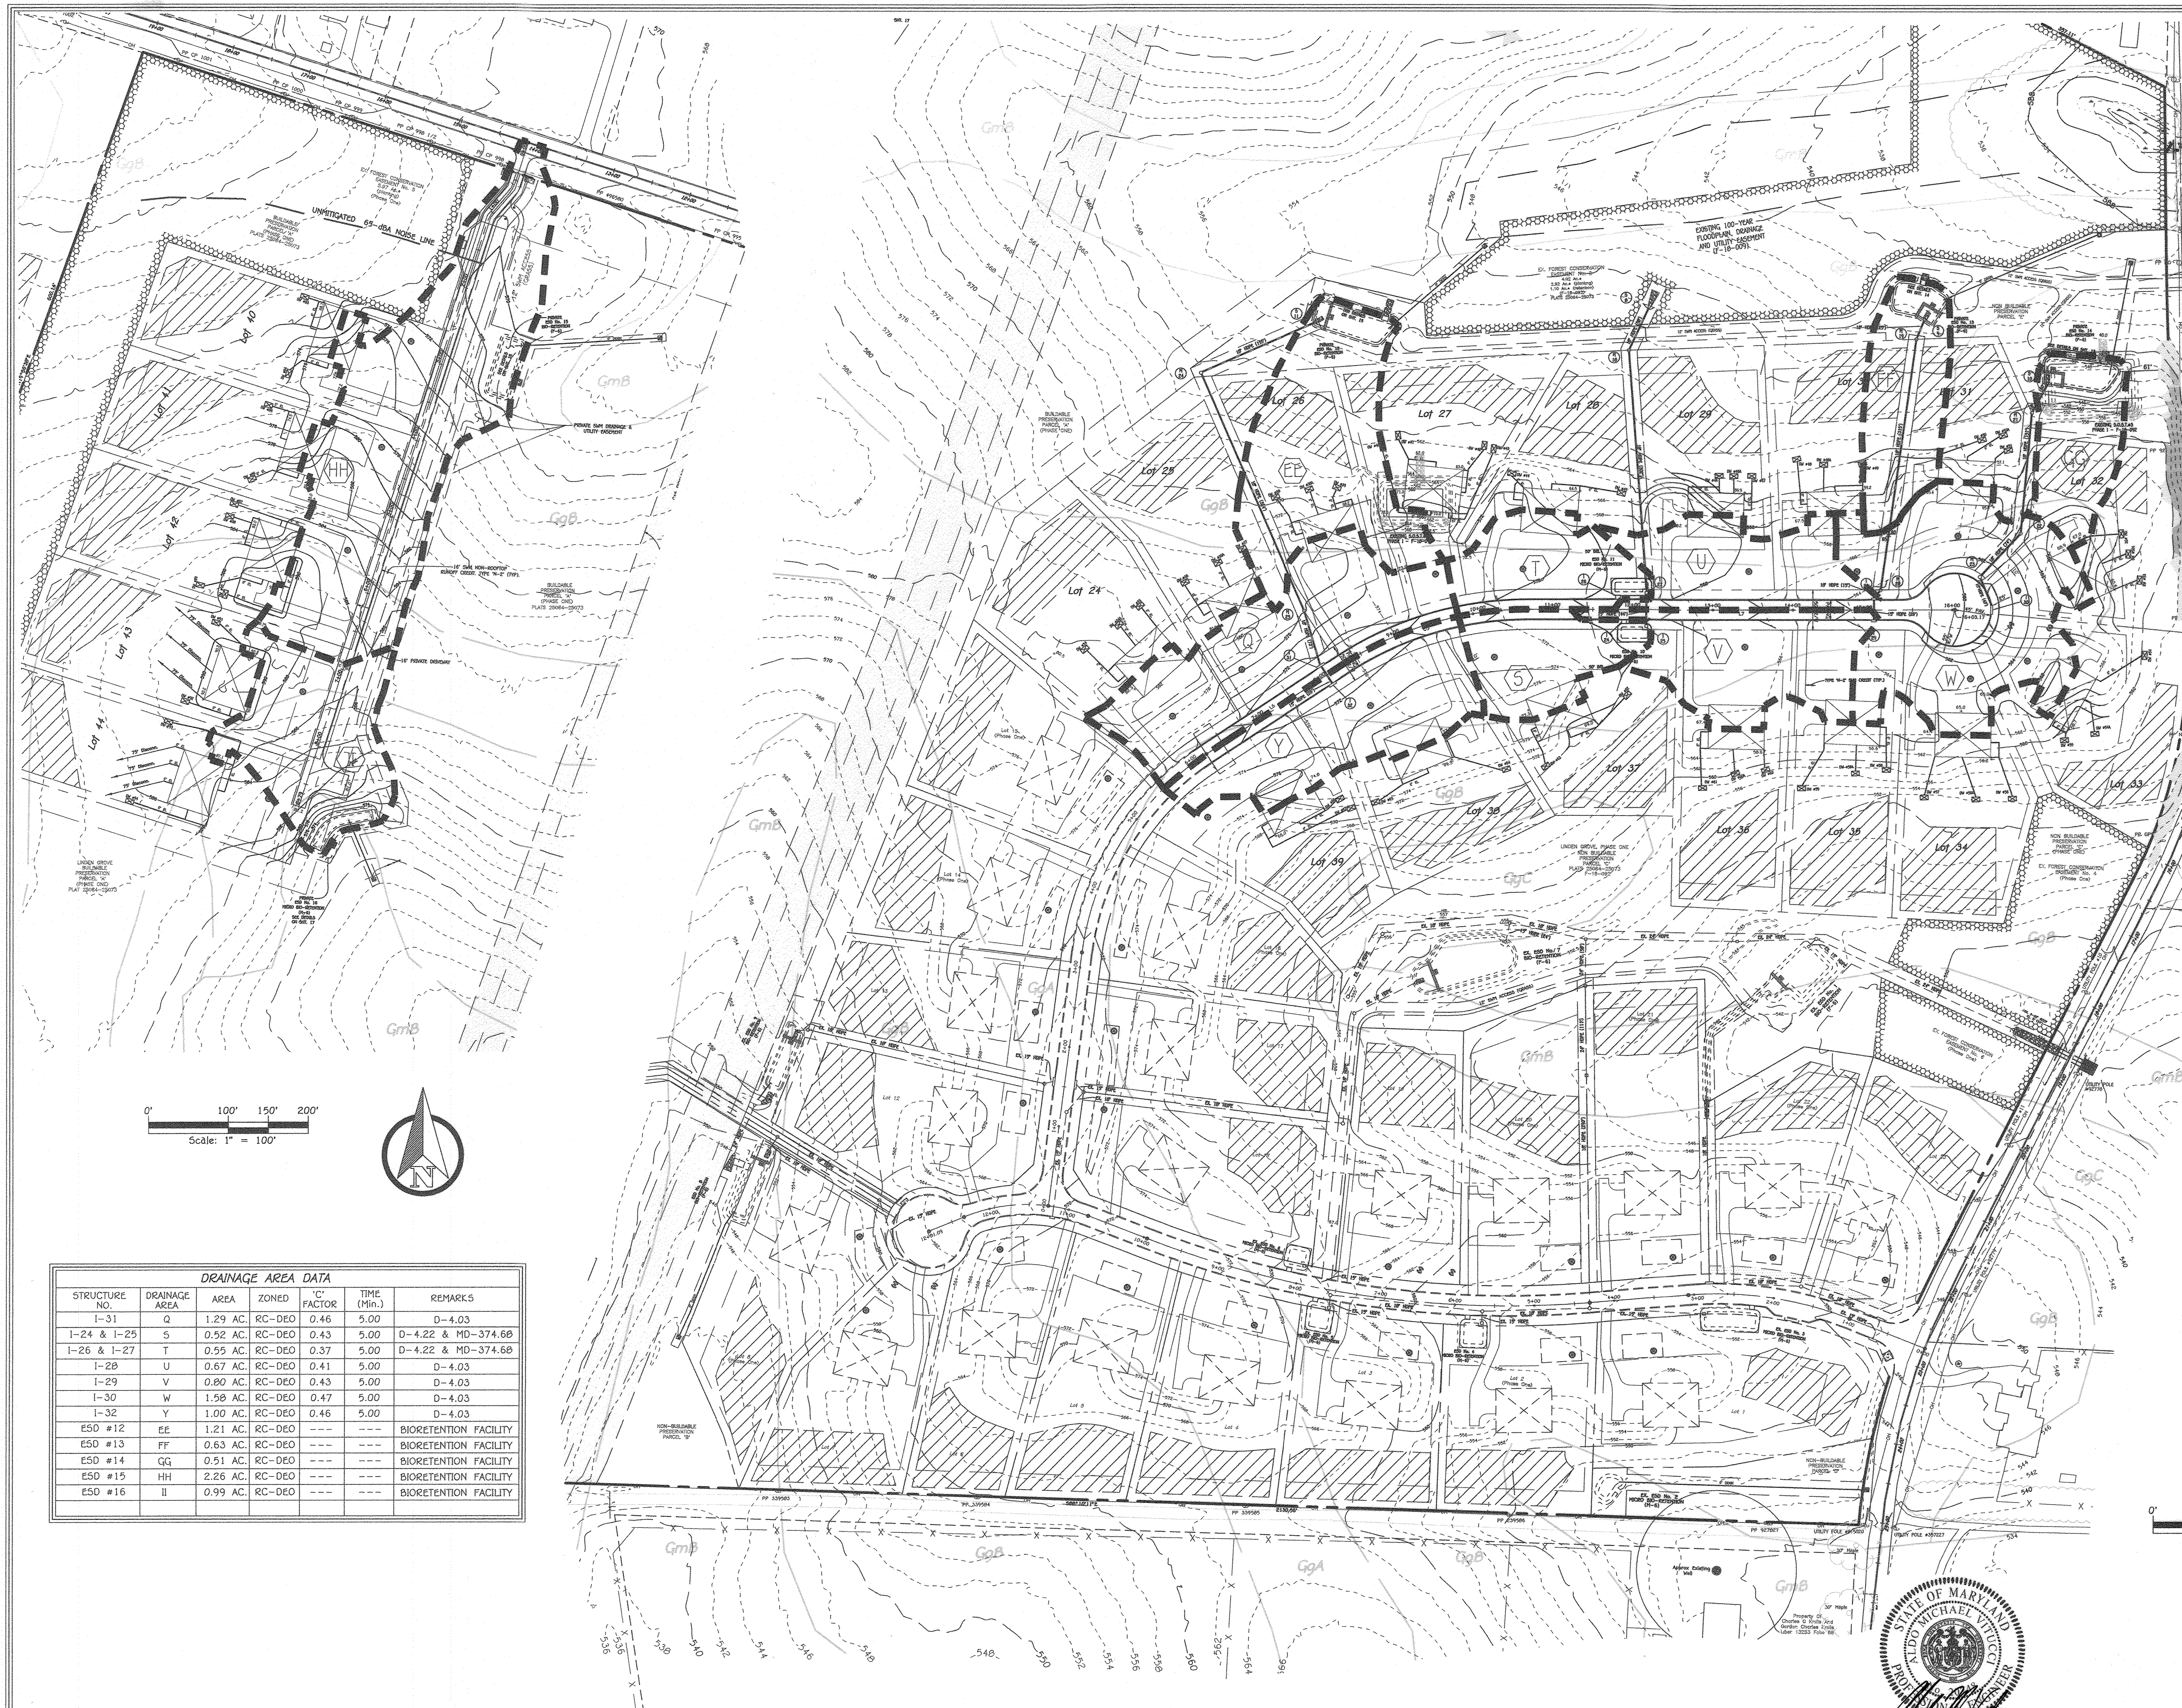

APPROVED: DEPARTMENT OF PUBLIC WORKS		
<i>[Signature]</i>	10/19/2020	DATE
CHIEF, BUREAU OF HIGHWAYS MK		
APPROVED: DEPARTMENT OF PLANNING AND ZONING		
<i>[Signature]</i>	10/22/20	DATE
CHIEF, DIVISION OF LAND DEVELOPMENT		
<i>[Signature]</i>	10/22/20	DATE
CHIEF, DEVELOPMENT ENGINEERING DIVISION		
REVISIONS		
NO.	DESCRIPTION	DATE

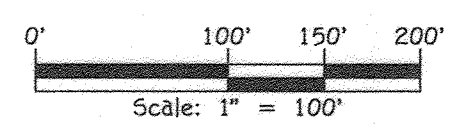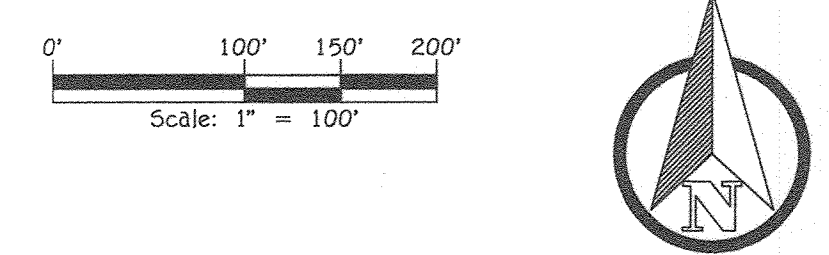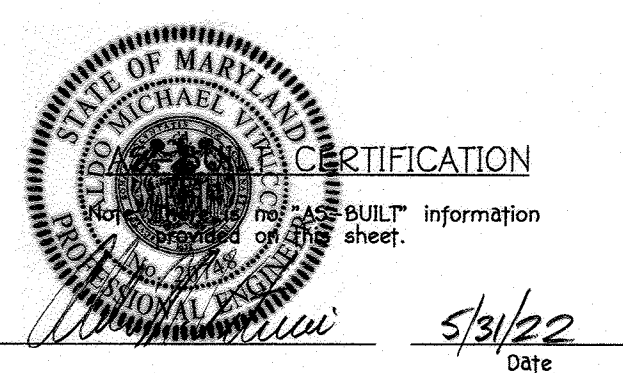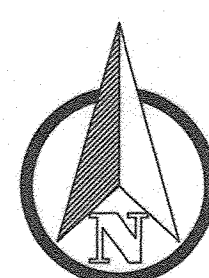

DRAINAGE AREA DATA						
STRUCTURE NO.	DRAINAGE AREA	AREA	ZONED	C FACTOR	TIME (Min.)	REMARKS
I-31	Q	1.29 AC.	RC-DEO	0.46	5.00	D-4.03
I-24 & I-25	S	0.52 AC.	RC-DEO	0.43	5.00	D-4.22 & MD-374.68
I-26 & I-27	T	0.55 AC.	RC-DEO	0.37	5.00	D-4.22 & MD-374.68
I-28	U	0.67 AC.	RC-DEO	0.41	5.00	D-4.03
I-29	V	0.80 AC.	RC-DEO	0.43	5.00	D-4.03
I-30	W	1.58 AC.	RC-DEO	0.47	5.00	D-4.03
I-32	Y	1.00 AC.	RC-DEO	0.46	5.00	D-4.03
ESD #12	EE	1.21 AC.	RC-DEO	---	---	BIORETENTION FACILITY
ESD #13	FF	0.63 AC.	RC-DEO	---	---	BIORETENTION FACILITY
ESD #14	GG	0.51 AC.	RC-DEO	---	---	BIORETENTION FACILITY
ESD #15	HH	2.26 AC.	RC-DEO	---	---	BIORETENTION FACILITY
ESD #16	II	0.99 AC.	RC-DEO	---	---	BIORETENTION FACILITY


SOILS LEGEND			
SOIL	NAME	CLASS	Kw
BrD	Brinklow channery loam, 15 to 25 percent slopes	B	.20
GgA	Glenelg loam, 0 to 3 percent slopes	B	.20
GgB	Glenelg loam, 3 to 8 percent slopes	B	.20
GgC	Glenelg loam, 8 to 15 percent slopes	B	.20
GmA	Glenville silt loam, 0 to 3 percent slopes	C	.37
GmB	Glenville silt loam, 3 to 8 percent slopes	C	***.37
GmC	Glenville-Baile silt loams, 0 to 8 percent slopes	C	***.37
MAc	Manor loam, 8 to 15 percent slopes	B	.24

- NOTES:
- * Hydric soils and/or contains hydric inclusions
 - ** May contain hydric inclusions
 - † Generally only within 100-year floodplain areas
 - *** Denotes Erodible Soils

FISHER, COLLINS & CARTER, INC.
 CIVIL ENGINEERING CONSULTANTS & LAND SURVEYORS
 CONFEDERATE SQUARE OFFICE PARK - 10272 BALTIMORE NATIONAL PIKE
 ELLESDITH CITY, MARYLAND 21042
 (410) 461-2999

OWNER:
 KIMBERLY/HERITAGE LLC
 3425 HIPSLEY MILL ROAD
 WOODBINE, MARYLAND 21797-7615
 410-489-7900

DEVELOPER:
 HERITAGE LAND DEVELOPMENT
 15950 NORTH AVENUE
 LISBON, MARYLAND 21765
 410-489-7900

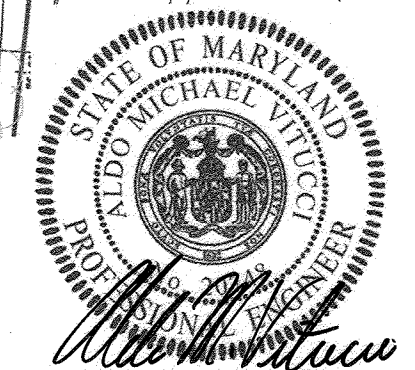


Aldo M. Vitucci, P.E.
 Date: 10/19/2020
 "Professional Certification: I hereby certify that these documents were prepared or approved by me, and that I am a duly Licensed Professional Engineer under the laws of the State of Maryland, License No. 20748, Expiration Date 2-22-21."

STORM DRAIN DRAINAGE AREA MAP & SOILS MAP
LINDEN GROVE
 PHASE TWO
 LOTS 24 THRU 44
 (A Resubdivision of Non-Buildable Bulk Parcels 'T' & 'C', Recorded As "Linden Grove, Phase One Lots 1 Thru 23, Buildable Preservation Parcel 'A', Non-Buildable Preservation Parcels 'B' Thru 'E', And Non-Buildable Bulk Parcels 'F' And 'G', Plot Nos. 25064 Thru 25073.)
 ZONED: RC-DEO
 TAX MAP No. 8 GRID No. 7 PARCEL No. 5
 4TH ELECTION DISTRICT HOWARD COUNTY, MARYLAND
 DATE: JUNE 18, 2020
 SHEET 21 of 24

THERE IS NO "AS-BUILT" INFORMATION PROVIDED ON THIS SHEET F-20-019





Approved: Department Of Planning And Zoning
 Chief, Division Of Land Development
 Chief, Development Engineering Division
 Approved: Howard County Department Of Public Works
 Chief, Bureau Of Highways
 11/2/20
 8/28/20
 8/17/2020

NO.	REVISIONS DESCRIPTION	DATE

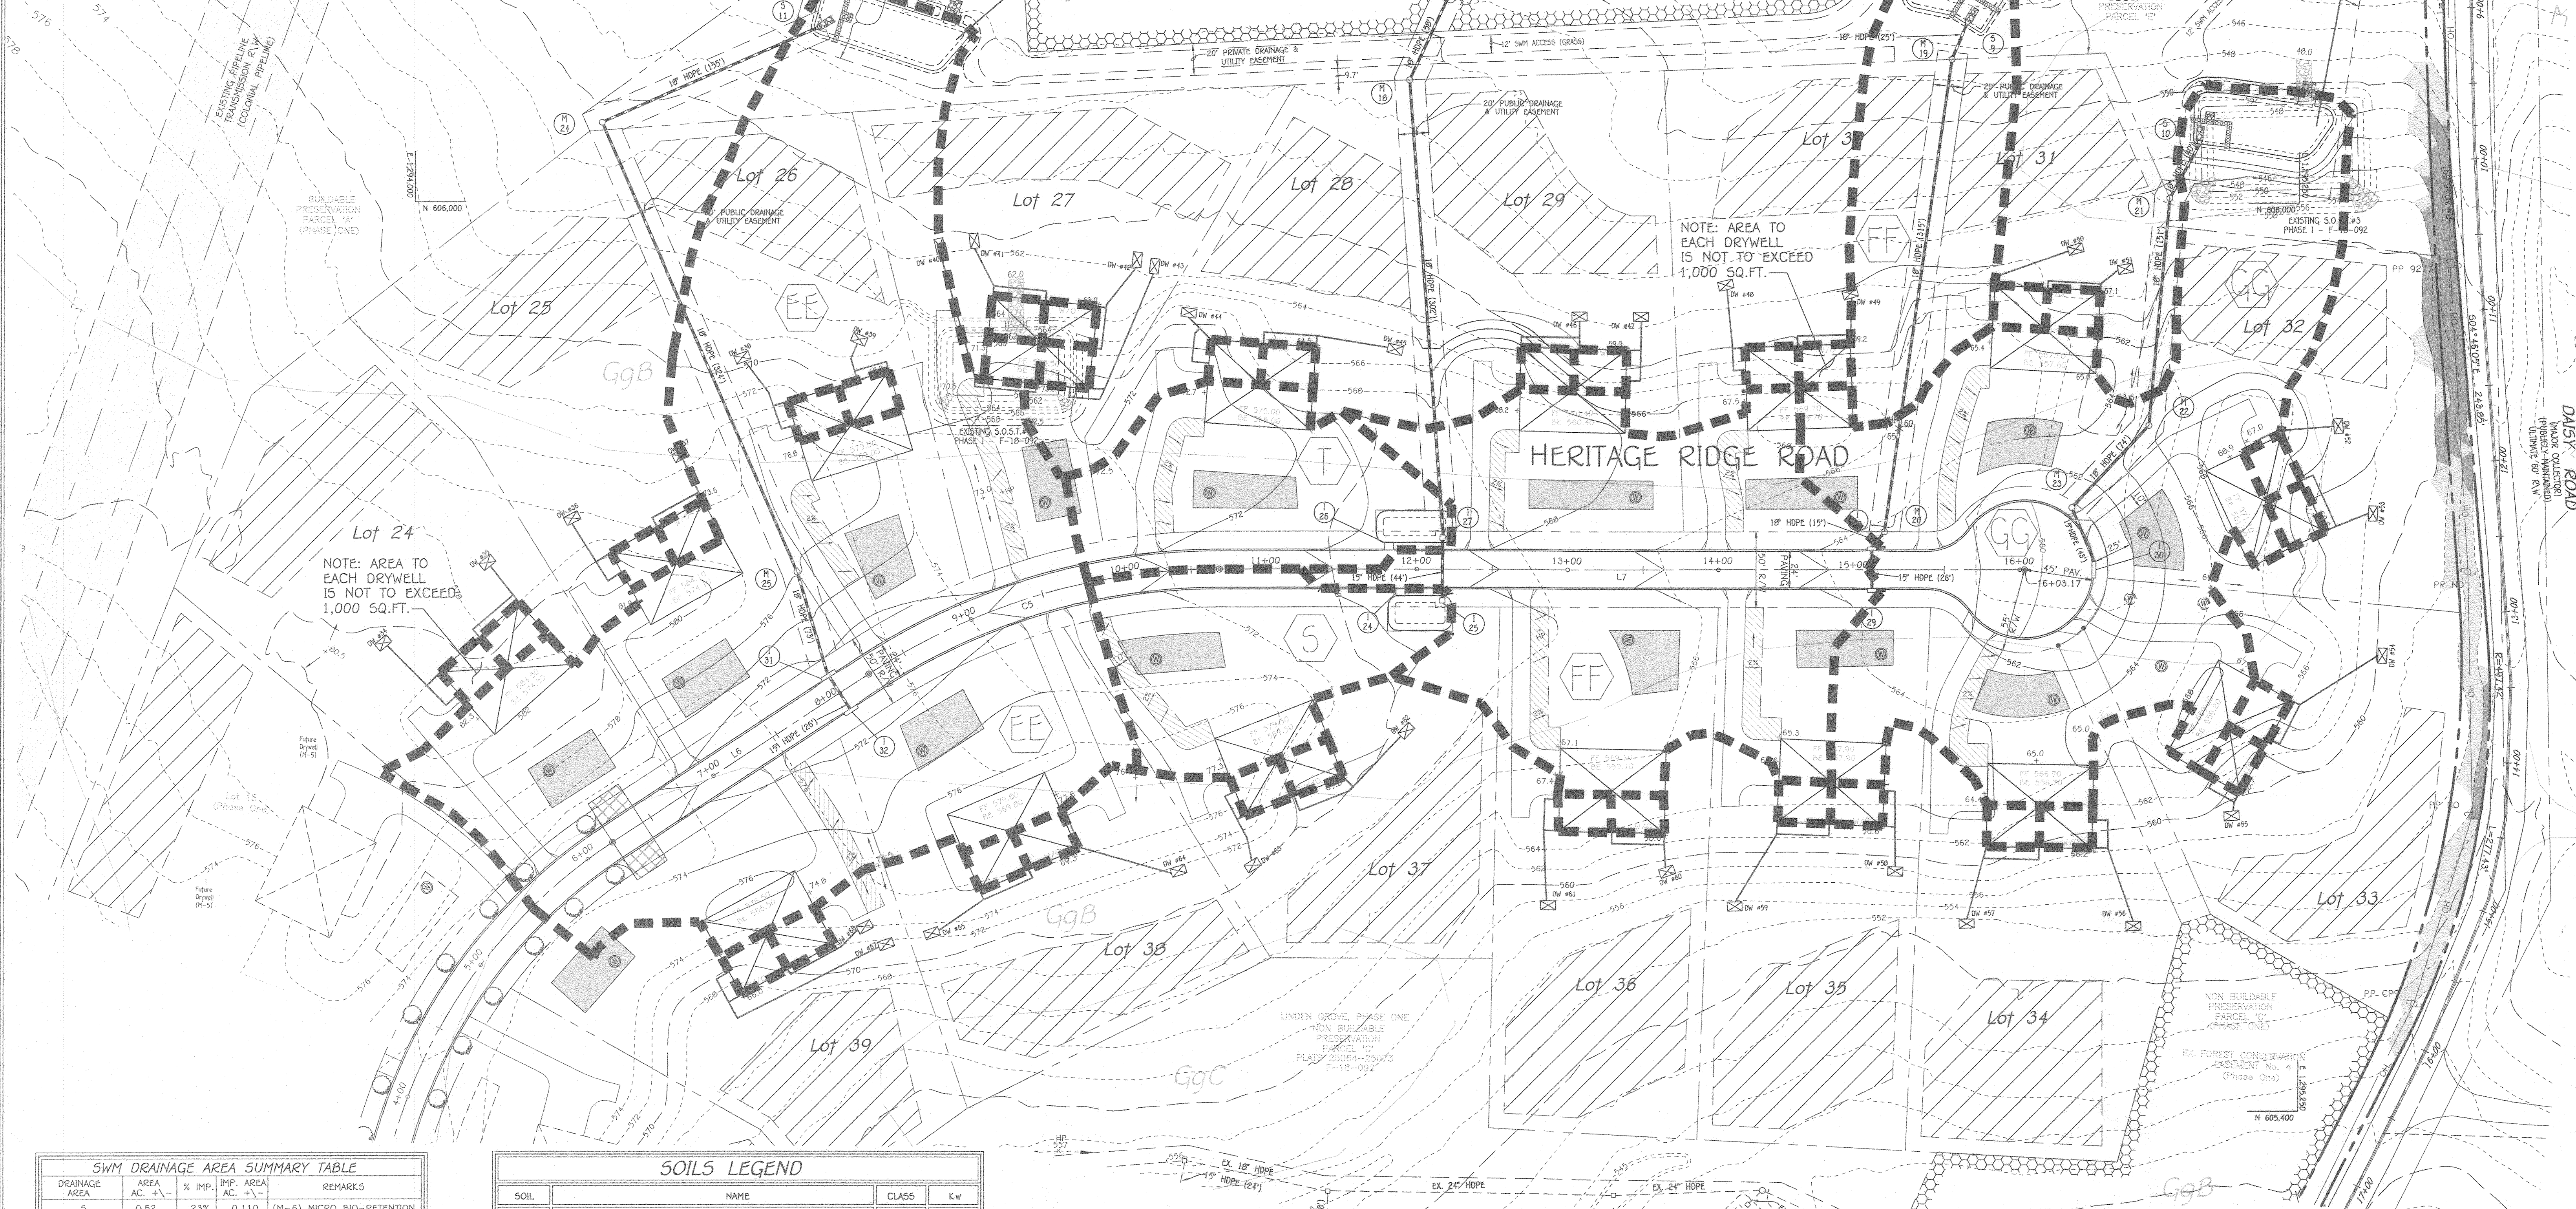

DRAINAGE AREA	AREA AC. +/-	% IMP.	IMP. AREA AC. +/-	REMARKS
S	0.52	23%	0.110	(M-6) MICRO BIO-RETENTION
T	0.55	26%	0.140	(M-6) MICRO BIO-RETENTION
EE	1.22	22%	0.217	(F-6) BIO-RETENTION
FF	0.63	20%	0.200	(F-6) BIO-RETENTION
GG	0.51	27%	0.273	(F-6) BIO-RETENTION
HH	2.34	20%	0.460	(F-6) BIO-RETENTION
II	1.17	20%	0.190	(M-6) MICRO BIO-RETENTION

SOIL	NAME	CLASS	Kw
BrD	Brinklow channery loam, 15 to 25 percent slopes	B	.20
GgA	Glenelg loam, 0 to 3 percent slopes	B	.20
GgB	Glenelg loam, 3 to 8 percent slopes	B	.20
GgC	Glenelg loam, 8 to 15 percent slopes	B	.20
GmA	Glenville silt loam, 0 to 3 percent slopes	C	.37
GmB	Glenville silt loam, 3 to 8 percent slopes	C	.37
GmC	Glenville-Baile silt loams, 0 to 8 percent slopes	C	.37
MaC	Manor loam, 8 to 15 percent slopes	B	.24

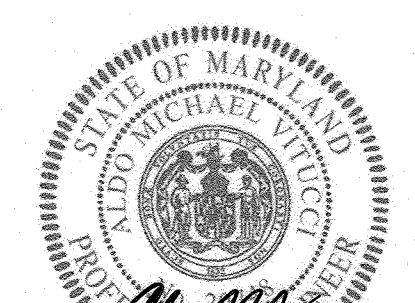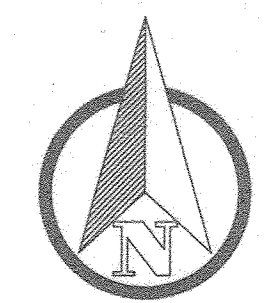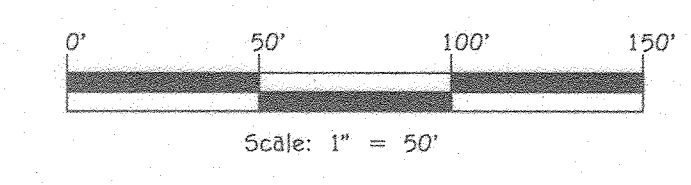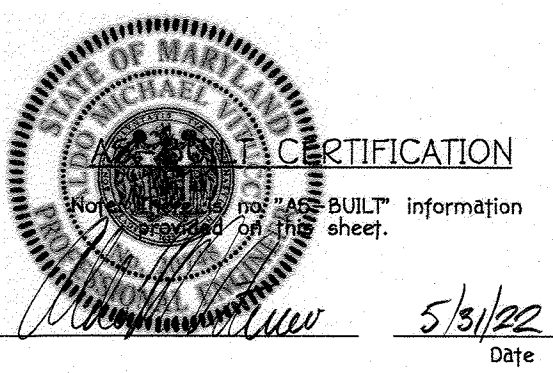

FISHER, COLLINS & CARTER, INC.
 CIVIL ENGINEERING CONSULTANTS & LAND SURVEYORS
 CENTRAL SOURCE OFFICE PARK - 10272 BALTIMORE NATIONAL PIKE
 ELICOTT CITY, MARYLAND 21042
 (410) 461-2895

NOTES:
 * Hydric soils and/or contains hydric inclusions
 ** May contain hydric inclusions
 † Generally only within 100-year floodplain areas
 *** Denotes Erodible Soils

OWNER:
 KIMBERLY/HERITAGE LLC
 3425 HIPSLEY HILL ROAD
 WOODBINE, MARYLAND 21797-7615
 410-489-7900

DEVELOPER:
 HERITAGE LAND DEVELOPMENT
 15950 NORTH AVENUE
 LISBON, MARYLAND 21765
 410-489-7900

Professional Certification: I hereby certify that these documents were prepared or approved by me, and that I am a duly Licensed Professional Engineer under the laws of the State of Maryland, License No. 20746, Expiration Date 2-22-21.

SWM DRAINAGE AREA MAP
 LINDEN GROVE
 PHASE TWO
 LOTS 24 THRU 44
 (A Resubdivision of Non-Buildable Bulk Parcels "F" & "G", Recorded As "Linden Grove, Phase One Lots 1 Thru 23, Buildable Preservation Parcel "A", Non-Buildable Preservation Parcels "B" Thru "E", And Non-Buildable Bulk Parcels "F" And "G"; Plot Nos. 25064 Thru 25073.)
 ZONED: RC-DEO
 TAX MAP No. 8 GRID No. 7 PARCEL No. 5
 4TH ELECTION DISTRICT HOWARD COUNTY, MARYLAND
 DATE: JANUARY 22, 2020
 SHEET 22 of 24


STONE/RIPRAP OUTLET SEDIMENT TRAP ST-II (F-18-092) TRAP NO. 3/ TRAP NO. 4

DRAINAGE AREA - INITIAL	3.28 AC.	1.93 AC.
DRAINAGE AREA - FINAL	4.34 AC.	2.92
TOTAL STORAGE REQUIRED	15,624 CF	9,072 CF
TOTAL STORAGE PROVIDED	31,699 CF	13,460 CF
WET STORAGE REQUIRED	7,812 CF	4,536 CF
WET STORAGE PROVIDED	7,812 CF	4,536 CF
DRY STORAGE REQUIRED	9,583 CF	4,792 CF
DRY STORAGE PROVIDED	9,583 CF	4,792 CF
EXISTING GROUND ELEVATION AT OUTLET (WET STORAGE ELEVATION)	548.25	562.30
TRAP BOTTOM ELEVATION	546.00	562.00
TRAP BOTTOM DIMENSIONS	80' x 40'	70' x 35'
WEIR LENGTH	22'	20'
WEIR CREST (DRY STORAGE) ELEVATION	546.00	563.55
CLEANOUT ELEVATION	547.00	562.75
TOP OF EMBANKMENT ELEVATION	552.00	566.00
SIDE SLOPE	2:1	2:1
EMBANKMENT TOP WIDTH	6.0'	6.0'
OUTLET PROTECTION - LENGTH	18'	30'
OUTLET PROTECTION - DEPTH	19'	19'

HOUSE CONSTRUCTION NOTES:

- THIS HOWARD (SCD) STANDARD SEDIMENT CONTROL PLAN MAY NOT BE USED TO OBTAIN PERMITS FOR HOUSE CONSTRUCTION FOR THIS PROJECT.
- HOUSES MAY NOT BE BUILT USING THIS DRAWING.

PROFESSIONAL CERTIFICATION: I HEREBY CERTIFY THAT THESE DOCUMENTS WERE PREPARED BY ME OR UNDER MY RESPONSIBLE CHARGE, AND THAT I AM A DULY LICENSED PROFESSIONAL LAND SURVEYOR UNDER THE LAWS OF MARYLAND, LICENSE NO. 21328, EXPIRATION DATE 10/23.

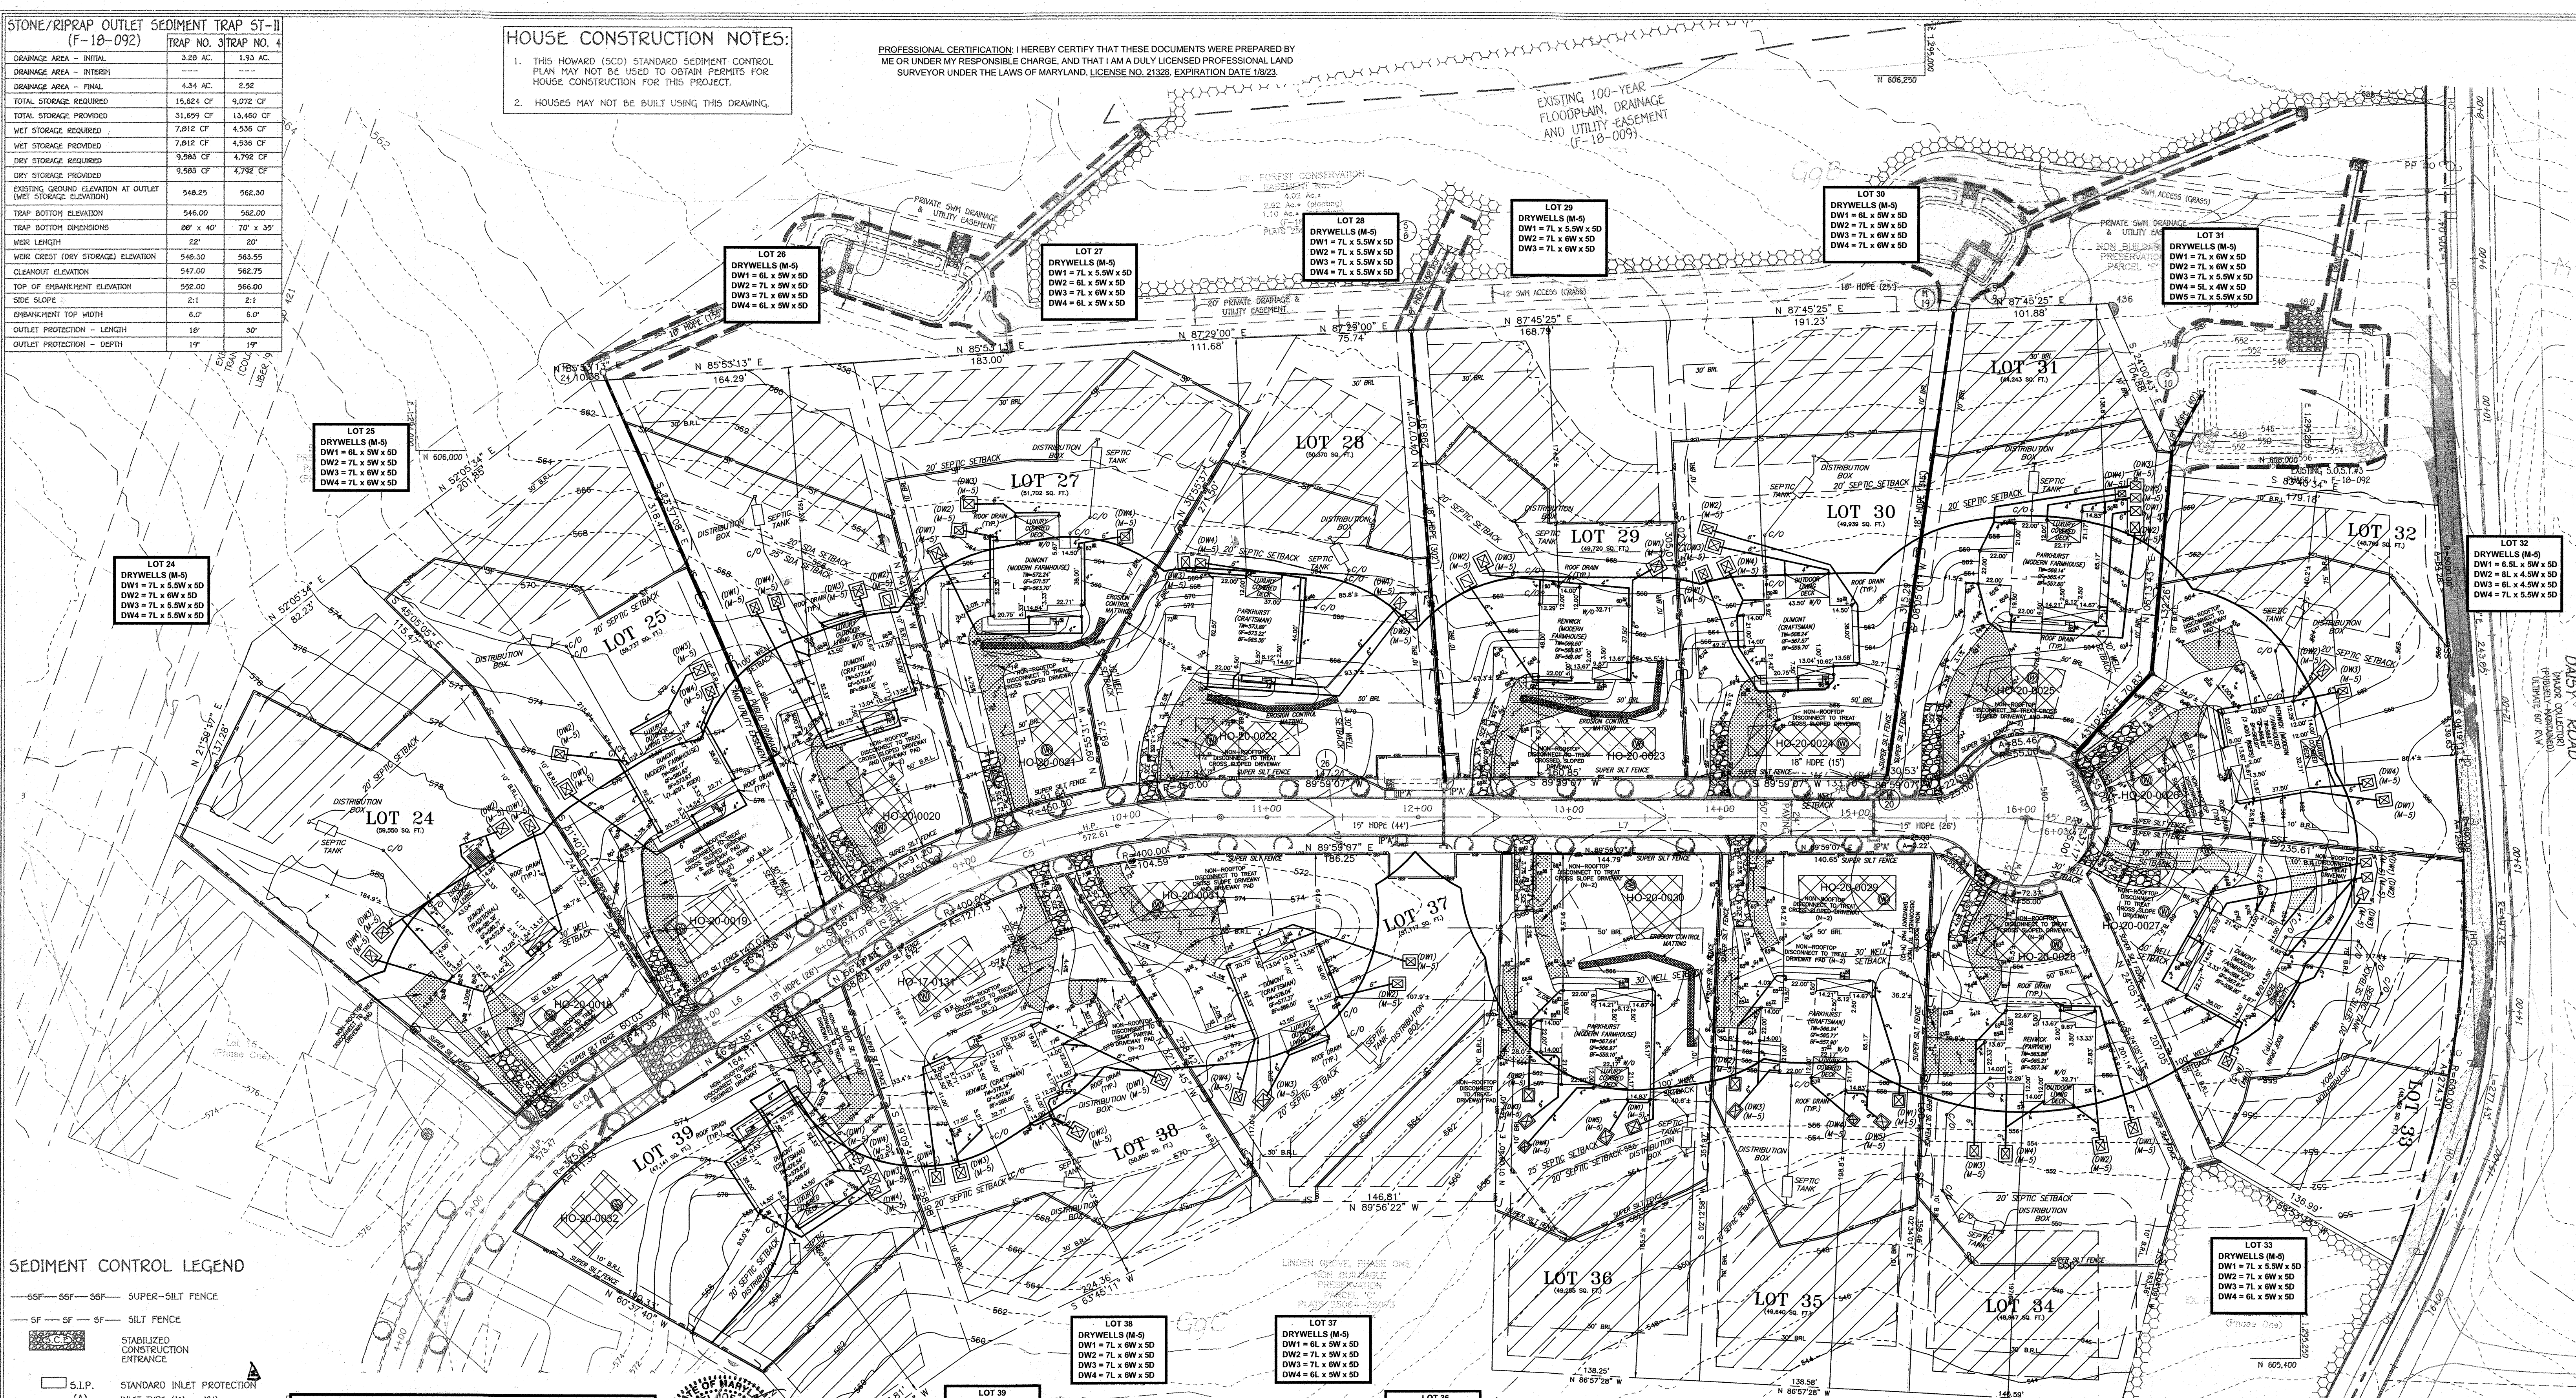

SEDIMENT CONTROL LEGEND

- S—S—S—S— SUPER-SILT FENCE
- S—S—S—S— SILT FENCE
- STABILIZED CONSTRUCTION ENTRANCE
- S.I.P. STANDARD INLET PROTECTION INLET TYPE 'A' OR 'B'
- L.O.D. LIMIT OF DISTURBANCE
- FUTURE LIMIT OF DISTURBANCE FOR SEPTIC SYSTEM INSTALL.
- R.P.S. REMOVABLE PUMPING STATION
- F.B. FILTER BAG
- TYPE A-2 EARTH DIKE
- 12' DISCONNECTION OF NON ROOF-TOP RUNOFF CREDIT. (TYPE N-2)

APPROVED: DEPARTMENT OF PLANNING AND ZONING

DATE: 7/16/22

APPROVED: HOWARD COUNTY DEPARTMENT OF PUBLIC WORKS

DATE: 7/14/22

APPROVED: HOWARD COUNTY DEPARTMENT OF PUBLIC WORKS

DATE: 07/07/2022

APPROVED: HOWARD SOIL CONSERVATION DISTRICT

DATE: 06/27/22

PROFESSIONAL CERTIFICATION

I HEREBY CERTIFY THAT THESE DOCUMENTS WERE PREPARED BY ME OR UNDER MY RESPONSIBLE CHARGE, AND THAT I AM A DULY LICENSED PROFESSIONAL LAND SURVEYOR IN THE STATE OF MARYLAND, LICENSE NO. 21328, EXPIRATION DATE 10/23.

DATE: 6/15/22

NO.	REVISIONS DESCRIPTION	DATE
1	LOTS 24 & 39 REVISIONS	07/15/2021
2	LOTS 27-30 REVISIONS	10/05/2021
3	LOT 33 REVISIONS	10/16/2021
4	LOTS 28 AND 36 REVISIONS	03/15/2022
5	LOTS 29 AND 33 REVISIONS	05/02/2022
6	LOT 27 REVISIONS	06/07/2022
7	LOTS 26, 30, 31, 32, 34 AND 35 REVISIONS	06/15/2022

CONTRACTOR NOTES:

- CONTRACTOR SHALL REMOVE ANY AND ALL JUNK, DEBRIS AND TRASH FROM WITHIN THE FLOODPLAIN, STREAMS, WETLANDS & THEIR BUFFERS.
- SHOULD THE STOCKPILE EXCEED 15 FT. IN HEIGHT IT MUST BE BENCHED.
- EARTH DIKES CROSSING THE ROADWAYS ARE TO BE CONNECTED TO MACADAM BERMS AT THE DIRECTION OF THE SEDIMENT CONTROL INSPECTOR.
- ANY ROADSIDE SHALE OR DITCH LOCATED IN FILL SHALL BE COMPACTED TO 95% COMPACTION TO AVOID EROSION IN THESE AREAS.

ROOFLEADER NOTE:

A OVERFLOW OUTFALL (SURCHARGE) SHALL BE PROVIDED AT EACH DOWNSPOUT PRIOR TO CONNECTION TO THE UNDERGROUND ROOFLEADER. SEE DETAIL SHEET 18.

NEW SHEET *REVISED*

GROWING & SEDIMENT CONTROL PLAN

LINDEN GROVE

PHASE TWO

LOTS 24 THRU 44

(A Resubdivision of Non-Buildable Bulk Parcels 'I' & 'G', Recorded As "Linden Grove, Phase One Lots 1 Thru 23, Buildable Preservation Parcel 'A', Non-Buildable Preservation Parcels 'B' Thru 'E' And Non-Buildable Parcel 'F' And 'G' ". Plot Nos. 25064 Thru 25073.)

ZONED: RC-DEO

TAX MAP No. 8 GRID No. 7 PARCEL No. 5

4TH ELECTION DISTRICT HOWARD COUNTY, MARYLAND

DATE: JUNE 16, 2020

SHEET 24 OF 24

FISHER, COLLINS & CARTER, INC.

CIVIL ENGINEERING CONSULTANTS & LAND SURVEYORS

1000 WASHINGTON AVENUE, SUITE 200

ELLSWORTH CITY, MARYLAND 21042

(410) 481-3229

OWNER: KIMBERLY/HERITAGE LLC

3425 HIPSLEY MILL ROAD

WOODBINE, MARYLAND 21797-7615

410-489-7900

DEVELOPER: HERITAGE LAND DEVELOPMENT

15950 NORTH AVENUE

LISBON, MARYLAND 21765

410-489-7900

PROFESSIONAL CERTIFICATION

I HEREBY CERTIFY THAT THESE DOCUMENTS WERE PREPARED BY ME, AND THAT I AM A DULY LICENSED PROFESSIONAL ENGINEER UNDER THE LAWS OF THE STATE OF MARYLAND, LICENSE NO. 20746, EXPIRATION DATE 2-22-21.

DATE: 6/15/2022