
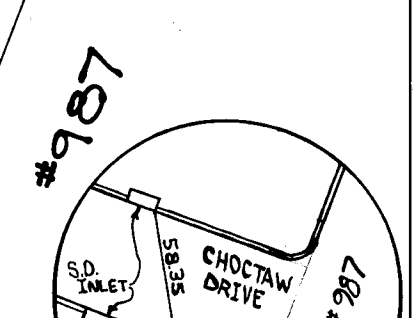


1. BASE WILL BE PRIMED IN ACCORDANCE WITH SECTION C-3C-3 AS PROVIDED IN WITH THE HOWARD COUNTY ROAD CONSTRUCTION CODE & STANDARD SPECIFICATIONS.
2. TACK COAT IS REQUIRED IN ACCORDANCE WITH SECTION C-31-4 OF THE HOWARD COUNTY ROAD CONSTRUCTION CODE & STANDARD SPECIFICATIONS.

NOTES:

1. ALL WORK SHALL BE PERFORMED IN ACCORDANCE WITH THE HOWARD CO. ROAD CONSTRUCTION CODE & STANDARD SPECIFICATIONS.
2. ALL UTILITY COMPANIES SHALL BE NOTIFIED AT LEAST 24 HOURS IN ADVANCE OF CONSTRUCTION.
3. ALL STORM DRAINAGE STRUCTURES SHALL BE HOWARD CO. STANDARDS.
4. DESIGN SPEED: 25 M.P.H.
5. SIDEWALK RAMP FOR HANDICAPPED TO BE PROVIDED AT ALL INTERSECTIONS.
6. FOR SEDIMENT CONTROL - SEE PLAN FOR GRADING & SEDIMENT CONTROL "KEYWAY" IN

MON. LOCATION (NOT TO SCALE)

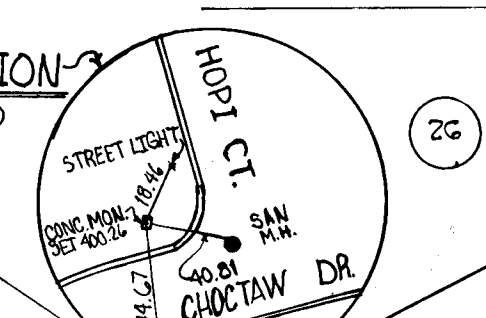

REV	DATE	DESCRIPTION	BY
1	11/1/87	REVISED LOCATION & DATE 11/1/87	SUR
2	11/1/87	ADD. D. 1, 3, 4	GLE
3	11/1/87	CHANGED PIPE CLASS FROM 24" TO 25" 0"	SUR

LOCATION MAP SCALE: 1" = 2000'

ENGINEERS
HUDKINS ASSOCIATES, INC.
100 N. MAIN ST. BELAIR, MD 21014

Richard S. Osborn

NOTE: FOR STORM WATER MANAGEMENT POND SEE SHEET 1 OF 1

DRAINAGE & UTILITY ENLARGEMENT

TOP DAM EL. 375.15

Rip Rap Facing

2+75 L.P.

2+50 L.P.

2+25 L.P.

2+00 L.P.

1+75 L.P.

1+50 L.P.

1+25 L.P.

1+00 L.P.

0+75 L.P.

0+50 L.P.

0+25 L.P.

0+00 L.P.

STA. 0+00 TO STA. 0+25

STA. 0+25 TO STA. 0+50

STA. 0+50 TO STA. 0+75

STA. 0+75 TO STA. 1+00

STA. 1+00 TO STA. 1+25

STA. 1+25 TO STA. 1+50

STA. 1+50 TO STA. 1+75

STA. 1+75 TO STA. 2+00

STA. 2+00 TO STA. 2+25

STA. 2+25 TO STA. 2+50

STA. 2+50 TO STA. 2+75

STA. 2+75 TO STA. 3+00

STA. 3+00 TO STA. 3+25

CHOCTAW DRIVE

HOPE COURT

ZCINI COURT

MARYLAND ROUTE

COOKS LANE

PLAN SCALE: 1" = 50'

DRIVE

COURT

COURT

CHOCTAW DRIVE

HOPE COURT

ZCINI COURT

MARYLAND ROUTE

COOKS LANE

PLAN SCALE: 1" = 50'

DRIVE

COURT

COURT

CHOCTAW DRIVE

HOPE COURT


ZCINI COURT

MARYLAND ROUTE

COOKS LANE

PLAN SCALE: 1" = 50'

1. BASE WILL BE PRIMED IN ACCORDANCE WITH SECTION C-30-5 AS PROVIDED IN WITH THE HOWARD COUNTY ROAD CONSTRUCTION CODE & STANDARD SPECIFICATIONS.
2. TACK COAT IS REQUIRED IN ACCORDANCE WITH SECTION C-31-4 OF THE HOWARD COUNTY ROAD CONSTRUCTION CODE & STANDARD SPECIFICATIONS.

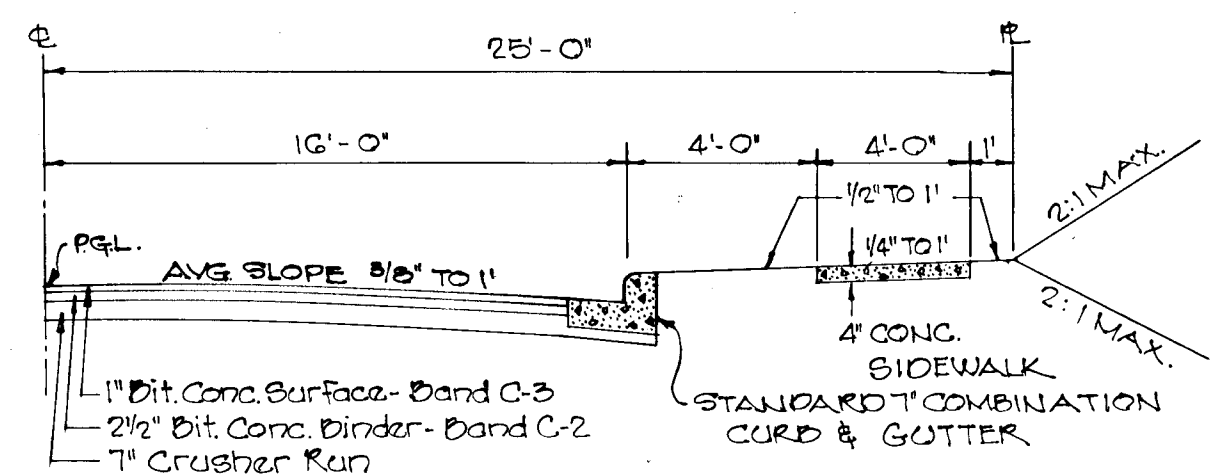


TYPICAL HALF SECTION
NO SCALE
ZUNI COURT - HOPI COURT
(CR-20 DISTRICT, RESIDENTIAL SINGLE 25 M.P.H. DESIGN SPEED)

NOTE: SIDEWALK RAMPS FOR HANDICAPPED TO BE PROVIDED AT ALL INTERSECTIONS.



- NOTES:
1. ALL WORK SHALL BE PERFORMED IN ACCORDANCE WITH THE HOWARD CO. ROAD CONSTRUCTION CODE & STANDARD SPECIFICATIONS.
 2. ALL UTILITY COMPANIES SHALL BE NOTIFIED AT LEAST 24 HOURS IN ADVANCE OF CONSTRUCTION.
 3. ALL STORM DRAINAGE STRUCTURES SHALL HOWARD CO. STANDARDS.
 4. DESIGN SPEED, HOPI COURT & ZUNI COURT 25 MPH.
 5. FOR SEDIMENT CONTROL-SEE PLAN FOR GRADING & SEDIMENT CONTROL "KEYWAYDII"

ENGINEERS
HUCKINS ASSOCIATES INC.
100 N. MAIN ST. BEL AIR, MD 21014
838-0888 877-8117


Howard W. Huckins 1/2/80
DATE

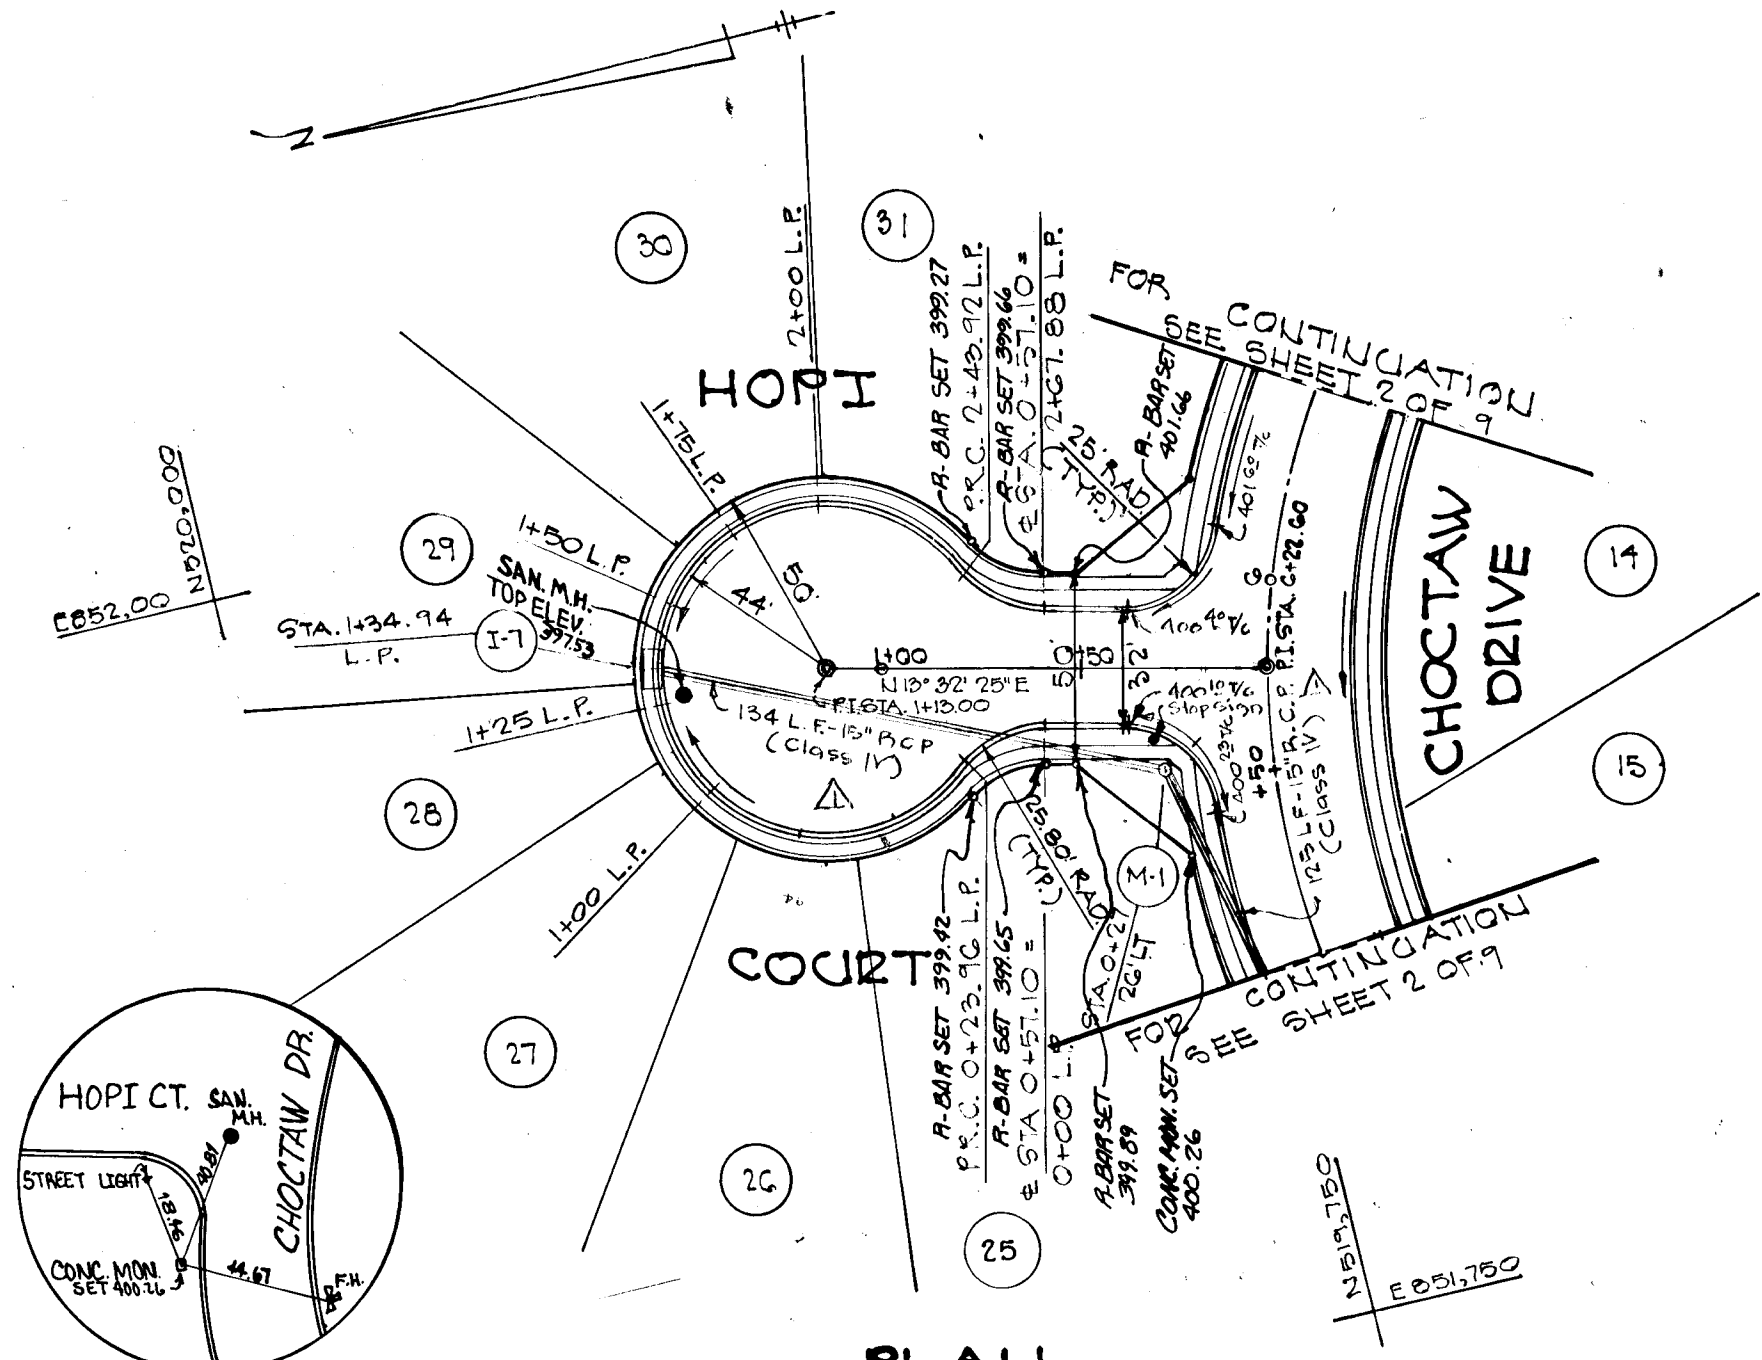




PLAN
SCALE: 1"=50'

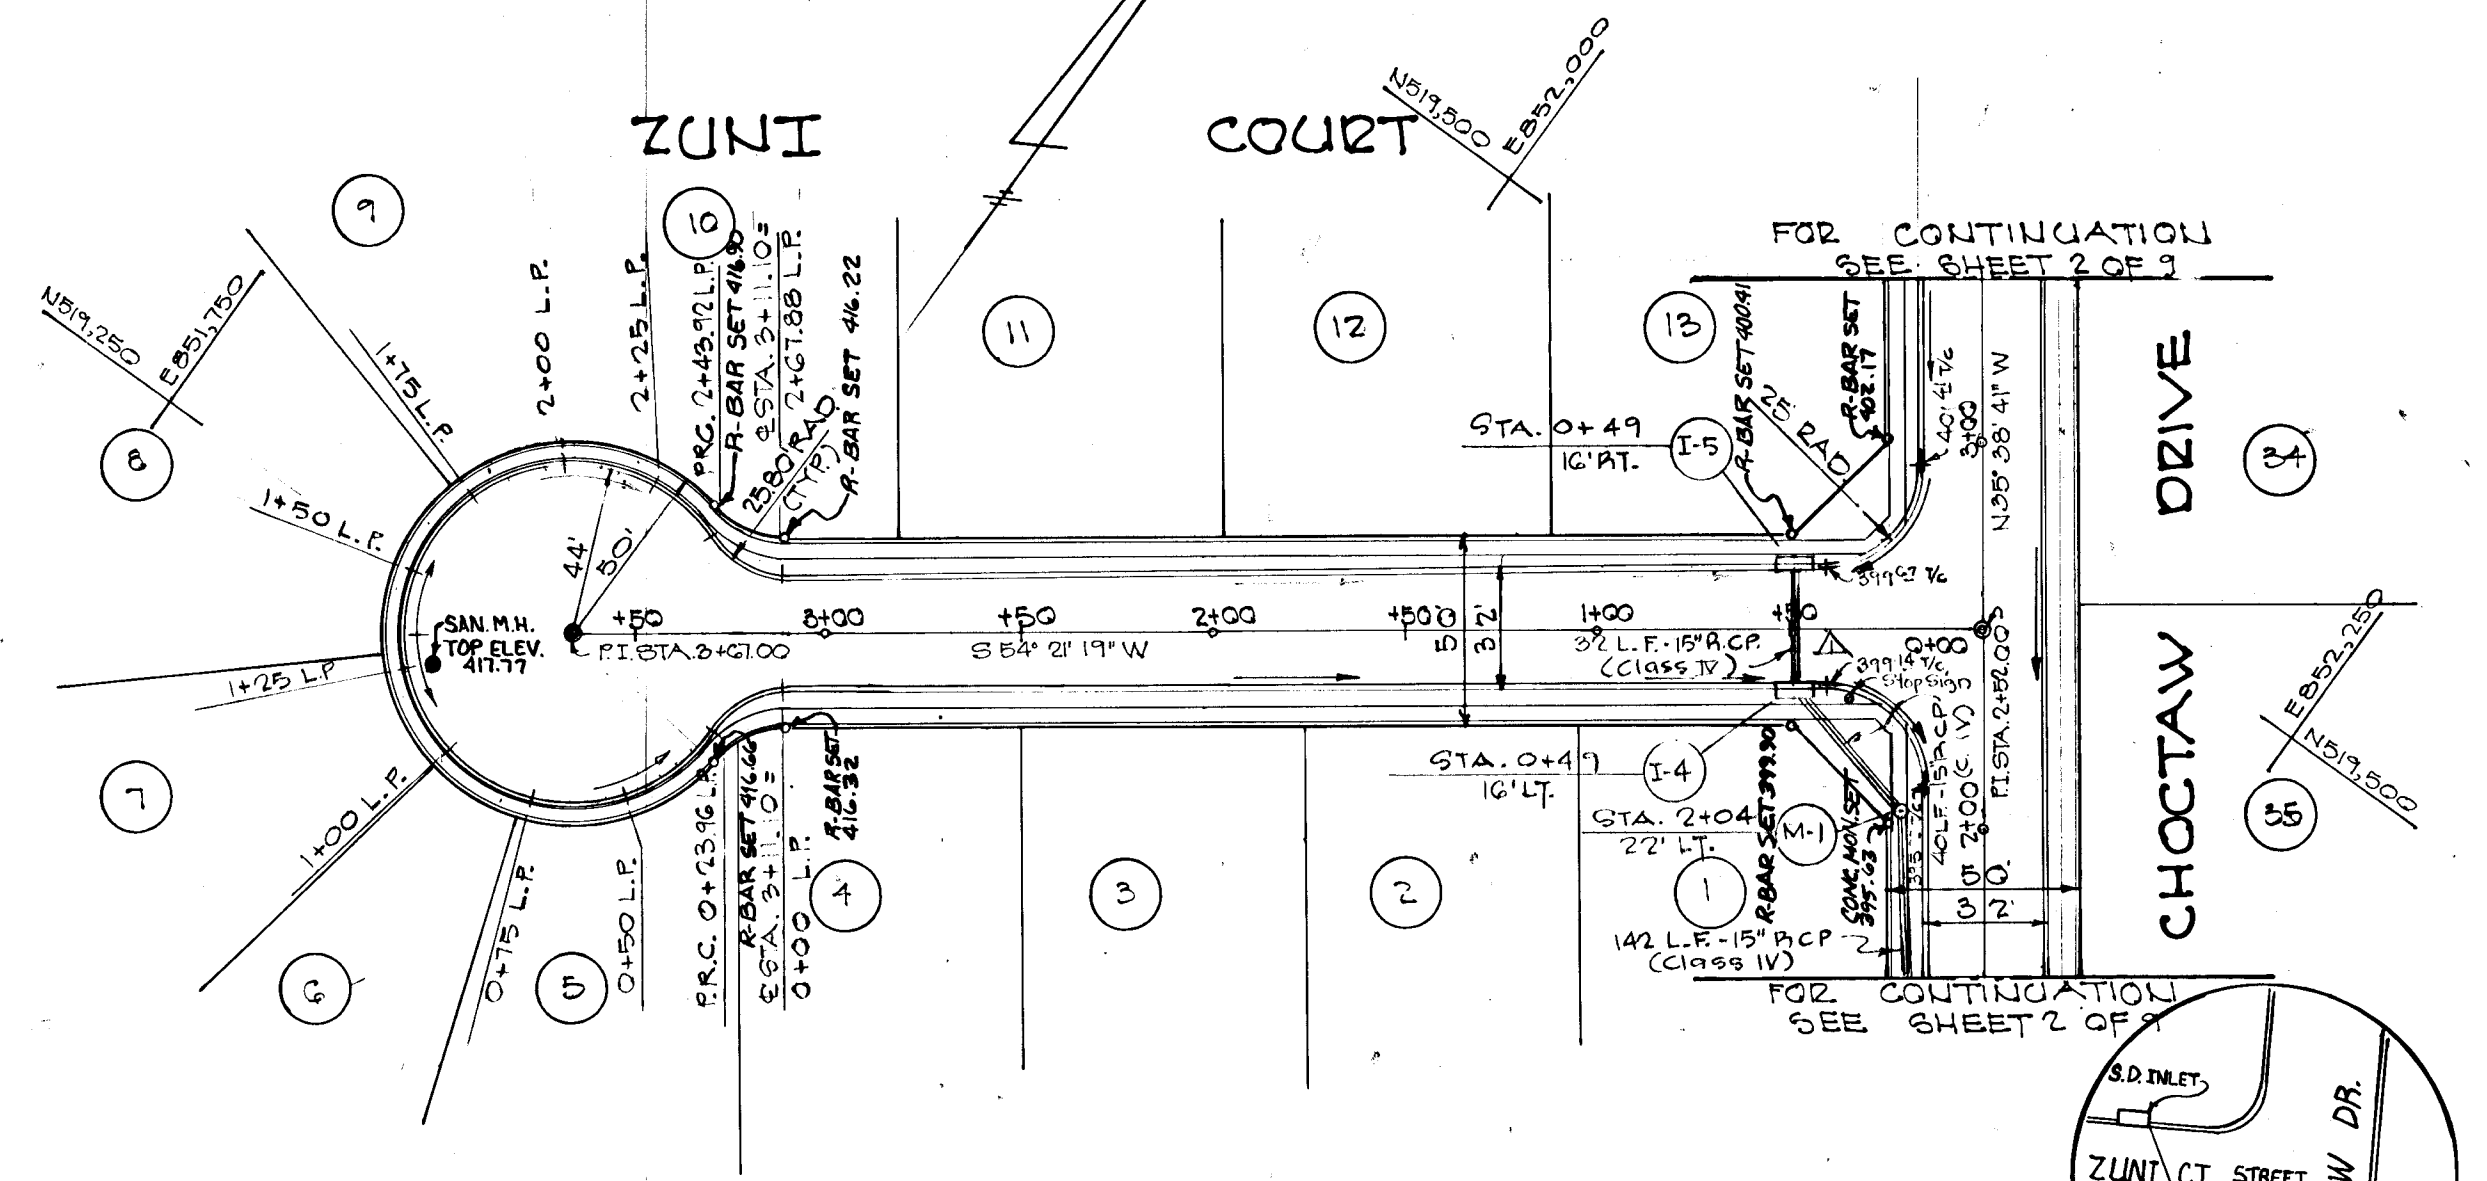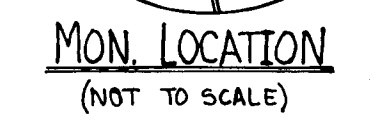

PLAN
SCALE: 1"=50'

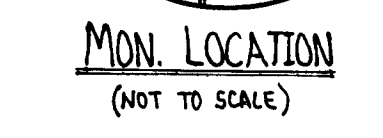

DEVELOPER
D & G ASSOCIATES
9008 DELAIR ROAD
BALTIMORE, MARYLAND
21236

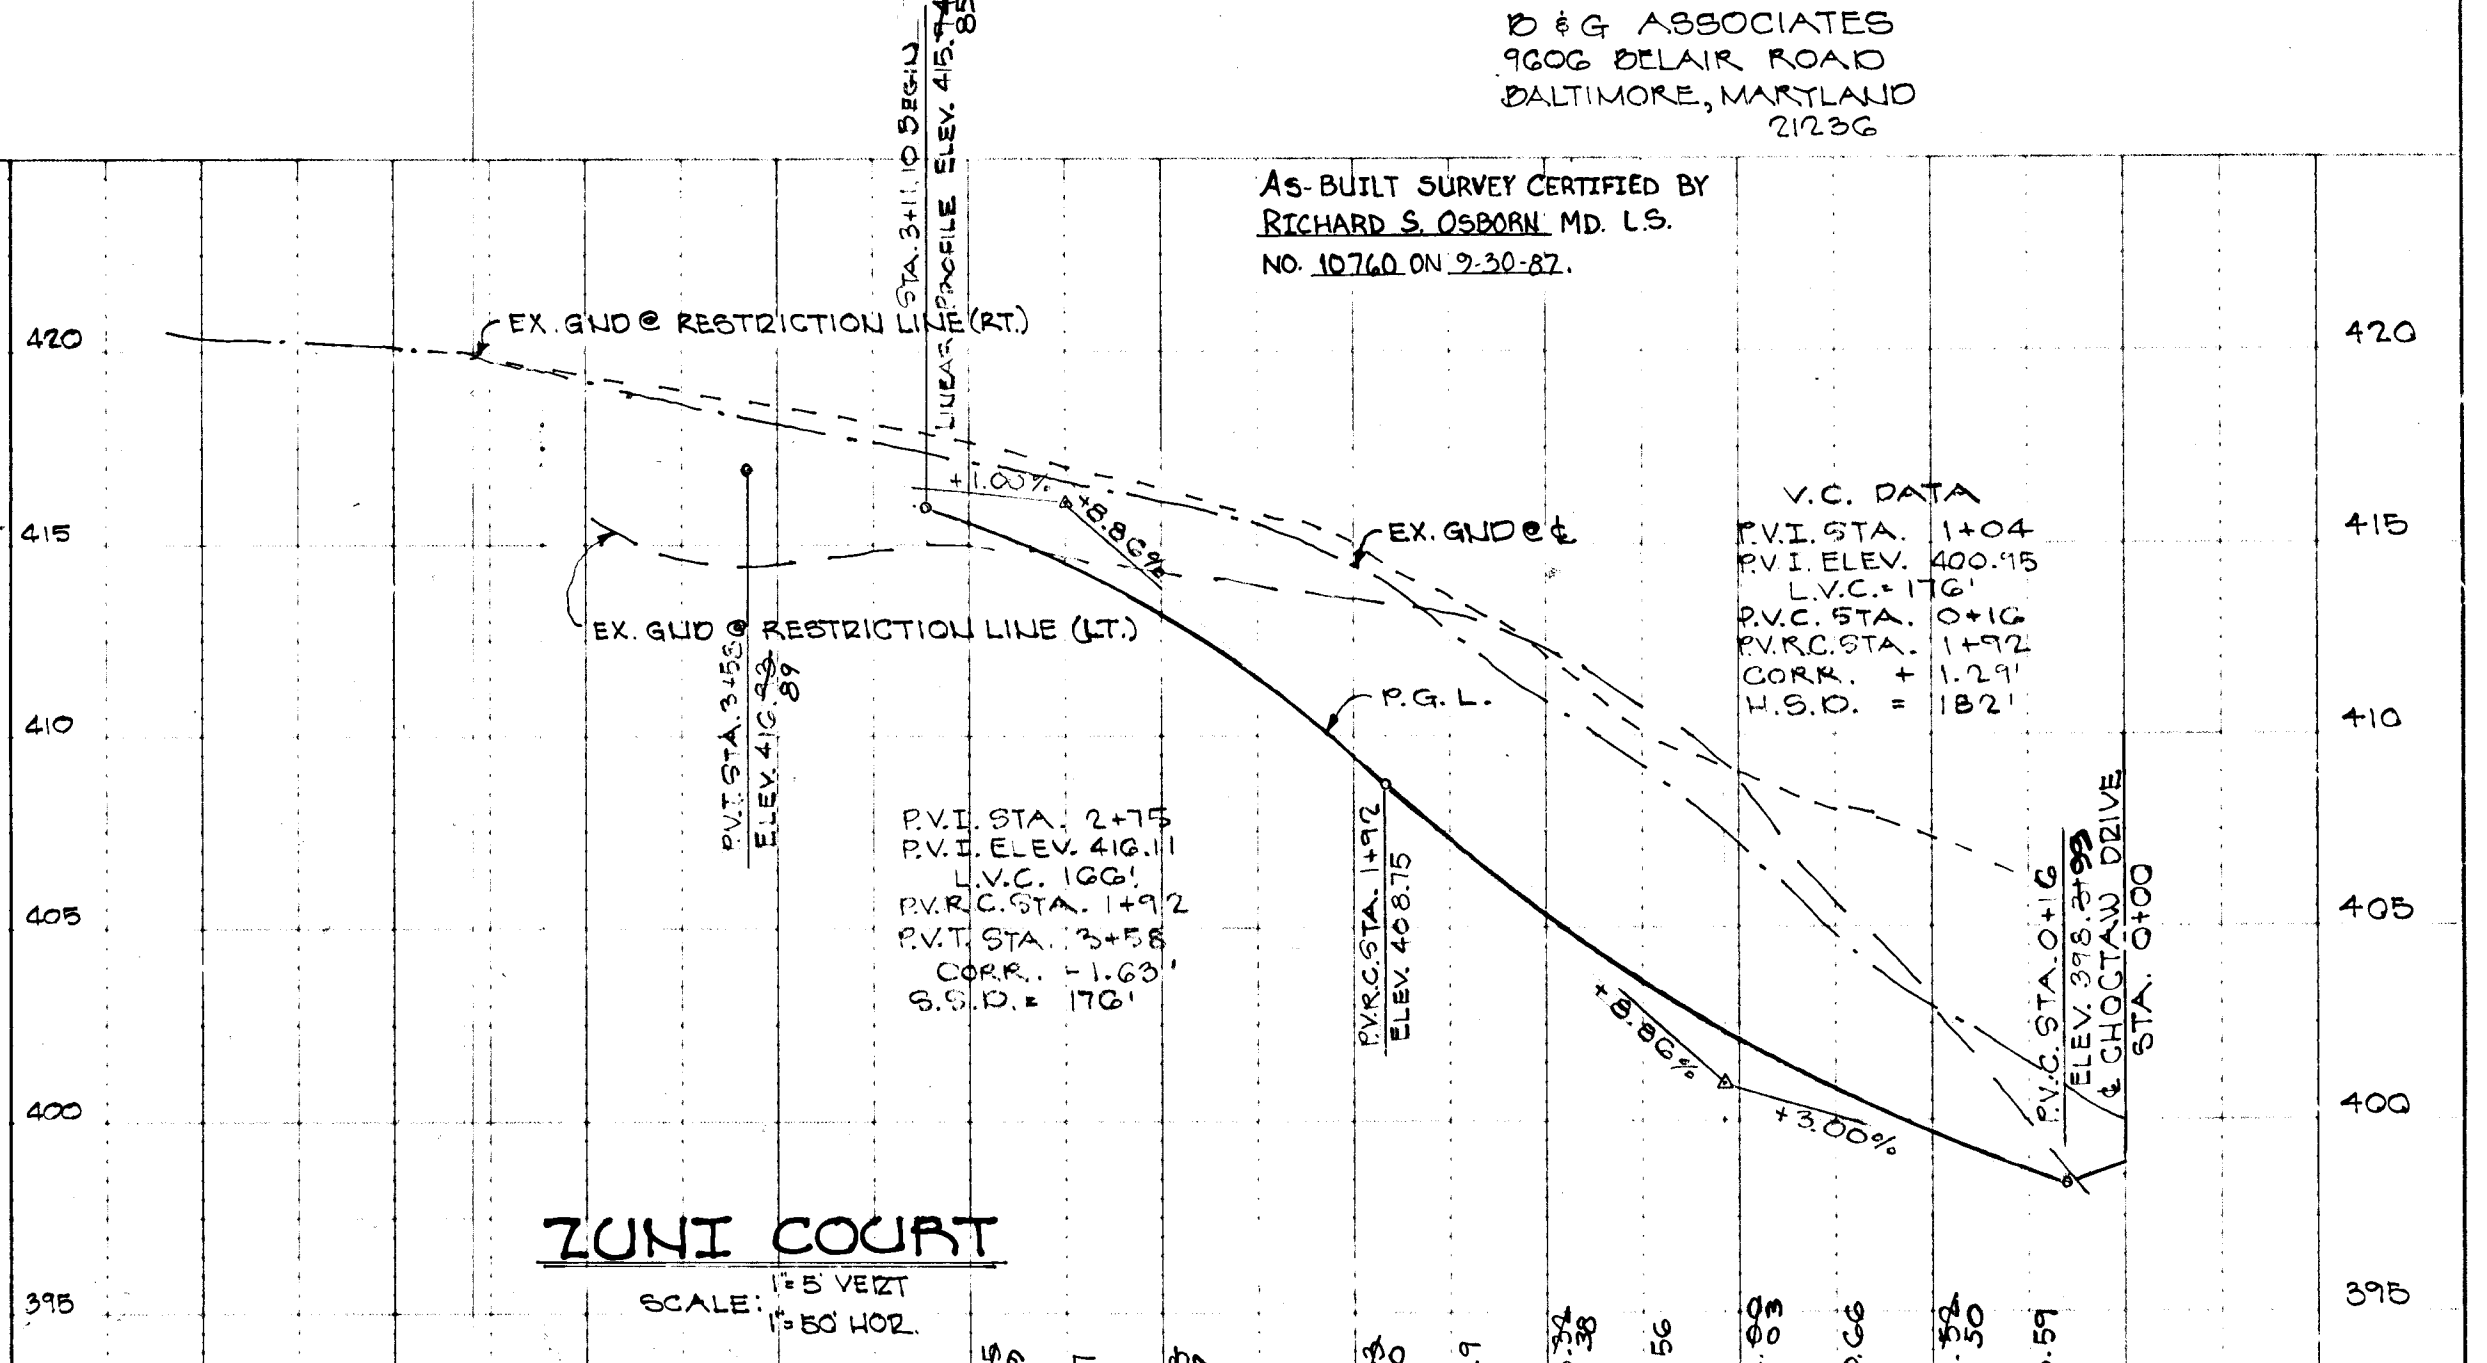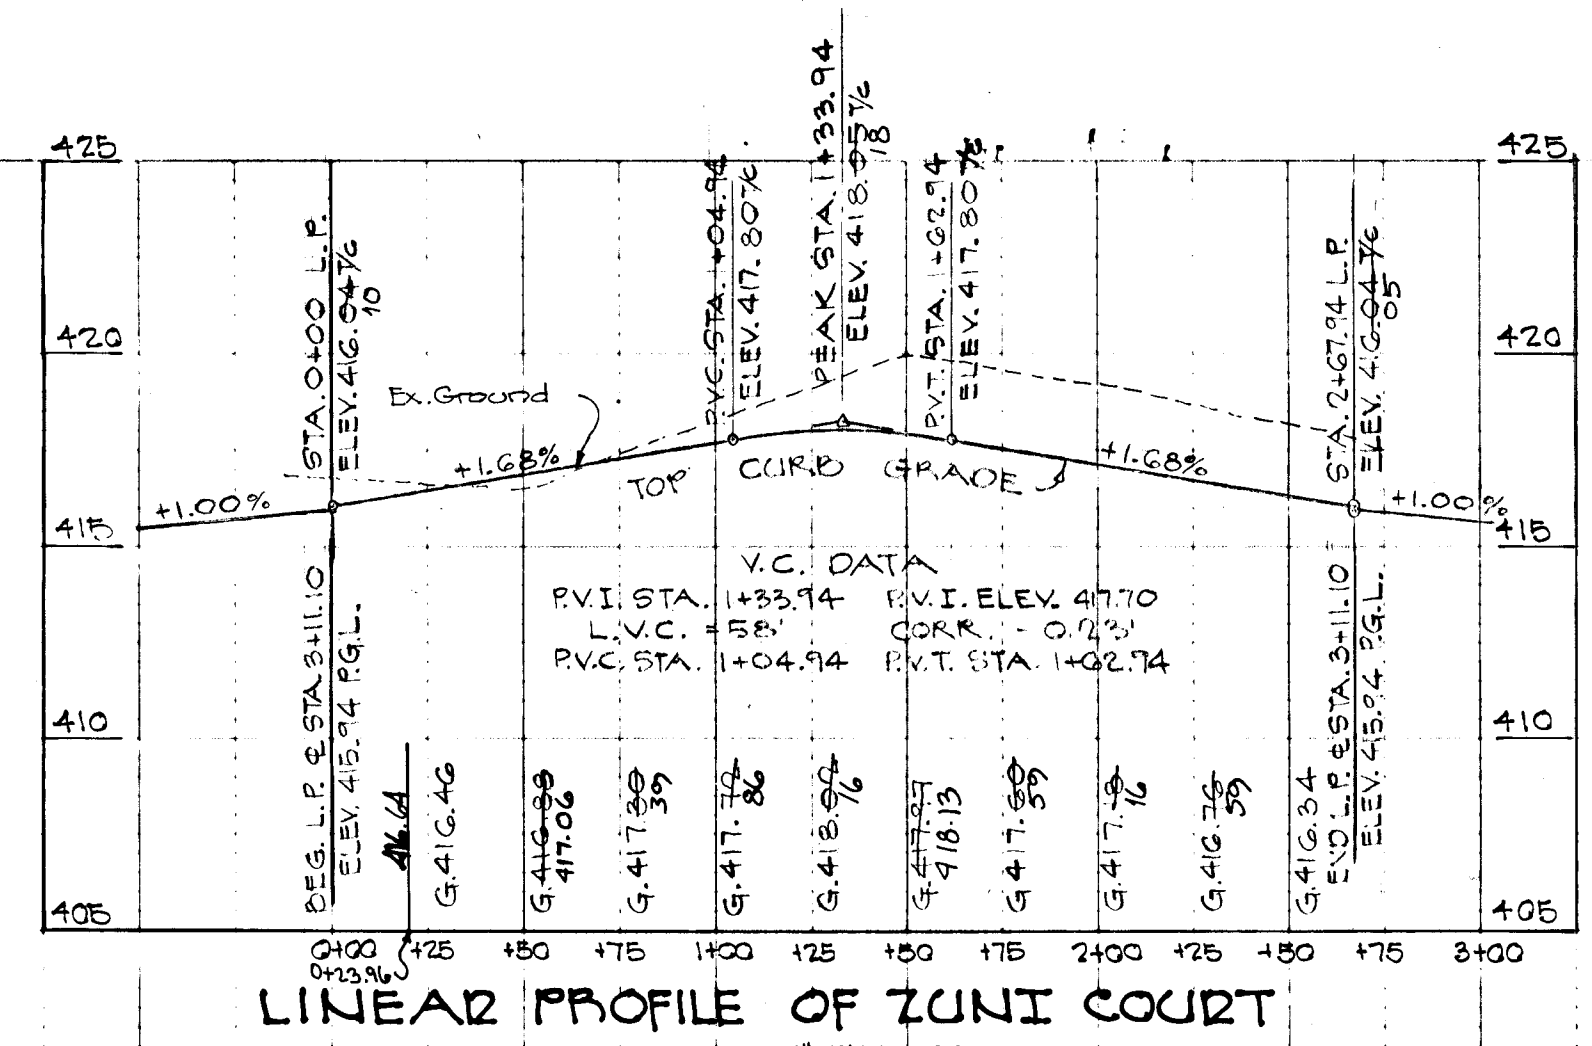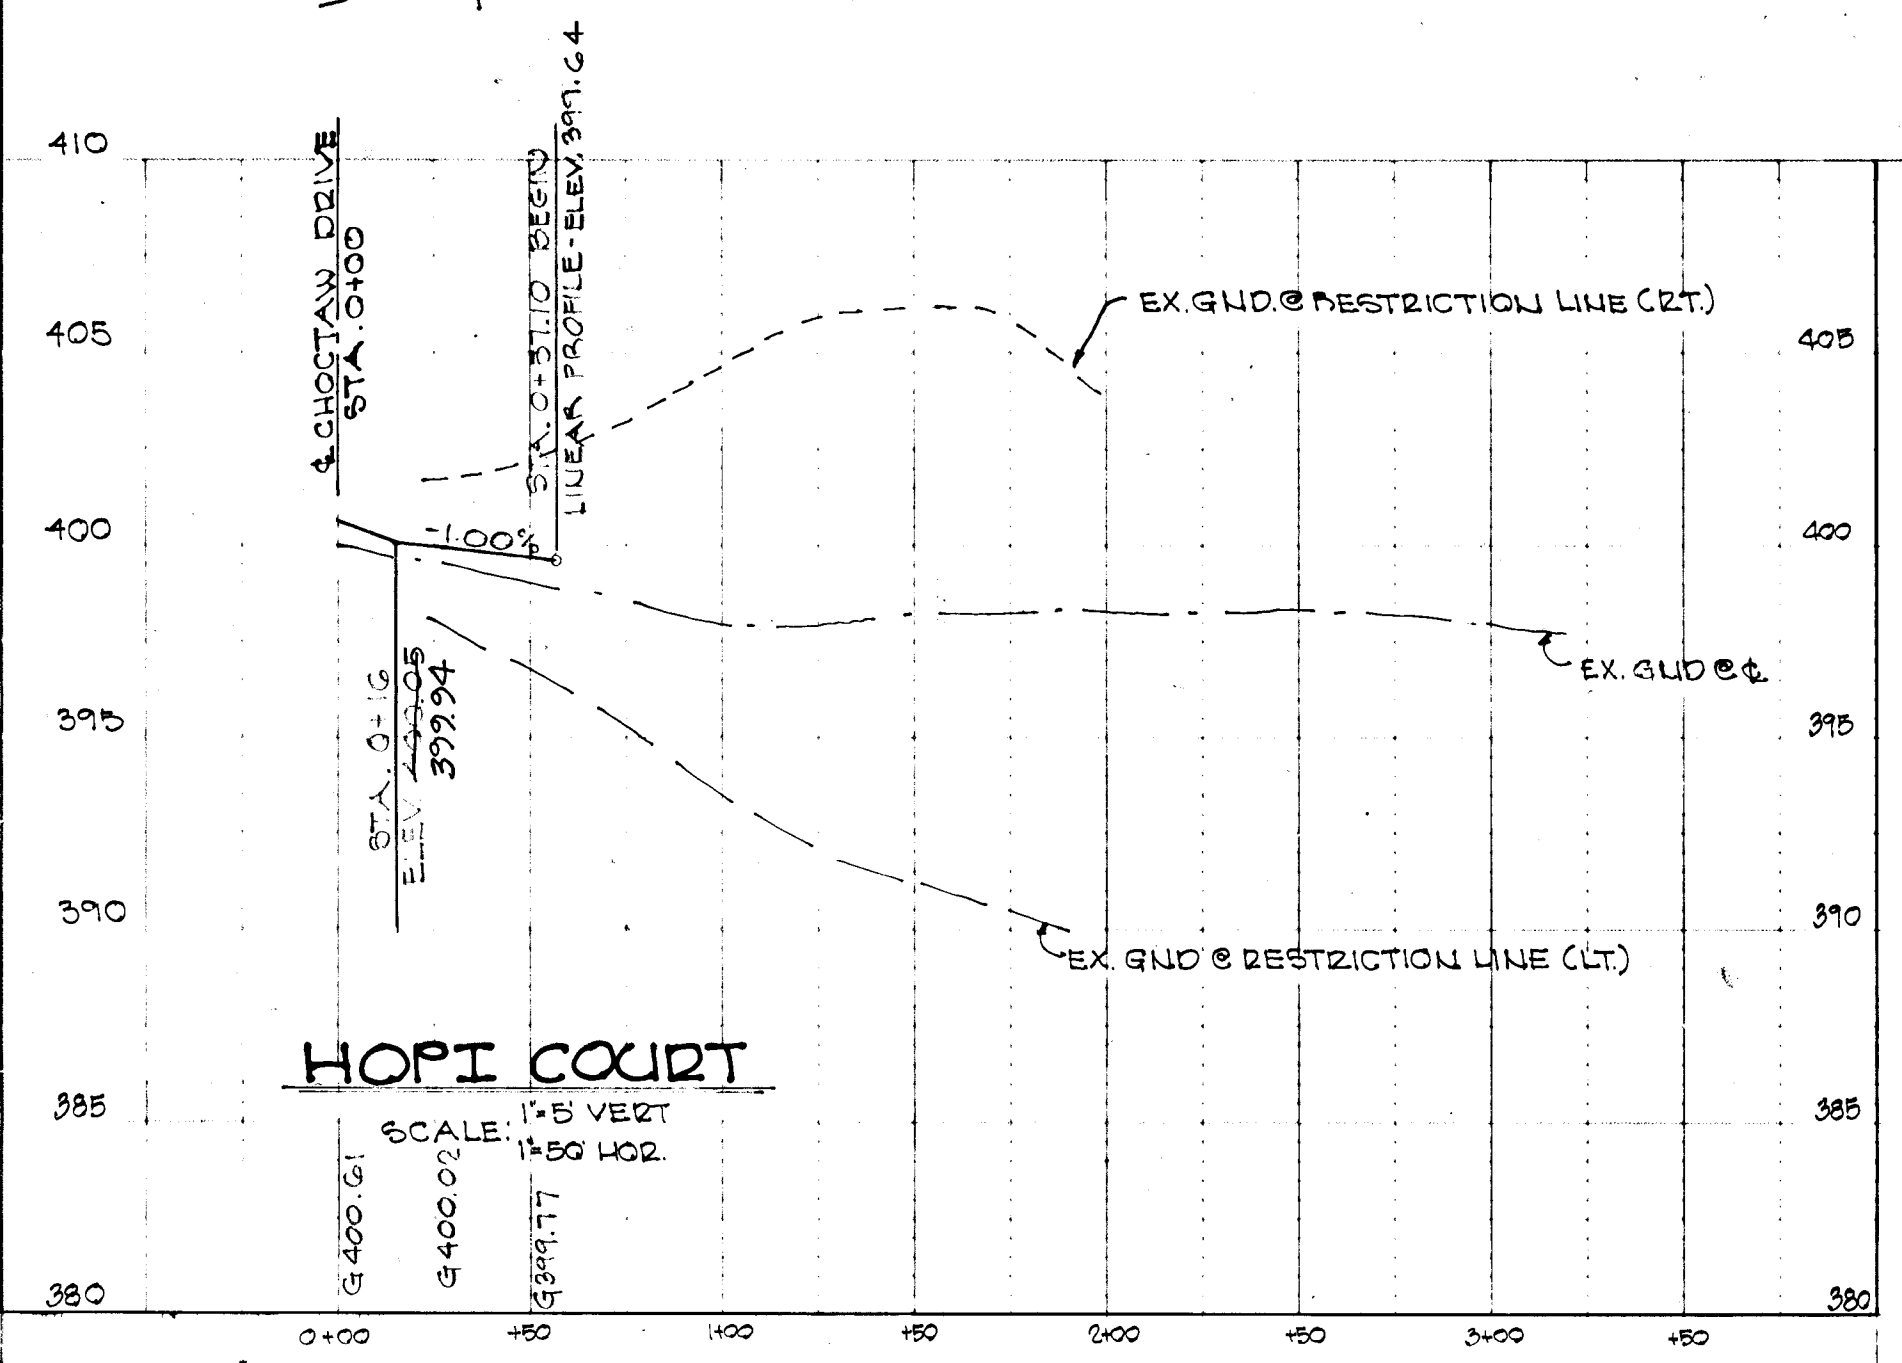


AS-BUILT SURVEY CERTIFIED BY
RICHARD S. OSBORN, M.D. L.S.
NO. 10760 ON 9-30-87.


V.C. DATA
PVI STA. 1+04
P.V.I. ELEV. 400.15
L.V.C. = 176'
P.V.C. STA. 0+46
P.V.T. STA. 1+77
CORR. = 1.29'
H.S.D. = 182'

PLAN & PROFILE
HOPI COURT - ZUNI COURT
"KEYWAYDII"
ELECT. DIST. NO. 2 HOWARD CO. MD
SCALE: AS SHOWN SHEET 3 OF 11


HOWARD COUNTY, MARYLAND
DEPARTMENT OF PUBLIC WORKS
4/23/80
CHIEF, BUREAU OF ENGINEERING
OFFICE OF PLANNING & ZONING
4/22/80
CHIEF, DIVISION OF LAND DEVELOPMENT DATE

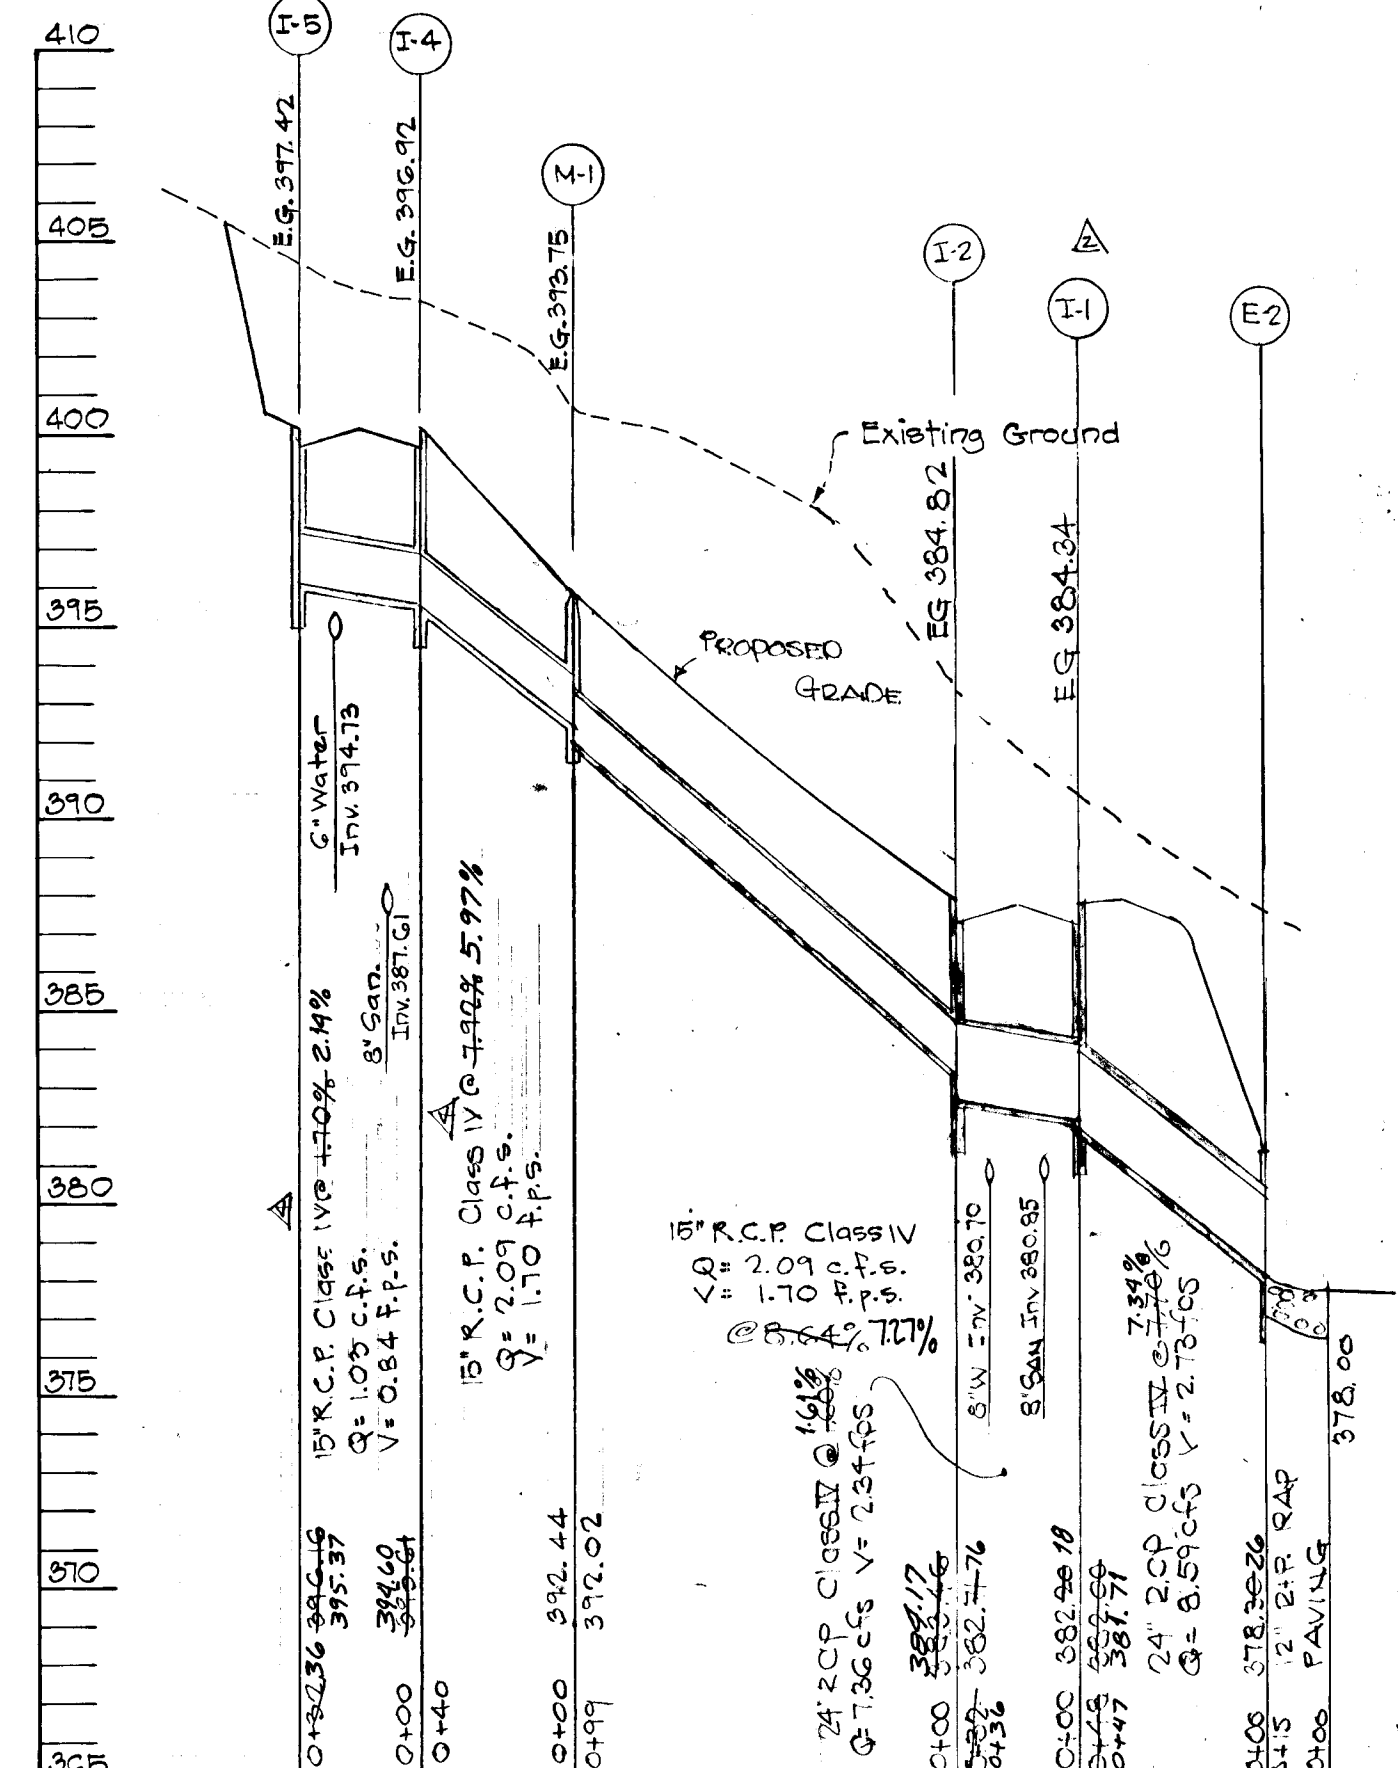

PROFILE
SCALE: HOR. 1"=50'
VERT. 1"=5'

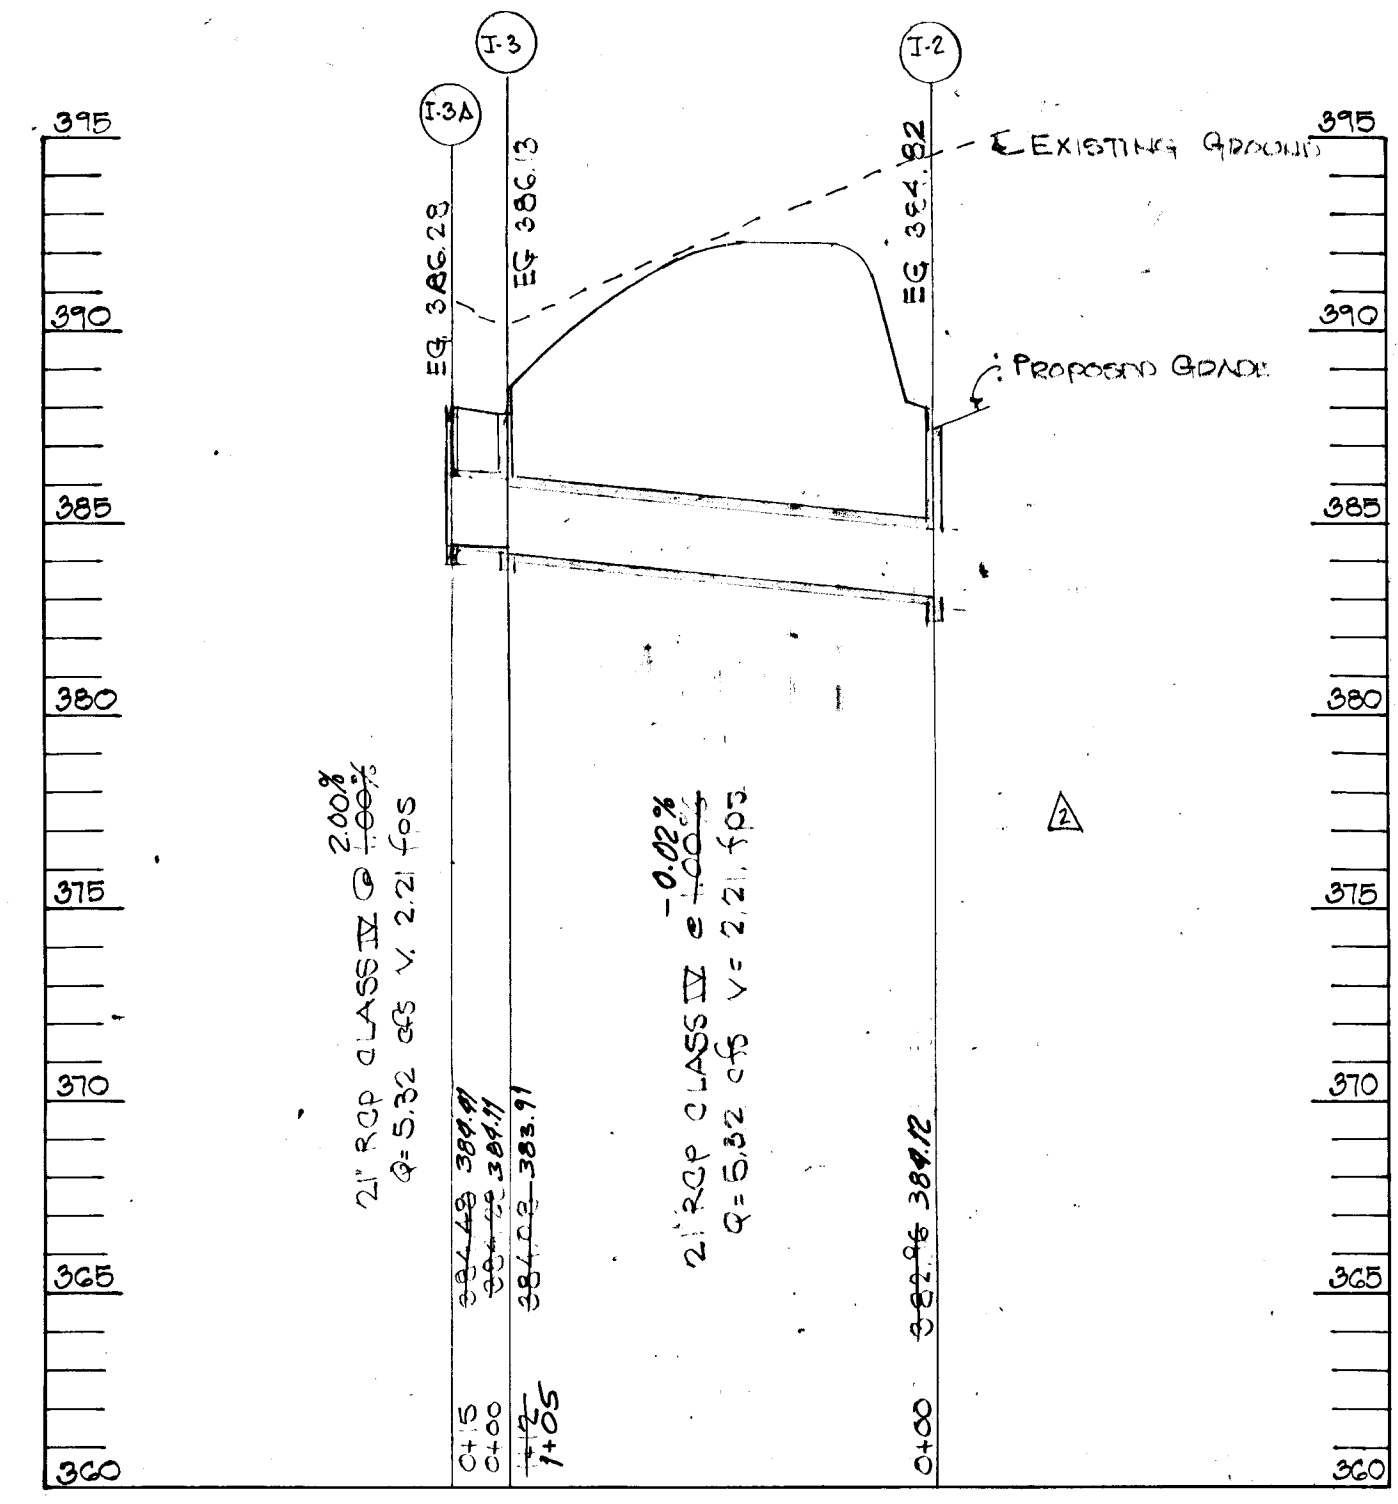


PROFILE
SCALE: HOR. 1"=50'
VERT. 1"=5'

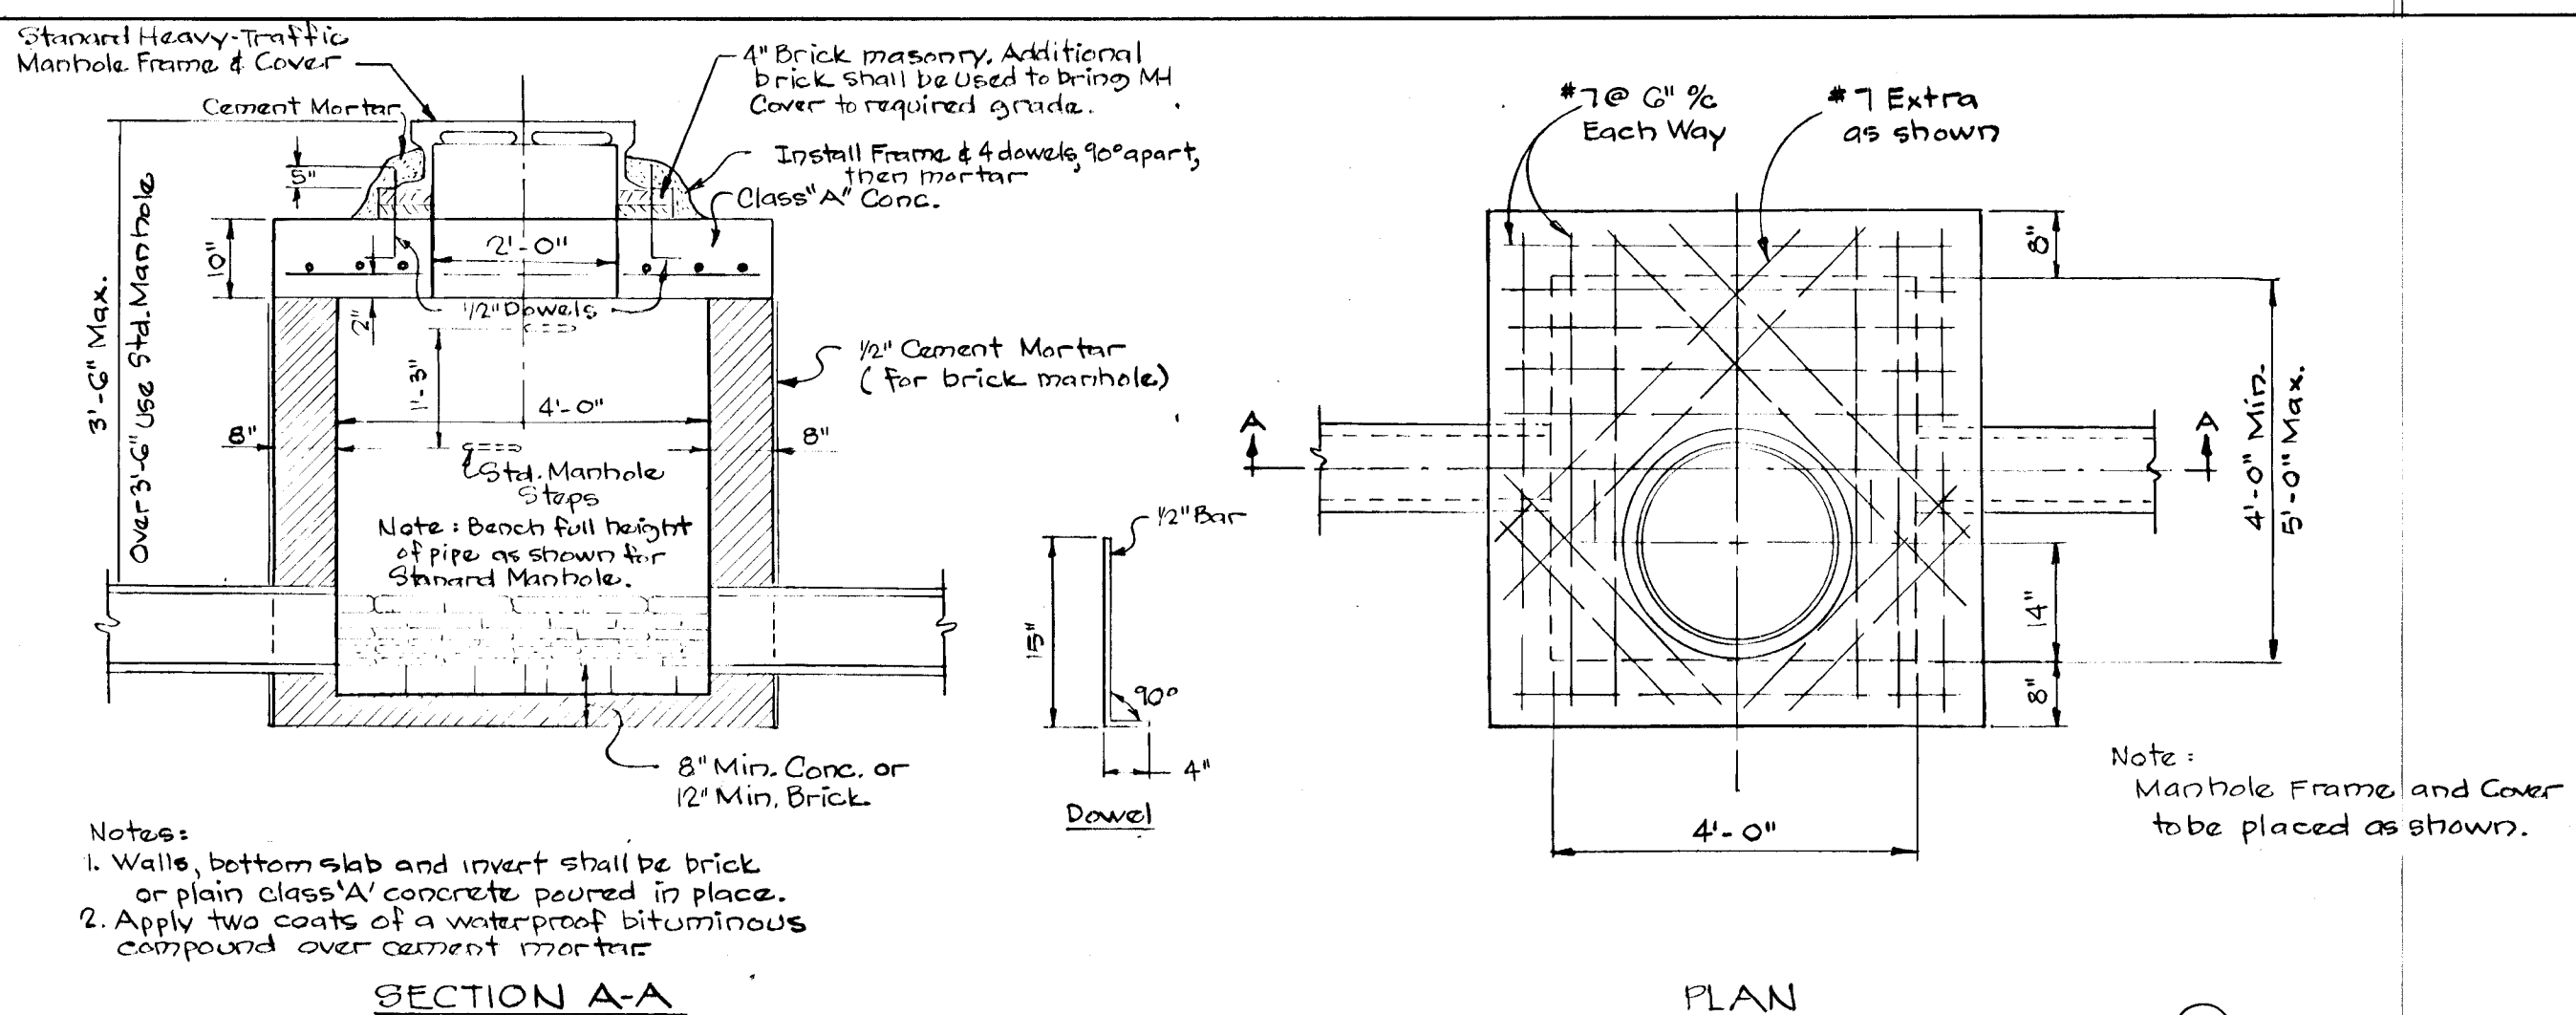


Notes:
1. Walls, bottom slab and invert shall be brick or plain class 'A' concrete poured in place.
2. Apply two coats of a waterproof bituminous compound over cement mortar.

Note: Manhole Frame and Cover to be placed as shown.


DETAIL SHALLOW MANHOLE
NO SCALE

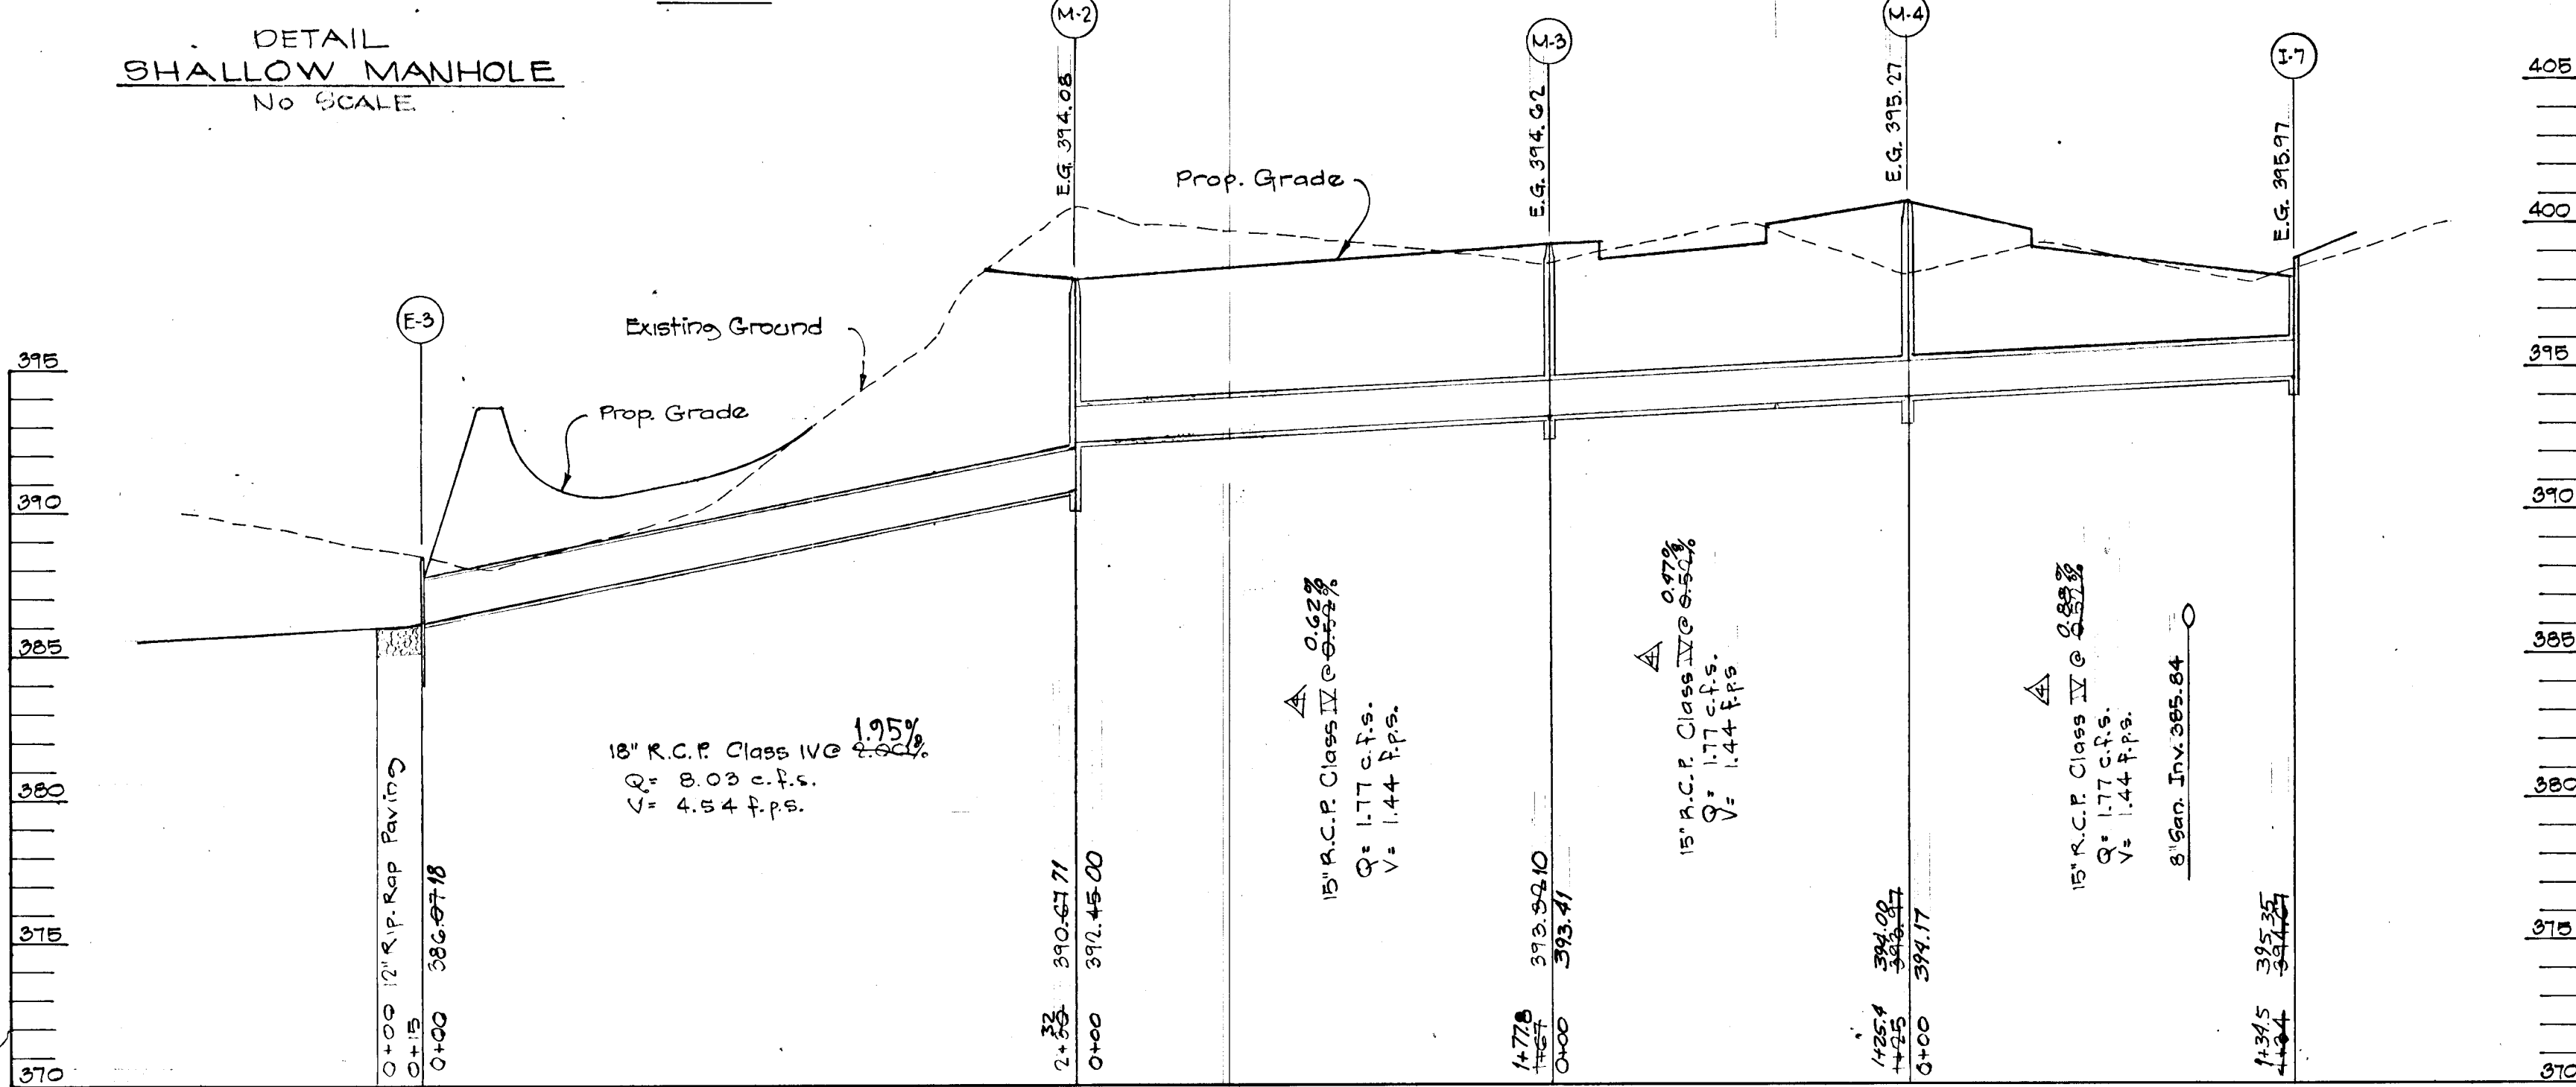


PROFILE
SCALE: HOR. 1"=50'
VERT. 1"=5'

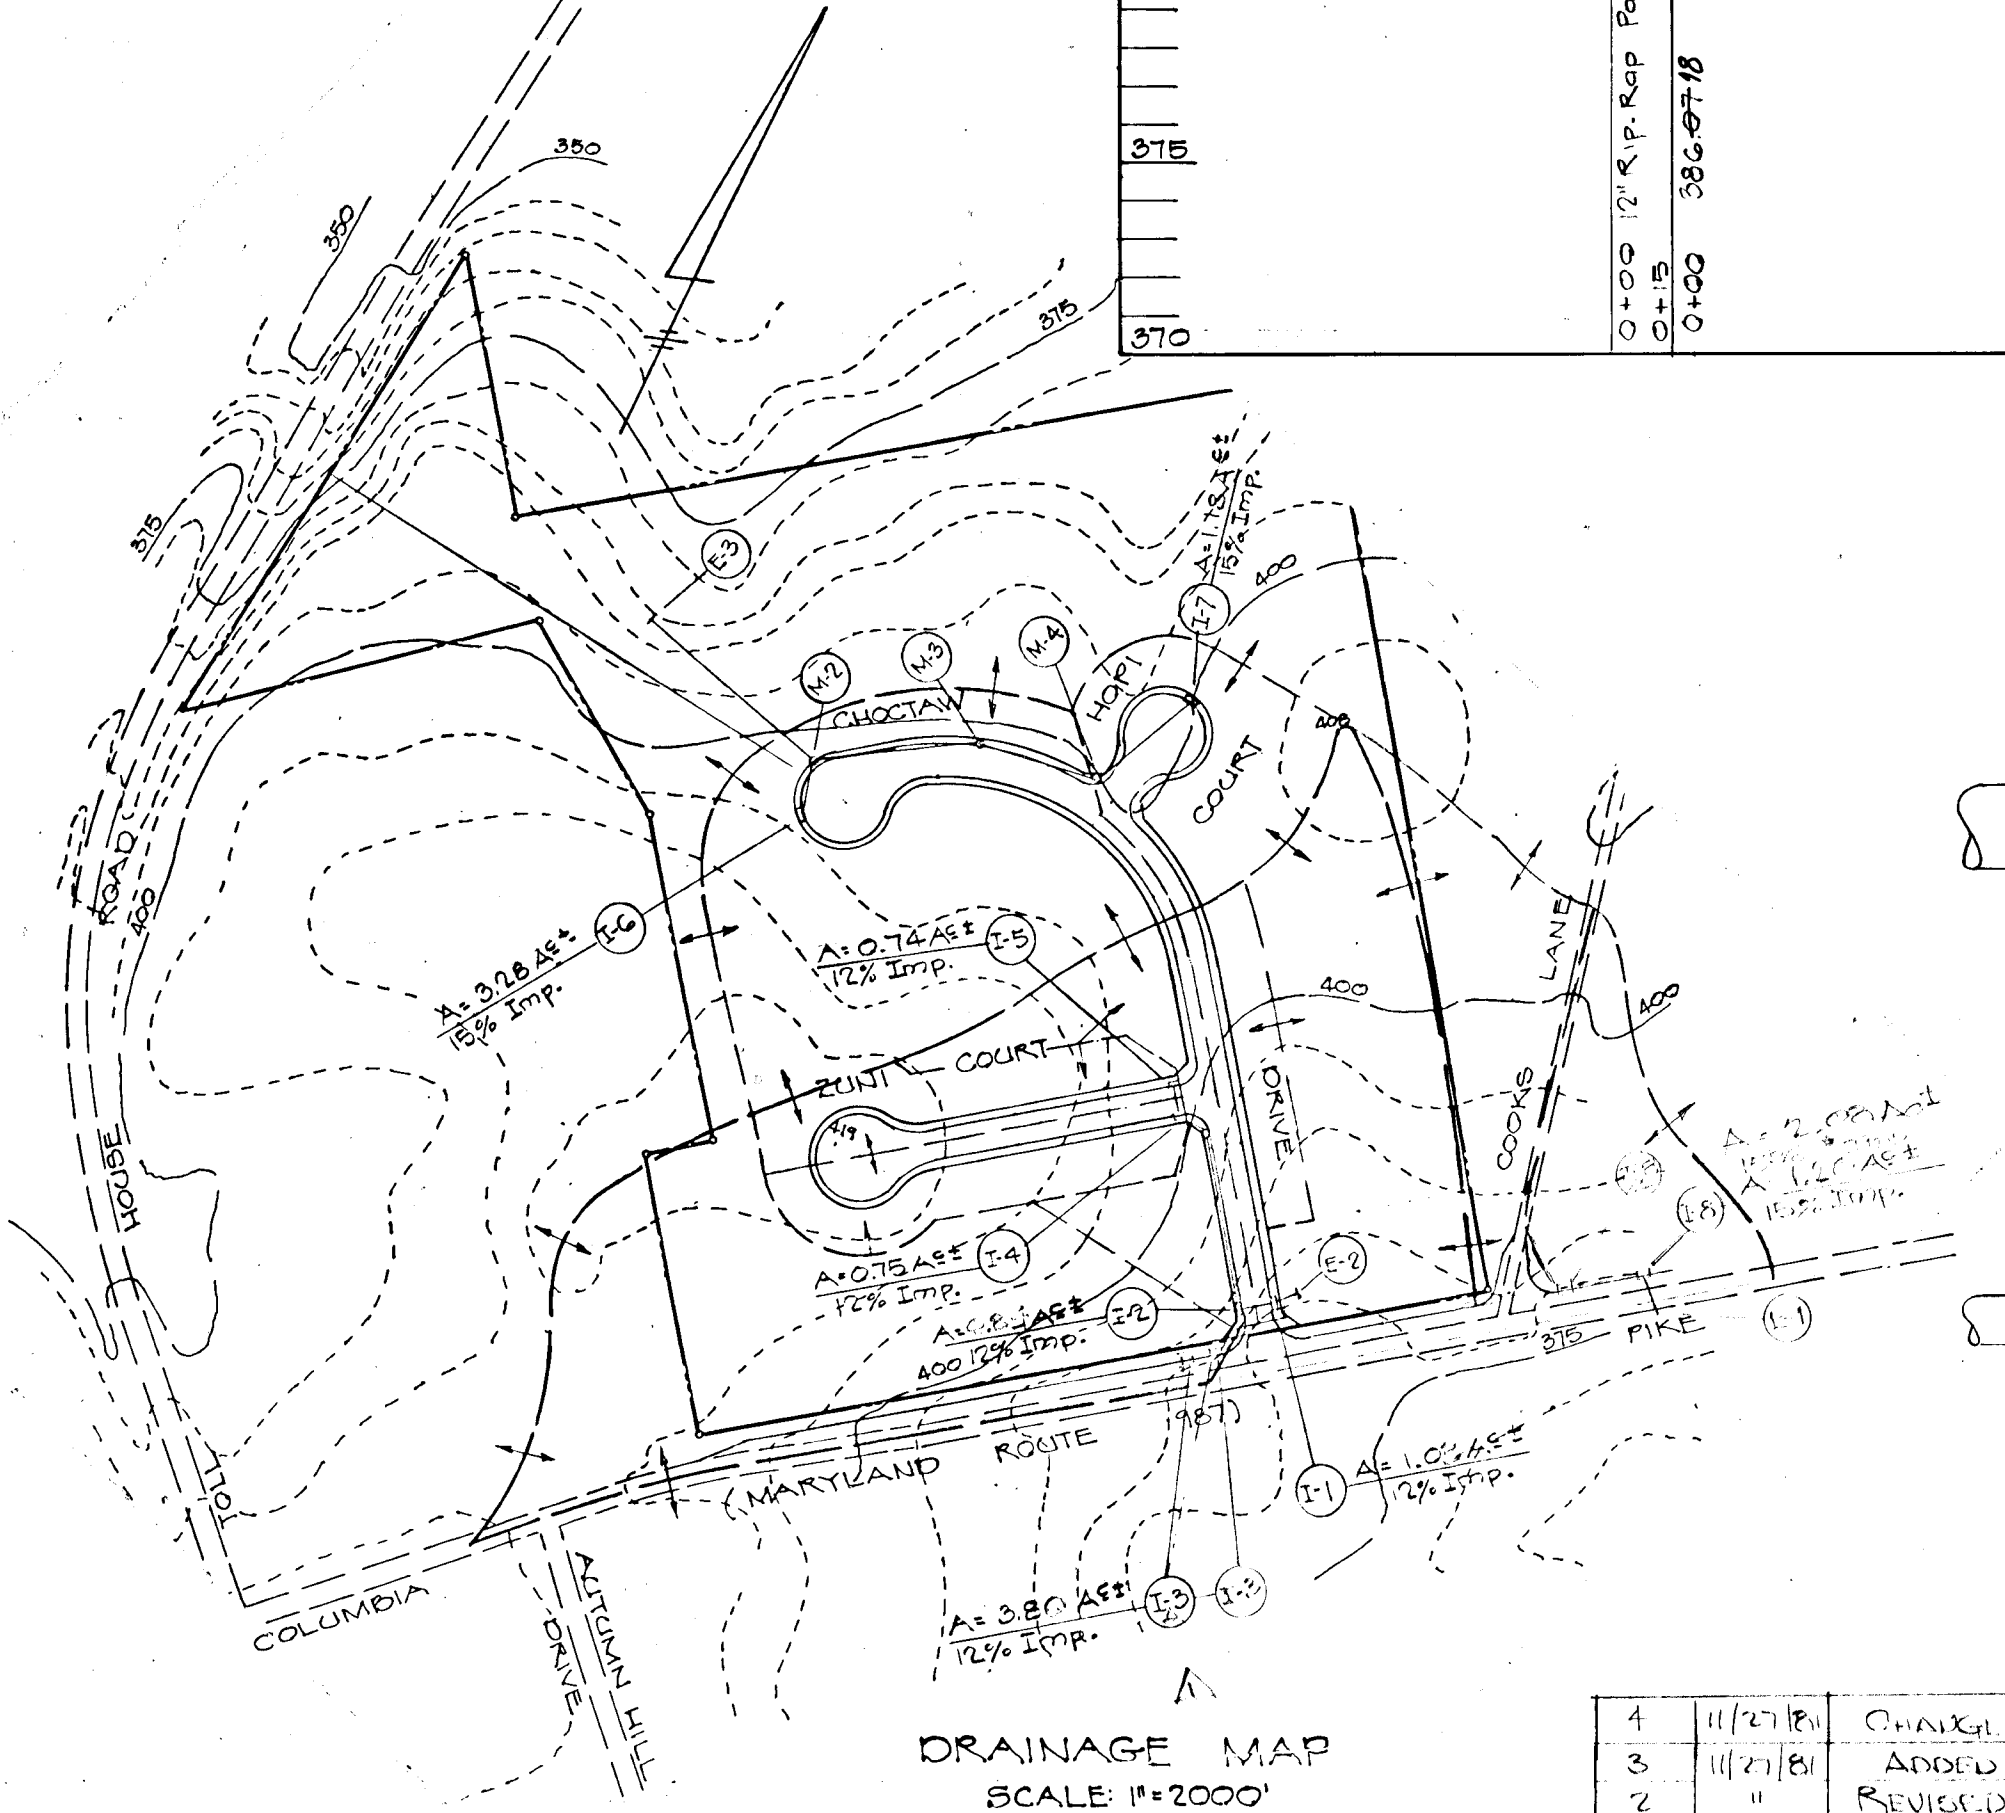


DRAINAGE MAP
SCALE: 1"=2000'

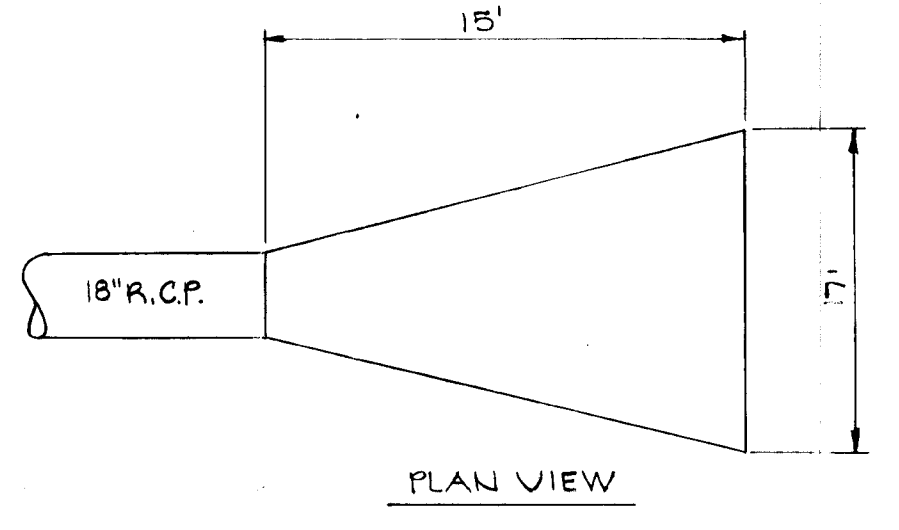

PLAN VIEW

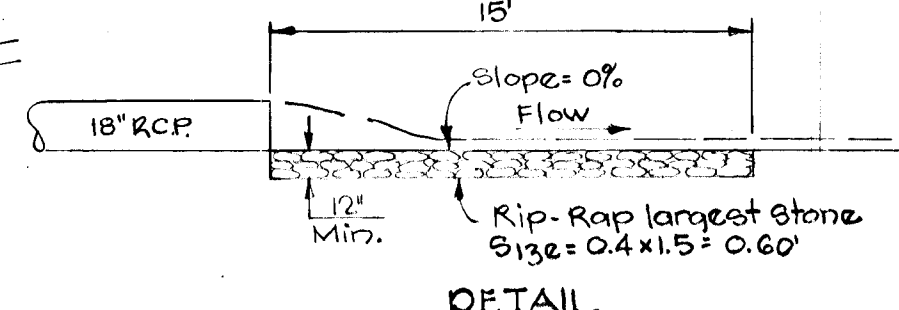

DETAIL OUTLET PROTECTION
NO SCALE

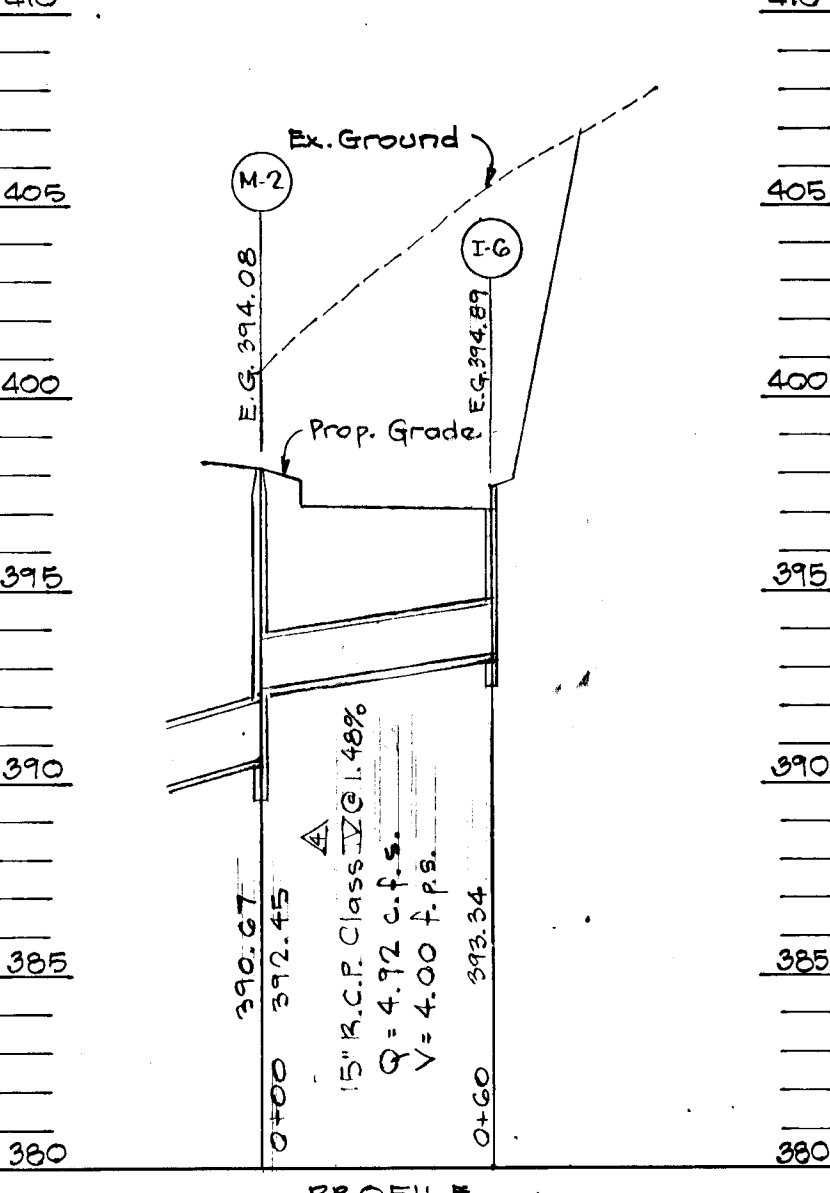

PROFILE
SCALE: HOR. 1"=50'
VERT. 1"=5'

STRUCTURE SCHEDULE						
No.	TYPE	LOCATION	INV. IN	INV. OUT	TOP ELEV.	REMARKS
E-2	C ENDWALL	SEE PLAN & PROFILE	-	378.30	380.55	DWG. D-52, PG. 107
I-1	A-10 W/UTRUTICS	STA. 1100+00 TO 1100+100 CHOCOLAY DRIVE	382.20	382.00	381.87	DWG. D-64A, PG. 119A
I-2	A-10 W/UTRUTICS	STA. 1100+100 TO 1100+200 CHOCOLAY DRIVE	382.90	382.71	381.87	DWG. D-64A, PG. 119A
I-3	A-10 W/UTRUTICS	STA. 1100+200 TO 1100+300 CHOCOLAY DRIVE	384.23	384.08	383.00	DWG. D-64A, PG. 119A
M-1	SHALLOW MH.	STA. 1100+00 TO 1100+100 CHOCOLAY DRIVE	372.44	372.02	375.75	SEE DETAIL
I-4	A-10	STA. 1100+100 TO 1100+200 CHOCOLAY DRIVE	375.01	375.01	377.58	DWG. D-64A, PG. 119A
I-5	A-10	STA. 1100+200 TO 1100+300 CHOCOLAY DRIVE	376.10	376.10	379.58	DWG. D-64A, PG. 119A
E-3	C ENDWALL	SEE PLAN & PROFILE	-	386.01	388.92	DWG. D-52, PG. 107
M-2	DROP MANHOLE	STA. 1100+00 TO 1100+100 CHOCOLAY DRIVE	372.45	370.07	388.00	DWG. D-104, PG. 157
I-6	A-10	STA. 1100+100 TO 1100+200 CHOCOLAY DRIVE	-	373.34	377.68	DWG. D-64A, PG. 119A
M-3	STD. MANHOLE	STA. 1100+00 TO 1100+100 CHOCOLAY DRIVE	373.92	373.92	377.24	DWG. D-103, PG. 158
M-4	STD. MANHOLE	STA. 1100+100 TO 1100+200 CHOCOLAY DRIVE	373.97	373.97	400.73	DWG. D-103, PG. 158
I-7	A-10	STA. 1100+200 TO 1100+300 CHOCOLAY DRIVE	-	374.07	378.65	DWG. D-64A, PG. 119A
I-2A	A-10 W/UTRUTICS	STA. 1100+00 TO 1100+100 CHOCOLAY DRIVE	-	381.43	385.00	DWG. D-64A, PG. 119A

DEVELOPER
D & G ASSOCIATES
906 BELAIR ROAD
BALTIMORE, MARYLAND 21236


ENGINEERS
HUDKINS ASSOCIATES, INC.
100 N. MAIN ST. BELAIR, MD. 21014
800-2808 370-3117

AS-BUILT SURVEY CERTIFIED BY
WILLIAM H. NOYES, JR., MD. P.E.
NO. 13719, ON 10-2-87.

STORM DRAIN PROFILES
"KEYWAYDIN"
ELECT. DIST. NO. 2 HOWARD CO., MD.
SCALE: AS SHOWN SHEET 4 OF 11

HOWARD COUNTY, MARYLAND
DEPARTMENT OF PUBLIC WORKS

Richard S. Riley 4-23-88
CHIEF, BUREAU OF ENGINEERING
OFFICE OF PLANNING & ZONING
DATE: 4-23-88
W. H. Noyes, Jr.
CHIEF, DIVISION OF LAND DEVELOPMENT

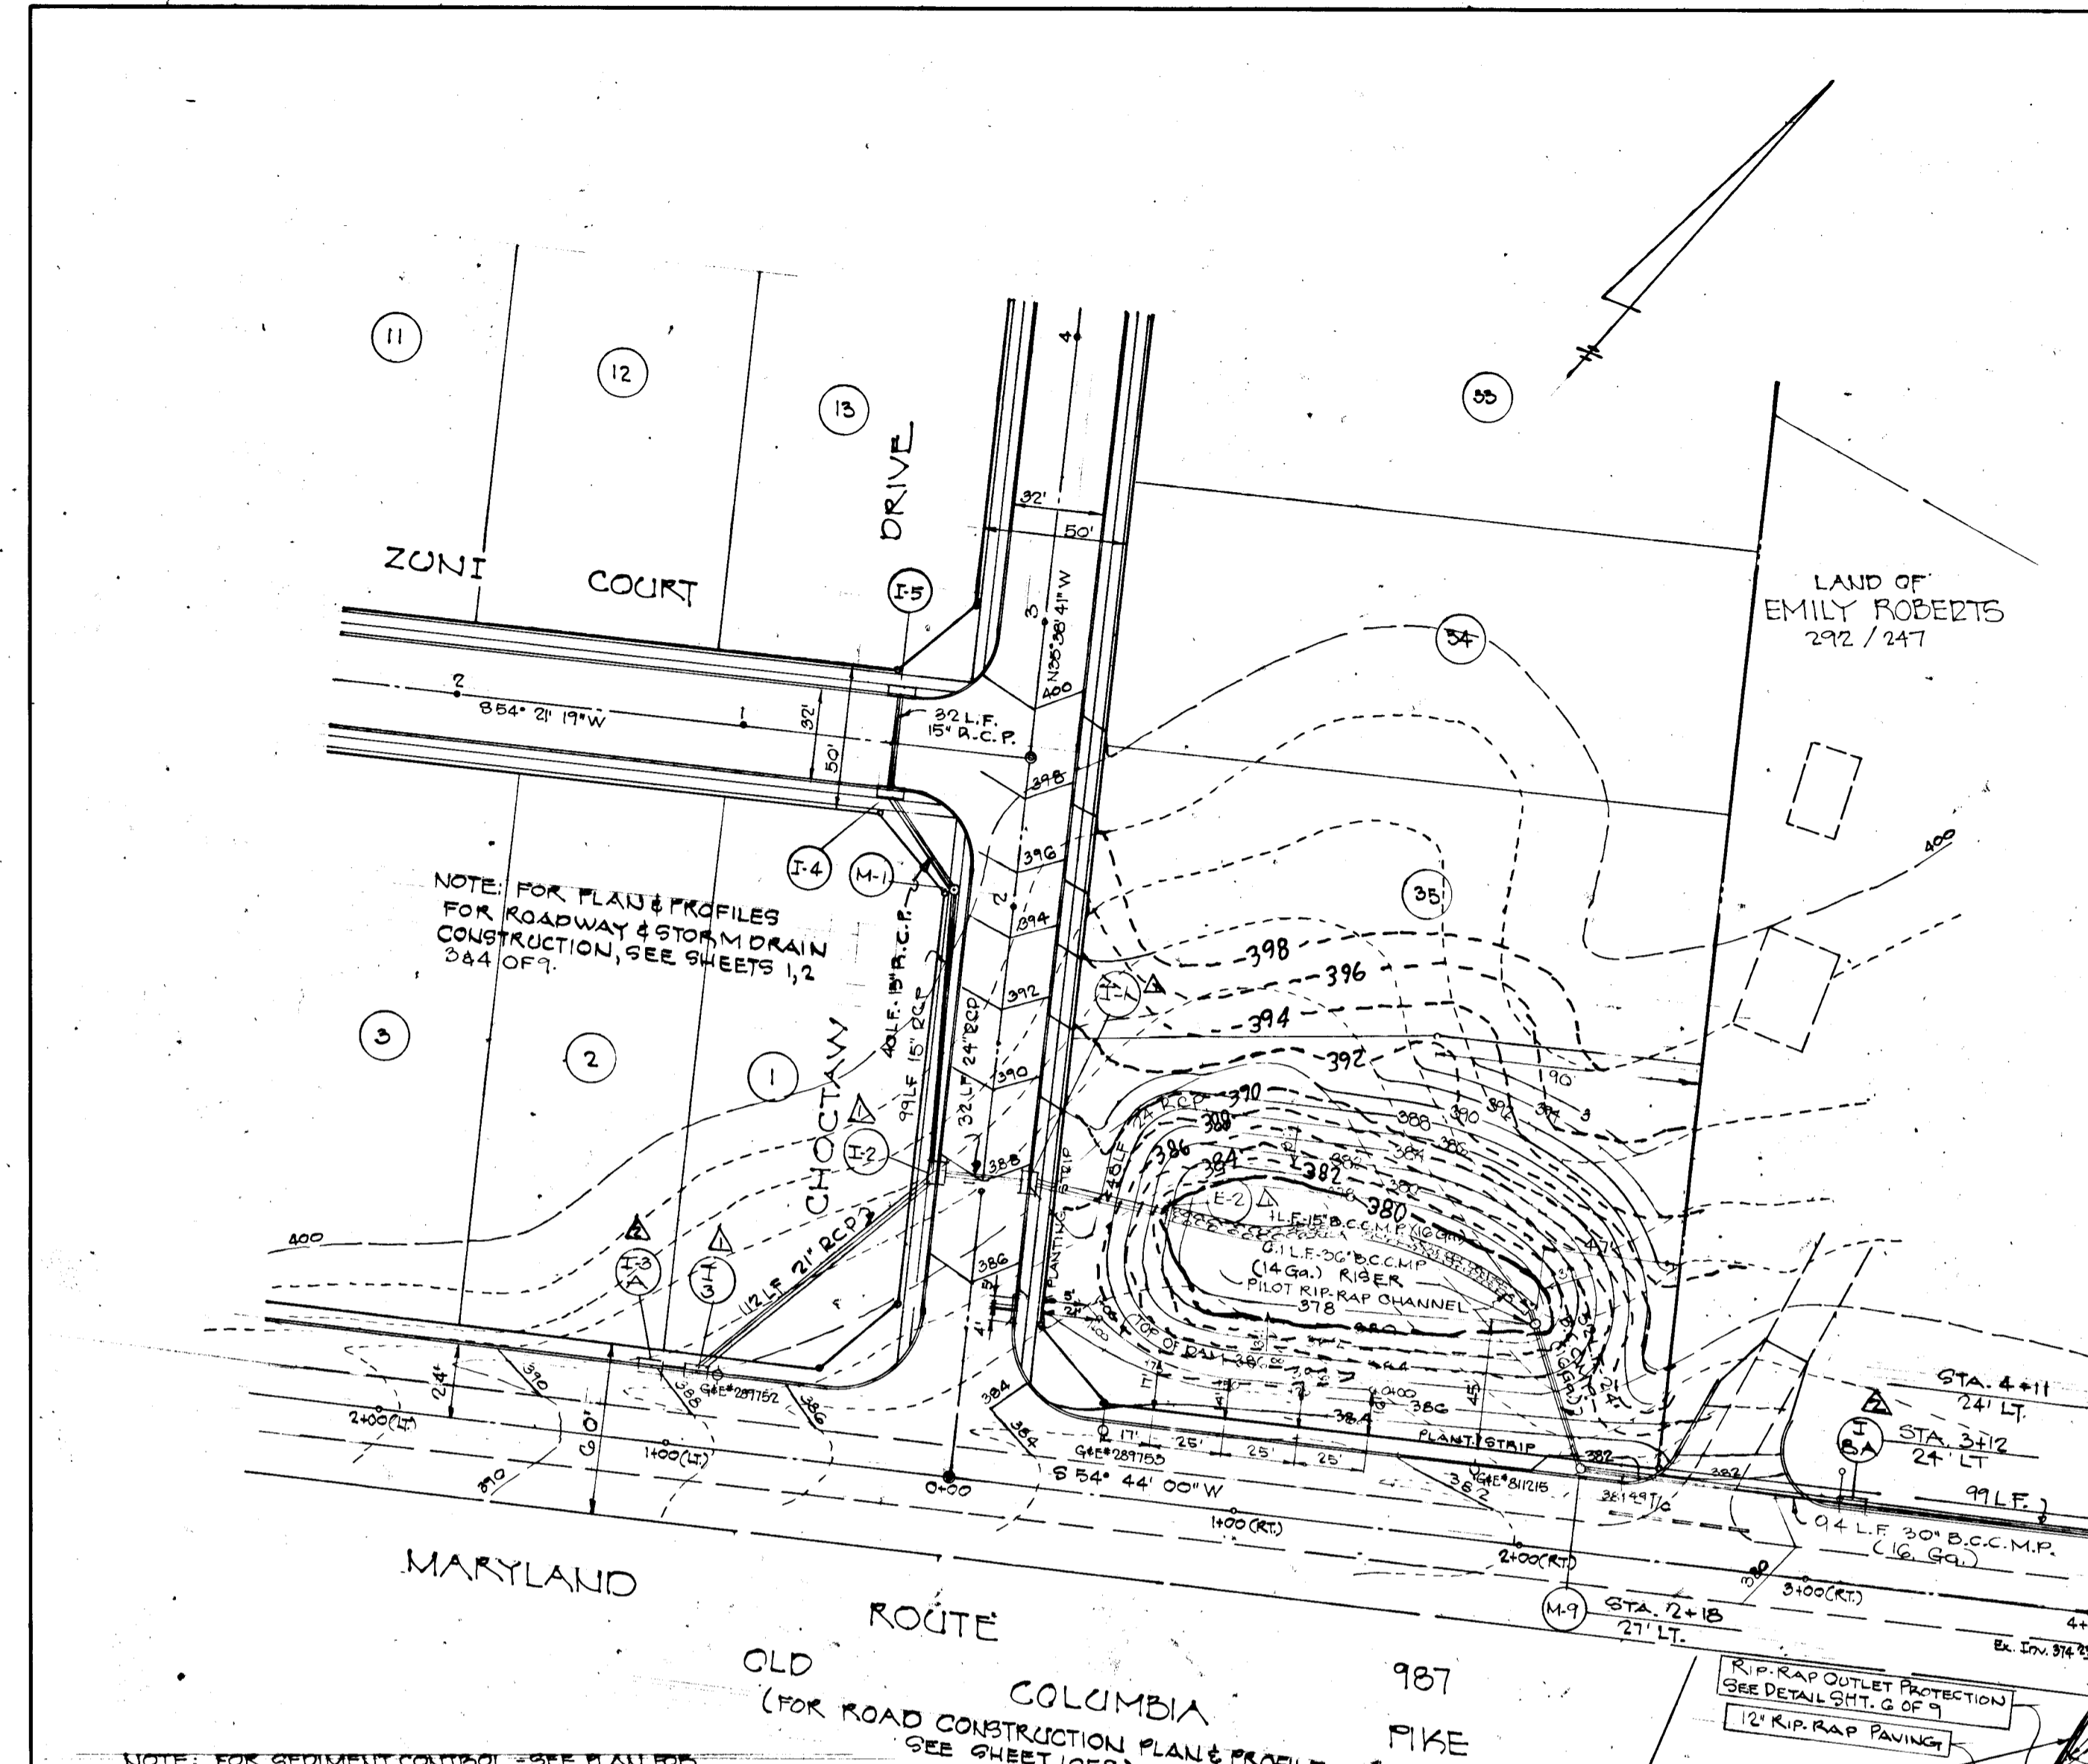

I CERTIFY THAT ALL DEVELOPMENT AND/OR CONSTRUCTION WILL BE DONE ACCORDING TO THESE PLANS OF DEVELOPMENT, POND CONSTRUCTION AND EROSION AND SEDIMENT CONTROL. I ALSO AUTHORIZE PERIODIC ON-SITE INSPECTION BY THE HOWARD SOIL CONSERVATION DISTRICT OR THEIR AUTHORIZED AGENTS, AS AFE DEEMED NECESSARY. DEVIATION FROM THIS PLAN WILL NOT BE MADE UNLESS AUTHORIZED BY THE HOWARD SOIL CONSERVATION DISTRICT. I WILL PROVIDE THE HOWARD SOIL CONSERVATION DISTRICT WITH A RED-LINED "AS BUILT" OF THE POND WITHIN 30 DAYS OF COMPLETION.

William H. Naves, Jr. 1/2/80 DATE
 B & G ASSOCIATES, JACK T. GIBSON-PARTNER

I CERTIFY THAT THIS PLAN FOR POND CONSTRUCTION, EROSION, AND SEDIMENT CONTROL REPRESENTS A PRACTICAL AND WORKABLE PLAN BASED ON MY PERSONAL KNOWLEDGE OF THE SITE CONDITIONS. THIS PLAN WAS PREPARED IN ACCORDANCE WITH THE REQUIREMENTS OF THE HOWARD SOIL CONSERVATION DISTRICT. I HAVE NOTIFIED THE DEVELOPER THAT HE MUST PROVIDE THE HOWARD SOIL CONSERVATION DISTRICT WITH A RED-LINED "AS BUILT" OF THE POND WITHIN 30 DAYS OF COMPLETION.

Howard S. C. Ziem 4-21-80 DATE
 HOWARD S. C. ZIEM




THESE PLANS HAVE BEEN REVIEWED FOR THE HOWARD SOIL CONSERVATION DISTRICT AND MEET THE TECHNICAL REQUIREMENTS FOR SMALL POND CONSTRUCTION, SOIL EROSION AND SEDIMENT CONTROL.

J. Helen B. E. 4-21-80 DATE
 U.S. SOIL CONSERVATION SERVICE

THESE PLANS FOR SMALL POND CONSTRUCTION, SOIL EROSION AND SEDIMENT CONTROL MEET THE REQUIREMENTS OF THE HOWARD SOIL CONSERVATION DISTRICT.

Robert W. Ziem 4-21-80 DATE
 HOWARD S. C. ZIEM

PLAN NUMBER

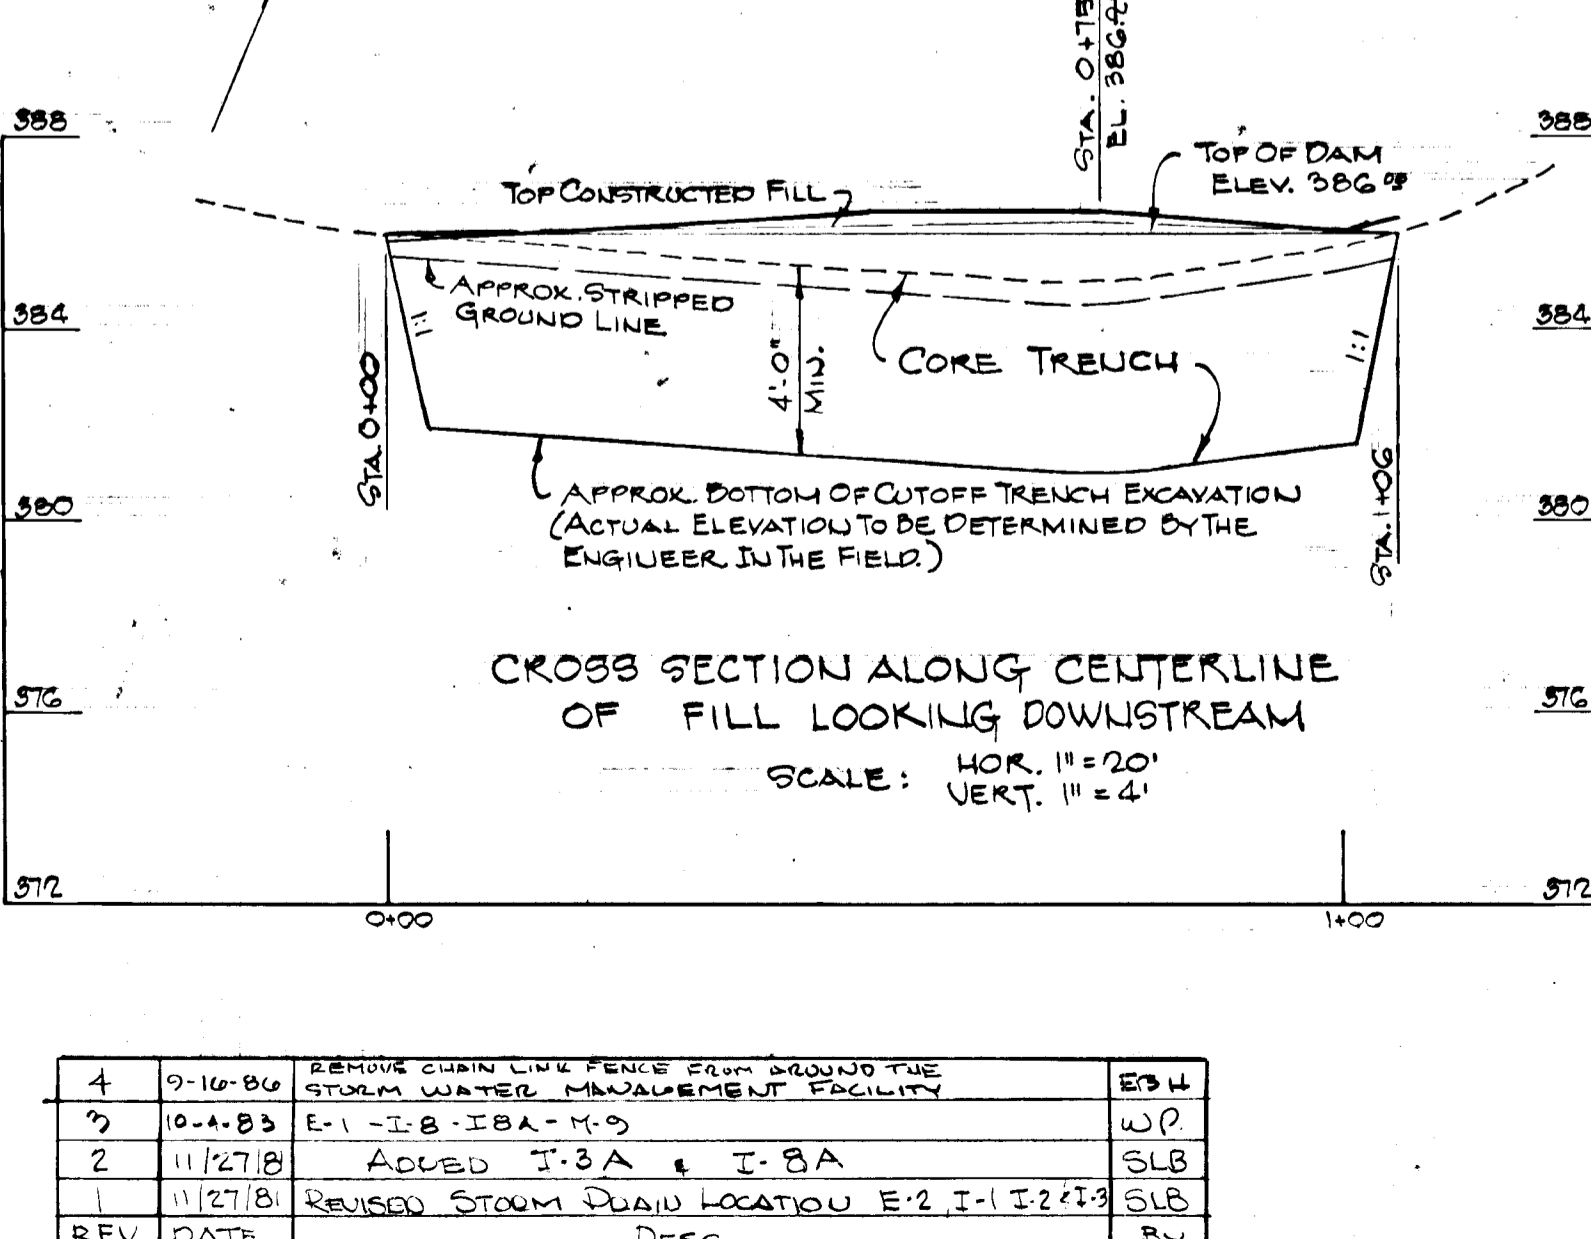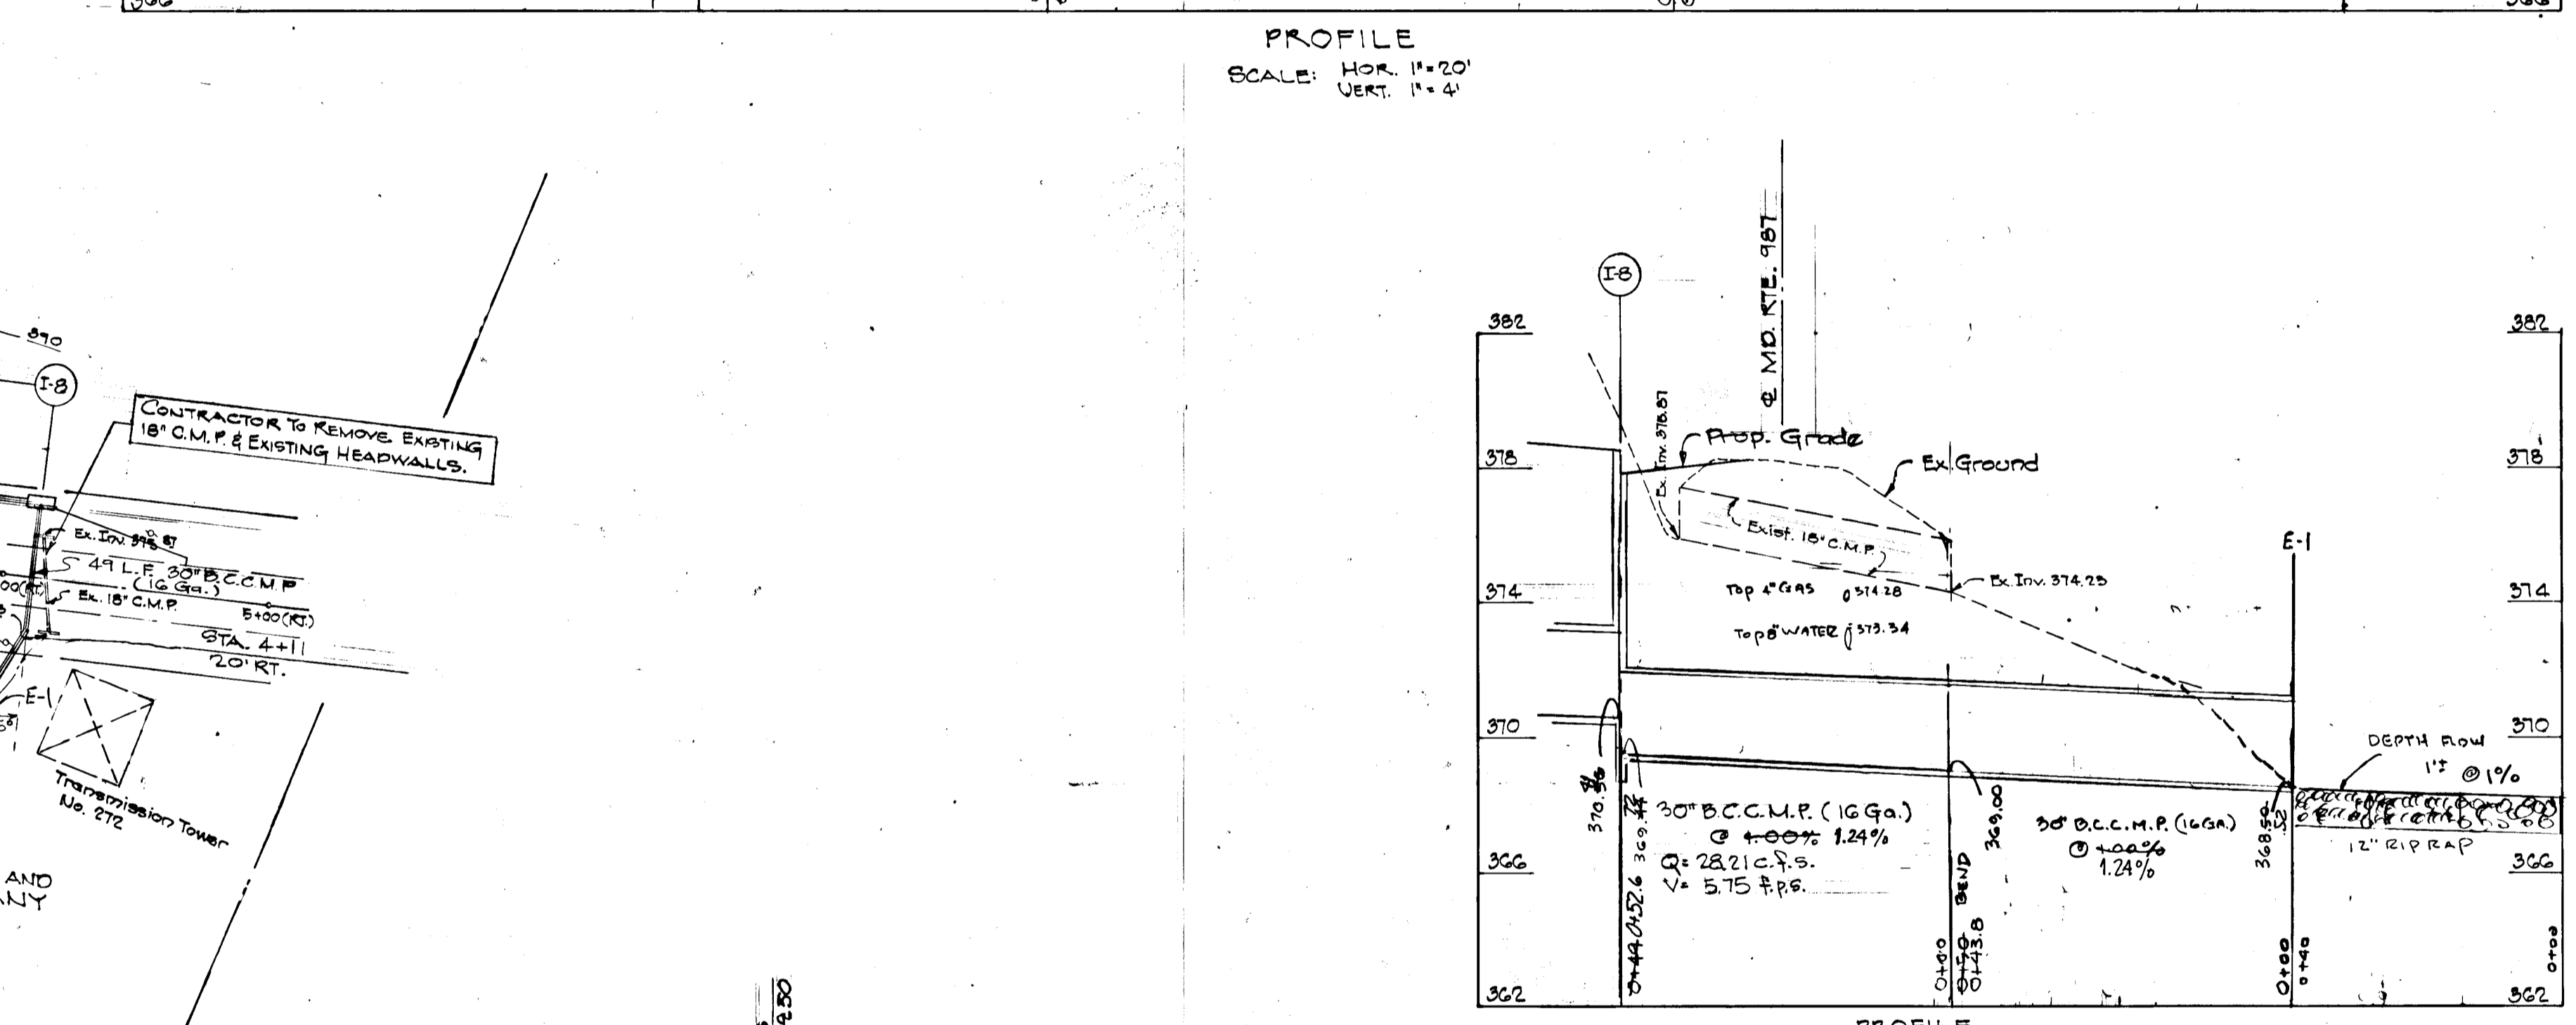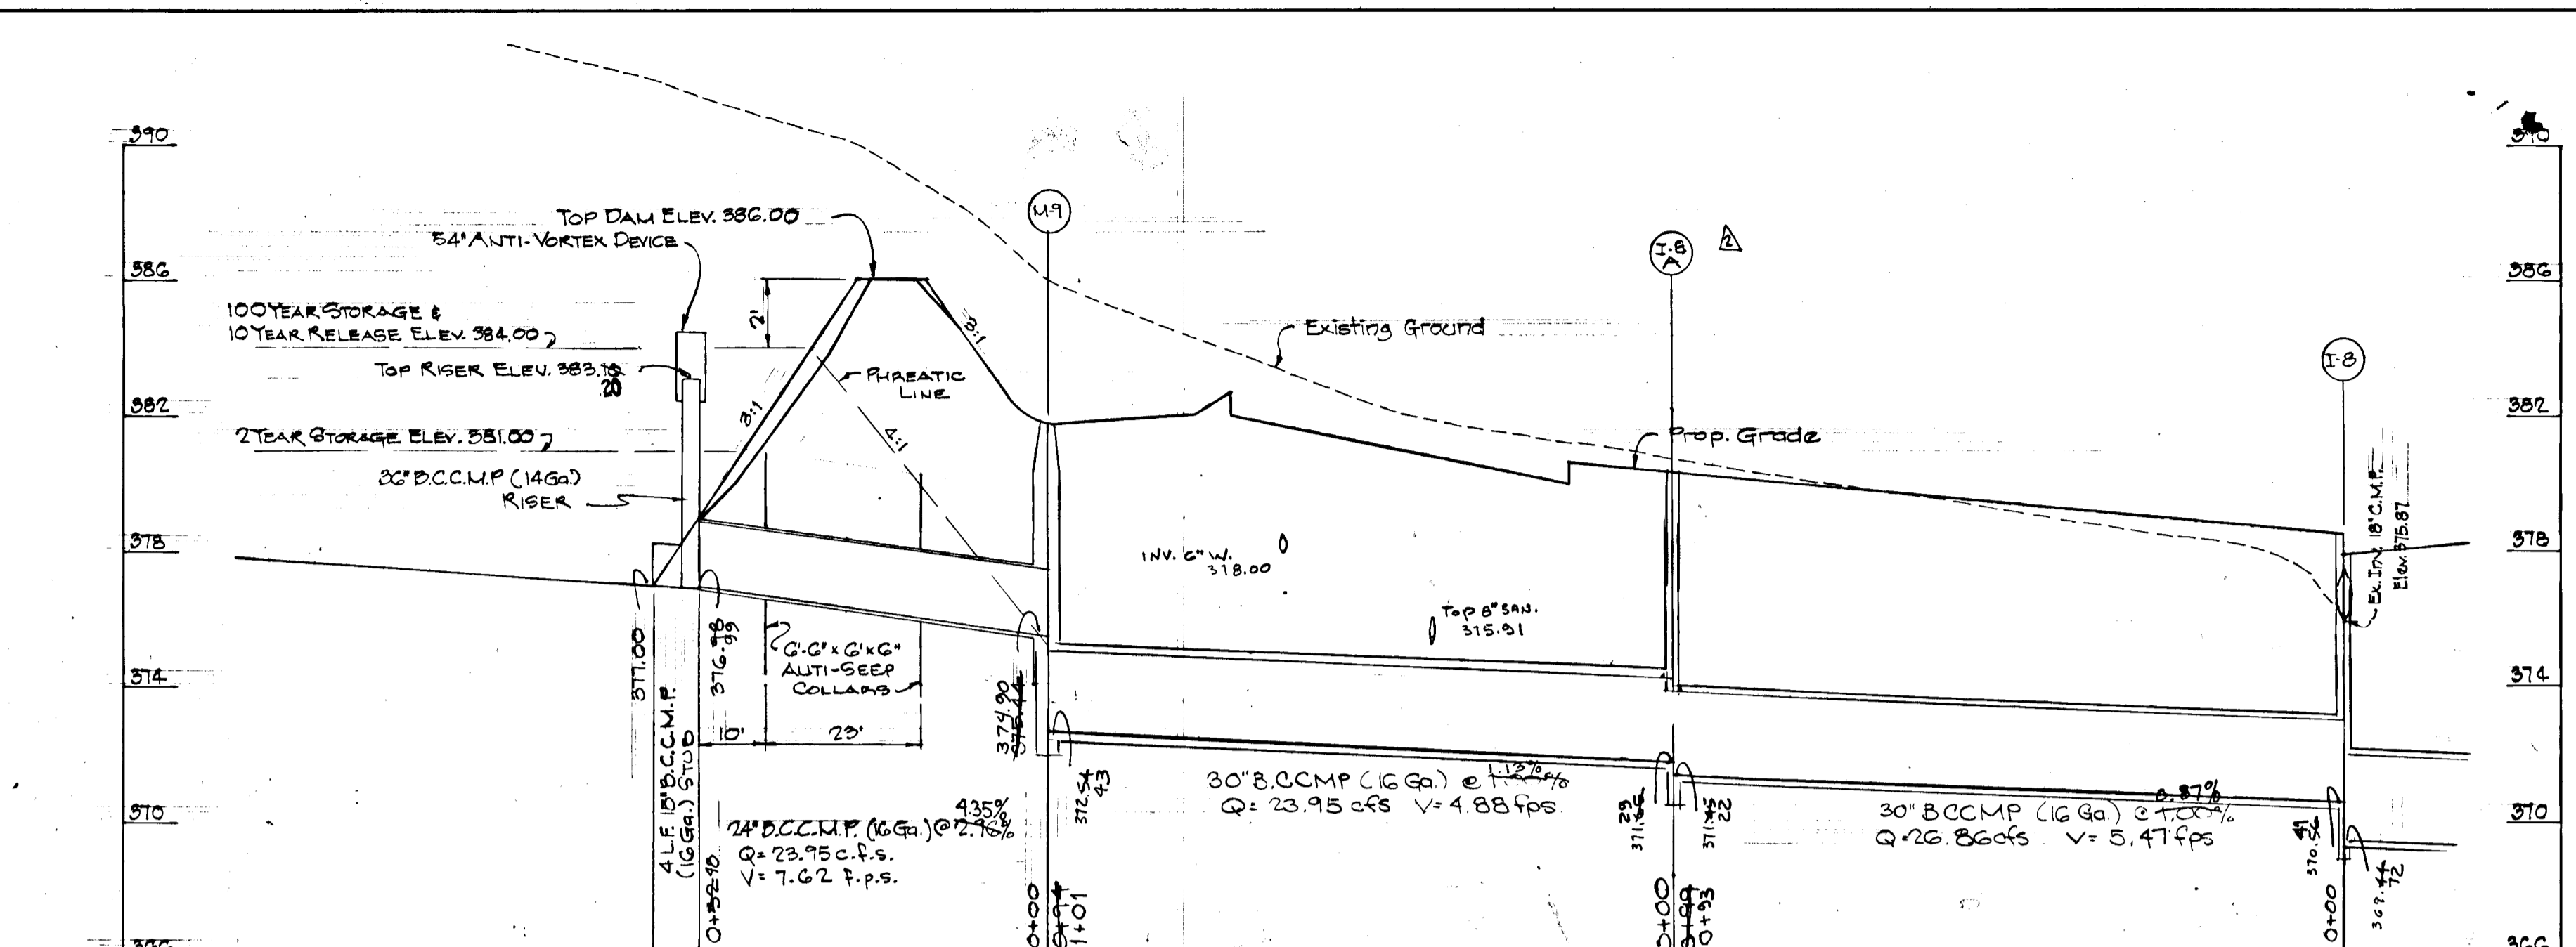

No.	TYPE	LOCATION	INV. IN	INV. OUT	TOP ELEV.	REMARKS
E-1	'C' ENDWALL	STA. 2+85.10 RT. MD. RTE. 987	368.50			DWG. D-52, PG. 107
I-B	A-10" DEFLECTOR	STA. 4+11.24 LT. MD. RTE. 987	370.50	369.44	378.45	DWG. D-44A, PG. 119A
M-9	STD. MANHOLE	STA. 2+18.23 LT. MD. RTE. 987	375.44	372.54	381.80	DWG. D-103, PG. 158
I-8A	A-10" W/DEFLECTORS	STA. 3+12.24 LT. MD. RTE. 987	371.05	371.45	380.40	DWG. D-103, PG. 158

DEVELOPER
 B & G ASSOCIATES
 9006 BELAIR ROAD
 BALTIMORE, MARYLAND 21286

ENGINEERS
 HUKKUS ASSOCIATES, INC.
 100 W. MAIN ST. 3EL AIR, MD. 21014
 828-0888 819-8117

AS-BUILT SURVEY CERTIFIED BY
 WILLIAM H. NAVES, JR., MD. PE.
 NO. 33712 ON 10-2-87.

STORM WATER MANAGEMENT POND - NO. I "KEYWAYDIN"
 ELECT. DIST. NO. 2 HOWARD CO., MD.
 SCALE: AS SHOWN SHEET 5 OF 11

HOWARD COUNTY, MARYLAND
 DEPARTMENT OF PUBLIC WORKS
 CHIEF, BUREAU OF HIGHWAYS
 OFFICE OF PLANNING & ZONING
 CHIEF, DIVISION OF LAND DEVELOPMENT

REV	DATE	DESC	BY
4	9-16-80	REMOVE CURB AND FENCE FROM AROUND THE STORM WATER MANAGEMENT FACILITY	EDH
3	10-4-80	E-1 - I-B - I-8A - M-9	W.P.
2	11-27-80	ADD I-8A & I-8A	SLB
1	11-27-80	REVISED STORM DRAIN LOCATION E-2 I-1 I-2 I-3	SLB

SITE PREPARATIONS

AREAS UNDER THE BORROW AREAS, EMBANKMENT, AND STRUCTURAL WORKS SHALL BE CLEARED, GRUBBED AND THE TOPSOIL STRIPPED TO REMOVE ALL TREES, VEGETATION, ROOTS OR OTHER OBJECTIONAL MATERIAL. CHANNEL BANKS AND SHARP BREAKS SHALL BE SLOPED TO NO STEEPER THAN 1:1.

AREAS COVERED BY THE POND OR RESERVOIR WILL BE CLEARED OF ALL TREES, BRUSH, LOGS, FENCES, RUBBISH AND OTHER OBJECTIONAL MATERIAL UNLESS OTHERWISE DESIGNATED ON THE PLANS. TREES, BRUSH AND STUMPS SHALL BE CUT APPROXIMATELY LEVEL WITH GROUND SURFACE.

ALL CLEARED AND GRUBBED MATERIAL SHALL BE DEPOSED OUTSIDE THE LIMITS OF THE DAM AND RESERVOIR AS DIRECTED BY THE OWNER OR HIS REPRESENTATIVE. WHEN SPECIFIED, A SUFFICIENT QUANTITY OF TOPSOIL WILL BE STOCKPILED IN A SUITABLE LOCATION FOR USE ON THE EMBANKMENT AND OTHER DESIGNATED AREAS.

EARTH FILL

MATERIAL

THE FILL MATERIAL SHALL BE TAKEN FROM APPROVED DESIGNATED AREA OR AREAS. IT SHALL BE FREE OF ROOTS, STUMPS, WOOD, RUBBISH, OVER-SIZE STONES, FROZEN OR OTHER OBJECTIONAL MATERIALS. THE EMBANKMENT SHALL BE CONSTRUCTED TO AN ELEVATION WHICH PROVIDES FOR ANTICIPATED SETTLEMENT TO THE DESIGN ELEVATION. THE FILL HEIGHT ALL ALONG THE LENGTH OF THE EMBANKMENT SHALL BE INCREASED ABOVE THE DESIGN ELEVATION (INCLUDING FREEBOARD) AS SHOWN ON THE PLANS.

PLACEMENT

AREAS ON WHICH FILL IS TO BE PLACED SHALL BE SCARIFIED PRIOR TO PLACEMENT OF FILL. MATERIALS SHALL BE PLACED IN 8-INCH MAXIMUM THICKNESS (BEFORE COMPACTION) LAYERS WHICH ARE TO BE CONTINUOUS OVER THE ENTIRE LENGTH OF THE FILL. THE MOST FAVORABLE MATERIAL SHALL BE PLACED IN THE DOWNSTREAM PORTIONS OF THE EMBANKMENT.

COMPACTION

THE MOVEMENT OF THE HAULING AND SPREADING EQUIPMENT OVER THE FILL SHALL BE CONTROLLED SO THAT THE ENTIRE SURFACE OF EARTH LIFT SHALL BE TRAVERSED BY NOT LESS THAN ONE TREAD TRACK OF THE EQUIPMENT OR COMPACTION SHALL BE ACHIEVED BY A MINIMUM OF FOUR COMPLETE PASSES OF A SHEEPFOOT, RUBBER TIRE OR VIBRATORY ROLLER. FILL MATERIAL SHALL CONTAIN SUFFICIENT MOISTURE SUCH THAT THE REQUIRED DEGREE OF COMPACTION CAN BE OBTAINED WITH THE EQUIPMENT USED. ALL COMPACTION TO BE 95%.

CUT-OFF TRENCH

WHERE SPECIFIED, A CUT OFF TRENCH SHALL BE EXCAVATED ALONG OR PARALLEL TO THE CENTER-LINE OF THE EMBANKMENT AS SHOWN ON THE PLANS. THE BOTTOM WIDTH OF THE TRENCH SHALL BE GOVERNED BY THE EQUIPMENT USED FOR EXCAVATION, WITH THE MINIMUM WIDTH BEING FOUR FEET. THE DEPTH SHALL BE AT LEAST FOUR FEET OR AS SHOWN ON THE PLANS. THE SIDE SLOPES OF THE TRENCH SHALL BE 1 TO 1 OR FLATTER. THE BACKFILL MATERIAL FOR THE CUT OFF TRENCH SHALL BE THE MOST IMPERVIOUS MATERIAL AVAILABLE AND SHALL BE COMPACTED WITH EQUIPMENT OR ROLLERS TO ASSURE MAXIMUM DENSITY AND MINIMUM PERMEABILITY.

STABILIZATION

ALL BORROW AREAS SHALL BE GRADED TO PROVIDE PROPER DRAINAGE AND LEFT IN A SLIGHTLY CONCAVED CONDITION. ALL EXPOSED SURFACES OF THE EMBANKMENT, SPILLWAY, SOIL AND BORROW AREAS, AND BERMS SHALL BE STABILIZED BY SEEDING, FERTILIZING AND MULCHING (IF REQUIRED) IN ACCORDANCE WITH THE VEGETATIVE TREATMENT SPECIFICATIONS SHOWN ON OR ACCOMPANYING THE DRAWINGS.

PIPE CONDUITS

A. CORRUGATED METAL PIPE

MATERIALS: (STEEL PIPE) THIS PIPE AND ITS APPURTENANCES SHALL BE GALVANIZED AND FULLY BITUMINOUS COATED AND SHALL CONFORM TO THE REQUIREMENTS OF A.A.S.H.T.O. SPECIFICATIONS M-190 TYPE A WITH WATER TIGHT COUPLING BANDS. ANY BITUMINOUS COATING DAMAGED OR OTHERWISE REMOVED SHALL BE REPLACED WITH COLD APPLIED BITUMINOUS COATING COMPOUND. (ALUMINUM PIPE) THIS PIPE AND ITS APPURTENANCES SHALL CONFORM TO THE REQUIREMENTS OF A.A.S.H.T.O. SPECIFICATIONS M-192 OR M-211 WITH WATER TIGHT COUPLING BANDS, COUPLING BANDS, ANTI-SEEP COLLARS, END SECTIONS, ETC. MUST BE COMPOSED OF THE SAME MATERIAL AS THE PIPE. METALS MUST BE INSULATED FROM DISSIMILAR MATERIALS WITH USE OF RUBBER OR PLASTIC INSULATING MATERIALS AT LEAST 24 MILS IN THICKNESS. ALUMINUM SURFACES THAT ARE TO BE IN CONTACT WITH CONCRETE SHALL BE PAINTED WITH ONE COAT OF ZINC CHROMATE PRIMER. HOT DIP GALVANIZED BOLTS MAY BE USED FOR CONNECTIONS. THE PH OF THE SURROUNDING SOILS SHALL BE LESS THAN 9 AND GREATER THAN 4. HELICALLY CORRUGATED PIPE IN ADDITION TO THE REQUIREMENTS ABOVE SHALL HAVE EITHER CONTINUOUSLY WELDED SEAMS OR HAVE LOCK SEAMS WHICH ARE CAULKED, DURING FABRICATION, WITH NEOPRENE BEAD.

- CONNECTIONS:** ALL CONNECTIONS WITH PIPES MUST BE COMPLETELY WATER TIGHT. THE DRAIN PIPE OR DRAIN CONNECTION TO THE RISER SHALL BE WELDED ALL AROUND WHEN THE PIPE AND RISER ARE METAL. WATER TIGHT COUPLING BANDS SHALL BE USED AT ALL JOINTS. ANTI-SEEP COLLARS SHALL BE CONNECTED TO THE PIPE IN SUCH A MANNER AS TO BE COMPLETELY WATER TIGHT.
- SEEDING:** THE PIPE SHALL BE FIRMLY AND UNIFORMLY SEEDED THROUGHOUT ITS ENTIRE LENGTH. WHERE ROCK OR SOFT, SPOGY OR OTHER UNSTABLE SOIL IS ENCOUNTERED, ALL SUCH MATERIAL SHALL BE REMOVED AND REPLACED WITH SUITABLE EARTH COMPACTED TO PROVIDE ADEQUATE SUPPORT.
- LAYING PIPE:** THE PIPE SHALL BE PLACED WITH INSIDE CIRCUMFERENTIAL LAPS POINTING DOWNSTREAM AND WITH LONGITUDINAL LAPS AT THE SIDES.
- BACKFILLING:** SHALL CONFORM TO STRUCTURAL BACKFILL AS SHOWN ABOVE
- OTHER DETAILS:** (ANTI-SEEP COLLARS, VALVES, ETC.) SHALL BE AS SHOWN ON THE DRAWINGS.

THESE PLANS HAVE BEEN REVIEWED FOR THE HOWARD SOIL CONSERVATION DISTRICT AND MEET THE TECHNICAL REQUIREMENTS FOR SMALL POND CONSTRUCTION, SOIL EROSION AND SEDIMENT CONTROL.

J. Helm, P.E. 4-21-80
 U.S. SOIL CONSERVATION SERVICE DATE

THESE PLANS FOR SMALL POND CONSTRUCTION, SOIL EROSION AND SEDIMENT CONTROL MEET THE REQUIREMENTS OF THE HOWARD SOIL CONSERVATION DISTRICT.

APPROVED: Robert Helm 4-21-80
 HOWARD S.C.D. DATE

PLAN NUMBER

CONCRETE

1. MATERIALS

- CEMENT:** NORMAL PORTLAND CEMENT SHALL CONFORM TO THE LATEST ASTM SPECIFICATION C-150.
- WATER:** THE WATER USED IN CONCRETE SHALL BE CLEAN, FREE FROM OIL, ACID, ALKALI, SCALES, ORGANIC MATTER OR OTHER OBJECTIONAL SUBSTANCES.
- SAND:** THE SAND USED IN CONCRETE SHALL BE CLEAN, HARD, STRONG AND DURABLE, AND SHALL BE GRADED WITH 100 PERCENT PASSING A ONE-QUARTER INCH SIEVE. LIMESTONE SAND SHALL NOT BE USED.
- COURSE AGGREGATE:** THE COURSE AGGREGATE SHALL BE CLEAN, HARD, STRONG, DURABLE, AND FREE FROM CLAY OR DIRT. IT SHALL BE WELL GRADED WITH A MAXIMUM SIZE OF ONE AND ONE-HALF (1-1/2) INCHES.
- REINFORCING STEEL:** THE REINFORCING STEEL SHALL BE DEFORMED BARS OF INTERMEDIATE GRADE BILLET STEEL OR RAIL STEEL CONFORMING TO A.S.T.M. SPECIFICATION A-36.



2. DESIGN MIX

THE CONCRETE SHALL BE MIXED IN THE FOLLOWING PROPORTIONS, MEASURED BY WEIGHT. THE WATER-CEMENT RATIO SHALL BE 5-7/8 TO 6 U.S. GALLONS OF WATER, PER 94 POUNDS OF CEMENT. THE PROPORTION OF MATERIALS FOR THE TRIAL MIX SHALL BE 1:2-3/4. THE COMBINATION OF AGGREGATES MAY BE ADJUSTED TO PRODUCE A PLASTIC AND WORKABLE MIX THAT WILL NOT PRODUCE HARSHNESS IN PLACING OR HONEYCOMBING IN THE STRUCTURE.

- MIXING:** THE CONCRETE INGREDIENTS SHALL BE MIXED IN BATCH MIXERS UNTIL THE MIXTURE IS HOMOGENEOUS AND OF UNIFORM CONSISTENCY. THE MIXING OF EACH BATCH SHALL CONTINUE FOR NOT LESS THAN ONE AND ONE-HALF MINUTES AFTER ALL THE INGREDIENTS, EXCEPT THE FULL AMOUNT OF WATER, ARE IN THE MIXER. THE MINIMUM MIXING TIME IS PREDICTED ON PROPER CONTROL OF THE SPEED OF ROTATION OF THE MIXER AND OF THE INTRODUCTION OF THE MATERIALS, INCLUDING WATER, INTO THE MIXER. WATER SHALL BE ADDED PRIOR TO, DURING, AND FOLLOWING THE MIXER CHANGING OPERATIONS. EXCESSIVE OVER MIXING REQUIRING THE ADDITION OF WATER TO PRESERVE THE REQUIRED CONCRETE CONSISTENCY SHALL NOT BE PERMITTED. TRUCK MIXING WILL BE ALLOWED PROVIDED THAT THE USE OF THIS METHOD SHALL CAUSE NO VIOLATION OF ANY APPLICABLE PROVISIONS OF THE SPECIFICATIONS GIVEN HERE.
- FORMS:** THE FORMS SHALL HAVE SUFFICIENT STRENGTH AND RIGIDITY TO HOLD THE CONCRETE AND TO WITHSTAND THE NECESSARY PRESSURE, TAMPING AND VIBRATION WITHOUT DEFLECTION FROM THE PRESCRIBED LINES. THEY SHALL BE WORKMAN-TIGHT AND CONSTRUCTED SO THAT THEY CAN BE REMOVED WITHOUT HAMMERS OR PRYING AGAINST THE CONCRETE. THE INSIDE OF FORMS SHALL BE OILED WITH A NON-STAINING MINERAL OIL OR THOROUGHLY WETTED BEFORE CONCRETE IS PLACED. FORMS MUST BE REMOVED 24 HOURS AFTER THE PLACEMENT OF CONCRETE. ALL WIRE TIES AND OTHER DEVICES USED SHALL BE RECESSED FROM THE SURFACE OF THE CONCRETE.
- REINFORCING STEEL:** ALL REINFORCING MATERIAL SHALL BE FREE OF DIRT, RUST, SCALE, OIL, PAINT OR ANY OTHER COATINGS. THE STEEL SHALL BE ACCURATELY PLACED AND SECURELY TIED AND BLOCKED INTO POSITION SO THAT NO MOVEMENT OF THE STEEL WILL OCCUR DURING PLACEMENT OF CONCRETE.
- CONSOLIDATING:** CONCRETE SHALL BE CONSOLIDATED WITH INTERNAL TYPE MECHANICAL VIBRATORS. VIBRATION SHALL BE SUPPLEMENTED BY GRADING AND HAND TAMPING AS NECESSARY TO INSURE SMOOTH AND DENSE CONCRETE ALONG FORM SURFACES IN CORNERS, AND AROUND EMBEDDED ITEMS.
- FINISHING:** DEFECTIVE CONCRETE, HONEYCOMBED AREAS, VOIDS LEFT BY THE REMOVAL OF THE FORMS, RIDGES OR ALL CONCRETE SURFACES PERMANENTLY EXPOSED TO VIEW OR EXPOSED TO WATER ON THE FINISHED STRUCTURE, SHALL BE REPAIRED IMMEDIATELY AFTER THE REMOVAL OF FORMS. ALL VOIDS SHALL BE REAMED AND COMPLETELY FILLED WITH DRY-PATCHING MORTAR.
- PROTECTION AND CURING:** EXPOSED SURFACES OF CONCRETE SHALL BE PROTECTED FROM DIRECT RAYS OF THE SUN FOR AT LEAST THE FIRST THREE (3) DAYS. ALL CONCRETE SHALL BE KEPT CONTINUOUSLY MOIST FOR AT LEAST TEN (10) DAYS AFTER BEING PLACED. MOISTURE MAY BE APPLIED BY SPRAYING. CONCRETE SHALL NOT BE EXPOSED TO FREEZING DURING THE CURING PERIOD. CURING COMPOUNDS MAY ALSO BE USED.
- PLACING TEMPERATURE:** CONCRETE MAY NOT BE PLACED AT TEMPERATURES BELOW 32 DEGREES F WITH THE TEMPERATURE FALLING, OR 34 DEGREES WITH THE TEMPERATURE RISING.

PERMANENT SEEDING NOTES

- SEEDING PREPARATION:** LOOSEN UPPER 3 INCHES OF SOIL BY RAKING, DISCING OR OTHER ACCEPTABLE MEANS BEFORE SEEDING.
- SOIL AMENDMENTS:** APPLY 2 TONS PER ACRE OOLITHIC LIMESTONE (92 lbs./1,000 sq. ft.) and 600 lbs PER ACRE 0-20-20 FERTILIZER (41 lbs./1,000 sq. ft.) HARROW OR DISC. LIME AND FERTILIZER INTO UPPER THREE INCHES OF SOIL. AT TIME OF SEEDING, APPLY 400 lbs PER ACRE (9.2 lbs./1,000 sq. ft.) OF 58-0-0 UREA FORM FERTILIZER AND 500 lbs PER ACRE (11.5 lbs./1,000 sq. ft.) OF 10-20-20 FERTILIZER.
- SEEDING:** FOR THE PERIODS MARCH 1 THRU APRIL 30, AND AUG 1 THRU OCT. 15, SEED WITH 60 lbs. PER ACRE (1.4 lbs./1,000 sq. ft.) OF KENTUCKY 31 TALL FESCUE. FOR THE PERIOD MAY 1 THRU JULY 31, SEED WITH 60 lbs. KENTUCKY 31 TALL FESCUE PER ACRE AND 2 lbs. PER ACRE (.05 lbs./1,000 sq. ft.) OF WEEPING LOVEGRASS. DURING THE PERIOD OF OCTOBER 15 THRU FEBRUARY 28, PROTECT SITE BY: OPTION (1) - 2 TONS PER ACRE OF WELL ANCHORED STRAW MULCH AND SEED AS SOON AS POSSIBLE IN THE SPRING. OPTION (2) USE BOD. OPTION (3) - SEED WITH 60 lbs/ACRE KENTUCKY 31 TALL FESCUE AND MULCH WITH 2 TONS/ACRE WELL ANCHORED STRAW.
- MULCHING:** APPLY 1/2 TO 2 TONS PER ACRE (70 TO 90 lbs./1,000 sq. ft.) OF GROUTED SMALL GRAIN STRAW IMMEDIATELY AFTER SEEDING. ANCHOR MULCH IMMEDIATELY AFTER APPLICATION USING 200 GALLONS PER ACRE (500 lbs./1,000 sq. ft.) OF EMULSIFIED ASPHALT ON FLAT AREAS. ON SLOPES 3 FEET OR HIGHER, USE 300 GALLONS PER ACRE (600 lbs./1,000 sq. ft.) FOR ANCHORING.
- MAINTENANCE:** INSPECT ALL SEEDING AREAS AND NEEDED REPAIRS, REPLACEMENTS AND RESEEDING.

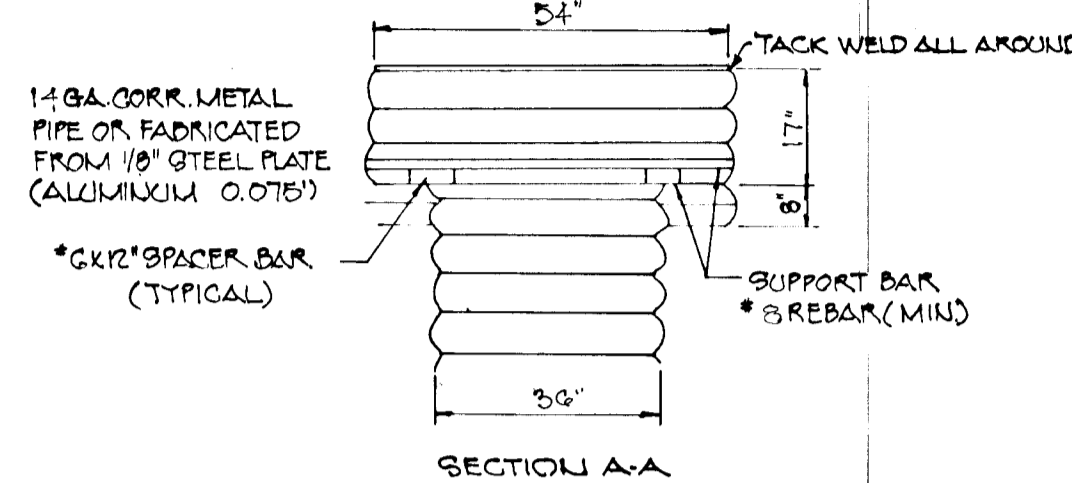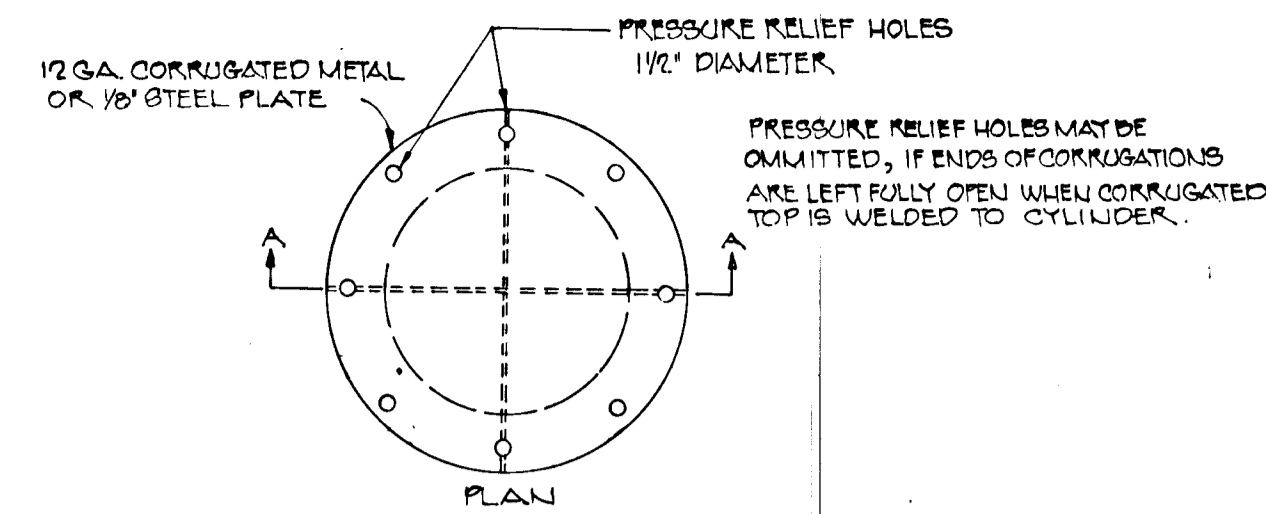

- THE CYLINDER MUST BE FIRMLY FASTENED TO THE TOP OF THE RISER.
- SUPPORT BARS ARE WELDED TO THE TOP OF THE RISER OR ATTACHED BY STRAPS BOLTED TO TOP RISER.

DETAIL TRASH RACK & ANTI-VORTEX DEVICE
 NO SCALE

I CERTIFY THAT ALL DEVELOPMENT AND/OR CONSTRUCTION WILL BE DONE ACCORDING TO THESE PLANS OF DEVELOPMENT, POND CONSTRUCTION AND EROSION AND SEDIMENT CONTROL. I ALSO AUTHORIZE PERIODIC ON-SITE INSPECTION BY THE HOWARD SOIL CONSERVATION DISTRICT OR THEIR AUTHORIZED AGENTS, AS ARE DEEMED NECESSARY. DEVIATION FROM THIS PLAN WILL NOT BE MADE UNLESS AUTHORIZED BY THE HOWARD SOIL CONSERVATION DISTRICT. I WILL PROVIDE THE HOWARD SOIL CONSERVATION DISTRICT WITH A RED-LINED "AS-BUILT" OF THE POND WITHIN 30 DAYS OF COMPLETION.


B+G Associates - David M. Gibson, Partner
 B+G ASSOCIATES - JACK T. GIBSON, PARTNER

4/21/80
 DATE

I CERTIFY THAT THIS PLAN FOR POND CONSTRUCTION, EROSION, AND SEDIMENT CONTROL REPRESENTS A PRACTICAL AND WORKABLE PLAN BASED ON MY PERSONAL KNOWLEDGE OF THE SITE CONDITIONS. THIS PLAN WAS PREPARED IN ACCORDANCE WITH THE REQUIREMENTS OF THE HOWARD SOIL CONSERVATION DISTRICT. I HAVE NOTIFIED THE DEVELOPER THAT HE MUST PROVIDE THE HOWARD SOIL CONSERVATION DISTRICT WITH A RED-LINED "AS-BUILT" OF THE POND WITHIN 30 DAYS OF COMPLETION.


Howard M. Helm
 HODKINS ASSOCIATES, INC.

4/21/80
 DATE

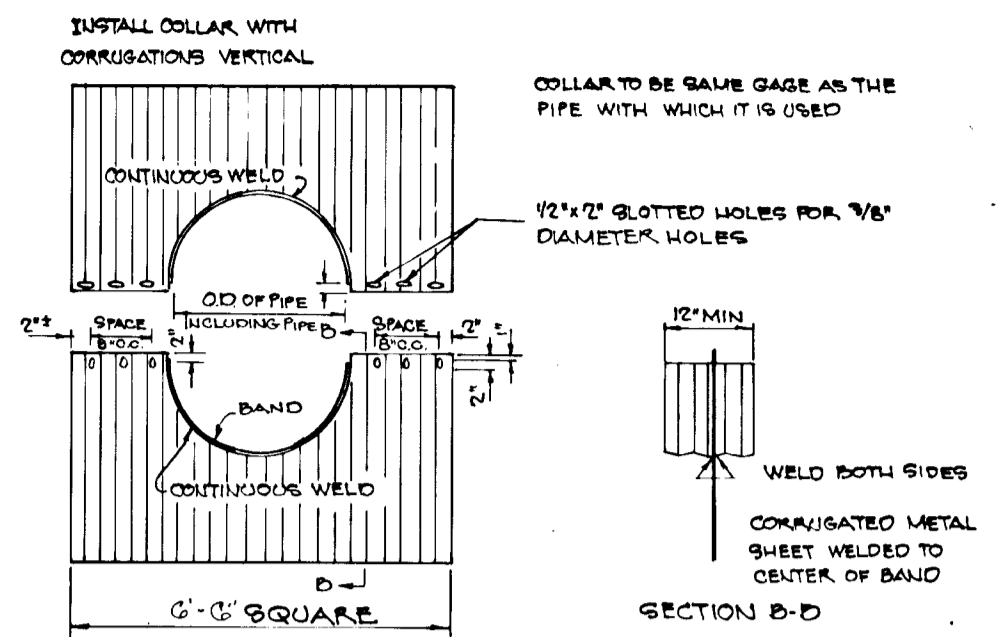


- NOTES FOR COLLARS:
- ALL MATERIALS TO BE IN ACCORDANCE WITH CONSTRUCTION AND CONSTRUCTION MATERIAL SPECIFICATIONS.
 - WHEN SPECIFIED ON THE PLANS COATING OF COLLARS SHALL BE IN ACCORDANCE WITH CONSTRUCTION AND CONSTRUCTION MATERIAL SPECIFICATIONS.
 - UNASSEMBLED COLLARS SHALL BE MARKED BY PAINTING OR TAGGING TO IDENTIFY MATCHING PAIRS.
 - THE LAP BETWEEN THE TWO HALF SECTIONS AND BETWEEN THE PIPE AND CONNECTION BAND SHALL BE CAULKED WITH ASPHALT MASTIC AT TIME OF INSTALLATION.
 - EACH COLLAR SHALL BE FURNISHED WITH TWO 1/2 INCH DIAMETER PDS WITH STANDARD TANK KISS FOR CONNECTING COLLARS TO PIPE.


DETAILS OF CORRUGATED METAL ANTI-SEEP COLLARS
 NO SCALE

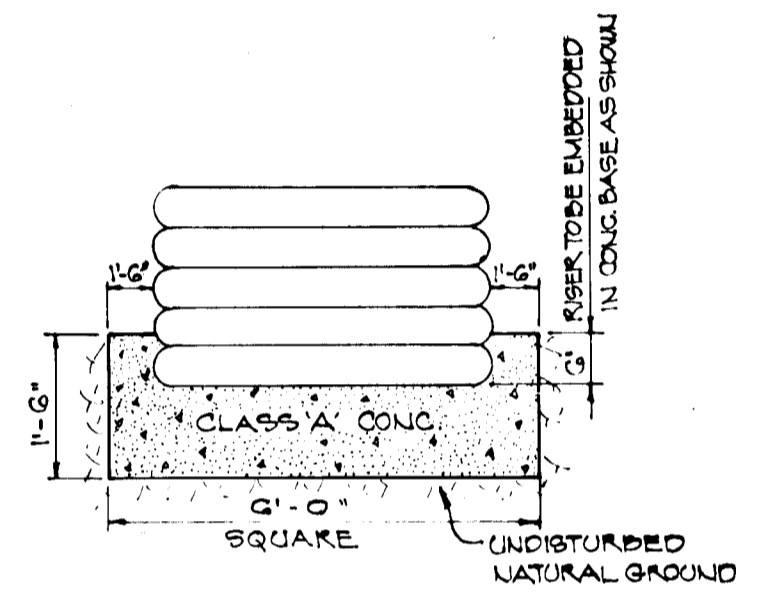


DETAIL CONCRETE BASE
 NO SCALE

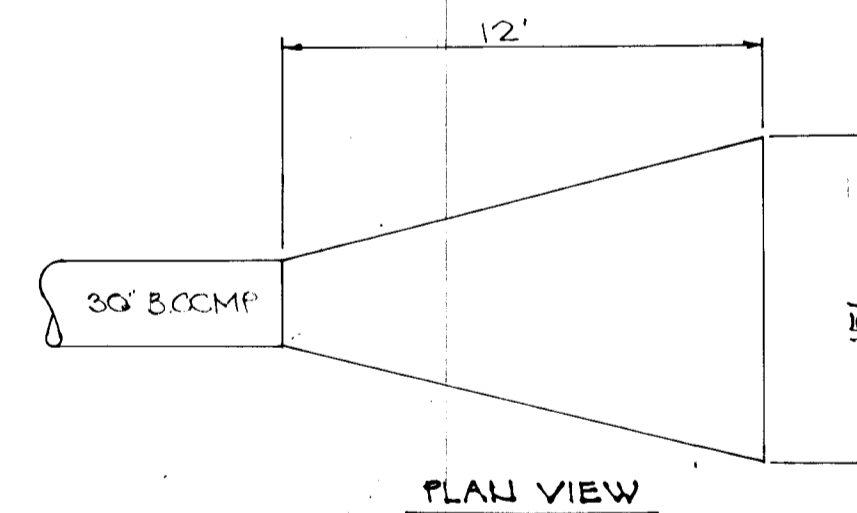

PLAN VIEW

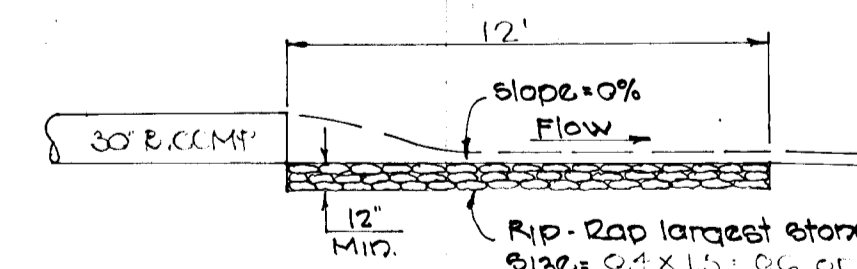


OUTLET PROTECTION
 NO SCALE

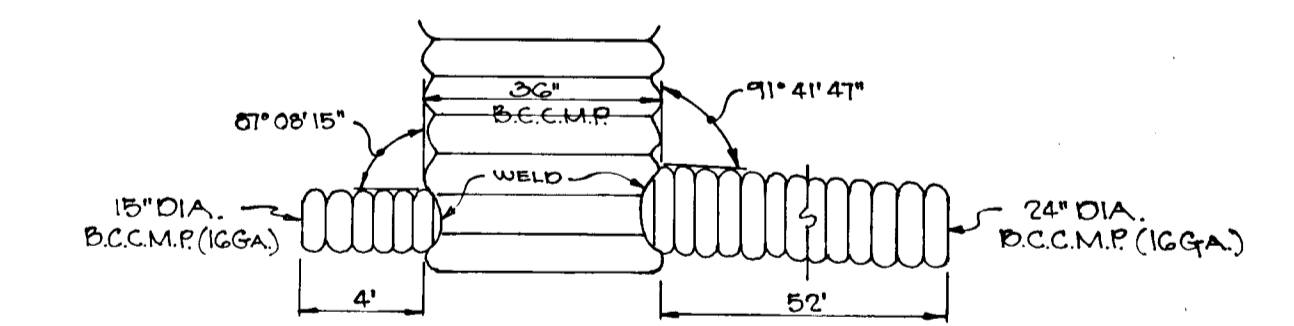

DETAIL RISER CONNECTION
 NO SCALE


STORM WATER MANAGEMENT POND - NO. 1

"KEYWAYON"
 ELECT. DIST. NO. HOWARD Co. MD.
 SCALE: AS SHOWN
 SHEET 6 OF 11
 HOWARD COUNTY, MARYLAND
 DEPARTMENT OF PUBLIC WORKS
 ENGINEERS
 HODKINS ASSOCIATES, INC.
 100 N. MAIN ST. BELAIR, MD. 21014
 898-0888 819-8117
 CHIEF, BUREAU OF ENGINEERING DATE
 OFFICE OF PLANNING & ZONING DATE
 CHIEF, DIVISION OF LAND DEVELOPMENT DATE

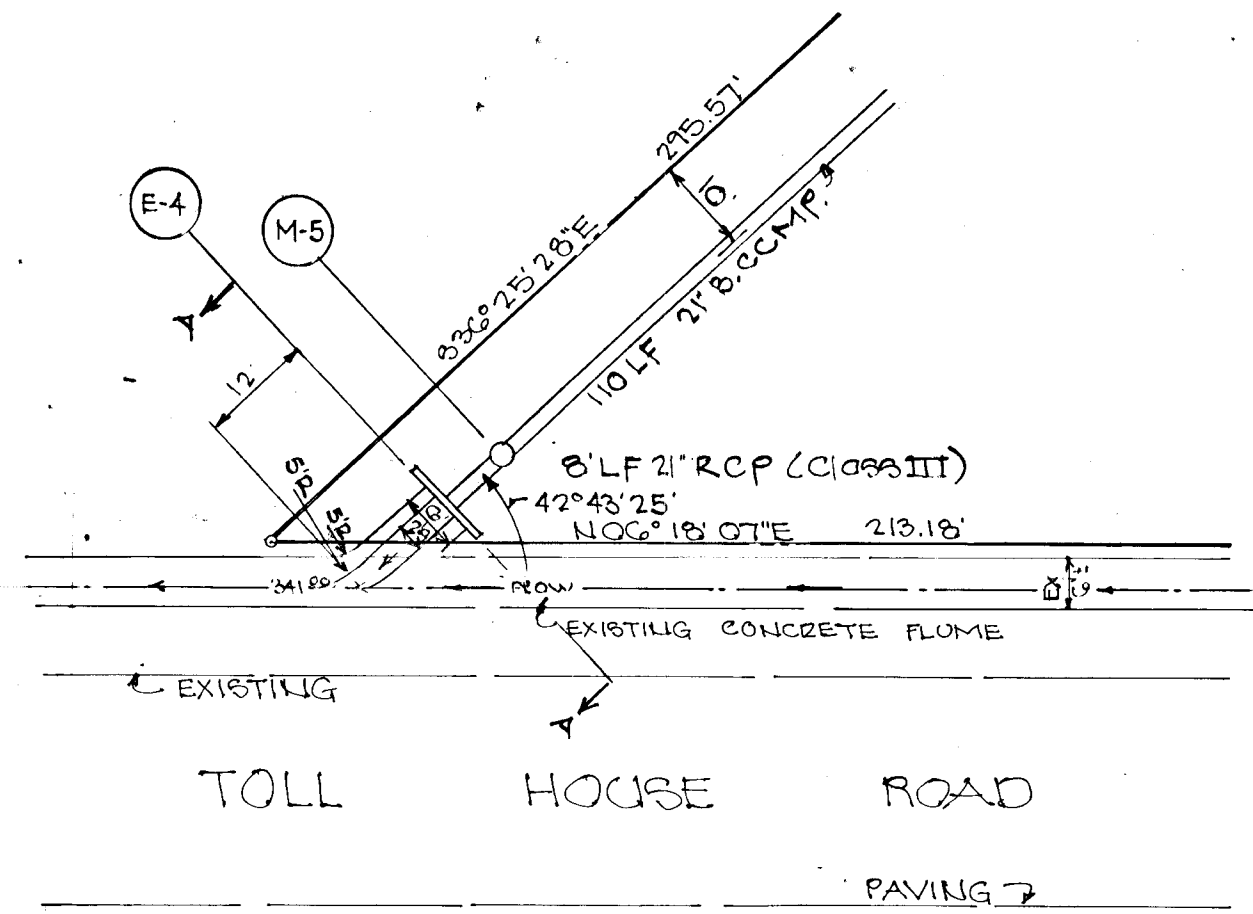


PLAN SCALE 1"=20'

DETAIL OUTFALL CHANNEL

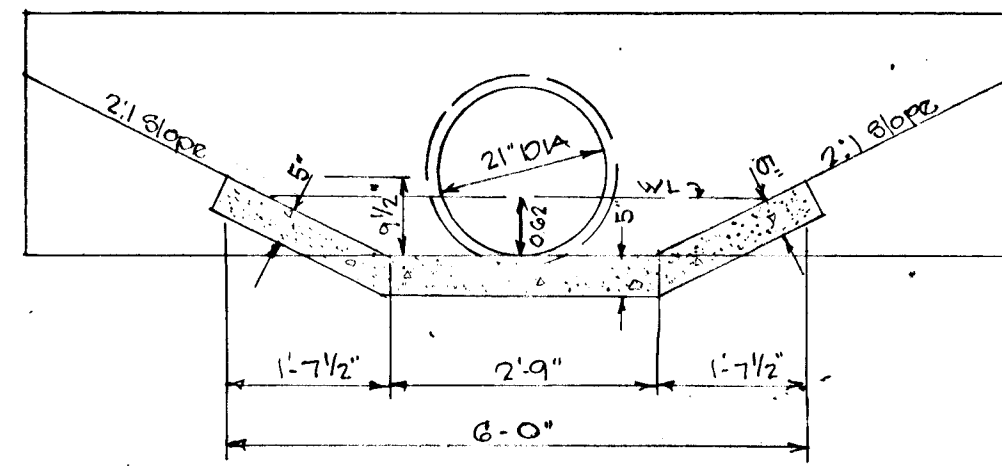


DESIGN Q=16.57 V=0.62

SECTION A-A SCALE 1"=2'

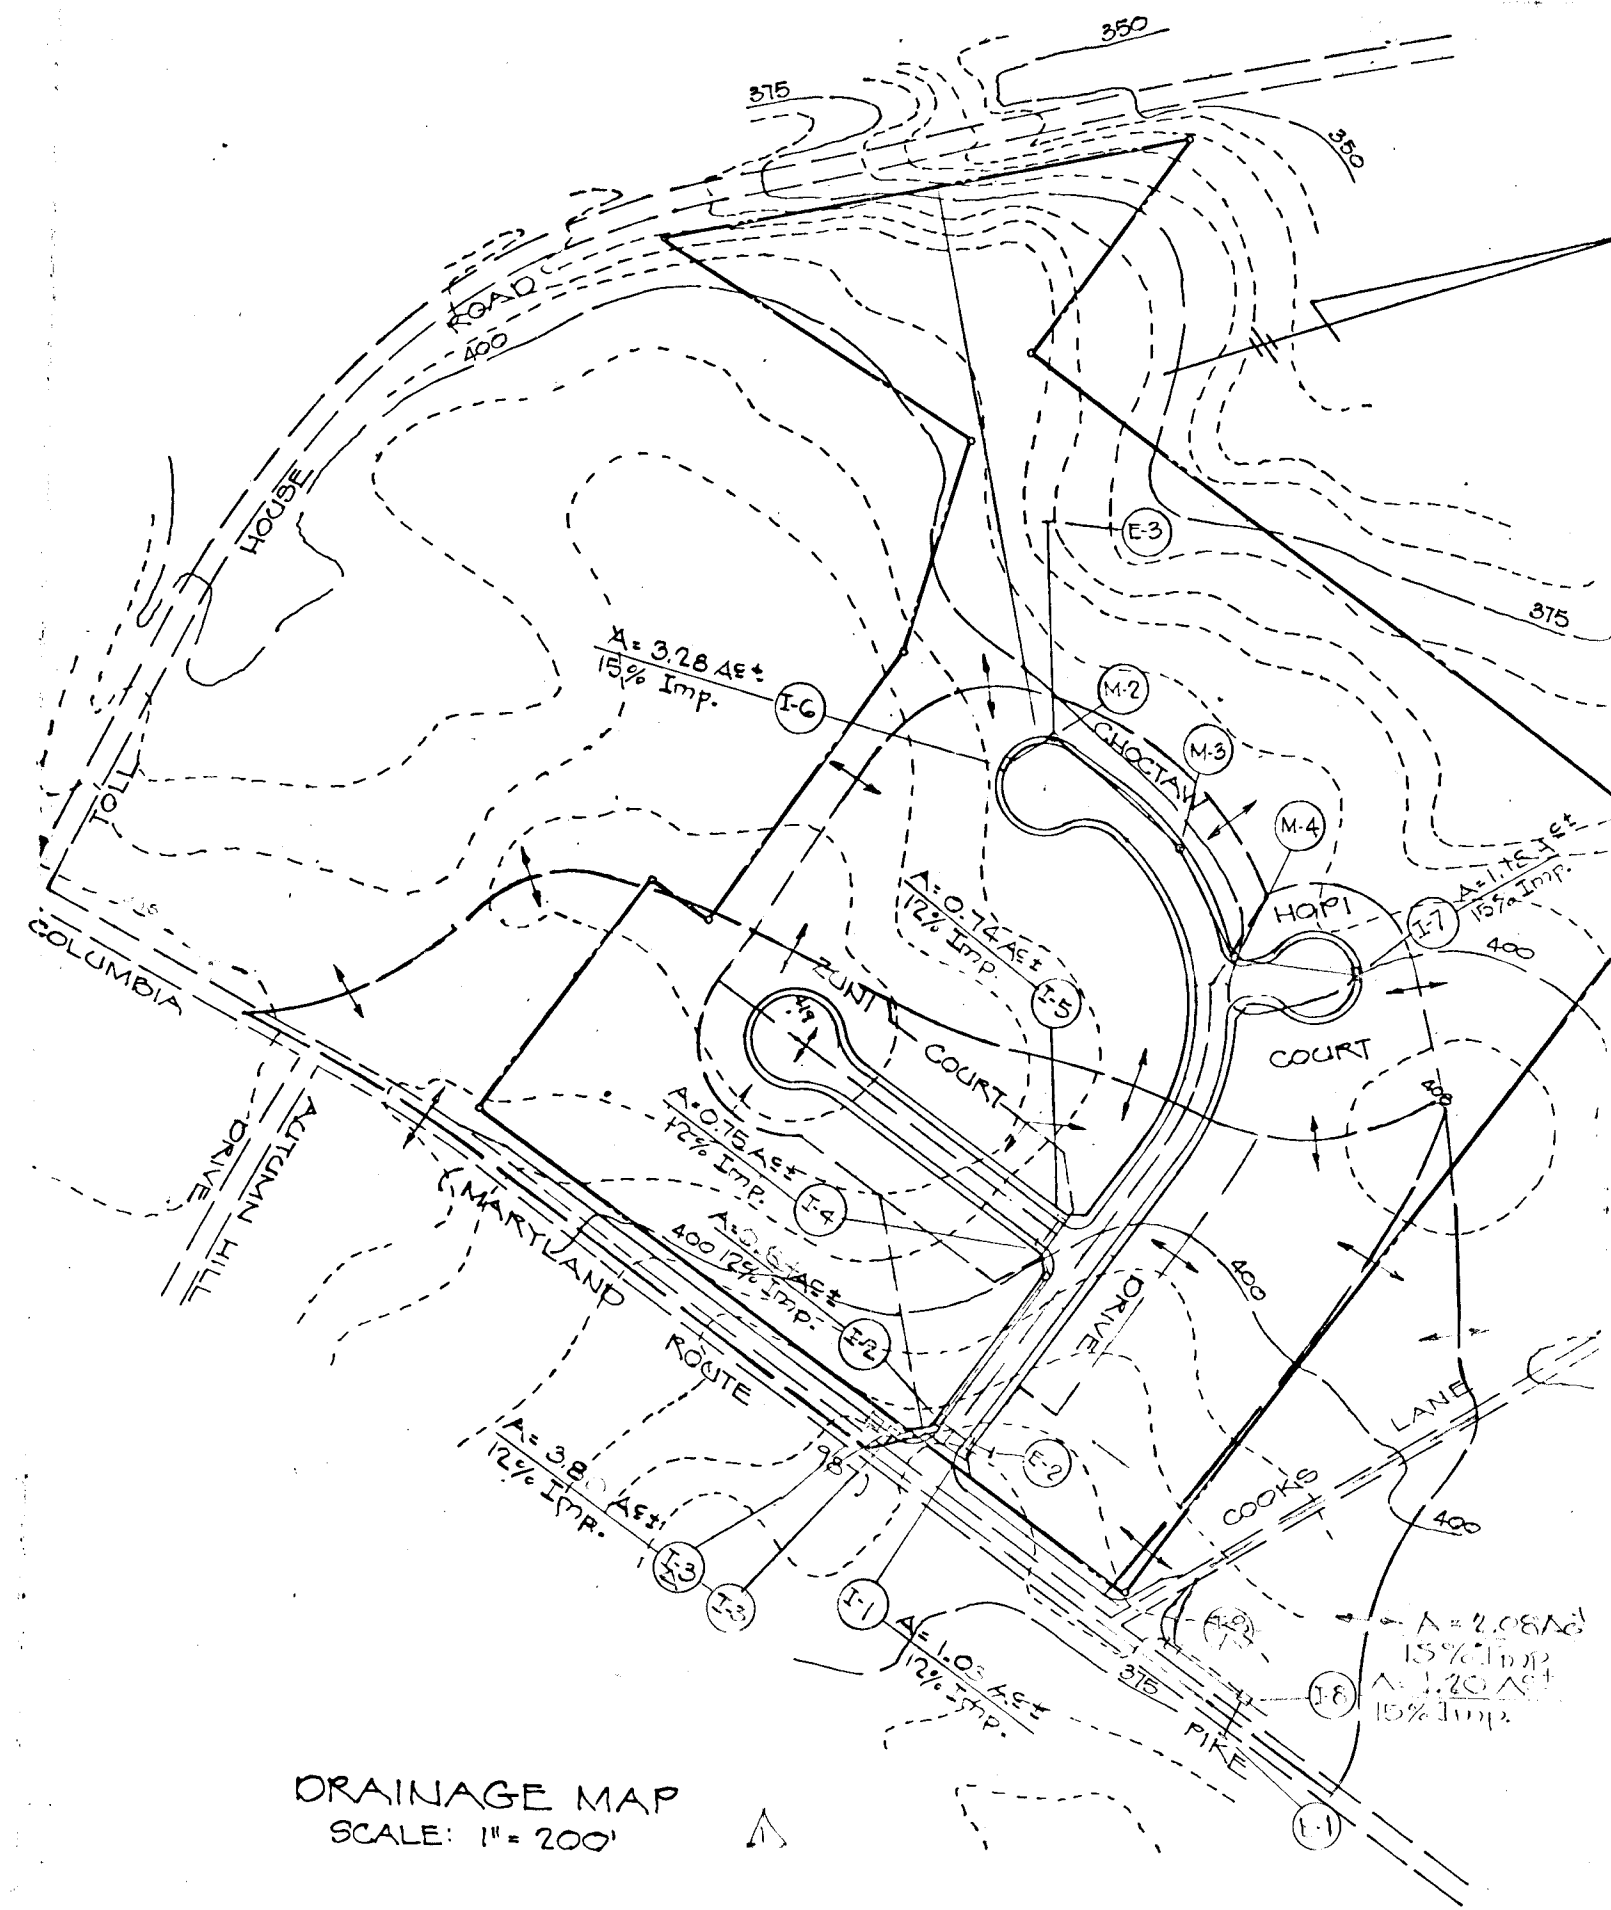

DRAINAGE MAP SCALE: 1"=200'

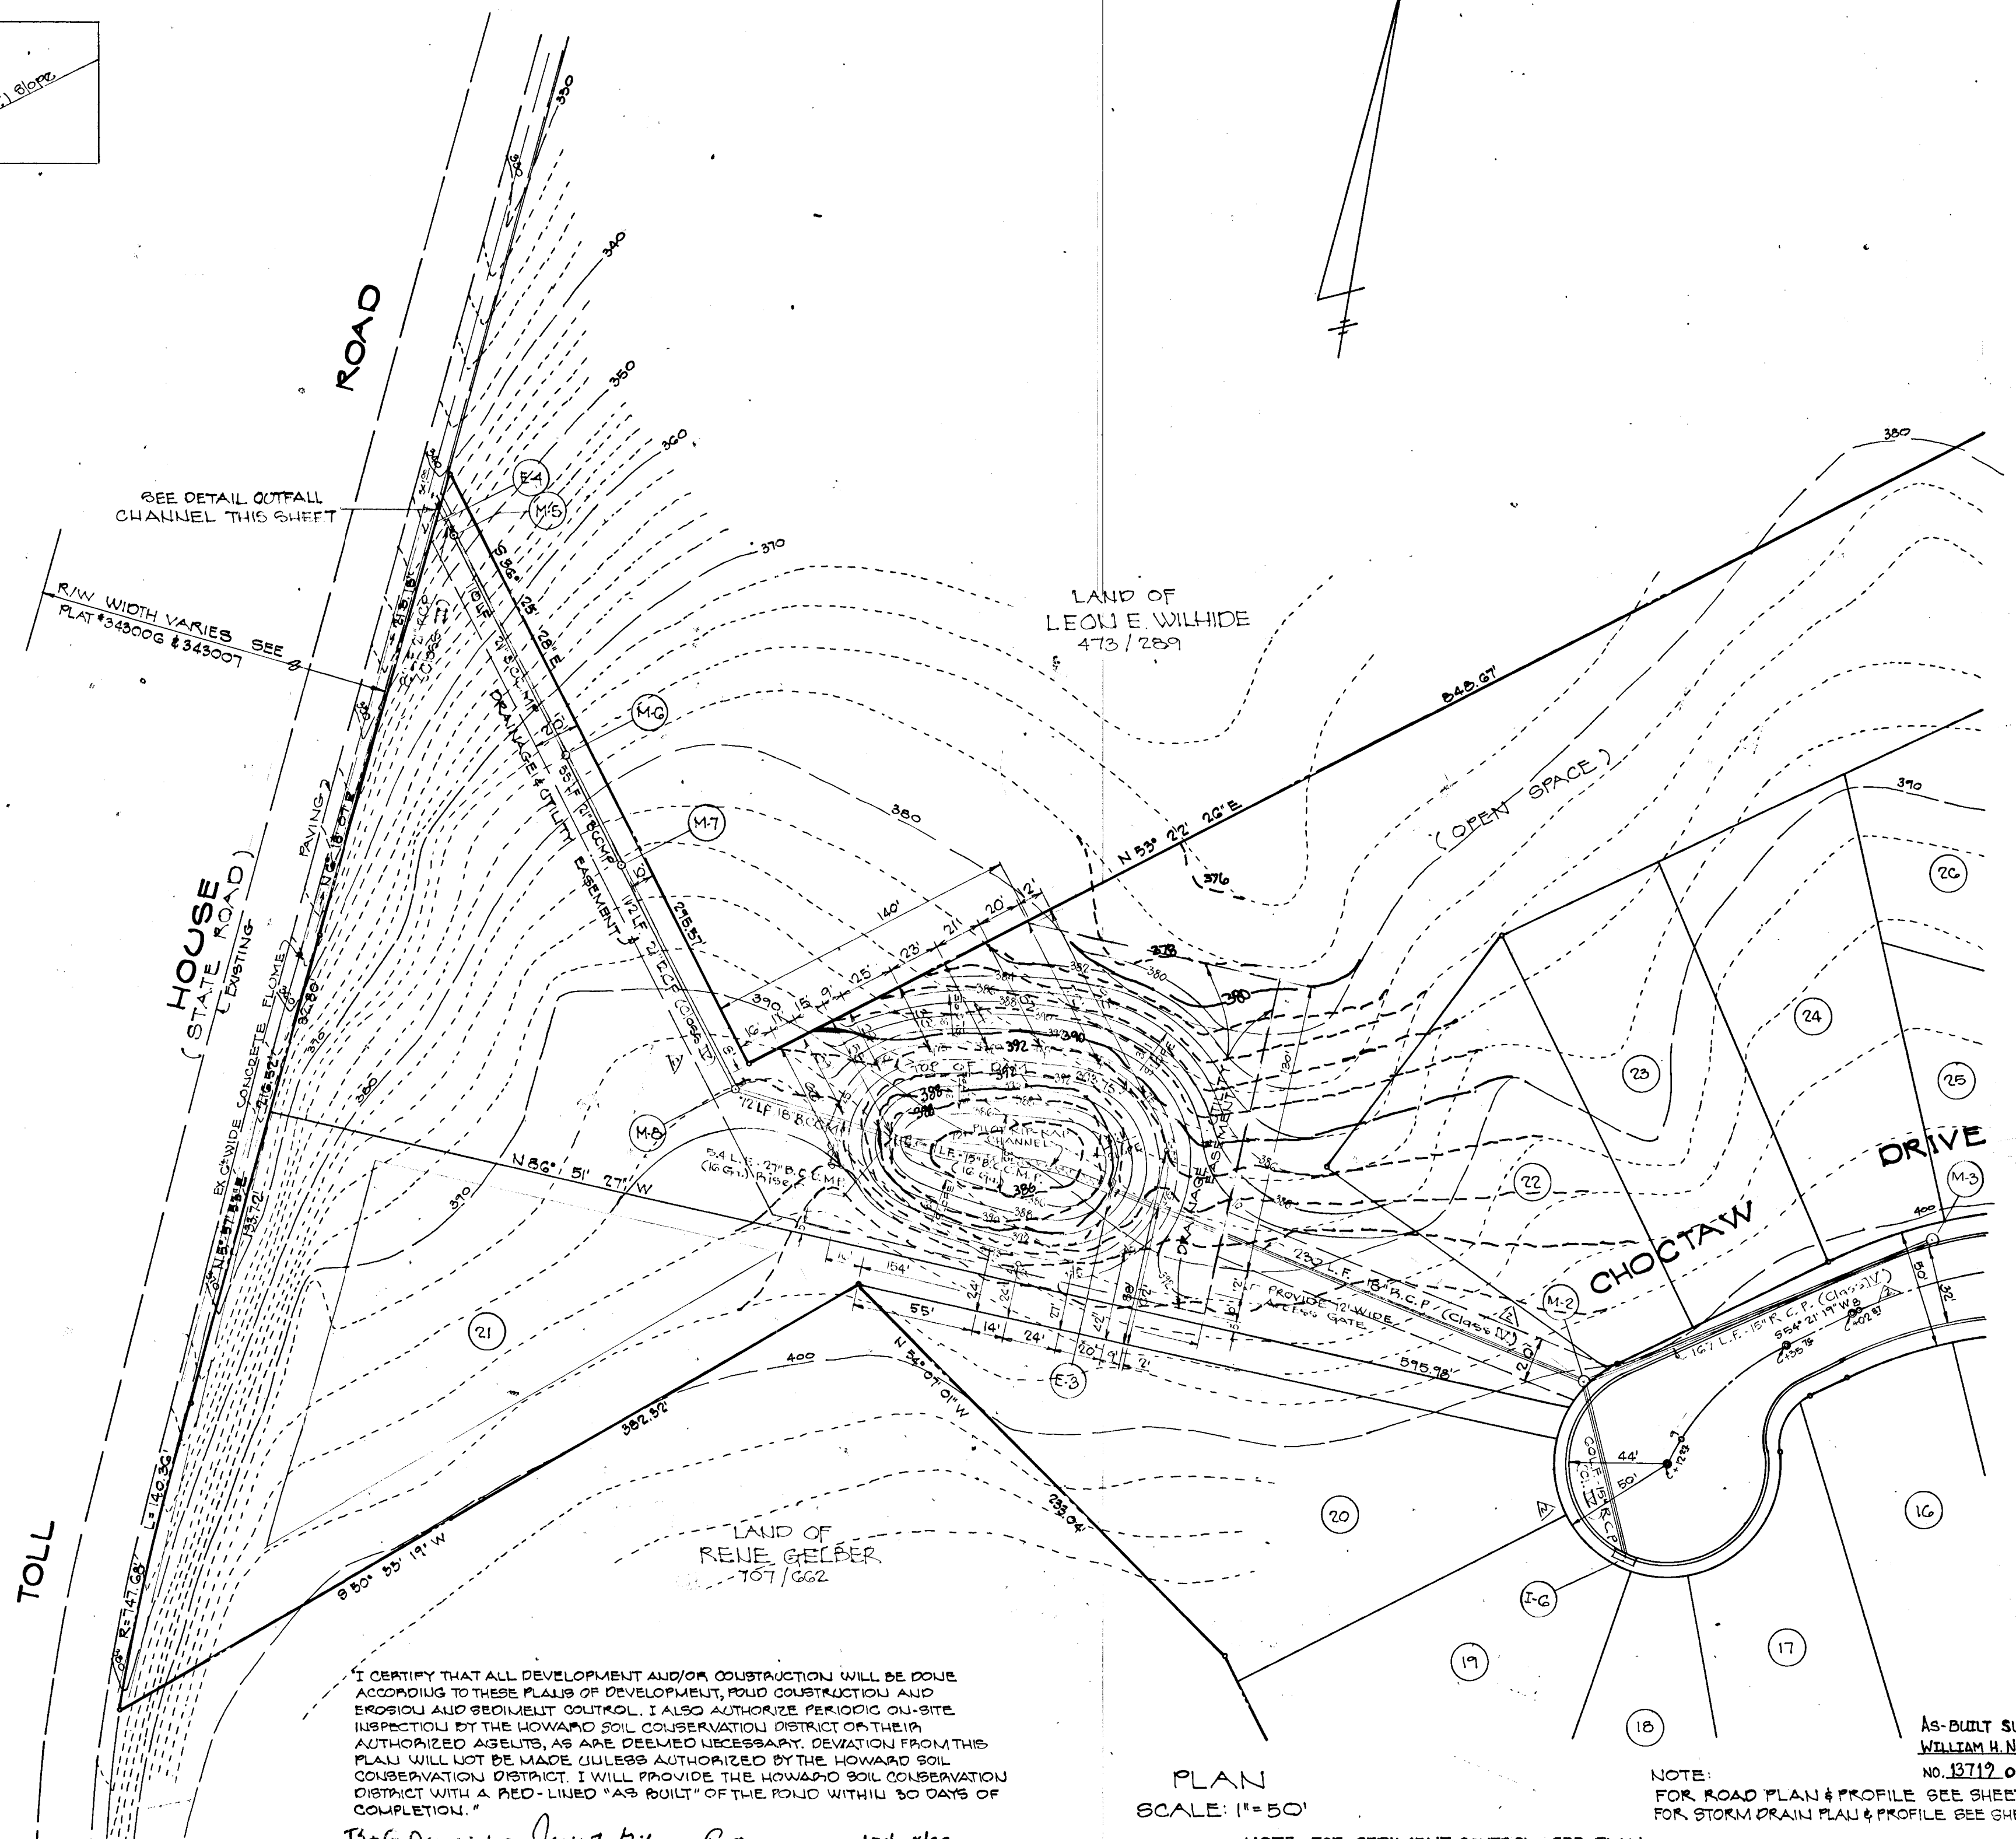

PLAN SCALE: 1"=50'

I CERTIFY THAT ALL DEVELOPMENT AND/OR CONSTRUCTION WILL BE DONE ACCORDING TO THESE PLANS OF DEVELOPMENT, ROAD CONSTRUCTION AND EROSION AND SEDIMENT CONTROL. I ALSO AUTHORIZE PERIODIC ON-SITE INSPECTIONS BY THE HOWARD SOIL CONSERVATION DISTRICT OF THE AUTHORIZED AREAS, AS ARE DEEMED NECESSARY. DEVIATION FROM THIS PLAN WILL NOT BE MADE UNLESS AUTHORIZED BY THE HOWARD SOIL CONSERVATION DISTRICT. I WILL PROVIDE THE HOWARD SOIL CONSERVATION DISTRICT WITH A RED-LINED "AS BUILT" OF THE POND WITHIN 30 DAYS OF COMPLETION.

Jack T. Gibson 12/18/79
 D & G ASSOCIATES, JACK T. GIBSON - PARTNER DATE

I CERTIFY THAT THIS PLAN FOR POND CONSTRUCTION, EROSION, AND SEDIMENT CONTROL REPRESENTS A PRACTICAL AND WORKABLE PLAN BASED ON MY PERSONAL KNOWLEDGE OF THE SITE CONDITIONS. THIS PLAN WAS PREPARED IN ACCORDANCE WITH THE REQUIREMENTS OF THE HOWARD SOIL CONSERVATION DISTRICT. I HAVE NOTIFIED THE DEVELOPER THAT HE MUST PROVIDE THE HOWARD SOIL CONSERVATION DISTRICT WITH A RED-LINED "AS BUILT" OF THE POND WITHIN 30 DAYS OF COMPLETION.

Howard Whelcker 1/2/80
 HOOKINS ASSOCIATES, INC. DATE

NOTE: FOR ROAD PLAN & PROFILE SEE SHEET 2 OF 9 FOR GRADING & SEDIMENT CONTROL "KEYWAYDIN"

NOTE: FOR SEDIMENT CONTROL - SEE PLAN FOR GRADING & SEDIMENT CONTROL "KEYWAYDIN"

DEVELOPER
 D & G ASSOCIATES
 JACK GIBSON, PARTNER
 9000 BELAIR ROAD
 BALTIMORE, MARYLAND
 21286

ENGINEERS
 HOOKINS ASSOCIATES INC.
 100 N. MAIN ST. BEL AIR, MD 21014
 838-0888 879-8117

THESE PLANS HAVE BEEN REVIEWED FOR THE HOWARD SOIL CONSERVATION DISTRICT AND MEET THE TECHNICAL REQUIREMENTS FOR SMALL POND CONSTRUCTION, SOIL EROSION AND SEDIMENT CONTROL.

J. Helm 4-21-80
 U.S. SOIL CONSERVATION SERVICE DATE

THESE PLANS FOR SMALL POND CONSTRUCTION, SOIL EROSION AND SEDIMENT CONTROL MEET THE REQUIREMENTS OF THE HOWARD SOIL CONSERVATION DISTRICT.

APPROVED: *Robert J. Helm* 4-21-80
 HOWARD S.C.D. DATE

3	9/10/80	REMOVE CHAIN LINK FENCE FROM AROUND STORM WATER MAIN/SEWER FACILITY	EISH
2	11/21/80	CHANGED POND CHANNEL	SLB
1	11/21/80	REVISED DRAINAGE MAP	SLB
REV	DATE	DESC	BY

AS-BUILT SURVEY CERTIFIED BY
 WILLIAM H. NOTES, JR., M.D., P.E.
 NO. 13719 ON 10-3-87


NOTE: FOR ROAD PLAN & PROFILE SEE SHEET 2 OF 9 FOR STORM DRAIN PLAN & PROFILE SEE SHEET 24 OF 9

STORM WATER MANAGEMENT
 POND - No. II
 "KEYWAYDIN"
 ELECT. DIST. No. 2 HOWARD Co., MD.
 SCALE: AS SHOWN
 SHEET 7 OF 11

HOWARD COUNTY, MARYLAND
 DEPARTMENT OF PUBLIC WORKS
William H. Notes, Jr. 4-23-80
 CHIEF, BUREAU OF ENGINEERING DATE
 OFFICE OF PLANNING & ZONING
William H. Notes, Jr. 4-22-80
 CHIEF, DIVISION OF LAND DEVELOPMENT DATE

STRUCTURE SCHEDULE						
No.	TYPE	LOCATION	INV. IN	INV. OUT	TOP ELEV.	REMARKS
E-4	C. ENDWALL	SEE PLAN & PROFILE	-	341.12	343.02	DWG. D-52, Pg. 107
M-5	STD. MANHOLE	SEE PLAN & PROFILE	341.40	341.20	341.2	DWG. D-103, Pg. 158
M-6	STD. MANHOLE	SEE PLAN & PROFILE	372.40	372.20	372.1	DWG. D-103, Pg. 158
M-7	STD. MANHOLE	SEE PLAN & PROFILE	380.85	380.65	380.4	DWG. D-103, Pg. 158
M-8	STD. MANHOLE	SEE PLAN & PROFILE	382.17	381.97	381.1	DWG. D-103, Pg. 158

REV	DATE	BY	CHKD
1	12/1/81	JAC	MS

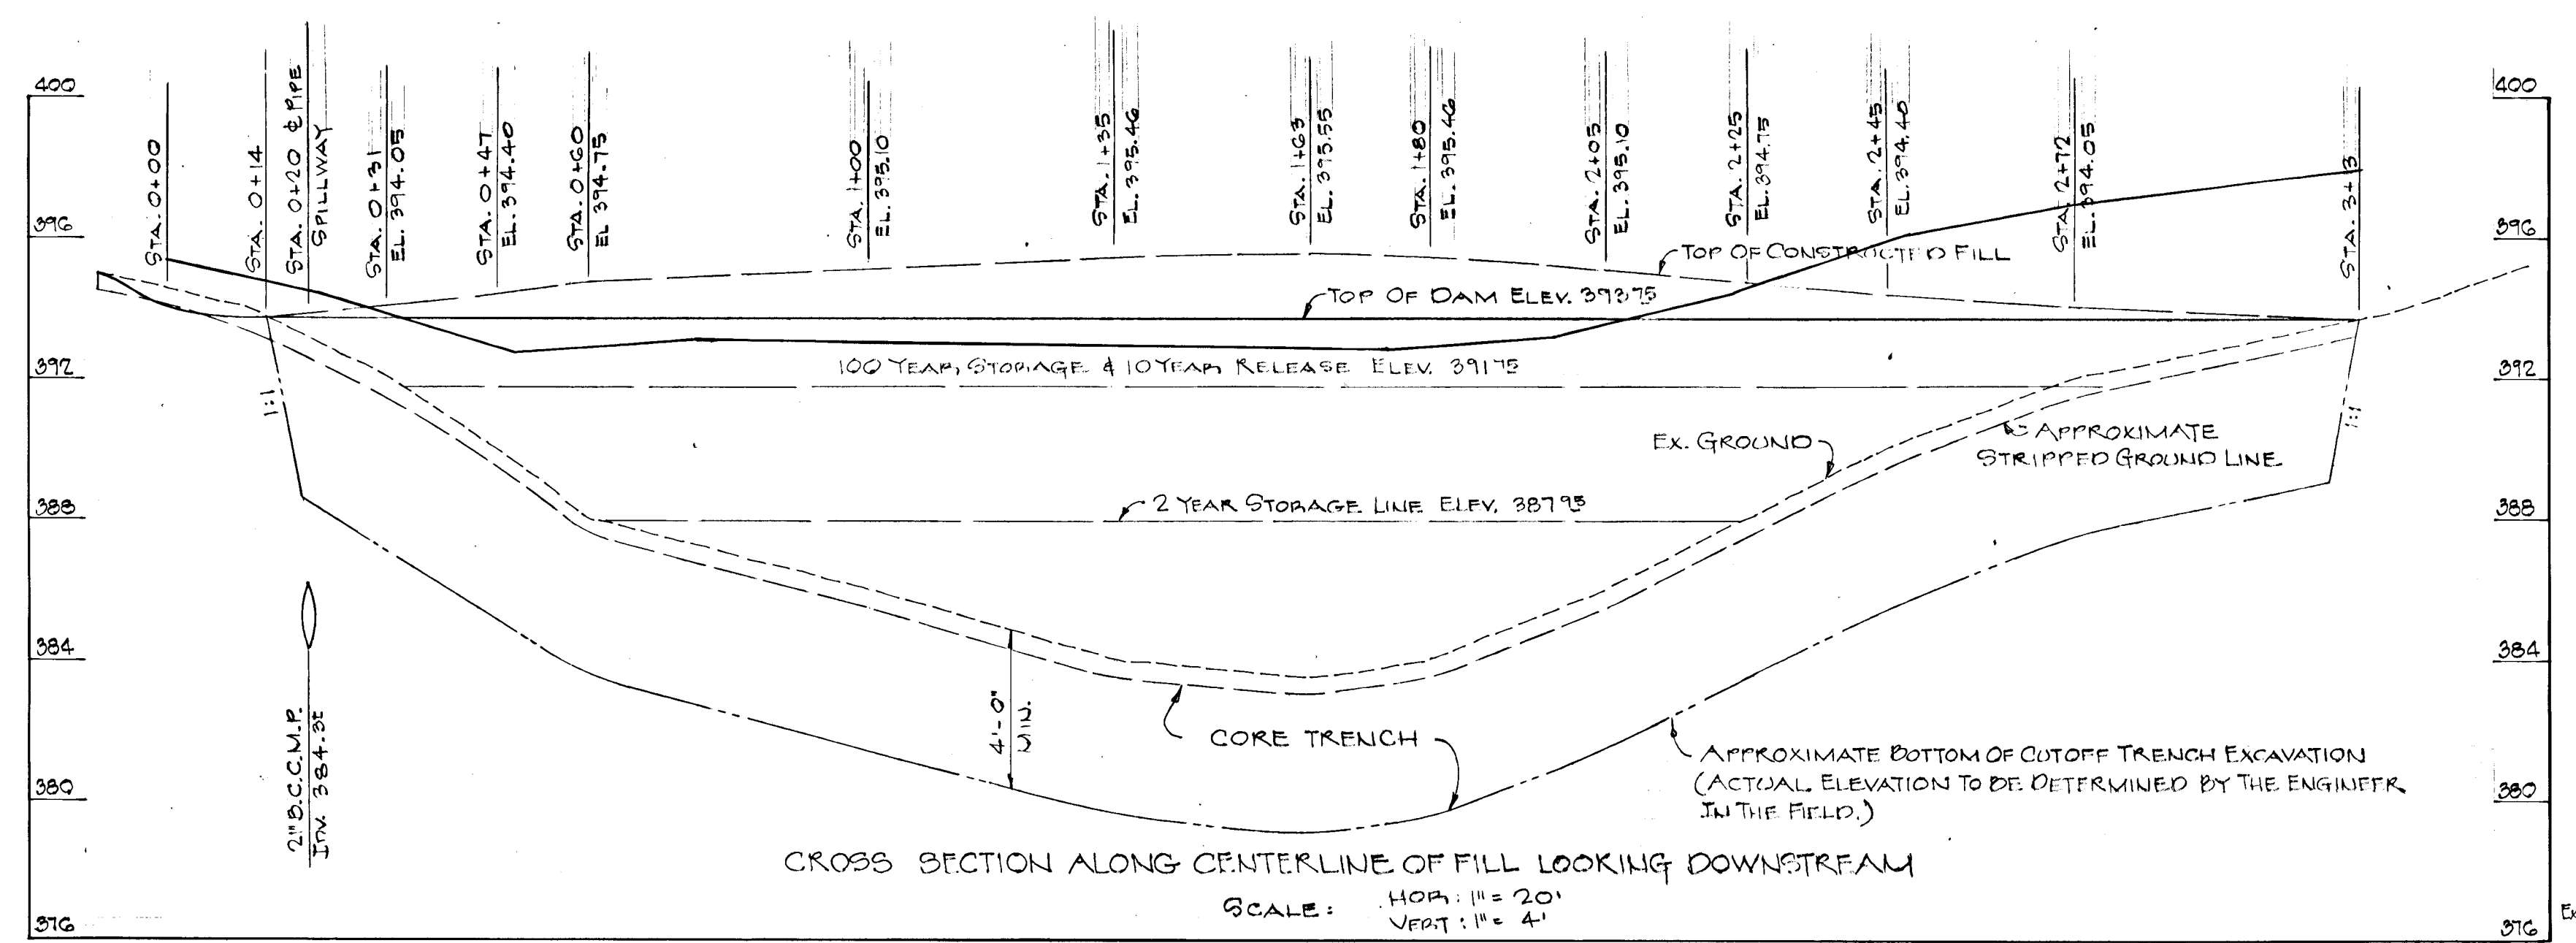

CROSS SECTION ALONG CENTERLINE OF FILL LOOKING DOWNSTREAM
SCALE: HOR. 1" = 20'
VERT. 1" = 4'

I CERTIFY THAT ALL DEVELOPMENT AND/OR CONSTRUCTION WILL BE DONE ACCORDING TO THESE PLANS OF DEVELOPMENT, POND CONSTRUCTION AND EROSION AND SEDIMENT CONTROL. I ALSO AUTHORIZE PERIODIC ON-SITE INSPECTIONS BY THE HOWARD SOIL CONSERVATION DISTRICT OR THEIR AUTHORIZED AGENTS, AS ARE DEEMED NECESSARY. DEVIATION FROM THIS PLAN WILL NOT BE MADE UNLESS AUTHORIZED BY THE HOWARD SOIL CONSERVATION DISTRICT. I WILL PROVIDE THE HOWARD SOIL CONSERVATION DISTRICT WITH A RED-LINED AS BUILT OF THE POND WITHIN 30 DAYS OF COMPLETION.

B & G Associates, Inc.
JACK T. GIBSON - PARTNER
DATE: 12/1/79

I CERTIFY THAT THIS PLAN FOR POND CONSTRUCTION, EROSION, AND SEDIMENT CONTROL REPRESENTS A PRACTICAL AND WORKABLE PLAN BASED ON MY PERSONAL KNOWLEDGE OF THE SITE CONDITIONS. THIS PLAN WAS PREPARED IN ACCORDANCE WITH THE REQUIREMENTS OF THE HOWARD SOIL CONSERVATION DISTRICT. I HAVE NOTIFIED THE DEVELOPER THAT HE MUST PROVIDE THE HOWARD SOIL CONSERVATION DISTRICT WITH A RED-LINED AS BUILT OF THE POND WITHIN 30 DAYS OF COMPLETION.

Howard Whiteley
HUDKINS ASSOCIATES, INC.
DATE: 1/2/80


THESE PLANS HAVE BEEN REVIEWED FOR HOWARD SOIL CONSERVATION DISTRICT AND MEET THE TECHNICAL REQUIREMENTS FOR SMALL POND CONSTRUCTION, SOIL EROSION AND SEDIMENT CONTROL.

J. Helm
S. SOIL CONSERVATION SERVICE
DATE: 4-21-80


THESE PLANS FOR SMALL POND CONSTRUCTION, SOIL EROSION AND SEDIMENT CONTROL MEET THE REQUIREMENTS OF THE HOWARD SOIL CONSERVATION DISTRICT.

Robert W. Zehm
HOWARD S.C.D.
DATE: 4-21-80

APPROVED: **F-80-92**
PLAN NUMBER

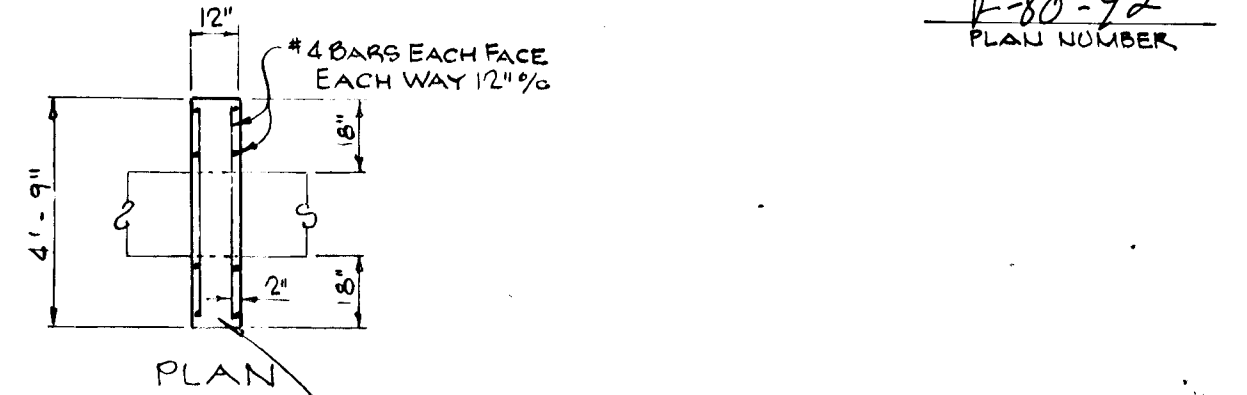



CLASS 'A' CONCRETE

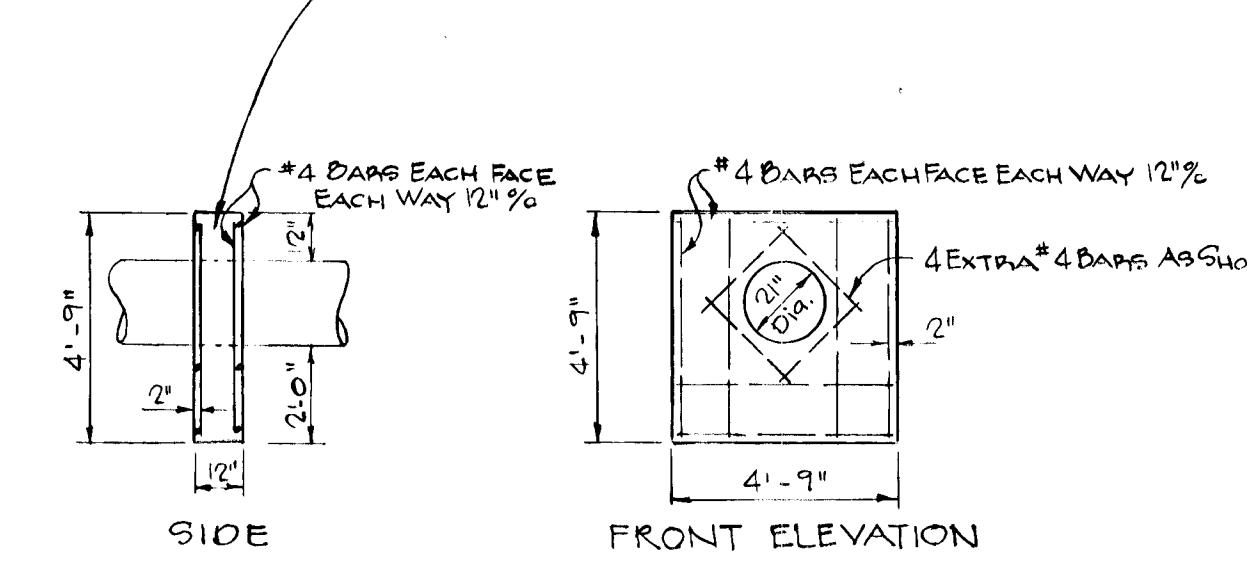

DETAIL OF THRUST BLOCK
SCALE: 1/4" = 1'-0"

NOTE: CONTRACTOR TO INSTALL A ROW OF STRAW BALES AT 50' INTERVALS ALONG STRAW DAM OUTFALL PIPE, TO BE INSTALLED AFTER PIPE HAS BEEN INSTALLED AND BACK-FILLED AND SHALL EXTEND ACROSS FULL WIDTH OF DISTURBED AREA.

NOTE: CONTRACTOR TO INSTALL 2" THRUST BLOCKS AS DIRECTED BY THE ENGINEER IN THE FIELD. (SEE DETAIL THIS SHEET)

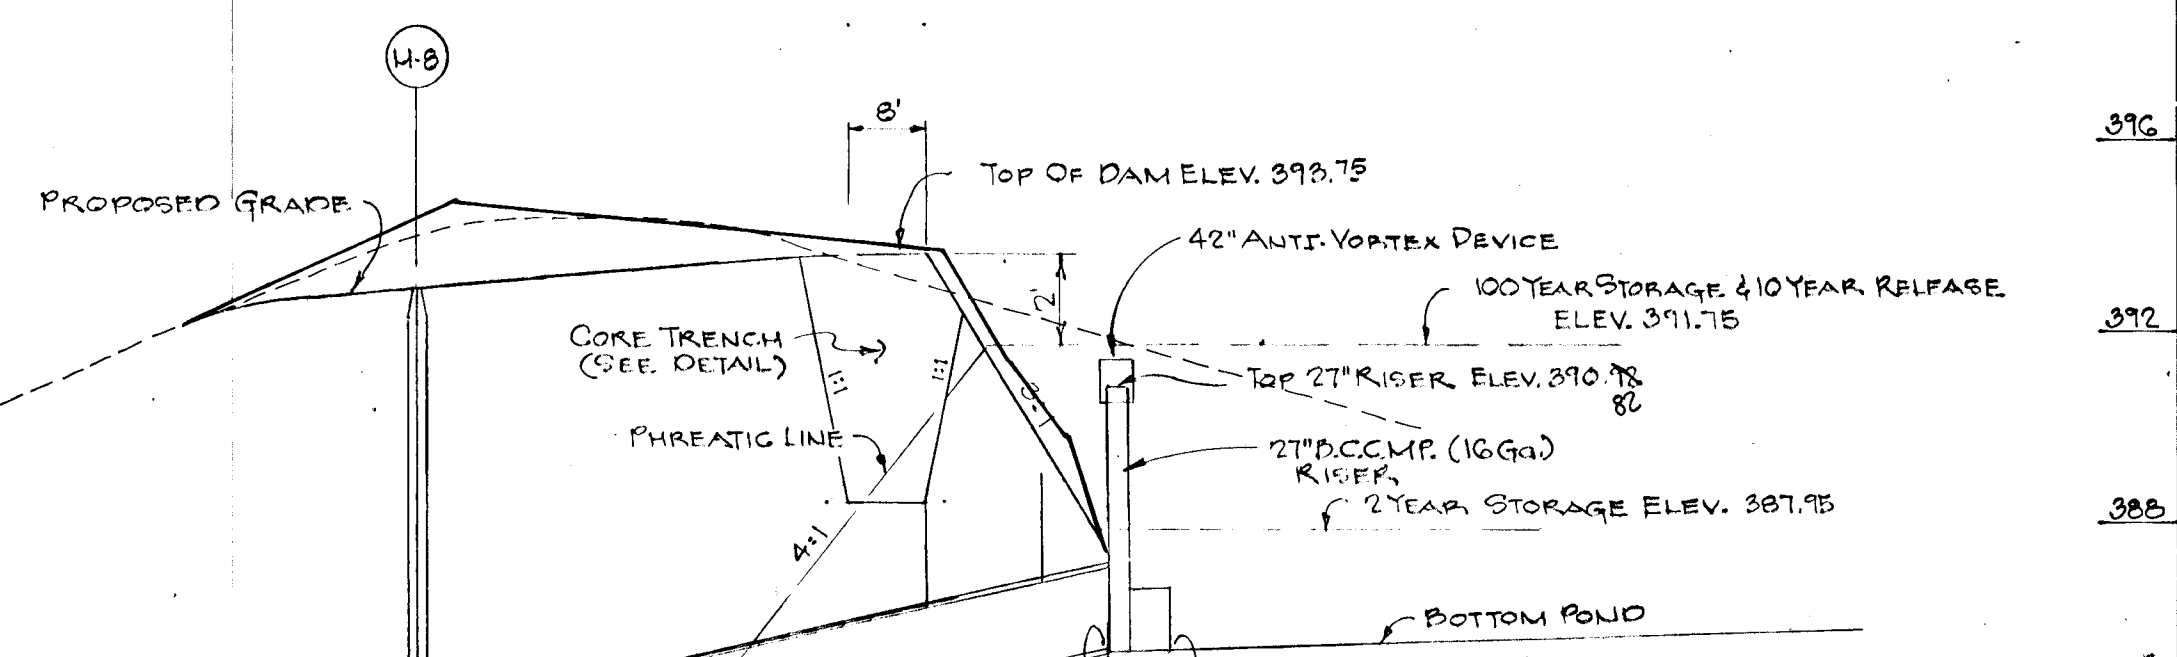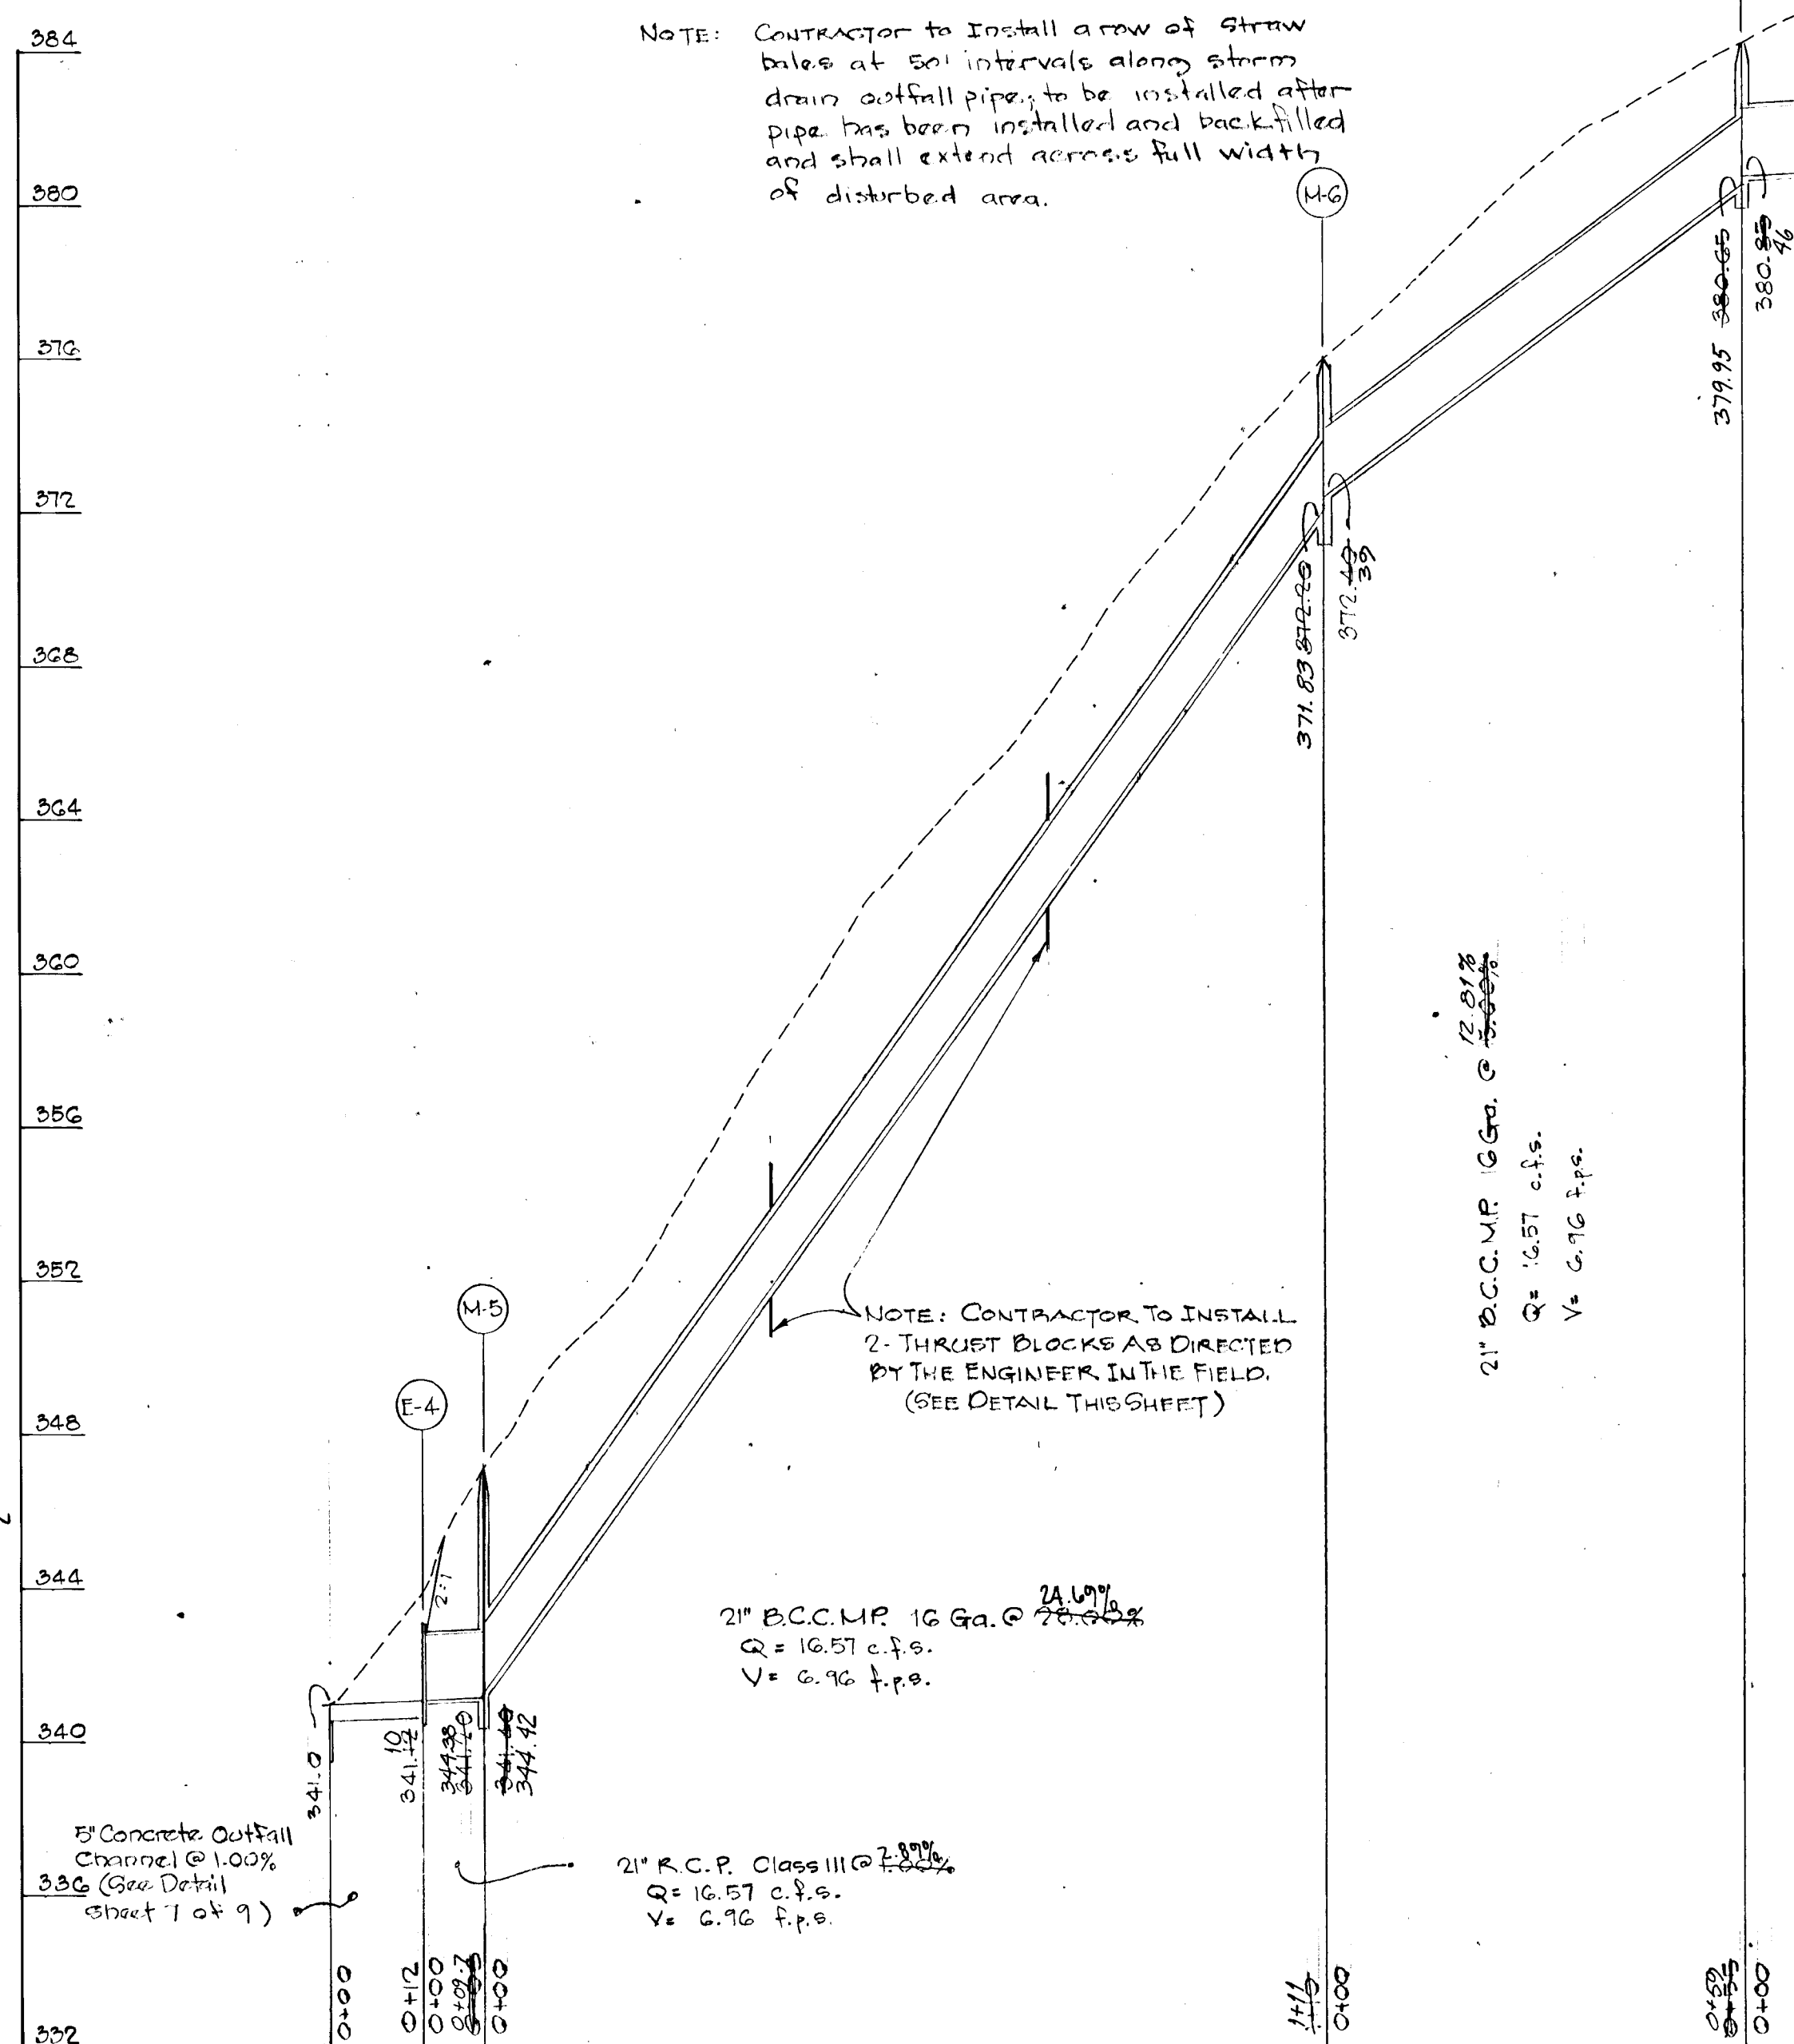

21" R.C.P. Class IV @ 1.04%
Q = 16.57 c.f.s.
V = 0.96 f.p.s.

21" B.C.C.M.P. 16 Ga. @ 2.50%
Q = 16.57 c.f.s.
V = 0.96 f.p.s.

21" B.C.C.M.P. 16 Ga. @ 2.50%
Q = 16.57 c.f.s.
V = 0.96 f.p.s.

21" R.C.P. Class III @ 2.50%
Q = 16.57 c.f.s.
V = 0.96 f.p.s.

PROFILE
SCALE: HOR. 1" = 20'
VERT. 1" = 4'

DEVELOPER:
B & G ASSOCIATES
9608 BELAIR ROAD
BALTIMORE, MARYLAND 21236

ENGINEERS:
HUDKINS ASSOCIATES, INC.
100 N. MAIN ST. DEL AIR, MD 21014
838-0888 879-8117

AS-BUILT SURVEY CERTIFIED BY
WILLIAM H. NOYES, JR., MD. P.E.
NO. 13719 ON 10-3-87.

STORM WATER MANAGEMENT POND - NO. II
"KEYWAYDILLI"
ELECT. DIST. NO. 2 HOWARD CO., MD.
SCALE: AS SHOWN SHEET 6 OF 11

HOWARD COUNTY, MARYLAND
DEPARTMENT OF PUBLIC WORKS

William D. Ray 4-23-80
CHIEF, BUREAU OF ENGINEERING & ZONING
OFFICE OF PLANNING & ZONING
CHIEF DIVISION OF LAND DEVELOPMENT

SITE PREPARATIONS

AREAS UNDER THE BORROW AREAS, EMBANKMENT, AND STRUCTURAL WORKS SHALL BE CLEARED, GRUBBED AND THE TOPSOIL SKIPPED TO REMOVE ALL TREES, VEGETATION, ROOTS OR OTHER OBJECTIONAL MATERIAL. CHANNEL BANKS AND SHARP BREAKS SHALL BE SLOPED TO NO STEEPER THAN 1:1.

AREAS COVERED BY THE POND OR RESERVOIR WILL BE CLEARED OF ALL TREES, BRUSH, LOGS, FENCES, RUBBISH AND OTHER OBJECTIONAL MATERIAL UNLESS OTHERWISE DESIGNATED ON THE PLANS. TREES, BRUSH AND STUMPS SHALL BE CUT APPROXIMATELY LEVEL WITH GROUND SURFACE.

ALL CLEARED AND GRUBBED MATERIAL SHALL BE DEPOSED OUTSIDE THE LIMITS OF THE DAM AND RESERVOIR AS DIRECTED BY THE OWNER OR HIS REPRESENTATIVE. WHEN SPECIFIED, A SUFFICIENT QUANTITY OF TOPSOIL WILL BE STOCKPILED IN A SUITABLE LOCATION FOR USE ON THE EMBANKMENT AND OTHER DESIGNATED AREAS.

EARTH FILL

MATERIAL
THE FILL MATERIAL SHALL BE TAKEN FROM APPROVED DESIGNATED AREA OR AREAS. IT SHALL BE FREE OF ROOTS, STUMPS, WOOD, RUBBISH, OVER-SIZE STONES, FROZEN OR OTHER OBJECTIONAL MATERIALS. THE EMBANKMENT SHALL BE CONSTRUCTED TO AN ELEVATION WHICH PROVIDES FOR ANTICIPATED SETTLEMENT TO THE DESIGN ELEVATION. THE FILL HEIGHT SHALL BE IN ACCORDANCE WITH THE DESIGN ELEVATION. THE FILL SHALL BE PLACED IN 8-INCH MAXIMUM THICKNESS (BEFORE COMPACTION) LAYERS WHICH ARE TO BE CONTINUOUS OVER THE ENTIRE LENGTH OF THE FILL. THE MOST ROMBUS BORROW MATERIAL SHALL BE PLACED IN THE DOWNSTREAM PORTIONS OF THE EMBANKMENT.

PLACEMENT
AREAS ON WHICH FILL IS TO BE PLACED SHALL BE SCARIFIED PRIOR TO PLACEMENT OF FILL. FILL MATERIALS SHALL BE PLACED IN 8-INCH MAXIMUM THICKNESS (BEFORE COMPACTION) LAYERS WHICH ARE TO BE CONTINUOUS OVER THE ENTIRE LENGTH OF THE FILL. THE MOST ROMBUS BORROW MATERIAL SHALL BE PLACED IN THE DOWNSTREAM PORTIONS OF THE EMBANKMENT.

COMPACTION
THE MOVEMENT OF THE HAULING AND SPREADING EQUIPMENT OVER THE FILL SHALL BE CONTROLLED SO THAT THE ENTIRE SURFACE OF EARTH LIFT SHALL BE TRAVERSED BY NOT LESS THAN ONE TREAD TRACK OF THE EQUIPMENT OR COMPACTION SHALL BE ACHIEVED BY A MINIMUM OF FOUR COMPLETE PASSES OF A SUBPLOW, RUBBER TIRE OR VIBRATORY ROLLER. FILL MATERIAL SHALL CONTAIN SUFFICIENT MOISTURE SUCH THAT THE REQUIRED DEGREE OF COMPACTION CAN BE OBTAINED WITH THE EQUIPMENT USED. ALL COMPACTION TO BE 95%.

CUT-OFF TRENCH
WHERE SPECIFIED, A CUT OFF TRENCH SHALL BE EXCAVATED ALONG OR PARALLEL TO THE CENTER-LINE OF THE EMBANKMENT AS SHOWN ON THE PLANS. THE BOTTOM WIDTH OF THE TRENCH SHALL BE GOVERNED BY THE EQUIPMENT USED FOR EXCAVATION, WITH THE MINIMUM WIDTH BEING FOUR FEET. THE DEPTH SHALL BE AT LEAST FOUR FEET OR AS SHOWN ON THE PLANS. THE SIDE SLOPES OF THE TRENCH SHALL BE 1 TO 1 OR FLATTER. THE BACKFILL MATERIAL FOR THE CUT OFF TRENCH SHALL BE THE MOST IMPERVIOUS MATERIAL AVAILABLE AND SHALL BE COMPACTED WITH EQUIPMENT OR ROLLERS TO ASSURE MAXIMUM DENSITY AND MINIMUM PERMEABILITY.

STABILIZATION
ALL BORROW AREAS SHALL BE GRADED TO PROVIDE PROPER DRAINAGE AND LEFT IN A SLIGHTLY CONDITION. ALL EXPOSED SURFACES OF THE EMBANKMENT, SPILLWAY, SOIL AND BORROW AREAS, AND BERMS SHALL BE STABILIZED BY SEEDING, FERTILIZING AND MULCHING (IF REQUIRED) IN ACCORDANCE WITH THE VEGETATIVE TREATMENT SPECIFICATIONS SHOWN ON OR ACCOMPANYING THE DRAWINGS.

PIPE COULDS

A. CORRUGATED METAL PIPE
1. MATERIALS - (STEEL PIPE) THIS PIPE AND ITS APPURTENANCES SHALL BE GALVANIZED AND FULLY BITUMINOUS COATED AND SHALL CONFORM TO THE REQUIREMENTS OF A.S.T.M. SPECIFICATIONS M-190 TYPE A WITH WATERTIGHT COUPLING BANDS. ANY BITUMINOUS COATING DAMAGED OR OTHERWISE REMOVED SHALL BE REPLACED WITH COLO APPLIED BITUMINOUS COATING COMPOUND.
(ALUMINUM PIPE) THIS PIPE AND ITS APPURTENANCES SHALL CONFORM TO THE REQUIREMENTS OF A.S.T.M. SPECIFICATIONS M-190 OR M-211 WITH WATERTIGHT COUPLING BANDS. COUPLING BANDS, ANTI-SEEP COLLARS, END SECTIONS, ETC. MUST BE COMPOSED OF THE SAME MATERIAL AS THE PIPE. METALS MUST BE INSULATED FROM DISSIMILAR MATERIALS WITH USE OF RUBBER OR PLASTIC INSULATING MATERIALS AT LEAST 24 MILS IN THICKNESS. ALUMINUM SURFACES THAT ARE TO BE IN CONTACT WITH CONCRETE SHALL BE PAINTED WITH ONE COAT OF ZINC CHROMATE PRIMER. HOT DIP GALVANIZED BOLTS MAY BE USED FOR CONNECTIONS. THE PH OF THE SURROUNDING SOILS SHALL BE LESS THAN 9 AND GREATER THAN 4. HELICALLY CORRUGATED PIPE IN ADDITION TO THE REQUIREMENTS ABOVE SHALL HAVE EITHER CONTINUOUSLY WELDED SEAMS OR HAVE LOCK SEAMS WHICH ARE CAULKED, DURING FABRICATION, WITH NEOPRENE BEAD.

2. CONNECTIONS - ALL CONNECTIONS WITH PIPES MUST BE COMPLETELY WATERTIGHT. THE DRAIN PIPE OR BARREL CONNECTION TO THE RISER SHALL BE WELDED ALL AROUND WHEN THE PIPE AND RISER ARE METAL. WATERTIGHT COUPLING BANDS SHALL BE USED AT ALL JOINTS. ANTI-SEEP COLLARS SHALL BE CONNECTED TO THE PIPE IN SUCH A MANNER AS TO BE COMPLETELY WATERTIGHT.

3. BEDDING - THE PIPE SHALL BE FIRMLY AND UNIFORMLY BEDDED THROUGHOUT ITS ENTIRE LENGTH. WHERE ROCK OR SOFT, SPOUGY OR OTHER UNSTABLE SOIL IS ENCOUNTERED, ALL SUCH MATERIAL SHALL BE REMOVED AND REPLACED WITH SUITABLE EARTH COMPACTED TO PROVIDE ADEQUATE SUPPORT.

4. LAYING PIPE - THE PIPE SHALL BE PLACED WITH INSIDE CIRCUMFERENTIAL LAPS POINTING DOWNSTREAM AND WITH LONGITUDINAL LAPS AT THE SIDES.

5. BACKFILLING - SHALL CONFORM TO STRUCTURAL BACKFILL AS SHOWN ABOVE

6. OTHER DETAILS (ANTI-SEEP COLLARS, VALVES, ETC.) SHALL BE AS SHOWN ON THE DRAWINGS.

THESE PLANS HAVE BEEN REVIEWED FOR THE HOWARD SOIL CONSERVATION DISTRICT AND MEET THE TECHNICAL REQUIREMENTS FOR SMALL POND CONSTRUCTION, SOIL EROSION AND SEDIMENT CONTROL.

J. Helm, Jr. 4-21-80
US SOIL CONSERVATION SERVICE DATE

THESE PLANS FOR SMALL POND CONSTRUCTION, SOIL EROSION AND SEDIMENT CONTROL MEET THE REQUIREMENTS OF THE HOWARD SOIL CONSERVATION DISTRICT

APPROVED: Robert J. Zahn 4-21-80
HOWARD S.O. DATE

CONCRETE

- 1. MATERIALS**
- A. CEMENT - NORMAL PORTLAND CEMENT SHALL CONFORM TO THE LATEST ASTM SPECIFICATION C-150.
 - B. WATER - THE WATER USED IN CONCRETE SHALL BE CLEAN, FREE FROM OIL, ACID, ALKALI, SALTS, ORGANIC MATTER OR OTHER OBJECTIONAL SUBSTANCES.
 - C. SAND - THE SAND USED IN CONCRETE SHALL BE CLEAN, HARD, STROUG AND DRAINABLE, AND SHALL BE GRADED WITH 100 PERCENT PASSING A ONE-QUARTER INCH SIEVE. LIMESTONE SAND SHALL NOT BE USED.
 - D. COURSE AGGREGATE - THE COURSE AGGREGATE SHALL BE CLEAN, HARD, STRONG, DURABLE, AND FREE FROM CLAY OR DIRT. IT SHALL BE WELL GRADED WITH A MAXIMUM SIZE OF ONE AND ONE-HALF (1-1/2") INCHES.
 - E. REINFORCING STEEL - THE REINFORCING STEEL SHALL BE DEFORMED BARS OF INTERMEDIATE GRADE BILLET STEEL OR RAIL STEEL CONFORMING TO A.S.T.M. SPECIFICATION A-G15.

- 2. DESIGN MIX**
THE CONCRETE SHALL BE MIXED IN THE FOLLOWING PROPORTIONS, MEASURED BY WEIGHT. THE WATER-CEMENT RATIO SHALL BE 5-1/2 TO 6 U.S. GALLONS OF WATER PER 94 POUND BAG OF CEMENT. THE PROPORTION OF MATERIALS FOR THE TRIAL MIX SHALL BE 1:2:3 1/2. THE COMBINATION OF AGGREGATES MAY BE ADJUSTED TO PRODUCE A PLASTIC AND WORKABLE MIX THAT WILL NOT PRODUCE HARSHNESS IN PLACING OR HONEYCOMBING IN THE STRUCTURE.

- 3. MIXING** - THE CONCRETE INGREDIENTS SHALL BE MIXED IN BATCH MIXERS UNTIL THE MIXTURE IS HOMOGENEOUS AND OF UNIFORM CONSISTENCY. THE MIXING OF EACH BATCH SHALL CONTINUE FOR NOT LESS THAN ONE AND ONE-HALF MINUTES AFTER ALL THE INGREDIENTS, EXCEPT THE FULL AMOUNT OF WATER, ARE IN THE MIXER. THE MINIMUM MIXING TIME IS PREDICTED ON PROPER CONTROL OF THE SPEED OF ROTATION OF THE MIXER, AND OF THE INTRODUCTION OF THE MATERIALS, INCLUDING WATER, INTO THE MIXER. WATER SHALL BE ADDED PRIOR TO, DURING, AND FOLLOWING THE MIXER CHANGING OPERATIONS. EXCESSIVE OVER MIXING REQUIRING THE ADDITION OF WATER TO PRESERVE THE REQUIRED CONCRETE CONSISTENCY SHALL NOT BE PERMITTED. TRUCK MIXING WILL BE ALLOWED PROVIDED THAT THE USE OF THIS METHOD SHALL CAUSE NO VIOLATION OF ANY APPLICABLE PROVISIONS OF THE SPECIFICATIONS GIVEN HERE.

- 4. FORMS** - THE FORMS SHALL HAVE SUFFICIENT STRENGTH AND RIGIDITY TO HOLD THE CONCRETE AND TO WITHSTAND THE NECESSARY PRESSURE, TAMPING AND VIBRATION WITHOUT DEFLECTION FROM THE PRESCRIBED LINES. THEY SHALL BE MORTAR-TIGHT AND CONSTRUCTED SO THAT THEY CAN BE REMOVED WITHOUT HAMMERING OR Prying AGAINST THE CONCRETE. THE INSIDE OF FORMS SHALL BE OILED WITH A NON-STAINING MINERAL OIL OR THOROUGHLY WETTED BEFORE CONCRETE IS PLACED. FORMS MUST BE REMOVED 24 HOURS AFTER THE PLACEMENT OF CONCRETE. ALL WIRE TIES AND OTHER DEVICES USED SHALL BE RECESSED FROM THE SURFACE OF THE CONCRETE.

- 5. REINFORCING STEEL** - ALL REINFORCING MATERIAL SHALL BE FREE OF DIRT, RUST, SCALE, OIL, PAINT OR ANY OTHER COATINGS. THE STEEL SHALL BE ACCURATELY PLACED AND SECURELY TIED AND BLOCKED INTO POSITION SO THAT NO MOVEMENT OF THE STEEL WILL OCCUR DURING PLACEMENT OF CONCRETE.

- 6. CONSOLIDATING** - CONCRETE SHALL BE CONSOLIDATED WITH INTERNAL TYPE MECHANICAL VIBRATORS. VIBRATION SHALL BE SUPPLEMENTED BY SPADING AND HAND TAMPING AS NECESSARY TO INSURE SMOOTH AND DENSE CONCRETE ALONG FORM SURFACES IN CORNERS, AND AROUND EMBEDDED ITEMS.

- 7. FINISHING** - DEFECTIVE CONCRETE, HONEYCOMBED AREAS, VOIDS LEFT BY THE REMOVAL OF THE FORMS, RIDGES OR ALL CONCRETE SURFACES PERMANENTLY EXPOSED TO VIEW OR EXPOSED TO WATER ON THE FINISHED STRUCTURE, SHALL BE REPAIRED IMMEDIATELY AFTER THE REMOVAL OF FORMS. ALL VOIDS SHALL BE REAMED AND COMPLETELY FILLED WITH DRY PATCHING MORTAR.

- 8. PROTECTION AND CURING** - EXPOSED SURFACES OF CONCRETE SHALL BE PROTECTED FROM DIRECT RAYS OF THE SUN FOR AT LEAST THE FIRST THREE (3) DAYS. ALL CONCRETE SHALL BE KEPT CONTINUOUSLY MOIST FOR AT LEAST TEN (10) DAYS AFTER BEING PLACED. MOISTURE MAY BE APPLIED BY SPRAYING. CONCRETE SHALL NOT BE EXPOSED TO FREEZING DURING THE CURING PERIOD. CURING COMPOUNDS MAY ALSO BE USED.

- 9. PLACING TEMPERATURE** - CONCRETE MAY NOT BE PLACED AT TEMPERATURES BELOW 37 DEGREES F WITH THE TEMPERATURE FALLING, OR 34 DEGREES WITH THE TEMPERATURE RISING.

PERMANENT SEEDING NOTES



SEEDING PREPARATION: LOOSELY UPPER 3 INCHES OF SOIL BY RAKING, DIGGING OR OTHER ACCEPTABLE MEANS BEFORE SEEDING.

SOIL AMENDMENTS: APPLY 2 TONS PER ACRE (92100/1000 SQ.FT) OF 0-20-20 FERTILIZER (14100/1000 SQ.FT) HARRROW OR DISC. LIME AND FERTILIZER INTO UPPER THREE INCHES OF SOIL. AT TIME OF SEEDING, APPLY 400 LBS PER ACRE (9.2100/1000 SQ.FT) OF 36-0-0 UREAFORM FERTILIZER AND 500 LBS PER ACRE (115100/1000 SQ.FT) OF 10-20-20 FERTILIZER.

SEEDING: FOR THE PERIODS MARCH 1 THRU APRIL 30, AND AUG 1 THRU OCT 15, SEED WITH 60 LBS PER ACRE (1.4100/1000 SQ.FT) OF KENTUCKY 31 TALL FESCUE. FOR THE PERIOD MAY 1 THRU JULY 31, SEED WITH 60 LBS PER ACRE OF KENTUCKY 31 TALL FESCUE PER ACRE AND 2100 LBS PER ACRE (0.5100/1000 SQ.FT) OF WEEPING LOVEGRASS. DURING THE PERIOD OF OCTOBER 16 THRU FEBRUARY 28, PROTECT SITE BY: OPTION (1) 2 TONS PER ACRE OF WELL ANCHORED STRAW MULCH AND SEED AS SOON AS POSSIBLE IN THE SPRING. OPTION (2) USE 600. OPTION (3) SEED WITH 60 LBS/ACRE KENTUCKY 31 TALL FESCUE AND MULCH WITH 2 TONS/ACRE WELL ANCHORED STRAW.

MULCHING: APPLY 1 1/2 TO 2 TONS PER ACRE (70 TO 90 LBS/1000 SQ.FT) OF UNROTTED SMALL GRAIN STRAW IMMEDIATELY AFTER SEEDING. ANCHOR MULCH IMMEDIATELY AFTER APPLICATION USING 200 GALLONS PER ACRE (500 LBS/1000 SQ.FT) OF EMULSIFIED ASPHALT ON FLAT AREAS ON SLOPES 8 FEET OR HIGHER, USE 340 GALLONS PER ACRE (86 GALLONS/1,000 SQ.FT) FOR ANCHORING.

MAINTENANCE: INSPECT ALL SEEDING AREAS AND NEEDED REPAIRS, REPLACEMENTS AND RESEEDING.

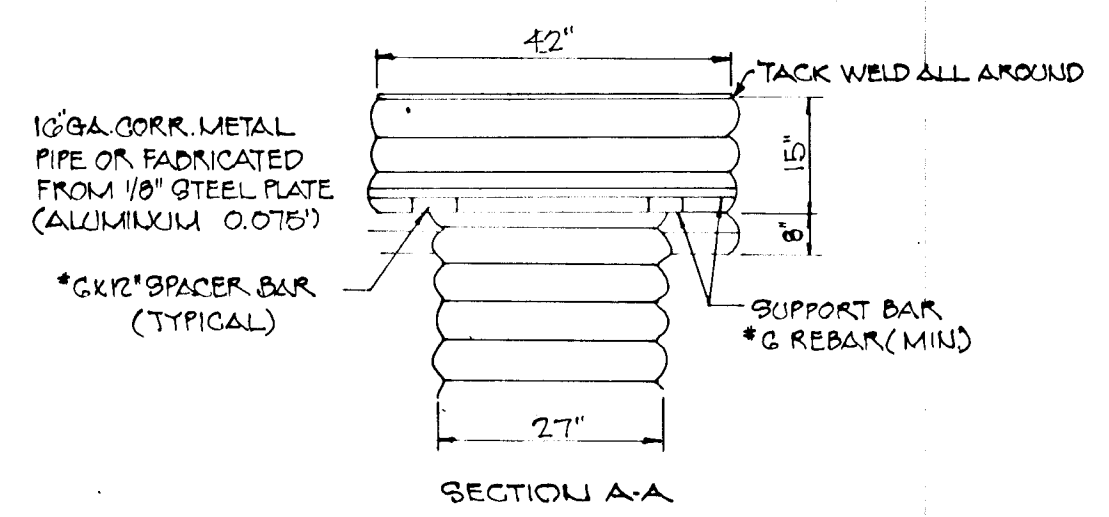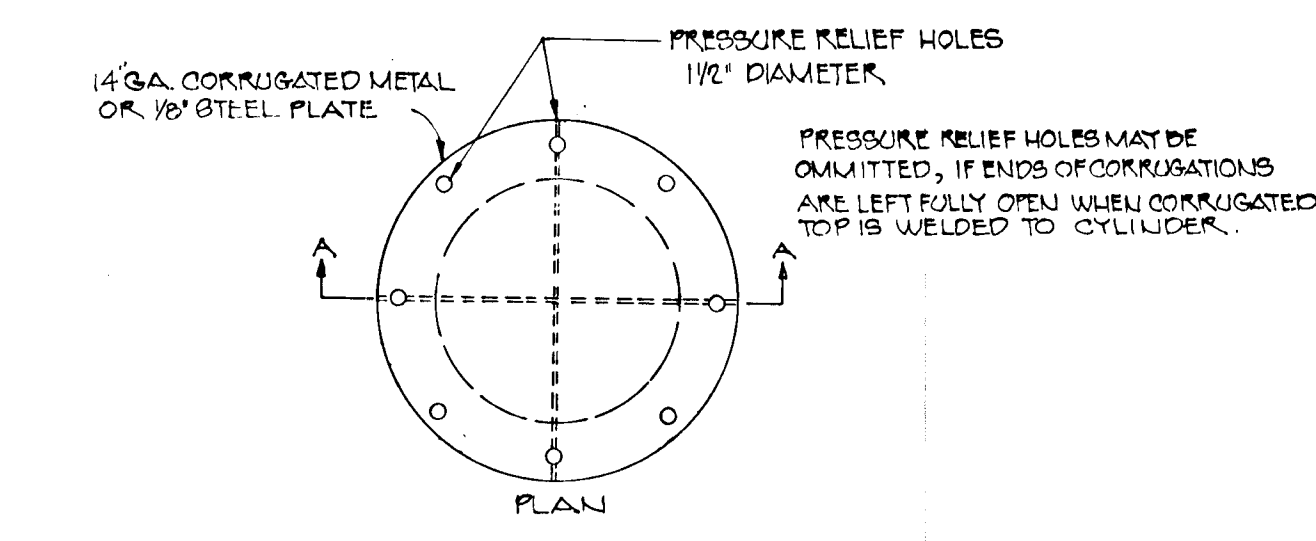


DETAIL TRASH RACK & ANTI-VORTEX DEVICE
NO SCALE

I CERTIFY THAT ALL DEVELOPMENT AND/OR CONSTRUCTION WILL BE DONE ACCORDING TO THESE PLANS OF DEVELOPMENT, POND CONSTRUCTION AND EROSION AND SEDIMENT CONTROL. I ALSO AUTHORIZE PERIODIC ON-SITE INSPECTION BY THE HOWARD SOIL CONSERVATION DISTRICT OR THEIR AUTHORIZED AGENTS, AS ARE DEEMED NECESSARY DEVIATION FROM THIS PLAN WILL NOT BE MADE UNLESS AUTHORIZED BY THE HOWARD SOIL CONSERVATION DISTRICT. I WILL PROVIDE THE HOWARD SOIL CONSERVATION DISTRICT WITH A RED-LINED 'AS-BUILT' OF THE POND WITHIN 30 DAYS OF COMPLETION.

B.G. Associates, Inc. Jack T. Gibson - Partner
DATE 12/29/79


I CERTIFY THAT THIS PLAN FOR POND CONSTRUCTION, EROSION AND SEDIMENT CONTROL REPRESENTS A PRACTICAL AND WORKABLE PLAN BASED ON MY PERSONAL KNOWLEDGE OF THE SITE CONDITIONS. THIS PLAN WAS PREPARED IN ACCORDANCE WITH THE REQUIREMENTS OF THE HOWARD SOIL CONSERVATION DISTRICT. I HAVE NOTIFIED THE DEVELOPER THAT HE MUST PROVIDE THE HOWARD SOIL CONSERVATION DISTRICT WITH A RED LINED 'AS-BUILT' OF THE POND WITHIN 30 DAYS OF COMPLETION.

Howard W. Colcher
HUDKINS ASSOCIATES INC. DATE 1/2/80

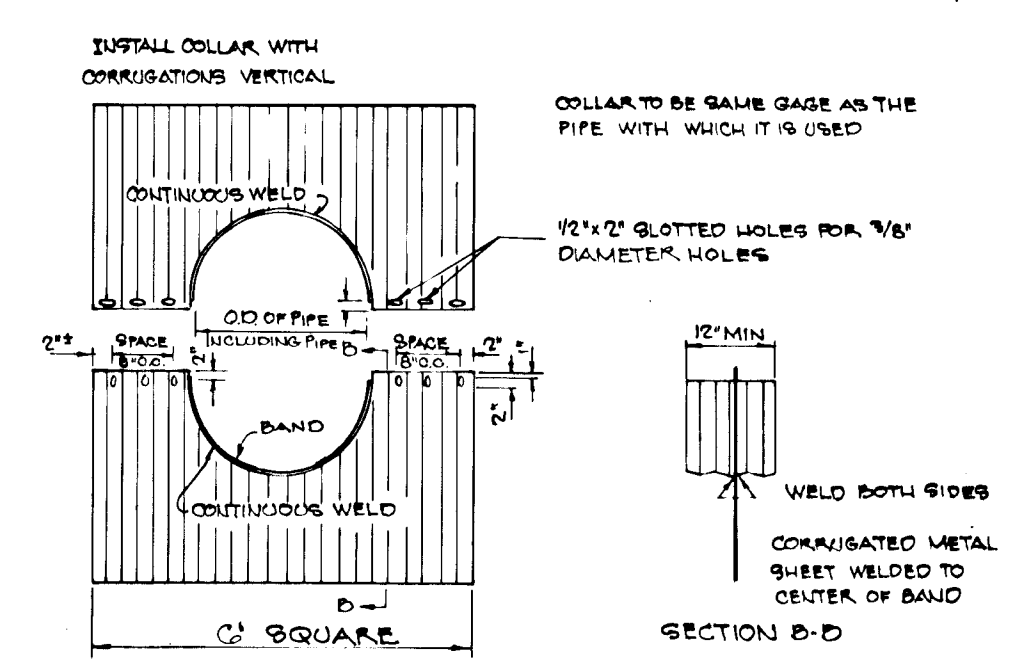


NOTES FOR COLLARS:
1. ALL MATERIALS TO BE IN ACCORDANCE WITH CONSTRUCTION AND CONSTRUCTION MATERIAL SPECIFICATIONS.
2. WHEN SPECIFIED ON THE PLANS, COATINGS OF COLLARS SHALL BE IN ACCORDANCE WITH CONSTRUCTION AND CONSTRUCTION MATERIAL SPECIFICATIONS.
3. UNASSEMBLED COLLARS SHALL BE MARKED BY PAINTING OR TAGGING TO IDENTIFY MATCHING BIRTS.
4. THE LAP BETWEEN THE TWO HALF SECTIONS AND BETWEEN THE PIPE AND CONNECTION BAND SHALL BE CAULKED WITH ASPHALT MASTIC AT TIME OF INSTALLATION.
5. EACH COLLAR SHALL BE REFINISHED WITH TWO 1/2" DIAMETER HOLES WITH STANDARD TANK KISS FOR COLLECTING COLLARS TO PIPE.


DETAILS OF CORRUGATED METAL ANTI-SEEP COLLARS
NO SCALE

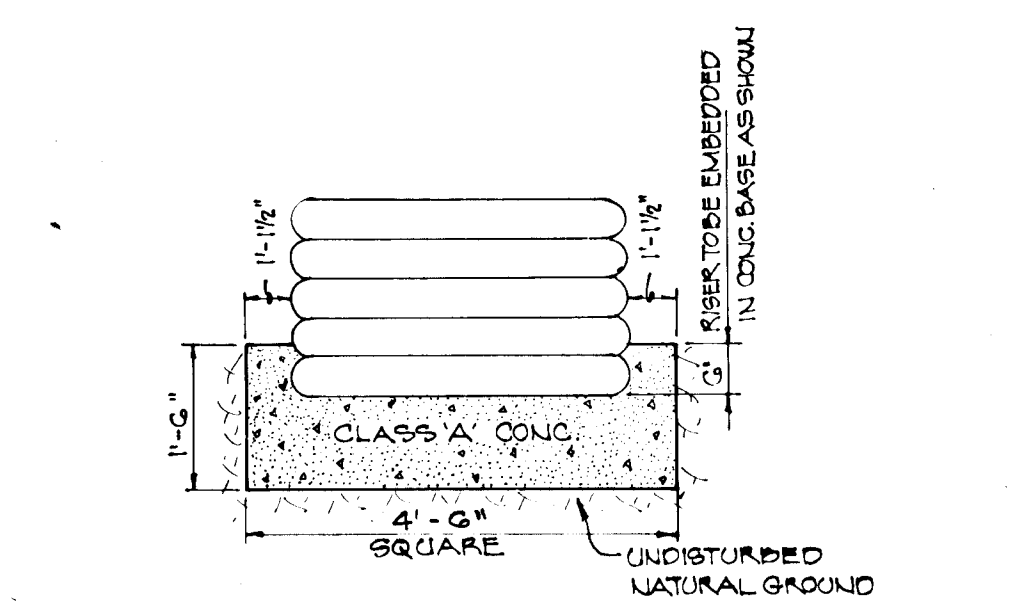

DETAIL CONCRETE BASE
NO SCALE

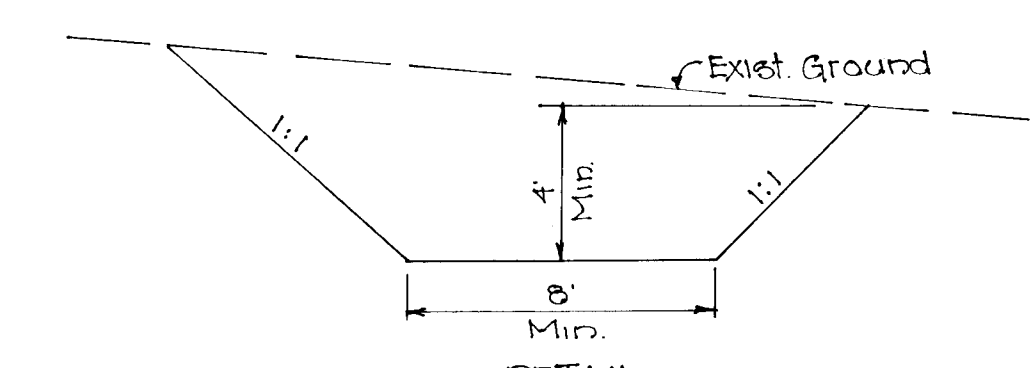

DETAIL CORE TRENCH
NO SCALE

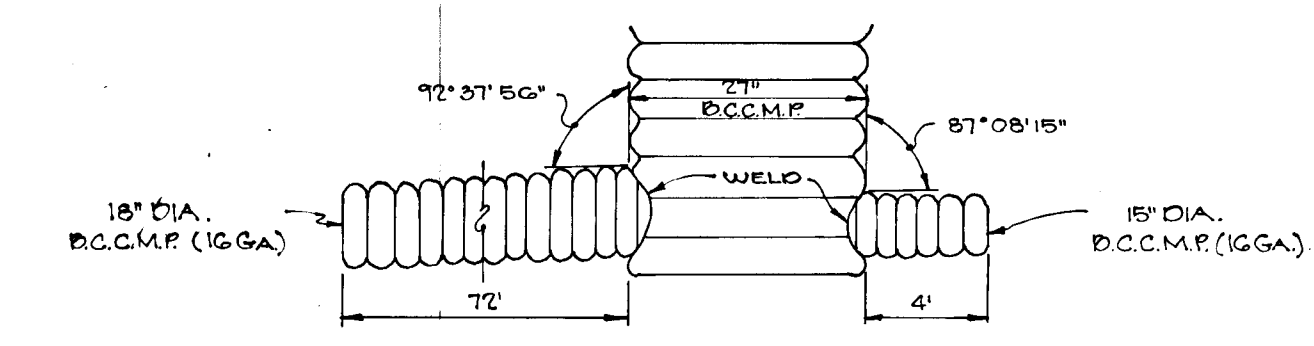

DETAIL RISER CONNECTION
NO SCALE

DEVELOPER
B.G. ASSOCIATES
9200 BELAIR ROAD
BALTIMORE, MARYLAND 21286

ENGINEERS
HUDKINS ASSOCIATES INC.
100 N. MAIN ST. BEL AIR, MD. 21014
838-0888 879-8177

STORM WATER MANAGEMENT
POND - NO. II
"KEYWAYDIN"
ELECT. DIST. NO. HOWARD CO. MD.
SCALE: AS SHOWN SHEET 9 OF 11
HOWARD COUNTY, MARYLAND
DEPARTMENT OF PUBLIC WORKS
Robert J. Zahn 4-23-80
CHIEF, BUREAU OF ENGINEERING & CONSTRUCTION
OFFICE OF PLANNING & ZONING
4-22-80
CHIEF, DIVISION OF LAND DEVELOPMENT DATE



REV	DATE	REVISION	INLET LOCATION	SCALE
1	11/27/80		DESC	BY

LOCATION MAP
SCALE: 1" = 200'

LAND OF JAMES MEADE
284 / 235
ZONING: R-20 DISTRICT
(RESIDENTIAL SINGLE)

LAND OF ROBERT VAN WAGENER
284 / 235
ZONING: R-20 DISTRICT
(RESIDENTIAL SINGLE)

LAND OF ROBERTS
EVALUATED
ZONING: R-20 DISTRICT
(RESIDENTIAL SINGLE)

2 RE-BAR STEEL PICKETS OR
2"x2" STAKES 1/2 TO 2'
IN THE GROUND

ANGLE FIRST STAKE
TOWARD PREVIOUSLY
LAID STAKE

WIRE OR NYLON BOUND
DALES PLACE ON THE
CONTOUR

ANCHORING DETAIL

EMBEDDING DETAIL


STANDARD SYMBOL
STRAW BALE DIKE
NO SCALE

GRADING & SEDIMENT CONTROL
'KEYWAYDIN'


ELECT. DIST. No. 2 HOWARD Co. MD.
SCALE: AS SHOWN SHEET 10 OF 11
F-80-92

HOWARD COUNTY, MARYLAND
DEPARTMENT OF PUBLIC WORKS


William E. Rely 4-23-80
CHIEF, BUREAU OF ENGINEERING DATE
OFFICE OF PLANNING & ZONING
William E. Rely 4-23-80
CHIEF, DIVISION OF LAND DEVELOPMENT DATE

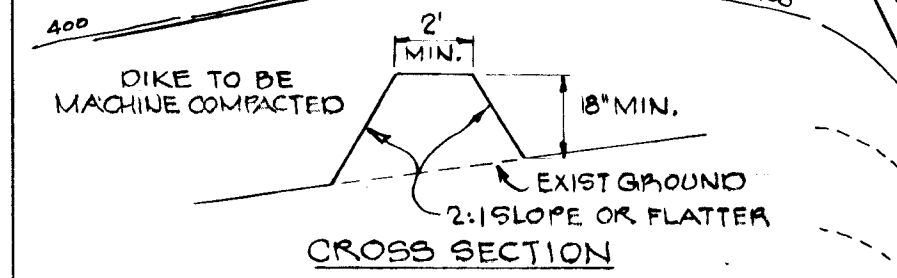

CROSS SECTION

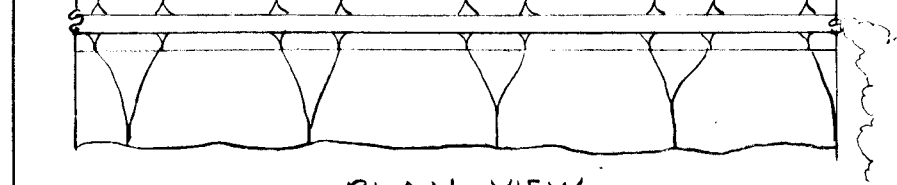

PLAN VIEW

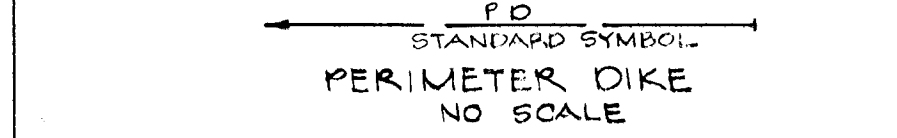


STONE OUTLET SEDIMENT TRAP



ELEVATION



PROFILE

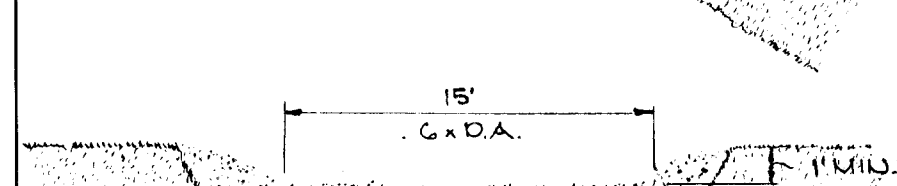

PLAN

STONE SIZE - USE MSHA SIZE No. 2 (2 1/2" TO 1") OR A ASHTO DESIGNATION M 43, SIZE No. 2 (2 1/2" TO 1 1/2") USE CAUGHED STONE

STABILIZED CONSTRUCTION ENTRANCE

I CERTIFY THAT ALL DEVELOPMENT AND/OR CONSTRUCTION WILL BE DONE ACCORDING TO THESE PLANS OF DEVELOPMENT, ROAD CONSTRUCTION AND EROSION AND SEDIMENT CONTROL. I ALSO AUTHORIZE PERIODIC ON-SITE INSPECTIONS BY THE HOWARD SOIL CONSERVATION DISTRICT OF THEIR AUTHORIZED DELETED AS NECESSARY. DEVIATION FROM THIS PLAN SHALL NOT BE MADE UNLESS AUTHORIZED BY THE HOWARD SOIL CONSERVATION DISTRICT. I WILL PROVIDE THE HOWARD SOIL CONSERVATION DISTRICT WITH A RED-LINED "AS BUILT" OF THE PILES WITHIN 90 DAYS OF COMPLETION.

B&G Associates, Jack T. Gibbon, Partner 2/19/80
DATE
B&G ASSOCIATES, JACK T. GIBBON, PARTNER

I CERTIFY THAT THIS PLAN FOR ROAD CONSTRUCTION, EROSION, AND SEDIMENT CONTROL REPRESENTS A PRACTICAL AND WORKABLE PLAN BASED ON MY PERSONAL KNOWLEDGE OF THE SITE CONDITIONS. THIS PLAN WAS PREPARED IN ACCORDANCE WITH THE REQUIREMENTS OF THE HOWARD SOIL CONSERVATION DISTRICT. I HAVE NOTIFIED THE DEVELOPER THAT HE MUST PROVIDE THE HOWARD SOIL CONSERVATION DISTRICT WITH A RED-LINED "AS BUILT" OF THE PILES WITHIN 90 DAYS OF COMPLETION.

Charles A. White 2/19/80
DATE
LUDKINS ASSOCIATES, INC.

DEVELOPER
B&G ASSOCIATES
JACK T. GIBBON, PARTNER
1600 BELAIR ROAD
BALTIMORE, MARYLAND 21286

ENGINEERS
LUDKINS ASSOCIATES INC.
100 N. MAIN ST. DEL. AVE., MD. 21014
206-0888 217-9117

THESE PLANS HAVE BEEN REVIEWED FOR THE HOWARD SOIL CONSERVATION DISTRICT AND MEET THE TECHNICAL REQUIREMENTS FOR SMALL ROAD CONSTRUCTION, SOIL EROSION AND SEDIMENT CONTROL.

J. Helms R.F. 4-21-80
DATE
CHIEF, SOIL CONSERVATION

THESE PLANS FOR SMALL ROAD CONSTRUCTION, SOIL EROSION AND SEDIMENT CONTROL MEET THE REQUIREMENTS OF THE HOWARD SOIL CONSERVATION DISTRICT.

APPROVED: *Robert J. Helm* 4-21-80
DATE
HOWARD C.O.D.

PLAN No. F-80-92

F-80-92

TEMPORARY SEEDING PROCEDURES

1. SEED IMMEDIATELY UPON CONSTRUCTION WITH RYE GRASS 11 LBS PER 1,000 S.F.
2. APPLY 42 LBS PER 1,000 S.F. OF PULVERIZED DOLOMITIC LIMESTONE AND 11 LBS TO 18 LBS PER 1,000 S.F. OF 10-10-10 OR EQUIVALENT FERTILIZER.
3. HARROW AND DISC LIME & FERTILIZER INTO SOIL TO A DEPTH OF AT LEAST 3 INCHES. CONTINUE TILLAGE UNTIL A REASONABLY FINE, FIRM SEED BED HAS BEEN PREPARED. ON SLOPING LAND THE FINAL HARROWING SHOULD BE ON THE CONTOUR.
4. MULCH WITH STRAW AT 75 LBS PER 1,000 S.F.

PERMANENT SEEDING & SOODING PROCEDURES

1. PLACE TOPSOIL IN DISTURBED AREAS TO A DEPTH OF 2 INCHES
2. APPLY 50 LBS PER 1,000 S.F. OF LIMESTONE.
3. APPLY FERTILIZER AT RATE OF 25 LBS OF 10-10-10 PER 1,000 S.F. DEPENDING ON SOIL TESTS.
4. HARROW OR DISC FERTILIZER INTO SOIL TO A DEPTH OF 3 INCHES.
5. SEED WITH KENTUCKY 31 TALL FESCUE AT THE RATE OF 50 LBS PER 1,000 S.F. (IF DONE DURING PERMITTED SEASON, OTHERWISE USE 500.)
6. MULCH WITH SMALL GRAIN STRAW AT 1.5 TO 2.0 TONS PER ACRE (75-90 LBS PER 1,000 S.F.)
7. ANCHOR MULCH WITH SPRAYED ASPHALT AT 0.1 GALLONS PER SQ. YDS.
8. PLACE APPROVED OR CERTIFIED KENTUCKY 31 TALL FESCUE SOD AND ANCHOR IN CRITICAL AREAS AS REQUIRED.
9. WATER SOODED AREAS AS REQUIRED TILL FIRMLY ESTABLISHED.

VEGETATIVE COVER OPTIONS

FEB 1 TO MAY 1	1. SOD 2. SEED & MULCH
MAY 1 TO AUG. 15	1. SOD 2. MULCH, ANCHOR, TOOL THEN SEED DURING NEXT SEEDING PERIOD
AUG. 15 TO NOV. 1	1. SOD 2. SEED & MULCH
NOV. 1 TO FEB. 1	1. SOD, DELAY UNTIL NEXT PERIOD IF FROZEN 2. MULCH, ANCHOR, TOOL, THEN SEED DURING NEXT SEEDING PERIOD

NOTE: ANY DISTURBED EARTH LEFT IDLE LONGER THAN 30 DAYS SHALL BE ESTABLISHED ACCORDING TO TEMPORARY SEEDING PROCEDURES.

SEDIMENT CONTROL NOTES

1. ALL REFERENCES TO U.S.D.A. S.C. MANUAL APPLY TO STDS. & SPECS FOR SOIL & EROSION CONTROL IN DEVELOPING AREAS. ALL WORK ON THIS PLAN MUST BE BUILT IN ACCORDANCE WITH THIS MANUAL.
2. ALL STABILIZATION TO BE DONE IN ACCORDANCE WITH TEMPORARY & PERMANENT SEEDING PROCEDURES IN THE ABOVE REFERENCED MANUAL.
3. ON SITE INSPECTION & MAINTENANCE OF ALL SEDIMENT MEASURES WILL BE THE RESPONSIBILITY OF THE DEVELOPER ON A CONTINUING DAY TO DAY BASIS.
4. ALL LOTS ARE SUBJECT TO SEDIMENT CONTROL ON AN INDIVIDUAL BASIS IN CONNECTION WITH EACH BUILDING PERMIT.
5. NO SLOPES TO BE GREATER THAN 2:1.
6. DURING THE LAYOUT OF THE SEDIMENT CONTROL DEVICES SHOWN ON THESE PLANS, MINOR FIELD ADJUSTMENTS CALL# WILL BE MADE TO INSURE THE ARREST & CONTROL OF ALL SEDIMENT BEFORE IT LEAVES THE CONSTRUCTION SITE. CHANGES IN SEDIMENT CONTROL PRACTICES REQUIRE PRIOR APPROVAL OF THE HOWARD SOIL CONSERVATION DISTRICT.
7. ALL BERMS TO BE COMPACTED, SEEDED AND MULCHED.
8. ANY CHANGES TO THE GRADING SHOWN ON THIS PLAN WILL REQUIRE IT TO BE RESUBMITTED TO THE HOWARD SOIL CONSERVATION DISTRICT.
9. STRUCTURE MEASURES SUCH AS BERMS, DIKES, TRAPS, BASINS ETC. WILL BE INSTALLED AND STABILIZED ACCORDING TO THIS PLAN PRIOR TO ANY OTHER GRADING, CLEARING OR DISTURBANCE OF THE EXISTING SURFACE OF THE SITE, EXCEPT WHEN CLEARING IS REQ'D TO INSTALL STRUCTURES.
10. ON SITE INSPECTION AND MAINTENANCE OF ALL SEDIMENT CONTROL MEASURES INCLUDING CLEANOUT OF SEDIMENT TRAPS AND BERMS AND PROPER ESTABLISHMENT OF ALL PLANNED VEGETATIVE MEASURES WILL BE THE RESPONSIBILITY OF THE DEVELOPER, ON THE SITE, ON A CONTINUING DAY TO DAY BASIS.
11. UPSTREAM END OF STORM DRAIN SYSTEMS TO BE BLOCKED AT THE END OF EACH WORKING DAY.

SEQUENCE OF CONSTRUCTION


1. NOTIFY HOWARD COUNTY BUREAU OF INSPECTIONS AND PERMITS AT LEAST 48 HOURS PRIOR TO STARTING WORK.
2. CLEAR AND GRAD ROADWAYS
3. ROUGH GRADE ENTRANCE AND CONSTRUCT STONE CONSTRUCTION ENTRANCE.
4. CONSTRUCT STONE OUTLET SEDIMENT TRAP
5. CONSTRUCT SILT FENCE ALONG MD RTE. 987, PERIMETER DIKES AND STABILIZE
6. ROUGH GRADE ROADWAYS.
7. FINE GRADE ROADS AND STABILIZE SLOPES.
8. CONSTRUCT STORM WATER MANAGEMENT PONDS AND STABLE CONSTRUCT STRAW BALE DIKE AROUND POND NO. II AS SHOWN.
9. CONSTRUCT DRAINAGE STRUCTURES, PROTECT INLETS WITH STONE FILTER UNTIL SITE IS STABILIZED.
10. CONSTRUCT UTILITIES, SANITARY SEWER AND WATER MAINS.
11. CONSTRUCT CONCRETE CURBS AND PLACE SUBGRADE MATERIALS.
12. COMPLETE ROAD CONSTRUCTION.
13. AT THE END OF EACH WORKING DAY, ALL SEDIMENT CONTROL DEVICES WILL BE INSPECTED AND LEFT IN OPERATIONAL CONDITIONS.
14. REMOVE TEMPORARY SEDIMENT CONTROL DEVICES AFTER OBTAINING APPROVAL BY THE HOWARD SOIL CONSERVATION DISTRICT.

"I CERTIFY THAT ALL DEVELOPMENT AND/OR CONSTRUCTION WILL BE DONE ACCORDING TO THESE PLANS OF DEVELOPMENT, POND CONSTRUCTION, AND EROSION AND SEDIMENT CONTROL. I ALSO AUTHORIZE PERIODIC ON-SITE INSPECTION BY THE HOWARD COUNTY SOIL CONSERVATION DISTRICT OR THEIR AUTHORIZED AGENTS, AS ARE DEEMED NECESSARY. DEVIATION FROM THIS PLAN WILL NOT BE MADE UNLESS AUTHORIZED BY THE HOWARD SOIL CONSERVATION DISTRICT. I WILL PROVIDE THE HOWARD SOIL CONSERVATION DISTRICT WITH A RED-LINED "AS BUILT" OF THE PONDS WITHIN 30 DAYS OF COMPLETION."

B & G Associates, Inc. *Jack T. Gibson - Partner* 2/19/80
D & G ASSOCIATES, JACK T. GIBSON - PARTNER DATE

I CERTIFY THAT THIS PLAN FOR POND CONSTRUCTION, EROSION, AND SEDIMENT CONTROL REPRESENTS A PRACTICABLE AND WORKABLE PLAN BASED ON MY PERSONAL KNOWLEDGE OF THE SITE CONDITIONS THIS PLAN WAS PREPARED IN ACCORDANCE WITH THE REQUIREMENTS OF THE HOWARD SOIL CONSERVATION DISTRICT. I HAVE NOTIFIED THE DEVELOPER THAT HE MUST PROVIDE THE HOWARD SOIL CONSERVATION DISTRICT WITH A RED-LINED "AS BUILT" OF THE PONDS WITHIN 30 DAYS OF COMPLETION."

Howard W. Holmes 2/19/80
HOLMES ASSOCIATES, INC. DATE

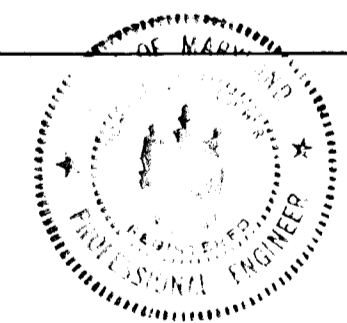


THESE PLANS HAVE BEEN REVIEWED FOR THE HOWARD SOIL CONSERVATION DISTRICT AND MEET THE TECHNICAL REQUIREMENTS FOR SMALL POND CONSTRUCTION, SOIL EROSION AND SEDIMENT CONTROL.


J. Helm / e.z. 4-21-80
U.S. SOIL CONSERVATION DATE

THESE PLANS FOR SMALL POND CONSTRUCTION, SOIL EROSION AND SEDIMENT CONTROL MEET THE REQUIREMENTS OF THE HOWARD SOIL CONSERVATION DISTRICT.


APPROVED: *Robert Ziehm* 4-21-80
HOWARD S.C.D. DATE
PLAN No. F-80-92

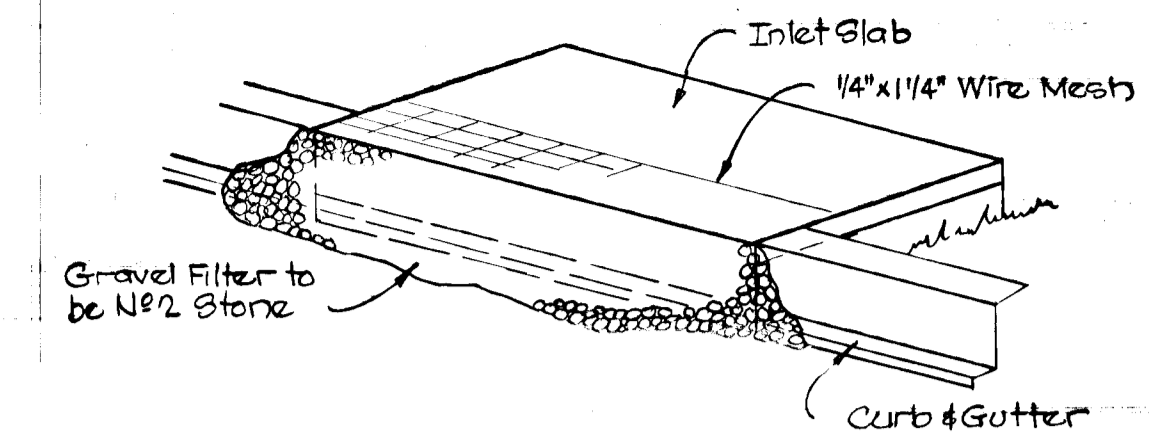

ISOMETRIC VIEW

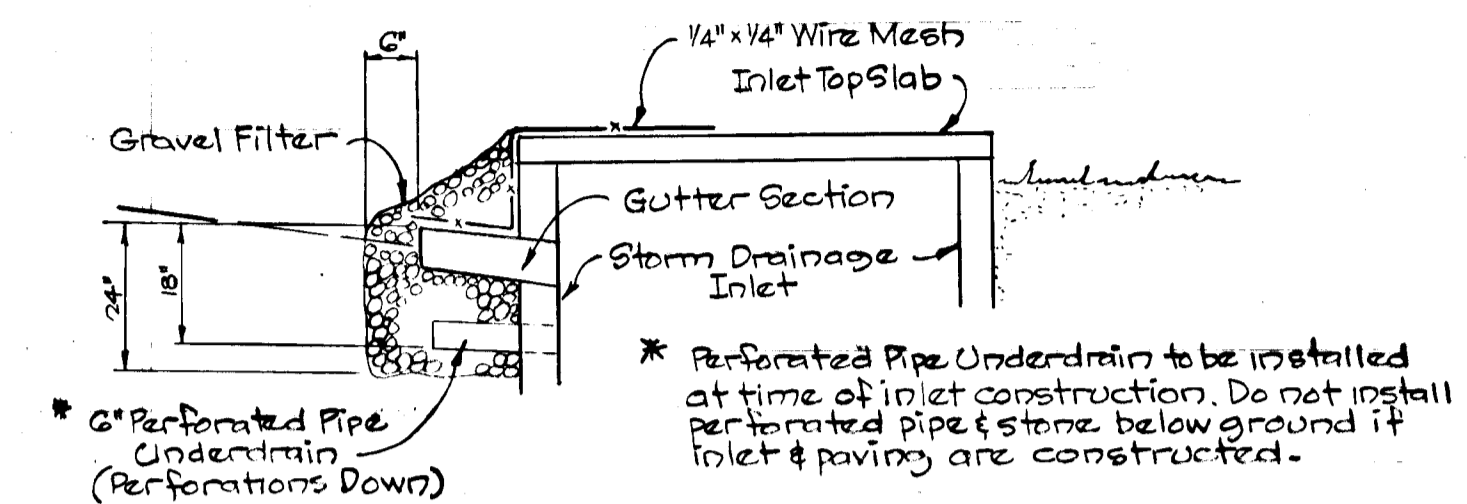

SECTION VIEW
STONE FILTER INLET PROTECTION
NO SCALE

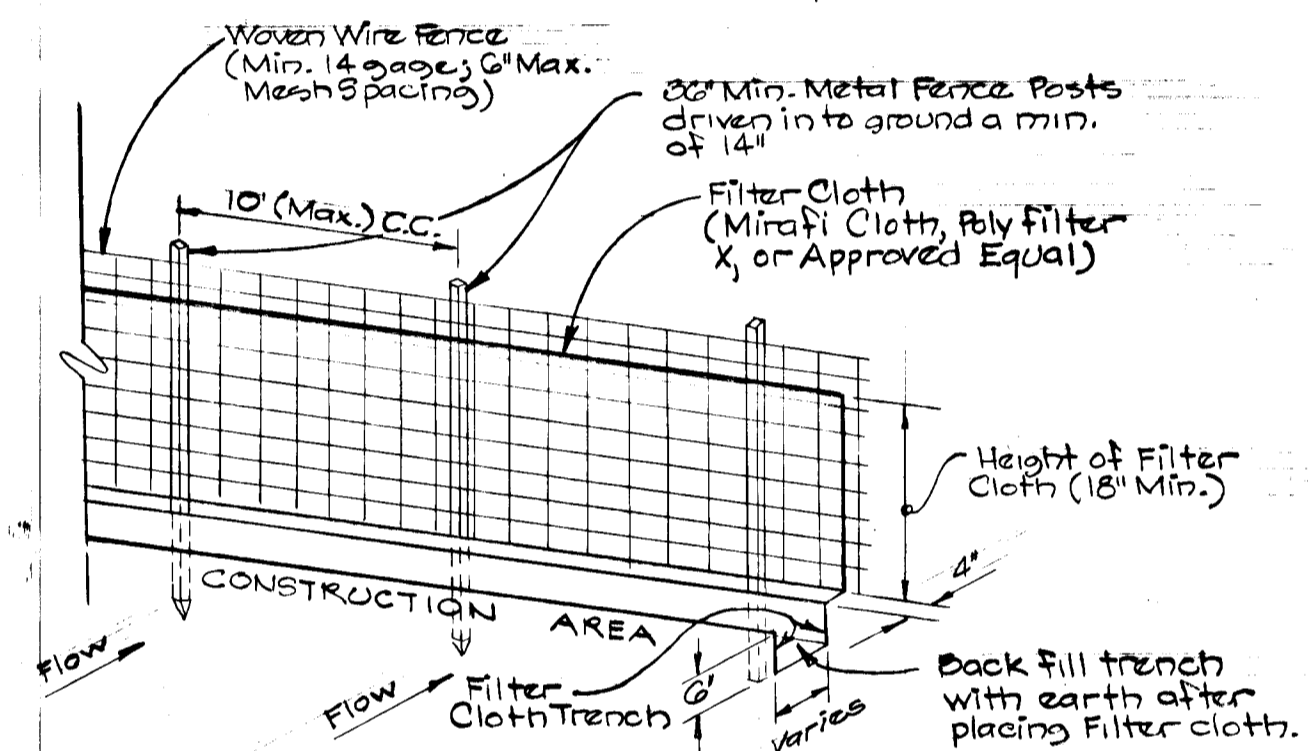

DETAIL
SILT FENCE
NO SCALE

- Notes:
1. Woven Wire Fence to be fastened securely to fence posts by use of wire ties.
 2. Filter Cloth to be fastened securely to woven wire fence by use of wire ties spaced every 24" x 24".

GRADING & SEDIMENT CONTROL

'KEYWAYDIN'
ELECT. DIST. No. 2 HOWARD CO. MD.
SCALE: AS SHOWN SHEET 11 OF 11
F-80-92

HOWARD COUNTY, MARYLAND
DEPARTMENT OF PUBLIC WORKS
William S. P. ... 4-23-80
CHIEF, BUREAU OF ENGINEERING DATE
OFFICE OF PLANNING & ZONING
William S. P. ... 4-22-80
CHIEF, DIVISION OF LAND DEVELOPMENT DATE