

THESE PLANS HAVE BEEN REVIEWED FOR THE HOWARD SOIL CONSERVATION DISTRICT AND MEET THE TECHNICAL REQUIREMENTS FOR SMALL POND CONSTRUCTION, SOIL EROSION AND SEDIMENT CONTROL.

*James M. Heib* 10/25/82  
U.S. SOIL CONSERVATION SERVICE DATE




THESE PLANS FOR SMALL POND CONSTRUCTION, SOIL EROSION AND SEDIMENT CONTROL MEET THE REQUIREMENTS OF THE HOWARD SOIL CONSERVATION DISTRICT.

*Robert W. Zilber* 10/21/82  
HOWARD SOIL CONSERVATION DISTRICT DATE


APPROVED: DEPARTMENT OF PUBLIC WORKS

*William S. Ray* 3/14/83  
CHIEF, BUREAU OF ENGINEERING DATE

APPROVED: OFFICE OF PLANNING AND ZONING  
*John M. Muehlen* 3-7-83  
CHIEF, DIVISION OF LAND DEVELOPMENT AND ZONING ADMINISTRATION DATE

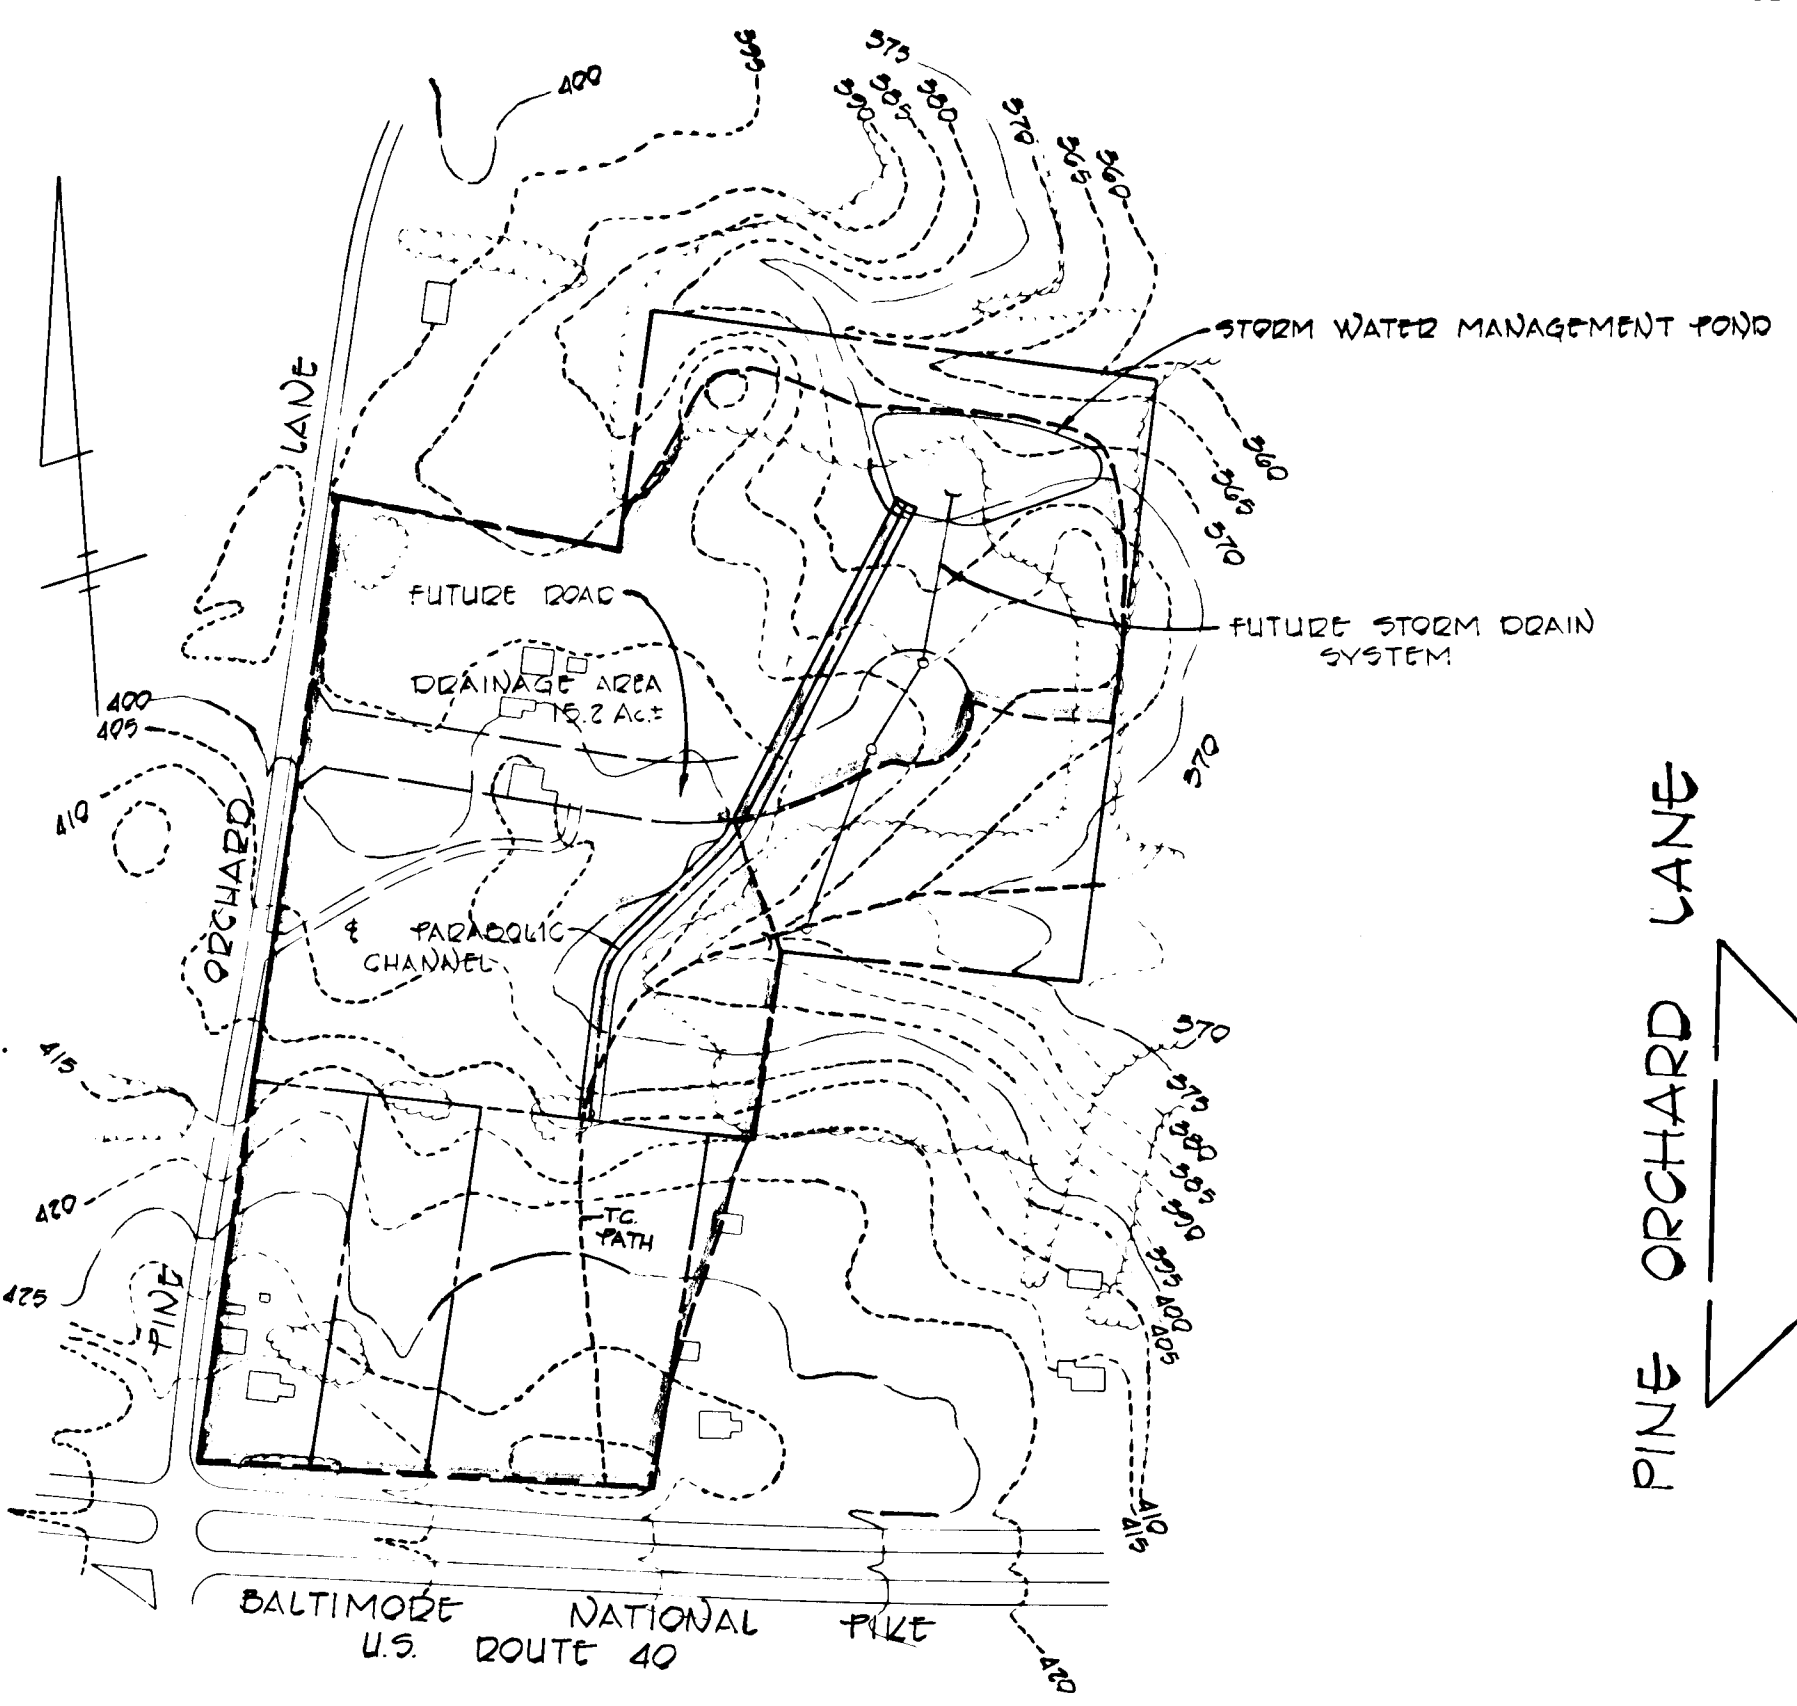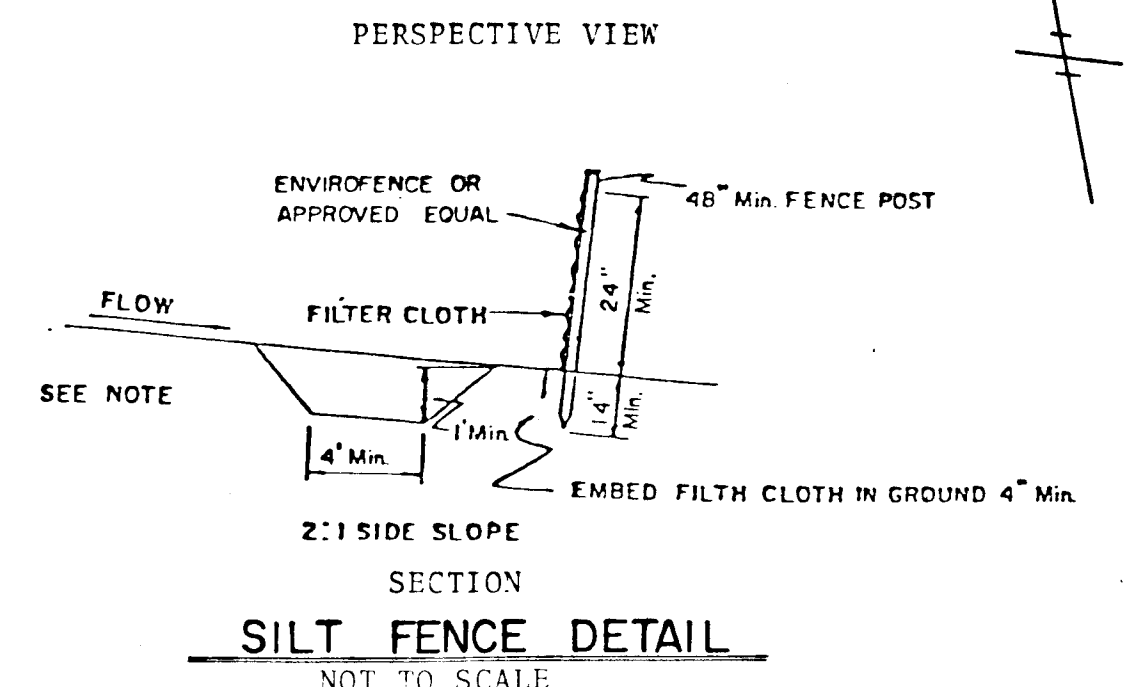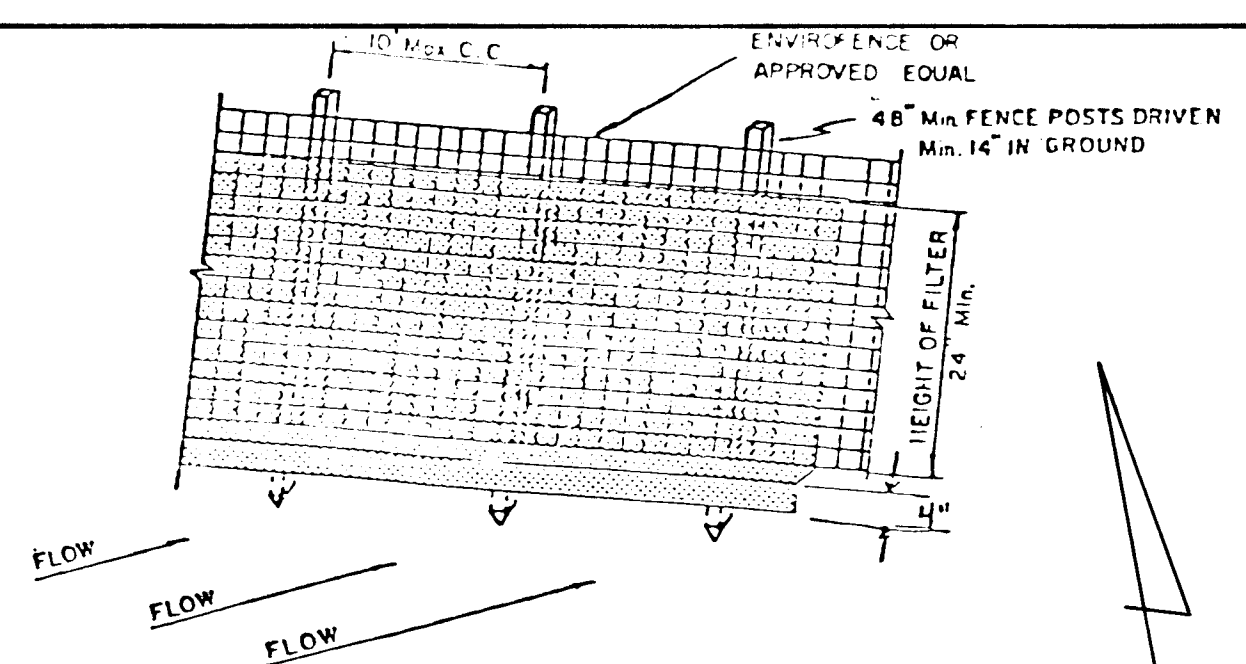

**DRAINAGE AREA MAP**  
SCALE: 1" = 200'

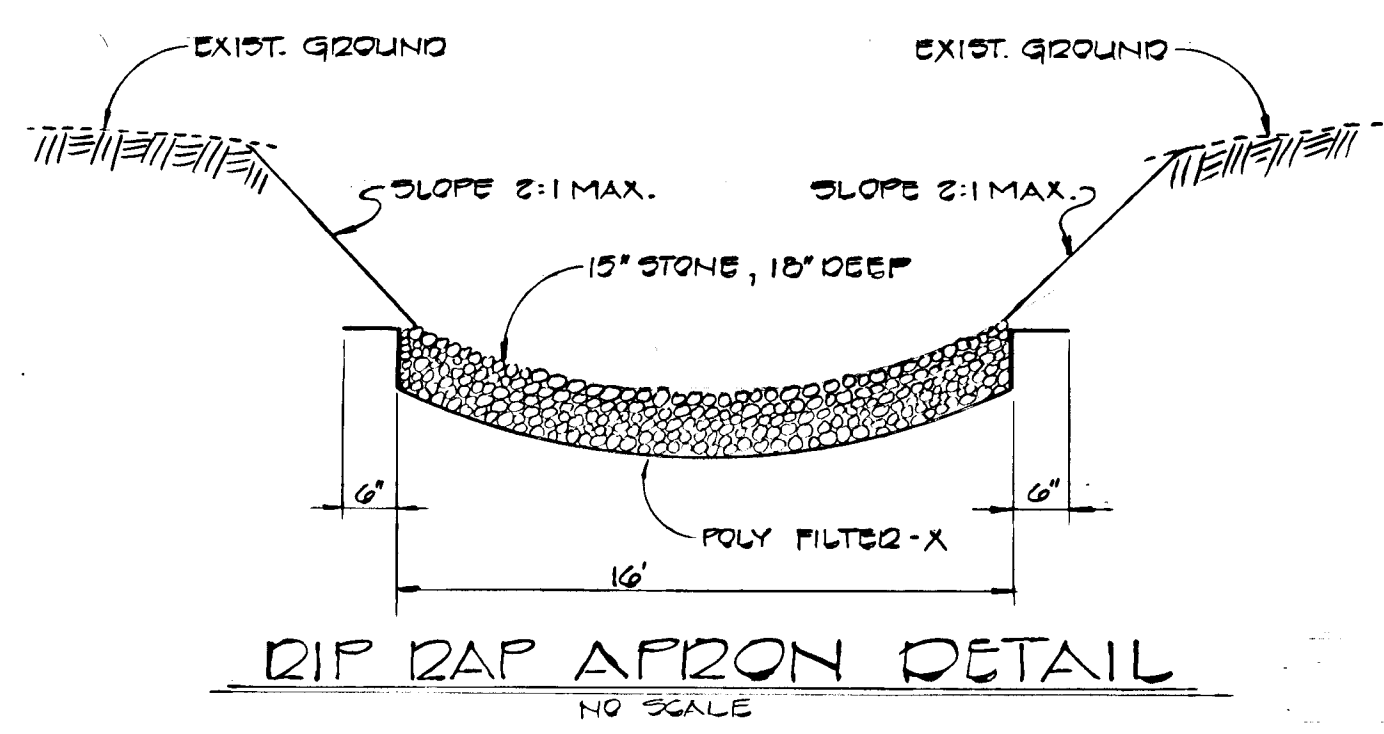



**DIP RAP APRON DETAIL**  
NO SCALE

**SOO NOTES**  
1) CLASS OF TURFGRASS SOO SHALL BE MARYLAND STATE CERTIFIED OR MARYLAND APPROVED.  
2) SOO SHALL BE LAID WITH THE LONG EDGES PARALLEL TO THE CONTOUR AND WITH SPACED JOINTS. SECURE THE SOO BY TAMING AND PEcking.  
3) AS SOODING IS COMPLETED IN ANY ONE SECTION, THE ENTIRE AREA SHALL BE ROLLED OR TAMPED TO INSURE SOLID CONTACT OF ROOTS WITH THE SOIL SURFACE.

**PLAN**  
SCALE: 1" = 50'

THIS IS TO CERTIFY THAT THIS AS-BUILT IS ACCURATE AND THAT THE POND AS CONSTRUCTED MEETS THE REQUIREMENTS OF THAT STANDARDS AND APPLICATIONS FOR PONDS.

CHARLES J. CROW, JR. DATE MAY 4, 1983

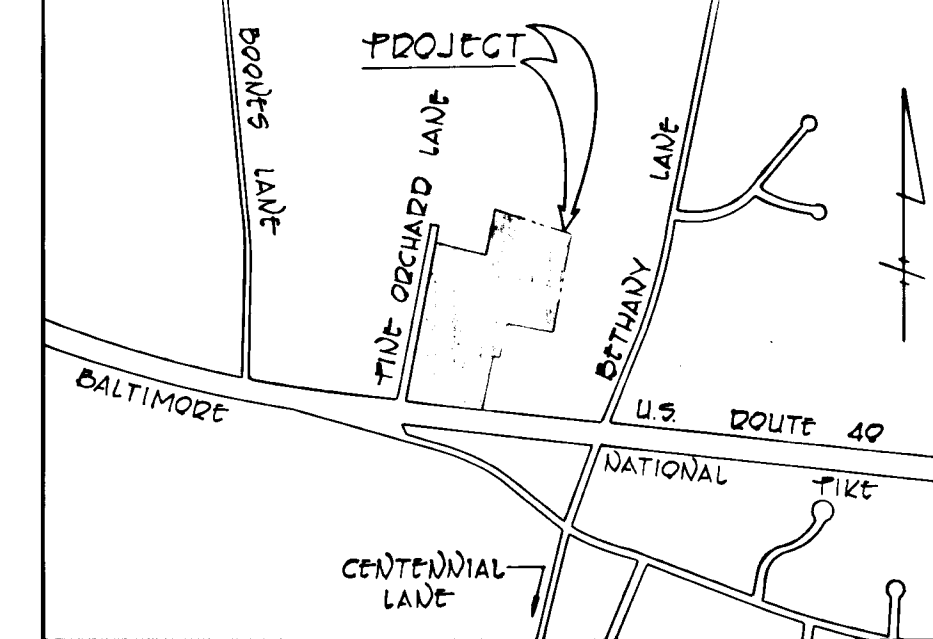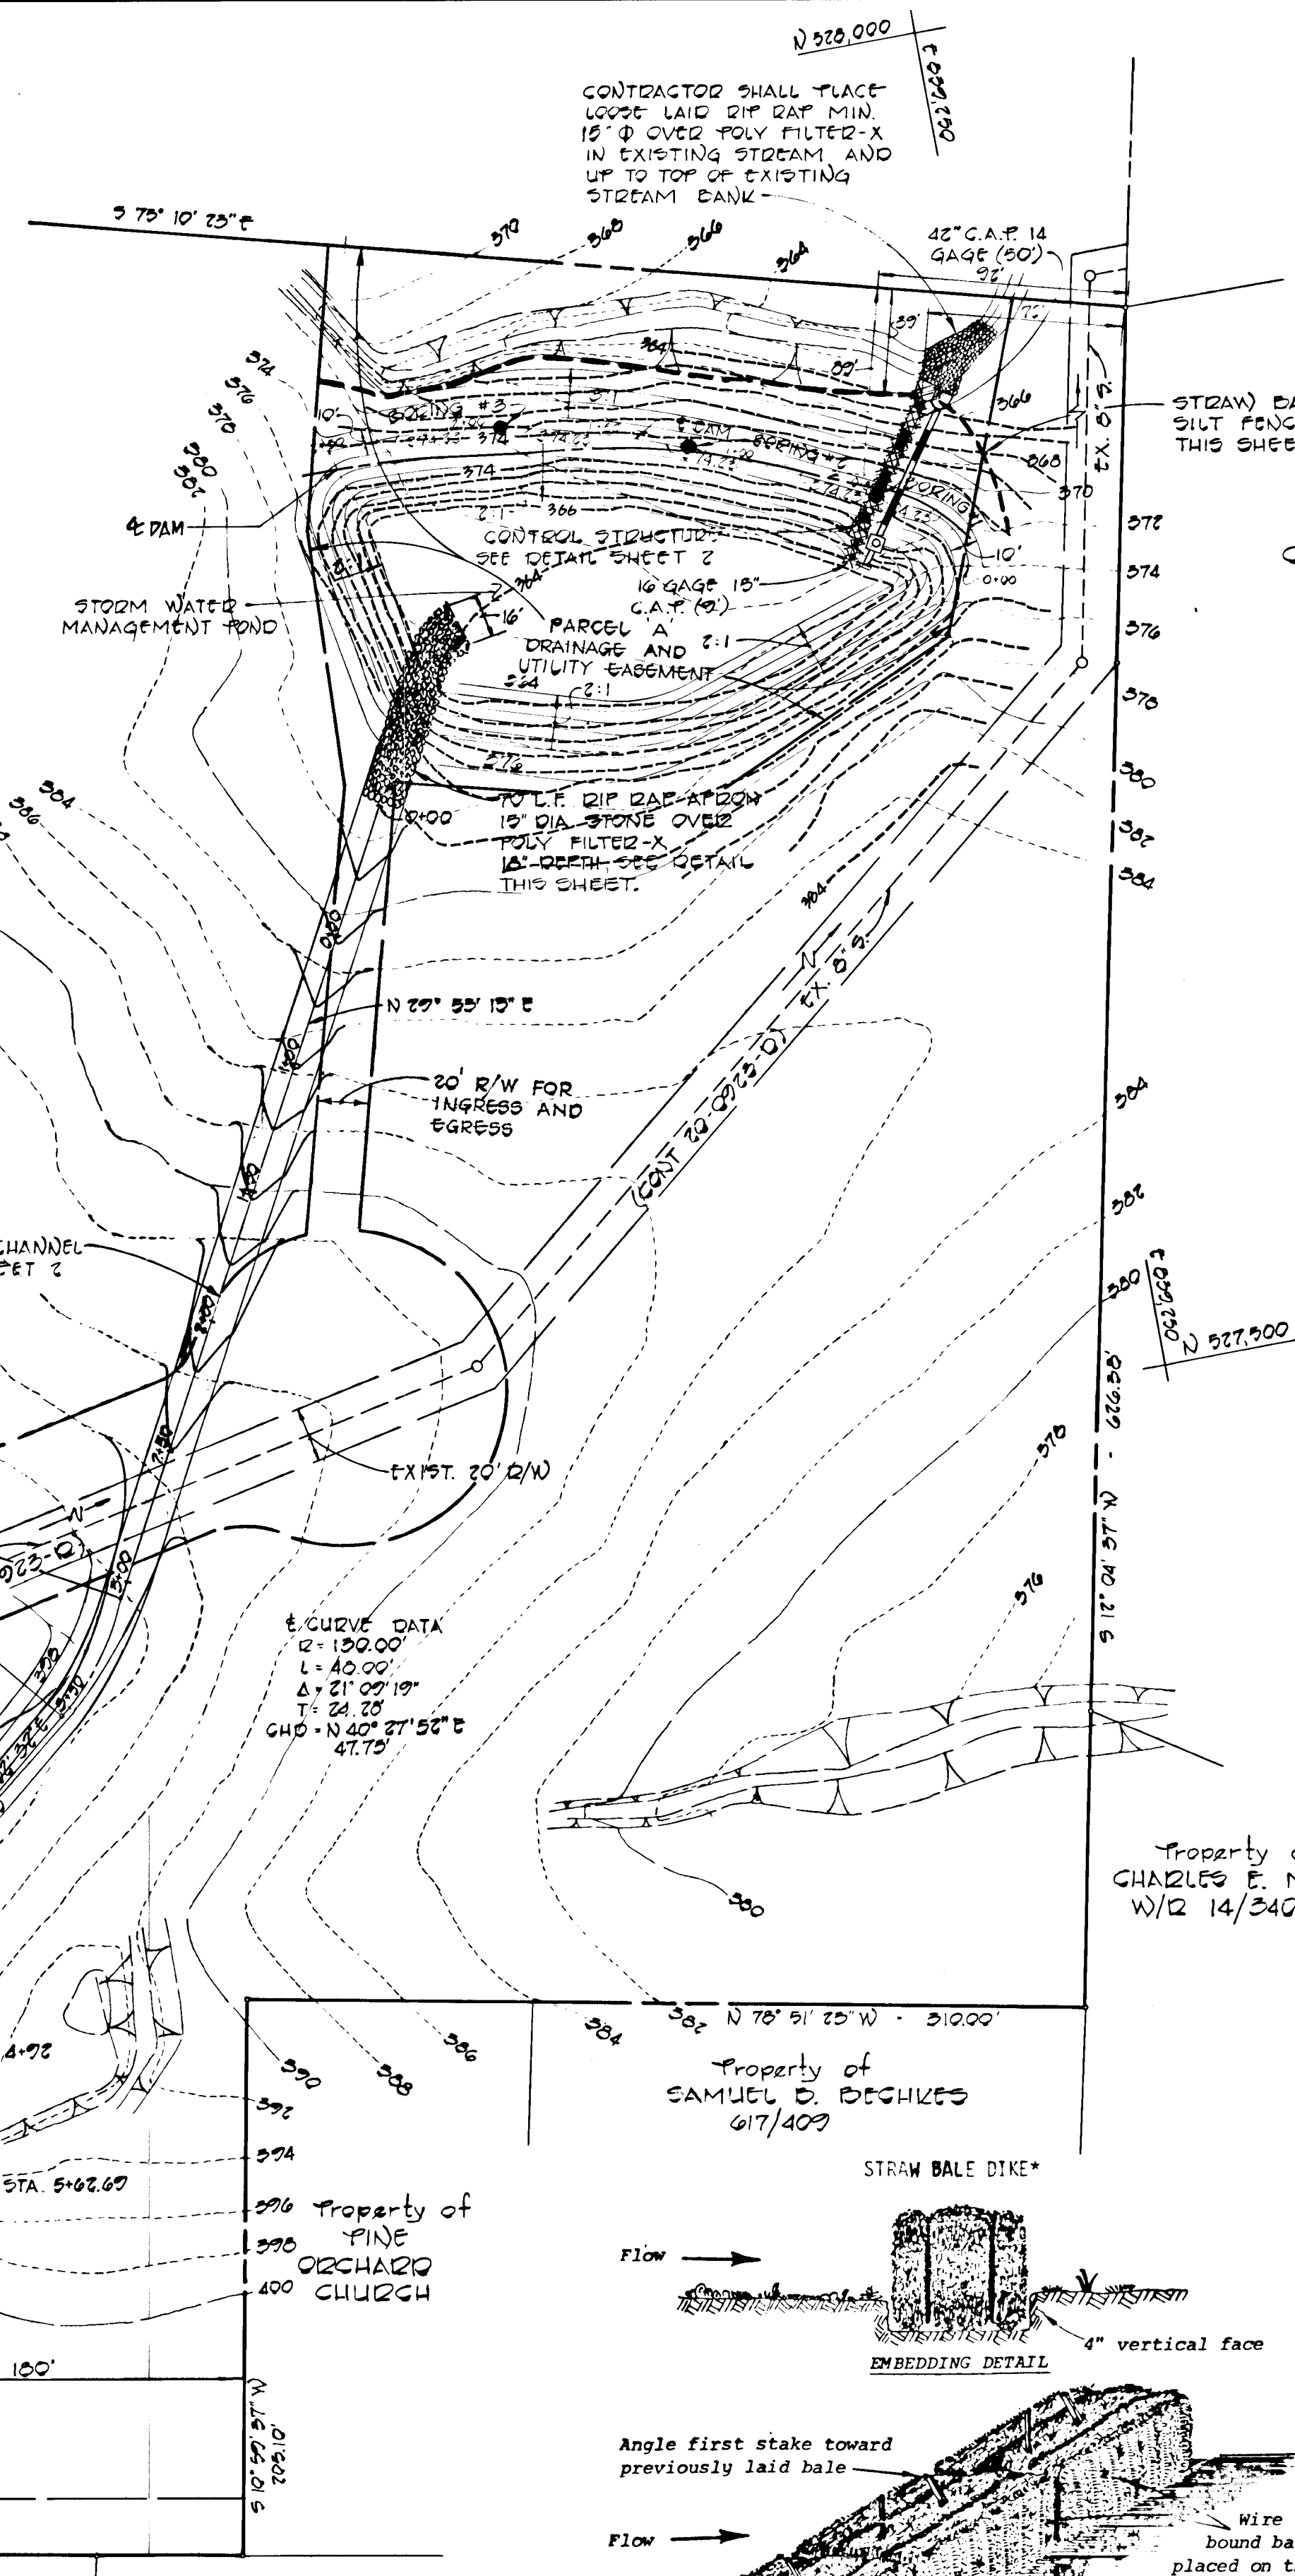

**VICINITY MAP**  
SCALE: 1" = 1,200'

Property of  
**C. E. MANN**  
226/401

Property of  
**CHARLES E. MANN**  
W/2 14/340

Property of  
**SAMUEL D. DESHIRE**  
617/409

Property of  
**PINE ORCHARD CHURCH**  
400


Property of  
**BA LUMBER COMPANY**  
1066/067

Property of  
**HOWARD ASSOCIATES**  
407/787

- SEDIMENT CONTROL NOTES**
- Specifications for the Sediment Control Details shown herein are included in the U.S.D.A. Soil Conservation Service "Standards and Specifications for Soil Erosion and Sediment Control in Developing Areas".
  - The developer shall notify the Howard County Office of Inspection and Permits at least 24 hours prior to beginning any construction shown herein (992-2433).
  - Sediment control structures to be constructed prior to any on-site grading or disturbance to an existing surface material, and are to be stabilized as soon as constructed.
  - All sediment control structures to remain in place until permission for their removal has been obtained from the Howard County Office of Inspection and Permits (992-2433).
  - All graded areas not to be sodded shall be stabilized by seeding and mulching in accordance with the following:
    - Site Preparation
      - Harrow or disc in areas proposed to be seeded the following materials:
        - Pulverized limestone at 2 tons/acre.
        - Commercial fertilizer 10-10-10 at 3/4 tons/acre.
        - Super phosphate at 600 lbs./acre.
      - Seeding
        - Sow the following seed mixture at the rate of 200 lbs./acre with a mechanical spreader:
          - Temporary: Italian or Perennial Rye Grass
          - Permanent: 40% Merion Blue Grass, 40% South Dakota Blue Grass and 20% Penn Lawn Creeping Fescue.
        - The seeded area shall then be raked with a York Rake (a minimum of 2 passes) covered and compacted with Cultipacker or other approved method.
      - Mulching
        - Seeded areas shall be uniformly mulched immediately after seeding with unweathered small grain straw at the rate of 1-1/2 - 2 tons/acre.
        - Tie mulch down with liquid asphalt at 0.1 gal./s.y. or emulsified asphalt at 0.04 gal./s.y. or mulch netting.

- CONSTRUCTION SEQUENCE**
- OBTAIN GRADING PERMIT.
  - INSTALL STRAW BALE DIKES AND/OR SILT FENCE. SEE DETAIL THIS SHEET.
  - CONSTRUCT STORM WATER MANAGEMENT POND AND STABILIZE USING TEMPORARY SEEDING.
  - THE ORIFICE AT THE 15" C.A.P. SHALL BE BLOCKED IN ACCORDANCE WITH THE DETAIL ON SHEET 2. THE ORIFICE SHALL REMAIN BLOCKED UNTIL SUCH TIME WHEN THE SEDIMENT BASIN TRANSITIONS TO FUNCTION AS A STORM WATER MANAGEMENT POND.
  - CONSTRUCT PARABOLIC CHANNEL AND APRONS, STABILIZE WITH PERMANENT SEEDING.
  - DURING CONSTRUCTION, SEDIMENT SHALL BE REMOVED FROM THE SEDIMENT BASIN WHEN THE CLEANOUT ELEVATION 364.75 HAS BEEN REACHED.
  - AFTER EACH RAINFALL, THE CONTRACTOR SHALL INSPECT AND PROVIDE NECESSARY MAINTENANCE ON THE SEDIMENT AND EROSION CONTROL STRUCTURES SHOWN HEREON.
  - THE SEDIMENT BASIN SHALL REMAIN IN PLACE UNTIL THE UPSTREAM AREA HAS BEEN STABILIZED.
  - THE SEDIMENT BASIN SHALL BE DEWATERED BY PUMPING.
  - THE SEDIMENT FROM THE BASIN SHALL BE SPREAD UPSTREAM OF THE POND AND STABILIZED WITH PERMANENT SEEDING.
  - THE STORM WATER MANAGEMENT POND SHALL BE GRADED IN ACCORDANCE WITH THIS SHEET AND STABILIZED WITH PERMANENT SEEDING.

AS CONSTRUCTED MEETS ALL STANDARDS AND SPECIFICATIONS.

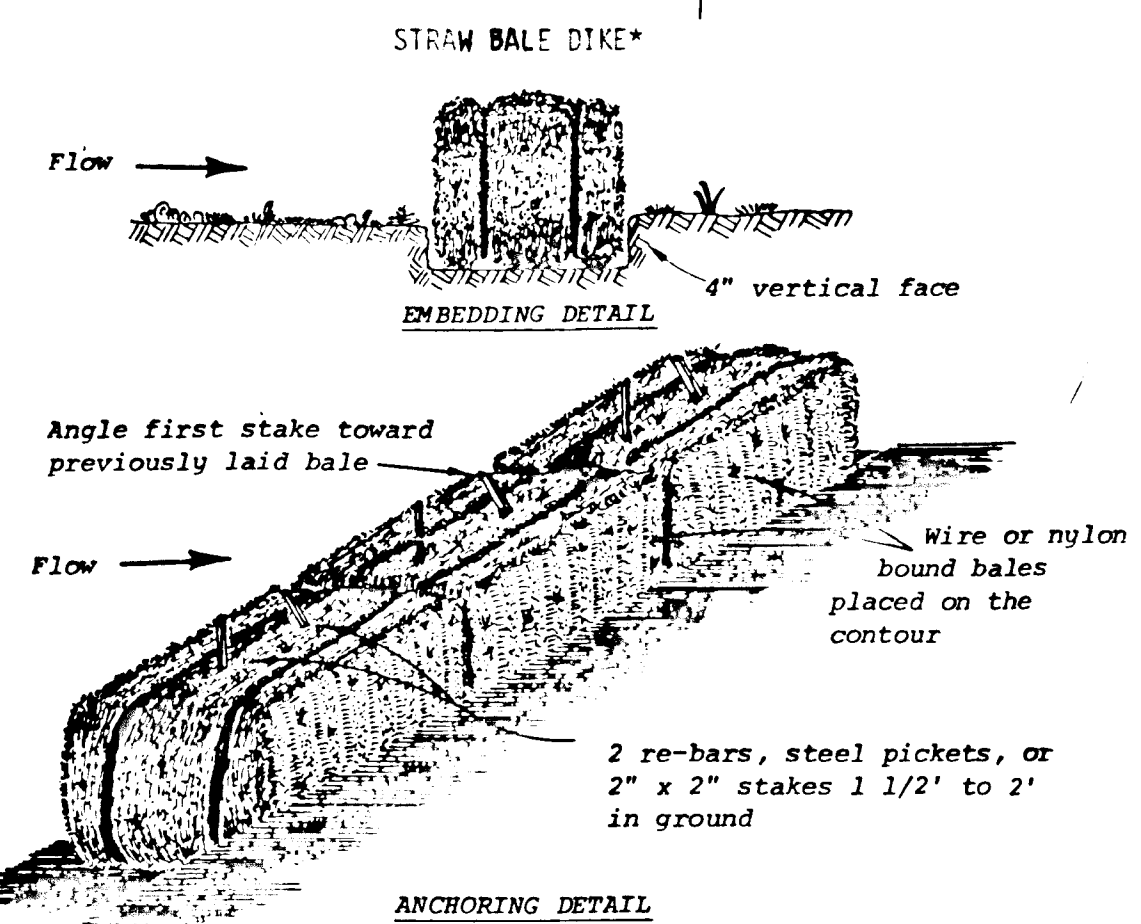

*Earl Collins* 8/10/82  
DATE

**STORM WATER MANAGEMENT POND**  
**PINE ORCHARD PARK**  
2<sup>ND</sup> ELECTION DISTRICT MARCH 15, 1983 SHEET 1 OF 2  
HOWARD COUNTY, MARYLAND  
SCALE: AS SHOWN

#921

**FISHER, COLLINS AND CARTER**  
CONSULTING ENGINEERS AND LAND SURVEYORS  
6000 COURT AVENUE  
ELLICOTT CITY, MARYLAND 21043  
301-461-2055



STORM WATER MANAGEMENT POND CERTIFICATION AND APPROVAL

DEVELOPER'S CERTIFICATE

"I HEREBY CERTIFY THAT ALL DEVELOPMENT AND/OR CONSTRUCTION WILL BE DONE ACCORDING TO THESE PLANS, AND THAT ANY RESPONSIBLE PERSONNEL INVOLVED IN THE CONSTRUCTION PROJECT WILL HAVE A CERTIFICATE OF ATTENDANCE AT A DEPARTMENT OF NATURAL RESOURCES APPROVED TRAINING PROGRAM FOR THE CONTROL OF SEDIMENT AND EROSION BEFORE BEGINNING THE PROJECT. I WILL PROVIDE THE HOWARD SOIL CONSERVATION DISTRICT WITH AN AS-BUILT PLAN OF THE POND WITHIN 30 DAYS OF COMPLETION."

Signature of Developer: *[Signature]* DATE: \_\_\_\_\_

ENGINEER'S CERTIFICATE

"I CERTIFY THAT THIS PLAN FOR POND CONSTRUCTION, EROSION AND SEDIMENT CONTROL REPRESENTS A PRACTICAL AND WORKABLE PLAN BASED ON MY PERSONAL KNOWLEDGE OF THE SITE CONDITIONS. THIS PLAN WAS PREPARED IN ACCORDANCE WITH THE REQUIREMENTS OF THE HOWARD SOIL CONSERVATION DISTRICT. I HAVE NOTIFIED THE DEVELOPER THAT HE MUST PROVIDE THE HOWARD SOIL CONSERVATION DISTRICT WITH AN "AS BUILT" PLAN OF THE POND WITHIN 30 DAYS OF COMPLETION."

Signature of Engineer: *[Signature]* DATE: *8/1/82*

THESE PLANS HAVE BEEN REVIEWED FOR THE HOWARD SOIL CONSERVATION DISTRICT AND MEET THE TECHNICAL REQUIREMENTS FOR SMALL POND CONSTRUCTION, SOIL EROSION AND SEDIMENT CONTROL.

Signature: *[Signature]* DATE: *10/25/82*  
U.S. SOIL CONSERVATION SERVICE

THESE PLANS FOR SMALL POND CONSTRUCTION, SOIL EROSION AND SEDIMENT CONTROL MEET THE REQUIREMENTS OF THE HOWARD SOIL CONSERVATION DISTRICT.

Signature: *[Signature]* DATE: *10/21/82*  
HOWARD SOIL CONSERVATION DISTRICT

APPROVED: DEPARTMENT OF PUBLIC WORKS

Signature: *[Signature]* DATE: *3-4-83*  
CHIEF, BUREAU OF ENGINEERING

APPROVED: OFFICE OF PLANNING AND ZONING

Signature: *[Signature]* DATE: *3-7-83*  
CHIEF, DIVISION OF LAND DEVELOPMENT AND ZONING ADMINISTRATION

S.W.M. POND SPECIFICATIONS

I. SITE PREPARATION  
Areas under the embankment and structural works shall be cleared, grubbed and the topsoil stripped to remove all trees, vegetation, roots or other objectionable material. To facilitate clean out and restoration, it is recommended that the permanent pool area be cleared of all brush and trees.

II. EARTH FILL  
Material  
The fill material shall be taken from approved designated borrow area or areas. It shall be free from roots, stumps, wood, rubbish, over-size stones, frozen or other objectionable materials. The embankment shall be constructed to an elevation which provides for anticipated settlement to the design elevation. The fill height all along the length of the embankment shall be increased at least 5 percent above the design elevation (including freeboard) unless otherwise shown on the plans.

Areas on which fill is to be placed shall be scarified prior to placement of fill. Fill materials shall be placed in 8-inch maximum thickness (before compaction) layers which are to be continuous over the entire length of the fill. The most porous borrow material shall be placed in the downstream portions of the embankment.

Compaction  
95% of Standard Proctor by A.S.T.M. 698  
Core Trench  
Where specified, a core trench shall be excavated along or parallel to the centerline of the embankment as shown on the plans. The bottom width of the trench shall be governed by the equipment used for excavation, with the minimum width being four feet. The depth shall be at least four feet or as shown on the plans. The side slopes of the trench shall be 1 to 1 or flatter. The backfill material for the core trench shall be the most impervious material available and shall be compacted with equipment or rollers to assure maximum density and minimum permeability.

III. STRUCTURAL BACKFILL  
Backfill material shall be of the type and quality conforming to that specified for the adjoining fill material. The fill shall be placed in horizontal layers not to exceed four inches in thickness and compacted by hand tampers or other compaction equipment. The material needs to fill completely all spaces under and adjacent to the pipe. At no time during the backfilling operation shall driven equipment be allowed to operate closer than four feet, measured horizontally, to any part of a structure. Under no circumstances shall the contractor drive equipment over any part of a concrete structure or pipe unless there is a compacted fill of twenty-four inches or greater over the structure or pipe.

IV. PIPE CONDUITS

A. CORRUGATED METAL PIPE

- Materials - Aluminum Pipe - This pipe and its appurtenances shall conform to the requirements of AASHTO Specification M-196 or M-211, with watertight coupling bands.
- Connections - All connections with pipes must be completely watertight. The drain pipe or barrel connection to the control structure shall be mortared all around. Watertight coupling bands shall be used at all joints. Anti-seep collars shall be connected to the pipe in such a manner as to be completely watertight.
- Bedding - The pipe shall be firmly and uniformly bedded throughout its entire length. Where rock or soft, spongy or other unstable soil is encountered, all such material shall be removed and replaced with suitable earth compacted to provide adequate support.
- Laying pipe - The pipe shall be placed with inside circumferential laps pointing downstream and with the longitudinal laps at the sides.
- Backfilling shall conform to structural backfill as shown above.
- Other details (anti-seep collars, valves, etc.) shall be as shown on the drawings.

V. CONCRETE


Concrete shall meet minimum requirements set forth in Maryland State Highway Administration Specifications for Materials, Highways, Bridges, and Incidental Structures, Article 20.07 (Portland Cement Concrete Mixtures), Mix No. 3.

VI. STABILIZATION


All borrow areas shall be graded to provide proper drainage and left in a slightly condition. All exposed surfaces of the embankment, spillway and borrow areas shall be stabilized by seeding and applying straw mulch in accordance with Standards and Specifications for Soil Erosion and Sediment Control in Urbanizing Areas immediately after finish grading.

All exposed areas of the embankment and pond shall be stabilized by:


- Spreading 4" topsoil
- Working in 1 ton of ground limestone and 1,000 pounds of 10-10-10 fertilizer per acre.
- Seed with 40 lbs./acre of "Kentucky 31" tall fescue, and 15 lbs./acre of Crownvetch inoculated.
- Mulch with 1-1/2 tons straw per acre.
- Tie down mulch with emulsified asphalt @ 348 gallons/acre.

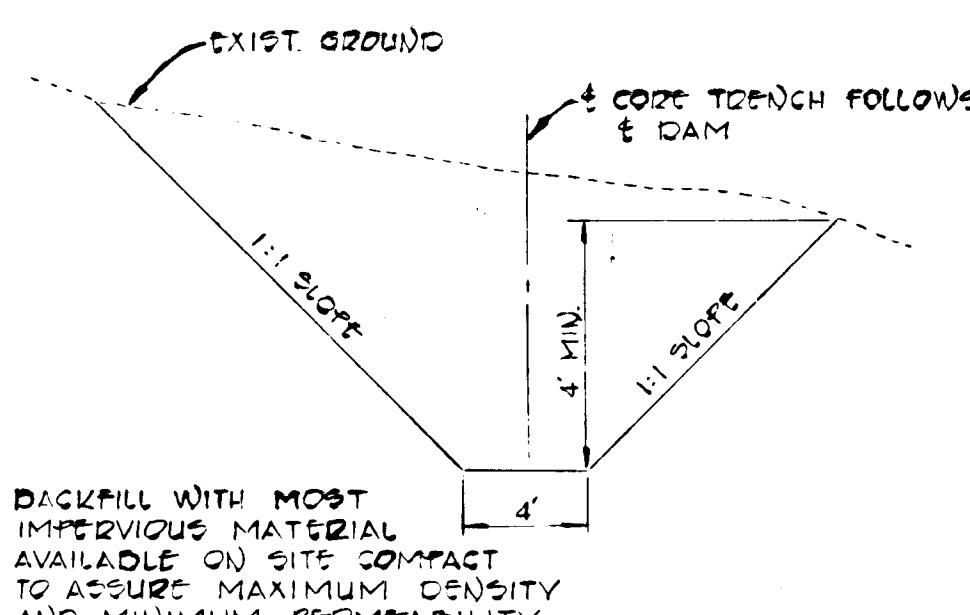

CORE TRENCH DETAIL  
NO SCALE

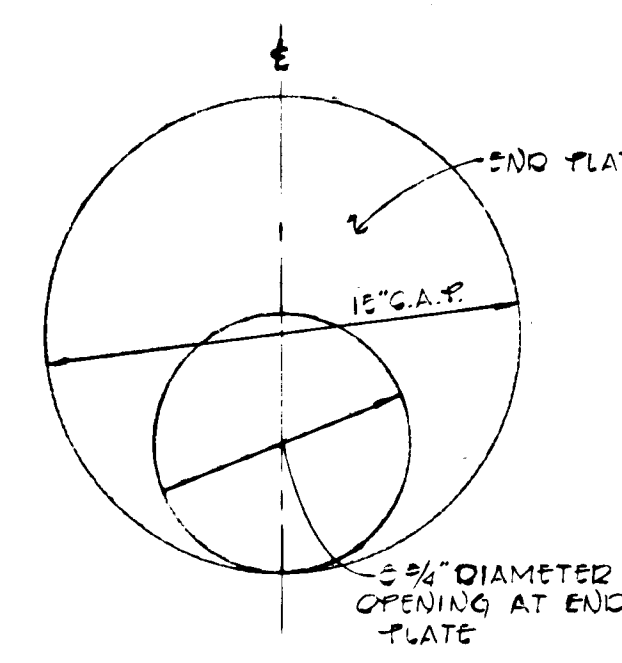


ORIFICE DETAIL  
NO SCALE

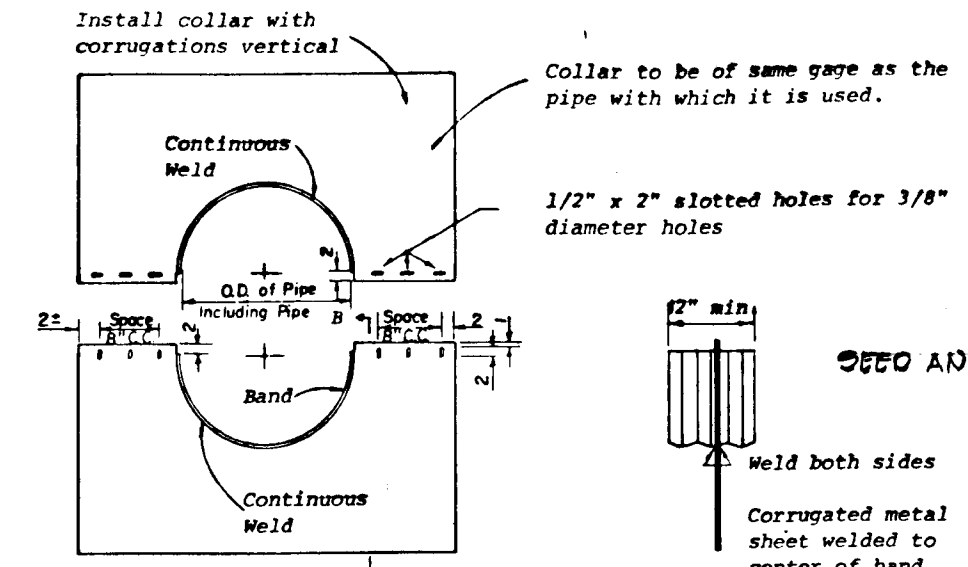

NOTES FOR COLLARS:  
1. All materials to be in accordance with construction and construction material specifications.  
2. When specified on the plans, coating of collars shall be in accordance with construction and construction material specifications.  
3. Unassembled collars shall be marked by painting or tagging to identify matching pairs.  
4. The lap between the two half sections and between the pipe and connecting band shall be caulked with asphalt mastic at time of installation.  
5. Each collar shall be furnished with two 1/2\"/>


DETAILS OF CORRUGATED METAL ANTI-SEEP COLLAR  
ASSEMBLED COLLARS TO BE 7'-6\"/>

NOTE: FOR CONSTRUCTION DETAIL AND SPECIFICATIONS SEE STANDARD DRAWING SW-1, U.S. DEPARTMENT OF AGRICULTURE STANDARDS AND SPECIFICATIONS FOR SOIL AND SEDIMENT CONTROL.

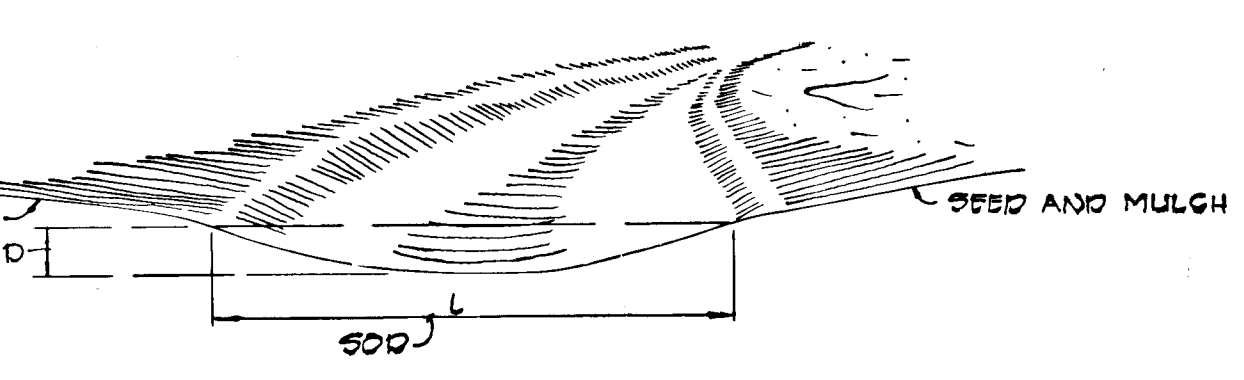


STATION	SLOPE	L	D	V
6+50 TO 6+87	1.00%	14'	1.5'	2.5 fps
6+20 TO 6+50	8.00%	16'	0.7'	4.5 fps
6+87 TO 6+70	8.00%	15.75'	0.7'	4.5 fps


PARABOLIC CHANNEL DETAIL  
NO SCALE

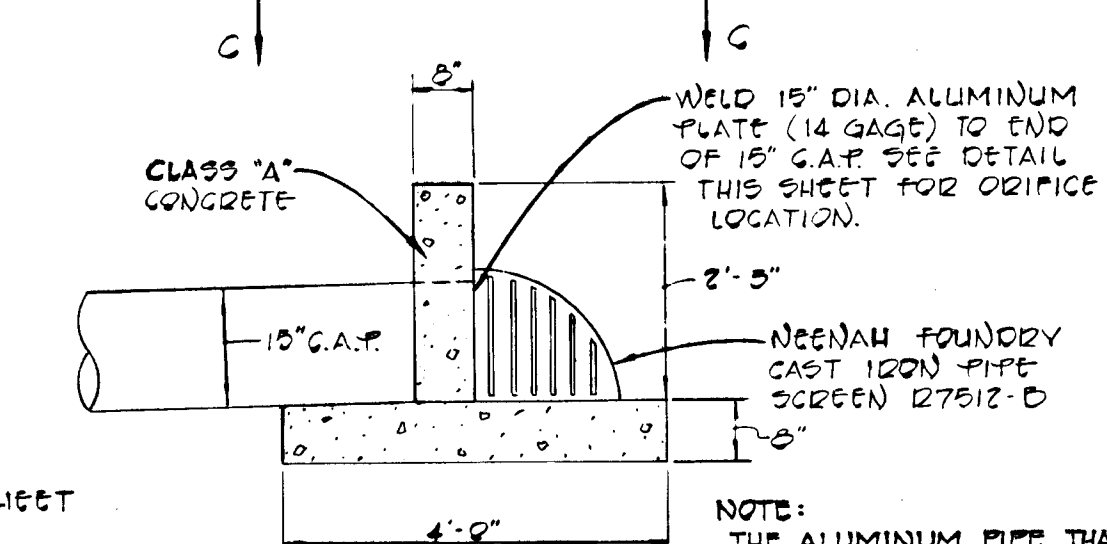


SECTION A-A  
NO SCALE

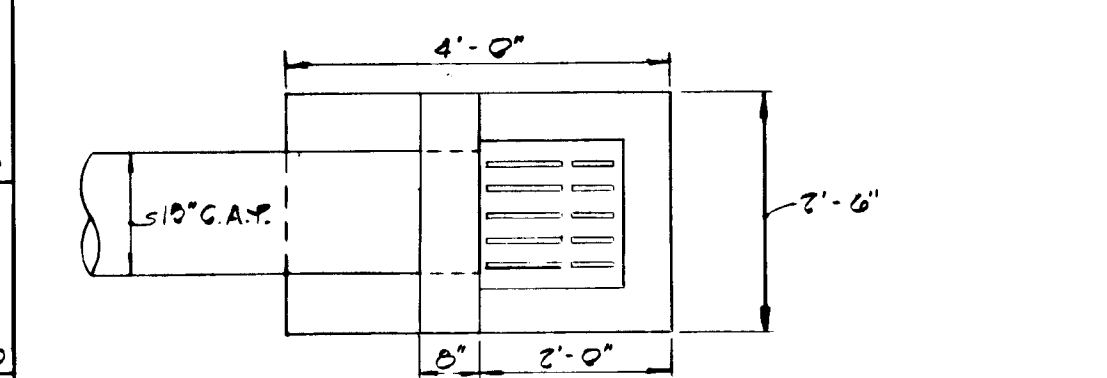


SECTION C-C  
NO SCALE

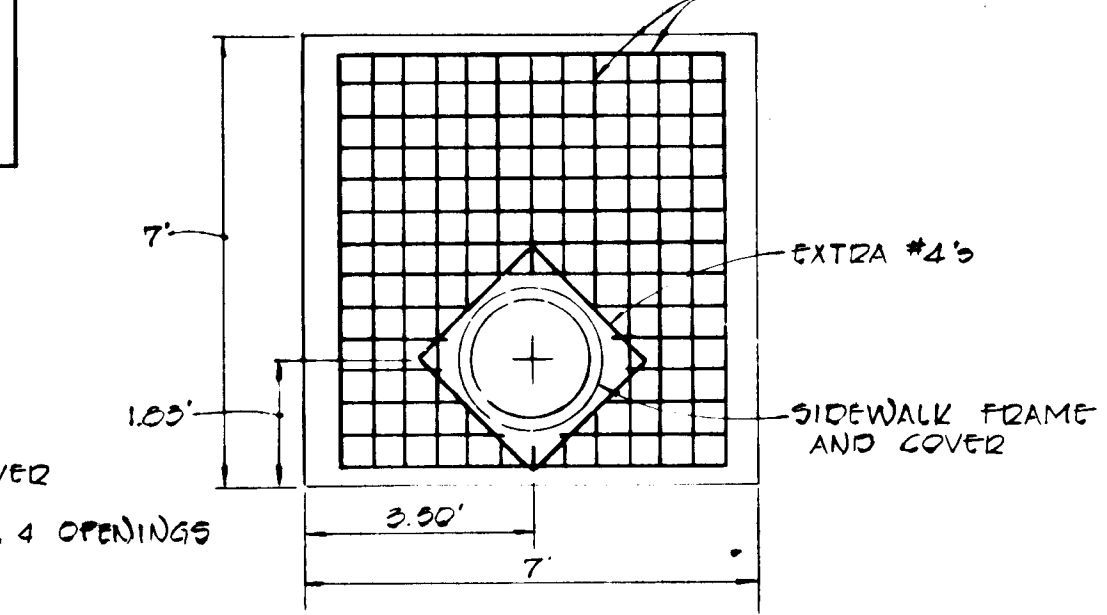


TOP SLAB DETAIL  
NO SCALE

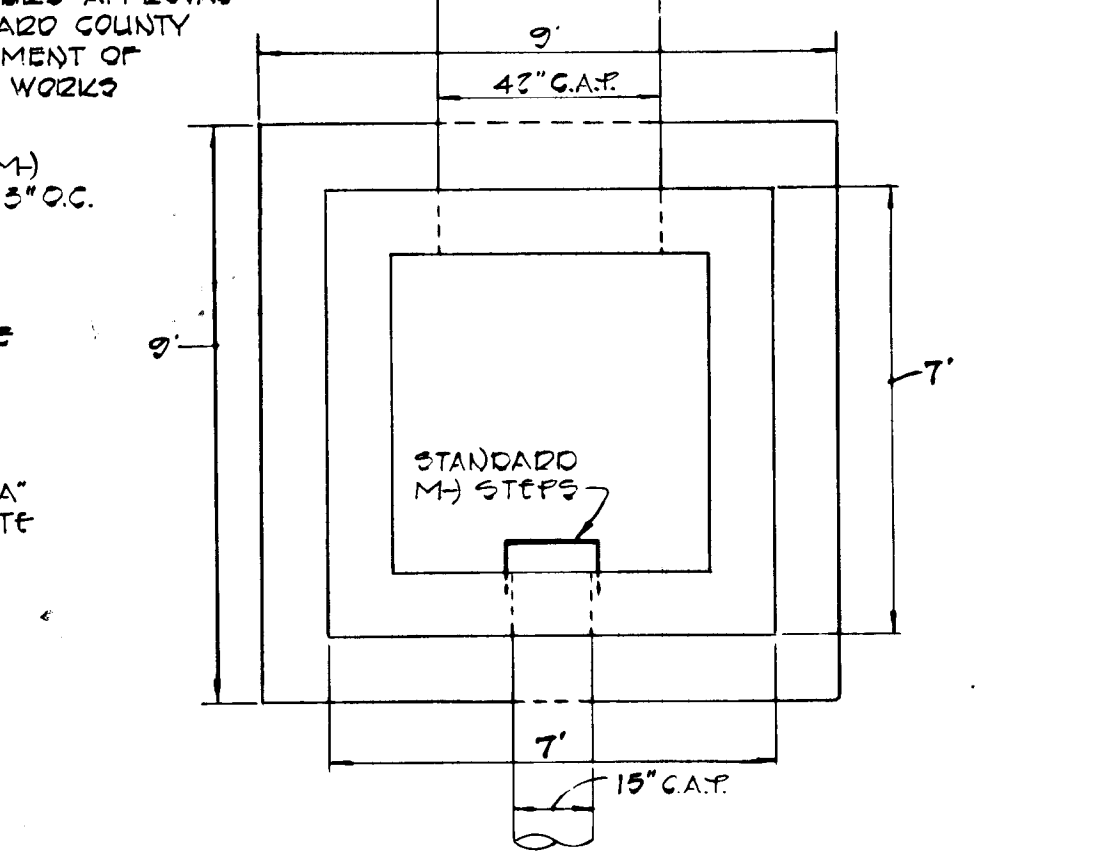


SECTION B-B  
NO SCALE

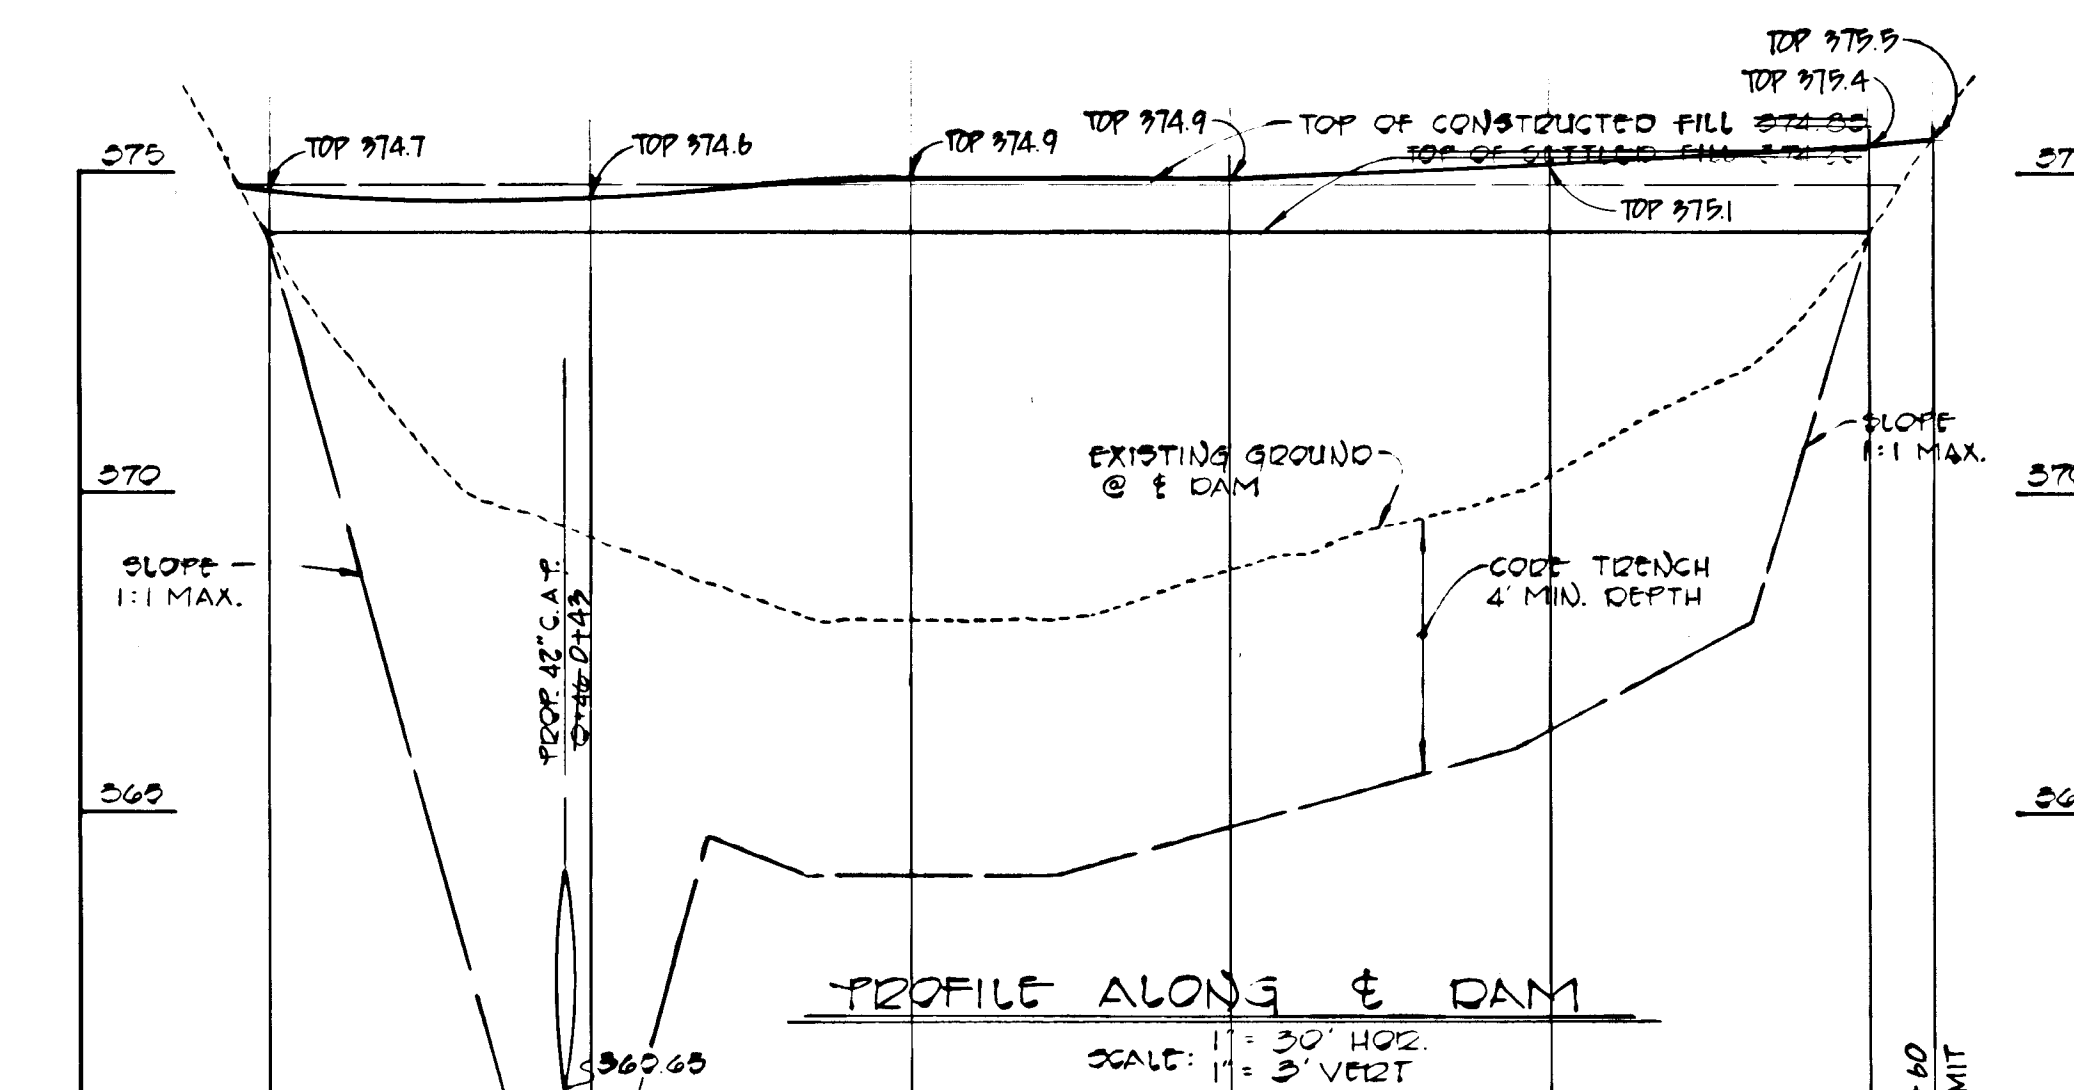


PROFILE ALONG E DAM  
SCALE: 1\"/>

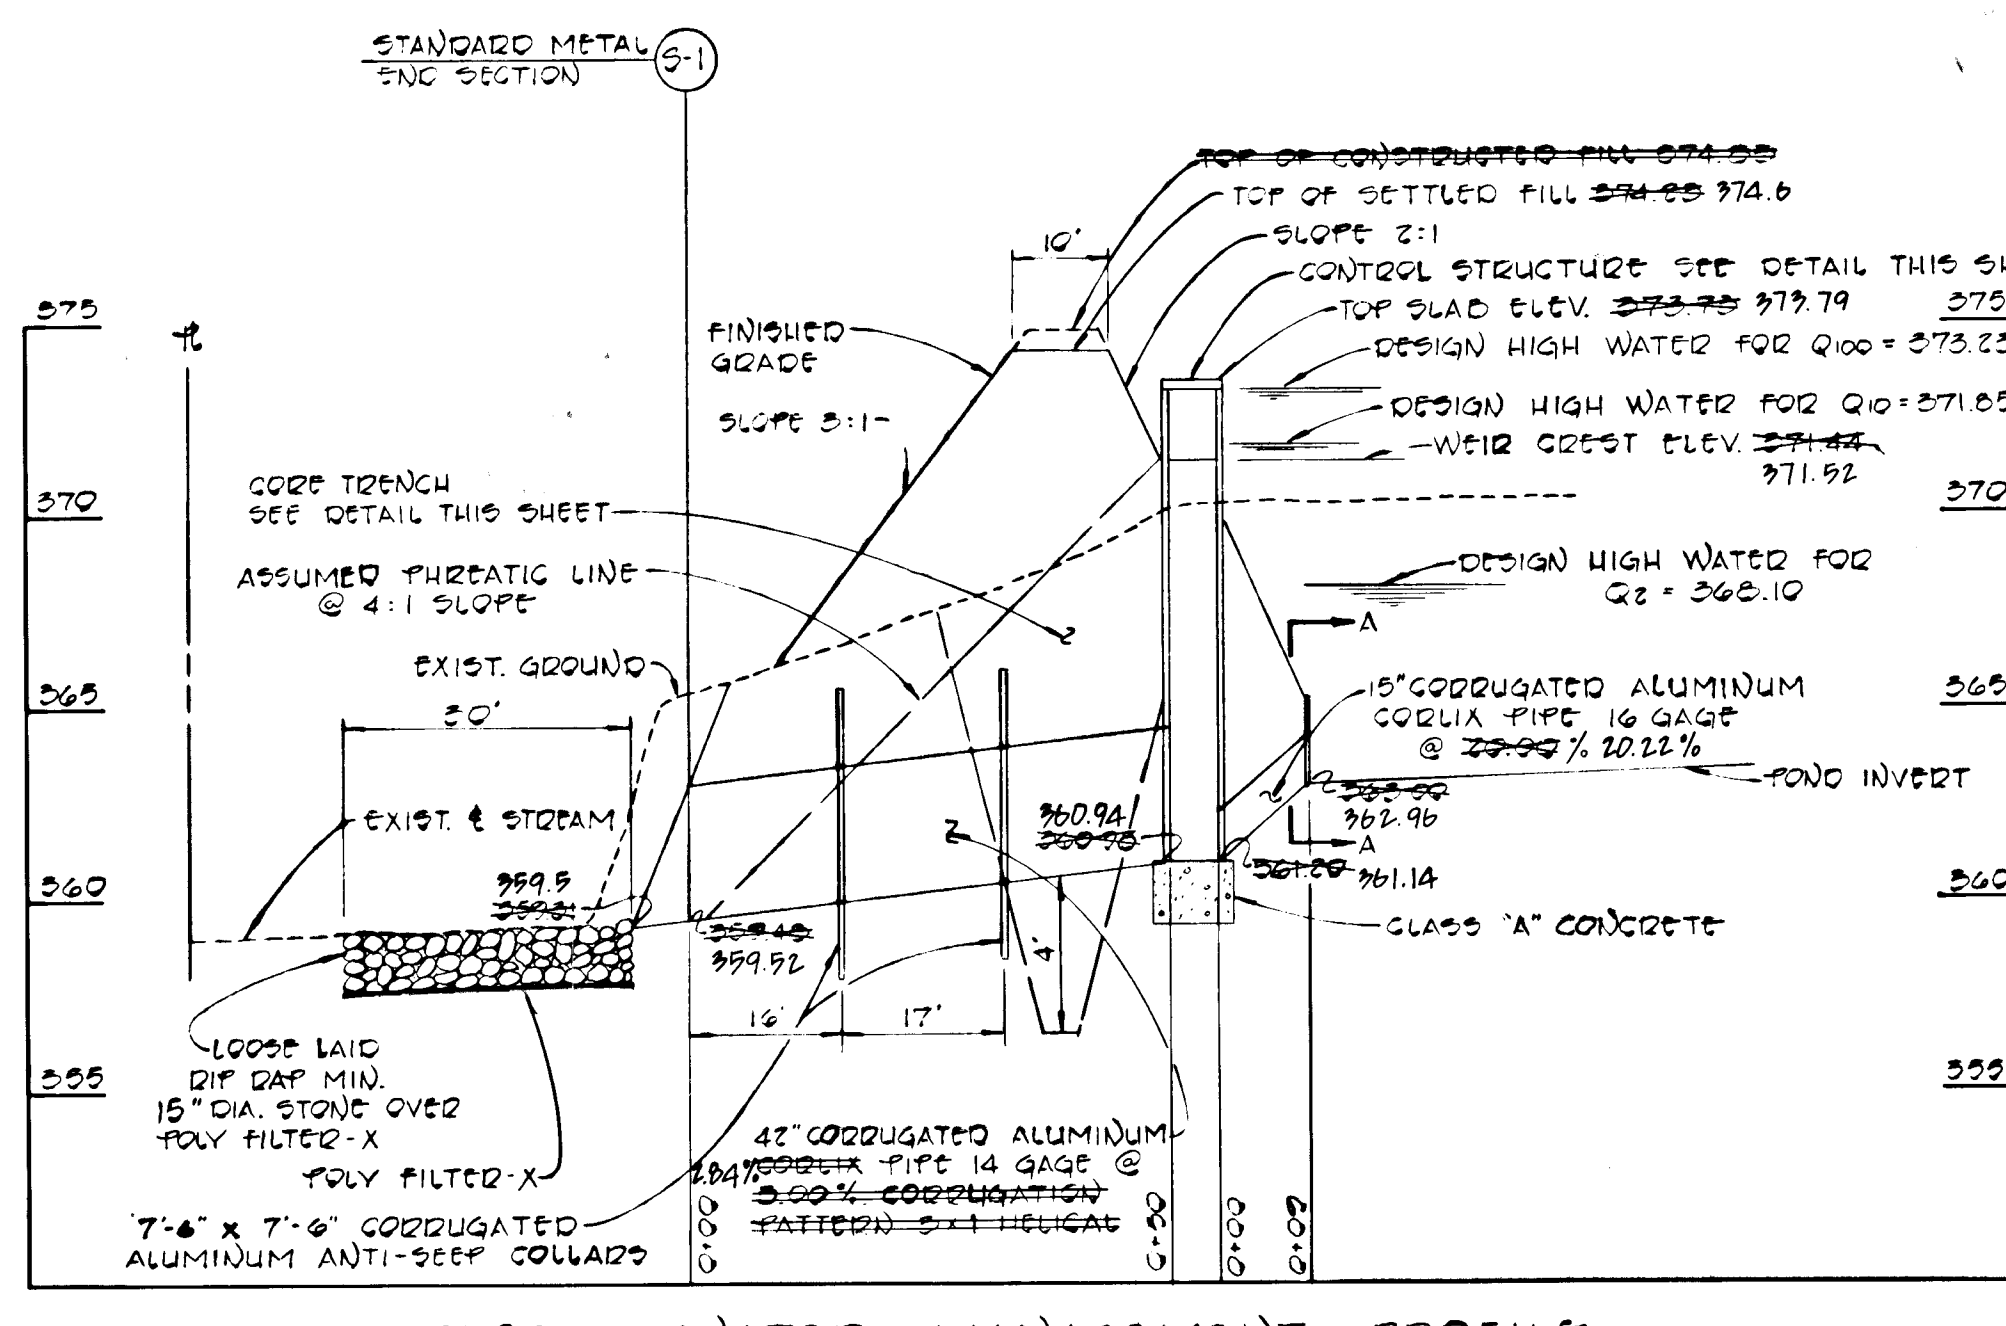


STORM WATER MANAGEMENT PROFILE  
SCALE: 1\"/>

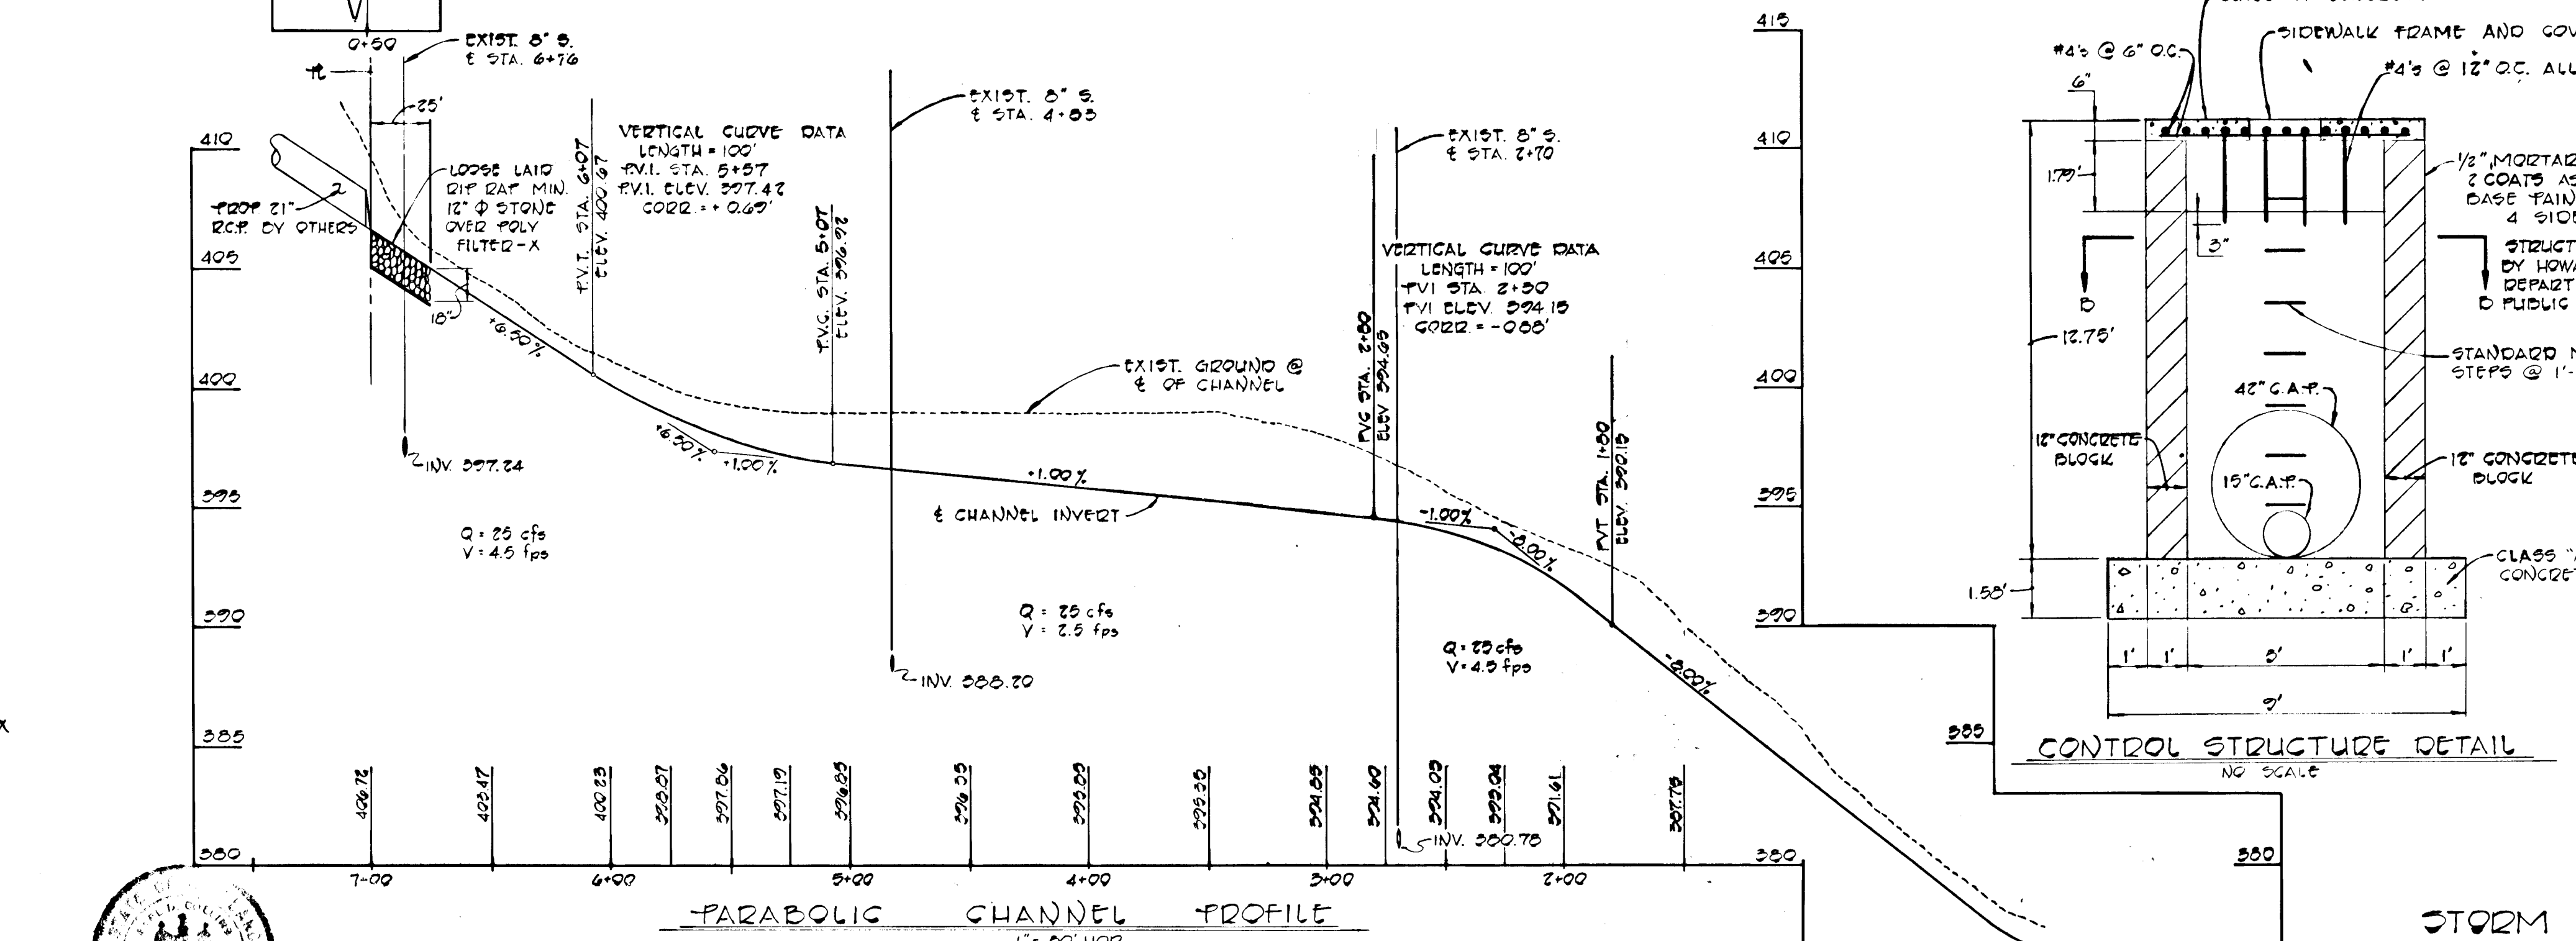

PARABOLIC CHANNEL PROFILE  
SCALE: 1\"/>

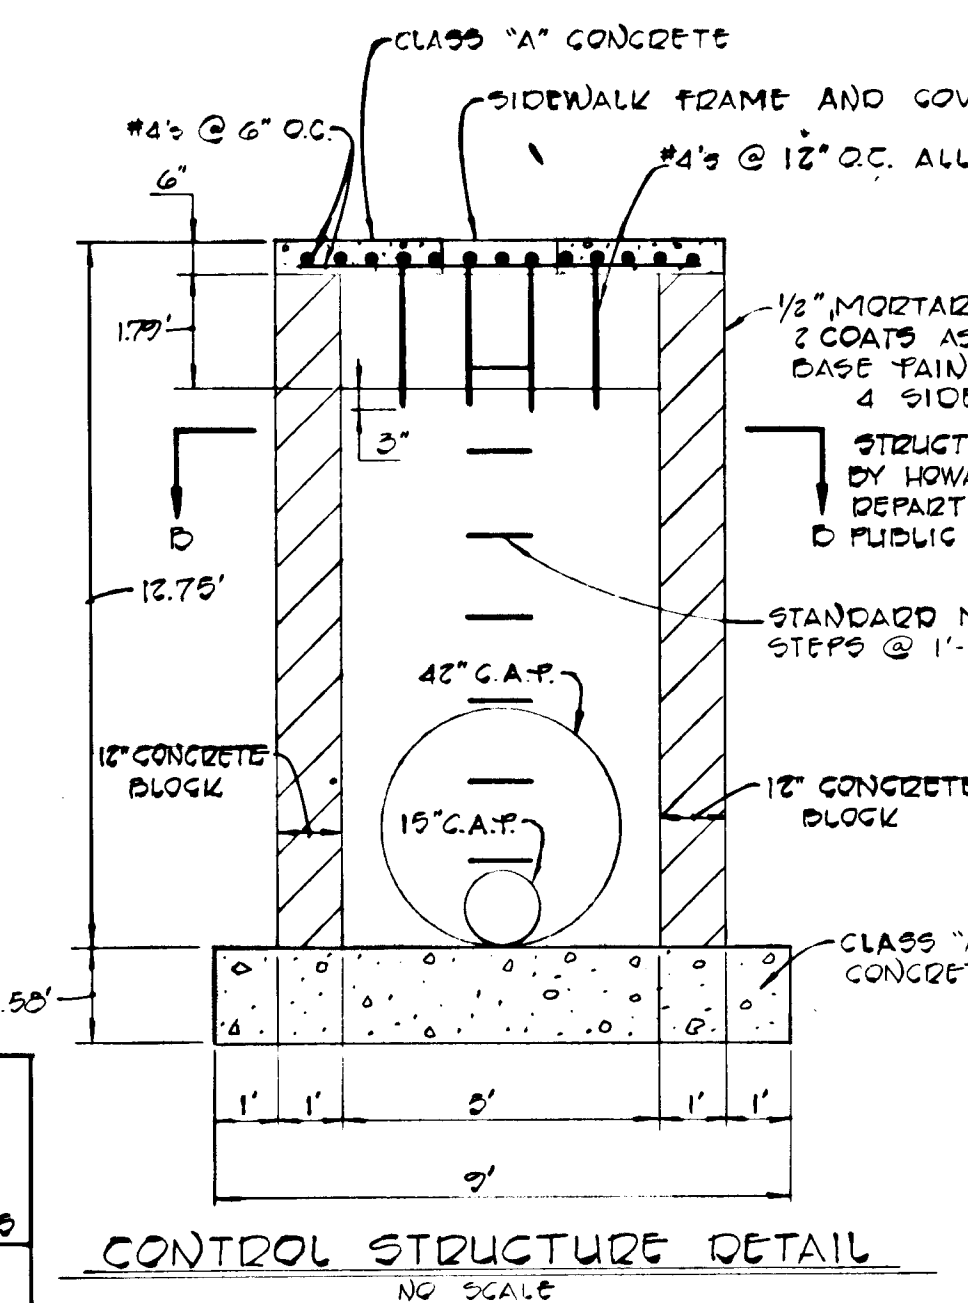

CONTROL STRUCTURE DETAIL  
NO SCALE

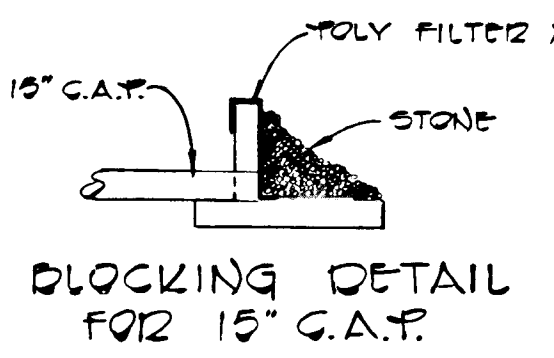

BLOCKING DETAIL FOR 15\"/>

FISHER, COLLINGS AND CARTER  
CONSULTING ENGINEERS AND LAND SURVEYORS  
8200 COURT AVENUE  
ELLICOTT CITY, MARYLAND 21043  
301-461-2855

Signature: *[Signature]* DATE: *8/1/82*  
E.A. COLLINGS

STORM WATER MANAGEMENT POND  
DETAIL SHEET  
PINE ORCHARD PARK  
2<sup>ND</sup> ELECTION DISTRICT  
MARCH 19, 1982  
HOWARD COUNTY, MARYLAND  
SCALE: AS SHOWN  
SHEET 2 OF 2