
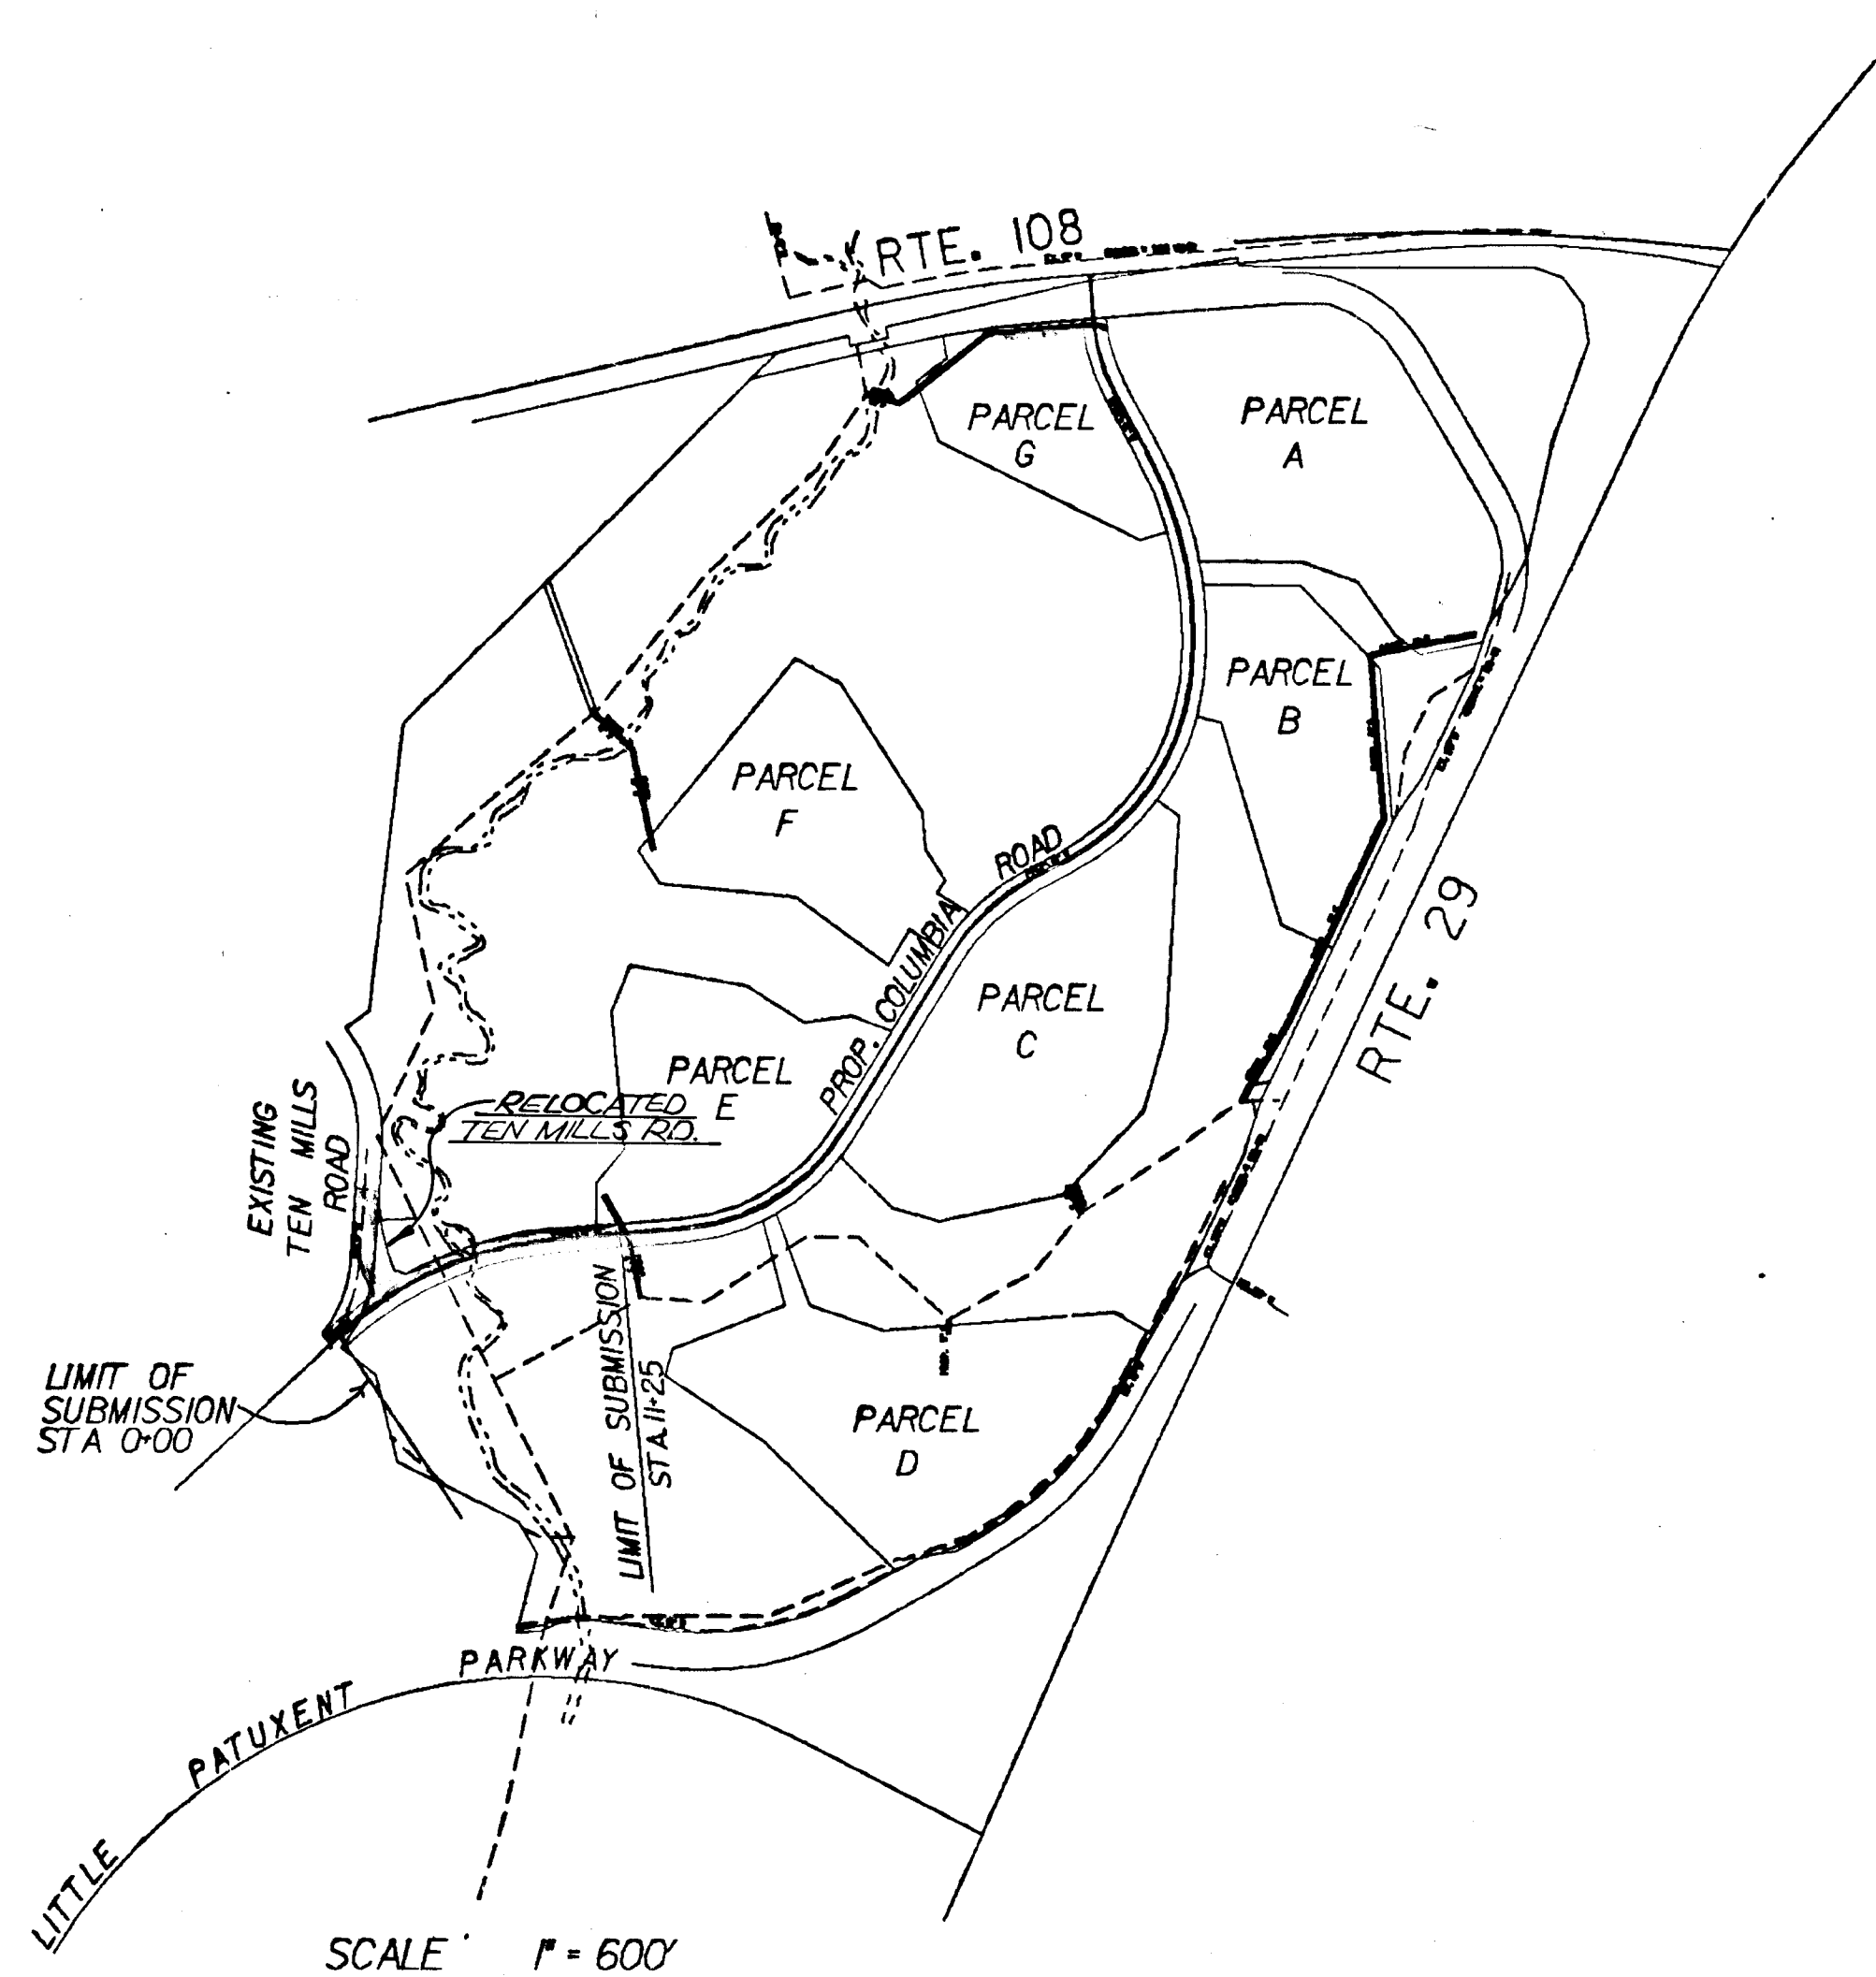


INDEX		
SHEET NO.	TITLE	
1	TITLE PAGE	
2	STREET GRADE, STORM DRAIN & PAVING PLAN - COLUMBIA RD.	
3	STREET GRADE, STORM DRAIN & PAVING PLAN - COLUMBIA RD.	
4	STREET GRADE, STORM DRAIN & PAVING PLAN - TEN MILLS RD.	
5	STORM DRAIN PROFILES AND DETAILS	
6	DRAINAGE AREA MAP	
7	SEDIMENT CONTROL	
8	SEDIMENT CONTROL	
9	COLUMBIA ROAD BRIDGE, GENERAL PLAN & ELEVATION	
10	COLUMBIA ROAD BRIDGE, FOUNDATION PLAN, ABUTMENTS A & B	
11	COLUMBIA ROAD BRIDGE, ABUTMENT A	
12	COLUMBIA ROAD BRIDGE, ABUTMENT B	
13	COLUMBIA ROAD BRIDGE, WINGWALL DETAILS	
14	COLUMBIA ROAD BRIDGE, PIER 1	
15	COLUMBIA ROAD BRIDGE, FRAMING PLAN AND TYPICAL SECTION	
16	COLUMBIA ROAD BRIDGE, GIRDER ELEVATION	
17	COLUMBIA ROAD BRIDGE, SUPERSTRUCTURE ELEVATIONS	
18	COLUMBIA ROAD BRIDGE, CAMBER SCHEDULE/STANDARD DETAILS	
19	COLUMBIA ROAD BRIDGE, STANDARD DETAILS	
20	COLUMBIA ROAD BRIDGE, STANDARD DETAILS	
21	COLUMBIA ROAD BRIDGE, STANDARD DETAILS	
22	COLUMBIA ROAD BRIDGE, STANDARD DETAILS	
23	COLUMBIA ROAD BRIDGE, BORING LOGS AND TESTS	
24	PARCEL "D" - ENTRANCE CULVERT	

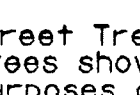

- GENERAL NOTES**
- ALL WORK SHALL BE PERFORMED IN ACCORDANCE WITH HOWARD COUNTY DESIGN MANUAL VOL. IV, DETAILS AND SPECIFICATIONS FOR CONSTRUCTION.
  - ALL UTILITY COMPANIES SHALL BE NOTIFIED 24 HOURS IN ADVANCE OF CONSTRUCTION.
  - ALL INLETS SHALL BE HOWARD COUNTY STANDARDS UNLESS OTHERWISE SHOWN.
  - ALL STREET CURB RETURNS SHALL HAVE A 30.0' RADIUS UNLESS OTHERWISE NOTED.
  - STORM DRAIN TRENCHES WITHIN ROAD RIGHTS-OF-WAY SHALL BE BACKFILLED AND COMPACTED IN ACCORDANCE WITH HOWARD COUNTY STANDARD SPECIFICATIONS.
  - APPROXIMATE LOCATION OF EXISTING UTILITIES ARE SHOWN. THE CONTRACTOR SHALL TAKE ALL NECESSARY PRECAUTIONS TO PROTECT THE EXISTING UTILITIES AND TO MAINTAIN UNINTERRUPTED SERVICE. ANY DAMAGE INCURRED DUE TO CONTRACTOR'S OPERATIONS SHALL BE REPAIRED IMMEDIATELY AT THE CONTRACTOR'S EXPENSE.
  - THE CONTRACTOR SHALL TEST PIT EXISTING UTILITIES WHERE DIRECTED BY THE ENGINEER A MINIMUM OF TWO WEEKS IN ADVANCE OF ANY CONSTRUCTION.
  - TEMPORARY COMPACTED 18" HIGH EARTH FILL DIVERSION DIKES SHALL BE CONSTRUCTED ABOUT THE LIPS OF FILL SLOPES ON THE R.O.W. CONCURRENTLY WITH THE INITIAL GRADING AND DIRECTED TO UNDISTURBED SOIL AREAS AT THE END OF EACH DAY.
  - CONTRACTOR TO NOTIFY THE HOWARD COUNTY DEPT. OF INSPECTIONS AND PERMITS AT LEAST 3 DAYS BEFORE STARTING WORK SHOWN ON THESE DRAWINGS. TELEPHONE NO. 992-2436.
  - ALL DISTURBED SLOPE AREAS TO BE STABILIZED AS SOON AS GRADING IS COMPLETED.
  - ALL REINFORCED CONCRETE FOR STORM DRAIN STRUCTURES SHALL HAVE A MINIMUM OF 28 DAYS STRENGTH OF 3500 P.S.I..
  - ALL SWALES AND SLOPES SHALL BE PERMANENTLY SEEDED. SEE THE SEED SPECIFICATIONS ON SHEET 13.
  - TRAFFIC CONTROL DEVICES AND THEIR INSTALLATION SHALL BE IN ACCORDANCE WITH THE MANUAL ON UNIFORM TRAFFIC CONTROL DEVICES, 1981 REVISED EDITION.
  - POLY-FILTER-X OR EQUAL SHALL BE PLACED UNDER ALL STONE RIP RAP (FULL WIDTH AND LENGTH OF STONE).
  - STONE FOR RIP RAP SHALL BE AS SPECIFIED ON THE DRAWINGS. ALL RIP RAP SHALL BE UNPAVED, EXCEPT WHERE NOTED.
  - STUBS FOR 6" P.V.C. UNDERDRAIN PIPE TO BE INSTALLED AT CENTER OF EACH WALL OF EVERY INLET.
  - Contractor shall notify the following utilities or agencies at least five (5) working days before starting work shown on these plans:
    - State Highway Administration - 531-5533
    - Baltimore Gas & Electric Company - Underground Electric Distribution Customer Service - 685-0123
    - Baltimore Gas & Electric Company - Underground Gas Distribution Customer Service - 685-0123
    - Chesapeake & Potomac Telephone Company - 725-9976
    - American Telephone & Telegraph - Cable Location Division - 393-3553
  - Street Trees - (6/Total) - The location type and number of trees shown on this plan are tentative and are used for bond purposes only. The final location and variety of trees may vary to accommodate field conditions and builders landscape program. Bond release is contingent upon Section 15.13 of the Howard County Subdivision Regulations, as approved by the Office of Planning and Zoning.
  - STORMWATER MANAGEMENT REQUIRED FOR THE PARCELS IN THIS DEVELOPMENT HAS BEEN WAIVED
  - Provide 250 watt Mercury Vapor Lamp (shown as thus ) pendant mounted fixture on 20 ft. Aluminum Bronze Pole to be located at Sta. 11+00 left & 7+50 left & 3+75 left &

HOWARD COUNTY TRAVERSE #2841002 N 511932.585  
(EL. 381.548) E 845,859.362

HOWARD COUNTY TRAVERSE #2841003 N 512011.507  
(EL. N/A) E 844,640.468

# VILLAGE OF DORSEY'S SEARCH


SECTION 3 AREA I PHASE 191

COLUMBIA, MARYLAND

CONTRACT NO. 1


## ROAD CONSTRUCTION DRAWINGS

PHASE II STA. 0+00 TO STA. 11+25 COLUMBIA ROAD  
STA. 0+00 TO STA. 3+95.95 RELOCATED TEN MILLS ROAD  
FIFTH ELECTION DISTRICT HOWARD CO., MARYLAND

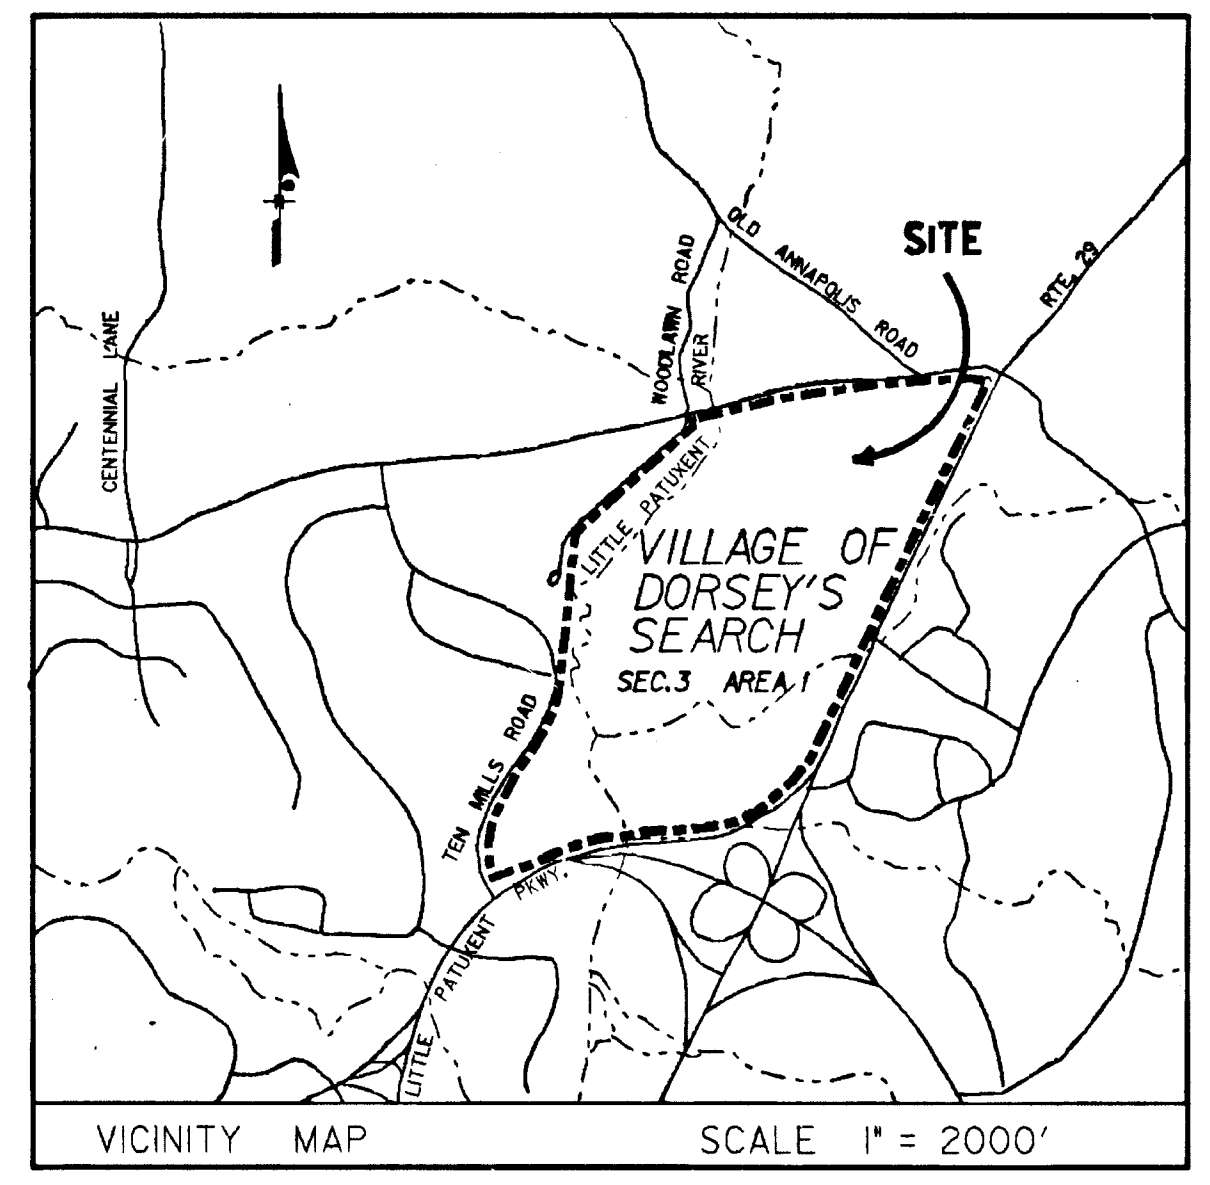

BRUCE D. BOLTZ  
MD. P.E. 12232

DATE

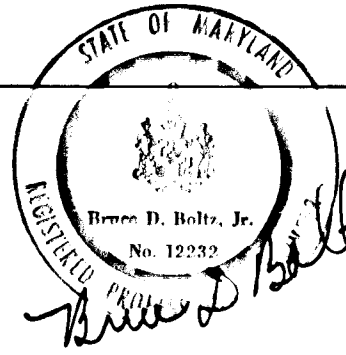

DEPARTMENT OF PUBLIC WORKS

*William R. De...* 2-28-86  
CHIEF, BUREAU OF ENGINEERING DATE

DEPARTMENT OF PLANNING AND ZONING

*William R. De...* 2-3-86  
CHIEF, DIVISION OF LAND DEVELOPMENT AND ZONING ADMINISTRATION DATE

THE HOWARD RESEARCH & DEVELOPMENT CORPORATION  
10275 LITTLE PATUXENT PARKWAY  
COLUMBIA, MARYLAND 21044  
(301) 992-6084

No.	REVISION	DATE	BY

ENGINEERS-ARCHITECTS-PLANNERS-SCIENTISTS-SURVEYORS-PHOTOGRAMMETRISTS

**GREENHORNE & O'MARA, INC.**  
2 RESEARCH PLACE ROCKVILLE, MD. 20850  
(301) 948-0900

ANNAPOLIS, MD - ATLANTA, GA - BECKLEY, WV - CULPEPER, VA - DENVER, CO - FAIRFAX, VA  
GREENSBORO, NC - MONROE, MI - N. HUNTINGDON, PA - ROCKVILLE, MD - WILLISTON PARK, NY



DESIGN	SCALE	AS SHOWN
CADD	SCALE	AS SHOWN
DRAWN GSK	1 OF 24	
CHECKED RHM	SHEET	
AUG. '85	R-1216-X	
DATE	JOB No.	FILE No.


#1159

F-86-85



DATE: \_\_\_\_\_  
 BY: \_\_\_\_\_  
 SURVEYED: \_\_\_\_\_  
 PLOTTED: \_\_\_\_\_  
 CHECKED: \_\_\_\_\_  
 NO. OF WAY CHECKED: \_\_\_\_\_  
 NO. OF STRUCTURE CHECKED: \_\_\_\_\_  
**PLAN**  
 NOTE BOOK NO. \_\_\_\_\_

DATE: \_\_\_\_\_  
 BY: \_\_\_\_\_  
 SURVEYED: \_\_\_\_\_  
 PLOTTED: \_\_\_\_\_  
 CHECKED: \_\_\_\_\_  
 NO. OF WAY CHECKED: \_\_\_\_\_  
 NO. OF STRUCTURE CHECKED: \_\_\_\_\_  
**PROFILE**  
 NOTE BOOK NO. \_\_\_\_\_

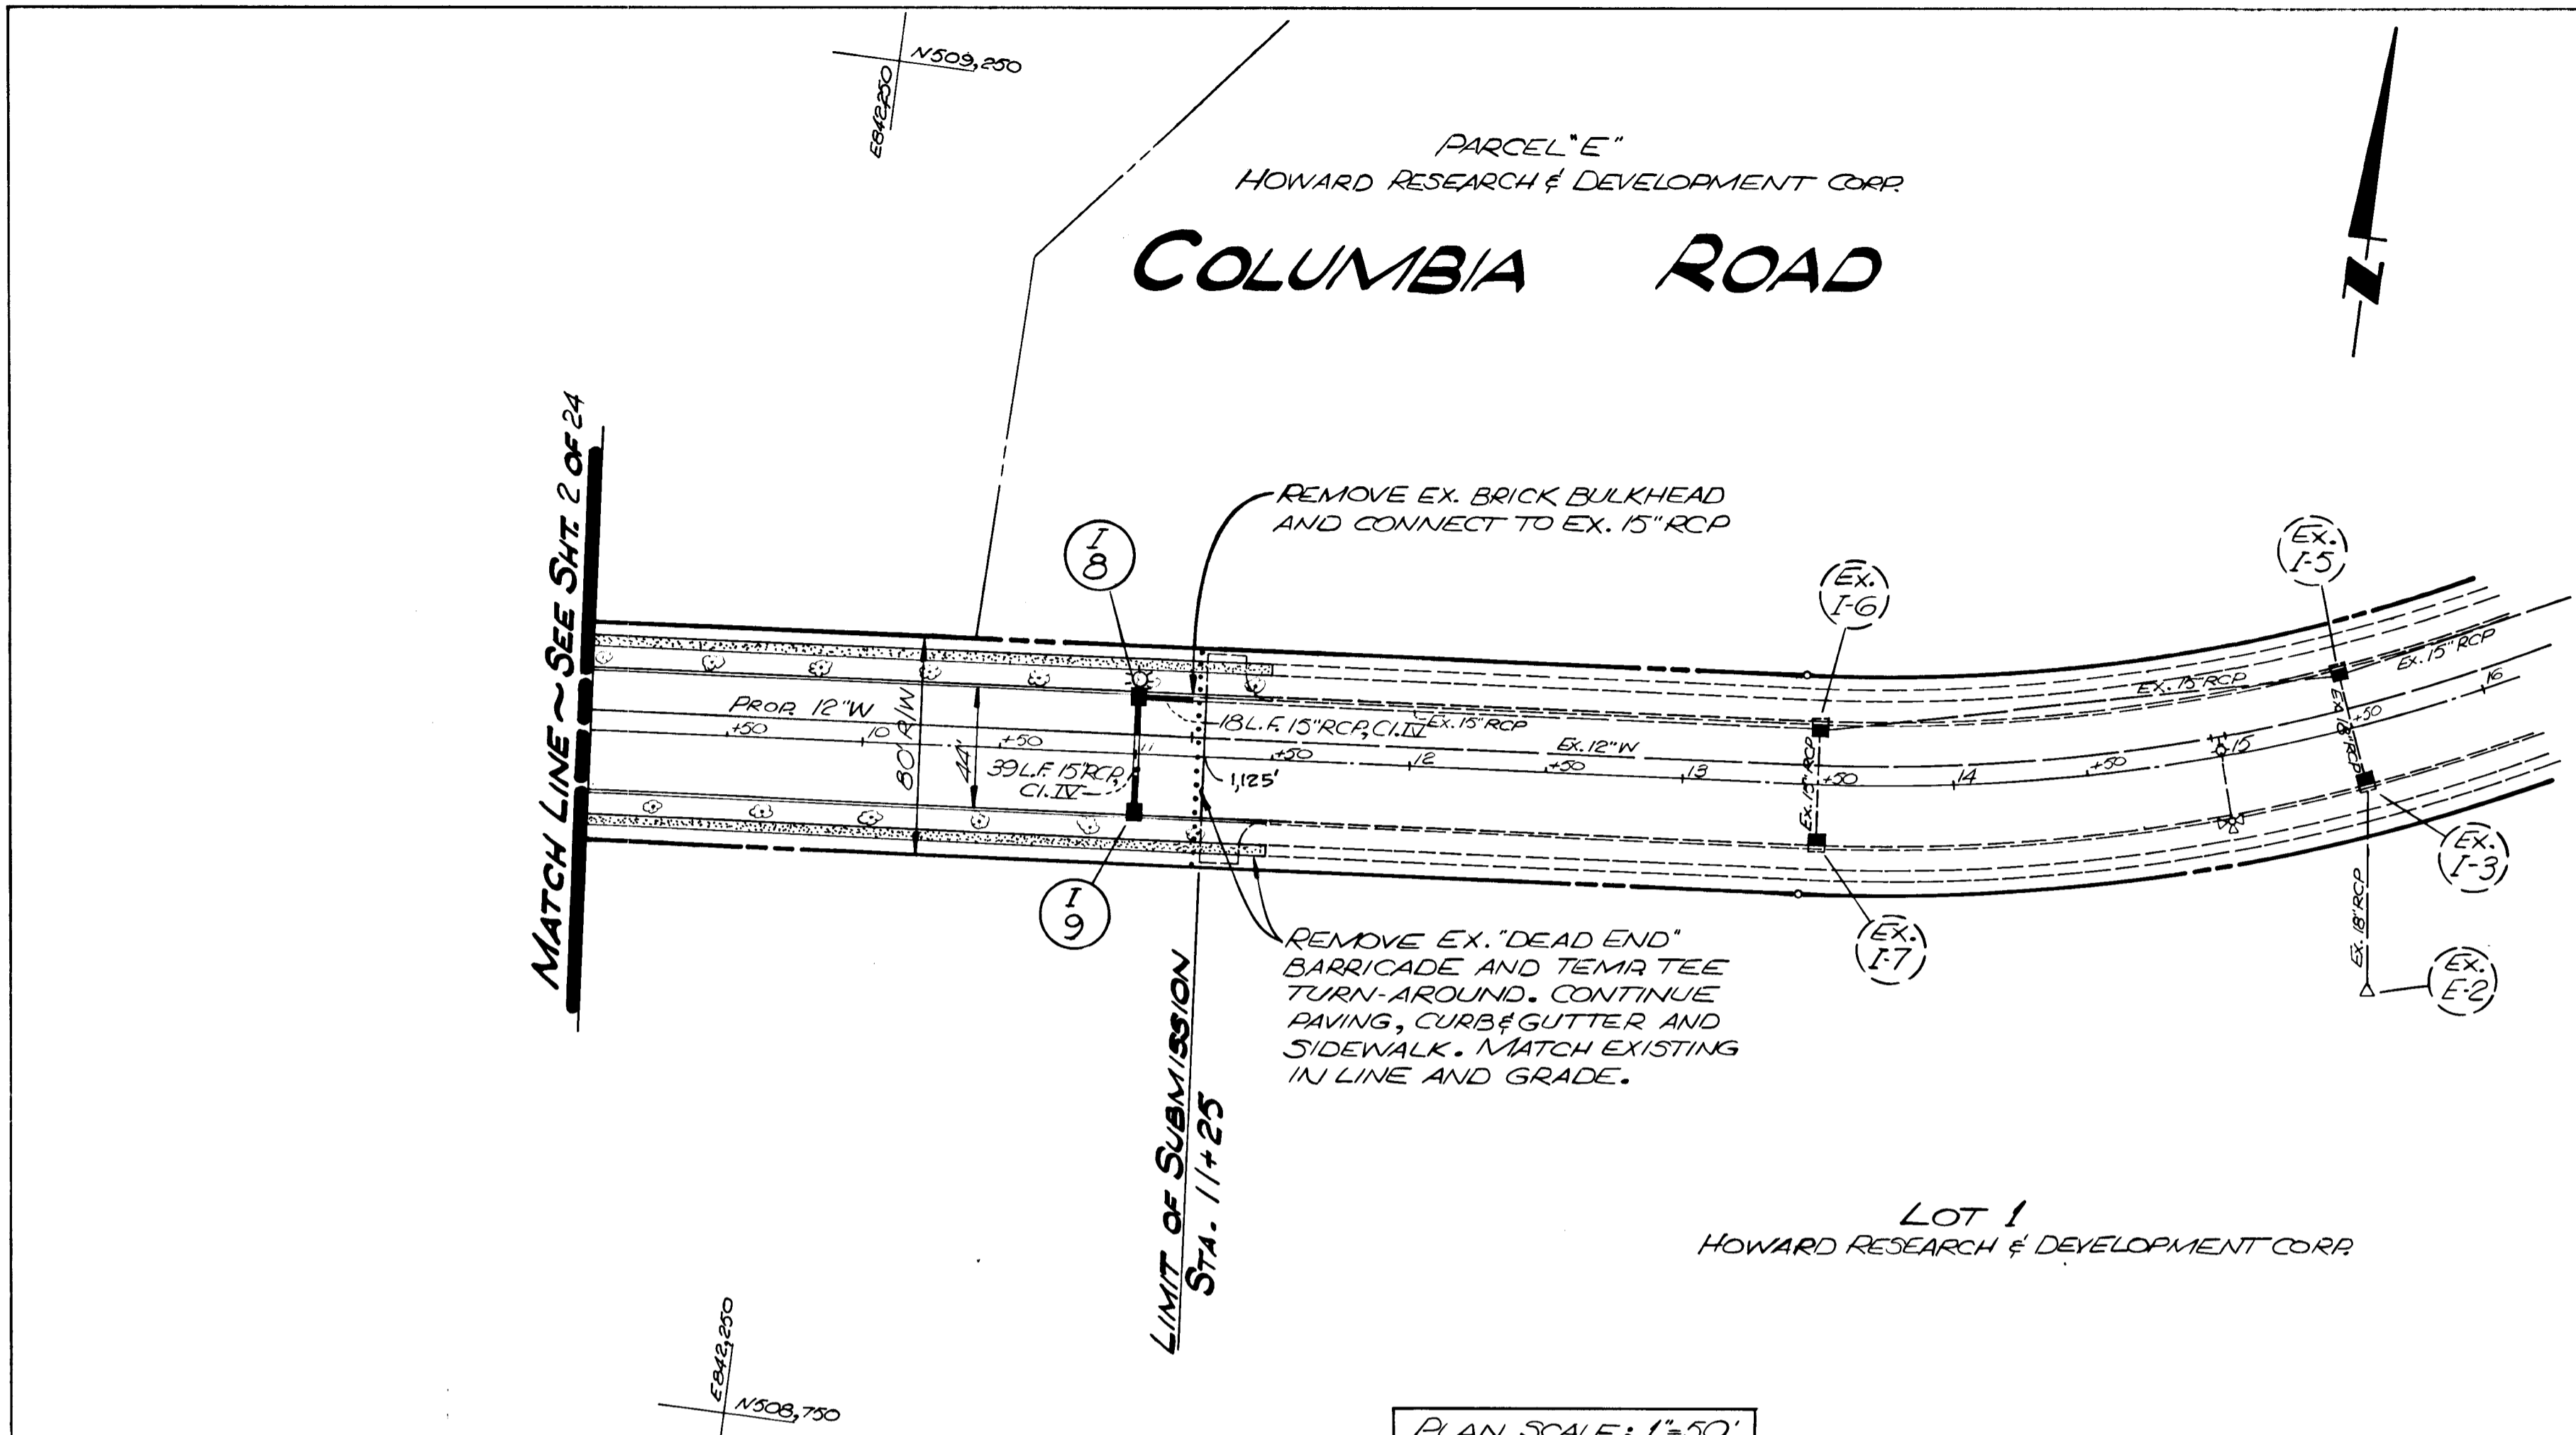

NOTE: FOR STORM DRAIN & PAVING BEYOND STA. 11+25, SEE CONTRACT F-86-26.

PLAN SCALE: 1"=50'


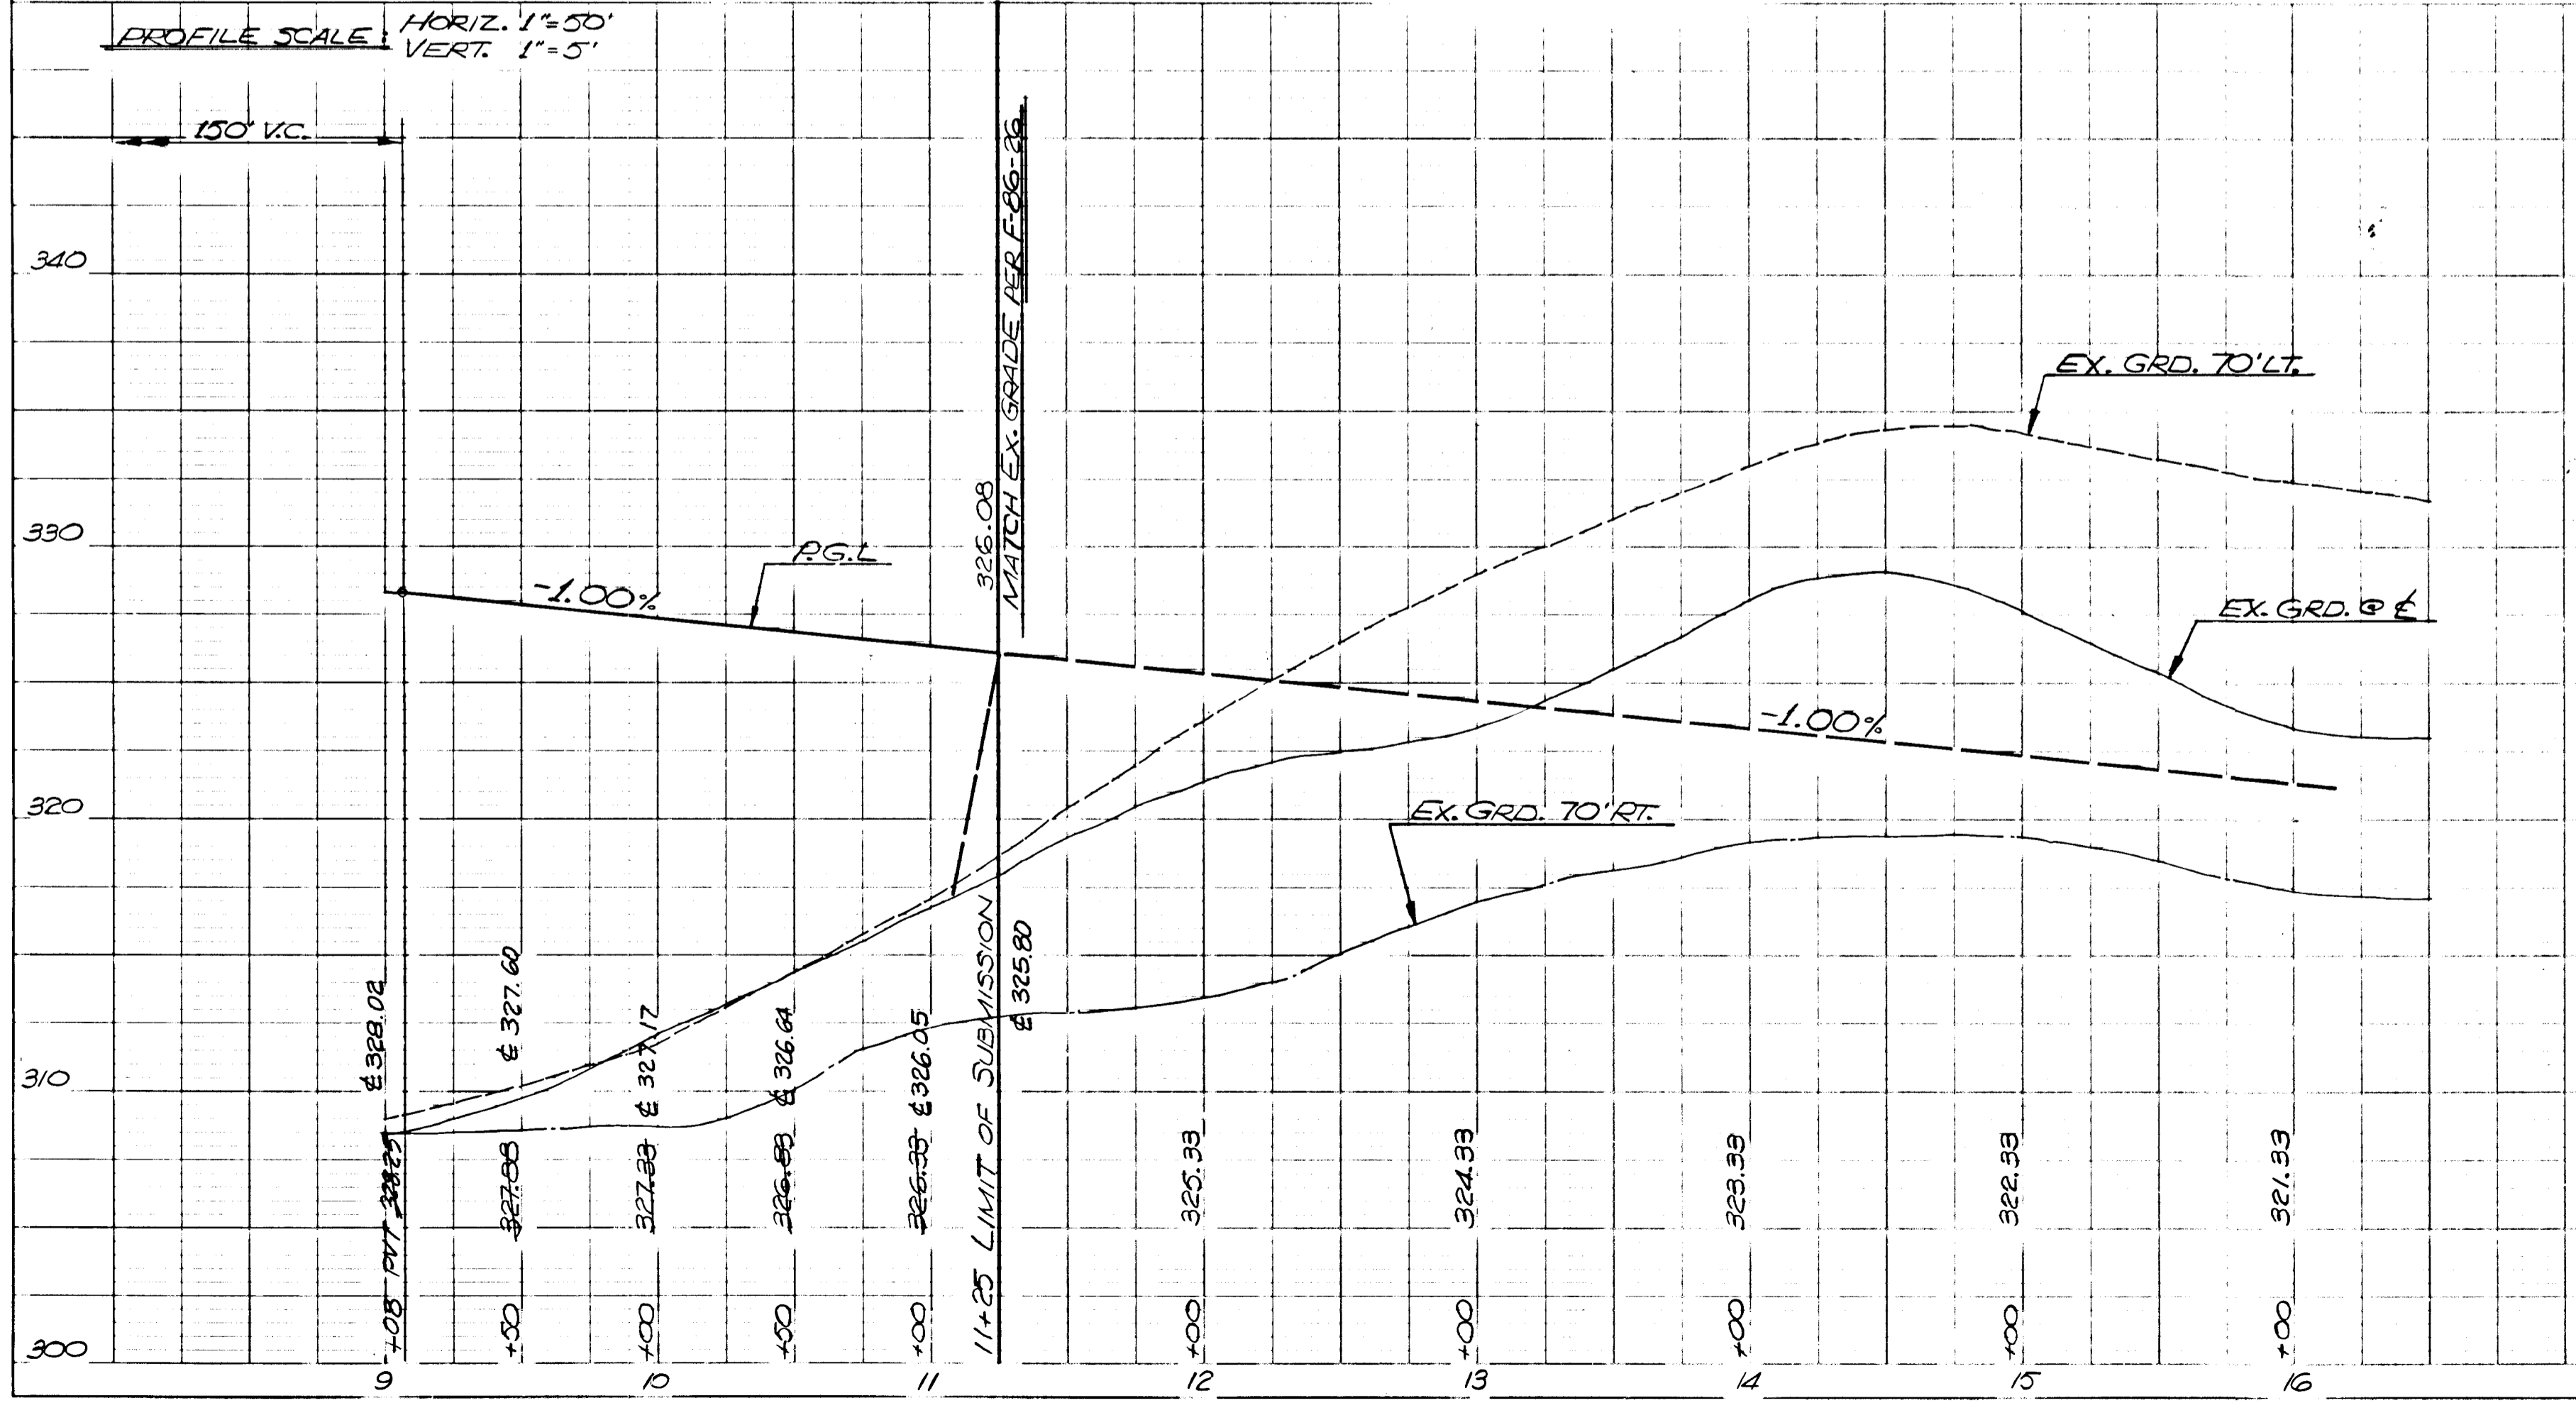


PLATE 1 PLAN PROFILE C. F. R. & L. STANDARD  
 DR. J. C. L. CORPORATION  
 FOUNDED IN U.S.A.

DEPARTMENT OF PUBLIC WORKS  
 Chief, Bureau of Engineering  
 Approved: Howard County Office of Planning and Zoning  
 Chief, Division of Land Development and Zoning Administration

DATE: \_\_\_\_\_ NO. \_\_\_\_\_ REVISION DESCRIPTION: \_\_\_\_\_  
**COLUMBIA VILLAGE OF DORSEY'S SEARCH**  
 SECTION 3 AREA 1  
 PHASE - 191  
 ELECTION DISTRICT NO. \_\_\_\_\_ HOWARD COUNTY, MD.  
 OWNER & DEVELOPER  
**THE HOWARD RESEARCH & DEVELOPMENT CORP.**  
 10275 LITTLE PATUXENT PARKWAY  
 COLUMBIA, MARYLAND 21043  
 (301) 992-6000  
**GREENHORNE AND O'MARA, INC.**  
 ENGINEERS ARCHITECTS PLANNERS SURVEYORS  
 \*2 RESEARCH PLACE ROCKVILLE, MARYLAND 20850  
 (301) 323-1929  
 AREA TAX MAP NO. 30 PARCELS 124, 224, & 210

TITLE  
**GRADE ESTABLISHMENT STORM DRAINAGE AND PAVING PLAN**  
 DESIGNED BY: JSL SCALE: AS SHOWN PROJECT NO. \_\_\_\_\_  
 DRAWN BY: JDP DATE: AUG. 85 DRAWING NUMBER  
 CHECKED BY: BCP/AM APPROVED: \_\_\_\_\_ 3 OF 24

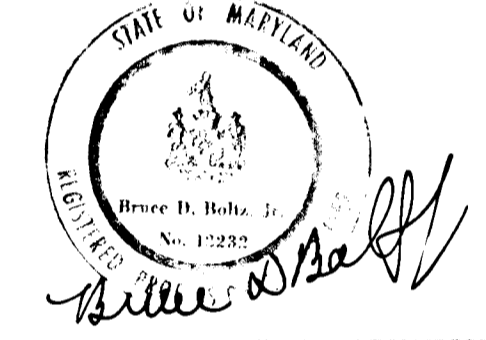

AS-BUILT SURVEY CERTIFIED BY  
 RICHARD F. LANE, MD. PLS. No. 301

#1159




STRUCTURE SCHEDULE						
No	TYPE	TOP ELEVATION		LOCATION	INVERTS	
		UPPER	LOWER		IN	OUT
E66	8 1/2" Conc. End Section	318.62	318.62	End 18" Pipe 77' Rt. & Sta. 4+98.04	308.40	307.82
M57	4' Precast MH - G.5.11	314.62	314.62	MH G.8' Rt. & Sta. 4+98.00	302.58	302.22/18
I58	8" Comb. Underp. Inlet	325.25	325.70	Box 20.02' Rt. & Sta. 4+98.00	321.60	320.88/2
I59	8" Comb. Underp. Inlet	325.25	325.70	Box 20.02' Lt. & Sta. 4+98.00	321.60	321.88/50
E60	8 1/2" Conc. End Section	318.30	318.30	See Plan	308.83	309.82/4
M61	4' Precast MH - G.5.12	318.30	318.30	MH 17' Rt. & Sta. 1+18	309.82	309.82/1
I62	A-5 Inlet w=2'-6"	318.30	318.30	Box 23.02' Rt. & Sta. 0+06.23	318.30	318.30/13.73
I63	SEE DETAIL THIS SHEET	318.30	318.30	*** & STA. 0+32	318.30	309.82/3
I64	Dbl. 8" Comb. Underp. Inlet Dep.	316.35	316.35	Box 16.42' Rt. & Sta. 3+52.450	316.35	316.35/1
I67	WRM Inlet MSHA Std. 374.05	316.35	316.35	Box 21.85' Lt. & Sta. 3+52.450	316.35	316.35/1
Ex. H1	Ex. 8" Comb. Inlet	320.37	320.37	Box 20.02' Lt. & Sta. 11+00	322.40	322.40/1
I8	8" Comb. Underp. Inlet	326.30	326.30	Box 20.02' Lt. & Sta. 11+00	322.40	322.40/1
I9	8" Comb. Underp. Inlet	326.30	326.30	Box 20.02' Rt. & Sta. 11+00	322.40	322.40/1

\*\* Location of Str's G6 & G7 to be field adjusted to meet end of existing pipes. Existing structures to be rebuilt or removed as necessary.  
 \* Normal to curb per SD-4.33








\*\*\* I-63 TO BE LOCATED FROM STATIONING OF FLOWERTUIT COURT. INLET TO BE @ FACE OF CURB PER STD. SD 4.06 & MODIFIED TO BE RADIAL W/FILLET AS NECESSARY.

PIPE SCHEDULE		
SIZE	TYPE	LENGTH
15"	RCP CI IIX	154 L.F.
21"	RCP CI IIX	67 L.F.
24"	RCP CI IIX	139 L.F.

- STRUCTURE SCHEDULE NOTES**
- 8" Comb. Inlet Howard County Standard S.D. 4.32. ("Dir" & "Under" designate Depressed & Underdepressed Inlets Respectively)
  - Dbl. 8" Comb. Inlet Howard County Standard S.D. 4.34. ("Dir" & "Under" designate Depressed & Underdepressed Inlets Respectively)
  - A-10 Inlet Howard County Standard S.D. 4.02.
  - Conc. End Section Howard County Standard S.D. 5.51.
  - Precast Manhole Howard County Standard G.5.12 & G.5.13
  - All Storm Drain Pipe Bedding to be Class "C" Shaped Subgrade Unless Otherwise Noted. If Rock is Encountered the Trench Invert should be Deepened 6 inches and the Overexcavation of 6" Inches Refilled with Granular Material.
  - ALL "S" INLETS SHALL HAVE RETICULAR GRATES PER HOWARD COUNTY STD. SD 4.33.

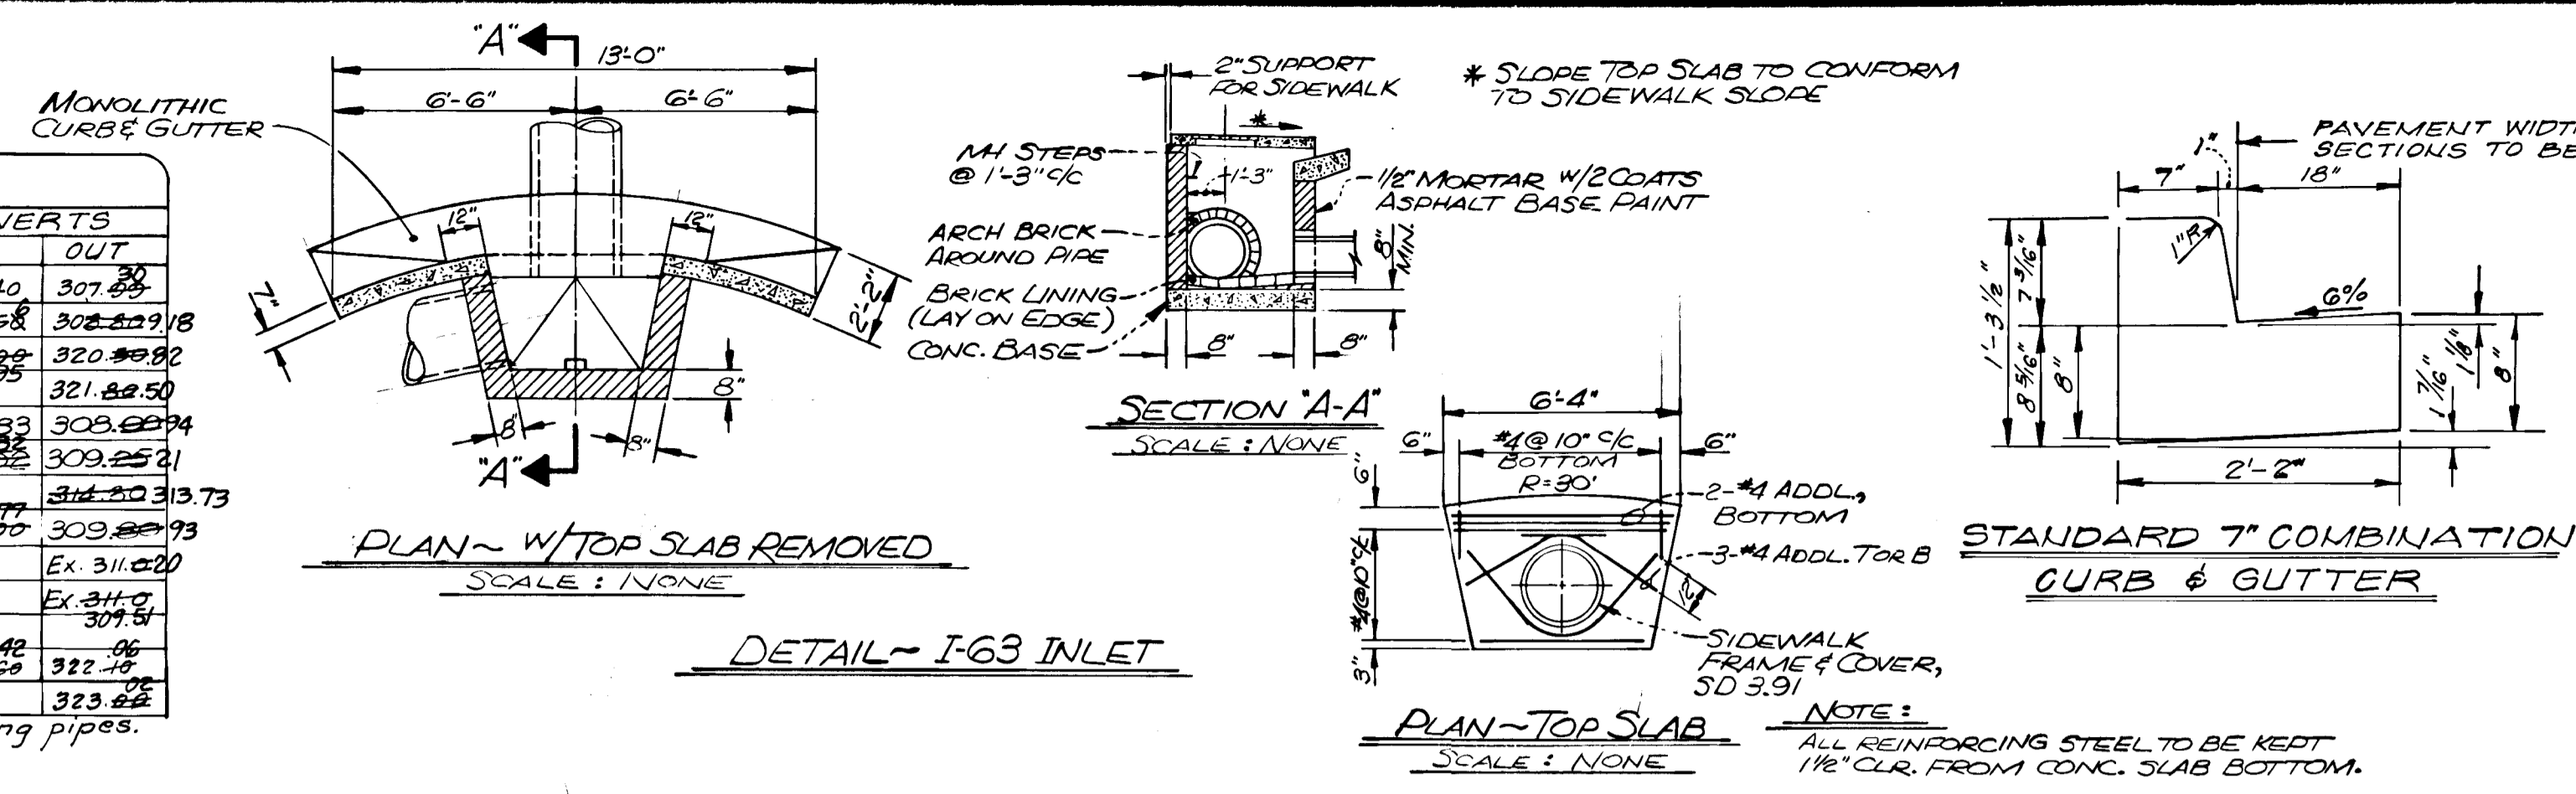

- NOTES (FOR "DETAIL-I-63 INLET")**
- INVERTS SHALL BE BRICK.
  - BASE SHALL BE CLASS "A" CONCRETE.
  - WALLS SHALL BE BRICK (BR.), PLAIN CLASS "A" CONCRETE (RC.) OR REINFORCED CONCRETE (R.C.)
  - REINFORCING = #4 @ 10" O.C. E.W. IN C WALLS. REINFORCING CONTINUOUS @ CORNERS. ALL LAPS 1'-4".
  - 700 4" O.W. WALLS SHALL BE BRICK MASONRY. ADDITIONAL BRICK SHALL BE USED TO BRING MH COVER TO EX. GRID, IF REQ'D.
  - BENCH (AS PER TYPE "A" MH) SHALL BE BUILT INTO INLET WHERE DRAINS 24" & LARGER RUN THROUGH INLET.

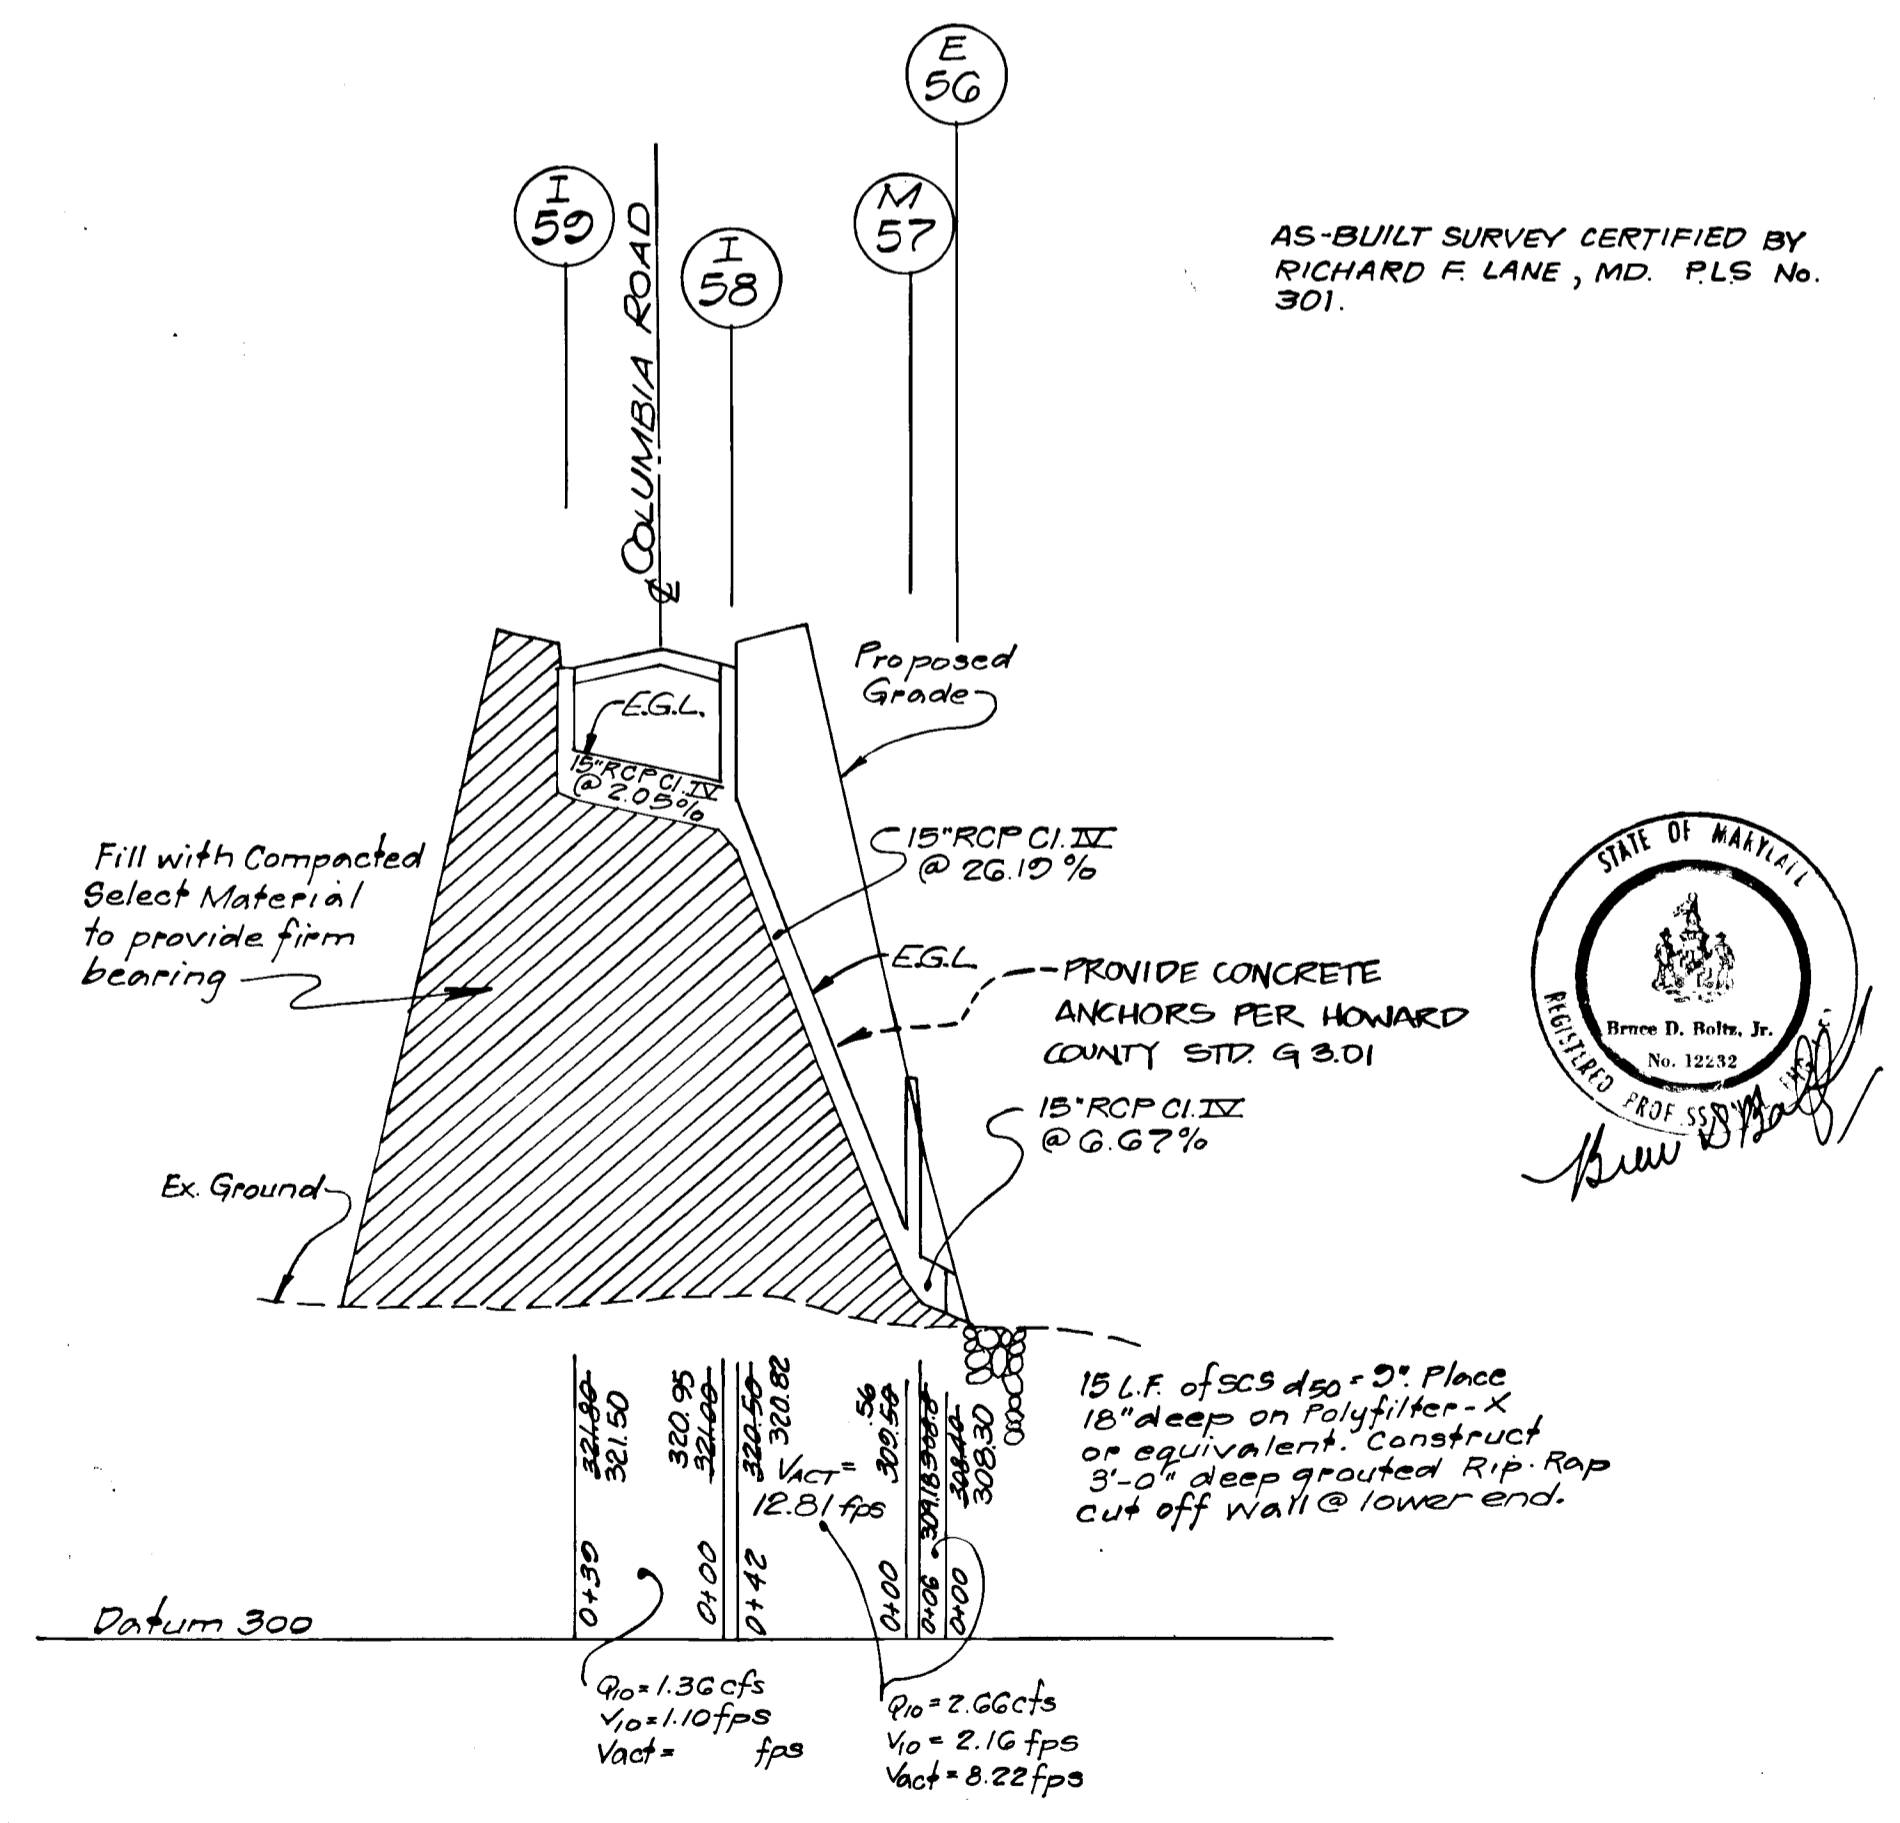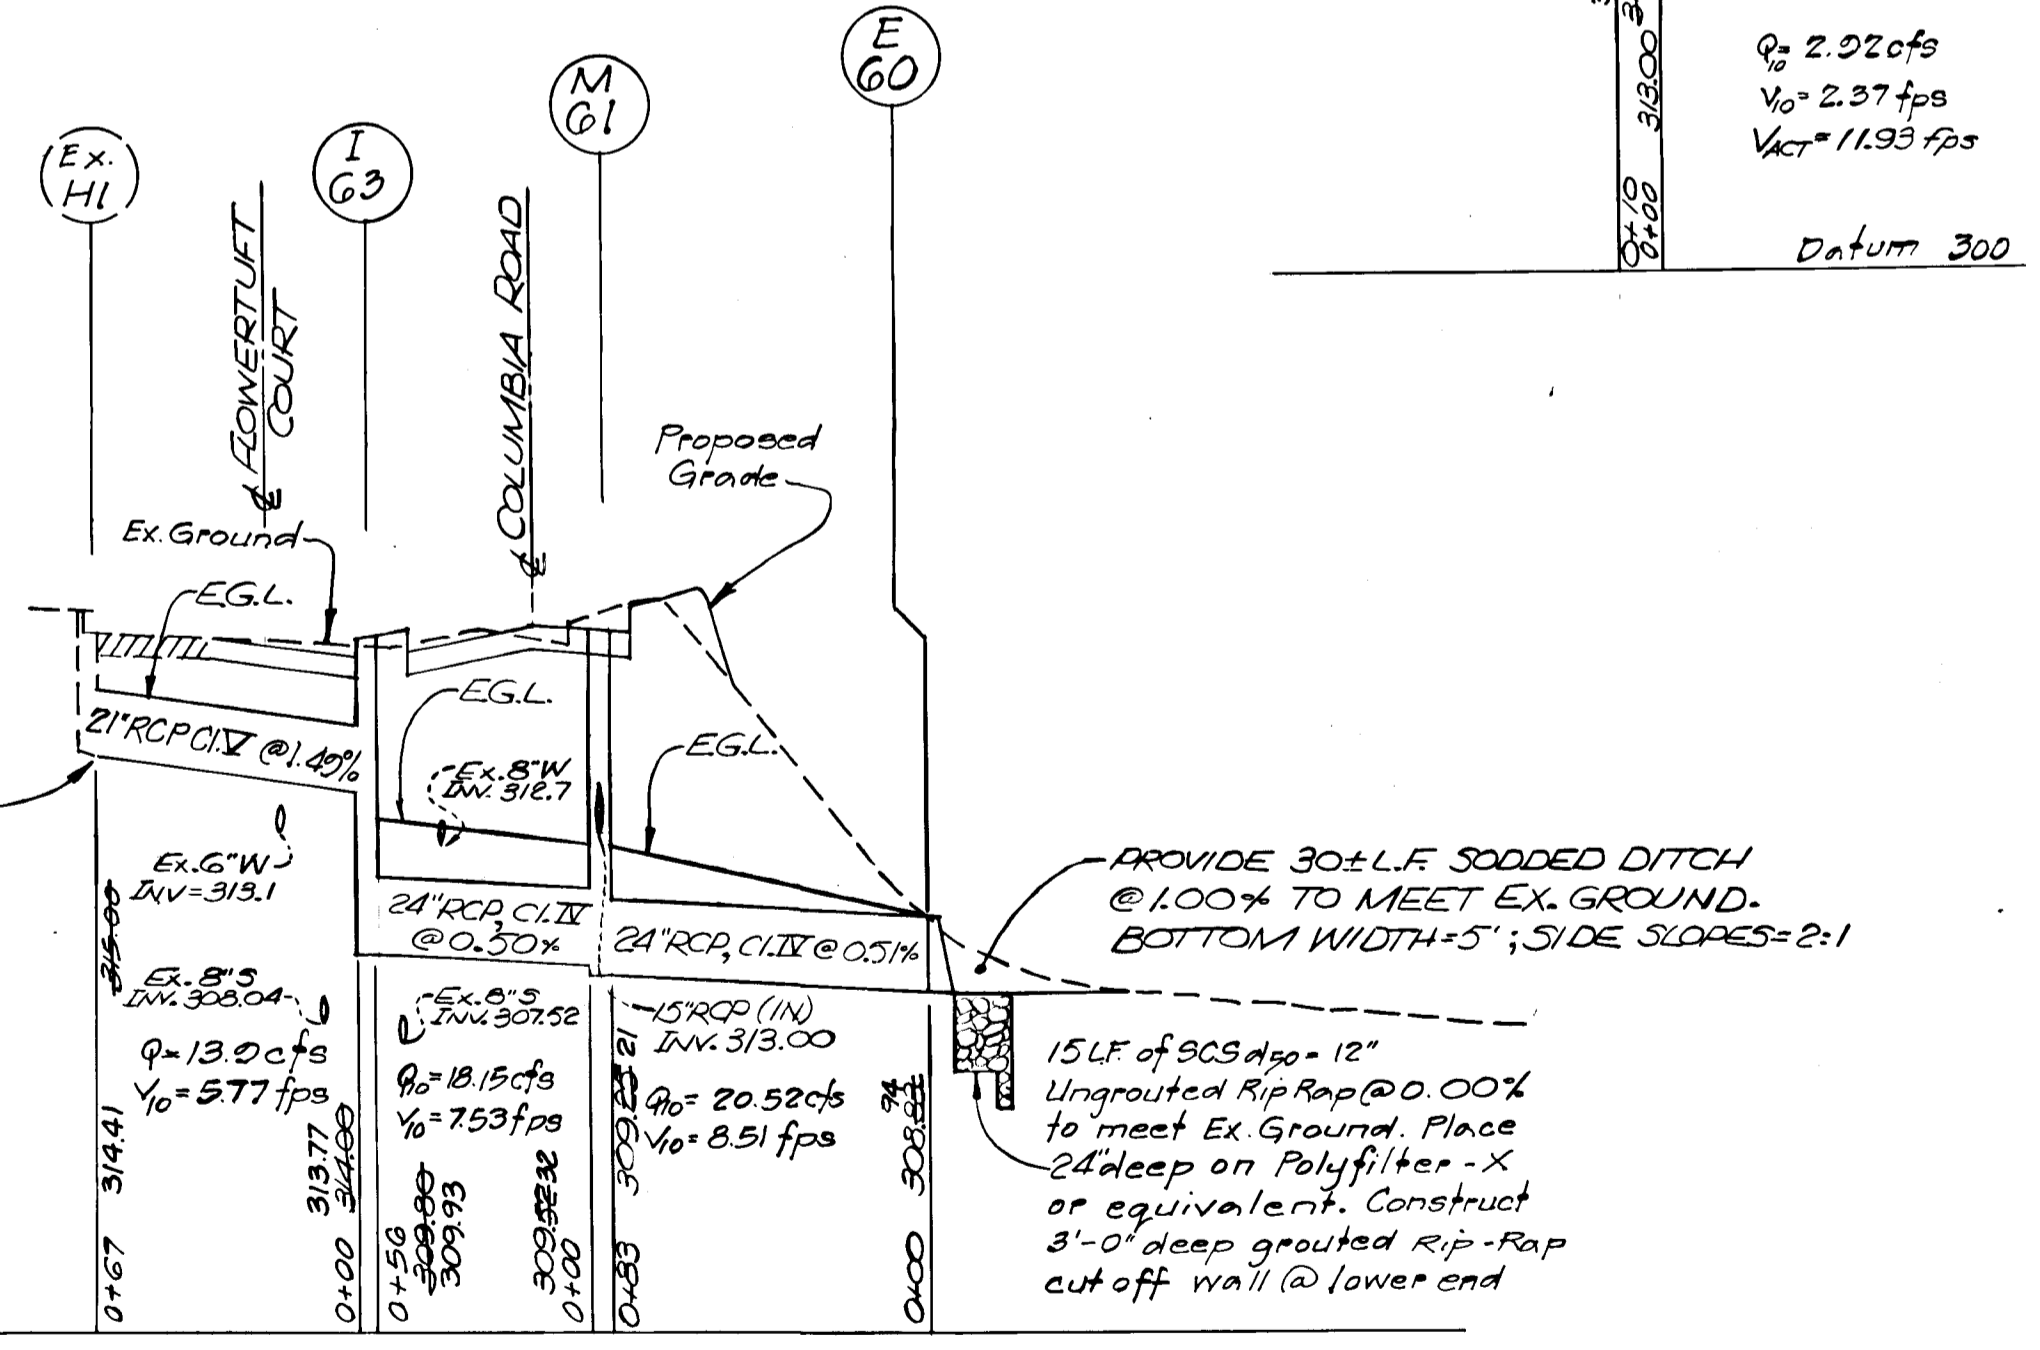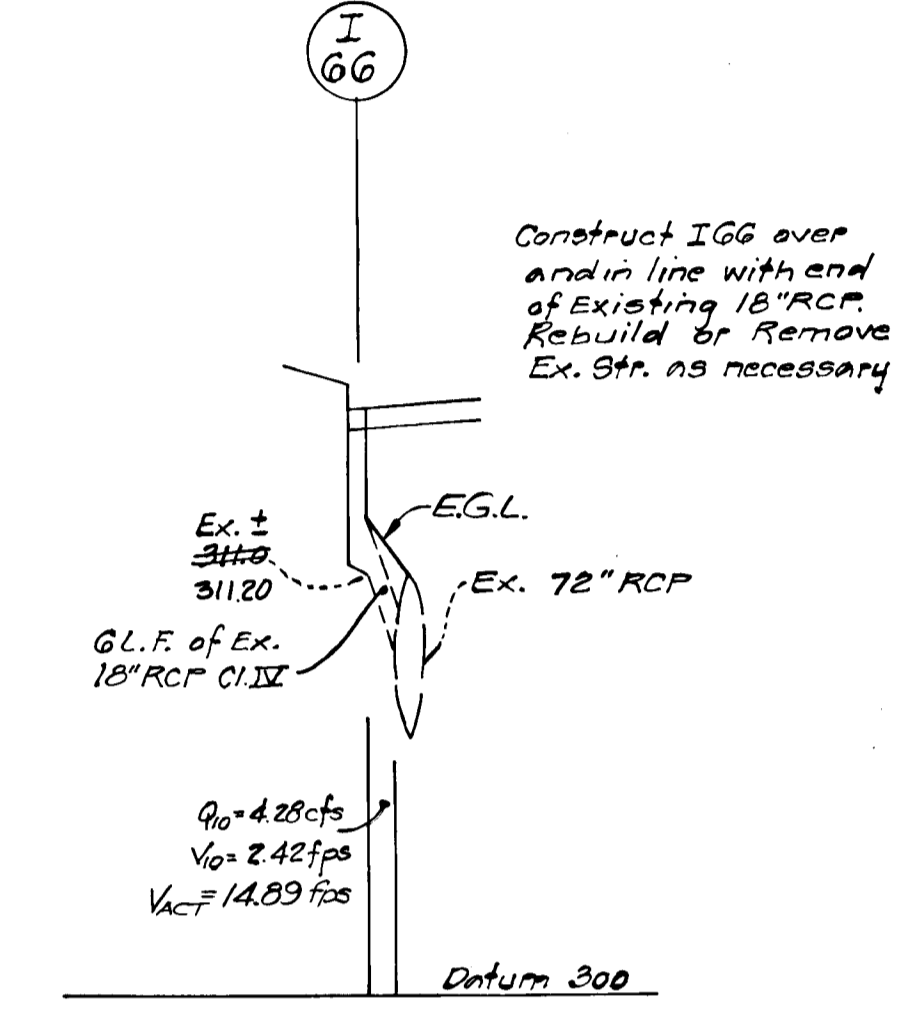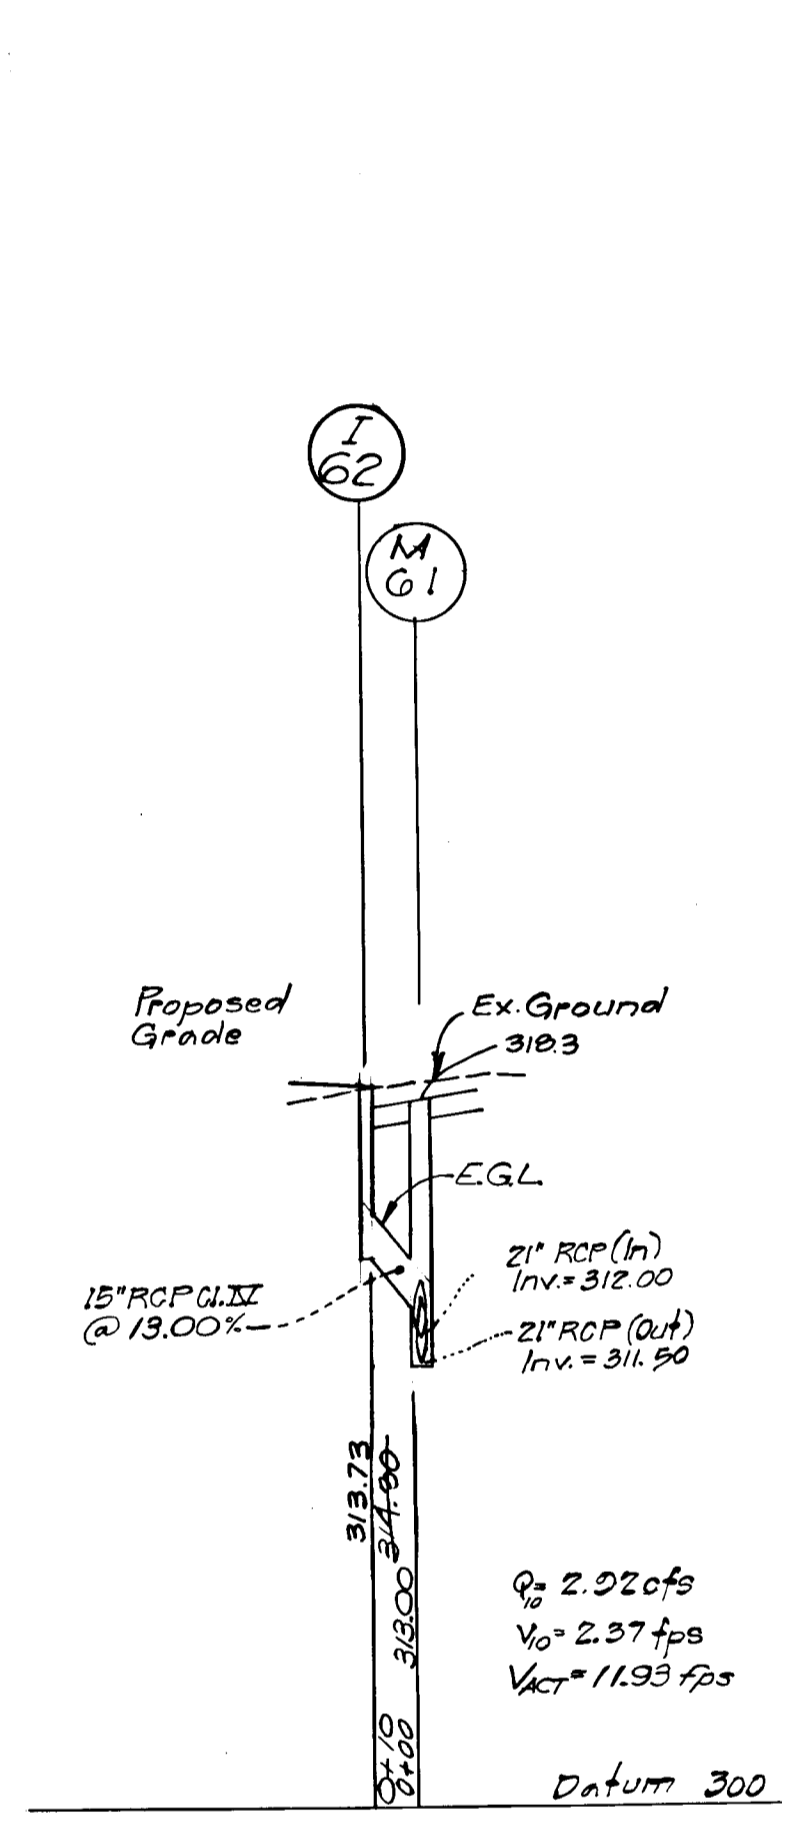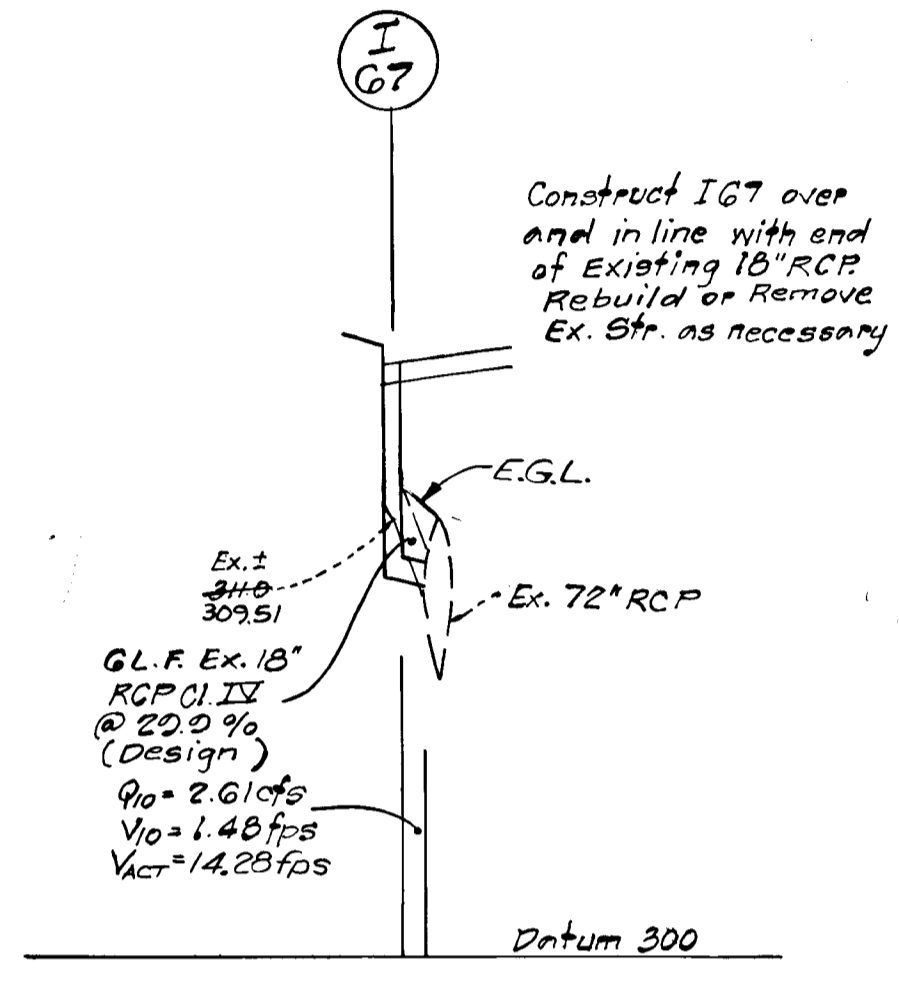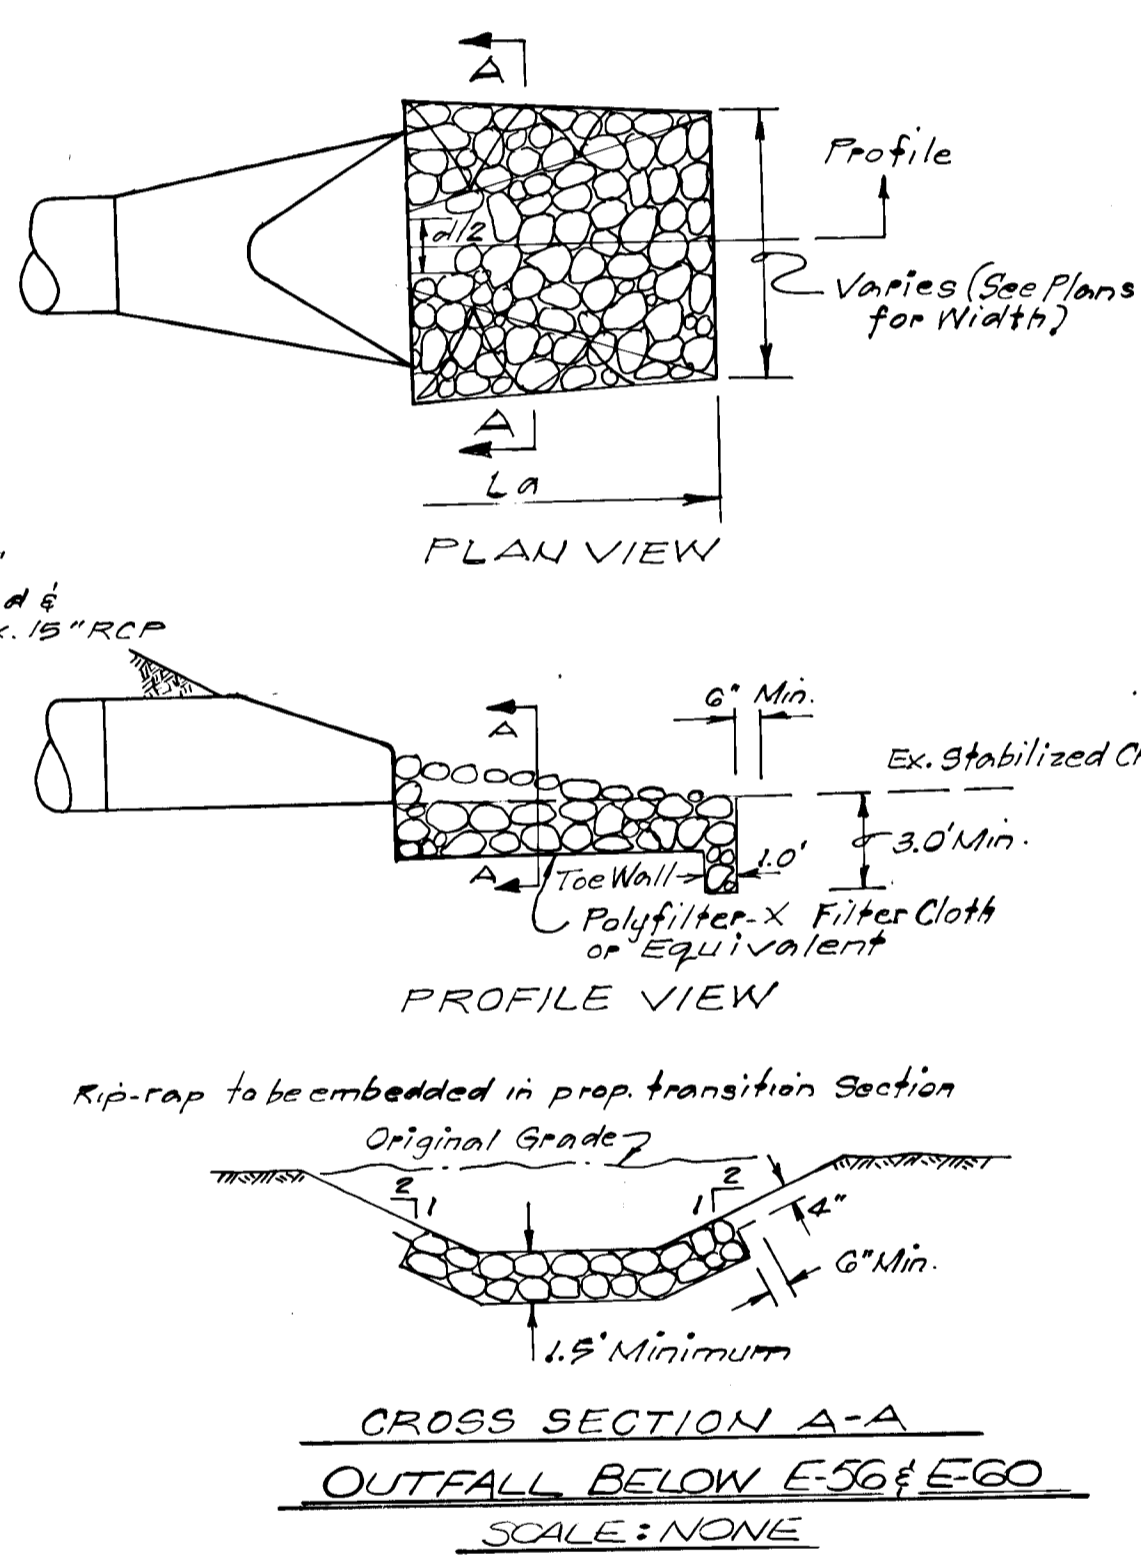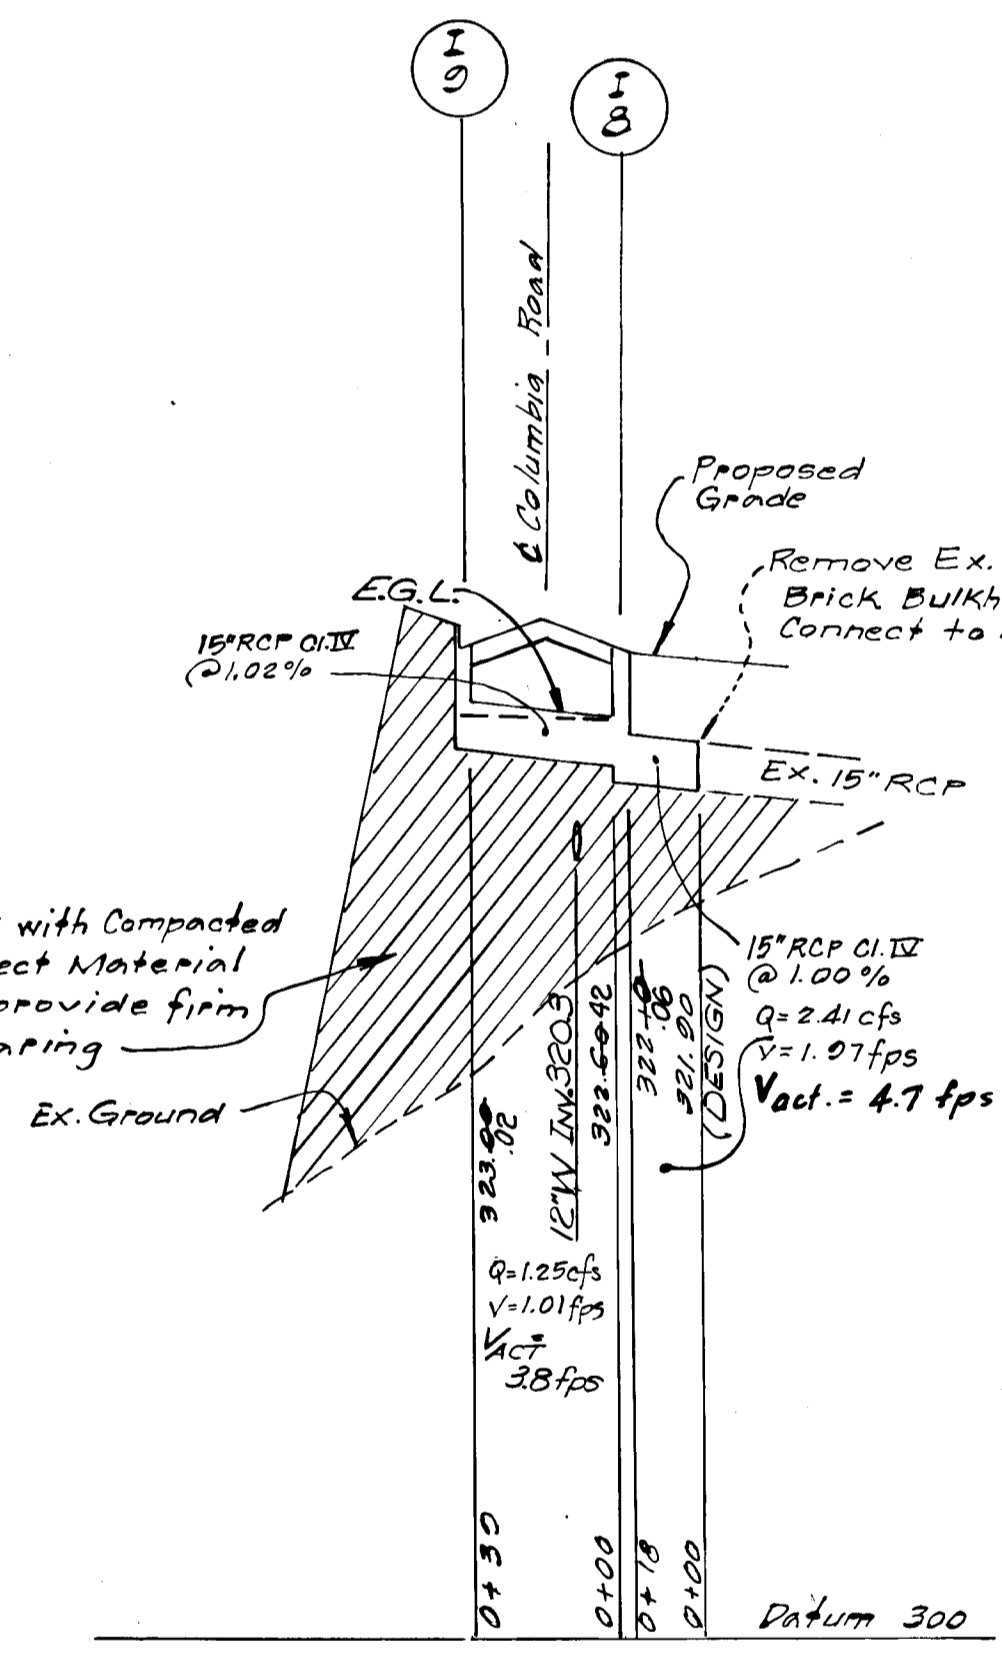

AS-BUILT SURVEY CERTIFIED BY RICHARD F. LANE, MD. PLS. No. 301.



DEPARTMENT OF PUBLIC WORKS  
 Precision & Ray  
 CHIEF, BUREAU OF ENGINEERING  
 DATE 2-28-86

DEPARTMENT OF PLANNING AND ZONING  
 John M. Muschman  
 CHIEF, DIVISION OF LAND DEVELOPMENT AND ZONING ADMINISTRATION  
 DATE 2-3-86

OWNER:  
 THE HOWARD RESEARCH & DEVELOPMENT CORPORATION  
 10275 LITTLE PATUXENT PARKWAY  
 COLUMBIA, MARYLAND 21044  
 (301) 992-6084


No.	REVISION	DATE	BY
1	REVISIONS TO STORM DRAIN PROFILE AS PER DPW LETTER 444	6/1/86	HRD




ENGINEERS • ARCHITECTS • PLANNERS • SCIENTISTS • SURVEYORS • PHOTOGRAMMETRISTS  
**GREENHORNE & O'MARA, INC.**  
 2 RESEARCH PLACE, ROCKVILLE, MARYLAND 20850  
 (301) 948-0900  
 GREENBELT, MD • ANNAPOLIS, MD • ATLANTA, GA • BECKLEY, WV • CULPEPER, VA • DENVER, CO  
 FAIRFAX, VA • GREENSBORO, NC • MONROE, MI • EXPORT, PA • WILLISTON PARK, NY

STORM DRAIN PROFILES AND DETAILS  
 VILLAGE OF DORSEY'S SEARCH  
 SECTION 3 AREA 1 PHASE 191  
 5th ELECTION DISTRICT  
 HOWARD COUNTY, MARYLAND

JSL DESIGN SCALE Horiz. 1" = 50' Vert. 1" = 5'  
 EG DRAWN 5 OF 24  
 BSP/AM CHECKED SHEET  
 Aug 1985 DATE  
 R-1216-X JOB No. FILE No.

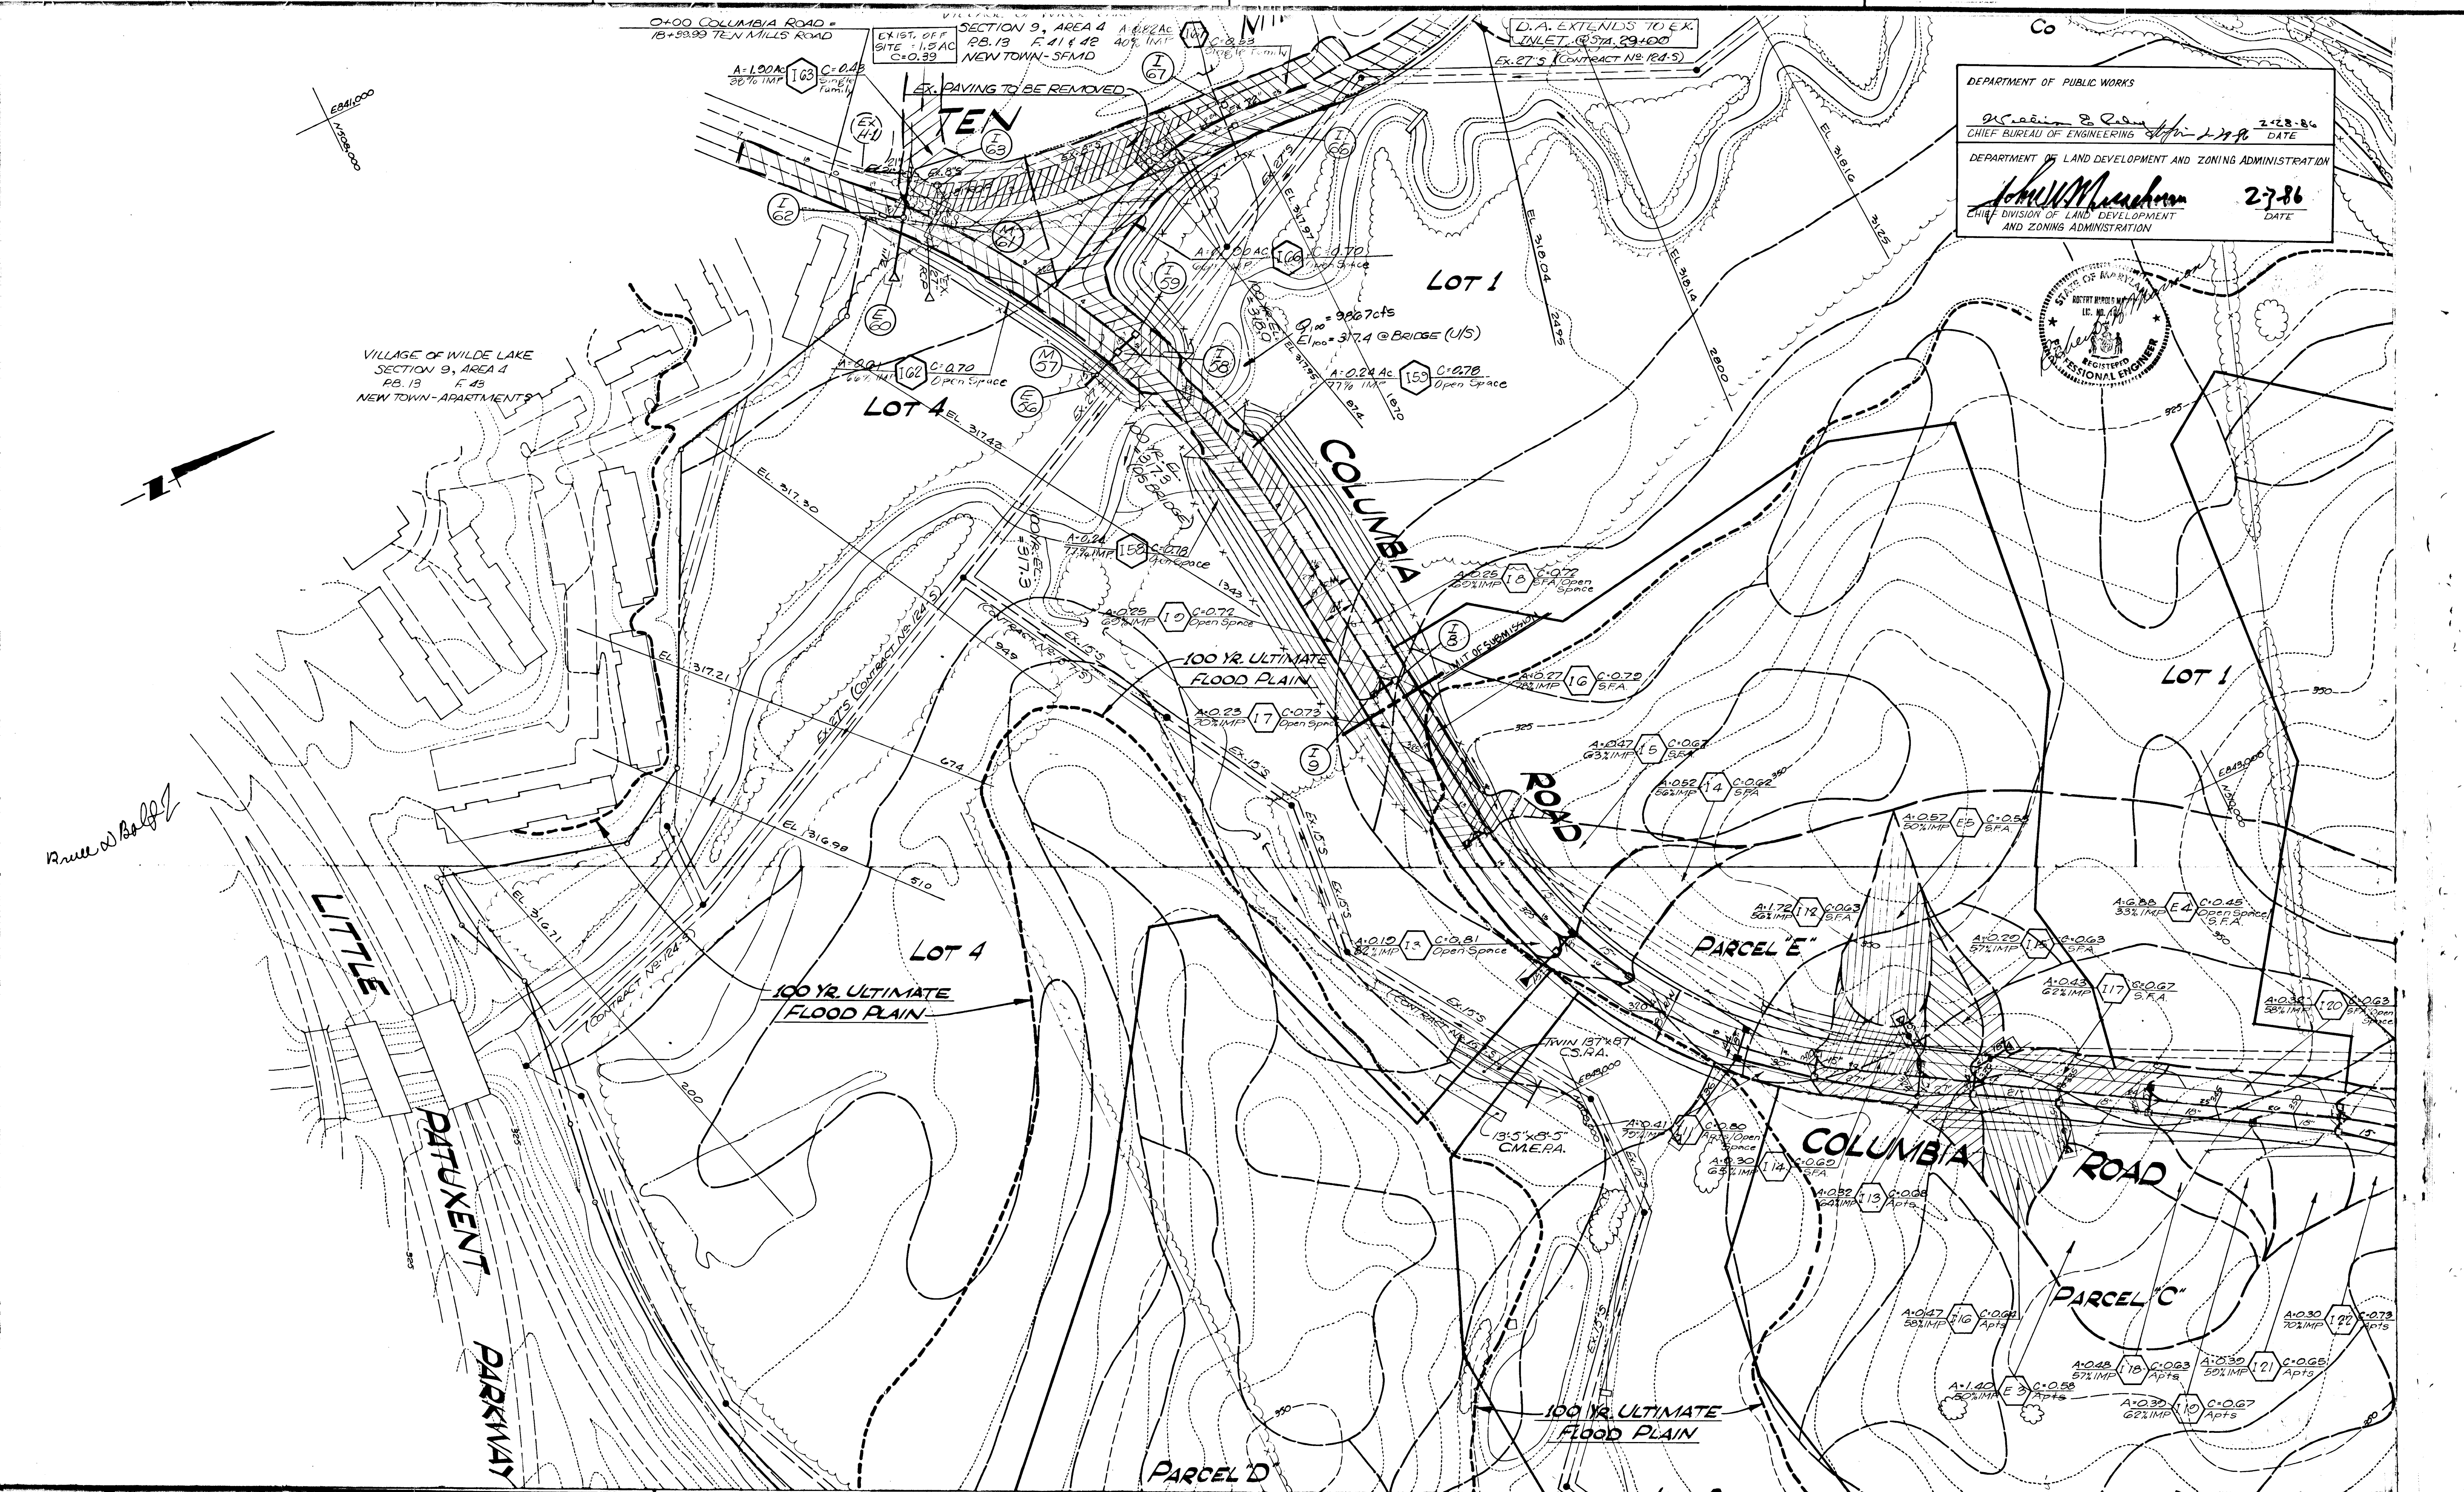


DEPARTMENT OF PUBLIC WORKS  
 Chief Bureau of Engineering *John W. Muschum* 2-28-86 DATE  
 DEPARTMENT OF LAND DEVELOPMENT AND ZONING ADMINISTRATION  
 Chief Division of Land Development and Zoning Administration *John W. Muschum* 2-7-86 DATE

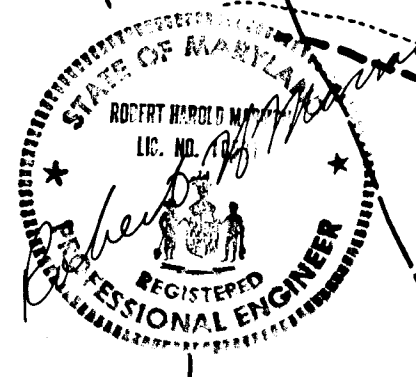

OWNER/DEVELOPER  
 HOWARD RESEARCH & DEVELOPMENT CORP.  
 10275 LITTLE PATUXENT PARKWAY  
 COLUMBIA, MARYLAND 21044

No.	REVISION	DATE	BY

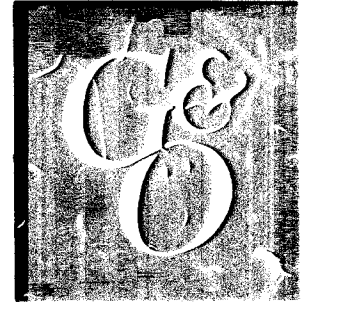

ENGINEERS • ARCHITECTS • PLANNERS • SCIENTISTS • SURVEYORS • PHOTOGRAMMETRISTS  
**GREENHORNE & O'MARA, INC.**  
 2 RESEARCH PLACE, ROCKVILLE, MARYLAND 20850  
 (301) 948-0900  
 GREENBELT, MD • ANNAPOLIS, MD • ATLANTA, GA • BECKLEY, WV • CULPEPER, VA • DENVER, CO  
 FAIRFAX, VA • GREENSBORO, NC • MONROE, MI • EXPORT, PA • WILLISTON PARK, NY

DRAINAGE AREA MAP  
**COLUMBIA**  
 VILLAGE OF DORSEY'S SEARCH  
 SECTION 3, AREA 1, PHASE 191  
 TAX MAP 30 ~ PARCELS 124, 224 & 210  
 5TH ELECTION DISTRICT ~ HOWARD COUNTY, MARYLAND

AS/IM DESIGN	SCALE 1" = 100'
RW/JDP DRAWN	6 OF 24
BOB CHECKED	SHEET
June, 85 DATE	JOB No. F-1216-X FILE No.

APPROVED:  
HOWARD COUNTY DEPT. OF PUBLIC WORKS

*William J. Reid* 2-28-86  
CHIEF, BUREAU OF ENGINEERING DATE

APPROVED: HOWARD COUNTY OFFICE OF PLANNING & ZONING

*Robert H. Marmor* 2-3-86  
CHIEF, DIV. OF LAND DEVELOPMENT & ZONING ADMIN. DATE

SEDIMENT CONTROL

by the Developer:  
\*I certify that all development and construction will be done according to this plan, and that many responsible personnel involved in the construction project will have a Certificate of Attendance at a Department of Natural Resources Approved Training Program for the control of Sediment and Erosion before beginning the project.\*

*William J. Reid* 1-17-86  
Signature of Developer Date  
Print name below signature  
By the Engineer:




\*I certify that this plan for erosion and sediment control represents a practical and workable plan based on my personal knowledge of the site conditions and that it was prepared in accordance with the requirements of the Howard Soil Conservation District.\*

*Robert H. Marmor* 1-16-86  
Signature of Engineer Date  
Print name below signature  
Robert H. MARMON  
Reviewed for Name S.C.D.

an meets Technical Requirements.  
*De Helms* 2/4/86  
U.S. Soil Conservation Service Date

THIS DEVELOPMENT PLAN IS APPROVED FOR SOIL EROSION AND SEDIMENT CONTROL BY THE HOWARD SOIL CONSERVATION DISTRICT  
*Stephen L. Fuller* 1/28/86  
Howard S.C.D. Date

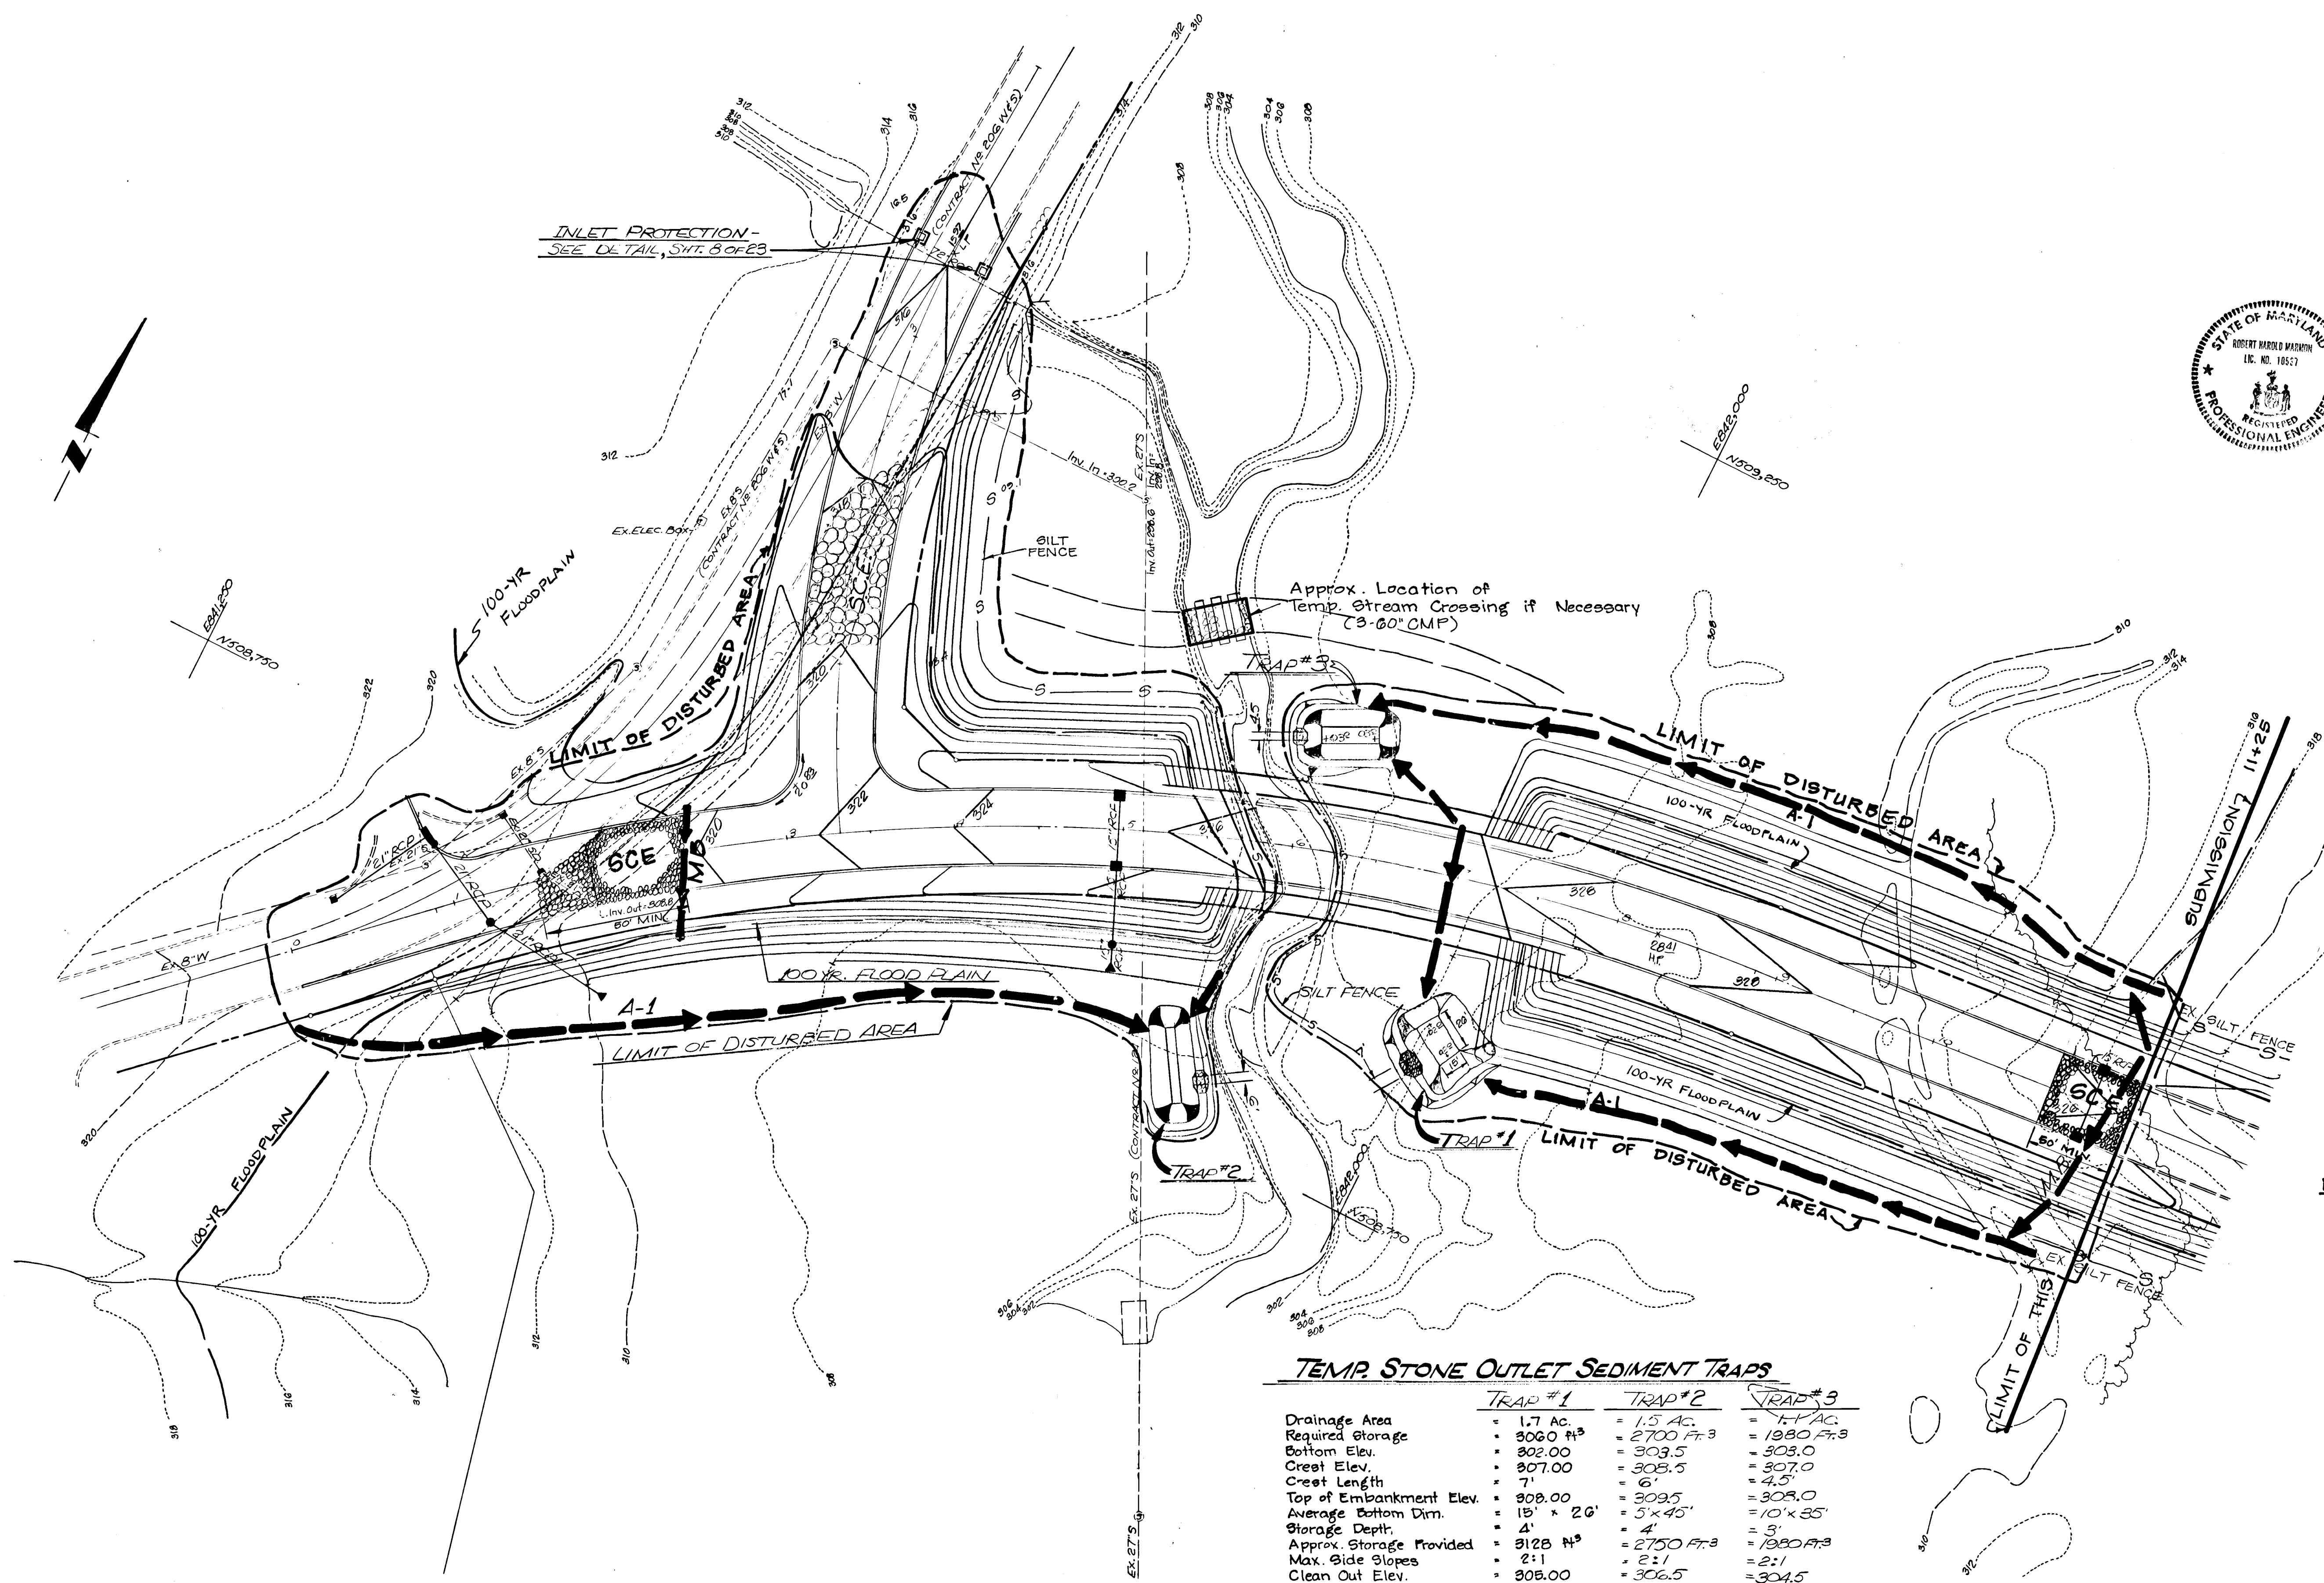

TEMP. STONE OUTLET SEDIMENT TRAPS

	TRAP #1	TRAP #2	TRAP #3
Drainage Area	= 1.7 AC.	= 1.5 AC.	= 1.4 AC.
Required Storage	= 3060 FT <sup>3</sup>	= 2700 FT <sup>3</sup>	= 1980 FT <sup>3</sup>
Bottom Elev.	= 302.00	= 303.5	= 303.0
Crest Elev.	= 307.00	= 308.5	= 307.0
Crest Length	= 7'	= 6'	= 4.5'
Top of Embankment Elev.	= 308.00	= 309.5	= 308.0
Average Bottom Dim.	= 15' x 26'	= 5' x 45'	= 10' x 35'
Storage Depth	= 4'	= 4'	= 3'
Approx. Storage Provided	= 3128 FT <sup>3</sup>	= 2750 FT <sup>3</sup>	= 1980 FT <sup>3</sup>
Max. Side Slopes	= 2:1	= 2:1	= 2:1
Clean Out Elev.	= 306.00	= 306.5	= 304.5

Note:  
PERIMETER A-1 DIVERSION DIKS MAY REMAIN AS PERMANENT FEATURES WITH THE APPROVAL OF THE HOWARD CO. SEDIMENT CONTROL INSPECTOR.

OWNER/DEVELOPER:  
HOWARD RESEARCH & DEVELOPMENT CORP.  
10275 LITTLE PATUXENT PARKWAY  
COLUMBIA, MARYLAND 21043

No.	REVISION	DATE	BY
	Add Perimeter Dike Note	3-13-86	GL



ENGINEERS • ARCHITECTS • PLANNERS • SCIENTISTS • SURVEYORS • PHOTOGRAMMETRISTS  
**GREENHORNE & O'MARA, INC.**  
2 RESEARCH PLACE, ROCKVILLE, MARYLAND 20850  
(301) 948-0900  
GREENBELT, MD • ANNAPOLIS, MD • ATLANTA, GA • BECKLEY, WV • CULPEPER, VA • DENVER, CO  
FAIRFAX, VA • GREENSBORO, NC • MONROE, MI • EXPORT, PA • WILLISTON PARK, NY

SEDIMENT CONTROL PLAN (STREETS ONLY)  
**COLUMBIA**  
VILLAGE OF DORSEY'S SEARCH  
SECTION 3, AREA 1, PHASE 191  
TAX MAP 30 ~ PARCELS 124, 224 & 210  
5TH ELECTION DISTRICT ~ HOWARD COUNTY, MARYLAND

JGL DESIGN	SCALE 1"=50'
JDP/MZ DRAWN	7 OF 24
RHM CHECKED	SHEET
MAY 85 DATE	JOB No. R-1216
	FILE No.

#1159

F-86-55

**SEQUENCE OF CONSTRUCTION \***

1. Obtain necessary permit to start grading, INCLUDING WPA PERMIT FOR BRIDGE CONSTRUCTION.
2. Clear and Grub Areas Necessary to construct Sediment Control Measures. (1 WEEK)
3. Construct all Sediment Control Measures. (1-2 WEEKS)
4. Clear & Grub Remainder of Site and Commence Road Grading. (5 WEEKS)
5. GRADE COLUMBIA ROAD & RELOCATED TEN MILLS ROAD, EX. TEN MILLS RD. TO REMAIN UNDISTURBED. STABILIZE FILL SLOPES WITHIN 7 DAYS.
6. COMMENCE BRIDGE CONSTRUCTION.
7. UPON COMPLETION OF GRADING, CONSTRUCT UTILITIES & STORM DRAINAGE.
8. COMMENCE CURB & GUTTER AND PAVING CONSTRUCTION.
9. UPON COMPLETION OF PAVING OF COLUMBIA ROAD AND RELOCATED TEN MILLS ROAD, TRAFFIC IS TO BE REDIRECTED AS NECESSARY ALONG NEW PAVING TO COMPLETE CONSTRUCTION.
10. STABILIZE ANY DISTURBED AREAS PER H.S.C.D. STANDARDS AND REMOVE TEMP. SEDIMENT CONTROL MEASURES. STABILIZE FILL SLOPES AGAIN AS REQ'D.

**TEMPORARY SEEDING NOTES**

Apply to graded or cleared areas likely to be redistributed where a short-term vegetative cover is needed.


**Seedbed Preparation:** Loosen upper three inches of soil by raking, discing or other acceptable means before seeding.

**Soil Amendments:** Apply 600 lbs per acre 10-10-10 fertilizer (14 lbs/1000 sq ft)

**Seeding:** For periods March 1 thru April 30 and from August 15 thru November 15, seed with 2 1/2 bushel per acre of annual rye (3.2 lbs/1000 sq ft). For the period May 1 thru August 14, seed with 3 lbs per acre of weeping lovegrass (.07 lbs/1000 sq ft). For the period November 16 thru February 28, protect site by applying 2 tons per acre of well anchored straw mulch and seed as soon as possible in the spring, or use sod.

**Mulching:** Apply 1 1/2 to 2 tons per acre (70 to 90 lbs/1000 sq ft) of rotted small grain straw immediately after seeding. Anchor mulch immediately after application using small anchoring tool or 218 gal per acre (5 gal/1000 sq ft) of emulsified asphalt on flat areas. On slopes, 8 ft or higher, use 348 gal per acre (8 gal/1000 sq ft) for anchoring.

Refer to the 1983 MARYLAND STANDARDS AND SPECIFICATIONS FOR SOIL EROSION AND SEDIMENT CONTROL for rate and methods not covered.

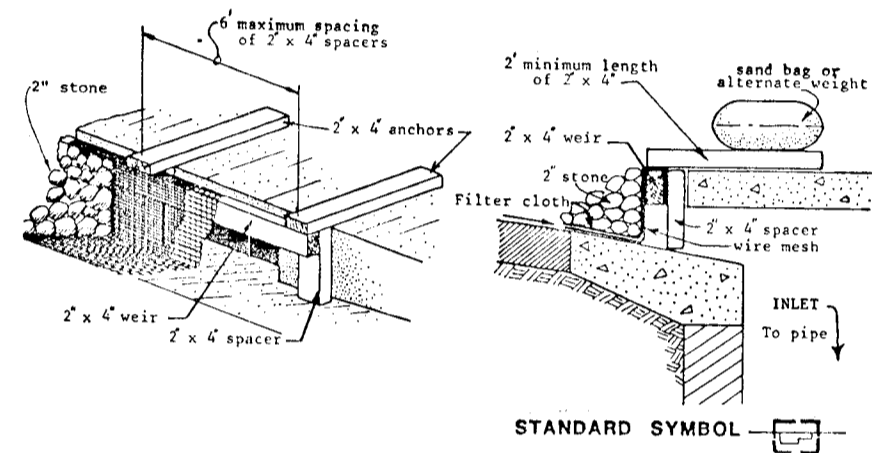



**CURB INLET PROTECTION DETAIL**  
SCALE: NONE

**SEDIMENT CONTROL NOTES**


1. A minimum of 24 hours notice must be given to the Howard County Office of Inspection and Permits prior to the start of any construction. (992-2437)
2. All vegetative and structural practices are to be installed according to the provisions of this plan and are to be in conformance with the 1983 MARYLAND STANDARDS AND SPECIFICATIONS FOR SOIL EROSION AND SEDIMENT CONTROL.
3. Following initial soil disturbance or redistribution, permanent or temporary stabilization shall be completed within: a) 7 calendar days for all perimeter sediment control structures, dikes, perimeter slopes and all slopes greater than 3:1, b) 14 days as to all other disturbed or graded areas on the project site.
4. All sediment traps/basins shown must be fenced and warning signs posted around their perimeter in accordance with Vol. 1, Chapter 12, of the HOWARD COUNTY DESIGN MANUAL, Storm Drainage.
5. All disturbed areas must be stabilized within the time period specified above in accordance with the 1983 MARYLAND STANDARDS AND SPECIFICATIONS FOR SOIL EROSION AND SEDIMENT CONTROL for permanent seedings (Sec. 51) sod (Sec. 54), temporary seeding (Sec. 50) and mulching (Sec. 52.) Temporary stabilization with mulch alone can only be done when recommended seeding dates do not allow for proper germination and establishment of grasses.
6. All sediment control structures are to remain in place and are to be maintained in operative condition until permission for their removal has been obtained from the Howard County Sediment Control Inspector.
7. Site Analysis:  
Total Area of Site: 290 Acres  
Area Disturbed: 125 Acres  
Area to be roofed or paved: 2.0 Acres  
Area to be vegetatively stabilized: 8.5 Acres  
Total Cut: 0 Cu. yds  
Total Fill: 25,000 Cu. yds  
Offsite waste/borrow area location: NONE
8. Any sediment control practice which is disturbed by grading activity for placement of utilities must be repaired on the same day of disturbance.
9. Additional sediment controls must be provided, if deemed necessary by the Howard County DPW sediment control inspector.
10. On all sites with disturbed areas in excess of 2 acres, approval of the inspection agency shall be requested upon completion of installation of perimeter erosion and sediment controls, but before proceeding with any other earth disturbance or grading. Other building or grading inspection approvals may not be authorized until this initial approval by the inspection agency is made.

\* SEE SHEET 24 of 2A FOR ADDITIONAL SEDIMENT CONTROL AND SEQUENCE OF CONSTRUCTION.

**TEMPORARY ACCESS CULVERT**

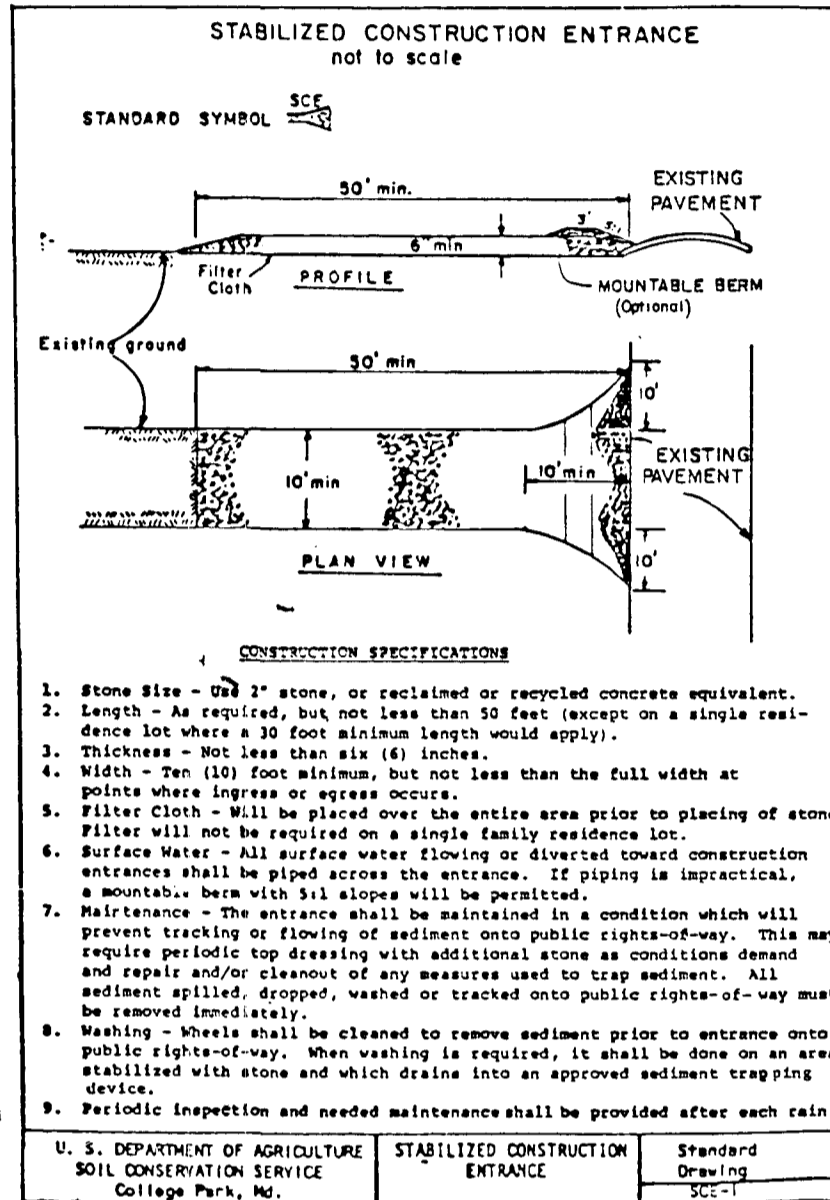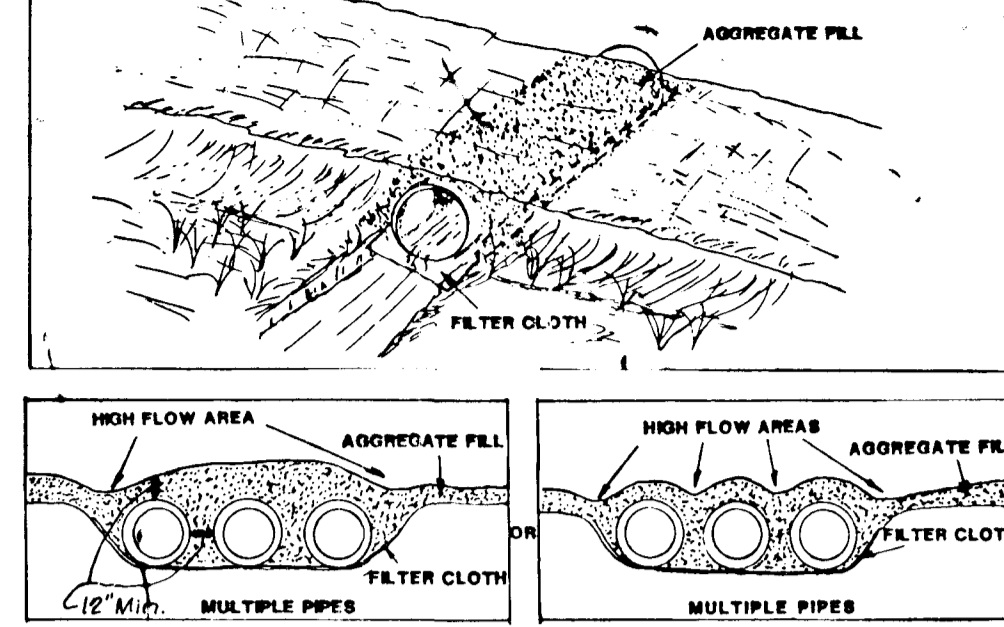


- Construction Specifications**
1. **Restrictions** - No construction or removal of a temporary access culvert will be permitted between October 1 through April 30 for all Class III and Class IV Trout Waters or between March 15 through June 15 for non-trout waterways.
  2. **Culvert Strength** - All culverts shall be strong enough to support their cross sectional area under maximum expected loads.
  3. **Culvert Size** - The size of the culvert pipe shall be the largest pipe diameter that will fit into the existing channel without major excavation of the waterway channel or without major approach fills. If a channel width exceeds 3 feet, additional pipes may be used until the cross sectional area of the pipes is greater than 60 percent of the cross sectional area of the existing channel. The minimum size culvert that may be used is a 12" diameter pipe.
  4. **Culvert Length** - The culvert(s) shall extend a minimum of one foot beyond the upstream and downstream toe of the aggregate placed around the culvert. In no case shall the culvert exceed 40 feet in length.
  5. **Filter Cloth** - Filter cloth shall be placed on the streambed and streambanks prior to placement of the pipe culvert(s) and aggregate. The filter cloth shall cover the streambed and extend a minimum six inches and a maximum one foot beyond the end of the culvert and bedding material. Filter cloth reduces settlement and improves crossing stability.
  6. **Culvert Placement** - The invert elevation of the culvert shall be installed on the natural streambed grade to minimize interference with fish migration (free passage of fish).
  7. **Culvert Protection** - The culvert(s) shall be covered with a minimum of one foot of aggregate. If multiple culverts are used they shall be separated by at least 12" of compacted aggregate fill. At a minimum, the bedding and fill material used in the construction of the temporary access culvert crossings shall conform with the aggregate requirements cited in Section I.H. 1. above.
  8. **Stabilization** - All areas disturbed during culvert installation shall be stabilized within 14 calendar days of the disturbance in accordance with the Standard for "Critical Area Stabilization With Permanent Seeding."

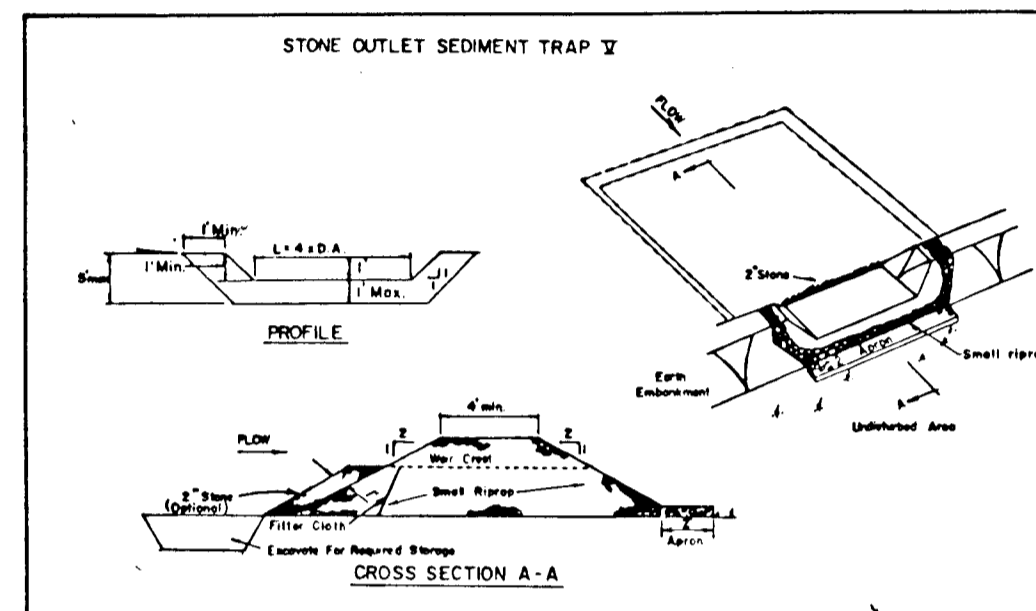


- Construction Specifications for ST-1**
1. The area under embankment shall be cleared, grubbed and stripped of any vegetation and rock soil. The pool area shall be cleared.
  2. The fill material for the embankment shall be free of roots and other woody vegetation as well as over-sized stones, rocks, organic material or other objectionable material. The embankment shall be compacted by tamping with equipment while it is being constructed. Maximum height of embankment shall be five (5) feet, measured at centerline.
  3. All fill slopes shall be 2:1 or flatter; out slopes 1:1 or flatter.
  4. Elevation of the top of the embankment shall be equal to or exceed the height of the adjacent.
  5. Storage area provided shall be figured by computing the volume available behind the outlet channel to an elevation of one (1) foot below the level weir crest.
  6. Filter cloth shall be placed over the bottom and sides of the outlet channel prior to placement of stone. A layer of filter cloth shall be at least one (1) foot wide with a minimum length of 10 feet. Fabric shall be secured to the top (1) foot of the outlet channel at entrance of outlet channel.
  7. Stone used in the outlet shall be 3/4" to 1 1/2" (1) to 1 1/2" (1) inches (trapezoid). To provide a filtering effect, a layer of filter cloth shall be embedded one (1) foot below the top surface of the outlet stone and a layer of filter cloth shall be placed on the upstream face of the outlet.
  8. Sediment shall be removed and trap restored to its original dimensions when the sediment has accumulated to 1/2 the design depth of the trap. Removal and restoration shall be completed within 14 calendar days of the time the structure shall be removed and the area stabilized when the drainage area has been properly stabilized.
  9. The structure shall be inspected after each rain and repaired as needed.
  10. Construction operations shall be carried out in such a manner that erosion and water pollution is minimized.
  11. The structure shall be removed and the area stabilized when the drainage area has been properly stabilized.
  12. Warning signs for this practice is limited to 15 acres or less.

DEPARTMENT OF PUBLIC WORKS  
 APPROVED: HOWARD COUNTY OFFICE OF PLANNING AND ZONING  
 DATE: 2-28-85  
 DATE: 2-7-86

- Culvert Maintenance Requirements**
1. **Inspection** - Periodic inspection shall be performed to ensure that the culvert, streambed, and streambanks are not damaged, and that sediment is not entering the stream or blocking fish passage or migration.
  2. **Maintenance** - Maintenance shall be performed, as needed in a timely manner to ensure that structures are in compliance with this standard and specification. This shall include removal and disposal of any trapped sediment or debris. Sediment shall be disposed of and stabilized outside the waterway flood plain.
- Culvert Removal and Clean-Up Requirements**
1. **Removal** - When the crossing has served its purpose, all structures including culverts, bedding and filter cloth materials shall be removed within 14 calendar days. In all cases, the culvert materials shall be removed within one year of installation. No structure shall be removed during the spawning season (March 15 through June 15).
  2. **Final Clean-up** - Final clean-up shall consist of removal of the temporary structure from the waterway, removal of all construction materials, restoration of original stream channel cross section, and protection of the stream banks from erosion. Removed material shall be stored outside of the waterway flood plain.
  3. **Method** - Removal of the structure and clean up of the area shall be accomplished without construction equipment working in the waterway channel.

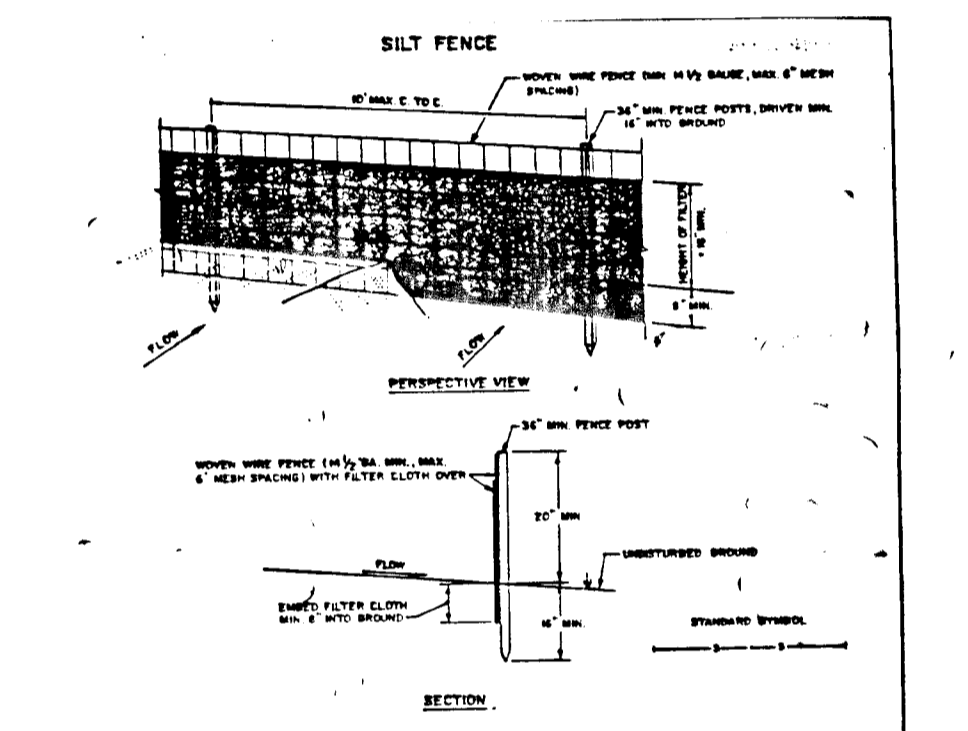

- Construction Notes for Proposed Silt Fence**
1. Never use fence to be fastened securely to fence posts with wire ties or staples.
  2. Filter cloth to be fastened securely to wooden fence posts with the plastic rope or as the and not section.
  3. Weep the sections of filter cloth along back strap they shall be overlapped by six inches and folded.
  4. Maintenance shall be performed as needed and material removed when raised, buried, or in the silt fence.

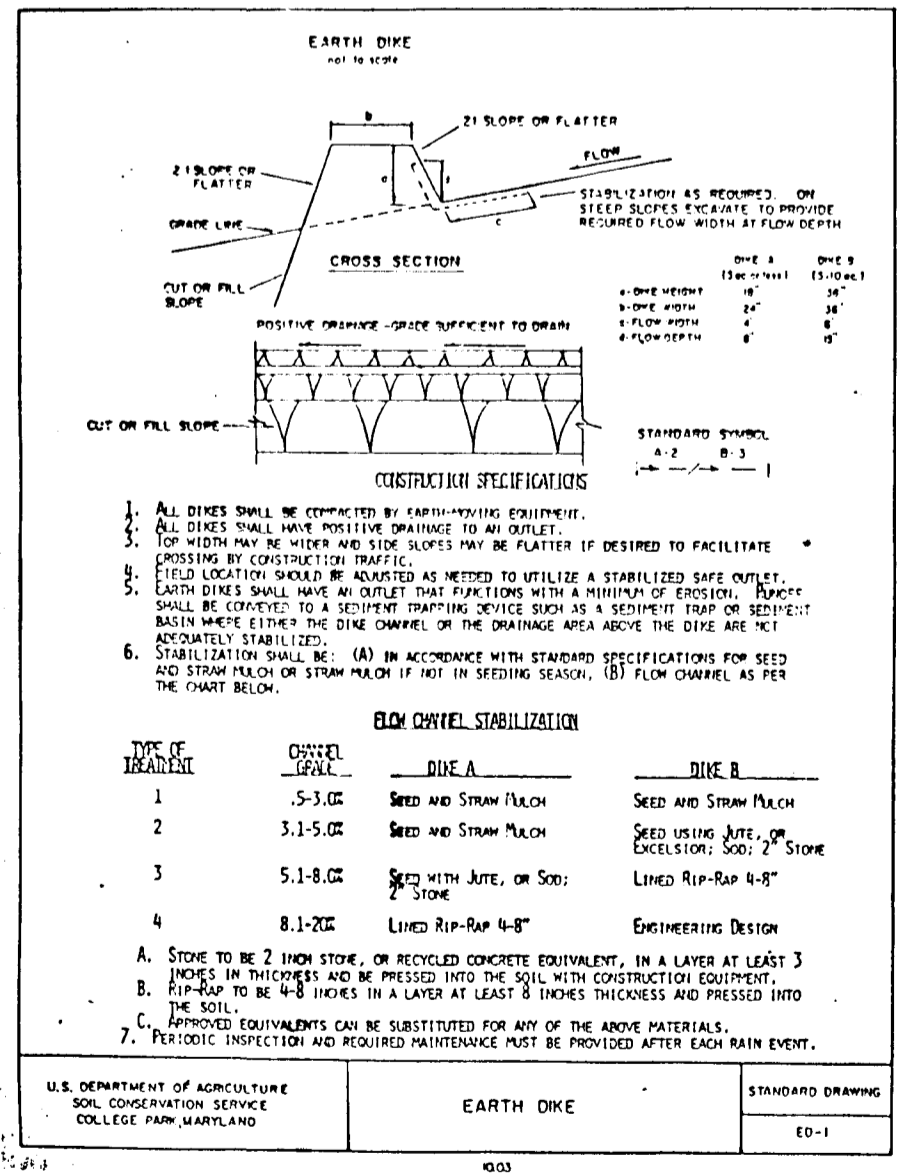

U.S. DEPARTMENT OF AGRICULTURE  
 SOIL CONSERVATION SERVICE  
 COLLEGE PARK, MARYLAND

"I/We certify that all development and construction will be done according to this plan, and that any responsible personnel involved in the construction project will have a Certificate of Attendance at a Department of Natural Resources Approved Training Program for the Control of Sediment and Erosion before beginning the project."

Signature of Developer: \_\_\_\_\_ Date: \_\_\_\_\_  
 Print name below signature: \_\_\_\_\_

I certify that this plan for erosion and sediment control represents a practical and workable plan based on my personal knowledge of the site conditions and that it was prepared in accordance with the requirements of the Howard Soil Conservation District.

Signature of Engineer: \_\_\_\_\_ Date: 9-23-85  
 Print name below signature: BRUCE D. BOLTZ, JR.



**OWNER/DEVELOPER**  
 HOWARD RESEARCH & DEVELOPMENT CORP.  
 10275 LITTLE PATUXENT PARKWAY  
 COLUMBIA, MARYLAND 21043

No.	REVISION	DATE	BY

ENGINEERS • ARCHITECTS • PLANNERS • SCIENTISTS • SURVEYORS • PHOTOGRAMMETRISTS

**GREENHORNE & O'MARA, INC.**  
 2 RESEARCH PLACE, ROCKVILLE, MARYLAND 20850  
 (301) 948-0900


\*GREENBELT, MD • ANNAPOLIS, MD • ATLANTA, GA • BECKLEY, WV • CULPEPER, VA • DENVER, CO  
 FAIRFAX, VA • GREENSBORO, NC • MONROE, MI • EXPORT, PA • WILLISTON PARK, NY

**SEDIMENT CONTROL DETAILS & NOTES**

**COLUMBIA VILLAGE OF DORSEY'S SEARCH**  
 SECTION 3, AREA 1, PHASE 191  
 TAX MAP 30 - PARCELS 124, 224 & 210  
 5TH ELECTION DISTRICT - HOWARD COUNTY, MARYLAND

JSL DESIGN SCALE: NONE  
 EG DRAWN 8 OF 24  
 BDB CHECKED SHEET  
 Ave 85 DATE R-1216-X  
 JOB No. FILE No.  
 F-86-55



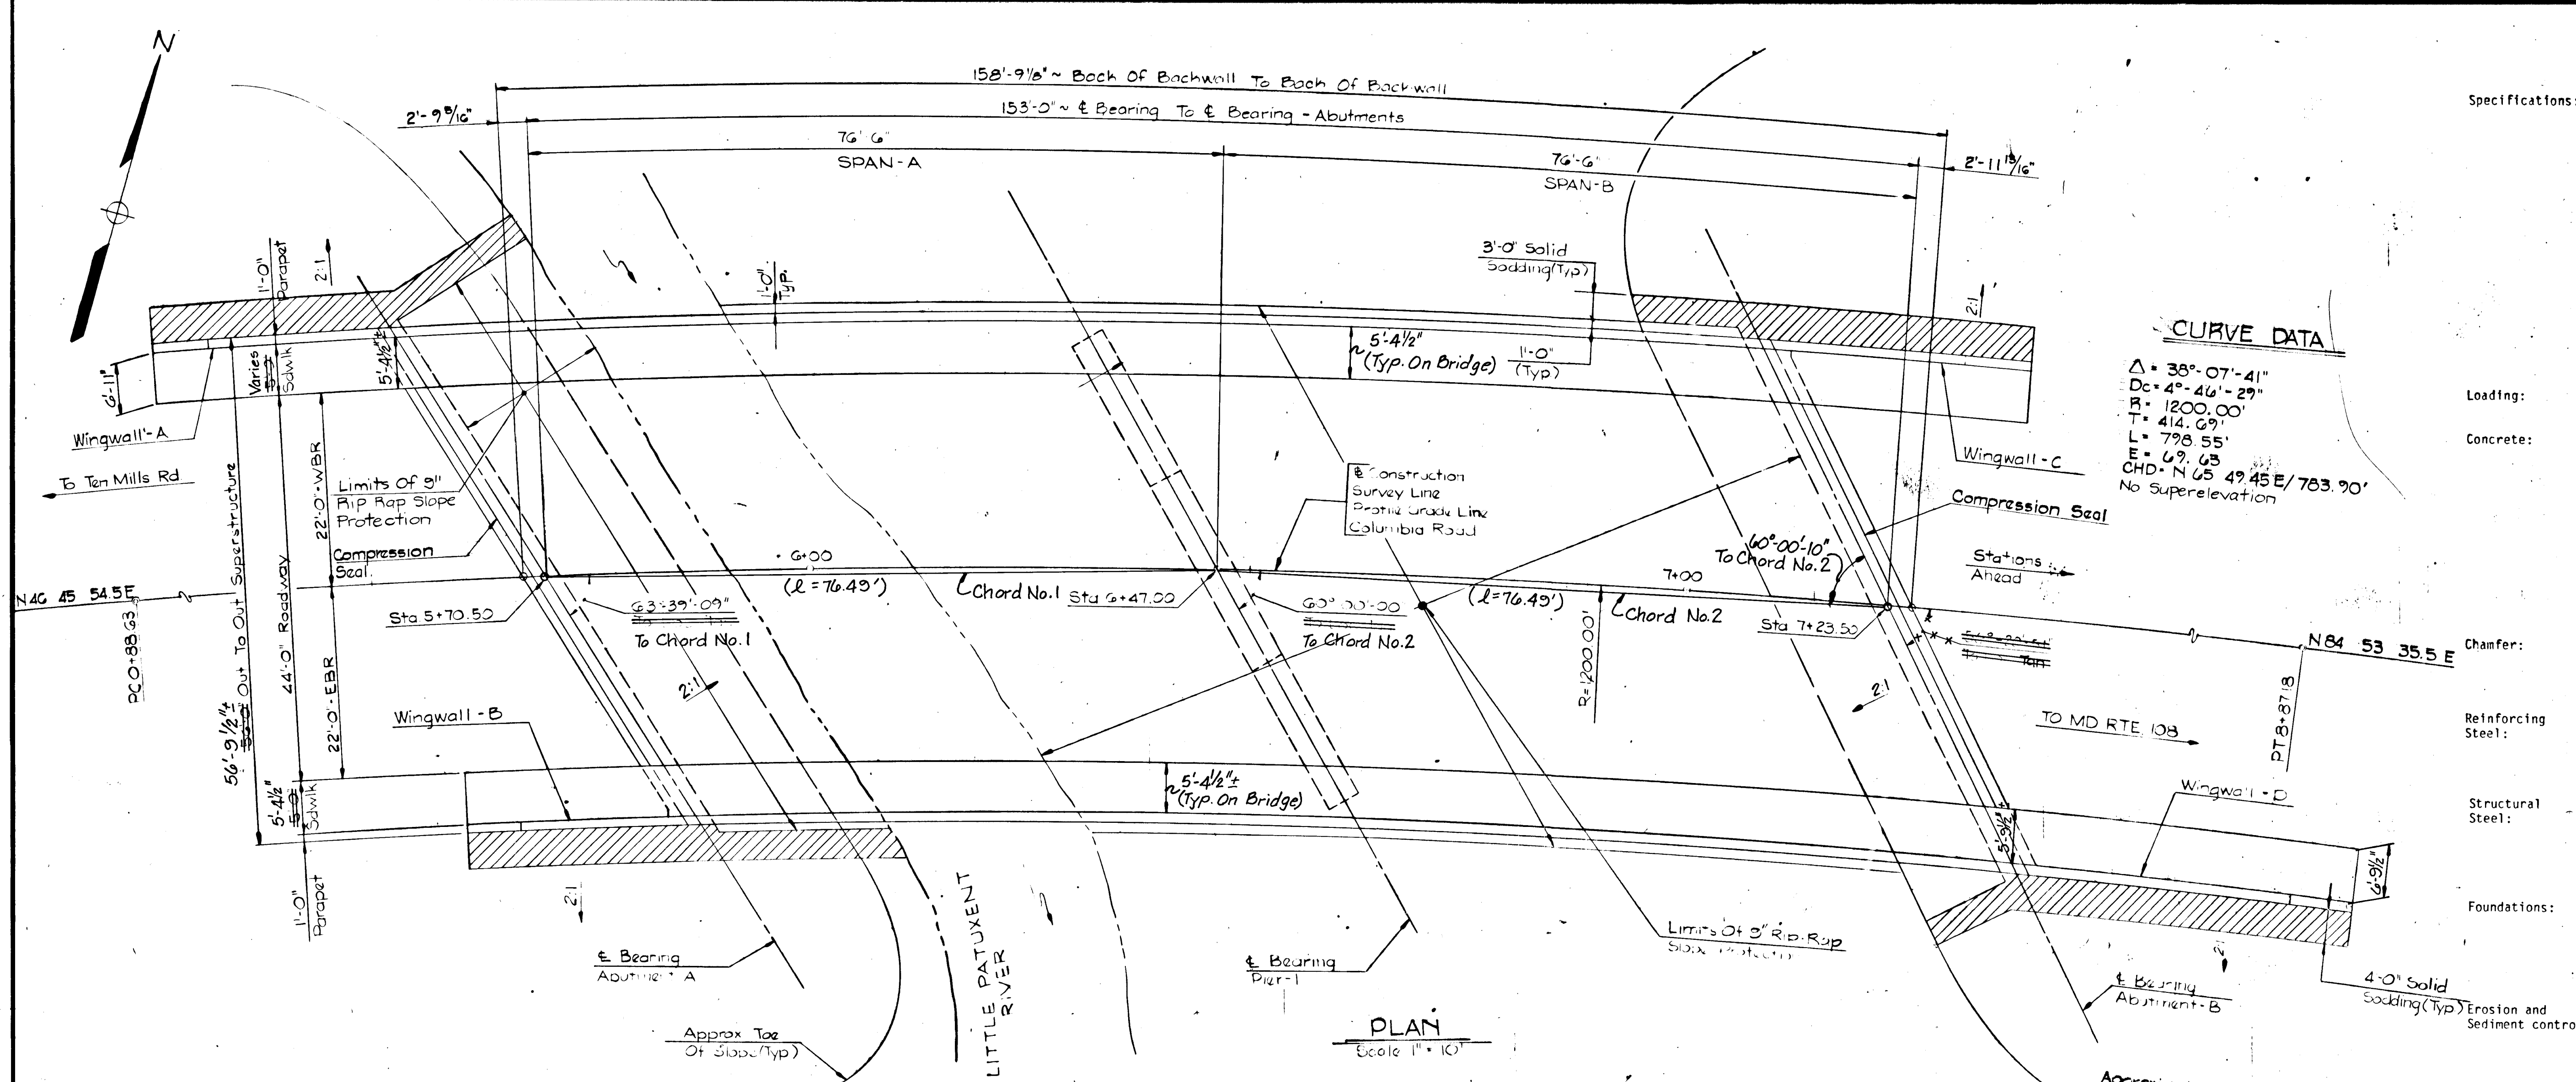


**CURVE DATA**  
 $\Delta = 38^{\circ}07'41''$   
 $Dc = 4^{\circ}46'29''$   
 $R = 1200.00'$   
 $T = 414.69'$   
 $L = 798.55'$   
 $E = 67.65'$   
 $CHD = N 65 49.45 E / 783.90'$   
 No Superelevation

**PLAN**  
 Scale 1" = 10'

**GENERAL NOTES**

- Specifications: Howard County Design Manual, Volume III - Roads and Bridges, Bureau of Engineering, Howard County, Maryland.
- AASHTO Standard Specifications for Highway Bridges dated 1983 for design including all interim specifications.
- Maryland Department of Transportation, State Highway Administration, Standard Specifications for Construction Materials dated January 1982, revisions thereof and additions thereto and Special Provisions for materials and Construction.
- Concrete Design: Service Load Design Method except for pier column which is Load Factor Method.
- Structural Steel Design: Elastic Design Method, main girders shall be designed as composite in positive moment regions only.
- Loading: HS 20-44 with provisions for 2" future wearing surface (25 psf) and permanent bridge deck forms (15 psf).
- Concrete: All superstructure concrete including parapets, abutment backwalls and parapet portion of wingwalls shall be Mix No. 6 (4500 psi). Slab concrete shall be low slump concrete. All other concrete shall be Mix No. 3 (3500 psi) and shall be air entrained except for footing concrete which shall not be air entrained. See Special Provisions.
- Allowable concrete working stresses shall be as follows:  
 $f'_c = 3500$        $f_c = 1:00$  psi  
 $f'_c = 4500$  except bridge deck concrete       $f_c = 1800$  psi  
 $f'_c = 4500$  bridge deck concrete       $f_c = 1050$  psi
- Chamfer: All exposed corners of concrete shall be chamfered with 3/4" x 3/4" milled chamfer strips, except on unexposed footings or where indicated by the following notation on the Plans "Do Not Chamfer."
- Reinforcing Steel: Reinforcing Steel shall conform to ASTM A-615 Grade 60. All splices, not shown, shall be lapped as per bar lap charts. Minimum cover for any bar shall be 2" unless otherwise noted. All Reinforcing Steel for Superstructure including Parapet, Abutments, Backwalls, Bearing Seat Pads, & Parapet Portions of Wingwalls Shall Be Epoxy Coated See Specs.
- Structural Steel: Structural steel shall be ASTM A-588 weathering steel except girder bearings. Girder steel shall include the additional requirements for Charpy V-notch testing of AASHTO M 222 for primary load carrying members. Girder bearings shall be ASTM A-36. See Special Provisions.
- Foundations: Design soil bearing capacity 12 tons per square foot to be verified in the field by a qualified geotechnical engineer.
- Erosion and Sediment control: For Erosion and Sediment See Sht. Nos. 7 & 8.

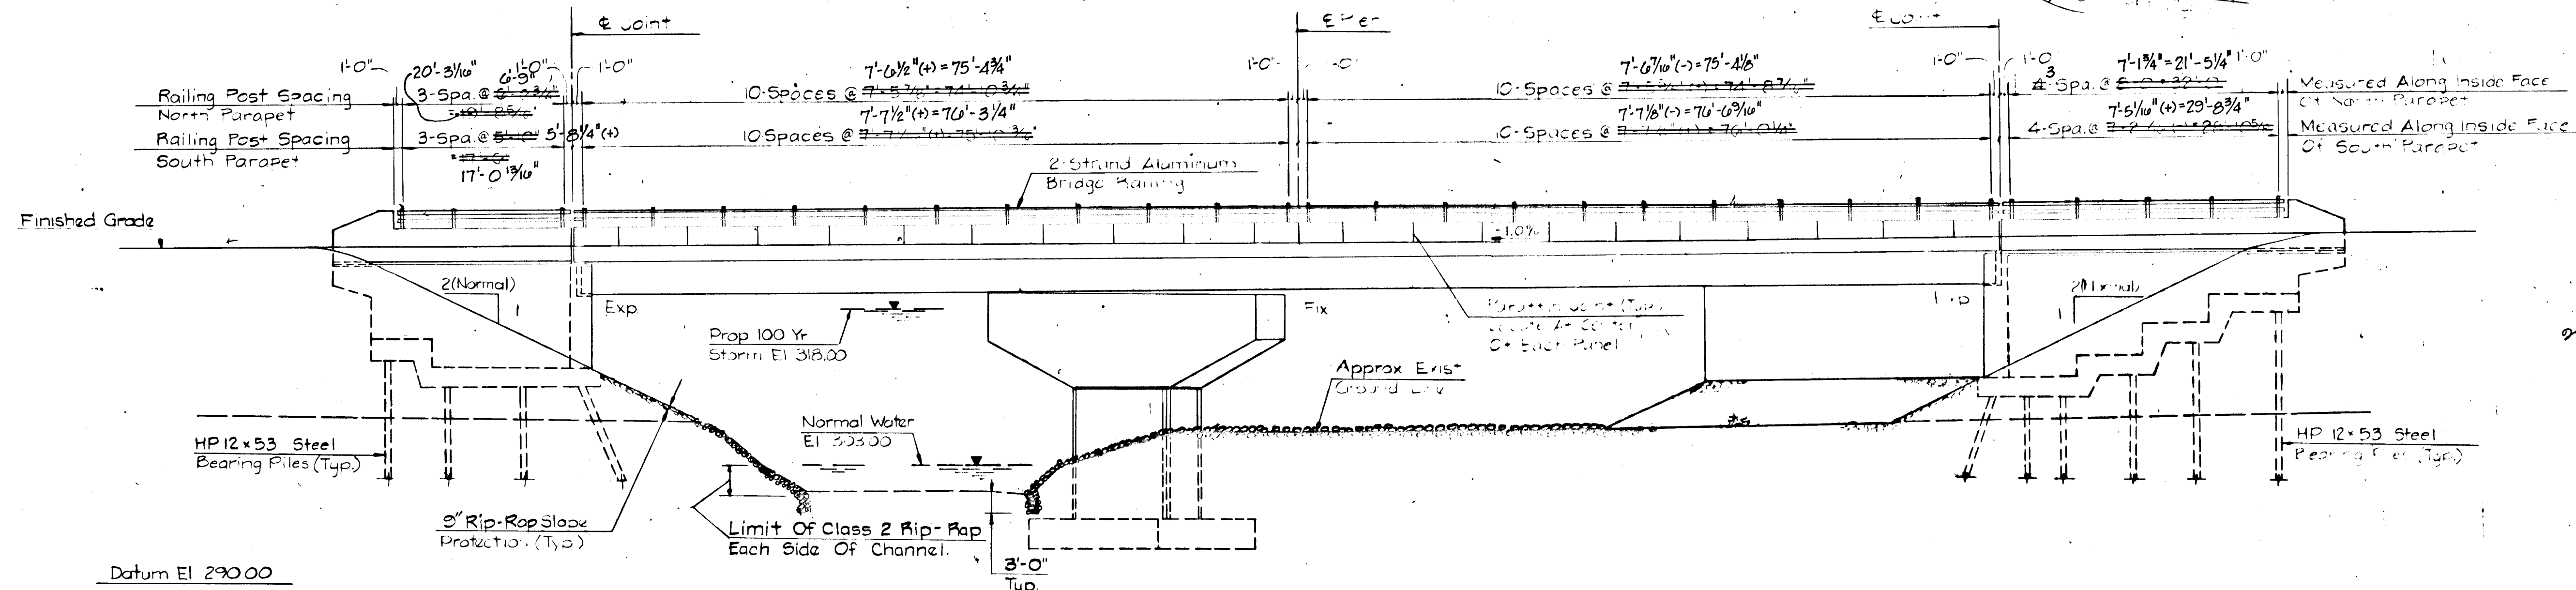

**ELEVATION**  
 Scale 1" = 10'

APPROVED: HOWARD COUNTY OFFICE OF PLANNING & ZONING  
*John M. Minichman* 2-3-86  
 CHIEF, BUREAU OF ENGINEERING

APPROVED:  
 HOWARD COUNTY DEPT. OF PUBLIC WORKS  
*Charles E. ...*  
 CHIEF, BUREAU OF ENGINEERING

**OWNER/DEVELOPER**  
 HOWARD RESEARCH & DEVELOPMENT CORP.  
 10275 LITTLE PATUXENT PARKWAY  
 COLUMBIA, MARYLAND 21044

No.	REVISION	DATE	BY
5	Revisions Due To Stake Out Error	1/5/88	RMJ




ENGINEERS • ARCHITECTS • PLANNERS • SCIENTISTS • SURVEYORS • PHOTOGRAMMETRISTS  
**GREENHORNE & O'MARA, INC.**  
 9001 EDMONSTON ROAD, GREENBELT, MARYLAND 20770  
 (301) 982-2800  
 ANNAPOLIS, MD • ATLANTA, GA • BECKLEY, WV • CULPEPER, VA • DENVER, CO • FAIRFAX, VA  
 GREENSBORO, NC • MONROE, MI • EXPORT, PA • ROCKVILLE, MD • WILLISTON PARK, NY

**GENERAL PLAN AND ELEVATION**  
**COLUMBIA**  
 VILLAGE OF DORSEY'S SEARCH  
 SECTION 3, AREA 1, PHASE 191  
 TAX MAP 30 ~ PARCELS 124, 224 & 210  
 5TH ELECTION DISTRICT ~ HOWARD COUNTY, MARYLAND


R.O.L. DESIGN	SCALE	1" = 10'
K.A.B. DRAWN		
D.C.C./R.L.P. CHECKED		
DATE	JOB No.	FILE No.

# 1159

F-86-55

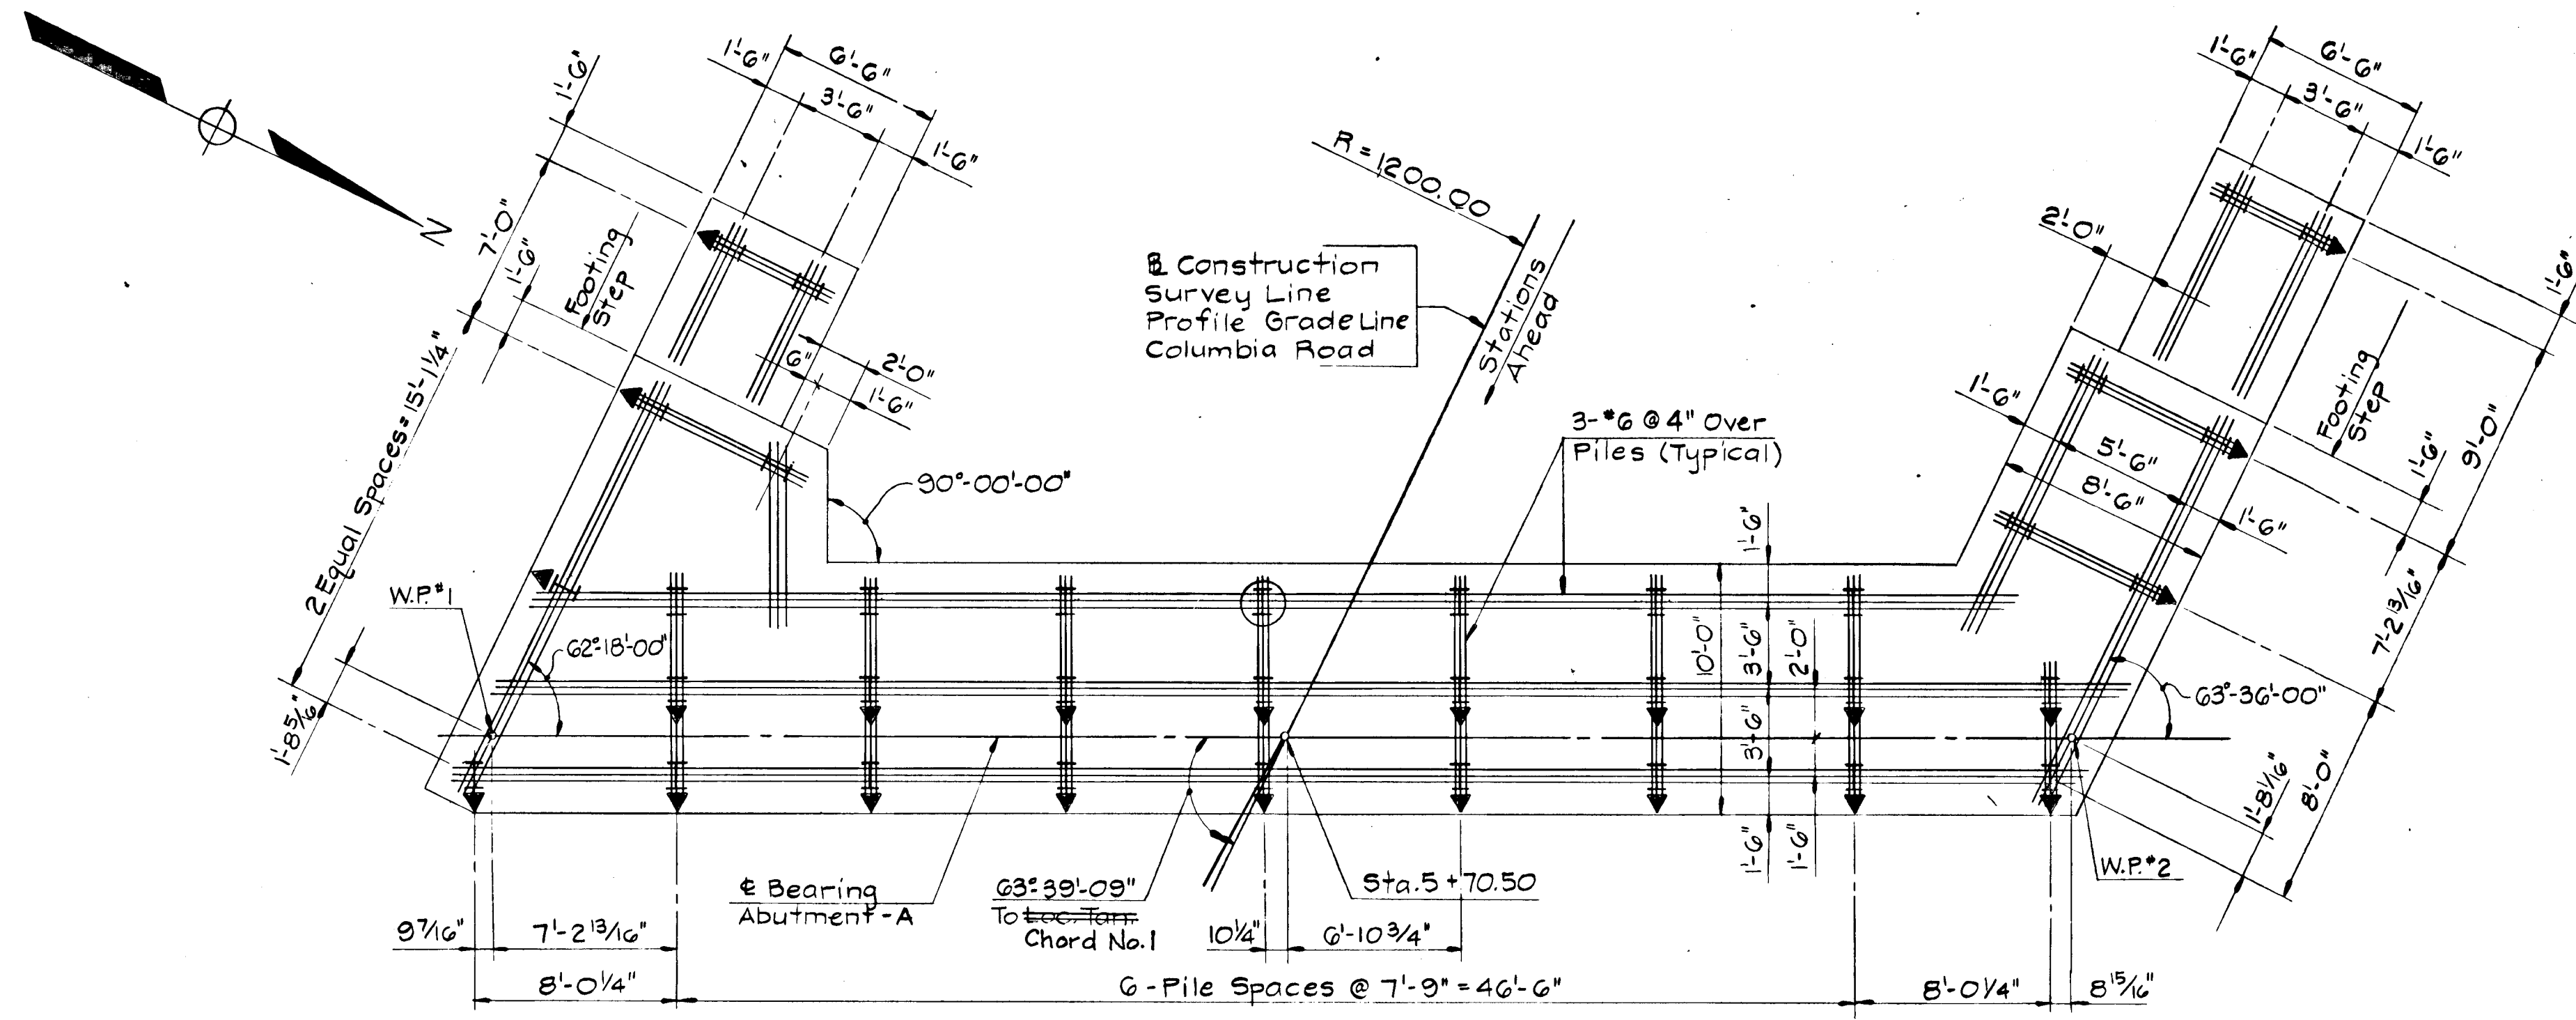

FOUNDATION PLAN  
ABUTMENT - A  
Scale: 3/16" = 1'-0"

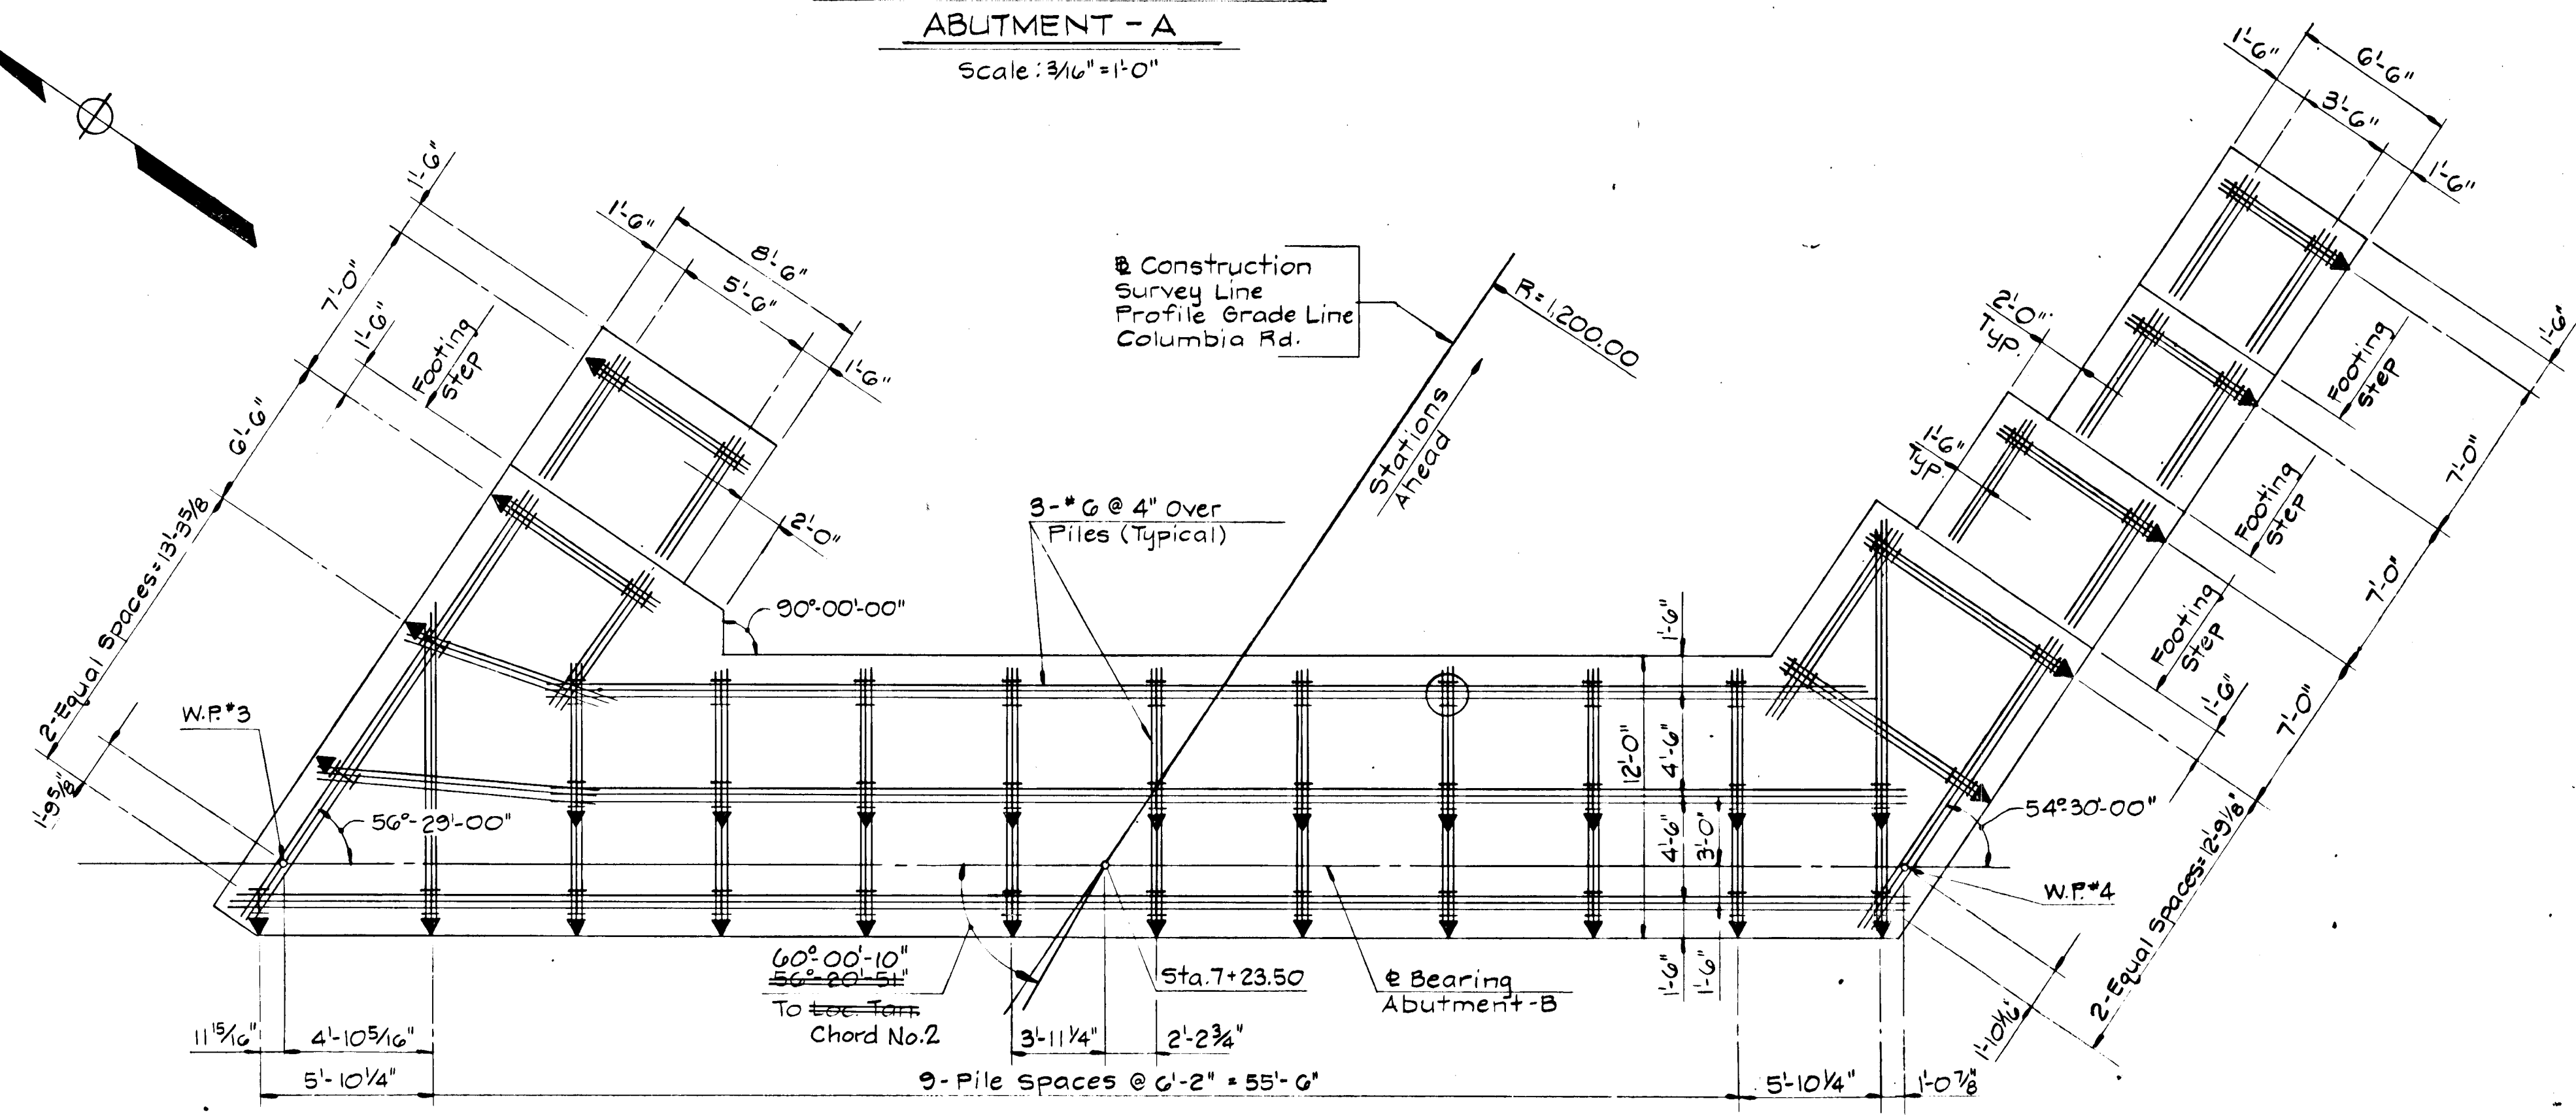

FOUNDATION PLAN  
ABUTMENT - B  
Scale: 3/16" = 1'-0"

- Legend**
- I Indicates Plumb Pile
  - I Indicates Battered Pile 5:12 in Direction Of Arrows
  - ⊙ Indicates Test Pile
  - WP Indicates Work Points

- Notes:**
1. All Piles Shall Be HP12x53 Bearing Piles.
  2. The Pile Design Bearing Value Is 70 Tons.
  3. The Minimum Safe Bearing Value To Which The HP12x53 Piling Is To Be Driven Is 85 Tons.
  4. The Minimum Penetration Of The HP12x53 Piling Shall Be El. 292.00 For Abut. -A And El. 295.00 For Abut. -B.
  5. The Estimated Tip Elevation For The HP12x53 Piling Is El. 287.00 For Abut. -A And El. 292.00 For Abut. -B.
  6. Shop Plans Shall Show How Rebars Are To Be Tied As Well As How They Are To Be Held In Place Above Piling While Concrete Is Poured.

APPROVED: HOWARD COUNTY OFFICE OF PLANNING & ZONING  
*John M. ...* 2-3-86  
 CHIEF, DIV. OF LAND DEVELOPMENT & ZONING ADMIN. DATE

APPROVED:  
 HOWARD COUNTY DEPT. OF PUBLIC WORKS  
*...* 2-28-86  
 CHIEF, BUREAU OF ENGINEERING DATE



Bridge No #HO-137

**OWNER/DEVELOPER**  
 HOWARD RESEARCH & DEVELOPMENT CORP.  
 10275 LITTLE PATUXENT PARKWAY  
 COLUMBIA, MARYLAND 21044

No.	REVISION	DATE	BY
5	Revisions Due To Stake Out Error	1/5/88	RMJ



ENGINEERS • ARCHITECTS • PLANNERS • SCIENTISTS • SURVEYORS • PHOTOGRAMMETRISTS  
**GREENHORNE & O'MARA, INC.**  
 9001 EDMONSTON ROAD, GREENBELT, MARYLAND 20770  
 (301) 982-2800  
 ANNAPOLIS, MD • ATLANTA, GA • BECKLEY, WV • CULPEPER, VA • DENVER, CO • EXPORT, PA • FAIRFAX, VA  
 GREENSBORO, NC • MONROE, MI • RALEIGH, NC • ROCKVILLE, MD • TAMPA, FL • WILLISTON PARK, NY

FOUNDATION PLAN ~ ABUTMENTS A & B  
**COLUMBIA**  
 VILLAGE OF DORSEY'S SEARCH  
 SECTION 3, AREA 1, PHASE 191  
 TAX MAP 30 ~ PARCELS 124, 224 & 210  
 5TH ELECTION DISTRICT ~ HOWARD COUNTY, MARYLAND

RJL DESIGN	SCALE 3/16" = 1'-0"
RMJ DRAWN	10 OF 24
DCC/RLP CHECKED	SHEET
8/85 DATE	21216X FILE No.


#1159

F-86-55

*John M. Macchiarini* 2-2-86  
CHIEF, DIV. OF LAND DEVELOPMENT & ZONING ADMIN. DATE


APPROVED:  
HOWARD COUNTY DEPT. OF PUBLIC WORKS

*Robert E. Ruff* 2-22-86  
CHIEF, BUREAU OF ENGINEERING DATE

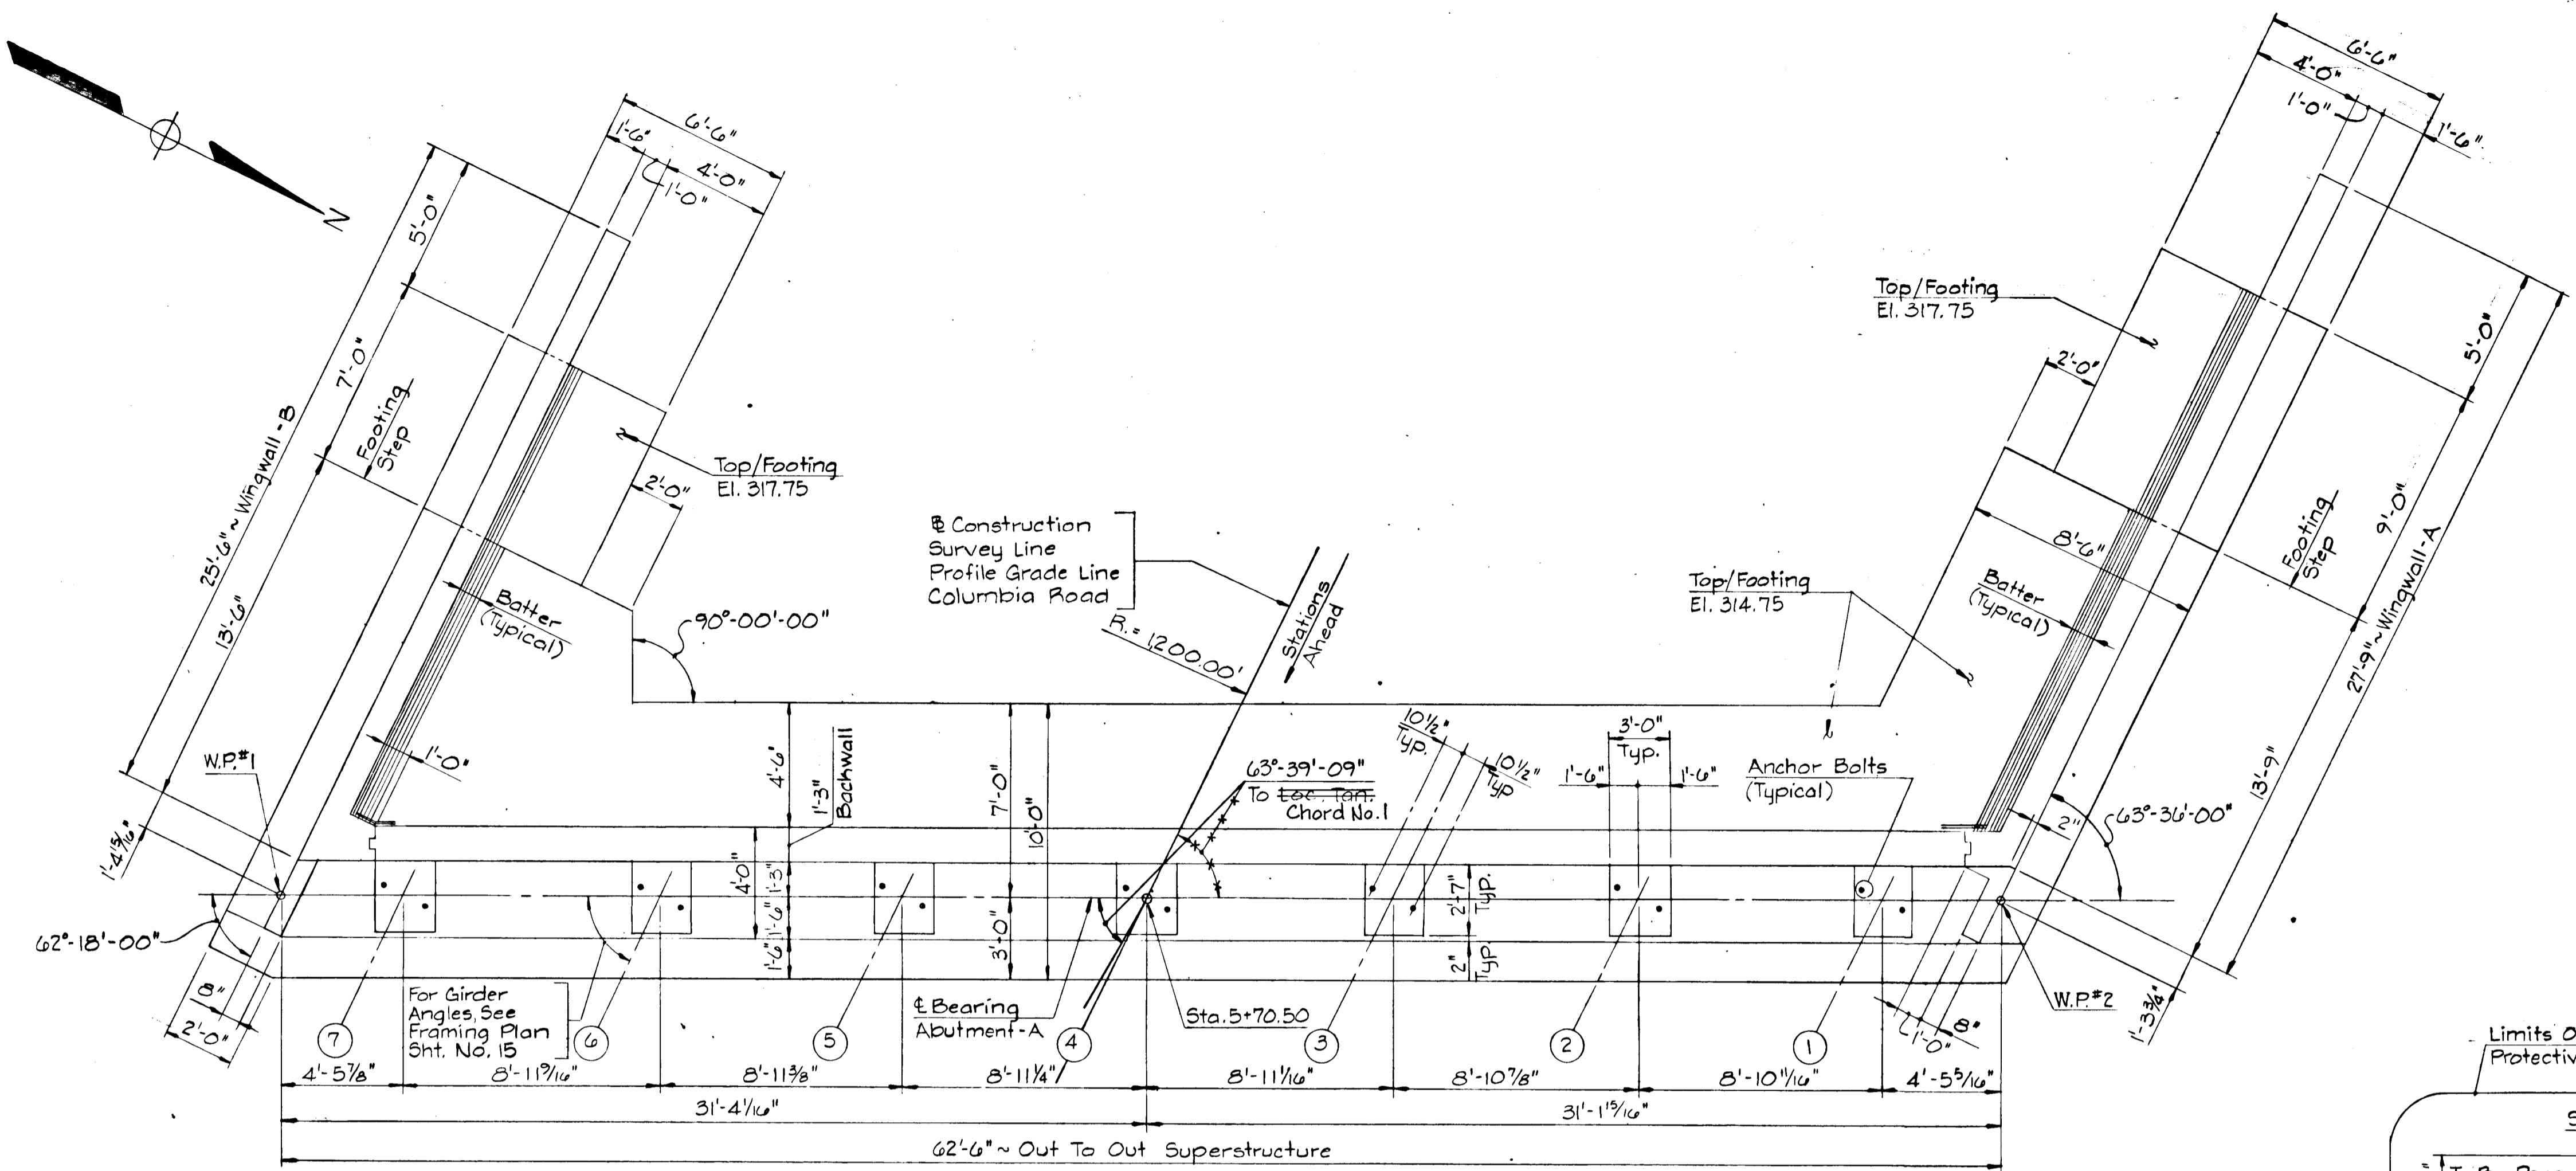


PLAN ~ ABUTMENT-A  
Scale: 1/4" = 1'-0"

Note:  
Sidewalk & Parapet Railing Not  
Shown In Plan For Clarity.

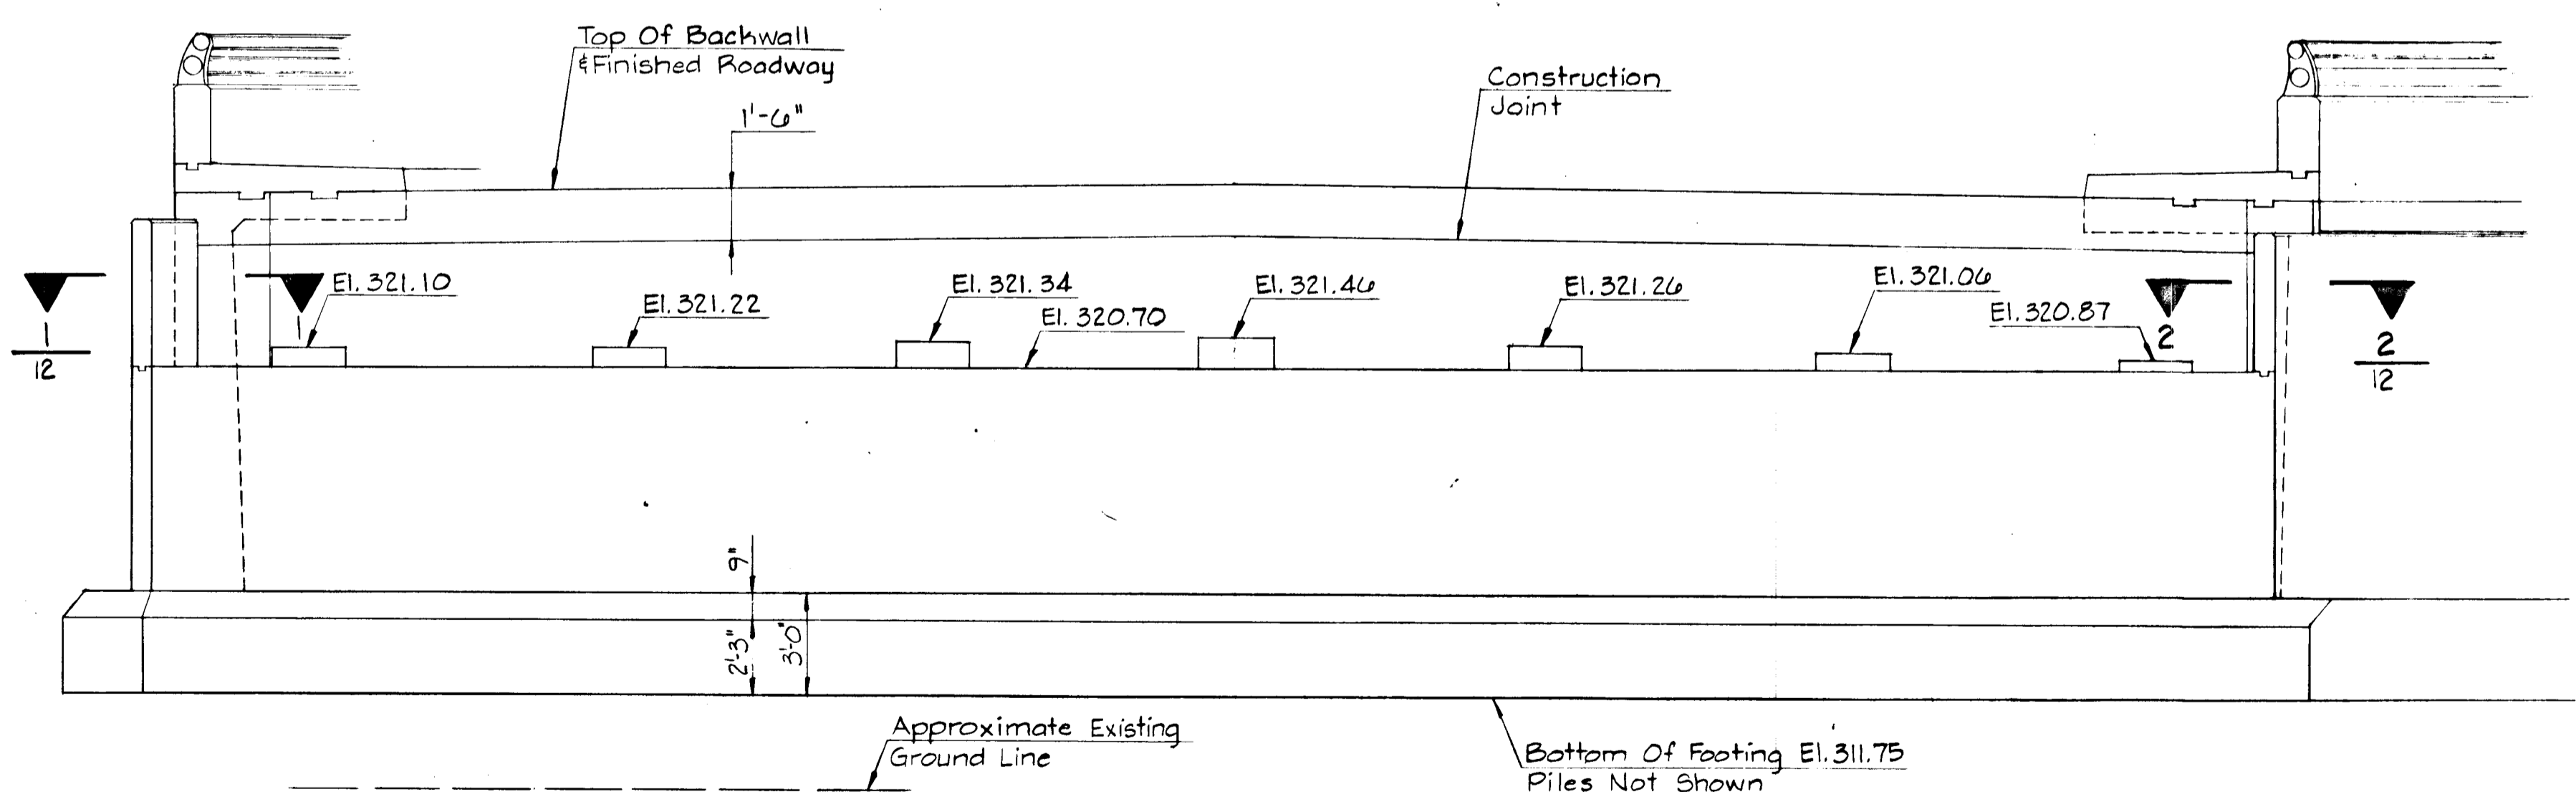


ELEVATION  
Scale: 1/4" = 1'-0"

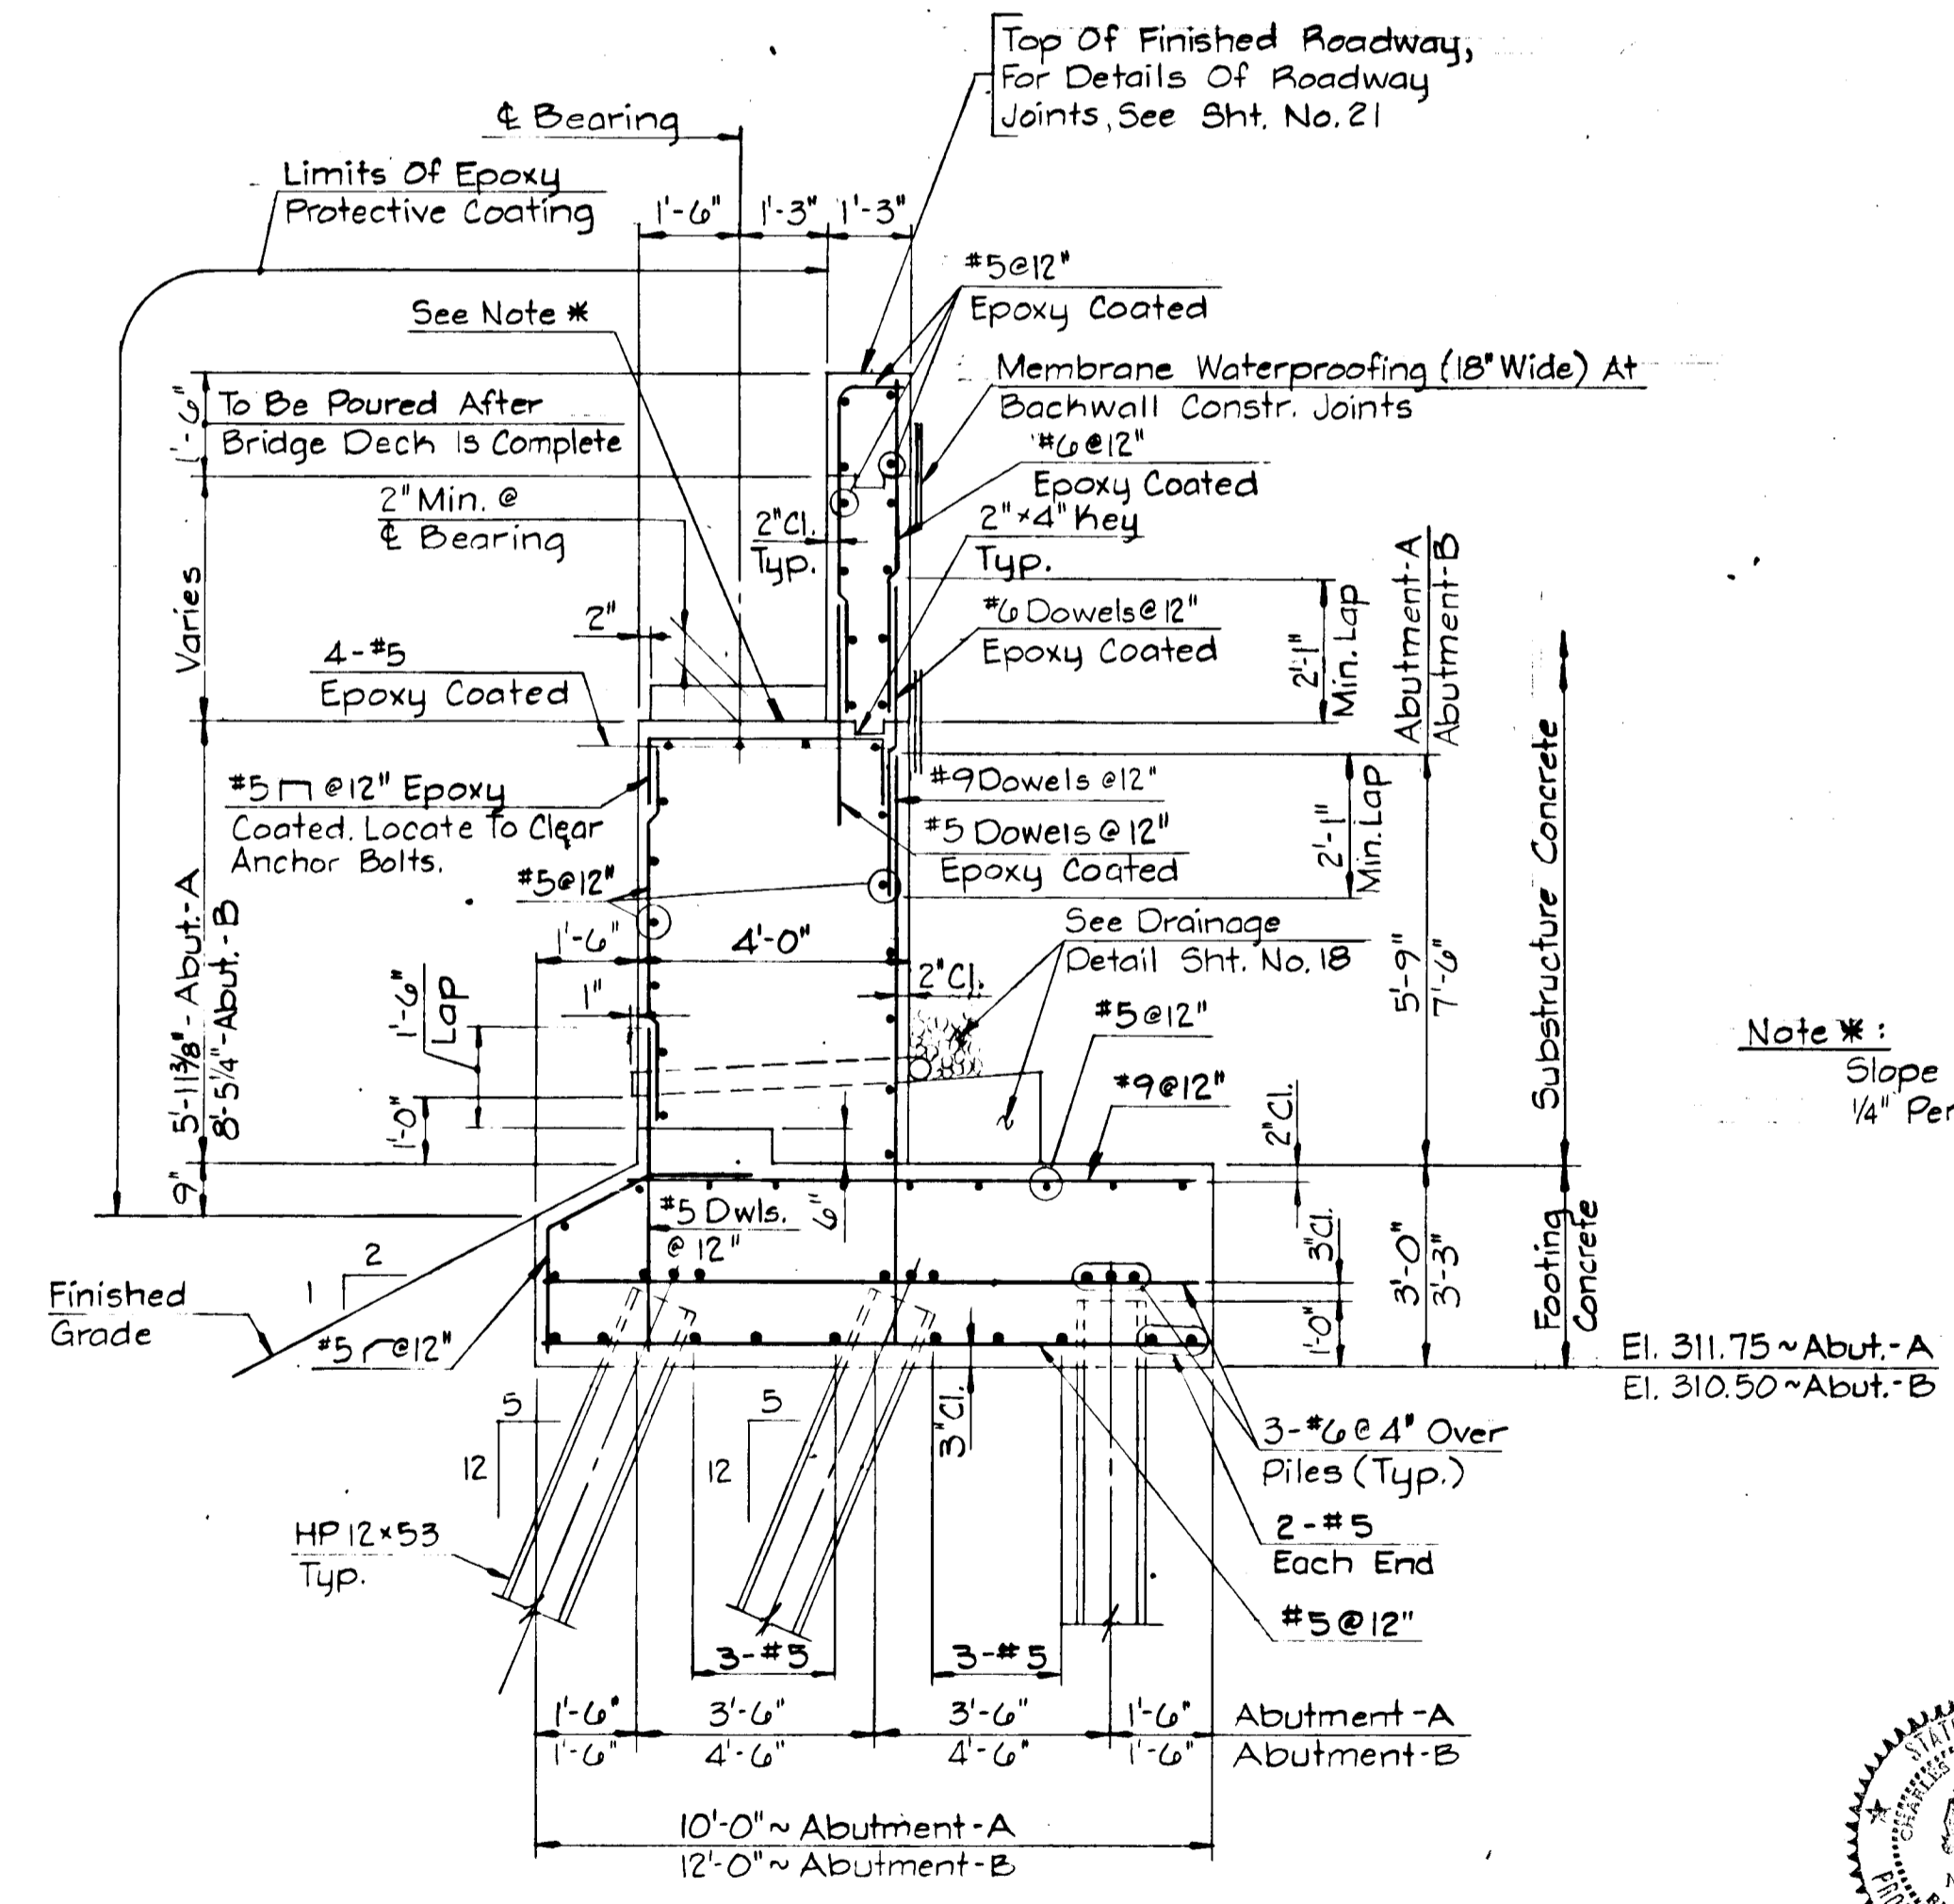

TYPICAL SECTION THRU ABUTMENTS  
Scale: 3/8" = 1'-0"


Note \*:  
Slope Abutment Seat  
1/4" Per Foot Between Pads.

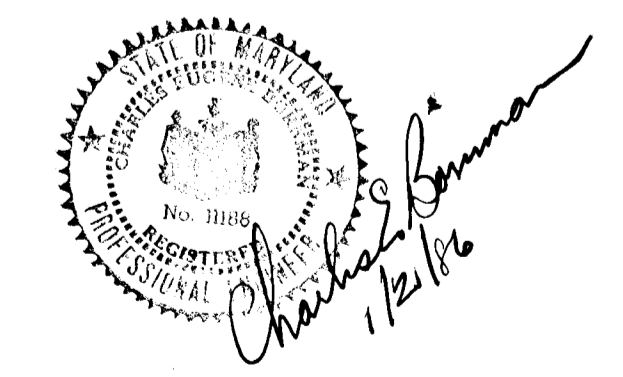

Bridge No. #HO-137

**OWNER/DEVELOPER**  
HOWARD RESEARCH & DEVELOPMENT CORP.  
10275 LITTLE PATUXENT PARKWAY  
COLUMBIA, MARYLAND 21044

No.	REVISION	DATE	BY
5	Revisions Due To Stake Out Error	1/5/88	RMJ

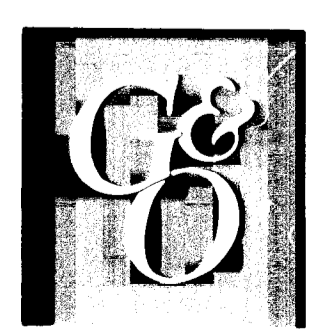


ENGINEERS • ARCHITECTS • PLANNERS • SCIENTISTS • SURVEYORS • PHOTOGRAMMETRISTS  
**GREENHORNE & O'MARA, INC.**  
9001 EDMONSTON ROAD, GREENBELT, MARYLAND 20770  
(301) 982-2800  
ANNAPOLIS, MD • ATLANTA, GA • BECKLEY, WV • CULPEPER, VA • DENVER, CO • EXPORT, PA • FAIRFAX, VA  
GREENSBORO, NC • MONROE, MI • RALEIGH, NC • ROCKVILLE, MD • TAMPA, FL • WILLISTON PARK, NC

**ABUTMENT-A  
COLUMBIA**  
VILLAGE OF DORSEY'S SEARCH  
SECTION 3, AREA 1, PHASE 191  
TAX MAP 30 ~ PARCELS 124, 224 & 210  
5TH ELECTION DISTRICT ~ HOWARD COUNTY, MARYLAND


RJL DESIGN	SCALE As Noted
RMJ DRAWN	11 OF 24
DCC/RLP CHECKED	SHEET
8/85 DATE	JOB No. <i>1216X</i> FILE No.

#1159

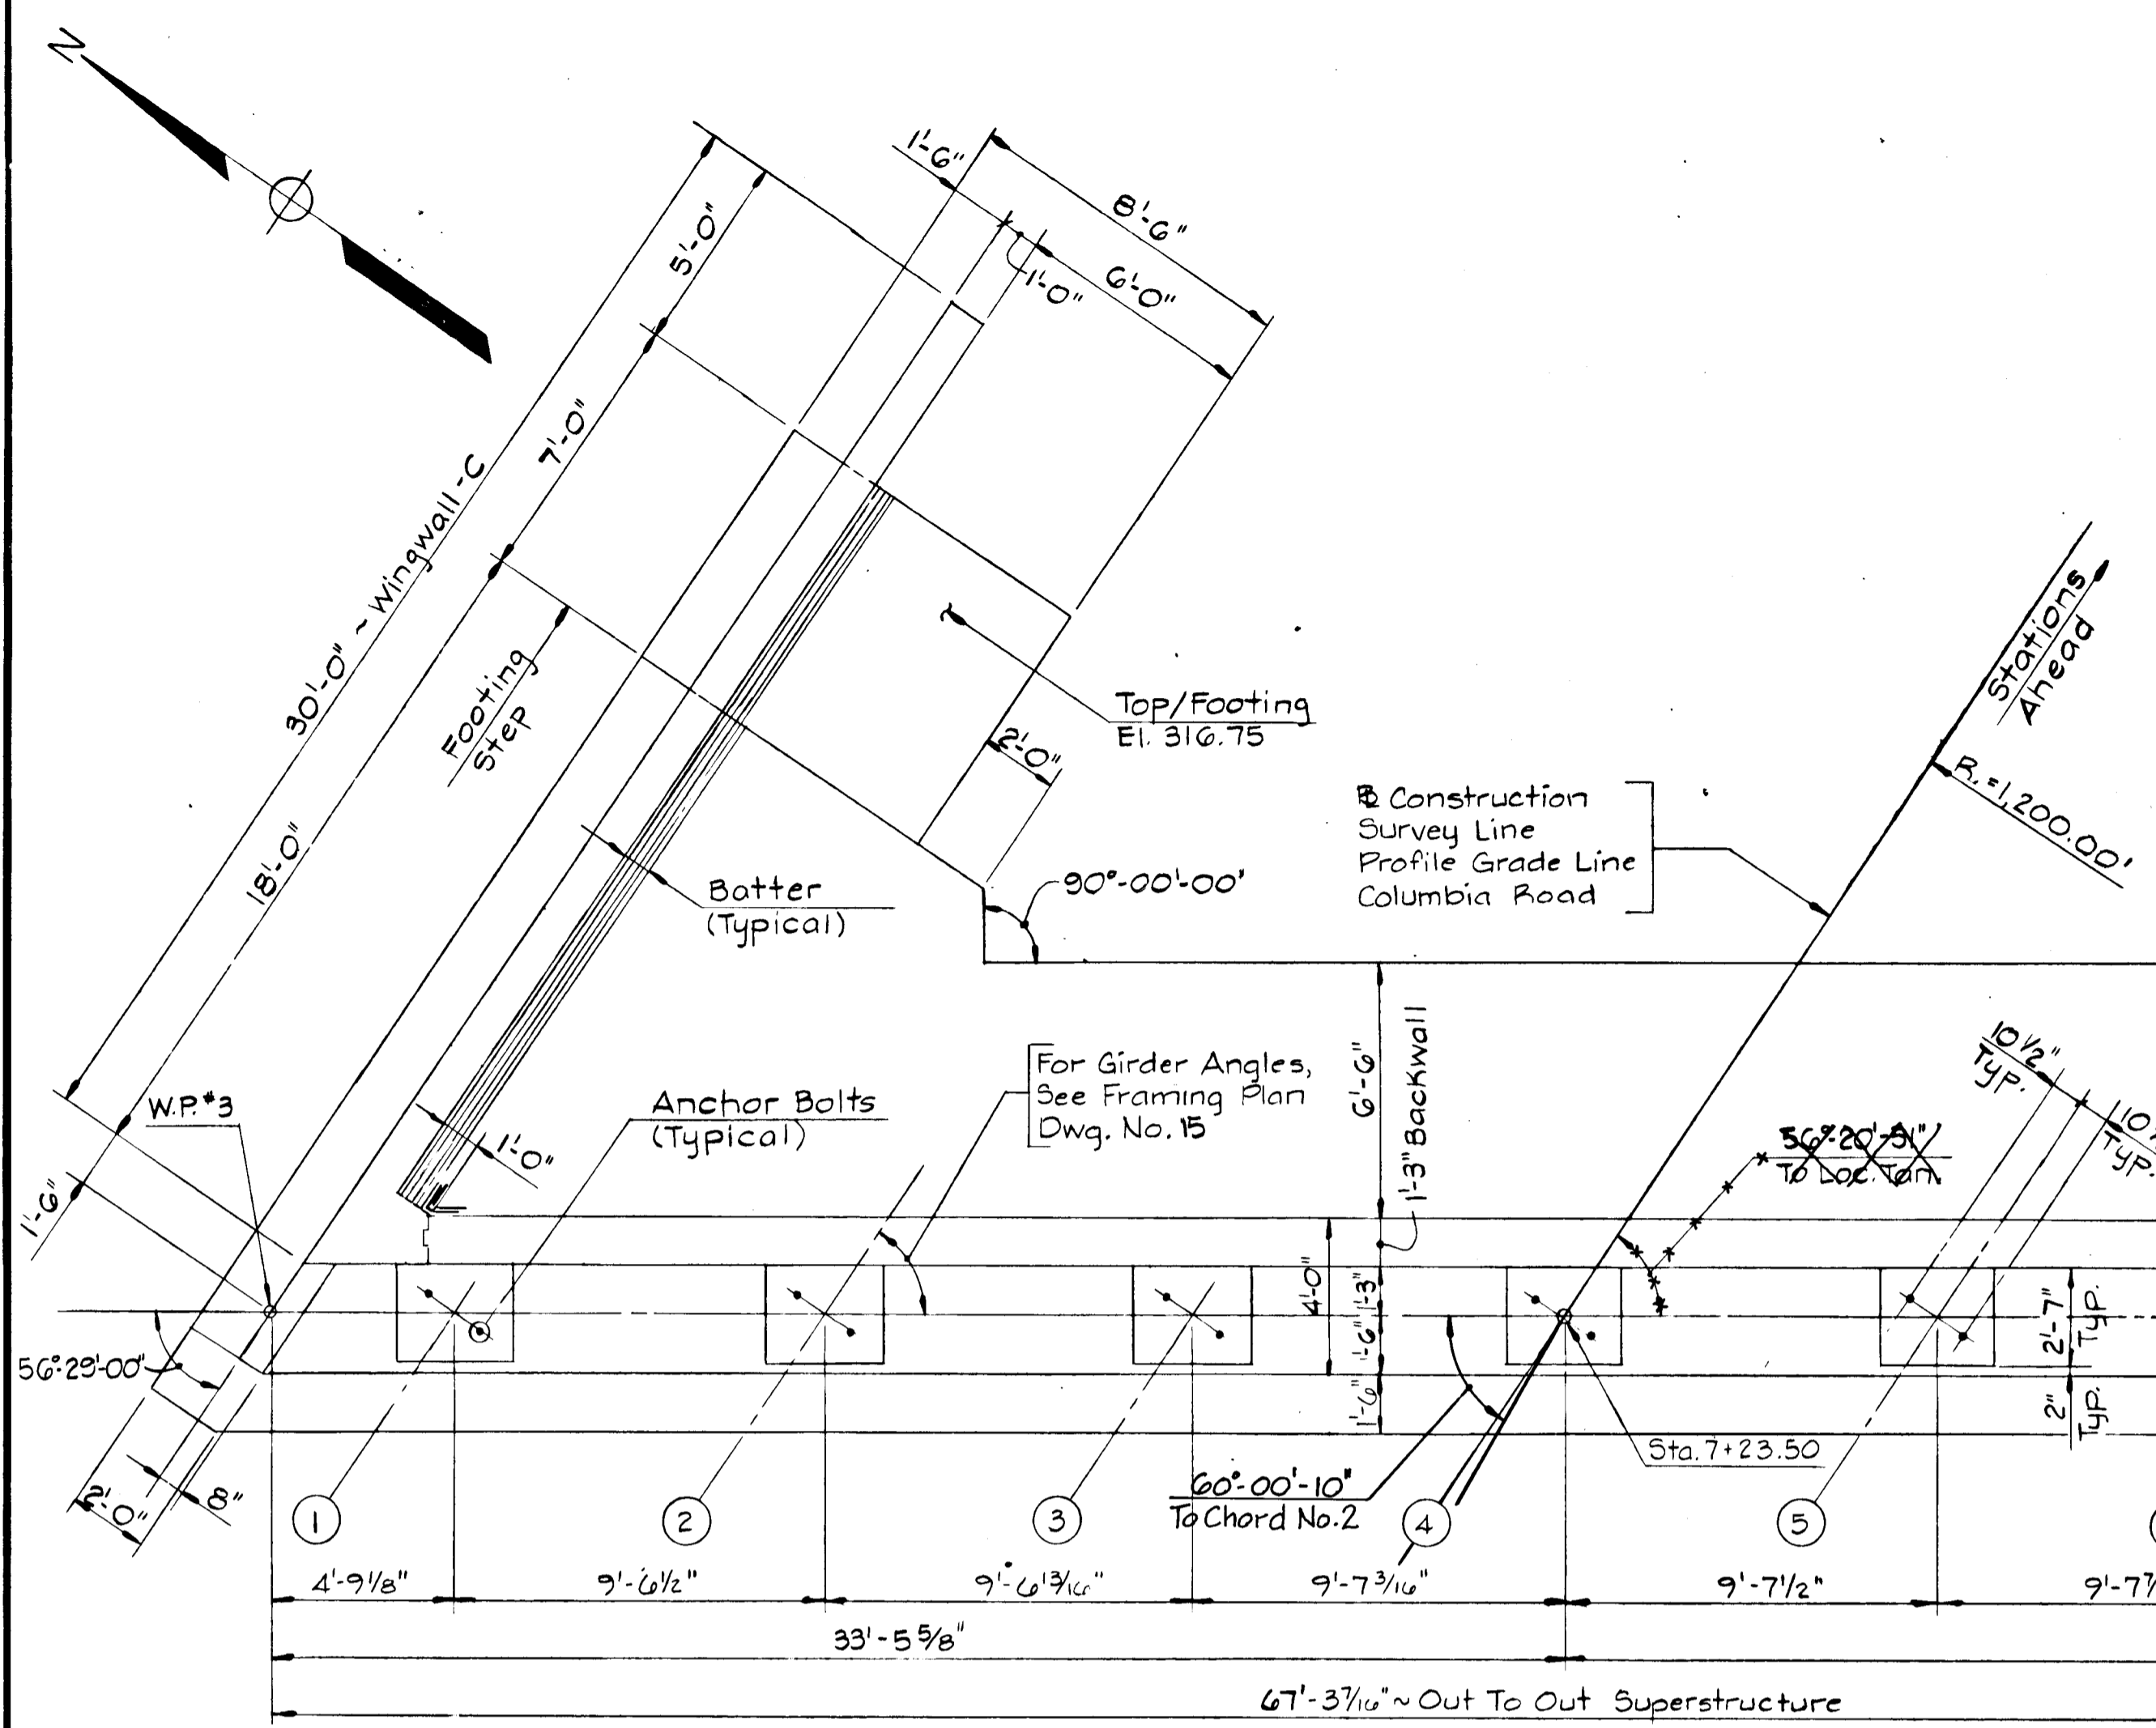


**PLAN ~ ABUTMENT - B**  
Scale: 1/4" = 1'-0"


Note:  
Sidewalk, Parapet & Railing Not Shown In Plan For Clarity

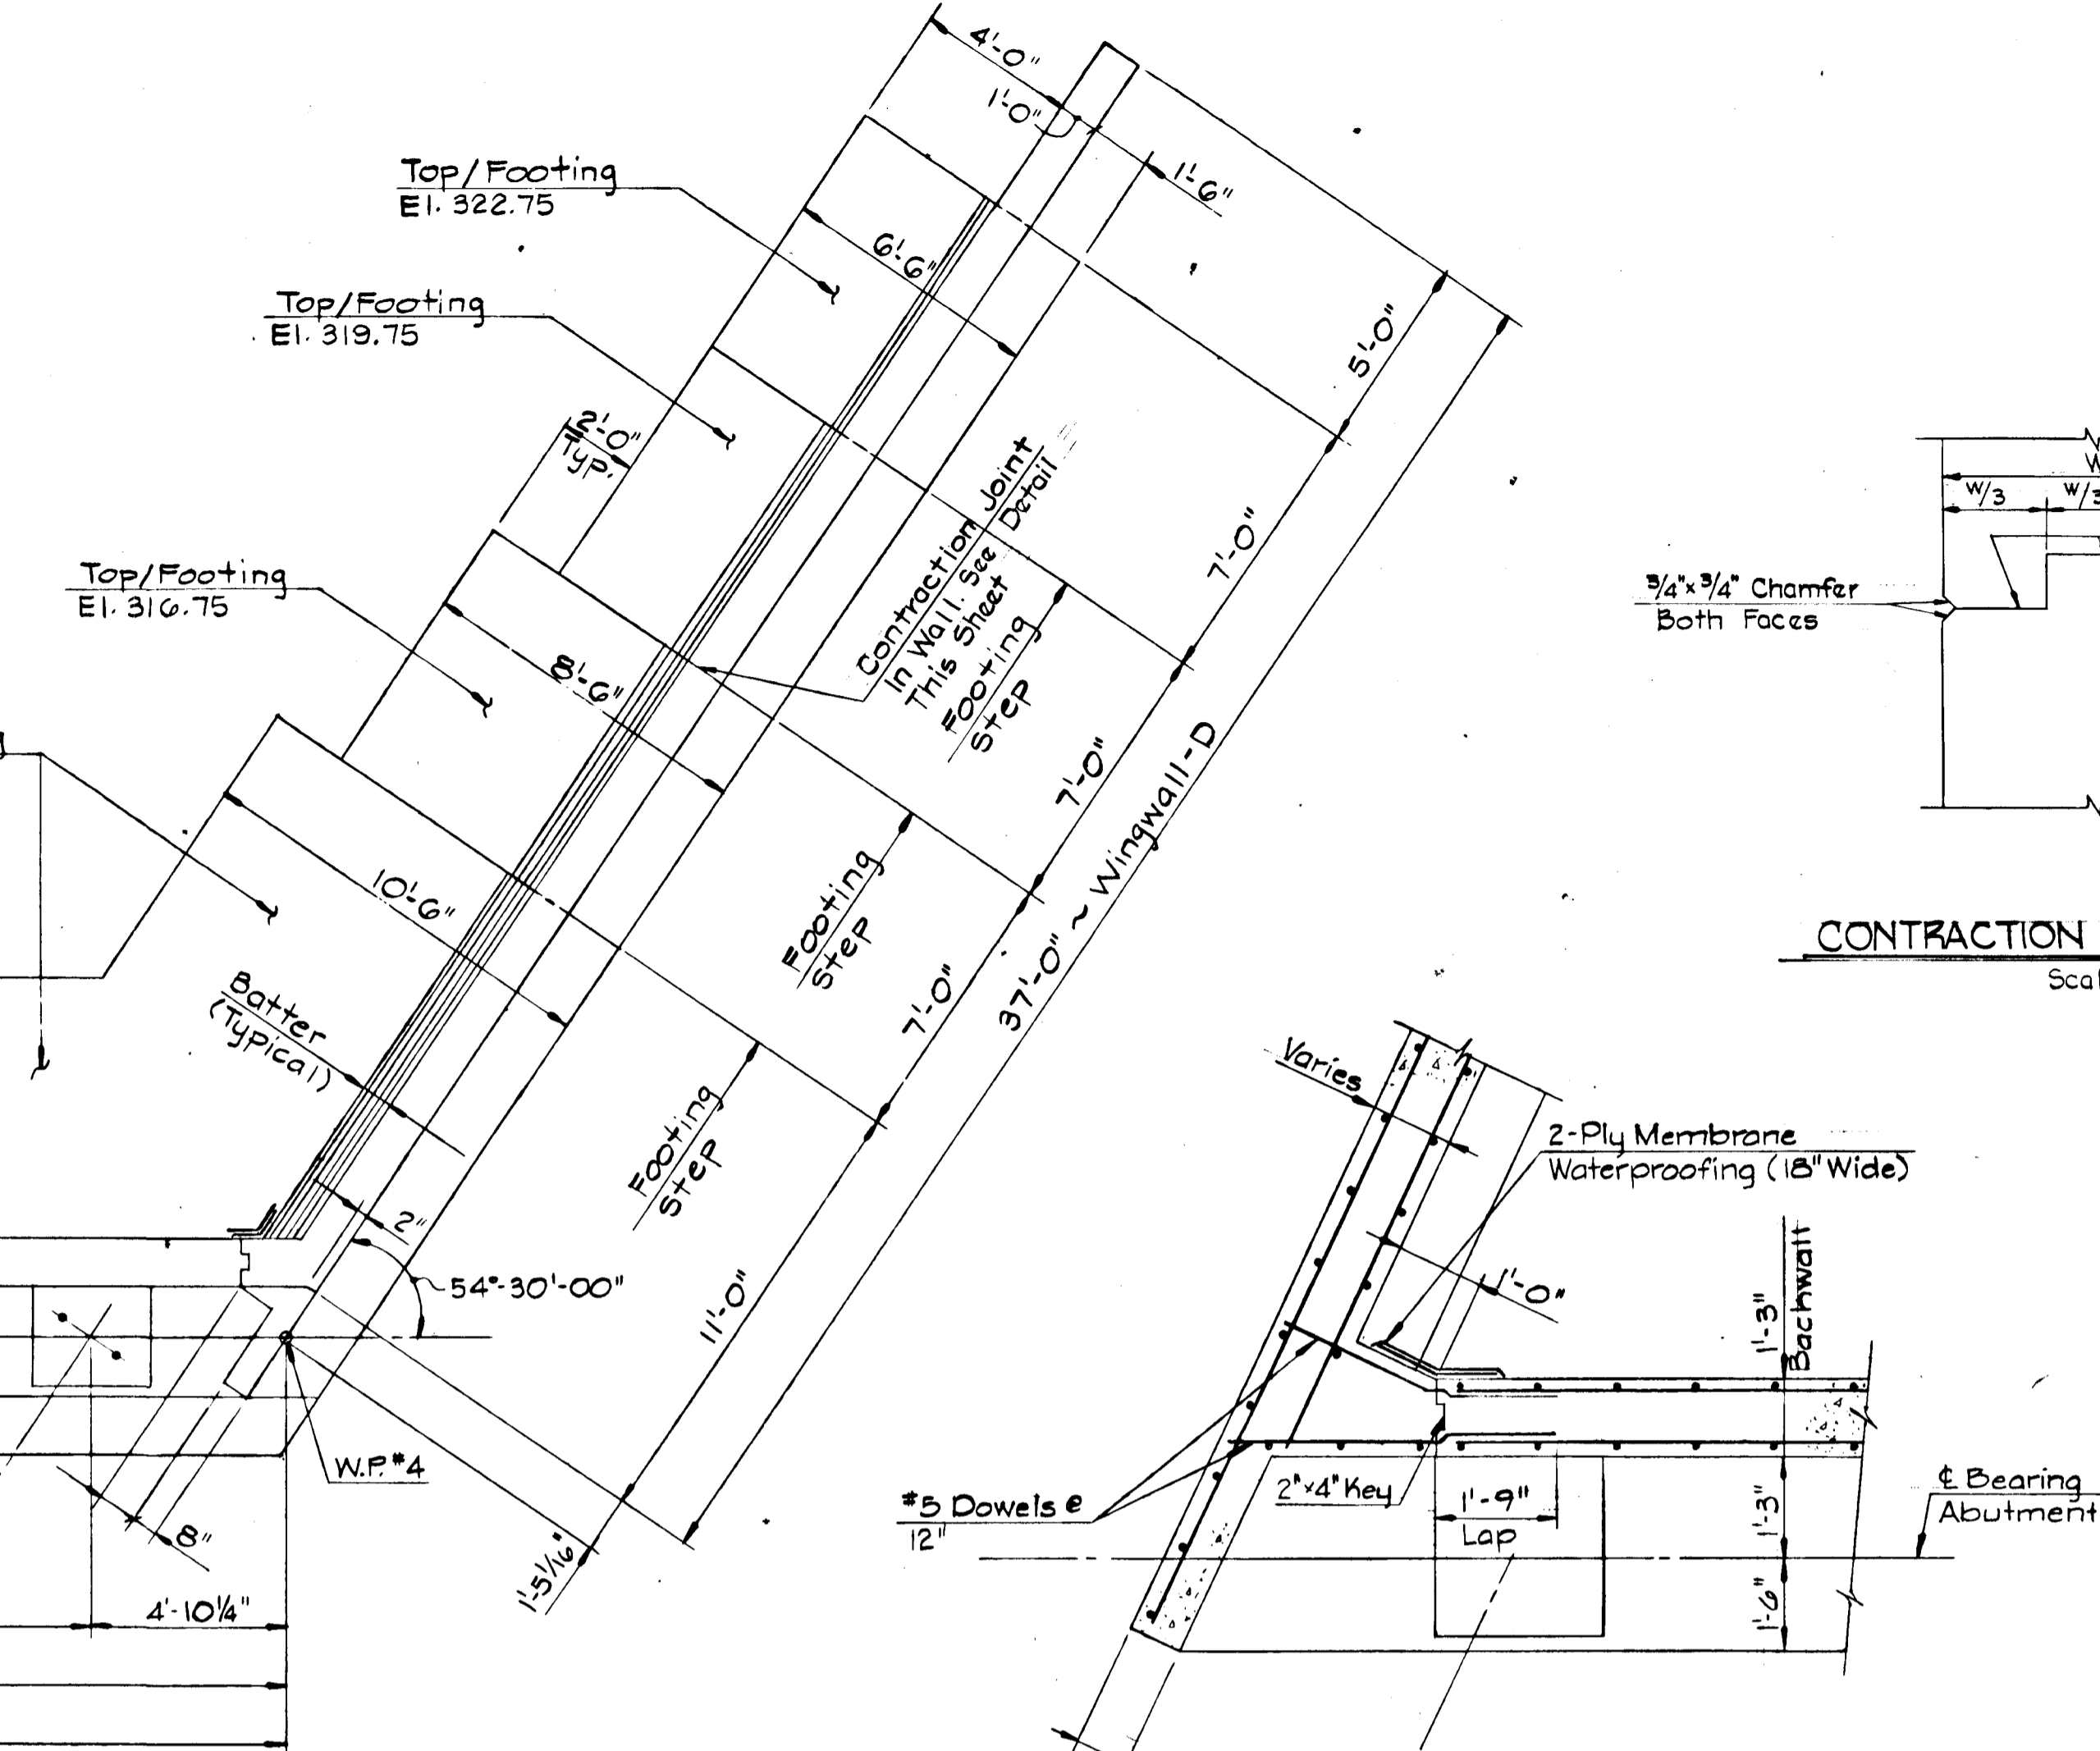


**SECTION 1-1**  
Sheet Nos. 11 & 12  
Scale: 1/2" = 1'-0"

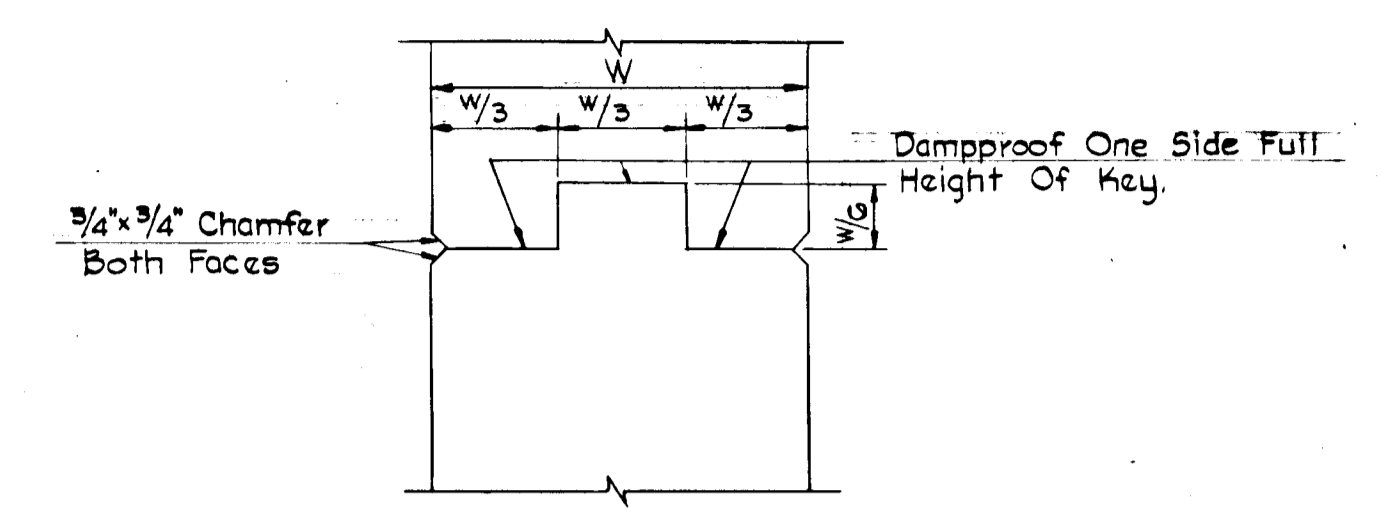

**CONTRACTION JOINT DETAIL**  
Scale: 1/2" = 1'-0"

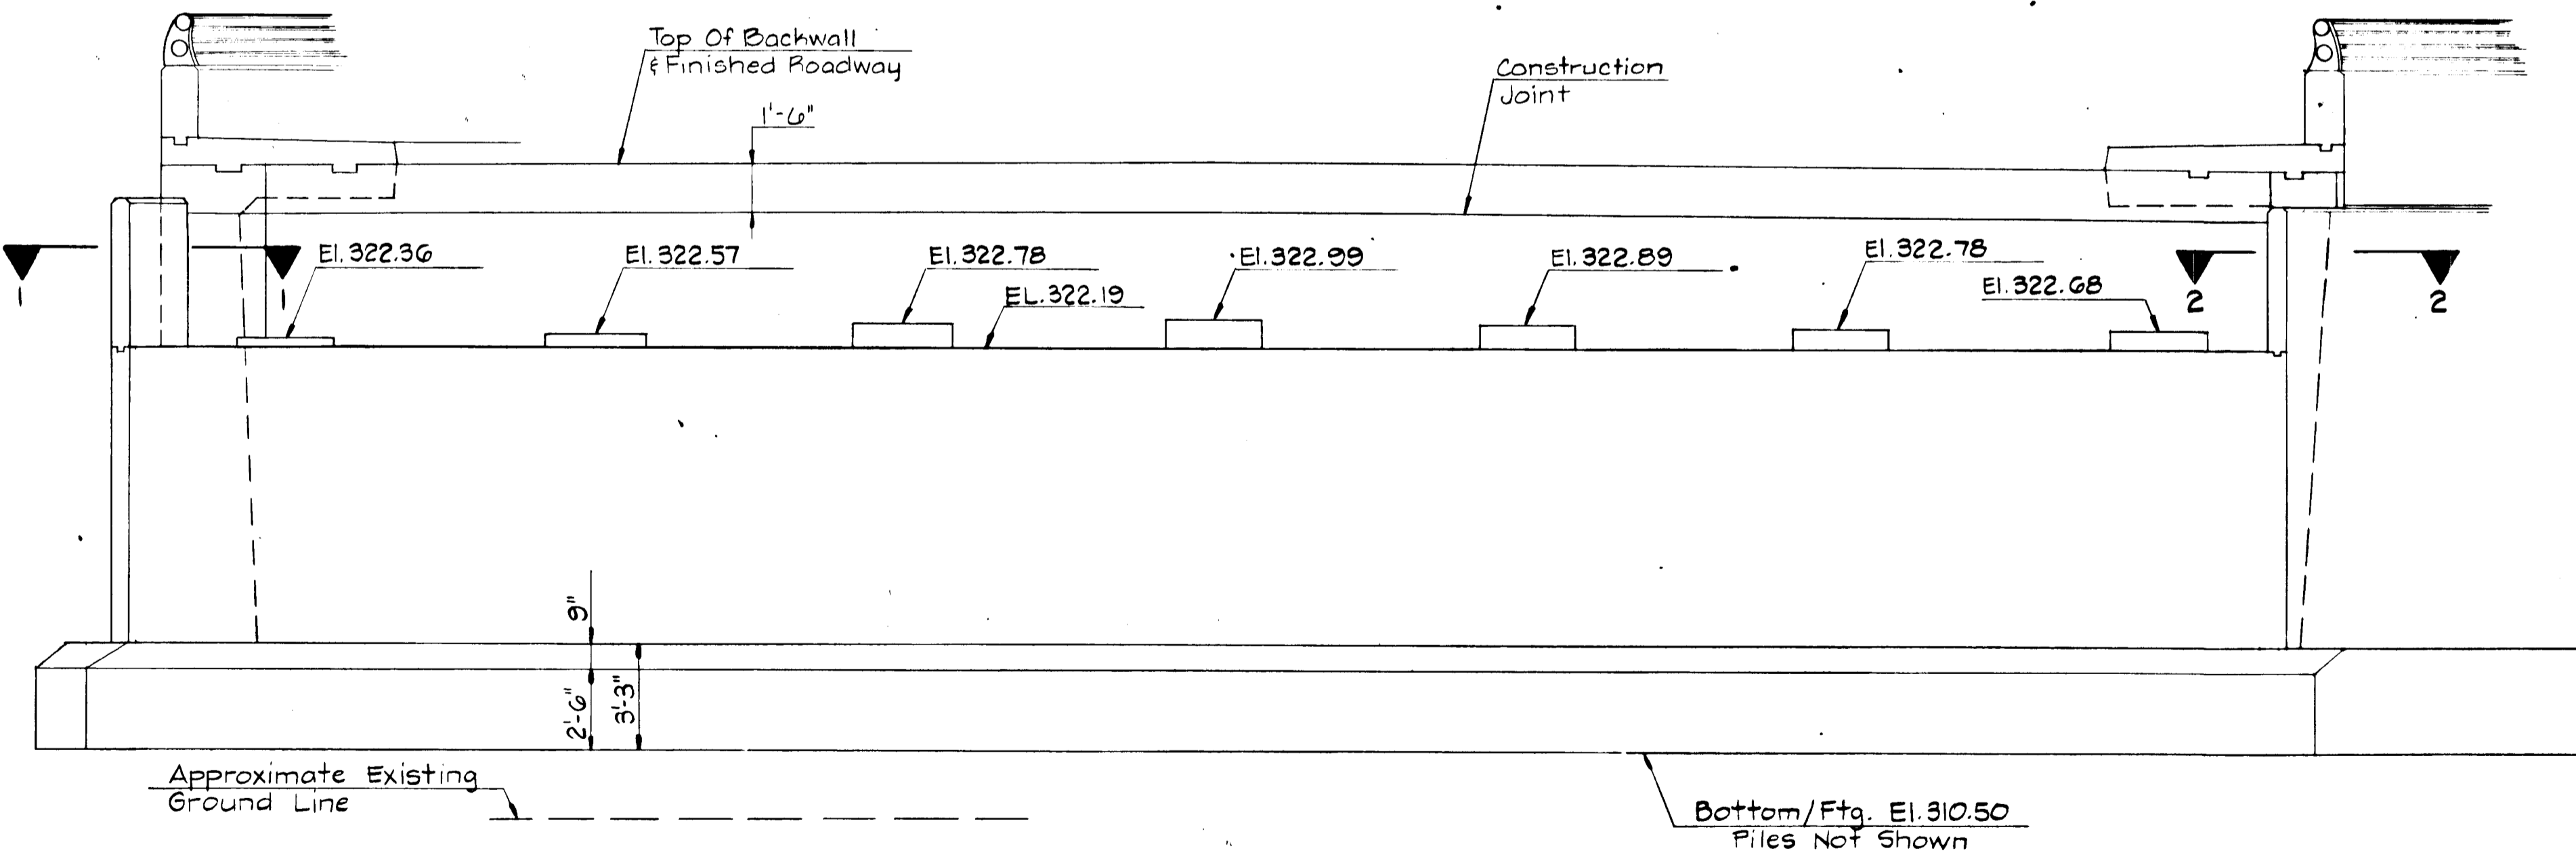

**ELEVATION**  
Scale: 1/4" = 1'-0"

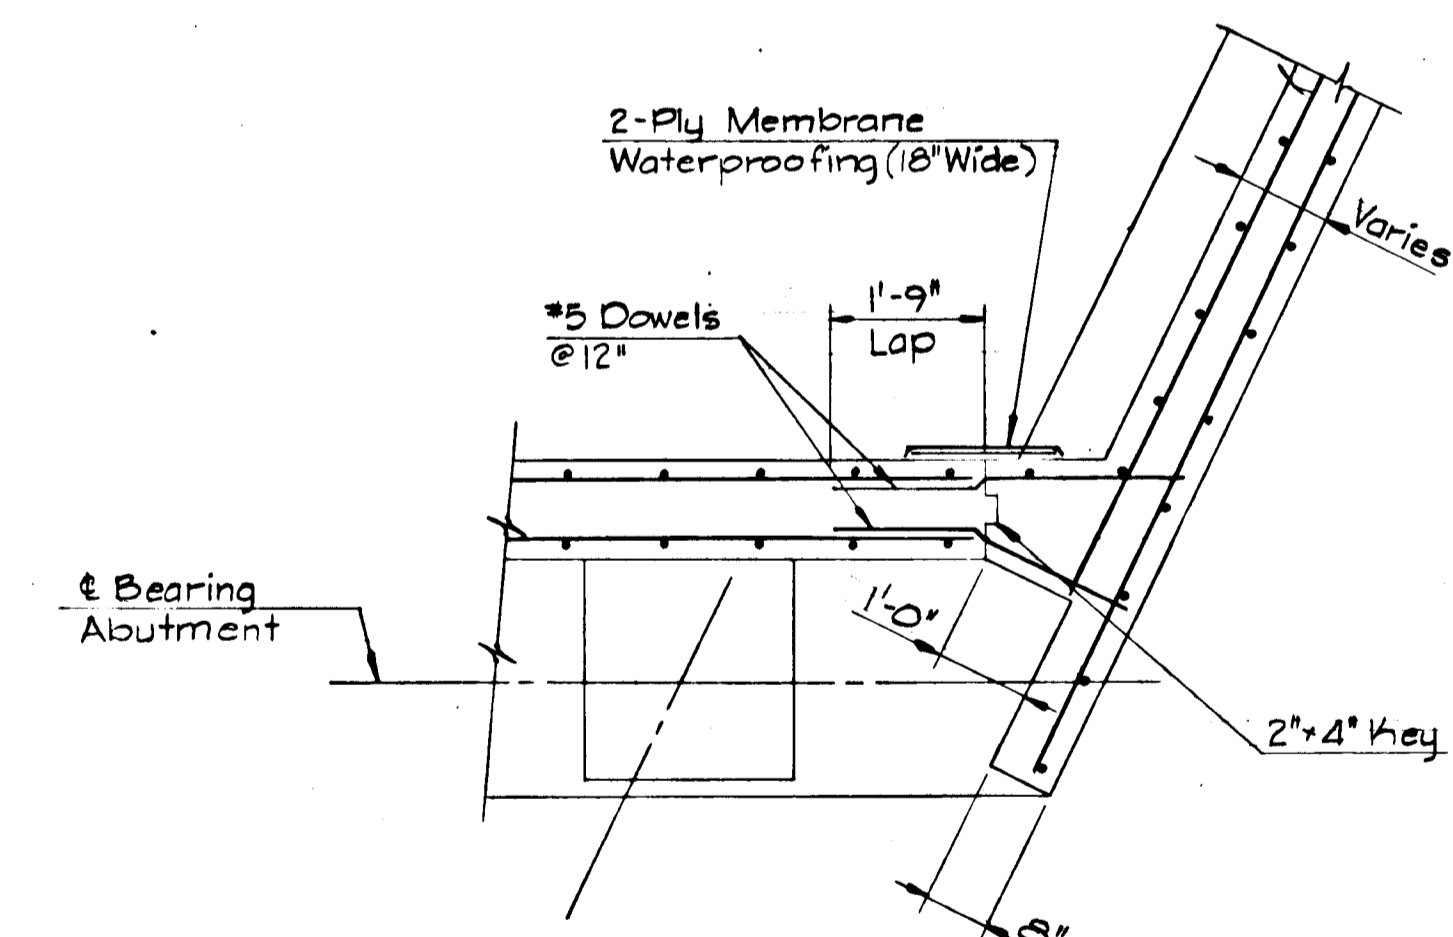


**SECTION 2-2**  
Sheet Nos. 11 & 12  
Scale: 1/2" = 1'-0"

APPROVED: HOWARD COUNTY OFFICE OF PLANNING & ZONING  
*John W. ...* 2-3-86  
CHIEF, DIV. OF LAND DEVELOPMENT & ZONING ADMIN. DATE  
APPROVED:  
HOWARD COUNTY DEPT. OF PUBLIC WORKS  
*...* 2-28-86  
CHIEF, BUREAU OF ENGINEERING DATE



**OWNER/DEVELOPER**  
HOWARD RESEARCH & DEVELOPMENT CORP.  
10275 LITTLE PATUXENT PARKWAY  
COLUMBIA, MARYLAND 21044

No.	REVISION	DATE	BY
5	Revisions Due To Stake Out Error	1/5/88	RMJ

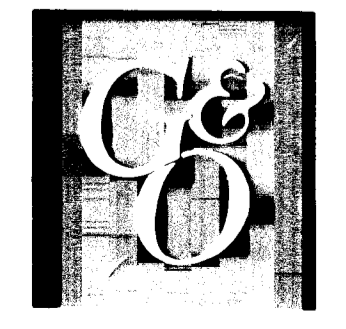

ENGINEERS • ARCHITECTS • PLANNERS • SCIENTISTS • SURVEYORS • PHOTOGRAMMETRISTS  
**GREENHORNE & O'MARA, INC.**  
9001 EDMONSTON ROAD, GREENBELT, MARYLAND 20770  
(301) 982-2800  
ANNAPOLIS, MD • ATLANTA, GA • BECKLEY, WV • CULPEPER, VA • DENVER, CO • EXPORT, PA • FAIRFAX, VA  
GREENSBORO, NC • MONROE, MI • RALEIGH, NC • ROCKVILLE, MD • TAMPA, FL • WILLISTON PARK, NY


**ABUTMENT - B**  
**COLUMBIA**  
VILLAGE OF DORSEY'S SEARCH  
SECTION 3, AREA 1, PHASE 191  
TAX MAP 30 ~ PARCELS 124, 224 & 210  
5TH ELECTION DISTRICT ~ HOWARD COUNTY, MARYLAND

RUL DESIGN	SCALE As Noted
DSA DRAWN	12 OF 24
DCC CHECKED	SHEET
B185 DATE	R10101 FILE No.


#1159

F-86-55




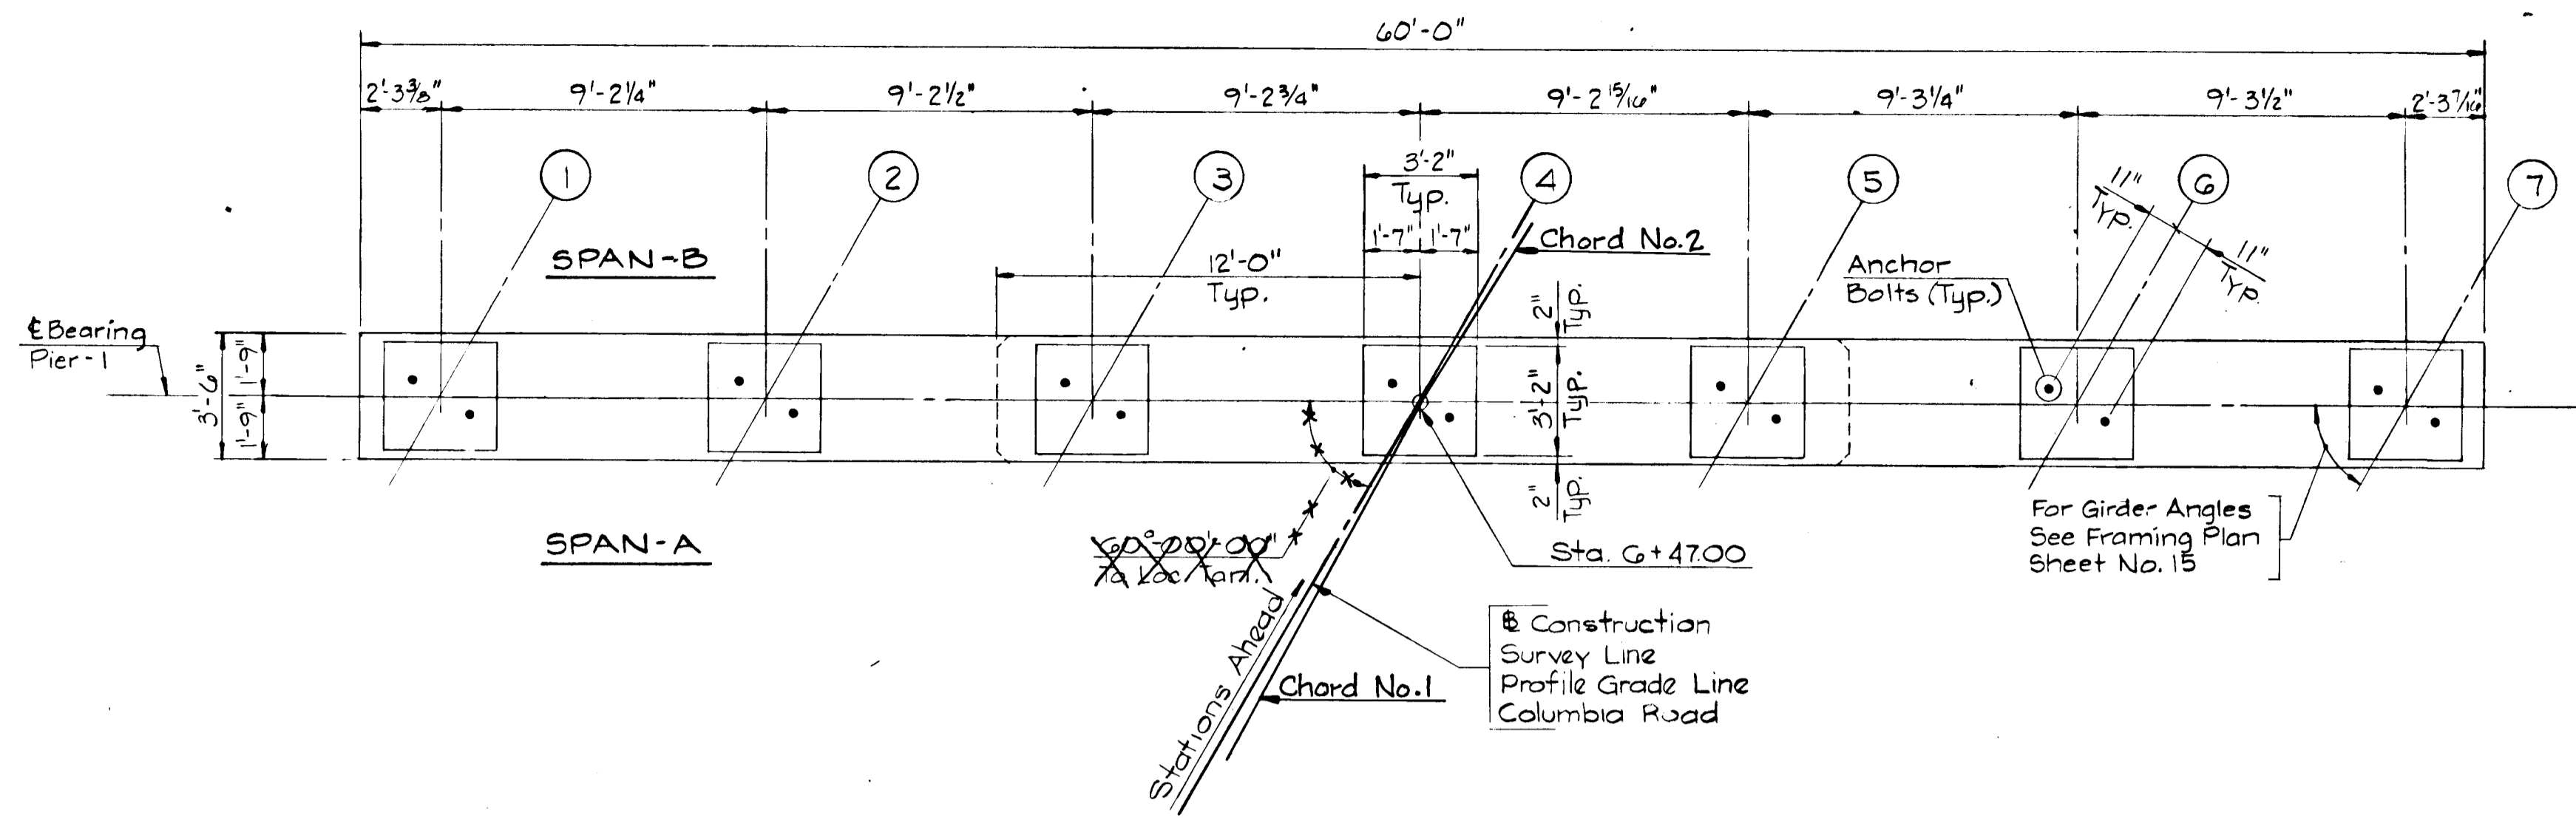


**PLAN**  
Scale: 1/4" = 1'-0"

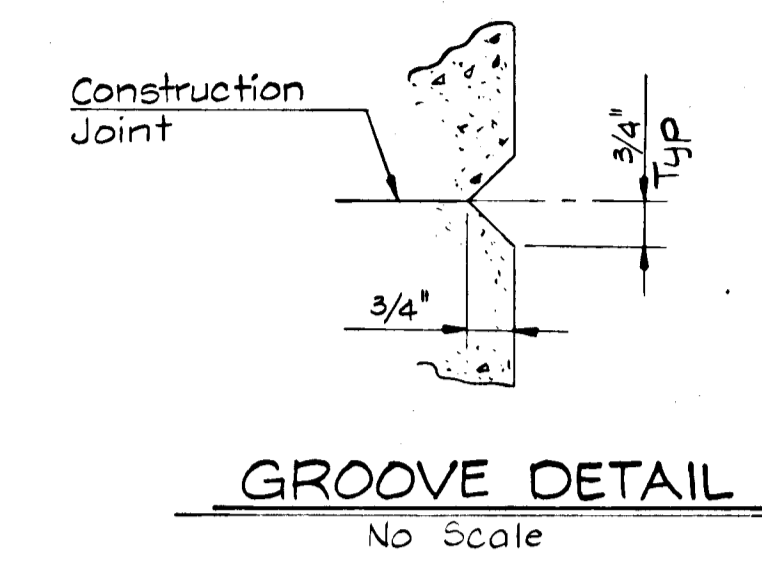


Note:  
Place Reinforcing  
in Pier Cap To  
Clear Anchor Bolts.

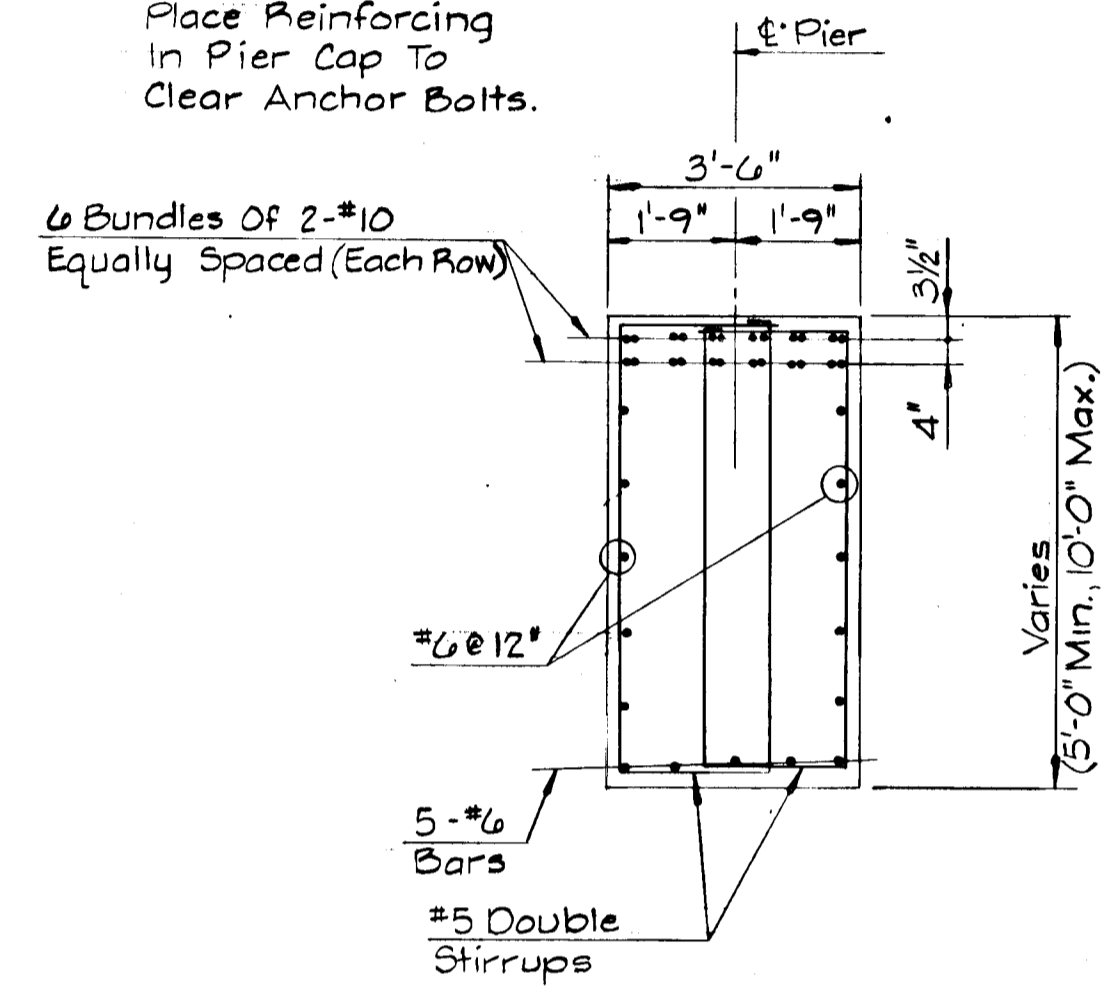


**SECTION G-G**  
Scale: 3/8" = 1'-0"

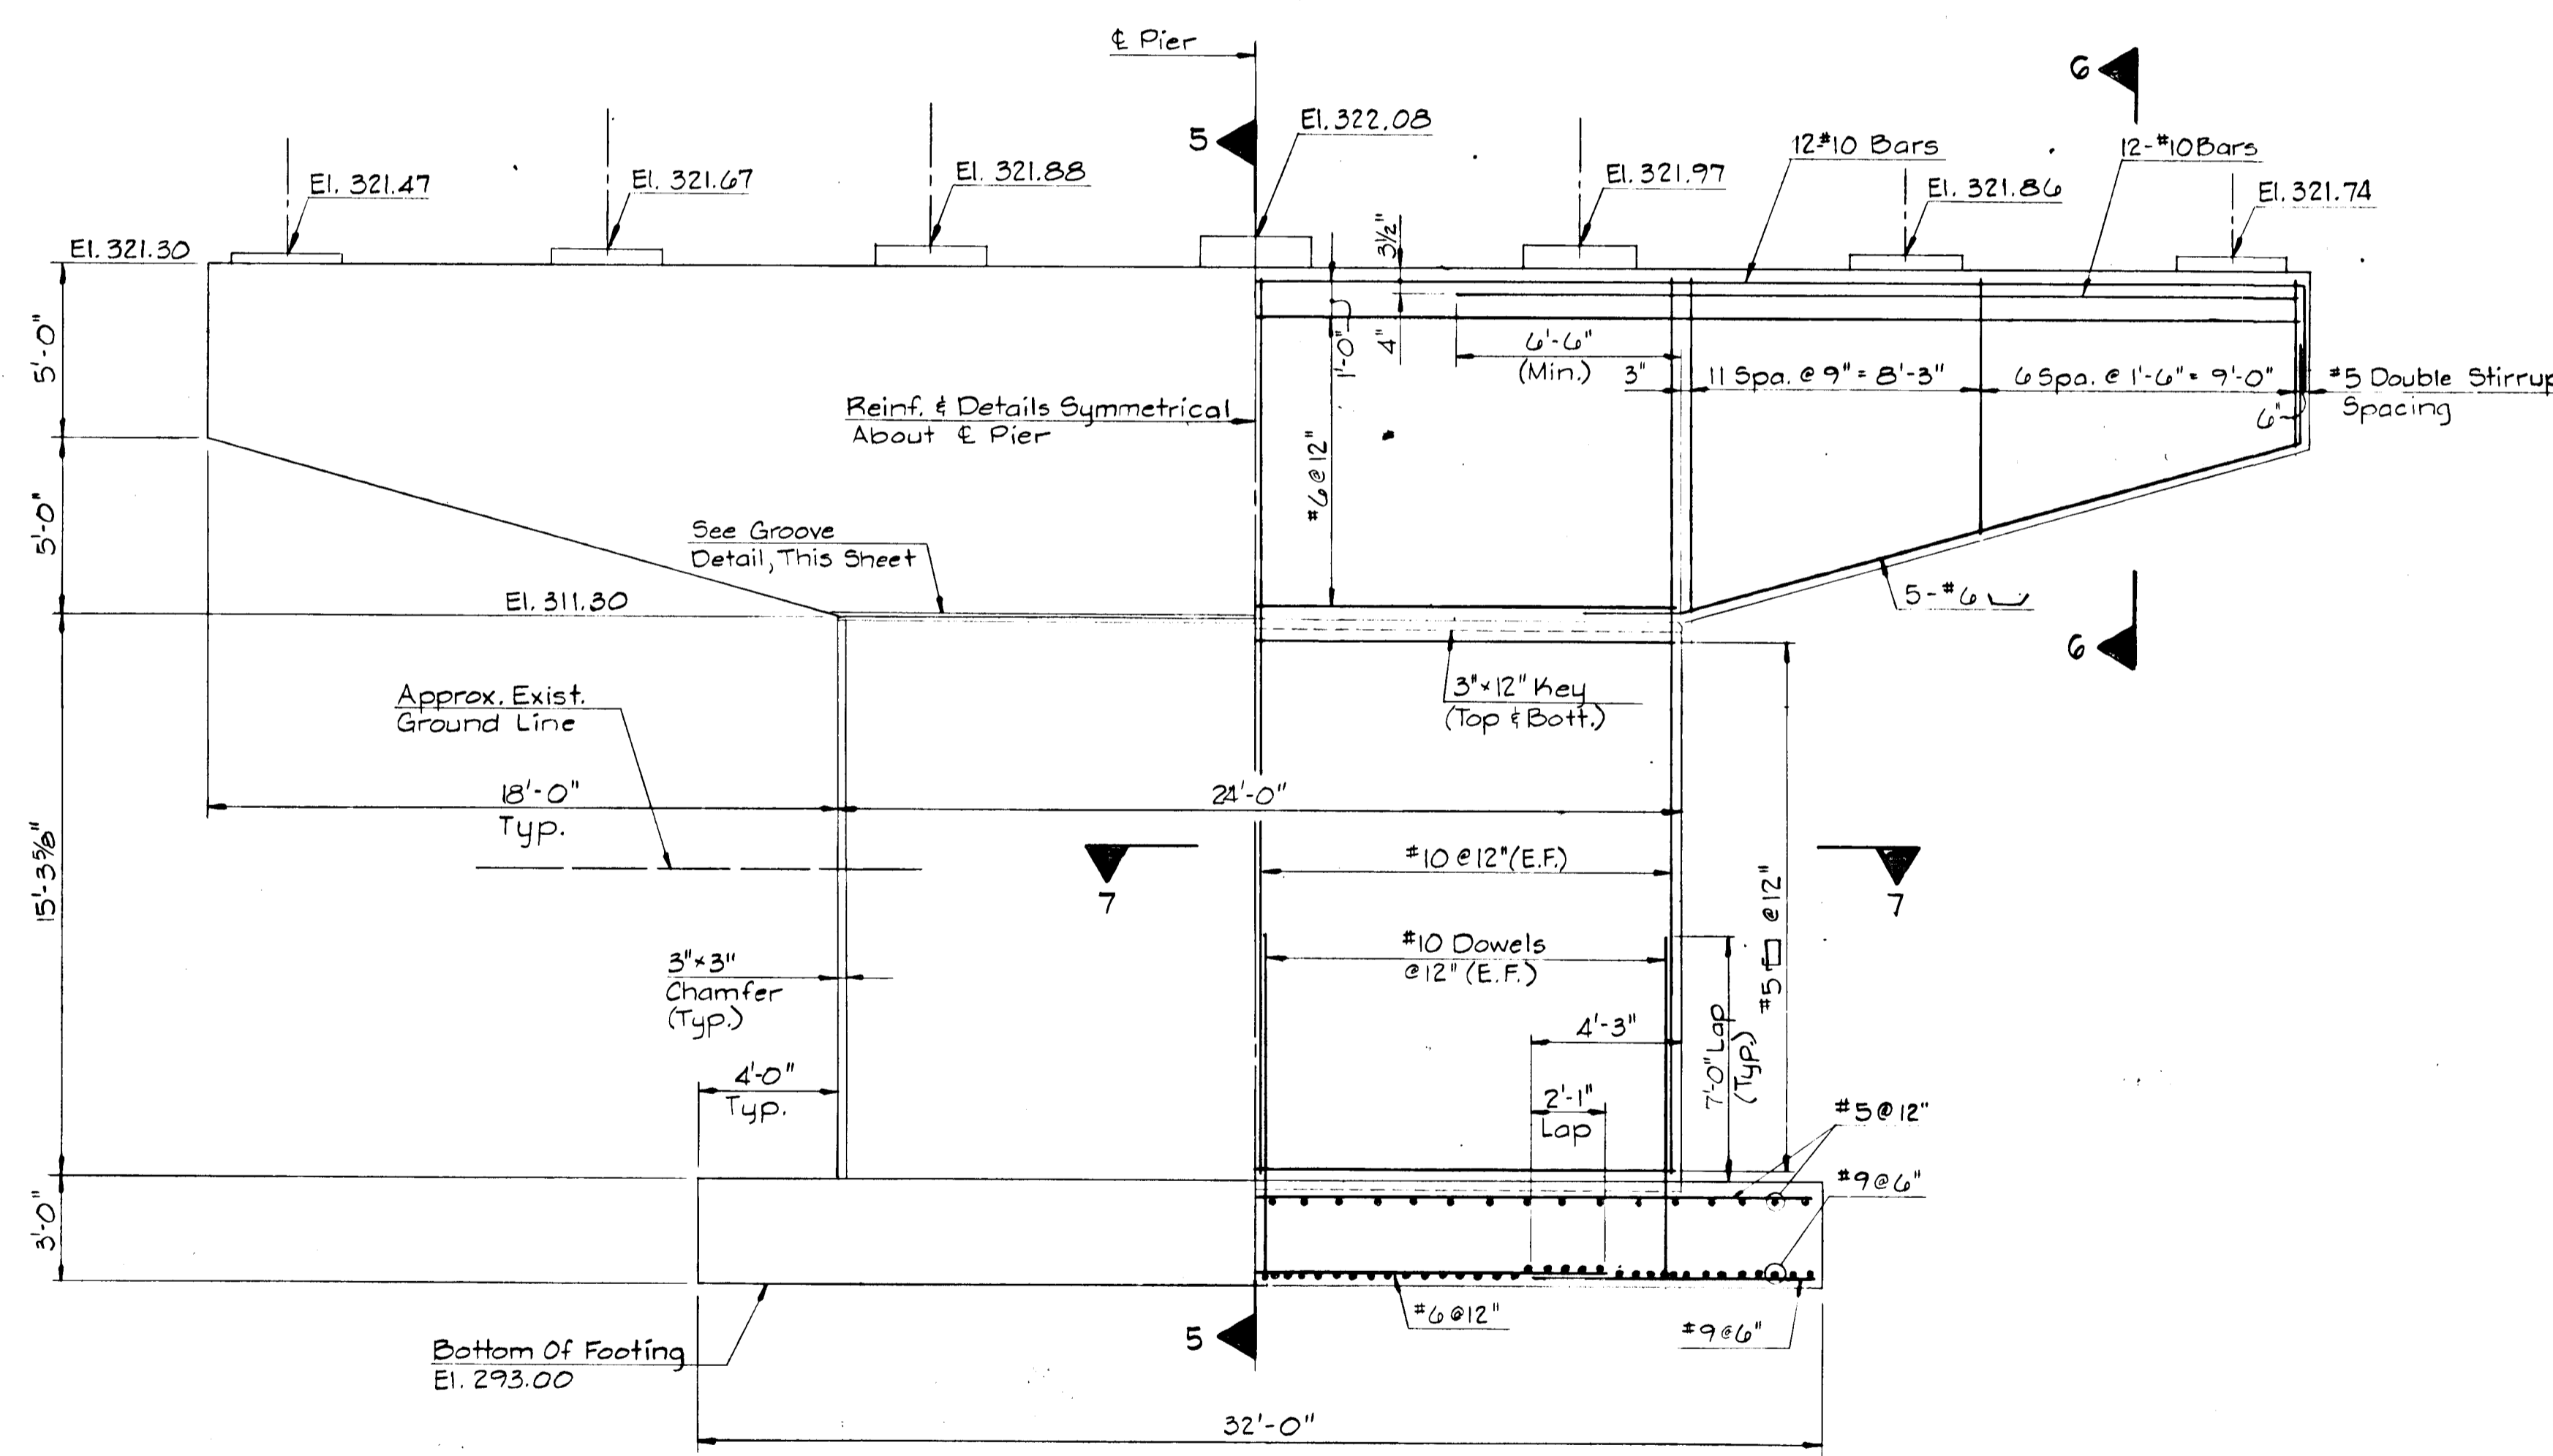

**ELEVATION**  
Scale: 1/4" = 1'-0"

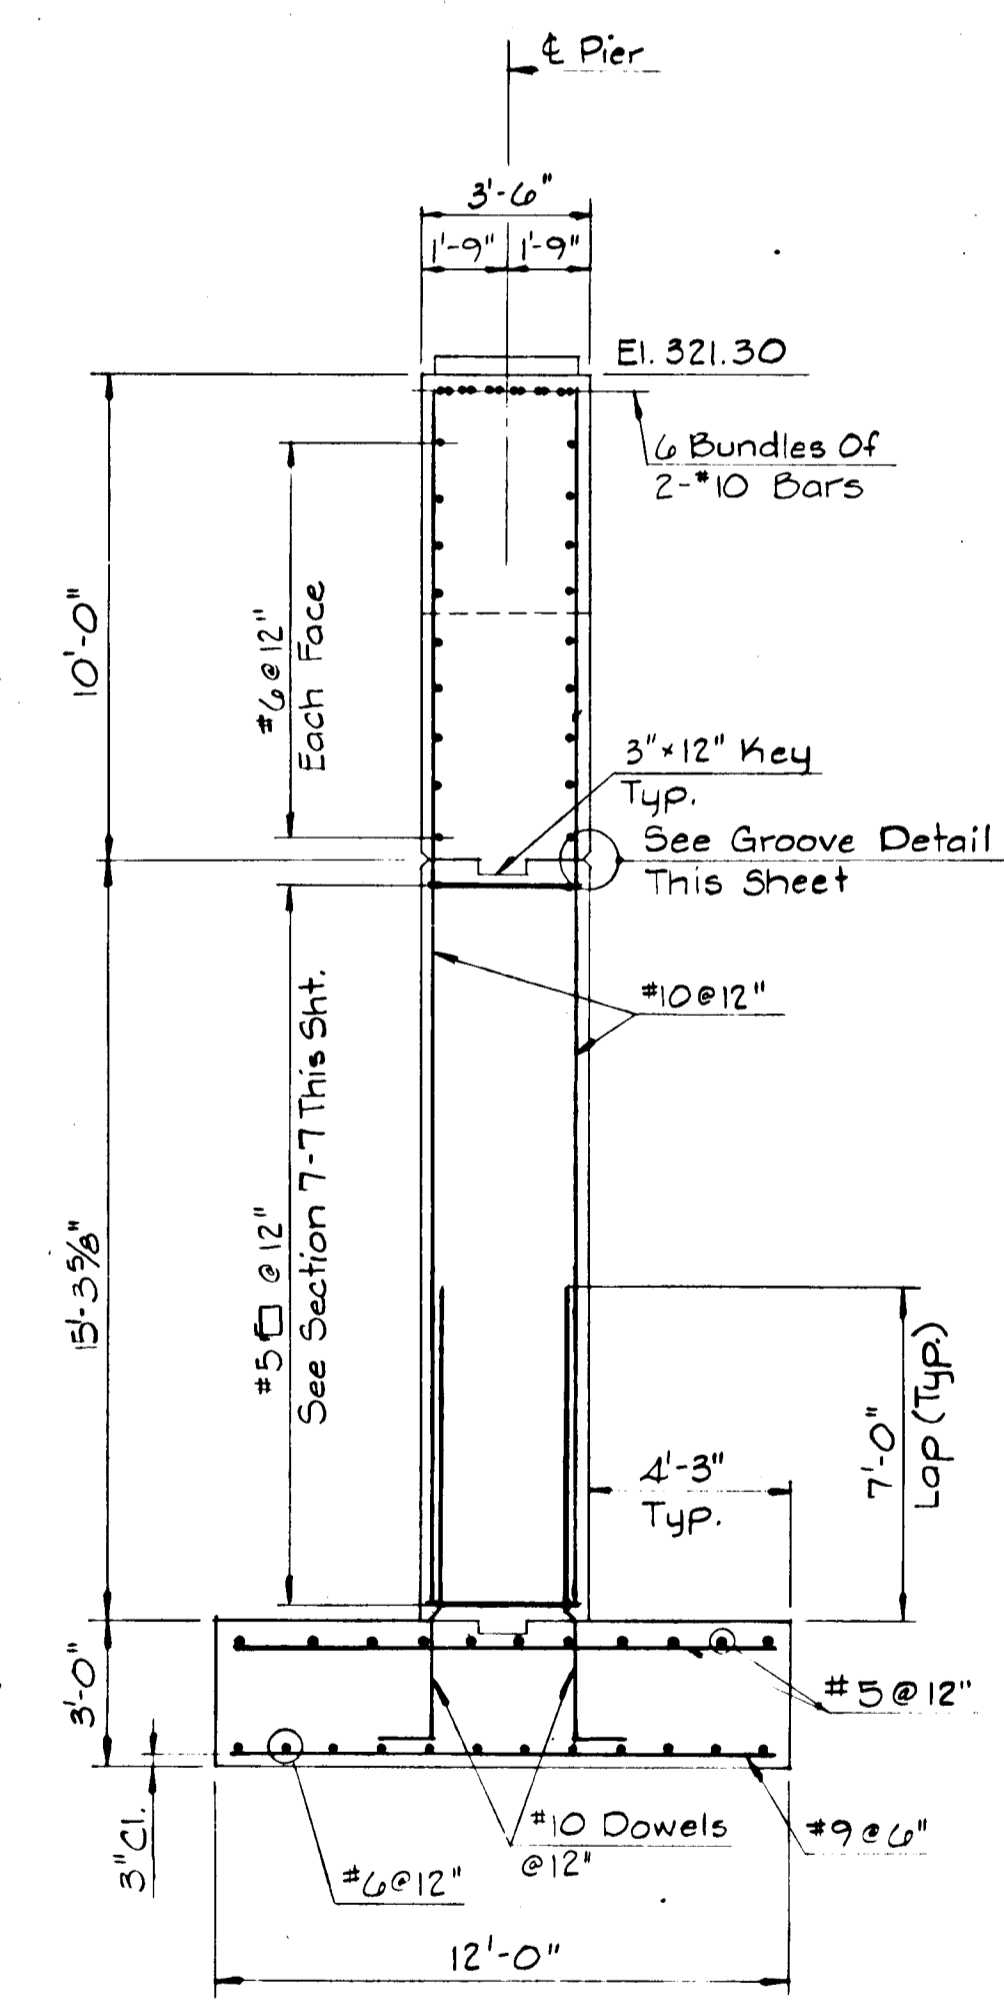


**SECTION 5-5**  
Scale: 1/4" = 1'-0"

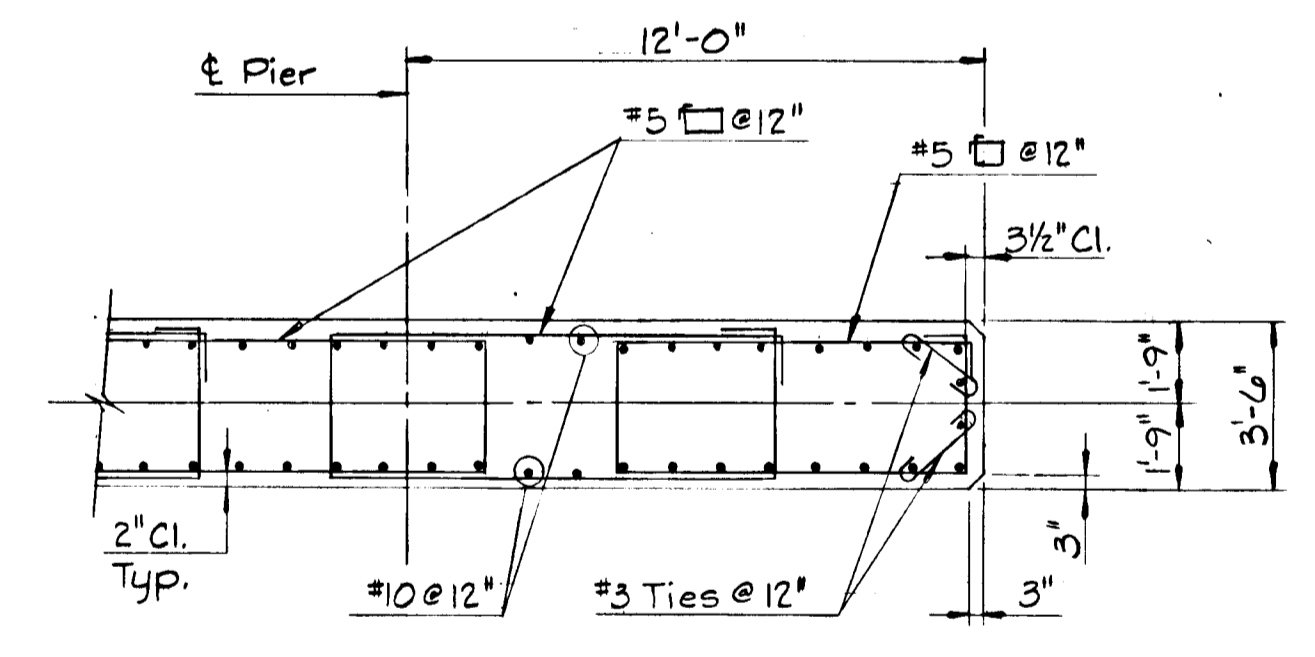

**SECTION 7-7**  
Scale: 1/4" = 1'-0"

APPROVED: HOWARD COUNTY OFFICE OF PLANNING & ZONING  
*Phillip Muechman* 2-3-86  
DATE

APPROVED:  
HOWARD COUNTY DEPT. OF PUBLIC WORKS  
*William B. Rain* 2-23-86  
DATE

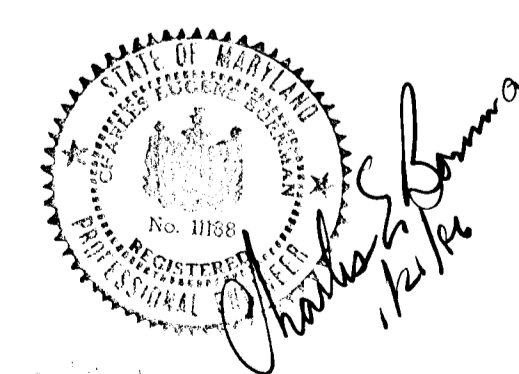

Bridge No #HO-137

**OWNER/DEVELOPER**  
HOWARD RESEARCH & DEVELOPMENT CORP.  
10275 LITTLE PATUXENT PARKWAY  
COLUMBIA, MARYLAND 21044

No.	REVISION	DATE	BY
5	Revisions Due To Stake Out Error	1/5/88	RMJ




ENGINEERS • ARCHITECTS • PLANNERS • SCIENTISTS • SURVEYORS • PHOTOGRAMMETRISTS  
**GREENHORNE & O'MARA, INC.**  
9001 EDMONSTON ROAD, GREENBELT, MARYLAND 20770  
(301) 982-2800  
ANNAPOLIS, MD • ATLANTA, GA • BECKLEY, WV • CULPEPER, VA • DENVER, CO • EXPORT, PA • FAIRFAX, VA  
GREENSBORO, NC • MONROE, MI • RALEIGH, NC • ROCKVILLE, MD • TAMPA, FL • WILLISTON PARK, NY

**PIER - 1**  
**COLUMBIA**  
VILLAGE OF DORSEY'S SEARCH  
SECTION 3, AREA 1, PHASE 191  
TAX MAP 30 ~ PARCELS 124,224 & 210  
5<sup>TH</sup> ELECTION DISTRICT ~ HOWARD COUNTY, MARYLAND

RJL DESIGN	SCALE As Noted
RMJ DRAWN	14 OF 24
DCC/RLP CHECKED	SHEET
8/85 DATE	JOB No.
	FILE No.

#1159


F-86-55

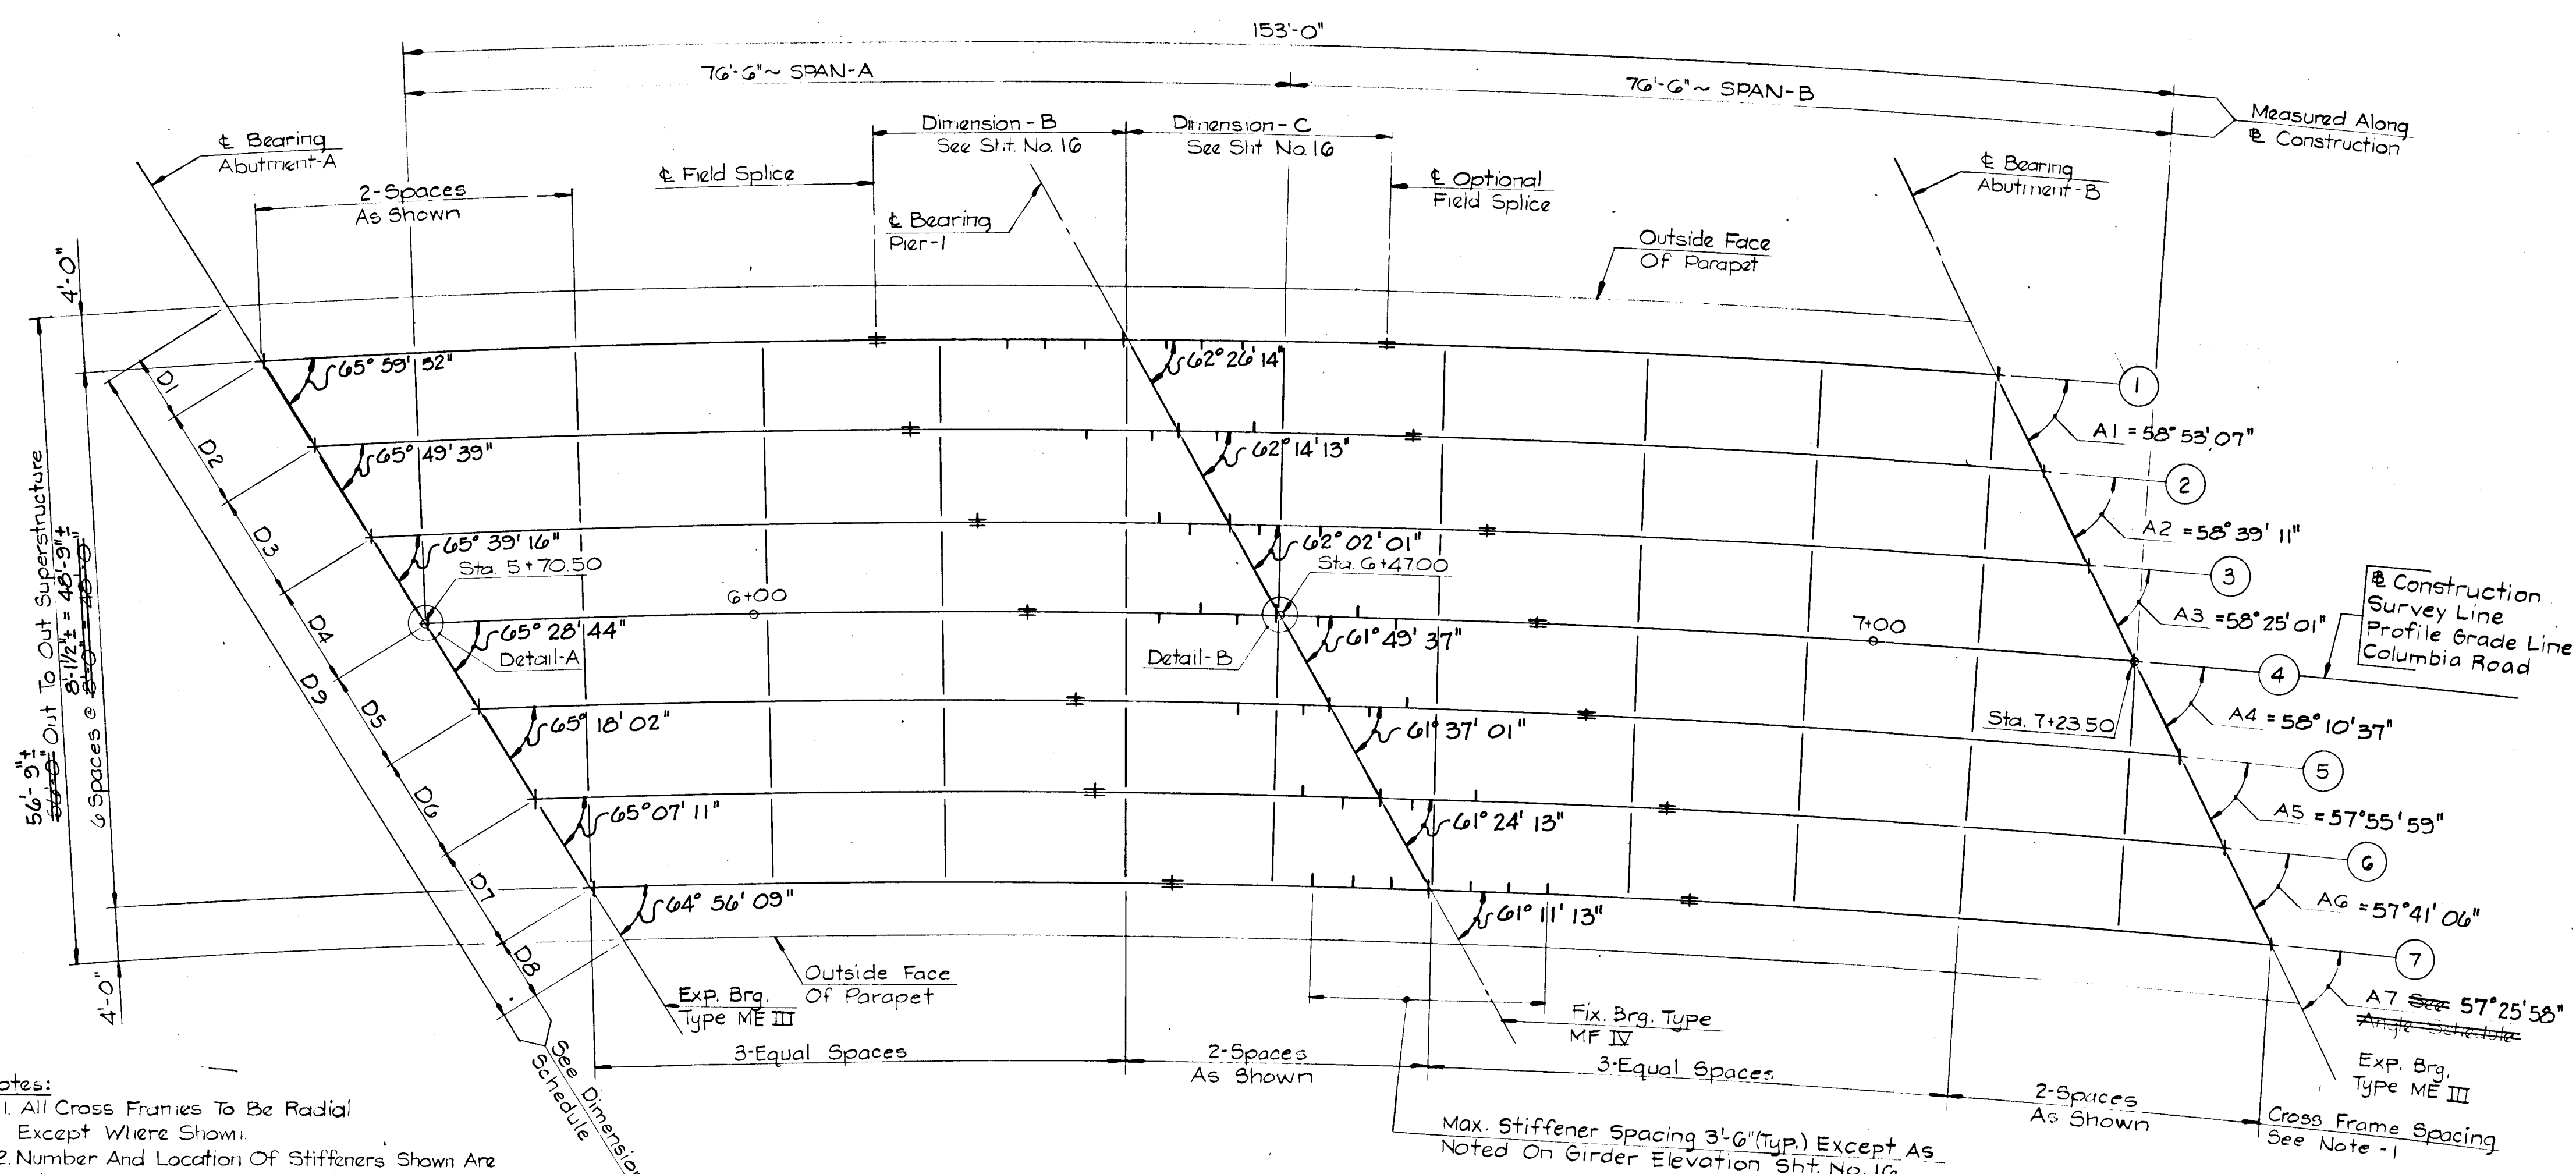

- Notes:**
- All Cross Frames To Be Radial Except Where Shown.
  - Number And Location Of Stiffeners Shown Are Schematic And May Be Adjusted As Necessary To Clear Shop And Field Splices. Provided Indicated Maximum Spacing Is Not Exceeded.
  - For Bearing Shoe Details, See Sht. No. 19.
  - For Splice And Connection Details, See Sht. No. 16.
  - For Girder Details, See Sht. No. 16.
  - For Expansion Joint For Conduit See MDSHA Std. Detail BR-55(O.OI)-75-13, On Sht. No. 22.

**FRAMING PLAN**  
Scale: 1" = 10'

Note: All Angles Shown In Framing Plan Are Measured From The  $\epsilon$  Bearing To The Local Tangent Of The Curved Girder.

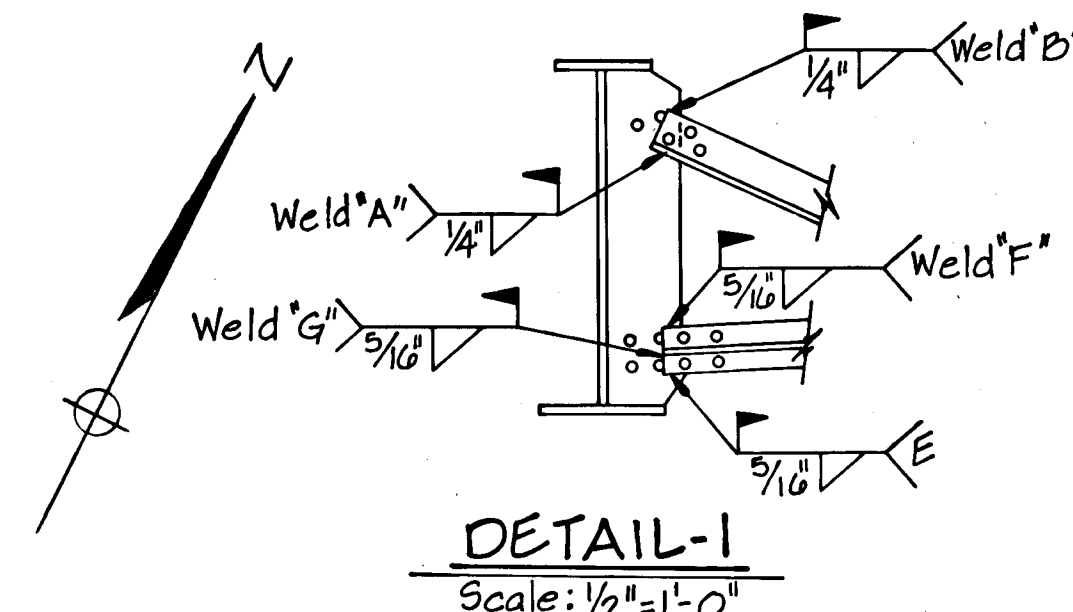

- Welding Requirements:**
- Weld "A" - Min. Length = 4"  
Weld "B" - Min. Length = 1 1/2"  
Sufficient Length Was Available To Meet 7" Min. Length In All Upper Connections Using Only "A" & "B" Welds.
  - Weld "E" - Min. Length = 1 1/2"  
Weld "F" - Min. Length = 1 1/2"  
Weld "G" - Min. Length = 3"  
Sufficient Length Was Available To Meet 8" Min. Length In All Lower Connections Using Only "E" & "F" And "G" Welds.
  - Bolt Holes In Cross-Frame Members & Connection Plates Were Left Open.


**ANGLE SCHEDULE**

LOCATION	A1	A2	A3	A4	A5	A6	A7
Abutment - A	64° 12' 28"	64° 01' 31"	63° 50' 25"	63° 39' 09"	63° 27' 43"	63° 16' 07"	63° 04' 19"
Pier - I	60° 38' 48"	60° 26' 04"	60° 13' 08"	60° 00' 00"	59° 46' 40"	59° 33' 07"	59° 19' 21"
Abutment - B	57° 05' 32"	56° 50' 52"	56° 35' 59"	56° 20' 51"	56° 05' 28"	55° 49' 49"	55° 33' 55"


Note: All Angles In Schedule Are Measured From The  $\epsilon$  Bearing To The Local Tangent Of Curved Girder Chord Between Adjacent Bearings.

**DIMENSION SCHEDULE**

LOCATION	D1	D2	D3	D4	D5	D6	D7	D8	D9
Abutment - A	4'-5 3/4"	8'-10 1/4"	8'-10 1/4"	8'-11 1/4"	8'-11 3/4"	8'-11 3/4"	8'-11 3/4"	4'-5 7/8"	6'-2' 6"
Pier - I	4'-7 1/4"	9'-2 1/4"	9'-2 1/2"	9'-2 3/4"	9'-2 3/4"	9'-3 1/4"	9'-3 1/2"	4'-7 1/4"	6'-4' 8 1/4"
Abutment - B	4'-9 1/8"	9'-6 1/2"	9'-6 3/4"	9'-7 3/4"	9'-7 1/2"	9'-7 7/8"	9'-8 3/4"	4'-10 1/4"	6'-7' 3 1/4"

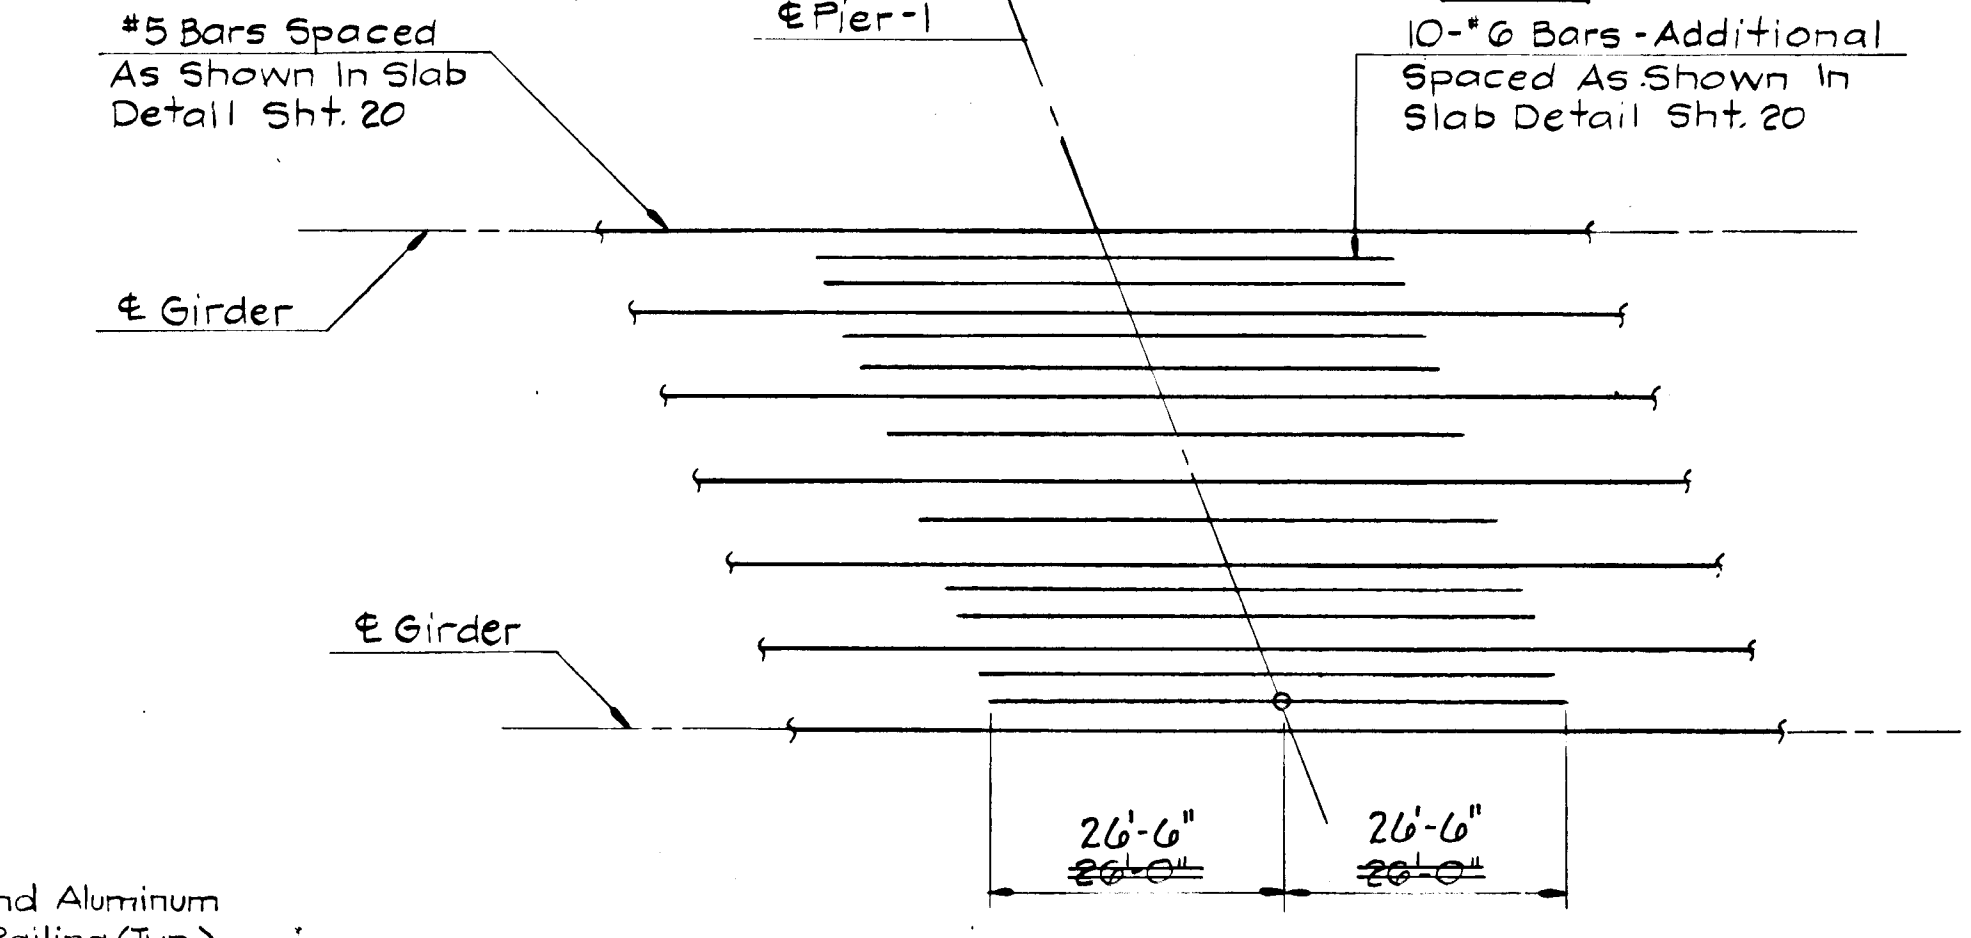

**DETAIL ~ ADDITIONAL SLAB REINFORCING AT PIER**  
No Scale

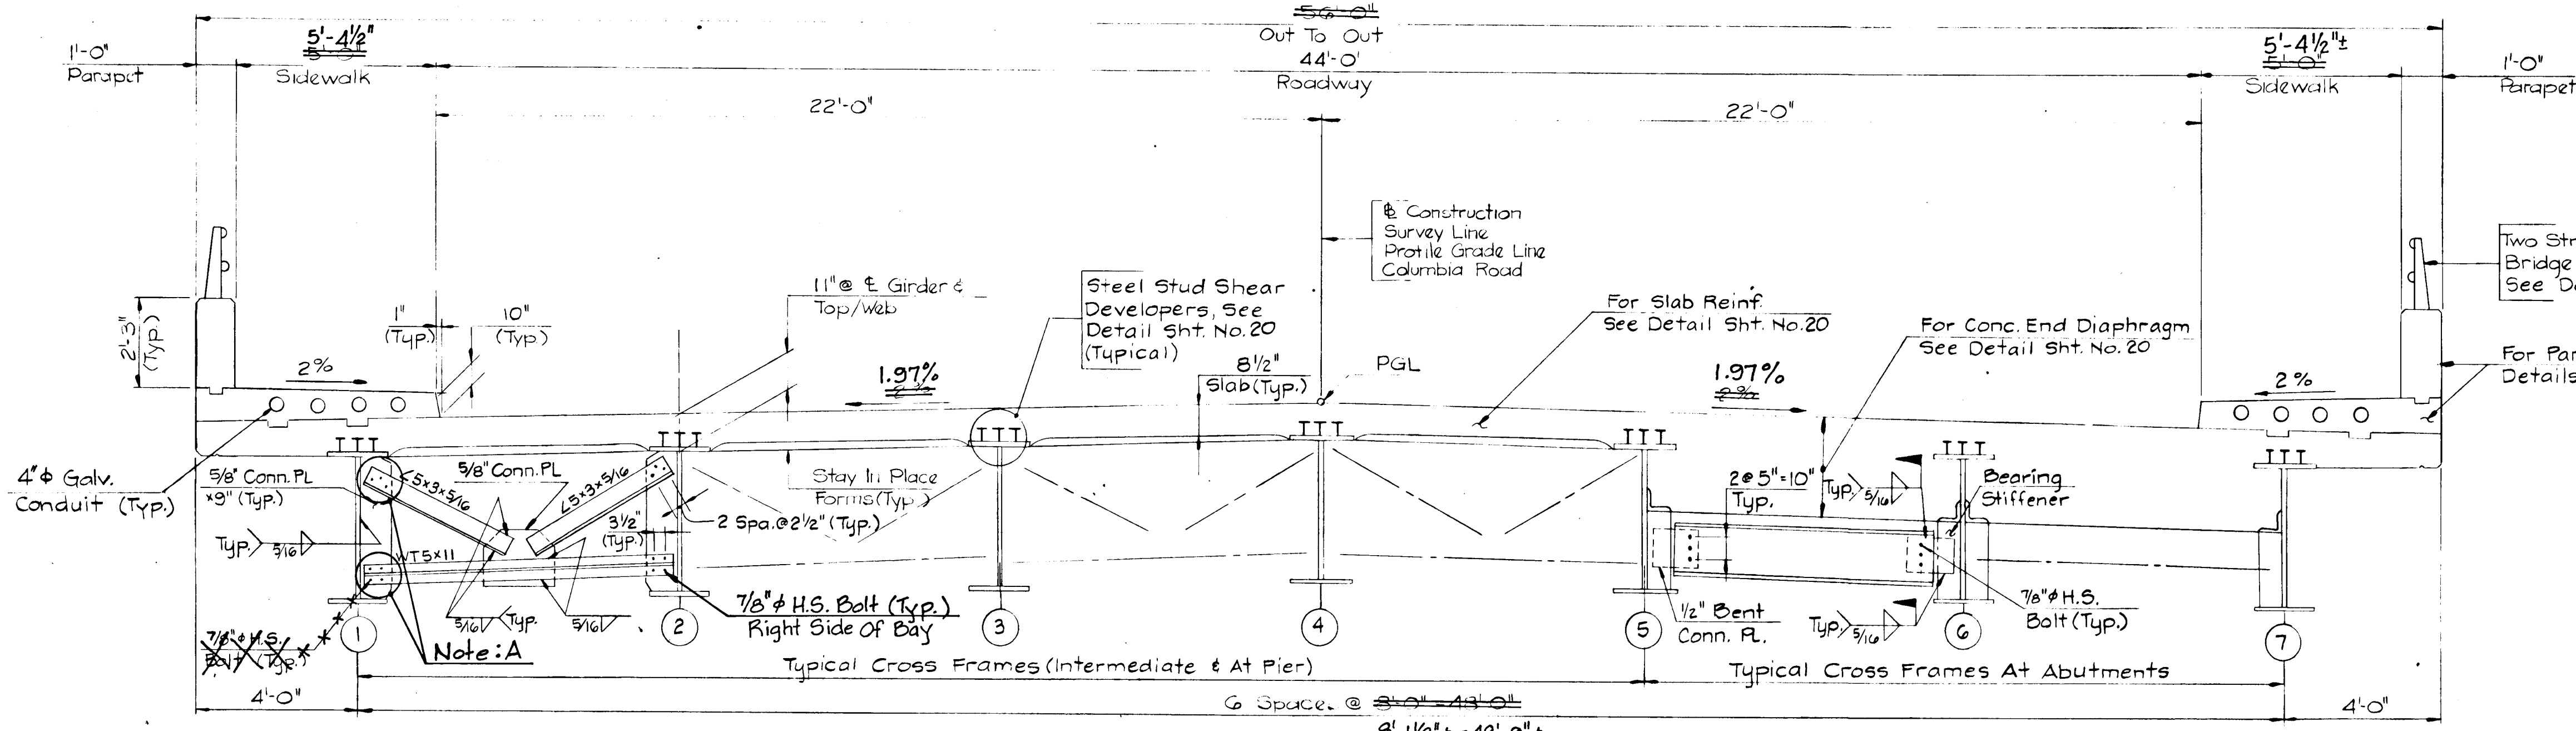


**TYPICAL SECTION**  
Scale: 3/8" = 1'-0"

Note: A - 7/8" H.S. Bolts Removed From Connections At Left Side Of Each Bay (Typ.). Cross Frames Reconnected In Accordance With The Welding Procedures As Indicated In Detail - 1, This Sheet.

APPROVED: HOWARD COUNTY OFFICE OF PLANNING & ZONING  
*Shullman* 2-3-86  
CHIEF, DIV. OF LAND DEVELOPMENT & ZONING ADMIN.  
APPROVED: HOWARD COUNTY DEPT. OF PUBLIC WORKS  
*W. J. ...* 2-28-86  
CHIEF, BUREAU OF ENGINEERING

**OWNER/DEVELOPER**  
HOWARD RESEARCH & DEVELOPMENT CORP.  
10275 LITTLE PATUXENT PARKWAY  
COLUMBIA, MARYLAND 21044

No.	REVISION	DATE	BY
5	Revisions Due To Stake Out Error	1/5/88	RMJ

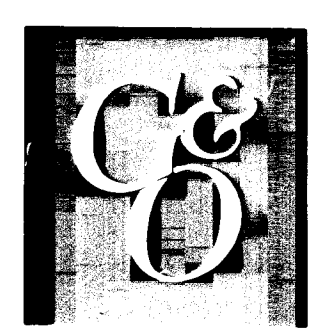


ENGINEERS • ARCHITECTS • PLANNERS • SCIENTISTS • SURVEYORS • PHOTOGRAMMETRISTS  
**GREENHORNE & O'MARA, INC.**  
9001 EDMONSTON ROAD, GREENBELT, MARYLAND 20770  
(301) 982-2800  
ANNAPOLIS, MD • ATLANTA, GA • BECKLEY, WV • CULPEPER, VA • DENVER, CO • EXPORT, PA • FAIRFAX, VA  
GREENSBORO, NC • MONROE, MI • RALEIGH, NC • ROCKVILLE, MD • TAMPA, FL • WILLISTON PARK, NY

**FRAMING PLAN & TYPICAL SECTION**  
**COLUMBIA**  
VILLAGE OF DORSEY'S SEARCH  
SECTION 3, AREA 1, PHASE 191  
TAX MAP 30 ~ PARCELS 124, 224 & 210  
5TH ELECTION DISTRICT ~ HOWARD COUNTY, MARYLAND

RJL DESIGN	SCALE As Noted
KAB DRAWN	15 OF 16
DCC/RLP CHECKED	SHEET
8/85 DATE	JOB No. FILE No.



#1159

F-86-55




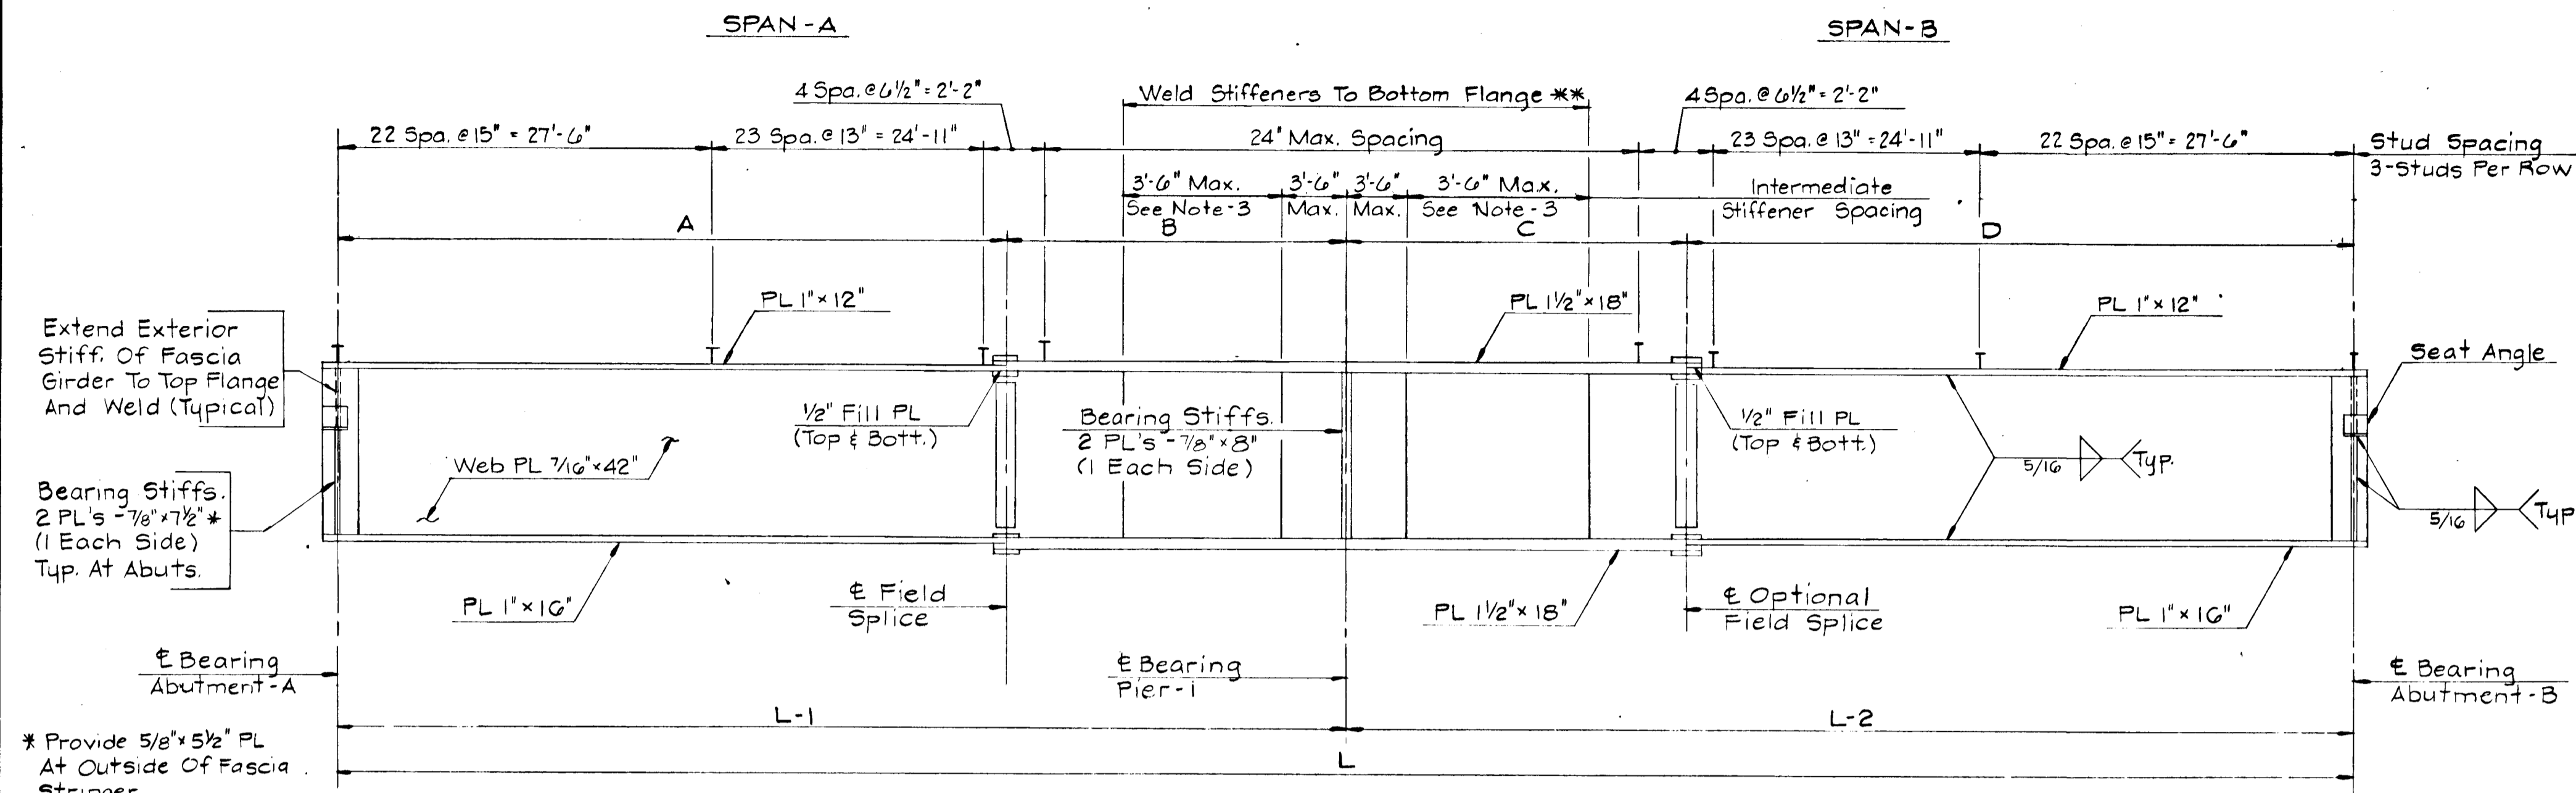


TYPICAL GIRDER ELEVATION  
No Scale

- Notes:
- The Estimated Number Of Steel Stud Shear Developers Required For This Bridge Is 2450.
  - \*\* Indicates Tension Flange At Top.
  - Attach Two Or Three Intermediate Transverse Stiffeners @ 42" Max. Spacing. For Exact Number And Approximate Location, See Framing Plan.

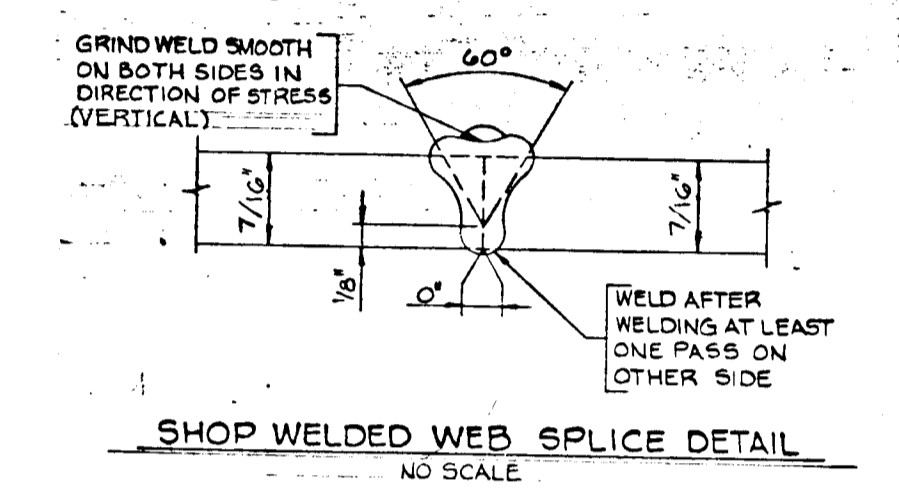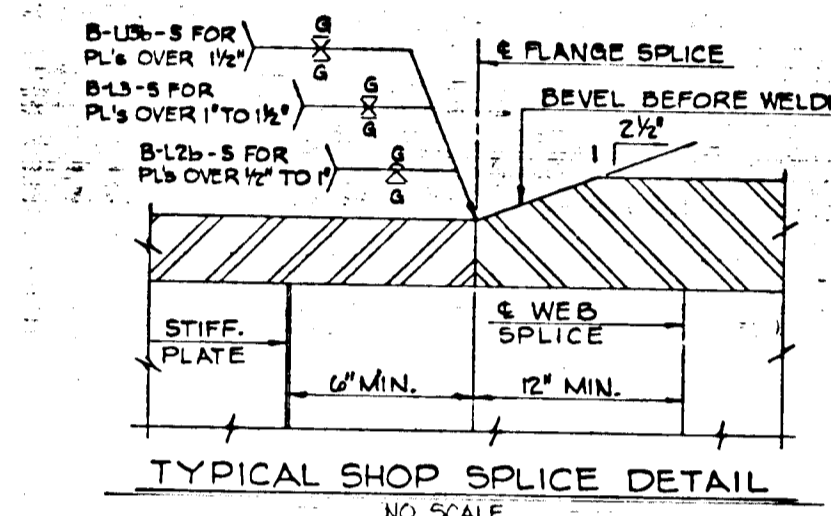

GIRDER DIMENSION SCHEDULE								
GIRDER NO.	RADIUS	L	L-1	L-2	A	B	C	D
①	1224.00	152'-0 1/8"	76'-0 5/16"	75'-11 3/16"	53'-2 9/16"	22'-10"	22'-10"	53'-1 3/16"
②	1216.00	152'-3 5/16"	76'-2 3/16"	76'-1 3/8"	51'-9 9/16"	24'-5"	20'-10"	55'-3 3/8"
③	1208.00	152'-7 5/16"	76'-4 1/4"	76'-3 3/16"	53'-5 1/4"	22'-11"	22'-11"	53'-4 1/16"
④	1200.00	153'-0"	76'-6"	76'-6"	53'-7"	22'-11"	22'-11"	53'-7"
⑤	1192.00	153'-4 3/16"	76'-7 5/16"	76'-8 3/8"	53'-7 13/16"	23'-0"	22'-2"	54'-6 3/8"
⑥	1184.00	153'-8 1/2"	76'-9 5/8"	76'-10 7/8"	51'-4 5/8"	25'-5"	23'-1"	53'-9 7/8"
⑦	1176.00	154'-0 7/8"	76'-11 1/2"	77'-1 3/8"	53'-10 1/2"	23'-1"	23'-2"	53'-11 3/8"

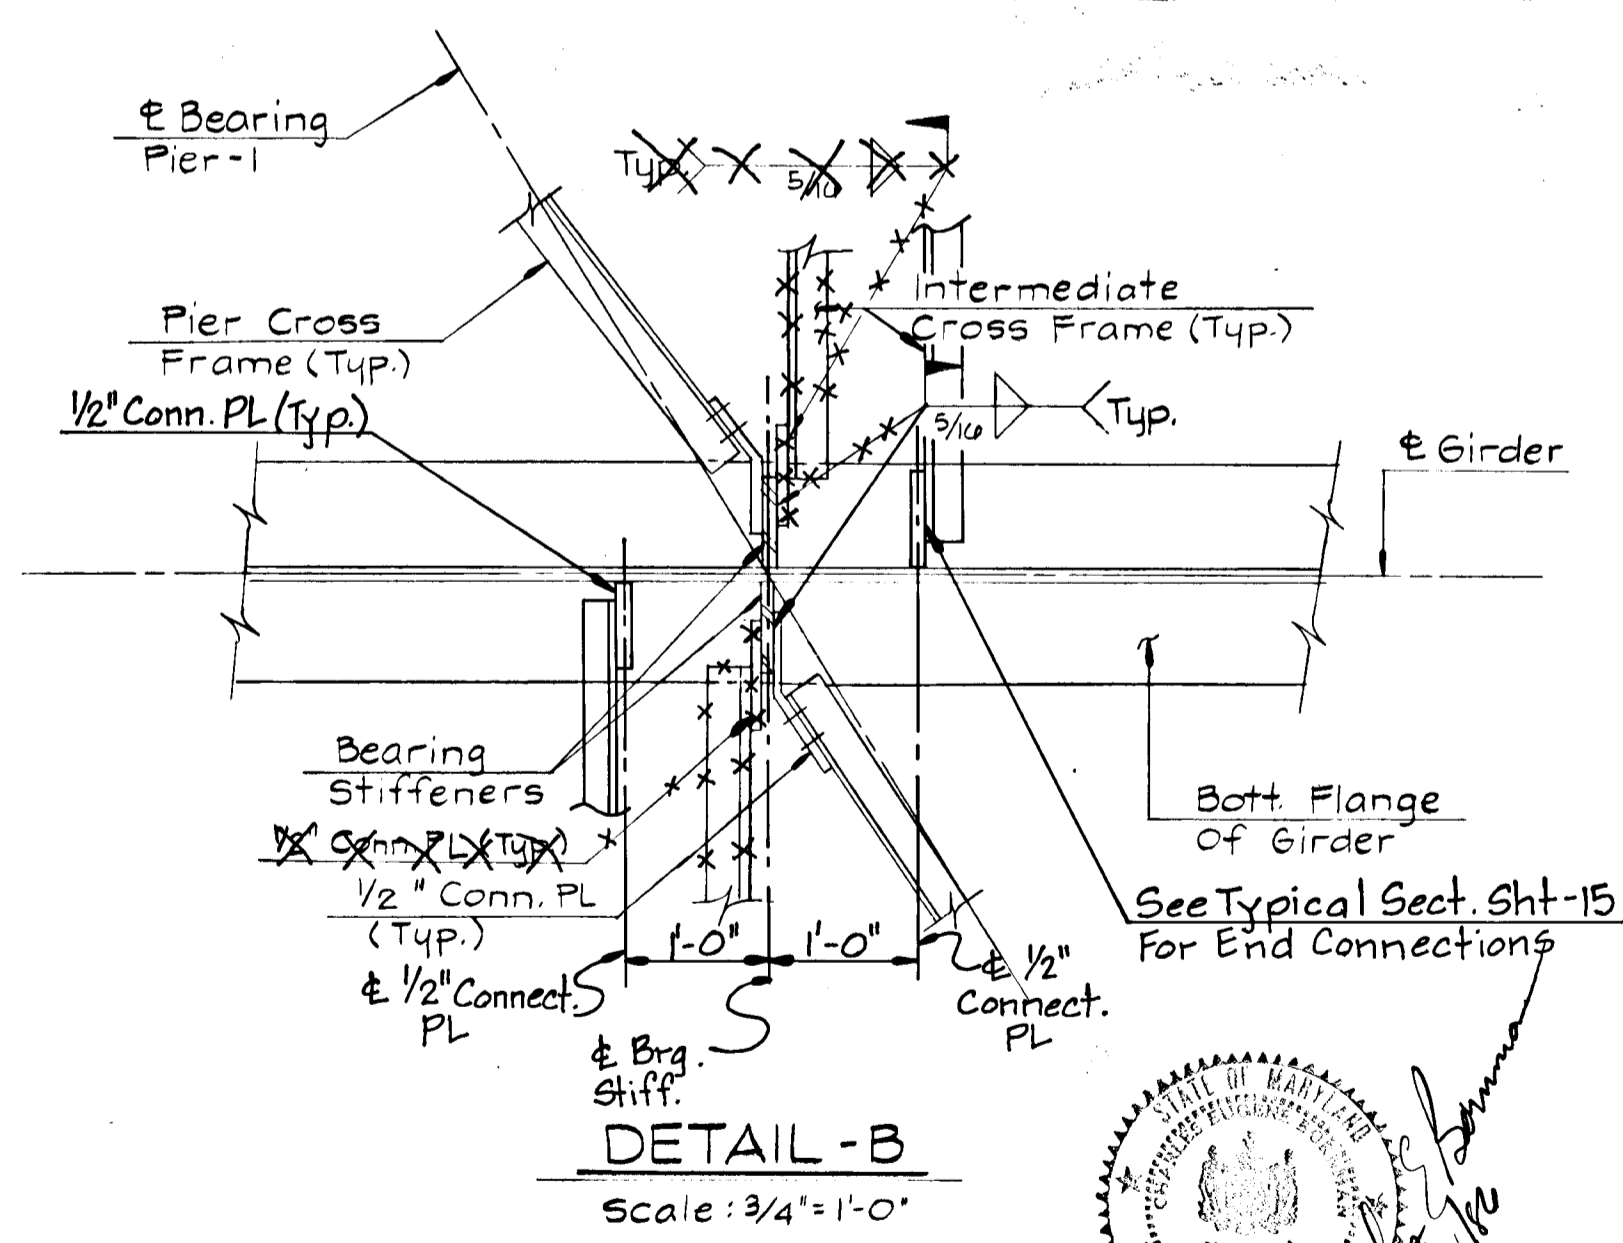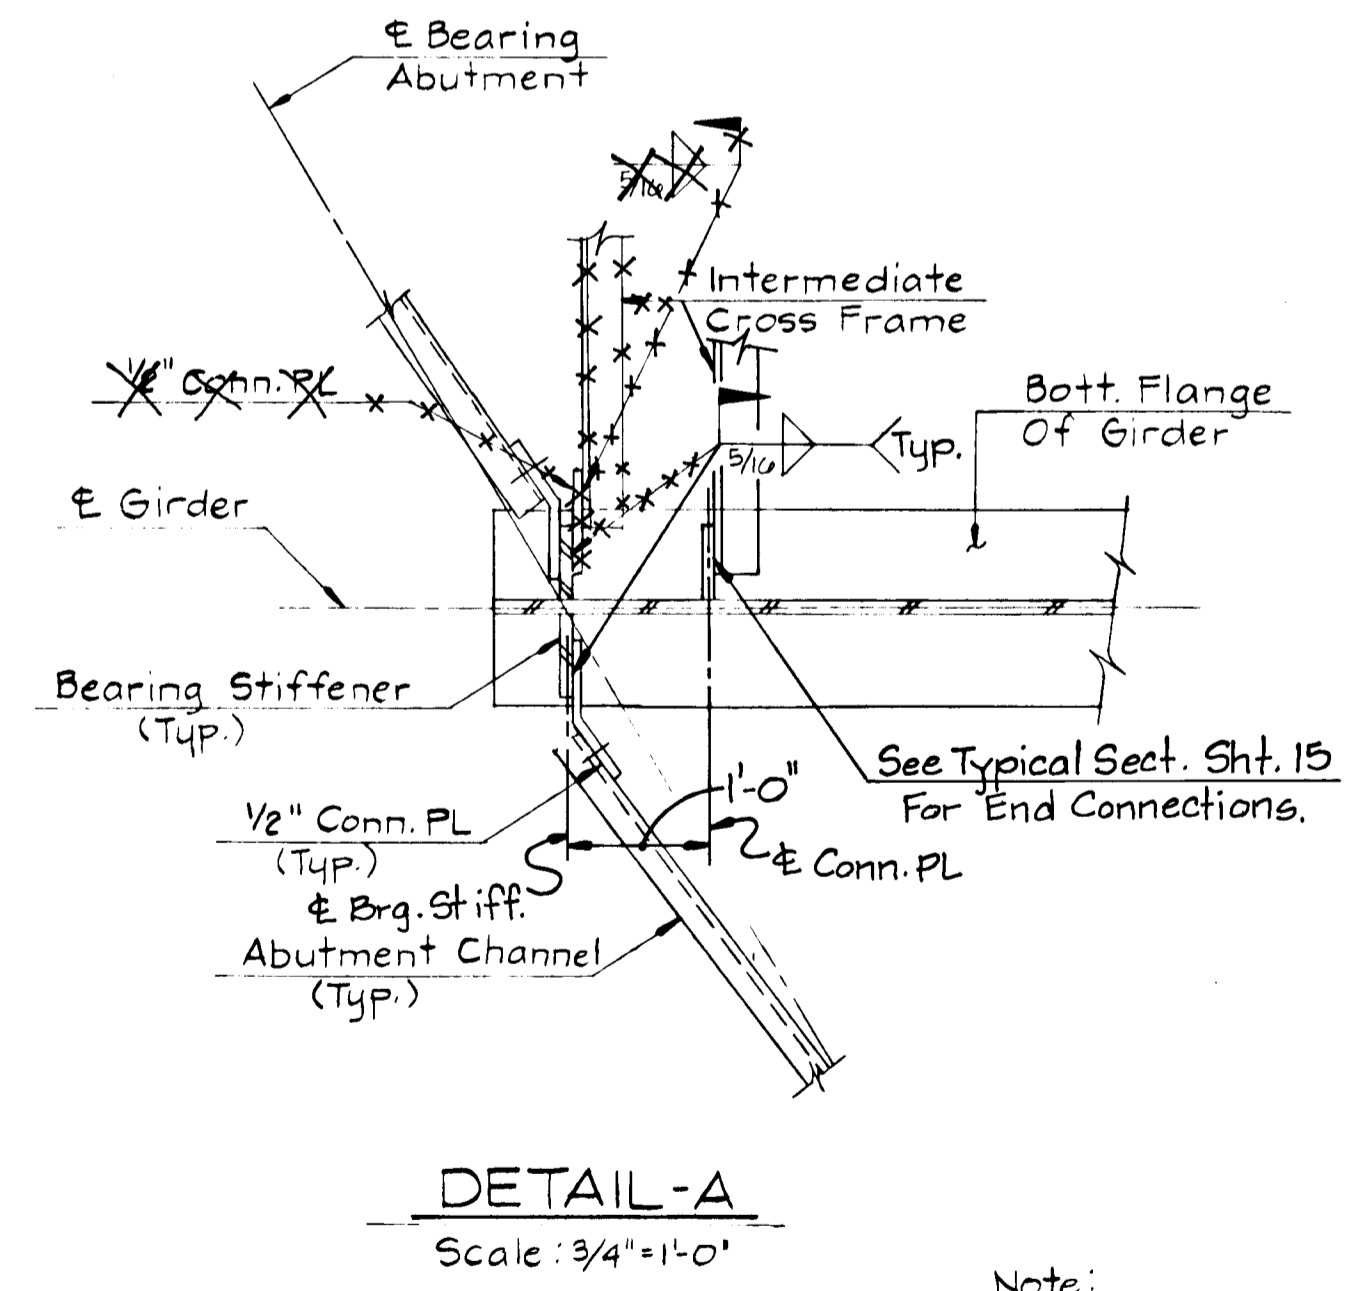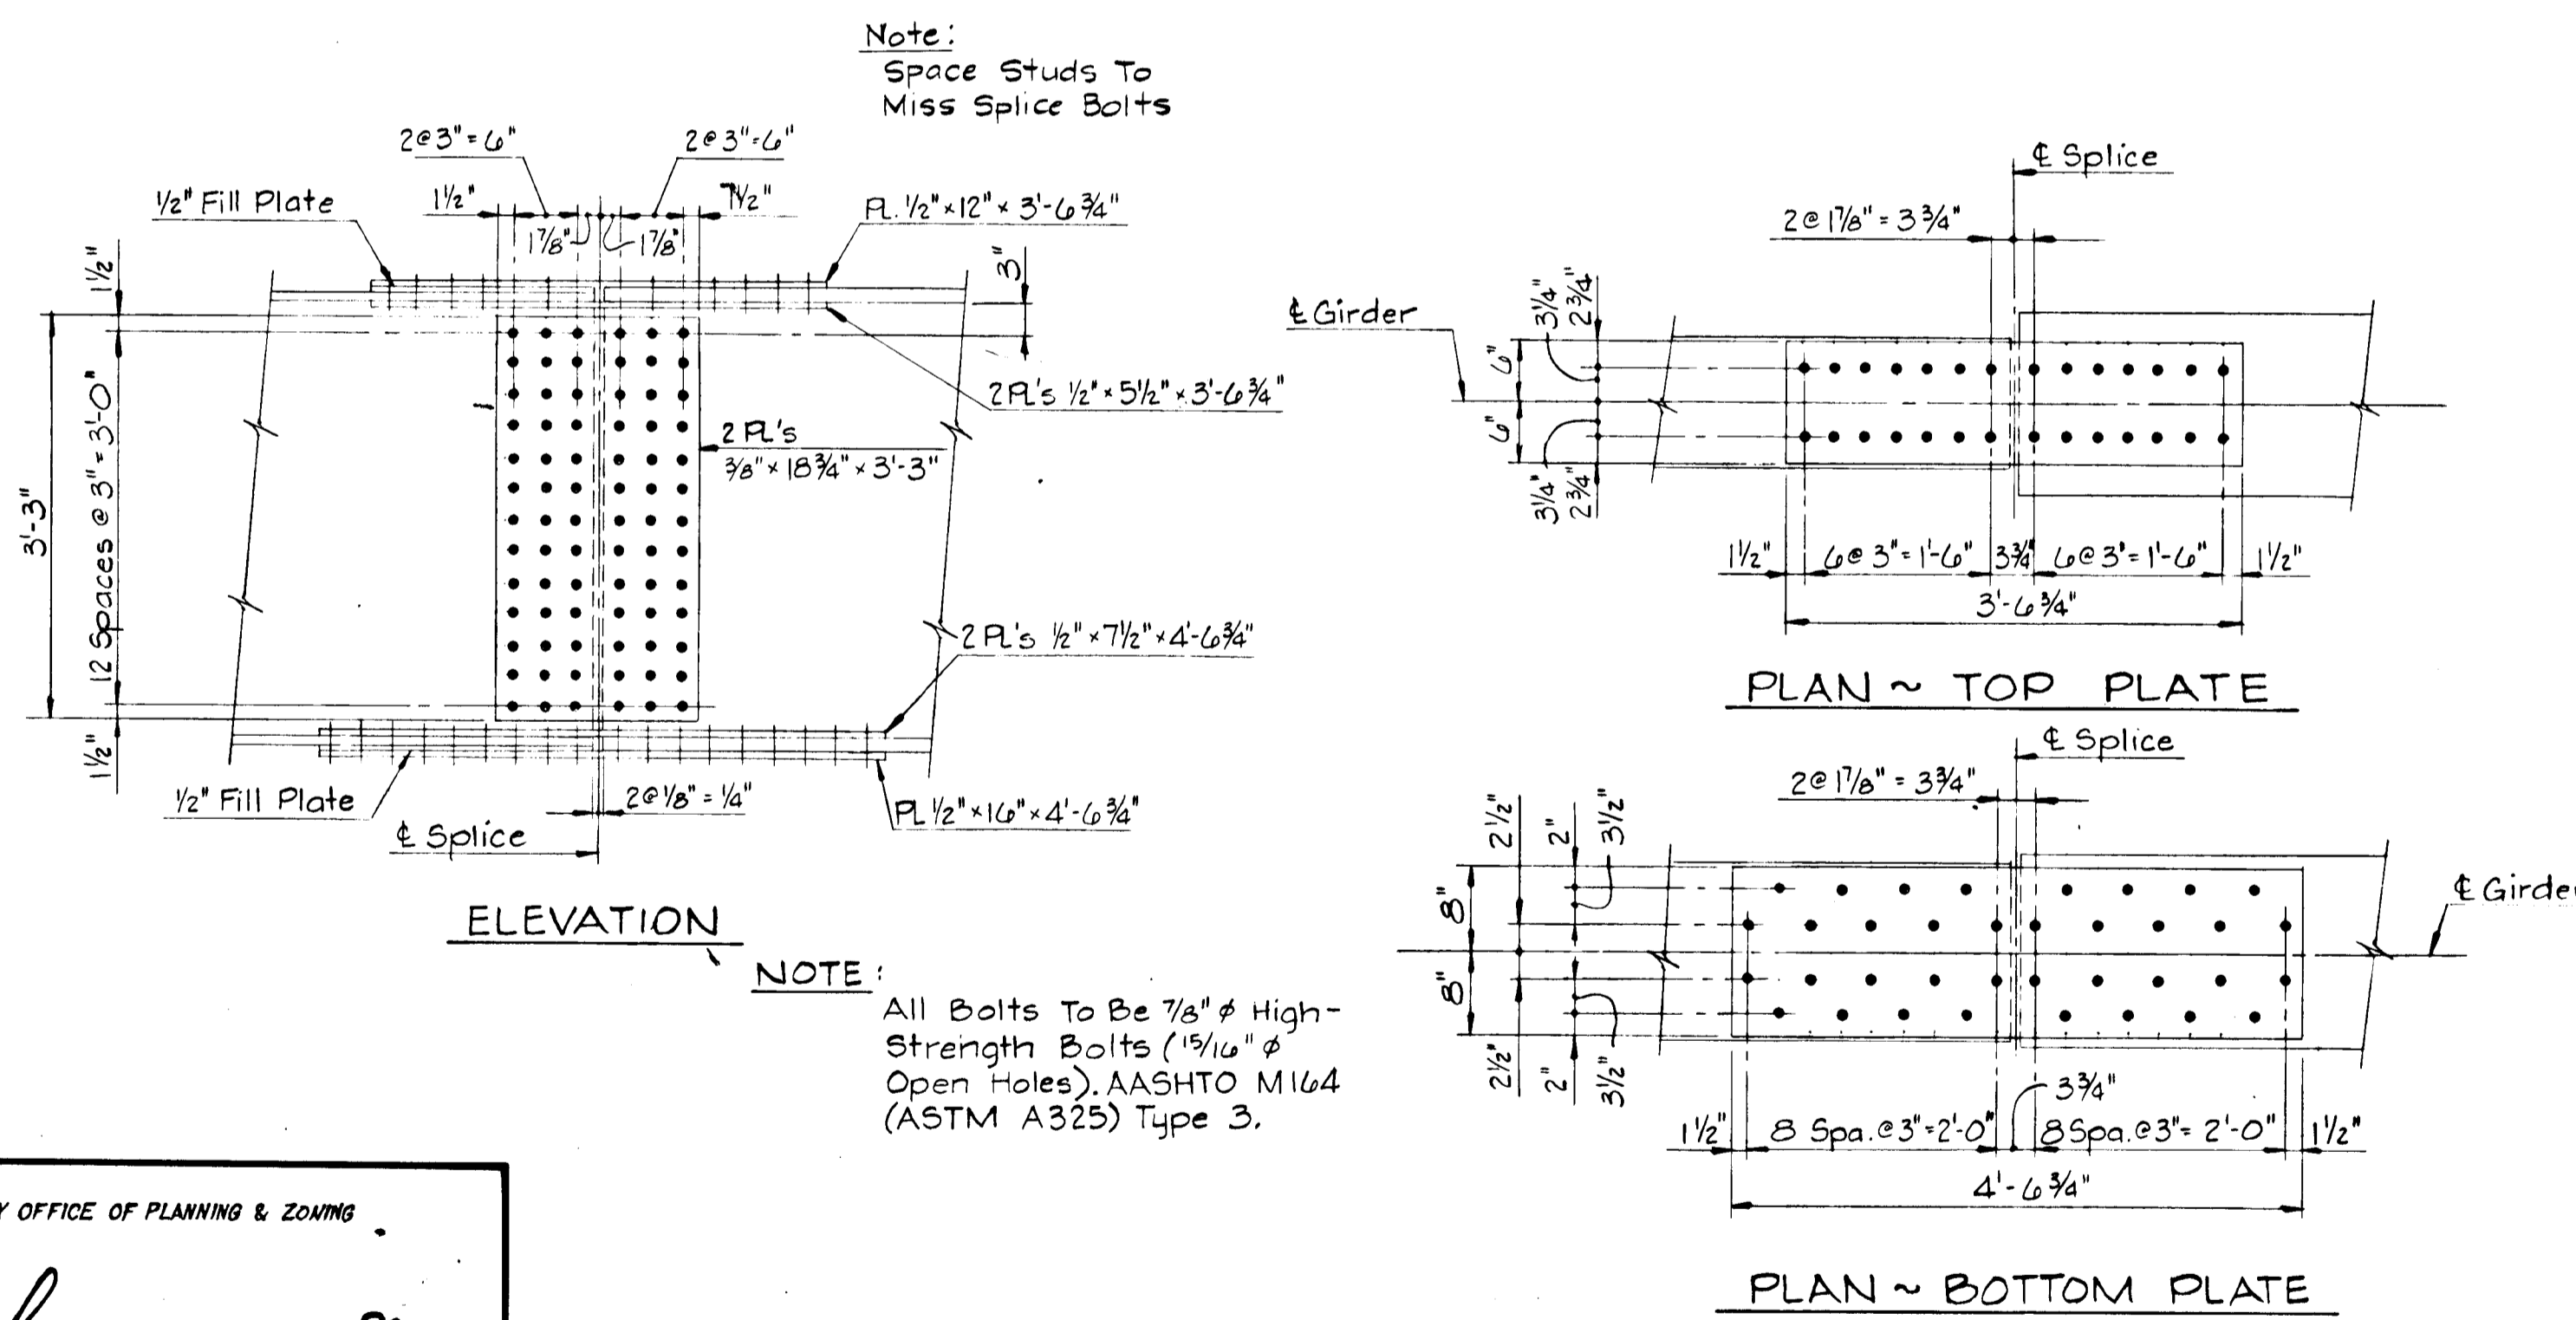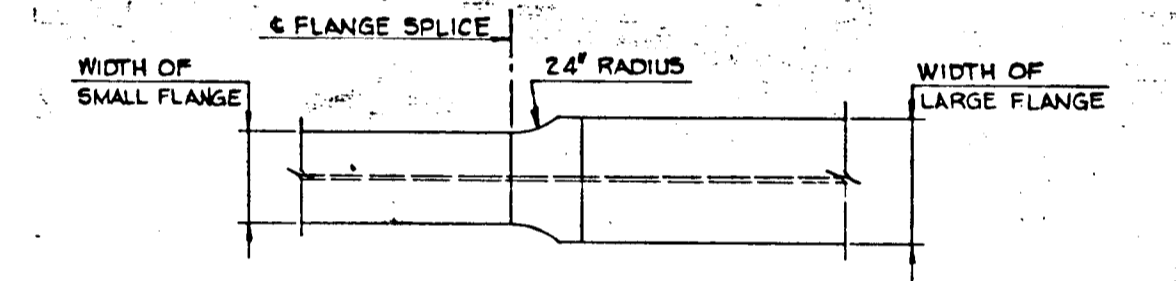

Note: For Connection Locations See Framing Plan, Sht. No. 15.

APPROVED: HOWARD COUNTY OFFICE OF PLANNING & ZONING

*Howard County* 2-3-86

CHIEF, BUREAU OF PLANNING & ZONING ADMIN.

APPROVED: HOWARD COUNTY DEPT. OF PUBLIC WORKS

*Howard County* 2-23-86

CHIEF, BUREAU OF ENGINEERING

OWNER/DEVELOPER


HOWARD RESEARCH & DEVELOPMENT CORP.

10275 LITTLE PATUXENT PARKWAY

COLUMBIA, MARYLAND 21044

#1159

No.	REVISION	DATE	BY
5	Revisions Due To Stake Out Error	1/5/88	RMJ

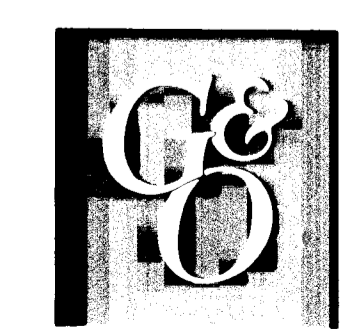

ENGINEERS • ARCHITECTS • PLANNERS • SCIENTISTS • SURVEYORS • PHOTOGRAMMETRISTS

**GREENHORNE & O'MARA, INC.**

9001 EDMONSTON ROAD, GREENBELT, MARYLAND 20770

(301) 982-2800

ANNAPOLIS, MD • ATLANTA, GA • BECKLEY, WV • CULPEPER, VA • DENVER, CO • EXPORT, PA • FAIRFAX, VA

GREENSBORO, NC • MONROE, MI • RALEIGH, NC • ROCKVILLE, MD • TAMPA, FL • WILLISTON PARK, NY

GIRDER ELEVATIONS & DETAILS

**COLUMBIA**

VILLAGE OF DORSEY'S SEARCH


SECTION 3, AREA 1, PHASE 191

TAX MAP 30 ~ PARCELS 124, 224 & 210

5TH ELECTION DISTRICT ~ HOWARD COUNTY, MARYLAND

DESIGN	SCALE AS NOTED
DRAWN	10 OF 24
DCC/RLP	SHEET
CHECKED	DATE
8/85	FILE No.
DATE	JOB No.



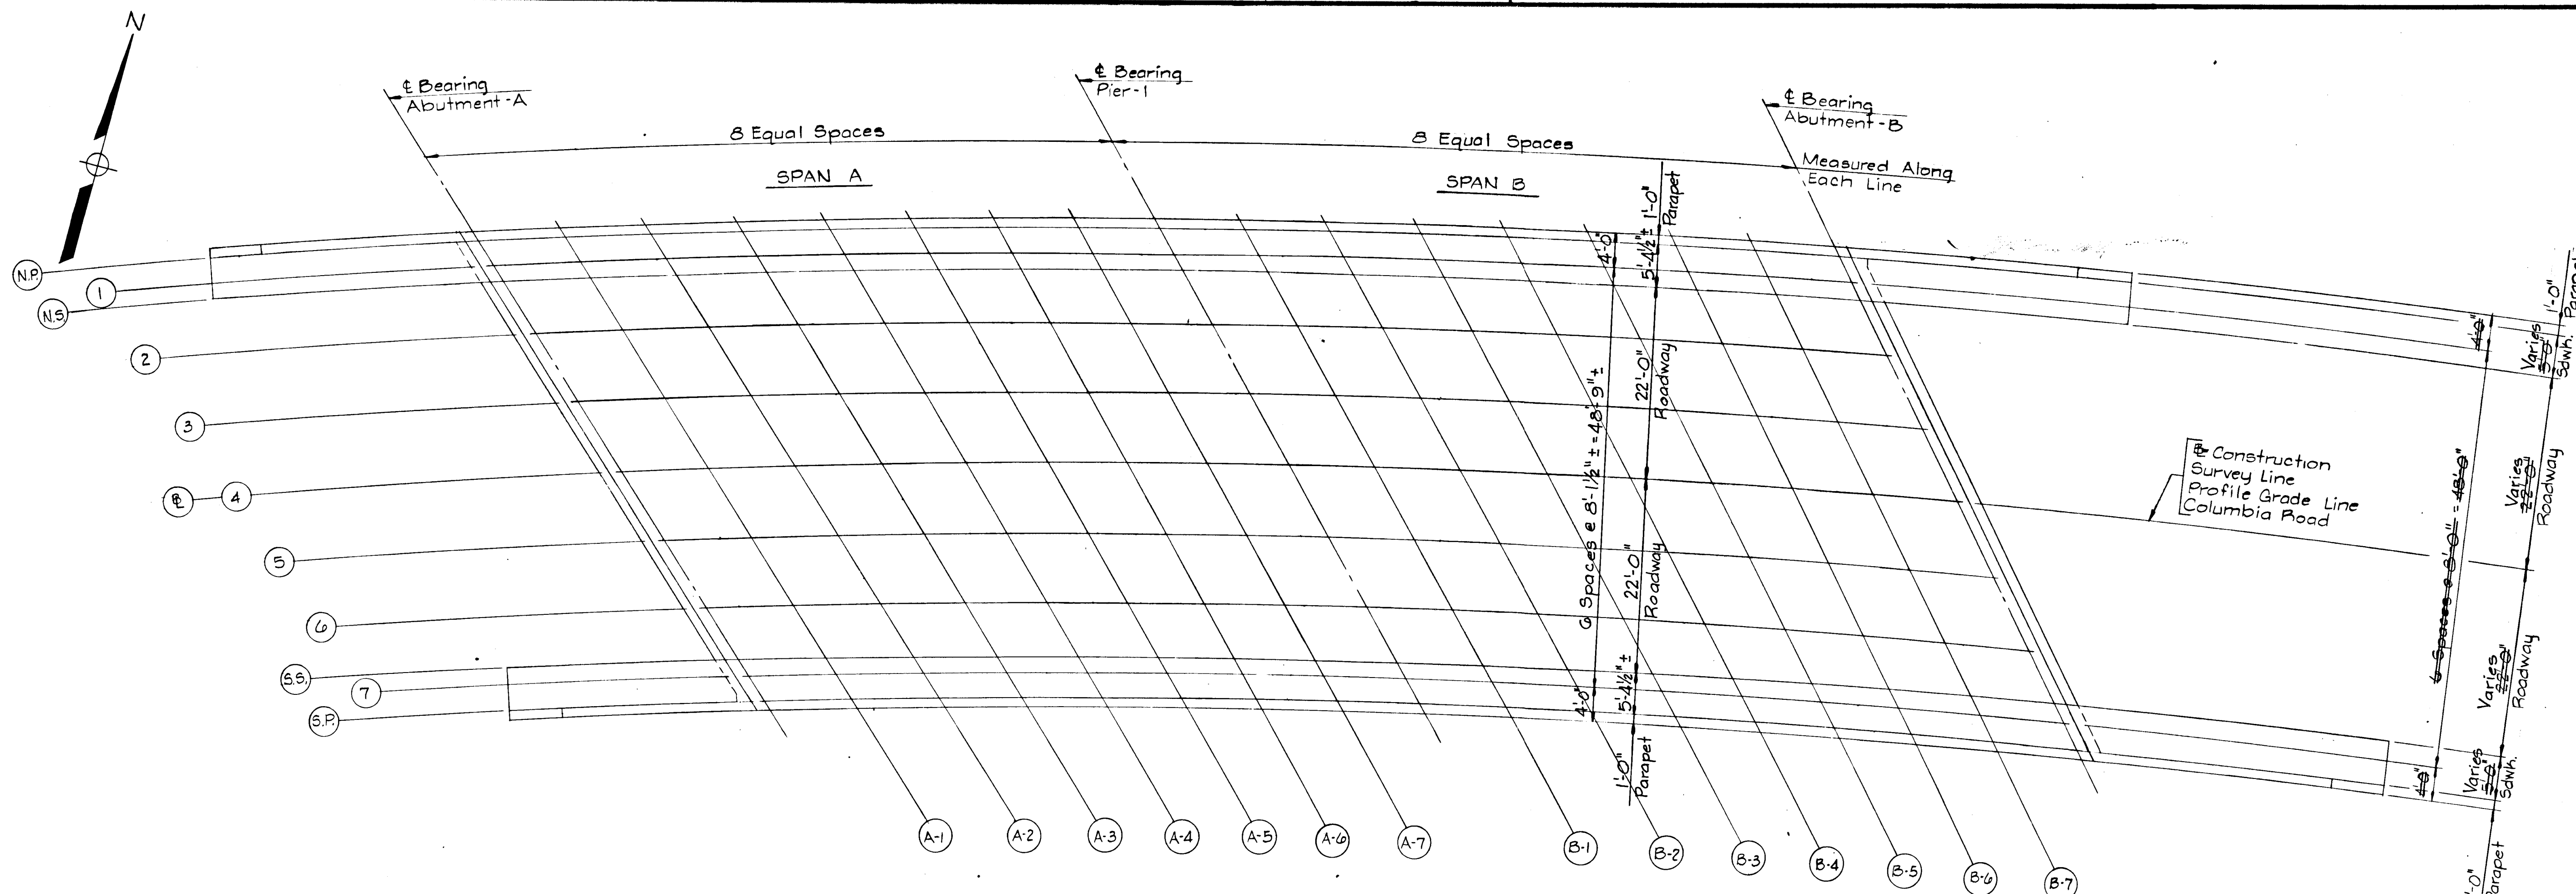


PLAN OF SUPERSTRUCTURE  
Scale: 1" = 10'

APPROVED: HOWARD COUNTY OFFICE OF PLANNING & ZONING  
*Howard M. ...* 2-3-86  
CHIEF, DIV. OF LAND DEVELOPMENT & ZONING ADMIN. DATE

APPROVED:  
HOWARD COUNTY DEPT. OF PUBLIC WORKS  
*...* 2-23-86  
CHIEF, BUREAU OF ENGINEERING DATE

		ELEVATION SCHEDULE																					
		SPAN - A							SPAN - B														
Abutment - A		A-1	A-2	A-3	A-4	A-5	A-6	A-7	Pier - 1							Abutment - B							
Line	Station	P.G.L. Elev.	Fin. Elev.	Fin. Elev.	Fin. Elev.	Fin. Elev.	Fin. Elev.	Fin. Elev.	Station	P.G.L. Elev.	Fin. Elev.	Fin. Elev.	Fin. Elev.	Fin. Elev.	Fin. Elev.	Fin. Elev.	Fin. Elev.	Station	P.G.L. Elev.	Fin. Elev.			
N.P.	5+57.44	326.14	326.63	326.73	326.82	326.91	327.01	327.10	327.19	327.29	6+31.81	326.89	327.38	327.47	327.56	327.66	327.75	327.84	327.93	328.03	7+06.01	327.63	328.12
(1)	5+58.87	326.16	325.68	325.77	325.86	325.96	326.05	326.14	326.24	326.33	6+33.46	326.90	326.42	326.52	326.61	326.70	326.80	326.89	326.98	327.08	7+07.90	327.65	327.17
N.S.	5+59.82	326.17	325.73	325.82	325.92	326.01	326.10	326.20	326.29	326.38	6+34.56	326.92	326.48	326.57	326.66	326.76	326.85	326.94	327.04	327.13	7+09.17	327.64	327.22
(2)	5+62.69	326.20	325.88	325.97	326.06	326.16	326.25	326.35	326.44	326.53	6+37.90	326.95	326.63	326.72	326.82	326.91	327.00	327.10	327.19	327.29	7+13.02	327.70	327.38
(3)	5+66.57	326.24	326.08	326.17	326.27	326.36	326.45	326.55	326.64	326.74	6+42.42	326.99	326.83	326.93	327.02	327.12	327.21	327.31	327.40	327.50	7+18.22	327.75	327.59
(4)	5+70.50	326.28	326.28	326.37	326.47	326.56	326.66	326.75	326.85	326.94	6+47.00	327.04	327.04	327.14	327.23	327.33	327.42	327.52	327.61	327.71	7+23.50	327.80	327.80
(5)	5+74.49	326.31	326.15	326.25	326.35	326.44	326.54	326.64	326.73	326.83	6+51.66	327.09	326.93	327.02	327.12	327.22	327.31	327.41	327.51	327.60	7+28.87	327.86	327.70
(6)	5+78.54	326.36	326.04	326.13	326.23	326.33	326.42	326.52	326.62	326.72	6+56.38	327.13	326.81	326.91	327.01	327.11	327.20	327.30	327.40	327.50	7+34.33	327.91	327.59
S.S.	5+81.62	326.39	325.95	326.04	326.14	326.24	326.34	326.44	326.53	326.63	6+59.98	327.17	327.73	326.83	326.93	327.02	327.12	327.22	327.32	327.42	7+38.48	327.95	327.52
(7)	5+82.66	326.40	325.92	326.01	326.11	326.21	326.31	326.41	326.51	326.60	6+61.19	327.18	326.70	326.80	326.90	327.00	327.10	327.20	327.30	327.40	7+39.88	327.97	327.49
S.P.	5+84.22	326.41	326.90	327.00	327.10	327.20	327.30	327.39	327.49	327.59	6+63.01	327.20	327.69	327.79	327.89	327.99	328.08	328.18	328.28	328.38	7+41.98	327.99	328.48

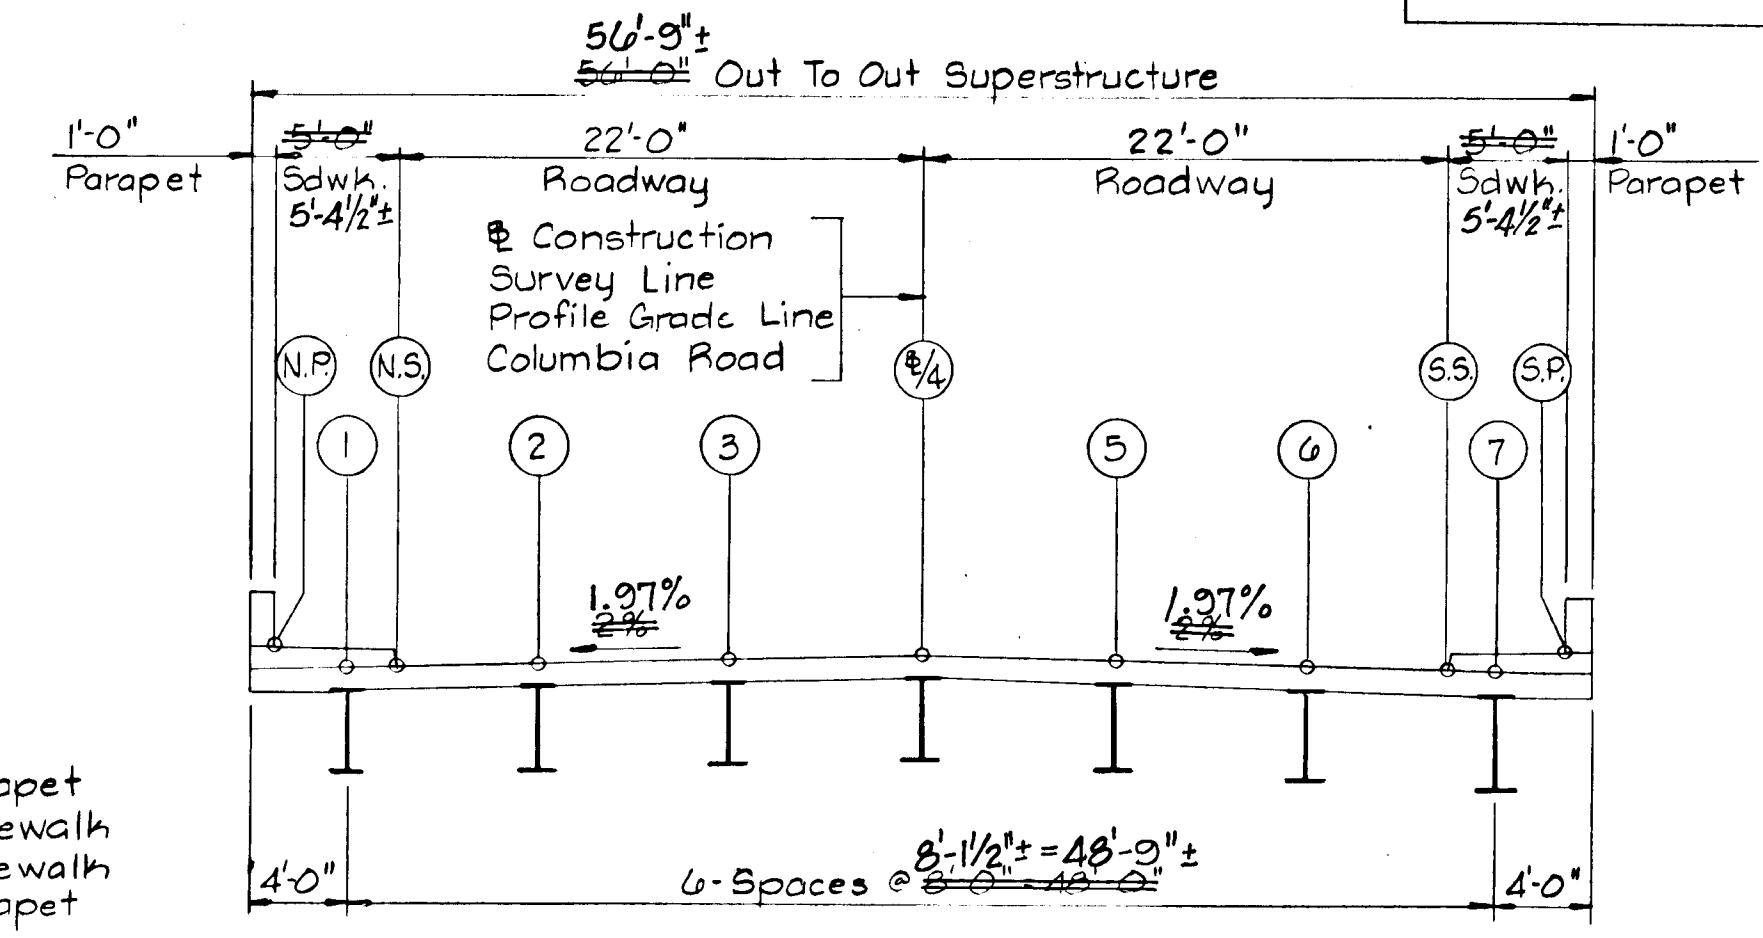

LEGEND:  
N.P. Denotes North Parapet  
N.S. Denotes North Sidewalk  
S.S. Denotes South Sidewalk  
S.P. Denotes South Parapet

NOTE:  
For Boring Sequence See Sht. 19

TYPICAL SECTION  
Scale: 1/8" = 1'-0"



Bridge No. #HO-137

OWNER/DEVELOPER  
HOWARD RESEARCH & DEVELOPMENT CORP.  
10275 LITTLE PATUXENT PARKWAY  
COLUMBIA, MARYLAND 21044

No.	REVISION	DATE	BY
5	Revisions Due To Stake Out Error	1/5/88	RMJ





ENGINEERS • ARCHITECTS • PLANNERS • SCIENTISTS • SURVEYORS • PHOTOGRAMMETRISTS  
**GREENHORNE & O'MARA, INC.**  
9001 EDMONSTON ROAD, GREENBELT, MARYLAND 20770  
(301) 982-2800  
ANNAPOLIS, MD • ATLANTA, GA • BECKLEY, WV • CULPEPER, VA • DENVER, CO • EXPORT, PA • FAIRFAX, VA  
GREENSBORO, NC • MONROE, MI • RALEIGH, NC • ROCKVILLE, MD • TAMPA, FL • WILLISTON PARK, NY

SUPERSTRUCTURE ELEVATIONS  
**COLUMBIA**  
VILLAGE OF DORSEY'S SEARCH  
SECTION 3, AREA 1, PHASE 191  
TAX MAP 30 ~ PARCELS 124, 224 & 210  
5TH ELECTION DISTRICT ~ HOWARD COUNTY, MARYLAND

R/L DESIGN	SCALE AS NOTED
RMJ DRAWN	17 OF 24
DCC/R/LP CHECKED	SHEET
8/85 DATE	JOB No. FILE No.

#1159

F-86-55

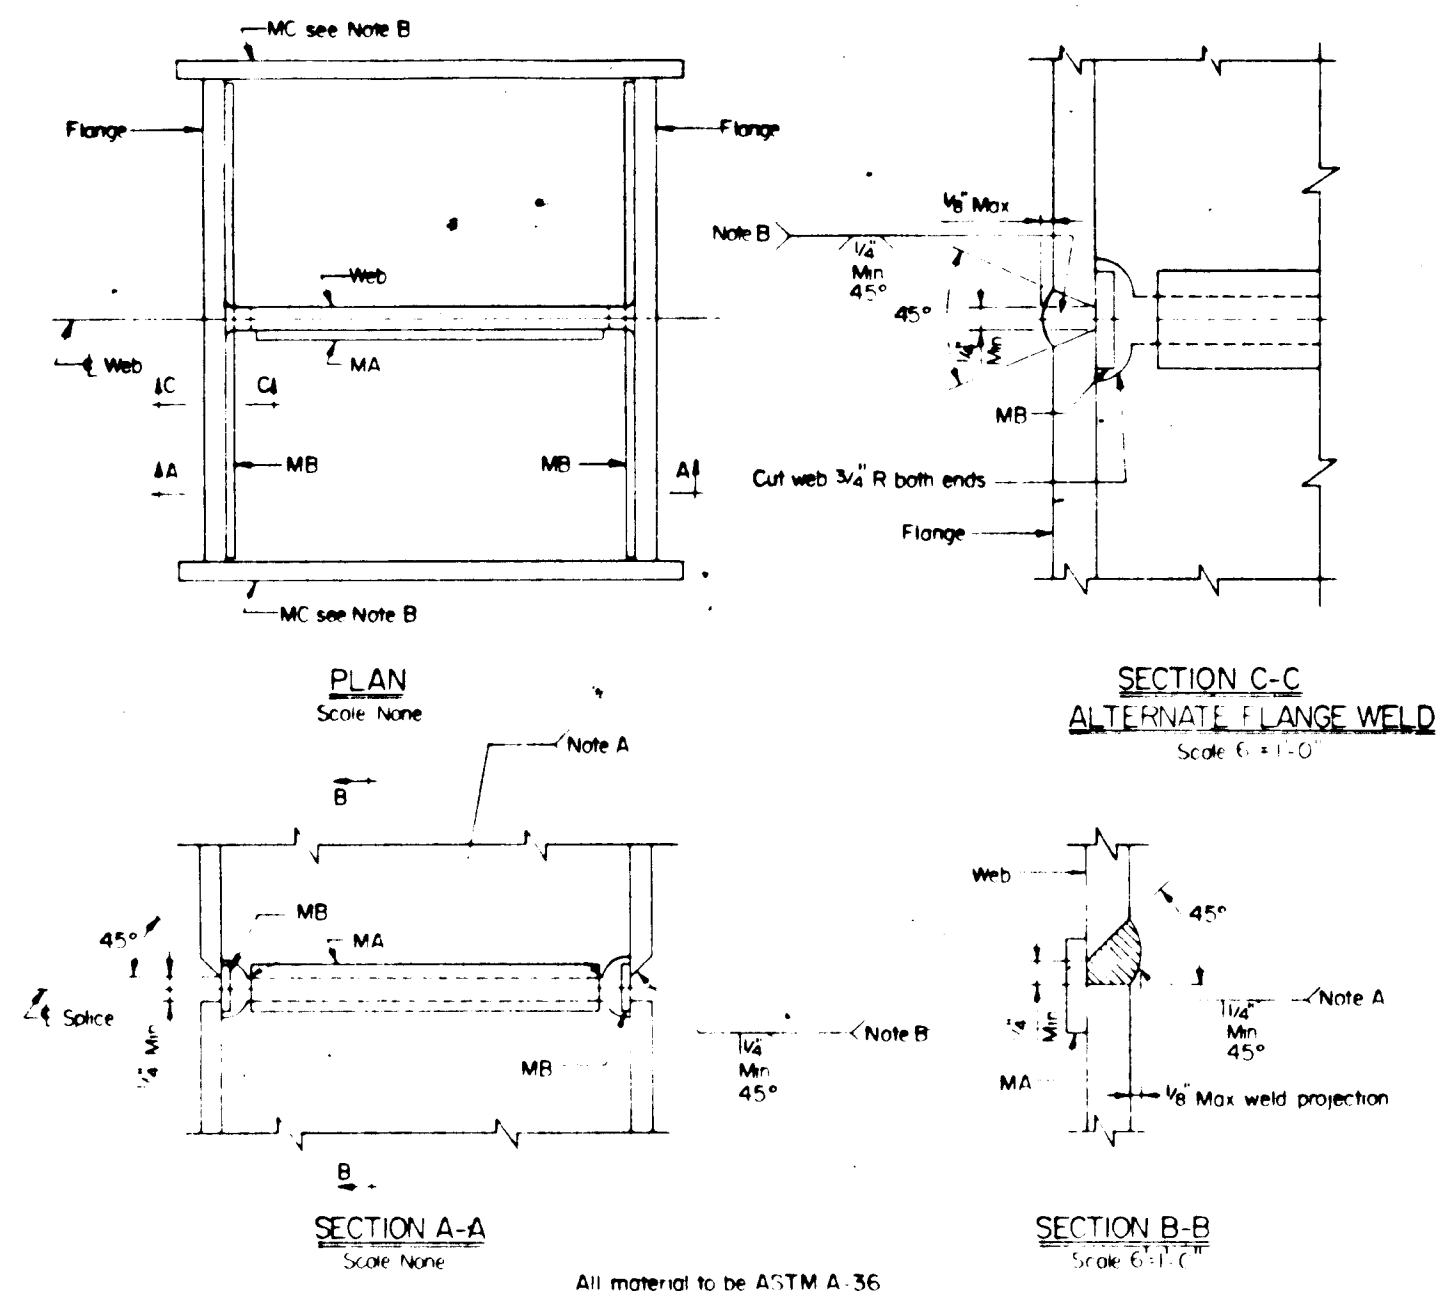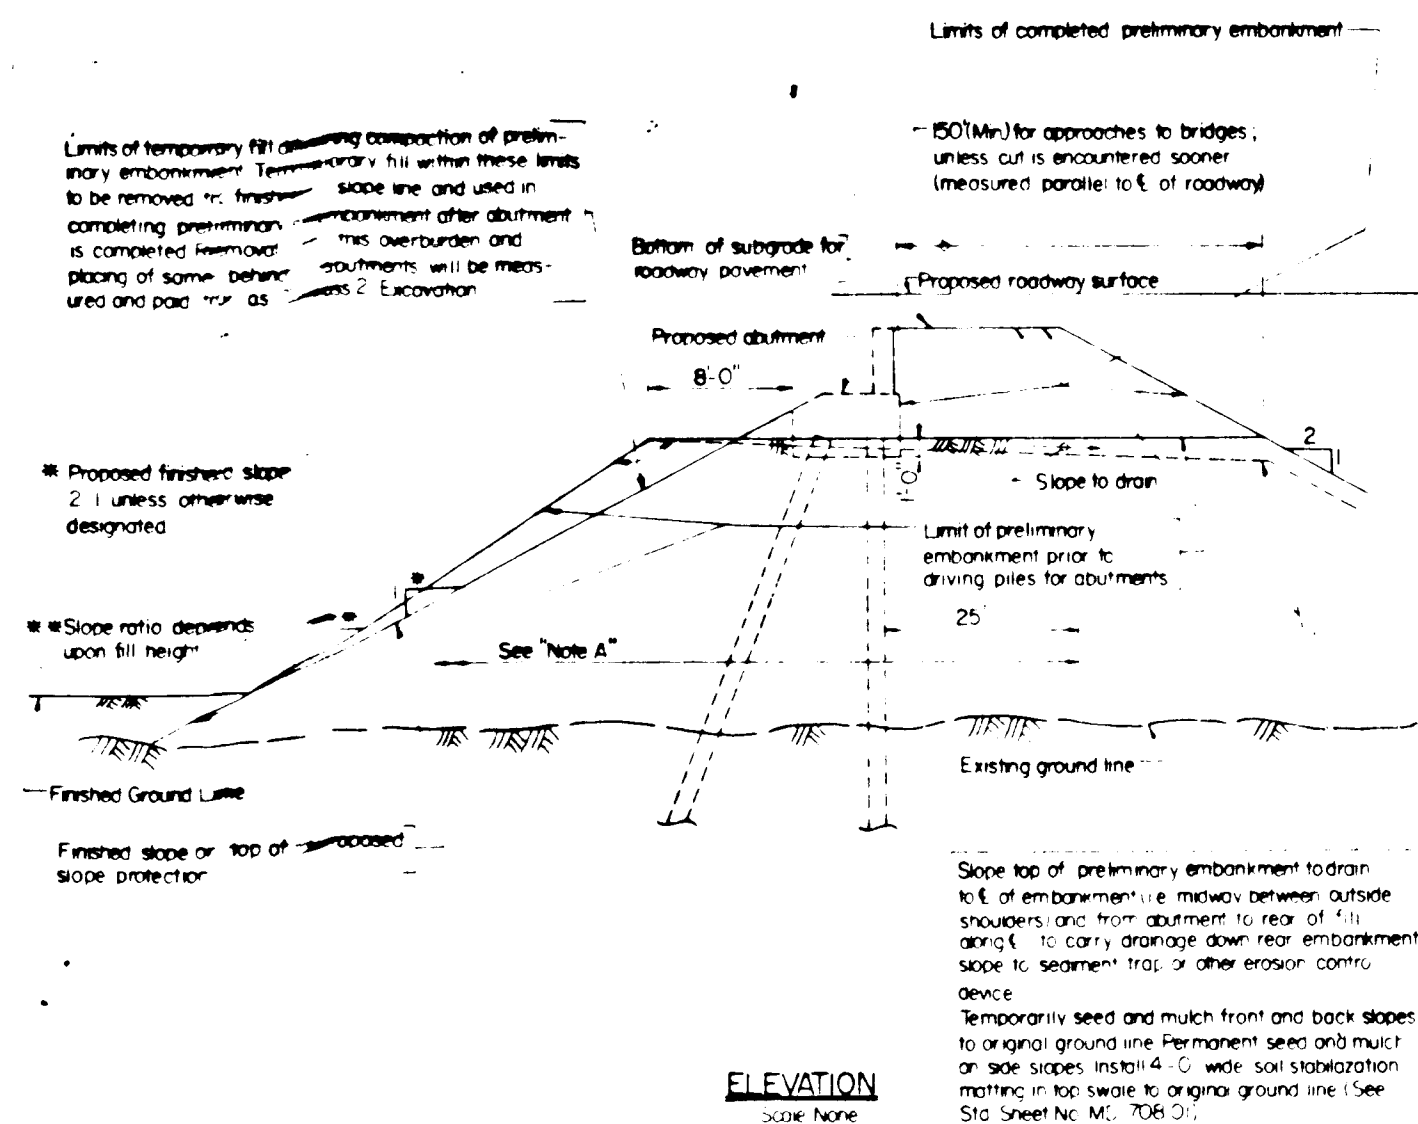

APPROVED: HOWARD COUNTY OFFICE OF PLANNING & ZONING

*John W. M... 2-7-86*  
CHIEF, DIV. OF LAND DEVELOPMENT & ZONING ADMIN. DATE

APPROVED:  
HOWARD COUNTY DEPT. OF PUBLIC WORKS

*[Signature]* 2-23-86  
CHIEF, BUREAU OF ENGINEERING DATE

Material Required

1 Bar MA 1" x 3/4" x 7/16"	1 Bar MA 1" x 3/4" x 9/16"	1 Bar MA 1" x 3/4" x 1" - 0"
For HP 10 x 42	For HP 12 x 53	For HP 14 x 73
2 Bars MB 1" x 3/4" x 10"	2 Bars MB 1" x 3/4" x 11"	2 Bars MB 1" x 3/4" x 12"
2 Bars MC 3" x 3/4" x 11"	2 Bars MC 3" x 3/4" x 11"	2 Bars MC 3" x 3/4" x 11"

Note A: End of weld to be smooth and flush with web cut.

Note B: Bar MC to be tack welded to flange at splice to back up end of flange weld, remove MC after weld is completed. End of weld must be smooth and flush with edge of flange. End of weld must be smooth and flush with edge of flange if pile is unsupported in wind area such as in air, water, or soft mud.

Note C: Let welds cool to air temperature before driving pile.

Note D: No pile splicing to be allowed on any portion of pile that is to remain exposed or to be above finished ground line in completed structure.

APPROVAL: [Signature] DATE: 8-24-84

STATE OF MARYLAND DEPARTMENT OF TRANSPORTATION STATE HIGHWAY ADMINISTRATION DIVISION OF BRIDGE DEVELOPMENT STEEL H PILE SPLICE DETAILS

NO BR-FD(001)-75-15 SHEET 1 OF 1

Note

- Material: Cast Steel ASTM A27 65/35
- All piles 1/2"
- Pile to be welded to pile with a continuous single level groove weld along outside face of flange.
- Exterior face of flange to be flame cut beveled at 45° prior to welding.
- For each shipment of points a foundry certificate verifying material meets the specifications is required.

APPROVAL: [Signature] DATE: 8-24-84

STATE OF MARYLAND DEPARTMENT OF TRANSPORTATION STATE HIGHWAY ADMINISTRATION DIVISION OF BRIDGE DEVELOPMENT PILE POINT FOR 12" H PILE

STANDARD NO BR-FD(005)-79-85 SHEET 1 OF 1

Note

- Material: Cast Steel ASTM A27 65/35
- All piles 1/2"
- Pile to be welded to pile with a continuous single level groove weld along outside face of flange.
- Exterior face of flange to be flame cut beveled at 45° prior to welding.
- For each shipment of points a foundry certificate verifying material meets the specifications is required.

APPROVAL: [Signature] DATE: 8-24-84



STATE OF MARYLAND DEPARTMENT OF TRANSPORTATION STATE HIGHWAY ADMINISTRATION DIVISION OF BRIDGE DEVELOPMENT TOOTHED PILE POINT FOR 12" H PILE

STANDARD NO BR-FD(008)-79-88 SHEET 1 OF 1

APPROVAL: [Signature] DATE: 8-24-84

STATE OF MARYLAND DEPARTMENT OF TRANSPORTATION STATE HIGHWAY ADMINISTRATION DIVISION OF BRIDGE DEVELOPMENT PRELIMINARY EMBANKMENT FOR PEDESTAL TYPE BRIDGE ABUTMENTS ON PILES

STANDARD NO BR-FD(001)-75-17 SHEET 1 OF 1

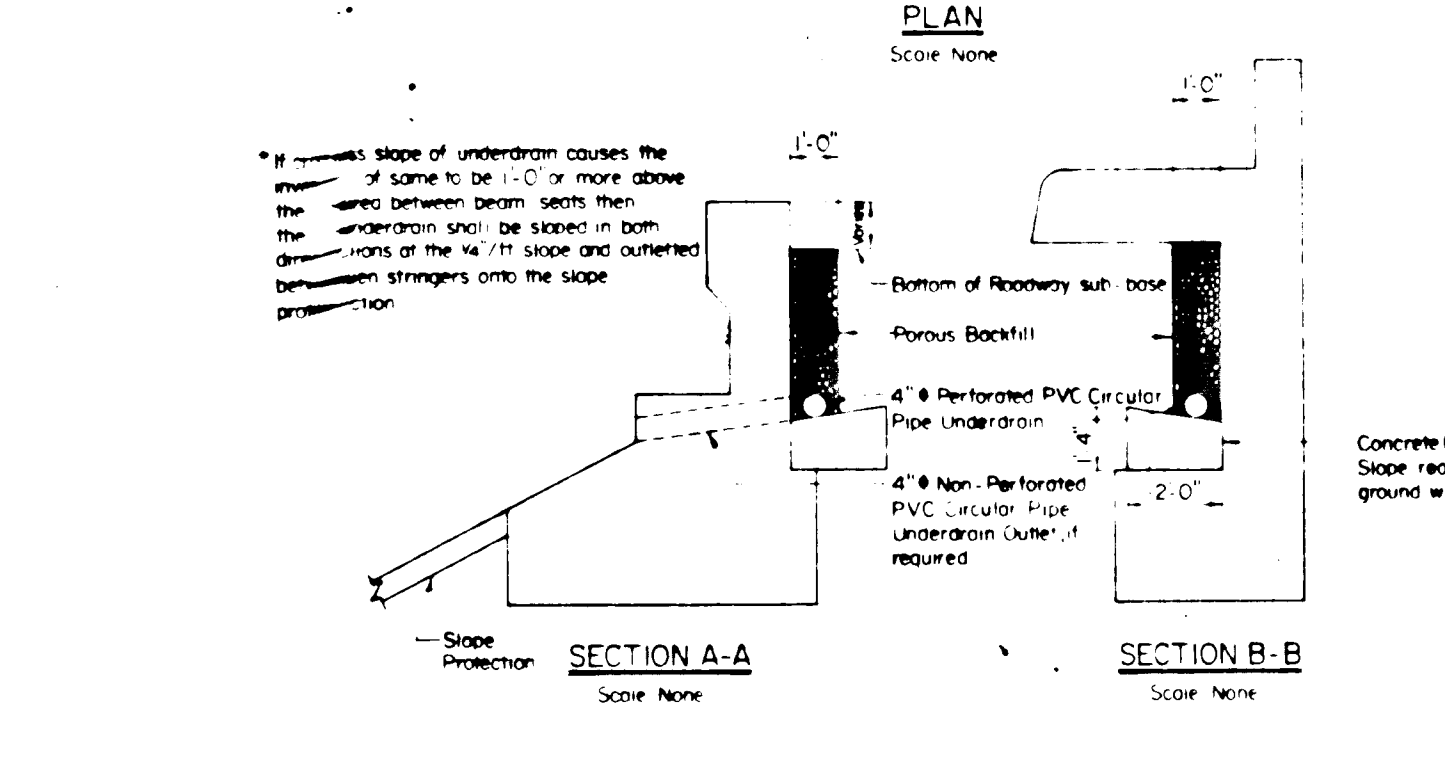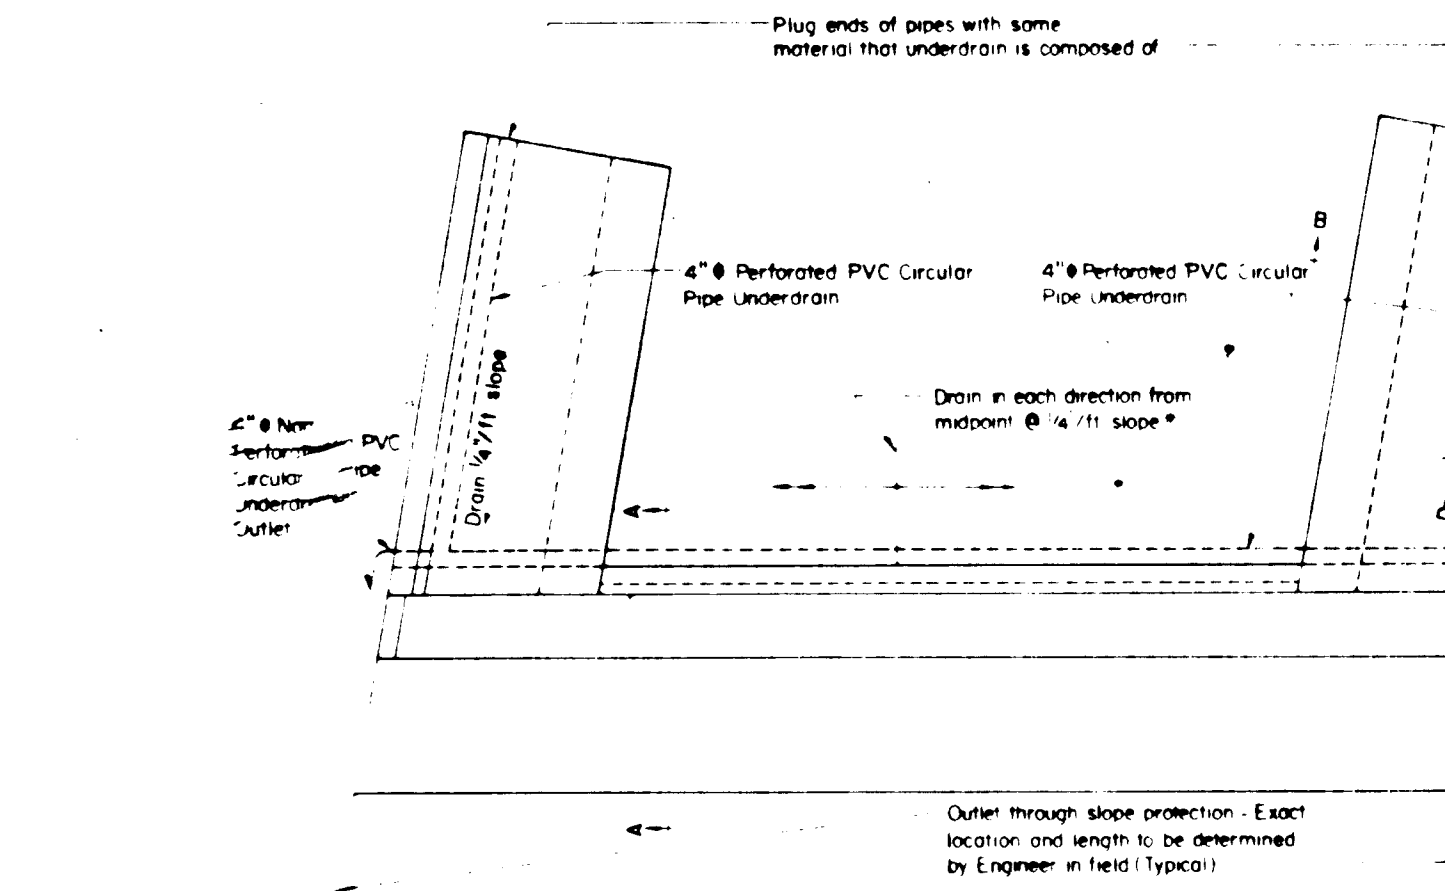



Note

- For details of underdrain see SH-4 Standard No. MC 5000-1-1 Sub-Base Drainage Detail Section.
- To be directed to the bottom of the approach roadway grades.
- Slope of Slope Underdrain Outlets is 1/4" ft.
- Porous backfill shall be stone conforming to AASHTO M 43, Size No 57.

APPROVAL: [Signature] DATE: 8-20-80

STATE OF MARYLAND DEPARTMENT OF TRANSPORTATION STATE HIGHWAY ADMINISTRATION DIVISION OF BRIDGE DEVELOPMENT DRAINAGE SYSTEM FOR PEDESTAL ABUTMENTS

NO BR-SB(001)-80-101 SHEET 1 OF 1

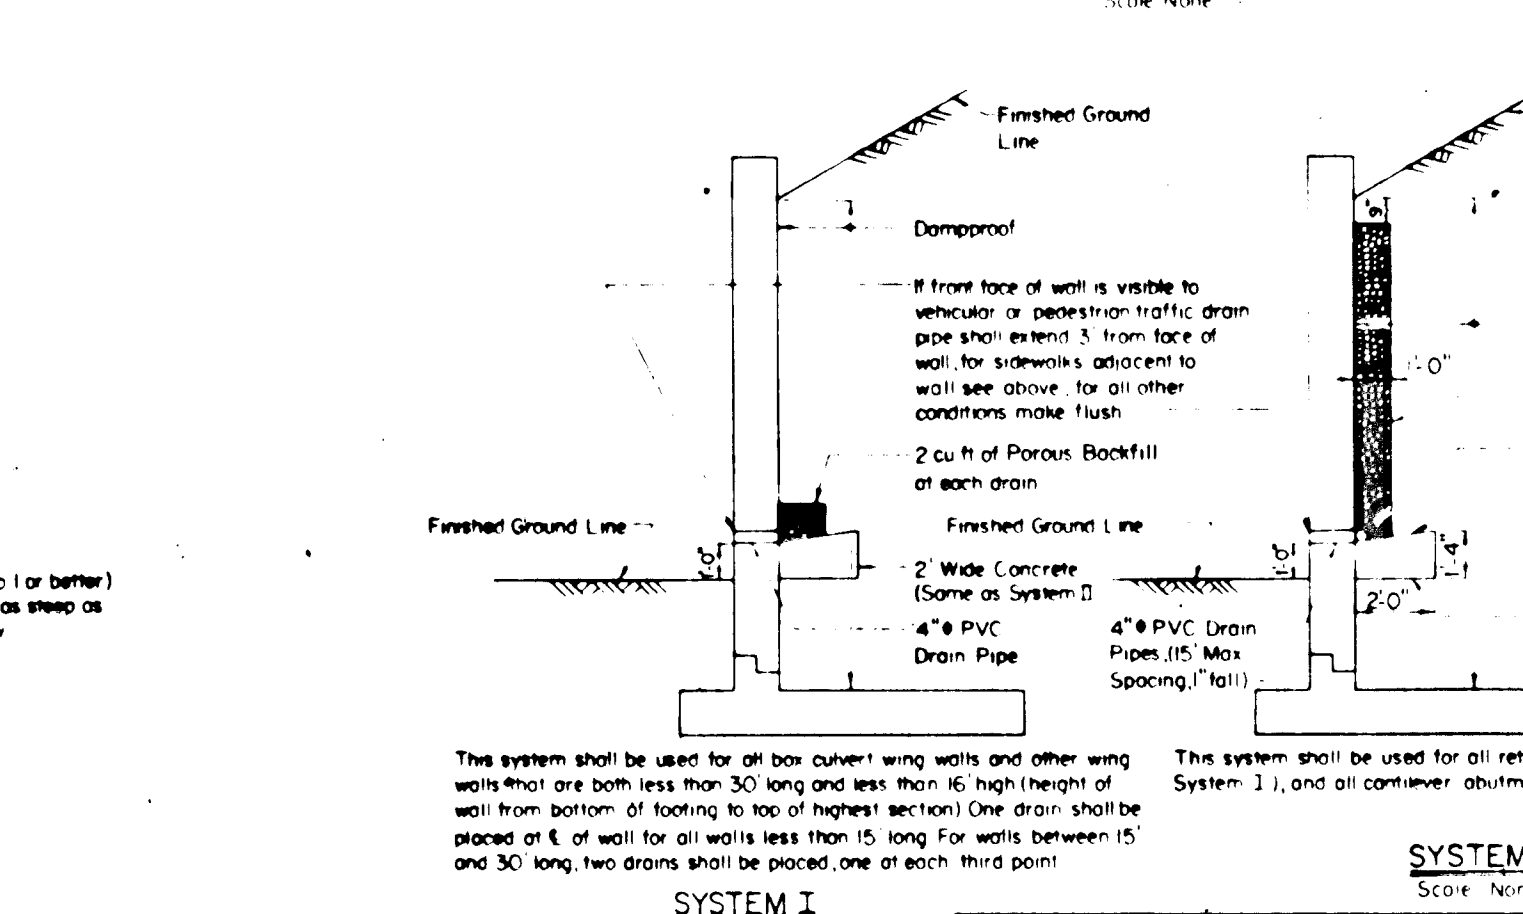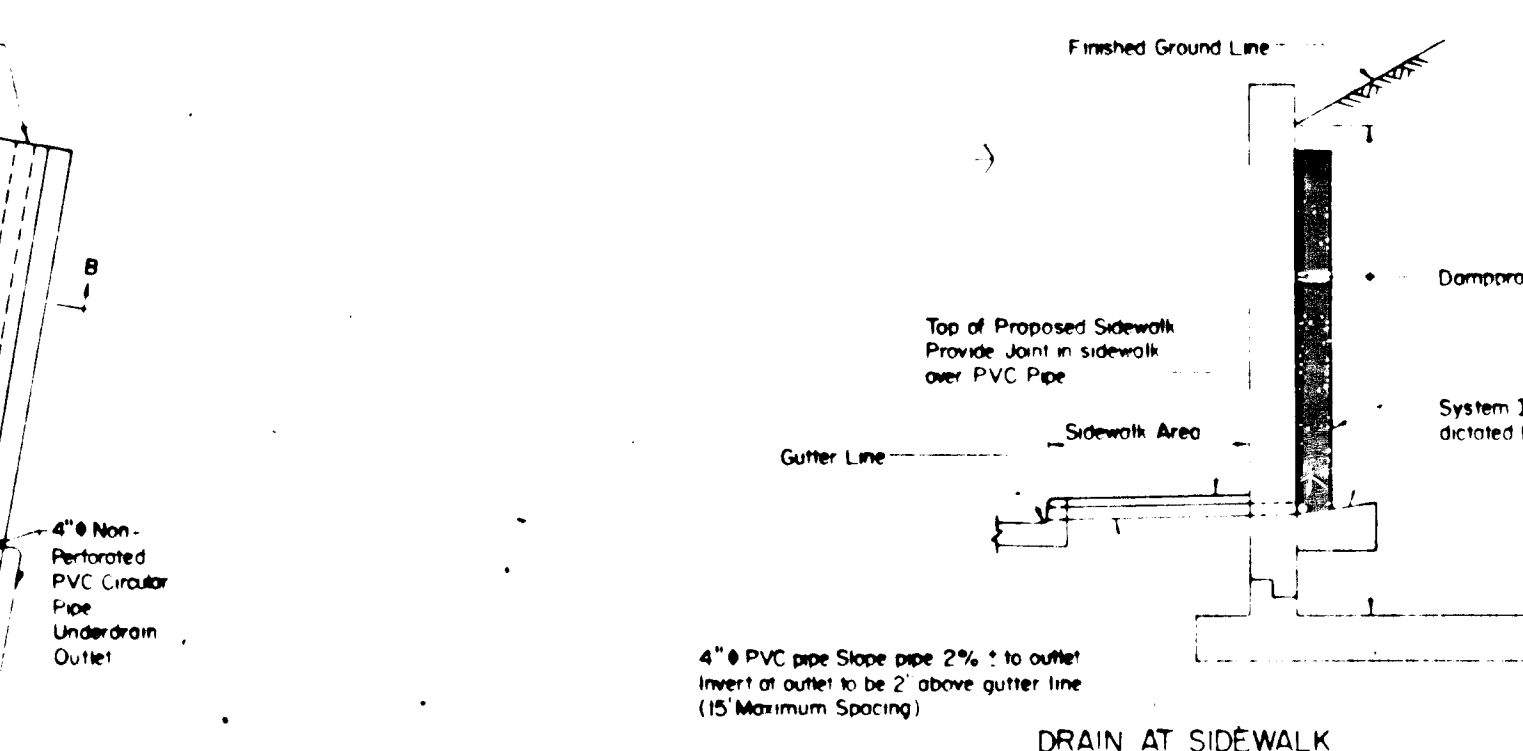



Note

- Exact elevation of drain to be determined by Engineer in the field.
- Porous Backfill shall be stone conforming to AASHTO M 43, Size No 57.

APPROVAL: [Signature] DATE: 8-20-80

STATE OF MARYLAND DEPARTMENT OF TRANSPORTATION STATE HIGHWAY ADMINISTRATION DIVISION OF BRIDGE DEVELOPMENT RETAINING WALL, WING WALL, AND CANTILEVER ABUTMENT DRAINAGE SYSTEMS

NO RW(001)-80-100 SHEET 1 OF 1

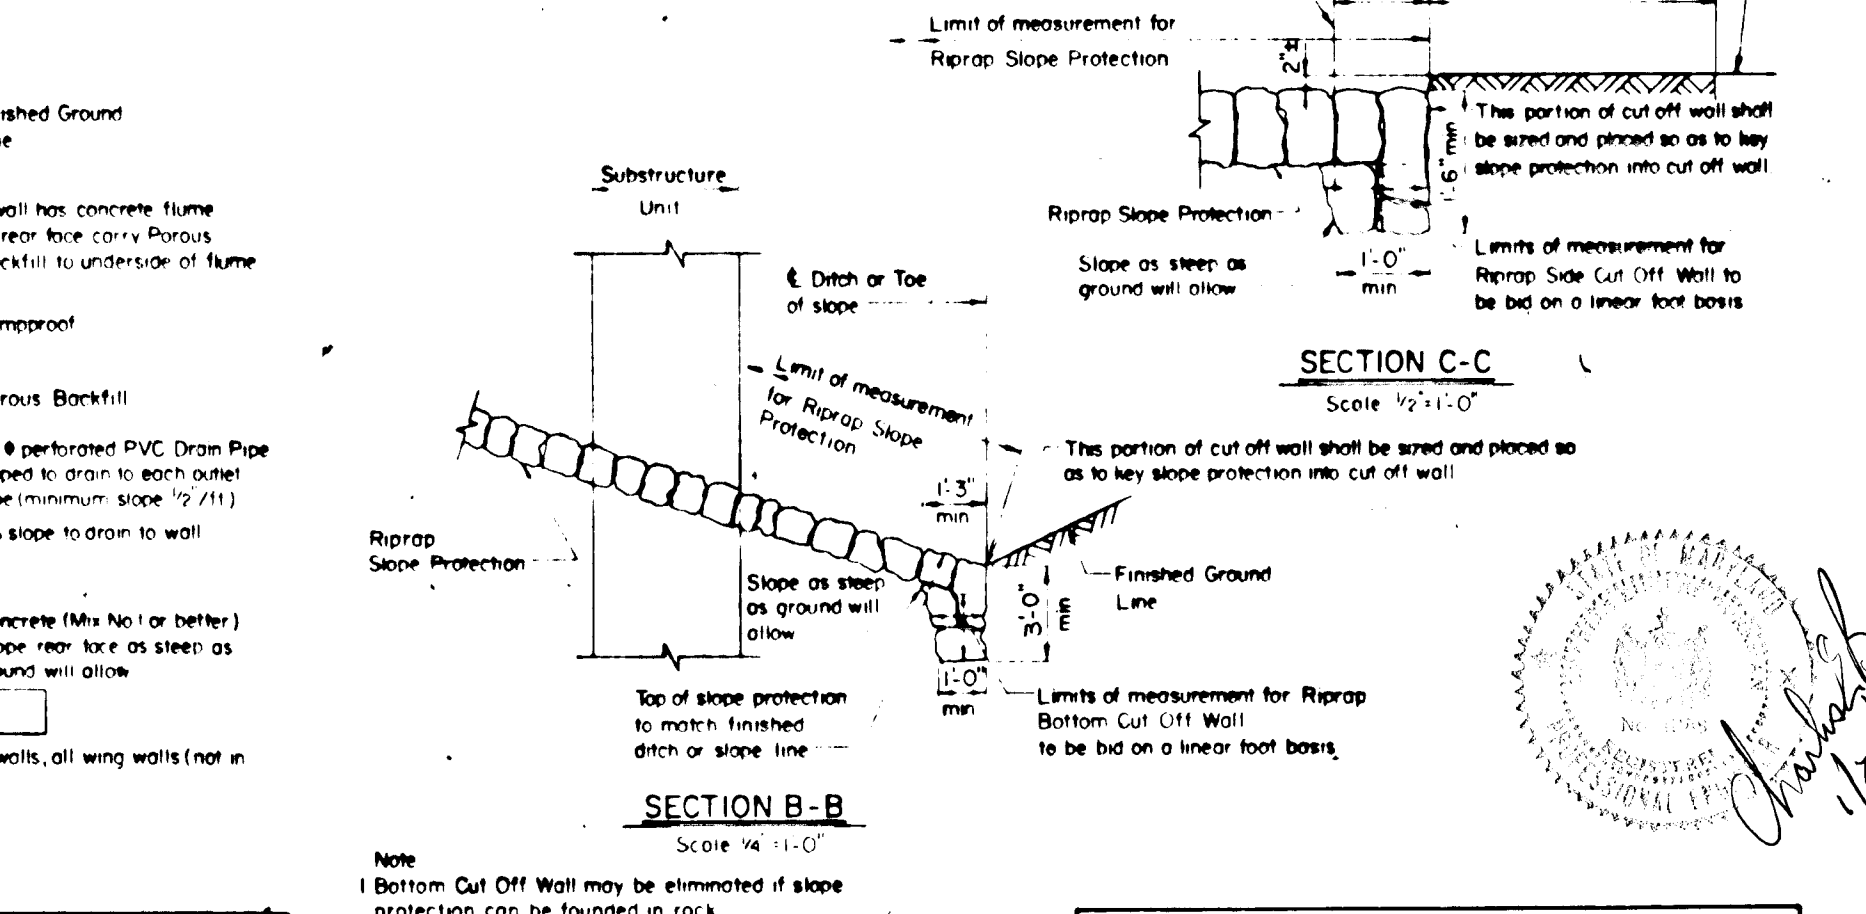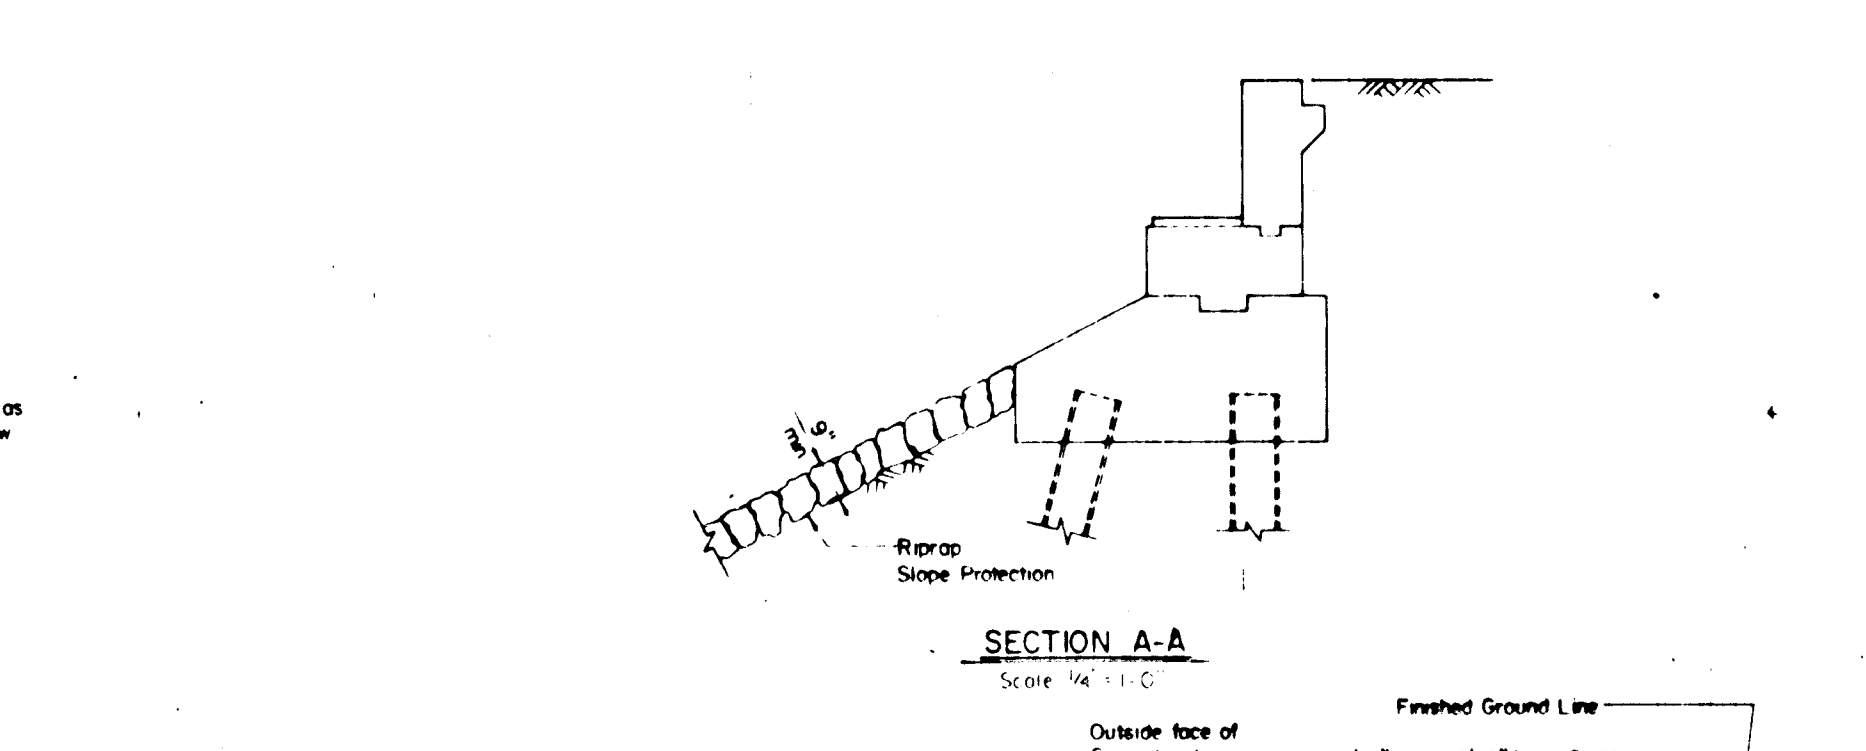



Note

- Bottom Cut Off Wall may be eliminated if slope protection can be founded in rock.
- All material for riprap slope protection shall be Class 1 conforming to Subsection 905.01 of the Specifications.
- In areas where scourer downspouts will be discharging onto this type of slope protection a 6" diameter of selected backfill shall be placed under the slope protection for an area 5' x 5' centered above outlet. Cost of Selected Backfill to be included in Slope Protection items.

APPROVAL: [Signature] DATE: 8-20-80

STATE OF MARYLAND DEPARTMENT OF TRANSPORTATION STATE HIGHWAY ADMINISTRATION DIVISION OF BRIDGE DEVELOPMENT RIPRAP SLOPE PROTECTION FOR BRIDGES CARRYING ROAD OVER ROAD OR RAILROAD

NO M(021)-78-75 SHEET 3 OF 3

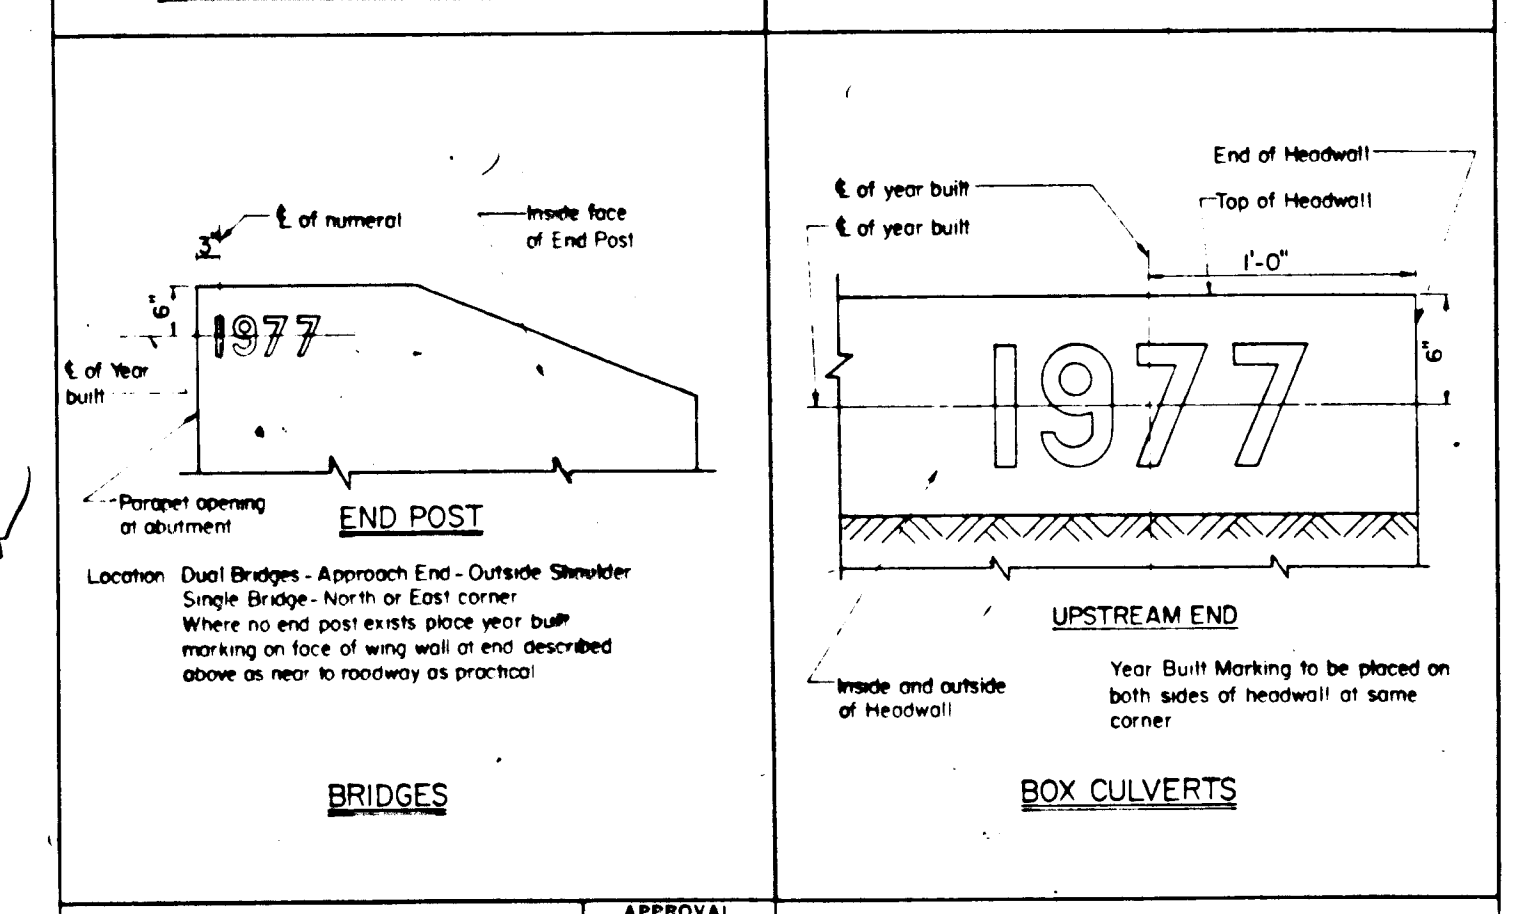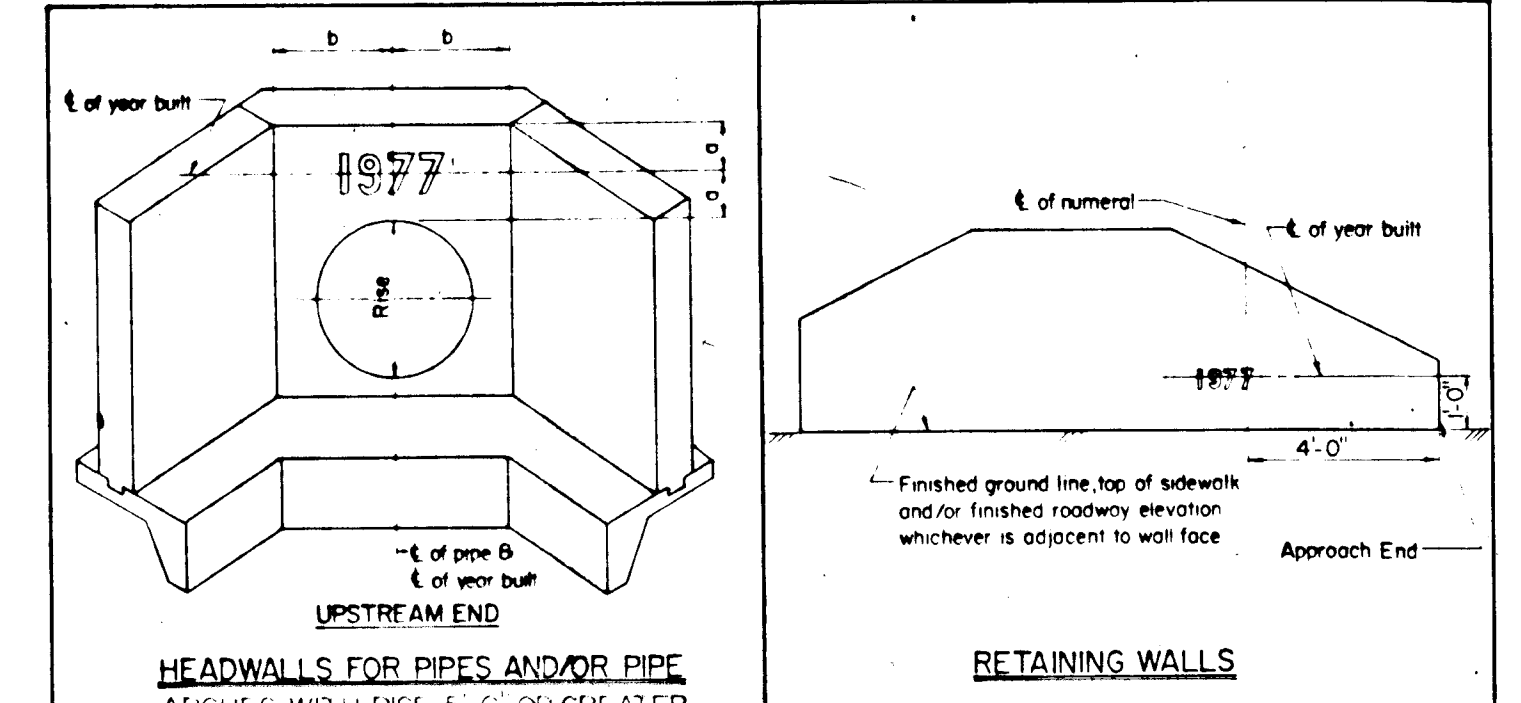

Note

- For details of Standard Numbers see Standards Numbers MD 400.01 thru MD 400.04.
- For existing structures where a year built is shown on the structure and structure is to be rehabilitated the marking should read (B42-77) (old year first - new year).
- For existing structures with no year built marking contact Div of Bridge Development for details.

APPROVAL: [Signature] DATE: 8-25-80

STATE OF MARYLAND DEPARTMENT OF TRANSPORTATION STATE HIGHWAY ADMINISTRATION DIVISION OF BRIDGE DEVELOPMENT LOCATION OF YEAR BUILT MARKING

STANDARD NO M(021)-78-74 SHEET 1 OF 1

OWNER/DEVELOPER

HOWARD RESEARCH & DEVELOPMENT CORP.

10275 LITTLE PATUXENT PARKWAY

COLUMBIA, MARYLAND 21044

#1159

NO	REVISION	DATE	BY

ENGINEERS • ARCHITECTS • PLANNERS • SCIENTISTS • SURVEYORS • PHOTOGRAMMETRISTS

**GREENHORNE & O'MARA, INC.**

9001 EDMONSTON ROAD, GREENBELT, MARYLAND 20770

(301) 982-2800

ANNAPOLIS MD • ATLANTA GA • BECKLEY WV • CULPEPER VA • DENVER CO • EXPORT PA • FAIRFAX VA

GREENSBORO NC • MONROE MI • RALEIGH NC • ROCKVILLE MD • TAMPA FL • WILLISTON PARK NY

STANDARD DETAILS

**COLUMBIA**

VILLAGE OF DORSEY'S SEARCH

SECTION 3, AREA 1, PHASE 191

TAX MAP 30 ~ PARCELS 124,224 & 210

5TH ELECTION DISTRICT ~ HOWARD COUNTY, MARYLAND

SHA DESIGN SCALE

SHA DRAWN 18 OF 24



DCC/RLP CHECKED SHEET

8/85 DATE

DATE JOB No. FILE No.



R12167

F-86-55

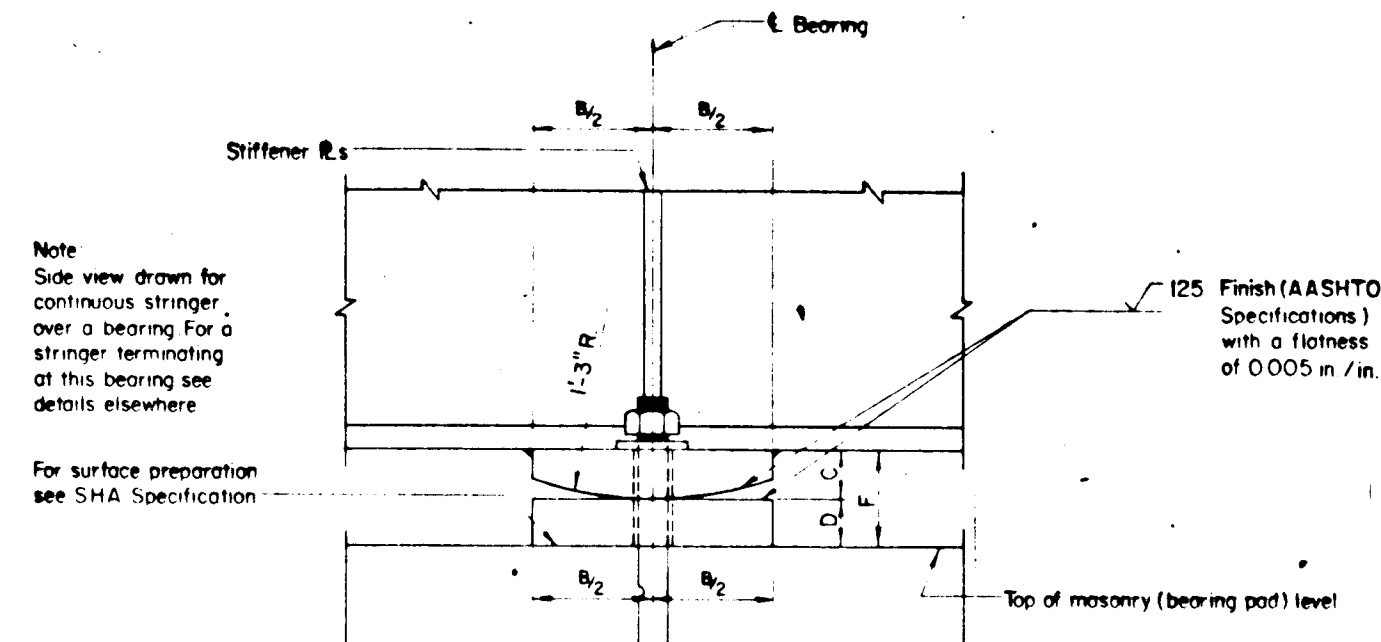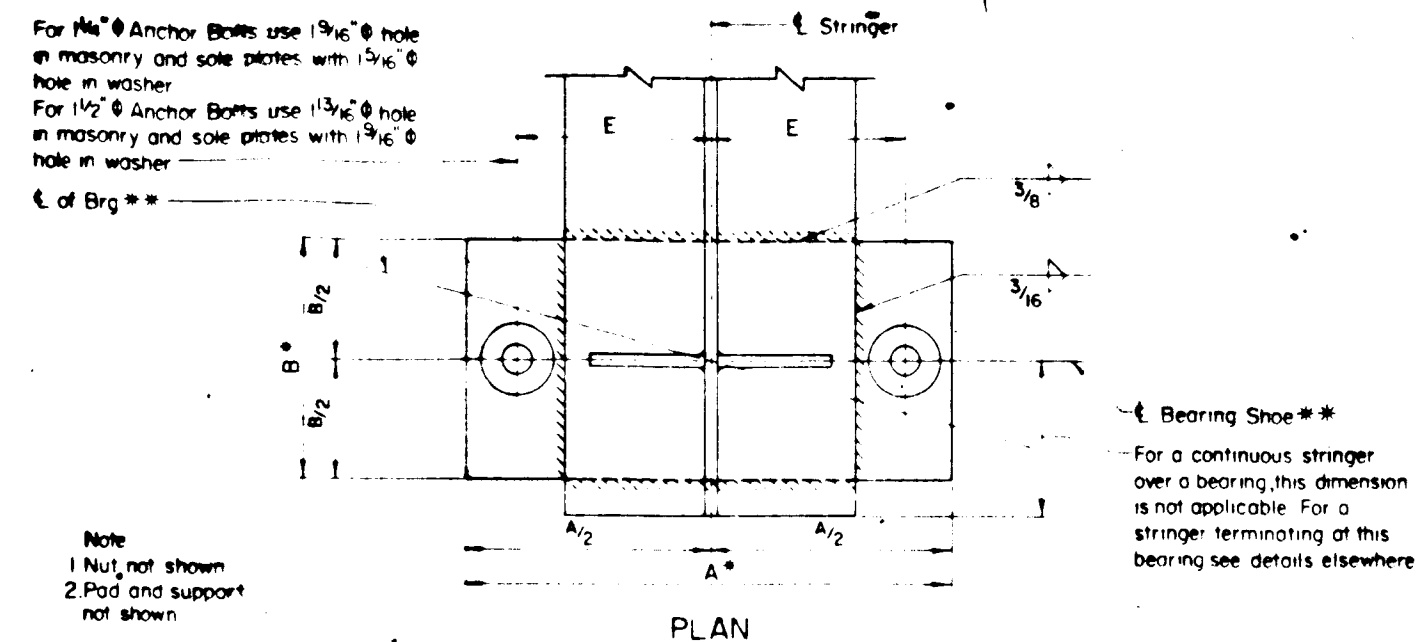

DATA SCHEDULE

Type	Sole Plate	Masonry R	Hole Loc	HGT	Ver	Dead
MF-I	20	9	13	20	9	13
MF-II	22	11	2	22	11	2
MF-III	24	12	2	24	12	2
MF-IV	26	13	2	26	13	2
MF-V	30	15	2	30	15	2
MF-VI	32	16	3	32	16	3

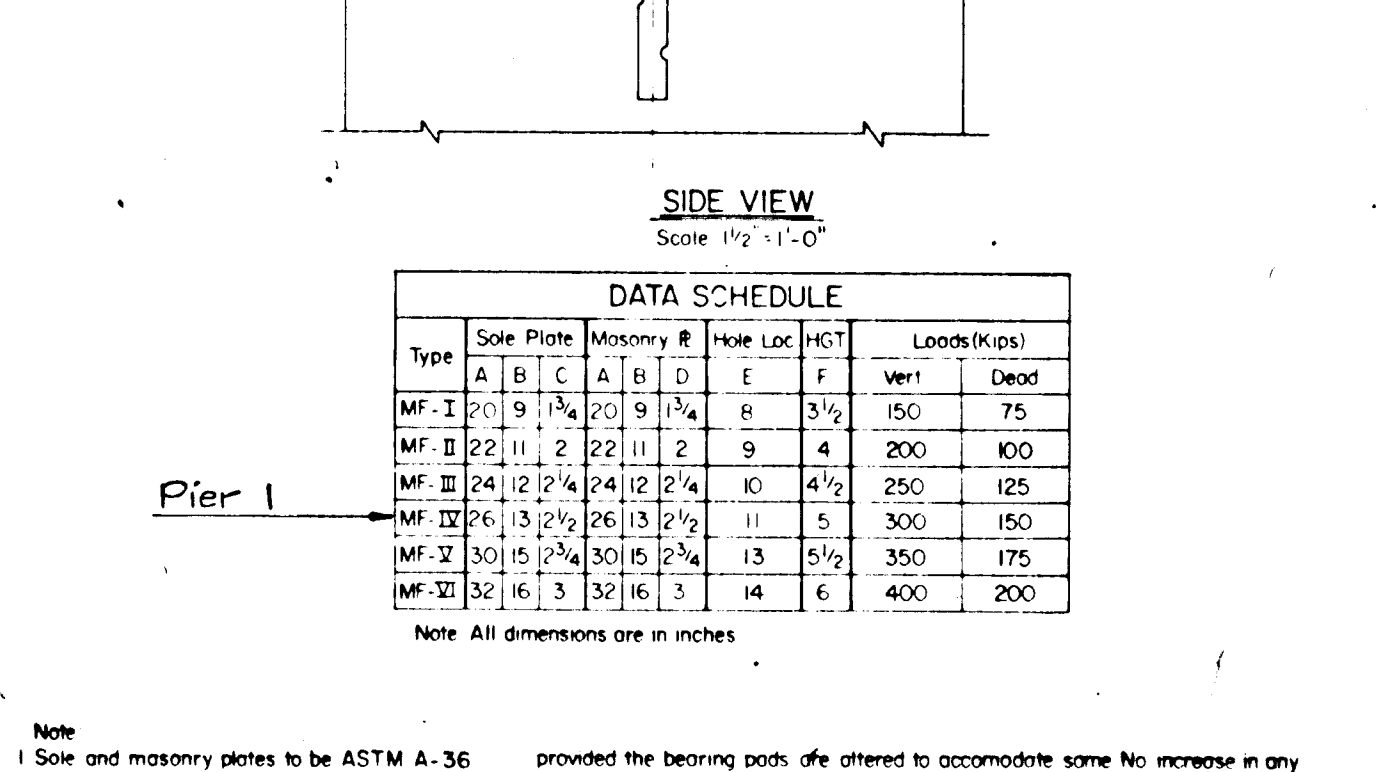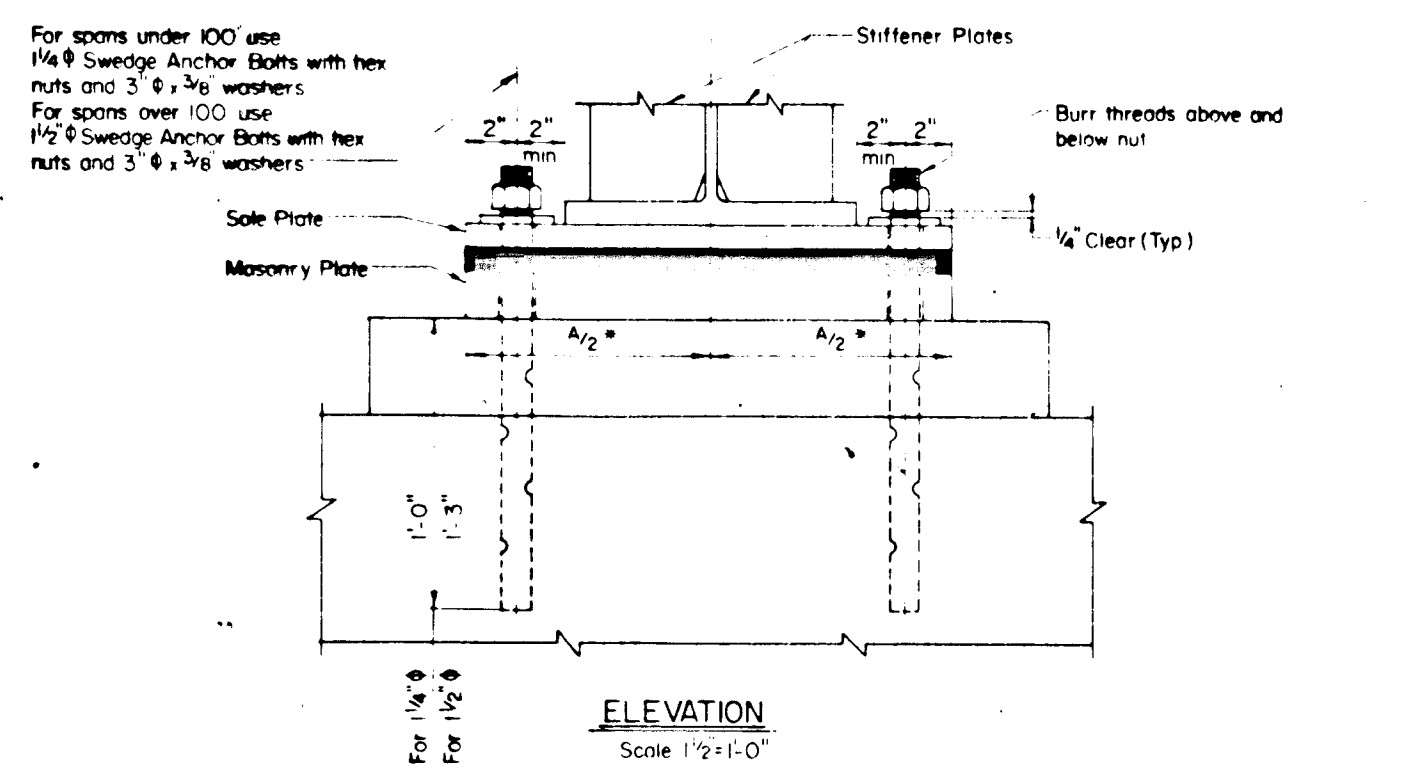

DATA SCHEDULE

Type	Sole Plate	Masonry R	Hole Loc	HGT	Ver	Dead
ME-I	21	10	14	21	10	14
ME-II	23	11	2	23	11	2
ME-III	25	12	2	25	12	2
ME-IV	26	13	2	26	13	2
ME-V	29	15	2	29	15	2
ME-VI	30	16	3	30	16	3

APPROVAL



STATE OF MARYLAND  
DEPARTMENT OF TRANSPORTATION  
STATE HIGHWAY ADMINISTRATION  
DIVISION OF BRIDGE DEVELOPMENT  
FIXED BEARING  
MEDIUM LENGTH SPANS

NO BR-SS(9.02)-80-115 SHEET 1 OF 2

APPROVAL

STATE OF MARYLAND  
DEPARTMENT OF TRANSPORTATION  
STATE HIGHWAY ADMINISTRATION  
DIVISION OF BRIDGE DEVELOPMENT  
FIXED BEARING  
MEDIUM LENGTH SPANS



NO BR-SS(9.02)-80-115 SHEET 2 OF 2

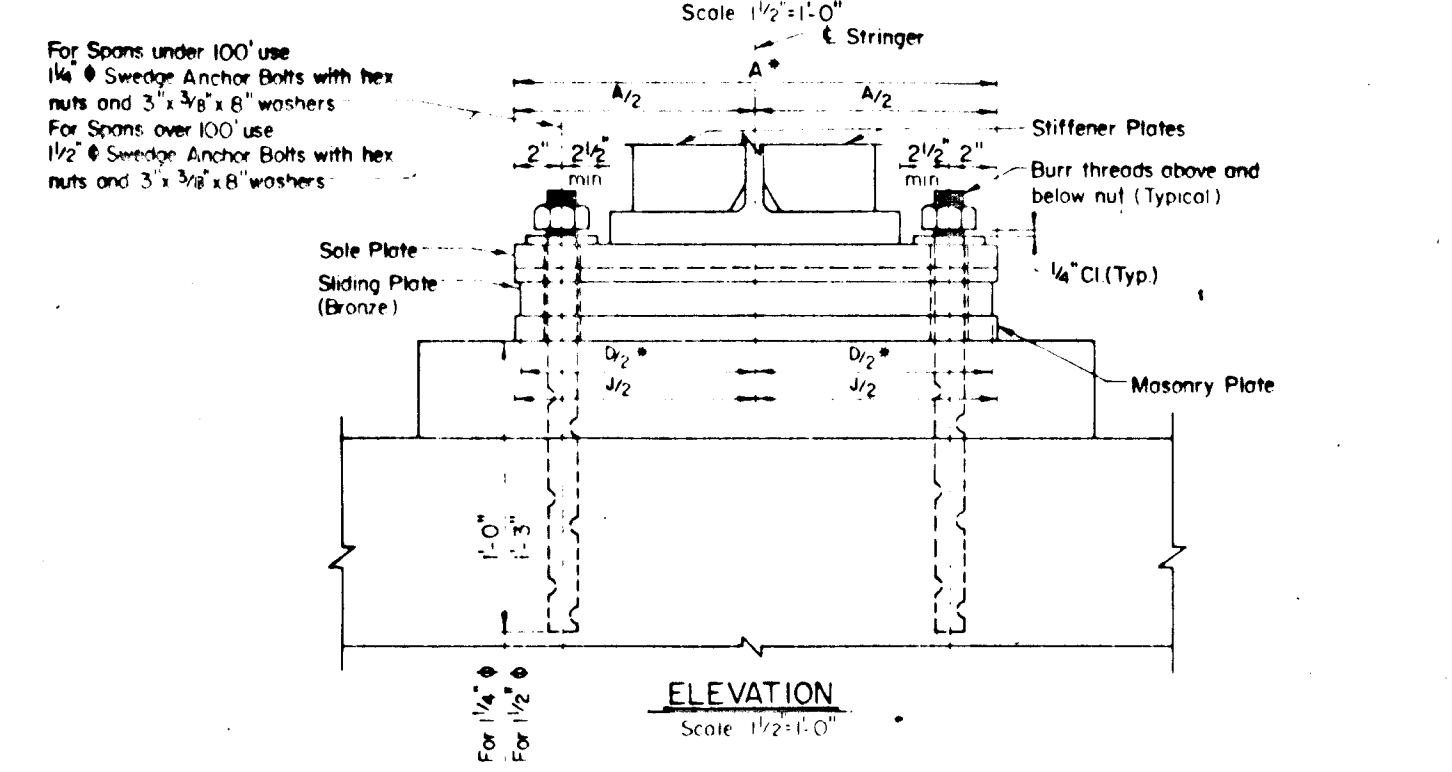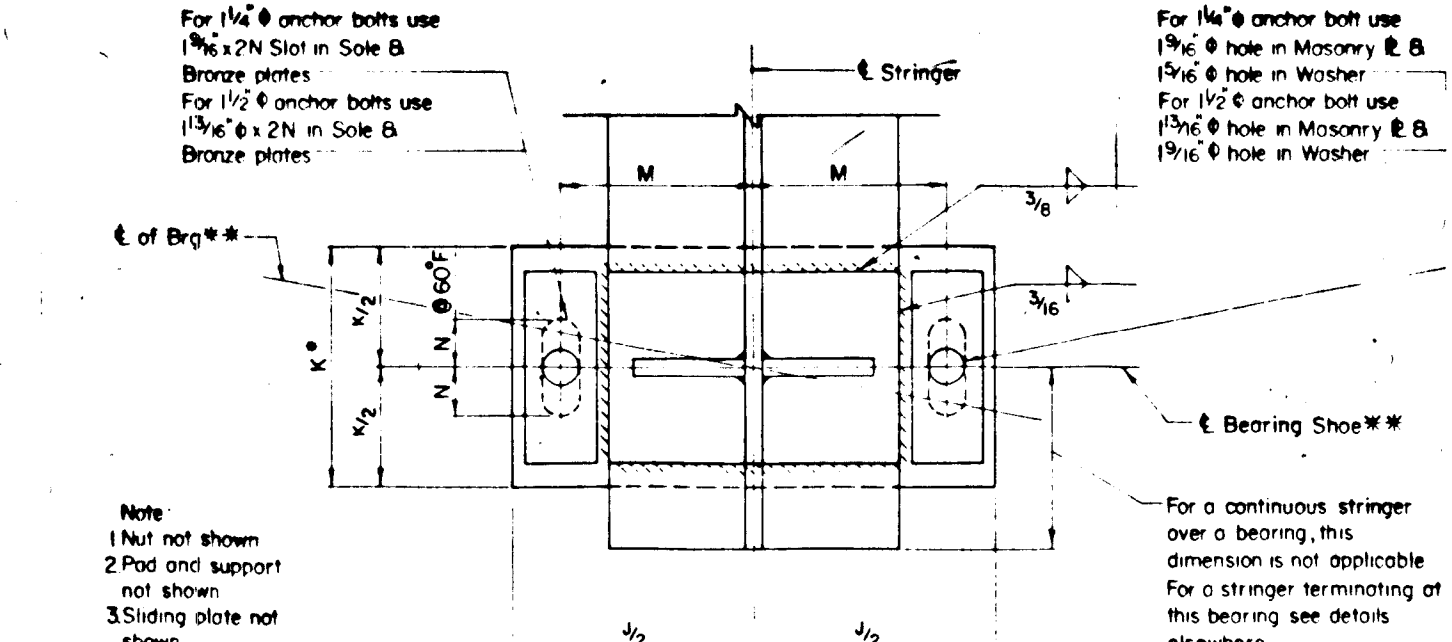

APPROVAL

STATE OF MARYLAND  
DEPARTMENT OF TRANSPORTATION  
STATE HIGHWAY ADMINISTRATION  
DIVISION OF BRIDGE DEVELOPMENT  
BRONZE EXPANSION BEARING  
MEDIUM LENGTH SPANS



NO BR-SS(9.01)-80-114 SHEET 1 OF 2

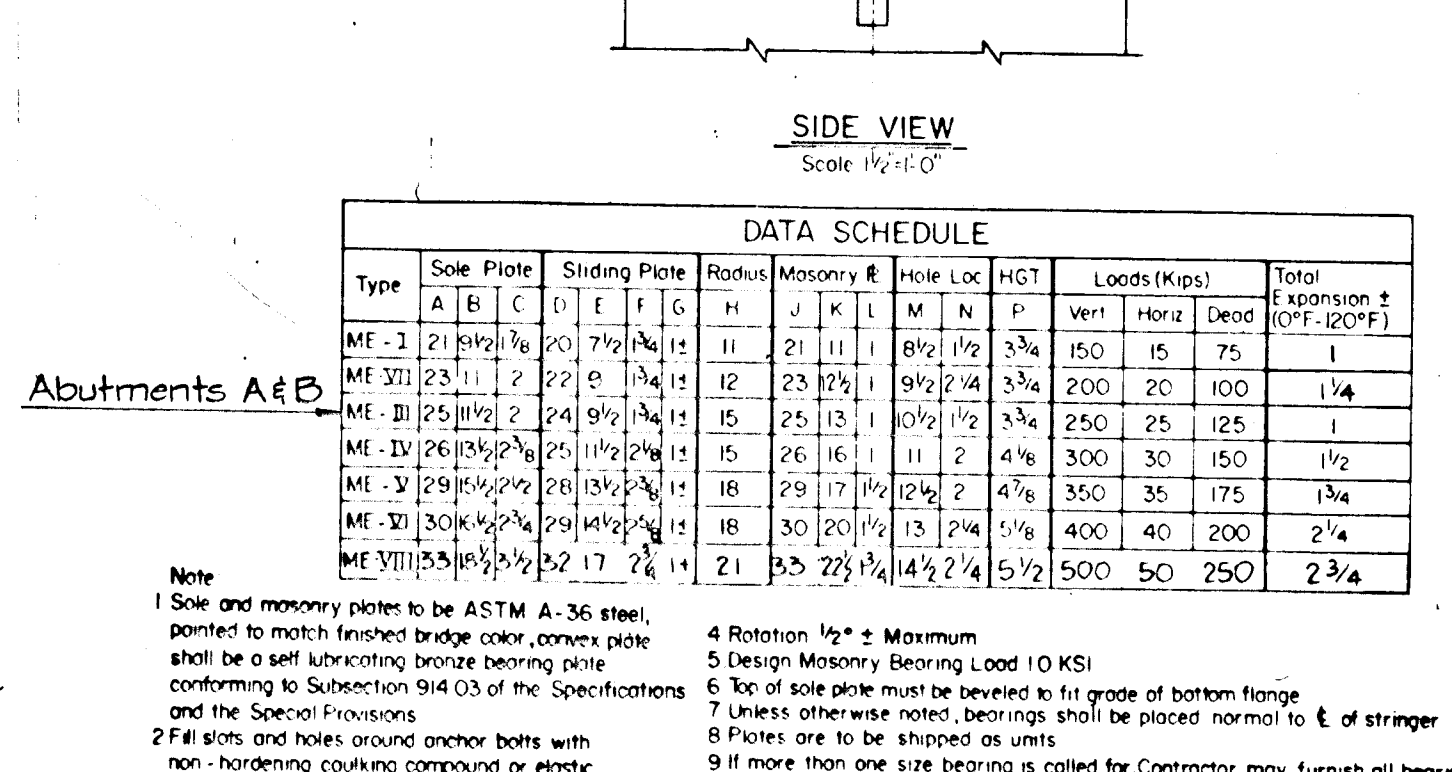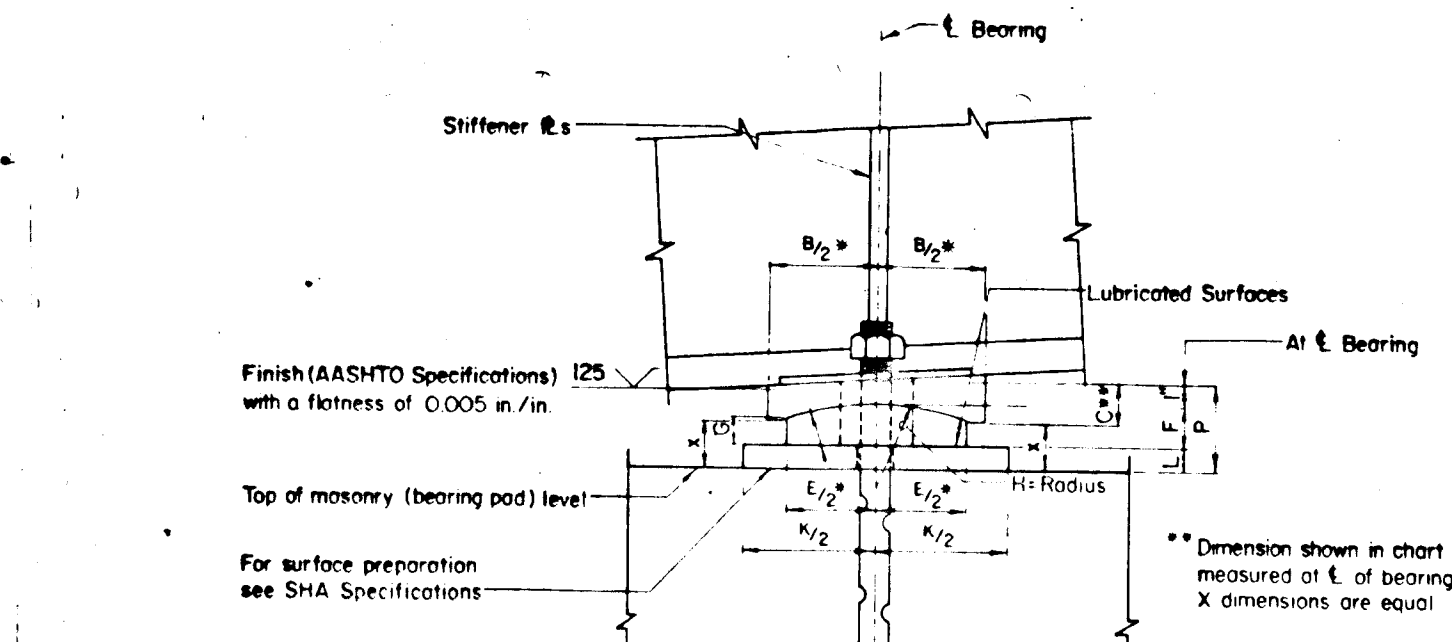

APPROVAL

STATE OF MARYLAND  
DEPARTMENT OF TRANSPORTATION  
STATE HIGHWAY ADMINISTRATION  
DIVISION OF BRIDGE DEVELOPMENT  
BRONZE EXPANSION BEARING  
MEDIUM LENGTH SPANS

NO BR-SS(9.01)-80-114 SHEET 2 OF 2

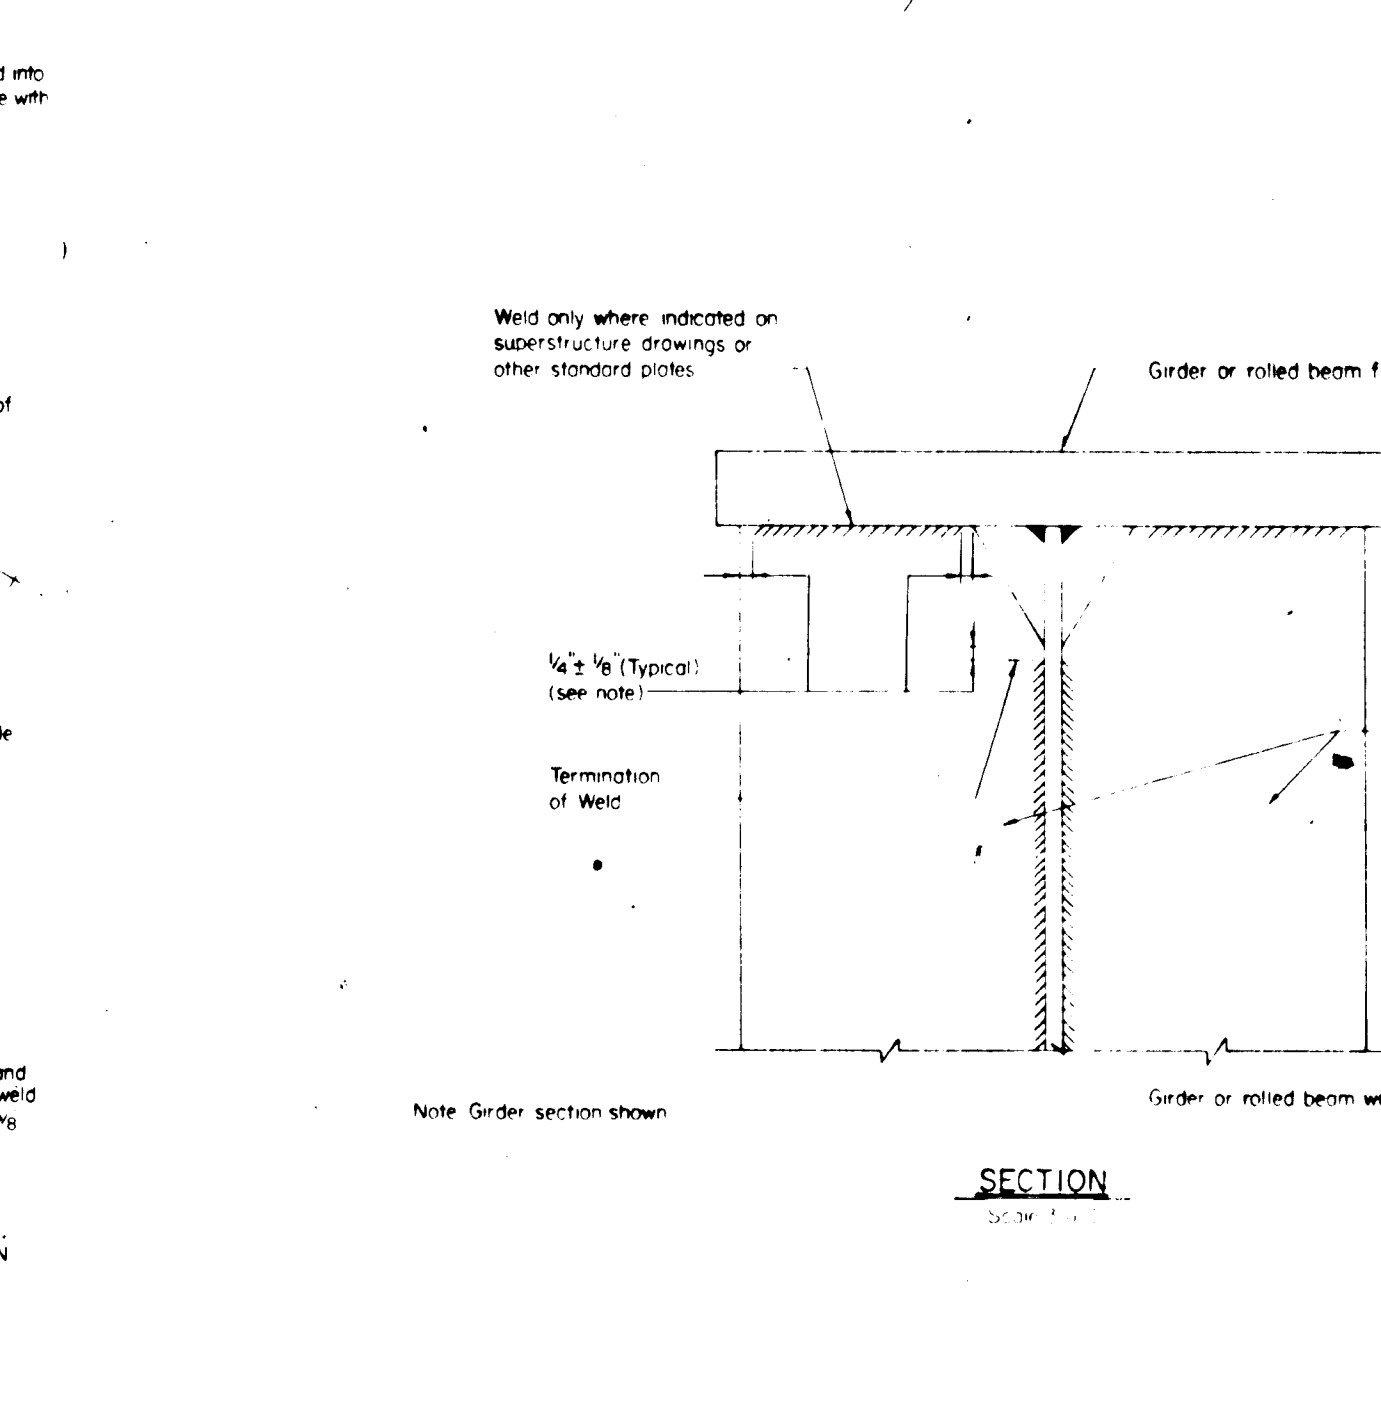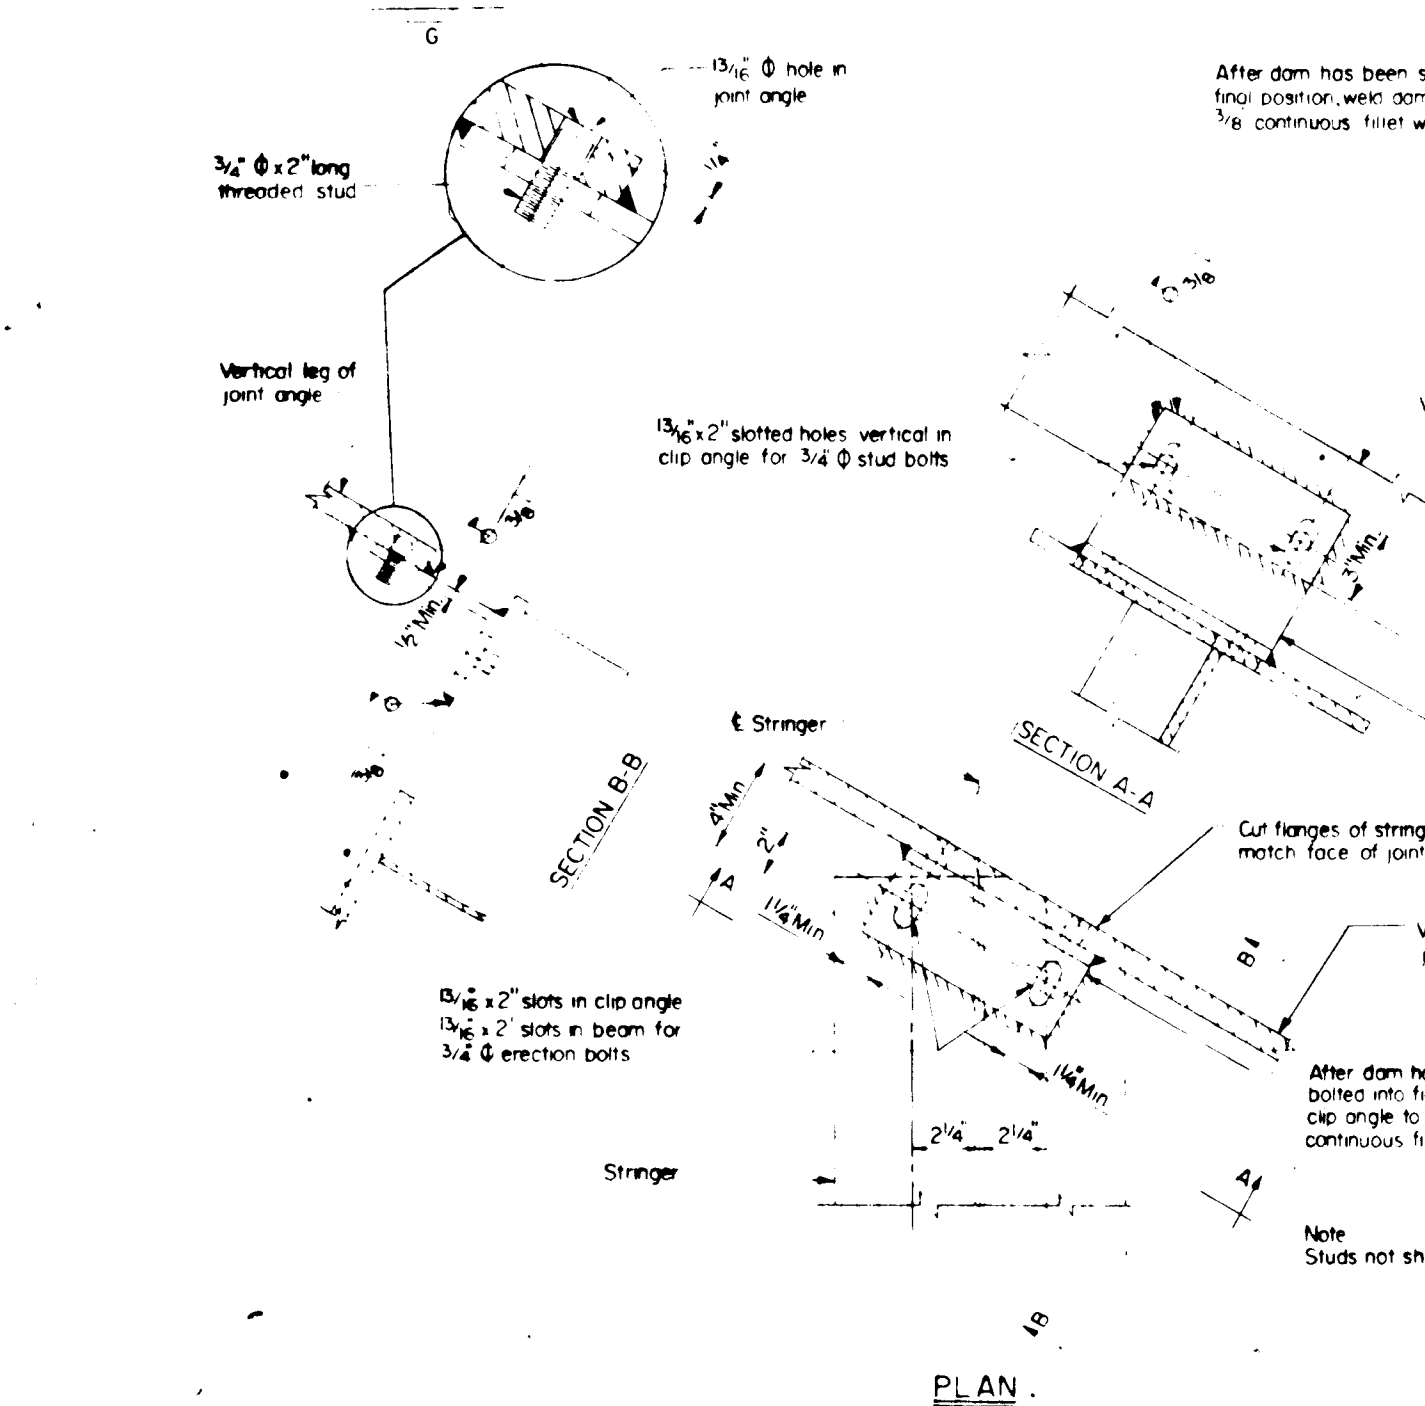

APPROVAL

STATE OF MARYLAND  
DEPARTMENT OF TRANSPORTATION  
STATE HIGHWAY ADMINISTRATION  
DIVISION OF BRIDGE DEVELOPMENT  
CLIP ANGLE DETAIL

NO BR-SS-(8.02)75-4 SHEET 1 OF 1

APPROVAL


STATE OF MARYLAND  
DEPARTMENT OF TRANSPORTATION  
STATE HIGHWAY ADMINISTRATION  
DIVISION OF BRIDGE DEVELOPMENT  
STIFFENER AND STRINGER CONNECTION  
PLATE WELD TERMINATION DETAIL

STANDARD NO BR-SS(8.10)83-154 SHEET 1 OF 1

CAMBER SCHEDULE

GIRDER NO.	DESCRIPTION	SPAN - A							SPAN - B									
		0 Bearing Abut.-A	1/8 PT.	2/8 PT.	3/8 PT.	4/8 PT.	5/8 PT.	6/8 PT.	7/8 PT.	0 Bearing Pier-1	1/8 PT.	2/8 PT.	3/8 PT.	4/8 PT.	5/8 PT.	6/8 PT.	7/8 PT.	0 Bearing Abut.-B
1	Δ1	0	1/16	1/16	1/8	1/8	1/16	1/16	0	0	0	1/16	1/16	1/8	1/16	1/16	1/16	0
THRU	Δ2	0	1/4	7/16	1/2	1/2	3/8	3/16	1/16	0	1/16	3/16	3/8	1/2	1/2	7/16	1/4	0
7	Δ3	0	1/16	1/8	3/16	1/8	1/8	1/16	1/16	0	1/16	1/16	1/8	1/8	3/16	1/8	1/16	0
	TOTAL	0	3/8	5/8	13/16	3/4	9/16	5/16	1/8	0	1/8	5/16	9/16	3/4	13/16	5/8	3/8	0

Δ1 = Deflection Due To Dead Weight Of Steel Girders (In Inches)  
 Δ2 = Deflection Due To Dead Weight Of Concrete Roadway Slab (In Inches)  
 Δ3 = Deflection Due To Dead Weight Of Parapets & Sidewalks (In Inches)

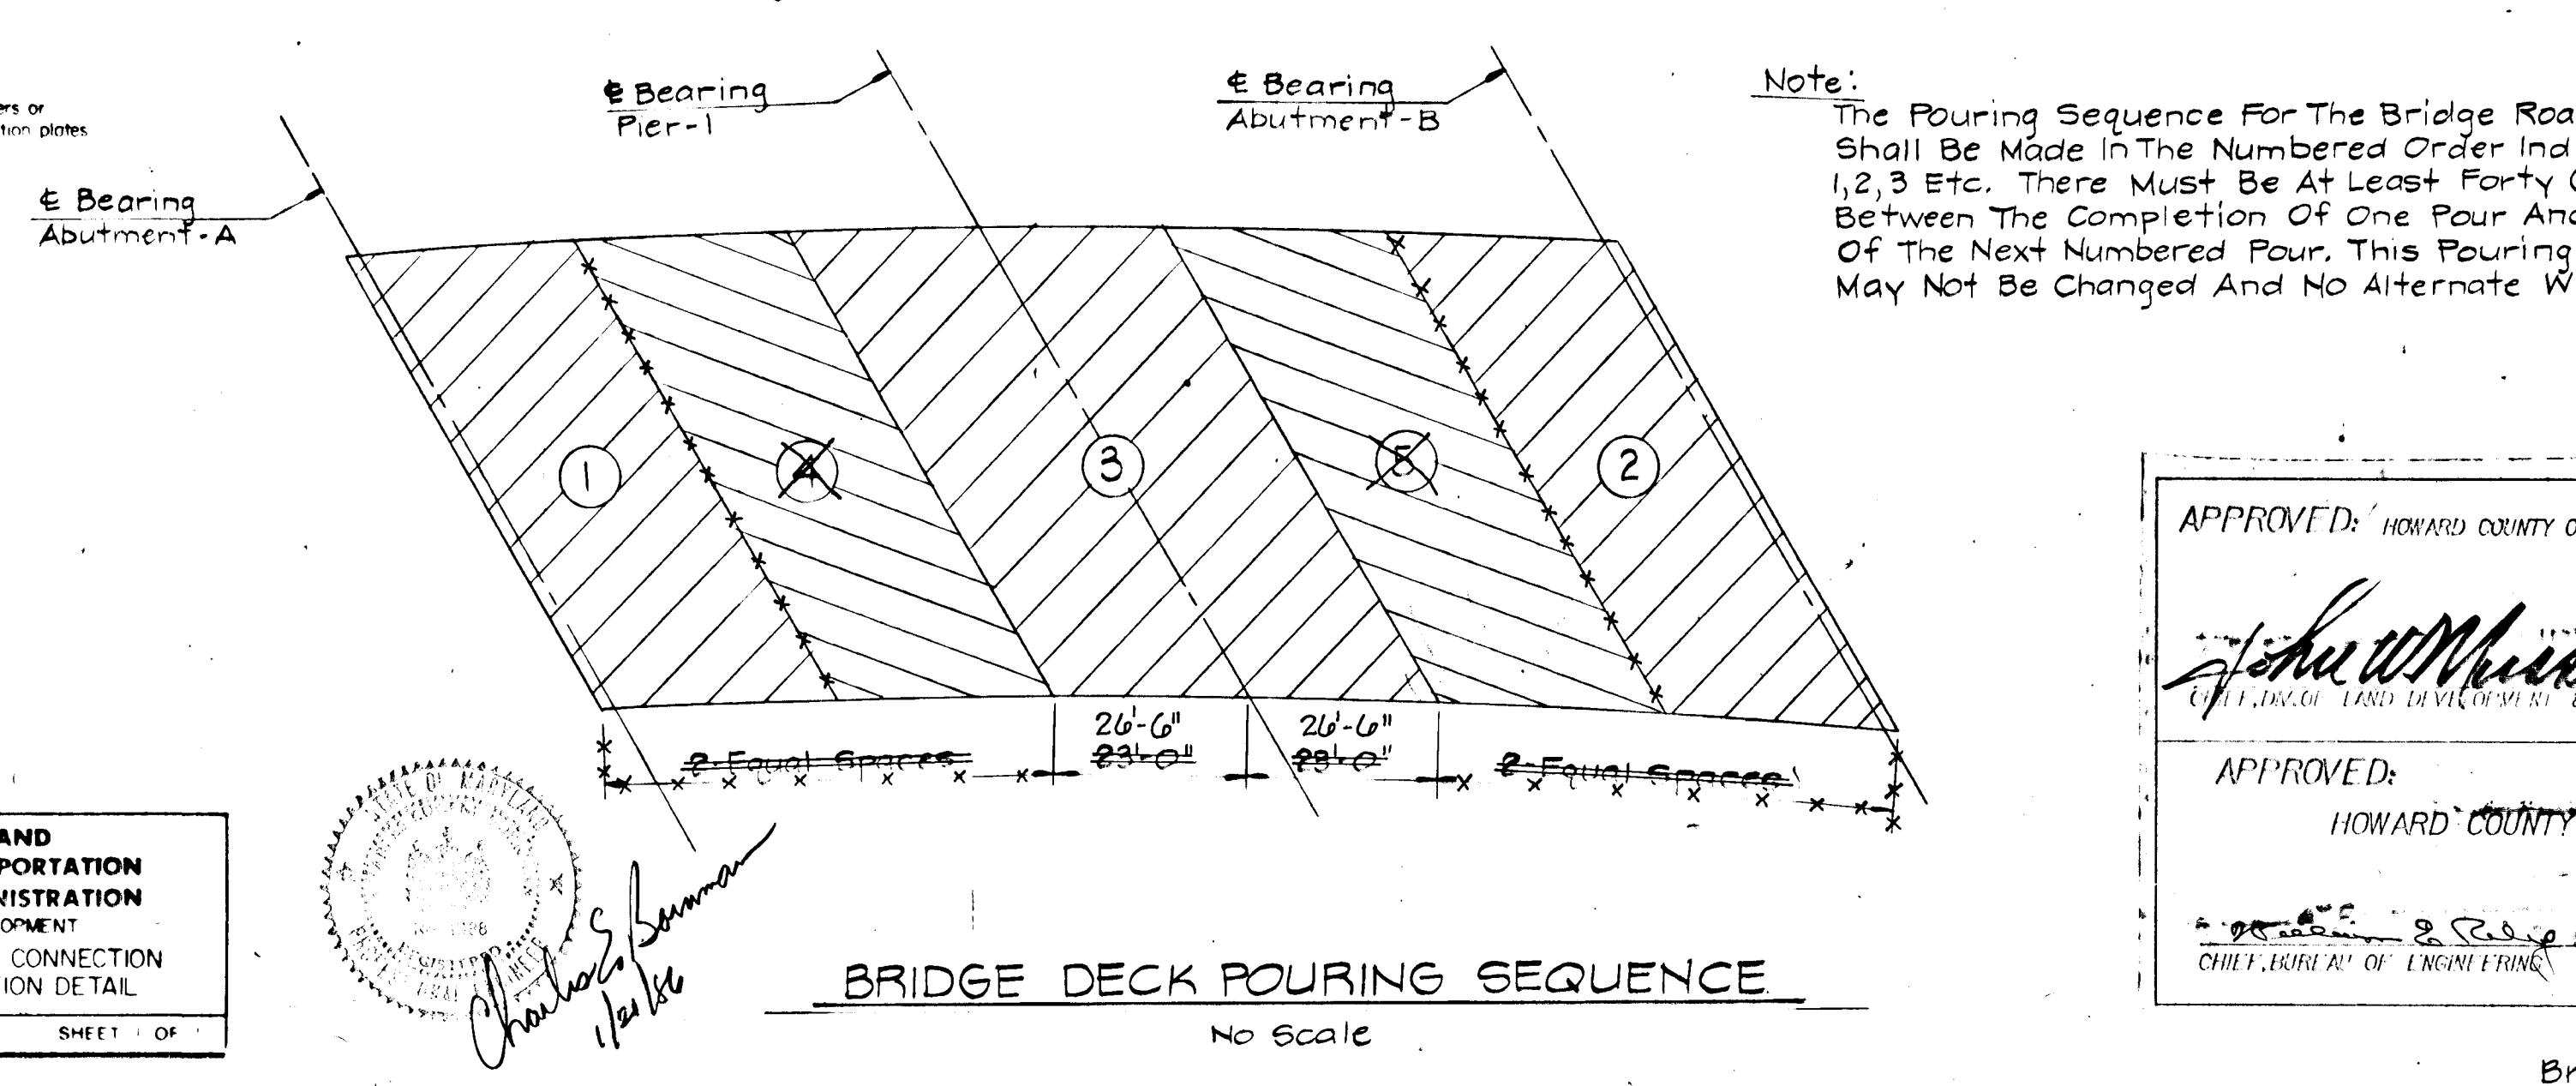

APPROVAL

STATE OF MARYLAND  
DEPARTMENT OF TRANSPORTATION  
STATE HIGHWAY ADMINISTRATION  
DIVISION OF BRIDGE DEVELOPMENT  
STIFFENER AND STRINGER CONNECTION  
PLATE WELD TERMINATION DETAIL

STANDARD NO BR-SS(8.10)83-154 SHEET 1 OF 1

APPROVED: HOWARD COUNTY OFFICE OF PLANNING & ZONING

*John W. ...* 2-3-86

APPROVED: HOWARD COUNTY DEPT. OF PUBLIC WORKS

BRIDGE NO. # HO-137

OWNER/DEVELOPER

HOWARD RESEARCH & DEVELOPMENT CORP.  
10275 LITTLE PATUXENT PARKWAY  
COLUMBIA, MARYLAND 21044

NO.	REVISION	DATE	BY
5	Revisions Due To Stake Out Error	1/5/88 RMJ	

ENGINEERS • ARCHITECTS • PLANNERS • SCIENTISTS • SURVEYORS • PHOTOGRAMMETRISTS


**GREENHORNE & O'MARA, INC.**  
9001 EDMONSTON ROAD, GREENBELT, MARYLAND 20770  
(301) 982-2800

ANNAPOLIS MD • ATLANTA GA • BECKLEY WV • CULPEPPER VA • DENVER CO • EXPORT PA • FAIRFAX VA  
GREENSBORO NC • MONROE MI • RALEIGH NC • ROCKVILLE MD • TAMPA FL • WILLISTON PARK NY

CAMBER SCHEDULE & STANDARD DETAILS

**COLUMBIA**  
VILLAGE OF DORSEY'S SEARCH  
SECTION 3, ARFA 1, PHASE 1B1  
TAX MAP 30 ~ PARCELS 124, 224 & 210  
5TH ELECTION DISTRICT ~ HOWARD COUNTY, MARYLAND

DESIGN SCALE  
DBA/SHA  
DRAWN 19 OF 24  
CHECKED SHEET  
DATE 8/85  
JOB No. R216X  
FILE No. F-86-55




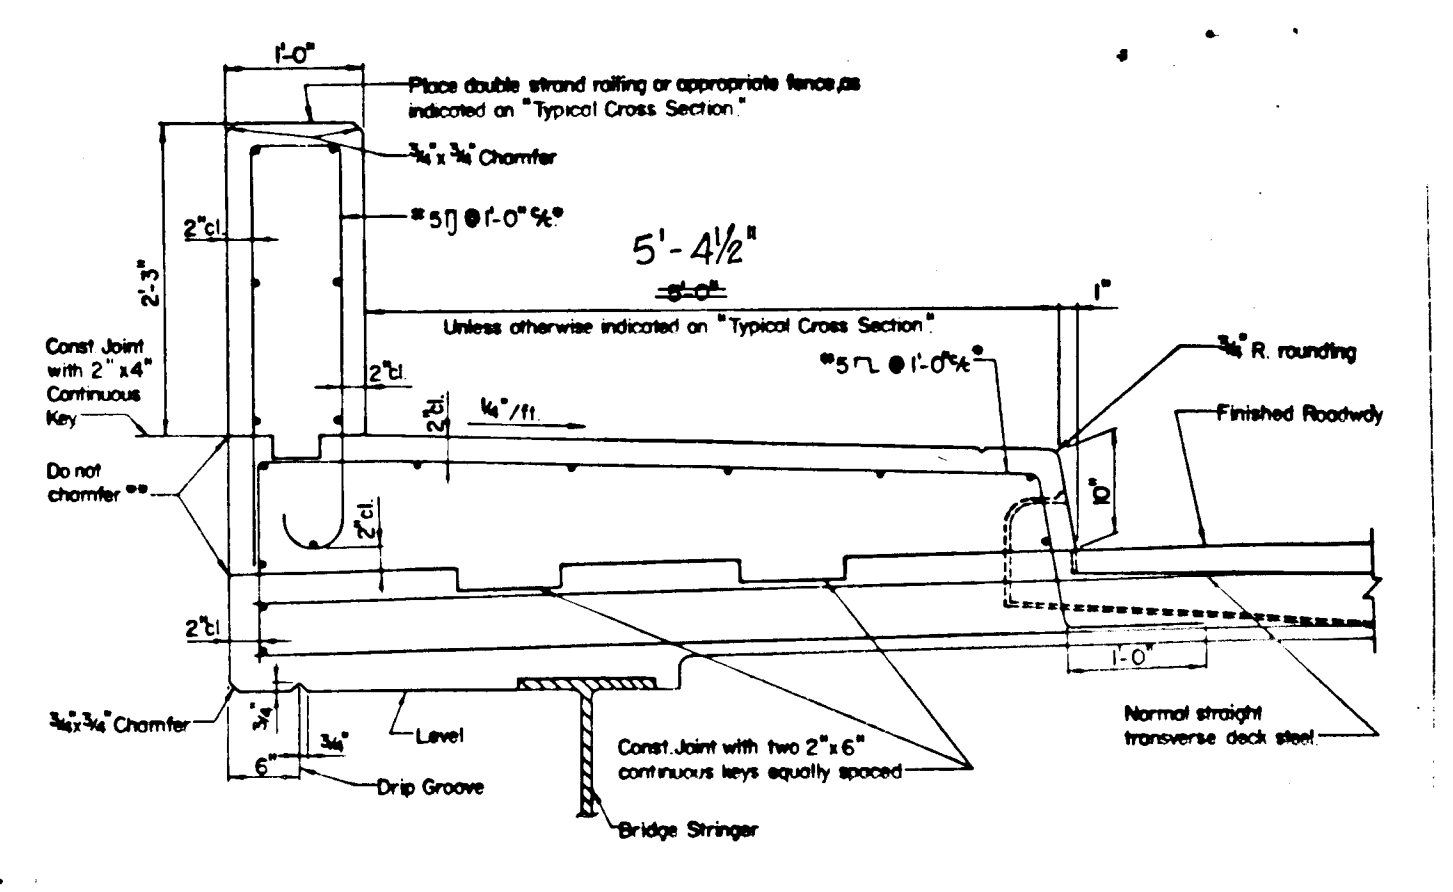


SECTION Scale 1/2"=1'-0"

Note: 1. All longitudinal bars are #5 spaced as shown, maximum spacing 1'-3". 2. All keys are nominal size. 3. Forms of normal longitudinal deck steel and truss bars not shown.


APPROVAL	DATE	BY
REVISIONS	DATE	BY
1	7-12-82	SHK / FHW
2	8-4-82	SHK / FHW
3	1-11-83	SHK / FHW

STATE OF MARYLAND  
DEPARTMENT OF TRANSPORTATION  
DIVISION OF BRIDGE DEVELOPMENT  
SIDEWALK WITH PARAPET  
FOR BRIDGES OVER WATER AND/OR RAILROADS  
STANDARD NO BR-SS(6.21)-80-106 SHEET 1 OF 1

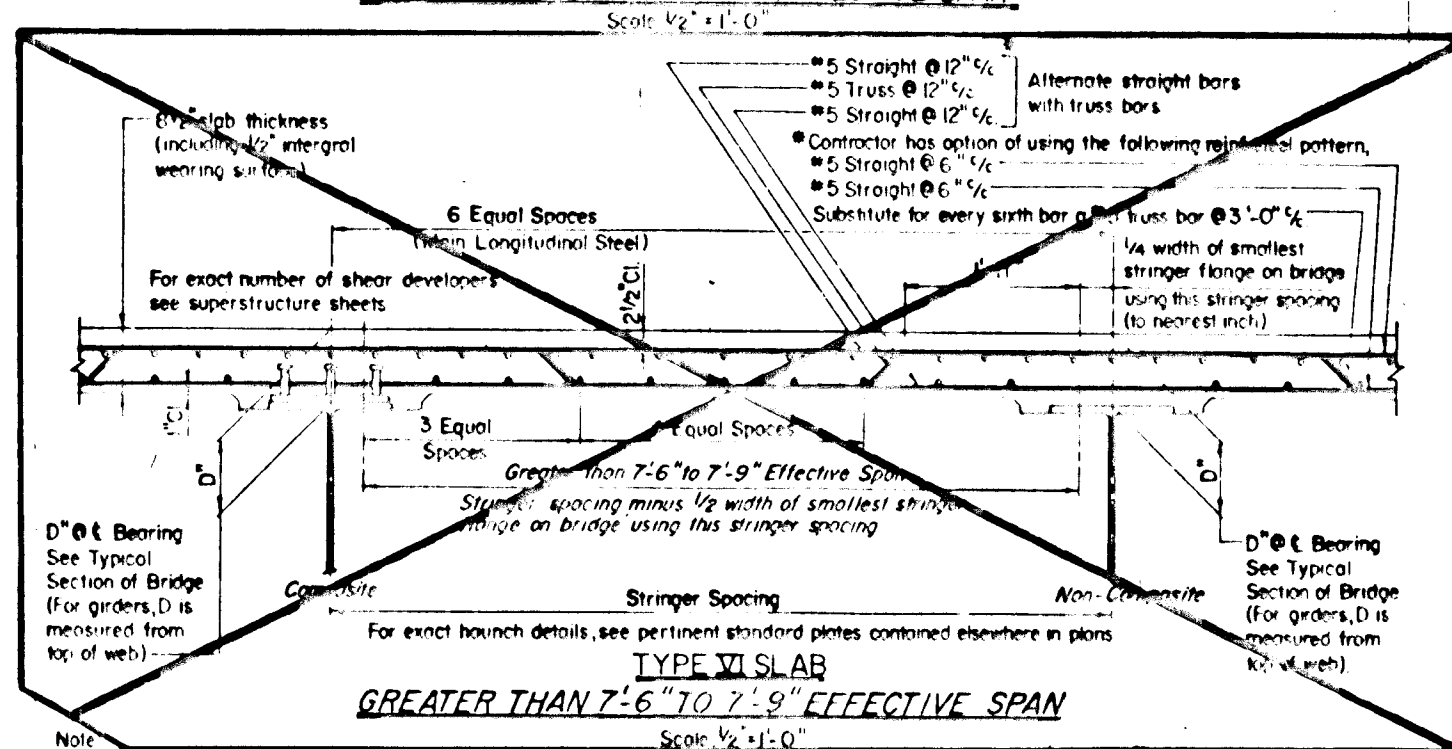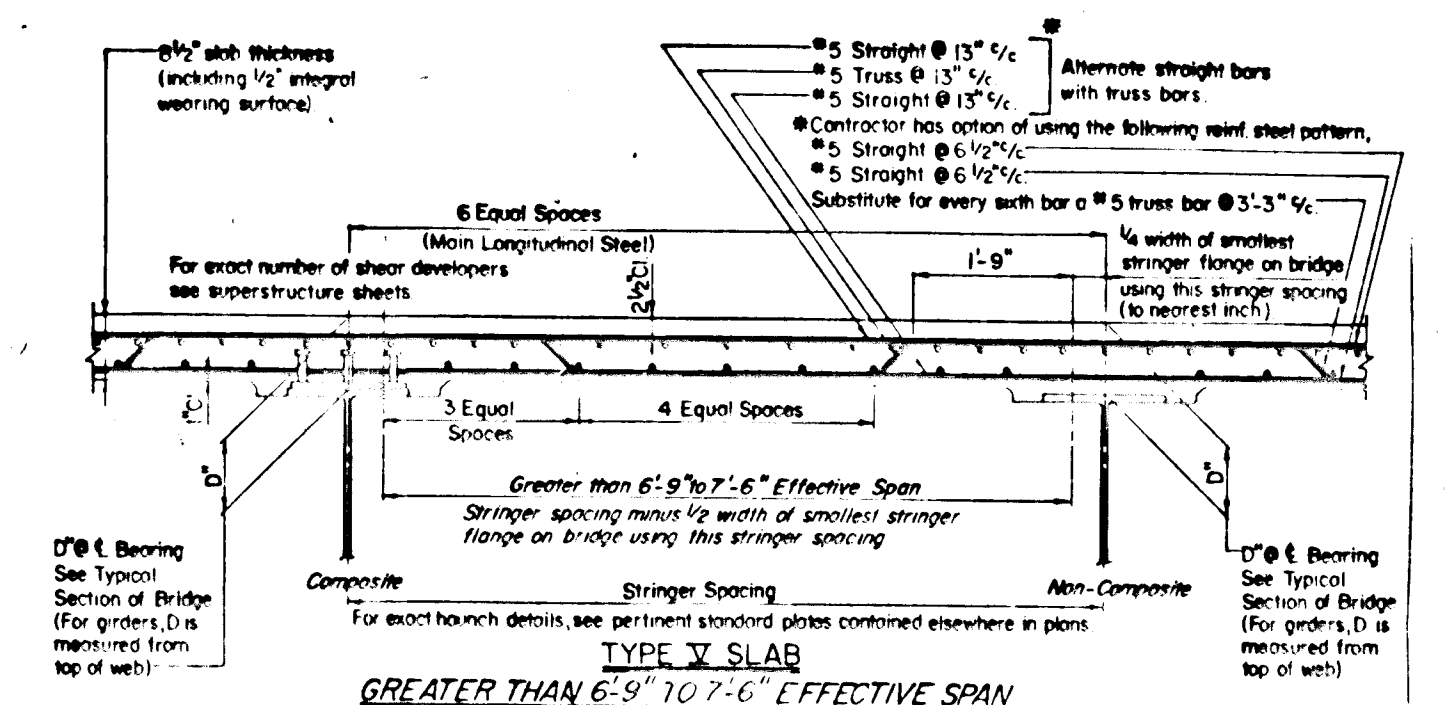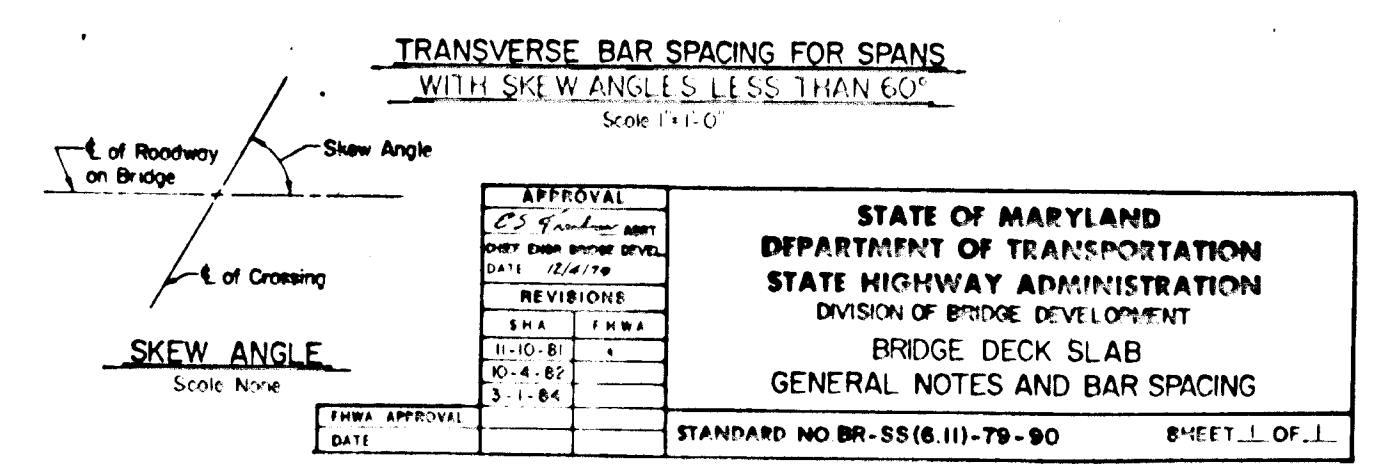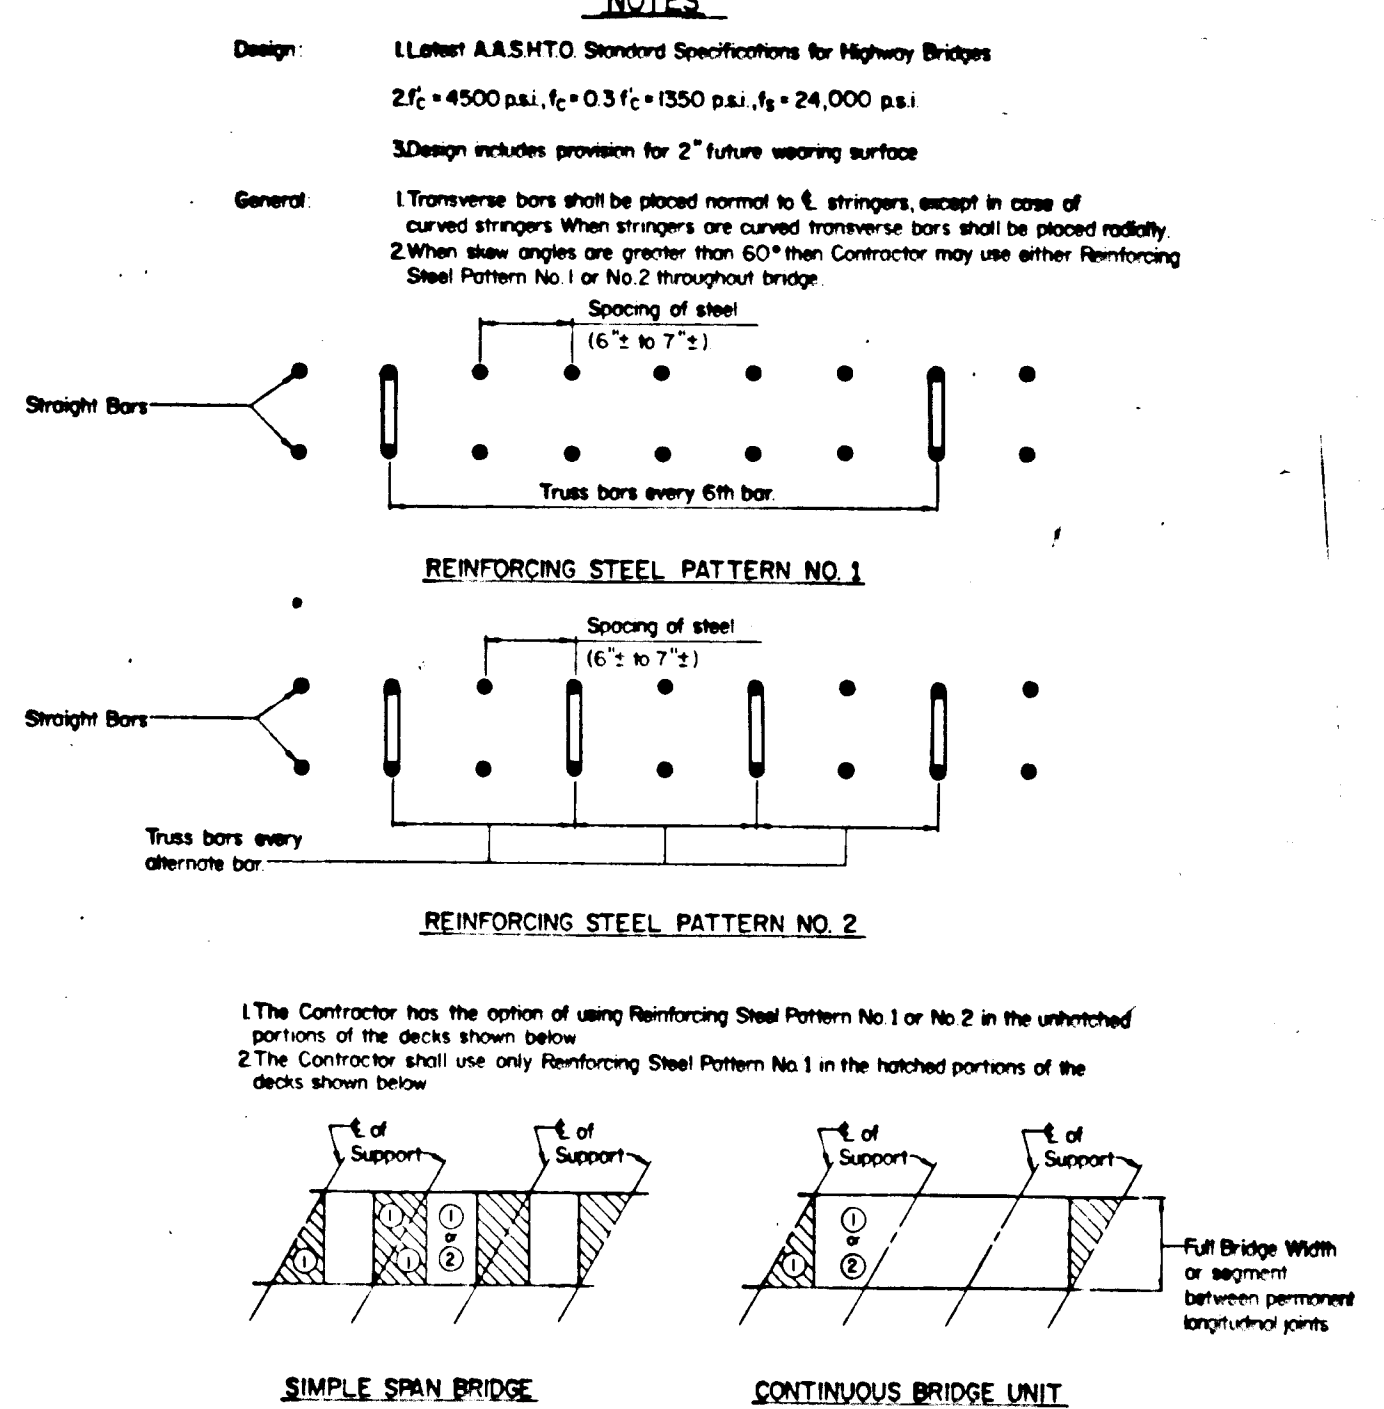



APPROVAL

STATE OF MARYLAND  
DEPARTMENT OF TRANSPORTATION  
DIVISION OF BRIDGE DEVELOPMENT  
TYPE V AND VI  
BRIDGE DECK SLABS  
STANDARD NO BR-SS(6.14)-79-93 SHEET 1 OF 1

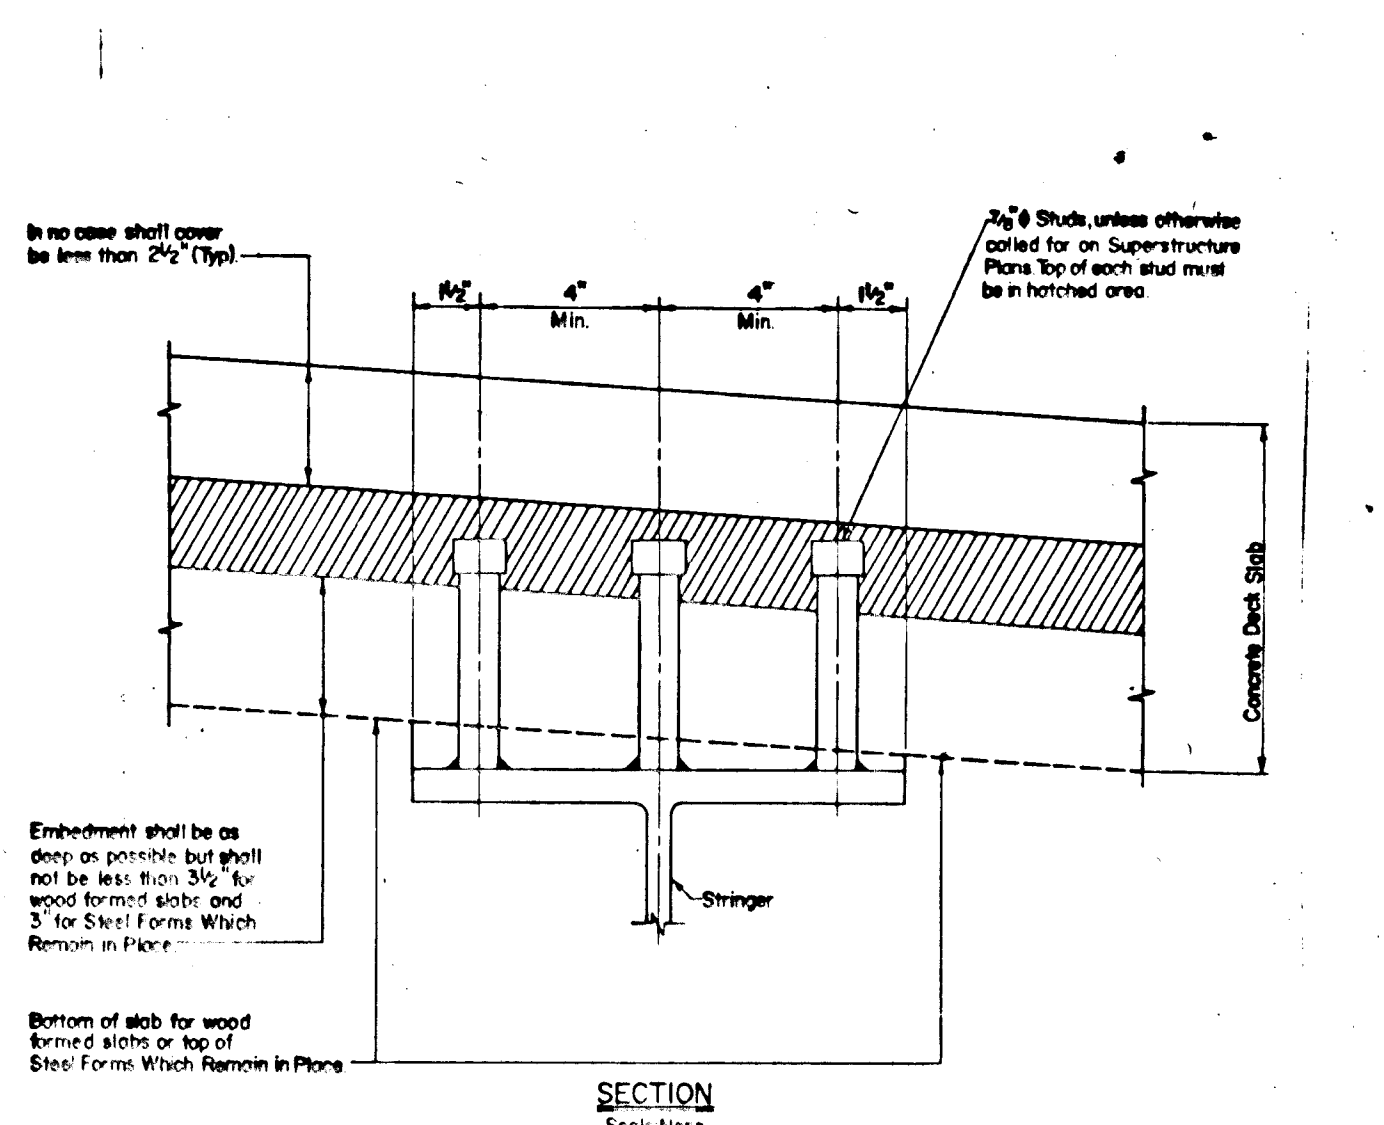



APPROVAL

STATE OF MARYLAND  
DEPARTMENT OF TRANSPORTATION  
DIVISION OF BRIDGE DEVELOPMENT  
STEEL STUD SHEAR  
DEVELOPER EMBODIMENT DETAIL  
STANDARD NO BR-SS(6.05)75-30 SHEET 1 OF 1

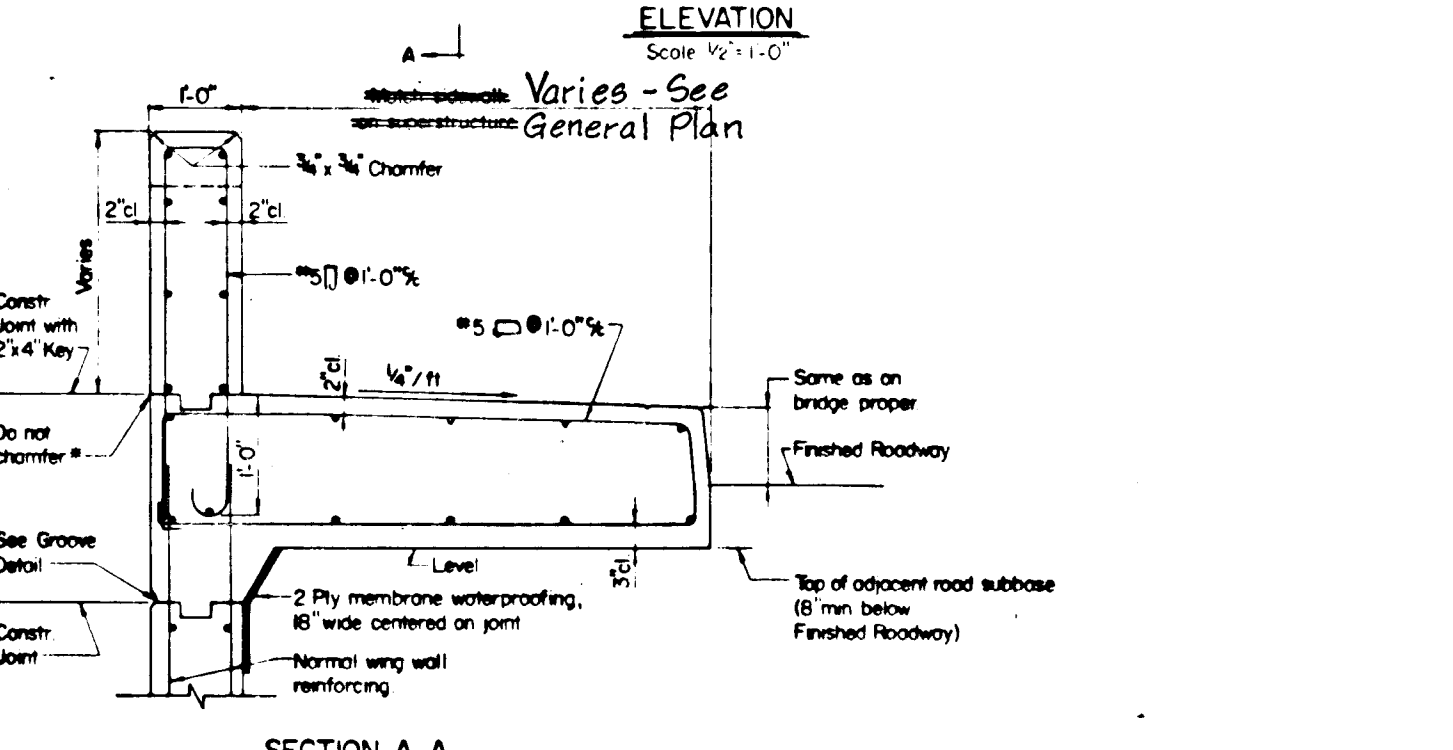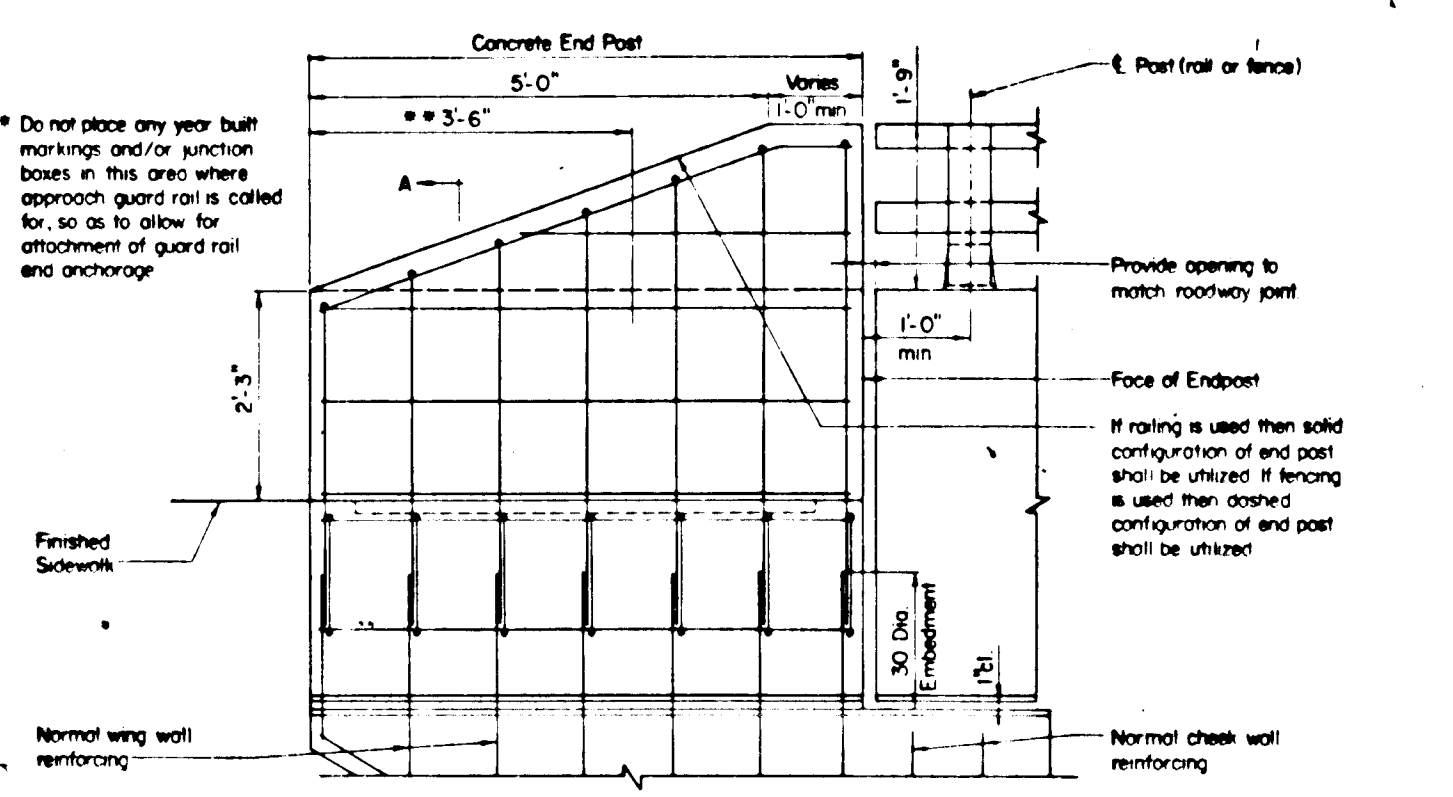


APPROVAL

STATE OF MARYLAND  
DEPARTMENT OF TRANSPORTATION  
DIVISION OF BRIDGE DEVELOPMENT  
BRIDGE END POST (WITH SIDEWALK)  
FOR BRIDGE WITH FENCE OR RAILING  
STANDARD NO BR-SB(6.05)-84-162 SHEET 1 OF 1

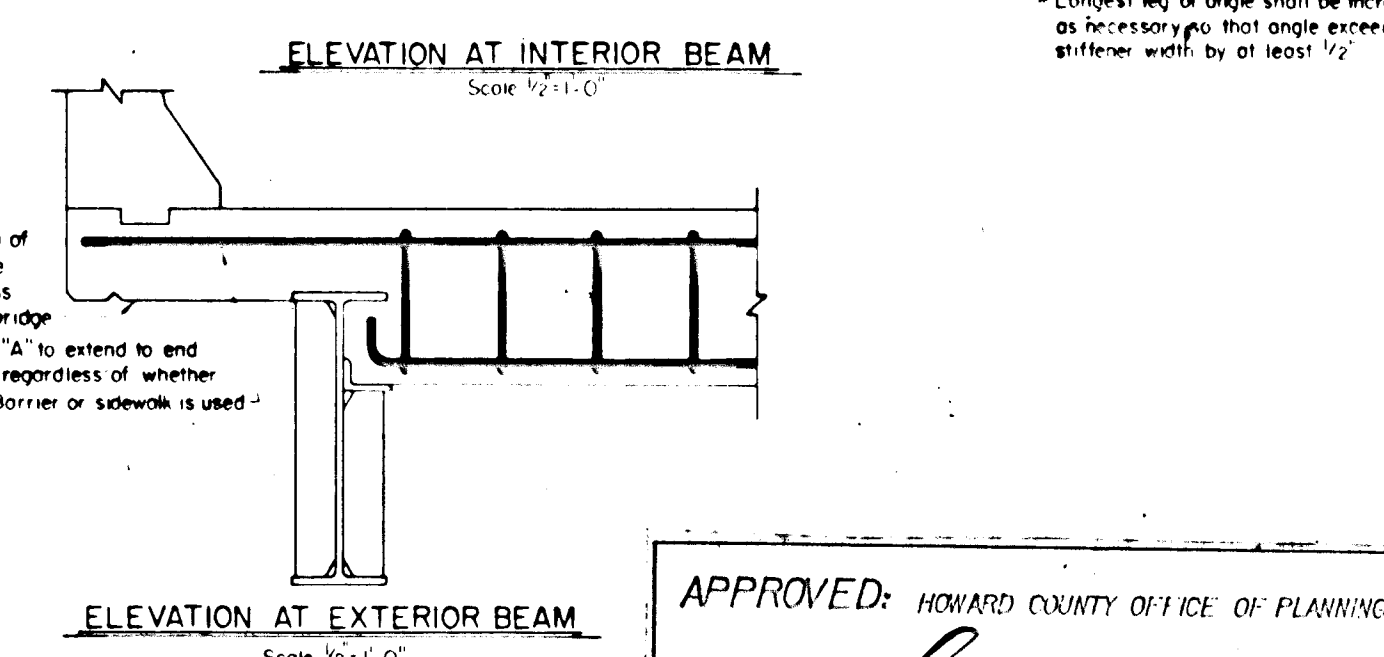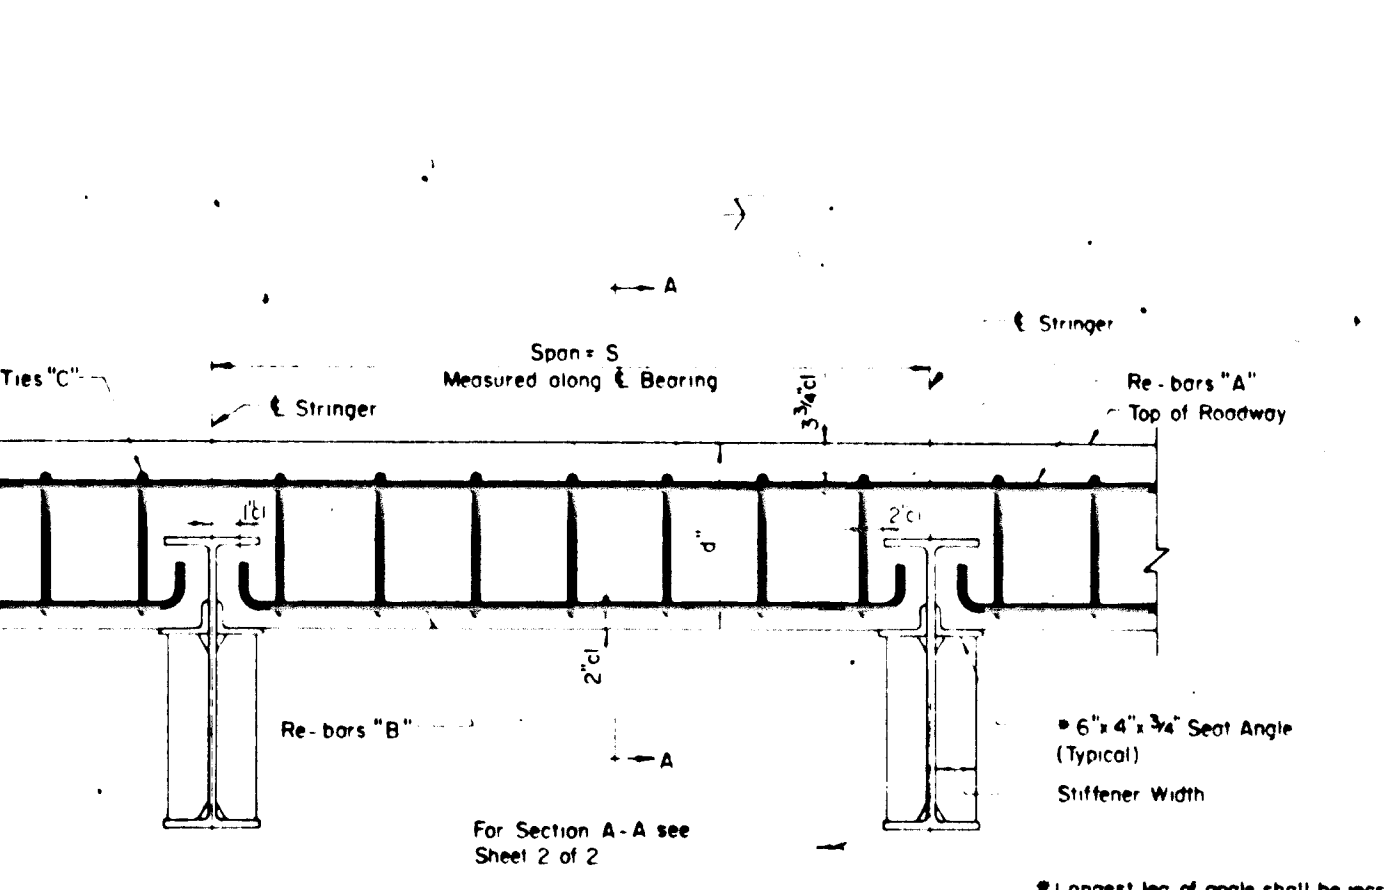

APPROVAL

STATE OF MARYLAND  
DEPARTMENT OF TRANSPORTATION  
DIVISION OF BRIDGE DEVELOPMENT  
CONCRETE DIAPHRAGMS AT PIERS (WITH EXPANSION JOINTS) AND AT ALL ABUTMENTS  
STANDARD NO BR-SS(6.22)-80-120 SHEET 1 OF 2

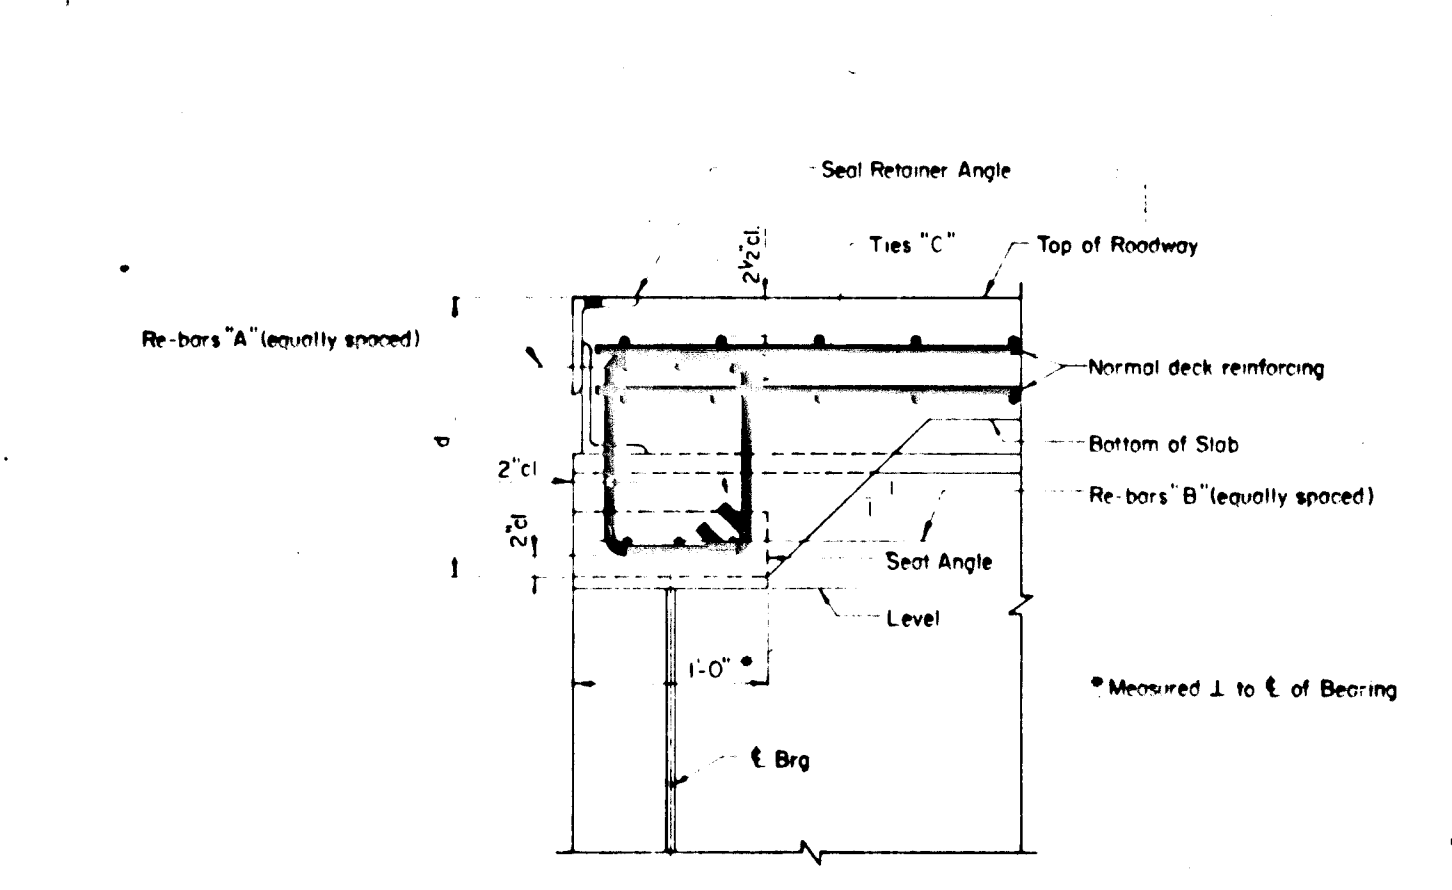



Span S	Depth of Diaphragm D	Re-bars "A"	Re-bars "B"	Ties "C"
Up to 8'	1'-11"	3 #7's	3 #7's	1 #4 @ 9" minimum spacing
Over 8' to 11'	1'-11"	3 #8's	3 #8's	1 #4 @ 9" minimum spacing
Over 11' to 14'	2'-0"	3 #8's	3 #8's	1 #4 @ 9" minimum spacing
Over 14' to 16'	2'-1"	3 #9's	3 #9's	1 #4 @ 9" minimum spacing

APPROVAL

HOWARD COUNTY OFFICE OF PLANNING & ZONING

APPROVED: *[Signature]* 2-3-86

APPROVED: *[Signature]* HOWARD COUNTY DEPT. OF PUBLIC WORKS

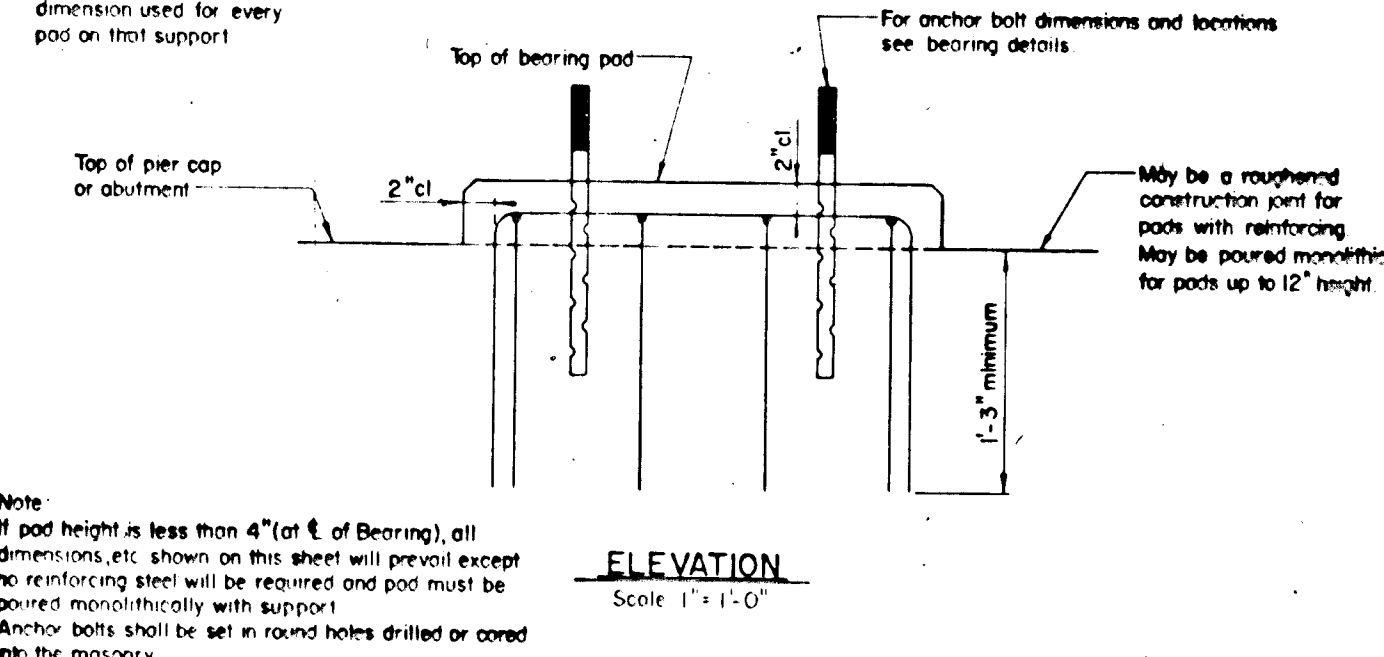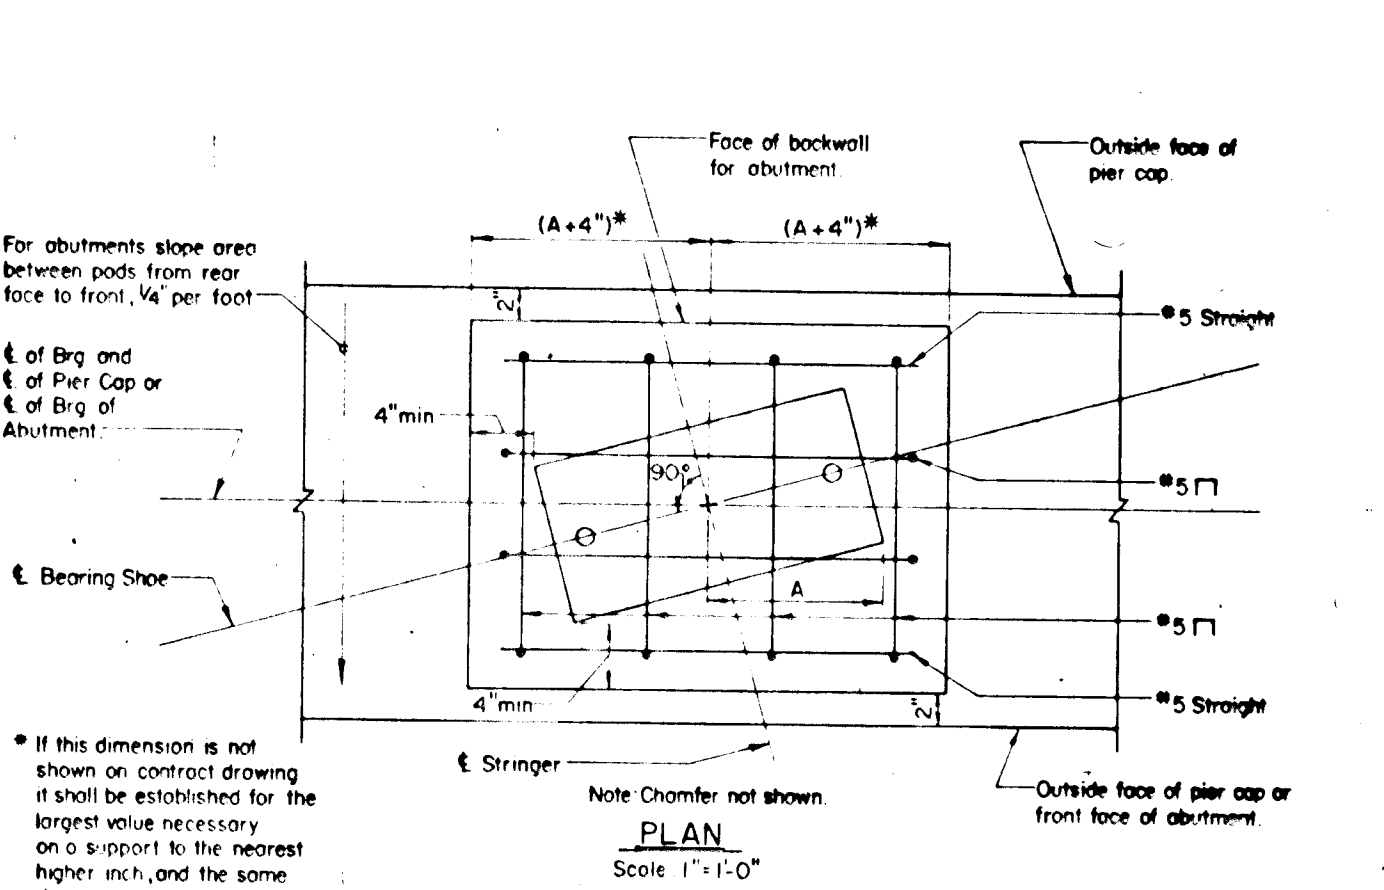

APPROVAL

STATE OF MARYLAND  
DEPARTMENT OF TRANSPORTATION  
DIVISION OF BRIDGE DEVELOPMENT  
BEARING PAD WHERE ONLY A SINGLE SHOE IS REQUIRED ON A SUPPORT  
STANDARD NO BR-SB(6.02)-80-121 SHEET 1 OF 1

OWNER/DEVELOPER  
HOWARD RESEARCH & DEVELOPMENT CORP.  
10275 LITTLE PATUXENT PARKWAY  
COLUMBIA, MARYLAND 21044

NO	REVISION	DATE	BY
5	Revisions Due To Stake Out Error	1/5/88	RMJ



ENGINEERS • ARCHITECTS • PLANNERS • SCIENTISTS • SURVEYORS • PHOTOGRAMMETRISTS


**GREENHORNE & O'MARA, INC.**  
9001 EDMONSTON ROAD, GREENBELT, MARYLAND 20770  
(301) 982-2800

ANNAPOLIS MD • ATLANTA GA • BECKLEY WV • CULPEPER VA • DENVER CO • EXPORT PA • FAIRFAX VA  
GREENSBORO NC • MONROE MI • RALEIGH NC • ROCKVILLE MD • TAMPA FL • WILLISTON PARK NY

STANDARD DETAILS  
**COLUMBIA**  
VILLAGE OF DORSEY'S SEARCH  
SECTION 3, ARFA 1, PHASE 191  
TAX MAP 30 ~ PARCELS 124, 224 & 210  
5TH ELECTION DISTRICT ~ HOWARD COUNTY, MARYLAND

SHA DESIGN	SCALE
SHA DRAWN	20 OF 24
DCC/RLP CHECKED	SHEET
DATE	JOB No
	FILE No

F-8655

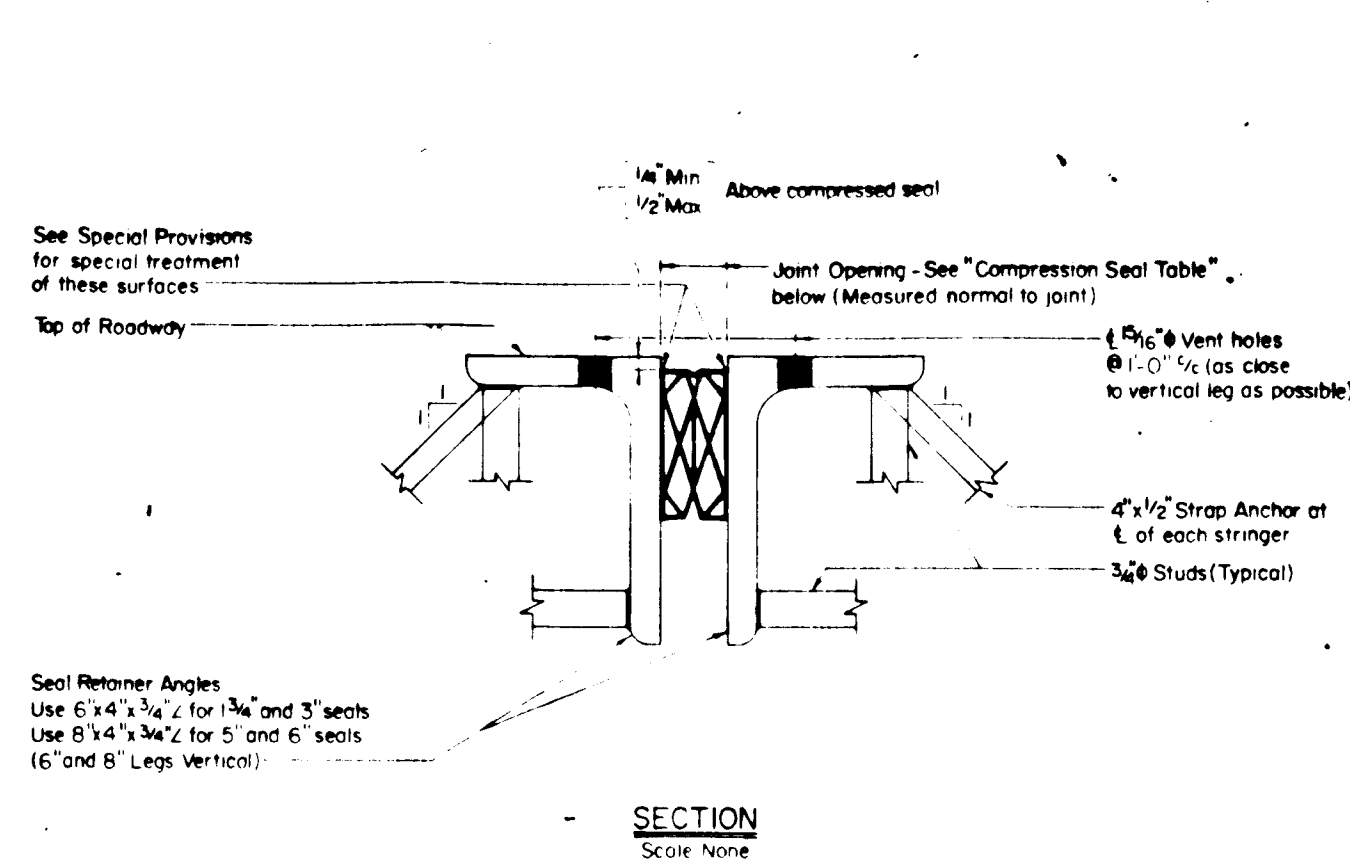


Location	Uncompressed Seal Width	Joint Opening @					
		40%	50%	60%	70%	80%	90%
	1 3/4"						
	3"			1 5/8"			
	5"			3"			
	6"			3 5/8"			

Note:  
1. The 1 3/4" and 3" seals to be one piece for full length of seal (no joints).  
2. The 5" and 6" seals may have one shop splice per joint, if the length of joint exceeds 50'. Splice shall be at least 15' from gutter line.

APPROVAL	DATE: 1-31-76	STATE OF MARYLAND DEPARTMENT OF TRANSPORTATION STATE HIGHWAY ADMINISTRATION DIVISION OF BRIDGE DEVELOPMENT COMPRESSION SEAL JOINT AND RETAINING ANGLE DETAIL STANDARD NO. BR-SS(701)-77-63 SHEET 1 OF 1
REVISIONS		
1	10-31-79	12-12-79
2	1-4-80	1-23-80
3	1-27-82	6-21-83
4	9-9-84	6-23-84

Note:  
1. The Contractor has the option of substituting the Ancel Frame Scaffolding System for steel forms which remain in place with the following exceptions:  
a) Bridges over existing highways.  
b) Bridges over high speed or electrified railroads.  
2. Ancel Frames may never be used on any fracture critical member.  
3. The Contractor has the option of substituting the Ancel Frame Scaffolding System for conventional overhead brackets on fascia stringers with the following exceptions:  
a) Bridges over new or existing highways.  
b) Bridges over navigable waterways with underclearance less than 30' feet.  
4. In any instance where studs are allowed they shall remain in place.


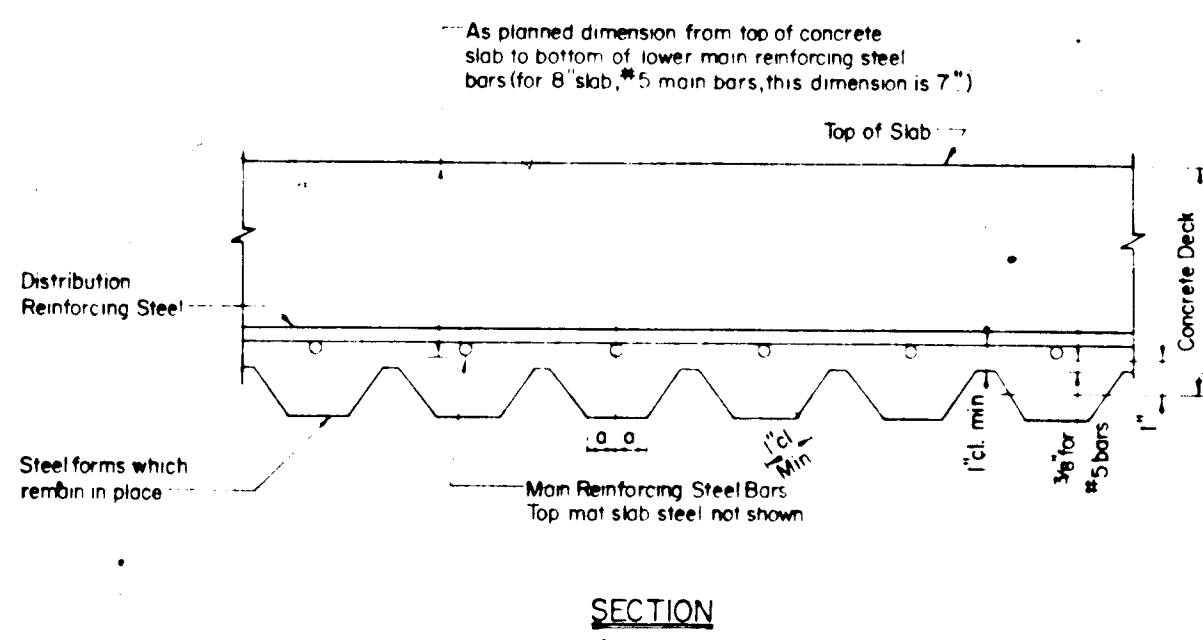


APPROVAL	DATE: 1-31-76	STATE OF MARYLAND DEPARTMENT OF TRANSPORTATION STATE HIGHWAY ADMINISTRATION DIVISION OF BRIDGE DEVELOPMENT COMPRESSION SEAL JOINT AND RETAINING ANGLE DETAIL STANDARD NO. BR-SS(701)-77-63 SHEET 1 OF 1
REVISIONS		
1	10-31-79	12-12-79
2	1-4-80	1-23-80
3	1-27-82	6-21-83
4	9-9-84	6-23-84

Note:  
1. Permanent steel bridge deck forms and supports shall meet the requirements of Section 914.2 of the Specifications. (Elev. Spacing shall be the clear distance between beams and/or girders, less two (2) inches.)  
2. No welding of these forms to parts carrying tension will be permitted. These forms shall be vertically adjusted to obtain line and grade as required.  
3. Any permanently exposed form metal where the galvanized coating has been damaged shall be thoroughly cleaned, wire brushed and painted with two coats of zinc oxide zinc dust primer. Federal Specification TT-P-641, Type B, no color added, to the satisfaction of the engineer. Minor heat distortion in areas of welds need not be touched up.  
4. Contractor has option of using this detail or that shown on 2 of 2, except for bridge decks with curved stringers or bridge with a flared re-bar pattern. For bridge with curved stringers or bridge with a flared re-bar pattern only the detail shown on sheet 2 of 2 can be used.  
5. Where shear connections are utilized, normal manufacturers detailing may be utilized of stringer flange.



APPROVAL	DATE: 1-31-76	STATE OF MARYLAND DEPARTMENT OF TRANSPORTATION STATE HIGHWAY ADMINISTRATION DIVISION OF BRIDGE DEVELOPMENT STEEL FORMS WHICH REMAIN IN PLACE FOR CONCRETE SLABS ON STEEL STRINGERS RE-BARS ALIGNED WITH TROUGHS STANDARD NO. BR-SS(606)-75-29 SHEET 1 OF 2
REVISIONS		
1	1-27-82	6-23-83
2	1-29-83	3-27-84
3	7-20-84	11-5-84

Note:  
1. For notes see sheet 1 of 2.  
2. This detail is applicable only on structures where the general notes under 'LOADING STATES' and 'LOADS' per square foot for use of bridge deck forms.

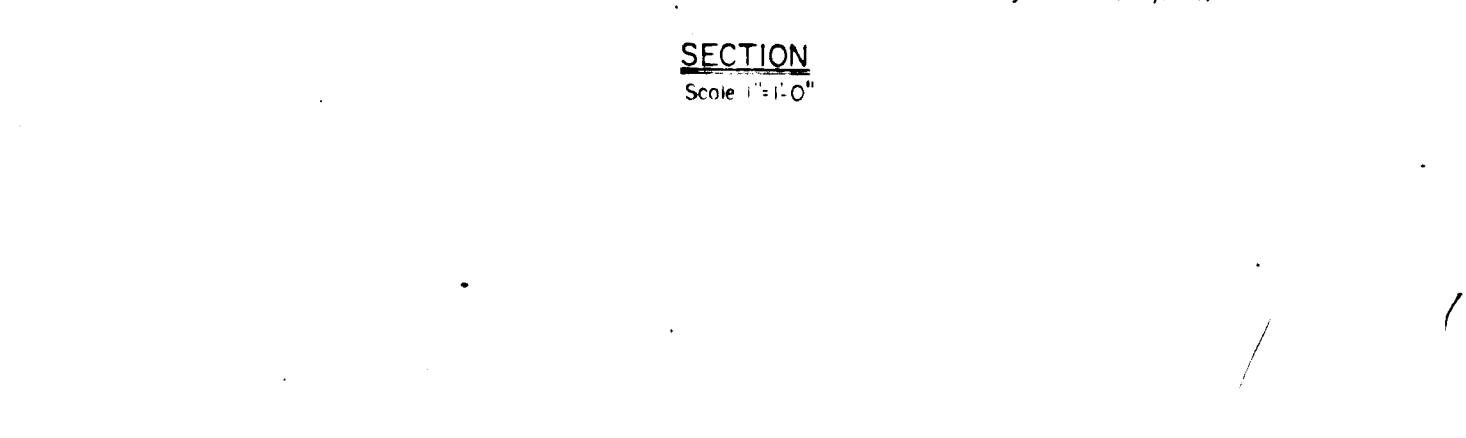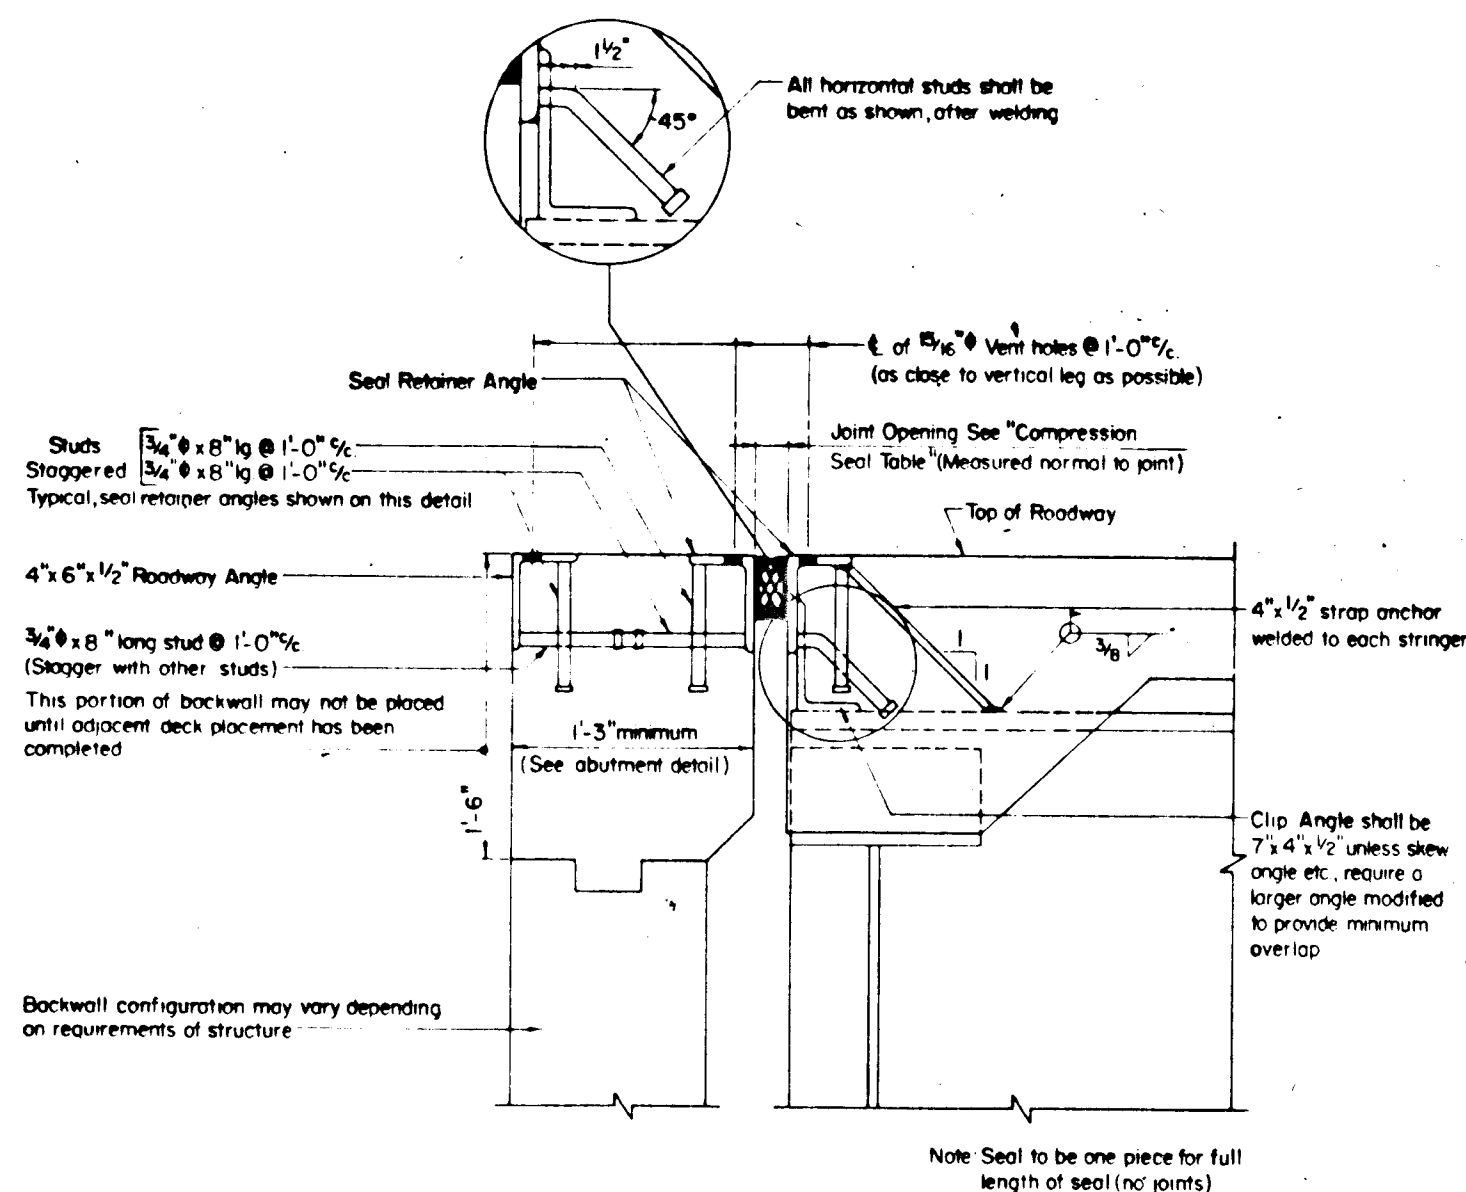



APPROVAL	DATE: 4-4-80	STATE OF MARYLAND DEPARTMENT OF TRANSPORTATION STATE HIGHWAY ADMINISTRATION DIVISION OF BRIDGE DEVELOPMENT COMPRESSION SEAL ROADWAY JOINTS AT ABUTMENTS STANDARD NO. BR-SS(702)-79-64 SHEET 1 OF 1
REVISIONS		
1	1-27-82	6-23-83
2	1-29-83	3-27-84
3	7-20-84	11-5-84

Note:  
1. New bridge details shown.  
2. When used for deck rehabilitation see Standard No. BR-SS(806)-78-72 showing special attachment of new clip angle.  
3. Compression seal to be placed after joint angles are set and deck and entire backwall are in place.  
4. See Standard No. BR-SS(701)-77-63 for additional details.

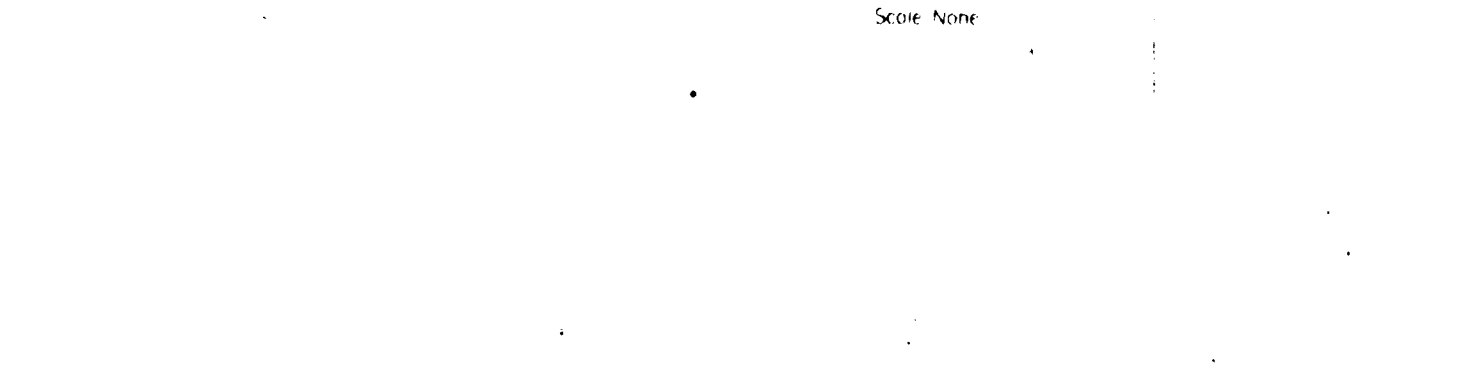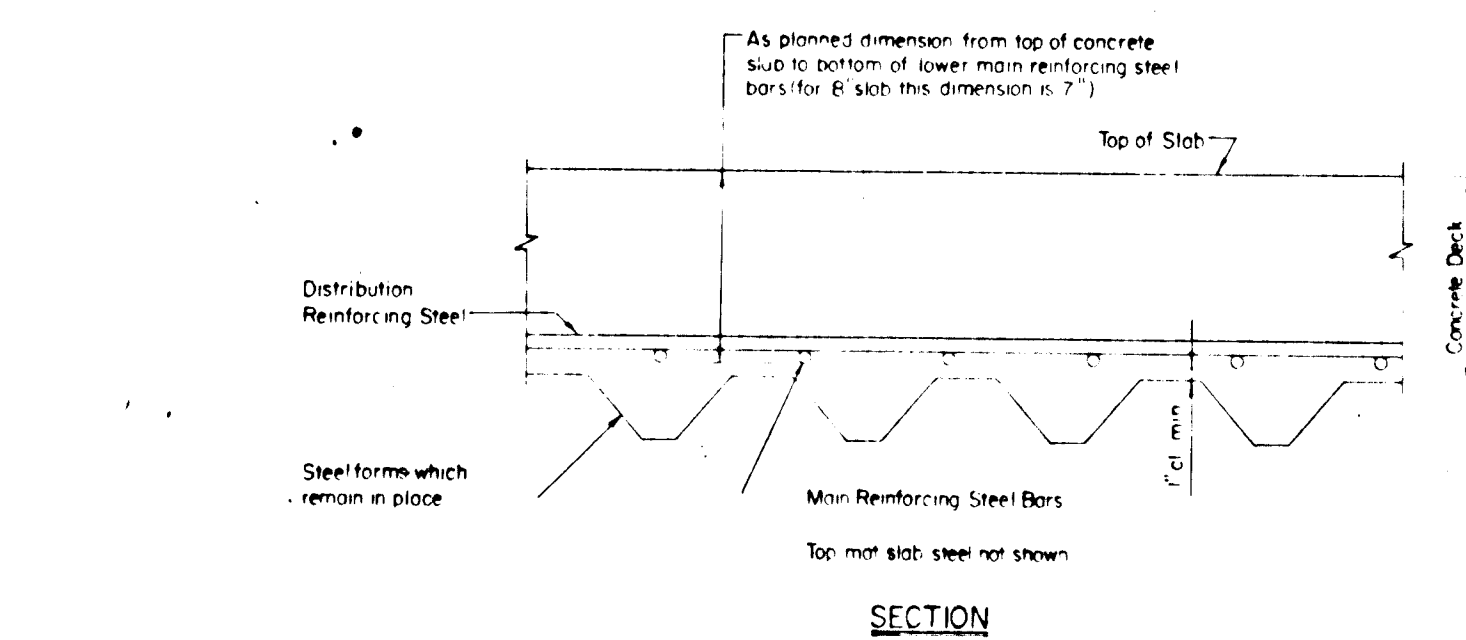



APPROVAL	DATE: 6-22-80	STATE OF MARYLAND DEPARTMENT OF TRANSPORTATION STATE HIGHWAY ADMINISTRATION DIVISION OF BRIDGE DEVELOPMENT STEEL FORMS WHICH REMAIN IN PLACE FOR CONCRETE SLABS ON STEEL STRINGERS RE-BARS INDEPENDENT OF TROUGHS STANDARD NO. BR-SS(606)-75-29 SHEET 2 OF 2
REVISIONS		
1	1-27-82	6-23-83
2	1-29-83	3-27-84
3	7-20-84	11-5-84

Note:  
1. For notes see sheet 1 of 2.  
2. This detail is applicable only on structures where the general notes under 'LOADING STATES' and 'LOADS' per square foot for use of bridge deck forms.

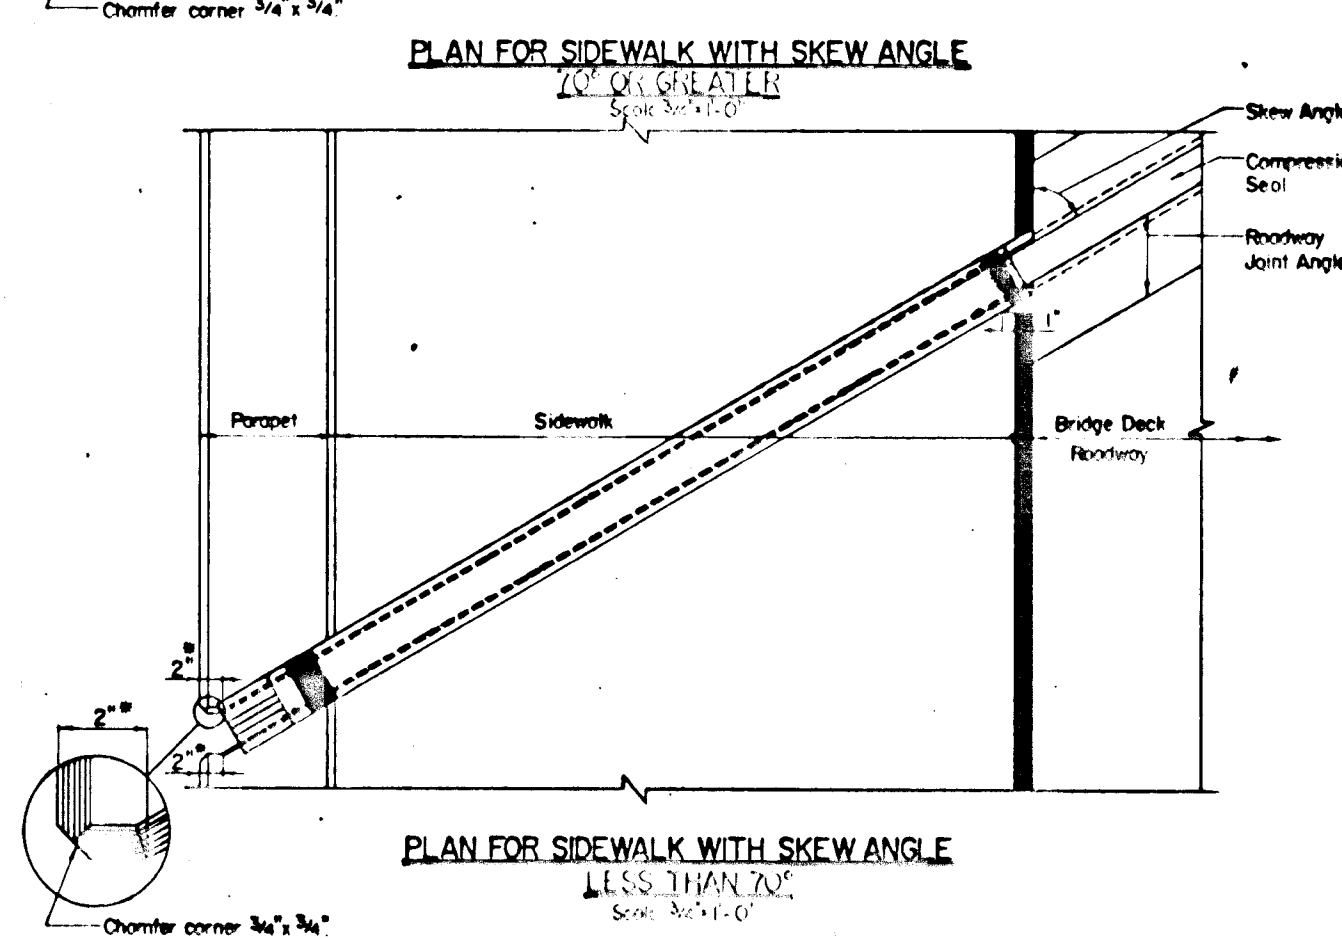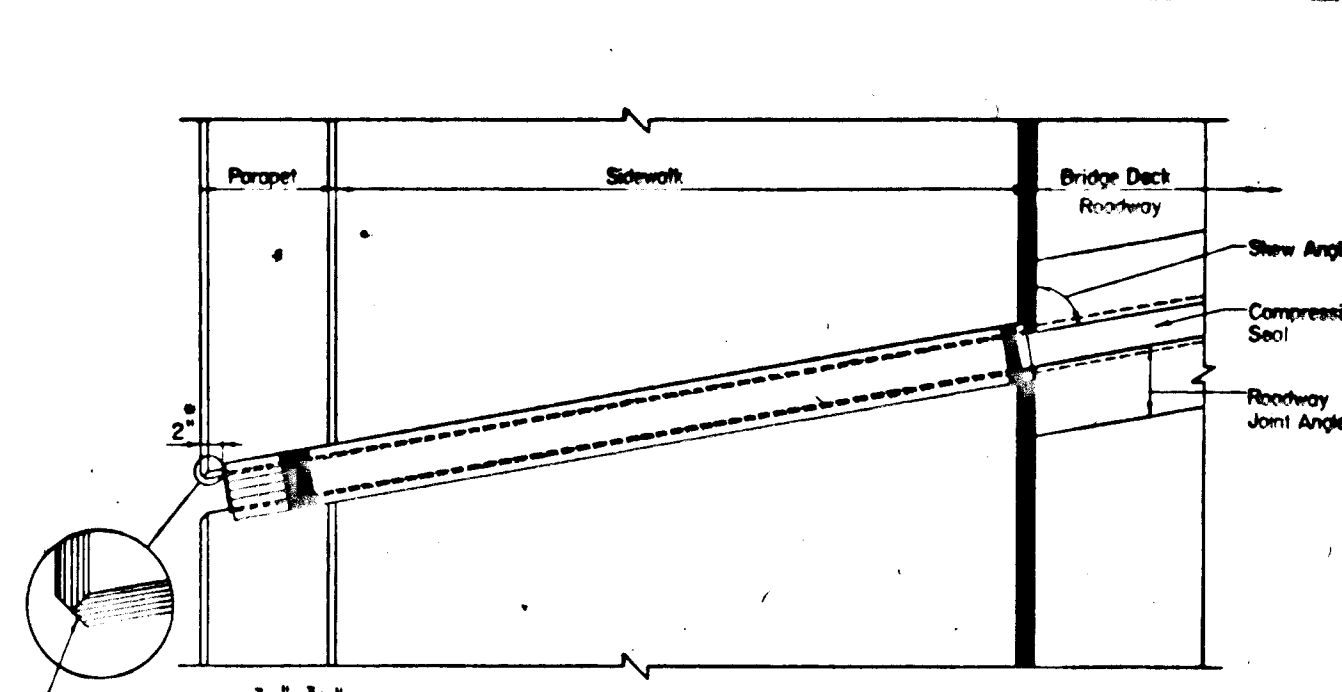



APPROVAL	DATE: 4-4-80	STATE OF MARYLAND DEPARTMENT OF TRANSPORTATION STATE HIGHWAY ADMINISTRATION DIVISION OF BRIDGE DEVELOPMENT FULL HEIGHT COMPRESSION SEAL ROADWAY JOINT AT SIDEWALKS STANDARD NO. BR-SS(701)-79-96 SHEET 1 OF 2
REVISIONS		
1	1-27-82	6-23-83
2	1-29-83	3-27-84
3	7-20-84	11-5-84

Note:  
1. All sections shown for 90° skew.  
2. All steel to be ASTM A-36, for piping specifications see Special Provision.  
3. Joint area shall be thoroughly cleaned just prior to placing of seal.

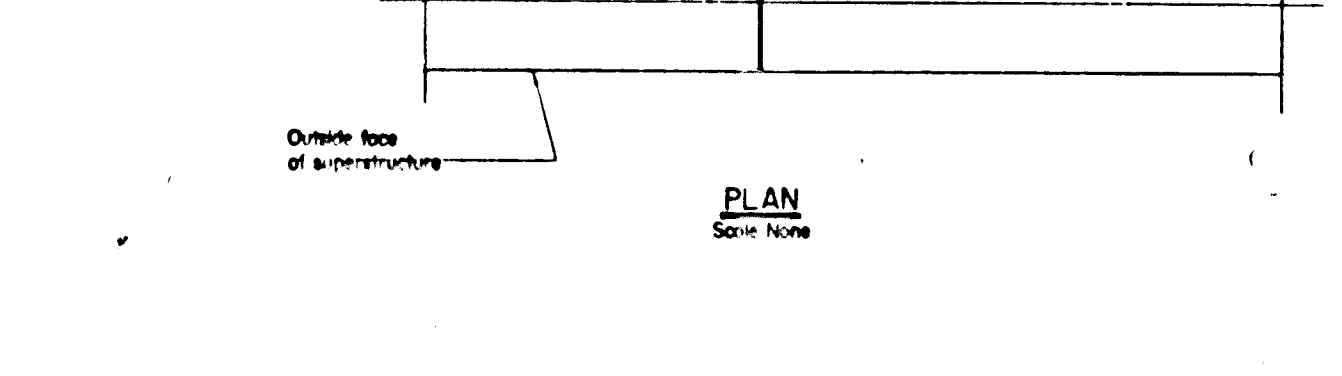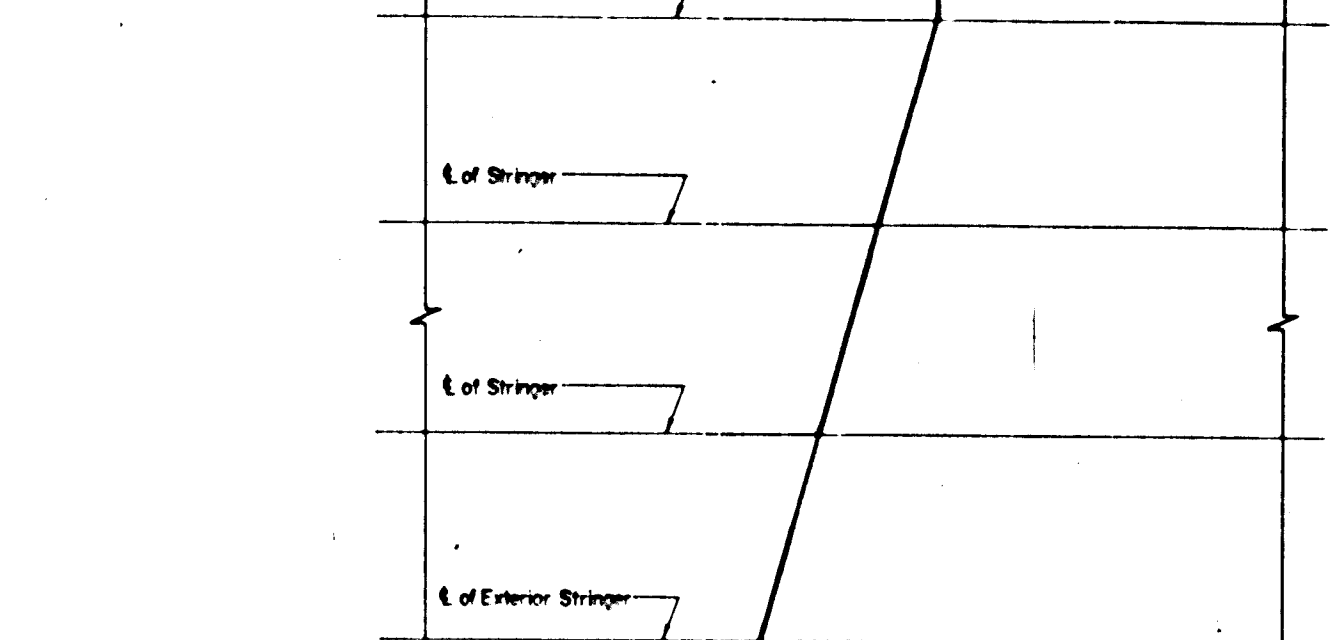


APPROVAL	DATE: 6-22-80	STATE OF MARYLAND DEPARTMENT OF TRANSPORTATION STATE HIGHWAY ADMINISTRATION DIVISION OF BRIDGE DEVELOPMENT LAYOUT OF TRANSVERSE JOINT FOR SKEWED BRIDGE DECK STANDARD NO. BR-SS(606)-78-69 SHEET 1 OF 1
REVISIONS		
1	1-27-82	6-23-83
2	1-29-83	3-27-84
3	7-20-84	11-5-84

Note:  
1. Reinforcing steel to be continuous thru joint.  
2. End of reinforcement shall be cast with 60# bars on exterior using binding brackets.

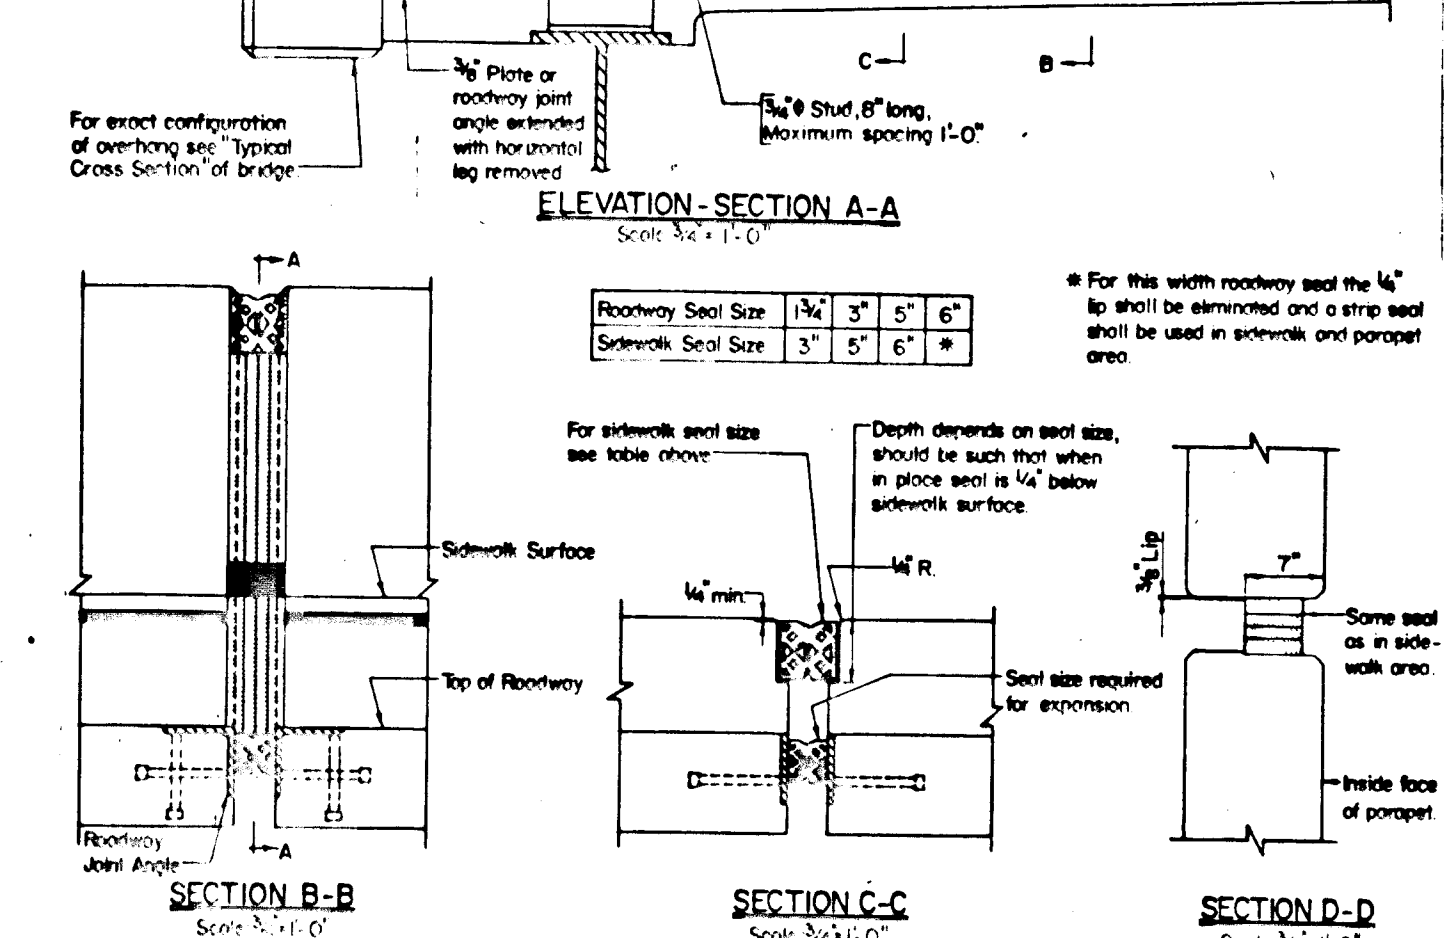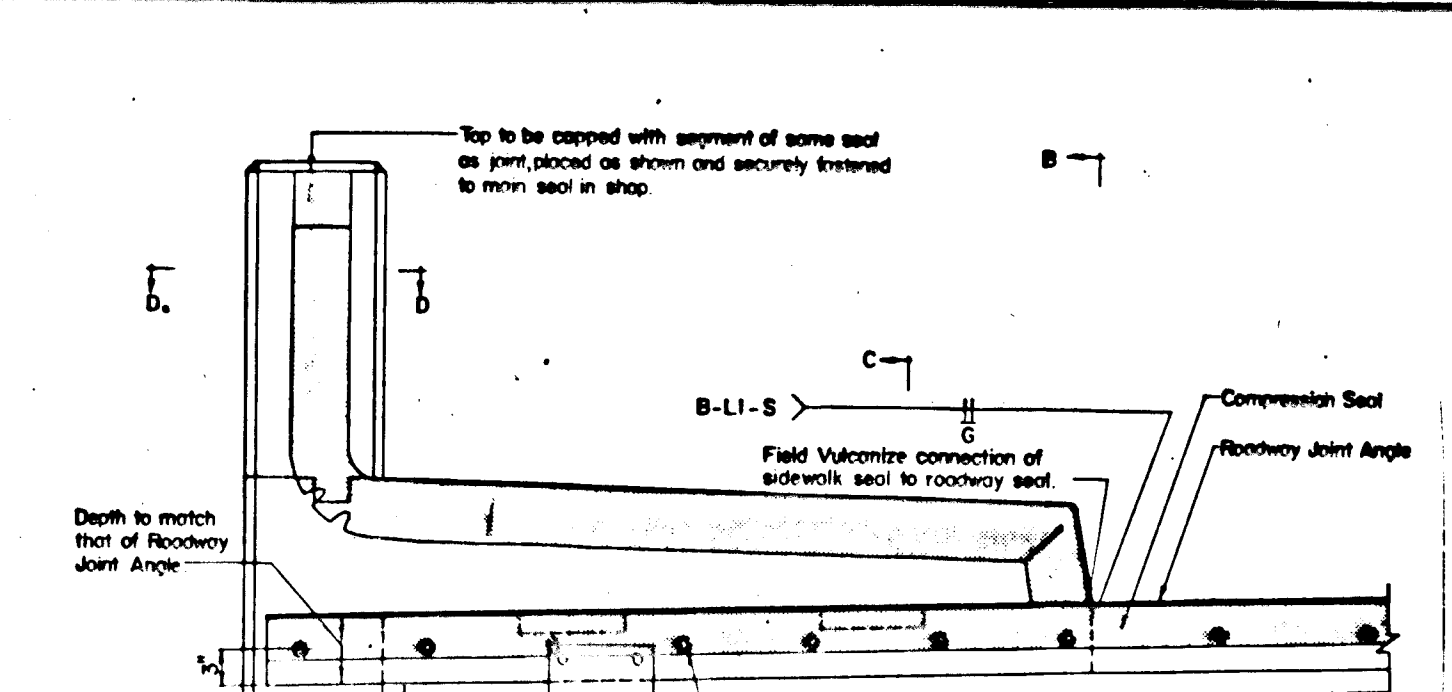

APPROVAL	DATE: 4-4-80	STATE OF MARYLAND DEPARTMENT OF TRANSPORTATION STATE HIGHWAY ADMINISTRATION DIVISION OF BRIDGE DEVELOPMENT FULL HEIGHT COMPRESSION SEAL ROADWAY JOINT AT SIDEWALKS STANDARD NO. BR-SS(701)-79-96 SHEET 2 OF 2
REVISIONS		
1	1-27-82	6-23-83
2	1-29-83	3-27-84
3	7-20-84	11-5-84

Note:  
1. All sections shown for 90° skew.  
2. All steel to be ASTM A-36, for piping specifications see Special Provision.  
3. Joint area shall be thoroughly cleaned just prior to placing of seal.

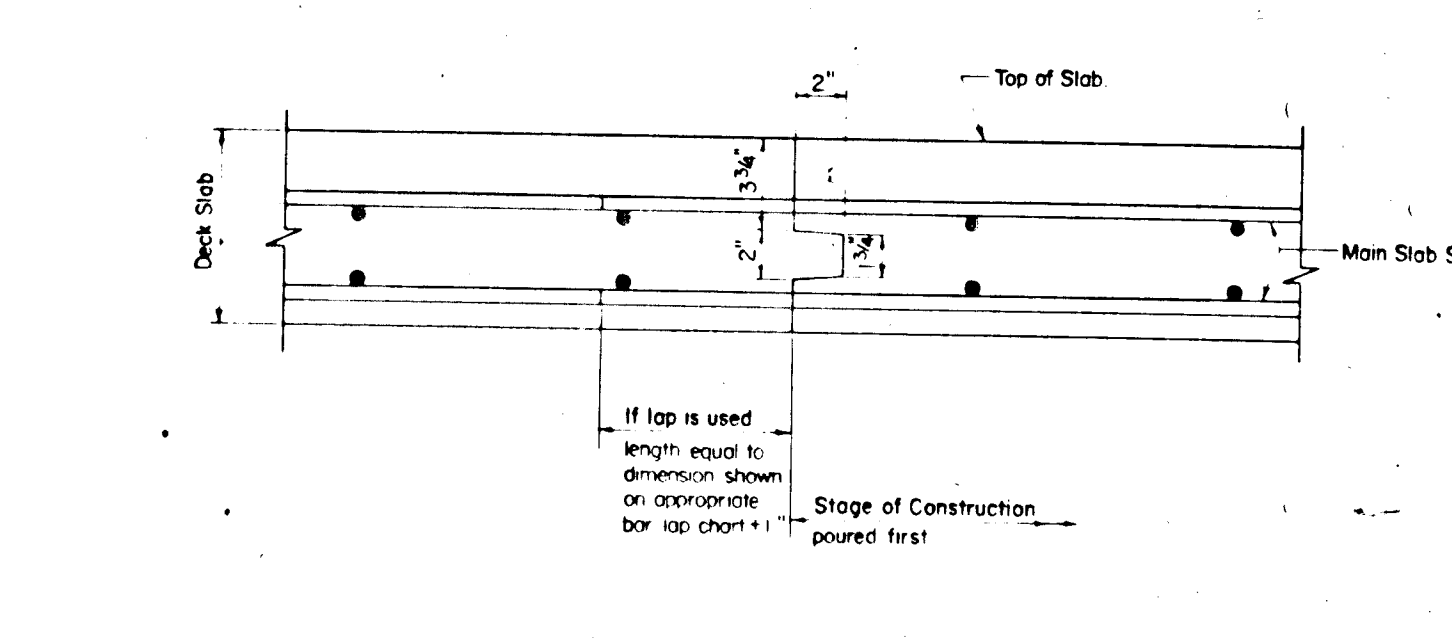

APPROVAL	DATE: 4-4-80	STATE OF MARYLAND DEPARTMENT OF TRANSPORTATION STATE HIGHWAY ADMINISTRATION DIVISION OF BRIDGE DEVELOPMENT BRIDGE DECK SLAB CONSTRUCTION JOINT STANDARD NO. BR-SS(07)-77-68 SHEET 1 OF 1
REVISIONS		
1	1-27-82	6-23-83
2	1-29-83	3-27-84
3	7-20-84	11-5-84

Note:  
1. Reinforcing steel to be continuous thru joint.  
2. End of reinforcement shall be cast with 60# bars on exterior using binding brackets.

OWNER/DEVELOPER  
HOWARD RESEARCH & DEVELOPMENT CORP.  
10275 LITTLE PATUXENT PARKWAY  
COLUMBIA, MARYLAND 21044

No	REVISION	DATE	BY



ENGINEERS • ARCHITECTS • PLANNERS • SCIENTISTS • SURVEYORS • PHOTOGRAMMETRISTS.  
**GREENHORNE & O'MARA, INC.**  
9001 EDMONSTON ROAD, GREENBELT, MARYLAND 20770  
(301) 982-2800  
ANNAPOLIS MD • ATLANTA GA • BECKLEY WV • CULPEPER VA • DENVER CO • EXPORT PA • FAIRFAX VA  
GREENSBORO NC • MONROE MI • RALEIGH NC • ROCKVILLE MD • TAMPA FL • WILLISTON PARK NY

STANDARD DETAILS  
**COLUMBIA**  
VILLAGE OF DORSEY'S SEARCH  
SECTION 3, AREA 1, PHASE 191  
TAX MAP 30 ~ PARCELS 124, 224 & 210  
5<sup>TH</sup> ELECTION DISTRICT ~ HOWARD COUNTY, MARYLAND

SHA DESIGN	SCALE	AS NOTED
SHA DRAWN	21	OF 24
DCC/RLP CHECKED	SHEET	
8/85 DATE	JOB No.	FILE No.

APPROVED: *[Signature]* 2-28-80  
HOWARD COUNTY DEPT. OF PUBLIC WORKS  
BRIDGE No # HO-137



#1159

F-86-55

**GENERAL NOTES**

- All railings shall be fabricated and erected as indicated on the contract drawing.
- Posts to be set perpendicular to top of parapet. For post spacing see contract drawing (Maximum 8'-0" Spacing).
- Rails shall be parallel to the grade of the roadway. Rail section to be attached to as many posts as possible, but not less than three (except where indicated otherwise on contract drawing).
- The centerline of any splice and/or expansion joint is to be located at least 2'-0" away from centerline of a post except where indicated otherwise on plans. Expansion and/or splice joints for each strand of two strand railing are to be placed in the same location and in the same plane.
- Material for rails, posts (including bases), splices and clamp bars shall conform to ASTM Designation B-221, Alloy 6061-T6. Rails shall have a mill finish. Posts shall have a mill finish except that any sawed surfaces shall have a finish comparable to 250 Micro. Each Rail and splice may conform to ASTM Designation B-221, Alloy 6155-T5 for chemical composition only.
- Material for rail and plates shall conform to ASTM Designation B-209, Alloy 6061-T6. Material for cast rail and caps shall conform to ASTM Designation B-108 Alloy 36 70A, 35A, and 37A for chemical composition only.
- Material for anchor studs shall conform to ASTM Designation A-276, Type 304 Stainless Steel, annealed, hot finished, ultimate strength 70,000 psi, min. 20% min elongation. Threads may be rolled or cut.
- Material for heavy aluminum nuts shall conform to ASTM Designation B-211, Alloy 6061-T6 or Alloy 6262-T9.
- Material for steel nuts shall conform to ASTM Designation A-307.
- Material for aluminum washers shall conform to ASTM Designation B-209, Alloy A1024-T4.
- Material for rivets shall conform to ASTM Designation B-316, Alloy 6061-T6 and 6053-T6 for chemical composition only and shall conform with MIL-R-1150 in all other respects. These rivets shall be button head and cone point and shall be cold drawn.
- In lieu of rivets connecting post to post base plate, bolts may be used. Material for bolts shall be of stainless steel and shall conform to ASTM Designation A-193, Identification Symbol B-8. Nuts shall conform to ASTM Specification A-194, Type B or B-NA. Material for washers shall conform to ASTM Specification A-276, Type 304 Specified Torque Level. Bolts connecting base plate to post shall be 50 to 175 ft lbs. Bolt threads by counter-punching at top of nut. Punch marks to be spaced at 120°.
- Material for clamp bar top screws and cap screws shall be stainless steel and conform to ASTM Designation A-193, Identification Symbol B8.
- Material for anchor plates shall be steel conforming to ASTM Designation A-36.
- Material for pins shall conform to ASTM Designation Alloy 6061-T6 and pins shall be press fit.
- Bottom of post bases shall be thoroughly coated with an approved caulking compound or an approved zinc chromate paint.
- Weld metal for the welded base plate shall be 5356 A-1.

APPROVAL	STATE OF MARYLAND DEPARTMENT OF TRANSPORTATION STATE HIGHWAY ADMINISTRATION DIVISION OF BRIDGE DEVELOPMENT GENERAL NOTES ALUMINUM BRIDGE RAILING
DATE: 2-25-77	STANDARD NO BR-SS15(01)76-35 SHEET 1 OF 2


Bar Size	LOCATION CATEGORY		
	A	B	C
#4	2'-5"	1'-9"	1'-5"
#5	3'-0"	2'-2"	1'-9"
#6	3'-7"	2'-7"	2'-1"
#7	4'-4"	3'-1"	2'-6"
#8	5'-0"	4'-0"	3'-3"
#9	7'-2"	5'-1"	4'-1"
#10	9'-0"	6'-6"	5'-2"
#11	11'-1"	7'-11"	6'-4"

**LOCATION CATEGORY**

- A - Bars in horizontal layers in top of pour with 12" or more of concrete below them such as in footings, pier caps, etc.
- B - All bars not in Category A spaced less than 6 inches apart.
- C - All bars not in Category A spaced 6 inches or more apart.

APPROVAL	STATE OF MARYLAND DEPARTMENT OF TRANSPORTATION STATE HIGHWAY ADMINISTRATION DIVISION OF BRIDGE DEVELOPMENT BAR LAP DIMENSIONS FOR GRADE 60 REINFORCING STEEL IN MIX NO. 3 (3500PSI) CONCRETE
DATE: 2-25-77	STANDARD NO. M(607)-81-122 SHEET 1 OF 1

- When bar lap is not specified on the plans, the above dimensions shall be used.
- These bar laps do not apply when bar is in lightweight concrete. Greater lengths are required for this material.
- These bar laps only apply where the General Notes indicate. Reinforcing Steel Design (4-24-00) ps.

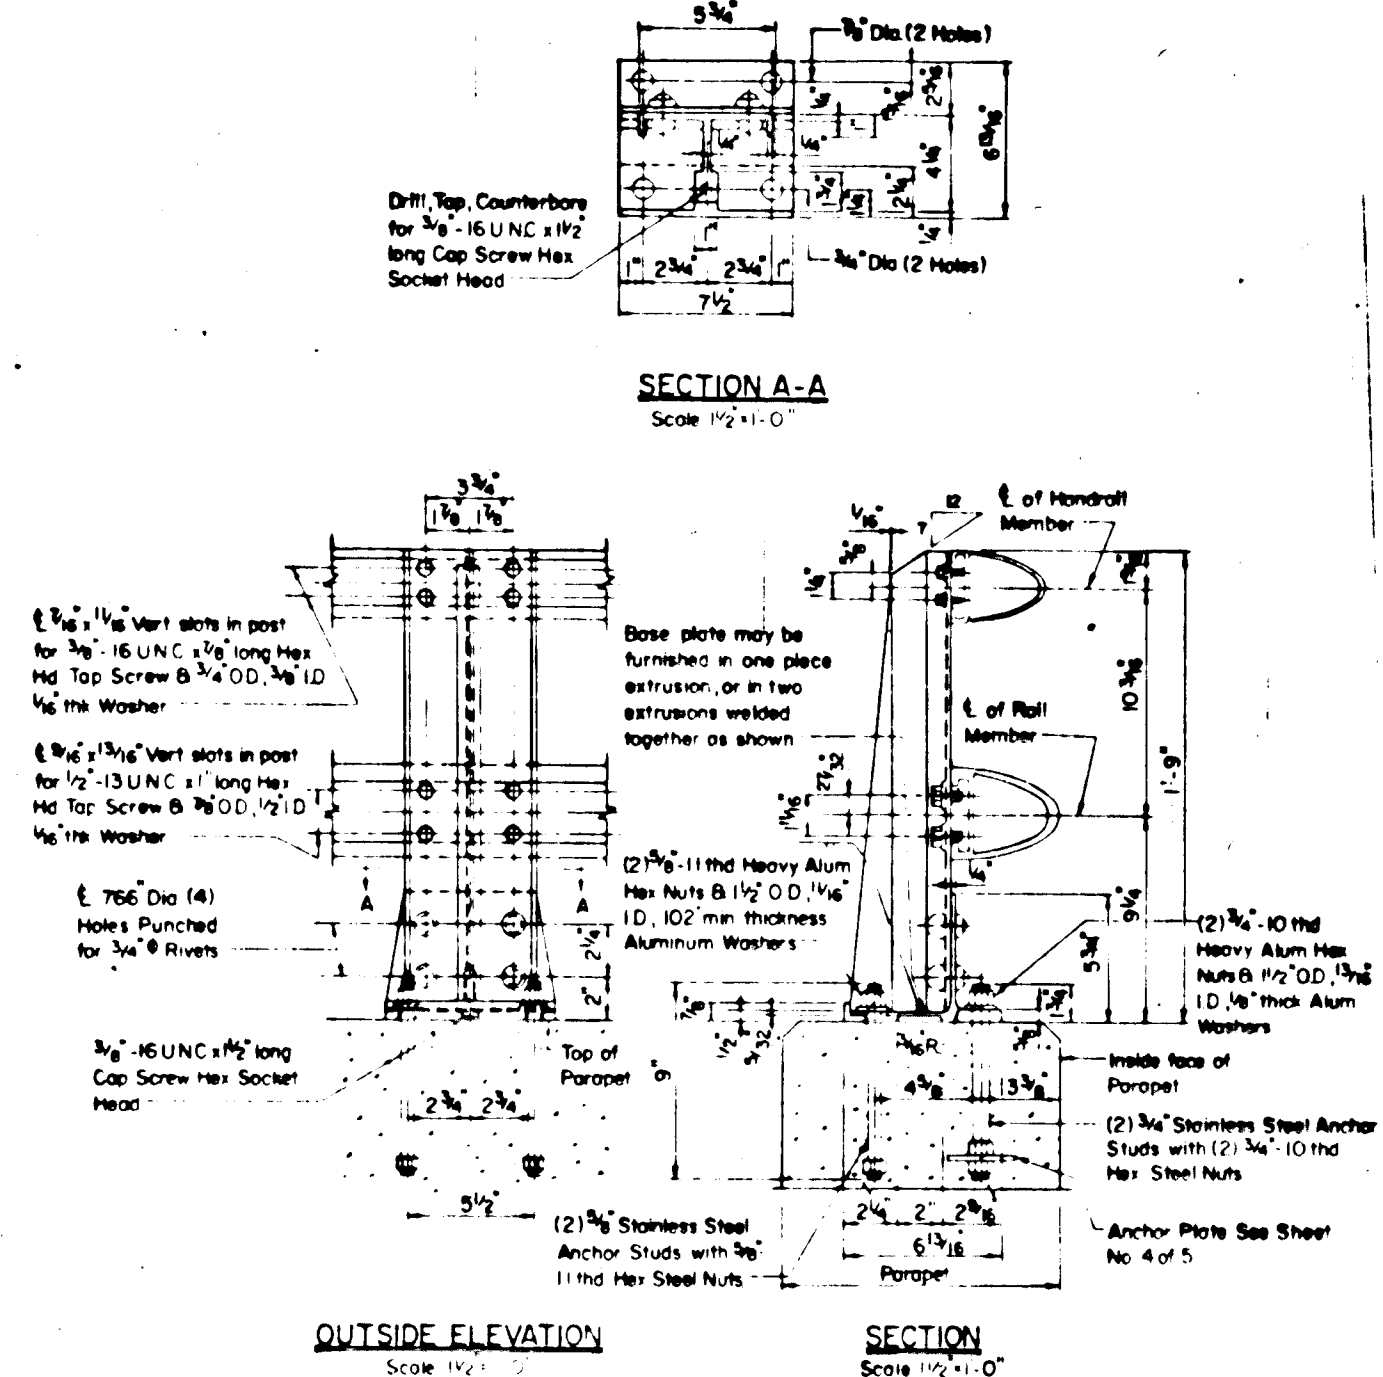

APPROVAL	STATE OF MARYLAND DEPARTMENT OF TRANSPORTATION STATE HIGHWAY ADMINISTRATION DIVISION OF BRIDGE DEVELOPMENT TWO STRAND ALUMINUM BRIDGE RAILING
DATE: 2-25-77	STANDARD NO BR-SS15(01)76-35 SHEET 2 OF 2


Bar Size	LOCATION CATEGORY		
	A	B	C
#4	2'-5"	1'-9"	1'-5"
#5	3'-0"	2'-2"	1'-9"
#6	3'-7"	2'-7"	2'-1"
#7	4'-4"	3'-1"	2'-6"
#8	5'-0"	4'-0"	3'-3"
#9	7'-2"	5'-1"	4'-1"
#10	9'-0"	6'-6"	5'-2"
#11	11'-1"	7'-11"	6'-4"

**LOCATION CATEGORY**

- A - Bars in horizontal layers in top of pour with 12" or more of concrete below them such as in footings, pier caps, etc.
- B - All bars not in Category A spaced less than 6 inches apart.
- C - All bars not in Category A spaced 6 inches or more apart.


APPROVAL	STATE OF MARYLAND DEPARTMENT OF TRANSPORTATION STATE HIGHWAY ADMINISTRATION DIVISION OF BRIDGE DEVELOPMENT BAR LAP DIMENSIONS FOR GRADE 60 REINFORCING STEEL IN MIX NO. 3 (3500PSI) CONCRETE
DATE: 2-25-77	NO M(607)-81-122 SHEET 1 OF 1

- When bar laps not specified on the plans, the above dimensions shall be used.
- These bar laps do not apply when bar is in lightweight concrete. Greater lengths are required for this material.
- These bar laps only apply where the General Notes indicate. Reinforcing Steel Design (4-24-00) ps.

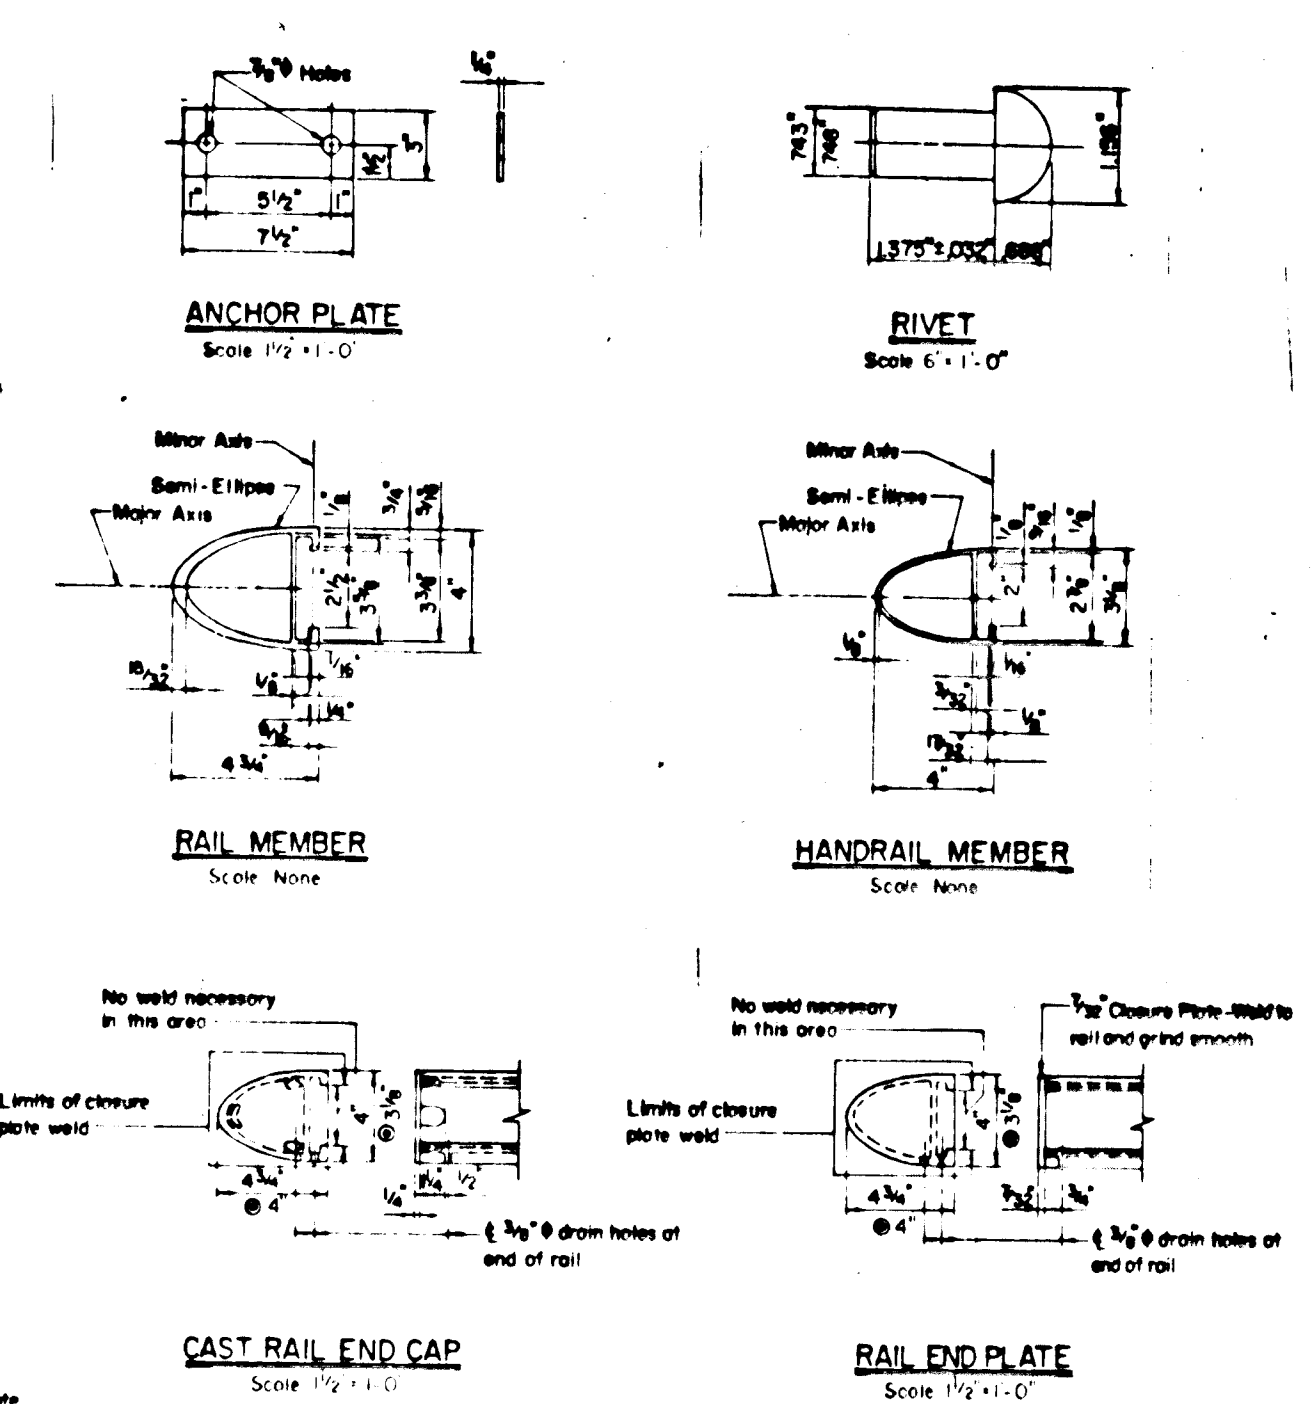


Note:  
All Contractors option, cast rail and caps may be substituted for rail and plates.  
Open ends of all Handrails and Rails shall be closed.  
Dimensions indicated thus  $\phi$  apply to Handrail.  
Other dimensions apply to Rail.

APPROVAL	STATE OF MARYLAND DEPARTMENT OF TRANSPORTATION STATE HIGHWAY ADMINISTRATION DIVISION OF BRIDGE DEVELOPMENT MISCELLANEOUS DETAILS ALUMINUM BRIDGE RAILING
DATE: 2-25-77	STANDARD NO BR-SS(01)76-35 SHEET 4 OF 5

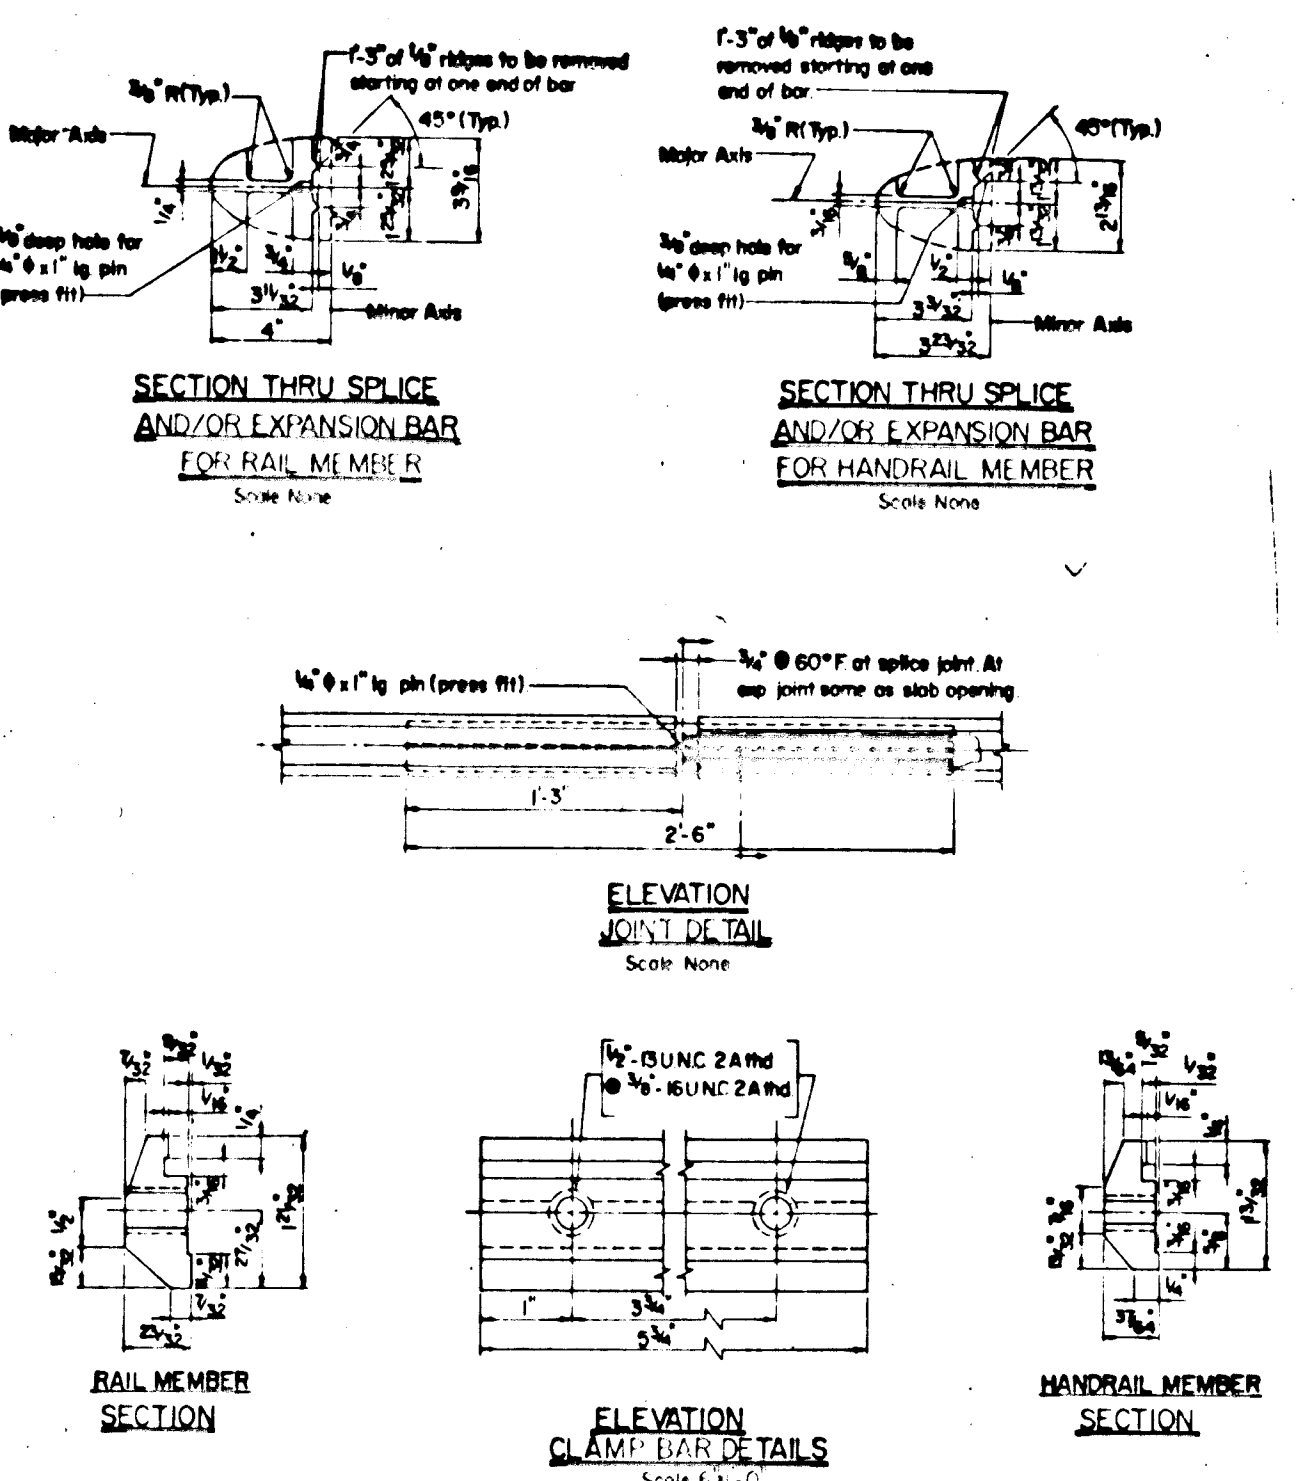

APPROVAL	STATE OF MARYLAND DEPARTMENT OF TRANSPORTATION STATE HIGHWAY ADMINISTRATION DIVISION OF BRIDGE DEVELOPMENT MISCELLANEOUS DETAILS ALUMINUM BRIDGE RAILING
DATE: 2-25-77	STANDARD NO BR-SS(01)76-35 SHEET 5 OF 5

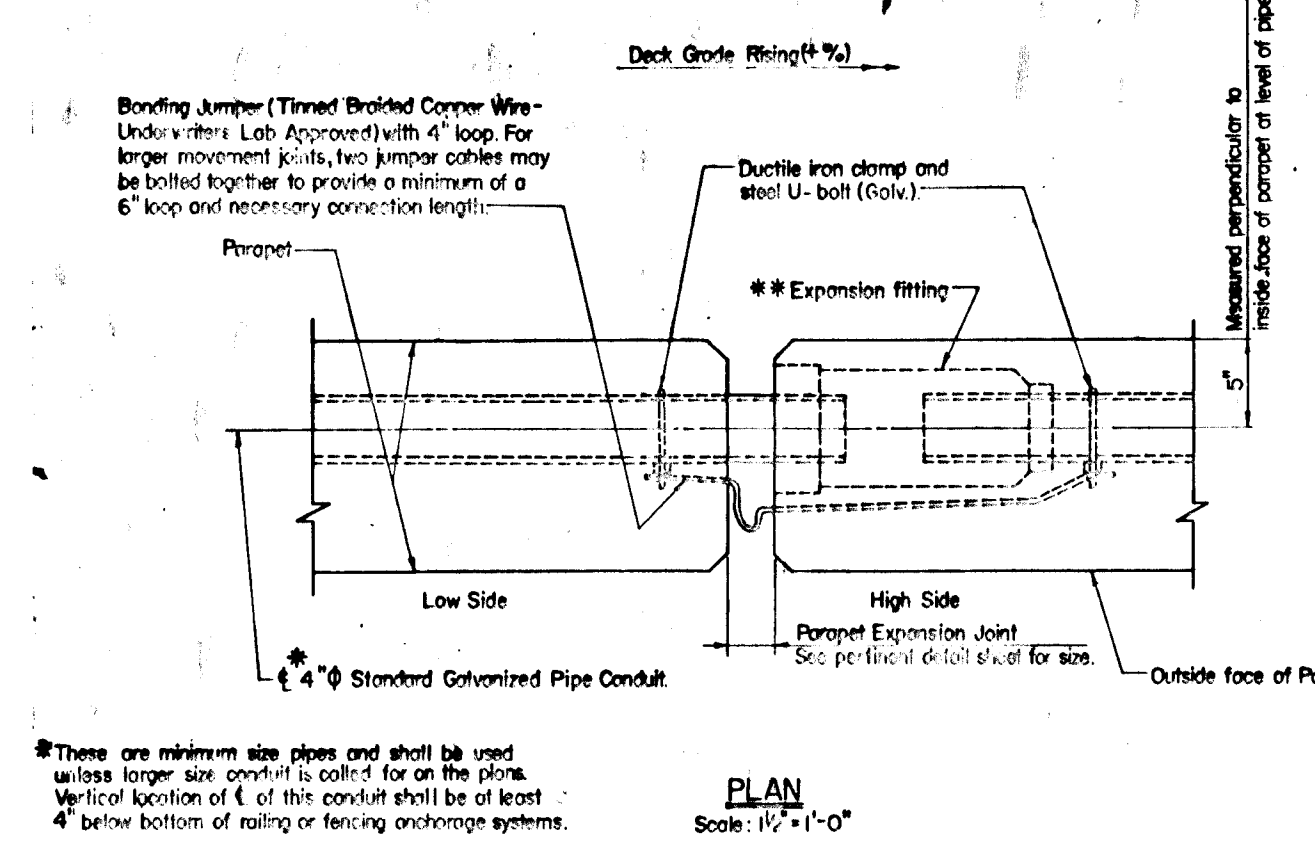

- These are minimum size pipes and shall be used unless larger size conduit is called for on the plans. Vertical location of  $\phi$  of this conduit shall be at least 4" below bottom of railing or fencing anchorage systems.
- Expansion fittings for use with rigid galvanized steel conduit shall consist of a malleable iron head and steel sleeve which shall be hot-dipped galvanized and assembled with a water-tight packing gland, an insulated bushing, pressure ring and gasket and a brass-copper bond to assure continuity of ground. The fitting shall provide, unless otherwise noted on the plans, 4" inches of movement for all compression seal roadway joints and 6" inches of movement for all other roadway joints, such as steel flange joints.

APPROVAL	STATE OF MARYLAND DEPARTMENT OF TRANSPORTATION STATE HIGHWAY ADMINISTRATION DIVISION OF BRIDGE DEVELOPMENT EXPANSION JOINT FOR CONDUIT IN PARAPETS
DATE: 2-25-77	STANDARD NO BR-SS(01)76-15 SHEET 1 OF 2

- Place expansion joint in pipe conduit and parapet at every expansion joint of support structure.
- Use 10 galvanized pipe with to be provided for full length of conduit and left in place.
- Contractor may furnish either PVC conduit as shown on sheet 2 of 2 or material shown on this detail. However, only one type can be used throughout a structure.

APPROVED: HOWARD COUNTY OFFICE OF PLANNING & ZONING  
*[Signature]* 2-28-78  
DATE  
APPROVED: HOWARD COUNTY DEPT. OF PUBLIC WORKS  
*[Signature]* 2-28-78  
DATE  
CHIEF ENGINEER

OWNER/DEVELOPER  
HOWARD RESEARCH & DEVELOPMENT CORP.  
10275 LITTLE PATUXENT PARKWAY  
COLUMBIA, MARYLAND 21044

No.	REVISION	DATE	BY




ENGINEERS • ARCHITECTS • PLANNERS • SCIENTISTS • SURVEYORS • PHOTOGRAMMETRISTS  
**GREENHORNE & O'MARA, INC.**  
9001 EDMONSTON ROAD, GREENBELT, MARYLAND 20770  
(301) 982-2800  
ANNAPOLIS MD • ATLANTA GA • BECKLEY WV • CULPEPPER VA • DENVER CO • EXPORT PA • FAIRFAX VA  
GREENSBORO NC • MONROE MI • RALEIGH NC • ROCKVILLE MD • TAMPA FL • WILLISTON PARK NY

STANDARD DETAILS  
COLUMBIA  
VILLAGE OF DORSEY'S SEARCH  
SECTION 3, AREA 1, PHASE 191  
TAX MAP 80 ~ PARCELS 124, 224 & 210  
5<sup>TH</sup> ELECTION DISTRICT ~ HOWARD COUNTY, MARYLAND

SHA DESIGN	SCALE	AS NOTED
SHA DRAWN	22	OF 24
DCC/R/LP CHECKED	SHEET	
8/85 DATE	JOB No.	R1316X FILE No.

F-86-55

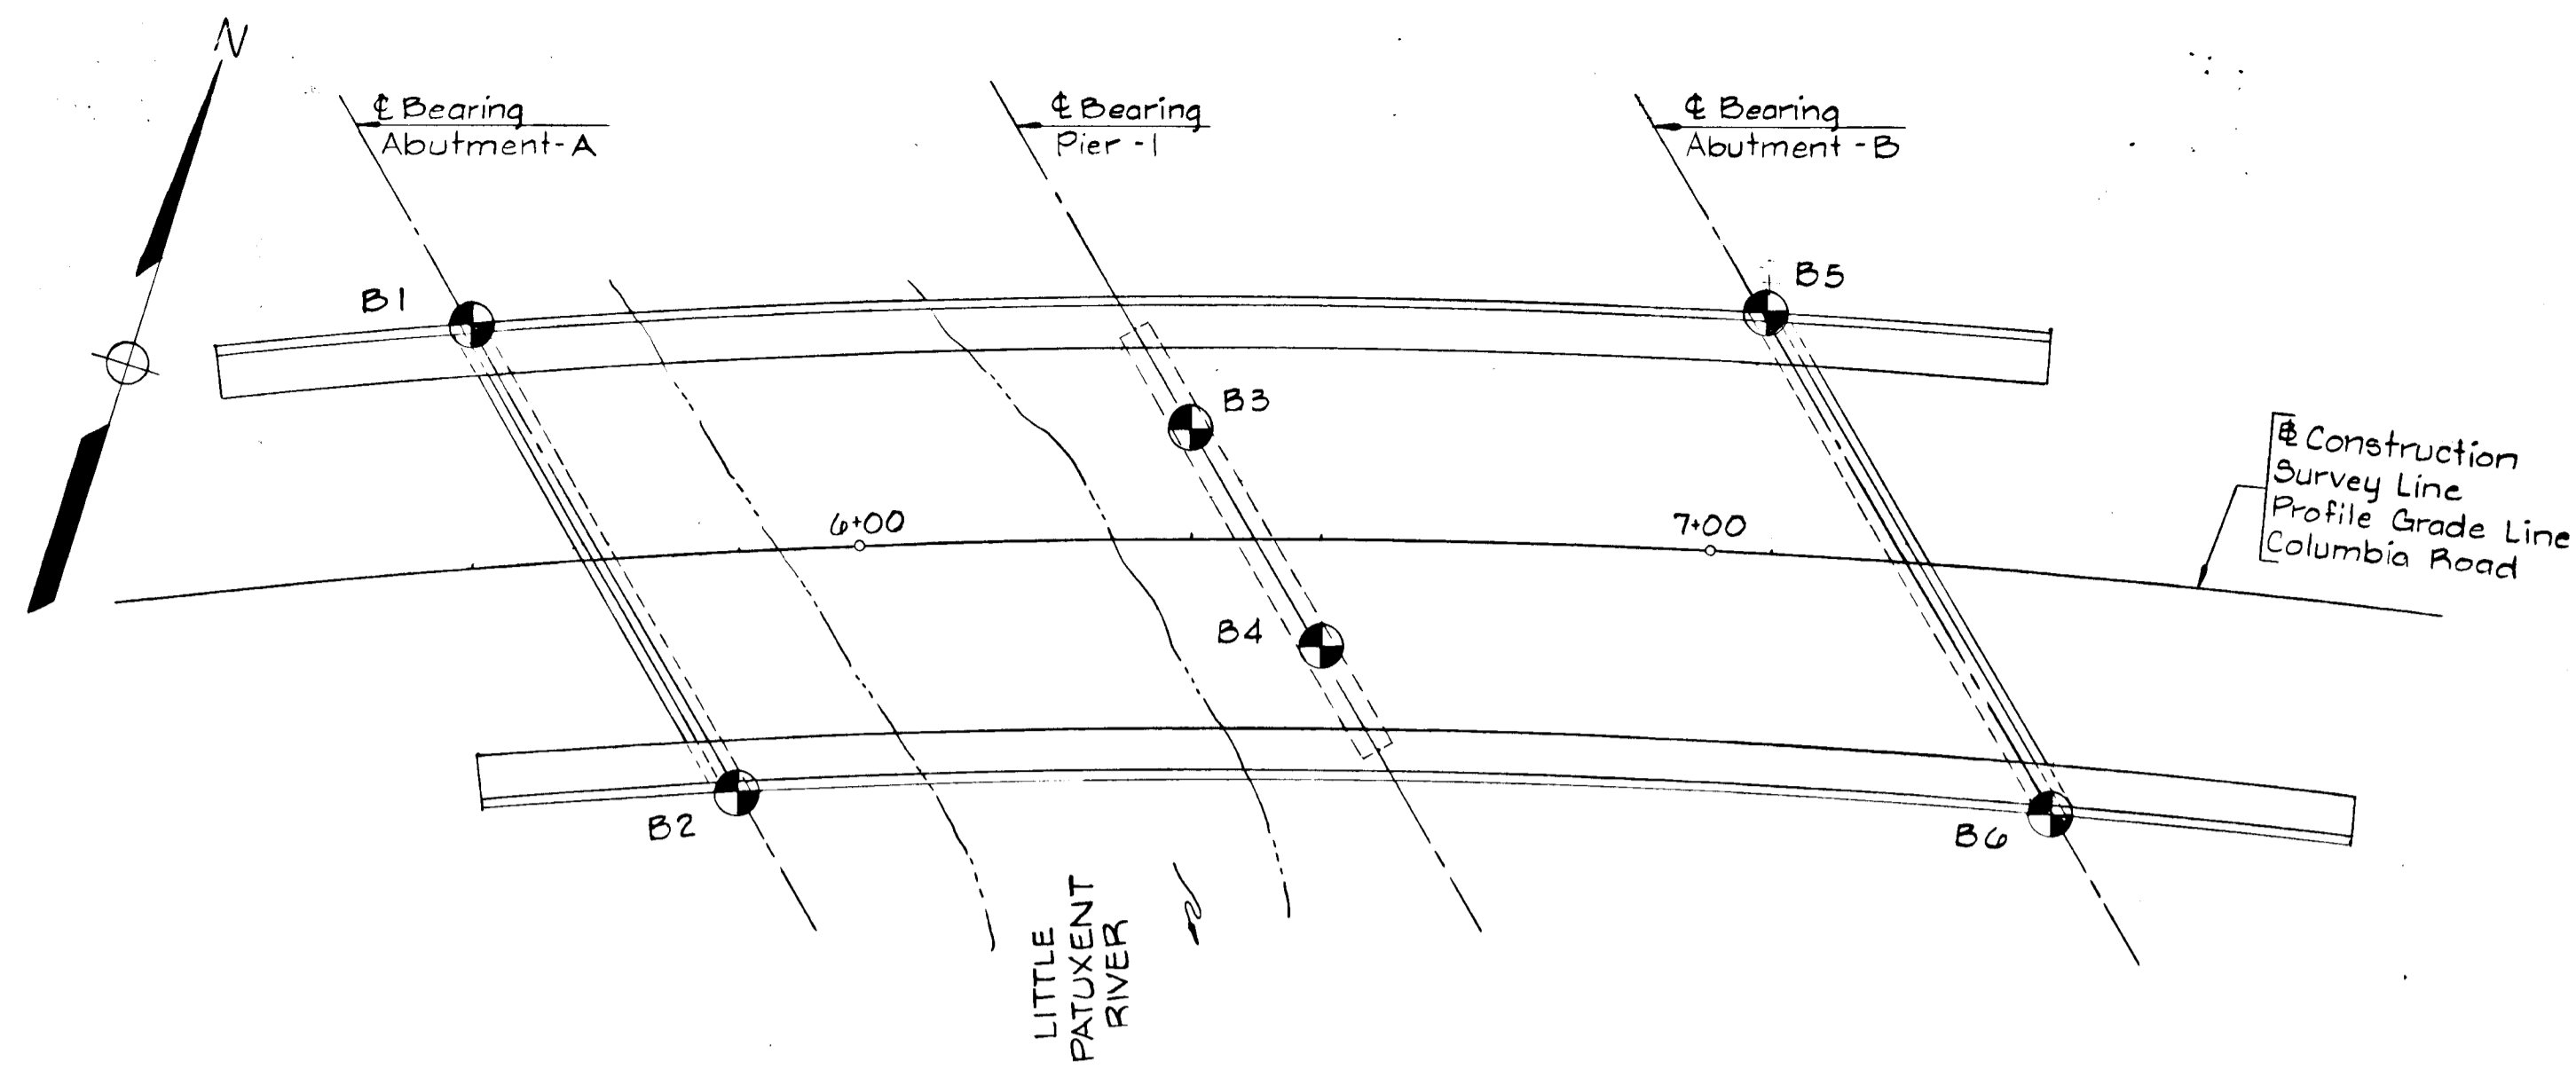

**BORING AND DRIVE TEST LOCATION PLAN**

Scale: 1"=20'

B1		311.75
STA. 5+54		Bott/Ftg.
N	DEPTH	
9	2.0	308.2
23	4.5	Brown, Slightly Wet, Medium Stiff To Very Stiff, Clayey SILT
8	7.0	302.7
16	9.5	See Note-A
52	12.0	297.7
176	14.5	Light Brown And Grey, Moist, Very Dense, Slightly Micaceous, Silty, Medium To Fine SAND
100/4	17.0	
54	19.5	
100/5	22.0	287.2
100/3	24.5	Brown, Moist, Very Dense, Micaceous Silty Fine SAND With Little Medium Sand
100/1	27.0	
100/1	29.0	279.6

B2		311.75
STA. 5+86		Bott/Ftg.
N	DEPTH	
4	2.0	307.7
2	4.5	See Note-B
2	7.0	304.2
19	9.5	See Note-C
41	12.0	300.7
100/6	14.5	See Note-D
100/3	19.5	295.7
100/3	24.5	Brown, Moist, Very Dense, Micaceous Fine Sandy SILT
100/3	29.5	278.9

B3		
STA. 6+39		
N	DEPTH	
4	2.0	307.2
4	4.5	Brown, Wet, Soft SILT With Little To Some Clay
53	7.0	301.7
32	9.5	See Note-E
100/6	12.0	299.2
100/3	14.5	Brown, Moist, Dense To Very Dense Micaceous Fine Sandy SILT
100/5	19.5	293.0
100/2	24.5	Bott/Ftg.
100/3	27.0	
100/1	29.0	278.6

B4		
STA. 6+54		
N	DEPTH	
6	2.0	307.4
3	4.5	See Note-F
15	7.0	304.4
23	9.5	See Note-G
100/5	12.0	301.9
100/4	14.5	See Note-H
100/4	19.5	299.4
100/2	24.5	Brown, Moist, Medium Dense To Very Dense, SILT With Little Fine Sand
100/1	29.0	278.8

B5		310.50
STA. 7+07		Bott/Ftg.
N	DEPTH	
5	2.0	307.7
17	4.5	Brown, Slightly Wet, Soft To Very Stiff Clayey SILT
26	7.0	302.2
21	9.5	Brown, Saturated, Medium Dense To Very Dense, Silty Coarse To Fine SAND With Little Fine Gravel
100/7.5	12.0	
100/2	14.5	294.7
100/1	17.0	Intact Fragments Of Decomposed Rock
		289.0

B6		310.50
STA. 7+40		Bott/Ftg.
N	DEPTH	
4	2.0	307.1
19	4.5	Brown To Grey, Wet To Slightly Wet, Soft To Very Stiff, Clayey SILT
27	7.0	301.6
73	9.5	See Note-J
100/6	12.0	298.6
100/1	15.0	Brown, Moist, Very Dense, Micaceous Silty Fine SAND
100/1	15.0	295.1
100/1	15.0	Light Grey, Dark Blue Grey, And Black, Schistose Gneiss
		285.1

Note-J  
Grey, Saturated, Medium Dense, Silty Coarse To Fine SAND With Little Fine Gravel

Note-A:  
Grey, Saturated, Loose To Medium Dense, Silty Medium To Fine SAND With Trace To Some Fine Gravel

Note-B:  
Brown, Slightly Wet, Very Loose, Micaceous Fine Sandy SILT

Note-C:  
Grey, Saturated, Very Loose, Micaceous SILT With Trace Clay And Trace Fine Sand

Note-D:  
Brown, Saturated, Medium Dense, Silty Medium To Fine SAND With Trace Coarse SAND And Little Fine Gravel

Note-E:  
Brown, Saturated, Very Dense Silty Coarse To Fine SAND And Fine Gravel

Note-F:  
Brown, Slightly Wet Medium Stiff Clayey SILT

Note-G:  
Grey, Wet, Very Loose, SILT With Trace Fine Sand And Trace Roots

Note-H:  
Brown, Saturated, Medium Dense, Silty Coarse To Fine SAND And Fine GRAVEL

APPROVED: HOWARD COUNTY OFFICE OF PLANNING & ZONING

*John W. ...* 2-28-86  
CHIEF, DIV. OF LAND DEVELOPMENT & ZONING ADMIN. DATE

APPROVED:  
HOWARD COUNTY DEPT. OF PUBLIC WORKS

*William S. ...* 2-28-86  
CHIEF, BUREAU OF ENGINEERING DATE

**OWNER/DEVELOPER**  
HOWARD RESEARCH & DEVELOPMENT CORP.  
10275 LITTLE PATUXENT PARKWAY  
COLUMBIA, MARYLAND 21044

No.	REVISION	DATE	BY

**GREENHORNE & O'MARA, INC.**  
9001 EDMONSTON ROAD, GREENBELT, MARYLAND 20770  
(301) 982-2800




ANNAPOLIS, MD • ATLANTA, GA • BECKLEY, WV • CULPEPER, VA • DENVER, CO • EXPORT, PA • FAIRFAX, VA  
GREENSBORO, NC • MONROE, MI • RALEIGH, NC • ROCKVILLE, MD • TAMPA, FL • WILLISTON PARK, NY

**BORING LOGS & DRIVE TEST**  
**COLUMBIA**  
**VILLAGE OF DORSEY'S SEARCH**  
SECTION 3, AREA 1, PHASE 191  
TAX MAP 30 ~ PARCELS 124, 224 & 210  
5<sup>TH</sup> ELECTION DISTRICT ~ HOWARD COUNTY, MARYLAND

DESIGN	SCALE	NONE
RMJ DRAWN		23 OF 24
DCC CHECKED		SHEET
8/85 DATE		FILE No.

#1159

F-86-55

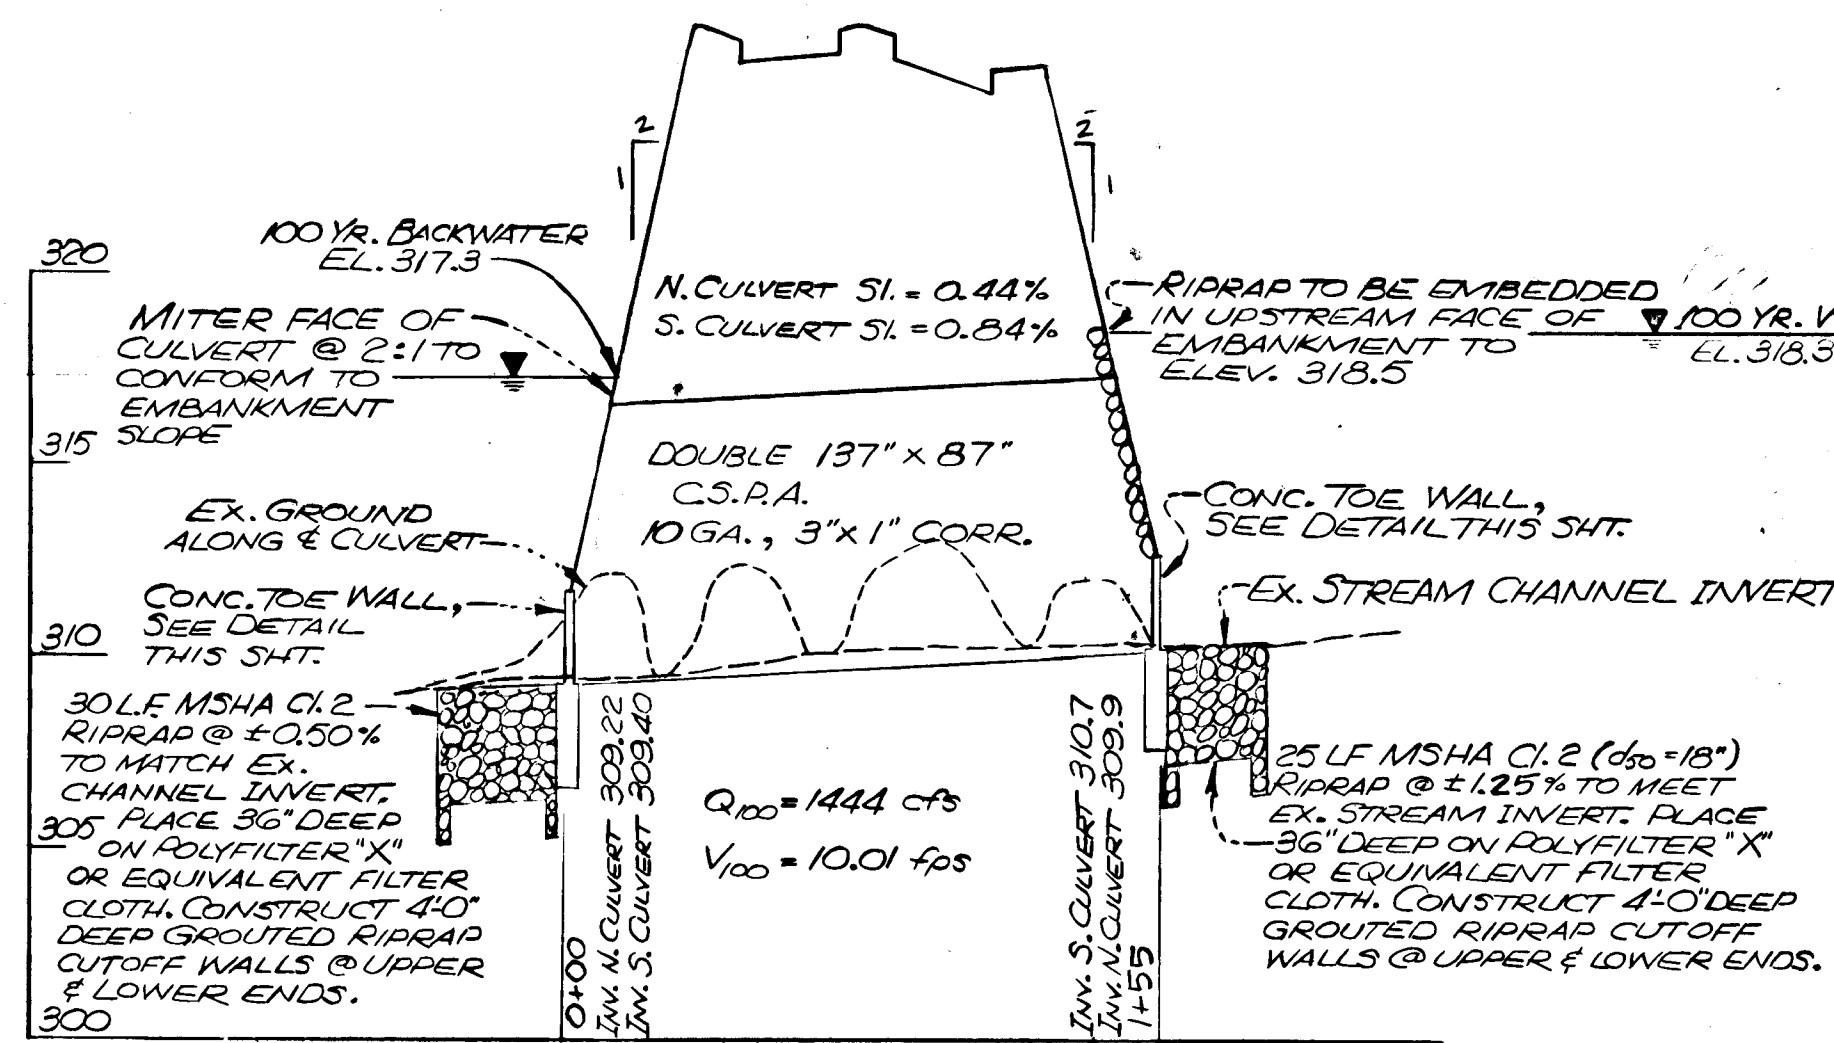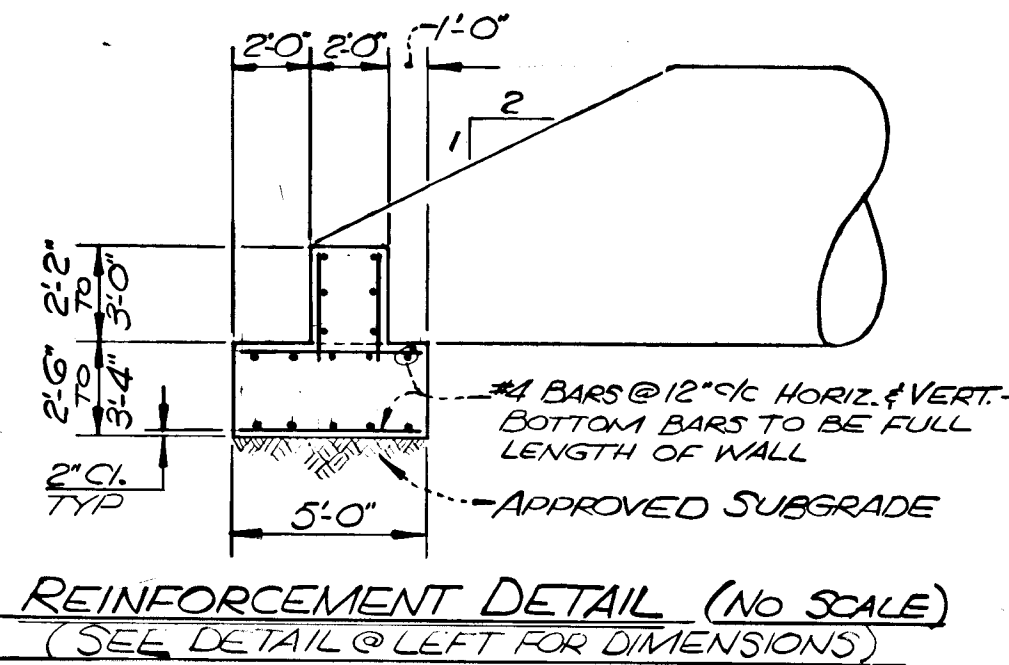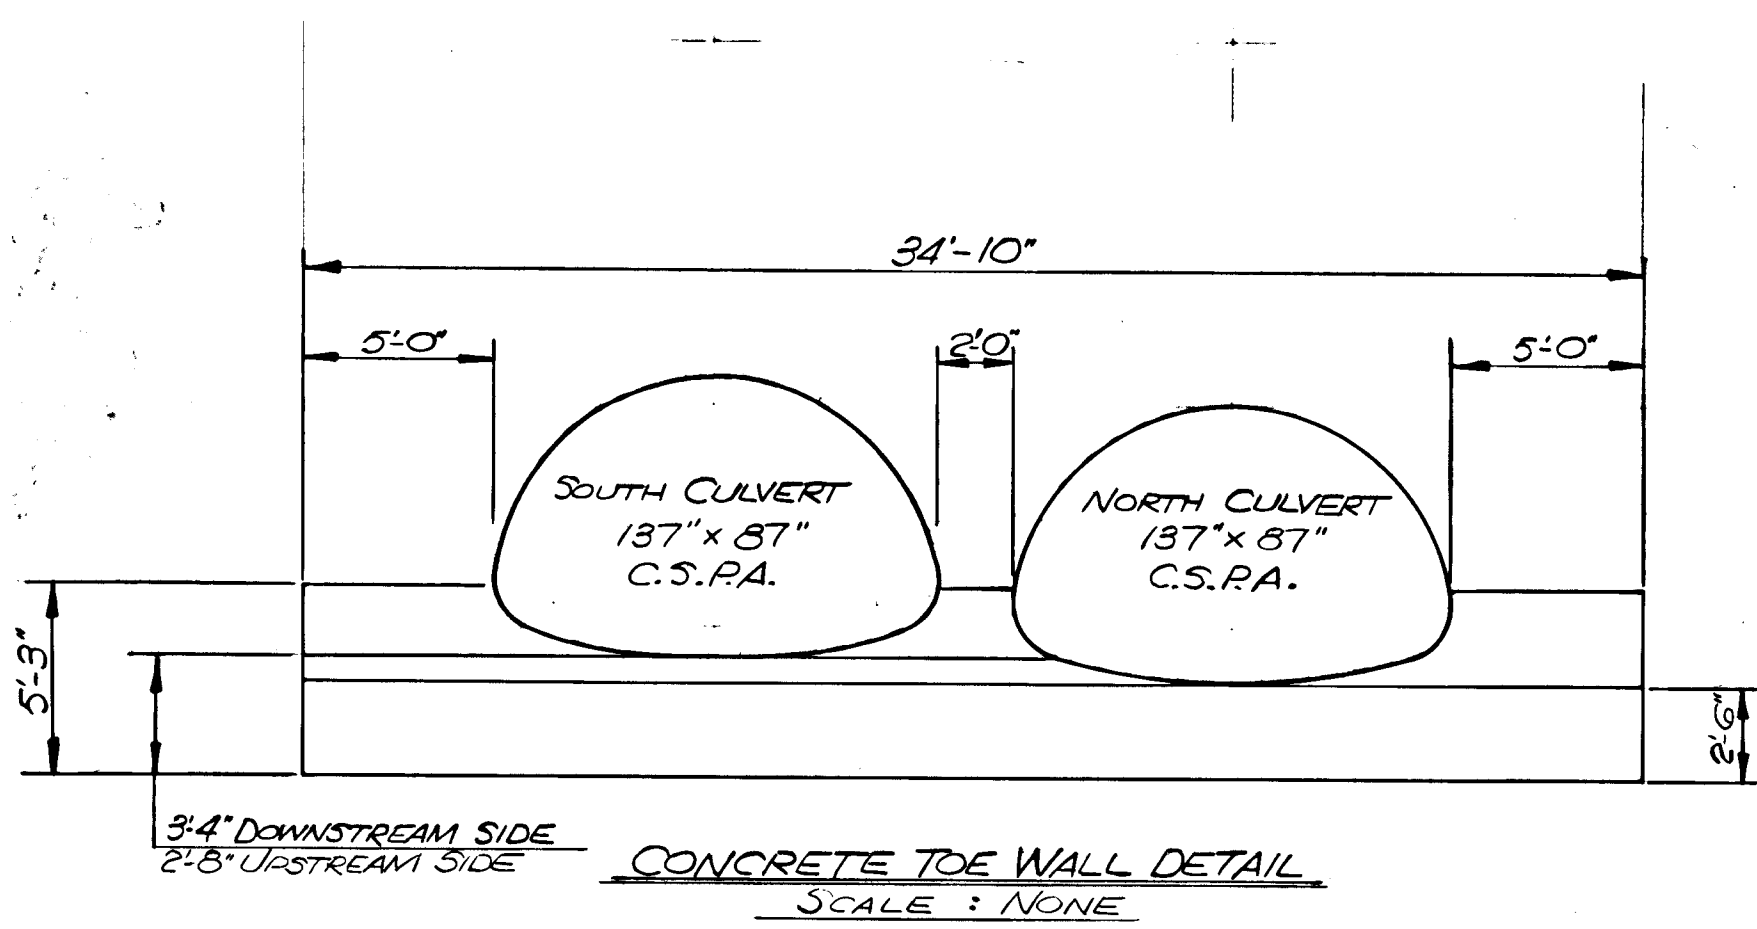

SEDIMENT CONTROL

by the Developer:  
 I/We certify that all development and construction will be done according to this plan, and that many responsible personnel involved in the construction project will have a Certificate of Attendance at a Department of Natural Resources Approved Training Program for the control of Sediment and Erosion before beginning the project.

*Robert H. Marmon* 11-12-85  
 Signature of Developer Date  
 Print name below signature  
 By the Engineer:  
 I certify that this plan for erosion and sediment control represents a practical and workable plan based on my personal knowledge of the site conditions and that it was prepared in accordance with the requirements of the Howard Soil Conservation District.

*Robert H. Marmon* 11-12-85  
 Signature of Engineer Date  
 Print name below signature  
 Reviewed for \_\_\_\_\_ S.C.D.  
 Name  
 and meets Technical Requirements.

*Stephen L. Huber* 1/21/86  
 U.S. Soil Conservation Service Date  
 HOWARD S.C.D.






THIS DEVELOPMENT PLAN IS APPROVED FOR SOIL EROSION AND SEDIMENT CONTROL BY THE HOWARD SOIL CONSERVATION DISTRICT

*Stephen L. Huber* 1/21/86  
 HOWARD S.C.D. Date




- NOTES:**
1. SELECT BACKFILL & BEDDING MATERIAL SHALL BE LOCAL CRUSHER RUN OR BANK RUN GRAVEL HAVING A MAXIMUM DRY WEIGHT NOT LESS THAN 115 POUNDS PER CUBIC FOOT AS DETERMINED BY AASHTO T-99, METHOD A, WITH A LIQUID LIMIT NOT EXCEEDING 30, A PLASTICITY INDEX NOT EXCEEDING 6 CONFORMING TO MSHA SRC GRADATION CR-6 OR GRAVEL SBII.
  2. PRIOR TO PLACEMENT OF SELECT BEDDING MATERIAL, CULVERT TRENCHES SHALL BE INSPECTED AND APPROVED BY A QUALIFIED GEOTECHNICAL ENGINEER. DEPTH OF BEDDING MATERIAL SHALL BE ADJUSTED TO MEET FIELD CONDITIONS AS DIRECTED BY THE GEOTECHNICAL ENGINEER.
  3. EARTH BACKFILL, ABOVE SELECT BACKFILL MATERIAL, SHALL CONSIST OF SOIL HAVING A MAXIMUM DENSITY OF NOT LESS THAN 105 LBS. PER CUBIC FOOT AS DETERMINED BY AASHTO T-99, METHOD A, WITH A LIQUID LIMIT NOT EXCEEDING 30, A PLASTICITY INDEX NOT EXCEEDING 6, CONTAINING NO STONES LARGER THAN 1 INCH IN THE GREATEST DIMENSION.
  4. STREAM DIVERSION DETAILS ARE PER WRA'S "MARYLAND'S GUIDELINES TO WATERWAY CONSTRUCTION". SEE "GUIDELINES" FOR CONSTRUCTION DETAILS AND SPECIFICATIONS, AND SEQUENCE OF CONSTRUCTION.

- SEQUENCE OF CONSTRUCTION FOR CULVERTS**
1. OBTAIN NECESSARY PERMITS TO COMMENCE CONSTRUCTION, INCLUDING W.R.A. PERMIT.
  2. CONSTRUCT SILT FENCES AND S.C.E.
  3. CONSTRUCT TEMP ACCESS CULVERT TO ALLOW EXCAVATION OF DIVERSION.
  4. DIVERT STREAM TO ALLOW CULVERT CONSTRUCTION.
  5. REMOVE TEMP ACCESS CULVERT.
  6. CONSTRUCT CONCRETE TOE WALLS, RIPRAP CHANNELS AND INSTREAM CULVERTS.
  7. RE-DIRECT STREAM THROUGH CULVERTS.
  8. COMMENCE ROUGH GRADING FOR ENTRANCE ROAD TO PARCEL D.
  9. CONSTRUCT GOLF COURSE CULVERTS.
  10. STABILIZE FILL SLOPES WITHIN 7 DAYS.
  11. UPON COMPLETION OF GRADING, RE-STABILIZE SLOPES AND REMOVE TEMP SEDIMENT CONTROL MEASURES.

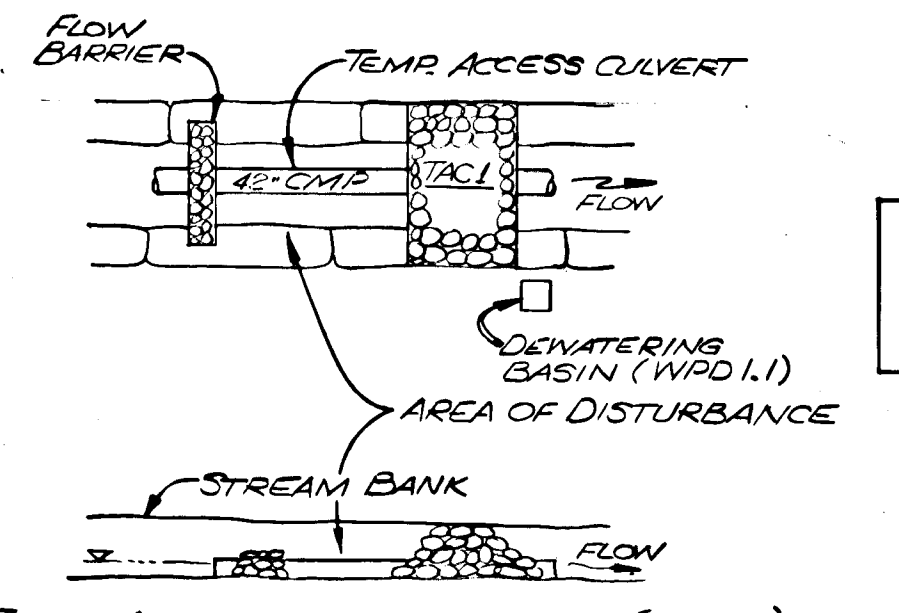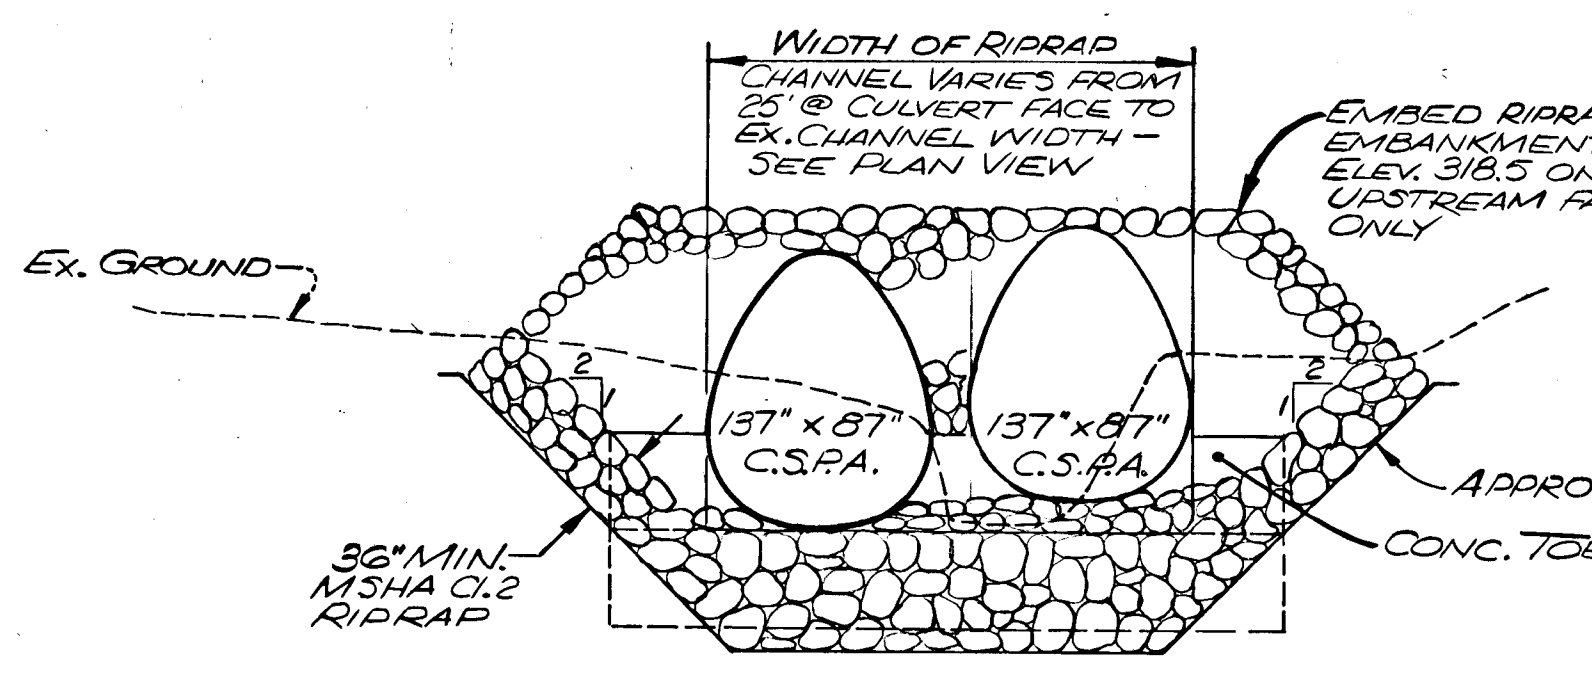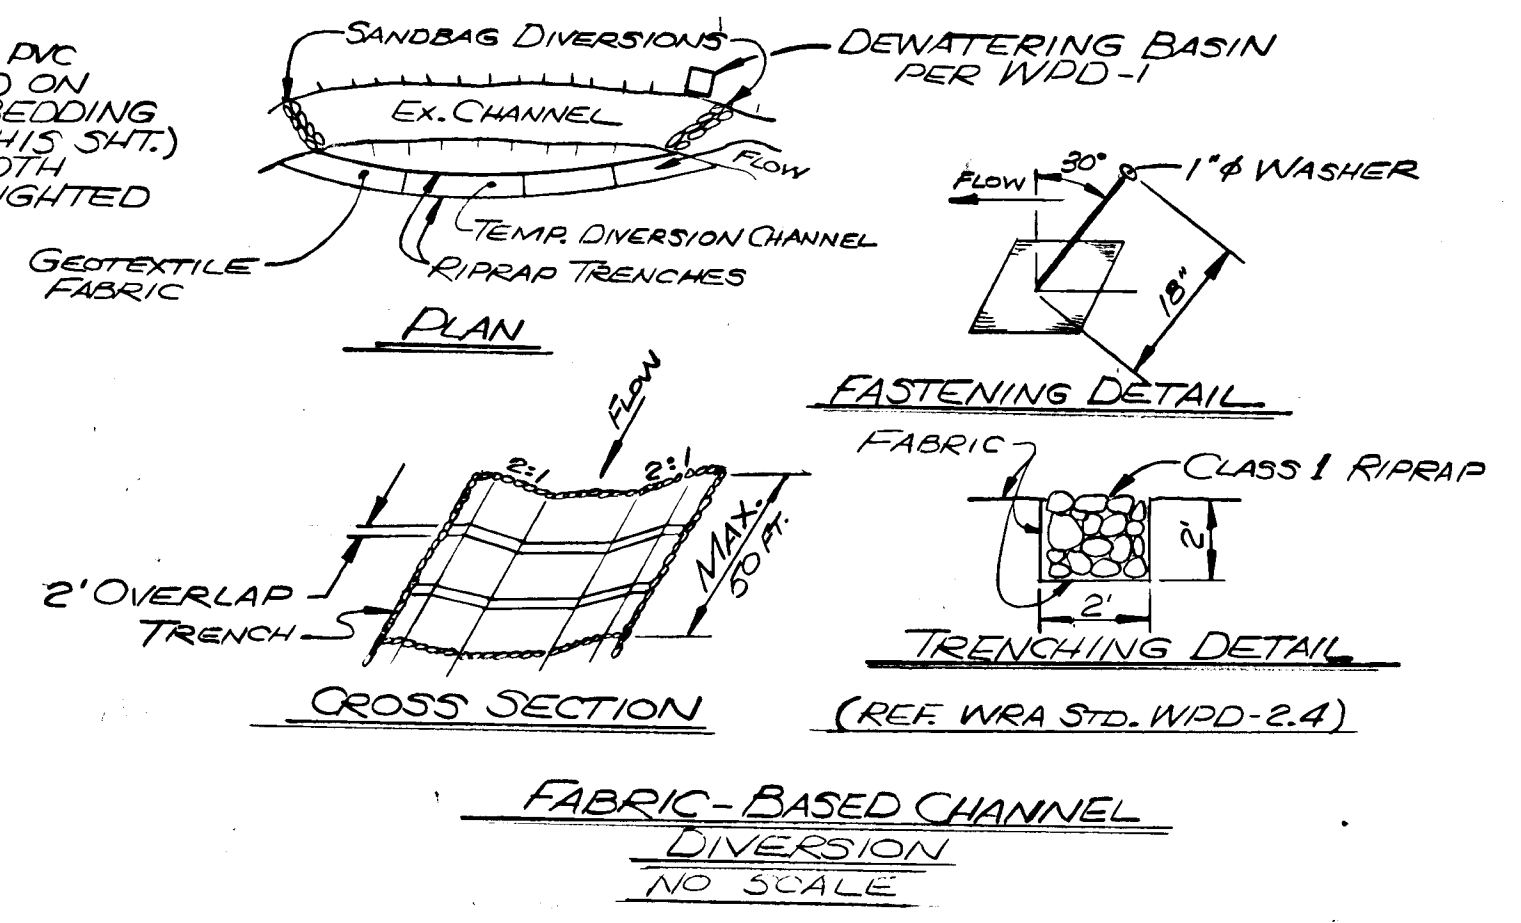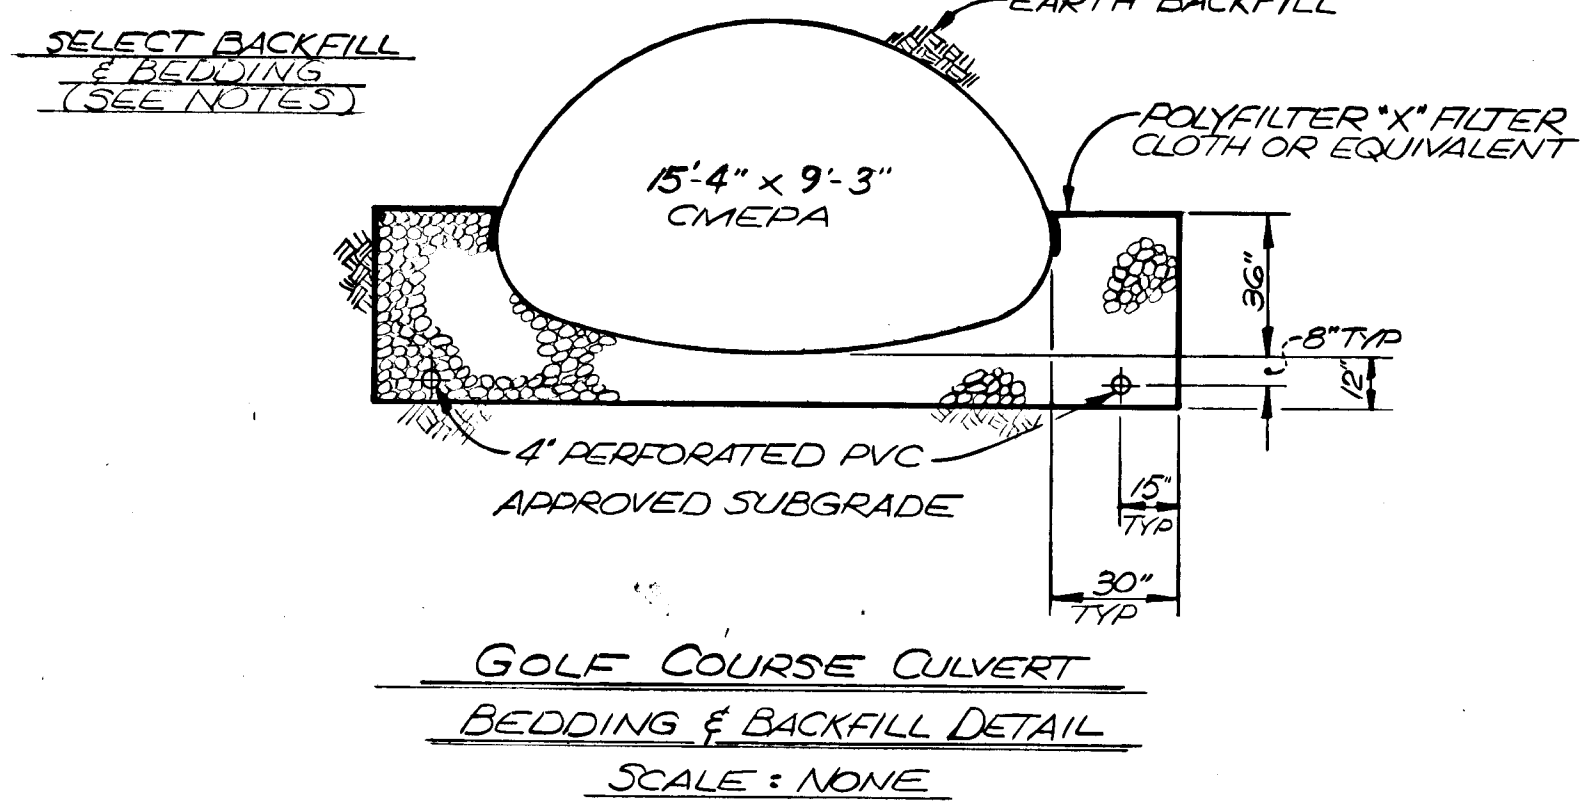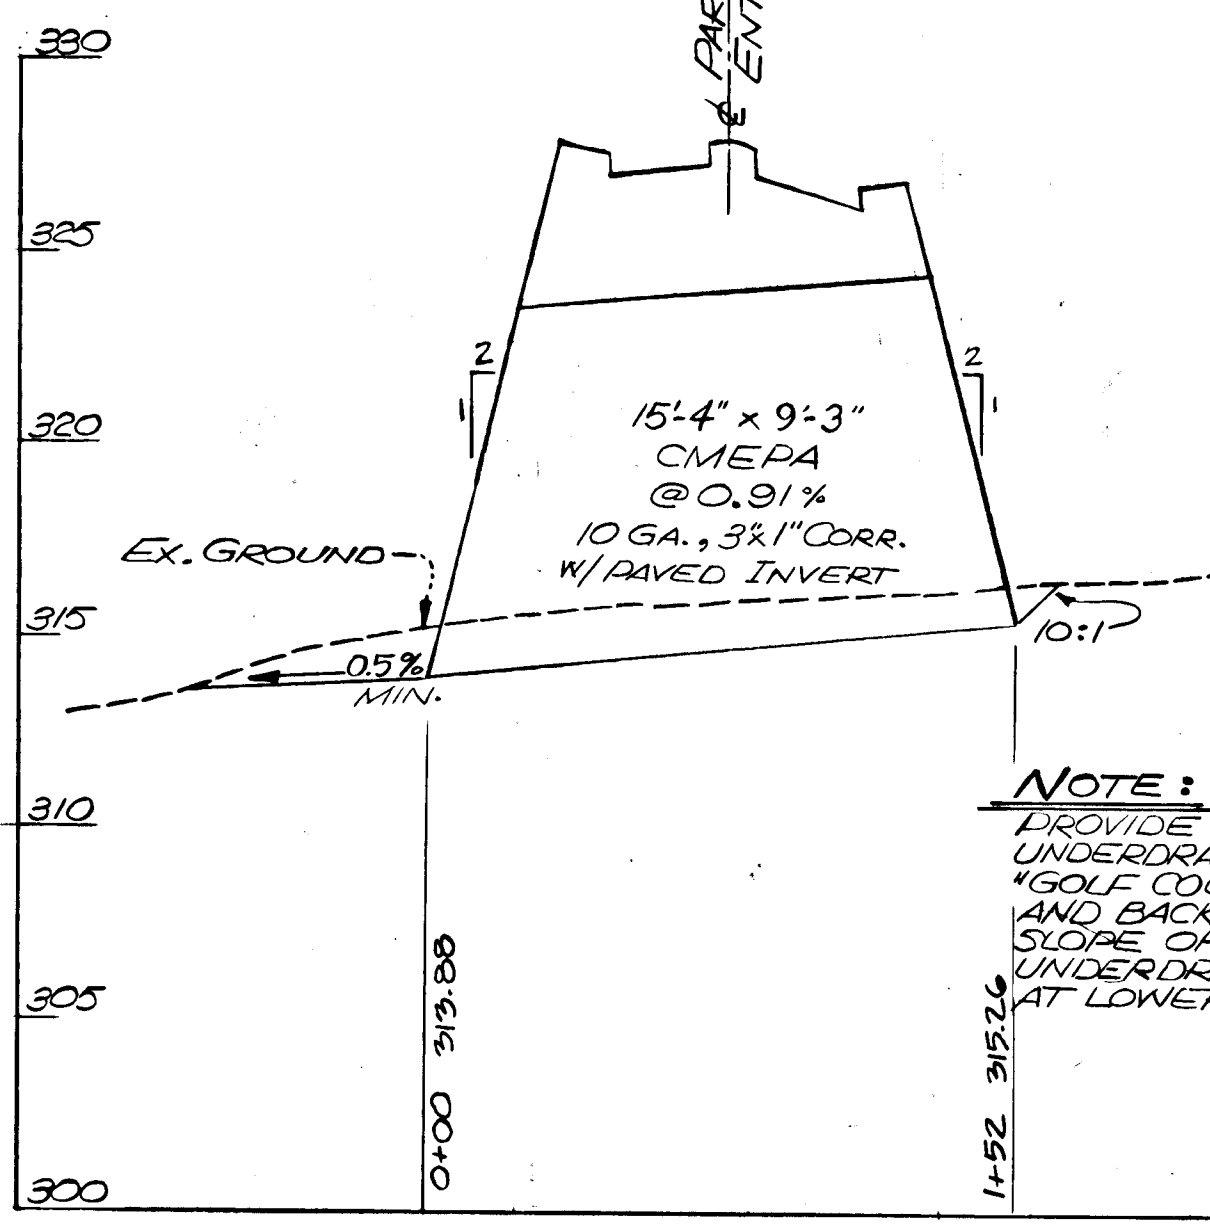

**NOTE:**  
 SEE SHIT. 8 OF 24 FOR SEDIMENT CONTROL NOTES AND DETAILS

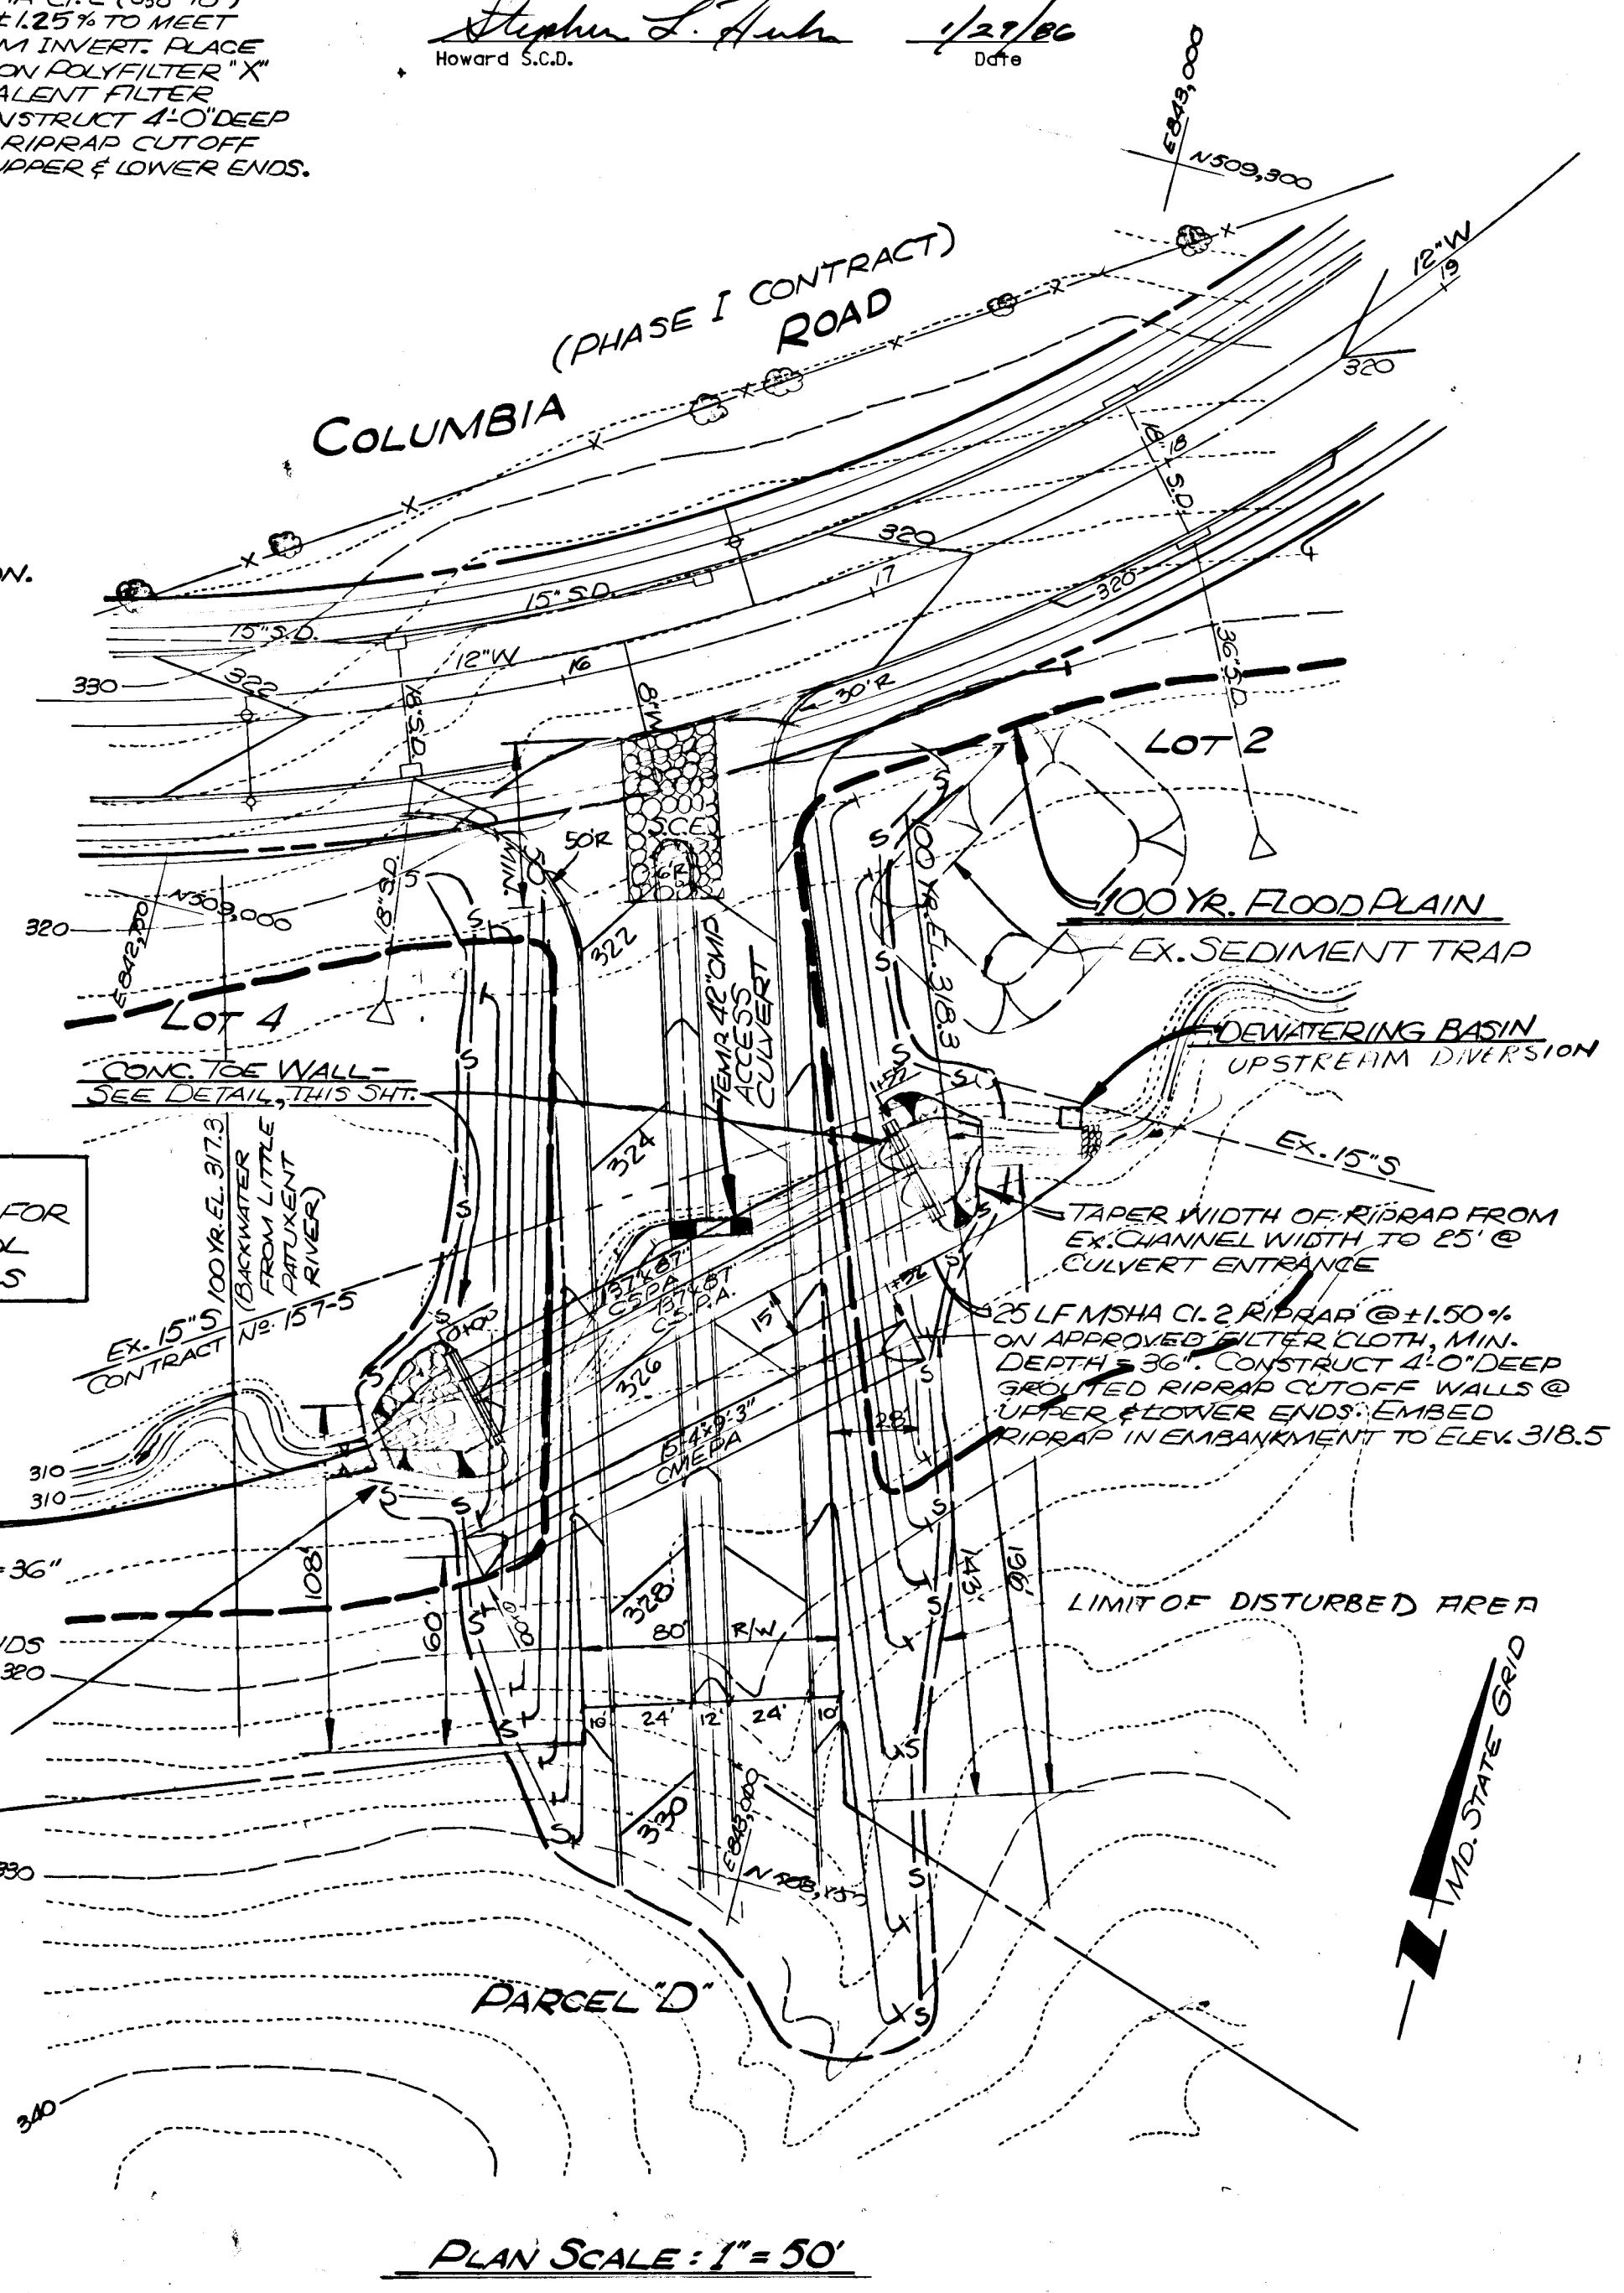

**NOTE:** CULVERTS ARE TO BE CONSTRUCTED AS PART OF PHASE II CONTRACT.

DEPARTMENT OF PUBLIC WORKS

*William S. Reid* 2-28-86  
 CHIEF, BUREAU OF ENGINEERING DATE

*John M. Muechman* 2-3-86  
 CHIEF, DIVISION OF LAND DEVELOPMENT AND ZONING ADMINISTRATION DATE

No.	REVISION	DATE	BY
1	WIDEN PARCEL 'D' ENTRANCE, ADJUST CULVERTS	MAY '86	JWC
2	REVISE TUNNEL CULVERT TO 15'4\"/>		



ENGINEERS • ARCHITECTS • PLANNERS • SCIENTISTS • SURVEYORS • PHOTOGRAMMETRISTS

**GREENHORNE & O'MARA, INC.**  
 2 RESEARCH PLACE, ROCKVILLE, MARYLAND 20850  
 (301) 948-0900

GREENBELT, MD • ANNAPOLIS, MD • ATLANTA, GA • BECKLEY, WV • CULPEPER, VA • DENVER, CO  
 FAIRFAX, VA • GREENSBORO, NC • MONROE, MI • EXPORT, PA • WILLISTON PARK, NY

PARCEL D ENTRANCE CULVERT  
 VILLAGE OF DORSEY'S SEARCH  
 SECTION 3 AREA 1 PHASE 191  
 5th ELECTION DISTRICT  
 HOWARD COUNTY, MARYLAND

JSL DESIGN	SCALE AS SHOWN
JOP DRAWN	24 OF 24
RHW CHECKED	SHEET
NOV, 85 DATE	JOB No. R-1216-X FILE No.

# 1154

F-86-55