
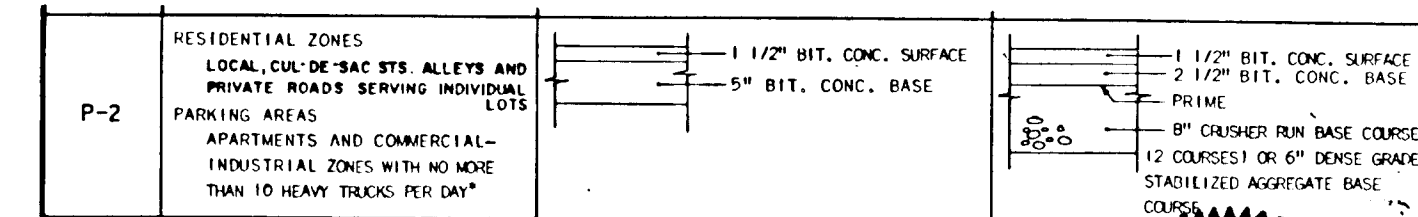


COORDINATES AND ELEVATIONS
BASED ON MARYLAND STATE
PLANE COORDINATE SYSTEM
HOWARD COUNTY CONTROL POINTS
NO'S. 2136002 AND 2136003

TYPE	SIZE	LENGTH
CM 16 GA	18"	38 LF
CM 16 GA	24"	333 LF

CURVE DATA
 @ STATION 0+02.72
 TO 3+51.49
 R = 325.00
 A = 348.77
 T = 193.31
 Δ = 61°29'13"
 CHD BANG = 512'44" STE
 CHR = 372.28'

No.	TYPE	TOP ELEVATION		INV. ELEVATION	REMARKS	STATIONS & OFFSETS
		UPPER	OUT			
M1	24" METAL END SECTION	---	---	463.8	SO 5.92	1+25 L 23'
M2	STD PRECAST MH	468.1	465.0	462.6	G 5.11	1+21 L 15'
M3	SHALLOW BRICK MH	473.9	469.9	469.4	G 5.09	0+5 @ E
I 4	TYPE "D" INLET	469.6	---	466.6	SO 4.11 OPENING 468.8	1+21 R 10'
G 11	12" METAL END SECTION	---	---	466.1	SO 3.52	12+55 L 26'
M12	STD PRECAST MH	469.6	468.0	467.1	G 5.11	12+13 L 42'
I 13	TYPE "D" INLET	466.8	---	462.7	SO 4.11 OPENING 466.0	11+35 L 17.5'
I 14	TYPE "D" INLET	466.8	---	463.6	SO 4.11 OPENING 466.0	11+35 R 17.5'

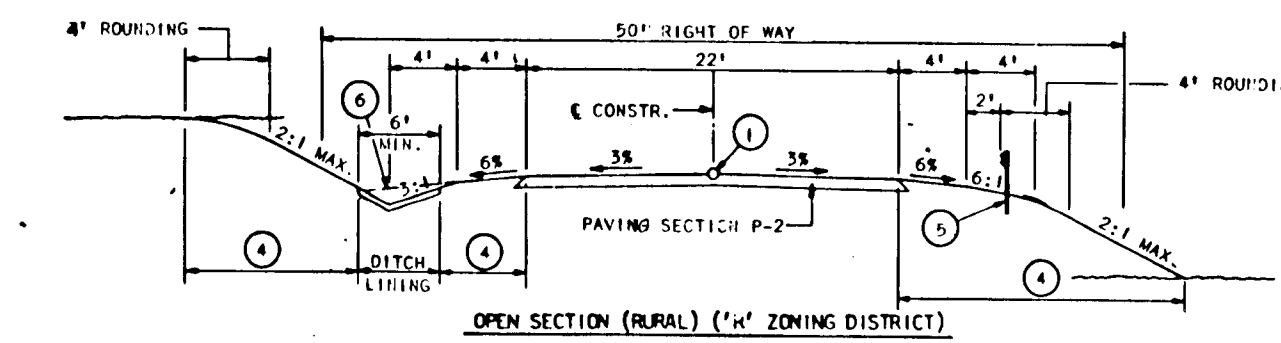

DEVELOPER'S CERTIFICATE
 I/WE CERTIFY THAT ALL DEVELOPMENT AND CONSTRUCTION WILL BE DONE ACCORDING TO THIS PLAN, AND THAT ANY RESPONSIBLE PERSONNEL INVOLVED IN THE CONSTRUCTION PROJECT WILL HAVE A CERTIFICATE OF ATTENDANCE AT A PROGRAM FOR THE CONTROL OF SEDIMENT AND EROSION BEFORE BEGINNING THE PROJECT. I ALSO AUTHORIZE PERIODIC ON-SITE INSPECTION BY THE HOWARD SOIL CONSERVATION DISTRICT.
Robert W. Muschman 8/21/87
 DATE

ENGINEER'S CERTIFICATE
 I CERTIFY THAT THIS PLAN FOR EROSION AND SEDIMENT CONTROL MEETS A PRACTICAL AND WORKABLE PLAN BASED ON MY PERSONAL KNOWLEDGE OF THE SITE CONDITIONS. THIS PLAN WAS PREPARED IN ACCORDANCE WITH THE REGULATIONS OF THE HOWARD SOIL CONSERVATION DISTRICT.
John W. Muschman 8/20/87
 DATE

REVIEWER'S CERTIFICATE
 HOWARD S.C.D.
AND TECHNICAL REQUIREMENTS
John W. Muschman 10/9/87
 DATE

APPROVED FOR PERMITS, WATER AND PRIVATE SEWERAGE SYSTEMS, HOWARD COUNTY HEALTH DEPARTMENT
John W. Muschman 10/9/87
 DATE


COUNTY HEALTH OFFICER
 APPROVED: Howard County Office of Planning & Zoning
John W. Muschman 10-13-87
 DATE

APPROVED: HOWARD COUNTY DEPARTMENT OF PUBLIC WORKS AND ZONING ADMINISTRATION
John W. Muschman 10-16-87
 DATE

APPROVED: HOWARD COUNTY DEPARTMENT OF PUBLIC WORKS AND ZONING ADMINISTRATION
John W. Muschman 10/19/87
 DATE

APPROVED: HOWARD COUNTY DEPARTMENT OF PUBLIC WORKS AND ZONING ADMINISTRATION
John W. Muschman 10-16-87
 DATE


LEGEND
 FGL (E.O.)
 TR BRL. LEFT
 TR BRL. RIGHT
 EX. & RIGHT OF WAY

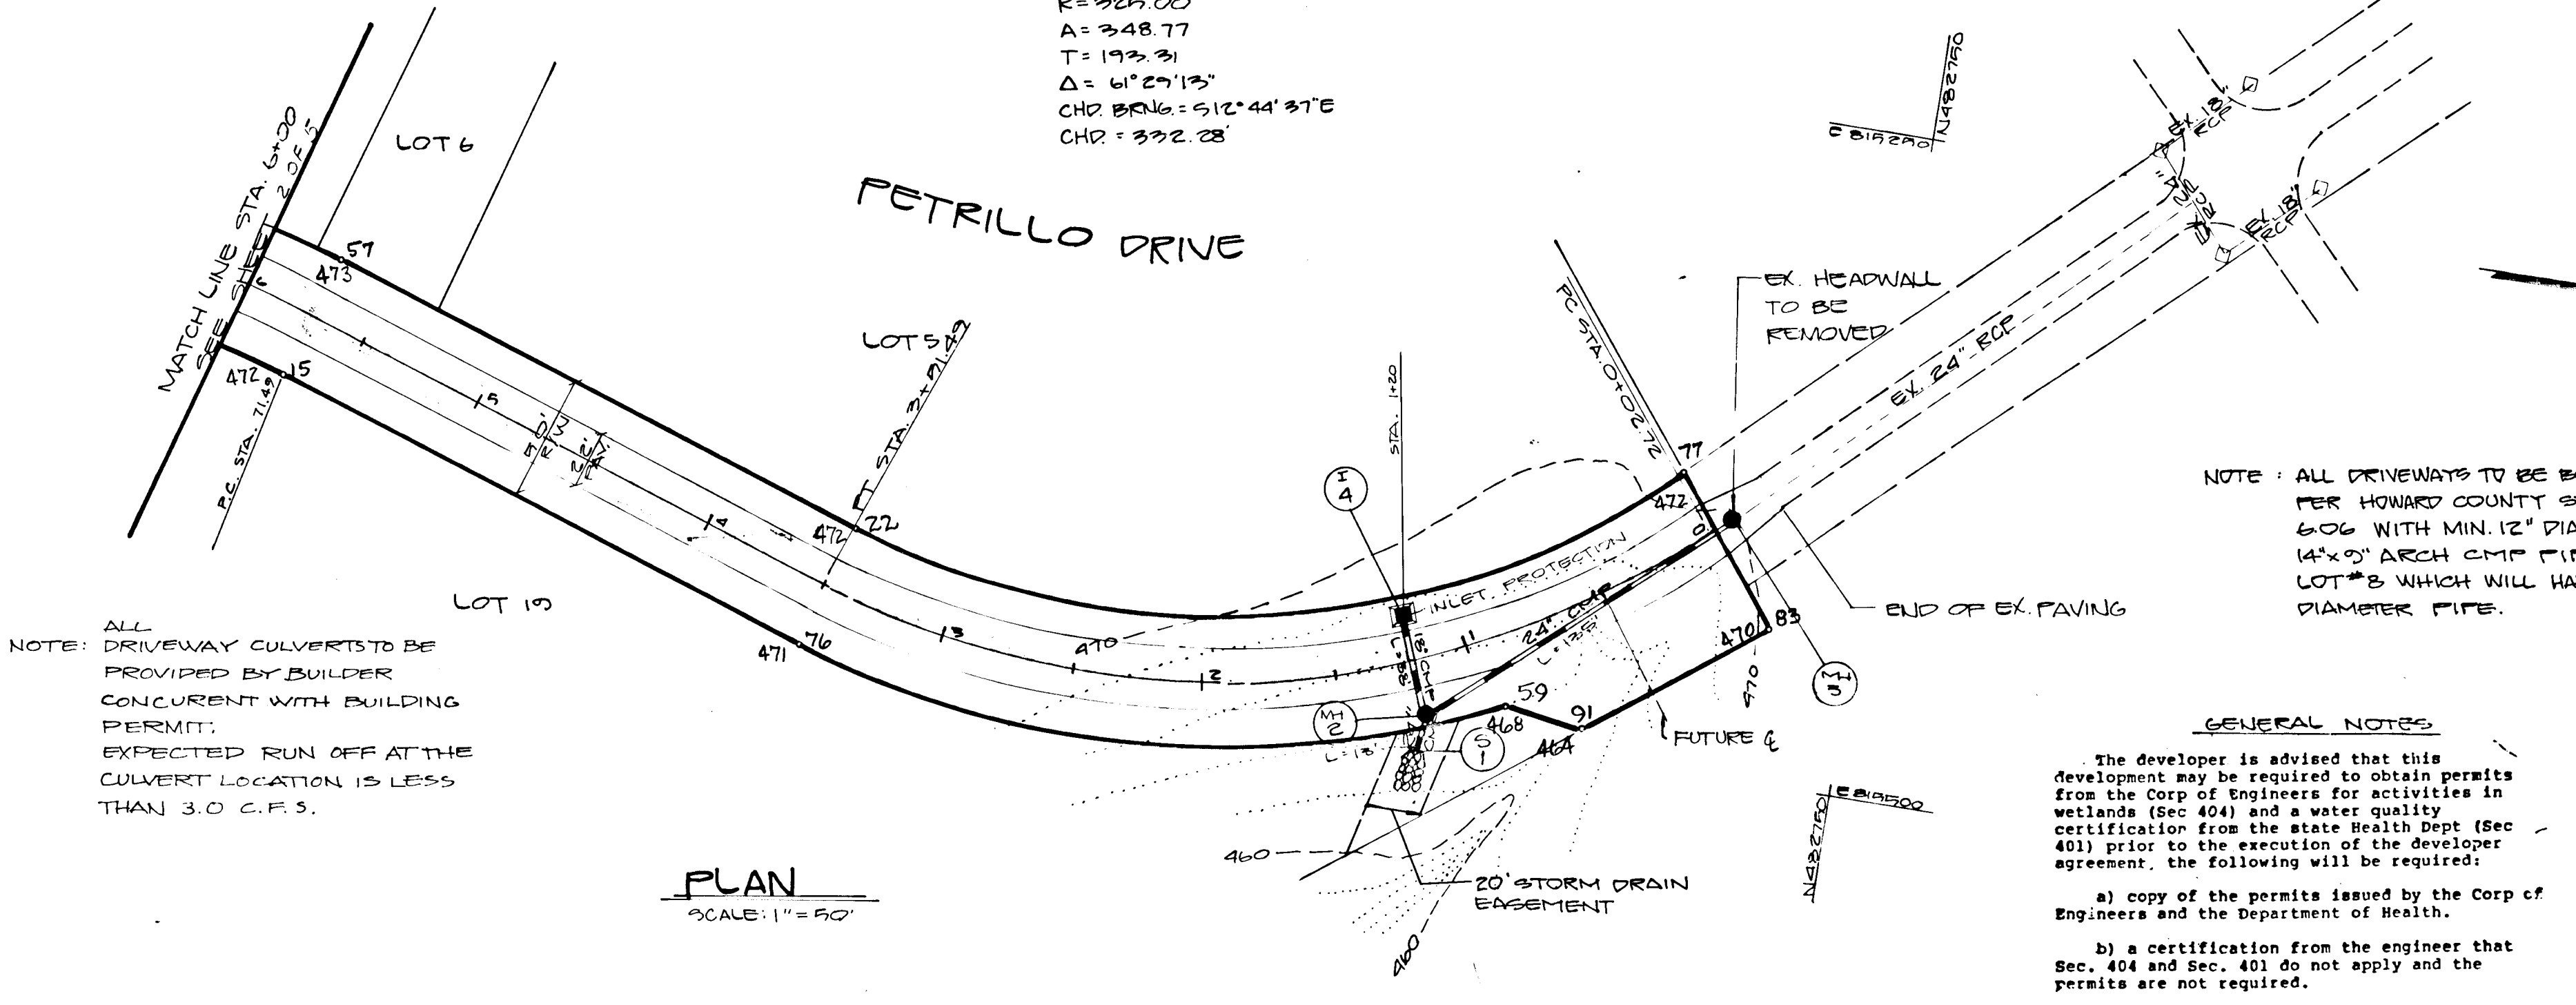


ALL DRIVEWAY CULVERTS TO BE PROVIDED BY BUILDER CONCURRENT WITH BUILDING PERMIT. EXPECTED RUN OFF AT THE CULVERT LOCATION IS LESS THAN 3.0 C.F.S.

NOTE - ALL DRIVEWAYS TO BE BUILT AS PER HOWARD COUNTY STANDARD 606 WITH MIN. 12" DIAMETER OR 14"x9" ARCH CMP PIPE, EXCEPT LOT#8 WHICH WILL HAVE A 15" DIAMETER PIPE.

GENERAL NOTES
 The developer is advised that this development may be required to obtain permits from the Corp of Engineers for activities in wetlands (Sec 404) and a water quality certification from the state Health Dept (Sec 401) prior to the execution of the developer agreement, the following will be required:
 a) a copy of the permits issued by the Corp of Engineers and the Department of Health.
 b) a certification from the engineer that Sec. 404 and Sec. 401 do not apply and the permits are not required.

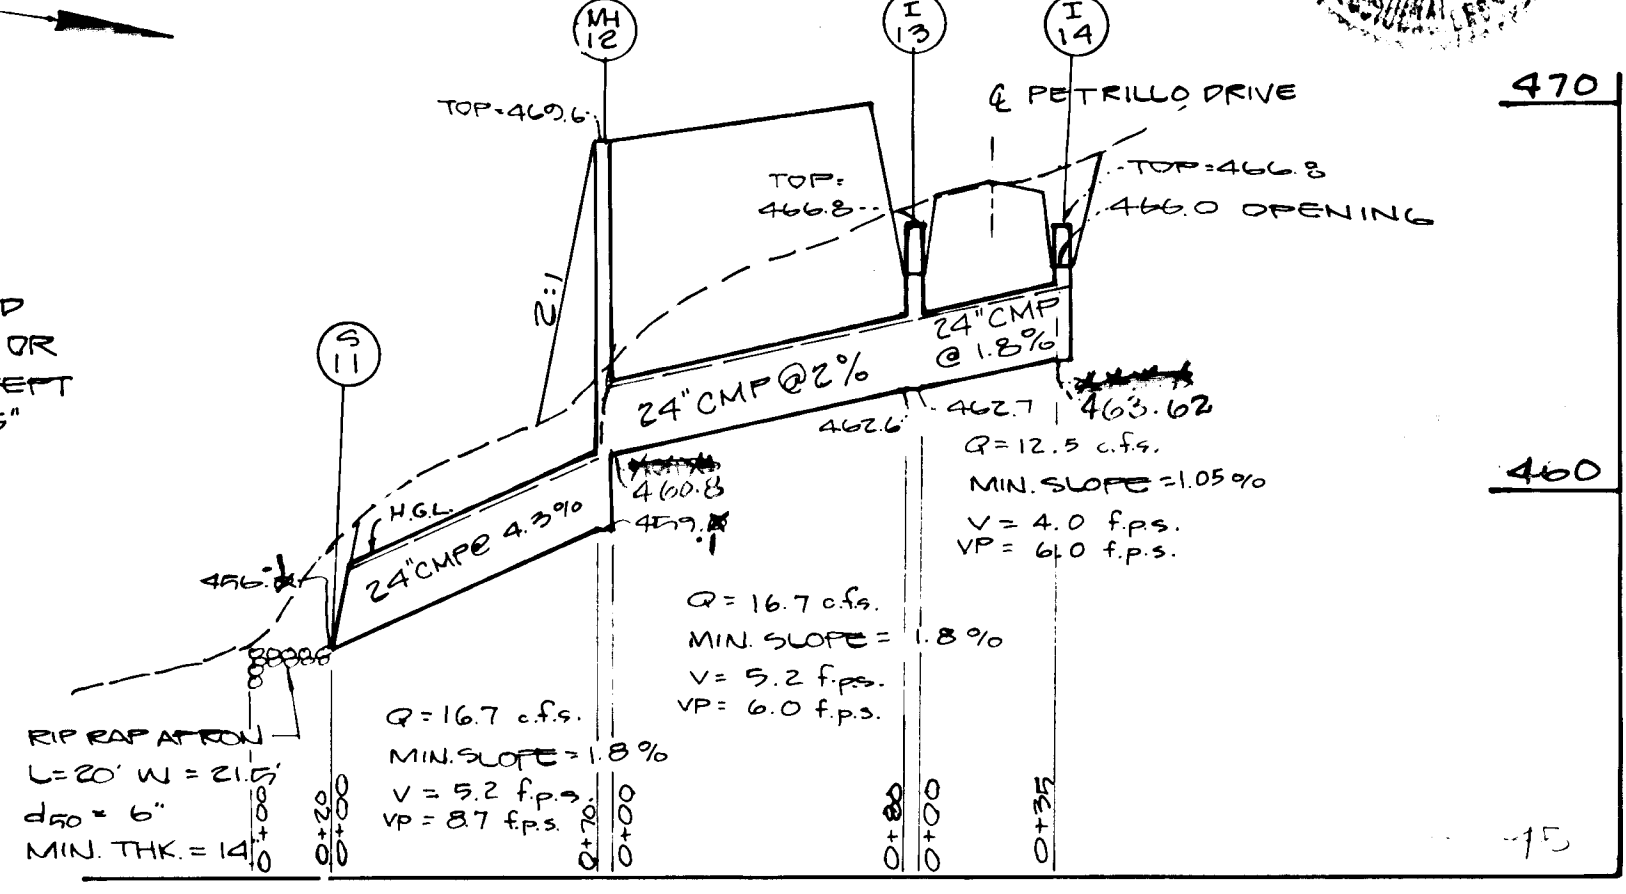


AS-BUILT SURVEY CERTIFIED BY
 NEHU SCHWARTZ, MD, PE, NO-11449
 ON JULY 15, 1988

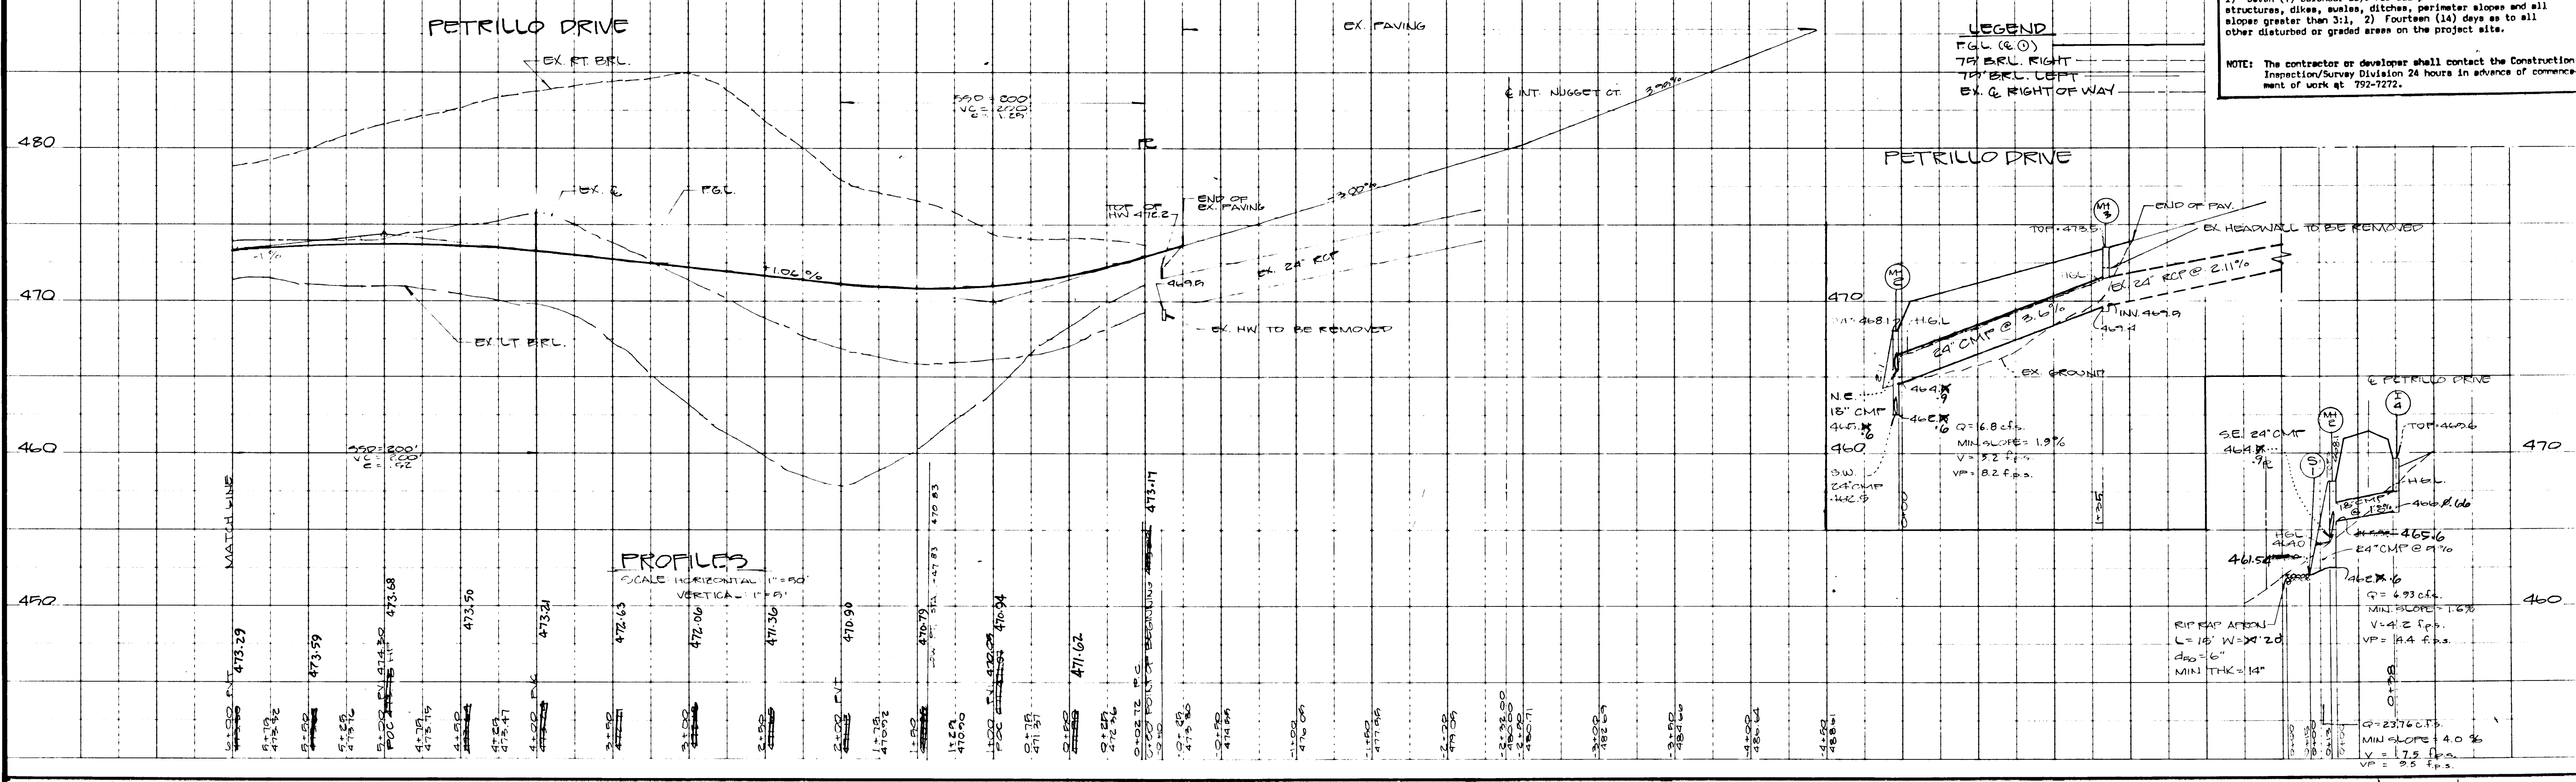

Owner/ Developer:
 HILLTOP DEVELOPMENT
 P.O. BOX 208
 CLARKSVILLE, MD 21029
 301-531-5537

NO.	REVISIONS	DATE

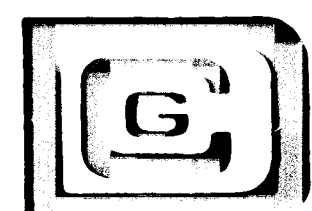


DEVELOPMENT CONSULTANTS GROUP, INC.
 17904 GEORGIA AVENUE # 102
 OLNEY, MARYLAND 20832
 301-924-4570

STORM DRAIN AND PAVING PLAN SECTION ONE WATERMAN ESTATES
 5TH ELECTION DISTRICT
 TAX MAP 40 PARCEL 297
 HOWARD COUNTY, MARYLAND

DATE: August 1987
 DRAWN: S.M.E.
 CHECKED: S.M.E.
 SCALE: AS SHOWN

Sheet of 5
 PROJECT NO. 136-04

1319

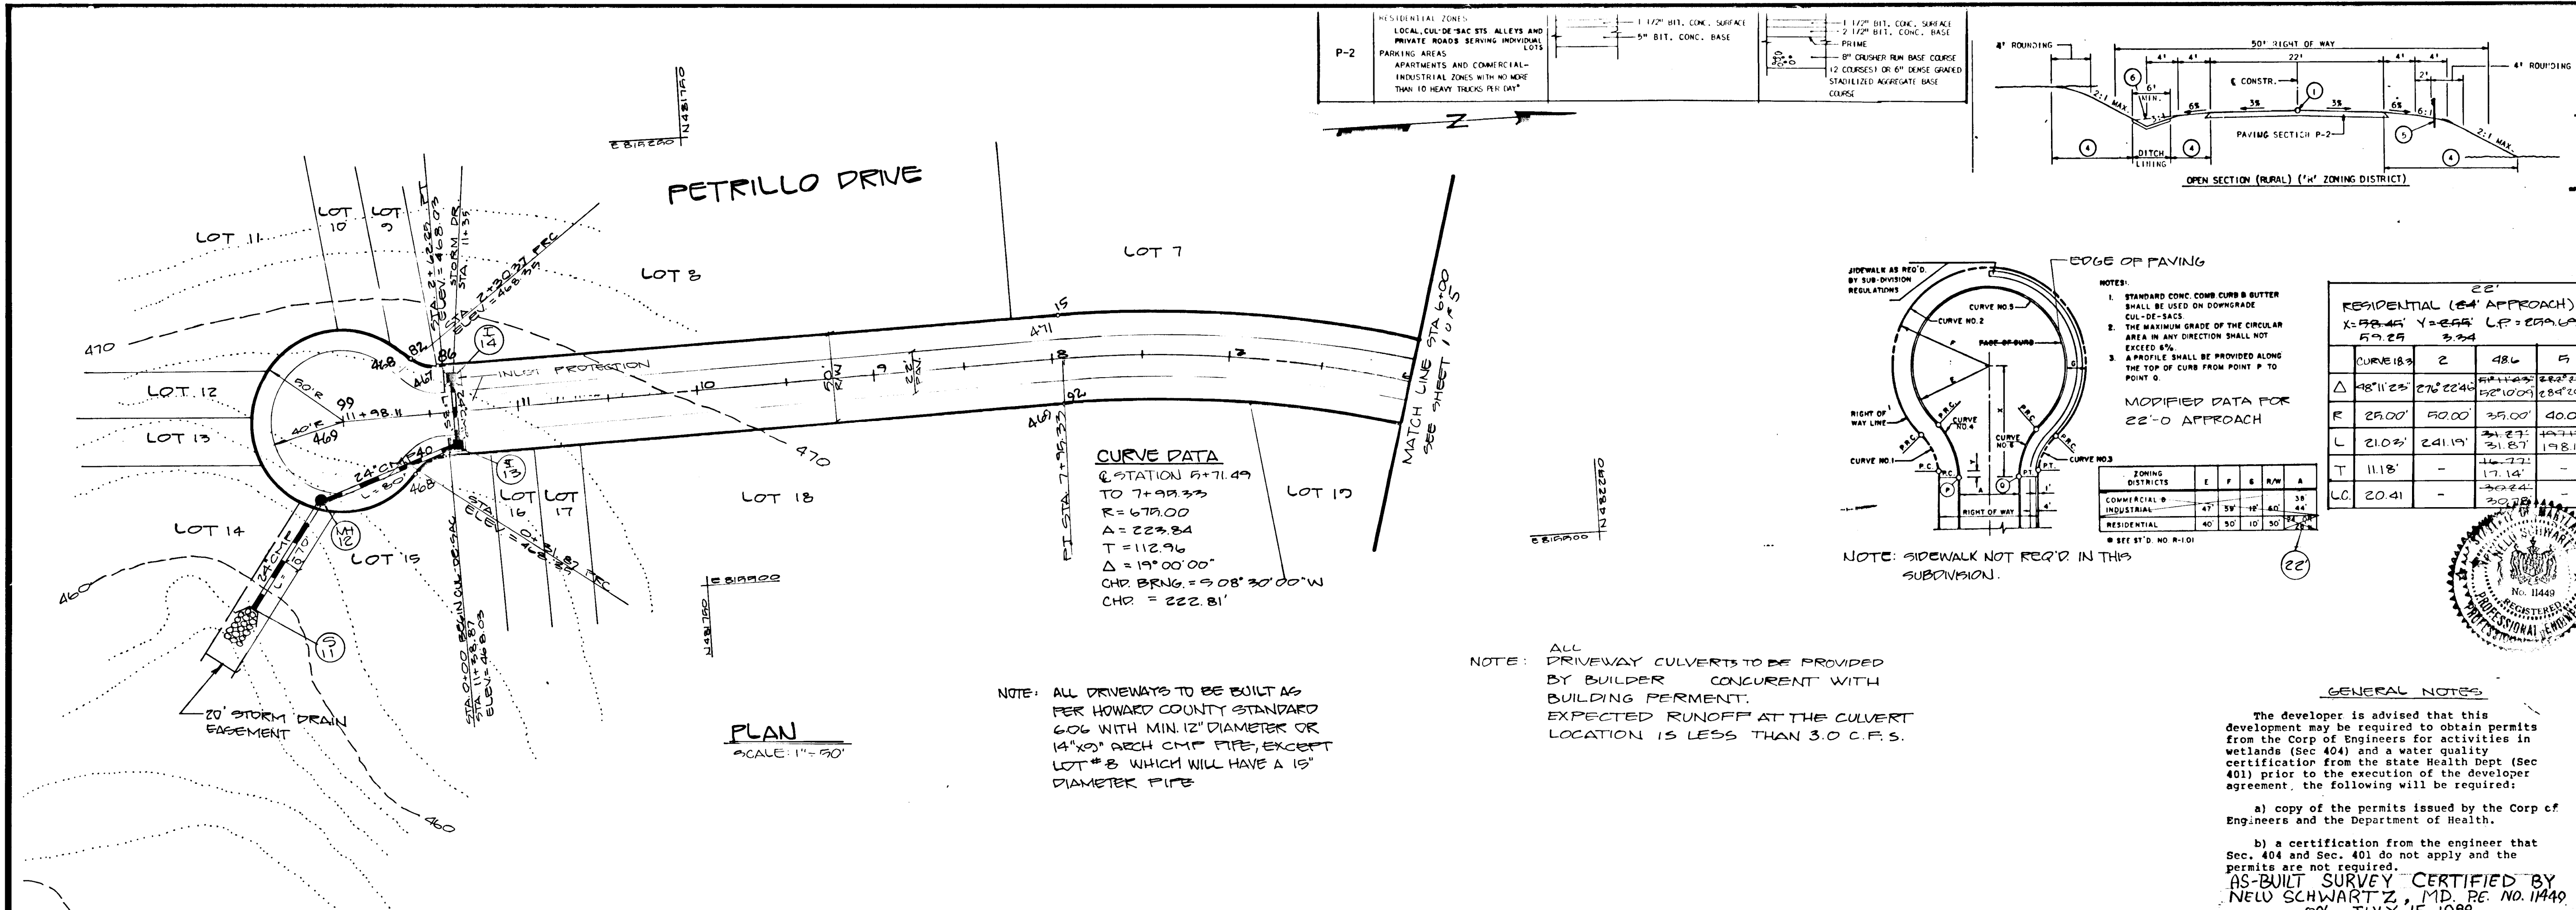

DEVELOPER'S CERTIFICATE
 I/WE CERTIFY THAT ALL DEVELOPMENT AND CONSTRUCTION WILL BE DONE ACCORDING TO THIS PLAN, AND THAT ANY RESPONSIBLE PERSONNEL INVOLVED IN THE CONSTRUCTION PROJECT WILL HAVE A CERTIFICATE OF ATTENDANCE AT A DEPARTMENT OF NATURAL RESOURCES APPROVED TRAINING PROGRAM FOR THE CONTROL OF SEDIMENT AND EROSION BEFORE BEGINNING THE PROJECT. I ALSO AUTHORIZE PERIODIC ON-SITE INSPECTION BY THE HOWARD SOIL CONSERVATION DISTRICT.
 Richard J. ... 9/21/87

ENGINEER'S CERTIFICATE
 I CERTIFY THAT THIS PLAN FOR EROSION AND SEDIMENT CONTROL REPRESENTS A PRACTICAL AND WORKABLE PLAN BASED ON MY KNOWLEDGE OF THE SITE CONDITIONS AND PREPARED IN ACCORDANCE WITH THE REQUIREMENTS OF THE HOWARD SOIL CONSERVATION DISTRICT.
 Howard S.E.D. 8/20/87

REVIEWED BY: HOWARD S.E.D. 10/9/87

AND MEETS TECHNICAL REQUIREMENTS
 U.S. SOIL CONSERVATION SERVICE 10/9/87

THIS DEVELOPMENT PLAN IS APPROVED FOR SOIL EROSION AND SEDIMENT CONTROL BY THE HOWARD SOIL CONSERVATION DISTRICT
 Howard S.E.D. 10/9/87

APPROVED FOR PRIVATE WATER AND PRIVATE SEWAGE SYSTEMS, HOWARD COUNTY HEALTH DEPARTMENT
 Howard S.E.D. 10/9/87


COUNTY HEALTH OFFICER DATE
 APPROVED: Howard County Office of Planning & Zoning

APPROVED: Howard County Department of Public Works
 Chief, Land Development Division 10/6/87
 Chief, Bureau of Highways 10/9/87

APPROVED: Howard County Department of Engineering
 Chief, Bureau of Engineering 10-16-87

Following initial soil disturbance or redistribution, permanent or temporary stabilization shall be completed within:
 1) Seven (7) calendar days for all perimeter erosion control structures, dikes, swales, ditches, perimeter slopes and all slopes greater than 3:1, 2) Fourteen (14) days as to all other disturbed or graded areas on the project site.

NOTE: The contractor or developer shall contact the Construction Inspection/Survey Division 24 hours in advance of commencement of work at 792-7272.

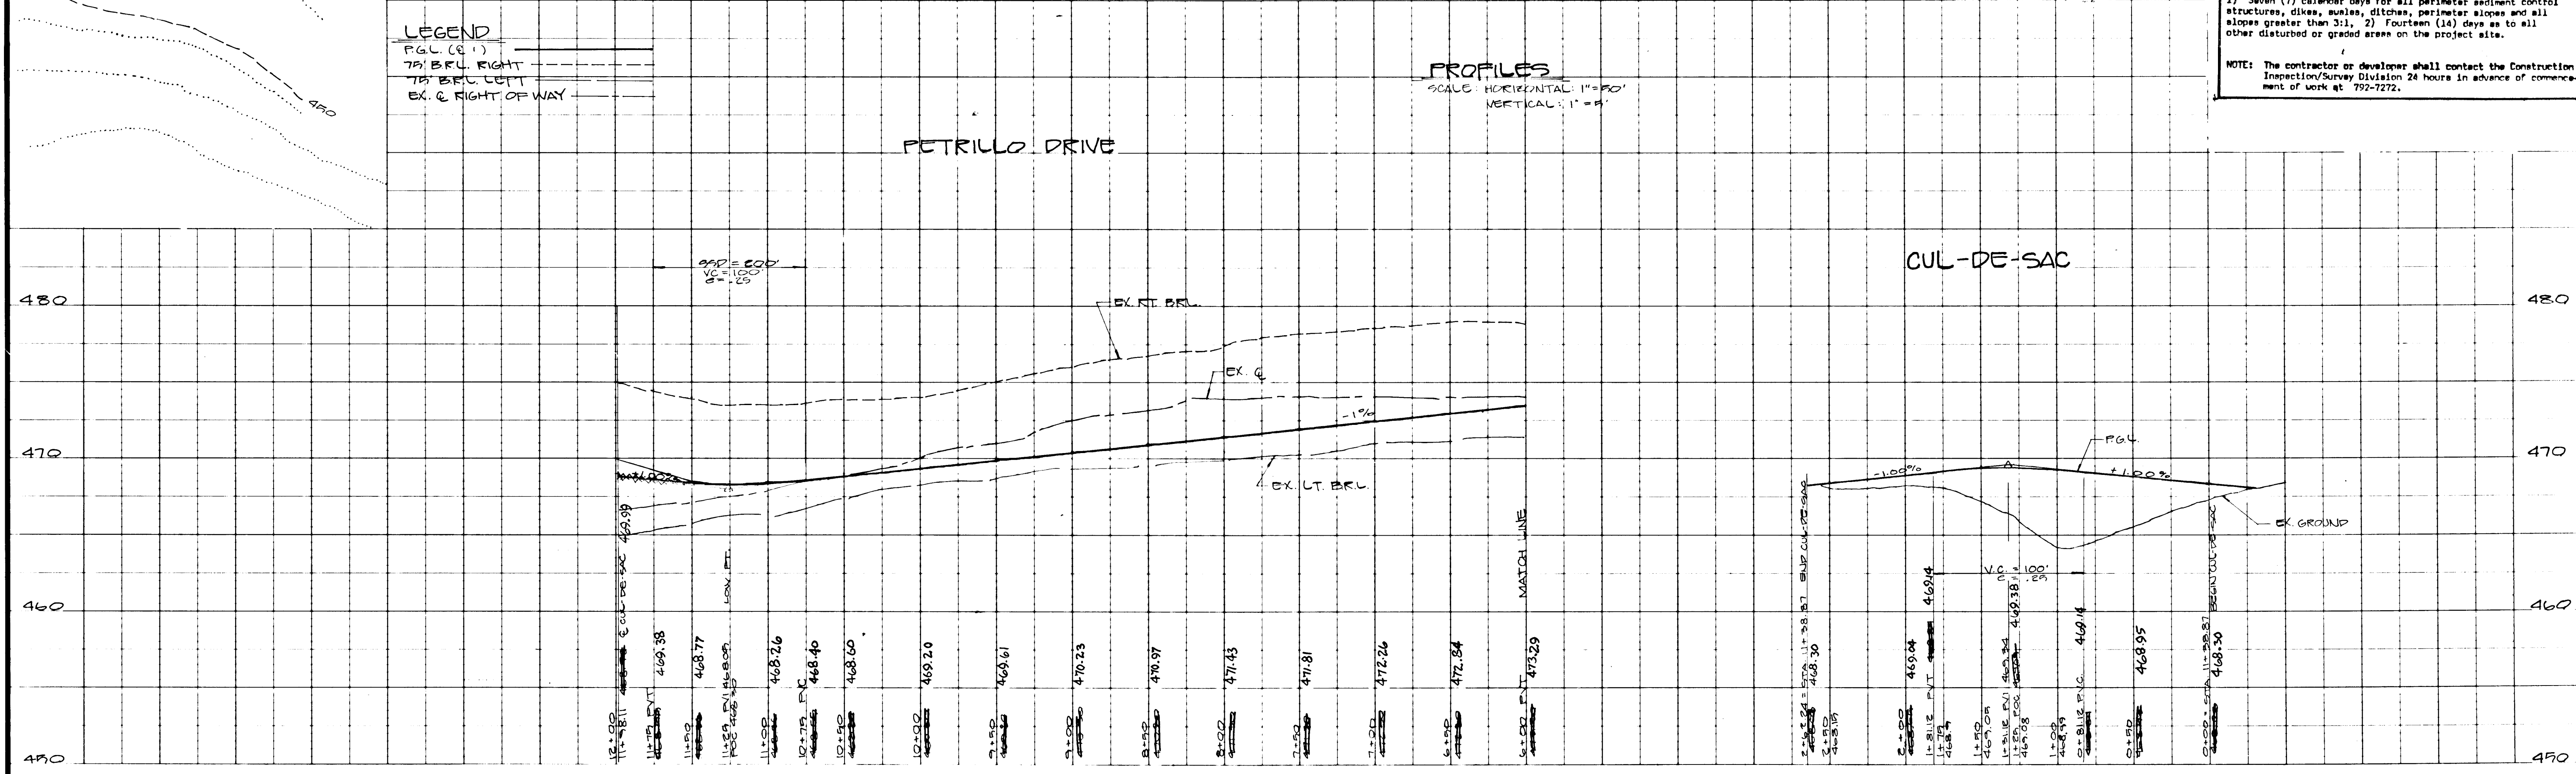

1319

Owner / Developer:	NO.	REVISIONS	DATE
HILLTOP DEVELOPMENT PO BOX 208 CLARKSVILLE, MD 21029 301-531-5939			

DEVELOPMENT CONSULTANTS GROUP, INC.
 17904 GEORGIA AVENUE # 102
 OLNEY, MARYLAND 20832
 301-924-4570

STORM DRAIN AND PAVING PLAN
 SECTION ONE
WATERMAN ESTATES
 5th ELECTION DISTRICT
 TAX MAP 40 PARCEL 250
 HOWARD COUNTY, MARYLAND

DATE: August 1987
 DRAWN: S.M.B.
 CHECKED: [Signature]
 SCALE: AS SHOWN

Sheet 2 of 5
 PROJECT NO. 136-04

CURVE DATA

STATION 0+02.72
 TO 3+21.47
 R = 329.00
 A = 348.77
 T = 193.31
 Δ = 61° 29' 15"
 CHD BRNG = S 12° 44' 37" E
 CHD = 332.28

CURVE DATA


STATION 3+71.49
 TO 7+93.33
 R = 679.00
 A = 223.84
 T = 112.76
 Δ = 19° 00' 00"
 CHD BRNG = S 08° 30' 00" W
 CHD = 222.81

PLAN

SCALE: 1" = 30'

SEDIMENT TRAP #1 (ST I)
 DA = 1.00 AC.
 STORAGE REQ'D = 1800
 STORAGE PROVIDED = 2000
 BOTT EL. = 457.0
 MAX STORAGE EL. = 460.0
 CLEANOUT EL. = 458.5
 WEIR CREST EL. = 461.0
 TOP OF EMBANKMENT EL. = 462.0
 L = 4.0'

NOTE: ALL DRIVEWAYS TO BE BUILT AS PER HOWARD COUNTY STANDARD 606 WITH MIN. 12" DIAMETER OR 14"x3" ARCH CMP PIPE, EXCEPT LOT # 8 WHICH WILL HAVE A 15" DIAMETER PIPE.

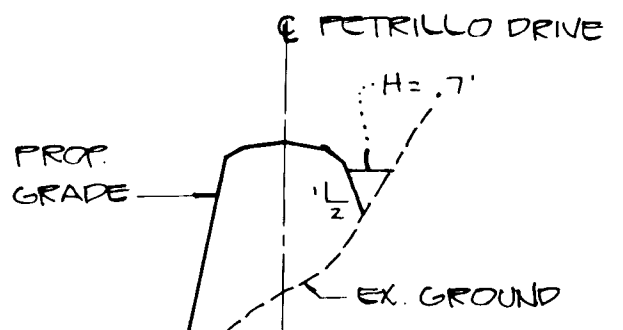

SECTION A-A
 SCALE: HORIZONTAL: 1" = 30'
 VERTICAL: 1" = 5'

SOPPED DITCH
 Q = 770 cfs
 n = 0.035
 s = 0.02



CONSTRUCTION SEQUENCE

1. Obtain necessary permits - 9/87
2. Notify County 24 hours prior to commencement of construction - 10/87
3. Clear and grub for SCE, earth dike and trap - 10/87
4. Install SCE-11 and all other sediment control devices, except inlet protection, install temporary flexible pipe from the existing 24" RCP to the stream and temporary 18" CMP pipe - 10/87
5. Clear and grub for grading of roads and storm drain - 10/87
6. Grade site and install storm drain system - 10-11/87
7. Install inlet protection - 11/87
8. Install bituminous paving, stabilize disturbed area - 11/87
9. Remove sediment control devices when approved by Sediment Control Inspector; including temporary 18" CMP pipe and 24" Flexible pipe.

- SEDIMENT CONTROL NOTES**
1. A minimum of 24 hours notice must be given to the Howard County Office of Inspection and Permits prior to the start of any construction. (892-2437)
 2. All vegetative and structural practices are to be installed according to the provisions of this plan and are to be in conformance with the 1983 MARYLAND STANDARDS AND SPECIFICATIONS FOR SOIL EROSION AND SEDIMENT CONTROL.
 3. Following initial soil disturbance or redistribution, permanent or temporary stabilization shall be completed within: a) 7 calendar days for all perimeter sediment control structures, dikes, perimeter slopes and all slopes greater than 3:1, b) 14 days as to all other disturbed or graded areas on the project site.
 4. All sediment traps/basins shown must be fenced and warning signs posted around their perimeter in accordance with Vol. 1, CHAPTER 12, of the HOWARD COUNTY DESIGN MANUAL, STORM DRAINAGE.
 5. All disturbed areas must be stabilized within the time period specified above in accordance with the 1983 MARYLAND STANDARDS AND SPECIFICATIONS FOR SOIL EROSION AND SEDIMENT CONTROL, for permanent seedings (Sec. 51) and (Sec. 52), temporary seedings (Sec. 50) and mulching (Sec. 52). Temporary stabilization with mulch alone can only be done when recommended seeding rates do not allow for proper germination and establishment of grasses.
 6. All sediment control structures are to remain in place and are to be maintained in operative condition until permission for their removal has been obtained from the Howard County Sediment Control Inspector.
 7. Site Analysis: Roads Only

Total Area of Site	90.00 Acres
Area Disturbed	2.50 Acres
Area to be paved	0.10 Acres
Area to be vegetatively stabilized	1.90 Acres / 1.86
Total Cut	42,000 Cu. Yds.
Total Fill	12,500 Cu. Yds.

 Offsite waste/borrow area location:
 8. Any sediment control practice which is disturbed by grading activity for placement of utilities must be repaired on the same day of disturbance.
 9. Additional sediment controls must be provided, if deemed necessary by the Howard County DPW Sediment Control Inspector.
 10. On all sites with disturbed areas in excess of 2 acres, approval of the inspection agency shall be requested upon completion of installation of perimeter erosion and sediment controls, but before proceeding with any other earth disturbance or grading. Other building or grading inspection approvals may not be authorized until this initial approval by the inspection agency is made.

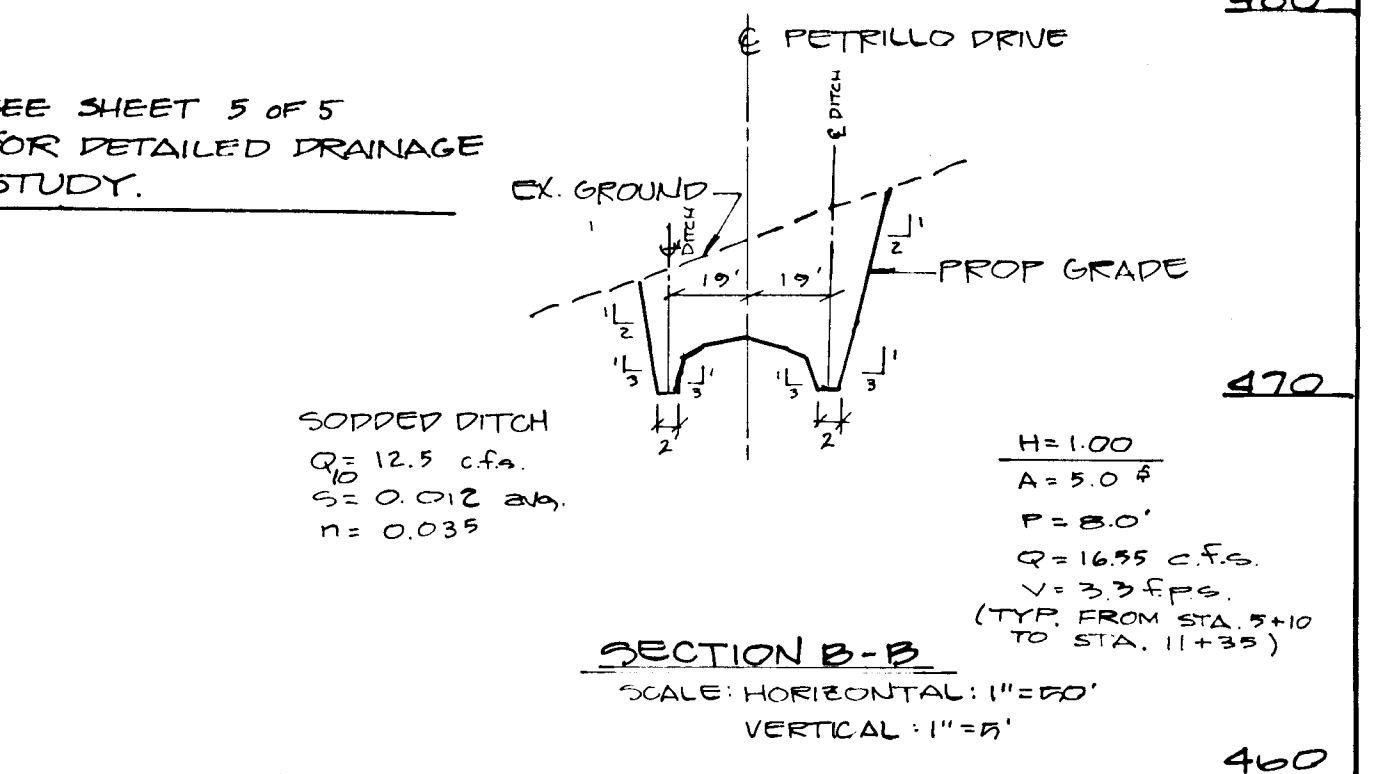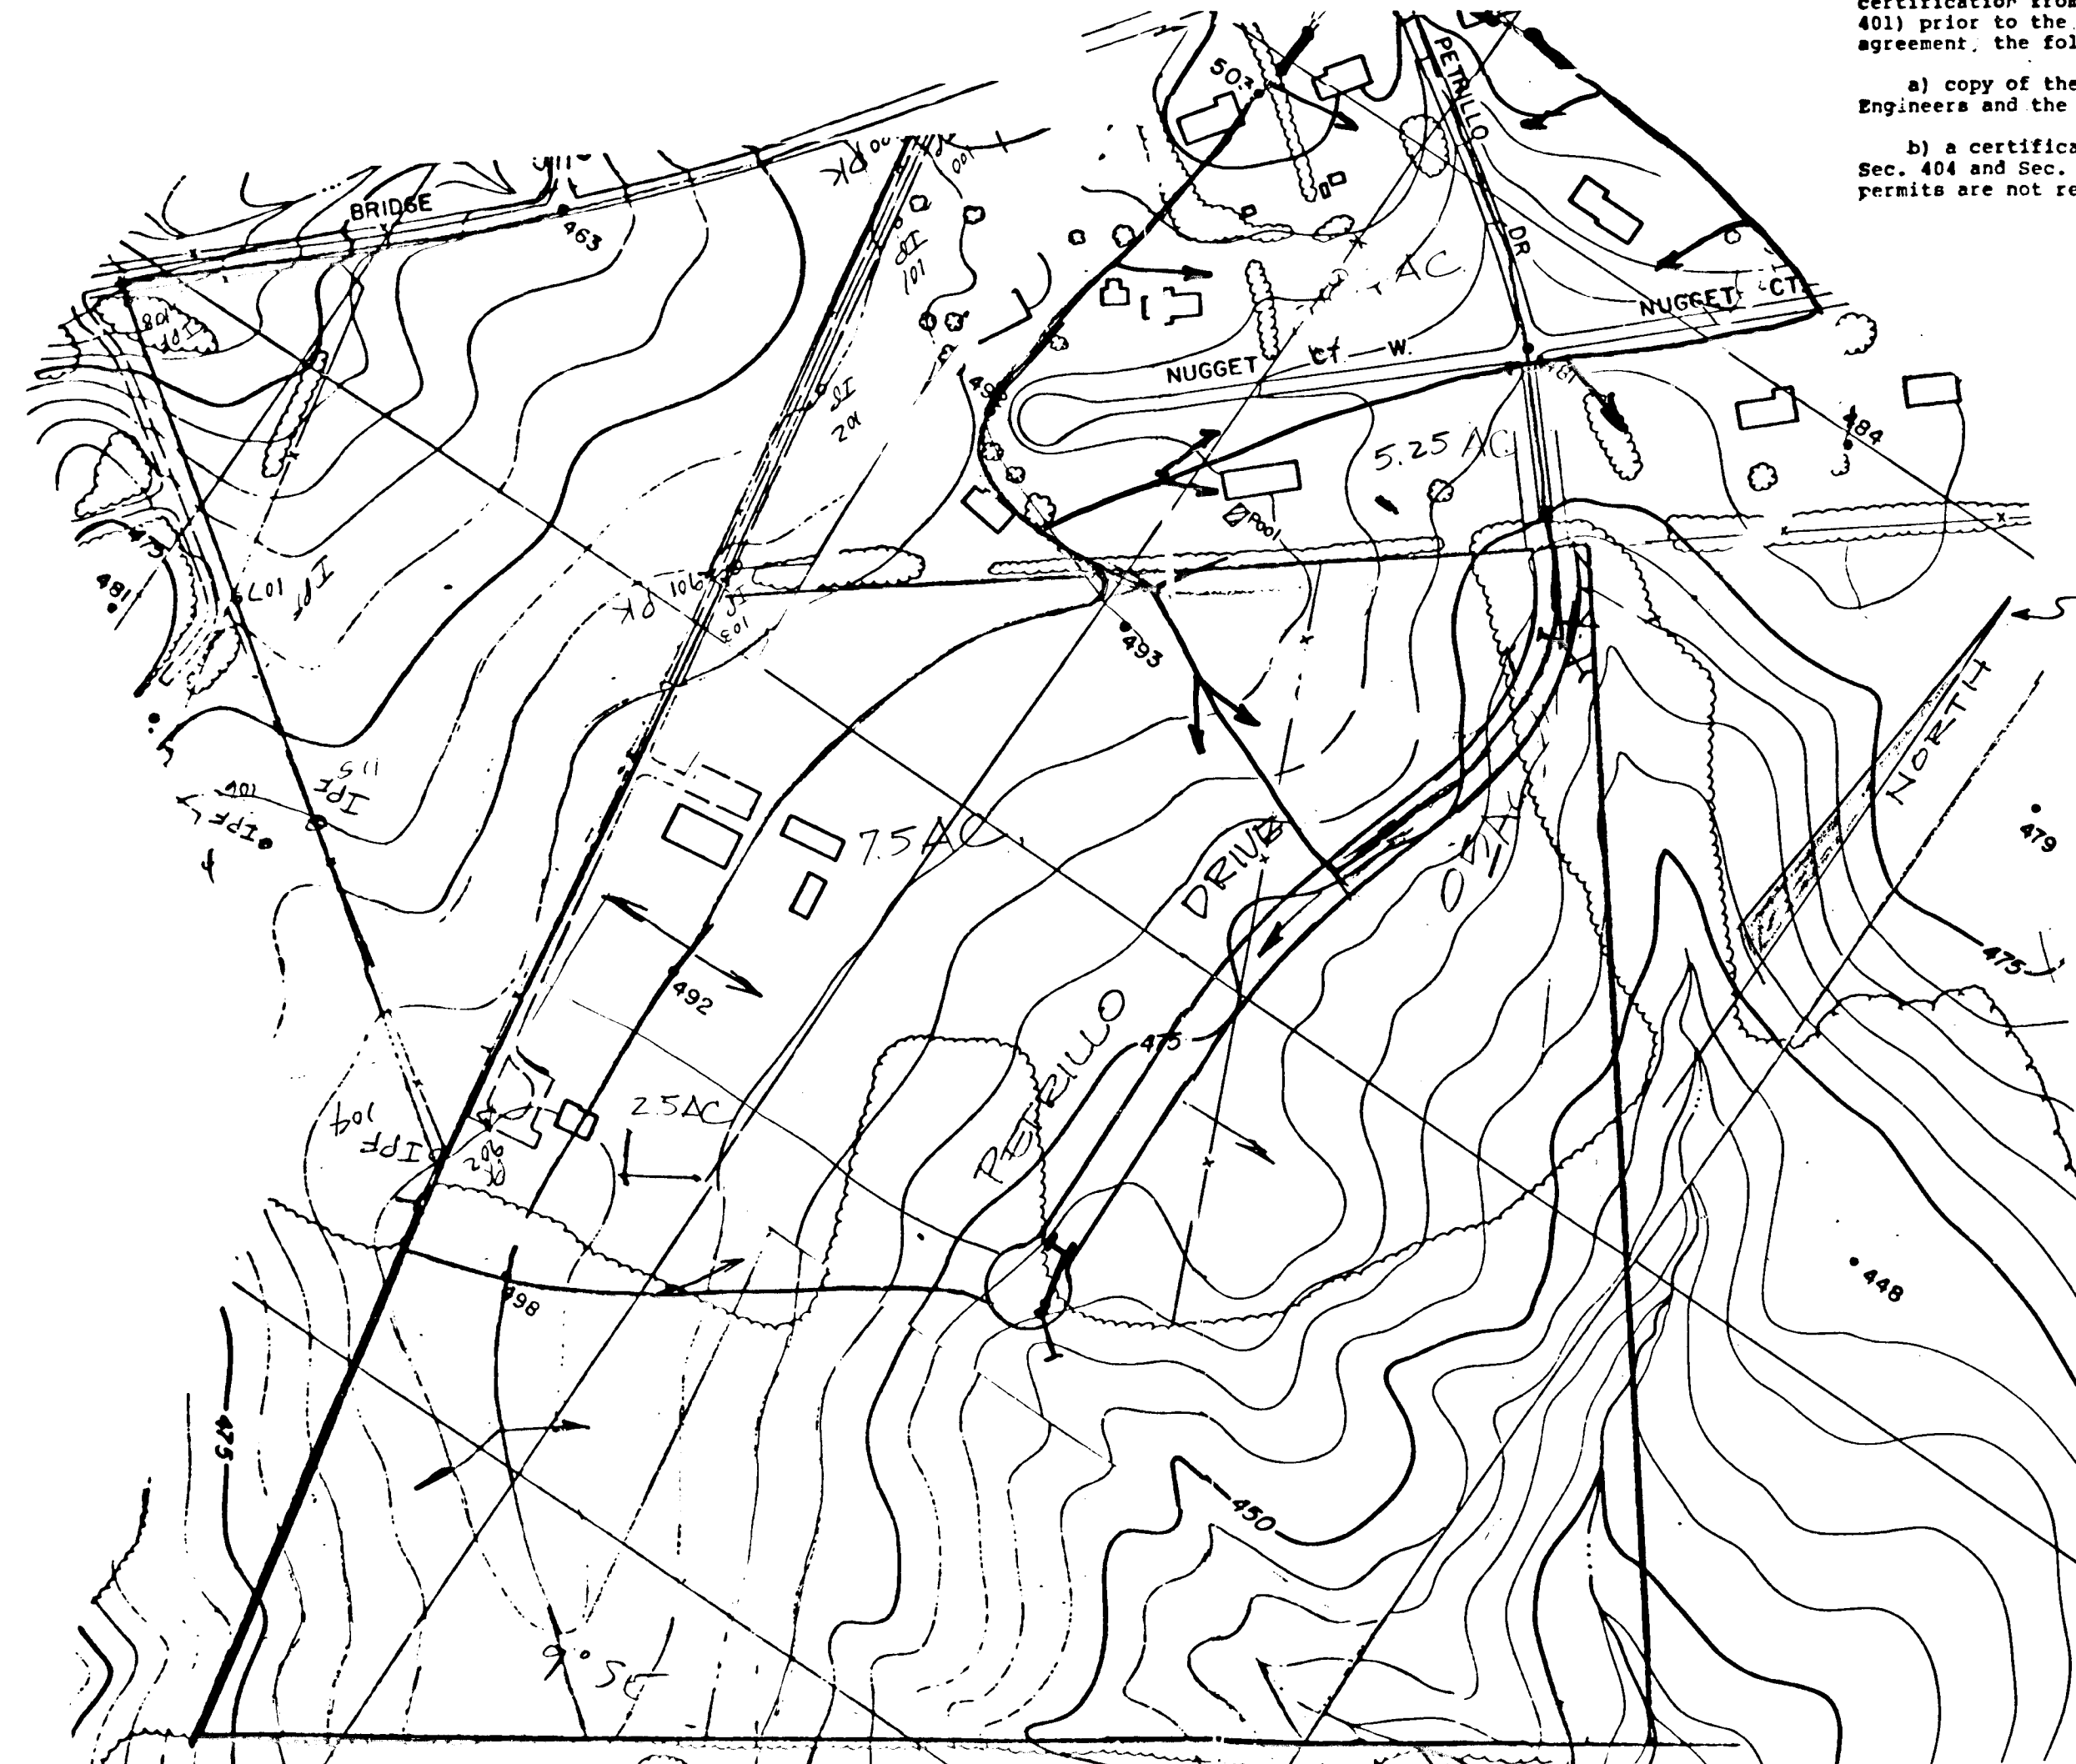

SECTION B-B
 SCALE: HORIZONTAL: 1" = 30'
 VERTICAL: 1" = 5'

SOPPED DITCH
 Q = 12.5 cfs
 n = 0.012
 s = 0.035

DRAINAGE AREA MAP
 SCALE: 1" = 30'

DEVELOPER'S CERTIFICATE
 I HEREBY CERTIFY THAT ALL DEVELOPMENT AND CONSTRUCTION WILL BE DONE ACCORDING TO THIS PLAN, AND THAT ANY RESPONSIBLE PERSONNEL INVOLVED IN THE CONSTRUCTION PROJECT WILL HAVE A CERTIFICATE OF ATTENDANCE AT A DEPARTMENT OF NATURAL RESOURCES APPROVED TRAINING PROGRAM FOR THE CONTROL OF SEDIMENT AND EROSION BEFORE BEGINNING THE PROJECT. I ALSO AUTHORIZE PERIODIC ON-SITE INSPECTION BY THE HOWARD SOIL CONSERVATION DISTRICT.
 Howard W. ... 9-21-87

ENGINEER'S CERTIFICATE
 I CERTIFY THAT THIS PLAN FOR EROSION AND SEDIMENT CONTROL IS A PRACTICAL AND WORKABLE PLAN BASED ON MY PERSONAL KNOWLEDGE OF THE SITE CONDITIONS AND THAT IT WAS PREPARED IN ACCORDANCE WITH THE REQUIREMENTS OF THE HOWARD SOIL CONSERVATION DISTRICT.
 Howard W. ... 8/20/87

REVIEWED BY: HOWARD S.C.D.
AND METS TECHNICAL REQUIREMENTS:
 Howard W. ... 10/9/87

THIS DEVELOPMENT PLAN IS APPROVED FOR SOIL EROSION AND SEDIMENT CONTROL BY THE HOWARD SOIL CONSERVATION DISTRICT
 Howard S.C.D. ... 10/8/87

APPROVED FOR PRIVATE WATER AND PRIVATE SEWAGE SYSTEMS, HOWARD COUNTY HEALTH DEPARTMENT
 County Health Officer ...

APPROVED: Howard County Office of Planning & Zoning
 Howard W. ... 10-16-87

APPROVED: Howard County Department of Public Works
 Howard W. ... 10/19/87

GENERAL NOTES
 The developer is advised that this development may be required to obtain permits from the Corp of Engineers for activities in wetlands (Sec 404) and a water quality certification from the state Health Dept (Sec 401) prior to the execution of the developer agreement. The following will be required:
 a) a copy of the permits issued by the Corp of Engineers and the Department of Health.
 b) a certification from the engineer that Sec. 404 and Sec. 401 do not apply and the permits are not required.

NOTE: The contractor or developer shall contact the Construction Inspection/Survey Division 24 hours in advance of commencement of work at 792-1272.

1519

Owner/Developer:
 HILLTOP DEVELOPMENT
 PO BOX 208
 CLARKSVILLE, MD 21029
 301-531-5539

NO.	REVISIONS	DATE



DEVELOPMENT CONSULTANTS GROUP, INC.
 17904 GEORGIA AVENUE # 102
 OLNEY, MARYLAND 20832
 301-924-4570

GRADE ESTABLISHMENT & SEDIMENT CONTROL
 SECTION ONE
WATERMAN ESTATES
 5th ELECTION DISTRICT
 TAX MAP 40 PARCEL 200
 HOWARD COUNTY, MARYLAND

DATE: AUGUST 1987
 DRAWN: S.M.B.
 CHECKED: S.M.B.
 SCALE: AS SHOWN
 SHEET NO. 3 OF 5
 PROJECT NO. 136-04

TEMPORARY SEEDING NOTES

APPLY TO GRADED OR CLEARED AREAS LIKELY TO BE REDISTURBED WHERE A SHORT-TERM VEGETATIVE COVER IS NEEDED.

SEEDING PREPARATION: LOOSEN UPPER THREE INCHES OF SOIL BY BARKING, DISCING OR OTHER ACCEPTABLE MEANS BEFORE SEEDING.

SOIL AMENDMENTS: APPLY 600 LBS. PER ACRE 10-10-10 FERTILIZER (14 LBS./1000 SQ. FT.) IN LIEU OF SOIL TEST APPLY ONE TON OF LIME PER ACRE.

SEEDING: FOR PERIODS MARCH 1 THRU APRIL 30 AND FROM AUGUST 15 THRU NOVEMBER 15, SEED WITH 2 1/2 BUSHEL PER ACRE OF ANNUAL RYE (1.2 LBS./1000 SQ. FT.). FOR THE PERIOD MAY 1 THRU AUGUST 14, SEED WITH 3 LBS. PER ACRE OF WEEFING, BOER, OR LEHMANN'S LOVEGRASS (.07 LBS./1000 SQ. FT.) HILLET 40 LBS./ACRE (1.92 LB./1000 SQ. FT.) AND SPURGRASS (.92 LB./1000 SQ. FT.). FOR THE PERIOD NOVEMBER 16 THRU FEBRUARY 28, PROTECT SITE BY APPLYING 2 TONS PER ACRE OF WELL ANCHORED STRAW MULCH AND SEED AS SOON AS POSSIBLE IN THE SPRING, OR USE SOU.

MULCHING: APPLY 1 1/2 TO 2 TONS PER ACRE (70 TO 90 LBS./1000 SQ. FT.) OF DISPERSED SMALL GRAIN IMMEDIATELY AFTER SEEDING. ANCHOR MULCH IMMEDIATELY AFTER APPLICATION USING MULCH ANCHORING TOOL OR 218 GAL PER ACRE (5 GAL/1000 SQ. FT.) OF ENULSIFIED ASPHALT ON FLAT AREAS. ON SLOPES, 8 FT OR HIGHER, USE 348 GAL PER ACRE (8 GAL/1000 SQ. FT.) FOR ANCHORING.

REFER TO THE 1983 MARYLAND STANDARDS AND SPECIFICATIONS FOR SOIL EROSION AND SEDIMENT CONTROL FOR RATE AND METHODS NOT COVERED.

APPLICATION: APPLY SEED UNIFORMLY WITH CYCLONE SEEDER, DRILL, CULTIPACKER BEETTER OR HYDROSEEDER (SLURRY INCLUDES SEED AND FERTILIZER).

MULCH ONLY IS TO BE USED DURING NON SEEDING DATES.

TEMP SEEDING (CHAPTER 50).

PERMANENT SEEDING NOTES

APPLY TO GRADED OR CLEARED AREAS NOT SUBJECT TO IMMEDIATE FURTHER DISTURBANCE WHERE A PERMANENT LONG-LIVED VEGETATIVE COVER IS NEEDED.

SEEDING PREPARATION: LOOSEN UPPER THREE INCHES OF SOIL BY BARKING, DISCING OR OTHER ACCEPTABLE MEANS BEFORE SEEDING.

SOIL AMENDMENTS: IN LIEU OF SOIL TEST RECOMMENDATIONS, USE ONE OF THE FOLLOWING SCHEDULES:


1. PREFERRED - APPLY 2 TONS PER ACRE DOLOMITIC LIMESTONE (92 LBS./1000 SQUARE FEET) AND 600 LBS. PER ACRE 10-10-10 FERTILIZER (14 LBS./1000 SQUARE FEET) BEFORE SEEDING. HARBOR OR DISC INTO UPPER THREE INCHES OF SOIL. AT TIME OF SEEDING, APPLY 400 POUNDS PER ACRE 30-0-0 UREAFORM FERTILIZER (9 LBS./1000 SQUARE FEET).
2. ACCEPTABLE - APPLY 2 TONS PER ACRE DOLOMITIC LIMESTONE (92 LBS./1000 SQUARE FEET) AND 600 LBS. PER ACRE 10-10-10 FERTILIZER (14 LBS./1000 SQUARE FEET) BEFORE SEEDING. HARBOR OR DISC INTO UPPER THREE INCHES OF SOIL.

SEEDING - FOR THE PERIODS FEBRUARY 1 THRU APRIL 30, AND AUGUST 15 THRU DECEMBER 31, SEED WITH 60 LBS. PER ACRE (1.4 LBS./1000 SQUARE FEET) OF KENTUCKY 31 TALL FESCUE. FOR THE PERIOD MAY 1 THRU AUGUST 14, SEED WITH 60 LBS. PER ACRE (1.4 LBS./1000 SQUARE FEET) OF KENTUCKY 31 TALL FESCUE PER ACRE AND 2 LBS. PER ACRE (1.05 LBS./1000 SQUARE FEET) OF WEEFING LOVEGRASS. DURING THE PERIOD OF OCTOBER 16 THRU FEBRUARY 28, PROTECT SITE BY: OPTION (1) 2 TONS PER ACRE OF WELL ANCHORED STRAW MULCH AND SEED AS SOON AS POSSIBLE IN THE SPRING. OPTION (2) USE SOU. OPTION (3) SEED WITH 60 LBS./ACRE KENTUCKY 31 TALL FESCUE AND MULCH WITH 2 TONS/ACRE WITH ANCHORED STRAW.

MULCHING - APPLY 1 1/2 TO 2 TONS PER ACRE (70 TO 90 LBS./1000 SQUARE FEET) OF DISPERSED SMALL GRAIN IMMEDIATELY AFTER SEEDING. ANCHOR MULCH IMMEDIATELY AFTER APPLICATION USING MULCH ANCHORING TOOL OR 218 GALLONS PER ACRE (5 GAL./1000 SQUARE FEET) OF ENULSIFIED ASPHALT ON FLAT AREAS. ON SLOPES 8 FEET OR HIGHER, USE 348 GALLONS PER ACRE (8 GAL./1000 SQUARE FEET) FOR ANCHORING.


MAINTENANCE - INSPECT ALL SEEDED AREAS AND MAKE NEEDED REPAIRS, REPLACEMENTS AND RESEEDINGS.

APPLICATION: APPLY SEED UNIFORMLY WITH A CYCLONE SEEDER, DRILL, CULTIPACKER BEETTER OR HYDROSEEDER (SLURRY INCLUDES SEED AND FERTILIZER).

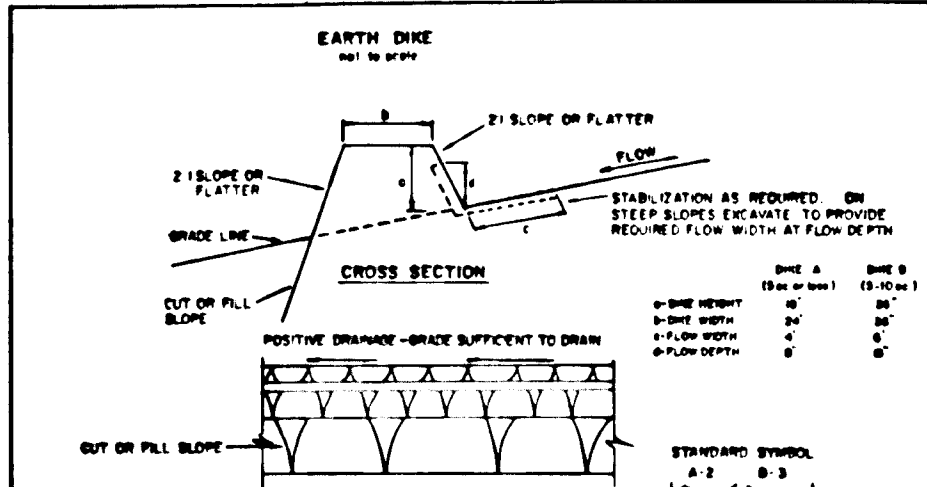

TYPE OF CHANNEL	DEPTH	LINE A	LINE B
1	5.3-DE	SEED AND STRAW MULCH	SEED AND STRAW MULCH
2	5.3-DE	SEED AND STRAW MULCH	SEED WITH LIME, OR EXCELUTION, SIZE 2 STONE
3	5.3-DE	SEED WITH LIME, OR SOU	LIME 10-10-10
4	8.1-DE	ON RECYCLED CONCRETE BRICKWORK, IN A LAYER AT LEAST 3 INCHES THICKNESS AND BE PRESSED INTO THE SOIL WITH CONSTRUCTION EQUIPMENT	


U.S. DEPARTMENT OF AGRICULTURE
SOIL CONSERVATION SERVICE
COLLEGE PARK, MARYLAND

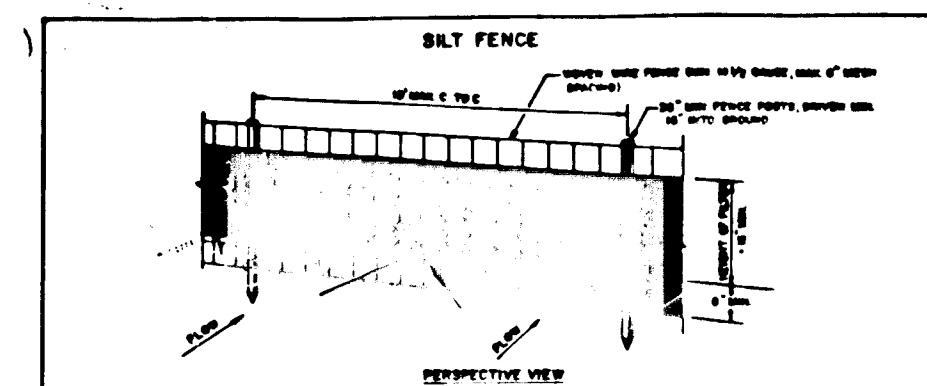

CONSTRUCTION AND MAINTENANCE FOR PREPARED SILT FENCE

1. MINOR SILT FENCE TO BE INSTALLED REGULARLY TO FACE POSTS WITH 100 LB STAKES.
2. FILTER CLOTH TO BE FASTENED REGULARLY TO SLOPE WITH 100 LB STAKES AT 10 FT INTERVALS.
3. WHEN TWO SECTIONS OF FILTER CLOTH MEET, THEY SHOULD BE OVERLAPPED BY SIX INCHES AND FILLED.
4. MAINTENANCE SHALL BE PERFORMED AS NEEDED. THE INITIAL MAINTENANCE SHALL BE DONE IN THE SILT FENCE.

STANDARD SYMBOL: 57-1

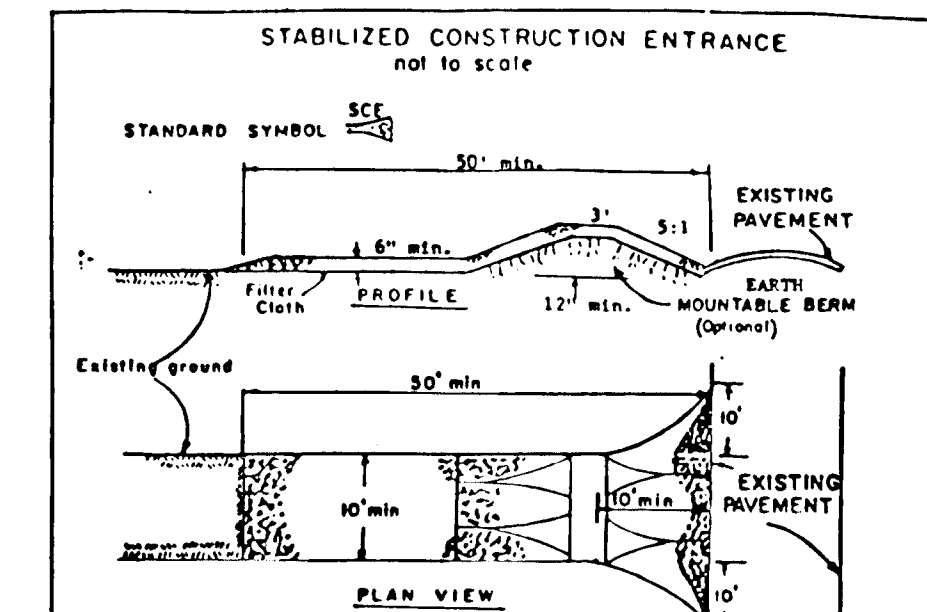


CONSTRUCTION SPECIFICATIONS

1. Stone Size - One 3" stone, or reclaimed or recycled concrete equivalent.
2. Length - As required, but not less than 80 feet (except on a single construction lot where a 30 foot stone length would apply).
3. Thickness - Not less than six (6) inches.
4. Width - Ten (10) foot minimum, but not less than the full width at points where ingress or egress occurs.
5. Filter Cloth - Will be placed over the entire area prior to placing of stone. Filter will not be replaced on a single family residence lot.
6. Surface Water - All surface water flowing or diverted toward construction entrance shall be piped across the entrance. If piping is impractical, a removable berm with 5:1 slopes will be permitted.
7. Maintenance - The entrance shall be maintained in a condition which will prevent tracking or flowing of sediment onto public rights-of-way. This may require periodic top dressing with additional stone as conditions demand and repair and/or cleaning of any measure used to trap sediment. All sediment spilled, dropped, washed or tracked onto public rights-of-way must be removed immediately.
8. Washing - Wheels shall be cleaned to remove sediment prior to entrance onto public rights-of-way. When washing is required, it shall be done on an area stabilized with stone and which drains into an approved sediment trapping device.
9. Periodic inspection and needed maintenance shall be provided after each rain.

STANDARD SYMBOL: 57-2

U.S. DEPARTMENT OF AGRICULTURE
SOIL CONSERVATION SERVICE
COLLEGE PARK, MARYLAND

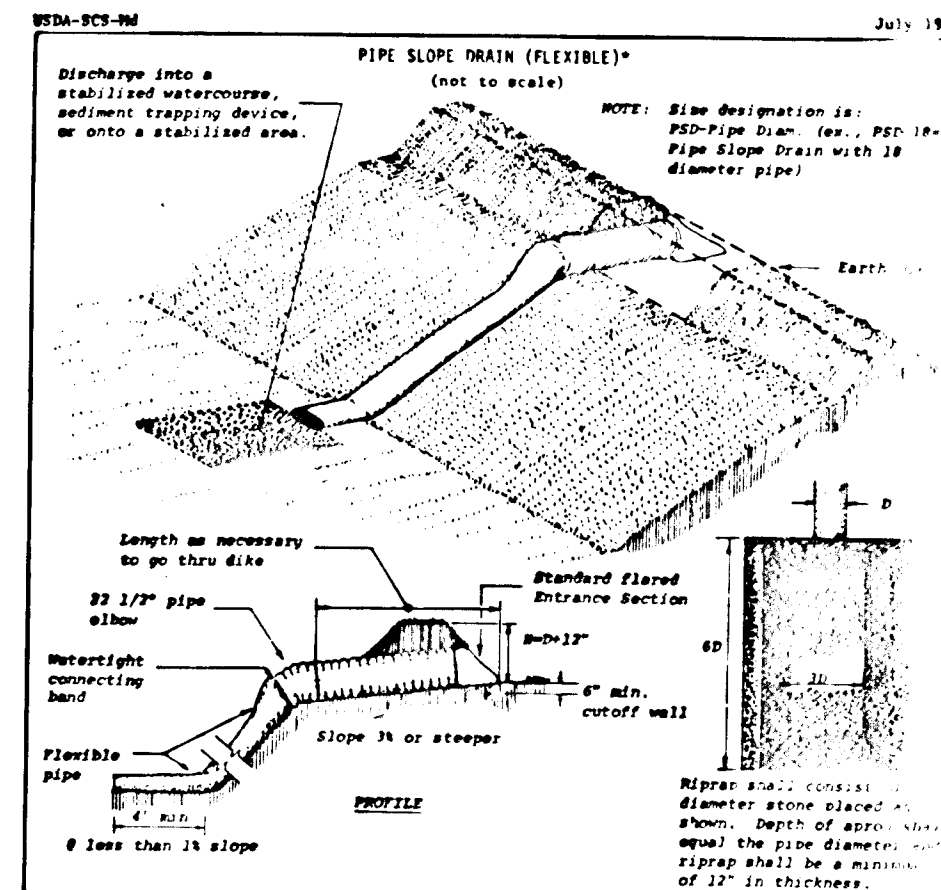


CONSTRUCTION SPECIFICATIONS


1. The inlet pipe shall have a slope of 3:1 or steeper.
2. The top of the earth dike over the inlet pipe and those dikes carrying water to the pipe shall be at least 12" higher at all points than the top of the inlet pipe.
3. The inlet pipe shall be corrugated metal pipe with watertight connecting bands.
4. The flexible tubing shall be the same diameter as the inlet pipe and shall be made of a durable material with hold-down grommets spaced 10' on centers.
5. The flexible tubing shall be securely fastened to the corrugated metal pipe with watertight or watertight connecting collars.
6. The flexible tubing shall be securely anchored to the slope by staking at the ground surface.
7. A riprap apron shall be provided at the outlet. This shall consist of 6" diameter stone placed as shown on Standard Drawing 57-3.
8. The soil around and under the inlet pipe and entrance section shall be hand tamped to 4" settle to the top of the earth dike.
9. Follow-up inspection and any needed maintenance shall be performed after each storm.

STANDARD SYMBOL: 57-3

U.S. DEPARTMENT OF AGRICULTURE
SOIL CONSERVATION SERVICE
COLLEGE PARK, MD

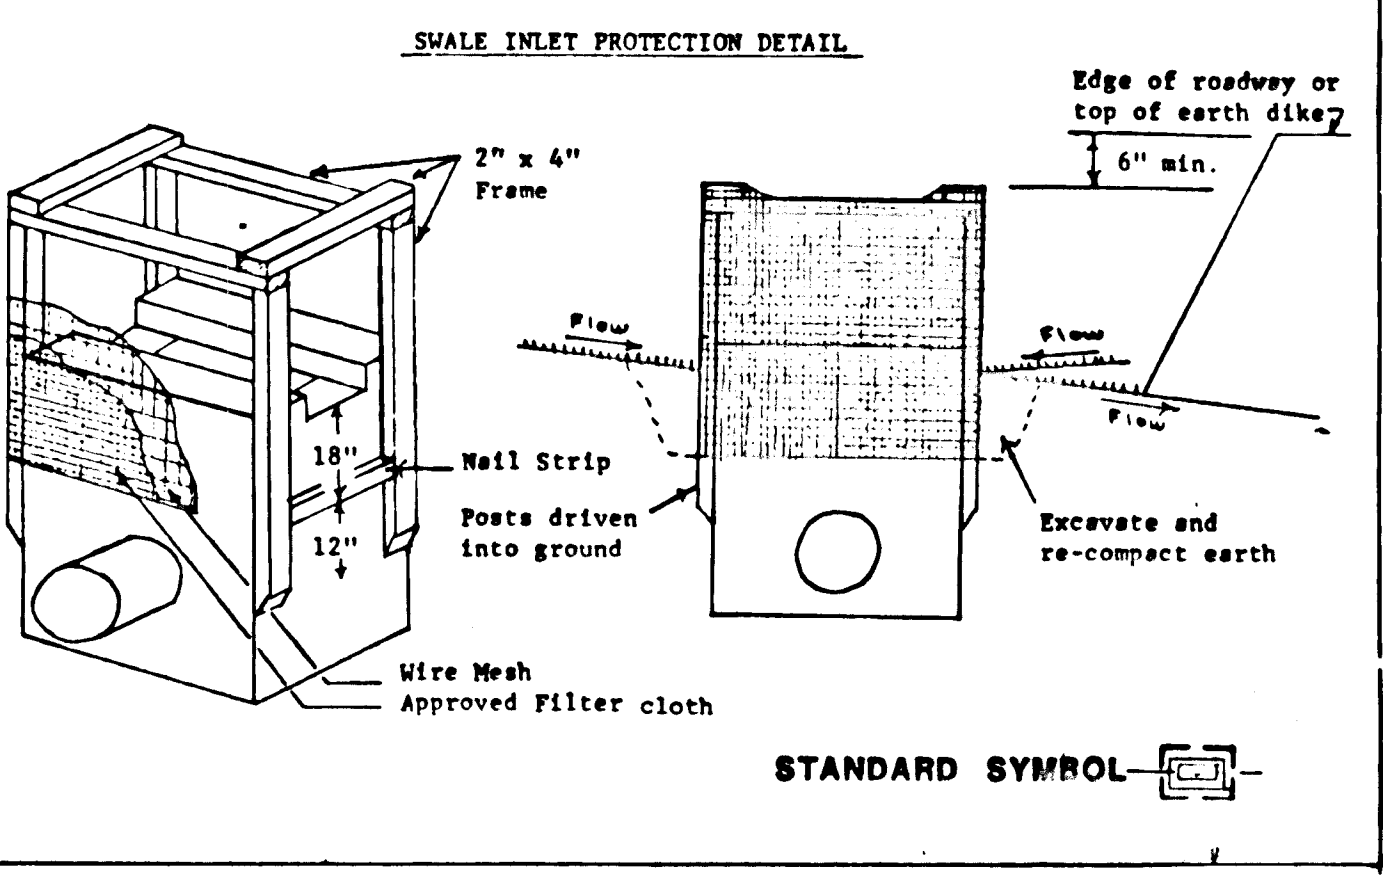

U.S. DEPARTMENT OF AGRICULTURE
SOIL CONSERVATION SERVICE
COLLEGE PARK, MD

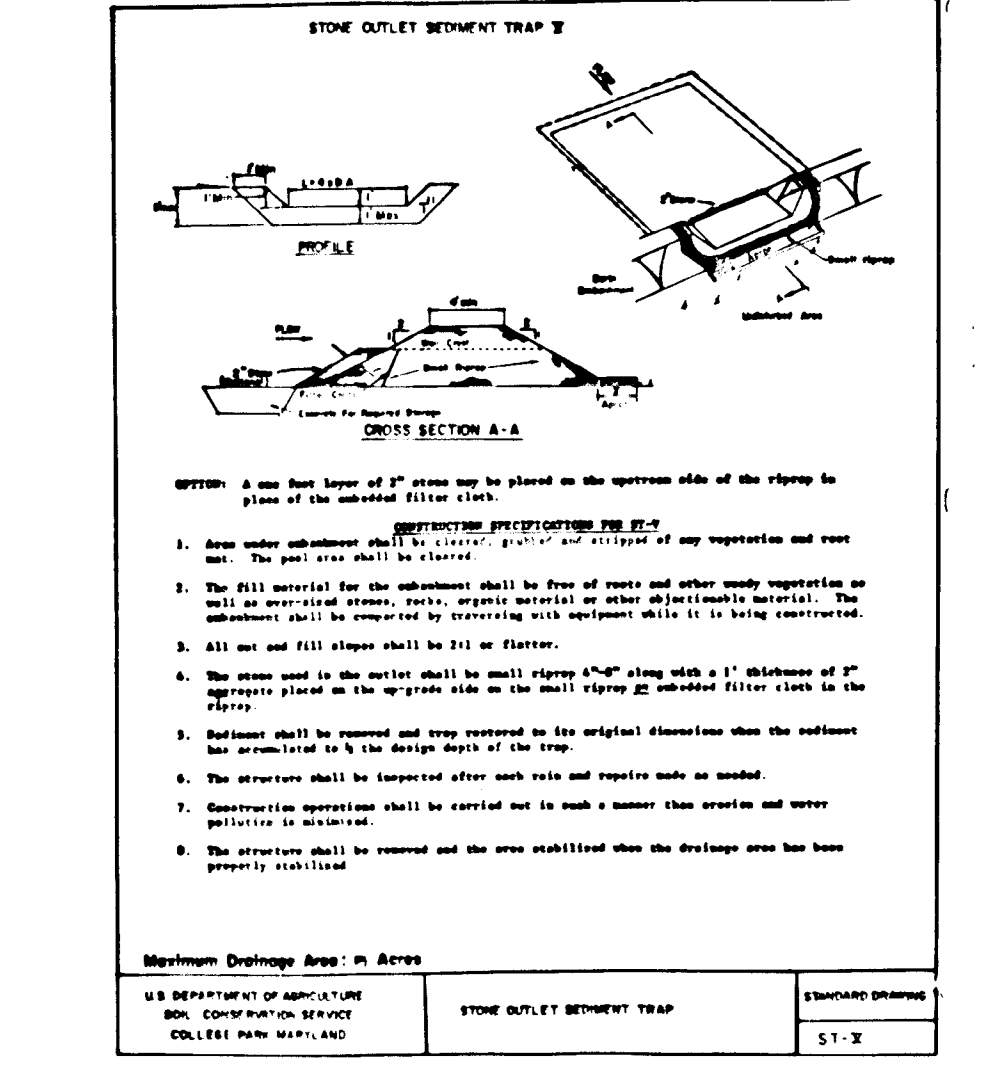

CONSTRUCTION SPECIFICATIONS

1. Stone Size - One 3" stone, or reclaimed or recycled concrete equivalent.
2. Length - As required, but not less than 80 feet (except on a single construction lot where a 30 foot stone length would apply).
3. Thickness - Not less than six (6) inches.
4. Width - Ten (10) foot minimum, but not less than the full width at points where ingress or egress occurs.
5. Filter Cloth - Will be placed over the entire area prior to placing of stone. Filter will not be replaced on a single family residence lot.
6. Surface Water - All surface water flowing or diverted toward construction entrance shall be piped across the entrance. If piping is impractical, a removable berm with 5:1 slopes will be permitted.
7. Maintenance - The entrance shall be maintained in a condition which will prevent tracking or flowing of sediment onto public rights-of-way. This may require periodic top dressing with additional stone as conditions demand and repair and/or cleaning of any measure used to trap sediment. All sediment spilled, dropped, washed or tracked onto public rights-of-way must be removed immediately.
8. Washing - Wheels shall be cleaned to remove sediment prior to entrance onto public rights-of-way. When washing is required, it shall be done on an area stabilized with stone and which drains into an approved sediment trapping device.
9. Periodic inspection and needed maintenance shall be provided after each rain.

STANDARD SYMBOL: 57-2

U.S. DEPARTMENT OF AGRICULTURE
SOIL CONSERVATION SERVICE
COLLEGE PARK, MARYLAND

Maryland 8CS/WVA April 1983

STANDARD AND SPECIFICATIONS FOR STORM DRAIN INLET PROTECTION

Definition
Filter cloth installed around inlets in the form of a fence or across an opening, thereby reducing sediment content of sediment laden water.

Purpose
To prevent sediment laden water from entering a storm drain system through inlets.

Conditions Where Practice Applies
This practice shall be used where the drainage area to an inlet is disturbed, it is not possible to temporarily divert the storm drain outlet into a sediment trapping device and watertight blocking of inlets is not advisable. It is not to be used in place of sediment trapping devices. This practice may be used in conjunction with storm drain diversion to help prevent siltation of pipes installed with a low slope angle.


Construction Specifications

- I. Materials**
1. A wooden frame is to be constructed of 2" x 4" construction grade lumber.
 2. Wire mesh must be of sufficient strength to support filter fabric, and stone for curb inlets, with frame fully impounded against it.
 3. Filter cloth must be of a type approved for this purpose; resistant to sunlight with weave size, 80S, 40-85, to allow sufficient passage of water and removal of sediment.
 4. Stone is to be 2" in size and clean, since fines would clog the cloth.

Maryland 8CS/WVA April 1983

II. Procedure

- A. A swale, ditchline or yard inlet protection.**
1. Excavate completely around inlet to a depth of 18" below notch elevation.
 2. Drive 2 x 4 post 1' into ground at four corners of inlet. Place nail strips between posts on ends of inlet. Assemble top portion of 2 x 4 frame using overlap joint method. Top of frame (weir) must be 6" below edge of roadway adjacent to inlet.
 3. Stretch wire mesh tightly around frame and fasten securely. Ends must seat at post.
 4. Stretch filter cloth tightly over wire mesh, the cloth must extend from top of frame to 18" below inlet notch elev. Fasten securely to frame. Ends must seat at post, be overlapped and folded, then fastened down.
 5. Backfill around inlet in compacted 6" layers until layer of earth is even with notch elevation on ends and top elevation on sides.
 6. If the inlet is not in a low point, construct a compacted earth dike in the ditchline below it. The top of this dike is to be at least 6" higher than the top of frame (weir).
 7. This structure must be inspected frequently and the filter fabric replaced when clogged.
- B. Curb Inlet Protection.**
1. Attach a continuous piece of wire mesh (30" min. width by throat length plus 4") to the 2" x 4" weir (measuring throat length plus 2") as shown on the standard drawing.
 2. Place a piece of approved filter cloth (40-85 size) of the same dimensions as the wire mesh over the wire mesh and securely attach to the 2" x 4" weir.
 3. Securely nail the 2" x 4" weir to 8" long vertical anchors to be located between the weir and inlet face (see 4" apart).
 4. Place the assembly against the inlet curb and nail (minimum 2" lengths of 2" x 4" to the top of the weir at spacer locations. These 2" x 4" anchors shall extend across the inlet top and be held in place by sandbags or alternate weight.

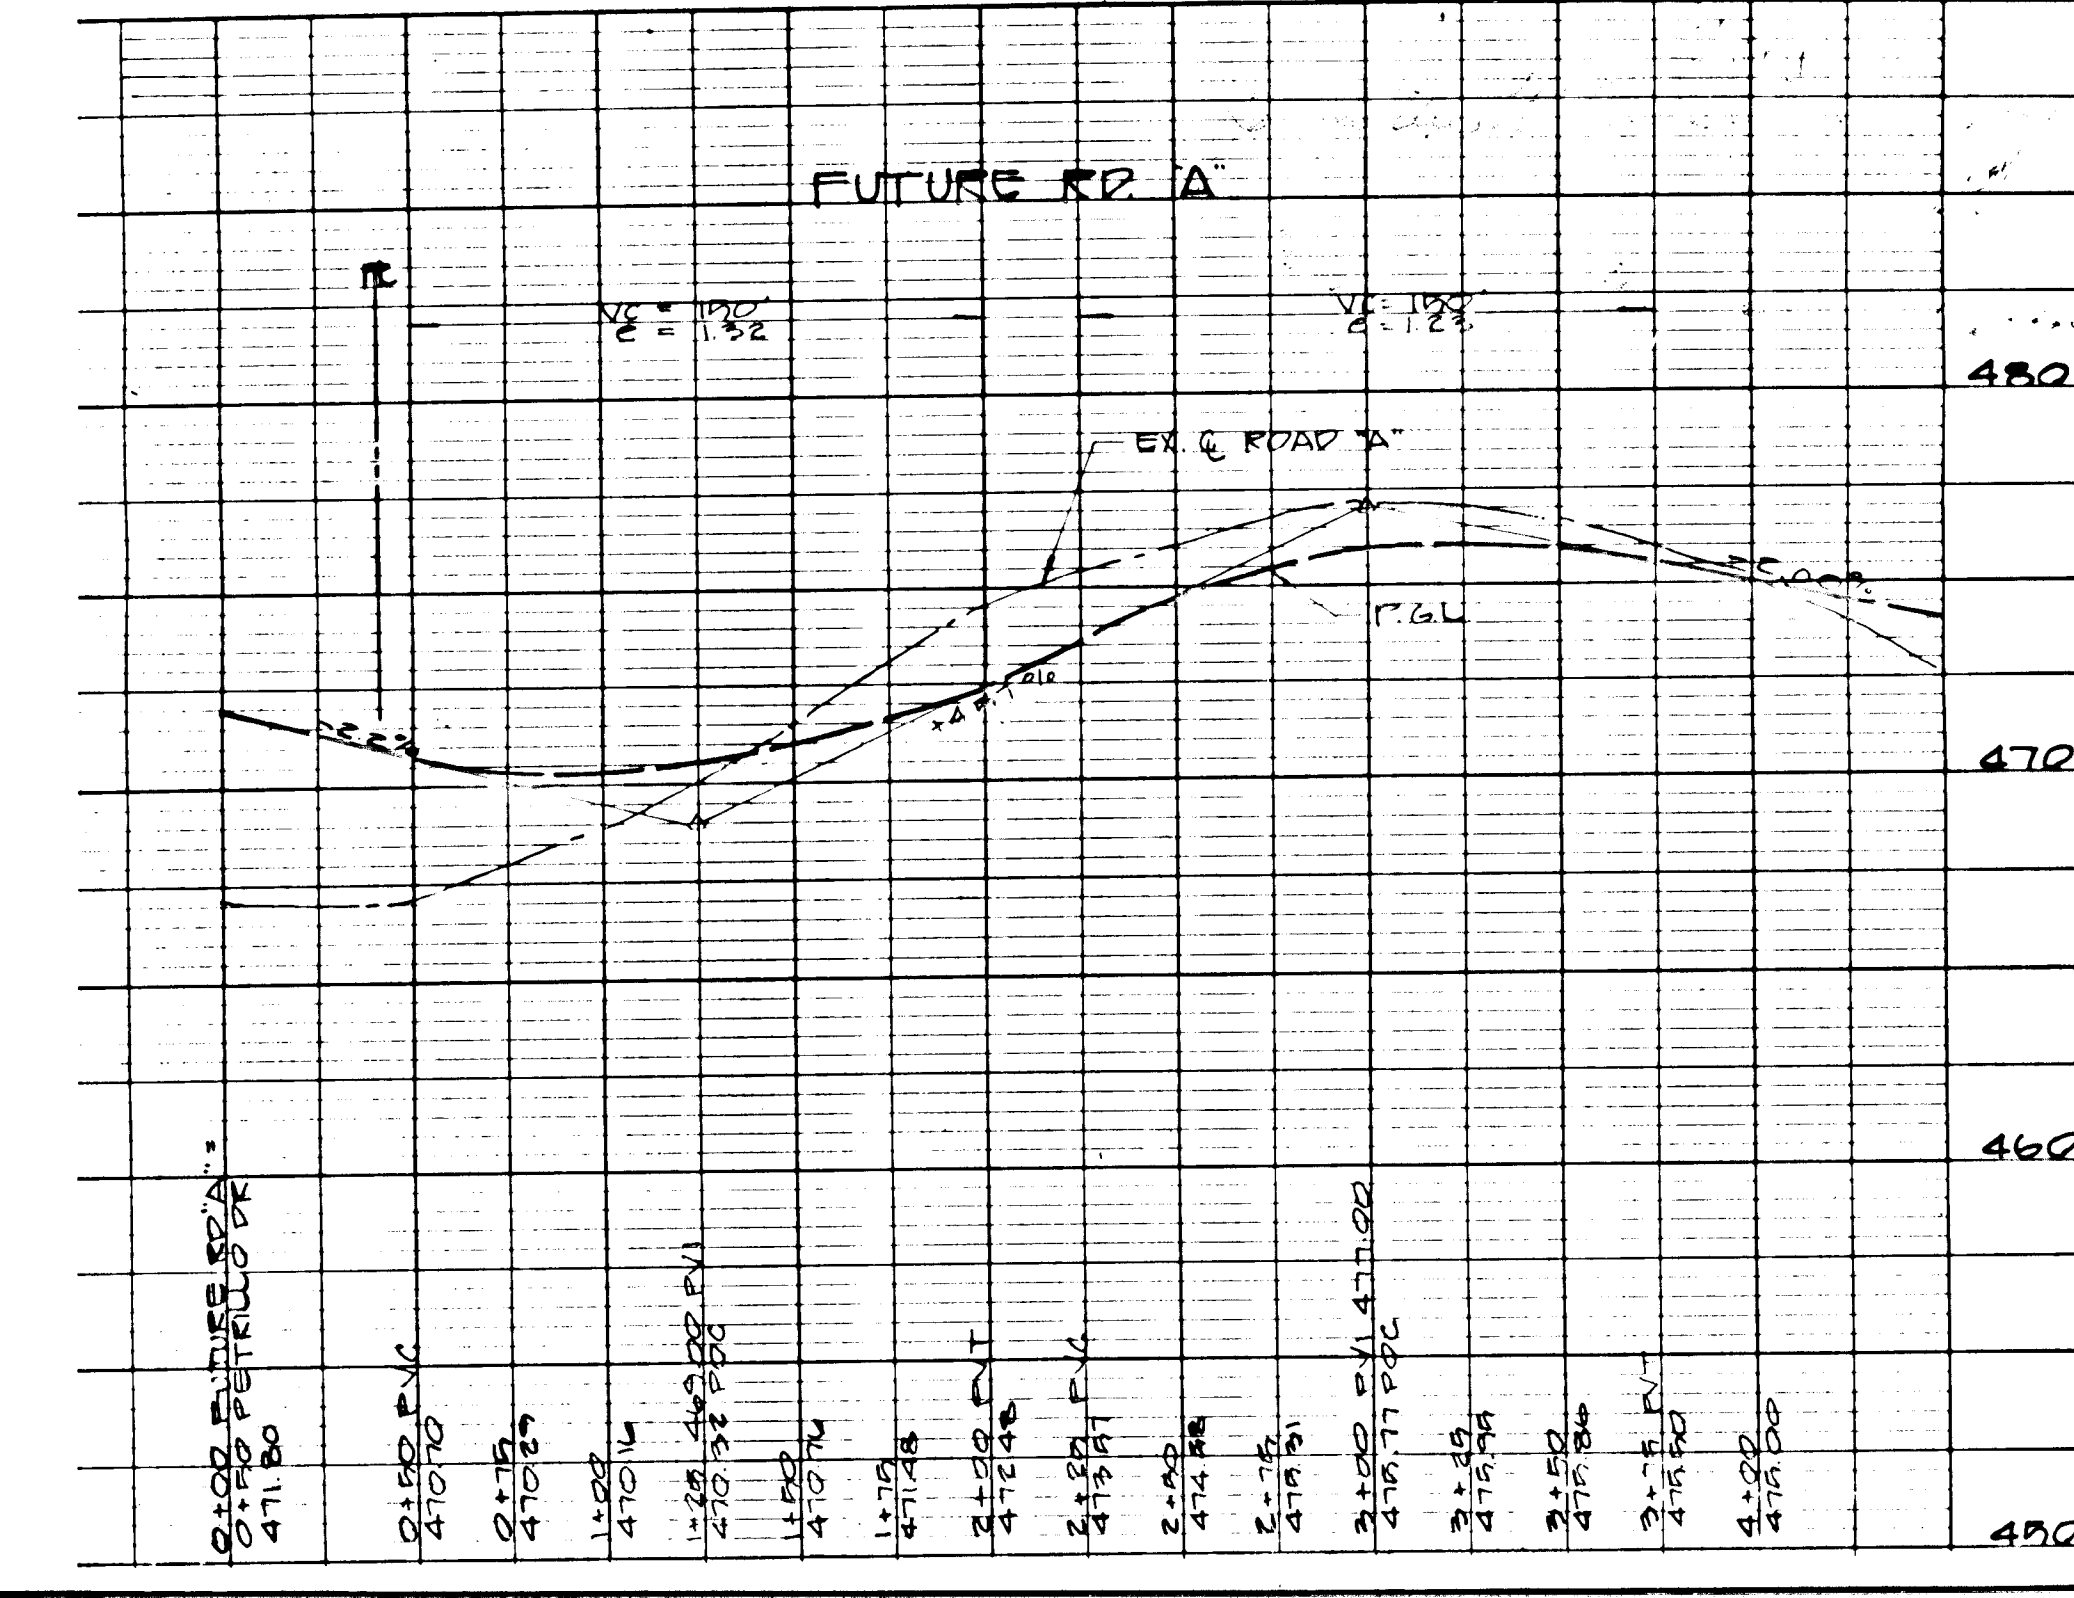

DEVELOPER'S CERTIFICATE

"I/WE CERTIFY THAT ALL DEVELOPMENT AND CONSTRUCTION WILL BE DONE ACCORDING TO THIS PLAN, AND THAT ANY RESPONSIBLE PERSONNEL INVOLVED IN THE CONSTRUCTION PROJECT WILL HAVE A CERTIFICATE OF ATTENDANCE AT A PROGRAM FOR THE CONTROL OF SEDIMENT AND EROSION BEFORE BEGINNING THE PROJECT. I ALSO AUTHORIZE PERIODIC ON-SITE INSPECTION BY THE HOWARD SOIL CONSERVATION DISTRICT."

Richard W. Mott 9-21-87

ENGINEER'S CERTIFICATE

I CERTIFY THAT THIS PLAN FOR EROSION AND SEDIMENT CONTROL MEETS A PRACTICAL AND WORKABLE PLAN BASED ON MY PROFESSIONAL KNOWLEDGE OF THE SITE CONDITIONS AND THE HOWARD SOIL CONSERVATION DISTRICT'S EROSION CONTROL STANDARDS.

Richard W. Mott 8/20/87

REVIEWED BY: *Howard* S.C.D.

AND MEETS TECHNICAL REQUIREMENTS OF THE HOWARD SOIL CONSERVATION SERVICE

James M. Mott 10/9/87

THIS DEVELOPMENT PLAN IS APPROVED FOR SOIL EROSION AND SEDIMENT CONTROL BY THE HOWARD SOIL CONSERVATION DISTRICT

John K. Mott 10/8/87

APPROVED FOR FURNISHING WATER AND FURNISHING SEWAGE SYSTEMS, HOWARD COUNTY HEALTH DEPARTMENT

COUNTY HEALTH OFFICER DATE

APPROVED: Howard County Office of Planning & Zoning

John Mott 10-13-87

APPROVED: HOWARD COUNTY DEPARTMENT OF PUBLIC WORKS

John Mott 10/19/87

John Mott 10-16-87

Following initial soil disturbance or redistribution, permanent or temporary stabilization shall be completed within: 1) Seven (7) calendar days for all perimeter sediment control structures, dikes, mounds, ditches, perimeter dikes and all slopes greater than 3:1, 2) fourteen (14) days as to all other disturbed or graded areas on the project site.

NOTE: The contractor or developer shall contact the Construction Inspection/Survey Division 24 hours in advance of commencement of work at 757-7272.

Owner/Developer: HILLTOP DEVELOPMENT
P.O. BOX 608
CLARKSVILLE, MD 21029
301-331-5939

NO.	REVISIONS	DATE

DEVELOPMENT CONSULTANTS GROUP, INC.

17904 GEORGIA AVENUE # 102
OLNEY, MARYLAND 20832
301-924-4570

SPECIFICATIONS AND DETAILS SECTION ONE WATERMAN ESTATES


5th ELECTION DISTRICT
TAX MAP 40 PARCEL 250
HOWARD COUNTY, MARYLAND

DATE: August 1987
DRAWN: MAB
CHECKED: MAB
SCALE: AS SHOWN

Sheet 4 of 5
PROJECT NO. 136-04

NOTE: THE COORDINATES FOR THIS PROJECT ARE BASED ON HOWARD COUNTY GEODETIC CONTROL STATION # 2186002 & # 2186003

VICINITY MAP

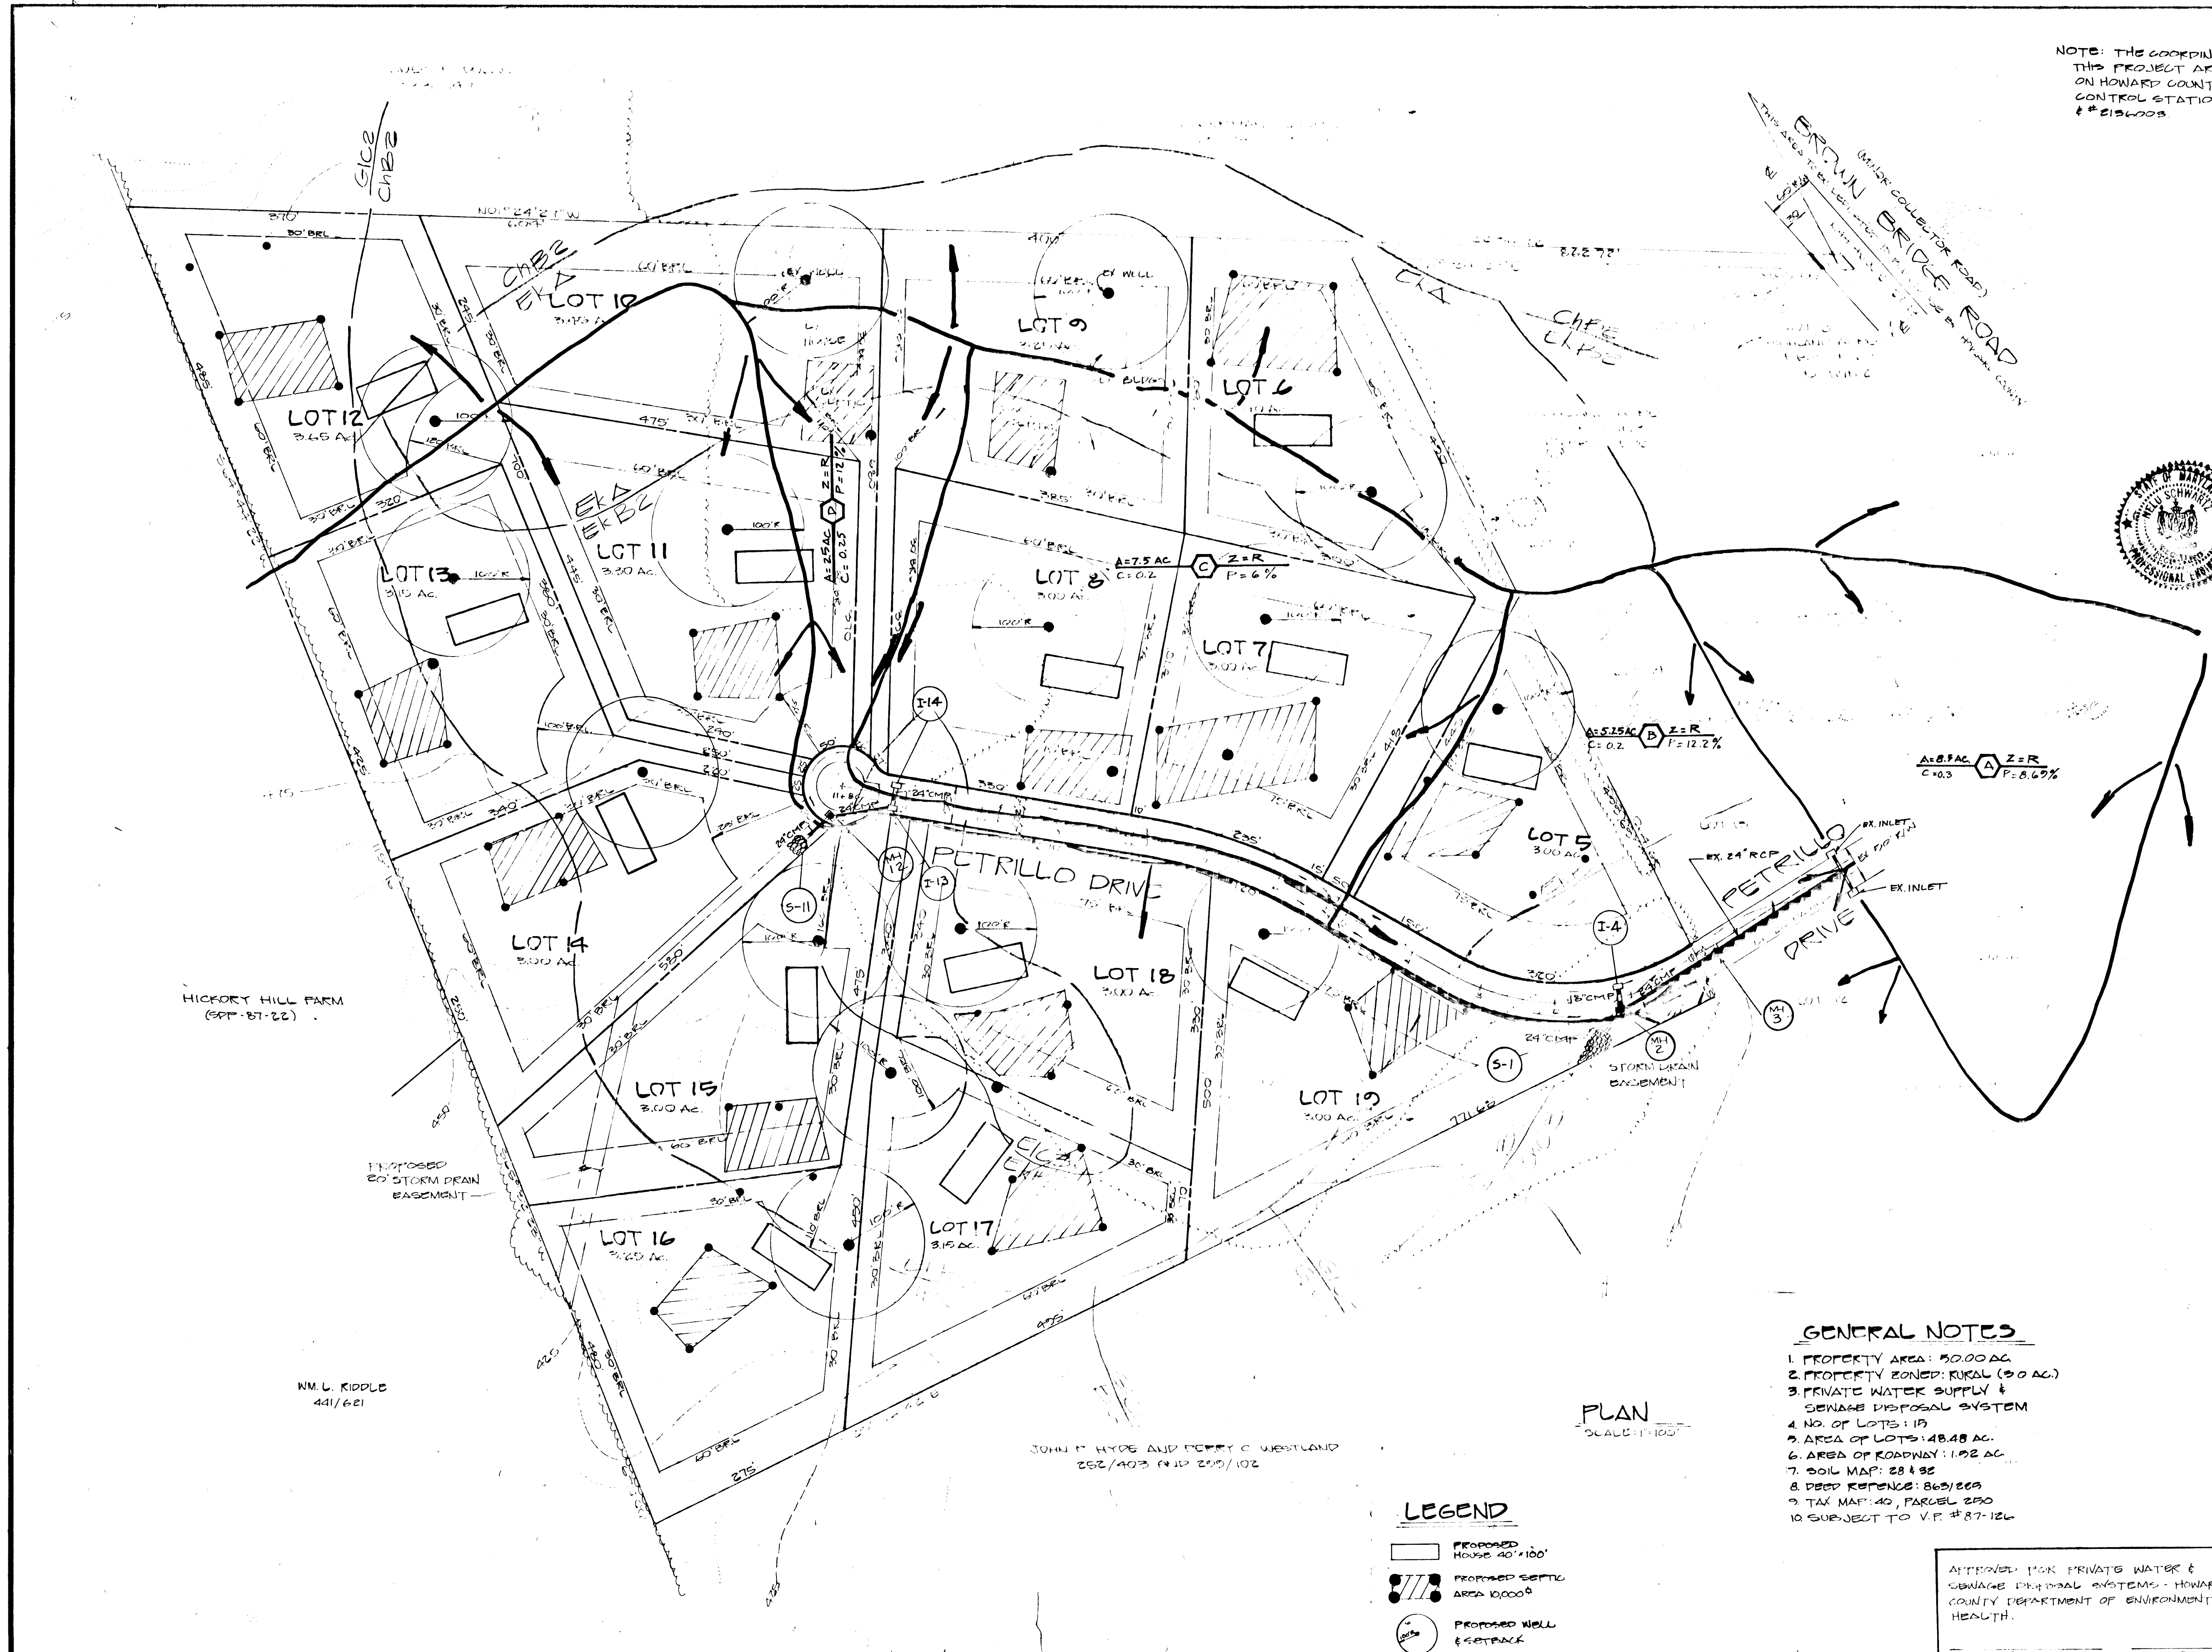

DEVELOPER'S CERTIFICATE
 I HAVE CERTIFY THAT ALL DEVELOPMENT AND CONSTRUCTION WILL BE DONE ACCORDING TO THIS PLAN, AND THAT ANY RESPONSIBLE PERSONNEL INVOLVED IN THE CONSTRUCTION PROJECT WILL HAVE A CERTIFICATE OF ATTENDANCE AT A DEPARTMENT OF NATURAL RESOURCES APPROVED TRAINING PROGRAM FOR THE CONTROL OF SEDIMENT AND EROSION BEFORE BEGINNING THE PROJECT. I ALSO AUTHORIZE PERIODIC ON-SITE INSPECTION BY THE HOWARD SOIL CONSERVATION DISTRICT.
 Michael J. Mammitt 9/21/87
 DATE

ENGINEER'S CERTIFICATE
 I CERTIFY THAT THIS PLAN FOR EROSION AND SEDIMENT CONTROL REPRESENTS A PRACTICAL AND WORKABLE PLAN BASED ON PROFESSIONAL KNOWLEDGE OF THE SITE CONDITIONS AND PREPARED IN ACCORDANCE WITH THE REGULATIONS OF THE HOWARD SOIL CONSERVATION DISTRICT.
 Howard S.C.D.
 AND MEET ALL REQUIREMENTS
 James M. Wilson 10/8/87
 U.S. SOIL CONSERVATION SERVICE

THIS DEVELOPMENT PLAN IS APPROVED FOR SOIL EROSION AND SEDIMENT CONTROL BY THE HOWARD SOIL CONSERVATION DISTRICT
 Howard S.C.D. 10/8/87
 DATE

APPROVED FOR PUBLIC WATER AND PUBLIC SEWAGE SYSTEMS, HOWARD COUNTY HEALTH DEPARTMENT
 COUNTY HEALTH OFFICER DATE

APPROVED: Howard County Office of Planning & Zoning
 Howard M. Murchman 10/15/87
 DATE

APPROVED: HOWARD COUNTY DEPARTMENT OF PUBLIC WORKS
 Chief, Land Development Division
 Dranville W. Weiland 10/19/87
 DATE

Chief, Bureau of Engineering
 10-16-87
 DATE
 Following initial soil disturbance or redisturbance, permanent or temporary stabilization shall be completed within:
 1) Seven (7) calendar days for all perimeter sediment control structures, ditches, swales, ditches, perimeter slopes and all slopes greater than 3:1, 2) Fourteen (14) days as to all other disturbed or graded areas on the project site.

NOTE: The contractor or developer shall contact the Construction Inspection/Survey Division 24 hours in advance of commencement of work at 792-7272.

GENERAL NOTES

1. PROPERTY AREA: 50.00 AC.
2. PROPERTY ZONED: RURAL (50 AC.)
3. PRIVATE WATER SUPPLY & SEWAGE DISPOSAL SYSTEM
4. NO. OF LOTS: 18
5. AREA OF LOTS: 48.48 AC.
6. AREA OF ROADWAY: 1.92 AC.
7. SOIL MAP: 28 & 92
8. DEED REFERENCE: 863/205
9. TAX MAP: 40, PARCEL 250
10. SUBJECT TO V.P. #87-126

LEGEND

- PROPOSED HOUSE 40'x100'
- PROPOSED SEPTIC AREA 10,000^{sq}
- PROPOSED WELL & STRUCK


APPROVED FOR PRIVATE WATER & SEWAGE DISPOSAL SYSTEMS - HOWARD COUNTY DEPARTMENT OF ENVIRONMENTAL HEALTH.
 COUNTY HEALTH OFFICER DATE

SURVEYOR'S CERTIFICATE
 I HEREBY CERTIFY THAT TO THE BEST OF MY KNOWLEDGE AND BELIEF THE INFORMATION SHOWN HEREON IS CORRECT.
 DATE
 PROFESSIONAL LAND SURVEYOR

1519

Owner/Developer
 HILLTOP DEVELOPMENT INC.
 P.O. BOX 208
 CLARESVILLE, MD 21027
 301-534-5530

NO.	REVISIONS	DATE

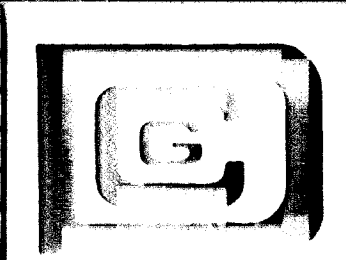

DEVELOPMENT CONSULTANTS GROUP, INC.
 17904 GEORGIA AVENUE # 102
 OLNEY, MARYLAND 20832
 301-924-4570

DRAINAGE STUDY & SOIL MAP
 LOTS 1-18 SECTION ONE
WATERMAN ESTATES
 HOWARD COUNTY DEPARTMENT OF ENVIRONMENTAL HEALTH
 DATE: 10/19/87
 TAX MAP: 40, PARCEL 250

DATE: June 1987	DRAWN: E.S.F.A.	SHEET: 5
CHECKED: [Signature]	SCALE: [Blank]	PROJECT NO. [Blank]