



GENERAL NOTES

1. THE APPROXIMATE LOCATION OF ALL UTILITIES IS SHOWN BASED ON INFORMATION OBTAINED FROM AVAILABLE RECORDS. THE CONTRACTOR SHALL LOCATE, PROTECT AND SUPPORT THE EXISTING UTILITIES AND MAINTAIN UNINTERRUPTED SERVICE. ANY DAMAGE INCURRED SHALL BE REPAIRED IMMEDIATELY TO THE SATISFACTION OF THE ENGINEER/SPECTOR, AT THE CONTRACTOR'S EXPENSE.
 2. CONTRACTOR SHALL LOCATE EXISTING UTILITIES A MINIMUM OF TWO (2) WEEKS IN ADVANCE OF CONSTRUCTION OPERATIONS IN THE VICINITY OF PROPOSED UTILITIES AT HIS OWN EXPENSE.
 3. CONTRACTOR SHALL NOTIFY THE FOLLOWING UTILITIES OR AGENCIES AT LEAST FIVE (5) WORKING DAYS BEFORE STARTING WORK SHOWN ON THESE PLANS.
STATE HIGHWAY ADMINISTRATION - 531-5533
BALTIMORE GAS & ELECTRIC COMPANY - 561-2585 (CONTRACTOR SERVICES)
BALTIMORE GAS & ELECTRIC COMPANY - 234-6313 (UNDERGROUND DAMAGE CONTROL)
BALTIMORE GAS & ELECTRIC COMPANY - 298-9013 (TROUBLE SHOOTING)
"MISS UTILITY" - 800-257-7777
CHESAPEAKE & POTOMAC (C&P) TELEPHONE COMPANY - 725-9976
BUREAU OF UTILITIES/HOWARD COUNTY - 992-7366
 4. ALL DETAILS NOT SHOWN ON THE DRAWINGS SHALL BE CONSTRUCTED IN ACCORDANCE WITH HOWARD COUNTY STANDARD DETAILS.
 5. ALL MATERIALS AND CONSTRUCTION METHODS SHALL BE IN ACCORDANCE WITH HOWARD COUNTY SPECIFICATIONS AND HOWARD COUNTY DESIGN MANUAL, VOLUME IV.
 6. ALL TRAFFIC CONTROL DEVICES SHALL BE IN ACCORDANCE WITH STANDARD SPECIFICATIONS FOR CONSTRUCTION AND MATERIALS, LATEST EDITION AND THE MANUAL ON UNIFORM TRAFFIC CONTROL DEVICES, LATEST EDITION.
 7. TREES SHALL BE PROTECTED FROM DAMAGE TO THE MAXIMUM EXTENT POSSIBLE. TREES SIX INCH (6") DIAMETER OR GREATER (MEASURED FOUR FEET (4') ABOVE EXISTING GRADE) ADJACENT TO THE LIMITS OF CONSTRUCTION SHALL NOT BE REMOVED OR DAMAGED BY THE CONTRACTOR.
 8. ALL HORIZONTAL AND VERTICAL CONTROLS ARE BASED ON MARYLAND STATE PLANE COORDINATES SYSTEM PROVIDED BY HOWARD COUNTY.
 9. TOPOGRAPHY TAKEN FROM MAPS PREPARED BY PHOTOGRAMMETRY BY "AERIAL SURVEYS" IN 1984. TOPOGRAPHY FIELD CHECKED 1986.
 10. ALL PIPE ELEVATIONS ARE INVERT ELEVATIONS.
 11. CLEAR ALL UTILITIES BY A MINIMUM OF 12" CLEAR, CLEAR AND POLES BY 2'-0" MINIMUM OR FUNNEL AS REQUIRED. ANY COST INCURRED TO THE CONTRACTOR FOR TUNNELING OR BRACING AT POLES SHALL BE INCLUDED IN UNIT PRICES BID FOR EXCAVATION AND SHALL BE INCLUDED IN UNIT PRICES BID FOR EXCAVATION BACKFILL.
 12. ALL PIPE BEDDING SHALL BE CLASS C.
 13. ROAD RIGHT OF WAY INFORMATION IS SHOWN ON THE RECORD PLATS.
 14. SPOT ELEVATIONS SHOWN ARE TOP OF CURB UNLESS OTHERWISE NOTED.
15. KNIGHTS BRIDGE ROAD DESIGN SPEED = 55 MPH
16. ZONING: RSA-8 for this submission

STRUCTURE SCHEDULE						
NO	TYPE	INV. IN	INV. OUT	UPPER END	LOWER END	LOCATION
I-1	A-5 INLET	203.35	203.35	210.70	210.70	SD 4.01 E 0+75.36'L
I-2	A-5 INLET	206.85	206.85	210.70	210.70	SD 4.01 E 0+75.36'R
I-3	A-5 INLET	206.85	206.85	215.50	215.50	SD 4.01 E 3+75.36'L
I-4	A-5 INLET	209.55	209.55	215.50	215.50	SD 4.01 E 3+75.36'R
I-5	A-5 INLET	206.85	206.85	215.50	215.50	SD 4.01 E 5+62.5.26'L
I-6	A-5 INLET	209.00	209.00	215.50	215.50	SD 4.01 E 5+62.5.26'R
I-7	A-5 INLET	215.45	215.45	219.30	219.30	SD 4.01 E 9+20.5.19'L
I-8	A-5 INLET	215.45	215.45	219.30	219.30	SD 4.01 E 9+20.5.19'R
I-9	A-5 Inlet	215.45	215.45	219.30	219.30	SD 4.01 E 14+52.19'R
I-10	A-5 Inlet	192.50	192.50	196.00	196.00	SD 4.01 E 17+67.5.19'R
I-11	A-5 Inlet	192.50	192.50	196.00	196.00	SD 4.01 E 17+67.5.19'L
EX. MH	MANHOLE	201.11	201.11	210.70	210.70	See Plan
M-2	MANHOLE	215.45	215.45	215.45	215.45	SD. G-5.12 E 7+95
M-3	MANHOLE	215.45	215.45	215.45	215.45	SD. G-5.12 E 15+10
M-4	MANHOLE	215.45	215.45	215.45	215.45	SD. G-5.12 E 16+13
M-5	MANHOLE	183.70	183.70	183.70	183.70	SD. G-5.13 See Plan
E-1	Flared End Section	181.04	181.04	181.04	181.04	SD. 5.52 See Plan

* CONTRACTOR TO VERIFY LOCATION & INVERTS.

BOWLING BROOK FARMS KNIGHTS BRIDGE ROAD

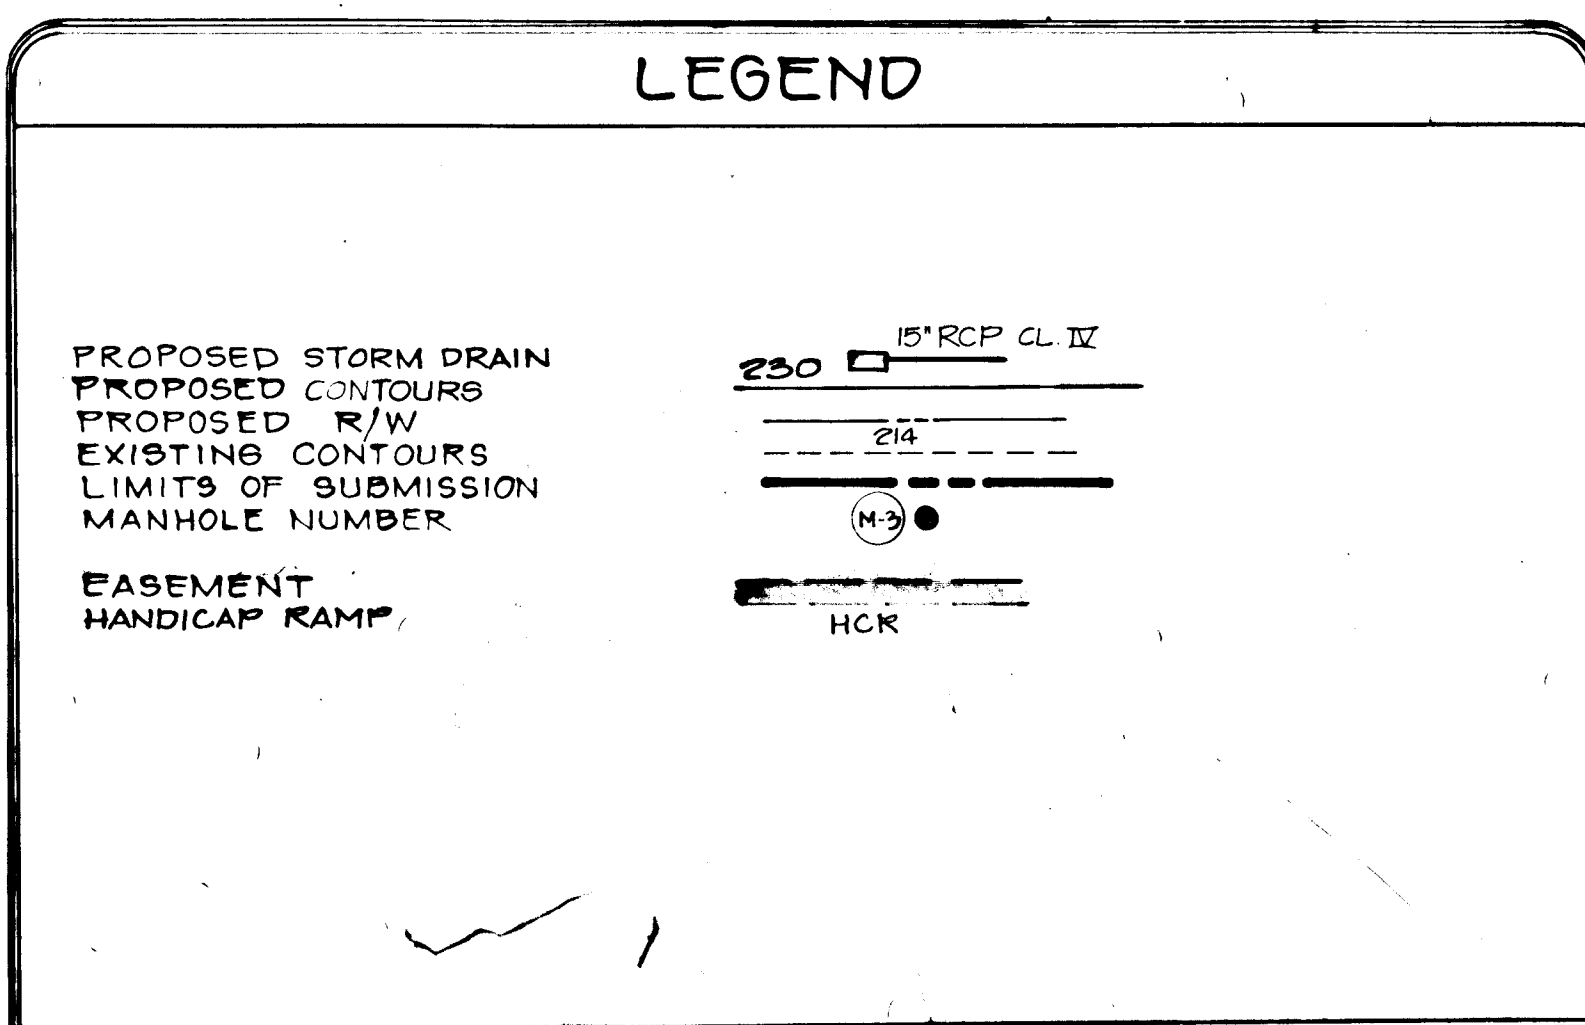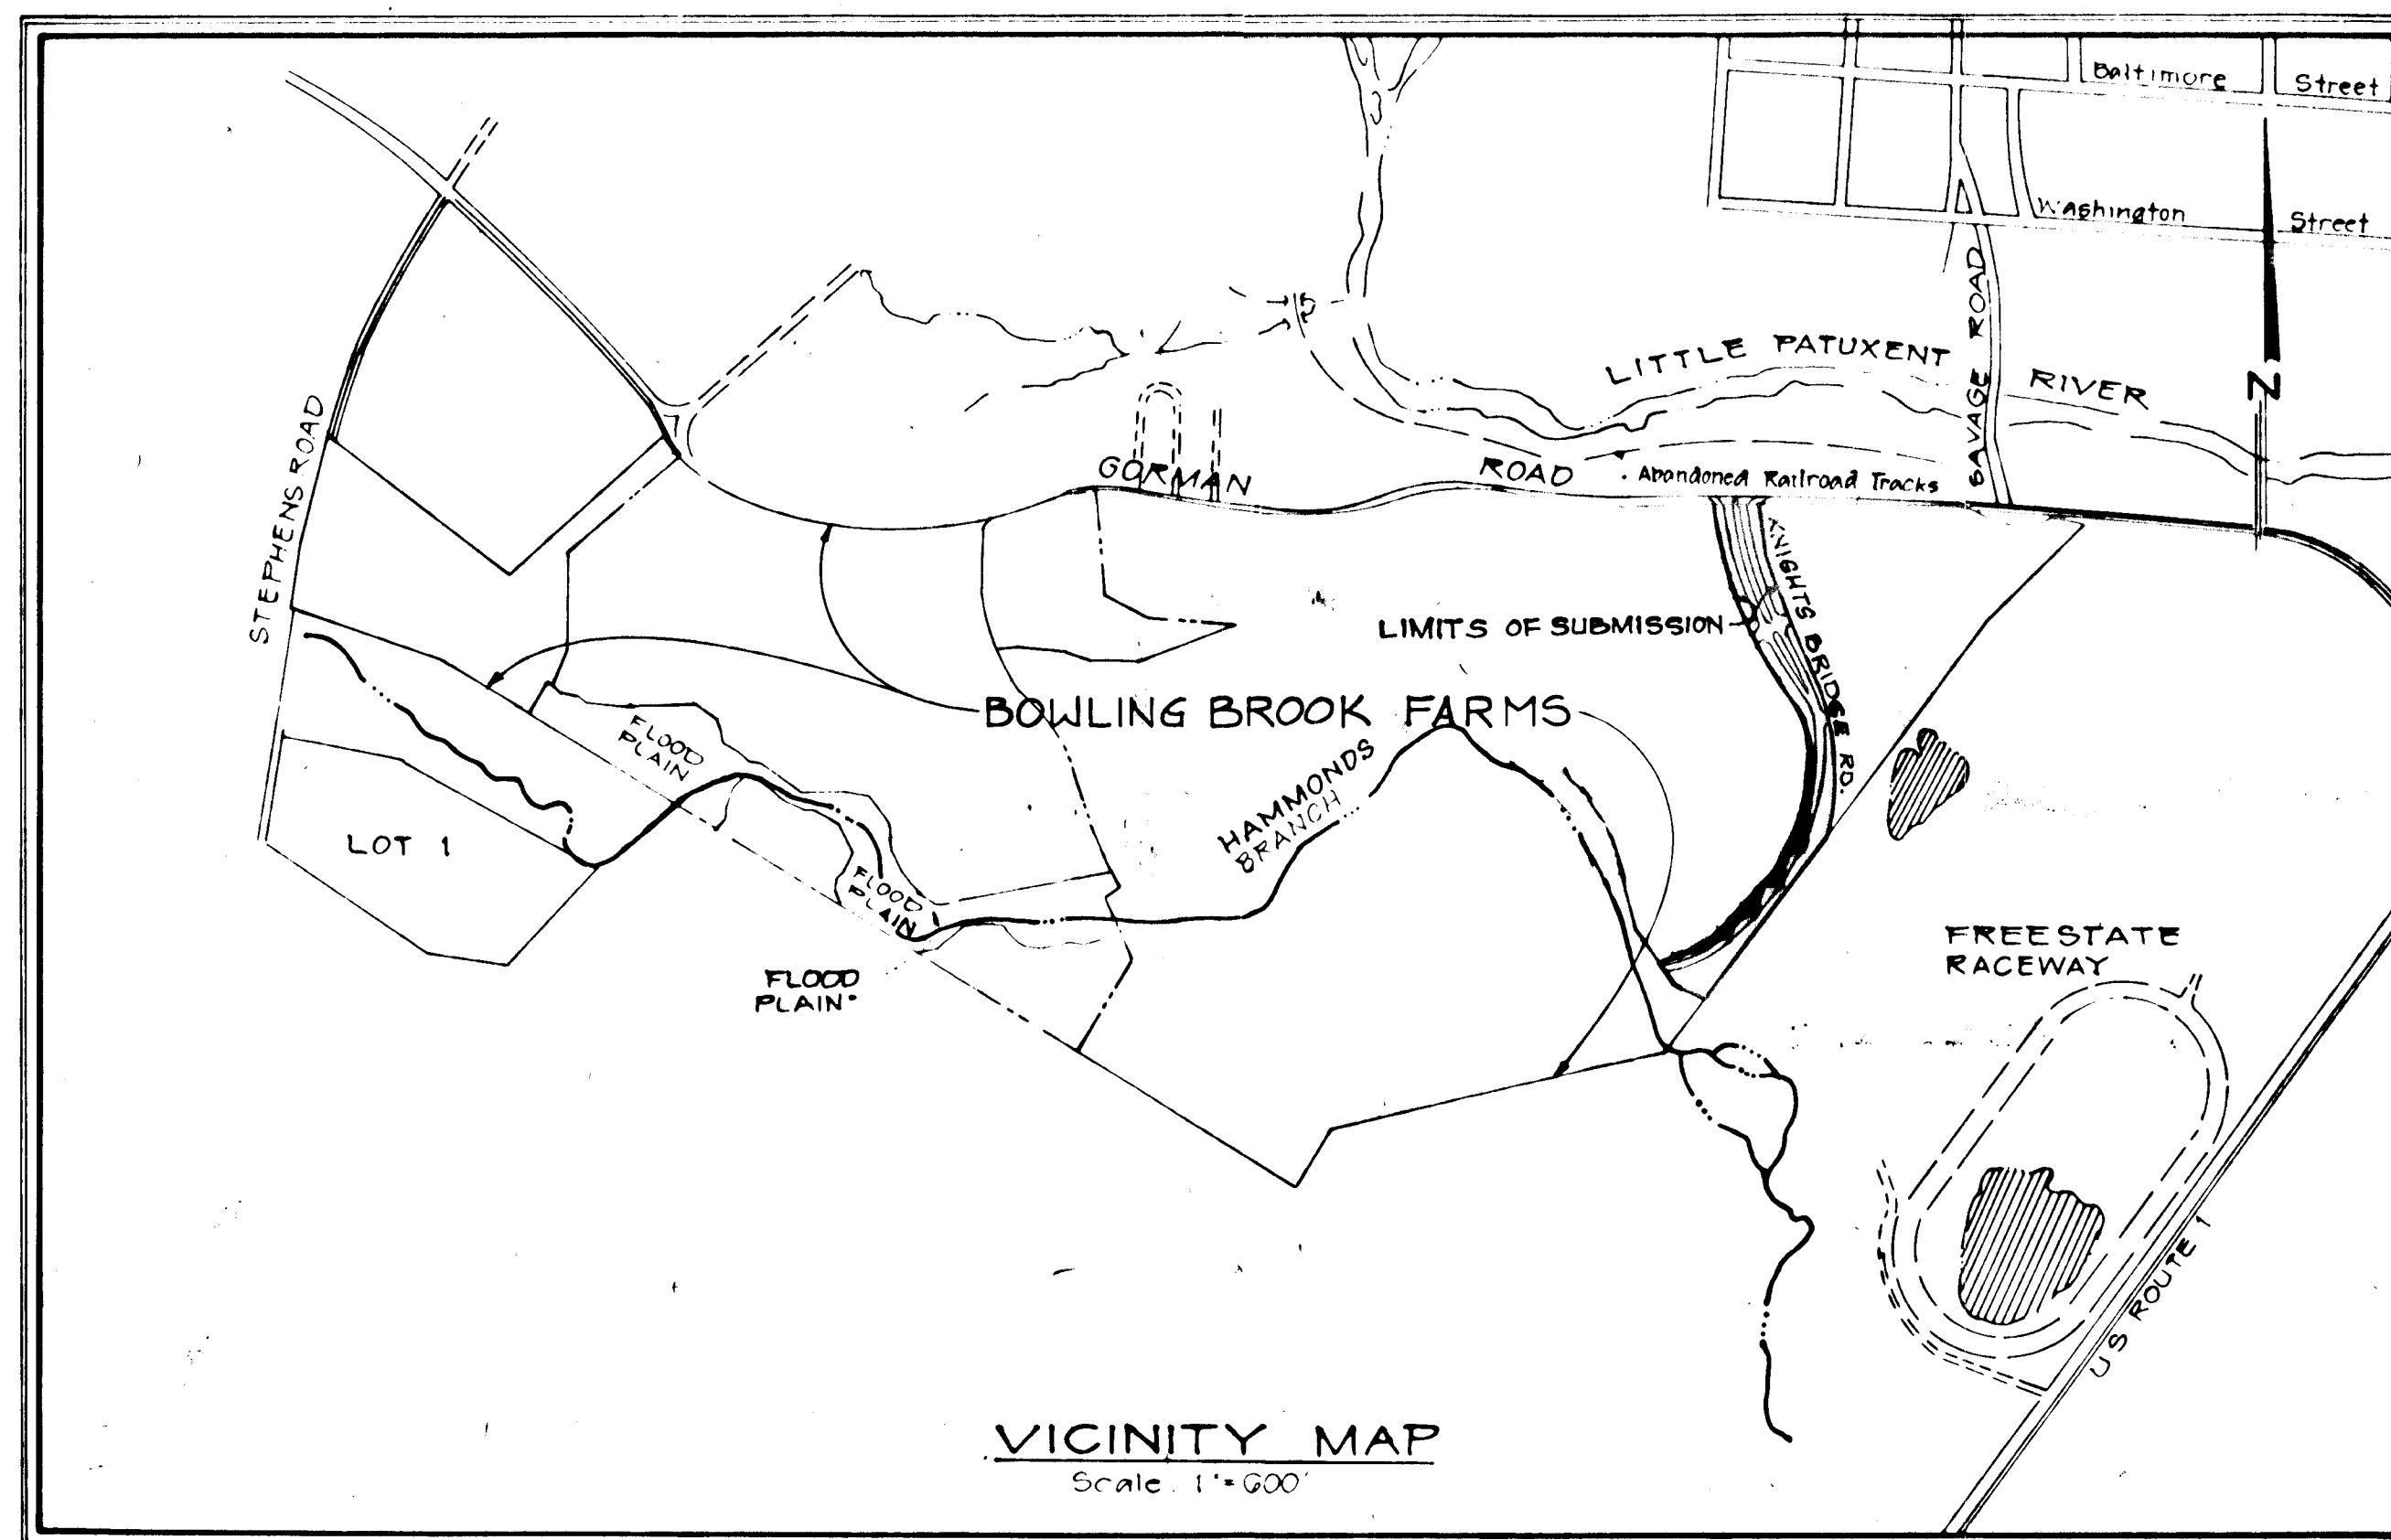

PAVING AND STORM DRAIN CONSTRUCTION PLANS HOWARD COUNTY, MARYLAND

PIPE SCHEDULE			
DIA.	MATERIAL	CLASS	LENGTH (FT)
15"	RCP	V	216'
18"	RCP	IV	230'
18"	RCP	V	455'
21"	RCP	V	76'
24"	RCP	IV	95'
27"	RCP	IV	507'
27"	RCP	V	44'
15"	RCP	IV	54'

- NOTES:
1. CONTRACTOR SHALL VERIFY LOCATION OF ALL UNDERGROUND UTILITIES PRIOR TO PLANTING (SEE NOTE #3 ABOVE).
 2. ALL PLANT MATERIAL AND PLANTING SHALL BE IN ACCORDANCE WITH "AMERICAN STANDARD FOR NURSERY STOCK" BY THE A.A.N.
 3. SUBSTITUTIONS MAY BE PERMITTED WITH THE APPROVAL OF THE LANDSCAPE ARCHITECT, (762-2220).
 4. PLACE "GREEN VASE, ZELKOVA" AND "SUMMER SHADE MAPLE" AT THE CENTER BETWEEN THE CURB AND THE SIDEWALK ALONG THE ROADWAYS.

INDEX TO DRAWINGS

SHEET #	DESCRIPTION
1	Title Sheet
2	Paving & Storm Drain - Plan & Profile
3	Paving & Storm Drain - Plan & Profile
4	Storm Drain Profiles
5	Paving & Storm Drain Detail Sheet
6	Erosion & Sediment Control Plan
7	Erosion & Sediment Control Plan
8	Erosion & Sediment Control Plan
9	Drainage Area Map

REVIEWED FOR HOWARD SOIL CONSERVATION DISTRICT AND MEETS TECHNICAL REQUIREMENT

Signature: *M. Nelson* DATE: 12-16-87

APPROVED: HOWARD COUNTY DEPARTMENT OF PUBLIC WORKS
Chief, Land Development Division DATE: 1-5-88

Signature: *Granville W. Weiland* DATE: 1/6/88
Chief, Bureau of Highways

APPROVED: *Stephen L. Fisher* DATE: 12-16-87
HOWARD SCD


Signature: *Kevin E. Ryan* DATE: 1-11-88
Chief, Bureau of Engineering

OWNER/DEVELOPER
GORMAN ROAD LIMITED PARTNERSHIP
C/O JAMES F. KNOTT DEVELOPMENT CORPORATION
118 WEST ROAD, SUITE 203
TOWSON, MARYLAND 21284
(801) 321-6436

APPROVED: HOWARD COUNTY OFFICE OF PLANNING AND ZONING
Signature: *James F. Knott* DATE: 2/12/88
Chief, Division of Land Development & COMMUNITY PLANNING

NO.	DESCRIPTION	DATE	APPROVED	DATE
AS-BUILT REVISIONS	BP	5/7/91		

REVISION APPROVED BY



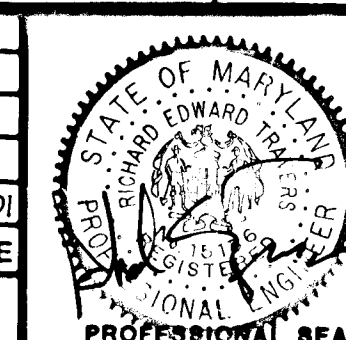


TITLE SHEET

Patton Harris Rust and Associates
A Professional Corporation
Engineers, Surveyors, Planners and Landscape Architects
7609 Standish Place Rockville, Md. 20855 (301) 762-2220

BOWLING BROOK FARMS
KNIGHTS BRIDGE ROAD
A RESUBDIVISION OF BOLLING BROOKE, LOT 2
SIXTH ELECTION DISTRICT
HOWARD COUNTY, MARYLAND

SURVEY	DATE
DESIGN	10/8/87
DRAWN	SHEET
CHECKED	1 OF 9
SCALE	FILE NO.
CL	284-1-0

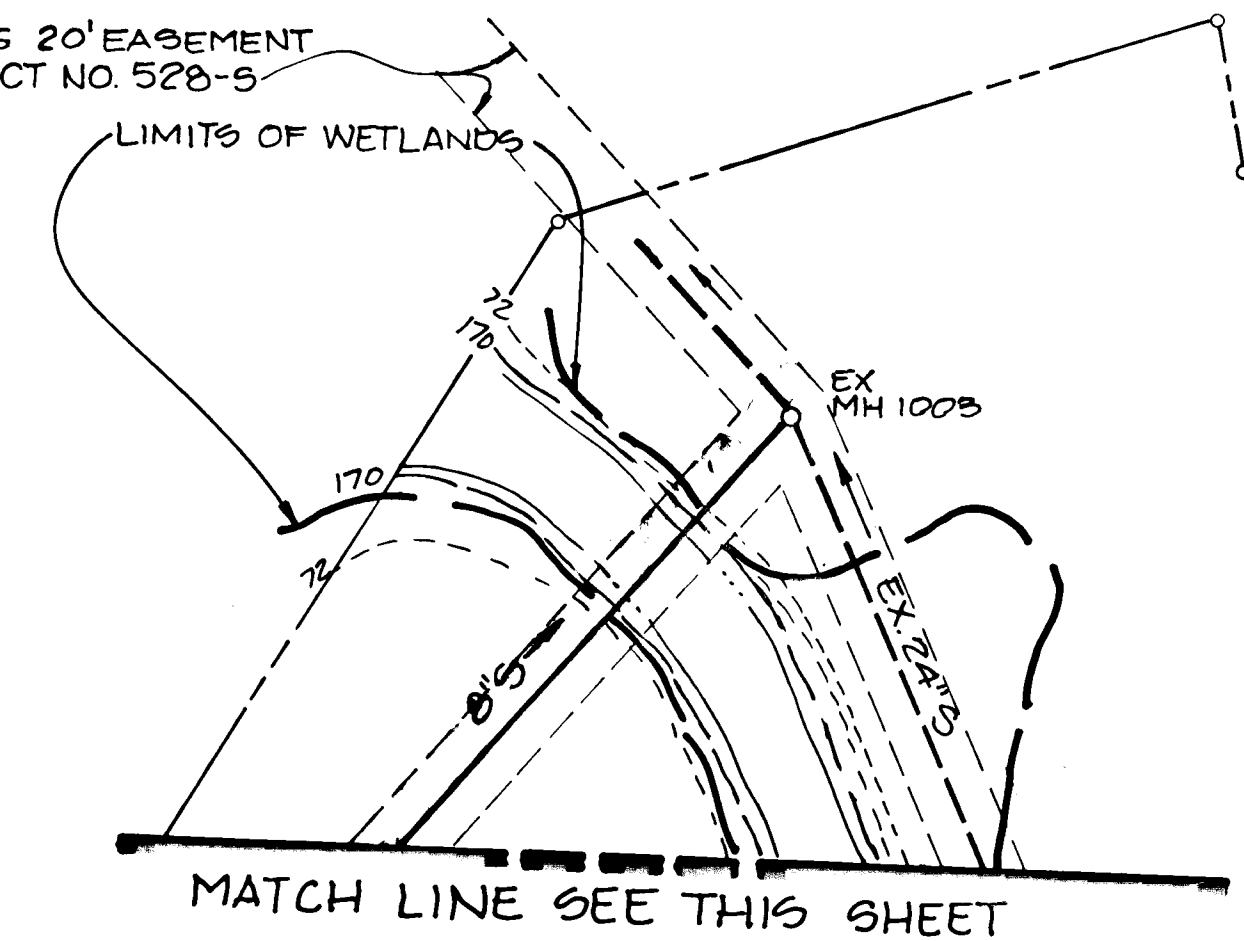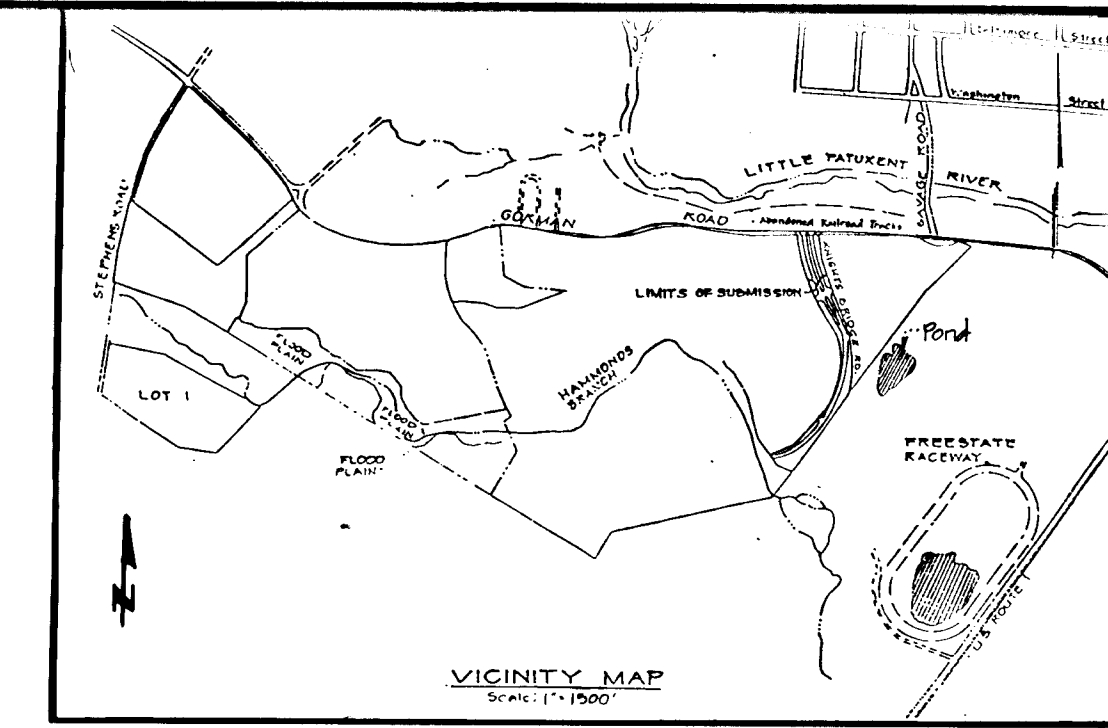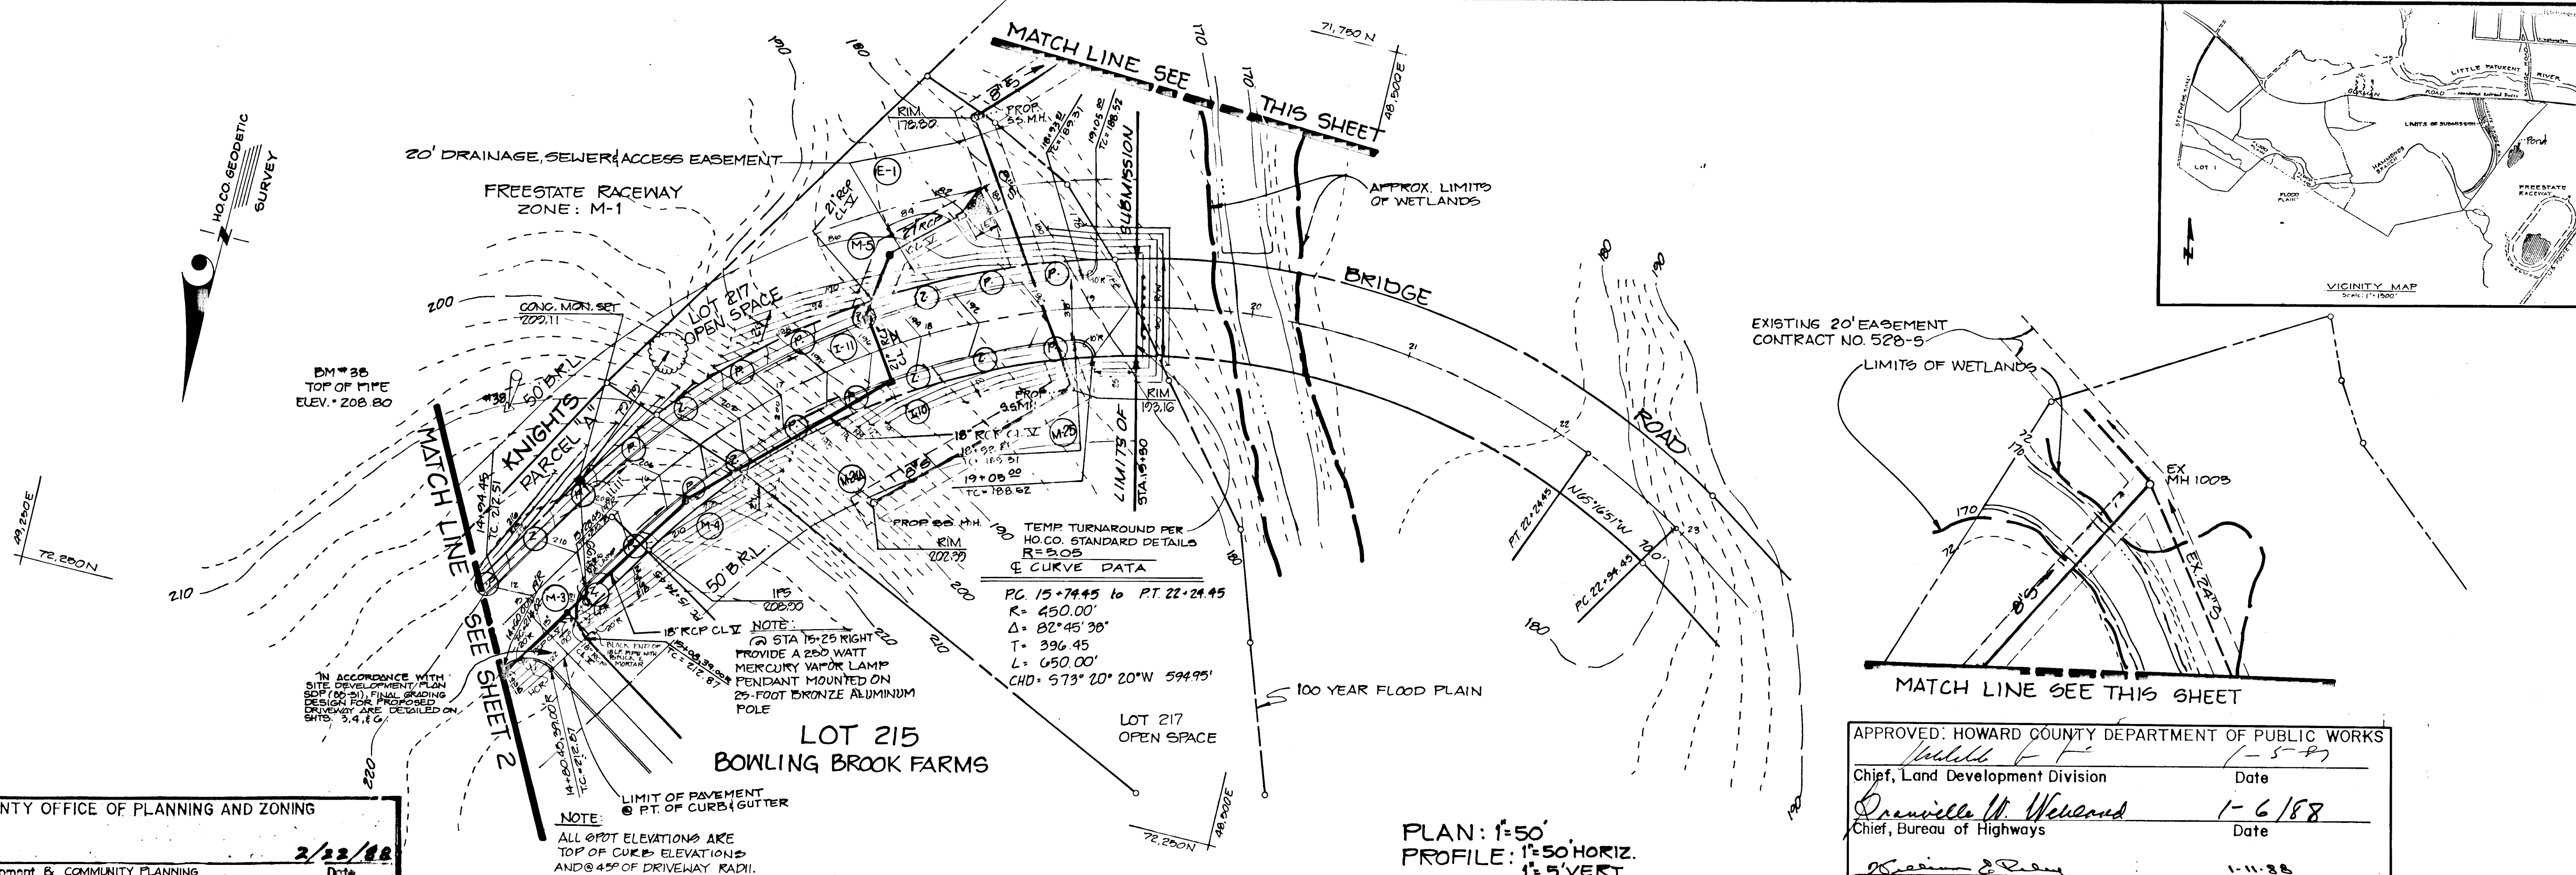


APPROVED: HOWARD COUNTY OFFICE OF PLANNING AND ZONING
James Butler
 Chief, Division of Land Development & COMMUNITY PLANNING
 Date: 2/22/88

NOTE:
 ALL SPOT ELEVATIONS ARE TOP OF CURB ELEVATIONS AND @ 4" OF DRIVEWAY RADII.


TEMP TURNAROUND PER HO. CO. STANDARD DETAILS
 R=205
 & CURVE DATA
 PC 15+74.45 to PT 22+24.45
 R= 450.00'
 Δ= 82°45'30"
 T= 396.45'
 L= 650.00'
 CHD= 573°20'20"W 594.95'

PLAN: 1"=50'
 PROFILE: 1"=50' HORIZ.
 1"=5' VERT.

APPROVED: HOWARD COUNTY DEPARTMENT OF PUBLIC WORKS
William F. F.
 Chief, Land Development Division Date: 1-5-87
Geneville M. Welton
 Chief, Bureau of Highways Date: 1-6-88
William J. Ryan
 Chief, Bureau of Engineering Date: 1-11-88

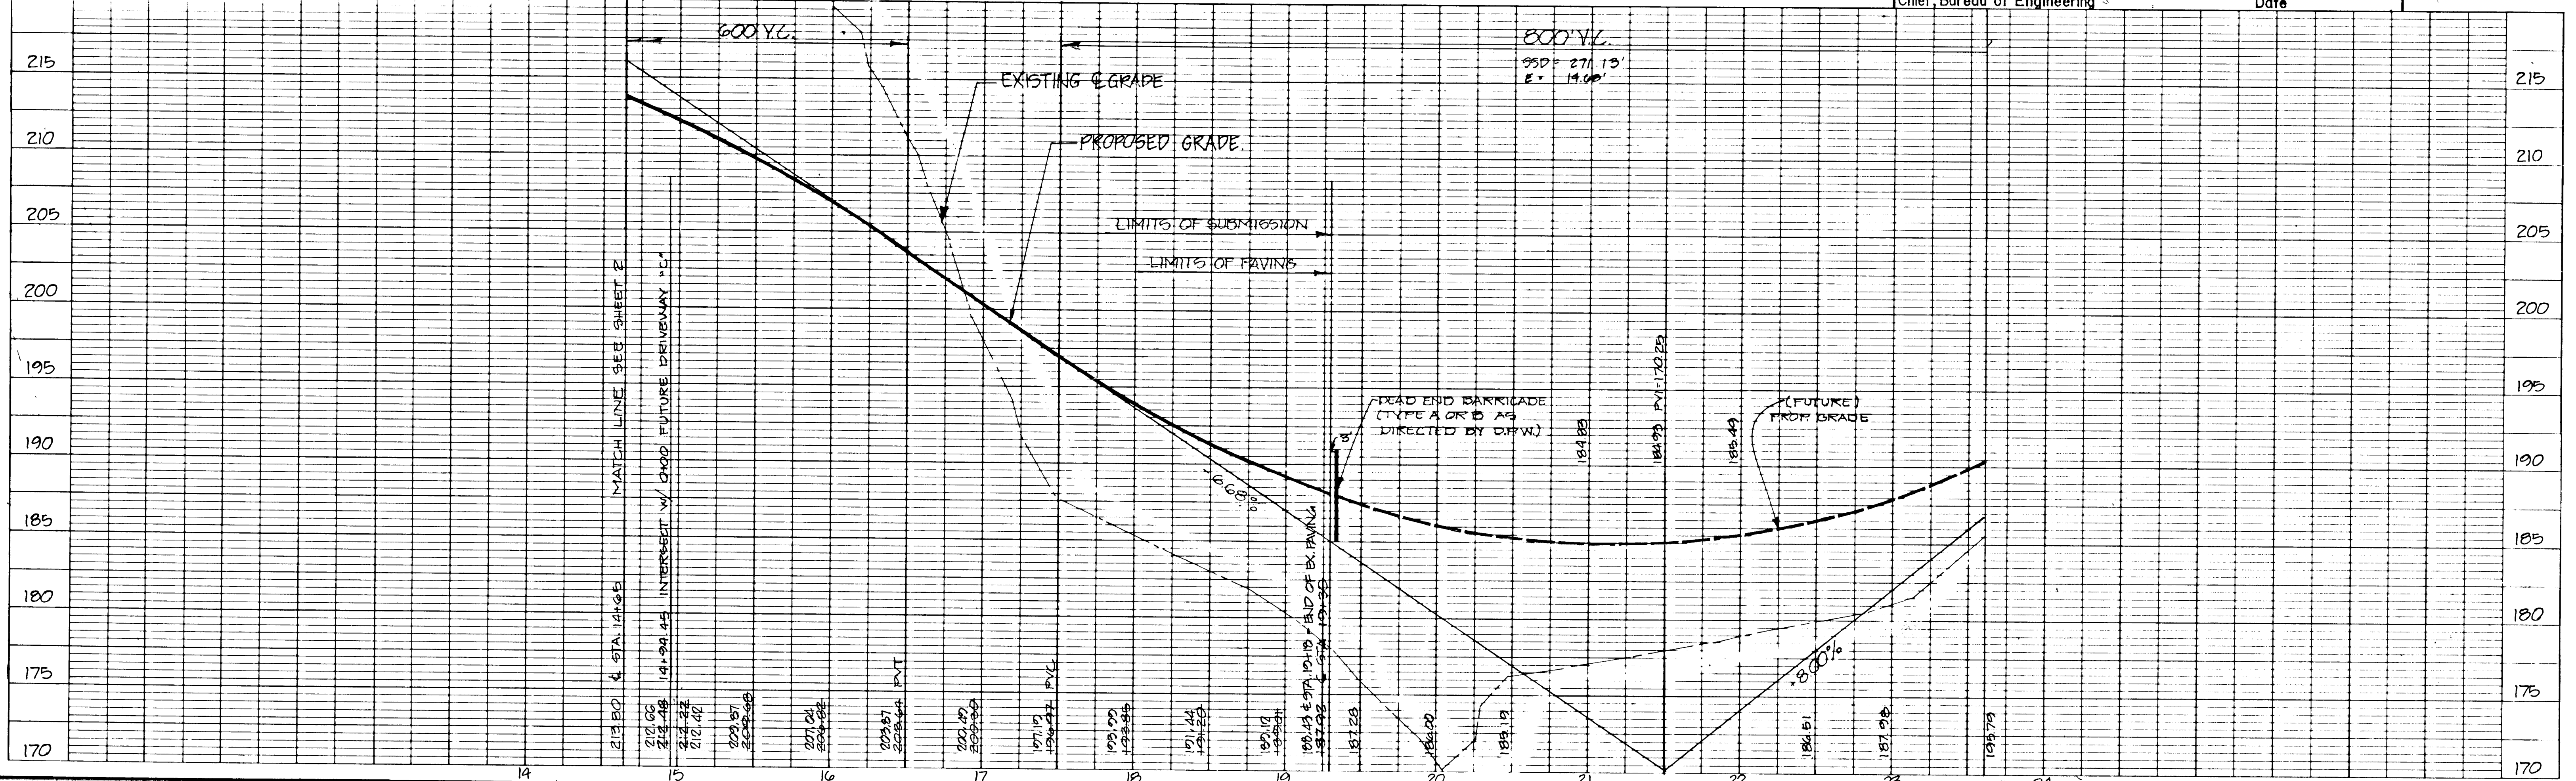

NO.	DESCRIPTION	DATE	APPROVED	DATE
1	AS-BUILT REVISIONS	5/7/91		

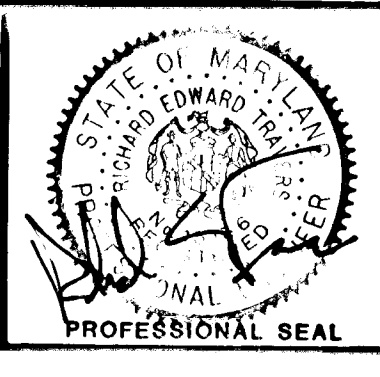





REVISID

PAVING & STORM DRAINAGE

Patton Harris Rust and Associates
 A Professional Corporation
 Engineers, Surveyors, Planners and Landscape Architects
 7609 Standish Place Rockville, Md. 20855 (301) 762-2220

BOWLING BROOK FARMS
 KNIGHTS BRIDGE ROAD
 A RESUBDIVISION OF BOLLING BROOKE, LOT 2
 SIXTH ELECTION DISTRICT
 HOWARD COUNTY, MARYLAND

SURVEY	DATE
DESIGN MJK	10/8/87
DRAWN JDW	SHEET
CHECKED	3 OF 9
SCALE 1"=50' C.I. 2"	FILE NO. 2184-10

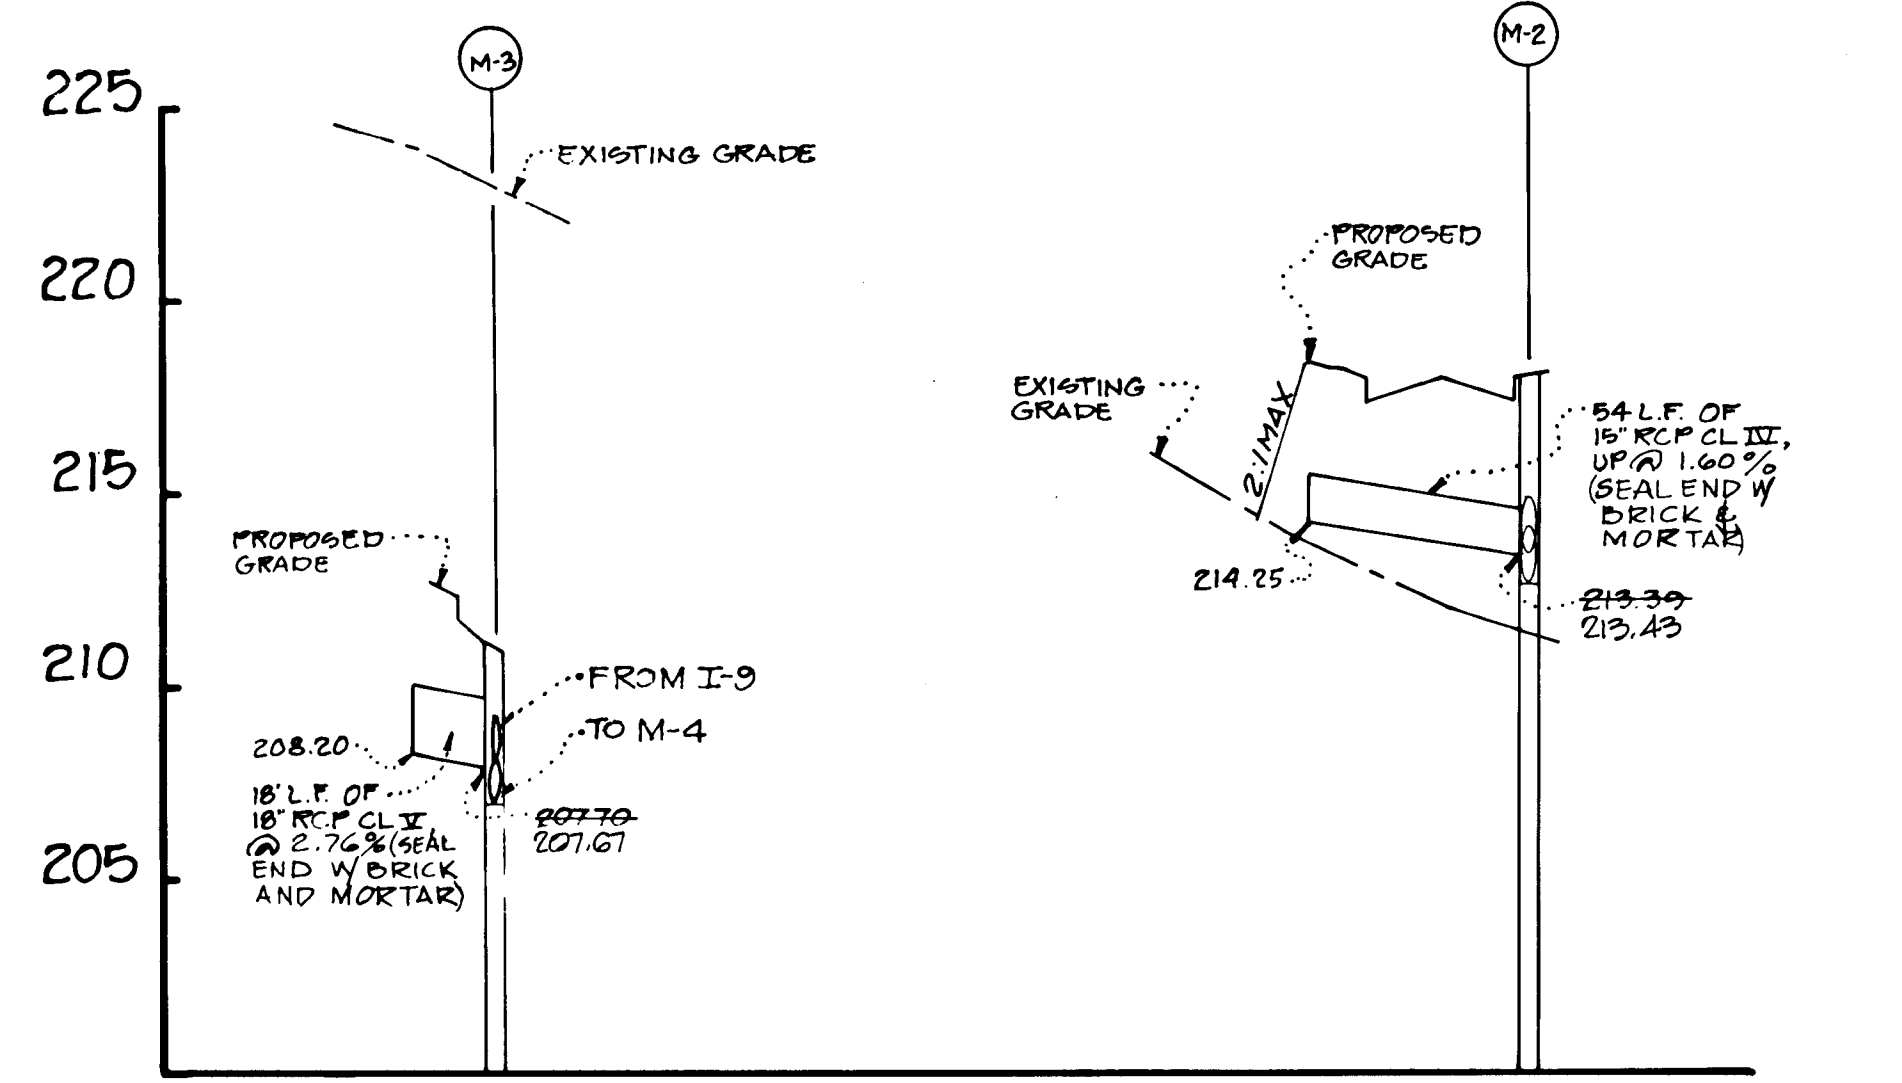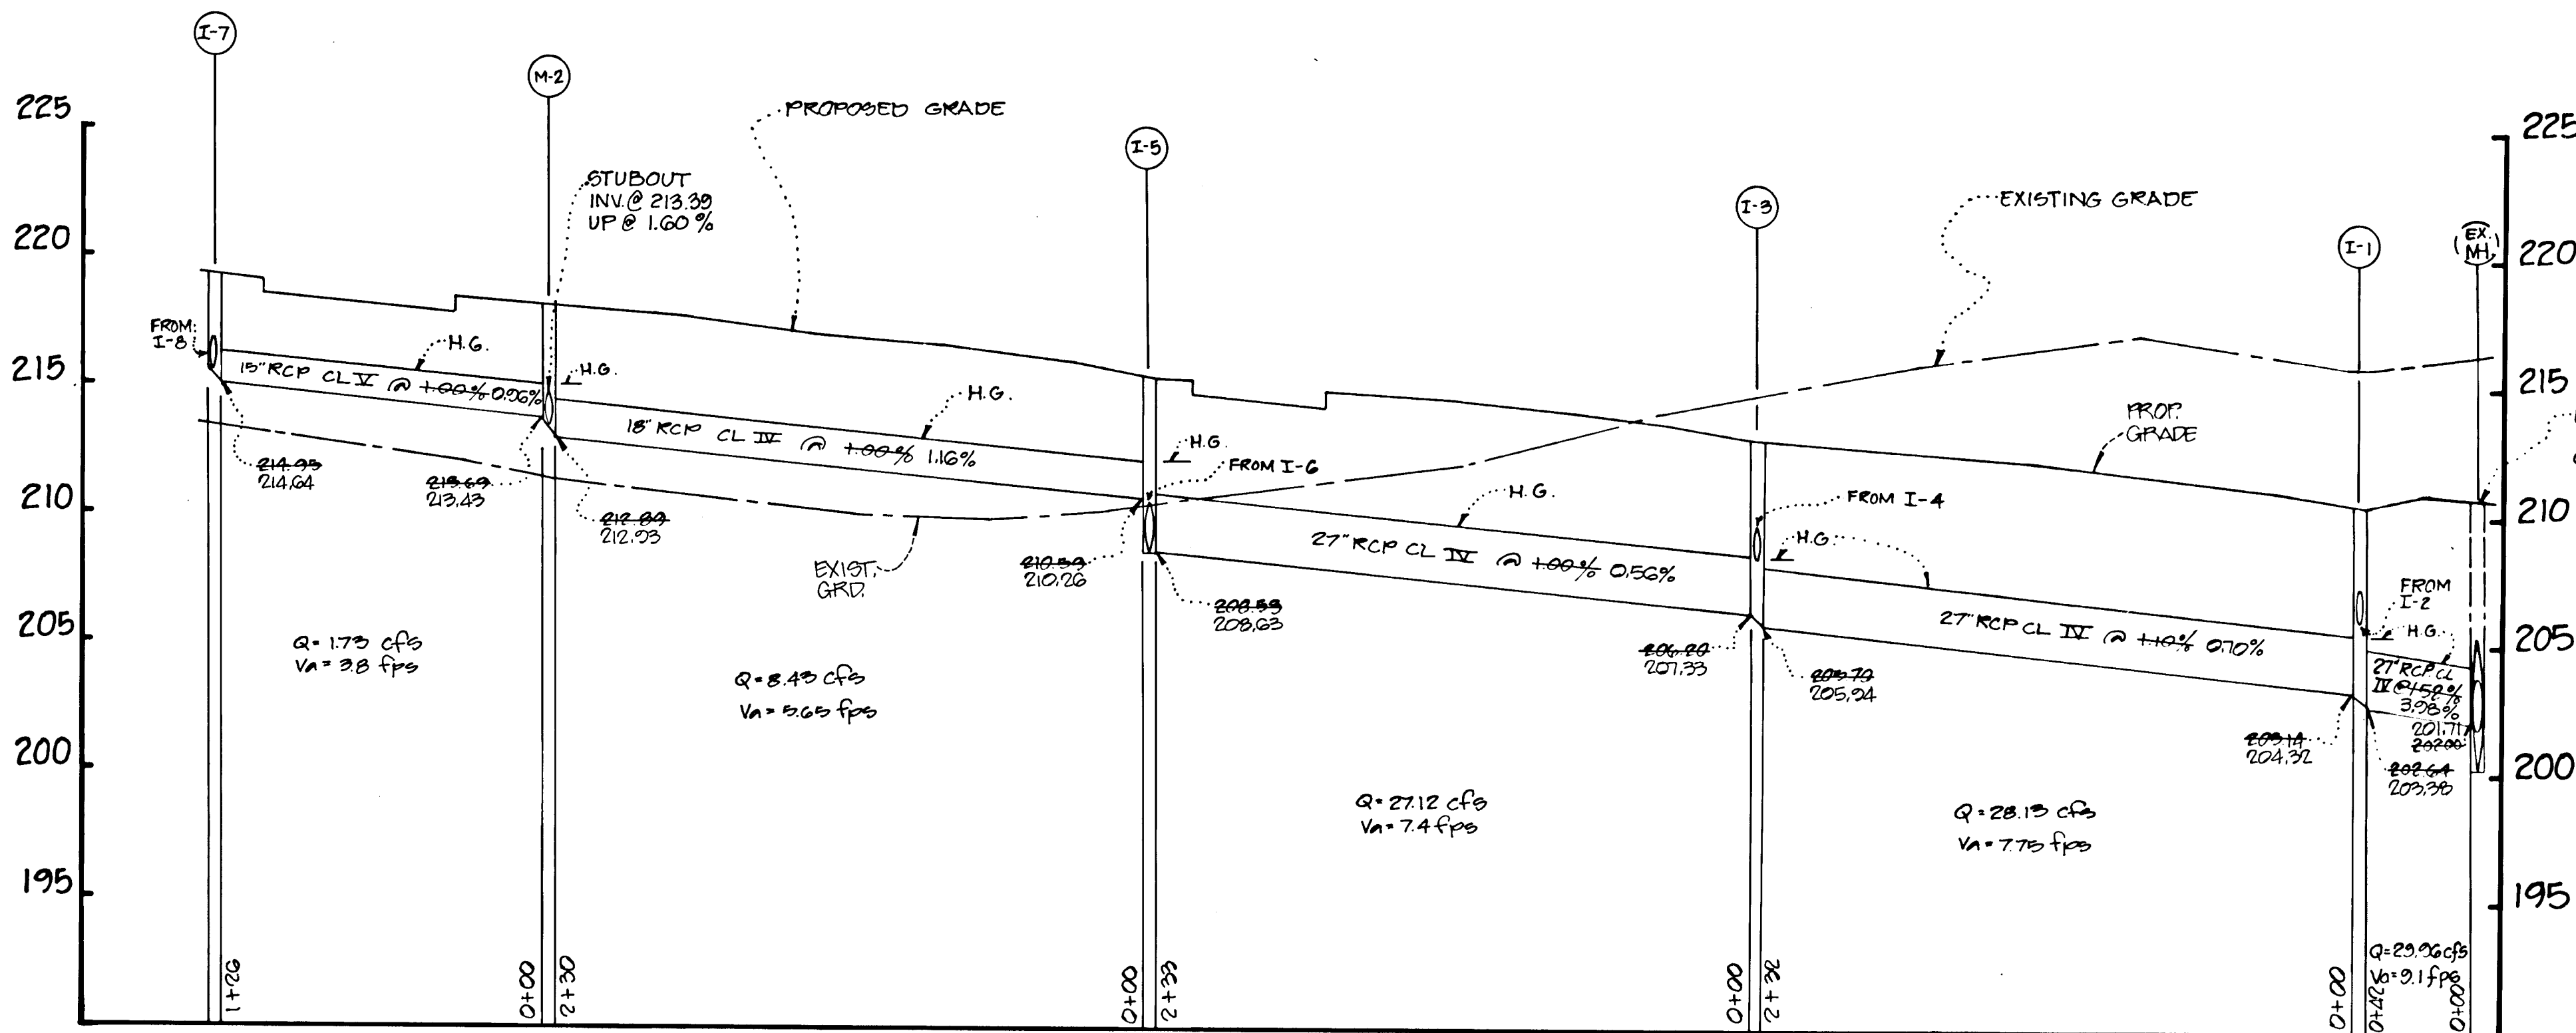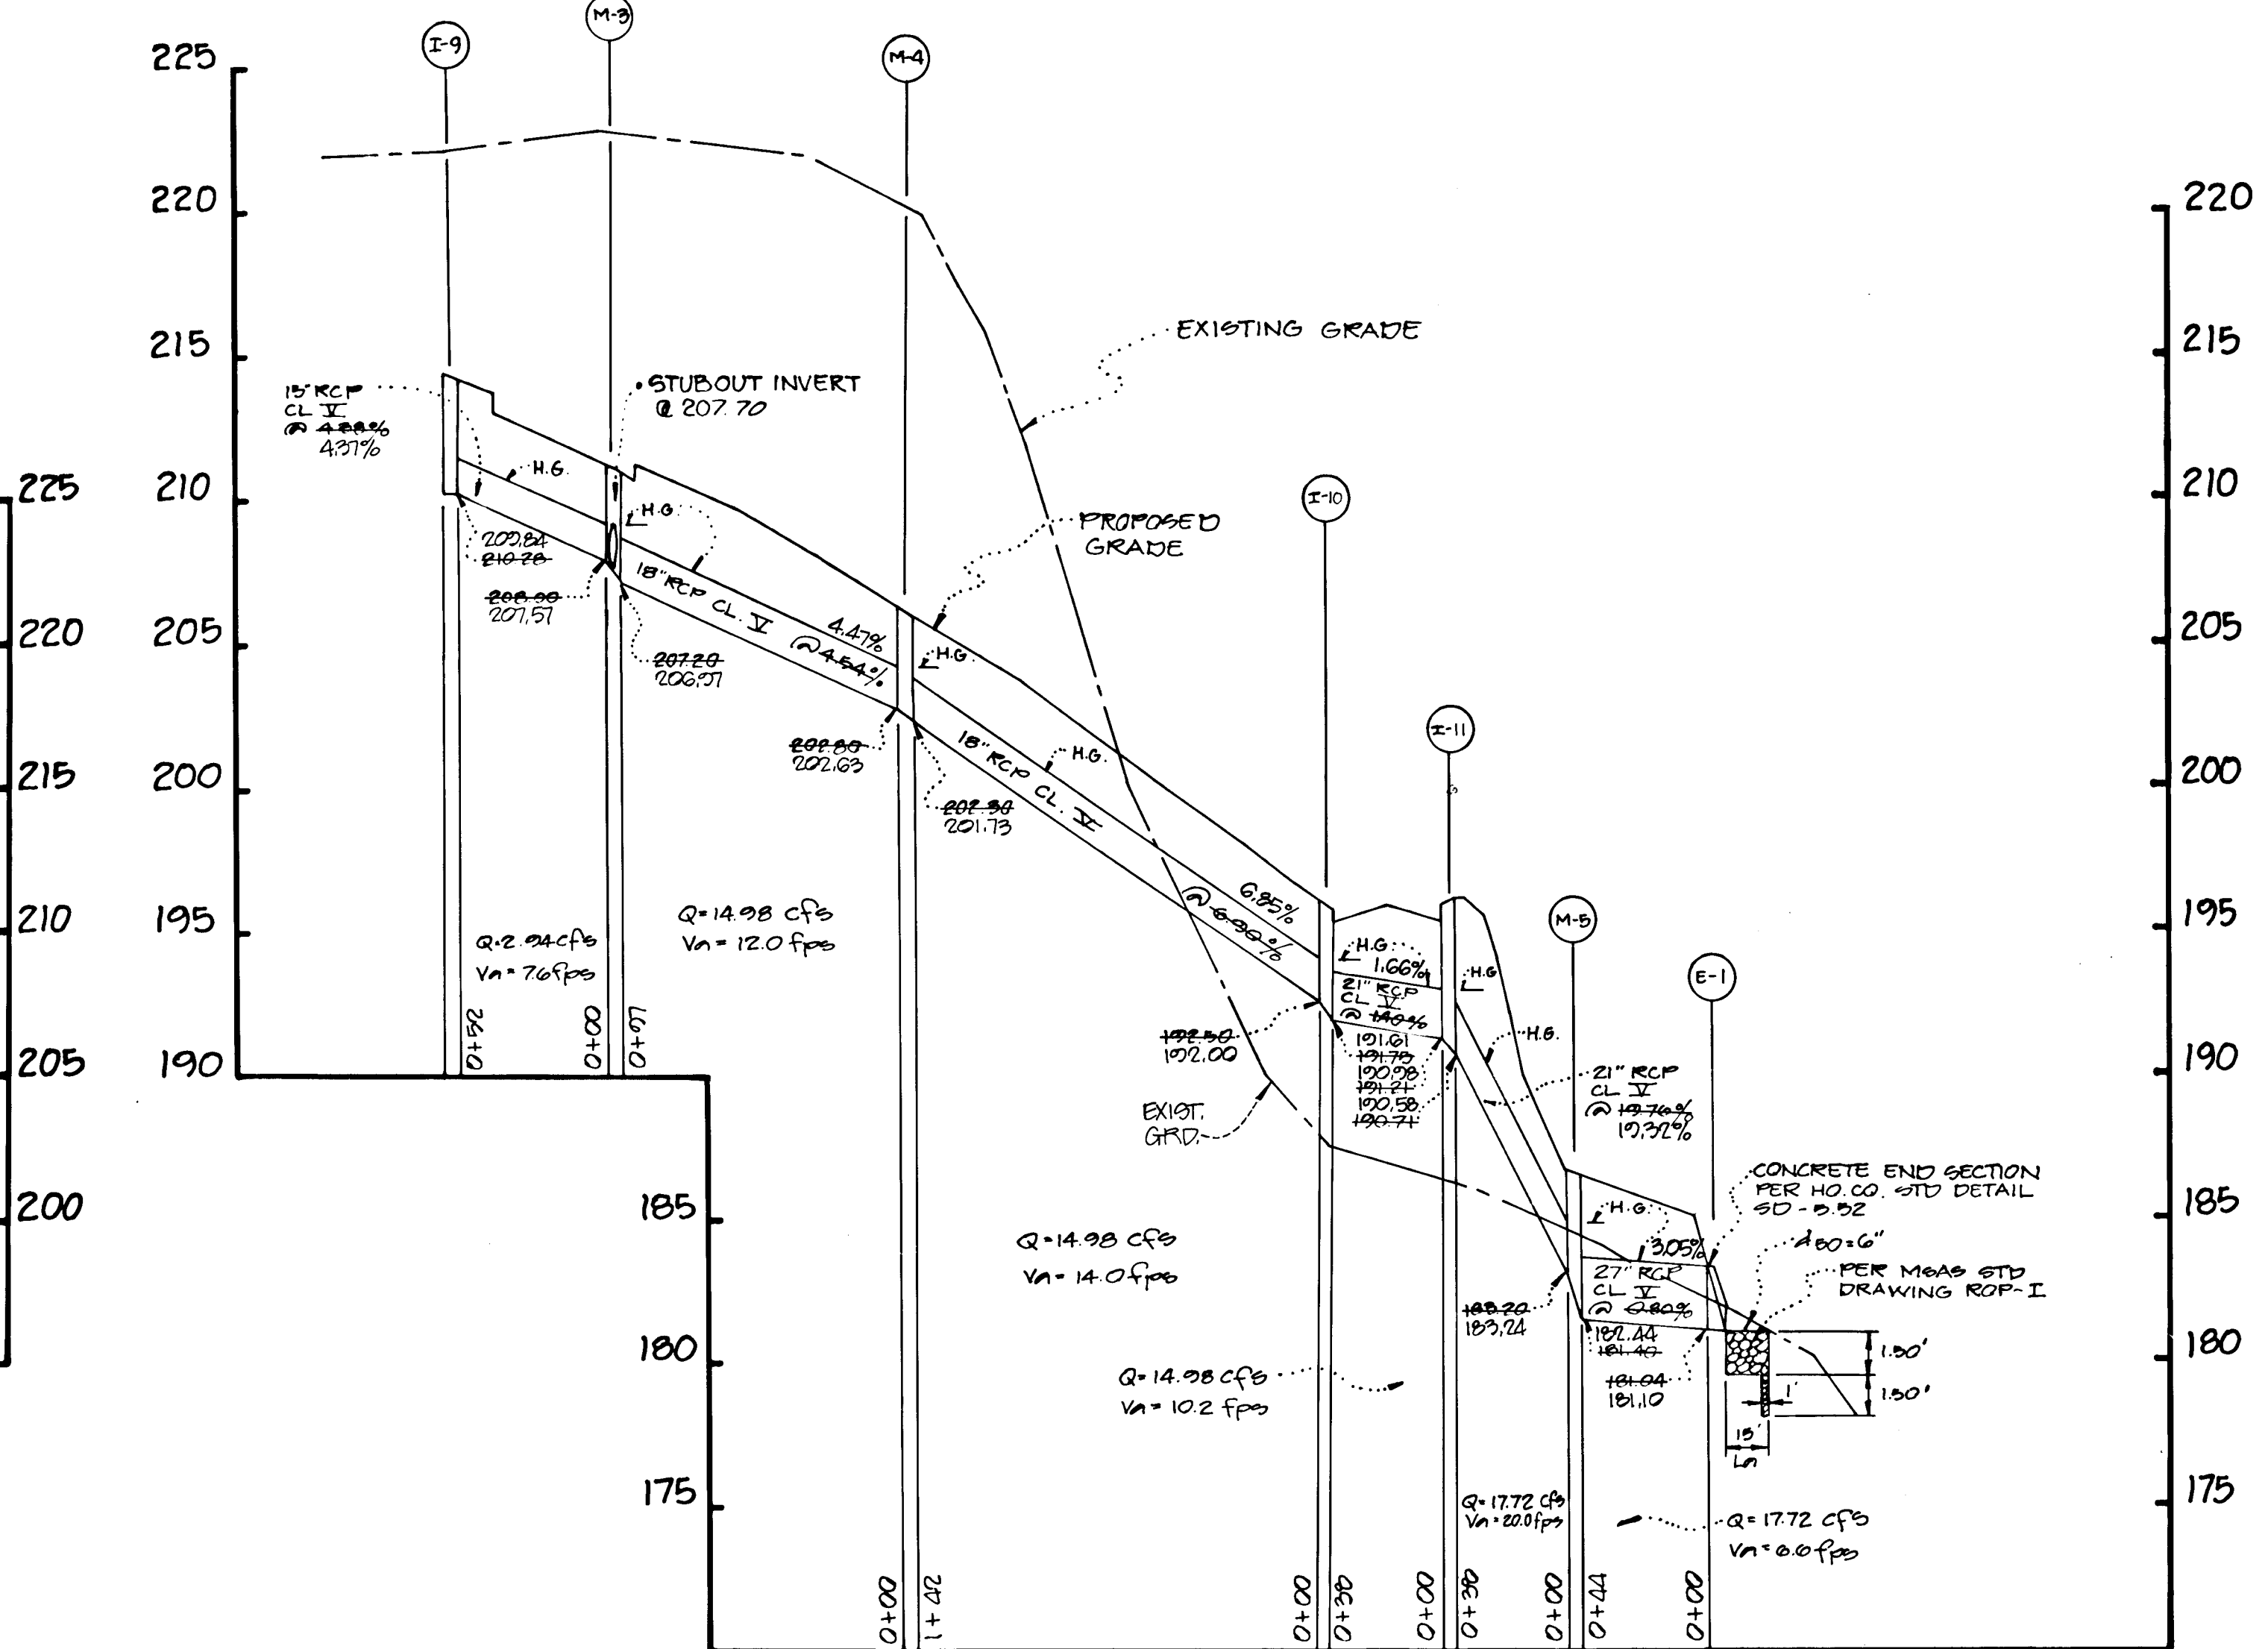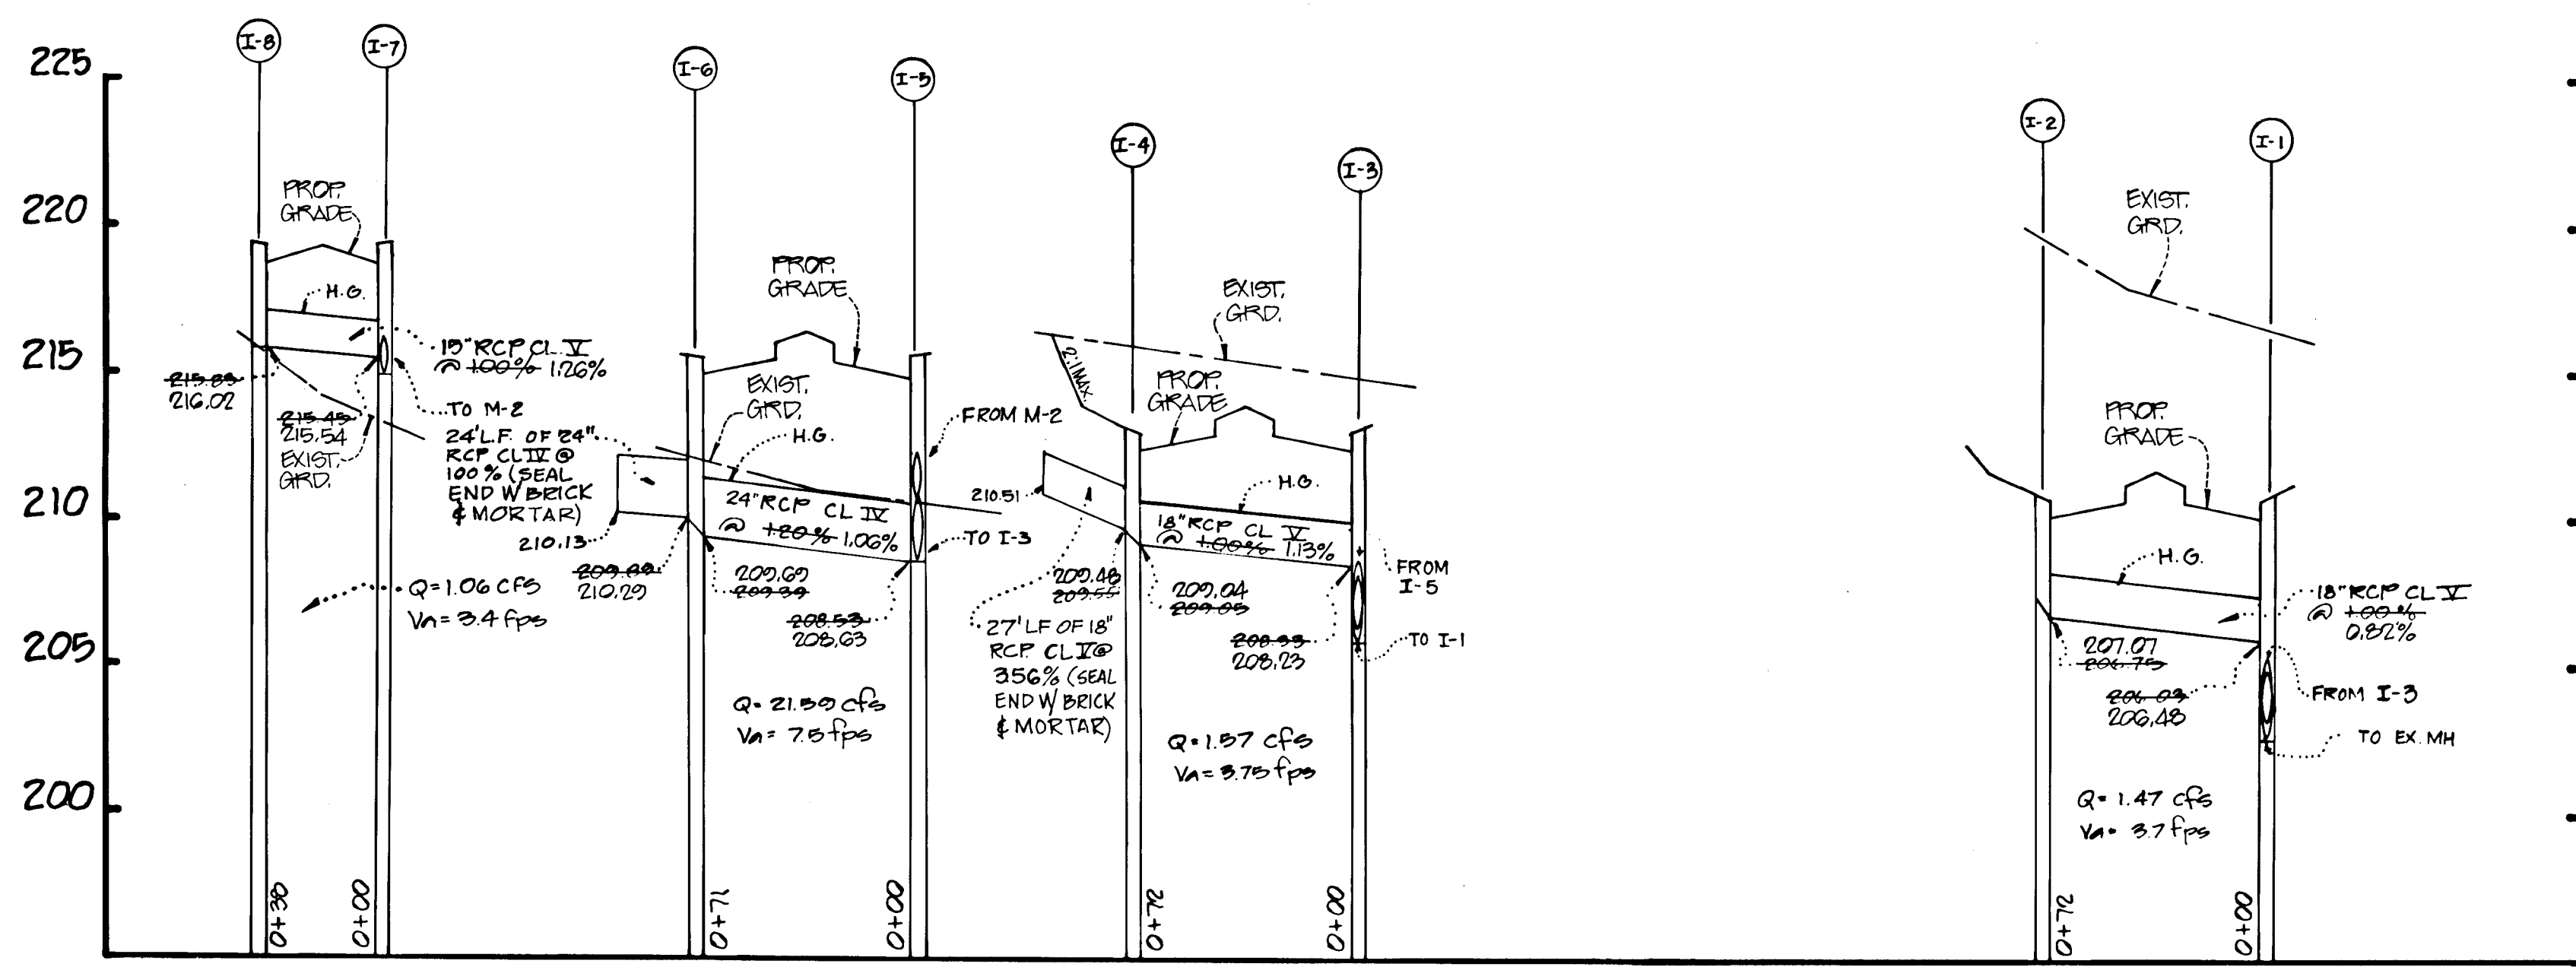

APPROVED: HOWARD COUNTY OFFICE OF PLANNING AND ZONING
James R. Smith 2/22/88
 Chief, Division of Land Development & COMMUNITY PLANNING Date

APPROVED: HOWARD COUNTY DEPARTMENT OF PUBLIC WORKS
William J. ... 1-5-88
 Chief, Land Development Division Date

Shirley W. ... 1/6/88
 Chief, Bureau of Highways Date

... 1-11-88
 Chief, Bureau of Engineering Date

SCALE: HORIZ. 1"=50'
 VERT. 1"=5'

NO.	DESCRIPTION	DATE	APPROVED	DATE
1	AS-BUILT REVISIONS	BP		5/7/91









REVISED

STORM DRAIN PROFILES

Patton Harris Rust and Associates
 A Professional Corporation
 Engineers, Surveyors, Planners and Landscape Architects
 7609 Standish Place Rockville, Md. 20855 (301) 762-2220

BOWLING BROOK FARMS
 KNIGHTS BRIDGE ROAD
 A RESUBDIVISION OF BOLLING BROOKE, LOT 2
 SIXTH ELECTION DISTRICT
 HOWARD COUNTY, MARYLAND

SURVEY P.H.R. & A DATE 10/8/87
 DESIGN M.J.K.
 DRAWN J.D.W. SHEET 4 OF 9
 CHECKED
 SCALE C.L. FILE NO. 2181-1-0

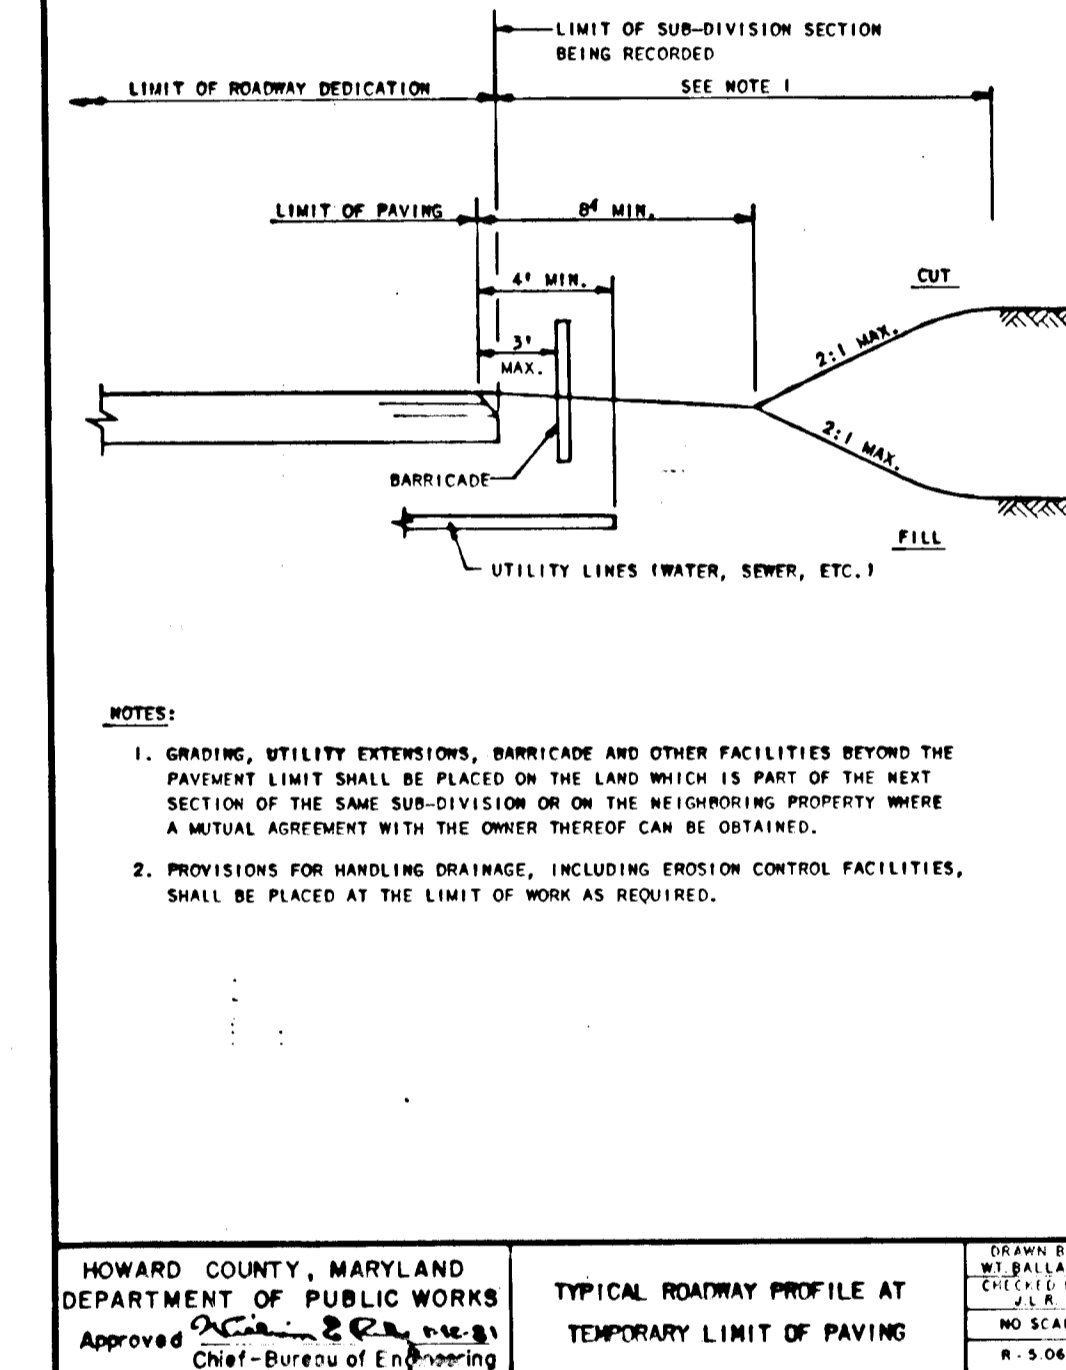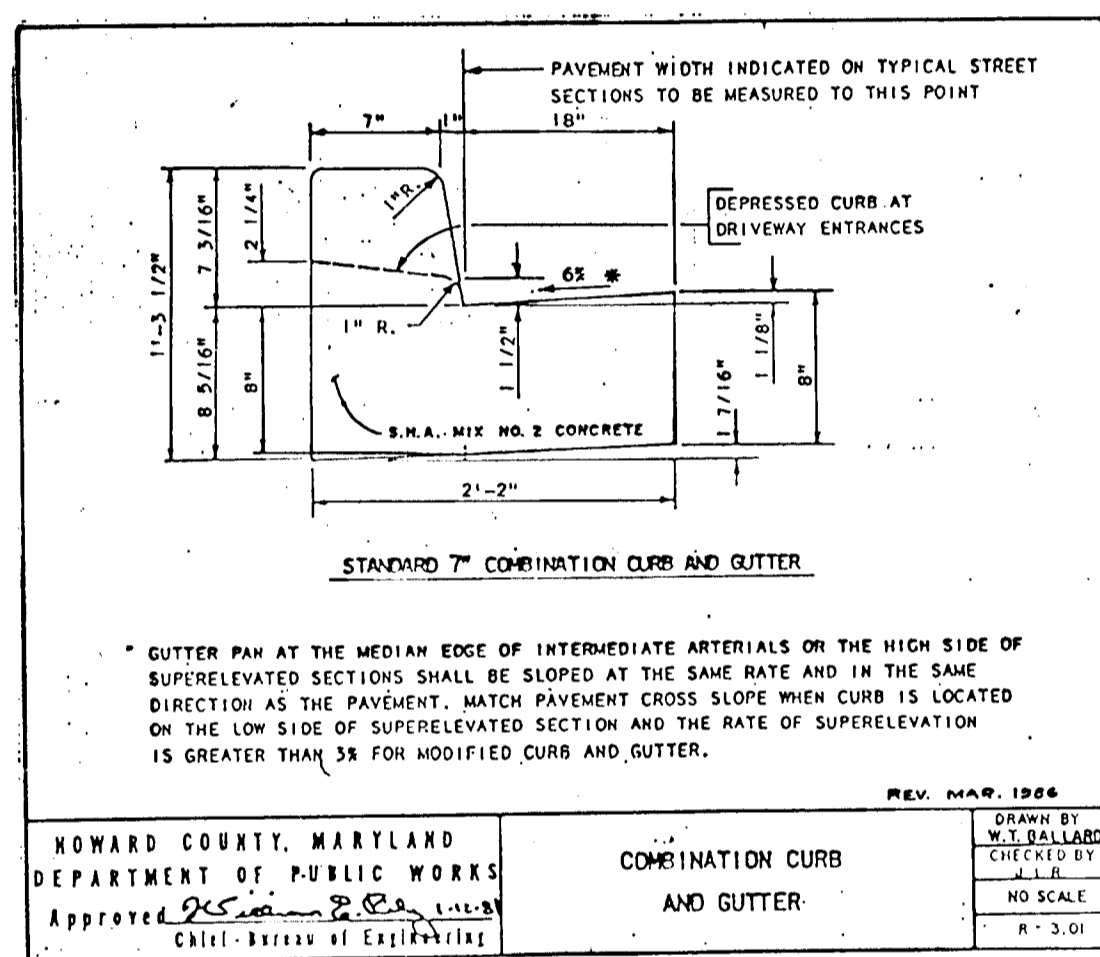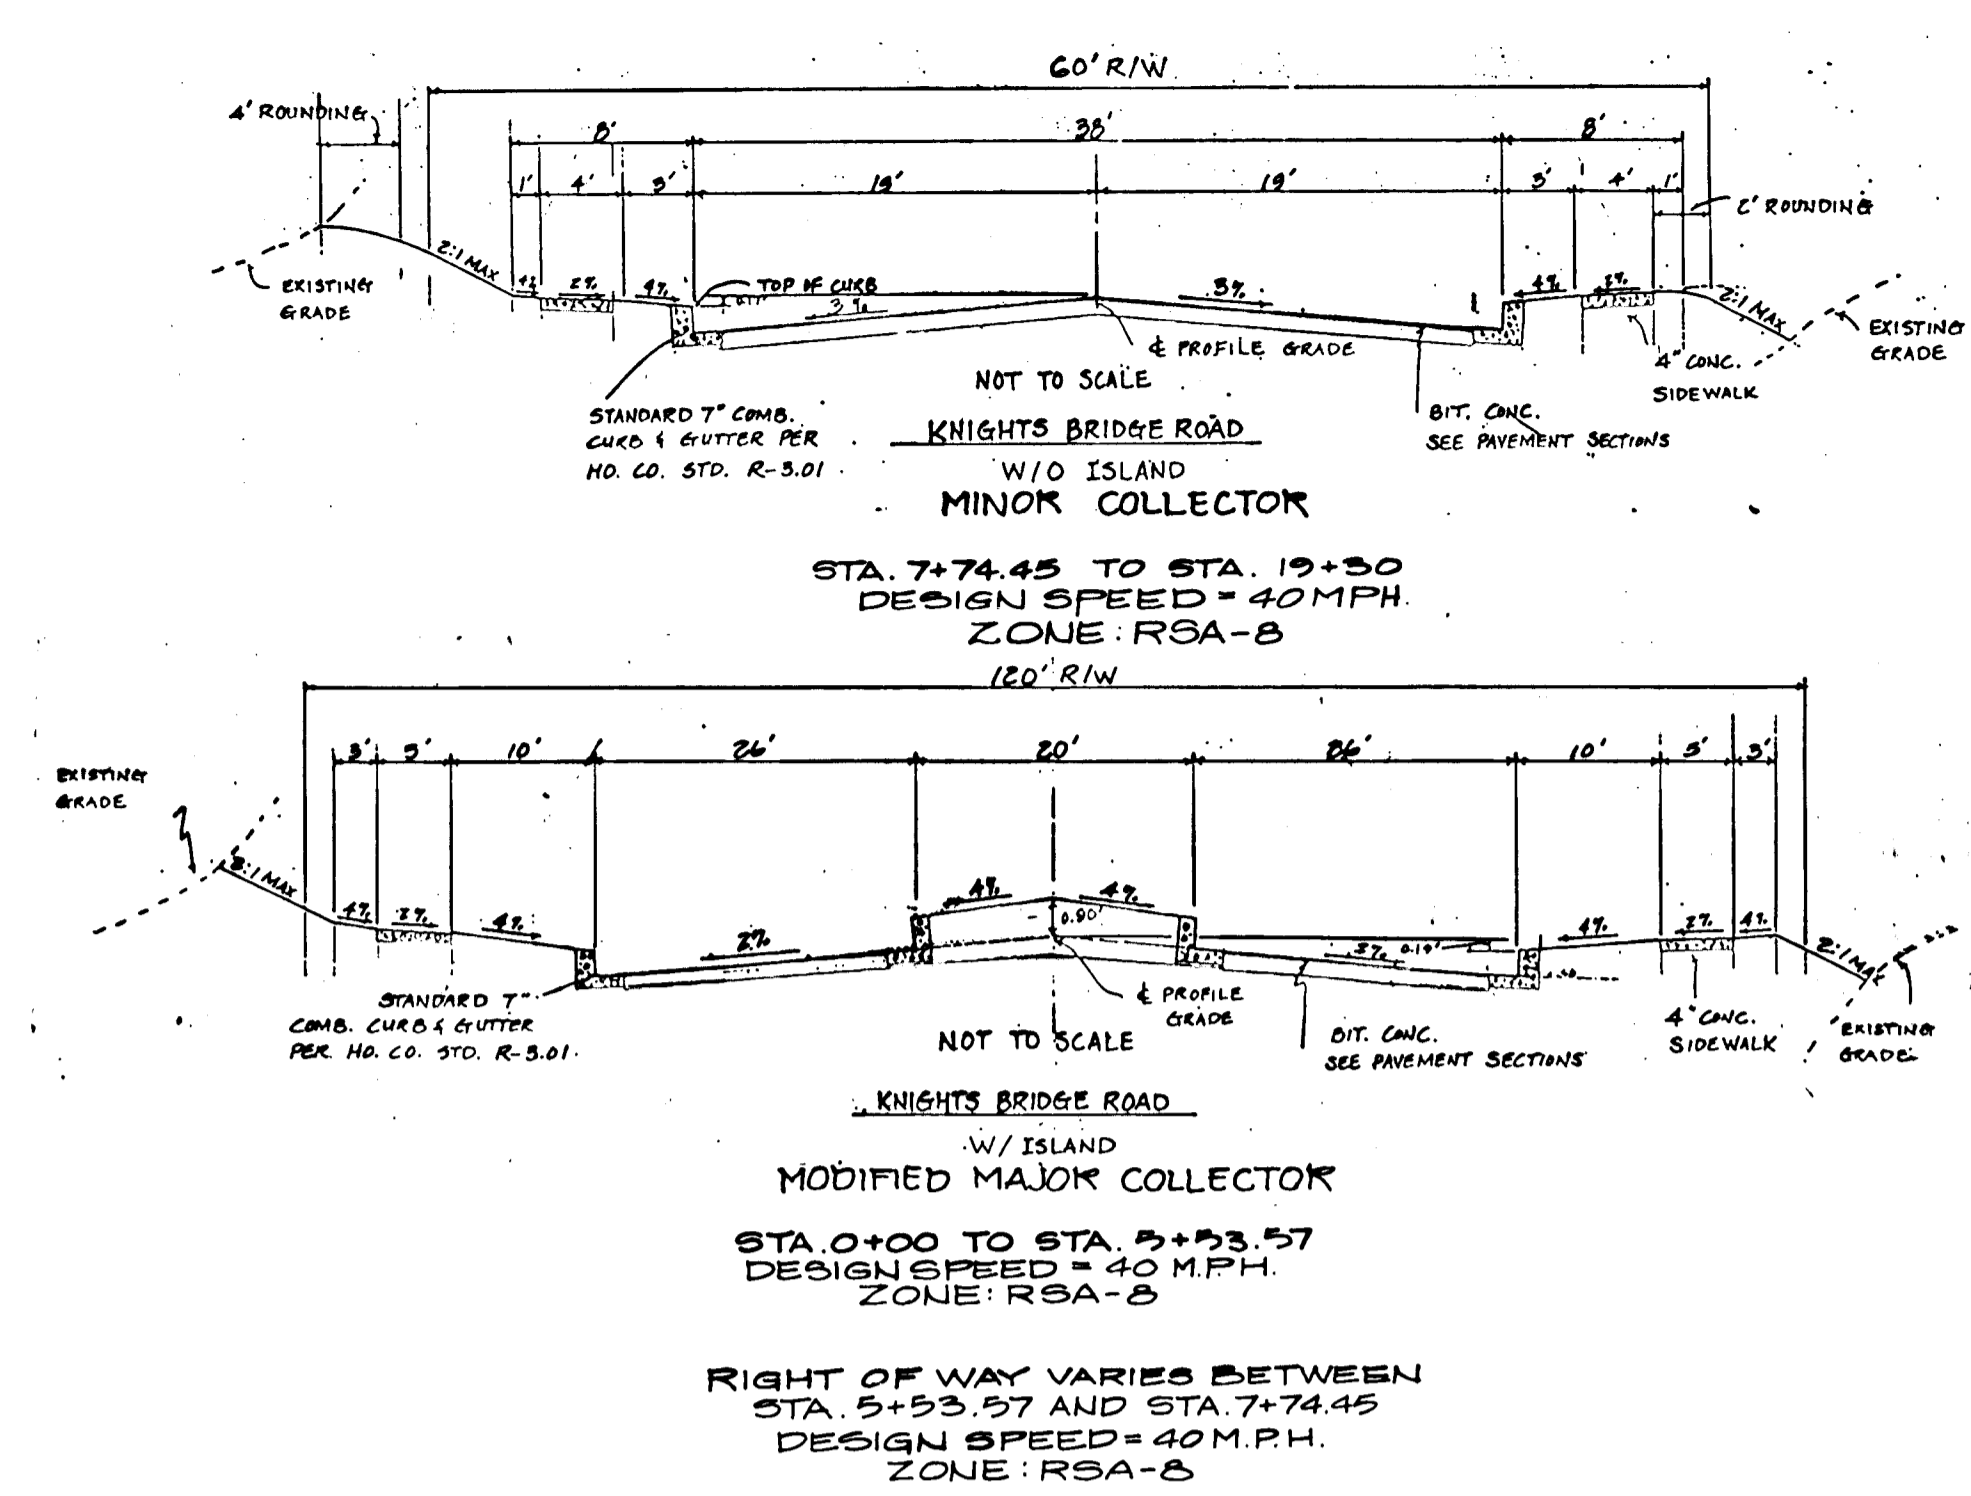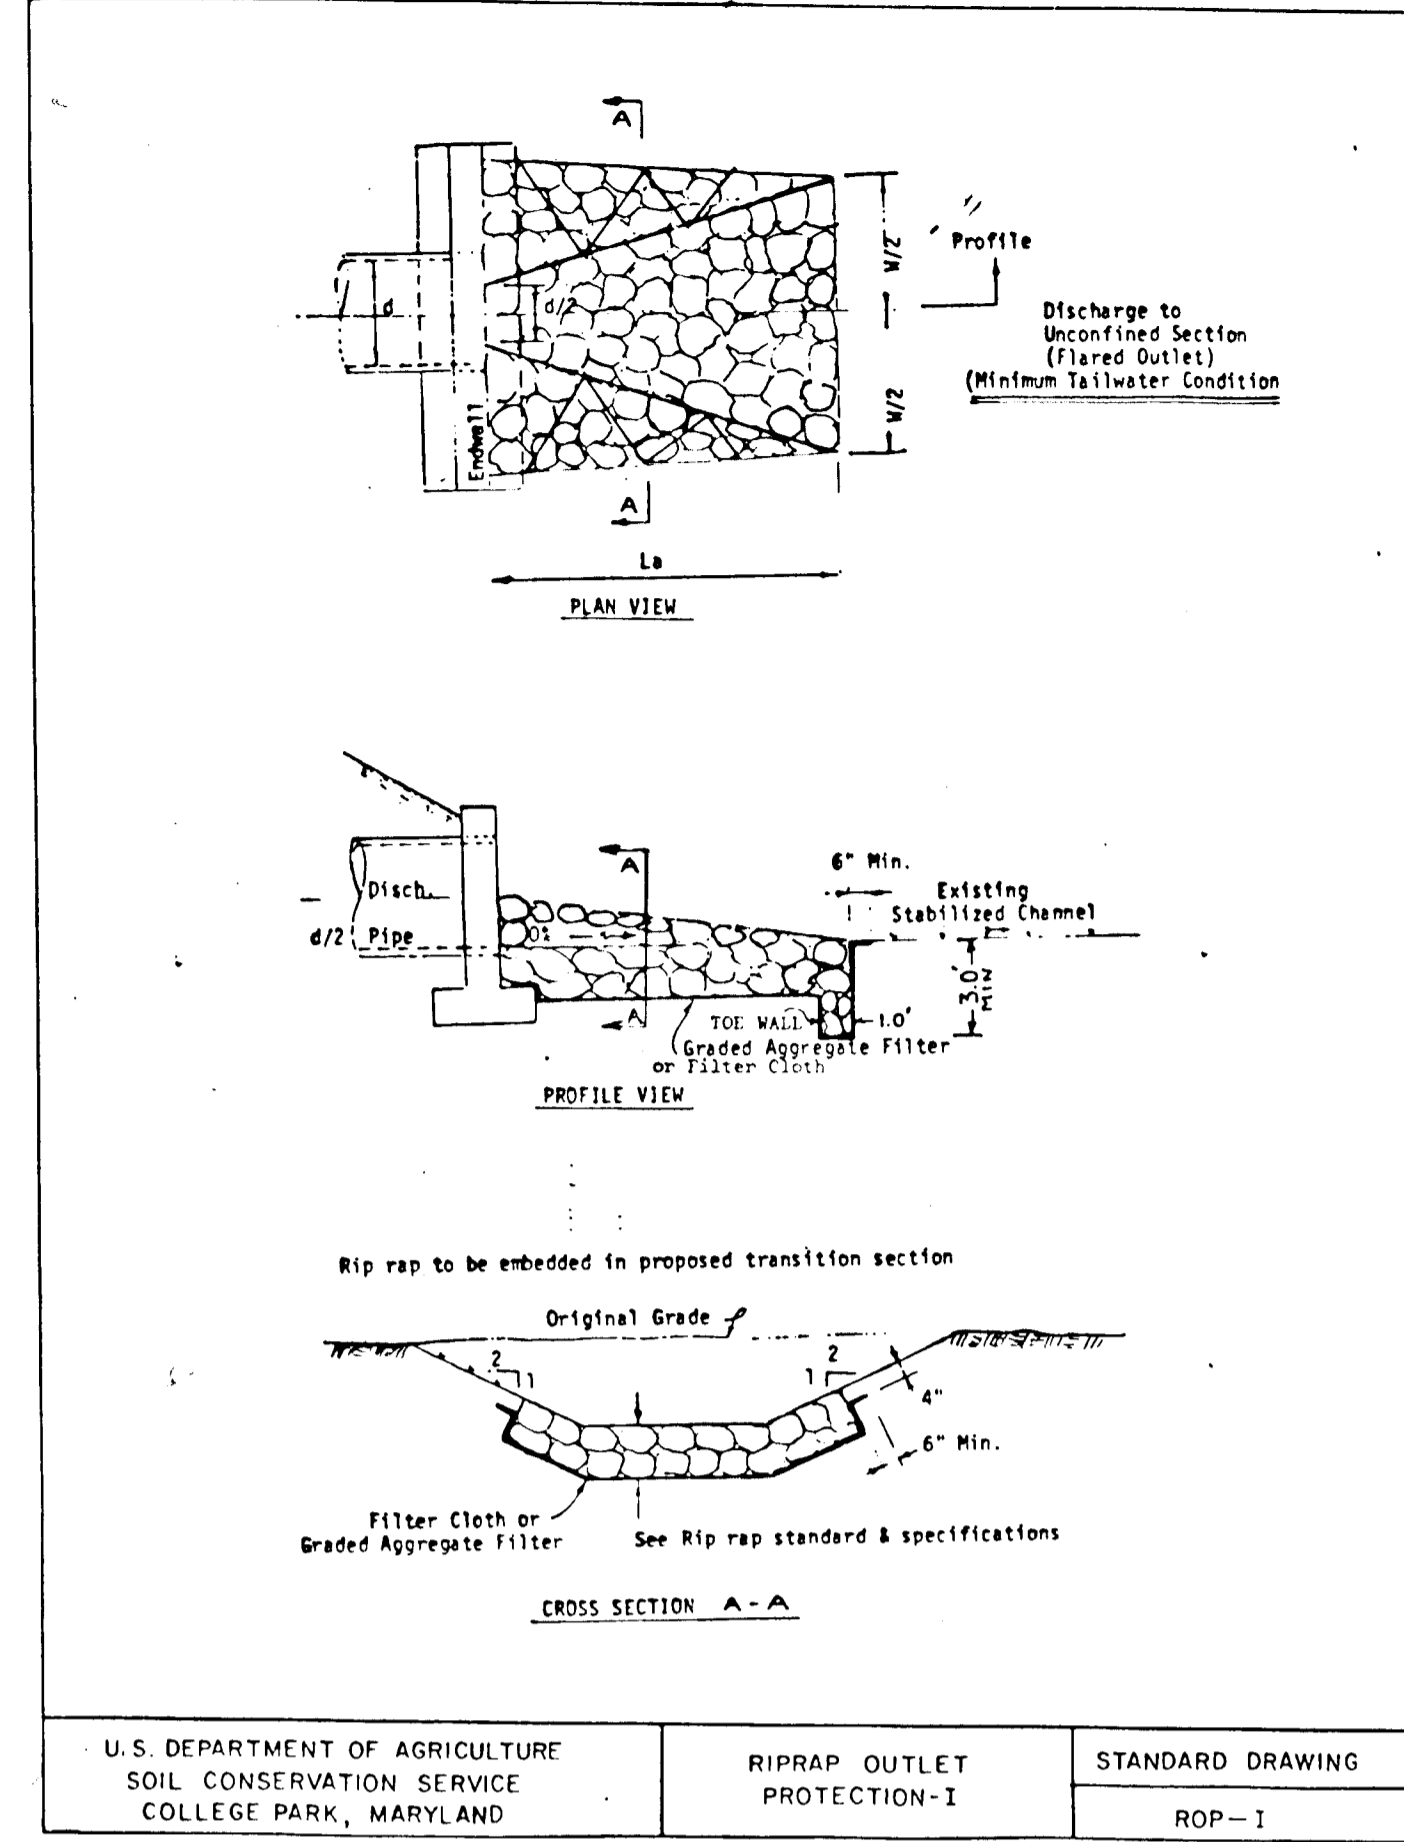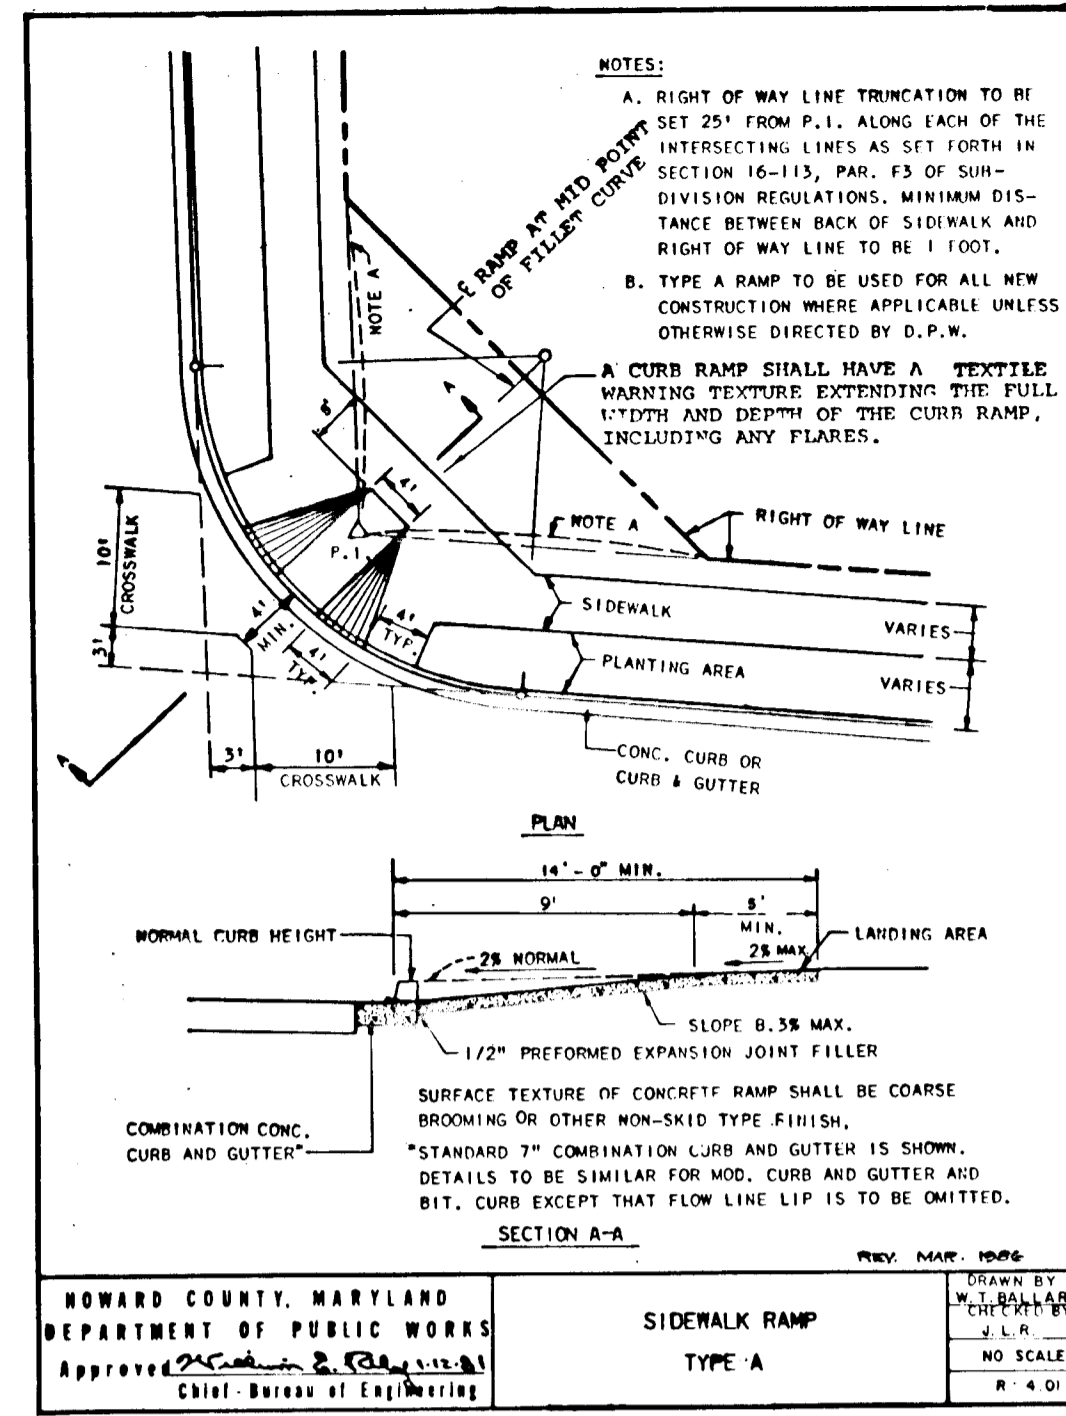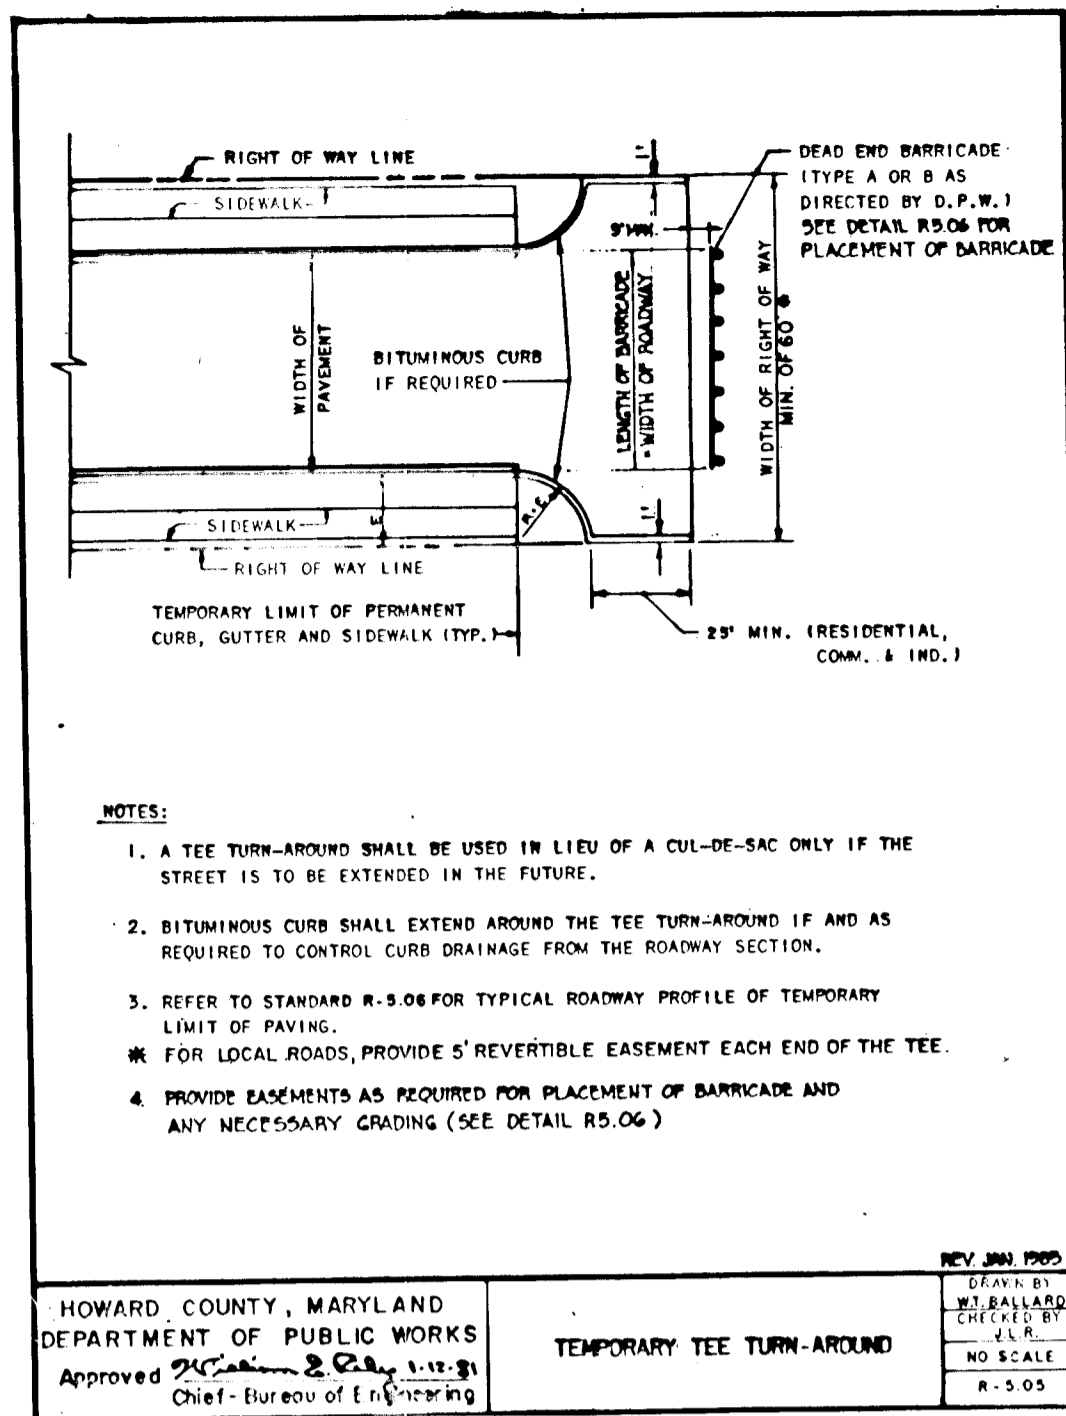


USE P-3 FOR ALL PAVING SECTIONS.

SECTION NUMBER	ROAD AND STREET CLASSIFICATION	PAVEMENT MATERIALS	
		FULL DEPTH BIT. CONC. ALTERNATE	GRANULAR BASE ALTERNATES
P-1	PARKING AREAS AND TRAVELWAYS APARTMENTS AND COMMERCIAL- INDUSTRIAL ZONES WITH NO HEAVY TRUCKS	1" BIT. CONC. SURFACE 4" BIT. CONC. BASE	1" BIT. CONC. SURFACE 2" BIT. CONC. BASE PRIME 3" CRUSHER RUN BASE COURSE OR 4" DENSE GRADED STABILIZED AGGREGATE BASE COURSE
P-2	RESIDENTIAL ZONES LOCAL CUL-DE-SAC STR. ALLEYS AND PRIVATE ROADS SERVING INDIVIDUAL LOTS	1 1/2" BIT. CONC. SURFACE 5" BIT. CONC. BASE	1 1/2" BIT. CONC. SURFACE 2 1/2" BIT. CONC. BASE PRIME 8" CRUSHER RUN BASE COURSE OR 4" DENSE GRADED STABILIZED AGGREGATE BASE COURSE
P-3	RESIDENTIAL ZONES MINOR AND MAJOR COLLECTORS COMMERCIAL-INDUSTRIAL ZONES LOCAL AND CUL-DE-SAC STREETS ALLEYS	1 1/2" BIT. CONC. SURFACE 5" BIT. CONC. BASE	1 1/2" BIT. CONC. SURFACE 4 1/2" BIT. CONC. BASE PRIME 6" CRUSHER RUN BASE COURSE OR 4 1/2" DENSE GRADED STABILIZED AGGREGATE BASE COURSE
P-4	COMMERCIAL-INDUSTRIAL ZONES MINOR COLLECTOR	1 1/2" BIT. CONC. SURFACE 5 1/2" BIT. CONC. BASE	1 1/2" BIT. CONC. SURFACE 3 1/2" BIT. CONC. BASE PRIME 5" CRUSHER RUN BASE COURSE OR 4" DENSE GRADED STABILIZED AGGREGATE BASE COURSE

* HEAVY TRUCKS DEFINED AS THOSE WITH 6 WHEELS OR MORE.

HOWARD COUNTY, MARYLAND
DEPARTMENT OF PUBLIC WORKS
Approved: [Signature] Chief, Bureau of Engineering

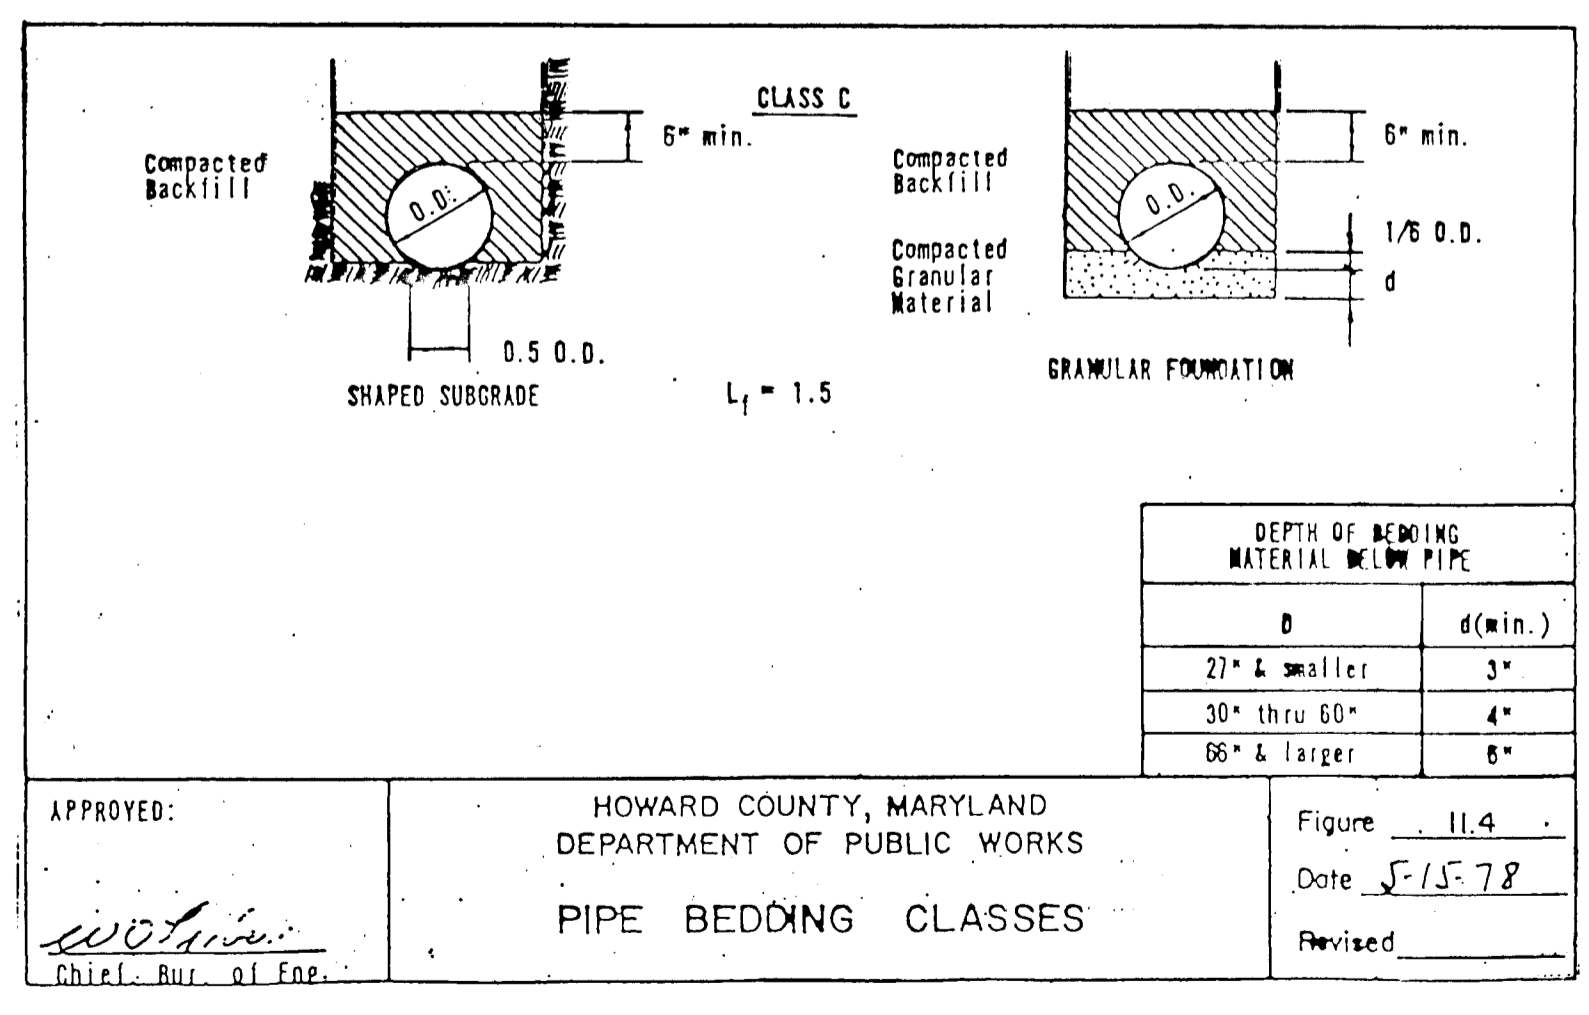

APPROVED: HOWARD COUNTY OFFICE OF PLANNING AND ZONING

[Signature]
Chief, Division of Land Development & COMMUNITY PLANNING

3/22/88
Date

APPROVED: HOWARD COUNTY DEPARTMENT OF PUBLIC WORKS

[Signature]
Chief, Land Development Division

Date 1-5-87

[Signature]
Chief, Bureau of Highways

Date 1/6/88

[Signature]
Chief, Bureau of Engineering

Date 1-11-88

NO.	DESCRIPTION	DATE	APPROVED	DATE

REVISION APPROVED BY



REVISED

PAVING & STORM DRAIN DETAIL SHEET

Patton Harris Rust and Associates
A Professional Corporation
Engineers, Surveyors, Planners and Landscape Architects
7609 Standish Place Rockville, Md. 20855 (301) 762-2220


BOWLING BROOK FARMS
KNIGHTS BRIDGE ROAD
A RESUBDIVISION OF BOLLING BROOKE, LOT 2
SIXTH ELECTION DISTRICT
HOWARD COUNTY, MARYLAND

SURVEY P.H.R. & A
DESIGN M.J.K.
DRAWN
CHECKED
SCALE AS SHOWN
C.I.

DATE
10/8/87


SHEET
5 of 9

FILE NO.
2184-1-0

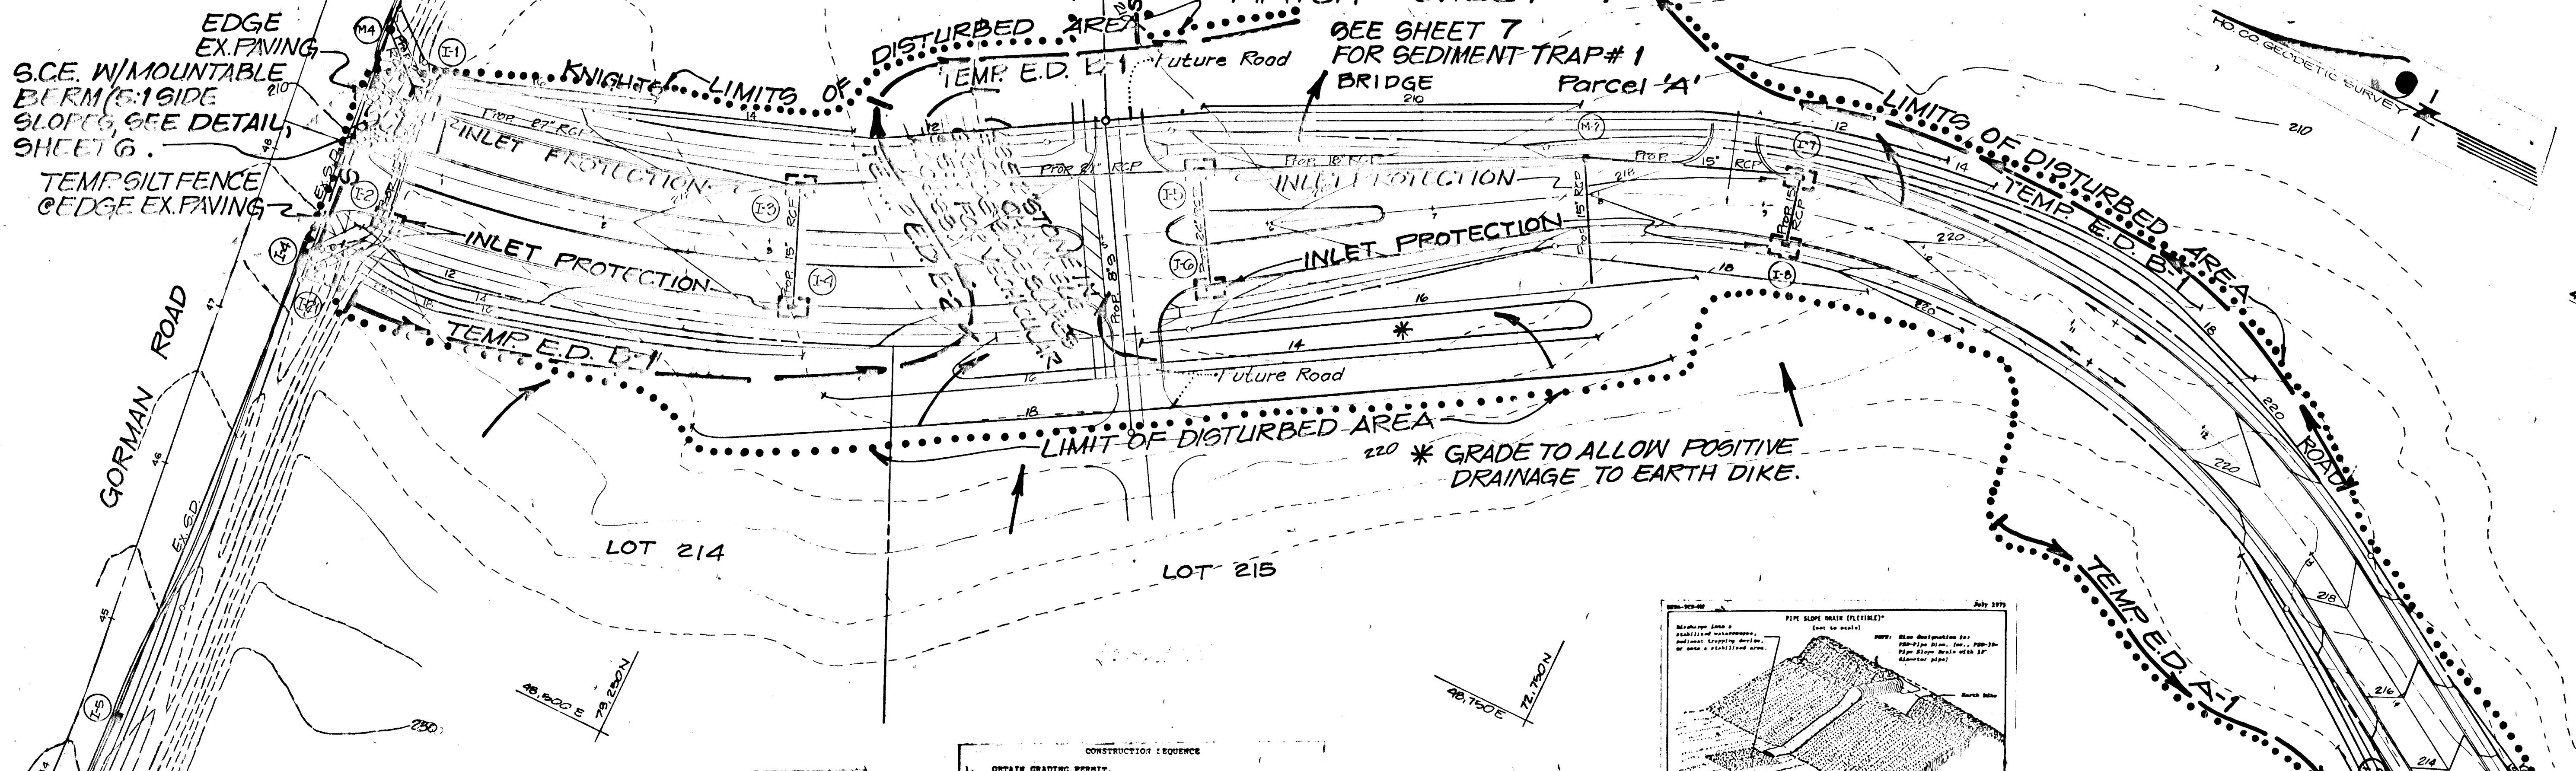

SEDIMENT TRAP SCHEDULE		
SEDIMENT TRAP #	1	2
TYPE OF TRAP - STD & SPEC #	ST-VI	ST-VI
DRAINAGE AREA (ACRES)	14.2	2.0
STORAGE REQUIRED (FT ³)	25,560	5,220
STORAGE PROVIDED (FT ³)	25,950	5,200
BASE DIMENSIONS & ELEV.	33' x 23' @ 201.0	43' x 13' @ 167.5
WEIR LENGTH & ELEV.	16' @ 205.0	6' @ 171.25
STORAGE DEPTH	3'	3'
EMBRANKMENT HT. & TOP ELEV.	3' @ 200.0	2.5' @ 174.0
MAX. DEPTH OF FLOW OVER WEIR	2.0'	1.5'


- CONSTRUCTION SEQUENCE**
- OBTAIN GRADING PERMIT.
 - INSTALL STABILIZED CONSTRUCTION ENTRANCE WITH MOUNTABLE BEEM AT PROPOSED KNIGHTS BRIDGE ROAD/GORMAN ROAD INTERSECTION. MAINTAIN/REPAIR S.C.E. AS REQUIRED THROUGHOUT DURATION OF CONSTRUCTION.
 - INSTALL SILT FENCE, STREAM DIVERSION AND ASSOCIATED UTILITY CROSSING DEVICES FOR CONSTRUCTION OF PROPOSED SANITARY SEWER OUTFALL.
 - CONSTRUCT TEMPORARY SEDIMENT TRAP 1 AND 2, EARTH DIKES AND SILT FENCE ALONG EDGE OF EXISTING PAVEMENT AT GORMAN ROAD. BEGIN STREET GRADING.
 - CONSTRUCT SANITARY SEWER FROM EXISTING MANHOLE 1003 TO MANHOLE 254, 255 AND 200. BACKFILL, STABILIZE THOSE AREAS NOT SUBJECT TO FURTHER DISTURBANCE, AND REMOVE STREAM PROTECTION DEVICES AT THE DIRECTION OF THE SEDIMENT CONTROL INSPECTOR.
 - EARTH DIKE ACROSS KNIGHTS BRIDGE ROAD IN VICINITY OF STATION 4+00 SHALL REMAIN IN PLACE TO DIRECT FLOW TO SEDIMENT TRAP 1 UNTIL CONTRIBUTING DRAINAGE AREA IS STABILIZED. DELAY PAVING OPERATIONS IN THIS AREA AS REQUIRED.
 - PROTECT STORM DRAIN INLETS WHERE INDICATED.
 - COMPLETE STREET CONSTRUCTION AND PAVING OPERATIONS. STABILIZE ADJACENT CUT/FILL SLOPES PER SEDIMENT CONTROL AND SEDIMENT MOISTURE REQUIREMENTS.
 - BEFORE REMOVING SEDIMENT TRAP 2, THOROUGHLY PULSE STORM DRAIN SYSTEM FROM INLET STRUCTURE 1-9 DOWN TO OUTFALL STRUCTURE 2-1.
 - AS THEIR CONTRIBUTING DRAINAGE AREAS ARE BROUGHT TO FINAL GRADE AND STABILIZED, TEMPORARY SEDIMENT CONTROL MEASURES MAY BE REMOVED WITH THE PERMISSION OF THE SEDIMENT CONTROL INSPECTOR AND REPAIRING DISTURBED AREAS STABILIZED.

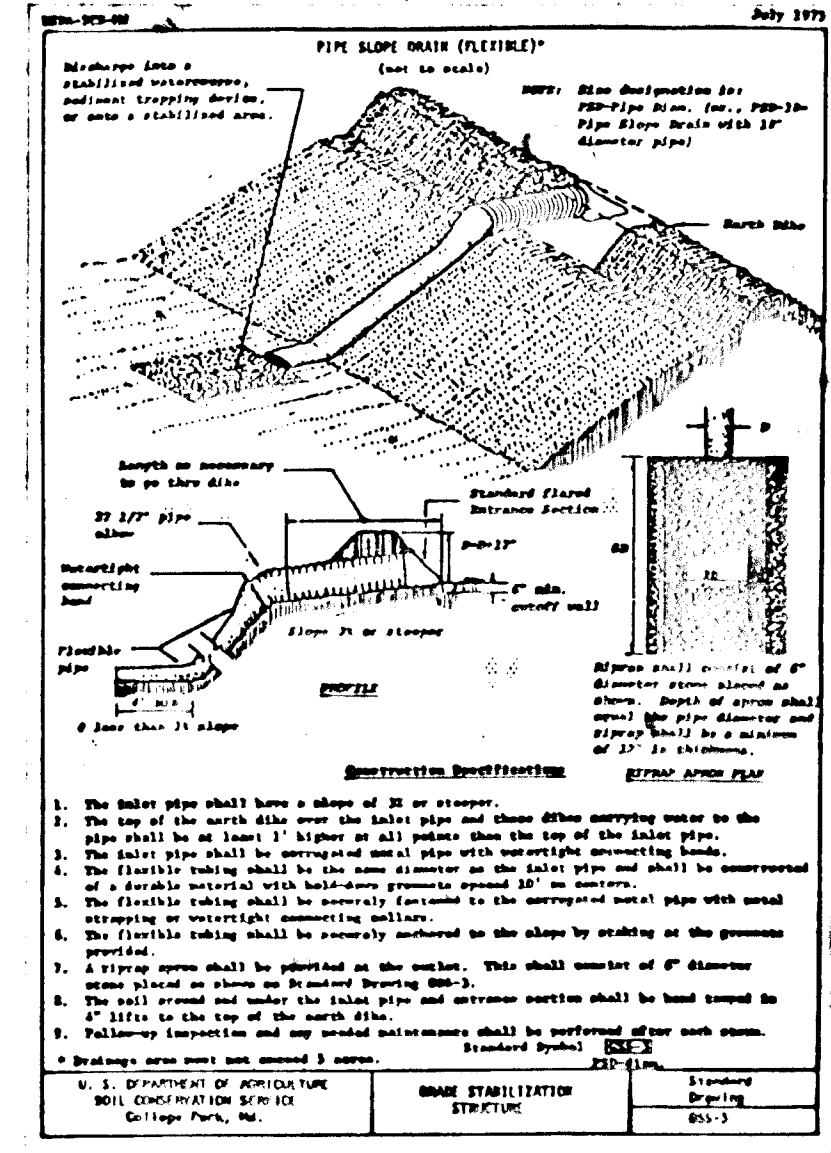

MATCH LINE AA SEE SHEET 8

APPROVED: HOWARD COUNTY DEPARTMENT OF PUBLIC WORKS
Walter H. F. Chief, Land Development Division Date 1-1-97
Francis W. Weissand Chief, Bureau of Highways Date 1/6/88
William D. Perry Chief, Bureau of Engineering Date 1-11-88

APPROVED: HOWARD COUNTY OFFICE OF PLANNING AND ZONING
James S. Rust Chief, Division of Land Development & COMMUNITY PLANNING Date 2/22/88

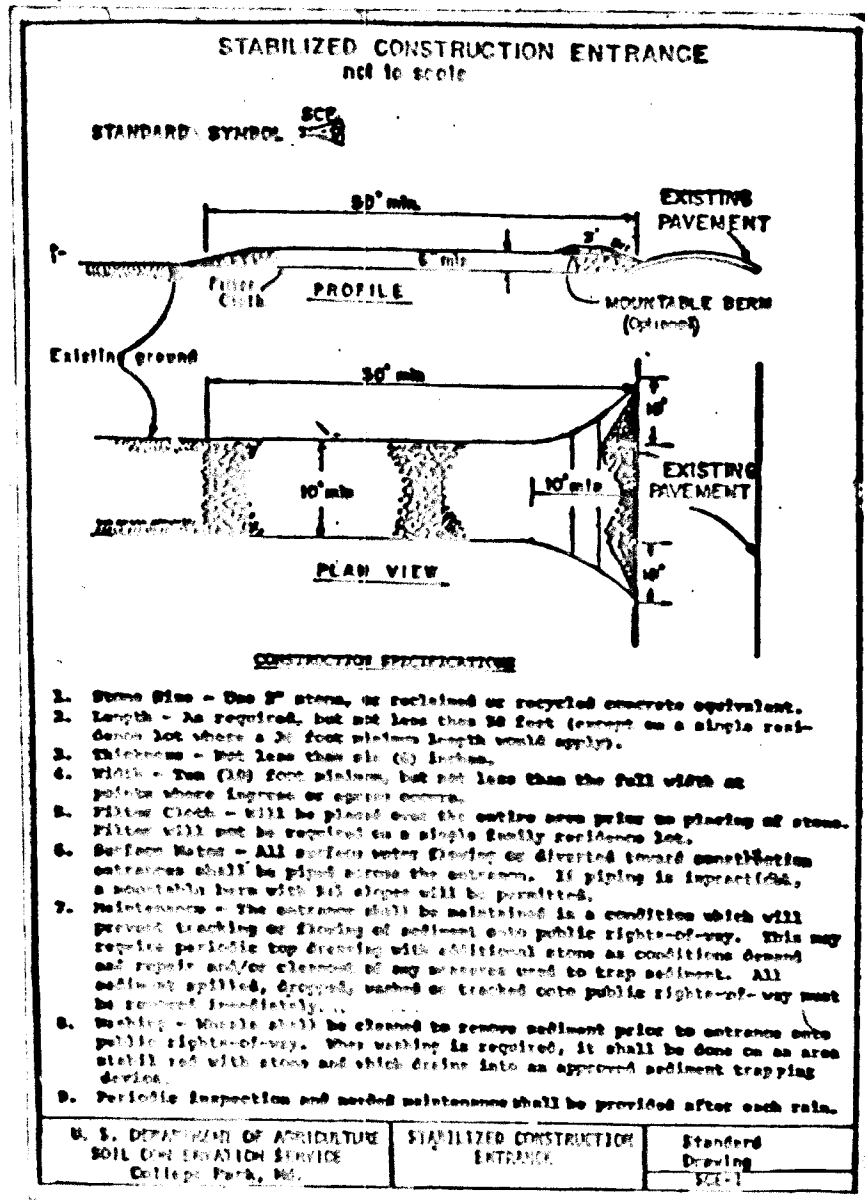

PERMANENT STABILIZATION NOTES

Apply to graded or cleared areas not subject to immediate further disturbance where a permanent long-lived vegetative cover is needed.

Seedbed Preparation: Loosen upper three inches of soil by raking, discing or other acceptable means before seeding.

Soil Amendments: In lieu of soil test recommendations, use one of the following schedules:

- Preferred** - Apply 2 tons per acre dolomitic limestone (92 lbs/1000 square ft) and 400 lbs per acre 10-10-10 fertilizer (14 lbs/1000 sq ft) before seeding. Harrow or disc into upper three inches of soil. At time of seeding, apply 400 lbs per acre 10-0-0 ureaform fertilizer (9 lbs/1000 sq ft).
- Acceptable** - Apply 2 tons per acre dolomitic limestone (92 lbs/1000 sq ft) and 1000 lbs per acre 10-10-10 fertilizer (23 lbs/1000 sq ft) before seeding. Harrow or disc into upper three inches of soil.

Seeding - For the periods March 1 thru April 30, and August 1 thru October 15, seed with 60 lbs per acre (3.4 lbs/1000 sq ft) of Kentucky 31 Tall Fescue. For the period May 1 thru July 31, seed with 60 lbs Kentucky 31 Tall Fescue per acre and 2 lbs per acre (0.5 lbs/1000 sq ft) of seeding fertilizer. During the period of October 16 thru February 28, protect site by: Option (1) 2 tons per acre of well anchored straw mulch and seed as soon as possible in the spring. Option (2) Use seed. Option (3) Seed with 60 lbs/acre Kentucky 31 Tall Fescue and mulch with 2 tons/acre well anchored straw.

Mulching - Apply 1/2 to 2 tons per acre (70 to 90 lbs/1000 sq ft) of untreated small grain straw immediately after seeding. Anchor mulch immediately after application using mulch anchoring tool or 218 gal per acre (5 gal/1000 sq ft) of emulsified asphalt on flat areas. On slopes 8 feet or higher, use 348 gal per acre (8 gal/1000 sq ft) for anchoring.

Maintenance - Inspect all seeded areas and make needed repairs, replacements and reseedings.

TEMPORARY STABILIZATION NOTES

Apply to graded or cleared areas likely to be redisturbed where a short-term vegetative cover is needed.

Seedbed Preparation: Loosen upper three inches of soil by raking, discing or other acceptable means before seeding.

Soil Amendments: Apply 60 lbs per acre 10-10-10 fertilizer (14 lbs/1000 sq ft).



Seeding: For periods March 1 thru April 30 and from August 1 thru November 15, seed with 1/2 bushel per acre of annual ryegrass (3.12 lbs/1000 sq ft). For the period May 1 thru August 31, seed with 3 lbs per acre of ureaform fertilizer (0.7 lbs/1000 sq ft). For the period November 16 thru February 28, protect site by applying 2 tons per acre of well anchored straw mulch and seed as soon as possible in the spring, or use seed.

Mulching: Apply 1/2 to 2 tons per acre (70 to 90 lbs/1000 sq ft) of untreated small grain straw immediately after seeding. Anchor mulch immediately after application using mulch anchoring tool or 218 gal per acre (5 gal/1000 sq ft) of emulsified asphalt on flat areas. On slopes 8 ft or higher, use 348 gal per acre (8 gal/1000 sq ft) for anchoring.

Refer to the 1983 MARYLAND STANDARDS AND SPECIFICATIONS FOR SOIL EROSION AND SEDIMENT CONTROL for rates and methods not covered.

SEDIMENT CONTROL NOTES

- A minimum of 24 hours notice must be given to the Howard County Office of Inspection and Permits prior to the start of any construction. (892-2433)
- All vegetative and structural practices are to be installed according to the provisions of this plan and are to be in conformance with the 1983 MARYLAND STANDARDS AND SPECIFICATIONS FOR SOIL EROSION AND SEDIMENT CONTROL.
- Following initial soil disturbance or redisturbance, permanent or temporary stabilization shall be completed within a) 7 calendar days for all permanent sediment control structures, dikes, perimeter slopes and all slopes greater than 3:1, b) 14 days as to all other disturbed or graded areas on the project site.
- All sediment traps/basins shown must be fenced and warning signs posted around their perimeter in accordance with Vol. 1, Chapter 12, of the HOWARD COUNTY DESIGN MANUAL, Storm Drainage.
- All disturbed areas must be stabilized within the time period specified above in accordance with the 1983 MARYLAND STANDARDS AND SPECIFICATIONS FOR SOIL EROSION AND SEDIMENT CONTROL. For permanent seedings (Sec. 51) and (Sec. 54), temporary seedings (Sec. 50) and mulching (Sec. 52). Temporary stabilization with mulch alone can only be done when recommended seeding dates do not allow for proper germination and establishment of grasses.
- All sediment control structures are to remain in place and are to be maintained in operative condition until permission for their removal has been obtained from the Howard County Sediment Control Inspector.
- Site Analysis:
 Total Area of Site: 6.78 Acres
 Area Disturbed: 2.22 Acres
 Area to be vegetatively stabilized: 2.22 Acres
 Total Cut: 0.00 cu. yds.
 Total Fill: 0.00 cu. yds.
 Office water/borrow area location: [Blank]
- Any sediment control structures which is disturbed by grading activity for placement of utilities must be repaired on the same day of disturbance.
- Additional sediment controls must be provided, if deemed necessary by the Howard County DPU sediment control Inspector.
- On all sites with disturbed areas in excess of 2 acres, approval of the inspection agency shall be requested upon completion of installation of perimeter erosion and sediment controls, but before proceeding with any other earth disturbance or grading. Other building or grading inspection approvals may not be authorized until this initial approval by the inspection agency is made.

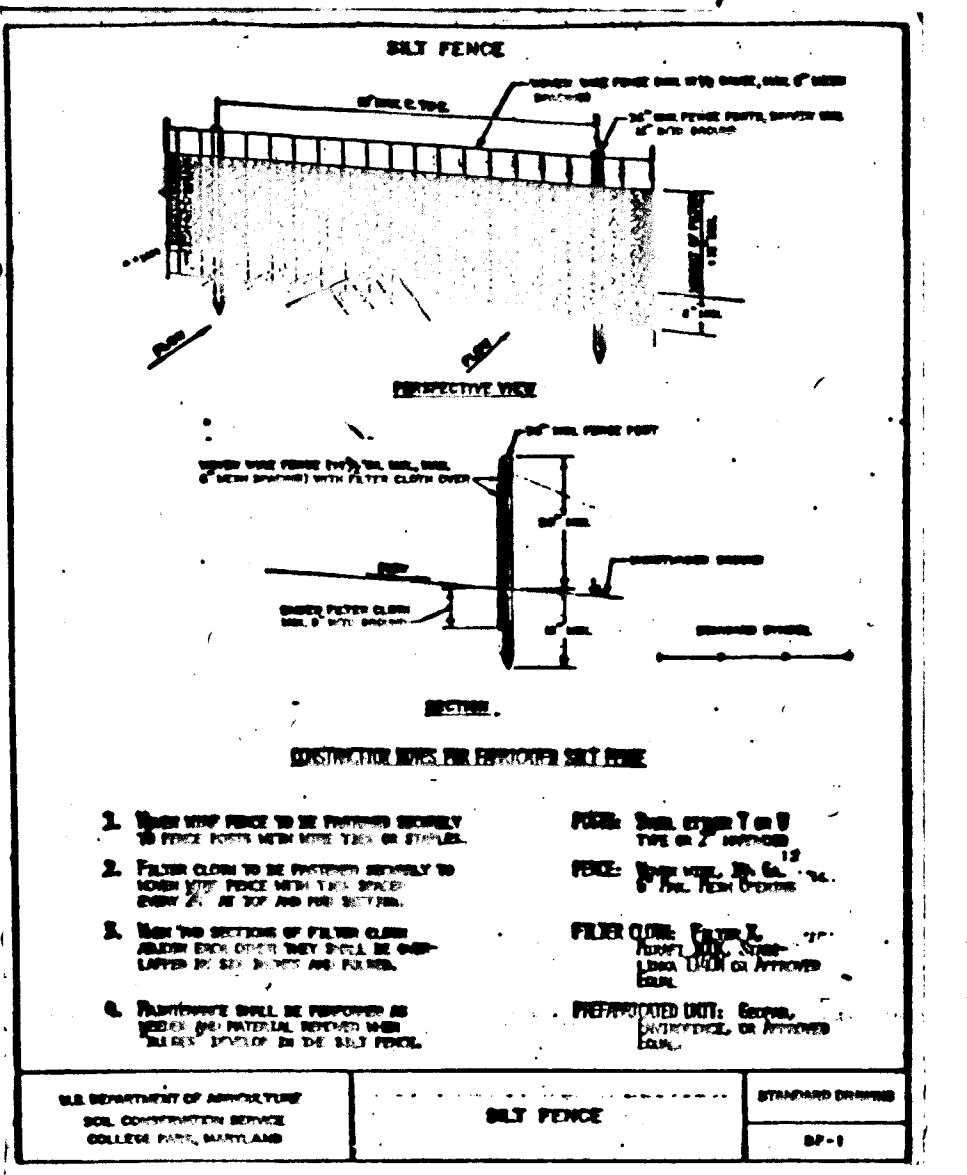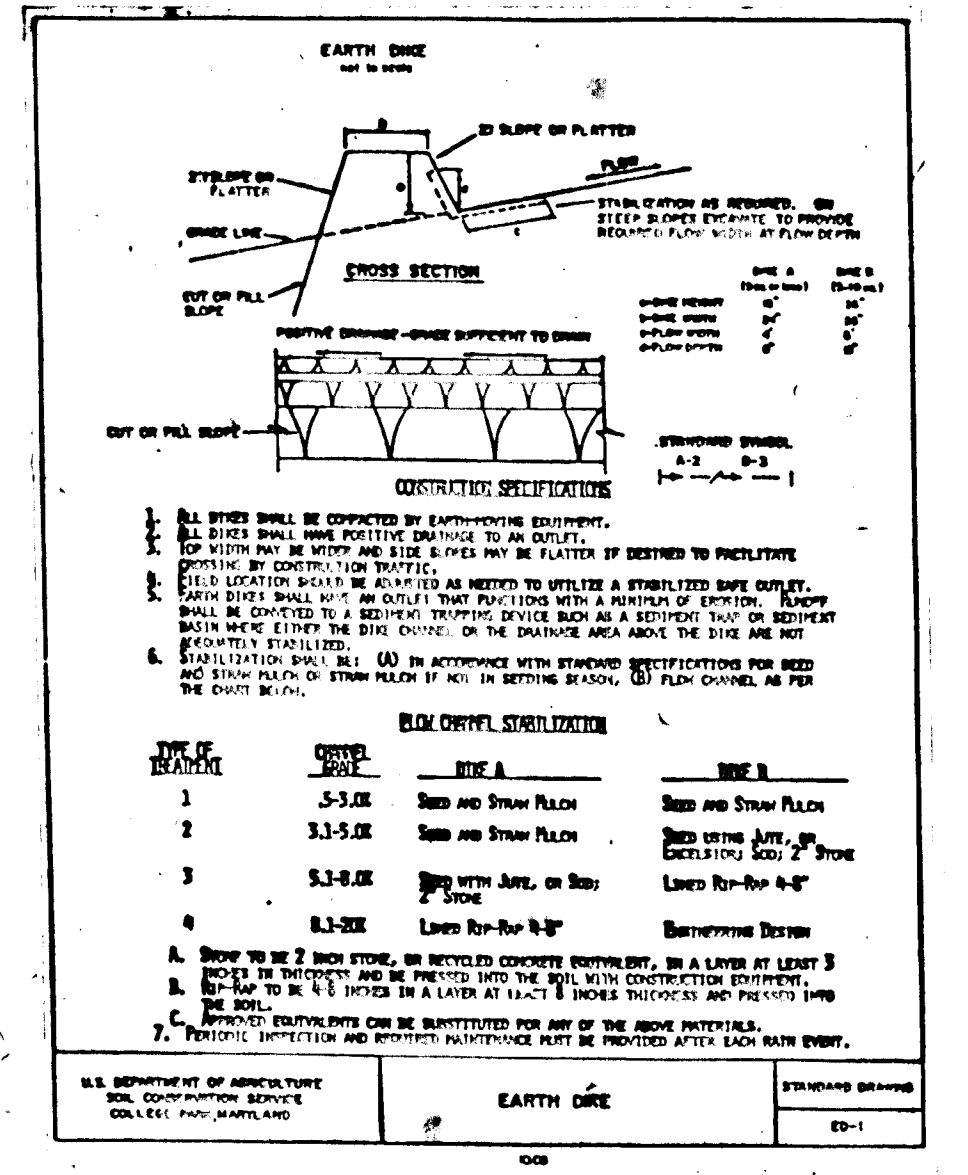

THESE PLANS HAVE BEEN REVIEWED FOR THE HOWARD SOIL CONSERVATION DISTRICT AND MEET TECHNICAL REQUIREMENTS.

James M. Nelson 12-16-87
 U.S. Soil Conservation Service Date

THIS PLAN IS APPROVED FOR SOIL EROSION AND SEDIMENT CONTROL BY THE HOWARD SOIL CONSERVATION DISTRICT.

APPROVED: *Howard S. C. D.* 12-16-87
 Howard S. C. D. Date

PLAN NUMBER: [Blank]

NO.	DESCRIPTION	DATE	APPROVED	DATE

REVISION APPROVED BY: [Blank]



REVISID

EROSION AND SEDIMENT CONTROL PLAN



Patton Harris Rust and Associates
 A Professional Corporation
 Engineers, Surveyors, Planners and Landscape Architects
 7609 Standish Place, Rockville, MD 20855 (301)762-2220

BOWLING BROOK FARMS		KNIGHTS BRIDGE ROAD		A RESUBDIVISION OF BOLLING BROOKE, LOT 2 SIXTH ELECTION DISTRICT HOWARD COUNTY, MARYLAND	
SURVEY	DATE	DESIGN	J.P.C.	10-8-87	
DRAWN	C.S.R.	CHECKED	J.P.C.	SHEET	6 OF 9
SCALE	1"=50'	FILE NO.	C.I. 2'	2184-1-0	


F-88-40

APPROVED: HOWARD COUNTY DEPARTMENT OF PUBLIC WORKS
 Chief, Land Development Division
 Date 1/6/88
 Approved: HOWARD COUNTY OFFICE OF PLANNING AND ZONING
 Chief, Division of Land Development & COMMUNITY PLANNING
 Date 2/28/88

Standard Specifications for
 Stream Bank Erosion Protection
 April 1983

1. Materials


- Frame to be constructed of 2" x 4" construction grade lumber.
- Wire mesh must be of sufficient strength to support filter fabric, and some for curb inlets, with water fully impounded against it.
- Filter cloth must be of a type approved for this purpose; resistant to sunlight with a life expectancy of 100,000 hours, to allow sufficient passage of water and removal of sediment.
- Stone to be 3" in size and clean, since these would clog the cloth.

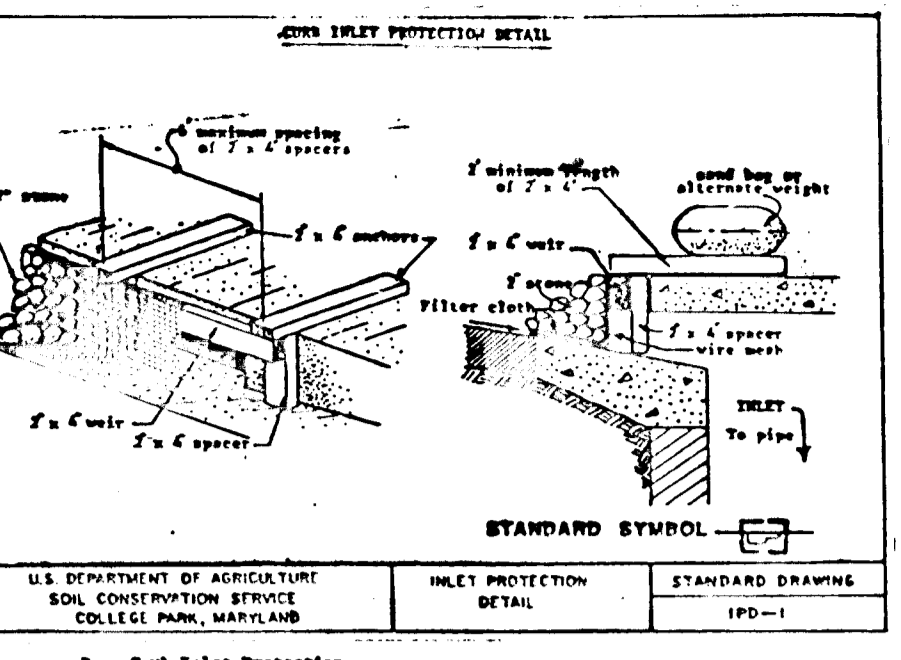

II. Structure

A. A curb, structure or yard inlet protection.



- Excavate completely around inlet to a depth of 18" below reach elevation.
- Drive 2 x 4 post 2" into ground at four corners of inlet. Place mesh fabric between posts on side of inlet. Assemble top portion of 2 x 4 frame using overlap joint shown. Top of frame (curb) must be 6" below edge of roadway adjacent to inlet.
- Stretch wire mesh tightly around frame and fasten securely. Side work must be done.
- Stretch filter cloth tightly over wire mesh, the cloth must extend from top of frame to 18" below inlet curb elev. Fasten securely to frame. Side work must be done.
- Backfill around inlet in compacted 3" layers until lower of earth is even with reach elevation on curb and top elevation on an inlet.
- If the inlet is set in a low point, construct a compacted earth dike in the direction below it. The top of this dike is to be at least 6" higher than the top of frame (curb).
- This structure must be inspected frequently and the filter fabric replaced when clogged.

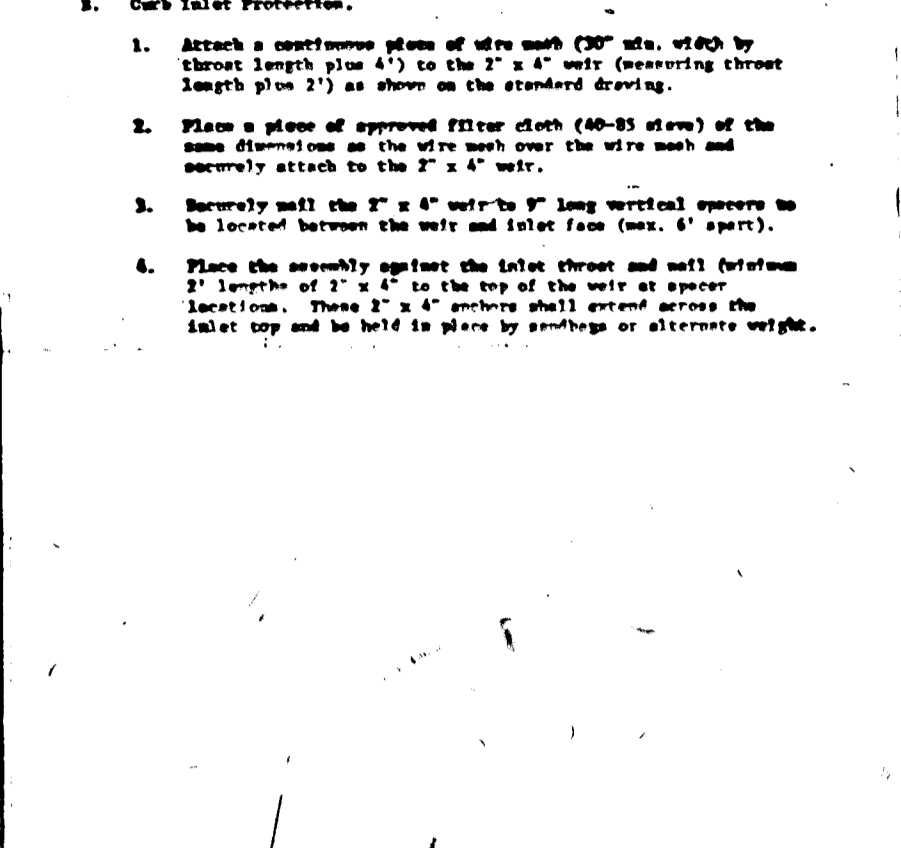

III. Structure

A. A curb, structure or yard inlet protection.

- Excavate completely around inlet to a depth of 18" below reach elevation.
- Drive 2 x 4 post 2" into ground at four corners of inlet. Place mesh fabric between posts on side of inlet. Assemble top portion of 2 x 4 frame using overlap joint shown. Top of frame (curb) must be 6" below edge of roadway adjacent to inlet.
- Stretch wire mesh tightly around frame and fasten securely. Side work must be done.
- Stretch filter cloth tightly over wire mesh, the cloth must extend from top of frame to 18" below inlet curb elev. Fasten securely to frame. Side work must be done.
- Backfill around inlet in compacted 3" layers until lower of earth is even with reach elevation on curb and top elevation on an inlet.
- If the inlet is set in a low point, construct a compacted earth dike in the direction below it. The top of this dike is to be at least 6" higher than the top of frame (curb).
- This structure must be inspected frequently and the filter fabric replaced when clogged.

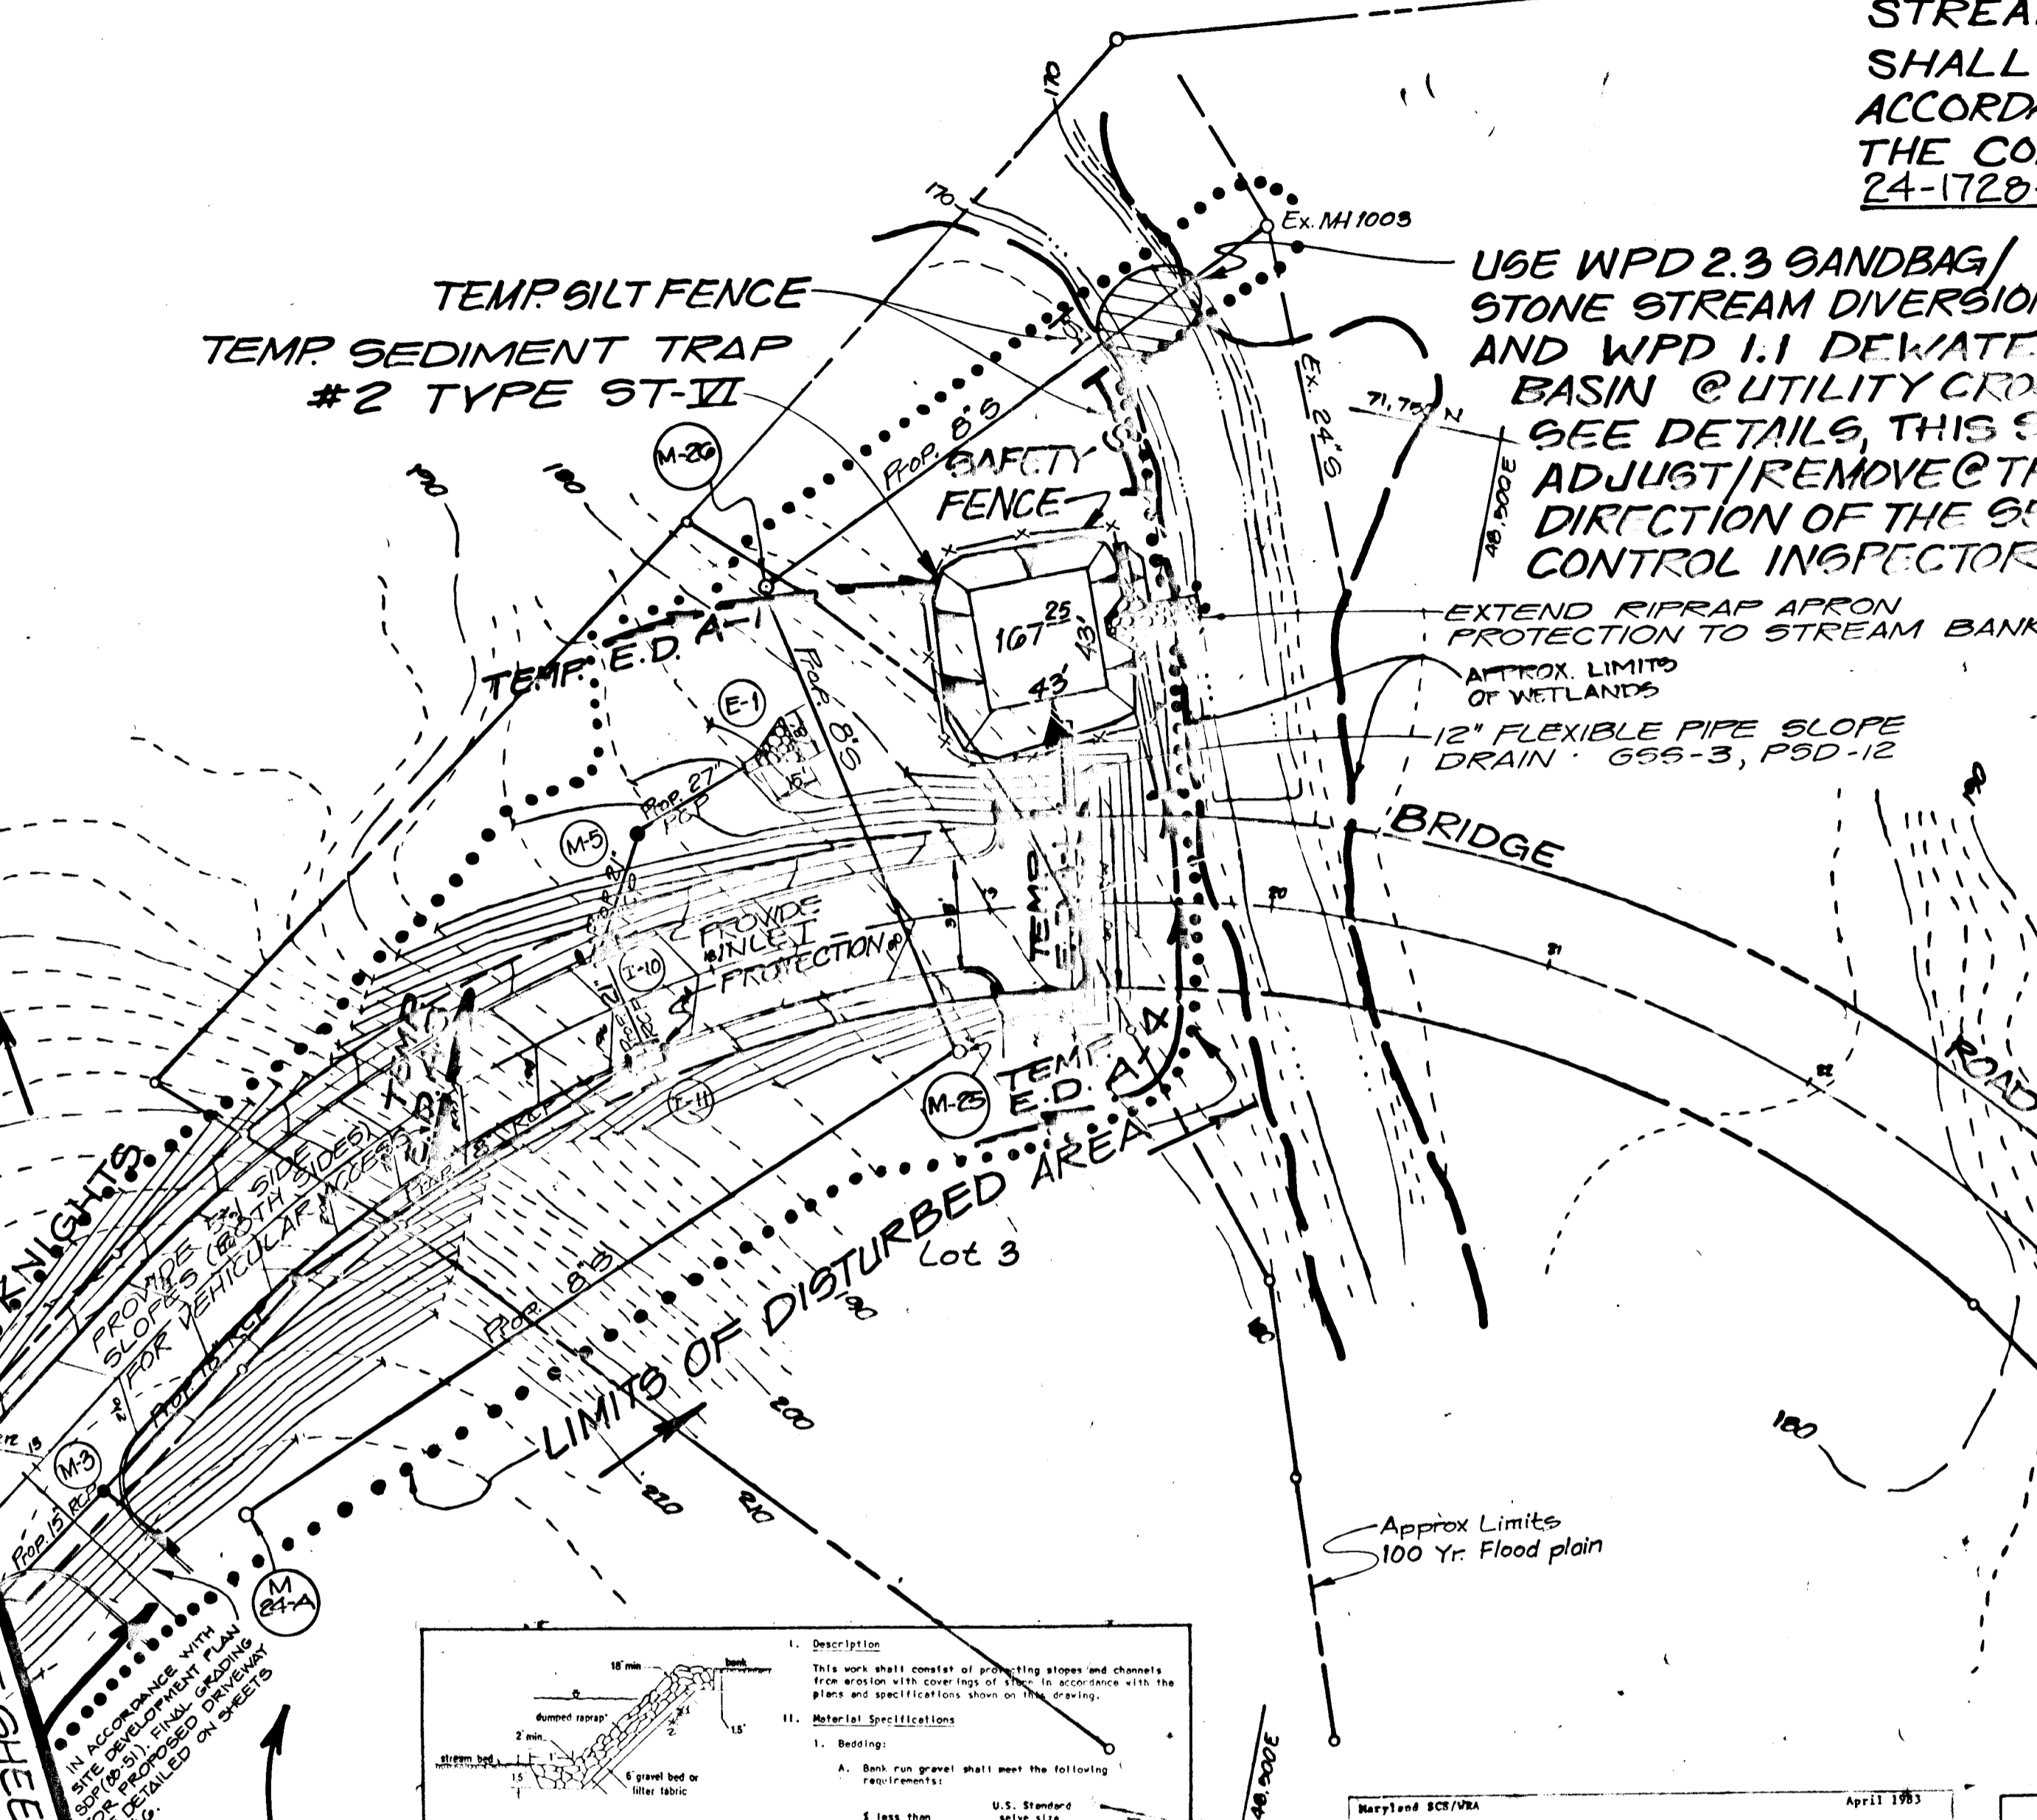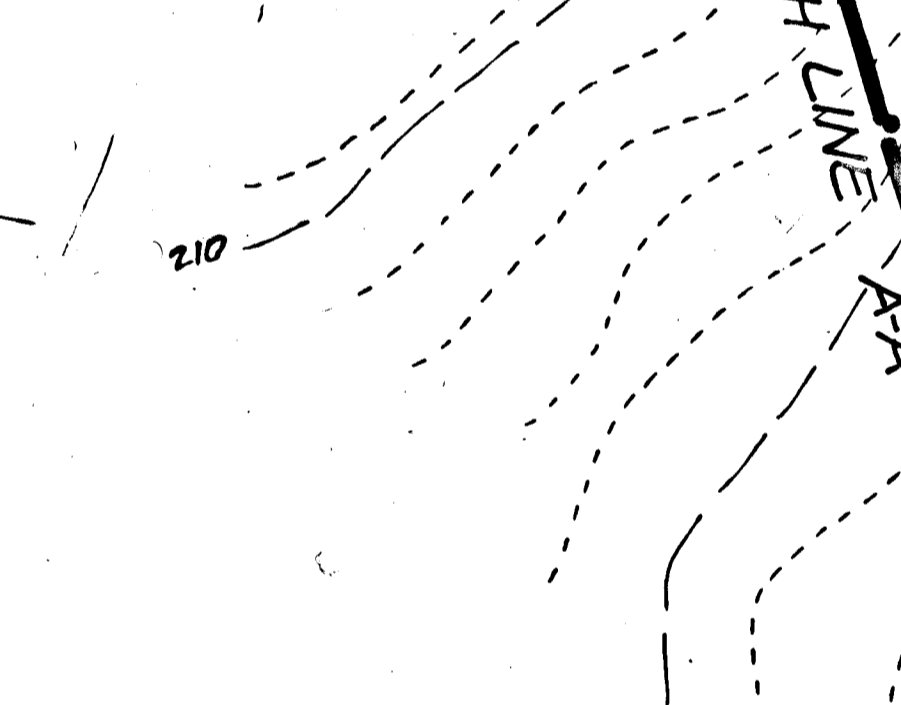

NOTE: ALL CONSTRUCTION OF PERMANENT STREAM PROTECTION SHALL BE IN ACCORDANCE WITH THE CONTRACT NO. 24-1720-D.

USE WPD 2.3 SANDBAG/STONE STREAM DIVERSION AND WPD 1.1 DEWATERING BASIN @ UTILITY CROSSING - SEE DETAILS, THIS SHEET. ADJUST/REMOVE @ THE DIRECTION OF THE SEDIMENT CONTROL INSPECTOR.

EXTEND RIPRAP APRON PROTECTION TO STREAM BANK (SEE WPD 3.1 DETAIL BELOW)

APPROX LIMITS OF WETLANDS

12\"/>

BRIDGE

ROAD

APPROX LIMITS 100 Yr. Flood plain

DEVELOPER'S/OWNER'S CERTIFICATE


I hereby certify that all development and construction will be done according to this plan of development and plan for erosion and sediment control and that all responsible personnel involved in the construction project will have a certificate of attendance at a Department of Natural Resources Approved Training Program for the Control of Sediment and Erosion before beginning the project. I also authorize periodic onsite inspection by the Howard Soil Conservation District or their authorized agents, as are deemed necessary.

R.P. Sawant 12/11/87
 Signature Date

ENGINEER'S CERTIFICATE


I hereby certify that this plan for Erosion and Sediment Control represents a practical and workable plan based on my personal knowledge of the site conditions and that it was prepared in accordance with the requirements of the Howard Soil Conservation District.

Al S... 12/11/87
 Signature Date

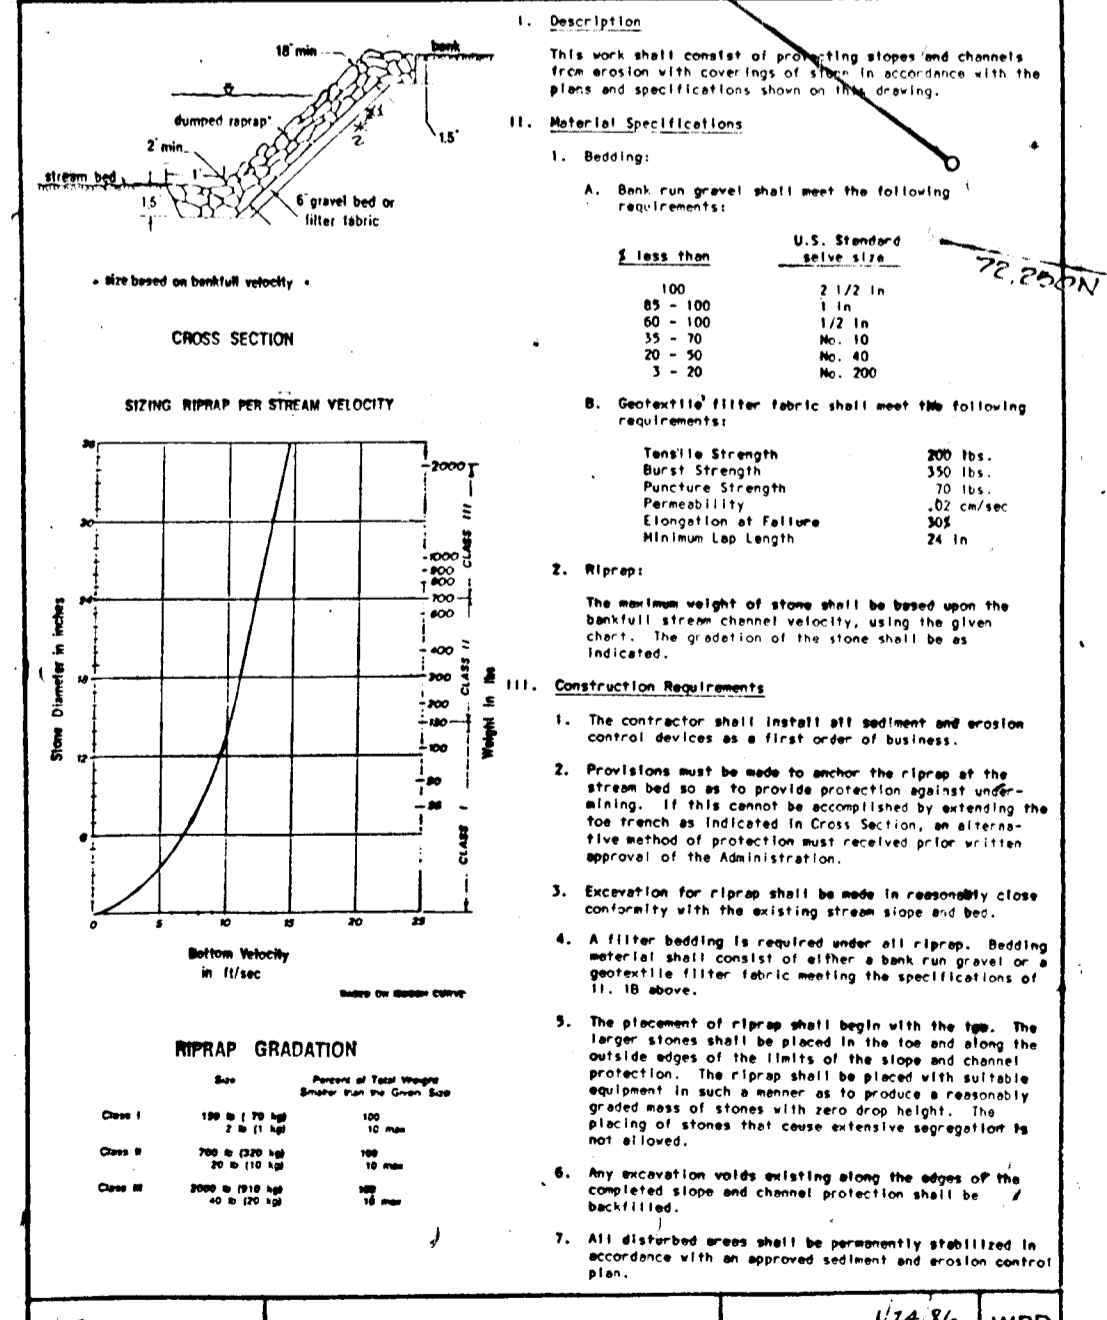

CONSTRUCTION SPECIFICATIONS FOR ST-VI

- The area under embankment shall be cleared, grubbed and stripped of any vegetation and root mat. The pool area shall be cleared.
- The fill material for the embankment shall be free of roots or other woody vegetation as well as oversized stones, rocks, organic material or other objectionable material. The embankment shall be compacted by traversing with equipment while it is being constructed. Maximum height of embankment shall be five (5) feet, measured at crestline of embankment.
- All fill slopes shall be 2:1 or flatter cut slope 1:1 or flatter.
- Elevation of the top of any dike diverting water into trap must equal or exceed the height of embankment.
- Storage area provided shall be figured by computing the volume available behind the outlet channel up to an elevation of one (1) foot below the level weir crest.
- Filter cloth shall be placed over the bottom and sides of the outlet channel prior to placement of stone. Sections of fabric must overlap at least one (1) foot with sections nearest the entrance placed on top.
- Stone used in the outlet channel shall be four (4) to eight (8) inches (rip-rap). To provide a filtering effect, a layer of filter cloth shall be embedded one (1) foot back into the upstream face of the outlet stone or one (1) foot thick layer of one (1) inch or finer aggregate shall be placed on the upstream face of the outlet.
- Sediment shall be removed and trap returned to its original dimensions when the sediment has accumulated to 1/2 the design depth of the trap. Removed sediment shall be deposited in a suitable area and in such a manner that it will not erode.
- The structure shall be inspected after each rain and repaired as needed.
- Construction operations shall be carried out in such a manner that erosion and water pollution are minimized.
- The structure shall be removed and the area stabilized when the drainage area has been properly stabilized.
- Drainage area for this practice is limited to 15 acres or less.

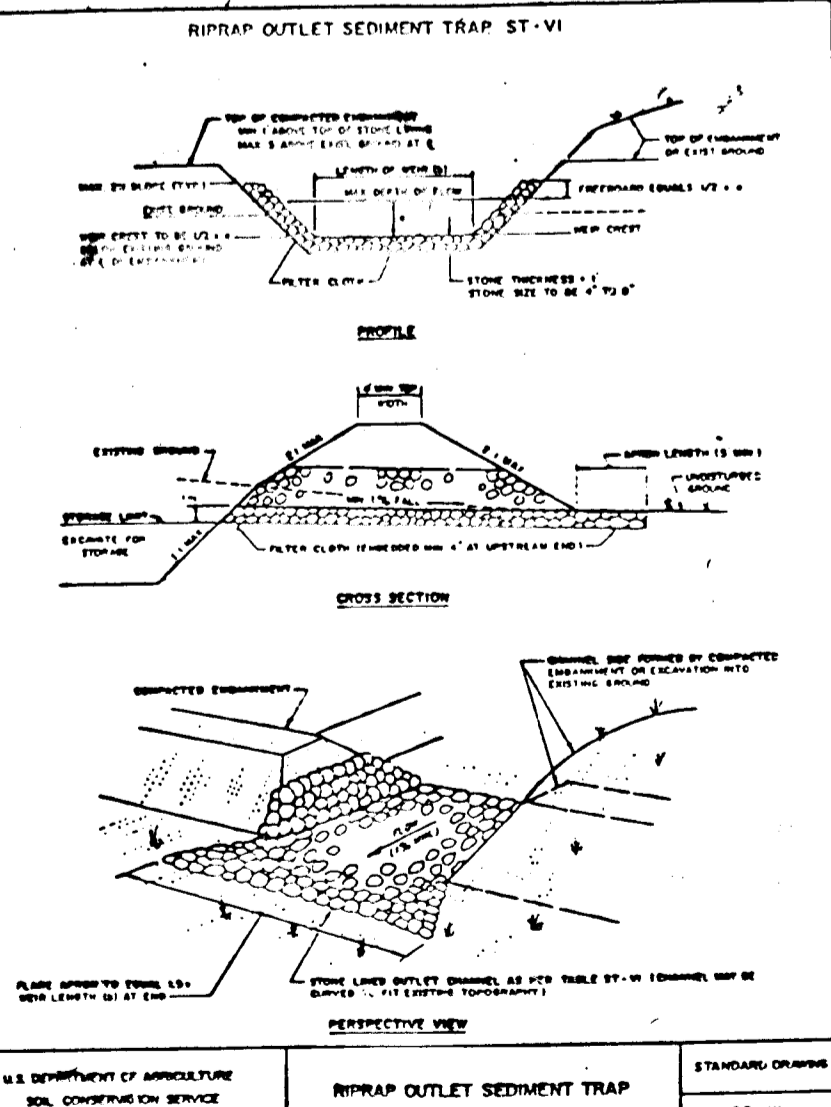

THESE PLANS HAVE BEEN REVIEWED FOR THE HOWARD SOIL CONSERVATION DISTRICT AND MEET TECHNICAL REQUIREMENTS.

James M. Helm 12-16-87
 U.S. Soil Conservation Service Date

THIS PLAN IS APPROVED FOR SOIL EROSION AND SEDIMENT CONTROL BY THE HOWARD SOIL CONSERVATION DISTRICT.

Howard S.C.D. 12-16-87
 APPROVED Date

PLAN NUMBER _____

NO.	DESCRIPTION	DATE	APPROVED	DATE

EROSION AND SEDIMENT CONTROL PLAN



WATER RESOURCES ADMINISTRATION

APPROVED: *Al S...* 12/11/87
 Chief, Waterway Permits

Patton Harris Rust and Associates
 A Professional Corporation
 Engineers, Surveyors, Planners and Landscape Architects
 7609 Standish Place, Rockville, MD 20855 (301)762-2220

BOWLING BROOK FARMS
 KNIGHTS BRIDGE ROAD
 A RESUBDIVISION OF BOWLING BROOKE, LOT 2
 SIXTH ELECTION DISTRICT
 HOWARD COUNTY, MARYLAND

SURVEY DATE 10-8-87
 DESIGN J.P.C. SHEET
 DRAWN C.S.R. SHEET
 CHECKED J.P.C. SHEET
 SCALE 1"=50' FILE NO. 2184-1-0
 C.I. 2

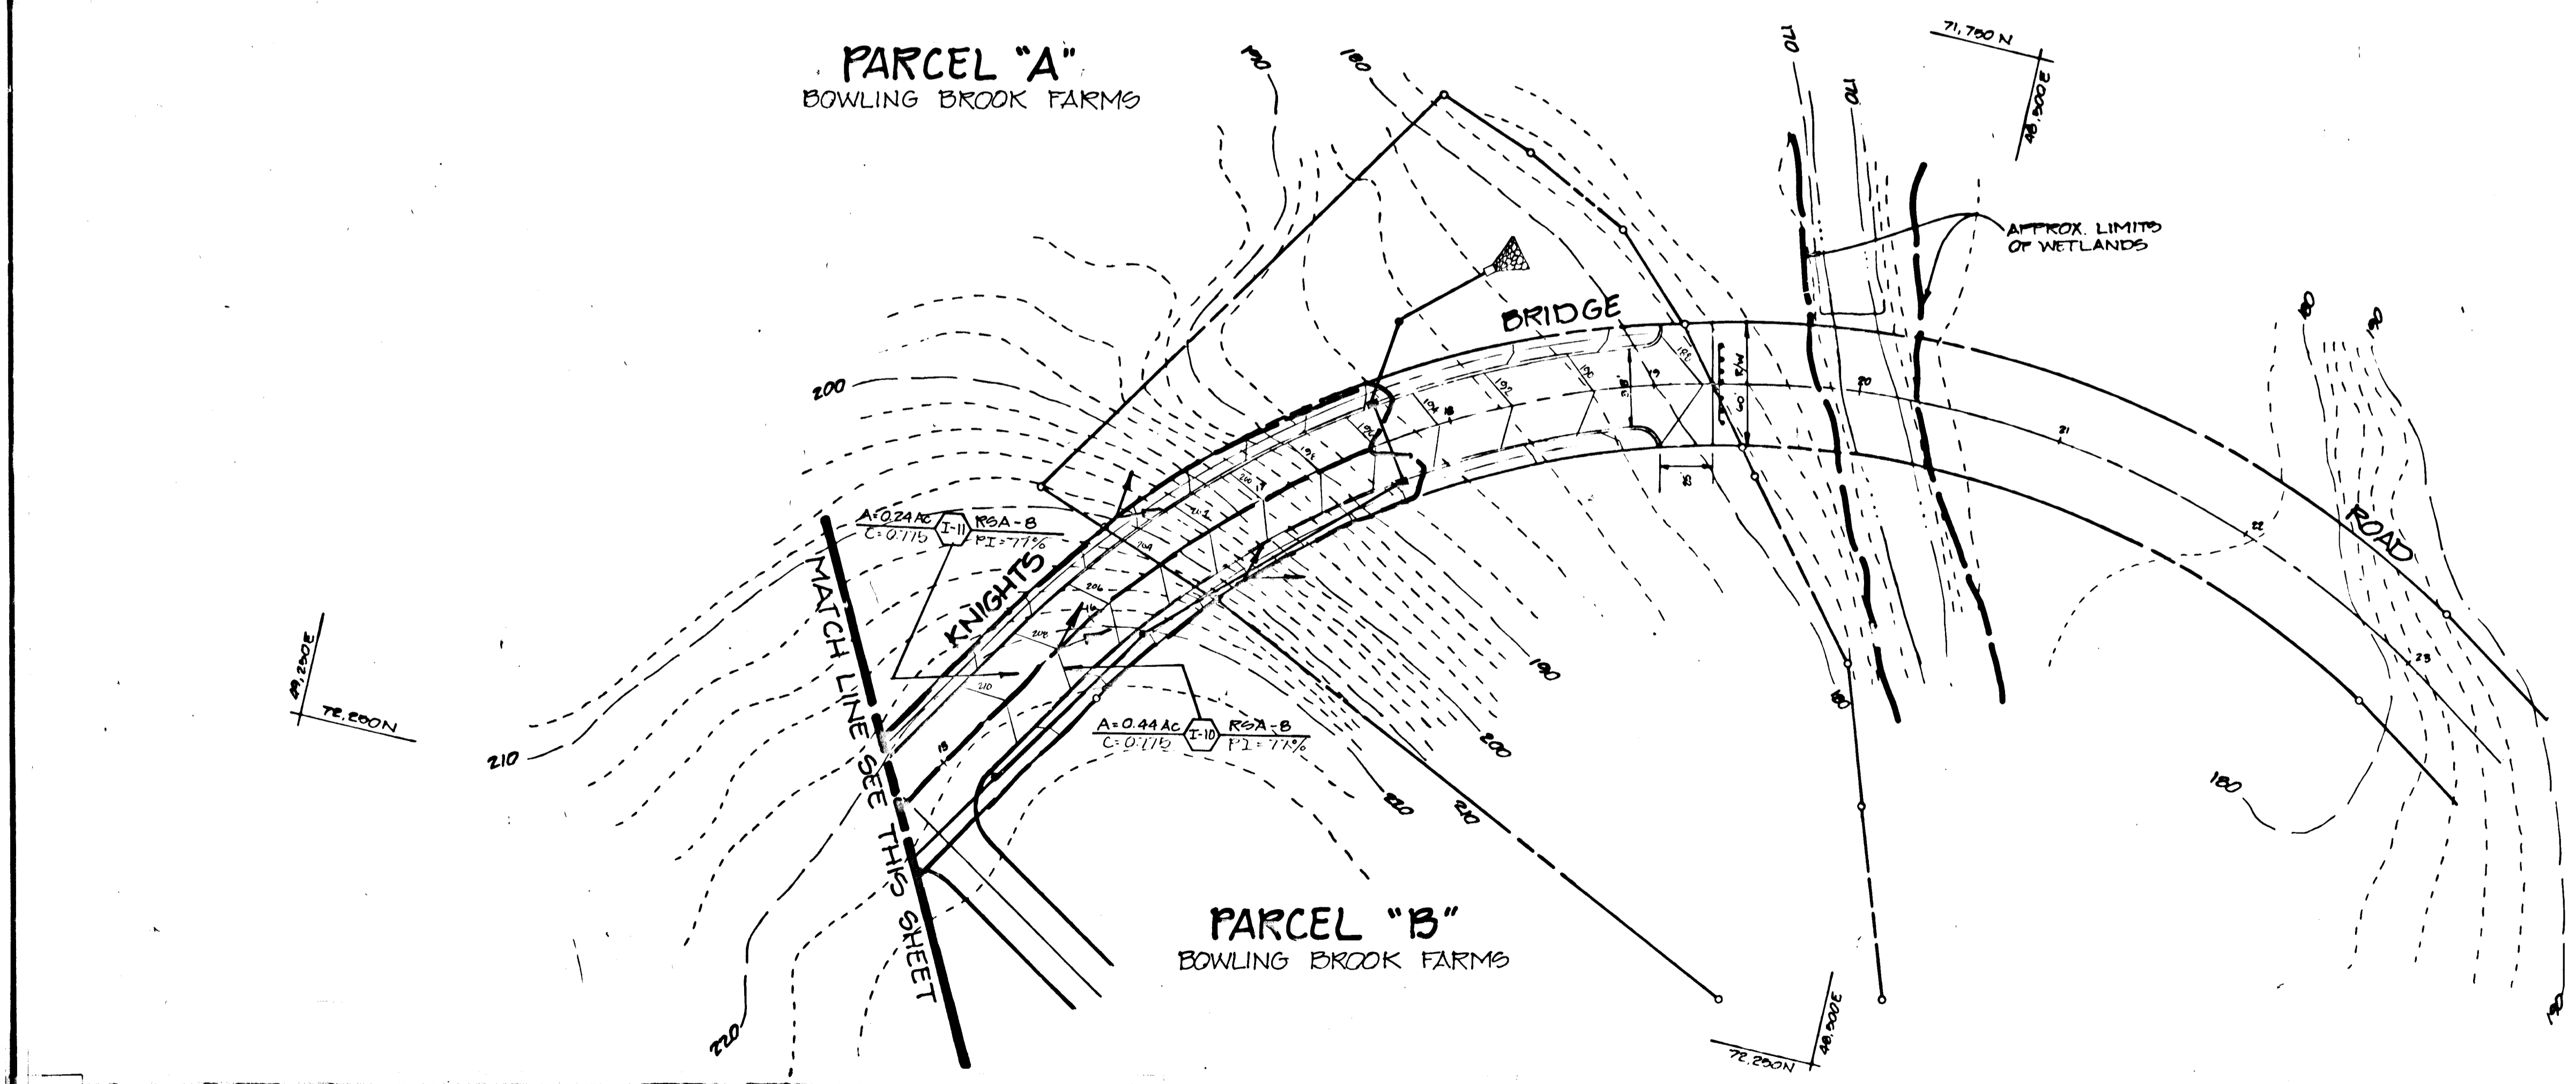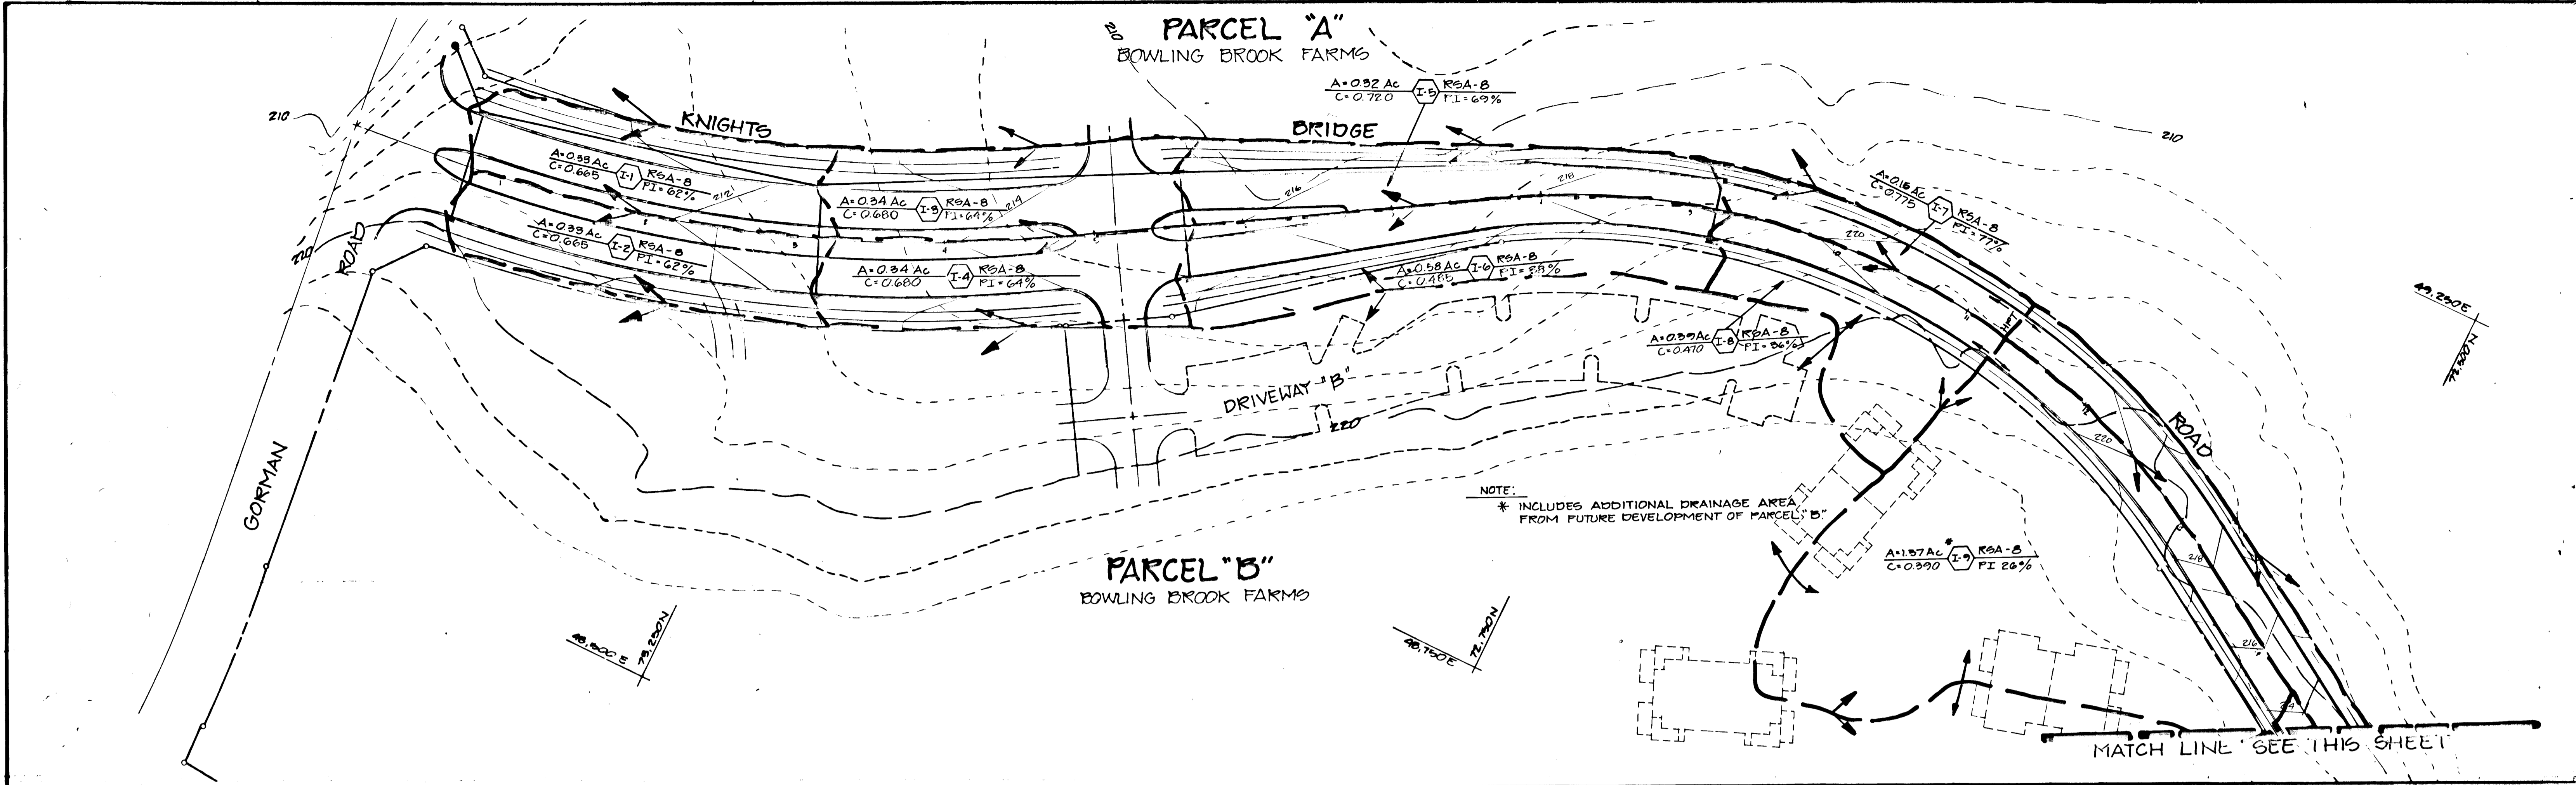

NOTE:
C FACTORS ARE DETERMINED BY APPLYING THE CALCULATED IMPERVIOUS AREAS TO FIGURE 6.09 ("C" FACTORS FOR CLAY SOILS) OF HOWARD COUNTY STORM DRAIN DESIGN MANUAL.
FOR DRAINAGE AREA I-9, THE DASHED BUILDINGS REFLECT THE ACTUAL FUTURE BUILDING LOCATION.

APPROVED: HOWARD COUNTY OFFICE OF PLANNING AND ZONING
[Signature] 2/22/88
 Chief, Division of Land Development & COMMUNITY PLANNING
 APPROVED: HOWARD COUNTY DEPARTMENT OF PUBLIC WORKS
[Signature] 1/5/88
 Chief, Land Development Division
[Signature] 1/6/88
 Chief, Bureau of Highways
[Signature] 1-11-88
 Chief, Bureau of Engineering

NO.	DESCRIPTION	DATE	APPROVED	DATE

REVISION APPROVED BY



DRAINAGE AREA MAP



Patton Harris Rust and Associates
 A Professional Corporation
 Engineers, Surveyors, Planners and Landscape Architects
 7609 STANDISH PLACE ROCKVILLE MD. 20855 (301) 762-2220

BOWLING BROOK FARMS
 KNIGHTS BRIDGE ROAD
 A RESUBDIVISION OF BOLLING BROOK, LOT 2
 SIXTH ELECTION DISTRICT
 HOWARD COUNTY, MARYLAND

SURVEY P.H.N.C.A.	10/8/87
DESIGN M.J.K.	
DRAWN J.D.W.	SHEET
CHECKED	9 OF 9
SCALE 1"=50'	FILE NO.
C.I. 2"	2181-1-0