


NOTES:  
 B-1 INDICATES SOIL BORING  
 RIP-RAP NOTE 1: 35 LF UNGRADED  
 RIP-RAP 450±0.8'  
 THICKNESS (MIN)=1.8'  
 (SEE DETAIL SHT. 3 OF 6)  
 RIP-RAP NOTE 2: 10 LF UNGRADED  
 RIP-RAP  
 450±0.8' THICKNESS (MIN)=14"  
 (SEE DETAIL SHT. 3 OF 6)

RICHARD WILSON  
 AND  
 ISABELLE WILSON  
 L. 155 F. 339  
 ZONED R-5C

**CURB & GUTTER LEGEND**  
 STD. 7" C&G  
 REV. 7" C&G  
 STD. 6" C&G  
 REV. 6" C&G

COMMUNITY OWNED OPEN SPACE  
 LOT 39  
**PLAN**  
 SCALE: 1"=50'

NOTE: WARP PAVING  
 (NO CROWN) FROM  
 STA. 4+00 TO STA. 5+00.

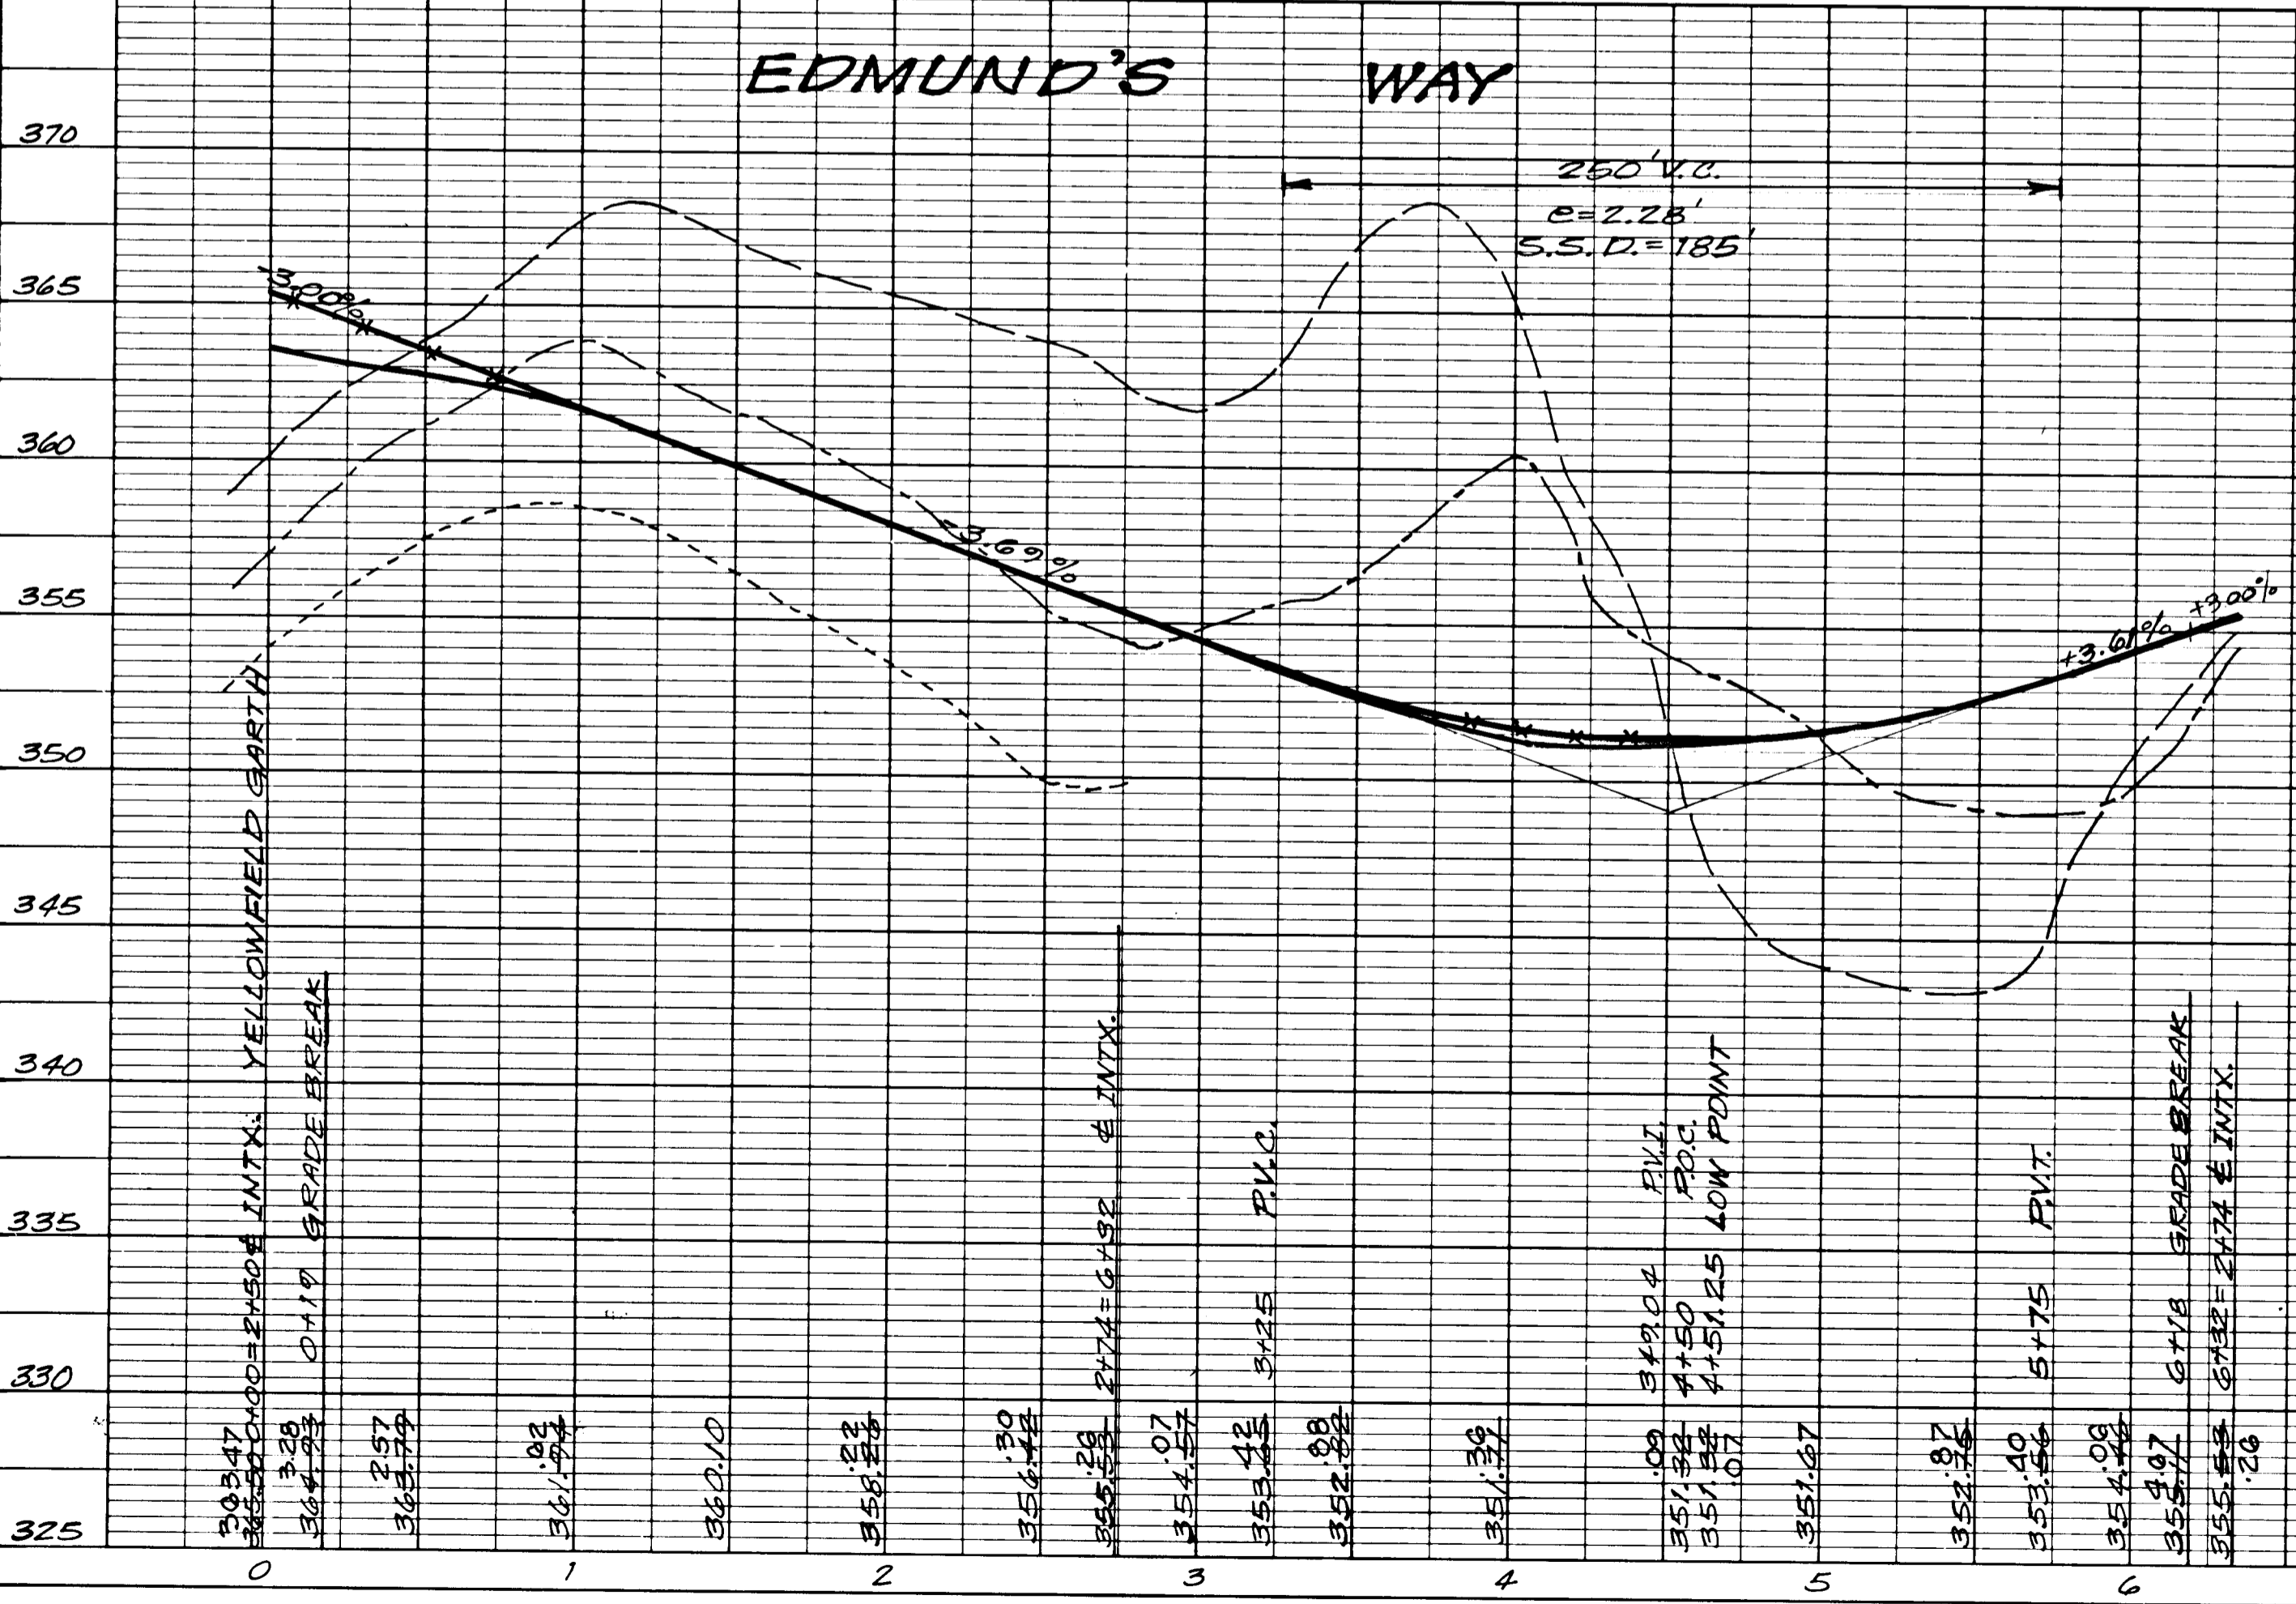

**PROFILE SCALE:**  
 HORIZ. 1"=50'  
 VERT. 1"=5'

**PROFILE LEGEND**  
 PROFILE GRADE LINE  
 EXISTING E  
 B.R.L. (RT)  
 B.R.L. (LT)

LOCATION	LAMP TYPE	MOUNTING	POLE TYPE
YELLOWFIELD GARTH @ STA. 2+12' (40.51 RT)	175 WATT H4	COLONIAL-POST TOP	14" BLACK FIBERGLASS

These Plans for small pond construction, soil erosion and sediment control meet the requirements of the Howard Soil Conservation District.



*Richard Wilson*  
 4/17/89  
 Date

*Isabelle Wilson*  
 4/17/89  
 Date

U.S. Soil Conservation Service

**DEVELOPER'S/BUILDER'S CERTIFICATE**  
 "I/We certify that all development and construction will be done according to this plan, and that any responsible personnel involved in the construction project will have a Certificate of Attendance at a Department of Natural Resources Approved Training Program for the Control of Sediment and Erosion before beginning the project." I also authorize periodic on-site inspection by the H.S.C.D.  
*Richard Wilson*  
 Signature of Developer/Builder  
 7/13/88  
 Date

**ENGINEER'S CERTIFICATE**  
 "I certify that this plan for pond construction, erosion and sediment control represents a practical and workable plan based on my personal knowledge of the site conditions. This plan was prepared in accordance with the requirements of the Howard Soil Conservation District. I have notified the developer that he must provide the Howard Soil Conservation District with an "as-built" plan of the pond within 30 days of completion."  
*CK Weber*  
 Signature of Engineer  
 7-13-88  
 Date

RECORD OF SOIL EXPLORATION  
 B-1

BLK.	SOIL DESCRIPTION	DEPTH	WATER TABLE	WATER TABLE DEPTH
1	Light brown moist sand with some gravel, trace silt (sandy sand)	0-1.2		
2	bottom of test hole at 4.5'	1.2-4.5		

RECORD OF SOIL EXPLORATION  
 B-2

BLK.	SOIL DESCRIPTION	DEPTH	WATER TABLE	WATER TABLE DEPTH
1	Dark grayish brown silt with some sand trace gravel (silt loam)	0-0.5		
2	Dark gray wet silty sand with some silt and gravel	0.5-1.5		
3	bottom of test hole at 4.5'	1.5-4.5		

NOTE: See the Stormwater Management Pond Notes, sht. 6 of 6, for core trench and embankment information.

RECORD OF SOIL EXPLORATION  
 B-3

BLK.	SOIL DESCRIPTION	DEPTH	WATER TABLE	WATER TABLE DEPTH
1	Light brown moist sand with some gravel, trace silt (sandy sand)	0-1.0		
2	(loamy sand)	1.0-10.0		
3	bottom of test hole at 10.0'	10.0-10.0		

APPROVED: DEPARTMENT OF PUBLIC WORKS  
*Richard Wilson*  
 DATE 4/20/89

CHIEF, LAND DEVELOPMENT DIVISION

*Lawrence W. Wever*  
 DATE 5/25/89

CHIEF, BUREAU OF HIGHWAYS

*Richard Wilson*  
 DATE 5/25/89

CHIEF, BUREAU OF ENGINEERING

APPROVED: HOWARD COUNTY OFFICE OF PLANNING & ZONING  
*Frank S. ...*  
 DATE 5/25/89

CHIEF, DIVISION OF COMMUNITY PLANNING & LAND DEVELOPMENT

**GW GUTSCHICK LITTLE & WEBER, P.A.**  
 ENGINEERS, PLANNERS, SURVEYORS  
 3909 NATIONAL DRIVE - SUITE 250 BURTONSVILLE OFFICE PARK - BURTONSVILLE, MD. 20866  
 TEL.: (301) 421-4024

DESIGNED: J.d.E.  
 DRAWN: R.R.S.  
 CHECKED: C.K.G.  
 DATE: MARCH 22, 1989






ROAD CONSTRUCTION PLANS  
**EDMUND'S WAY**  
**BRIGHTFIELD**  
 SECTION 3  
 1st ELECTION DISTRICT  
 HOWARD COUNTY, MARYLAND

SCALE: AS SHOWN  
 DRAWING: 2 OF 6  
 JOB NO.: 86-058

FOR: 100 INVESTMENT LTD. PARTNERSHIP  
 9035 REED BRANCH ROAD SUITE 250  
 COLUMBIA, MARYLAND 21045 (301) 740-3323

1302



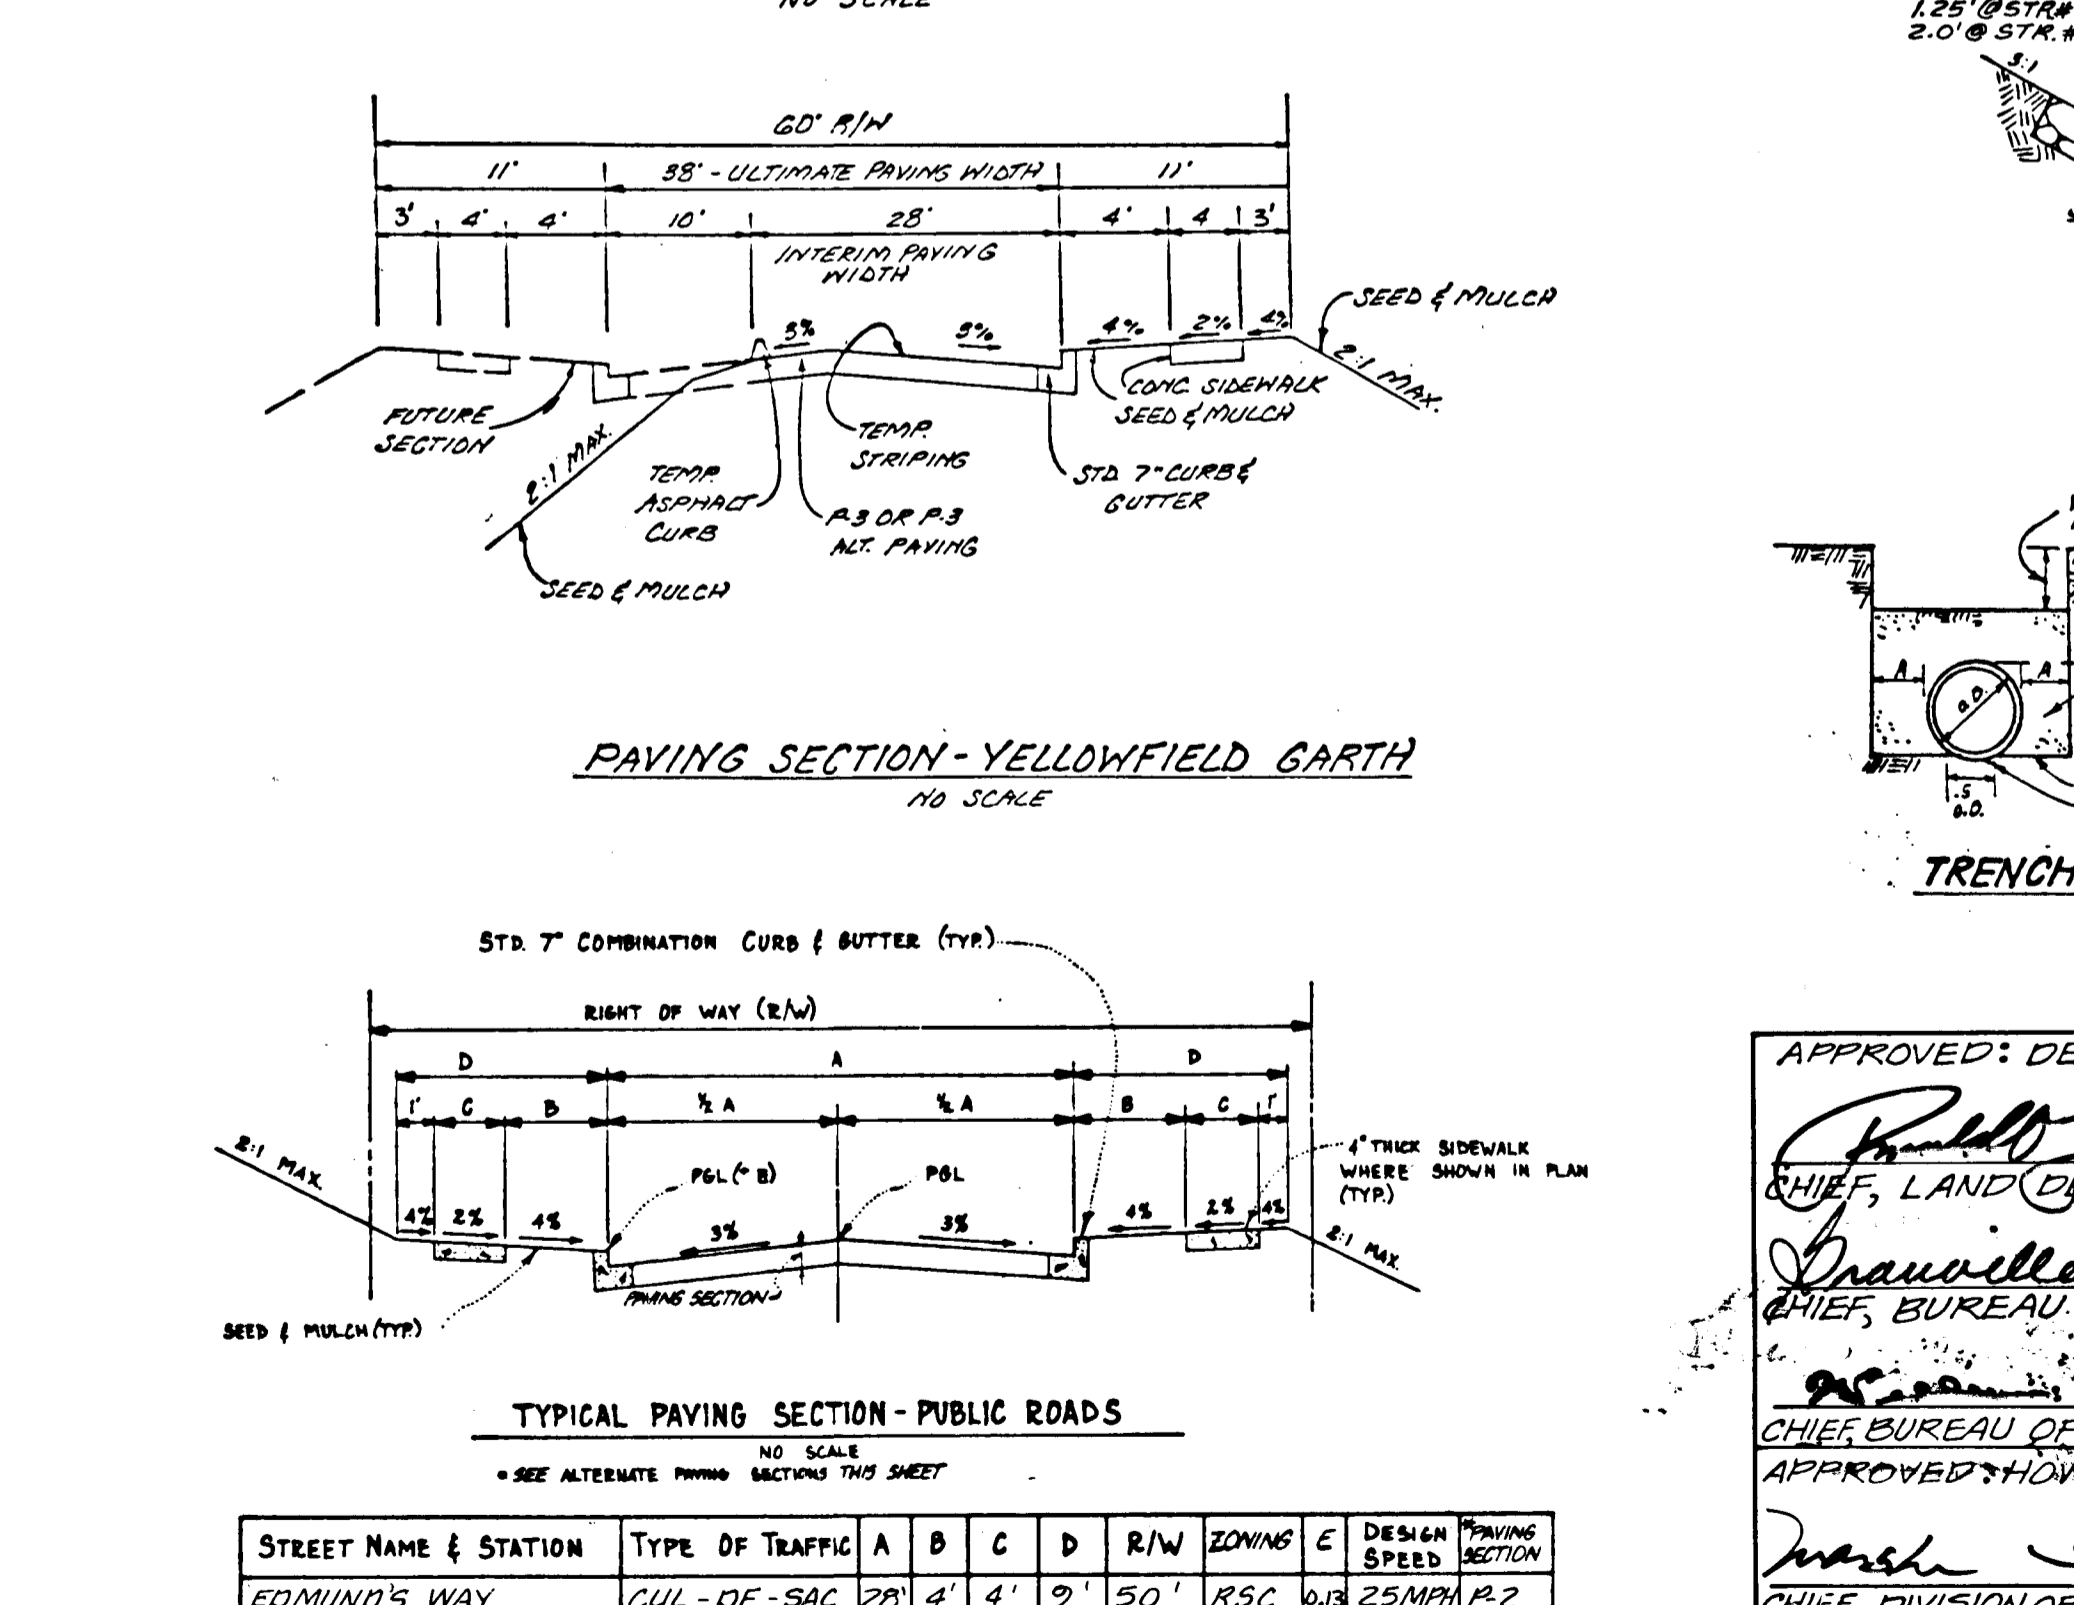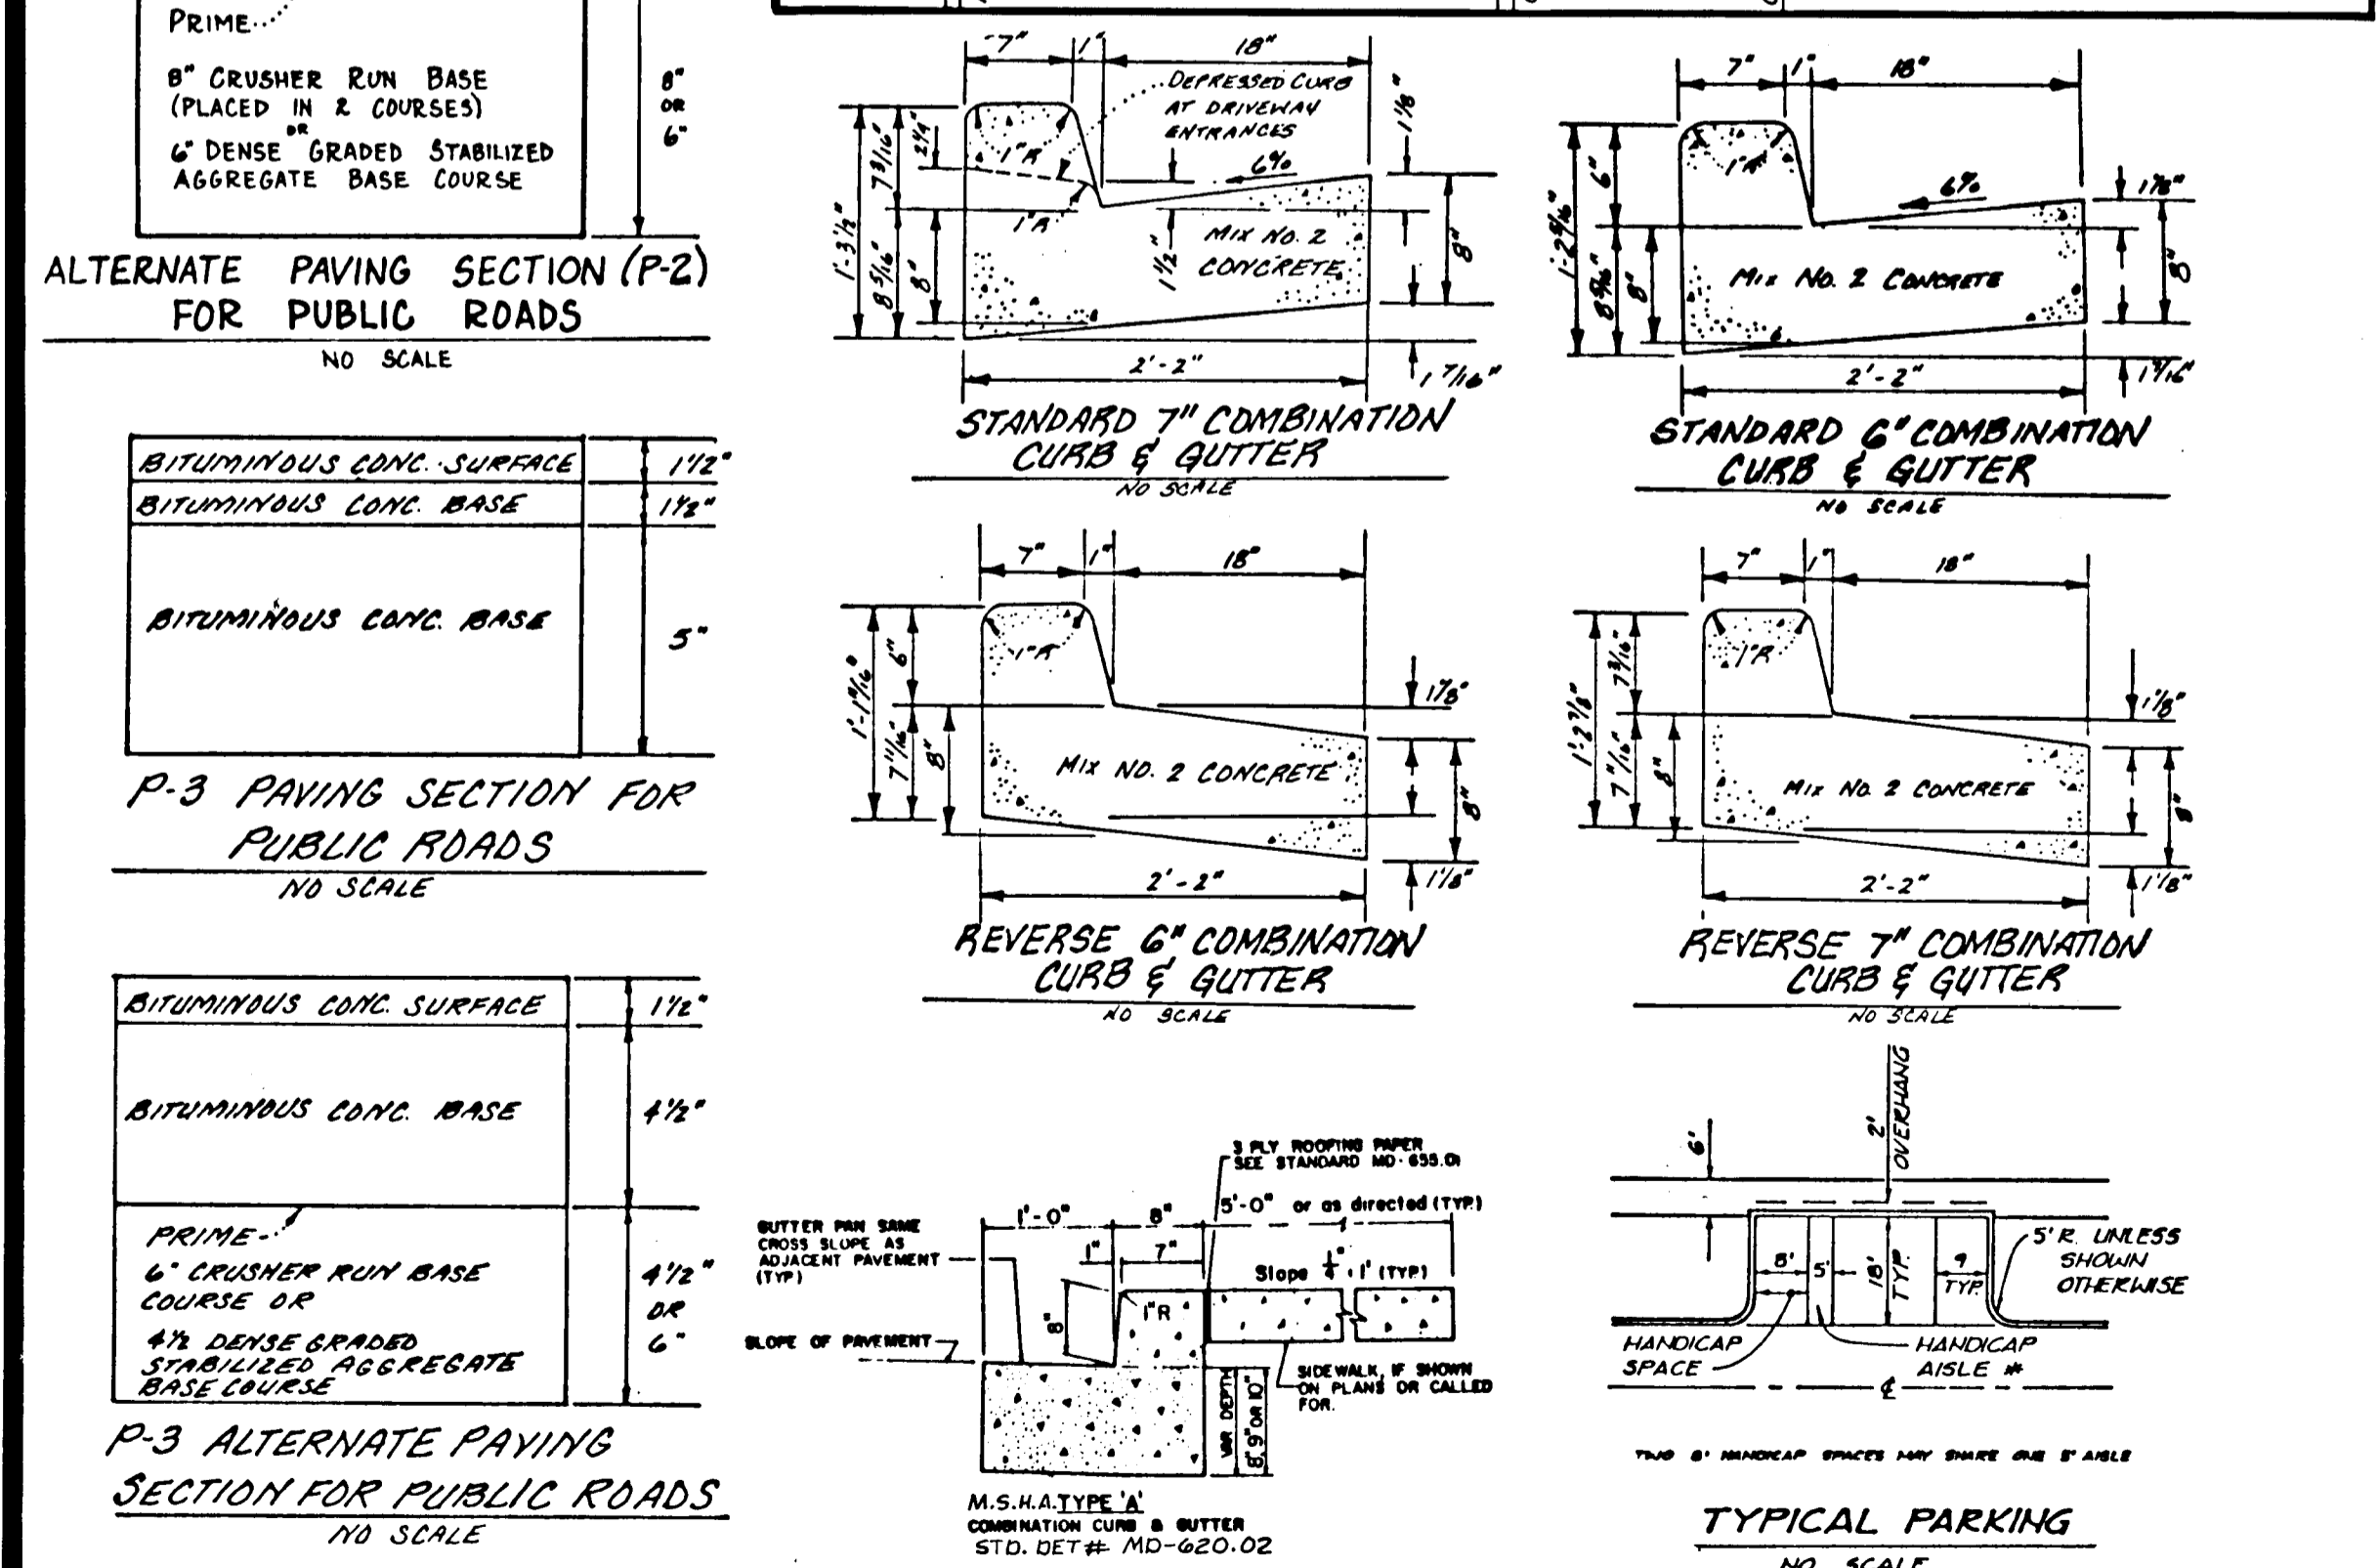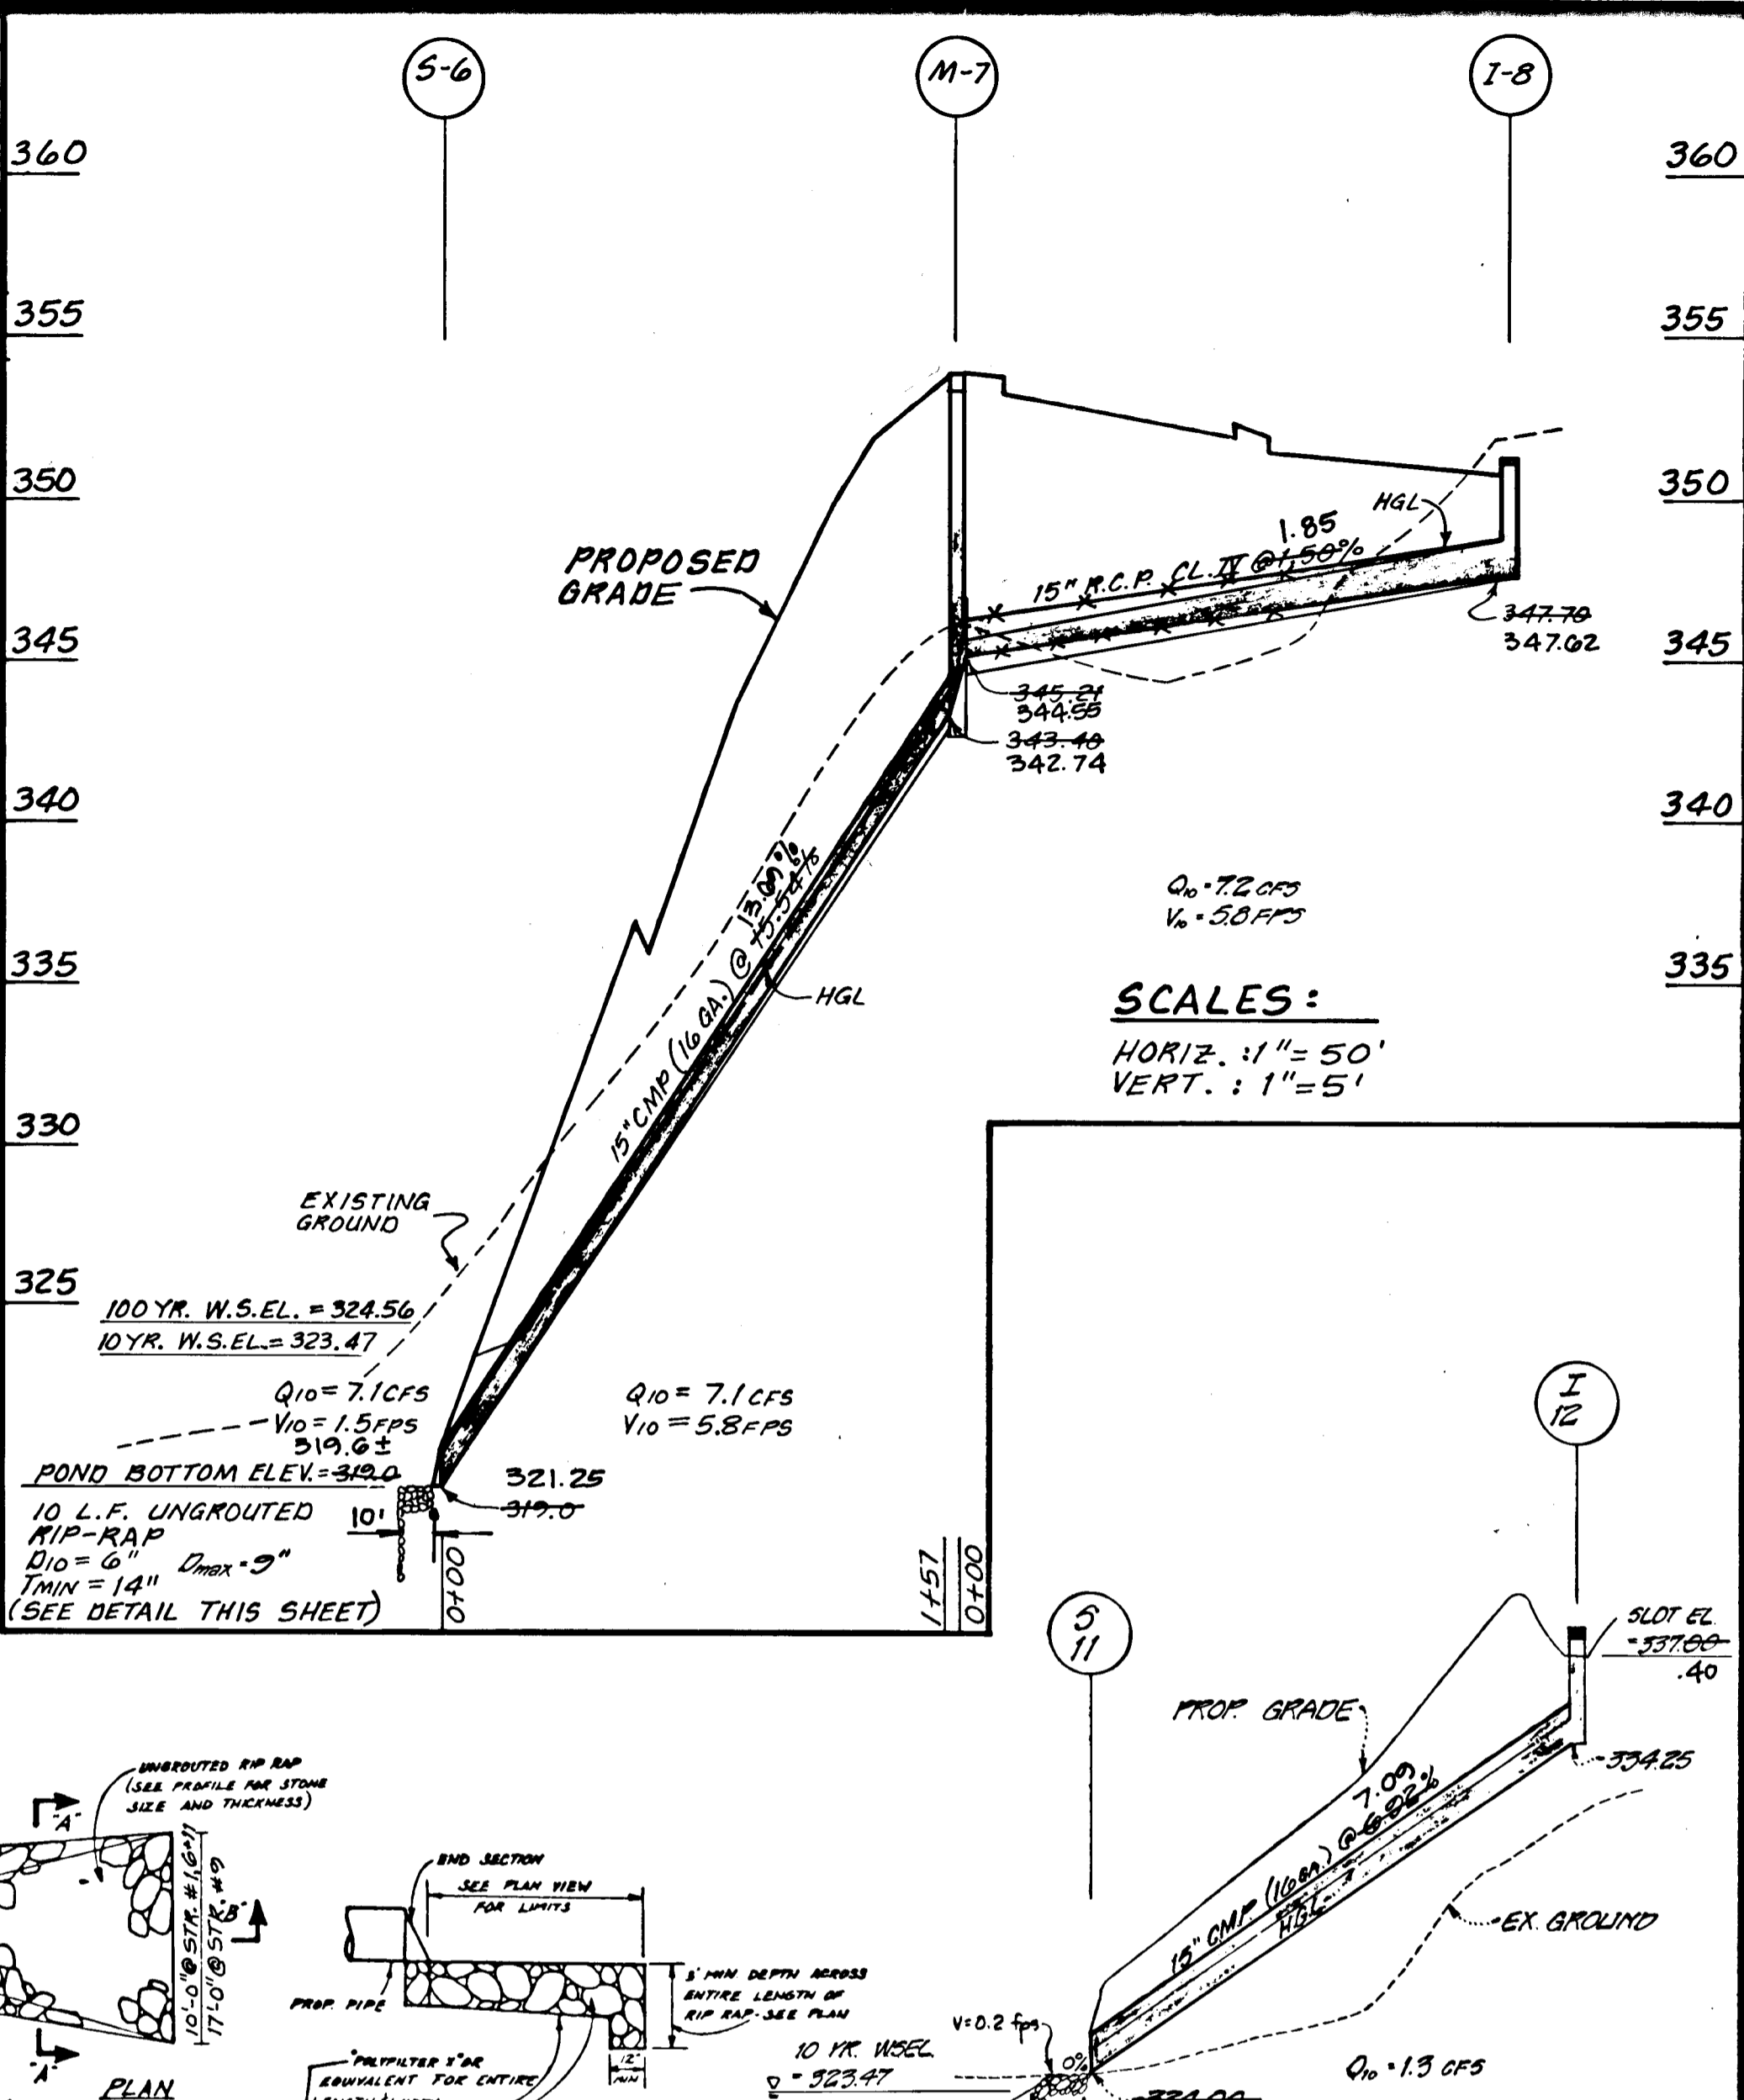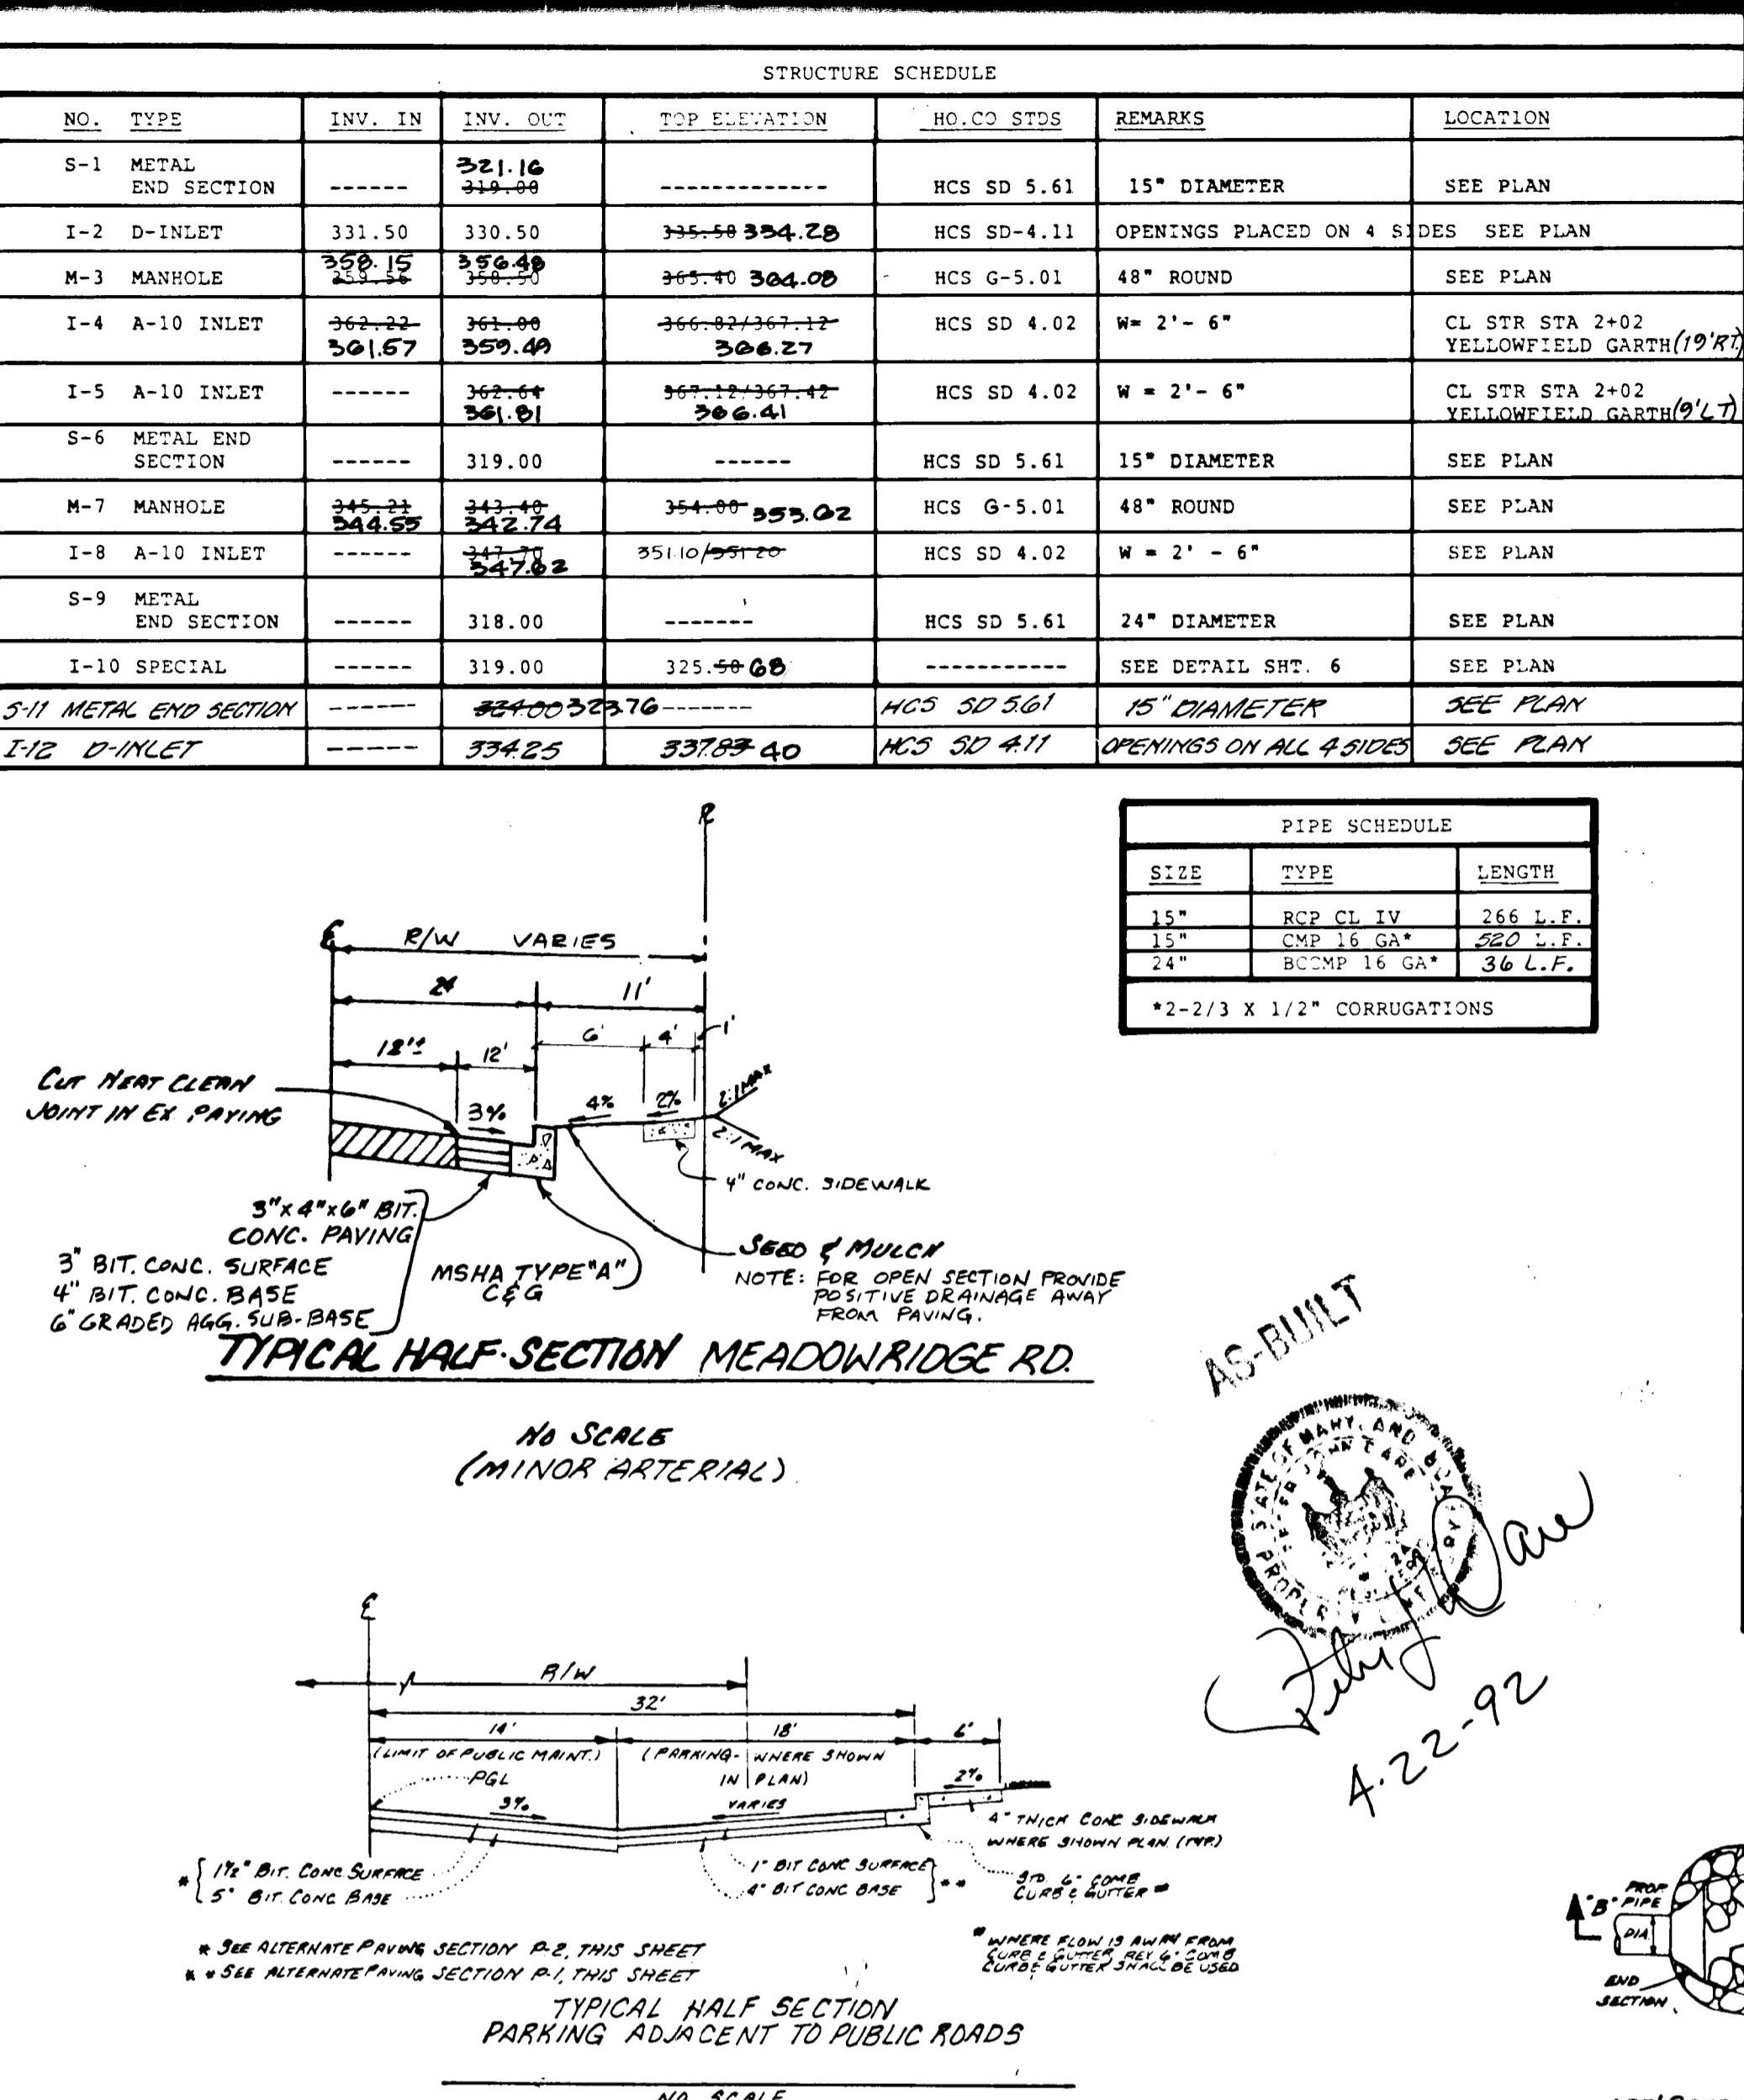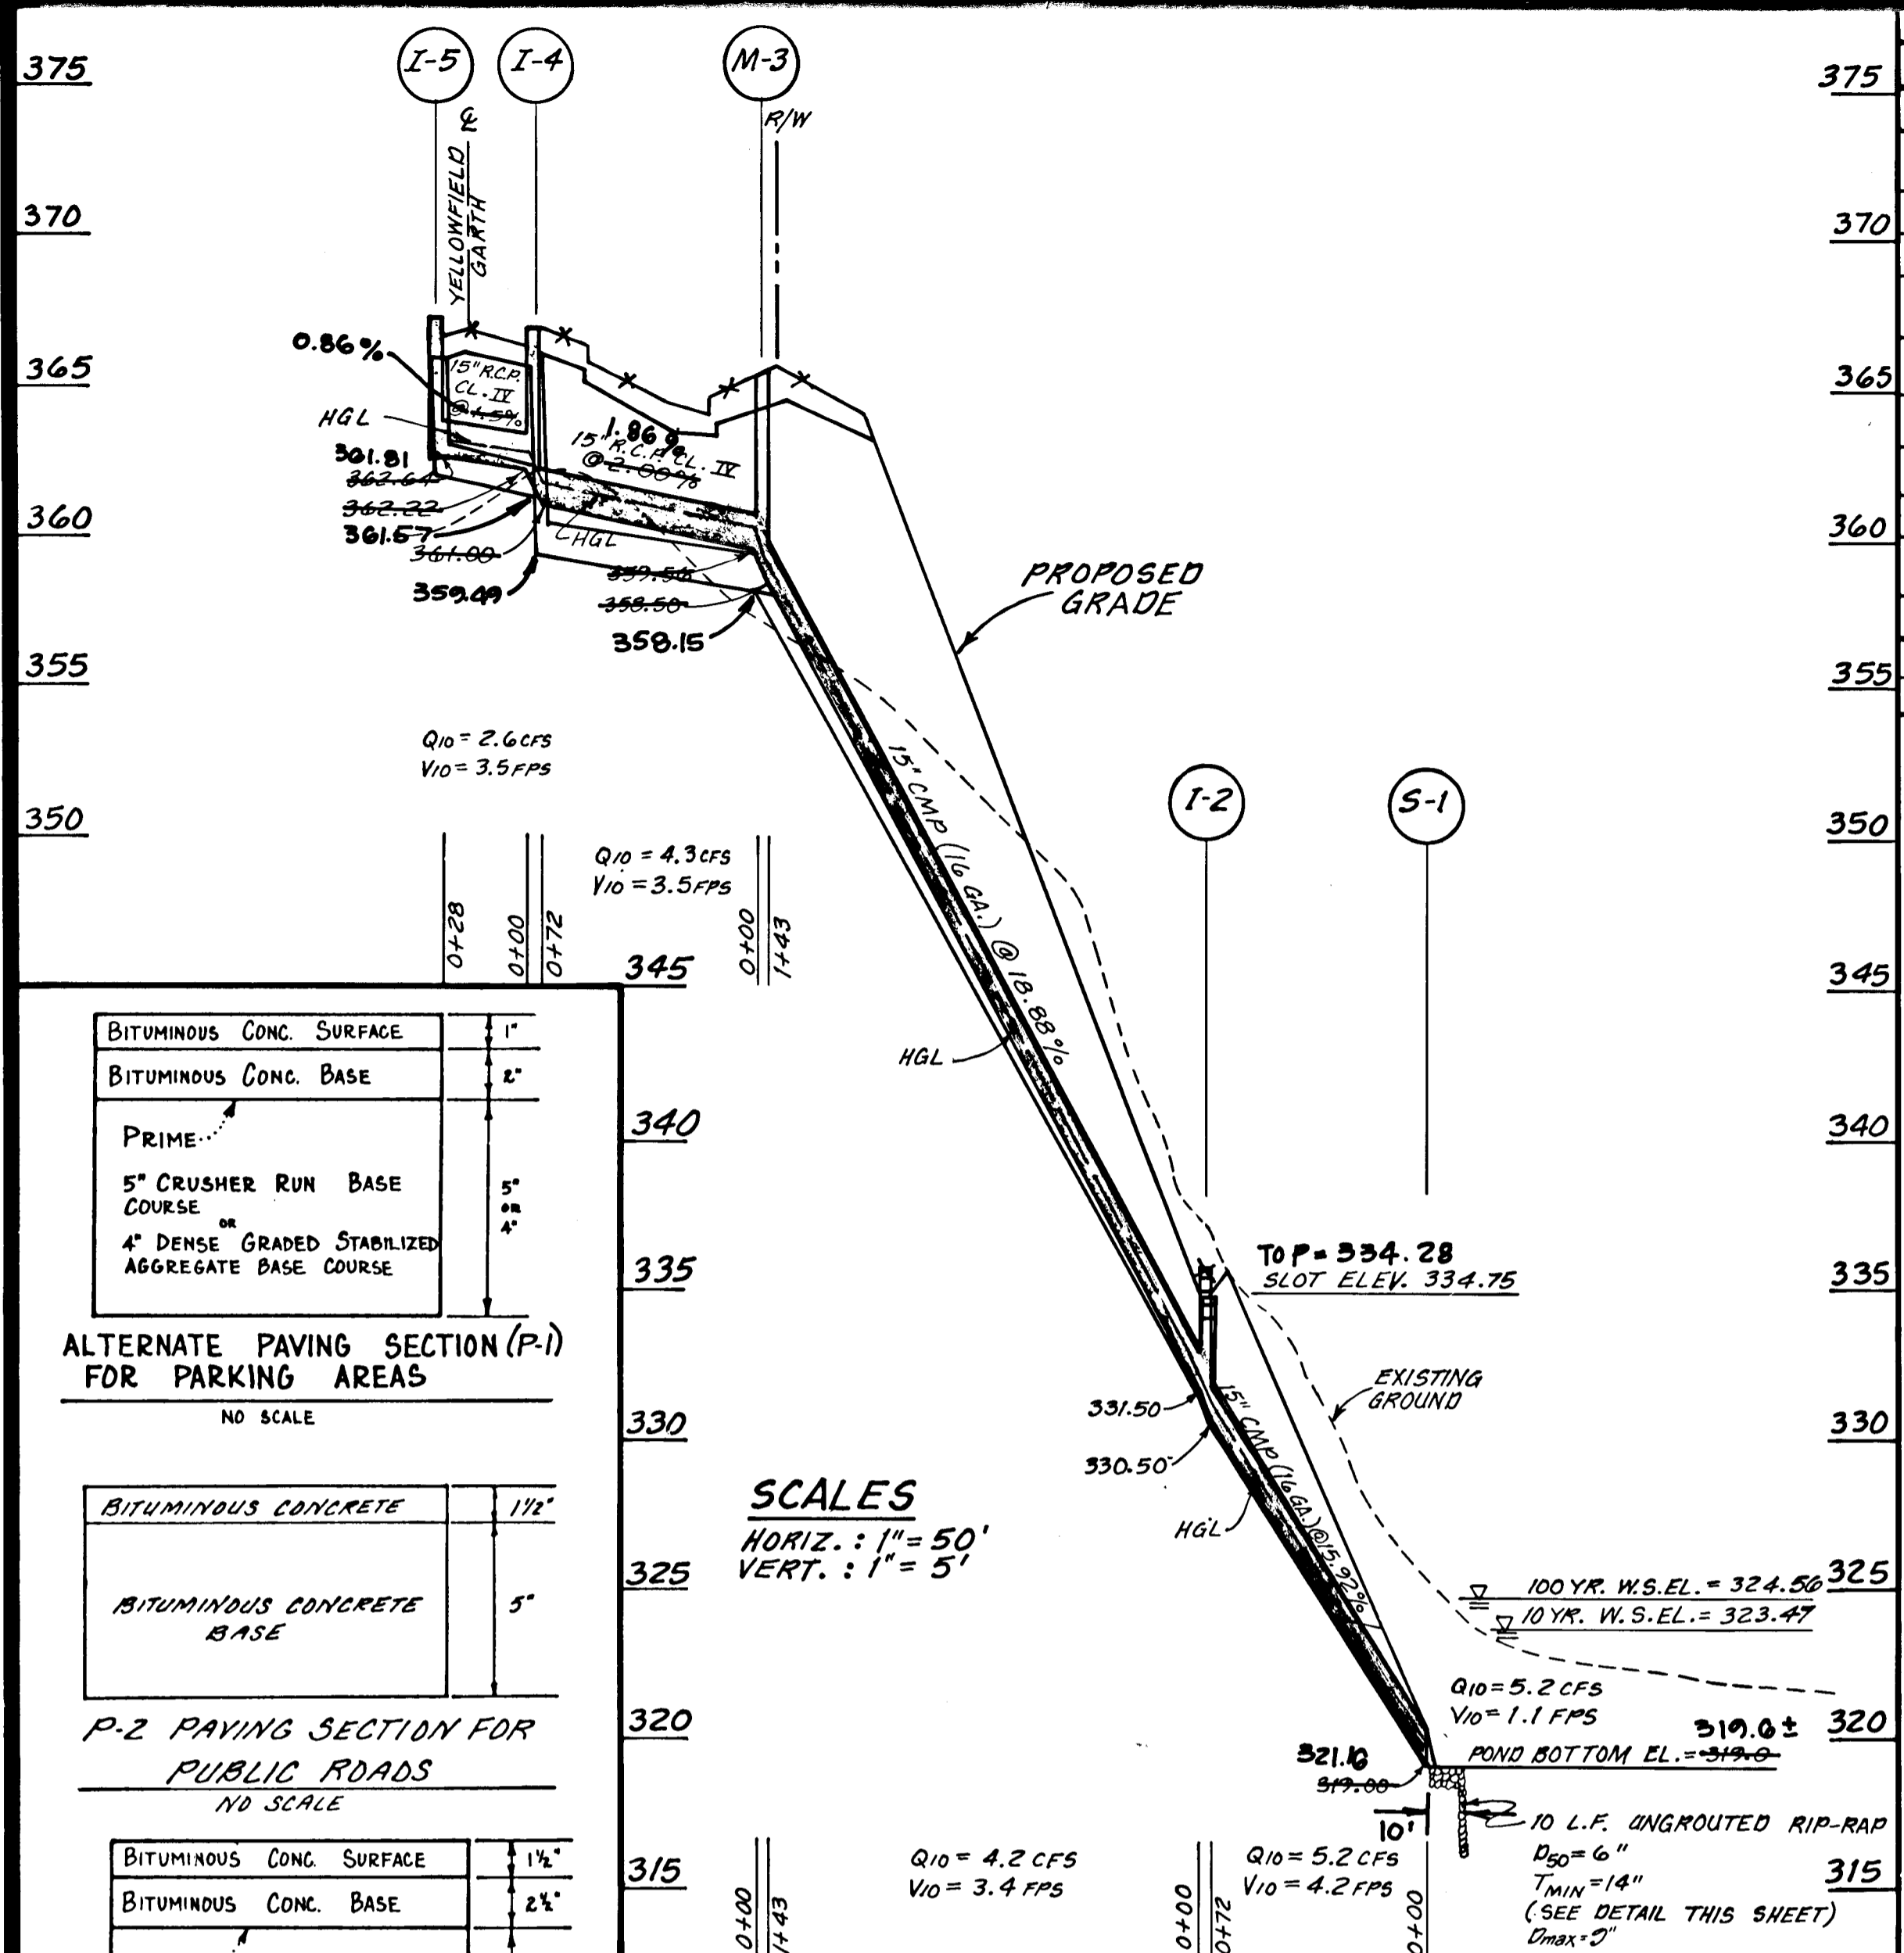

**DEVELOPER'S/BUILDER'S CERTIFICATE**

"I/We certify that all development and construction will be done according to this plan, and that any responsible personnel involved in the construction project will have a Certificate of Attendance at a Department of Natural Resources approved training program for the Control of Sediment and Erosion before beginning the project. I also authorize periodic on-site inspection by the Department of Natural Resources."

*Robert M. ...* 7/13/88

**ENGINEER'S CERTIFICATE**

"I certify that this plan for pond construction, erosion and sediment control represents a practical and workable plan based on my personal knowledge of the site conditions. This plan was prepared in accordance with the requirements of the Howard Soil Conservation District. I have notified the developer that he must provide the Howard Soil Conservation District with an 'as-built' plan of the pond within 30 days of completion."

*C.K. ...* 7-13-88

**APPROVED: DEPARTMENT OF PUBLIC WORKS**

*Richard ...* 4/2/89

**APPROVED: HOWARD COUNTY OFFICE OF PLANNING & ZONING**

*... ..* 5/2/89

**GLW GUTSCHICK LITTLE & WEBER, P.A.**  
 ENGINEERS, PLANNERS, SURVEYORS  
 3909 NATIONAL DRIVE - SUITE 250 - BURTONSVILLE OFFICE PARK - BURTONSVILLE, MD. 20886  
 TELEPHONE: (301) 421-4024

PREPARED FOR:  
 100 INVESTMENT LTD. PARTNERSHIP  
 C/O BRITAM DEVELOPMENT  
 9030 RED BRANCH RD.  
 SUITE 250  
 COLUMBIA, MD. 21045  
 (301) 740-3323

ROAD CONSTRUCTION PLANS - PAVING DETAILS & STORM DRAIN DETAILS  
**BRIGHTFIELD**  
 SECTION 3  
 LIBER 939 - FOLIO 390  
 ELECTION DISTRICT NO. 1

STREET NAME & STATION	TYPE OF TRAFFIC	A	B	C	D	R/W	ZONING	E	DESIGN SPEED	PAVING SECTION
EDMUND'S WAY	CUL-DE-SAC	28'	4'	9'	50'	RSC	D/B	25 MPH	P-2	

SCALE: AS SHOWN  
 ZONING: 86-05B  
 DATE: MARCH 22 1989  
 TAX MAP NO.: 37  
 SHEET: 3 OF 6  
 F-89-20  
 AS-BUILT 4-22-92




MARY L. LAINGER  
506/433

SEQUENCE OF CONSTRUCTION

1. OBTAIN A GRADING PERMIT.
2. INSTALL STABILIZED CONSTRUCTION ENTRANCE.
3. INSTALL EARTH DIKES, SEDIMENT BASIN, AND STRAWBALE DIKES/SILT FENCES AS SHOWN ON THE PLAN.
4. CLEAR AND GRADE THE SITE. NOTE: SWALE ON SOUTHEAST SIDE OF SITE MUST BE MAINTAINED AND FUNCTIONAL AS SITE IS GRADED.
5. INSTALL UTILITIES.
6. STABILIZE THE SITE WITH BUILDINGS, PAVING, AND SEEDING/SODDING PER THE SITE PLAN.
7. CLEAN OUT THE STORM DRAIN SYSTEM.
8. REMOVE SEDIMENT BASIN AND OTHER SEDIMENT CONTROL MEASURES ONLY AFTER THOSE AREAS WHICH ARE SERVED BY THESE MEASURES HAVE BEEN STABILIZED AND PERMISSION HAS BEEN GRANTED BY THE SEDIMENT CONTROL INSPECTOR.
9. CLEAN OUT AND REGRADE SWM POND AS NECESSARY TO CONFORM TO THE PLANS. REMOVE LOW FLOW BLOCKING DEVICE FROM THE 42" CMP RISER.

LEGEND

- S.B.D./S = STRAW BALE DIKE OR SILT FENCE
- E.D. (AK) = EARTH DIKE
- = EXISTING CONTOUR
- = PROPOSED CONTOUR
- ..... = LIMIT OF DISTURBANCE
- [Symbol] = STABILIZED CONSTRUCTION ENTRANCE
- = SAFETY FENCE
- = PROP. DRAINAGE AREAS
- = EXIST. DRAINAGE AREAS

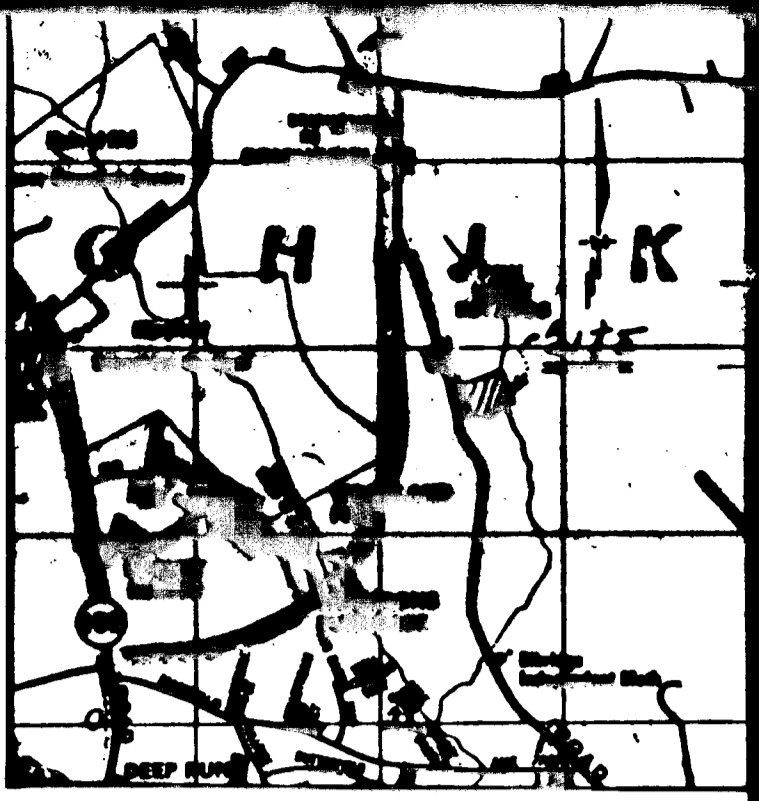


SCALE: 1"=50'


100 YR. FLOODPLAIN

FOX HUNT ESTATES  
PLAT NO. 4033  
LOT 7

NOTE:  
THE LIMIT OF DISTURBANCE IS  
LOCATED ON THE PROPERTY  
LINE.

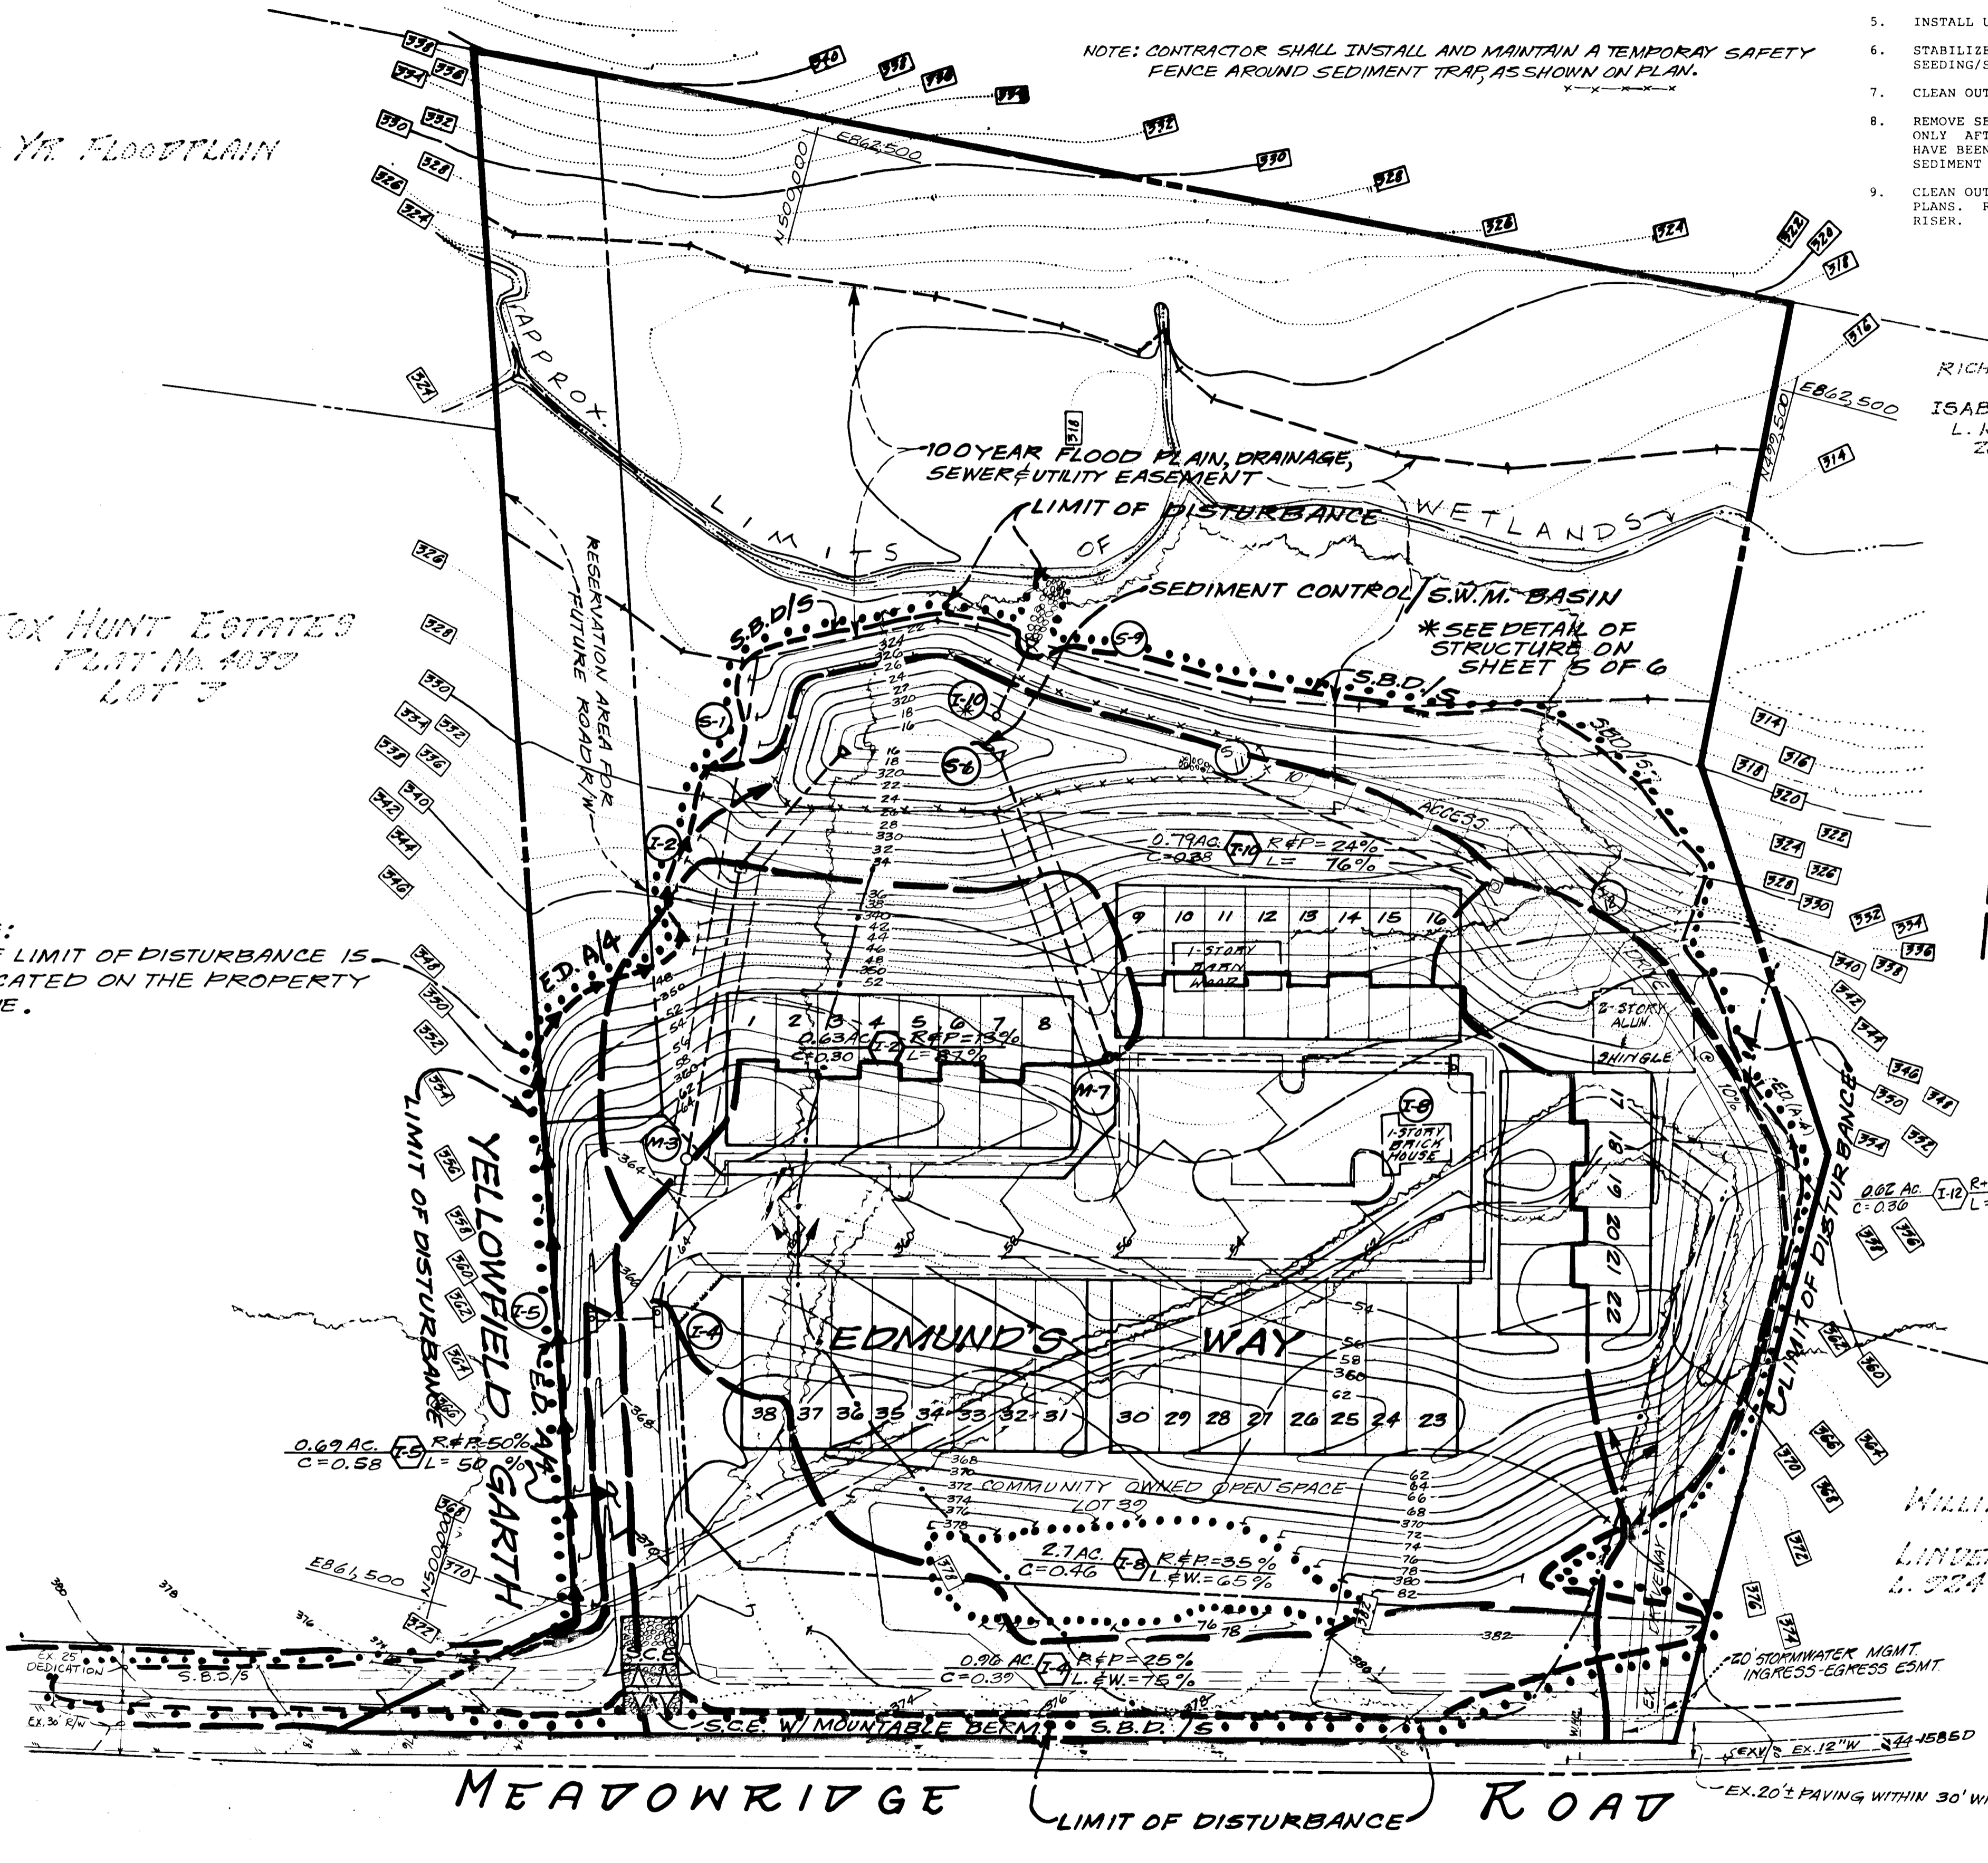

RICHARD WILSON  
AND  
ISABELLE WILSON  
L. 155 F. 330  
ZONED R-5C

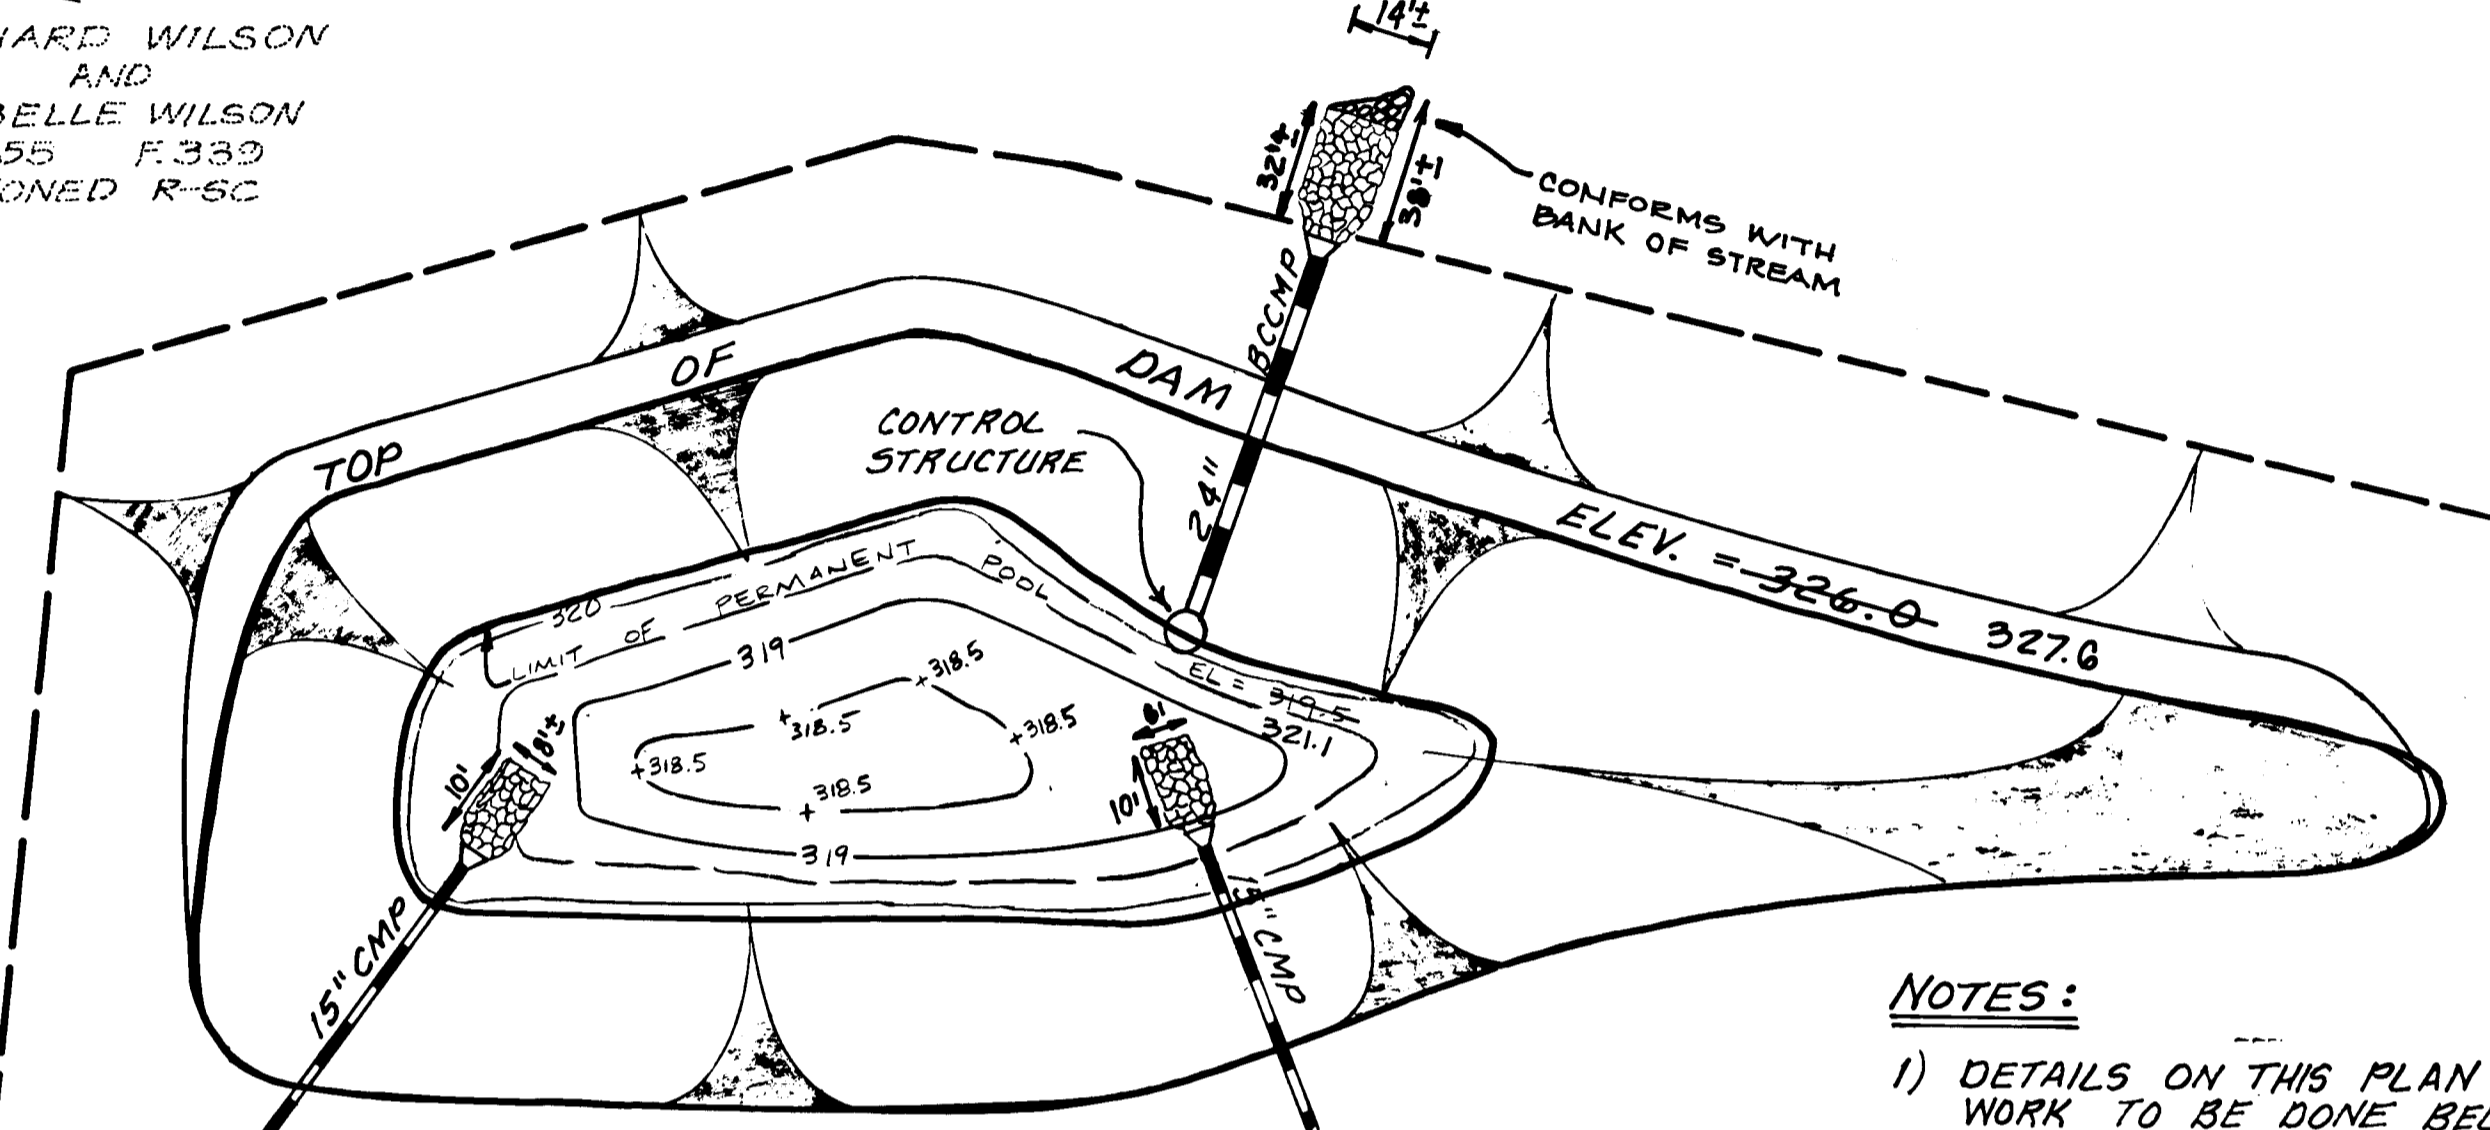

SHALLOW MARSH PLAN  
PERMANENT POOL SURFACE AREA = 2890 SQ. FT.  
SCALE: 1"=20'

- NOTES:
- 1) DETAILS ON THIS PLAN SHOW WORK TO BE DONE BELOW THE PERMANENT POOL.
  - 2) MARSH PLANTINGS AND LOCATIONS TO BE DONE BY OTHERS.
  - 3) GRADING SHOWN HERE REPRESENTS FINAL POND GRADING.

AS-BUILT

*[Signature]*  
4-22-92

These plans for small pond construction, soil erosion and sediment control meet the requirements of the Howard Soil Conservation District.

*[Signature]* 4/12/89  
District Engineer

These plans have been reviewed for the Howard Soil Conservation District and meet the technical requirements for small pond construction, soil erosion and sediment control.

*[Signature]* 4/12/89  
District Engineer

"I certify that all development and construction will be done according to this plan, and that any responsible personnel involved in the construction project will have a Certificate of Attendance at a Department of Natural Resources Approved Training Program for the Control of Sediment and Erosion before beginning construction. I also authorize periodic on-site inspection by the District." 7/13/88

"I certify that this plan for pond construction, erosion and sediment control represents a practical and workable plan based on my personal knowledge of the site conditions. This plan was prepared in accordance with the requirements of the Howard Soil Conservation District. I have notified the developer that he must provide the Howard Soil Conservation District with an 'as-built' plan of the pond within 30 days of completion." 7-13-88

APPROVED DEPARTMENT OF PUBLIC WORKS

*[Signature]* 4/20/89  
CHIEF, LAND DEVELOPMENT DIVISION

*[Signature]* 5/25/89  
CHIEF, BUREAU OF HIGHWAYS

*[Signature]* 5/25/89  
CHIEF, BUREAU OF ENGINEERING

*[Signature]* 5/25/89  
CHIEF, DIVISION OF COMMUNITY PLANNING & LAND DEVELOPMENT



**GLW GUTSCHICK LITTLE & WEBER, P.A.**  
ENGINEERS, PLANNERS, SURVEYORS  
3909 NATIONAL DRIVE - SUITE 250 - BURTONSVILLE OFFICE PARK - BURTONSVILLE, MD. 20866





DES.	CHK.	DATE	REVISION	BY	APP'R.
J.D.E.	DRM, R.R.S., CHK. C.K.G.				

PREPARED FOR:  
100 INVESTMENT LTD. PARTNERSHIP  
% BRITAM DEVELOPMENT  
9030 RED BRANCH ROAD, SUITE 250  
COLUMBIA, MARYLAND 21045  
(301) 740-3823

SEDIMENT CONTROL PLAN, DRAINAGE AREA MAP & SHALLOW MARSH PLAN  
**BRIGHTFIELD**  
SECTION 3  
L. 939 F. 390  
YELLOWFIELD GARTH AND EDMUND'S WAY  
HOWARD COUNTY, MARYLAND  
1<sup>st</sup> ELECTION DISTRICT

SCALE	CONTOUR INTERVAL	G.L.W. FILE NO.
AS SHOWN	2 FT.	86-058
DATE	TAX MAP NO.	SHEET
MARCH 22 1989	37 PARCELTT	4 OF 6



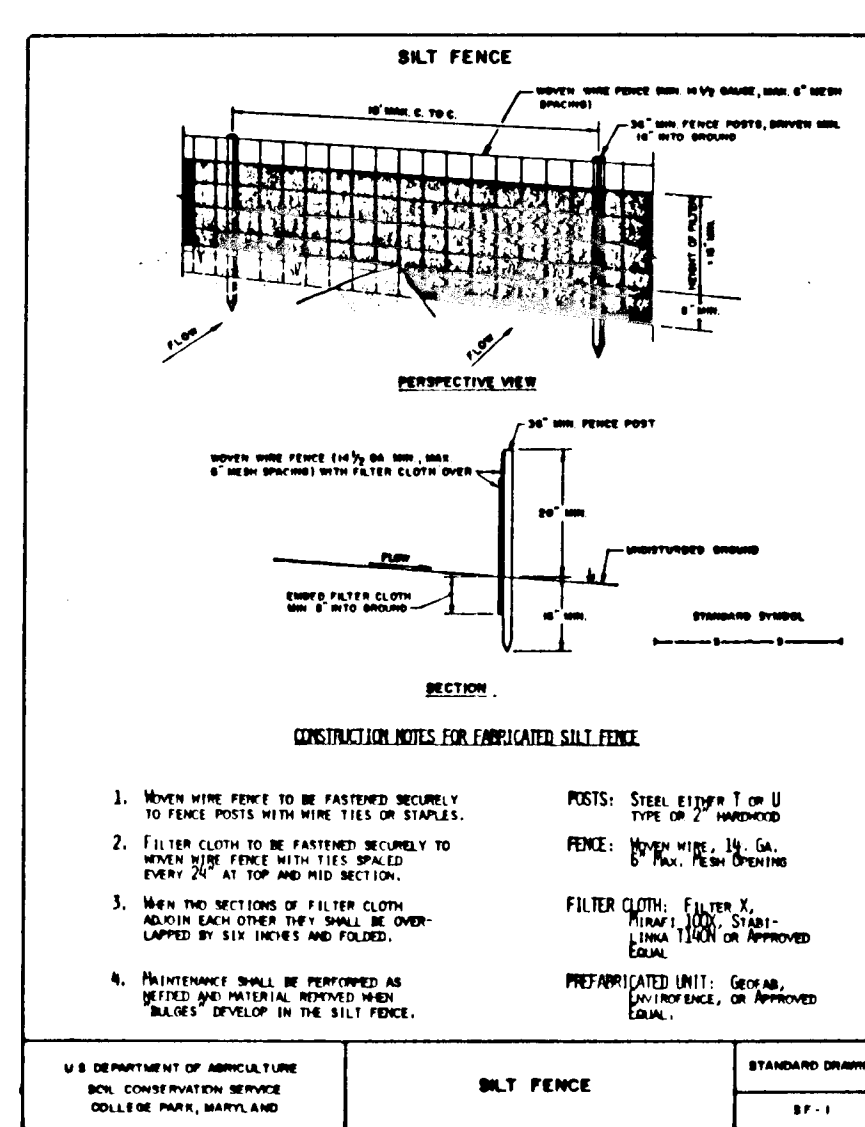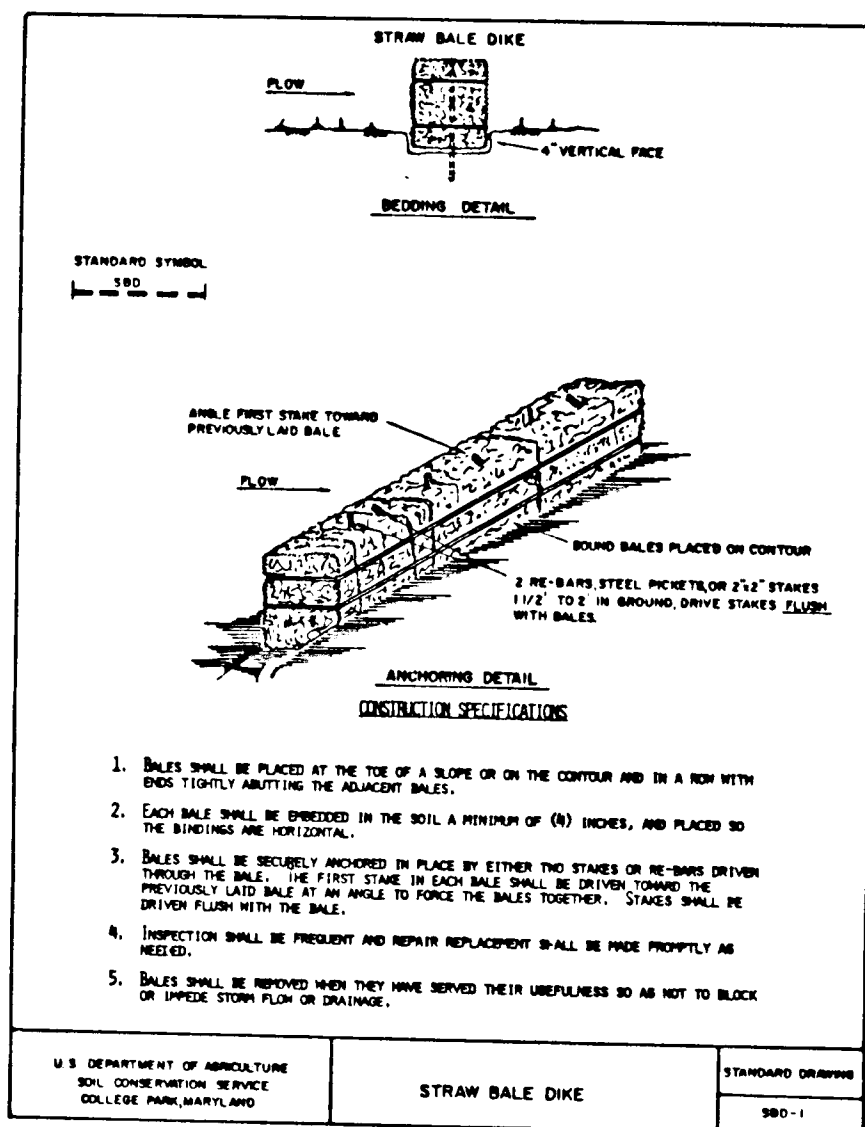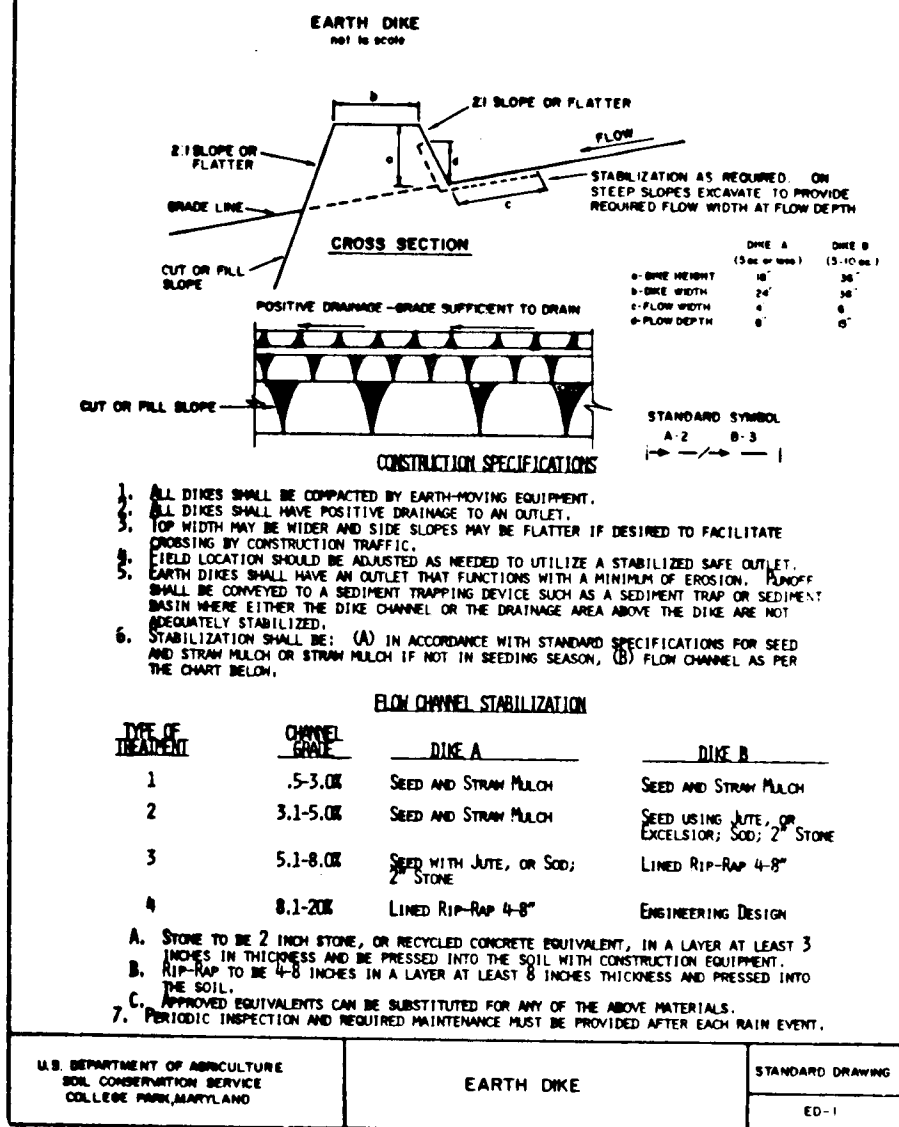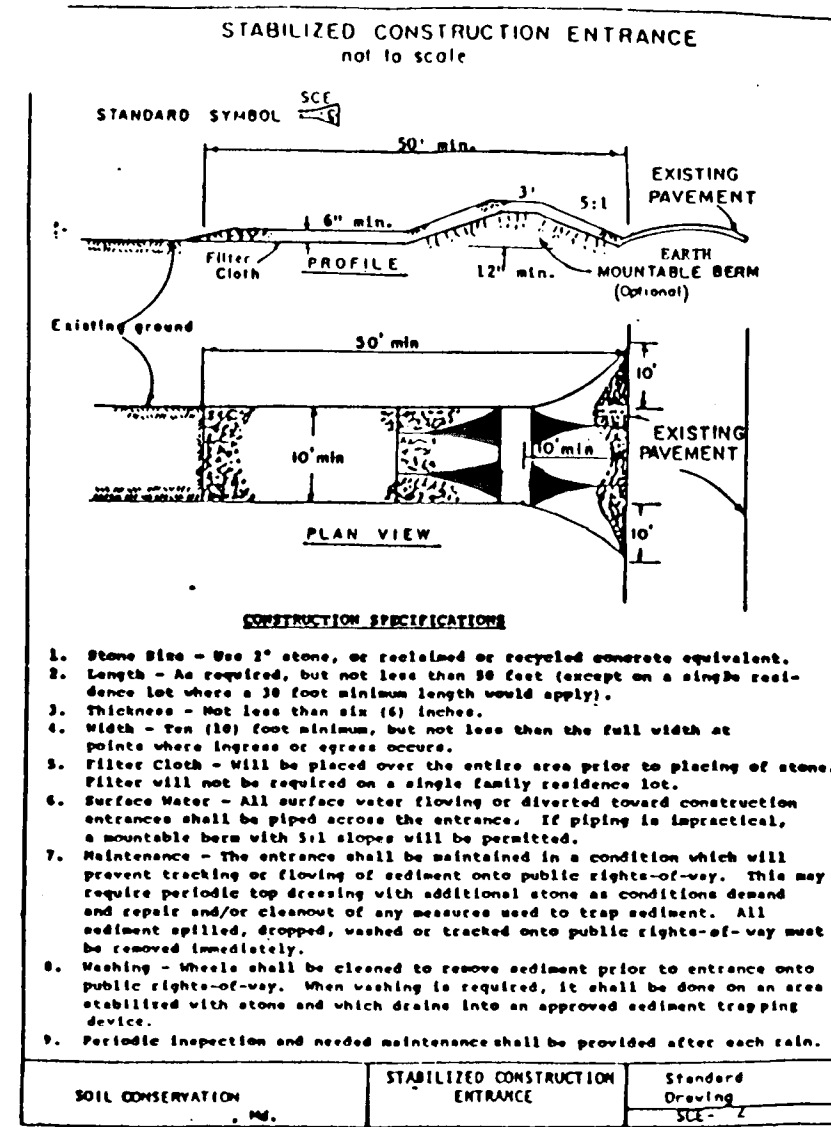

**TEMPORARY SEEDING NOTES**

Apply to graded or cleared areas likely to be redisturbed where a short-term vegetative cover is needed.

**Seeding Preparation** - Loosen upper three inches of soil by raking, discing or other acceptable means before seeding, unless previously loosened.

**Soil Amendment** - Apply 600 lbs per acre 10-10-10 fertilizer (14 lbs/1000 sq ft).

**Seeding** - For periods March 1 thru April 30 and from August 15 thru November 15, seed with 2-1/2 bushel per acre of annual type (3.2 lbs/1000 sq ft). For the period May 1 thru August 14, seed with 3 lbs per acre of creeping foregrass (2.0 lbs/1000 sq ft). For the period November 16 thru February 28, protect site by applying 2 tons per acre of well anchored straw mulch and seed as soon as possible in the spring, or use seed.

**Mulching** - Apply 1-1/2 to 2 tons per acre (10 to 20 lbs/1000 sq ft) of untreated small grain straw immediately after seeding. Anchor mulch immediately after application using mulch anchoring tool or 218 gal per acre (5 gal/1000 sq ft) of emulsified asphalt on flat areas. On slopes, 8 ft or higher, use 348 gal per acre (8 gal/1000 sq ft) for anchoring.

Refer to the 1983 MARYLAND STANDARDS AND SPECIFICATIONS FOR SOIL EROSION AND SEDIMENT CONTROL for rate and methods not covered.

**PERMANENT SEEDING NOTES**

Apply to graded or cleared areas not subject to immediate further disturbance where a permanent long-lived vegetative cover is needed.

**Seeding Preparation** - Loosen upper three inches of soil by raking, discing or other acceptable means before seeding, unless previously loosened.

**Soil Amendment** - In lieu of soil test recommendations, use one of the following methods:

- 1) Preferred - Apply 2 tons per acre doublets (100 lbs/1000 square feet) and 800 lbs per acre 10-10-10 fertilizer (14 lbs/1000 sq ft) before seeding. Mow or disc into upper three inches of soil. At time of seeding, apply 400 lbs per acre 30-0-30 urea-formaldehyde (8 lbs/1000 sq ft).
- 2) Acceptable - Apply 2 tons per acre doublets (100 lbs/1000 sq ft) and 800 lbs per acre 10-10-10 fertilizer (14 lbs/1000 sq ft) before seeding. Mow or disc into upper three inches of soil.

**Seeding** - For the periods March 1 thru April 30, and August 1 thru October 15, seed with 60 lbs per acre (1.4 lbs/1000 sq ft) of Kentucky 31 Tall Fescue. For the period May 1 thru July 31, seed with 80 lbs Kentucky 31 Tall Fescue per acre and 2 lbs per acre (0.04 lbs/1000 sq ft) of vernal ryegrass. During the period of October 16 thru February 28, protect site by: Option (1) 2 tons per acre of well anchored straw mulch and seed as soon as possible in the spring; Option (2) Use seed; Option (3) Seed with 60 lbs Kentucky 31 Tall Fescue and mulch with 2 tons/acre well anchored straw.

**Mulching** - Apply 1-1/2 to 2 tons per acre (10 to 20 lbs/1000 sq ft) of untreated small grain straw immediately after seeding. Anchor mulch immediately after application using mulch anchoring tool or 218 gallons per acre (5 gal/1000 sq ft) of emulsified asphalt on flat areas. On slopes, 8 ft or higher, use 348 gal per acre (8 gal/1000 sq ft) for anchoring.

**Maintenance** - Inspect all seeded areas and make needed repairs, replacements and reseedings.

**CONSTRUCTION SPECIFICATIONS**

1. Storm Silt - Use 12" stone, or equivalent or approved concrete equivalent.
2. Length - As required, but not less than 30 feet (except on a slope less than 1:1 where 20 feet minimum is required).
3. Thickness - Not less than six (6) inches.
4. Width - Ten (10) foot minimum, but not less than the full width at points where ingress or egress occurs.
5. Filter Cloth - Will be placed over the entire area before placing of stone. Filter will not be covered on a single family residence lot.
6. Surface Water - All surface water flowing or diverted toward construction entrances shall be piped across the entrance. If piping is impractical, a manhole may be used.
7. Maintenance - The entrance shall be maintained in a condition which will prevent creating or flowing of sediment onto public right-of-way. This may require periodic top dressing with additional stone as conditions demand and repair and/or removal of any material used to trap sediment. All sediment spilled, dropped, washed or tracked onto public right-of-way must be removed immediately.
8. Washing - Vehicles shall be cleaned to remove sediment prior to entrance onto public right-of-way. When washing is required, it shall be done on an area established with stone and catch drain line or approved sediment trapping device.
9. Periodic inspection and needed maintenance shall be provided after each rain.

TYPE OF TREATMENT	CONSTRUCTION SPECIFICATIONS	STANDARD DRAWING
1	5-3-00 SEED AND STRAW MULCH	ED-1
2	3-1-00 SEED AND STRAW MULCH	ED-1
3	5-1-00 SEED WITH MULCH OF SOIL	ED-1
4	8-1-00 LINED PIPE-PILE	ED-1

**CONSTRUCTION SPECIFICATIONS**

1. Bales shall be placed at the toe of a slope or on the contour and in a row with ends tightly abutting the adjacent bales.
2. Each bale shall be embedded in the soil a minimum of 6" inches, and placed so the openings are horizontal.
3. Bales shall be securely anchored in place by either two stakes or rebar driven through the bale. The first stake in each bale shall be driven through the bale from the top to the bottom. The second stake shall be driven through the bale from the side to the side.
4. Inspection shall be provided and repair/replacement shall be made promptly as needed.
5. Bales shall be removed when they have served their usefulness and are not to block or impede storm flow or drainage.

**CONSTRUCTION NOTES FOR FABRICATED SILT FENCE**

1. When wire fence is to be fastened securely to fence posts with wire ties or staples.
2. Filter cloth to be fastened securely to wood fence posts with ties/staples.
3. Make the bottom of filter cloth extend below surface of soil. Make sure the bottom of filter cloth is secured to the fence post.
4. Maintenance shall be performed as needed and material removed when bales develop on the silt fence.

**SEDIMENT CONTROL NOTES**

1. A minimum of 24 hours notice must be given to the Howard County Office of Inspection and Permits prior to the start of any construction. (892-2437)
2. All vegetative and structural practices are to be installed according to the provisions of this plan and are to be in accordance with the 1983 MARYLAND STANDARDS AND SPECIFICATIONS FOR SOIL EROSION AND SEDIMENT CONTROL.
3. Following initial soil disturbance or redisturbance, permanent or temporary stabilization shall be completed within: a) 7 calendar days for all perimeter sediment control structures, dikes and perimeter slopes and all slopes greater than 3:1; b) 14 days as to all other disturbed or graded areas on the project site.
4. All sediment traps/basins shown must be fenced and warning signs posted around their perimeter in accordance with Vol. 1, Chapter 12, of the HOWARD COUNTY DESIGN MANUAL, Storm Drainage.
5. All disturbed areas must be stabilized within the time period specified above in accordance with the 1983 MARYLAND STANDARDS AND SPECIFICATIONS FOR SOIL EROSION AND SEDIMENT CONTROL for permanent seedings (Sec. 51) and (Sec. 54), temporary stabilization with mulch alone can only be done when recommended seeding dates do not allow for proper germination and establishment of grasses.
6. All sediment control structures are to remain in place and are to be maintained in operative condition until permission for their removal has been obtained from the Howard County Sediment Control Inspector.
7. Site Analysis:  
Total Area of Site: 10.7 Acres  
Area Disturbed: 6.8 Acres  
Area to be vegetatively stabilized: 1.7 Acres  
Total Cut: 24,500 Cu. Yds.  
Total Fill: 2,500 Cu. Yds.  
Offsite waste/borrow area location: N/A
8. Any sediment control practice which is disturbed by grading activity for placement of utilities must be repaired on the same day of disturbance.
9. Additional sediment control must be provided, if deemed necessary by the Howard County DPW sediment control inspector.
10. On all sites with disturbed areas in excess of 2 acres, approval of the inspection agency shall be requested upon completion of installation of perimeter erosion and sediment controls, but before proceeding with any other earth disturbance or grading. Other building or grading inspection approvals may not be authorized until this initial approval by the inspection agency is made.
11. If houses are to be constructed on an "As-Built" basis, at random, Single Lot Sediment Control as shown below shall be implemented.
12. All pipes to be blocked at the end of each day (see detail below).
13. The total amount of straw bale dikes/silt fences equals 1430 L.F.

**DEVELOPER'S/BUILDER'S CERTIFICATE**

"I certify that all development and construction will be done according to this plan, and that any responsible personnel involved in the construction project will have a Certificate of Attendance at a Department of Natural Resources Approved Training Program for the Control of Sediment and Erosion before beginning the project."

Signature of Developer/Builder: *Robert M. Ward* Date: 7/13/88

**ENGINEER'S CERTIFICATE**


"I certify that this plan for pond construction, erosion and sediment control represents a practical and workable plan based on my personal knowledge of the site conditions. This plan was prepared in accordance with the requirements of the Howard Soil Conservation District. I have notified the developer that he must provide the Howard Soil Conservation District with an "as-built" plan of the pond within 30 days of completion."

Signature of Engineer: *C.K. Guter* Date: 7-13-88

These plans for small pond construction, soil erosion and sediment control meet the requirements of the Howard Soil Conservation District.

Signature of District Engineer: *Robert A. Ziehm* Date: 4/12/89

Signature of District Engineer: *D. Helms* Date: 4/12/89

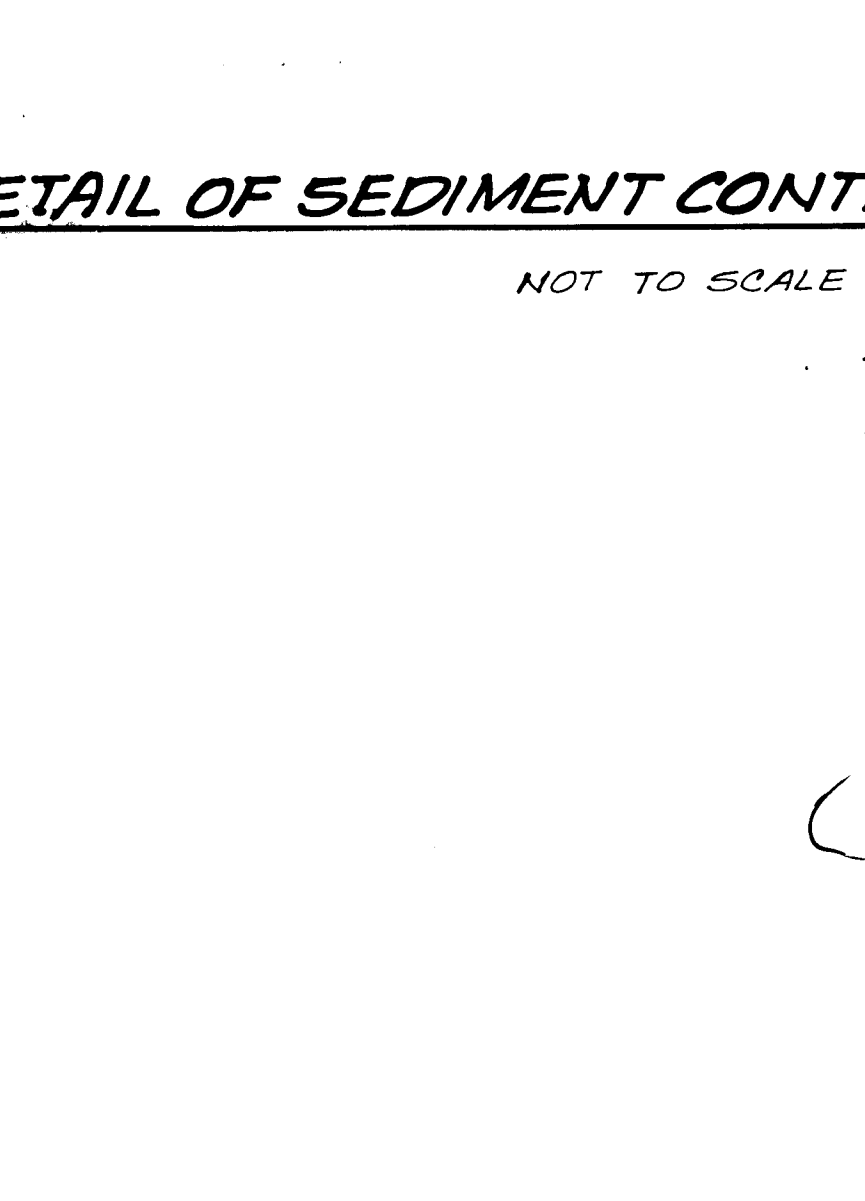

**LOW FLOW ORIFICE TO BE BLOCKED FOR SEDIMENT CONTROL PURPOSE AS FOLLOWS:**

1. WRAP FILTER CLOTH AROUND PIPE STUB. TIE TO STUB WITH TIE WIRE.
2. PACK SANDBAGS ALL AROUND PIPE STUB.

These plans have been reviewed for the Howard Soil Conservation District and meet the technical requirements for small pond construction, soil erosion and sediment control.

Signature of District Engineer: *D. Helms* Date: 4/12/89

Signature of District Engineer: *Robert A. Ziehm* Date: 4/12/89

Signature of District Engineer: *D. Helms* Date: 4/12/89

Signature of District Engineer: *Peter J. Law* Date: 4-22-92

APPROVED: DEPARTMENT OF PUBLIC WORKS

Signature: *Robert J. Brown* Date: 4/20/89

Signature: *David W. Williams* Date: 5/25/89

Signature: *James S. Ziegler* Date: 5/4/89



# STORM WATER MANAGEMENT POND NOTES:

## I. SITE PREPARATION:

- A. Areas designated for borrow areas, embankment, and structural works shall be cleared, grubbed and stripped of topsoil. All trees, vegetation, roots and other objectionable material shall be removed. Channel banks and sharp breaks shall be sloped no steeper than 1:1.
- B. Areas to be covered by pond or reservoir will be cleared of all trees, brush, logs, fences, rubbish and other objectionable material unless otherwise designated on the plans. Trees, brush, and stumps shall be cut approximately level with the ground surface.
- C. All cleared and grubbed material shall be disposed of outside and below the limits of the dam and reservoir as directed by the owner or his representative. When specified, a sufficient quantity of spoil will be stockpiled in a suitable location for use on the embankment and other designated areas.

## II. EARTH FILL:

- \*A. MATERIAL: The fill material shall be taken from approved designated borrow area or areas. It shall be free of roots, stumps, wood, rubbish, oversized stones, frozen or other objectionable materials. The embankment shall be constructed to an elevation which provides for anticipated settlement to the design elevation. The fill height, all along the length of the embankment shall be increased above the design elevation (including frost) as shown on the plans.
- B. PLACEMENT: Areas on which fill is to be placed shall be scarified prior to placement of fill. Fill materials shall be placed in 8-inch maximum thickness (before compaction) layers which are to be continuous over the entire length of the fill. The most porous borrow material shall be placed in the downstream portions of the embankment.
- \*C. COMPACTION: The movement of the hauling and spreading equipment over the fill shall be controlled so that the entire surface of each lift shall be traversed by not less than one tread track of the equipment or compaction shall be achieved by a minimum of four complete passes of a sheepsfoot, rubber tired or vibratory roller. Fill material shall contain sufficient moisture so that the required degree of compaction can be obtained with the equipment used. Where a minimum required density is specified, each layer of fill shall be compacted as necessary to obtain that density and to be certified by the Engineer.
- \*\*D. CUTOFF TRENCH: Where specified a cutoff trench shall be excavated along or parallel to the centerline of the embankment as shown on the plans. The bottom width of the trench shall be as shown on the drawings, with the minimum width being four feet. The depth shall be at least four feet or as shown on the plans. The side slope of the trench shall be 1:1 or flatter. The backfill material for the cutoff trench shall be the most impervious material available and shall be compacted with equipment or rollers to assure maximum density and minimum permeability.

## III. STRUCTURAL BACKFILL:

Backfill material shall be of the type and quality conforming to that specified for the adjoining fill material. The backfill shall be placed in horizontal layers not to exceed four inches in thickness and compacted by hand tampers or other compaction equipment. The material needs to fill completely all spaces under and adjacent to the pipe. At no time during the backfilling operation shall be allowed to operate closer than four feet, measured horizontally, to any part of the structure. Under no circumstances shall equipment be driven over any part of a concrete structure or pipe unless there is a compacted fill of twenty-four inches or greater over the structure or pipe.

## IV. PIPE CONDUITS: (All pipes shall be circular in cross-section)

### A. CORRUGATED METAL PIPE:

1. MATERIALS (Steel Pipe): This pipe and its appurtenances shall be galvanized and fully bituminous coated and shall conform to the requirements of AASHTO Specifications M-100 Type A with water-tight coupling bands. Any bituminous coating damaged or otherwise removed shall be replaced with cold applied bituminous coating compound. Steel pipes with polymeric coatings shall have a minimum coating thickness of 0.01 inch (10 mil) on both sides of the pipe. The following coatings are commercially available: Necon, Plast-Coat, Baco-Klad, and Balm-Co-Lay Coated corrugated steel pipe shall meet the requirements of AASHTO M-285 and M-286.
- MATERIALS (Aluminized Steel Pipe): This pipe and its appurtenances shall conform to the requirements of AASHTO Specification M-274-721 with water-tight coupling bands or flanges.
- MATERIALS (Aluminum Pipe): This pipe and its appurtenances shall conform to the requirements of AASHTO Specification M-106 or M-211 with water-tight coupling bands or flanges. Coupling bands, anti-seep collars, and sections, etc. must be composed of the same material as the pipe. Metals must be insulated from dissimilar materials with use of rubber or plastic insulating materials at least 24 mils in thickness. Aluminum surfaces that are to be in contact with concrete shall be painted with one coat of Zinc Chromate Primer. Hot dip galvanized bolts may be used for connections. The pH of the surrounding soils shall be less than 3 and greater than 4.
2. CONNECTIONS: All connections with pipes must be completely water-tight. The drain pipe or barrel connection to the riser shall be welded all around when the pipe and riser are metal. Water-tight coupling bands or flanges shall be used at all joints. Anti-seep collars shall be connected to the pipe in such a manner as to be completely water-tight. Dimple bands are not considered to be water-tight.
3. BEDDING: The pipe shall be firmly and uniformly bedded throughout its entire length. Where rock or soft, springy or other unstable soil is encountered, such material shall be removed and replaced with suitable earth compacted to provide adequate support.
4. LAYING PIPE: The pipe shall be placed with usual circumferential laps pointing downstream and with the longitudinal laps at the sides.
5. Backfilling shall conform to structural backfill as shown above.
6. Other details (anti-seep collars, valves, etc.) shall be as shown on the drawings.

### B. REINFORCED CONCRETE PIPE:

1. MATERIALS: Reinforced concrete pipe shall have a rubber gasket joint and shall equal or exceed ASTM Specification C-361. An approved equivalent is ANWA Specification C-301.
2. BEDDING: All reinforced concrete pipe conduits shall be laid in a concrete bedding for their entire length. This bedding shall consist of high slump concrete placed under the pipe and up the sides of the pipe at least 10% of its outside diameter with a minimum thickness of 3" or as shown on the drawings.
3. LAYING PIPE: Bell and spigot pipe shall be placed with the bell end upstream. Joints shall be made in accordance with recommendations of the manufacturer of the material. After the joints are sealed for the entire line, the bedding shall be placed so that all spaces under the pipe are filled. Care shall be exercised to prevent any deviation from the original line and grade of the pipe.
4. Backfilling shall conform to structural backfill as shown above.
5. Other details (anti-seep collars, valves, etc.) shall be shown on the drawing.
- C. For pipes of other materials, specific specifications shall be shown on the drawings.

## V. CONCRETE:

- A. MATERIALS
  1. CEMENT: Normal Portland cement shall conform to latest ASTM Specification C-150.
  2. WATER: The water used in concrete shall be clean, free from oil, acid, alkali, scales, organic matter or other objectionable substances.
  3. SAND: The sand used in concrete shall be clean, hard, strong and durable, and shall be well graded with 100% passing a one-quarter inch sieve. Limestone sand shall not be used.
  4. COURSE AGGREGATE: The coarse aggregate shall be clean, hard, strong and durable, and free from clay and dirt. It shall be well graded with a maximum size of one and one-half (1 1/2) inches.
  5. REINFORCING STEEL: The reinforcing steel shall be deformed bars of intermediate grade billet steel or rail steel conforming to ASTM Specification A-615.
- B. DESIGN MIX: The concrete shall be mixed in the following proportions, measured by weight. The water-cement ratio shall be 5 1/4 to 6 U.S. Gals. of water (40 pounds) per bag of cement. The proportions of materials for the trial mix shall be 1:2:3 1/2. The combination of the aggregates may be adjusted to produce a plastic and workable mix that will not produce harshness in placing or honeycombing in the structure.
- C. MIXING: The concrete ingredients shall be mixed in batch mixers until the mixture is homogeneous and of uniform consistency. The mixing of each batch shall continue for not less than one and one-half minutes after all the ingredients, except the full amount of water, are in the mixer. The maximum mixing time is restricted on proper control of the speed of rotation of the mixer and the introduction of the materials including water into the mixer. Water shall be added or to during and following the mixer-charging operations. Excessive overmixing requiring the addition of water to preserve concrete consistency shall not be permitted. Truck mixing will be allowed provided that the use of this method shall cause no violation of any applicable provisions of the specifications given here.
- D. PLACING: The forms shall have sufficient strength and rigidity to hold the concrete and to withstand the necessary pressure, temperature and vibration without deflection from the prescribed lines. They should be water-tight and constructed so they can be removed without hammering or prying against the concrete. The inside of the forms will be lined with a non-staining material, oil or thoroughly wetted before concrete is placed. Forms may be removed 24 hours after the placement of concrete. All wires, ties and other devices used shall be removed from the surface of the concrete.
- E. REINFORCING STEEL: All reinforcing material shall be free of dirt, rust scale, oil, paint or any other coatings. The steel shall be accurately placed and securely tied and blocked into position so that no movement of the steel will occur during placement of concrete.
- F. CONSOLIDATION: Concrete shall be consolidated with internal type mechanical vibrators. Vibration shall be supplemented by rodding and hand tamping to insure smooth and dense concrete along form surfaces, corners, and around embedded items.
- G. FINISHING: Defective concrete, honeycombed areas, voids left by removal of tie rods, ridges on all concrete surfaces permanently exposed to view or exposed to water on the finished structure, shall be repaired immediately after the removal of forms. All voids shall be tamped and completely filled with dry packing mortar.
- H. PROTECTION AND CURING: Exposed surfaces of concrete shall be protected from the direct rays of the sun for at least three (3) days. All concrete shall be kept continuously moist for at least ten (10) days after being placed. Moisture may be applied by spraying or sprinkling as necessary. To prevent the concrete from drying, concrete shall not be exposed to freezing during the curing period. Curing compound may also be used.
- I. PLACING TEMPERATURE: Concrete may not be placed at temperature below 32°F with the temperature falling or 34°F with the temperature rising.


## VI. STABILIZATION:

All borrow areas shall be graded to provide drainage and left in a slightly concave form. All exposed surfaces of the embankment, spillway, spoil and borrow areas, and berms shall be stabilized by seeding, liming, fertilizing and mulching (if required) in accordance with the vegetative treatment specifications or as shown on the accompanying drawings.

## VII. EROSION AND SEDIMENT CONTROL:


All construction operations will be carried out in such a manner that erosion will be controlled and water and air pollution minimized. State and local laws concerning pollution abatement will be followed. Construction plans shall detail erosion and sediment control measures to be employed during the construction process.

- \* Core trench and embankment material for the pond shall be obtained from the Brightfield Sect. 1 Subdivision, GP-88-39. Soil shall be ML, CL, CH or MH material per the Unified Soil Classification.

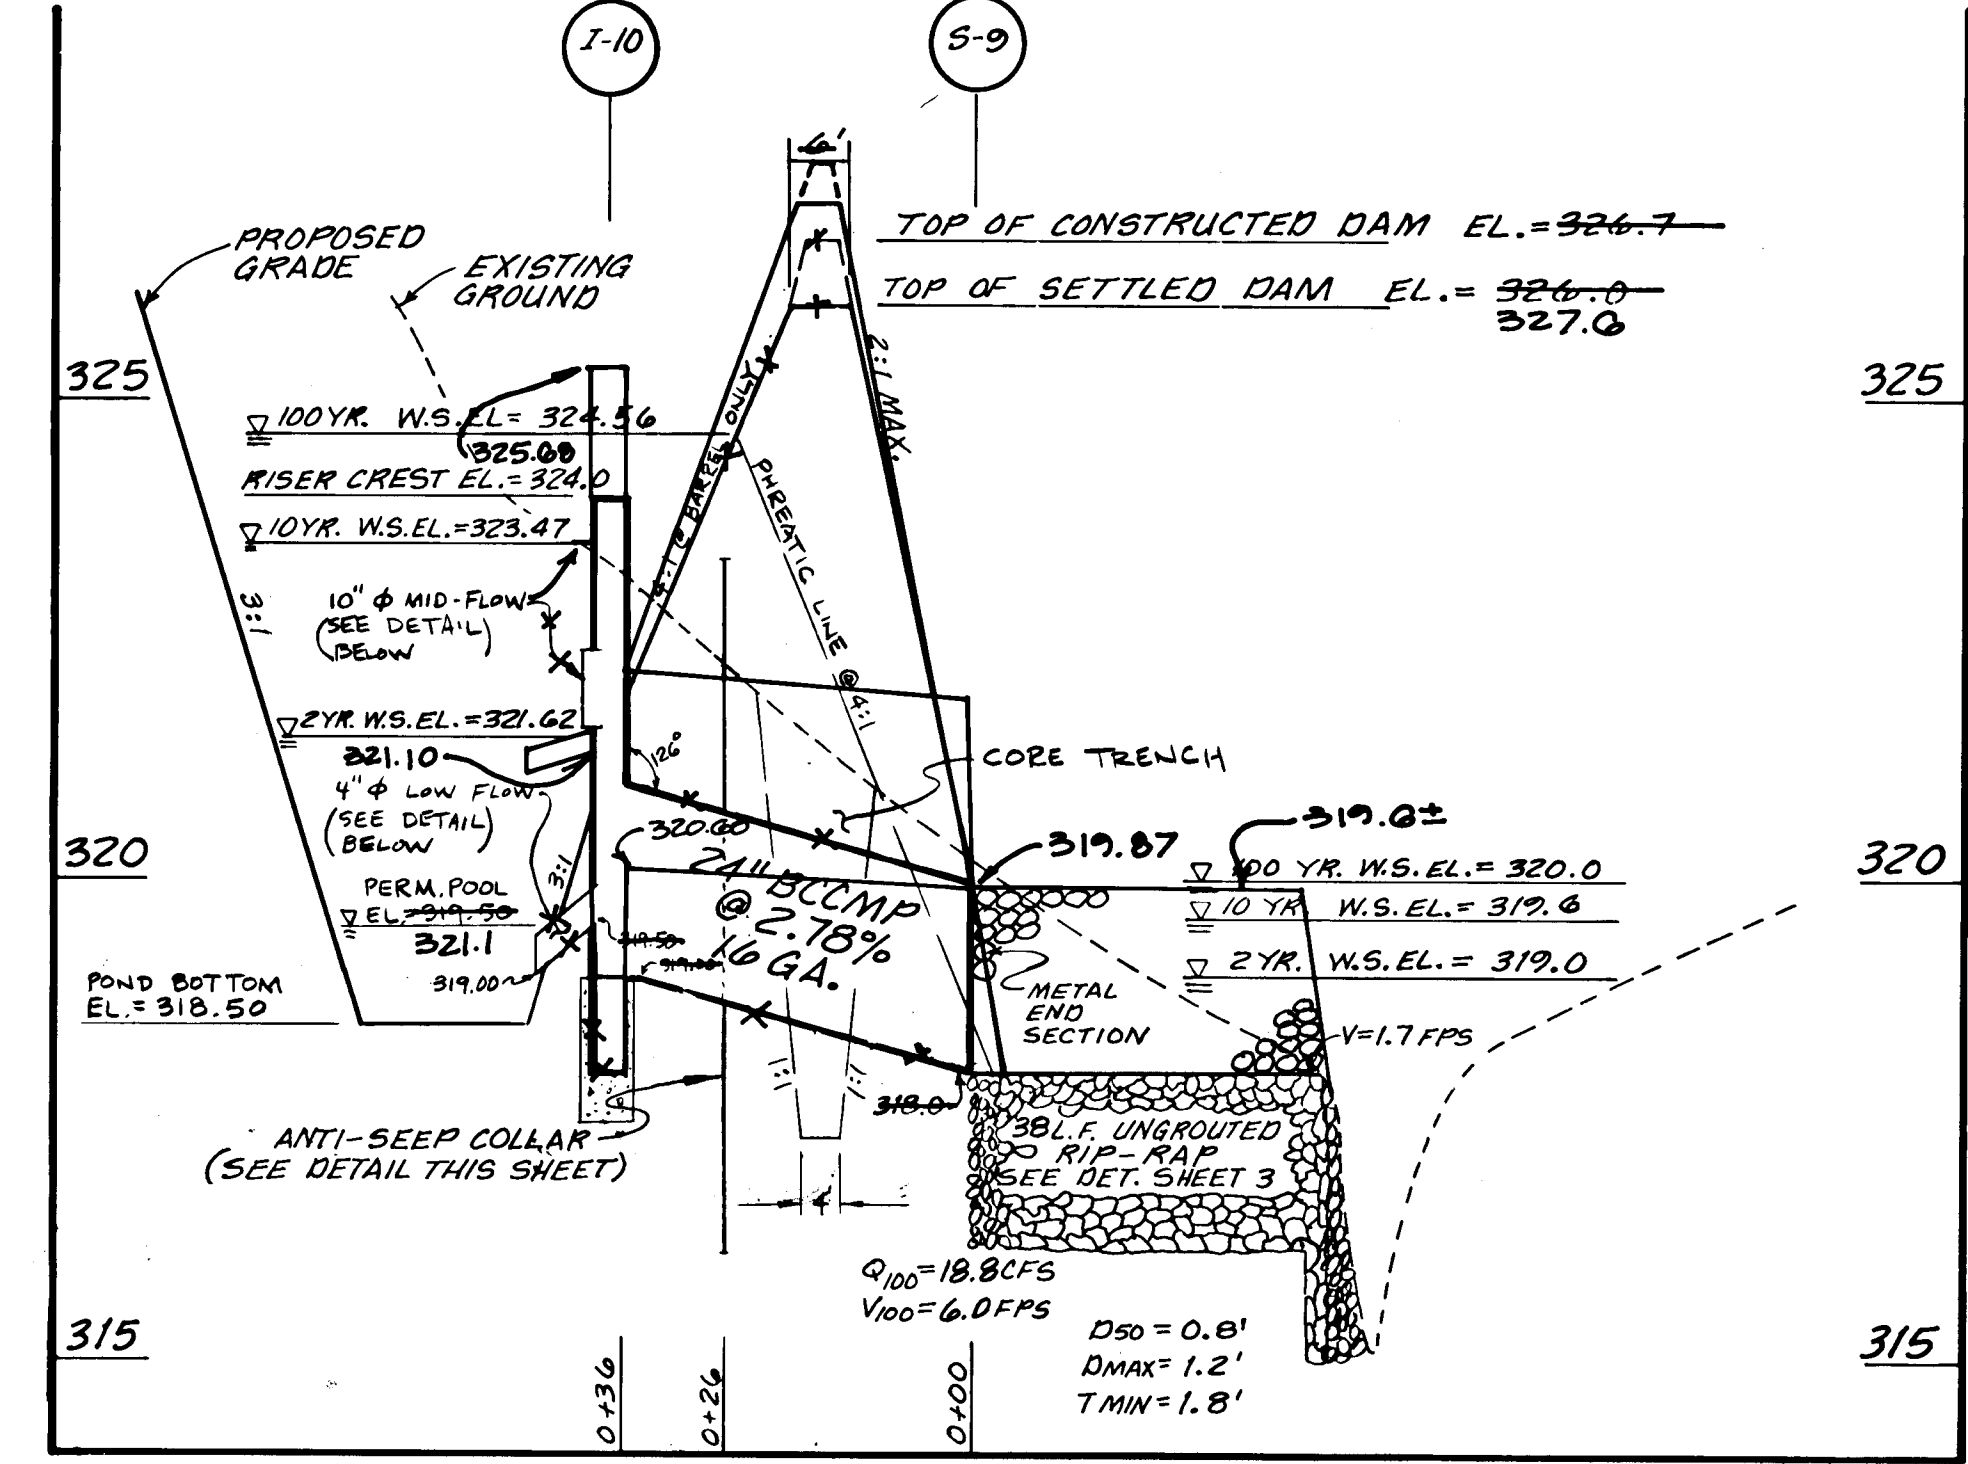

PROFILE THRU PRINCIPAL SPILLWAY

SCALE: HORIZ. : 1" = 20' VERT. : 1" = 2'

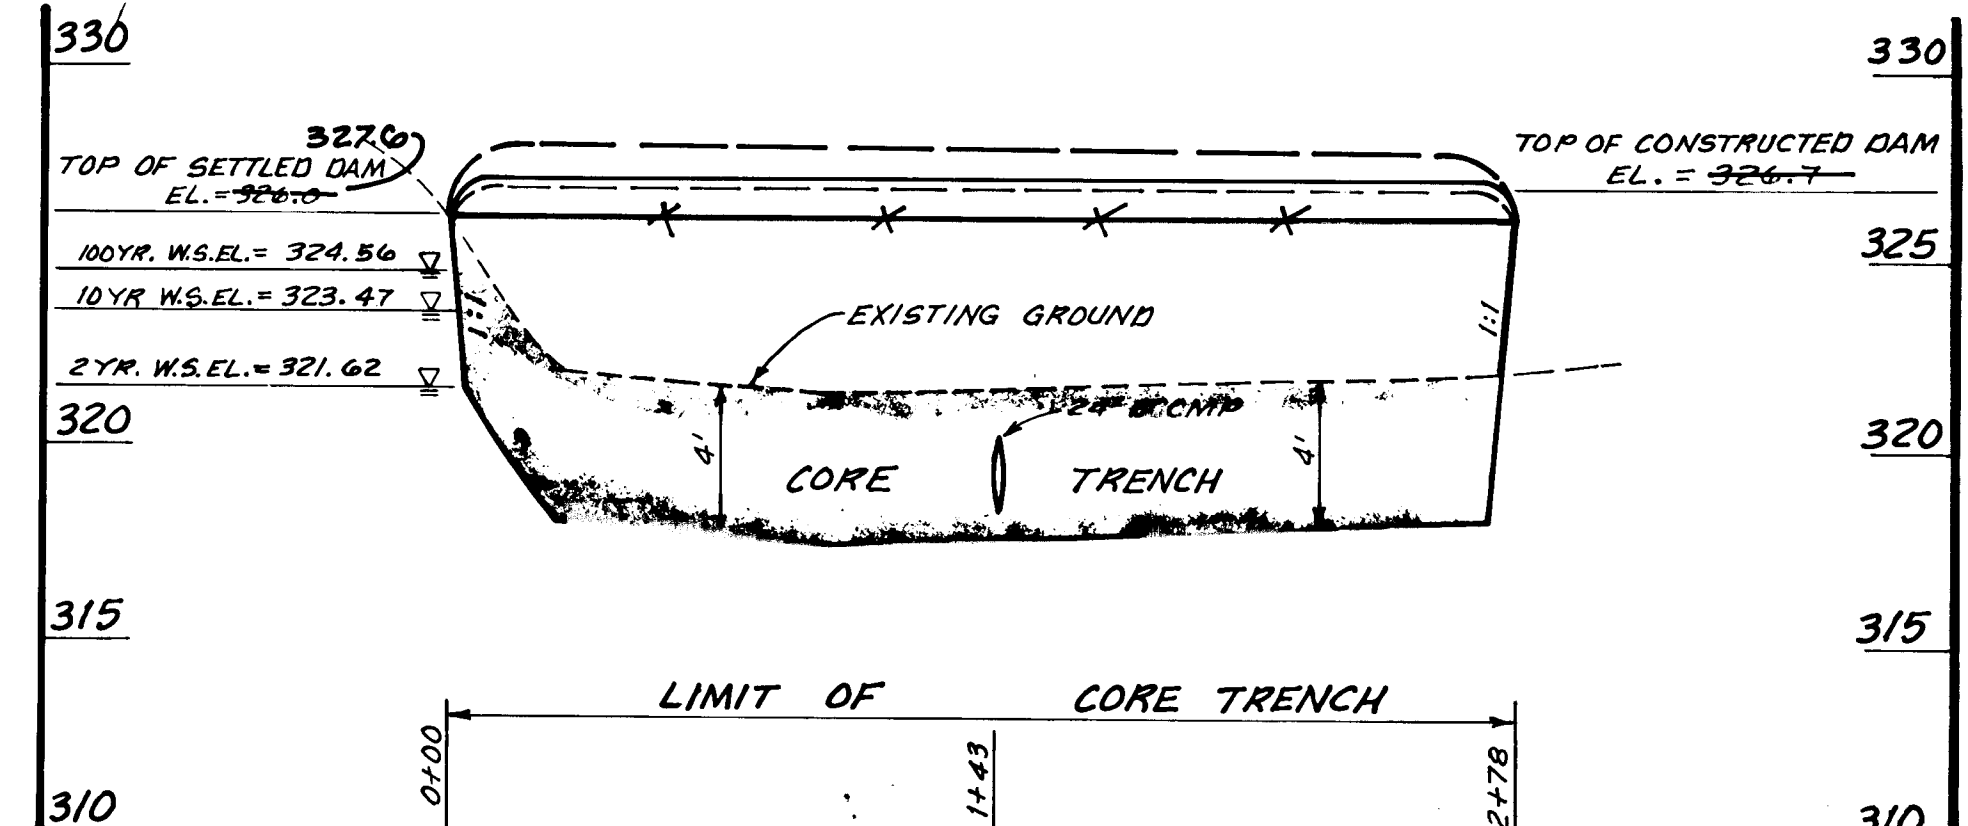


SECTION A-A

PROFILE THRU § OF DAM - LOOKING DOWNSTREAM

SCALE: HORIZ. : 1" = 50' VERT. : 1" = 5'


60" CMP (12 GA.) TRASH RACK & ANTI-VORTEX DEVICE. (SEE DETAIL THIS SHEET)

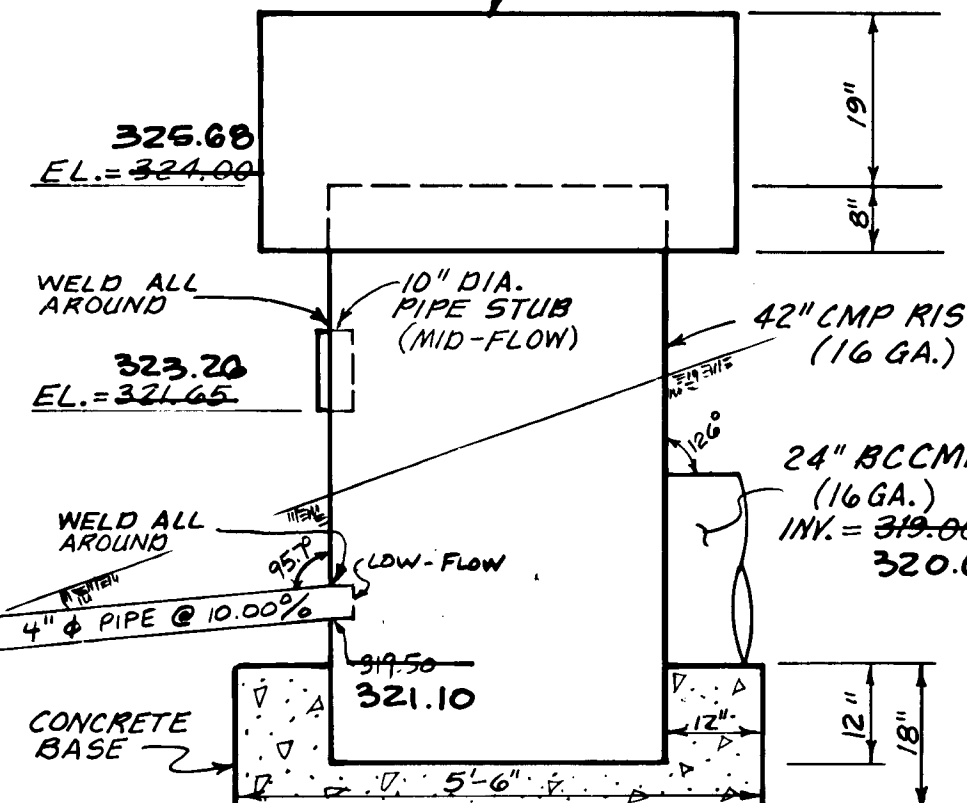

DETAIL STORM WATER MANAGEMENT STRUCTURE #10


SCALE: 1" = 2'

APPROVED: <i>Donald E. Sporn</i>	4/20/89
DATE	
CHIEF, LAND DEVELOPMENT DIVISION	
<i>Deanne W. Holland</i>	5/15/89
DATE	
CHIEF, BUREAU OF HIGHWAYS	
<i>James E. Paine</i>	5/15/89
DATE	
CHIEF, BUREAU OF ENGINEERING	
<i>Mark S. J. Lamb</i>	5/16/89
DATE	
CHIEF, DIVISION OF COMMUNITY PLANNING & LAND DEVELOPMENT	

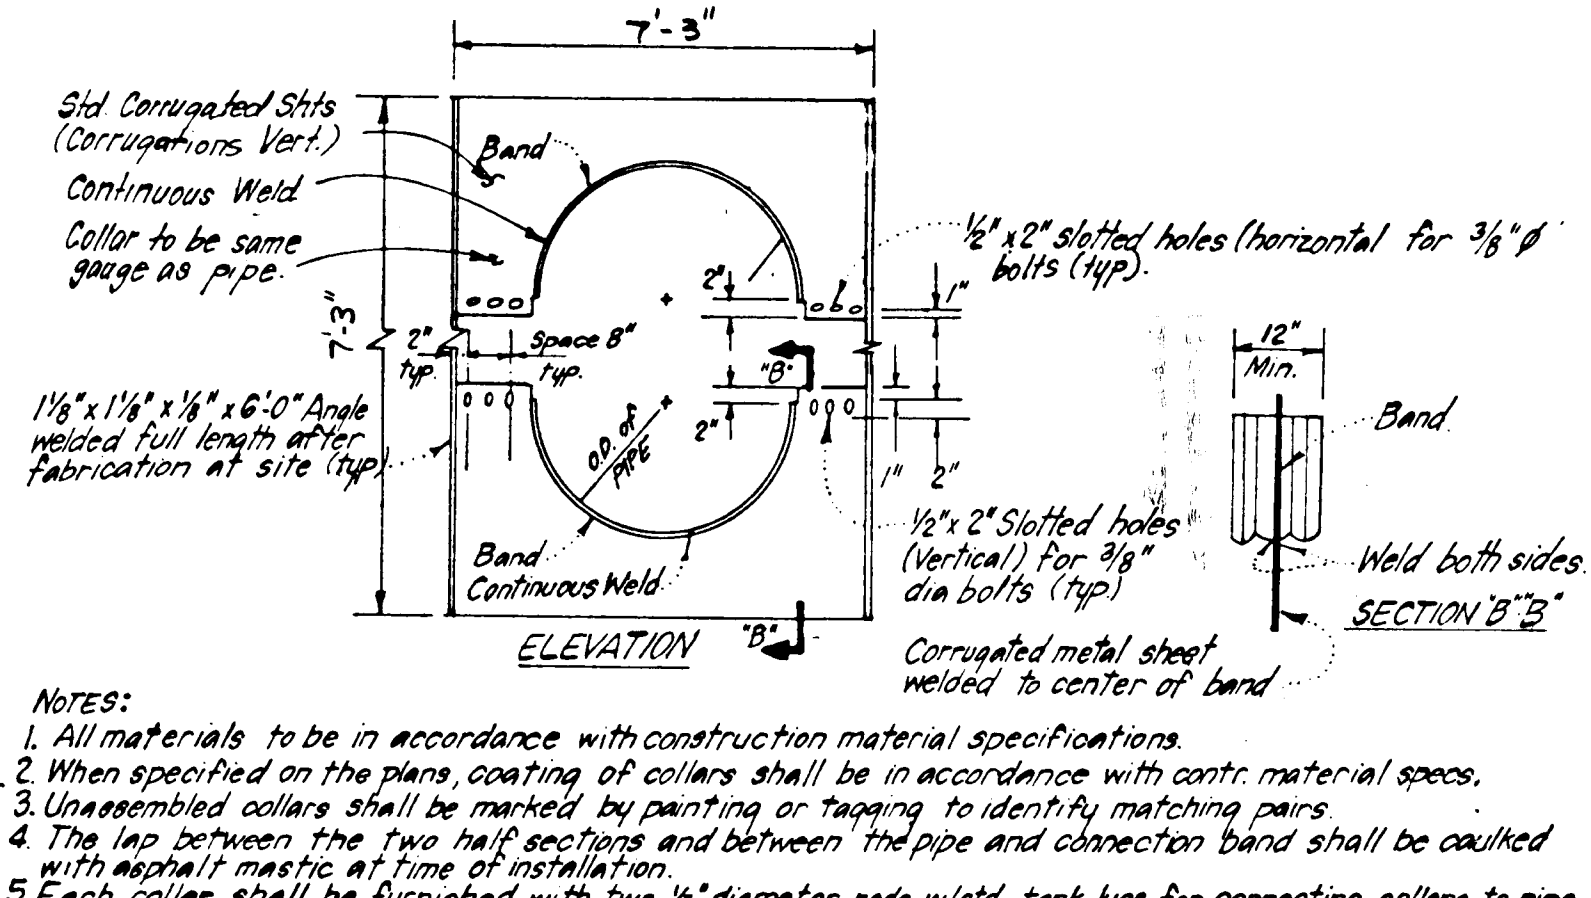

CORRUGATED METAL ANTI-SEEP COLLAR DETAILS

NO SCALE

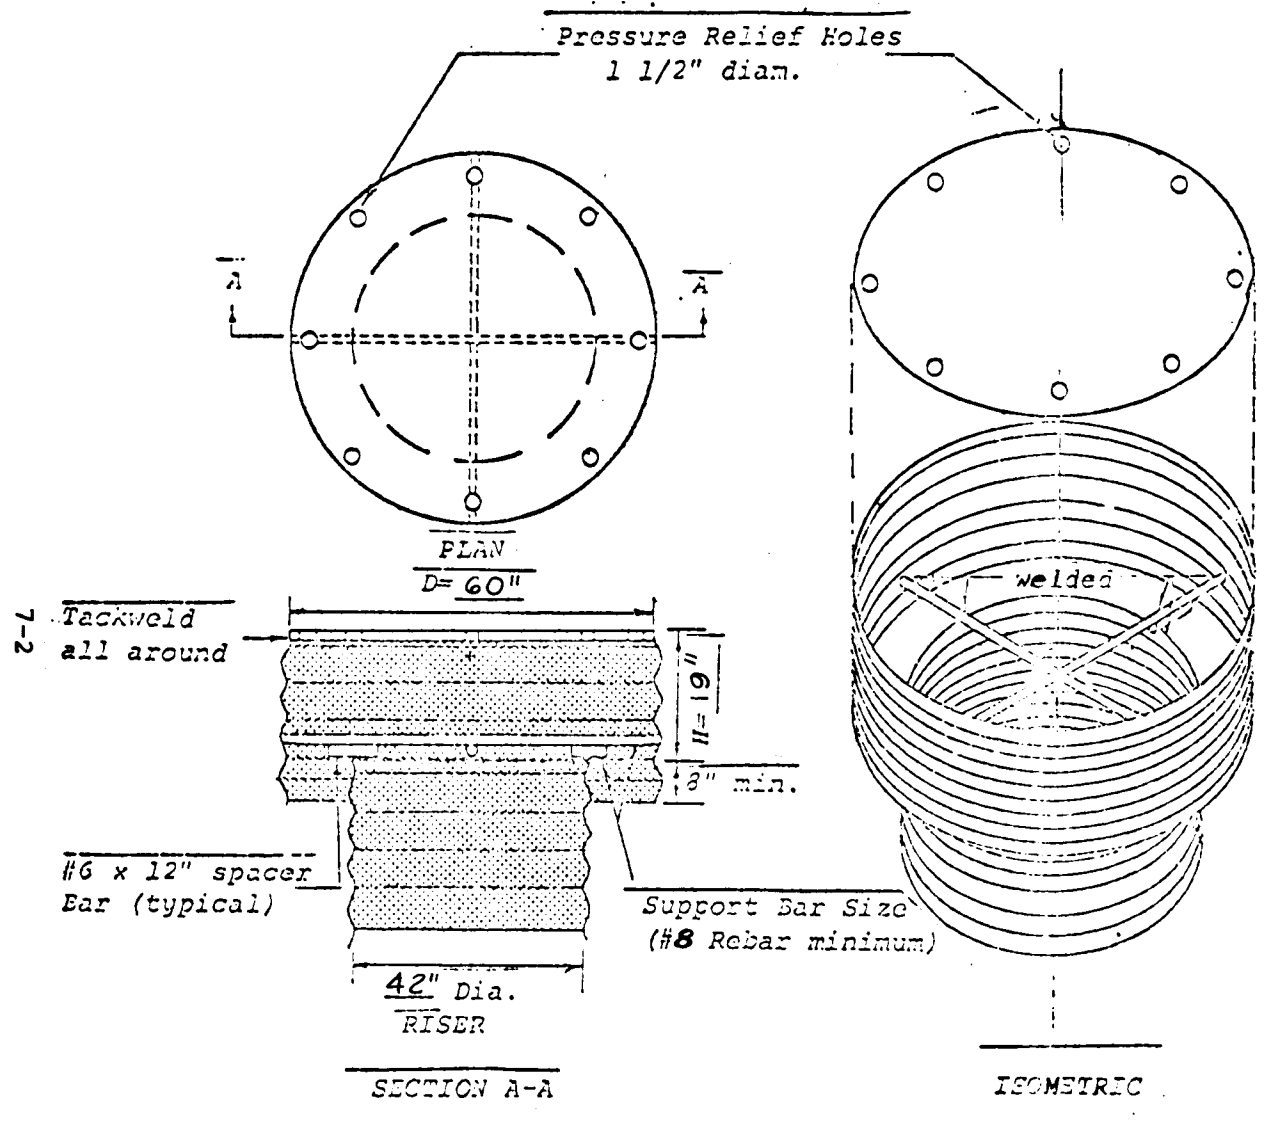

CONCENTRIC TRASH RACK AND ANTI-VORTEX DEVICE

(not to scale)

Top is 12 gage corrugated metal or 1/8" steel plate. Pressure relief holes may be omitted, if ends of corrugations are left fully open when corrugated top is welded to cylinder.

Cylinder is 12 gage corrugated metal pipe or fabricated from 1/8" steel plate.

- Notes:
- 1) The cylinder must be firmly fastened to the top of the riser.
  - 2) Support bars are welded to the top of the riser or attached by straps bolted to top of riser.

DEVELOPER'S/BUILDER'S CERTIFICATE

"I/We certify that all development and construction will be done according to this plan, and that any responsible personnel involved in the construction project will have a Certificate of Attendance at a Department of Natural Resources Approved Training Program for the Control of Sediment and Erosion before beginning the project." I also authorize periodic O&M inspection by the H.S.C.D.

*Kathleen Wain* 7/13/88

ENGINEER'S CERTIFICATE

"I certify that this plan for pond construction, erosion and sediment control represents a practical and workable plan based on my personal knowledge of the site conditions. This plan was prepared in accordance with the requirements of the Howard Soil Conservation District. I have notified the developer that he must provide the Howard Soil Conservation District with an 'as-built' plan of the pond within 30 days of completion."

*C.K. Jantanto* 7-13-88

These Plans for small pond construction, soil erosion and sediment control meet the requirements of the Howard Soil Conservation District.

*Robert J. Zick* 4/12/89

These plans have been reviewed for the Howard Soil Conservation District and meet the technical requirements for small pond construction, soil erosion and sediment control.

*D. Helms* 4/12/89

**GW GUTSCHICK LITTLE & WEBER, P.A.**  
 ENGINEERS, PLANNERS, SURVEYORS  
 3909 NATIONAL DRIVE - SUITE 250 - BURTONSVILLE OFFICE PARK - BURTONSVILLE, MD. 20866  
 TELEPHONE: (301) 421-4024

REVISION	BY	APP'R.

PREPARED FOR:  
 100 INVESTMENT LTD. PARTNERSHIP  
 C/O BRITAM DEVELOPMENT  
 2030 RED BRANCH RD.  
 SUITE 250  
 COLUMBIA, MD. 21045  
 (301) 740-3323

**STORM WATER MANAGEMENT DETAILS & NOTES**  
**BRIGHTFIELD**  
 SECTION 3  
 LIBER 939 - FOLIO 390  
 ELECTION DISTRICT NO. 1  
 HOWARD COUNTY, MARYLAND

SCALE	ZONING	G.L.W. FILE NO.
AS SHOWN		86-058
DATE	TAX MAP NO.	SHEET
MARCH 22 1989	37 PARCEL 77	6 OF 6

1-89-20  
 AS-BUILT 4-27-92