

SHEET INDEX	
NO.	DESCRIPTION
1	TITLE SHEET
2	TYPICAL SECTIONS AND DETAILS
3	PLAN & PROFILE - BROKENLAND PARKWAY
4	PLAN & PROFILE - MALL CONNECTOR ROAD
5	STORM DRAIN PROFILES
6&7	GRADING AND SEDIMENT CONTROL PLAN
8	SEDIMENT AND EROSION CONTROL NOTES & DETAILS
9	DRAINAGE AREA MAP


# ROADWAY & STORM DRAINS

## BROKEN LAND PARKWAY AND MALL CONNECTOR ROAD

### SECTION 2, AREA 7

### 5TH ELECTION DISTRICT

### HOWARD COUNTY, MARYLAND

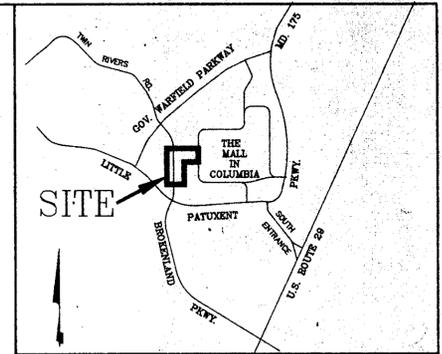

VICINITY MAP  
1" = 2,000'


**BENCH MARK DESCRIPTION**

B.M.# 13 ELEV. 343.930  
 CUT IN CONCRETE HEADWALL WEST B.L.P.  
 STA. 151+70

OTHER BENCH MARKS IN THE CONSTRUCTION AREA ARE SHOWN ON THE PLANS.

GENERAL NOTES

- ALL CONSTRUCTION SHALL BE IN ACCORDANCE WITH THE LATEST STANDARDS AND SPECIFICATIONS OF HOWARD COUNTY.
- THE CONTRACTOR SHALL NOTIFY THE DEPARTMENT OF PUBLIC WORKS/BUREAU OF CONSTRUCTION INSPECTION AT (301) 792-7272 AT LEAST FIVE (5) WORKING DAYS PRIOR TO THE START OF WORK.
- THE CONTRACTOR SHALL NOTIFY "MISS UTILITY" AT 1-800-257-7777 AT LEAST 48 HOURS PRIOR TO ANY EXCAVATION WORK.
- APPROXIMATE LOCATION OF EXISTING UTILITIES ARE SHOWN. THE CONTRACTOR SHALL TAKE ALL NECESSARY PRECAUTIONS TO PROTECT THE EXISTING UTILITIES AND MAINTAIN UNINTERRUPTED SERVICE. ANY DAMAGE INCURRED DUE TO CONTRACTOR'S OPERATION SHALL BE IMMEDIATELY AT THE CONTRACTOR'S EXPENSE. THE CONTRACTOR SHALL TEST PIT EXISTING UTILITIES, WHERE DIRECTED BY THE ENGINEER, A MINIMUM TWO WEEKS IN ADVANCE OF CONSTRUCTION OPERATIONS.
- TRAFFIC CONTROL DEVICES, MARKINGS AND SIGNING SHALL BE IN ACCORDANCE WITH THE LATEST EDITION OF THE MANUAL ON UNIFORM TRAFFIC CONTROL DEVICES (MUTCD). ALL STREET AND REGULATORY SIGNS SHALL BE IN PLACE PRIOR TO THE PLACEMENT OF ANY ASPHALT.
- STORM DRAIN TRENCHES WITHIN ROAD RIGHT-OF-WAY SHALL BE BACKFILLED AND COMPACTED IN ACCORDANCE WITH HOWARD COUNTY ROAD CODE. THE TYPE OF BEDDING USED FOR STORM DRAIN PIPE SHALL BE CLASS C, SHAPED SUBGRADE. IF ROCK IS ENCOUNTERED, THE TRENCH INVERT SHOULD BE OVER EXCAVATED 6" AND THE OVER EXCAVATION REFILLED WITH GRANULAR MATERIAL.
- THE LOCATION AND LENGTHS OF ALL PROPOSED STORM DRAINS SHALL BE VERIFIED BY THE CONTRACTOR.
- STUBS FOR P.V.C. UNDERDRAIN PIPE TO BE INSTALLED AT CENTER OF EACH WALL OF EVERY INLET.
- LAMP POST - 150 WATT HIGH PRESSURE SODIUM VAPOR PENDANTS MOUNTED AT 30' HIGH ON STEEL POLES NO LESS THAN 6' FROM PAVEMENT EDGE.
- CONTRACTOR TO RESTORE ALL EXISTING PAVING, SIDEWALKS OR LAWNS AFFECTED BY THE CONSTRUCTION SHOWN HEREON TO A CONDITION COMPARABLE TO THAT EXISTING PRIOR TO CONSTRUCTION.
- STORMWATER MANAGEMENT FOR THIS PROJECT PROVIDED BY FACILITY CONSTRUCTED WITH (F-85-131)
- ALL ELEVATIONS SHOWN ARE BASED ON U.S.C.G.S. MEAN SEA LEVEL DATUM 1929. ALL COORDINATES BASED ON MARYLAND STATE GRID SYSTEM.

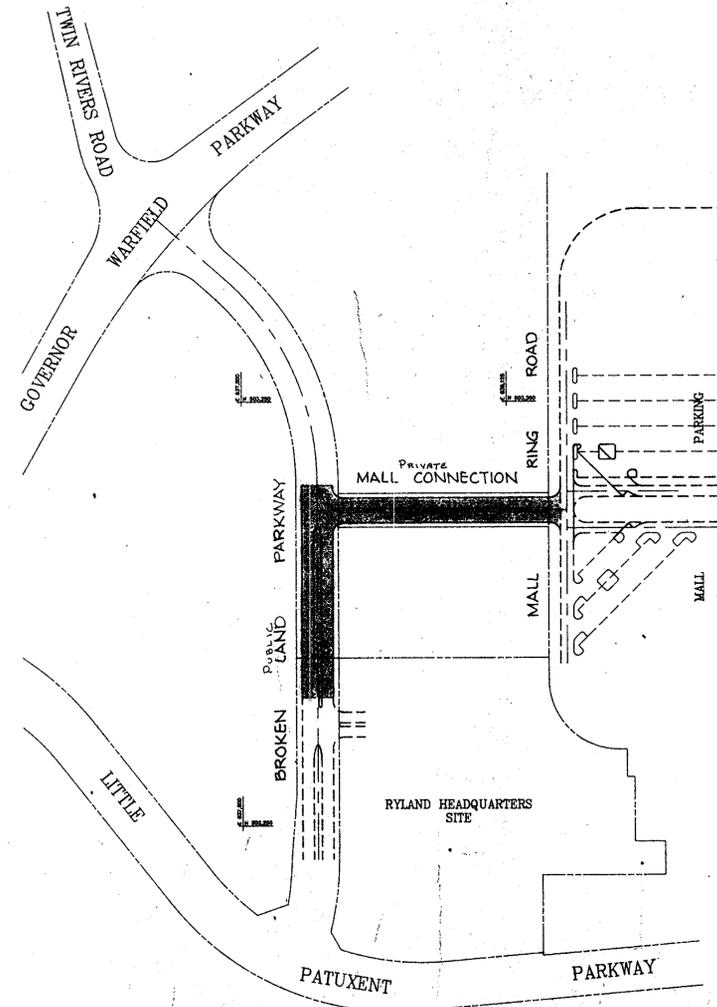

**Note:**  
 A Portion of this plan has been updated as a part of the revitalization of Downtown Columbia-Warfield Neighborhood, Blocks N-1 and W-2. These blocks are adjacent to Town Center Avenue (Mall Connector Road) and the required infrastructure improvements overlap with the roadbed.  
 For details of these improvements, see F 19-015.

AS-BUILT

*G. Scott Shanaberger*  
 G. SCOTT SHANABERGER  
 PROFESSIONAL L.S.#10847

SHANABERGER & LANE  
 8726 TOWN & COUNTRY BLVD.  
 SUITE 104  
 ELLIOTT CITY, MARYLAND 21043

NOTE:  
 WATER QUALITY STRUCTURE TO BE PRIVATELY MAINTAINED


1/1/2003 **Note:** add note to reference F 19-015 (N/G/W)  
 Date Revision Description

APPROVED: HOWARD COUNTY DEPARTMENT OF PUBLIC WORKS	
<i>John A. Brown</i> CHIEF, LAND DEVELOPMENT DIVISION	9/4/92 DATE
<i>Calvin M. Sengstack</i> CHIEF, BUREAU OF HIGHWAYS	9/3/92 DATE
<i>Shabir K. Anderson-Cole</i> CHIEF, BUREAU OF ENGINEERING	9/4/92 DATE
APPROVED: HOWARD COUNTY DEPARTMENT OF PLANNING AND ZONING	
<i>Shirley A. Brown</i> CHIEF, DIVISION OF COMMUNITY PLANNING AND LAND DEVELOPMENT	9/6/92 DATE


**PHOENIX ENGINEERING, INC.**  
 CONSULTING ENGINEERS  
 817 MAIDEN CHOICE LANE, SUITE 300  
 BALTIMORE, MARYLAND 21228  
 PHONE: (410) 247-8888 FAX: (410) 247-8397

AREA:	BROKEN LAND PARKWAY	
AREA:	TITLE SHEET	
DES. BY HRP	SCALE: -AS SHOWN	PROJ. No.
DRN. BY AJR	DATE: JUNE 1992	DRAWING No.
CHK. BY HRP	APPROVED:	1 OF 9


7/6/92  
 DATE  
*Robert R. Platt*  
 PROFESSIONAL ENGINEER No. 5407

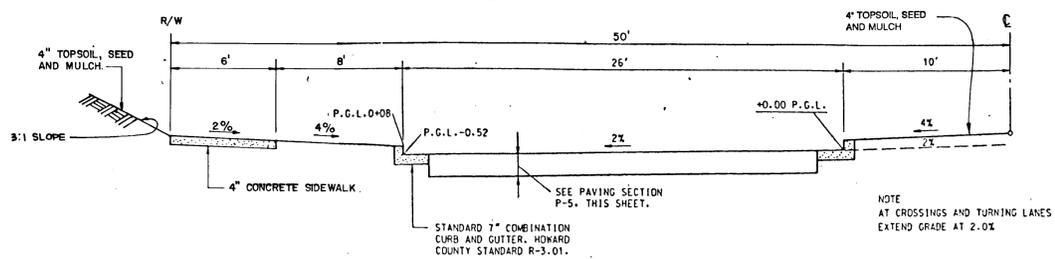


**TYPICAL HALF SECTION (100' R/W)  
BROKEN LAND PARKWAY**  
NO SCALE

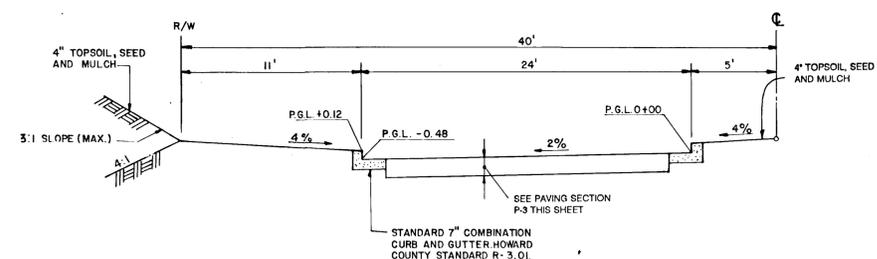


**TYPICAL HALF SECTION WITH MEDIAN (80' R/W)  
MALL ROAD CONNECTOR**  
NO SCALE

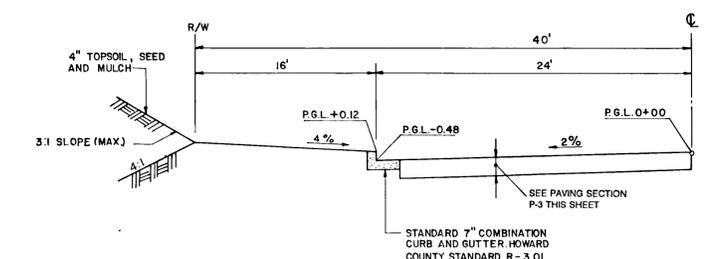


**TYPICAL HALF SECTION (80' R/W)  
MALL ROAD CONNECTOR**  
NO SCALE

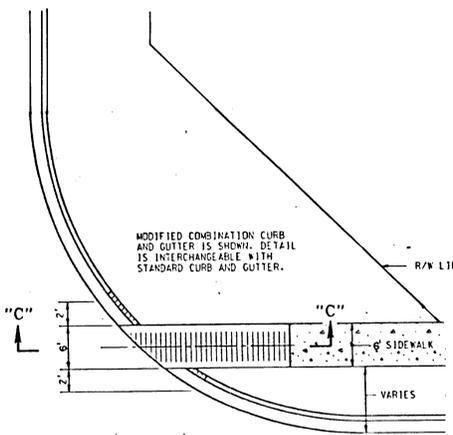


**HANDICAP RAMP DETAIL**  
NO SCALE

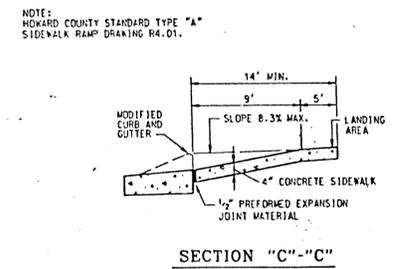

**SECTION "C"- "C"**

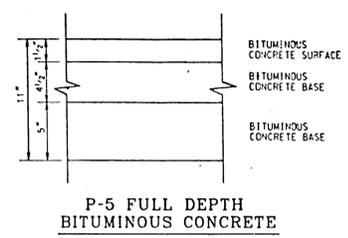


**P-5 FULL DEPTH  
BITUMINOUS CONCRETE**

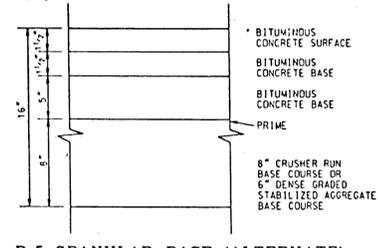


**P-5 GRANULAR BASE (ALTERNATE)**


**TYPICAL PAVING SECTION**  
NO SCALE

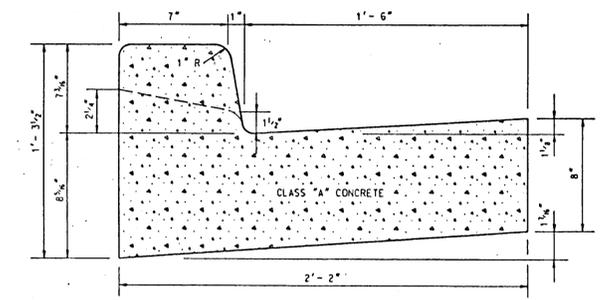

**STANDARD 7" COMBINATION CURB & GUTTER**  
NO SCALE

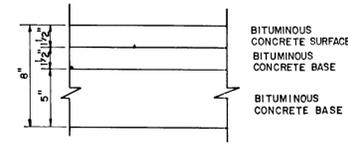


**P-3 FULL DEPTH  
BITUMINOUS CONCRETE**

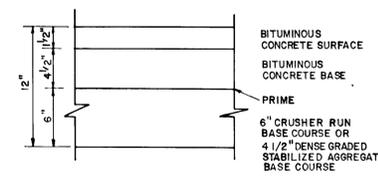


**P-3 GRANULAR BASE (ALTERNATE)**

**TYPICAL PAVING SECTION**  
NO SCALE


QUANTITY OF TREES	COMMON NAME	BOTANICAL NAME	HEIGHT
24	PIN OAK	QUERCUS PALUSTRIS	10'

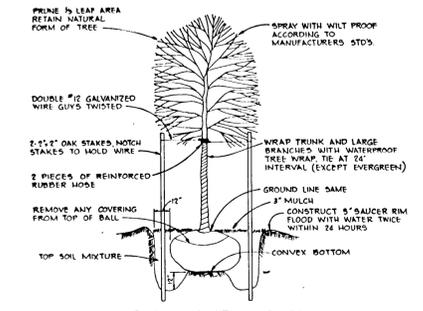

**TREE PLANTING DETAIL**  
NO SCALE

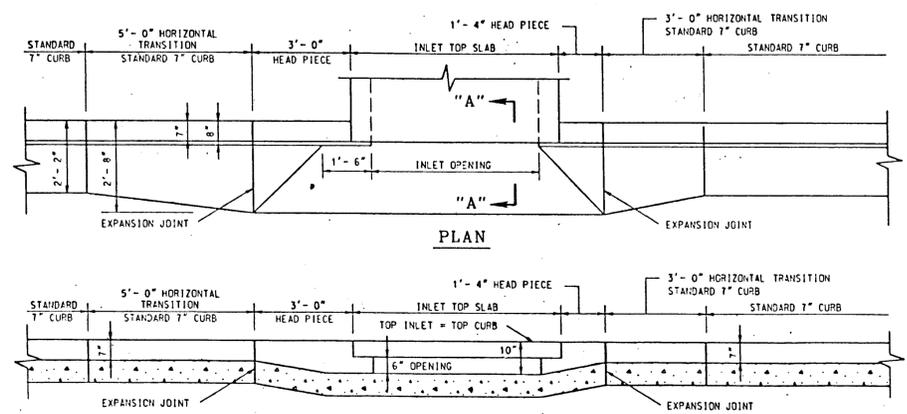

**SECTION ALONG FLOW LINE  
"A" INLETS - STANDARD CURB**  
NO SCALE

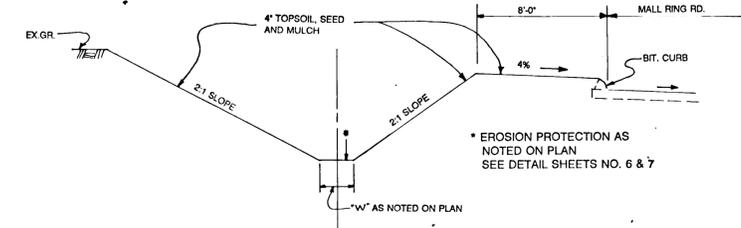

**GRADING SECTION  
CHANNEL ALONG MALL RING RD.**

APPROVED:  
HOWARD COUNTY DEPARTMENT OF PUBLIC WORKS  
*John M. Simpson* 9/4/92  
CHIEF, LAND DEVELOPMENT DIVISION DATE  
*John M. Simpson* 9/3/92  
CHIEF, BUREAU OF HIGHWAYS DATE  
*John M. Simpson* 9/4/92  
CHIEF, BUREAU OF ENGINEERING DATE


APPROVED:  
HOWARD COUNTY DEPARTMENT OF PLANNING AND ZONING  
*Anna J. Hornath* 9/6/92  
CHIEF, DIVISION OF COMMUNITY PLANNING AND LAND DEVELOPMENT DATE

**PHOENIX ENGINEERING, INC.**  
CONSULTING ENGINEERS  
817 MAIDEN CHOICE LANE, SUITE 300  
BALTIMORE, MARYLAND 21220  
PHONE (410) 247-8833 FAX (410) 247-8837

AREA:  
**BROKEN LAND PARKWAY**




AREA:  
**ROADWAY DETAILS**

DES. BY HRP SCALE: 1" = 50' PROJ. No.  
DRN BY AJR DATE: JUNE 1992 DRAWING No.  
CHK. BY HRP APPROVED: DATE: 7/6/92 2 OF 9

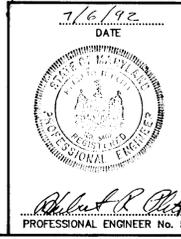

B.M.#1 ELEV. 375.275  
P.K. NAIL IN POINT  
AT BLP @ STA. 166+00


B.M.#2 ELEV. 405.55  
REBAR AND CAP AT BLP  
@ STA. 171+43.22

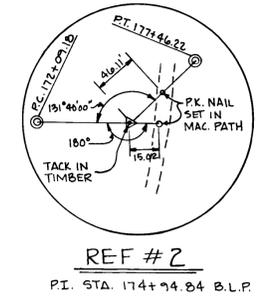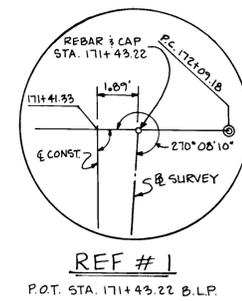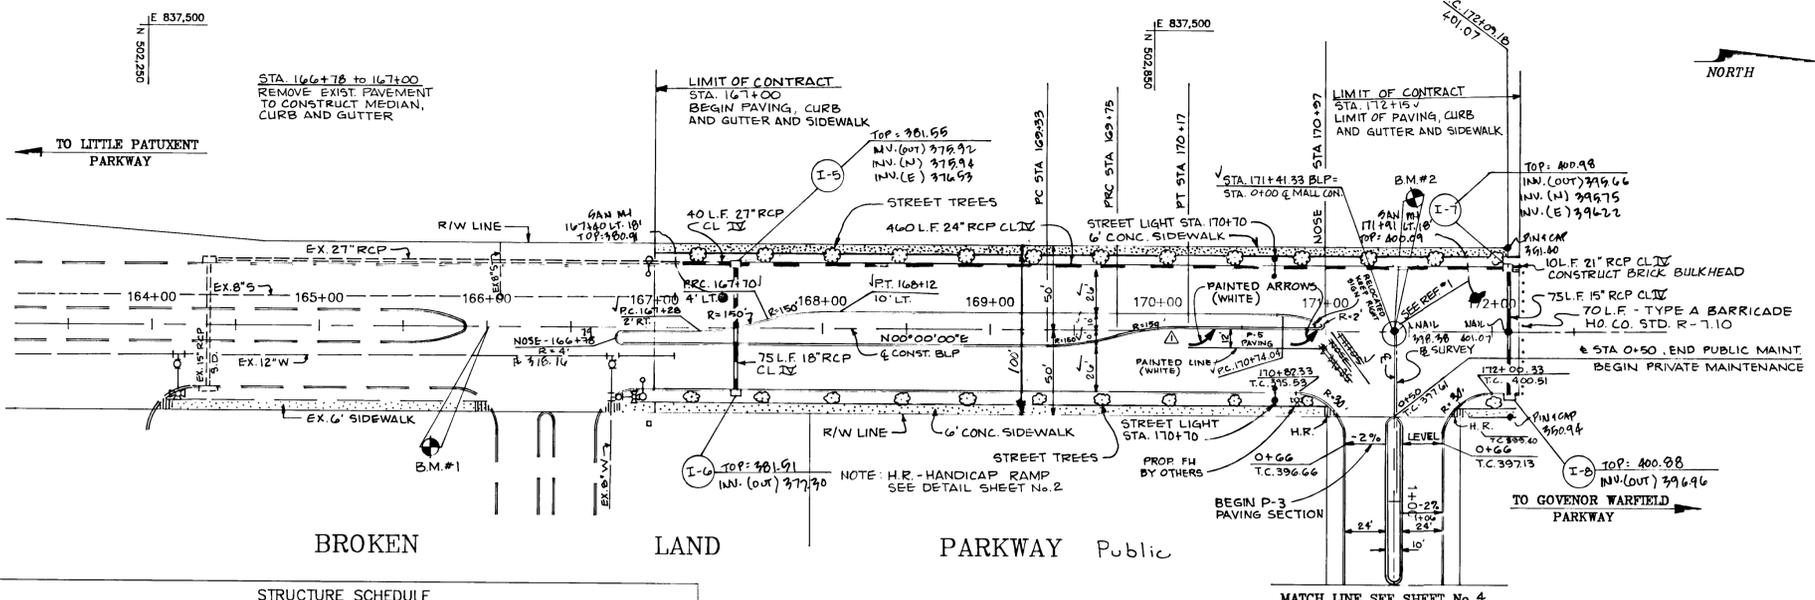

STRUCTURE SCHEDULE						
No.	TYPE	LOCATION	INV. IN	INV. OUT	TOP EL.	REMARKS
I-5	A-5 INLET W/DEFL.	STA. 167+50 - 36' LT.	N 375.88 E 376.38	375.68 375.92	381.51	HO.CO. STD. SD-4.01
I-6	A-5 INLET W/DEFL.	STA. 167+50 - 36' RT.	---	377.05	381.51	HO.CO. STD. SD-4.01
I-7	A-5 INLET W/DEFL.	STA. 172+10 - 36' LT.	N 395.91 E 396.16	395.41 395.66	400.92	HO.CO. STD. SD-4.01
I-8	A-5 INLET W/DEFL.	STA. 172+10 - 36' RT.	---	396.92	400.92	HO.CO. STD. SD-4.01

PLAN  
SCALE: 1" = 50'

**STREET TREES**  
THE LOCATION AND TYPE OF TREES SHOWN ON THESE PLANS ARE TENTATIVE AND ARE FOR BOND PURPOSES ONLY. THE FINAL LOCATION AND VARIETY OF TREES MAY VARY TO ACCOMMODATE FIELD CONDITIONS AND BUILDERS LANDSCAPE PROGRAM. BOND RELEASE IS CONTINGENT UPON SECTION 16.131 OF THE HOWARD COUNTY SUBDIVISION REGULATIONS. AS APPROVED BY THE DEPARTMENT OF PLANNING AND ZONING.

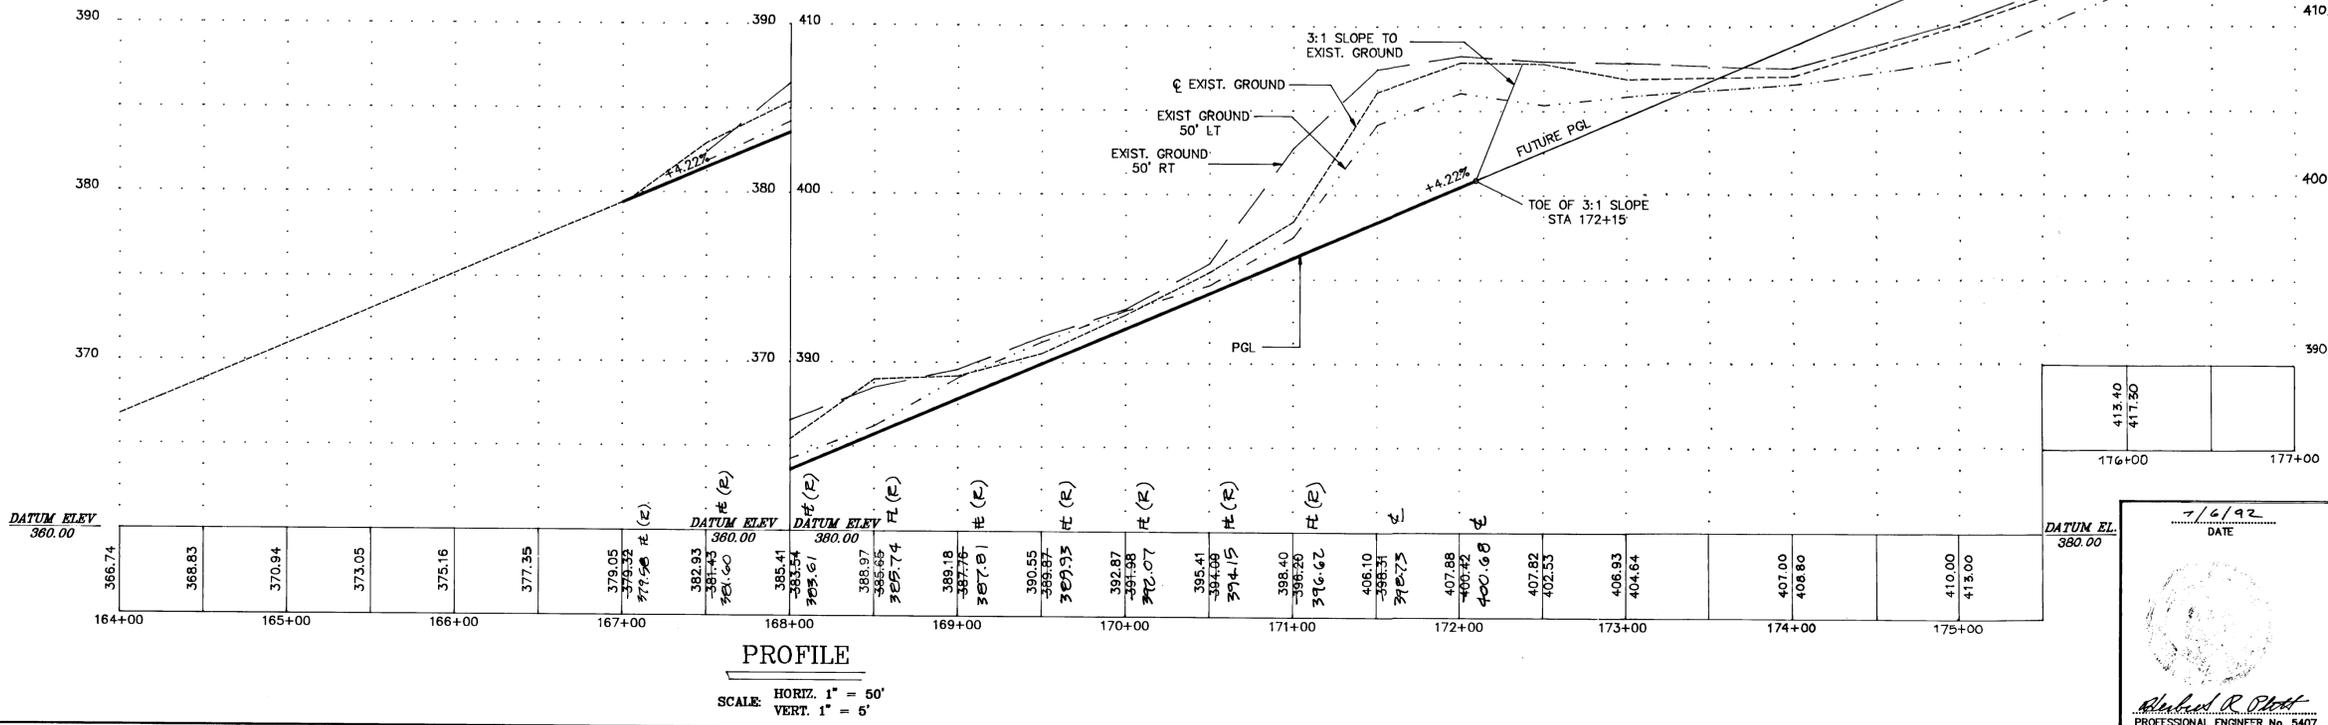

PROFILE  
SCALE: HORIZ. 1" = 50'  
VERT. 1" = 5'

DATE	NO.	DESCRIPTION
2-3-92	1	ADDED LEFT TURN LANE @ STA 171+00

AS-BUILT

*Scott Shanaberger*  
SCOTT SHANABERGER  
PROFESSIONAL L.S. # 10849

**SHANABERGER & LANE**  
8726 TOWN & COUNTRY BLVD.  
SUITE 104  
ELLICOTT CITY, MARYLAND 21043

APPROVED:  
HOWARD COUNTY DEPARTMENT OF PUBLIC WORKS  
*John M. Szymanski* 9/14/92  
CHIEF, LAND DEVELOPMENT DIVISION DATE  
*Colin M. Szymanski* 9/13/92  
CHIEF, BUREAU OF HIGHWAYS DATE  
*Elizabeth P. Szymanski* 9/14/92  
CHIEF, BUREAU OF ENGINEERING DATE

APPROVED:  
HOWARD COUNTY DEPARTMENT OF PLANNING AND ZONING  
*Anna K. Szymanski* 9/16/92  
CHIEF, DIVISION OF COMMUNITY PLANNING AND LAND DEVELOPMENT DATE


**PHOENIX ENGINEERING, INC.**  
CONSULTING ENGINEERS  
817 MAIDEN CHOICE LANE, SUITE 300  
BALTIMORE, MARYLAND 21228

AREA: BROKEN LAND PARKWAY




AREA: ROADWAY PLAN AND PROFILE

DES. BY HRP	SCALE: AS SHOWN	PROJ. No.
DRN BY AJR	DATE: JUNE 1992	DRAWING No.
CHK. BY HRP	APPROVED:	3 OF 3

DATUM EL. 380.00  
413.40  
417.50  
176+00  
177+00  
DATE: 7/6/92  
PROFESSIONAL ENGINEER No. 5407

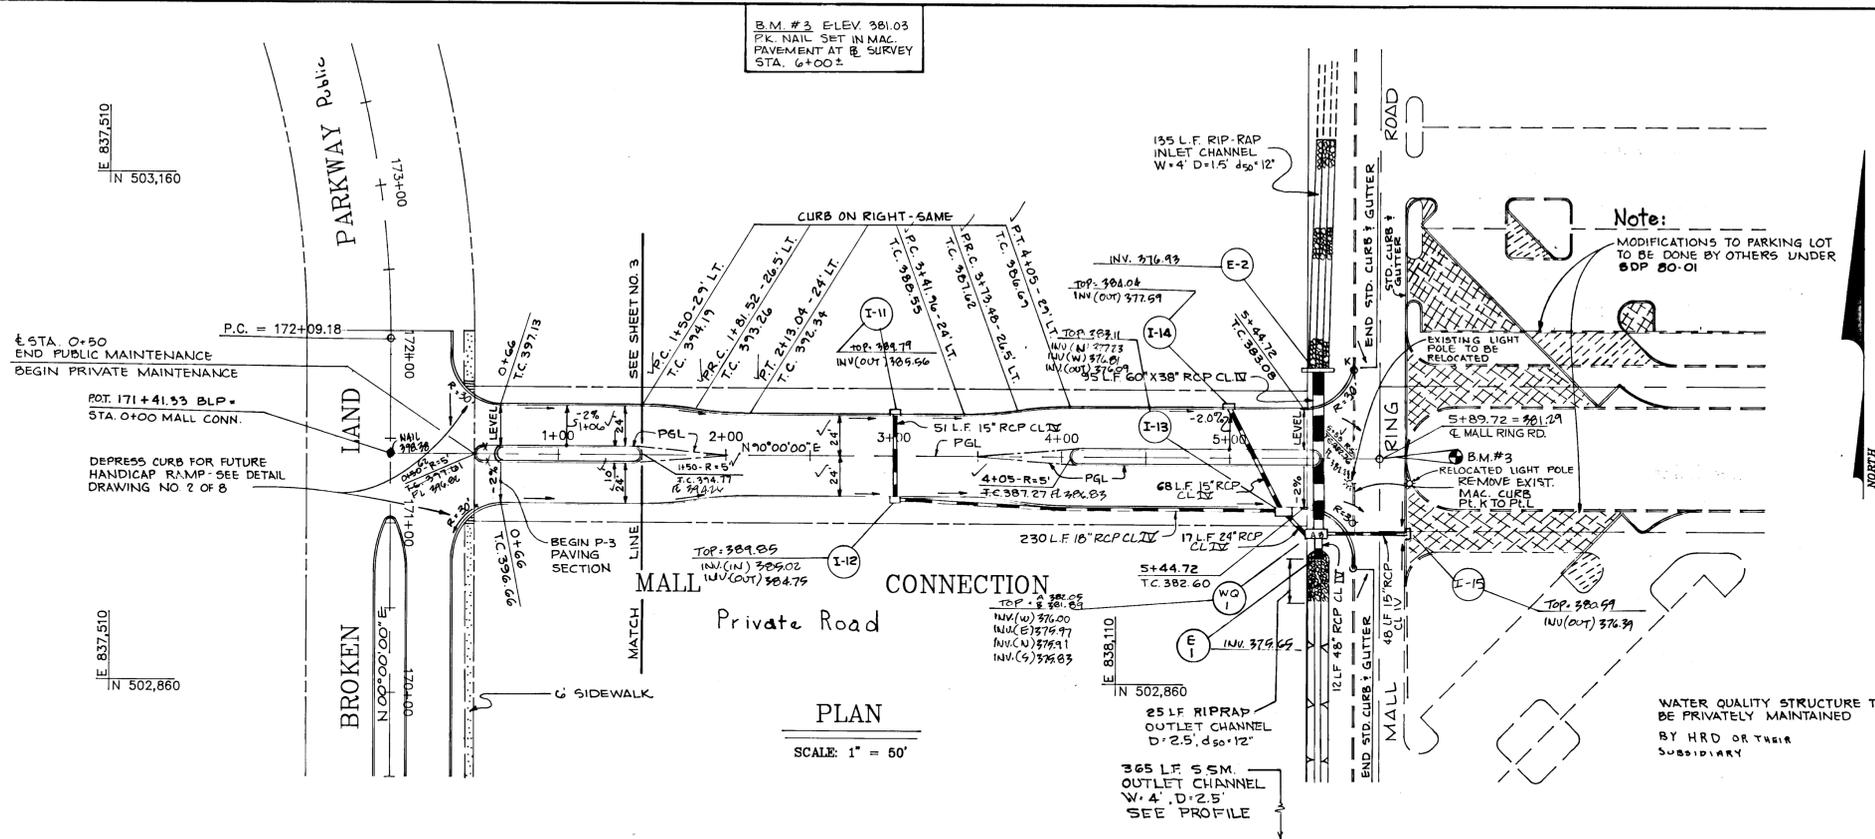

STRUCTURE SCHEDULE						
NO.	TYPE	LOCATION	INV. IN	INV. OUT	TOP EL.	REMARKS
I-11	A-5 INLET W/DEFL	STA. 3+00' 24' LT.	-	385.50	389.75	HO. CO. STD. SD-4.01
I-12	A-5 INLET W/DEFL	STA. 3+00' 24' RT.	385.00	384.20	389.75	HO. CO. STD. SD-4.01
I-13	MODIFIED A-10 INLET W/DEFL	STA. 5+30' 29' RT.	N 317.05 W 376.80	376.09	383.02	SEE DETAIL THIS SHEET
I-14	A-5 INLET W/DEFL	STA. 5+00' 29' LT.	-	377.35	383.90	HO. CO. STD. SD-4.01
E-1	SPIGOT END PIPE	STA. 5+52' 58' RT.	-	375.25	-	FOR FUTURE CONN.
E-2	MOD. TYPE 'C' ENDWALL	STA. 5+52' 56' LT.	-	377.00	-	HO. CO. STD. SD-5.21
WQ-1	MODIFIED A-10 INLET	STA. 5+52' 46' RT.	376.09	375.85	382.00	SEE DETAIL SHT. NO. 8
I-15	A-5 INLET	STA. 6+05' 43' RT.	-	377.60	380.25	HO. CO. STD. SD-4.01

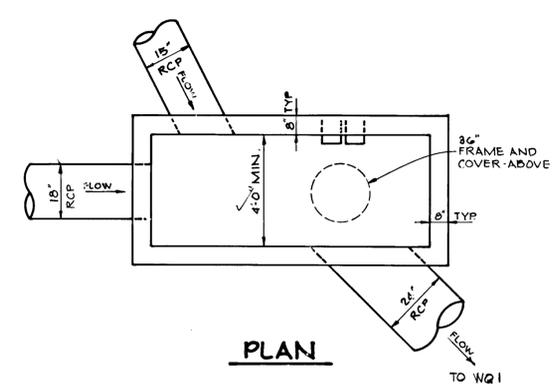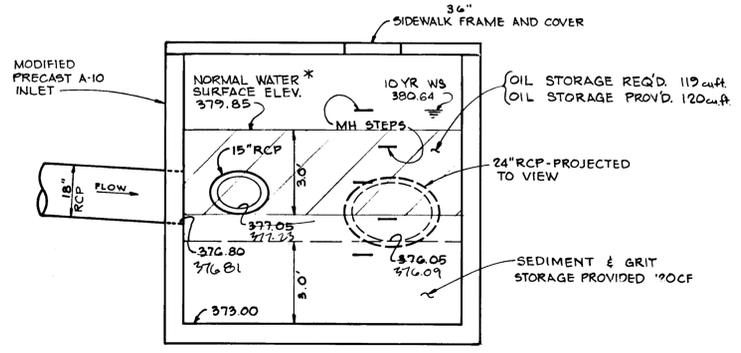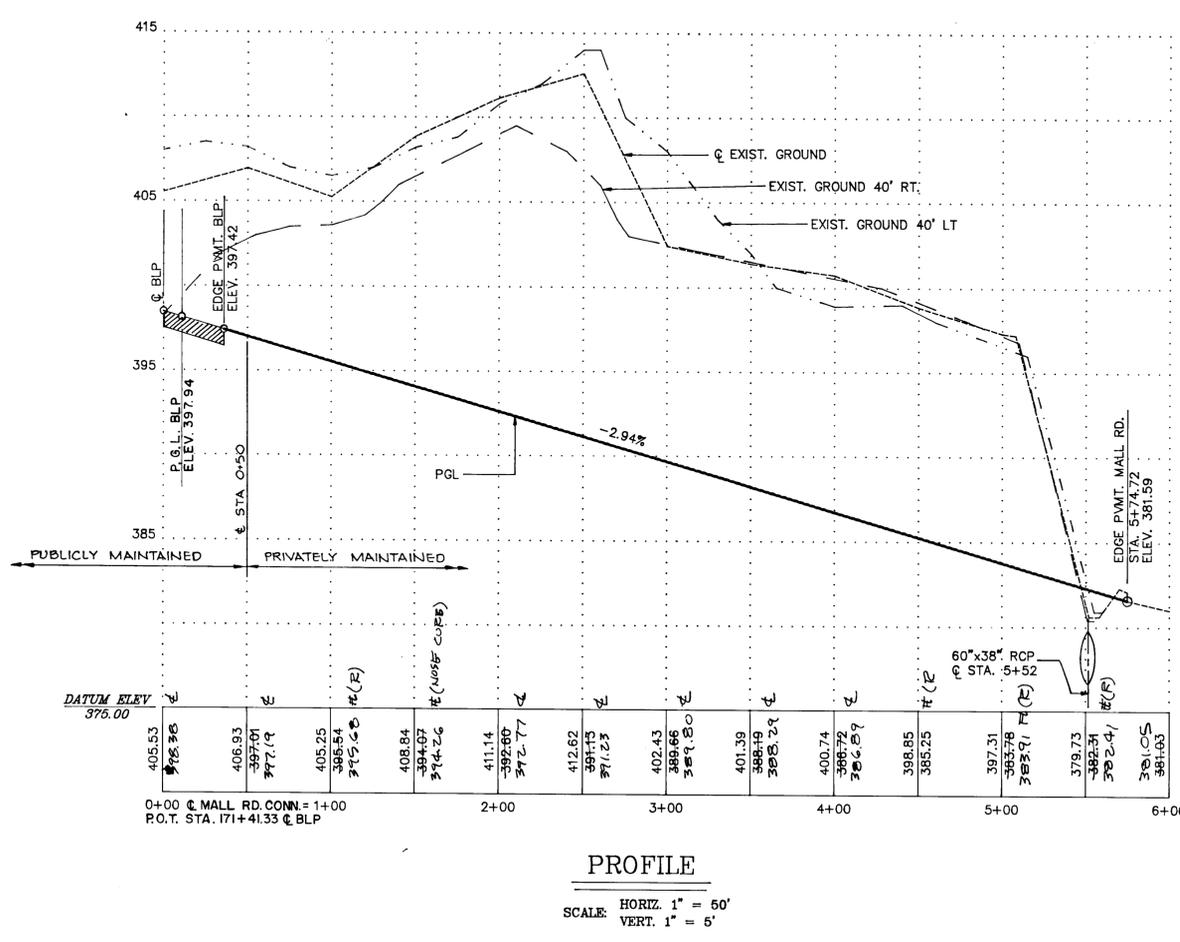

AS-BUILT

*Carol Ann...*  
 69101 GUALABERGER  
 PROFESSIONAL U.S. # 10849

7/26/92  
 PKTE

SHANBERGER & LANE  
 8726 TOWN & COUNTRY BLVD.  
 SUITE 104  
 BELLICOTT CITY, MARYLAND 21043

APPROVED:  
 HOWARD COUNTY DEPARTMENT OF PUBLIC WORKS

*Howard...* 9/4/92  
 CHIEF, LAND DEVELOPMENT DIVISION DATE

*John M....* 9/3/92  
 CHIEF, BUREAU OF HIGHWAYS DATE

*Elizabeth...* 9/4/92  
 CHIEF, BUREAU OF ENGINEERING DATE

APPROVED:  
 HOWARD COUNTY DEPARTMENT OF PLANNING AND ZONING

*Anna...* 9/6/92  
 CHIEF, DIVISION OF COMMUNITY PLANNING AND LAND DEVELOPMENT DATE

PHOENIX ENGINEERING, INC.  
 CONSULTING ENGINEERS  
 817 MAIDEN CHOICE LANE, SUITE 300  
 BALTIMORE, MARYLAND 21228




AREA: BROKEN LAND PARKWAY

AREA: ROADWAY PLAN AND PROFILE

DES. BY HRP	SCALE: AS SHOWN	PROJ. No.
DRN BY AJR	DATE: JUNE 1992	DRAWING No.
CHK. BY HRP	APPROVED:	4 OF 9

7/6/92  
 DATE


*Robert R. Pitt*  
 PROFESSIONAL ENGINEER No. 5407

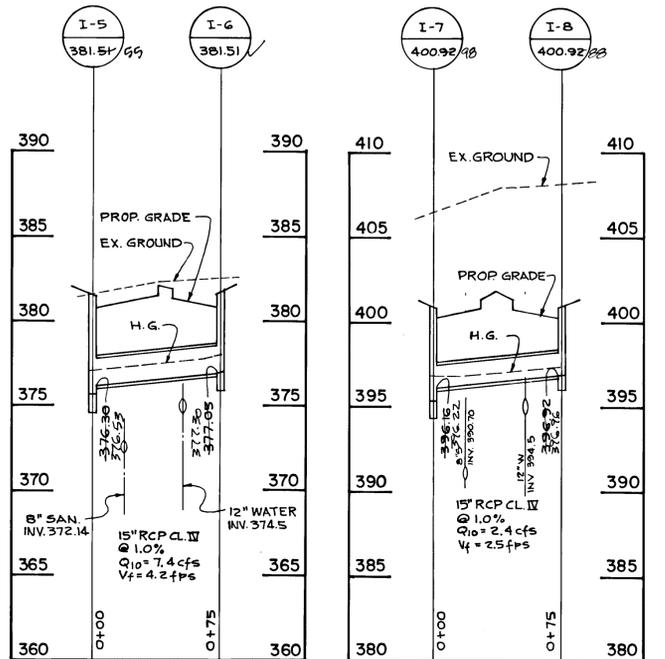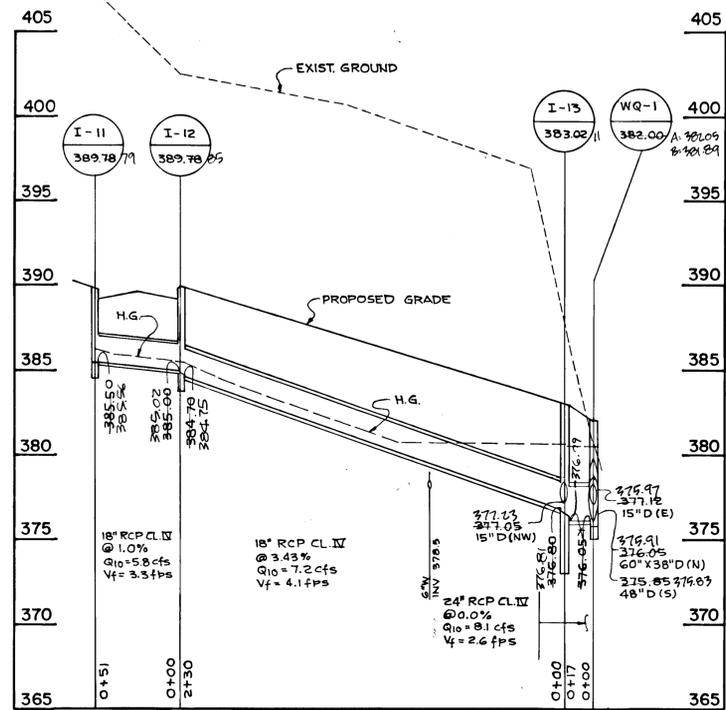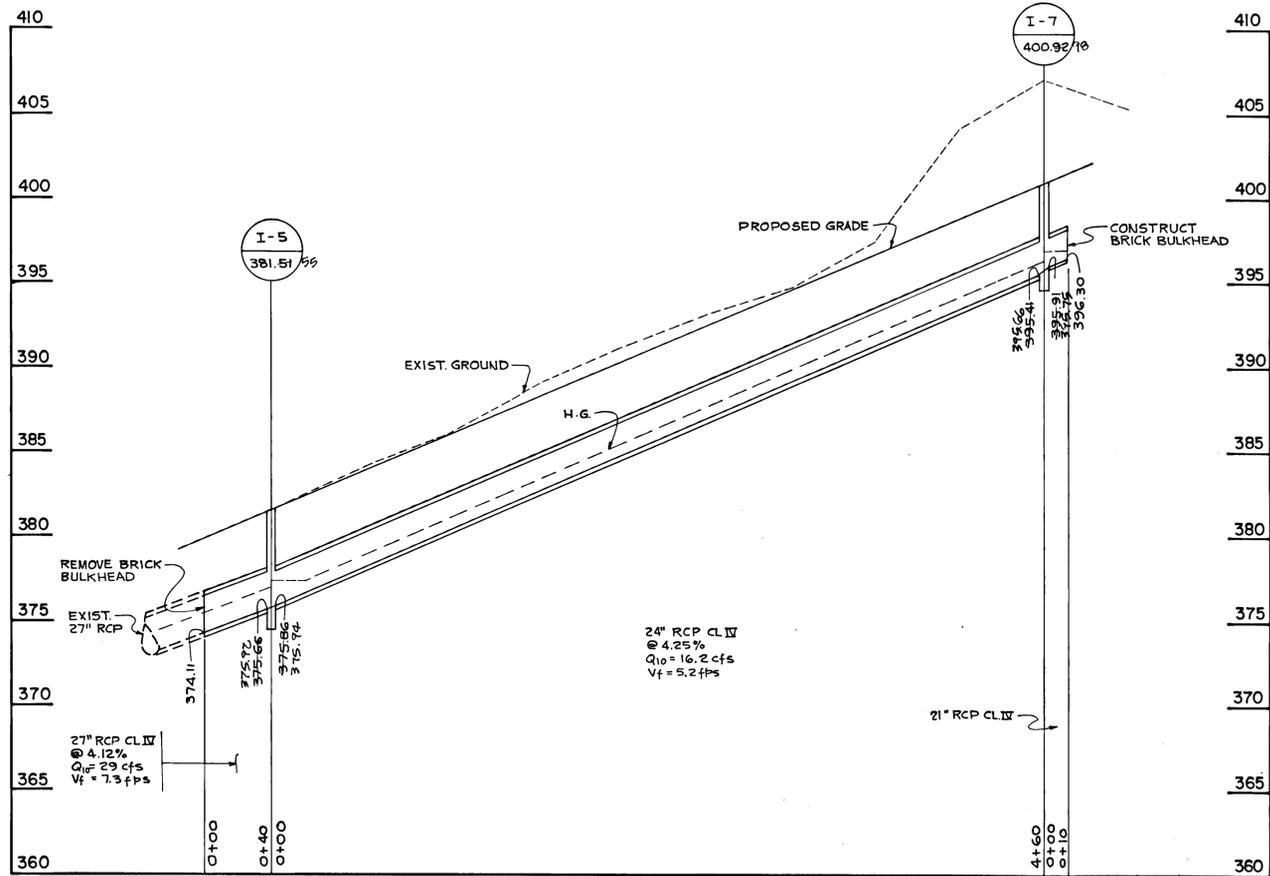


**MALL ROAD CONNECTOR**  
SCALE: HOR. 1" = 50'  
VER. 1" = 5'

**BROKEN LAND PARKWAY**  
SCALE: HOR. 1" = 50'  
VER. 1" = 5'

**BROKEN LAND PARKWAY**  
SCALE: HOR. 1" = 50'  
VER. 1" = 5'

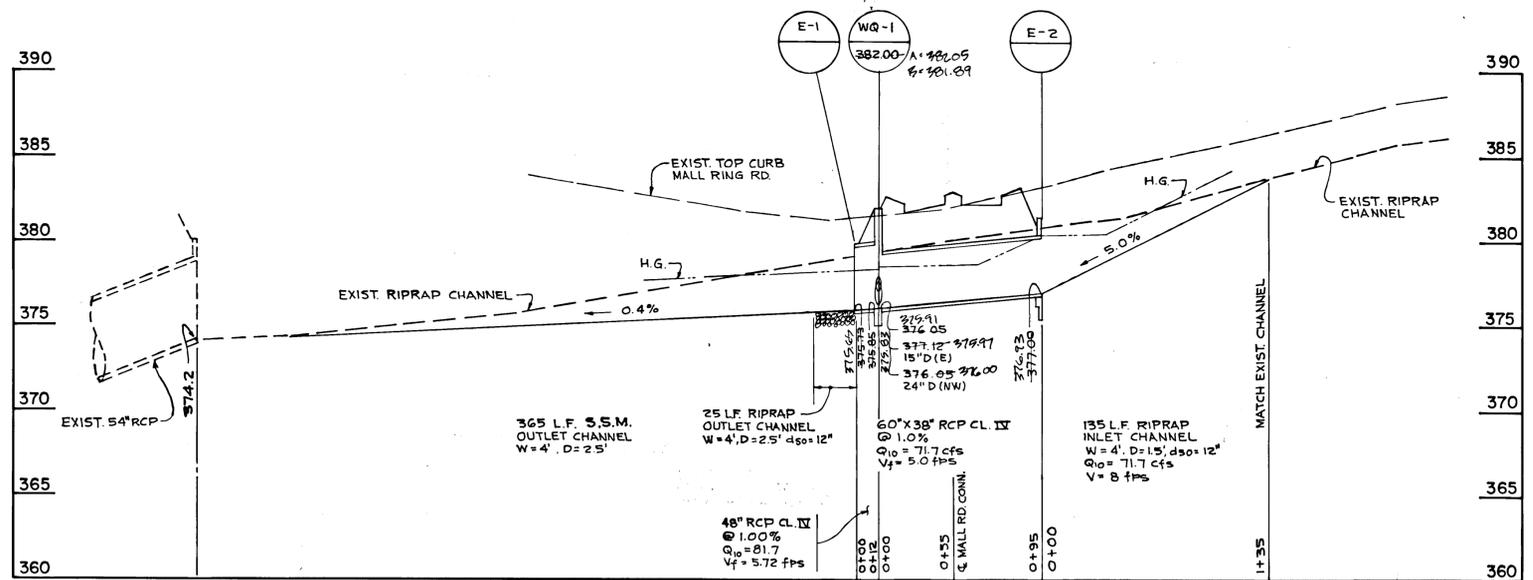

**MALL RING ROAD**  
SCALE: HOR. 1" = 50'  
VER. 1" = 5'

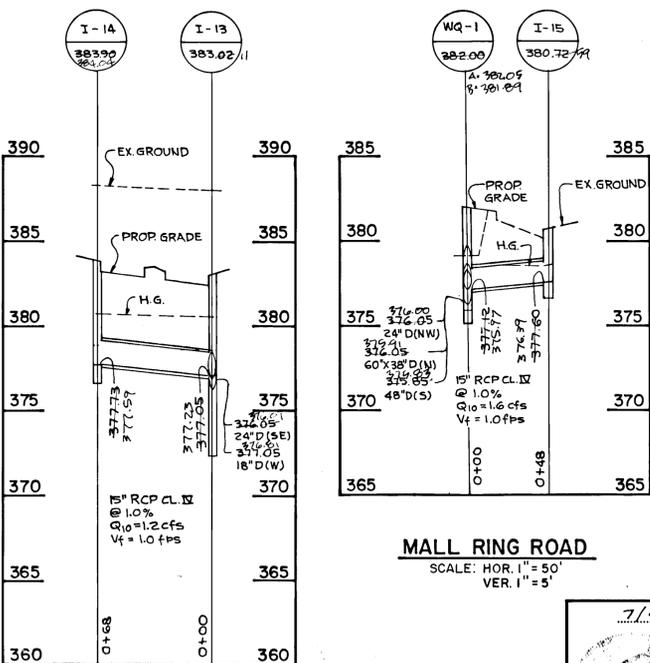


**MALL ROAD CONNECTOR**  
SCALE: HOR. 1" = 50'  
VER. 1" = 5'

**MALL RING ROAD**  
SCALE: HOR. 1" = 50'  
VER. 1" = 5'

AS-BUILT

*Scott Handberg*  
G. SCOTT SHANABERGER  
PROFESSIONAL L.S. # 10844

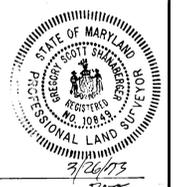

WATER QUALITY STRUCTURE TO BE PRIVATELY MAINTAINED  
**SHANABERGER & LANE**  
8726 TOWN & COUNTRY BLVD.  
SUITE 104  
ELLICOTT CITY, MARYLAND 21043

APPROVED:  
HOWARD COUNTY DEPARTMENT OF PUBLIC WORKS  
*Howard County* 9/14/92  
CHIEF, LAND DEVELOPMENT DIVISION  
*John M. Johnson* 9/14/92  
CHIEF, BUREAU OF HIGHWAYS  
*Elizabeth R. Calin* 9/14/92  
CHIEF, BUREAU OF ENGINEERING

APPROVED:  
HOWARD COUNTY DEPARTMENT OF PLANNING AND ZONING  
*Anna S. Holmstedt* 9/14/92  
CHIEF, DIVISION OF COMMUNITY PLANNING AND LAND DEVELOPMENT




**PHOENIX ENGINEERING, INC.**  
CONSULTING ENGINEERS  
817 MAIDEN CHOICE LANE, SUITE 300  
BALTIMORE, MARYLAND 21228  
PHONE (410) 247-8853 FAX (410) 247-8337

AREA: BROKEN LAND PARKWAY

AREA: STORM DRAIN PROFILES

DES. BY HRP	SCALE: AS SHOWN	PROJ. No.
DRN BY AJR	DATE: JUNE 1992	DRAWING No.
CHK. BY HRP	APPROVED:	5 OF 9

7/6/92  
DATE  
*Richard R. Blott*  
PROFESSIONAL ENGINEER No. 5407

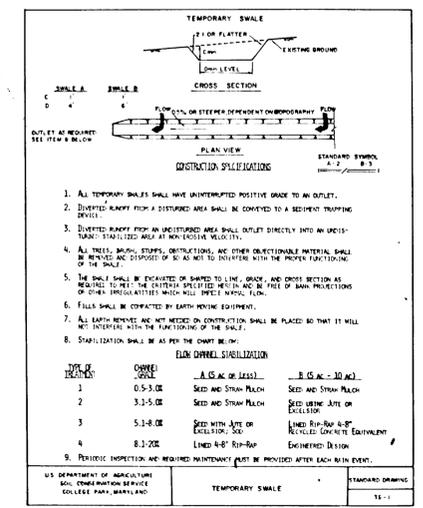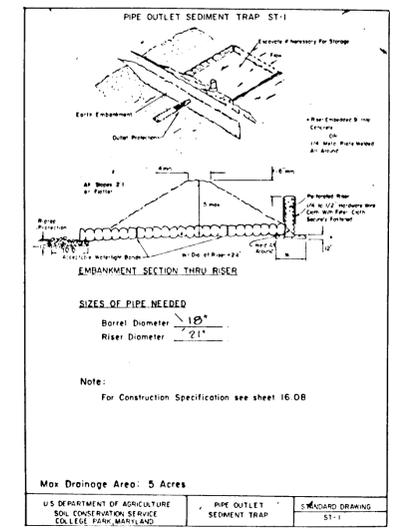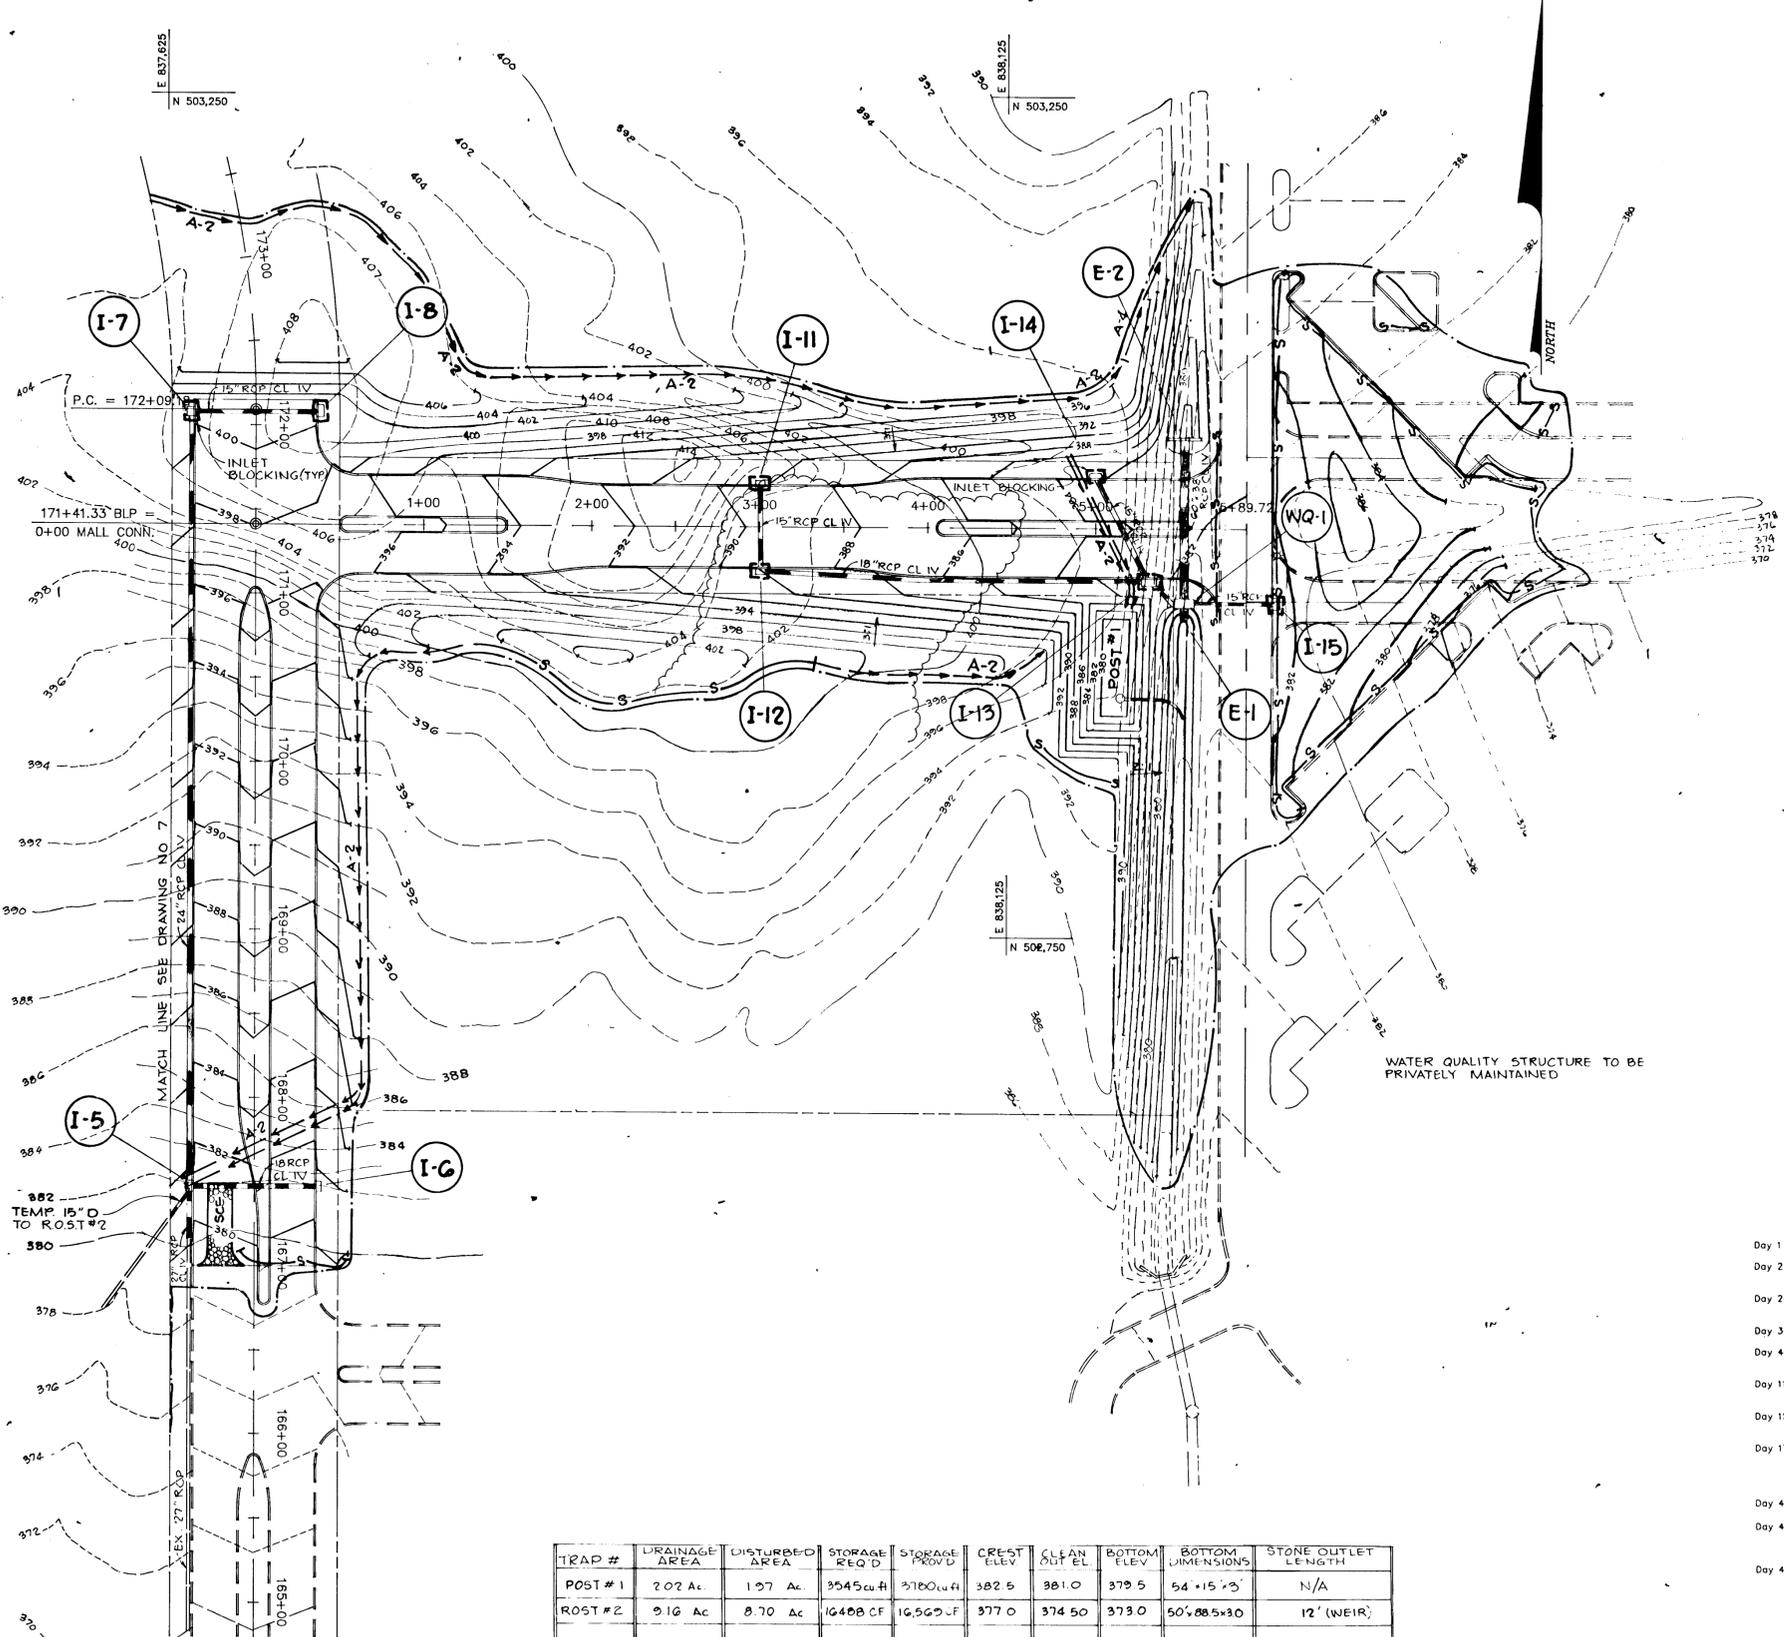

- CONSTRUCTION SPECIFICATION FOR ST-1**
1. Area under embankment shall be cleared, grubbed and stripped of any vegetation and root mat. The soil area shall be cleared.
  2. The fill material for the embankment shall be free of roots or other woody vegetation as well as oversized stones, rocks, organic material, or other objectionable material. The embankment shall be compacted by traversing with equipment while it is being constructed.
  3. Volume of sediment storage shall be 1800 cubic feet per acre of contributory drainage.
  4. Sediment shall be removed and trap returned to its original dimensions when the sediment has accumulated to 1/2 the design depth of the trap. Removed sediment shall be deposited in a suitable area and in such a manner that it will not erode.
  5. The structure shall be inspected after each rain and repairs made as needed.
  6. Construction operations shall be carried out in such a manner that erosion and water pollution are minimized.
  7. The structure shall be removed and area stabilized when the drainage area has been properly stabilized.
  8. All fill slopes shall be 1:1 or flatter; cut slopes 1:1 or flatter.
  9. All pipe connections shall be watertight.
  10. The top 2/3 of the riser shall be perforated with one (1) inch diameter holes or slots spaced six (6) inches vertically and horizontally and placed in the concrete portion of pipe. No holes will be allowed within six (6) inches of the horizontal barrel.
  11. The riser shall be wrapped with 1/4 to 1/2 inch hardware cloth wire then wrapped with filter cloth (having an equivalent sieve size of 10 - 80). The filter cloth shall extend six (6) inches above the highest hole and six (6) inches below the lowest hole. Where ends of filter cloth come together, they shall be overlapped, folded and stapled to prevent bypass.
  12. Straps or connecting bands shall be used to hold the filter cloth and wire fabric in place. They shall be placed at the top and bottom of the cloth.
  13. Fill material around the pipe spillway shall be hand compacted in four (4) inch layers. A minimum of two (2) feet of hand-compacted backfill shall be placed over the pipe spillway before crossing it with construction equipment.
  14. The riser shall be anchored with either a concrete base or steel plate base to prevent flotation. For concrete base the depth shall be 12 inches with the riser embedded nine (9) inches. A 1/4 inch minimum thickness steel plate shall be attached to the riser by a continuous weld around the bottom to form a watertight connection and then place two (2) feet of stone, gravel, or tamped earth on the plate.

**CERTIFICATION BY THE DEVELOPER:**

"I CERTIFY THAT ALL DEVELOPMENT AND/OR CONSTRUCTION WILL BE DONE ACCORDING TO THESE PLANS OF DEVELOPMENT AND PLANS FOR SEDIMENT AND EROSION CONTROL AND THAT ALL RESPONSIBLE PERSONNEL INVOLVED IN THE CONSTRUCTION PROJECT WILL HAVE A CERTIFICATE OF ATTENDANCE AT A MID DEPARTMENT OF THE ENVIRONMENT APPROVED TRAINING PROGRAM FOR THE CONTROL OF SEDIMENT AND EROSION BEGINNING THE PROJECT. I ALSO AUTHORIZE PERIODIC ON-SITE INSPECTION BY THE HOWARD COUNTY SOIL CONSERVATION DISTRICT OR THEIR AUTHORIZED AGENTS, AS ARE DEEMED NECESSARY."

*Anthony R. Clark* 7/9/92  
 SIGNATURE OF DEVELOPER DATE

**CERTIFICATION BY THE ENGINEER:**

"I CERTIFY THAT THIS PLAN FOR EROSION AND SEDIMENT CONTROL REPRESENTS A PRACTICAL AND WORKABLE PLAN BASED ON MY KNOWLEDGE OF THE SITE CONDITIONS AND THAT IT WAS PREPARED IN ACCORDANCE WITH THE REQUIREMENTS OF THE HOWARD COUNTY SOIL CONSERVATION DISTRICT."

*Robert N. West* 7/9/92  
 SIGNATURE OF ENGINEER DATE

THESE PLANS HAVE BEEN REVIEWED FOR THE HOWARD SOIL CONSERVATION DISTRICT AND MEET THE TECHNICAL REQUIREMENTS FOR SOIL, EROSION AND SEDIMENT CONTROL

*James W. Miller, JCS* 8/2/92  
 U.S. SOIL CONSERVATION SERVICE DATE

THESE PLANS FOR SEDIMENT CONTROL MEET THE REQUIREMENTS OF THE HOWARD SOIL CONSERVATION DISTRICT

*Robert N. West* 8/1/92  
 HOWARD COUNTY SOIL CONSERVATION DISTRICT DATE

APPROVED:  
 HOWARD COUNTY DEPARTMENT OF PUBLIC WORKS

*John R. Brown* 9/10/92  
 CHIEF, LAND DEVELOPMENT DIVISION DATE

*Alan M. Sengman* 9/10/92  
 CHIEF, BUREAU OF HIGHWAYS DATE

*Elizabeth P. Gales* 9/10/92  
 CHIEF, BUREAU OF ENGINEERING DATE

APPROVED:  
 HOWARD COUNTY DEPARTMENT OF PLANNING AND ZONING

*Emma J. Blomath* 9/8/92  
 CHIEF, DIVISION OF COMMUNITY PLANNING AND LAND DEVELOPMENT DATE


**PHOENIX ENGINEERING, INC.**  
 CONSULTING ENGINEERS  
 817 MAIDEN CHOICE LANE, SUITE 300  
 BALTIMORE, MARYLAND 21228

PHONE (410) 247-6833 FAX (410) 247-9307

AREA: BROKEN LAND PARKWAY

AREA: SEDIMENT AND EROSION CONTROL PLAN


DES. BY HRP SCALE: 1" = 50' PROJ. No.  
 DRN BY AJR DATE: JUNE 1992 DRAWING No.  
 CHK. BY HRP APPROVED: 6 OF 9

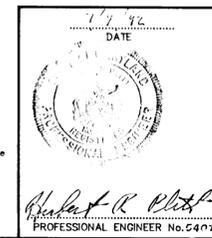

TRAP #	DRAINAGE AREA	DISTURBED AREA	STORAGE REQ'D	STORAGE PROVIDED	CREST ELEV.	CLEAN OUT EL.	BOTTOM ELEV.	BOTTOM DIMENSIONS	STONE OUTLET LENGTH
POST #1	2.02 Ac.	1.97 Ac.	3545 cu ft	3760 cu ft	382.5	381.0	379.5	54' x 15' x 3'	N/A
ROST #2	9.16 Ac.	8.70 Ac.	16408 cu ft	16569 cu ft	377.0	374.50	373.0	50' x 88.5' x 30'	12' (WEIR)


- SEQUENCE OF CONSTRUCTION**
- Day 1: Obtain Grading Permit.
  - Day 2: Clear and grub for, and install, stabilized construction entrance, (SCE).
  - Day 2-3: Clear and grub area for the sediment traps and construct sediment traps.
  - Day 3-4: Install remainder of sediment control devices.
  - Day 4-11: Grade channel below E-1 and stabilize with jute or excelsior matting.
  - Day 11-15: Construct storm drain from E-1 to E-2 and channel upstream of E-2.
  - Day 15-17: Clear and grub remaining area to be disturbed and begin grading. Grade roadbeds to subgrade.
  - Day 17-40: Install water, sewer, and storm drains.  
 Install temp. 15" pipe at inlet I-5 and black 27" rcp while R.O.S.T. is in use.
  - Day 40-42: Install inlet blocking as shown.
  - Day 42-47: Stabilize roadbeds by constructing base course and all other disturbed areas in accordance with the seeding notes.
  - Day 47-48: Remove sediment traps with the approval and under direction of the Sediment Control Inspector.
  - Day 48-59: Install curb and gutter, pave roads, and complete fine grading.
  - Day 59-62: Remove remaining sediment control devices with the approval of the sediment control inspector and stabilize any remaining disturbed areas.



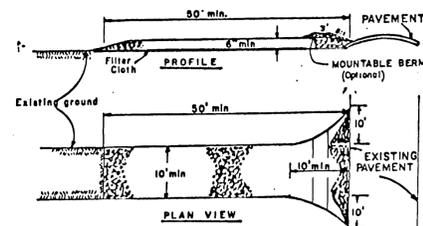

- CONSTRUCTION SPECIFICATIONS**
- Stone Blot - Use 2" stone, or reclaimed or recycled concrete equivalent.
  - Length - As required, but not less than 30 feet (except on a single residence lot where a 20 foot minimum length would apply).
  - Thickness - Not less than 18 inches.
  - Width - Ten (10) foot minimum, but not less than the full width at points where ingress or egress occurs.
  - Filter Cloth - Will be placed over the entire area prior to placing of stone. Filter will not be required on a single family residence lot.
  - Surface Water - All surface water flowing or diverted toward construction entrances shall be piped across the entrance. If piping is impractical, a mountable beam with 2:1 slopes will be permitted.
  - Maintenance - The entrance shall be maintained in a condition which will prevent tracking or flowing of sediment onto public rights-of-way. This may require periodic top dressing with additional stone as conditions demand and repair and/or cleanout of any measures used to trap sediment. All sediment spilled, dropped, washed or tracked onto public rights-of-way must be removed immediately.
  - Washing - Wheels shall be cleaned to remove sediment prior to entrance onto public rights-of-way. When washing is required, it shall be done on an area stabilized with stone and which drains into an approved sediment trapping device.
  - Periodic inspection and needed maintenance shall be provided after each rain.

**STABILIZED CONSTRUCTION ENTRANCE**

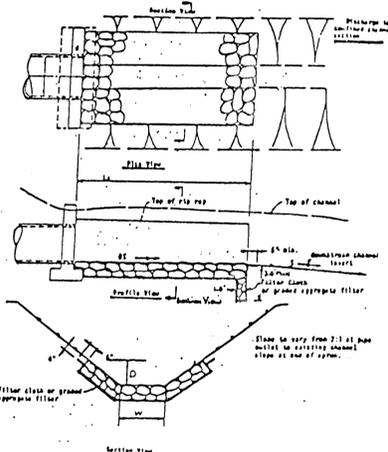

**ROCK RIPRAP SIZES AND THICKNESS**

d50 (Inches)	Max (Inches)	Min Blanket Thickness (Inches)
4	9	9
6	14	14
9	18	18
12	22	22
15	27	27
18	32	32
21	36	36
24	43	43



**Stone Quality.** Stone for riprap shall consist of field stone or rough broken quarry stone. The stone shall be hard and angular and of a quality that will not disintegrate on exposure to water or weathering. The specific gravity of the individual stones shall be at least 2.5.

**Filter.** A filter is a layer of material placed between the riprap and the underlying soil surface to prevent soil movement into and through the riprap. Riprap shall have a filter placed under it in all cases.

A filter can be of two general forms: A gravel layer or a plastic filter cloth. The plastic filter cloth can be woven or non-woven monofilament yarn, and shall meet these basic requirements: Thickness 20-40 mils; Grab strength 90-120 lbs; and shall conform to ASTM D-1777 and ASTM D-1682.


Gravel filter blanket when used shall be designed by comparing particle sizes of the overlying material and the base material. Design criteria is available in any soil or civil engineering reference or from the Soil Conservation Service.

**RIP-RAP PROTECTION**

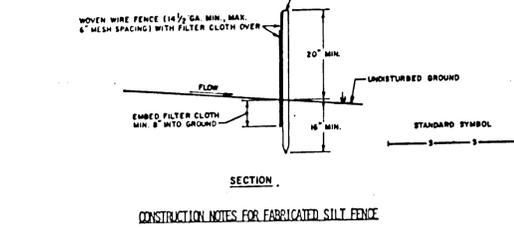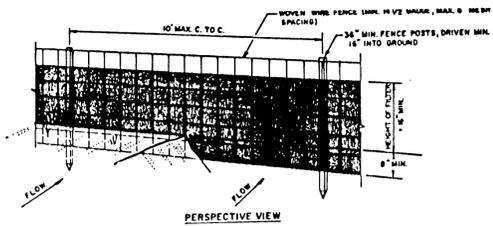


- CONSTRUCTION NOTES FOR FABRICATED SILT FENCE**
- WOVEN WIRE FENCE TO BE FASTENED SECURELY TO FENCE POSTS WITH WIRE TIES OR STAPLES.
  - FILTER CLOTH TO BE FASTENED SECURELY TO WOVEN WIRE FENCE WITH TIES SPACED EVERY 2' AT TOP AND MID SECTION.
  - WHEN TWO SECTIONS OF FILTER CLOTH ADJOIN EACH OTHER THEY SHALL BE OVERLAPPED BY SIX INCHES AND FOLDED.
  - MAINTENANCE SHALL BE PERFORMED AS NEEDED AND MATERIAL REMOVED WHEN "MUDS" DEVELOP IN THE SILT FENCE.
- POSTS:** STEEL EITHER T OR U TYPE OR 2" HARDWOOD
- FENCE:** WOVEN WIRE, 1/4" GA. 6" MAX. FISH OPENING
- FILTER CLOTH:** FILTER X, MIRAFI 1000, STABILINKA 1100H OR APPROVED EQUAL
- PREFABRICATED UNIT:** GEOTAB, ENVIRFENCE, OR APPROVED EQUAL

**SILT FENCE**

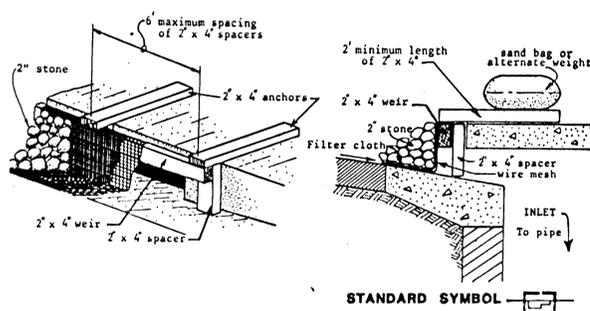

- CONSTRUCTION SPECIFICATIONS**
- Materials**
    - Wooden frame is to be constructed of 2" x 4" construction grade lumber.
    - Wire mesh must be of sufficient strength to support filter fabric, and stone for curb inlets, with water fully impounded against it.
    - Filter cloth must be of a type approved for this purpose; resistant to sunlight with sieve size, EOS, 40-85, to allow sufficient passage of water and removal of sediment.
    - Stone is to be 2" in size and clean, since fines would clog the cloth.
  - Procedure**
    - Attach a continuous piece of wire mesh (30" min. width by throat length plus 4") to the 2" x 4" weir (measuring throat length plus 2") as shown on the standard drawing.
    - Place a piece of approved filter cloth (40-85 sieve) of the same dimensions as the wire mesh over the wire mesh and securely attach to the 2" x 4" weir.
    - Securely nail the 2" x 4" weir to 9" long vertical spacers to be located between the weir and inlet face (max. 6' apart).
    - Place the assembly against the inlet throat and nail (minimum 2' lengths of 2" x 4" to the top of the weir at spacer locations. These 2" x 4" anchors shall extend across the inlet top and be held in place by sandbags or alternate weight.

**INLET PROTECTION**

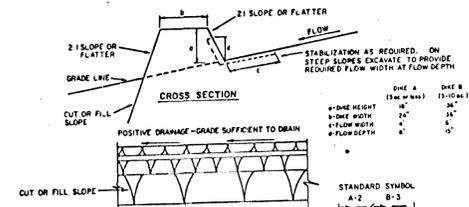

- CONSTRUCTION SPECIFICATIONS**
- ALL DIKES SHALL BE COMPACTED BY EARTH-MOVING EQUIPMENT.
  - ALL DIKES SHALL HAVE POSITIVE DRAINAGE TO AN OUTLET, PASSING BY CONSTRUCTION TRAFFIC.
  - FIELD LOCATION SHOULD BE ADJUSTED AS NEEDED TO UTILIZE A STABILIZED SAFE OUTLET.
  - EARTH DIKES SHALL HAVE AN OUTLET THAT FUNCTIONS WITH A MINIMUM OF EROSION. RUNOFF SHALL BE CONVEYED TO A SEDIMENT TRAPPING DEVICE SUCH AS A SEDIMENT TRAP OR SEDIMENT BASIN WHERE EITHER THE DIKE CHANNEL, OR THE DRAINAGE AREA ABOVE THE DIKE ARE NOT ADEQUATELY STABILIZED.
  - STABILIZATION SHALL BE: (A) IN ACCORDANCE WITH STANDARD SPECIFICATIONS FOR SEED AND STRAW MULCH IF NOT IN SEEDING SEASON; (B) FLOW CHANNEL AS PER THE CHWIT BELOW.
- BLOCK CHANNEL STABILIZATION**
- | TYPE OF TREATMENT | CHANNEL WIDTH | DIKE A                           | DIKE B                                     |
|-------------------|---------------|----------------------------------|--|
| 1                 | 5-3.00        | SEED AND STRAW MULCH             | SEED AND STRAW MULCH                       |
| 2                 | 3.1-5.00      | SEED AND STRAW MULCH             | SEED LIME, LIME, OR LIME/SOD, SEE 2" STONE |
| 3                 | 5.1-8.00      | SEED WITH LIME, OR SOD; 2" STONE | LIME RIP-RAP 4-8"                          |
| 4                 | 8.1-200       | LIME RIP-RAP 4-8"                | ENGINEERING DESIGN                         |
- A. STONE TO BE 2" DIA. STONE, OR RECYCLED CONCRETE EQUIVALENT, IN A LAYER AT LEAST 3 INCHES IN THICKNESS AND BE PRESSED INTO THE SOIL WITH CONSTRUCTION EQUIPMENT.
- B. RIP-RAP TO BE 4-8 INCHES IN A LAYER AT LEAST 8 INCHES THICKNESS AND PRESSED INTO THE SOIL.
- C. APPROVED EQUIVALENTS CAN BE SUBSTITUTED FOR ANY OF THE ABOVE MATERIALS.
7. PERIODIC INSPECTION AND REQUIRED MAINTENANCE MUST BE PROVIDED AFTER EACH RAIN EVENT.

**EARTH DIKE**

- SEDIMENT CONTROL NOTES**
- A MINIMUM OF 24 HOURS NOTICE MUST BE GIVEN TO THE HOWARD COUNTY OFFICE OF INSPECTION AND PERMITS PRIOR TO THE START OF ANY CONSTRUCTION (992-2437).
  - ALL VEGETATIVE AND STRUCTURAL PRACTICES ARE TO BE INSTALLED ACCORDING TO THE PROVISIONS OF THIS PLAN AND ARE TO BE IN CONFORMANCE WITH THE 1983 MARYLAND STANDARDS AND SPECIFICATIONS FOR SOIL EROSION AND SEDIMENT CONTROL.
  - FOLLOWING INITIAL SOIL DISTURBANCE OR REDISTURBANCE, PERMANENT OR TEMPORARY STABILIZATION SHALL BE COMPLETED WITHIN: a) SEVEN CALENDAR DAYS FOR ALL PERIMETER SEDIMENT CONTROL STRUCTURES, DIKES, PERIMETER SLOPES, AND ALL SLOPES GREATER THAN 3:1; b) 14 DAYS AS TO ALL OTHER DISTURBED OR GRADED AREAS ON THE PROJECT SITE.
  - ALL SEDIMENT TRAPBASINS SHOWN MUST BE FINISHED AND WARNING SIGNS POSTED AROUND THEIR PERIMETER IN ACCORDANCE WITH VOL. 1, CHAPTER 12, OF THE HOWARD COUNTY DESIGN MANUAL, STORM DRAINAGE.
  - ALL DISTURBED AREAS MUST BE STABILIZED WITHIN THE TIME PERIOD SPECIFIED ABOVE IN ACCORDANCE WITH THE 1983 MARYLAND STANDARDS AND SPECIFICATIONS FOR SOIL EROSION AND SEDIMENT CONTROL. FOR PERMANENT STABILIZATION (SFC 5) SOD (SFC 54), TEMPORARY STABILIZATION (SFC 50) AND MULCHING (SFC 52). TEMPORARY STABILIZATION WITH MULCH ALONE CAN ONLY BE DONE WHEN RECONSTRUCTION STARTING DATES DO NOT ALLOW FOR PROPER GERMINATION AND ESTABLISHMENT OF GRASS.
  - ALL SEDIMENT CONTROL STRUCTURES ARE TO REMAIN IN PLACE AND ARE TO BE MAINTAINED IN PROPER OPERATIVE CONDITION UNTIL PERMISSION FOR THEIR REMOVAL HAS BEEN OBTAINED FROM THE HOWARD COUNTY SEDIMENT CONTROL INSPECTOR.
  - SITE ANALYSIS
 

TOTAL AREA OF SITE	14.75	ACRES
AREA DISTURBED	14.75	ACRES
AREA TO BE ROOFED OR PAVED	1.00	ACRES
AREA TO BE VEGETATIVELY STABILIZED	13.75	ACRES
TOTAL CUT	94200	CU. YDS.
TOTAL FILL	34200	CU. YDS.
  - ANY SEDIMENT CONTROL PRACTICE WHICH IS DISTURBED BY GRADING ACTIVITY FOR PLACEMENT OF UTILITIES MUST BE REPAIRED ON THE SAME DAY OF DISTURBANCE.
  - ADDITIONAL SEDIMENT CONTROL MUST BE PROVIDED, IF DEEMED NECESSARY BY THE HOWARD COUNTY DEPT. SEDIMENT CONTROL INSPECTOR.
  - ON ALL SITES WITH DISTURBED AREAS IN EXCESS OF 2 ACRES, APPROVAL OF THE INSPECTION AGENCY SHALL BE REQUESTED UPON COMPLETION OF INSTALLATION OF PERIMETER EROSION AND SEDIMENT CONTROLS, BUT BEFORE PROCEEDING WITH ANY OTHER EARTH DISTURBANCE OR GRADING. OTHER BUILDING OR GRADING INSPECTION APPROVALS MAY NOT BE AUTHORIZED UNTIL THIS INITIAL APPROVAL BY THE INSPECTION AGENCY IS MADE.

- PERMANENT SEEDING NOTE**
- SEEDBED PREPARATION: LOOSEN UPPER 3 INCHES OF SOIL BY RAKING, DISCING OR OTHER ACCEPTABLE MEANS BEFORE SEEDING.
- SOIL AMENDMENTS: USE ONE OF THE FOLLOWING SCHEDULES.
- PREFERRED - APPLY 2 TONS PER ACRE DOLOMITIC LIMESTONE (92 LBS/1000 SQ.FT.) AND 60 LBS. PER ACRE 10-10-10 FERTILIZER (14 LBS./1000 SQ. FT.) BEFORE SEEDING. HARROW OR DISC INTO UPPER THREE INCHES OF SOIL. AT TIME OF SEEDING, APPLY 400 LBS. PER ACRE 30-0-0 UREA-FORM FERTILIZER (9 LBS. PER 1000 SQ. FT.).
  - ACCEPTABLE - APPLY 2 TONS PER ACRE DOLOMITIC LIMESTONE (92 LBS./1000 SQ.FT.) AND 1000 LBS. PER ACRE 10-10-10 FERTILIZER (23 LBS./1000 SQ.FT.) BEFORE SEEDING. HARROW OR DISC INTO UPPER THREE INCHES OF SOIL.
- SEEDING - FOR THE PERIODS MARCH 1 THRU APRIL 30, AND AUGUST 1 THRU OCTOBER 15, SEED WITH 60 LBS. PER ACRE (1.4 LBS./1000 SQ.FT.) OF KENTUCKY 31 TALL FESCUE. FOR THE PERIOD MAY 1 THRU JULY 31, SEED WITH 60 LBS. PER ACRE OF KENTUCKY 31 TALL FESCUE PER ACRE AND 2 LBS. PER ACRE (0.5 LBS./1000 SQ.FT.) OF WEeping LOVEGRASS. DURING THE PERIOD OF OCTOBER 16 THRU FEBRUARY 28, PROTECT SITE BY: OPTION (1) 2 TONS PER ACRE OF WELL ANCHORED STRAW MULCH AND SEED AS SOON AS POSSIBLE IN THE SPRING. OPTION (2) USE SOD. OPTION (3) SEED WITH 60 LBS. PER ACRE KENTUCKY 31 TALL FESCUE AND MULCH WITH 2 TONS ACRES OF WELL ANCHORED STRAW.**
- MULCHING - APPLY 1-1/2 TO 2 TONS PER ACRE (70 TO 90 LBS./1000 SQ.FT.) OF UNROTTED SMALL GRAIN STRAW IMMEDIATELY AFTER SEEDING. ANCHOR MULCH IMMEDIATELY AFTER APPLICATION USING MULCH ANCHORING TOOL OR 218 GALLONS PER ACRE (5 GAL./1000 SQ.FT.) OF EMULSIFIED ASPHALT ON FLAT AREAS. ON SLOPES 8 FEET OR HIGHER, USE 348 GALLONS PER ACRE (8 GAL./1000 SQ.FT.) FOR ANCHORING.**
- MAINTENANCE - INSPECT ALL SEEDING AREAS AND MAKE NEEDED REPAIRS, RE PLACEMENTS AND RESEEDINGS.**

- TEMPORARY SEEDING NOTES**
- SEEDBED PREPARATION: LOOSEN UPPER 3 INCHES OF SOIL BY RAKING, DISCING OR OTHER ACCEPTABLE MEANS BEFORE SEEDING.
- SOIL AMENDMENTS APPLY 600 LBS. PER ACRE 10-10-10 FERTILIZER (14 LBS./1000 SQ.FT.).
- SEEDING: FOR PERIODS MARCH 1 THRU APRIL 30 AND FROM AUGUST 15 THRU NOVEMBER 15, SEED WITH 2-1/2 TONS PER ACRE OF ANNUAL RYE (32 LBS./1000 SQ.FT.). FOR THE PERIOD MAY 1 THRU AUGUST 14, SEED WITH 3 LBS. PER ACRE OF WEeping LOVEGRASS (0.7 LBS./1000 SQ.FT.). FOR THE PERIOD NOVEMBER 16 THRU FEBRUARY 28, PROTECT SITE BY APPLY 2 TONS PER ACRE OF WELL ANCHORED STRAW MULCH AND SEED AS SOON AS POSSIBLE IN THE SPRING OR USE SOD.
- MULCHING: APPLY 1-1/2 TO 2 TONS PER ACRE (70 TO 90 LBS./1000 SQ.FT.) OF UNROTTED SMALL GRAIN STRAW IMMEDIATELY AFTER SEEDING. ANCHOR MULCH IMMEDIATELY AFTER APPLICATION USING MULCH ANCHORING TOOL OR 218 GALLONS PER ACRE (5 GAL./1000 SQ.FT.) OF EMULSIFIED ASPHALT ON FLAT AREAS. ON SLOPES 8 FT. OR HIGHER, USE 348 GAL. PER ACRE (8 GAL./1000 SQ.FT.) FOR ANCHORING.**
- REFER TO THE 1983 MARYLAND STANDARDS AND SPECIFICATIONS FOR SOIL EROSION AND SEDIMENT CONTROL FOR RATE AND METHODS NOT COVERED.

**CERTIFICATION BY THE DEVELOPER:**

I CERTIFY THAT ALL DEVELOPMENT AND/OR CONSTRUCTION WILL BE DONE ACCORDING TO THESE PLANS OF DEVELOPMENT AND PLANS FOR EROSION AND SEDIMENT CONTROL AND THAT ALL RESPONSIBLE PERSONNEL INVOLVED IN THE CONSTRUCTION PROJECT WILL HAVE A CERTIFICATE OF ATTENDANCE AT A MD. DEPT. OF THE ENVIRONMENT APPROVED TRAINING PROGRAM FOR THE CONTROL OF SEDIMENT AND EROSION BEFORE BEGINNING THE PROJECT. I ALSO AUTHORIZE PERIODIC ON-SITE INSPECTION BY THE HOWARD SOIL CONSERVATION DISTRICT OR THEIR AUTHORIZED AGENTS, AS ARE DEEMED NECESSARY.

*Signature of Developer* 7/9/92 Date

**CERTIFICATION BY THE ENGINEER:**

I CERTIFY THAT THIS PLAN FOR EROSION AND SEDIMENT CONTROL REPRESENTS A PRACTICAL AND WORKABLE PLAN BASED ON MY PERSONAL KNOWLEDGE OF THE SITE CONDITIONS AND THAT IT WAS PREPARED IN ACCORDANCE WITH THE REQUIREMENTS OF THE HOWARD SOIL CONSERVATION DISTRICT.

*Signature of Engineer* 7/6/92 Date

THESE PLANS HAVE BEEN REVIEWED FOR THE HOWARD SOIL CONSERVATION DISTRICT AND MEET THE TECHNICAL REQUIREMENTS FOR SOIL EROSION AND SEDIMENT CONTROL.

*Signature of U.S. Soil Conservation Service* 8/1/92 Date

THESE PLANS FOR EROSION AND SEDIMENT CONTROL MEET THE REQUIREMENTS OF THE HOWARD SOIL CONSERVATION DISTRICT.

*Signature of Howard Soil Conservation District* 8/1/92 Date

**APPROVED:**

HOWARD COUNTY DEPARTMENT OF PUBLIC WORKS

*Signature of Chief, Land Development Division* 9/1/92 DATE

*Signature of Chief, Bureau of Highways* 9/5/92 DATE

*Signature of Chief, Bureau of Engineering* 9/4/92 DATE

**APPROVED:**

HOWARD COUNTY DEPARTMENT OF PLANNING AND ZONING

*Signature of Chief, Division of Community Planning and Land Development* 9/6/92 DATE

**PHOENIX ENGINEERING, INC.**  
CONSULTING ENGINEERS  
817 MAIDEN CHOICE LANE, SUITE 300  
BALTIMORE, MARYLAND 21228  
PHONE (410) 847-8833 FAX (410) 847-8397


AREA: BROKEN LAND PARKWAY EXTENSION




AREA: SEDIMENT AND EROSION CONTROL NOTES & DETAILS

DES. BY HRP SCALE: AS SHOWN PROJ. No.

DRN BY AJR DATE: JUNE 1992 DRAWING No.

CHK. BY HRP APPROVED: 8 OF 9

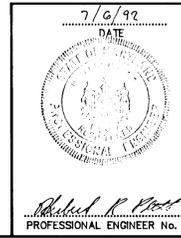

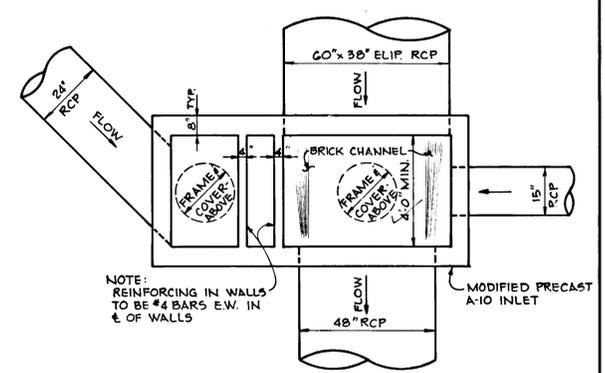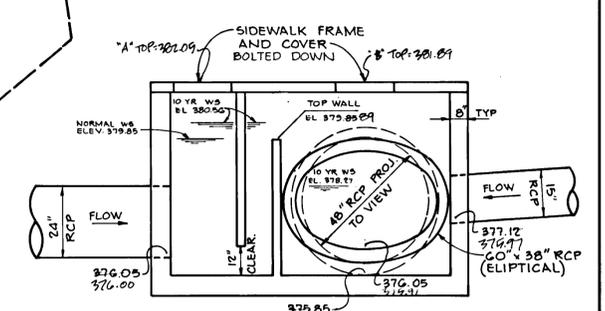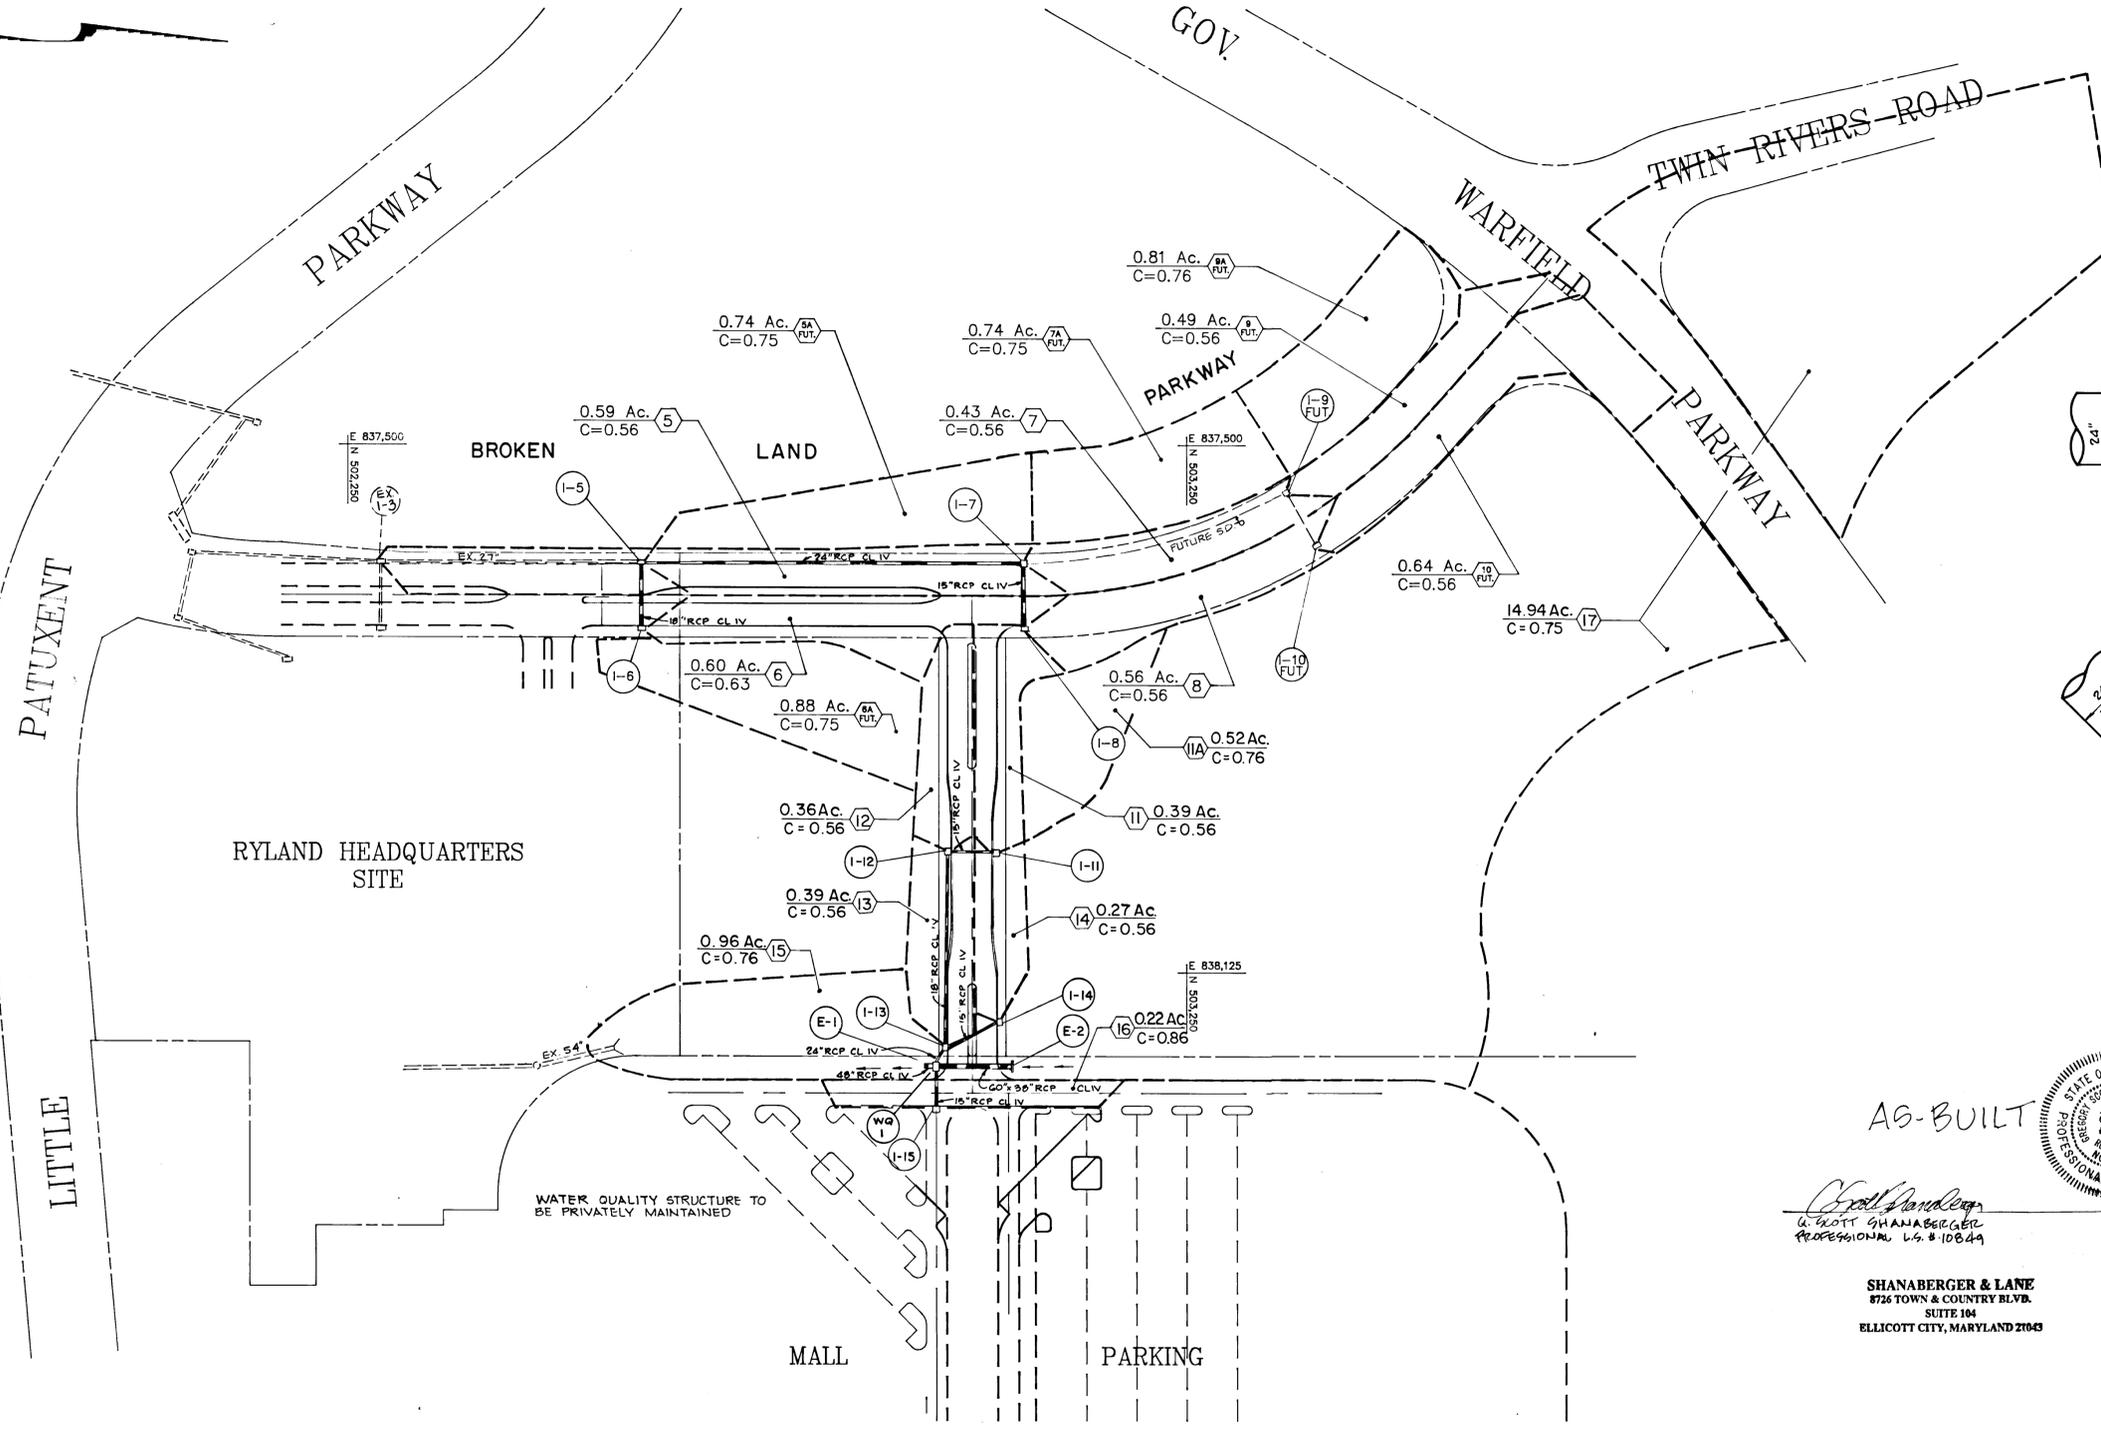


**DETAILS - INLET WQ-1**  
NO SCALE

AS-BUILT

*G. Scott Shanabarger*  
G. SCOTT SHANABARGER  
PROFESSIONAL L.S. #10849

SHANABERGER & LANE  
8726 TOWN & COUNTRY BLVD.  
SUITE 104  
ELLICOTT CITY, MARYLAND 21043

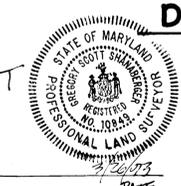

APPROVED:  
HOWARD COUNTY DEPARTMENT OF PUBLIC WORKS  
*A. Scott Girma* 9/14/92  
CHIEF, LAND DEVELOPMENT DIVISION  
*Oliver M. Panyam* 9/3/92  
CHIEF, BUREAU OF HIGHWAYS  
*Elizabeth A. Caler* 9/14/92  
CHIEF, BUREAU OF ENGINEERING

APPROVED:  
HOWARD COUNTY DEPARTMENT OF PLANNING AND ZONING  
*Anna Schomack* 9/15/92  
CHIEF, DIVISION OF COMMUNITY PLANNING AND LAND DEVELOPMENT

PHOENIX ENGINEERING, INC.  
CONSULTING ENGINEERS  
817 MAIDEN CHOICE LANE, SUITE 300  
BALTIMORE, MARYLAND 21228  
PHONE: (410) 247-8833 FAX: (410) 247-8327

AREA: BROKEN LAND PARKWAY

AREA: DRAINAGE AREA MAP

DES. BY HRP SCALE: 1" = 100' PROJ. No.  
DRN BY AJR DATE: JUNE 1992 DRAWING No.  
CHK. BY HRP APPROVED: 9 OF 9

7/6/92  
DATE  
*Harold R. Platt*  
PROFESSIONAL ENGINEER No. 5407