


VICINITY MAP
SCALE: 1"=2000'

NO.	DESCRIPTION
1	COVER SHEET
2	GRADE ESTABLISHMENT, STORM DRAIN AND PAVING PLAN
3	GRADE ESTABLISHMENT, STORM DRAIN AND PAVING PLAN
4	GRADE ESTABLISHMENT, STORM DRAIN AND PAVING PLAN
5	STORM DRAIN PROFILES
6	DETAIL SHEET
7	SEDIMENT & EROSION CONTROL, GRADING AND D.A. MAP
8	SEDIMENT & EROSION CONTROL, GRADING AND D.A. MAP
9	SEDIMENT EROSION DETAILS
10	DETAIL SHEET
11	SOIL BORING LOGS

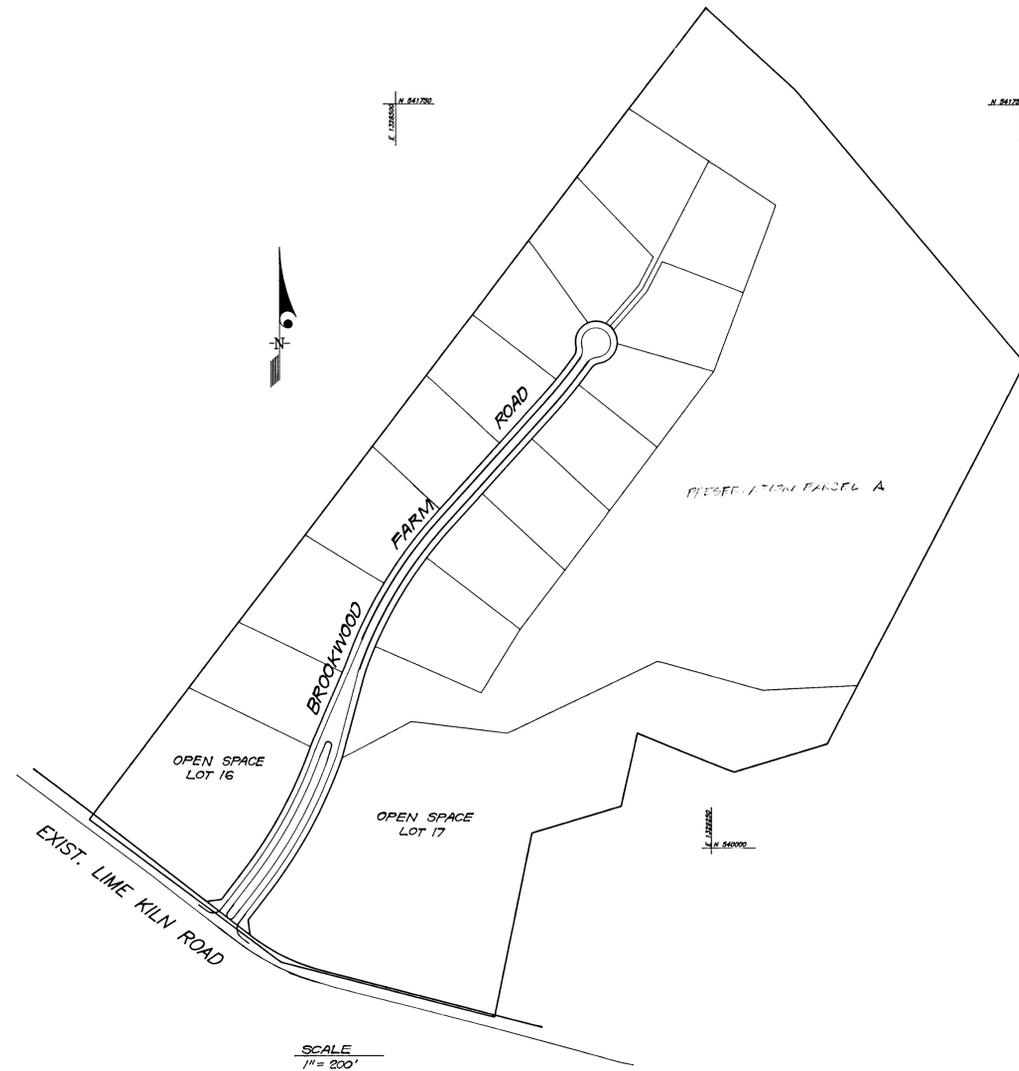

GENERAL NOTES

- All construction shall be in accordance with the latest standards and specifications of Howard County plus MSHA standards and specifications, if applicable.
- The contractor shall notify the Department of Public Works/Bureau of Engineering / Construction Inspection Division at (410)313-1880 at least five (5) working days prior to the start of work.
- The Contractor shall notify "Miss Utility" at 1-800-257-7777 at least 48 hours prior to any excavation work.
- Tax Map: 40 & 45
Parcel: P-1
Zoning: RR-DEO
Election District: 5TH
Total Tract Area: 57.16 ac.
Number of Proposed lots: 15 Residential, 2 Open Space
Date Preliminary Plan Approved: 12/11/94 DPZ Reference#: P-95-01
- Traffic control devices, markings, and signing shall be in accordance with the latest edition of the Manual on Uniform Traffic Control Devices (MUTCD). All street and regulatory signs shall be in place prior to the placement of any asphalt.
- Field survey conducted by Clark, Finefrock, and Sackett, Inc. using 2 foot contour intervals, May 1994.
- Boundary coordinates are based on NAD 83 Maryland Coordinates System as projected by Howard County, Maryland Geodetic Control Station Numbers 4.5 CA and 40 IA.
- 95% compaction in fill areas shall be in accordance with AASHTO T-180.
- Private on-site water and sewer to be utilized. (Well and Septic)
- Lot areas are exempted from stormwater management as approved by Ho. Co. DPW 10-5-95. A fee-in-lieu of Stormwater Management Quantity Control for the roads has been approved by Ho. Co. DPW 10-5-94. Stormwater Management Quality Control for the roads will be provided by Shallow Marsh Facilities.
- The Floodplain Study was conducted by Clark, Finefrock, and Sackett, Inc. on October 14, 1994. The Reference number is P-95.01, and the study was approved by Ho. Co. on May 16, 1994.
- Wetland inventory and Forest Stand Delineation was prepared by Exploration Research, Inc. as submitted with sketch plan, S-94-28. Forest Conservation Plan approved under P-95.01.
- A.P.F.O. study by the traffic Group, Inc. approved Jan. 20, 1994.
- A noise study was not applicable to this project and therefore was not done.
- Soils report by Hillis Carnes Engineering Assoc., Inc., Dated May 16, 1994.
- Existing utilities were located in a field study conducted May, 1994.
- The Developer will be responsible for the Street Trees, Perimeter Landscape Edge and Stormwater Management Area plantings indicated on the plans.

AS-BUILT
3-16-99

APPROVED: HOWARD COUNTY DEPARTMENT OF PUBLIC WORKS <i>[Signature]</i> 4/26/95 CHIEF, LAND DEVELOPMENT DIVISION DATE	
APPROVED: HOWARD COUNTY DEPT. OF PLANNING & ZONING <i>[Signature]</i> 5/2/95 CHIEF, DIVISION OF LAND DEVELOPMENT AND RESEARCH DATE	
CLARK • FINEFROCK & SACKETT, INC. ENGINEERS • PLANNERS • SURVEYORS 7135 MINSTREL WAY • COLUMBIA, MD. 21045 • (410) 381-7500 - BALTO. • (301) 621-8100 - WASH.	
DESIGNED ZAL	SCALE As Shown
DRAWN ZAH	DRAWING 1 of 13
CHECKED WHT	JOB NO. 04-064
DATE 3-2-95	FILE NO. 01-064.7

DEVELOPER'S/BUILDER'S CERTIFICATE

"I/We certify that all development and construction will be done according to this plan of development and plan for sediment and erosion control and that all responsible personnel involved in the construction project will have a Certificate of Attendance at a Department of the Environment Approved Training Program for the Control of Sediment and Erosion before beginning the project. I also authorize periodic on-site inspection by the Howard Soil Conservation District or their authorized agents, as are deemed necessary."

[Signature] 3-2-95
NAME DATE

ENGINEER'S CERTIFICATE

"I hereby certify that this plan for Sediment and Erosion Control represents a practical and workable plan based on my personal knowledge of the site conditions and that it was prepared in accordance with the requirements of the Howard Soil Conservation District."

[Signature] 1-4-95
G. NELSON CLARK DATE

Approved for HOWARD S.C.D. and meets Technical requirements of the Howard Soil Conservation Service
[Signature] Date


THIS DEVELOPMENT PLAN IS APPROVED FOR SOIL EROSION AND SEDIMENT CONTROL BY THE HOWARD SOIL CONSERVATION DISTRICT.

[Signature] Approved

1732

CENTERLINE CURVE DATA						
PC to PT STATIONS	RADIUS	Δ	ARC	TAN	CHORD	BEARING
PC 426.94 to PT 6+23.45	500.00	23-17-09	203.21	103.03	201.81	N 64-08-35 W

⊕ = R.C. (C.P.) UNLESS NOTED OTHERWISE
 □ = CONCRETE MONUMENT SET

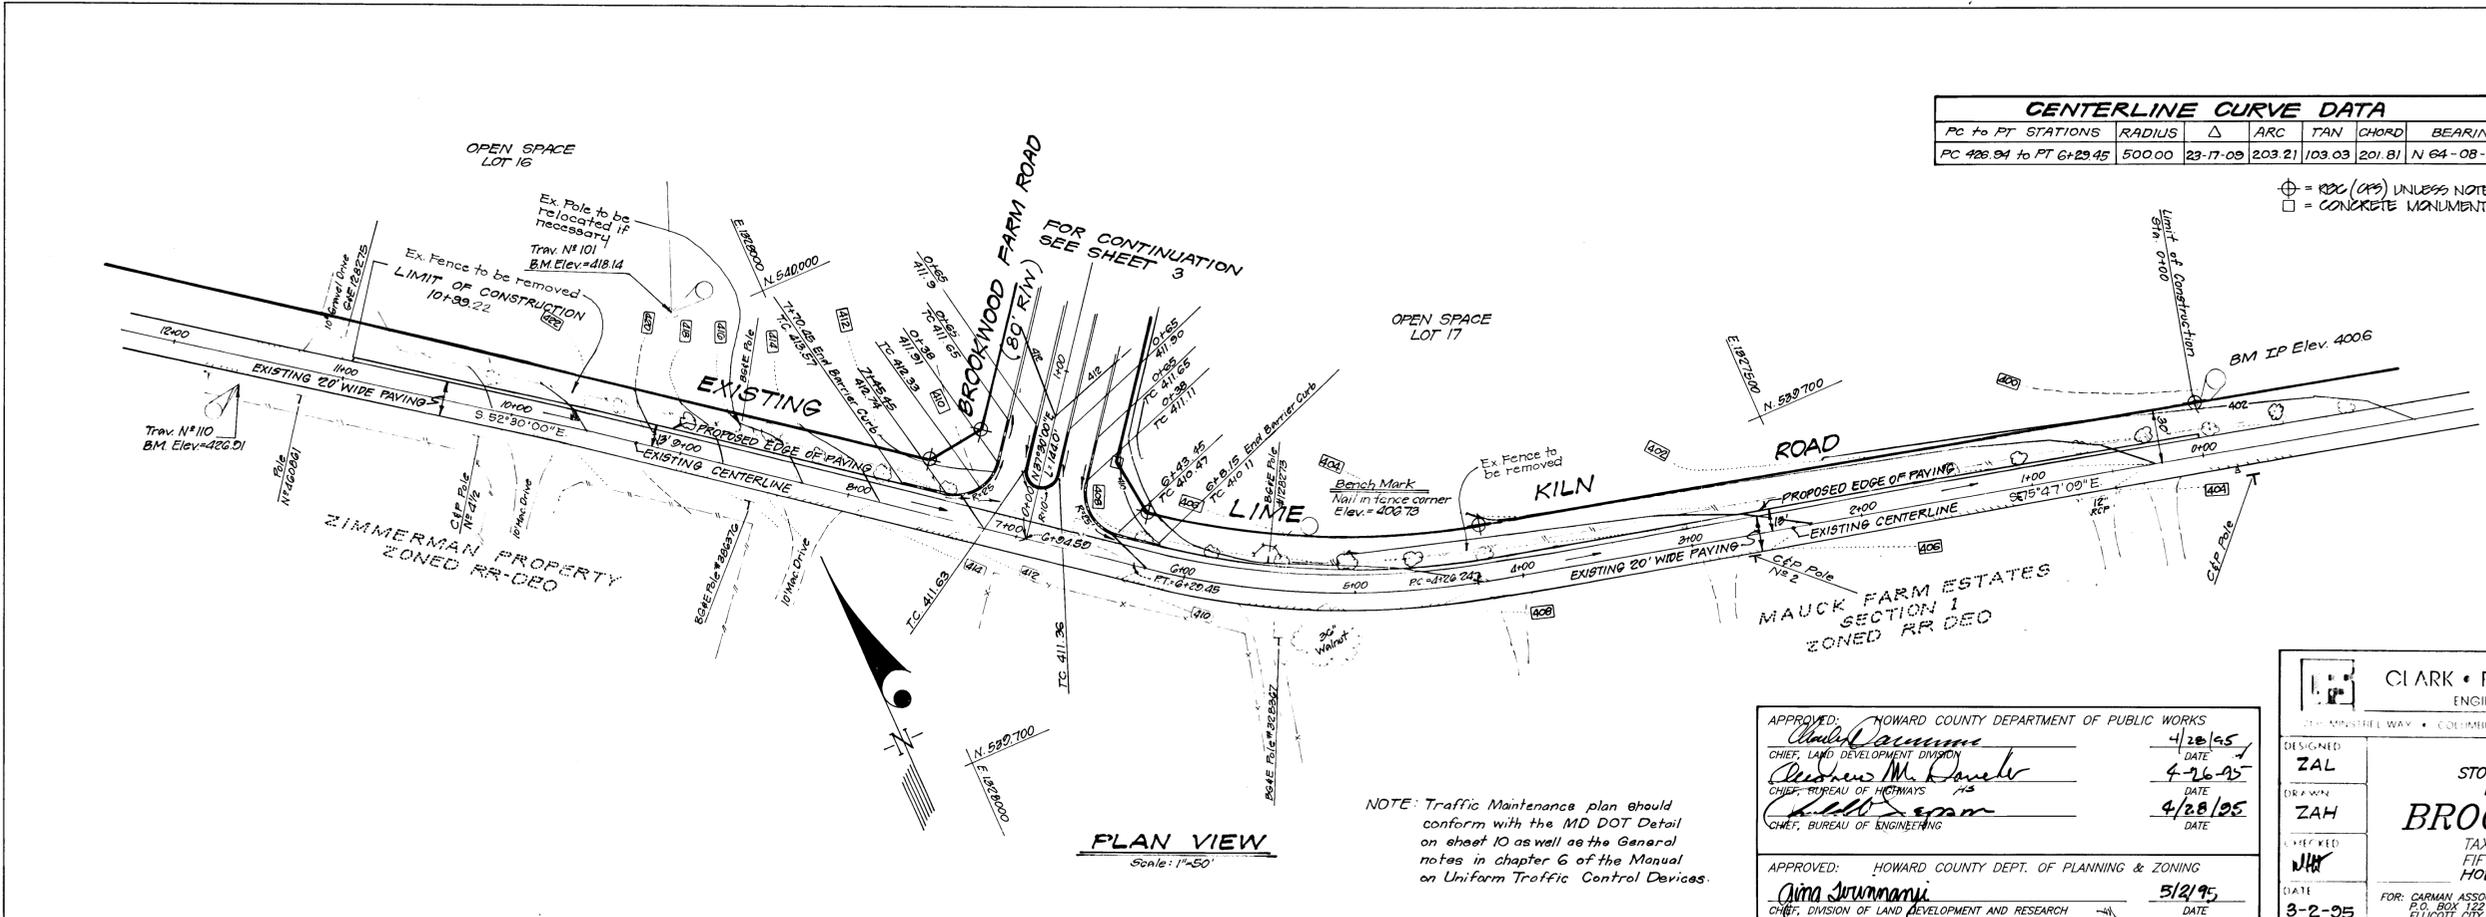

APPROVED: HOWARD COUNTY DEPARTMENT OF PUBLIC WORKS
 DATE: 4/28/95
 CHIEF, LAND DEVELOPMENT DIVISION
 DATE: 4-26-95
 CHIEF, BUREAU OF HIGHWAYS
 DATE: 4/28/95
 CHIEF, BUREAU OF ENGINEERING

APPROVED: HOWARD COUNTY DEPT. OF PLANNING & ZONING
 DATE: 5/2/95
 CHIEF, DIVISION OF LAND DEVELOPMENT AND RESEARCH


CLARK • FINFROCK & SACKETT INC.
 ENGINEERS • PLANNERS • SURVEYORS

DESIGNED: ZAL
 DRAWN: ZAH
 CHECKED: JWH
 DATE: 3-2-95

SCALE: AS SHOWN
 SHEET NO: 2 OF 13
 JOB NO: 04064
 FILE NO: 04064



BROOKWOOD FARMS
 TAX MAP 40 & 45 PARCEL 1
 FIFTH (5th) ELECTION DISTRICT
 HOWARD COUNTY, MARYLAND

FOR: CARMAN ASSOCIATES
 P.O. BOX 122
 ELLICOTT CITY, MARYLAND

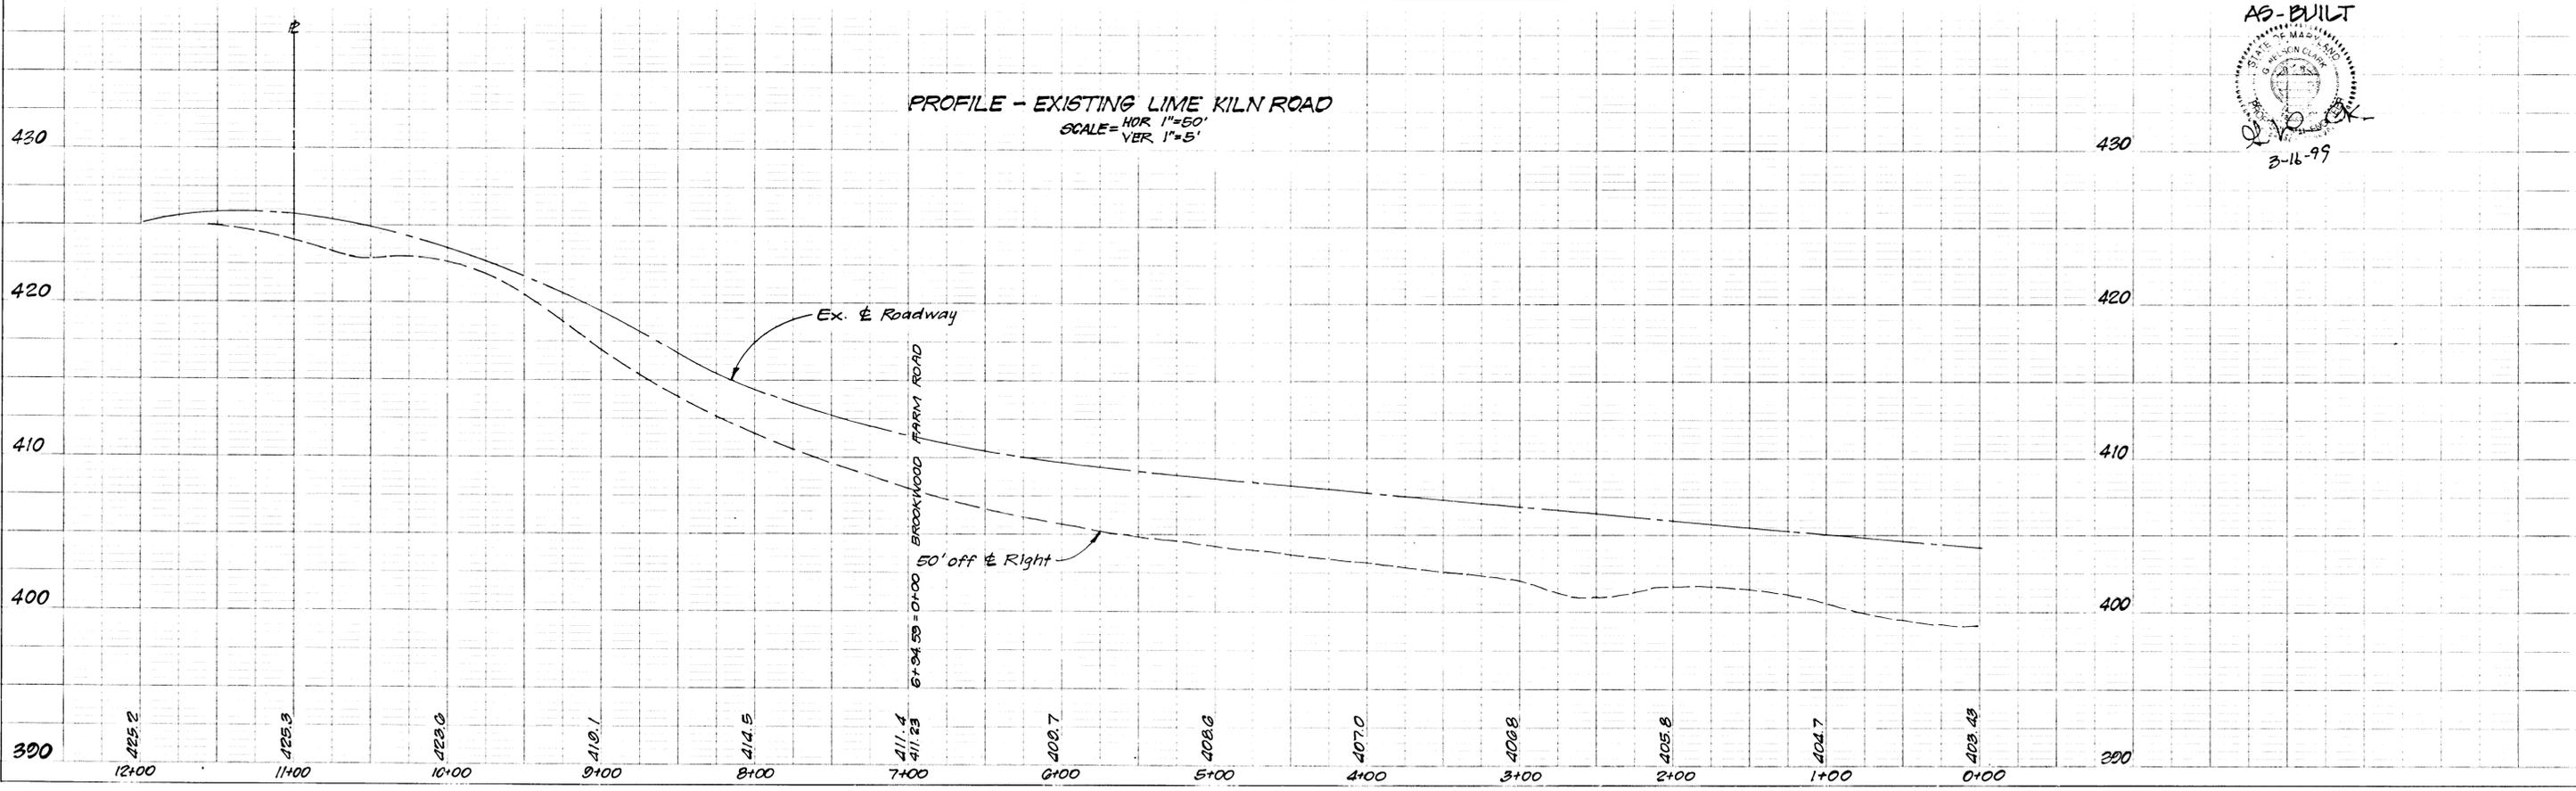


AS-BUILT
 3-16-99

1732

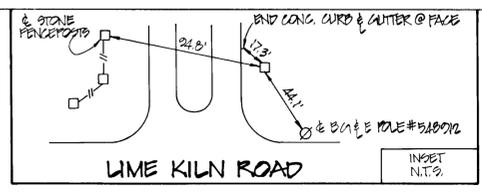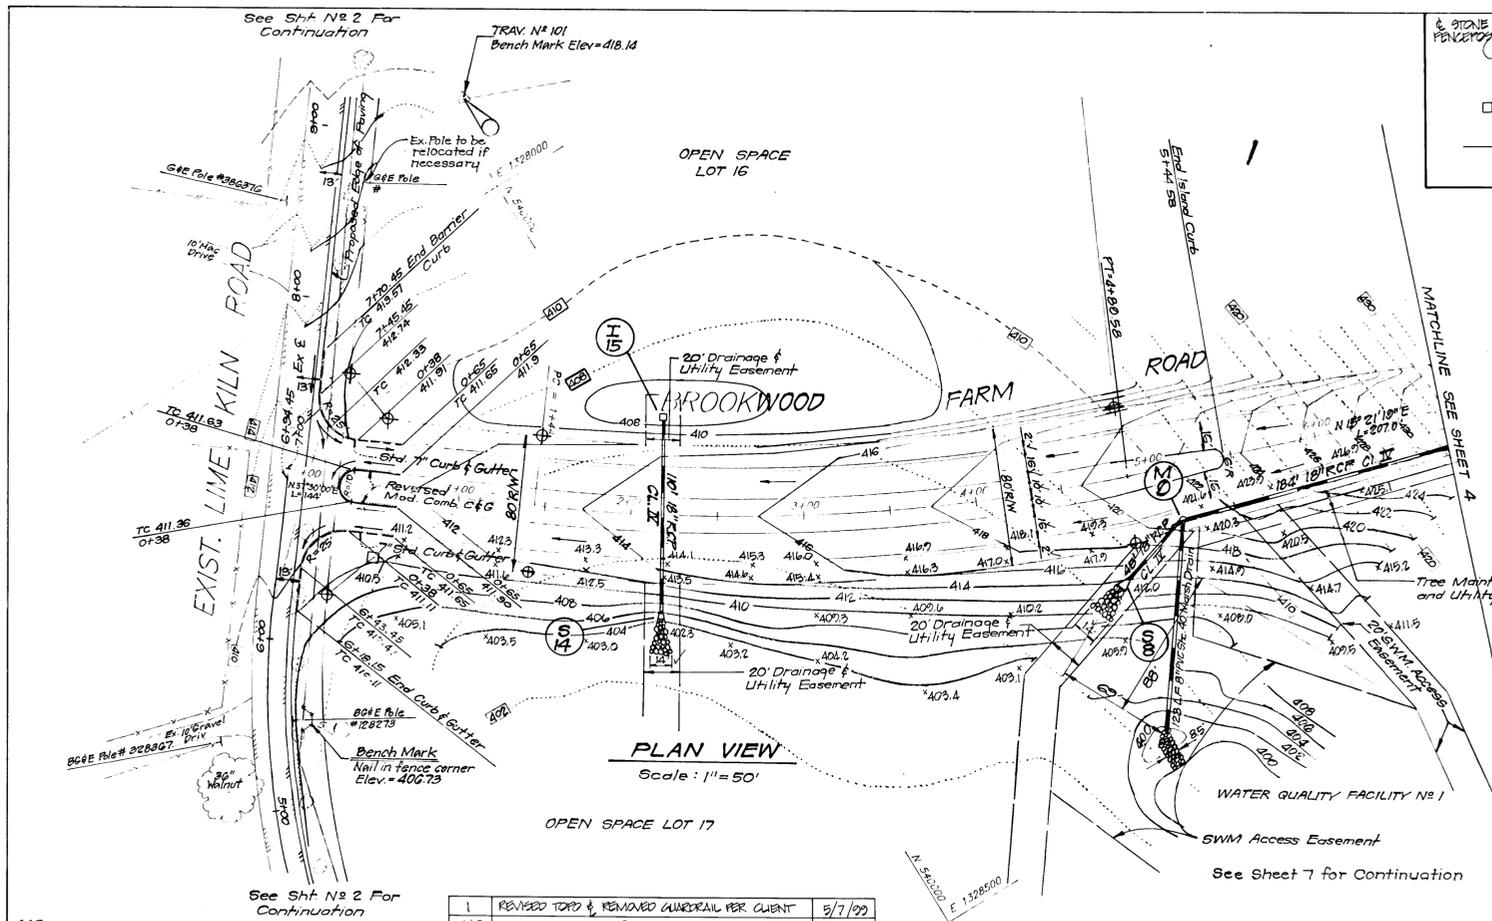

ENGINEER'S CERTIFICATE
 I hereby certify that this plan for Sediment and Erosion Control represents a practical and workable plan based on my personal knowledge of the site conditions and that it was prepared in accordance with the requirements of the Howard Soil Conservation District.
 G. NELSON CLARK 1-4-95
 DATE

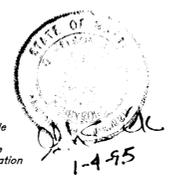

DEVELOPER'S/BUILDER'S CERTIFICATE
 I/We certify that all development and construction will be done according to this plan of development and plan for sediment and erosion control and that all responsible personnel involved in the construction project will have a Certificate of Attendance at a Department of the Environment Approved Training Program for the Control of Sediment and Erosion before beginning the project. I also authorize periodic on-site inspection by the Howard Soil Conservation District or their authorized agents, as are deemed necessary.
 Phil Margolis 3-2-05
 NAME DATE

Reviewed for HOWARD S.C.D. and meets Technical Requirements.
 Signature Date
 US Soil Conservation Service

THIS DEVELOPMENT PLAN IS APPROVED FOR SOIL EROSION AND SEDIMENT CONTROL BY THE HOWARD SOIL CONSERVATION DISTRICT.
 John R. Rhoads 4/2/95
 Approved

CENTERLINE CURVE DATA

PC to PT Stations	Radius	Δ	Arc	Tan	Chord & Bearing
PC 114.94 to PT 418.58	1100	18.00.00	345.58	174.22	344.16 N28.30.00E

⊕ = R.C.C. (C.P.S) UNLESS NOTED OTHERWISE
 ⊖ = CONCRETE MONUMENT SET

APPROVED: HOWARD COUNTY OFFICE OF PLANNING AND ZONING
 Anita Swannick 5/2/95
 Chief, Division of Community Planning & Land Development
APPROVED: HOWARD COUNTY DEPARTMENT OF PUBLIC WORKS
 Billy Dawson 4/28/95
 Chief, Land Development Division
 Stephen M. Daniels 4-26-95
 Chief, Bureau of Highways
 Charles E. Evans 4/26/95
 Chief, Bureau of Engineering


CLARK • FINEFROCK & SACKETT, INC.
 ENGINEERS • PLANNERS • SURVEYORS
 710 MINISTREE WAY • COLUMBIA, MD 21045 • 410.481.7000 • BALT. • 410.481.8000 • WASH.


DESIGNED ZAL	GRADE ESTABLISHMENT, STORM DRAIN AND PAVING PLAN BROOK FARM ROAD BROOKWOOD FARMS TAX MAP 40 & 45 PARCEL 1 FIFTH (5th) ELECTION DISTRICT HOWARD COUNTY, MARYLAND	SCALE As Shown
DRAWN BAL		DRAWING 3 OF 13
CHECKED WJK		JOB NO. 94-064
DATE 3-2-05		FILE NO. 94-064-D

FOR: CARMAN ASSOCIATES
 P.O. BOX 122
 ELLICOTT CITY, MD 21043

NO.	REVISION	DATE
1	REVISED TOPD & REMOVED GUARDRAIL PER CLIENT	5/7/99

1732

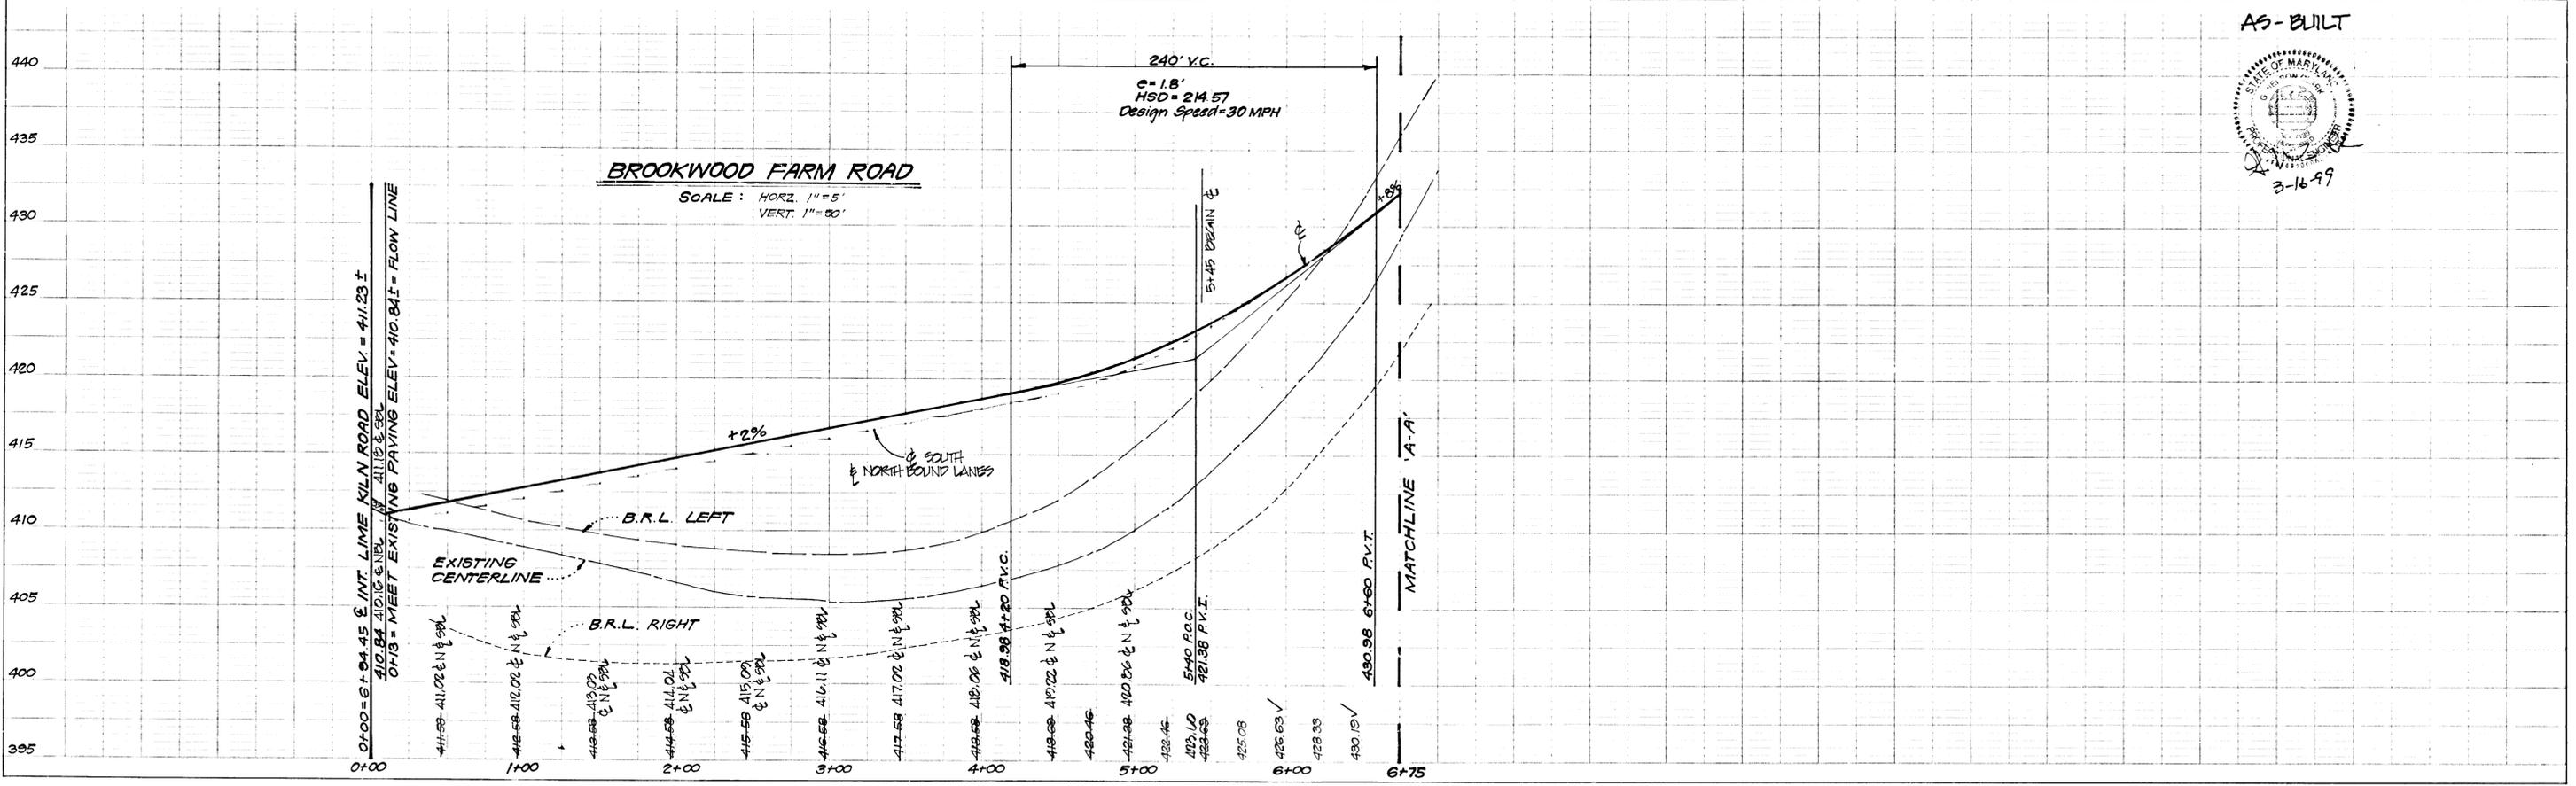

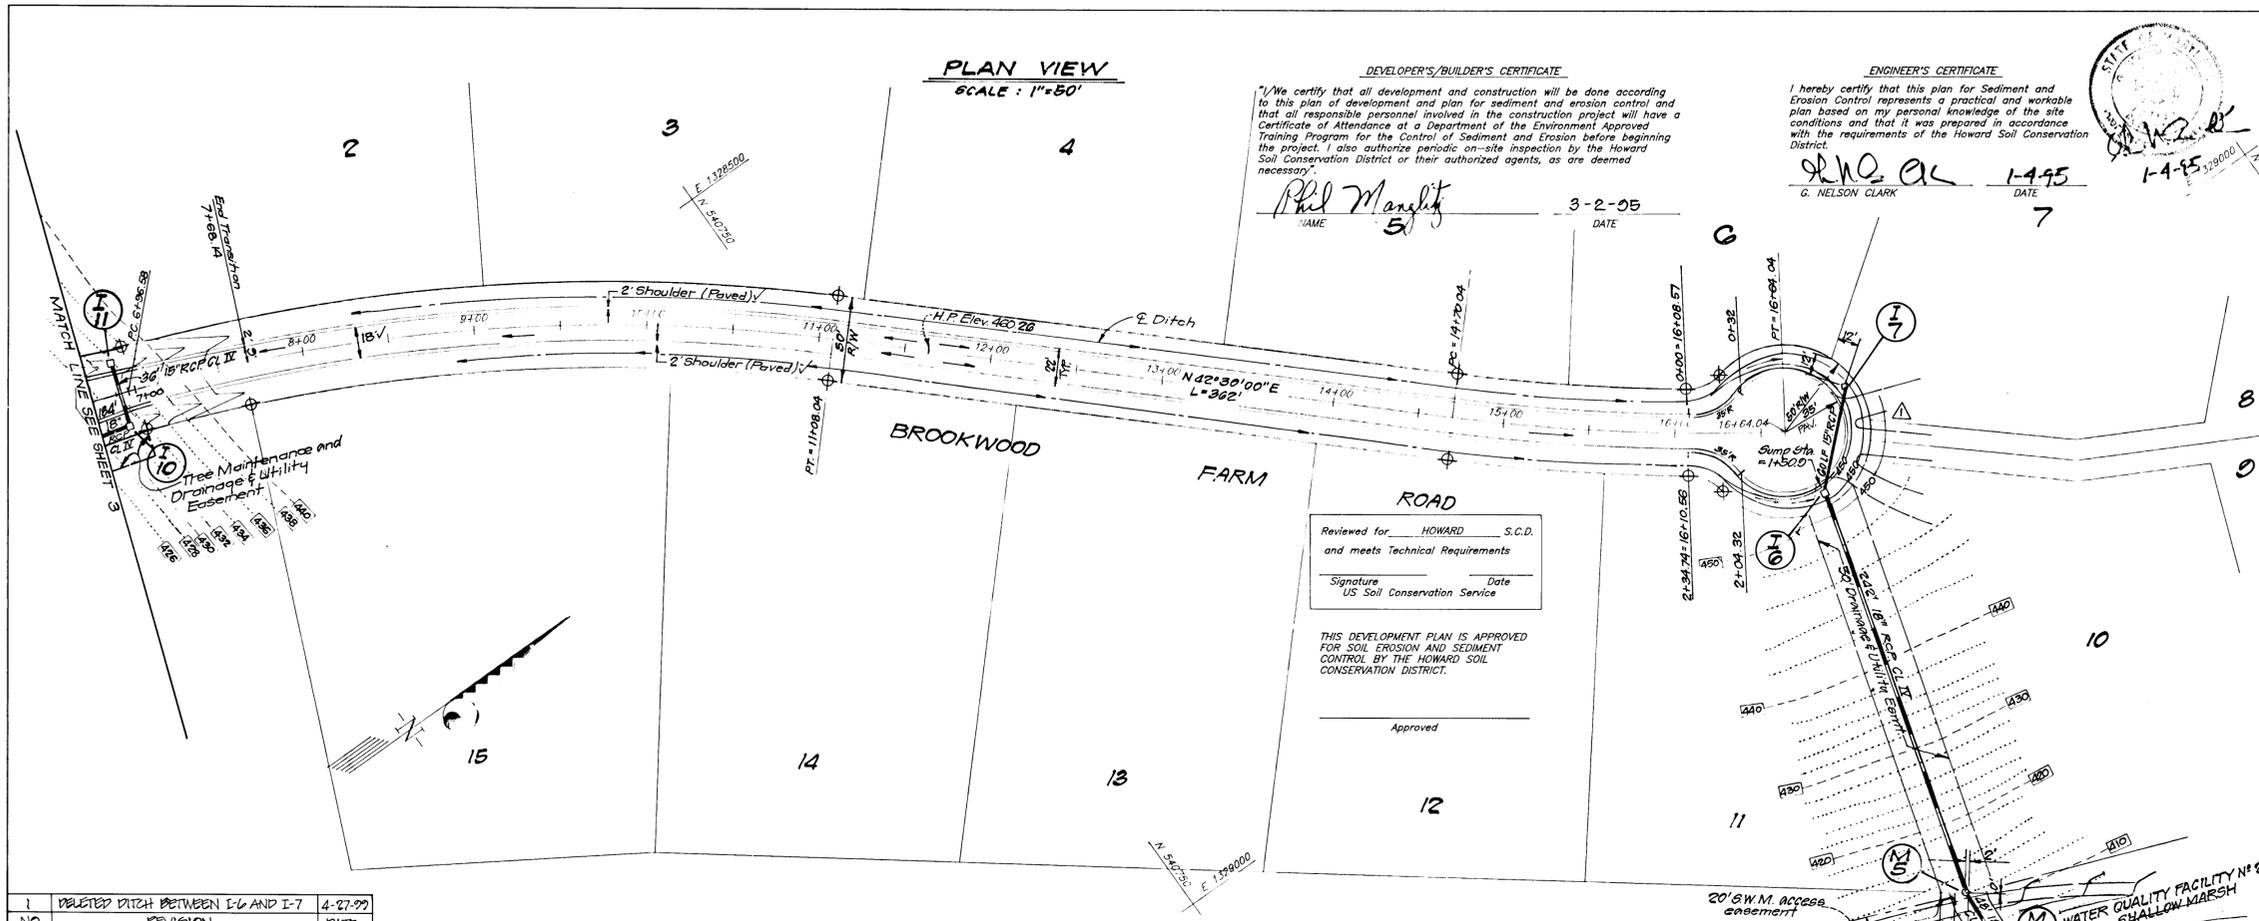

CUL-DE-SAC CURVE DATA

N#	Radius	Δ	Arc	TAN	Chord & Bearing
1	35'	52-23-31	32.00	17.22	30.00 N 05°41'24"E
2	35'	282-05-12	172.92	0.00	44.01 S 55°27'40"E
3	35'	49-47-24	30.42	12.24	20.47 S 00°41'08"W



CENTERLINE CURVE DATA

P.C. to P.T. STATIONS	Radius	Δ	Arc	Tan	Chord & Bearing
P.C. 6+96.58 to P.T. 11+08.04	1025	23-00-00	411.46	208.54	408.70 N 31-00-00"E
P.C. 14+70.04 to P.T. 16+65.04	1200	09-15-46	194.00	97.21	193.75 N 37-52-07"E


Φ = RDC (C/S) UNLESS NOTED OTHERWISE

REVISIONS


NO.	REVISION	DATE
1	DELETED DITCH BETWEEN I-6 AND I-7	4-27-99

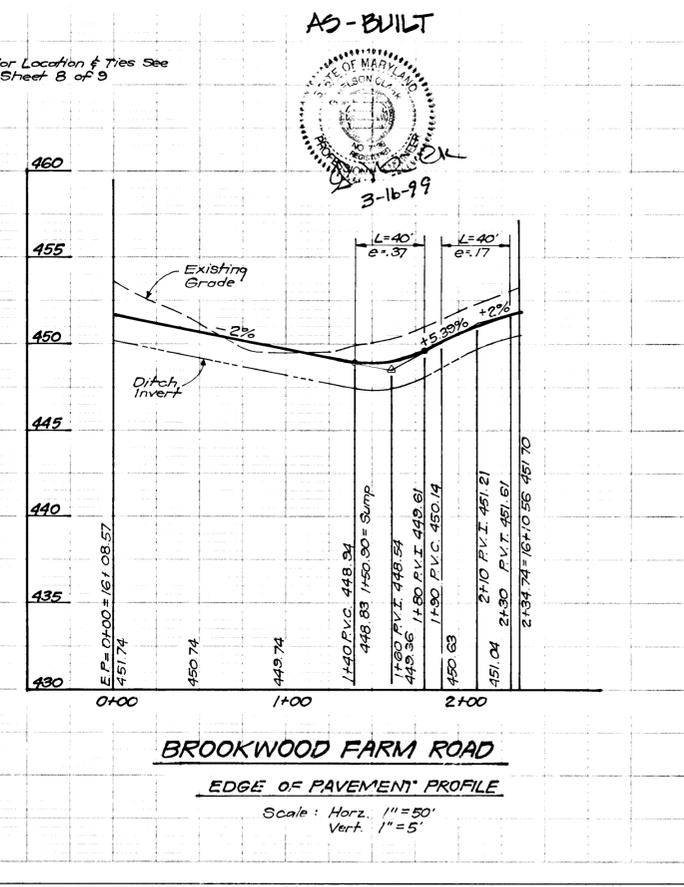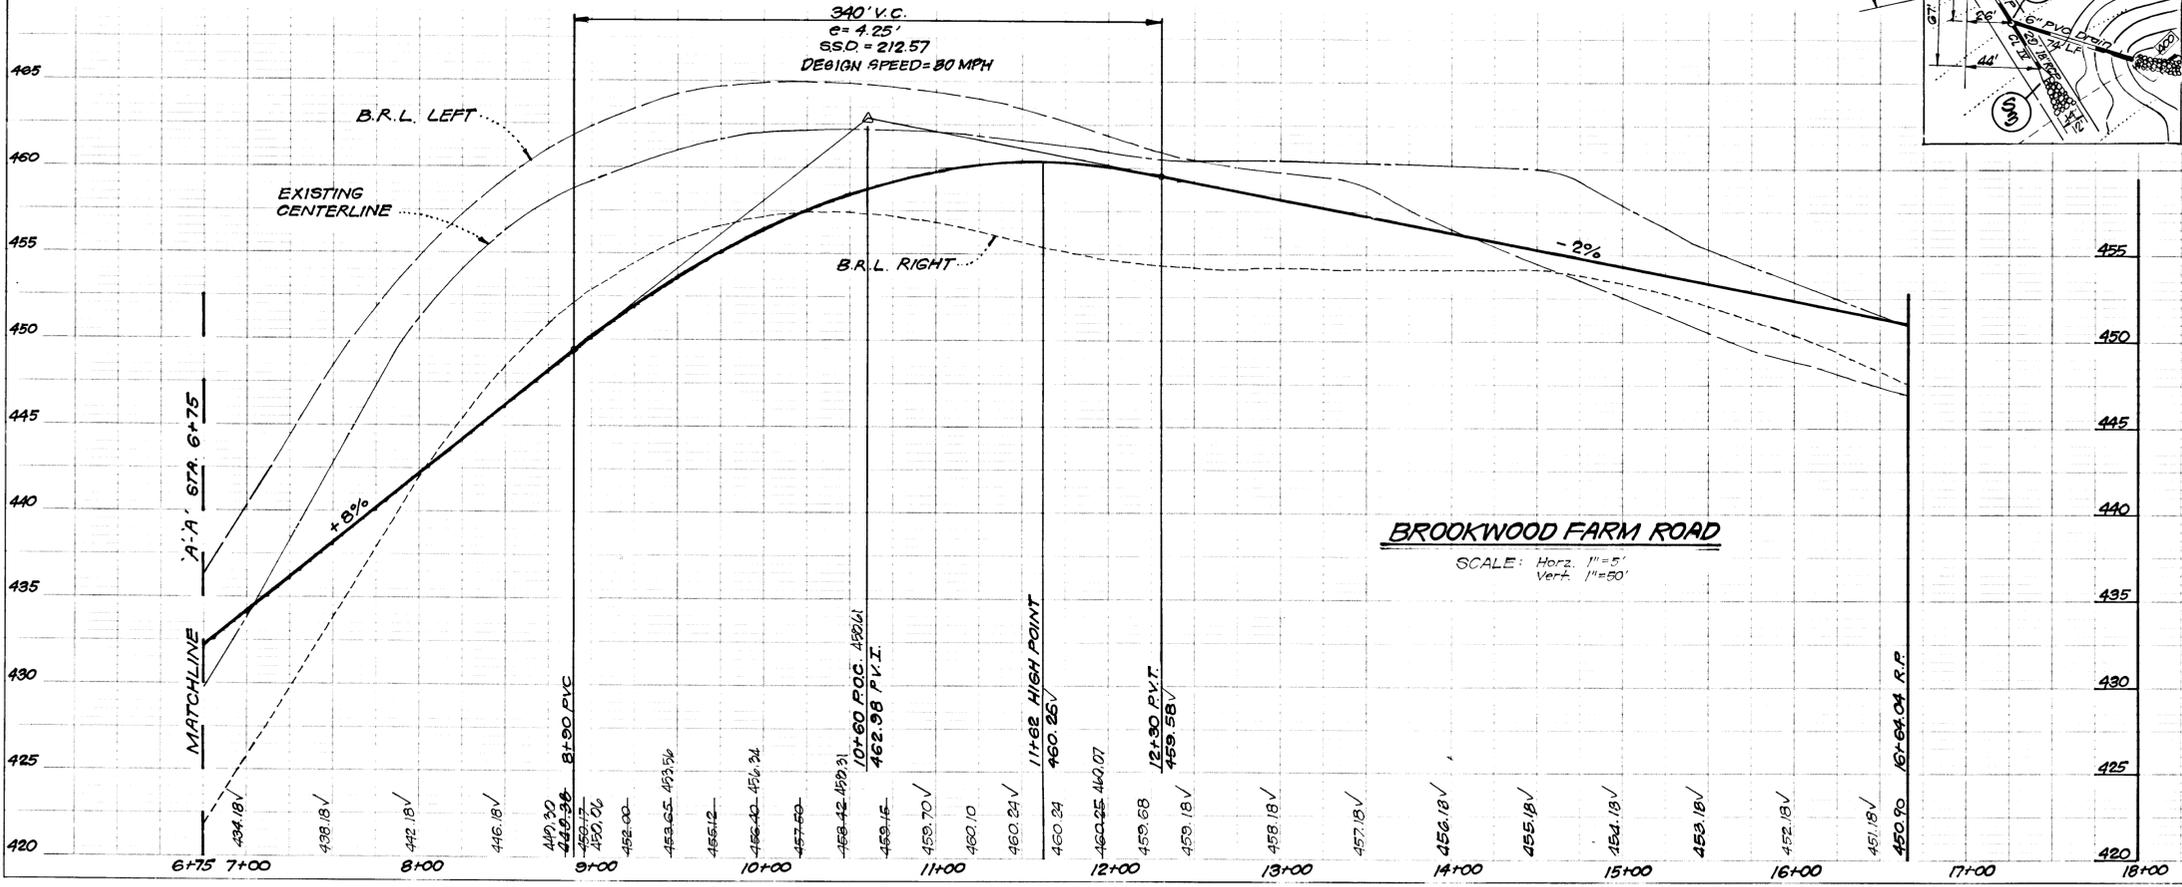

1732

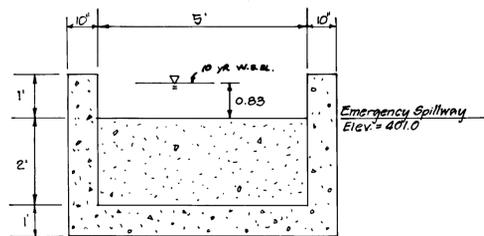

SHALLOW MARSH NO.1
CROSS SECTION
EMERGENCY SPILLWAY

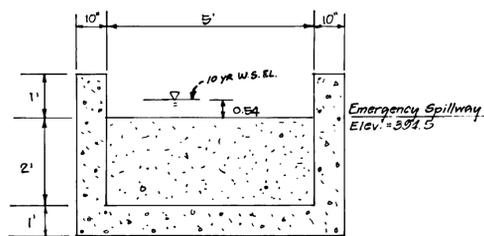

SHALLOW MARSH NO.2
CROSS SECTION
EMERGENCY SPILLWAY

Reviewed for Howard S.C.D.
Name: *Howard S.C.D.*
Signature: *Howard S.C.D.*
U.S. Soil Conservation Service

THIS DEVELOPMENT PLAN IS APPROVED FOR SOIL EROSION AND SEDIMENT CONTROL BY THE HOWARD SOIL CONSERVATION DISTRICT.

Approved: *John R. [Signature]* Date: 4/20/95

NR	TYPE	INVERT		TOP ELEVATION	REMARKS	LOCATION
		IN	OUT			
S-3	Concrete End Section	400.11	400.05		Ho. Co. Std. SD 5.51	See Plan
M-4	Shallow Precast Manhole	400.5	400.5	402.0-402.0	Ho. Co. Std. G-5.12	See Plan
M-5	Standard Precast Manhole	400.0	405.0	412.5-411.76	Ho. Co. Std. G-5.12	See Plan
T-6	K-Inlet	-	444.0	448.33-449.19	Ho. Co. Std. SD 4.12	Edge of Precast Profile
S-8	Concrete End Section	402.8	408.02		Ho. Co. Std. SD 5.51	Edge of Precast Profile
M-9	Standard Precast Manhole	402.0	408.0	420.5-421.19	Ho. Co. Std. G-5.12	Edge of Precast Profile
T-10	K-Inlet	428.04	428.20	433.85-433.70	Ho. Co. Std. SD 4.12	Edge of Precast Profile
T-11	K-Inlet	-	429.0	432.63	Ho. Co. Std. SD 4.12	Edge of Precast Profile
E-14	Concrete End Section	402.5	402.43		Ho. Co. Std. SD 5.51	Edge of Precast Profile
I-15	Concrete End Section	-	402.5		Ho. Co. Std. SD 5.51	Edge of Precast Profile
T-7	K-Inlet	-	445.0	440.25	Ho. Co. Std. SD 4.12	See Plan

Δ Inverts that are to be fully developed.
* SEE PROFILES FOR AS-BUILT INVERTS

SIZE	TYPE	LENGTH
15"	RCP CL IV	96 LF
18"	RCP CL IV	948 LF
8"	Schedule 40 PVC	123 LF
6"	Schedule 40 PVC	74 LF
18"	RCP CL IV	110 LF

DEVELOPER'S/BUILDERS CERTIFICATE

"I/We certify that all development and construction will be done according to this plan of development and plan for erosion and sediment control and that all responsible personnel involved in the construction project will have a Certificate of Attendance at a Dept. of the Environment Approved Training Program for the Control of Sediment and Erosion before beginning the project. I also authorize periodic on-site inspection by Howard Soil Conservation District or their authorized agencies, as are deemed necessary."

Approved: *Phil Mangit* Date: 3-2-95


ENGINEER'S CERTIFICATE

I hereby certify that this plan for Erosion and Sediment Control represents a practical and workable plan based on my personal knowledge of the site conditions and that it was prepared in accordance with the requirements of the Howard Soil Conservation District.


Approved: *E. Nelson Clark* Date: 1-4-95




APPROVED: HOWARD COUNTY DEPARTMENT OF PUBLIC WORKS	
<i>Phil Mangit</i> Chief, Land Development Division	4/20/95 Date
<i>Richard M. Davelos</i> Chief, Bureau of Highways	4-26-95 Date
<i>Richard M. Davelos</i> Chief, Bureau of Engineering	4/28/95 Date
APPROVED: HOWARD COUNTY OFFICE OF PLANNING AND ZONING	
<i>Anna Jurimany</i> Chief, Division of Community Planning & Land Development	5/2/95 Date

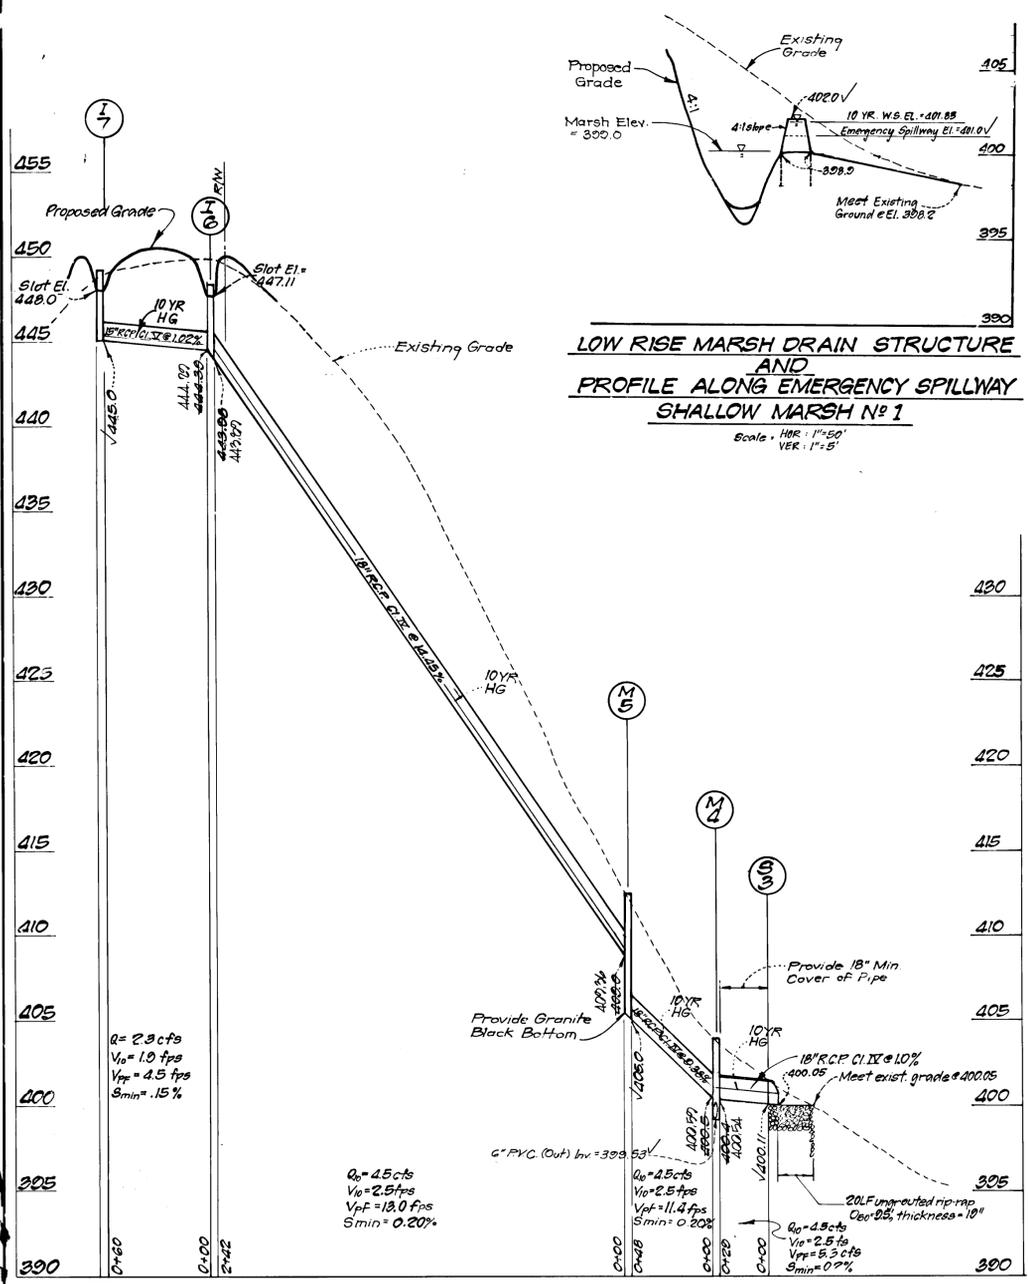


LOW RISE MARSH DRAIN STRUCTURE AND PROFILE ALONG EMERGENCY SPILLWAY SHALLOW MARSH NO. 1

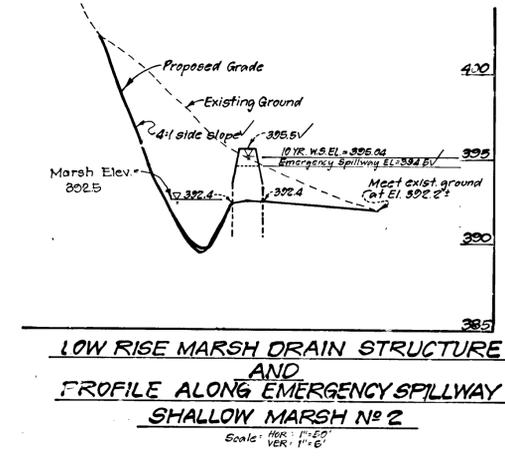


LOW RISE MARSH DRAIN STRUCTURE AND PROFILE ALONG EMERGENCY SPILLWAY SHALLOW MARSH NO. 2

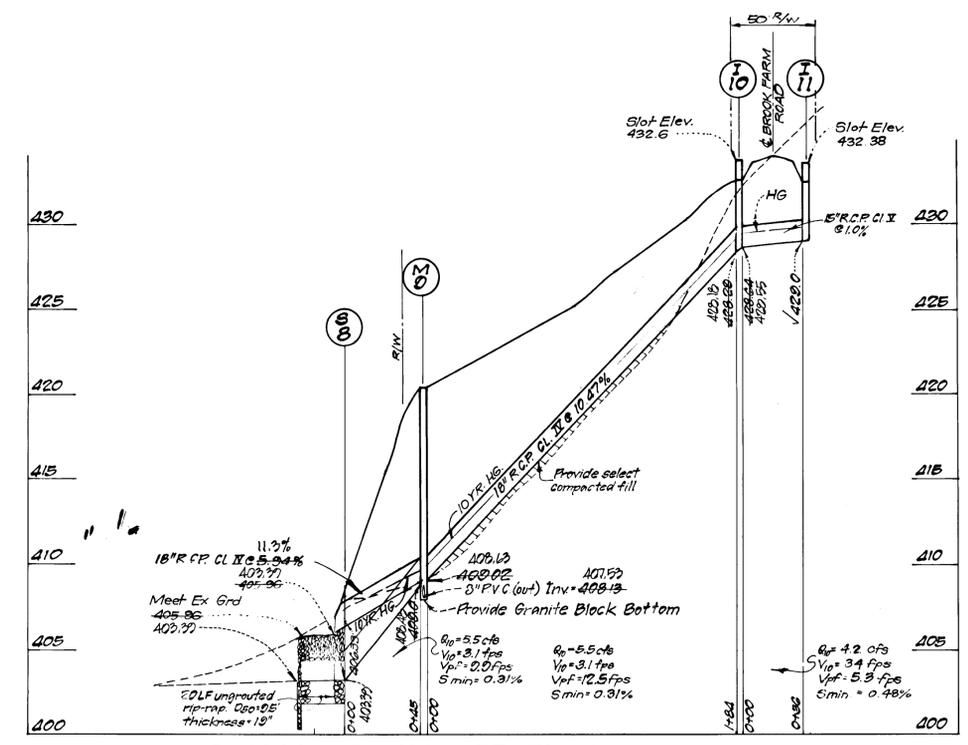

STORM DRAIN PROFILES
Scale: Horiz 1"=50'
Ver 1"=5'



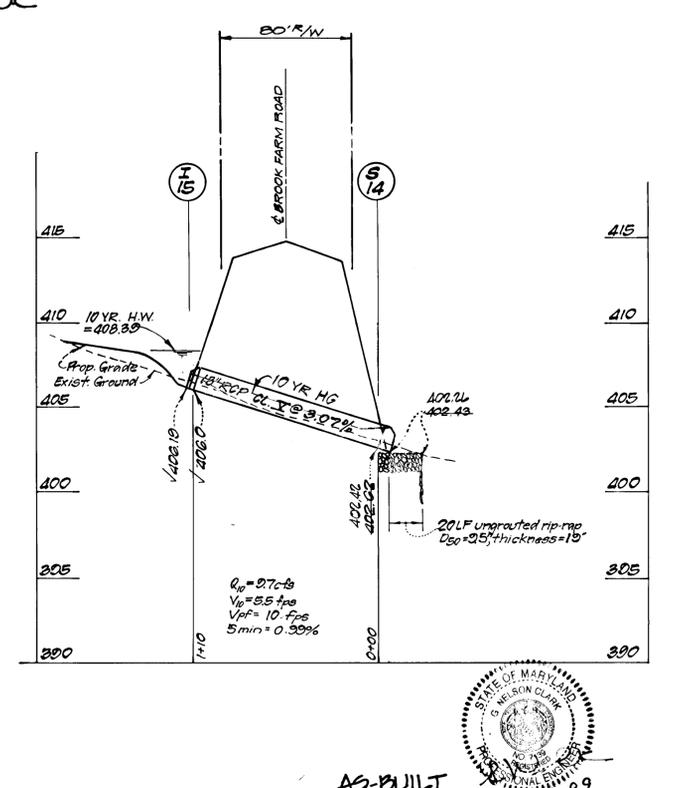


AS-BUILT

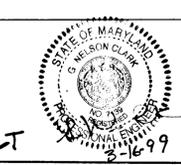

CLARK • FINEFROCK & SACKETT, INC.
ENGINEERS • PLANNERS • SURVEYORS
7135 MINSTREL WAY • COLUMBIA, MD 21045 • (410) 351-7500 - BALTO. • (301) 621-8100 - WASH.

DESIGNED ZAL	BROOKWOOD FARMS TAX MAP 40 & 45 PARCEL 1 FIFTH (5th) ELECTION DISTRICT HOWARD COUNTY, MARYLAND	SCALE AS SHOWN	
DRAWN BAL		DRAWING 5 OF 13	
CHECKED WJK		JOB NO. 04-061	
DATE 3-2-95		FOR: GARMAN ASSOCIATES P.O. BOX 123 ELLCOTT CITY, MARYLAND	FILE NO. 01-0210

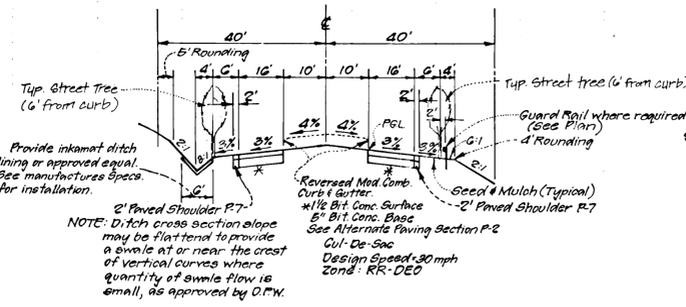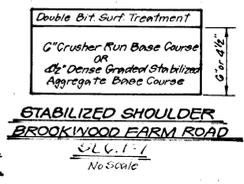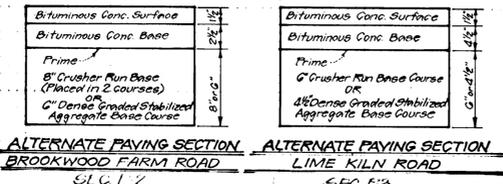

TYPICAL PAVING SECTION - BROOKWOOD FARM ROAD
STA. 0+00-4+89.58
No Scale



CURB & GUTTER LEGEND
Standard 7" curb and gutter
Reverse modified curb and gutter


SCHEDULE A
PERIMETER LANDSCAPE EDGE

Category	Adjacent to Roadways	Adjacent to Perimeter Properties
Landscape Type	A	A
Linear Feet of Project Perimeter		3300 LF
Credit for Existing Vegetation	No	No
Credit for Wall, Fence or Berm	No	No
Number of Plants Required Shade Trees Evergreen Trees		55
Number of Plants Provided Shade Trees Evergreen Trees		55


Comments: Required Number of Trees as per Schedules A & D = 58 Shade Trees and 10 Evergreen Trees (73 Total)

SCHEDULE D
STORMWATER MANAGEMENT AREA LANDSCAPING


Category	400 LF. of Type B
Linear Feet of Perimeter	400 LF. of Type B
Number of Trees Required Shade Trees Evergreen Trees	8 10
Credit for Existing Vegetation	No
Credit for Other Landscaping	No
Number of Trees Provided Shade Trees Evergreen Trees	8 10

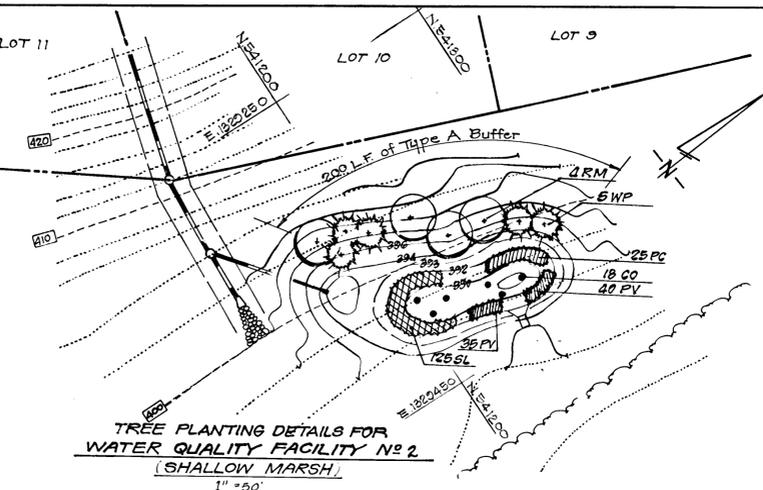


TREE PLANTING DETAILS FOR
WATER QUALITY FACILITY NO. 2
(SHALLOW MARSH)
1" = 50'

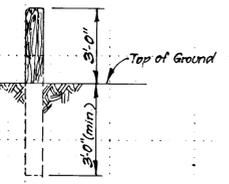


TYPICAL TIMBER BOLLARD
No Scale

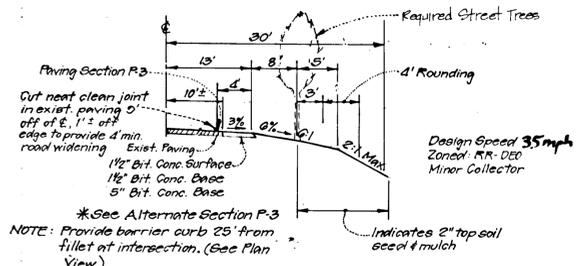


TYPICAL HALF SECTION - LIME KILN ROAD
Not to Scale

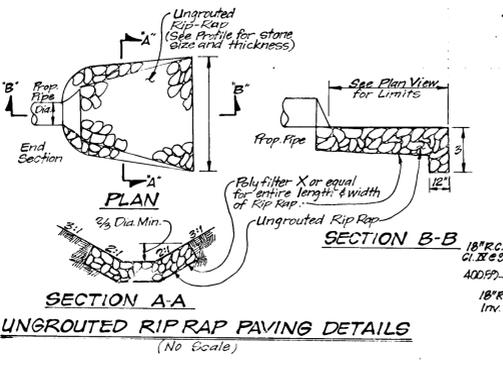


UNGRAUNTED RIP RAP PAVING DETAILS
(No Scale)

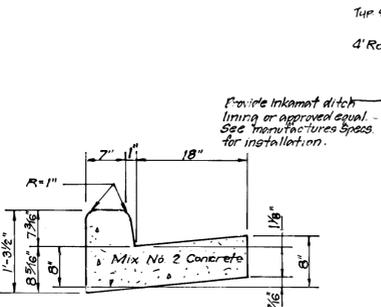

STANDARD 7" COMBINATION
CURB AND GUTTER
No Scale

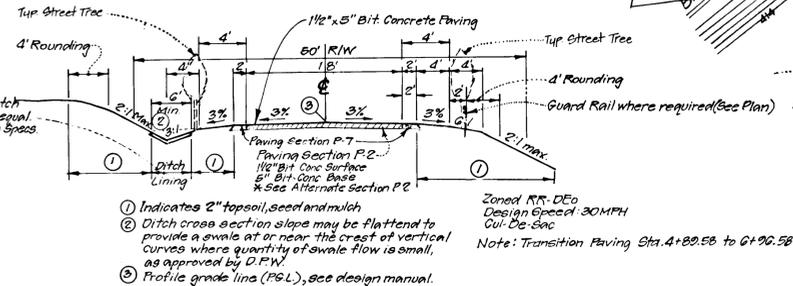

OPEN SECTION (RURAL) - BROOKWOOD FARM ROAD
STA. 4+89.58 TO 10+64.04
No Scale

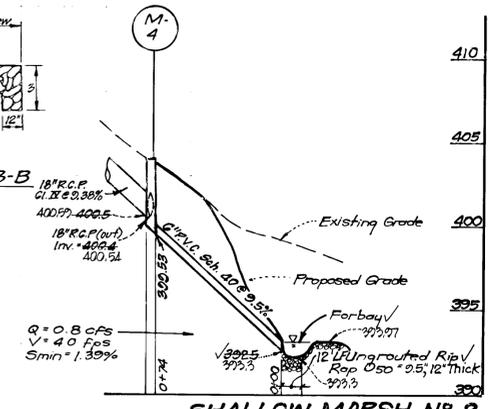


SHALLOW MARSH NO. 2
"PVC MARSH DRAIN"
Scale: Horz. 1" = 50'
Vert. 1" = 5'


- PLANT SCHEDULE NOTES
- Water quality facilities plant material to be wet grown or adapted to wetland conditions.
 - Alterations to the proposed grading shown may affect the success of the plant materials.
 - Contractor shall verify location of all underground utilities prior to digging.
 - STREET TREE TABULATION
 - A. Linear Feet of R.O.W. 4400 L.F.
 - B. Required No. of Trees 110 (1 per 40 L.F.) (Per L.S. Manual)
 - C. Credit for Ex. Street Trees 18
 - D. Min. Street Trees Required 92
 - E. No. of Street Trees Provided 97

PLANT SCHEDULE


KEY	QNTY	PLANT SPECIES	SIZE	REMARKS
STREET TREES (Sheets 7 & 8)				
ST	97	ZELKOVA SEKR. VILL. GREEN	2 1/2" Cal.	B+B
		Village Green Zelkova	12'-14' Ht.	
BUFFER PLANTING (This Sheet)				
RM	43	ACER RUBRUM	2 1/2" Cal.	B+B
		Red Maple	12'-14' Ht.	
QP	20	QUERCUS PALUSTRIS	2 1/2" Cal.	B+B
		Pin Oak	12'-14' Ht.	
WP	10	PINUS STROBUS	6'-8' Ht.	B+B
		White Pine		
WATER QUALITY FACILITIES PLANTINGS				
PRIMARY WETLAND VEGETATION				
SL	205	SAGITTARIA LATIFOLIA	Bare Roots	36% O/C
		Duck Potato		
SECONDARY WETLAND VEGETATION				
CO	30	CEPHALATHUS OCCIDENTALIS	Bare Roots	36% O/C
		Button Bush		
FV	105	PELTANDRA VIRGINICA	Bare Roots	36% O/C
		Arrow Arum		
PC	00	PONTERDERIA ORDATA	Bare Roots	36% O/C
		Pickarel Wood		

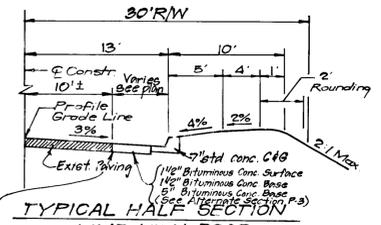

TYPICAL HALF SECTION
LIME KILN ROAD
STA. 6+18.15 TO 7+70.45
No Scale

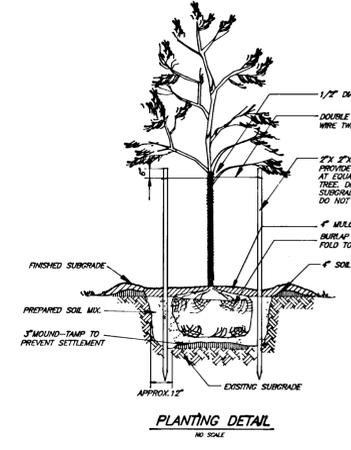


PLANTING DETAIL
NO SCALE

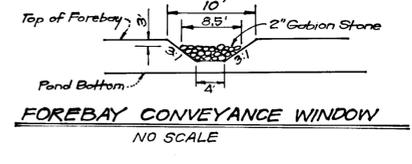

FOREBAY CONVEYANCE WINDOW
NO SCALE

LANDSCAPE BONDING NOTE:
This plan has been prepared in accordance with the Provision of Sec. 16.124 of the Howard County Code and the Landscape Manual. Financial surety for the required 73 trees in the amount of \$730,000 is part of the developer's agreement. The street trees are bonded under the road construction.

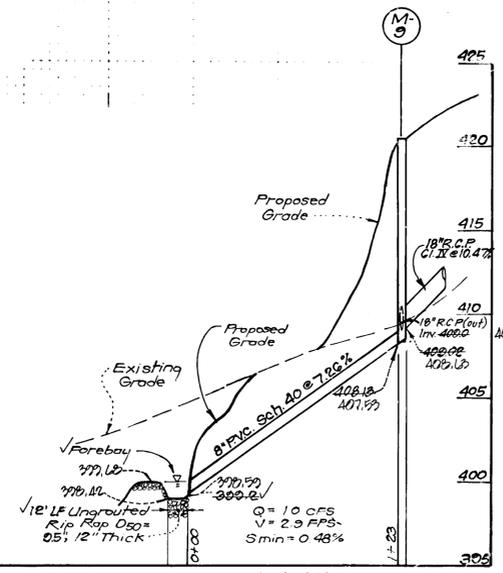

SHALLOW MARSH NO. 1
"PVC MARSH DRAIN"
Scale: Horz. 1" = 50'
Vert. 1" = 5'

Reviewed for HOWARD COUNTY S.C.D. Name: Patricia Hylle, U.S. Soil Conservation Service

THIS DEVELOPMENT PLAN IS APPROVED FOR SOIL EROSION AND SEDIMENT CONTROL BY THE HOWARD SOIL CONSERVATION DISTRICT.

John R. Blanton, Approved, 4/2/95

DEVELOPER'S/BUILDERS CERTIFICATE: I/We certify that all development and construction will be done according to the plan of development and plan for erosion and sediment control and that all responsible personnel involved in the construction project will have a Certificate of Attendance at a Dept. of the Environment Approving Training Program for the Control of Sediment and Erosion before beginning the project.

Phil Manglitz, 3-2-95

ENGINEER'S CERTIFICATE: I/We certify that this plan for Erosion and Sediment Control represents a practical and workable plan prepared by my personal knowledge of the site conditions and that it was prepared in accordance with the requirements of the Howard Soil Conservation District.

G. Nelson Clark, 1-4-95

APPROVED: HOWARD COUNTY DEPARTMENT OF PUBLIC WORKS
Chief, Land Development Division: Andrew M. Daniels, 4/28/95
Chief, Bureau of Highways: [Signature], 4-26-95
Chief, Bureau of Engineering: [Signature], 4/28/95


APPROVED: HOWARD COUNTY DEPT. OF PLANNING & ZONING
Chief, Division of Land Development and Research: Gino Summary, 5/2/95

CLARK • FINEFROCK & SACKETT, INC.
ENGINEERS • PLANNERS • SURVEYORS

DESIGNED: ZAL	PAVING, MARSH, STALLS, WETLANDS AND LANDSCAPE PLAN	SCALE: As Shown
DRAWN: ZAH	BROOKWOOD FARMS	DRAWING: 6 OF 13
CHECKED: [Signature]	TAX MAP 40-45 PARCEL P-1	JOB NO: 94-064
DATE: 3-2-95	5TH ELECTION DISTRICT HOWARD COUNTY, MARYLAND	FILE NO: 94-064P

Owner/Developer: Carman Associates, P.O. Box 122, Ellicott City, MD 21043

1733

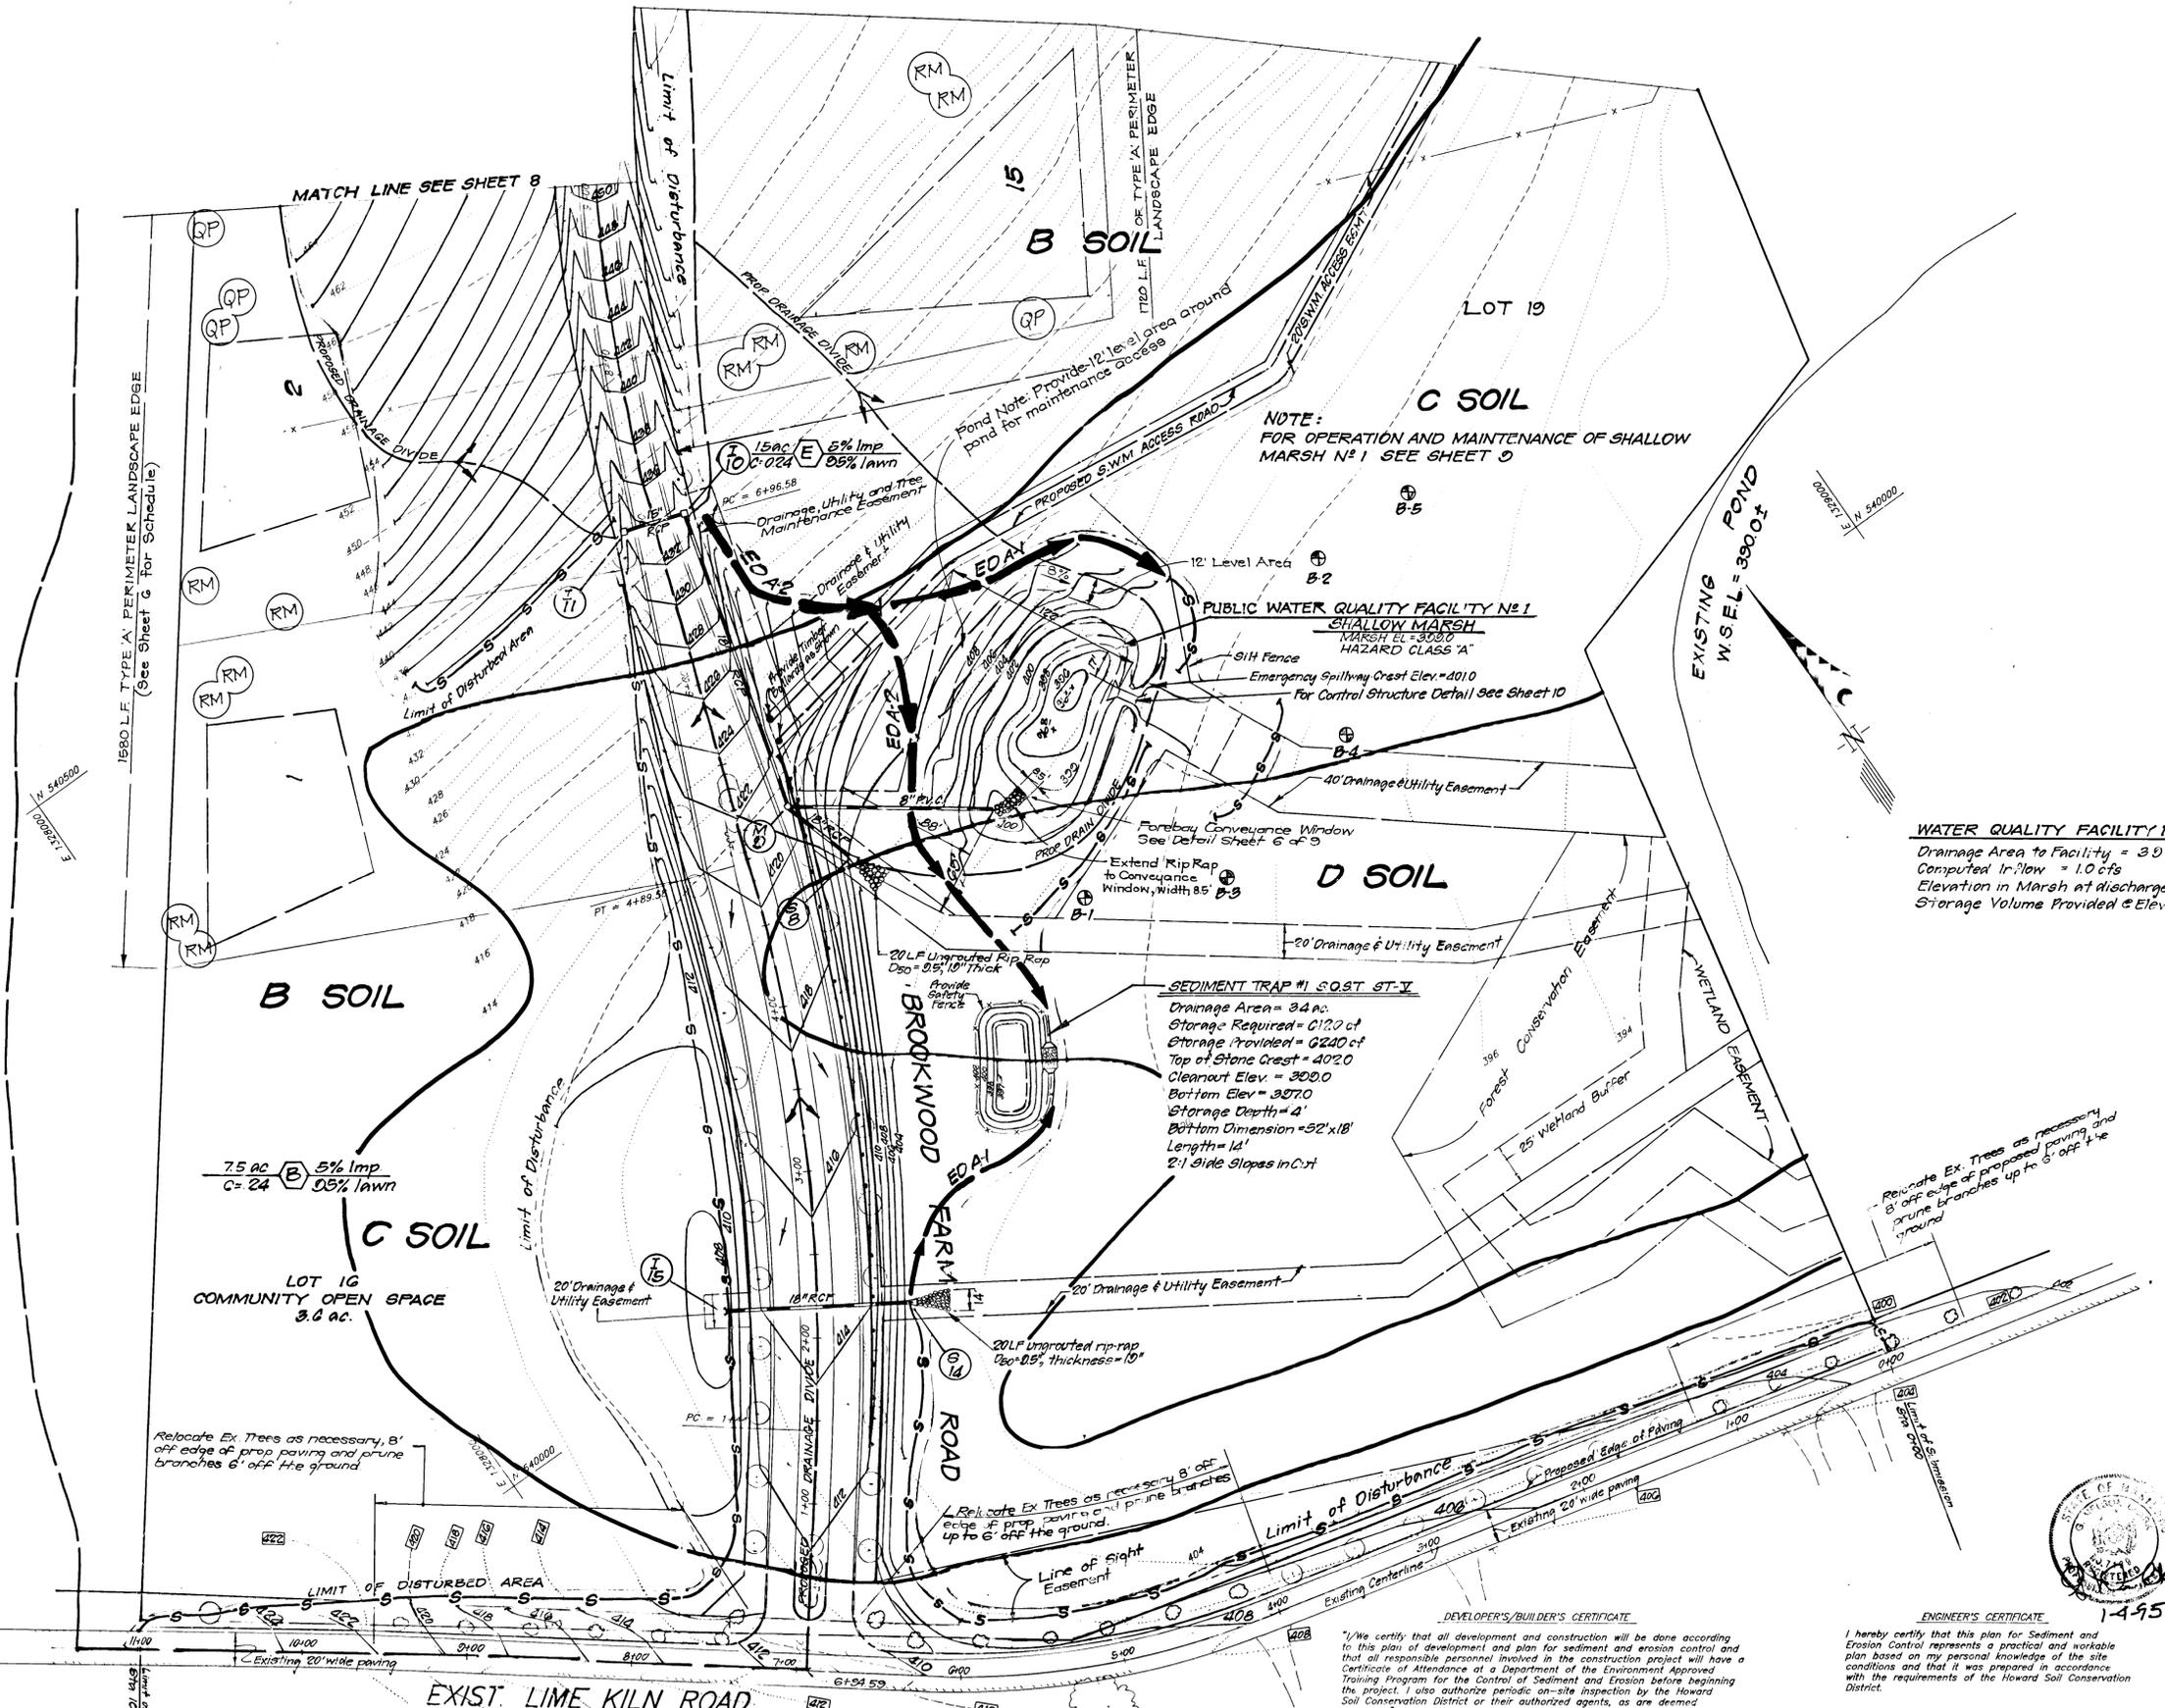

NOTE:
FOR OPERATION AND MAINTENANCE OF SHALLOW MARSH NO. 1 SEE SHEET 9

WATER QUALITY FACILITY NO. 1 SUMMARY
 Drainage Area to Facility = 3.0 ac.
 Computed Inflow = 1.0 cfs
 Elevation in Marsh at discharge = 390.0
 Storage Volume Provided @ Elev. = 0.82 ac-ft

SEDIMENT TRAP #1 SQST ST-V
 Drainage Area = 3.4 ac.
 Storage Required = 0.120 of
 Storage Provided = 0.220 of
 Top of Stone Crest = 402.0
 Cleanout Elev. = 390.0
 Bottom Elev. = 397.0
 Storage Depth = 4'
 Bottom Dimension = 52'x18'
 Length = 14'
 2:1 Side Slopes in Cut

Reviewed for HOWARD S.C.D.
 and Technical Requirements
Patricia E. Hester
 US Soil Conservation Service



THIS DEVELOPMENT PLAN IS APPROVED FOR SOIL EROSION AND SEDIMENT CONTROL BY THE HOWARD SOIL CONSERVATION DISTRICT.
John P. Robertson 4/28/95
 Approve

AS-BUILT

DESIGNED <i>John P. Robertson</i>	4/28/95
DRAWN <i>Andrew M. Conner</i>	4-26-95
CHECKED <i>Paul M. Sackett</i>	4/28/95
APPROVED <i>Anna Summari</i>	5/2/95

CLARK • FINEFROCK & SACKETT, INC.
 ENGINEERS • PLANNERS • SURVEYORS
 7135 MINSTREL WAY • COLUMBIA, MD. 21045 • (410) 381-7500 • BALTO. • (301) 621-8100 - WASH.

SEDIMENT & EROSION CONTROL GRADING, SOILS AND DRAINAGE AREA MAP
BROOKWOOD FARMS

TAX MAP 40 & 45 PARCEL 1
 FIFTH (5th) ELECTION DISTRICT
 HOWARD COUNTY, MARYLAND

DESIGNED Z.A.L.	SCALE 1" = 50'
DRAWN Z.A.H.	DRAWING 7 OF 13
CHECKED W.H.K.	JOB NO. 94-064
DATE 3-2-95	FILE NO. 94-064-D

FOR: CARMAN ASSOCIATES
 P.O. BOX 132
 ELLICOTT CITY, MARYLAND


DEVELOPER'S/BUILDER'S CERTIFICATE
 I/We certify that all development and construction will be done according to this plan of development and plan for sediment and erosion control and that all responsible personnel involved in the construction project will have a Certificate of Attendance of a Department of the Environment Approved Training Program for the Control of Sediment and Erosion before beginning the project. I also authorize periodic on-site inspection by the Howard Soil Conservation District or their authorized agents, as are deemed necessary.

Paul Mangitz 3-2-95
 Signature Date

ENGINEER'S CERTIFICATE
 I hereby certify that this plan for Sediment and Erosion Control represents a practical and workable plan based on my personal knowledge of the site conditions and that it was prepared in accordance with the requirements of the Howard Soil Conservation District.

John P. Robertson 4-28-95
 Signature Date



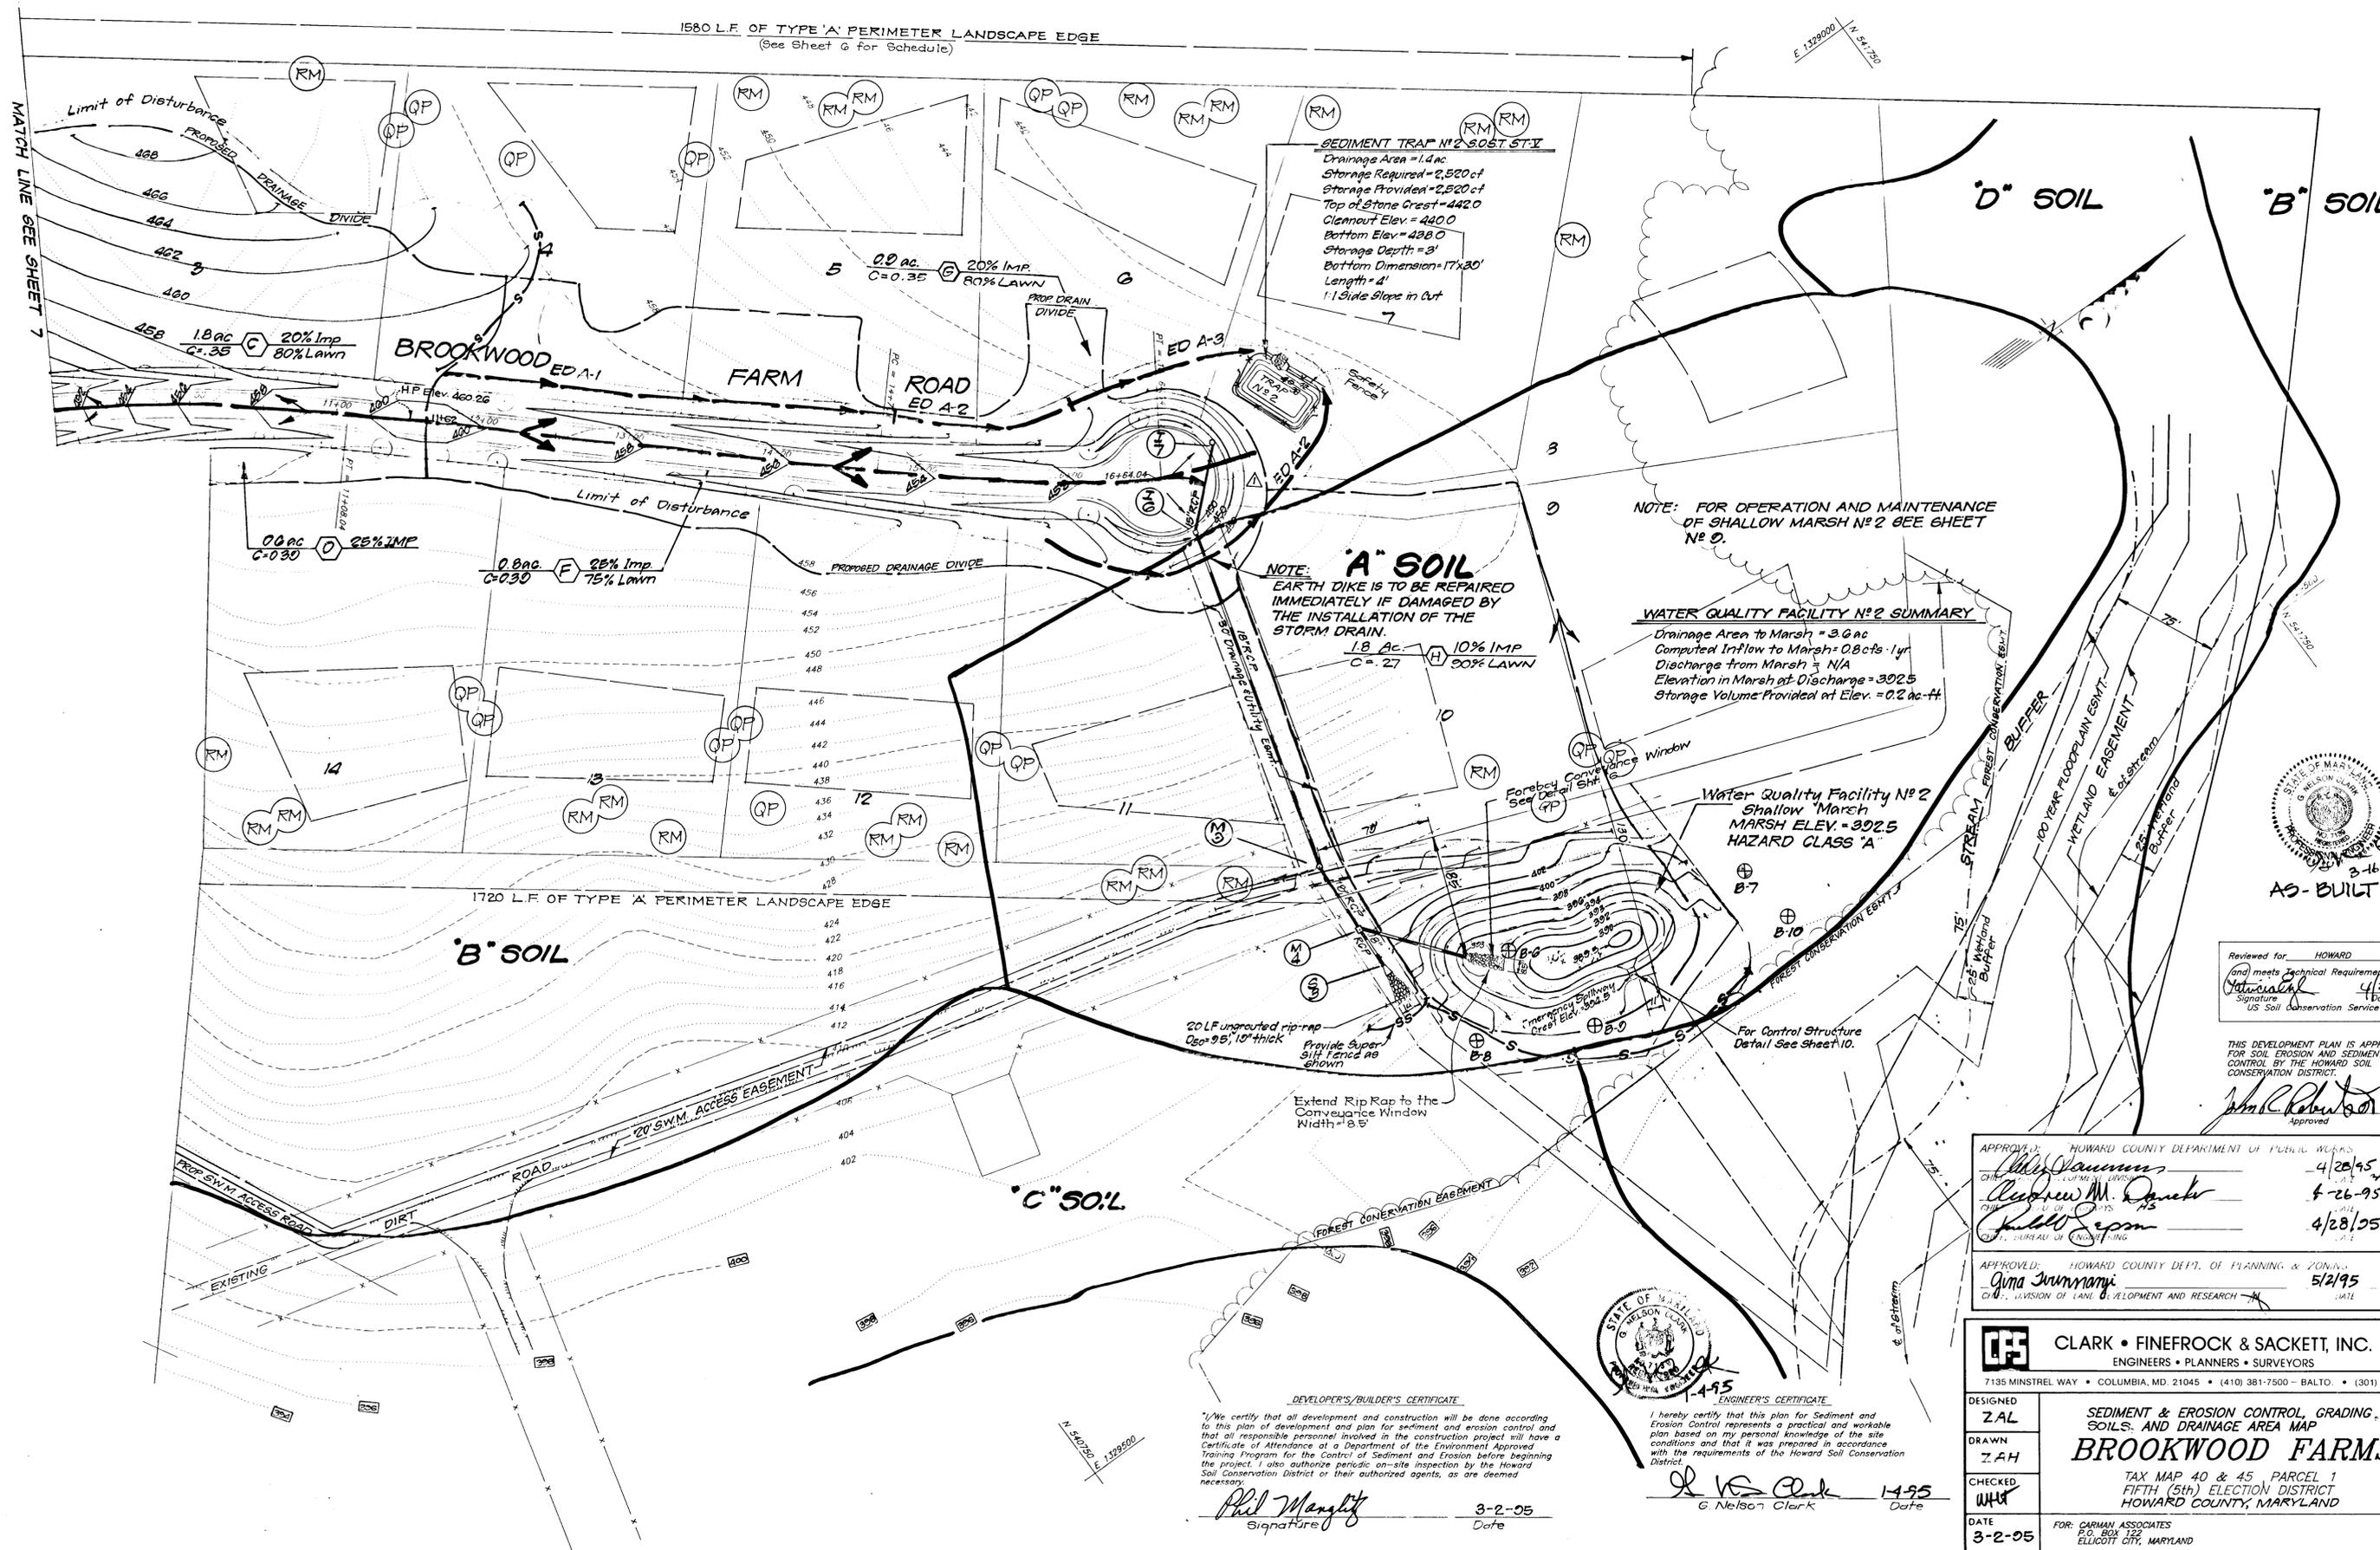

SEDIMENT TRAP #2 SOST ST-Y
 Drainage Area = 1.4 ac
 Storage Required = 2,520 cf
 Storage Provided = 2,520 cf
 Top of Stone Crest = 442.0
 Cleanout Elev. = 440.0
 Bottom Elev. = 438.0
 Storage Depth = 3'
 Bottom Dimension = 17'x30'
 Length = 4'
 1:1 Side Slope in Cut

NOTE: 'A' SOIL
 EARTH DIKE IS TO BE REPAIRED IMMEDIATELY IF DAMAGED BY THE INSTALLATION OF THE STORM DRAIN.
 1.8 ac. 10% IMP
 C=0.27 90% LAWN

NOTE: FOR OPERATION AND MAINTENANCE OF SHALLOW MARSH #2 SEE SHEET #2.

WATER QUALITY FACILITY #2 SUMMARY
 Drainage Area to Marsh = 3.0 ac
 Computed Inflow to Marsh = 0.8 cfs/yr
 Discharge from Marsh = N/A
 Elevation in Marsh at Discharge = 302.5
 Storage Volume Provided at Elev. = 0.2 ac-ft

Water Quality Facility #2
 Shallow Marsh
 MARSH ELEV. = 302.5
 HAZARD CLASS 'A'

Reviewed for: HOWARD S.C.D.
 and meets Technical Requirements
 Signature: [Signature] 4/28/95
 Title: District
 US Soil Conservation Service

THIS DEVELOPMENT PLAN IS APPROVED FOR SOIL EROSION AND SEDIMENT CONTROL BY THE HOWARD SOIL CONSERVATION DISTRICT.
 [Signature] 4/28/95
 Approved

APPROVED: HOWARD COUNTY DEPARTMENT OF PUBLIC WORKS
 [Signature] 4/28/95
 APPROVED: HOWARD COUNTY DEPT. OF PLANNING & ZONING
 [Signature] 5/2/95

DEVELOPER'S/BUILDER'S CERTIFICATE
 I, the undersigned, certify that all development and construction will be done according to this plan of development and plan for sediment and erosion control and that all responsible personnel involved in the construction project will have a Certificate of Attendance at a Department of the Environment Approved Training Program for the Control of Sediment and Erosion before beginning the project. I also authorize periodic on-site inspection by the Howard Soil Conservation District or their authorized agents, as are deemed necessary.
 [Signature] 3-2-05
 Date

ENGINEER'S CERTIFICATE
 I hereby certify that this plan for Sediment and Erosion Control represents a practical and workable plan based on my personal knowledge of the site conditions and that it was prepared in accordance with the requirements of the Howard Soil Conservation District.
 [Signature] 4-28-95
 Date

CLARK • FINEFROCK & SACKETT, INC.
 ENGINEERS • PLANNERS • SURVEYORS
 7135 MINSTREL WAY • COLUMBIA, MD. 21045 • (410) 381-7500 - BALTO. • (301) 621-8100 - WASH.

DESIGNED ZAL	SEDIMENT & EROSION CONTROL, GRADING, SOILS, AND DRAINAGE AREA MAP BROOKWOOD FARMS TAX MAP 40 & 45 PARCEL 1 FIFTH (5th) ELECTION DISTRICT HOWARD COUNTY, MARYLAND	SCALE 1" = 50'
DRAWN ZAH		DRAWING 8 OF 13
CHECKED WHH		JOB NO. 04-064
DATE 3-2-05		FILE NO. 04-064-0

FOR: GARMAN ASSOCIATES
 P.O. BOX 122
 ELLICOTT CITY, MARYLAND

222

SEDIMENT AND EROSION CONTROL NOTES

- A minimum of 24 hours notice must be given to the Howard County Office of Inspection and Permits prior to the start of any construction. (313-2437).
- All vegetative and structural practices are to be installed according to the provisions of this plan and are to be in conformance with the 1983 MARYLAND STANDARDS AND SPECIFICATIONS FOR SOIL EROSION AND SEDIMENT CONTROL.
- Following initial soil disturbance or redistribution, permanent or temporary stabilization shall be completed within: a) 7 calendar days for all perimeter sediment control structures, dikes, perimeter slopes and all slopes greater than 3:1, b) 14 days as to all other disturbed or graded areas on the project site.
- All sediment traps/basins shown must be fenced and warning signs posted around their perimeters in accordance with Vol. 1, Chapter 12, of the HOWARD COUNTY DESIGN MANUAL, Storm Drainage.
- All disturbed areas must be stabilized within the time period specified above in accordance with the 1983 MARYLAND STANDARDS AND SPECIFICATIONS FOR SOIL EROSION AND SEDIMENT CONTROL for permanent seedings (Sec.51) sod (Sec.54), temporary seeding (Sec.50) and mulching (Sec.52). Temporary stabilization with mulch alone can only be done when recommended seeding dates do not allow for proper germination and establishment of grasses.
- All sediment control structures are to remain in place and are to be maintained in operative condition until permission for their removal has been obtained from the Howard County Sediment Control Inspector.
- SITE ANALYSIS:

Total Area of Site:	57.16 ac.
Area Disturbed:	4.88 ac.
Area to be roofed or paved:	1.15 ac.
Area to be vegetatively stabilized:	5.67 ac.
Total Cut:	28,080 CY
Total Fill:	28,080 CY

 Offsite Waste/Borrow Area Location: _____
- Any sediment control practice which is disturbed by grading activity for placement of utilities must be repaired on the same day of disturbance.
- Additional sediment control must be provided, if deemed necessary by the Howard County DPW Sediment Control Inspector. On all sites with disturbed areas in excess of 2 acres, approval of the inspection agency shall be requested upon completion of installation of perimeter erosion and sediment controls, but before proceeding with any other earth disturbance or grading. Other building or grading inspection approvals may not be authorized until this initial approval by the inspection agency is made.
- If houses are to be constructed on an "as shown" basis, at random, Single Family Sediment Control, as shown below shall be implemented.
- The total amount of silt fence = 2330 LF

HOMEOWNERS ASSOCIATION RESPONSIBLE FOR OPERATION, MAINTENANCE & INSPECTION

Inspection of the pond(s) shown hereon shall be performed at least annually, in accordance with the checklist and requirements contained within USDA, SCS "Standards and Specifications for Ponds" (MD-378). The pond owner(s) and any heirs, successors, or assigns shall be responsible for the safety of the pond and the continued operation, surveillance, inspection and maintenance thereof. The pond owner(s) shall promptly notify the Ho. Co. Dept. of Public Works of any unusual observations that may be indications of distress such as excessive seepage, turbid seepage, sliding or slumping.

HOMEOWNERS ASSOCIATION MAINTENANCE RESPONSIBILITIES FOR WATER QUALITY FACILITIES N^o 1 AND 2

- Removal of accumulated paper, trash and debris after every storm as necessary.
- Mow embankment faces and top once a month during the growing season.
- Inspect forebay after each storm. If sediment buildup exceeds four (4) inches, notify the Department of Public Works, Bureau of Highways to facilitate cleanout operations.
- Inspect diversion structures and trash racks within M-4 and M-5 monthly and remove any accumulation of trash or debris as necessary.

It is the responsibility of the contractor to identify the spoil/borrow site and notify and gain approval from the sediment control inspector of the site and it's grading permit number at the time of construction.

PERMANENT SEEDING NOTES

APPLY TO GRADED OR CLEARED AREAS NOT SUBJECT TO IMMEDIATE FURTHER DISTURBANCE WHERE A PERMANENT LONG-LIVED VEGETATIVE COVER IS NEEDED.

SEEDBED PREPARATION: Loosen upper three inches of soil by raking, discing or other acceptable means before seeding, if not previously loosened.

SOIL AMENDMENTS: In lieu of soil test recommendations, use one of the following schedules:
 1) Preferred - Apply 2 tons per acre dolomitic limestone (92 lbs./1000 sq ft.) and 600 lbs per acre 10-10-10 fertilizer (14 lbs./1000 sq ft.) before seeding, harrow or disc into upper three inches of soil. At the time of seeding, apply 400 lbs. per acre 30-0-0 ureaform fertilizer (9 lbs./1000 sq ft.)
 2) Acceptable - Apply 2 tons per acre dolomitic limestone (92 lbs./1000 sq ft.) and 1000 lbs. per acre 10-10-10 fertilizer (23 lbs./1000 sq ft.) before seeding, harrow or disc into upper three inches of soil.

SEEDING: For the periods March 1 thru April 30, and August 1 thru October 15, seed with 50lbs per acre (1.4 lbs./1000 sq ft) of Kentucky 31 Tall Fescue. For the period May 1 thru July 31, seed with 60 lbs. Kentucky 31 Tall Fescue per acre and 2 lbs per acre (.05 lbs./1000 sq ft) of weeping lovegrass. During the period of October 16 thru February 28, protect site by: Option (1) 2 tons per acre well anchored straw mulch and seed as Kentucky 31 Tall Fescue and mulch with 2 tons/acre well anchored straw.

MULCHING: Apply 1 1/2 to 2 tons per acre (70 to 90 lbs./1000 sq ft) of unrattled small grain straw immediately after seeding. Anchor mulch immediately after application using mulch anchoring tool or 218 gallons per acre (5 gal/1000 sq ft) of emulsified asphalt on flat areas. On slopes 8 feet or higher, use 348 gallons per acre (8 gal/1000 sq ft) for anchoring.

MAINTENANCE: Inspect all seeded areas and make needed repairs, replacements and reseedings.

TEMPORARY SEEDING NOTES

SEEDBED PREPARATION: Loosen upper three inches of soil by raking, discing or other acceptable means before seeding, if not previously loosened.

SOIL AMENDMENTS: Apply 600 lbs per acre 10-10-10 fertilizer (14lbs/1000 sq ft).



SEEDING: For periods March 1 thru April 30 and from August 15 thru November 15, seed with 2 1/2 bushel per acre of annual ryegrass (3.2 lbs./1000 sq ft). For the period May 1 thru August 14, seed with 3 lbs per acre of weeping lovegrass (.07 lbs./1000 sq ft). For the period November 15 thru February 28, protect site by applying 2 tons per acre of well anchored straw mulch and seed as soon as possible in the spring, or use sod.

MULCHING: Apply 1 1/2 to 2 tons per acre (70 to 90 lbs./1000 sq ft) of unrattled small grain straw immediately after seeding. Anchor mulch immediately after application using mulch anchoring tool or 218 gallons per acre (5 gal/1000 sq ft) of emulsified asphalt on flat areas. On slopes 8 feet or higher, use 348 gallons per acre (8 gal/1000 sq ft) for anchoring.

REFER TO THE 1983 MARYLAND STANDARDS AND SPECIFICATIONS FOR SOIL EROSION AND SEDIMENT CONTROL FOR RATE AND METHODS NOT COVERED.

CONSTRUCTION SEQUENCE


- Obtain a grading permit. 7 days
- Construct additional paving on Lime Kiln Road. 7 days
- Construct storm drainage structures I-15 thru I-14. 14 days
- Stabilize and break shot 8" PVC in M-2.
- Install all sediment and erosion control structures, 14 days
- Clear and rough grade roads. 30 days
- Clear and grade water quality facilities 1 and 2. 30 days
- Construct remaining storm drainage and stabilize. 30 days
- Fine grade and construct paving. 30 days
- Stabilize all disturbed areas on site in accordance 10 days
- Upon approval of the sediment control inspector remove. 14 days
- sediment and erosion control measures and stabilize.

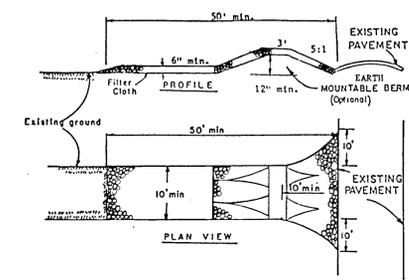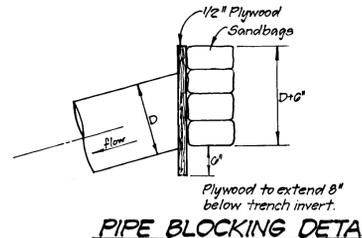

- CONSTRUCTION SPECIFICATIONS**
- Stone Size - Use 2" stone, or reclaimed or recycled concrete equivalent.
 - Length - As required, but not less than 50 feet (except on a single residence lot where a 30 foot minimum length would apply).
 - Thickness - Not less than six (6) inches.
 - Width - Ten (10) foot minimum, but not less than the full width at points where ingress or egress occurs.
 - Filter Cloth - Will be placed over the entire area prior to placing of stone. Filter will not be required on a single family residence lot.
 - Surface Water - All surface water flowing or directed toward construction entrances shall be piped across the entrance. If piping is impractical, a mountable berm with silt slopes will be permitted.
 - Maintenance - The entrance shall be maintained in a condition which will prevent tracking or blowing of sediment onto public rights-of-way. This may require periodic top dressing with additional stone as conditions demand and repair and/or cleanup of any material used to grade sidewalks. All sediment applied, dropped, washed or tracked onto public rights-of-way must be removed immediately.
 - Washing - Wheels shall be cleaned to remove sediment prior to entrance onto public rights-of-way. When washing is required, it shall be done on an area stabilized with stone and which drains into an approved sediment trapping device.
 - Periodic inspection and needed maintenance shall be provided after each rain.

STABILIZED CONSTRUCTION ENTRANCE (SCE)

No Scale

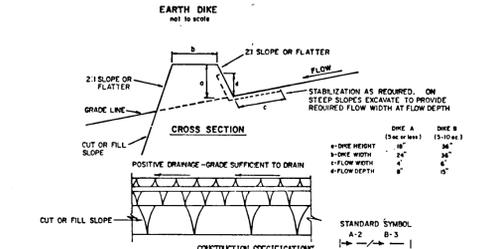

CONSTRUCTION SPECIFICATIONS

- ALL DIKES SHALL BE COMPACTED BY EARTH-MOVING EQUIPMENT.
- DIKES SHALL HAVE POSITIVE DRAINAGE TO AN OUTLET.
- TOP WIDTH MAY BE WIDER AND SIDE SLOPES MAY BE FLATTER IF DESIRED TO FACILITATE CROSSING BY CONSTRUCTION TRAFFIC.
- FIELD LOCATION SHOULD BE ADJUSTED AS NEEDED TO UTILIZE A STABILIZED SAFE OUTLET. EARTH DIKES SHALL HAVE AN OUTLET THAT FUNCTIONS WITH A MINIMUM OF EROSION. TRAPPIST SHALL BE CONVEYED TO A SEDIMENT TRAPPING DEVICE SUCH AS A SEDIMENT TRAP OR SEDIMENT BASIN WHERE EITHER DIKE CHANNEL OR THE DRAINAGE AREA ABOVE THE DIKE ARE NOT ADEQUATELY STABILIZED.
- STABILIZATION SHALL BE DIKE CHANNEL, (A) IN ACCORDANCE WITH STANDARD SPECIFICATIONS FOR SEED AND STRAW MULCH OR STRAW MULCH IF NOT IN SEEDING SEASON, (B) FLOW CHANNEL AS PER THE CHART BELOW.

TYPE OF TRAFFIC	CHANNEL	DIKE A	DIKE B
1	5-5.0\"/>		

A. Stone to be 2 inch stone, or recycled concrete equivalent, in a layer at least 3 inches in thickness and be pressed into the soil with construction equipment.
 B. Rip-rap to be 1/2 inches in a layer at least 3 inches in thickness and pressed into the soil.
 C. APPROVED EQUIVALENTS CAN BE SUBSTITUTED FOR ANY OF THE ABOVE MATERIALS.
 7. PERIODIC INSPECTION AND REQUIRED MAINTENANCE MUST BE PROVIDED AFTER EACH RAIN.

LEGEND

- Contour Interval 2 feet
- Existing Contour ---212---
- Proposed Contour ---212---
- Direction of Drainage ---
- Spot Elevation +213
- Silt Fence s - s - s - s -
- Earth Dike -----
- Limit of Disturbance -----
- Proposed Drainage Divide -----
- Stabilized Construction Entrance -----
- Exist trees -----

DEVELOPER'S/BUILDER'S CERTIFICATE

I/we certify that all development and construction will be done according to this plan of development and plan for sediment and erosion control and that all responsible personnel involved in the construction project will have a Certificate of Attendance at a Department of the Environment Approved Training Program for the Control of Sediment and Erosion before beginning the project. I also authorize periodic on-site inspection by the Howard Soil Conservation District or their authorized agents, as are deemed necessary.

Paul Mangit 3-2-95
Signature Date

ENGINEER'S CERTIFICATE


I hereby certify that this plan for Sediment and Erosion Control represents a practical and workable plan based on my personal knowledge of the site conditions and that it was prepared in accordance with the requirements of the Howard Soil Conservation District.

G. Nelson Clark 4/20/95
Signature Date

Reviewed for HOWARD S.C.D.
and meets Technical Requirements
G. Nelson Clark 4/20/95
Signature Date
US Soil Conservation Service

THIS DEVELOPMENT PLAN IS APPROVED FOR SOIL EROSION AND SEDIMENT CONTROL BY THE HOWARD SOIL CONSERVATION DISTRICT.

John R. Roberts 4/20/95
Approved

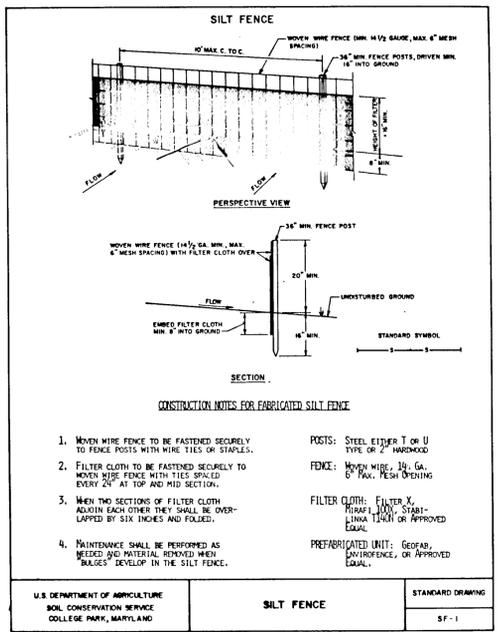


CONSTRUCTION NOTES FOR FABRICATED SILT FENCE

- Woven wire fence to be fastened securely to fence posts with wire ties or staples.
- Filter cloth to be fastened securely to woven wire fence with ties spaced every 24" at top and mid section.
- When two sections of filter cloth abut each other they shall be overlapped by six inches and folded.
- Maintenance shall be performed as needed and material removed when blades develop in the silt fence.

POSTS: STEEL EITHER T OR U TYPE OR 2" HAWKWOOD
 FENCE: WOVEN WIRE, 1/2 GAL. 6\"/>

PREPARED UNIT: GEOTAF, ENVIRONMENTAL, OR APPROVED EQUAL.

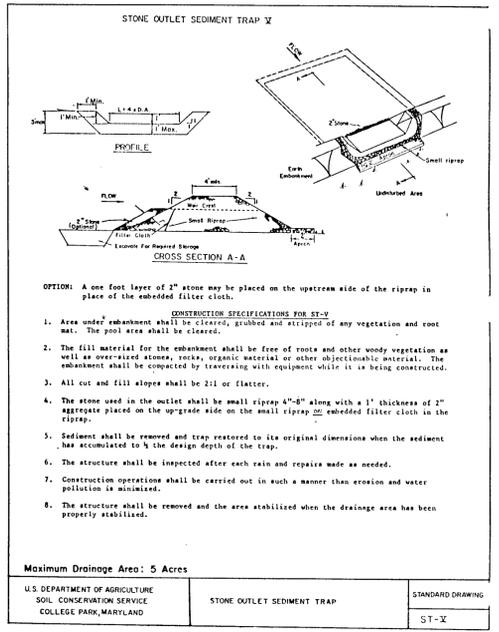

CONSTRUCTION SPECIFICATIONS FOR ST-O

- Area under embankment shall be cleared, grubbed and stripped of any vegetation and root mat. The pool area shall be cleared.
- The fill material for the embankment shall be free of roots and other woody vegetation as well as oversized stones, rocks, organic material or other objectionable material. The embankment shall be compacted by traversing with equipment while it is being constructed.
- All cut and fill slopes shall be 2:1 or flatter.
- The stone used in the outlet shall be small riprap 4"-8" along with a 1" thickness of 2" aggregate placed on the updrain side on the small riprap embedded filter cloth in the riprap.
- Sediment shall be removed and trap restored to its original dimensions when the sediment has accumulated to 1/2 the design depth of the trap.
- The structure shall be inspected after each rain and repairs made as needed.
- Construction operations shall be carried out in such a manner that erosion and water pollution is minimized.
- The structure shall be removed and the area stabilized when the drainage area has been properly stabilized.

Maximum Drainage Area: 5 Acres




AS-BUILT

APPROVED: HOWARD COUNTY DEPARTMENT OF PUBLIC WORKS
Chris Damann 4/20/95
CHIEF, LAND DEVELOPMENT DIVISION DATE
Charles M. Danks 4-26-95
CHIEF, COUNTY OF PROJECTS DATE
Shirley Egan 4/28/95
SENIOR BUREAU OF ENGINEERING DATE

APPROVED: HOWARD COUNTY DEPARTMENT OF PLANNING AND ZONING
Gina Summery 5/2/95
CHIEF, DIVISION OF COMMUNITY PLANNING AND LAND DEVELOPMENT DATE

CLARK • FINEFROCK & SACKETT, INC.
 ENGINEERS • PLANNERS • SURVEYORS
 1135 MINSTREL WAY • COLUMBIA MD 21045 • (410) 381-7500 BALTO • (301) 621-8100 WASH

DESIGNED <u>ZAL</u>	SEDIMENT AND EROSION CONTROL PLAN DETAIL SHEET BROOKWOOD FARMS TAX MAP 40 & 45 PARCEL 1 FIFTH (5th) ELECTION DISTRICT HOWARD COUNTY, MARYLAND	SCALE No Scale
DRAWN <u>ZAM</u>		DRAWING 9 OF 13
CHECKED <u>WHT</u>		JOB NO. 04064
DATE 3-2-95		FILE NO. 04064
FOR: GARMAN ASSOCIATES P.O. BOX 122 ELLIOTT CITY, MARYLAND		

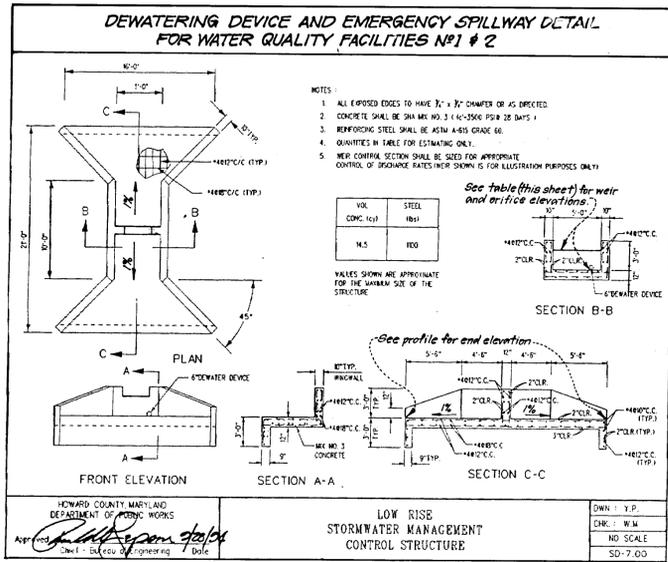

WATER QUALITY CONSTRUCTION SPECIFICATIONS

These specifications are appropriate to all ponds within the scope of the Standard Practice MD-378. All references to ASTM and AASHTO specifications apply to the most recent version.

1. Site Preparation

Areas designated for borrow areas, embankment, and structural works shall be cleared, grubbed and stripped of topsoil. All trees, vegetation, roots and other objectionable material shall be removed.

Areas to be covered by the reservoir will be cleared of all trees, brush, logs, fences, rubbish and other objectionable material unless otherwise designated on the plans. Trees, brush and stumps shall be cut approximately level with the ground surface.

All cleared and grubbed material shall be disposed of outside and below the limits of the dam and reservoir as directed by the owner or his representative. When specified, a sufficient quantity of topsoil will be stockpiled in a suitable location for use on the embankment and other designated areas.

2. Structure Backfill

Backfill adjacent to pipes or structures shall be of the type and quality conforming to that specified for the adjoining fill material. The fill shall be placed in horizontal layers not to exceed four inches in thickness and compacted by hand tampers or other manually directed compaction equipment. The material needs to fill completely all spaces under and adjacent to the pipe. At no time during the backfilling operation shall driven equipment be allowed to operate closer than four feet, measured horizontally, to any part of a structure. Under no circumstances shall equipment be driven over any part of a concrete structure or pipe, unless there is a compacted fill of 24" or greater over the structure or pipe.

3. Compaction

Where a minimum required density is specified, it shall not be less than 95% of maximum dry density with a moisture content within ±2% of the optimum. Each layer of fill shall be compacted as necessary to obtain that density, and is to be certified by the Engineer at the time of construction. All compaction is to be determined by AASHTO Method T-99.

4. Concrete

Concrete shall meet the requirements of Maryland Department of Transportation, State Highway Administration Standard Specifications for Construction and Materials, Section 608, Mix No. 3.


5. Rock Riprap

Rock riprap shall meet the requirements of Maryland Department of Transportation, State Highway Administration Standard Specifications for Construction and Materials, Section 905.

The riprap shall be placed to the required thickness in one operation. The rock shall be delivered and placed in a manner that will insure the riprap in place shall be reasonably homogeneous with the larger rocks uniformly distributed and firmly in contact one to another with the smaller rocks filling the voids between the larger rocks. Filter cloth shall be placed under all riprap and shall meet the requirements of Maryland Department of Transportation, State Highway Administration Standard Specifications for Construction and Materials, Section 919.12.


6. Stabilization

All borrow areas shall be graded to provide proper drainage and left in a slightly condition. All exposed surfaces of the embankment, spillway, spoil and borrow areas, and berms shall be stabilized by seeding, liming, fertilizing and mulching in accordance with the Maryland Soil Conservation Service Standards and Specifications for Critical Area Planning (MD-342) or as shown on the accompanying drawings.

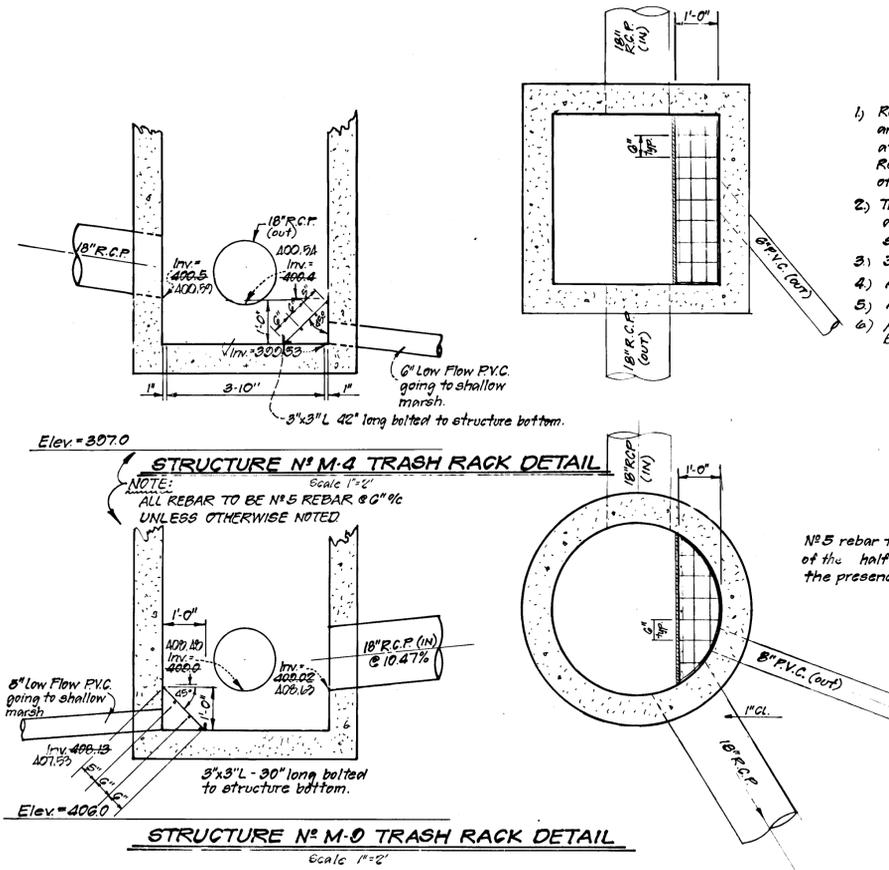

TRASH RACK NOTES

- Removable trash rack is to be placed on the bottom angle and is to rest against the side of the structure at a 45° angle as shown. Removal of the trash rack will allow access to the bottom of the structure for maintenance.
- Trash racks are to lay angled as shown to prevent accumulation of debris in front of the outgoing shallow marsh pipe.
- 3"x3" L's to be placed 1 ft back from the structure side wall.
- All rebar to be #5 at 6" o.c. unless otherwise noted.
- All rebar to be painted Battleship Gray.
- All trash racks and their components shall be galvanized after fabrication.

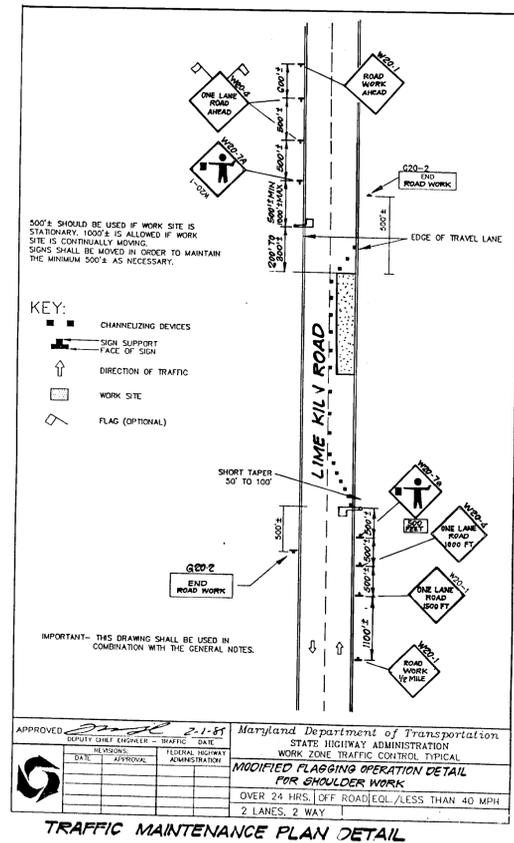

	WATER QUALITY FACILITY #1	WATER QUALITY FACILITY #2
Emergency Spillway Weir Elevation	401.0 ✓	394.5 ✓
6" Orifice Elev. (Dewatering Device)	398.0 398.7	392.5 ✓

NOTE: The control structure dimensions for Water Quality Facility Nos 1 & 2 are the same and are to be built in accordance with detail SD 700 (this sheet).

DEVELOPER'S/BUILDER'S CERTIFICATE

"I/We certify that all development and construction will be done according to this plan of development and plan for sediment and erosion control and that all responsible personnel involved in the construction project will have a Certificate of Attendance at a Department of the Environment Approved Training Program for the Control of Sediment and Erosion before beginning the project. I also authorize periodic on-site inspection by the Howard Soil Conservation District or their authorized agents, as are deemed necessary."

Phil Mangley 3-2-95
NAME DATE



AS-BUILT

APPROVED: HOWARD COUNTY DEPARTMENT OF PUBLIC WORKS
[Signature] 4/28/95
CHIEF, LAND DEVELOPMENT DIVISION
[Signature] 4-26-95
CHIEF, BUREAU OF HIGHWAYS
[Signature] 4/28/95
CHIEF, BUREAU OF ENGINEERING

APPROVED: HOWARD COUNTY DEPT. OF PLANNING & ZONING
[Signature] 5/2/95
CHIEF, DIVISION OF LAND DEVELOPMENT AND RESEARCH

CLARK • FINEFROCK & SACKETT, INC.
ENGINEERS • PLANNERS • SURVEYORS
7135 MINSTREL WAY • COLUMBIA, MD. 21045 • (410) 381-7500 - BALTO. • (301) 621-8100 - WASH.

DESIGNED Z.A.L.	DETAIL SHEET BROOKWOOD FARMS TAX MAP 40 & 45 PARCEL 1 FIFTH (5th) ELECTION DISTRICT HOWARD COUNTY, MARYLAND	SCALE As Shown
DRAWN Z.A.H.		DRAWING 10 of 13
CHECKED [Signature]		JOB NO. 04-064
DATE 3-2-95		FILE NO. 04-064-D
FOR: DARMAN ASSOCIATES P.O. BOX 12 ELICOTT CITY, MARYLAND		

HOLLY HOUSE DIVISION
P. 7 P. 22


Septic Areas Shown
For Record Plats
7518 and 7519

0.85 AC% EXISTING FOREST
TO BE REMOVED

VICINITY MAP
Scale 1"=2000'

LEGEND

- Contour Interval 2 feet
- Existing Contour
- Proposed Contour
- Existing Trees to be Saved
- Proposed Spot Elev. +20'
- Septic Fields
- Proposed Well Site
- Existing Well Site
- Passed Septic Test Sites
- Failed Septic Test Sites
- 15% - 25% Slopes
- Limit of Wetlands
- LIMIT OF DISTURBANCE (L.O.D.)
- TREE PROTECTION DEVICE
- PROPOSED AFFORESTATION
- EXISTING FOREST TO BE REMOVED

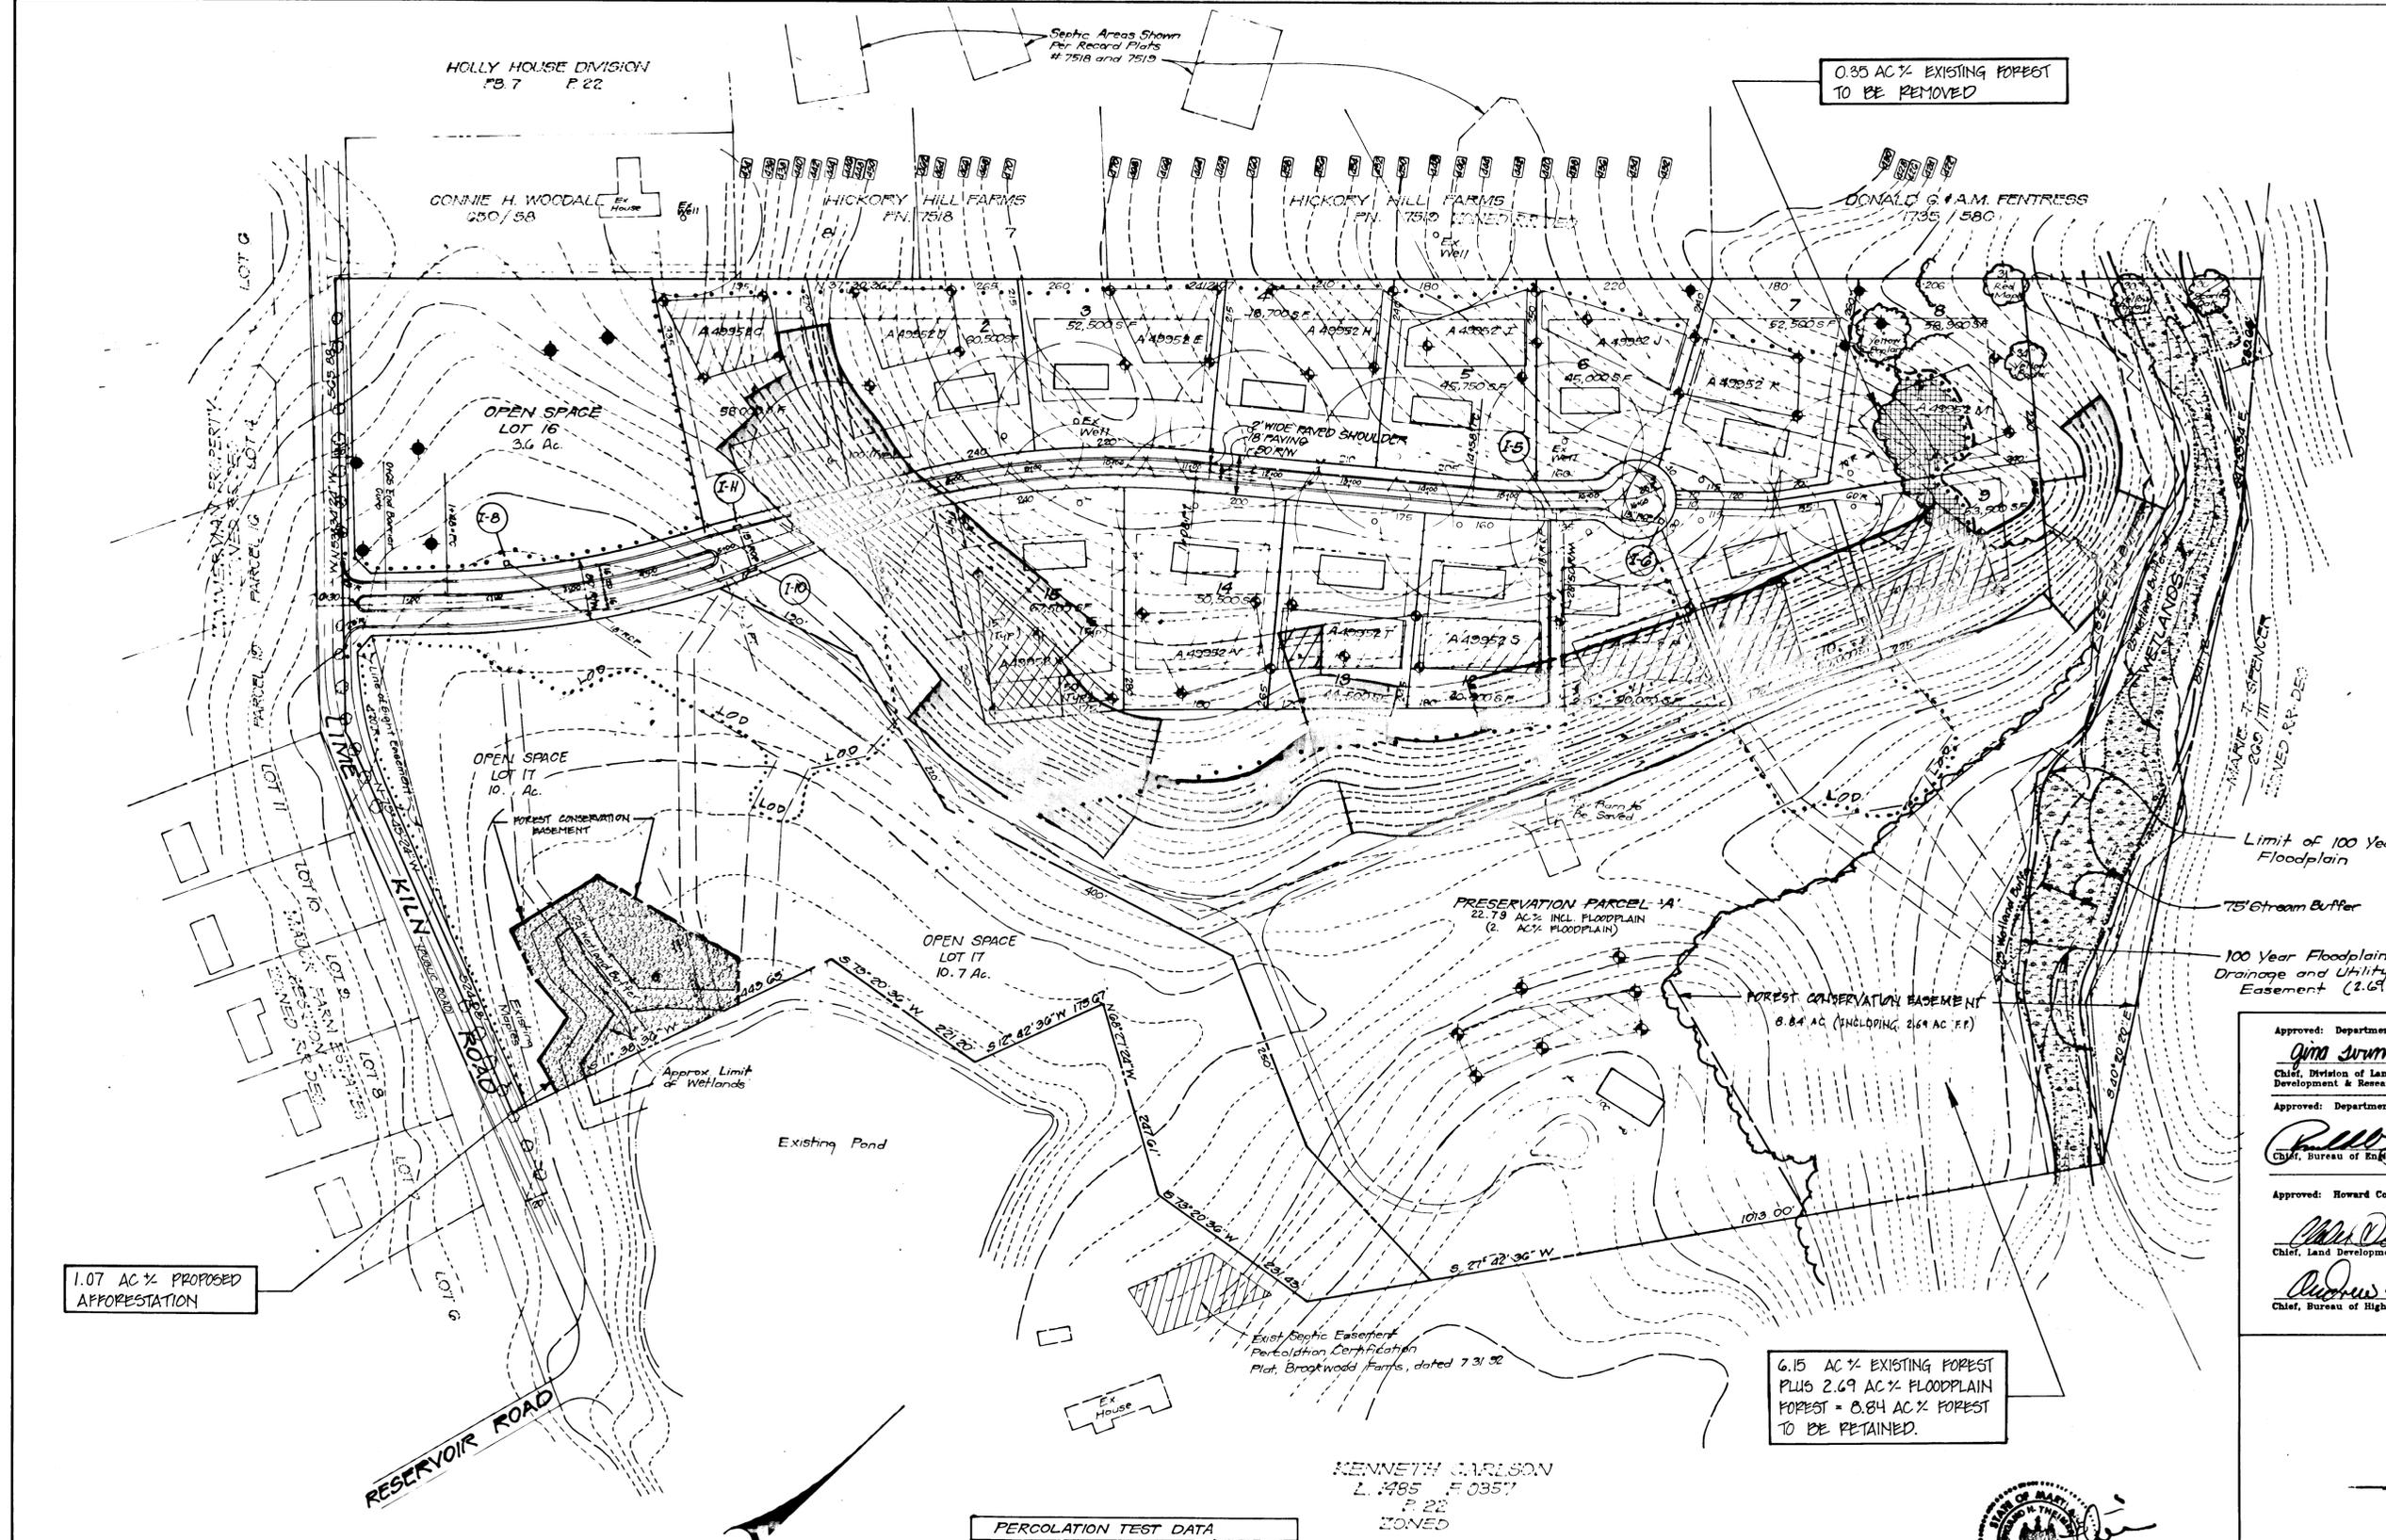

1.07 AC% PROPOSED
AFFORESTATION

6.15 AC% EXISTING FOREST
PLUS 2.69 AC% FLOODPLAIN
FOREST = 8.84 AC% FOREST
TO BE RETAINED.

KENNETH CARLSON
L. 485 F. 0357
P. 22
ZONED

PERCOLATION TEST DATA

PRESENT LOT NUMBER	AVERAGE PER TIME IN MIN	MINIMUM INLET DEPTH IN FEET	PERC AREA IDENTIFICATION A NUMBERS
PRES. PAR. A	21	4.0	49952A
1	8	4.0	49952C
2	26	4.0	49952D
3	3	4.5	49952E
4	28	4.5	49952H
5	12	4.5	49952I
6	12	4.5	49952J
7	5	4.0	49952K
8	5	4.0	49952M
9	5	4.0	49952O
10	20	5.0	49952P
11	18	4.5	49952R
12	22	4.0	49952S
13	22	5.0	49952T
14	10	5.0	49952V
15	22	4.0	49952X

MINIMUM LOT SIZE CHART

LOT NO	Gross Area	Paveable Area	Net Area	Min Lot Size
8	58,000 sq ft	1900 sq ft	57,000 sq ft	40,000 sq ft
9	53,500 sq ft	2000 sq ft	51,500 sq ft	49,000 sq ft


NOTE: This symbol designates a proposed private sewage easement of 10,000 sq ft minimum as required by the Maryland State Department of the Environment for individual sewage disposal. Improvements of any nature in these areas are restricted until public sewerage is available and serving any residential structure constructed on these building sites. These easements shall become null and void upon connection to a public sewerage system. The final lot configuration shall comply with the minimum ownership width and lot areas, as required by the Maryland State Department of the Environment.

Approved: Department of Planning and Zoning
Quinn Summery 5/2/95
Chief, Division of Land Development & Research
Date

Approved: Department of Public Works
Phillip Saper 4/28/95
Chief, Bureau of Engineering
Date

Approved: Howard County Department of Public Works
Mr. Dorman 4/20/95
Chief, Land Development Division
Date

Andrew M. Danks 4-26-95
Chief, Bureau of Highways
Date

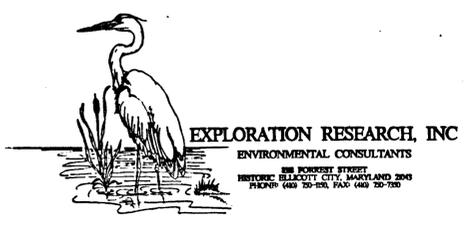

CLARK • FINEFROCK & SACKETT, INC.
ENGINEERS • PLANNERS • SURVEYORS
7135 MINTREL WAY • COLUMBIA, MD 21045 • (410) 381-7500 - BALTO. • (301) 621-8100 - WASH.


DESIGNED: FOREST CONSERVATION PLAN
LOTS 1 THRU 17 & PRESERVATION PARCEL A
BROOKWOOD FARMS
TAX MAP 40145 PARCEL P-1
5TH ELECTION DISTRICT
HOWARD COUNTY, MARYLAND

SCALE: 1"=100'
DRAWING: 12 of 13
JOB NO.: 94-064
FILE NO.: 94-064-P

DATE: 6/22/94
OWNER/DEVELOPER: CARMAN ASSOCIATES
P.O. Box 122
ELLICOTT CITY, MD 21043

REVISED 4/10/95 AS PER ENGINEER COMMENTS


DETAIL 1: TREE PROTECTIVE DEVICE
SOURCE: M-NCPPC, 1989

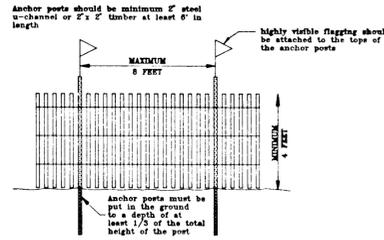

GENERAL NOTES

1. Limits of disturbance will be set as part of the review process for an approved TCP.
2. The boundaries of the limits of disturbance should be staked and flagged prior to erecting the protective measures.
3. Anchor posts should be placed to avoid severing or damaging large tree roots.
4. Fencing material should be fastened securely to the anchor posts.

DETAIL 4: WHIP PLANTING DETAIL
CONTAINER NOT TO SCALE

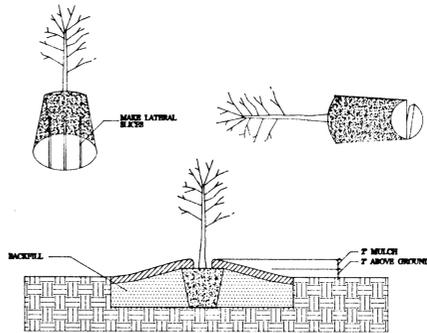

PLANTING PROCEDURES FOR POT BOUND CONTAINER GROWN PLANTS

1. REMOVE THE PLANT EITHER BY CUTTING OR INVERTING THE CONTAINER.
2. USE A KNIFE TO CUT THROUGH BOTTOM HALF OF THE ROOT BALL.
3. PLANT ABOVE THE EXISTING GRADE WHEN HIGH WATER TABLE CONDITIONS EXIST, OTHERWISE PLANT FLUSH WITH EXISTING GRADE.
4. PLANTING HOLE TO BE THREE TIMES THE DIAMETER OF THE CONTAINER.


PRESERVATION AREA NOTES

1. ALL PROPOSED ACTIVITIES SHALL CONFORM TO THE TERMS, CONDITIONS AND SCHEDULES OF AN APPROVED SOIL EROSION AND SEDIMENT CONTROL PLAN.
2. SNOW FENCING, [TYPICAL SECTION SHOWN IN PLAN DETAIL 1] SHALL BE INSTALLED ALONG ALL TREE SAVE AREAS THAT ARE WITHIN FIFTY FEET (50') OF PROPOSED CONSTRUCTION ACTIVITIES. THE TREE PROTECTIVE DEVICES SHALL BE IN PLACE AT THE TIME CONSTRUCTION ACTIVITIES COMMENCE. NO PROTECTIVE DEVICES SHALL BE INSTALLED ALONG TREE SAVE AREAS THAT ARE GREATER THAN FIFTY (50') FEET FROM CONSTRUCTION ACTIVITY. THE LOCATION OF ALL TREE PROTECTION DEVICES ARE SHOWN ON THE SOIL EROSION AND SEDIMENT CONTROL PLAN DRAWINGS WHICH WILL BE INCORPORATED INTO THIS TREE CONSERVATION PLAN BY REFERENCE.

FENCING AND SIGNAGE NOTES

1. WOODLAND CONSERVATION/TREE SAVE AREAS AND LIMITS OF CLEARING WILL BE CLEARLY MARKED PRIOR TO THE BEGINNING OF ANY ACTIVITIES.
2. IF DETERMINED TO BE NECESSARY, THE AFFORESTATION AREA WILL BE ENCLOSED BY A POST AND SMOOTH WIRE FENCE, SUITABLY MARKED TO IDENTIFY THE AREA. THE FENCE SHALL BE OF SUFFICIENT CONSTRUCTION TO IMPEDE ENTRY AND MARKED AT SUITABLE FREQUENCY WITH CONSPICUOUS MARKERS AND SIGNAGE.

PROPOSED SIGNAGE

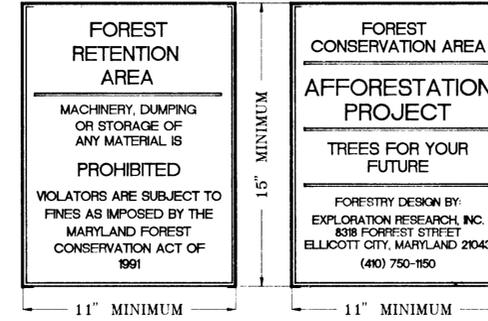

PLANTING MATERIALS & HANDLING NOTES

1. PLANTING MATERIALS WILL CONSIST OF CONTAINERIZED WHIP STOCK WITH MINIMUM HEIGHTS AS SHOWN IN PLAN DETAIL 4. ALL STOCK WILL BE PLANTED AS RECEIVED; NO ROOT OR TOP PRUNING WILL BE DONE AT THE SITE. STOCK NOT MEETING SPECIFICATIONS SHALL BE RETURNED TO THE SUPPLIER.
2. ALL PLANTING STOCK SHALL BE PROTECTED FROM SUNSCALD, DESICCATION, AND STRUCTURAL DAMAGE DURING SHIPMENT TO THE SITE. DELIVERY OF MATERIALS WILL BE NO SOONER THAN ONE WEEK PRIOR TO PLANTING. MATERIALS HELD FOR PLANTING WILL BE MOISTENED AND PLACED IN COOL, SHADED AREAS UNTIL READY FOR PLACEMENT. DURING PLANTING ALL MATERIALS WILL BE KEPT MOIST WITH THE ROOTS PROTECTED FROM DESICCATION.

PLANTING METHODOLOGY NOTES

1. STOCK WILL BE HAND-PLANTED. HOLES SHOULD BE EXCAVATED BY MECHANICAL AUGER. TYPICAL PLANTING DETAILS FOR PLANTING IS SHOWN IN PLANTING DETAIL 4.
2. MULCH MAY BE APPLIED BY HAND OR BY SUITABLE EQUIPMENT.

CONSTRUCTION TIMETABLE

1. OBTAIN GRADING/BUILDING PERMIT
2. INSTALL TREE PROTECTION FENCE ALONG DISTURBED LIMITS
3. EXCAVATE & CONSTRUCT ROADS UNDER AN APPROVED FINAL PLAN.
4. COMPLETE HOUSE CONSTRUCTION
5. REMOVE TEMPORARY TREE PROTECTION DEVICES
6. INSTALL AFFORESTATION PLANTINGS
7. INSPECT AND MAINTAIN AFFORESTATION PLANTINGS FOR A 2 YEAR PERIOD.
8. PROVIDE FINAL REPORT AND CERTIFICATION OF PLANTING.

SOIL EROSION AND SEDIMENT CONTROL NOTES

1. ALL ACTIVITIES SHALL CONFORM TO THE TERMS, CONDITIONS, AND SCHEDULES OF A SOIL EROSION AND SEDIMENT CONTROL PLAN APPROVED BY THE HOWARD SOIL CONSERVATION DISTRICT.
2. ALL FEASIBLE & PRACTICAL EROSION AND SEDIMENT CONTROL DEVICES WILL BE INTEGRATED INTO THE TREE CONSERVATION PLAN.
3. ALL ACTIVITIES SHALL BE DESIGNED TO MINIMIZE SEDIMENTATION AND EROSION INTO AND ADJACENT TO TREE PRESERVATION AREAS.

PLANTING SCHEDULE NOTES

1. AREAS WILL BE PLANTED IN LATE WINTER AND EARLY SPRING. PLANTING MAY BEGIN AS SOON AS THE GROUND IS NO LONGER FROZEN AND THE DANGER OF KILLING FROSTS IS MINIMAL. EARLIEST PLANTING DATES WILL VARY FROM YEAR TO YEAR.
2. SOIL AMENDMENT AND FERTILIZATION RECOMMENDATIONS WILL BE MADE BASED UPON THE RESULTS OF SOIL ANALYSES FOR NITROGEN, PHOSPHORUS, POTASSIUM, ORGANIC MATTER CONTENT, AND PH. IF REQUIRED LINE AND FERTILIZER WILL BE APPLIED AS A SIDERAND SIX TO TEN INCHES (6-10") FROM THE CENTERLINE OF THE PLANTING ROWS. THESE MATERIALS WILL BE WORKED INTO THE SOIL USING A DISC OR CHISEL HARROW OR OTHER MORE SPECIALIZED EQUIPMENT. APPLY WOOD CHIPS OR HARDWOOD BARK MULCH IN A 2 FOOT MIN. RADIUS AROUND EACH TREE AS SHOWN IN THE DETAIL PROVIDED.
3. PLANTING MATERIALS WILL CONSIST OF WHIPSTOCK PLANTED ON 11 X 11 FOOT SPACING. AVERAGE DENSITY OVER THE AFFORESTATION AREA WILL BE 350 TREES/ACRE. HARDWOOD PLANTINGS WILL CONSIST OF A RANDOMIZED MIX OF FOUR MAJOR SPECIES (TULIP POPLAR, GREEN ASH, PIN OAK, AND RED MAPLE), AND ONE MINOR SPECIES (FLOWERING DOGWOOD). A TYPICAL PLANTING PLAN IS SHOWN IN PLANT DETAIL 3.


MONITORING PLAN NOTES

1. MONTHLY VISITS DURING THE FIRST GROWING SEASON [YEAR 1] ARE TO ASSESS THE SUCCESS OF THE PLANTINGS AND TO DETERMINE IF SUPPLEMENTAL WATERING OR OTHER ACTIONS ARE NECESSARY. EARLY SPRING VISITS WILL DETERMINE WINTER KILL AND AUTUMN VISITS WILL DETERMINE SUMMER KILL.
2. STOCK SURVIVAL IS ESTIMATED TO BE 75 PERCENT AFTER TWO YEARS. IF SURVIVAL FALLS BELOW 350 TREES PER ACRE, AREAS WILL BE REPLANTED TO MEET AN AVERAGE DENSITY OF 263 TREES PER ACRE OVER THE ENTIRE AFFORESTATION AREA.
3. SURVIVAL WILL BE DETERMINED BY A STRATIFIED RANDOM SAMPLING OF THE PLANTINGS. SAMPLE LOCATIONS WILL BE CHOSEN PRIOR TO PLANTING. THE SPECIES COMPOSITION OF THE SAMPLE POPULATION SHOULD BE PROPORTIONATE TO THE AMOUNT OF EACH SPECIES IN THE ENTIRE PLANTING TO BE SAMPLED.



AS-BUILT

DETAIL 2: ROOT PRUNING

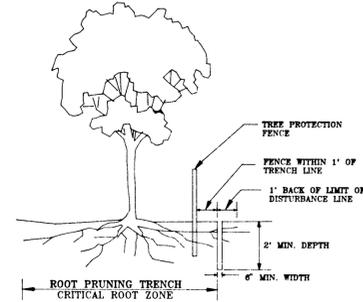


NOTES:

1. RETENTION AREAS WILL BE SET AS PART OF THE REVIEW PROCESS
2. BOUNDARIES OF RETENTION AREAS SHOULD BE STAKED FLAGGED PRIOR TO TRENCHING
3. EXACT LOCATION OF TRENCH SHOULD BE IDENTIFIED.
4. TRENCH SHOULD BE IMMEDIATELY BACKFILLED WITH SOIL REMOVED OR OTHER HIGH ORGANIC SOIL.
5. ROOTS SHOULD BE CLEANLY CUT USING VIBRATORY KNIFE OR OTHER ACCEPTABLE EQUIPMENT.

SOURCE: CITY OF GAITHERSBURG, MARYLAND

DETAIL 5: TYPICAL 11' X 11' PLAN VIEW

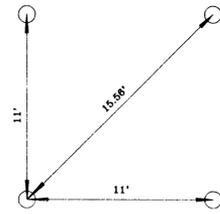

FOREST MANAGEMENT NOTES

PRECONSTRUCTION
CONDUCT A PRECONSTRUCTION MEETING WITH CONTRACTOR TO ENSURE FOREST PROTECTION MEASURES ARE FOLLOWED

DURING CONSTRUCTION
PROVIDE MAINTENANCE TO TREE PROTECTION DEVICES.
WATER TREES HAVING CRITICAL ROOT ZONE IMPACTS ON A BI-WEEKLY BASIS OR AS NEEDED
MONITOR CONDITIONS OF REMAINING TREES, I.E. INSECT INFESTATIONS, LEAF DISCOLORATION, EARLY LEAFDROOP ETC. *

POST CONSTRUCTION TWO (2) YEAR MINIMUM
INSPECT EXISTING TREES AROUND THE PERIMETER OF DISTURBED LIMITS FOR SIGNS OF ROOT OR TRUNK DAMAGE AND SOIL COMPACTION. *

EVALUATE REMAINING TREES FOR SIGNS OF STRESS AND CONDUCT APPROPRIATE CULTURAL MANAGEMENT: CROWN REDUCTION, PRUNING, WATERING, SOIL AERATION, FERTILIZING, ETC. REMOVE DEAD OR DYING TREES AND EVALUATE FOR HAZARD TREES. *


* A LICENSED ARBORIST OR FORESTER SHOULD BE RETAINED FOR THESE SERVICES.

DETAIL 3: TYPICAL RANDOMIZED PLANTING PLAN

ROW	1	2	3	4	5	6	7	8
1	M	G	T	O	G	M	G	T
2	T	D	O	G	G	T	M	O
3	O	G	D	G	M	T	G	T
4	T	M	M	G	O	D	D	O
5	O	G	O	O	T	O	D	M
6	M	O	D	G	M	T	G	M
7	T	D	M	M	G	M	O	T
8	T	M	M	T	O	T	G	M

20.0%	RED MAPLE	O
22.5%	GREEN ASH	T
22.5%	TULIP POPLAR	M
22.5%	RED MAPLE	D
10.0%	FLOWERING DOGWOOD	

ALL TREES TO BE CONTAINERIZED WHIPS 3-4 FEET HEIGHT

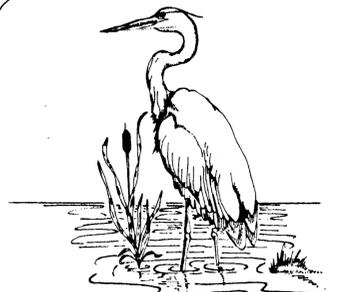

EXPLORATION RESEARCH, INC.
ENVIRONMENTAL CONSULTANTS
8318 FORREST STREET
HISTORIC ELLICOTT CITY, MARYLAND 21043
TEL: (410) 750-1150 FAX: (410) 750-7350

CLARK, FINEFROCK, & SACKETT, INC.
ENGINEERS, PLANNERS, SURVEYORS

715 MINSTREL WAY
COLUMBIA, MARYLAND 21045
(410) 381-7500

FOREST CONSERVATION NOTES
BROOKWOOD FARMS
 LOTS 1-17 & PRESERVATION PARCEL 'A'
 FIFTH ELECTION DISTRICT
 TAX MAP NUMBER 40 & 45, PARCEL P-1
 HOWARD COUNTY, MARYLAND

Approved: Department of Planning and Zoning
Aino Jounmari 5/2/95
Chief, Division of Land Development & Research
Approved: Department of Public Works
Paul J. Sporn 4/28/95
Chief, Bureau of Engineering
Approved: Howard County Department of Public Works
John J. Williams 4/28/95
Chief, Land Development Division
Robert M. Dangle 4-26-95
Chief, Bureau of Highways

OWNER AND DEVELOPER

CARMAN ASSOCIATES
P.O. BOX 122
ELLICOTT CITY, MARYLAND 21043

DRAWN BY: SJR SCALE: NTS
DESIGNED BY: SJR DATE: JUNE 1994
CHECKED BY: SLH / M.J.F. SHEET 13 OF 13

REVISED 4/10/95 AS PER ENGINEER COMMENTS