


ROAD CONSTRUCTION, STORM DRAINAGE AND GRADING PLANS FOR DANIELS MILL OVERLOOK SECOND (2ND) ELECTION DISTRICT HOWARD COUNTY, MARYLAND

GENERAL NOTES

1. Construction of this project is intended to be executed in close conjunction with the Site Development Plans for Northern Elementary School #3; Open Space Lots 1 & 2, Daniels Mill Overlook. (SDP-96-34)
2. All construction shall be in accordance with the latest standards and specifications of Howard County plus MSHA standards and specifications if applicable.
3. The contractor shall notify the Bureau of Engineering/Construction Inspection Division at (410) 313-1880 at least five (5) working days prior to the start of work.
4. The contractor shall notify "Miss Utility" at 1-800-257-7777 at least 48 hours prior to any excavation work.
5. Project Background:
 - a) Location: Tax Map #17, Part of Parcel 41
 - b) Zoning: R-ED
 - c) ZB/BA REF: ZB-965M
 - d) Election District: 2nd Election District
 - e) Section/Area: N/A
 - f) Proposed Lots & Parcels: 3 O.S. Lots, 1 Parcel
 - g) Preliminary Plan - waived per WP 96-30 Approved 11-3-95.
 - h) Other DPZ References: S-95-18, Approved 5-15-95; WP-95-74, Approved 4-21-95; ZB-965M;
6. Traffic control devices, markings and signing shall be in accordance with the latest edition of the Manual on Uniform Traffic Control Devices (MUTCD). All street and regulatory signs shall be in place prior to the placement of any asphalt.
7. Topographic survey mapping at 2' contour intervals was provided by Photo Science, Inc. dated April 13, 1989; c/o Fisher, Collins and Carter, Inc.
8. Boundary coordinates are based on NAD 83 Maryland Coordinate System as projected by Howard County Geodetic Control Stations No. H.C.M. 17EA & No. HCM 17EB.

STATION No. H.C.M. 17 EA	N 181160.5724 (METERS)
	E 413772.7247 (METERS)
STATION No. H.C.M. 17 EB	N 180994.8448 (METERS)
	E 413227.8979 (METERS)
9. Street lights will be required in this development in accordance with the Design Manual. Street light placement and the type of fixture and pole selected shall be in accordance with the latest Howard County Design Manual, Volume III (1993) and as modified by "Guidelines for Street Lights in Residential Developments (June 1993)". The June 1993 policy includes guidelines for lateral and longitudinal placement. A minimum spacing of 20' shall be maintained between any street light and any tree.
10. Public water and public sewer systems are to be utilized for this site and are extended from the limits of existing Contract Nos. 70-W and 10-1352-D. (Patapsco Water Shed) Water Extension Contract No. 14-3499. Sewer Extension Contract No. 14-3499. Water Main Extension Contract No. 14-3487-D.
11. STORMWATER MANAGEMENT: Ultimately, but no later than 36 months after obtaining grading permits, a regional on-stream quantity control facility will be provided by the developer of Daniels Mill Overlook per S-95-18. At such time, Basin #1 will be reconstructed, per these plans, into a shallow marsh pre-treatment facility for the area of this submission.
12. No floodplain exists within Open Space Lots 1, 2 & 3 or Parcel 'A' which are part of this submission.
13. Wetland determination provided by Environmental Systems Analysis, 48 Maryland Avenue, Annapolis, MD 21401 in a report dated December 1990 per S-95-18, Approved 5/15/95.
14. A traffic study is not required for Open Space Lots 1, 2 & 3 or Parcel 'A' which are part of this submission.
15. A noise study is not required for Open Space Lots 1, 2 & 3 or Parcel 'A' which are part of this submission.
16. The Geotechnical Report was prepared by Hills-Carnes Engineering Associates, Inc., dated July 25, 1995; Approved on
17. Forest Stand Delineation was provided by M.A. Dircks and Co., Inc., dated June 1993 per S-95-18; Approved 5/15/95.
18. The existing utilities were located by aerial and field surveys. The contractor must dig test pits, by hand, at all utility crossings and connection points to verify exact location.
19. The developer will be responsible for the street trees and stormwater management area plantings indicated on the plans.

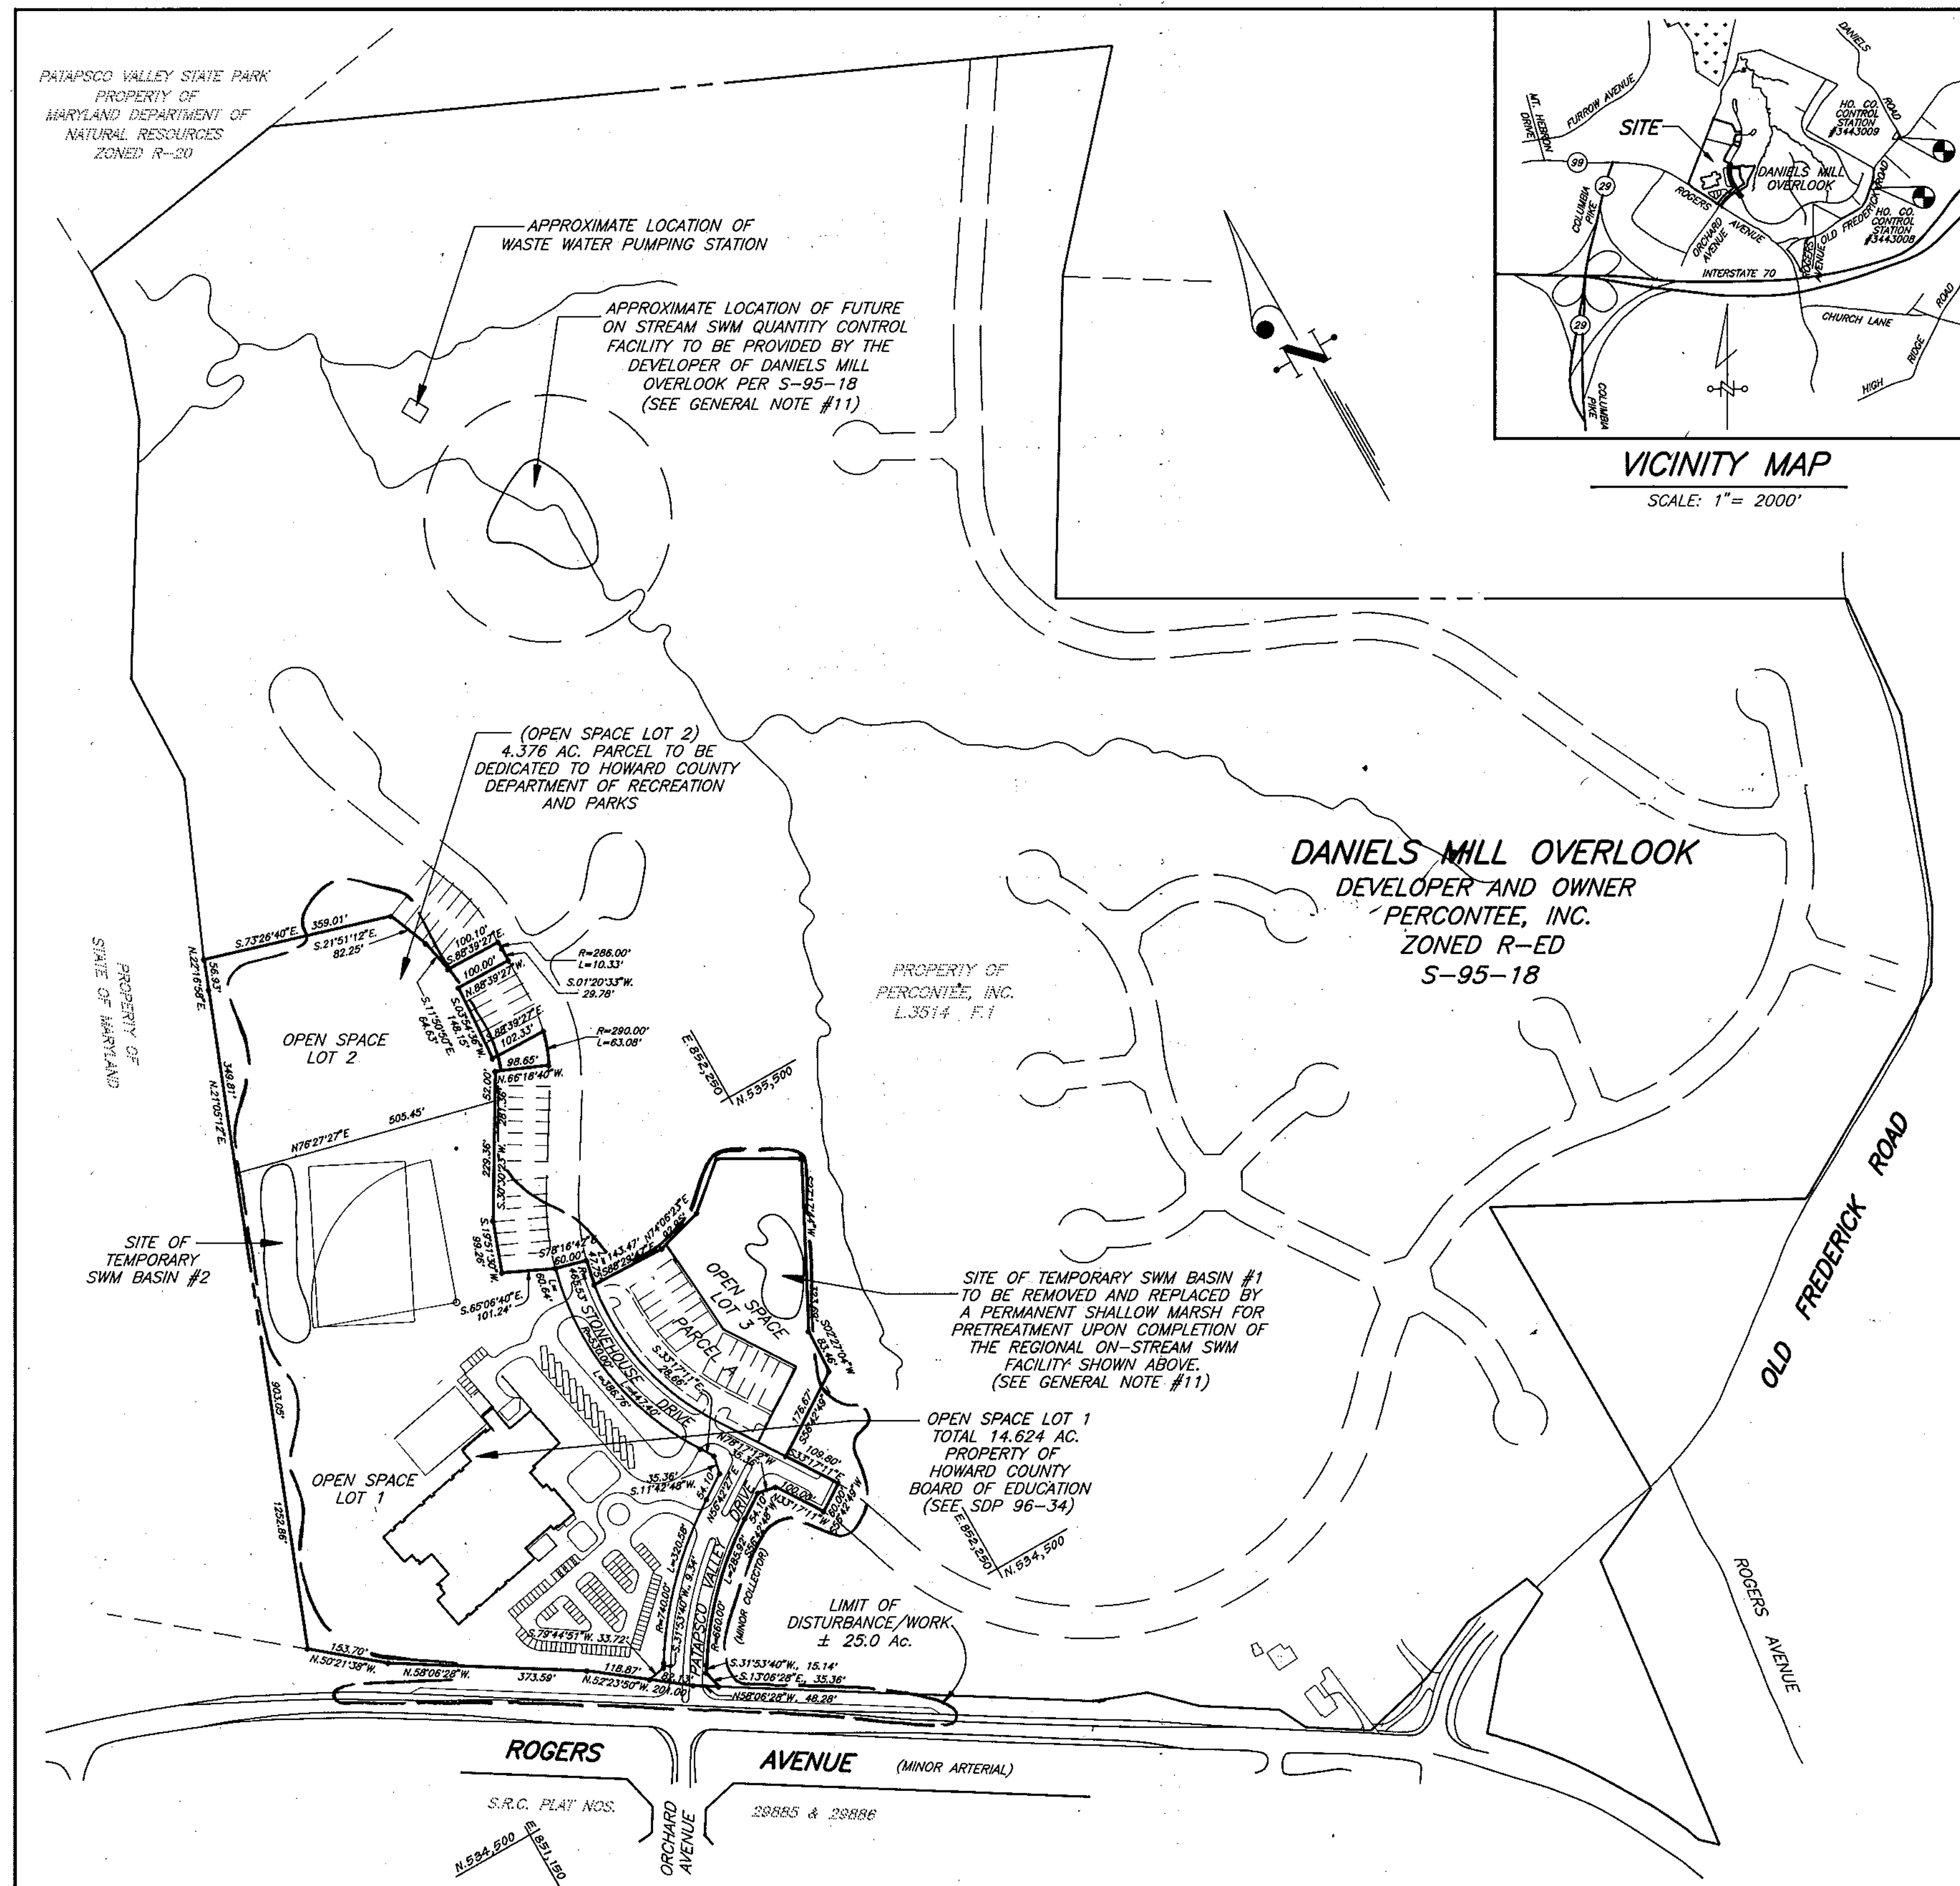

SHEET INDEX	
NO.	DESCRIPTION
1	COVER SHEET
2	PLAN & PROFILE - ROGERS AVENUE
3	STRIPING & TRAFFIC CONTROL PLAN FOR ROGERS AVENUE
4	PLAN & PROFILE - PATAPSCO VALLEY DRIVE
5	PLAN & PROFILE - STONEHOUSE DRIVE
6	PAVING DETAILS
7	SIGHT DISTANCE ANALYSIS - ROGERS AVENUE & PATAPSCO VALLEY DRIVE
8	STORM DRAINAGE PROFILES
9	STORM DRAINAGE PROFILES
10	STORM DRAINAGE AND SHALLOW MARSH DETAILS
11	SPECIFICATIONS FOR SHALLOW MARSH
12	DRAINAGE AREA MAP FOR EXISTING CONDITIONS
13	DRAINAGE AREA MAP FOR PROPOSED CONDITIONS
14	MASS GRADING & SEDIMENT AND EROSION CONTROL PLAN
15	MASS GRADING & SEDIMENT AND EROSION CONTROL PLAN
16	SEDIMENT BASIN PROFILES
17	SEDIMENT BASIN DETAILS
18	SEDIMENT AND EROSION CONTROL DETAILS
19	SOILS AND SLOPES ANALYSIS
20	LANDSCAPE PLAN FOR WATER QUALITY BASIN & STREET TREE DETAILS

DEVELOPER:
PERCONTEE, INC.
% MICHAEL DIFFENDAL
11000 TECH ROAD
SILVER SPRING, MD. 20904

LOCATION PLAN

SCALE: 1" = 200'

OWNERS:
PERCONTEE, INC.
% MICHAEL DIFFENDAL
11000 TECH ROAD
SILVER SPRING, MD. 20904
THE BOARD OF EDUCATION OF HOWARD COUNTY
c/o MR. BILL GRAU
10910 RTE. 108
ELLCOTT CITY, MD 21043


APPROVED: DEPARTMENT OF PUBLIC WORKS
Robert M. Daulton 1-30-96
CHIEF, DIVISION OF LAND DEVELOPMENT AND RESEARCH
APPROVED: DEPARTMENT OF PLANNING AND ZONING
Jim Munnery 2/2/96
CHIEF, DIVISION OF LAND DEVELOPMENT AND RESEARCH
Mr. [Signature] 2/1/96
CHIEF, DEVELOPMENT ENGINEERING DIVISION

CLARK • FINEFROCK & SACKETT, INC.
ENGINEERS • PLANNERS • SURVEYORS
7135 MINSTREL WAY • COLUMBIA, MD. 21045 • (410) 381-7500 - BALTO. • (301) 621-8100 - WASH.

DESIGNED KIWM	COVER SHEET ROAD CONSTRUCTION PLANS DANIELS MILL OVERLOOK LOTS 1 THRU 3 AND PARCEL "A" TAX MAP 17 PART OF PARCEL 41 SECOND (2ND) ELECTION DISTRICT HOWARD COUNTY, MARYLAND FOR: HOWARD COUNTY BOARD OF EDUCATION 10910 ROUTE 108 ELLCOTT, MARYLAND 21043	SCALE AS SHOWN DRAWING
DRAWN LAJ/DM		1 OF 20
CHECKED WHT		JOB NO. 94-203
DATE 12-27-95		FILE NO. 94-203 D



17817

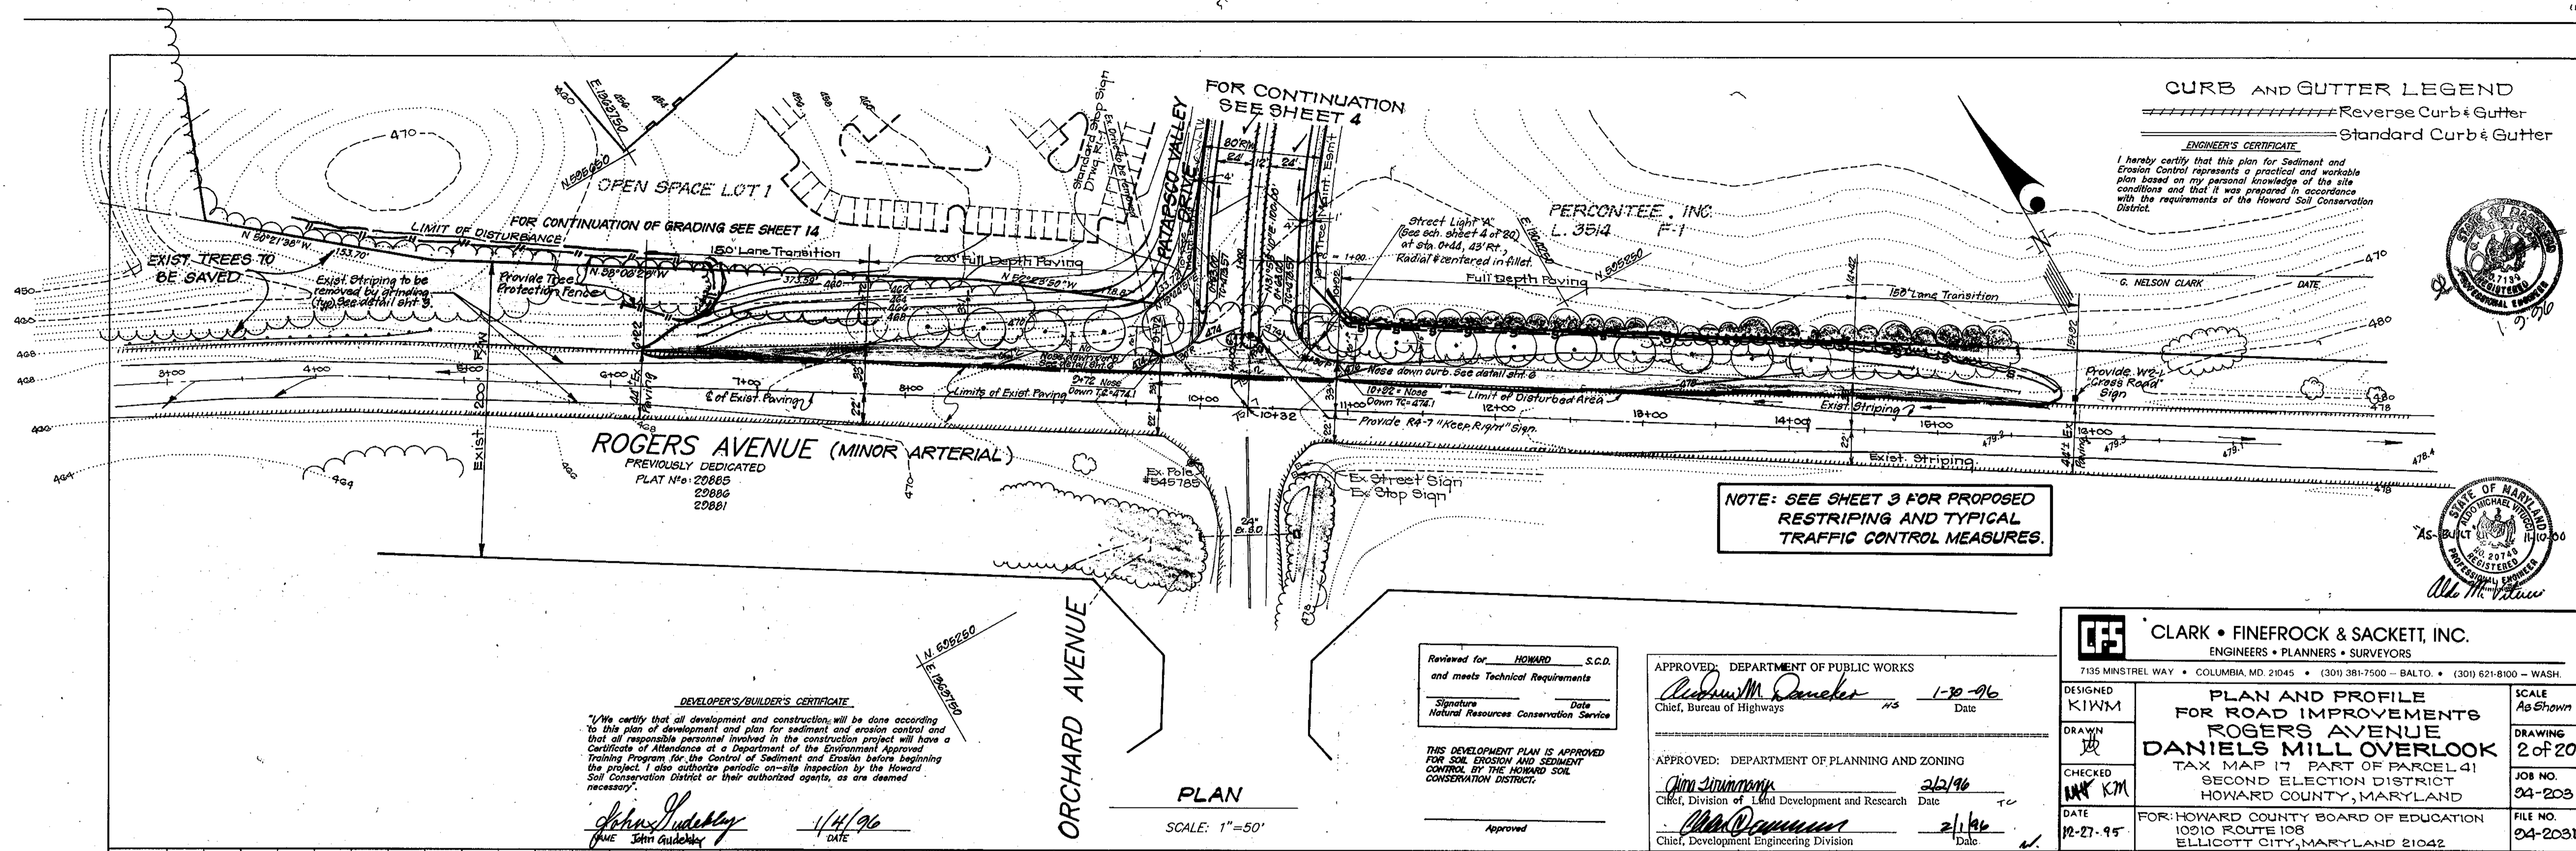

CURB AND GUTTER LEGEND
 ===== Reverse Curb & Gutter
 _____ Standard Curb & Gutter

ENGINEER'S CERTIFICATE
 I hereby certify that this plan for Sediment and Erosion Control represents a practical and workable plan based on my personal knowledge of the site conditions and that it was prepared in accordance with the requirements of the Howard Soil Conservation District.



NOTE: SEE SHEET 3 FOR PROPOSED RESTRIPIING AND TYPICAL TRAFFIC CONTROL MEASURES.

DEVELOPER'S/BUILDER'S CERTIFICATE
 We certify that all development and construction will be done according to this plan of development and plan for sediment and erosion control and that all responsible personnel involved in the construction project will have a Certificate of Attendance at a Department of the Environment Approved Training Program for the Control of Sediment and Erosion before beginning the project. I also authorize periodic on-site inspection by the Howard Soil Conservation District or their authorized agents, as are deemed necessary.

John Gudobsky
 DATE: 1/4/96

Reviewed for: HOWARD S.C.D.
 and meets Technical Requirements
 Signature: _____ Date: _____
 Natural Resources Conservation Service

THIS DEVELOPMENT PLAN IS APPROVED FOR SOIL EROSION AND SEDIMENT CONTROL BY THE HOWARD SOIL CONSERVATION DISTRICT.
 Approved: _____

APPROVED: DEPARTMENT OF PUBLIC WORKS
Richard M. Daniels 1-30-96
 Chief, Bureau of Highways Date

APPROVED: DEPARTMENT OF PLANNING AND ZONING
Jim Zimmerman 2/2/96
 Chief, Division of Land Development and Research Date
John O'Connell 2/1/96
 Chief, Development Engineering Division Date


CLARK • FINEROCK & SACKETT, INC.
 ENGINEERS • PLANNERS • SURVEYORS
 7135 MINSTREL WAY • COLUMBIA, MD 21045 • (301) 381-7500 - BALTO. • (301) 621-8100 - WASH.

DESIGNED KIWM	PLAN AND PROFILE FOR ROAD IMPROVEMENTS ROGERS AVENUE DANIELS MILL OVERLOOK TAX MAP 17 PART OF PARCEL 41 SECOND ELECTION DISTRICT HOWARD COUNTY, MARYLAND FOR: HOWARD COUNTY BOARD OF EDUCATION 10310 ROUTE 108 ELLICOTT CITY, MARYLAND 21042	SCALE As Shown
DRAWN JK		DRAWING 2 of 20
CHECKED KJM		JOB NO. 04-203
DATE 12-27-95		FILE NO. 04-203D

PLAN
 SCALE: 1"=50'


ROGERS AVENUE
 SEE TYPICAL SECTION FOR PAVEMENT WIDENING SHEET 6

PROFILE SCALE
 HOR: 1"=50'
 VER: 1"=8'

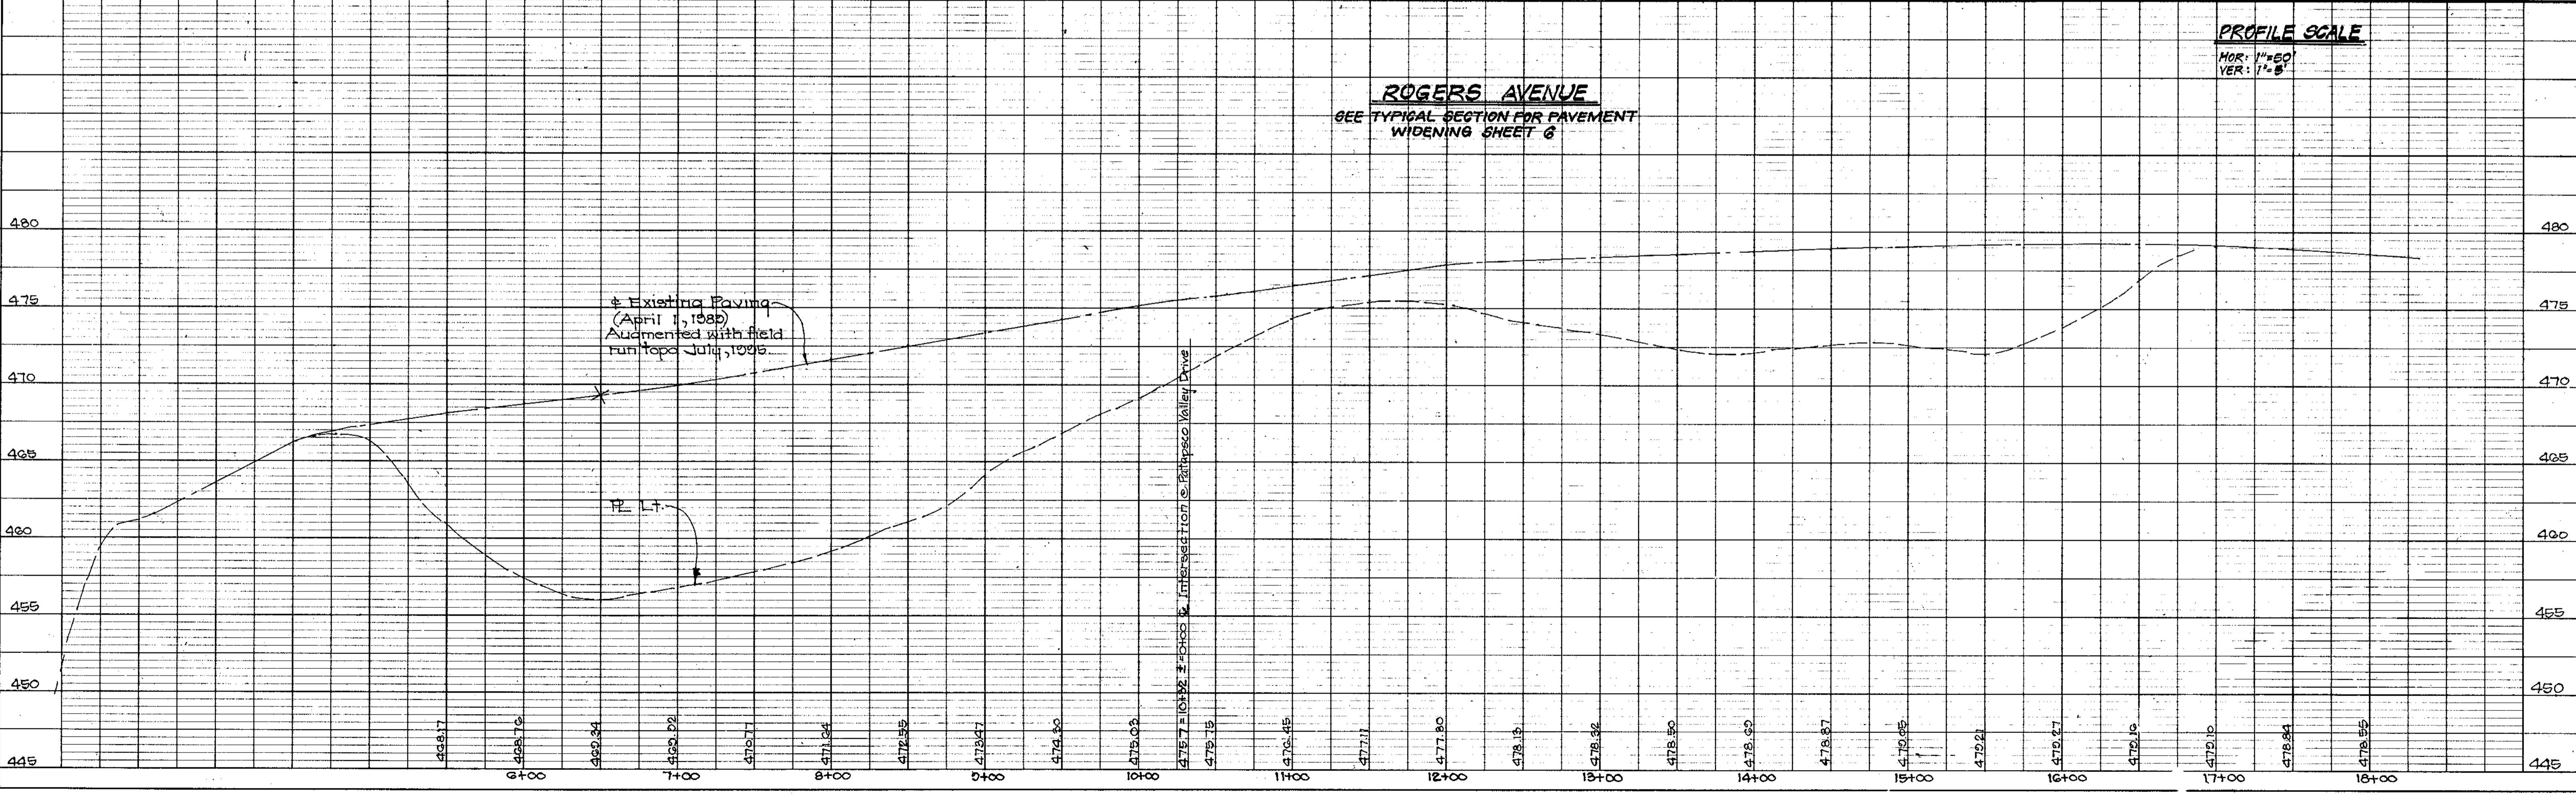

1785

F-96-37

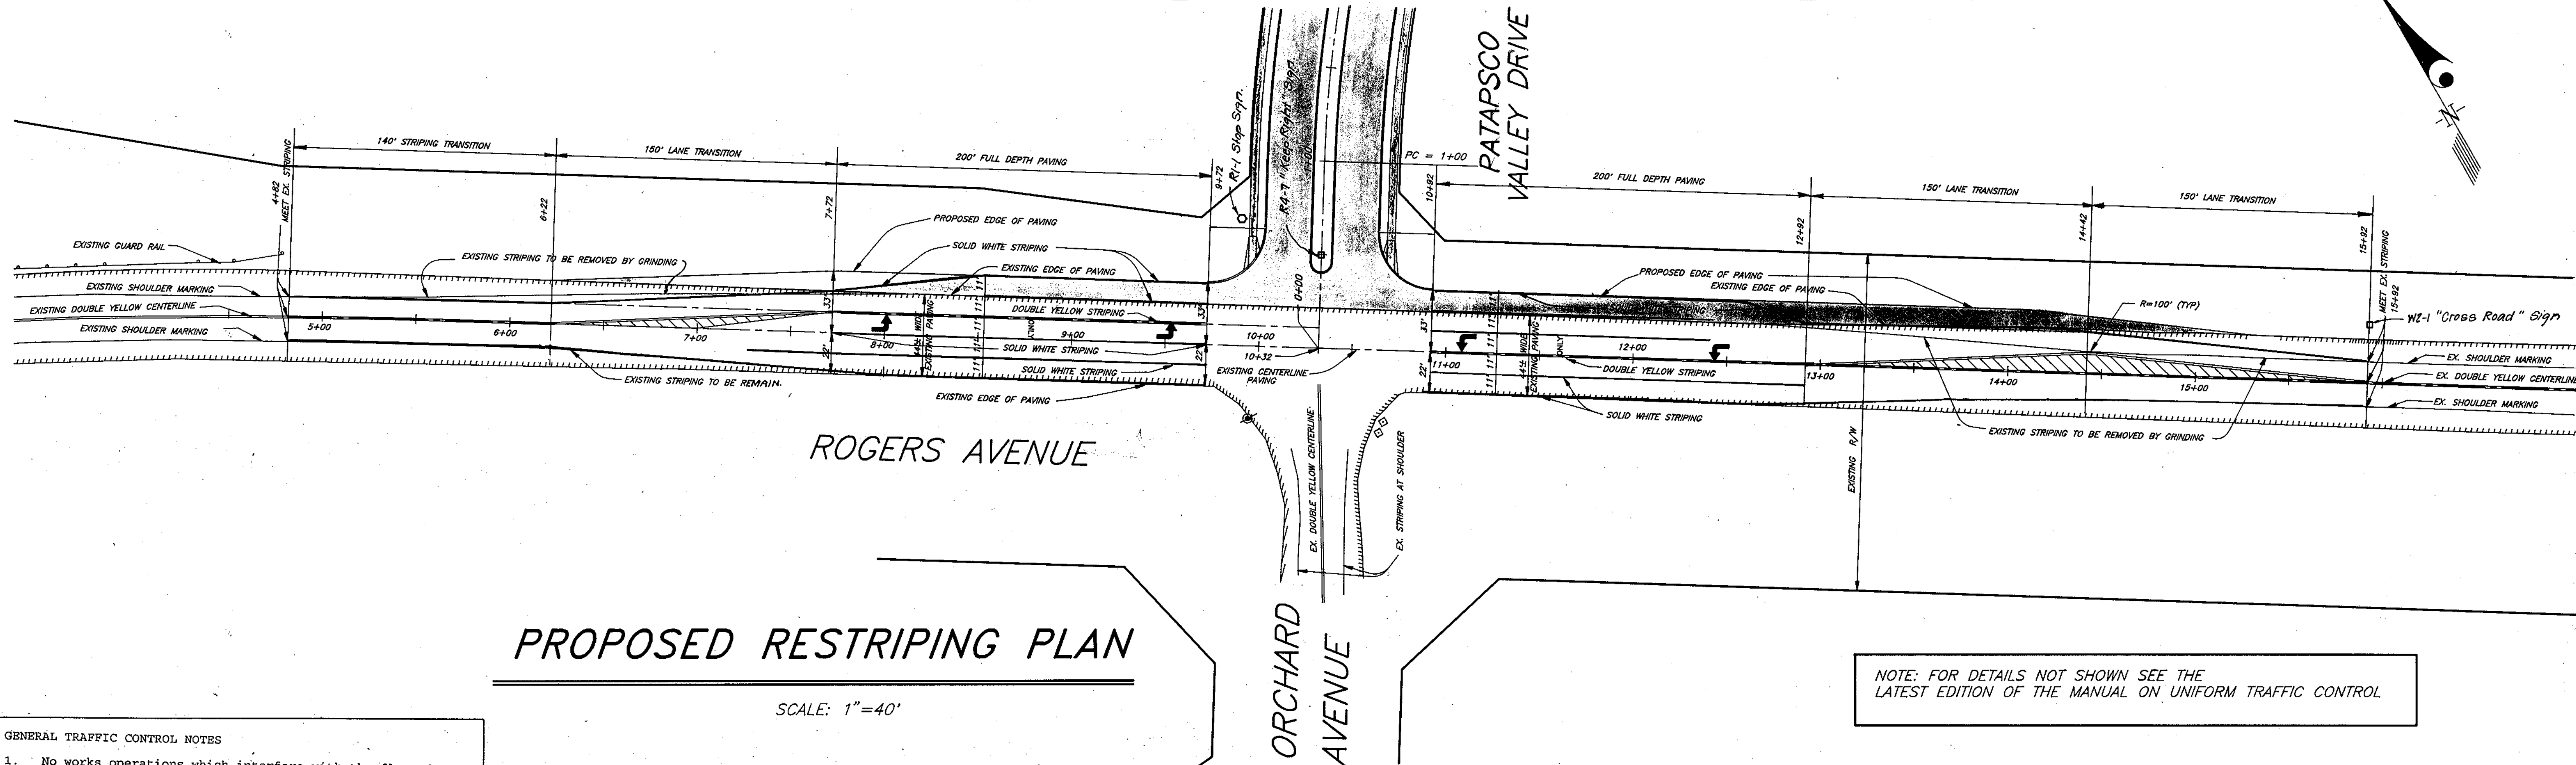


PROPOSED RESTRIPIING PLAN

SCALE: 1"=40'

NOTE: FOR DETAILS NOT SHOWN SEE THE LATEST EDITION OF THE MANUAL ON UNIFORM TRAFFIC CONTROL


GENERAL TRAFFIC CONTROL NOTES

- No works operations which interfere with the flow of traffic may take place during peak hours 6 A.M. - 9 A.M. and 3 P.M. - 7 P.M. Monday - Friday unless written approval is received from the county inspector.
- All signs, channelizing devices, etc. shall be in accordance with the Manual on Uniform Traffic Control Devices (MUTCD).

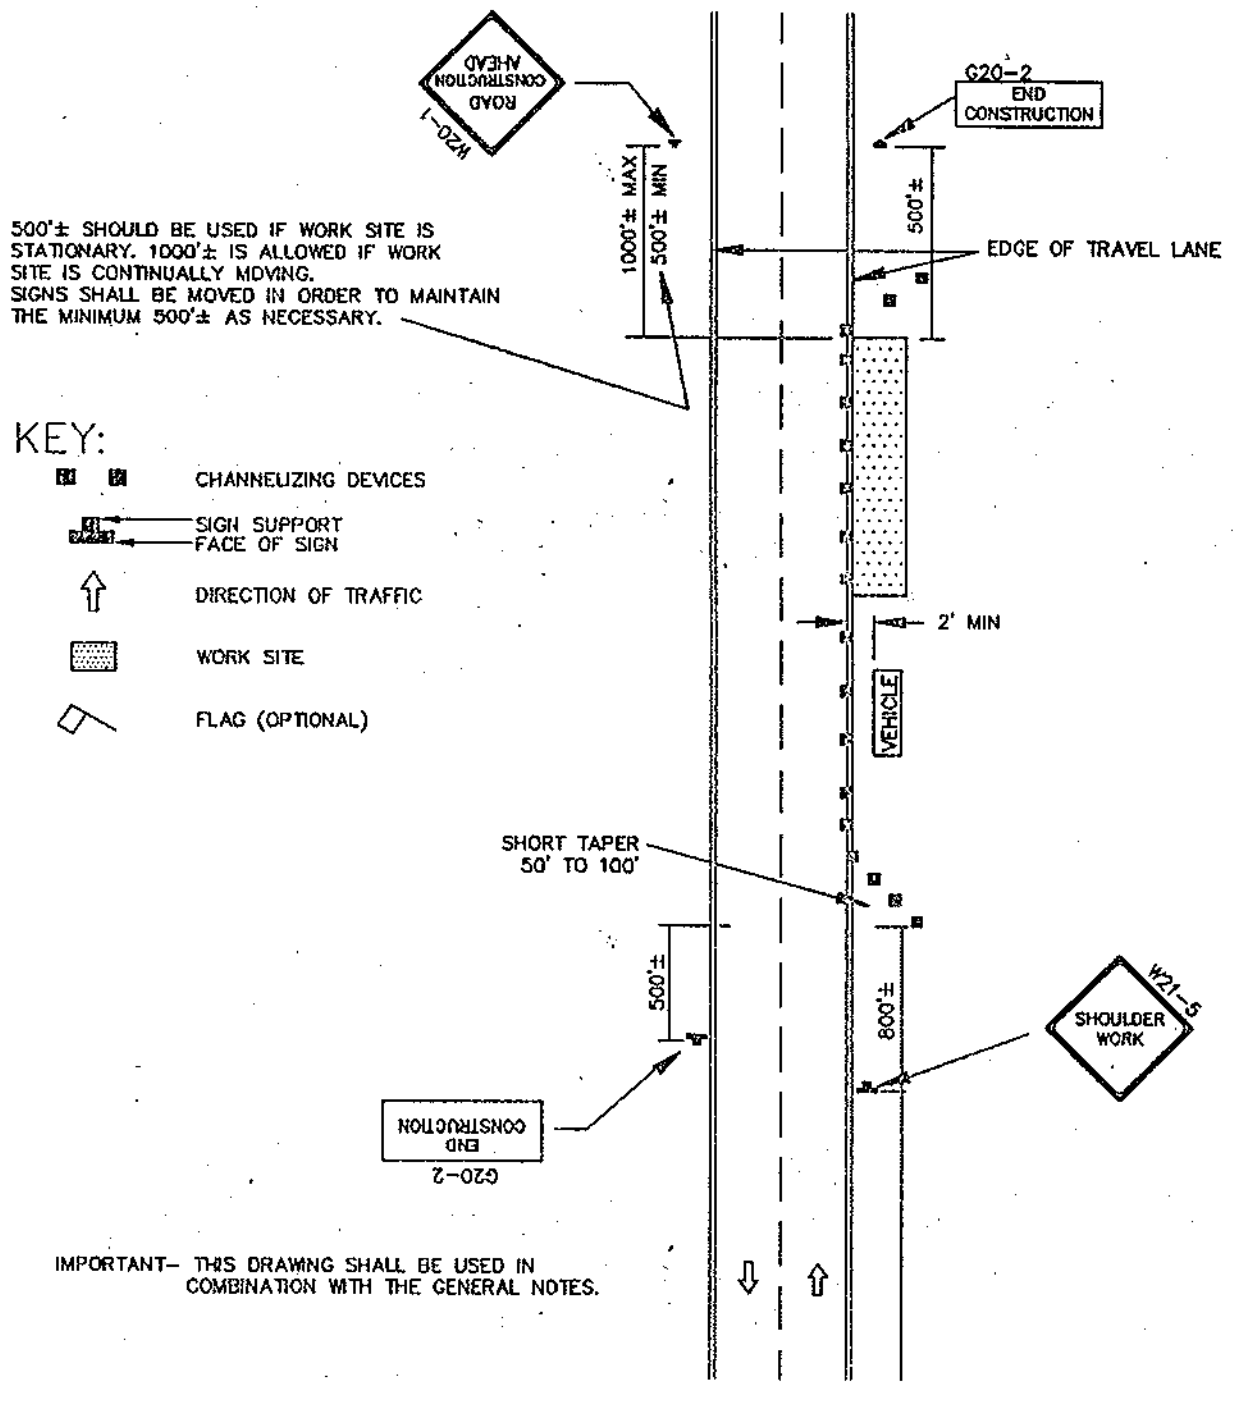


APPROVED	2-1-81	Maryland Department of Transportation
DEPUTY CHIEF ENGINEER - TRAFFIC	DATE	STATE HIGHWAY ADMINISTRATION
REVISIONS	FEDERAL HIGHWAY ADMINISTRATION	WORK ZONE TRAFFIC CONTROL TYPICAL
SHOULDER WORK		
15 MIN-24 HRS OFF ROAD EQL/LESS THAN 40 MPH		
2 LANES, 2 WAY STANDARD NO. MD-105.106		

TYPICAL TRAFFIC CONTROL PLAN FOR PAVING WIDENING AT ROGERS AVENUE

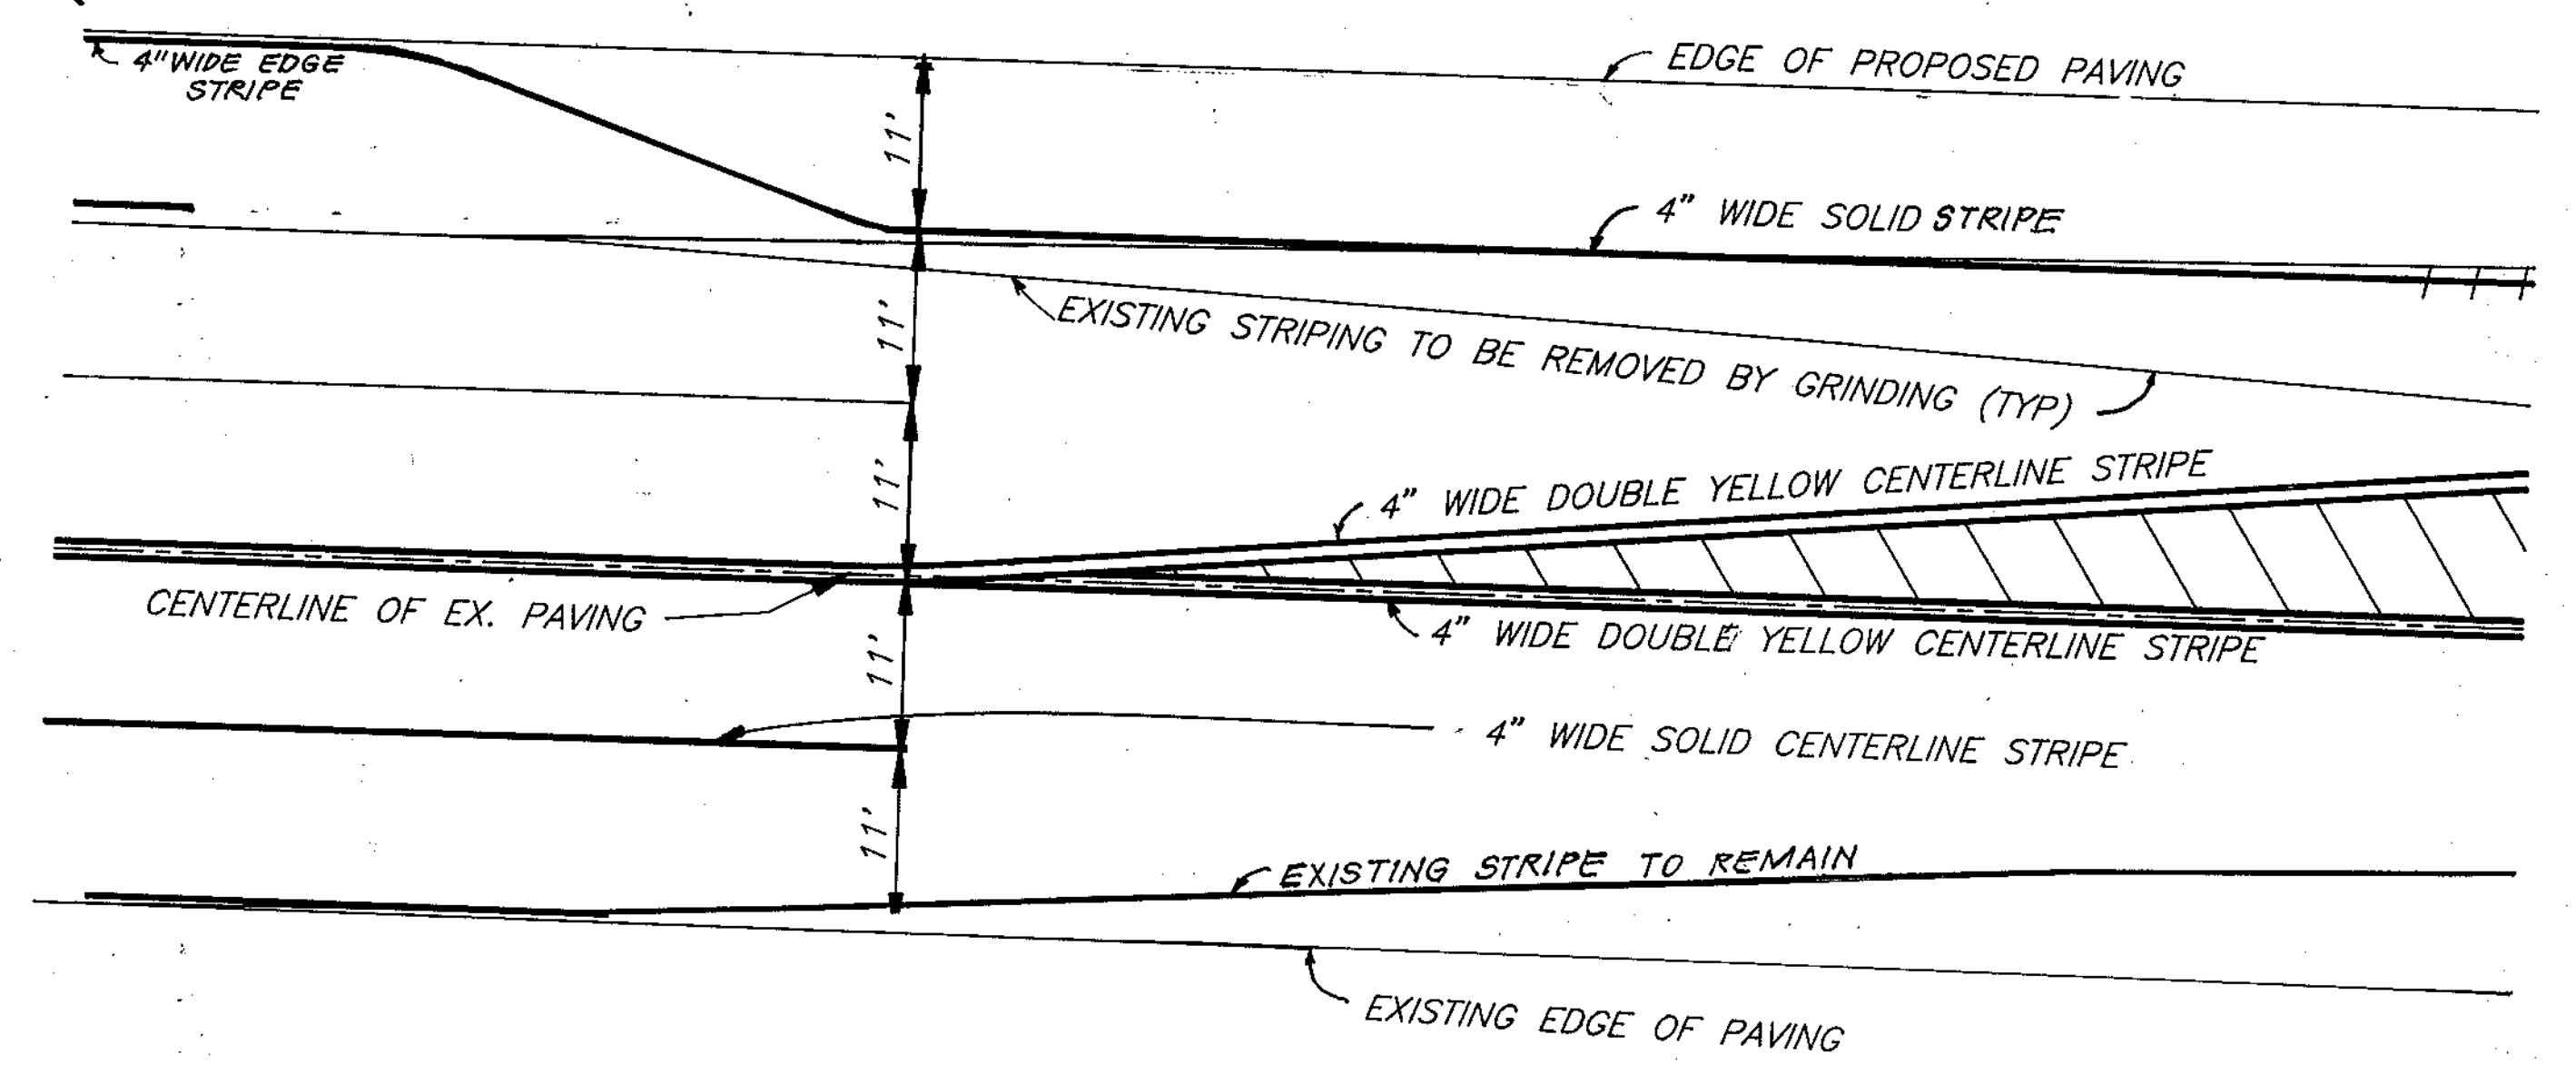

TYPICAL STRIPIING DETAIL

NO SCALE

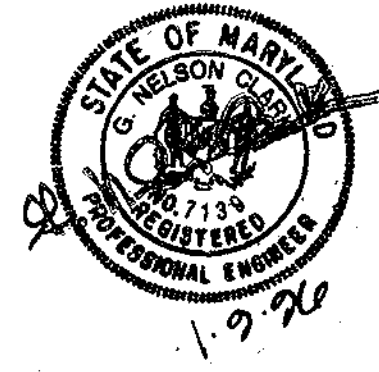


APPROVED: DEPARTMENT OF PUBLIC WORKS
Richard M. Daneker 1-30-96
 Chief, Bureau of Highways Date

APPROVED: DEPARTMENT OF PLANNING AND ZONING
Jim Wynn 2/2/96
 Chief, Division of Land Development and Research Date

Chris Damann 2/1/96
 Chief, Development Engineering Division Date

CLARK • FINEFROCK & SACKETT, INC. ENGINEERS • PLANNERS • SURVEYORS 7135 MINSTREL WAY • COLUMBIA, MD. 21045 • (410) 381-7500 - BALTO. • (301) 621-8100 - WASH.		
DESIGNED KIWM	STRIPING AND TRAFFIC CONTROL PLAN FOR ROGERS AVENUE	SCALE As Shown
DRAWN ZAH	DANIELS MILL OVERLOOK	DRAWING 304-20
CHECKED KJWM	TAX MAP 17 PART OF PARCEL 41 SECOND ELECTION DISTRICT HOWARD COUNTY, MARYLAND	JOB NO. 24-203
DATE 12-27-95	FOR: HOWARD COUNTY BOARD OF EDUCATION 10910 ROUTE 108 ELLCOTT CITY, MARYLAND 21042	FILE NO. 24-203


1783

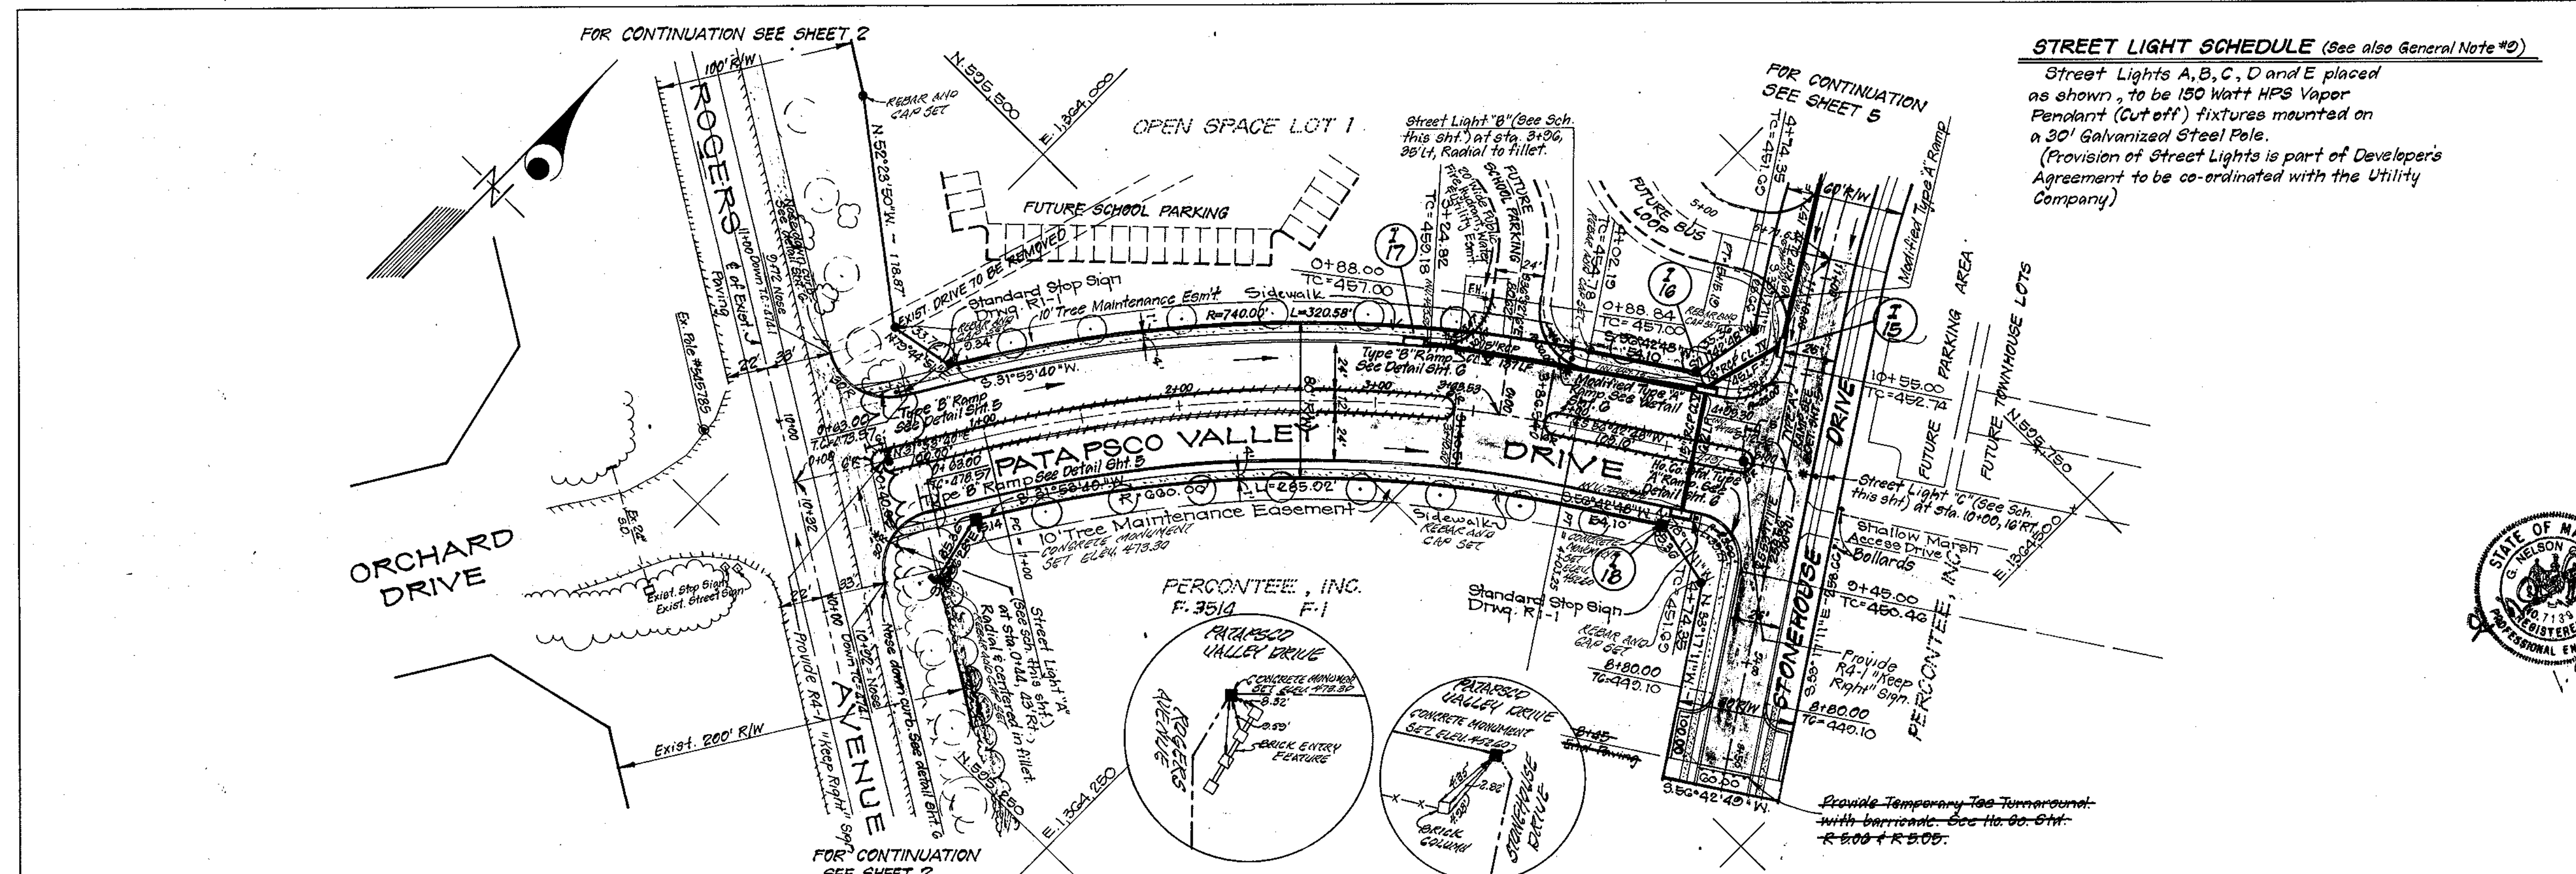

CENTER LINE CURVE DATA

PC STA. TO PT. STA.	RADIUS	DELTA	ARC	TAN	CHORD	BEARING
1+00 TO 4+03.25	700.00'	24°40'17"	303.25'	154.04'	300.88'	8.42°18'11"W

PLAN
 SCALE: 1"=50'

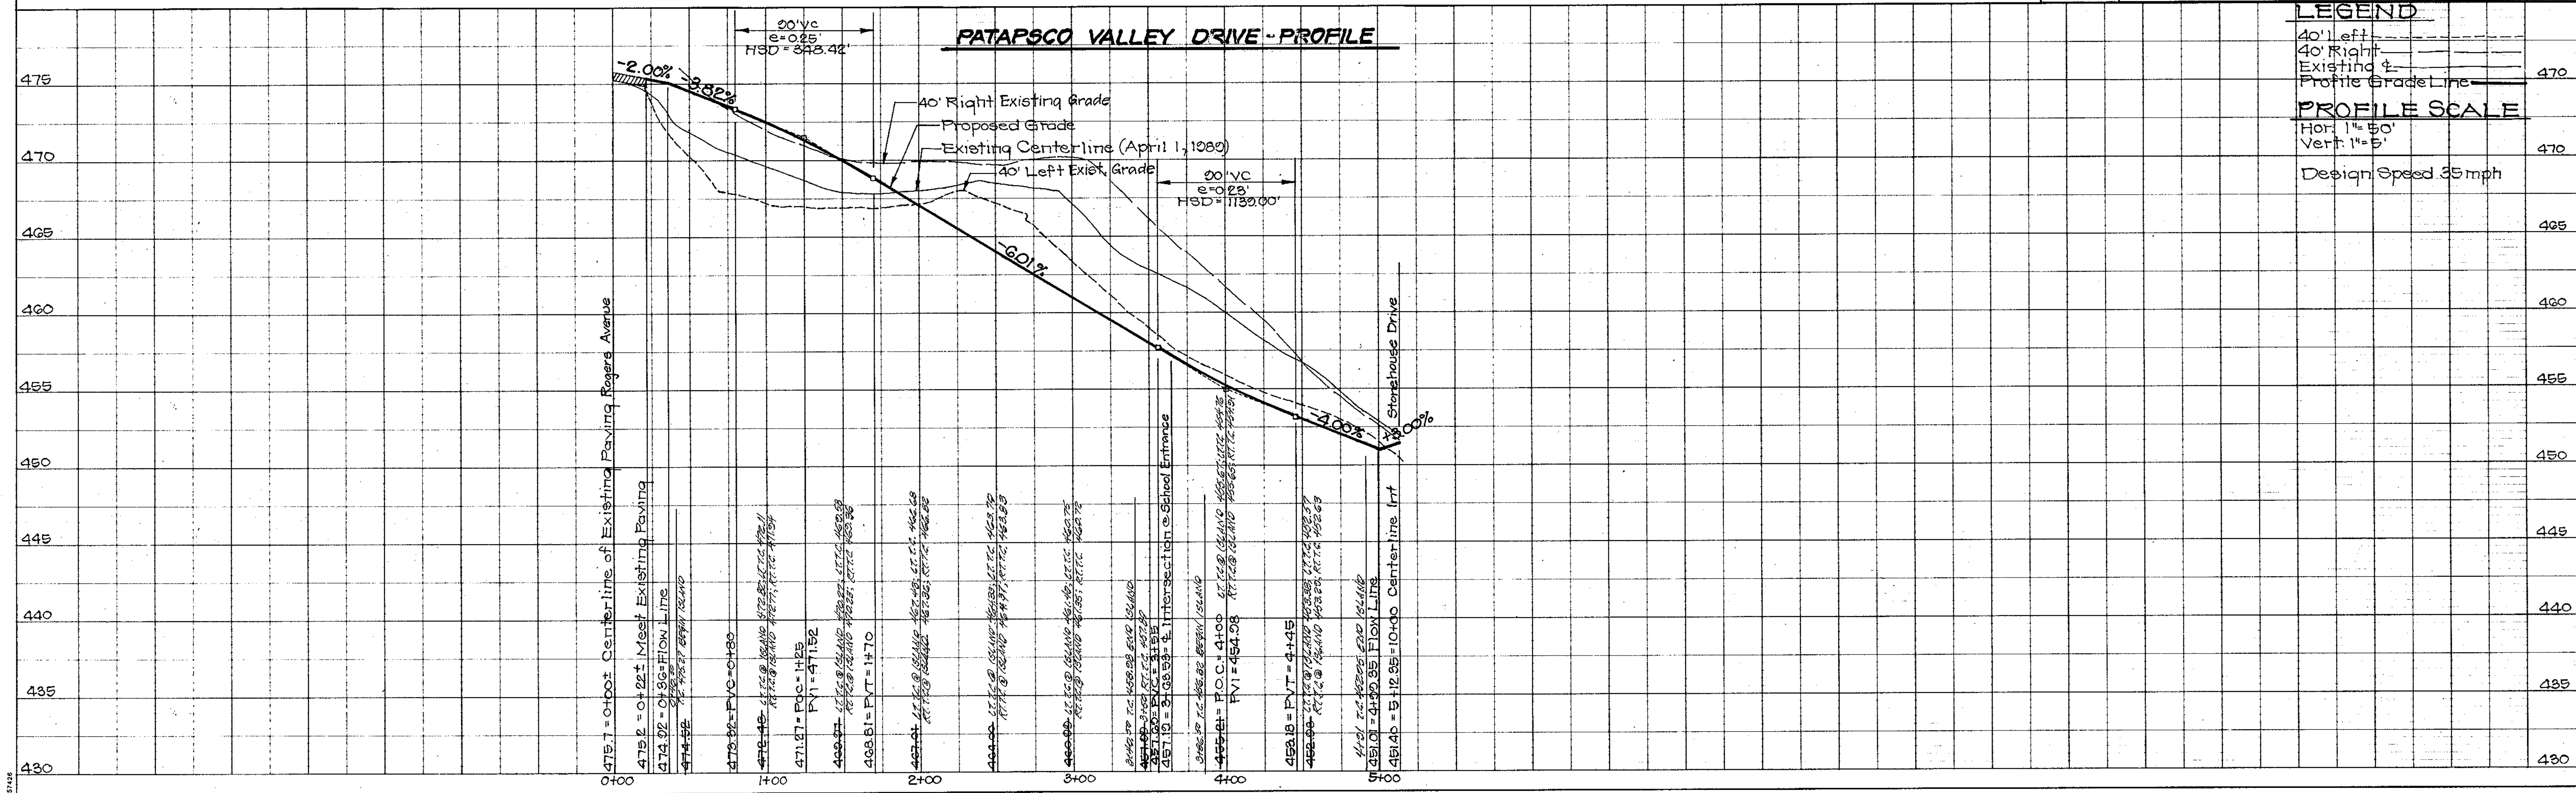

1783

F-96-37

CURB AND GUTTER LEGEND
 // Reverse Curb & Gutter
 = Standard Curb & Gutter



APPROVED: DEPARTMENT OF PUBLIC WORKS
Robert M. Daniels 1-30-96
 Chief, Bureau of Highways Date

APPROVED: DEPARTMENT OF PLANNING AND ZONING
Jim [unclear] 2/2/96
 Chief, Division of Land Development and Research Date TC

John [unclear] 2/1/96
 Chief, Development Division Date W


CLARK • FINEROCK & SACKETT, INC.
 ENGINEERS • PLANNERS • SURVEYORS
 7135 MINSTREL WAY • COLUMBIA, MD. 21045 • (301) 381-7500 - BALTO. • (301) 621-8100 - WASH.

DESIGNED: **KIWM**
 DRAWN: **[Signature]**
 CHECKED: **[Signature]**
 DATE: 12-27-95

GRADE ESTABLISHMENT, STORM DRAINAGE & PAVING PLAN
STONEHOUSE DRIVE
DANIELS MILL OVERLOOK
 TAX MAP 17 PART OF PARCEL 41
 SECOND ELECTION DISTRICT
 HOWARD COUNTY, MARYLAND


SCALE: 1"=50'
 DRAWING: 5 of 20
 JOB NO.: 94-203
 FILE NO.: 94-203D

FOR: HOWARD COUNTY BOARD OF EDUCATION
 10010 ROUTE 108
 ELLICOTT CITY, MARYLAND 21042

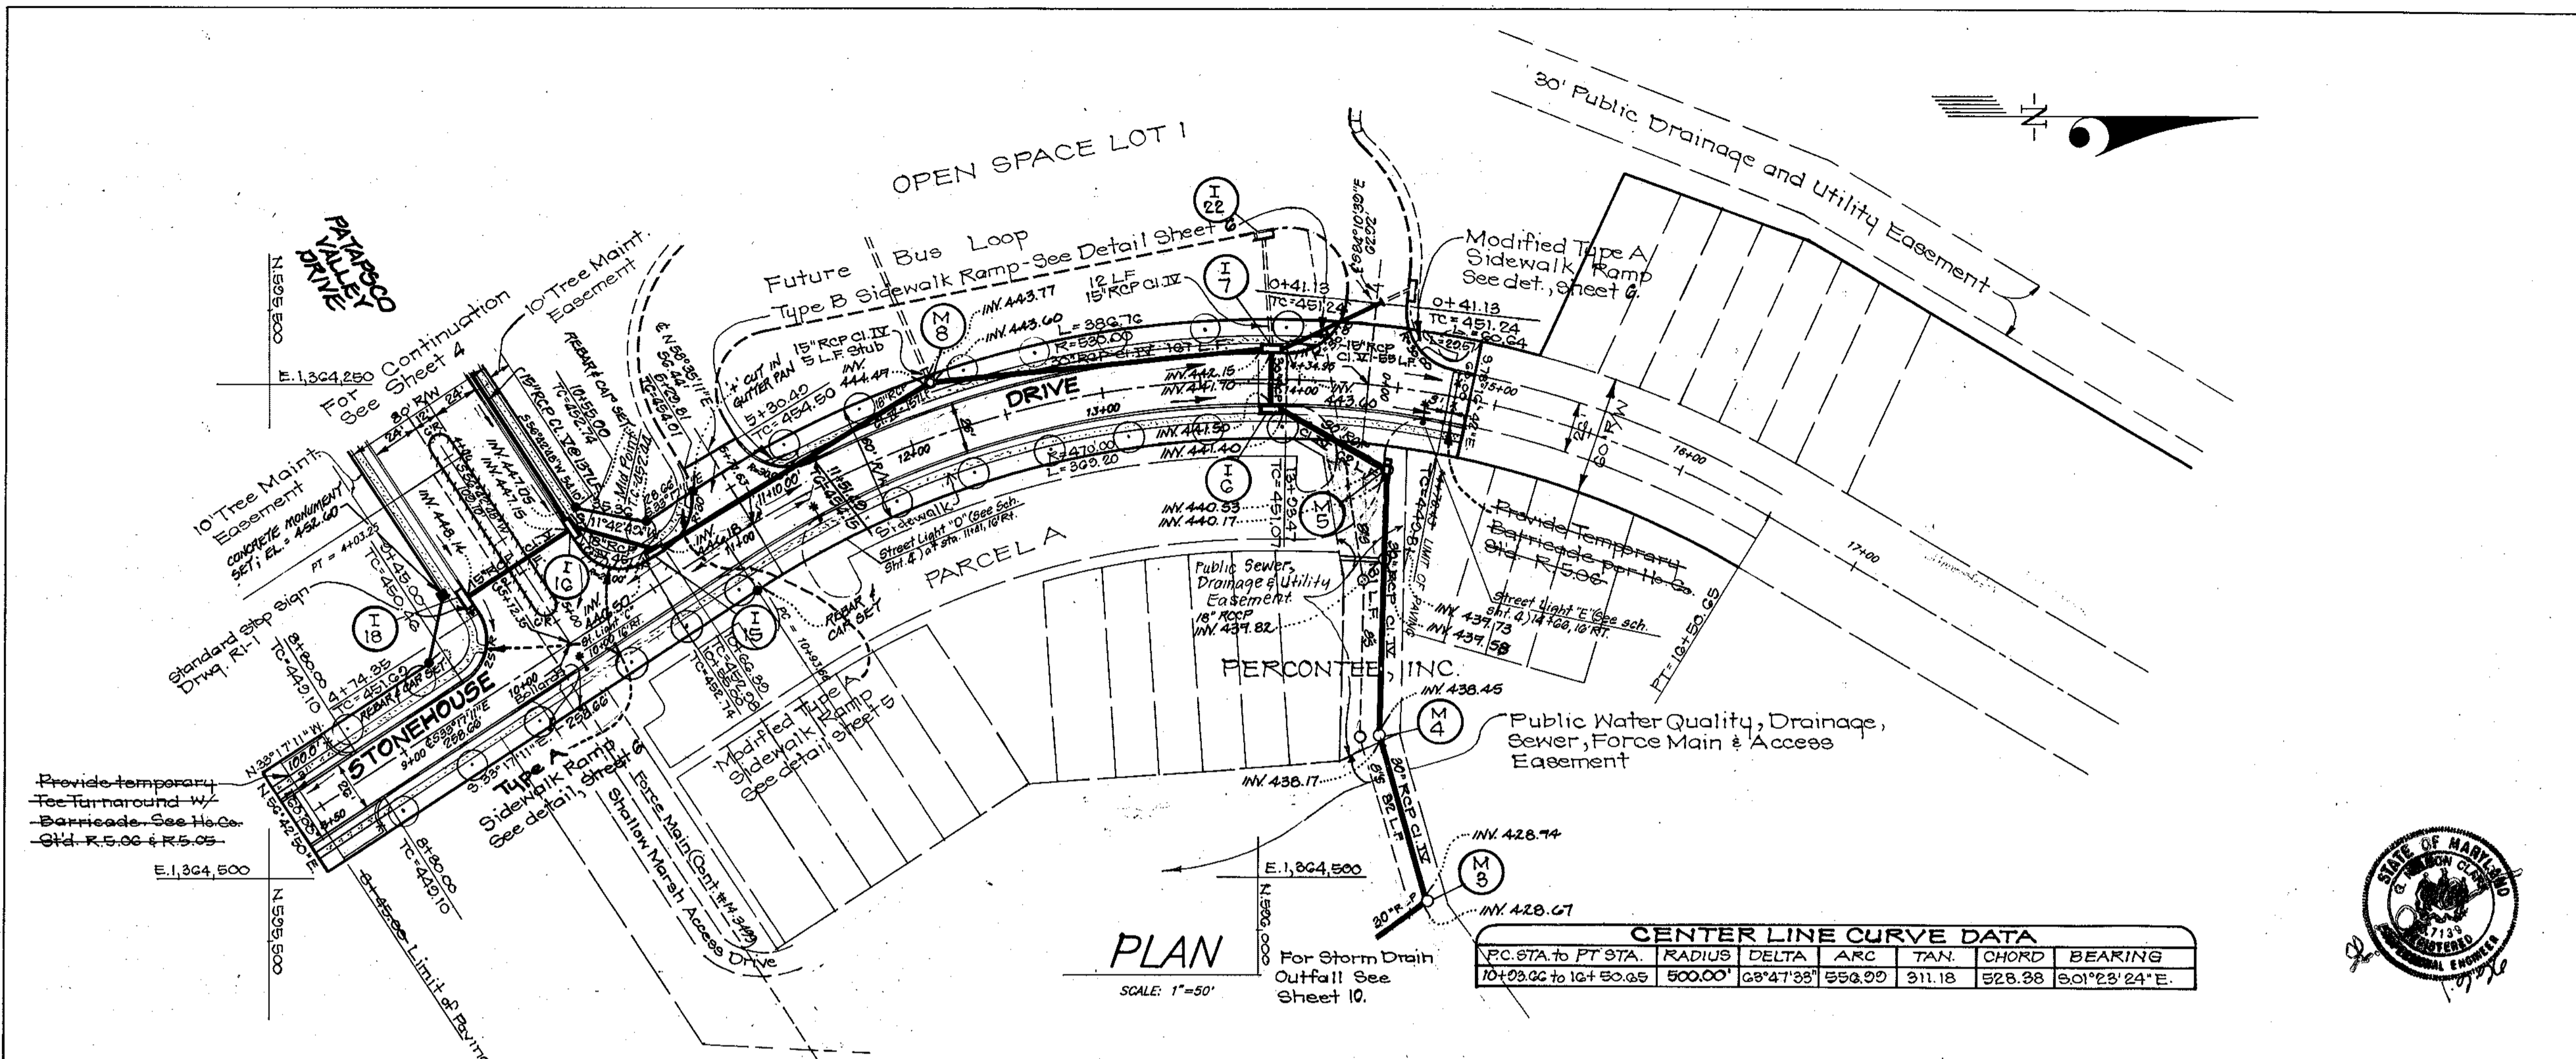

CENTER LINE CURVE DATA

P.C. STA. to P.T. STA.	RADIUS	DELTA	ARC	TAN.	CHORD	BEARING
10+23.02 to 10+53.05	500.00'	68°47'38"	553.99'	311.18'	528.38'	S01°23'24"E

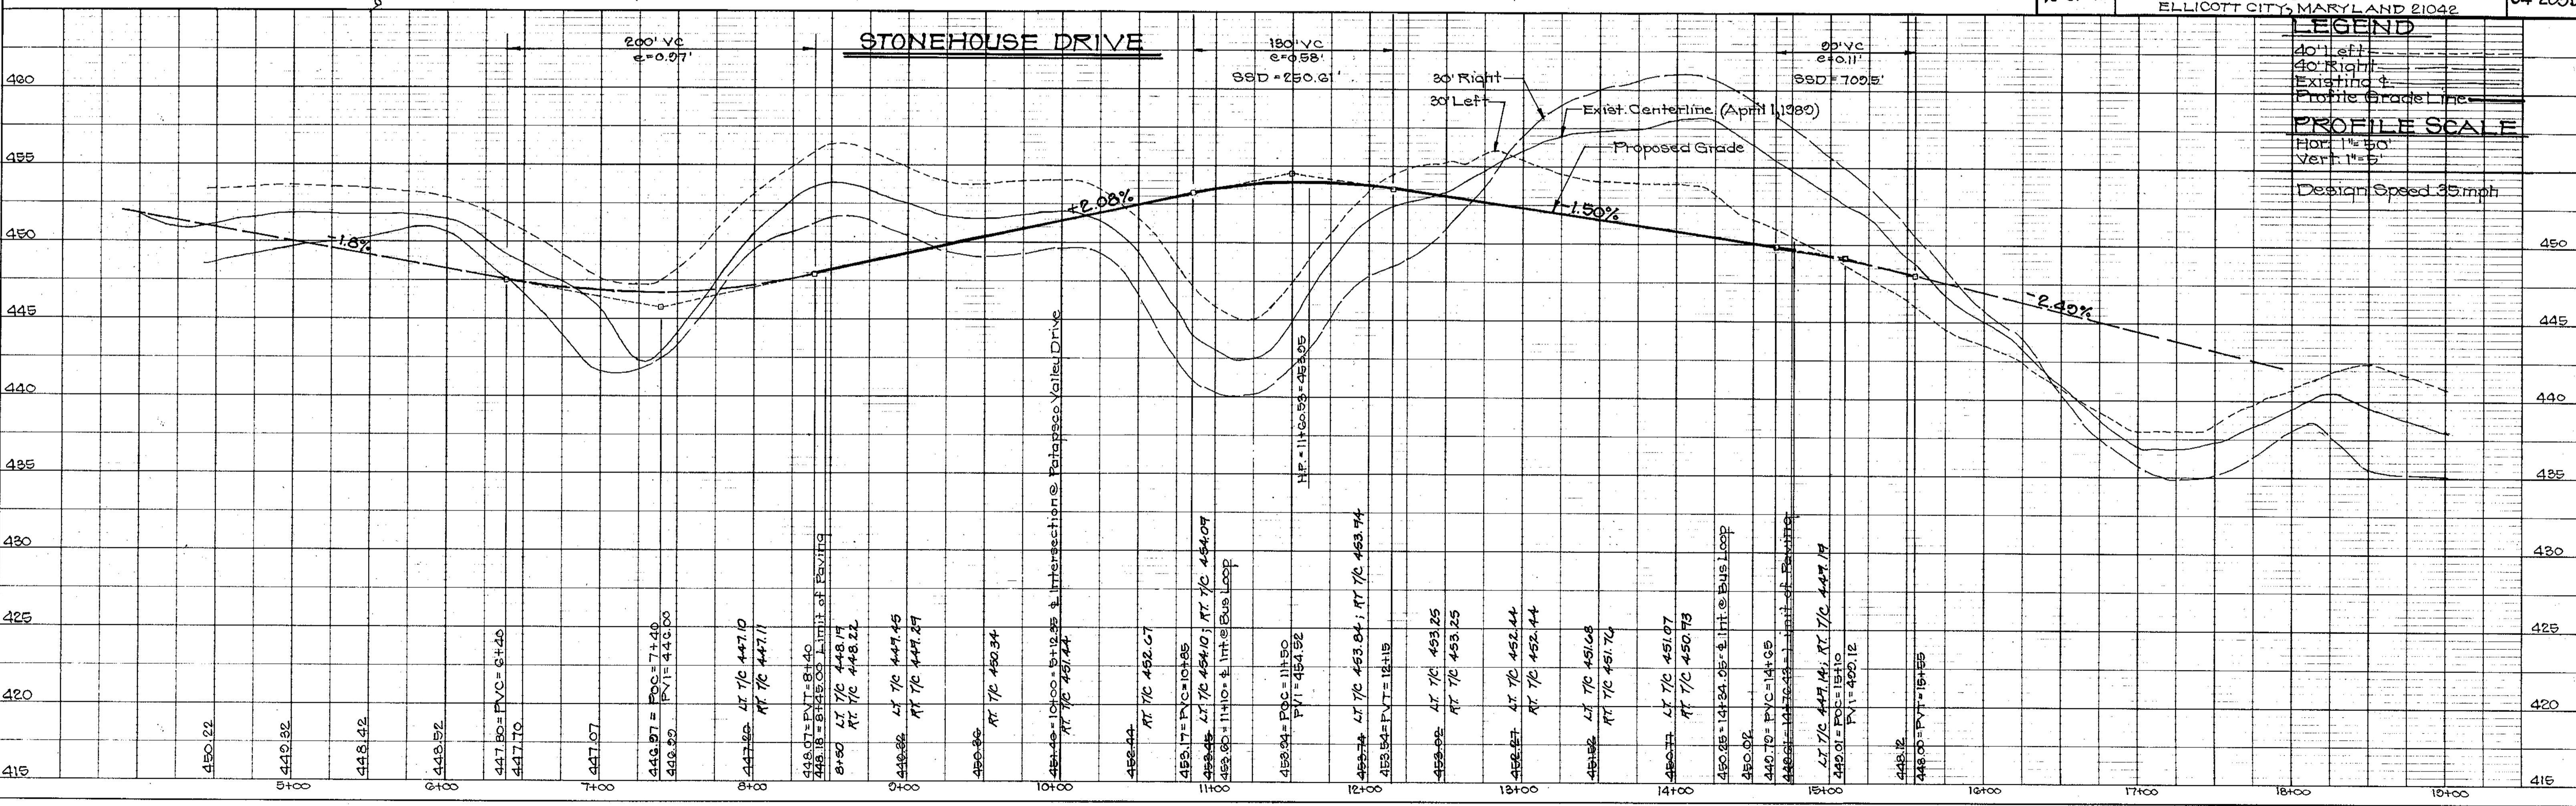


LEGEND
 40' Left
 40' Right
 Existing
 Profile Grade Line


PROFILE SCALE
 Hor. 1"=50'
 Vert. 1"=5'

Design Speed 35mph

1783

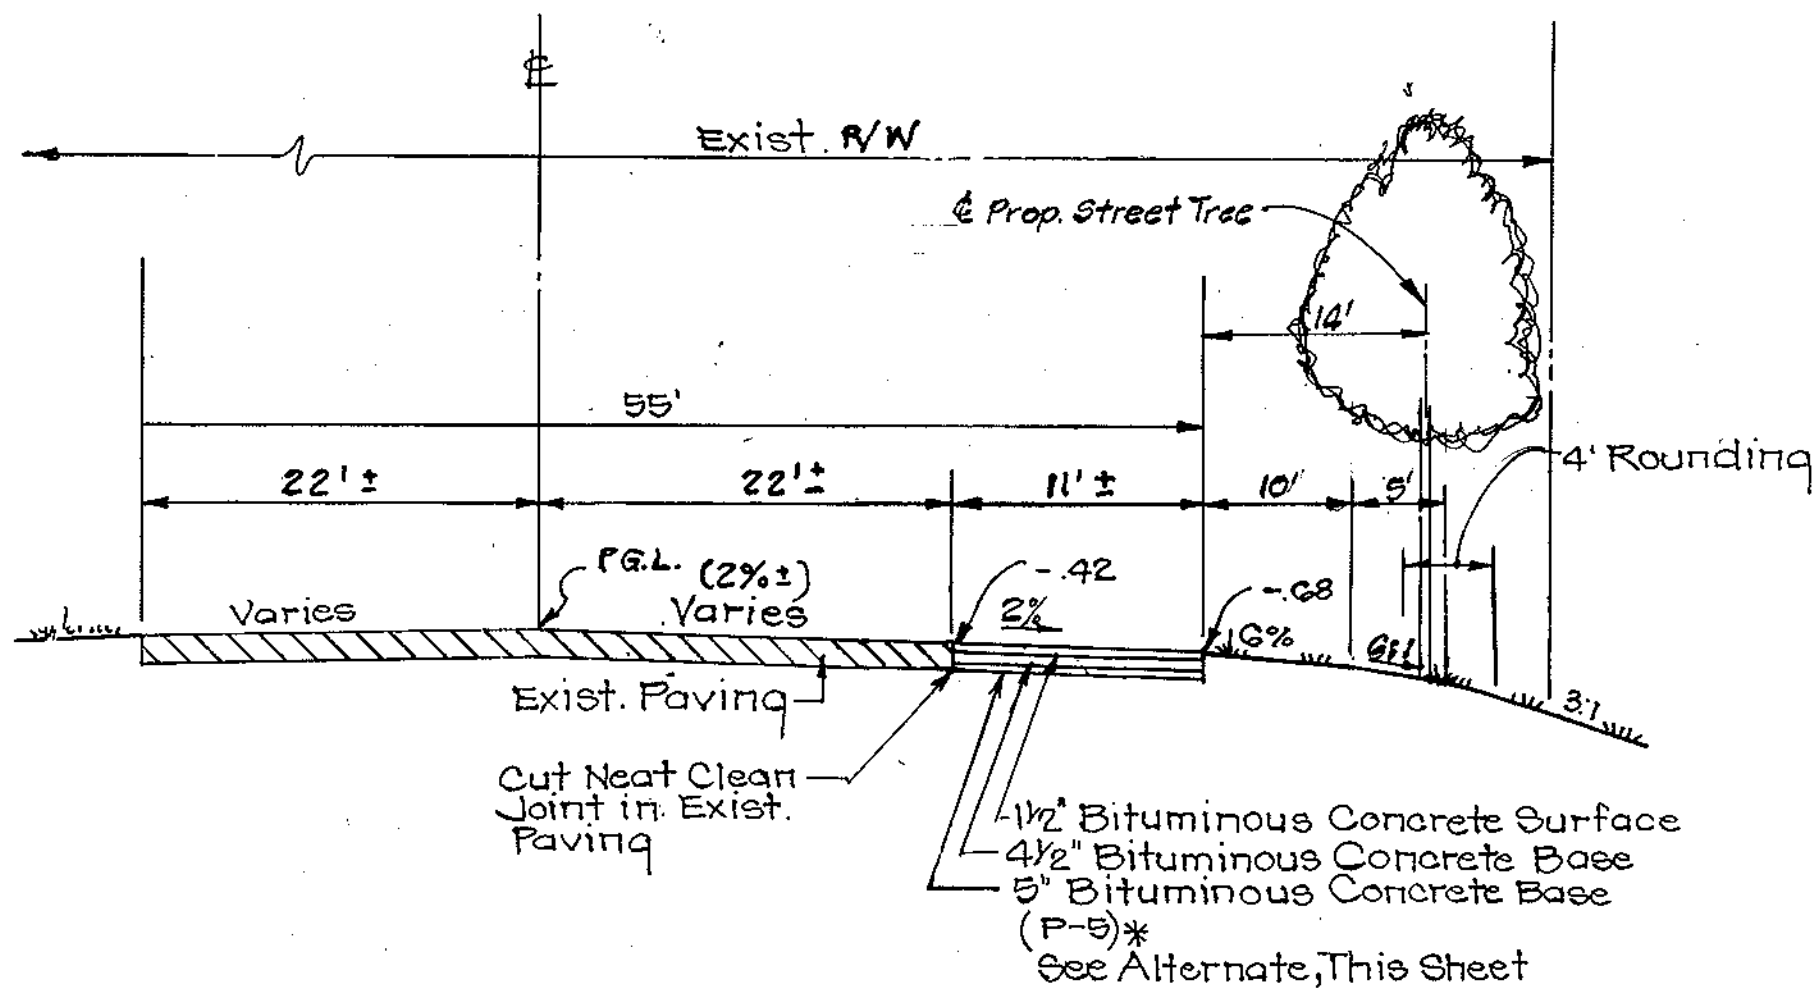


TYPICAL HALF SECTION (MINOR ARTERIAL)
ROGERS AVENUE
 No Scale

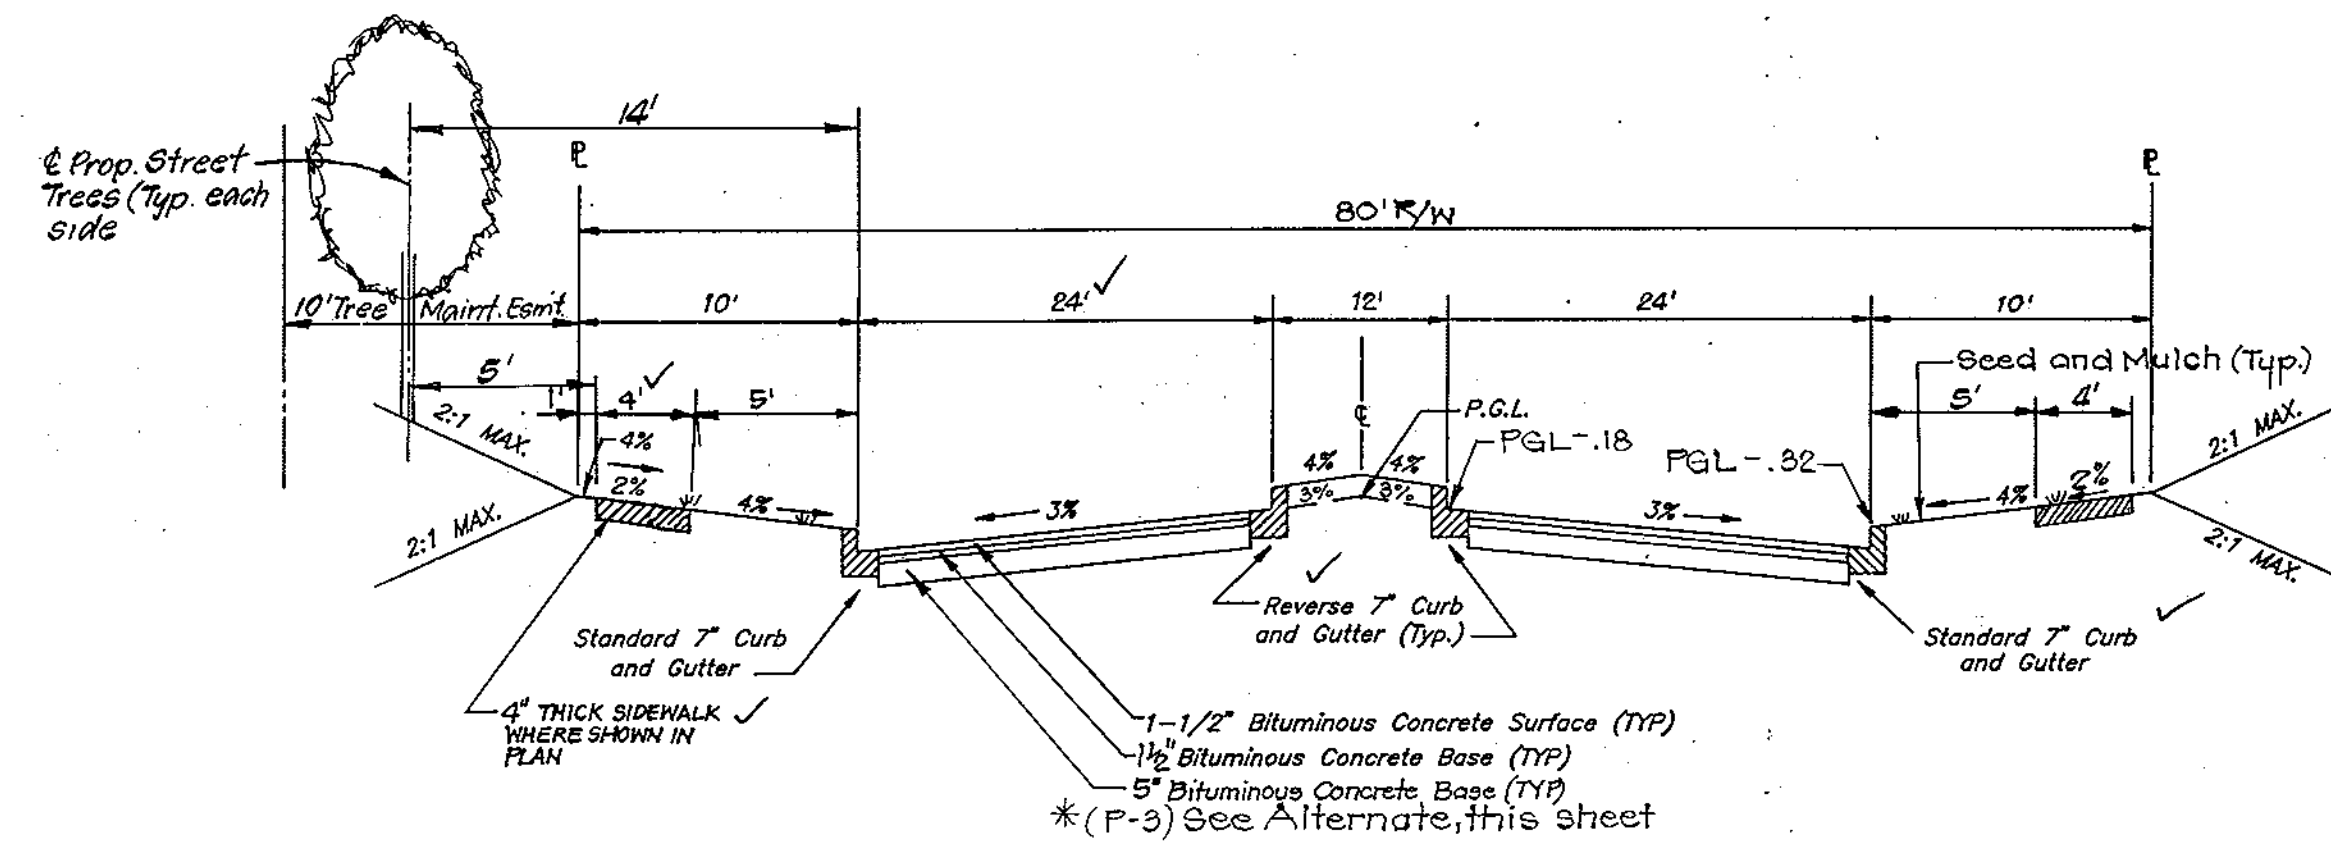

TYPICAL PAVING SECTION
PATAPSCO VALLEY DRIVE (MINOR COLLECTOR)
 NO SCALE

Design Speed: 35 mph
 Zoning: SFA, SFD, Commercial, Industrial
 Sta. 0+00 to 5+12.95

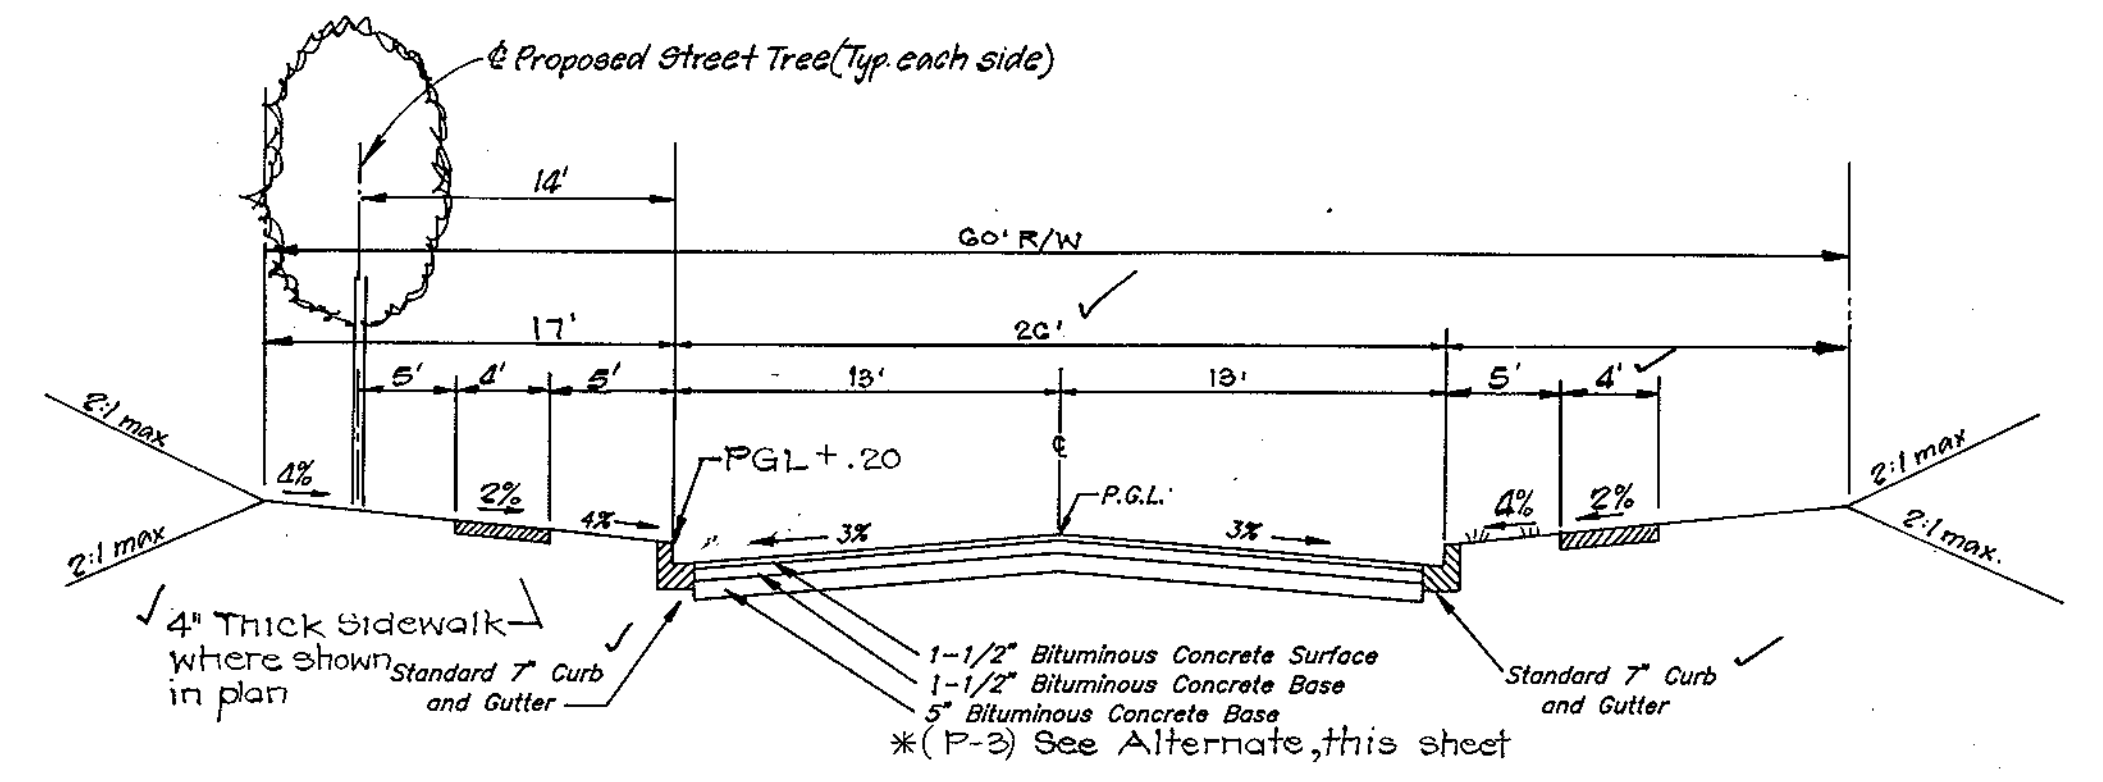

TYPICAL PAVING SECTION
STONEHOUSE DRIVE (MINOR COLLECTOR)
 NO SCALE

Design speed: 35 mph
 Zoning: SFA
 Sta. 8+45 to 14+76.43

1-1/2" Bituminous Concrete Surface	1-1/2"
4-1/2" Bituminous Concrete Base	4-1/2"
Prime	
8" Crusher Run Base Course or 4-1/2" Dense Graded Stabilized Aggregate Base Course	8" OR 4-1/2"


(P-3)

ALTERNATE PAVING SECTION
PUBLIC ROADS
 NO SCALE


1 1/2" Bituminous Concrete Surface	1 1/2"
1 1/2" Bituminous Concrete Base	1 1/2"
5" Bituminous Concrete Base	5"
Prime	
8" Crusher Run Base Course or 6" Dense Graded Stabilized Aggregate Base Course	8" OR 6"

(P-5)

ALTERNATE PAVING SECTION
ROGERS AVENUE
 NO SCALE

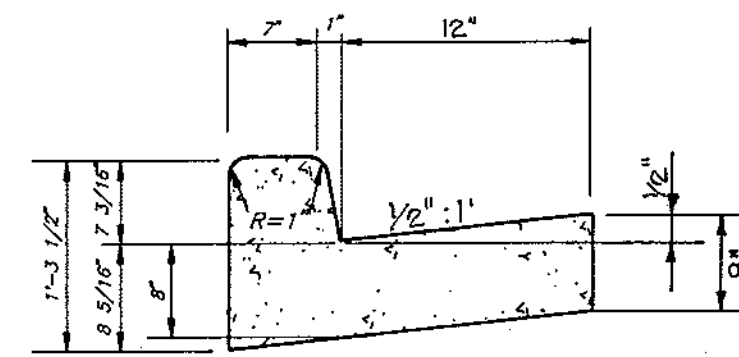


STANDARD 7" COMBINATION CURB AND GUTTER
 NO SCALE

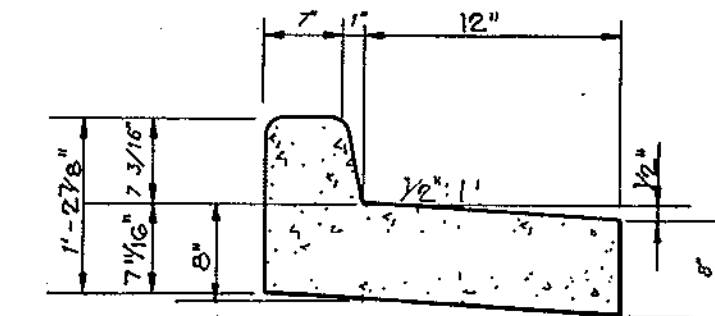


REVERSE 7" COMBINATION CURB AND GUTTER
 NO SCALE


4000 psi Air Entrained Concrete
 10' Max. between control joints
 50' Max. between expansion joints

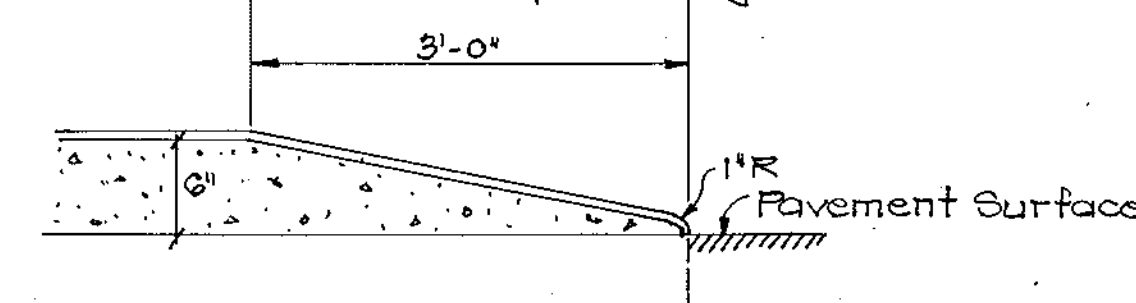


NOSE DOWN CURB & GUTTER DETAIL
 NO SCALE

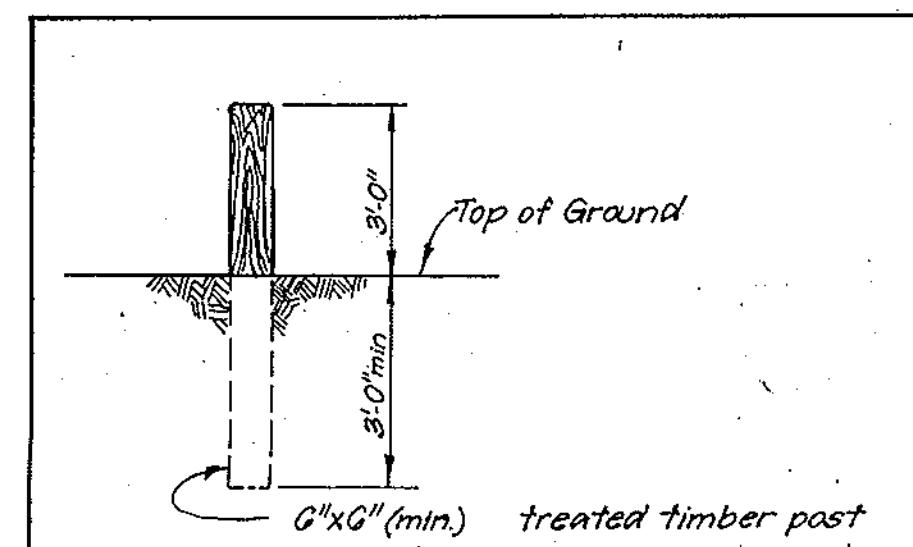


TIMBER BOLLARD DETAIL
 NO SCALE

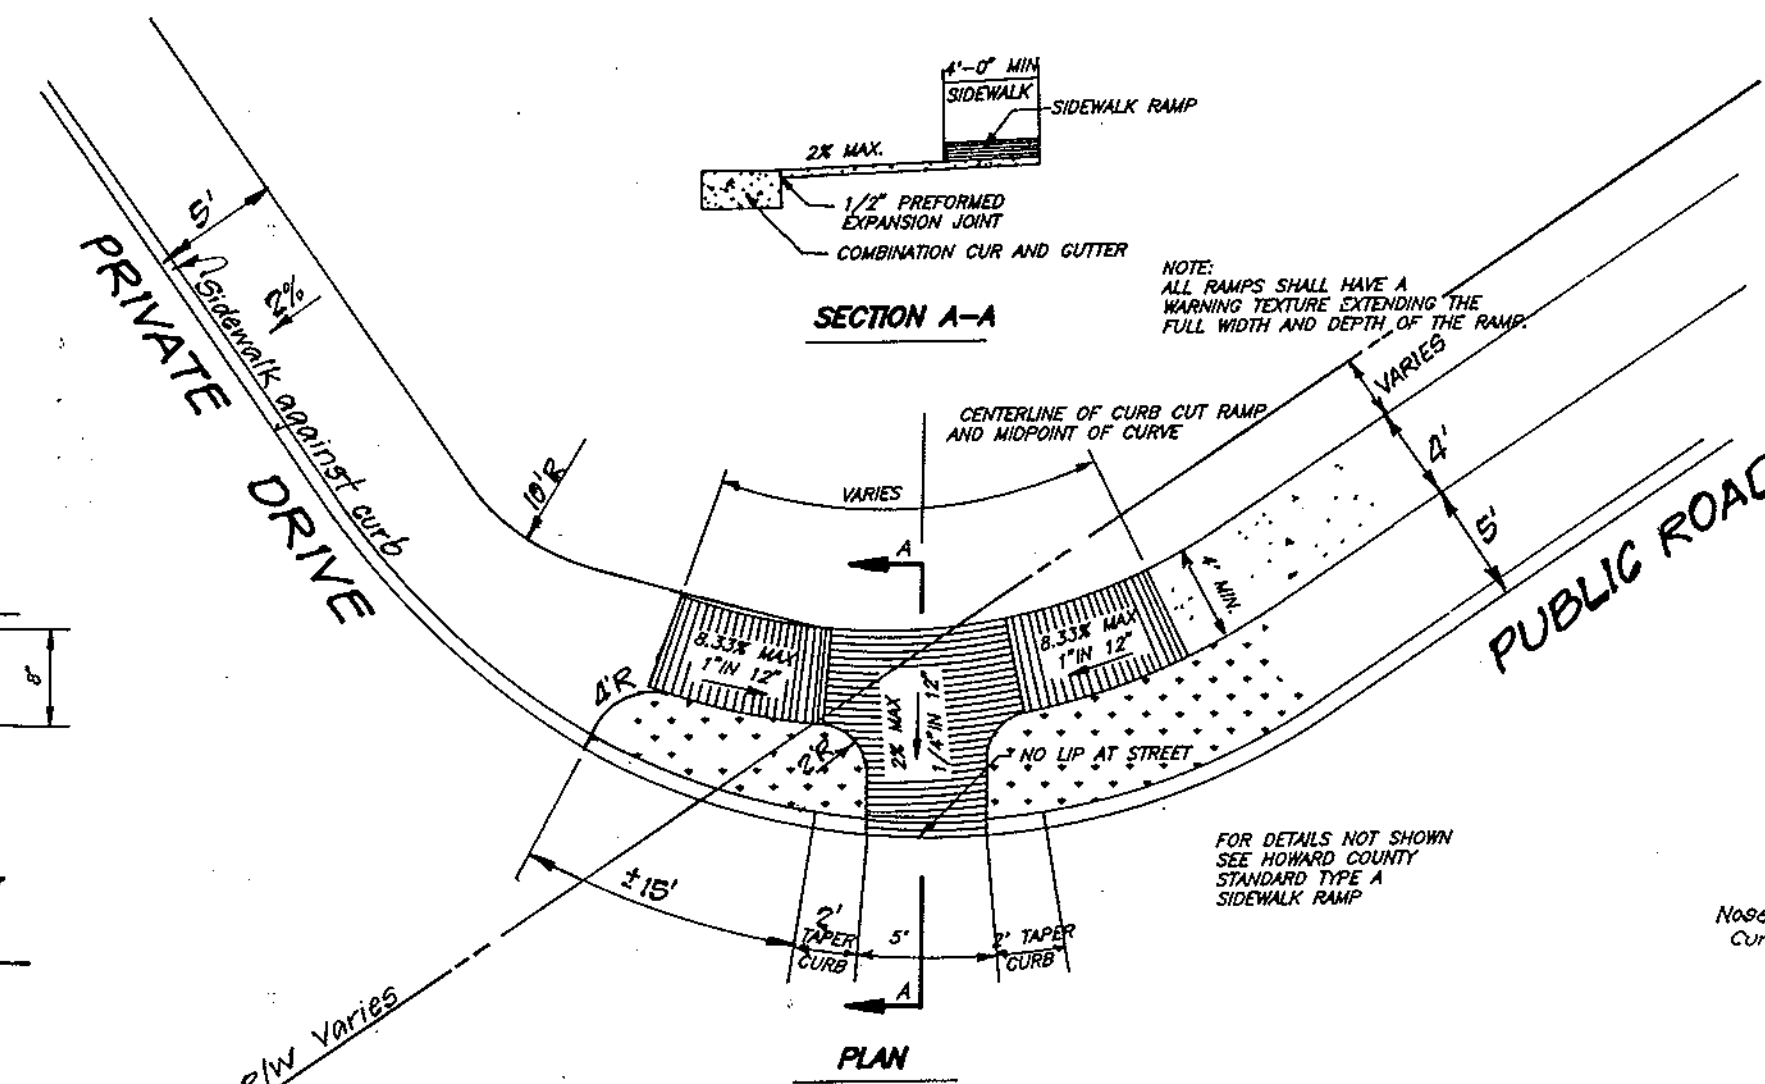


MODIFIED TYPE A SIDEWALK RAMP
 SEE PLAN VIEW FOR LOCATION
 NO SCALE

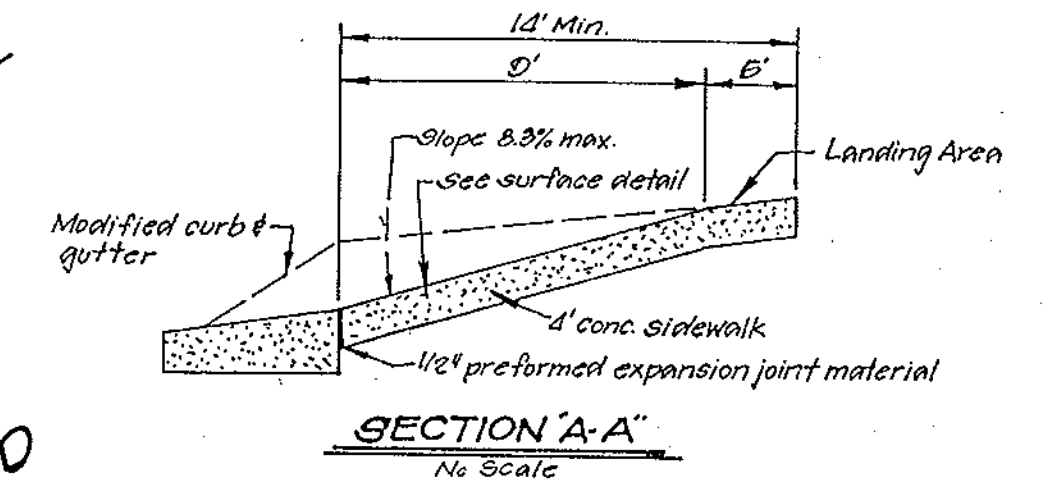


SECTION A-A
 NO SCALE

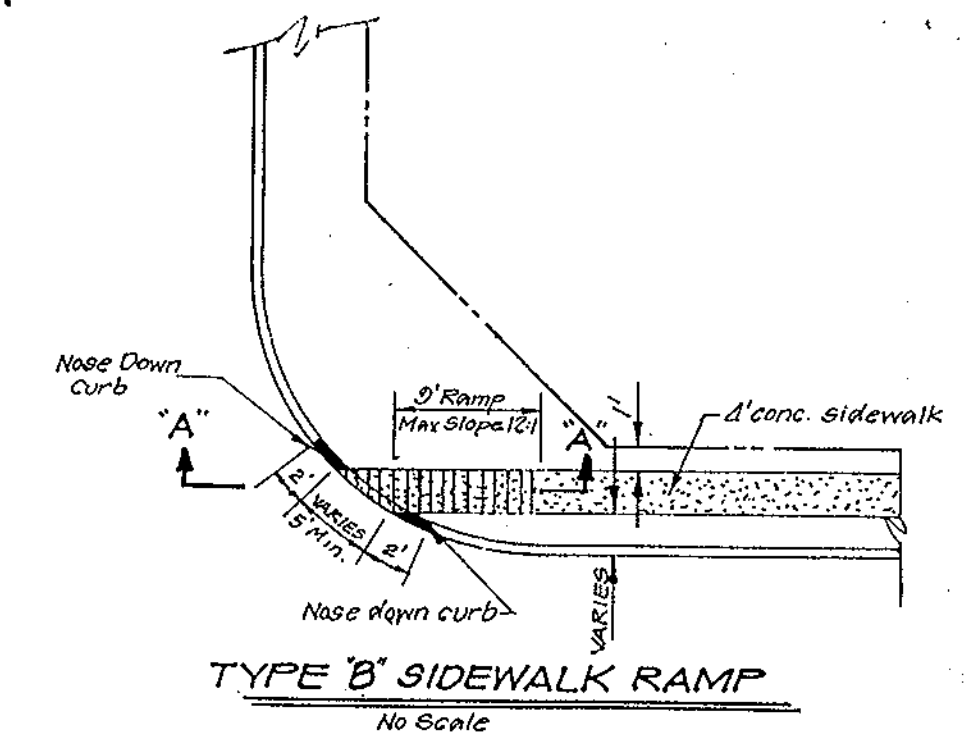


TYPE B SIDEWALK RAMP
 NO SCALE

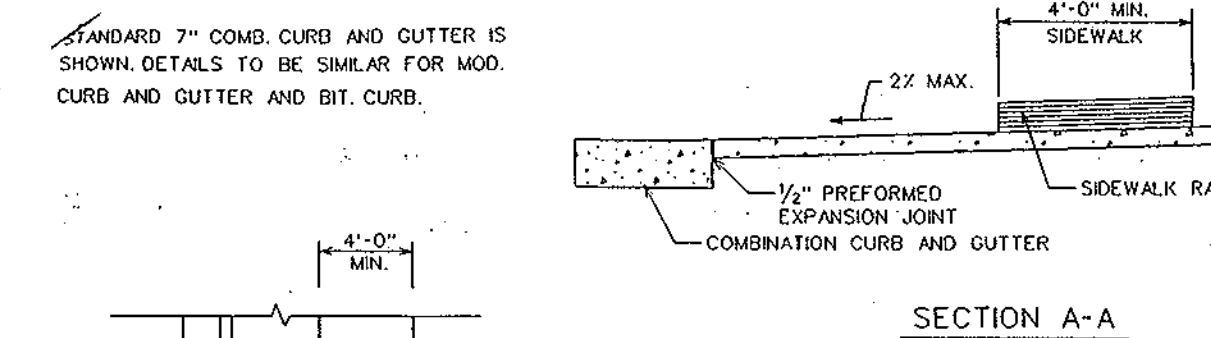


SECTION A-A

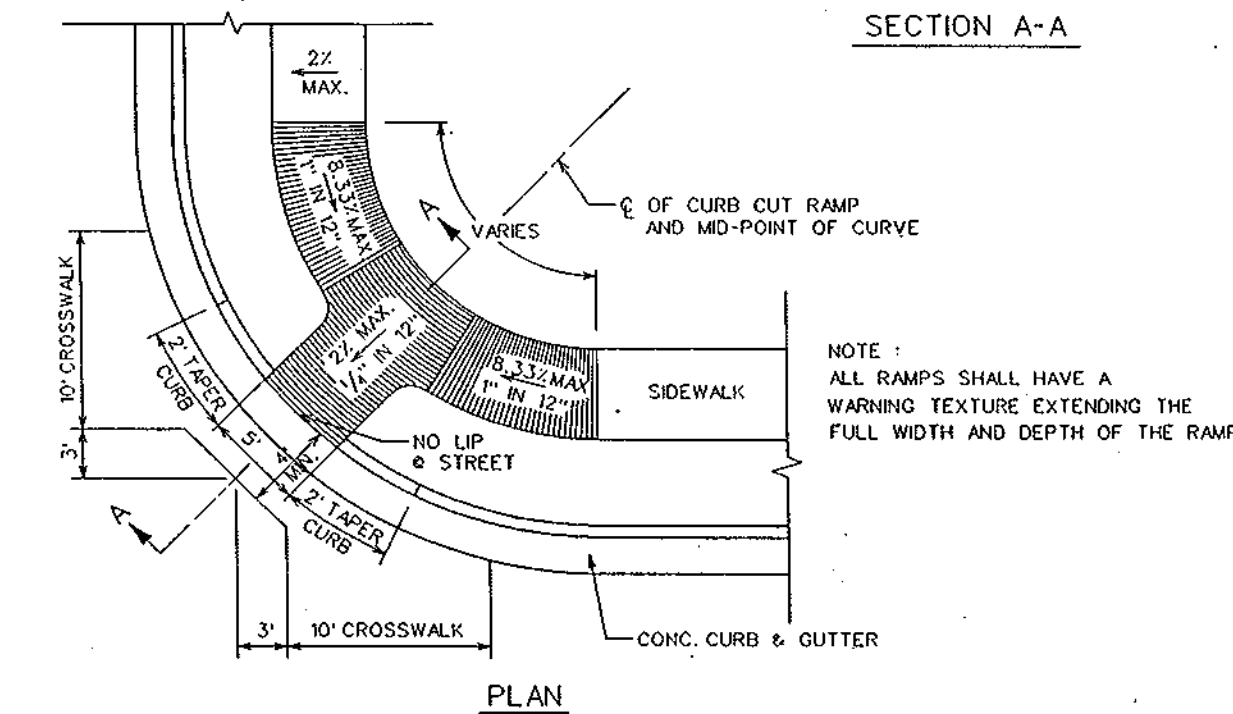

PLAN

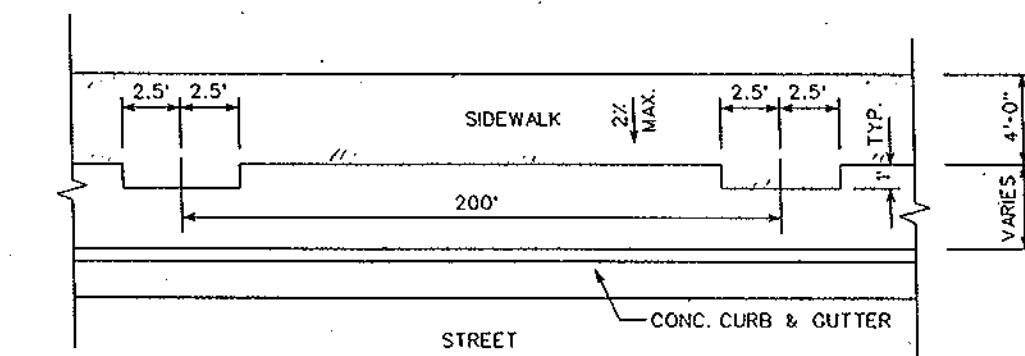

SIDEWALK WITH PASSING AREA
 NOTE: ALL SIDEWALKS TO HAVE PASSING AREA AT 20' SPACING.

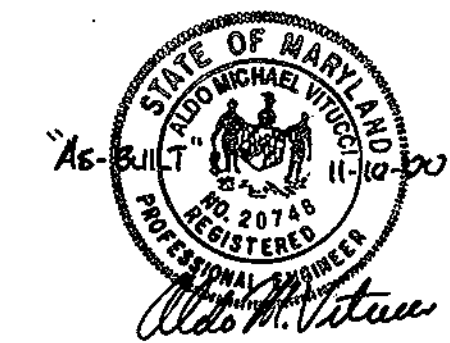

APPROVED: DEPARTMENT OF PUBLIC WORKS
 Chief, Bureau of Highways
 Date: 1-30-96

APPROVED: DEPARTMENT OF PLANNING AND ZONING
 Chief, Division of Land Development and Research
 Date: 2/2/96


Chief, Development Engineering Division
 Date: 2/1/96

CLARK • FINEROCK & SACKETT, INC.
 ENGINEERS • PLANNERS • SURVEYORS
 7135 MINSTREL WAY • COLUMBIA, MD. 21045 • (410) 381-7500 - BALTO. • (301) 621-8100 - WASH.


DESIGNED KIWM	PAVING DETAILS DANIELS MILL OVERLOOK TAX MAP 17 PART OF PARCEL 41 SECOND ELECTION DISTRICT HOWARD COUNTY, MARYLAND	SCALE -
DRAWN KIWM		DRAWING 6 of 20
CHECKED KIWM		JOB NO. 04-203
DATE 12-21-95		FILE NO. 04-203D

FOR: HOWARD COUNTY BOARD OF EDUCATION
 10910 ROUTE 108
 ELLICOTT CITY, MARYLAND 21042

1783

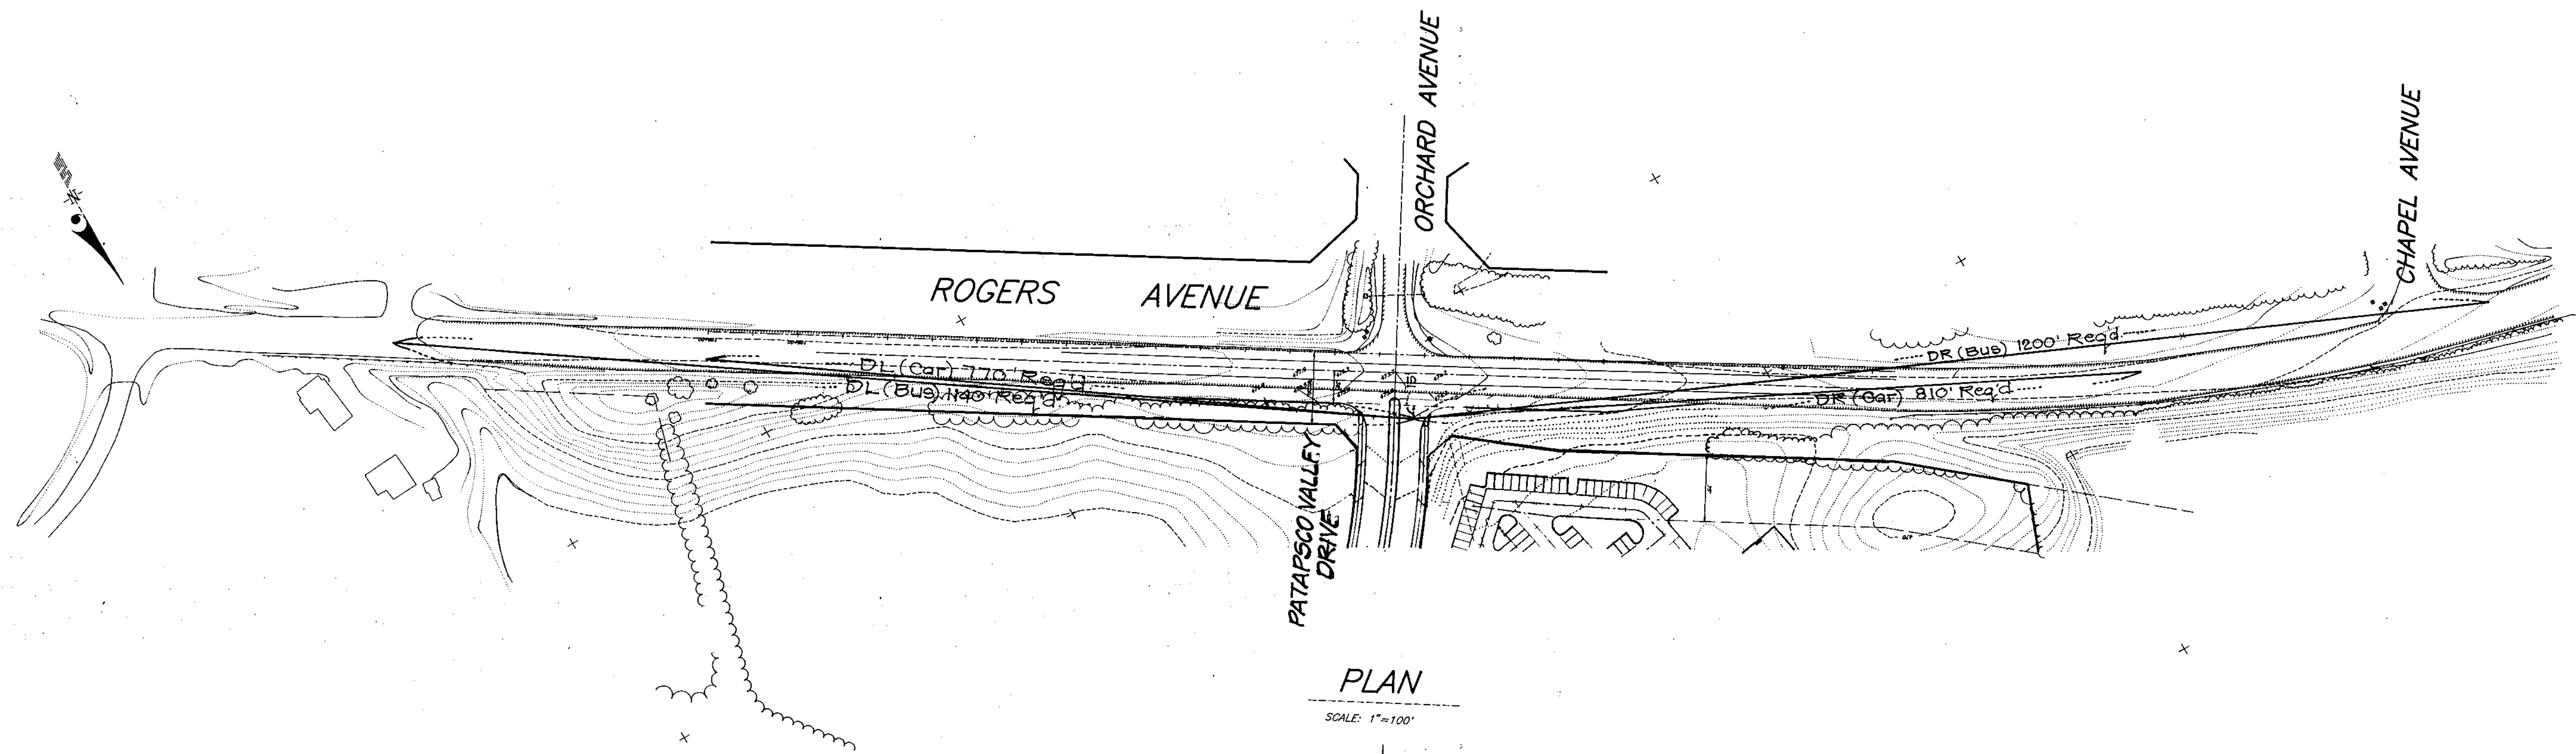

Rogers Avenue = Major Road - 4 Lanes
 Grade = < 2%
 Posted Speed Limit = 40 mph
 Operating Speed = 40 + 5 = 45 mph *
 * Study uses 50 mph as design speed

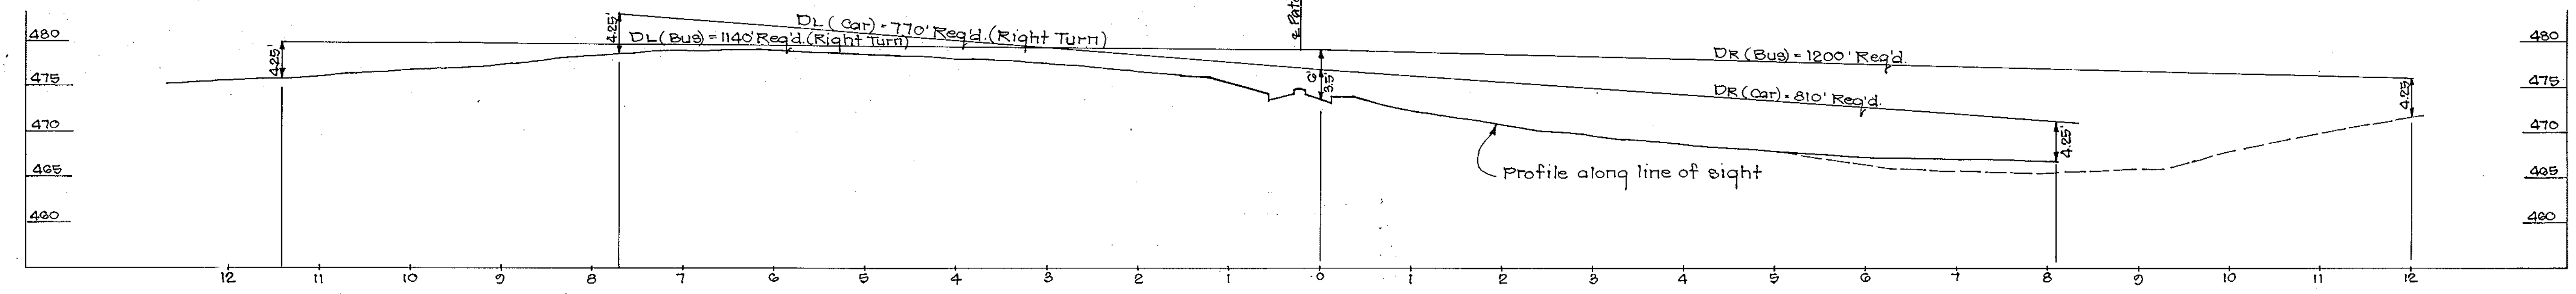

SIGHT DISTANCE ANALYSIS ROGERS AVENUE AND PATAPASCO VALLEY DRIVE







APPROVED: DEPARTMENT OF PUBLIC WORKS
Andrew M. Daniels 1-30-96
 Chief, Bureau of Highways Date

APPROVED: DEPARTMENT OF PLANNING AND ZONING
Jim Swinney 2/1/96
 Chief, Division of Land Development and Research Date TC

William M. Vitour 2/1/96
 Chief, Development Engineering Division Date

CLARK • FINEFROCK & SACKETT, INC. ENGINEERS • PLANNERS • SURVEYORS 7135 MINSTREL WAY • COLUMBIA, MD. 21045 • (410) 381-7500 - BALTO. • (301) 621-8100 - WASH.		
DESIGNED KIWM	SIGHT DISTANCE ANALYSIS	SCALE AS SHOWN
DRAWN <i>[Signature]</i>	ROGERS AVE. & PATAPASCO VALLEY DR.	DRAWING 7 of 20
CHECKED KIWM	DANIELS MILL OVERLOOK	JOB NO. 04-203
DATE 12-27-95	TAX MAP 17 PART OF PARCEL 41 SECOND (2ND) ELECTION DISTRICT HOWARD COUNTY, MARYLAND FOR: HOWARD COUNTY BOARD OF EDUCATION 10910 ROUTE 108 ELLCOTT CITY, MARYLAND 21047	FILE NO. 04-203D

1783

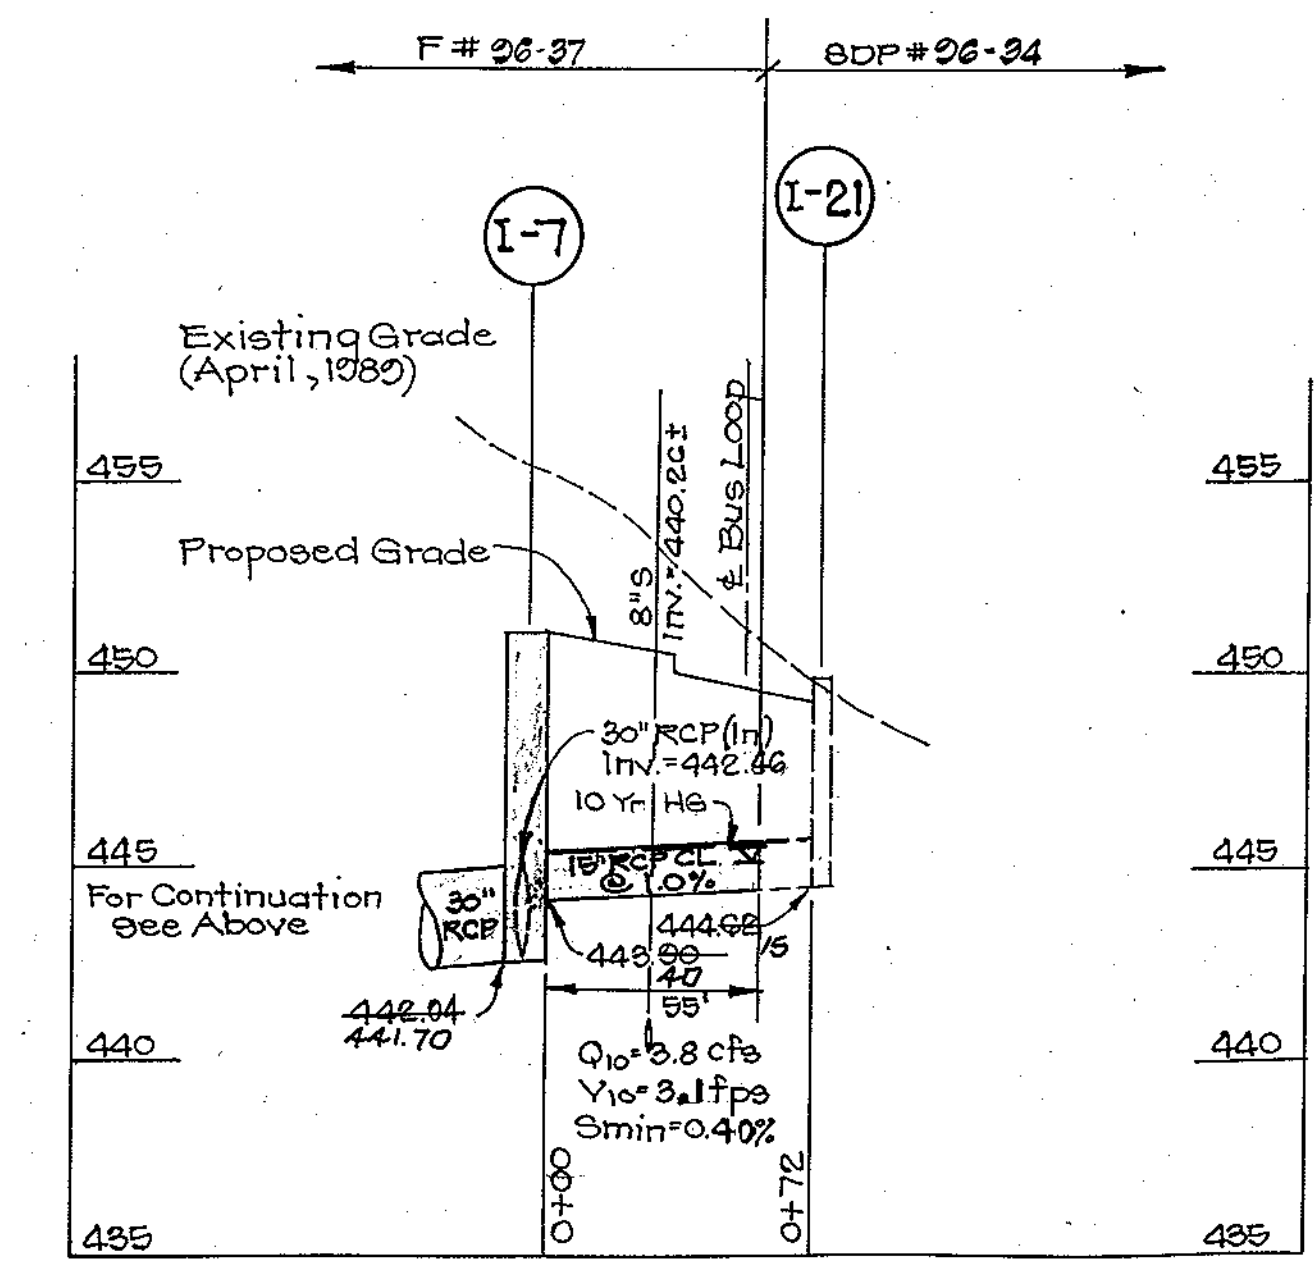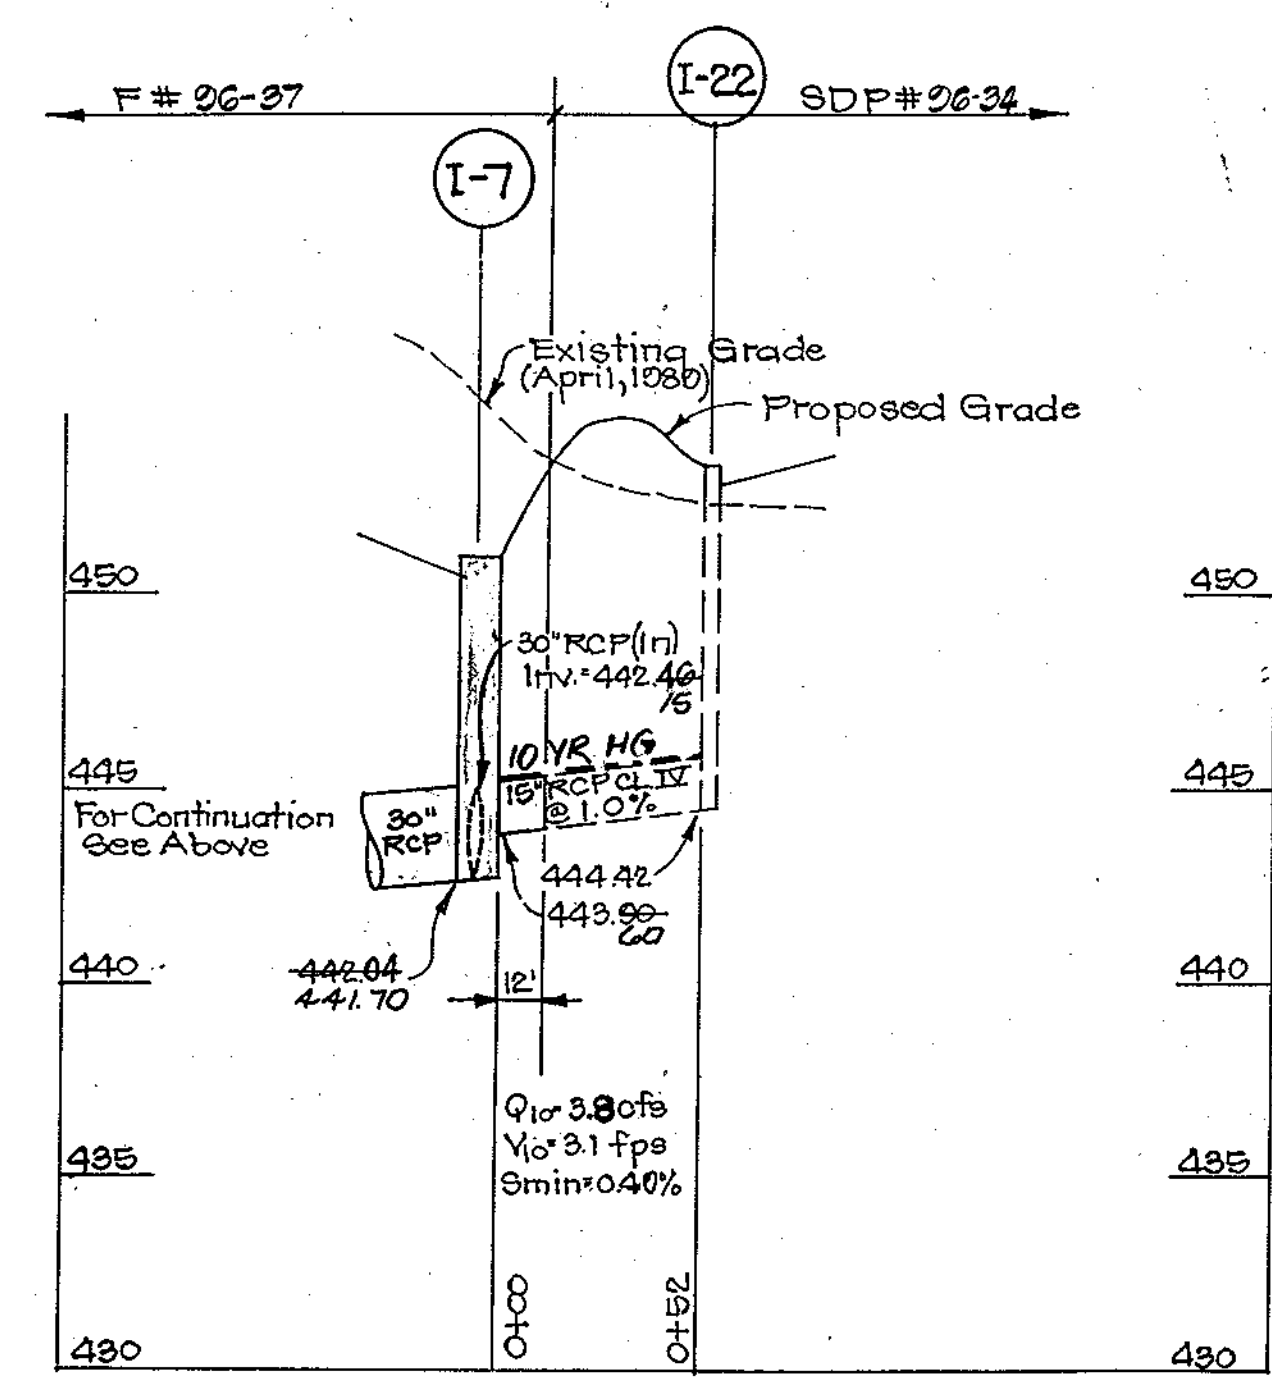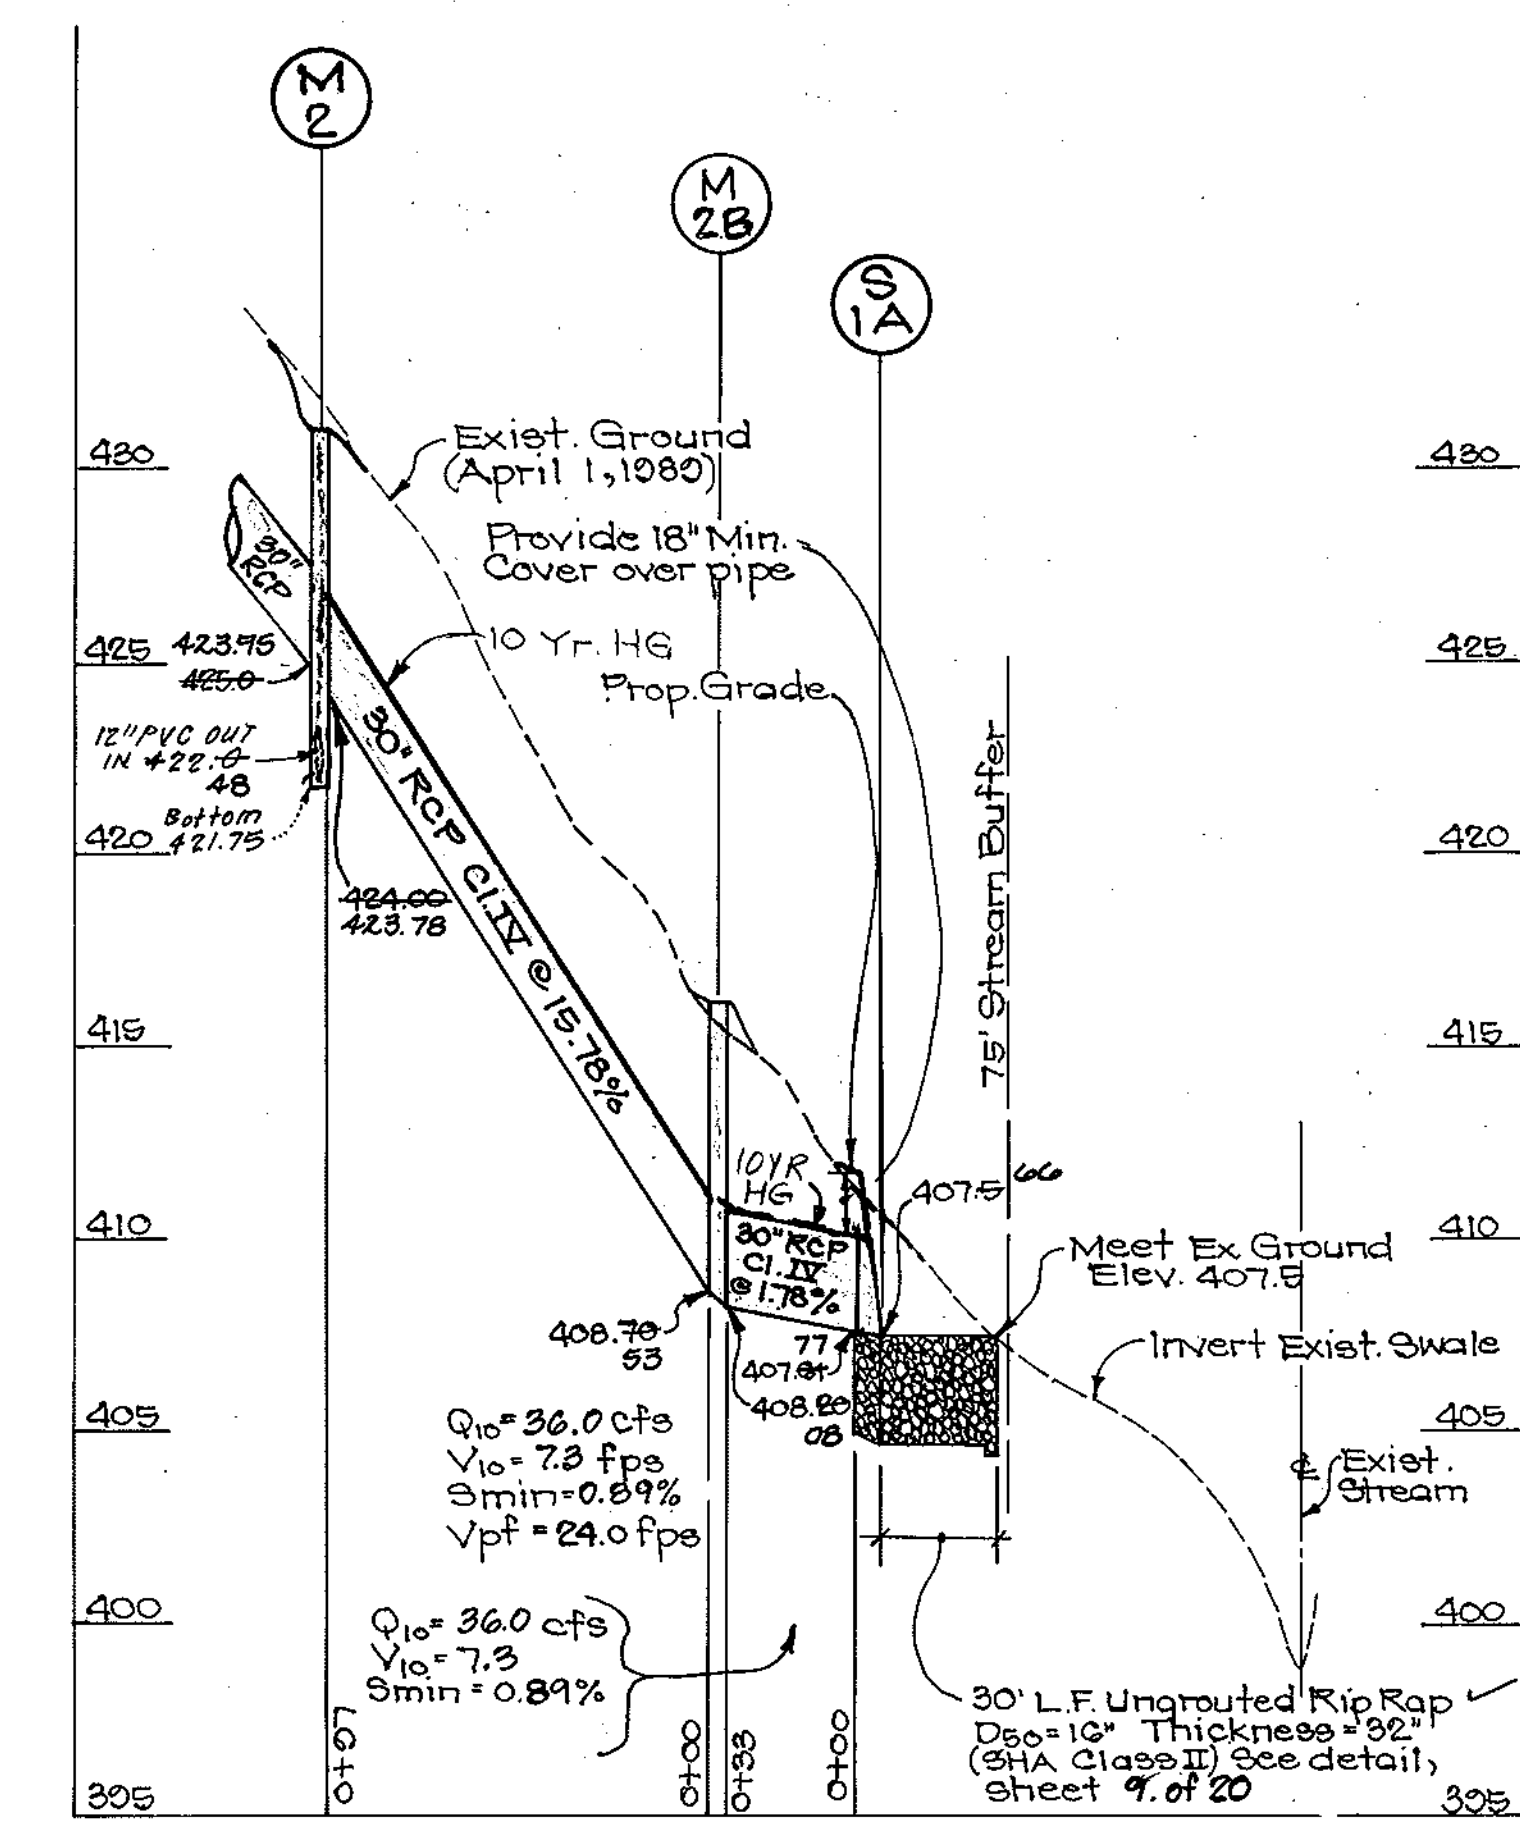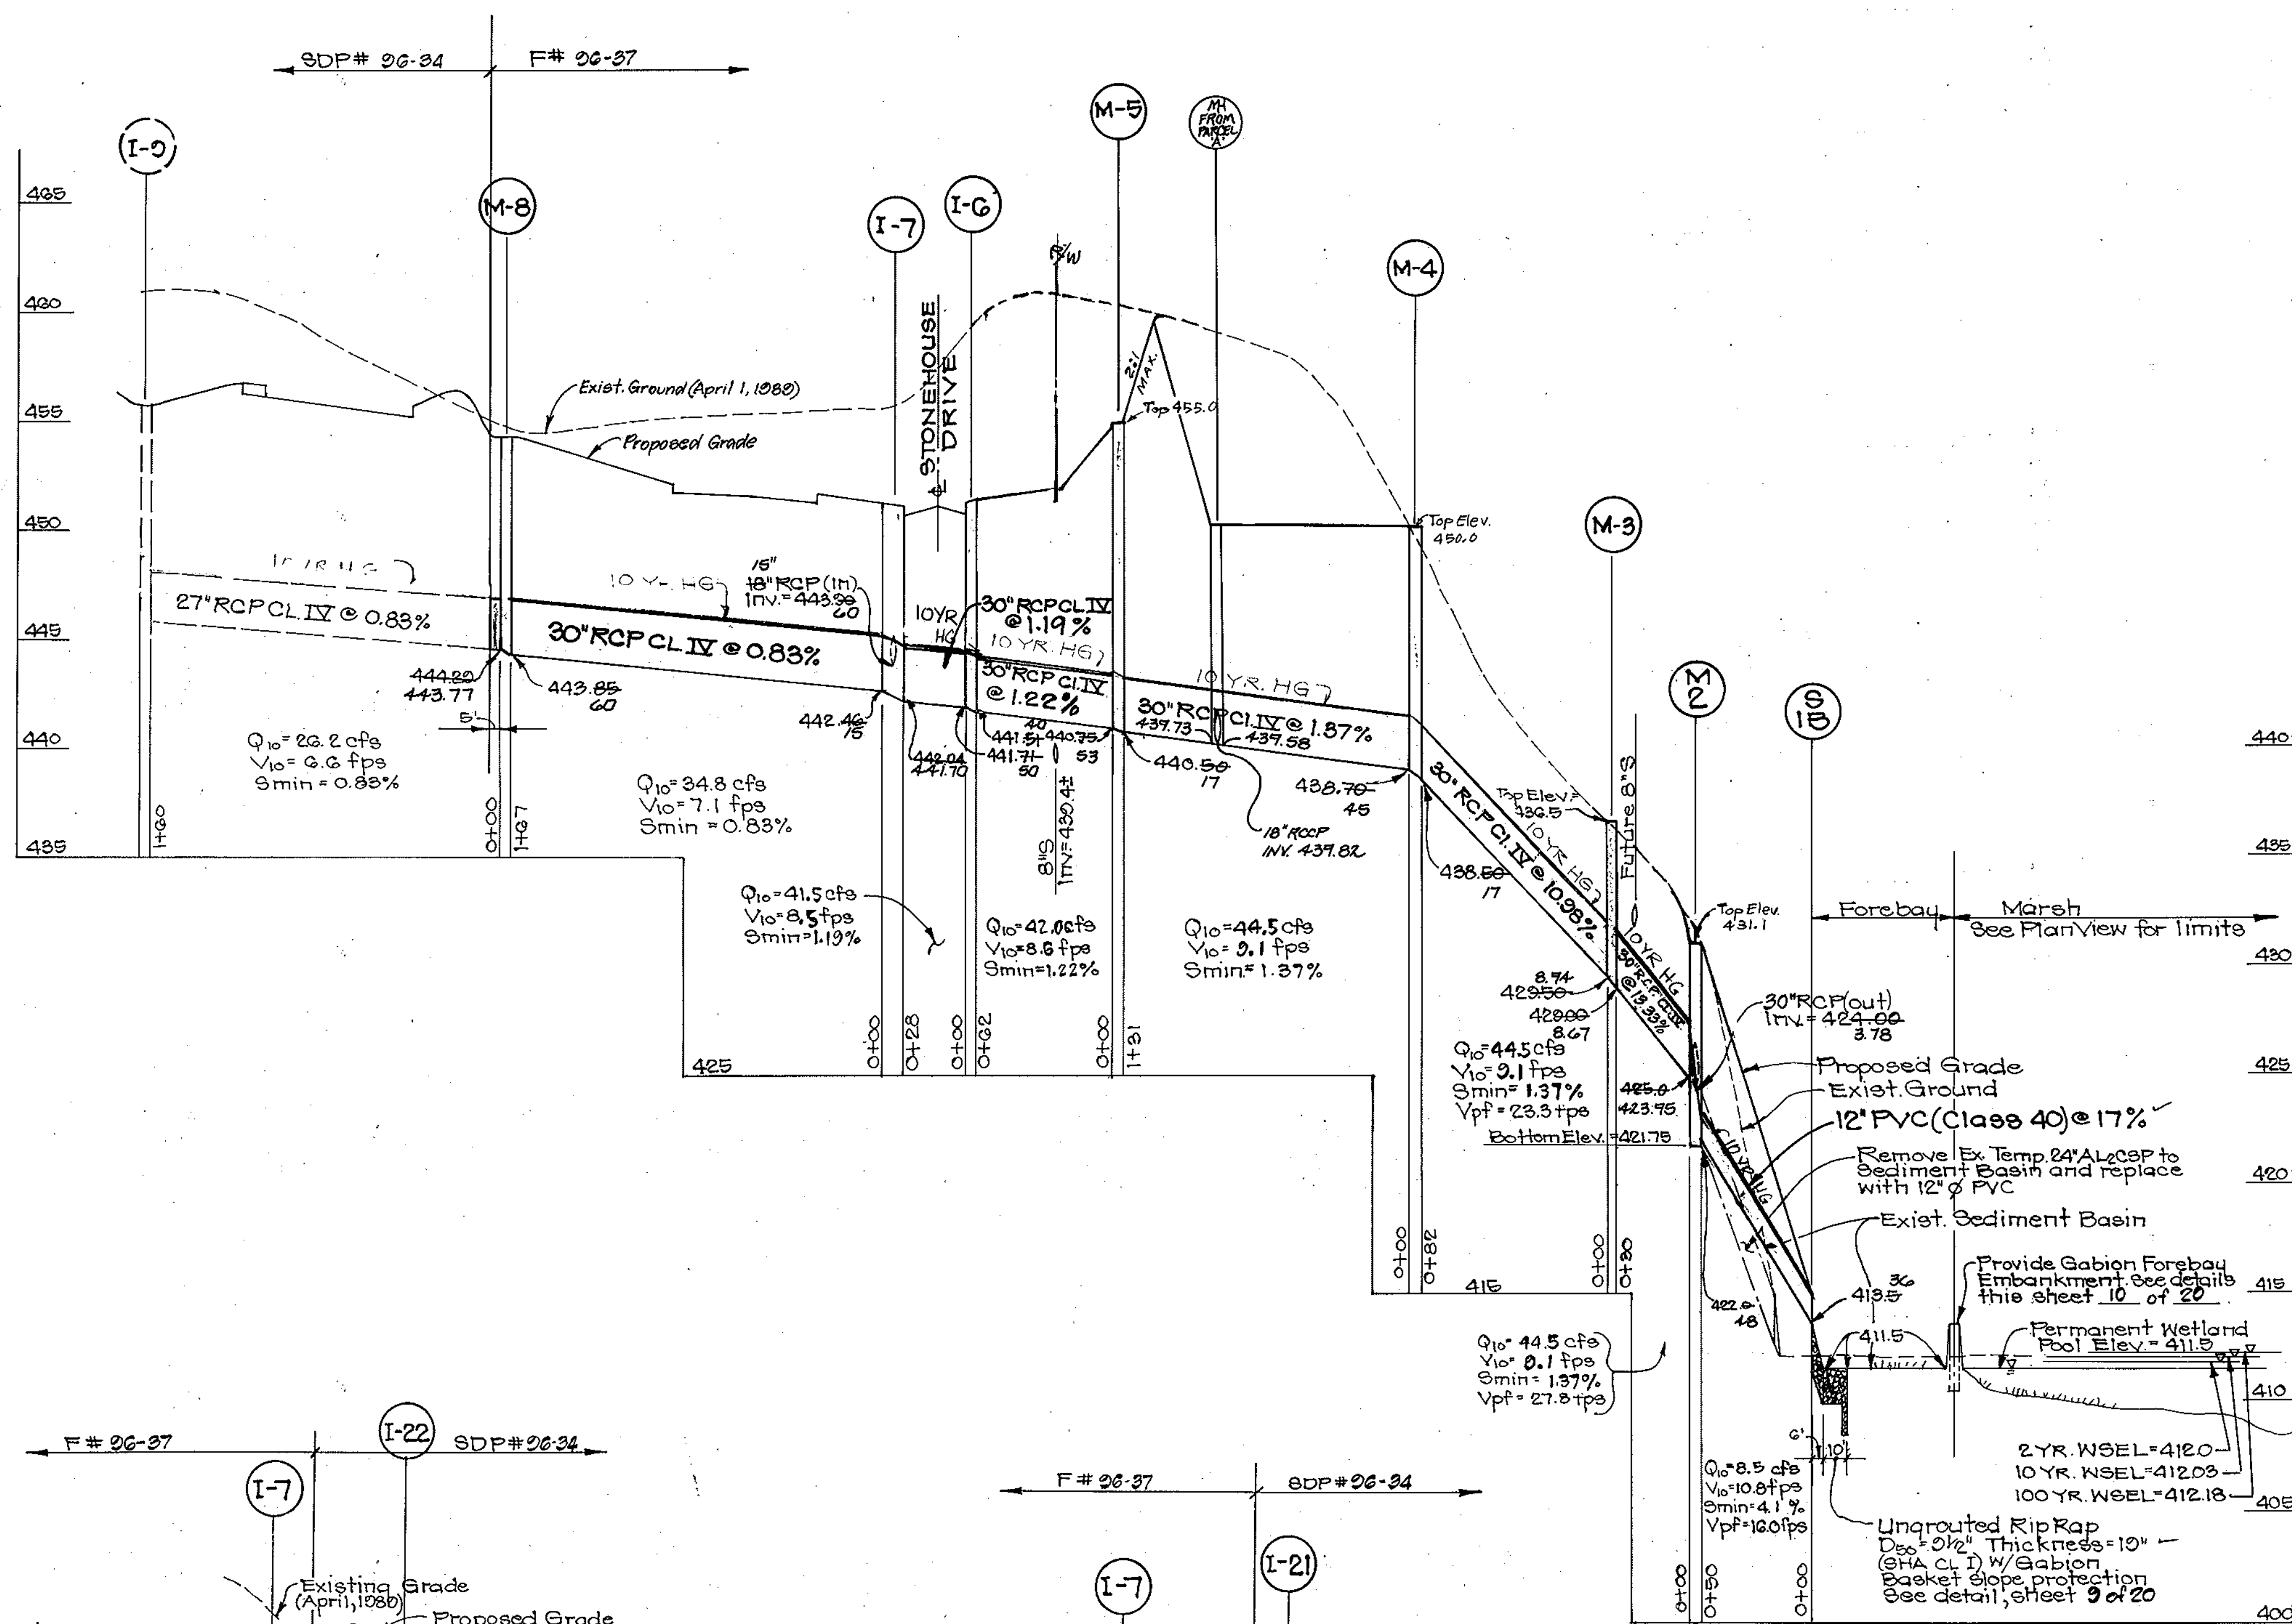

BORING PROFILES FOR SHALLOW MARSH

Station	Depth (ft)	Soil Description	Moisture (%)	Specific Gravity	Notes
M-2	0-10
	10-20
	20-30
	30-40
M-3	0-10
	10-20
	20-30
	30-40
M-4	0-10
	10-20
	20-30
	30-40

Reviewed for: HOWARD S.C.D.
and meets Technical Requirements
John Guadagnoli 1/19/96
Signature Date
Natural Resources Conservation Service

THIS DEVELOPMENT PLAN IS APPROVED FOR SOIL EROSION AND SEDIMENT CONTROL BY THE NATURAL RESOURCES CONSERVATION SERVICE.


John Guadagnoli 1/19/96
Approved

DEVELOPER'S/BUILDER'S CERTIFICATE
I/We certify that all development and construction will be done according to this plan of development and plan for sediment and erosion control and that all responsible personnel involved in the construction project will have a Certificate of Attendance at a Department of the Environment Approved Training Program for the Control of Sediment and Erosion before beginning the project. I also authorize periodic on-site inspection by the Howard Soil Conservation District or their authorized agents, as are deemed necessary.

John Guadagnoli 1/19/96
DATE

ENGINEER'S CERTIFICATE
I hereby certify that this plan for Sediment and Erosion Control represents a practical and workable plan based on my personal knowledge of the site conditions and that it was prepared in accordance with the requirements of the Howard Soil Conservation District.

G. Nelson Clark 1-20-96
DATE

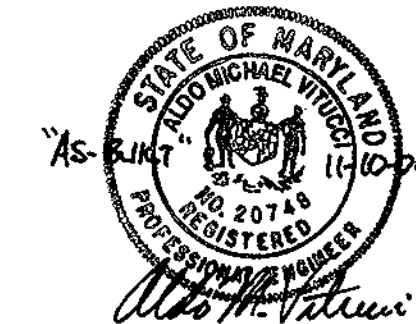

APPROVED: DEPARTMENT OF PUBLIC WORKS
Richard M. Daniels 1-30-96
Chief, Bureau of Highways Date

APPROVED: DEPARTMENT OF PLANNING AND ZONING
Jim Swannery 2/1/96
Chief, Division of Land Development and Research Date TC

Richard M. Daniels 2/1/96
Chief, Development Engineering Division Date


CLARK • FINEPROCK & SACKETT, INC.
ENGINEERS • PLANNERS • SURVEYORS
7135 MINTREL WAY • COLUMBIA, MD. 21045 • (410) 381-7500 - BALTO. • (301) 621-8100 - WASH.

DESIGNED KIWM
DRAWN JWB
CHECKED JWB
DATE 12-27-95

SCALE AS SHOWN
DRAWING 8 OF 20
JOB NO. 94-203
FILE NO. 94-203D

STORM DRAINAGE PROFILES
DANIELS MILL OVERLOOK
TAX MAP 17 PART OF PARCEL 41
SECOND ELECTION DISTRICT
HOWARD COUNTY, MARYLAND

FOR: HOWARD COUNTY BOARD OF EDUCATION
10910 ROUTE 108
ELLCOTT CITY, MARYLAND 21042

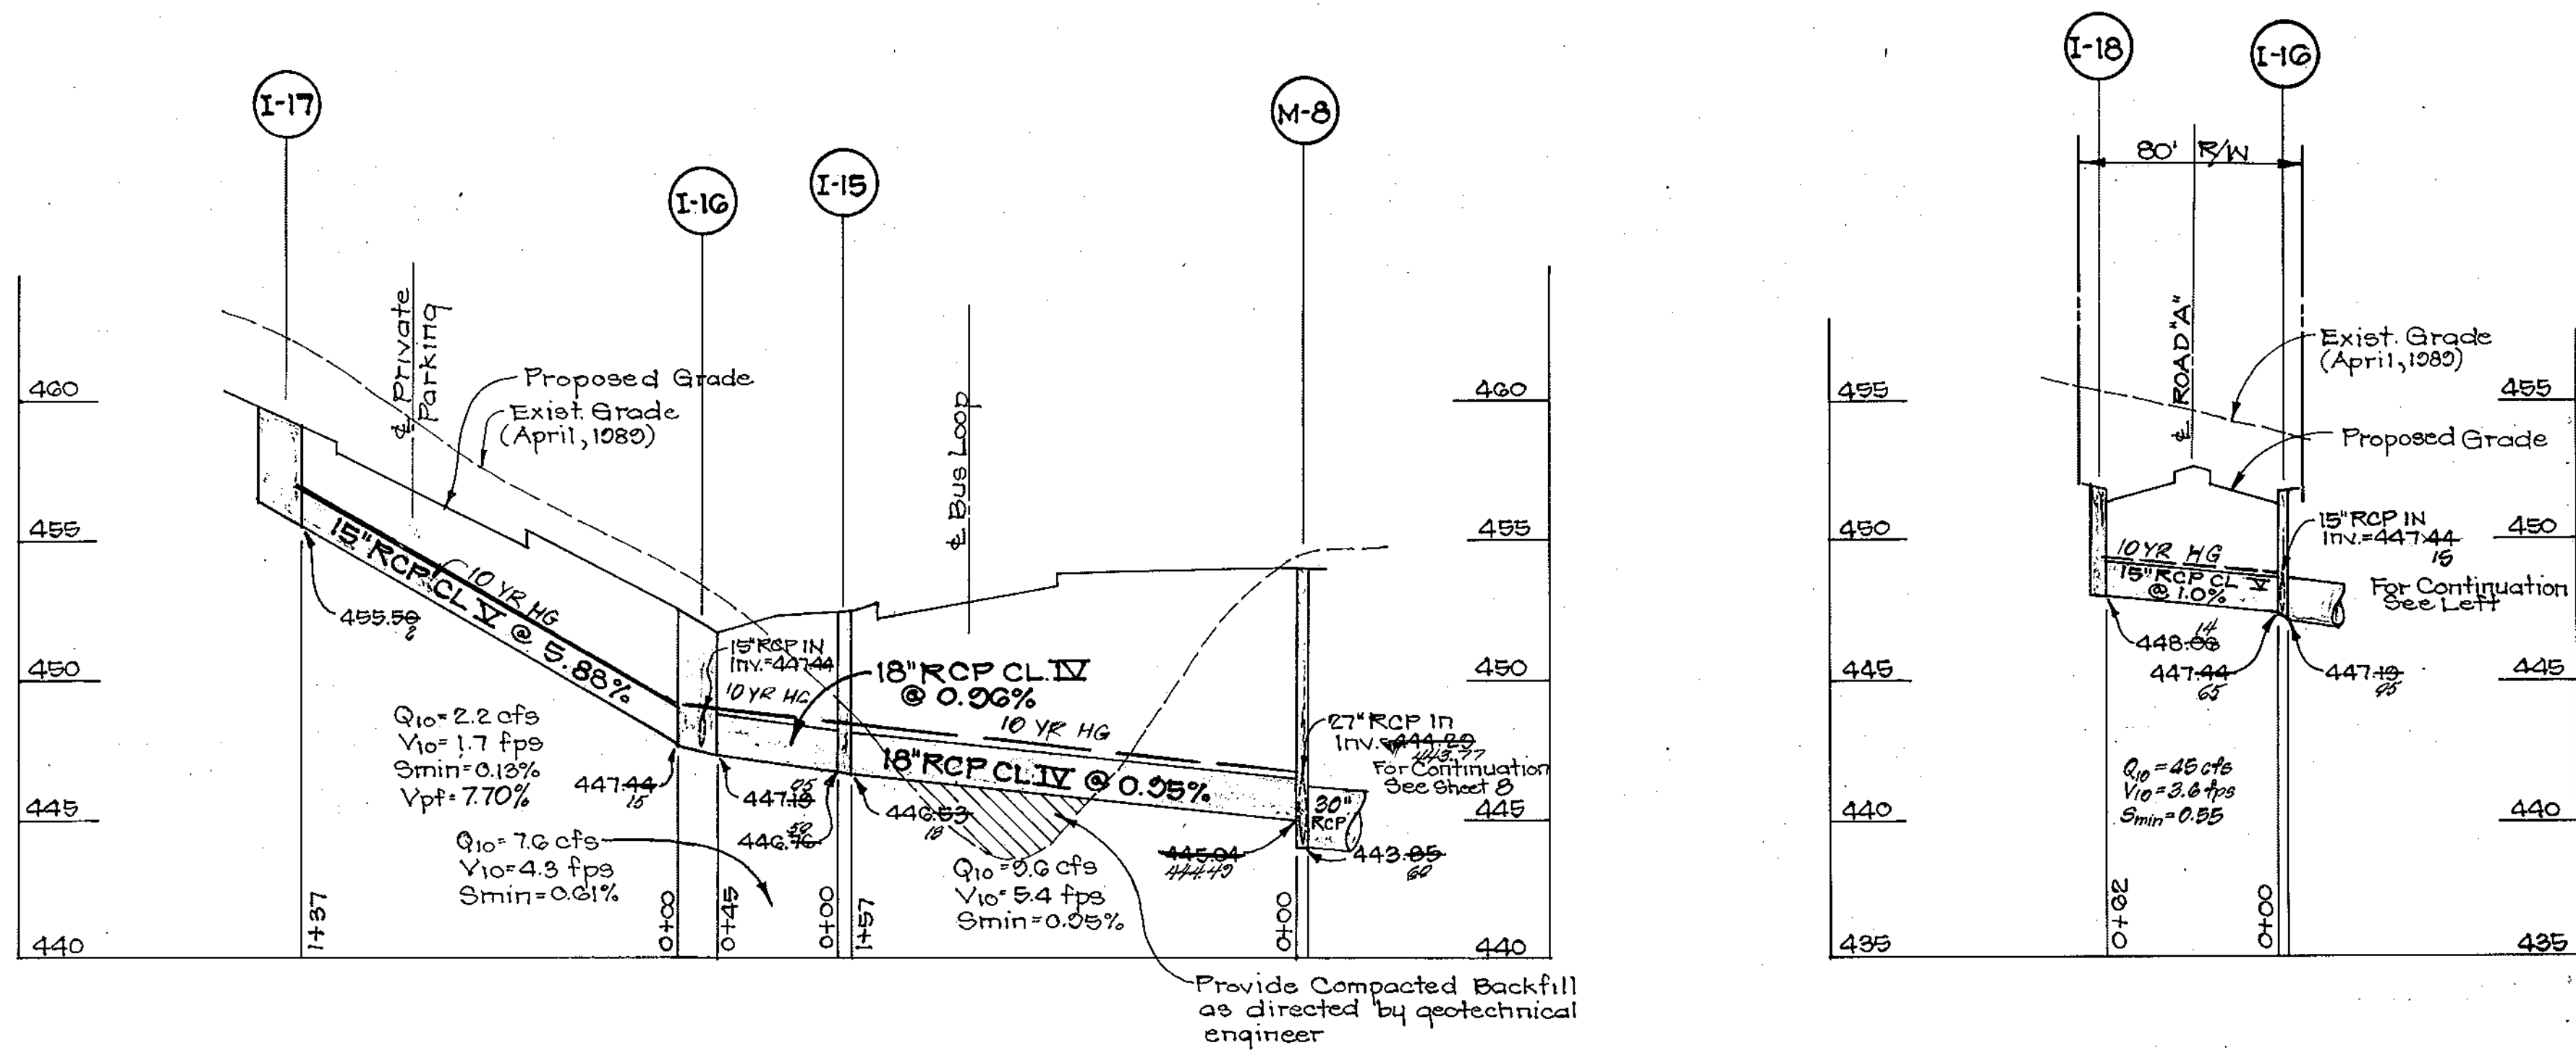

STORM DRAIN PROFILES
SCALE: HOR. 1"=50'
VERT. 1"=5'

STRUCTURE SCHEDULE									
NR	TYPE	INV. IN	INV. OUT	TOP ELEVATION		REMARKS	LOCATION		
				UPPER	LOWER				
S-2A	Metal End Section	412.00	412.0			Ho. Co. Std. SD 5.01 24"	End Pipe N 50002.8 E 104400.0		
M-2B	Std. Precast Manhole	408.70	408.20	416.0		Ho. Co. Std. G 5.13 5'	N 518 086.3 E 136 409.0		
S-1A	Concrete End Section	407.04	407.5			Ho. Co. Std. SD 5.51 30"	N 50002.8 E 104400.0		
S-1B	End Pipe		413.5				N 50002.8 E 104400.0		
M-2	Std. Precast Manhole	425.50	425.00	431.5		Ho. Co. Std. G 5.13 5'	N 50002.8 E 104400.0		
M-3	Std. Precast Manhole	425.50	425.00	426.5		Ho. Co. Std. G 5.13 5'	N 50002.8 E 104400.0		
M-4	Std. Precast Manhole	425.50	425.00	450.0		Ho. Co. Std. G 5.13 5'	N 50002.8 E 104400.0		
M-5	Std. Precast Manhole	440.75	440.20	455.0		Ho. Co. Std. G 5.13 5'	N 50002.8 E 104400.0		
I-6	A-10 Inlet	441.7	441.5	451.2	451.00	Ho. Co. Std. SD 4.02 W=2'-0"	LFC 131 855 20' Lt. Rd. B		
I-7	A-10 Inlet	441.7	441.5	451.2	451.00	Ho. Co. Std. SD 4.02 W=2'-0"	RFC 131 855 20' Lt. Rd. B		
M-8	Std. Precast Manhole	443.7	443.5	454.5		Ho. Co. Std. G 5.13 5'	N 50002.8 E 104400.0		
M-8	Std. Precast Manhole	443.7	443.5	450.2		Ho. Co. Std. G 5.13 5'	N 50002.8 E 104400.0		
I-15	A-10 Inlet	440.7	440.5	452.0	452.0	Ho. Co. Std. SD 4.01 W=2'-0"	LFC 10+50.00 20' Lt. Rd. B		
I-16	A-15 Inlet	447.7	447.5	452.4	451.8	Ho. Co. Std. SD 4.02 W=2'-0"	RFC 4+05.00 30' Lt. Rd. A		
I-17	A-10 Inlet	447.7	447.5	450.5	450.5	Ho. Co. Std. SD 4.02 W=2'-0"	RFC 3+22.5 30' Lt. Rd. A		
I-18	A-15 Inlet	448.5	448.5	452.4	451.8	Ho. Co. Std. SD 4.02 W=2'-0"	LFC 4+05.00 30' Lt. Rd. A		
S-26	Metal End Section	410.20	410.20			Ho. Co. Std. SD 5.01 10"	End Pipe N 50002.8 E 104400.0		
I-26	18" Riser			410.20		See detail sheet 14 of	Structure N 50002.8 E 104400.0		
S-27	Metal End Section	407.05	407.0			Ho. Co. Std. SD 5.01 12"	End Pipe N 50002.8 E 104400.0		
I-28	18" Riser			408.0		See detail sheet 14 of	Structure N 50002.8 E 104400.0		



□ All inverts to be fully developed, except at M-2.

* See Trash Rack grate details, Sheet 10
Invert is not developed.

STR. NR.	L.	W.	D ₅₀	THICKNESS	SHA CL.	*
S-25	20'	20'	9 1/2"	19"	I	1.0'
S-27	20'	20'	9 1/2"	19"	I	1.0'
S-1A	30'	23'	10"	32"	II	Varies

1.5' at pipe outlet
1.0' at end of Rip Rap

PIPE SCHEDULE		
SIZE	TYPE	LENGTH
12"	PVC SCHEDULE 40	50 L.F.
15"	RCP CL. IV	12 L.F.
15"	RCP CL. IV	254 L.F.
18"	RCP CL. IV	202 L.F.
30"	RCP CL. IV	230 L.F.
Temp. 24"	AL ₂ CSP 1G qa.	32 L.F.
Temp. 12"	BCCMP 1G qa.	55 L.F.
Temp. 10"	BCCMP 1G qa.	60 L.F.

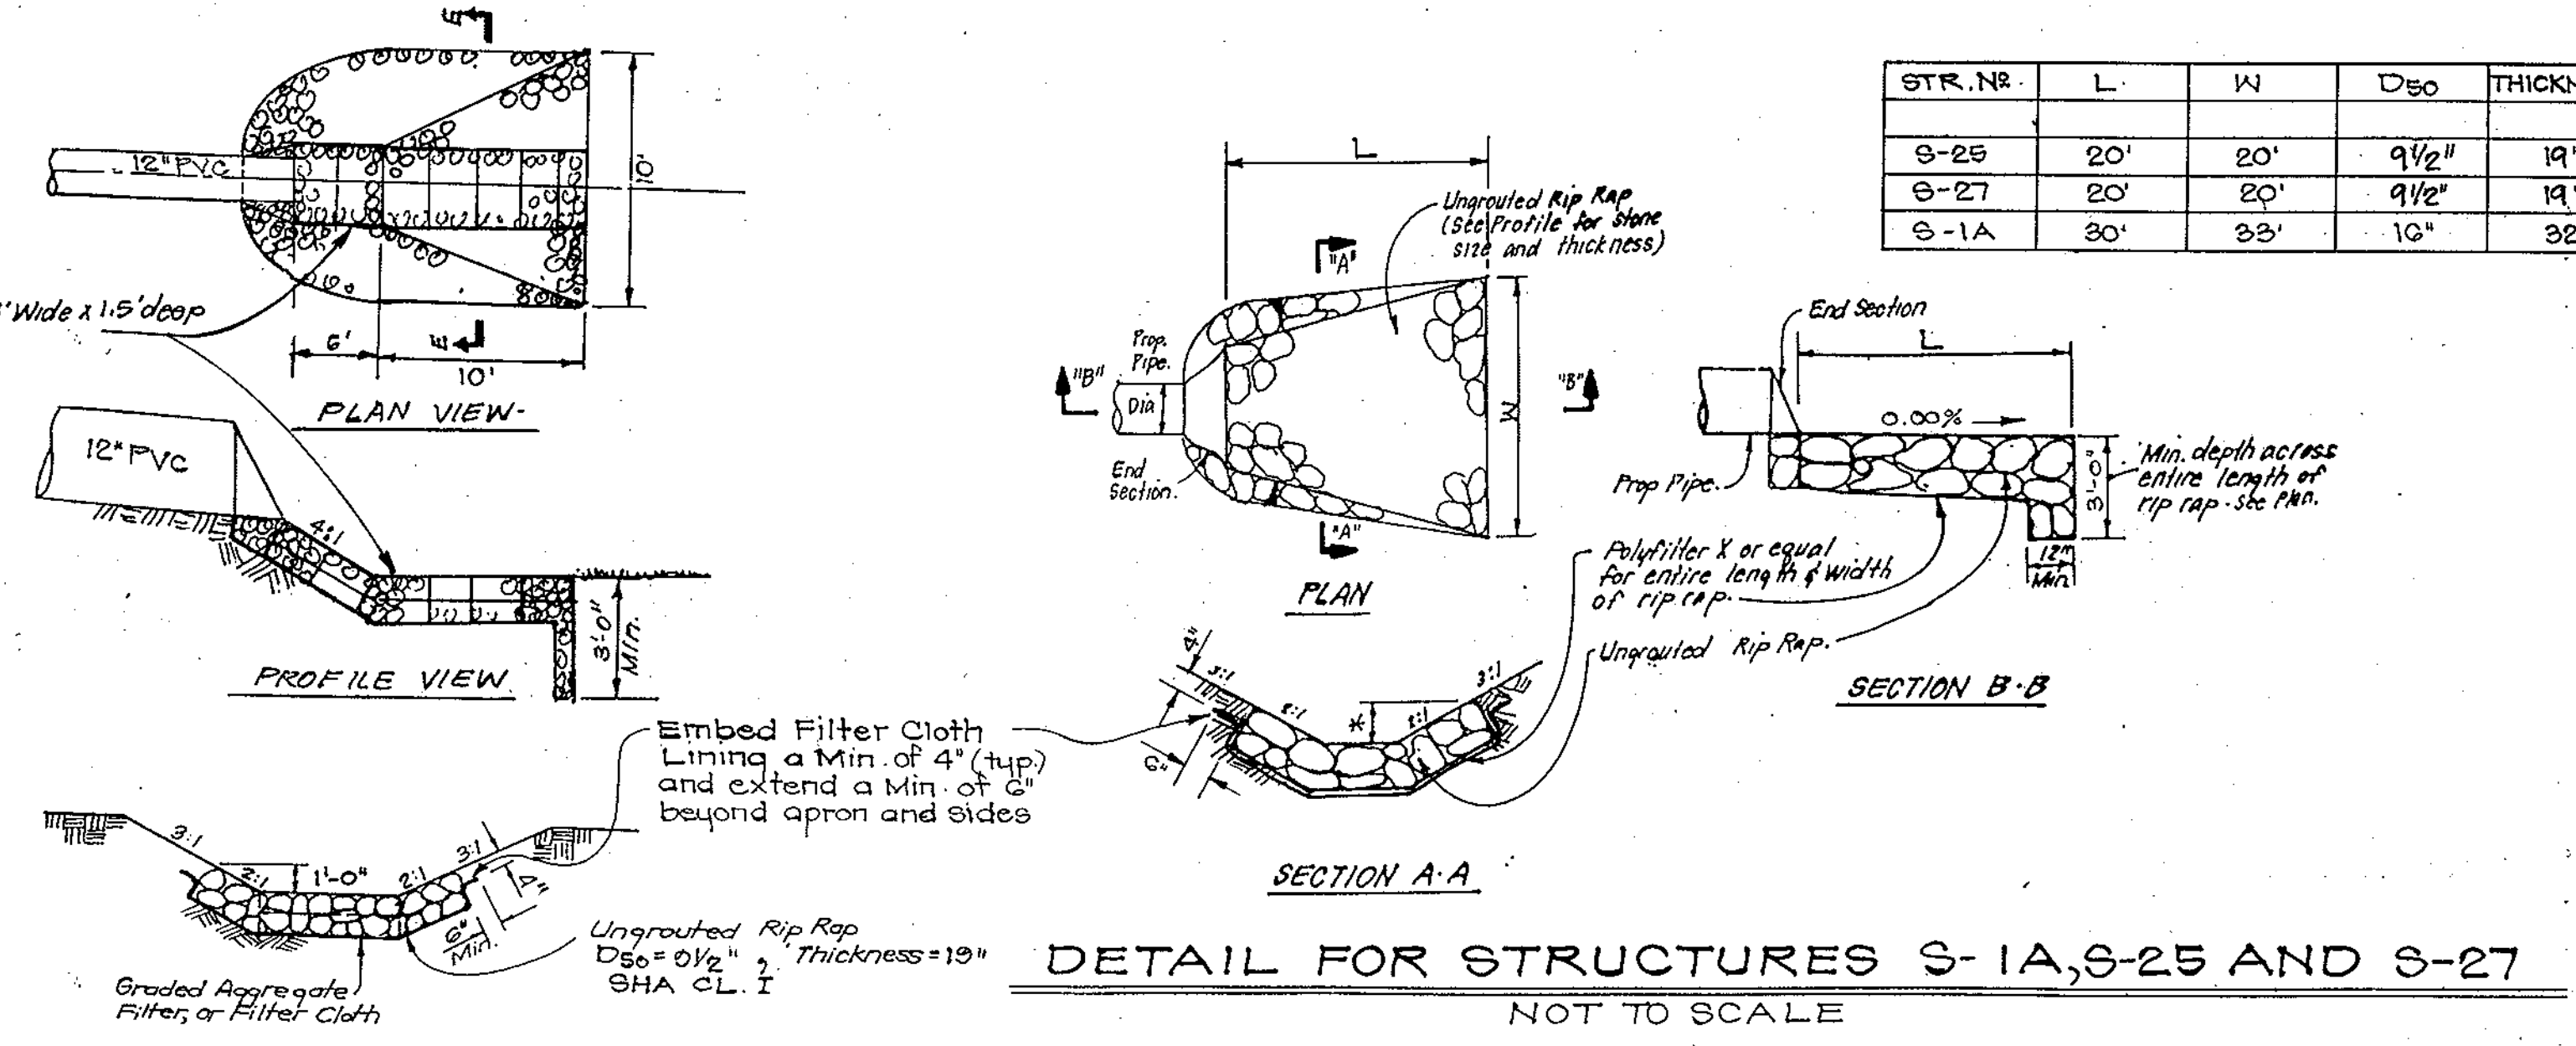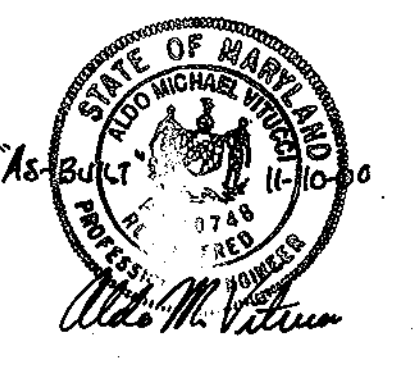

DETAIL FOR STRUCTURES S-1A, S-25 AND S-27
NOT TO SCALE

STRUCTURE #S-1B
UNGRADED RIP-RAP DETAIL
NO SCALE

DEVELOPER'S/BUILDER'S CERTIFICATE
I/We certify that all development and construction will be done according to this plan of development and plan for sediment and erosion control and that all responsible personnel involved in the construction project will have a Certificate of Attendance at a Department of the Environment approved 14-day Training Program for the Control of Sediment and Erosion before beginning the project. I also authorize periodic on-site inspection by the Howard Soil Conservation District or their authorized agents, as are deemed necessary.

John Gudelsky
DATE: 1/4/96

Reviewed for: HOWARD S.C.D.
and meets Technical Requirements
Signature: [Signature] Date: 1/19/96
Natural Resources Conservation Service

THIS DEVELOPMENT PLAN IS APPROVED FOR SOIL EROSION AND SEDIMENT CONTROL BY THE HOWARD NATURAL RESOURCES CONSERVATION SERVICE.
Signature: [Signature] Date: 1/19/96
Approved

APPROVED: DEPARTMENT OF PUBLIC WORKS
Signature: [Signature] Date: 1-30-96
Chief, Bureau of Highways

APPROVED: DEPARTMENT OF PLANNING AND ZONING
Signature: [Signature] Date: 2/6/96
Chief, Division of Land Development and Research


Signature: [Signature] Date: 2/1/96
Chief, Development Engineering Division

CLARK • FINEFROCK & SACKETT, INC.
ENGINEERS • PLANNERS • SURVEYORS
7135 MINSTREL WAY • COLUMBIA, MD. 21045 • (410) 381-7500 - BALTO. • (301) 621-8100 - WASH.



DESIGNED KIWM	SCALE AS SHOWN
DRAWN AK	DRAWING 9 of 20
CHECKED AK	JOB NO. 04-208
DATE 12-27-95	FILE NO. 04-203D

STORM DRAINAGE PROFILES AND DETAILS
DANIELS MILL OVERLOOK
TAX MAP 17 PART OF PARCEL 41
SECOND ELECTION DISTRICT
HOWARD COUNTY, MARYLAND
FOR: HOWARD COUNTY BOARD OF EDUCATION
10910 ROUTE 103
ELLICOTT CITY, MARYLAND 21042

ENGINEER'S CERTIFICATE
I hereby certify that this plan for Sediment and Erosion Control represents a practical and workable plan based on my personal knowledge of the site conditions and that it was prepared in accordance with the requirements of the Howard Soil Conservation District.
G. NELSON CLARK
DATE: 1-9-96

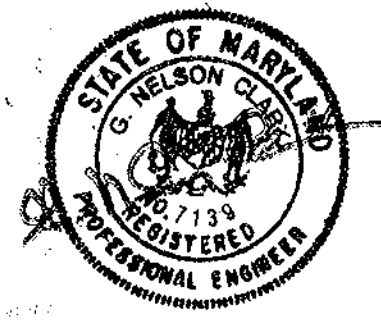

1783

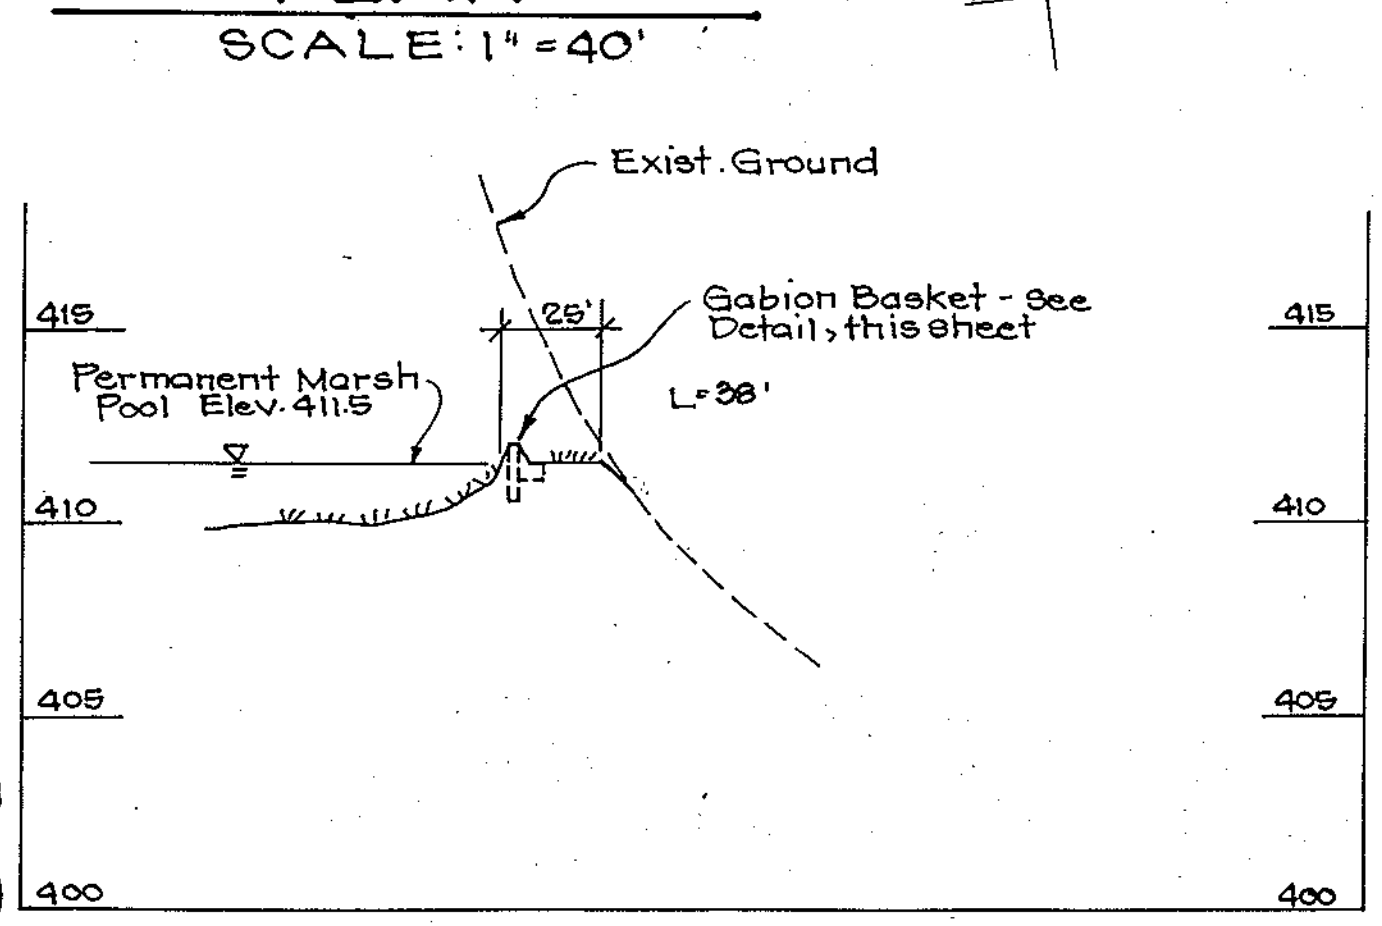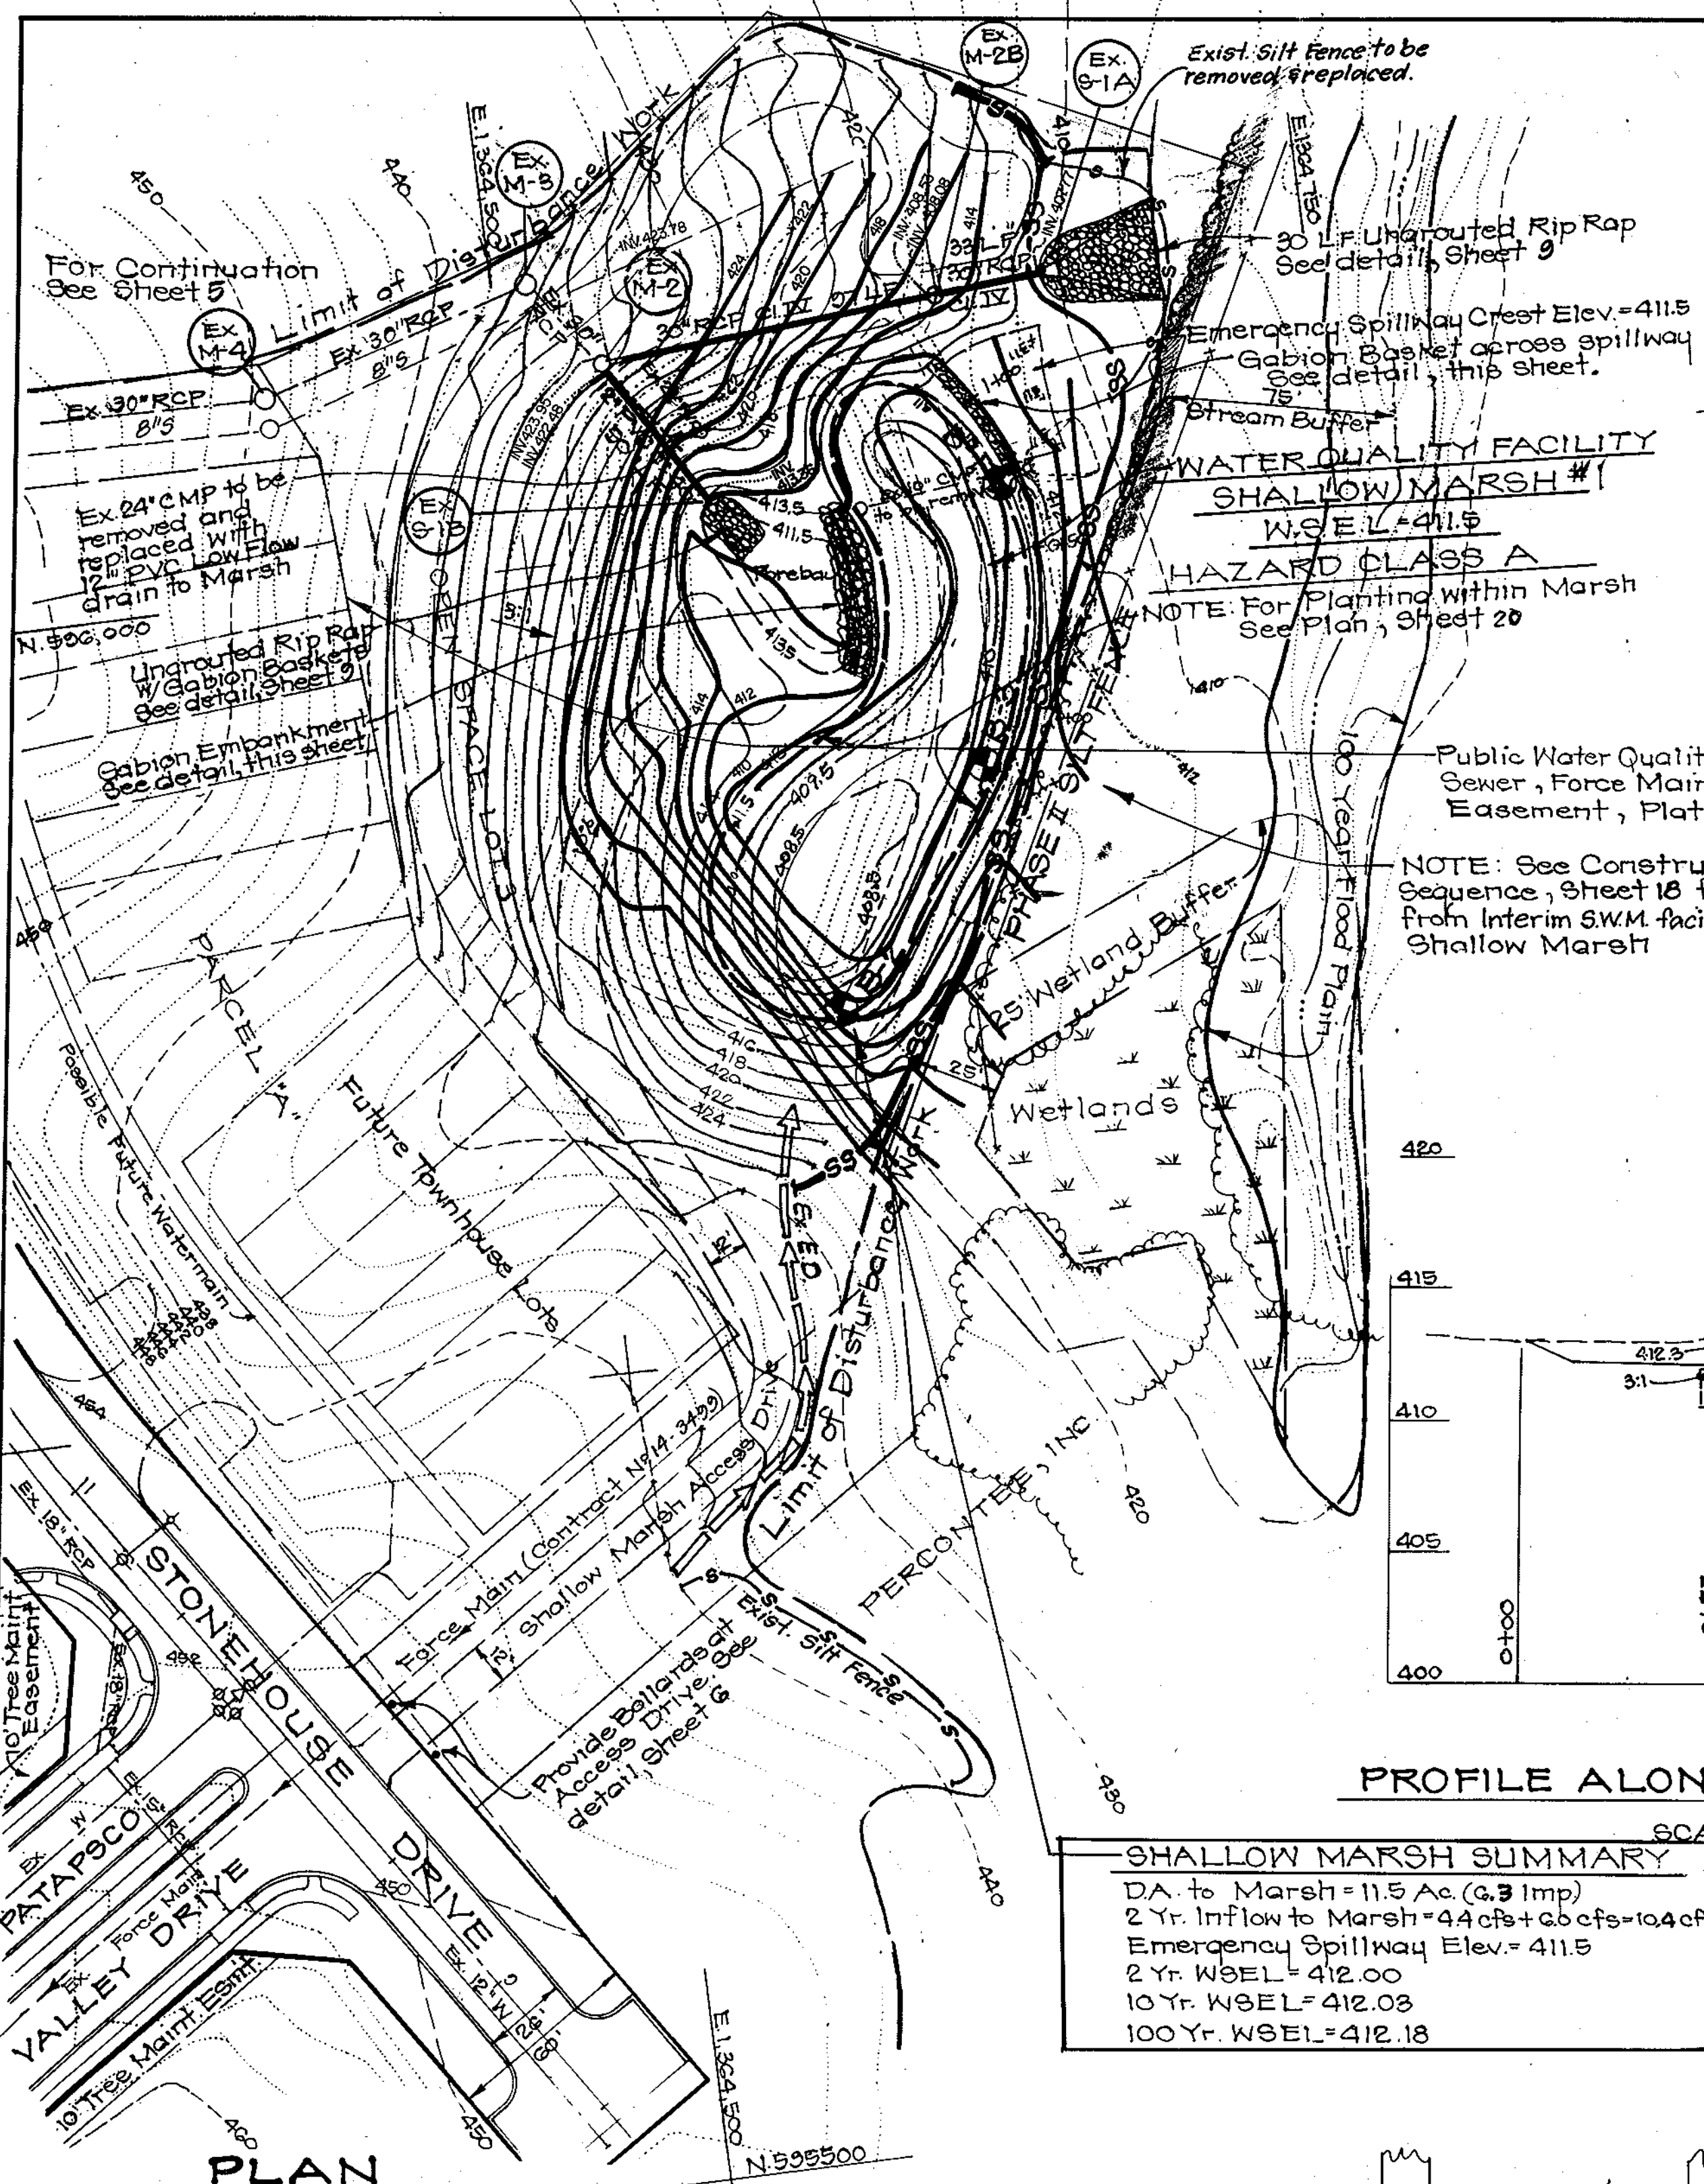

SHALLOW MARSH SUMMARY

DA. to Marsh = 11.5 Ac. (2.9 Imp)

2 Yr. Inflow to Marsh = 44 cfs + 66 cfs = 110 cfs

Emergency Spillway Elev. = 411.5


2 Yr. WSEL = 412.00

10 Yr. WSEL = 412.03

100 Yr. WSEL = 412.18

TRASH RACK NOTES

- Removable trash rack is to be placed on the bolted angle and is to rest against the side of the structure at a 45° angle as shown. Removal of the trash rack will allow access to the bottom of the structure for maintenance.
- Trash racks are to lay angled as shown to prevent accumulation of debris in front of the outgoing shallow marsh pipe.
- 3'x3' L's to be placed 1 ft. back from the struct. side wall.
- All rebar to be #5 at 6" unless otherwise noted.
- All rebar to be painted Battleship Gray.
- Trash rack to be galvanized after fabrication.
- Structure M-2 is to be a standard precast manhole without channeling. See Ho. Co. Std. G-5.13 for details not shown.

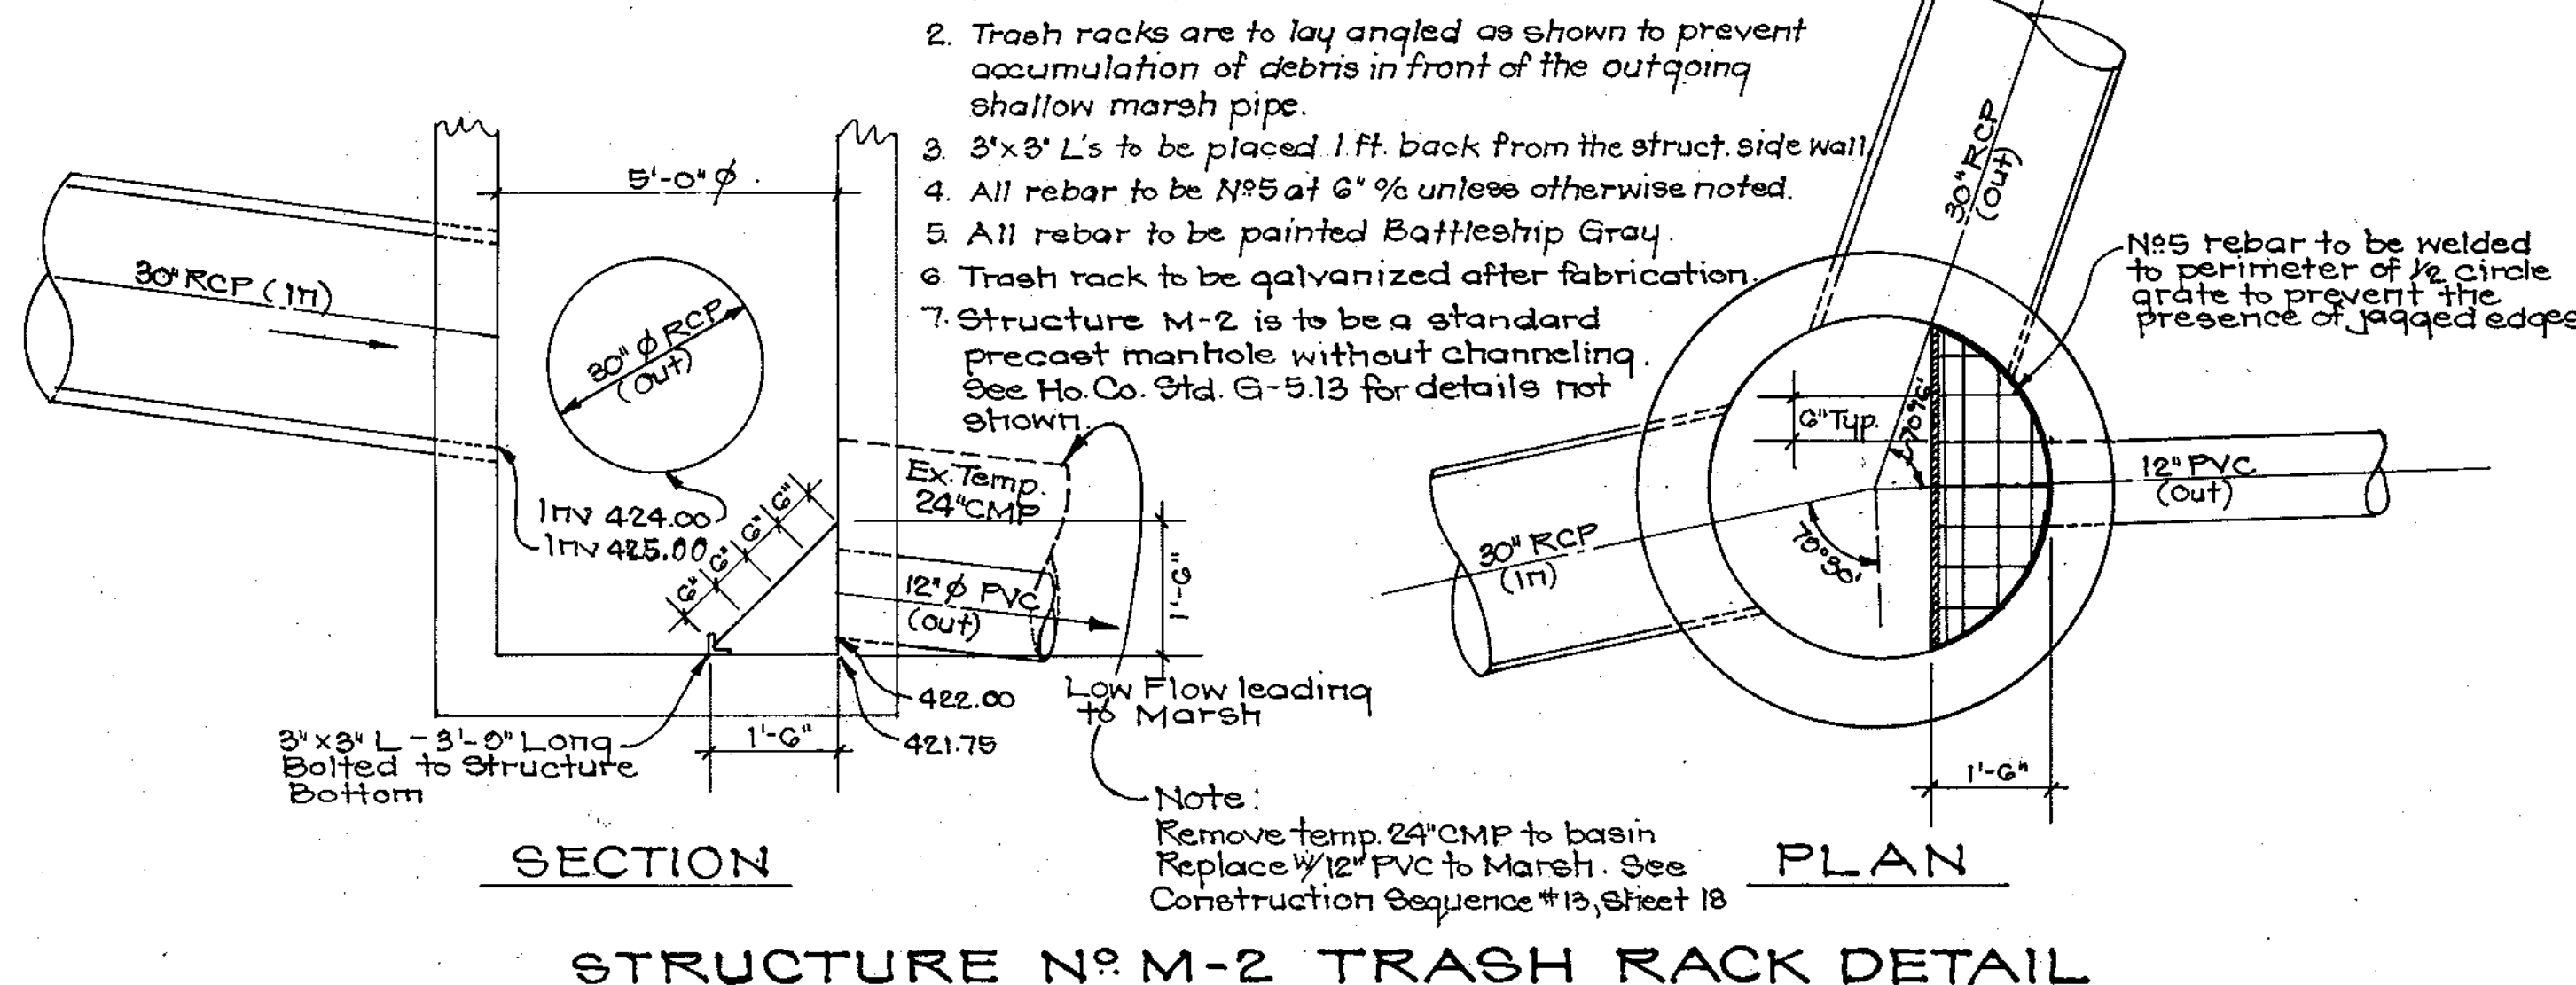




See Sheet 11 for Water Quality Construction Specifications (378 Pond Specs)

HOMEOWNER'S ASSOCIATION RESPONSIBLE FOR OPERATION, MAINTENANCE & INSPECTION

Inspection of the Shallow Marsh shown hereon shall be performed at least annually, in accordance with the checklist and requirements contained within USDA, 909 Standards and Specifications for Ponds (MD-378) The Shallow Marsh owner(s) and any heirs, successors, or assigns shall be responsible for the safety of the marsh and the continued operation, surveillance, inspection and maintenance thereof. The pond owner(s) shall promptly notify the Ho. Co. Dept. of Public Works of any unusual observations that may be indications of distress such as excessive seepage, turbid seepage, sliding or slumping.

HOMEOWNER'S ASSOCIATION MAINTENANCE RESPONSIBILITIES FOR SHALLOW MARSH


- Inspect forebay after each storm. If sediment buildup exceeds four (4) inches, notify the Department of Public Works, Bureau of Highways to facilitate cleanout operations.
- Removal of accumulated paper, trash and debris after every storm as necessary.
- Annual inspection and repair of the gabion structures as needed.
- Vegetation growing on the embankment top or faces is not allowed to exceed 18 inches in height at any time.
- Corrective maintenance is required any time the forebay does not drain down to the designed surface elevation within 60 hours.
- NOTE: This facility is to be jointly maintained by the H.O.A. for Daniels Mill Overlook and the Department of Public Works.

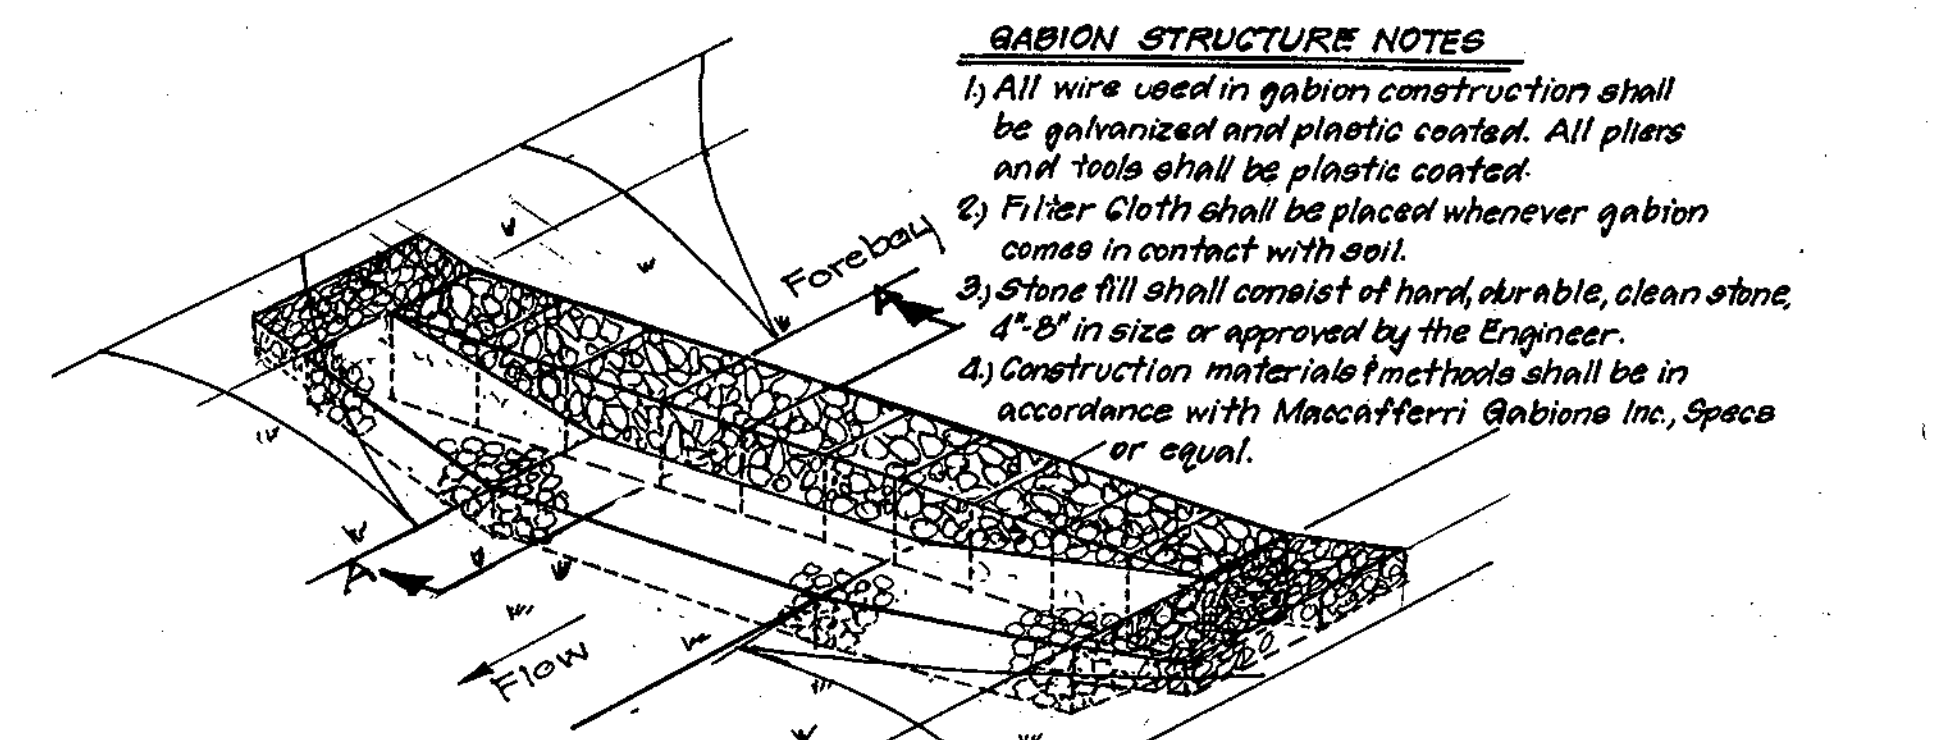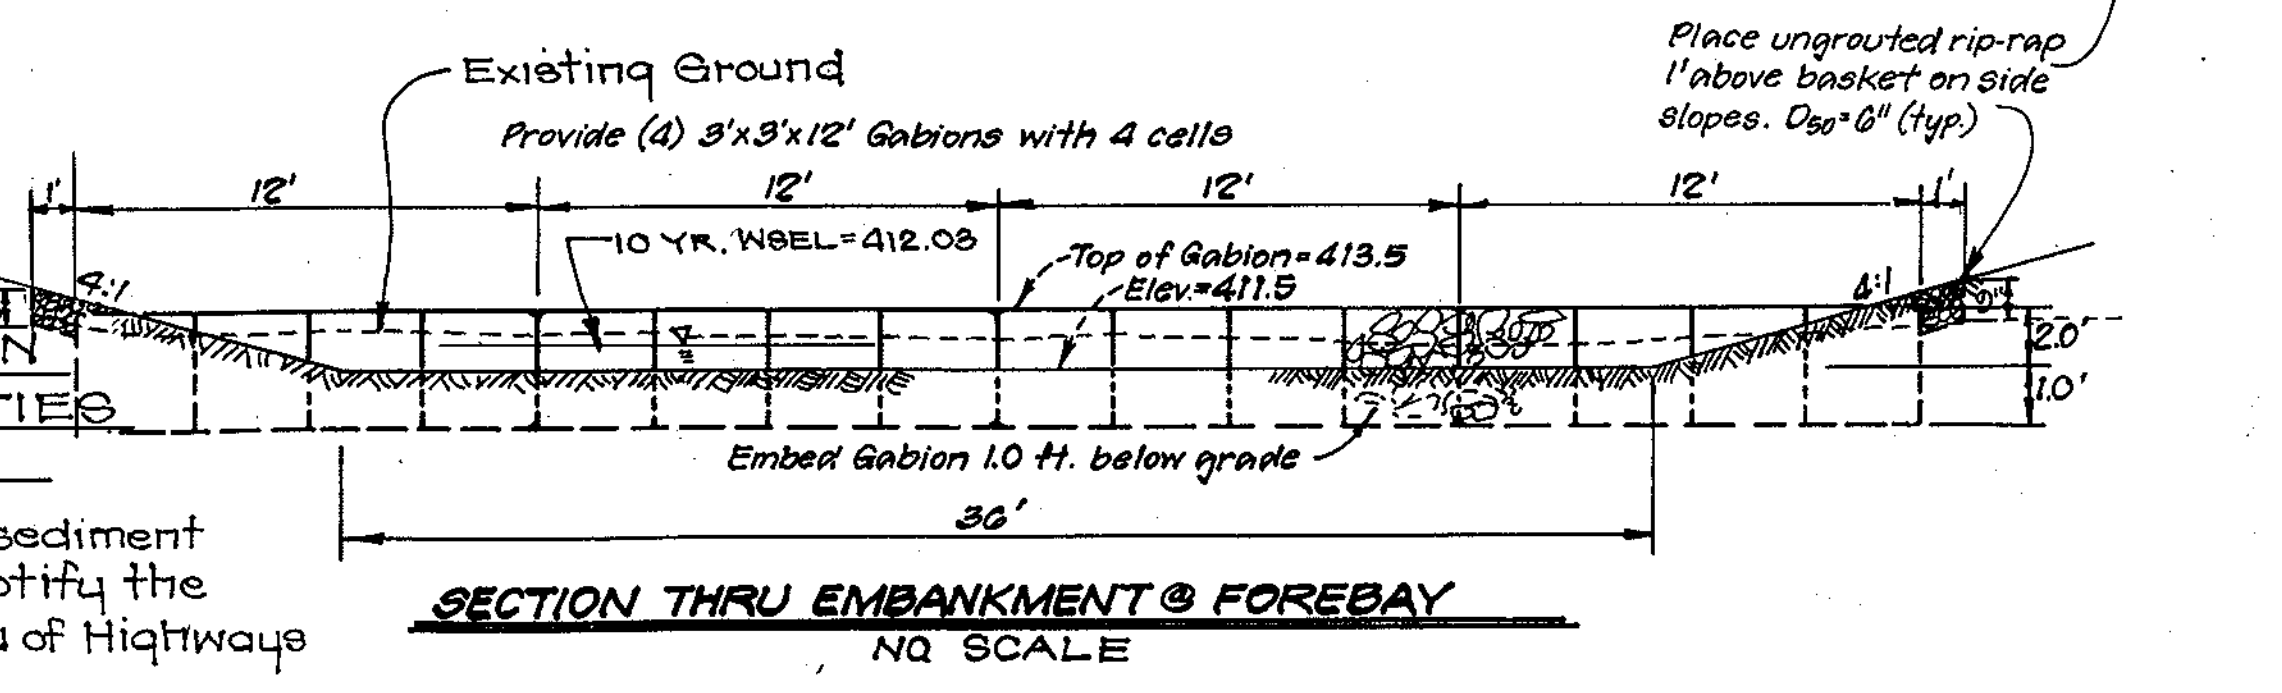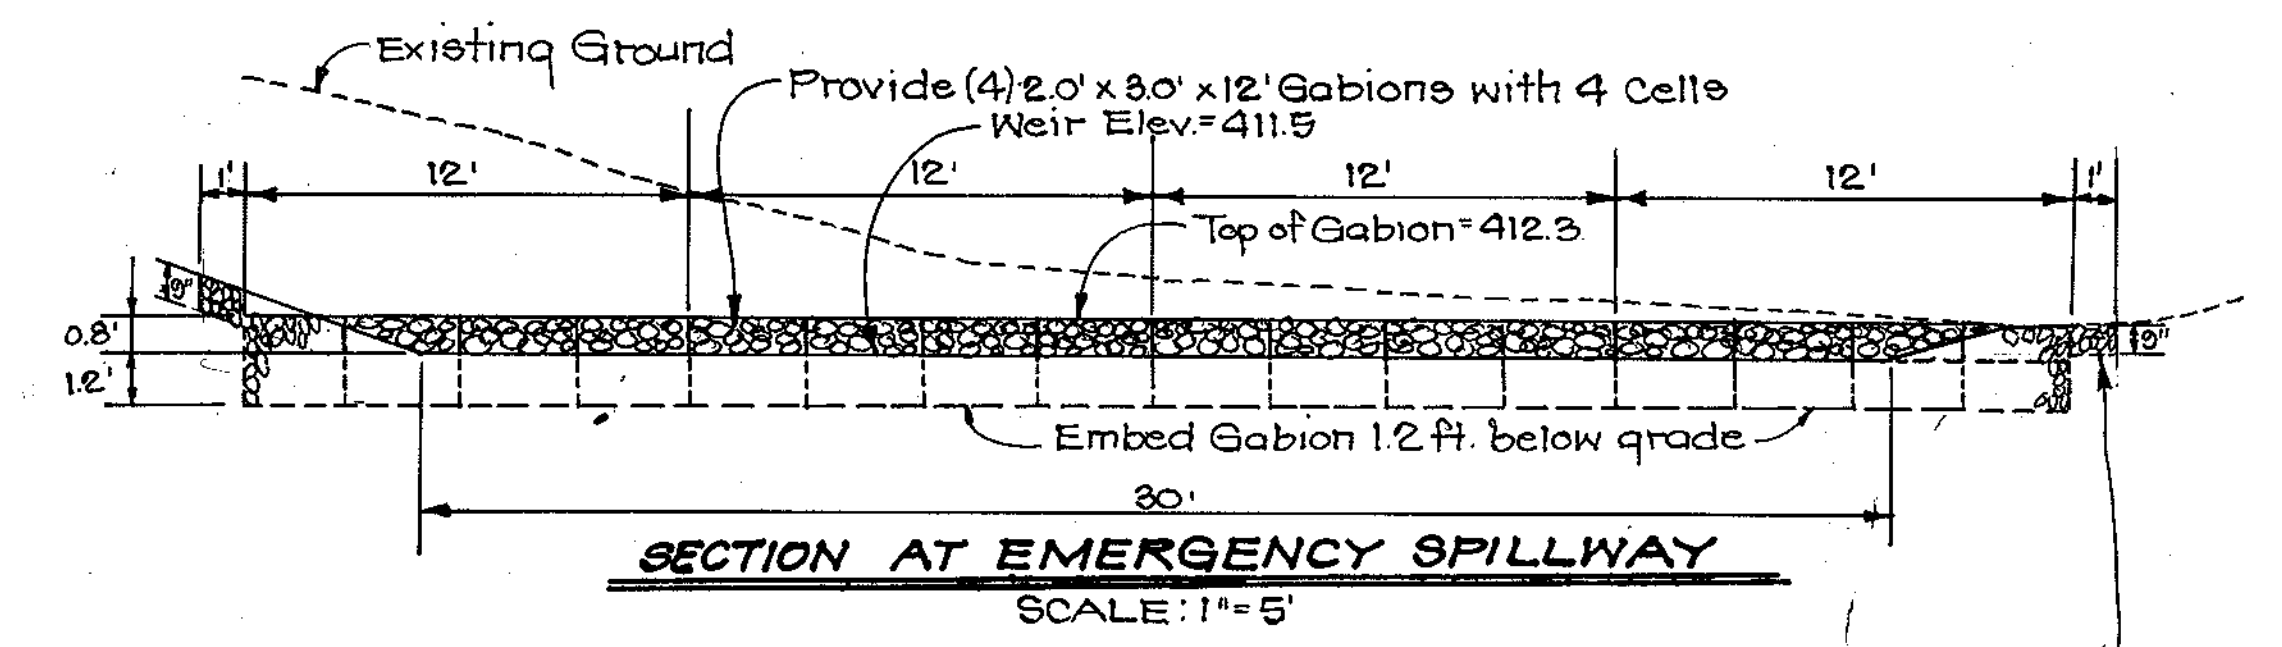

GABION STRUCTURE NOTES

- All wire used in gabion construction shall be galvanized and plastic coated. All pliers and tools shall be plastic coated.
- Filter Cloth shall be placed whenever gabion comes in contact with soil.
- Stone fill shall consist of hard, durable, clean stone 4" to 8" in size or approved by the Engineer.
- Construction materials & methods shall be in accordance with Maccaferri Gabions Inc. Specs or equal.

ISOMETRIC VIEW N.T.S.

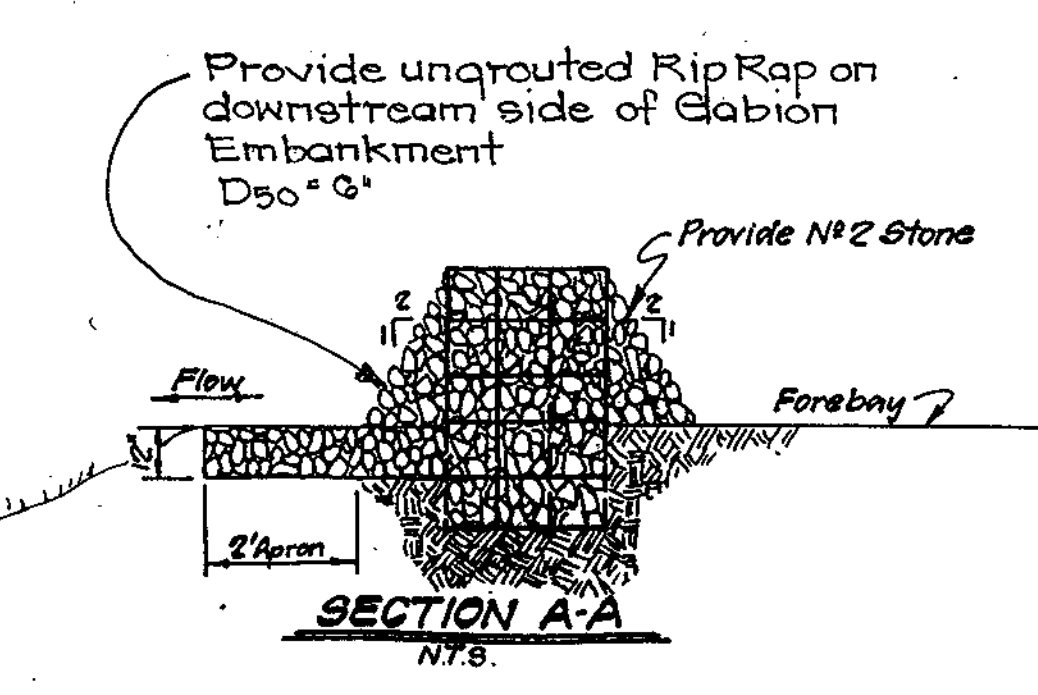

SECTION A-A N.T.S.

DEVELOPER'S/BUILDER'S CERTIFICATE

I/We certify that all development and construction will be done according to this plan of development and plan for sediment and erosion control and that all responsible personnel involved in the construction project will have a Certificate of Attendance at a Department of the Environment Approved Training Program for the Control of Sediment and Erosion before beginning the project. I also authorize periodic on-site inspection by the Howard Soil Conservation District or their authorized agents, as are deemed necessary.

John Gudelsky 1/11/96

ENGINEER'S CERTIFICATE

I hereby certify that this plan for Sediment and Erosion Control represents a practical and workable plan based on my personal knowledge of the site conditions and that it was prepared in accordance with the requirements of the Howard Soil Conservation District.

G. NELSON CLARK 1-9-96

APPROVED: DEPARTMENT OF PUBLIC WORKS

Richard M. Daniels 1-30-96

Chief, Bureau of Highways

APPROVED: DEPARTMENT OF PLANNING AND ZONING

Aime Summerville 2/2/96

Chief, Division of Land Development and Research

APPROVED: DEPARTMENT OF PLANNING AND ZONING

Chief, Development Engineering Division



Reviewed for HOWARD S.C.D. and meets Technical Requirements

Signature: [Signature] Date: 1/11/96

Natural Resources Conservation Service

THIS DESIGN PLAN IS APPROVED FOR SOIL EROSION AND SEDIMENT CONTROL BY THE NATURAL RESOURCES CONSERVATION SERVICE

CLARK • FINEBROCK & SACKETT, INC.
ENGINEERS • PLANNERS • SURVEYORS

7135 MINSTREL WAY • COLUMBIA, MD. 21045 • (410) 381-7600 - BALTO. • (301) 821-8100 - WASH.

DESIGNED KIWM	WATER QUALITY FACILITY / SHALLOW MARSH PLAN, PROFILES AND DETAILS DANIELS MILL OVERLOOK TAX MAP 17 PART OF PARCEL 41 SECOND (2ND) ELECTION DISTRICT HOWARD COUNTY, MARYLAND	SCALE AS SHOWN
DRAWN		DRAWING 100P20
CHECKED		JOB NO. 04-203
DATE 12-27-95		FILE NO. 04-203D
		FOR: HOWARD COUNTY BOARD OF EDUCATION 10010 ROUTE 108 ELLIGOTT CITY, MARYLAND 21042

1783

WATER QUALITY CONSTRUCTION SPECIFICATIONS

SPECIFICATIONS

These specifications are appropriate to all ponds within the scope of the Standard for practice MD-370. All references to ASTM and AASHTO specifications apply to the most recent version.

Site Preparation

Areas designated for borrow areas, embankment, and structural works shall be cleared, grubbed and stripped of topsoil. All trees, vegetation, roots and other objectionable material shall be removed. Channel banks and sharp breaks shall be sloped to no steeper than 1:1.

Areas to be covered by the reservoir will be cleared of all trees, brush, logs, fences, rubbish and other objectionable material unless otherwise designated on the plans. Trees, brush and stumps shall be cut approximately level with the ground surface. For dry stormwater management ponds, a minimum of a 50 foot radius around the inlet structure shall be cleared.

All cleared and grubbed material shall be disposed of outside and below the limits of the dam and reservoir as directed by the owner or his representative. When specified, a sufficient quantity of topsoil will be stockpiled in a suitable location for use on the embankment and other designated areas.

Earth Fill

Material: The fill material shall be taken from approved designated borrow areas. It shall be free of roots, stumps, wood, rubbish, stones greater than 6", frozen or other objectionable materials. Fill material for the center of the embankment and cut-off trench shall conform to Unified Soil Classification SC, CH, or CL. Consideration may be given to the use of other materials in the embankment if design and construction are supervised by a geotechnical engineer.

Placement: Areas on which fill is to be placed shall be scarified prior to placement of fill. Fill materials shall be placed in maximum 8 inch thick (before compaction) layers which are to be continuous over the entire length of the fill. The most permeable borrow material shall be placed in the downstream portions of the embankment. The principal spillway must be installed concurrently with fill placement and not excavated into the embankment.

Connection: The movement of the hauling and spreading equipment over the fill shall be controlled

1. **Materials - (Steel Pipe)** - This pipe and its appurtenances shall be galvanized and fully bituminous coated and shall conform to the requirements of AASHTO Specification M-190 Type A with watertight coupling bands. Any bituminous coating damaged or otherwise removed shall be replaced with cold applied bituminous coating compound. Steel pipes with polymeric coatings shall have a minimum coating thickness of 0.01 inch (10 mil) on both sides of the pipe. The following coatings or an approved equal may be used: Nexon, Plasti-Cote, Blac-Klad, and Beth-Cu-Loy. Coated corrugated steel pipe shall meet the requirements of AASHTO M-245 and M-246.

Materials - (Aluminum Coated Steel Pipe) - This pipe and its appurtenances shall conform to the requirements of AASHTO Specification M-274 with watertight coupling bands or flanges. Any aluminum coating damaged or otherwise removed shall be replaced with cold applied bituminous coating compound.

Materials - (Aluminum Pipe) - This pipe and its appurtenances shall conform to the requirements of AASHTO Specification M-196 or M-211 with watertight coupling bands or flanges. Aluminum surfaces that are to be in contact with concrete shall be painted with one coat of zinc chromate primer. Hot dip galvanized bolts may be used for connections. The pH of the surrounding soils shall be between 4 and 9.

2. **Coupling bands, anti-seep collars, end sections, etc.,** must be composed of the same material as the pipe. Metals must be insulated from dissimilar materials with use of rubber or plastic insulating materials at least 24 mils in thickness.

3. **Connections** - All connections with pipes must be completely watertight. The drain pipe or barrel connection to the riser shall be welded all around when the pipe and riser are metal. Anti-seep collars shall be connected to the pipe in such a manner as to be completely watertight. Diplo bands are not considered to be watertight.

All connections shall use a rubber or neoprene gasket when joining pipe sections. The end of each pipe shall be re-rolled an adequate number of corrugations to accommodate the band width. The following type connections are acceptable for pipes less than 24" in diameter: flanges on both ends of the pipe, a 12" wide standard lap type band with 12" wide by 3/8" thick closed cell circular

so that the entire surface of each lift shall be traversed by not less than one tread track of the equipment or compaction shall be achieved by a minimum of four complete passes of a sheepfoot, rubber tired or vibratory roller. Fill material shall contain sufficient moisture such that the required degree of compaction will be obtained with the equipment used. The fill material shall contain sufficient moisture so that if formed into a ball it will not crumble yet not be so wet that water can be squeezed out.

Where a minimum required density is specified, it shall not be less than 95% of maximum dry density with a moisture content within $\pm 2\%$ of the optimum. Each layer of fill shall be compacted as necessary to obtain that density, and is to be certified by the Engineer at the time of construction. All compaction is to be determined by AASHTO Method T-99.

Cut Off Trench: The cutoff trench shall be excavated into impervious material along or parallel to the centerline of the embankment as shown on the plans. The bottom width of the trench shall be governed by the equipment used for excavation, with the minimum width being four feet. The depth shall be at least four feet below existing grade or as shown on the plans. The side slopes of the trench shall be 1 to 1 or flatter. The backfill shall be compacted with construction equipment, rollers, or hand tampers to assure maximum density and minimum permeability.

Structure Backfill

Backfill adjacent to pipes or structures shall be of the type and quality conforming to that specified for the adjoining fill material. The fill shall be placed in horizontal layers not to exceed four inches in thickness and compacted by hand tampers or other manually directed compaction equipment. The material needs to fill completely all spaces under and adjacent to the pipe. At no time during the backfilling operation shall driven equipment be allowed to operate closer than four feet, measured horizontally, to any part of a structure. Under no circumstances shall equipment be driven over any part of a concrete structure or pipe, unless there is a compacted fill of 24" or greater over the structure or pipe.

Pipe Conduits

All pipes shall be circular in cross section.

Corrugated Metal Pipe: All of the following criteria shall apply for corrugated metal pipe:

1. **Materials** - Heli-cally corrugated pipe shall have either continuously welded seams or have lead seams with internal caulking or a neoprene bead.

4. **Bedding** - The pipe shall be firmly and uniformly bedded throughout its entire length. Where rock or soft, spongy or other unstable soil is encountered, all such material shall be removed and replaced with suitable earth compacted to provide adequate support.

5. **Backfilling** shall conform to "Structure Backfill."

6. **Other details** (anti-seep collars, valves, etc.) shall be as shown on the drawings.

Reinforced Concrete Pipe: All of the following criteria shall apply for reinforced concrete pipe:

1. **Materials** - Reinforced concrete pipe shall have bell and spigot joints with rubber gaskets and shall equal or exceed ASTM Designation C-361.

2. **Bedding** - All reinforced concrete pipe conduits shall be laid in a concrete bedding for their entire length. This bedding shall consist of high slump concrete placed under the pipe and up the sides of the pipe at least 10% of its outside diameter with a minimum thickness of 3 inches, or as shown on the drawings.

3. **Laying pipe** - Bell and spigot pipe shall be placed with the bell end upstream. Joints shall be made in accordance with recommendations of the manufacturer of the material. After the joints are sealed for the entire line, the bedding shall be placed so that all spaces under the pipe are filled. Care shall be exercised to prevent any deviation from the original line and grade of the pipe. The first joint must be located within 2 feet from the riser.

4. **Backfilling** shall conform to "Structure Backfill."

5. **Other details** (anti-seep collars, valves, etc.) shall be as shown on the drawings.

Polyvinyl Chloride (PVC) Pipe: All of the following criteria shall apply for polyvinyl chloride (PVC) pipe:

1. **Materials** - PVC pipe shall be PVC-1120 or PVC-1220 conforming to ASTM D-1785 or ASTM D-2241.

2. **Joints and connections** to anti-seep collars shall be completely watertight.

3. **Bedding** - The pipe shall be firmly and uniformly bedded throughout its entire length. Where rock or soft, spongy or other unstable soil is encountered, all such material shall be removed and replaced with suitable earth compacted to provide adequate support.

4. **Backfilling** shall conform to "Structure Backfill."

5. **Other details** (anti-seep collars, valves, etc.) shall be as shown on the drawings.

Concrete

Concrete shall meet the requirements of Maryland Department of Transportation, State Highway Administration Standard Specifications for Construction and Materials, Section 608, Mix No. 3

Rock Riprap

Rock riprap shall meet the requirements of Maryland Department of Transportation, State Highway Administration Standard Specifications for Construction and Materials, Section 905.

The riprap shall be placed to the required thickness in one operation. The rock shall be delivered and placed in a manner that will insure the riprap in place shall be reasonably homogeneous with the larger rocks uniformly distributed and firmly in contact one to another with the smaller rocks filling the voids between the larger rocks. Filter cloth shall be placed under all riprap and shall meet the requirements of Maryland Department of Transportation, State Highway Administration Standard Specifications for Construction and Materials, Section 919.12.

Care of Water during Construction

All work on permanent structures shall be carried out in areas free from water. The Contractor shall construct


and maintain all temporary dikes, levees, cofferdams, drainage channels, and stream diversions necessary to protect the areas to be occupied by the permanent works. The contractor shall also furnish, install, operate, and maintain all necessary pumping and other equipment required for removal of water from the various parts of the work and for maintaining the excavations, foundation, and other parts of the work free from water as required or directed by the engineer for constructing each part of the work. After having served their purpose, all temporary protective works shall be removed or leveled and graded to the extent required to prevent obstruction in any degree whatsoever of the flow of water to the spillway or outlet works and so as not to interfere in any way with the operation or maintenance of the structure. Stream diversions shall be maintained until the full flow can be passed through the permanent works. The removal of water from the required excavation and the foundation shall be accomplished in a manner and to the extent that will maintain stability of the excavated slopes and bottom of required excavations and will allow satisfactory performance of all construction operations. During the placing and compacting of material in required excavations, the water level at the locations being refilled shall be maintained below the bottom of the excavation at such locations which may require draining the water to pumps from which the water shall be pumped.

Stabilization

All borrow areas shall be graded to provide proper drainage and left in a slightly condition. All exposed surfaces of the embankment, spillway, spoil and borrow areas, and berms shall be stabilized by seeding, liming, fertilizing and mulching in accordance with the Maryland Soil Conservation Service Standards and Specifications for Critical Area Planting (MD-342) or as shown on the accompanying drawings.

Erosion and Sediment Control

Construction operations will be carried out in such a manner that erosion will be controlled and water and air pollution minimized. State and local laws concerning pollution abatement will be followed. Construction plans shall detail erosion and sediment control measures to be employed during the construction process.

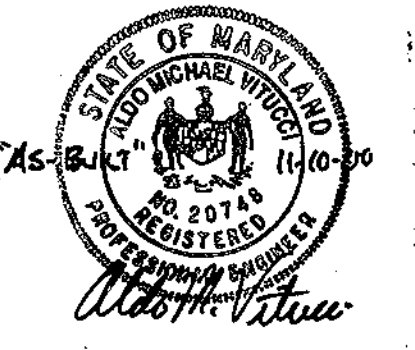

APPROVED: DEPARTMENT OF PUBLIC WORKS
Andrew M. Demello 1-30-96
 Chief, Bureau of Highways Date

APPROVED: DEPARTMENT OF PLANNING AND ZONING
Jim Swinomy 2/2/96
 Chief, Division of Land Development and Research Date


Bill Drayton 2/1/96
 Chief, Development Engineering Division Date

CLARK • FINEFROCK & SACKETT, INC.
 ENGINEERS • PLANNERS • SURVEYORS
 7135 MINSTREL WAY • COLUMBIA, MD. 21045 • (410) 381-7500 - BALTO. • (301) 621-8100 - WASH.

DESIGNED KJWM	WATER QUALITY SPECIFICATIONS	SCALE -
DRAWN [Signature]	DANIELS MILL OVERLOOK	DRAWING 11 of 20
CHECKED	TAX MAP 17 PART OF PARCEL 41	JOB NO. 04-203
DATE 12-27-95	SECOND (2ND) ELECTION DISTRICT HOWARD COUNTY, MARYLAND	FILE NO. 04-203D
	FOR HOWARD COUNTY BOARD OF EDUCATION 10010 ROUTE 108 ELLCOTT CITY, MARYLAND 21042	

1783

1783

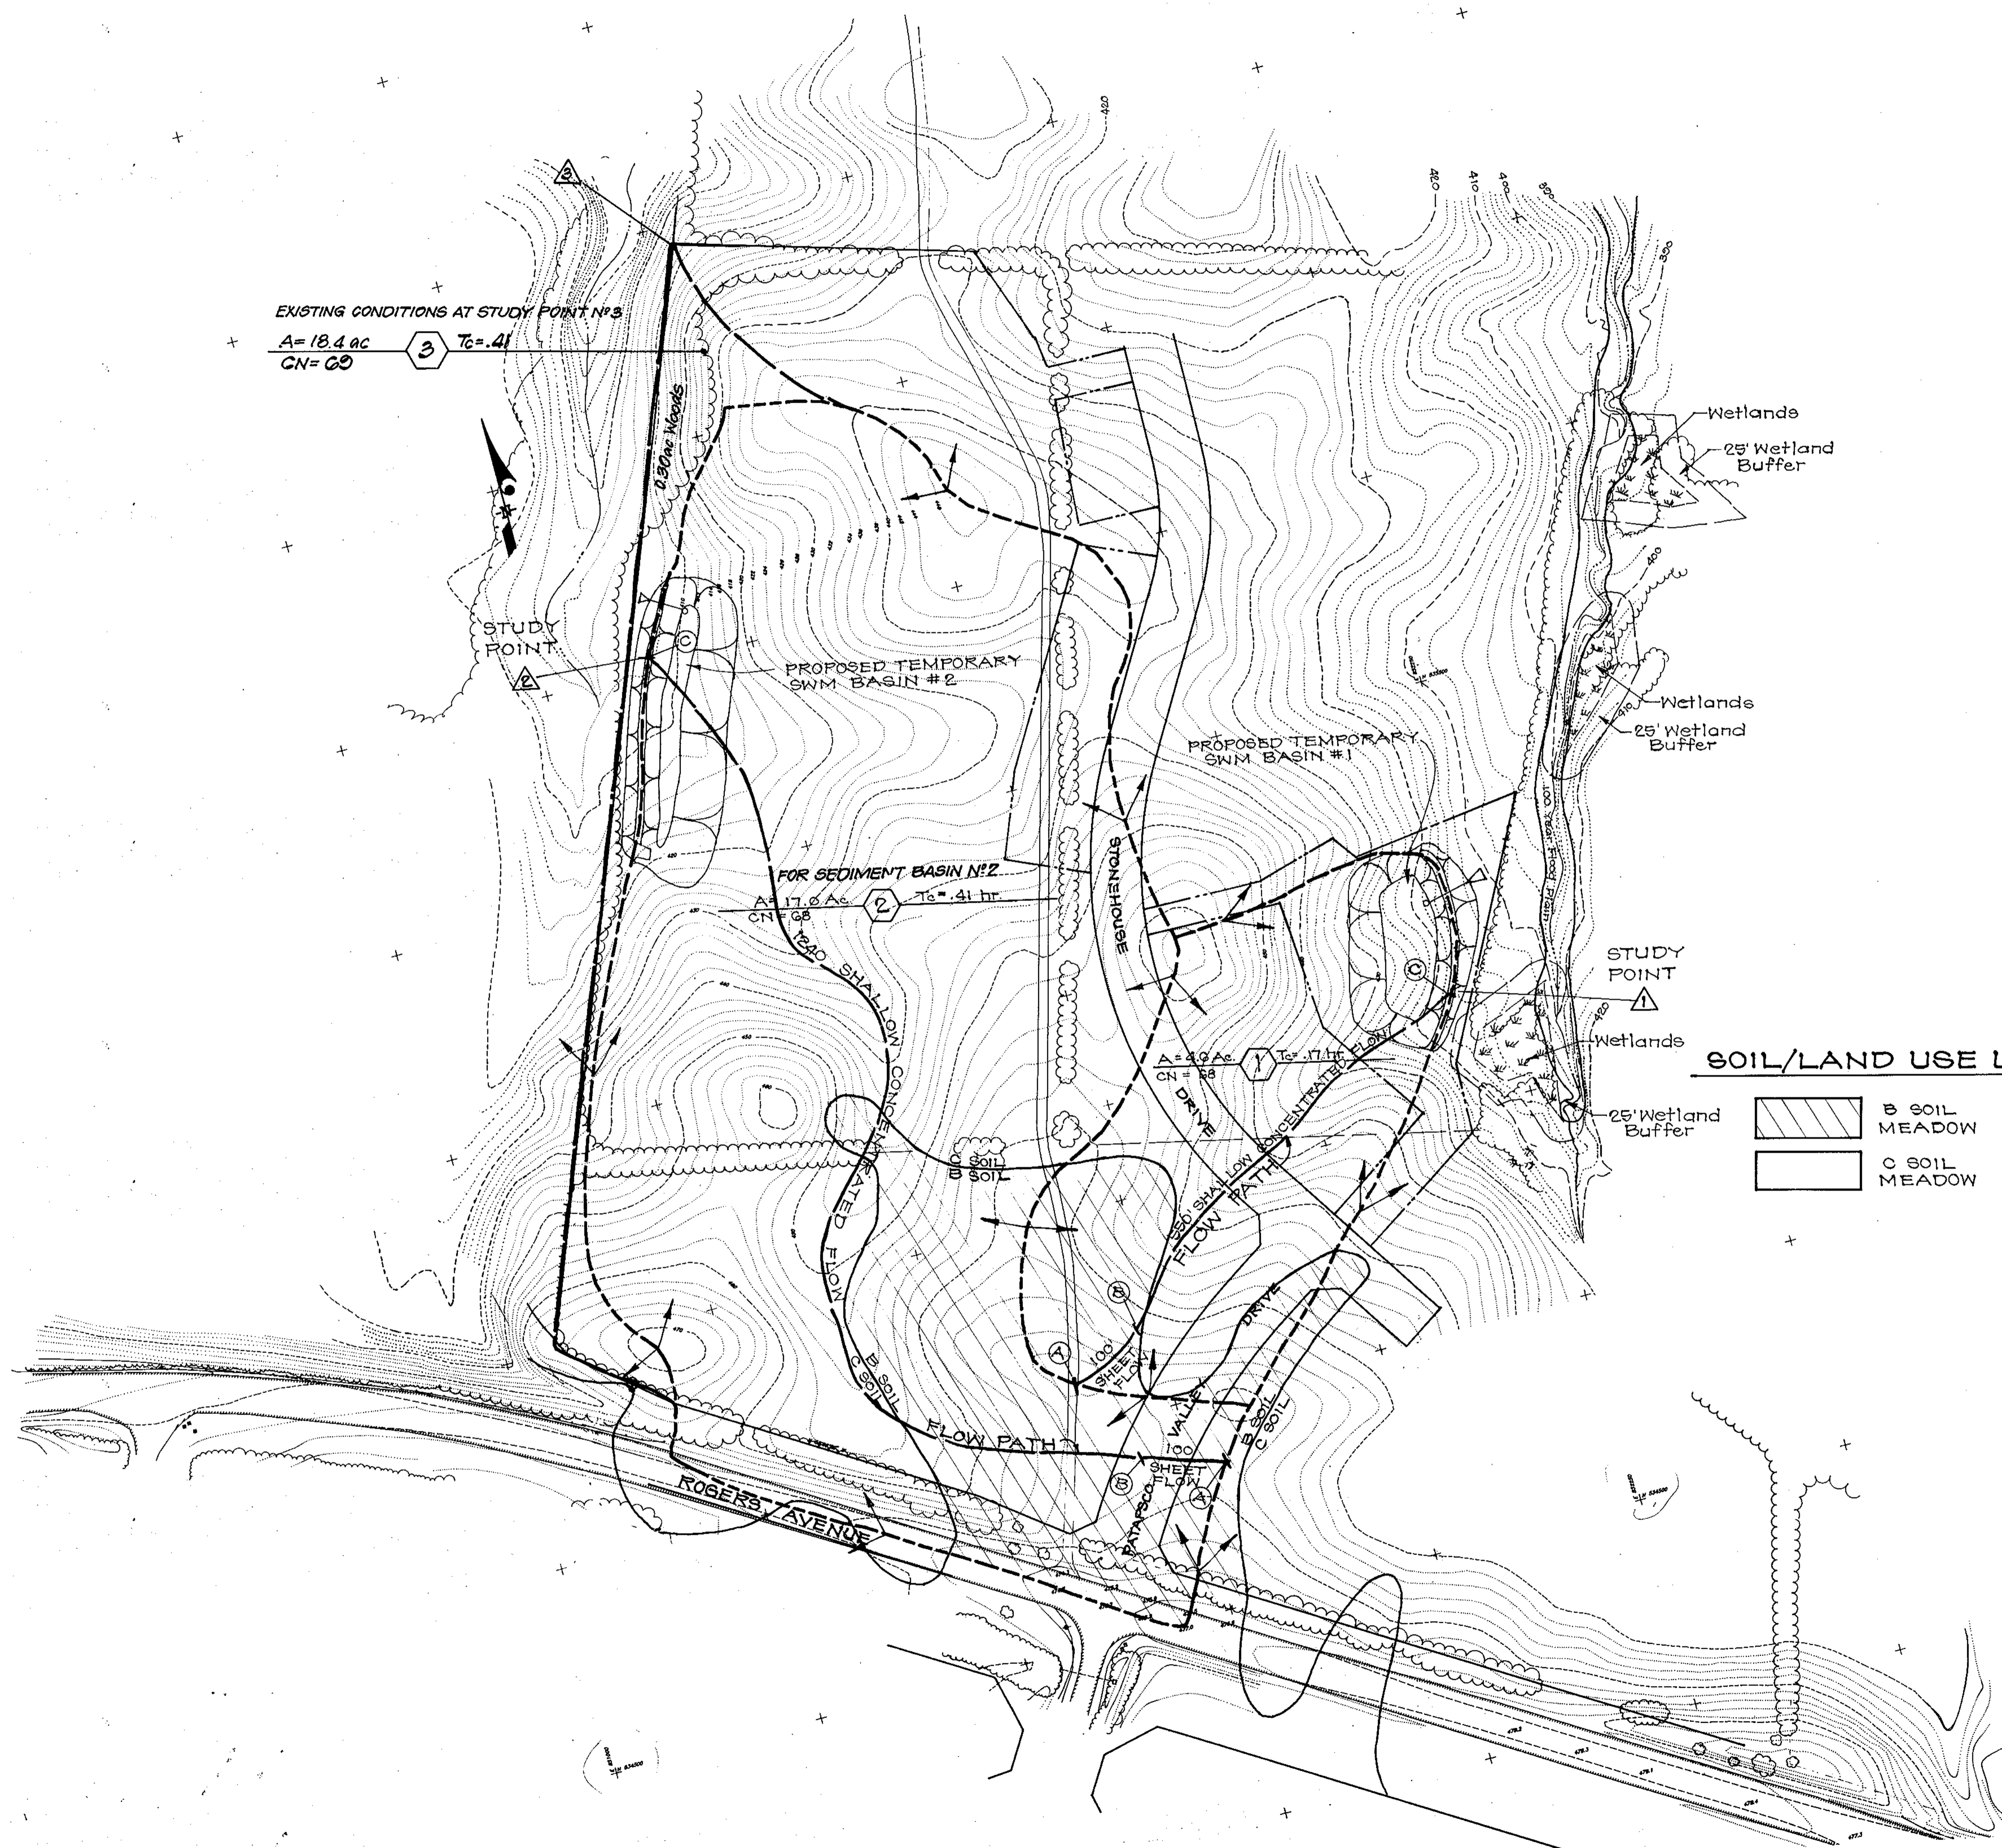


EXISTING CONDITIONS AT STUDY POINT N°3
 $A = 18.4 \text{ ac}$
 $CN = 60$
 $T_c = .41 \text{ hr}$

FOR SEDIMENT BASIN N°2
 $A = 17.6 \text{ ac}$
 $CN = 68$
 $T_c = .41 \text{ hr}$

$A = 4.9 \text{ ac}$
 $CN = 68$
 $T_c = .17 \text{ hr}$

SOIL/LAND USE LEGEND

- B SOIL MEADOW
- C SOIL MEADOW

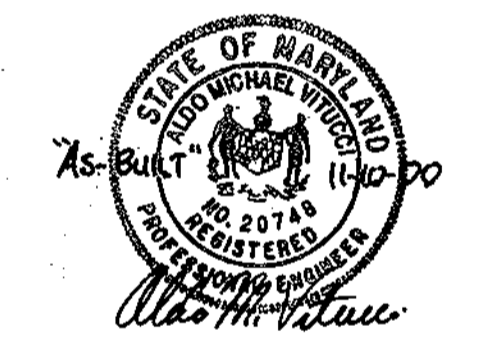


APPROVED: DEPARTMENT OF PUBLIC WORKS
Richard M. Daniels 1-30-96
 Chief, Bureau of Highways Date

APPROVED: DEPARTMENT OF PLANNING AND ZONING
Jane Zimmerman 2/2/96
 Chief, Division of Land Development and Research Date

Chris D. ... 2/1/96
 Chief, Development Engineering Division Date

CLARK • FINEFROCK & SACKETT, INC. ENGINEERS • PLANNERS • SURVEYORS 7135 MINSTREL WAY • COLUMBIA, MD. 21045 • (410) 381-7500 - BALTO. • (301) 621-8100 - WASH.		
DESIGNED KIWM	DRAINAGE AREA MAP EXISTING CONDITIONS DANIELS MILL OVERLOOK TAX MAP 17 PART OF PARCEL 41 SECOND (2ND) ELECTION DISTRICT HOWARD COUNTY, MARYLAND FOR: HOWARD COUNTY BOARD OF EDUCATION 10210 ROUTE 108 ELLICOTT CITY, MARYLAND 21042	SCALE 1"=100'
DRAWN JK		DRAWING 12 OF 20
CHECKED WJM KJM		JOB NO. 04-203
DATE 12-27-95		FILE NO. 04-203D

1783

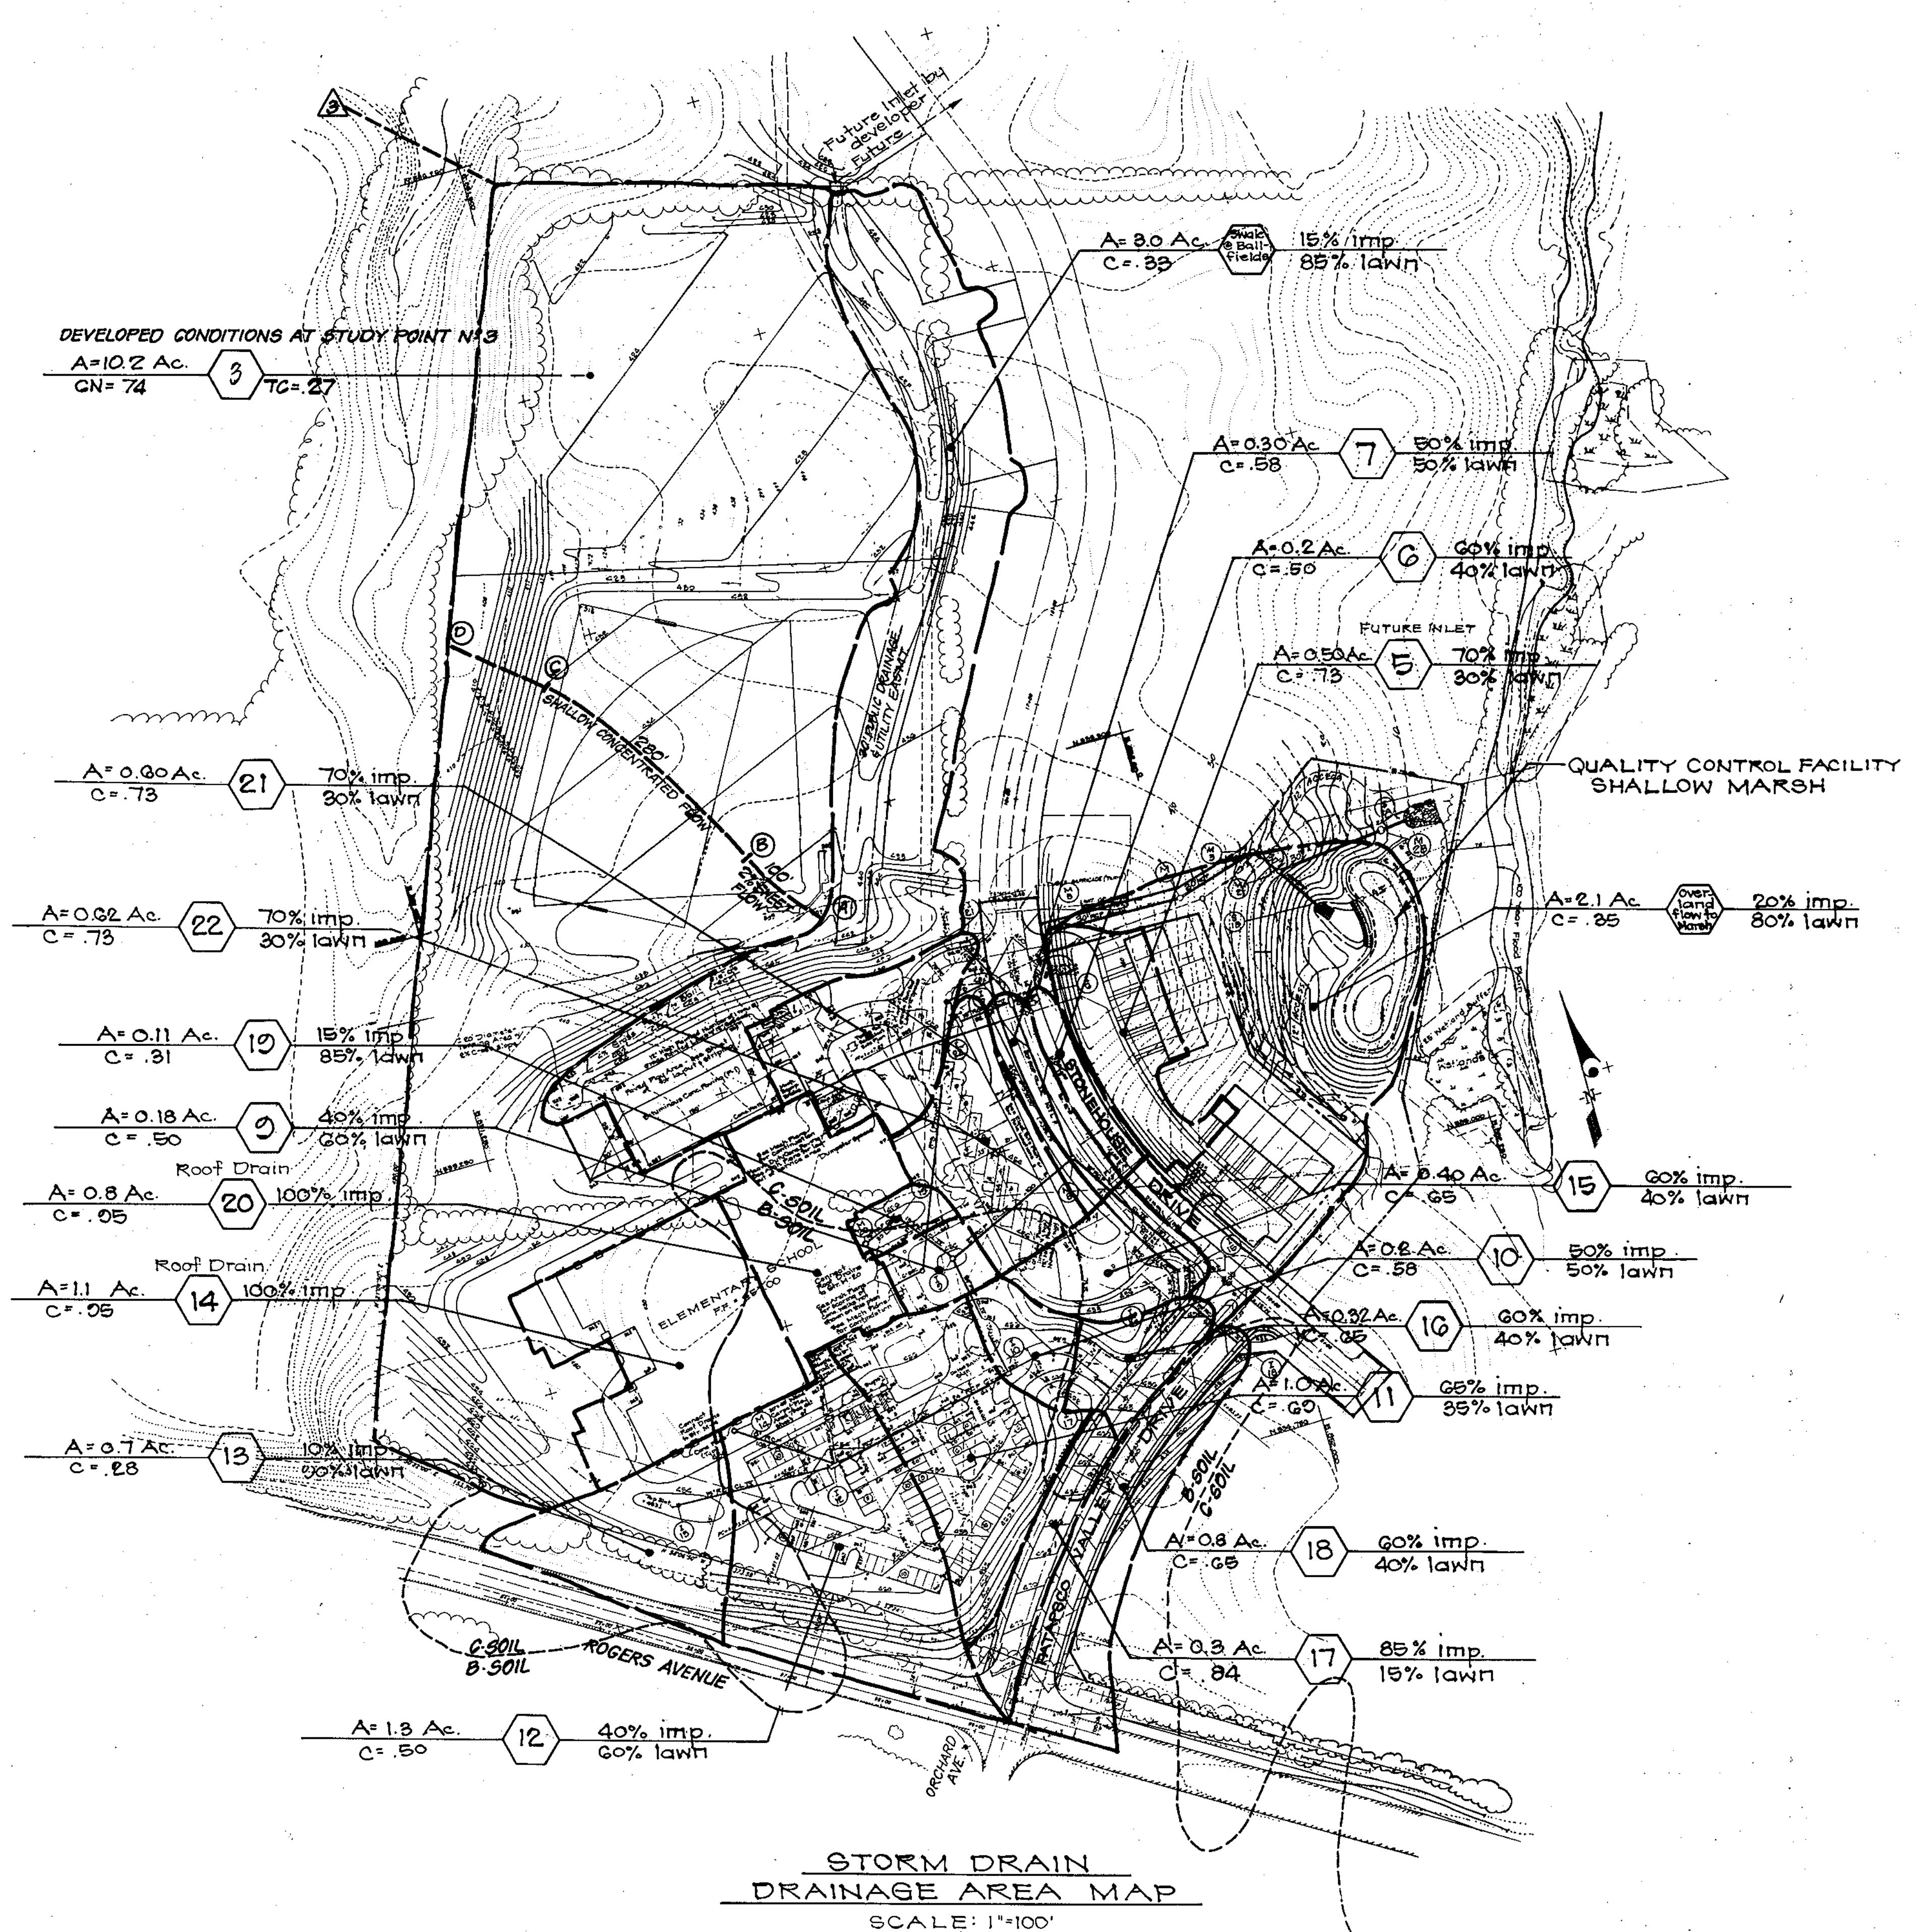

STORM DRAIN
DRAINAGE AREA MAP
SCALE: 1"=100'




APPROVED: DEPARTMENT OF PUBLIC WORKS
Richard M. Cantel 1-30-96
 Chief, Bureau of Highways Date

APPROVED: DEPARTMENT OF PLANNING AND ZONING
Gina Surmanis 2/2/96
 Chief, Division of Land Development and Research Date

Mark Damman 2/1/96
 Chief, Development Engineering Division Date

CLARK • FINEROCK & SACKETT, INC. ENGINEERS • PLANNERS • SURVEYORS 7135 MINSTREL WAY • COLUMBIA, MD. 21045 • (410) 381-7500 - BALTO. • (301) 821-8100 - WASH.		
DESIGNED KIWM	DRAINAGE AREA MAP PROPOSED CONDITIONS DANIELS MILL OVERLOOK TAX MAP 17 PART OF PARCEL 41 SECOND (2ND) ELECTION DISTRICT HOWARD COUNTY, MARYLAND FOR: HOWARD COUNTY BOARD OF EDUCATION 10910 ROUTE 108 ELLICOTT CITY, MARYLAND 21042	SCALE 1" = 100'
DRAWN JK		DRAWING 13 of 20
CHECKED MM		JOB NO. 04-203
DATE 12-27-95		FILE NO. 04-203D

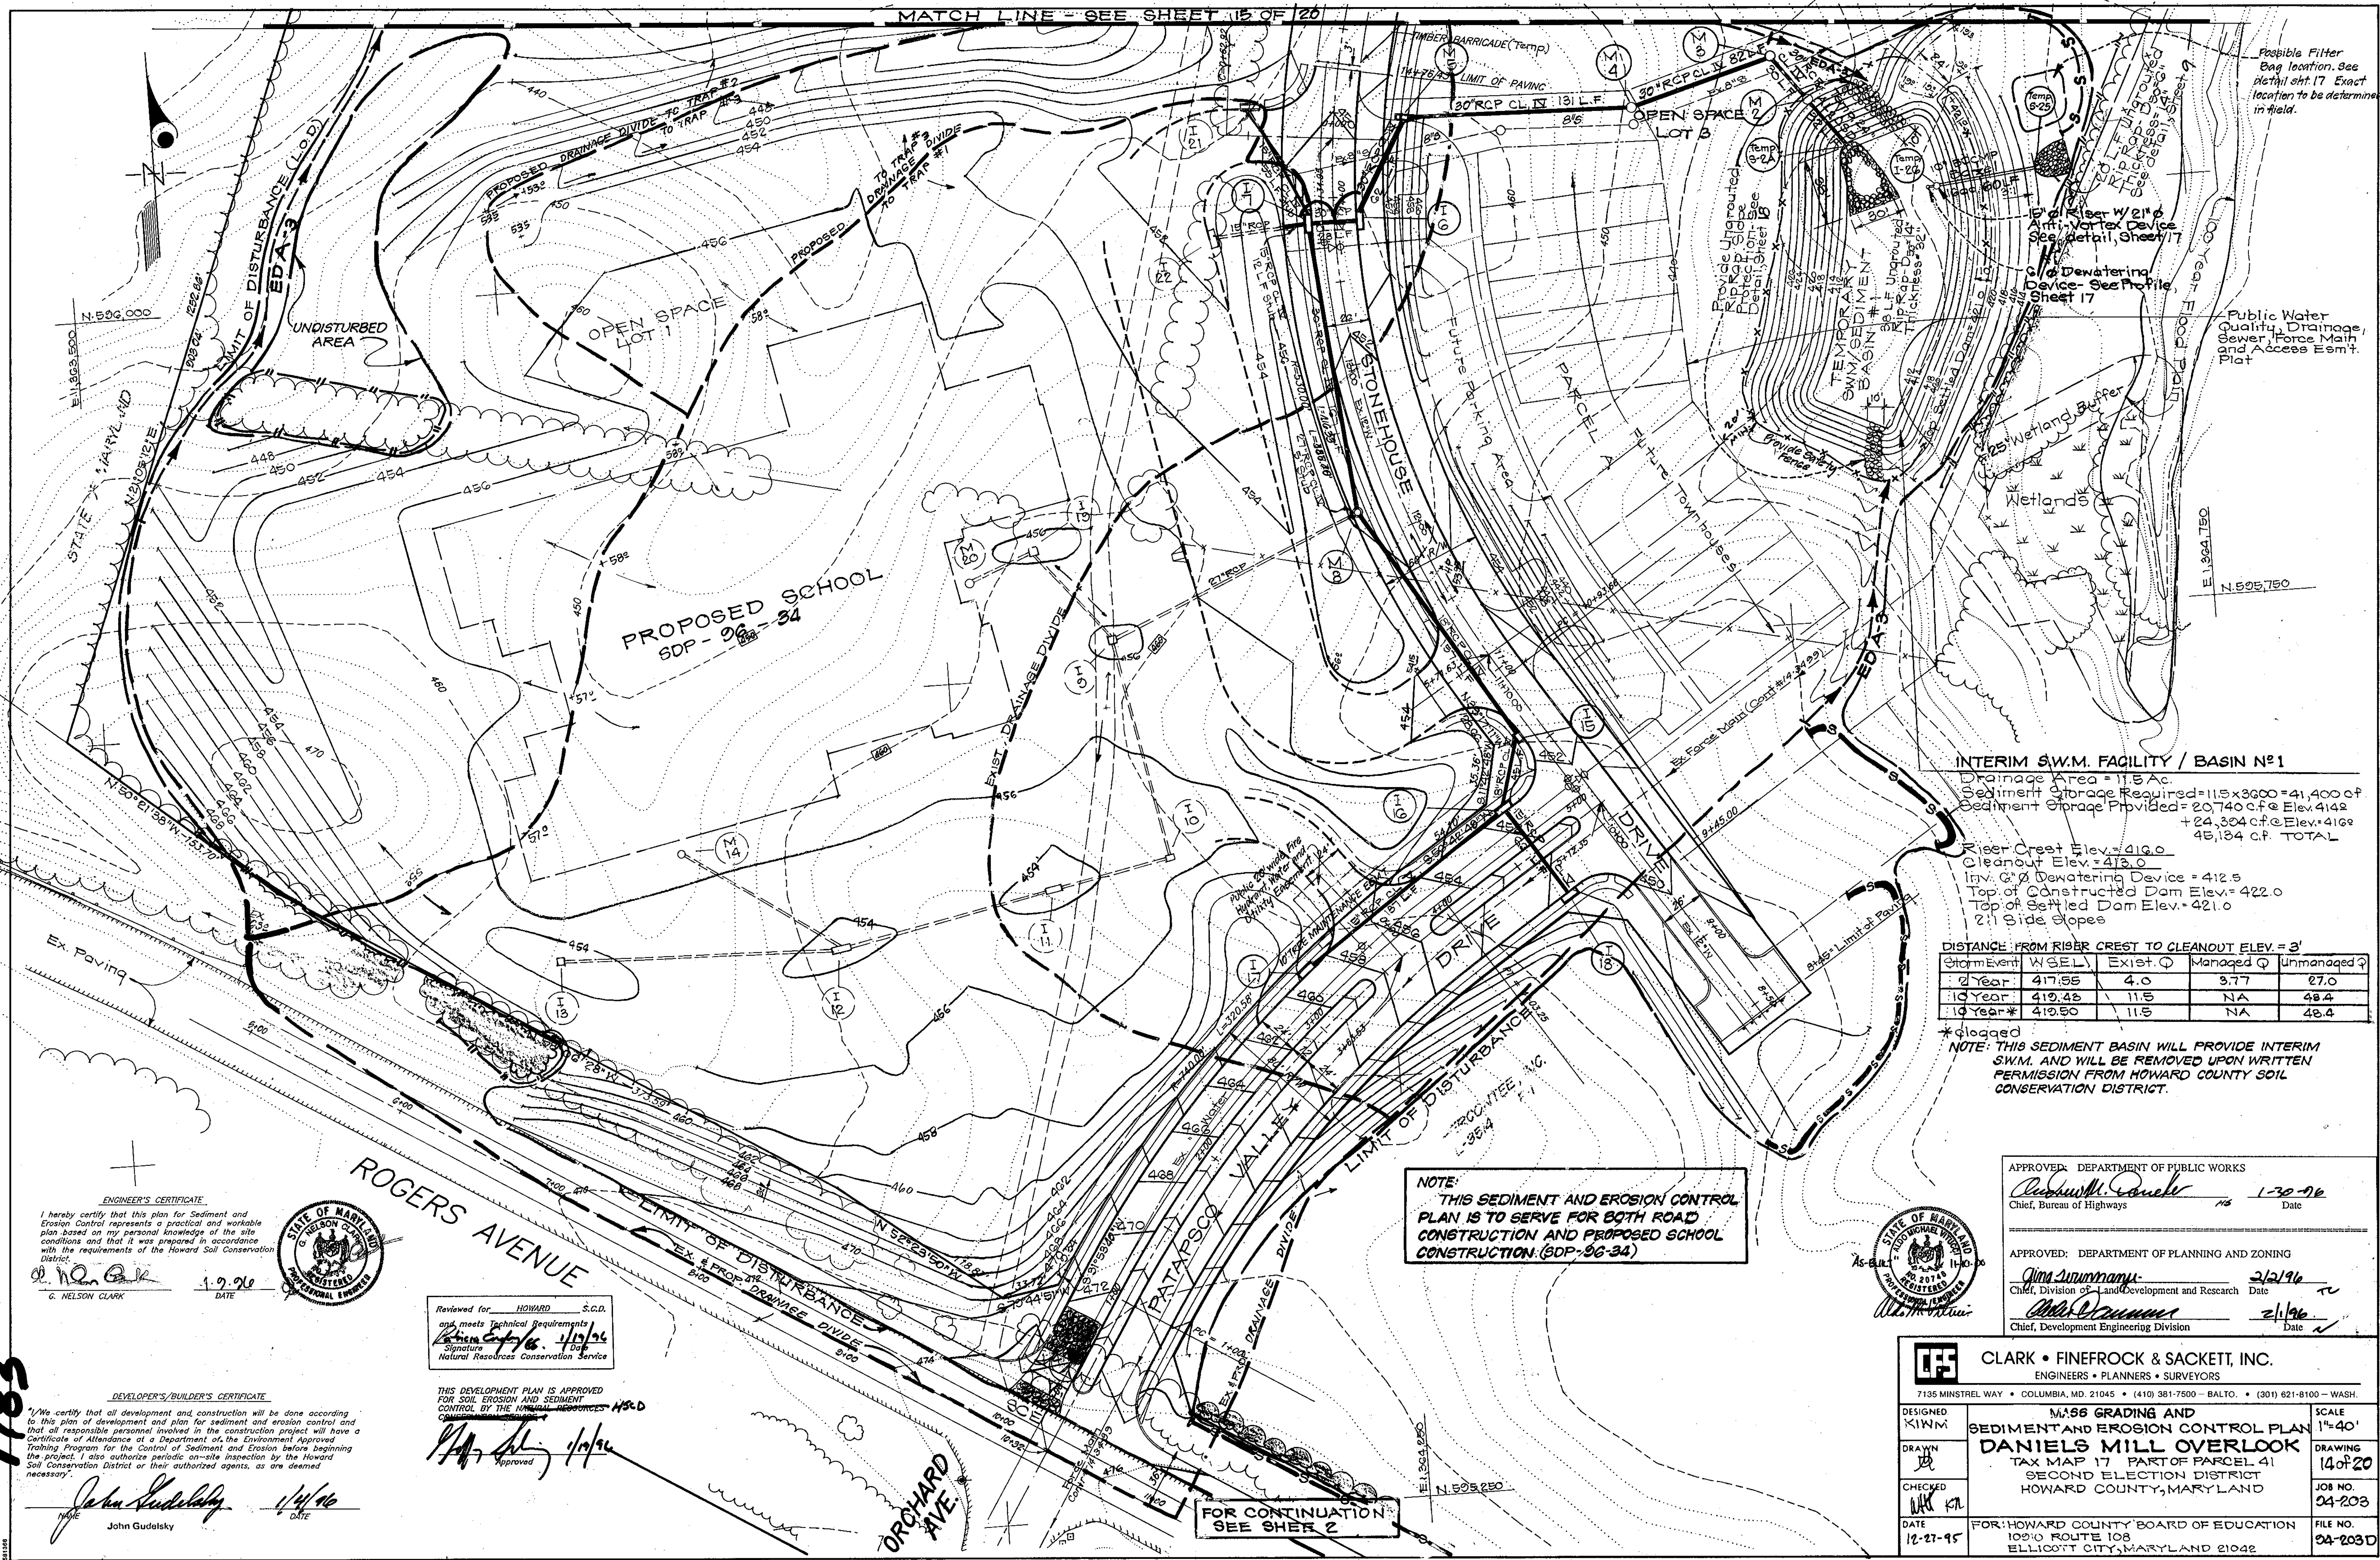

Possible Filter Bag location. See Detail sheet 17. Exact location to be determined in field.

Public Water Quality Drainage Sewer Force Main and Access Easement Plat

INTERIM S.W.M. FACILITY / BASIN No 1
 Drainage Area = 11.5 Ac.
 Sediment Storage Required = 11.5 x 3600 = 41,400 cf.
 Sediment Storage Provided = 20,740 c.f. @ Elev. 414.2
 + 24,304 c.f. @ Elev. 416.9
 45,044 c.f. TOTAL

Riser Crest Elev. = 416.0
 Cleanout Elev. = 413.0
 Inv. G. of Dewatering Device = 412.5
 Top of Constructed Dam Elev. = 422.0
 Top of Settled Dam Elev. = 421.0
 2:1 Side Slopes

DISTANCE FROM RISER CREST TO CLEANOUT ELEV. = 3'

Storm Event	WSL	Exist. Q	Managed Q	Unmanaged Q
2 Year	417.55	4.0	3.77	27.0
10 Year	419.43	11.5	NA	48.4
10 Year*	419.50	11.5	NA	48.4


* flooged
 NOTE: THIS SEDIMENT BASIN WILL PROVIDE INTERIM S.W.M. AND WILL BE REMOVED UPON WRITTEN PERMISSION FROM HOWARD COUNTY SOIL CONSERVATION DISTRICT.

NOTE: THIS SEDIMENT AND EROSION CONTROL PLAN IS TO SERVE FOR BOTH ROAD CONSTRUCTION AND PROPOSED SCHOOL CONSTRUCTION. (SDP-26-34)

APPROVED: DEPARTMENT OF PUBLIC WORKS
Richard M. Conner 1-20-96
 Chief, Bureau of Highways Date

APPROVED: DEPARTMENT OF PLANNING AND ZONING
Jim Swann 2/2/96
 Chief, Division of Land Development and Research Date

John Gudulsky 2/1/96
 Chief, Development Engineering Division Date

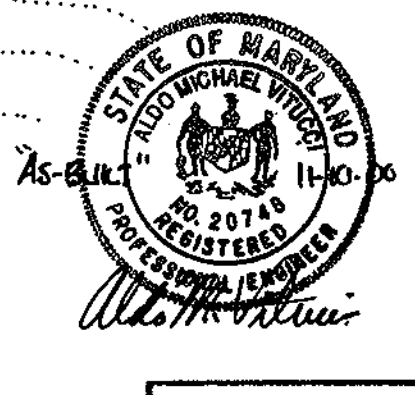

ENGINEER'S CERTIFICATE
 I hereby certify that this plan for Sediment and Erosion Control represents a practical and workable plan based on my personal knowledge of the site conditions and that it was prepared in accordance with the requirements of the Howard Soil Conservation District.
G. Nelson Clark 1-9-96
 G. NELSON CLARK DATE



Reviewed for HOWARD S.C.D. and meets Technical Requirements
Karen Enty 1/19/96
 Signature Date
 Natural Resources Conservation Service

DEVELOPER'S/BUILDER'S CERTIFICATE
 I/We certify that all development and construction will be done according to this plan of development and plan for sediment and erosion control and that all responsible personnel involved in the construction project will have a Certificate of Attendance at a Department of the Environment Approved Training Program for the Control of Sediment and Erosion before beginning the project. I also authorize periodic on-site inspection by the Howard Soil Conservation District or their authorized agents, as are deemed necessary.
John Gudulsky 1/14/96
 John Gudulsky DATE


THIS DEVELOPMENT PLAN IS APPROVED FOR SOIL EROSION AND SEDIMENT CONTROL BY THE NATURAL RESOURCES CONSERVATION SERVICE
John Gudulsky 1/19/96
 Approved

FOR CONTINUATION SEE SHEET 2

CLARK • FINEROCK & SACKETT, INC.
 ENGINEERS • PLANNERS • SURVEYORS
 7135 MINSTREL WAY • COLUMBIA, MD. 21045 • (410) 381-7500 • BALTO. • (301) 621-8100 - WASH.

DESIGNED KJWM	MASS GRADING AND SEDIMENT AND EROSION CONTROL PLAN	SCALE 1"=40'
DRAWN JK	DANIELS MILL OVERLOOK TAX MAP 17 PART OF PARCEL 41 SECOND ELECTION DISTRICT HOWARD COUNTY, MARYLAND	DRAWING 14 OF 20
CHECKED JK		JOB NO. 04-203
DATE 12-27-95	FOR: HOWARD COUNTY BOARD OF EDUCATION 10010 ROUTE 108 ELlicott CITY, MARYLAND 21042	FILE NO. 04-203D

1783

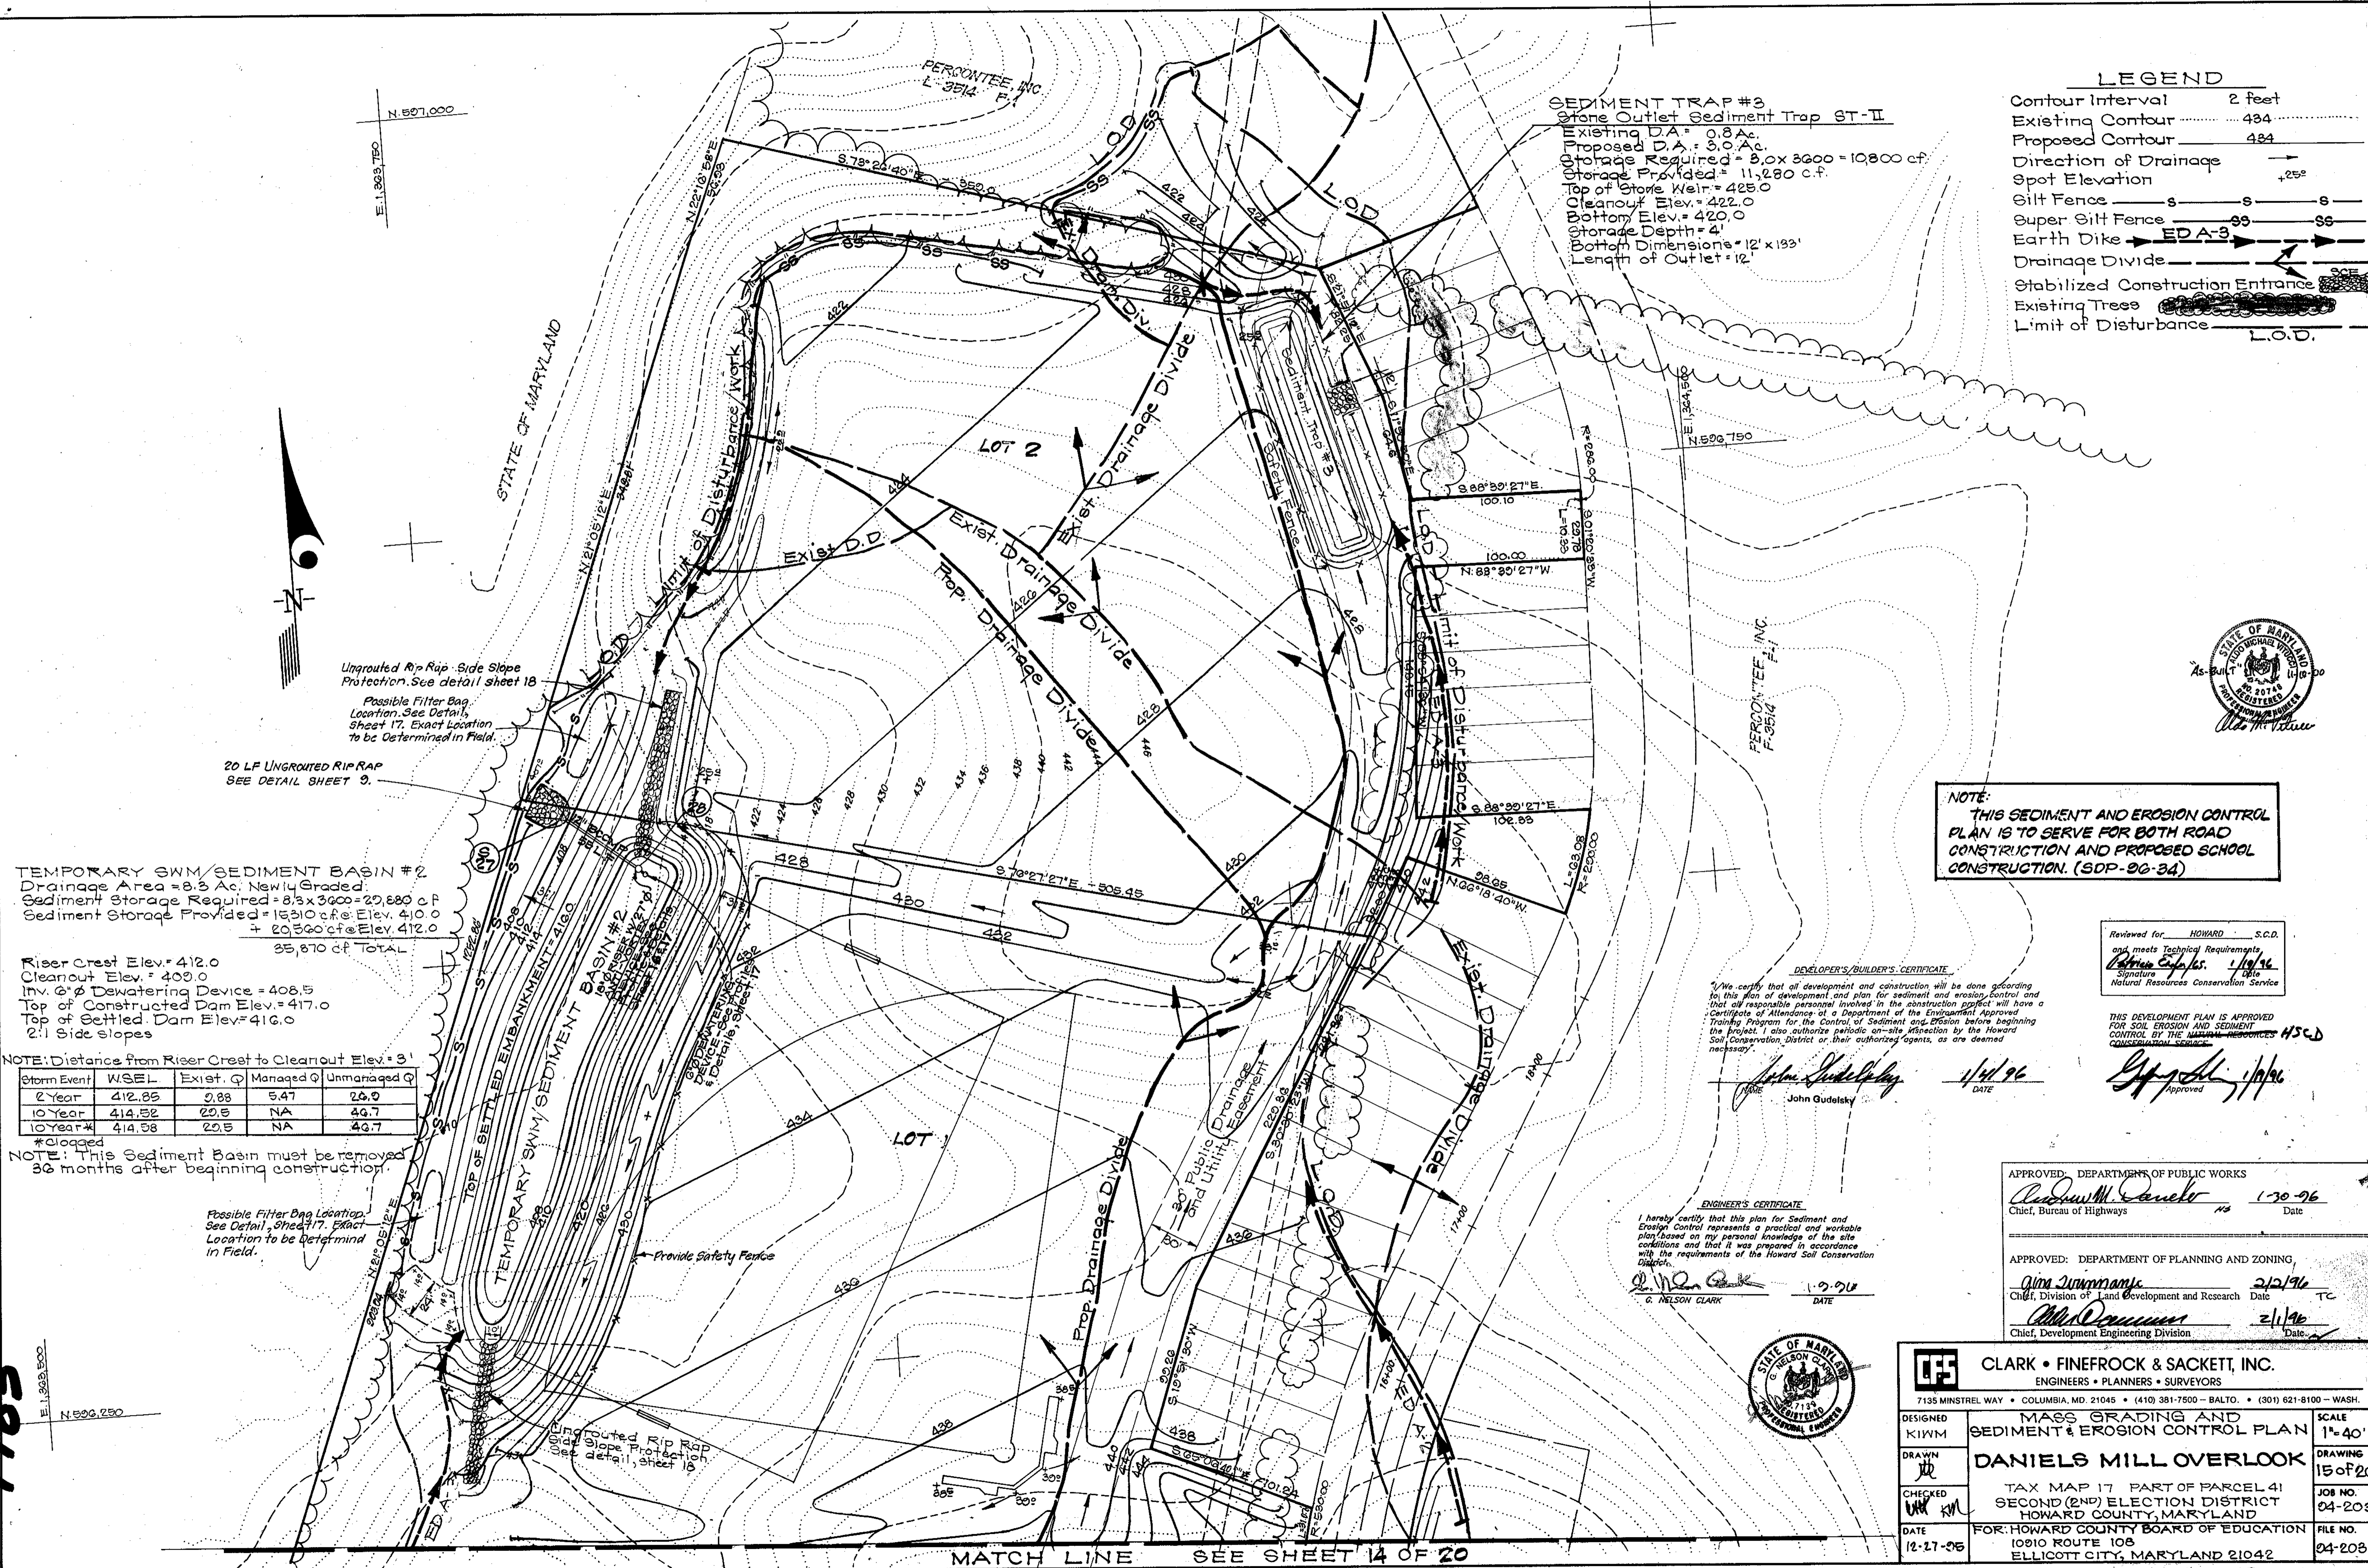

LEGEND

Contour Interval	2 feet
Existing Contour 434
Proposed Contour 434
Direction of Drainage	→
Spot Elevation	+25'
Silt Fence	—s—s—s—
Super Silt Fence	—SS—SS—SS—
Earth Dike	—EDA-3—
Drainage Divide	—▲—▲—▲—
Stabilized Construction Entrance	—[Symbol]—
Existing Trees	—[Symbol]—
Limit of Disturbance	L.O.D.

SEDIMENT TRAP #3
 Stone Outlet Sediment Trap ST-II
 Existing D.A. = 0.8 Ac.
 Proposed D.A. = 9.0 Ac.
 Storage Required = 9.0 x 3600 = 10,800 cf.
 Storage Provided = 11,280 cf.
 Top of Stone Weir = 425.0
 Cleanout Elev. = 422.0
 Bottom Elev. = 420.0
 Storage Depth = 4'
 Bottom Dimensions = 12' x 132'
 Length of Outlet = 12'

Ungrouted Rip-Rap Side Slope Protection. See detail sheet 18
 Possible Filter Bag Location. See Detail, sheet 17. Exact Location to be Determined in Field.

20 LF UNGROUTED RIP-RAP SEE DETAIL SHEET 9.

TEMPORARY SWM/SEDIMENT BASIN #2
 Drainage Area = 8.3 Ac. Newly Graded
 Sediment Storage Required = 8.3 x 3600 = 29,880 cf
 Sediment Storage Provided = 16,310 cf @ Elev. 410.0
 + 20,360 cf @ Elev. 412.0
 36,670 cf TOTAL

Riser Crest Elev. = 412.0
 Cleanout Elev. = 409.0
 Inv. 6" Dewatering Device = 408.5
 Top of Constructed Dam Elev. = 417.0
 Top of Settled Dam Elev. = 416.0
 2:1 Side slopes

NOTE: Distance from Riser Crest to Cleanout Elev. = 3'

Storm Event	WSEL	Exist. Q	Managed Q	Unmanaged Q
2 Year	412.85	0.88	5.47	26.9
10 Year	414.52	20.5	NA	49.7
10 Year #	414.58	20.5	NA	49.7

*Clogged

NOTE: This Sediment Basin must be removed 36 months after beginning construction.

Possible Filter Bag Location. See Detail, sheet 17. Exact Location to be Determined in Field.

NOTE:
 THIS SEDIMENT AND EROSION CONTROL PLAN IS TO SERVE FOR BOTH ROAD CONSTRUCTION AND PROPOSED SCHOOL CONSTRUCTION. (SOP-96-34)

DEVELOPER'S/BUILDER'S CERTIFICATE
 I/We certify that all development and construction will be done according to this plan of development and plan for sediment and erosion control and that all responsible personnel involved in the construction project will have a Certificate of Attendance at a Department of the Environment Approved Training Program for the Control of Sediment and Erosion before beginning the project. I also authorize periodic on-site inspection by the Howard Soil Conservation District or their authorized agents, as are deemed necessary.

John Gudelsky 1/11/96
 John Gudelsky DATE

Reviewed for HOWARD S.C.D. and meets Technical Requirements
William S. [Signature] 1/11/96
 Signature Date
 Natural Resources Conservation Service

THIS DEVELOPMENT PLAN IS APPROVED FOR SOIL EROSION AND SEDIMENT CONTROL BY THE NATURAL RESOURCES CONSERVATION SERVICE
[Signature] 1/11/96
 Approved

ENGINEER'S CERTIFICATE
 I hereby certify that this plan for Sediment and Erosion Control represents a practical and workable plan based on my personal knowledge of the site conditions and that it was prepared in accordance with the requirements of the Howard Soil Conservation District.

G. Nelson Clark 1/29/96
 G. NELSON CLARK DATE


APPROVED: DEPARTMENT OF PUBLIC WORKS
Andrew M. Daniels 1/30/96
 Chief, Bureau of Highways Date

APPROVED: DEPARTMENT OF PLANNING AND ZONING
Aime Stummans 2/2/96
 Chief, Division of Land Development and Research Date TC
William [Signature] 2/1/96
 Chief, Development Engineering Division Date




CLARK • FINEFROCK & SACKETT, INC.
 ENGINEERS • PLANNERS • SURVEYORS
 7135 MINSTREL WAY • COLUMBIA, MD. 21045 • (410) 381-7500 • BALTO. • (301) 621-8100 • WASH.


DESIGNED KIWM	MASS GRADING AND SEDIMENT & EROSION CONTROL PLAN	SCALE 1"=40'
DRAWN [Signature]	DANIELS MILL OVERLOOK	DRAWING 15 OF 20
CHECKED [Signature]	TAX MAP 17 PART OF PARCEL 41 SECOND (2ND) ELECTION DISTRICT HOWARD COUNTY, MARYLAND	JOB NO. 04-208
DATE 12-27-95	FOR: HOWARD COUNTY BOARD OF EDUCATION 10810 ROUTE 108 ELLICOTT CITY, MARYLAND 21042	FILE NO. 04-208D

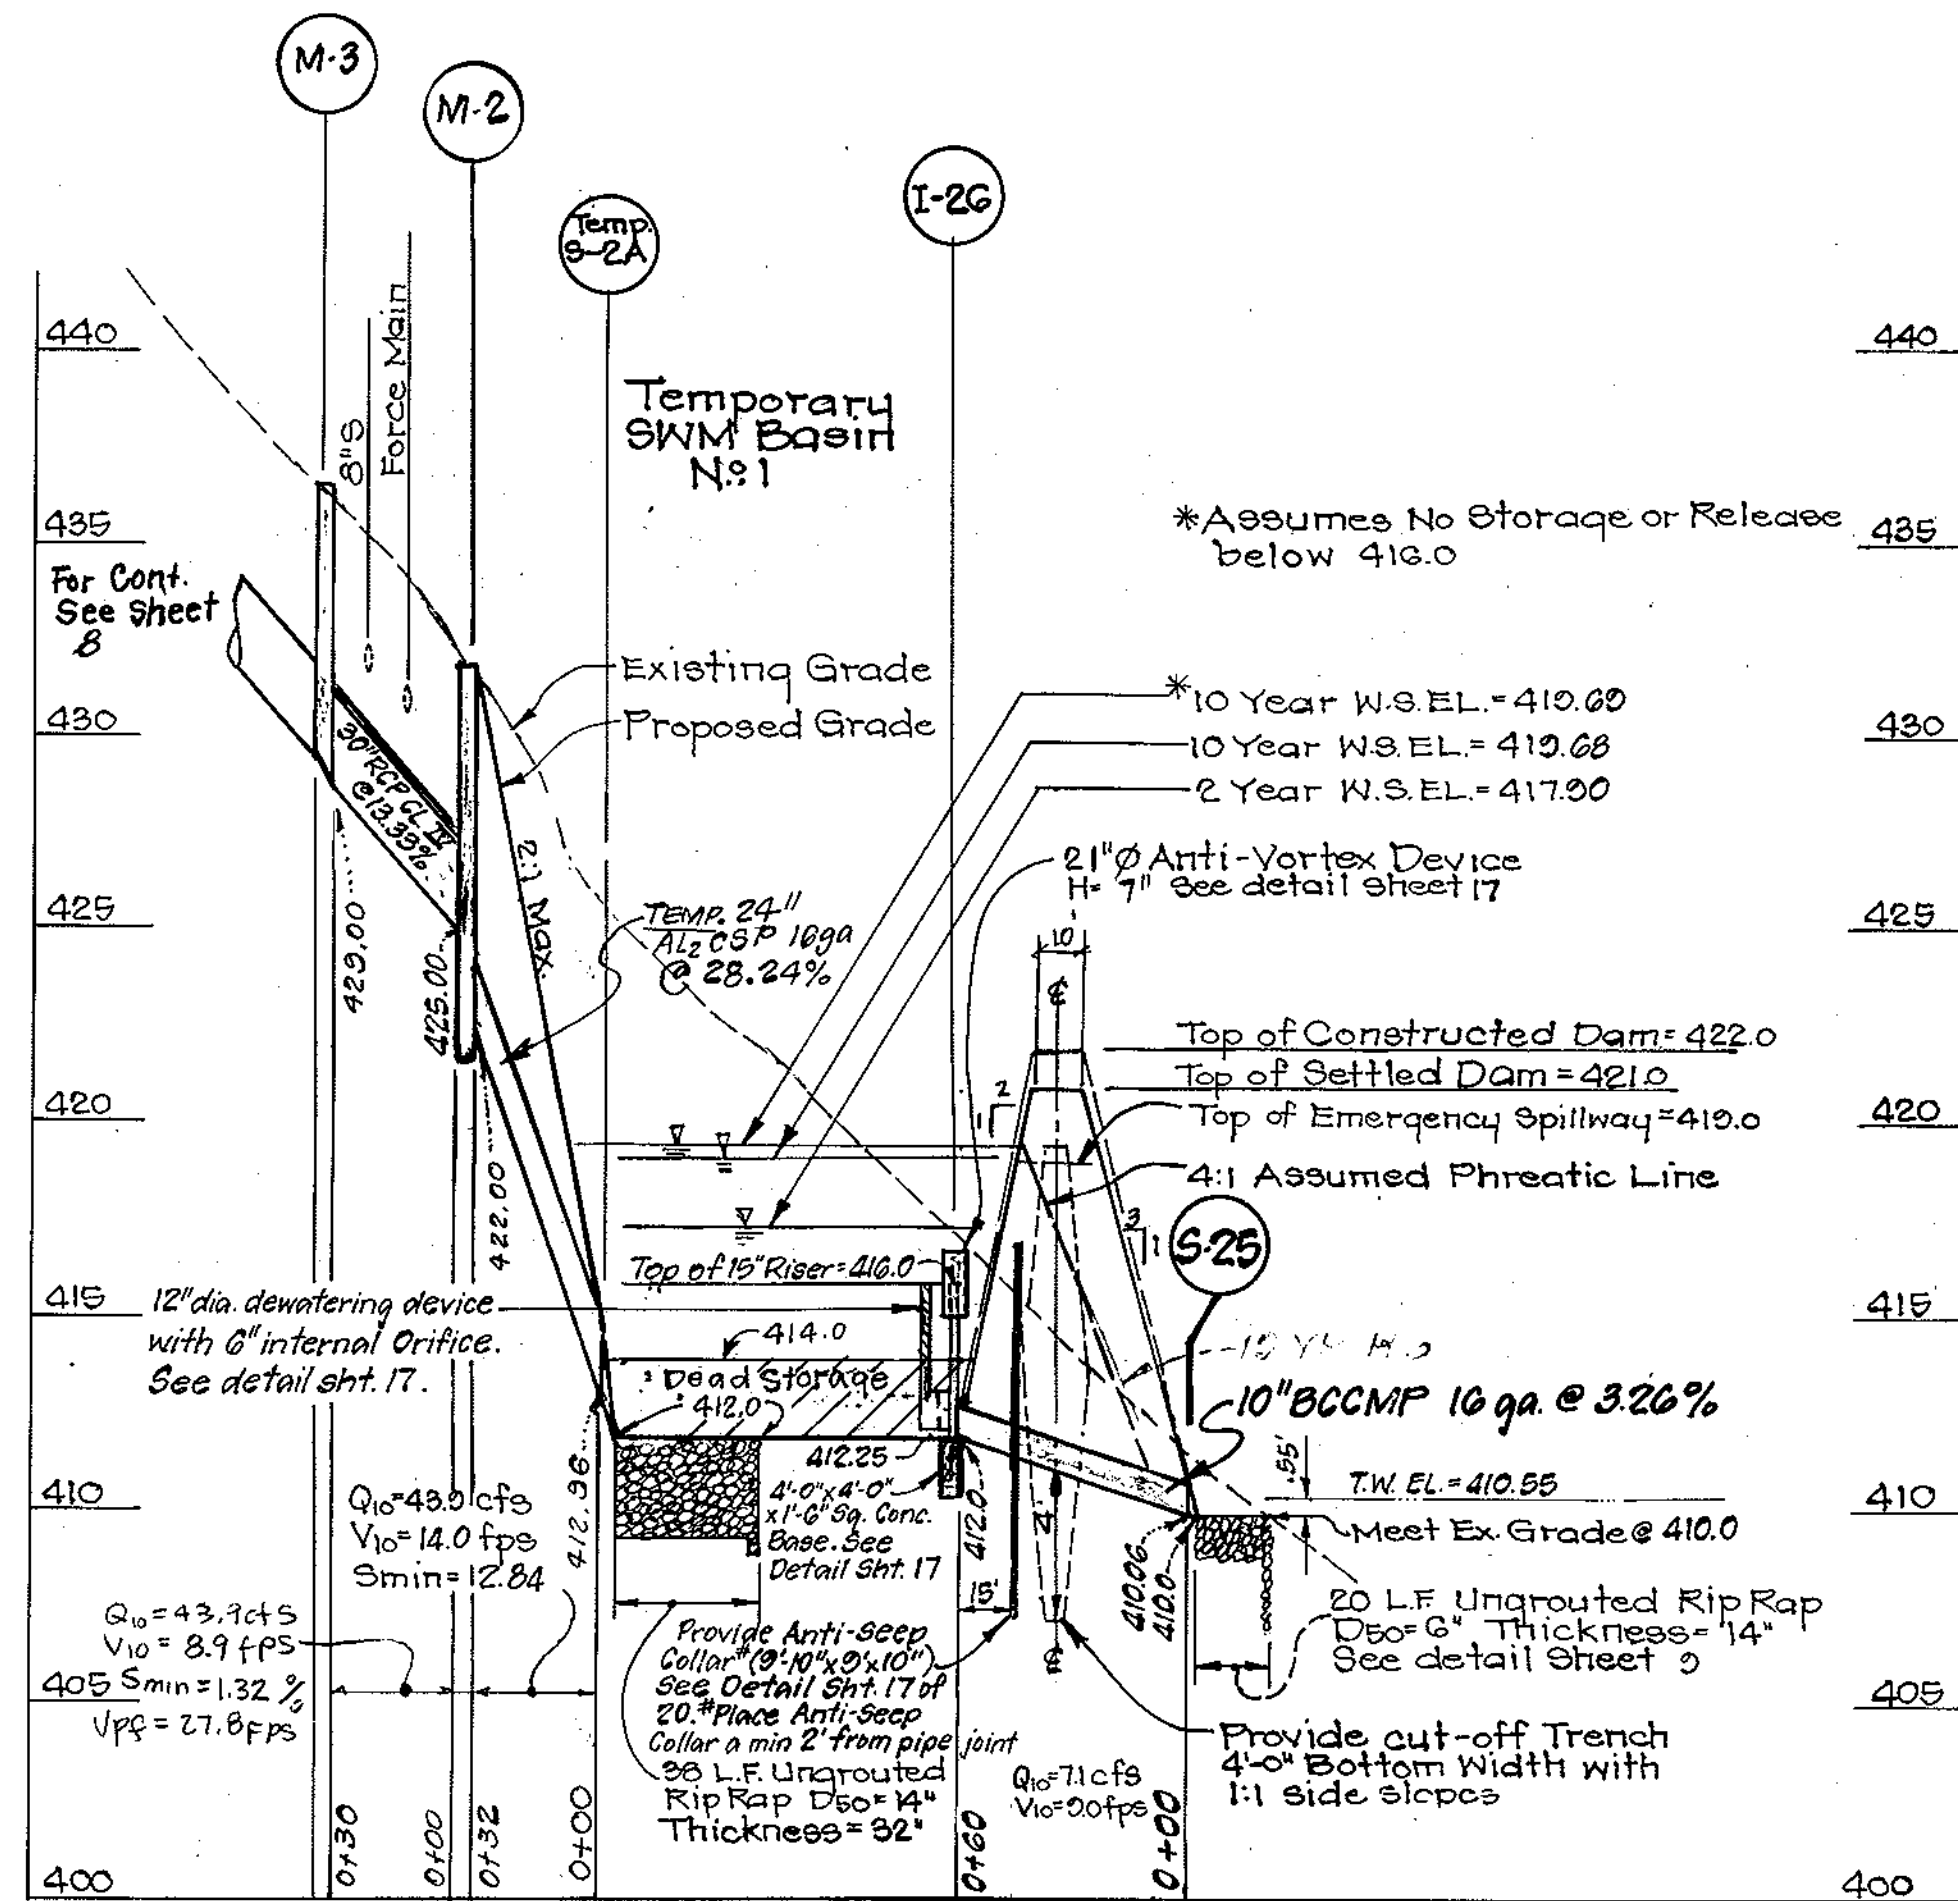


PROFILE THRU PRINCIPAL SPILLWAY
INTERIM S.W.M. FACILITY - BASIN No 1

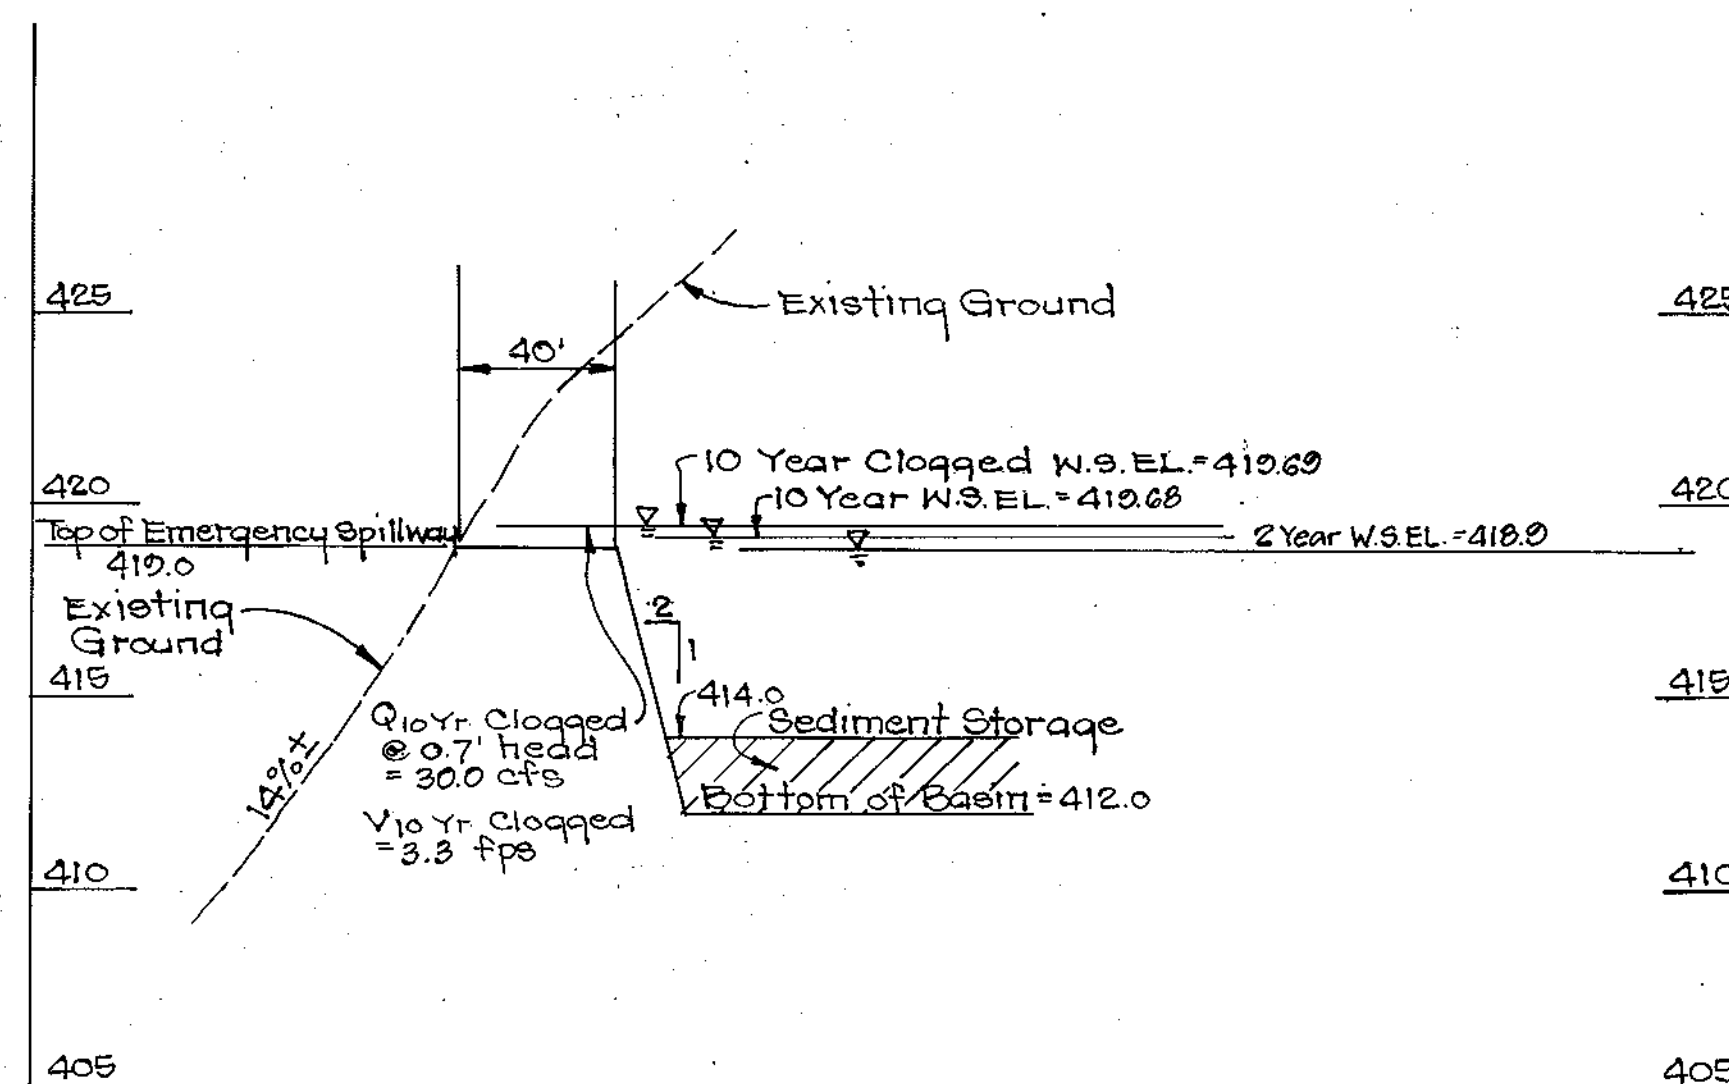


PROFILE THRU EMERGENCY SPILLWAY
INTERIM S.W.M. FACILITY - BASIN No 1

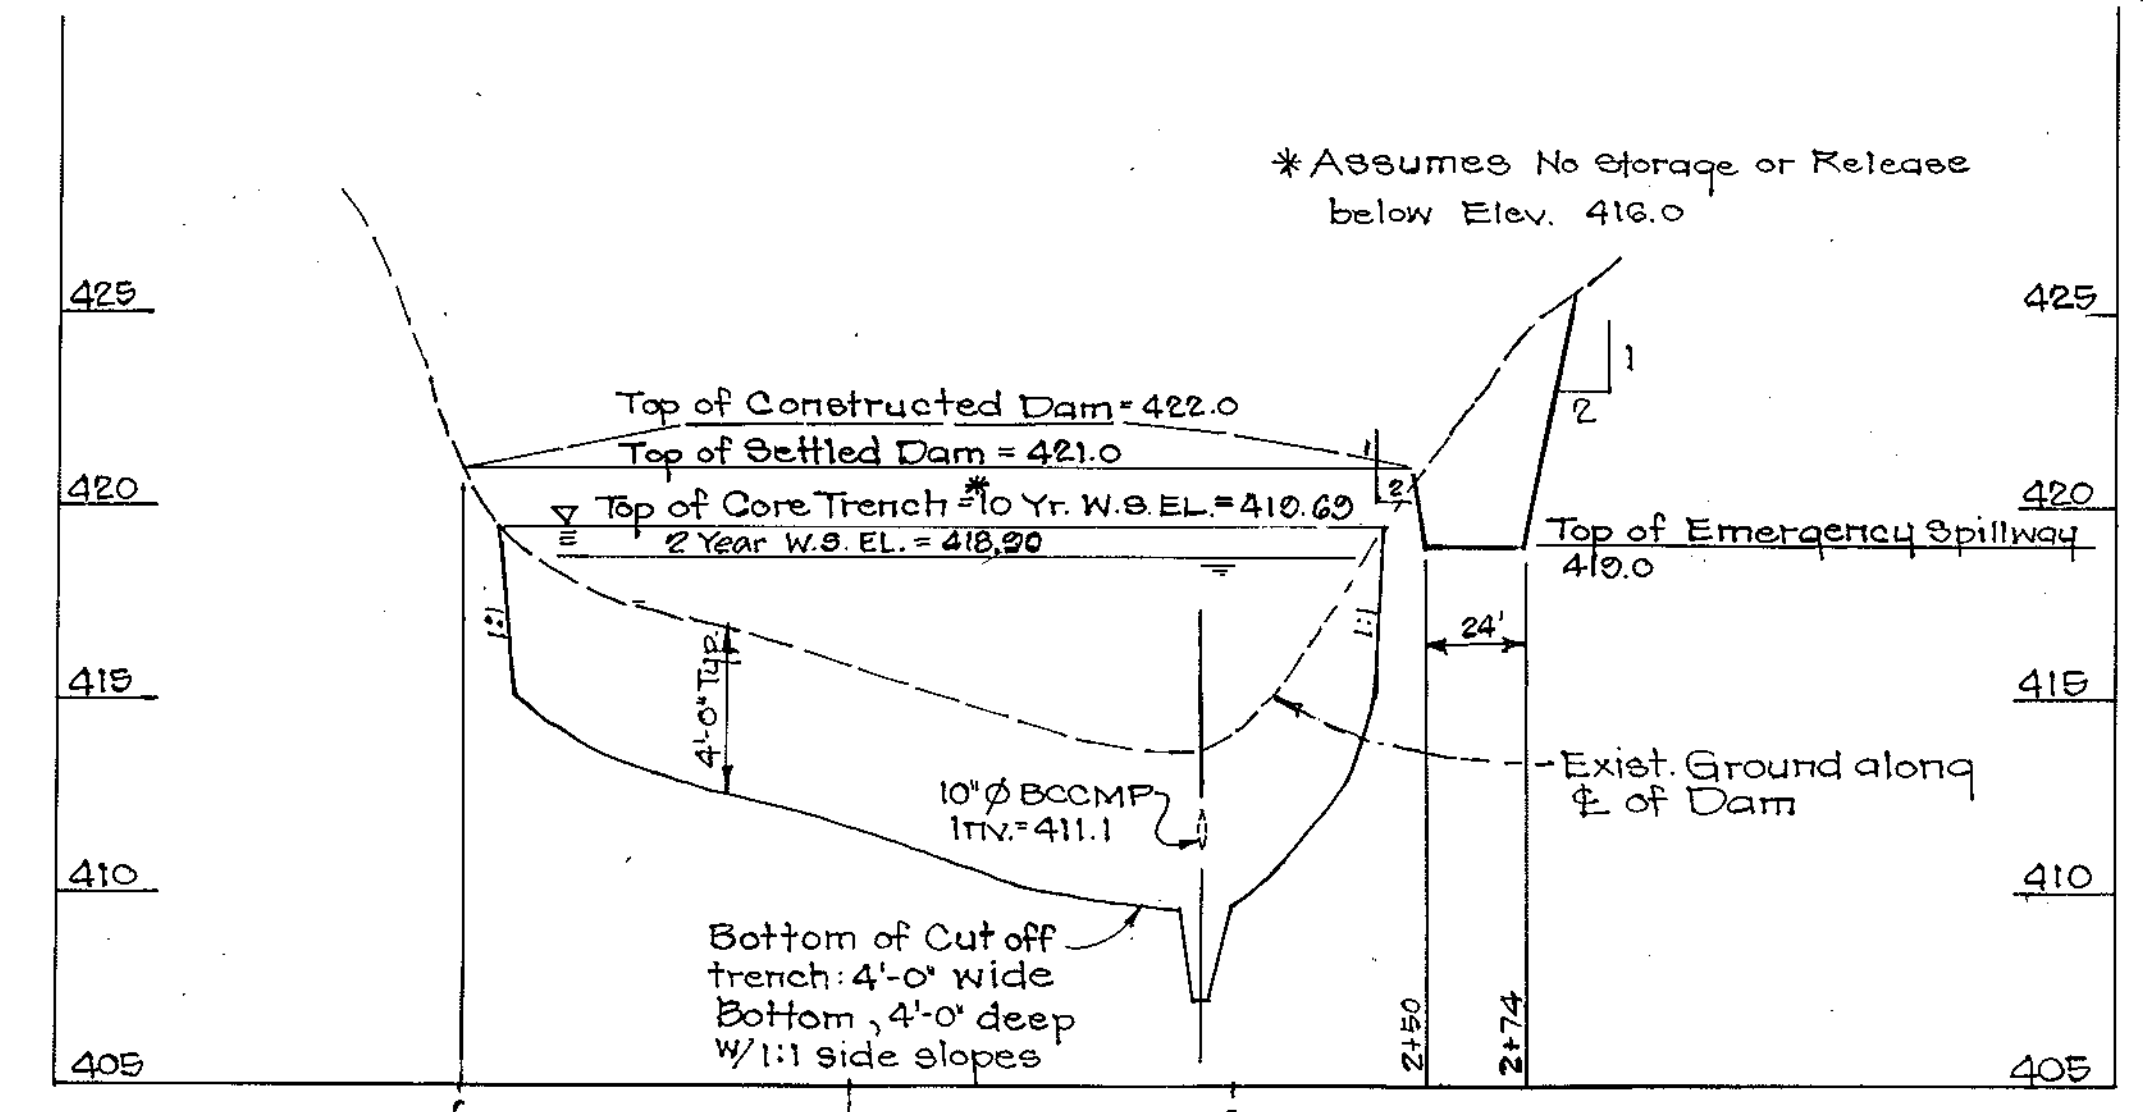


PROFILE ALONG CENTERLINE OF DAM
INTERIM S.W.M. FACILITY - BASIN No 1

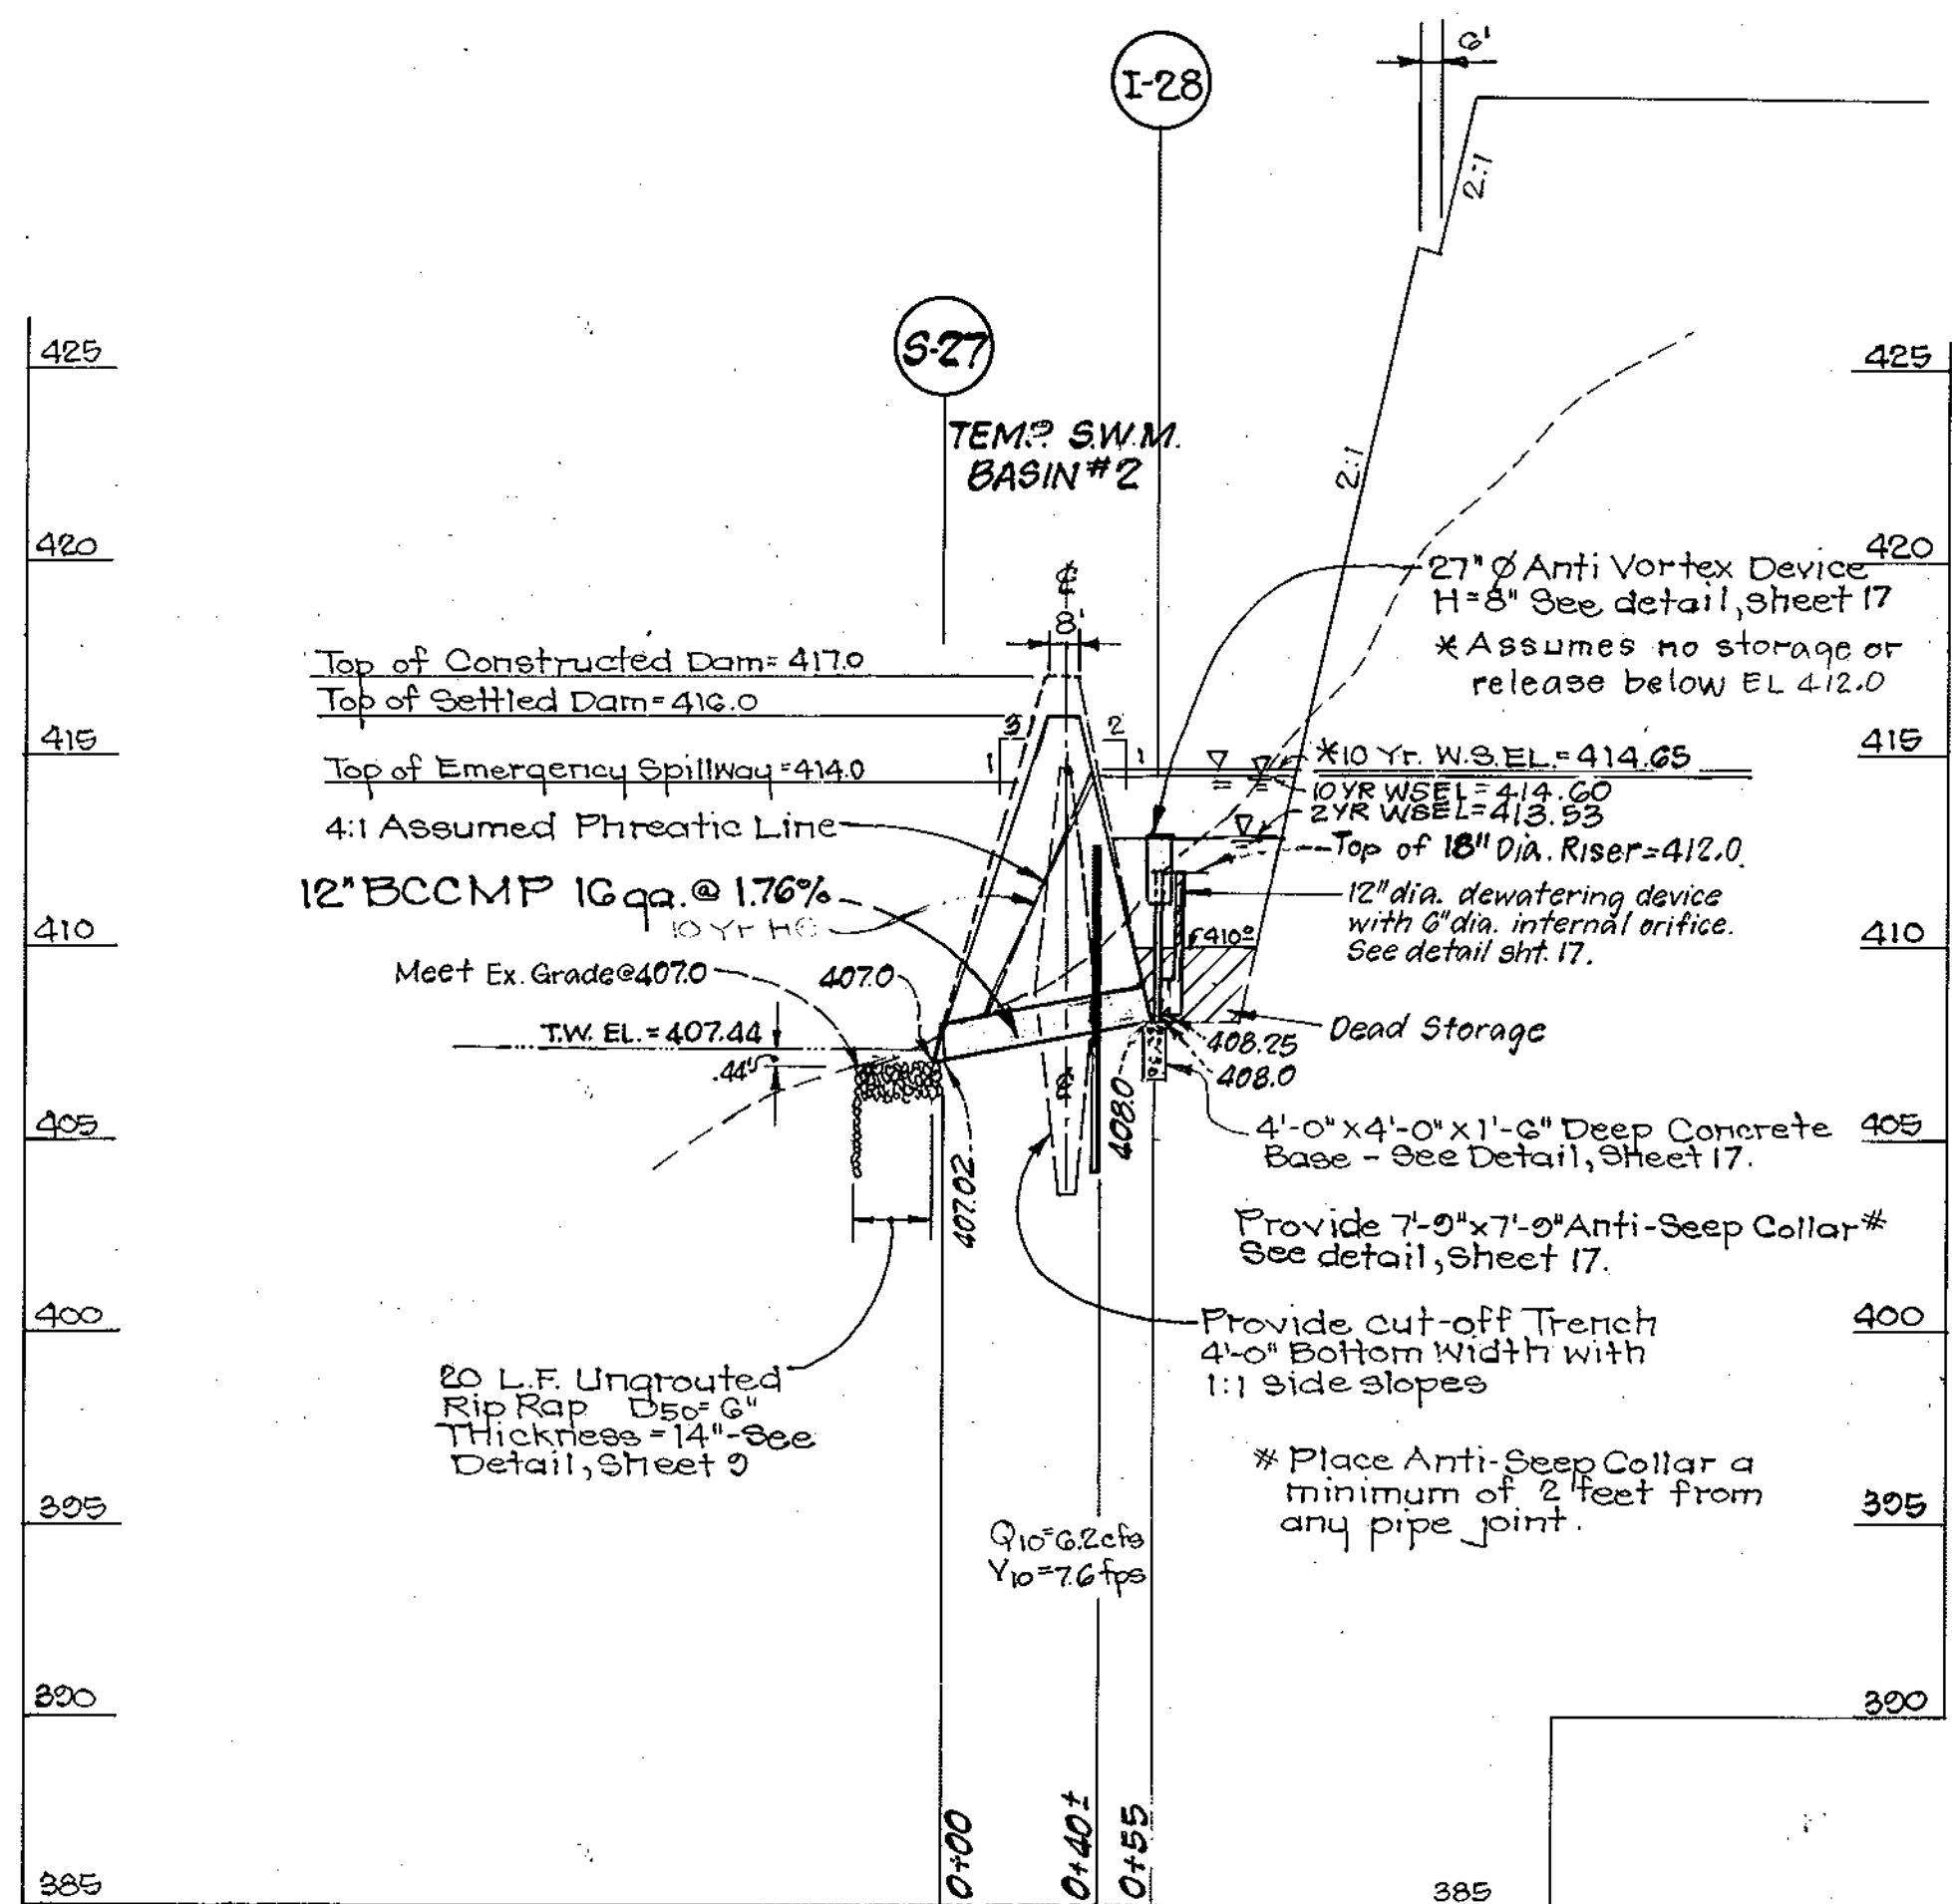

PROFILE THRU PRINCIPAL SPILLWAY
TEMPORARY SEDIMENT BASIN No 2

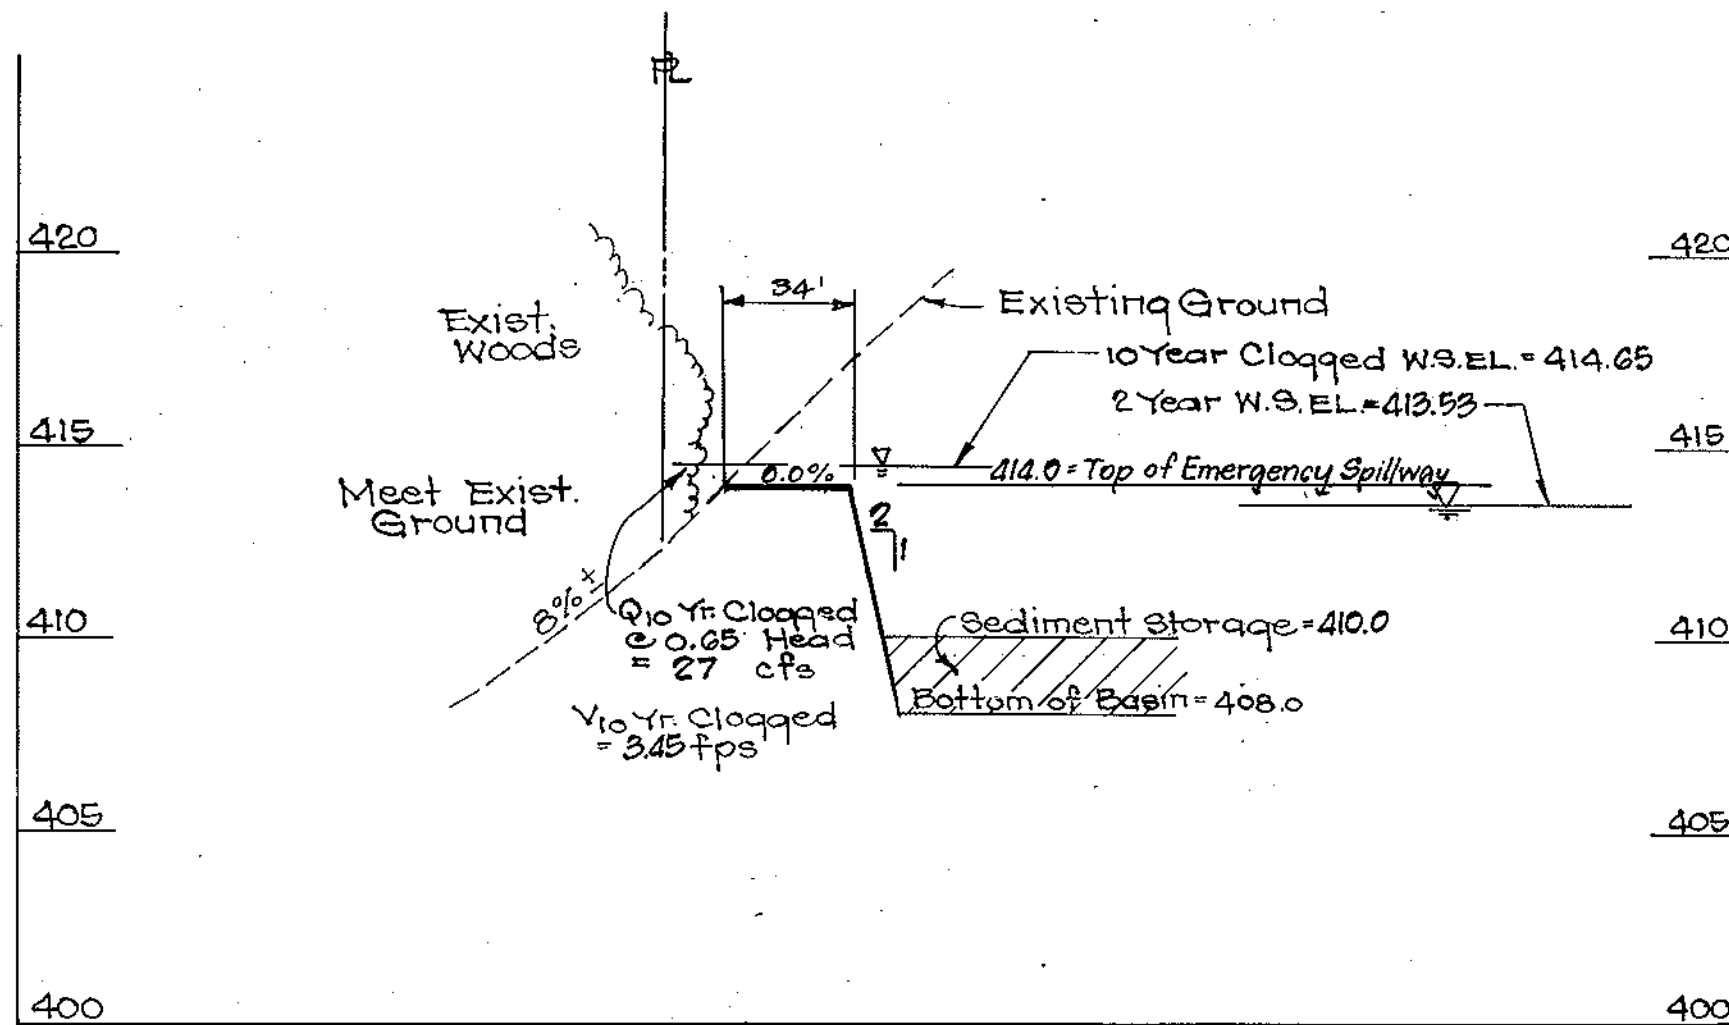

PROFILE THRU EMERGENCY SPILLWAY
TEMPORARY SEDIMENT BASIN No 2

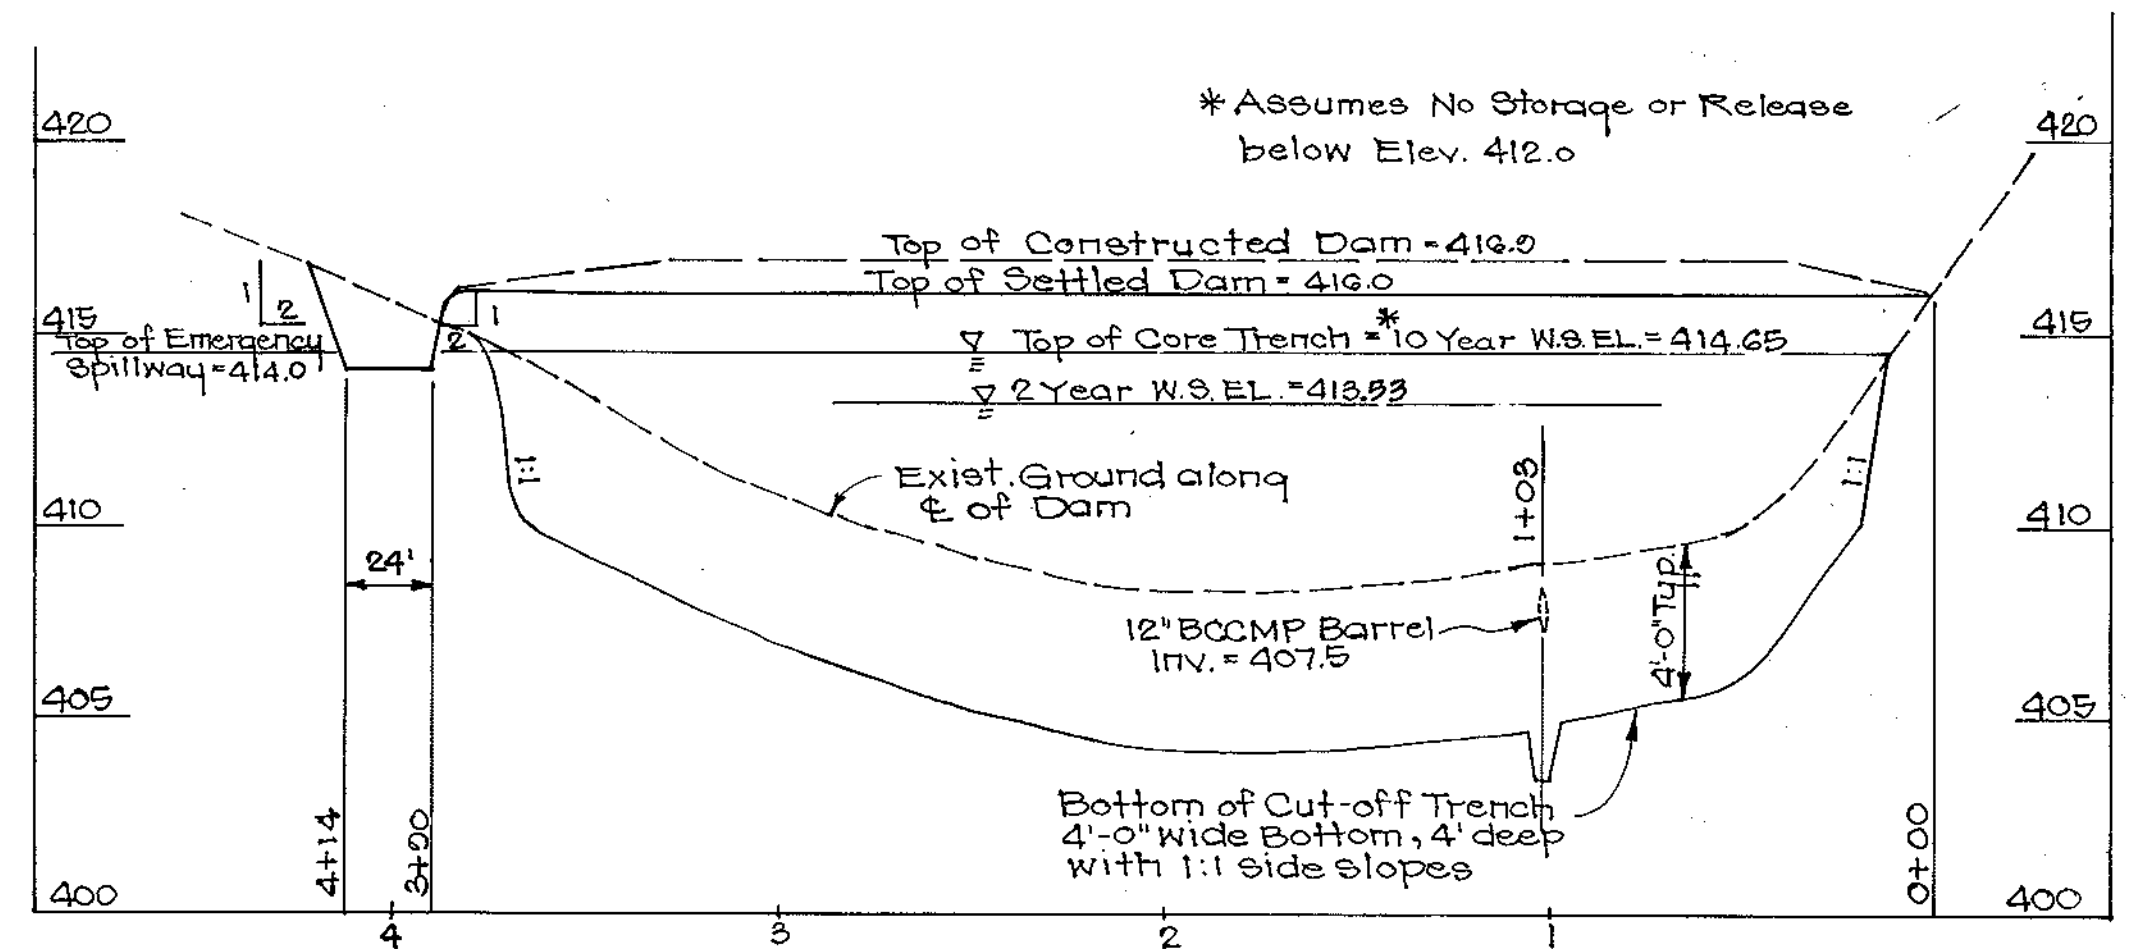

PROFILE ALONG CENTERLINE OF DAM
TEMPORARY SEDIMENT BASIN No 2



ENGINEER'S CERTIFICATE
I hereby certify that this plan for Sediment and Erosion Control represents a practical and workable plan based on my personal knowledge of the site conditions and that it was prepared in accordance with the requirements of the Howard Soil Conservation District.
G. Nelson Clark 1/7/96
G. NELSON CLARK DATE

DEVELOPER'S/BUILDER'S CERTIFICATE

"We certify that all development and construction will be done according to this plan of development and plan for sediment and erosion control and that all responsible personnel involved in the construction project will have a Certificate of Attendance at a Department of the Environment Approved Training Program for the Control of Sediment and Erosion before beginning the project. I also authorize periodic on-site inspection by the Howard Soil Conservation District or their authorized agents, as are deemed necessary."
John Gudelsky 1/4/96
NAME John Gudelsky DATE

APPROVED: DEPARTMENT OF PUBLIC WORKS
Richard M. Daniels 1-30-96
Chief, Bureau of Highways Date
APPROVED: DEPARTMENT OF PLANNING AND ZONING
Jim Swannomy 2/2/96
Chief, Division of Land Development and Research Date TC
Bill Damman 2/1/96
Chief, Development Engineering Division Date

Reviewed for HOWARD S.C.D. and meets Technical Requirements
John Gudelsky 1/19/96
Signature Date
Natural Resources Conservation Service

PROFILE SCALE



HOR. 1" = 50'
VERT. 1" = 5'

THIS DEVELOPMENT PLAN IS APPROVED FOR SOIL EROSION AND SEDIMENT CONTROL BY THE NATURE RESOURCES AND CONSERVATION SERVICE
John Gudelsky 1/19/96
Approved



CLARK • FINEFROCK & SACKETT, INC. ENGINEERS • PLANNERS • SURVEYORS 7135 MINSTREL WAY • COLUMBIA, MD. 21045 • (410) 981-7500 - BALTO. • (301) 621-8100 - WASH.		
DESIGNED KIWM	INTERIM S.W.M. AND SEDIMENT BASIN PROFILES	SCALE AS SHOWN
DRAWN KIWM	DANIELS MILL OVERLOOK	DRAWING 16 OF 20
CHECKED KIWM	TAX MAP 17 PART OF PARCEL 41 SECOND (2ND) ELECTION DISTRICT HOWARD COUNTY, MARYLAND	JOB NO. 04-203
DATE 12-27-95	FOR: HOWARD COUNTY BOARD OF EDUCATION 10810 ROUTE 108 ELLCOTT CITY, MARYLAND 21042	FILE NO. 04-203D


17821

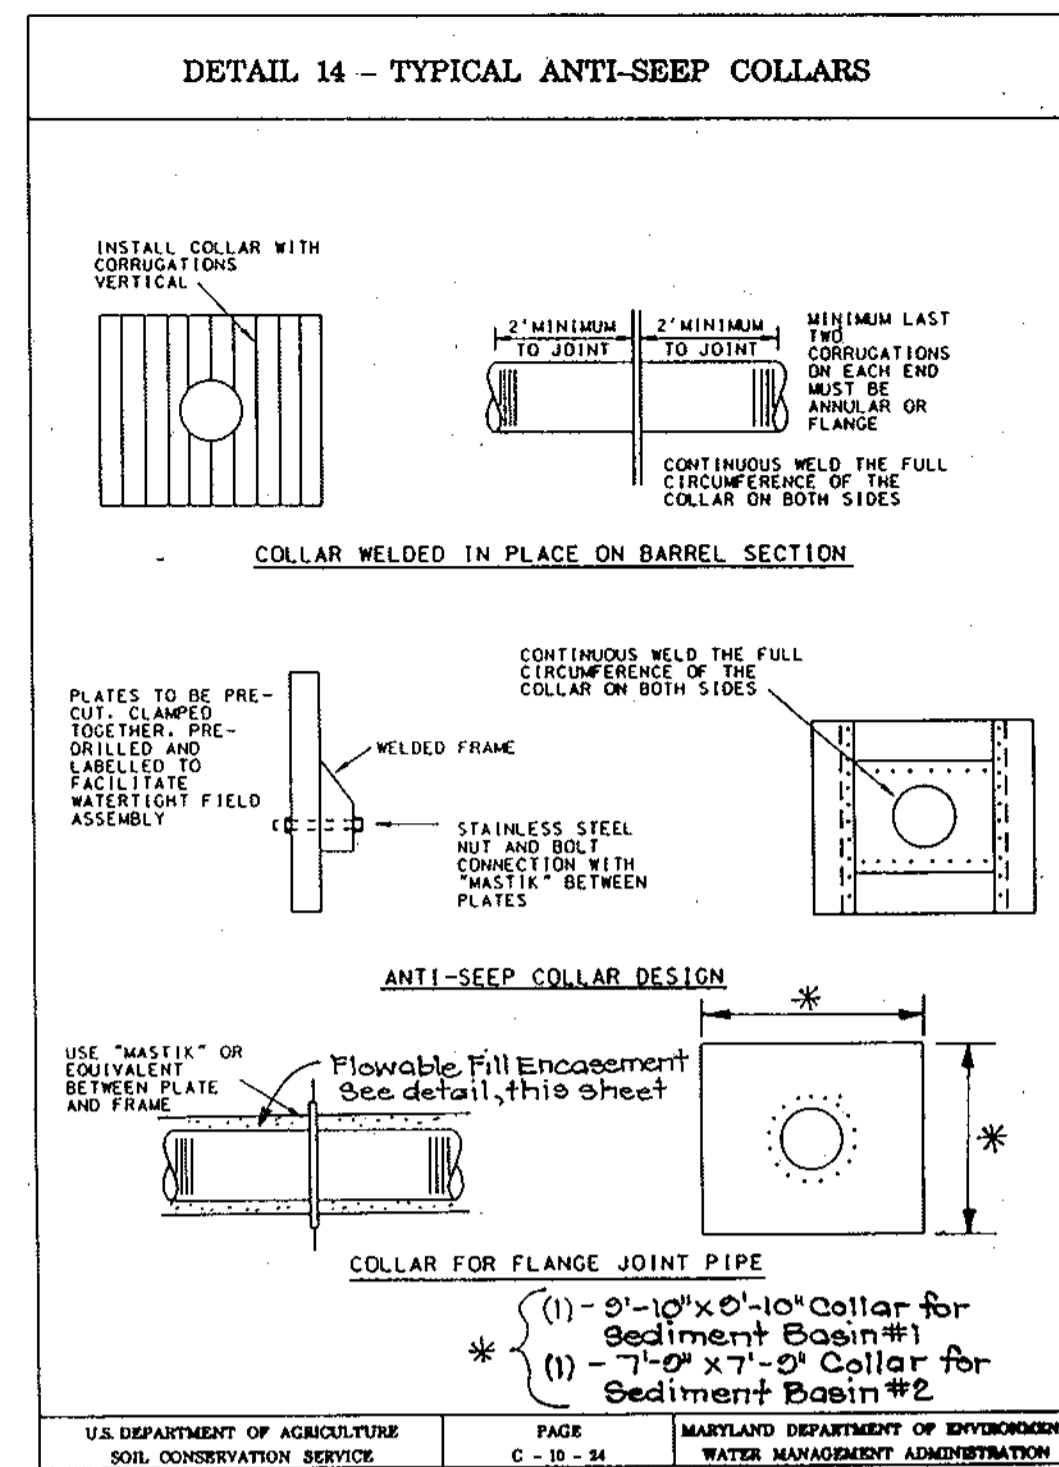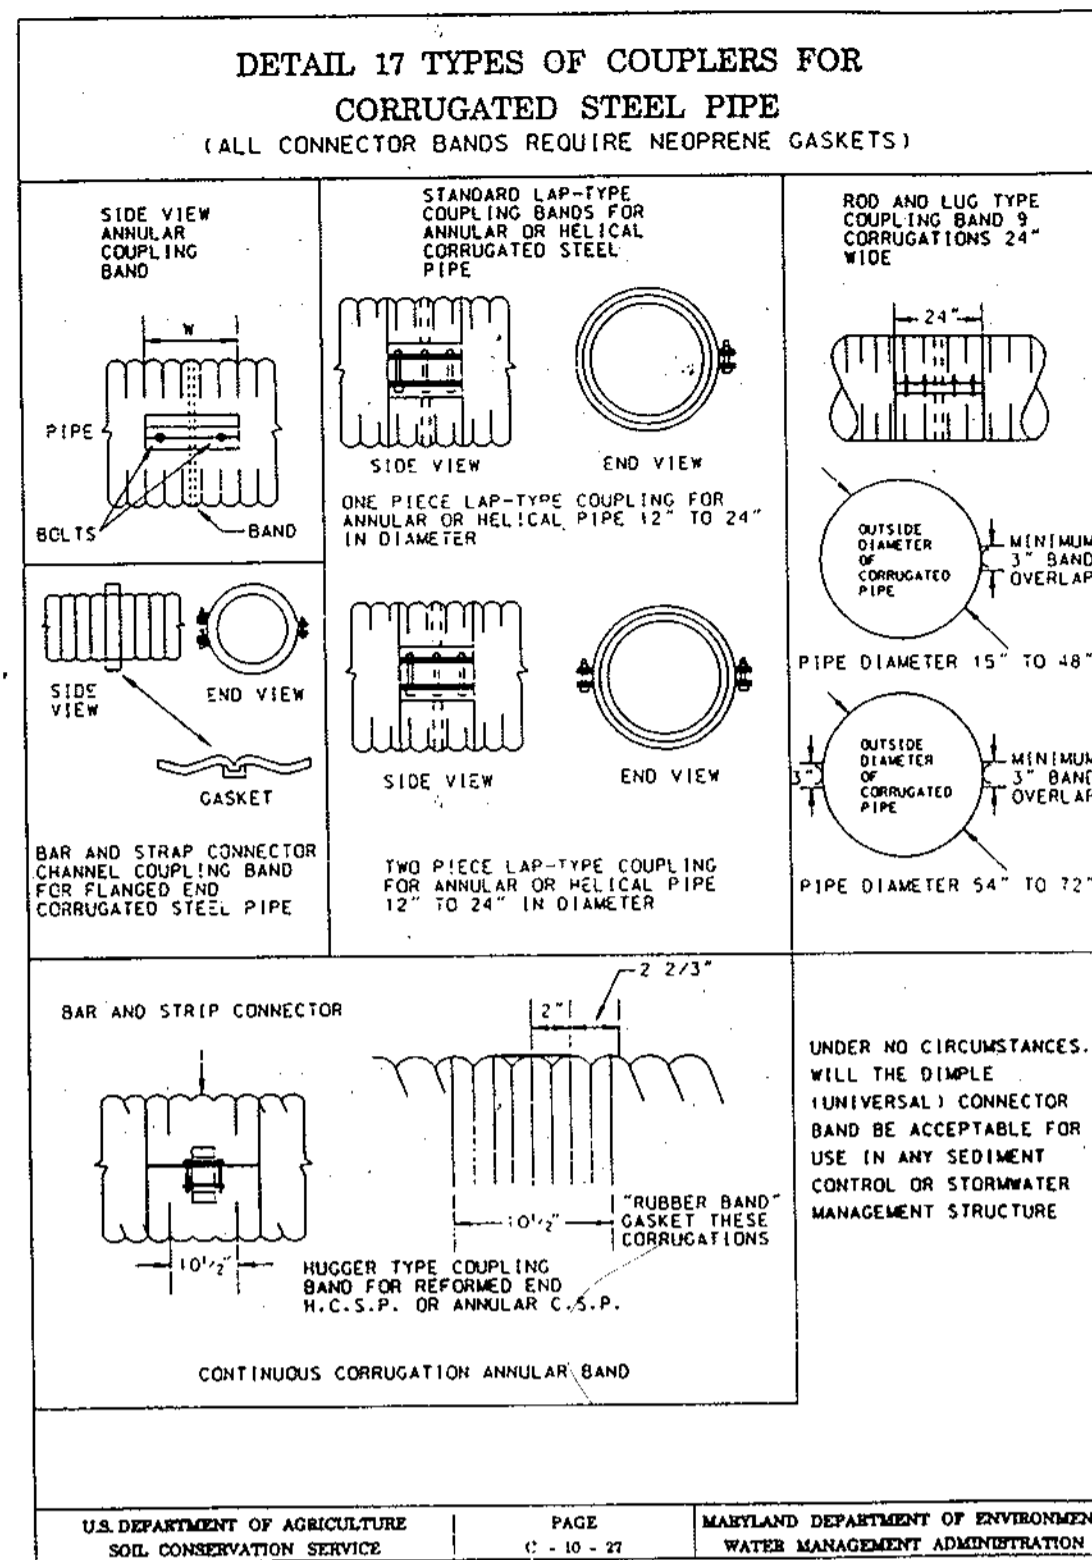

Note: Place anti-seep collar a minimum of 2 feet from any joint.

Construction Specifications

- Site Preparation:** Perimeter sediment control devices must be installed prior to clearing and grubbing. Areas where the embankment is to be placed shall be cleared, grubbed, and stripped of topsoil to remove trees, vegetation, roots or other objectionable material. The pool area shall not be cleared until completion of the dam embankment unless the pool area is to be used for borrow. In order to facilitate clean-out and restoration, the pool area (measured at the top of the pipe spillway) shall be cleared of all brush, trees, and other objectionable materials.
- Cut-off Trench:** A cut-off trench shall be excavated along the centerline of earth fill embankments. The minimum depth shall be four feet. The cut-off trench shall extend up both abutments to the riser crest elevation. The minimum bottom width shall be two feet, but wide enough to permit operation of excavation and compaction equipment. The side slopes shall be no steeper than 1:1. Compaction requirements shall be the same as those for the embankment. The trench shall be dewatered during the backfilling-compaction operations. For dewatering see Section D.
- Embankment:** The fill material shall be taken from approved areas shown on the plans. It shall be clean mineral soil free of roots, woody vegetation, oversized stones, rocks, or other objectionable material. Relatively pervious materials such as sand or gravel (Unified Soil Classes GW, GP, SW & SP) or organic materials (Unified Soil Classes OL and OH) shall not be placed in the embankment. Areas on which fill is to be placed shall be scarified prior to placement of fill. The fill material shall contain sufficient moisture so that it can be formed by hand into a ball without crumbling. If water can be squeezed out of the ball, it is too wet for proper compaction. Fill material shall be placed in six-inch to eight-inch thick continuous lifts over the entire length of the fill. Compaction shall be obtained by routing and hauling the construction equipment over the fill so that the entire surface of each layer of the fill is traversed by at least one wheel or tread track of the equipment or by the use of a compactor. The embankment shall be constructed to an elevation 10 percent higher than the design height to allow for settlement.
- Principal Spillway:** Steel risers shall be securely attached to the barrel or barrel stub by welding the full circumference making a watertight structural connection. Concrete risers shall be poured with the principal spillway in place or precast with voids around the principal spillway filled with concrete or shrink proof grout for watertight connection. The barrel stub must be attached to the riser at the same percent (angle) of grade as the outlet conduit. The connection between the riser and the riser base shall be watertight. All connections between barrel sections must be achieved by approved watertight band assemblies. The barrel and riser shall be placed on a firm, smooth foundation of impervious soil so that the embankment is constructed. Breaching the embankment to install the barrel is unacceptable. Pervious materials such as sand, gravel, or crushed stone shall not be used as backfill around the pipe or anti-seep collar. The fill material around the pipe spillway shall be placed in four inch lifts and hand compacted under and around the pipe to at least the same density as the adjacent embankment. A depth of 1.5 times the pipe diameter (min.) shall be backfilled over the principal spillway and hand compacted before crossing it with construction equipment.
- Emergency Spillway:** The emergency spillway shall be installed in undisturbed ground. The achievement of planned elevations, grades, design width, entrance and exit channel slopes are critical to the successful operation of the emergency spillway and must be constructed within a tolerance of ± 0.2 feet.
- Vegetative Treatment:** Stabilize the embankment in accordance with the appropriate vegetative Standard and Specifications immediately following construction. In no case shall the embankment remain unstabilized for more than seven (7) days. Once constructed, the top and outside face of the embankment shall be stabilized with seed and mulch. The remainder of the interior slopes should be stabilized (one time) with seed and mulch upon basin completion and monitored and maintained erosion free during the life of the basin.
- Safety:** Local requirements concerning fencing and signs shall be met, warning the public of hazards of soft sediment and floodwater.
- Maintenance:** Repair all damage caused by soil erosion and construction equipment at or before the end of each working day. Sediment shall be removed from the basin when it reaches the specified distance below the top of the riser as shown on the plan. This sediment shall be placed in such a manner that it will not erode from the site. The sediment shall not be deposited downstream from the embankment, adjacent to a stream or floodplain. Disposal areas must be stabilized.
- Final Disposal:** When temporary structures have served their intended purpose and the contributing drainage area has been properly stabilized, the embankment and resulting sediment deposits are to be leveled or otherwise disposed of in accordance with the approved sediment control plan. The proposed use of a sediment basin site will often dictate final disposition of the basin and any sediment contained therein. If the site is scheduled for future construction, then the basin material and trapped sediments must be removed and safely disposed of and the basin shall be backfilled with a structural fill. When the basin area is to remain open space, the pond may be pumped dry (using methods in Section D - Dewatering), graded, and back filled.
- Conversion to Stormwater Management Structure:** After permanent stabilization of all disturbed contributory drainage areas, temporary sediment basins, if initially built and certified to meet permanent standards, may be converted to permanent stormwater management structures. To convert the basin from temporary to permanent use, the outlet structure must be modified in accordance with approved stormwater management design plans. Additional grading may also be necessary to provide the required storage volume in the basin. Conversion can only take place after all disturbed areas have been permanently stabilized to the satisfaction of the inspection authority and storm drains have been flushed.

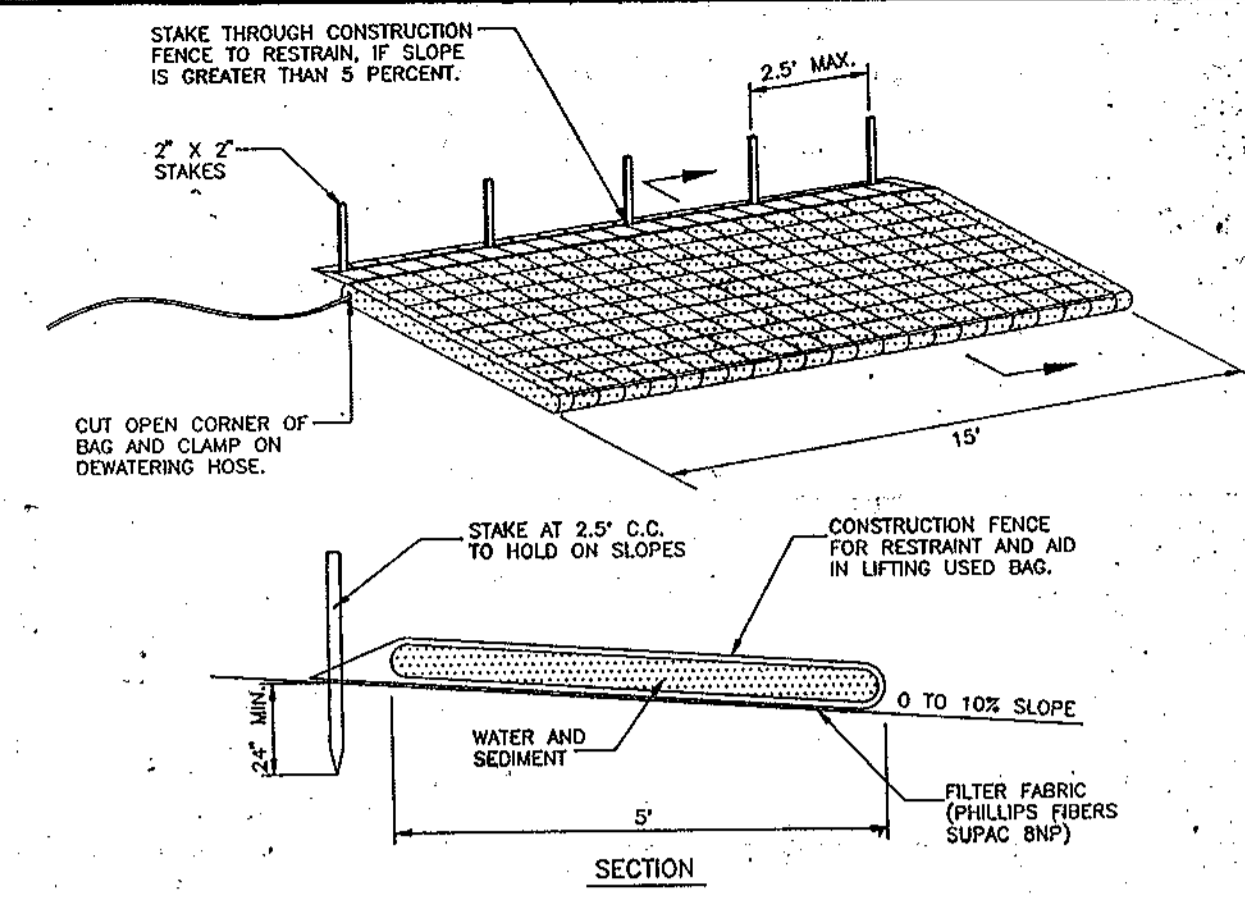






- NOTES:
- FILTER BAG SHALL BE PLACED ON A SLOPING OR LEVEL, WELL GRADED VEGETATED SITE SUCH THAT WATER WILL FLOW AWAY FROM DEVICE AND ANY WORK AREAS.
 - WIDTH AND LENGTH SHALL BE AS SHOWN.
 - THE FILTER BAG MUST BE STAKED IN PLACE AND SECURED TO THE PUMP DISCHARGE LINE.
 - FILTER BAG SHALL NOT BE USED FOR DISCHARGE FLOWS GREATER THAN 300 GPM.
 - DEVICE SHALL BE REMOVED AND DISPOSED OF AFTER BAG IS FILLED WITH SEDIMENT. SEDIMENT FROM BAG SHALL BE SPREAD IN AN UPLAND AREA.

AVAILABLE FROM:

ACE ENVIRONMENTAL 1801-A WILIS ROAD RICHMOND, VA 23237 TOLL FREE 1-800-448-3000

INDIAN VALLEY INDUSTRIES, INC. P. O. BOX 810 JOHNSON CITY, NY 13790 (868) 859-5111

PRICE & COMPANY, INC. 425 38TH STREET WYOMING, WY 80548 (616) 530-8230

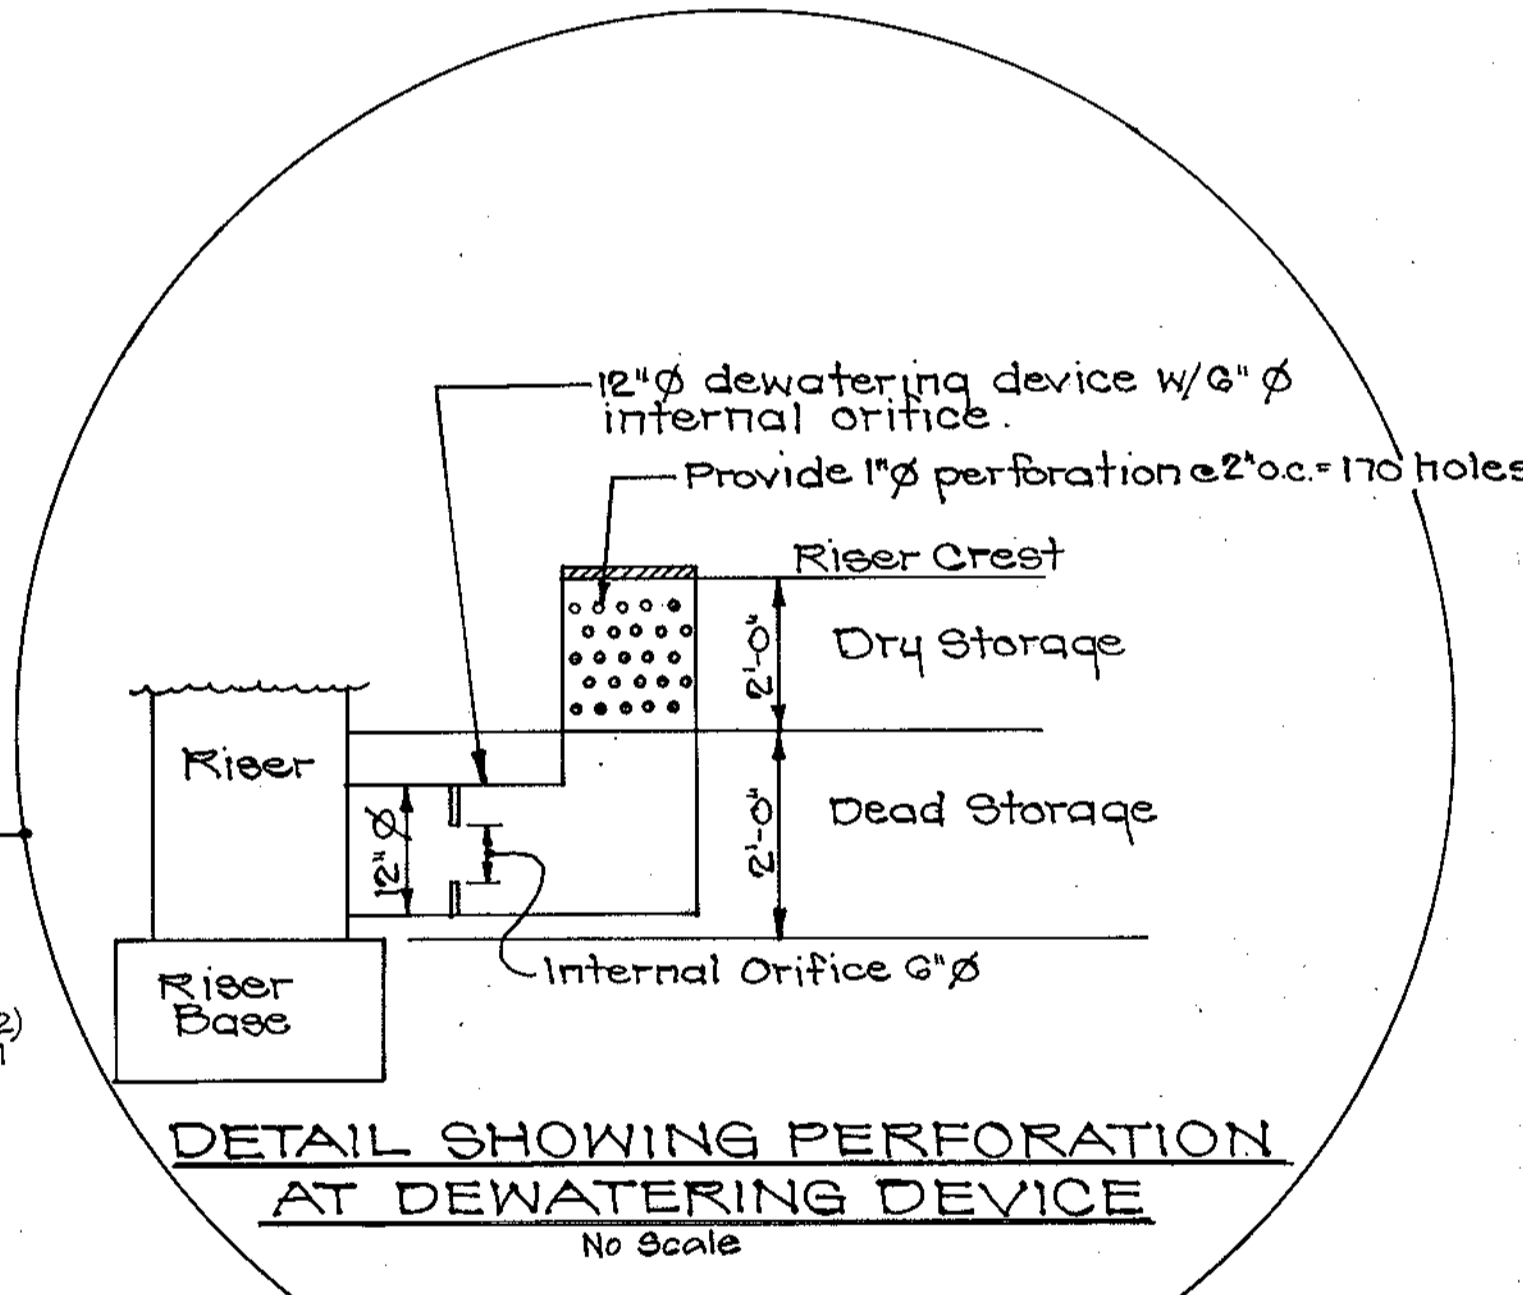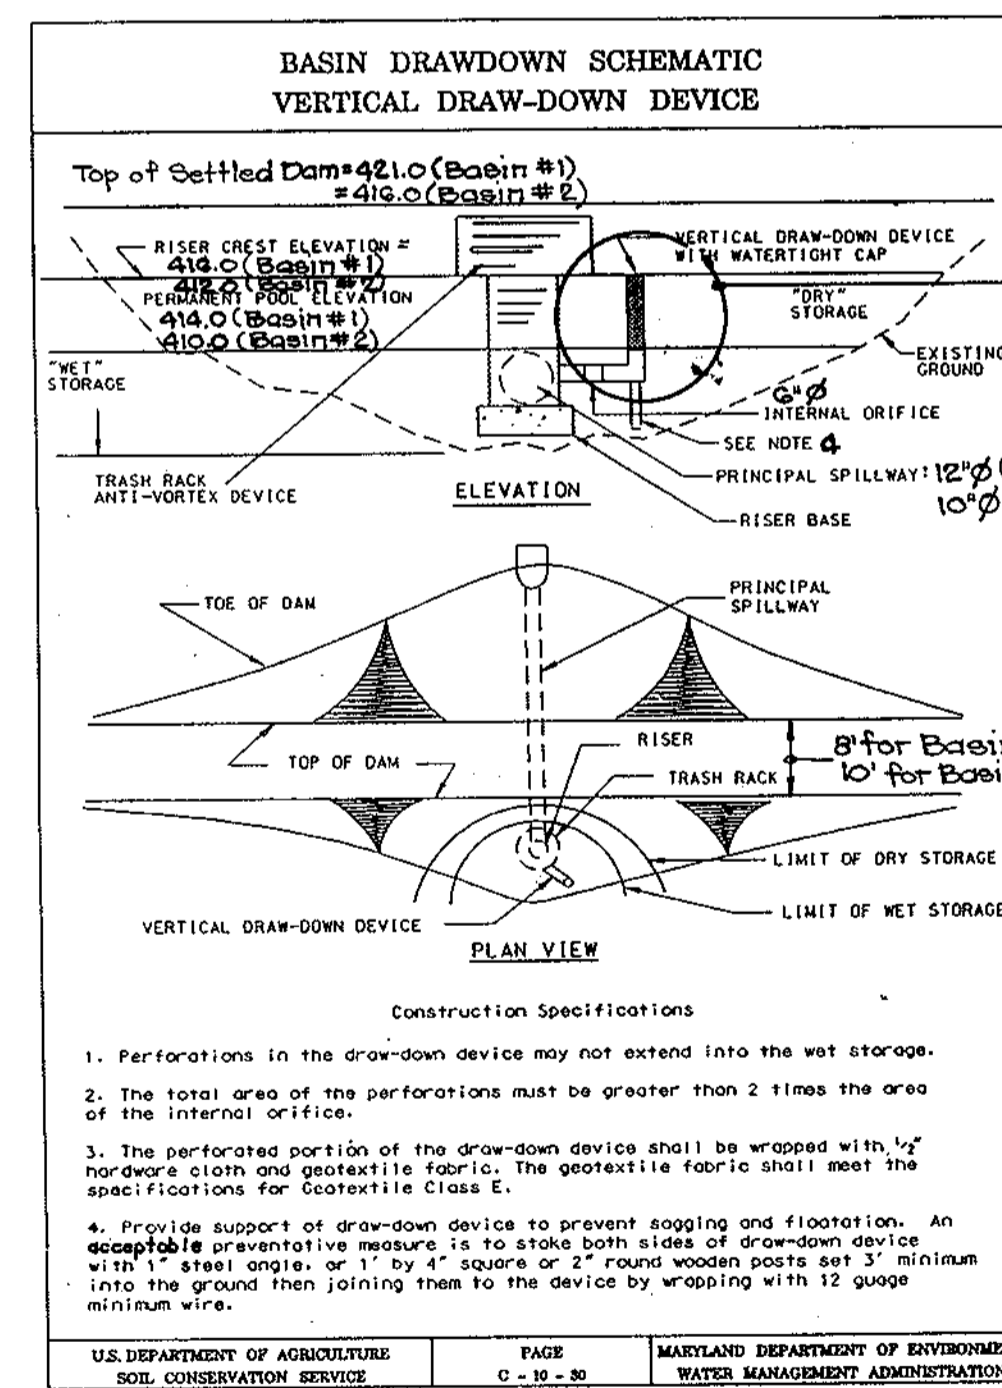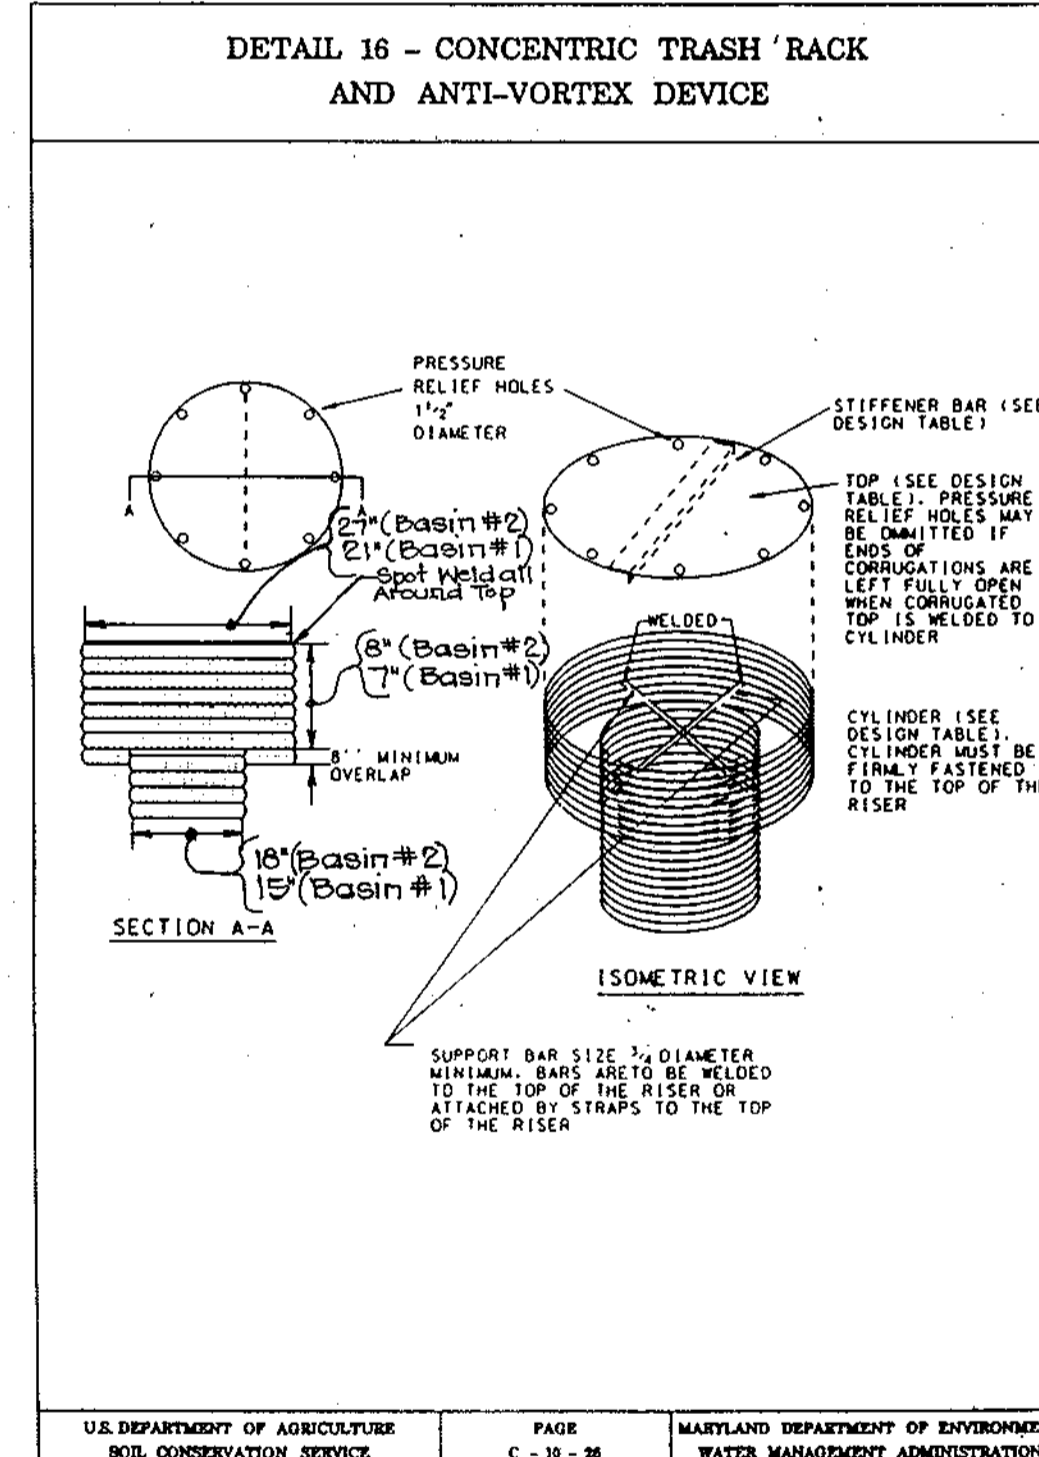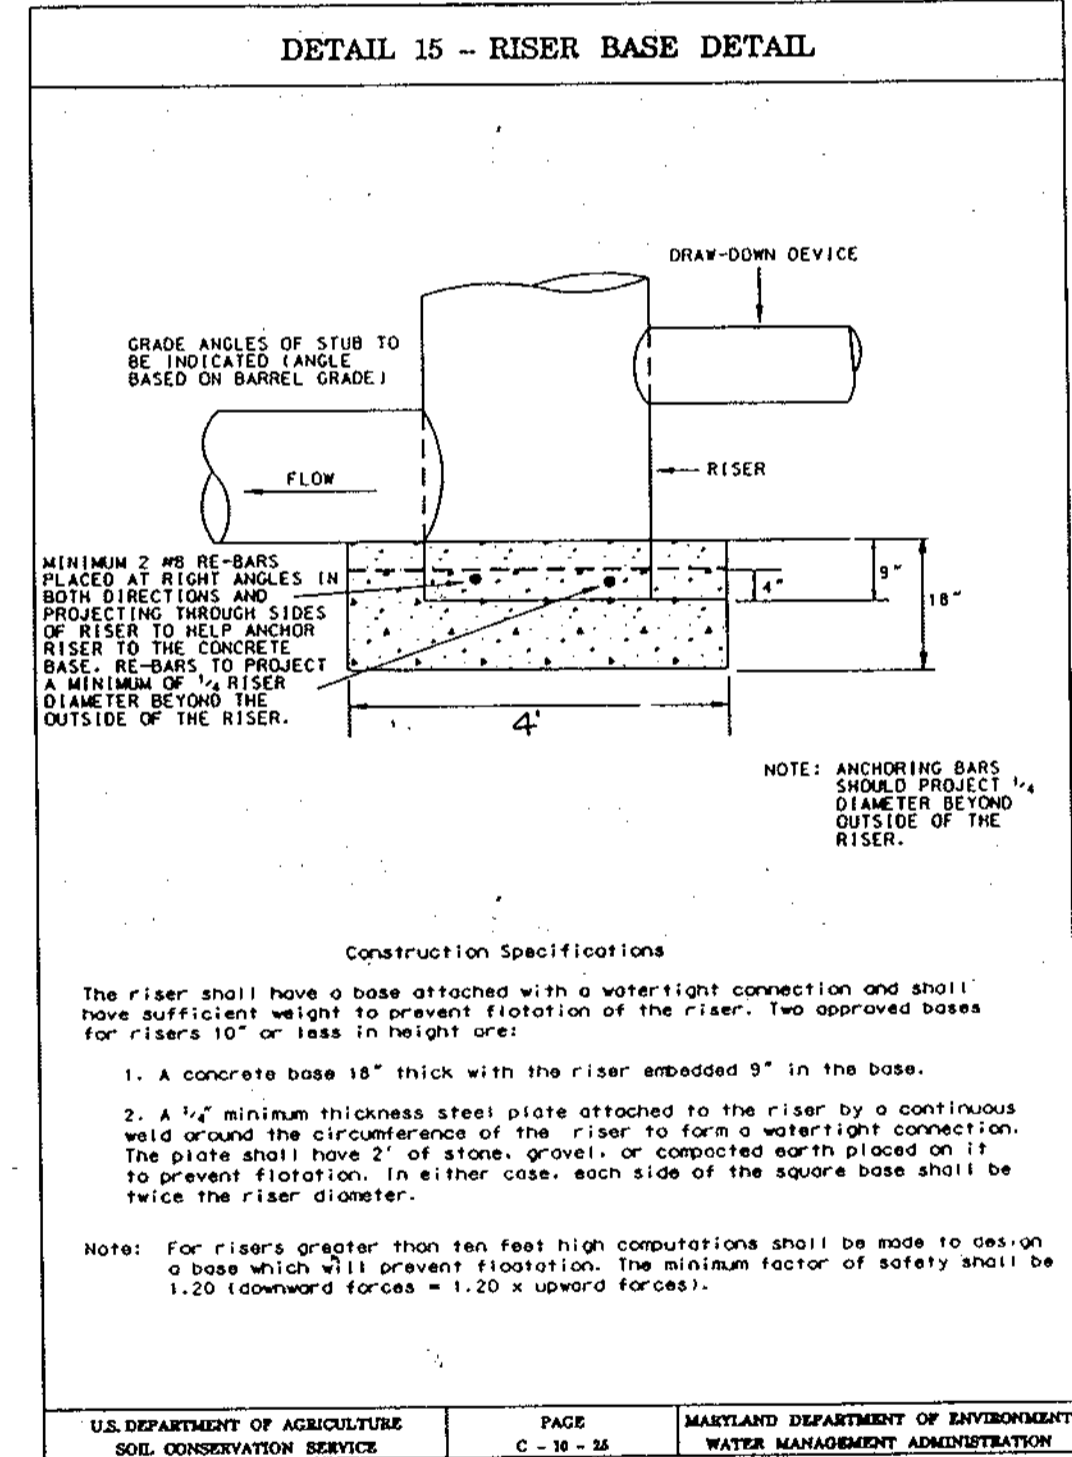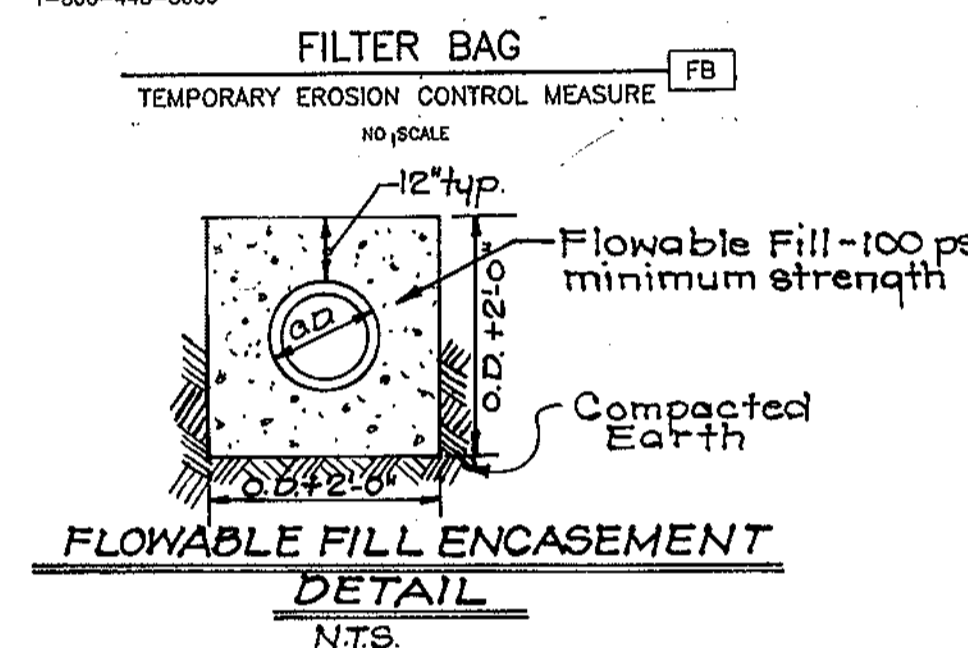

APPROVED: DEPARTMENT OF PUBLIC WORKS

Richard M. Danks 1-30-96
Chief, Bureau of Highways Date

APPROVED: DEPARTMENT OF PLANNING AND ZONING

Jim Strimmon 2/2/96
Chief, Division of Land Development and Research Date TC

John D. ... 2/1/96
Chief, Development Engineering Division Date

NOTE: Dewatering Device to be used with Temporary Sediment Basin.

Reviewed for: HOWARD, S.C.D. and meets Technical Requirements

Signature Date
Natural Resources Conservation Service

DEVELOPER'S/BUILDER'S CERTIFICATE

"I/We certify that all development and construction will be done according to this plan of development and plan for sediment and erosion control and that all responsible personnel involved in the construction project will have a Certificate of Attendance at a Department of the Environment Approved Training Program for the Control of Sediment and Erosion before beginning the project. I/We also authorize periodic air-mile inspection by the Howard Soil Conservation District or their authorized agents, as are deemed necessary."

John Gudetsky 1/4/96
NAME DATE

ENGINEER'S CERTIFICATE

I hereby certify that this plan for Sediment and Erosion Control represents a practical and workable plan based on my personal knowledge of the site conditions and that it was prepared in accordance with the requirements of the Howard Soil Conservation District.

G. Nelson Clark 1-9-96
NAME DATE



CLARK • FINEFROCK & SACKETT, INC.
ENGINEERS • PLANNERS • SURVEYORS

7135 MINSTREL WAY • COLUMBIA, MD 21045 • (410) 381-7500 • BALTO • (301) 821-8100 • WASH.




DESIGNED KIWM	SCALE -
DRAWN KJM	DRAWING 17 of 20
CHECKED KJM	JOB NO. 04-203
DATE 12-27-05	FILE NO. 04-203D

INTERIM S.W.M. AND SEDIMENT BASIN PROFILES
DANIELS MILL OVERLOOK

TAX MAP 17 PART OF PARCEL 41
SECOND (2ND) ELECTION DISTRICT
HOWARD COUNTY, MARYLAND

FOR: HOWARD COUNTY BOARD OF EDUCATION
10010 ROUTE 108
ELLCOTT CITY, MARYLAND 21042

1783

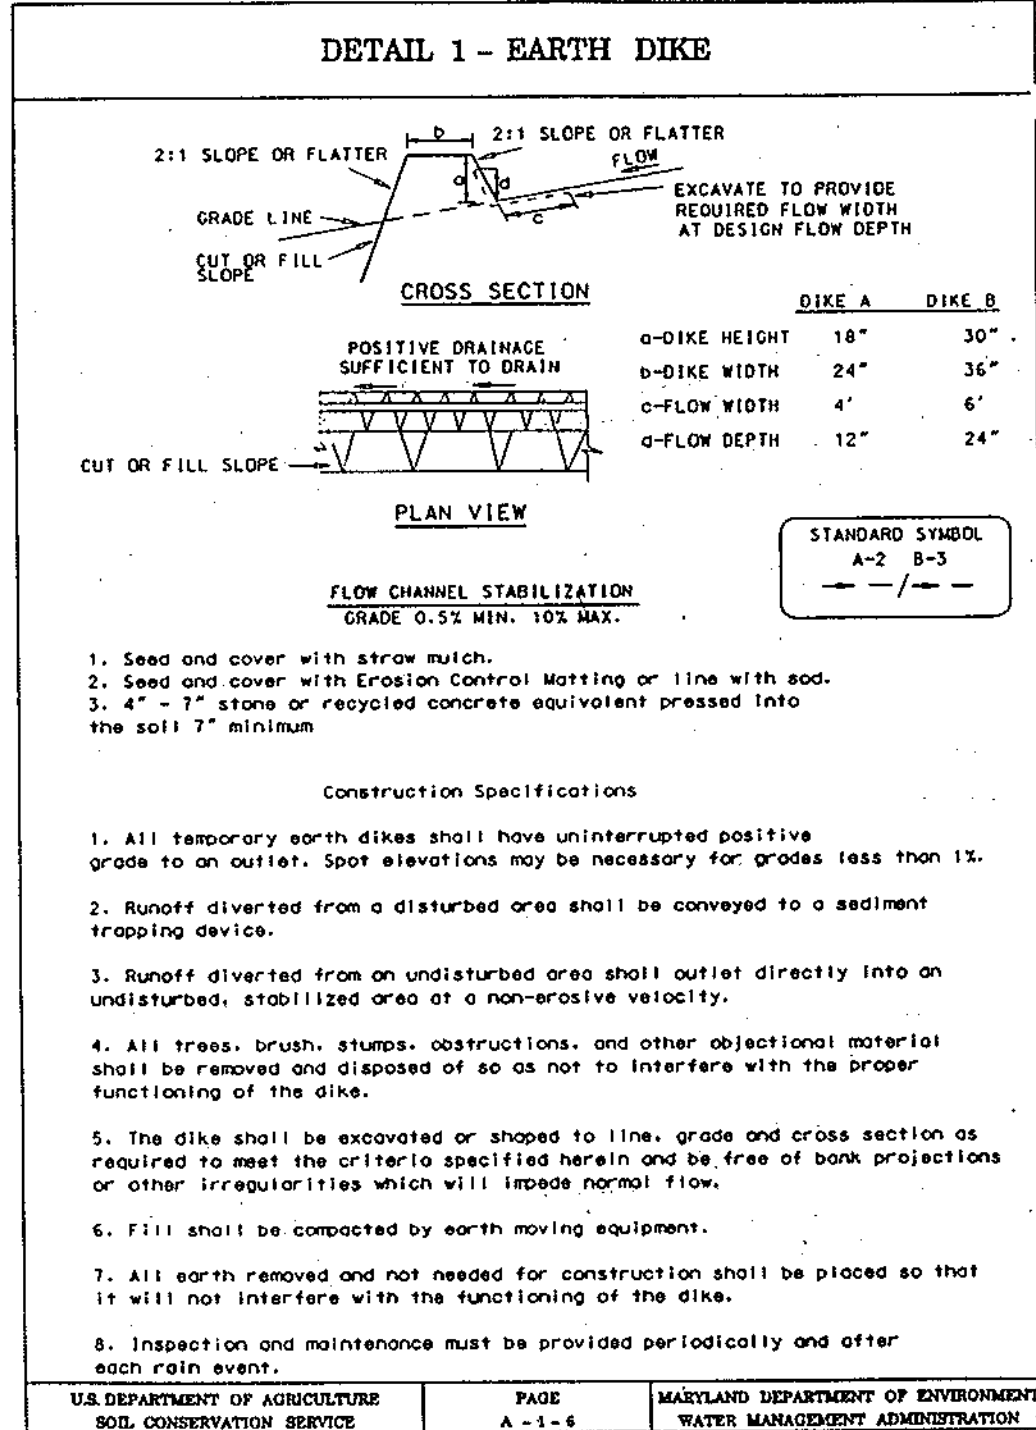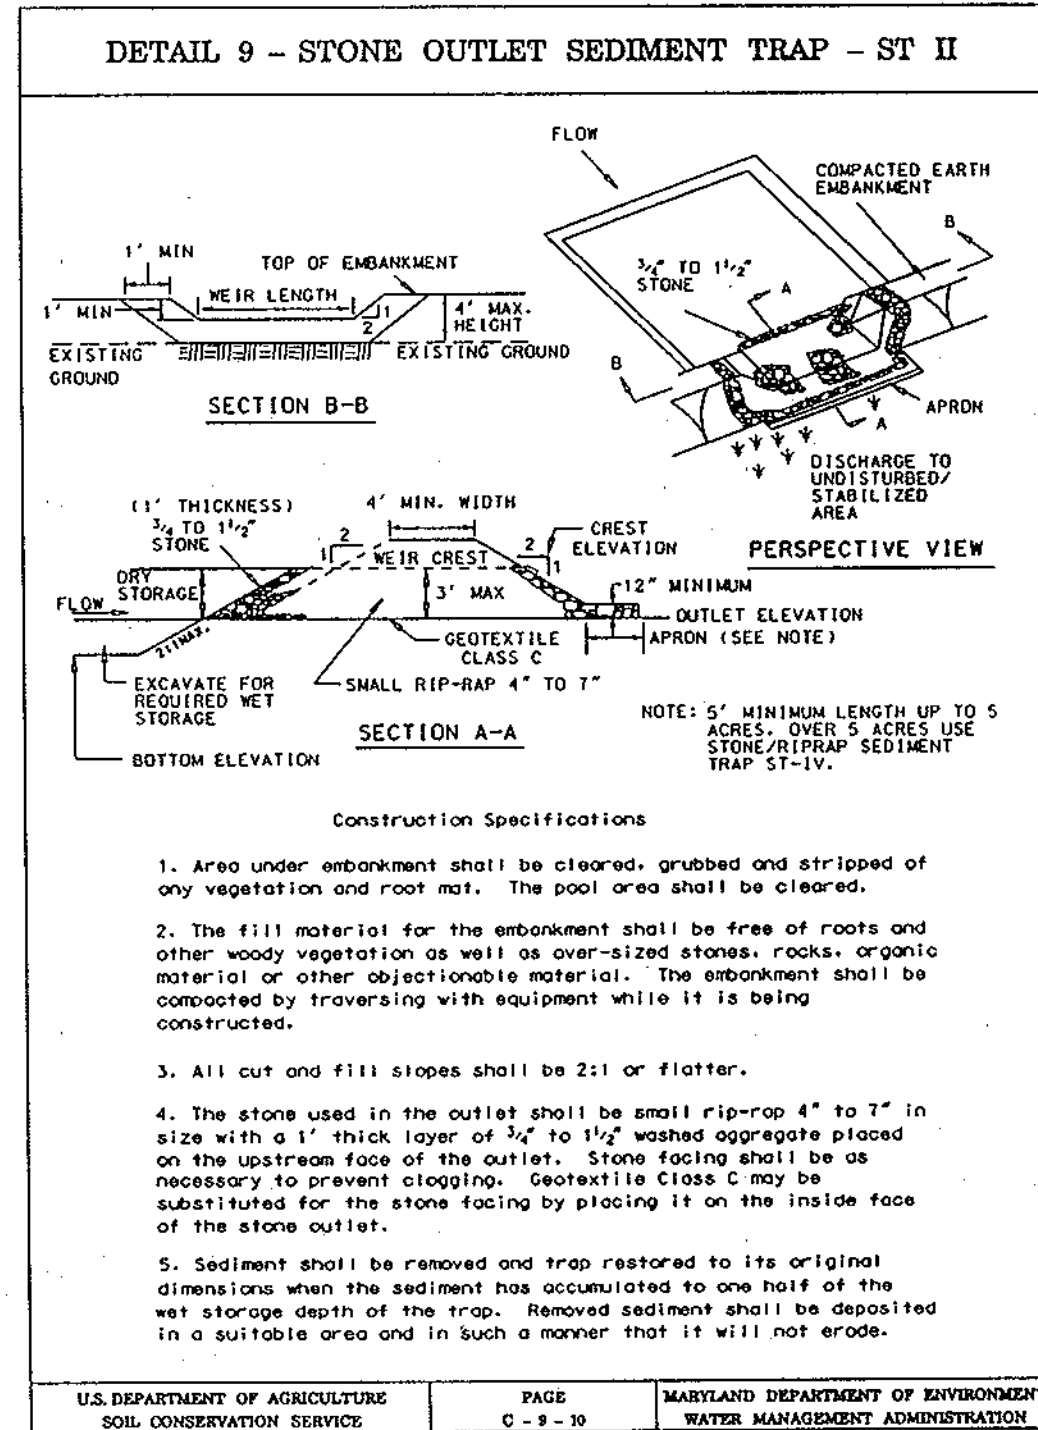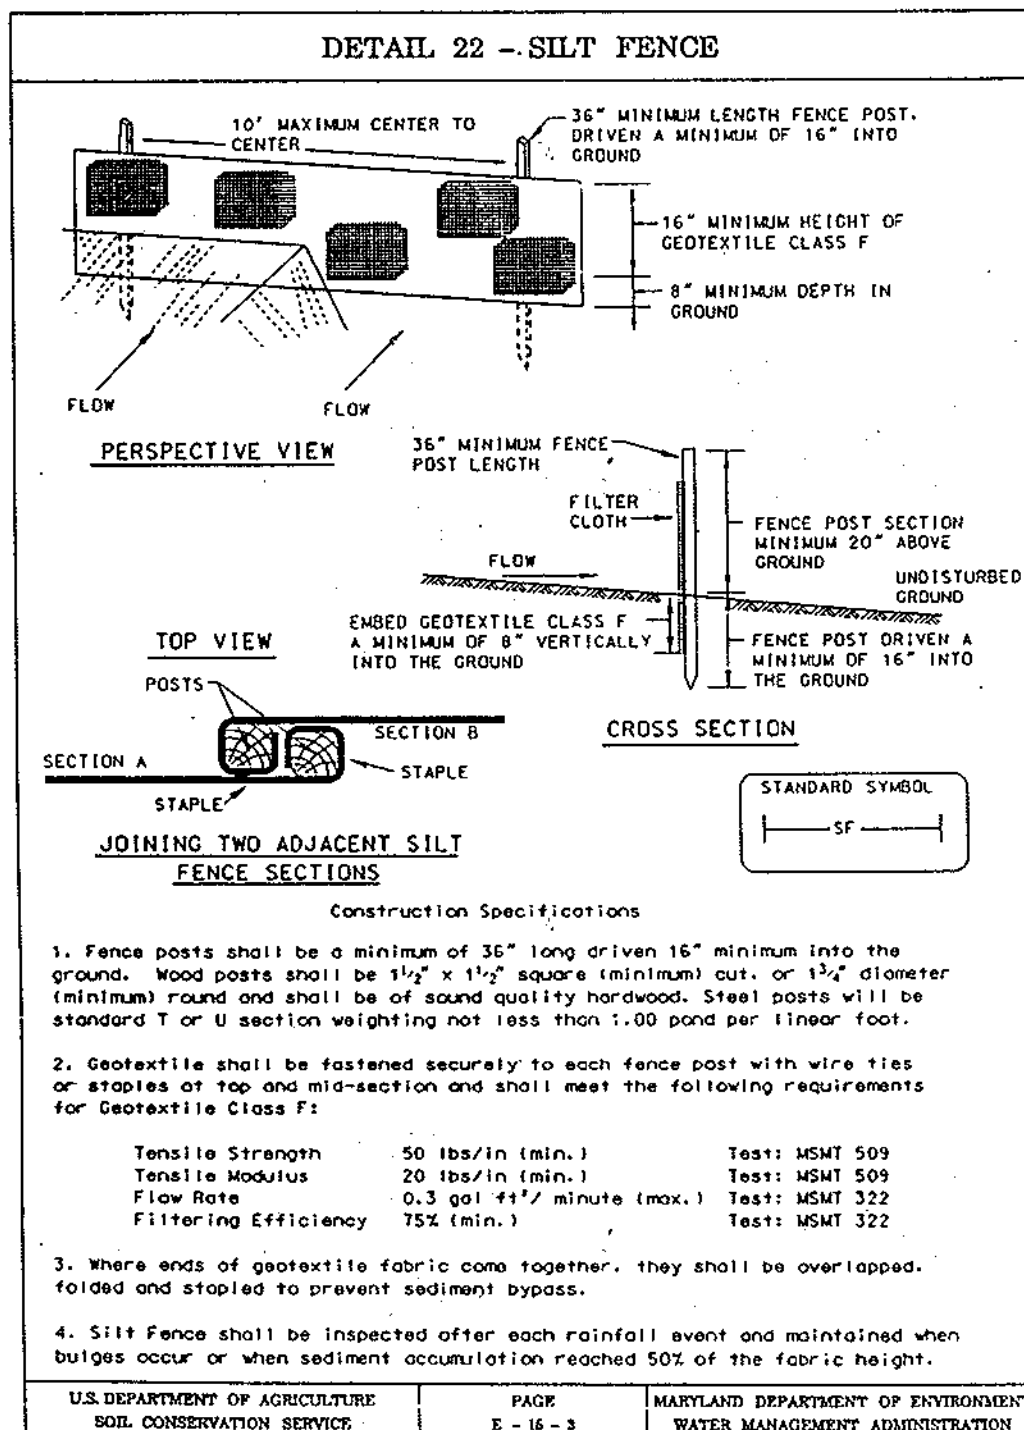

SEDIMENT AND EROSION CONTROL NOTES

- A minimum of 24 hours notice must be given to the Howard County Office of Inspection and Permits prior to the start of any construction. (13-1885).
- All vegetative and structural practices are to be installed according to the provisions of this plan and are to be in conformance with the 1983 MARYLAND STANDARDS AND SPECS. FOR SOIL EROSION AND SEDIMENT CONTROL.
- Following initial soil disturbance or redistribution, permanent or temporary stabilization shall be completed within:
 - 7 calendar days for all perimeter sediment control structures, dikes, perimeter slopes and all slopes greater than 3:1
 - 14 days as to all other disturbed or graded areas on the project site.
- All sediment traps/basins shown must be fenced and warning signs posted around their perimeters in accordance with Vol. 1, Chapter 12, of the HOWARD COUNTY DESIGN MANUAL, Storm Drainage.
- All disturbed areas must be stabilized within the time period specified above, in accordance with the 1983 MARYLAND STANDARDS AND SPECIFICATIONS FOR SOIL EROSION AND SEDIMENT CONTROL for permanent seedings (Sec. 51), sod (Sec. 54), temporary seedings (Sec. 50) and mulching (Sec. 52). Temporary stabilization with mulch alone can only be done when recommended seeding dates do not allow for proper germination, and establishment of grasses.
- All sediment control structures are to remain in place and are to be maintained in operative condition until permanent removal has been obtained from the Howard County Sediment Control Inspector.
- SITE ANALYSIS:

Total Area of Site:	23.07 AC (7.9 AC ROADS ONLY)
Area Disturbed:	6.3 AC (1.4 AC ROADS ONLY)
Area to be roofed or paved:	4.3 AC
Area to be vegetatively stabilized:	19.52 AC (6.5 AC ROADS ONLY)
Total Cut:	7146.04 CU (212.5 CU ROADS ONLY)
Total Fill:	7525.64 CU (670 CU ROADS ONLY)

 Offsite Waste/Borrow Area Location:
- Any sediment control practice which is disturbed by grading activity for placement of utilities must be repaired on the same day of disturbance. (Includes this school)
- Additional sediment control must be provided, if deemed necessary by the Howard County DPW Sediment Control Inspector.
- On all sites with disturbed areas in excess of 2 acres, approval of the inspection agency shall be requested upon completion of installation of perimeter erosion and sediment controls, but before proceeding with any other earth disturbance or grading. Other building or grading inspection approvals may not be authorized until this initial approval by the inspection agency is made.
- The total amount of silt fence = $\frac{1260 LF}{600 LF} = 2.1$ miles of fence

PERMANENT SEEDING NOTES

APPLY TO GRADED OR CLEARED AREAS NOT SUBJECT TO IMMEDIATE FURTHER DISTURBANCE WHERE A PERMANENT LONG-LIVED VEGETATIVE COVER IS NEEDED. FOR ALL AREAS EXCEPT OPEN SPACE LOTS 1 & 2.

SEEDBED PREPARATION: Loosen upper three inches of soil by raking, discing or other acceptable means before seeding, if not previously loosened.

SOIL AMENDMENTS: In lieu of soil test recommendations, use one of the following schedules:

- Preferred—Apply 2 tons per acre dolomitic limestone (92 lbs./1000 sq.ft.) and 600 lbs per acre 10-10-10 fertilizer (14 lbs./1000 sq.ft.) before seeding. Harrow or disc into upper three inches of soil. At the time of seeding apply 400 lbs. per acre 30-0-0 ureaform fertilizer (9 lbs./1000 sq.ft.)
- Acceptable—Apply 2 tons per acre dolomitic limestone (92 lbs./1000 sq.ft.) and apply 1000 lbs. per acre 10-10-10 fertilizer (23 lbs./1000 sq.ft.) before seeding. Harrow or disc into upper three inches of soil.

SEEDING: For the periods March 1 thru April 30, and August 1 thru October 15, seed with 60 lbs. per acre (14 lbs./1000 sq.ft.) of Kentucky 31 Tall Fescue. For the period May 1 thru July 31, seed with 60 lbs. Kentucky 31 Tall Fescue per acre and 2 lbs. per acre (.05 lbs./1000 sq.ft.) of weeping lovegrass. During the period of October 16 thru February 28, protect site by Option (1) 2 tons per acre well anchored straw mulch and seed as soon as possible in the spring. Option (2) Use sod. Option (3) Seed with 60 lbs/acre Kentucky 31 Tall Fescue and mulch with 2 tons/acre well anchored straw.

MULCHING: Apply 1 1/2 to 2 tons per acre (70 to 90 lbs./1000 sq.ft.) of unrotted small grain straw immediately after seeding. Anchor mulch immediately after application using mulch anchoring tool or 218 gallons per acre (5 gal/1000 sq.ft.) of emulsified asphalt on flat areas. On slopes 8 feet or higher, use 348 gallons per acre (8 gal/1000 sq.ft.) for anchoring.

MAINTENANCE: Inspect all seeded areas and make needed repairs, replacements and reseedings.

TEMPORARY SEEDING NOTES

SEEDBED PREPARATION: Loosen upper three inches of soil by raking, discing or other acceptable means before seeding, if not previously loosened.

SOIL AMENDMENTS: Apply 600 lbs. per acre 10-10-10 fertilizer (14 lbs./1000 sq.ft.).

SEEDING: For periods March 1 thru April 30 and from August 15 thru November 15, seed with 2 1/2 bushel per acre of annual ryegrass (3.2 lbs./1000 sq.ft.). For the period May 1 thru August 14, seed with 3 lbs. per acre of weeping lovegrass (.07 lbs./1000 sq.ft.). For the period November 1 thru February 28, protect site by applying 2 tons per acre of well anchored straw mulch and seed as soon as possible in the spring, or use sod.

MULCHING: Apply 1 1/2 to 2 tons per acre (70 to 90 lbs./1000 sq.ft.) of unrotted small grain straw immediately after seeding. Anchor mulch immediately after application using mulch anchoring tool or 218 gallons per acre (5 gal/1000 sq.ft.) of emulsified asphalt on flat areas. On slopes 8 feet or higher, use 348 gallons per acre (8 gal/1000 sq.ft.) for anchoring.

REFER TO THE 1983 MARYLAND STANDARDS AND SPECIFICATIONS FOR SOIL EROSION AND SEDIMENT CONTROL FOR RATE AND METHODS NOT COVERED.



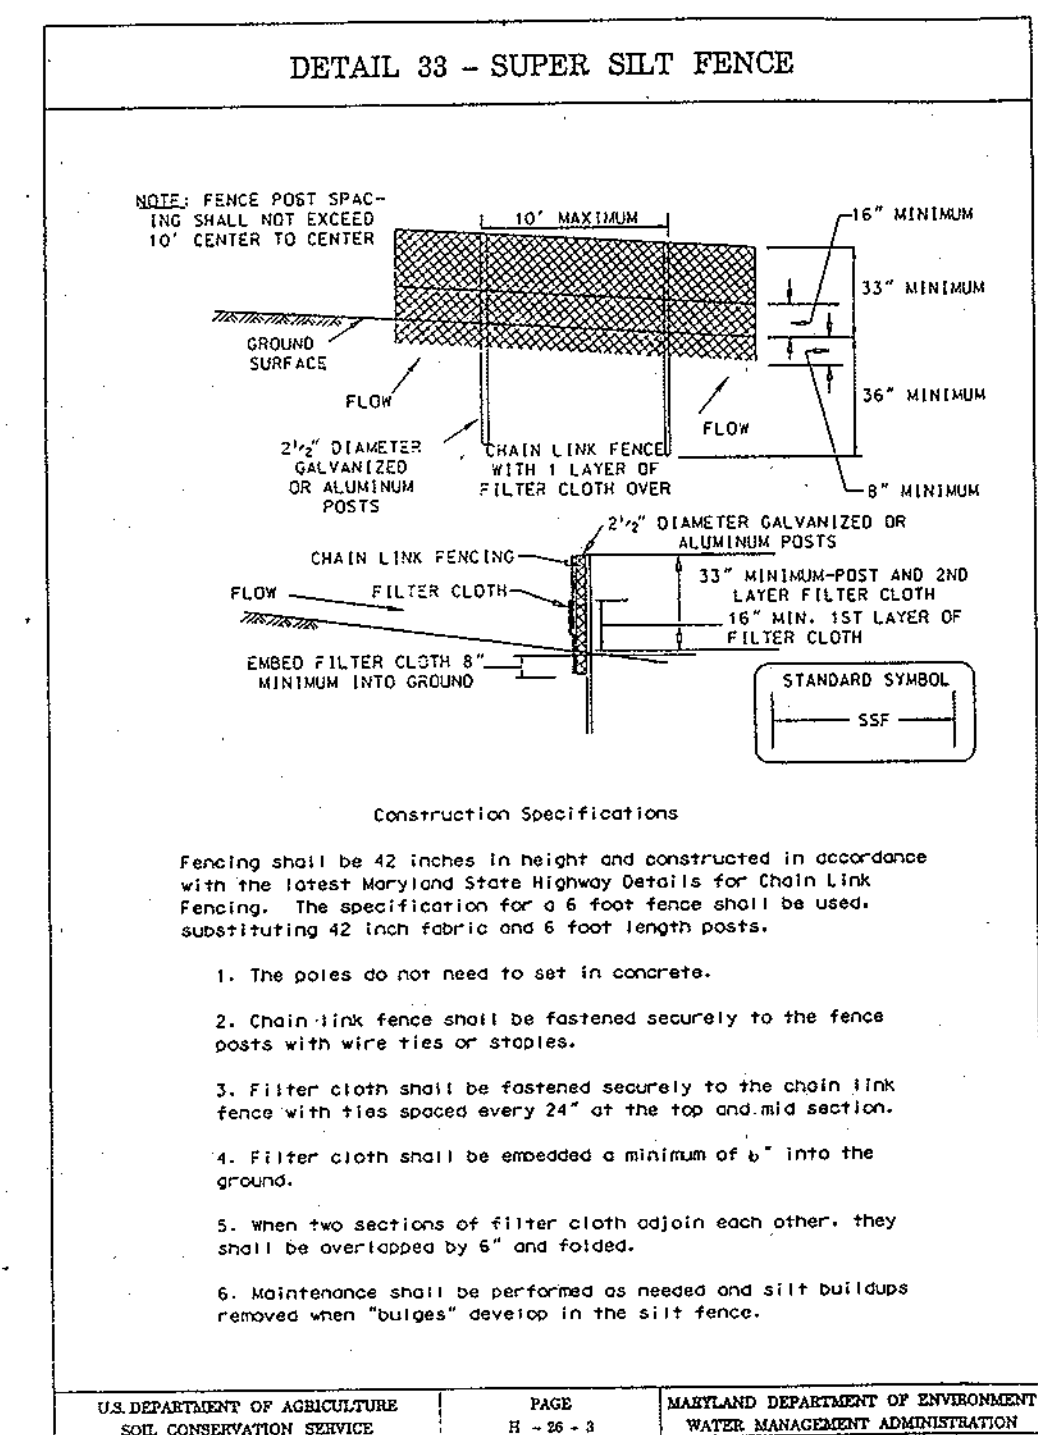


Table 2 - Earth Dike Selection

Slope % **	Drainage Area (acres)									
	1	2	3	4	5	6	7	8	9	10
1	SEED AND MULCH	4	4	4	4	4	4	4	4	4
2	MULCH	4	SEED AND MULCH	4	4	4	4	4	4	4
3				SEED AND MULCH	4	4	4	4	4	4
4	4*				SEED AND MULCH	4	4	4	4	4
5					4	4	4	4	4	4
6					4	4*	4*	4*	4*	4*
7					6	6	6	6	6	6
8										
9										
10										

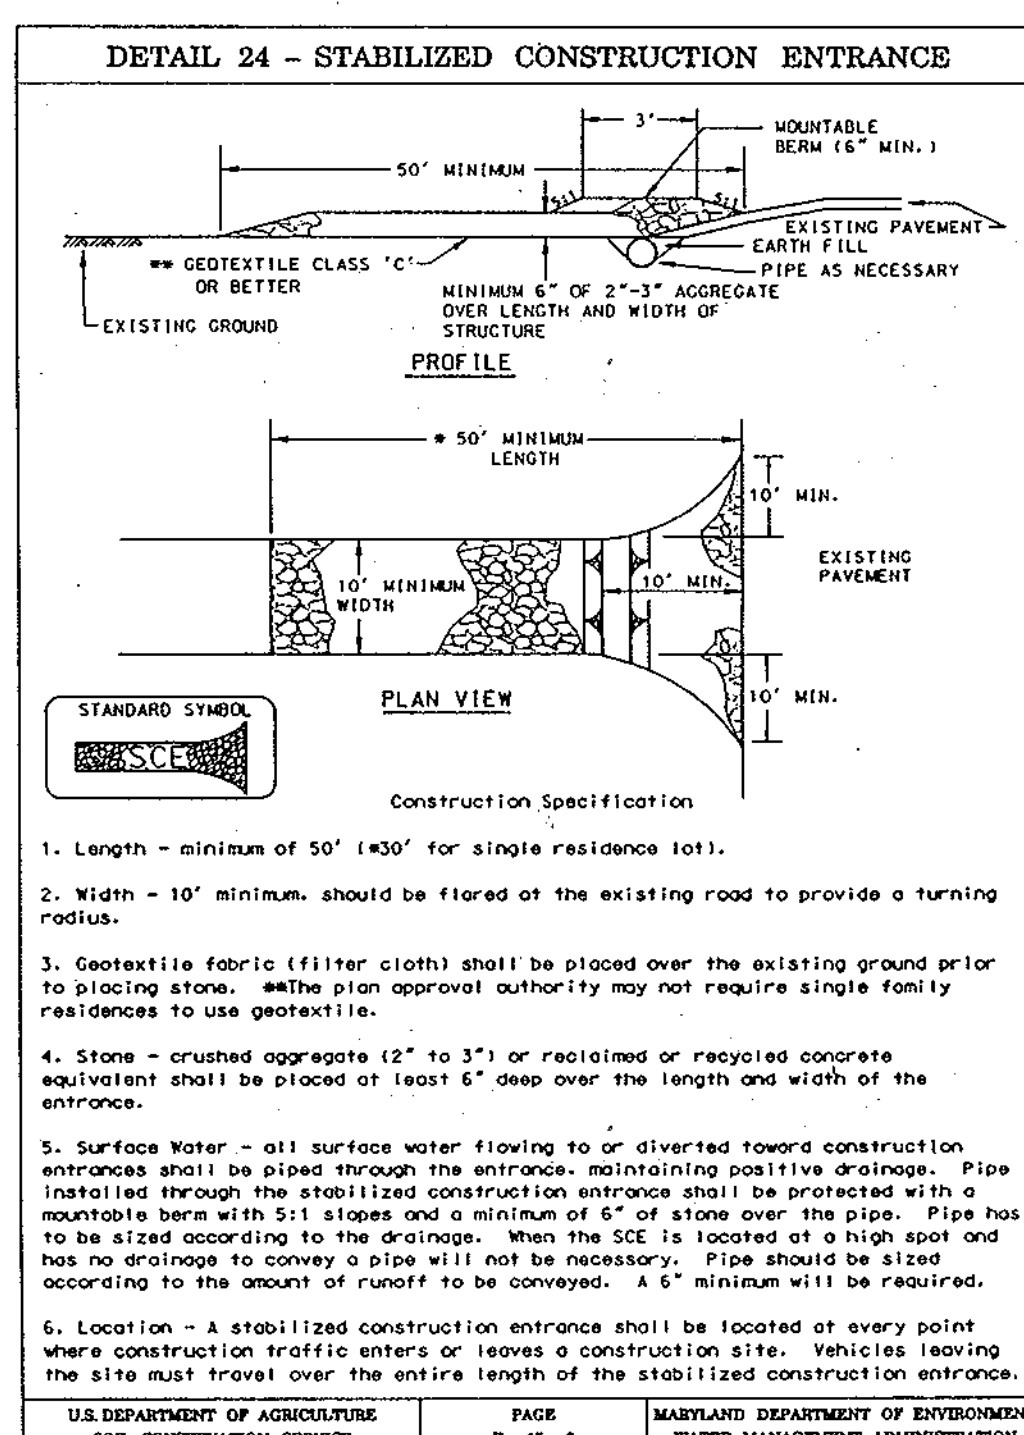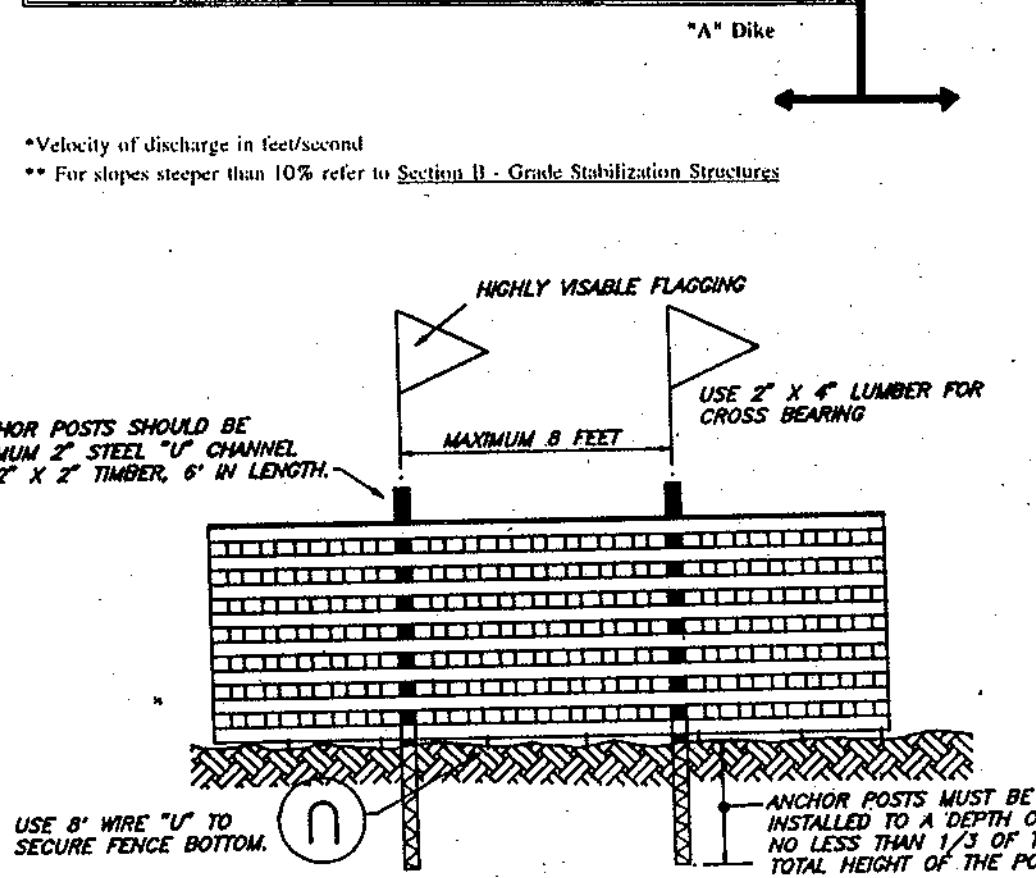

CONSTRUCTION SEQUENCE: NO. OF DAYS

- OBTAIN GRADING PERMIT..... 7
- INSTALL TREE PROTECTION FENCE..... 7
- INSTALL SEDIMENT AND EROSION CONTROL DEVICES INCLUDING SEDIMENT BASIN #1 AND #2, TRAP #3 SILT FENCE AND STABILIZED CONSTRUCTION ENTRANCE.....14
- CLEAR AND ROUGH GRADE SITE.....10
- EXCAVATE FOR FOUNDATION AND CONSTRUCT SCHOOL.....180
- CONSTRUCT ALL STORM DRAINAGE EXCEPT PERMANENT PIPES BETWEEN M2 TO S1B AND M2 TO S1A. TEMPORARILY DIRECT WATER TO SEDIMENT BASIN #1 WITH 24" CMP (M2 TO TEMP S2A).....45 (See Detail Sheet 10 for temp. S2A to basin)
- CONSTRUCT WATER AND SEWER.....90
- CONSTRUCT UTILITIES.....60
- FINE GRADE AND CONSTRUCT CURB AND GUTTER, PAVING ROADWAYS AND SIDEWALKS.....60
- STABILIZE ALL DISTURBED AREAS ON-SITE IN ACCORDANCE WITH THE STANDARDS AND SPECIFICATIONS.....14
- UPON APPROVAL OF THE SEDIMENT CONTROL INSPECTOR REMOVE SEDIMENT AND EROSION CONTROL MEASURES EXCEPT FOR TEMPORARY SEDIMENT BASIN #1.....14
- INSTALL PHASE II SILT FENCE.....7
- UPON APPROVAL OF THE SEDIMENT CONTROL INSPECTOR, CONVERT SEDIMENT BASIN #1 INTO SHALLOW MARSH.....7
 - FLUSH ALL STORM DRAIN SYSTEMS TO REMOVE ANY SEDIMENT BUILD-UP.
 - PUMP OUT IMPOUNDED WATER IN BASIN.
 - COMPLETE PERMANENT STORM DRAIN CONSTRUCTION BETWEEN STRUCTURE M2 AND S1A/S1B. Install trash rack for 12" PVC per Det. Sheet 10.
 - GRADE FOREBAY AND INSTALL RIP RAP AS SHOWN ON PLAN.
 - GRADE SHALLOW MARSH.
 - PERMANENTLY STABILIZE AND PLANT ACCORDING TO THE LANDSCAPE PLAN SHEET 20.....90
- UPON APPROVAL OF THE INSPECTOR REMOVE REMAINING SEDIMENT AND EROSION CONTROL MEASURES AND STABILIZE.....7

* NOTE: ON-SITE SCHOOL CONSTRUCTION IS TO BE COORDINATED WITH THIS PLAN. THE SEDIMENT CONTROLS ARE DESIGNED TO BE UTILIZED FOR SCHOOL CONSTRUCTION AND ROADWAY CONSTRUCTION.

* NOTE: Sediment Basins must be removed 30 months after beginning construction.

DEVELOPER'S/BUILDER'S CERTIFICATE


"I, the undersigned, certify that all development and construction will be done according to this plan of development and plan for sediment and erosion control and that all responsible personnel involved in the construction project will have a certificate of attendance at a Department of the Environment approved Training Program for the Control of Sediment and Erosion before beginning the project. I also authorize periodic on-site inspection by the Howard County Department of the Environment or their authorized agents, as are deemed necessary."

John Gudasky 1/6/96

ENGINEER'S CERTIFICATE

I hereby certify that this plan for Sediment and Erosion Control represents a practical and workable plan based on my personal knowledge of the site conditions and that it was prepared in accordance with the requirements of the Howard County Department of the Environment."

G. NELSON CLARK 1-9-96

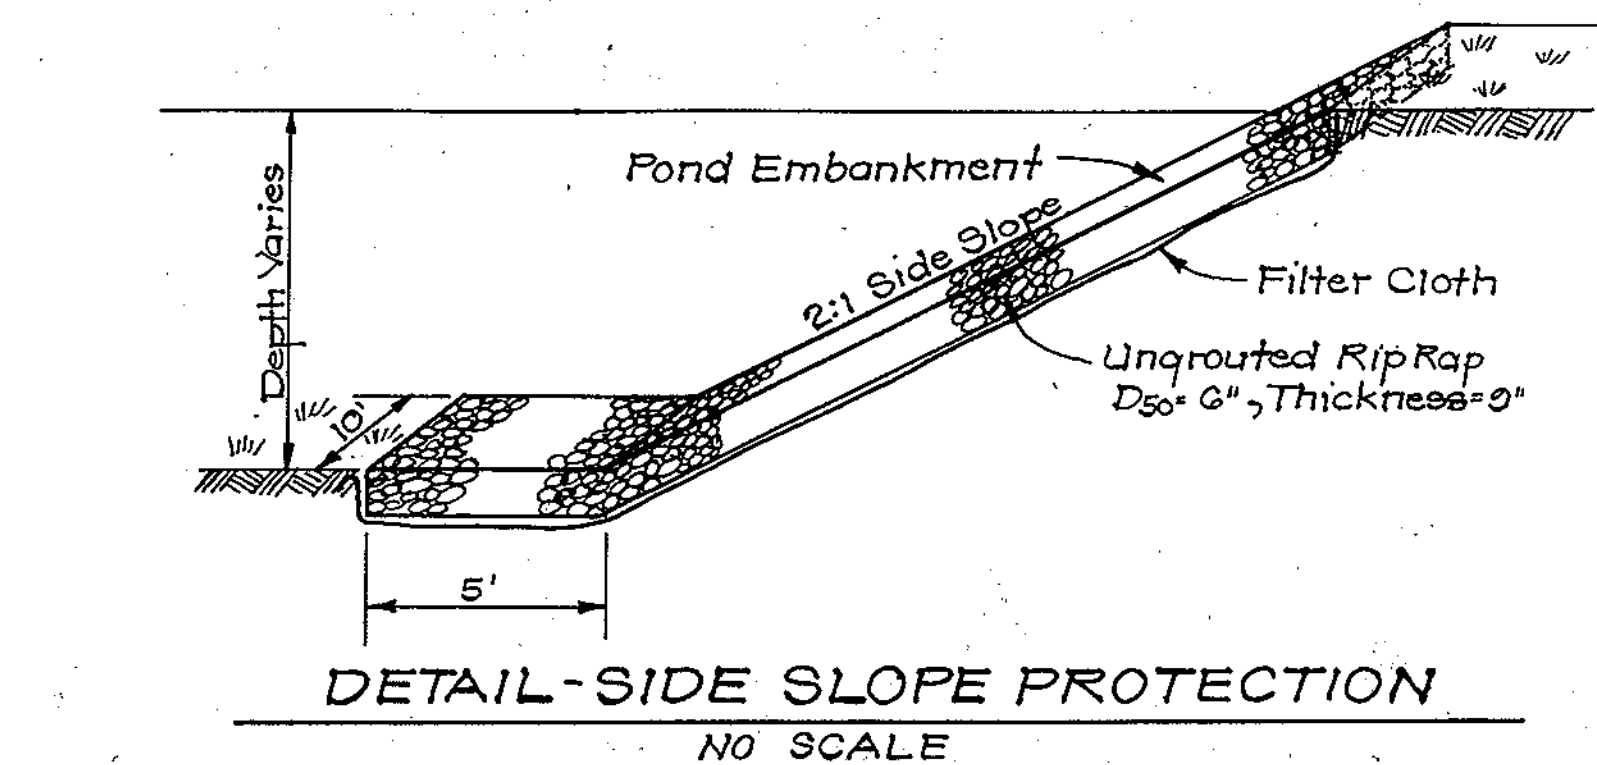

CLARK • FINEROCK & SACKETT, INC.
ENGINEERS • PLANNERS • SURVEYORS
7135 MINSTREL WAY • COLUMBIA, MD. 21045 • (410) 381-7500 • BALTO. • (301) 621-8100 - WASH.

DESIGNED BY: KJMM
DRAWN BY: KJMM
CHECKED BY: KJMM
DATE: 12-27-99

SCALE: 1" = 20'
DRAWING NO.: 18 OF 20
JOB NO.: 04-203
FILE NO.: 04-203D

SEDIMENT & EROSION CONTROL DETAILS
DANIELS MILL OVERLOOK
TAX MAP 17 PART OF PARCEL 41
SECOND (2ND) ELECTION DISTRICT
HOWARD COUNTY, MARYLAND
FOR: HOWARD COUNTY BOARD OF EDUCATION
10910 ROUTE 108
ELLCOTT CITY, MARYLAND 21042

APPROVED: DEPARTMENT OF PUBLIC WORKS
Chief, Bureau of Highways 1-30-96
Date

APPROVED: DEPARTMENT OF PLANNING AND ZONING
Chief, Division of Land Development and Research 2/2/96
Date TC

APPROVED: DEPARTMENT OF PLANNING AND ZONING
Chief, Development Engineering Division 2/1/96
Date

AS-BUILT 12-1-99 F-96-37

1783



SOILS CHART			
SYMBOL	TYPE	DESCRIPTION	
C	BrB2	Brandywine Loam	3-8% slopes, moderately eroded
C	BrC2	Brandywine Loam	8-15% slopes, moderately eroded
C	BrC3	Brandywine Loam	8-15% slopes, severely eroded
C	BrD2	Brandywine Loam	15-25% slopes, moderately eroded
C	BrD3	Brandywine Loam	15-25% slopes, severely eroded
B	GIB2	Glendale Loam	3-8% slopes, moderately eroded
C	GnB2	Glennville Silt Loam	3-8% slopes, moderately eroded
B	MIB2	Manor Loam	3-8% slopes, moderately eroded
B	MIC2	Manor Loam	8-15% slopes, moderately eroded

Note: See Howard County Soils Map No. 10



Denotes Slopes 15% - 25%
 Denotes Slopes 25% or Greater

APPROVED: DEPARTMENT OF PUBLIC WORKS
Andrew M. Daniels 1-30-96
 Chief, Bureau of Highways Date


APPROVED: DEPARTMENT OF PLANNING AND ZONING
China Summary 2/2/96
 Chief, Division of Land Development and Research Date TC

Allen Cameron 2/1/96
 Chief, Development Engineering Division Date M.





CLARK • FINEFROCK & SACKETT, INC.
 ENGINEERS • PLANNERS • SURVEYORS
 7135 MINSTREL WAY • COLUMBIA, MD. 21045 • (410) 381-7500 - BALTO. • (301) 821-8100 - WASH.

DESIGNED KIWM	SOILS AND SLOPES ANALYSIS PLAN DANIELS MILL OVERLOOK TAX MAP 17 PART OF PARCEL 41 SECOND (2ND) ELECTION DISTRICT HOWARD COUNTY, MARYLAND FOR: HOWARD COUNTY BOARD OF EDUCATION 10910 ROUTE 108 ELLICOTT CITY, MARYLAND 21042	SCALE 1"=100'
DRAWN KIWM		DRAWING 10 of 20
CHECKED KIWM		JOB NO. 04-203
DATE 12-27-95		FILE NO. 04-203D

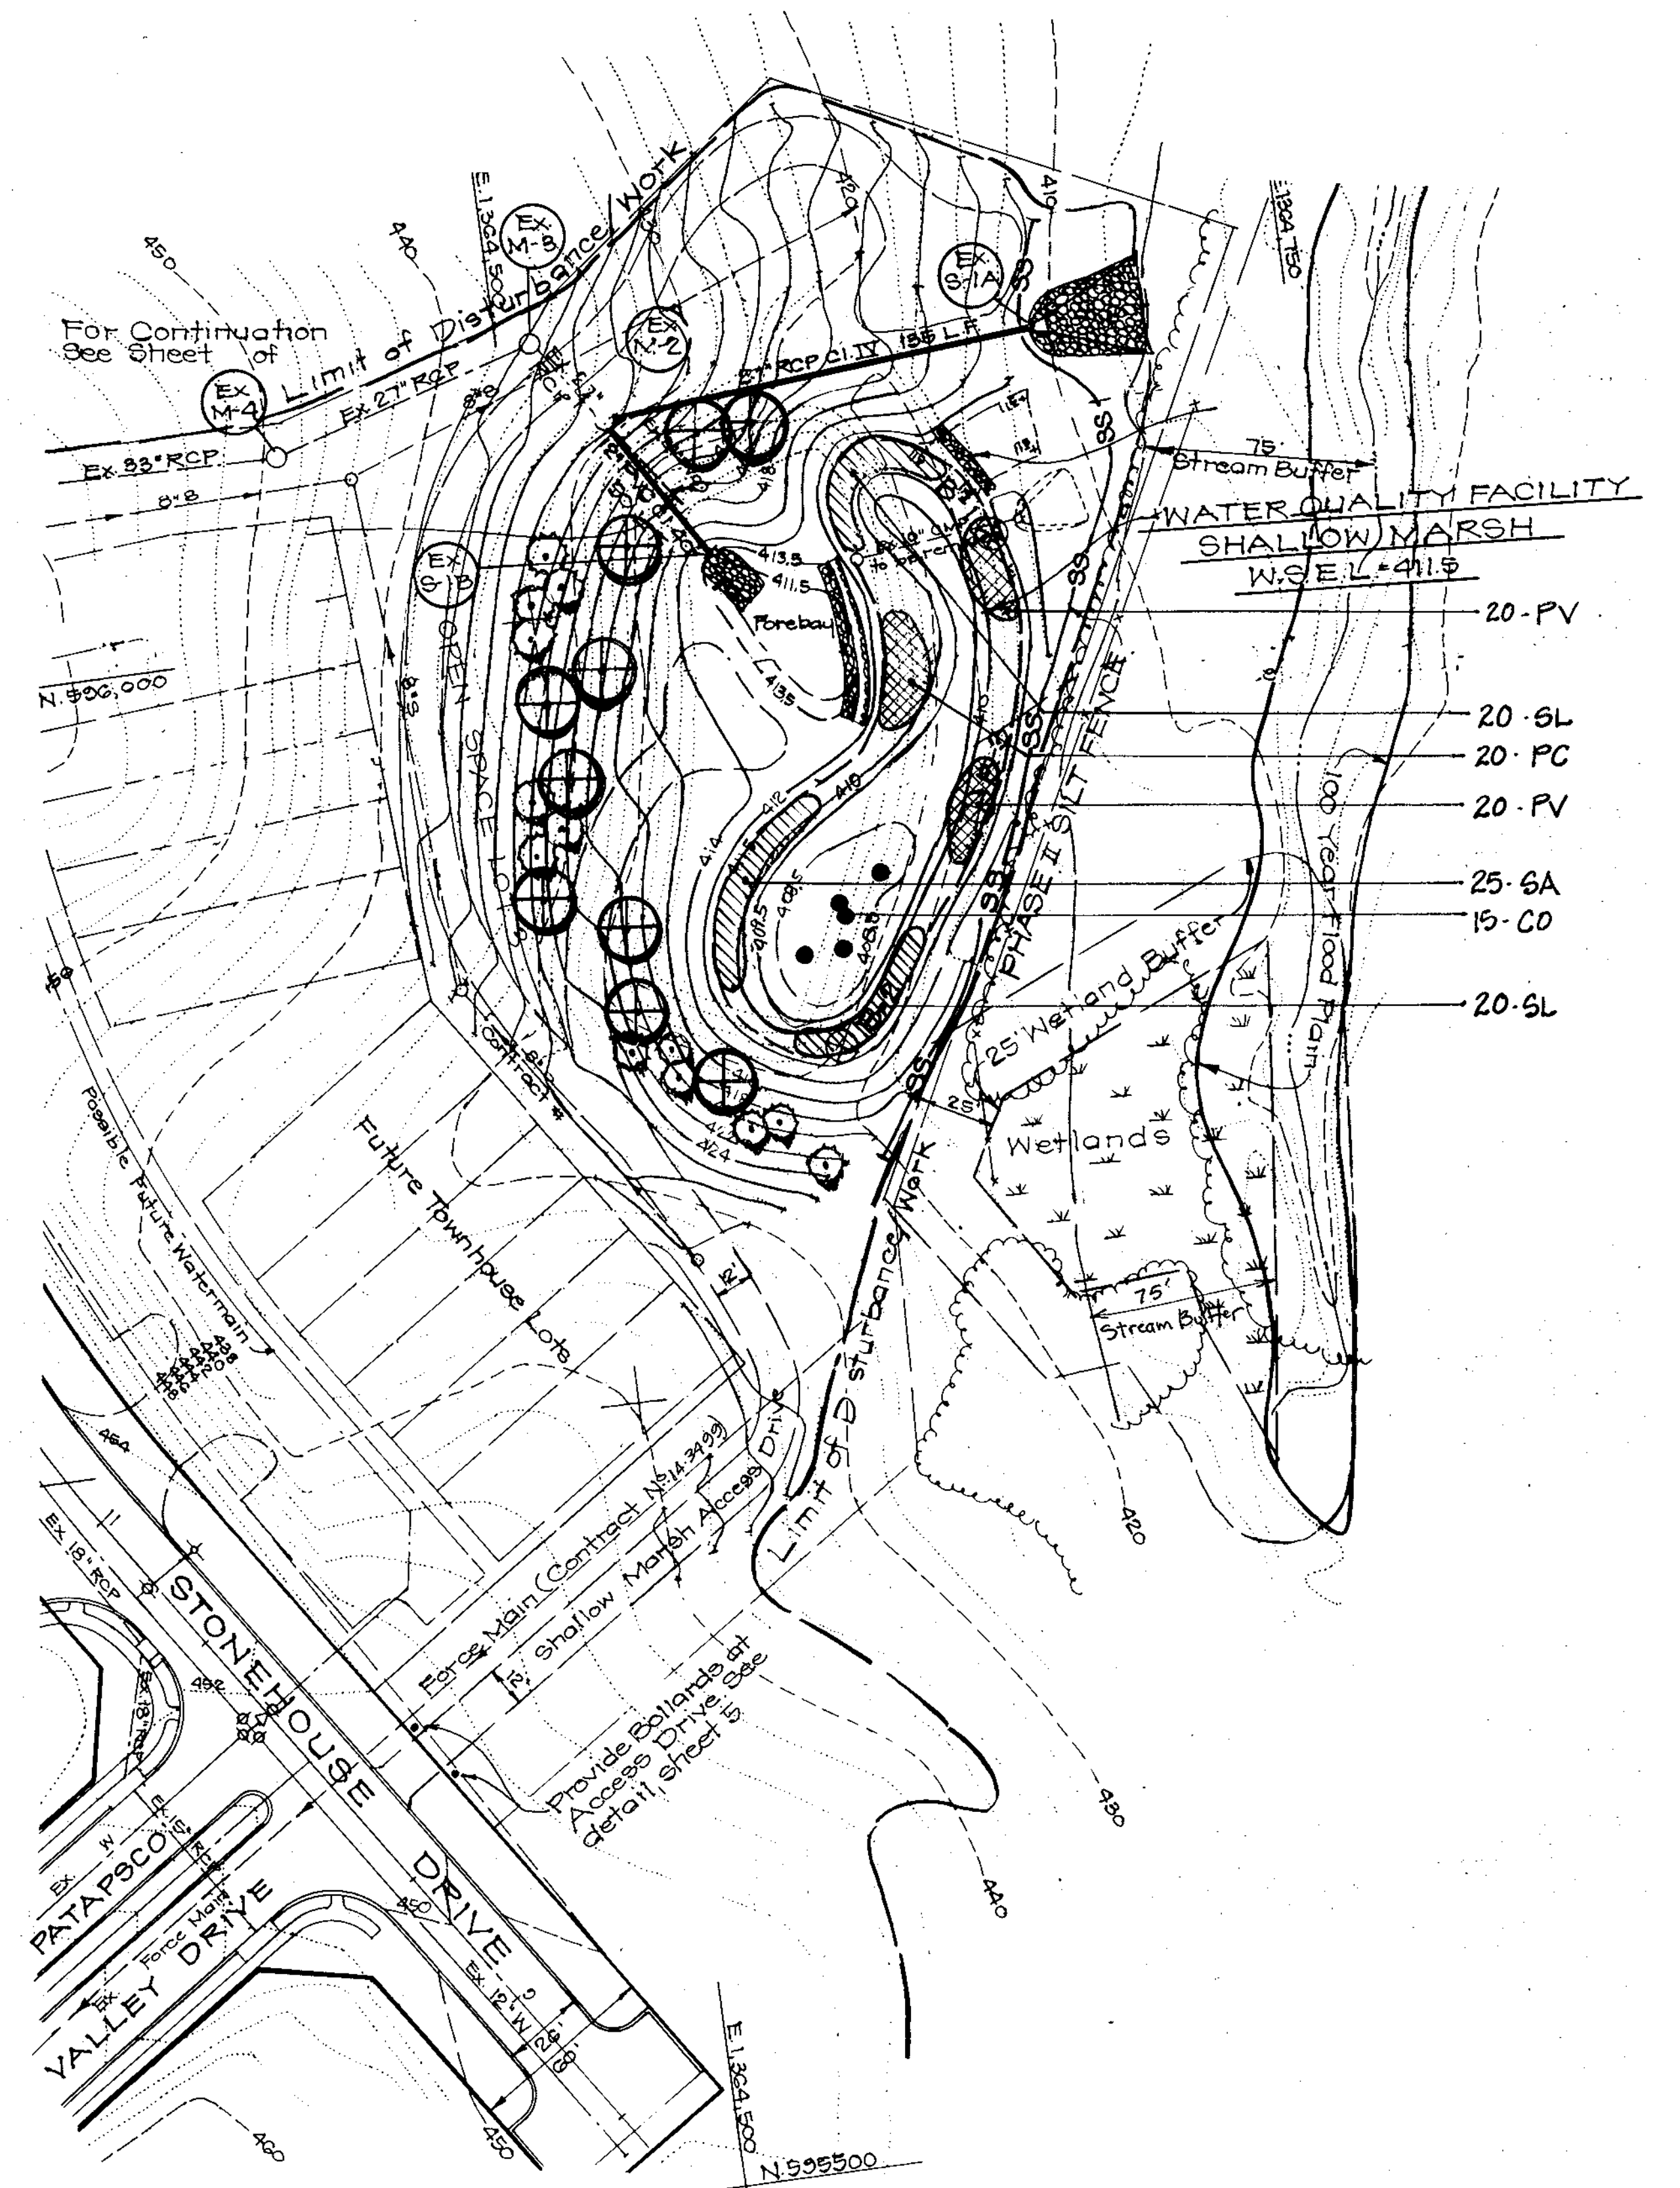

**WATER QUALITY FACILITY
SHALLOW MARSH**
SCALE: 1" = 40'

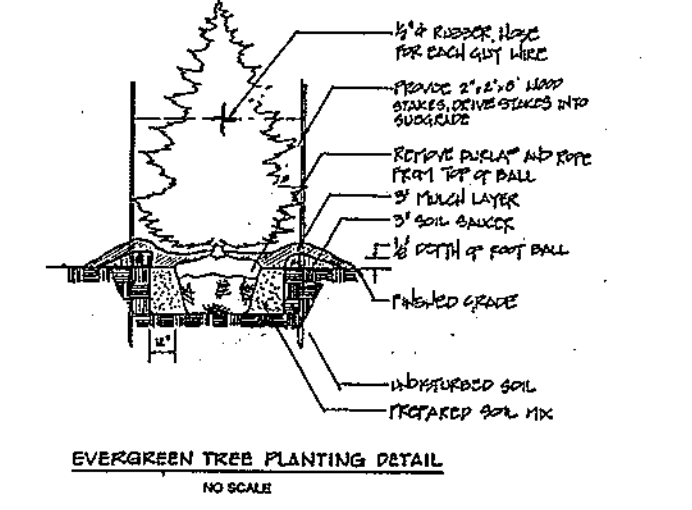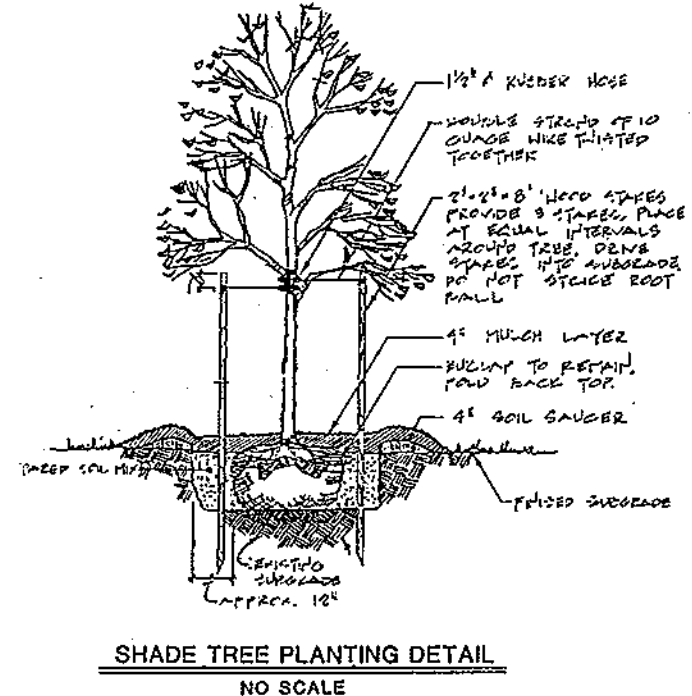

**SCHEDULE D
STORMWATER MANAGEMENT AREA LANDSCAPING**

Linear Feet of Perimeter	705'
Number of Trees Required	Based on 500 L.F.
Shade Trees	10 (1/50)
Evergreen Trees	18 (1/40)
Credit for Existing Vegetation (No., Yes and %)	205'
Credit for Other Landscaping (No., Yes and %)	-
Number of Trees Provided	
Shade Trees	10
Evergreen Trees	18
Other Trees (2:1 substitution)	

PLANT LIST FOR WATER QUALITY FACILITY, SHALLOW MARSH

KEY	QTY	PLANT SPECIES	SIZE	REMARKS
PRIMARY WETLAND VEGETATION				
SL	40	SAGITTARIA LATIFOLIA Duck Potato	ROOTS	36" OC
SA	25	SCIRPUS AMERICANUS Common Three Square	ROOTS	36" OC
SECONDARY WETLAND VEGETATION				
CO	15	CEPHALATHUS OCCIDENTALIS Button Bush	ROOTS	5 clumps of 3
PV	40	PELTANDRA VIRGINICA Arrow-Arum	ROOTS	36" OC
PC	20	PONTEDERIA CORDATA Pickerel Weed	ROOTS	36" OC

- NOTES:**
- All plant material to be wet grown or adapted to wetland conditions.
 - Alterations to the proposed grading shown may affect the success of the plant material.
 - Contractor shall verify location of all underground utilities prior to digging.

PLANT LIST FOR STREET TREES (SEE SHTS 2,3,& 4)

57	ACER RUBRUM "Red Sunset" Red Sunset Maple	2 1/2"C	B&B
----	--	---------	-----

PLANT LIST FOR WATER QUALITY FACILITY BUFFER

10	ACER RUBRUM "Red Sunset" Red Sunset Maple	2 1/2"C	B&B
13	PINUS STROBUS White Pine	6'-8'HT	B&B

80 Total Trees for Bonding

- NOTES:**
- ALL PLANTING SHALL BE DONE IN ACCORDANCE WITH THE BALT./WASH. LANDSCAPE SPECIFICATIONS OF L.C.A.M.W.
 - CONTRACTOR SHALL VERIFY LOCATION OF ALL UNDERGROUND UTILITIES PRIOR TO DIGGING.
 - FINAL LOCATION OF PLANT MATERIAL MAY VARY PER FINAL FIELD CONDITIONS.
 - FOR SEEDING SPECIFICATIONS SEE SHEET 18

LANDSCAPE BONDING NOTE:
This plan has been prepared in accordance with the provisions of Section 16.124 of the Howard County Code and the Landscape Manual.
Financial surety for the required 80 trees in the amount of \$2000 is part of the Developers Agreement.



APPROVED: DEPARTMENT OF PUBLIC WORKS
Andrew M. Danilek 1-30-96
Chief, Bureau of Highways Date

APPROVED: DEPARTMENT OF PLANNING AND ZONING
Jim Summery 2/2/96
Chief, Division of Land Development and Research Date TC

Chad Danmeyer 2/1/96
Chief, Development Engineering Division Date

CLARK • FINEFROCK & SACKETT, INC.
ENGINEERS • PLANNERS • SURVEYORS
7135 MINSTREL WAY • COLUMBIA, MD. 21045 • (301) 381-7200 - BALTO. • (301) 621-8100 - WASH.

DESIGNED MJP	LANDSCAPE PLAN FOR WATER QUALITY FACILITY AND STREET TREE DETAILS DANIELS MILL OVERLOOK TAX MAP 17, PARCEL 41 SECOND (2ND) ELECTION DISTRICT HOWARD COUNTY, MARYLAND FOR: HOWARD COUNTY BOARD OF EDUCATION 10910 ROUTE 108 ELICOTT CITY, MARYLAND 21042	SCALE AS SHOWN
DRAWN MJP		DRAWING 20 OF 20
CHECKED WHY		JOB NO. 04-208
DATE 12-27-95		FILE NO. 04-208D

1783

F-96-37

AS-BUILT 12-1-99

F-96-37