

# ROADWAYS AND STORM DRAINS

# CHAPEL WOODS III


## LOTS 28 - 36 & PARCEL A

### A RESUBDIVISION OF LOTS 7 AND 8

### 5th ELECTION DISTRICT

### HOWARD COUNTY, MARYLAND

SHEET INDEX	
NO	DESCRIPTION
1	TITLE SHEET
2	PLAN AND PROFILE OF CHAPEL ESTATES DRIVE
3	GRADING AND SEDIMENT CONTROL PLAN
4	DRAINAGE AREA MAP, DRIVEWAY PROFILE & LANDSCAPE PLAN
5	PROFILES AND DETAIL SHEET
6	FOREST CONSERVATION PLAN
7	FOREST CONSERVATION DETAILS

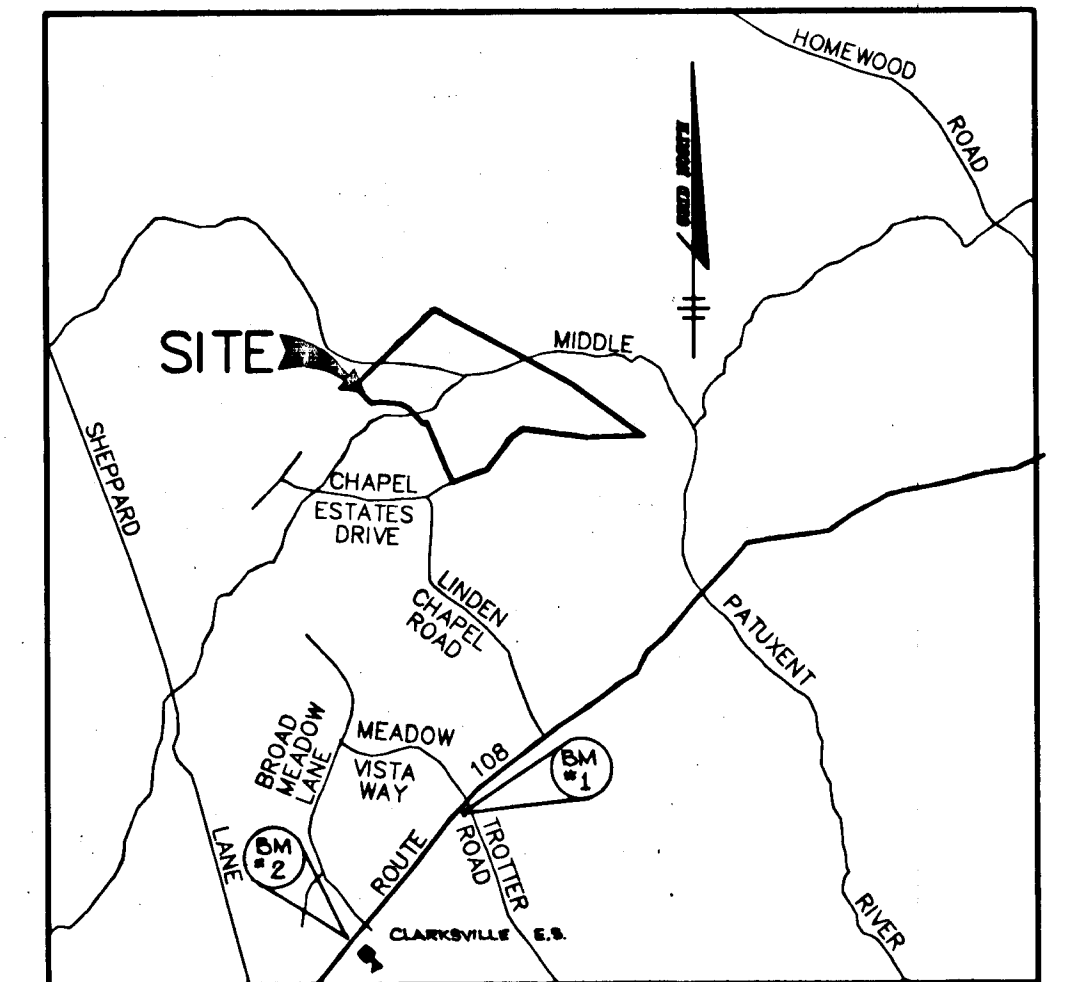

**VICINITY MAP**  
SCALE: 1" = 2000'

**BENCHMARKS**


BM#1	2737001	
	N 506189.520	E 820993.367
BM#2	2737002	
	N 504681.048	E 819776.534

**GENERAL NOTES**

1. THE LOTS SHOWN HEREON COMPLY WITH THE MINIMUM OWNERSHIP WIDTH AND LOT AREA AS REQUIRED BY THE MARYLAND STATE DEPARTMENT OF THE ENVIRONMENT.
2. PERCOLATION AREAS AND WATER WELLS FOR ADJOINING LOTS ARE SHOWN WHERE PERTINENT.
3. SEE DEPARTMENT OF PLANNING AND ZONING FILE NO'S: S-94-37, WP-94-39.
4. FOR FLAG OR PIPESTEM LOTS, REFUSE COLLECTION, SNOW REMOVAL AND MAINTENANCE TO BE PROVIDED AT THE JUNCTION OF THE FLAG OR PIPESTEM AND THE ROAD RIGHT OF WAY AND NOT ONTO THE FLAG OR PIPESTEM DRIVEWAY.
5. DE-FACTO SWM FOR THE PROPOSED ROADWAY IS TO BE PROVIDED IN THE EXISTING POND AS PER LETTER DATED APRIL 15, 1994 BY MR. JAMES IRVIN.
6. UNDER S-94-37 DPW APPROVED REQUEST TO ALLOW THE LENGTH OF CUL-DE-SAC TO BE GREATER THAN 1200' AND ALLOW A 200' RADIUS FOR THE ROAD.
7. THIS PROJECT IS IN CONFORMANCE WITH THE LATEST HOWARD COUNTY STANDARDS UNLESS WAIVERS HAVE BEEN APPROVED.
8. TOPOGRAPHIC SURVEY BASED ON FIELD RUN SURVEY PERFORMED BY RIEMER MUEGGE & ASSOCIATES, INC. IN JUNE, 1994. THE CONTOUR INTERVAL IS 2'.
9. THE 100-YEAR FLOODPLAIN SHOWN IS BASED ON THE CLYDE BRANCH STUDY PERFORMED BY HOWARD COUNTY AND DELINEATED ON F-88-231.
10. WETLANDS HAVE BEEN FIELD DELINEATED BY RIEMER MUEGGE & ASSOCIATES, INC. IN SEPTEMBER, 1994.
11. NO GEOTECHNICAL STUDY WAS PERFORMED FOR THIS DEVELOPMENT.
12. THE PRIMARY PURPOSES FOR PRESERVATION PARCEL 'A' ARE FOREST CONSERVATION AND OPEN SPACES.
13. ALL WELLS ARE TO BE DRILLED PRIOR TO RECORD PLAT.
14. WP-94-39 - A REQUEST TO WAIVE SECTION 16.120(b)(6)(1) OF THE HOWARD COUNTY SUBDIVISION & LAND DEVELOPMENT REGULATIONS WAS DENIED DECEMBER 14, 1993.
15. WETLANDS DISTURBANCE AUTHORIZED UNDER NON-TIDAL WETLANDS PERMIT NT-94-1127, TRACKING # 1995G010, LETTER OF AUTHORIZATION.

**SITE ANALYSIS**

AREA OF SITE	53.23 AC
PRESENT ZONING	RC
PROPOSED USE	SINGLE-FAMILY HOMES
NUMBER OF ALLOWABLE LOTS	12
NUMBER OF LOTS PROVIDED	9 + 1 PRESERVATION PARCEL

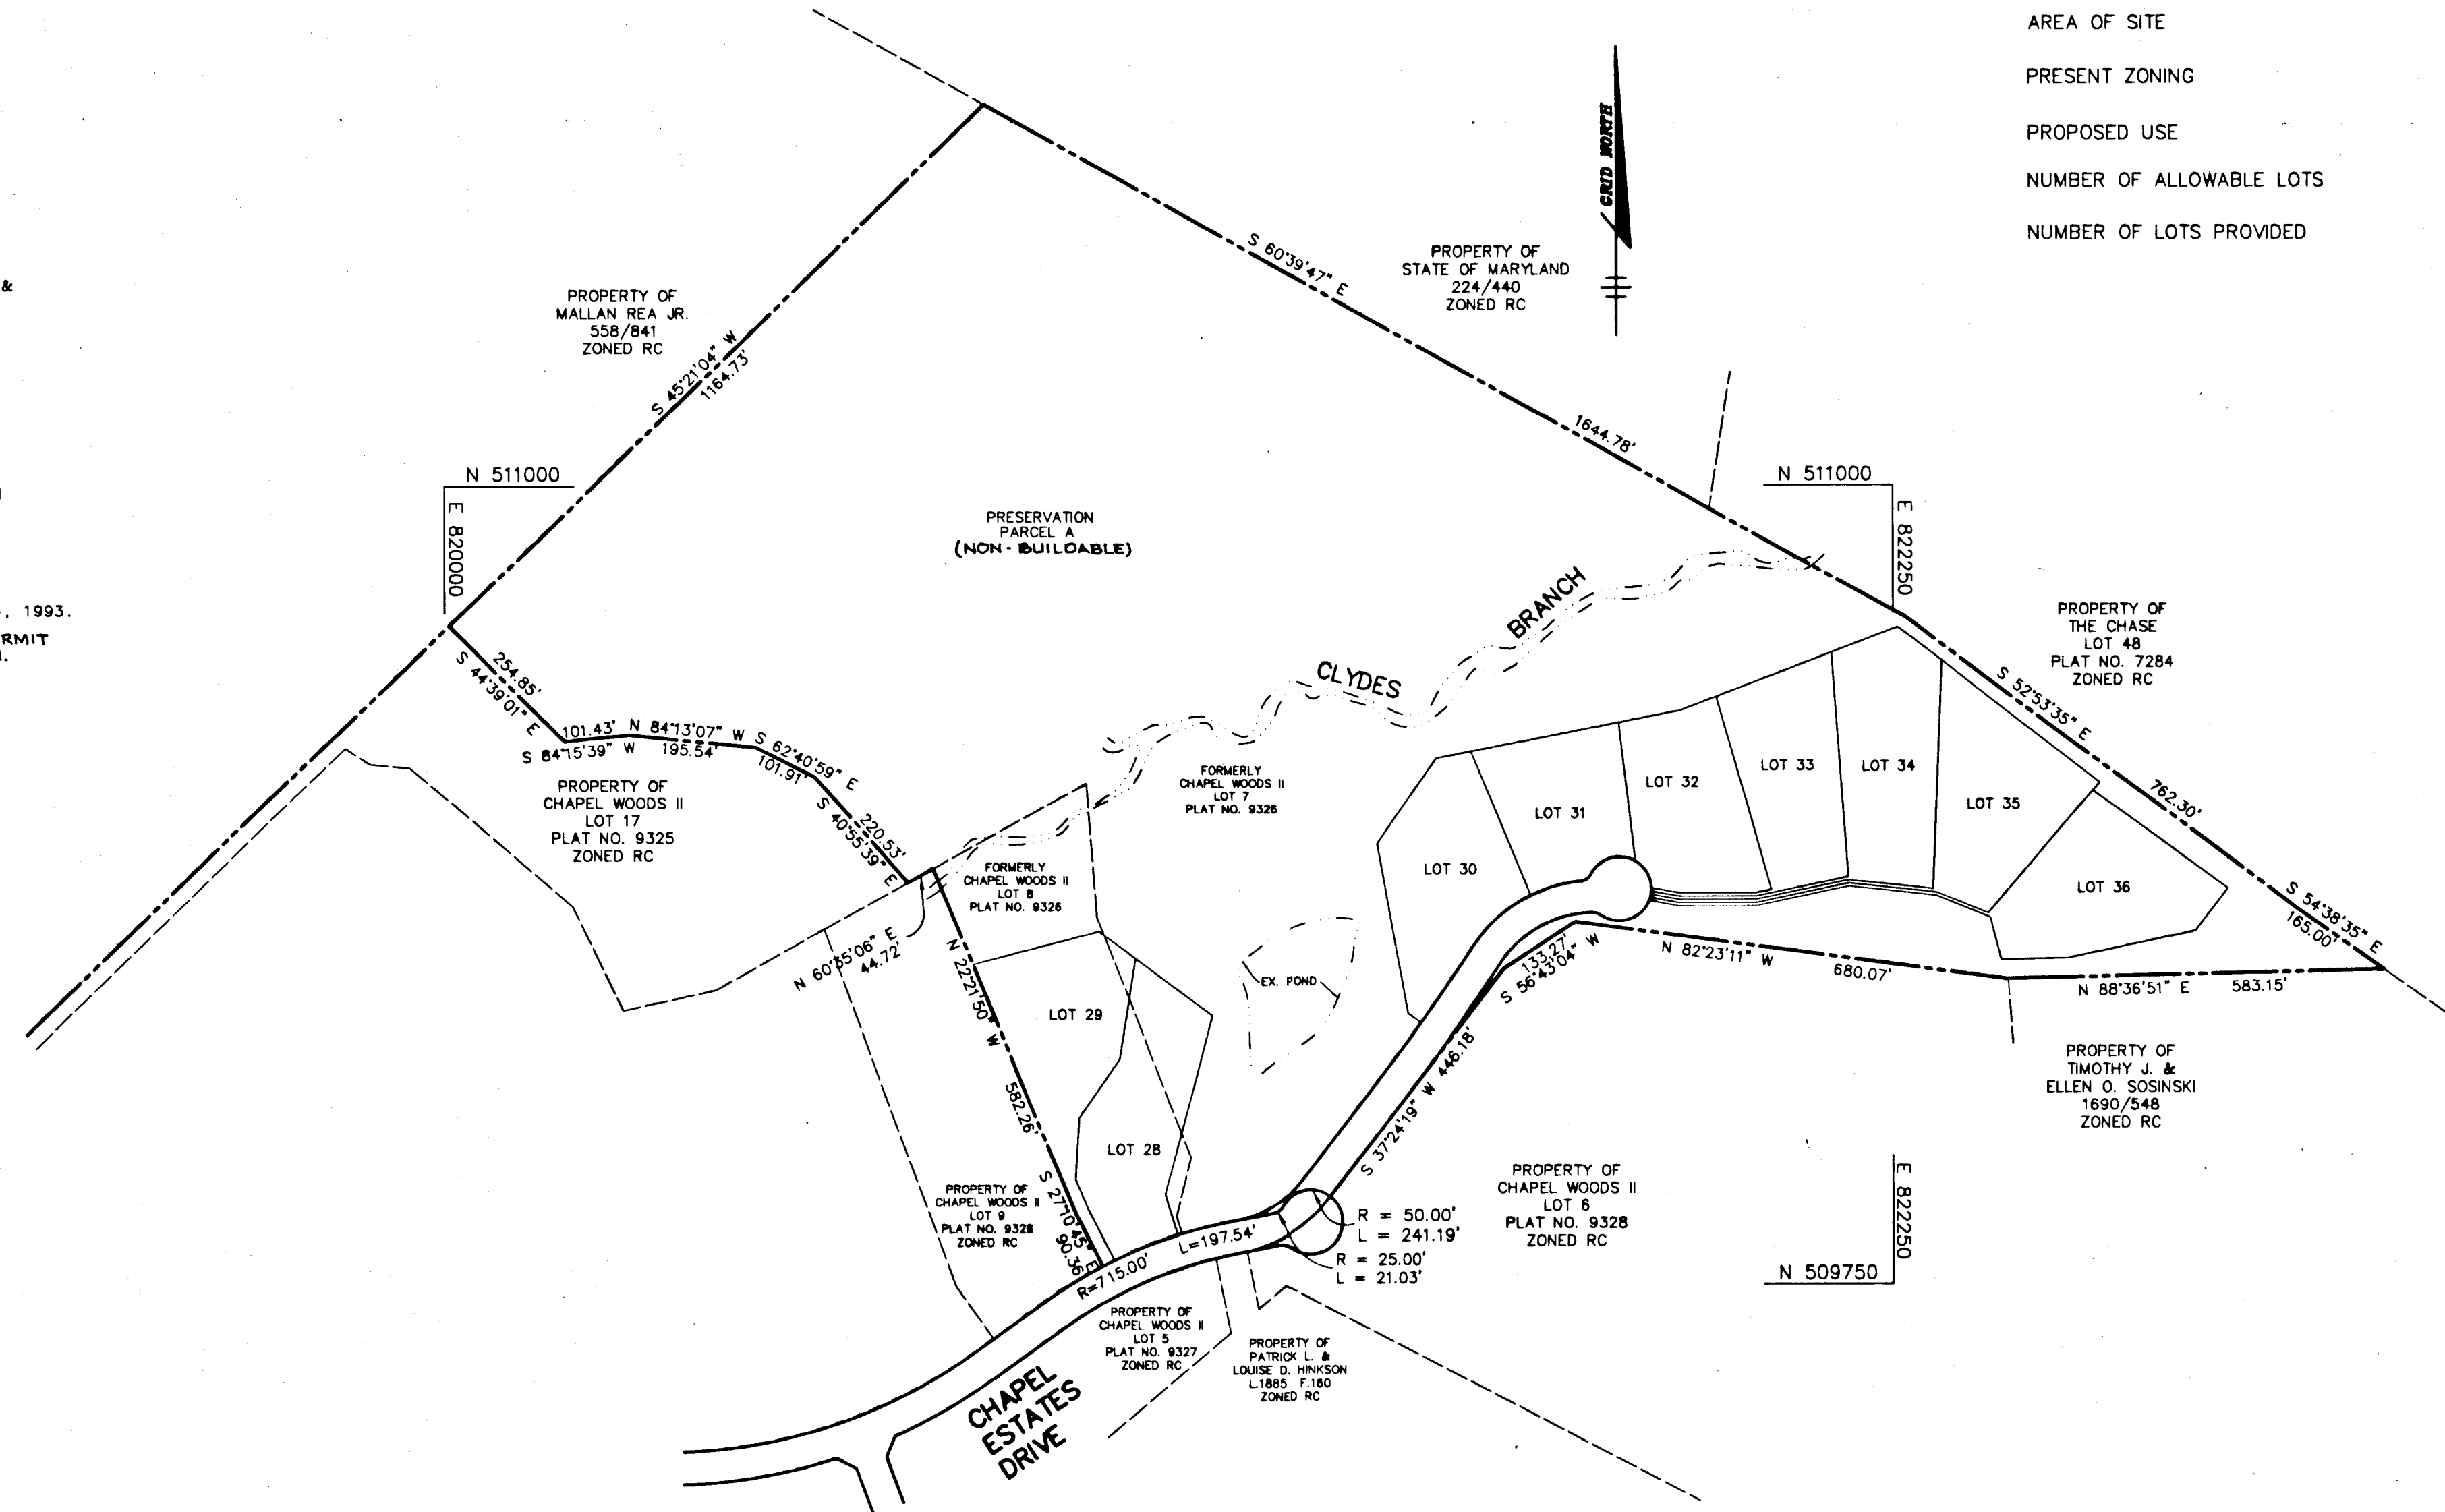

**PLAN**  
SCALE: 1" = 200'

**OPERATION AND MAINTENANCE SCHEDULE OF PRIVATELY OWNED AND MAINTAINED STORMWATER MANAGEMENT FACILITY WET DETENTION POND**

**ROUTINE MAINTENANCE**

1. Facility shall be inspected annually and after major storms. Inspections should be performed during wet weather to determine if the pond is functioning properly.
2. Top and side slopes of the embankment shall be mowed a minimum of two (2) times a year, once in June and once in September. Other side slopes and maintenance access should be mowed as needed.
3. Debris and litter next to the outlet structure shall be removed during regular mowing operations and as needed.
4. Visible signs of erosion in the pond as well as riprap outlet area shall be repaired as soon as it is noticed.


**NON-ROUTINE MAINTENANCE**

1. Structural components of the pond such as the dam, the riser, and the pipes shall be repaired upon the detection of any damage. The components should be inspected during routine maintenance operations.
2. Sediment should be removed when its accumulation significantly reduces the design storage, interfere with the function of the riser, when deemed necessary for aesthetic reasons, or when deemed necessary by the Howard County's Department of Public Works.

AS BUILT CERTIFICATE	
APPROVED : HOWARD COUNTY DEPARTMENT OF PUBLIC WORKS.	DATE
<i>Andrew M. Davelos</i>	2-6-96
CHIEF, BUREAU OF HIGHWAYS	DATE
APPROVED : HOWARD COUNTY DEPARTMENT OF PLANNING AND ZONING.	DATE
<i>Quin Summum</i>	2/15/96
CHIEF, DIVISION OF LAND DEVELOPMENT AND RESEARCH	DATE
APPROVED : <i>Michael DeMunn</i>	2/6/96
CHIEF, DEVELOPMENT ENGINEERING DIVISION	DATE
DATE NO.	REVISION
OWNER / DEVELOPER	
ERIC MIKOLASKO c/o J.M. INC. 5570 STERRETT PLACE SUITE 205 COLUMBIA, MARYLAND 21044 410-740-4466	
PROJECT <b>CHAPEL WOODS III</b> LOTS 28 - 36 & PARCEL A A RESUBDIVISION OF LOTS 7 AND 8	
AREA	TAX MAP NO. 29 PARCEL 86 5th ELECTION DISTRICT HOWARD COUNTY, MARYLAND
TITLE SHEET	
<b>RIEMER MUEGGE &amp; ASSOCIATES, INC.</b> Planners • Engineers • Surveyors 8818 Centre Park Drive • Suite 200 • Columbia, MD 21045 410-997-8900 FAX : 410-997-9282	
1-17-96 DATE	S-94-37 P-95-18 WP-94-39
	DESIGNED BY : C.J.R.
<i>J. Savell</i>	DRAWN BY : DAM
JAYKANT D. PAREKH #19148	PROJECT NO : HOCO\28810 RD1.DWG
	DATE : JANUARY 17, 1996
	SCALE : AS SHOWN
	DRAWING NO. 1 OF 7



DETAIL-STONE OUTLET SEDIMENT TRAP

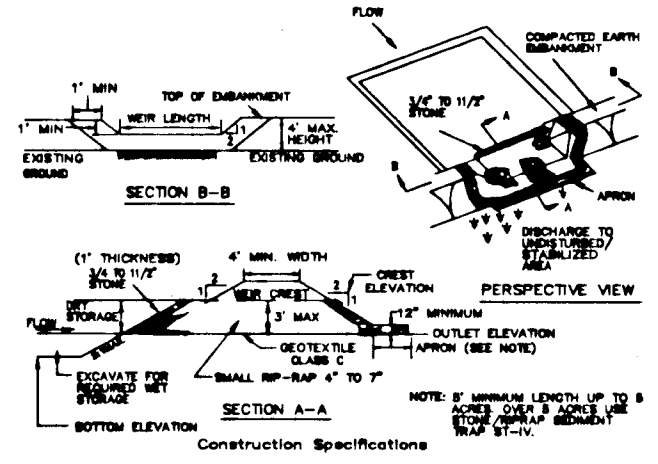


TEMPORARY STONE OUTLET SEDIMENT TRAP

DRAINAGE AREA	4.7 AC
STORAGE VOLUME REQUIRED	17,640 CF
STORAGE VOLUME PROVIDED	18,120 CF @ 347.0
CREST ELEVATION	347.0
TOP OF DAM	348.0
BOTTOM ELEVATION	341.0
CLEANOUT ELEVATION	344.0
SIDE SLOPES	2:1
CREST WIDTH	20'

- Area under embankment shall be cleared, grubbed and stripped of any vegetation and root mat. The pool area shall be cleared.
- The fill material for the embankment shall be free of roots and other woody vegetation and shall be well-sorted, clean, organic material or other objectionable material. The embankment shall be constructed by trimming with equipment while it is being constructed.
- All cut and fill slopes shall be 2:1 or flatter.
- The stone used in the outlet shall be small rip-rap 4" to 2" in size with a 1" thick layer of 3/4" to 1 1/2" washed aggregate placed on the upstream face of the outlet. Stone facing shall be as necessary to prevent sloughing. Geotextile Cloth C may be substituted for the stone facing by placing it on the inside face of the stone outlet.
- Sediment shall be removed and trap restored to its original dimensions when the sediment has accumulated to one half of the total storage depth of the trap. Removed sediment shall be deposited in a suitable area and in such a manner that it will not erode.
- The structure shall be inspected periodically and after each rain and repairs made as needed.
- Construction of traps shall be carried out in such a manner that sediment pollution is avoided. Once constructed, the top and outside face of the embankment shall be stabilized with seed and mulch. Plants of construction shall be planted in accordance with Grade Stabilization Structure criteria. The remainder of the interior slopes shall be stabilized (one time) with seed and mulch upon trap completion and monitored and maintained erosion free during the life of the trap.
- The structure shall be designed by approved methods, removed and the area stabilized when the drainage area has been properly stabilized.
- Refer to Section D for specifications concerning trap dewatering.
- Minimum trap depth shall be measured from the weir elevation.
- Minimum trap depth shall be measured from the weir elevation.
- The elevation of the top of any dirt entering water into the trap must equal or exceed the elevation of the trap embankment.
- Geotextile cloth C shall be over the bottom slope of the outlet channel prior to the placement of stone. Bottoms of the trap must slope at least 1" with the section toward the entrance placed on top. The entrance of the outlet channel.
- Outlet - An outlet shall be provided, including a means of conveying the discharge in an erosion free manner to an existing stable channel.

NOTE: GRADING ON LOTS 20 & 21 IS SCHEMATIC ONLY.

CLC

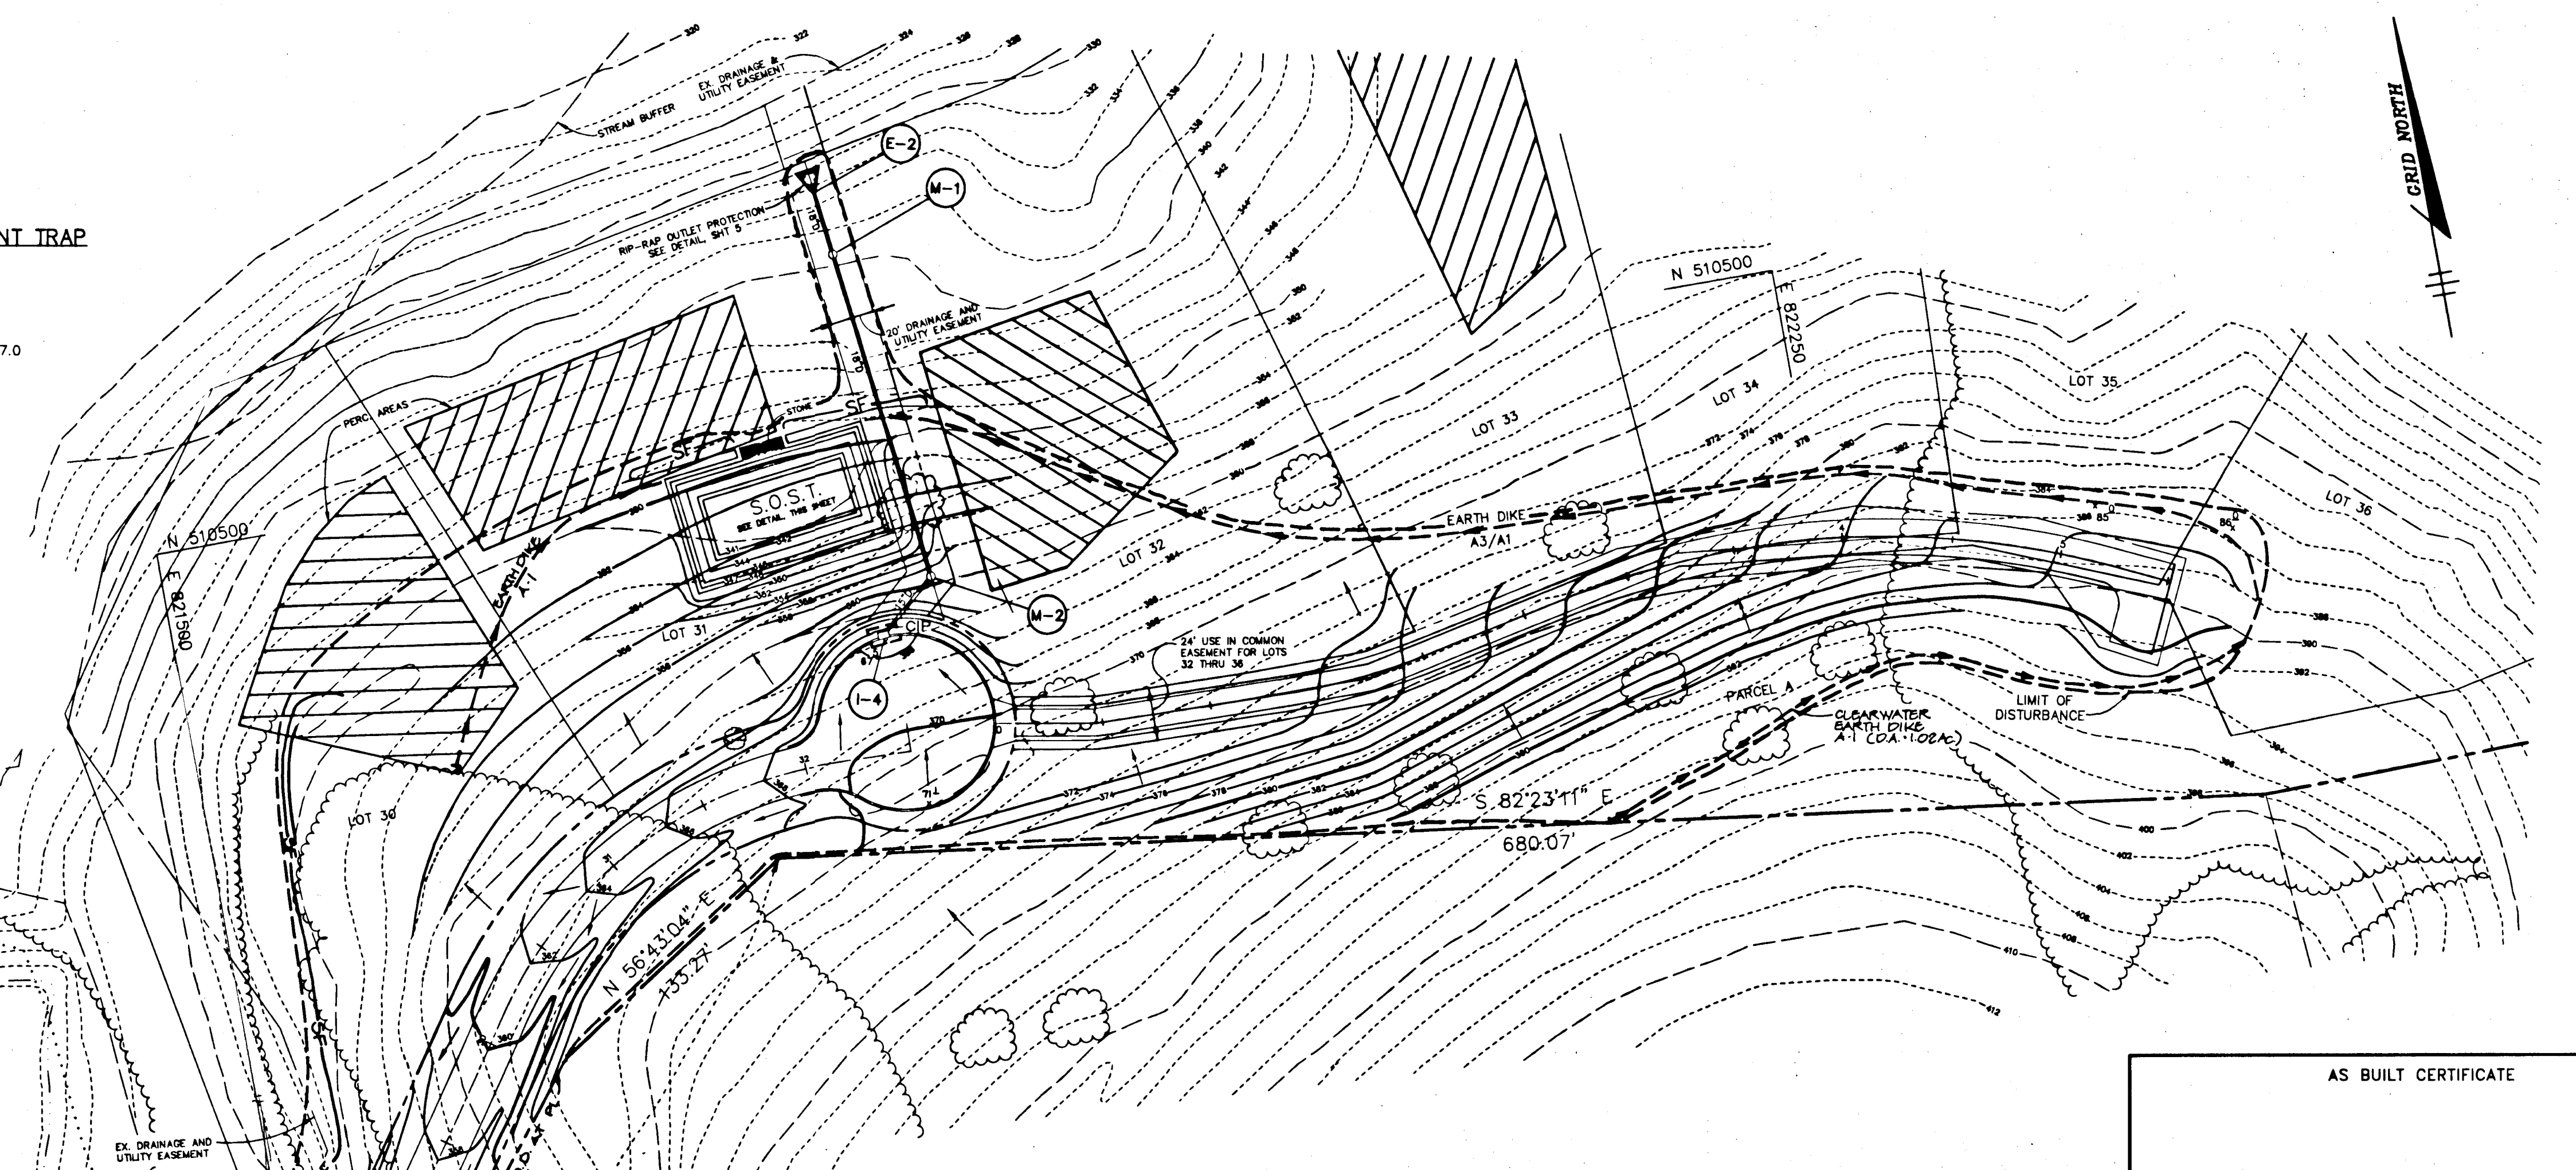

PLAN  
SCALE: 1" = 50'

NOTE: IF EARTH DIKE IS DAMAGED DURING CONSTRUCTION OF STORM DRAIN FROM M-2 TO M-1, REPAIR IMMEDIATELY.

SEQUENCE OF CONSTRUCTION

- OBTAIN A GRADING PERMIT.
- INSTALL STABILIZED CONSTRUCTION ENTRANCE, SILT FENCE, AND STONE OUTLET SEDIMENT TRAP. (1 WEEK)
- BEGIN ROUGH GRADING. (1 WEEK)
- AS SUBGRADE ELEVATION IS REACHED, INSTALL STORM DRAIN PIPES, INLETS, AND INLET PROTECTION. (1 WEEK)
- REMOVE EXISTING CUL-DE-SAC, EXISTING STORM DRAIN PIPES, AND EXISTING INLETS. (1 WEEK)
- INSTALL CURB & GUTTER, THEN PAVE. (10 DAYS)
- STABILIZE DISTURBED AREAS IN ACCORDANCE WITH PERMANENT SEEDING NOTES. (1 DAY)
- INSTALL LANDSCAPING AND COMPLETE REMAINING CONSTRUCTION. (3 DAYS)
- UPON APPROVAL OF HOWARD COUNTY DILP SEDIMENT CONTROL INSPECTOR, REMOVE REMAINING SEDIMENT CONTROL DEVICES AND STABILIZE IN ACCORDANCE WITH PERMANENT SEEDING NOTES. (1 DAY)

STORM DRAIN STRUCTURE SCHEDULE

NO.	TYPE	LOCATION	INV. IN	INV. OUT	TOP ELEV.	REMARKS
I-1	S	17' RT. @ STA 26+55	344.15(15") 344.15(15")	343.40	347.9	HOCO STD DET SD 4.22
I-2	DOUBLE S	17' RT. @ STA 25+85	-	344.75	348.45	HOCO STD DET SD 4.23
I-3	DOUBLE S	17' RT. @ STA 27+55	-	346.05	349.8	HOCO STD DET SD 4.23
I-4	A-5	54' LT. @ STA 32+49	-	358.43	368.1	HOCO STD DET SD 4.01
M-1	4" MANHOLE	SEE PLAN	335.80	332.15	339.5	HOCO STD DET G 5.01
M-2	4" MANHOLE	SEE PLAN	355.55	347.98	359.8	HOCO STD DET G 5.01
E-1	24" END SECTION	61' LT. @ STA 26+55	338.70	-	-	HOCO STD DET SD 5.51/5.52
E-2	18" END SECTION	SEE PLAN	332.00	-	-	HOCO STD DET SD 5.51/5.52

BY THE DEVELOPER :

I/WE CERTIFY THAT ALL DEVELOPMENT AND CONSTRUCTION WILL BE DONE ACCORDING TO THIS PLAN, AND THAT ANY RESPONSIBLE PERSONNEL INVOLVED IN THE CONSTRUCTION PROJECT WILL HAVE A CERTIFICATE OF ATTENDANCE AT A DEPARTMENT OF THE ENVIRONMENT APPROVED TRAINING PROGRAM FOR THE CONTROL OF SEDIMENT AND EROSION BEFORE BEGINNING THE PROJECT. I ALSO AUTHORIZE PERIODIC ON-SITE INSPECTIONS BY THE HOWARD SOIL CONSERVATION DISTRICT.

*Eric Stubb*  
DEVELOPER DATE

BY THE ENGINEER :

I CERTIFY THAT THIS PLAN FOR EROSION AND SEDIMENT CONTROL REPRESENTS A PRACTICAL AND WORKABLE PLAN BASED ON MY PERSONAL KNOWLEDGE OF THE SITE CONDITIONS AND THAT IT WAS PREPARED IN ACCORDANCE WITH THE REQUIREMENTS OF THE HOWARD SOIL CONSERVATION DISTRICT.

*J. Larell* 1-17-96  
ENGINEER DATE

THESE PLANS HAVE BEEN REVIEWED FOR THE HOWARD SOIL CONSERVATION DISTRICT AND MEET THE TECHNICAL REQUIREMENTS FOR SOIL EROSION AND SEDIMENT CONTROL.

*Patricia Engler* 1/24/96  
NATURAL RESOURCES CONSERVATION SERVICE DATE

THIS DEVELOPMENT PLAN IS APPROVED FOR SOIL EROSION AND SEDIMENT CONTROL BY THE HOWARD SOIL CONSERVATION DISTRICT.

*John R. Robertson* 1/24/96  
HOWARD SOIL CONSERVATION DISTRICT DATE


AS BUILT CERTIFICATE	
DATE	
APPROVED : HOWARD COUNTY DEPARTMENT OF PUBLIC WORKS.	
<i>Richard M. Doncker</i> 2-6-96 CHIEF, BUREAU OF HIGHWAYS	DATE
APPROVED : HOWARD COUNTY DEPARTMENT OF PLANNING AND ZONING.	
<i>Jim Sawin</i> 2/15/96 CHIEF, DIVISION OF LAND DEVELOPMENT AND RESEARCH	DATE
<i>Bill Deamus</i> 2/10/96 CHIEF, DEVELOPMENT ENGINEERING DIVISION	DATE
DATE NO.	REVISION
OWNER / DEVELOPER	ERIC MIKOLASKO c/o J.M. INC. 5570 STERETT PLACE SUITE 205 COLUMBIA, MARYLAND 21044
PROJECT	CHAPEL WOODS III LOTS 28 - 36 & PARCEL A A RESUBDIVISION OF LOTS 7 AND 8
AREA	TAX MAP NO. 29 PARCELS 86 5th ELECTION DISTRICT HOWARD COUNTY, MARYLAND
TITLE	GRADING AND SEDIMENT CONTROL PLAN
RIEMER MUEGGE & ASSOCIATES, INC. Planners Engineers Surveyors 8818 Centre Park Drive • Suite 200 • Columbia, Md 21045 410-997-8900 FAX : 410-997-9282	
DATE	1-17-96
DESIGNED BY :	C.J.R.
DRAWN BY :	DAM
PROJECT NO :	HOCO 28810 RDS.DWG
DATE :	JANUARY 17, 1996
SCALE :	AS SHOWN
DRAWING NO.	3 OF 7



N 510750  
E 820500

N 509750  
E 820500

PLAN  
SCALE: 1" = 100'

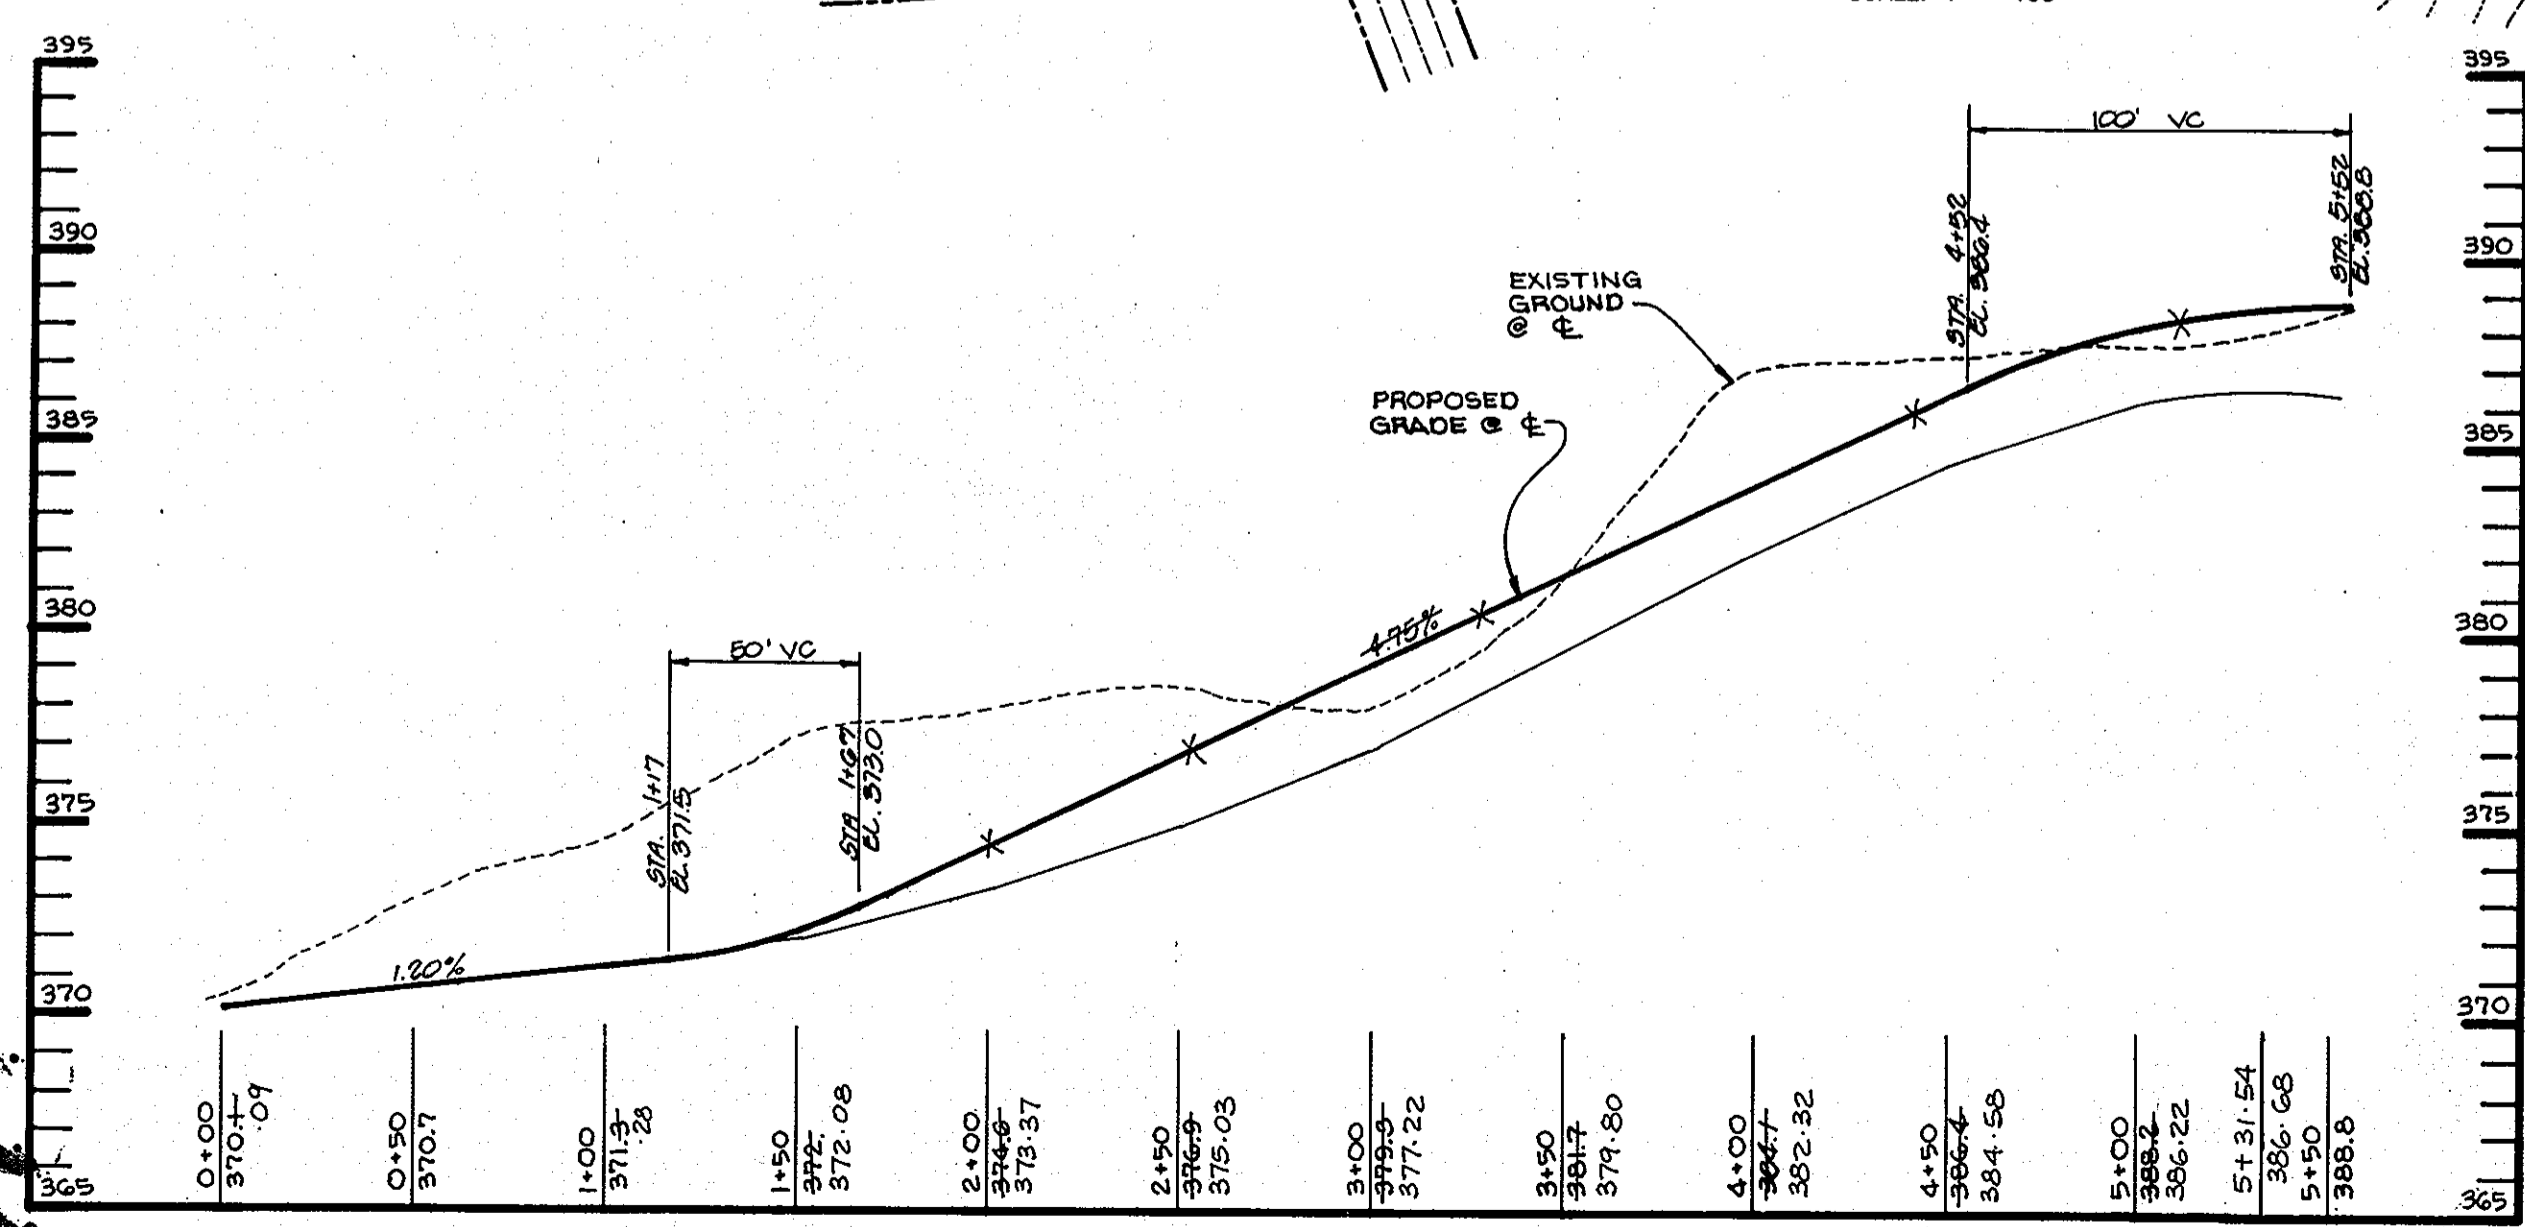


CHAPEL WOODS III - DRIVEWAY PROFILE

SCALE: HORIZ. 1" = 50'  
VERT. 1" = 5'

SCHEDULE A  
PERIMETER LANDSCAPE EDGE

CATEGORY	ADJACENT TO PERIMETER PROPERTIES			
	1	2	3	4
PERIMETER EDGE	1	2	3	4
LANDSCAPE TYPE	A	A	A	A
LINEAR FEET OF PERIMETER	500	920	1200	775
CREDIT FOR EXISTING VEGETATION	YES	YES	YES	YES
YES NO LINEAR FEET DESCRIBE BELOW IF NEEDED	500	920	1200	775
NUMBER OF PLANTS REQUIRED	2*2	10*2	20*1	12*2
SHADE TREES				
EVERGREEN TREES				
NUMBER OF PLANTS PROVIDED				
SHADE TREES				
EVERGREEN TREES				
DESCRIBE PLANT SUBSTITUTION DESCRIBE BELOW IF NEEDED				

- \*1. CREDIT FOR EXISTING WOODS TO REMAIN AND AREAS OF WETLAND MITIGATION (F-50 021 & W-05 75, CHAPEL WOODS II & F-50 20, THE FOREST), SEPARATING LOTS 28-34 AND THE PRESERVATION PARCEL A.
- \*2. CREDIT FOR EXISTING WOODS TO REMAIN.
- \*3. THIS PLAN HAS BEEN PREPARED IN ACCORDANCE WITH THE PROVISIONS OF SECTION 16.02 OF THE HOWARD COUNTY COUNTY CODE AND THE LANDSCAPE MANUAL.

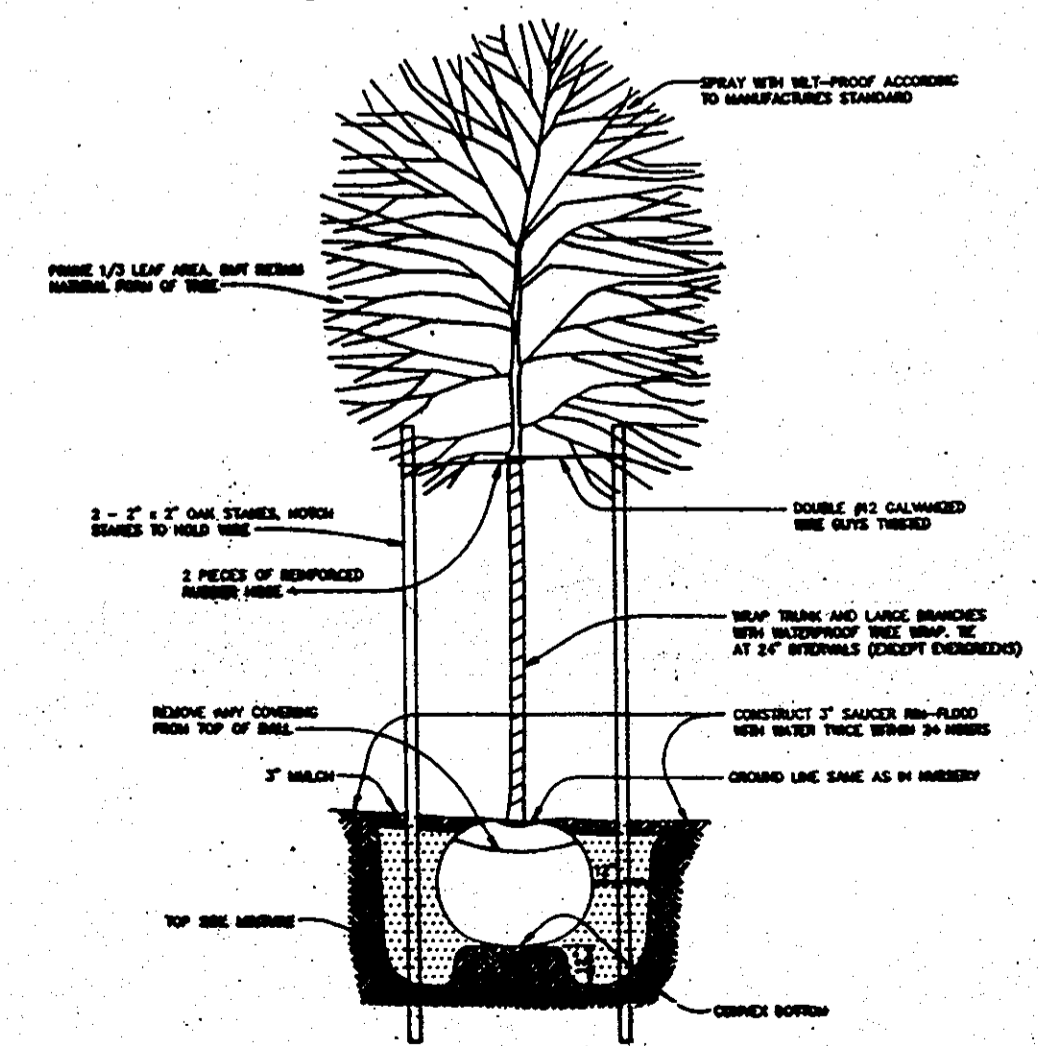

TREE PLANTING DETAIL



**BUILT CERTIFICATE**

*Christopher J. Reid*  
CHRISTOPHER J. REID #19949 DATE 10-18-00

APPROVED: HOWARD COUNTY DEPARTMENT OF PUBLIC WORKS.  
*Richard M. Daniels* 2-6-96  
CHIEF, BUREAU OF HIGHWAYS DATE

APPROVED: HOWARD COUNTY DEPARTMENT OF PLANNING AND ZONING.  
*Jim Swannery* 2/15/96  
CHIEF, DIVISION OF LAND DEVELOPMENT AND RESEARCH DATE

*Chris Daniels* 2/15/96  
CHIEF, DEVELOPMENT ENGINEERING DIVISION DATE

24 APR 12 1 REVISE DRAINAGE DIVIDES PER F-12-041  
DATE NO. REVISION

OWNER / DEVELOPER  
ERIC MIKOLASKO  
c/o JLM, INC.  
5570 STERRETT PLACE  
SUITE 205  
COLUMBIA, MARYLAND 21044

PROJECT  
CHAPEL WOODS III  
LOTS 28 - 36 & PARCEL A  
A RESUBDIVISION OF LOTS 7 AND 8

AREA  
TAX MAP NO. 29 PARCELS 86  
5th ELECTION DISTRICT  
HOWARD COUNTY, MARYLAND

TITLE  
DRAINAGE AREA MAP, DRIVEWAY  
PROFILE AND LANDSCAPE PLAN

RIEMER MUEGGE & ASSOCIATES, INC.  
Planners • Engineers • Surveyors  
8818 Centre Park Drive • Suite 200 • Columbia, Md 21045  
410-997-8900 FAX: 410-997-9282

1-17-96 DATE  
S-94-37 P-95-19

*J. Zarell*  
JAYKANT D. PAREKH #19148

DESIGNED BY: C.J.R.  
DRAWN BY: DAM  
PROJECT NO: HOCO 28810 RD4.DWG  
DATE: JANUARY 17, 1996  
SCALE: AS SHOWN  
DRAWING NO. 4 OF 7

**TEMPORARY SEEDING NOTES**

Apply to graded or cleared areas likely to be reseeded where a short-term vegetative cover is needed.

**Soil Preparation** - Loosen upper three inches of soil by raking, disking or other acceptable means before seeding, if not previously loosened.

**Soil Amendments** - Apply 600 lbs. per acre 10-10-10 fertilizer (14 lbs. per 1000 sq.ft.).

**Seeding** - For periods March 1 thru April 30 and from August 15 thru November 15, seed with 2-1/2 bushels per acre of annual ryegrass (3.2 lbs. per 1000 sq.ft.). For the period May 1 thru August 14, seed with 3 lbs. per acre of weeping lovegrass (0.97 lbs. per 1000 sq.ft.). For the period November 16 thru February 28, protect site by applying 2 tons per acre of well-anchored straw mulch and seed as soon as possible in the spring, or use sod.

**Mulches** - Apply 1-1/2 to 2 tons per acre (70 to 90 lbs. per 1000 sq.ft.) of unweeded straw straw immediately after seeding.

Anchor mulch immediately after application using mulch anchoring tool or 218 gal. per acre (5 gal. per 1000 sq.ft.) of emulsified asphalt on flat areas. On slopes, 8 ft. or higher, use 347 gal. per acre (8 gal. per 1000 sq.ft.) for anchoring.

Refer to the 1983 MARYLAND STANDARDS AND SPECIFICATIONS FOR SOIL EROSION AND SEDIMENT CONTROL FOR rate and methods not covered.

**PERMANENT SEEDING NOTES**

Apply to graded or cleared areas not subject to immediate further disturbance where a permanent long-lived vegetative cover is needed.

**Soil Preparation** - Loosen upper three inches of soil by raking, disking or other acceptable means before seeding, if not previously loosened.

**Soil Amendments** - In lieu of soil test recommendations, use one of the following schedules:

- 1) Preferred - Apply 2 tons per acre dolomitic limestone (92 lbs. per 1000 sq.ft.) and 500 lbs. per acre 10-10-10 fertilizer (14 lbs. per 1000 sq.ft.) before seeding. Mow and reseed with 2 tons per acre of well-anchored straw mulch. At time of seeding, apply 400 lbs. per acre 30-0-0 urea-formaldehyde fertilizer (8 lbs. per 1000 sq.ft.).
- 2) Acceptable - Apply 2 tons per acre dolomitic limestone (92 lbs. per 1000 sq.ft.) and 1000 lbs. per acre 10-10-10 fertilizer (23 lbs. per 1000 sq.ft.) before seeding. Mow or disc into upper three inches of soil.

**Seeding** - For the period March 1 thru April 30 and from August 1 thru October 15, seed with 60 lbs. per acre (1.4 lbs. per 1000 sq.ft.) of Kentucky 31 Tall Fescue. For the period May 1 thru August 14, seed with 60 lbs. Kentucky 31 Tall Fescue per acre and 2 lbs. per acre (0.5 lbs. per 1000 sq.ft.) of weeping lovegrass. For the period October 15 thru February 28, protect site by one of the following options:

- 1) 2 tons per acre of well-anchored straw mulch and seed as soon as possible in the spring.
- 2) Use sod.
- 3) Seed with 60 lbs. per acre Kentucky 31 Tall Fescue and mulch with 2 tons per acre well-anchored straw.



**Mulches** - Apply 1-1/2 to 2 tons per acre (70 to 90 lbs. per 1000 sq.ft.) of unweeded straw straw immediately after seeding.

Anchor mulch immediately after application using mulch anchoring tool or 218 gal. per acre (5 gal. per 1000 sq.ft.) of emulsified asphalt on flat areas. On slopes, 8 ft. or higher, use 347 gal. per acre (8 gal. per 1000 sq.ft.) for anchoring.

**Maintenance** - Inspect all seeded areas and make needed repairs, replacements and reseedings.

**SEDIMENT CONTROL NOTES**



- 1) A MINIMUM OF 48 HOURS NOTICE MUST BE GIVEN TO THE HOWARD COUNTY DEPARTMENT OF INSPECTIONS AND PERMITS PRIOR TO THE START OF ANY CONSTRUCTION (313-1855).
- 2) ALL VEGETATIVE AND STRUCTURAL PRACTICES ARE TO BE INSTALLED ACCORDING TO THE PROVISIONS OF THIS PLAN AND ARE TO BE IN CONFORMANCE WITH THE MARYLAND STANDARDS AND SPECIFICATIONS FOR SOIL AND EROSION CONTROL, AND REVISIONS THEREOF.
- 3) FOLLOWING INITIAL SOIL DISTURBANCE OR REDISTURBANCE, PERMANENT OR TEMPORARY STABILIZATION SHALL BE COMPLETED WITHIN: A) CALENDAR DAYS FOR ALL PERMETER STRUCTURES, DITCHES, PERMETER SLOPES AND ALL SLOPES AND ALL SLOPES GREATER THAN 3:1, B) 14 DAYS AS TO OTHER DISTURBED OR GRADED AREAS ON THE PROJECT SITE.
- 4) ALL SEDIMENT TRAPS/BASINS SHOWN MUST BE FENCED AND WARNING SIGNS POSTED AROUND THE PERMETER IN ACCORDANCE WITH VOL. 1, CHAPTER 12 OF THE HOWARD COUNTY DESIGN MANUAL, STORM DRAINAGE.
- 5) ALL DISTURBED AREAS MUST BE STABILIZED WITHIN THE TIME PERIOD SPECIFIED ABOVE IN ACCORDANCE WITH THE 1981 MARYLAND STANDARDS AND SPECIFICATIONS FOR SOIL AND EROSION CONTROL FOR PERMANENT SEEDINGS (SEC. 51), SOIL (SEC. 54), TEMPORARY SEEDING (SEC. 50) AND MULCHING (SEC. 52). TEMPORARY STABILIZATION WITH MULCH ALONG CAN ONLY BE DONE WHEN RECOMMENDED SEEDING DATES DO NOT ALLOW FOR PROPER GERMINATION AND ESTABLISHMENT OF GRASSES.
- 6) ALL SEDIMENT CONTROL STRUCTURES ARE TO REMAIN IN PLACE AND ARE TO BE MAINTAINED IN OPERATIVE CONDITION UNTIL PERMITS FOR THEIR REMOVAL HAS BEEN OBTAINED FROM THE HOWARD COUNTY SEDIMENT CONTROL INSPECTOR.
- 7) SITE ANALYSIS:
  - TOTAL AREA OF SITE: 89.52 ACRES
  - AREA DISTURBED: 2.21 ACRES
  - AREA TO BE ROOFED OR PAVED: 2.74 ACRES
  - AREA TO BE VEGETATIVELY STABILIZED: 6.47 ACRES
  - TOTAL CUT: 8000 CU.YDS.
  - TOTAL FILL: 8000 CU.YDS.
- 8) ANY SEDIMENT CONTROL PRACTICE WHICH IS DISTURBED BY GRADING ACTIVITY FOR PLACEMENT OF UTILITIES MUST BE REPAIRED ON THE SAME DAY OF DISTURBANCE.
- 9) ADDITIONAL SEDIMENT CONTROLS MUST BE PROVIDED, IF DEEMED NECESSARY BY THE HOWARD COUNTY SEDIMENT CONTROL INSPECTOR.
- 10) SITE GRADING WILL BEGUN ONLY AFTER ALL PERMETER SEDIMENT CONTROL MEASURES HAVE BEEN INSTALLED AND ARE IN A FUNCTIONING CONDITION.
- 11) SEDIMENT WILL BE REMOVED FROM TRAPS WHEN ITS DEPTH REACHES CLEAN OUT ELEVATION SHOWN ON THE PLANS.
- 12) CUT AND FILL QUANTITIES PROVIDED UNDER SITE ANALYSIS DO NOT REPRESENT ED QUANTITIES. THESE QUANTITIES DO NOT DISTINGUISH BETWEEN TOPSOIL, STRUCTURAL FILL OR EMBANKMENT MATERIAL, NOR DO THEY REFLECT CONSIDERATION OF UNDERROUTING OR REMOVAL OF INSTABLE MATERIAL. THE CONTRACTOR SHALL FAMILIARIZE HIMSELF WITH SITE CONDITIONS WHICH MAY AFFECT THE WORK.
- 13) ON ALL SITES WITH DISTURBED AREAS IN EXCESS OF 2 AC., APPROVAL OF THE INSPECTION AGENCY SHALL BE REQUESTED UPON COMPLETION OF INSTALLATION OF PERMETER EROSION AND SEDIMENT CONTROLS, BUT BEFORE PROCEEDING WITH ANY OTHER EARTH DISTURBANCE OR GRADING. OTHER BUILDING OR GRADING INSPECTION APPROVALS MAY NOT BE AUTHORIZED UNTIL THIS INITIAL APPROVAL BY THE INSPECTION AGENCY IS MADE.
- 14) TRENCHES FOR THE CONSTRUCTION OF UTILITIES IS LIMITED TO THREE PIPE LENGTHS OR THAT WHICH CAN BE BACKFILLED AND STABILIZED WITH ONE WORKING DAY, WHICHEVER IS SHORTER.

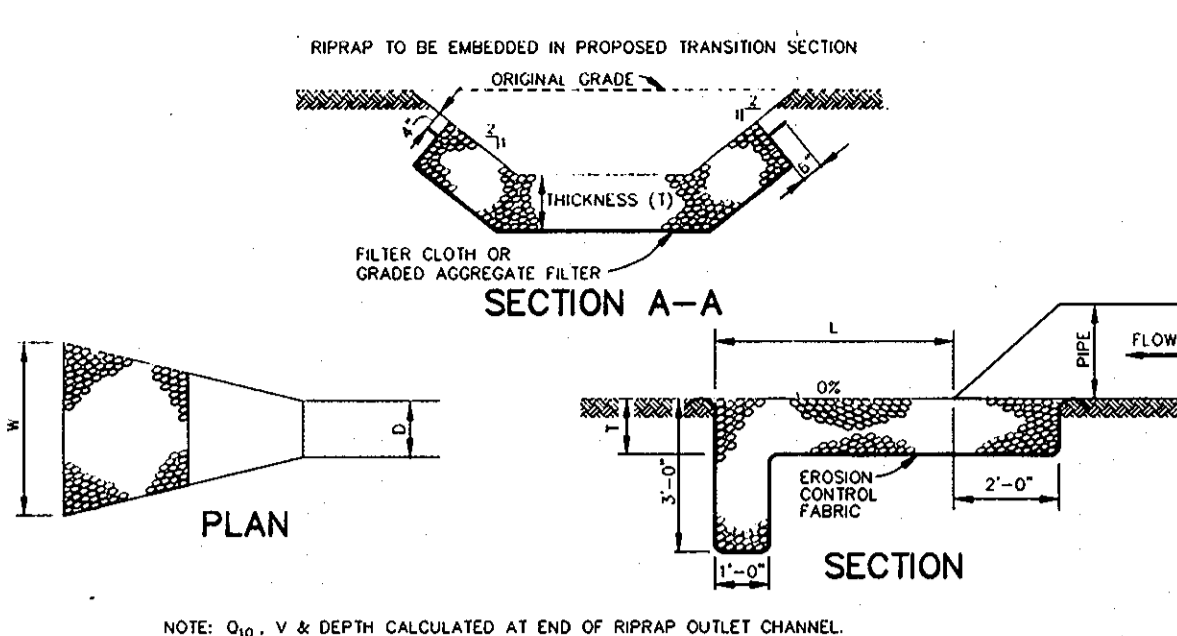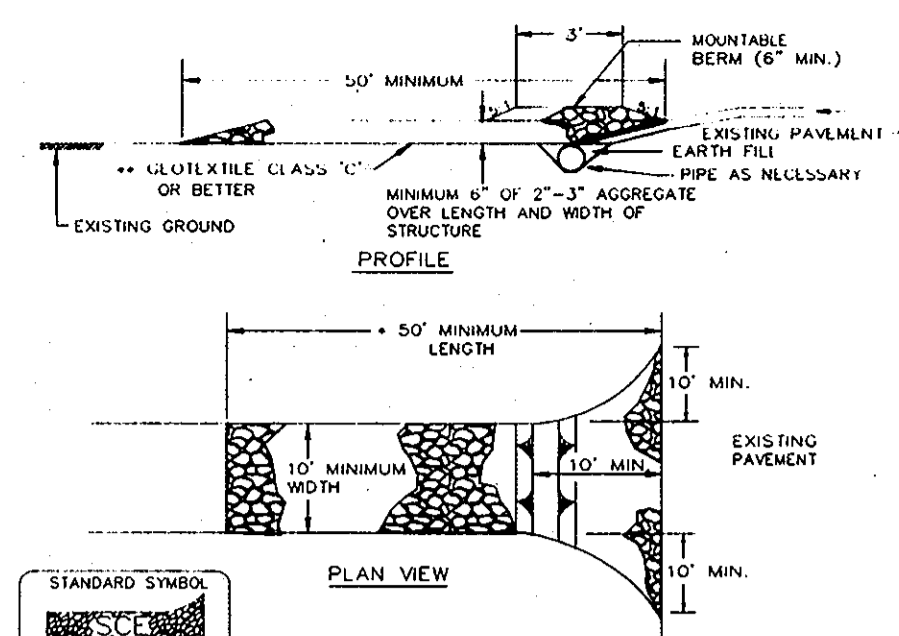

NOTE:  $Q_0$ ,  $V$  & DEPTH CALCULATED AT END OF RIPRAP OUTLET CHANNEL.

STRUCTURE	MEAN STONE DIA.	LENGTH (L)	WIDTH (W)	THICKNESS (T)	$Q_0$	$V$	DEPTH
E-1	16"	15'	17'	32"	20.1 cfs	15.6 fps	1.9 ft
E-2	9.5"	10'	12'	19"	1.1 cfs	2.9 fps	0.4 ft

**RIPRAP OUTLET PROTECTION DETAIL**

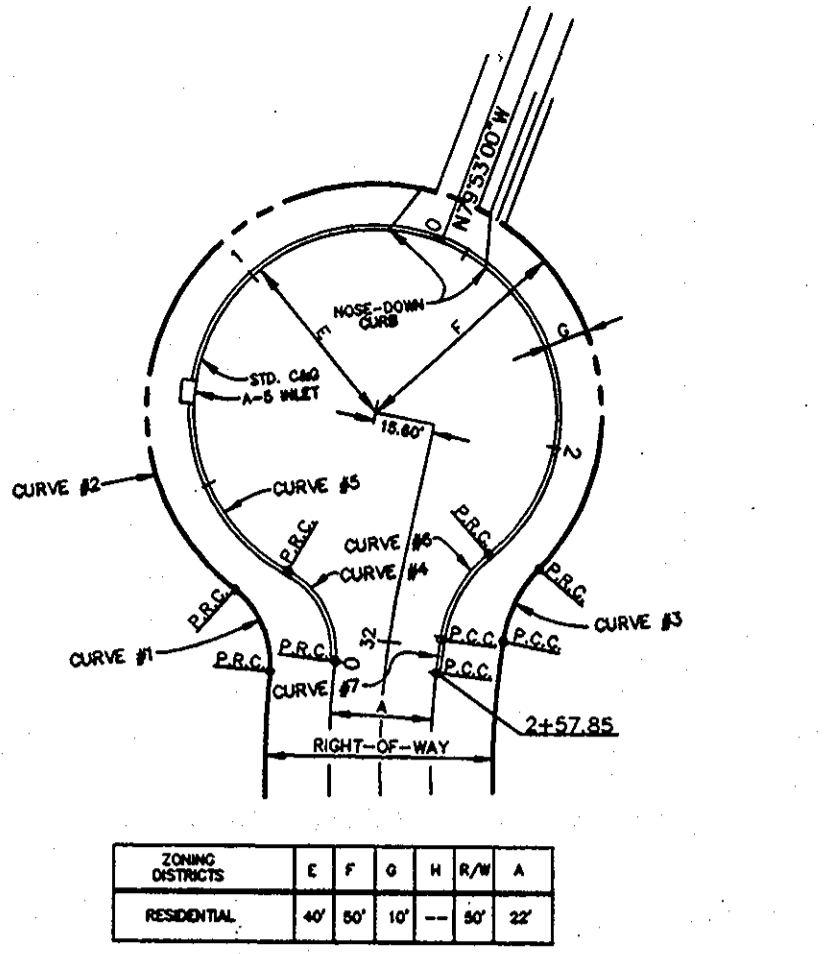
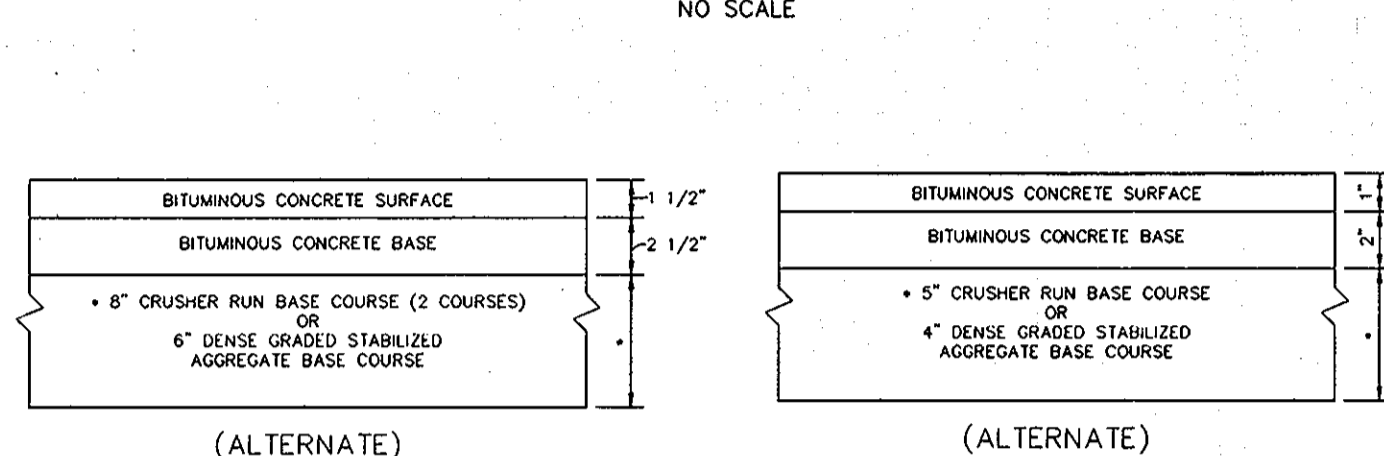


**CURVE DATA**

RESIDENTIAL (22 APPROACH)  
L.P. = 257.85'


STATION	1	2	3	4	5	6	7
STATION	572.33	725.28	813.30	875.92	925.00	941.31	913.32
P	30.00	30.00	30.00	20.00	20.00	30.00	180.00
L	10.97	45.12	9.22	13.77	25.27	11.72	3.67
L	20.10	240.70	18.07	23.71	204.44	22.30	7.34
LCL	19.77	66.99	17.89	22.38	44.26	21.86	7.34

**CHAPEL ESTATES DRIVE CUL-DE-SAC DETAIL**

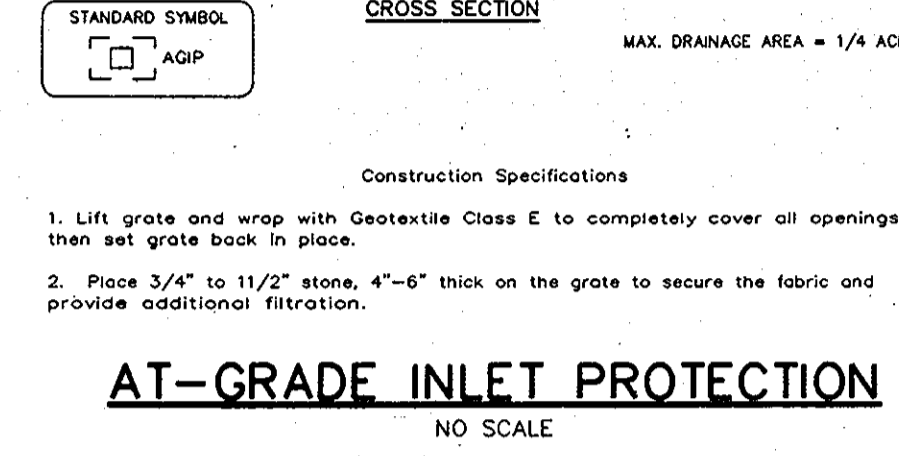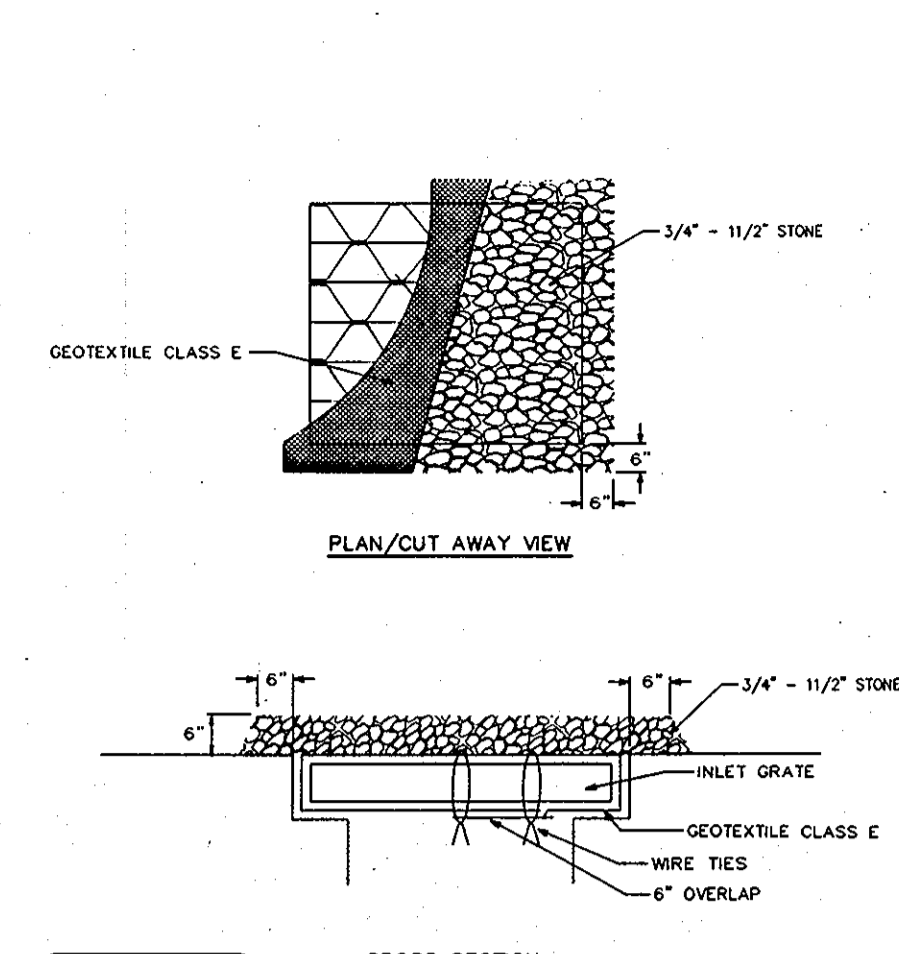

**STABILIZED CONSTRUCTION ENTRANCE**


NO SCALE

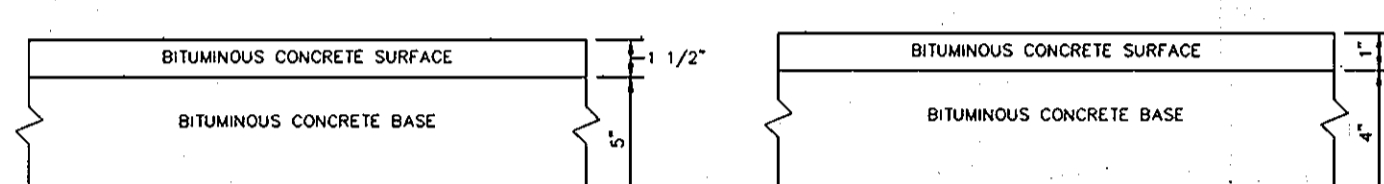

HOWARD COUNTY DESIGN MANUAL VOLUME IV - STANDARD SPECIFICATIONS AND DETAILS FOR CONSTRUCTION (DRAWING R-2.01)



**P-2 PAVING** and **P-1 PAVING**

NO SCALE

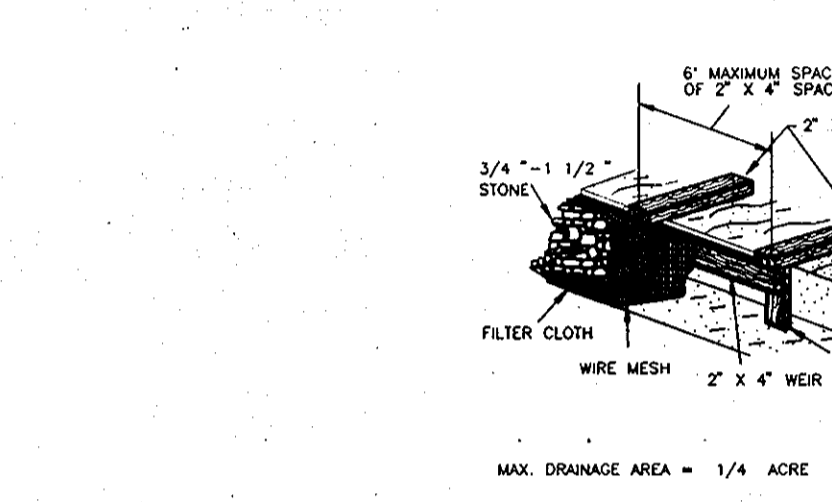


**CURB INLET PROTECTION**

NO SCALE

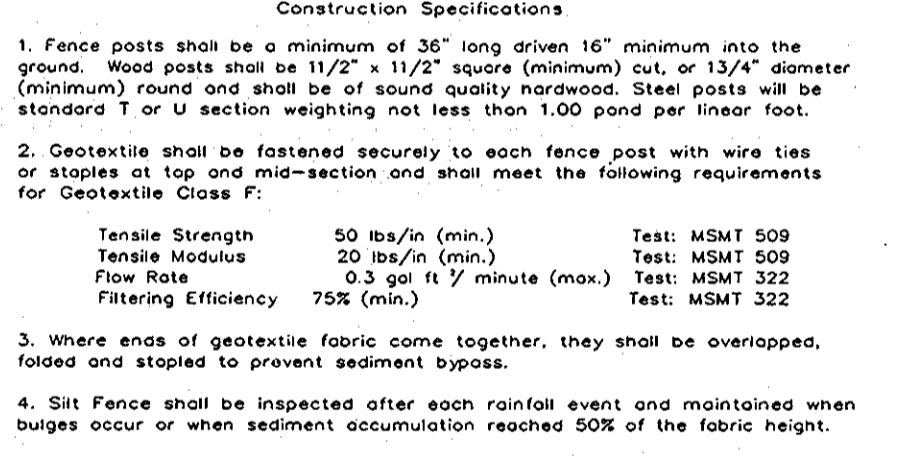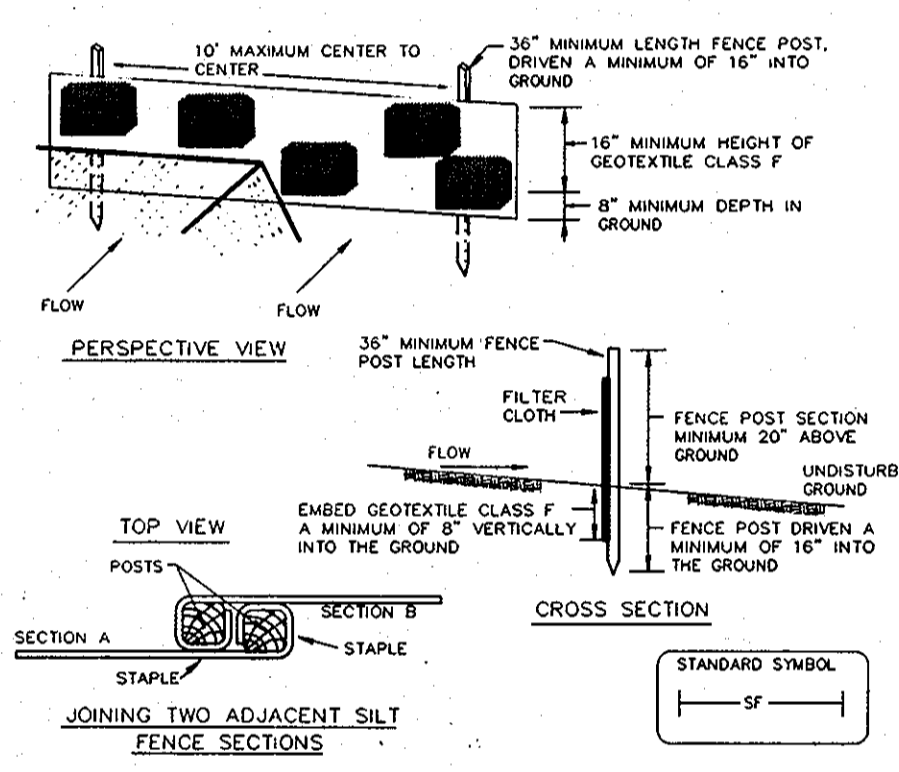


**SILT FENCE DETAIL**

NO SCALE

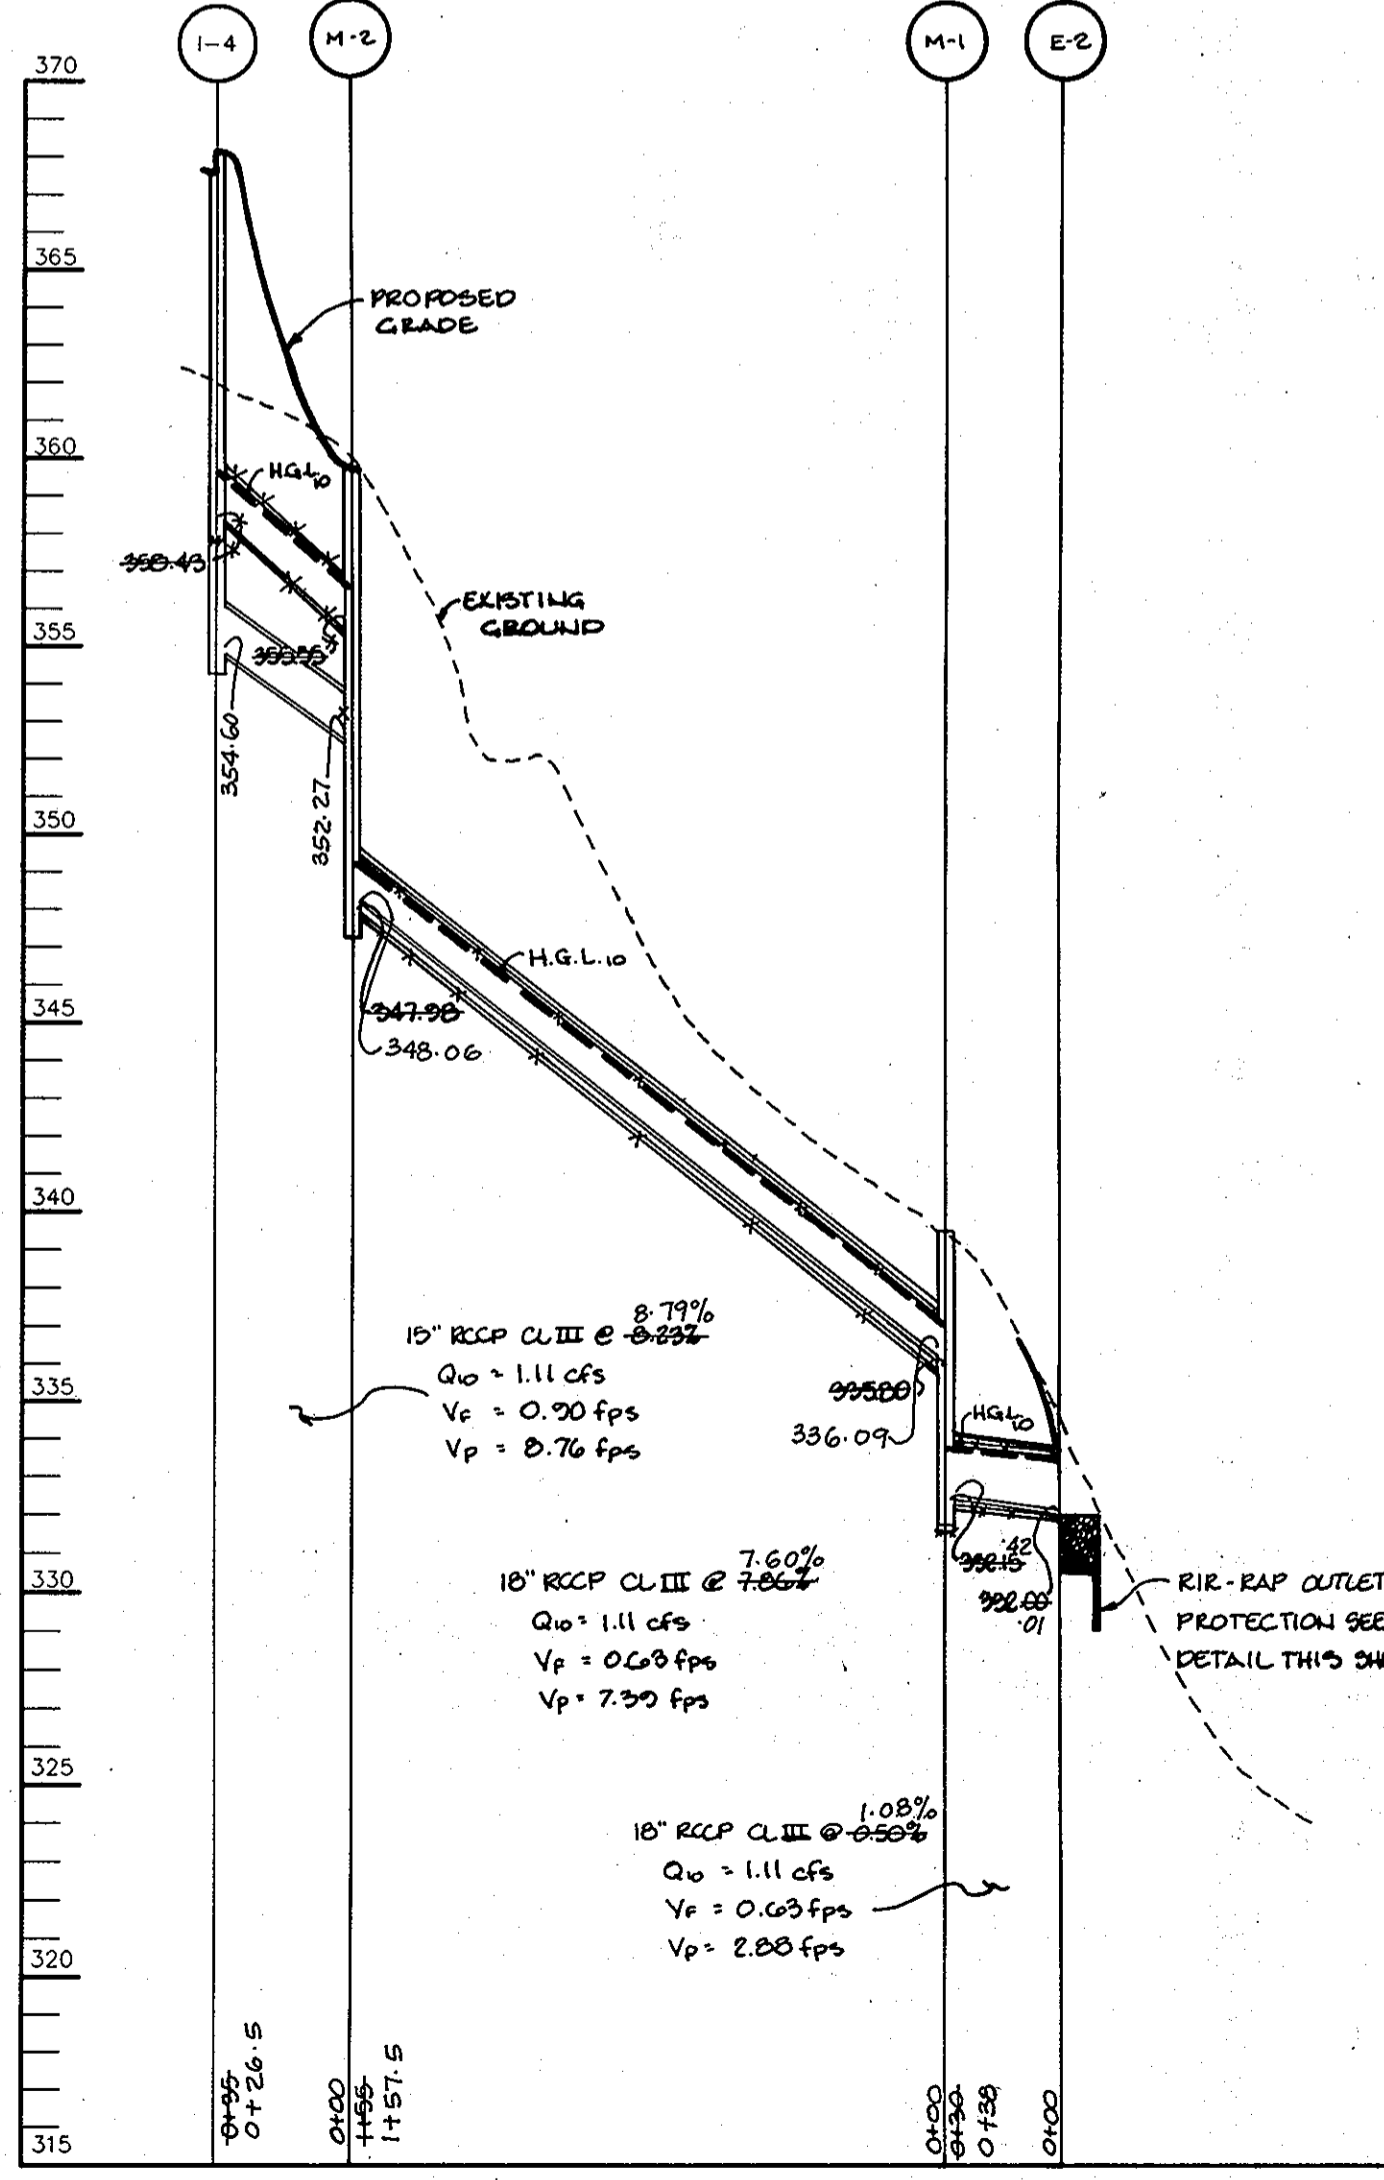


**STORM DRAIN PROFILE**

SCALE: HOR. - 1"=50', VERT. - 1"=5'

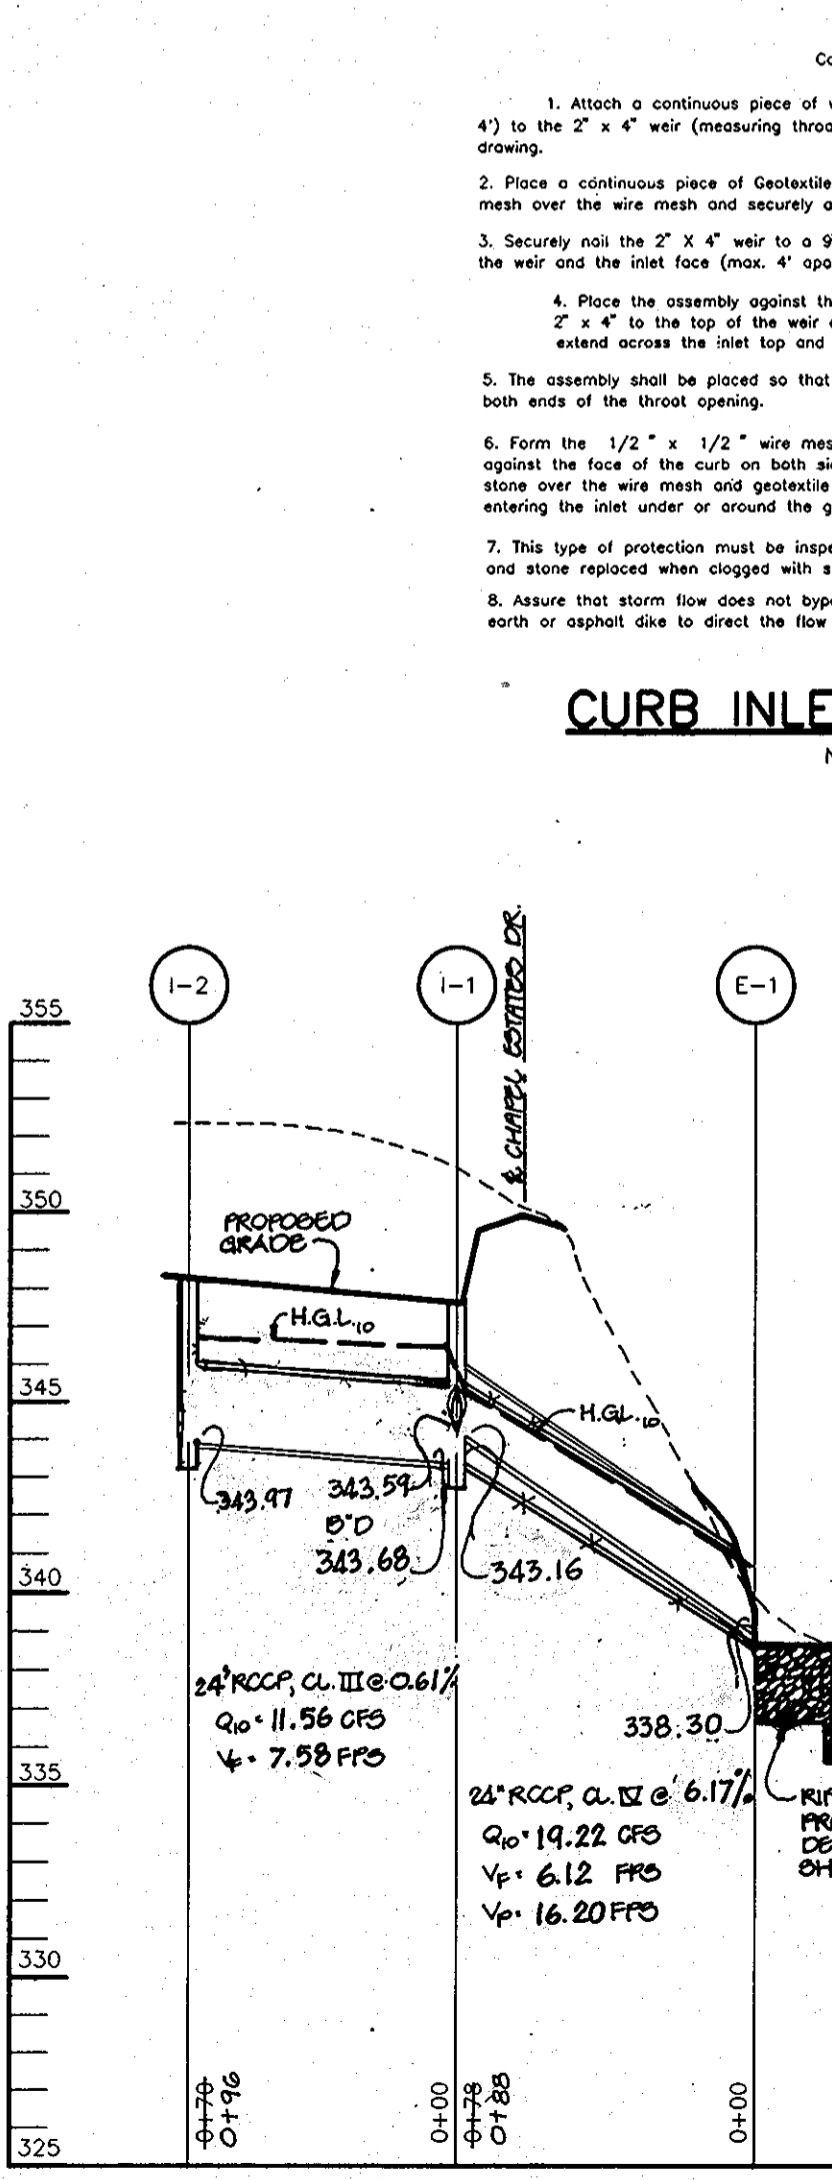

**STORM DRAIN PROFILE**

SCALE: HOR. - 1"=50', VERT. - 1"=5'

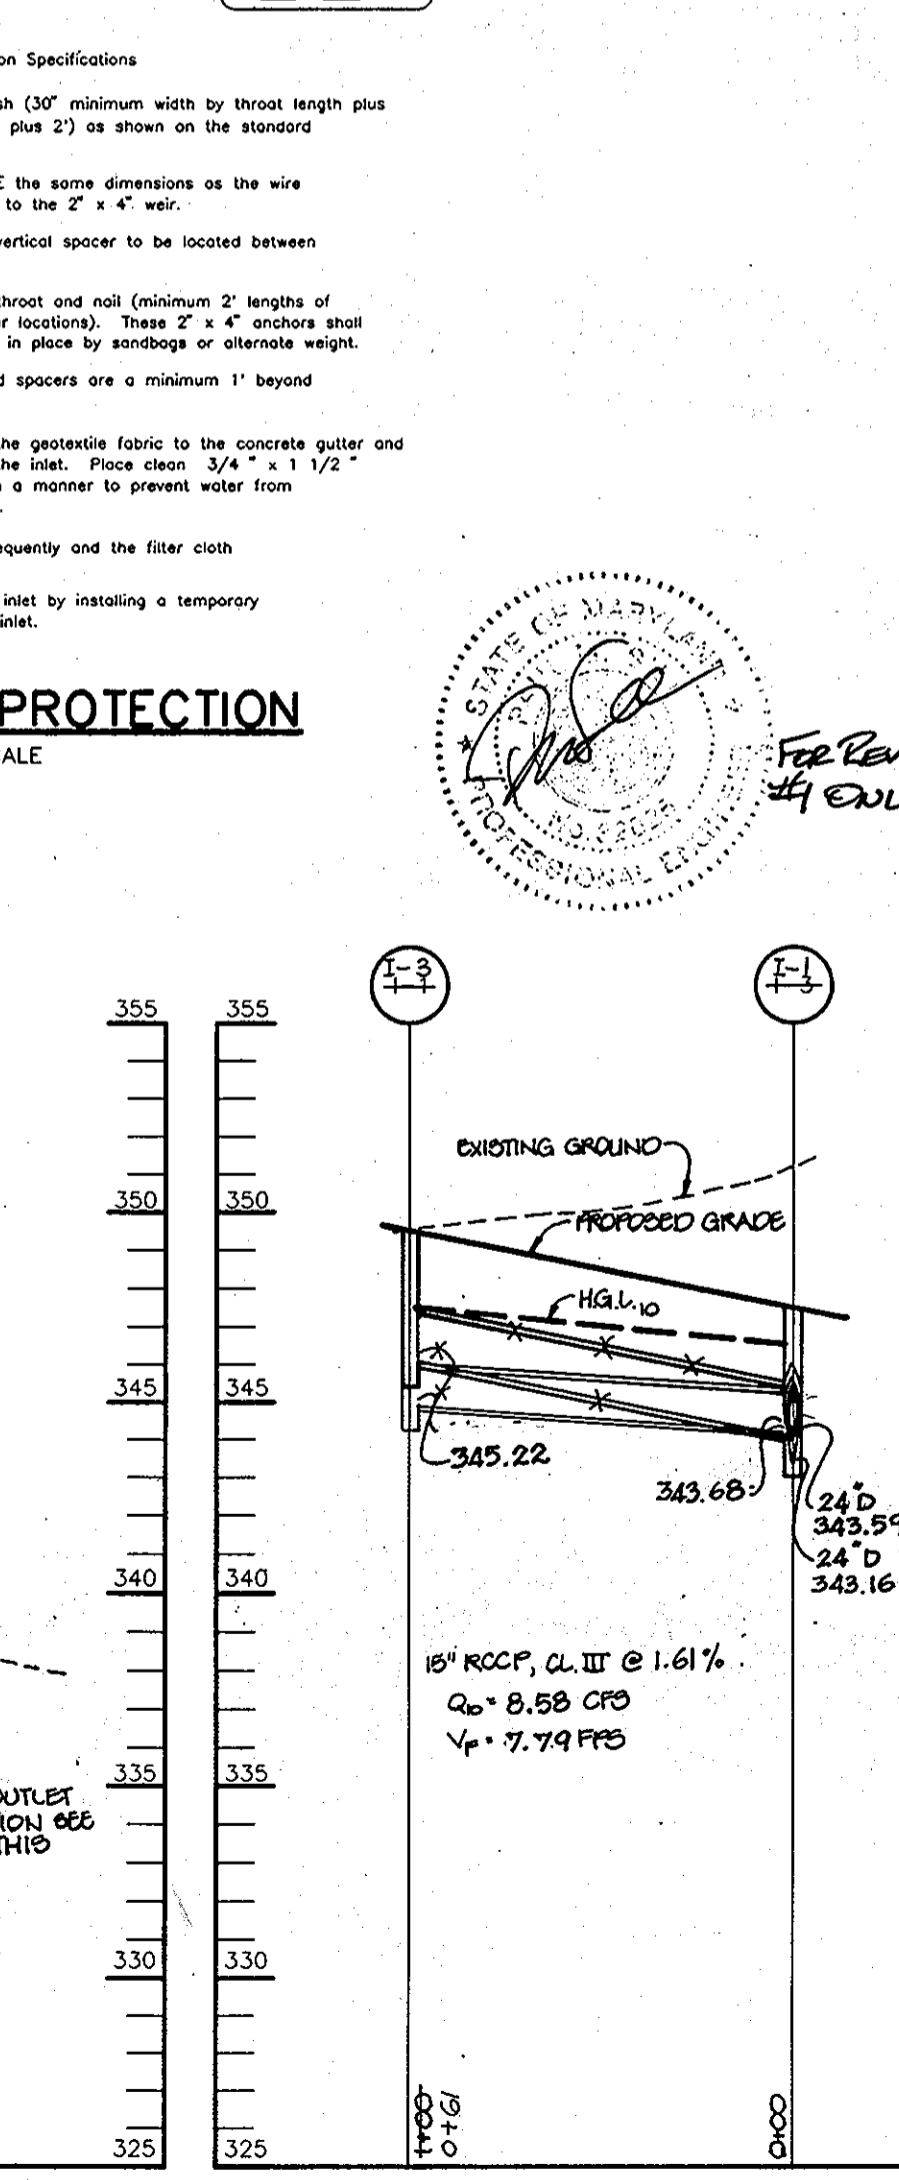

**STORM DRAIN PROFILE**

SCALE: HOR. - 1"=50', VERT. - 1"=5'

**TYPICAL SECTION CUL-DE-SAC STREET**

NO SCALE

FROM CL STA 24+06 TO CL STA 32+04

BY THE DEVELOPER:

I/WE CERTIFY THAT ALL DEVELOPMENT AND CONSTRUCTION WILL BE DONE ACCORDING TO THIS PLAN, AND THAT ANY RESPONSIBLE PERSONNEL INVOLVED IN THE CONSTRUCTION PROJECT WILL HAVE A CERTIFICATE OF ATTENDANCE AT A DEPARTMENT OF THE ENVIRONMENT APPROVED TRAINING PROGRAM FOR THE CONTROL OF SEDIMENT AND EROSION BEFORE BEGINNING THE PROJECT. I ALSO AUTHORIZE PERIODIC ON-SITE INSPECTIONS BY THE HOWARD SOIL CONSERVATION DISTRICT.

*J. Sarell*  
DEVELOPER DATE

BY THE ENGINEER:

I CERTIFY THAT THIS PLAN FOR EROSION AND SEDIMENT CONTROL REPRESENTS A PRACTICAL AND WORKABLE PLAN BASED ON MY PERSONAL KNOWLEDGE OF THE SITE CONDITIONS AND THAT IT WAS PREPARED IN ACCORDANCE WITH THE REQUIREMENTS OF THE HOWARD SOIL CONSERVATION DISTRICT.

*J. Sarell* 1.17.96  
ENGINEER DATE

THESE PLANS HAVE BEEN REVIEWED FOR THE HOWARD SOIL CONSERVATION DISTRICT AND MEET THE TECHNICAL REQUIREMENTS FOR SOIL EROSION AND SEDIMENT CONTROL.

*Patricia Engler/PEC* 1/24/96  
NATURAL RESOURCES CONSERVATION SERVICE DATE

THIS DEVELOPMENT PLAN IS APPROVED FOR SOIL EROSION AND SEDIMENT CONTROL BY THE HOWARD SOIL CONSERVATION DISTRICT.

*John B. Robertson* 1/24/96  
HOWARD SOIL CONSERVATION DISTRICT DATE

AS BUILT CERTIFICATE

*Christopher Reid* 10.18.00  
CHRISTOPHER REID #19949 DATE

APPROVED: HOWARD COUNTY DEPARTMENT OF PUBLIC WORKS.

*Richard M. Savelle* 2-6-96  
CHIEF, BUREAU OF HIGHWAYS DATE

APPROVED: HOWARD COUNTY DEPARTMENT OF PLANNING AND ZONING.

*Jim Swannick* 2/15/96  
CHIEF, DIVISION OF LAND DEVELOPMENT AND RESEARCH DATE

*John D. Dawson* 2/6/96  
CHIEF, DEVELOPMENT ENGINEERING DIVISION DATE

24 APR 1 1996

DATE NO. REVISE SD TO SHOW AS-BUILT CONDITIONS REVISION

OWNER / DEVELOPER

ERIC MIKOLASKO  
c/o J.M. INC.  
5570 STERRETT PLACE  
SUITE 205  
COLUMBIA, MARYLAND 21044

PROJECT

CHAPEL WOODS III  
LOTS 28 - 36 & PARCEL A  
A RESUBDIVISION OF LOTS 7 AND 8

AREA

TAX MAP NO. 29 PARCELS 86  
5th ELECTION DISTRICT  
HOWARD COUNTY, MARYLAND

TITLE


STORM DRAIN PROFILES,  
NOTES AND DETAIL SHEET

RIEMER MUEGGE & ASSOCIATES, INC.  
Planners • Engineers • Surveyors  
8818 Centre Park Drive • Suite 200 • Columbia, Md 21045  
410-997-8900 FAX: 410-997-9282

1.17.96 DATE

DESIGNED BY: C.J.R.  
DRAWN BY: DAM  
PROJECT NO.: HOCO/28810  
R05.DWG  
DATE: JANUARY 17, 1996  
SCALE: AS SHOWN  
DRAWING NO. 5 OF 7

AS-BUILT 10/17/00 F-36-G5

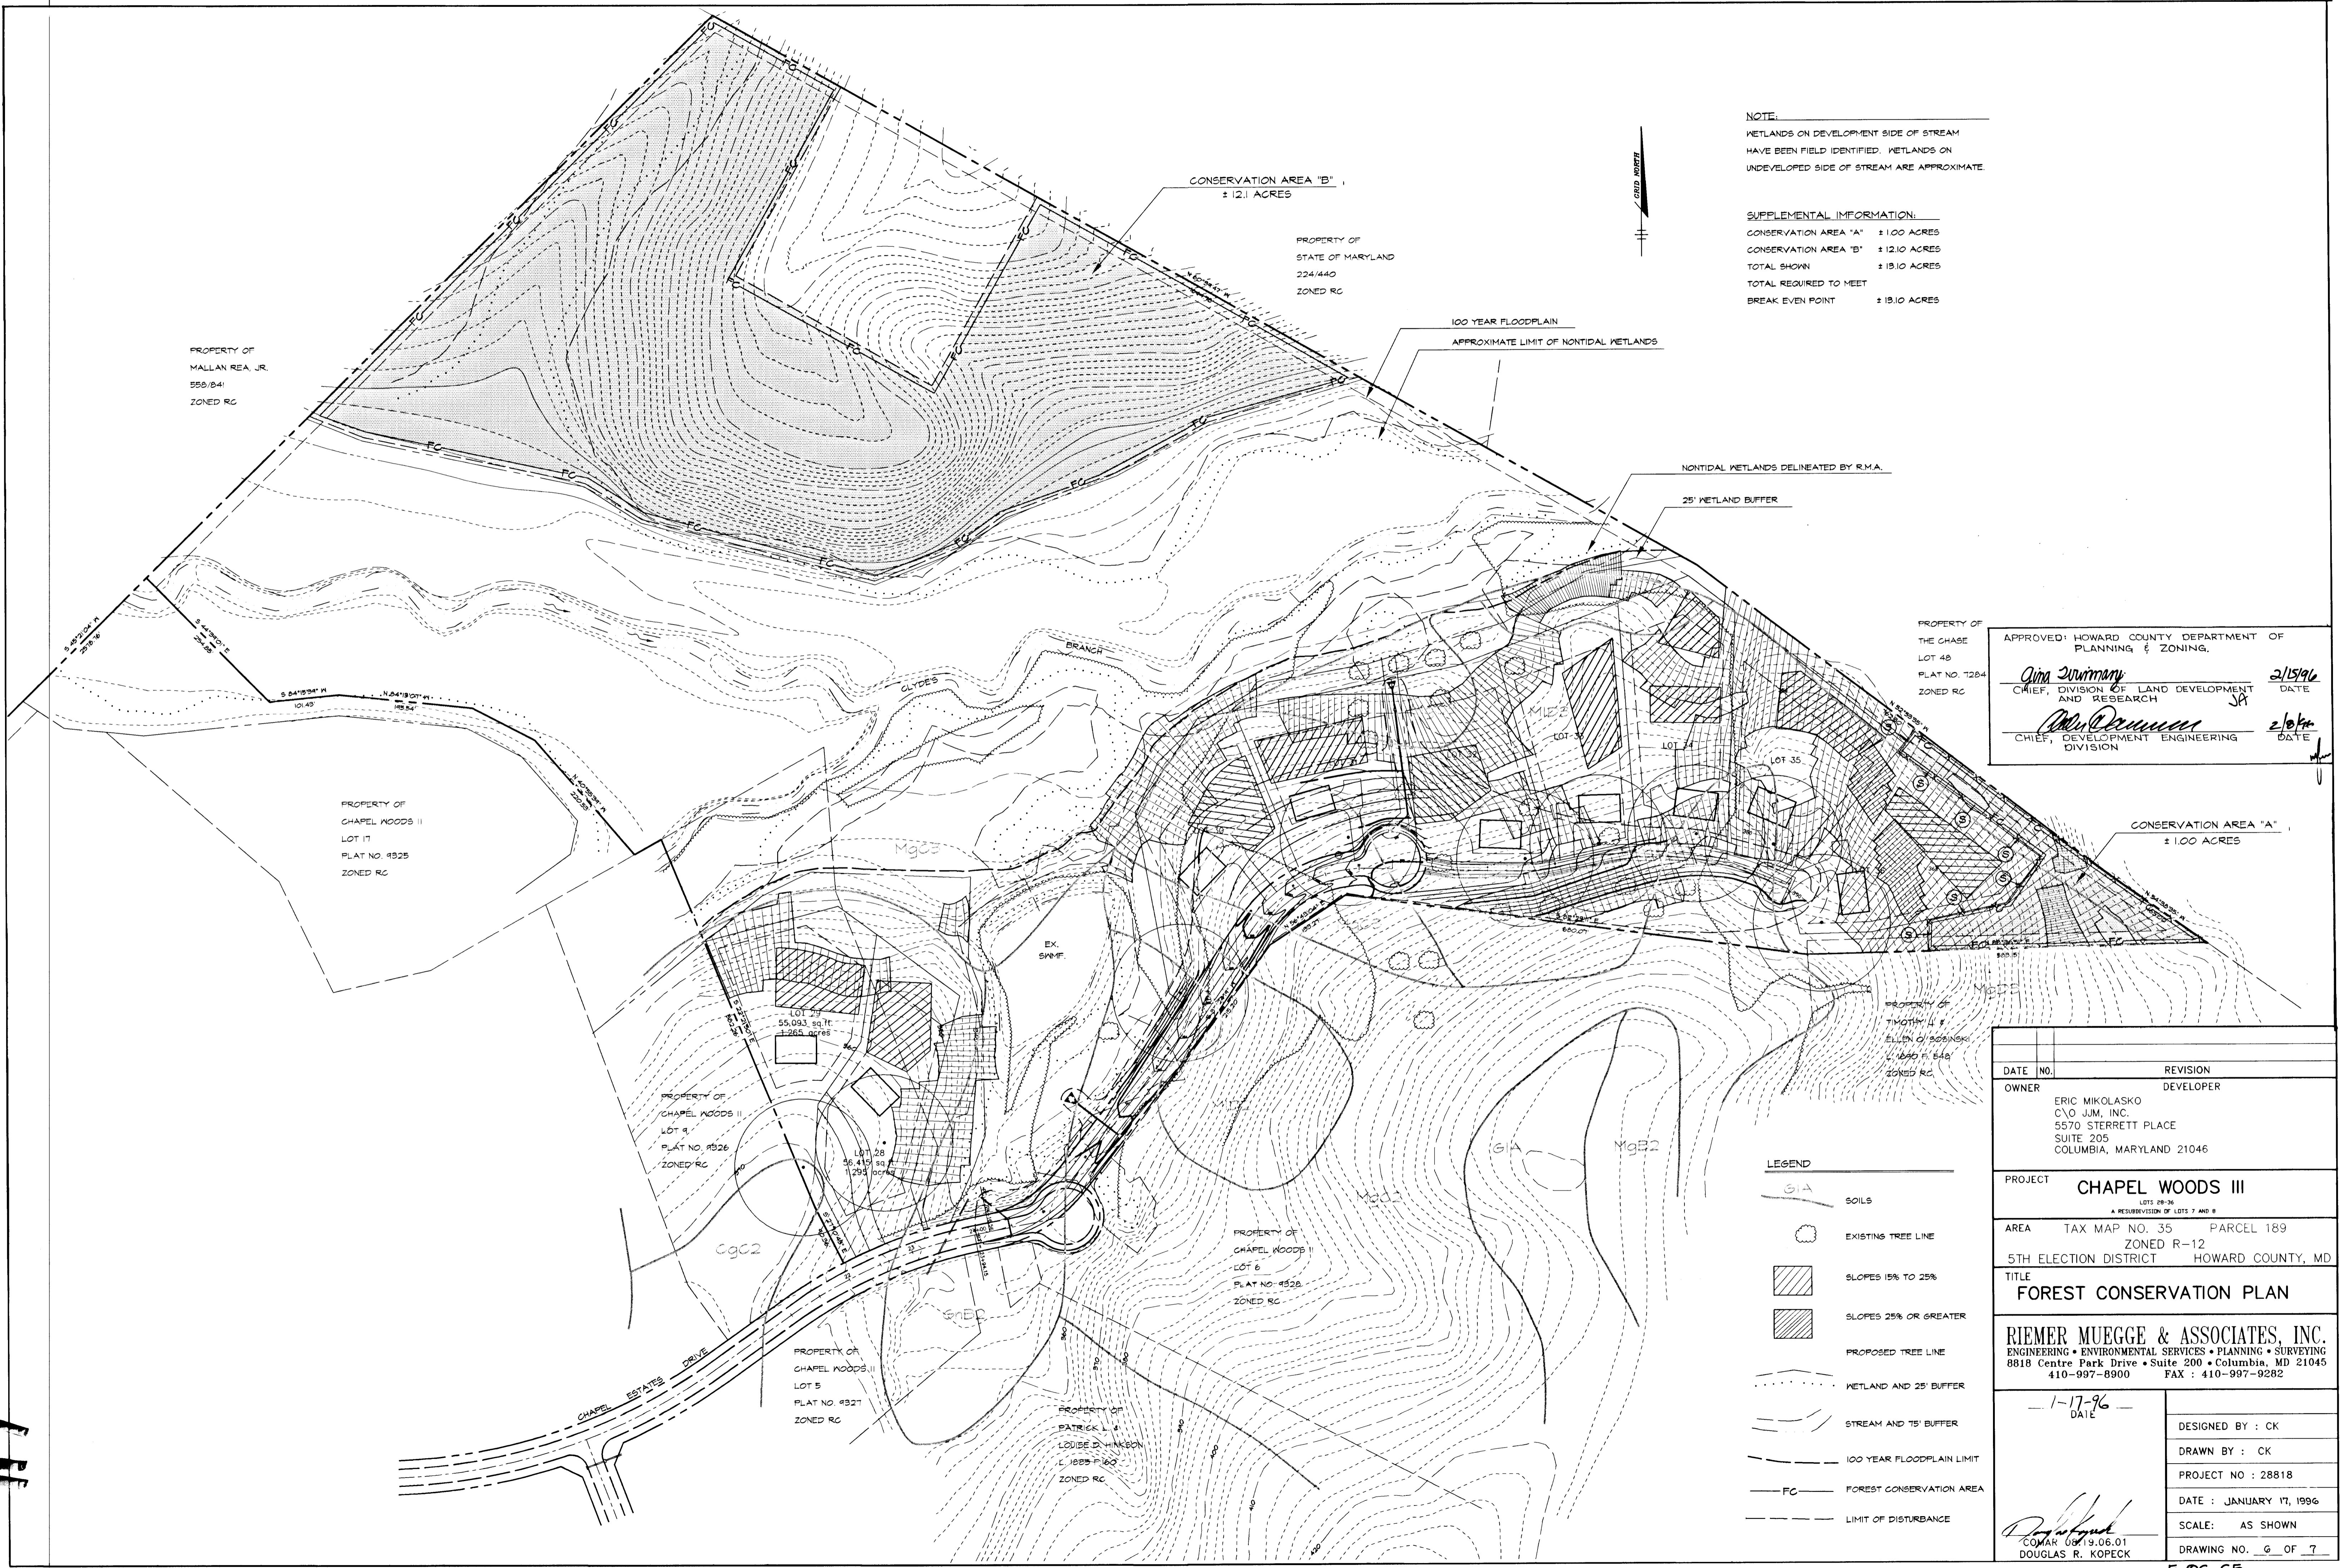

NOTE:  
 WETLANDS ON DEVELOPMENT SIDE OF STREAM  
 HAVE BEEN FIELD IDENTIFIED. WETLANDS ON  
 UNDEVELOPED SIDE OF STREAM ARE APPROXIMATE.

SUPPLEMENTAL INFORMATION:  
 CONSERVATION AREA "A" ± 1.00 ACRES  
 CONSERVATION AREA "B" ± 12.10 ACRES  
 TOTAL SHOWN ± 13.10 ACRES  
 TOTAL REQUIRED TO MEET ± 13.10 ACRES  
 BREAK EVEN POINT ± 13.10 ACRES

APPROVED: HOWARD COUNTY DEPARTMENT OF  
 PLANNING & ZONING.  
*Aina Surimany* 2/15/96  
 CHIEF, DIVISION OF LAND DEVELOPMENT  
 AND RESEARCH DATE  
*Alan J. Deussen* 2/16/96  
 CHIEF, DEVELOPMENT ENGINEERING  
 DIVISION DATE

DATE	NO.	REVISION
OWNER		DEVELOPER
ERIC MIKOLASKO C/O JIM, INC. 5570 STERRETT PLACE SUITE 205 COLUMBIA, MARYLAND 21046		

PROJECT **CHAPEL WOODS III**  
LOTS 28-36  
 A RESUBDIVISION OF LOTS 7 AND 8  
 AREA TAX MAP NO. 35 PARCEL 189  
 ZONED R-12  
 5TH ELECTION DISTRICT HOWARD COUNTY, MD

TITLE **FOREST CONSERVATION PLAN**

**RIEMER MUEGGE & ASSOCIATES, INC.**  
 ENGINEERING • ENVIRONMENTAL SERVICES • PLANNING • SURVEYING  
 8818 Centre Park Drive • Suite 200 • Columbia, MD 21045  
 410-997-8900 FAX: 410-997-9282

DATE	1-17-96
DESIGNED BY	CK
DRAWN BY	CK
PROJECT NO	28818
DATE	JANUARY 17, 1996
SCALE	AS SHOWN
DRAWING NO.	G OF 7

- LEGEND
- G1A SOILS
  - EXISTING TREE LINE
  - SLOPES 15% TO 25%
  - SLOPES 25% OR GREATER
  - PROPOSED TREE LINE
  - WETLAND AND 25' BUFFER
  - STREAM AND 75' BUFFER
  - 100 YEAR FLOODPLAIN LIMIT
  - FC FOREST CONSERVATION AREA
  - LIMIT OF DISTURBANCE

WTC

# HOWARD COUNTY FOREST CONSERVATION WORKSHEET

## I. BASIC SITE DATA

GROSS SITE AREA	53.30 AC.
AREA WITHIN 100 YEAR FLOODPLAIN	13.00 AC.
AREA WITHIN AGRICULTURAL USE OR PRESERVATION PARCEL (IF APPLICABLE)	30.30 AC.
NET TRACT AREA	37.60 AC.
LAND USE CATEGORY (R-RLD, R-RMD, R-S, C/A/O, I)	BC

## II. INFORMATION FOR CALCULATIONS

NET TRACT AREA	37.60 AC.
REFORESTATION THRESHOLD (25% X A)	9.40 AC.
AFFORESTATION MINIMUM (20% X A)	7.50 AC.
EXISTING FOREST ON NET TRACT AREA	22.80 AC.
FOREST AREAS TO BE CLEARED	5.60 AC.
FOREST AREAS TO BE RETAINED	22.24 AC.

## III. DETERMINING REQUIREMENTS: AFFORESTATION OR REFORESTATION

1. REFORESTATION  
 IF EXISTING FOREST AREAS EQUAL OR EXCEED THE AFFORESTATION MINIMUM (IF D EQUALS OR IS MORE THAN C), AND CLEARING OF FOREST AREAS IS PROPOSED, REFORESTATION REQUIREMENTS MAY APPLY.  
 GO TO SECTION IV

IF EXISTING FORESTS EXCEED THE AFFORESTATION MINIMUM (IF D EQUALS OR IS MORE THAN C) AND NO CLEARING OF EXISTING FOREST RESOURCES IS PROPOSED, NO REFORESTATION IS REQUIRED. NO FURTHER CALCULATIONS ARE NEEDED.

2. AFFORESTATION  
 IF EXISTING FOREST AREAS ARE LESS THAN THE AFFORESTATION MINIMUM (IF D IS LESS THAN C), AFFORESTATION REQUIREMENTS APPLY.  
 GO TO SECTION V

## IV. REFORESTATION CALCULATIONS

A. NET TRACT AREA	37.60 AC.	37.60 AC.
B. REFORESTATION THRESHOLD (25% X A)	9.40 AC.	9.40 AC.
C. EXISTING FOREST ON NET TRACT AREA	22.80 AC.	22.80 AC.
D. FOREST AREAS TO BE CLEARED	5.60 AC.	14.80 AC.
E. FOREST AREAS TO BE RETAINED	22.24 AC.	13.10 AC.
F. FOREST AREAS CLEARED ABOVE REFORESTATION THRESHOLD (D-F, IF F EQUALS OR IS GREATER THAN B, ALTERNATE 1)	5.60 AC.	14.80 AC.
G. FOREST AREAS CLEARED BELOW REFORESTATION THRESHOLD (D-F, IF F IS LESS THAN B, ALTERNATE 2)	0.0 AC.	0.0 AC.
H. FOREST AREAS CLEARED BELOW REFORESTATION THRESHOLD (B-F, IF APPLICABLE)	0.0 AC.	0.0 AC.
I. FOREST AREAS RETAINED ABOVE REFORESTATION THRESHOLD (F-B, RETENTION CREDIT, IF APPLICABLE)	13.1 AC.	3.7 AC.

SELECT THE ALTERNATIVE THAT APPLIES:

1. CLEARING ABOVE THE THRESHOLD ONLY

IF FOREST AREAS TO BE RETAINED EQUAL OR ARE GREATER THAN THE REFORESTATION THRESHOLD (IF F EQUALS OR IS GREATER THAN B), THE FOLLOWING CALCULATIONS APPLY:

REFORESTATION FOR CLEARING ABOVE THRESHOLD G X 1/4	1.40 AC.	3.70 AC.
CREDIT FOR FOREST AREAS RETAINED ABOVE THRESHOLD I = RETENTION CREDIT	13.0 AC.	3.70 AC.
TOTAL REFORESTATION REQUIRED (G X 1/4) - I	-11.6 AC.	0.00 AC.

IF THE TOTAL REFORESTATION REQUIREMENT IS EQUAL TO OR LESS THAN 0, NO REFORESTATION IS REQUIRED

2. CLEARING BELOW THE THRESHOLD

IF FOREST AREAS TO BE RETAINED ARE LESS THAN THE REFORESTATION THRESHOLD (IF F IS LESS THAN B), THE FOLLOWING CALCULATIONS APPLY:

REFORESTATION FOR CLEARING ABOVE THRESHOLD G X 1/4	0.0 AC.	0.0 AC.
REFORESTATION FOR CLEARING BELOW THRESHOLD H X 2	0.0 AC.	0.0 AC.
TOTAL REFORESTATION REQUIRED (G X 1/4) + (H X 2)	0.0 AC.	0.0 AC.

\* NOTE: THE BREAK-EVEN POINT (13.1 ACRES) IS SHOWN IN FOREST CONSERVATION EASEMENTS.

BREAK-EVEN PT.

# FOREST CONSERVATION PROGRAM

## GENERAL NOTES:

- INSTALL PROTECTIVE TREE FENCING AND SIGNAGE ALONG FOREST RETENTION AREAS BEFORE ANY GRADING HAS COMMENCED ON SITE.
- THERE WILL BE NO STAGING, STORING OR STOCKPILING OF EQUIPMENT WITHIN THE LIMIT OF THE LIMIT OF THE NONTIDAL WETLANDS OR THE 25' BUFFER.
- INSTALL TREE PROTECTION SIGNAGE AND IMPLEMENT TREE PROTECTION METHODS AS SHOWN.

## POST CONSTRUCTION MANAGEMENT PRACTICE:

### OBJECTIVE:

IT IS THE OBJECTIVE OF THE FOREST CONSERVATION PLAN FOR THE CHAPEL WOODS III PROPERTY TO RETAIN ENVIRONMENTAL INTEGRITY BY PRESERVING A PORTION OF THE EXISTING FOREST ON SITE.

### MANAGEMENT PRACTICE SCHEDULE:

IT IS THE INTENT OF THE FOREST CONSERVATION PROGRAM FOR THE CHAPEL WOODS III PROPERTY TO PROTECT AREAS STATED IN THE OBJECTIVE.

### THE FOLLOWING MANAGEMENT PRACTICES ARE RECOMMENDED:



- TRAIL SYSTEMS THROUGH FORESTED AREAS ARE ACCEPTABLE IN THE FOREST CONSERVATION EASEMENT. HOWEVER, IF A TRAIL SYSTEM IS IMPLEMENTED, IT SHOULD DISTURB AS LITTLE VEGETATION AS POSSIBLE. A TRAIL SYSTEM THROUGH A REFORESTATION AREA IS NOT ACCEPTABLE UNTIL THE FOREST BECOMES ESTABLISHED AS DETERMINED BY A REGISTERED FORESTER, LANDSCAPE ARCHITECT, OR OTHER STATE QUALIFIED PROFESSIONAL.
- TREE CUTTING IS ALLOWED FOR SAFETY AND ROUTINE MAINTENANCE OF EXISTING FORESTED AREAS.
- SENSITIVE AREAS SUCH AS STEEP SLOPES, WETLANDS, STREAMS AND THEIR ASSOCIATED BUFFERS AND WILDLIFE CORRIDORS ARE CONSIDERED INACCESSIBLE FOR SELECTIVE TIMBER HARVESTING AND SHOULD BE LEFT TO CONTINUE UNDER NATURAL FOREST SUCCESSION.
- THE FOREST CONSERVATION AREAS SHOULD BE REASSESSED BY A REGISTERED FORESTER, LANDSCAPE ARCHITECT OR OTHER STATE QUALIFIED PROFESSIONAL TO DETERMINE ITS CONDITION AND MAKE RECOMMENDATIONS FOR CONTINUAL STRUCTURAL FOREST GROWTH.

### A TWO (2) YEAR POST-CONSTRUCTION AND MANAGEMENT PROGRAM TO ENSURE PROBABILITY OF A HIGH SURVIVAL RATE INCLUDES THE FOLLOWING:

- MAINTENANCE OF SIGNS, FENCES AND TREE PROTECTION DEVICES TO PREVENT UNWARRANTED INTRUSIONS AND DAMAGE.
- CAREFUL REMOVAL OF ALL TEMPORARY STRUCTURES AFTER CONSTRUCTION.
- ROUTINE INSPECTIONS OF FOREST CONSERVATION EASEMENTS.
- PROVIDE SUITABLE THINNING, WATERING AND FERTILIZING TO ENSURE PROPER GROWTH AND SURVIVAL.
- CERTIFICATION THAT THE REQUIRED SURVIVAL RATES HAVE BEEN MET.

# TREE PROTECTION FOREST RETENTION & REFORESTATION SIGN DETAIL

N.T.S.

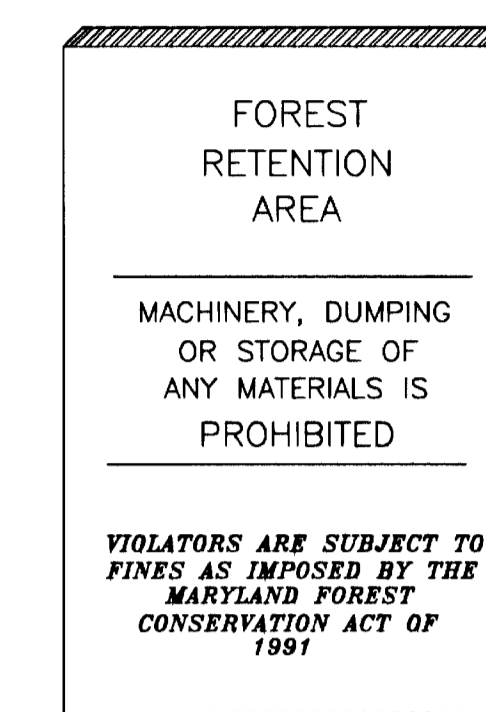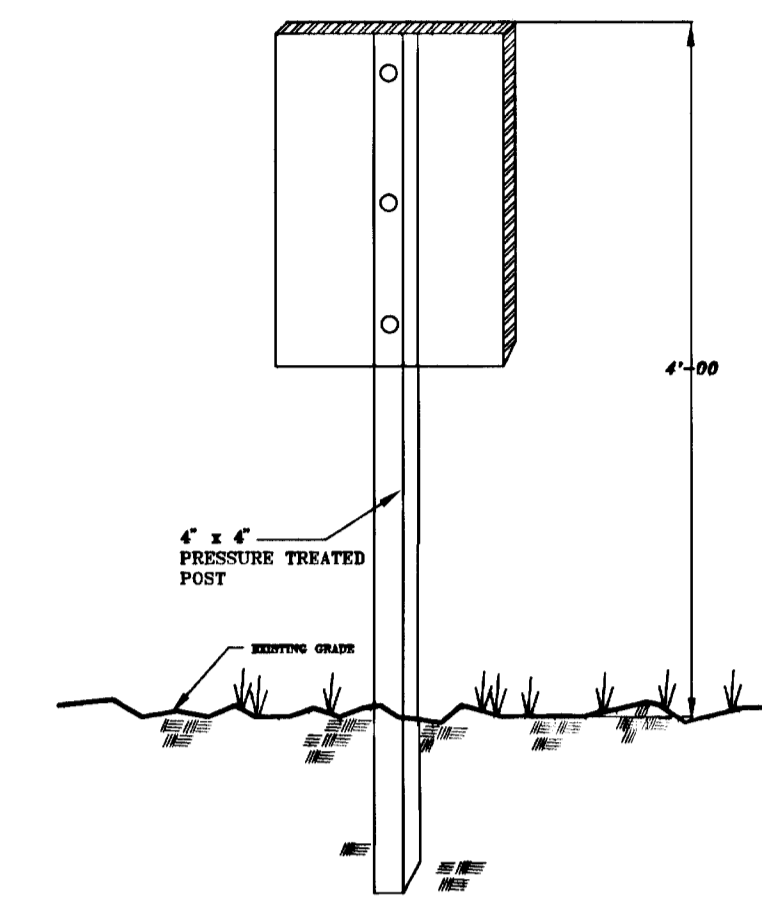


S

APPROVED: HOWARD COUNTY DEPARTMENT OF PLANNING AND ZONING.

*Gina Summons* 2/15/96  
 CHIEF, DIVISION OF LAND DEVELOPMENT AND RESEARCH DATE


*Robert Summers* 2/15/96  
 CHIEF, DEVELOPMENT ENGINEERING DIVISION DATE

## CRITICAL ROOT ZONE

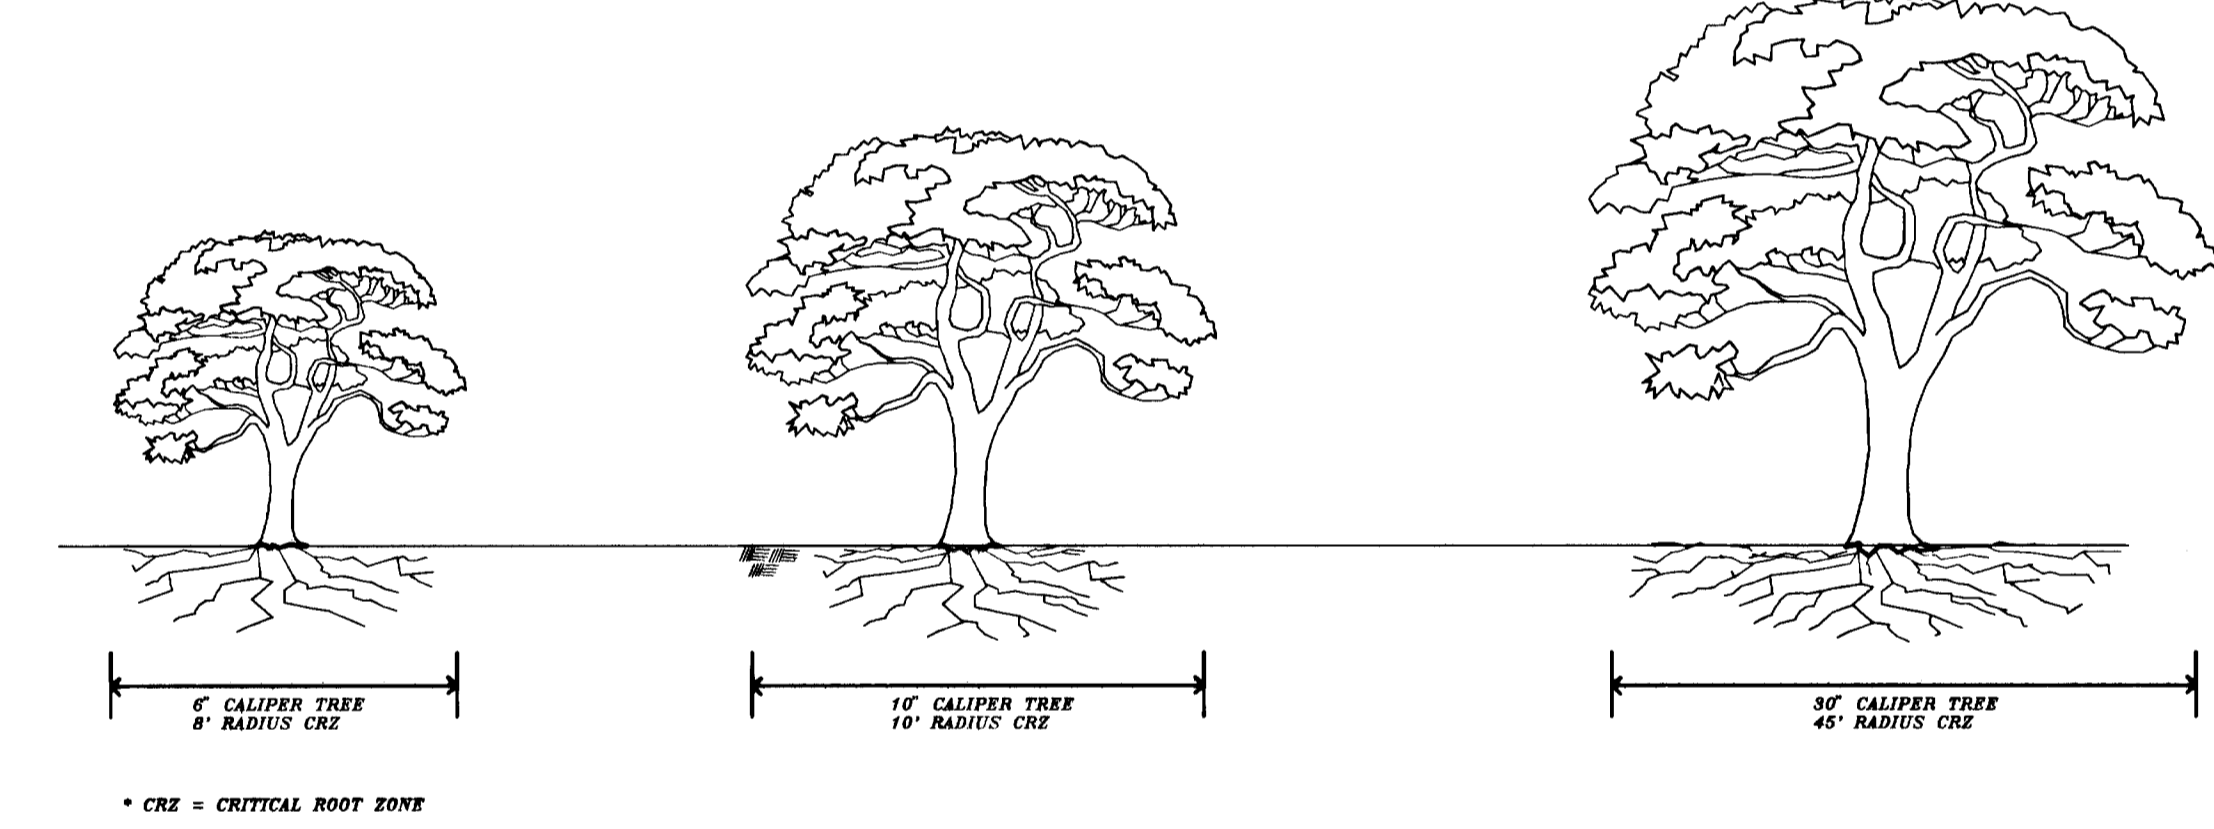


## PROTECTIVE TREE FENCING

N.T.S.

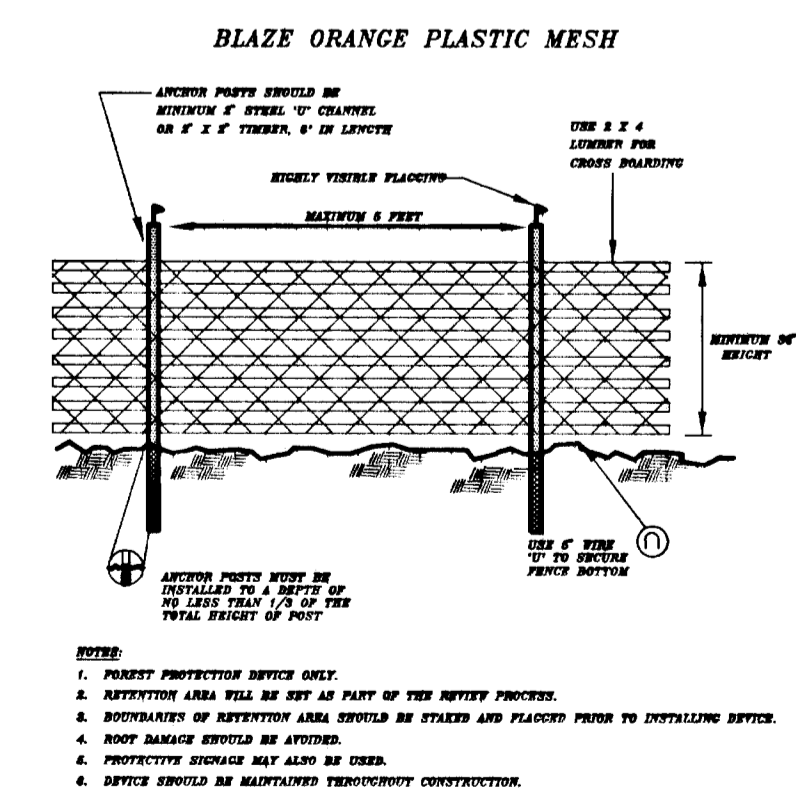

## CONSTRUCTION ACTIVITIES: POTENTIAL IMPACT TO TREES

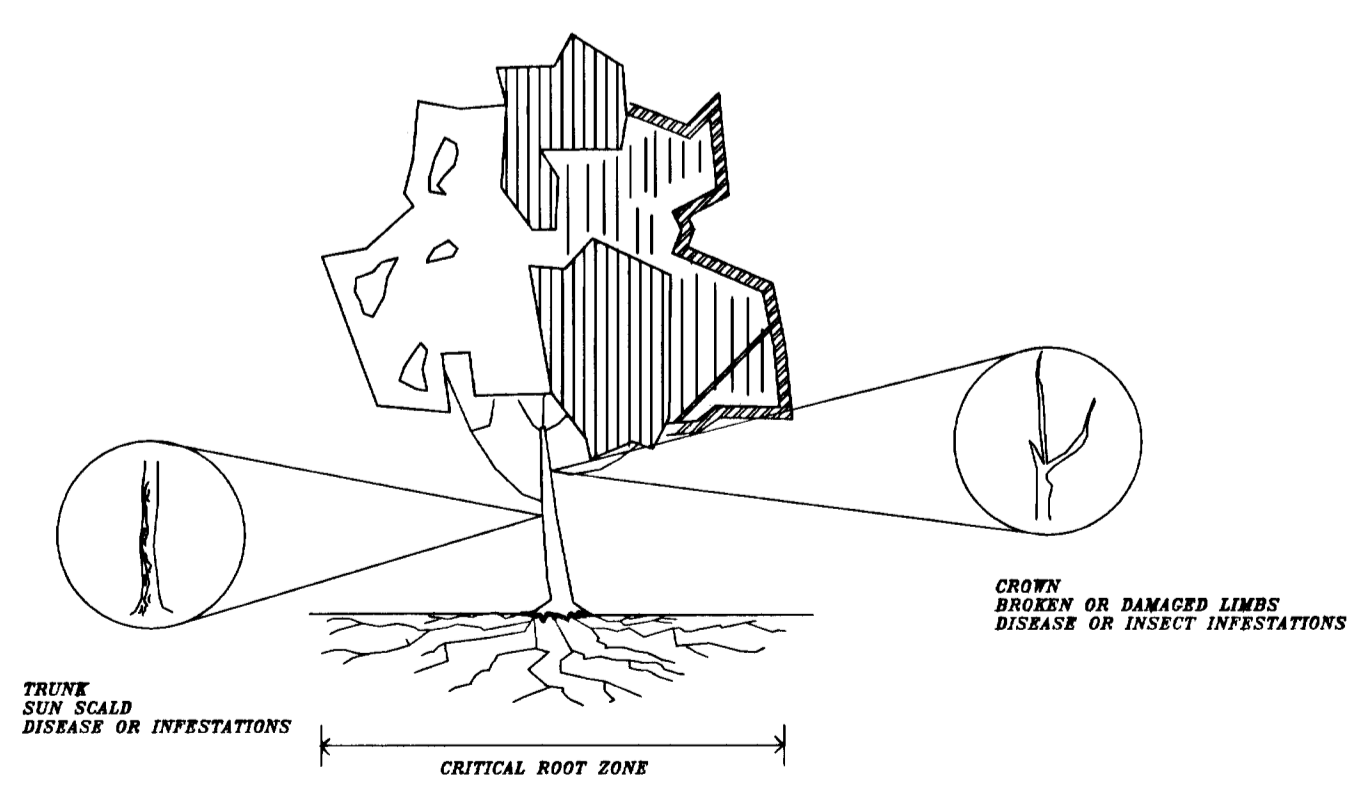

DATE NO.	REVISION
OWNER	DEVELOPER
PROJECT	ERIC MILOLASKO C/O JJM, INC. 5570 STERRETT PLACE COLUMBIA, MARYLAND 21046
AREA	CHAPEL WOODS III LOTS 28-28 A RESUBDIVISION OF LOTS 7 AND 8
TITLE	TAX MAP NO. 29 PARCEL 86 ZONED R-12 5TH ELECTION DISTRICT HOWARD COUNTY, MD FOREST CONSERVATION DETAILS
DESIGNED BY :	CK
DRAWN BY :	CK
PROJECT NO :	20010
DATE :	JANUARY 17, 1996
SCALE :	AS SHOWN
DRAWING NO. :	7 OF 7

RIEMER MUEGGE & ASSOCIATES, INC.  
 ENGINEERING • ENVIRONMENTAL SERVICES • PLANNING • SURVEYING  
 8818 Centre Park Drive • Suite 200 • Columbia, MD 21045  
 410-997-8900 FAX : 410-997-9282

1-17-96  
 DATE

*Robert Summers*  
 COMR 08.19.06.01  
 DOUGLAS R. KOPECK