

SHEET INDEX	
SHEET No.	SHEET
1	TITLE SHEET
2	HOLLAND COURT-PLAN & PROFILES
3	NORWAY COURT & OSLO COURT PLAN & PROFILE
4	STREET TREE, GRADING & SEDIMENT CONTROL PLAN
5	DRAINAGE AREA & LANDSCAPE PLAN
6 & 7	STORM DRAIN PROFILES
8	STORMWATER MANAGEMENT PLAN & DETAILS
9	SEDIMENT CONTROL NOTES & DETAILS

FINAL ROAD CONSTRUCTION, STORM DRAINAGE AND STORMWATER MANAGEMENT PLANS

FOR
LOTS 1 THRU 36

CEDAR ACRES


A RESUBDIVISION OF LOTS 3, 4 AND 5
HOWARD COUNTY, MARYLAND
ZONED R-SC

APPROVED: DEPARTMENT OF PLANNING AND ZONING	
<i>Cindy Hamilton</i> CHIEF, DIVISION OF LAND DEVELOPMENT TC	7/2/97 DATE
<i>Michael J. ...</i> CHIEF, DEVELOPMENT ENGINEERING DIVISION	9/2/97 DATE
APPROVED: DEPARTMENT OF PUBLIC WORKS	
<i>Richard M. Jancke</i> CHIEF, BUREAU OF HIGHWAYS HS	8-26-97 DATE

SCHEDULE D STORMWATER MANAGEMENT AREA LANDSCAPING	
LINEAR FEET OF PERIMETER	1128
NUMBER OF TREES REQUIRED:	
SHADE TREES	19
EVERGREEN TREES	24
CREDIT FOR EXISTING VEGETATION (NO, YES AND #)	YES 160
CREDIT FOR OTHER LANDSCAPING (NO, YES AND #)	NO
NUMBER OF TREES PROVIDED:	
SHADE TREES	19
EVERGREEN TREES	24
OTHER TREES (2:1 SUBSTITUTION)	---

ROAD CLASSIFICATION CHART		
ROAD	CLASSIFICATION	R/W WIDTH
HOLLAND COURT	LOCAL ROAD	50'
NORWAY COURT	LOCAL ROAD	50'
OSLO COURT	LOCAL ROAD	50'

TRAFFIC CONTROL SIGNS				
STREET NAME	STATION	OFFSET	POSTED SIGN	SIGN CODE
HOLLAND COURT	0+60	15'L	STOP	RI-1
NORWAY COURT	0+40	15'L	STOP	RI-1
OSLO COURT	0+40	15'L	STOP	RI-1

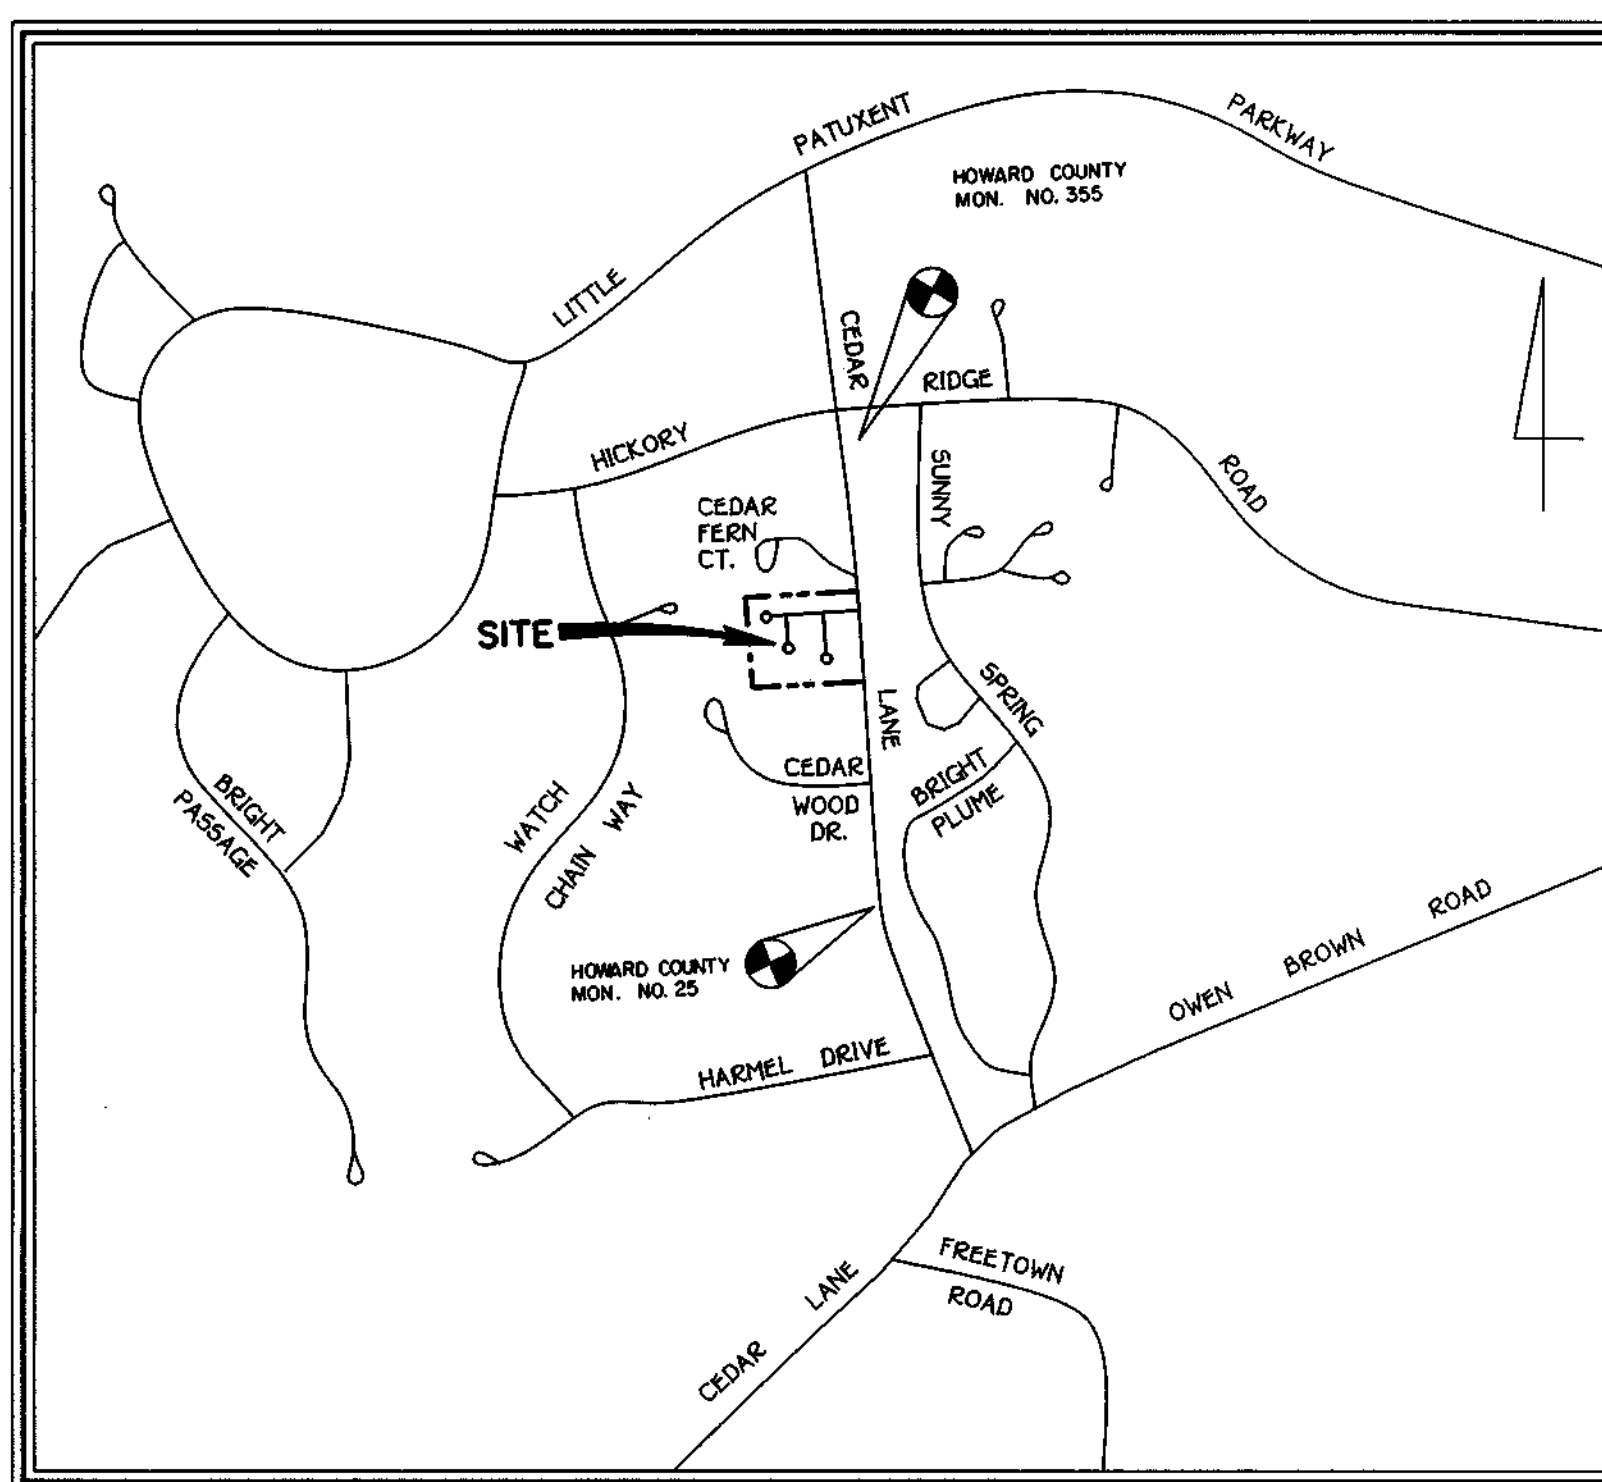

VICINITY MAP
SCALE: 1"=1200'

GENERAL NOTES

- UNLESS OTHERWISE NOTED, ALL CONSTRUCTION IS TO BE IN ACCORDANCE WITH THE FOLLOWING:
 - HOWARD COUNTY STANDARD SPECIFICATION AND DETAILS FOR CONSTRUCTION VOLUME IV.
 - MARYLAND STATE HIGHWAY ADMINISTRATION STANDARD SPECIFICATIONS FOR CONSTRUCTION AND MATERIALS, AS AMENDED.
 - SOIL CONSERVATION SERVICE 1983 MARYLAND STANDARD AND SPECIFICATIONS FOR SOIL EROSION AND SEDIMENT CONTROL.
 - SOIL CONSERVATION SERVICE 1993 MARYLAND STANDARDS AND SPECIFICATION FOR POND CONSTRUCTION (CODE 378)
 - EXISTING UTILITIES ARE BASED ON FIELD RUN TOPOGRAPHY.
- THE CONTRACTOR SHALL NOTIFY THE DEPARTMENT OF PUBLIC WORKS, DIVISION OF CONSTRUCTION INSPECTION AT 410-313-1000 AT LEAST (5) WORKING DAYS PRIOR TO THE START OF CONSTRUCTION.
- THE CONTRACTOR SHALL NOTIFY "MISS UTILITY" AT 1-800-257-7777 AT LEAST 48 HOURS PRIOR TO ANY EXCAVATION.
- SITE DATA:

LOCATION: TAX MAP-35	PARCEL NO.-38	ZONING-R-SC
ELECTION DISTRICT NO.-5	TOTAL TRACT AREA-0.54 AC.	
TOTAL NO. OF SINGLE FAMILY LOTS-33		
- TRAFFIC CONTROL DEVICES, MARKINGS, AND SIGNING SHALL BE IN ACCORDANCE WITH THE LATEST EDITION OF THE MANUAL ON UNIFORM TRAFFIC DEVICES (MUTCD). ALL STREET AND REGULATORY SIGNS SHALL BE IN PLACE PRIOR TO THE PLACEMENT OF ASPHALT.
- THIS HORIZONTAL AND VERTICAL DATUM SHOWN ARE BASED ON THE FOLLOWING NAD'83 HOWARD COUNTY CONTROL STATIONS:

HOWARD COUNTY MONUMENT 25	N 592255.3513	ELEV. = 411.069
	E 1344803.9511	
HOWARD COUNTY MONUMENT 355	N 552140.4423	ELEV. = 452.339
	E 1344954.5028	
- TOPOGRAPHIC SURVEY BY FISHER, COLLINS AND CARTER INC., APRIL, 1996, 2 FOOT CONTOUR INTERVAL.
- WATER AND SEWER SYSTEMS ARE PUBLIC AND THEY ARE LOCATED IN THE PATAPSCO DRAINAGE AREA.
- STORMWATER MANAGEMENT IS PROVIDED VIA A DETENTION POND AND EXTENDED DETENTION FOR WATER QUALITY. IT IS A PUBLIC FACILITY TO BE MAINTAINED BY HOME OWNERS ASSOCIATION.
- WETLANDS AND FOREST STAND DELINEATIONS BY ECO-SCIENCE PROFESSIONALS, INC. COMPILED ON 3/8/1996.
- TRAFFIC STUDY WAS PREPARED BY TRAFFIC GROUP AND APPROVED ON APRIL 8, 1996.
- NOISE STUDY BY THE WILSON T. BALLARD CO. ON APRIL 18, 1996.
- GEOTECHNICAL REPORT PREPARED BY I.T.E. INC. ON APRIL 12, 1996.
- EXISTING UTILITIES WERE LOCATED BY ACTUAL FIELD MEASUREMENT WHERE POSSIBLE SUPPLEMENT BY INFORMATION OBTAINED FROM THE VARIOUS AGENCIES INVOLVED. WE CANNOT GUARANTEE THE ACCURACY OR THE COMPLETENESS OF THE INFORMATION RECEIVED. THE CONTRACTOR MUST VERIFY ALL SUCH INFORMATION TO THEIR OWN SATISFACTION PRIOR TO THE START OF THE CONSTRUCTION.
- ANY MATERIAL OR EARTHWORK QUANTITIES SHOWN HEREON ARE PROVIDED FOR THE APPROVING AUTHORITIES USE ONLY.
- PREVIOUS FILE NUMBERS-S-96-14 AND P-96-23.
- STREET LIGHT PLACEMENT AND THE TYPE OF FIXTURE AND POLE SELECTED SHALL BE IN ACCORDANCE WITH THE LATEST HOWARD COUNTY DESIGN MANUAL, VOLUME III (1993) AND AS MODIFIED BY "GUIDELINES FOR STREET LIGHTS IN RESIDENTIAL DEVELOPMENTS JUNE 1993." A MINIMUM SPACING OF 20' SHALL BE MAINTAINED BETWEEN ANY STREET LIGHT AND ANY TREE.

STREET LIGHT CHART				
DWG. No.	STREET NAME	STATION	OFF-SET	FIXTURE/POLE TYPE
2	HOLLAND COURT	0+38	26'R	150-WATT HPS VAPOR PENDANT FIXTURE (CUT-OFF) MOUNTED ON A 30 FOOT BRONZE FIBERGLASS POLE USING A 12' ARM
2	HOLLAND COURT	3+60 5+78	19'R 21'L	100-WATT "TRADITIONAIRE" HP.5.VAPOR FIXTURE POST TOP FIXTURE MOUNTED ON A 14-FOOT BLACK FIBERGLASS POLE.
3	NORWAY COURT	L.P. STA. 1+58	3'	100-WATT "TRADITIONAIRE" HP.5.VAPOR FIXTURE POST TOP FIXTURE MOUNTED ON A 14-FOOT BLACK FIBERGLASS POLE.
3	OSLO COURT	L.P. STA. 1+65	3'	100-WATT "TRADITIONAIRE" HP.5.VAPOR FIXTURE POST TOP FIXTURE MOUNTED ON A 14-FOOT BLACK FIBERGLASS POLE.

SCHEDULE A PERIMETER LANDSCAPE EDGE									
PERIMETER	P-1	P-2	P-3	P-4	P-5	P-6	P-7	P-8	P-9
CATEGORY	Adjacent to Roadway	Adjacent to Perimeter Properties	Adjacent to Perimeter Properties	Adjacent to Perimeter Properties	Adjacent to Roadway	SIDE YARD	SIDE YARD	SIDE YARD	SIDE YARD
LANDSCAPE TYPE	B	A	A	A	B	B	B	B	B
LINEAR FEET OF PERIMETER	64.6'	652.7'	572.6'	655'	403'	39'	60'	60'	67'
CREDIT FOR EXISTING VEGETATION (YES, NO, LINEAR FEET) (DESCRIBE BELOW IF NEEDED)	NO	NO	NO	NO	YES 10'	NO	NO	NO	NO
CREDIT FOR WALL, FENCE OR BERM (YES, NO, LINEAR FEET) (DESCRIBE IF NEEDED)	NO	NO	NO	NO	NO	NO	NO	NO	NO
NUMBER OF PLANTS REQUIRED									
SHADE TREES	1	10	10	10	8	1	1	1	1
EVERGREEN TREES	2	-	-	-	10	-	-	-	-
SHRUBS	-	-	-	-	-	-	-	-	-

FISHER, COLLINS & CARTER, INC.
CIVIL ENGINEERING CONSULTANTS & LAND SURVEYORS
CONTINENTAL SQUARE OFFICE PARK - 10272 BALTIMORE NATIONAL PIKE
ELICOTT CITY, MARYLAND 21042
(410) 461-2855


OWNER
DENABY L. BASLER
AND
ELISE MAC BASLER
17729 MARYLAND ROUTE 99
WOODSTOCK, MD. 21783

DEVELOPER
CHARNORTH TRUST INC.
P.O. BOX 5446
ALEXANDRIA, VIRGINIA 22304-0446




Jayesh V. Panchohi
JAYESH V. PANCHOLHI
4-24-97
DATE

TITLE SHEET
LOTS 1 THRU 36
CEDAR ACRES
A RESUBDIVISION OF LOTS 3, 4 AND 5
ZONING: RSC
TAX MAP No. 35 PARCEL 38
FIFTH ELECTION DISTRICT
HOWARD COUNTY, MARYLAND
DATE: APRIL 22, 1997
SHEET 1 OF 9

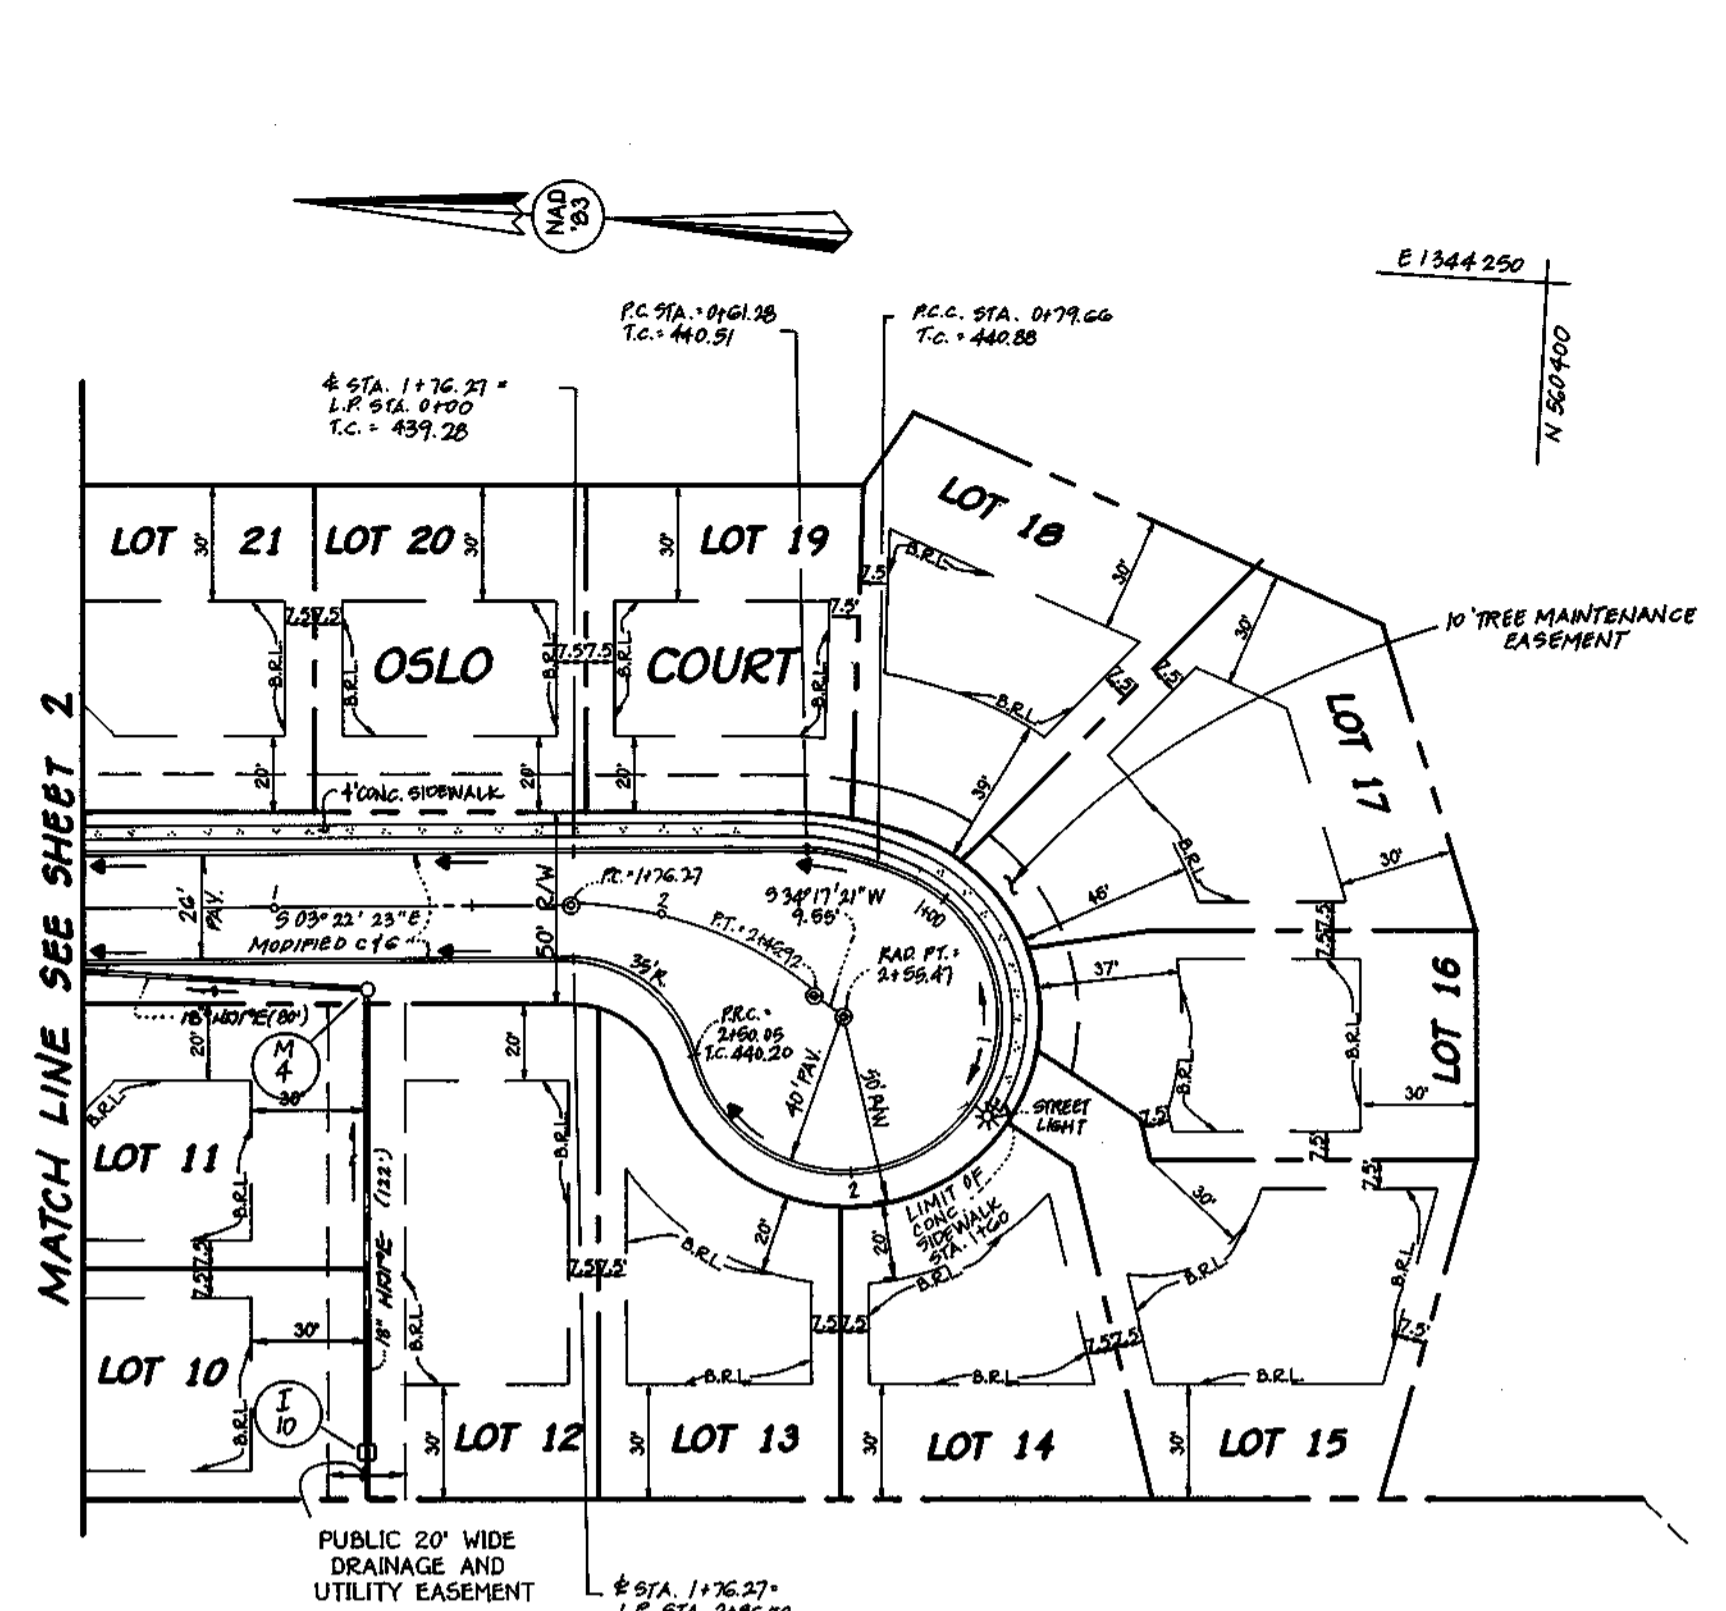

@ CURVE DATA
OSLO COURT
 STA. 1+76.27 TO STA. 2+45.92
 R=106.57
 L=69.65'
 Δ=37°39'44"
 T=36.28'
 CHD= 5 15°27'29"W, 68.67'

PLAN
 SCALE: 1"=50'

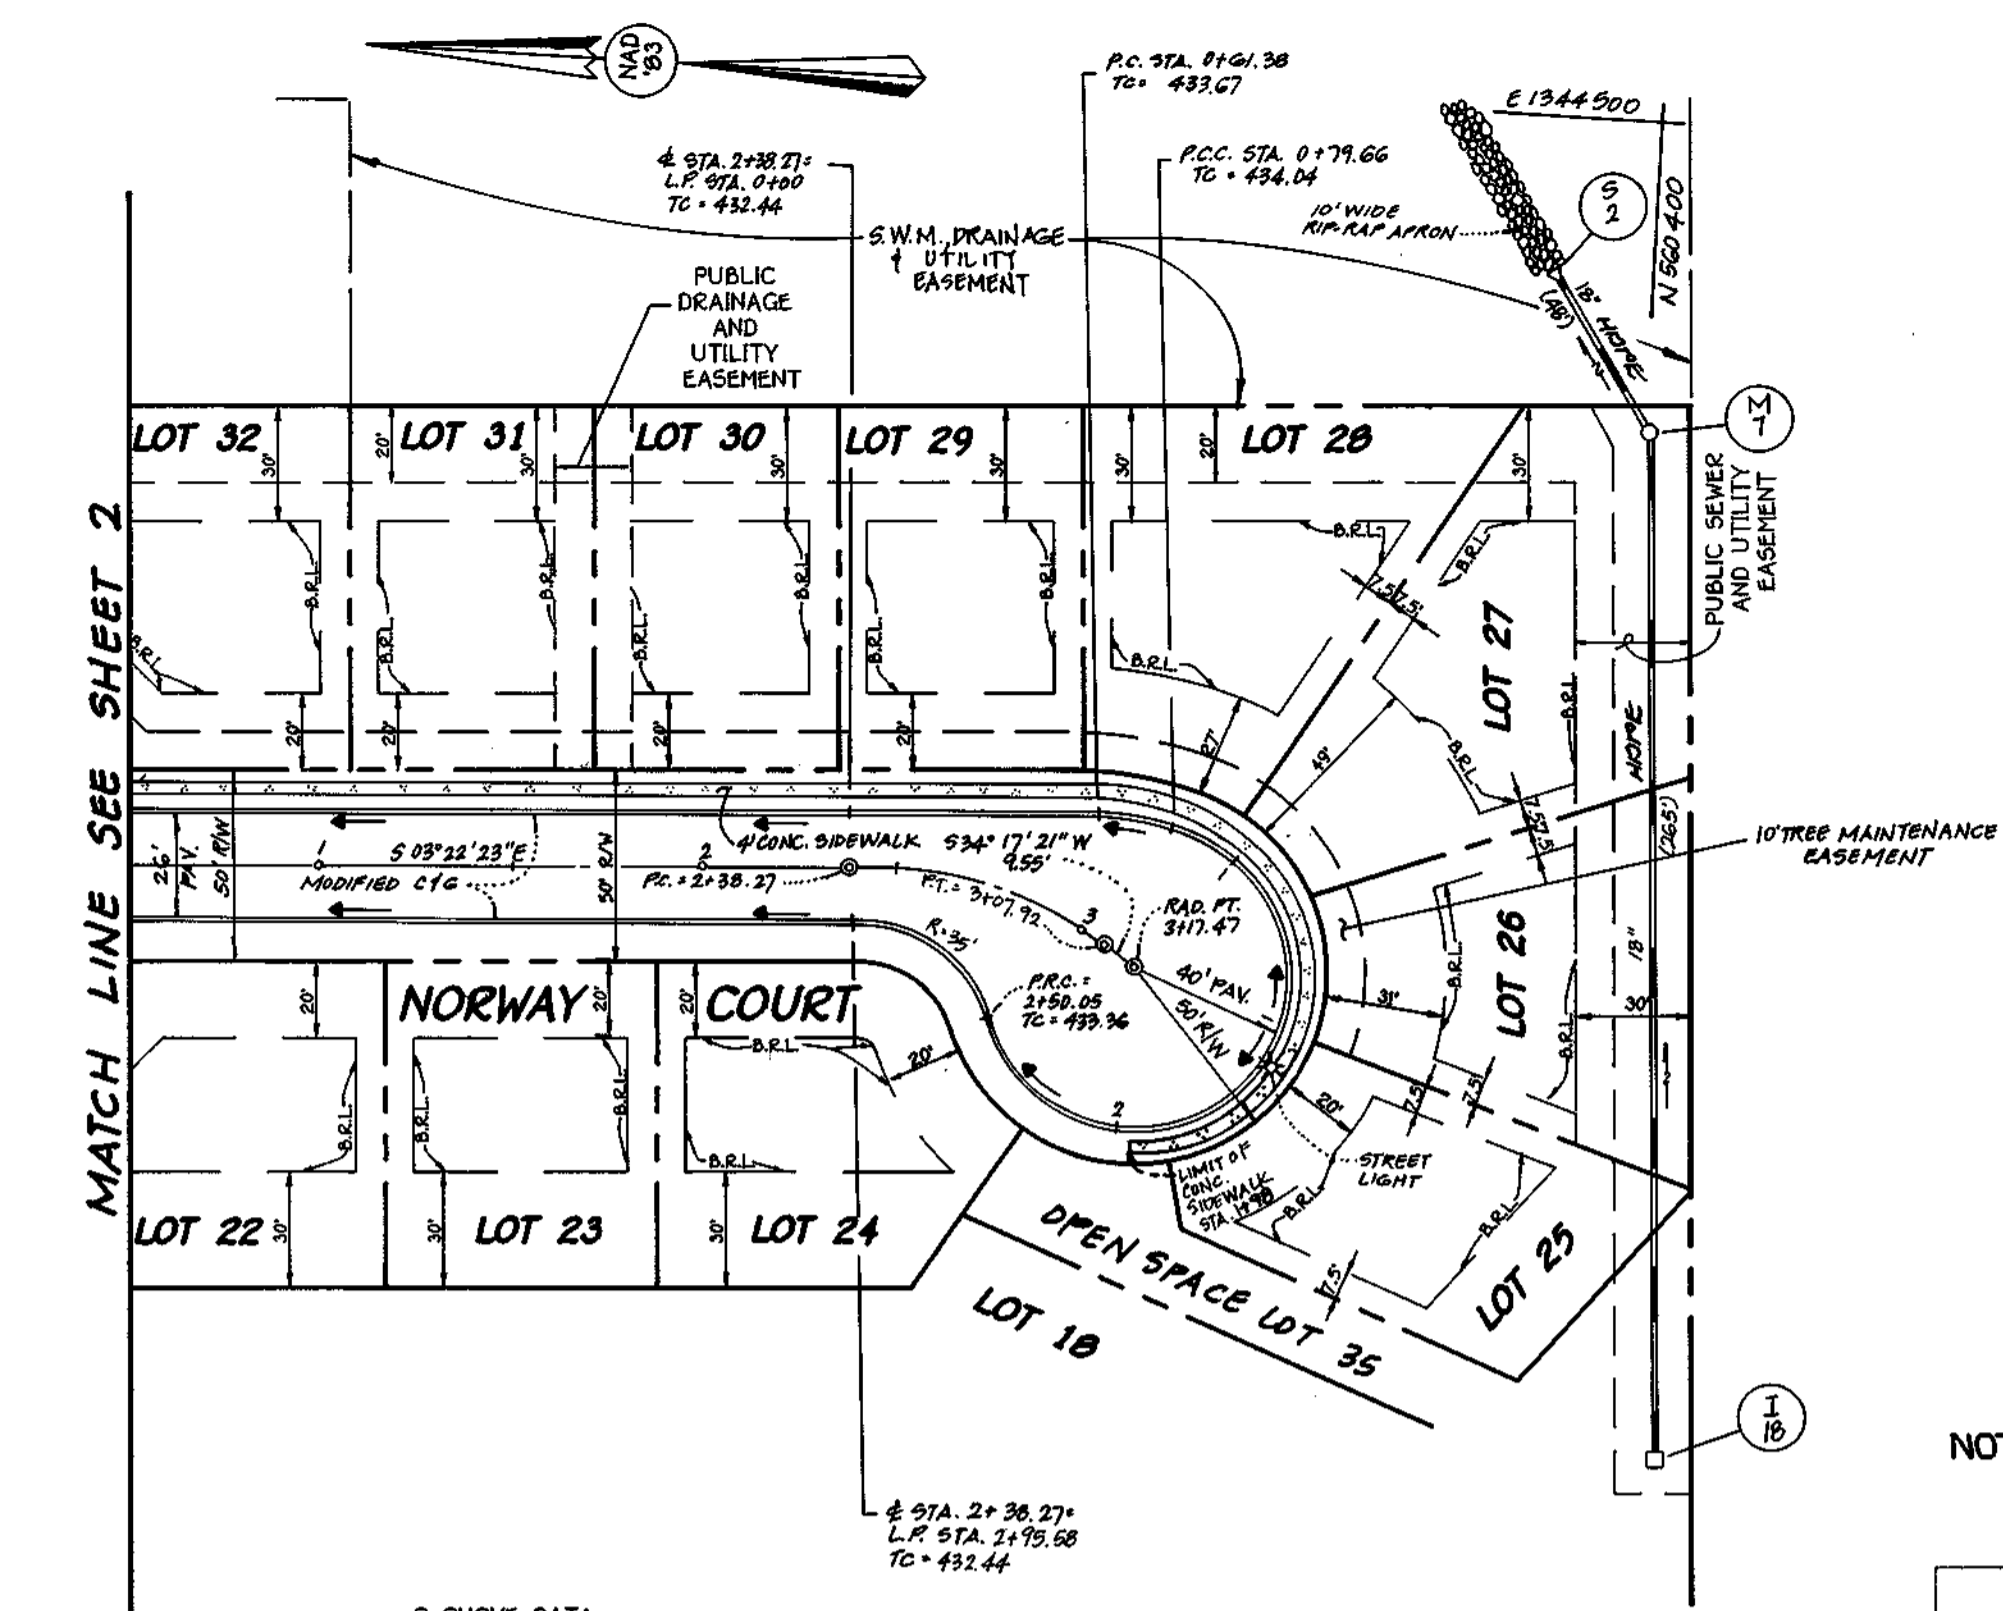

@ CURVE DATA
NORWAY COURT
 STA. 2+38.27 TO STA. 3+07.92
 R=106.37'
 L=69.65'
 Δ=37°39'44"
 T=36.28'
 CHD= 5 15°27'29"W, 68.67'

PLAN
 SCALE: 1"=50'

NOTE: THIS SHEET SUPERSEDES THE PREVIOUSLY
 SIGNED ORIGINAL DRAWING

APPROVED: DEPARTMENT OF PLANNING AND ZONING
Candy Hamilton 7/23/98
 CHIEF, DIVISION OF LAND DEVELOPMENT
 DATE

APPROVED: DEPARTMENT OF PLANNING AND ZONING
William J. ... 7/23/98
 CHIEF, DEVELOPMENT ENGINEERING DIVISION
 DATE

APPROVED: HOWARD COUNTY DEPARTMENT OF PUBLIC WORKS
Andrew M. ... 7-17-98
 CHIEF, BUREAU OF HIGHWAYS
 DATE

CEDAR ACRES
 LOTS 1-36
 A RESUBDIVISION OF LOTS 3, 4 & 5
 FIFTH ELECTION DISTRICT HOWARD COUNTY, MARYLAND


OSLO COURT & NORWAY COURT
 PLAN AND PROFILE


OWNER AND DEVELOPER
 BENJAMIN K. BASSLER AND
 ELSE MAE BASSLER
 10735 ROUTE 99
 WOODSTOCK, MARYLAND 21163

DEVELOPER
 CHADSWORTH HOMES, INC.
 P.O. BOX 6641
 McLEAN, VIRGINIA 22106-6641

SCALE: AS SHOWN DATE: JAN. 1998 DWG. NO. 3 OF 9
 DES. JAYESH PANCHOL DRN. J.A.U. CHK. A.M.V.

FISHER, COLLINS & CARTER, INC.
 CIVIL ENGINEERING CONSULTANTS & LAND SURVEYORS
 CENTRAL SQUARE OFFICE PARK - 10772 DALTHOUSE NATIONAL PIKE
 ELICOTT CITY, MARYLAND 21042
 (410) 461-2900

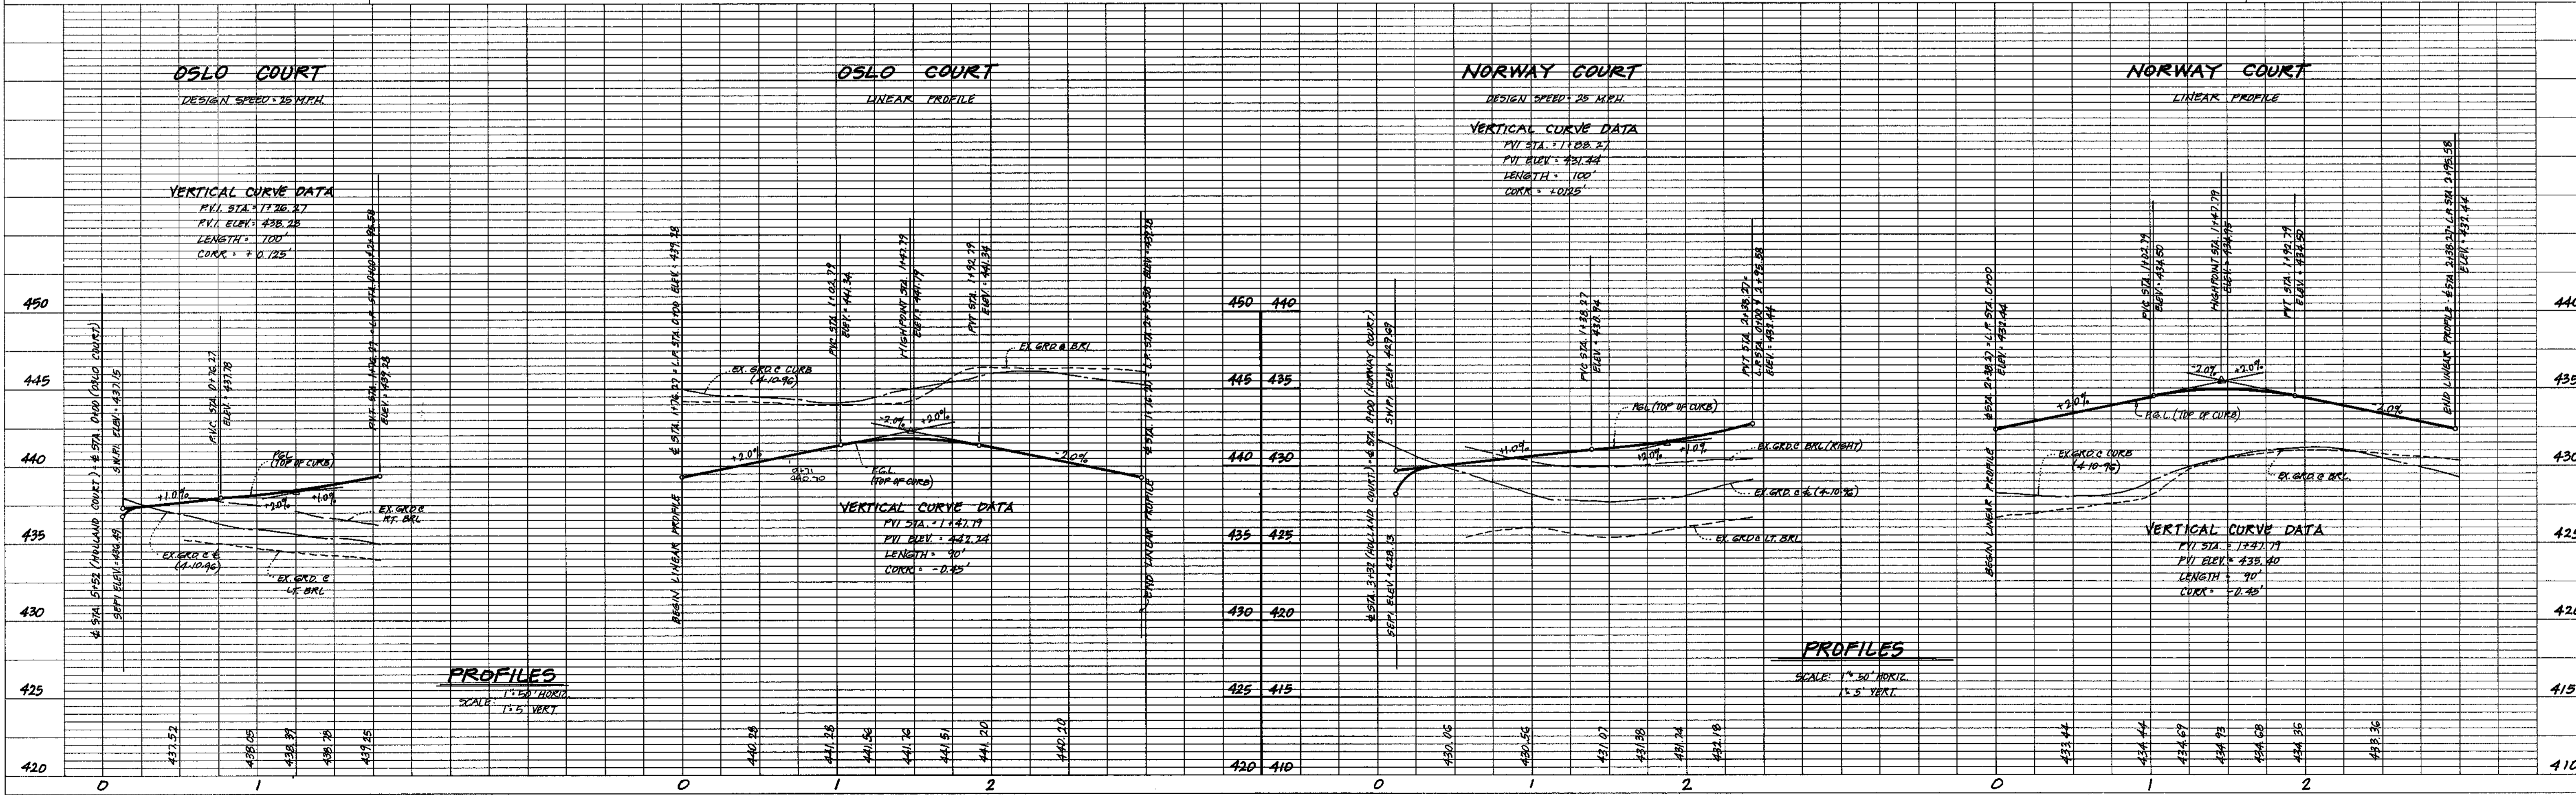

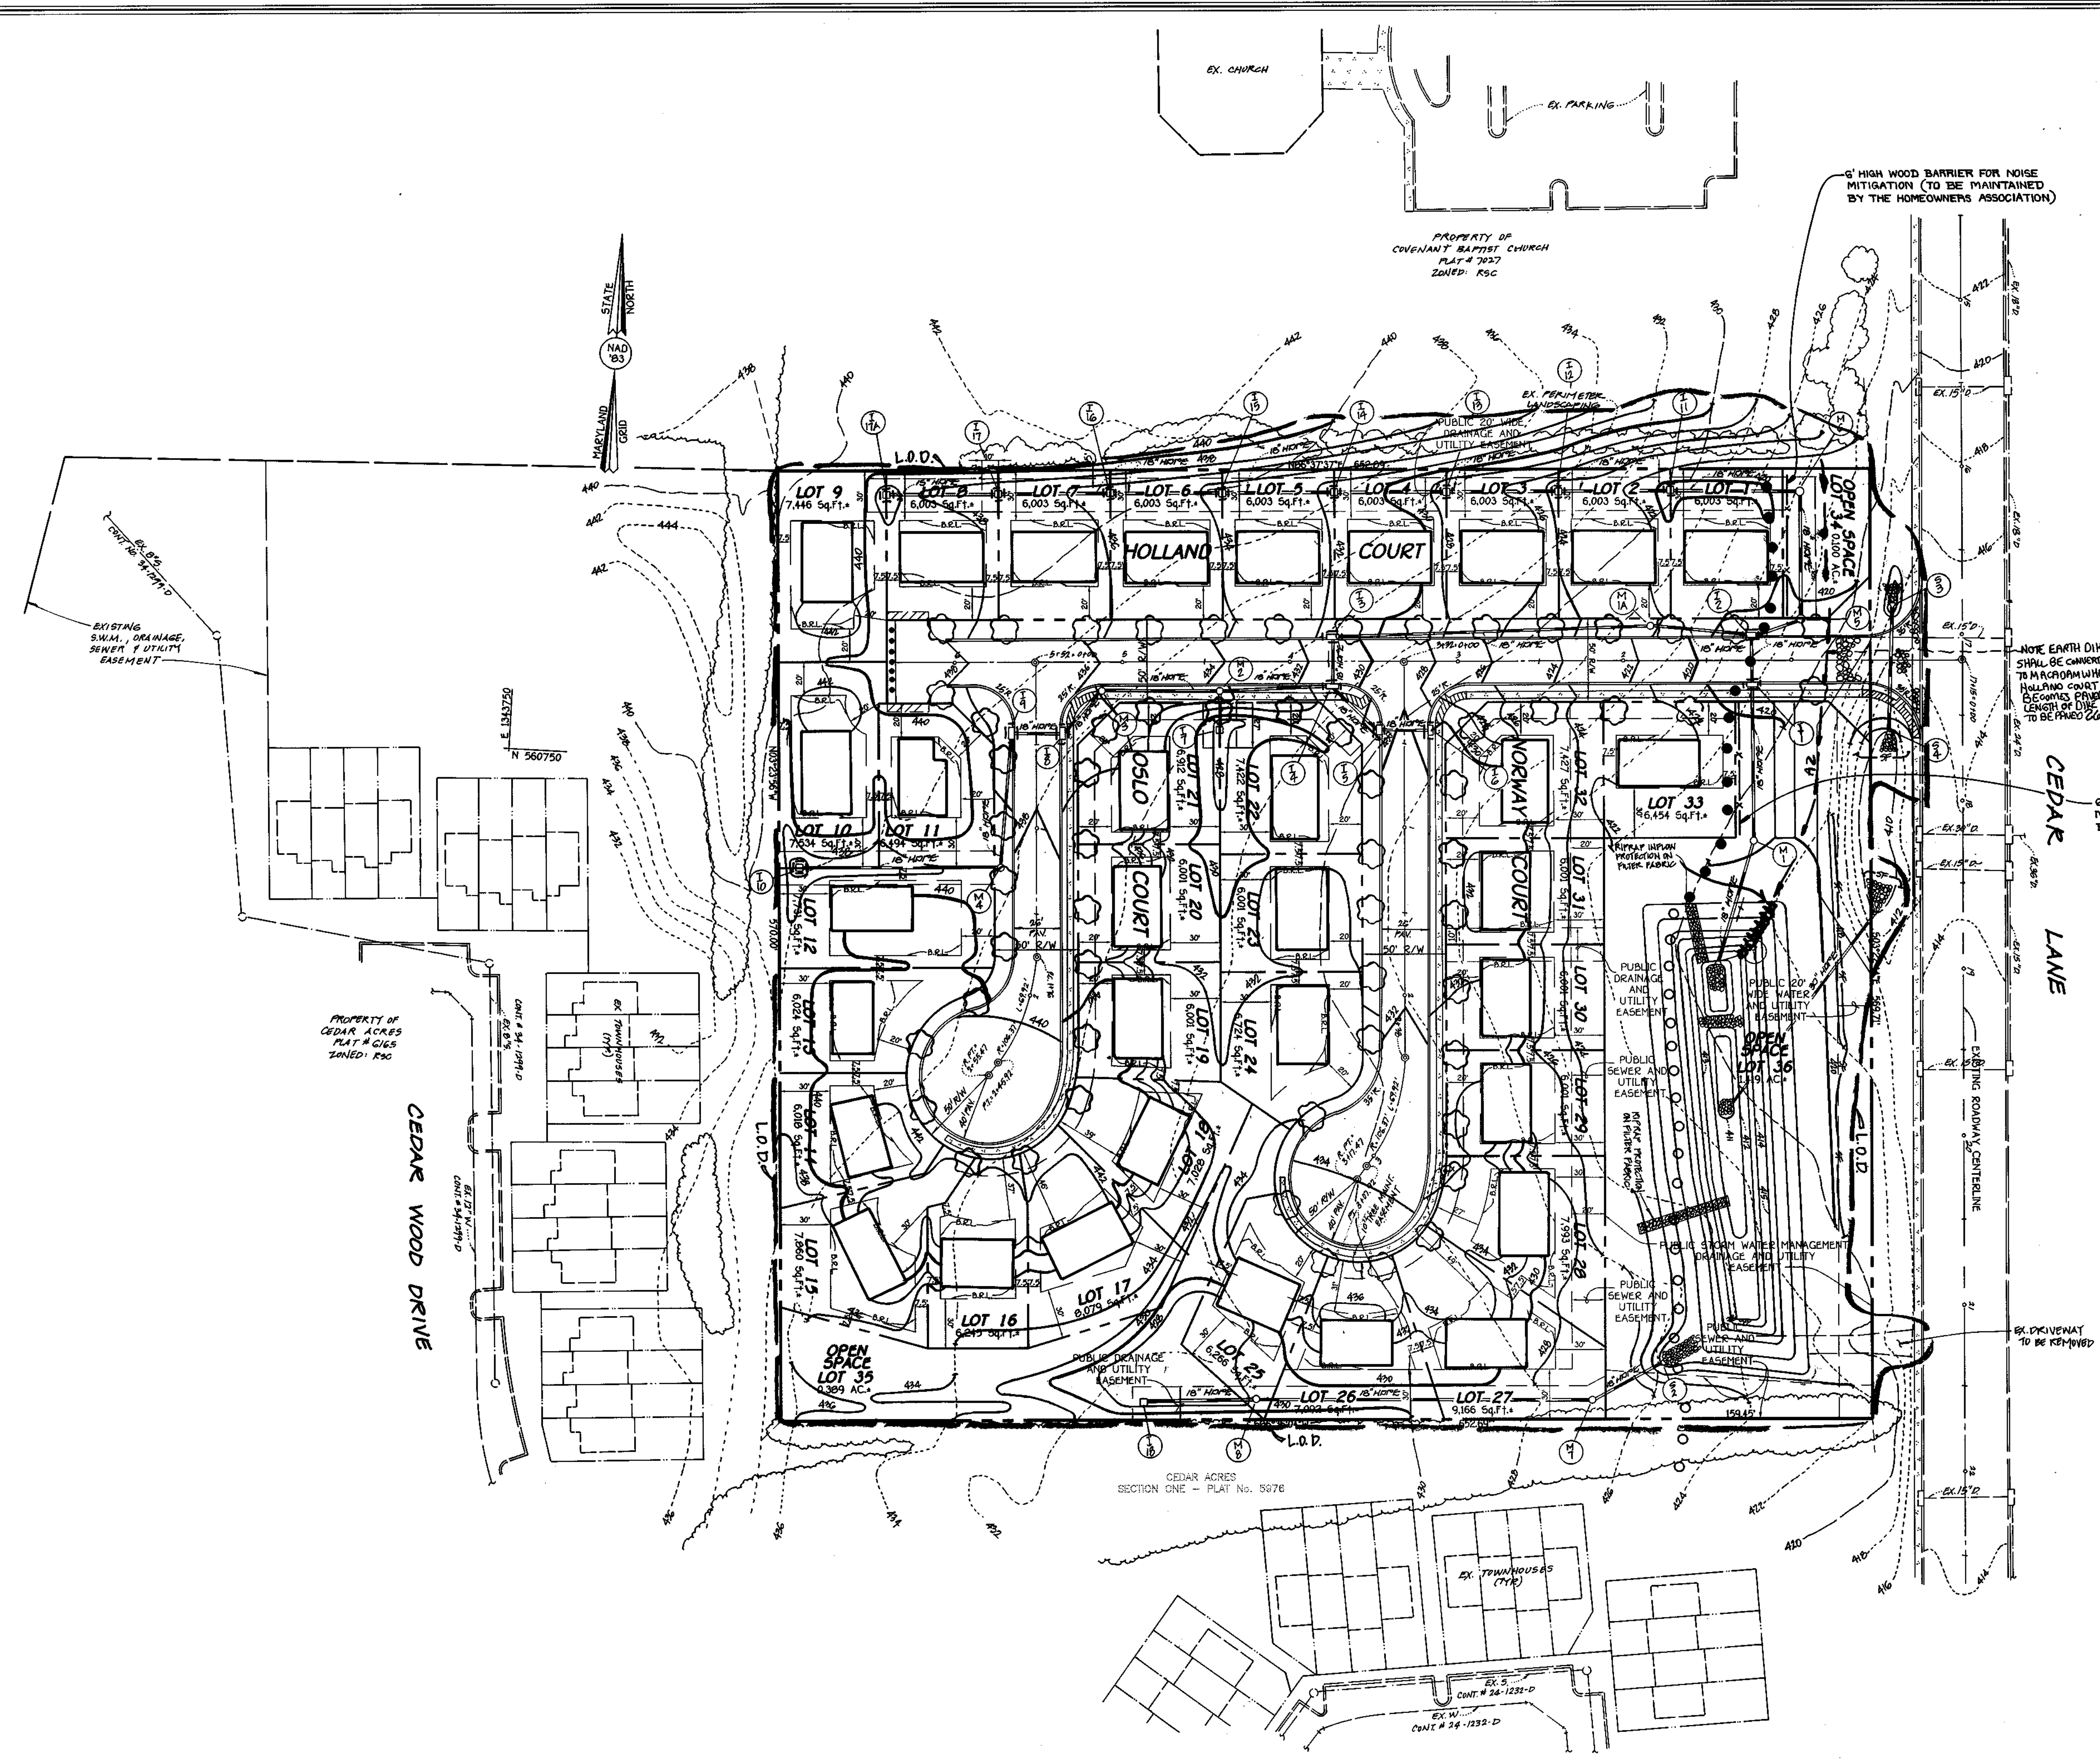

By The Developer:
 I/We Certify That All Development And/Or Construction Will Be Done According To These Plans. And That Any Responsible Personnel Involved In The Construction Project Will Have A Certificate Of Attendance At A Department Of The Environment Approved Training Program For The Control Of Sediment And Erosion Before Beginning The Project. I Shall Engage A Registered Professional Engineer To Supervise Pond Construction And Provide The Howard Soil Conservation District With An "As-Built" Plan Of The Pond Within 30 Days Of Completion. I Also Authorize Periodic On-Site Inspections By The Howard Soil Conservation District.

Signature Of Developer: Altera Homes Date: 6/21/99
 Printed Name Of Developer: Altera Homes

By The Engineer:
 I Certify That This Plan For Pond Construction, Erosion And Sediment Control Represents A Practical And Workable Plan Based On My Personal Knowledge Of The Site Conditions. This Plan Was Prepared In Accordance With The Requirements Of The Howard Soil Conservation District. I Have Notified The Developer That He/She Must Engage A Registered Professional Engineer To Supervise Pond Construction And Provide The Howard Soil Conservation District With An "As-Built" Plan Of The Pond Within 30 Days Of Completion.

Signature Of Engineer: Charles J. Coates Jr. Date: 3/22/99
 Printed Name Of Engineer: Charles J. Coates Jr.

These Plans Have Been Reviewed For The Howard Soil Conservation District And Meet The Technical Requirements For Small Pond Construction, Soil Erosion And Sediment Control.

Signature: Cheryl Simmons Date: 2/14/99
 Printed Name: Cheryl Simmons
 Title: USDA-Natural Resources Conservation Service

These Plans For Small Pond Construction, Soil Erosion And Sediment Control Meet The Requirements Of The Howard Soil Conservation District.

Signature: John R. Rebutson Date: 2/14/99
 Printed Name: John R. Rebutson
 Title: Howard Soil Conservation District

Approved: Department Of Public Works
 Signature: Richard M. Jewels Date: 7-17-98
 Printed Name: Richard M. Jewels
 Title: Chief, Bureau Of Highways

Approved: Department Of Planning And Zoning
 Signature: Cathy Hamilton Date: 7/23/98
 Printed Name: Cathy Hamilton
 Title: Chief, Division Of Land Development

Signature: David Williams Date: 7/22/98
 Printed Name: David Williams
 Title: Chief, Development Engineering Division

6' HIGH WOOD BARRIER FOR NOISE MITIGATION (TO BE MAINTAINED BY THE HOMEOWNERS ASSOCIATION)

NOTE: EARTH DIKE SHALL BE CONCRETE TO MATCH ADJACENT HOLLAND COURT (SEE PLAN) LENGTH OF DIKE TO BE PHASE 2C

Symbol	Description
---	Existing Contour 2' Interval
---	Existing Contour 10' Interval
---	Proposed Contour 2' Interval
---	Proposed Contour 10' Interval
—SF—SF—	5ft Fence
○ ○ ○ ○ ○	Unmitigated 65 dBA Noise Line
● ● ● ● ●	Mitigated 65 dBA Noise Line
---	Earth Dike
-X-X-	Tree Protection
---	Existing Tree Line
L.O.D.	Limit Of Disturbance
(T)	Existing Street Tree
---	Stabilized Construction Entrance

STREET TREE SCHEDULE

SYMBOL	BOTANICAL AND COMMON NAME	SIZE	COMMENTS
(T)	ACER RUBRUM OCTOBER GLORY/	2-1/2"-3"	40' APART ON PUBLIC R/W
(T)	RED MAPLE		

NOTE: STREET TREES ARE ONLY A RECOMMENDATION. THIS MAY BE REVISED TO A COUNTY ACCEPTABLE EQUIVALENT. A MINIMUM SPACING OF 20' SHALL BE MAINTAINED BETWEEN TREE AND STREET LIGHT.

TOTAL NUMBER OF STREET TREES

(T) 50 STREET TREES

NOTE: THIS SHEET SUPERSEDES THE PREVIOUSLY SIGNED ORIGINAL DRAWING

STATE OF MARYLAND
 PROFESSIONAL ENGINEER

STREET TREE, GRADING & SEDIMENT CONTROL PLAN
 CEDAR ACRES LOTS 1 THRU 36

(A RESUBDIVISION OF LOTS 3, 4, AND 5, BLOCK 'A' AS SHOWN ON A PLAT ENTITLED "CEDAR ACRES" AND RECORDED IN PLAT BOOK 4 AT FOLIO 11)

ZONED: RSC
 TAX MAP No. 35 PARCEL No. 38 GRID No. 11
 FIFTH ELECTION DISTRICT
 HOWARD COUNTY, MARYLAND
 SCALE: 1"=50' DATE: AUGUST 22, 1997

OWNER: BENJAMIN E. BASSLER AND ELSIE MAE BASSLER, 10739 ROUTE 99, WOODSTOCK, MARYLAND 21163

DEVELOPER: CHADSWORTH HOMES, INC., P.O. BOX 6641, MCLEAN, VIRGINIA 22106-6641

SHEET 4 OF 9

G:\Drawings\30538\supplemental\grading plan.dwg Wed Jun 21 14:02:02 1999 PREPARED BY JULIE LUTCH
 30538supplemental grading plan.dwg

FISHER, COLLINS & CARTER, INC.
 CIVIL ENGINEERING CONSULTANTS & LAND SURVEYORS
 CENTENNIAL SQUARE OFFICE PARK - 10272 BALTIMORE NATIONAL PIKE
 ELICOTT CITY, MARYLAND 21042
 4100 451 - 2955

SPECIFICATIONS

These specifications are appropriate to all ponds within the scope of the standard for practice MD-37B. All references to ASTM and AASHTO specifications apply to the most recent version.

Site Preparation

Areas designated for borrow areas, embankment, and structural works shall be cleared, grubbed and stripped of topsoil. All trees, vegetation, roots and other objectionable material shall be removed. Channel banks and sharp breaks shall be sloped to no steeper than 1:1.

Areas to be covered by the reservoir will be cleared of all trees, brush, logs, fences, rubbish and other objectionable material unless otherwise designated on the plans. Trees, brush and stumps shall be cut approximately level with the ground surface. For dry stormwater management ponds, a minimum of a 50 foot radius around the inlet structure shall be cleared.

All cleared and grubbed material shall be disposed of outside and below the limits of the dam and reservoir as directed by the owner or his representative. When specified, a sufficient quantity of topsoil will be stockpiled in a suitable location for use on the embankment and other designated areas.

Earth Fill

Material-The fill material shall be taken from approved designated borrow areas. It shall be free of roots, stumps, wood, rubbish, stones greater than 6" from any other objectionable materials. Fill material for the center of the embankment and cut off trench shall conform to Unified Soil Classification GC, SC, CH, or CL. Consideration may be given to the use of other materials in the embankment if design and construction are supervised by a geotechnical engineer.

Placement - Areas on which fill is to be placed shall be scarified prior to placement of fill. Fill materials shall be placed in maximum 6 inch thick (before compaction) layers which are to be continuous over the entire length of the fill. The most permeable borrow material shall be placed in the downstream portions of the embankment. The principal spillway must be installed concurrently with fill placement and not excavated into the embankment.

Compaction - The movement of the hauling and spreading equipment over the fill shall be controlled so that the entire surface of each lift shall be traversed by not less than one tread track of the equipment or compaction shall be achieved by a minimum of four complete passes of a sheepfoot, rubber tired or vibratory roller. Fill material shall contain sufficient moisture such that the required degree of compaction will be obtained with the equipment used. The fill material shall contain sufficient moisture so that if formed into a ball it will not crumble yet not be so wet that water can be squeezed out.

Where a minimum required density is specified, it shall not be less than 95% of maximum dry density with a moisture content within +2% of the optimum. Each layer of fill shall be compacted as necessary to obtain that density, and is to be certified by the engineer at the time of construction. All compaction is to be determined by AASHTO Method T-99.

Cut Off Trench - The cutoff trench shall be excavated into impervious material along or parallel to the centerline of the embankment as shown. The bottom width of the trench shall be governed by the equipment used for excavation, with the minimum width being four feet. The depth shall be at least four feet below existing grade or as shown on the plans. The side slopes of the trench shall be 1 to 1 or flatter. The backfill shall be compacted with construction equipment, rollers or hand tampers to assure maximum density and minimum permeability.

Structure Backfill

Backfill adjacent to pipes or structures shall be of the type and quality conforming to that specified for the adjoining fill material. The fill shall be placed in horizontal layers not to exceed four inches in thickness and compacted by hand tampers or other manually directed compaction equipment. The material needs to fill completely all spaces under and adjacent to the pipe. At no time during the backfilling operation shall driven equipment be allowed to operate closer than four feet, measured horizontally, to any part of a structure. Under no circumstances shall equipment be driven over any part of a concrete structure or pipe, unless there is a compacted fill of 24" or greater over the structure or pipe.

Pipe Conduits

All pipes shall be circular in cross section.

Corrugated Metal Pipe - All of the following criteria shall apply for corrugated metal pipe:

1. Materials - (Steel Pipe) - This pipe and its appurtenances shall be galvanized and fully bituminous coated and shall conform to the requirements of AASHTO Specification M-190 Type A with watertight coupling bands. Any bituminous coating damaged or otherwise removed shall be replaced with cold applied bituminous coating compound. Steel pipes with polymeric coatings shall have a minimum coating thickness of 0.01 inch (0 mil) on both sides of the pipe. The following coatings or an approved equal may be used: Nexon, Phallic-Cote, Blac-Klad, and Beth-Cu-Loy. Coated corrugated steel pipe shall meet the requirements of AASHTO M-245 and M-246.

Materials - (Aluminum Coated Steel Pipe) - This pipe and its appurtenances shall conform to the requirements of AASHTO Specification M-274 with watertight coupling bands or flanges. Any aluminum coating damaged or otherwise removed shall be replaced with cold applied bituminous coating compound. Aluminum surfaces that are to be in contact with concrete shall be painted with one coat of zinc chromate primer. Hot dip galvanized bolts may be used for connections. The pH of the surrounding soils shall be between 4 and 9.

2. Coupling bands, anti-seep collars, end sections, etc., must be composed of the same material as the pipe. Metals must be insulated from dissimilar materials with use of rubber or plastic insulating materials at least 24 mils in thickness.

3. Connections - All connections with pipes must be completely watertight. The drain pipe or barrel connection to the riser shall be welded all around when the pipe and riser are metal. Anti-seep collars shall be connected to the pipe in such a manner as to be completely watertight. Dimple bands are not considered to be watertight.

All connections shall use a rubber or neoprene gasket when joining pipe sections. The end of each pipe shall be re-rolled an adequate number of corrugations to accommodate the band width. The following type connections are acceptable for pipes less than 24" in diameter. Flanges on both ends of the pipe, a 12" wide standard lap type band with 12" wide by 3/8" thick closed cell circular neoprene gasket and a 12" wide huggar type band with O-ring gaskets having a minimum diameter of 1/2" greater than the corrugation depth. Pipes 24" in diameter and larger shall be connected by a 24" long annular corrugated band using rods and nuts. A 12" wide by 3/8" thick closed cell circular neoprene gasket will be installed on the end of each pipe for a total of 24".

Helically corrugated pipe shall have either continuously welded seams or have lock seams with internal caulking or a neoprene bead.

4. Bedding - The pipe shall be firmly and uniformly bedded throughout its entire length. Where rock or soft, spongy or other unstable soil is encountered, all such material shall be removed and replaced with suitable earth compacted to provide adequate support.

5. Backfilling shall conform to "Structure Backfill".

6. Other details (anti-seep collars, valves, etc.) shall be as shown on the drawings.

Reinforced Concrete Pipe - All of the following criteria shall apply for reinforced concrete pipe:

1. Materials - Reinforced concrete pipe shall have bell and spigot joints with rubber gaskets and shall equal or exceed ASTM Designation C-361.

2. Bedding - All reinforced concrete pipe conduits shall be laid in a concrete bedding for their entire length. This bedding shall consist of high slump concrete placed under the pipe and up the sides of the pipe at least 10% of its outside diameter with a minimum thickness of 3 inches, or as shown on the drawings.

3. Laying pipe - Bell and spigot pipe shall be placed with the bell end upstream. Joints shall be made in accordance with recommendations of the manufacturer of the material. After the joints are sealed for the entire line, the bedding shall be placed so that all spaces under the pipe are filled. Care shall be exercised to prevent any deviation from the original line and grade of the pipe. The first joint must be located within 2 feet from the riser.

4. Backfilling shall conform to "Structure Backfill".

5. Other details (anti-seep collars, valves, etc.) shall be as shown on the drawings.

Polyvinyl Chloride (PVC) Pipe - All of the following criteria shall apply for polyvinyl chloride (PVC) pipe:

1. Materials-PVC pipe shall be PVC-1120 or PVC-1220 conforming to ASTM D-1785 or ASTM D-2241.

2. Joints and connections to anti-seep collars shall be completely watertight.

3. Bedding - The pipe shall be firmly and uniformly bedded throughout its entire length. Where rock or soft, spongy or other unstable soil is encountered, all such material shall be removed and replaced with suitable earth compacted to provide adequate support.

4. Backfilling shall conform to "Structure Backfill".

5. Other details (anti-seep collars, valves, etc.) shall be as shown on the drawings.

Concrete

Concrete shall meet the requirements of Maryland Department of Transportation, State Highway Administration Standard Specifications for Construction and Materials, Section 600: Mix No. 3.

Rock Riprap

The riprap shall meet the requirements of Maryland Department of Transportation, State Highway Administration Standard Specifications for Construction and Materials, Section 909.

The riprap shall be placed to the required thickness in one operation. The rock shall be delivered and placed in a manner that will insure the riprap in place shall reasonably homogeneous with the larger rocks uniformly distributed and firmly in contact one to another with the smaller rocks filling the voids between the larger rocks. Filter cloth shall be placed under all riprap and shall meet the requirements of Maryland Department of Transportation, State Highway Administration Standard Specifications for Construction and Materials, Section 912.

Care of Water during Construction

All work on permanent structures shall be carried out in areas free from water. The contractor shall construct and maintain all temporary dikes, levees, cofferdams, drainage channels, and stream diversions necessary to protect the areas to be occupied by the permanent works. The contractor shall also furnish, install, operate, and maintain all necessary pumping and other equipment required for removal of water from the various parts of the work and for maintaining the excavations, foundation, and other parts of the work free from water as required or directed by the engineer for constructing each part of the work. After having served their purpose, all temporary protective works shall be removed or leveled and graded to the extent required to prevent obstruction in any degree whatsoever of the flow of water to the spillway or outlet works and so as not to interfere in any way with the operation or maintenance of the structure. Stream diversions shall be maintained until the full flow can be passed through the permanent works. The removal of water from the required excavation and the foundation shall be accomplished in a manner and to the extent that will maintain stability of the excavated slopes and bottom of required excavations and will allow satisfactory performance of all construction operations. During the placing and compacting of material in required excavations, the water level at the locations being refilled shall be maintained below the bottom of the excavation at such locations which may require draining the water to sumps from which the water shall be pumped.

Stabilization

All borrow areas shall be graded to provide proper drainage and left in a slightly condition. All exposed surfaces of the embankment, spillway, spoil and borrow areas, and berms shall be stabilized by seeding, liming, fertilizing and mulching in accordance with the Maryland Soil Conservation Service Standards and Specifications for Critical Area Planting (MD-342) or as shown on the accompanying drawings.

Erosion and Sediment Control

Construction operations will be carried out in such a manner that erosion will be controlled and water and air pollution minimized. State and local laws concerning pollution abatement will be followed. Construction plans shall detail erosion and sediment control measures to be employed during the construction process.

STRUCTURE NO.	TOP ELEVATION	INV.IN	INV.OUT	ROAD NAME	ROAD STA.	OFFSET	TYPE	REMARKS
I-1	418.91	413.13	412.88	HOLLAND COURT	C.L. STA. 1+25	13.43' LT*	A-5 INLET	S.D. 4.40
I-2	418.91	413.68	413.43	HOLLAND COURT	C.L. STA. 1+25	13.43' RT*	A-10 INLET	S.D. 4.41
I-3	431.37	421.53	421.28	HOLLAND COURT	C.L. STA. 3+75.50	13.43' RT*	A-10 INLET	S.D. 4.41
I-4	431.37	424.72	422.08	HOLLAND COURT	C.L. STA. 3+75.50	13.43' LT*	A-10 INLET	S.D. 4.41
I-5	429.98	425.35	425.10	HOLLAND COURT	C.L. STA. 0+41	13.43' LT*	A-5 INLET	S.D. 4.40
I-6	429.98	425.35	423.31	HOLLAND COURT	C.L. STA. 0+41	13.43' RT*	A-5 INLET	S.D. 4.40
I-7	427.33	427.33	427.20	HOLLAND COURT	C.L. STA. 4+42	47' LT*	D INLET	S.D. 4.39
I-8	437.44	430.56	430.31	OSLO COURT	C.L. STA. 0+41	15' LT*	A-5 INLET	S.D. 4.40
I-9	437.44	431.11	430.86	OSLO COURT	C.L. STA. 0+41	15' RT*	A-5 INLET	S.D. 4.40
I-10	436.73	433.38	433.38				D INLET	S.D. 4.39
I-11	420.24	416.23	415.98				D INLET	S.D. 4.39
I-12	422.91	417.38	416.88				D INLET	S.D. 4.39
I-13	427.48	422.80	422.55				D INLET	S.D. 4.39
I-14	430.85	425.72	423.47				D INLET	S.D. 4.39
I-15	433.95	428.64	426.39				D INLET	S.D. 4.39
I-16	435.16	429.56	429.31				D INLET	S.D. 4.39
I-17	436.85	430.48	430.23				D INLET	S.D. 4.39
I-18	427.43	423.44	423.41				D INLET	S.D. 4.39
I-17A	438.36	431.15	431.15				D INLET	S.D. 4.39
M-1	420.00	411.90	411.73				PRECAST MANHOLE	G. 5.12
M-2	434.15	429.00	422.75	HOLLAND COURT	C.L. STA. 4+42	16.5' LT	PRECAST MANHOLE	G. 5.12
M-3	435.96	429.97	429.72	HOLLAND COURT	C.L. STA. 5+12	16.5' LT	PRECAST MANHOLE	G. 5.12
M-4	438.69	432.16	431.91	OSLO COURT	C.L. STA. 1+23.64	21' RT	PRECAST MANHOLE	G. 5.12
M-5	419.50	414.21	413.96	HOLLAND COURT	C.L. STA. 0+97	21' RT	PRECAST MANHOLE	G. 5.12
M-6	421.50	415.20	414.95	HOLLAND COURT			PRECAST MANHOLE	G. 5.12
M-7	426.00	419.70	419.45				PRECAST MANHOLE	G. 5.12
M-1A	421.49	417.19	416.94		C.L. STA. 1+84	18.5' RT	PRECAST MANHOLE	G. 5.12
S-1	412.50	411.00	411.00				CONC. END SECTION	S.D. 5.51
S-2	420.47	418.97	418.97				CONC. END SECTION	S.D. 5.51
S-3	412.50	411.00	411.00				CONC. END SECTION	S.D. 5.51
S-4	411.50	410.00	410.00				CONC. END SECTION	S.D. 5.51

* DENOTES OFFSET TO FLOWLINE AT INLET

By The Developer:
 "I/We Certify That All Development And/Or Construction Will Be Done According To These Plans, And That Any Responsible Personnel Involved In The Construction Project Will Have A Certificate Of Attendance At A Department Of The Environment Approved Training Program For The Control Of Sediment And Erosion Before Beginning The Project. I Shall Engage A Registered Professional Engineer To Supervise Pond Construction And Provide The Howard Soil Conservation District With An "As-Built" Plan Of The Pond Within 30 Days Of Completion. I Also Authorize Periodic On-Site Inspections By The Howard Soil Conservation District."
 Signature of Developer: *[Signature]*
 Date: 6/24/98
 Printed Name Of Developer: ANTHONY HANES

By The Engineer:
 "I Certify That This Plan For Pond Construction, Erosion And Sediment Control Represents A Practical And Workable Plan Based On My Personal Knowledge Of The Site Conditions. This Plan Was Prepared In Accordance With The Requirements Of The Howard Soil Conservation District. I Have Notified The Developer That He/She Must Engage A Registered Professional Engineer To Supervise Pond Construction And Provide The Howard Soil Conservation District With An "As-Built" Plan Of The Pond Within 30 Days Of Completion."
 Signature of Engineer: *[Signature]*
 Date: 6/24/98
 Printed Name Of Engineer: CHARLES J. CARROLL SR.

These Plans Have Been Reviewed For The Howard Soil Conservation District And Meet The Technical Requirements For Small Pond Construction, Soil Erosion And Sediment Control.
 Signature: *[Signature]* 7/14/98
 Date: 7/14/98
 Signature: *[Signature]* 7/14/98
 Date: 7/14/98
 Signature: *[Signature]*
 Date: 7/14/98

Field Inspector: C.S. Bakhshi

SUMMARY OF TEST PITS

TEST PIT	DEPTH	SOIL DESCRIPTION	REMARKS
B-1	0.0-6.0	Yellowish Red fine SAND, trace clay, mica.	Groundsurface: wooded
		USC: SM USDA: Sandy Loam	Top Soil: 12.0"
			Rock fragments below 8.0 feet depth.
6.0-8.0		Yellowish Sand with olive green clay lenses, trace mica	Groundwater not encountered during excavation.
		USC: SM USDA: Sandy Loam	

SUMMARY OF TEST PITS


TEST PIT	DEPTH	SOIL DESCRIPTION	REMARKS
B-2	0.0-4.0	Olive Brown Sand with dark red lenses of clay, trace mica.	Groundsurface: wooded with
		USC: SM USDA: Sandy Loam	Top Soil: 2.0"
			Backhoe refusal at 11.0 feet depth. Test Pit backfilled on completion of observations. Test Pit terminated at 11.0 feet depth.
4.0-11.0		Strong brown to yellow fine SAND, trace mica	Groundwater not encountered during excavation.
		USC: SM USDA: Sandy Sand	

SUMMARY OF TEST PITS

TEST PIT	DEPTH	SOIL DESCRIPTION	REMARKS
B-3	1.0-5.0	Yellowish Red clayey SAND, trace mica.	Groundsurface: open grassy field
		USC: SM USDA: Sandy Loam	Top Soil: 12.0"
			Groundwater not encountered during excavation.
5.0-11.0		Yellowish Brown fine SAND, trace mica	
		USC: SM USDA: Loamy Sand	

SUMMARY OF TEST PITS

TEST PIT	DEPTH	SOIL DESCRIPTION	REMARKS
B-3	1.0-5.0	Yellowish Red clayey SAND, trace mica.	Groundsurface: open grassy field
		USC: SM USDA: Sandy Loam	Top Soil: 12.0"
			Groundwater not encountered during excavation.
5.0-11.0		Yellowish Brown fine SAND, trace mica	
		USC: SM USDA: Loamy Sand	

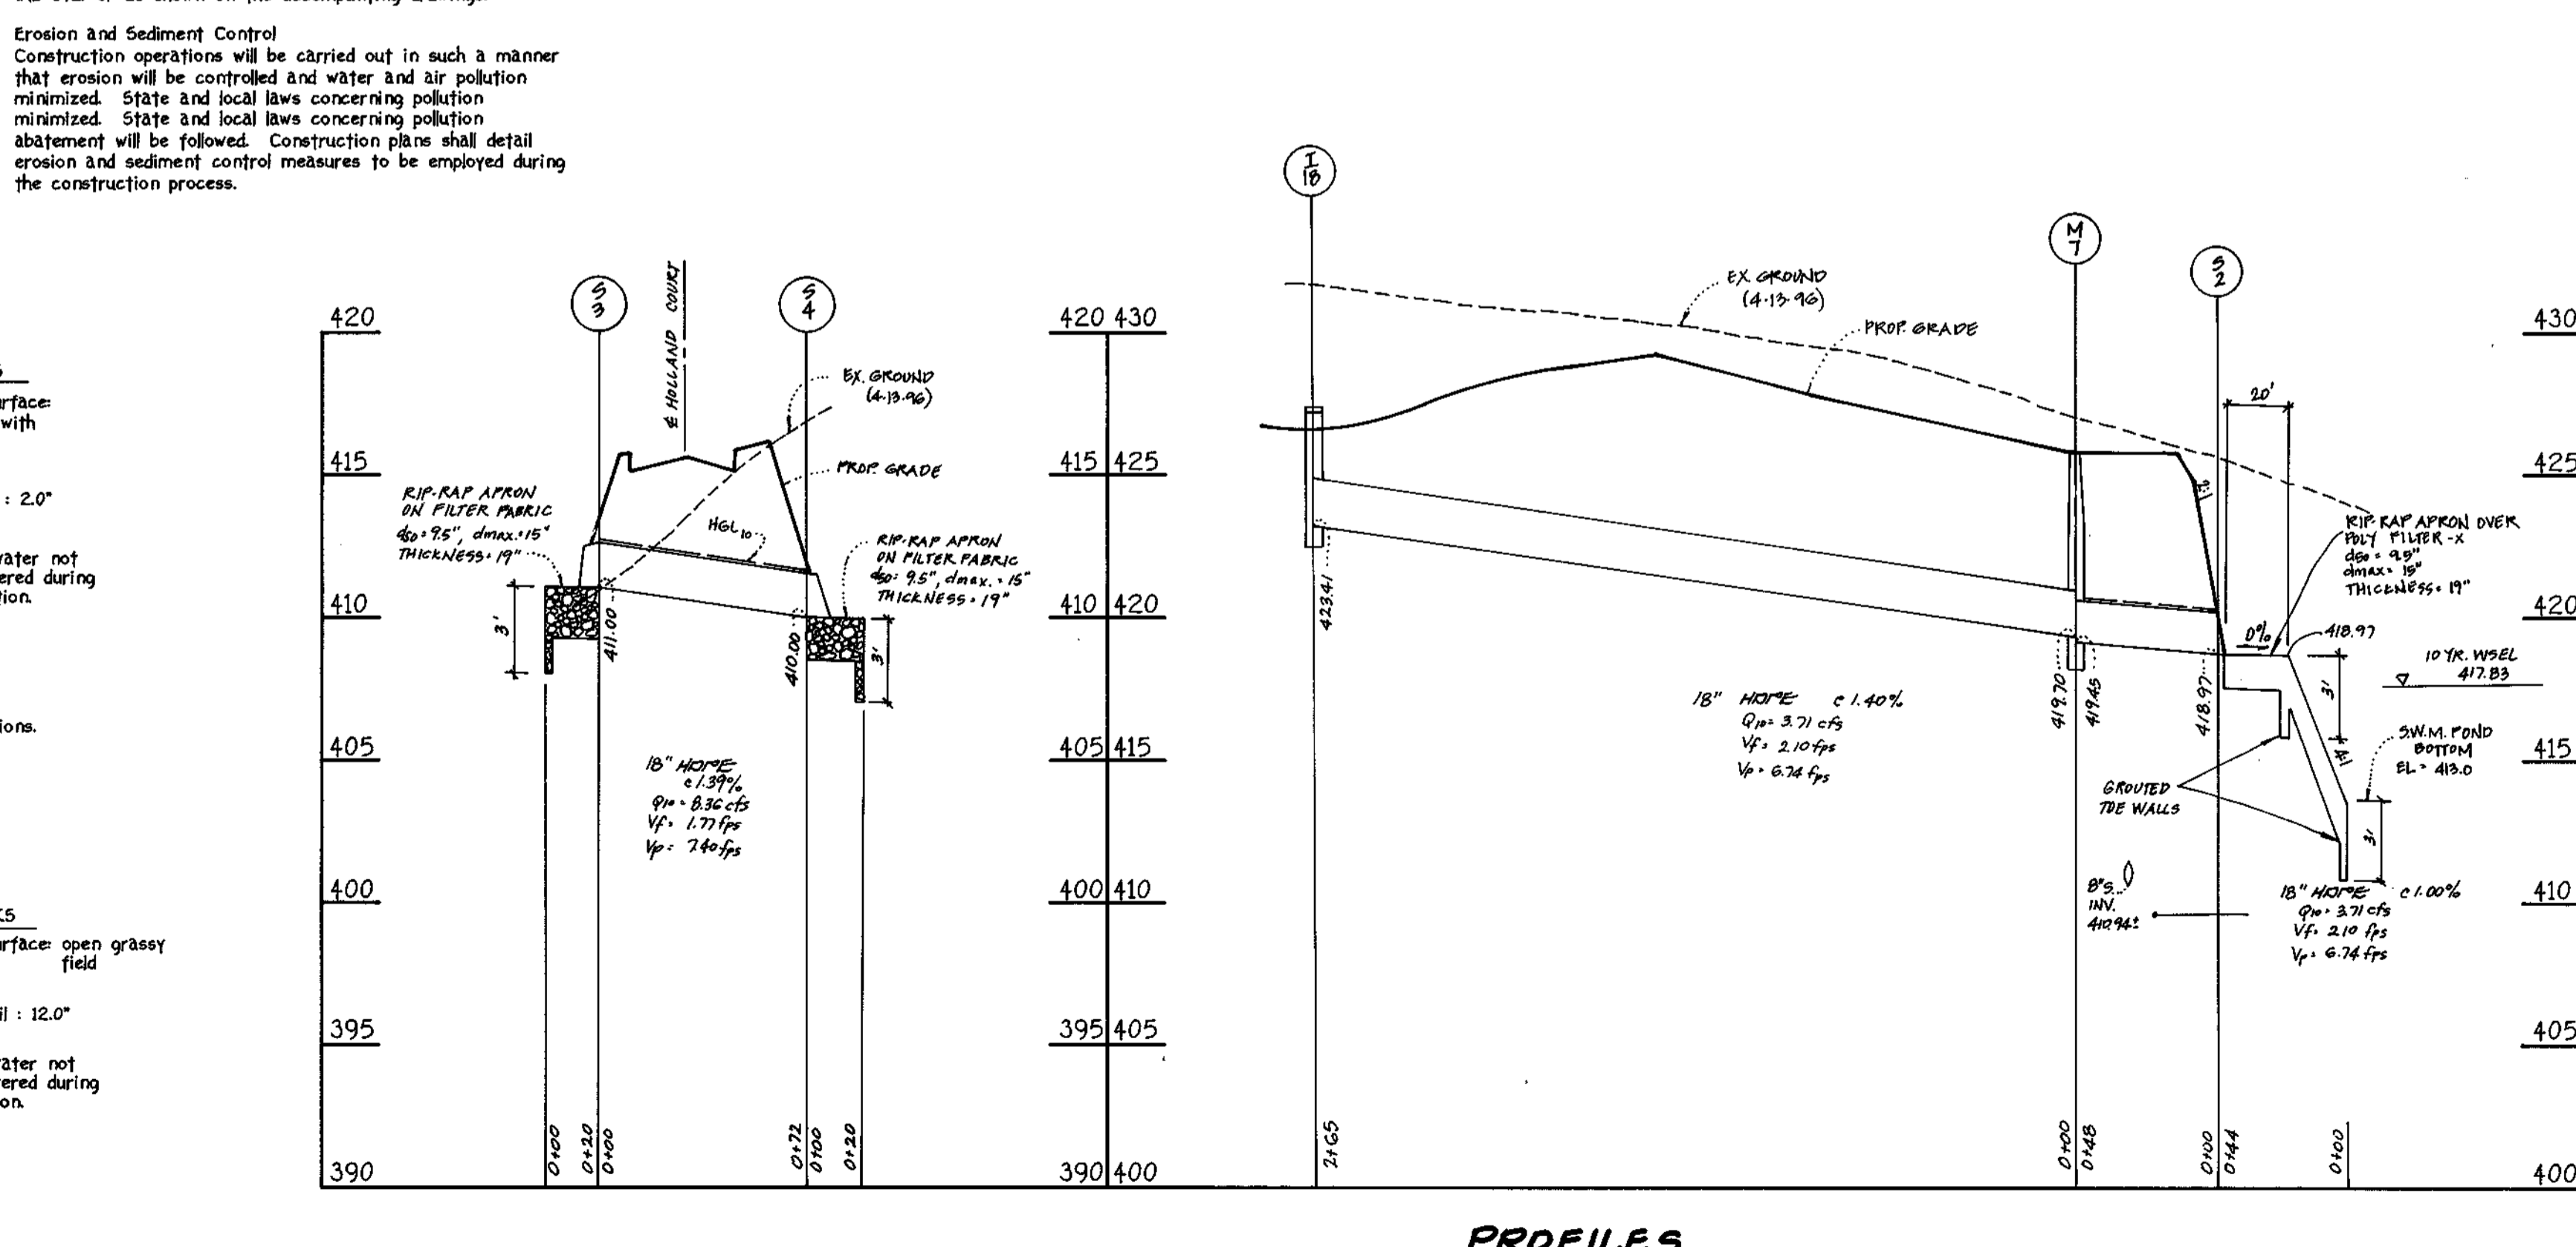

NOTE: THIS SHEET SUPERSEDES THE PREVIOUSLY SIGNED ORIGINAL DRAWING

STORM DRAIN PROFILES
 LOTS 1 THRU 36
 CEDAR ACRES
 A RESUBDIVISION OF LOTS 3, 4 AND 5
 ZONED: R5C
 TAX MAP NO. 35 PARCEL 38
 FIFTH ELECTION DISTRICT HOWARD COUNTY, MARYLAND
 SHEET 6 OF 9

FISHER, COLLINS & CARTER, INC.
 CIVIL ENGINEERING CONSULTANTS & LAND SURVEYORS
 CENTRAL OFFICE: 10272 BALTIMORE NATIONAL PKE
 ELLETTT CITY, MARYLAND 21114
 410-471-2825


OWNER:
 BENJAMIN K. BASSLER
 AND ELSIE MAE BASSLER
 10739 MARYLAND ROUTE 99
 WOODSTOCK, MARYLAND 21163

DEVELOPER:
 CHADSWORTH HOMES, INC.
 P.O. BOX 8611
 MCLEAN, VIRGINIA 22106-6641


APPROVED: DEPARTMENT OF PUBLIC WORKS
 CHIEF, BUREAU OF HIGHWAYS
 [Signature] 7-17-98
 DATE

APPROVED: DEPARTMENT OF PLANNING AND ZONING
 CHIEF, DIVISION OF LAND DEVELOPMENT
 [Signature] 7/23/98
 DATE

APPROVED: [Signature] 7/22/98
 CHIEF, DEVELOPMENT ENGINEERING DIVISION
 DATE

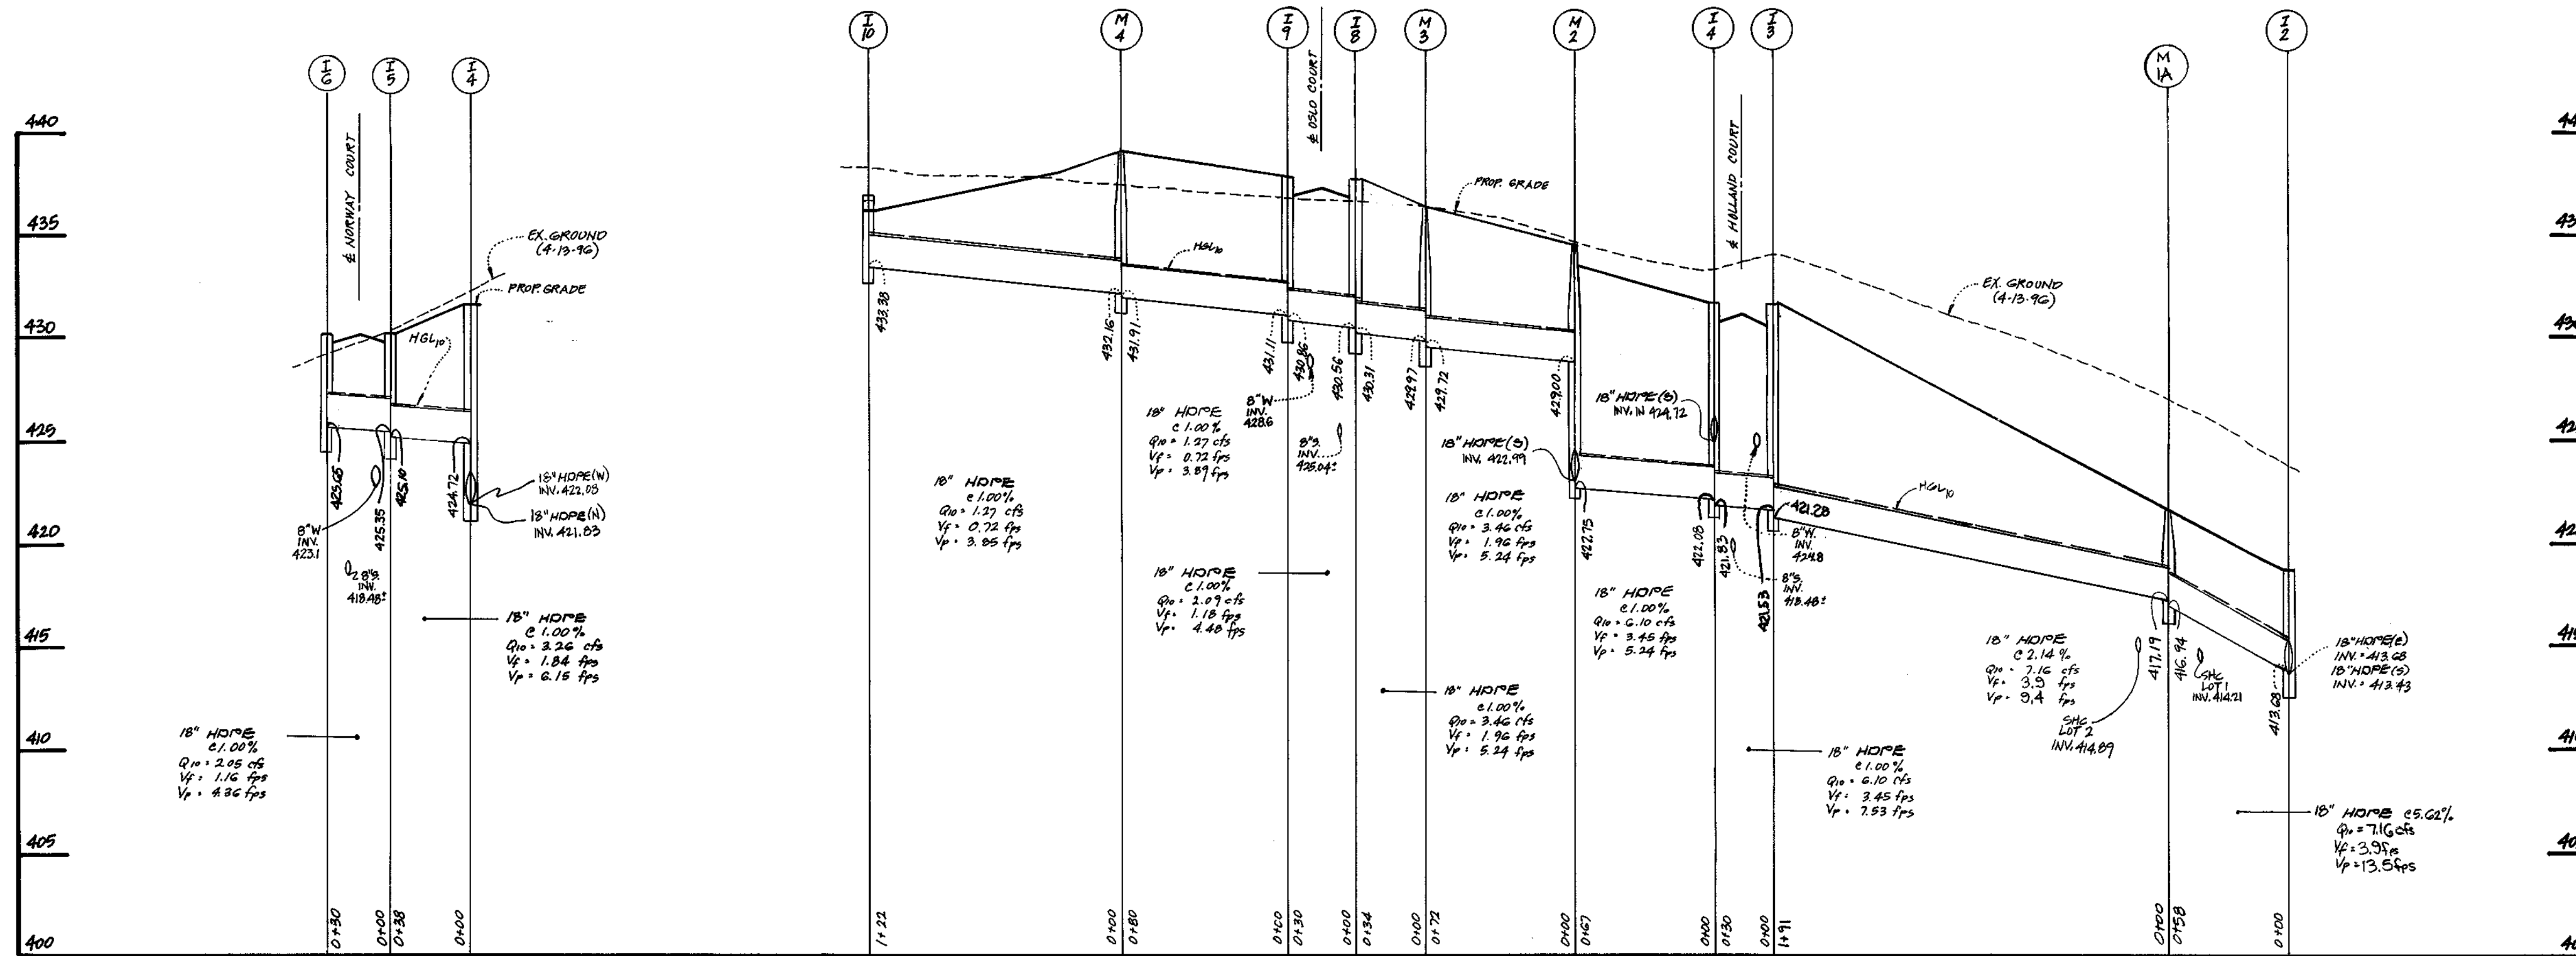

PROFILES
 HORIZ. : 1" = 50'
 VERT. : 1" = 5'

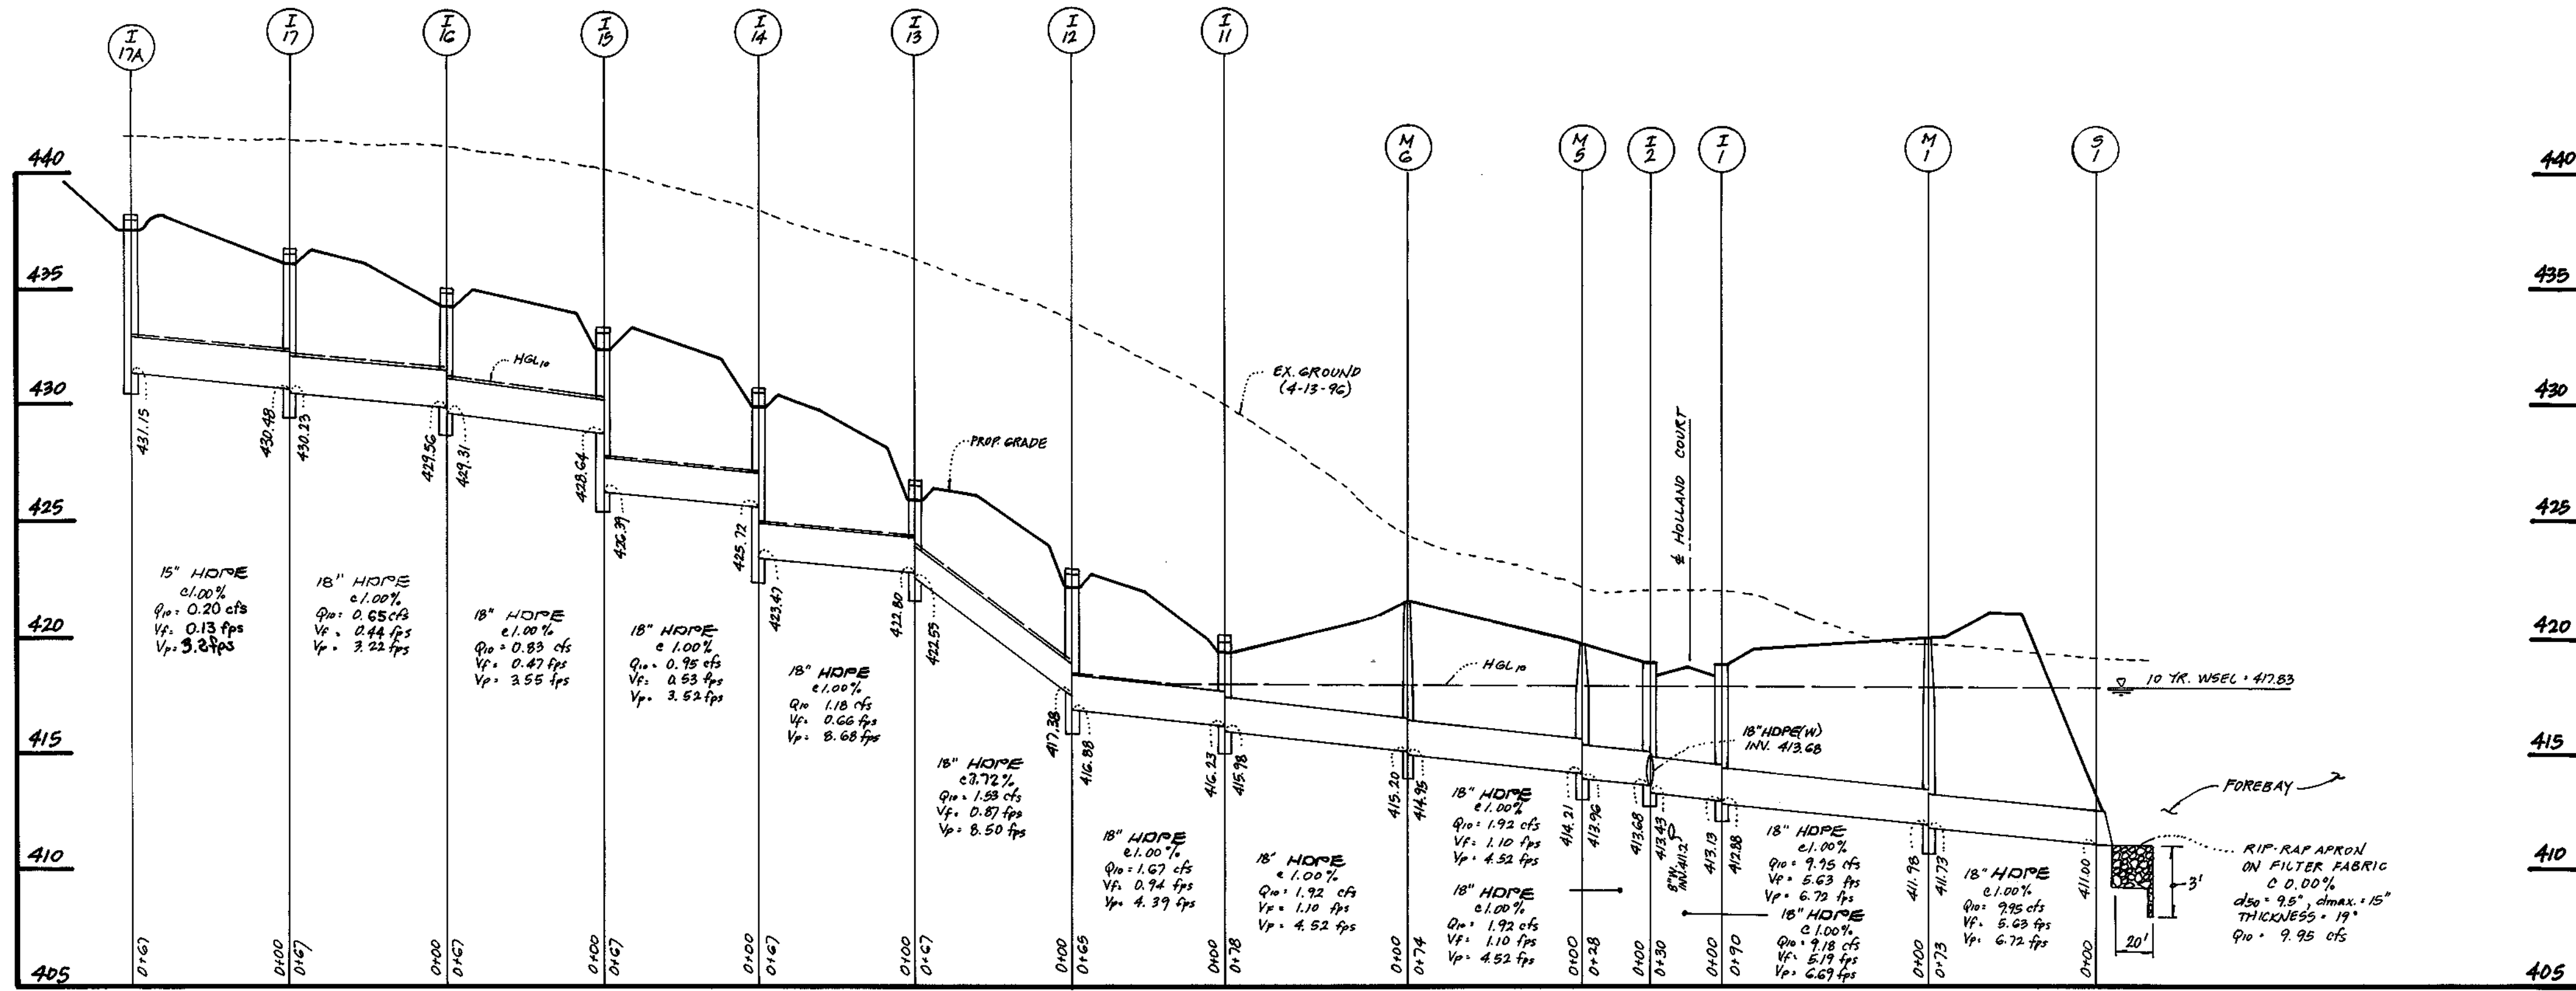

PROFILE
 HORIZ. : 1" = 50'
 VERT. : 1" = 5'

NOTE: THIS SHEET SUPERSEDES THE PREVIOUSLY SIGNED ORIGINAL DRAWING




STORM DRAIN PROFILES
 LOTS 1 THRU 36
CEDAR ACRES
 A RESUBDIVISION OF LOTS 3, 4 AND 5
 ZONED: RSC
 TAX MAP NO. 35 PARCEL 36
 FIFTH ELECTION DISTRICT HOWARD COUNTY, MARYLAND
 SHEET 7 OF 9

FISHER, COLLINS & CARTER, INC.
 CIVIL ENGINEERING CONSULTANTS & LAND SURVEYORS
 CENTRAL SQUARE OFFICE PARK - 10272 BALTIMORE NATIONAL PIKE
 ELLICOTT CITY, MARYLAND 21114
 4100 461 - 2995

OWNER
 BENJAMIN K. BASSLER
 AND ELSIE MAE BASSLER
 10739 MARYLAND ROUTE 99
 WOODSTOCK, MARYLAND 21163

DEVELOPER
 CHADSWORTH HOMES, INC.
 P.O. BOX 6641
 MCLEAN, VIRGINIA 22106-6641

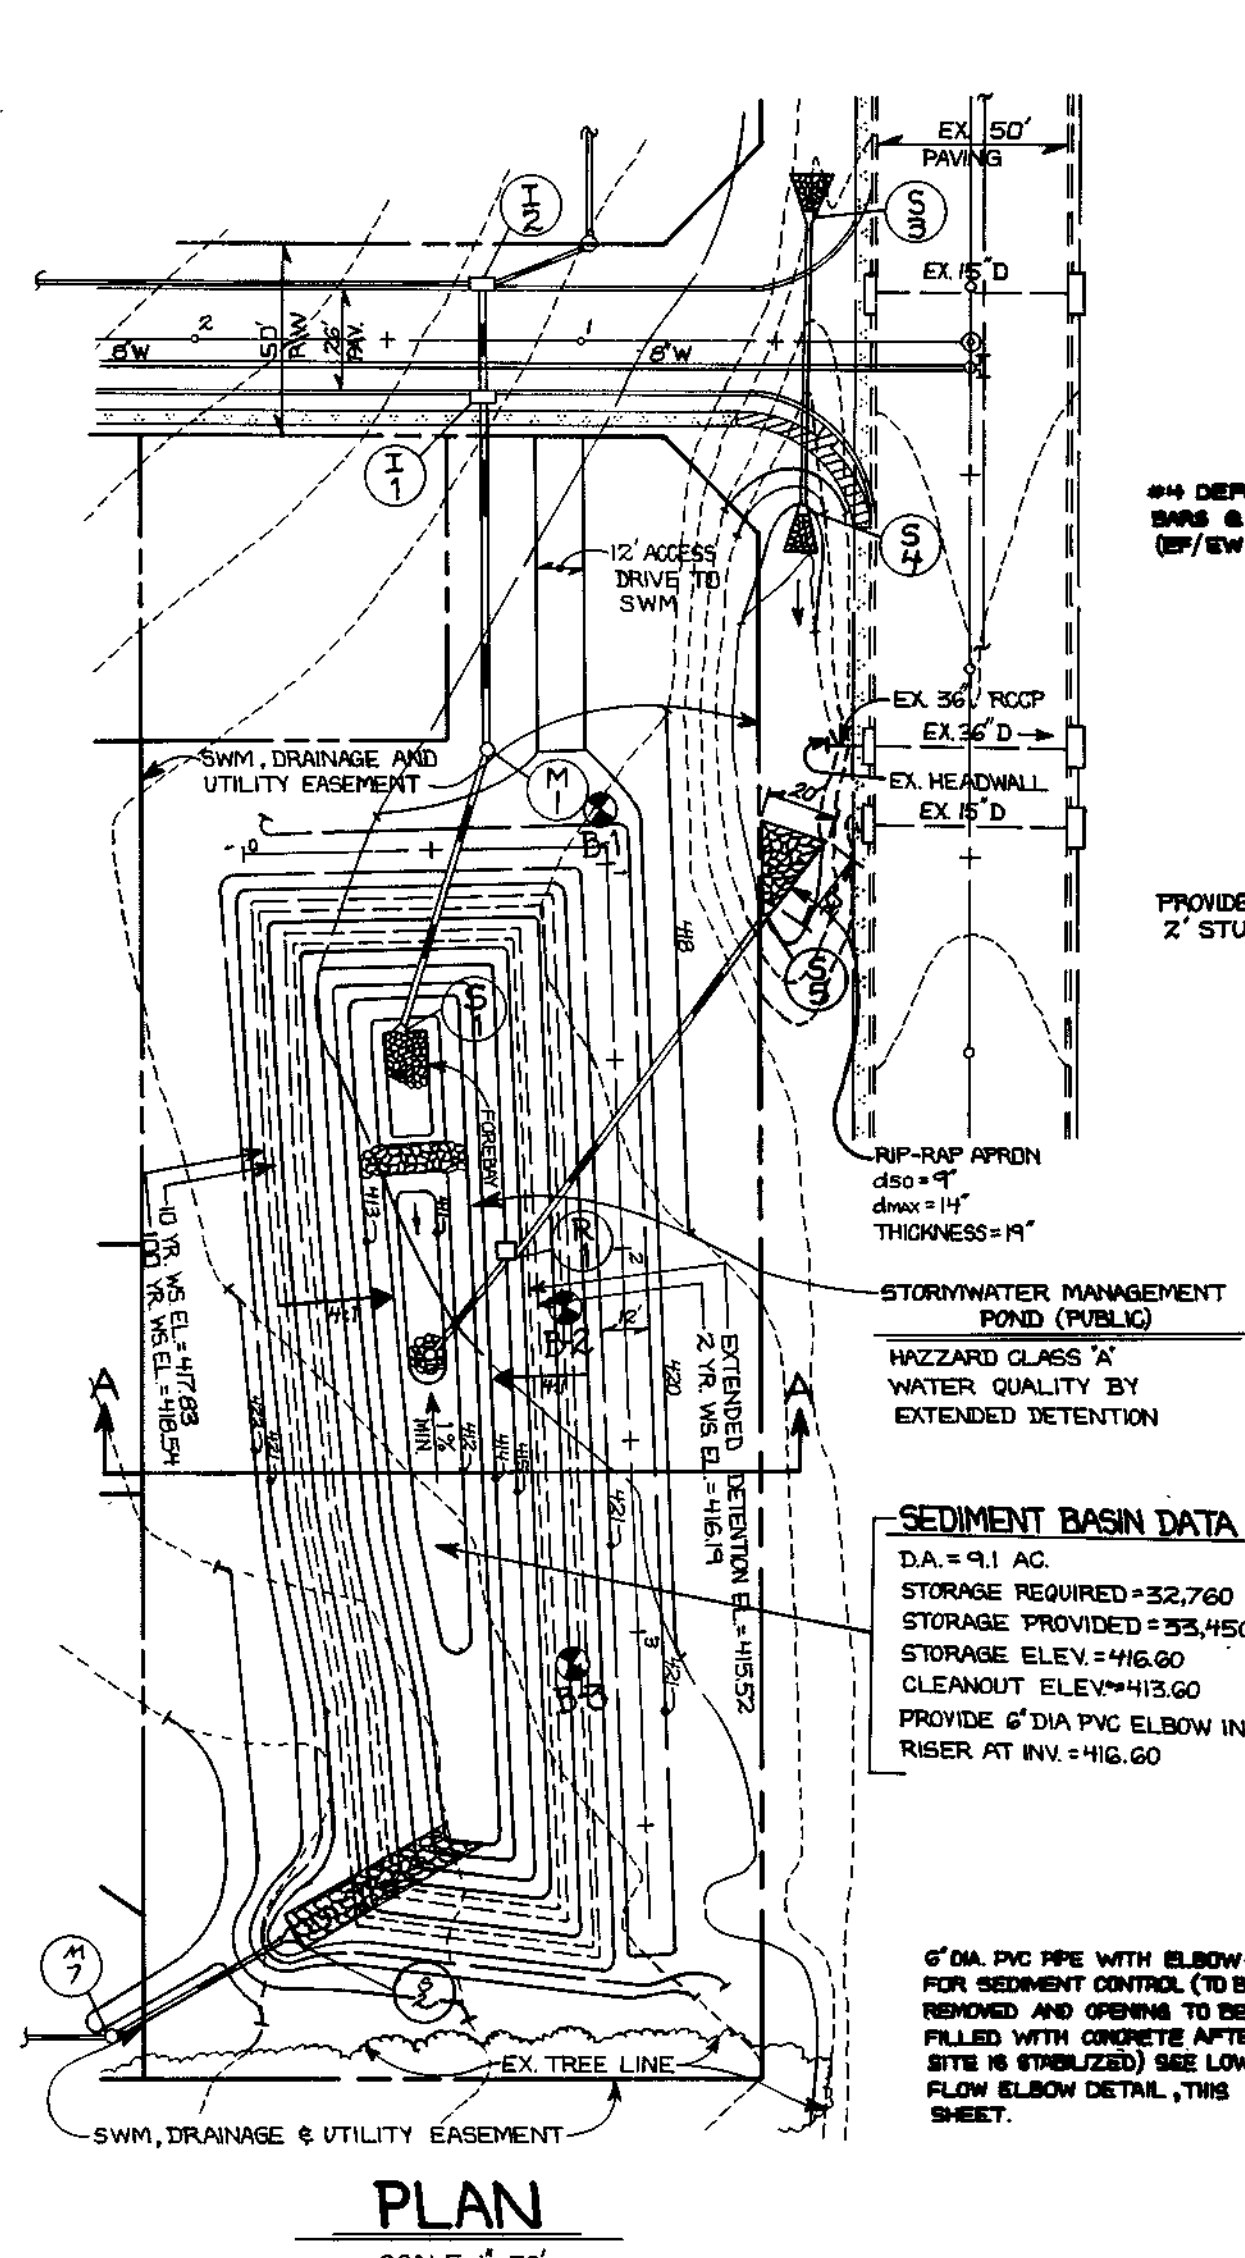


PLAN
SCALE: 1"=50'

STORMWATER MANAGEMENT POND SUMMARY (DA=9.1 AC)


STORM EVENT	EXISTING CONDITION DISCHARGE (CFS)	DEVELOPED CONDITION DISCHARGE (CFS)	ALLOWABLE RELEASE (CFS)	ACTUAL RELEASE (CFS)	STORAGE ELEVATION (FT)	STORAGE (CF)
2 YEAR	1.06	11.04	1.86	0.53	416.19	27,474
10 YEAR	10.72	25.61	10.72	1.54	417.85	51,585
100 YEAR	24.08	43.09	N/A	21.28	418.54	64,540

SEDIMENT BASIN DATA
 D.A. = 9.1 AC
 STORAGE REQUIRED = 32,760
 STORAGE PROVIDED = 33,450
 STORAGE ELEV. = 416.00
 CLEAROUT ELEV. = 413.00
 PROVIDE 6" DIA. PVC ELBOW IN RISER AT INV. = 416.00


6" DIA. PVC PIPE WITH ELBOW FOR SEDIMENT CONTROL (TO BE REMOVED AND OPENING TO BE FILLED WITH CONCRETE AFTER SITE IS STABILIZED) SEE LOW FLOW ELBOW DETAIL, THIS SHEET.

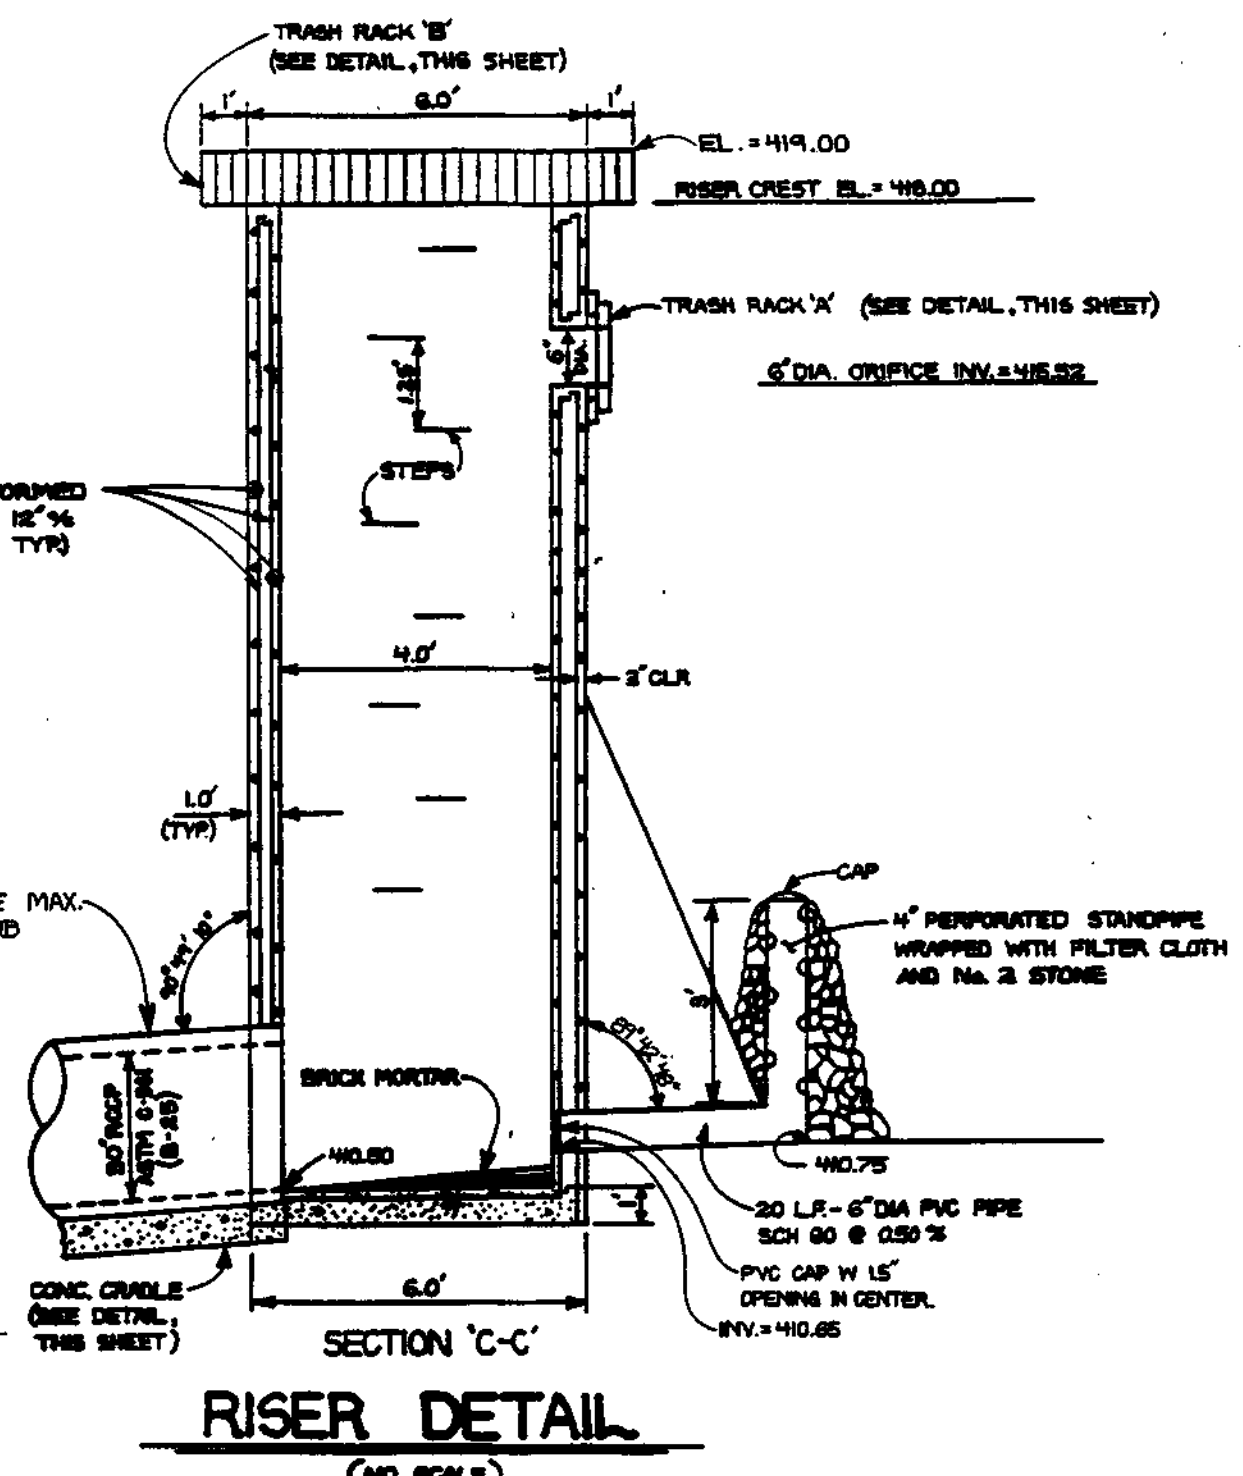


SECTION C-C
RISER DETAIL
(NO SCALE)

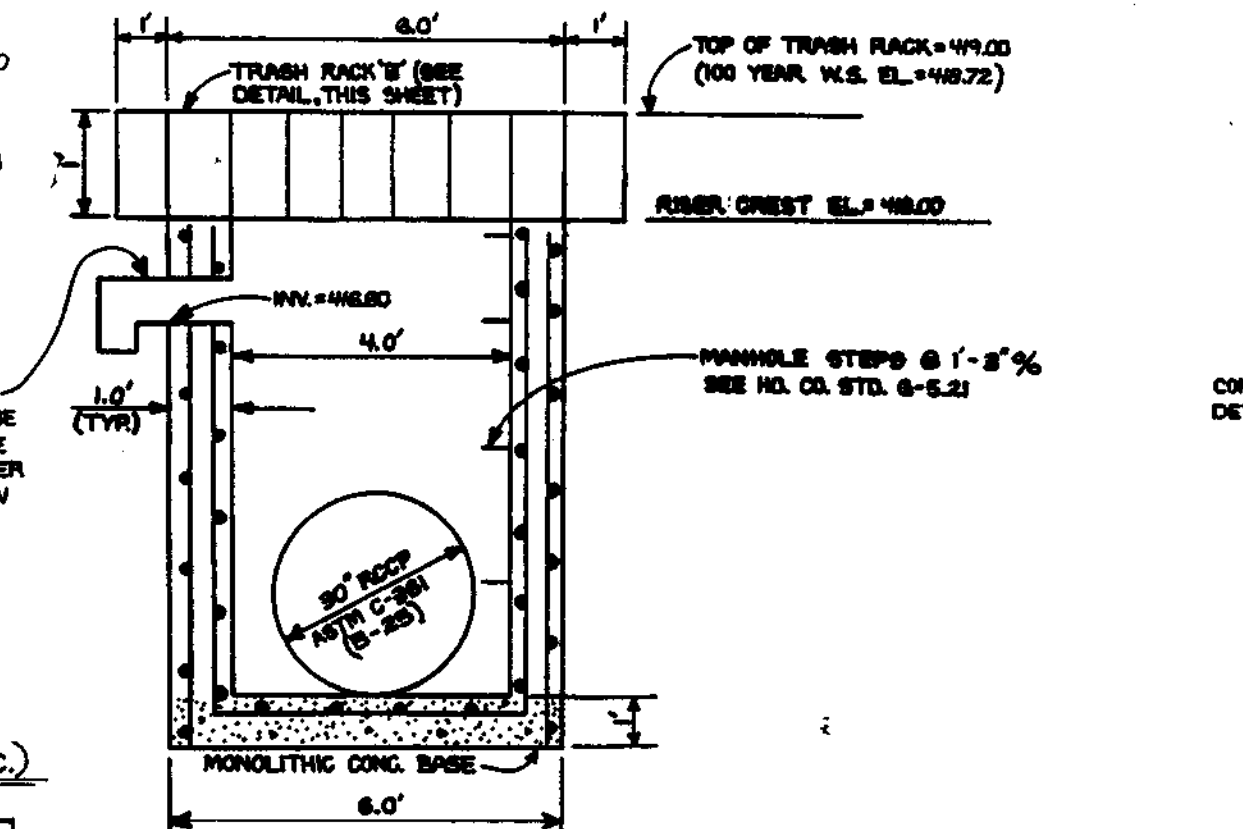

SECTION D-D
RISER DETAIL
(NO SCALE)

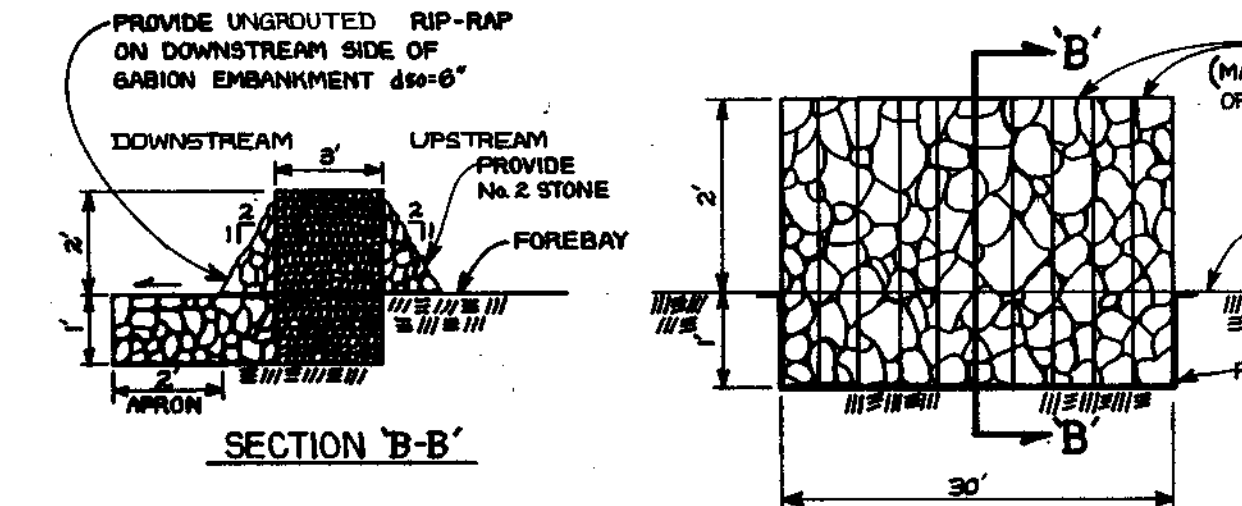


SECTION B-B
GABION FILTER AT FOREBAY
(NO SCALE)

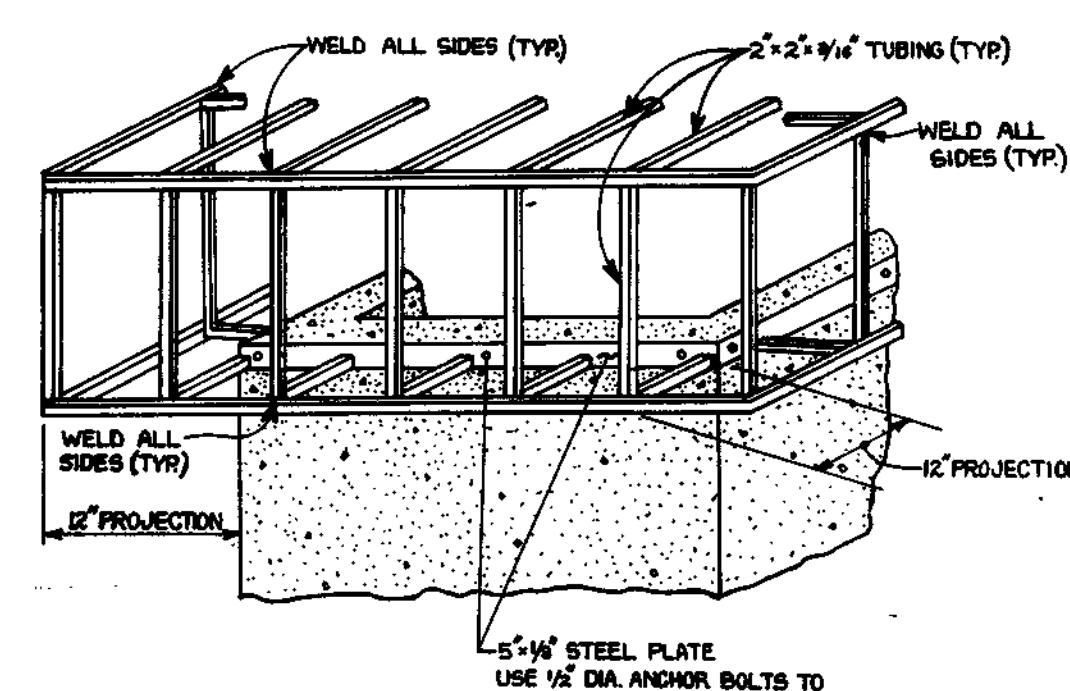


FASTENING DETAIL
(NO SCALE)


NOTE: (CONTRACTOR SHALL)
 1. FIELD MEASURE THE STRUCTURE DIMENSIONS FOR EXACT FITTING OF TRASH RACK.
 2. GALVANIZE ENTIRE TRASH RACK.
 3. ALL NUTS AND BOLTS SHALL BE GALVANIZED.

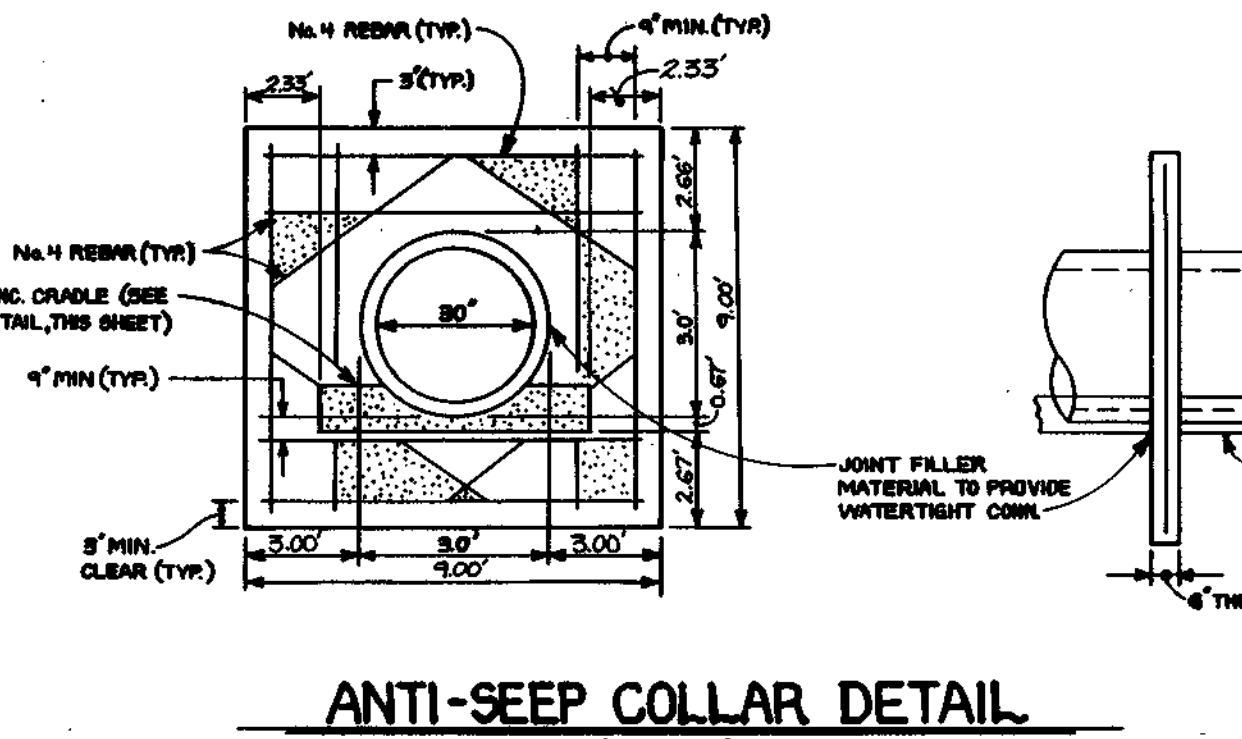


ANTI-SEEP COLLAR DETAIL
(NO SCALE)

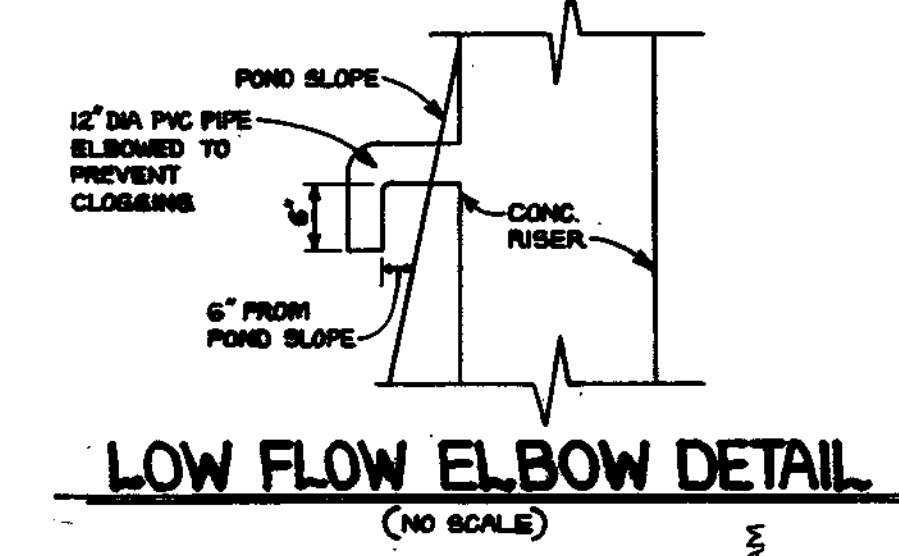


LOW FLOW ELBOW DETAIL
(NO SCALE)

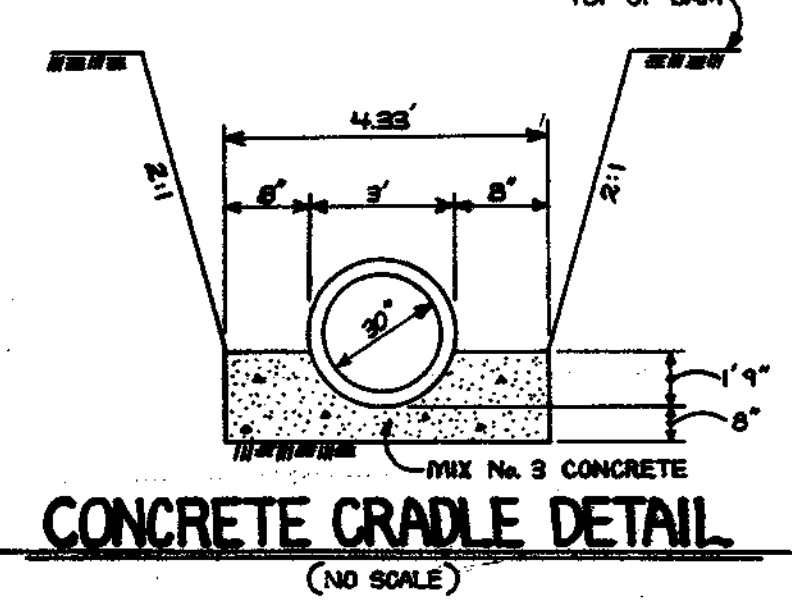


CONCRETE CRADLE DETAIL
(NO SCALE)

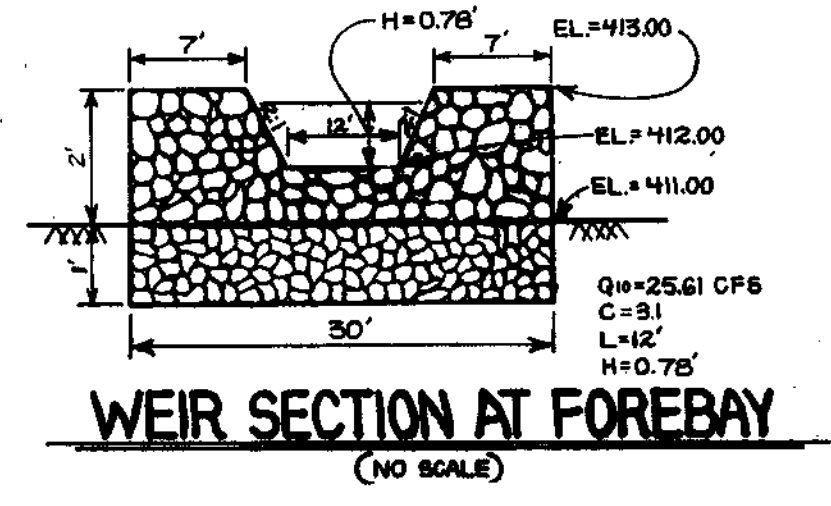


WEIR SECTION AT FOREBAY
(NO SCALE)

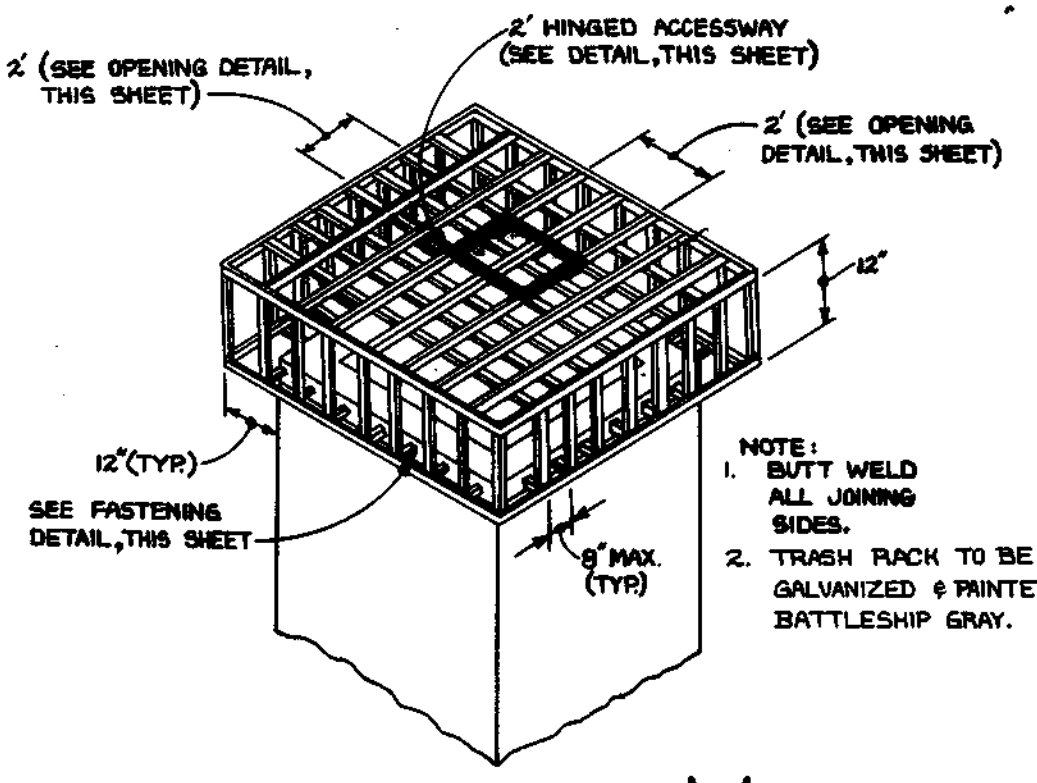


TRASH RACK B'
(NO SCALE)

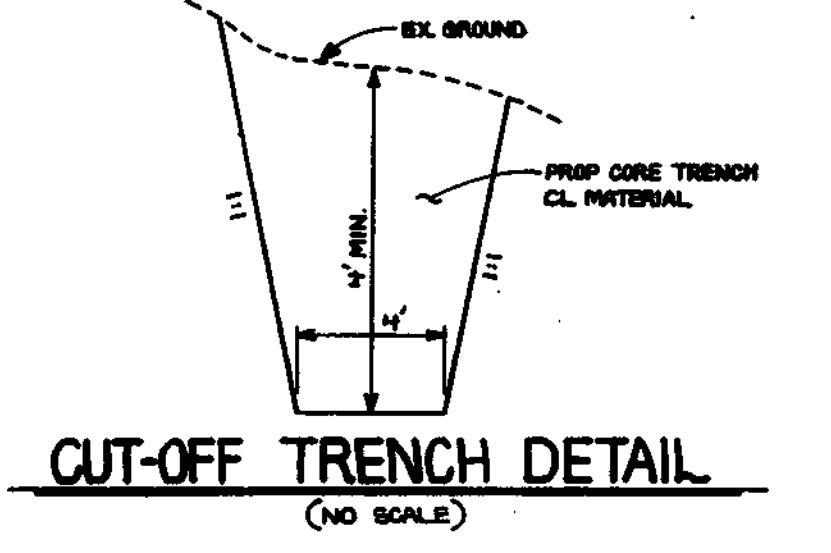


CUT-OFF TRENCH DETAIL
(NO SCALE)

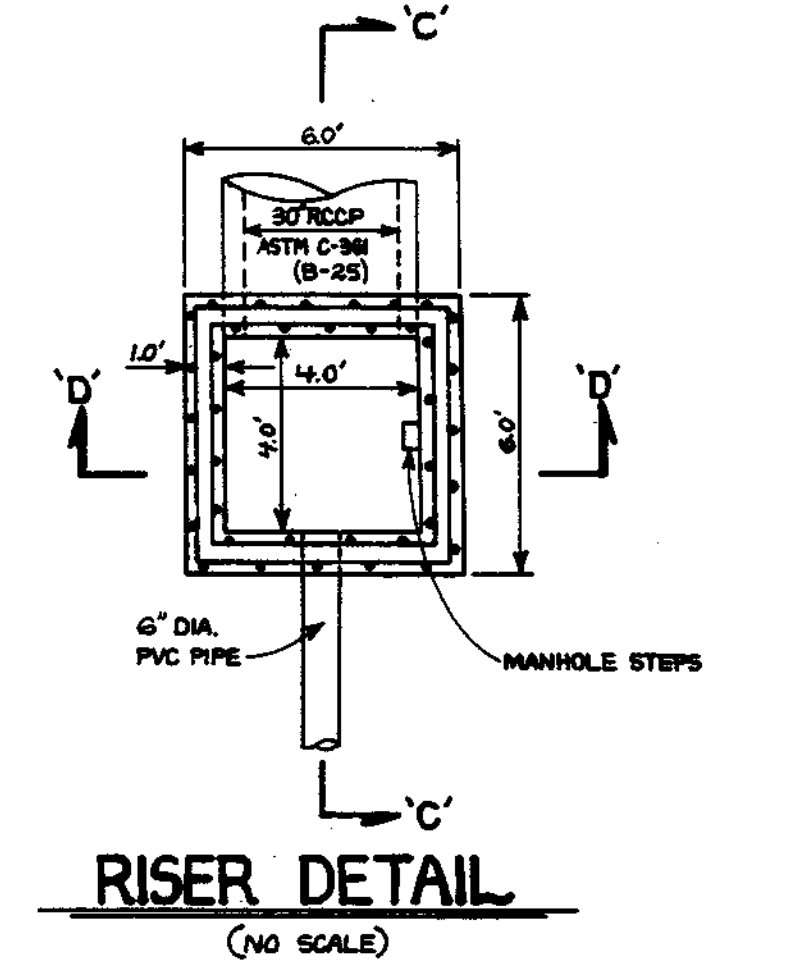


RISER DETAIL
(NO SCALE)

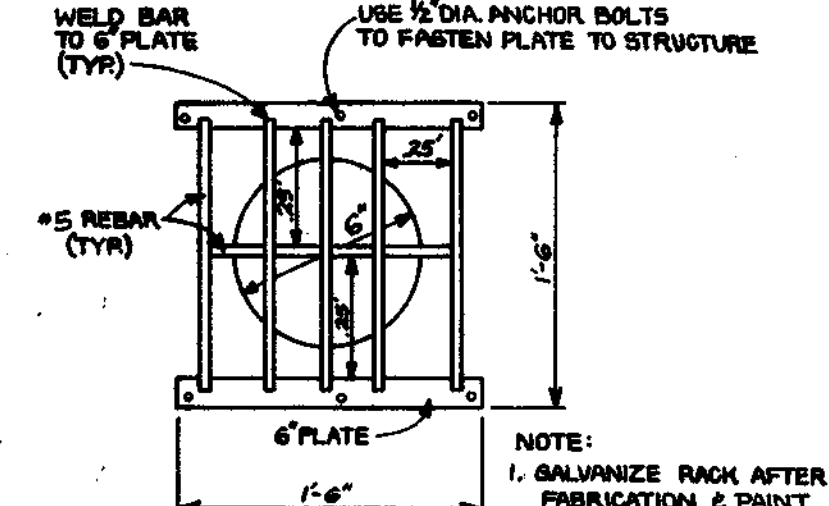


TRASH RACK A'
(NO SCALE)

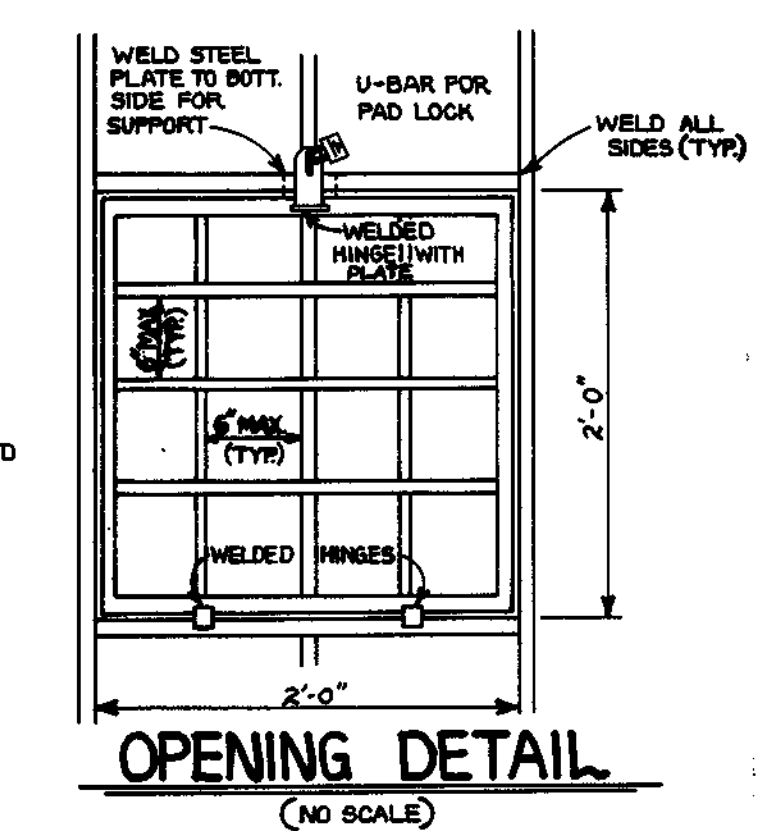


OPENING DETAIL
(NO SCALE)

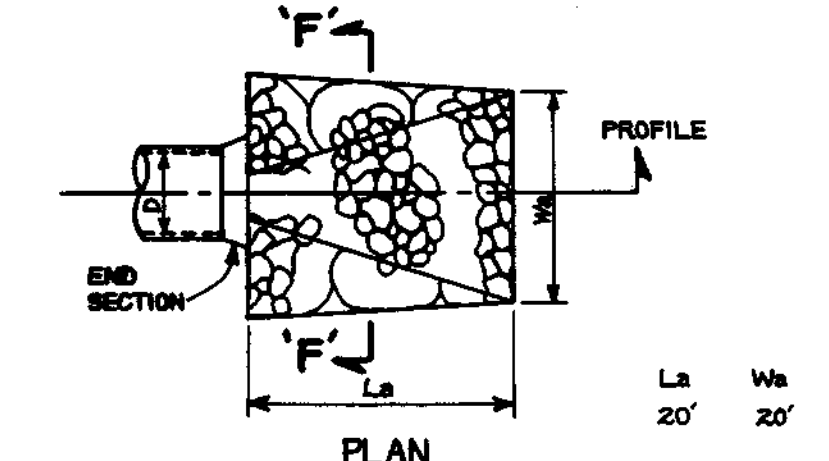


PLAN
LA 20'
WB 20'

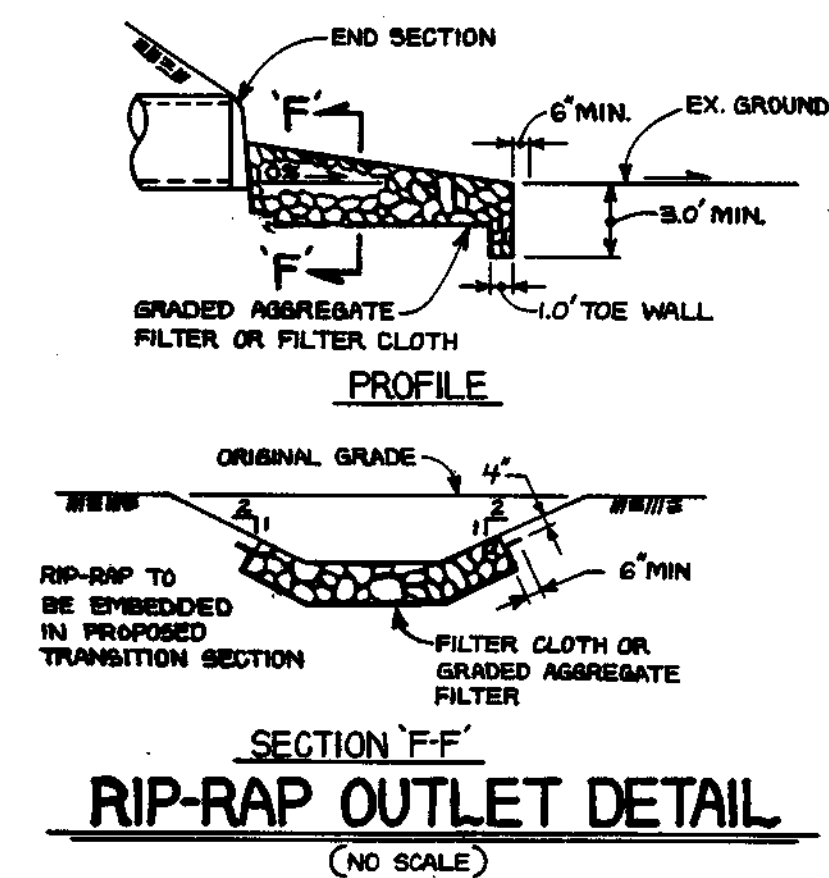


SECTION F-F
RIP-RAP OUTLET DETAIL
(NO SCALE)

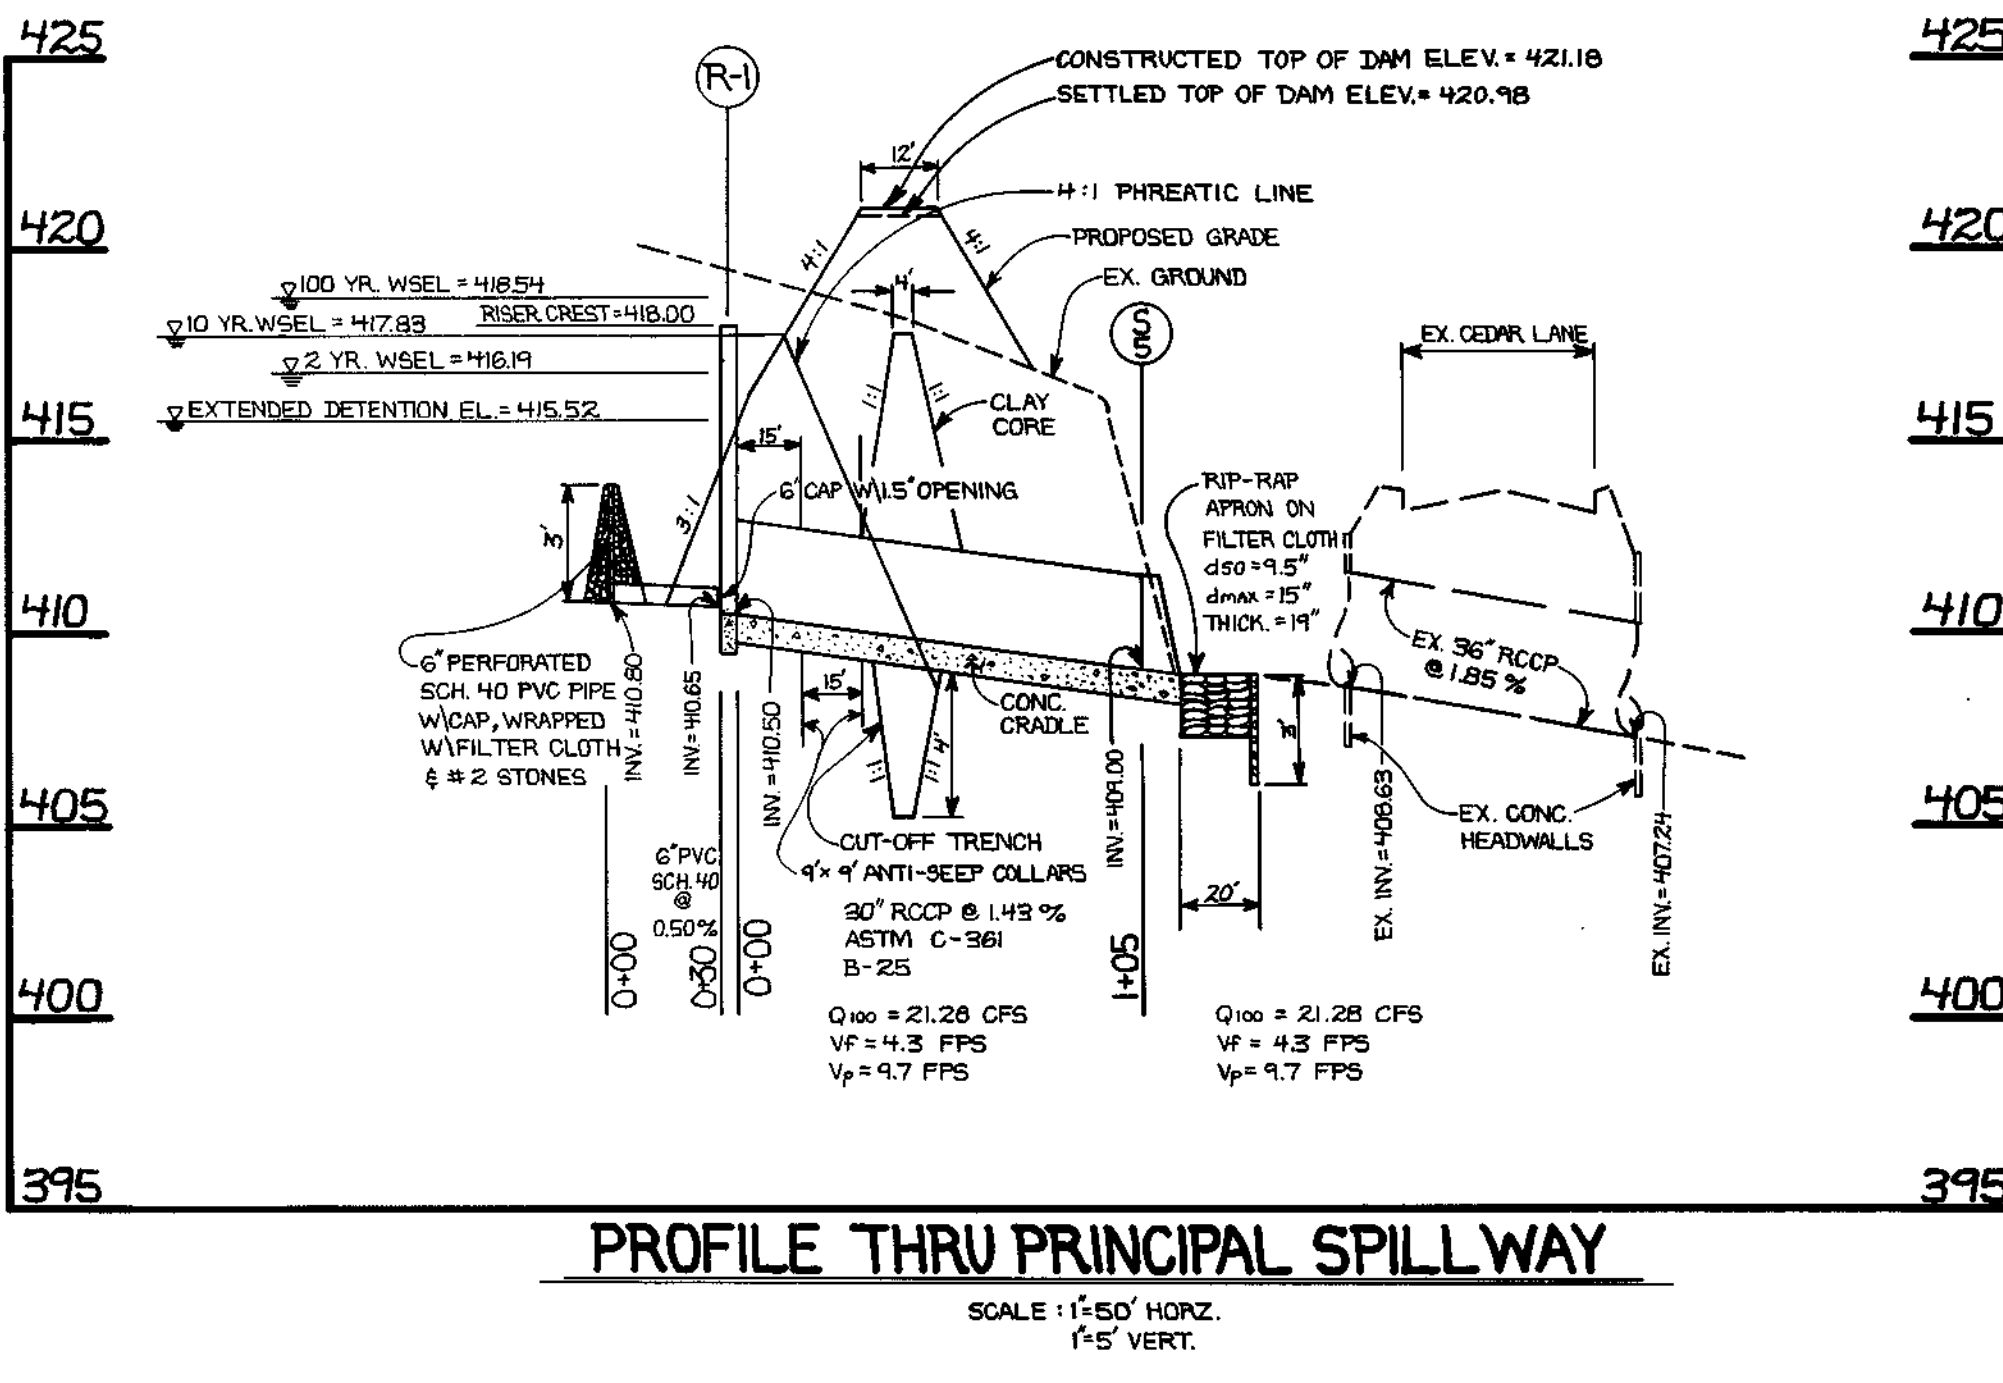

PROFILE THRU PRINCIPAL SPILLWAY
SCALE: 1"=50' HORIZ.
1"=5' VERT.

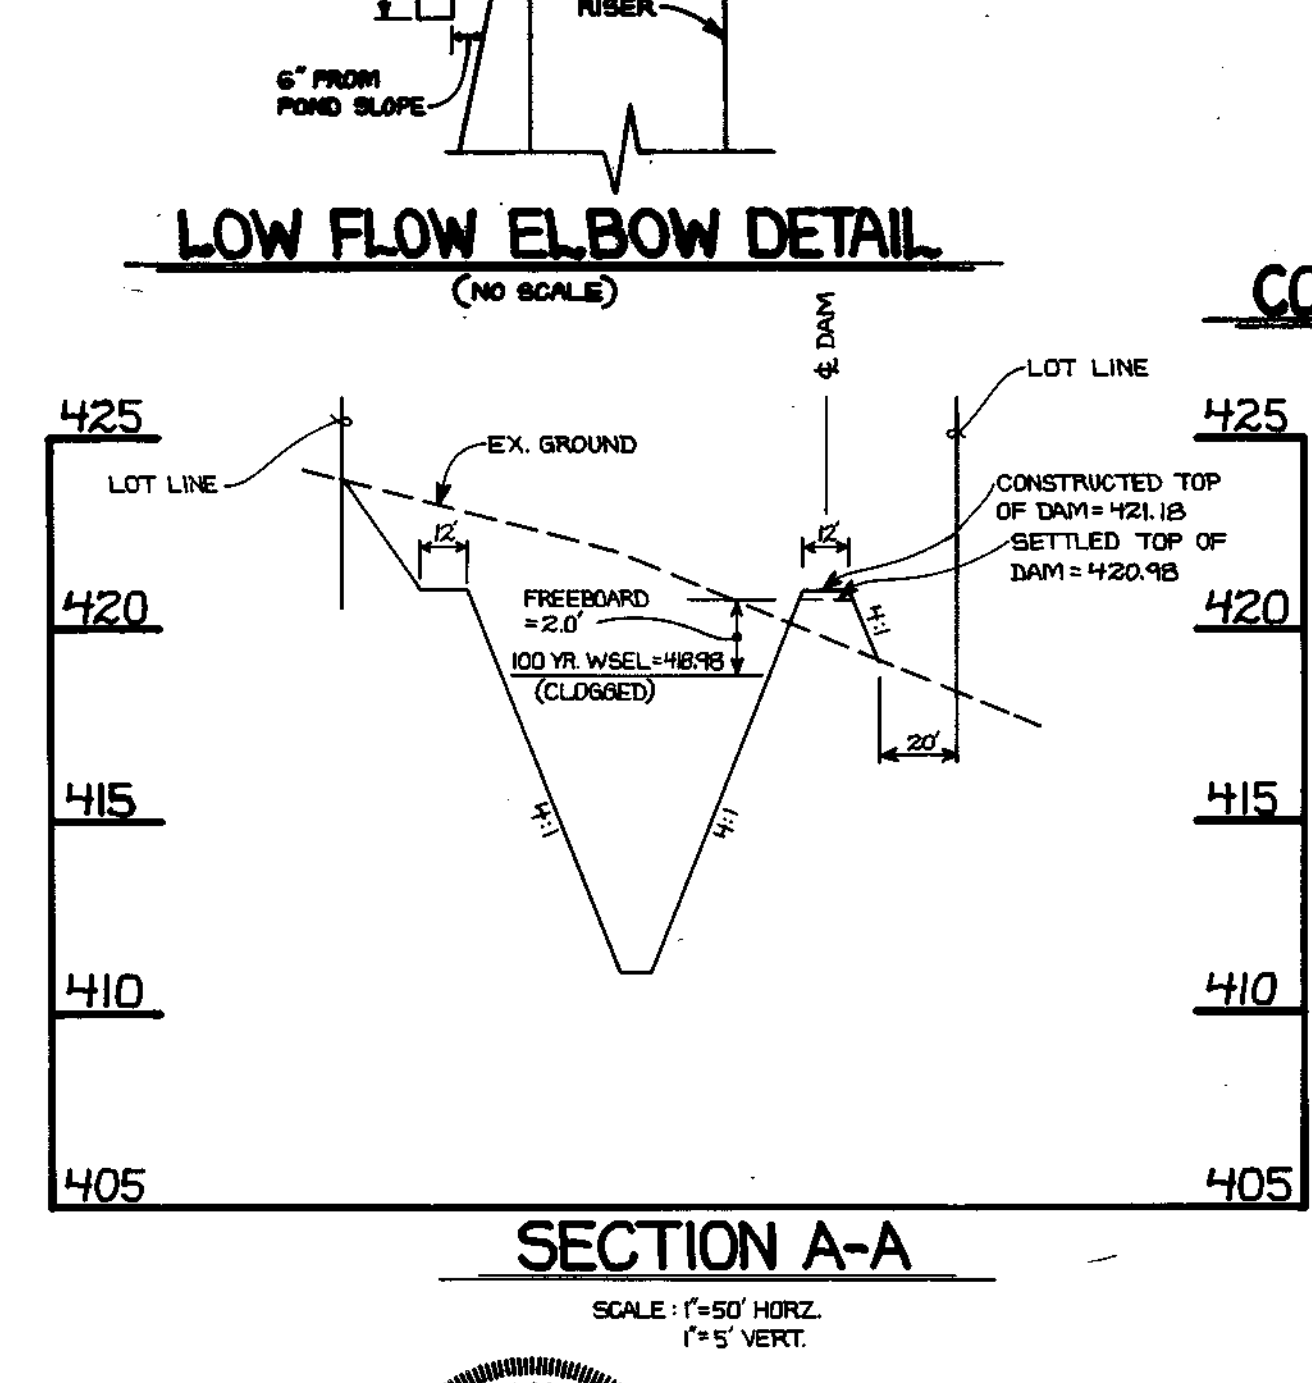

SECTION A-A
SCALE: 1"=50' HORIZ.
1"=5' VERT.

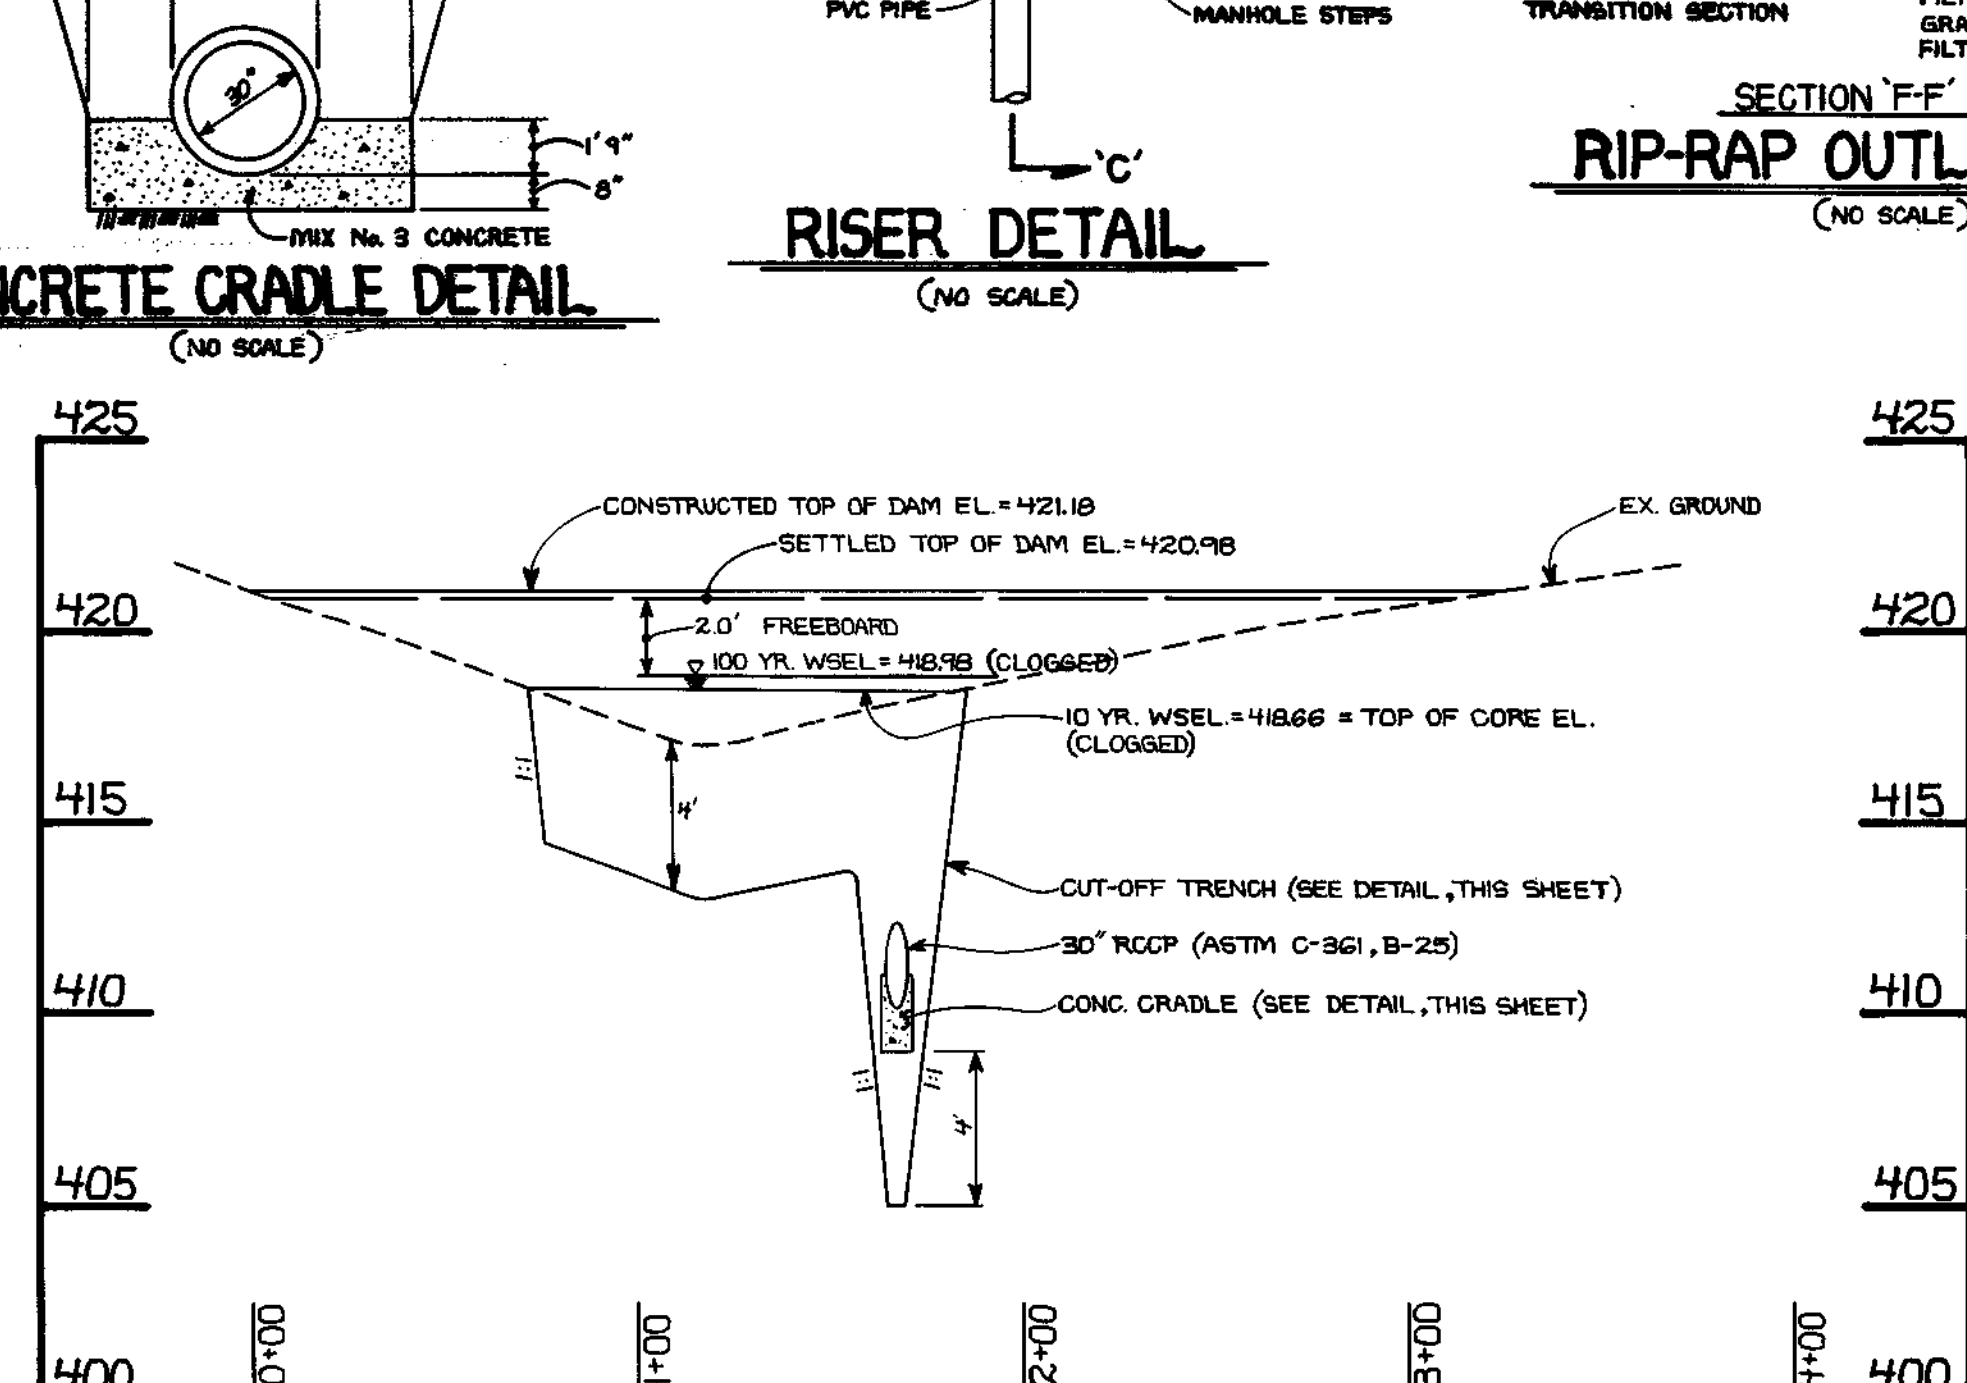

PROFILE THRU DAM
SCALE: 1"=50' HORIZ.
1"=5' VERT.

By The Developer:
 "I/We Certify That All Development And/Or Construction Will Be Done According To These Plans, And That Any Responsible Personnel Involved In The Construction Project Will Have A Certificate Of Attendance At A Department Of The Environment Approved Training Program For The Control Of Sediment And Erosion Before Beginning The Project. I Shall Engage A Registered Professional Engineer To Supervise Pond Construction And Provide The Howard Soil Conservation District With An "As-Built" Plan Of The Pond Within 30 Days Of Completion. I Also Authorize Periodic On-Site Inspections By The Howard Soil Conservation District."
 Signature Of Developer: *[Signature]* Date: 4/23/97
 Printed Name Of Developer: Par Brank

By The Engineer:
 "I Certify That This Plan For Pond Construction, Erosion And Sediment Control Represents A Practical And Workable Plan Based On My Personal Knowledge Of The Site Conditions. This Plan Was Prepared In Accordance With The Requirements Of The Howard Soil Conservation District. I Have Notified The Developer That He/She Must Engage A Registered Professional Engineer To Supervise Pond Construction And Provide The Howard Soil Conservation District With An "As-Built" Plan Of The Pond Within 30 Days Of Completion."
 Signature Of Engineer: *[Signature]* Date: 4-24-97
 Printed Name Of Engineer: JAYESH V. PANCHOLI

These Plans Have Been Reviewed For The Howard Soil Conservation District And Meet The Technical Requirements For Small Pond Construction, Soil Erosion And Sediment Control.
 Signature: *[Signature]* Date: 4/24/97
 USDA-Natural Resources Conservation Service

OWNER AND MAINTENANCE SCHEDULES OF HOME OWNERS ASSOCIATION OWNED AND MAINTAINED STORMWATER MANAGEMENT FACILITY WET POND.
 HOMEOWNERS ASSOCIATION'S MAINTENANCE RESPONSIBILITIES:
 1. TOP AND SIDE SLOPES OF THE EMBANKMENT SHALL BE MOWED A MIN. OF TWO (2) TIMES A YEAR, ONCE IN JUNE AND ONCE IN SEPTEMBER. OTHER SIDE SLOPES, AND MAINTENANCE ACCESS SHOULD BE MOWED, AS NEEDED.
 2. DEBRIS AND LITTER SHALL BE REMOVED DURING REGULAR MOWING OPERATIONS AND AS NEEDED.
 3. WHEN DEEMED NECESSARY FOR AESTHETIC REASONS, SEDIMENT SHOULD BE REMOVED FROM THE POND. APPROVAL FROM THE DEPARTMENT OF PUBLIC WORKS IS NEEDED.

OPERATION AND MAINTENANCE SPECIFICATIONS
 I HEREBY CERTIFY THAT I WILL OPERATE AND MAINTAIN THE COMPLETED POND IN ACCORDANCE WITH THE FOLLOWING:
 1. PERIODIC INSPECTIONS OF THE FACILITY WILL BE MADE TO IDENTIFY POTENTIAL PROBLEMS THAT MAY AFFECT ITS SAFETY. THESE INSPECTIONS WILL BE MADE AFTER PERIODS OF HEAVY RAINFALL AND AT LEAST TWICE ANNUALLY. INSPECTION REPORTS SHALL BE KEPT UNTIL THE NEXT SUBSEQUENT INSPECTION. INSPECTION ITEMS TO BE LOOKED AT INCLUDE:
 A) SPILLWAY AND OUTLET WORKS;
 B) RIP-RAP;
 C) VEGETATIVE COVER;
 D) CRACKS IN THE DAM;
 E) SLOPE FAILURES; AND
 F) SEEPAGE AND OTHER SIGNS OF DISTRESS.
 2. PROBLEMS IDENTIFIED DURING INSPECTIONS WILL BE PROMPTLY CORRECTED. MAJOR PROBLEMS WILL BE BROUGHT TO THE ATTENTION OF THE SOIL CONSERVATION DISTRICT AND THE DAM SAFETY DIVISION OF THE MARYLAND WATER RESOURCES ADMINISTRATION. AS A VERY MINIMUM, GRASSY VEGETATION WILL BE MAINTAINED IN A DENSE AND HEALTHY STATE, AND WOODY VEGETATION WILL NOT BE PERMITTED TO GROW ON THE EMBANKMENT.


NOTES:
 1. CONCRETE SHALL CONFORM TO THE HARBARD D.O.T. S.I.A. STANDARD SPEC'S FOR CONSTRUCTION AND MATERIALS, 1987 EDITION, 6, EXCEPT THAT TT, III CEMENT AND S.S.T.M. C 33 IS 1 COARSE AGG. SHALL BE USED.
 2. REINFORCING FABRIC SHALL CONFORM TO A.S.T.M. A-185, CAP SPACERS SHALL BE A MIN. OF 1 1/2" REINFORCING TIE SPACES. TIE BARS SHALL BE TACK WELDED TO PROVIDE A STIFF JOINT.
 3. ALL PIPES CONNECTING TO RISER SHALL DATE WATER-TIGHT CONNECTIONS.
 4. RISER SHALL BE CONSTRUCTED IN ONE PIECE.

These Plans For Small Pond Construction, Soil Erosion And Sediment Control Meet The Requirements Of The Howard Soil Conservation District.
 Signature: *[Signature]* Date: 8/12/97
 Howard Soil Conservation District

Approved: Department Of Public Works
 Signature: *[Signature]* Date: 9-26-97
 Chief, Bureau Of Highways

Approved: Department Of Planning And Zoning
 Signature: *[Signature]* Date: 9/12/97
 Chief, Division Of Land Development


STORMWATER MANAGEMENT PLAN
 NOTES & DETAILS
CEDAR ACRES
 LOTS 1 THRU 36
 A RESUBDIVISION OF LOTS 34 AND 5
 ZONED: RSC
 TAX MAP No. 35 PARCEL 36
 FIFTH ELECTION DISTRICT HOWARD COUNTY, MARYLAND
 SCALE: 1"=50' DATE: APRIL 22, 1997
 SHEET: 8 OF 9

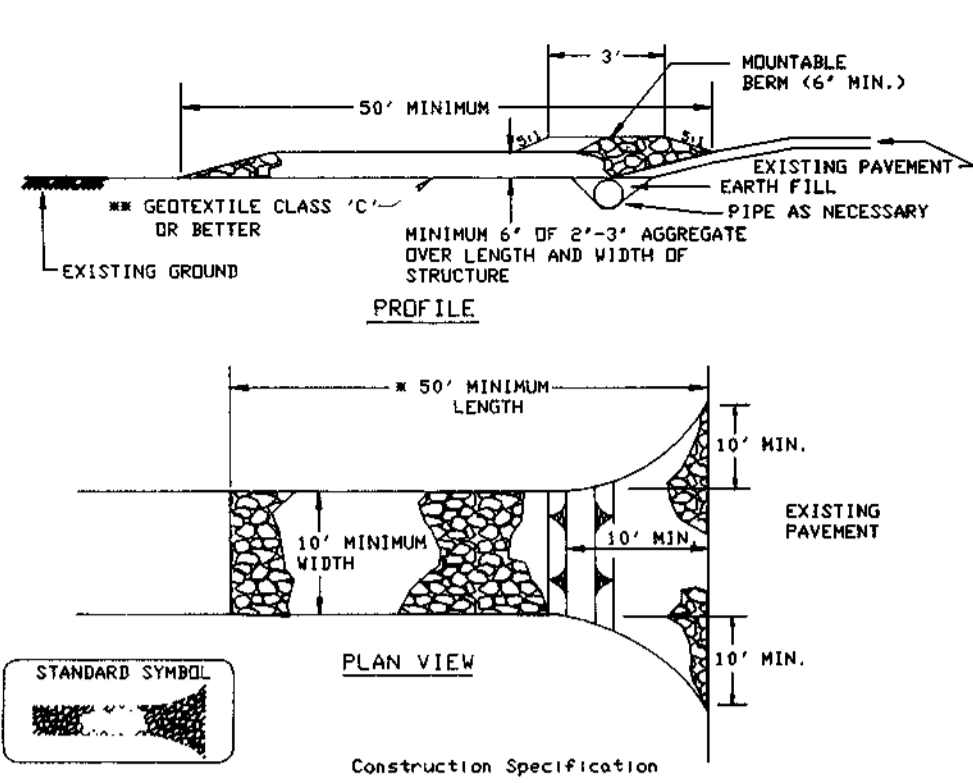

- Construction Specifications**
- Length - minimum of 50' (40' for single residence lot).
 - Width - 10' minimum, should be flared at the existing road to provide a turning radius.
 - Geotextile fabric (filter cloth) shall be placed over the existing ground prior to placing stone. Written plan approval authority may not require single family residences to use geotextile.
 - Stone - crushed aggregate (2" to 3") or reclaimed or recycled concrete equivalent shall be placed at least 6" deep over the length and width of the entrance.
 - Surface Water - all surface water flowing to or diverted toward construction entrances shall be piped through the entrance, maintaining positive drainage. Pipe installed through the stabilized construction entrance shall be protected with a mountable berm with 2:1 slopes and a minimum of 6" of stone over the pipe. Pipe has to be sized according to the drainage. When the size is located at a high spot and has no drainage to convey a pipe will not be necessary. Pipe should be sized according to the amount of runoff to be conveyed. A 6" minimum will be required.
 - Location - A stabilized construction entrance shall be located at every point where construction traffic enters or leaves a construction site. Vehicles leaving the site must drive over the entire length of the stabilized construction entrance.

STABILIZED CONSTRUCTION ENTRANCE - 2

NOT TO SCALE

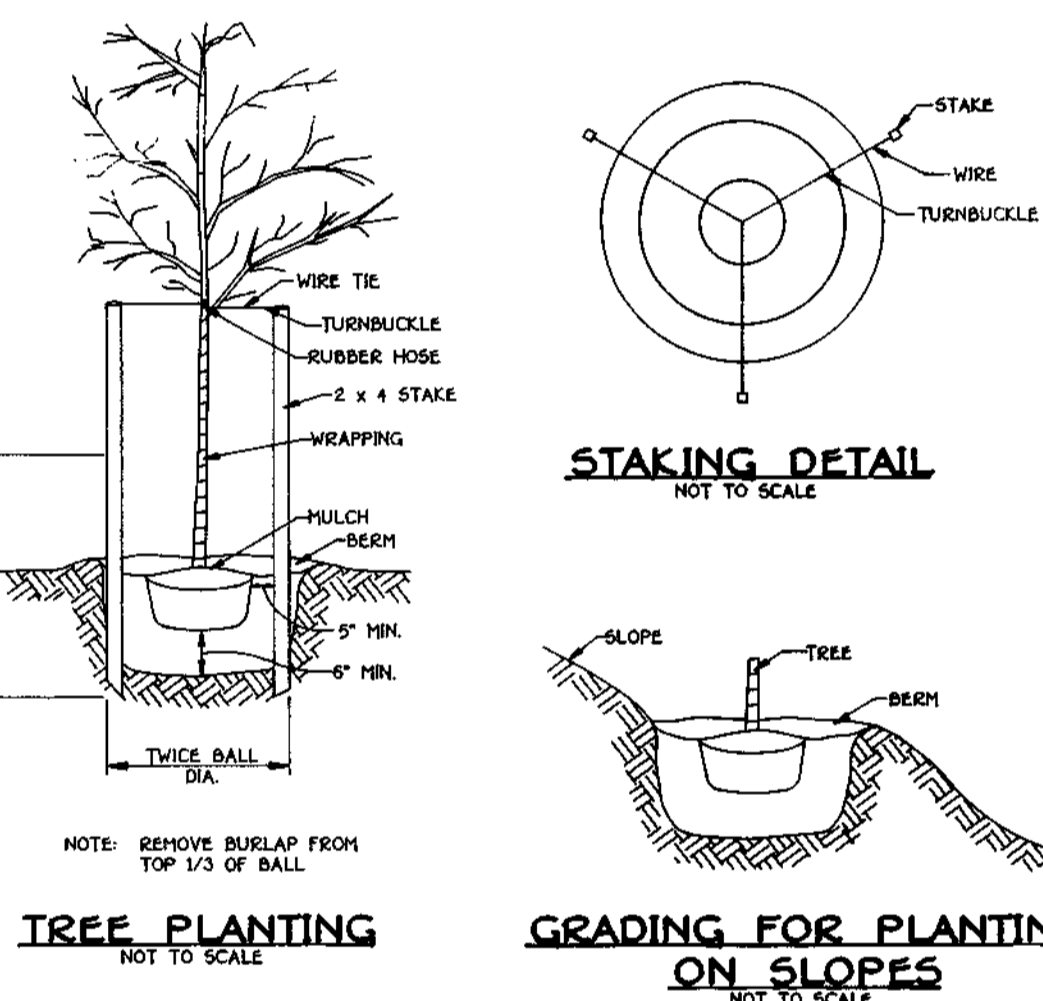

TREE PLANTING

GRADING FOR PLANTING ON SLOPES

SEDIMENT CONTROL NOTES

- A MINIMUM OF 48 HOURS NOTICE MUST BE GIVEN TO THE HOWARD COUNTY DEPARTMENT OF INSPECTIONS, LICENSES AND PERMITS, SEDIMENT CONTROL DIVISION PRIOR TO THE START OF ANY CONSTRUCTION (03-18-99).
- ALL VEGETATIVE AND STRUCTURAL PRACTICES ARE TO BE INSTALLED ACCORDING TO THE PROVISIONS OF THIS PLAN AND ARE TO BE IN CONFORMANCE WITH THE MOST CURRENT MARYLAND STANDARDS AND SPECIFICATIONS FOR SOIL EROSION AND SEDIMENT CONTROL AND REVISIONS THERETO.
- FOLLOWING INITIAL SOIL DISTURBANCE OR RE-DISTURBANCE, PERMANENT OR TEMPORARY STABILIZATION SHALL BE COMPLETED WITHIN: a) 7 CALENDAR DAYS FOR ALL PERIMETER SEDIMENT CONTROL STRUCTURES, DIKES, PERIMETER SLOPES AND ALL SLOPES STEEPER THAN 3:1, b) 14 DAYS AS TO ALL OTHER DEREGULATED OR GRADED AREAS ON THE PROJECT SITE.
- ALL SEDIMENT TRAP/VASONS SHOW MUST BE FENCED AND WARNING SIGNS POSTED AROUND THEIR PERIMETER IN ACCORDANCE WITH VOL. 1, CHAPTER 12, OF THE HOWARD COUNTY DESIGN MANUAL, STORM DRAINAGE.
- ALL DISTURBED AREAS MUST BE STABILIZED WITHIN THE TIME PERIOD SPECIFIED ABOVE IN ACCORDANCE WITH THE 1994 MARYLAND STANDARDS AND SPECIFICATIONS FOR SOIL EROSION AND SEDIMENT CONTROL FOR PERMANENT SEEDING (SEC. 50), SOD (SEC. 54), TEMPORARY SEEDING (SEC. 50), AND MULCHING (SEC. 52). TEMPORARY STABILIZATION WITH MULCH ALONE CAN ONLY BE DONE WHEN RECOMMENDED SEEDING DATES DO NOT ALLOW FOR PROPER GERMINATION AND ESTABLISHMENT OF GRASSES.
- ALL SEDIMENT CONTROL STRUCTURES ARE TO REMAIN IN PLACE AND ARE TO BE MAINTAINED IN OPERATIVE CONDITION UNTIL PERMISSION FOR THEIR REMOVAL HAS BEEN OBTAINED FROM THE HOWARD COUNTY SEDIMENT CONTROL INSPECTOR.
- SITE ANALYSIS:

TOTAL AREA OF SITE	8.54 ACRES
AREA DISTURBED	2.50 ACRES
AREA TO BE ROOFED OR PAVED	2.10 ACRES
AREA TO BE VEGETATIVELY STABILIZED	5.40 ACRES
TOTAL FILL	10,000 CU.YDS.
OFFSITE WASTE/BORROW AREA LOCATION	CU.YDS.
- ALL DISTURBED AREAS WHICH IS DISTURBED BY CONING ACTIVITY FOR PLACEMENT OF UTILITIES MUST BE REPAIRED ON THE SAME DAY OF DISTURBANCE.
- ADDITIONAL SEDIMENT CONTROLS MUST BE PROVIDED, IF DEEMED NECESSARY BY THE HOWARD COUNTY SEDIMENT CONTROL INSPECTOR.
- ON ALL SITES WITH DISTURBED AREAS IN EXCESS OF 2 ACRES, APPROVAL OF THE INSPECTION AGENCY SHALL BE REQUESTED UPON COMPLETION OF INSTALLATION OF PERIMETER EROSION AND SEDIMENT CONTROLS, BUT BEFORE PROCEEDING WITH ANY OTHER EARTH DISTURBANCE OR GRADING. OTHER BUILDING OR GRADING INSPECTION APPROVALS MAY NOT BE AUTHORIZED UNTIL THIS INITIAL APPROVAL BY THE INSPECTION AGENCY IS MADE.
- TRENCHES FOR THE CONSTRUCTION OF UTILITIES IS LIMITED TO THREE PIPE LENGTHS OR THAT WHICH SHALL BE BACK-FILLED AND STABILIZED WITHIN ONE WORKING DAY, WHICHEVER IS SHORTER.


FISHER, COLLINS & CARTER, INC.
 CIVIL ENGINEERING CONSULTANTS & LAND SURVEYORS
 CENTENNIAL SQUARE OFFICE PARK - 10772 BALTIMORE NATIONAL PIKE
 ELLICOTT CITY, MARYLAND 21114
 (410) 461-2855

OWNER

BENJAMIN K. BAGSLER
 AND ELISE WAE BAGSLER
 10755 MARYLAND ROUTE 99
 WOODSTOCK, MD. 21163

DEVELOPER


CHADSWORTH HOMES, INC.
 P.O. BOX 6641
 MCLEAN, VIRGINIA 22106-6641

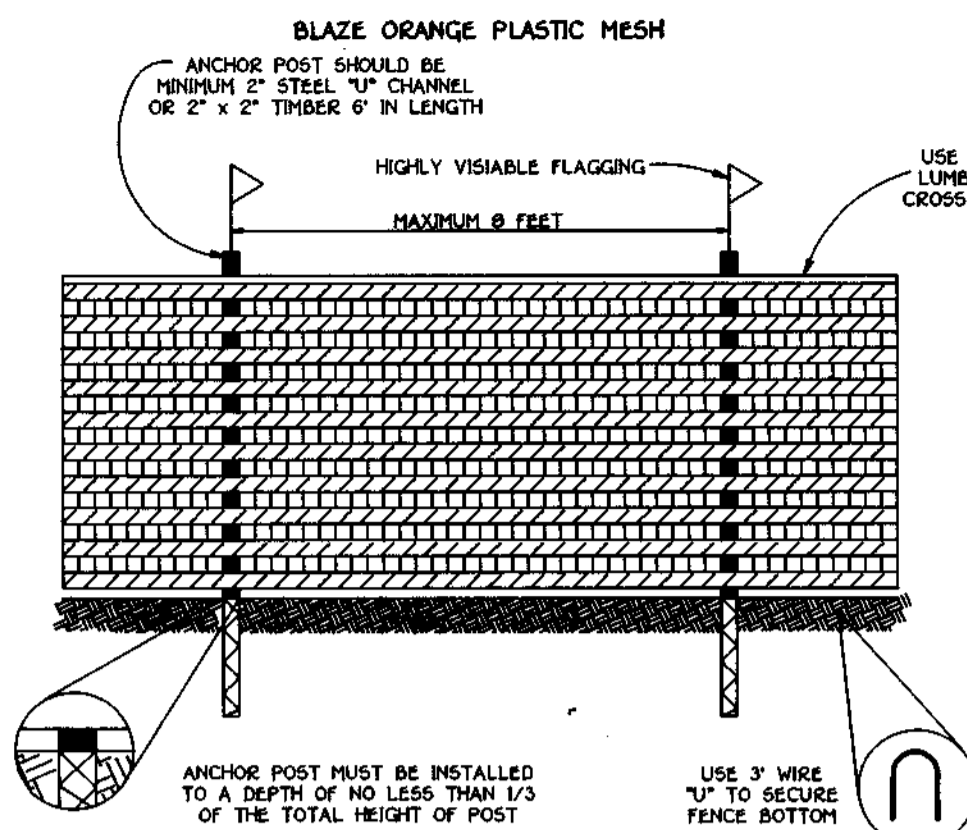

TREE PROTECTION DETAIL

NOT TO SCALE

- NOTES:**
- FORREST PROTECTION DEVICE ONLY.
 - RETENTION AREA WILL BE SET AS PART OF THE REVIEW PROCESS.
 - BOUNDARIES OF RETENTION AREA SHOULD BE STAKED AND FLAGGED PRIOR TO INSTALLING DEVICE.
 - ROOT DAMAGE SHOULD BE AVOIDED.
 - PROTECTIVE SIGNAGE MAY ALSO BE USED.
 - DEVICE SHOULD BE MAINTAINED THROUGHOUT CONSTRUCTION.

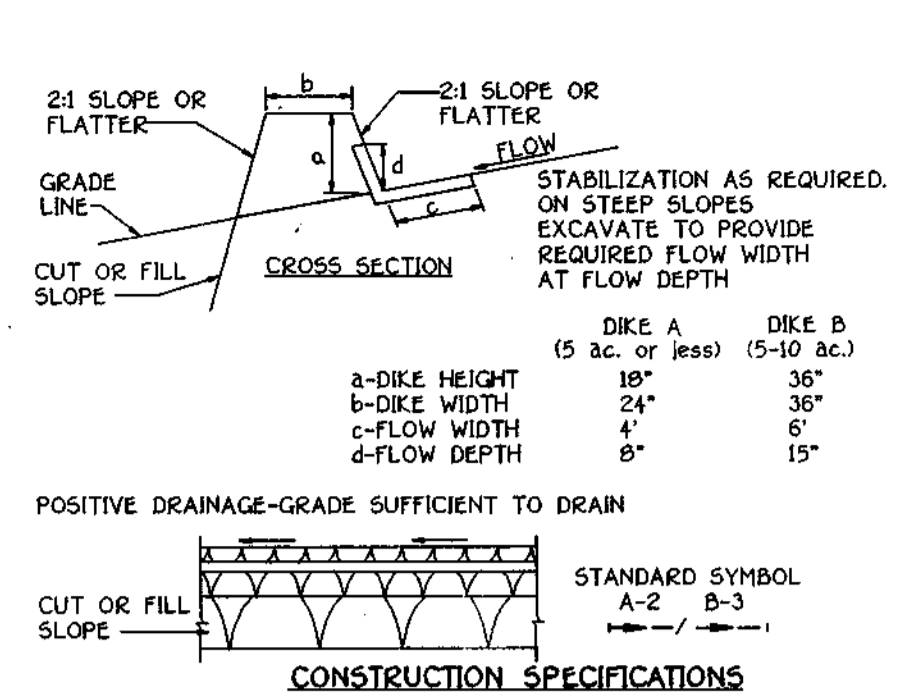

CONSTRUCTION SPECIFICATIONS

- ALL DIKES SHALL BE COMPACTED BY EARTH-MOVING EQUIPMENT.
- ALL DIKES SHALL HAVE POSITIVE DRAINAGE TO AN OUTLET.
- TOP WIDTH MAY BE WIDER AND SIDE SLOPES MAY BE FLATTER IF DESIRED TO FACILITATE CROSSING BY CONSTRUCTION TRAFFIC.
- FIELD LOCATION SHOULD BE ADJUSTED AS NEEDED TO UTILIZE A STABILIZED SAFE OUTLET.
- EARTH DIKES SHALL HAVE AN OUTLET THAT FUNCTIONS WITH A MINIMUM OF EROSION RUNOFF SHALL BE CONVEYED TO A SEDIMENT BASIN WHERE EITHER THE DIKE CHANNEL OR THE DRAINAGE AREA ABOVE THE DIKE ARE NOT ADEQUATELY STABILIZED.
- STABILIZATION SHALL BE: (A) IN ACCORDANCE WITH STANDARD SPECIFICATIONS FOR SEED AND STRAW MULCH OR STRAW MULCH IF NOT IN SEEDING SEASON, (B) FLOW CHANNEL AS PER THE CHART BELOW.

FLOW CHANNEL STABILIZATION

TYPE OF TREATMENT	CHANNEL GRADE	DIKE A	DIKE B
1	5-3.0X	SEED AND STRAW MULCH	SEED AND STRAW MULCH
2	3:1-5.0X	SEED AND STRAW MULCH	SEED USING JUTE, OR EXCELLO-SOD, 2" STONE
3	5:1-8.0X	SEED WITH JUTE, OR SOD, 2" STONE	LINED RIP-RAP 4"-8"
4	8:1-20X	LINED RIP-RAP 4"-8"	ENGINEERING DESIGN

- STONE TO BE 2 INCH STONE, OR RECYCLED CONCRETE EQUIVALENT, IN A LAYER AT LEAST 3 INCHES IN THICKNESS AND BE PRESSED INTO THE SOIL WITH CONSTRUCTION EQUIPMENT.
 - RIE-RAP TO BE 4-8 INCHES IN A LAYER AT LEAST 8 INCHES THICKNESS AND PRESSED INTO THE SOIL.
 - APPROVED EQUIVALENTS CAN BE SUBSTITUTED FOR ANY OF THE ABOVE MATERIALS.
7. PERIODIC INSPECTION AND REQUIRED MAINTENANCE MUST BE PROVIDED AFTER EACH RAIN EVENT.

EARTH DIKE

NOT TO SCALE

VEGETATIVE STABILIZATION

DEFINITION

PURPOSE

CONDITIONS WHERE PRACTICE APPLIES

EFFECTS ON WATER QUALITY AND QUANTITY

SECTION 1 - VEGETATIVE STABILIZATION METHODS AND MATERIALS

A. Site Preparation

B. Soil Amendments (Fertilizer and Lime Specifications)

C. Seeded Preparation

D. Permanent Seeding


E. Methods of Seeding

F. Mulch Specifications (in order of preference)

G. Mating Seeded Areas - Mulch

H. Securing Straw Mulch (Mulch Anchoring)

DETAIL 23C - CURB INLET PROTECTION (COG OR COS INLETS)

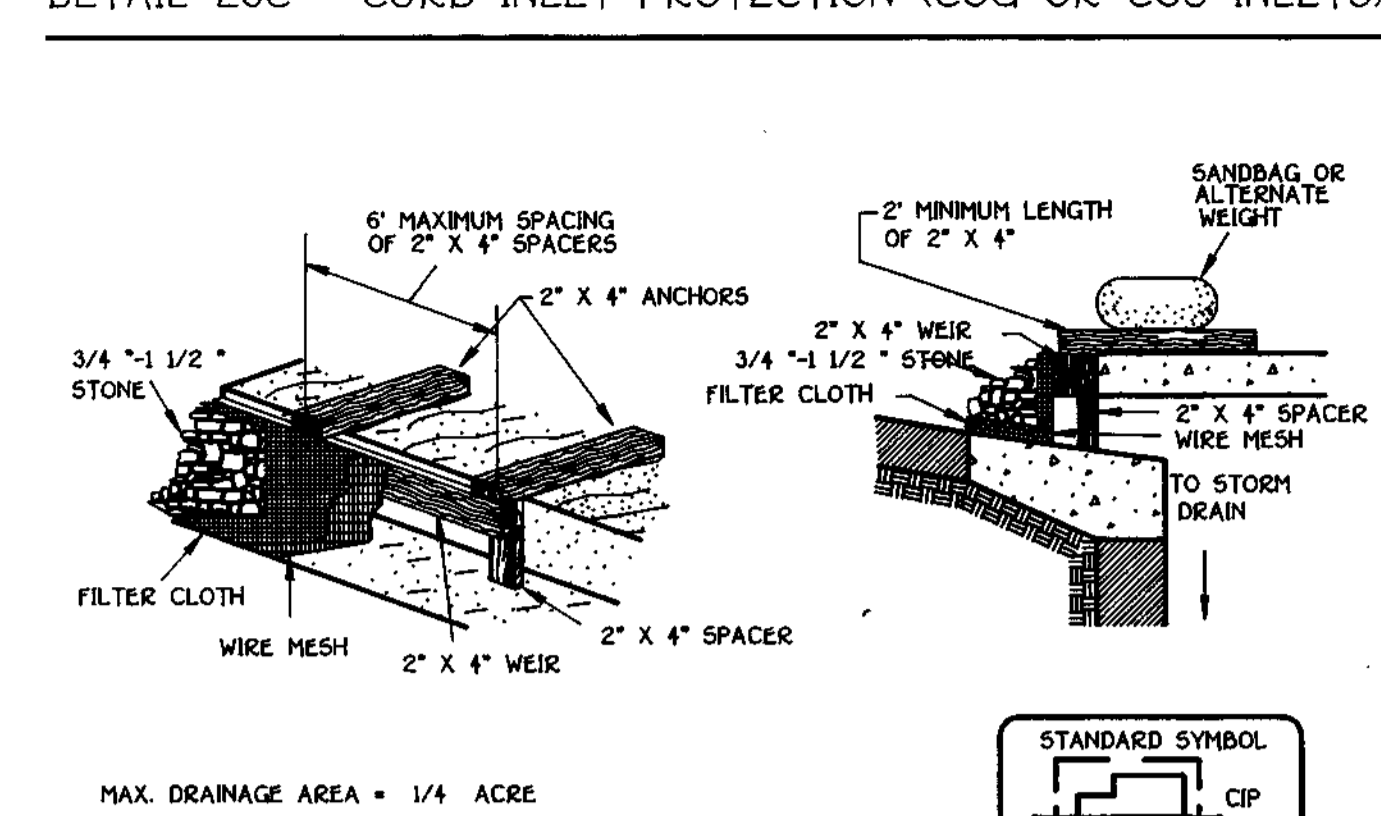

MAX. DRAINAGE AREA = 1/4 ACRE

CONSTRUCTION SPECIFICATIONS

- Attach a continuous piece of wire mesh (30" minimum width by throat length plus 4") to the 2" x 4" weir (measuring throat length plus 2") as shown on the standard drawing.
- Place a continuous piece of Geotextile Class F of the same dimensions as the wire mesh over the wire mesh and securely attach it to the 2" x 4" weir.
- Securely nail the 2" x 4" weir to a 9" long vertical spacer to be located between the weir and the inlet face (max. 4" apart).
- Place the assembly against the inlet throat and nail (minimum 2" length of 2" x 4" to the top of the weir at spacer locations). These 2" x 4" anchors shall extend across the inlet top and be held in place by sandbags or alternate weight.
- The assembly shall be placed so that the end spacers are a minimum 1" beyond both ends of the throat opening.
- Form the 1/2" x 1/2" wire mesh and the geotextile fabric to the concrete gutter and against the face of the curb on both sides of the inlet. Place clean 3/4" x 1/2" stone over the wire mesh and geotextile in such a manner to prevent water from entering the inlet under or around the geotextile.
- This type of protection must be inspected frequently and the filter cloth and stone replaced when clogged with sediment.
- Assure that storm flow does not bypass the inlet by installing a temporary earth or asphalt dike to direct the flow to the inlet.

INCREMENTAL STABILIZATION - CUT SLOPES

CONSTRUCTION SEQUENCE (Refer to Figure 3 below)

CONSTRUCTION SEQUENCE (Refer to Figure 4 below)

CONSTRUCTION SEQUENCE (Refer to Figure 5 below)

CONSTRUCTION SEQUENCE (Refer to Figure 58 below)

DEVELOPER'S CERTIFICATE

"I/WE CERTIFY THAT ALL DEVELOPMENT AND CONSTRUCTION WILL BE DONE ACCORDING TO THIS PLAN OF DEVELOPMENT AND THAT ANY RESPONSIBLE PERSONNEL IN THE CONSTRUCTION PROJECT WILL HAVE A CERTIFICATE OF ATTENDANCE AT A DEPARTMENT OF NATURAL RESOURCES APPROVED TRAINING PROGRAM FOR THE CONTROL OF SEDIMENT AND EROSION BEFORE BEGINNING THE PROJECT. I ALSO AUTHORIZE PERIODIC ON-SITE INSPECTION BY THE HOWARD COUNTY SOIL CONSERVATION DISTRICT OR THEIR AUTHORIZED AGENTS, AS ARE DEEMED NECESSARY."

SIGNATURE OF DEVELOPER: _____ DATE: 1/23/97

ENGINEER'S CERTIFICATE

"I HEREBY CERTIFY THAT THIS PLAN FOR EROSION AND SEDIMENT CONTROL REPRESENTS A PRACTICAL AND WORKABLE PLAN BASED ON MY PERSONAL KNOWLEDGE OF THE SITE CONDITION AND THAT IT WAS PREPARED IN ACCORDANCE WITH THE REQUIREMENTS OF THE HOWARD COUNTY SOIL CONSERVATION DISTRICT."

SIGNATURE OF ENGINEER: _____ DATE: 4-24-97

REVIEW FOR HOWARD COUNTY SOIL CONSERVATION DISTRICT AND MEETS TECHNICAL REQUIREMENTS. DATE: 8/12/97

THIS DEVELOPMENT IS APPROVED FOR EROSION AND SEDIMENT CONTROL BY THE HOWARD COUNTY SOIL CONSERVATION DISTRICT. DATE: 8/12/97

APPROVED: DEPARTMENT OF PLANNING AND ZONING. DATE: 9/12/97

APPROVED: DEPARTMENT OF PLANNING AND ZONING. DATE: 9/12/97


APPROVED: HOWARD COUNTY DEPARTMENT OF PUBLIC WORKS. DATE: 8-26-97

CHIEF, BUREAU OF HIGHWAYS

SEQUENCE OF CONSTRUCTION

- OBTAIN GRADING PERMIT (1 DAY).
- NOTIFY "MISS UTILITY" 48 HOURS BEFORE BEGINNING ANY WORK AT 1-800-257-7777. NOTIFY HOWARD COUNTY OFFICE OF CONSTRUCTION/INSPECTION DIVISION (430) 313-1870, 24 HOURS BEFORE STARTING ANY WORK.
- INSTALL ALL TREE PROTECTION FENCE FOR TREES TO BE UNDISTURBED (1 DAY).
- INSTALL SEDIMENT CONTROL MEASURES, STONE CONSTRUCTION ENTRANCE, EARTH DIKES, SILT FENCE, INLET PROTECTIONS AND SEDIMENT BASIN.
- GRADE SITE TO SUBGRADE, STABILIZE AND INSTALL STORM DRAINAGE (14 WEEKS).
- THE CONTRACTOR SHALL INSPECT AND PROVIDE NECESSARY MAINTENANCE ON ALL SEDIMENT AND EROSION CONTROL STRUCTURES SHOWN HEREON AFTER EACH RAINFALL AND ON A DAILY BASIS.
- SEDIMENT SHALL BE REMOVED FROM THE SEDIMENT BASIN, ONCE THE CLEAROUT ELEVATIONS HAVE BEEN REACHED. ALL AREAS DISTURBED DUE TO THE REMOVAL OF SEDIMENT CONTROL STRUCTURES SHALL BE GRADED AND STABILIZED BY PERMANENT SEEDING (2 DAYS).
- INSTALL CURB AND GUTTER AND ROAD BASE COURSE (7 DAYS).
- STABILIZE ALL DISTURBED AREAS AND OBTAIN PERMISSION FROM SEDIMENT CONTROL INSPECTORS TO PROCEED (2 DAYS).
- CONVERT SEDIMENT BASIN TO THE PERMANENT STORMWATER MANAGEMENT POND (2 DAYS).
- UPON APPROVAL OF THE SEDIMENT CONTROL INSPECTOR, REMOVE ALL SEDIMENT CONTROL MEASURES NOT NEEDED AND FLUSH STORM DRAIN SYSTEM TO REMOVE TRAPPED SEDIMENT (2 DAYS).
- ALL AREAS DISTURBED DUE TO THE REMOVAL OF SEDIMENT CONTROL STRUCTURES SHALL BE GRADED AND STABILIZED BY PERMANENT SEEDING (2 DAYS).

DETAIL 22 - SILT FENCE

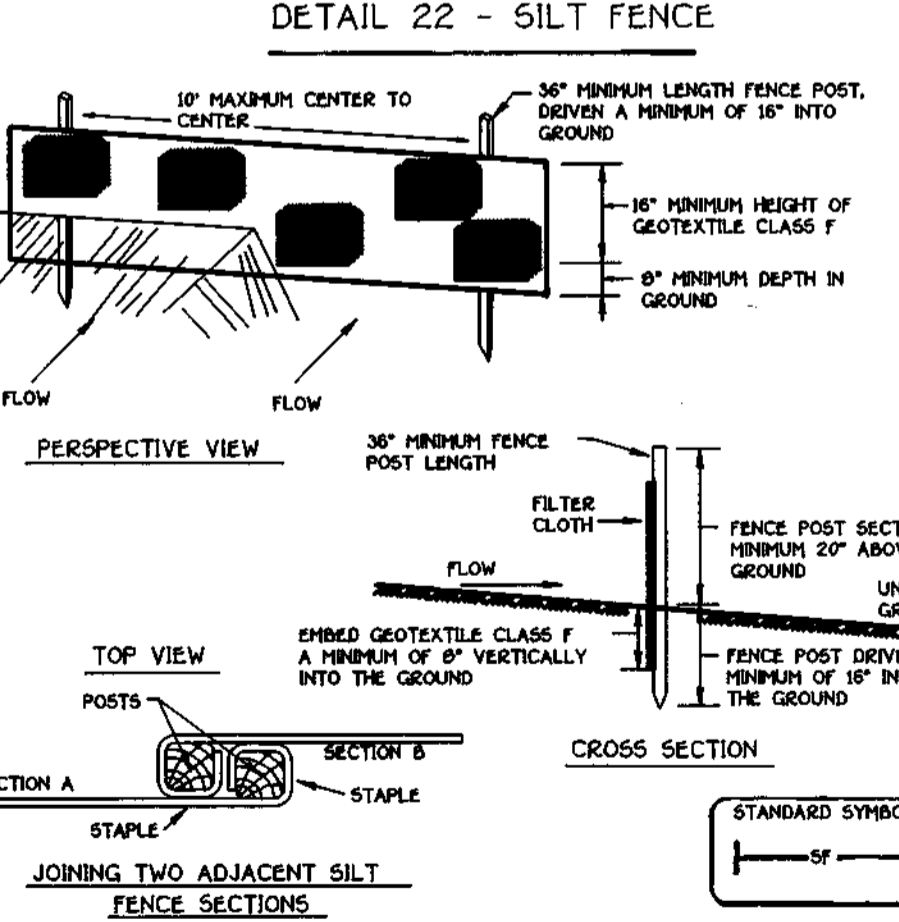

CONSTRUCTION SPECIFICATIONS

- Fence posts shall be a minimum of 36" long driven 18" minimum into the ground. Wood posts shall be 1 1/2" x 1 1/2" square (minimum cut), or 1 1/4" diameter (minimum) round and shall be of sound quality hardwood. Steel posts will be standard T or U section weighing not less than 1.00 pound per linear foot.
 - Geotextile shall be fastened securely to each fence post with wire ties or staples at top and mid-section and shall meet the following requirements for Geotextile Class F:
- | | | |
|----------------------|----------------|----------------|
| Tensile Strength | 50 lb/in (min) | Test: HSMT 509 |
| Tensile Modulus | 20 lb/in (min) | Test: HSMT 509 |
| Fiber Rate | 80 lb/ft (min) | Test: HSMT 509 |
| Filtering Efficiency | 75% (min) | Test: HSMT 509 |
- Where ends of geotextile fabric come together, they shall be overlapped, folded and stapled to prevent sediment bypass.
 - Silt fence shall be inspected after each rainfall event and maintained when damaged or when sediment accumulation reaches 50% of the fabric height.

SEDIMENT CONTROL NOTES AND DETAILS

LOTS 1 THRU 36

CEDAR ACRES

A RESUBDIVISION OF LOTS 3,4 AND 5

ZONED: RSC


TAX MAP NO. 35 PARCEL 3B

FIFTH ELECTION DISTRICT HOWARD COUNTY, MARYLAND

SCALE: AS SHOWN DATE: APRIL 22, 1997



SHEET 3 OF 9

F-97-115

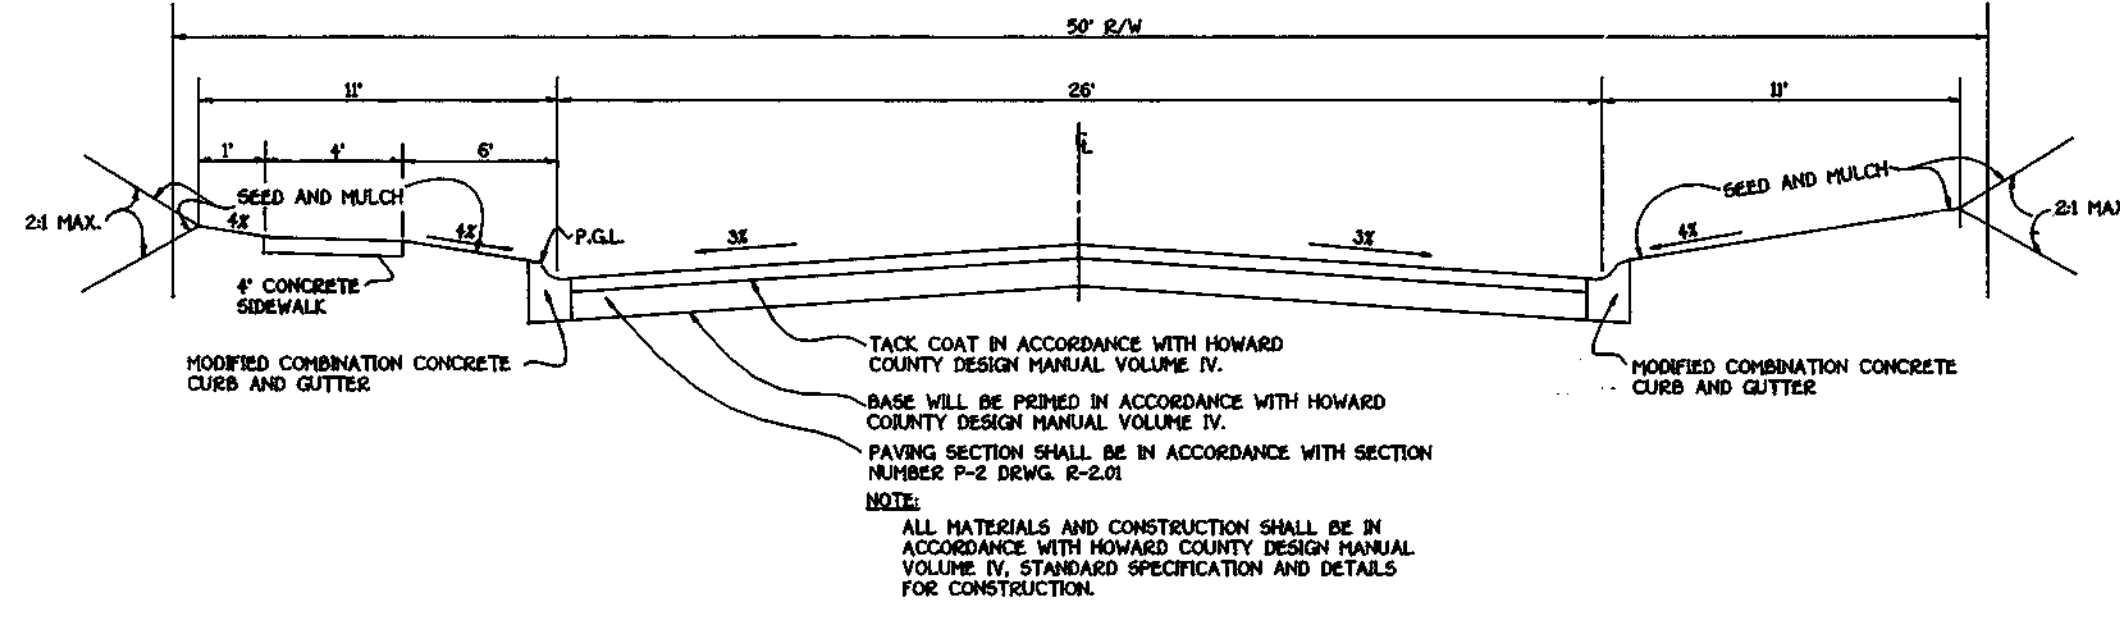

ROADWAY INFORMATION CHART

ROAD NAME	CLASSIFICATION	DESIGN SPEED	ZONING	STATION LIMITS
HOLLAND COURT	LOCAL ROAD	30 MPH	RSC	0+00 TO 6+35
NORWAY COURT	CL-DE-SAC	25 MPH	RSC	0+00 TO 301+47
OSLO COURT	CL-DE-SAC	25 MPH	RSC	0+00 TO 2+55.47

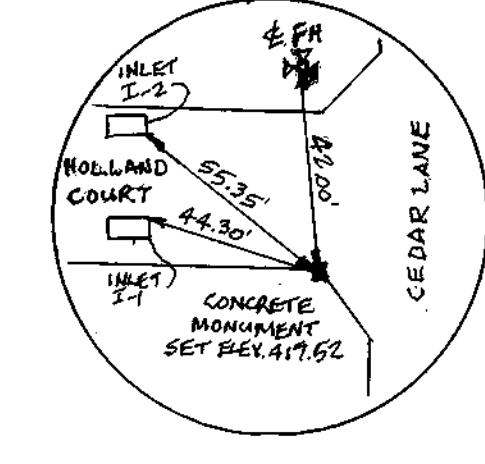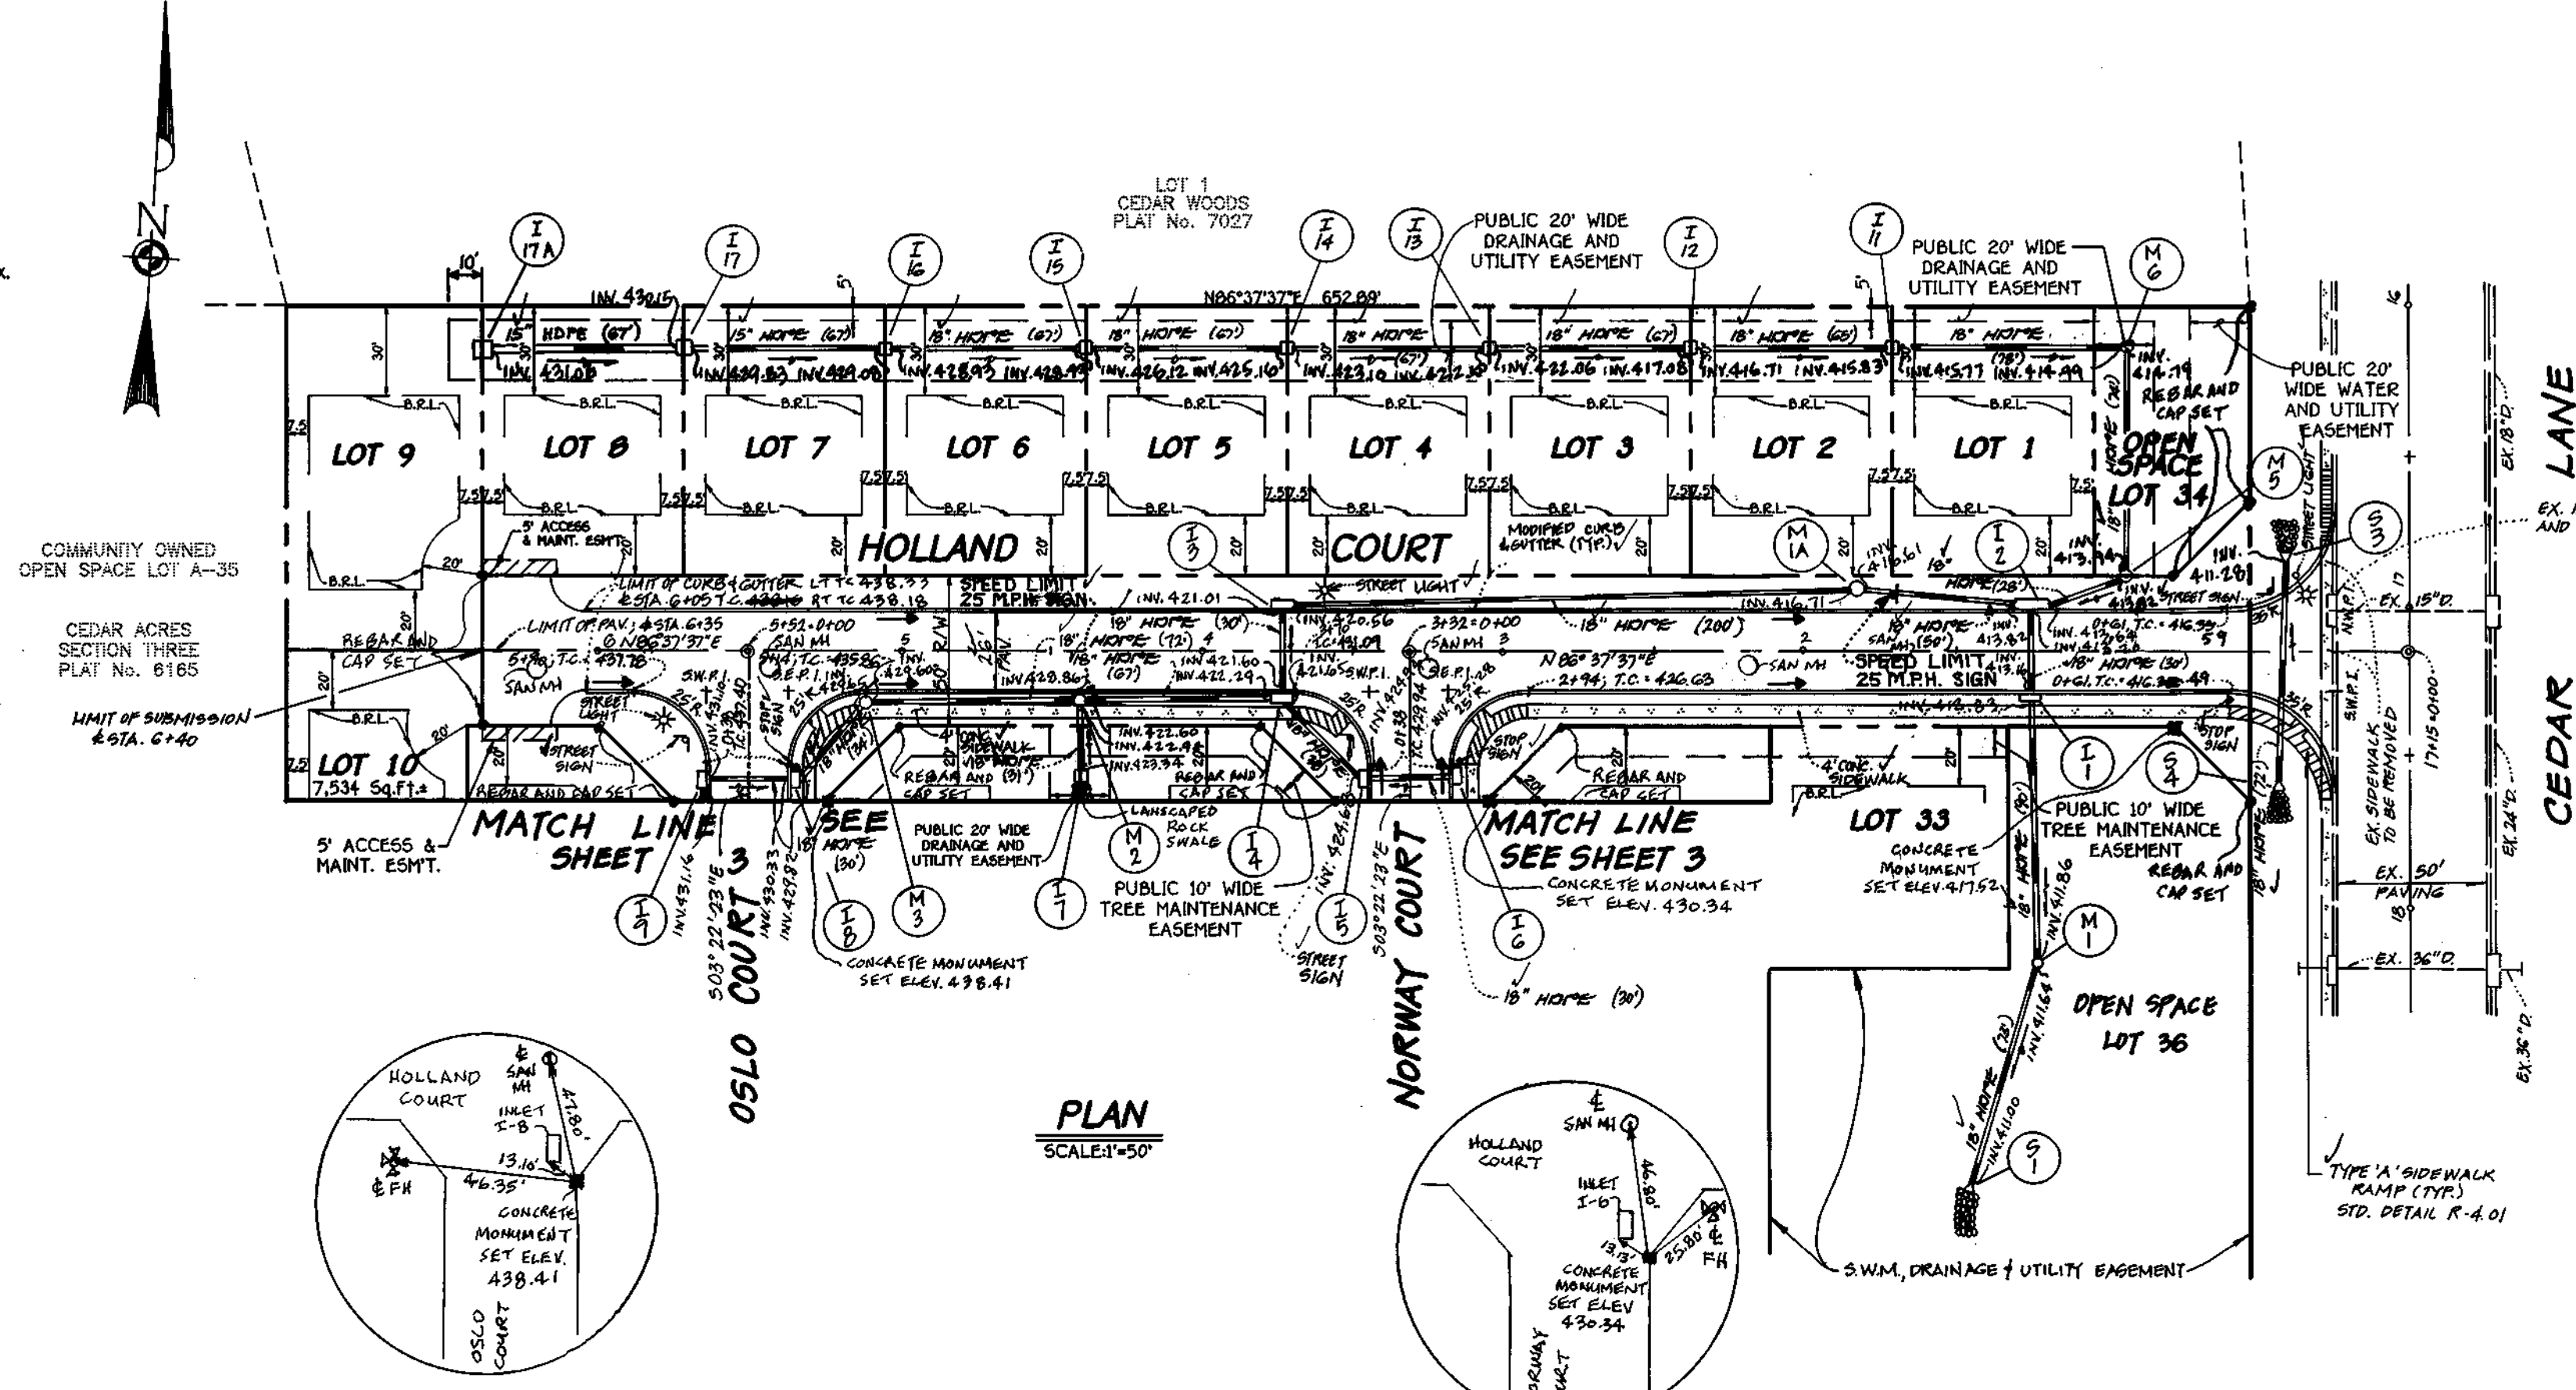

NOTE: THIS SHEET SUPERSEDES THE PREVIOUSLY SIGNED ORIGINAL DRAWING.

APPROVED: DEPARTMENT OF PLANNING AND ZONING

Cinda Hammett 7/23/98
CHIEF, DIVISION OF LAND DEVELOPMENT AND RESEARCH DATE

APPROVED: DEPARTMENT OF PLANNING AND ZONING

Mark Dammann 7/23/98
CHIEF, DEVELOPMENT ENGINEERING DIVISION DATE

APPROVED: HOWARD COUNTY DEPARTMENT OF PUBLIC WORKS

Robert M. Daniels 7-17-98
CHIEF, BUREAU OF HIGHWAYS DATE

CEDAR ACRES SECTION 3, LOTS 1-36
A RESUBDIVISION OF LOTS 3, 4 & 5
FIFTH ELECTION DISTRICT HOWARD COUNTY, MARYLAND



HOLLAND COURT PLAN AND PROFILE


OWNER
BENJAMIN E. BASSLER AND
ELSIE MAE BASSLER
10739 ROUTE 99
WOODSTOCK, MARYLAND 21163

DEVELOPER
CHADSWORTH HOMES, INC.
P.O. BOX 6641
MCLEAN, VIRGINIA 22106-6641

SCALE: AS SHOWN DATE: JANUARY, 1998 DWG. NO. 2 OF 9
DES. JAYESH PANCHOL DRN. J.A.U. CHK. C.J.C.

FISHER, COLLINS & CARTER, INC.
CIVIL ENGINEERING CONSULTANTS & LAND SURVEYORS
CENTENNIAL SQUARE OFFICE PARK - 10272 BALTIMORE NATIONAL FIRE
ELICOTT CITY, MARYLAND 21042
1931-1935

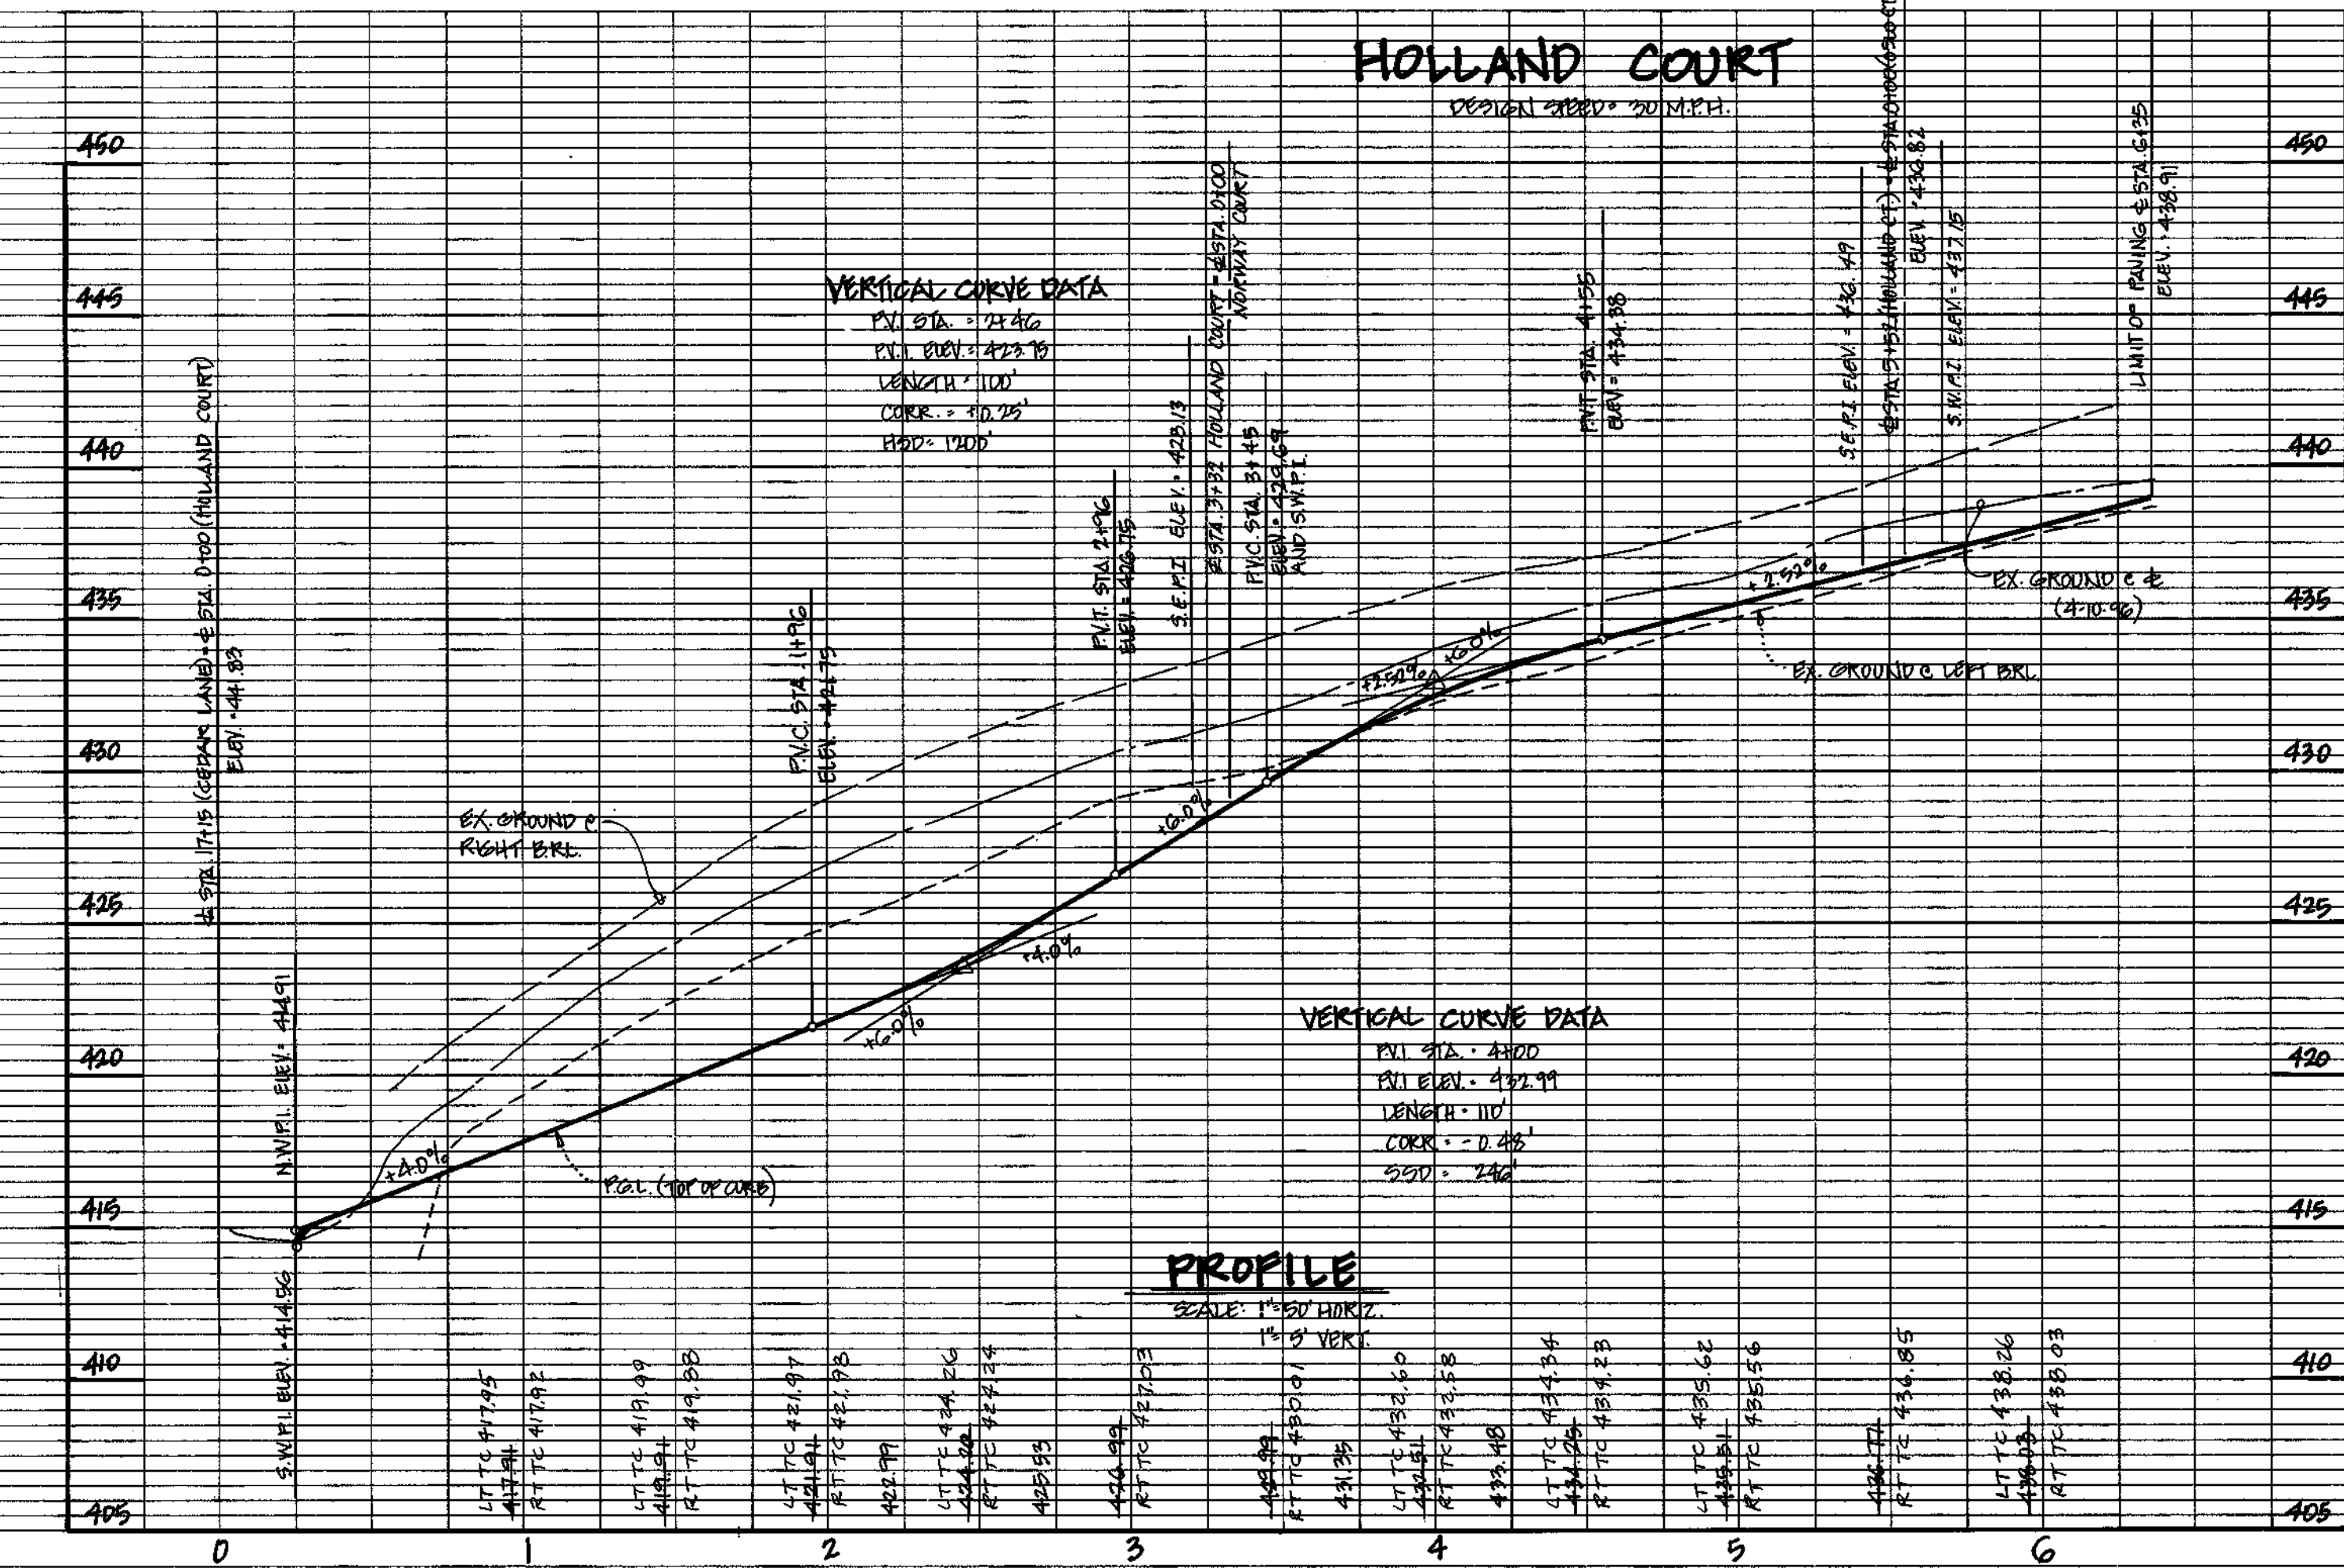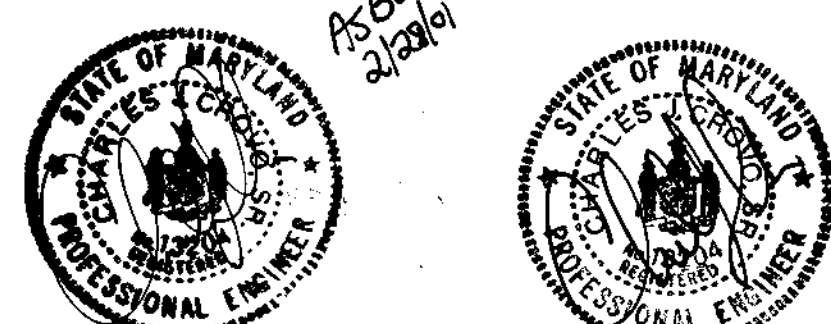

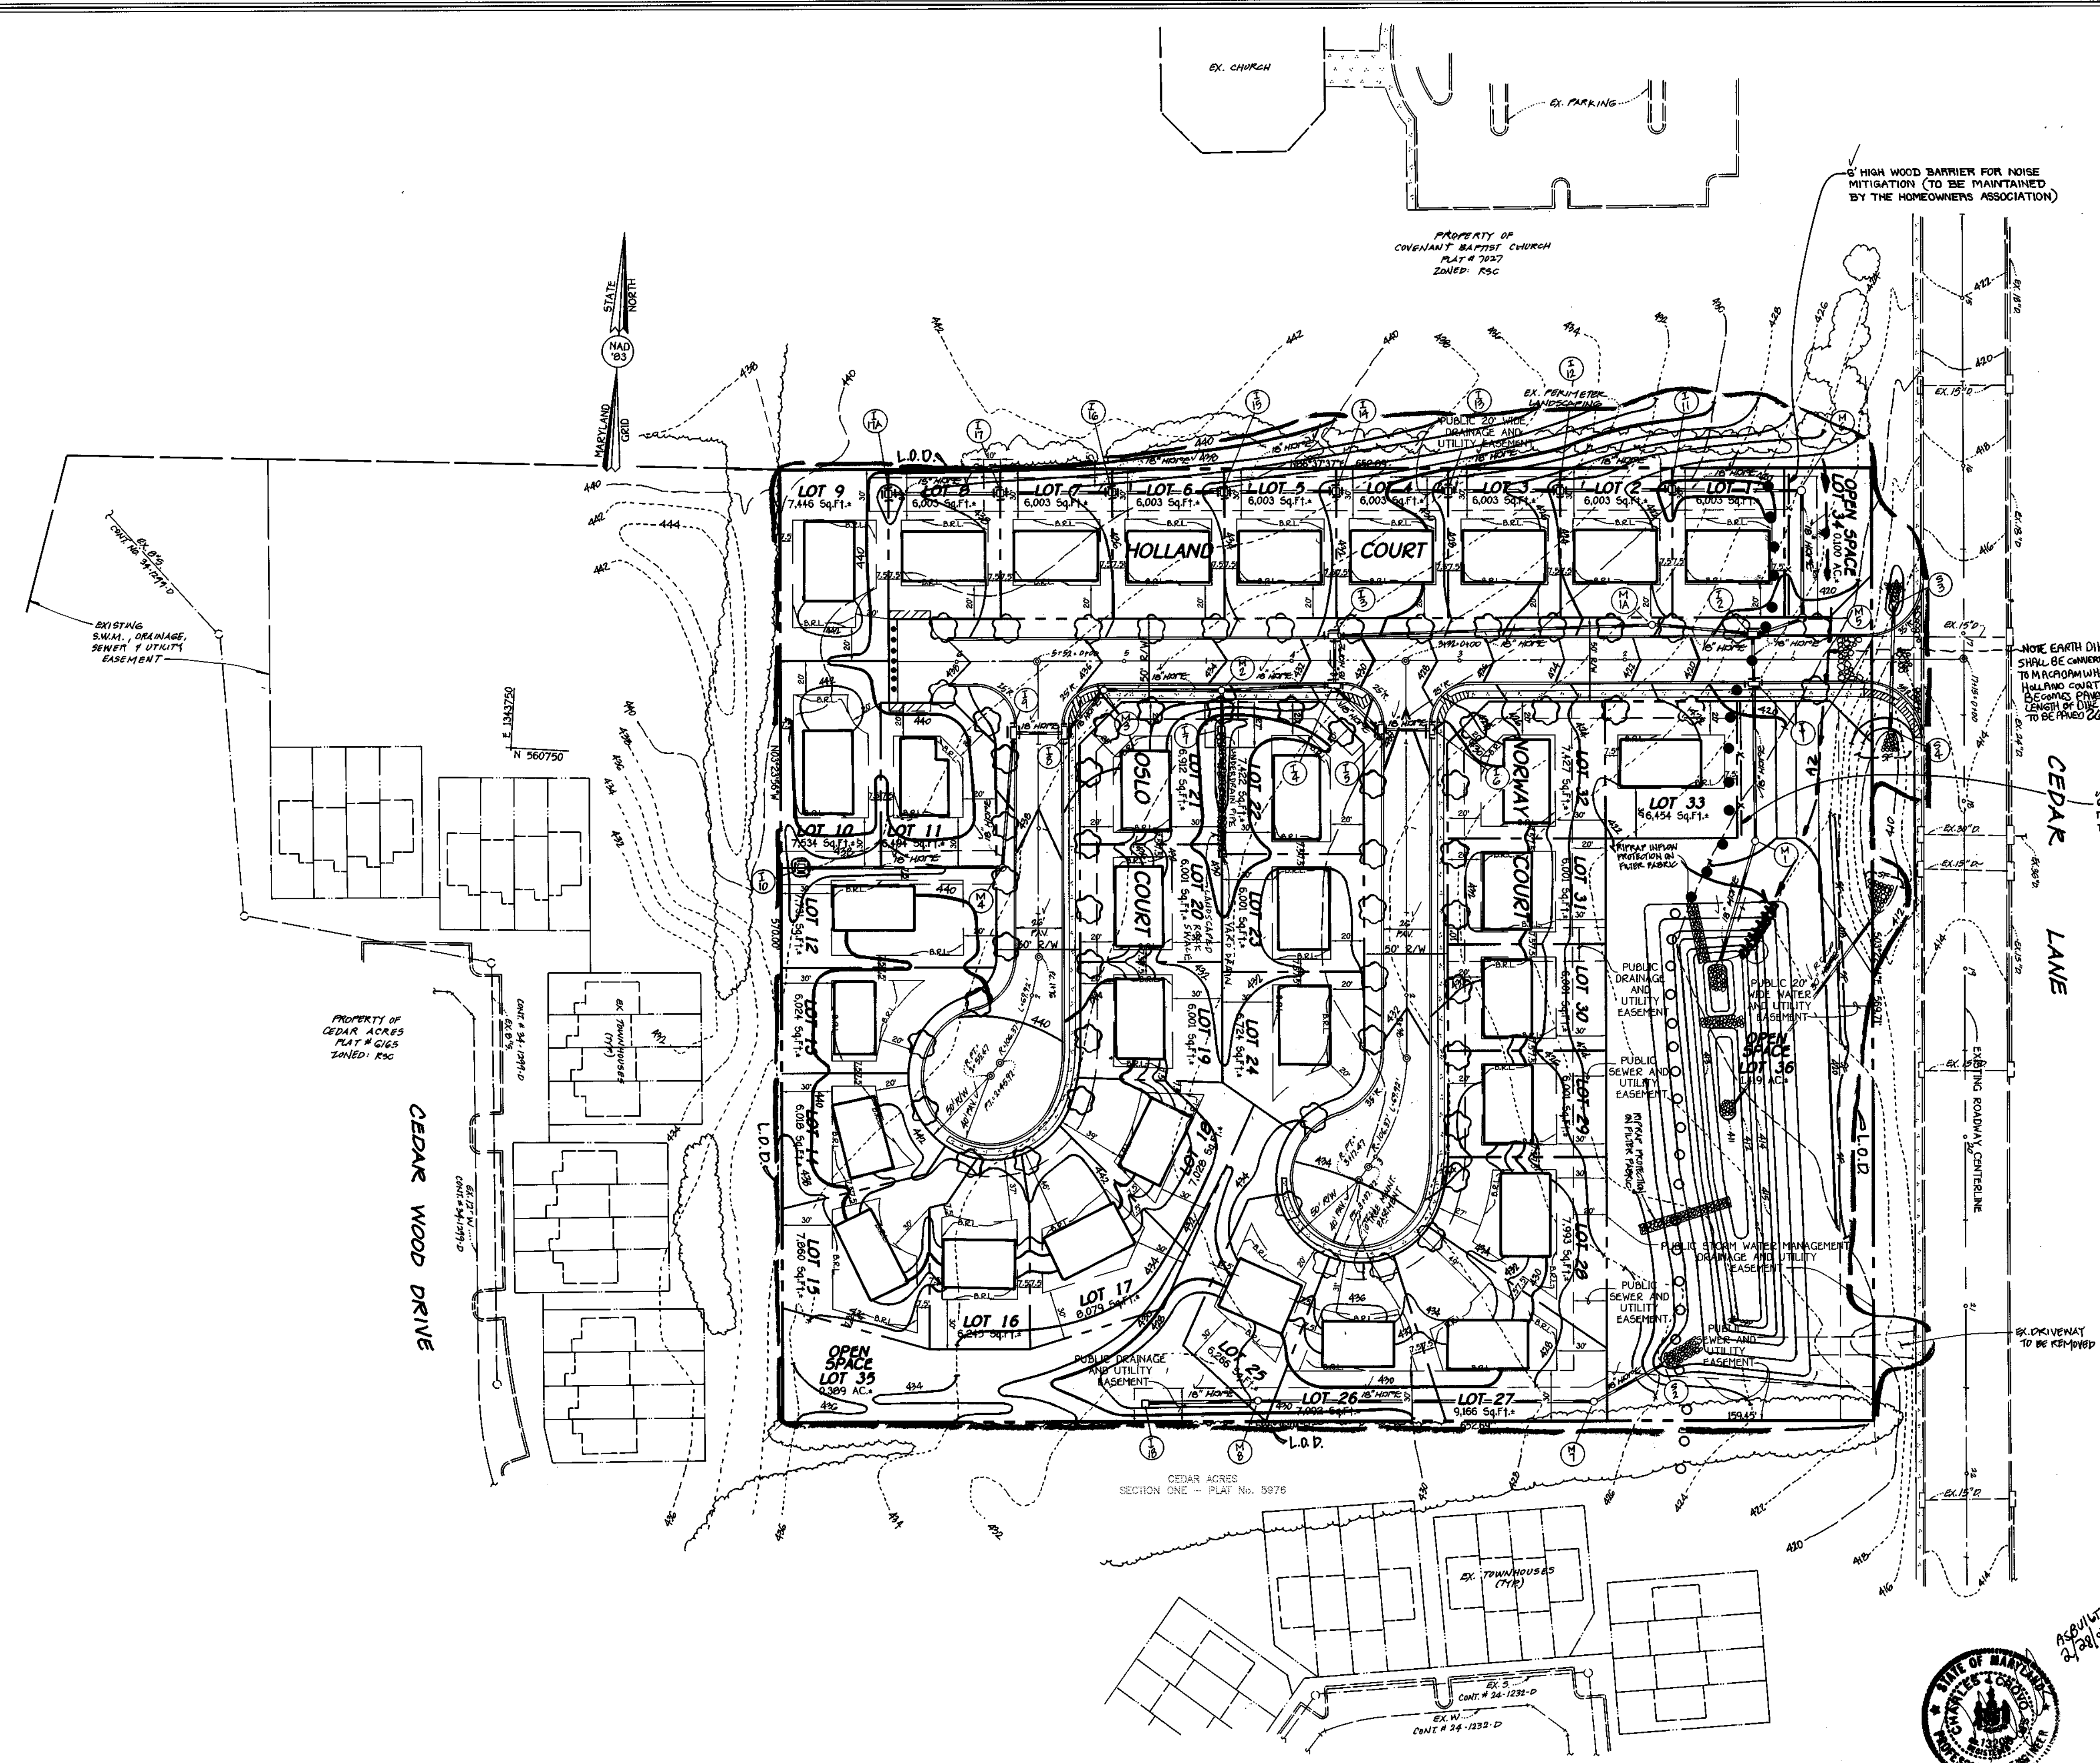

By The Developer:
 I/We Certify That All Development And/Or Construction Will Be Done According To These Plans. And That Any Responsible Personnel Involved In The Construction Project Will Have A Certificate Of Attendance At A Department Of The Environment Approved Training Program For The Control Of Sediment And Erosion Before Beginning The Project. I Shall Engage A Registered Professional Engineer To Supervise Pond Construction And Provide The Howard Soil Conservation District With An "As-Built" Plan Of The Pond Within 30 Days Of Completion. I Also Authorize Periodic On-Site Inspections By The Howard Soil Conservation District.

Signature Of Developer: *Alma Jones* Date: *6/21/99*
 Printed Name Of Developer: **Alma Jones**

By The Engineer:
 I Certify That This Plan For Pond Construction, Erosion And Sediment Control Represents A Practical And Workable Plan Based On My Personal Knowledge Of The Site Conditions. This Plan Was Prepared In Accordance With The Requirements Of The Howard Soil Conservation District. I Have Notified The Developer That He/She Must Engage A Registered Professional Engineer To Supervise Pond Construction And Provide The Howard Soil Conservation District With An "As-Built" Plan Of The Pond Within 30 Days Of Completion.

Signature Of Engineer: *Charles J. Coates* Date: *3/23/99*
 Printed Name Of Engineer: **Charles J. Coates**

These Plans Have Been Reviewed For The Howard Soil Conservation District And Meet The Technical Requirements For Small Pond Construction, Soil Erosion And Sediment Control.

Cheryl Simmons Date: *7/14/99*
 USDA-Natural Resources Conservation Service

These Plans For Small Pond Construction, Soil Erosion And Sediment Control Meet The Requirements Of The Howard Soil Conservation District.

John R. Robertson Date: *7/14/99*
 Howard Soil Conservation District

Approved Department Of Public Works
Richard M. Swartz Date: *7-17-98*
 Chief, Bureau Of Highways

Approved Department Of Planning And Zoning
Cathy Hamilton Date: *7/23/98*
 Chief, Division Of Land Development

John D. Williams Date: *7/22/98*
 Chief, Development Engineering Division

LEGEND

Symbol	Description
---	Existing Contour 2' Interval
---	Existing Contour 10' Interval
---	Proposed Contour 2' Interval
---	Proposed Contour 10' Interval
—SF—SF—	Silt Fence
○ ○ ○ ○ ○	Unmitigated 65 dBA Noise Line
● ● ● ● ●	Mitigated 65 dBA Noise Line
---	Earth Dike
-X-X-	Tree Protection
---	Existing Tree Line
L.O.D.	Limit Of Disturbance
(X)	Existing Street Tree
---	Stabilized Construction Entrance

STREET TREE SCHEDULE

SYMBOL	BOTANICAL AND COMMON NAME	SIZE	COMMENTS
○	ACER RUBRUM OCTOBER GLORY/ RED MAPLE	2-1/2"-3"	40' APART ON PUBLIC R/W

NOTE: STREET TREES ARE ONLY A RECOMMENDATION. THIS MAY BE REVISED TO A COUNTY ACCEPTABLE EQUIVALENT. A MINIMUM SPACING OF 20' SHALL BE MAINTAINED BETWEEN TREE AND STREET LIGHT.


TOTAL NUMBER OF STREET TREES

○ 50 STREET TREES

NOTE: THIS SHEET SUPERSEDES THE PREVIOUSLY SIGNED ORIGINAL DRAWING.

STREET TREE, GRADING & SEDIMENT CONTROL PLAN
CEDAR ACRES
LOTS 1 THRU 36

(A RESUBDIVISION OF LOTS 3, 4 AND 5, BLOCK 'A' AS SHOWN ON A PLAT ENTITLED "CEDAR ACRES" AND RECORDED IN PLAT BOOK 4 AT FOLIO 11.)
 ZONED: RSC
 TAX MAP No. 35 PARCEL No. 36 GRID No. 11
 FIFTH ELECTION DISTRICT
 HOWARD COUNTY, MARYLAND
 SCALE: 1"=50' DATE: AUGUST 22, 1997

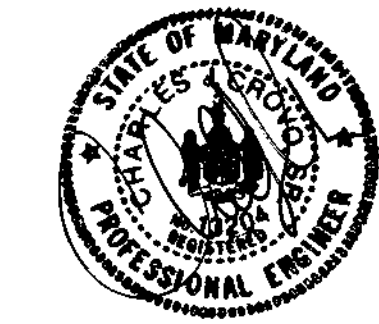

OWNER
 BENJAMIN E. BASSLER AND
 ELSIE MAE BASSLER
 10739 ROUTE 99
 WOODSTOCK, MARYLAND 21163

DEVELOPER
 CHADSWORTH HOMES, INC.
 P.O. BOX 6641
 MCLEAN, VIRGINIA 22106-6641

FISHER, COLLINS & CARTER, INC.
 CIVIL ENGINEERING, CONSULTANTS & LAND SURVEYORS
 CENTENNIAL SQUARE OFFICE PARK - 10272 BALTIMORE NATIONAL PIKE
 ELLICOTT CITY, MARYLAND 21042
 (410) 481-2955
 305326supplemental_grading_plan.dwg

G:\upworkings\305326\305326supplemental_grading_plan.dwg Mod: Jan 21 14:02:02 1998 PREPARED BY: JULIE WIDICH

STRUCTURE	DRAIN. AREA	AREA	"C"	ZONING	% IMP
I-1	C	0.30 Ac±	0.49	RSC	34 %
I-2	B	0.35 Ac±	0.55	RSC	43 %
I-3	M	0.46 Ac±	0.44	RSC	28 %
I-4	N	0.26 Ac±	0.49	RSC	35 %
I-5	G	0.40 Ac±	0.51	RSC	37 %
I-6	D	0.57 Ac±	0.54	RSC	41 %
I-7	J	0.44 Ac±	0.37	RSC	17 %
I-8	O	0.49 Ac±	0.54	RSC	42 %
I-9	Q	0.36 Ac±	0.53	RSC	40 %
I-10	K	0.47 Ac±	0.41	RSC	24 %
I-11	A	0.22 Ac±	0.33	RSC	12 %
I-12	E	0.21 Ac±	0.31	RSC	8 %
I-13	F	0.28 Ac±	0.33	RSC	12 %
I-14	H	0.18 Ac±	0.31	RSC	9 %
I-15	I	0.12 Ac±	0.35	RSC	14 %
I-16	L	0.17 Ac±	0.32	RSC	10 %
I-17	P	0.31 Ac±	0.33	RSC	11 %
I-18	K	1.04 Ac±	0.33	RSC	11 %
I-17A	S	0.08 Ac±	0.33	RSC	11 %

PLANT LIST			
SYMBOLS	BOTANICAL & COMMON NAME	SIZE	QTY
☉	QUERCUS PALUSTRIS "SOVEREIGN"	2 1/2" - 3" CALIPER	G2
☉	SOVEREIGN PIN OAK		
☉	PINUS NIGRA "AUSTRIAN PINE"	6'-8" HIGH	40

"THIS PLAN HAS BEEN PREPARED IN ACCORDANCE WITH THE PROVISIONS OF SECTION 16.124 OF THE HOWARD COUNTY CODE AND THE LANDSCAPE MANUAL. FINANCIAL SURETY FOR THE 77 REQUIRED LANDSCAPE TREES HAS BEEN POSTED AS PART OF THE DEVELOPER'S AGREEMENT IN THE AMOUNT OF \$10,200.00.

NOTE: A MIN. SPACING OF 20' SHALL BE MAINTAINED BETWEEN ANY STREET LIGHT AND ANY TREE.


NOTE: FOR S.W.M. AREA LANDSCAPING CHART, SEE SHEET 1 SCHEDULE D

- ☉ - SHADE TREE (19 TREES)
- ☉ - EVERGREEN TREE (24 TREES)

FOR PERIMETER LANDSCAPING CHART, SEE SHEET 1 SCHEDULE A

- ☉ - SHADE TREE (43 TREES)
- ☉ - EVERGREEN TREE (10 TREES)

FISHER, COLLINS & CARTER, INC.
 CIVIL ENGINEERING CONSULTANTS & LAND SURVEYORS
 CENTENNIAL SQUARE OFFICE PARK - 18272 BALTIMORE NATIONAL PKE
 ELICOTT CITY, MARYLAND 21042
 (410) 461-2955
 305305.ecolm@comcast.net

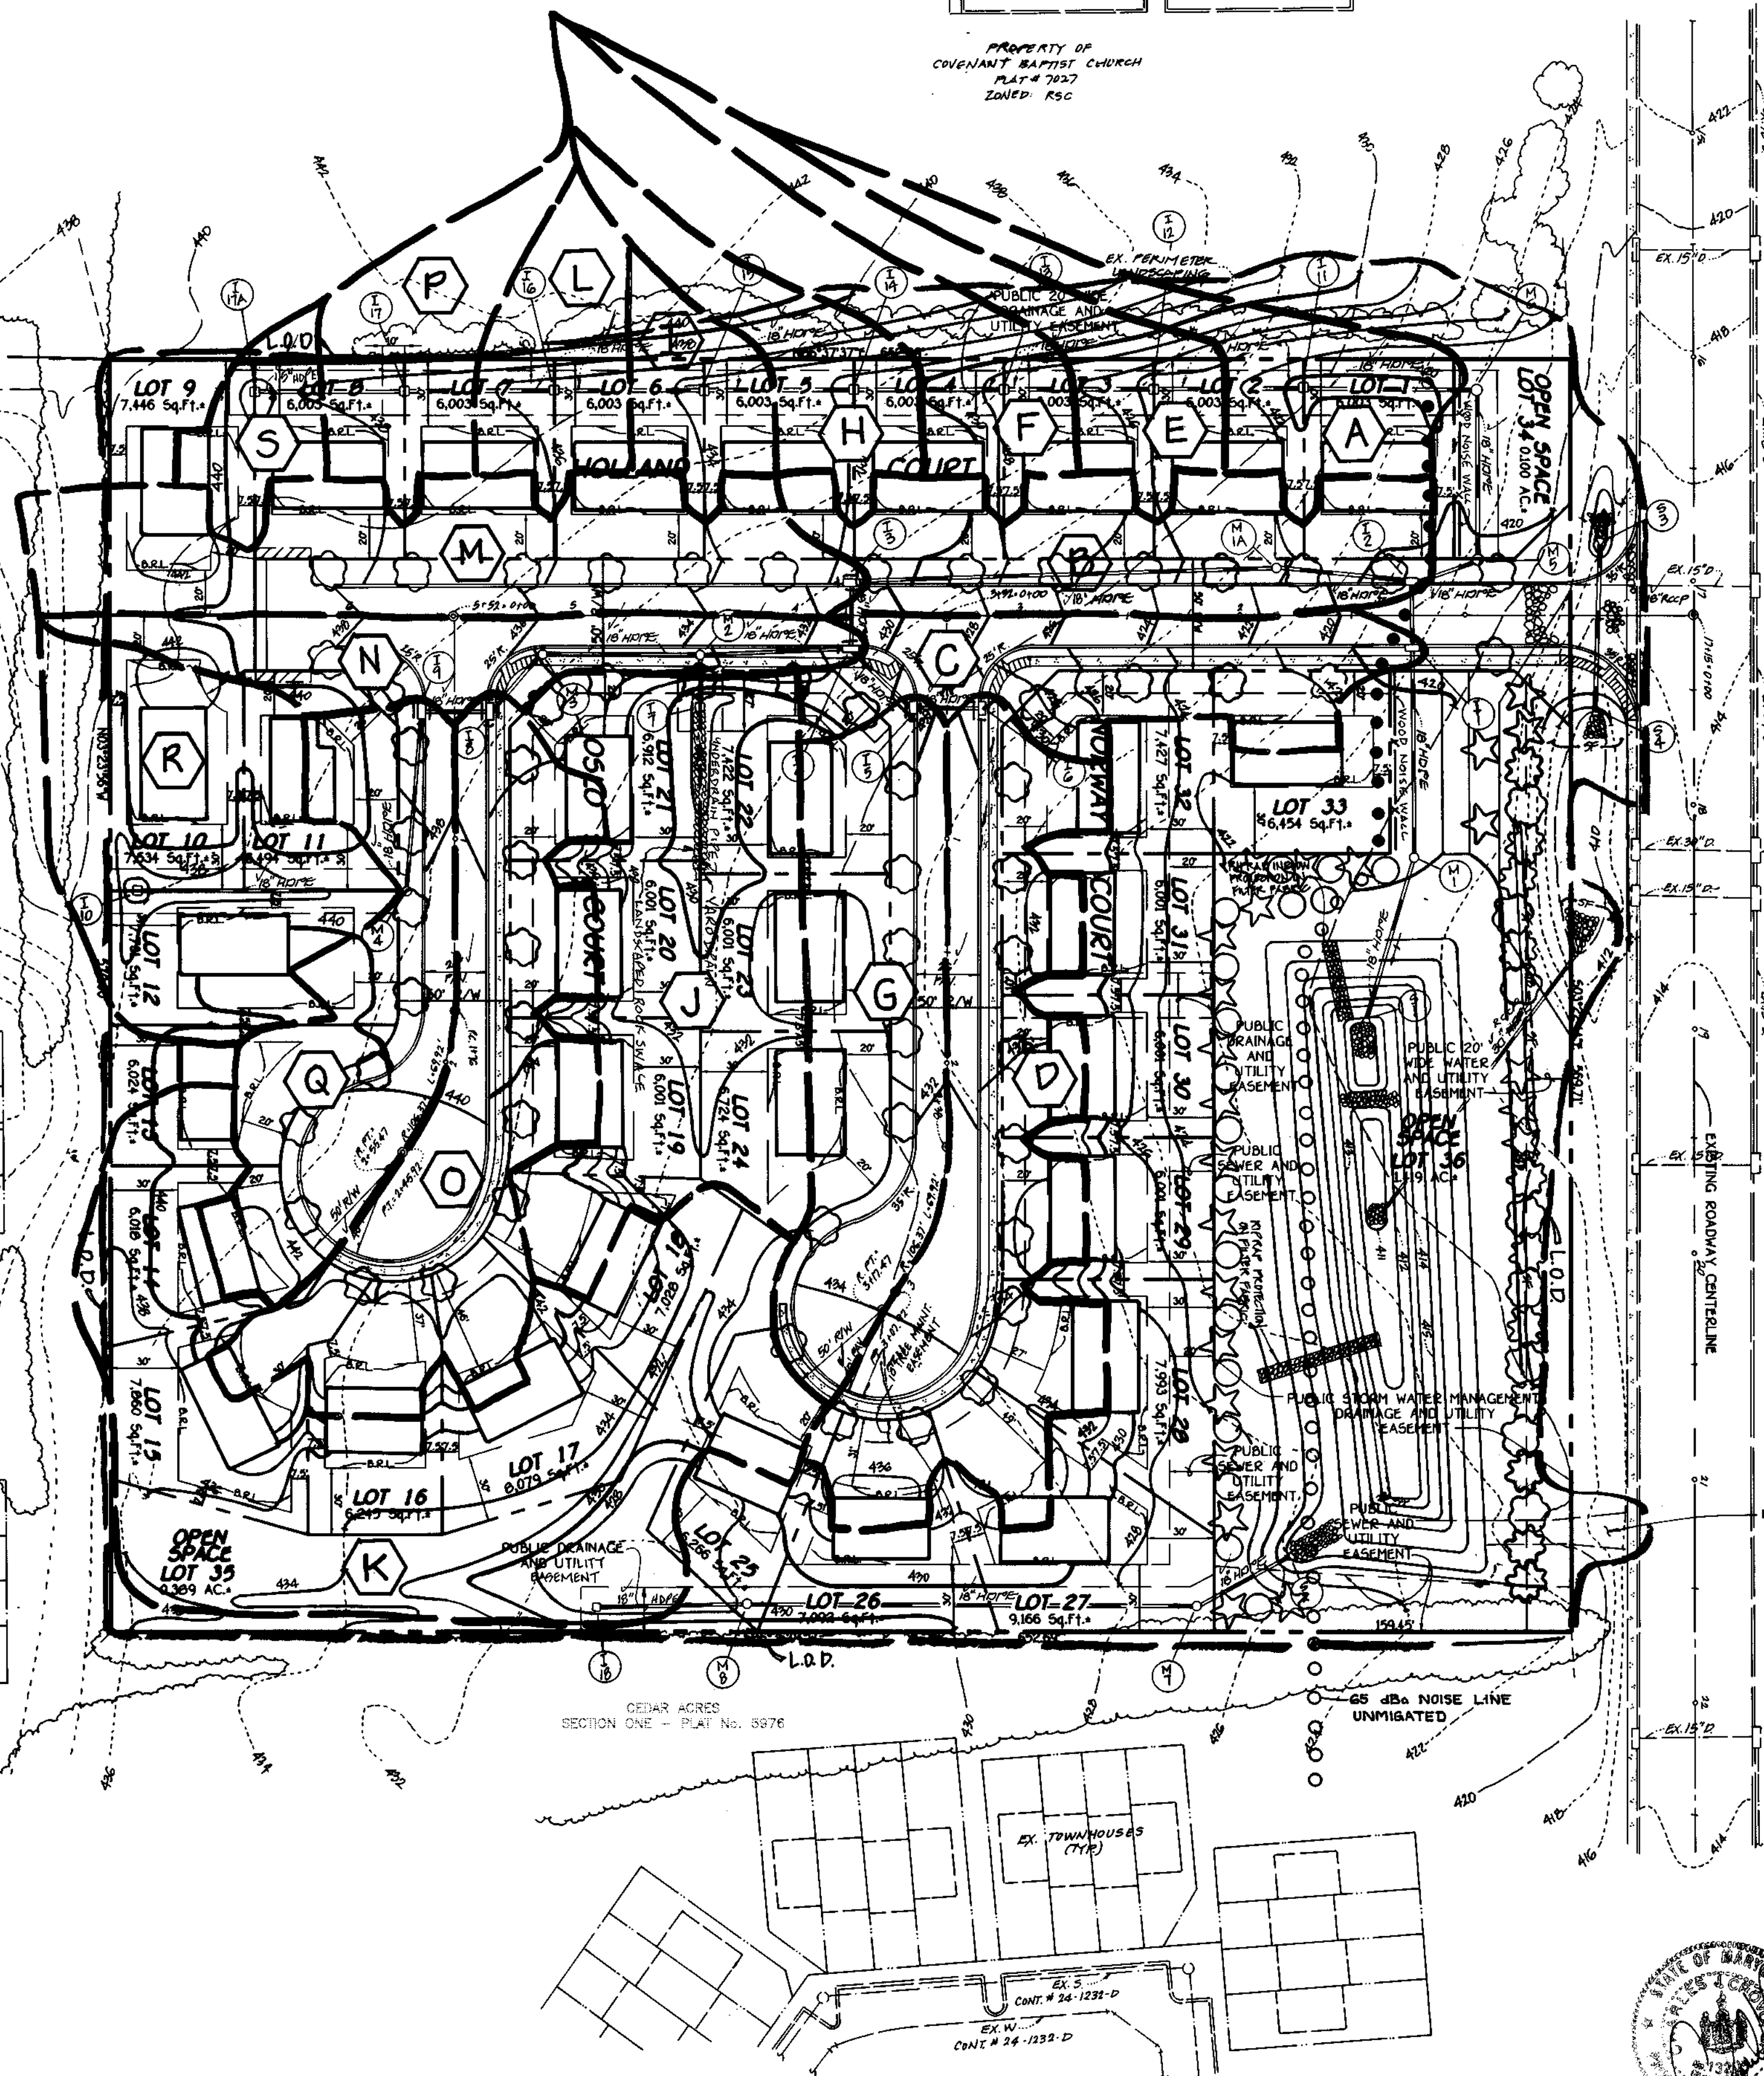

By The Developer:
 "I/We Certify That All Development And/Or Construction Will Be Done According To These Plans, And That Any Responsible Personnel Involved In The Construction Project Will Have A Certificate Of Attendance At A Department Of The Environment Approved Training Program For The Control Of Sediment And Erosion Before Beginning The Project. I Shall Engage A Registered Professional Engineer To Supervise Pond Construction And Provide The Howard Soil Conservation District With An "As-Built" Plan Of The Pond Within 30 Days Of Completion. I Also Authorize Periodic On-Site Inspections By The Howard Soil Conservation District."

Signature of Developer: *[Signature]* Date: 3/29/98
 Printed Name of Developer: **CHADSWORTH HOMES**

By The Engineer:
 "I Certify That This Plan For Pond Construction, Erosion And Sediment Control Represents A Practical And Workable Plan Based On My Personal Knowledge Of The Site Conditions. This Plan Was Prepared In Accordance With The Requirements Of The Howard Soil Conservation District. I Have Notified The Developer That He/She Must Engage A Registered Professional Engineer To Supervise Pond Construction And Provide The Howard Soil Conservation District With An "As-Built" Plan Of The Pond Within 30 Days Of Completion."

Signature of Engineer: *[Signature]* Date: 3/29/98
 Printed Name of Engineer: **CHARLES J. COLEMAN, P.E.**

Printed Name of Engineer: **Charles J. Coleman, P.E.** Date: 7/14/98
 Signature of Engineer: *[Signature]* Date: 7/14/98
 Printed Name of Engineer: **Robert W. Zuhm**

Approved Department of Public Works: *[Signature]* Date: 7-17-98
 Chief, Bureau of Highways: **Richard M. Ducker**

Approved Department of Planning And Zoning: *[Signature]* Date: 7/23/98
 Chief, Division Of Land Development: **Conde Hamstra**

Approved Department of Planning And Zoning: *[Signature]* Date: 7/22/98
 Chief, Development Engineering Division: **Chris Rammann**

LEGEND	
Symbol	Description
---	Existing Contour 2' Interval
---	Existing Contour 10' Interval
---	Proposed Contour 2' Interval
---	Proposed Contour 10' Interval
-S- S-	Silt Fence
○ ○ ○ ○ ○	Unmitigated 65 dba Noise Line
● ● ● ● ●	Mitigated 65 dba Noise Line
---	Earth Dike
-X-X-	Tree Protection
---	Existing Tree Line
L.O.D.	Limit of Disturbance
(S)	Existing Street Tree
---	Stabilized Construction Entrance

STREET TREE SCHEDULE			
SYMBOL	BOTANICAL AND COMMON NAME	SIZE	COMMENTS
☉	ACER RUBRUM OCTOBER GLORY/ RED MAPLE	2-1/2"-3"	40' APART ON PUBLIC R/W

NOTE: STREET TREES ARE ONLY A RECOMMENDATION. THIS MAY BE REVISED TO A COUNTY ACCEPTABLE EQUIVALENT. A MINIMUM SPACING OF 20' SHALL BE MAINTAINED BETWEEN TREE AND STREET LIGHT.

TOTAL NUMBER OF STREET TREES

☉ 50 STREET TREES

NOTE: THIS SHEET SUPERSEDES THE PREVIOUSLY SIGNED ORIGINAL DRAWING.

DRAINAGE AREA MAP AND LANDSCAPE PLAN
CEDAR ACRES
 LOTS 1 THRU 36
 (A RESUBDIVISION OF LOTS 3 & 4 AND 5, BLOCK "A" AS SHOWN ON A PLAT ENTITLED "CEDAR ACRES" AND RECORDED IN PLAT BOOK 4 AT FOLIO 11)

OWNER
 BENJAMIN K. BASSLER AND
 ELSIE MAE BASSLER
 10739 ROUTE 99
 WOODSTOCK, MARYLAND 21763

DEVELOPER
 CHADSWORTH HOMES, INC.
 P.O. BOX 6641
 McLEAN, VIRGINIA 22106-6641

ZONED: RSC
 PARCEL No. 35 PARCEL No. 36
 FIFTH ELECTION DISTRICT
 HOWARD COUNTY, MARYLAND
 SCALE: 1"=50' DATE: AUGUST 22, 1997

SPECIFICATIONS
These specifications are appropriate to all ponds within the scope of the Standard for Practice MD-378. All references to ASTM and AASHTO specifications apply to the most recent version.

Site Preparation
Areas designated for borrow areas, embankment, and structural works shall be cleared, grubbed and stripped of topsoil. All trees, vegetation, roots and other objectionable material shall be removed. Channel banks and sharp breaks shall be sloped to no steeper than 1:1.

Areas to be covered by the reservoir will be cleared of all trees, brush, logs, fences, rubbish and other objectionable material unless otherwise designated on the plans. Trees, brush and stumps shall be cut approximately level with the ground surface. For dry stormwater management ponds, a minimum of a 50 foot radius around the inlet structure shall be cleared.

All cleared and grubbed material shall be disposed of outside and below the limits of the dam and reservoir as directed by the owner or his representative. When specified, a sufficient quantity of topsoil will be stockpiled in a suitable location for use on the embankment and other designated areas.

Earth Fill
Material-The fill material shall be taken from approved designated borrow areas. It shall be free of roots, stumps, wood, rubbish, stones greater than 6" frozen or other objectionable materials. Fill material for the center of the embankment and cut off trench shall conform to Unified Soil Classification GC, SC, CH, or CL. Consideration may be given to the use of other materials in the embankment if design and construction are supervised by a geotechnical engineer.

Placement - Areas on which fill is to be placed shall be scarified prior to placement of fill. Fill materials shall be placed in maximum 8 inch thick (before compaction) layers which are to be continuous over the entire length of the fill. The most permeable borrow material shall be placed in the downstream portions of the embankment. The principal spillway must be installed concurrently with fill placement and not excavated into the embankment.

Compaction - The movement of the hauling and spreading equipment over the fill shall be controlled so that the entire surface of each lift shall be traversed by not less than one track of the equipment or compaction shall be achieved by a minimum of four complete passes of a sheepsfoot, rubber tired or vibratory roller. Fill material shall contain sufficient moisture such that the required degree of compaction will be obtained with the equipment used. The fill material shall contain sufficient moisture so that if formed into a ball it will not crumble yet not be so wet that water can be squeezed out.

Where a minimum required density is specified, it shall not be less than 95% of maximum dry density with a moisture content within 2% of the optimum. Each layer of fill shall be compacted as necessary to obtain that density, and is to be certified by the Engineer at the time of construction. All compaction is to be determined by AASHTO Method T-99.

Cut Off Trench - The cutoff trench shall be excavated into impervious material along or parallel to the centerline of the embankment as shown on the plans. The bottom width of the trench shall be governed by the equipment used for excavation, with the minimum width being four feet. The depth shall be at least four feet below existing grade or as shown on the plans. The side slopes of the trench shall be 1 to 1 or flatter. The backfill shall be compacted with construction equipment, rollers or hand tampers to assure maximum density and minimum permeability.

Structure Backfill
Backfill adjacent to pipes or structures shall be of the type and quality conforming to that specified for the adjoining fill material. The fill shall be placed in horizontal layers not to exceed four inches in thickness and compacted by hand tampers or other manually directed compaction equipment. The material needs to fill completely all spaces under and adjacent to the pipe. At no time during the backfilling operation shall driven equipment be allowed to operate closer than four feet, measured horizontally, to any part of a structure. Under no circumstances shall equipment be driven over any part of a concrete structure or pipe, unless there is a compacted fill of 24" or greater over the structure or pipe.

Pipe Conduits
All pipes shall be circular in cross section.

Corrugated Metal Pipe - All of the following criteria shall apply for corrugated metal pipe:

1. Materials - (Steel Pipe) - This pipe and its appurtenances shall be galvanized and fully bituminous coated and shall conform to the requirements of AASHTO Specification M-190 Type A with watertight coupling bands. Any bituminous coating damaged or otherwise removed shall be replaced with cold applied bituminous coating compound. Steel pipes with polymeric coatings shall have a minimum coating thickness of 0.01 inch (0.001 mil) on both sides of the pipe. The following coatings or an approved equal may be used: Nexon, Plast-Cote, Blac-Klad, and Beth-Cu-Loy. Coated corrugated steel pipe shall meet the requirements of AASHTO M-245 and M-246.

Materials - (Aluminum Coated Steel Pipe) - This pipe and its appurtenances shall conform to the requirements of AASHTO Specification M-274 with watertight coupling bands or flanges. Any aluminum coating damaged or otherwise removed shall be replaced with cold applied bituminous coating compound.

Materials - (Aluminum Pipe) - This pipe and its appurtenances shall conform to the requirements of AASHTO Specification M-196 or M-211 with watertight coupling bands or flanges. Aluminum surfaces that are to be in contact with concrete shall be painted with one coat of zinc chromate primer. Hot dip galvanized bolts may be used for connections. The pH of the surrounding soils shall be between 4 and 9.

2. Coupling bands, anti-seep collars, end sections, etc., must be composed of the same material as the pipe. Metals must be insulated from dissimilar materials by use of rubber or plastic insulating materials at least 24 mils in thickness.

3. Connections - All connections with pipes must be completely watertight. The drain pipe or barrel connection to the riser shall be welded all around when the pipe and riser are metal. Anti-seep collars shall be connected to the pipe in such a manner as to be completely watertight. Dimple bands are not considered to be watertight.

All connections shall use a rubber or neoprene gasket when joining pipe sections. The end of each pipe shall be re-rolled in an adequate number of corrugations to accommodate the band width. The following type connections are acceptable for pipes less than 24" in diameter. Flanges on both ends of the pipe, a 12" wide standard lap type band with 12" wide by 3/8" thick closed cell circular neoprene gasket and a 12" wide hugger type band with O-ring gaskets having a minimum diameter of 1/2" greater than the corrugation depth. Pipes 24" in diameter and larger shall be connected by a 24" long annular closed band using rods and nuts. A 12" wide by 3/8" thick closed cell circular neoprene gasket will be installed on the end of each pipe for a total of 24".

Helically corrugated pipe shall have either continuously welded seams or have lock seams with internal caulking or a neoprene bead.

4. Bedding - The pipe shall be firmly and uniformly bedded throughout its entire length. Where rock or soft, spongy or other unstable soil is encountered, all such material shall be removed and replaced with suitable earth compacted to provide adequate support.

5. Backfilling shall conform to "Structure Backfill".

6. Other details (anti-seep collars, valves, etc.) shall be as shown on the drawings.

Reinforced Concrete Pipe - All of the following criteria shall apply for reinforced concrete pipe:

1. Materials - Reinforced concrete pipe shall have bell and spigot joints with rubber gaskets and shall equal or exceed ASTM Designation C-361.

2. Bedding - All reinforced concrete pipe conduits shall be laid in a concrete bedding for their entire length. This bedding shall consist of high slump concrete placed under the pipe and up the sides of the pipe at least 10% of its outside diameter with a minimum thickness of 3 inches, or as shown on the drawings.

3. Laying pipe - Bell and spigot pipe shall be placed with the bell end upstream. Joints shall be made in accordance with the recommendations of the manufacturer of the material. After the joints are sealed for the entire length, the bedding shall be placed so that all spaces under the pipe are filled. Care shall be exercised to prevent any deviation from the original line and grade of the pipe. The first joint must be located within 2 feet from the riser.

4. Backfilling shall conform to "Structure Backfill".

5. Other details (anti-seep collars, valves, etc.) shall be as shown on the drawings.

Polyvinyl Chloride (PVC) Pipe - All of the following criteria shall apply for polyvinyl chloride (PVC) pipe:

1. Materials-PVC pipe shall be PVC-1220 or PVC-1221 conforming to ASTM D-1785 or ASTM D-2241.

2. Joints and connections to anti-seep collars shall be completely watertight.

3. Bedding - The pipe shall be firmly and uniformly bedded throughout its entire length. Where rock or soft, spongy or other unstable soil is encountered, all such material shall be removed and replaced with suitable earth compacted to provide adequate support.

4. Backfilling shall conform to "Structure Backfill".

5. Other details (anti-seep collars, valves, etc.) shall be as shown on the drawings.

Concrete
Concrete shall meet the requirements of Maryland Department of Transportation, State Highway Administration Standard Specifications for Construction and Materials, Section 608; Mix No. 3.

Rock Riprap
Rock riprap shall meet the requirements of Maryland Department of Transportation, State Highway Administration Standard Specifications for Construction and Materials, Section 905.

The riprap shall be placed to the required thickness in one operation. The rock shall be delivered and placed in a manner that will insure the riprap in place shall reasonably homogeneous with the larger rocks uniformly distributed and firmly in contact one to another with the smaller rocks filling the voids between the larger rocks. Filter cloth shall be placed under all riprap and shall meet the requirements of Maryland Department of Transportation, State Highway Administration Standard Specifications for Construction and Materials, Section 919.2.

Care of Water during Construction
All work on permanent structures shall be carried out in areas free from water. The Contractor shall construct and maintain all temporary dikes, levees, cofferdams, drainage channels, and stream diversions necessary to protect the areas to be occupied by the permanent works. The contractor shall also furnish, install, operate, and maintain all necessary pumping and other equipment required for removal of water from the various parts of the work and for maintaining the excavations, foundation, and other parts of the work free from water as required or directed by the engineer for constructing each part of the work. After having served their purpose, all temporary protective works shall be removed or leveled and graded to the extent required to prevent obstruction in any degree whatsoever of the flow of water to the spillway or outlet works and so as not to interfere in any way with the operation or maintenance of the structure. Stream diversions shall be maintained until the full flow can be passed through the permanent works. The removal of water from the required excavation and the foundation shall be accomplished in a manner and to the extent that will maintain stability of the excavated slopes and bottom of required excavations and will allow satisfactory performance of all construction operations. During the placing and compacting of material in required excavations, the water level at the locations being refilled shall be maintained below the bottom of the excavation at such locations which may require draining the water to pumps from which the water shall be pumped.

Stabilization
All borrow areas shall be graded to provide proper drainage and left in a slightly condition. All exposed surfaces of the embankment, spillway, spoil and borrow areas, and berms shall be stabilized by seeding, liming, fertilizing and mulching in accordance with the Maryland Soil Conservation Service Standards and Specifications for Critical Area Planting (MD-342) or as shown on the accompanying drawings.

Erosion and Sediment Control
Construction operations will be carried out in such a manner that erosion will be controlled and water and air pollution minimized. State and local laws concerning pollution abatement will be followed. Construction plans shall detail erosion and sediment control measures to be employed during the construction process.

STRUCTURE SCHEDULE

STRUCTURE NO.	TOP ELEVATION	INV. IN	INV. OUT	ROAD NAME	ROAD STA.	OFFSET	TYPE	REMARKS
I-1	419.13 418.91	413.64 413.13	412.00	HOLLAND COURT ✓	C.L. STA. 4+25.1+22	13.43' LT ✓	A-5 INLET ✓	S.D. 4.40
I-2	419.12 418.91	413.64 413.60 413.62	413.43	HOLLAND COURT ✓	C.L. STA. 4+25.1+22	13.43' RT ✓	A-10 INLET ✓	S.D. 4.41
I-3	431.61 431.47	421.01 421.53	421.28	HOLLAND COURT ✓	C.L. STA. 3+75.55	13.43' RT ✓	A-10 INLET ✓	S.D. 4.41
I-4	431.88 431.37	424.39 424.83	424.03	HOLLAND COURT ✓	C.L. STA. 3+75.55	13.43' LT ✓	A-10 INLET ✓	S.D. 4.41
I-5	430.21 429.98	424.84 425.35	425.10	NORWAY HOLLAND COURT	C.L. STA. 0+41	13.43' LT ✓	A-5 INLET ✓	S.D. 4.40
I-6	430.16 429.98	424.84 425.35	423.31	NORWAY HOLLAND COURT	C.L. STA. 0+41	13.43' RT ✓	A-5 INLET ✓	S.D. 4.40
I-7	428.99 427.33	427.20	427.20	HOLLAND COURT ✓	C.L. STA. 0+42	47' LT ✓	D INLET ✓	S.D. 4.39
I-8	437.98 437.44	430.93 430.55	430.30	OSLO COURT ✓	C.L. STA. 0+41	15.15' LT ✓	A-5 INLET ✓	S.D. 4.40
I-9	437.81 437.44	431.16 431.11	430.86	OSLO COURT ✓	C.L. STA. 0+41	15.15' RT ✓	A-5 INLET ✓	S.D. 4.40
I-10	436.84 436.73	433.30	433.30		N 56°09'30" E 134.34' 130 E 134°34'30" S 130.00'		D INLET ✓	S.D. 4.39
I-11	420.11 420.24	415.83 416.23	415.98		N 56°09'30" E 134.34' 130 E 134°34'30" S 130.00'		D INLET ✓	S.D. 4.39
I-12	423.40 422.94	417.08 417.30	416.80		N 56°09'30" E 134.34' 130 E 134°34'30" S 130.00'		D INLET ✓	S.D. 4.39
I-13	427.63 427.48	422.10 422.20	422.55		N 56°09'30" E 134.34' 130 E 134°34'30" S 130.00'		D INLET ✓	S.D. 4.39
I-14	430.85 430.05	425.16 425.72	423.47		N 56°09'30" E 134.34' 130 E 134°34'30" S 130.00'		D INLET ✓	S.D. 4.39
I-15	433.85 433.95	428.13 428.64	426.33		N 56°09'30" E 134.34' 130 E 134°34'30" S 130.00'		D INLET ✓	S.D. 4.39
I-16	435.18 435.16	429.08 429.56	426.33		N 56°09'30" E 134.34' 130 E 134°34'30" S 130.00'		D INLET ✓	S.D. 4.39
I-17	436.85 436.85	430.15 430.48	430.23		N 56°09'30" E 134.34' 130 E 134°34'30" S 130.00'		D INLET ✓	S.D. 4.39
I-18	427.41 427.43	423.41	423.41		N 56°09'30" E 134.34' 130 E 134°34'30" S 130.00'		D INLET ✓	S.D. 4.39
I-17A	430.18 430.35	401.15	401.15		N 56°09'30" E 134.34' 130 E 134°34'30" S 130.00'		D INLET ✓	S.D. 4.39
M-1	411.85 420.00	411.85 411.90	411.72		N 56°09'30" E 134.34' 130 E 134°34'30" S 130.00'		PRECAST MANHOLE ✓	G. 5.12
M-2	434.20 434.15	429.60 429.99	428.75	HOLLAND COURT ✓	C.L. STA. 4+42	16.5' LT ✓	PRECAST MANHOLE ✓	G. 5.12
M-3	435.87 435.96	429.65 429.97	428.72	HOLLAND COURT ✓	C.L. STA. 5+12	16.5' LT ✓	PRECAST MANHOLE ✓	G. 5.12
M-4	438.88 438.69	433.88 432.16	431.91	OSLO COURT ✓	C.L. STA. 1+23.54	21' RT ✓	PRECAST MANHOLE ✓	G. 5.12
M-5	419.46 419.50	413.94 414.21	413.96	HOLLAND COURT ✓	C.L. STA. 0+97	25' RT ✓	PRECAST MANHOLE ✓	G. 5.12
M-6	421.15 421.50	414.93 415.20	414.95	HOLLAND COURT ✓	N 56°09'30" E 134.34' 130 E 134°34'30" S 130.00'		PRECAST MANHOLE ✓	G. 5.12
M-7	426.44 426.00	414.41 419.70	419.45		N 56°09'30" E 134.34' 130 E 134°34'30" S 130.00'		PRECAST MANHOLE ✓	G. 5.12
M-1A	421.31 421.49	416.71 417.19	416.94		C.L. STA. 1+04+18.88 N 56°09'30" E 134.34' 130 E 134°34'30" S 130.00'		PRECAST MANHOLE ✓	G. 5.12
S-1	412.50	411.00			N 56°09'30" E 134.34' 130 E 134°34'30" S 130.00'		CONG. END SECTION	S.D. 5.51
S-2	418.97 418.47	418.07 418.97			N 56°09'30" E 134.34' 130 E 134°34'30" S 130.00'		CONG. END SECTION	S.D. 5.51
S-3	412.78 412.50	411.26 411.00			N 56°09'30" E 134.34' 130 E 134°34'30" S 130.00'		CONG. END SECTION	S.D. 5.51
S-4	411.53 411.50	410.00			N 56°09'30" E 134.34' 130 E 134°34'30" S 130.00'		CONG. END SECTION	S.D. 5.51

* DENOTES OFFSET TO FLOWLINE AT INLET

SUMMARY OF TEST PITS
Date: April 13, 1995
Field Inspector: C.S. Bakshi

TEST PIT	DEPTH	SOIL DESCRIPTION	REMARKS
B-2	0.0-4.0	Olive Brown Sand with dark red lenses of clay, trace mica.	Groundsurface: wooded
B-1	0.0-6.0	USC: SM USDA: Sandy Loam	Top Soil: 2.0" Groundsurface: wooded
B-1	6.0-8.0	USC: SM USDA: Sandy Loam	Top Soil: 2.0" Rock fragments below 8.0 feet depth. Groundwater not encountered during excavation.

SUMMARY OF TEST PITS
Date: April 13, 1995
Field Inspector: C.S. Bakshi

TEST PIT	DEPTH	SOIL DESCRIPTION	REMARKS
B-3	1.0-5.0	USC: SM USDA: Sandy Loam	Groundsurface: open grassy field
B-3	5.0-11.0	USC: SM USDA: Loamy Sand	Top Soil: 12.0" Groundwater not encountered during excavation.

FISHER, COLLINS & CARTER, INC.
CIVIL ENGINEERING CONSULTANTS & LAND SURVEYORS
CENTRAL SQUARE OFFICE PARK - 10272 BALTIMORE NATIONAL PIKE
ELLSWORTH CITY, MARYLAND 21042
410-341-2955

OWNER
BENJAMIN K. BASSLER
AND ELSIE MAE BASSLER
10739 MARYLAND ROUTE 99
WOODSTOCK, MARYLAND 21163

DEVELOPER
CHADSWORTH HOMES, INC.
P.O. BOX 6641
MCLEAN, VIRGINIA 22106-6641

APPROVED: DEPARTMENT OF PUBLIC WORKS
Richard M. Danks 7-17-98
CHIEF, BUREAU OF HIGHWAYS DATE


APPROVED: DEPARTMENT OF PLANNING AND ZONING
Cindy Hamatta 7/23/98
CHIEF, DIVISION OF LAND DEVELOPMENT DATE

Richard M. Danks 7/23/98
CHIEF, DEVELOPMENT ENGINEERING DIVISION DATE

- GEOTECHNICAL RECOMMENDATIONS**
- The stormwater management pond facility on the site should be constructed as an extended detention pond.
 - At locations where removal of vegetation and objectionable material results in an opening greater than 12 inches in depth, they should be backfilled with soil compacted to a minimum of 95% of the maximum dry density as determined by the Standard Moisture Density Relationship Test (ASTM D-698).
 - Soil material meeting the classification requirements for GC, SC, CH, or CL as classified in accordance with the Unified Soil Classification System and recommended by Soil Conservation Service Maryland Standards and Specifications, November 1992 should be used for the construction of the center of the embankment and the cut-off trench. The fill material should be approved by the geotechnical engineer prior to being used. It should be free from roots, stumps, woods, rubbish, stone greater than six (6) inches, frozen soil or other deleterious material.
 - Additionally, we recommend a minimum 4.0 feet thick compacted layer of relatively impermeable soil material, as specified in item three (3) above should be used below the foundation of the principal spillway structure and below the pipeline at the location of the cut-off trench.
 - The depth of the core trench should be extended a minimum of four (4) feet below the invert of the pond at the principal spillway.
 - The impervious core shall extend from the cut-off trench up to the 10 year water surface elevation throughout the embankment.
 - Core and dike embankment fill and backfill soils should be compacted to a minimum of 95% of the maximum dry density (ASTM D-698).
 - The ungraded access road to the pond should be designed and constructed to support the contact tire pressure and axle load exerted by the service traffic anticipated. We recommend subgrade soil with sufficient shear strength to support contact pressure of 80 psi and 8 kip axle load. The subgrade in the access road area should be constructed with on-site sandy soils compacted to a minimum of 95% of the maximum dry density (ASTM D-698) and with a minimum soaked California Bearing Ratio (CBR) of 5.0.
 - The principal spillway structure should be founded on subgrade soil with an allowable soil pressure of no less than 2000 pounds per square foot and should be verified during foundation construction.
 - We recommend the contractor provide the geotechnical engineer and the design engineer with a plan for dewatering prior to beginning excavation on the site. The plan should include a written description of the dewatering system, a schedule and sketches. The dewatering system should be approved by the design engineer, installed and functioning effectively prior to excavation below the water level.

These Plans Have Been Reviewed For The Howard Soil Conservation District And Meet The Technical Requirements For Small Pond Construction, Soil Erosion And Sediment Control.
Cheryl Semman 7/14/98
DISTRICT NATURAL RESOURCES CONSERVATION SERVICE DATE

These Plans For Small Pond Construction, Soil Erosion And Sediment Control Meet The Requirements Of The Howard Soil Conservation District.
Robert W. Zuhm 7/14/98
HOWARD SOIL CONSERVATION DISTRICT DATE

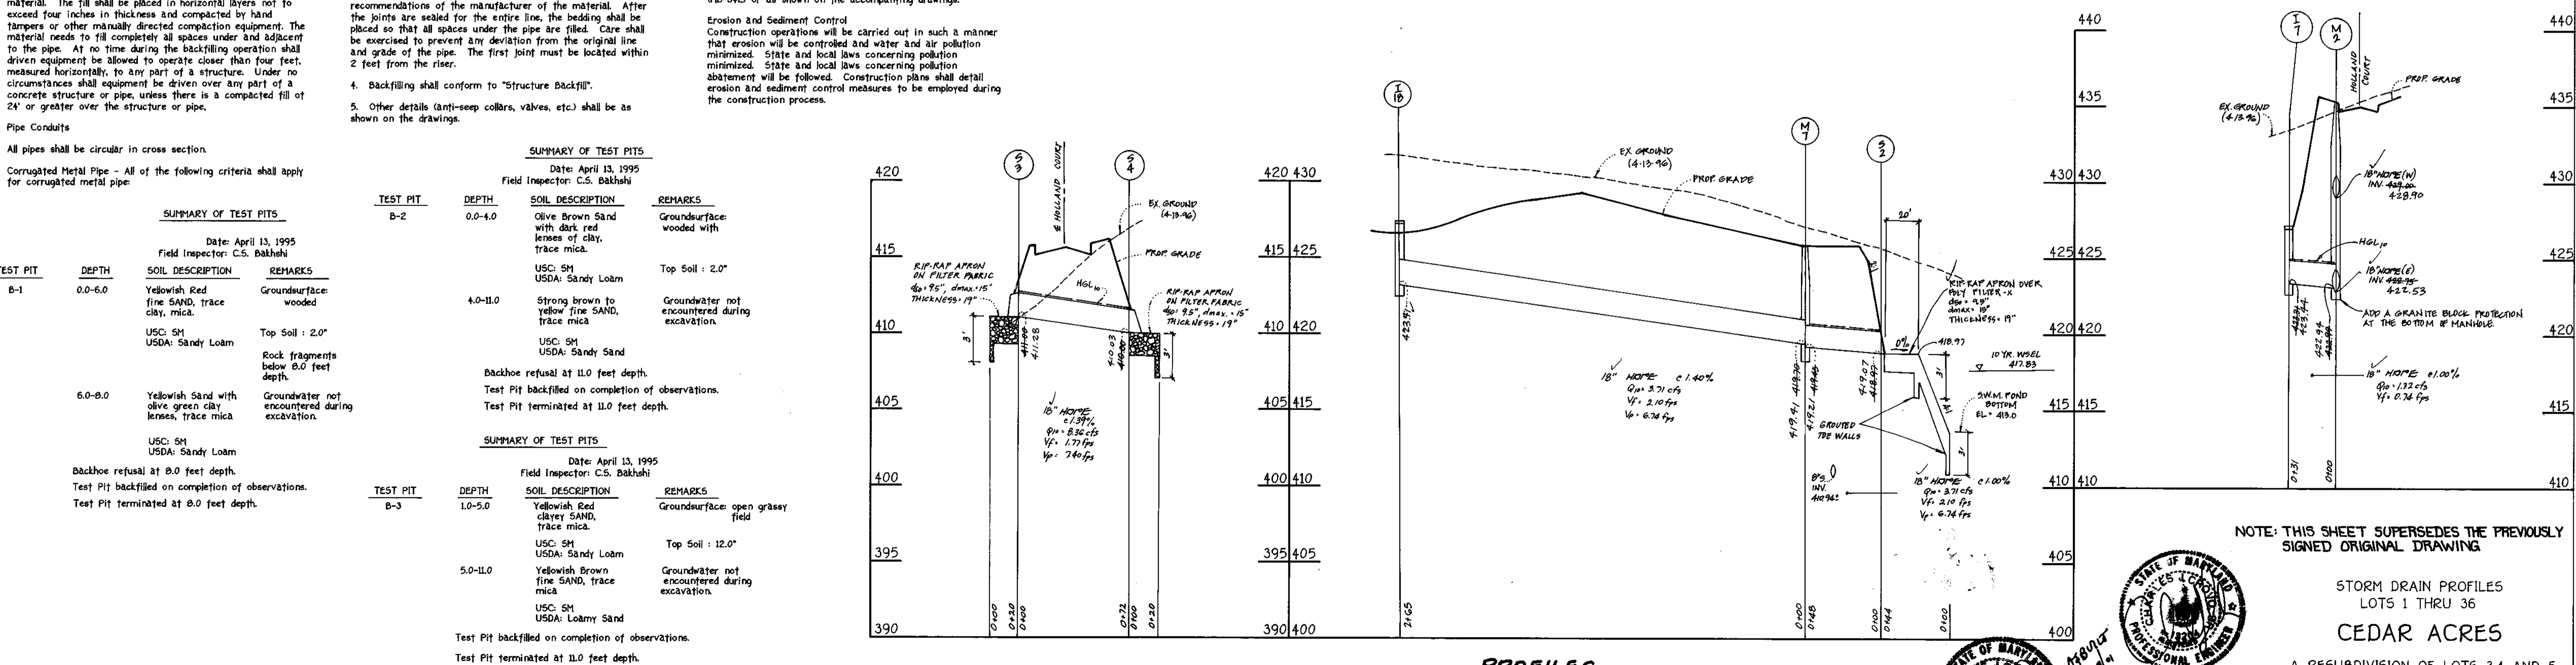

NOTE: THIS SHEET SUPERSEDES THE PREVIOUSLY SIGNED ORIGINAL DRAWING

STATE OF MARYLAND
REGISTERED PROFESSIONAL ENGINEER

STATE OF MARYLAND
REGISTERED PROFESSIONAL ENGINEER


STORM DRAIN PROFILES
LOTS 1 THRU 36
CEDAR ACRES
A RESUBDIVISION OF LOTS 3, 4 AND 5
ZONED: R5C
TAX MAP NO. 35 PARCEL 36
FIFTH ELECTION DISTRICT HOWARD COUNTY, MARYLAND
SHEET 6 OF 9

AS BUILT F17-115


APPROVED: DEPARTMENT OF PUBLIC WORKS
 CHIEF, BUREAU OF HIGHWAYS
 Andrew M. Danke 7-17-98
 DATE

APPROVED: DEPARTMENT OF PLANNING AND ZONING
 CHIEF, DIVISION OF LAND DEVELOPMENT
 Linda Hamilton 7/23/98
 DATE

APPROVED: DEPARTMENT OF PLANNING AND ZONING
 CHIEF, DEVELOPMENT ENGINEERING DIVISION
 Mike Dawson 7/22/98
 DATE

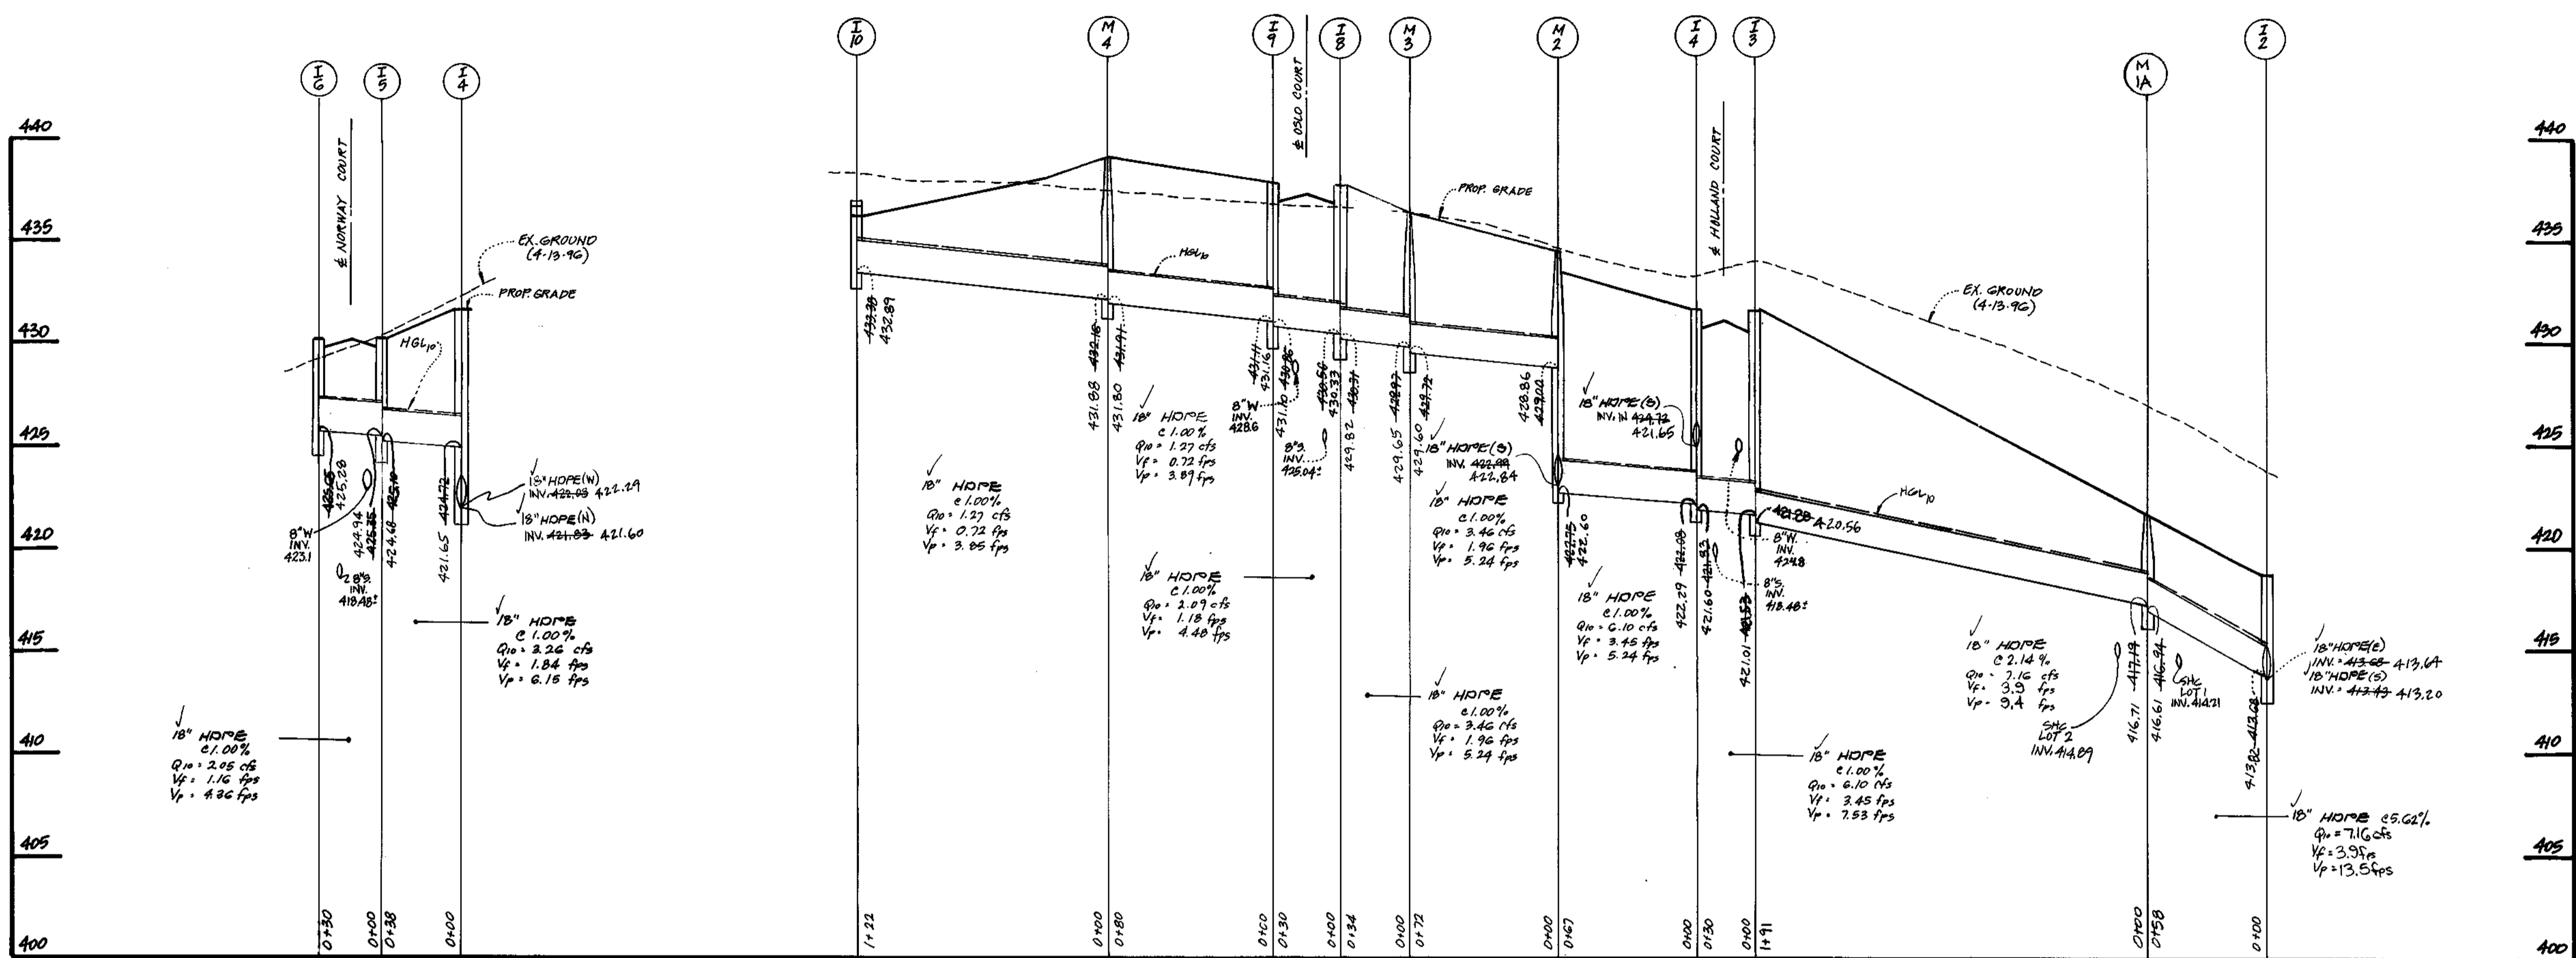

PROFILES
 SCALE: HORIZ. : 1"=50'
 VERT. : 1"=5'

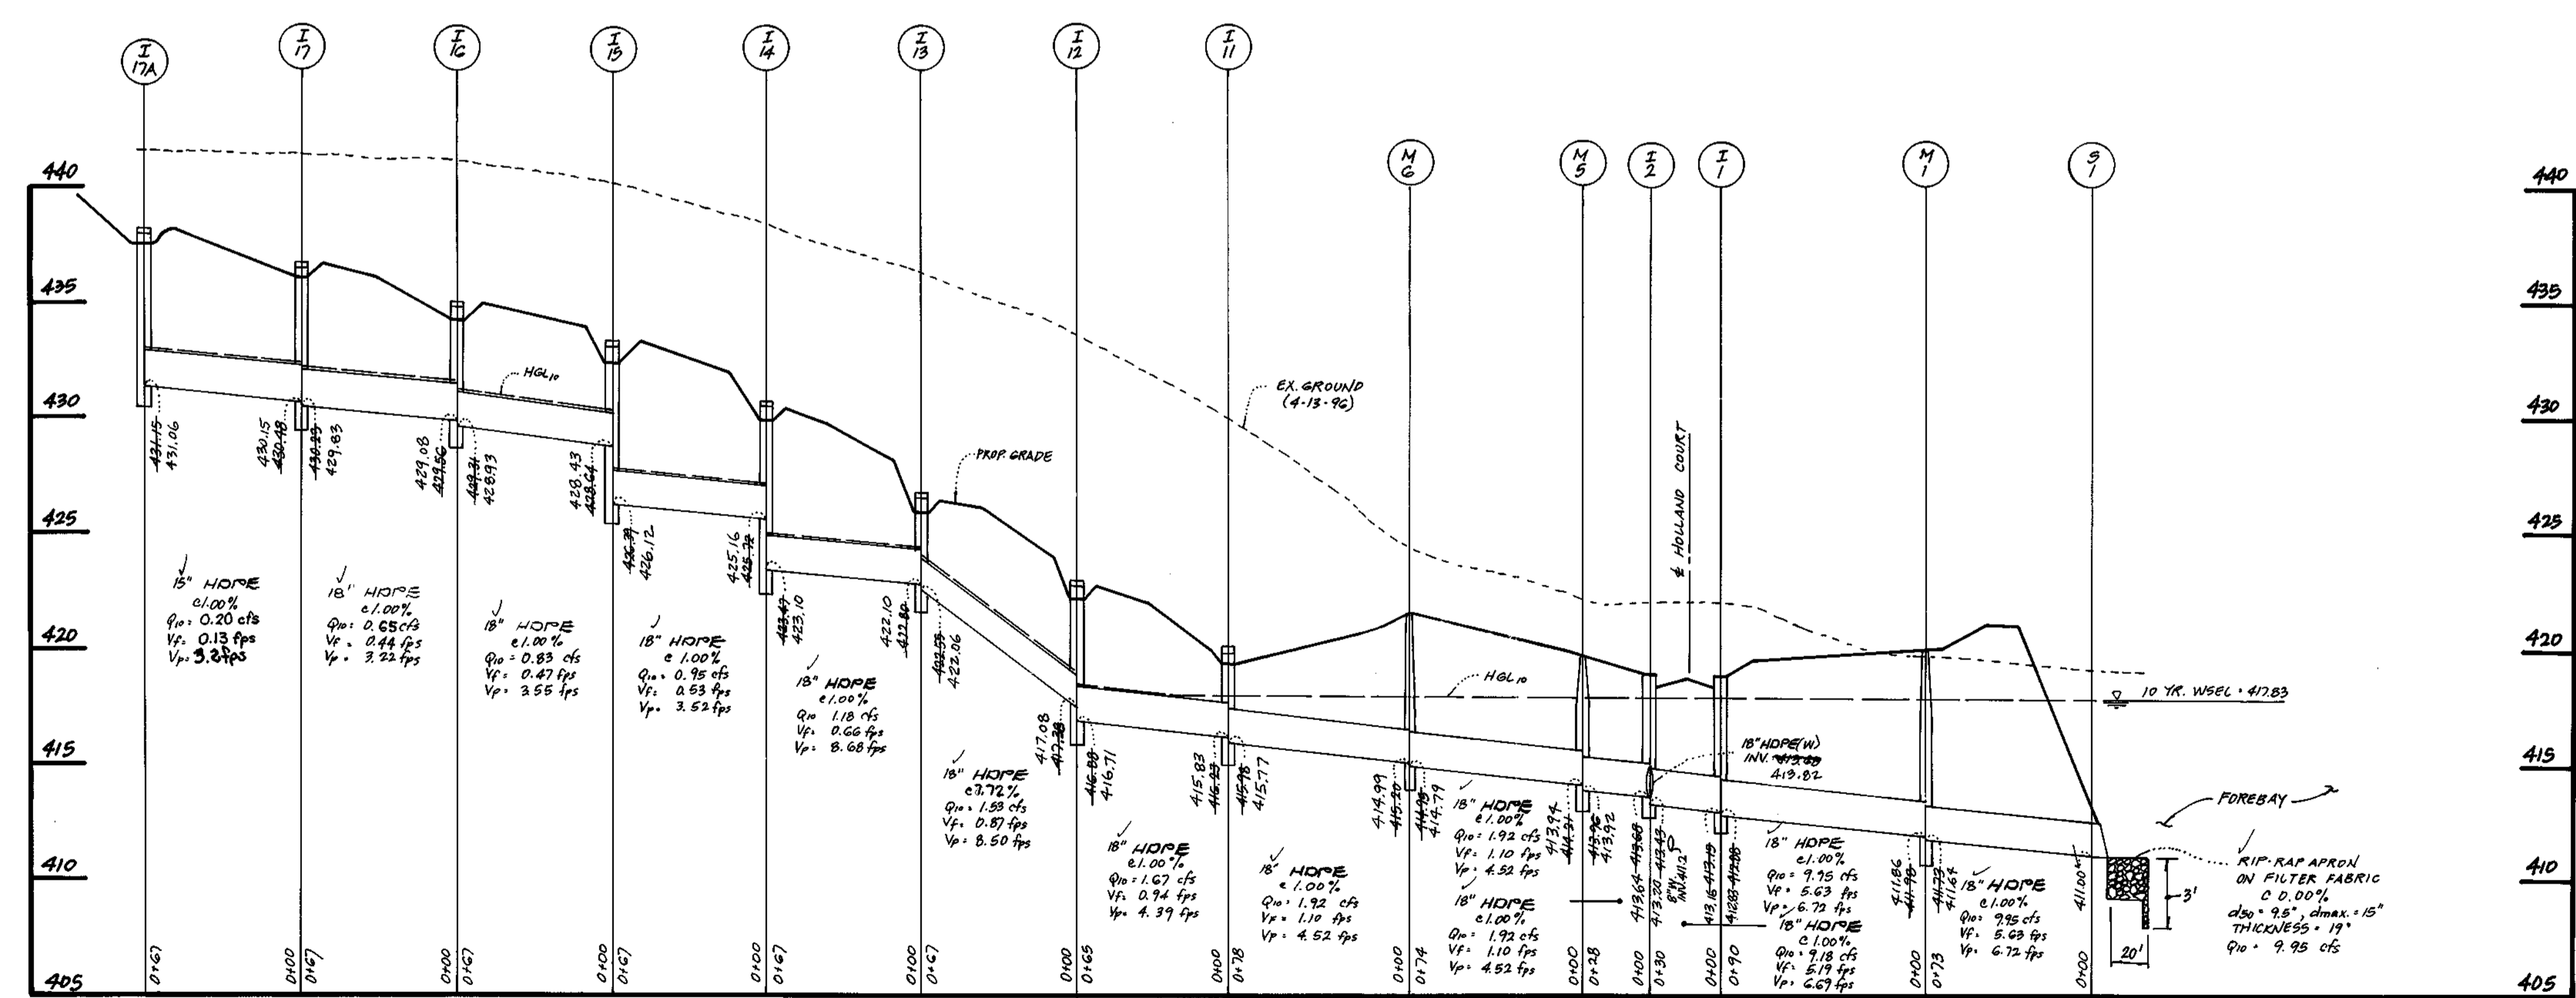

PROFILE
 SCALE: HORIZ. : 1"=50'
 VERT. : 1"=5'



NOTE: THIS SHEET SUPERSEDES THE PREVIOUSLY SIGNED ORIGINAL DRAWING.

STORM DRAIN PROFILES
 LOTS 1 THRU 36
 CEDAR ACRES


A RESUBDIVISION OF LOTS 3, 4 AND 5
 ZONED: R5C
 TAX MAP NO. 35 PARCEL 38
 FIFTH ELECTION DISTRICT HOWARD COUNTY, MARYLAND
 SHEET 7 OF 9

FISHER, COLLINS & CARTER, INC.
 CIVIL ENGINEERING CONSULTANTS & LAND SURVEYORS
 CENTRAL SQUARE OFFICE PARK - 16772 BALTIMORE NATIONAL PIKE
 ELK COTT CITY, MARYLAND 21046
 410-461-2855

OWNER
 BENJAMIN K. BASSLER
 AND ELSIE MAE BASSLER
 10739 MARYLAND ROUTE 99
 WOODSTOCK, MARYLAND 21163

DEVELOPER
 CHADSWORTH HOMES, INC.
 P.O. BOX 6641
 MCLEAN, VIRGINIA 22106-6641

AS BUILT F17-15

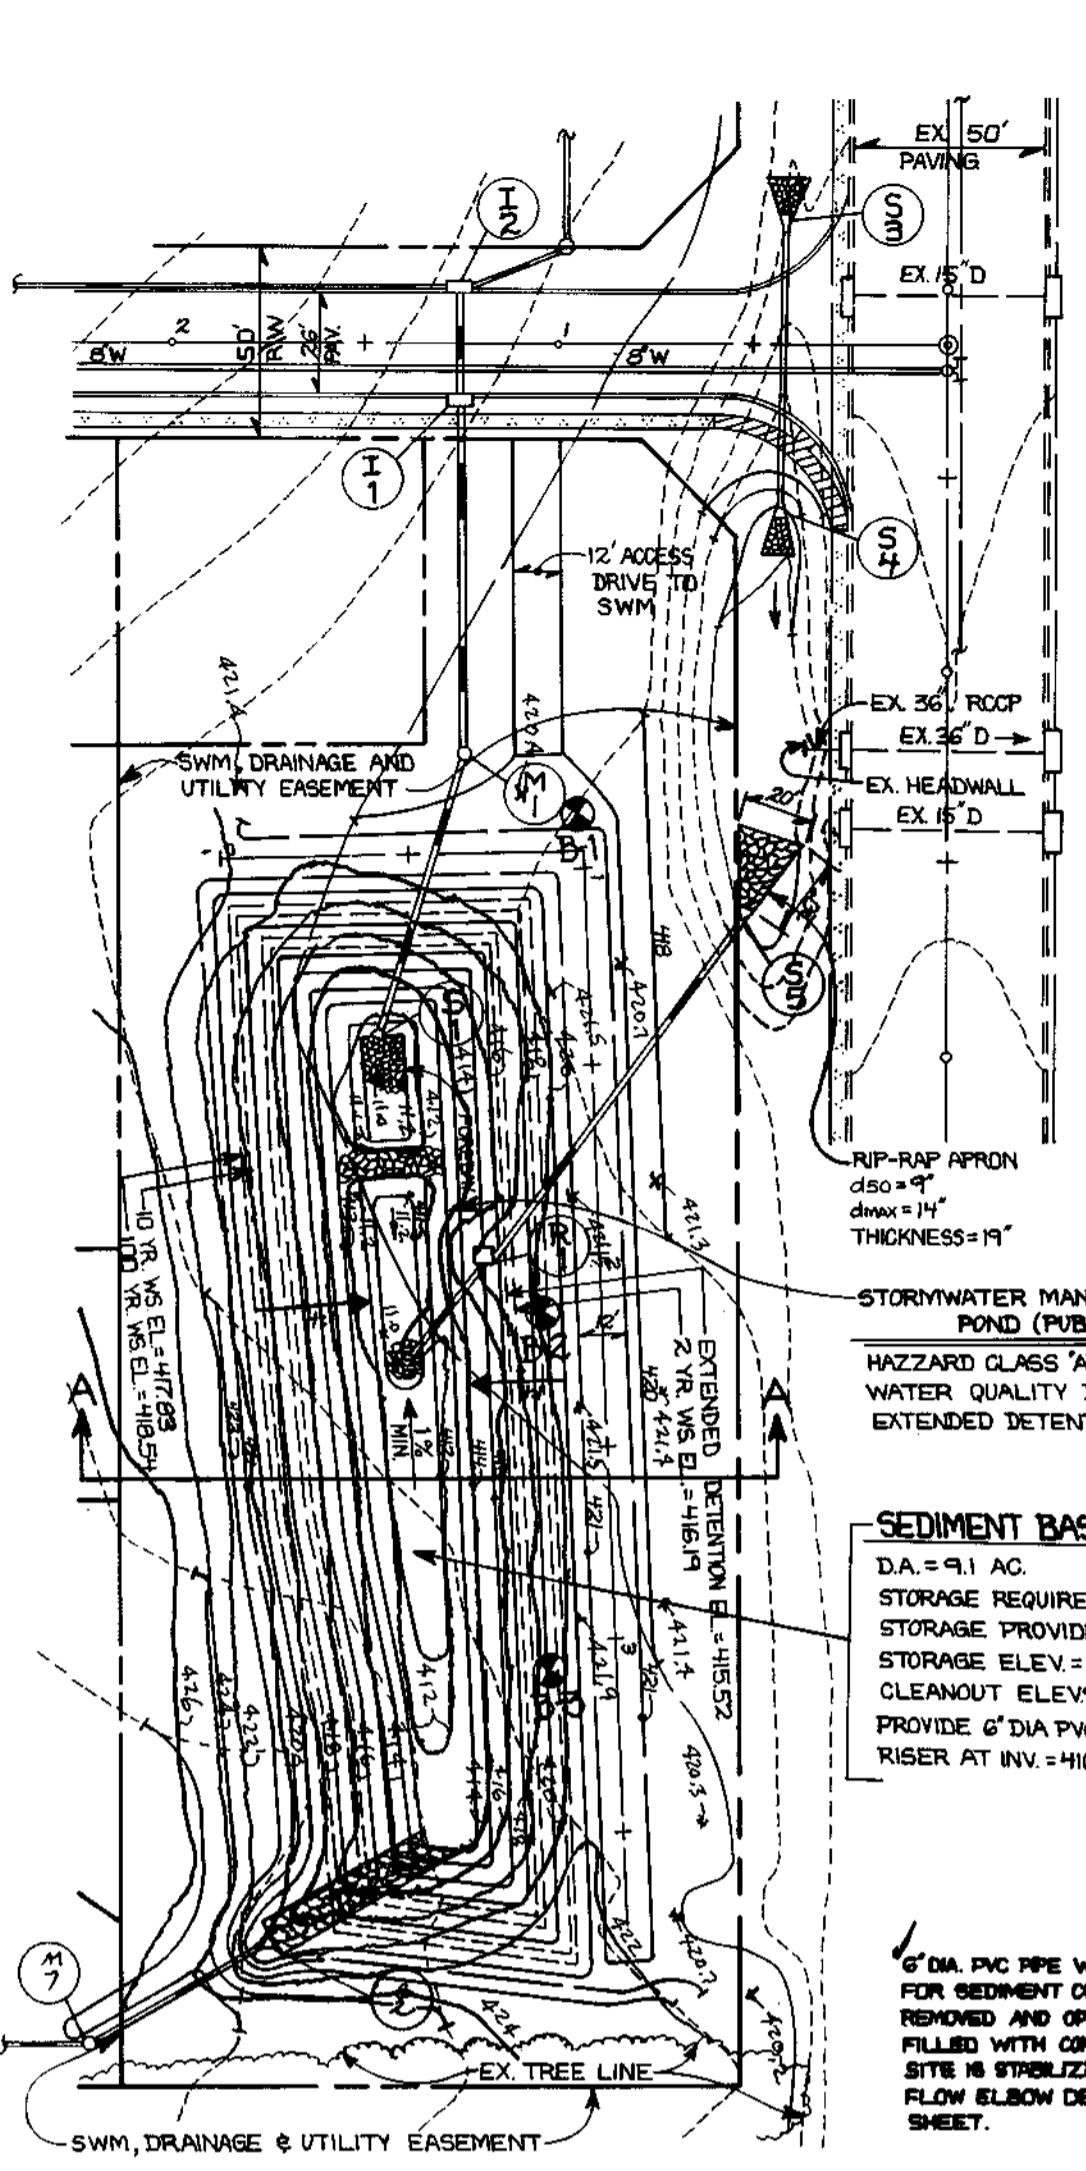


PLAN
SCALE: 1"=50'


STORMWATER MANAGEMENT POND SUMMARY (DA=9.1 Ac)

STORM EVENT	EXISTING CONDITION DISCHARGE (CFS)	DEVELOPED CONDITION DISCHARGE (CFS)	ALLOWABLE RELEASE (CFS)	ACTUAL RELEASE (CFS)	STORAGE (CF)	STORAGE (CF)
2 YEAR	1.86	11.04	1.86	0.33	416.19	27,474
10 YEAR	10.72	25.61	10.72	1.54	417.85	51,585
100 YEAR	24.08	43.09	N/A	21.28	418.54	64,540


SEDIMENT BASIN DATA
 D.A. = 9.1 AC
 STORAGE REQUIRED = 32,760
 STORAGE PROVIDED = 33,450
 STORAGE ELEV. = 416.60
 CLEANOUT ELEV. = 413.60
 PROVIDE 6" DIA. PVC ELBOW IN RISER AT INV. 416.60

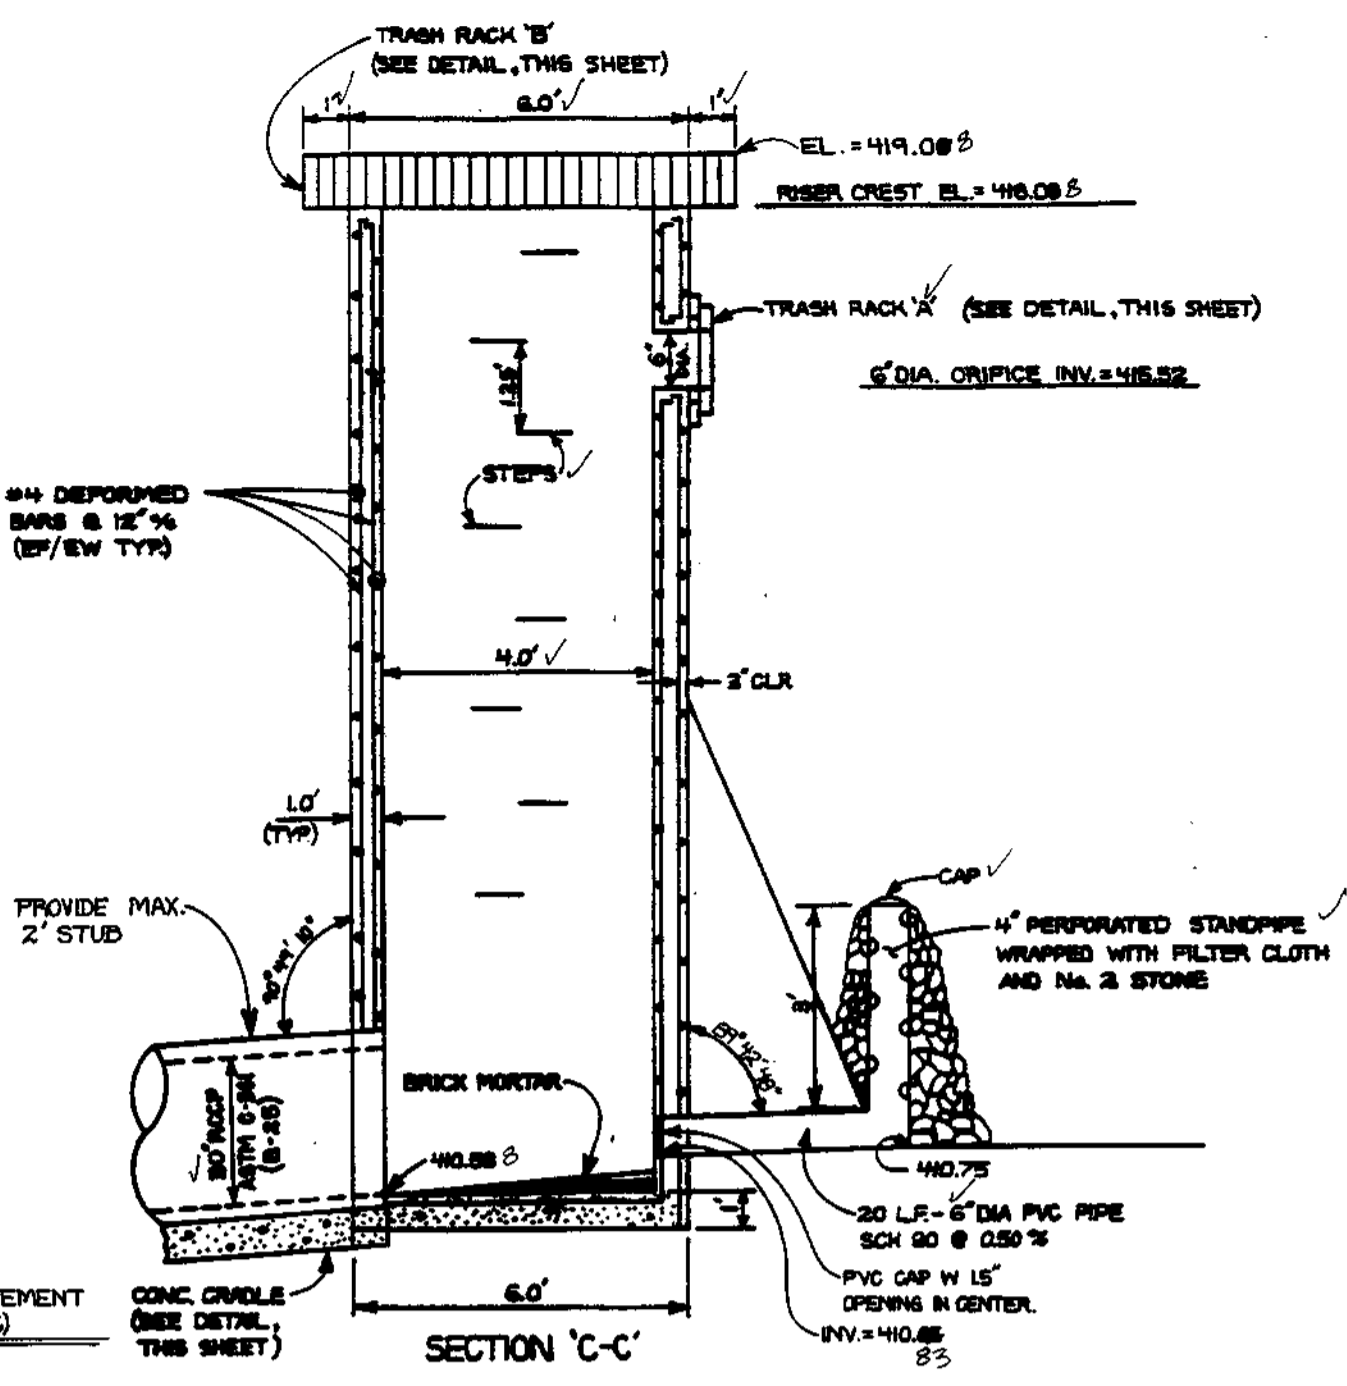


RISER DETAIL
(NO SCALE)

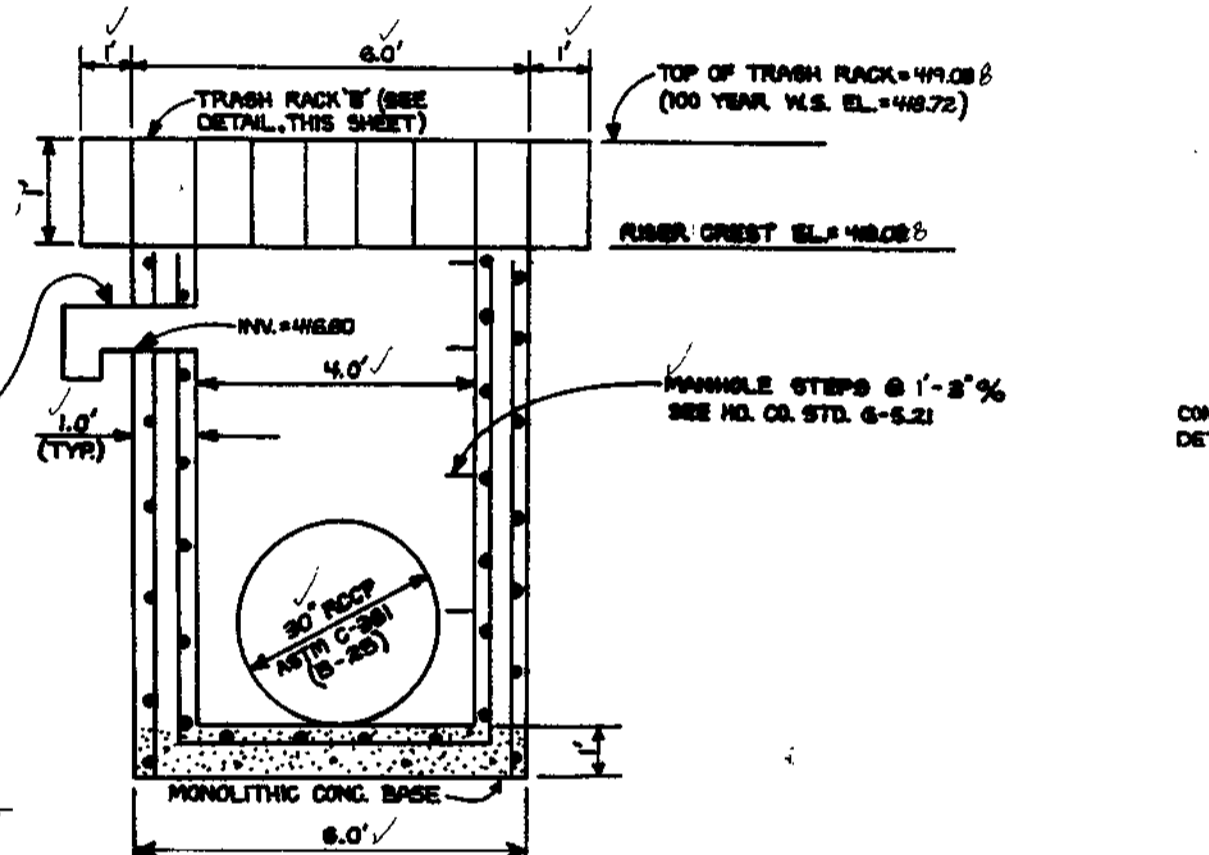

SECTION D-D' RISER DETAIL
(NO SCALE)

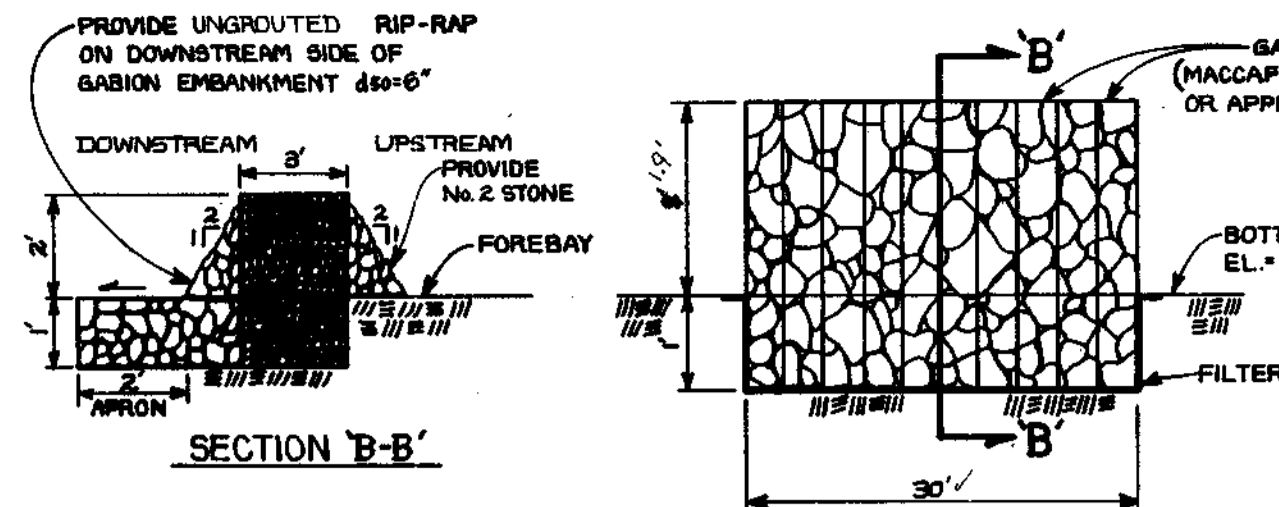


GABION FILTER AT FOREBAY
(NO SCALE)

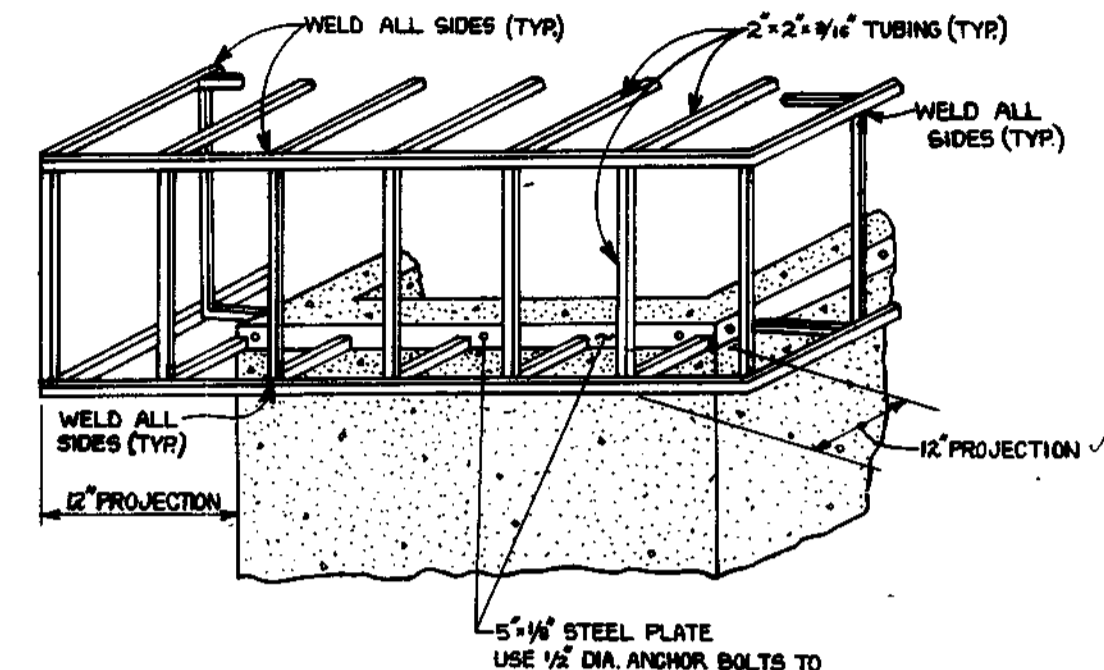


FASTENING DETAIL
(NO SCALE)


NOTE: (CONTRACTOR SHALL)
 1. FIELD MEASURE THE STRUCTURE DIMENSIONS FOR EXACT FITTING OF TRASH RACK.
 2. GALVANIZE ENTIRE TRASH RACK.
 3. ALL NUTS AND BOLTS SHALL BE GALVANIZED.

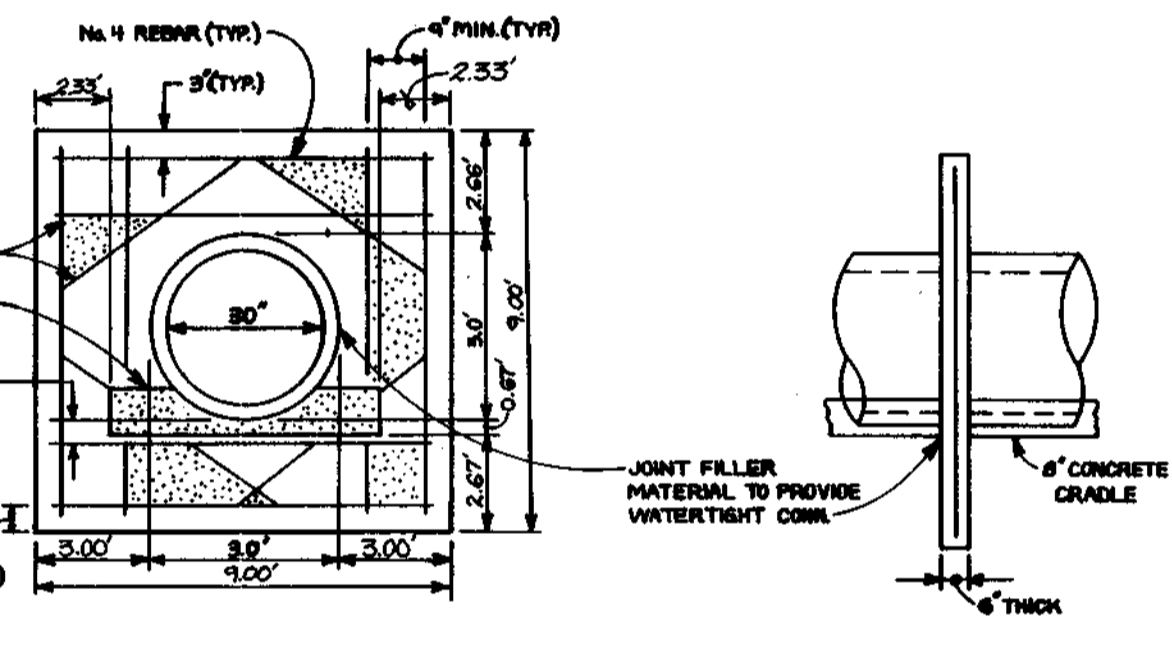


ANTI-SEEP COLLAR DETAIL
(NO SCALE)

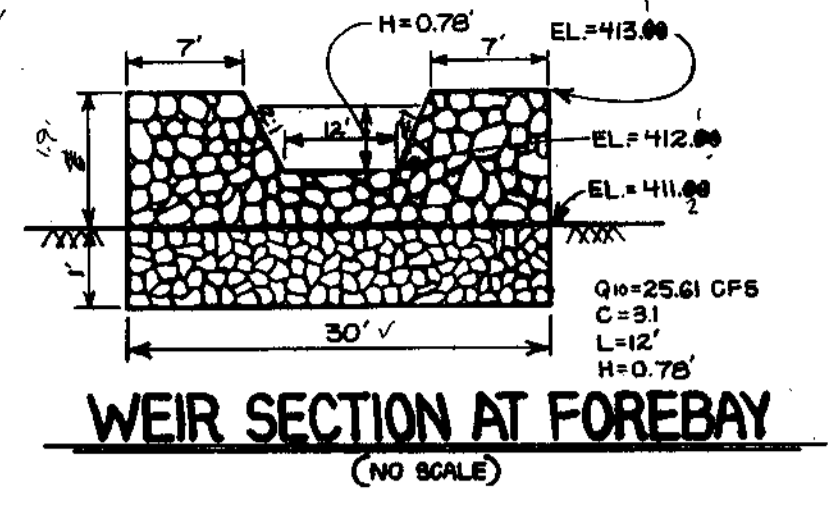


WEIR SECTION AT FOREBAY
(NO SCALE)

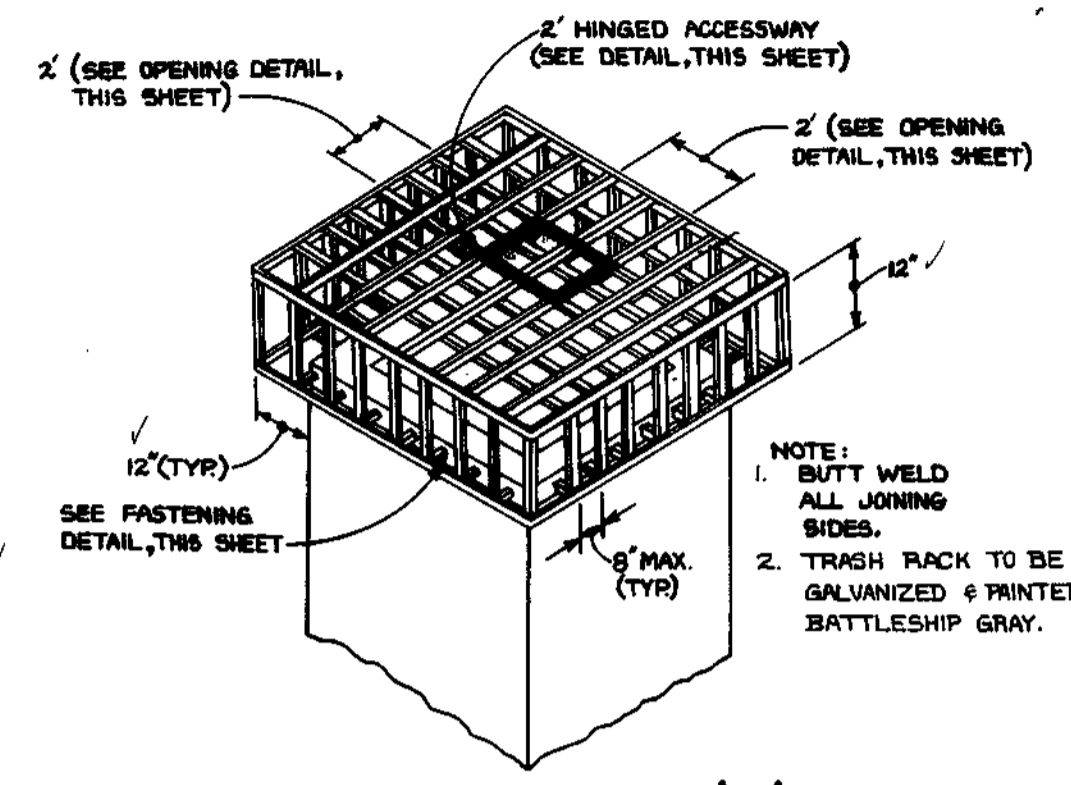


TRASH RACK B'
(NO SCALE)

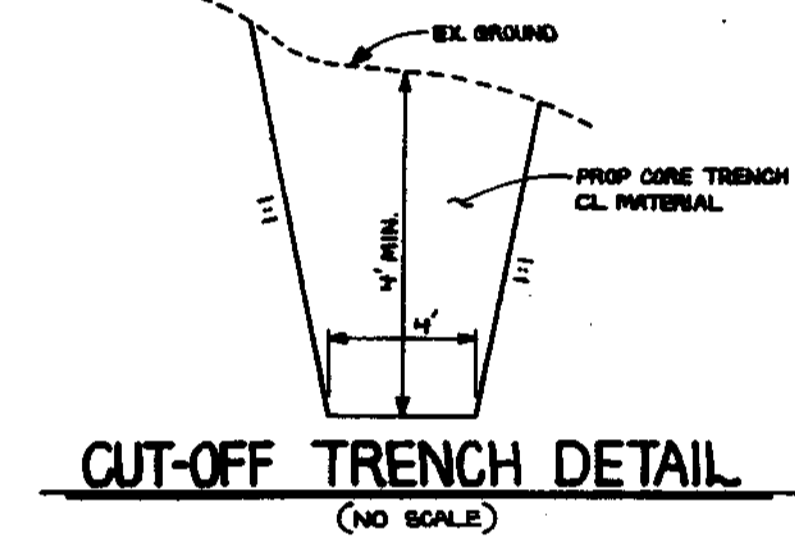


CUT-OFF TRENCH DETAIL
(NO SCALE)

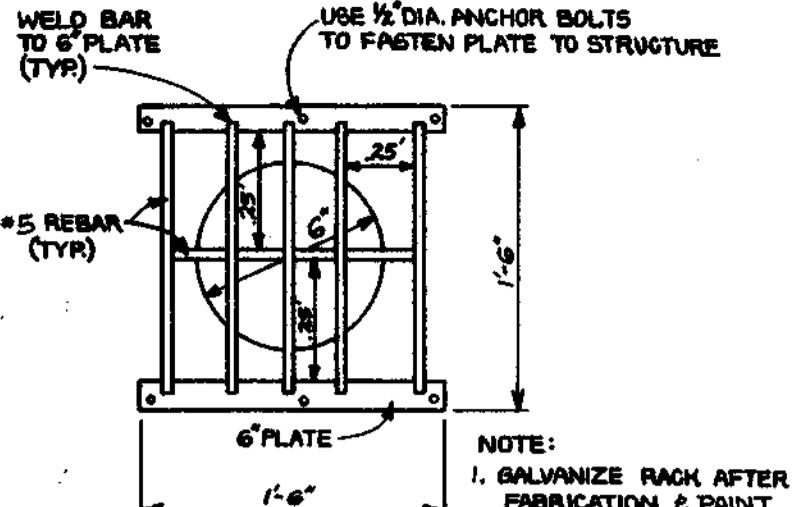


TRASH RACK A'
(NO SCALE)

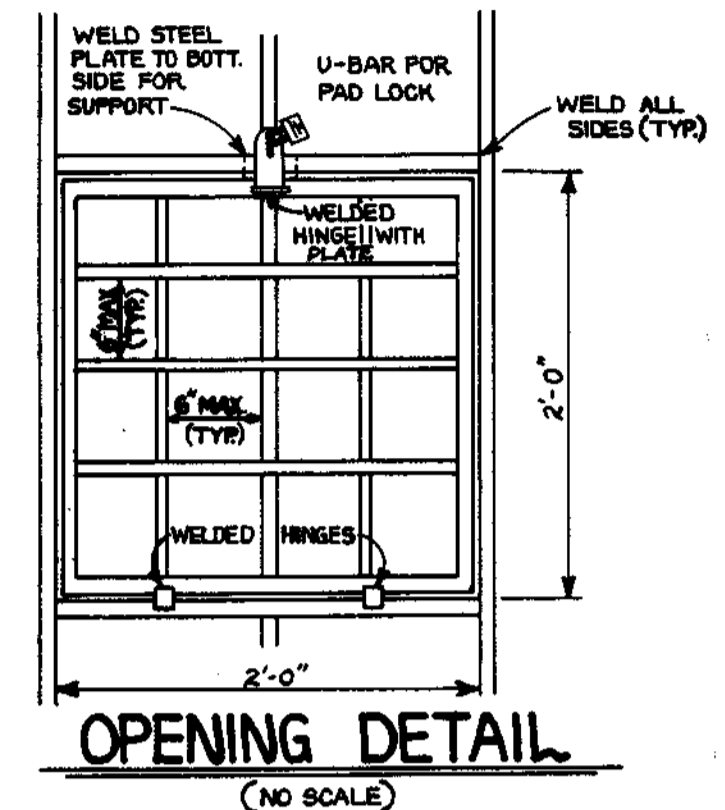


OPENING DETAIL
(NO SCALE)

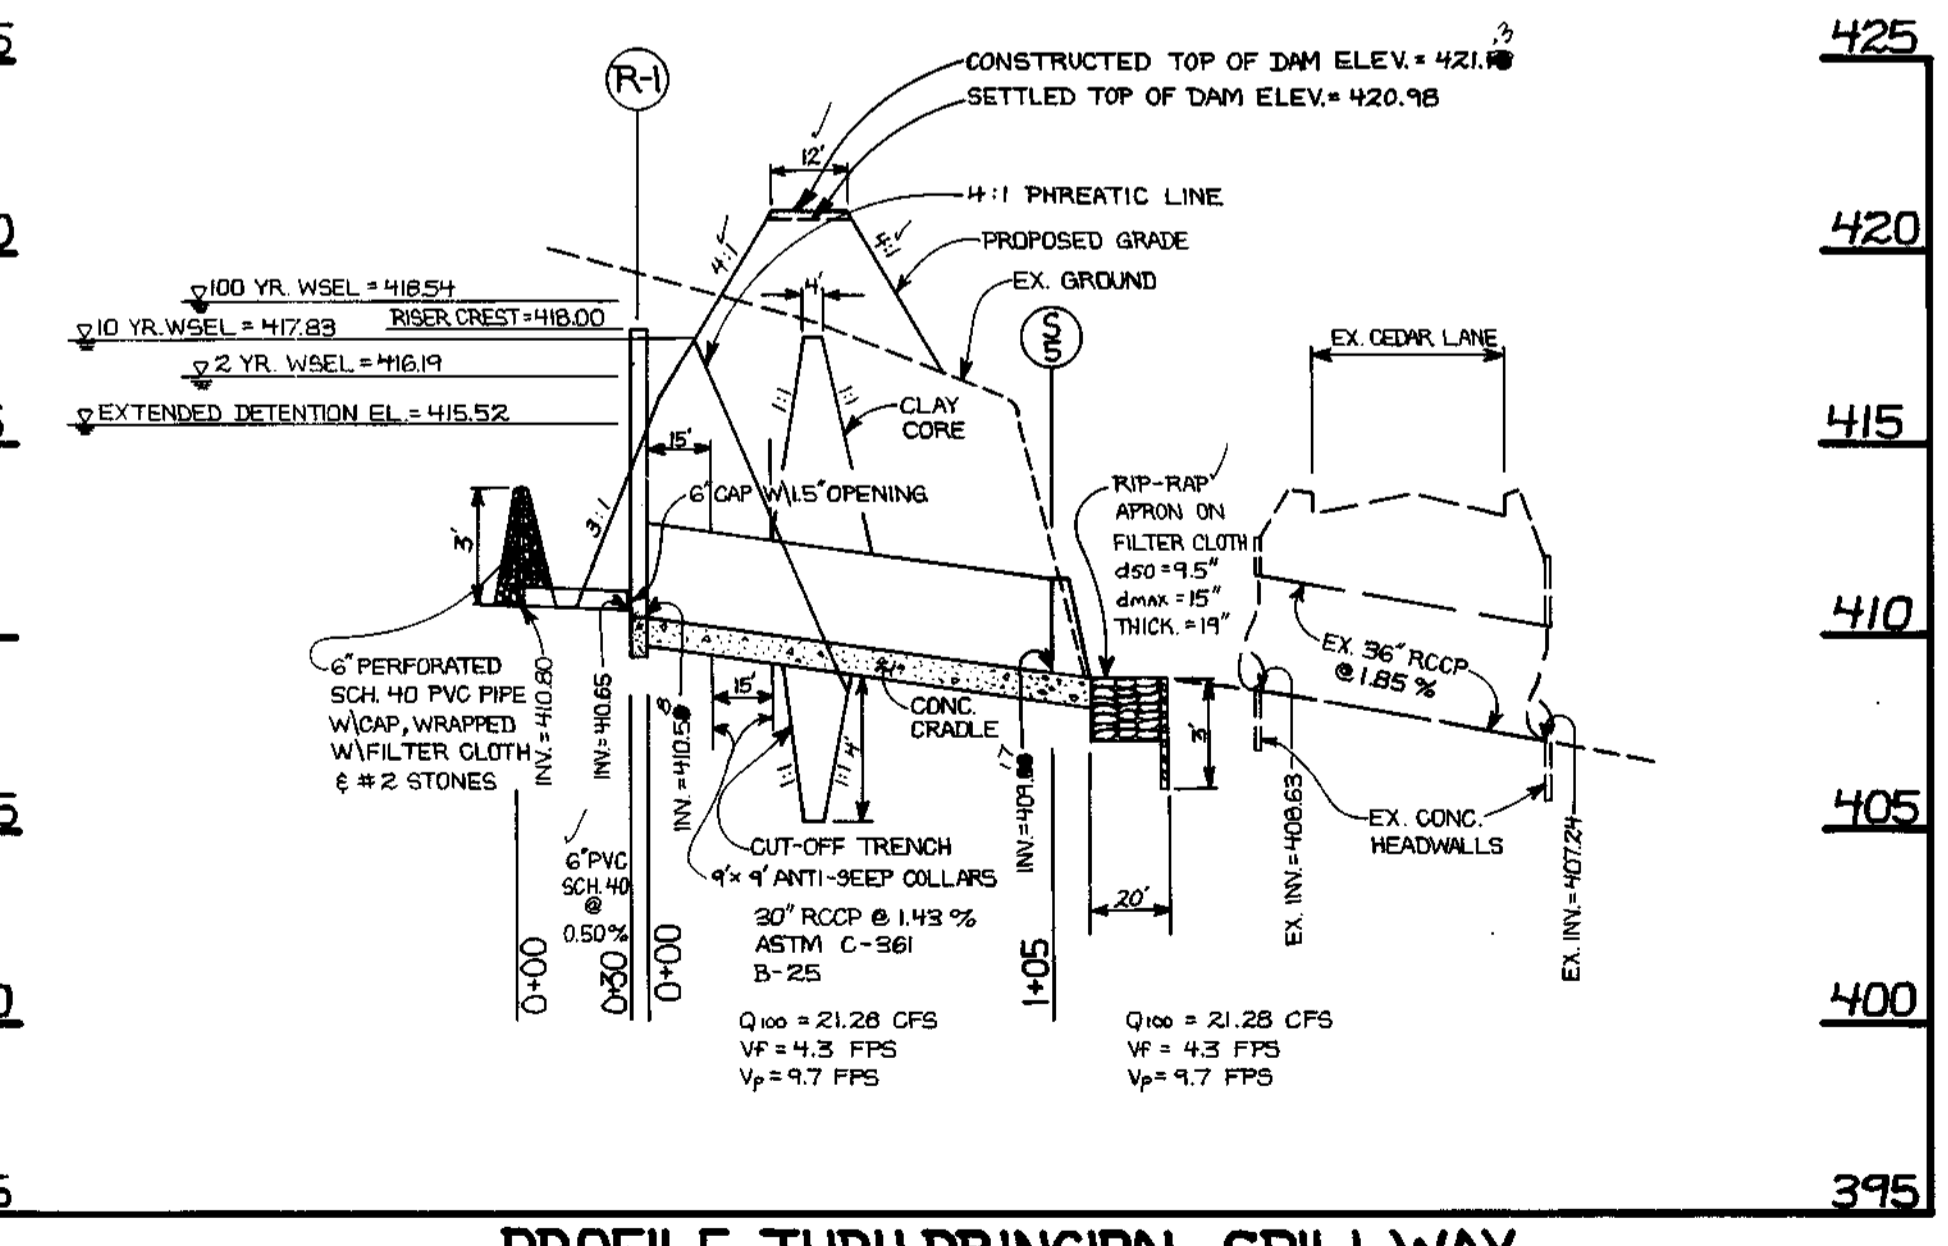

PROFILE THRU PRINCIPAL SPILLWAY
SCALE: 1"=50' HORIZ. 1"=5' VERT.

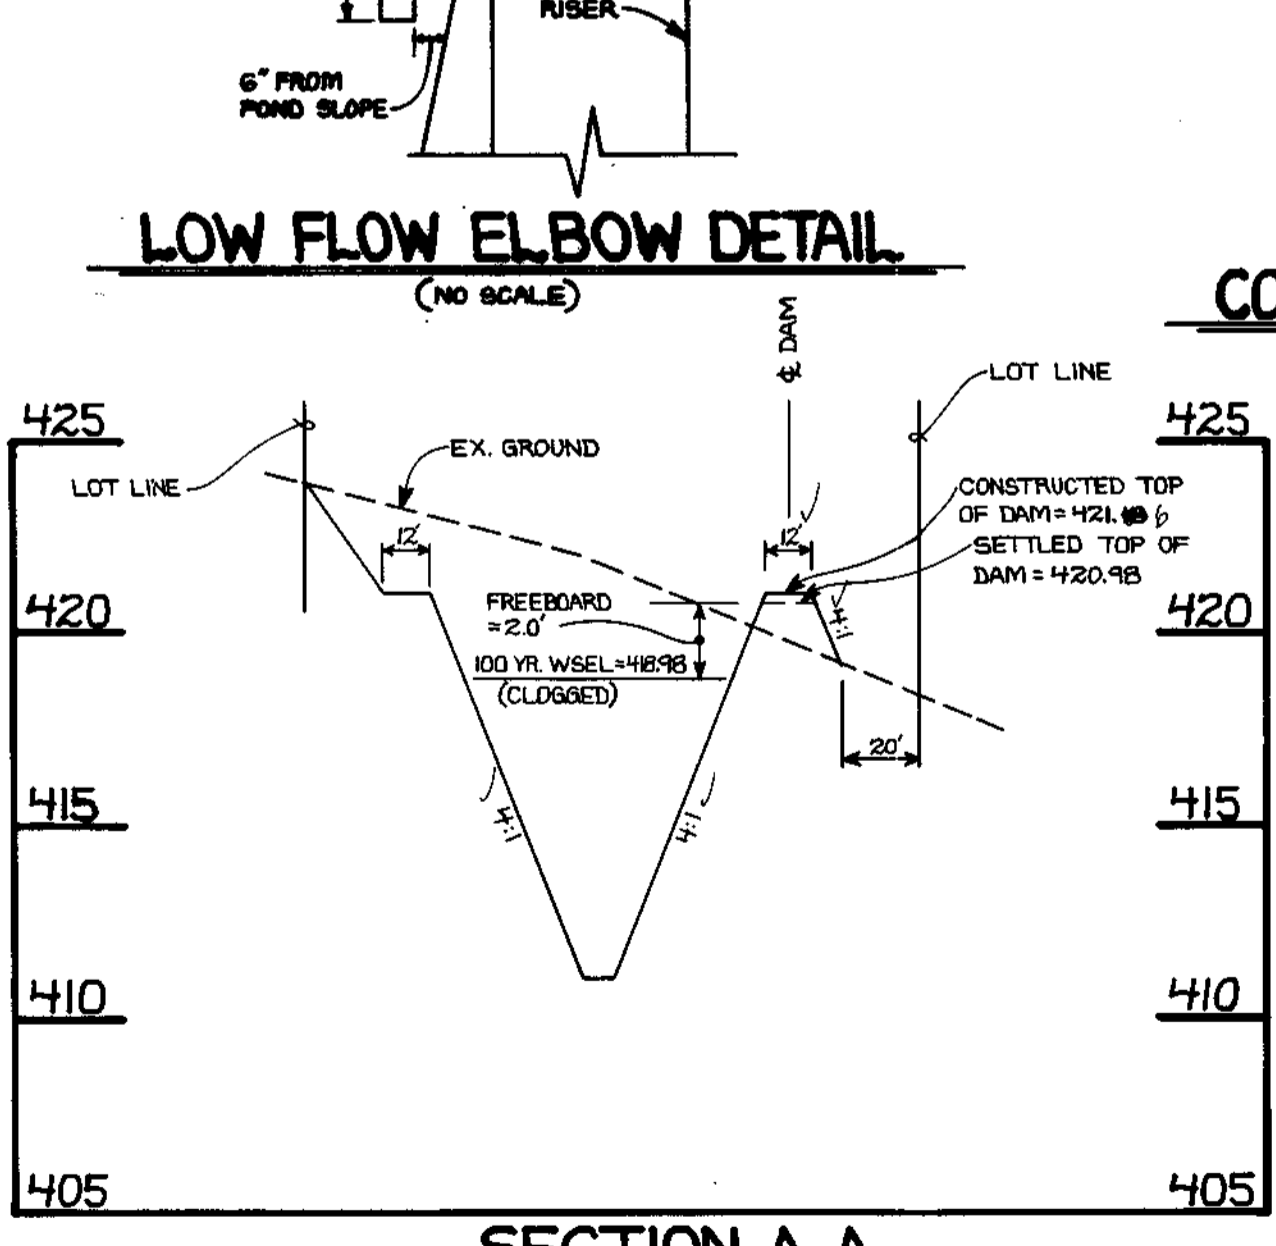

SECTION A-A
SCALE: 1"=50' HORIZ. 1"=5' VERT.

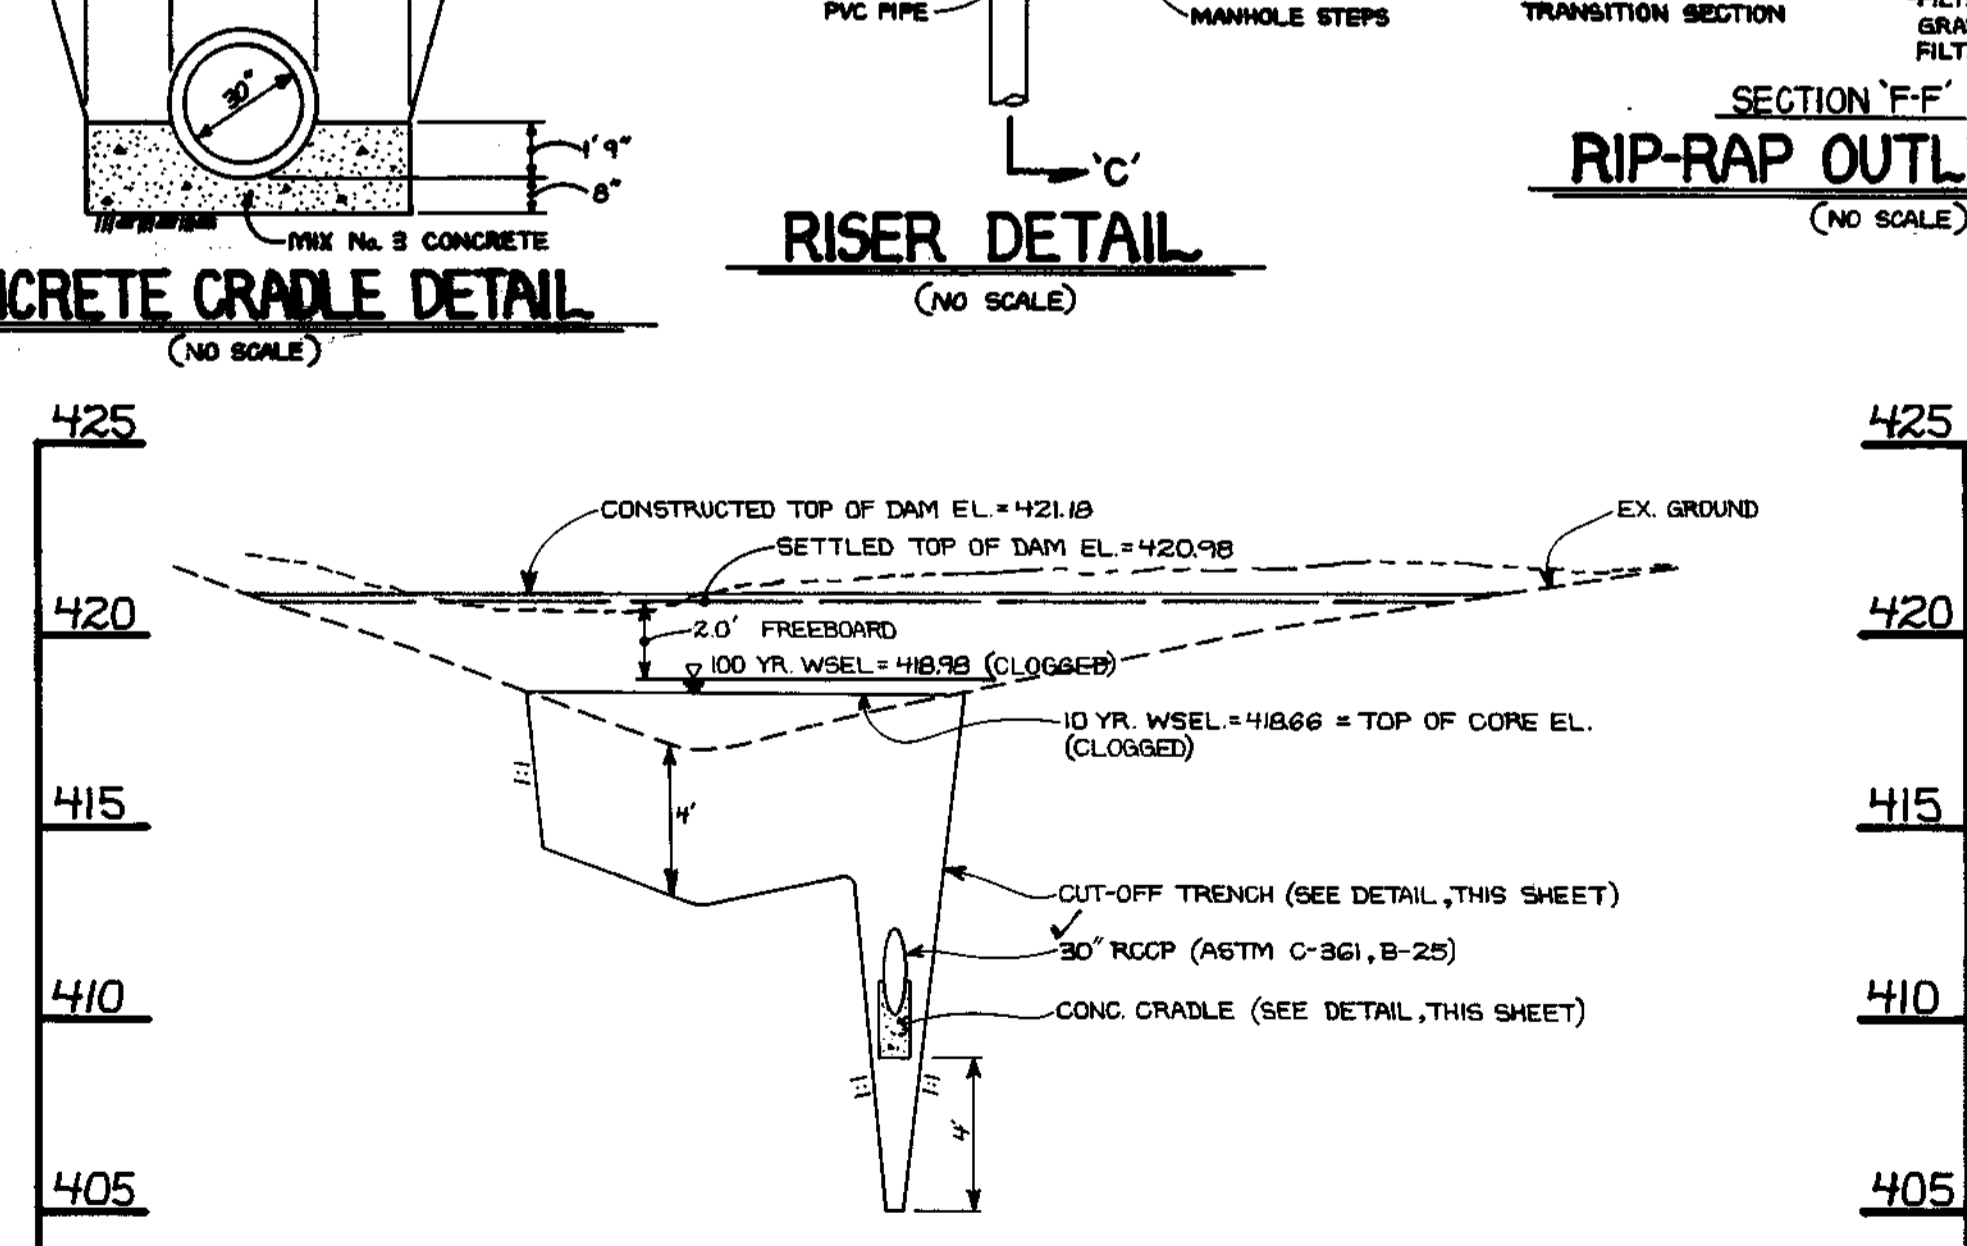

PROFILE THRU DAM
SCALE: 1"=50' HORIZ. 1"=5' VERT.

By The Developer:
 "We Certify That All Development And/Or Construction Will Be Done According To These Plans, And That Any Responsible Personnel Involved In The Construction Project Will Have A Certificate Of Attendance At A Department Of The Environment Approved Training Program For The Control Of Sediment And Erosion Before Beginning The Project. I Shall Engage A Registered Professional Engineer To Supervise Pond Construction And Provide The Howard Soil Conservation District With An "As-Built" Plan Of The Pond Within 30 Days Of Completion. I Also Authorize Periodic On-Site Inspections By The Howard Soil Conservation District."
 Signature Of Developer: *[Signature]* Date: 4/28/97
 Printed Name Of Developer: **Par Bank**

By The Engineer:
 "I Certify That This Plan For Pond Construction, Erosion And Sediment Control Represents A Practical And Workable Plan Based On My Personal Knowledge Of The Site Conditions. This Plan Was Prepared In Accordance With The Requirements Of The Howard Soil Conservation District. I Have Notified The Developer That He/She Must Engage A Registered Professional Engineer To Supervise Pond Construction And Provide The Howard Soil Conservation District With An "As-Built" Plan Of The Pond Within 30 Days Of Completion."
 Signature Of Engineer: *[Signature]* Date: 4-24-97
 Printed Name Of Engineer: **JAYESH V. PANCHOLI**

These Plans Have Been Reviewed For The Howard Soil Conservation District And Meet The Technical Requirements For Small Pond Construction, Soil Erosion And Sediment Control.
 Signature: *[Signature]* Date: 4/28/97
 USDA-Natural Resources Conservation Service

OWNER AND MAINTENANCE SCHEDULE OF HOME OWNERS ASSOCIATION OWNED AND MAINTAINED STORMWATER MANAGEMENT FACILITY WEST POND.
 HOMEOWNERS ASSOCIATION'S MAINTENANCE RESPONSIBILITIES:
 1. TOP AND SIDE SLOPES OF THE EMBANKMENT SHALL BE MOWED A MIN. OF TWO (2) TIMES A YEAR, ONCE IN JUNE AND ONCE IN SEPTEMBER. OTHER SIDE SLOPES, AND MAINTENANCE ACCESS SHOULD BE MOWED, AS NEEDED.
 2. DEBRIS AND LITTER SHALL BE REMOVED DURING REGULAR MOWING OPERATIONS AND AS NEEDED.
 3. WHEN DEEMED NECESSARY FOR AESTHETIC REASONS, SEDIMENT SHOULD BE REMOVED FROM THE POND. APPROVAL FROM THE DEPARTMENT OF PUBLIC WORKS IS NEEDED.

OPERATION AND MAINTENANCE SPECIFICATIONS
 I HEREBY CERTIFY THAT I WILL OPERATE AND MAINTAIN THE COMPLETED POND IN ACCORDANCE WITH THE FOLLOWING:
 1. PERIODIC INSPECTIONS OF THE FACILITY WILL BE MADE TO IDENTIFY POTENTIAL PROBLEMS THAT MAY AFFECT ITS SAFETY. THESE INSPECTIONS WILL BE MADE AFTER PERIODS OF HEAVY RAINFALL AND AT LEAST TWICE ANNUALLY. INSPECTION REPORTS SHALL BE KEPT UNTIL THE NEXT SUBSEQUENT INSPECTION. INSPECTION ITEMS TO BE LOOKED AT INCLUDE:
 A) SPILLWAY AND OUTLET WORKS;
 B) RIP-RAP;
 C) VEGETATIVE COVER;
 D) CRACKS IN THE FILL;
 E) SLOPE FAILURES; AND
 F) SEEPAGE AND OTHER SIGNS OF DISTRESS.
 2. PROBLEMS IDENTIFIED DURING INSPECTIONS WILL BE PROMPTLY CORRECTED. MAJOR PROBLEMS WILL BE BROUGHT TO THE ATTENTION OF THE SOIL CONSERVATION DISTRICT AND THE DAM SAFETY DIVISION OF THE MARYLAND WATER RESOURCES ADMINISTRATION. AS A VERY MINIMUM, GRASSY VEGETATION WILL BE MAINTAINED IN A DENSE AND HEALTHY STATE, AND WOODY VEGETATION WILL NOT BE PERMITTED TO GROW ON THE EMBANKMENT.

NOTES:
 1. CONCRETE SHALL CONFORM TO THE MARYLAND D.O.T. S.I.A. STANDARD SPEC'S FOR CONSTRUCTION AND MATERIALS, 1992 EDITION, 6, EXCEPT THAT TT. III CEMENT AND I.S.T.M. C 33 NO. 1 COARSE AGG. SHALL BE USED.
 2. REBAR WIRE FABRIC SHALL CONFORM TO A.S.T.M. A-305, LAP SPICES SHALL BE A MIN. OF 1 1/2 TRANSVERSE BARS SPACES. WIRE CAGES SHALL BE TACK WELDED TO PRODUCE A RIGID UNIT.
 3. ALL PIPES CONNECTING TO RISER SHALL HAVE WATER-TIGHT CONNECTIONS.
 4. RISER SHALL BE CONSTRUCTED IN ONE PIECE.

These Plans For Small Pond Construction, Soil Erosion And Sediment Control Meet The Requirements Of The Howard Soil Conservation District.
 Signature: *[Signature]* Date: 8/12/97
 Howard Soil Conservation District

Approved: Department Of Public Works
 Signature: *[Signature]* Date: 9-26-97
 Chief, Bureau Of Highways

Approved: Department Of Planning And Zoning
 Signature: *[Signature]* Date: 9/12/97
 Chief, Division Of Land Development
 Signature: *[Signature]* Date: 9/26/97
 Chief, Development Engineering Division

STORMWATER MANAGEMENT PLAN
 NOTES & DETAILS
CEDAR ACRES
 LOTS 1 THRU 36
 A RESUBDIVISION OF LOTS 3,4 AND 5
 ZONED: RSC
 TAX MAP No. 35 PARCEL 36
 FIFTH ELECTION DISTRICT HOWARD COUNTY, MARYLAND
 SCALE: 1"=50' DATE: APRIL 22, 1997
 SHEET: 8 OF 9

