


Hanut



ADABLE PARCEL B COURSEST SECTION TWO FUTURE DEVELOPEMENT TAX MAP 37, P-25 CHATEAU HOMES EASEMENT FOR LOTS 2-5 PLAT 16262 N19°06'06'E-PRIVATE INFILTRATION BASIN (BMP) LO1 97 THAMPSANS PURCHUS - SECTION A AREA! LOTS 15 THRU 107 181.82 , MAYFIELD WARDS ASSOCIATION INC. THOMPSONS PURCHASE SECTION 4. AREA WETLAND PER 1457/591 & 1358/466 PLAT NO. 6352 ZONE 00. 6352 EVC + EX 20 DRAININGE & VEHICULAR INGRESS/EGRESS IS RESTRICTED TABLE OF CONTENTS

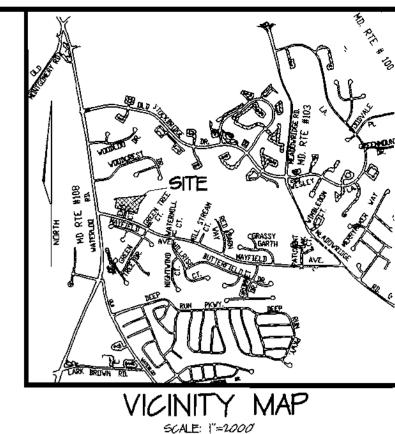

GENERAL NOTES:

I. CURRENT ZONING IS R-SC PER 10/18/93 COMPREHENSIVE ZONING PLAN. 2. IN ACCORDANCE WITH SECTION 128 OF THE HOWARD COUNTY REGULATIONS, BAY WINDOWS CHIMNEYS OR EXTERIOR STAIRWAYS NOT MORE THAN 16 FEET IN WIDTH MAY PROJECT NOT MORE THAN 4 FEET INTO ANY SETDACKS, PORCHES OR DECKS, OPEN OR ENCLOSED MAY PROJECT NOT MORE THAN 10 FEET INTO THE FRONT OR REAR YARD SETBACK. 3. NO CLEARING, GRAPING OR CONSTRUCTION IS PERMITTED WITHIN THE REQUIRED WETLANDS, STREAM(S) OR THEIR BUTTERS AND FOREST CONSERVATION EASEMENT AREAS. 4. DRIVEWAYS SHALL BE PROVIDED PRIOR TO ISSUANCE OF A RESIDENTIAL OCCUPANCY PERMIT FOR ANY NEW DWELLINGS TO ENSURE SAFE ACCESS FOR FIRE AND EMERGENCY VEHICLES PER THE FOLLOWING

MINIMUM REQUIREMENTS. a) WIDTH - RESIDENTAL DRIVEWAY 14 FEET

B) SURFACE - 6 INCHES OF COMPACTED CRUSHER RUN BASE W/TAR AND CHIP COATING (1-1/2" MIN) C) GEOMETRY - MAX. 15% GRADE, MAX. 10% GRADE. CHANGE, AND MIN 45' TURNING RADIUS;

D) STRUCTURES (CULVERTS/BRIDGES) CAPABLE OF SUPPORTING 25 GROSS TONS ((H25 LOADING) E) DRAINAGE ELEMENTS - CAPABLE OF SAFELY PASSING 100-YEAR FLOOD WITH NO MORE THAN

F.) MAINTENANCE - SUFFICIENT TO INSURE ALL WEATHER USE. 5. THE CONTRACTOR SHALL NOTIFY THE DEPARTMENT OF PUBLIC WORKS/BUREAU OF

ENGINEERING /CONSTRUCTION INSPECTION DIVISION AT (4/0) 3/3-1880 AT LEAST FIVE (5) WORKING DAYS PRIOR TO THE START OF WORK.

6. THE CONTRACTOR SHALL NOTIFY "MISS UTILITY" AT 1-800-257-7777 AT LEAST 48 HOURS PRIOR TO ANY EXCAVATION WORK BEING DONE

7. THE EXISTING TOPOGRAPHY IS FIELD RUN PREPARED BY CHARLES R. CROCKEN &ASSOCIATES,

3. COORDINATES BASED ON NAD '83, MARYLAND COORDINATE SYSTEM AS PROJECTED BY HOWARD COUNTY GEODETIC CONTROL STATIONS #37HA AND NO.#37HB

9. SWM APPROVED AS PER F- 01-54

10. EXISTING UTILITIES ARE PLOTTED FROM HOWARD COUNTY UTILITY DRAWINGS AND FIELD LOCATED WHERE POSSIBLE.

II. ANY DAMAGE DUE TO THE CONTRACTORS ACTIVITIES DONE TO COUNTY'S RIGHT-OF-WAY SHALL BE CORRECTED AT THE DEVELOPER'S EXPENSE.

12. SHC ELEVATIONS SHOWN ARE LOCATED AT THE PROPERTY LINE.

26 STADE TREES AND 13 EVERGREEN TREES APPROVED F-01-54

13. FOR PRIVEWAY ENTRANCE PETAILS REFER TO THE HOWARD COUNTY DESIGN MANUAL, VOLUME IV, STANDARD DETAIL R- 607

14. THE FOREST CONSERVATION OPLIGATION FOR REFORESTATION AND AFFORESTATION, INCURRED BY THE SUDDIVISION SHOWN HEREON, 139 ACRES HAS BEEN SATISFIED BY THE AQUISITION OF 120 ACRES OF FOREST MITIGATION CREDITS FROM ENVIRONMENTAL BANC & EXCHANGE LLC. (EXB) BY EMA'S MANOR LLC. (EXB) AND THAT THE OUTSTANDING REFORESTATION OFLIGATION OF 0.13 ACRES HAS BEEN MET BY A FEE-IN-LIEU PAYMENT OF \$2,851.40 TO THE HOWARD CO. FOREST CONSERVATION FUND. APPROVED F-02-54 IS THIS PLAN HAS BEEN PREPARED IN ACCORDANCE WITH THE PROVISIONS OF SECTION 16114 OF THE HOWARD COUNTY CODE AND THE LANDSCAPE MANUAL FINANCIAL SURETY FOR THE REQUIRED LANDSCAPING MAS DEEN POSTED AS PART OF THE DPW DEVELOPERS AGREEMENT IN THE AMOUNT OF \$5,7000 FOR

(6, THIS PLAN IS SUBJECT TO THE 5TH EDITION OF THE SUBDIVISION AND LAND DEVELOPEMENT REGULATIONS AND THE ZONING REGULATIONS AS AMENDED UNDER COUNCIL BILL #50~2001

17. COORDINATES BASED ON NAD '83, MARYLAND COORDINATE SYSTEM AS PROJECTED BY HOWARD COUNTY

GEODETIC CONTROL STATIONS NOTIFA AND NOTIFE 18. TYPICAL HOUSE DIMENSIONS AND SCHEMATIC ARE SHOWN ON THIS SHEET.

19. THE HOWEOWNERS ASSOCIATION POCLMENTS HAVE BEEN RECORDED WITH THE MARYLAND STATE DEPARTMENT OF ASSESSMENTS AND TAXATION ON 2-03-03 AS RECORDING NUMBER \$00475/LIABT 20. ALL INTERIOR ROADS WILL BE PUBLIC

21. ALL PAVING AND STORM DRAIN CONSTRUCTION SHALL BE IN ACCORDANCE WITH

HOWARD COUNTY ROAD CONSTRUCTION CODE AND STANDARD SPECIFICATIONS AND ROAD CONSTRUCTION ROAD CONSTRUCTION PLAN F- 02-54

22.THE TOPOGRAPHY SHOWN IS BASED ON A SURVEY PERFORMED BY FREDERICK WARD

ASSOCIATES IN DECEMBER, 2000.

23. THE USE-IN-COMMON MAINTENANCE AGREEMENT FOR LOTS 2 TO 5 HAS BEEN RECORDED AS LIBER 07749 FOLIO185 IN THE LAND RECORDS OFFICE OF HOWARD COUNTY MD. ON 12-91-02 24. PLAN OF THE SUPPINISION SHOWN HEREON IS SUPLECT TO A WAIVER FROM THE REQUIREMENTS OF SECTION 16/192(a)(1)(i)(b) TO CONSTRUCT IMPROVEMENTS TO A MAJOR COLLECTOR ROAD, SPECIFICALLY TO CONSTRUCT ACCEL/DECEL LANES ALONG THE NORTHSIDE OF MAYFIELD AVENUE AT THE INTERSECTION OF EMAS COURT. WP-02-61 APPROVED MARCH 4, 2001

25 PLAN OF THE SUBDIVISION SHOWN HEREON IS SUBJECT TO A WAIVER FROM THE REQUIREMENTS OF SECTIONS 16:144(a) and (f), 16:145, and 16:146 TO NOT BE REQUIRED TO SUBMIT SKETCH AND PRELIMINARY PLANS FOR THE PROPOSED ADDITION OF LAND (P/O PARCEL 1/25) TO A MAJOR SUBDIVISION (F-O2-54, EMA'S MANOR), AND SECTION (4/21(e)(1) TO PERMIT THE REQUIRED PUBLIC ROAD FRONTAGE FOR OPEN SPACE TO BE REDUCED TO. 20 FEET FOR PROPOSED OPEN SPACE LOT 2, WOODCREST, SECTION 2 WITHOUT REQUIRING THE ADJACENT SIDE BRL'S ON ADJACENT LOTS TO BE INCREASED BY 10 FEET AND, ZERO FEET FOR THE TWO PROPOSED OPEN SPACE PARCELS, SHOWN AS LOTS 10 & 11. FILE NO. WP-01-120 APPROVED JULY 30, 2001

26. WATER AND SEWER CONTRACT NO.14-4004-0 27. NON-BUILDABLE PARCEL 'A' IS TO BE CONNEYED TO THE OWNER OF ADJACENT LOT 4 MAYFIELD WOODS

29. THE SCHOOL BUS PAD IS TO BE OWNED AND MAINTAINED BY THE HOME OWNER ASSOCIATION 29. THE TRASH PAD FOR LOTS 2 TO 5 SHALL BE MAINTAINED BY THE OWNERS OF LOTS \$\frac{4}{2}\$ TO 5. A MAINTENANCE AGREEMENT HAS BEEN RECORDED IN THE LAND RECORDS OFFICE OF HOWARD COUNTY,

30. PERMETER LANDSCAPING OF THE TRASH PAD IN ACCORDANCE WITH SECTION 16124 OF THE LANDSCAPE MANUAL SHALL BE PROVIDED AS SHOWN ON THIS SITE PLAN. SURETY FOR THE REQUIRED <u>G</u> SCHRUBS IN THE AMOUNT OF \$ 120°2 SHALL BE PROVIDED WITH THE GRADING PERMIT



UNITS ALLOWED 8 UNITS # UNITS PROVIDED 8 UNITS

HOWARD COUNTY FILE NO.'S: F- 01-54, DPZ NO 5-00-11, P-01-18, WP-01-61 & WP-01-120 DEDIAIT INFAOLATION

	PERMIT INFORMATION						
SUDDIVISION NAME:			SECTION/AREA		LOT/ PAPOEL #		
EMA'S MANOR					1-8		
PLAT & OR L/F 6262	11.00K #	ZONE R-SC	TAX/ZONE MAP #37	ST ST	CENSUS TRACT #60 D		
WATER CO	DE:	DO	SEWER (CODE:	2 50562		

NO. DATE REVISION SITE DEVELOPEMENT PLAN EMA'S MANOR SINGLE FAMILY DETACHED SUBDIVISION LOTS | TO 8 AND O.S. LOT 9. PARCEL #143 & P/O PARCEL 125 TAX MAP 37 GRID 14 HOWARD COUNTY, MARYLAND IST ELECTION DISTRICT DATE: 4/10/03 DEVELOPER: FAIRMONT REAL ESTATE SERVICES 946-A MARIMICH CT. ELDERSBURG, MD 21784 OWNER:

SCALE.

CHARLES R. CROCKEN & ASSOCIATES, INC

ONL EIGHERING - LAP PLANING P.O. BOX 307 WESTMINSTER, MAYLLAND PH. 410-549-2705 FAX 410-543-3063

1. SITE DEVELOPMENT PLAN

2. SEDIMENT CONTROL PLAN

3. SEDIMENT CONTROL NOTES


AND DETAILS/Landscaping

50P-04-00

SHEET | OF 3

EMA'S MANOR, LLC.

946—A MARIMICH CT. ELDERSBURG, MD 21784

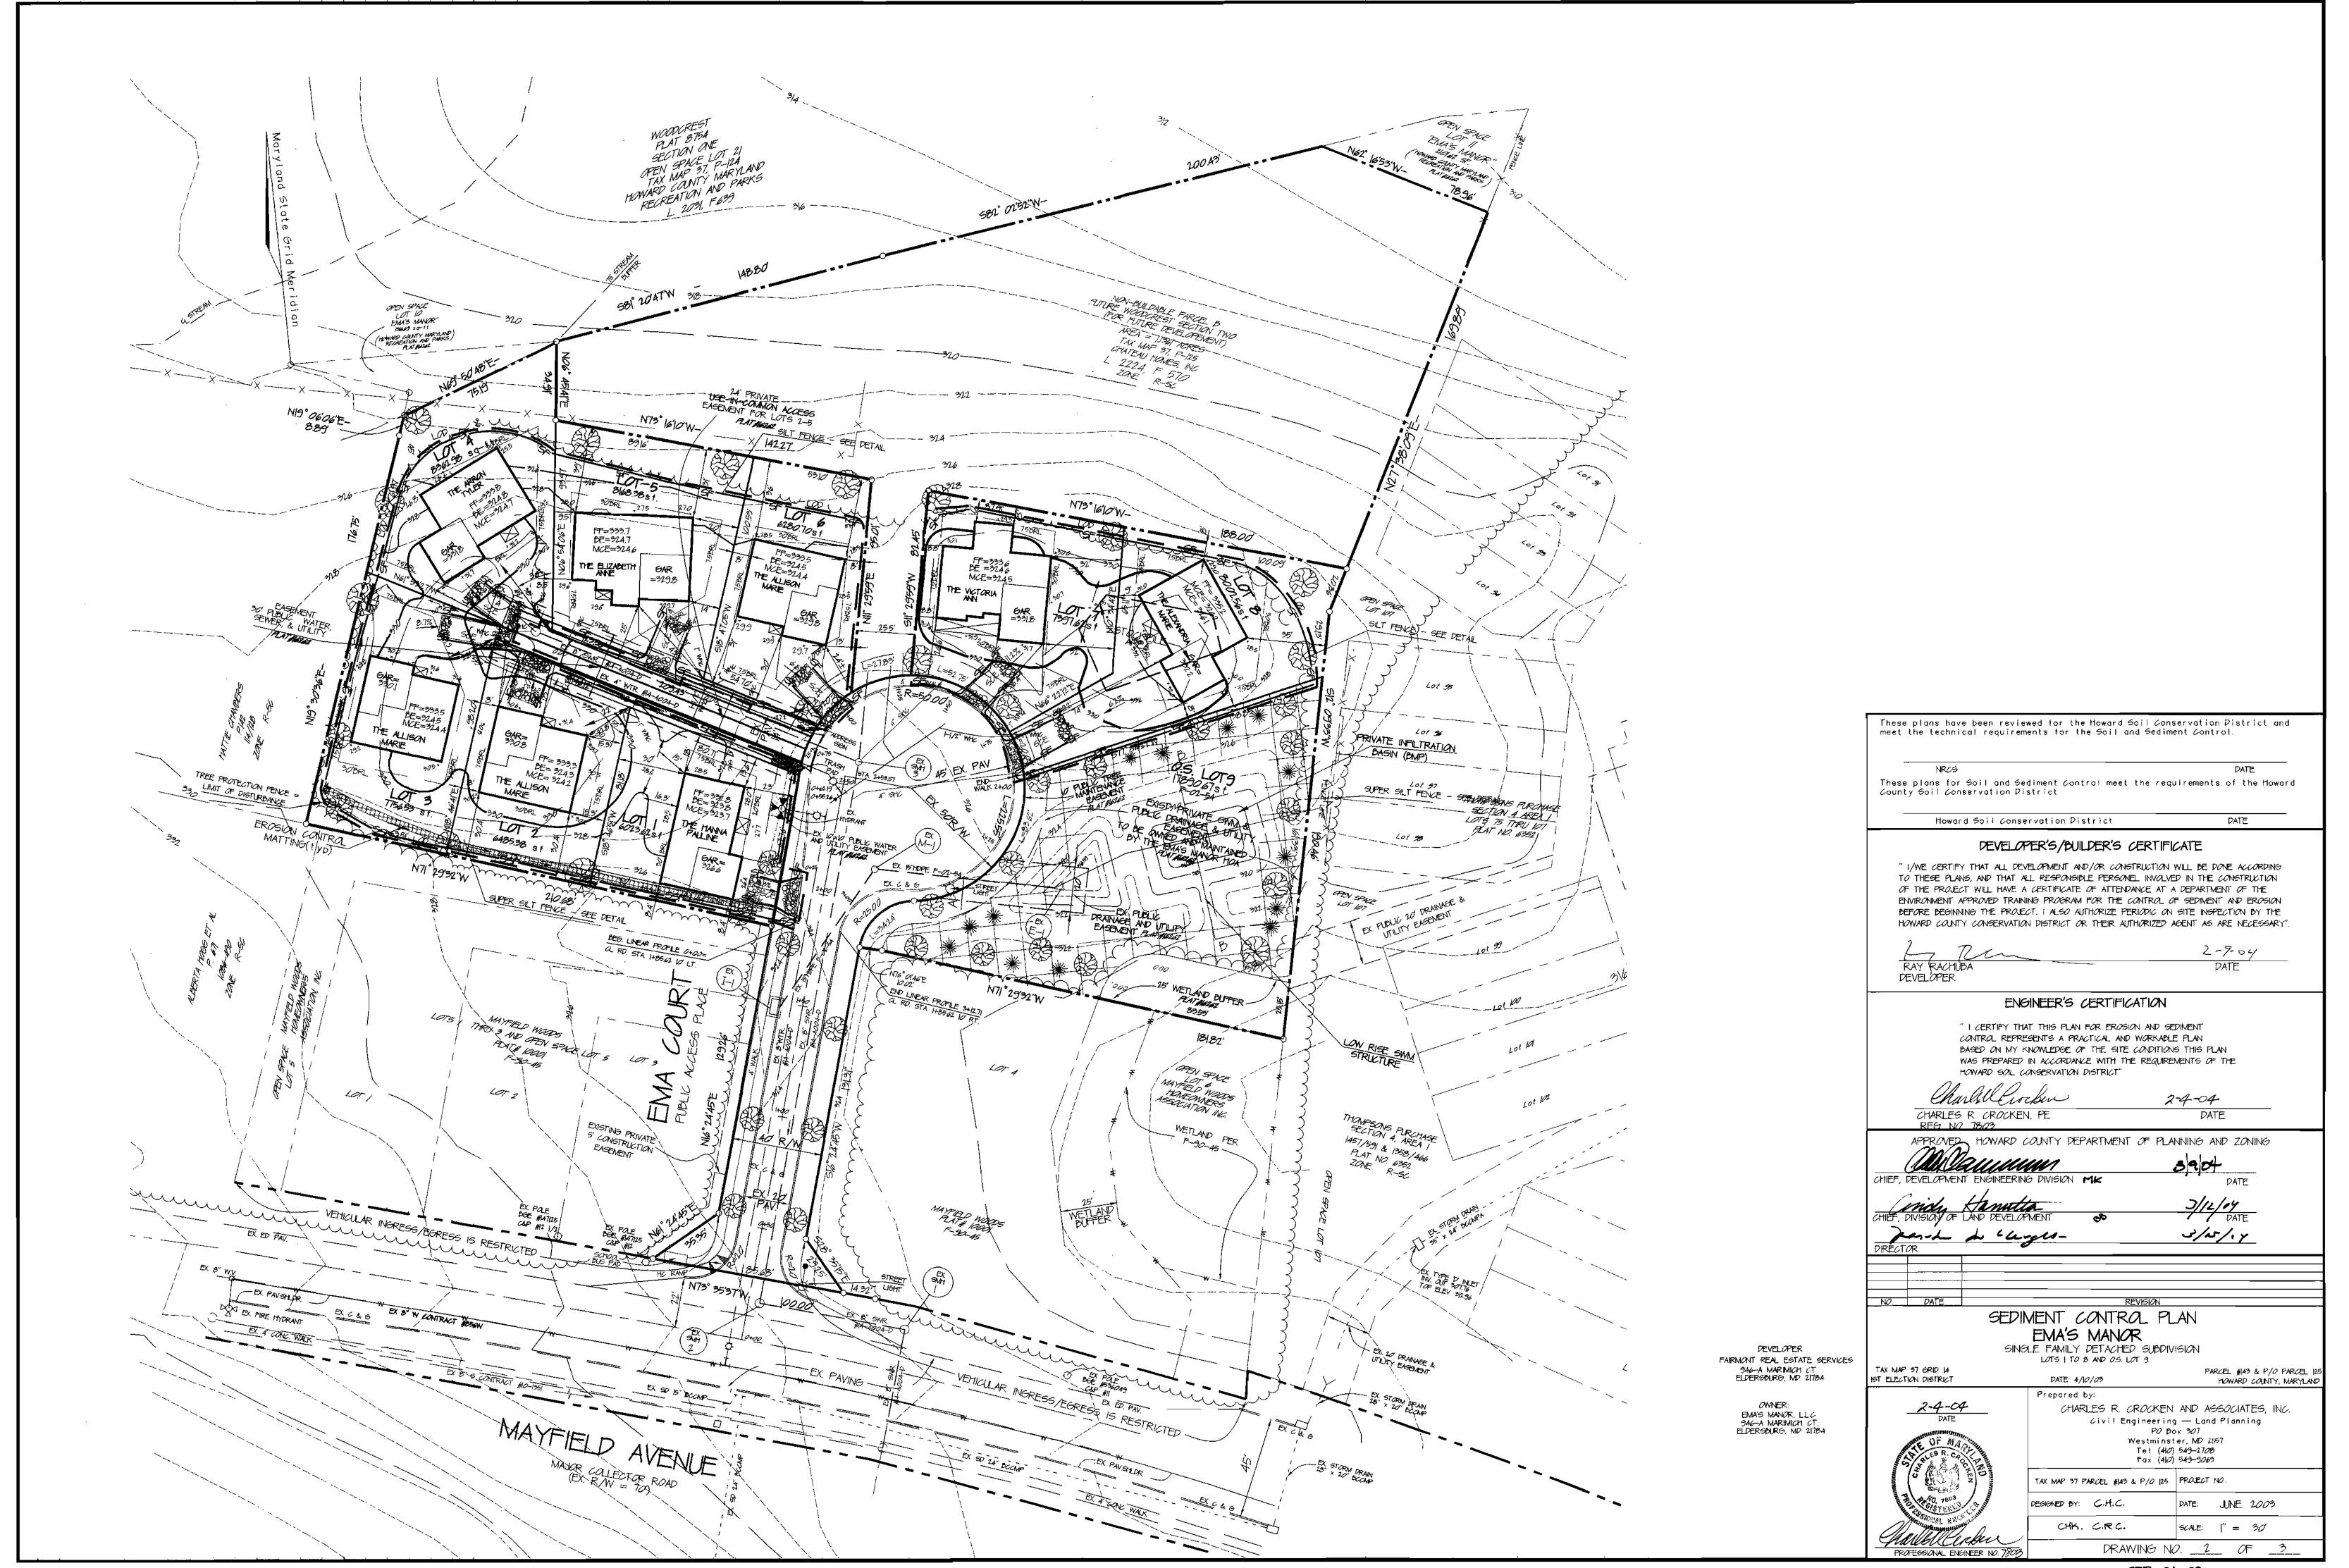

PERMANENT SEEDING NOTES

Apply to graded or cleared areas not subject to immediate further disturbance where a permanent long-lived vegetative cover is needed Seedbed Preparation: Loosen upper 3 inches of soil by raking, discing, or other suitable means before seeding, unless otherwise loosened.

Soil Amendments: In lieu of soil test recommendations, use the following schedules:

1) Preferred - apply 1 tons per acre dolomitic limestone (92 lbs./1000 sq. ft) and 600 lbs. per ocre 10-10-10 fertilizer (14 lbs./1000 sq. ft.) before seeding. Harrow or disc into upper 3 inches of soil. At time of seeding, apply 400 lbs. per acre 30-0-0 ureaform fertilizer (9 lbs./1000 sq. ft.).

2) Acceptable - apply 2 tons per acre dolomitic Timestone (92 lbs./1000 sq. ft.) and 1000 lbs. per acre 10-10-10 fertilizer (23 lbs./1000 sq. ft.) before seeding. Harrow or disc into upper 3 inches of soil one of the following schedules.

Seeding — For the periods March | through April 30, and Aug. | through Oct. |5, seed with 60 lbs./acre (14 lbs./1000 sq. ft.) of Kentucky 3 tall fescue. For the period May | through July 3|, seed with 60 ibs./acre of Kentucky 🔊 tall fescue and 2 lbs. per acre (05 lb./1000 sq. ft) of weeping lovegrass for the period Oct 15 through feb. 28 protect by Option (1) 2 tons/acre of well-anchored straw mulch and seed as soon as possible in the spring, Option (2) use sod, Option (3) seed with 60 lbs./acre of Kentucky 게 tall fescue and mulch with 2 tons/acre of well-anchored straw.

Mulching - Apply $\frac{1}{2}$ to 2 tons/acre (70 to 90 lbs./100 sq. ft) of unrotted small grain straw immediately after seeding. Anchor mulch immediately after application using mulch anchoring tool or 218 gallons/acre (5gal./1000 sq. ft.) of emulsified asphalt on flat areas. On slopes & feet or higher use 348 gallons/acre (8 gallons/1000 sq. ft.) for anchoring

Maintenance - Inspect all seeded areas and make needed repairs, replacements, and reseedings. For the period Nov. 16 through Feb. 28, protect site by applying 2 tons/acre of well anchored strow mulch and seed as soon as possible in the spring, or use sod.

TEMPORARY SEEDING NOTES

Apply to graded or cleared areas likely to be redisturbed where a short-term vegetative cover is needed.

Seedbed Preparation Loosen upper three inches of soil by raking, discing, or other acceptable means before seeding, unless previously loosened.

Soil Amendments: Apply 600 lbs./acre 10-10-10 fertilizer (14 lbs./1000 sq. ft.)

Seeding: For periods March | through April 30 and August 15 through Nov. 15, seed with 2-1/2 bushels/acre (3.2 Ibs/1000 sq. ft.) of annual rye. For the period May | through Nov. 14, seed with 3 lbs./acre (1) lbs./1000 sq. ft.) of weeping lovegrass

Mulching: Apply |-|/2| to 2 tons/acre (70 to 90 lbs/100 sq. ft.) of unrotted small grain straw immediately after seeding. Anchor mulch immediately after application using mulch anchoring tool or 218 gallons/acre (5gai./1000 sq. ft.) of emulsified asphalt on flat areas. On slopes & feet or higher use 348 gallons/acre (8 gallons/1000 sq ft.) for anchoring Refer to 1994 Maryland Standards for Sail Erosion and Sediment Control for rates and methods not covered.


TOPSOIL SPECIFICATIONS TOPSOIL SALVAGED FROM THE EXISTING SITE MAYBE USED PROVIDED THAT IT MEETS THE STANDARDS AS SET FORTH IN THESE SPECIFICATIONS TYPICALLY, THE DEPTH OF TOPSOIL TO BE SALVAGED FOR A GIVEN SOIL TYPE CAN BE FOUND IN THE REPRESENTATIVE SOIL PROFILE SECTION IN THE SOIL SURVEY PUBLISHED BY USDA-SCS IN COOPERATION WITH MARYLAND AGRICULTURAL EXPERIMENTAL STATION

II. TOPSOIL SPECIFICATIONS - SOIL TO DE USED AS TOPSOIL MUST MEET THE FOLLOWING :

TOPSOIL SHALL BE A LOAM, SANDY LOAM, CLAY LOAM, SANDY CLAY LOAM, LOAMY SAND OTHER SOILS MAYBE USED IF RECOMMENDED BY AN AGRONOMIST OR SOIL SCIENTIST AND APPROVED BY THE APPROPRIATE APPROVAL AUTHORITY. REGARDLESS, TOPSOIL SHALL NOT BE A MIXTURE OF CONTRASTING TEXTURED SUBSCILS AND SHALL CONTAIN LESS THAN 5% BY VOLLME OF CINDERS STONES SLAG COARSE FRAGMENTS GRAVE STICKS, ROOTS, TRASH, OR OTHER MATERIALS LARGER THAN I 1/2" IN DIAMETER

II. TOPSOIL MUST BE FREE OF PLANTS OR PLANT PARTS SUCH AS BERMUDA GRASS, QUACKGRASS, JOHNSONGRASS, NUTSEDGE, POISON IVY, THISTLE, OR OTHERS AS SPECIFIED

iii. WHERE THE SUBSOIL IS EITHER HIGHLY ACIDIC OR COMPOSED OF HEAVY CLAYS, GROUND LIMESTONE SHALL BE SPREAD AT THE RATE OF 4-8 TONS/ACRE (200-400 POUNDS PER 1,000 SQUARE FEET) PRIOR TO THE PLACEMENT OF TOPSOIL LIME SHALL BE DISTURBED UNIFORMLY OVER DESIGNATED AREAS AND WORKED INTO THE SOIL IN CONJUNCTION WITH TILLAGE

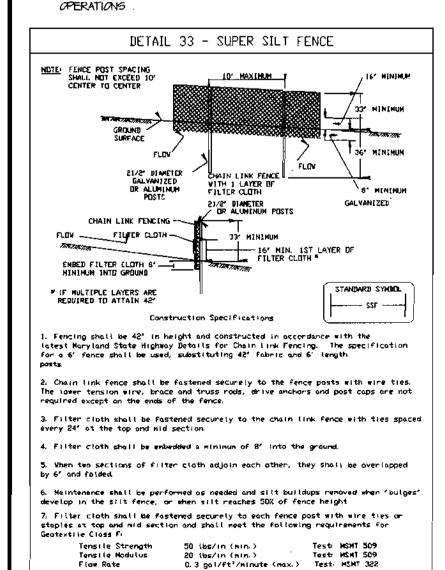

20 (bs/in (nin.)

H - 26 - 3 VATER MANAGEMENT ADMINISTRATION

Flow Rate 0.3 gal/ft*/minute (max.)
Filtering Efficiency 75% (min.)

Tensile Modulus

SOIL CONSERVATION SERVICE

STANDARD SEDIMENT CONTROL NOTES

1) A minimum of 48 hours notice must be given to the Howard County Office of Inspection and Permits prior to the start of any construction (410-313-1855)

2) All vegetative and structural practices are to be installed according to the provisions of this plan and are to be in conformance with the 1983 Maryland Standards and Specifications for Soil Erosion and Control.

3) Following initial soil disturbance or redisturbance, permanent or temporary stabilization shall be completed within a) 7 calendar days for all perimeter sediment control structures, dikes, perimeter slopes and all slopes greater than 31, b) 14 days as to all other disturbed or graded areas on the project site

4) All sediment traps/basins shown must be fenced and warning signs posted around their perimeters in accordance with Vol. | Chap 12 of the Howard County Design Manual, Storm Drainage.

5) All disturbed areas must be stabilized within the time period specified above in accordance with the 1989 Maryland Standards and Specifications for soil erosion and sediment control for permanent seedings (Sec. 51), sod (Sec. 54), temporary seeding (Sec. 50), and mulching (Sec. 52). Temporary stabilization with mulch alone can only be done when recommended seeding dates do not allow for proper germination and establishment of grasses


6) All sediment control structures are to remain in place and are to be maintained in operative condition until permission for their removal has been obtained from the Howard County Sediment Control Inspector.


7) Site analysis: Total area of site - 2.1999 acres 5 acres Area disturbed -Area to be roofed or paved - 0.43 acres Area to be vegetatively stabilized - 107 acres 430 cu. yds. SINGLE FAMLIY LOT Total cut Total fill-Offisite waste/borrow area location - n/a

B) Any sediment control practice which is disturbed by grading activity for placement of utilities must be repaired on the same day of disturbance.

9) Additional sediment controls must be provided if deemed necessary by the Howard County DPW Sediment Control Inspector.

 $|O\rangle$ On all sites with disturbed areas in excess of 2 acres, approval of the inspection agency shall be requested upon completion of installation of perimeter erosion and sediment controls, but before proceeding with any other earth disturbance or grading. Other building or grading inspection approvals may not be authorized until this initial approval by the inspection agency is made.

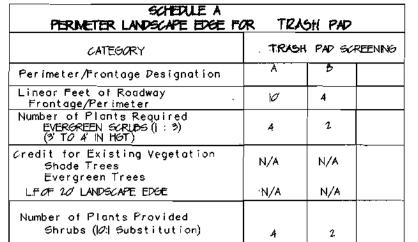

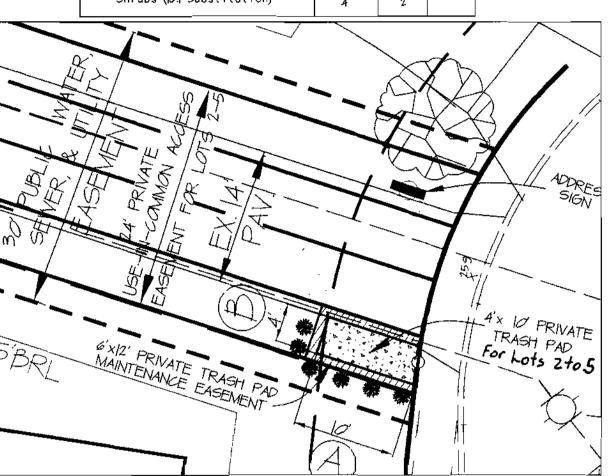

TRASH PAD SCREENING DETAIL SCALE | = 0

LANDSCAPE NOTE:
THE OWNER, TENNIT, INDIOR THEIR AGENTS SHALL BE RESPONSIBLE FOR MAINTENANCE OF THE REQUIRED. LANDSCAFING, FLANT MATERIALS, DERMS, FENCES AND WALLS. ALL FLANT MATERIALS STALL DE MAINTAINED IN 6000 GROWING CONDITION AND WHEN NECESSARY, REPLACED WITH NEW MATERIALS TO ENGURE CONTINUED COMPLIANCE WITH APPLICABLE REGULATIONS, OTHER REQUIRED LANDSCAPING SHALL BE PERMANENTLY MAINTAINED IN GOOD CONDITION AND WHEN NECESSARY, REPAIRED OR REPLACED.

DEVELOPER'S BUILDER'S CERTIFICATE

I/WE CERTIFY THAT THE LANDSCAPING SHOWN ON THIS PLAN WILL BE DONE ACCORDING TO THE PLAN, SECTION 16/14 OF THE HOWARD COUNTY SUPPLYISION AND LAND PEVELOPMENT REGULATIONS AND THE LANDSCAPE MANUAL I/WE FURTHER CERTIFY THAT UPON COMPLETION, A LETTER OF NOTICE, ACCOMPANIED BY AN EXECUTED ONE YEAR GUARANTEE OF PLANT MATERIALS, WILL BE SUBMITTED TO THE DEPARTMENT OF PLANTS AND THE PERFORMENT.



THIS LIST INCLUDES LANDSCAPE MATERIAL FOR PERIMETER LANDSCAPE EDGE

		PLANT LIST		
SYMBOL.	QUANTITY	BOTANICAL/COMMON NAME	SIZE	REMARKS
*	6	takus media 'densiformis"/ PEYSFORMIS YEW	3° - 4′ HT.	3 Oi

REQUIRED SEQUENCE OF CONSTRUCTION -(SINGLE FAMILY LOTS)

- | OBTAIN GRADING PERMIT -(3 DAYS)
- 2. CLEAR AND GRUB FOR INSTALLATION OF TEMPORARY SEDIMENT CONTROL _(3 DAYS) MEASURES, SILT FENCE AND STONE CONSTRUCTION ENTRANCE.
- 3. INSTALL TEMPORARY SEDIMENT CONTROL MEASURES . -(I DAYS)
- SITE FOR CONSTRUCTION OF DWELLING, DRIVEWAY AND SIDEWALKS. 5 GRADE SITE AND CONSTRUCT DWELLINGS, DRIVEWAYS AND SIDEWALKS -(12 WEEKS)
- PER THE PLAN.

4. UPON APPROVAL OF SEDIMENT CONTROL INSPECTOR CLEAR AND GRUB --(| DAYS)

- 6 STABILIZE ALL DISTURBED AREAS WITH SEED AND MULCH PER SCS -(2 DAYS)
- 7. UPON APPROVAL OF THE SEDIMENT CONTROL INSPECTOR REMOVE ALL -(| DAYS) TEMPORARY SEDIMENT CONTROL MEASURES AND STABILIZE ALL DISTURBED AREAS AS PER PERMANENT SEEDING NOTES.

DEVELOPER.

ELDERSBURG, MD 21784

OMNER!

EMA'S MANOR, LL

946-A MARIMICH CT. ELDERSBURG, MD 21784

and Sediment Control meet the requirements of the Howard County Soil Conservation District. Moward Soll Conservation District DEVELOPER'S /BUILDER'S CERTIFICATE " I/WE CERTIFY THAT ALL DEVELOPMENT AND/OR CONSTRUCTION WILL BE DONE ACCORDING TO THESE PLANS, AND THAT ALL RESPONSIBLE PERSONEL INVOLVED IN THE CONSTRUCTION OF THE PROJECT WILL HAVE A CERTIFICATE OF ATTENDANCE AT A DEPARTMENT OF THE ENVIRONMENT APPROVED TRAINING PROGRAM FOR THE CONTROL OF SEDIMENT AND EROSION BEFORE BEGINNING THE PROJECT. I ALSO AUTHORIZE PERIODIC ON SITE INSPECTION BY THE HOWARD COUNTY CONSERVATION DISTRICT OR THEIR AUTHORIZED AGENT AS ARE NECESSARY" DEVELOPER ENGINEER'S CERTIFICATION " I CERTIFY THAT THIS PLAN FOR EROSION AND SEDIMENT CONTROL REPRESENTS A PRACTICAL AND WORKABLE PLAN BASED ON MY KNOWLEDGE OF THE SITE CONDITIONS THIS PLAN WAS PREPARED IN ACCORDANCE WITH THE REQUIREMENTS OF THE HOWARD SOIL CONSERVATION DISTRICT". 2-4-04 KAMILL CIRPIN CHARLES R. CROCKEN, PE APPROVED: HOWARD COUNTY DEPARTMENT OF PLANNING AND ZONING THEF, DEVELOPMENT ENGINEERING DIVISION MK 4/15/04 SEDIMENT CONTROL NOTES AND DETAILS/ EMA'S MANOR Landscaping SINGLE FAMILY DETACHED SUBDIVISION LOTS | TO 8 AND O.S. LOT 9. FAIRMONT REAL ESTATE SERVICES TAX MAP 37 GRID 14 PARCEL #143 & P/O PARCEL IST ELECTION DISTRICT DATE: 4/10/03 HOWARD COUNTY, MARYLANI CHARLES R. CROCKEN AND ASSOCIATES, INC. Civil Engineering — Land Planning PO Box 307 Westminster, MD 21157 Tel (4|0) 549-2708 Fox. (40) 549-5063 TAX MAP 37 PARCEL #143 & P/O 125 PROJECT NO:

DATE: JUNE 2003


SCALE: |'' = 50

DRAWING NO. 3 OF 3

SDP-04-09


These plans have been reviewed for the Howard Soil Conservation District and


meet the technical requirements for the Soil and Sediment Control.

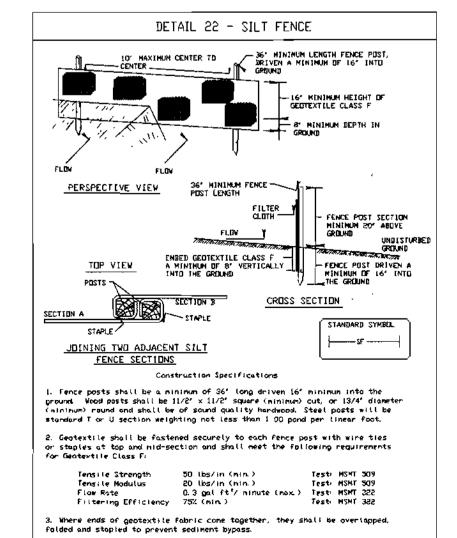


bulges occur or when sediment accumulation reached 50% of the fabric height.


U.S. DEPARTMENT OF AGRICULTURE PAGE NARYLAND DEPARTMENT OF ENVIRONMENT SUIL CONSERVATION SERVICE F - 15 - 3 WATER MANAGEMENT ADMINISTRATION

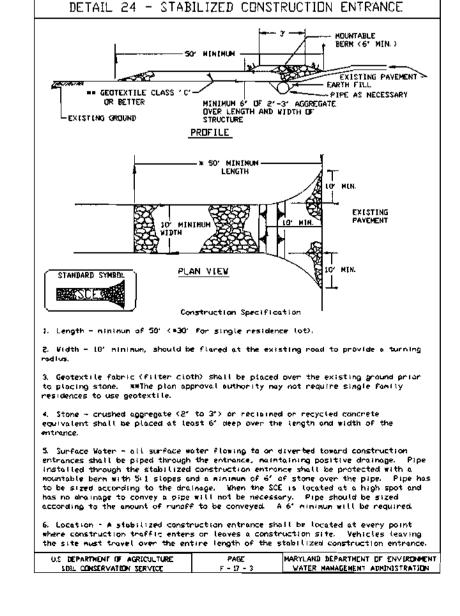

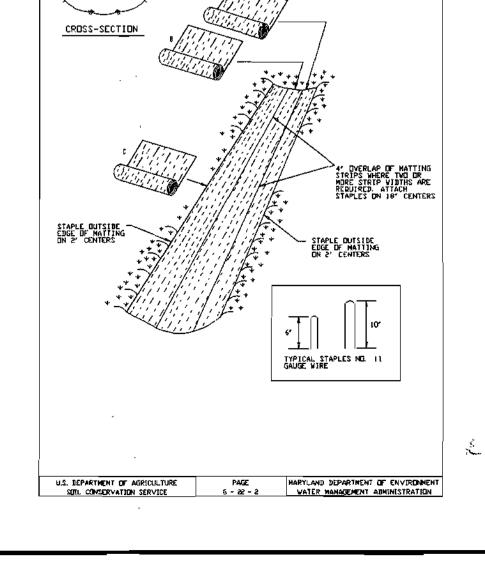

DETAIL 30 - EROSION CONTROL MATTING

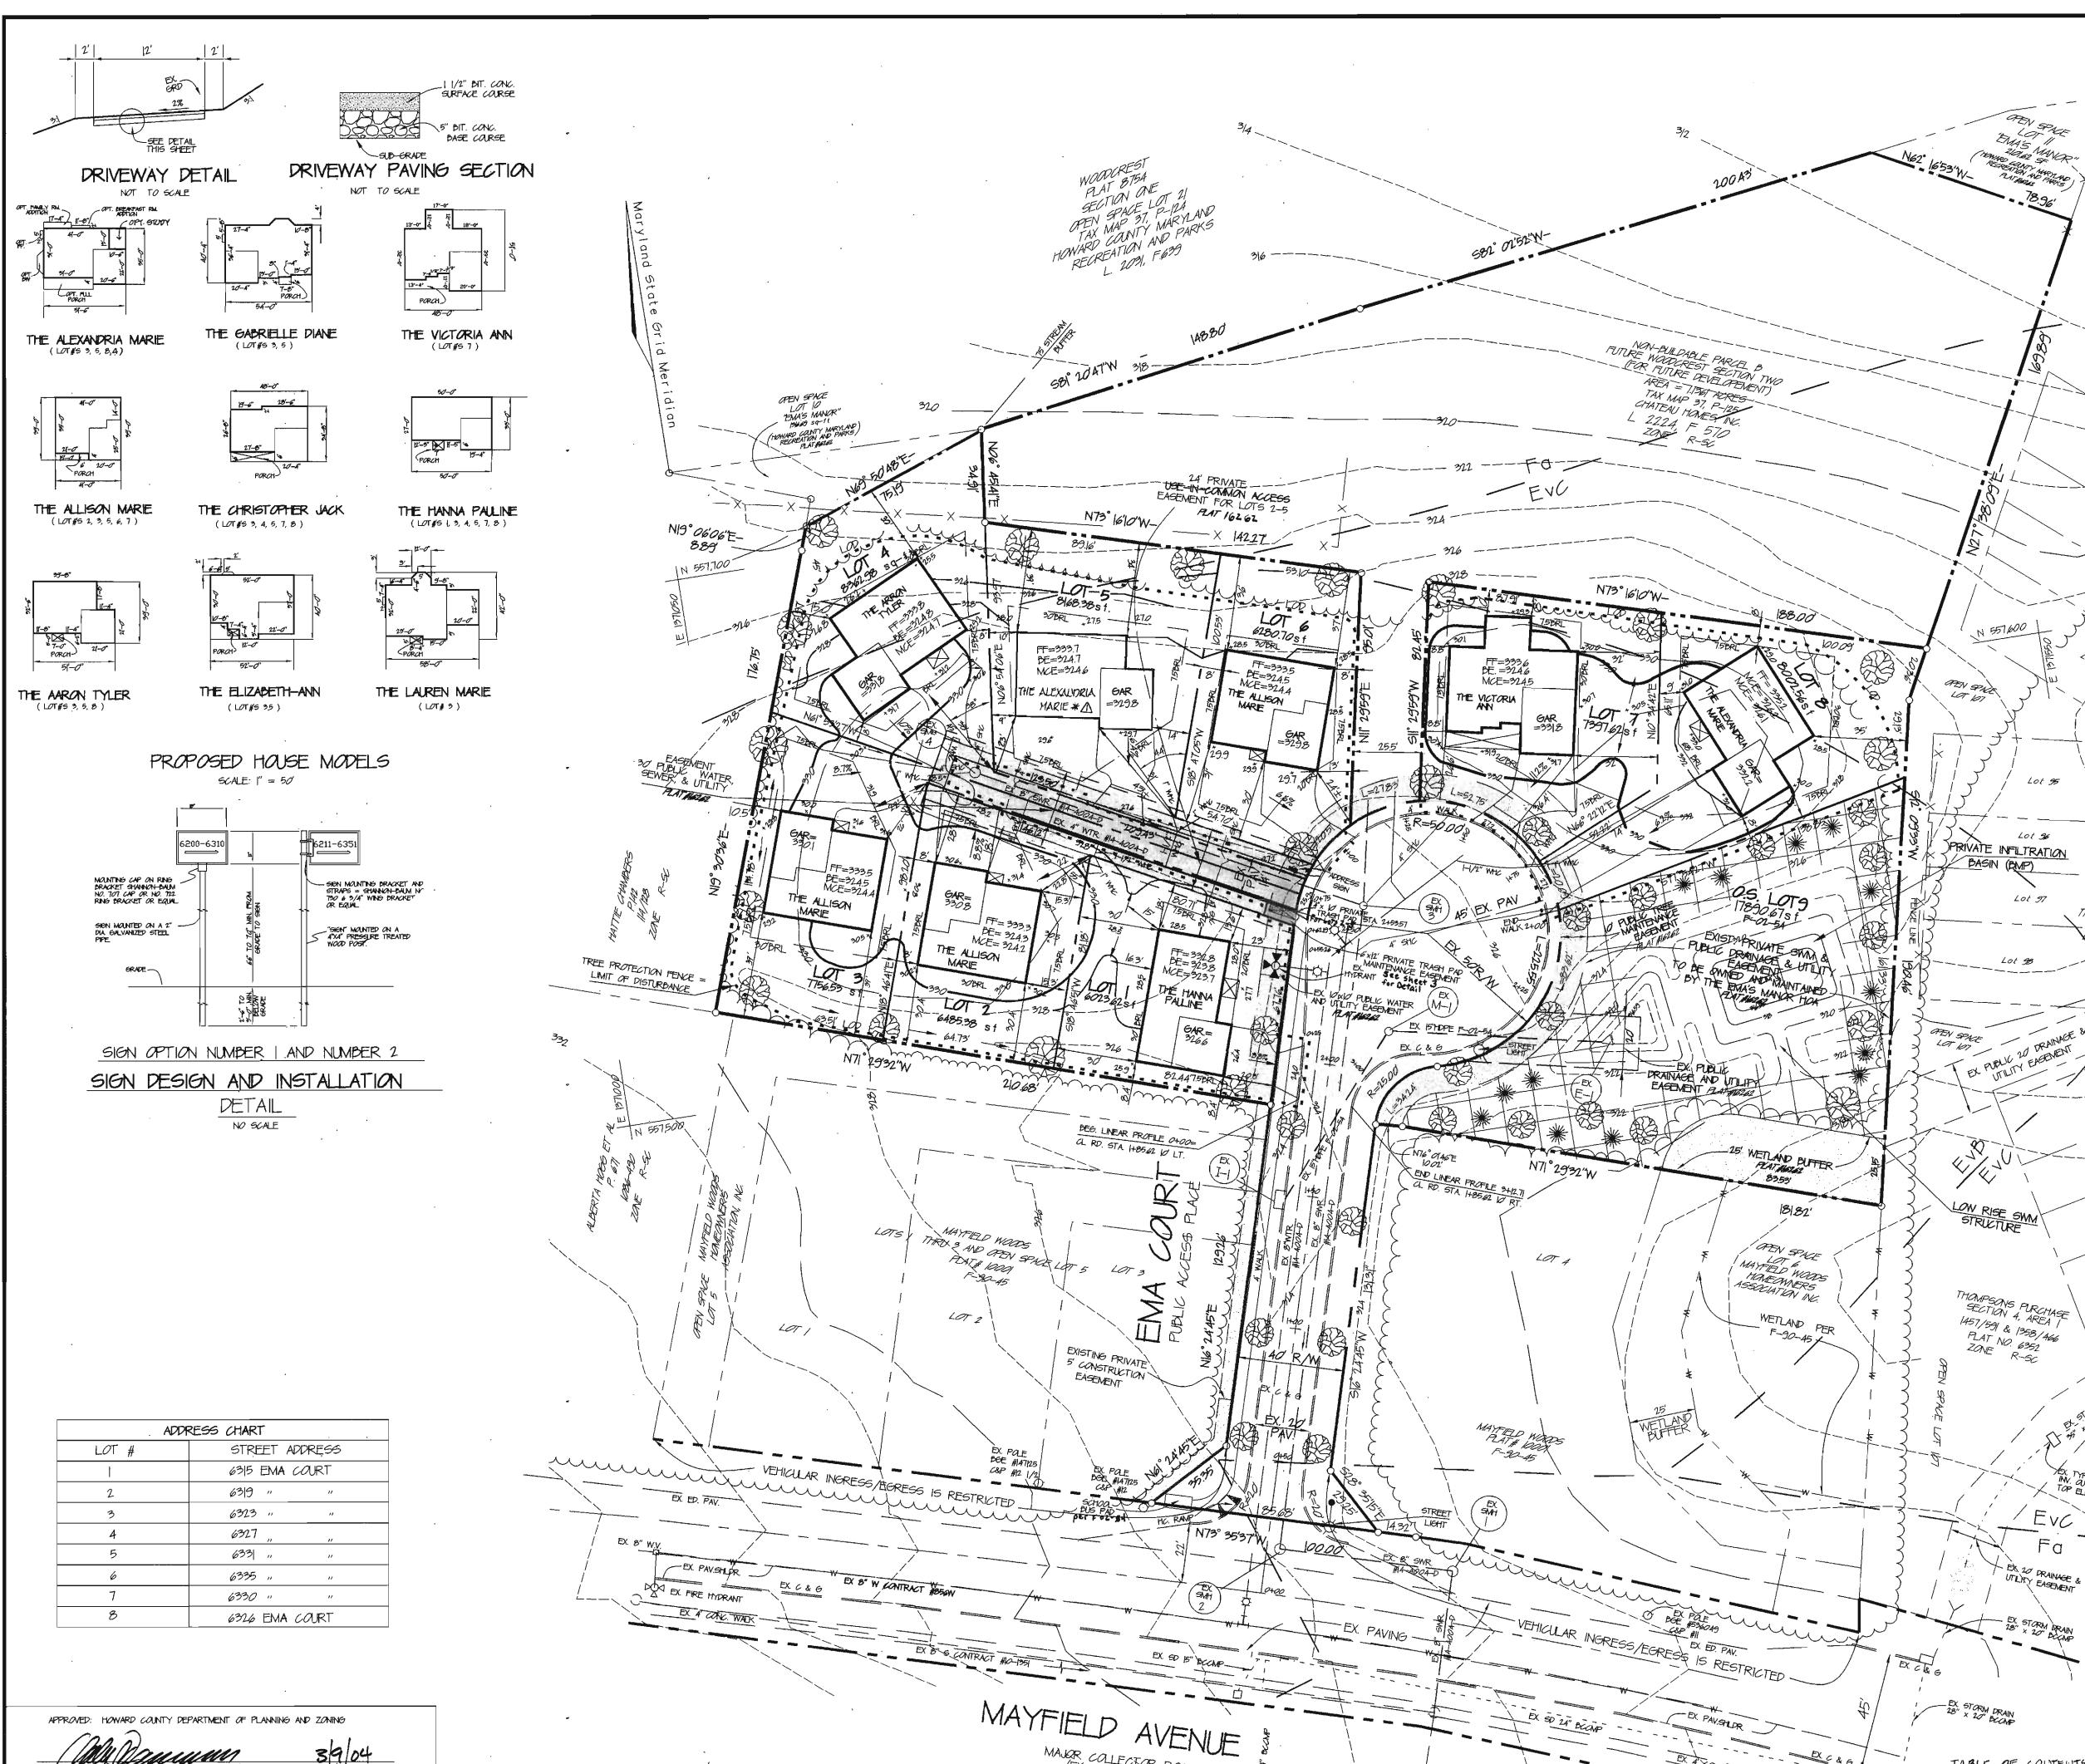

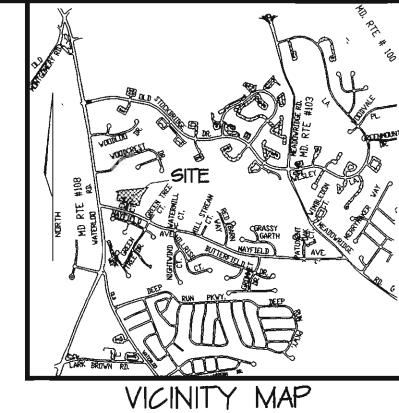

SCALE: |"=2000

GENERAL NOTES:

MINIMUM REQUIREMENTS.

Lot 95

TABLE OF CONTENTS

1. SITE DEVELOPMENT PLAN

2. SEDIMENT CONTROL PLAN

3. SEDIMENT CONTROL NOTES

AND DETAILS/Landscaping

THAMPSANS PURCHAS

1013 75 THRU 101 PLAT NO. 63521

1. CURRENT ZONING IS R-SC PER 10/18/93 COMPREHENSIVE ZONING PLAN. 2. IN ACCORDANCE WITH SECTION 128 OF THE HOWARD COUNTY REGULATIONS, BAY WINDOWS , CHIMNEYS OR EXTERIOR STARWAYS NOT MORE THAN 16 FEET IN WIDTH MAY PROJECT NOT MORE THAN 4 PEET INTO ANY SETBACKS, PORCHES OR DECKS, OPEN OR ENCLOSED MAY PROJECT NOT MORE THAN 10 FEET INTO THE FRONT OR REAR YARD SETBACK. 3. NO CLEARING, GRADING OR CONSTRUCTION IS PERMITTED WITHIN THE REQUIRED WETLANDS, STREAM(S) OR THEIR BUTTERS AND FOREST CONSERVATION EASIEMENT AREAS. 4. DRIVEWAYS SHALL BE PROVIDED PRIOR TO ISSUANCE OF A RESIDENTIAL OCCUPANCY PERMIT FOR ANY NEW DWELLINGS TO ENSURE SAFE ACCESS FOR FIRE AND EMERGENCY VEHICLES PER THE FOLLOWING

A) WIDTH - RESIDENTAL DRIVEWAY 14 FEET B) SURFACE - 6 INCHES OF COMPACTED CRUSHER RUN BASE W/TAR AND CHIP COATING (I-1/2" MIN).

C) GEOMETRY - MAX. 15% GRADE, MAX. 10% GRADE. CHANGE, AND MIN. 45' TURNING RADIUS; D) STRUCTURES (CULVERTS/BRIDGES) CAPABLE OF SUPPORTING 25 GROSS TONS ((H25 LOADING) E) DRAINAGE ELEMENTS - CAPABLE OF SAFELY PASSING 100-YEAR FLOOD WITH NO MORE THAN I FOOT DEPTH OVER DRIVEWAY SURFACE: F.) MAINTENANCE - SUFFICIENT TO INSURE ALL WEATHER USE.

5. THE CONTRACTOR SHALL NOTIFY THE DEPARTMENT OF PUBLIC WORKS/BUREAU OF ENGINEERING /CONSTRUCTION INSPECTION DIVISION AT (410) 313-1880 AT LEAST FIVE (5) WORKING DAYS PRIOR TO THE START OF WORK.

6. THE CONTRACTOR SHALL NOTIFY "MISS UTILITY" AT 1-800-257-7777 AT LEAST 48 HOURS PRIOR TO ANY EXCAVATION WORK BEING DONE. 7. THE EXISTING TOPOGRAPHY IS FIELD RUN PREPARED BY CHARLES R. CROCKEN &ASSOCIATES,

8. COORDINATES BASED ON NAD '83, MARYLAND COORDINATE SYSTEM AS PROJECTED BY HOWARD COUNTY GEODETIC CONTROL STATIONS #37HA AND NO.#37HB

9. SMM APPROVED AS PER F- 01-54 10. EXISTING UTILITIES ARE PLOTTED FROM HOWARD COUNTY UTILITY DRAWINGS AND

FIELD LOCATED WHERE POSSIBLE. II. ANY DAMAGE DUE TO THE CONTRACTORS ACTIVITIES DONE TO COUNTY'S RIGHT-OF-WAY

SHALL BE CORRECTED AT THE DEVELOPER'S EXPENSE

12. SHC ELEVATIONS SHOWN ARE LOCATED AT THE PROPERTY LINE.

13. FOR DRIVEWAY ENTRANCE DETAILS REFER TO THE HOWARD COUNTY DESIGN MANUAL, VOLUME IV, STANDARD DETAIL R- 607

14. THE FOREST CONSERVATION OPLIGATION FOR REFORESTATION AND AFFORESTATION, INCURRED BY THE SUBDIVISION SHOWN HEREON, 139 ACRES HAS BEEN SATISFIED BY THE AQUISITION OF 120 ACRES OF FOREST MITIGATION CREDITS FROM ENVIRONMENTAL BANC & EXCHANGE LLC. (EXB) BY EMA'S MANOR LLC. (EXB)

AND THAT THE OUTSTANDING REFORESTATION OPLIGATION OF 0.13 ACRES HAS BEEN MET BY A FEE-IN-LIEU PAYMENT OF \$1,831.40 TO THE HOWARD CO. FOREST CONSERVATION FUND. APPROVED F-02-54 15. THIS PLAN HAS BEEN PREPARED IN ACCORDANCE WITH THE PROVISIONS OF SECTION 16:124 OF THE HOWARD COUNTY CODE AND THE LANDSCAPE MANUAL FINANCIAL SURETY FOR THE REQUIRED LANDSCAPING HAS DEEN POSTED AS PART OF THE DPW DEVELOPERS AGREEMENT IN THE AMOUNT OF \$5,7000 FOR 26 SHADE TREES AND 19 EVERGREEN TREES APPROVED 19-02-54.

16. THIS PLAN IS SUBJECT TO THE 5TH EDITION OF THE SUDDIVISION AND LAND DEVELOPEMENT REGULATIONS AND THE ZONING REGULATIONS AS AMENDED UNDER COUNCIL BILL #50-2001

17. COORDINATES BASED ON NAD '83, MARYLAND COORDINATE SYSTEM AS PROJECTED BY HOWARD COUNTY GEODETIC CONTROL STATIONS NOTIFA AND NOTIFT

18. TYPICAL HOUSE DIMENSIONS AND SCHEMATIC ARE SHOWN ON THIS SHEET. 19. THE HOWEOWNERS ASSOCIATION DOCUMENTS HAVE BEEN RECORDED WITH THE MARYLAND STATE DEPARTMENT OF ASSESSMENTS AND TAXATION ON 2-03-03 AS RECORDING NUMBER BOO475/LIA87

20. ALL INTERIOR ROADS WILL BE PUBLIC. 21. ALL PAVING AND STORM DRAIN CONSTRUCTION SHALL BE IN ACCORDANCE WITH HOWARD COUNTY ROAD CONSTRUCTION CODE AND STANDARD SPECIFICATIONS AND

ROAD CONSTRUCTION ROAD CONSTRUCTION PLAN F- 02-54

22.THE TOPOGRAPHY SHOWN IS BASED ON A SURVEY PERFORMED BY FREDERICK WARD

ASSOCIATES IN DECEMBER, 2000. 23. THE USE-IN-COMMON MAINTENANCE AGREEMENT FOR LOTS 2 TO 5 HAS BEEN RECORDED AS LIBER 07743 FOLIO185 IN THE LAND RECORDS OFFICE OF HOWARD COUNTY MD. ON 12-31-02


24. PLAN OF THE SUPPLYISION SHOWN HEREON IS SUBJECT TO A WAIVER FROM THE REQUIREMENTS OF SECTION 16.192(a)(3)(i)(b) TO CONSTRUCT IMPROVEMENTS TO A MAJOR COLLECTOR ROAD, SPECIFICALLY TO CONSTRUCT ACCEL/DECEL LANES ALONG THE NORTHSIDE OF MAYFIELD AVENUE AT THE INTERSECTION OF EMAS COURT. WP-02-62 APPROVED MARCH 4, 2001

15. PLAN OF THE SUPPLYISION SHOWN HEREON IS SUBJECT TO A WAIVER FROM THE REQUIREMENTS OF SECTIONS 16.144(a) and (1), 16.145, and 16.146 TO NOT BE REQUIRED TO SUPPLIT SKETCH AND PRELIMINARY PLANS FOR THE PROPOSED ADDITION OF LAND (P/O. PARCEL 125) TO A MAJOR SUBDIVISION (F-02-54, EMA'S MANOR). AND SECTION 16/121(e)(1) TO PERMIT THE REQUIRED PUBLIC ROAD FRONTAGE FOR OPEN SPACE TO BE REDUCED TO: 20 FEET FOR PROPOSED OPEN SPACE LOT 2, WOODCREST, SECTION 2 WITHOUT REQUIRING THE ADJACENT SIDE BRL'S ON ADJACENT LOTS TO BE INCREASED BY TO FEET AND, ZERO FEET FOR THE TWO PROPOSED OPEN SPACE PARCELS, SHOWN AS LOTS 10 & 11. FILE NO. WP-01-120 APPROVED JLLY 30, 2001 26. WATER AND SEWER CONTRACT NO:14-4004-D

27. NON-BUILDABLE PARCEL 'A' IS TO BE CONVEYED TO THE OWNER OF ADJACENT LOT 4 MAYFIELD WOODS 28. THE SCHOOL BUS PAD IS TO BE OWNED AND MAINTAINED BY THE HOME OWNER ASSOCIATION

29. THE TRASH PAD FOR LOTS 1 TO 5 SHALL DE MAINTAINED BY THE OWNERS OF LOTS 1 TO 5, A MAINTENANCE AGREEMENT HAS BEEN RECORDED IN THE LAND RECORDS OFFICE OF HOWARD COUNTY, MARYLAND ON 12-31-02 AS LIBER 7743 / FOLIO 185

30. PERMETER LANDSCAPING OF THE TRASH PAD IN ACCORDANCE WITH SECTION 16:114 OF THE LANDSCAPE MANUAL SHALL BE PROVIDED AS SHOWN ON THIS SITE PLAN. SURETY FOR THE REQUIRED <u>G</u> SCHOLIBS IN THE AMOUNT OF \$ 100° SHALL BE PROVIDED WITH THE GRADING PERMIT.

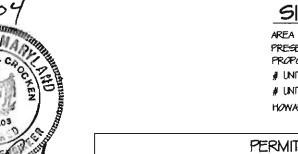

SITE ANALYSIS AREA OF PLAN SUBMISSION 2,1999 AC± PRESENT ZONING R-SC PROPOSED USE OF STRUCTURES SINGLE PANILY

UNIT'S ALLOWED & UNITS # UNITS PROVIDED 8 UNITS HOWARD COUNTY FILE NO.'S: F- 01-54, DPZ NO. S-00-11, P-01-18, WP-01-62 & WP-01-120

automisian nume: EMA'S MANOR			SECTION/AREA		LOT/ PARCEL #	
PLAT # OR L/F	DLOCK #	ZONE	TAX/ZONE MAP	ELECTION DISTR	CENSUS TRACT	
6262	4	R-50	#37	5T	#60 0	

* A MAY 4,2004 TO REVISE HOUSE MODEL ON LOT 5 FROM THE "ELIZABETH" ALL TO THE ALEXANDRIA NO. DATE REVISION MARIE" SITE DEVELOPEMENT PLAN SINGLE FAMILY DETACHED SUBDIVISION LOTS | TO 8 AND O.S. LOT 9.

PARCEL #143 & P/O PARCEL 125 TAX MAP 37 GRID 14 HOWARD COUNTY, MARYLAND IST ELECTION DISTRICT

DEVELOPER: FAIRMONT REAL ESTATE SERVICES 946-A MARIMICH CT. ELDERSBURG, MD 21784 OWNER: EMA'S MANOR, LLC. 946-A MARIMICH CT. ELDERSBURG, MD 21784 CHARLES R. CROCKEN & ASSOCIATES, INC


50P-04-00

SHEET | OF 3

SCALE: WESTMINSTER, MARYLAND PH. 410-549-2708 FAX 410-549-9063 |" = 3*0*

3/15/14 DATE

CHIER DIVISION OF LAND DEVELOPMENT 89

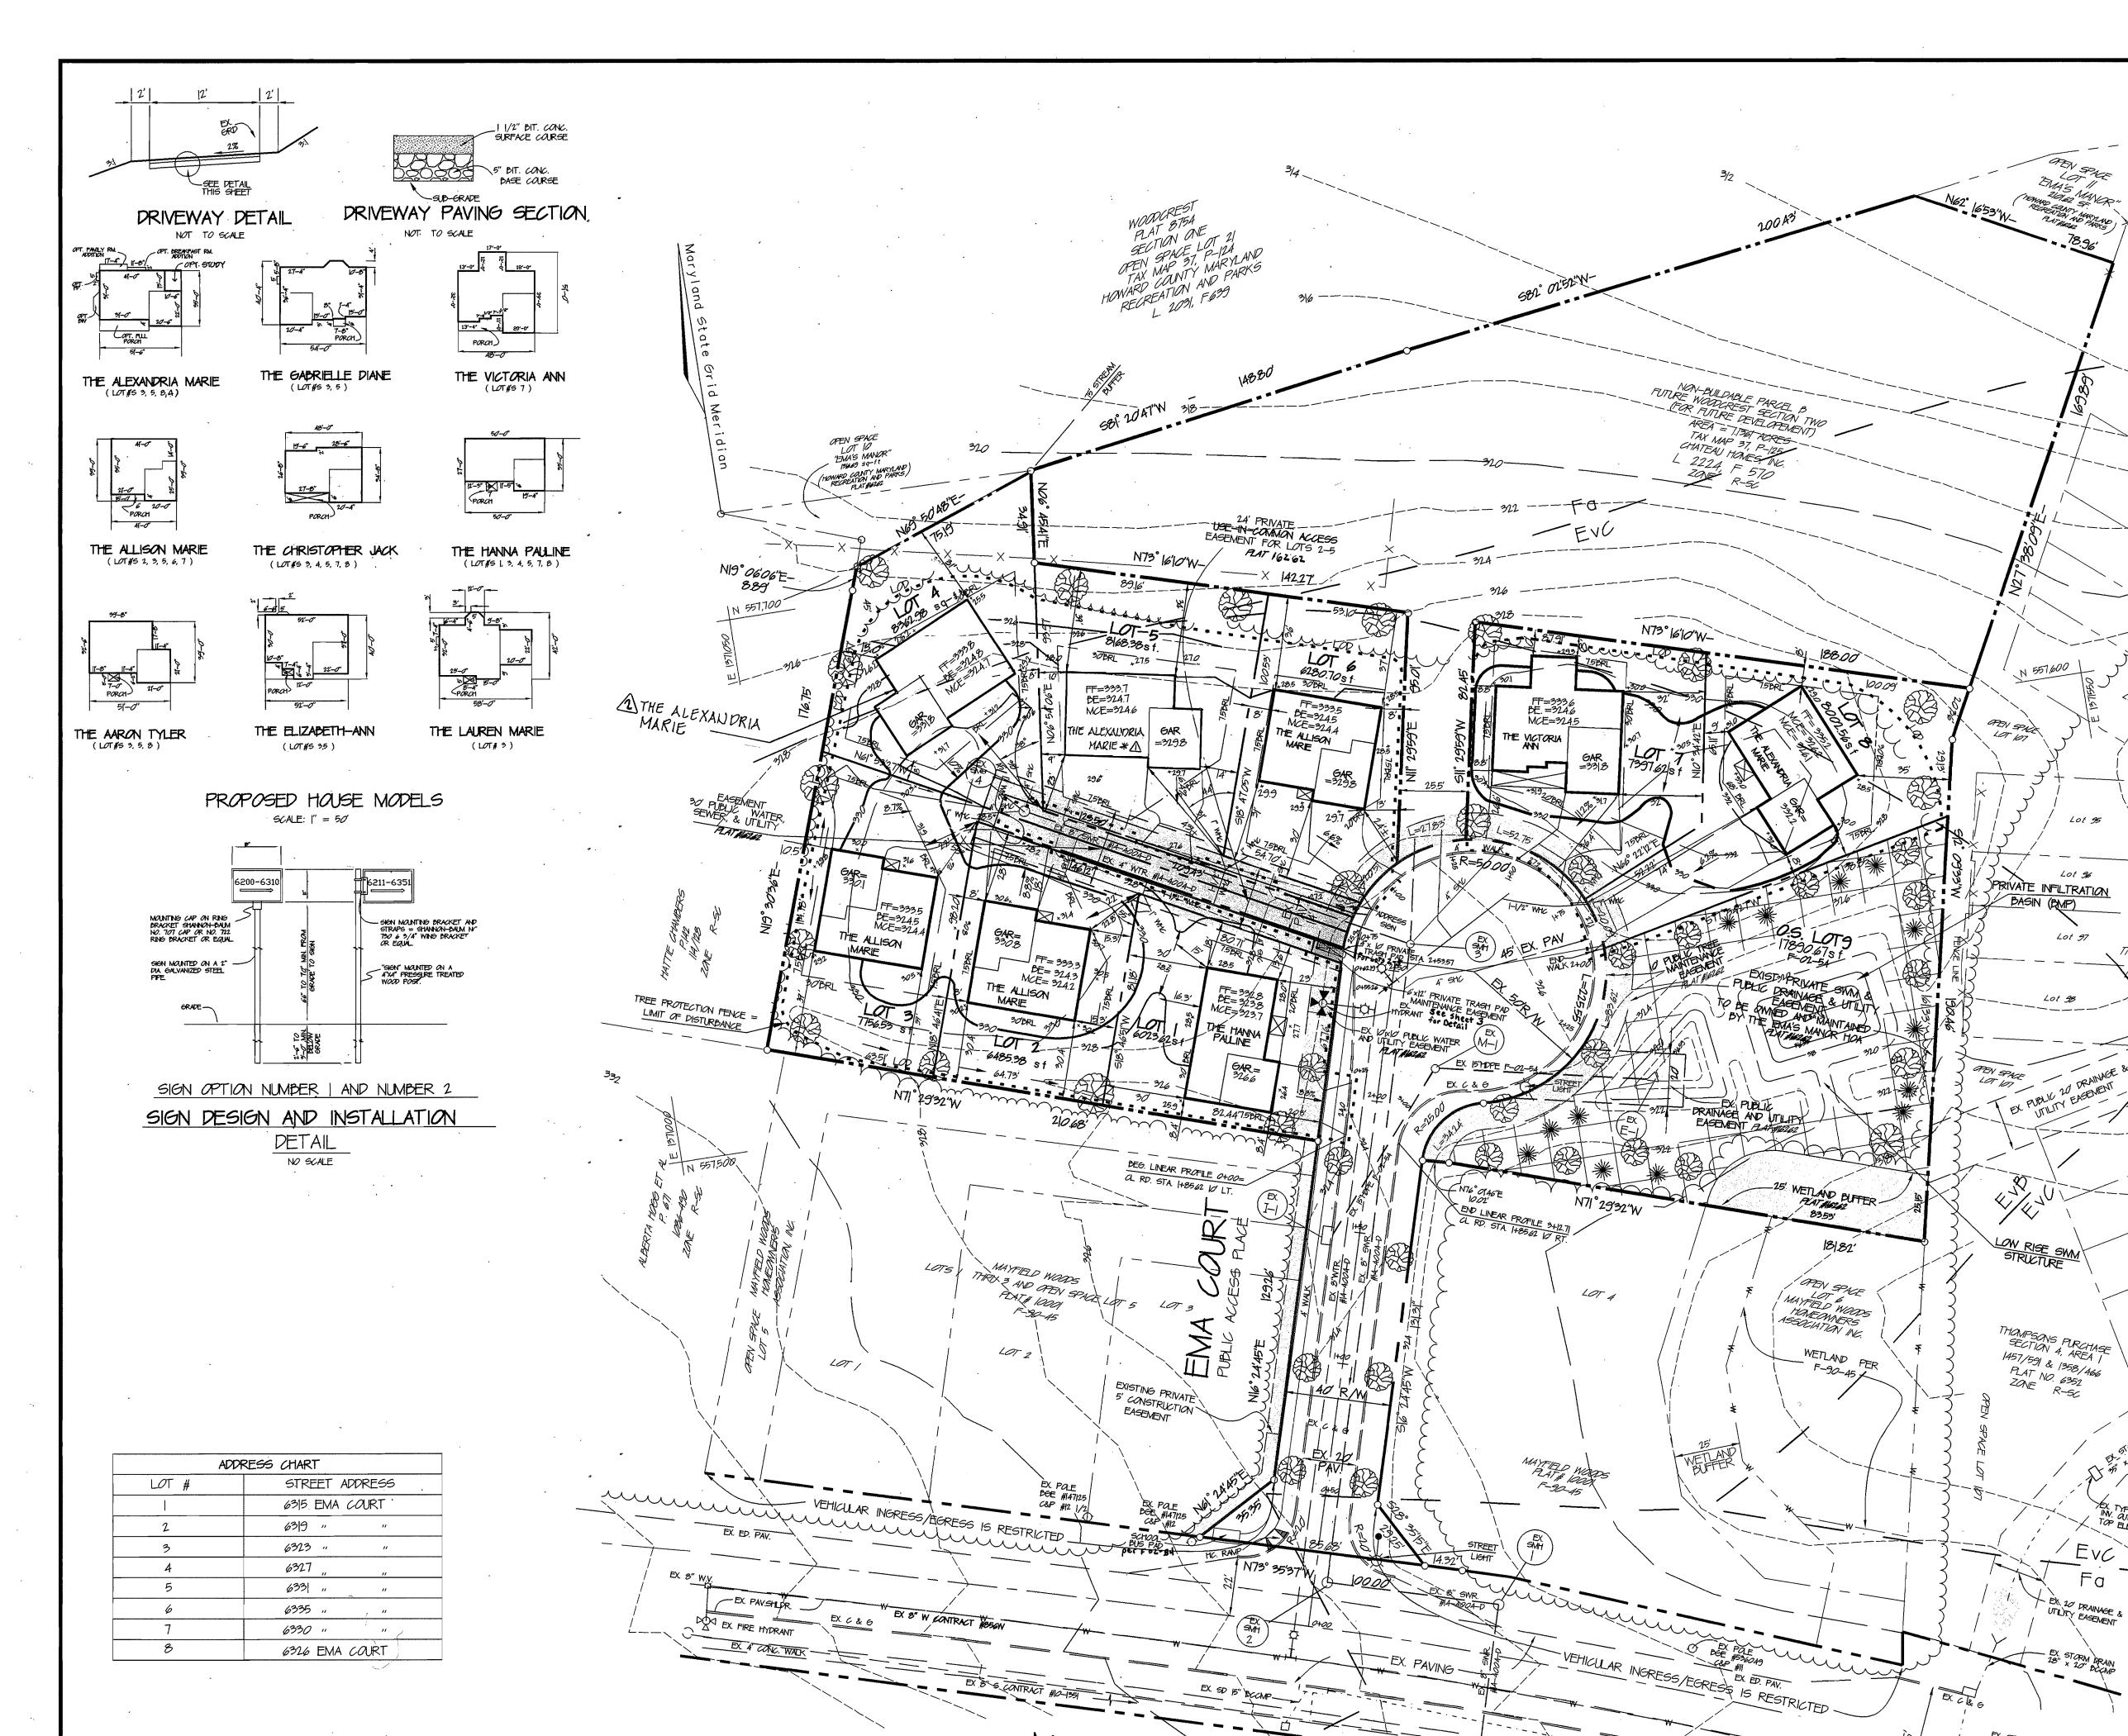

GENERAL NOTES:

MINIMUM REQUIREMENTS.

557,600

PLAT NO. 6352 ZONE 06352

TABLE OF CONTENTS

1. SITE DEVELOPMENT PLAN

2. SEDIMENT CONTROL PLAN

3. SEDIMENT CONTROL NOTES

AND DETAILS/Landscaping

1. CURRENT ZONING IS R-SC PER 10/18/93 COMPREHENSIVE ZONING PLAN. 2. IN ACCORDANCE WITH SECTION 128 OF THE HOWARD COUNTY REGULATIONS, BAY WINDOWS , CHIMNEYS OR EXTERIOR STAIRWAYS NOT MORE THAN 16 FEET IN WIDTH MAY PROJECT NOT MORE THAN 4 FEET INTO ANY SETBACKS, PORCHES OR DECKS, OPEN OR ENCLOSED MAY PROJECT NOT MORE THAN 10 FEET INTO THE FRONT OR REAR YARD SETBACK. 3. NO CLEARING, GRADING OR CONSTRUCTION IS PERMITTED WITHIN THE REQUIRED WETLANDS, STREAM(S) OR THEIR BUFFERS AND FOREST CONSERVATION EASEMENT AREAS. 4. DRIVEWAYS SHALL BE PROVIDED PRIOR TO ISSUANCE OF A RESIDENTIAL OCCUPANCY PERMIT FOR ANY NEW DWELLINGS TO ENSURE SAFE ACCESS FOR FIRE AND EMERGENCY VEHICLES PER THE FOLLOWING

A) WIDTH - RESIDENTAL DRIVEWAY 14 FEET B) SURFACE - 6 INCHES OF COMPACTED CRUSHER RUN BASE W/TAR AND CHIP COATING (1-1/2" MIN.). C) GEOMETRY - MAX. 15% GRADE, MAX. 10% GRADE CHANGE, AND MIN. 45' TURNING RADIUS;

D) STRUCTURES (CULVERTS/BRIDGES) CAPABLE OF SUPPORTING 25 GROSS TONS ((H25 LOADING) E) DRAINAGE ELEMENTS - CAPABLE OF SAFELY PASSING 100-YEAR FLOOD WITH NO MORE THAN I FOOT DEPTH OVER DRIVEWAY SURFACE: F.) MAINTENANCE - SUFFICIENT TO INSURE ALL WEATHER USE

5. THE CONTRACTOR SHALL NOTIFY THE DEPARTMENT OF PUBLIC WORKS/BUREAU OF ENGINEERING /CONSTRUCTION INSPECTION DIVISION AT (410) 313-1880 AT LEAST FIVE (5) WORKING DAYS PRIOR TO THE START OF WORK.

6. THE CONTRACTOR SHALL NOTIFY "MISS UTILITY" AT 1-800-257-7777 AT LEAST 48 HOURS PRIOR TO ANY EXCAVATION WORK BEING DONE.

7. THE EXISTING TOPOGRAPHY IS FIELD RUN PREPARED BY CHARLES R. CROCKEN &ASSOCIATES,

8. COORDINATES BASED ON NAD '83, MARYLAND COORDINATE SYSTEM AS PROJECTED BY HOWARD COUNTY GEODETIC CONTROL STATIONS #37HA AND NO.#37HB 9. SWM APPROVED AS PER F- 01-54

10. EXISTING UTILITIES ARE PLOTTED FROM HOWARD COUNTY UTILITY DRAWINGS AND

FIELD LOCATED WHERE POSSIBLE. II. ANY DAMAGE DUE TO THE CONTRACTORS ACTIVITIES DONE TO COUNTY'S RIGHT-OF-WAY

SHALL BE CORRECTED AT THE DEVELOPER'S EXPENSE.

12. SHC ELEVATIONS SHOWN ARE LOCATED AT THE PROPERTY LINE.

)3. FOR DRIVEWAY ENTRANCE DETAILS REFER TO THE HOWARD COUNTY DESIGN MANUAL, VOLUME IV, STANDARD DETAIL R- 607

14. THE FOREST CONSERVATION OBLIGATION FOR REFORESTATION AND AFFORESTATION, INCURRED BY THE SUBDIVISION SHOWN HEREON, 1.39 ACRES HAS BEEN SATISFIED BY THE AQUISITION OF 120 ACRES OF FOREST MITIGATION CREDITS FROM ENVIRONMENTAL BANC & EXCHANGE LLC. (EXB) BY EMA'S MANOR LLC. (EXB) AND THAT THE OUTSTANDING REFORESTATION OPLIGATION OF 0.19 ACRES HAS BEEN MET BY A FEE-IN-LIEU PAYMENT OF \$2,831,40 TO THE HOWARD CO. FOREST CONSERVATION FUND. APPROVED F-02-54 15. THIS PLAN HAS BEEN PREPARED IN ACCORDANCE WITH THE PROVISIONS OF SECTION 16,124 OF THE

HOWARD COUNTY CODE AND THE LANDSCAPE MANUAL FINANCIAL SURETY FOR THE REQUIRED LANDSCAPING HAS BEEN POSTED AS PART OF THE DPW DEVELOPERS AGREEMENT IN THE AMOUNT OF \$9,7000 FOR 26 SHADE TREES AND 13 EVERGREEN TREES APPROVED F-02-54. 16. THIS PLAN IS SUBJECT TO THE 5TH EDITION OF THE SUPPLYISION AND LAND DEVELOPEMENT REGULATIONS

AND THE ZONING REGULATIONS AS AMENDED UNDER COUNCIL BILL #50-200

[7. COORDINATES BASED ON NAD '83, MARYLAND COORDINATE SYSTEM AS PROJECTED BY HOWARD COUNTY GEODETIC CONTROL STATIONS NO.17FA AND NO.17F7 18. TYPICAL HOUSE DIMENSIONS AND SCHEMATIC ARE SHOWN ON THIS SHEET 19. THE HOMEOWNERS ASSOCIATION DOCUMENTS HAVE BEEN RECORDED WITH THE MARYLAND STATE

DEPARTMENT OF ASSESSMENTS AND TAXATION ON 2-03-03 AS RECORDING NUMBER 1500475/LI487 20. ALL INTERIOR ROADS WILL BE PUBLIC. 21. ALL PAVING AND STORM DRAIN CONSTRUCTION SHALL BE IN ACCORDANCE WITH

HOWARD COUNTY ROAD CONSTRUCTION CODE AND STANDARD SPECIFICATIONS AND ROAD CONSTRUCTION ROAD CONSTRUCTION PLAN F- 02-54

22.THE TOPOGRAPHY SHOWN IS BASED ON A SURVEY PERFORMED BY FREDERICK WARD ASSOCIATES IN DECEMBER, 2000.

23. THE USE-IN-COMMON MAINTENANCE AGREEMENT FOR LOTS 2 TO 5 HAS BEEN RECORDED AS LIBER 07743 FOLIO185 IN THE LAND RECORDS OFFICE OF HOWARD COUNTY MD. ON 12-31-02

24. PLAN OF THE SUBDIVISION SHOWN HEREON IS SUBJECT TO A WAIVER FROM THE REQUIREMENTS OF SECTION 16/92(0X3)(1Xb) TO CONSTRUCT IMPROVEMENTS TO A MAJOR COLLECTOR ROAD, SPECIFICALLY TO CONSTRUCT ACCEL/DECEL LANES ALONG THE NORTHSIDE OF MAYFIELD AVENUE AT THE INTERSECTION OF EMAS COURT. WP-02-62 APPROVED MARCH 4, 2001

25. PLAN OF THE SUPPLIVISION SHOWN HEREON IS SUBJECT TO A WAIVER FROM THE REQUIREMENTS OF SECTIONS 16:144(a) and (f), 16:145, and 16:146 TO NOT BE REQUIRED TO SUBMIT SKETCH AND PRELIMINARY PLANS FOR THE PROPOSED ADDITION OF LAND (P/O PARCEL 125) TO A MAJOR SUPPLIVISION (F-02-54, EMA'S MANOR). AND SECTION 16/121(e)(1) TO PERMIT THE REQUIRED PUBLIC ROAD FRONTAGE FOR OPEN SPACE TO BE REDUCED TO: 20 FEET FOR PROPOSED OPEN SPACE LOT 2, WOODCREST, SECTION 2 WITHOUT REQUIRING THE ADJACENT SIDE BRL'S ON ADJACENT LOTS TO BE INCREASED BY 10 FEET AND, ZERO FEET FOR THE TWO PROPOSED OPEN SPACE PARCELS, SHOWN AS LOTS 10 & 11. FILE NO. WP-02-120 APPROVED JULY 30, 2001

26. WATER AND SEWER CONTRACT NO.14-4004-D 27. NON-BUILDABLE PARCEL 'A' IS TO BE CONNEYED TO THE OWNER OF ADJACENT LOT 4 MAYFIELD WOODS

28. THE SCHOOL BUS PAD IS TO BE OWNED AND MAINTAINED BY THE HOME OWNER ASSOCIATION 29. THE TRASH PAD FOR LOTS 2 TO 5 SHALL BE MAINTAINED BY THE OWNERS OF LOTS \$ TO 5. A MAINTENANCE AGREEMENT HAS BEEN RECORDED IN THE LAND RECORDS OFFICE OF HOWARD COUNTY, MARYLAND ON 12:31:02 AS LIBER 7743 / FOLIO 185

30. PERIMETER LANDSCAPING OF THE TRASH PAD IN ACCORDANCE WITH SECTION 16:124 OF THE LANDSCAPE MANUAL SHALL BE PROVIDED AS SHOWN ON THIS SITE PLAN. SURETY FOR THE REQUIRED <u>G</u> SCHOLIBS IN THE AMOUNT OF \$ 100° SHALL BE PROVIDED WITH THE GRADING PERMIT.



SECTION 4 AREA !

1013 75 THRU 107 PLAT NO. 6352

SITE ANALYSIS AREA OF PLAN SUBMISSION 2.1999 AC± PRESENT ZONING R-SC PROPOSED USE OF STRUCTURES SINGLE FAMILY # UNITS ALLOWED 8 UNITS # UNITS PROVIDED 8 UNITS

HOWARD COUNTY FILE NO.'S: F- 02-54, DPZ NO. 5-00-11, P-01-18, WP-01-61 & WP-01-120 DEDIVIT INFOOLATION

EMA'S MANOR		SECTION/AREA		LOT/ PARCEL #	
PLAT # OR L/F 6262	18LOCK #	ZANE R-SC	TAX/ZONE MAP #37	ELECTION DISTR	CENSUS TRACT #60 0
WATER CODE: DO		SEWER CODE: 2 50562			

A 7-20-04 IST REDLINE REVISE HOUSE MODEL LOT 4 TO ALEXANDRIA MARIE ** A MY 4,2004 TO REVISE HOUSE MODEL ON LOT 5 FROM THE "ELIZABETH" ALLY TO THE ALEXANDRIA SITE DEVELOPEMENT PLAN

EMA'S MANOR SINGLE FAMILY DETACHED SUBDIVISION LOTS | TO 8 AND O.S. LOT 9.

PARCEL #143 & P/O PARCEL 125 TAX MAP 37 GRID 14 HOWARD COUNTY, MARYLAND IST ELECTION DISTRICT FAIRMONT REAL ESTATE SERVICES

|'' = 30

CHARLES R. CROCKEN & ASSOCIATES, INC CALL ENGINEERING ~ LAND PLANNING P.O. BOX 307 SCALE:

WESTMINSTER, MARYLAND PH. 410-549-2708 FAX 410-549-9063

946-A MARIMICH CT. ELDERSBURG, MD 21784 OWNER: EMA'S MANOR, LLC. 946-A MARIMICH CT. ELDERSBURG, MD 21784 SHEET | OF 3

50P-04-00

APPROVED: HOWARD COUNTY DEPARTMENT OF PLANNING AND ZONING

Hanut 3/15/14 DATE