


BENCH MARKS
 T.P. 176A ELEV. 479.462
 N. 594,357.610
 E. 1,357,919.371
 LOC. NEAR INTERSECTION OF
 OLD FREDERICK RD. & DANIELS RD.
 ALONG OLD FREDERICK ROAD

T.P. 176B ELEV. 420.696
 N. 593,013.910
 E. 1,355,781.960
 LOC. NEAR INTERSECTION OF
 OLD FREDERICK RD. & DANIELS RD.
 ALONG OLD FREDERICK ROAD

VICINITY MAP
 SCALE 1" = 1200'

GENERAL NOTES

- THE PROPERTY IS ZONED R-20 PER THE 2/2/04 COMPREHENSIVE ZONING PLAN.
- THE TOTAL AREA INCLUDED IN THIS SUBMISSION IS 0.7955 AC.
- THE TOTAL NUMBER OF LOTS INCLUDED IN THIS SUBMISSION IS 1.
- PROPOSED USE OF SITE: SINGLE FAMILY DETACHED UNIT.
- THE TOTAL DISTURBED AREA IS 0.0411 AC.
- DEPARTMENT OF PLANNING AND ZONING REFERENCE FILE NUMBERS ARE F-77-84, F-01-150, W. CONT. 11-3799-9 & F-01-150.
- UTILITIES SHOWN AS EXISTING ARE TAKEN FROM APPROVED WATER PLANS CONTRACT 14-3799-D.
- THIS AREA DESIGNATES A PRIVATE SEWERAGE EASEMENT OF 10,000 SQUARE FEET AS REQUIRED BY THE MARYLAND STATE DEPARTMENT OF THE ENVIRONMENT FOR INDIVIDUAL SEWAGE DISPOSAL. IMPROVEMENTS OF ANY NATURE IN THIS AREA ARE RESTRICTED UNTIL PUBLIC SEWERAGE IS AVAILABLE. THESE EASEMENTS SHALL BECOME NULL AND VOID UPON CONNECTION TO A PUBLIC SEWERAGE SYSTEM. THE COUNTY HEALTH OFFICER SHALL HAVE THE AUTHORITY TO GRANT VARIANCES FOR ENCROACHMENTS INTO THE PRIVATE SEWERAGE EASEMENT. RECONSTRUCTION OF A MODIFIED EASEMENT SHALL NOT BE NECESSARY. COORDINATES BASED ON NAD 83, MARYLAND COORDINATE SYSTEM AS PROVIDED BY HOWARD COUNTY GEODETIC CONTROL STATIONS NO. 176A AND NO. 176B. STA. H.C.H. 176A N. 594,357.610 E. 1,357,919.371 ELEV. 479.462. STA. H.C.H. 176B N. 593,013.910 E. 1,355,781.960 ELEV. 420.696.
- THIS PLAN IS BASED ON A FIELD BORN PERIMETER BOUNDARY SURVEY PERFORMED ON OR ABOUT 3/12/2002, BY FISHER, COLLINS AND CARTER, INC.
- USE-IN-COMMON DRIVEWAYS SHALL BE PROVIDED PRIOR TO ISSUANCE OF A RESIDENTIAL OCCUPANCY PERMIT TO ENSURE SAFE ACCESS FOR FIRE AND EMERGENCY VEHICLES PER THE FOLLOWING MINIMUM REQUIREMENTS:
 - A) WIDTH - 12 FEET OR FEET SERVING MORE THAN ONE RESIDENCE;
 - B) SURFACE - SIX (6) INCHES OF COMPACTED CRUSHER RUN BASE WITH TAR AND CHIP COATING, 1/2" MINIMUM;
 - C) GEOMETRY - MAXIMUM 1% GRADE, MAXIMUM 10% GRADE CHANGE AND 45-FOOT TURNING RADIUS;
 - D) STRUCTURES - (CULVERTS/BRIDGES) - CAPABLE OF SUPPORTING 25 GROSS TONS (NET-LOADING);
 - E) DRAINAGE ELEMENTS - CAPABLE OF SAFELY PASSING 100 YEAR FLOOD WITH NO MORE THAN ONE FOOT DEPTH OVER SURFACE;
 - F) STRUCTURE CLEARANCES - MINIMUM 12 FEET;
 - G) MAINTENANCE - SUFFICIENT TO ENSURE ALL WEATHER USE.
- THIS PLAN HAS BEEN PREPARED IN ACCORDANCE WITH THE PROVISIONS OF SECTION 1612A OF THE HOWARD COUNTY CODE AND THE LANDSCAPE MANUAL. THE REQUIRED PERIMETER LANDSCAPING AND THE ASSOCIATED SURETY HAVE BEEN SATISFIED UNDER SDP-02-100 FOR LOT 3.
- IN ACCORDANCE WITH SECTION 1612B OF THE HOWARD COUNTY CODE AND FOREST CONSERVATION MANUAL, THE FOREST CONSERVATION OBLIGATIONS FOR LOTS 3 AND 4, THE RE-SUBDIVISION OF LOT 1, F-01-150, HAVE BEEN PROVIDED BY THE RETENTION CREDIT OF 50 ACRES OF EXISTING FOREST LOCATED ON LOT 4 PER THE ORIGINAL 60,000 SQUARE FOOT LOT PROJECT OF THE DEPARTMENT OF PLANNING AND ZONING DATED MAY 11, 1999.
- NO TYPICAL METEOROLOGICAL RECORDS EXIST ON SITE BASED ON A SITE EVALUATION BY WILDMAN ENVIRONMENTAL SERVICES DURING DECEMBER, 2000.
- NO 100 YEAR FLOOD PLAIN OR STEEP SLOPES EXIST ON THIS SITE.
- THE SHARED DRIVEWAY ACCESS AND MAINTENANCE AGREEMENT FOR LOTS 3 AND 4 HAS BEEN RECORDED AMONG THE LAND RECORDS OF HOWARD COUNTY, L-3799-1504.
- STORMWATER MANAGEMENT IS PROVIDED UNDER 7-01-150 FOR LOTS 1, 2 & 3 BY A SURFACE SAND FILTER ADJACENT TO THE USE-IN-COMMON DRIVEWAY. THIS FACILITY PROVIDES FOR THE REQUIRED WATER QUALITY VOLUME (WQV) AND THE REQUIRED WATER CHARGE VOLUME (WCV) AND SHALL BE PRIVATELY OWNED AND MAINTAINED.
- ANY DAMAGE TO COUNTY RIGHTS-OF-WAY SHALL BE REPAIRED AT THE DEVELOPER'S EXPENSE.
- IN ACCORDANCE WITH SECTION 1602 OF THE HOWARD COUNTY ZONING REGULATIONS, ANY WINDOWS, CHIMNEYS OR EXTERIOR STAIRWAYS NOT MORE THAN 10 FEET IN WIDTH MAY PROJECT NOT MORE THAN 4 FEET INTO ANY SETBACKS, PORCHES OR DECKS, OPEN OR ENCLOSED MAY PROJECT NOT MORE THAN 10 FEET INTO THE FRONT OR REAR YARD SETBACK.
- THE DRIVEWAY ENTRANCE IS PER HOWARD COUNTY STANDARD DETAIL R-406.
- THE CONTRACTOR SHALL NOTIFY THE CONSTRUCTION INSPECTION DIVISION (410-313-0800) AT LEAST 24 HOURS PRIOR TO THE START OF WORK.
- THE CONTRACTOR SHALL NOTIFY "THESE UTILITIES" 1-800-257-7777 AT LEAST 48 HOURS PRIOR TO EXCAVATION WORK.
- THIS PLAN IS SUBJECT TO THE AMENDED FIFTH EDITION OF THE SUBDIVISION AND LAND DEVELOPMENT REGULATIONS PER CODE BOOK 15-2000 AND THE ZONING REGULATIONS AS AMENDED BY CODE BOOK 175-2003. DEVELOPMENT OR CONSTRUCTION ON THESE LOTS MUST COMPLY WITH SETBACK AND BUFFER REGULATIONS IN EFFECT AT THE TIME OF SUBMISSION OF THE SITE DEVELOPMENT PLAN, VARIANCE PETITION APPLICATION, OR BUILDING/GRADING PERMIT.
- THE STAKING OF FOUNDATIONS PRIOR TO CONSTRUCTION TO ENSURE COMPLIANCE WITH REGULATORY BUILDING RESTRICTION LINES IS RECOMMENDED.
- FOR FLAG OR PIPESTEM LOTS, REFUSE COLLECTION, SNOW REMOVAL AND ROAD MAINTENANCE ARE PROVIDED TO THE JUNCTION OF THE FLAG OR PIPESTEM AND ROAD RIGHT-OF-WAY LINE AND NOT ONTO THE PIPESTEM LOT DRIVEWAY.

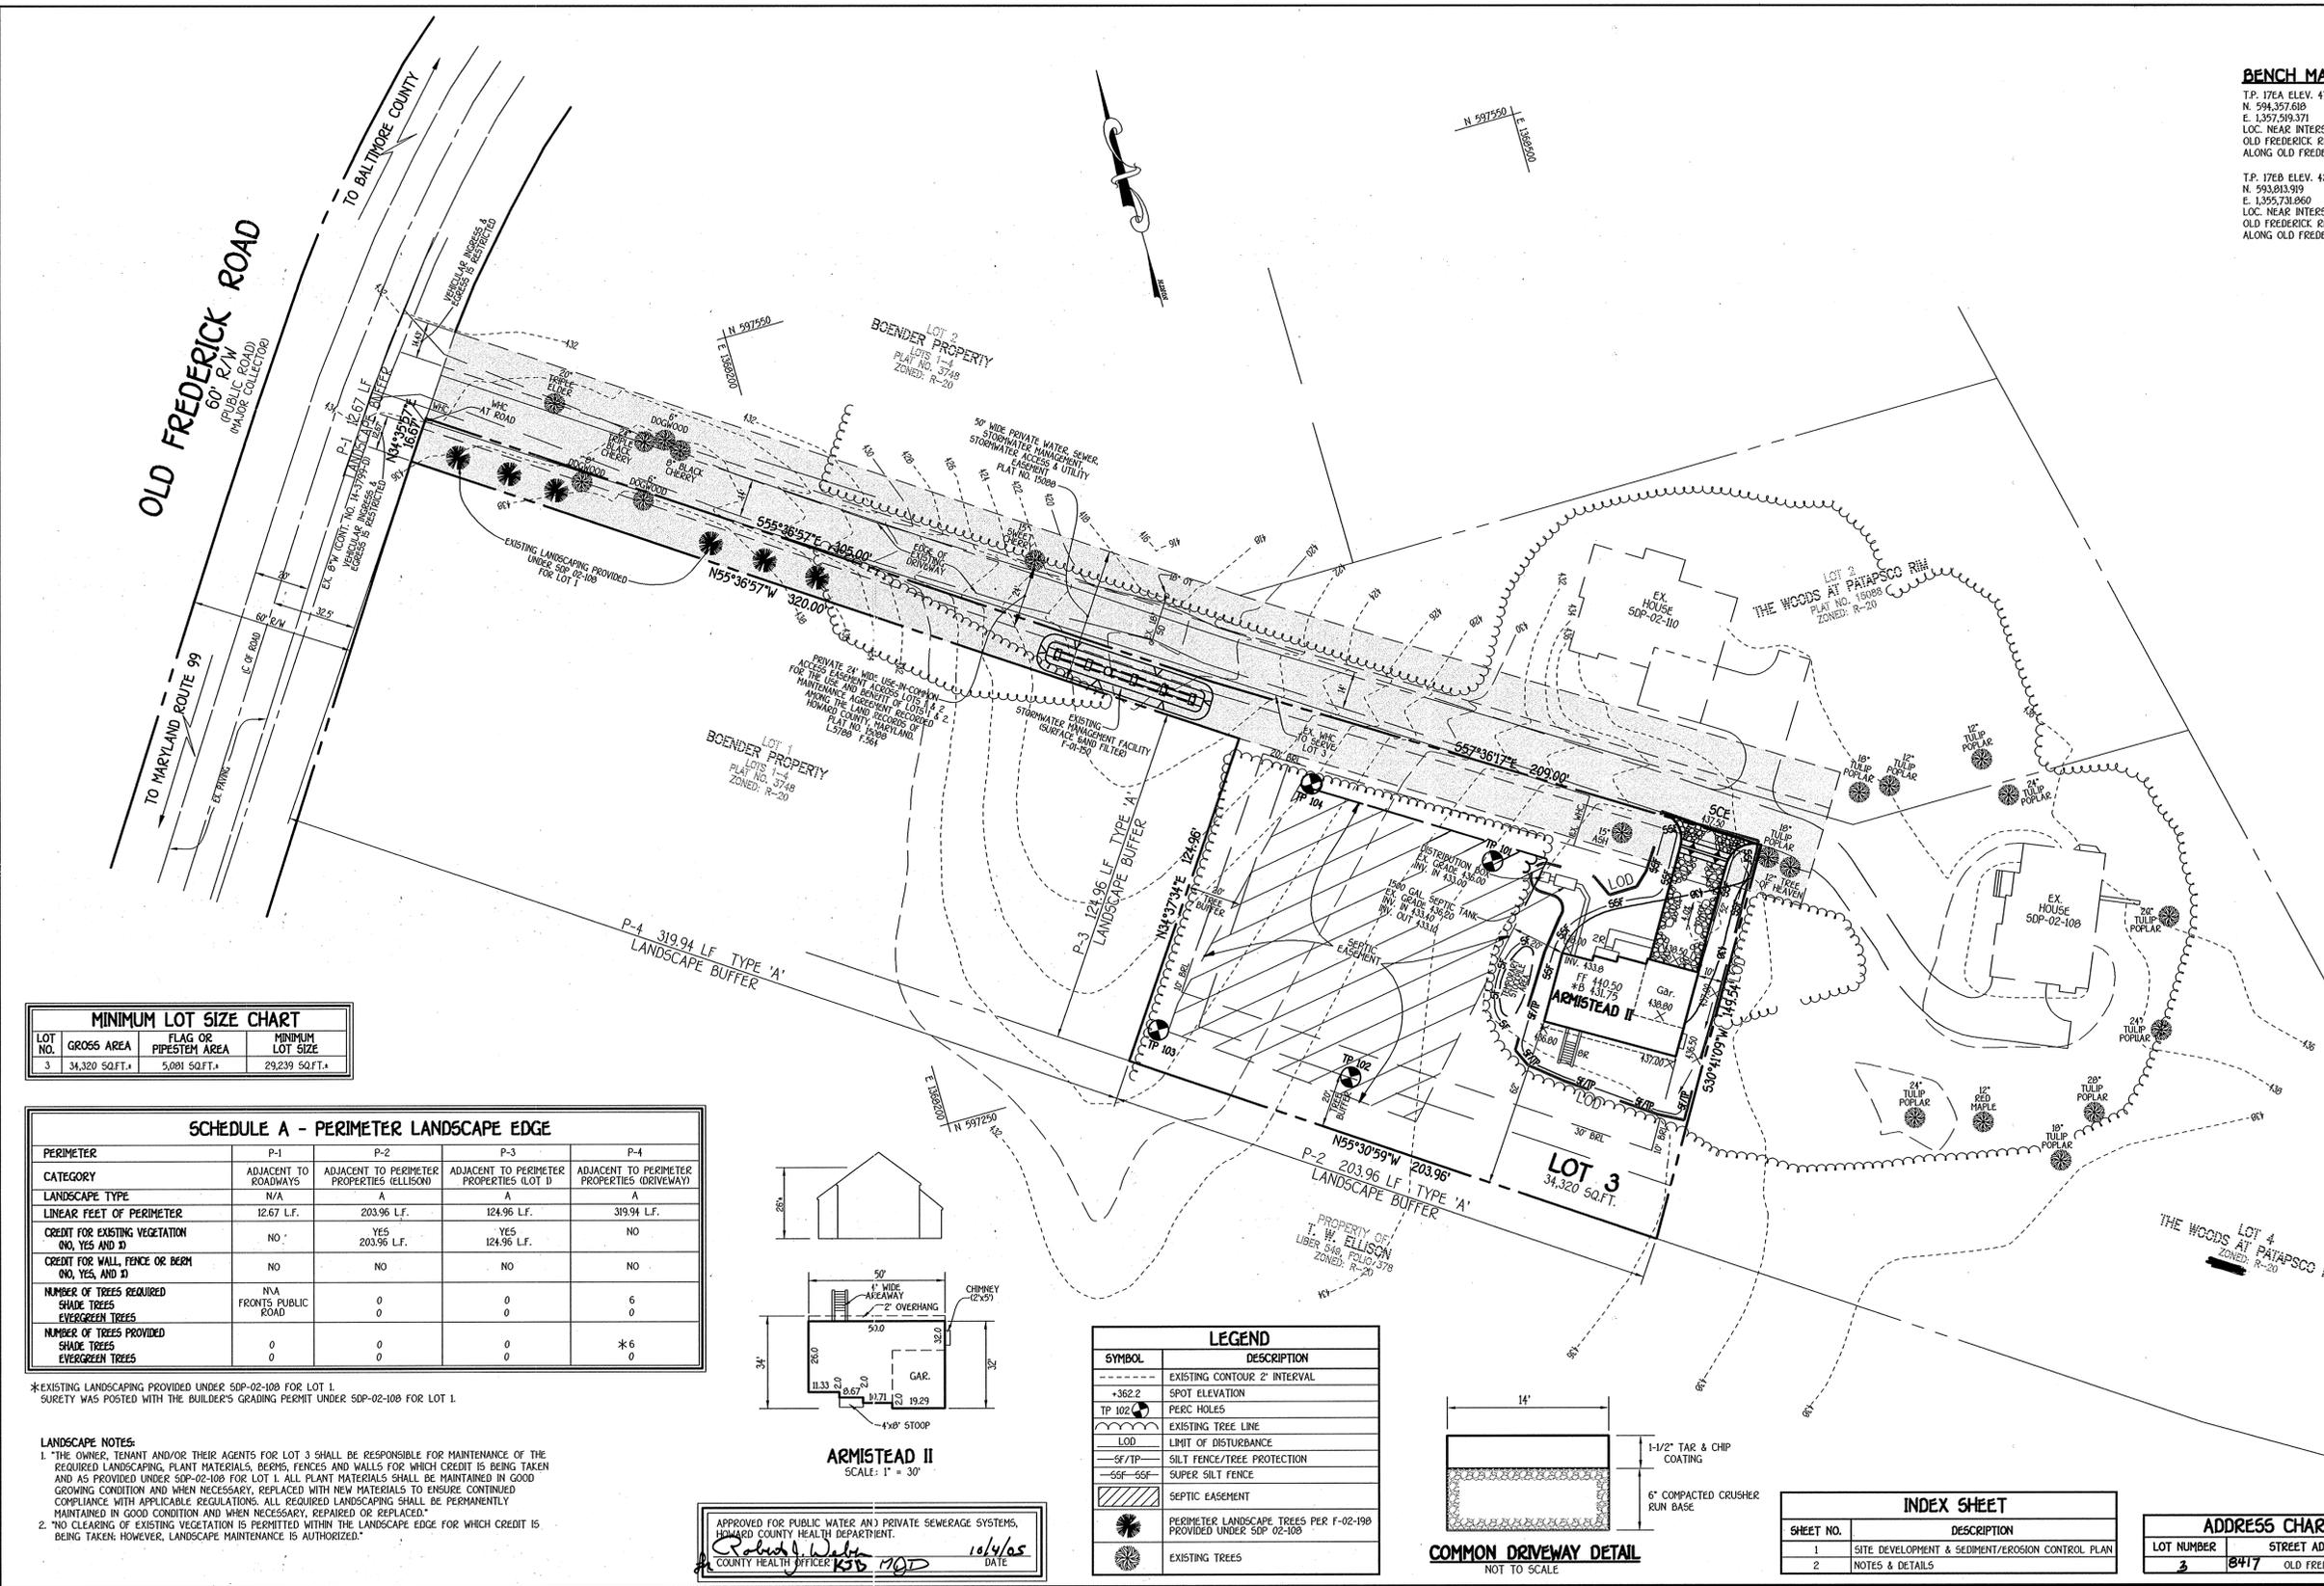

MINIMUM LOT SIZE CHART

LOT NO.	GROSS AREA	FLAG OR PIPESTEM AREA	MINIMUM LOT SIZE
3	34,320 SQ.FT.	5,081 SQ.FT.	29,239 SQ.FT.


SCHEDULE A - PERIMETER LANDSCAPE EDGE

PERIMETER	P-1	P-2	P-3	P-4
ADJACENT TO ROADWAYS	N/A	A	A	A
ADJACENT TO PERIMETER PROPERTIES (ELLIPSON)	N/A	A	A	A
ADJACENT TO PERIMETER PROPERTIES (LOT D)	N/A	A	A	A
ADJACENT TO PERIMETER PROPERTIES (DRIVEWAY)	N/A	A	A	A
LANDSCAPE TYPE	N/A	A	A	A
LINEAR FEET OF PERIMETER	12.67 L.F.	203.96 L.F.	124.96 L.F.	319.94 L.F.
CREDIT FOR EXISTING VEGETATION (NO, YES AND D)	NO	YES 203.96 L.F.	YES 124.96 L.F.	NO
CREDIT FOR WALL, FENCE OR BERM (NO, YES, AND D)	NO	NO	NO	NO
NUMBER OF TREES REQUIRED	N/A	0	0	6
SHADE TREES	FRONTS PUBLIC ROAD	0	0	0
EVERGREEN TREES	0	0	0	*6
NUMBER OF TREES PROVIDED	0	0	0	0
SHADE TREES	0	0	0	0
EVERGREEN TREES	0	0	0	0

*EXISTING LANDSCAPING PROVIDED UNDER SDP-02-100 FOR LOT 1. SURETY WAS POSTED WITH THE BUILDER'S GRADING PERMIT UNDER SDP-02-100 FOR LOT 1.


LANDSCAPE NOTES:

- THE OWNER, TENANT AND/OR THEIR AGENTS FOR LOT 3 SHALL BE RESPONSIBLE FOR MAINTENANCE OF THE REQUIRED LANDSCAPING, PLANT MATERIALS, BERMS, FENCES AND WALLS FOR WHICH CREDIT IS BEING TAKEN AND AS PROVIDED UNDER SDP-02-100 FOR LOT 1. ALL PLANT MATERIALS SHALL BE MAINTAINED IN GOOD GROWING CONDITION AND WHEN NECESSARY, REPLACED WITH NEW MATERIALS TO ENSURE CONTINUED COMPLIANCE WITH APPLICABLE REGULATIONS. ALL REQUIRED LANDSCAPING SHALL BE PERMANENTLY MAINTAINED IN GOOD CONDITION AND WHEN NECESSARY, REPAIRED OR REPLACED.
- NO CLEANSING OF EXISTING VEGETATION IS PERMITTED WITHIN THE LANDSCAPE EDGE FOR WHICH CREDIT IS BEING TAKEN; HOWEVER, LANDSCAPE MAINTENANCE IS AUTHORIZED.

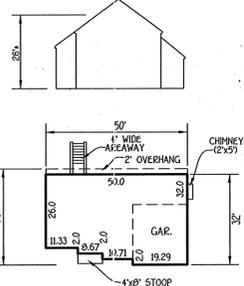

LEGEND

SYMBOL	DESCRIPTION
---	EXISTING CONTOUR 2' INTERVAL
+362.2	SPOT ELEVATION
TP 102	PERC HOLES
---	EXISTING TREE LINE
LOD	LIMIT OF DISTURBANCE
SF/TP	SILT FENCE/TREE PROTECTION
SSP	SUPER SILT FENCE
---	SEPTIC EASEMENT
---	PERIMETER LANDSCAPE TREES PER F-02-100 PROVIDED UNDER SDP-02-100
---	EXISTING TREES

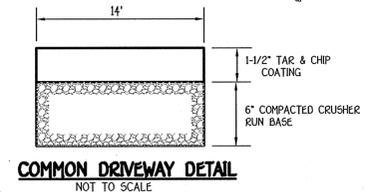

INDEX SHEET

SHEET NO.	DESCRIPTION
1	SITE DEVELOPMENT & SEDIMENT/EROSION CONTROL PLAN
2	NOTES & DETAILS

ADDRESS CHART

LOT NUMBER	STREET ADDRESS
3	8417 OLD FREDERICK ROAD

APPROVED FOR PUBLIC WATER AND PRIVATE SEWERAGE SYSTEMS,
 HOWARD COUNTY HEALTH DEPARTMENT.
 Robert J. Weber
 COUNTY HEALTH OFFICER
 10/4/05
 DATE

ENGINEER'S CERTIFICATE
 I certify that this plan for erosion and sediment control represents a practical and workable plan based on my personal knowledge of the site conditions and that it was prepared in accordance with the requirements of the Howard Soil Conservation District.
 Signature of Engineer: Earl D. Collins
 Date: 8-22-05

BUILDER/DEVELOPER'S CERTIFICATE
 I/we certify that all development and construction will be done according to this plan, for sediment and erosion control and that any responsible personnel involved in the construction project will have a Certificate of Attendance at a Department of the Environment Approved Training Program for the Control of Sediment and Erosion before beginning the project. I also authorize periodic on-site inspection by the Howard Soil Conservation District.
 Signature of Developer: Mark Kovach
 Date: 8/22/05

Reviewed for HOWARD SCD and meets Technical Requirements.
 Yvonne Meyler
 8-29-05
 Date
 This development plan is approved for sediment and erosion control by the HOWARD SOIL CONSERVATION DISTRICT.
 John K. Robinson
 8-29-05
 Date
 OWNER/DEVELOPER/BUILDER
 MARK KOVACH
 9527 OLD FREDERICK ROAD
 ELLICOTT CITY, MARYLAND 21043
 410-313-3366

APPROVED: HOWARD COUNTY DEPARTMENT OF PLANNING AND ZONING
 Cindy Hamilton
 10/7/05
 Date
 Chief, Division of Land Development
 Approved: gno
 9/2/05
 Date
 Director - Department of Planning and Zoning
 PROJECT: THE WOODS AT PATAPSCO RIM SECTION: N/A LOT NO.: 3
 PLAT: #17746 BLOCK NO.: 7 ZONE: R-20 TAX/ZONE: 1B ELEC. DIST.: SECOND CENSUS TR.: 6121.00
 WATER CODE: SEWER CODE: PRIVATE FOI: PRIVATE

PERC CERTIFICATION, SITE DEVELOPMENT, SEDIMENT/EROSION CONTROL PLAN
 THE WOODS AT PATAPSCO RIM
 LOT 3
 TAX MAP NO.: 1B PARCEL NO.: 349
 SECOND ELECTION DISTRICT, HOWARD COUNTY, MARYLAND
 SCALE: 1" = 30' DATE: FEBRUARY, 2005
 SHEET 1 OF 2

SDP 05-142

K:\Drawings\303729\KOVACH\microsheet\lts 3 and 4\303729 SDP La 3.dwg, 8/22/05 2:05:53 PM

20.0 STANDARDS AND SPECIFICATIONS FOR VEGETATIVE STABILIZATION DEFINITION

Using vegetation as cover for barren soil to protect it from forces that cause erosion.

PURPOSE

Vegetative stabilization specifications are used to promote the establishment of vegetation on exposed soil. When soil is stabilized with vegetation, the soil is less likely to erode and more likely to allow infiltration of rainfall, thereby reducing sediment loads and runoff to downstream areas, and improving wildlife habitat and visual resources.

CONDITIONS WHERE PRACTICE APPLIES

This practice shall be used on denuded areas as specified on the plans and may be used on highly erodible or critically eroding areas. This specification is divided into three categories: temporary cover for short duration (up to one year), and Permanent Seeding, for long term vegetative cover. Examples of applicable areas for Temporary Seeding are temporary soil stockpiles, cleared areas left idle between construction phases, earth dikes, etc. and for Permanent Seeding are lawns, dams, cut and fill areas, and other areas of long-term stockpiles and erosion areas, etc.

EFFECTS ON WATER QUALITY AND QUANTITY

Planting vegetation in disturbed areas will have an effect on the water budget, especially on volumes and rates of runoff, infiltration, evaporation, transpiration, percolation, and groundwater recharge. Vegetation, over time, will increase organic matter content and improve the water holding capacity of the soil and subsequent plant growth. Vegetation will help reduce the movement of sediment, nutrients, and other chemicals carried by runoff to receiving waters. Plants will also help protect groundwater supplies by assimilating those substances present within the root zone.

Sediment control devices must remain in place during grading, seeded preparation, seeding, mulching and vegetative establishment to prevent large quantities of sediment and associated chemicals and nutrients from washing into surface waters.

SECTION 1 - VEGETATIVE STABILIZATION METHODS AND MATERIALS

- A. Site Preparation
 - i. Install erosion and sediment control structures (either temporary or permanent) such as diversions, grade stabilization structures, berms, waterways, or sediment control basins.
 - ii. Perform all grading operations at right angles to the slope. Final grading and shaping is not usually necessary for temporary seeding.
 - iii. Schedule required soil tests to determine soil amendment composition and application rates for sites having disturbed area over 5 acres.

- B. Soil Amendments (Fertilizer and Lime Specifications)
 - i. Soil tests must be performed to determine the exact ratios and application rates for both lime and fertilizer on sites having disturbed areas over 5 acres. Soil analysis may be performed by the University of Maryland or a recognized commercial laboratory. Soil samples taken for engineering purposes may also be used for chemical analysis.
 - ii. Fertilizers shall be uniform in composition and suitable for accurate application by approved equipment. Manure may be substituted for fertilizer with prior approval from the appropriate approval authority. Fertilizers shall be delivered to the site fully bagged and according to the applicable state fertilizer laws and shall bear the name, trade name or trademark and address of the producer.
 - iii. Lime materials shall be ground limestone (hydrated or burnt lime may be substituted which contains at least 50% total oxides calcium oxide plus magnesium oxide). Limestone shall be ground to such fineness that at least 50% will pass through a #100 mesh sieve and 90-100% will pass through a #20 mesh sieve.
 - iv. Incorporate lime and fertilizer into the top 3-5" of soil by disking or other suitable means.

- C. Seeded Preparation
 - i. Temporary Seeding
 - a. Seeded preparation shall consist of loosening soil to a depth of 3" to 5" by means of suitable agricultural or construction equipment, such as disc harrows or chisel plows or rippers mounted on construction equipment. After the soil is loosened it should not be rolled or dragged smooth, but left in the roughened condition. Sloped areas (greater than 3%) should be tracked leaving the surface in an irregular condition with ridges running parallel to the contour of the slope.
 - b. Apply fertilizer and lime as prescribed on the plans.
 - c. Incorporate lime and fertilizer into the top 3-5" of soil by disking or other suitable means.
 - ii. Permanent Seeding
 - a. Minimum soil conditions required for permanent vegetative establishment:
 1. Soil pH shall be between 6.0 and 7.0.
 2. Soluble salts shall be less than 500 parts per million (ppm).
 3. The soil shall contain less than 40% clay, but enough fine grained material (30% silt plus clay) to provide the capacity to hold a moderate amount of moisture. An exception is for lowgrass or serecia lespedeza to be planted, then a sandy soil (30% silt plus clay) would be acceptable.
 4. Soil shall contain 1.5% minimum organic matter by weight.
 5. Soil must contain sufficient pore space to permit adequate root penetration.
 6. If these conditions cannot be met by soils on site, adding topsoil is required in accordance with Section 21 Standard and Specification for Topsoil.
 - b. Areas previously graded in conformance with the drawings shall be maintained in a true and even grade, then scarified or otherwise loosened to a depth of 3-5" to permit bonding of the topsoil to the surface area and to create horizontal erosion check slots to prevent topsoil to the surface area and to create horizontal erosion check slots to prevent topsoil from sliding down a slope.
 - c. Apply soil amendments as per soil test or as included on the plans.
 - d. Mix soil amendments into the top 3-5" of soil by disking or other suitable means. Lawn areas should be raked to smooth the surface, remove large objects like stones and branches, and ready the area for seed application. Where site conditions will not permit normal seeded preparation, loosen surface soil by dragging with a heavy chain or other equipment to roughen the surface. Steep slopes (steeper than 3%) should be tracked by a dozer leaving the soil in an irregular condition with ridges running parallel to the contour of the slope. The top 1-3" of soil should be loose and friable. Seeded loosening may not be necessary on newly disturbed areas.

- D. Seed Specifications
 - i. All seed must meet the requirements of the Maryland State Seed Law. All seed shall be subject to re-testing by a recognized seed laboratory. All seed used shall have been tested within the 6 months immediately preceding the date of sowing such material on this job.
 - ii. Inoculant - The inoculant for treating legume seed in the seed mixtures shall be a pure culture of nitrogen-fixing bacteria specifically for the species. Inoculants shall not be used later than the date indicated on the container. Add fresh inoculant as directed on package. Use four times the recommended amount when important to keep inoculant as cool as possible until used. Temperatures above 75°-80° F. can weaken bacteria and make the inoculant less effective.

- E. Methods of Seeding
 - i. Hydroseeding - Apply seed uniformly with hydroseeder (slurry includes seed and fertilizer), broadcast or drop seeded, or a cultipacker seeder.
 - a. If fertilizer is being applied at the time of seeding, the application rates amounts will not exceed the following: Nitrogen maximum of 100 lbs. per acre total of soluble nitrogen; P2O5 (phosphorous) 200 lbs/acre; K2O (potassium) 200 lbs/acre.
 - b. Lime - use only ground agricultural limestone, up to 3 tons per acre may be applied by hydroseeding. Normally, not more than 2 tons are applied by hydroseeding at any one time. Do not use burnt or hydrated lime when hydroseeding.
 - c. Seed and fertilizer shall be mixed on site and seeding shall be done immediately and without interruption.
 - ii. Dry Seeding - This includes use of conventional drop or broadcast spreaders.
 - a. Seed spread dry shall be incorporated into the subsoil at the rates prescribed on the Temporary or Permanent Seeding Summaries or Tables 265 or 26. The seeded area shall then be rolled with a weighted roller to provide good seed to soil contact.
 - b. Where practical, seed should be applied in two directions perpendicular to each other. Apply half the seeding rate in each direction.
 - iii. Drill or Cultipacker Seeding - Mechanized seeders that apply and cover seed with soil.
 - a. Cultipacker seeders are required to bury the seed in such a fashion as to provide at least 1/4 inch of soil covering. Seeded must be firm after planting.
 - b. Where practical, seed should be applied in two directions perpendicular to each other. Apply half the seeding rate in each direction.

- F. Mulch Specifications (in order of preference)
 - i. Straw mulch consist of thoroughly threshed wheat, rye or oat straw, reasonable bright in color, and shall not be musty, moldy, caked, decayed, or excessively dried and shall be free of noxious weed seeds as specified in the Maryland Seed Law.
 - ii. Wood Cellulose Fiber Mulch (WCFF)
 - a. WCFF shall consist of specially prepared wood cellulose processed into a uniform fibrous physical state.
 - b. WCFF shall be dried green or contain a green dye in the package that will provide an appropriate color to facilitate visual inspection of the uniform spread slurry.
 - c. WCFF, including dye, shall contain no germination or growth inhibiting factors.
 - d. WCFF materials shall be manufactured and processed in such a manner that the wood cellulose fiber mulch will remain in uniform suspension in water under agitation and will blend with seed, fertilizer and other additives to form a homogeneous slurry. The mulch material shall form a blotter-like ground cover, on application, having moisture absorption and retention properties and soil cover and hold grass seed in contact with the soil without inhibiting the growth of the grass seedlings.
 - e. WCFF material shall contain no elements or compounds at concentration levels that will be phytotoxic.
 - f. WCFF must conform to the following physical requirements: fiber length to approximately 10 mm., diameter approximately 1 mm., pH range of 4.0 to 8.5, ash content of 10% maximum and water holding capacity of 90% minimum.

- Note: Only straw mulch should be used in areas where one species of grass is desired.

- G. Mulching Seeded Areas - Mulch shall be applied to all seeded areas immediately after seeding.
 - i. If grading is completed outside of the seeding season, mulch along shall be applied as prescribed in this section and maintained until the seeding season returns and seeding can be performed in accordance with these specifications.
 - ii. When straw mulch is used, it shall be spread over all seeded areas at the rate of 2 tons/acre. Mulch shall be applied to a uniform loose depth of between 1" and 2". Mulch applied shall achieve a uniform distribution and depth so that the soil surface is not exposed. If a mulch anchoring tool is to be used, the rate should be increased to 2.5 tons/acre.
 - iii. Wood cellulose fiber used as a mulch shall be applied at a net dry weight of 1,500 lbs. per acre. The wood cellulose fiber shall be mixed with water, and the mixture shall contain a maximum of 50 lbs. of wood cellulose fiber per 100 gallons of water.

- H. Securing Straw Mulch (Mulch Anchoring) - Mulch anchoring shall be performed immediately following mulch application to minimize loss by wind or water. This may be done by one of the following methods (listed by preference, depending upon size of area and erosion hazard):
 - i. A mulch anchoring tool is a tractor drawn implement designed to punch and anchor mulch into the soil surface a minimum of two (2) inches. This practice is most effective on large areas, but is limited to flatter slopes where equipment can operate safely. If used on sloping land, this practice should be used on the contour if possible.
 - ii. Wood cellulose fiber may be used for anchoring straw. The fiber binder shall be applied at a net dry weight of 750 pounds/acre. The wood cellulose fiber shall be mixed with water and the mixture shall contain a maximum of 50 pounds of wood cellulose fiber per 100 gallons of water.
 - iii. Application of liquid binders should be heavier at the edges where wind catches mulch, such as in valleys and crest of banks. The remainder of area should be applied uniform after binder application. Synthetic binders - such as Acrylic ULR (Agro-Tack), DCA-70 Petrosol, Terra Tax II, Terra Tack AR, or other approved equal may be used at rates recommended by the manufacturer to anchor mulch.
 - iv. Lightweight plastic netting may be stapled over the mulch according to manufacturer's recommendations. Netting is usually available in rolls 4' to 15' feet wide and 300 to 3,000 feet long.

- I. Incremental Stabilization - Cut Slopes
 - i. All cuts slopes shall be dressed prepared, seeded and mulched as the work progresses. Slopes shall be excavated and stabilized in equal increments not to exceed 15'.
 - ii. Construction sequence (Refer to Figure 3 below):
 - a. Excavate and stabilize all temporary swales, side ditches, or berms that will be used to convey runoff from the excavation.
 - b. Perform Phase 1 excavation, dress and stabilize.
 - c. Perform Phase 2 excavation, dress and stabilize. Overseed Phase 1 areas as necessary.
 - d. Perform final phase excavation, dress and stabilize. Overseed previously seeded areas as necessary.

- Note: Once excavation has begun the operation should be continuous from grubbing through the completion of grading and placement of topsoil (if required) and permanent seed and mulch. Any interruptions in the operation out of the seeding season will necessitate the application of temporary stabilization.
- J. Incremental Stabilization of Embankments - Fill Slopes
 - i. Embankments shall be constructed in lifts as prescribed on the plans.
 - ii. Slopes shall be stabilized immediately when the vertical height of the multiple lifts reaches 15' or when the grading operation ceases on the plans.
 - iii. At the end of each day, temporary berms and pipe slope drains should be constructed along the top edge of the embankment to intercept surface runoff and convey it down the slope in a non-erosive manner to the adjacent grading.
 - ii. Construction sequence (Refer to Figure 4 below):
 - a. Excavate and stabilize all temporary swales, side ditches, or berms that will be used to divert runoff around the fill. Construct slope silt fence on low side of fill as shown in Figure 5, unless other methods shown on the plans address this area.
 - b. Place Phase 1 embankment, dress and stabilize.
 - c. Place Phase 2 embankment, dress and stabilize.
 - d. Place final phase embankment, dress and stabilize. Overseed previously seeded areas as necessary.

- Note: Once the placement of fill has begun the operation should be continuous from grubbing through the completion of and placement of topsoil (if required) grading and permanent seed and mulch. Any interruptions in the operation or completing the operation out of the seeding season will necessitate the application of temporary stabilization.

SEDIMENT CONTROL NOTES

1. A MINIMUM OF 48 HOURS NOTICE MUST BE GIVEN TO THE HOWARD COUNTY DEPARTMENT OF INSPECTIONS, LICENSES AND PERMITS, SEDIMENT CONTROL DIVISION PRIOR TO THE START OF ANY CONSTRUCTION (31-1859).
2. ALL VEGETATIVE AND STRUCTURAL PRACTICES ARE TO BE INSTALLED ACCORDING TO THE PROVISIONS OF THIS PLAN AND ARE TO BE IN CONFORMANCE WITH THE MOST CURRENT MARYLAND STANDARDS AND SPECIFICATIONS FOR SOIL EROSION AND SEDIMENT CONTROL AND REVISIONS THERETO.
3. FOLLOWING INITIAL SOIL DISTURBANCE OR RE-DISTURBANCE, PERMANENT OR TEMPORARY STABILIZATION SHALL BE COMPLETED WITHIN:
 - a. 7 CALENDAR DAYS FOR ALL PERIMETER SEDIMENT CONTROL STRUCTURES, DIKES, PERIMETER SLOPES AND ALL SLOPES STEEPER THAN 3:1, BY 14 DAYS AS TO ALL OTHER DISTURBED OR GRADED AREAS ON THE PROJECT SITE.
 - b. ALL SEDIMENT TRAPS/BASINS SHOWN MUST BE FENCED AND WARNING SIGNS POSTED AROUND THEIR PERIMETER IN ACCORDANCE WITH VOL. 1, CHAPTER 12, OF THE HOWARD COUNTY DESIGN MANUAL, STORM DRAINAGE.
4. ALL DISTURBED AREAS MUST BE STABILIZED WITHIN THE TIME PERIOD SPECIFIED ABOVE IN ACCORDANCE WITH THE 1994 MARYLAND STANDARDS AND SPECIFICATIONS FOR SOIL EROSION AND SEDIMENT CONTROL, FOR PERMANENT SEEDING (SEC. 50, 50D (GEC. 54), TEMPORARY SEEDING (SEC. 50, 50A) AND MULCHING (SEC. 52). TEMPORARY STABILIZATION WITH MULCH ALONE CAN ONLY BE DONE WHEN RECOMMENDED SEEDING DATES DO NOT ALLOW FOR PROPER GERMINATION AND ESTABLISHMENT OF GRASSES.
5. ALL SEDIMENT CONTROL STRUCTURES ARE TO REMAIN IN PLACE AND ARE TO BE MAINTAINED IN OPERATIVE CONDITION UNTIL PERMISSION FOR THEIR REMOVAL HAS BEEN OBTAINED FROM THE HOWARD COUNTY SEDIMENT CONTROL INSPECTOR.
6. SITE ANALYSIS:

TOTAL AREA OF SITE	0.7879 ACRES
AREA OF DISTURBED AREA TO BE ROOFED OR PAVED	0.0571 ACRES
AREA TO BE VEGETATIVELY STABILIZED	0.9400 ACRES
TOTAL CUT	52 CU.YDS.
OFFSITE WASTE/BORROW AREA LOCATION	N/A CUYDVS.
7. ANY SEDIMENT CONTROL PRACTICE WHICH IS DISTURBED BY GRADING ACTIVITY FOR PLACEMENT OF UTILITIES MUST BE REPAIRED ON THE SAME DAY OF DISTURBANCE.
8. APPROVAL OF THE INSPECTION AGENCY SHALL BE REQUESTED UPON COMPLETION OF INSTALLATION OF PERIMETER EROSION AND SEDIMENT CONTROLS, BUT BEFORE PROCEEDING WITH ANY OTHER EARTH DISTURBANCE OR GRADING. OTHER BUILDING OR GRADING INSPECTION APPROVALS MAY NOT BE AUTHORIZED UNTIL THIS INITIAL APPROVAL BY THE INSPECTION AGENCY IS MADE.
9. APPROVAL OF THE INSPECTION AGENCY SHALL BE REQUESTED UPON COMPLETION OF INSTALLATION OF PERIMETER EROSION AND SEDIMENT CONTROLS, BUT BEFORE PROCEEDING WITH ANY OTHER EARTH DISTURBANCE OR GRADING. OTHER BUILDING OR GRADING INSPECTION APPROVALS MAY NOT BE AUTHORIZED UNTIL THIS INITIAL APPROVAL BY THE INSPECTION AGENCY IS MADE.
10. TRENCHES FOR THE CONSTRUCTION OF UTILITIES IS LIMITED TO THREE PIPE LENGTHS OR THAT WHICH SHALL BE BACK-FILLED AND STABILIZED WITHIN ONE WORKING DAY, WHICHEVER IS SHORTER.

SEQUENCE OF CONSTRUCTION

1. OBTAIN GRADING PERMIT.
2. INSTALL SEDIMENT AND EROSION CONTROL DEVICES AS SHOWN ON PLAN.
3. CLEAR AND GRUB TO LIMITS OF DISTURBANCE AND MASS GRADE TO SUN-BASE.
4. INSTALL TEMPORARY SEEDING.
5. CONSTRUCT DRIVEWAY.
6. FINE GRADE SITE AND INSTALL PERMANENT SEEDING AND LANDSCAPE.
7. REMOVE SEDIMENT CONTROL DEVICES AS UPLAND AREAS ARE STABILIZED AND PERMISSION IS GRANTED BY E/S CONTROL INSPECTOR.

1. Silt Fence to be heeled into the soil.
2. Wire, snow fence, etc. for tree protection only.
3. Boundaries of Retention Area will be established as part of the forest conservation plan review process.
4. Boundaries of Retention Area should be staked and flagged prior to installing devices.
5. Avoid root damage when placing anchor posts.
6. Device should be properly maintained throughout construction.
7. Protection signs are also required, see Figure C-4.
8. Locate fence outside the Critical Root Zone.

1. Silt Fence and Tree Protection
2. Wire, snow fence, etc. for tree protection only.
3. Boundaries of Retention Area will be established as part of the forest conservation plan review process.
4. Boundaries of Retention Area should be staked and flagged prior to installing devices.
5. Avoid root damage when placing anchor posts.
6. Device should be properly maintained throughout construction.
7. Protection signs are also required, see Figure C-4.
8. Locate fence outside the Critical Root Zone.


1. Silt Fence and Tree Protection
2. Wire, snow fence, etc. for tree protection only.
3. Boundaries of Retention Area will be established as part of the forest conservation plan review process.
4. Boundaries of Retention Area should be staked and flagged prior to installing devices.
5. Avoid root damage when placing anchor posts.
6. Device should be properly maintained throughout construction.
7. Protection signs are also required, see Figure C-4.
8. Locate fence outside the Critical Root Zone.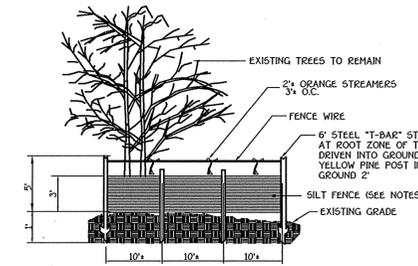

1. Silt Fence to be heeled into the soil.
2. Wire, snow fence, etc. for tree protection only.
3. Boundaries of Retention Area will be established as part of the forest conservation plan review process.
4. Boundaries of Retention Area should be staked and flagged prior to installing devices.
5. Avoid root damage when placing anchor posts.
6. Device should be properly maintained throughout construction.
7. Protection signs are also required, see Figure C-4.
8. Locate fence outside the Critical Root Zone.

1. Silt Fence and Tree Protection
2. Wire, snow fence, etc. for tree protection only.
3. Boundaries of Retention Area will be established as part of the forest conservation plan review process.
4. Boundaries of Retention Area should be staked and flagged prior to installing devices.
5. Avoid root damage when placing anchor posts.
6. Device should be properly maintained throughout construction.
7. Protection signs are also required, see Figure C-4.
8. Locate fence outside the Critical Root Zone.


1. Silt Fence and Tree Protection
2. Wire, snow fence, etc. for tree protection only.
3. Boundaries of Retention Area will be established as part of the forest conservation plan review process.
4. Boundaries of Retention Area should be staked and flagged prior to installing devices.
5. Avoid root damage when placing anchor posts.
6. Device should be properly maintained throughout construction.
7. Protection signs are also required, see Figure C-4.
8. Locate fence outside the Critical Root Zone.

-

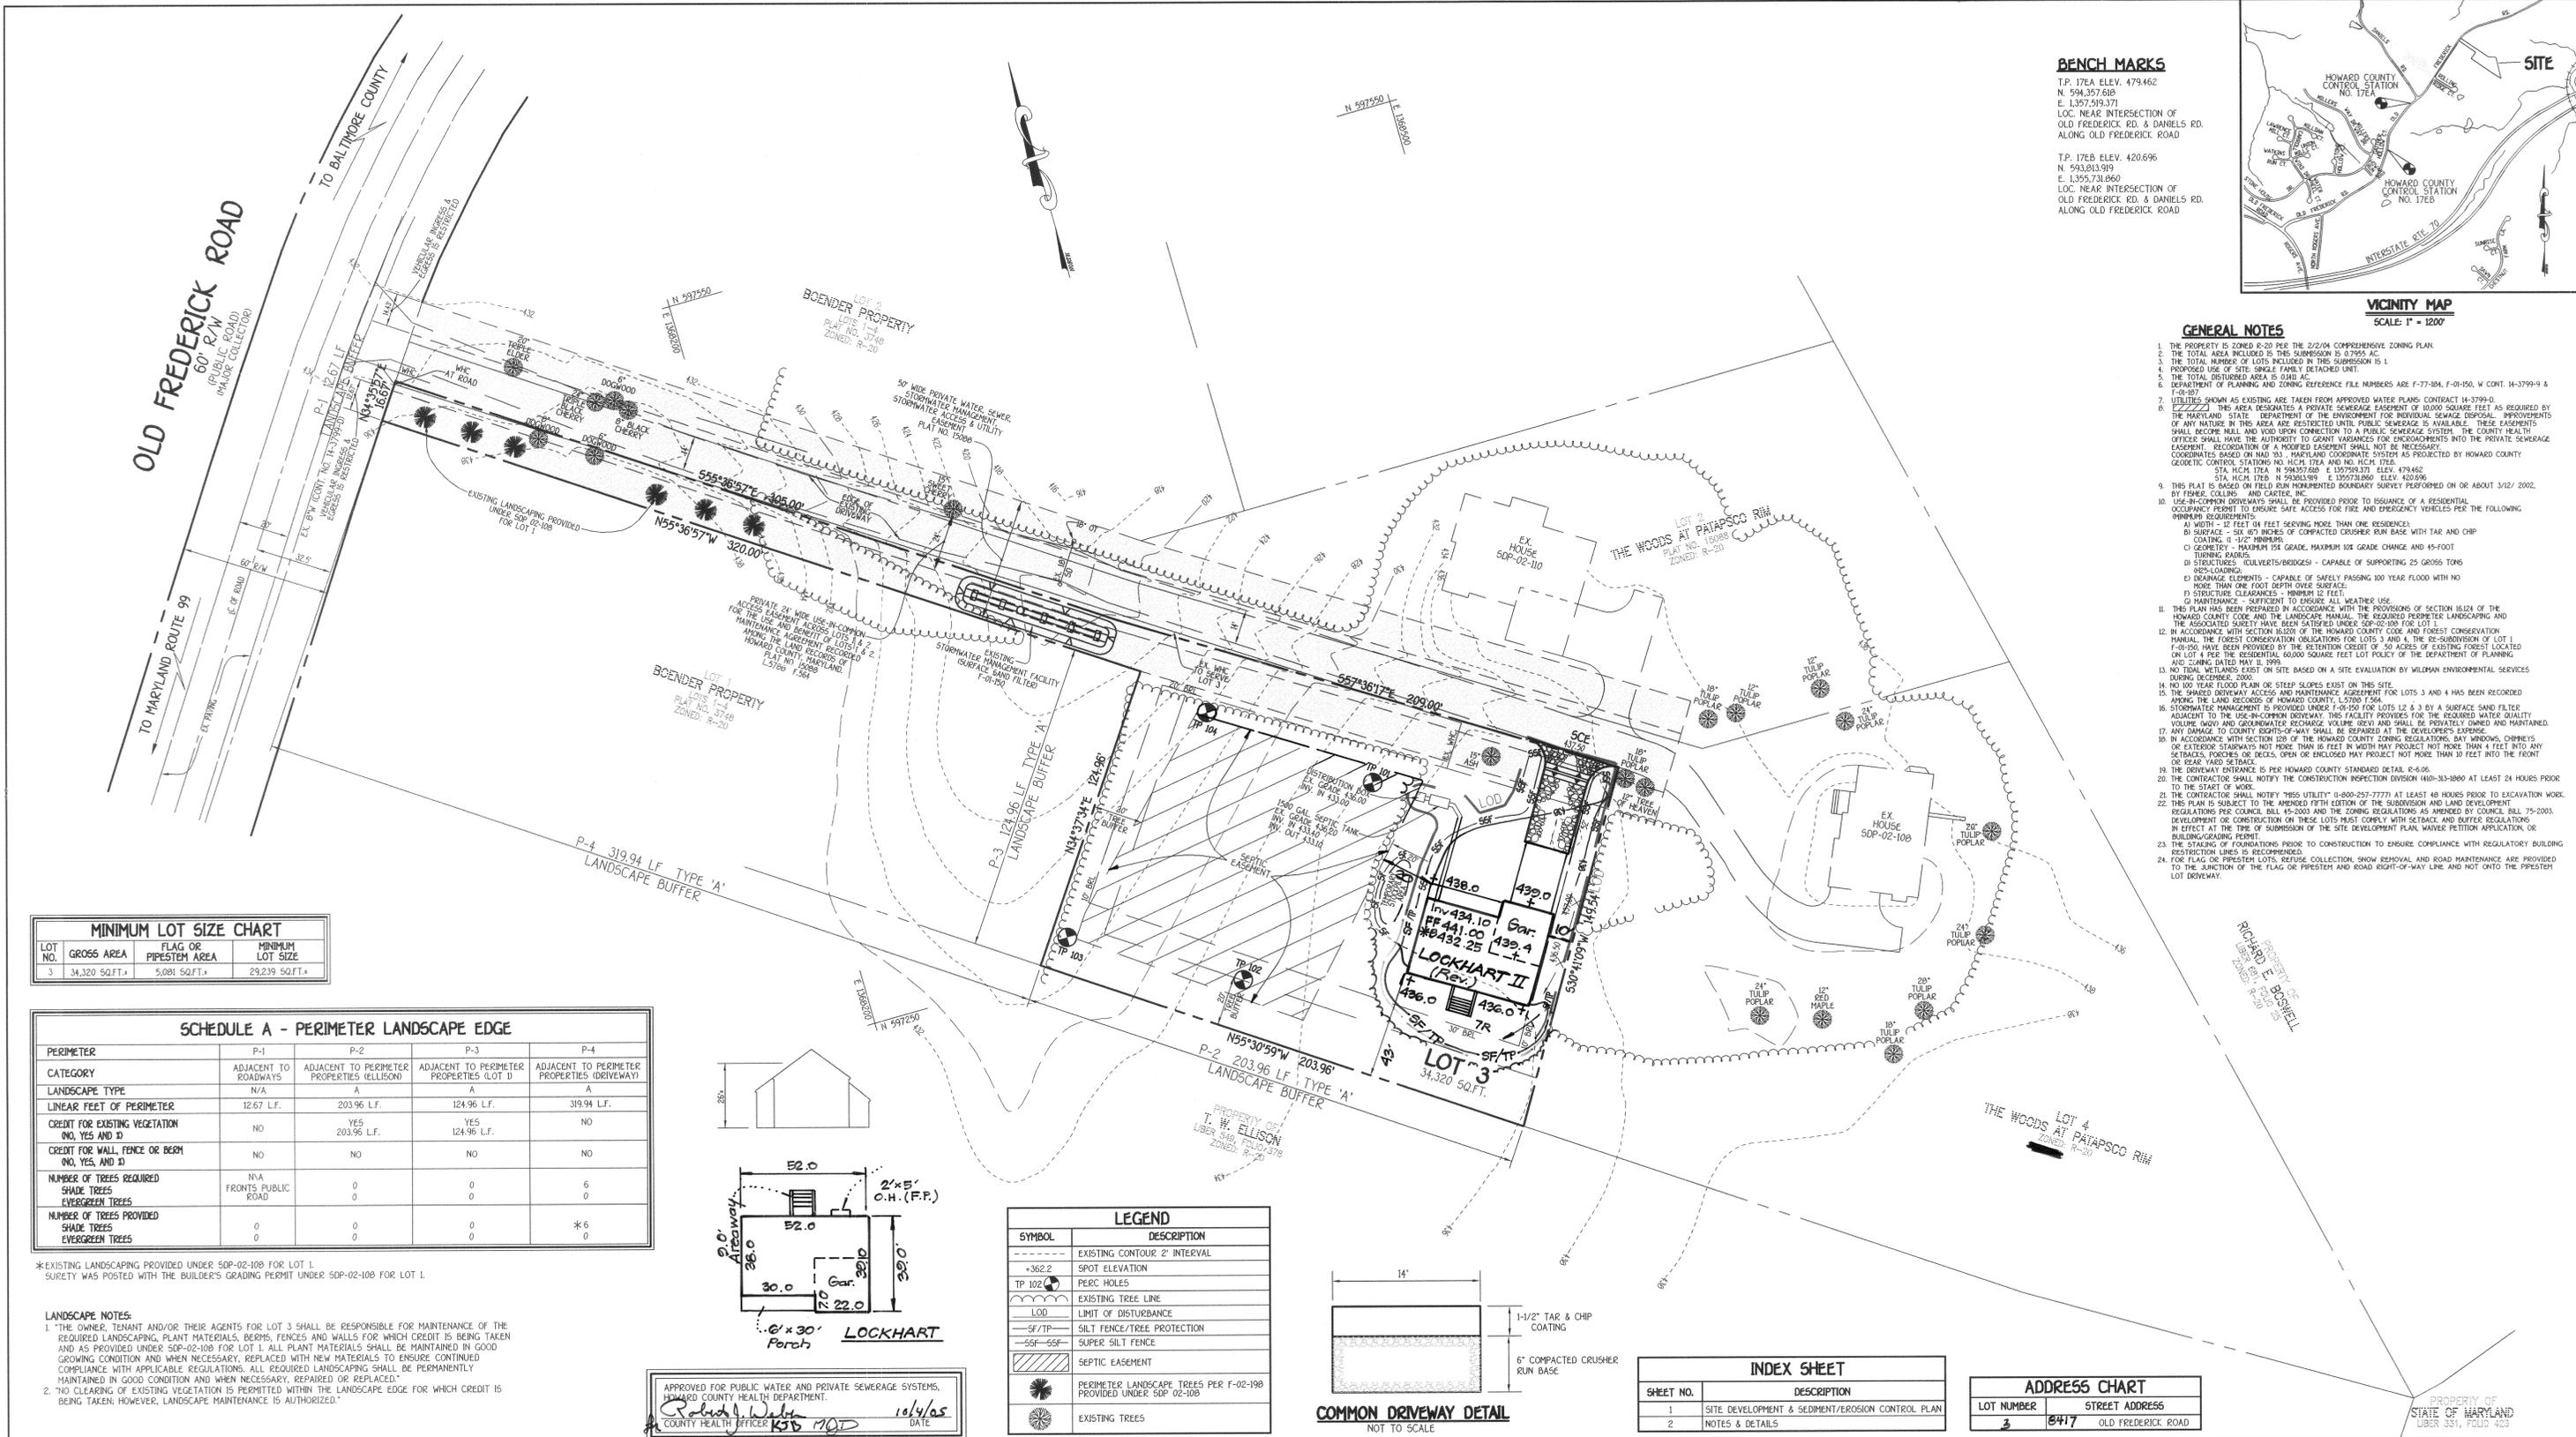

BENCH MARKS
 T.P. 17EA ELEV. 479.462
 N. 594.357.610
 E. 1,357.519.371
 LOC. NEAR INTERSECTION OF
 OLD FREDERICK RD. & DANIELS RD.
 ALONG OLD FREDERICK ROAD

T.P. 17EB ELEV. 420.696
 N. 593.013.919
 E. 1,395.731.860
 LOC. NEAR INTERSECTION OF
 OLD FREDERICK RD. & DANIELS RD.
 ALONG OLD FREDERICK ROAD

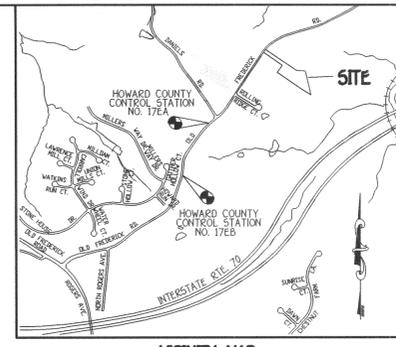

- GENERAL NOTES**
- THE PROPERTY IS ZONED R-20 PER THE 2/2/04 COMPREHENSIVE ZONING PLAN.
 - THE TOTAL NUMBER OF LOTS INCLUDED IN THIS SUBDIVISION IS 1.
 - PROPOSED USE OF SITE: SINGLE FAMILY DETACHED UNIT.
 - THE TOTAL DISTURBED AREA IS 0.2400 AC.
 - DEPARTMENT OF PLANNING AND ZONING REFERENCE FILE NUMBERS ARE: F-77-804, F-01-150, W. CONT. 14-3799-9 & F-01-150.
 - UTILITIES SHOWN AS EXISTING ARE TAKEN FROM APPROVED WATER PLANS CONTRACT 14-3799-0.
 - THIS AREA DESIGNATES A PRIVATE SEWERAGE EASEMENT OF 10,000 SQUARE FEET AS REQUIRED BY THE MARYLAND STATE DEPARTMENT OF THE ENVIRONMENT FOR INDIVIDUAL SEWER DISPOSAL. IMPROVEMENTS OF ANY NATURE IN THIS AREA ARE RESTRICTED UNTIL PUBLIC SEWERAGE IS AVAILABLE. THESE EASEMENTS SHALL BECOME NULL AND VOID UPON CONNECTION TO A PUBLIC SEWERAGE SYSTEM. THE COUNTY HEALTH OFFICER SHALL HAVE THE AUTHORITY TO GRANT VARIANCES FOR ENCROACHMENTS INTO THE PRIVATE SEWERAGE EASEMENT. RECONSTRUCTION OF A MODELED EASEMENT SHALL NOT BE NECESSARY. COORDINATES BASED ON NAD 83. MARYLAND COORDINATE SYSTEM AS PROJECTED BY HOWARD COUNTY GEODETIC CONTROL STATIONS NO. HCH 17EA AND NO. HCH 17EB.
 - STA. HCH 17EA N 594.357.610 E 1,357.519.371 ELEV. 479.462
 STA. HCH 17EB N 593.013.919 E 1,395.731.860 ELEV. 420.696
 - THIS PLAT IS BASED ON FIELD RUN NONMENTED BOUNDARY SURVEY PERFORMED ON OR ABOUT 3/12/2002 BY FISHER, COLLINS & CARTER, INC.
 - USE-IN-COMMON DRIVEWAYS SHALL BE PROVIDED PRIOR TO ISSUANCE OF A RESIDENTIAL OCCUPANCY PERMIT TO ENSURE SAFE ACCESS FOR FIRE AND EMERGENCY VEHICLES PER THE FOLLOWING MINIMUM REQUIREMENTS:
 A) WIDTH - 12 FEET OR FEET SEEWING MORE THAN ONE RESIDENCE;
 B) SURFACE - 5% TO 7% INCHES OF COMPACTED CRUSHER RUN BASE WITH TAR AND CHIP COATING. II - 1/2" MINIMUM;
 C) GEOMETRY - MAXIMUM 15% GRADE, MAXIMUM 1% GRADE CHANGE AND 15-FOOT TURNING RADIUS;
 D) STRUCTURES - CULVERTS/BRIDGES - CAPABLE OF SUPPORTING 25 GROSS TONS WES-LOADING;
 E) DRAINAGE ELEMENTS - CAPABLE OF SAFELY PASSING 100 YEAR FLOOD WITH NO MORE THAN ONE FOOT DEPTHS OVER SURFACE;
 F) STRUCTURE CLEARANCES - MINIMUM 12 FEET;
 G) MAINTENANCE - SUFFICIENT TO ENSURE ALL WEATHER USE.
 - THIS PLAN HAS BEEN PREPARED IN ACCORDANCE WITH THE PROVISIONS OF SECTION 162(a) OF THE HOWARD COUNTY CODE AND THE LANDSCAPE MANUAL. THE REQUIRED PERIMETER LANDSCAPING AND THE ASSOCIATED SURETY HAVE BEEN SATISFIED UNDER SDP-02-100 FOR LOT 1.
 - IN ACCORDANCE WITH SECTION 162(b) OF THE HOWARD COUNTY CODE AND FOREST CONSERVATION MANUAL, THE FOREST CONSERVATION OBLIGATIONS FOR LOTS 3 AND 4, THE RE-SUBDIVISION OF LOT 1 F-01-150, HAVE BEEN PROVIDED BY THE RETENTION CREDIT OF 50 ACRES OF EXISTING FOREST LOCATED ON LOT 4 AND THE RESIDENTIAL 60,000 SQUARE FEET LOT POLICY OF THE DEPARTMENT OF PLANNING AND ZONING DATED MAY 11, 1994.
 - NO TYPICAL WETLANDS OR OTHER SENSITIVE AREAS EXIST ON THIS SITE.
 - NO 100 YEAR FLOOD PLAIN OR STEEP SLOPES EXIST ON THIS SITE.
 - AMONG THE LAND RECORDS OF HOWARD COUNTY, L17000 F104.
 - STORMWATER MANAGEMENT IS PROVIDED UNDER F-01-150 FOR LOTS 1, 2 & 3 BY A SURFACE SAND FILTER ADJACENT TO THE USE-IN-COMMON DRIVEWAY. THIS FACILITY PROVIDES FOR THE REQUIRED WATER QUALITY VOLUME (WQV) AND GROUNDWATER RECHARGE VOLUME (GRV) AND SHALL BE PRIVATELY OWNED AND MAINTAINED.
 - ANY DAMAGE TO COUNTY RIGHTS-OF-WAY SHALL BE REPAIRED AT THE DEVELOPER'S EXPENSE.
 - IN ACCORDANCE WITH SECTION 129 OF THE HOWARD COUNTY ZONING REGULATIONS, BAY WINDOWS, CHIMNEYS OR EXTERIOR STAIRWAYS NOT MORE THAN 16 FEET IN WIDTH MAY PROJECT NOT MORE THAN 4 FEET INTO ANY SETBACK, PORCHES OR DECKS, OPEN OR ENCLOSED MAY PROJECT NOT MORE THAN 10 FEET INTO THE FRONT OR REAR YARD SETBACK.
 - THE DRIVEWAY ENTRANCE IS PER HOWARD COUNTY STANDARD DETAIL R-6.06.
 - THE CONTRACTOR SHALL NOTIFY THE CONSTRUCTION INSPECTION DIVISION (410-313-1800) AT LEAST 24 HOURS PRIOR TO THE START OF WORK.
 - THE CONTRACTOR SHALL NOTIFY "555 UTILITY" (1-800-257-7777) AT LEAST 48 HOURS PRIOR TO EXCAVATION WORK.
 - THIS PLAN IS SUBJECT TO THE APPROVED FIFTH EDITION OF THE SUBDIVISION AND LAND DEVELOPMENT REGULATIONS PER COUNCIL BILL 15-2003 AND THE ZONING REGULATIONS AS AMENDED BY COUNCIL BILL 75-2003. DEVELOPMENT OR CONSTRUCTION ON THESE LOTS MUST COMPLY WITH SETBACK AND BUFFER REGULATIONS IN EFFECT AT THE TIME OF SUBMISSION OF THE SITE DEVELOPMENT PLAN, WAIVER PETITION APPLICATION, OR BUILDING/GRADING PERMIT.
 - THE STAGING OF FOUNDATIONS PRIOR TO CONSTRUCTION TO ENSURE COMPLIANCE WITH REGULATORY BUILDING RESTRICTION IS RECOMMENDED.
 - FOR FLAG OR PIRESTON LOTS, REFUSE COLLECTION, SNOW REMOVAL AND ROAD MAINTENANCE ARE PROVIDED TO THE JUNCTION OF THE FLAG OR PIRESTON ROAD RIGHT-OF-WAY LINE AND NOT ONTO THE PIRESTON LOT DRIVEWAY.

MINIMUM LOT SIZE CHART

LOT NO.	GROSS AREA	FLAG OR PIPESTEM AREA	MINIMUM LOT SIZE
3	34,320 SQ.FT.*	5,081 SQ.FT.*	29,239 SQ.FT.*


SCHEDULE A - PERIMETER LANDSCAPE EDGE

PERIMETER	P-1	P-2	P-3	P-4
CATEGORY	ADJACENT TO ROADWAYS	ADJACENT TO PERIMETER PROPERTIES (ELLISION)	ADJACENT TO PERIMETER PROPERTIES (LOT 1)	ADJACENT TO PERIMETER PROPERTIES (DRIVEWAY)
LANDSCAPE TYPE	N/A	A	A	A
LINEAR FEET OF PERIMETER	12.67 L.F.	203.96 L.F.	124.96 L.F.	319.94 L.F.
CREDIT FOR EXISTING VEGETATION (NO, YES AND ID)	NO	YES 203.96 L.F.	YES 124.96 L.F.	NO
CREDIT FOR WALL, FENCE OR BERM (NO, YES, AND ID)	NO	NO	NO	NO
NUMBER OF TREES REQUIRED	N/A	0	0	6
SHADE TREES	FRONTS PUBLIC ROAD	0	0	0
EVERGREEN TREES		0	0	0
NUMBER OF TREES PROVIDED		0	0	*6
SHADE TREES		0	0	0
EVERGREEN TREES		0	0	0

*EXISTING LANDSCAPING PROVIDED UNDER SDP-02-100 FOR LOT 1. SURETY WAS POSTED WITH THE BUILDER'S GRADING PERMIT UNDER SDP-02-100 FOR LOT 1.


LANDSCAPE NOTES:

- THE OWNER, TENANT AND/OR THEIR AGENTS FOR LOT 3 SHALL BE RESPONSIBLE FOR MAINTENANCE OF THE REQUIRED LANDSCAPING, PLANT MATERIALS, BERMS, FENCES AND WALLS FOR WHICH CREDIT IS BEING TAKEN AND AS PROVIDED UNDER SDP-02-100 FOR LOT 1. ALL PLANT MATERIALS SHALL BE MAINTAINED IN GOOD GROWING CONDITION AND WHEN NECESSARY, REPLACED WITH NEW MATERIALS TO ENSURE CONTINUED COMPLIANCE WITH APPLICABLE REGULATIONS. ALL REQUIRED LANDSCAPING SHALL BE PERMANENTLY MAINTAINED IN GOOD CONDITION AND WHEN NECESSARY, REPAIRED OR REPLACED.
- "NO CLEANSING OF EXISTING VEGETATION IS PERMITTED WITHIN THE LANDSCAPE EDGE FOR WHICH CREDIT IS BEING TAKEN, HOWEVER, LANDSCAPE MAINTENANCE IS AUTHORIZED."

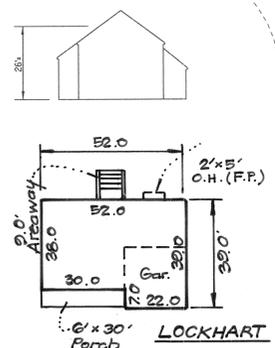

LEGEND

SYMBOL	DESCRIPTION
---	EXISTING CONTOUR 2' INTERVAL
+362.2	SPOT ELEVATION
TP 102	PERC HOLES
---	EXISTING TREE LINE
LOD	LIMIT OF DISTURBANCE
SF/TP	SILT FENCE/TREE PROTECTION
---	SUPER SILT FENCE
---	SEPTIC EASEMENT
---	PERIMETER LANDSCAPE TREES PER F-02-100 PROVIDED UNDER SDP-02-100
---	EXISTING TREES

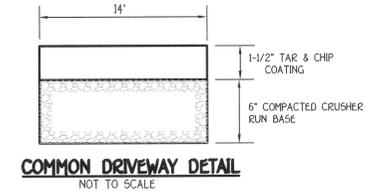

INDEX SHEET

SHEET NO.	DESCRIPTION
1	SITE DEVELOPMENT & SEDIMENT/EROSION CONTROL PLAN
2	NOTES & DETAILS

ADDRESS CHART

LOT NUMBER	STREET ADDRESS
3	8417 OLD FREDERICK ROAD

APPROVED FOR PUBLIC WATER AND PRIVATE SEWERAGE SYSTEMS,
 HOWARD COUNTY HEALTH DEPARTMENT.
 Robert J. Walker
 COUNTY HEALTH OFFICER
 10/4/05
 DATE

FISHER, COLLINS & CARTER, INC.
 CIVIL ENGINEERING CONSULTANTS & LAND SURVEYORS
 CENTRAL SQUARE OFFICE PARK - 10272 BALTIMORE NATIONAL PIKE
 ELLICOTT CITY, MARYLAND 21042
 410.416.2955

Revise house model from Armistead II to Lockhart II
 10.25.05

ENGINEER'S CERTIFICATE
 I certify that this plan for erosion and sediment control represents a practical and workable plan based on my personal knowledge of the site conditions and that it was prepared in accordance with the requirements of the Howard Soil Conservation District.
 Signature of Engineer: Earl D. Collins
 Date: 8/22/05

BUILDER/DEVELOPER'S CERTIFICATE
 I/We certify that all development and construction will be done according to this plan for sediment and erosion control and that any responsible personnel involved in the construction project will have a Certificate of Attendance of a Department of the Environment Approved Training Program for the Control of Sediment and Erosion before beginning the project. I also authorize periodic on-site inspection by the Howard Soil Conservation District.
 Signature of Developer: Mark Kovach
 Date: 8/22/05

Reviewed for HOWARD SCD and meets Technical Requirements.
 Jim Meyer
 Land/A-Natural Resources Conservation Service
 Date: 8-29-05

This development plan is approved for soil erosion and sediment control by the HOWARD SOIL CONSERVATION DISTRICT.
 John R. Robertson
 Howard SCD
 Date: 8-29-05

OWNER/DEVELOPER/BUILDER
 MARK KOVACH
 9527 OLD FREDERICK ROAD
 ELLICOTT CITY, MARYLAND 21043
 410-313-3366

APPROVED: HOWARD COUNTY DEPARTMENT OF PLANNING AND ZONING
 Chief, Division of Land Development: 10/4/05
 Chief, Development Engineering Division: 9/21/05
 Director - Department of Planning and Zoning: 10/14/05

PROJECT: THE WOODS AT PATAPSCO RIM SECTION: N/A LOT NO.: 3

PLAT: #17746 BLOCK NO.: 7 ZONE: R-20 TAX/ZONE: 10 ELEC. DIST.: SECOND CENSUS TR.: 6121.00

WATER CODE: F01 SEWER CODE: PRIVATE

PERC CERTIFICATION, SITE DEVELOPMENT, SEDIMENT/EROSION CONTROL PLAN

THE WOODS AT PATAPSCO RIM
 LOT 3

TAX MAP NO.: 1B PARCEL NO.: 349
 SECOND ELECTION DISTRICT, HOWARD COUNTY, MARYLAND
 SCALE: 1" = 30' DATE: FEBRUARY, 2005

SHEET 1 OF 2

SDP 05-142