



GENERAL NOTES

- ALL ASPECTS OF THE PROJECT ARE IN CONFORMANCE WITH THE LATEST HOWARD COUNTY STANDARDS UNLESS OTHERWISE SHOWN BY WAIVERS INDICATED.
- PROJECT BACKGROUND:
 LOCATION: TAX MAP 16 - P/O PARCEL 8- GRID 16 & 17; POD I per S-86-13; (PB 368)
 (4th AMENDED) PARCEL Q per F-02-82
 PGCC MULTI-USE SUBDISTRICT
 ZONING: THIRD
 ELECTION DISTRICT: S-86-13 (PB 181); 1st AMENDED S-86-13 (PB 294); 2nd AMENDED S-86-13 (PB 300); 3rd AMENDED S-86-13 (PB 351); 4th AMENDED S-86-13 (PB 368); PLAT #3054-A-1434; PLAT #3054-A1510/1511; F-04-06; SDP-95-12; S-94-45; SP-95-14; F-96-107; F-96-150; F-96-151; SP-97-12; F-02-74; F-02-82; S-04-12
 LIBER 11747, FOLIO 106
 DEED REFERENCE:
 AREA OF TRACT: 6.07 ACRES
 LIMIT OF SUBMISSION: 15 % OF 6.07 ACRES = 0.91 ACRES
 OPEN SPACE REQUIRED: 23.22 ACRES (PARCELS W, X & Y) PER F-02-82
 OPEN SPACE PROVIDED: NONE
 RIGHT OF WAY DEDICATION: NONE
 PROPOSED USES FOR SITE AND STRUCTURES: 11 NURSING HOME BEDS (37,250 SF)
 100 ASSISTED LIVING UNITS WHICH EQUATES TO 25 NON-RESIDENTIAL UNITS (4 ASSISTED LIVING UNITS=1 NON-RESIDENTIAL UNIT)
 AREA OF ASSISTED LIVING COMPONENT=75,139 SF.
 5.99 ACRES
 LIMIT OF DISTURBED AREA: 5.99 ACRES
- ALL CONSTRUCTION SHALL BE IN ACCORDANCE WITH THE LATEST STANDARDS AND SPECIFICATIONS OF HOWARD COUNTY PLUS MSHA STANDARDS AND SPECIFICATIONS IF APPLICABLE.
- THE CONTRACTOR SHALL NOTIFY THE DEPARTMENT OF PUBLIC WORKS/BUREAU OF ENGINEERING/CONSTRUCTION INSPECTION DIVISION AT (410) 313-1880 AT LEAST FIVE (5) WORKING DAYS PRIOR TO THE START OF WORK.
- THE CONTRACTOR SHALL NOTIFY "MISS UTILITY" AT 1-800-257-7777 AT LEAST 48 HOURS PRIOR TO ANY EXCAVATION WORK BEING DONE.
- CONTRACTOR TO VERIFY ELEVATIONS IN FIELD BEFORE BEGINNING ANY CONSTRUCTION.
- TRAFFIC CONTROL DEVICES, MARKINGS AND SIGNING SHALL BE IN ACCORDANCE WITH THE LATEST EDITION OF THE MANUAL OF UNIFORM TRAFFIC CONTROL DEVICES (MUTCD). ALL STREET AND REGULATORY SIGNS SHALL BE IN PLACE PRIOR TO THE PLACEMENT OF ANY ASPHALT.
- ALL PLAN DIMENSIONS ARE TO FACE OF CURB UNLESS OTHERWISE NOTED.
- BRL DEMONSTRATES BUILDING RESTRICTION LINE.
- THERE ARE NO FLOODPLAINS ON SITE. FLOODPLAIN STUDY IS ON FILE WITH THE COUNTY UNDER F-02-74, WHICH HAS BEEN APPROVED BY THE COUNTY.
- THERE ARE NO WETLANDS ON SITE. COMPLETE WETLAND REPORT IS ON FILE WITH THE COUNTY UNDER PLAT ENTITLED OAKMONT AT TURF VALLEY (DPZ FILE NUMBER F-02-082 AND PLAT NUMBERS 18773-18775) WHICH HAS BEEN APPROVED BY THE COUNTY.
- TOPOGRAPHIC INFORMATION IS BASED ON FIELD RUN SURVEY BY HILDENBERG, BOENDER AND ASSOCIATES, INC. ON OR ABOUT MARCH 2006. AND PER MASS GRADING PERFORMED UNDER SDP-07-088. VERTICAL DATUM IS NAD'83.
- COORDINATES BASED ON NAD'83 MARYLAND COORDINATE SYSTEM AS PROJECTED BY HOWARD COUNTY GEODETIC CONTROL STATIONS NO: 16 E1 & 16 IA
 STA. No. 16 E1 N 593,250.960 EL. 463.981
 E 1,340,192.70
 STA. No. 16 IA N 598,509.366 EL. 463.085
 E 1,346,343.63
- POD BOUNDARY INFORMATION IS BASED ON 2nd AMENDED FINAL DEVELOPMENT PLAN FOR TURF VALLEY, PGCC DISTRICT, MULTI-USE SUBDISTRICT.
- PROPERTY IS LOCATED WITHIN THE METROPOLITAN DISTRICT PER COUNTY COUNCIL BILL NO.17-2007 EFFECTIVE JULY 10, 2007. PUBLIC SEWER IS AVAILABLE FROM THE WAVERLY SEWER INTERCEPTOR (#24-3447). PROJECT WILL BE SERVICED THROUGH #44-3480. SUBJECT TO APPROVAL OF WATER EXTENSION PLANS BY THE DEPARTMENT OF PUBLIC WORKS.
- STORMWATER MANAGEMENT HAS BEEN PROVIDED IN ACCORDANCE WITH 2000 MDE STORMWATER DESIGN MANUAL AND HOWARD COUNTY DESIGN MANUAL VOL. 1. STORMWATER MANAGEMENT IS MANAGED BY AN UNDERGROUND (80%) EXTENDED DETENTION FACILITY TO PROVIDE CPV AND UNDERGROUND WATER QUALITY TREATMENT FACILITY (STORMVAULT) TO PROVIDE WQV & Rev FOR DRAINAGE AREA 1; AND AN UNDERGROUND WATER QUALITY TREATMENT FACILITY (STORMFILTER) TO PROVIDE WQV FOR DRAINAGE AREA 2. THE FACILITIES WILL BE PRIVATELY OWNED AND MAINTAINED. CPV IS NOT REQUIRED TO BE TREATED FOR DRAINAGE AREA #2. AS 1-YEAR PEAK DISCHARGE IS LESS THAN 2 cfs. ALL FACILITIES WILL BE PRIVATELY OWNED AND MAINTAINED.
- STORMWATER MANAGEMENT HAS BEEN PROVIDED FOR PROPOSED ADDITION USING 2 MICRO-BIORETENTION FACILITIES AND PERMEABLE PAVEMENT.
- NO CEMETERIES OR HISTORIC STRUCTURES EXIST ON SITE.
- THE ORIGINAL TRAFFIC STUDY WAS PREPARED BY THE TRAFFIC GROUP DATED 31/3/1986. AN UPDATED TRAFFIC STUDY WAS PREPARED BY THE TRAFFIC GROUP DATED 1/7/05 AND WAS APPROVED BY THE PLANNING BOARD ON 4/27/06. RESORT ROAD IN THIS AREA WILL BE BUILT UNDER F-02-74. SUPPLEMENTED APPD STUDY APPROVAL DATE 6/26/07.
- THIS PROJECT IS EXEMPT FROM HOWARD COUNTY FOREST CONSERVATION REQUIREMENTS UNDER SECTION 16.1202(b)(iv) OF THE COUNTY CODE BECAUSE IT IS A PLANNED UNIT DEVELOPMENT WHICH HAS PRELIMINARY DEVELOPMENT PLAN APPROVAL AND 50% OR MORE OF THE LAND IS RECORDED AND SUBSTANTIALLY DEVELOPED BEFORE DECEMBER 31, 1992.
- BULK REGULATIONS:
 PERMITTED USES: ALL USES AS PER 2nd AMENDED FINAL DEVELOPMENT PLAN FOR TURF VALLEY PGCC DISTRICT, MULTI-USE SUBDISTRICT. PROPOSED USE: NURSING HOME AND ASSISTED LIVING FACILITY.
 PERMITTED SETBACKS:
 FROM ARTERIAL ROADS (MARRIOTTVILLE ROAD)
 NON-RESIDENTIAL STRUCTURES - 30 FEET
 PARKING - 25 FEET
 FROM COLLECTORS AND LOCAL STREETS (RESORT ROAD)
 NON-RESIDENTIAL STRUCTURES - 30 FEET FROM 60 FT. ROW
 20 FEET FROM 50 FT. ROW
 FROM NON-PGCC ADJACENT PROPERTIES
 FROM RESIDENTIAL DISTRICTS - 75 FEET
 FROM ALL OTHER DISTRICTS - 30 FEET
 FROM LOT LINES WITHIN PGCC MULTI-USE DISTRICT
 SINGLE FAMILY DETACHED (SIDE) - 7.5 FEET
 ZERO LOT LINE & ALL OTHER USES (SIDE, - 0 FEET
 A MINIMUM OF 10 FT. MUST BE PROVIDED BTW. STRUCTURES
 RESIDENTIAL (REAR) - 20 FEET

TURF VALLEY, LORIE

NURSING HOME AND ASSISTED LIVING FACILITY

HOWARD COUNTY, MARYLAND

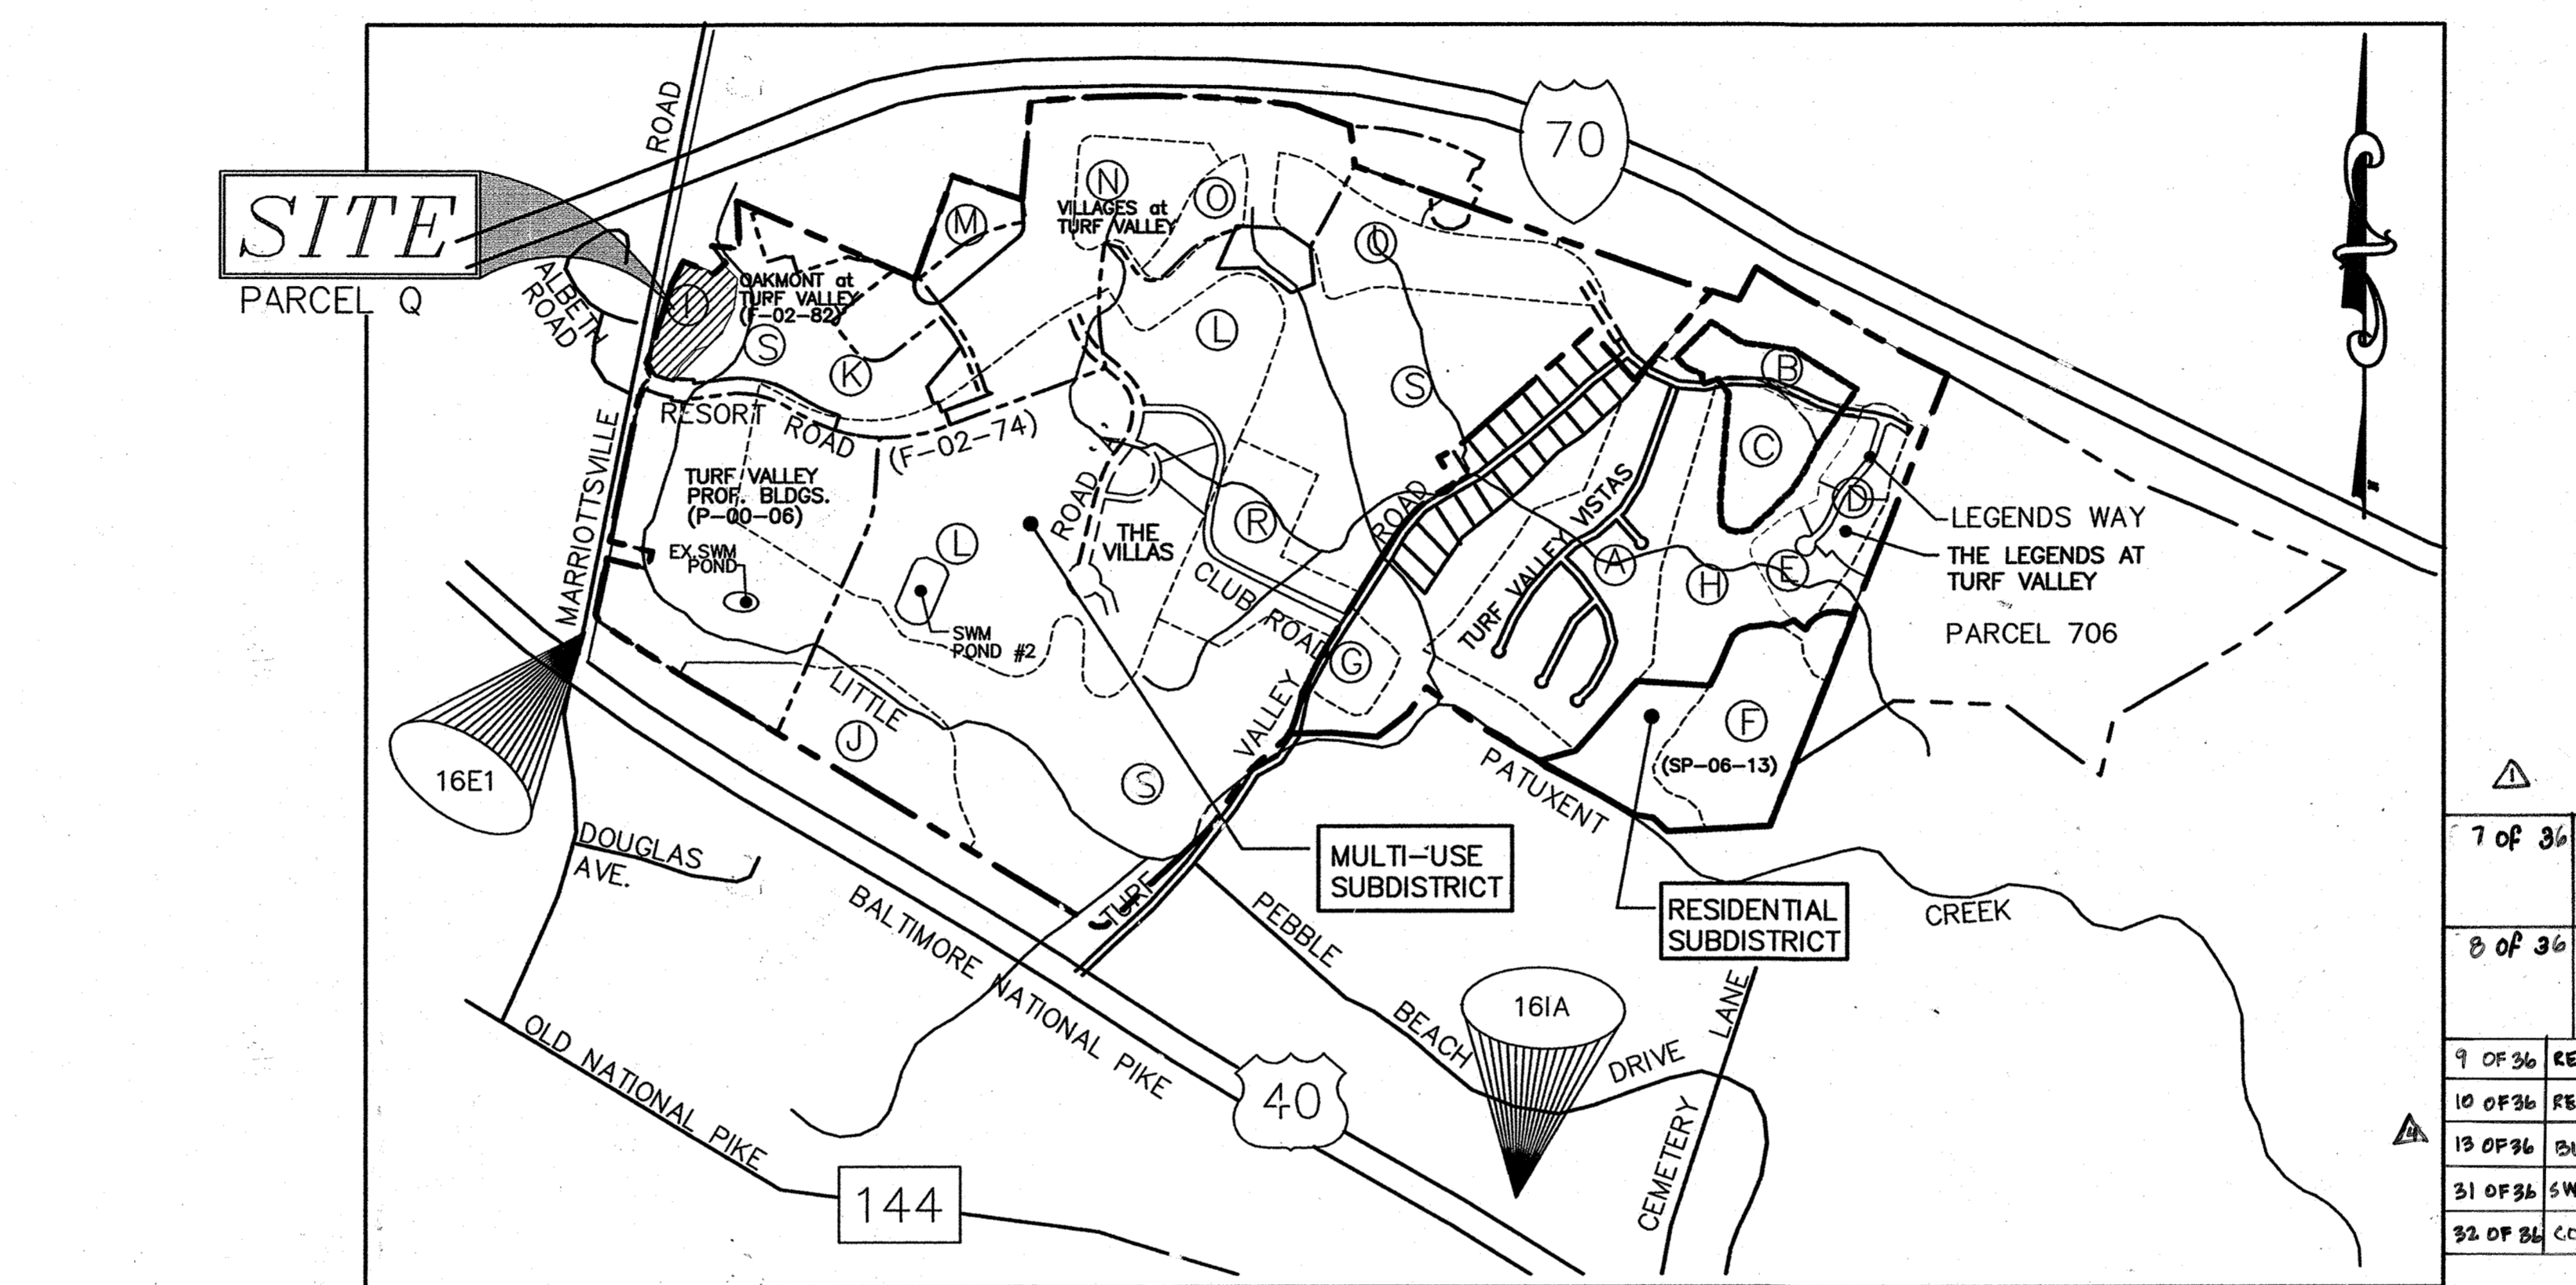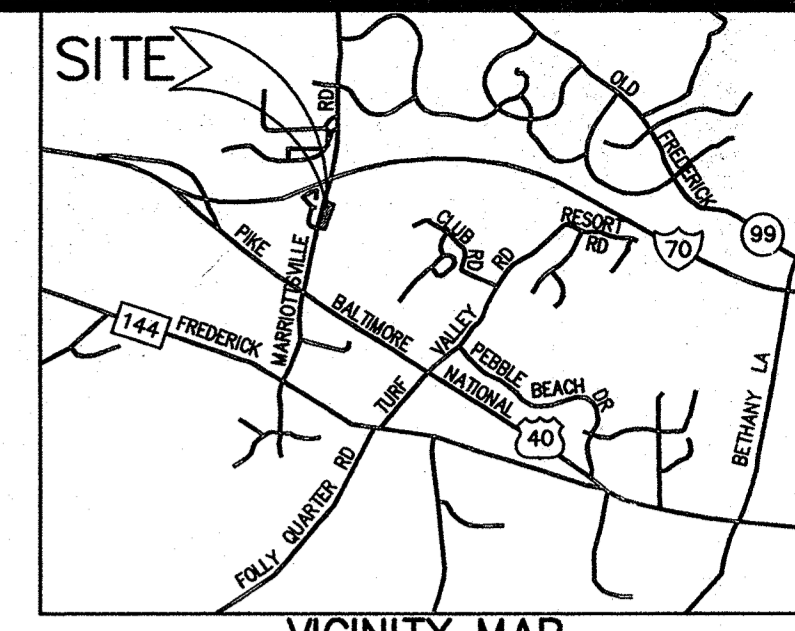


USES FOR TURF VALLEY PARCEL Q (POD I) SITE
 AREA PROJECTED LAND USE
 POD I ALL PERMITTED USES IN THE PGCC MULTI-USE SUBDISTRICT PER 2ND AMENDED FDP

LOCATION MAP
 SCALE: 1" = 1000'
 ADC MAP NO. 11, GRID A3

SHEET INDEX	
SHEET NO.	TITLE
1 OF 36	COVER SHEET
2 OF 36	SITE PLAN
3 OF 36	GRADING & STORMWATER MANAGEMENT PLAN
4 OF 36	SITE DETAILS
5 OF 36	RETAINING WALLS 1&2 - PLANS, SECTIONS & DETAILS
6 OF 36	RETAINING WALLS 1&2 - ELEVATIONS
11 OF 36	SEGMENTAL BLOCK RETAINING WALL PLAN
12 OF 36	BUILDING ELEVATIONS
19 OF 36	OUTDOOR LIGHTING PLAN
15 OF 36	SEWER PROFILES
16 OF 36	STORM DRAIN DRAINAGE AREA MAP
17 OF 36	STORM DRAIN PROFILES
18 OF 36	BORING LOGS
19 OF 36	SWM FACILITY #1- LOCATION PLAN & GENERAL NOTES
20 OF 36	STORM VAULT PLAN & SECTION
21 OF 36	STORM VAULT FOUNDATION PLAN & DETAILS
22 OF 36	STORM VAULT DETAILS
23 OF 36	CMV/STORM PLAN- SECTION & DETAILS
23 OF 36	CMV/STORM SECTIONS & DETAILS
24 OF 36	STORMVAULT INSTALLATION SPECIFICATIONS
25 OF 36	SWMF #1 BACKFILL PLAN
26 OF 36	SWM CONSTRUCTION DETAILS - I
27 OF 36	STORM FILTER LAYOUT PLAN & NOTES
28 OF 36	SWM CONSTRUCTION DETAILS - II
29 OF 36	MD-378 CONSTRUCTION SPECIFICATION & OPERATION & MAINTENANCE SCHEDULE - I
30 OF 36	OPERATION & MAINTENANCE SCHEDULE - II
33 OF 36	SEDIMENT AND EROSION CONTROL PLAN
34 OF 36	SEDIMENT AND EROSION CONTROL NOTES & DETAILS
35 OF 36	LANDSCAPE PLAN
36 OF 36	LANDSCAPE NOTES & DETAILS

- PER SECTION 16.116(c)(1) OF THE HOWARD COUNTY SUBDIVISION AND LAND DEVELOPMENT REGULATIONS, CLEARING, GRADING, OR CONSTRUCTION HAS BEEN DETERMINED TO BE NECESSARY AND IS PERMITTED WITHIN THE STREAM BUFFER FOR THE PURPOSE OF CONSTRUCTION OF ACCESS DRIVEWAY TO THE SITE.
- THE TYPE OF STREET LIGHT TO BE USED ARE 250 WATT HPS VAPOR FIXTURE MOUNTED ON A 30-FOOT BRONZE FIBERGLASS POLE USING A 12-FOOT ARM.
- LANDSCAPING HAS BEEN PROVIDED IN ACCORDANCE WITH THE PROVISIONS OF SECTION 16.124 OF THE HOWARD COUNTY CODE AND THE LANDSCAPE MANUAL. FINANCIAL SURETY FOR THE REQUIRED LANDSCAPING HAS BEEN POSTED AS PART OF THE DEVELOPER'S AGREEMENT FOR 34 SHADE TREES, 30 EVERGREEN TREES AND 114 SHRUBS IN THE AMOUNT OF \$18,120.
- THIS PROJECT IS SUBJECT TO THE AMENDED FIFTH EDITION SUBDIVISION AND LAND DEVELOPMENT REGULATIONS EFFECTIVE OCTOBER 2, 2003 AND TO THE ZONING REGULATIONS EFFECTIVE APRIL 13, 2004 PER SECTION 126(h)(1).
- NO COVERAGE REQUIREMENT IS IMPOSED UPON NON-RESIDENTIAL USES, EXCEPT IN ACCORDANCE WITH A SITE DEVELOPMENT PLAN APPROVED BY THE HOWARD COUNTY PLANNING BOARD.
- THE EXISTING WELL AND SEPTIC AREA SHALL BE PROPERLY ABANDONED AS PER STATE REGULATIONS PRIOR TO SDP APPROVAL.
- STREET LIGHT PLACEMENT AND THE TYPE OF FIXTURE AND POLE SHALL BE IN ACCORDANCE WITH THE HOWARD COUNTY DESIGN MANUAL, VOLUME III (1993) AND AS MODIFIED BY "GUIDELINES FOR STREET LIGHT RESIDENTIAL DEVELOPMENTS" (JUNE 1993). A MINIMUM SPACING OF 20' SHALL BE MAINTAINED BETWEEN ANY STREETLIGHT AND ANY TREE.
- ALL SIGN POSTS USED FOR TRAFFIC CONTROL SIGNS INSTALLED IN THE COUNTY RIGHT-OF-WAY SHALL BE MOUNTED ON A 2" GALVANIZED STEEL PERFORATED, SQUARE TUBE POST (14 GAUGE) INSERTED INTO A 2-1/2" GALVANIZED STEEL PERFORATED, SQUARE TUBE SLEEVE (12 GAUGE) - 3' LONG. A GALVANIZED STEEL POLE CAP SHALL BE MOUNTED ON TOP OF EACH POST.
- THE SUBJECT PROPERTY IS ZONED PGCC PER THE 2/2/04 COMPREHENSIVE ZONING PLAN AND PER THE "COMP LITE" ZONING REGULATION AMENDMENTS EFFECTIVE 7/28/06.
- THE 65 dBA NOISE CONTOUR LINE DRAWN ON THIS DEVELOPMENT PLAN IS ADVISORY AS REQUIRED BY THE HOWARD COUNTY DESIGN MANUAL, CHAPTER 5, REVISED FEBRUARY, 1992 AND CANNOT BE CONSIDERED TO EXACTLY LOCATE THE 65 dBA NOISE EXPOSURE. THE 65 dBA NOISE LINE WAS ESTABLISHED BY HOWARD COUNTY TO ALERT DEVELOPERS, BUILDERS AND FUTURE RESIDENTS THAT AREAS BEYOND THIS THRESHOLD MAY EXCEED GENERALLY ACCEPTED NOISE LEVELS ESTABLISHED BY THE U.S. DEPARTMENT OF HOUSING AND URBAN DEVELOPMENT.
- NO GRADING, REMOVAL OF VEGETATIVE COVER OR TREES, PAVING & NEW STRUCTURES SHALL BE PERMITTED WITHIN THE REQUIRED WETLANDS, STREAM OR THEIR BUFFERS, FOREST CONSERVATION EASEMENT AREAS AND 100-YEAR FLOODPLAIN.
- THE CLEARANCE UNDER THE ENTRANCE CANOPY SHALL BE LESS THAN 13'-6" FOR FIRE DEPARTMENT ACCESS.
- THE NOISE STUDY FOR THIS PROJECT WAS PREPARED BY POLYSYNCS CORP. DATED JUNE 20, 2007, AND WAS APPROVED ON SEPTEMBER 19, 2007.
- PRIOR TO GRADING PERMIT APPLICATION, THE PROJECT SHALL COMPLY WITH THE REQUIREMENTS OF HOWARD COUNTY COUNCIL BILL 60-2007.
- INDIVIDUAL ASSISTED LIVING UNITS WILL NOT BE EQUIPPED WITH FULL KITCHEN FACILITIES.
- ON SEPTEMBER 1, 2010, THE HOWARD COUNTY PLANNING BOARD APPROVED THE PETITIONER'S REQUEST TO ADJUST THE STRUCTURE SETBACKS, REDUCING IT FROM 30 TO 10 FEET, TO ALLOW CONSTRUCTION OF A RETAINING WALL, SIDEWALK AND BUILDING ADDITION IN ACCORDANCE WITH SECTION 126-C.4.2 OF THE HOWARD COUNTY ZONING REGULATIONS.

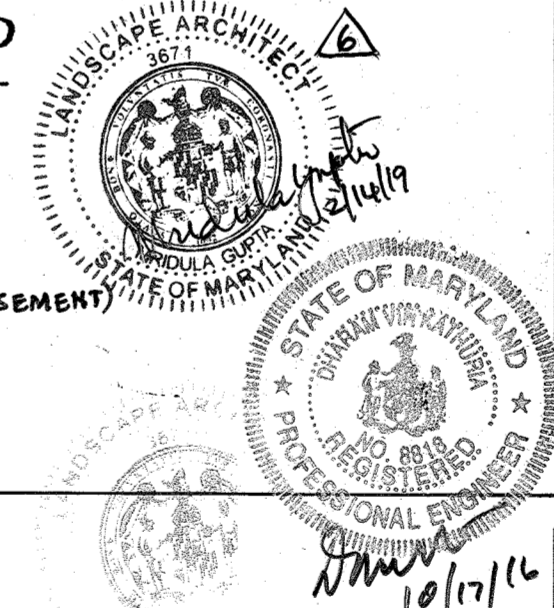

AS-BUILT CERTIFICATION

I hereby certify that the facility shown on this plan was constructed as shown on the "as-built" plans and meets the approved plans and specifications.

[Signature]
 Signature
 PEN: 8818
 Date: 04/30/2008

Certification means to state or declare professional opinion based on site inspection and accordance with the described and requirements mentioned within USBC, HES, standards and specifications for final (MD-378). The pond construction and any trees, successors, or assigns shall be responsible for the safety of the pond and the continued operation, surveillance, inspection, and maintenance thereof. The pond owner(s) shall promptly notify the Soil Conservation District of any unusual observations that may be indication of distress such as excessive seepage, turbid seepage, sliding or slumping.

OPERATION, MAINTENANCE AND INSPECTION

Inspection of the pond(s) shall be performed at least annually in accordance with the described and requirements mentioned within USBC, HES, standards and specifications for final (MD-378). The pond construction and any trees, successors, or assigns shall be responsible for the safety of the pond and the continued operation, surveillance, inspection, and maintenance thereof. The pond owner(s) shall promptly notify the Soil Conservation District of any unusual observations that may be indication of distress such as excessive seepage, turbid seepage, sliding or slumping.

AS-BUILT CERTIFICATION

OWNER

THERE IS NO "AS-BUILT" INFORMATION PROVIDED ON THIS SHEET

[Signature]
 MICHAEL D. ADCOCK, PROFESSIONAL AND SURVEYOR
 MD REG. NO. 21257, EXPIRATION DATE 04-16-21
 Date: 01/23/19

APPROVED
 PLANNING BOARD
 OF HOWARD COUNTY
 DATE 3/27/08

[Signature]
 Date: 3/27/08

APPROVED
 DEPARTMENT OF PLANNING AND ZONING

[Signature]
 Chief, Development Engineering Division
 Date: 4/25/08

[Signature]
 Chief, Division of Land Development
 Date: 4/30/08

KCE ENGINEERING, INC.
 EXECUTIVE CENTER
 3300 NORTH RIDGE ROAD, SUITE 315
 ELLICOTT CITY, MARYLAND 21043
 PHONE (410) 203-9800 FAX (410) 203-9228

Professional Certification, I hereby certify that these documents were prepared or approved by me, and that I am a duly licensed professional engineer under the laws of the State of Maryland, License No. 8818, expiration Date: 10/17/08.


DRAWN BY: MG
 CHECKED BY: DVS
 SCALE: AS SHOWN
 DATE: 04/30/2008

SHEET:
 1
 OF
 36

CURVE TABLE					
NO.	ARC LENGTH	CHORD LENGTH	CHORD BEARING	RADIUS	DELTA
C1	125.84'	125.61'	N 74°03'14" W	610.00'	11°49'11"

PROPERTY LINE TABLE		
NO.	LENGTH	BEARING
L1	74.34'	S 42°06'44" E
L2	58.40'	S 46°20'11" E
L3	39.62'	S 11°12'36" W
L4	53.61'	S 07°27'29" E
L5	135.80'	S 12°13'13" W
L6	62.18'	S 23°40'13" W
L7	86.37'	S 33°48'39" W
L8	109.12'	S 48°26'32" W
L9	88.27'	S 71°24'49" W
L10	65.27'	S 45°07'07" W
L11	38.60'	S 25°41'33" W
L12	43.15'	S 54°25'44" W
L13	44.38'	S 21°31'21" W
L14	48.85'	S 29°05'01" W
L15	15.00'	S 10°02'11" W
L16	52.43'	N 33°33'29" W
L17	47.38'	N 33°30'48" W

COORDINATE TABLE		
NO.	NORTHING	EASTING
668	595704.5297	1340842.4238
669	595031.8285	1340601.5238

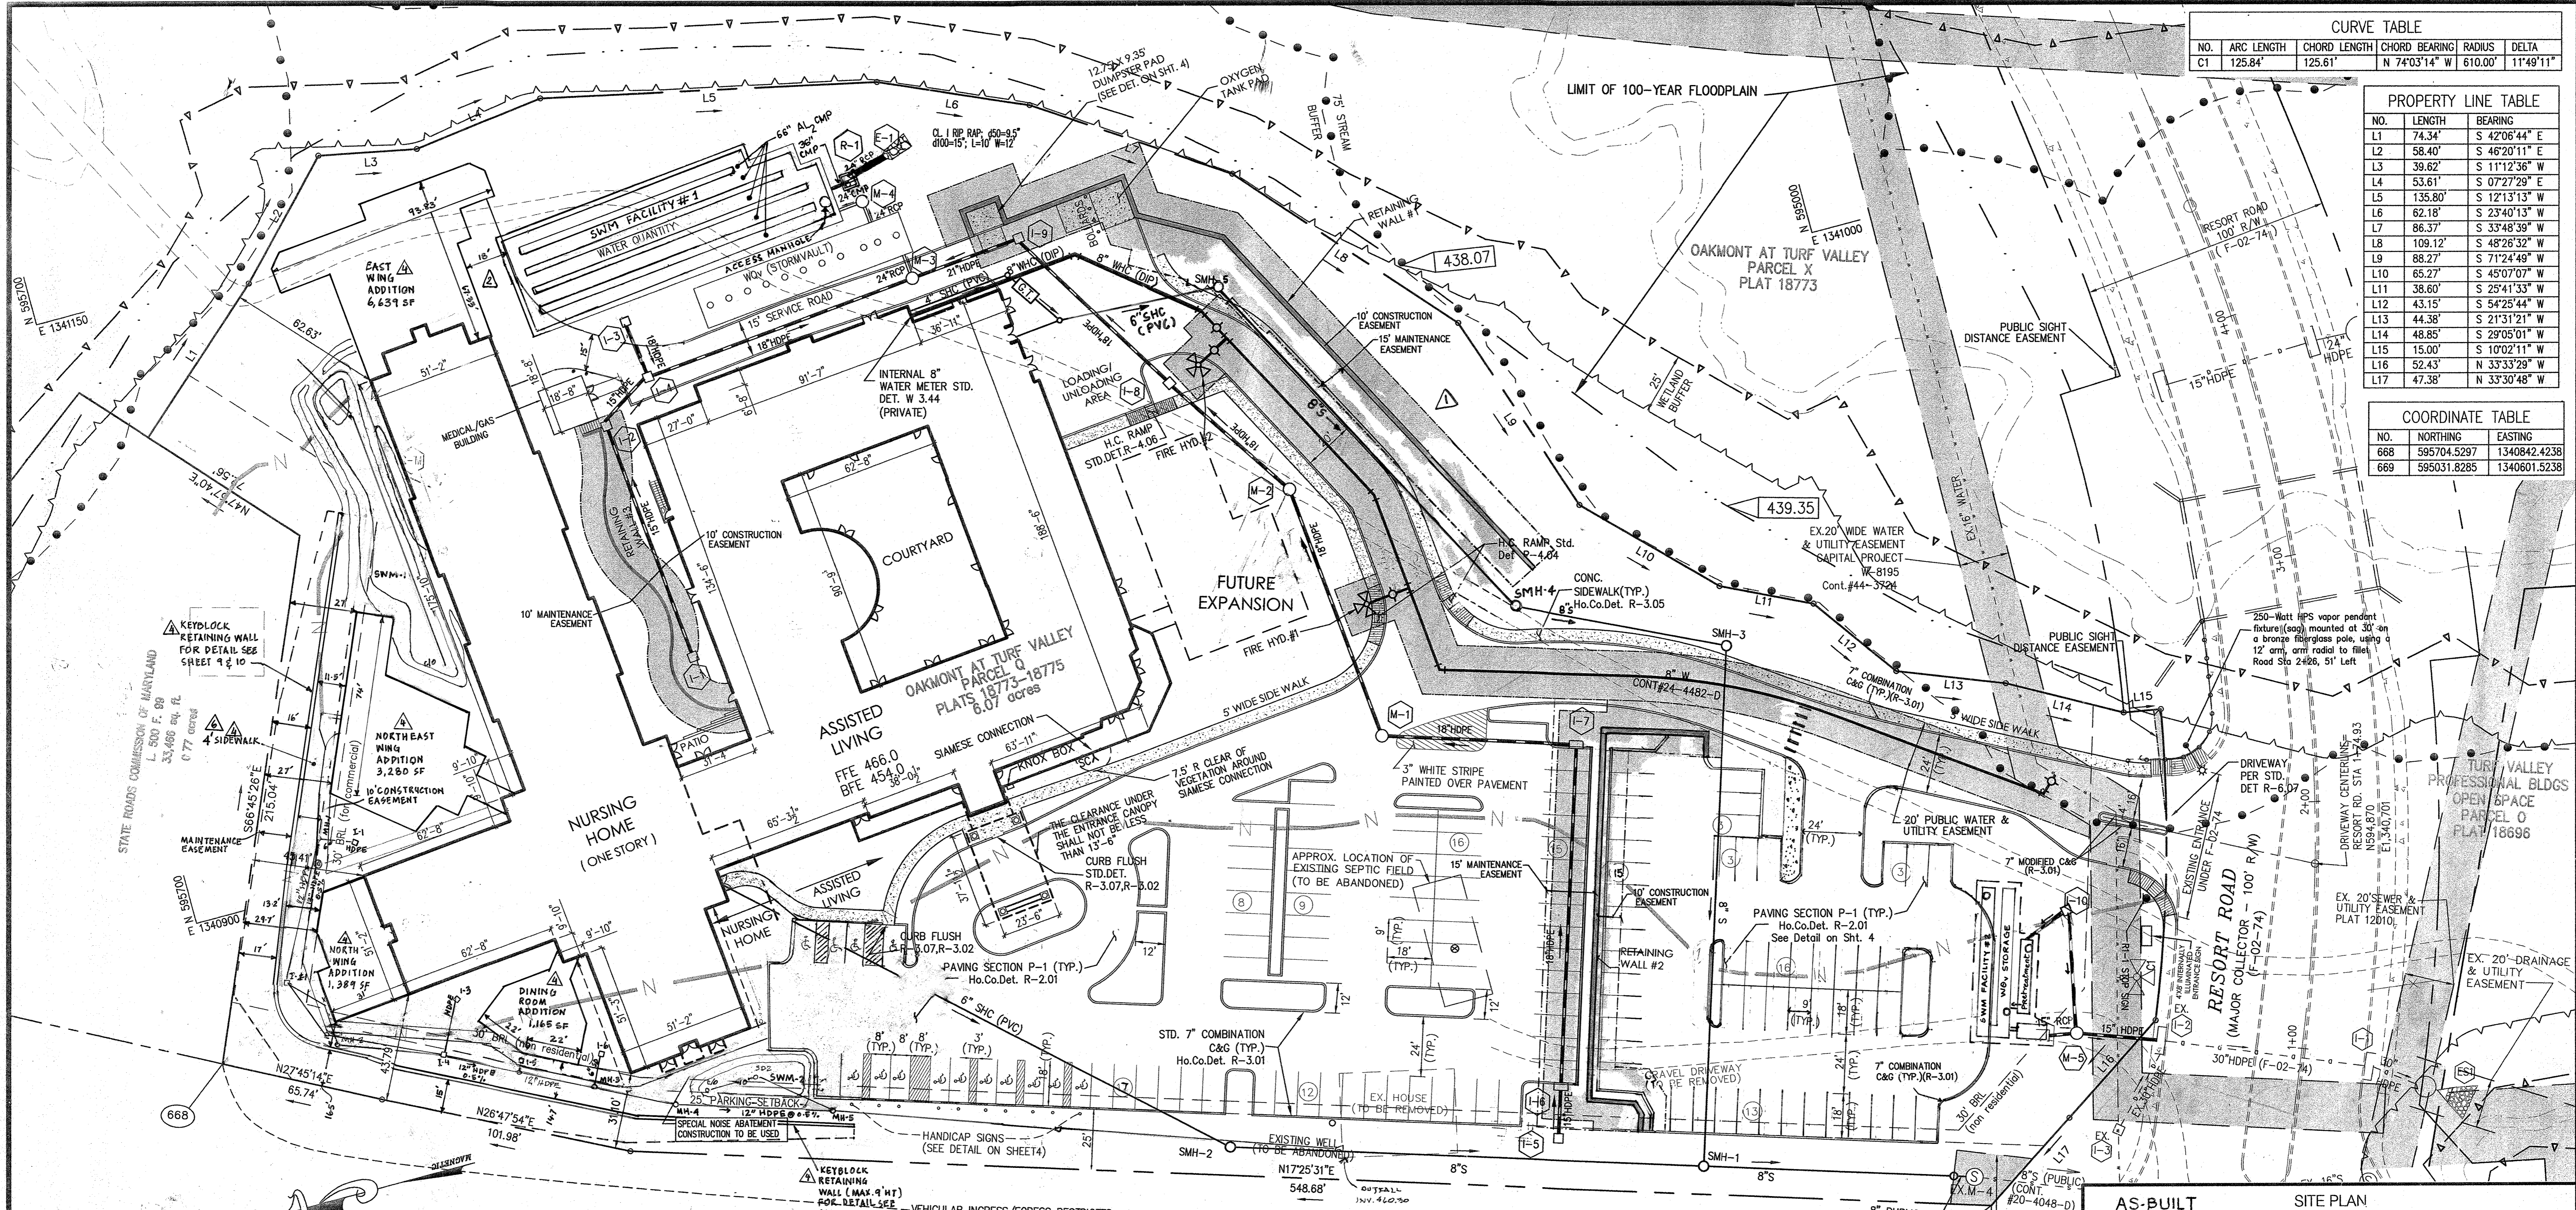

NO.	BY	DATE	REVISION
1	KCE	07/16/08	REVISE RETAINING WALLS #1 & #2 TO BE SEGMENTAL BLOCK WALLS, MODIFY SWM # 2, REALIGN PRIVATE SEWER.
2	KCE	09/02/08	REVISED SWM FACILITY #1
3	KCE	03/01/10	SWM AS BUILT INFORMATION ADDED
4	KCE	10/13/10	ADDITION OF BUILDING, SWM FACILITY, RETAINING WALL, SERVICE LANE
5	JJT	04/11/13	REVISED SWM FACILITY #2, STREAM POND, GROUNDING, CURBS, & PARKING
6	KCE	2/18/19	DELETE PERMEABLE CONCRETE SIDEWALK

MARRIOTTVILLE ROAD

EX. INTERMEDIATE ARTERIAL (ULTIMATE 120' ROW)

APPROVED
PLANNING BOARD
OF HOWARD COUNTY
DATE 3/27/08

APPROVED: DEPARTMENT OF PLANNING AND ZONING
Chief, Development Engineering Division
Chief, Division of Land Development
Director

AS-BUILT CERTIFICATION
I HEREBY CERTIFY BY MY SEAL THAT THE CONDITIONS SHOWN ON THIS PLAN WERE CONSTRUCTED TO THE LINES AND GRADE SHOWN ON THIS 'AS-BUILT' PLAN AND MEET THE APPROVED PLANS AND SPECIFICATIONS AND ALSO THAT THESE DOCUMENTS WERE PREPARED BY ME OR UNDER MY RESPONSIBLE CHARGE AND THAT I AM A DULY LICENSED PROFESSIONAL LAND SURVEYOR UNDER THE LAWS OF THE STATE OF MARYLAND.
MICHAEL D. ADCOCK, PROFESSIONAL LAND SURVEYOR
MD REG. NO. 21257, EXPIRATION DATE 06/30/21

PROFESSIONAL CERTIFICATION: I HEREBY CERTIFY THAT THESE DOCUMENTS WERE PREPARED OR APPROVED BY ME, AND THAT I AM A DULY LICENSED PROFESSIONAL LAND SURVEYOR, UNDER THE LAWS OF THE STATE OF MARYLAND, REG. NO. 21257, EXPIRATION DATE 6-16-2019.


OWNER
LORIEN AT TURF VALLEY, LLC
1205 YORK ROAD, PENTHOUSE
LUTHERVILLE, MARYLAND 21093
PHONE (410) 825-8400

LEGEND	
SC	SIAMSESE CONNECTION
N	MITIGATED 65 dBA NOISE LINE
W	EX. WETLANDS
B	EX. WETLAND BUFFER
S	EX. STREAM
H	EX. STREAM BUFFER
F	EX. 100-YEAR FLOODPLAIN
E	EXISTING EASEMENTS

TURF VALLEY, LORIEN
NURSING HOME & ASSISTED LIVING FACILITY
OAKMONT AT TURF VALLEY
PARCEL Q
PLATS 18773 - 18775
TAX MAP 16 - P/O PARCEL 8- GRID 16 & 17;
POD 1 per S-86-13 (4th AMENDED)
THIRD ELECTION DISTRICT HOWARD COUNTY, MARYLAND

KCE ENGINEERING, INC.
EXECUTIVE CENTER
3300 NORTH RIDGE ROAD, SUITE 315
ELLICOTT CITY, MARYLAND 21043
PHONE (410) 203-9800 FAX (410) 203-9228

Professional Certification, I hereby certify that these documents were prepared or approved by me, and that I am a duly licensed professional engineer under the laws of the State of Maryland, License No. 8818, Expiration Date: 10/21/28.
DRAWN BY: MG
CHECKED BY: DVK
SCALE: 1"=30'
DATE: 04/30/2008
SHEET: 2 OF 36

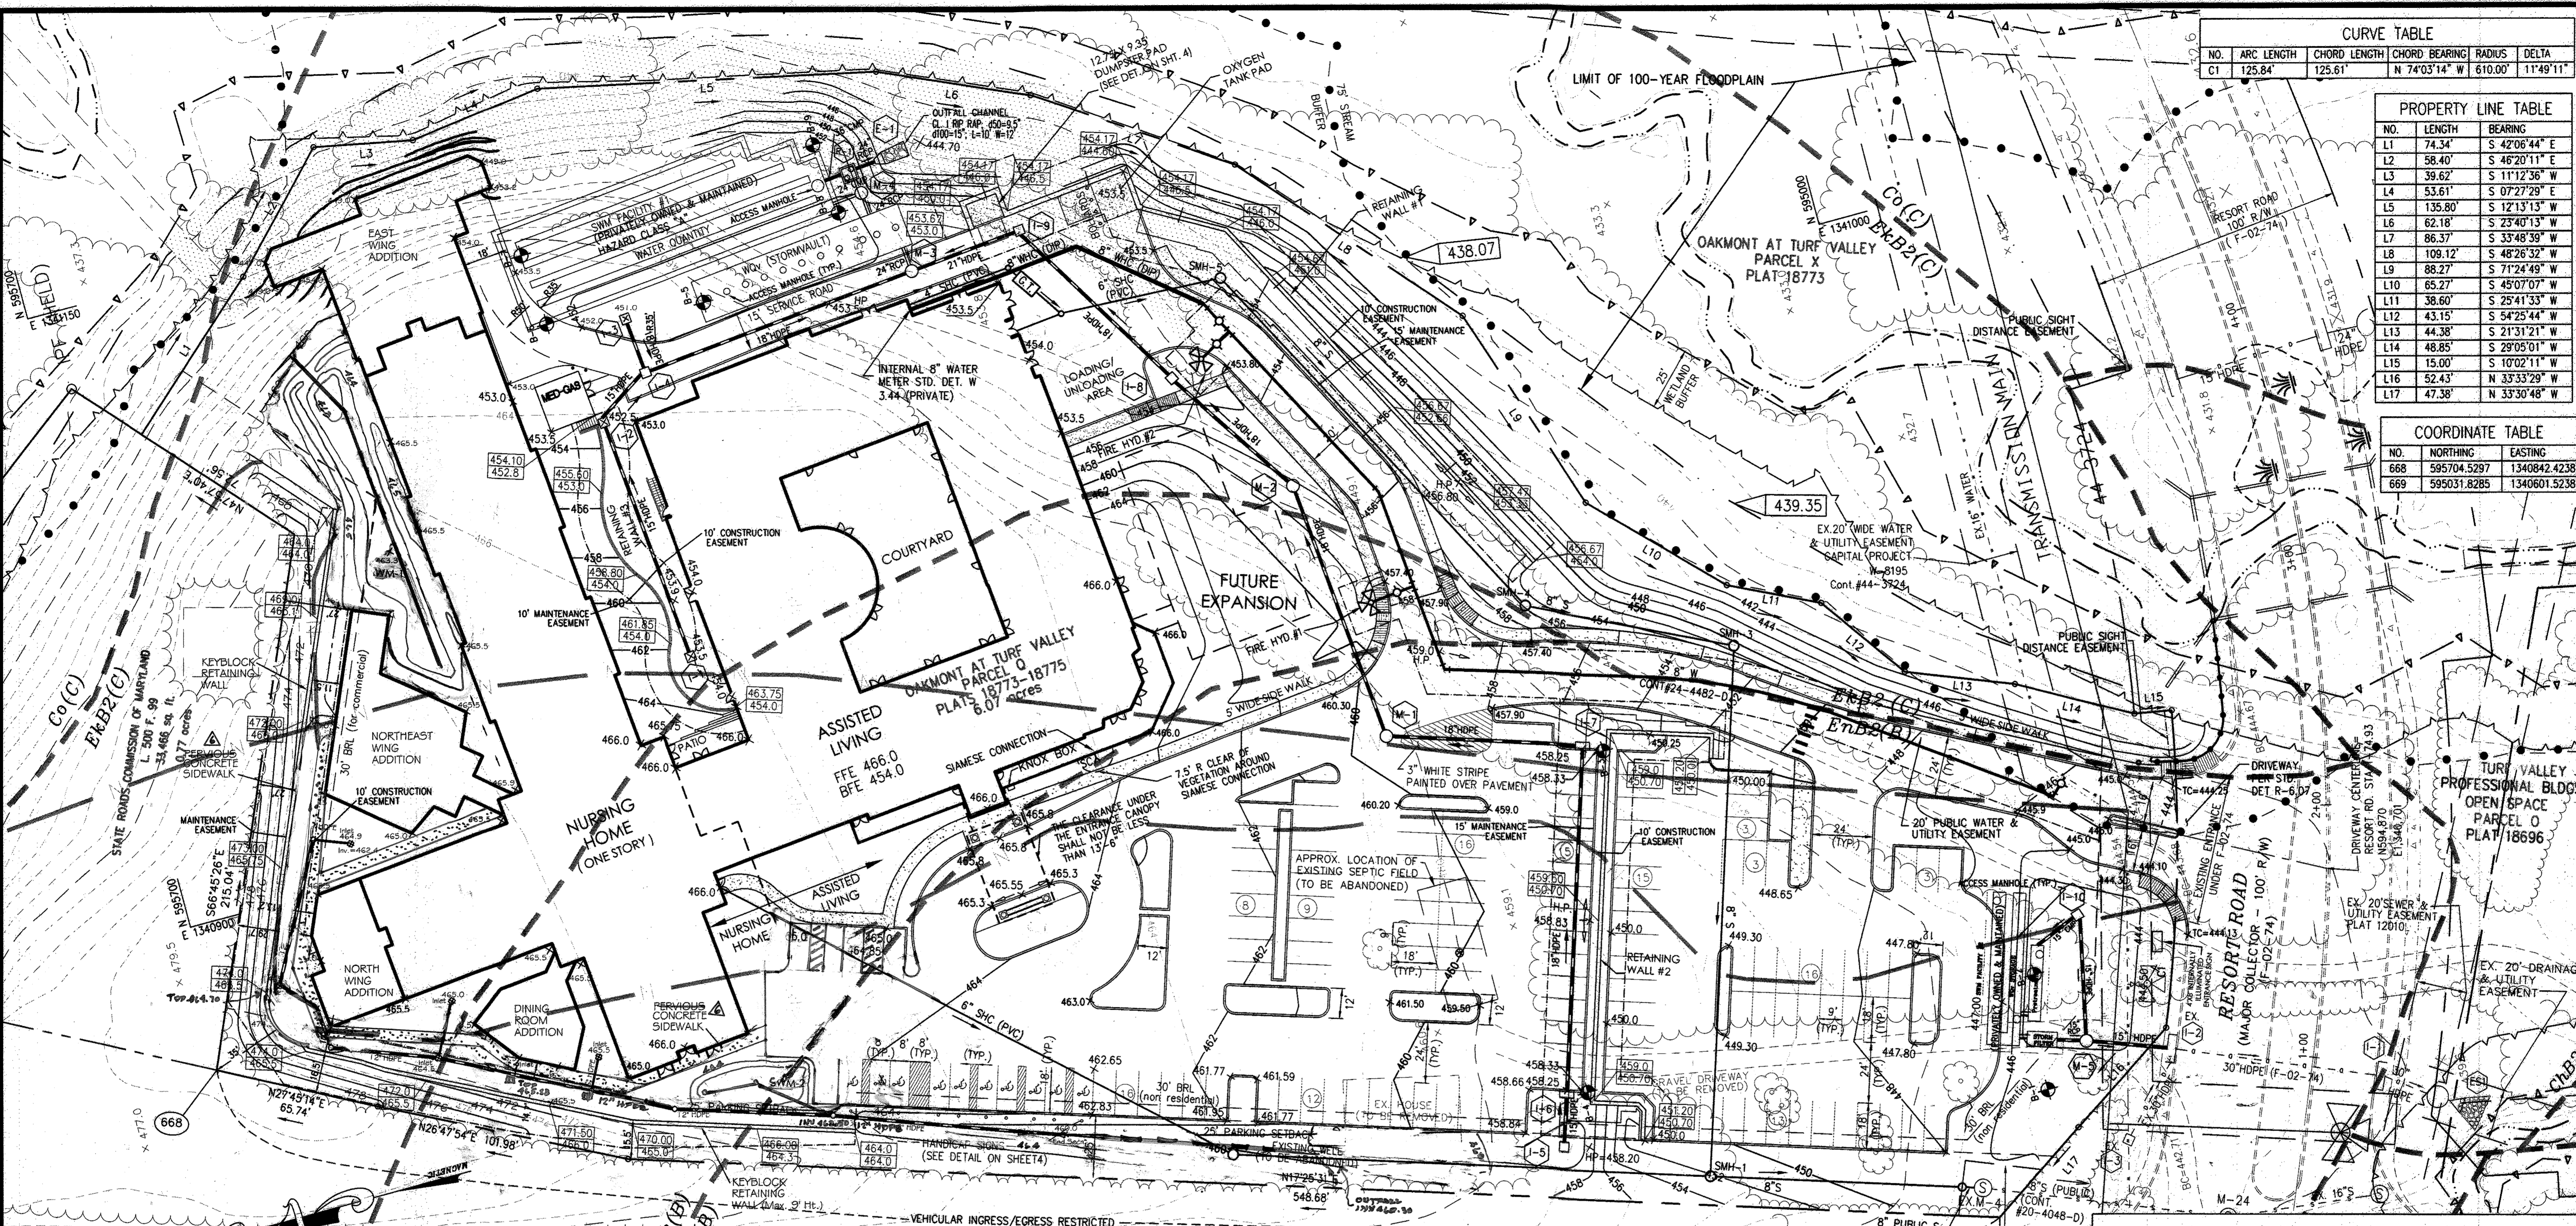

NO.	ARC LENGTH	CHORD LENGTH	CHORD BEARING	RADIUS	DELTA
CT 1	125.84'	125.61'	N 74°03'14" W	610.00'	11°49'11"

NO.	LENGTH	BEARING
L1	74.34'	S 42°06'44" E
L2	58.40'	S 46°20'11" E
L3	39.62'	S 11°12'36" W
L4	53.61'	S 07°27'29" E
L5	135.80'	S 12°13'13" W
L6	62.18'	S 23°40'13" W
L7	86.37'	S 33°48'39" W
L8	109.12'	S 46°26'32" W
L9	88.27'	S 71°24'49" W
L10	65.27'	S 45°07'07" W
L11	38.60'	S 25°41'33" W
L12	43.15'	S 54°25'44" W
L13	44.38'	S 21°31'21" W
L14	48.85'	S 29°05'01" W
L15	15.00'	S 10°02'11" W
L16	52.43'	N 33°33'29" W
L17	47.38'	N 33°30'48" W

NO.	NORTHING	EASTING
668	595704.5297	1340842.4238
669	595031.8285	1340601.5238

KCI	2/19/14	DELETE PERMEABLE CONC. SIDEWALK
5	4/1/15	REVISION: SWIM # 2, 270000, 280000, 290000, 300000, 310000
KCI	10/4/16	ADDITION OF BUILDING, SWM FACILITIES, RETAINING WALL AND SERVICE LANE
KCE	3/1/10	SWIM AS-BUILT INFORMATION ADDED
KCE	9/2/08	REVISED SWM FACILITY #1
KCE	7/16/08	REVISE RETAINING WALLS #1 & #2 TO SEGMENTAL BLOCK WALLS, MODIFY SWM #2, REALIGN PRIVATE SEWER



MARRIOTTSVILLE ROAD
EX. INTERMEDIATE ARTERIAL (ULTIMATE 120' ROW)

APPROVED
PLANNING BOARD OF HOWARD COUNTY
DATE 3/27/2018
9/10/2016

APPROVED: DEPARTMENT OF PLANNING AND ZONING
Chief, Development Engineering Division
Chief, Division of Land Development

APPROVED
PLANNING BOARD OF HOWARD COUNTY
DATE 3/27/2018
9/10/2016

SOIL TYPE	DESCRIPTION
EK82 C	ELOAK SILT LOAM, 3 TO 8% SLOPES, MODERATELY ERODED
EH2 B	ELINBORO LOAM, 8 TO 15% SLOPES, MODERATELY ERODED
GIC2 B	GLENEIG LOAM, 8 TO 15% SLOPES, MODERATELY ERODED
CO C	CODORUS SILT LOAM

HOWARD COUNTY SOIL MAP # 9

REQUIREMENT	VOLUME REQUIREMENT	VOLUME PROVIDED	NOTES
1 WATER QUALITY VOLUME Wv	0.21 AC.FT.	0.21 AC.FT.	PROVIDED WITHIN UNDERGROUND STORAGE FACILITY (STORM VAULT)
2 RECHARGE VOLUME Rev	0.04 AC.FT.	0.09 AC.FT.	PROVIDED IN STONE STORAGE UNDERGROUND FACILITY
3 CHANNEL PROTECTION VOLUME Cvp	0.30 AC.FT.	0.47 AC.FT.	PROVIDED WITHIN UNDERGROUND STORAGE FACILITY (CMP STORAGE)
4 OVERHEAD FLOOD PROTECTION Q _{10P}	-	-	NOT REQUIRED
5 EXTREME FLOOD VOLUME Q _{100P}	-	-	NOT REQUIRED

REQUIREMENT	VOLUME REQUIREMENT	VOLUME PROVIDED	NOTES
1 WATER QUALITY VOLUME Wv	0.053 AC.FT.	0.053 AC.FT.	TREATMENT PROVIDED BY UNDERGROUND STORM FILTER STORAGE WITHIN UNDERGROUND CMP FACILITY
2 RECHARGE VOLUME Rev	0.011 AC.FT.	0.02 AC.FT.	INCLUDED IN Wv ABOVE
3 CHANNEL PROTECTION VOLUME Cvp	0.069 AC.FT.	-	WAIVER REQUESTED
4 OVERHEAD FLOOD PROTECTION Q _{10P}	-	-	NOT REQUIRED
5 EXTREME FLOOD VOLUME Q _{100P}	-	-	NOT REQUIRED

SC	SIAMSE CONNECTION
25% SLOPES	15% - 24.9% SLOPES
MITIGATED 65 dBA NOISE LINE	EX. WETLANDS
EX. WETLANDS BUFFER	EX. STREAM
EX. STREAM BUFFER	EX. 100-YEAR FLOODPLAIN
EX. 100-YEAR FLOODPLAIN	SOIL TYPES
SOIL TYPES	EXISTING EASEMENTS
EXISTING EASEMENTS	EX. WATER

GRADING & STORMWATER MANAGEMENT PLAN
REVISED SITE DEVELOPMENT PLAN
AS-BUILT TURF VALLEY, LORIEN
NURSING HOME & ASSISTED LIVING FACILITY

OAKMONT AT TURF VALLEY
PARCEL Q
PLATS 18773 - 18775
TAX MAP 16 - P/O PARCEL 8 - GRID 16 & 17;
POD 1 per S-86-13 (4th AMENDED)
THIRD ELECTION DISTRICT HOWARD COUNTY, MARYLAND

ENGINEERS
PLANNERS
SCIENTISTS
CONSTRUCTION MANAGERS


KCI TECHNOLOGIES
3900 North Ridge Road
Bloomer City, MD 21030
Phone (410) 263-9228
www.kci.com

Professional Certification:
I hereby certify that these documents were prepared or approved by me, and that I am a duly licensed professional engineer under the laws of the State of Maryland, License No. 8818, Expiration Date: 10/17/18.


DRAWN BY: SK
CHECKED BY: DVK
SCALE: 1"=30'
DATE: 10/4/2016

SHEET: 3 OF 36


SDP-07-084

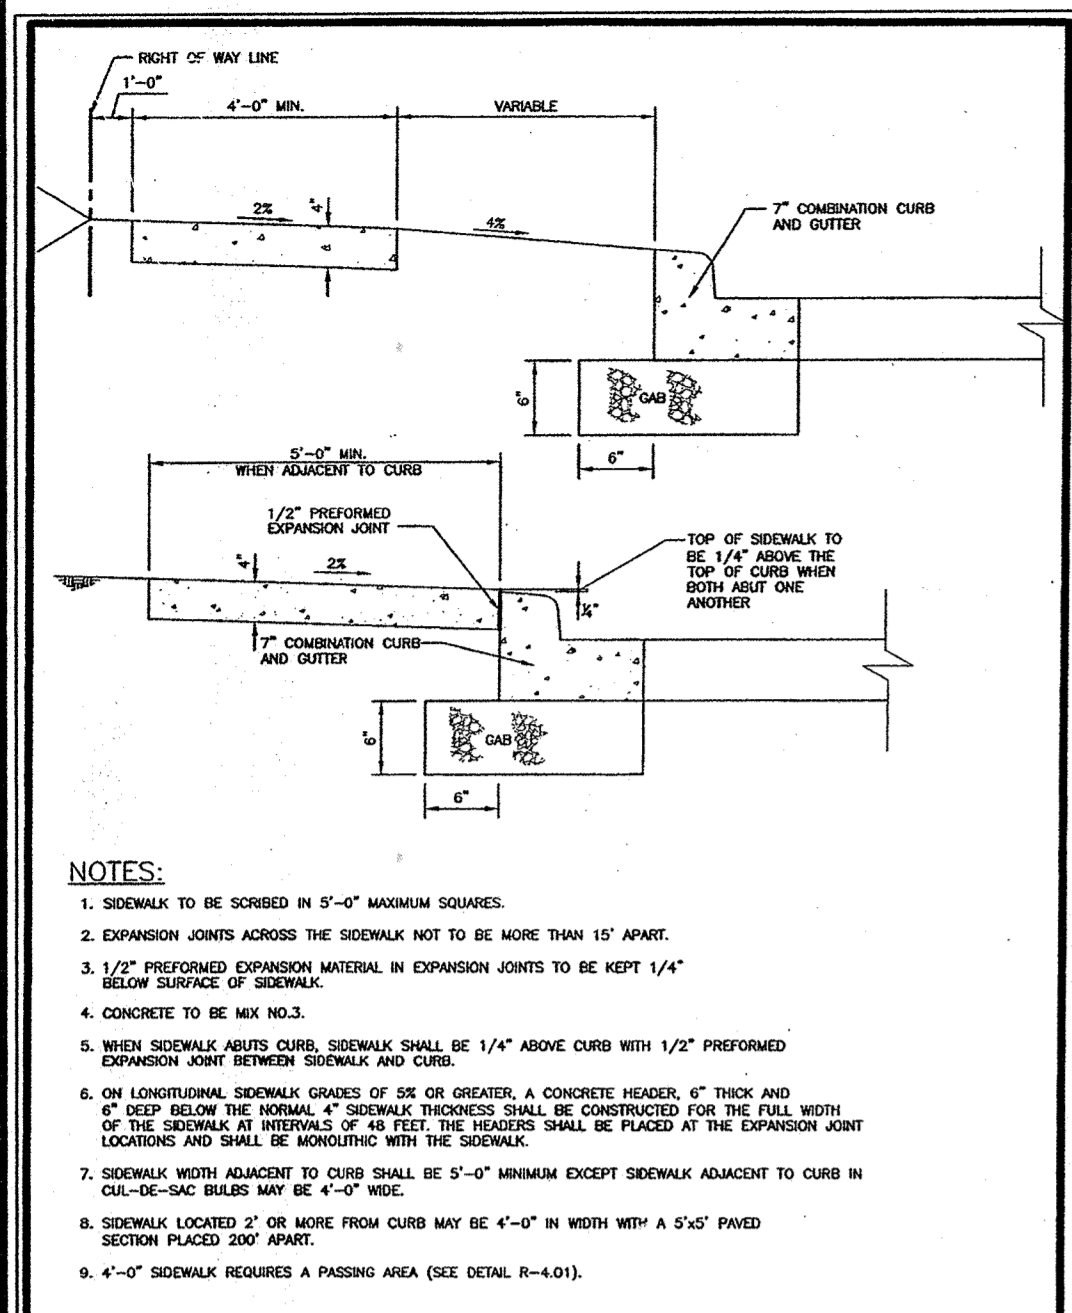

Project: Howard County, Maryland Department of Public Works	Detail: Concrete Sidewalk	Sheet: R-3.05
---	---------------------------	---------------

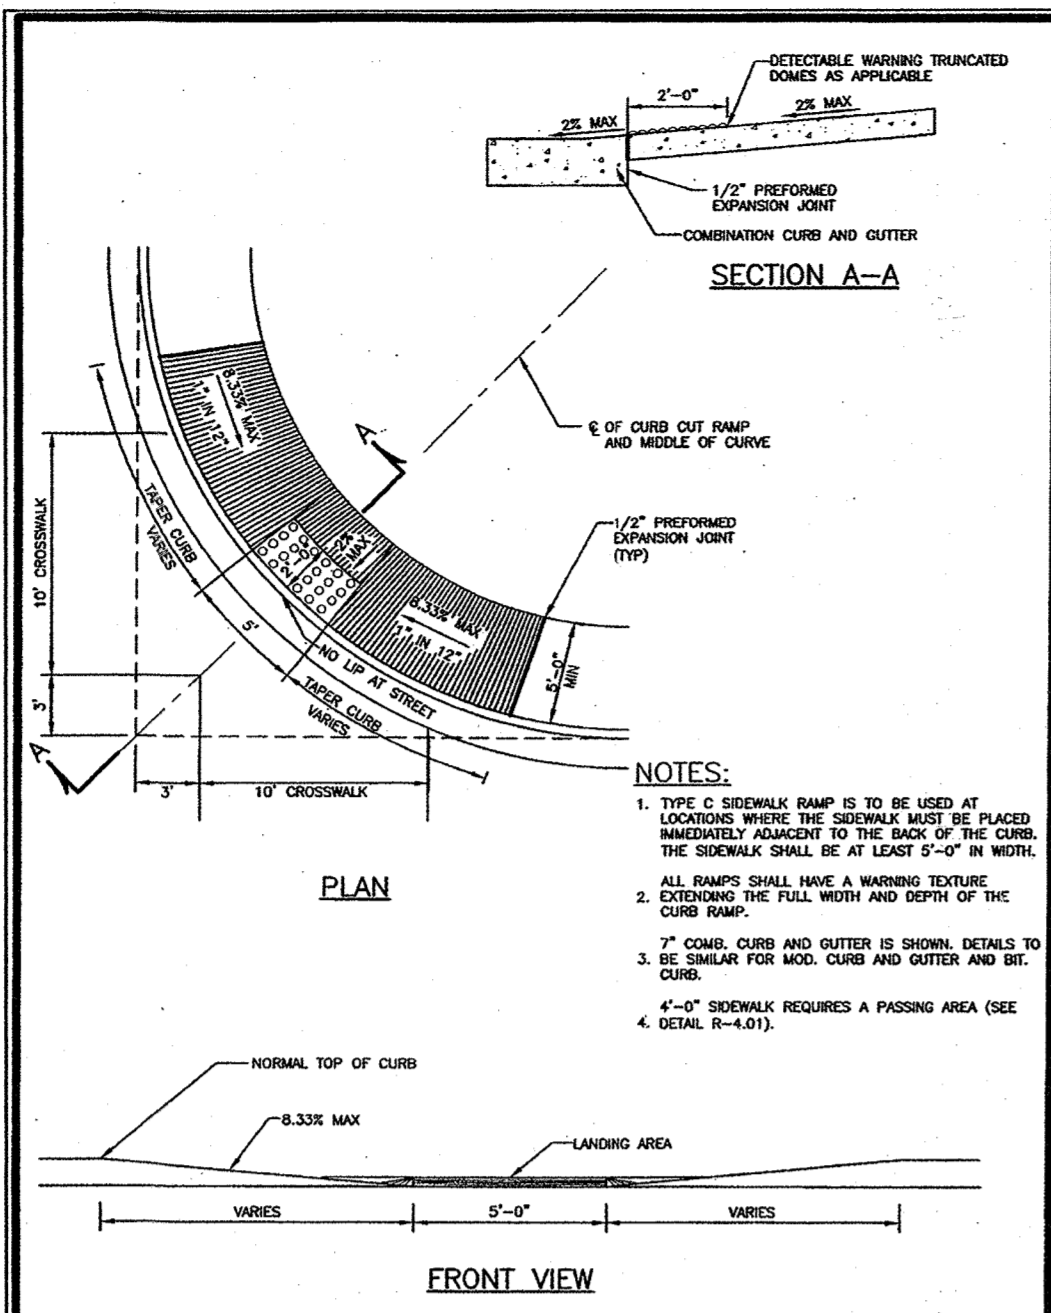

Project: Howard County, Maryland Department of Public Works	Detail: SIDEWALK RAMP Type C	Sheet: R-4.04
---	------------------------------	---------------

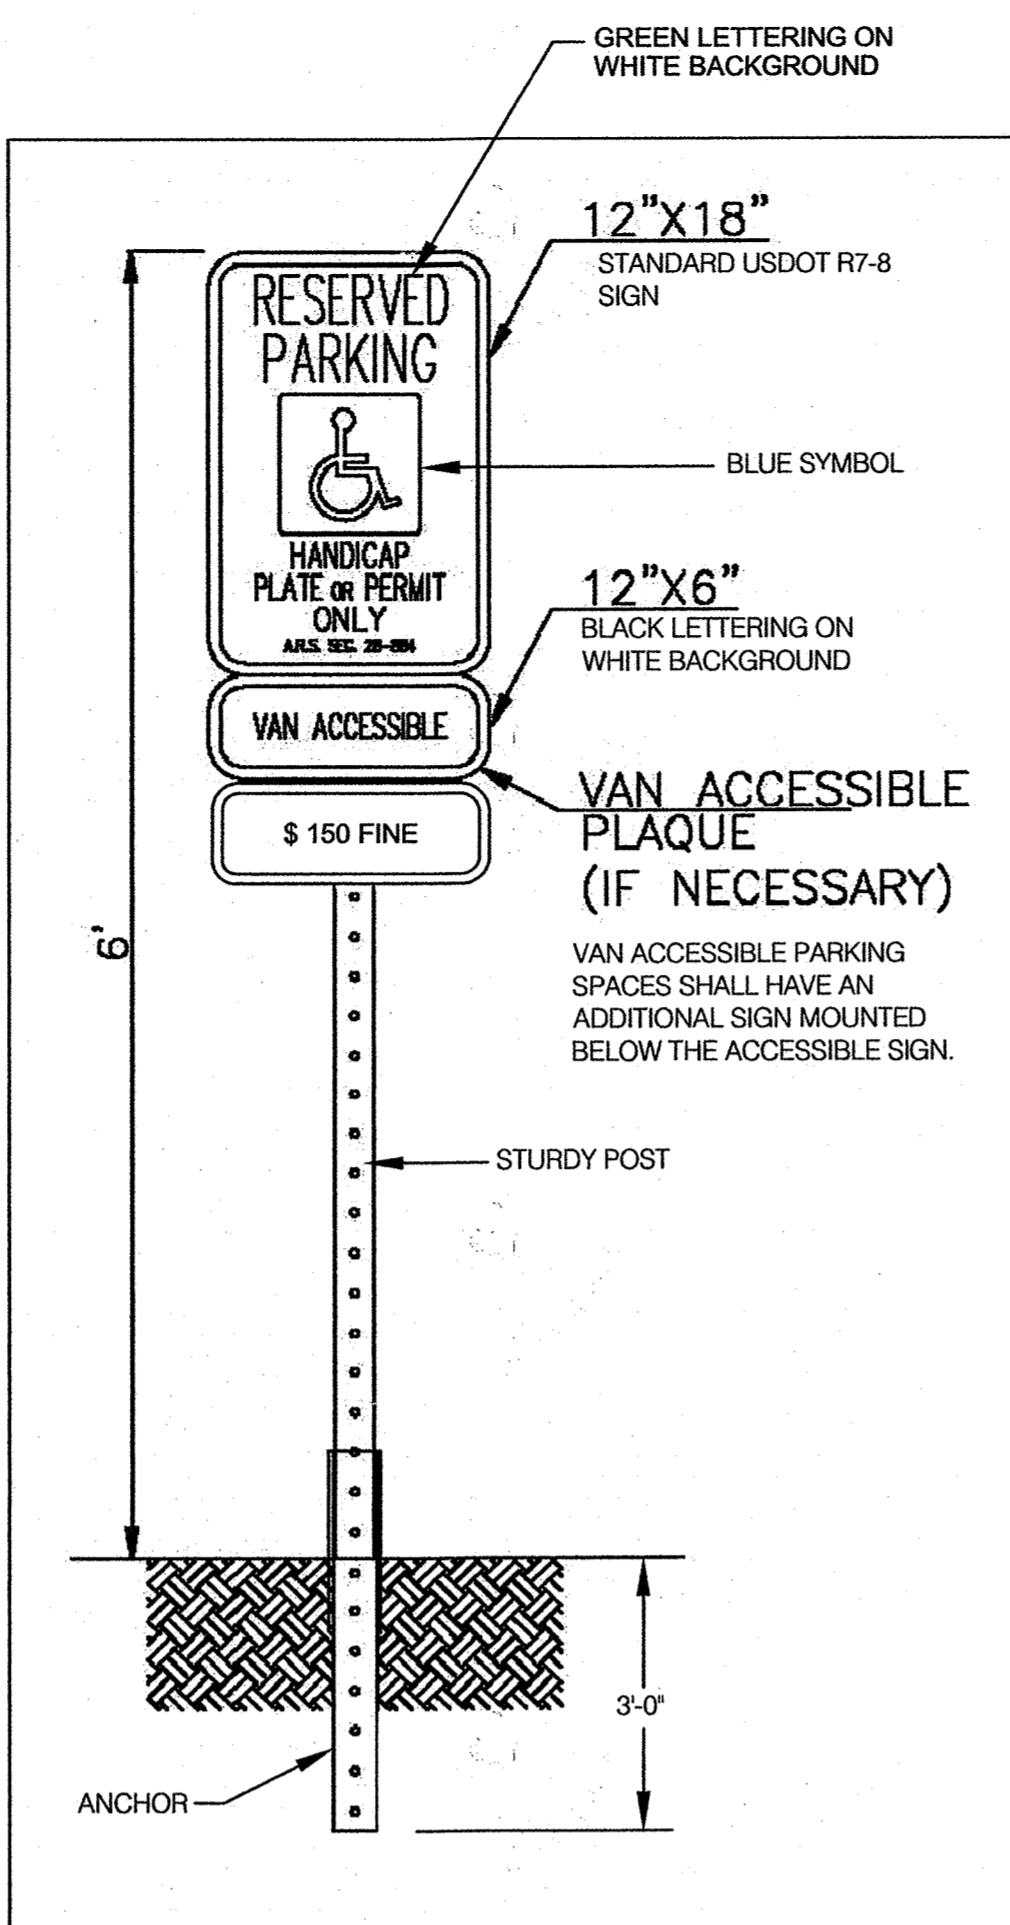


ACCESSIBLE PARKING SIGN DETAIL

SCALE: NTS


NOTE:

A U.S. DEPARTMENT OF TRANSPORTATION R7-8 (RESERVED PARKING) AND SUPPLEMENTAL SIGNS AS NOTED ABOVE MUST BE MOUNTED ON A PERMANENT POST NO LOWER THAN FOUR FEET FROM THE PAVEMENT. THE POST MUST BE MOUNTED IN THE CENTER OF THE 8 FOOT WIDE ACCESSIBLE PARKING SPACE, NO MORE THAN 5 FEET FROM THE FRONT OF THE PARKING SPACE.


Project: Howard County, Maryland Department of Public Works	Detail: SOLID WASTE Single Container Enclosure	Sheet: R-8.04
---	--	---------------

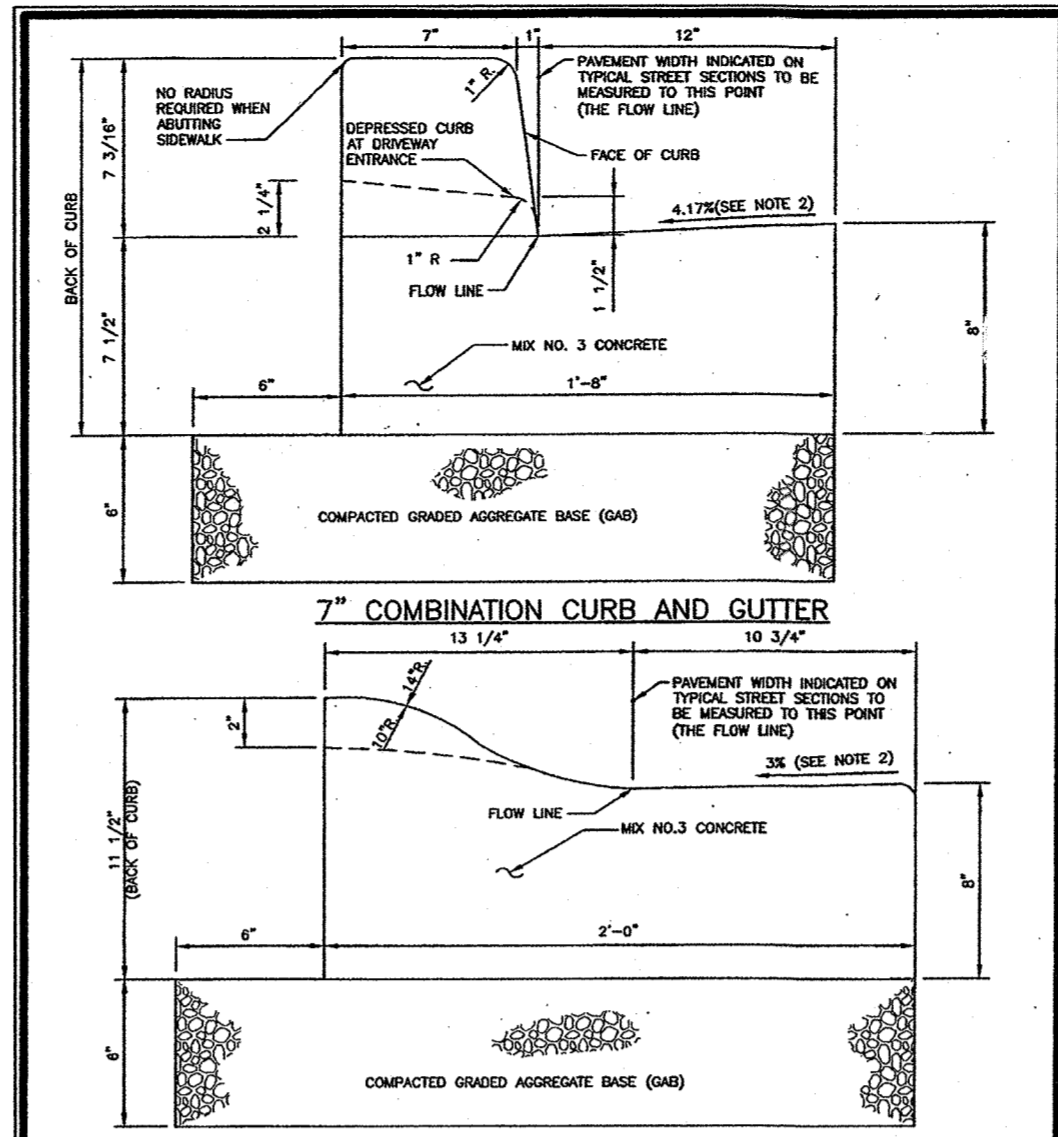


Project: Howard County, Maryland Department of Public Works	Detail: CURB AND GUTTER 7" & Modified	Sheet: R-3.01
---	---------------------------------------	---------------

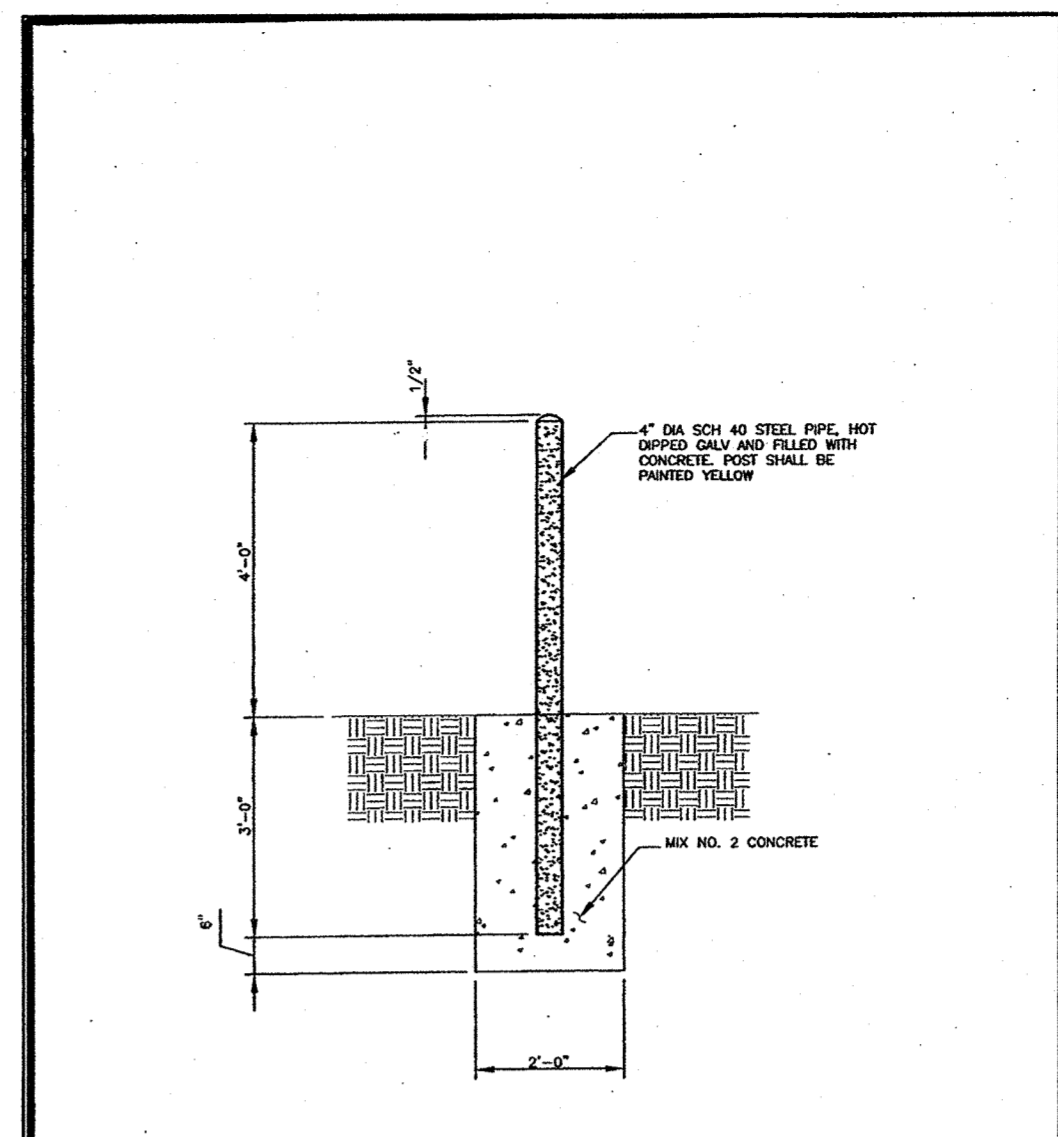


Project: Howard County, Maryland Department of Public Works	Detail: Metal Bollard	Sheet: G-7.42
---	-----------------------	---------------

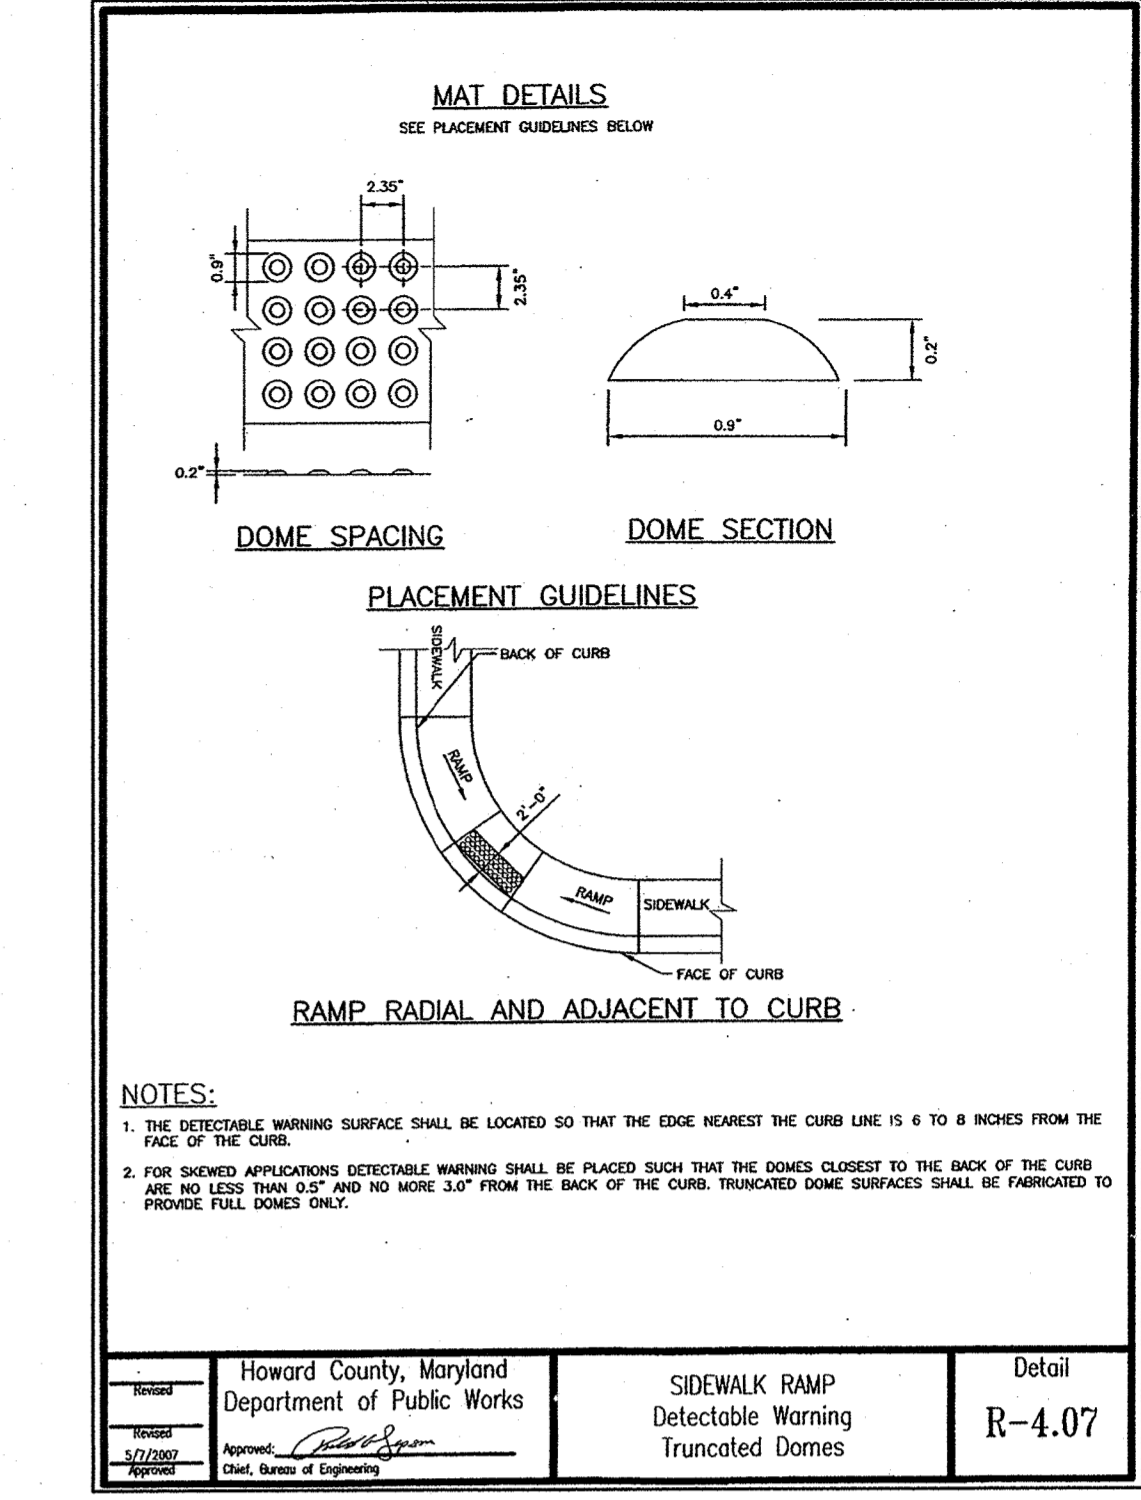


Project: Howard County, Maryland Department of Public Works	Detail: SIDEWALK RAMP Detectable Warning Truncated Domes	Sheet: R-4.07
---	--	---------------

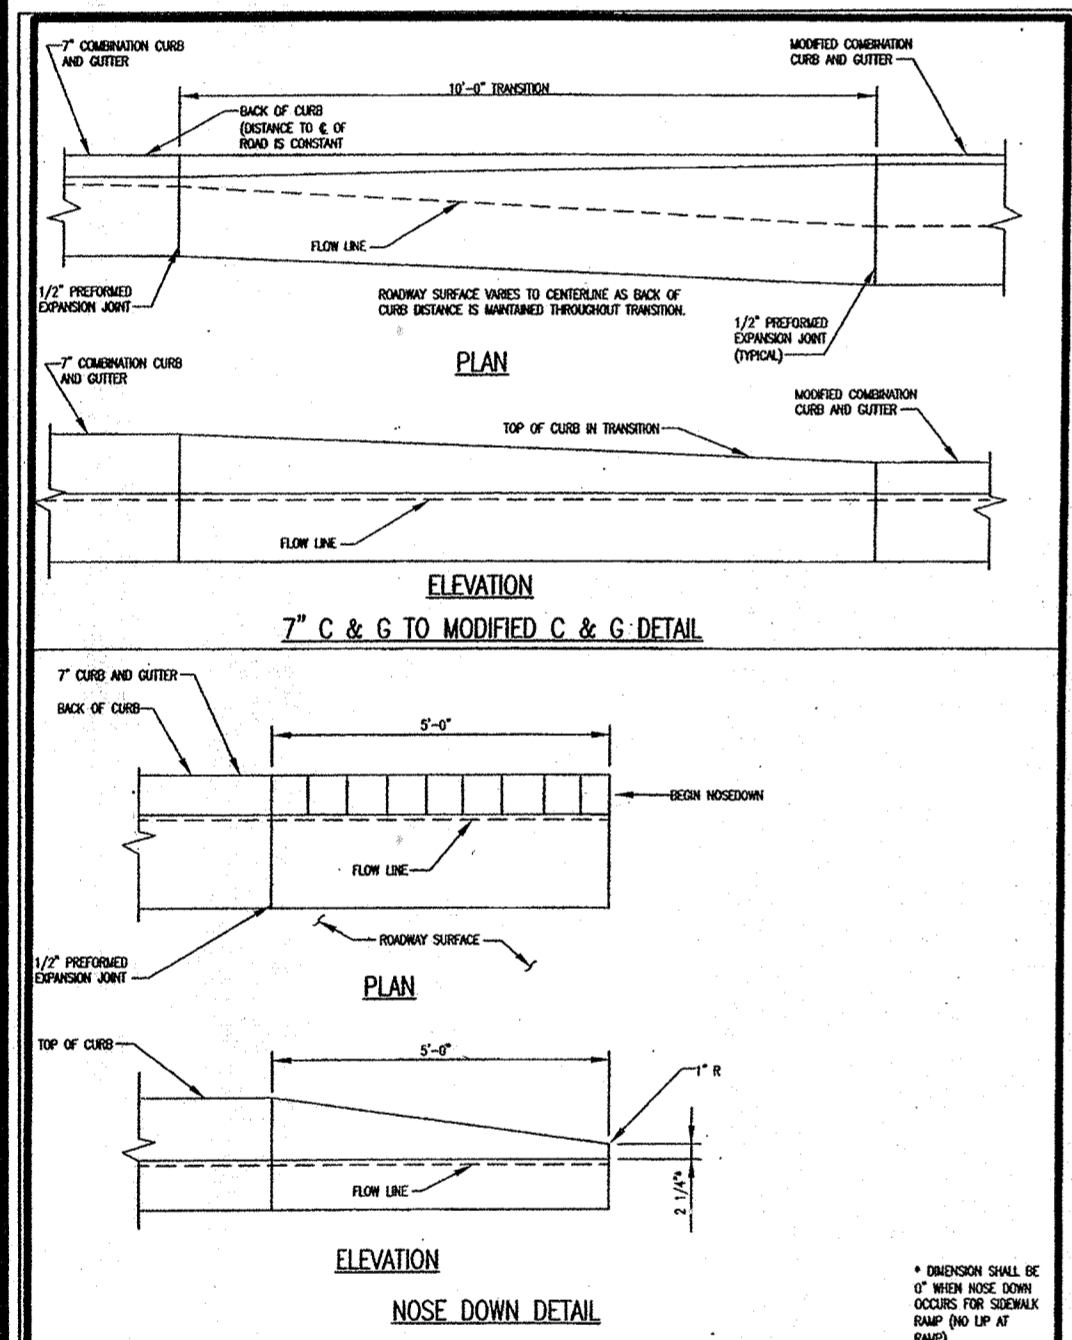


Project: Howard County, Maryland Department of Public Works	Detail: CURB AND GUTTER 7" Transition to Modified & Nose Down	Sheet: R-3.02
---	---	---------------

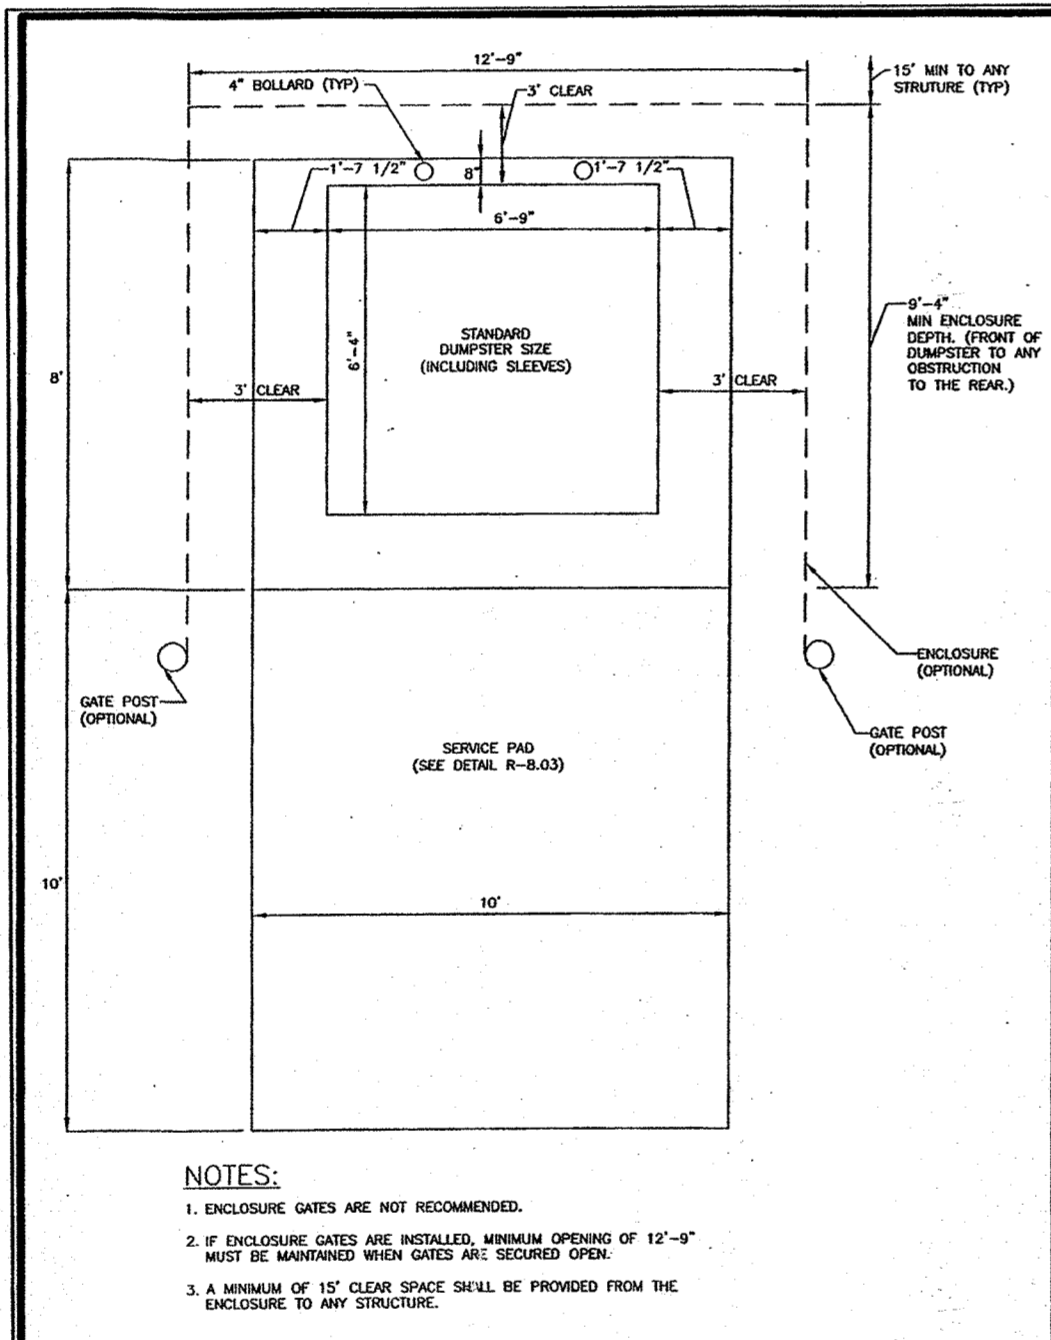

Project: Howard County, Maryland Department of Public Works	Detail: SOLID WASTE Single Container Enclosure	Sheet: R-8.04
---	--	---------------

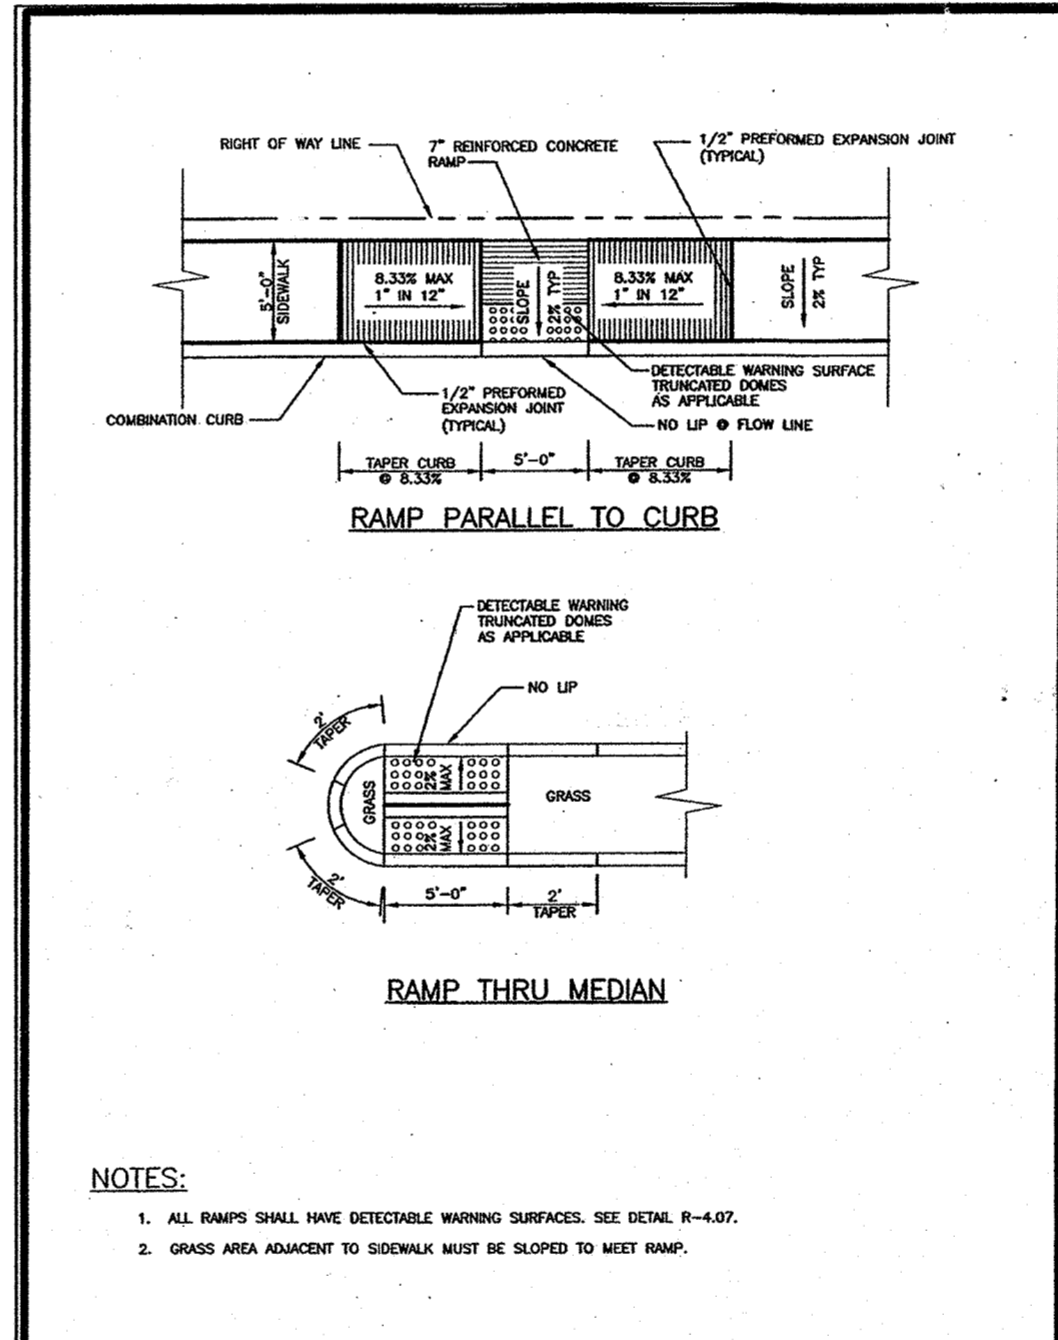

Project: Howard County, Maryland Department of Public Works	Detail: SIDEWALK RAMP Layout & Grading Parallel to Curb & Thru Median	Sheet: R-4.06
---	---	---------------

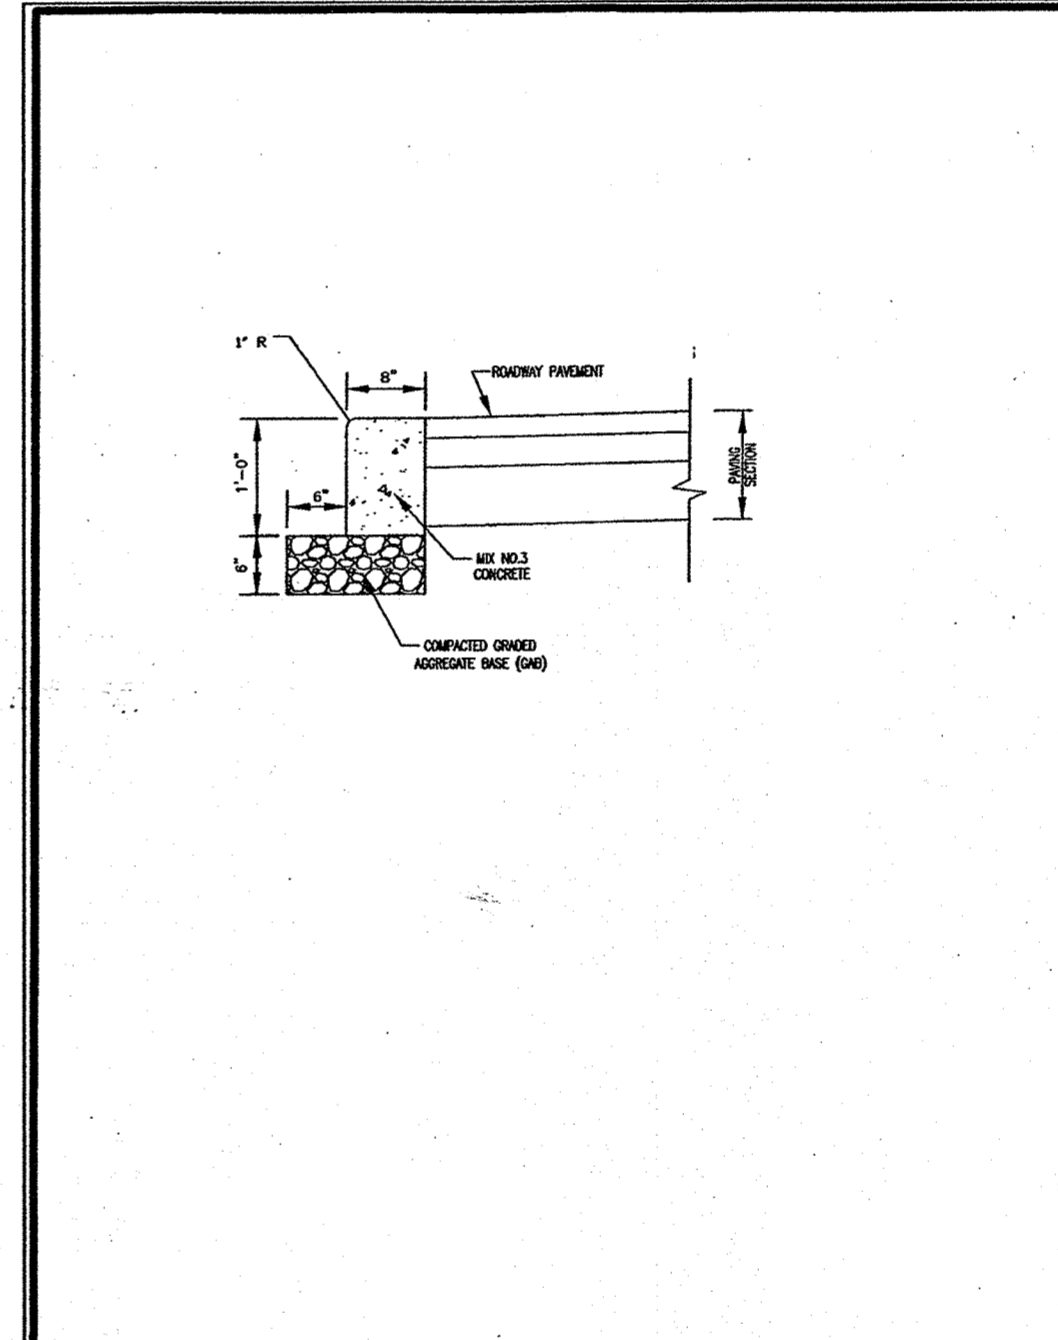

Project: Howard County, Maryland Department of Public Works	Detail: Curb Flush	Sheet: R-3.07
---	--------------------	---------------

APPROVED PLANNING BOARD OF HOWARD COUNTY DATE 3/27/08

[Signature] Date 3/27/08

APPROVED: DEPARTMENT OF PLANNING AND ZONING

[Signature] Date 6/21/08


Chief, Development Engineering Division

[Signature] Date 6/20/08


Chief, Division of Land Development

[Signature] Date 6/20/08

Dir.

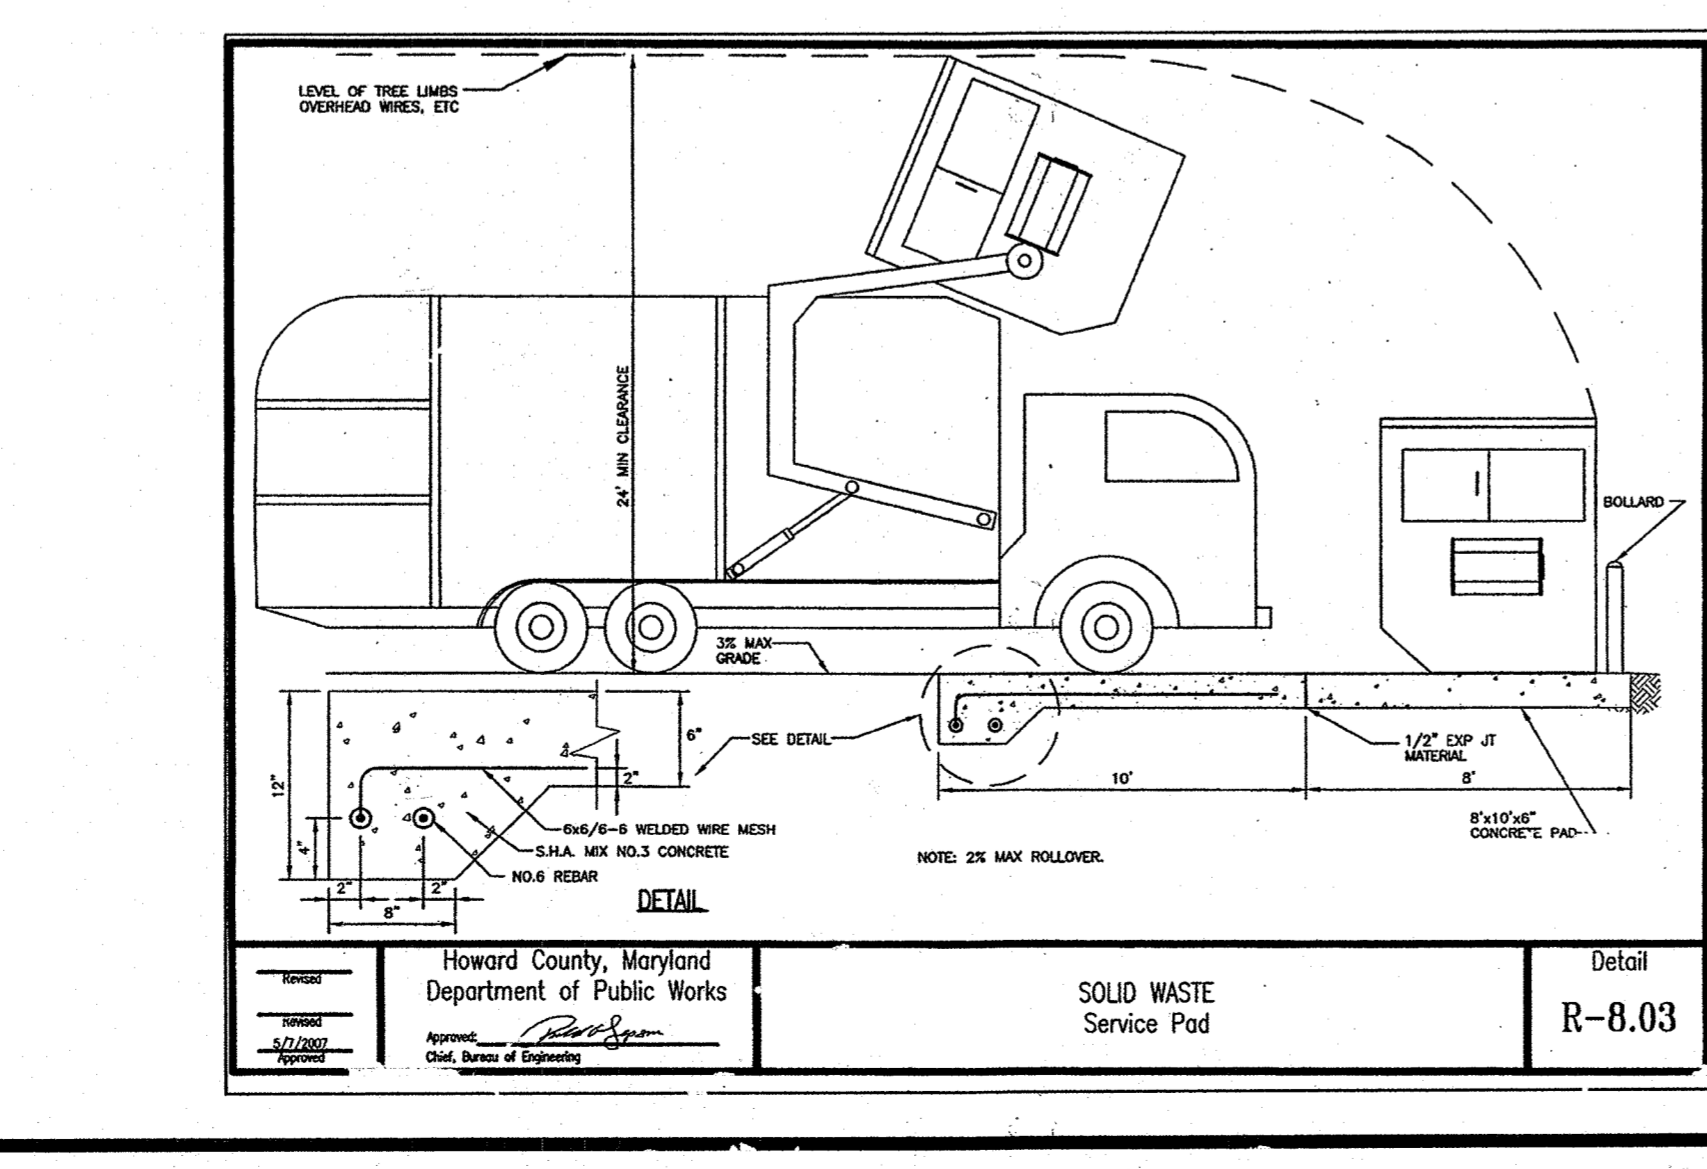

Project: Howard County, Maryland Department of Public Works	Detail: SOLID WASTE Service Pad	Sheet: R-8.03
---	---------------------------------	---------------

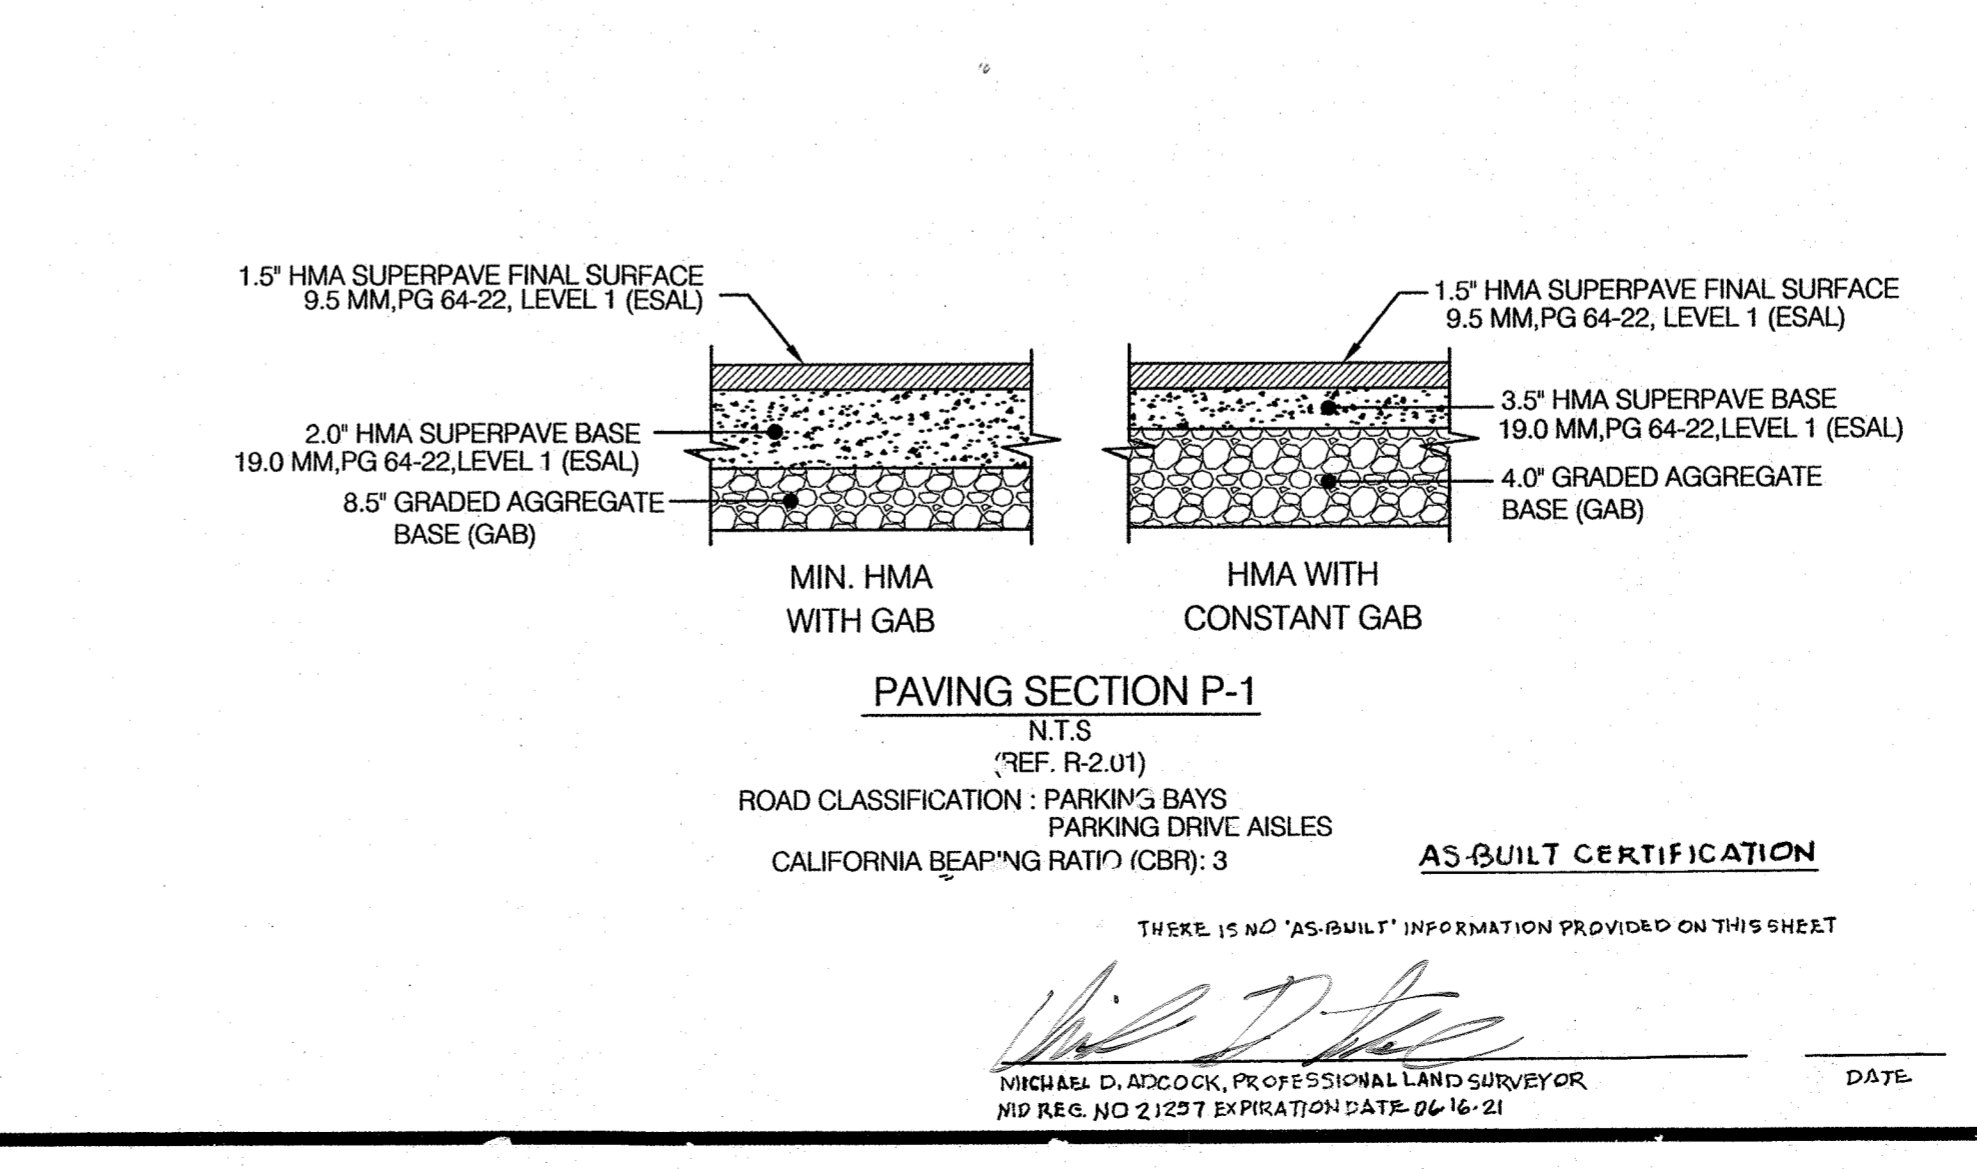

OWNER

MANGIONE ENTERPRISES OF TURF VALLEY LIMITED PARTNERSHIP
1205 YORK ROAD, PENTHOUSE
LUTHERVILLE, MARYLAND 21093
PHONE (410) 825-8400

NO	REVISION	DATE

AS-BUILT SITE DETAILS

TURF VALLEY, LORIE

NURSING HOME & ASSISTED LIVING FACILITY

OAKMONT AT TURF VALLEY
PARCEL Q
PLATS 18773 - 18775
TAX MAP 16 - P/O PARCEL 8- GRID 16 & 17;
POD I per S-86-13 (4th AMENDED)
THIRD ELECTION DISTRICT HOWARD COUNTY, MARYLAND

KCE ENGINEERING, INC.

EXECUTIVE CENTER

3300 NORTH RIDGE ROAD, SUITE 315
ELLCOTT CITY, MARYLAND 21043
PHONE (410) 203-9800 FAX (410) 203-9228

Professional Certification: I hereby certify that these documents were prepared or approved by me, and that I am a duly licensed professional engineer under the laws of the State of Maryland, license NO. 8218, Expiration Date: 10/12/13

[Signature] Date 4/21/08




DRAWN BY: MG

CHECKED BY: DVK

SCALE: AS SHOWN

DATE: 04/30/2008

SHEET: 4 OF 36

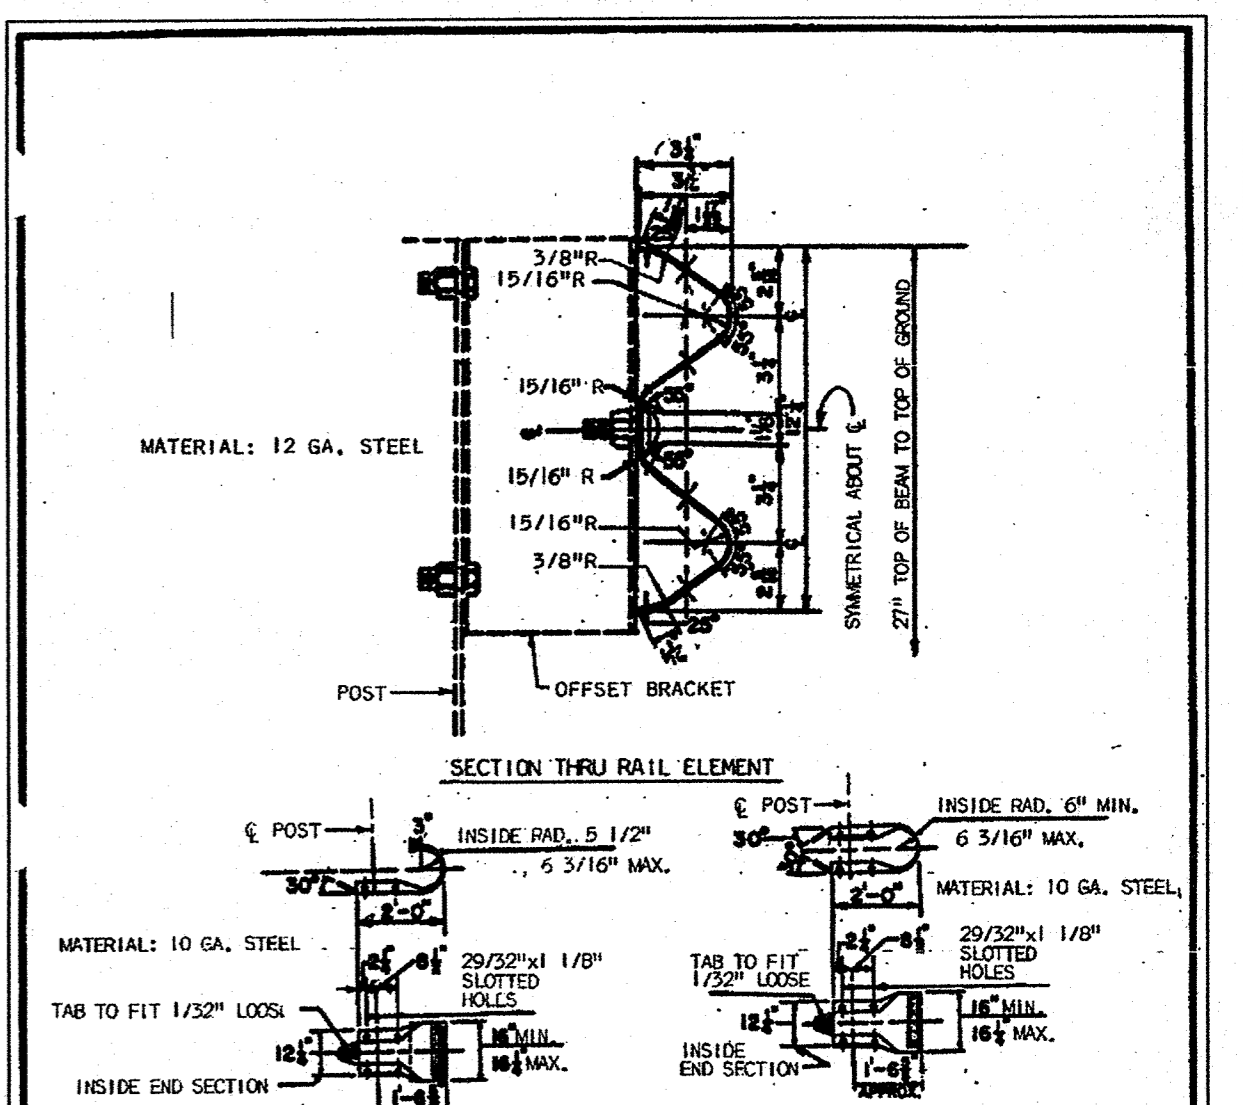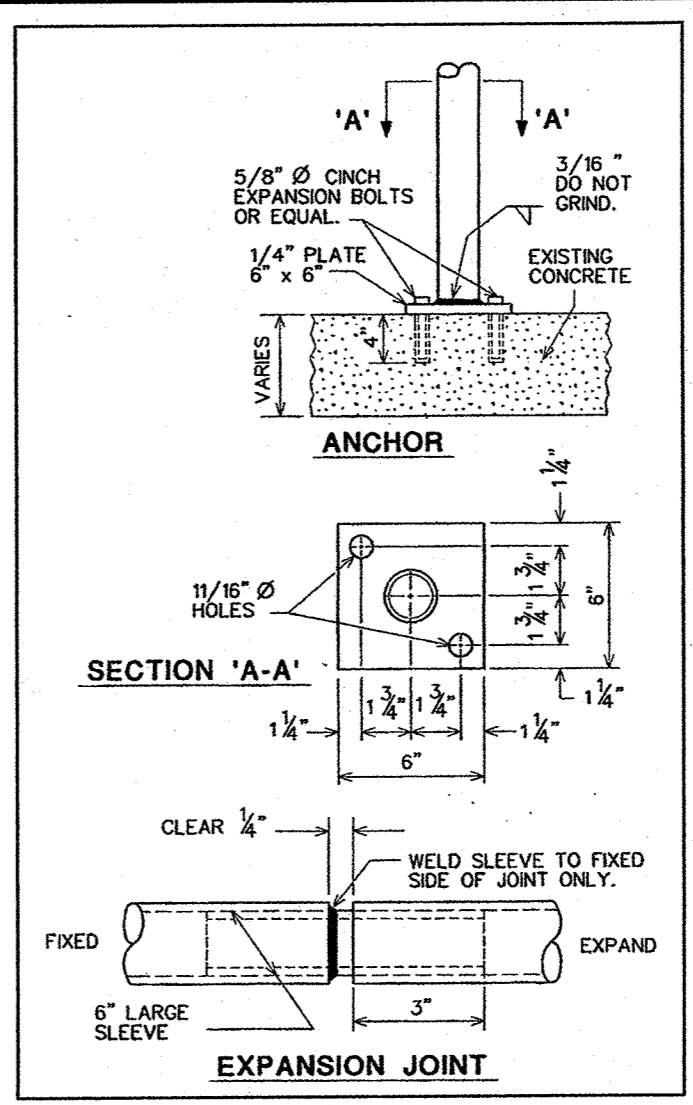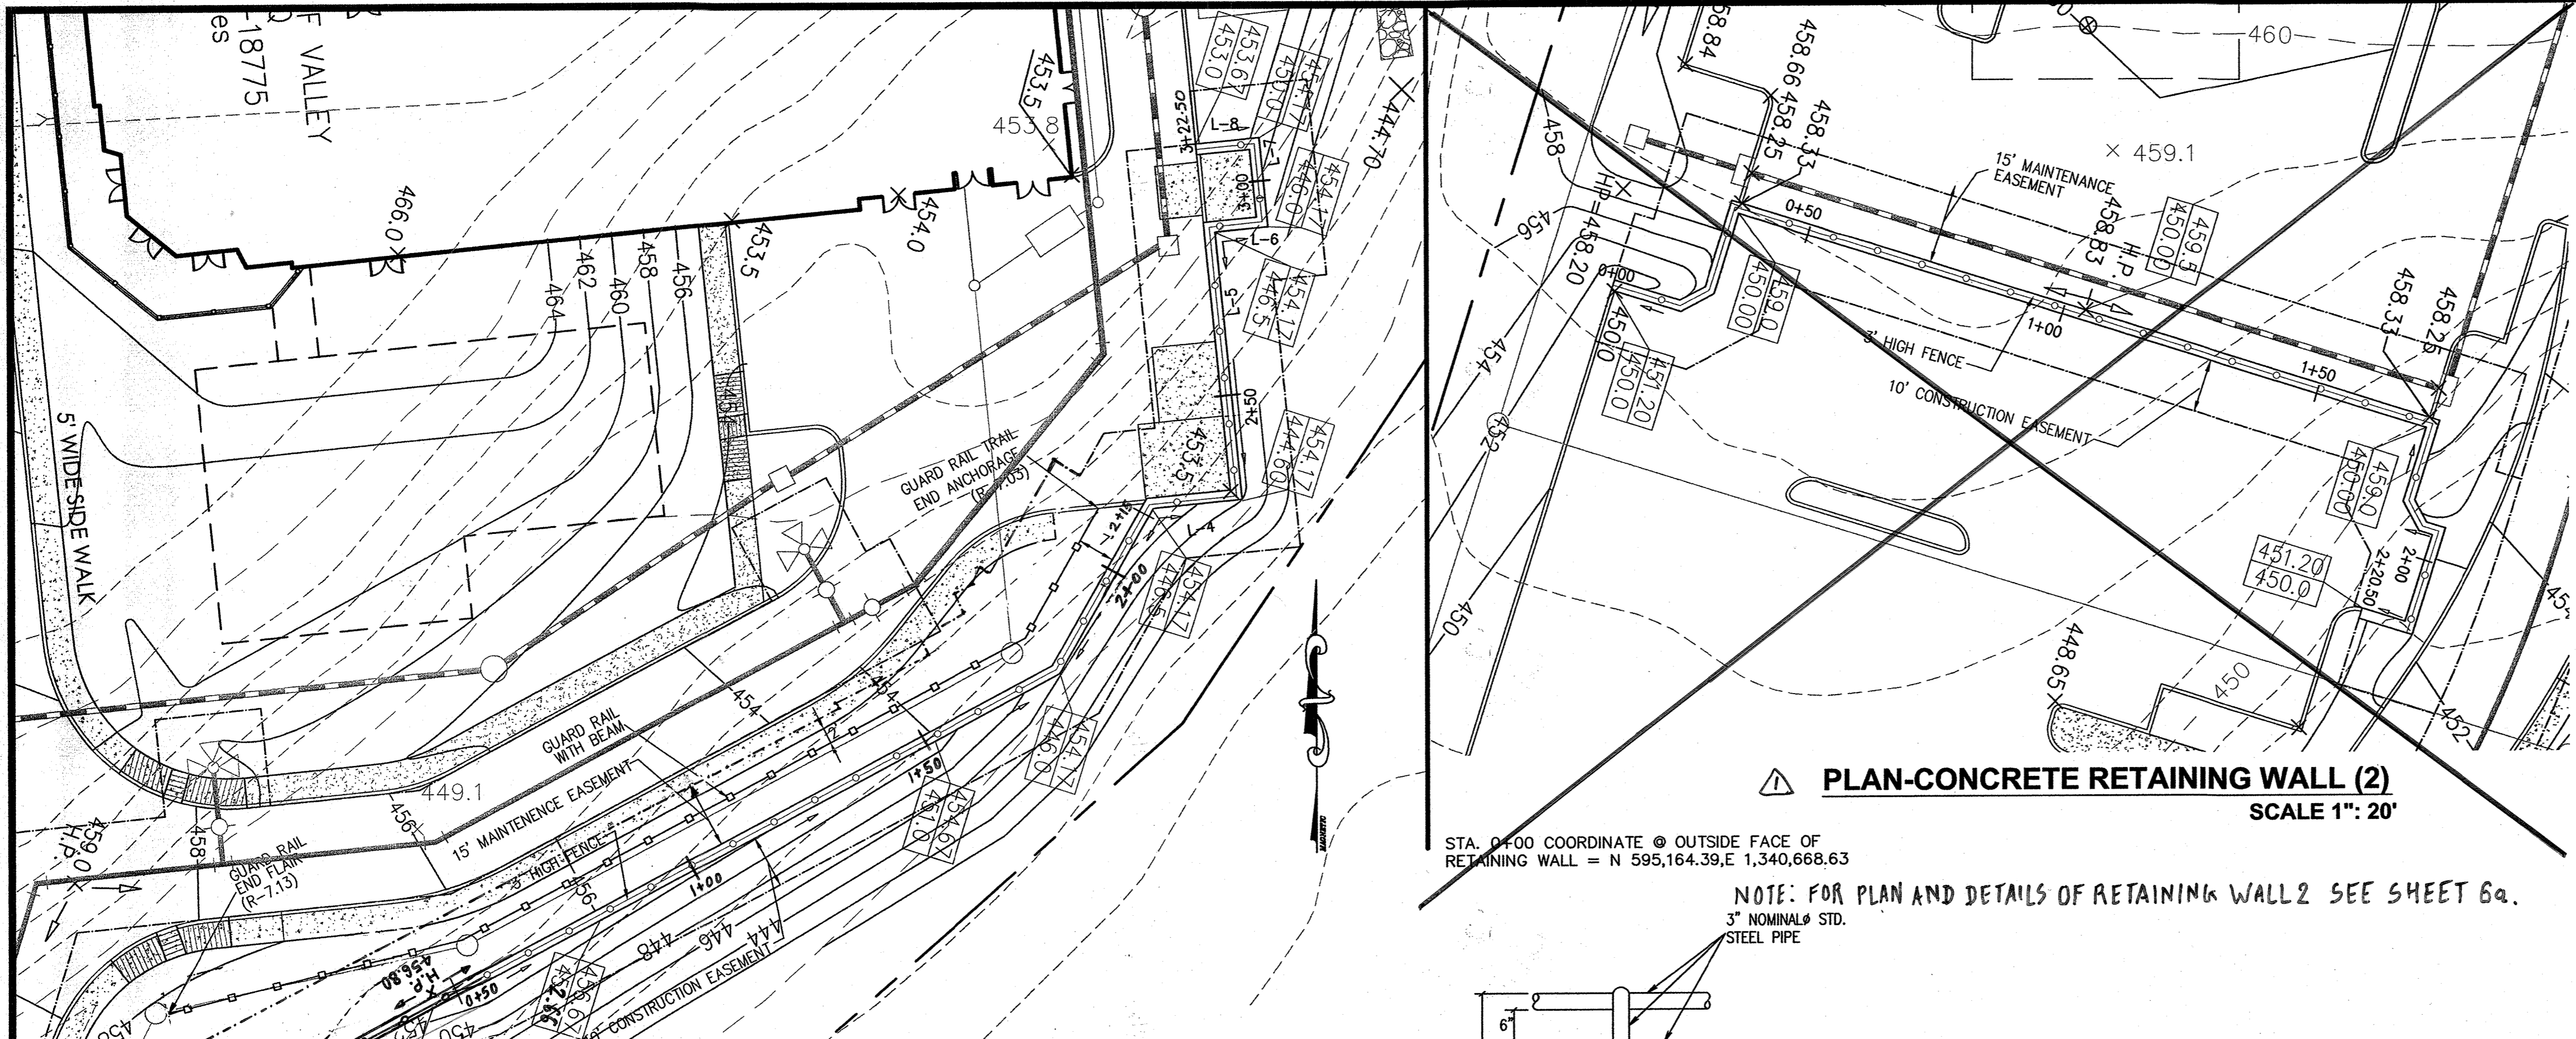

PLAN-CONCRETE RETAINING WALL (2)
SCALE 1" = 20'

FENCE EXPANSION JOINT NTS


DETAIL - EXPANSION JOINT RETAINING WALLS (1) AND (2) NTS

STA. 0+00 COORDINATE @ OUTSIDE FACE OF RETAINING WALL = N 595,164.39, E 1,340,668.63


NOTE: FOR PLAN AND DETAILS OF RETAINING WALL 2 SEE SHEET 6a.

PLAN-CONCRETE RETAINING WALL (1)
SCALE 1" = 20'


STA. 0+00 COORDINATE @ OUTSIDE FACE = N 595,157.71, E 1,340,895.08

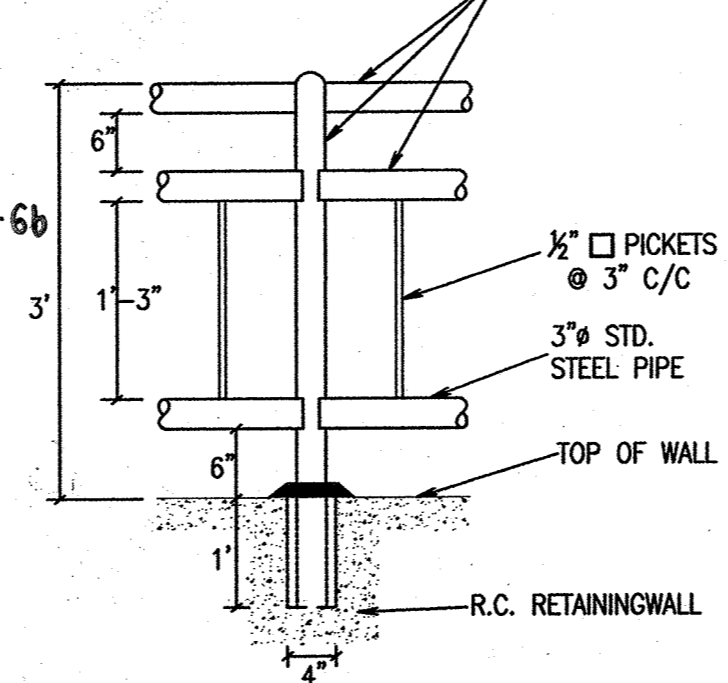

FENCE FOOTING NTS
AS-BUILT CERTIFICATION
THERE IS NO AS-BUILT INFORMATION PROVIDED ON THIS SHEET

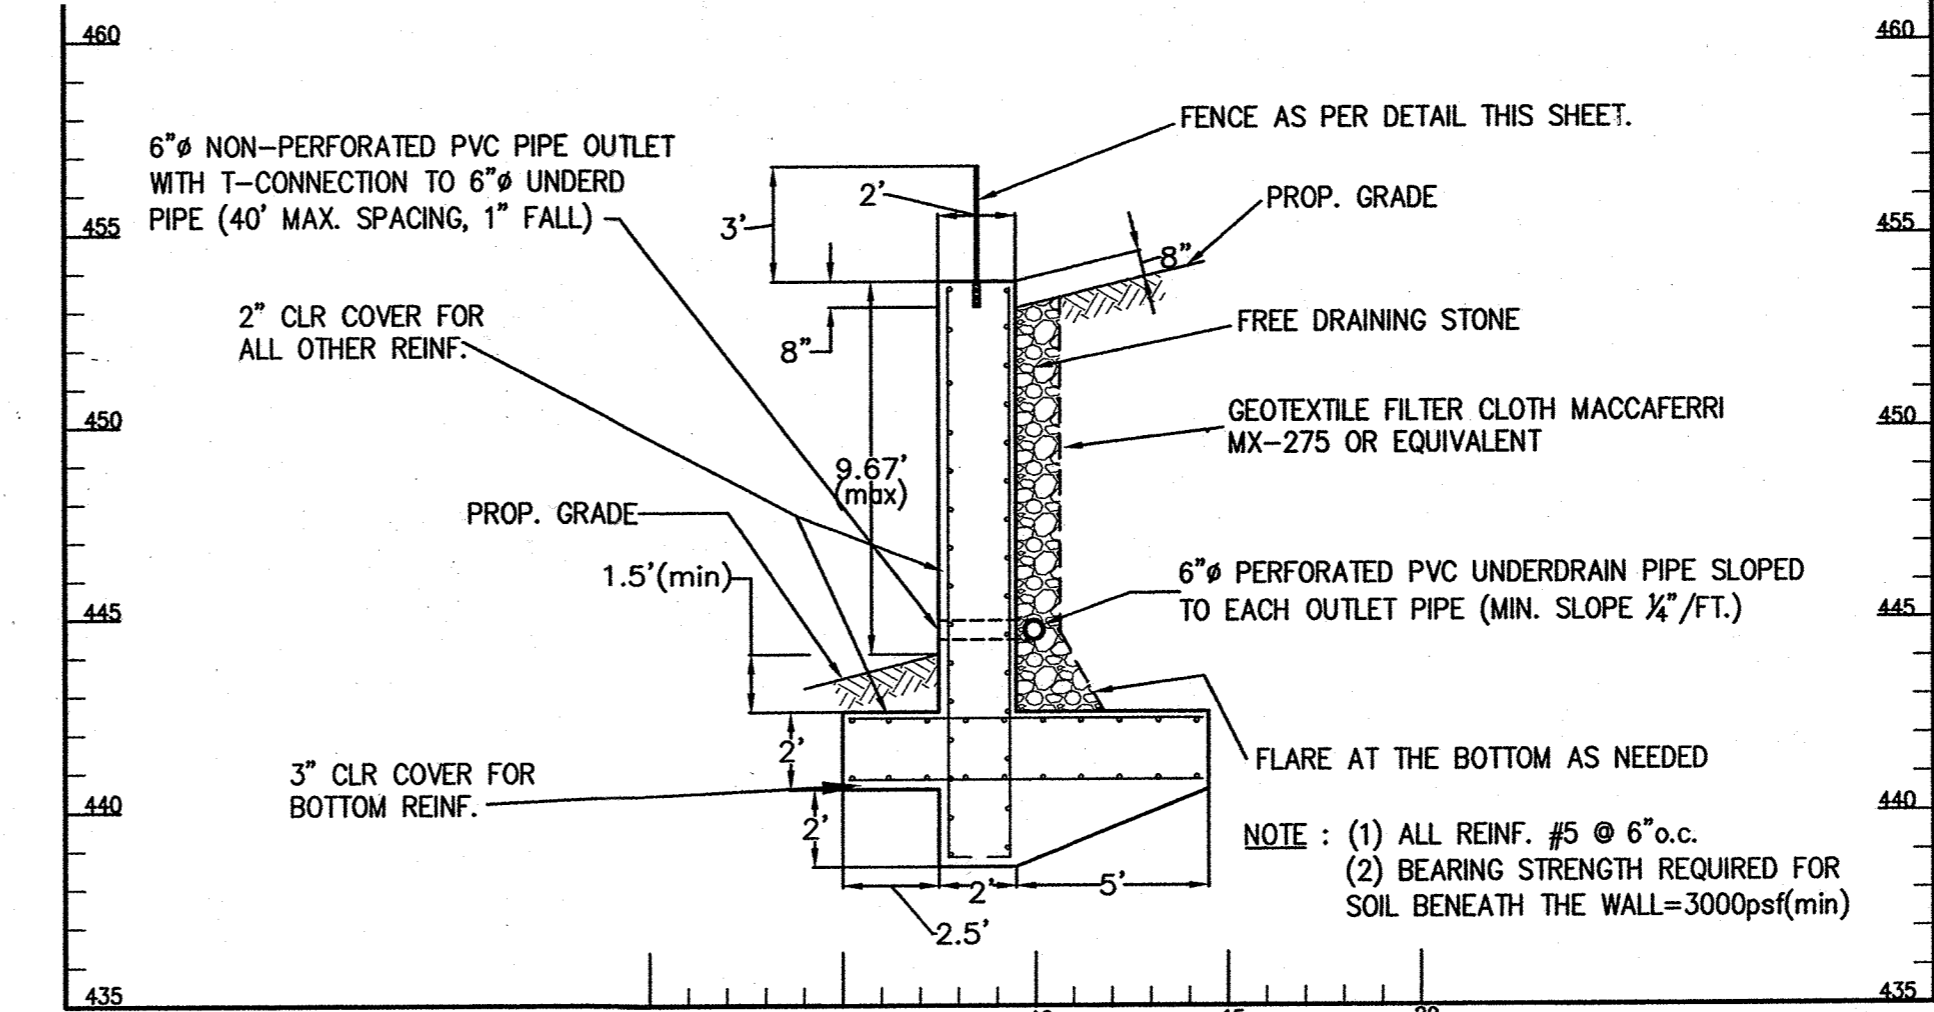

SECTION A-A & REINFORCEMENT DETAILS RETAINING WALLS (1) (STA 2+15 TO STA 3+2.2)
SCALE: 1" = 5'

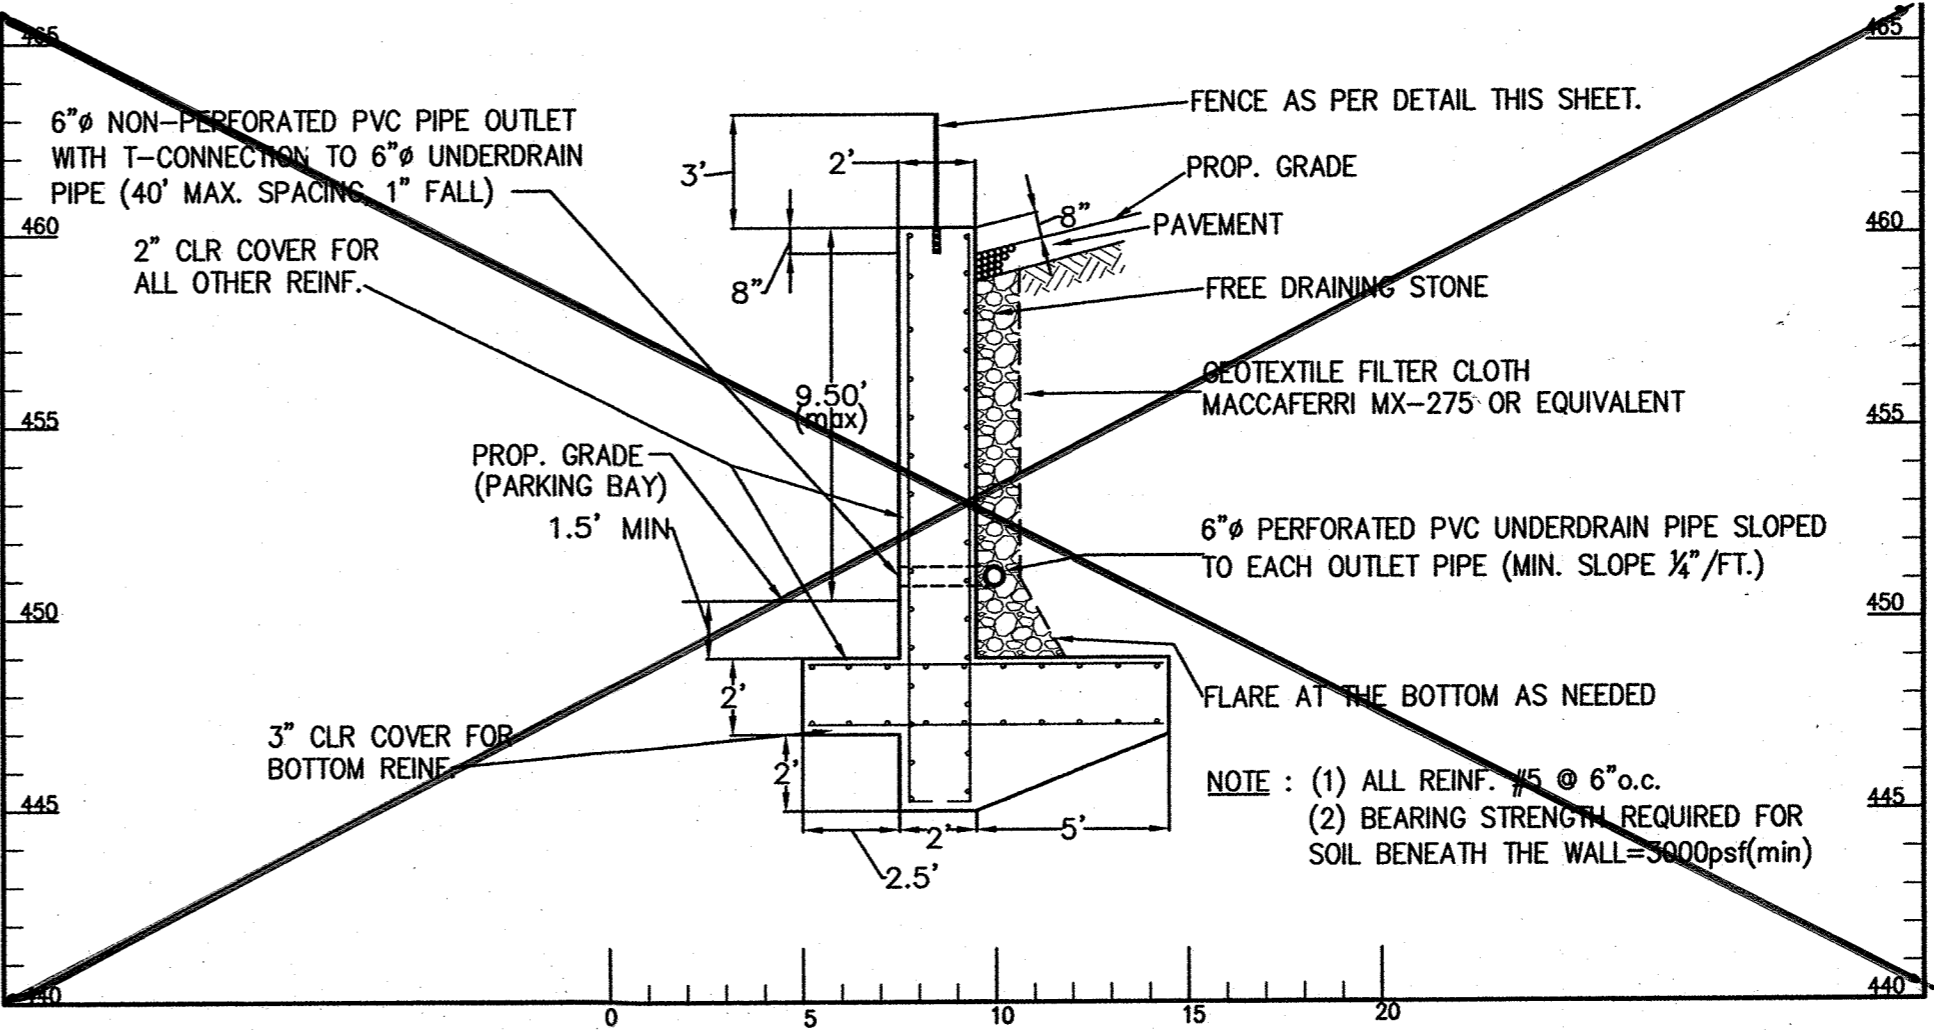


SECTION B-B & REINFORCEMENT DETAILS RETAINING WALLS (2)
SCALE: 1" = 5'

NOTE: ALL COORDINATES, DIMENSIONS AND STATIONING ARE GIVEN FOR OUTSIDE FACE OF RETAINING WALL.

LINE	BEARING	DISTANCE
L-1	180.44'	N 61° 55' 03" E
L-2	33.39'	N 28° 22' 16" E
L-4	16.96'	N 84° 22' 16" E
L-5	50.62'	N 05° 37' 44" W
L-6	10.00'	N 84° 22' 16" E
L-7	16.75'	N 05° 37' 44" W
L-8	12.00'	S 84° 22' 16" W

STRUCTURAL NOTES

- 1.0 DESIGN PARAMETERS
- 1.1 Design assumptions are as follows:
 - Effective Friction Angle (°) 30
 - Unit Weight (PCF) 120
 - Effective Cohesion (PSF) 0
 - Retained soil 30
 - Foundation soil 110
 - Bearing capacity of foundation soil: 3000 PSF
 - Surcharge: 250 PSF of equivalent live load (for retaining wall only)
 - No seismic analysis
- 2.0 MATERIAL
- 2.1 Concrete: All concrete shall develop a minimum compressive strength of 4,000 PSI in 28 days. All concrete shall have max. water cement ratio of 0.45.
 - 2.1.1 All concrete work shall conform to all the revisions of the "Specifications for the structural concrete for buildings" (ACI 301) & to the "Building code requirements for structural concrete" (ACI 318-02).
 - 2.1.2 The concrete shall conform to all the provisions of "Recommended practice for hot weather concreting" (ACI 305R-91) & "Recommended practice for cold weather concreting" (ACI 306R-88). All formwork shall be in accordance with the American Concrete Institute "Formwork for concrete" special publication no. 4 & ACI's "Standard recommended practice for concrete formwork" (ACI-347R).
 - 2.1.3 All concrete exposed to the weather shall have an air entrainment of 6% +/- 1%. No admixtures containing calcium chloride shall be permitted. The max. water cement ratio of concrete shall not exceed 0.5. The max. slump of all concrete shall be 5".
 - 2.1.4 One set of Compressive Test Cylinders for each 50 cubic yards poured, but not less than one set for each day's pour & each class of concrete, along with slump tests shall be performed by a testing laboratory approved by the structural engineer.
 - 2.2 Steel: Grade 60, 60000 PSI yield strength
 - 2.2.1 Reinforcing steel shall be deformed bars in accordance with ASTM A-615.
- 3.0 CONSTRUCTION NOTES
- 3.1 Retaining walls shall not be constructed on fill material.
- 3.2 Retaining walls shall only be constructed under the observation of a Maryland Registered Professional Engineer and a (NICET, WACEL or equivalent) certified soils technician.
- 3.3 The required bearing pressure beneath the footing of the wall shall be verified in the field by a certified soils technician. Testing documentation must be provided to the Howard County Inspector prior to the start of construction. The required test procedure shall be the dynamic cone penetrometer test ASTM STP-399.
- 3.4 The suitability of fill material shall be confirmed by the on-site soils technician. Each 8-inch lift must be compacted to a minimum of 95% Standard Proctor Density and the testing report shall be made available to the Howard County Inspector upon completion of construction.
- 3.5 For retaining walls, provide weep holes (6" Ø PVC PIPE) @ 40' spacing.
- 3.6 For retaining walls, provide expansion joint with spacing not to exceed 60 feet.
- 3.7 Laps in the reinforcement shall be as minimum as possible. Provide 40" lap-length for tensile bars & 35" lap-length for all other bars.
- 3.8 No structures or underground utilities are allowed within the maintenance easements or passing under the proposed retaining walls. The contractor should field verify for such before start constructing the walls and should relocate if anything comes across.
- 4.0 GENERAL
- 4.1 This drawing shall be read in conjunction with all other contract documents.
- 4.2 If conditions are different than those stated in the drawings, notes and specifications, the design modification may be needed prior to proceeding with construction.

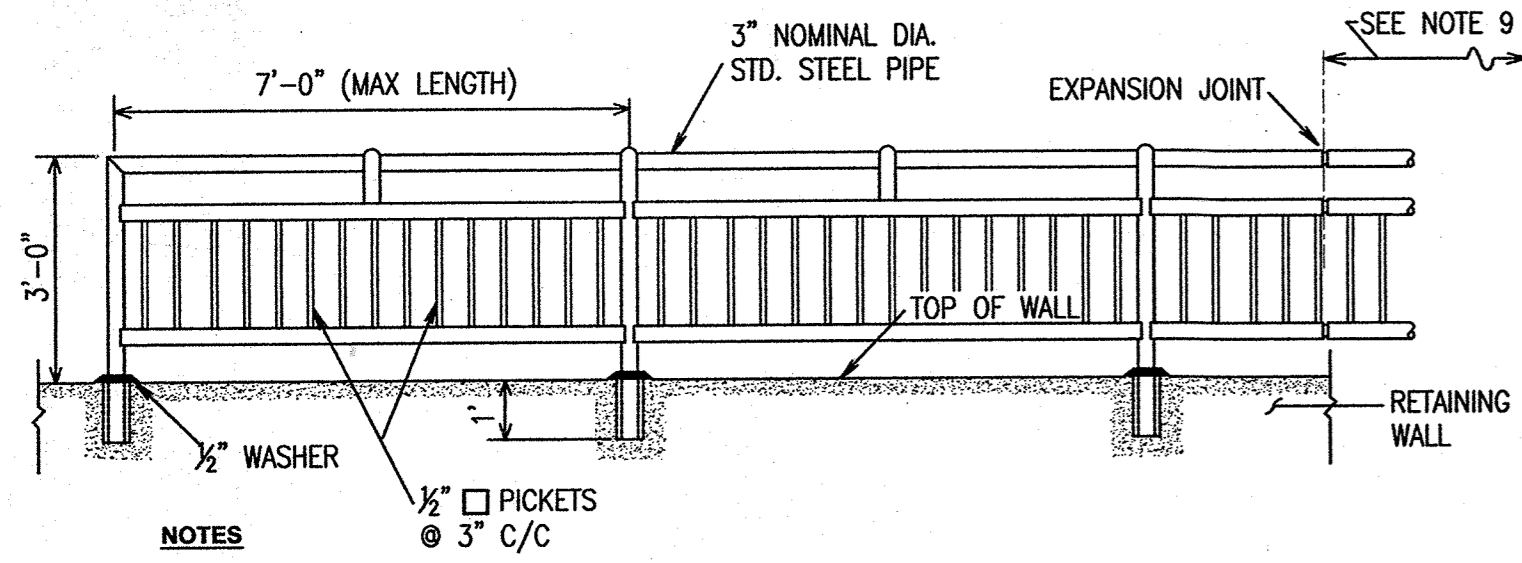

FENCE DETAIL NTS

APPROVED PLANNING BOARD OF HOWARD COUNTY
DATE 3/27/08

APPROVED: DEPARTMENT OF PLANNING AND ZONING
[Signatures]
Date: 6/27/08
Date: 6/20/08

[Signature: Michael D. Adcock]
MICHAEL D. ADCKOCK, PROFESSIONAL LAND SURVEYOR
MD REG. NO. 21257 EXPIRATION DATE 04-16-21

- NOTES:**
1. ALL DIMENSIONS ARE SUBJECT TO MFG. TOLERANCES.
 2. RAIL ELEMENTS ARE FURNISHED SHOP CLEANED, CONCRETE OR CONVEY TO RADI1 BETWEEN 20 FT. AND 150 FT.
 3. THE STEEL FOR RAIL ELEMENTS AND BOLTS IS OF A QUALITY TO DEVELOP SPECIFICATION VALUES FOR BEAM AND TENSILE STRENGTHS.
 4. FOR MATERIALS, MATERIAL PROCESSING AND ASSEMBLY, SEE SPECIFICATIONS.
 5. FOR OFFSET BRACKET DETAIL, SEE STD. NO. R-7-02
 6. POSTS TO BE N5-9.
 7. BACK-UP PLATE (1/2" LENGTH OF BEAM) CENTERED OR OFFSET BRACKET BOLT TO BE PLACED WHERE NO OVERLAP OF RAIL SPLICE OCCURS.

HOWARD COUNTY, MARYLAND DEPARTMENT OF PUBLIC WORKS
APPROVED: *[Signature]* DATE: *[Blank]*
CHIEF, BUREAU OF ENGR.

GUARD RAIL W/BEAM GENERAL NOTES AND DETAILS
DRAWN BY: *[Blank]*
CHECKED BY: *[Blank]*
NO SCALE
R-2.01


OWNER:
MANGIONE ENTERPRISES OF TURF VALLEY LIMITED PARTNERSHIP
1205 YORK ROAD
LUTHERVILLE, MARYLAND 21093
PHONE: (410) 825-8400

AS-BUILT
RETAINING WALLS 1&2 - PLANS, SECTIONS & DETAILS


TURF VALLEY, LORIAN NURSING HOME & ASSISTED LIVING FACILITY
OAKMONT AT TURF VALLEY PARCEL Q
PLATS 18773 - 18775
TAX MAP 16 - P/O PARCEL 8- GRID 16 & 17; POD 1 per S-86-13 (4th AMENDED)
THIRD ELECTION DISTRICT HOWARD COUNTY, MARYLAND

KCE ENGINEERING, INC.
EXECUTIVE CENTER
3300 NORTH RIDGE ROAD, SUITE 315
ELLCOTT CITY, MARYLAND 21043
PHONE (410) 203-9800 FAX (410) 203-9228

[Professional Certification Stamp]
Professional Certification. I hereby certify that these documents were prepared or approved by me, and that I am a duly licensed professional engineer under the laws of the State of Maryland, License No. 8818, Expiration Date: 10/17/08.
DRAWN BY: MG
CHECKED BY: DVK
SCALE: AS SHOWN
DATE: 04/30/2008

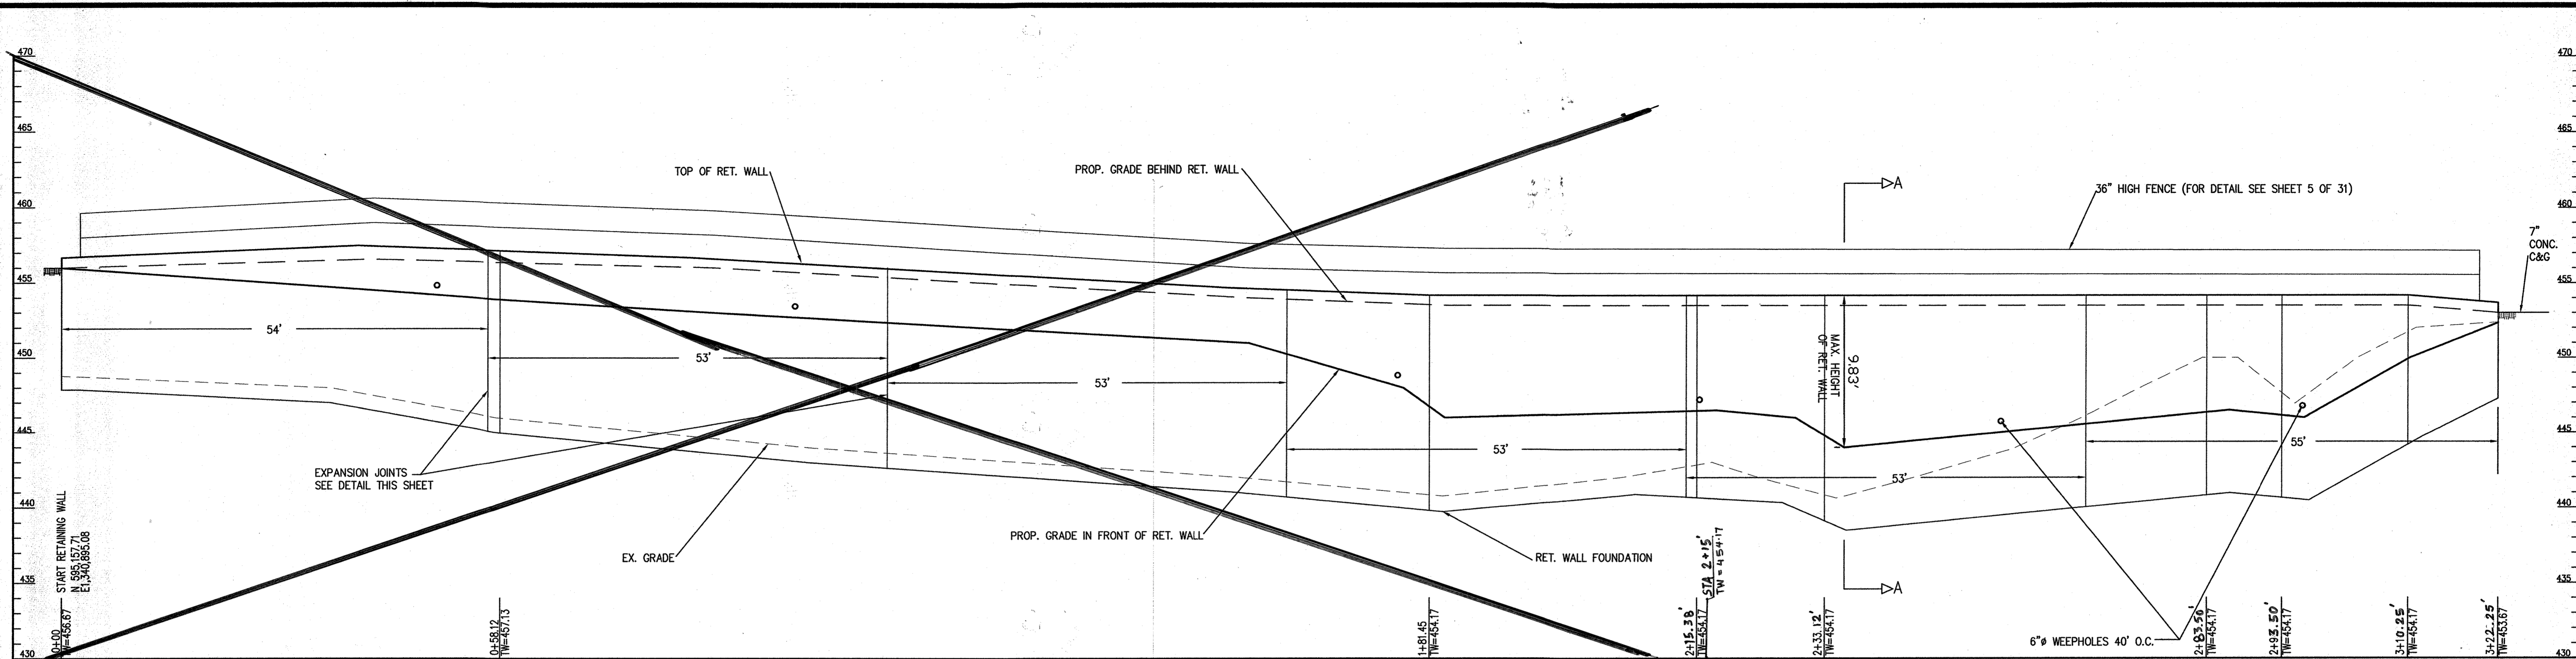

ELEVATION-CONCRETE RETAINING WALL (1)
SCALE: V 1" = 5', H 1" = 10'

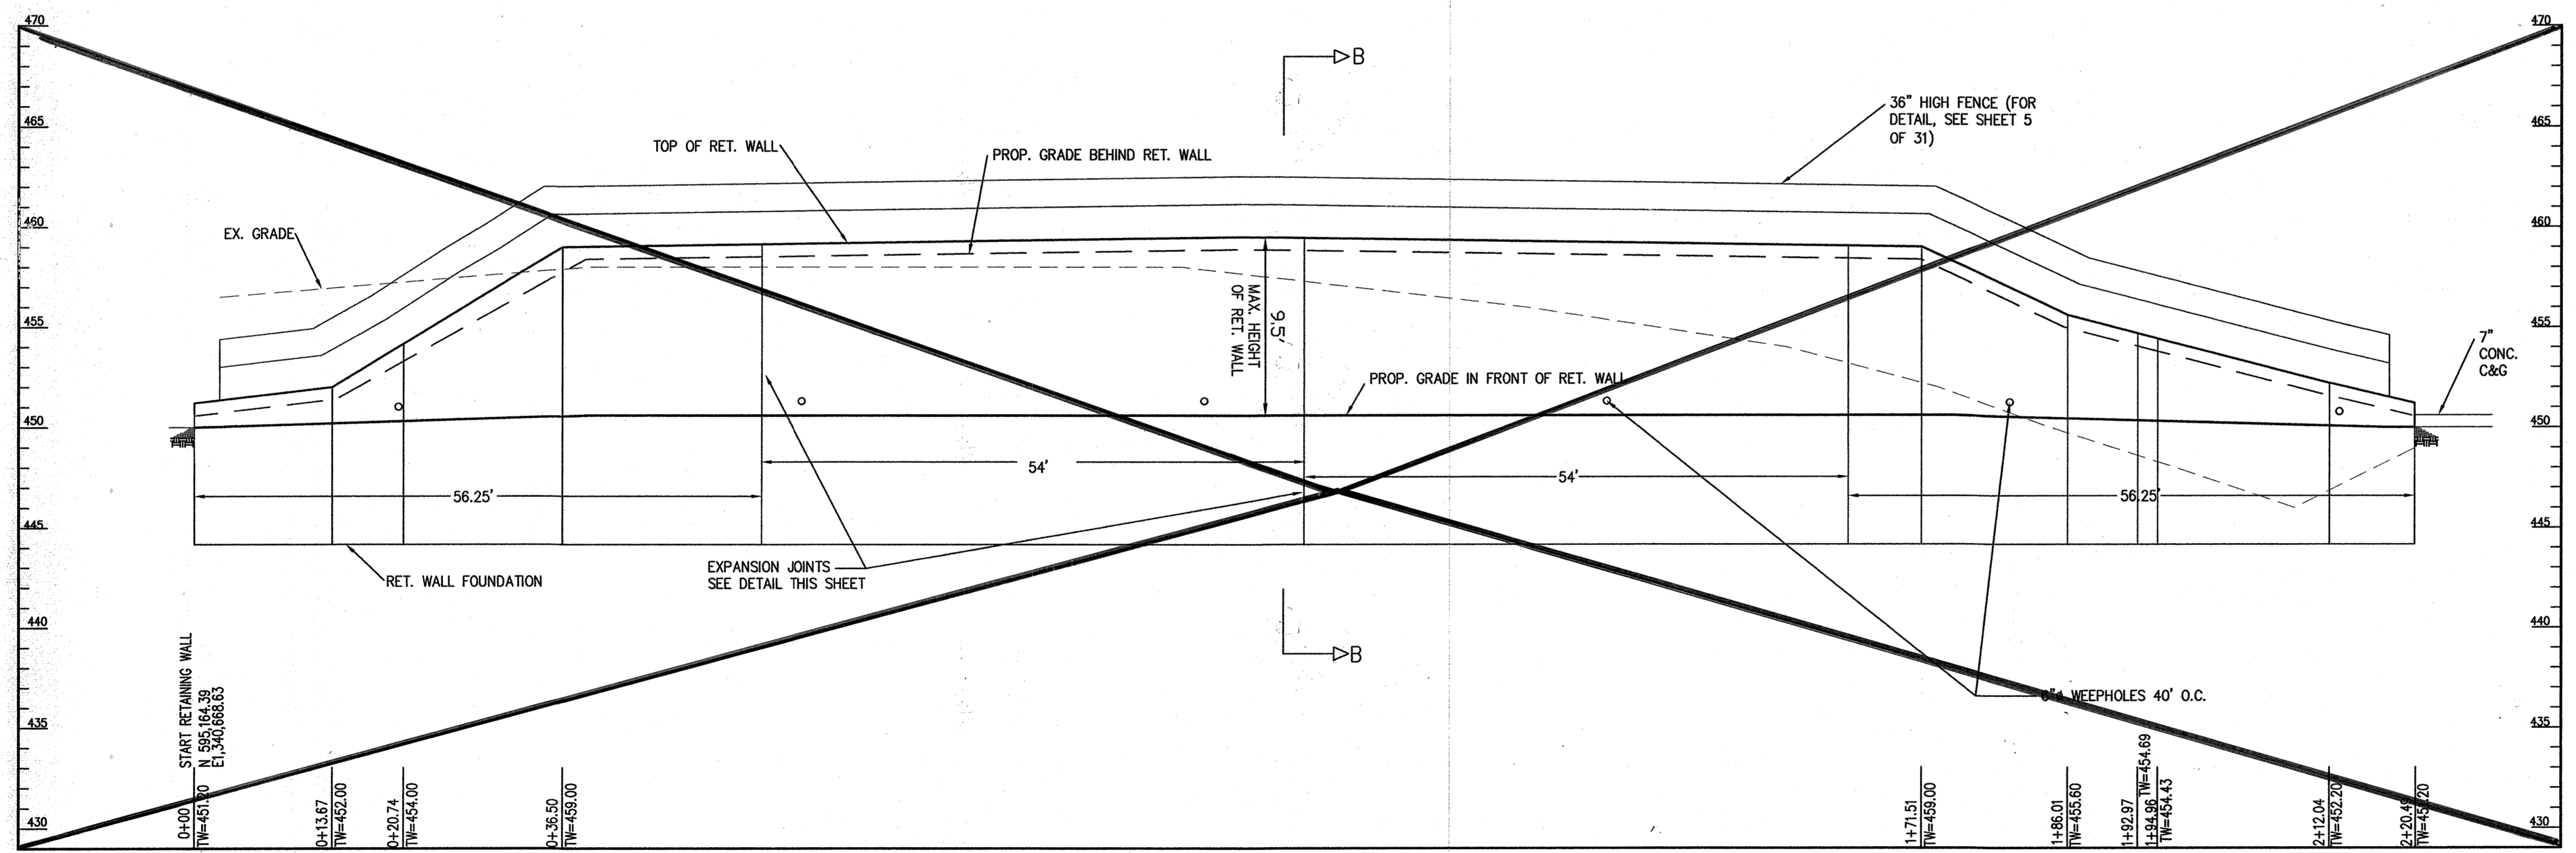

ELEVATION-CONCRETE RETAINING WALL (2)
SCALE: V 1" = 5', H 1" = 10'

OWNER
MANGIONE ENTERPRISES OF TURF VALLEY
LIMITED PARTNERSHIP
1205 YORK ROAD
LUTHERVILLE, MARYLAND 21093
PHONE: (410) 825-8400

AS-BUILT RETAINING WALLS 1&2- ELEVATIONS

TURF VALLEY, LORIE
NURSING HOME & ASSISTED LIVING FACILITY
OAKMONT AT TURF VALLEY
PARCEL Q
PLATS 18773 - 18775
TAX MAP 16 - P/O PARCEL 8- GRID 16 & 17;
POD I per S-86-13 (4th AMENDED)
THIRD ELECTION DISTRICT HOWARD COUNTY, MARYLAND

KCE ENGINEERING, INC.
EXECUTIVE CENTER
3300 NORTH RIDGE ROAD, SUITE 315
ELLCOTT CITY, MARYLAND 21043
PHONE (410) 203-9800 FAX (410) 203-9228

APPROVED
PLANNING BOARD
OF HOWARD COUNTY
DATE 3/27/08
[Signature]

APPROVED: DEPARTMENT OF PLANNING AND ZONING

[Signature] 4/2/08
Chief, Development Engineering Division Date

[Signature] 6/2/08
Chief, Division of Land Development Date

[Signature] 6/20/08
Director Date

NOTE: ALL COORDINATES, DIMENSIONS AND STATIONING ARE GIVEN FOR OUTSIDE FACE OF RETAINING WALL.

AS-BUILT CERTIFICATION

THERE IS NO "AS-BUILT" INFORMATION PROVIDED ON THIS SHEET

[Signature] 3/23/11
MICHAEL D. ADCOCK, PROFESSIONAL LAND SURVEYOR
MD REG. NO. 81252 EXPIRATION DATE: 08-16-21
DATE

NO.	BY	DATE	REVISION
1	KCE	07/16/08	REVISED RETAINING WALL 1 & 2.

Professional Certification. I hereby certify that these documents were prepared or approved by me, and that I am a duly licensed professional engineer under the laws of the State of Maryland, License No. 8818, Expiration Date: 10/17/08.

[Signature] 4/21/08

DRAWN BY: MG
CHECKED BY: DVK
SCALE: AS SHOWN
DATE: 04/30/2008

SHEET: **6**
OF
36

SPECIFICATIONS
MODULAR CONCRETE BLOCK RETAINING WALL

PART 1: GENERAL

1.01 Description
 A. Work shall consist of furnishing and construction of a Modular Block Retaining Wall System. In accordance with these specifications and in reasonably close conformity with the lines, grades, design, and dimensions shown on the plans.
 B. Work includes preparing foundation soil, furnishing and installing leveling pad, unit drainage fill and backfill to the lines and grades shown on the construction drawings.
 C. Work includes furnishing and installing geogrid soil reinforcement of the type, size, location, and lengths designated on the construction drawings.

1.02 Delivery, Storage and Handling
 A. Contractor shall check all materials upon delivery to assure that the proper type, grade, color, and certification has been received.
 B. Contractor shall protect all materials from damage due to job site conditions and in accordance with manufacturer's recommendations. Damaged materials shall not be incorporated into the work.

PART 2: PRODUCTS

2.01 Modular Concrete Retaining Wall Units
 A. Modular concrete units shall conform to the following architectural requirements:
 face color - concrete gray - standard manufacturers' color may be specified by the Owner.
 face finish - sculptured rock face in angular tri-planer configuration. Other face finishes will not be allowed without written approval of Owner.
 bond configuration - running with bonds nominally located at midpoint vertically adjacent units, in both straight and curved alignments.
 exposed surfaces of units shall be free of chips, cracks or other imperfections when viewed from a distance of 10 feet under diffused lighting.
 B. Modular concrete materials shall conform to the requirements of ASTM C1372 - Standard Specifications for Segmental Retaining Wall Units.
 C. Modular concrete units shall conform to the following structural and geometric requirements measured in accordance with appropriate references:
 compressive strength = 3000 psi minimum;
 absorption = 9% maximum (6% in northern states) for standard weight aggregates;
 dimensional tolerances = ± 1/8" from nominal unit dimensions not including rough split unit dimensions not including rough split face, ± 1/16" unit height - top and bottom planes;
 unit size - 8" (H) x 22" (W) x 18" (D) minimum;
 unit weight - 95 lbs/unit minimum for standard weight aggregates;
 inter-unit shear strength - 600 pif minimum at 2 psi normal pressure;
 geogrid/unit peak connection strength - 600 pif minimum at 2 psi normal force.
 D. Modular concrete units shall conform to the following constructability requirements:
 vertical setback = 1/8" per course (near vertical) or 1" per course per the design;
 alignment and grid positioning mechanism - fiberglass pins, two per unit minimum;
 maximum horizontal gap between erected units shall be - 1/2 inch.

2.03 Base Leveling Pad Material
 A. Material shall consist of a compacted #57 crushed stone base as shown on the construction drawings.

2.04 Unit Drainage Fill
 A. Unit drainage fill shall consist of #57 crushed stone

2.05 Reinforced Backfill
 A. Reinforced backfill shall type SM, be free of debris and meet the following gradation tested in accordance with ASTM D-422 and meet other properties shown on the plan:

Sieve Size	Percent Passing
2 inch	100-75
3/4 inch	100-75
No. 40	0-80
No. 200	0-40

Plasticity Index (PI) <10 and Liquid Limit <40 per ASTM D-4318.
 B. Material can be site excavated soils where the above requirements can be met. Unsuitable soils for backfill (high plastic clays or organic soils) shall not be used in the reinforced soil mass.

2.06 Geogrid Soil Reinforcement
 A. Geosynthetic reinforcement shall consist of geogrids manufactured specifically for soil reinforcement applications and shall be manufactured from high tenacity polyester yarn.

2.07 Drainage Pipe
 A. The drainage pipe shall be perforated corrugated HDPE pipe manufactured in accordance with ASTM D-1248.

PART 3 EXECUTION

3.01 Excavation
 A. Contractor shall excavate to the lines and grades shown on the construction drawings. Owner's representative shall be responsible for inspecting and approving the excavation prior to placement of leveling material or fill soils.

3.02 Base Leveling Pad
 A. Leveling pad material shall be placed to the lines and grades shown on the construction drawings, to a minimum thickness of 6 inches and extend laterally a minimum of 6" in front and behind the modular wall unit.
 B. Leveling pad shall be prepared to insure full contact to the base surface of the concrete units.

3.03 Modular Unit Installation
 A. First course of units shall be placed on the leveling pad at the appropriate line and grade. Alignment and level shall be checked in all directions and insure that all units are in full contact with the base and properly seated.
 B. Place the front of units side-by-side. Do not leave gaps between adjacent units. Layout of corners and curves shall be in accordance with manufacturer's recommendations.
 C. Install shear/connecting devices per manufacturer's recommendations.
 D. Place and compact drainage fill within and behind wall units. Place and compact backfill soil behind drainage fill. Follow wall erection and drainage fill closely with structure backfill.

E. Maximum stacked vertical height of wall units, prior to unit drainage fill and backfill placement and compaction, shall not exceed three courses.

3.04 Structural Geogrid Installation
 A. Geogrid shall be oriented with the highest strength axis perpendicular to the wall alignment.
 B. Geogrid reinforcement shall be placed at the strengths, lengths, and elevations shown on the construction design drawings or as directed by the Engineer.
 C. The geogrid shall be laid horizontally on compacted backfill and attached to the modular wall units. Place the next course of modular concrete units over the geogrid. The geogrid shall be pulled taut, and anchored prior to backfill placement on the geogrid.
 D. Geogrid reinforcements shall be continuous throughout their embedment lengths and placed side-by-side to provide 100% coverage at each level. Spliced connections between shorter pieces of geogrid or gaps between adjacent pieces of geogrid are not permitted.

3.05 Reinforced Backfill Placement
 A. Reinforced backfill shall be placed, spread, and compacted in such a manner that minimizes the development of slack in the geogrid and installation damage.
 B. Reinforced backfill shall be placed and compacted in lifts not to exceed 6 inches where hand compaction is used, or 8 - 10 inches where heavy compaction equipment is used. Lift thickness shall be decreased to achieve the required density as required.
 C. Reinforced backfill shall be compacted to 95% of the maximum density as determined by ASTM D698. The moisture content of the backfill material prior to and during compaction shall be uniformly distributed throughout each layer and shall be + 3% to - 3% of optimum.
 D. Only lightweight hand-operated equipment shall be allowed within 3 feet from the tail of the modular concrete unit.
 E. Tracked construction equipment shall not be operated directly upon the geogrid reinforcement. A minimum fill thickness of 6 inches is required prior to operation of tracked vehicles over the geogrid. Tracked vehicle turning should be kept to a minimum to prevent tracks from displacing the fill and damaging the geogrid.
 F. Rubber tired equipment may pass over geogrid reinforcement at slow speeds, less than 10 MPH. Sudden braking and sharp turning shall be avoided.
 G. At the end of each day's operation, the Contractor shall slope the last lift of reinforced backfill away from the wall units to direct runoff away from wall face. The Contractor shall not allow surface runoff from adjacent areas to enter the wall construction site.

3.06 Cap Installation
 A. Cap units shall be glued to underlying units with an all-weather adhesive recommended by the manufacturer.

3.07 Field Quality Control
 A. The Owner shall engage inspection and testing services, including independent laboratories, to provide quality assurance and testing services during construction.
 B. As a minimum, quality assurance testing should include foundation soil inspection, soil and backfill testing, verification of design parameters, and observation of construction for general compliance with design drawings and specifications.

NOTES:

- No trees shall be planted within 10 feet of the top of the retaining wall.
- Retaining walls shall only be constructed under the observation of a registered professional engineer and a (NICET, WACEL, or equiv.) certified soils technician.
- One soil boring shall be required every one hundred feet along the entire length of the wall. Copies of all boring reports shall be provided to the Howard County Inspector prior to the start of construction.
- The required bearing pressure beneath the wall system shall be verified in the field by a certified soils technician. Testing documentation must be provided to the Howard County Inspector prior to start of construction. The required bearing test shall be the Dynamic Cone Penetrometer test ASTM S7P-399.
- The suitability of fill material shall be confirmed by the on-site soils technician. Each 8" lift must be compacted to a minimum 95% standard proctor density and the testing report shall be made available to the Howard County Inspector upon completion of construction.
- Walls shall not be constructed on uncertified fill materials.
- Walls shall not be constructed within a Howard Co. right-of-way or easement.

SEGMENTAL BLOCK RETAINING WALLS #1 & 2 PLAN AND DETAILS



TURF VALLEY, LORIAN
NURSING HOME & ASSISTED LIVING
 AS-BUILT
 OAKMONT AT TURF VALLEY
 PARCEL Q
 PLATS 18773 - 18775
 TAX MAP 16 - P/O PARCEL 8- GRID 16 & 17;
 POD 1 per S-86-13 (4th AMENDED)
 FIFTH ELECTION DISTRICT HOWARD COUNTY, MARYLAND

HILLIS-CARNES
ENGINEERING ASSOCIATES
 10975 Guilford Road, Suite A Annapolis Junction, Maryland
 (410) 880-4788 Fax: (410) 880-4098

PROFESSIONAL CERTIFICATION
 I HEREBY CERTIFY THAT THESE PLANS WERE PREPARED OR APPROVED BY ME, AND THAT I AM A DULY LICENSED PROFESSIONAL ENGINEER UNDER THE LAWS OF THE STATE OF MARYLAND. LICENSE NO. 14434 EXPIRATION DATE: 08/13/09

HCEA NO: 08209-B
 DRAWN BY: AM
 CHECKED BY: RWS
 SCALE: AS SHOWN
 DATE: 08/11/2008

SHEET: 7 OF 36

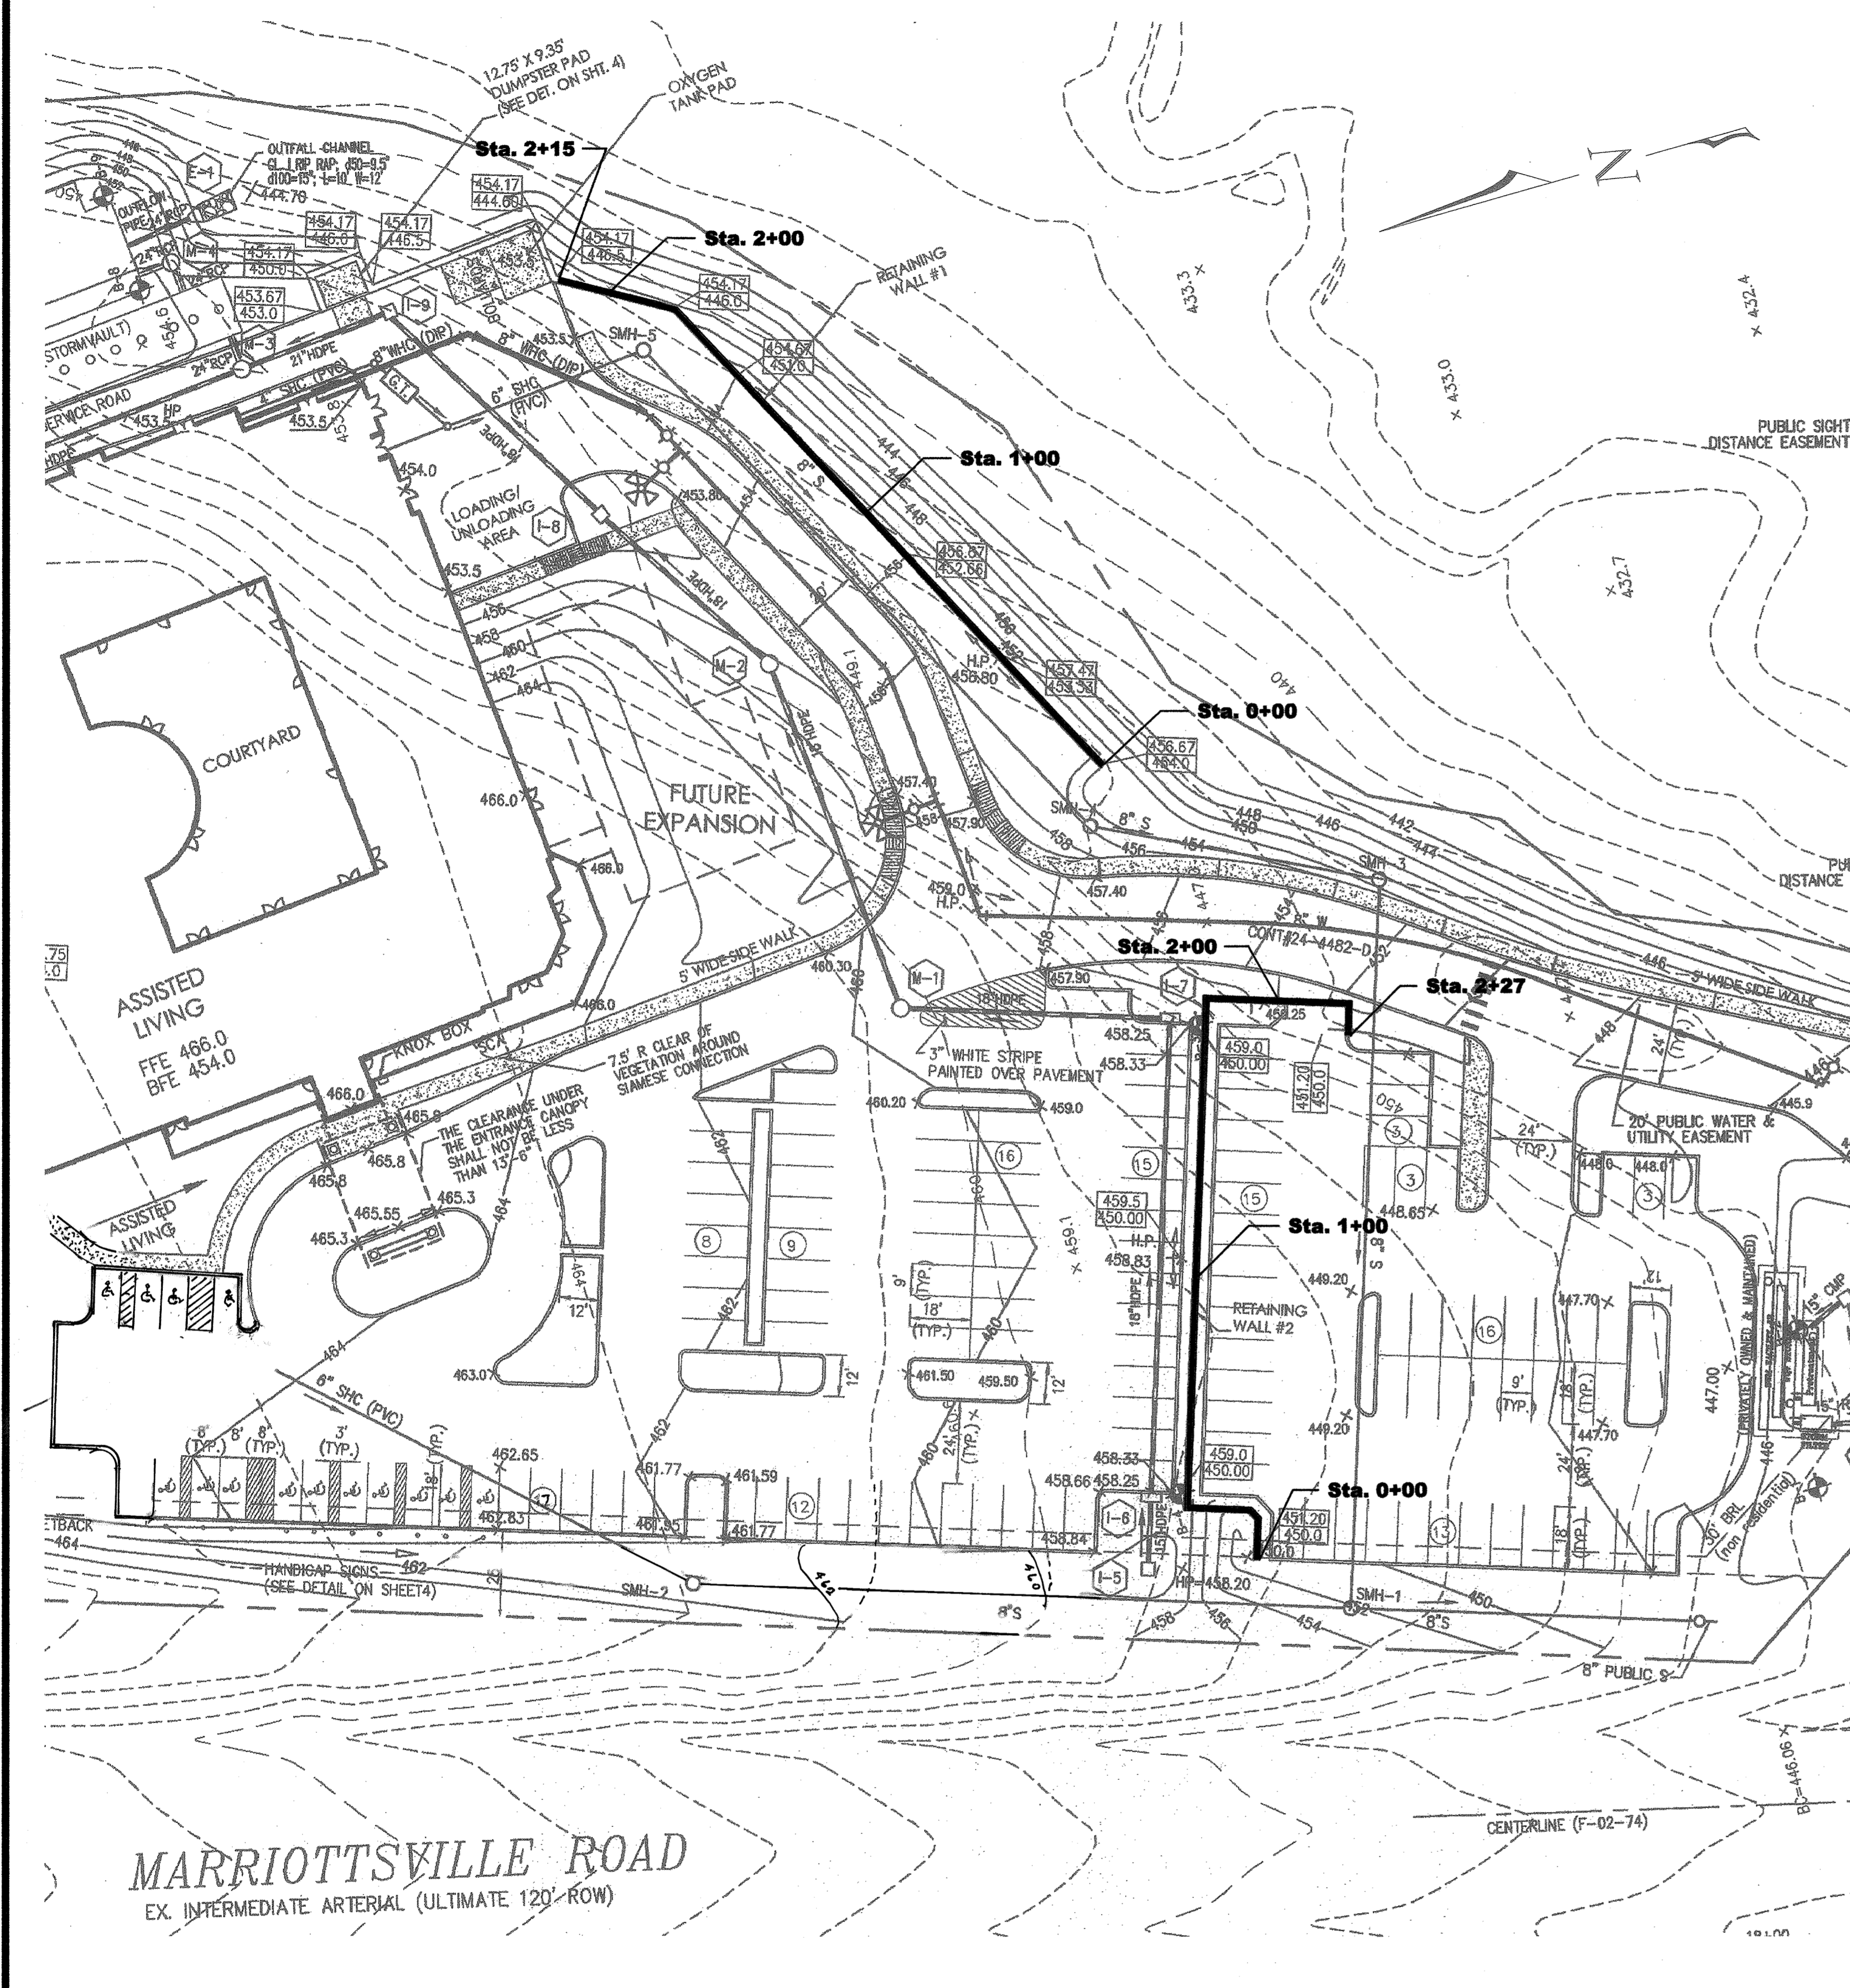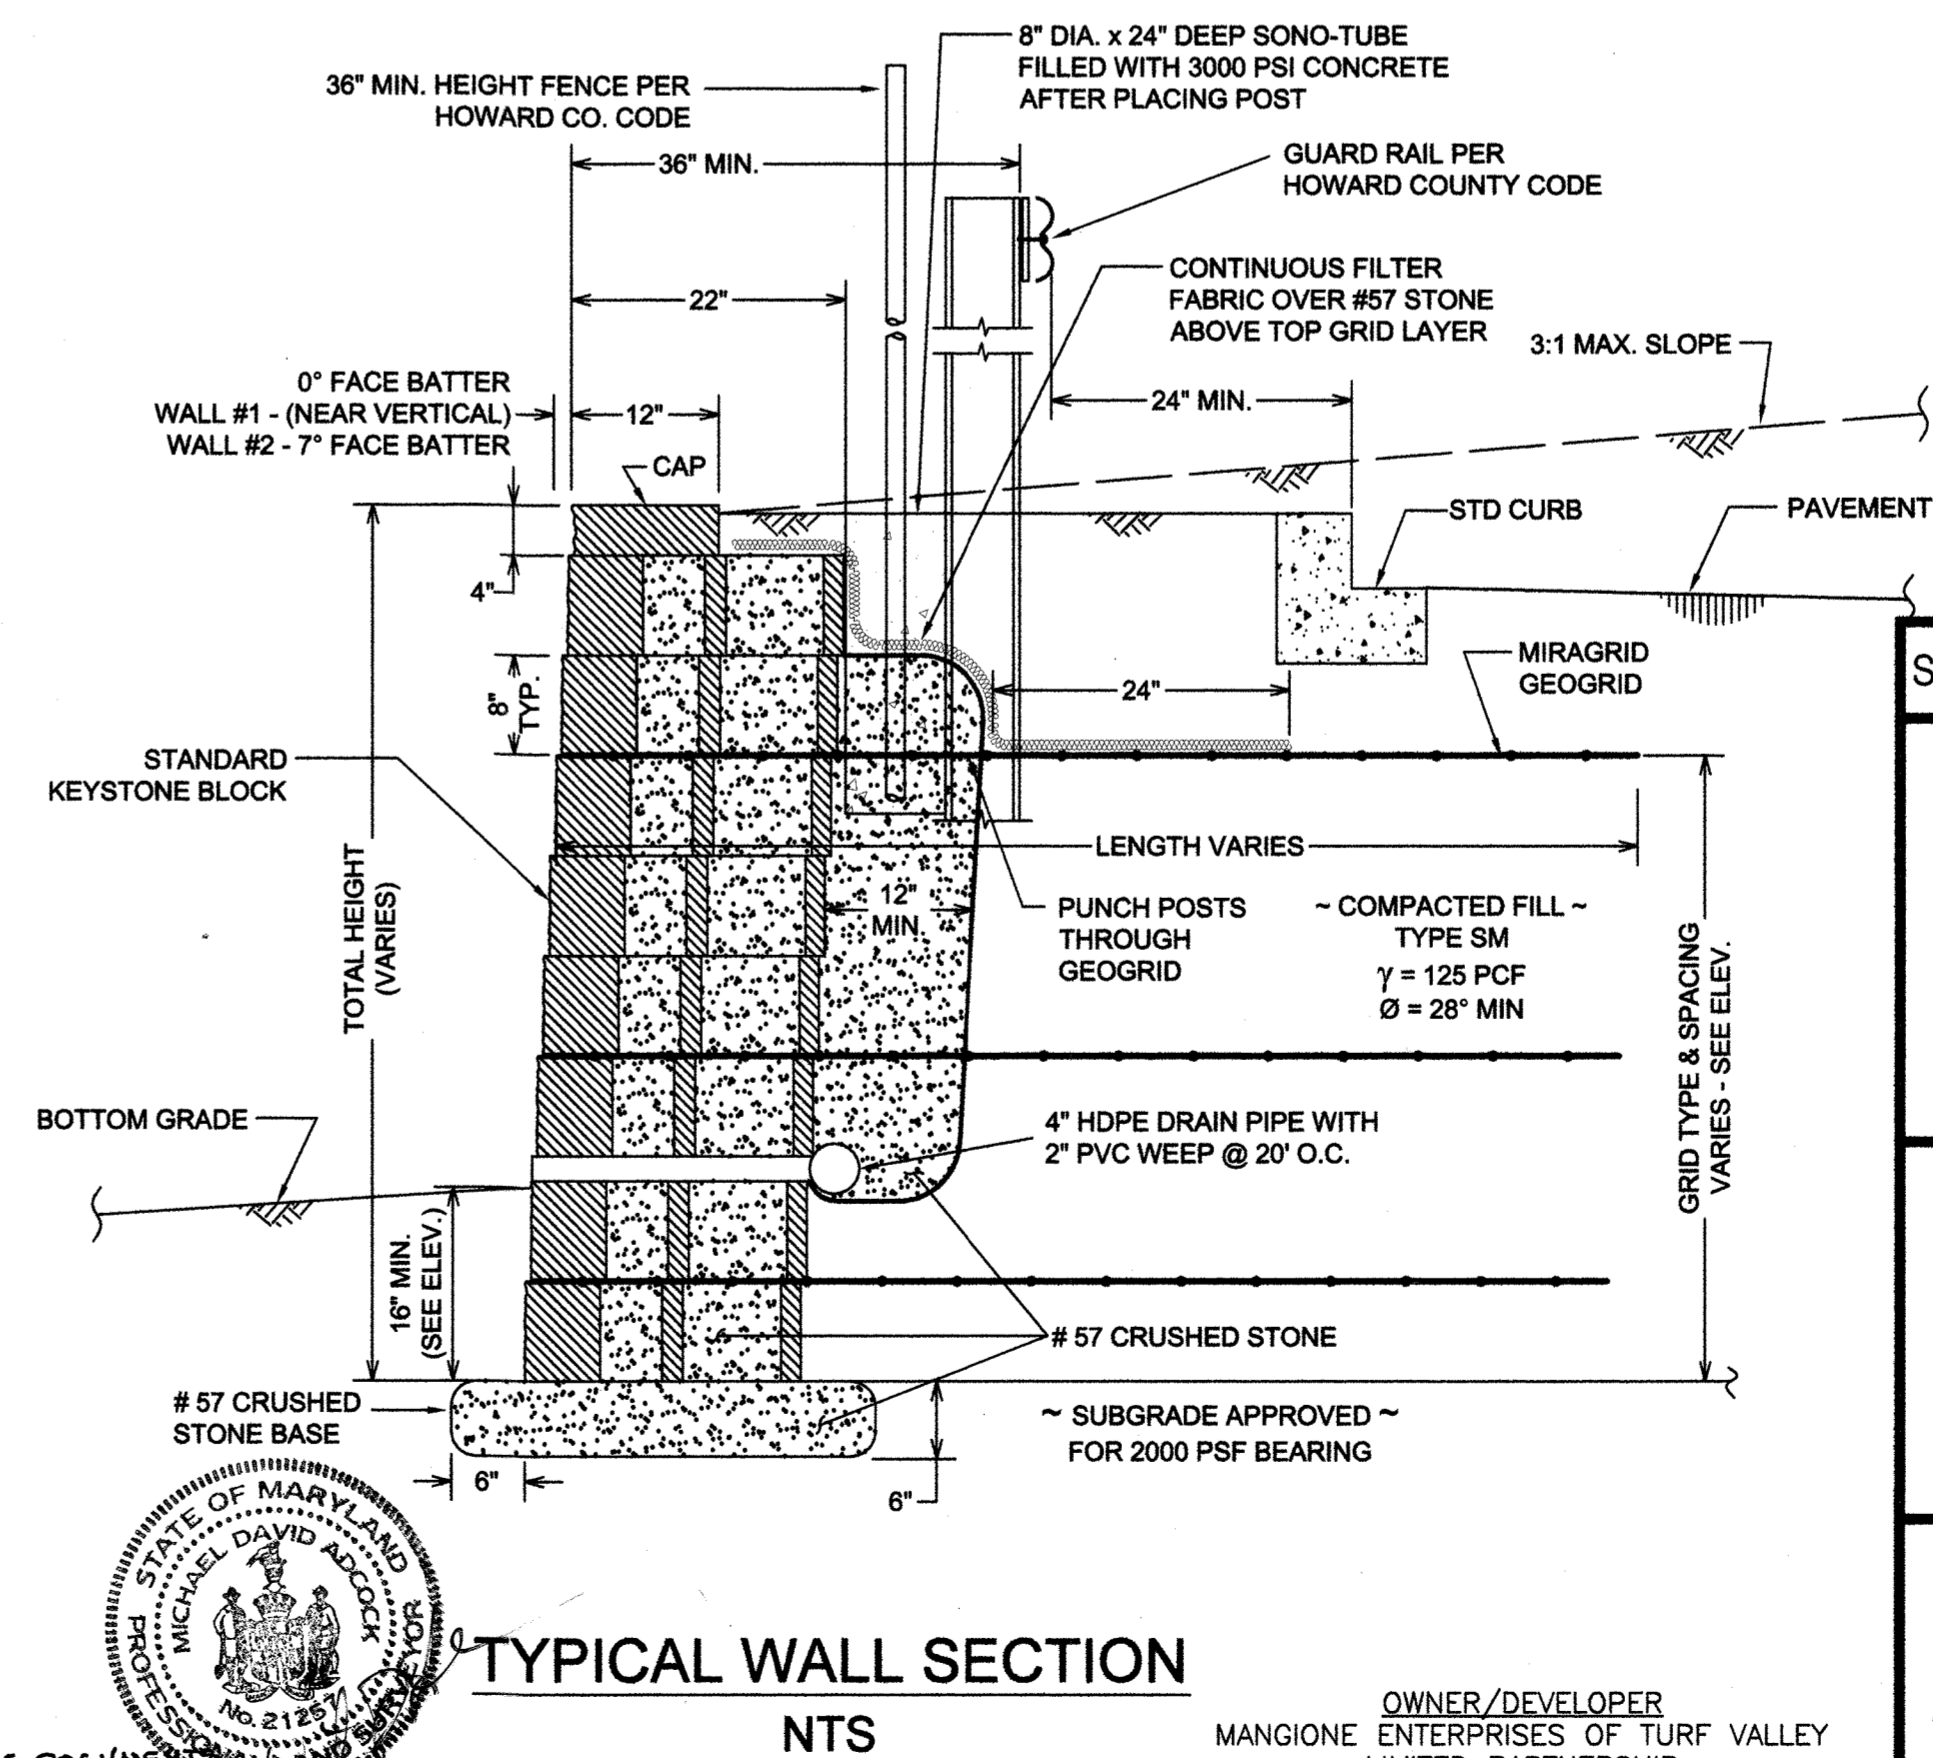

AS-BUILT CERTIFICATION

I HEREBY CERTIFY, BY MY SEAL, THAT THE CONDITIONS SHOWN ON THIS PLAN WERE CONSTRUCTED TO THE LINES AND GRADES SHOWN ON THIS AS-BUILT PLAN AND MEET THE APPROVED PLANS AND SPECIFICATIONS AND ALSO THAT THESE DOCUMENTS WERE PREPARED BY ME OR UNDER MY RESPONSIBLE CHARGE AND THAT I AM A DULY LICENSED PROFESSIONAL LAND SURVEYOR UNDER THE LAWS OF THE STATE OF MARYLAND.

Michael D. Adcock
 MICHAEL D. ADCOCK, PROFESSIONAL LAND SURVEYOR
 MD REG. NO. 21257, EXPIRATION DATE 06-16-21

8/23/19

PROFESSIONAL CERTIFICATION: I HEREBY CERTIFY THAT THESE DOCUMENTS WERE PREPARED OR APPROVED BY ME, AND THAT I AM A DULY LICENSED PROFESSIONAL LAND SURVEYOR UNDER THE LAWS OF THE STATE OF MARYLAND, REG. NO. 21257, EXPIRATION DATE 6-16-2019



APPROVED: DEPARTMENT OF PLANNING AND ZONING

Chief, Development Engineering Division
 Chief, Division of Land Development
 Director

8/26/08
 8/26/08
 8/26/10

REFER TO GRADING PLAN (C-3) FOR ELEVATIONS.

OWNER/DEVELOPER
 MANGIONE ENTERPRISES OF TURF VALLEY
 LIMITED PARTNERSHIP
 1205 YORK ROAD, PENTHOUSE
 LUTHERVILLE, MARYLAND 21093
 PHONE (410) 825-8400

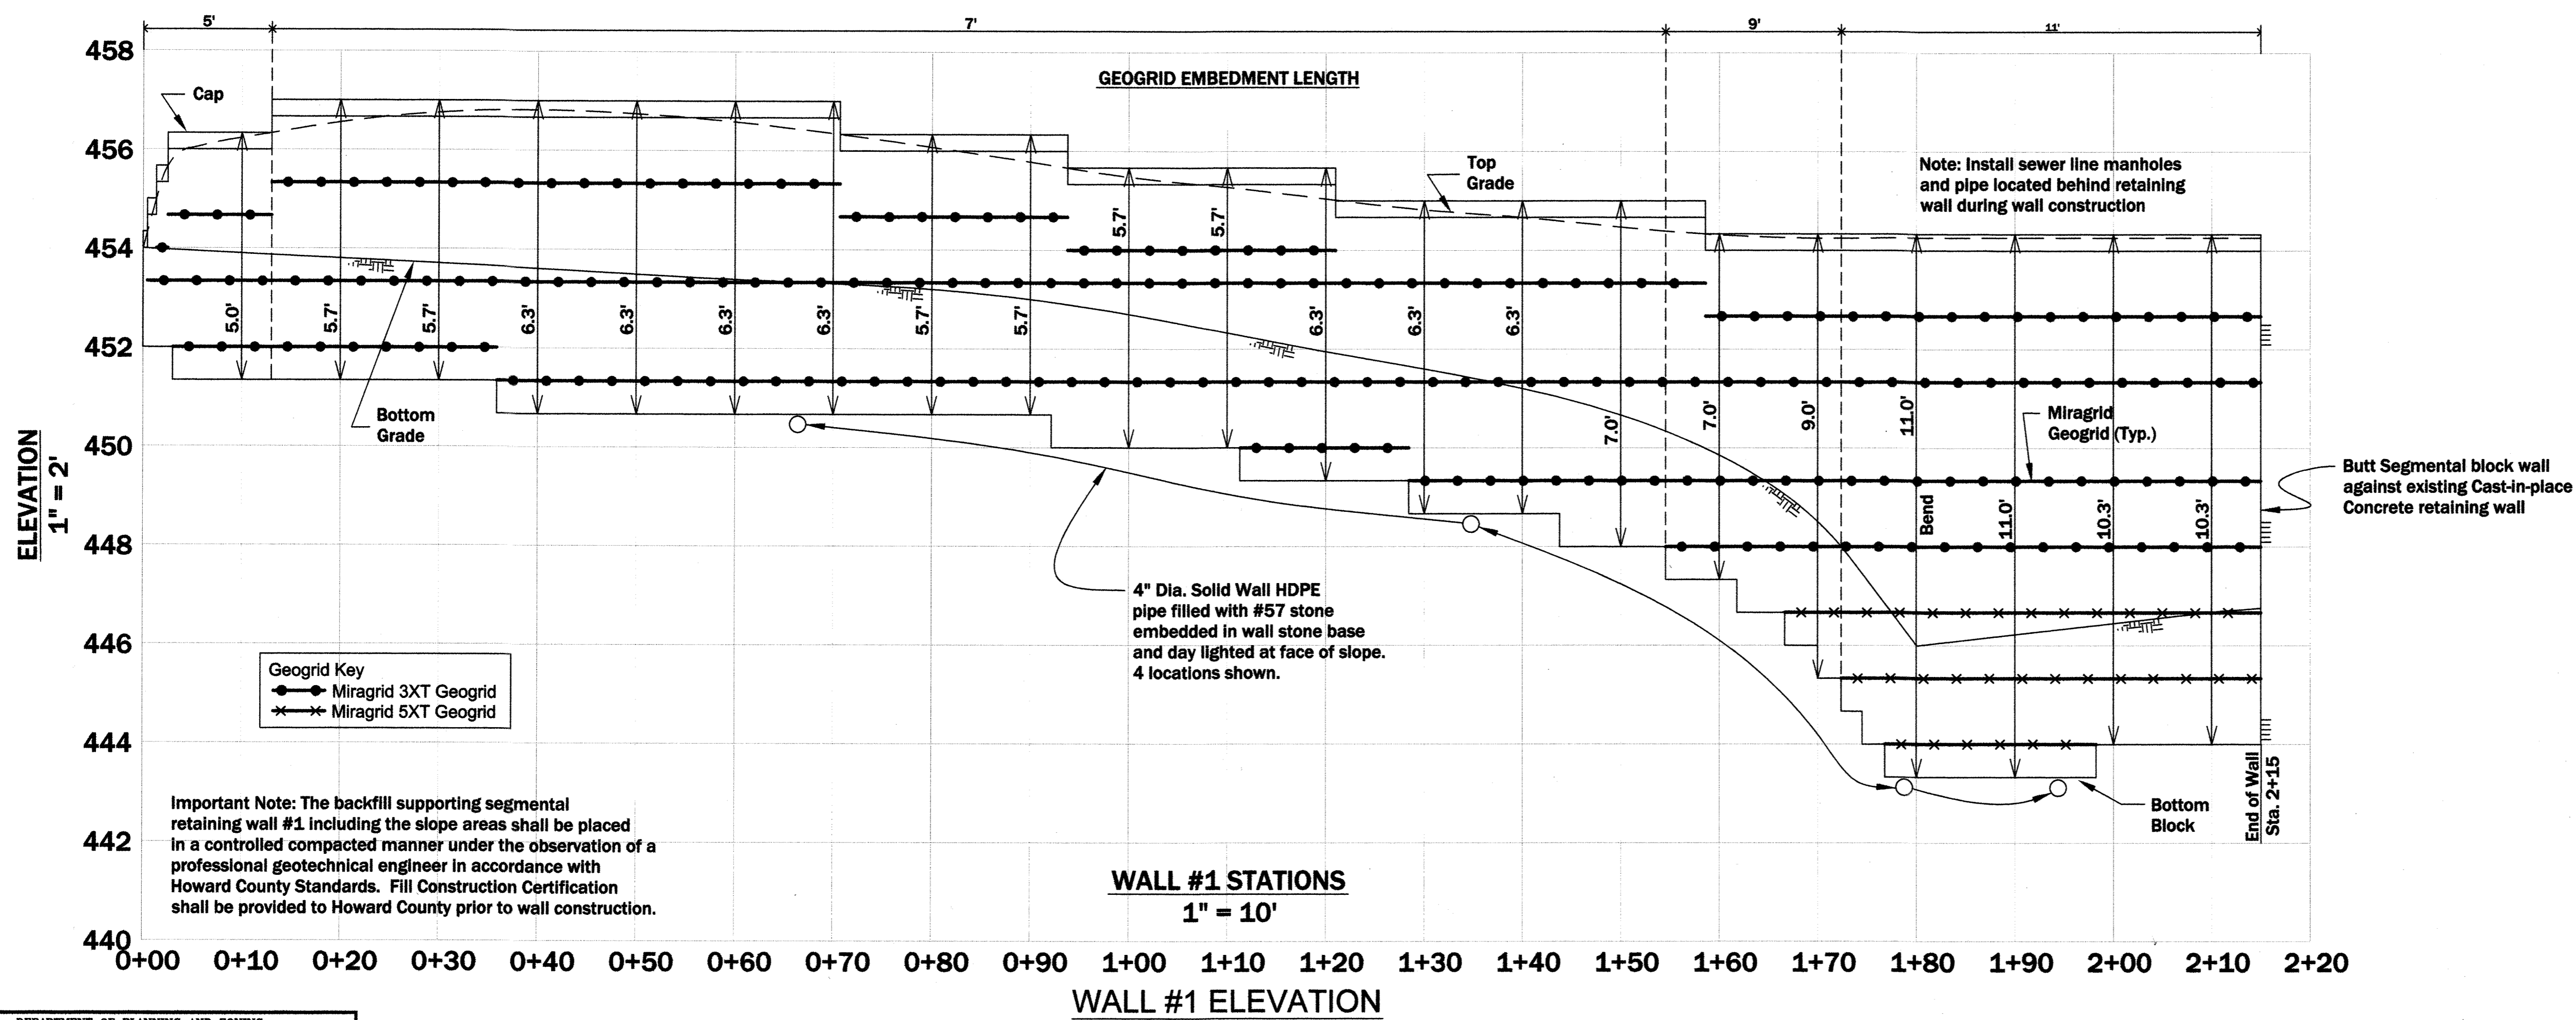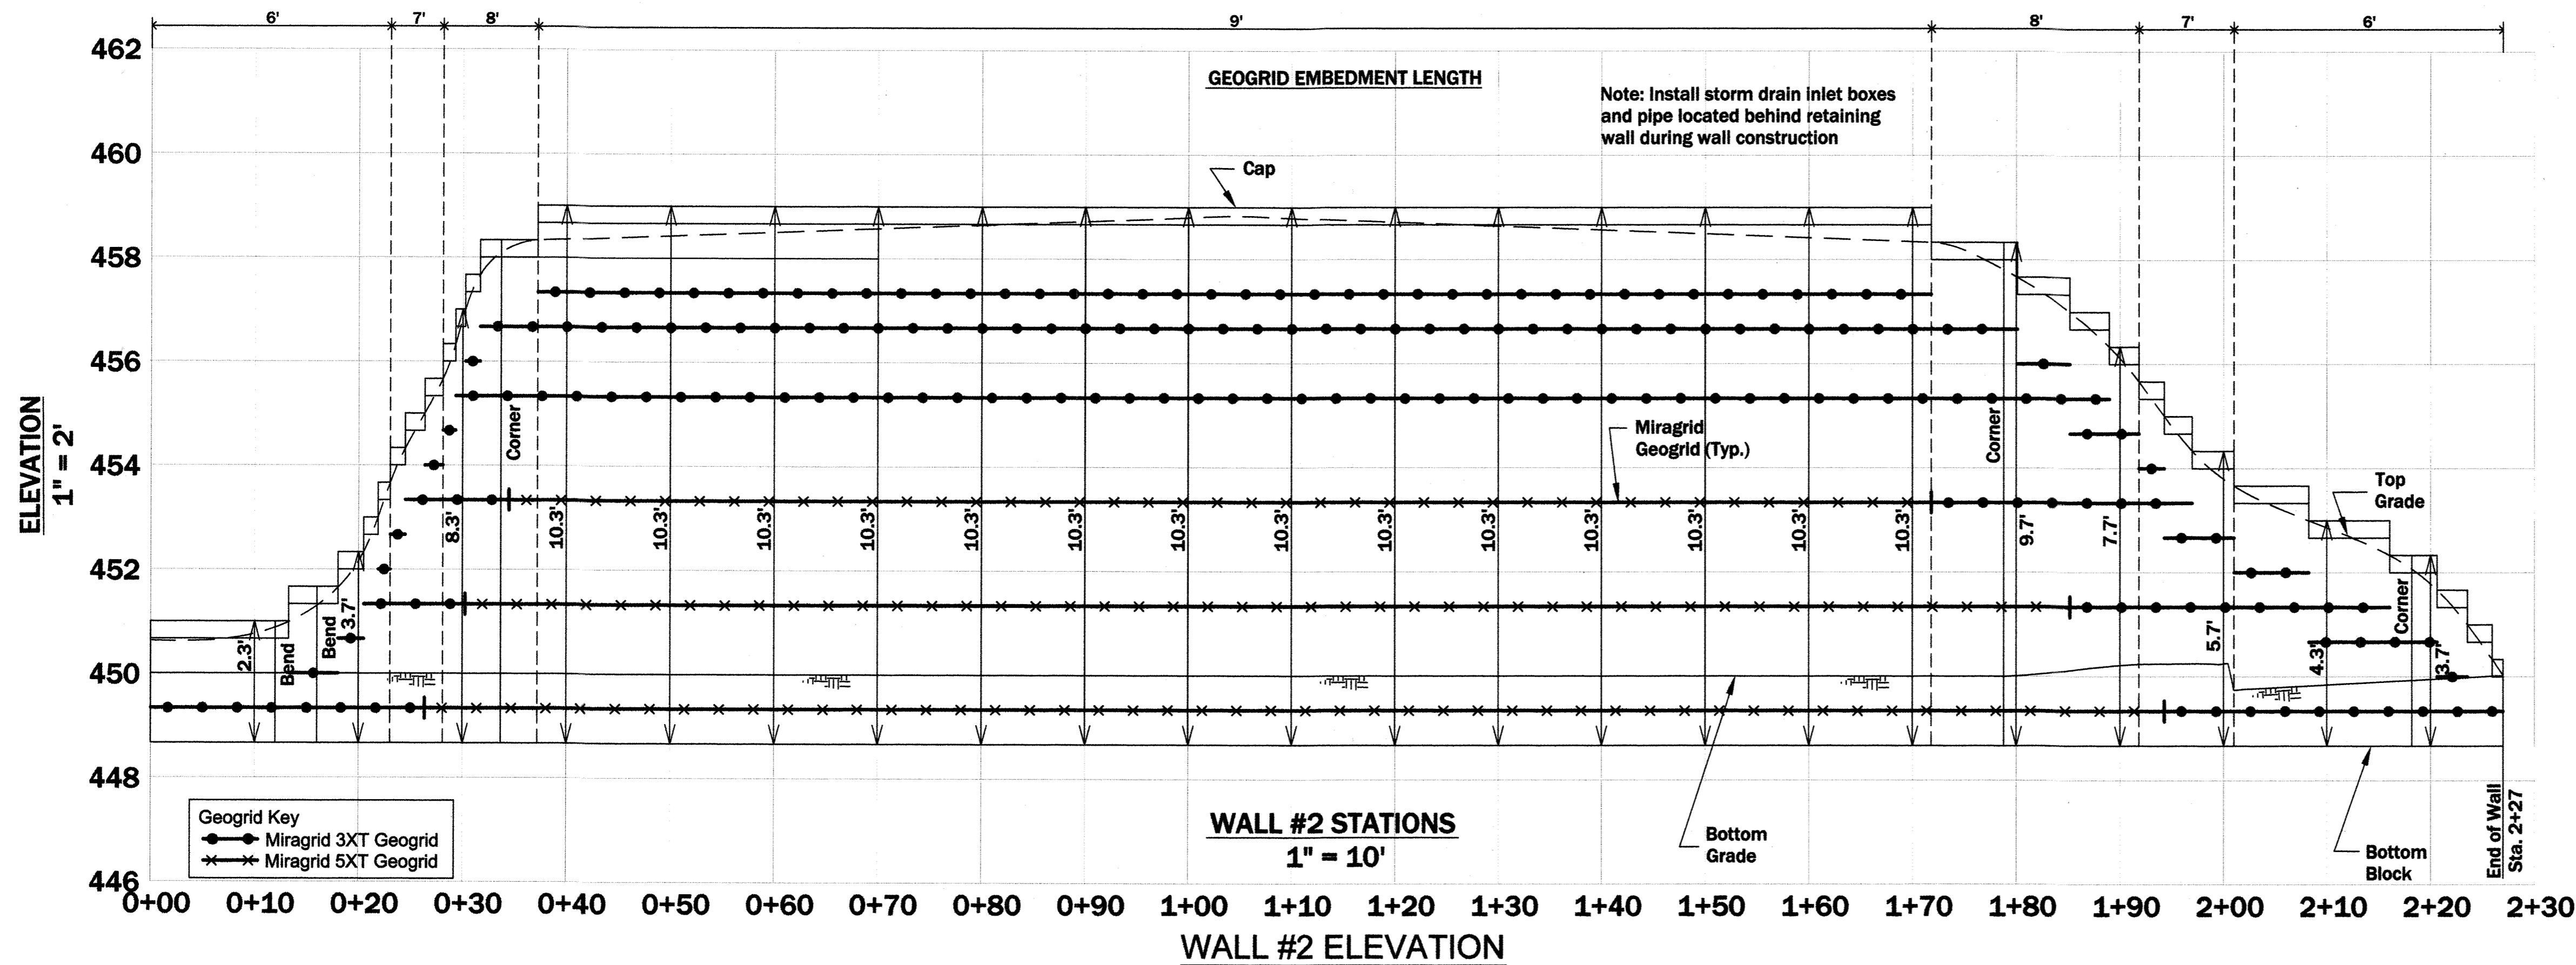

Important Note: The backfill supporting segmental retaining wall #1 including the slope areas shall be placed in a controlled compacted manner under the observation of a professional geotechnical engineer in accordance with Howard County Standards. Fill Construction Certification shall be provided to Howard County prior to wall construction.

APPROVED: DEPARTMENT OF PLANNING AND ZONING

[Signature] 8/26/08
 Chief, Development Engineering Division

[Signature] 8/26/08
 Chief, Division of Land Development

[Signature] 8/26/08
 Director

AS-BUILT CERTIFICATION

THERE IS NO 'AS-BUILT' INFORMATION PROVIDED ON THIS SHEET

[Signature] 07/23/12
 MICHAEL D. ADOLFO, PROFESSIONAL LAND SURVEYOR
 MD REG. NO. 21297, EXPIRATION DATE 06-16-21

OWNER/DEVELOPER
 MANGIONE ENTERPRISES OF TURF VALLEY LIMITED PARTNERSHIP
 1205 YORK ROAD, PENTHOUSE LUTHERVILLE, MARYLAND 21093
 PHONE (410) 825-8400

SEGMENTAL BLOCK RETAINING WALL ELEVATIONS

TURF VALLEY, LORIE
NURSING HOME & ASSISTED LIVING

AS-BUILT OAKMONT AT TURF VALLEY PARCEL Q

PLATS 18773 - 18775
 TAX MAP 16 - P/O PARCEL 8- GRID 16 & 17;
 POD I per S-86-13 (4th AMENDED)
 ELECTION DISTRICT HOWARD COUNTY, MARYLAND


HILLIS-CARNES
ENGINEERING ASSOCIATES
 10975 Guilford Road, Suite A Annapolis Junction, Maryland
 (410) 880-4788 Fax: (410) 880-4098

PROFESSIONAL CERTIFICATION

I HEREBY CERTIFY THAT THESE PLANS WERE PREPARED OR APPROVED BY ME, AND THAT I AM A DULY LICENSED PROFESSIONAL ENGINEER UNDER THE LAWS OF THE STATE OF MARYLAND, LICENSE NO. 14436, EXPIRATION DATE: 08/11/2008.

HCEA NO: 08209-B
 DRAWN BY: AM
 CHECKED BY: RWS
 SCALE: AS SHOWN
 DATE: 08/11/2008

SHEET: 8 OF 36

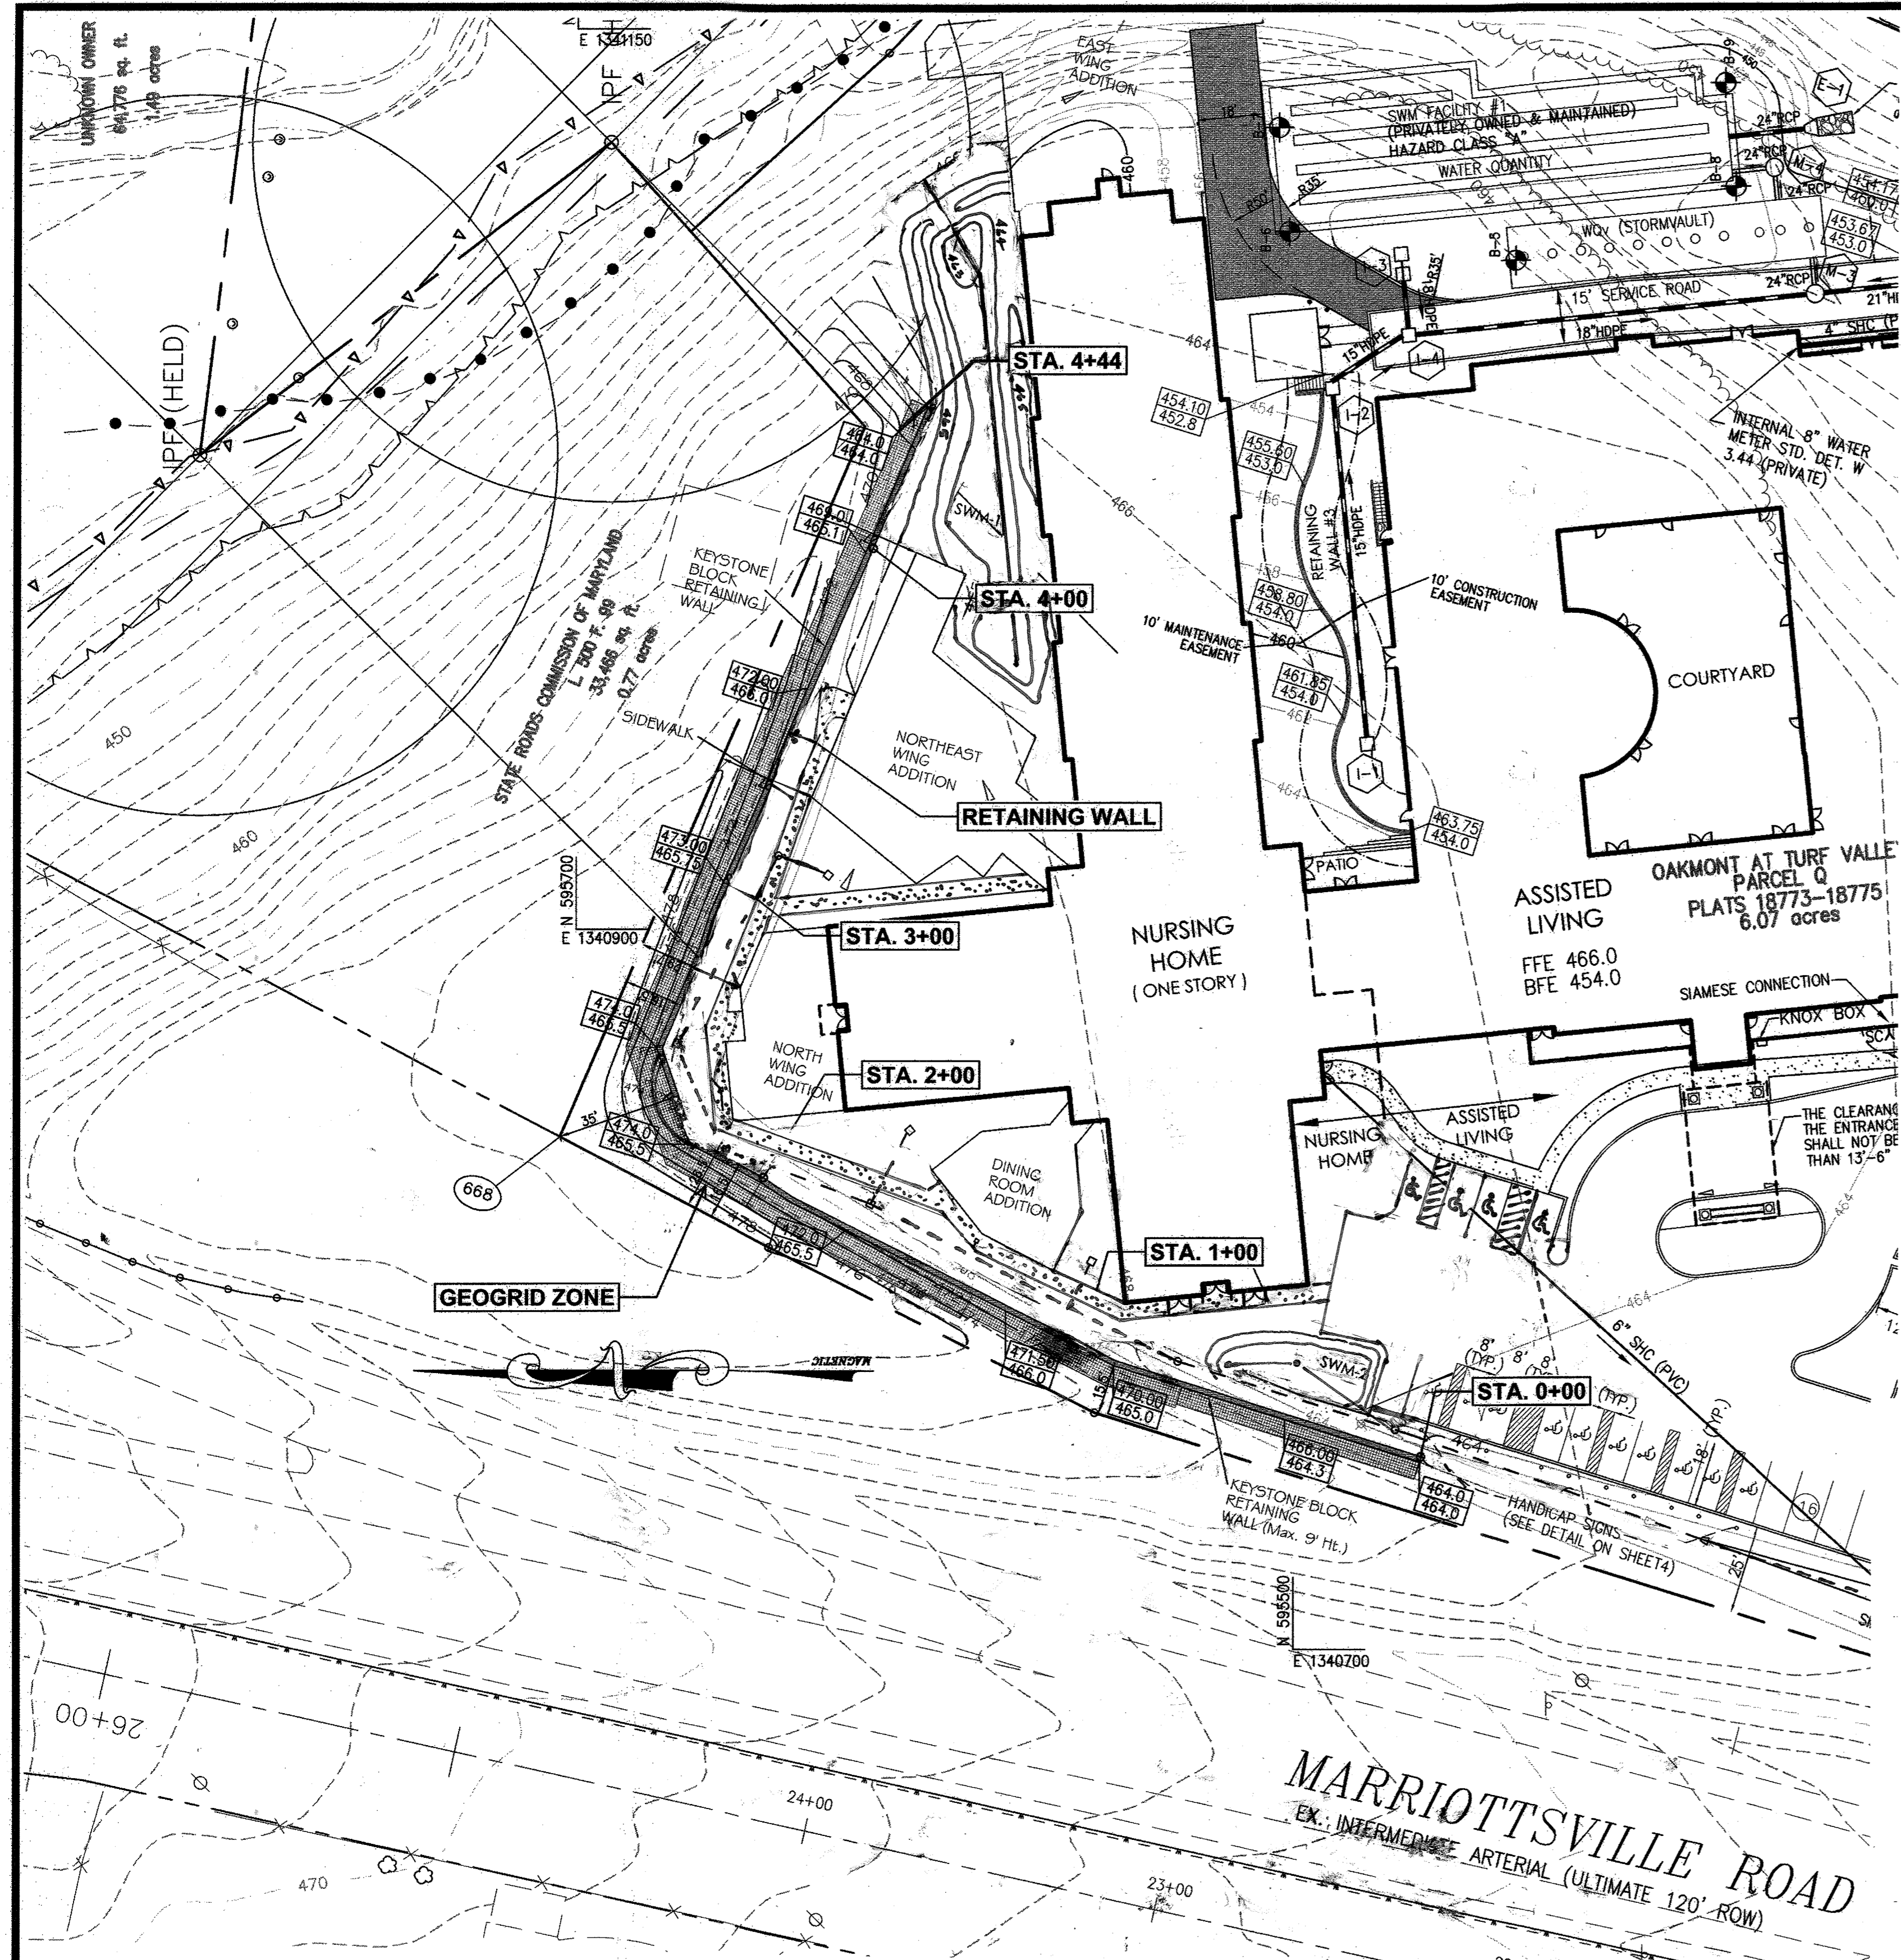

WALL LOCATION PLAN
1" = 30'

SPECIFICATIONS
MODULAR CONCRETE BLOCK RETAINING WALL

PART 1: GENERAL

1.01 DESCRIPTION

- A. WORK SHALL CONSIST OF FURNISHING AND CONSTRUCTION OF A MODULAR RETAINING WALL SYSTEM IN ACCORDANCE WITH THESE SPECIFICATIONS AND IN REASONABLY CLOSE CONFORMITY WITH THE LINES, GRADES, DESIGN, AND DIMENSIONS SHOWN ON THE PLANS.
- B. WORK INCLUDES PREPARING FOUNDATION SOIL, FURNISHING AND INSTALLING LEVELING PAD, UNIT DRAINAGE FILL AND BACKFILL TO THE LINES AND GRADES SHOWN ON THE CONSTRUCTION DRAWINGS.
- C. WORK INCLUDES FURNISHING AND INSTALLING GEOGRID SOIL REINFORCEMENT OF THE TYPE, SIZE, LOCATION, AND LENGTHS DESIGNATED ON THE CONSTRUCTION DRAWINGS.

1.02 DELIVERY, STORAGE AND HANDLING

- A. CONTRACTOR SHALL CHECK ALL MATERIALS UPON DELIVERY TO ASSURE THAT THE PROPER TYPE, GRADE, COLOR, AND CERTIFICATION HAS BEEN RECEIVED.
- B. CONTRACTOR SHALL PROTECT ALL MATERIALS FROM DAMAGE DUE TO JOB SITE CONDITIONS AND IN ACCORDANCE WITH MANUFACTURER'S RECOMMENDATIONS. DAMAGED MATERIALS SHALL NOT BE INCORPORATED INTO THE WORK.

PART 2: PRODUCTS

2.01 MODULAR CONCRETE RETAINING WALL UNITS

- A. MODULAR CONCRETE UNITS SHALL CONFORM TO THE FOLLOWING ARCHITECTURAL REQUIREMENTS:
FACE COLOR - COLOR MAY BE SPECIFIED BY THE OWNER.
FACE FINISH - SCULPTURED ROCK FACE IN ANGULAR TRI-PLANNER OR FLAT CONFIGURATION. OTHER FACE FINISHES WILL NOT BE ALLOWED WITHOUT WRITTEN APPROVAL OF OWNER.

BOND CONFIGURATION - RUNNING WITH BONDS NOMINALLY LOCATED AT MIDPOINT VERTICALLY ADJACENT UNITS, IN BOTH STRAIGHT AND CURVED ALIGNMENTS.

EXPOSED SURFACES OF UNITS SHALL BE FREE OF CHIPS, CRACKS OR OTHER IMPERFECTIONS WHEN VIEWED FROM A DISTANCE OF 10 FEET UNDER DIFFUSED LIGHTING.

- B. MODULAR CONCRETE MATERIALS SHALL CONFORM TO THE REQUIREMENTS OF ASTM C1372 - STANDARD SPECIFICATIONS FOR SEGMENTAL RETAINING WALL UNITS.

- C. MODULAR CONCRETE UNITS SHALL CONFORM TO THE FOLLOWING STRUCTURAL AND GEOMETRIC REQUIREMENTS MEASURED IN ACCORDANCE WITH APPROPRIATE REFERENCES:

COMPRESSIVE STRENGTH = 3000 PSI MINIMUM;
ABSORPTION = 8% MAXIMUM (8% IN NORTHERN STATES) FOR STANDARD WEIGHT AGGREGATES;

DIMENSIONAL TOLERANCES = ±1/8" FROM NOMINAL UNIT DIMENSIONS NOT INCLUDING ROUGH SPLIT FACE, ±1/16"

UNIT HEIGHT - TOP AND BOTTOM PLANES, UNIT SIZE - 8" (H) x 16" (W) x 12" (D) MINIMUM.

- D. MODULAR CONCRETE UNITS SHALL CONFORM TO THE FOLLOWING CONSTRUCTABILITY REQUIREMENTS: (IF APPLICABLE)
VERTICAL SETBACK = 1/8" PER COURSE (NEAR VERTICAL) OR 1" PER COURSE PER THE DESIGN ALIGNMENT AND GRID POSITIONING MECHANISM - FIBERGLASS PINS, TWO PER UNIT MINIMUM;
MAXIMUM HORIZONTAL GAP BETWEEN ERECTED UNITS SHALL BE - 1/2 INCH.

2.02 SHEAR CONNECTORS

- A. SHEAR CONNECTORS SHALL BE 1/2 INCH DIAMETER THERMOSET ISOPHTHALIC POLYESTER RESIN-PROTRUDED FIBERGLASS REINFORCEMENT RODS OR EQUIVALENT TO PROVIDE CONNECTION BETWEEN VERTICALLY AND HORIZONTALLY ADJACENT UNITS. STRENGTH OF SHEAR CONNECTORS BETWEEN VERTICAL ADJACENT UNITS SHALL BE APPLICABLE OVER A DESIGN TEMPERATURE OF 10 DEGREES F TO + 100 DEGREES F. B. SHEAR CONNECTORS SHALL BE CAPABLE OF HOLDING THE GEOGRID IN THE PROPER DESIGN POSITION DURING GRID PRE-TENSIONING AND BACKFILLING.

2.03 BASE LEVELING PAD MATERIAL

- A. MATERIAL SHALL CONSIST OF A COMPACTED #57 CRUSHED STONE BASE AS SHOWN ON THE CONSTRUCTION DRAWINGS.

2.04 UNIT DRAINAGE FILL

- A. UNIT DRAINAGE FILL SHALL CONSIST OF #57 CRUSHED STONE

2.05 REINFORCED BACKFILL

- A. REINFORCED BACKFILL SHALL BE TYPE SM, BE FREE OF DEBRIS AND MEET THE FOLLOWING GRADATION TESTED IN ACCORDANCE WITH ASTM D-422 AND MEET OTHER PROPERTIES SHOWN ON THE PLAN:

SIEVE SIZE	PERCENT PASSING
2 INCH	100-75
3/4 INCH	100-75
NO. 40	0-60
NO. 200	0-35

PLASTICITY INDEX (PI) <10 AND LIQUID LIMIT <35 PER ASTM D-4318.

- B. MATERIAL CAN BE SITE EXCAVATED SOILS WHERE THE ABOVE REQUIREMENTS CAN BE MET. UNSUITABLE SOILS FOR BACKFILL (HIGH PLASTIC CLAYS OR ORGANIC SOILS) SHALL NOT BE USED IN THE REINFORCED SOIL MASS.

2.06 GEOGRID SOIL REINFORCEMENT

- A. GEOSYNTHETIC REINFORCEMENT SHALL CONSIST OF GEOGRIDS MANUFACTURED SPECIFICALLY FOR SOIL

- REINFORCEMENT APPLICATIONS AND SHALL BE MANUFACTURED FROM HIGH TENACITY POLYESTER YARN.
- 2.07 DRAINAGE PIPE**
A. THE DRAINAGE PIPE SHALL BE PERFORATED CORRUGATED HDPE PIPE MANUFACTURED IN ACCORDANCE WITH ASTM D-1248.

PART 3: EXECUTION

3.01 EXCAVATION

- A. CONTRACTOR SHALL EXCAVATE TO THE LINES AND GRADES SHOWN ON THE CONSTRUCTION DRAWINGS. OWNER'S REPRESENTATIVE SHALL BE RESPONSIBLE FOR INSPECTING AND APPROVING THE EXCAVATION PRIOR TO PLACEMENT OF LEVELING MATERIAL OR FILL SOILS.

3.02 BASE LEVELING PAD

- A. LEVELING PAD MATERIAL SHALL BE PLACED TO THE LINES AND GRADES SHOWN ON THE CONSTRUCTION DRAWINGS, TO A MINIMUM THICKNESS OF 6 INCHES AND EXTEND LATERALLY A MINIMUM OF 6" IN FRONT AND BEHIND THE MODULAR WALL UNIT.
- B. LEVELING PAD SHALL BE PREPARED TO INSURE FULL CONTACT TO THE BASE SURFACE OF THE CONCRETE UNITS.

3.03 MODULAR UNIT INSTALLATION

- A. FIRST COURSE OF UNITS SHALL BE PLACED ON THE LEVELING PAD AT THE APPROPRIATE LINE AND GRADE. ALIGNMENT AND LEVEL SHALL BE CHECKED IN ALL DIRECTIONS AND INSURE THAT ALL UNITS ARE IN FULL CONTACT WITH THE BASE AND PROPERLY SEATED.
- B. PLACE THE FRONT OF UNITS SIDE-BY-SIDE. DO NOT LEAVE GAPS BETWEEN ADJACENT UNITS. LAYOUT OF CORNERS AND CURVES SHALL BE IN ACCORDANCE WITH MANUFACTURER'S RECOMMENDATIONS.
- C. INSTALL SHEAR-CONNECTING DEVICES PER MANUFACTURER'S RECOMMENDATIONS.
- D. PLACE AND COMPACT DRAINAGE FILL WITHIN AND BEHIND WALL UNITS. PLACE AND COMPACT BACKFILL SOIL BEHIND DRAINAGE FILL. FOLLOW WALL ERECTION AND DRAINAGE FILL CLOSELY WITH STRUCTURE BACKFILL.
- E. MAXIMUM STACKED VERTICAL HEIGHT OF WALL UNITS PRIOR TO UNIT DRAINAGE FILL AND BACKFILL PLACEMENT AND COMPACT, SHALL NOT EXCEED THREE COURSES.

3.04 STRUCTURAL GEOGRID INSTALLATION

- A. GEOGRID SHALL BE ORIENTED WITH THE HIGHEST STRENGTH AXIS PERPENDICULAR TO THE WALL ALIGNMENT.
- B. GEOGRID REINFORCEMENT SHALL BE PLACED AT THE STRENGTHS, LENGTHS, AND ELEVATIONS SHOWN ON THE CONSTRUCTION DESIGN DRAWINGS OR AS DIRECTED BY THE ENGINEER.
- C. THE GEOGRID SHALL BE LAID HORIZONTALLY ON COMPACTED BACKFILL AND ATTACHED TO THE MODULAR WALL UNITS. PLACE THE NEXT COURSE OF MODULAR CONCRETE UNITS OVER THE GEOGRID. THE GEOGRID SHALL BE PULLED TIGHT, AND ANCHORED PRIOR TO BACKFILL PLACEMENT ON THE GEOGRID.

- D. GEOGRID REINFORCEMENTS SHALL BE CONTINUOUS THROUGHOUT THEIR EMBEDMENT LENGTHS AND PLACED SIDE-BY-SIDE TO PROVIDE 100% COVERAGE AT EACH LEVEL. SPLICES BETWEEN SHORTER PIECES OF GEOGRID OR GAPS BETWEEN ADJACENT PIECES OF GEOGRID ARE NOT PERMITTED.

3.05 REINFORCED BACKFILL PLACEMENT

- A. REINFORCED BACKFILL SHALL BE PLACED, SPREAD, AND COMPACTED IN SUCH A MANNER THAT MINIMIZES THE DEVELOPMENT OF SLACK IN THE GEOGRID AND INSTALLATION DAMAGE.
- B. REINFORCED BACKFILL SHALL BE PLACED AND COMPACTED IN LIFTS NOT TO EXCEED 6 INCHES WHERE HAND COMPACTION IS USED, OR 8 - 10 INCHES WHERE HEAVY COMPACTION EQUIPMENT IS USED. LIFT THICKNESS SHALL BE DECREASED TO ACHIEVE THE REQUIRED DENSITY AS REQUIRED.
- C. REINFORCED BACKFILL SHALL BE COMPACTED TO 95% OF THE MAXIMUM DENSITY AS DETERMINED BY ASTM D698. THE MOISTURE CONTENT OF THE BACKFILL MATERIAL PRIOR TO AND DURING CONSTRUCTION SHALL BE UNIFORMLY DISTRIBUTED THROUGHOUT EACH LAYER AND SHALL BE + 3% TO - 3% OF OPTIMUM.
- D. ONLY LIGHTWEIGHT HAND-OPERATED EQUIPMENT SHALL BE ALLOWED WITHIN 3 FEET FROM THE TAIL OF THE MODULAR CONCRETE UNIT.
- E. TRACKED CONSTRUCTION EQUIPMENT SHALL NOT BE OPERATED DIRECTLY UPON THE GEOGRID REINFORCEMENT. A MINIMUM FILL THICKNESS OF 6 INCHES IS REQUIRED PRIOR TO OPERATION OF TRACKED VEHICLES OVER THE GEOGRID. TRACKED VEHICLE TURNING SHALL BE KEPT TO A MINIMUM TO PREVENT TRACKS FROM DISPLACING THE FILL AND DAMAGING THE GEOGRID.
- F. RUBBER Tired EQUIPMENT MAY PASS OVER GEOGRID REINFORCEMENT AT SLOW SPEEDS, LESS THAN 10 MPH. SUDDEN BRAKING AND SHARP TURNING SHALL BE AVOIDED.
- G. AT THE END OF EACH DAY'S OPERATION, THE CONTRACTOR SHALL SLOPE THE LAST LIFT OF REINFORCED BACKFILL AWAY FROM THE WALL UNITS TO DIRECT RUNOFF AWAY FROM WALL FACE. THE CONTRACTOR SHALL NOT ALLOW SURFACE RUNOFF FROM ADJACENT AREAS TO ENTER THE WALL CONSTRUCTION SITE.

3.06 CAP INSTALLATION


- A. CAP UNITS SHALL BE GLUED TO UNDERLYING UNITS WITH AN ALL-WEATHER ADHESIVE RECOMMENDED BY THE MANUFACTURER.

3.07 FIELD QUALITY CONTROL

- A. THE OWNER SHALL ENGAGE INSPECTION AND TESTING SERVICES, INCLUDING INDEPENDENT LABORATORIES, TO PROVIDE QUALITY ASSURANCE AND TESTING SERVICES DURING CONSTRUCTION.
- B. AS A MINIMUM, QUALITY ASSURANCE TESTING SHOULD INCLUDE FOUNDATION SOIL INSPECTION, SOIL AND BACKFILL TESTING, VERIFICATION OF DESIGN PARAMETERS, AND OBSERVATION OF CONSTRUCTION FOR GENERAL COMPLIANCE WITH DESIGN DRAWINGS AND SPECIFICATIONS.

GENERAL NOTES:

1. No trees shall be planted within 10 feet of the top of the retaining wall.
2. Retaining walls shall only be constructed under the observation of a registered professional engineer and a (NICET, WACEL, or equiv.) certified soils technician.
3. The required bearing pressure beneath the wall system shall be verified in the field by a certified soils technician. Testing documentation must be provided to the Howard County Inspector prior to start of construction. The required bearing test shall be the Dynamic Cone Penetrometer test ASTM STP-399.
4. The suitability of fill material shall be confirmed by the on-site soils technician. Each 8" lift must be compacted to a minimum 95% standard proctor density and the testing report shall be made available to the Howard County Inspector upon completion of construction.
5. Walls shall not be constructed on uncertified fill materials.
6. Walls shall not be constructed within a Howard Co. right-of-way or easement.
7. For "CRITICAL" walls, one soil boring is required for 100' along length of the wall. Copies of the boring report shall be provided to the Howard County inspector upon completion of construction.

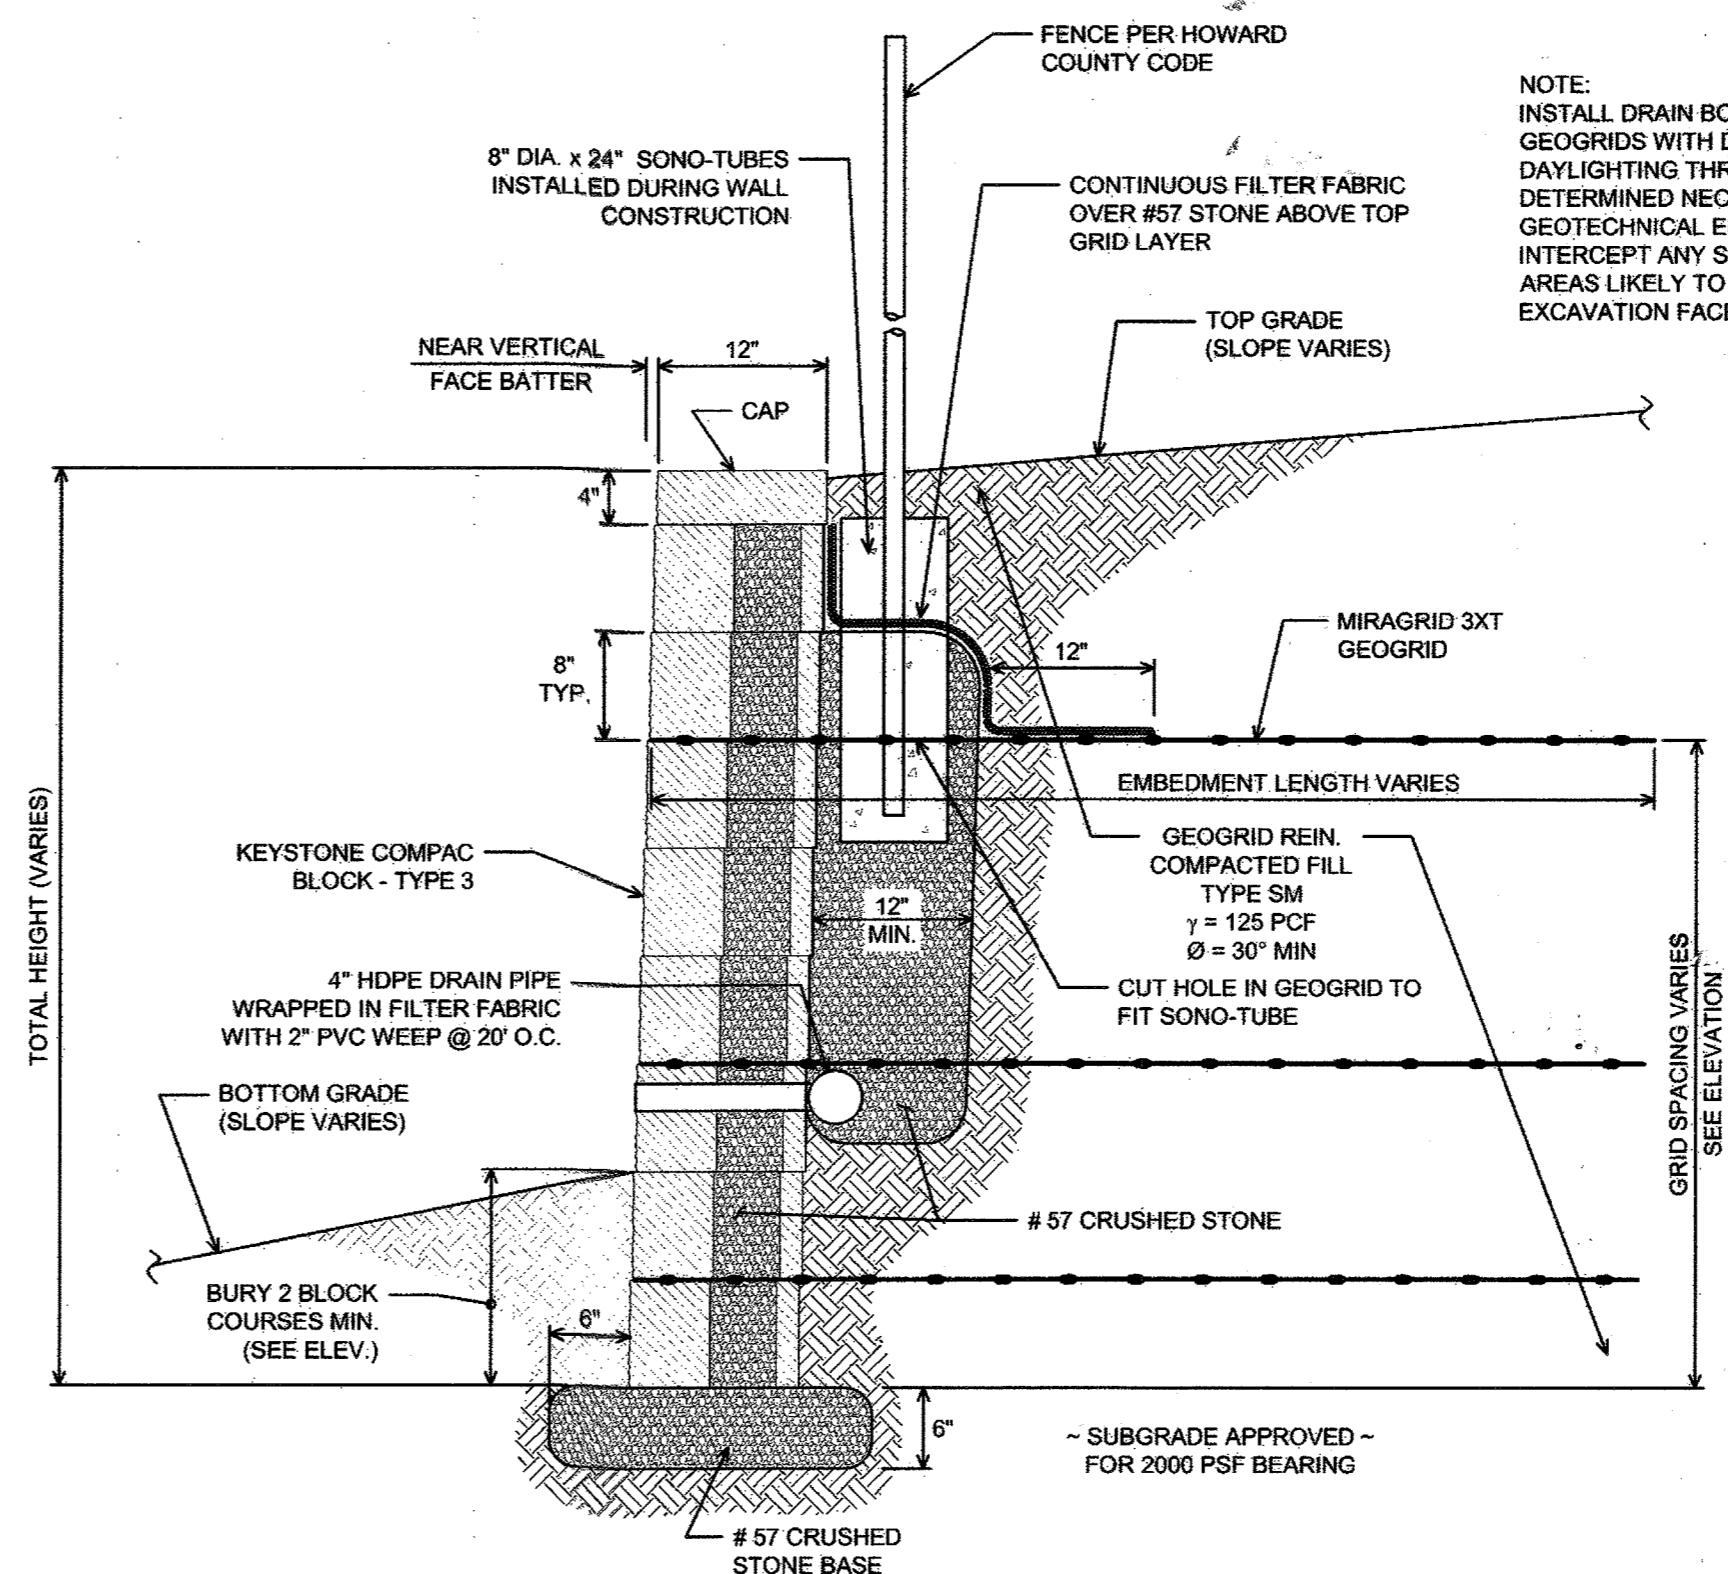

TYPICAL WALL SECTION
N.T.S.

RETAINING WALL PLAN AND DETAILS

TURF VALLEY, LORIEN
NURSING HOME & ASSISTED LIVING FACILITY
AS-BUILT
OAKMONT AT TURF VALLEY
PARCEL Q
PLATS 18773 - 18775
TAX MAP 16 - P/O PARCEL 8- GRID 16 & 17;
POD 1 per S-86-13 (4th AMENDED)
THIRD ELECTION DISTRICT HOWARD COUNTY, MARYLAND

HILLIS-CARNES
ENGINEERING ASSOCIATES
10975 Guilford Road, Suite A Annapolis Junction, Maryland
(410) 880-4788 WWW.HCEA.COM Fax: (410) 880-4098

APPROVED
PLANNING BOARD
OF HOWARD COUNTY
DATE 3/27/2008
9/01/2016

AS-BUILT CERTIFICATION
I HEREBY CERTIFY, BY MY SEAL, THAT THE CONDITIONS SHOWN ON THIS PLAN WERE CONSTRUCTED TO THE LINES AND GRADES SHOWN ON THIS PLAN AND THAT THE APPROVED PLANS AND SPECIFICATIONS AND ALSO THAT THESE DOCUMENTS WERE PREPARED BY ME OR UNDER MY SUPERVISION AND THAT I AM A DULY LICENSED PROFESSIONAL ENGINEER UNDER THE LAWS OF THE STATE OF MARYLAND.
MICHAEL D. BOZOCK, PROFESSIONAL LAND SURVEYOR
NO REG. NO. 21257, EXPIRATION DATE 6-16-2019

APPROVED: DEPARTMENT OF PLANNING AND ZONING
Chief, Development Engineering Division 11-28-16
Chief, Division of Land Development 12-6-16
Director 12-16-16



PROFESSIONAL CERTIFICATION: I HEREBY CERTIFY THAT THESE DOCUMENTS WERE PREPARED OR APPROVED BY ME, AND THAT I AM A DULY LICENSED PROFESSIONAL LAND SURVEYOR UNDER THE LAWS OF THE STATE OF MARYLAND, REG. NO. 21257, EXPIRATION DATE 6-16-2019.

DATE 9/1/2016

Professional Certification: I hereby certify that these documents were prepared or approved by me, and that I am a duly licensed professional engineer under the laws of the State of Maryland, License No. 14434, Expiration Date: 05/13/17.

DRAWN BY: AM
CHECKED BY: RWS
SCALE: AS NOTED
HCEA JOB#: 16239A
DATE: 08/15/2016

SHEET: 9 OF 36

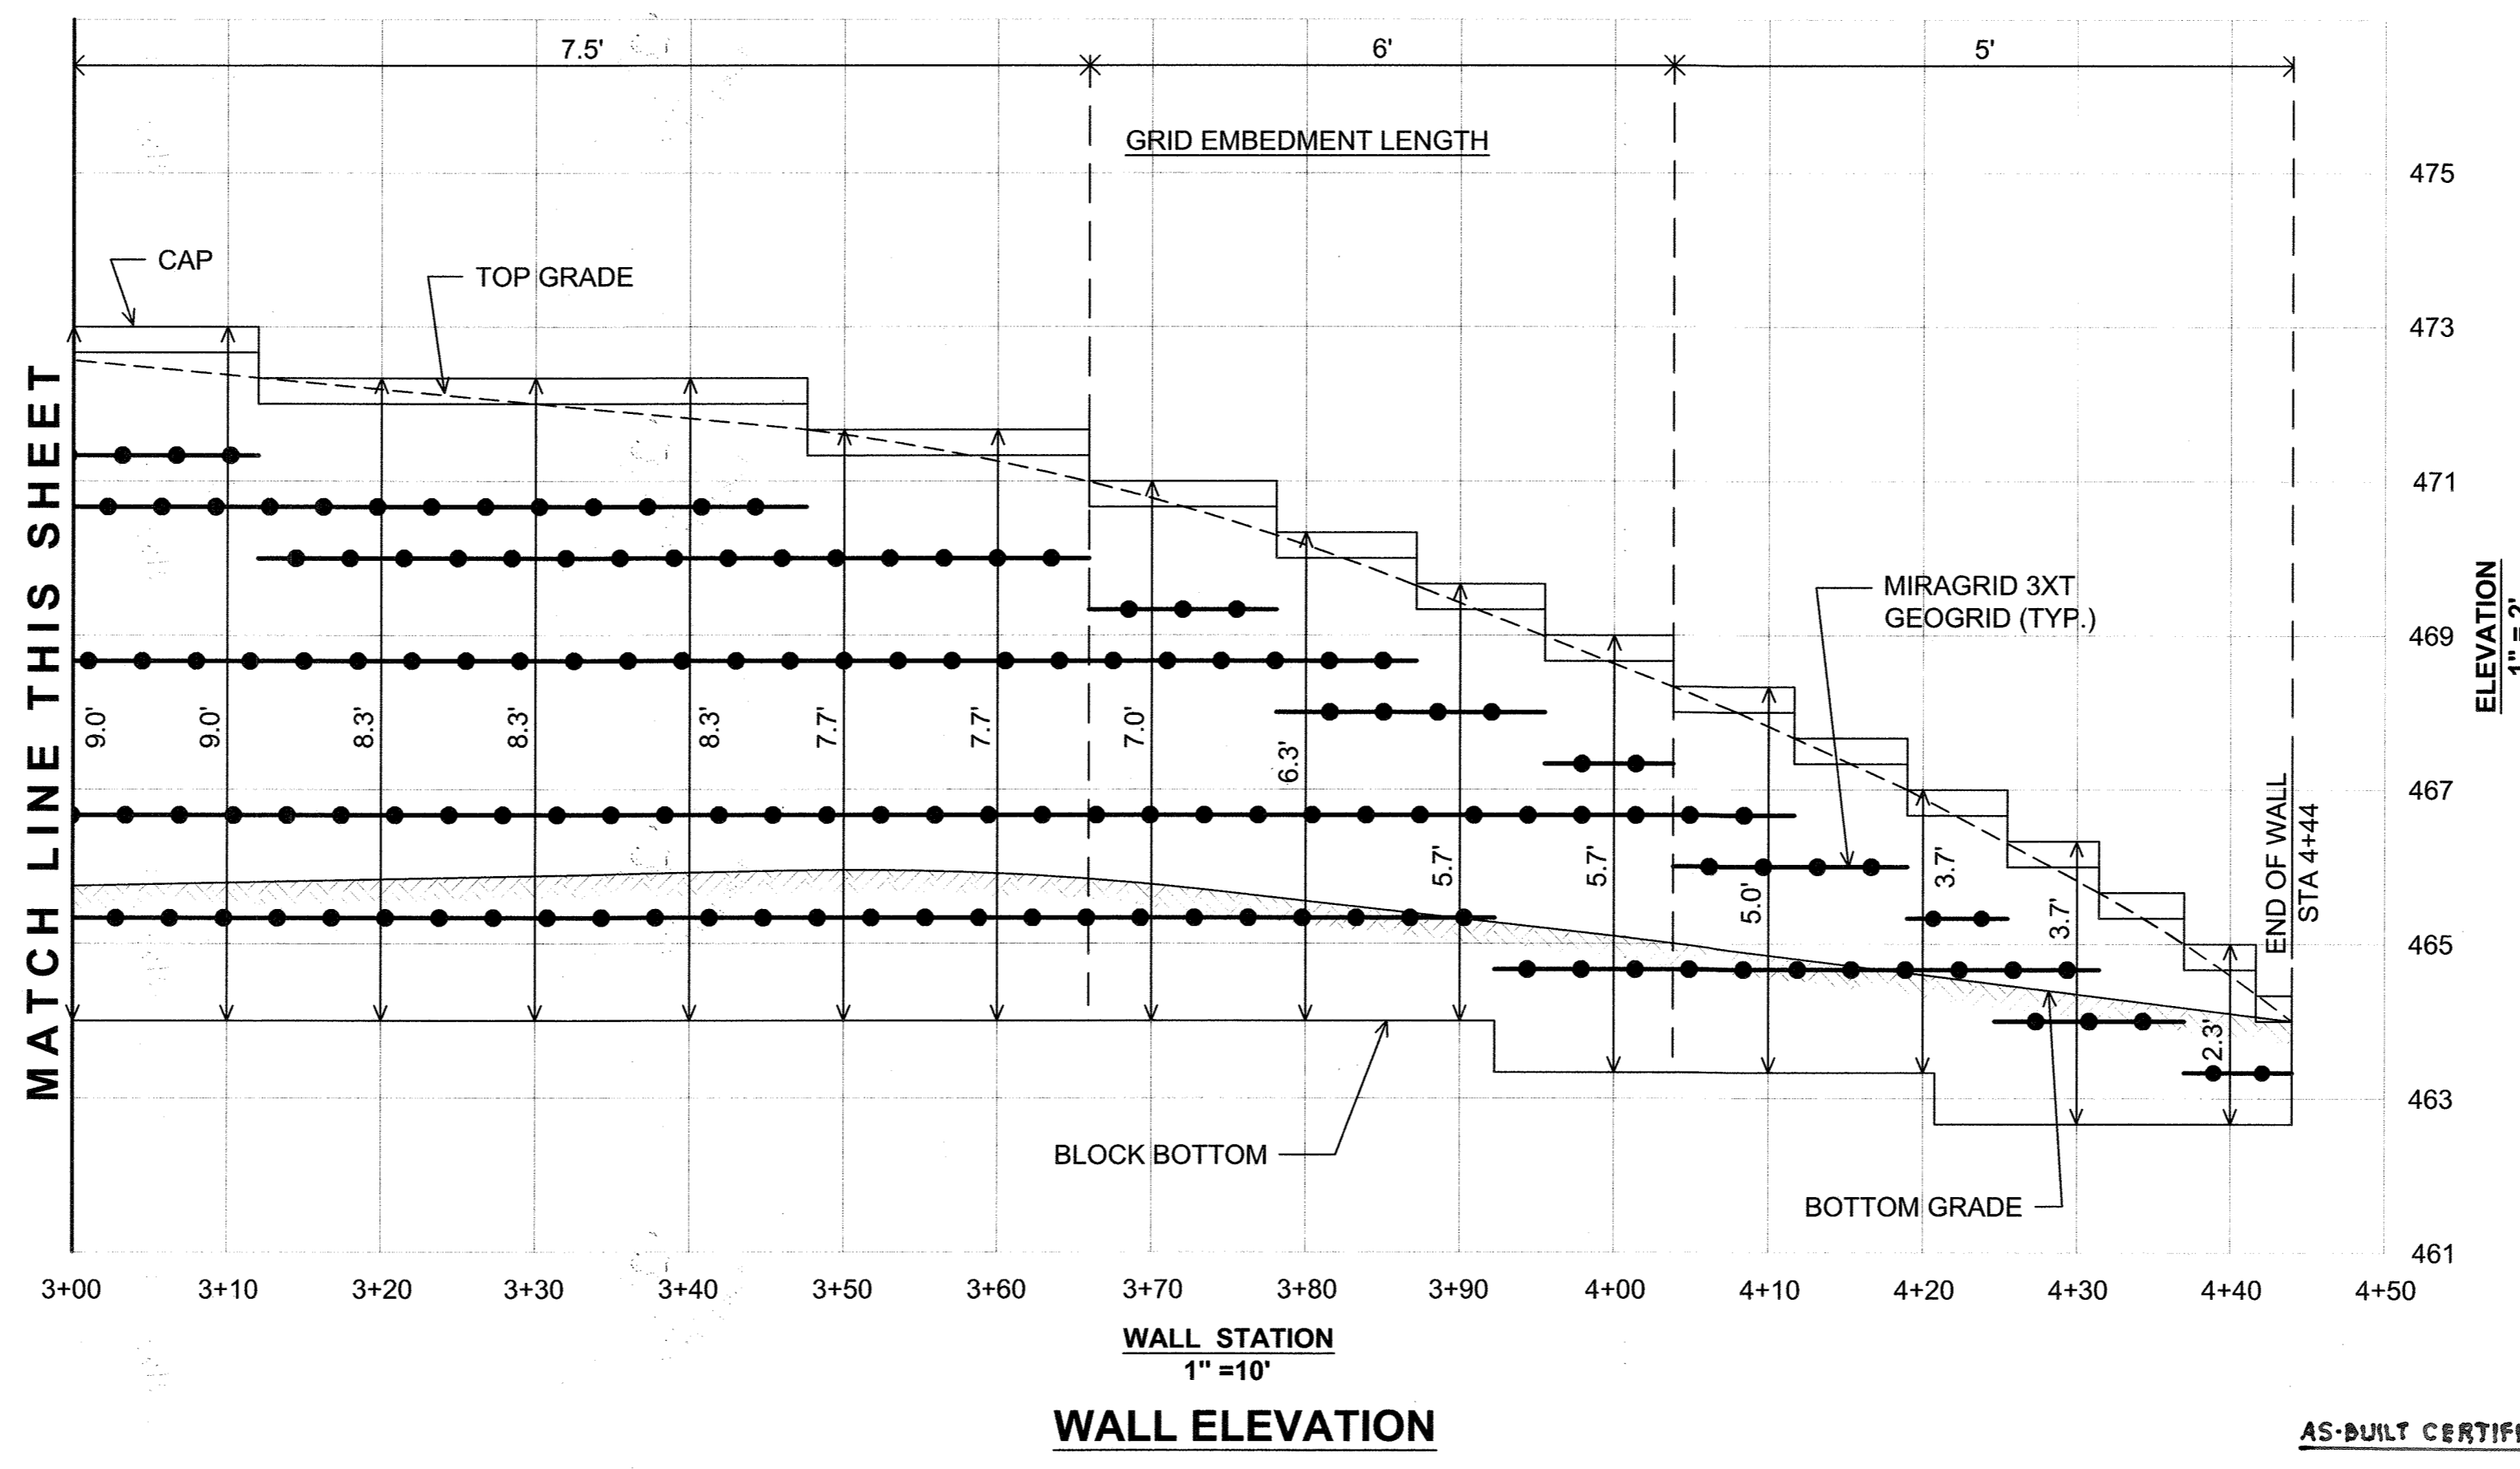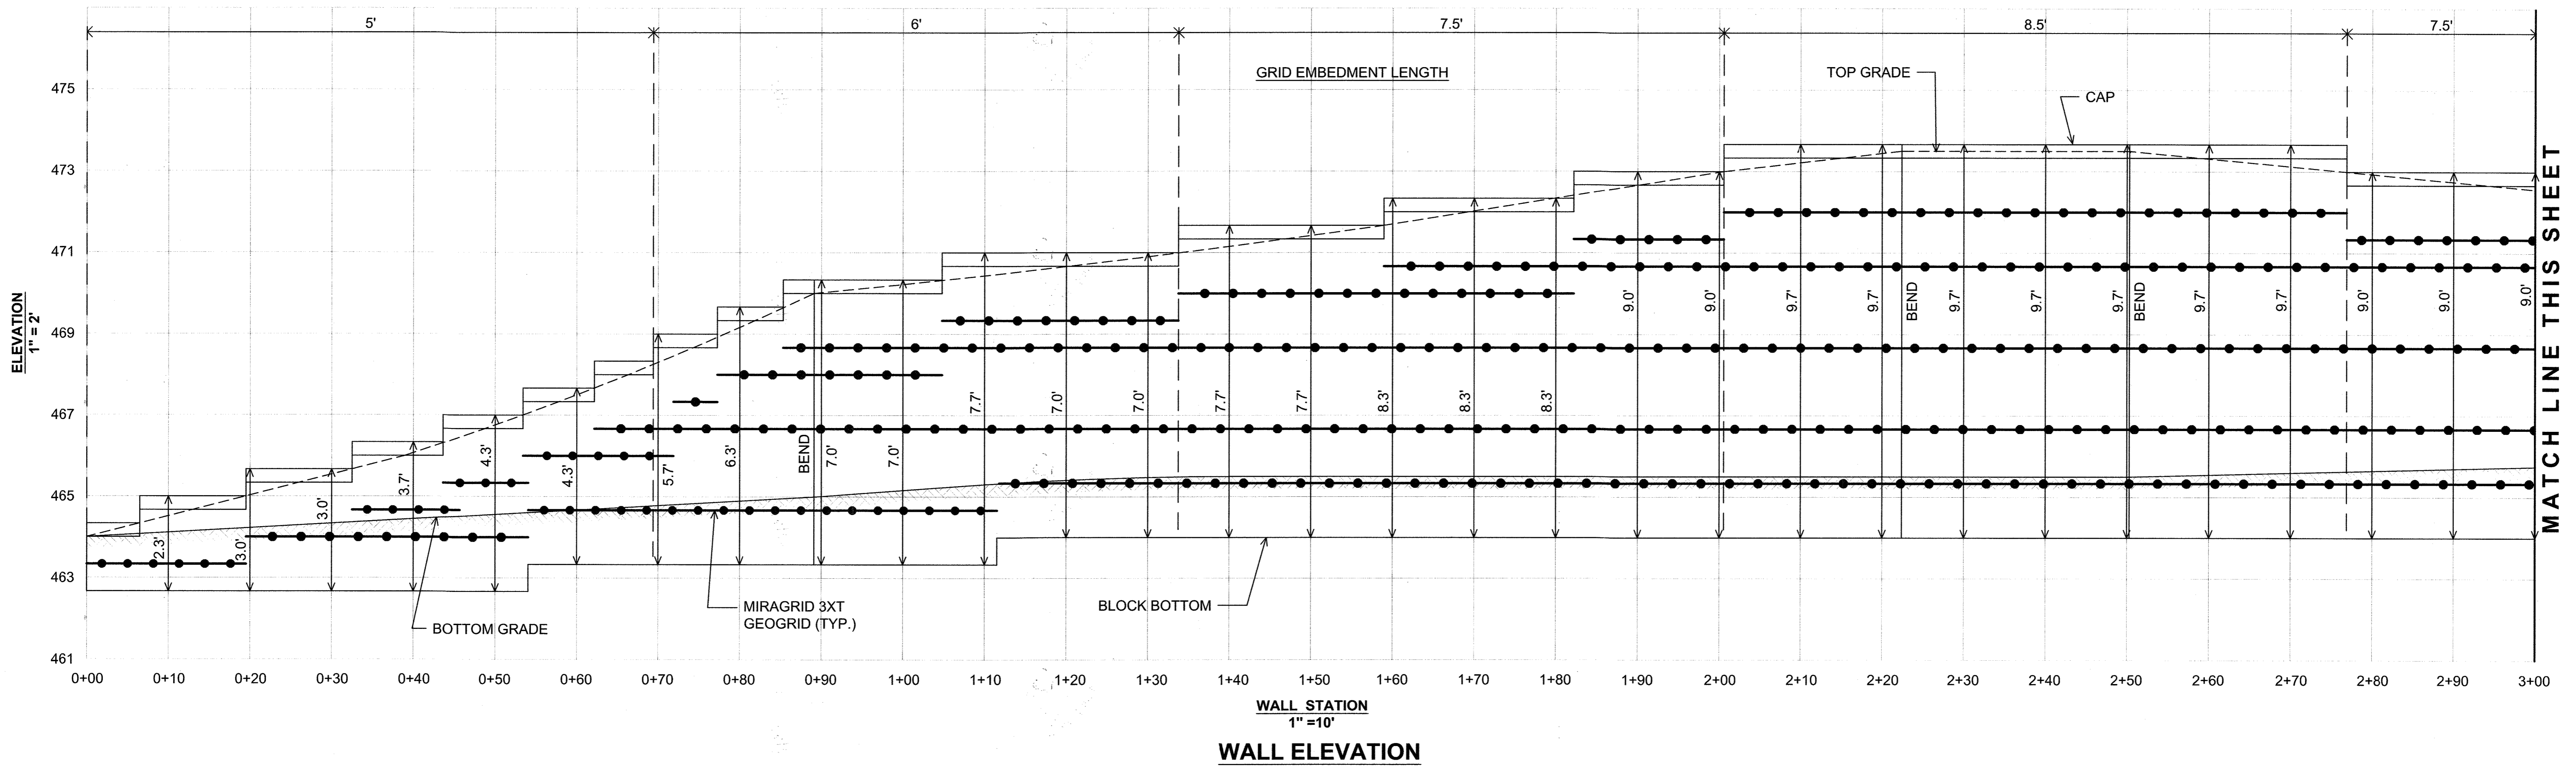

APPROVED
 PLANNING BOARD
 OF HOWARD COUNTY
 DATE 3/27/2008
9/01/2016


APPROVED: DEPARTMENT OF PLANNING AND ZONING
 Chief, Development Engineering Division 11-28-16
 Chief, Division of Land Development 12-6-16
 Director 12-6-16

AS-BUILT CERTIFICATION
 I hereby certify that these documents were prepared or approved by me, and that I am a duly licensed professional engineer under the laws of the State of Maryland, License No. 14434, Expiration Date: 05/13/17.
 MICHAEL D. APLO CH., PROFESSIONAL ENGINEER
 M.D. No. 11257, EXPIRATION DATE 05-13-17

RETAINING WALL ELEVATION
TURF VALLEY, LORIE
NURSING HOME & ASSISTED LIVING FACILITY
 AS-BUILT OAKMONT AT TURF VALLEY
 PARCEL Q
 PLATS 18773 - 18775
 TAX MAP 16 - P/O PARCEL 8- GRID 16 & 17;
 POD I per S-86-13 (4th AMENDED)
 THIRD ELECTION DISTRICT HOWARD COUNTY, MARYLAND


HILLIS-CARNES
ENGINEERING ASSOCIATES
 10975 Guilford Road, Suite A Annapolis Junction, Maryland
 (410) 880-4788 WWW.HCEA.COM Fax: (410) 880-4098

Professional Certification
 I hereby certify that these documents were prepared or approved by me, and that I am a duly licensed professional engineer under the laws of the State of Maryland, License No. 14434, Expiration Date: 05/13/17.

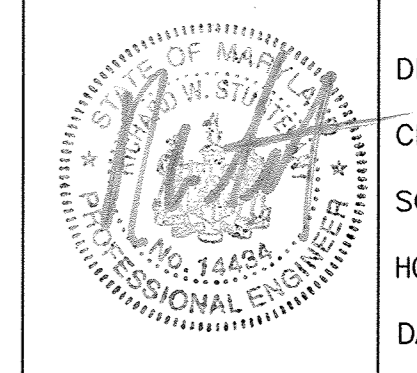


DRAWN BY: AM
 CHECKED BY: RWS
 SCALE: AS NOTED
 HCEA JOB#: 16239A
 DATE: 08/15/2016


SHEET:
 10
 OF
 36

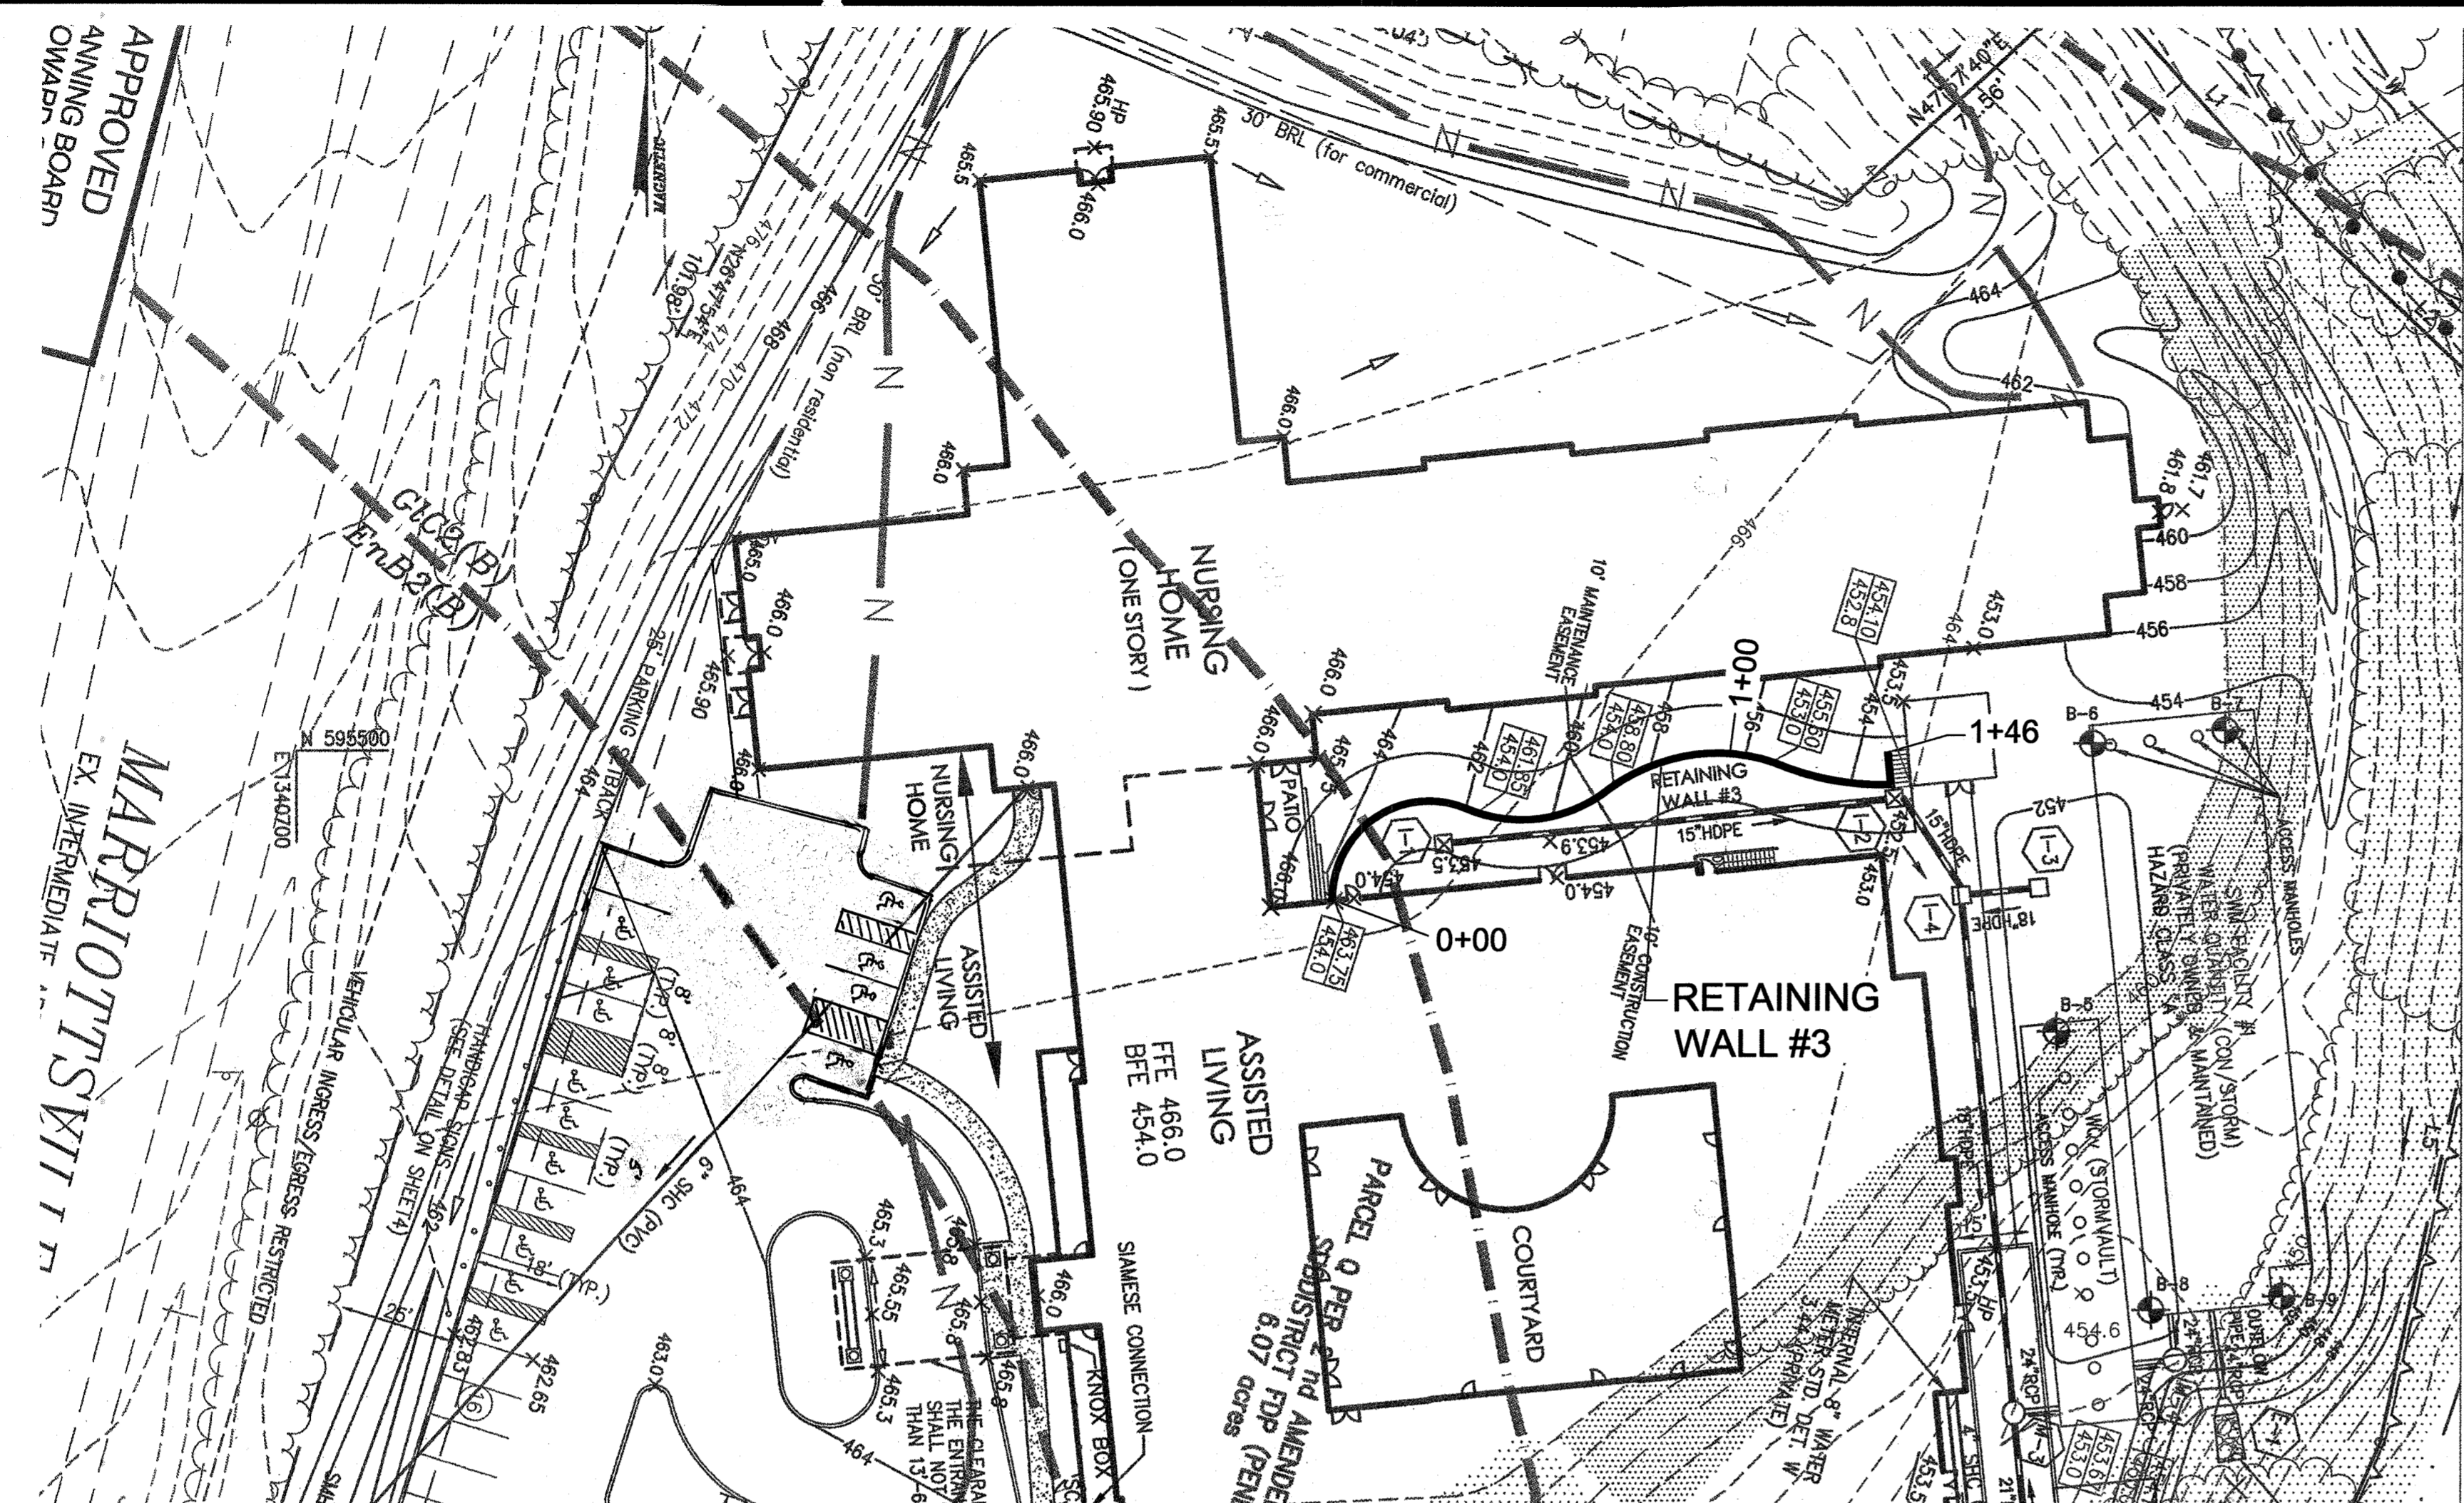

WALL LOCATION PLAN
1" = 30'

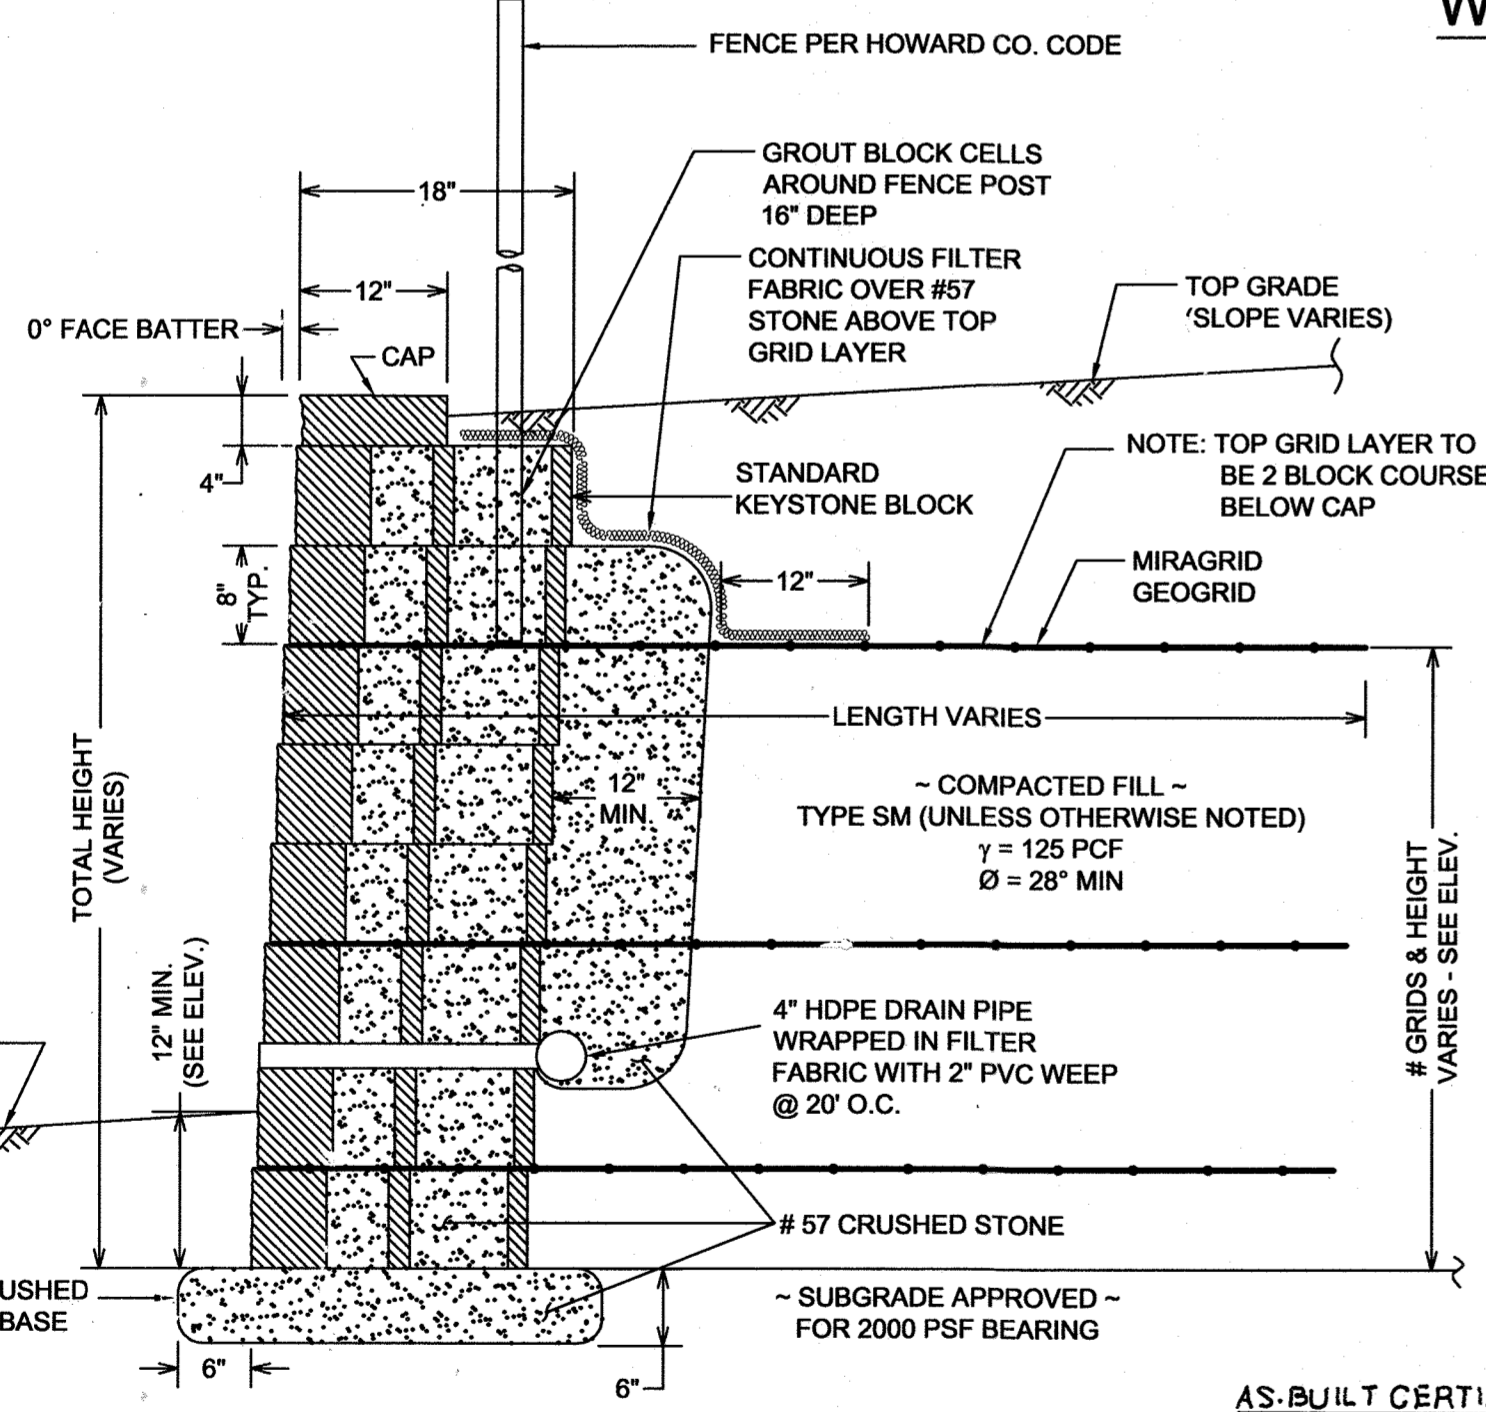

TYPICAL WALL SECTION
NTS

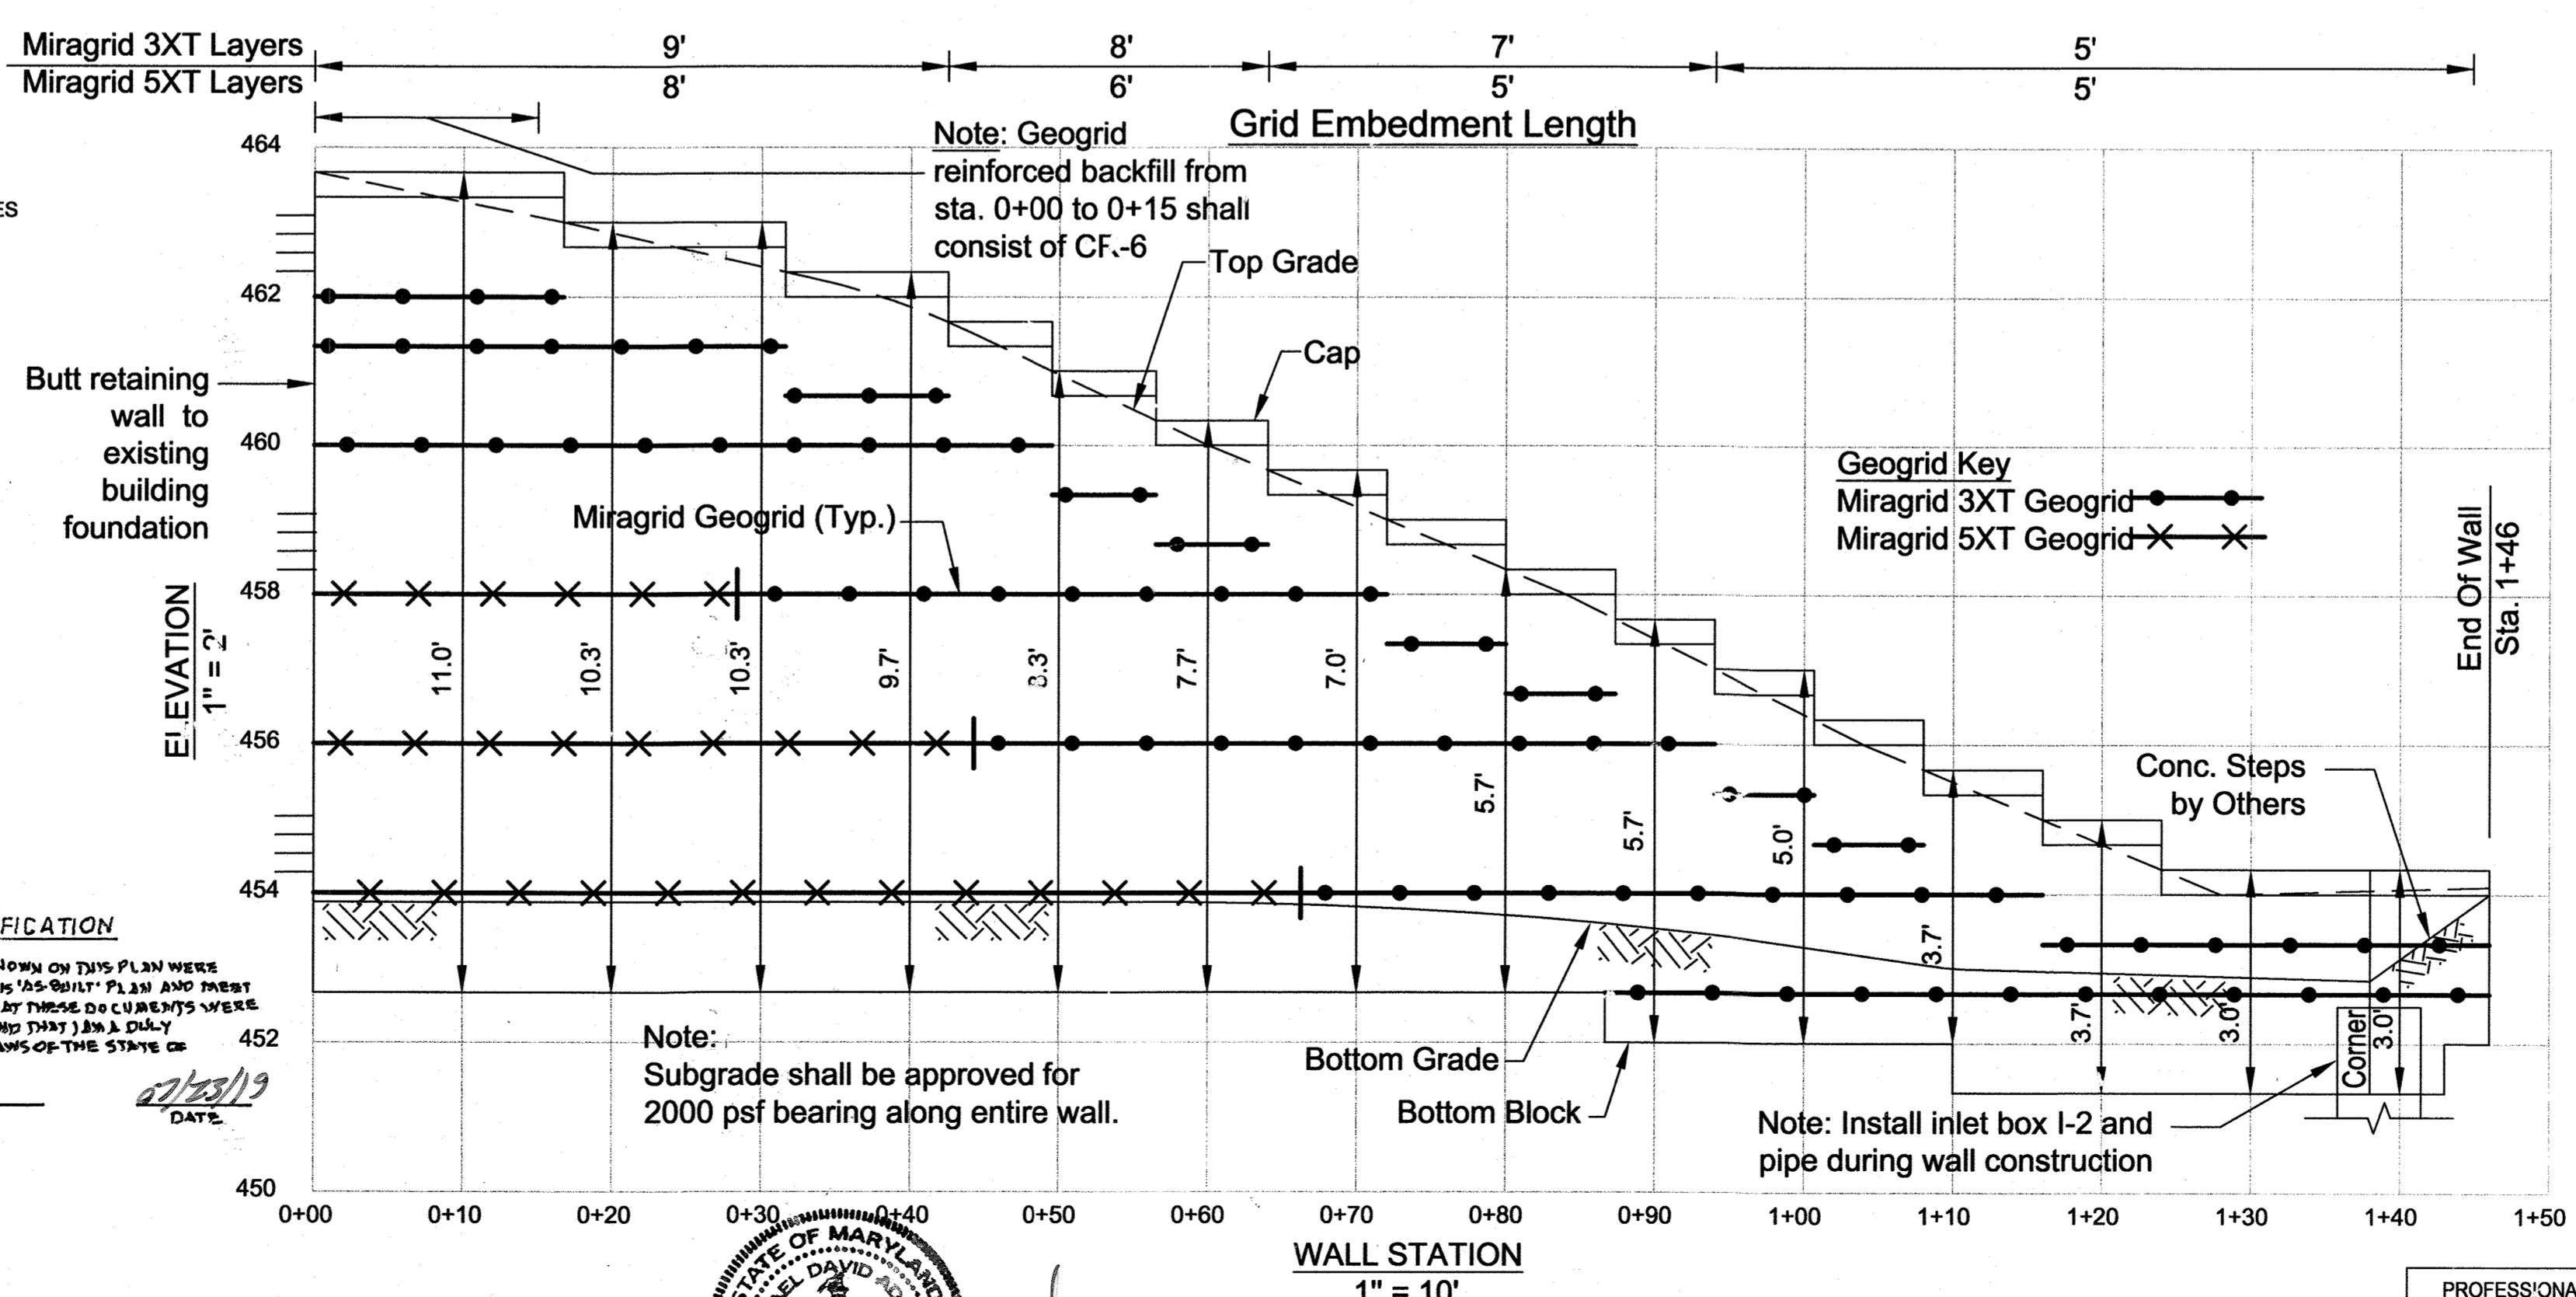

WALL ELEVATION
1" = 10'

SPECIFICATIONS
MODULAR CONCRETE BLOCK RETAINING WALL

- PART 1: GENERAL**
- 1.01 Description
A. Work shall consist of furnishing and construction of a Modular Block Retaining Wall System in accordance with these specifications and in reasonably close conformity with the lines, grades, design, and dimensions shown on the plans.
B. Work includes preparing foundation soil, furnishing and installing leveling pad, unit drainage fill and backfill to the lines and grades shown on the construction drawings.
C. Work includes furnishing and installing geogrid soil reinforcement of the type, size, location, and lengths designated on the construction drawings.
- 1.02 Delivery, Storage and Handling
A. Contractor shall check all materials upon delivery to assure that the proper type, grade, color, and certification has been received.
B. Contractor shall protect all materials from damage due to job site conditions and in accordance with manufacturer's recommendations. Damaged materials shall not be incorporated into the work.
- PART 2: PRODUCTS**
- 2.01 Modular Concrete Retaining Wall Units
A. Modular concrete units shall conform to the following architectural requirements:
face color - concrete gray - standard manufacturers' color may be specified by the Owner.
face finish - sculptured rock face in angular tri-planer configuration. Other face finishes will not be allowed without written approval of Owner.
bond configuration - running with bonds nominally located at midpoint vertically adjacent units, in both straight and curved alignments.
exposed surfaces of units shall be free of chips, cracks or other imperfections when viewed from a distance of 10 feet under diffused lighting.
B. Modular concrete materials shall conform to the requirements of ASTM C1372 - Standard Specifications for Segmental Retaining Wall Units.
C. Modular concrete units shall conform to the following structural and geometric requirements measured in accordance with appropriate references:
compressive strength = 3000 psi minimum;
absorption = 8% maximum (8% in northern states) for standard weight aggregates;
dimensional tolerances = ± 1/8" from nominal unit dimensions not including rough split unit dimensions not including rough split face, ± 1/16" unit height - top and bottom planes;
unit size - 8" (H) x 18" (W) x 18" (D) minimum;
unit weight - 95 lbs/unit minimum for standard weight aggregates;
inter-unit shear strength - 600 pif minimum at 2 psi normal pressure;
geogrid/unit peak connection strength - 600 pif minimum at 2 psi normal force.
D. Modular concrete units shall conform to the following constructability requirements:
vertical setback = 1/8" per course (near vertical) or 1" per course per the design;
alignment and grid positioning mechanism - fiberglass pins, two per unit minimum;
maximum horizontal gap between erected units shall be - 1/2 inch.
- 2.03 Base Leveling Pad Material
A. Material shall consist of a compacted #57 crushed stone base as shown on the construction drawings.
- 2.04 Unit Drainage Fill
A. Unit drainage fill shall consist of #57 crushed stone
- 2.05 Reinforced Backfill
A. Reinforced backfill shall type SM, be free of debris and meet the following gradation tested in accordance with ASTM D-422 and meet other properties shown on the plan:

Sieve Size	Percent Passing
2 inch	100-75
3/4 inch	100-75
No. 40	0-60
No. 200	0-40

Plasticity Index (PI) <10 and Liquid Limit <40 per ASTM D-4318.
B. Material can be site excavated soils where the above requirements can be met. Unsuitable soils for backfill (high plastic clays or organic soils) shall not be used in the reinforced soil mass.
- 2.06 Geogrid Soil Reinforcement
A. Geosynthetic reinforcement shall consist of geogrids manufactured specifically for soil reinforcement applications and shall be manufactured from high tenacity polyester yarn.
- 2.07 Drainage Pipe
A. The drainage pipe shall be perforated corrugated HDPE pipe manufactured in accordance with ASTM D-1248.
- PART 3: EXECUTION**
- 3.01 Excavation
A. Contractor shall excavate to the lines and grades shown on the construction drawings. Owner's representative shall be responsible for inspecting and approving the excavation prior to placement of leveling material or fill soils.
- 3.02 Base Leveling Pad
A. Leveling pad material shall be placed to the lines and grades shown on the construction drawings, to a minimum thickness of 6 inches and extend laterally a minimum of 6" in front and behind the modular wall unit.
B. Leveling pad shall be prepared to insure full contact to the base surface of the concrete units.
- 3.03 Modular Unit Installation
A. First course of units shall be placed on the leveling pad at the appropriate line and grade. Alignment and level shall be checked in all directions and insure that all units are in full contact with the base and properly seated.
B. Place the front of units side-by-side. Do not leave gaps between adjacent units. Layout of corners and curves shall be in accordance with manufacturer's recommendations.
C. Install shear/connecting devices per manufacturer's recommendations.
D. Modular concrete units shall be placed and compacted in lifts not to exceed 6 inches where hand compaction is used, or 8 - 10 inches where heavy compaction equipment is used. Lift thickness shall be decreased to achieve the required density as required.
- 3.04 Structural Geogrid Installation
A. Geogrid shall be oriented with the highest strength axis perpendicular to the wall alignment.
B. Geogrid reinforcement shall be placed at the strengths, lengths, and elevations shown on the construction design drawings or as directed by the Engineer.
C. The geogrid shall be laid horizontally on compacted backfill and attached to the modular wall units. Place the next course of modular concrete units over the geogrid. The geogrid shall be pulled taut, and anchored prior to backfill placement on the geogrid.
D. Geogrid reinforcements shall be continuous throughout their embankment lengths and placed side-by-side to provide 100% coverage at each level. Spliced connections between shorter pieces of geogrid or gaps between adjacent pieces of geogrid are not permitted.
- 3.05 Reinforced Backfill Placement
A. Reinforced backfill shall be placed, spread, and compacted in such a manner that minimizes the development of slack in the geogrid and installation damage.
B. Reinforced backfill shall be placed and compacted in lifts not to exceed 6 inches where hand compaction is used, or 8 - 10 inches where heavy compaction equipment is used. Lift thickness shall be decreased to achieve the required density as required.
C. Reinforced backfill shall be compacted to 95% of the maximum density as determined by ASTM D698. The moisture content of the backfill material prior to and during compaction shall be uniformly distributed throughout each layer and shall be + 3% to - 3% of optimum.
D. Only lightweight hand-operated equipment shall be allowed within 3 feet from the tail of the modular concrete unit.
E. Tracked construction equipment shall not be operated directly upon the geogrid reinforcement. A minimum fill thickness of 6 inches is required prior to operation of tracked vehicles over the geogrid. Tracked vehicle turning should be kept to a minimum to prevent tracks from displacing the fill and damaging the geogrid.
F. Rubber tired equipment may pass over geogrid reinforcement at slow speeds, less than 10 MPH. Sudden braking and sharp turning shall be avoided.
G. At the end of each day's operation, the Contractor shall slope the last lift of reinforced backfill away from the wall units to direct runoff away from wall face. The Contractor shall not allow surface runoff from adjacent areas to enter the wall construction site.
- 3.06 Cap Installation
A. Cap units shall be glued to underlying units with an all-weather adhesive recommended by the manufacturer.
- 3.07 Field Quality Control
A. The Owner shall engage inspection and testing services, including independent laboratories, to provide quality assurance and testing services during construction.
B. As a minimum, quality assurance testing should include foundation soil inspection, soil and backfill testing, verification of design parameters, and observation of construction for general compliance with design drawings and specifications.

- NOTES:**
- No trees shall be planted within 10 feet of the top of the retaining wall.
 - Retaining walls shall only be constructed under the observation of a registered professional engineer and a (NICET, WACE, or equiv.) certified soils technician.
 - One soil boring shall be required every one hundred feet along the entire length of the wall. Copies of all boring reports shall be provided to the Howard County Inspector Prior to the start of construction.
 - The required bearing pressure beneath the wall system shall be verified in the field by a certified soils technician. Testing documentation must be provided to the Howard County Inspector prior to start of construction. The required bearing test shall be the Dynamic Cone Penetrometer test ASTM STP-399.
 - The suitability of fill material shall be confirmed by the on-site soils technician. Each 8" lift must be compacted to a minimum 95% standard proctor density and the testing report shall be made available to the Howard County Inspector upon completion of construction.
 - Walls shall not be constructed on uncertified fill materials.
 - Walls shall not be constructed within a Howard Co. right-of-way or easement.

SEGMENTAL BLOCK RETAINING WALL #3 PLAN

TURF VALLEY, LORIE
NURSING HOME & ASSISTED LIVING

PARCEL Q (per F-02-82) MULTI-USE SUBDISTRICT
AS-BUILT PLAT 18773 - 18775
TAX MAP 16 - P/O PARCEL 8- GRID 16 & 17;
POD 1 per S-86-13 (4th AMENDED)
FIFTH ELECTION DISTRICT HOWARD COUNTY, MARYLAND

HILLIS-CARNES
ENGINEERING ASSOCIATES

10975 Guilford Road, Suite A Annapolis Junction, Maryland
(410) 880-4783 Fax: (410) 880-4098



HCEA PROJECT #: 07235-R

DRAWN BY: HM

CHECKED BY: RWS

SCALE: AS SHOWN

DATE: 04/30/2008

SHEET:
11 OF 36

APPROVED: *[Signature]* 4/30/08
Chief, Development Engineering Division

APPROVED: *[Signature]* 6/23/08
Chief, Division of Land Development


APPROVED: *[Signature]* 6/30/08
Director

PROFESSIONAL CERTIFICATION: I HEREBY CERTIFY THAT THESE DOCUMENTS WERE PREPARED OR APPROVED BY ME, AND THAT I AM A DULY LICENSED PROFESSIONAL LAND SURVEYOR, UNDER THE LAWS OF THE STATE OF MARYLAND, REG. NO. 21297, EXPIRATION DATE 6-14-2019




OWNER/DEVELOPER
MANGIONE ENTERPRISES OF TURF VALLEY
LIMITED PARTNERSHIP
1205 YORK ROAD, PENTHOUSE
LUTHERVILLE, MARYLAND 21093
PHONE (410) 825-8400

PROFESSIONAL CERTIFICATION
I HEREBY CERTIFY THAT THESE PLANS WERE PREPARED OR APPROVED BY ME, AND THAT I AM A DULY LICENSED PROFESSIONAL ENGINEER UNDER THE LAWS OF THE STATE OF MARYLAND, LICENSE NO. 14434, EXPIRATION DATE: 05/13/09

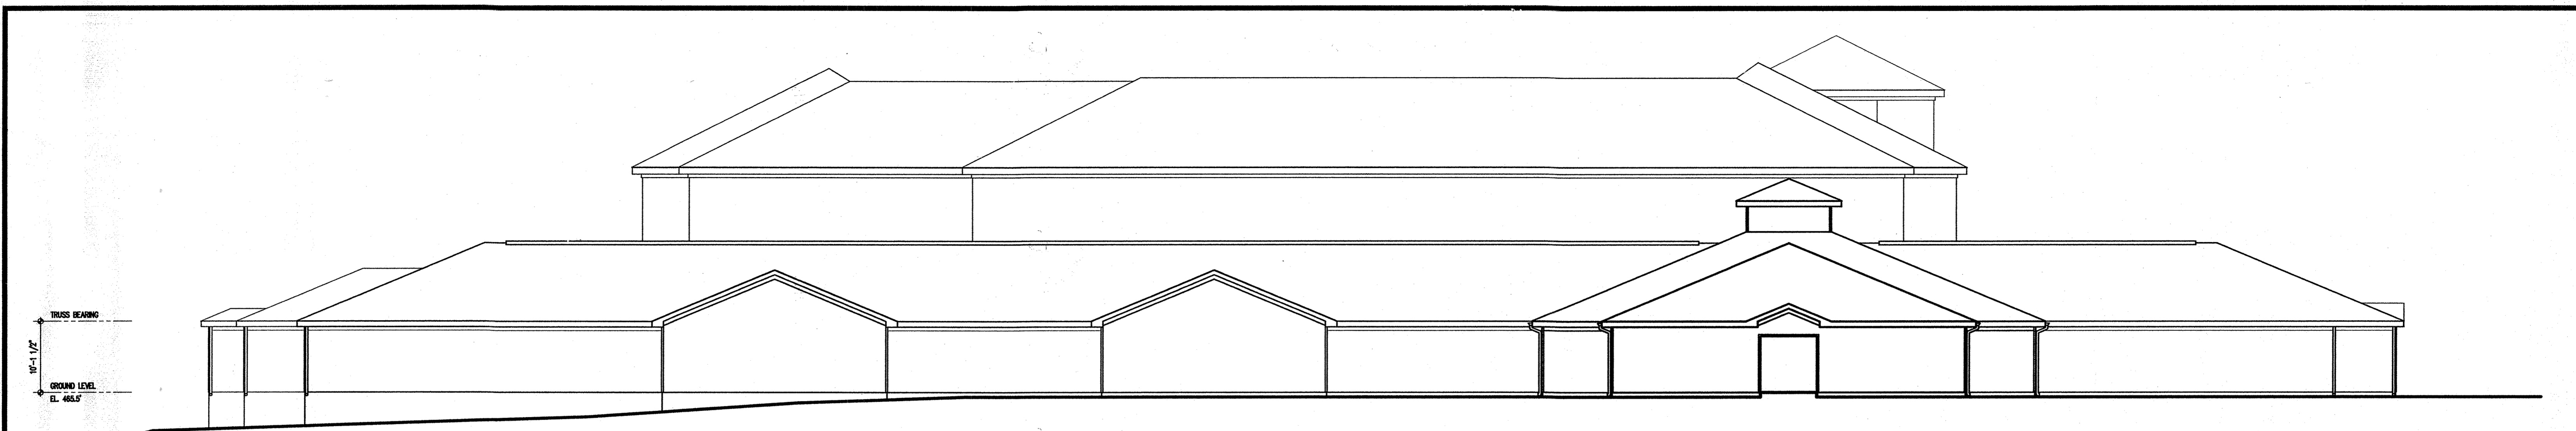

LEFT ELEVATION

3/32" = 1'-0"

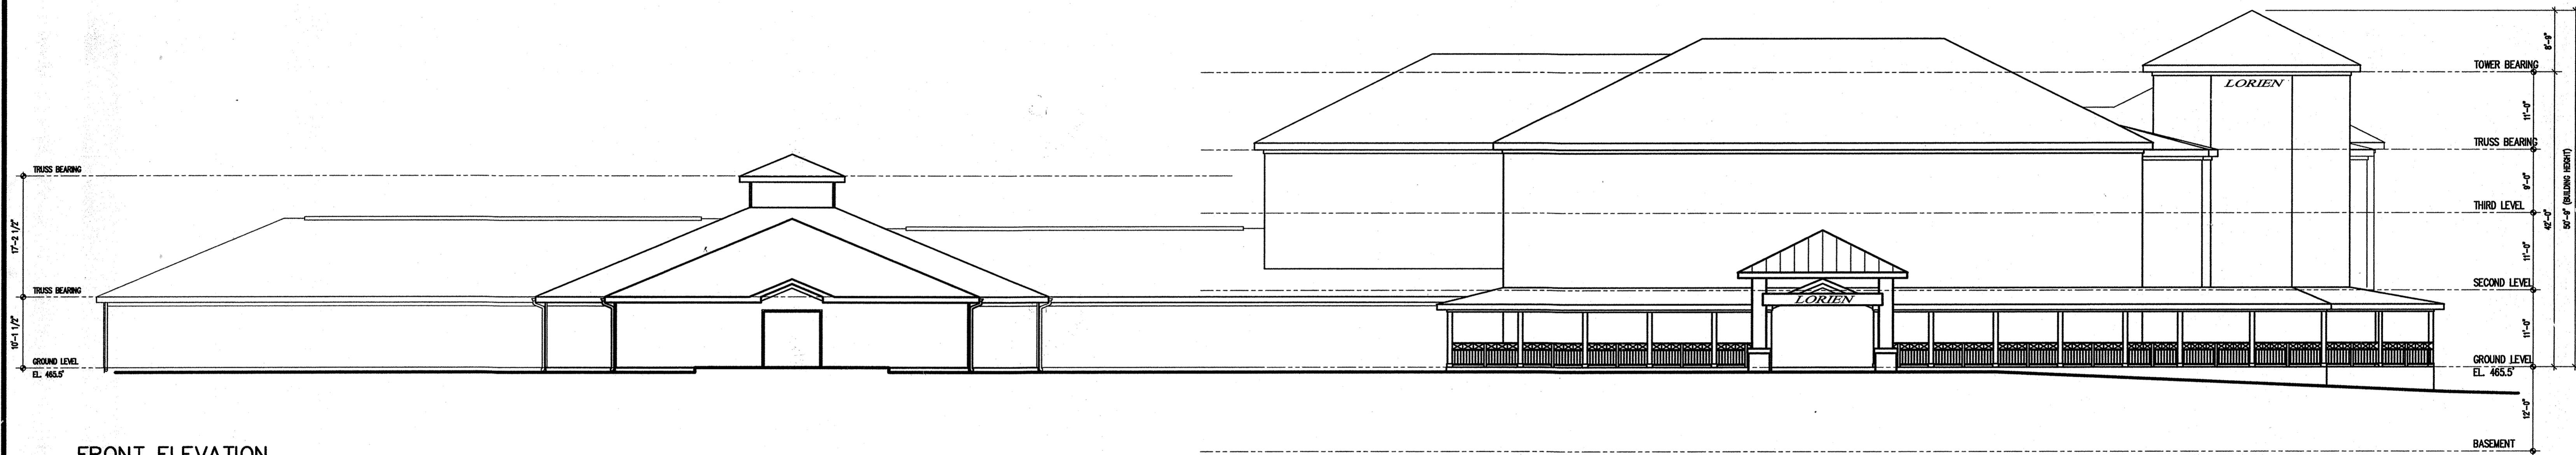


FRONT ELEVATION

3/32" = 1'-0"

NOTE- THE CLEARANCE UNDER THE ENTRANCE CANOPY SHALL NOT BE LESS THAN 13'-6" FOR FIRE DEPARTMENT ACCESS.

OWNER
MANGIONE ENTERPRISES OF TURF VALLEY LIMITED PARTNERSHIP
1205 YORK ROAD, PENTHOUSE LUTHERVILLE, MARYLAND 21093
PHONE (410) 825-8400

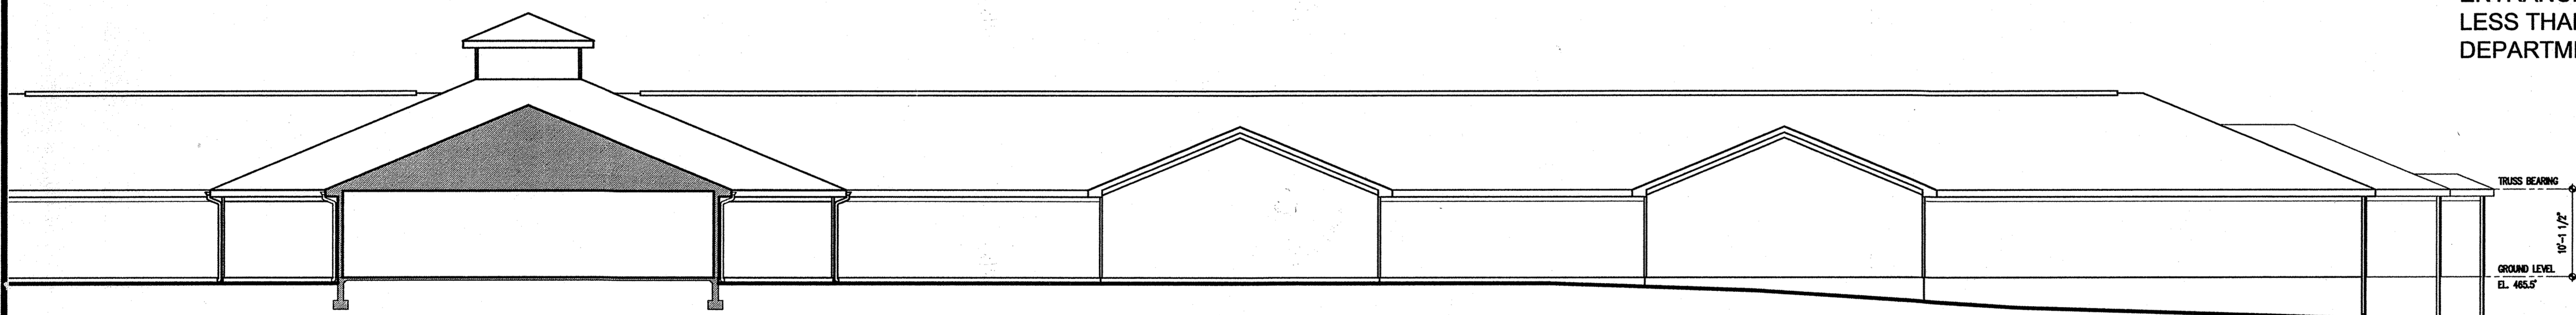

RIGHT ELEVATION - NURSING


3/32" = 1'-0"

APPROVED
PLANNING BOARD
OF HOWARD COUNTY
DATE 3/27/08
EAS


APPROVED: DEPARTMENT OF PLANNING AND ZONING
[Signature] 4/25/08 Date
Chief, Development Engineering Division
[Signature] 6/27/08 Date
Chief, Division of Land Development
[Signature] 6/20/08 Date
Director

AS-BUILT CERTIFICATION
THERE IS NO "AS-BUILT" INFORMATION PROVIDED ON THIS SHEET
[Signature] 02/22/19 DATE
MICHAEL D. BOCKER, PROFESSIONAL LAND SURVEYOR
NO REG. NO. 21257, EXPIRATION DATE 01-16-21


AS-BUILT BUILDING ELEVATIONS	
TURF VALLEY, LORIE	
NURSING HOME & ASSISTED LIVING FACILITY	
OAKMONT AT TURF VALLEY	
PARCEL Q	
PLATS 18773 - 18775	
TAX MAP 16 - P/O PARCEL 8- GRID 16 & 17;	
POD, per S-86-13 (4th AMENDED)	
THIRD ELECTION DISTRICT HOWARD COUNTY, MARYLAND	
	KCE ENGINEERING, INC.
	EXECUTIVE CENTER 3300 NORTH RIDGE ROAD, SUITE 315 ELLCOTT CITY, MARYLAND 21043 PHONE (410) 203-9800 FAX (410) 203-9228
"Professional Certification, I hereby certify that these documents were prepared or approved by me, and that I am a duly licensed professional engineer under the laws of the State of Maryland, License NO. 8818, Expiration Date: 10/17/08."	DRAWN BY: MG CHECKED BY: DVK SCALE: AS SHOWN DATE: 04/30/2008
	SHEET: 12 OF 36

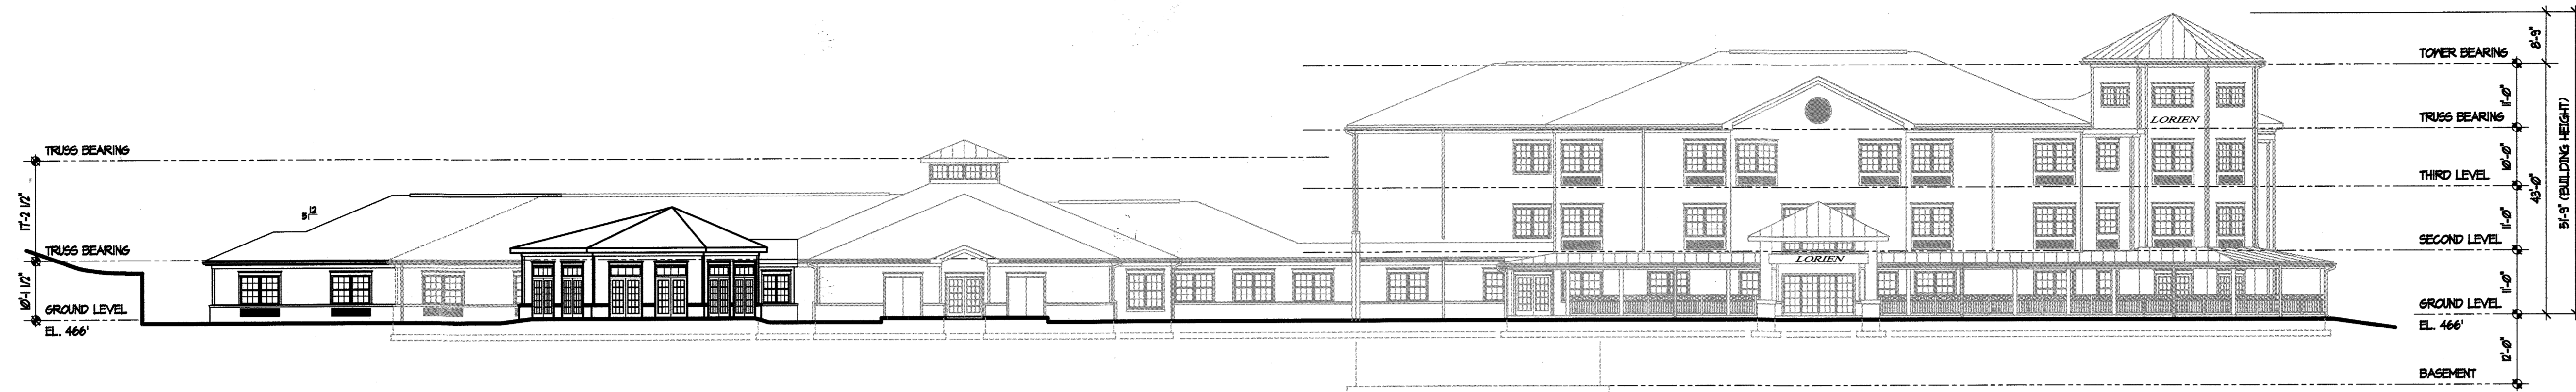

WEST ELEVATION
3/32" = 1'-0"

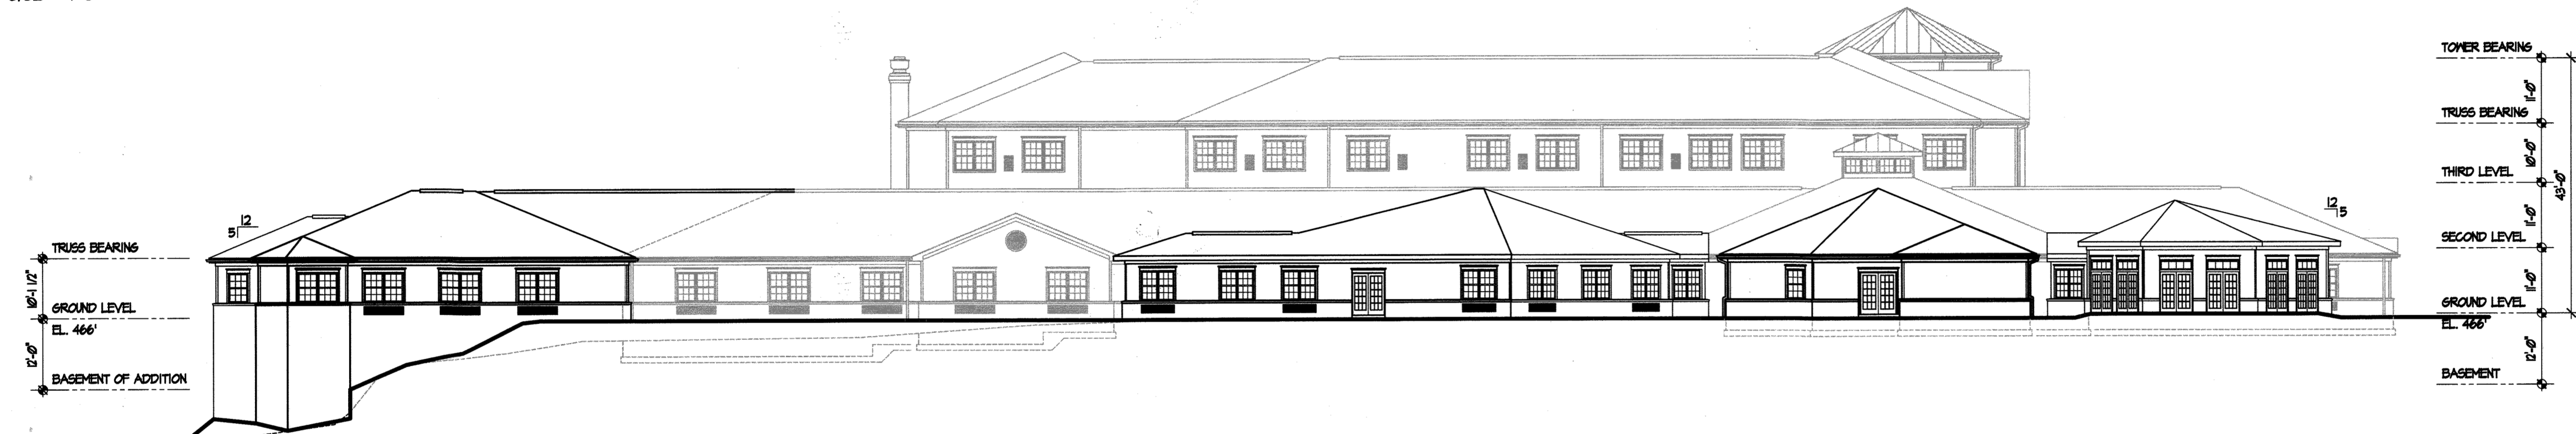

NORTH ELEVATION
3/32" = 1'-0"

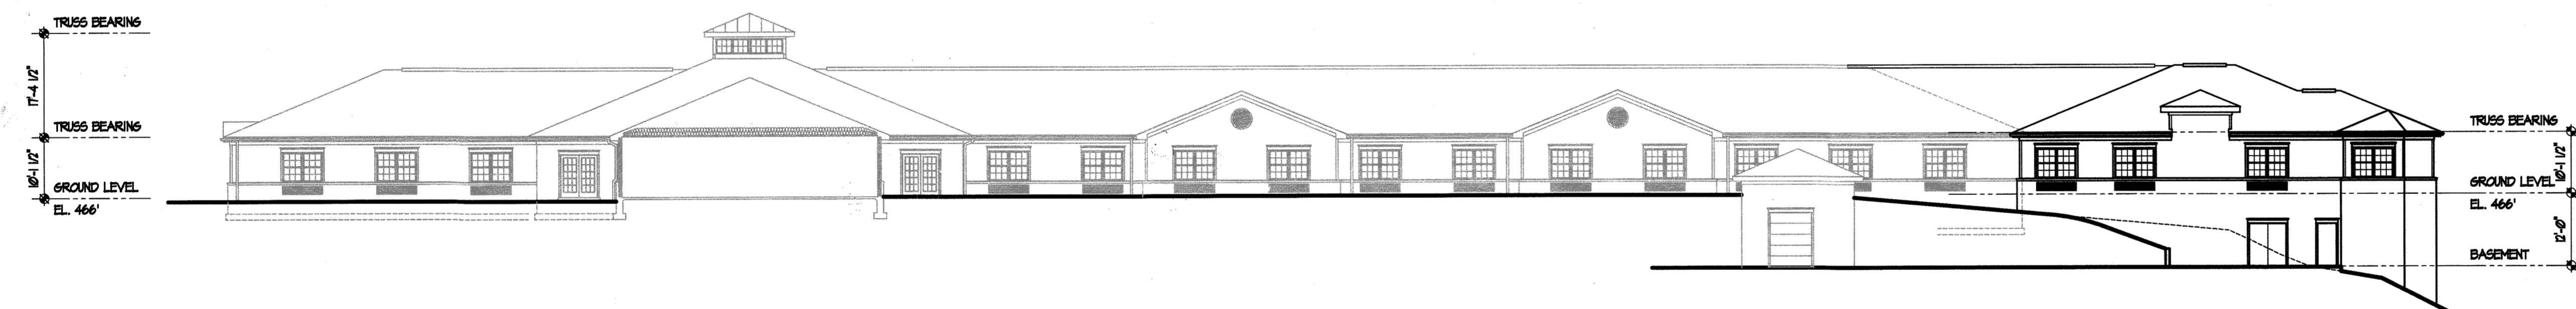


SOUTH ELEVATION
3/32" = 1'-0"

APPROVED
PLANNING BOARD
OF HOWARD COUNTY
DATE 3/27/2008
9/01/2016

APPROVED: DEPARTMENT OF PLANNING AND ZONING
 Chief, Development Engineering Division 11-28-16
 Chief, Division of Land Development 12-6-16
 Director 12-6-16

AS-BUILT CERTIFICATION
 THERE IS NO "AS-BUILT" INFORMATION PROVIDED ON THIS SHEET
 MICHAEL D. AD COCK, PROFESSIONAL LAND SURVEYOR
 MD REG. NO. 2327, EXPIRATION DATE 05-16-21
 01/23/19 DATE

AS-BUILT BUILDING ELEVATIONS	
TURF VALLEY, LORIENT NURSING HOME & ASSISTED LIVING FACILITY OAKMONT AT TURF VALLEY PARCEL Q PLATS 18773 - 18775 TAX MAP 16 - P/O PARCEL 8- GRID 16 & 17; POD 1 per S-86-13 (4th AMENDED) THIRD ELECTION DISTRICT HOWARD COUNTY, MARYLAND	
ARCHITECTS PLANNERS 1400 West Jones Road Towson, MD 21286 Phone 410-321-8866 Fax 410-321-1749	DRAWN BY: JJS CHECKED BY: WJM SCALE: 1/16" = 1'-0" DATE: 08/10/2016
	SHEET: 13 OF 36

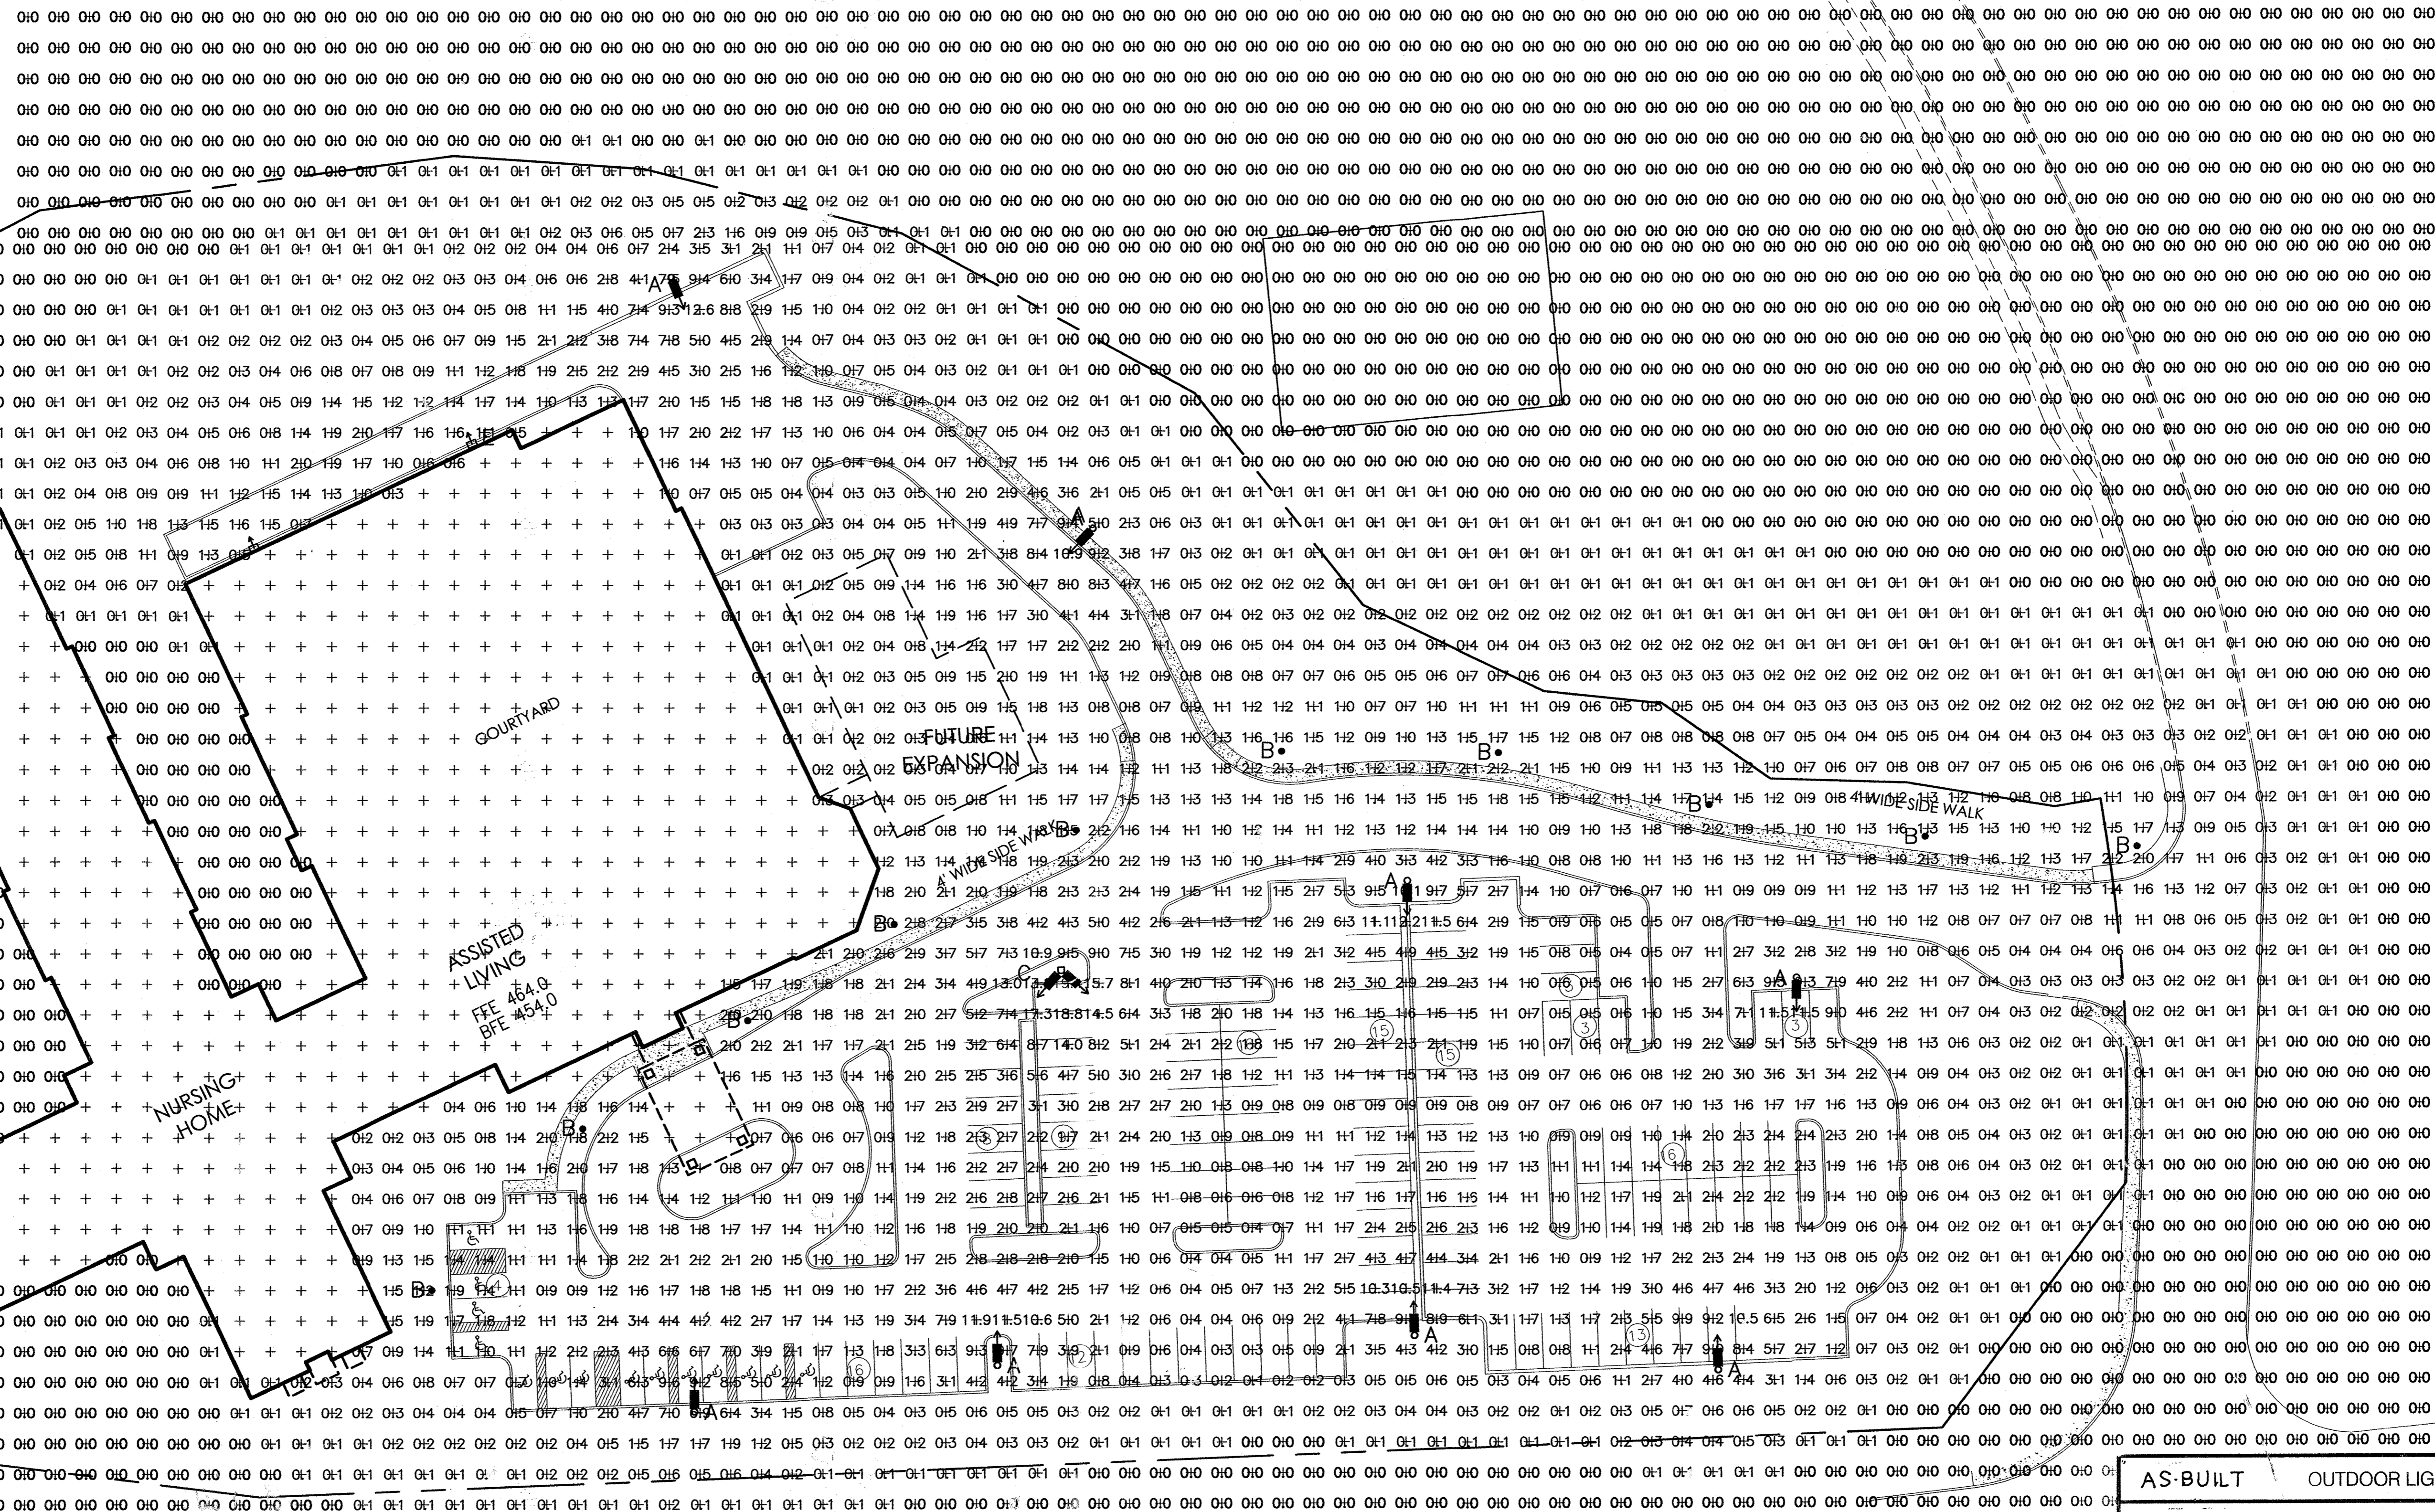

MARRIOTTSVILLE ROAD
EX. INTERMEDIATE ARTERIAL (120' R/W)

RESORT ROAD
(MAJOR COLLECTOR - 100' R/W)

Category	A	B	C
Height	0.8	0.8	0.8
Maximum	19.4	19.4	19.4
Minimum	0.0	0.0	0.0
Wg:Min	N/A	N/A	N/A
Max:Min	N/A	N/A	N/A
Coef Var	2.98	2.98	2.98
Unit/Grad	N/A	N/A	N/A

APPROVED
PLANNING BOARD
OF HOWARD COUNTY
DATE 3/27/08
EAAA

- A Streetworks MFT40Mw73D 400wMH 30'pole 277v
- B Streetworks ANE17MH733WHBF/STL 12'pole
- C Streetworks (2)MFT40MHW73D 400WMMH 30'pole 277v
- E Hubble 175w MH #PV- II 175H-128

AS-BUILT CERTIFICATION

THERE IS NO "AS-BUILT" INFORMATION PROVIDED ON THIS SHEET

Michael D. Adcock
MICHAEL D. ADCOCK, PROFESSIONAL LAND SURVEYOR
MD REG. NO. 21237, EXPIRATION DATE 06-16-21

07/23/19
DATE


OWNER
MANGIONE ENTERPRISES OF TURF VALLEY
LIMITED PARTNERSHIP
1205 RESORT ROAD, PENTHOUSE
LUTHERVILLE, MARYLAND 21093
PHONE (410) 825-8400

AS-BUILT OUTDOOR LIGHTING PLAN
TURF VALLEY, LORIE
NURSING HOME & ASSISTED LIVING FACIL
OAKMONT AT TURF VALLEY
PARCEL 2
PLATS 18773 - 18775
TAX MAP 16 - P/O PARCEL 8- GRID 16 & 17
POD 1 per S-86-13 (4th AMENDED)
THIRD ELECTION DISTRICT HOWARD COUNTY, MARYLAND



KCE ENGINEERING, INC.
EXECUTIVE CENTER
3300 NORTH RIDGE ROAD, SUITE 315
ELLCOTT CITY, MARYLAND 21043
PHONE (410) 203-9800 FAX (410) 203-9228


Professional Certification. I hereby certify that these documents were prepared or approved by me, and that I am a duly licensed professional engineer under the laws of the State of Maryland, License No. 8818, expiration date 10/17/28.

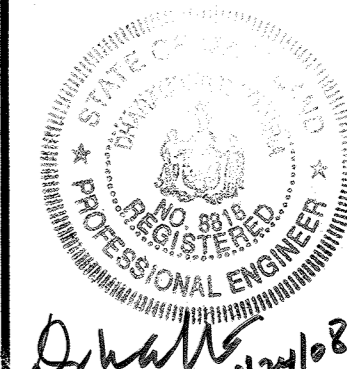


DRAWN BY: MG
CHECKED BY: DMK
SCALE: AS SHOWN
DATE: 09/30/2008

SHEET:
14
OF
36


DEPARTMENT OF PLANNING AND ZONING
Michael D. Adcock
Engineering Division
Michael D. Adcock
Director
Date: 09/30/08

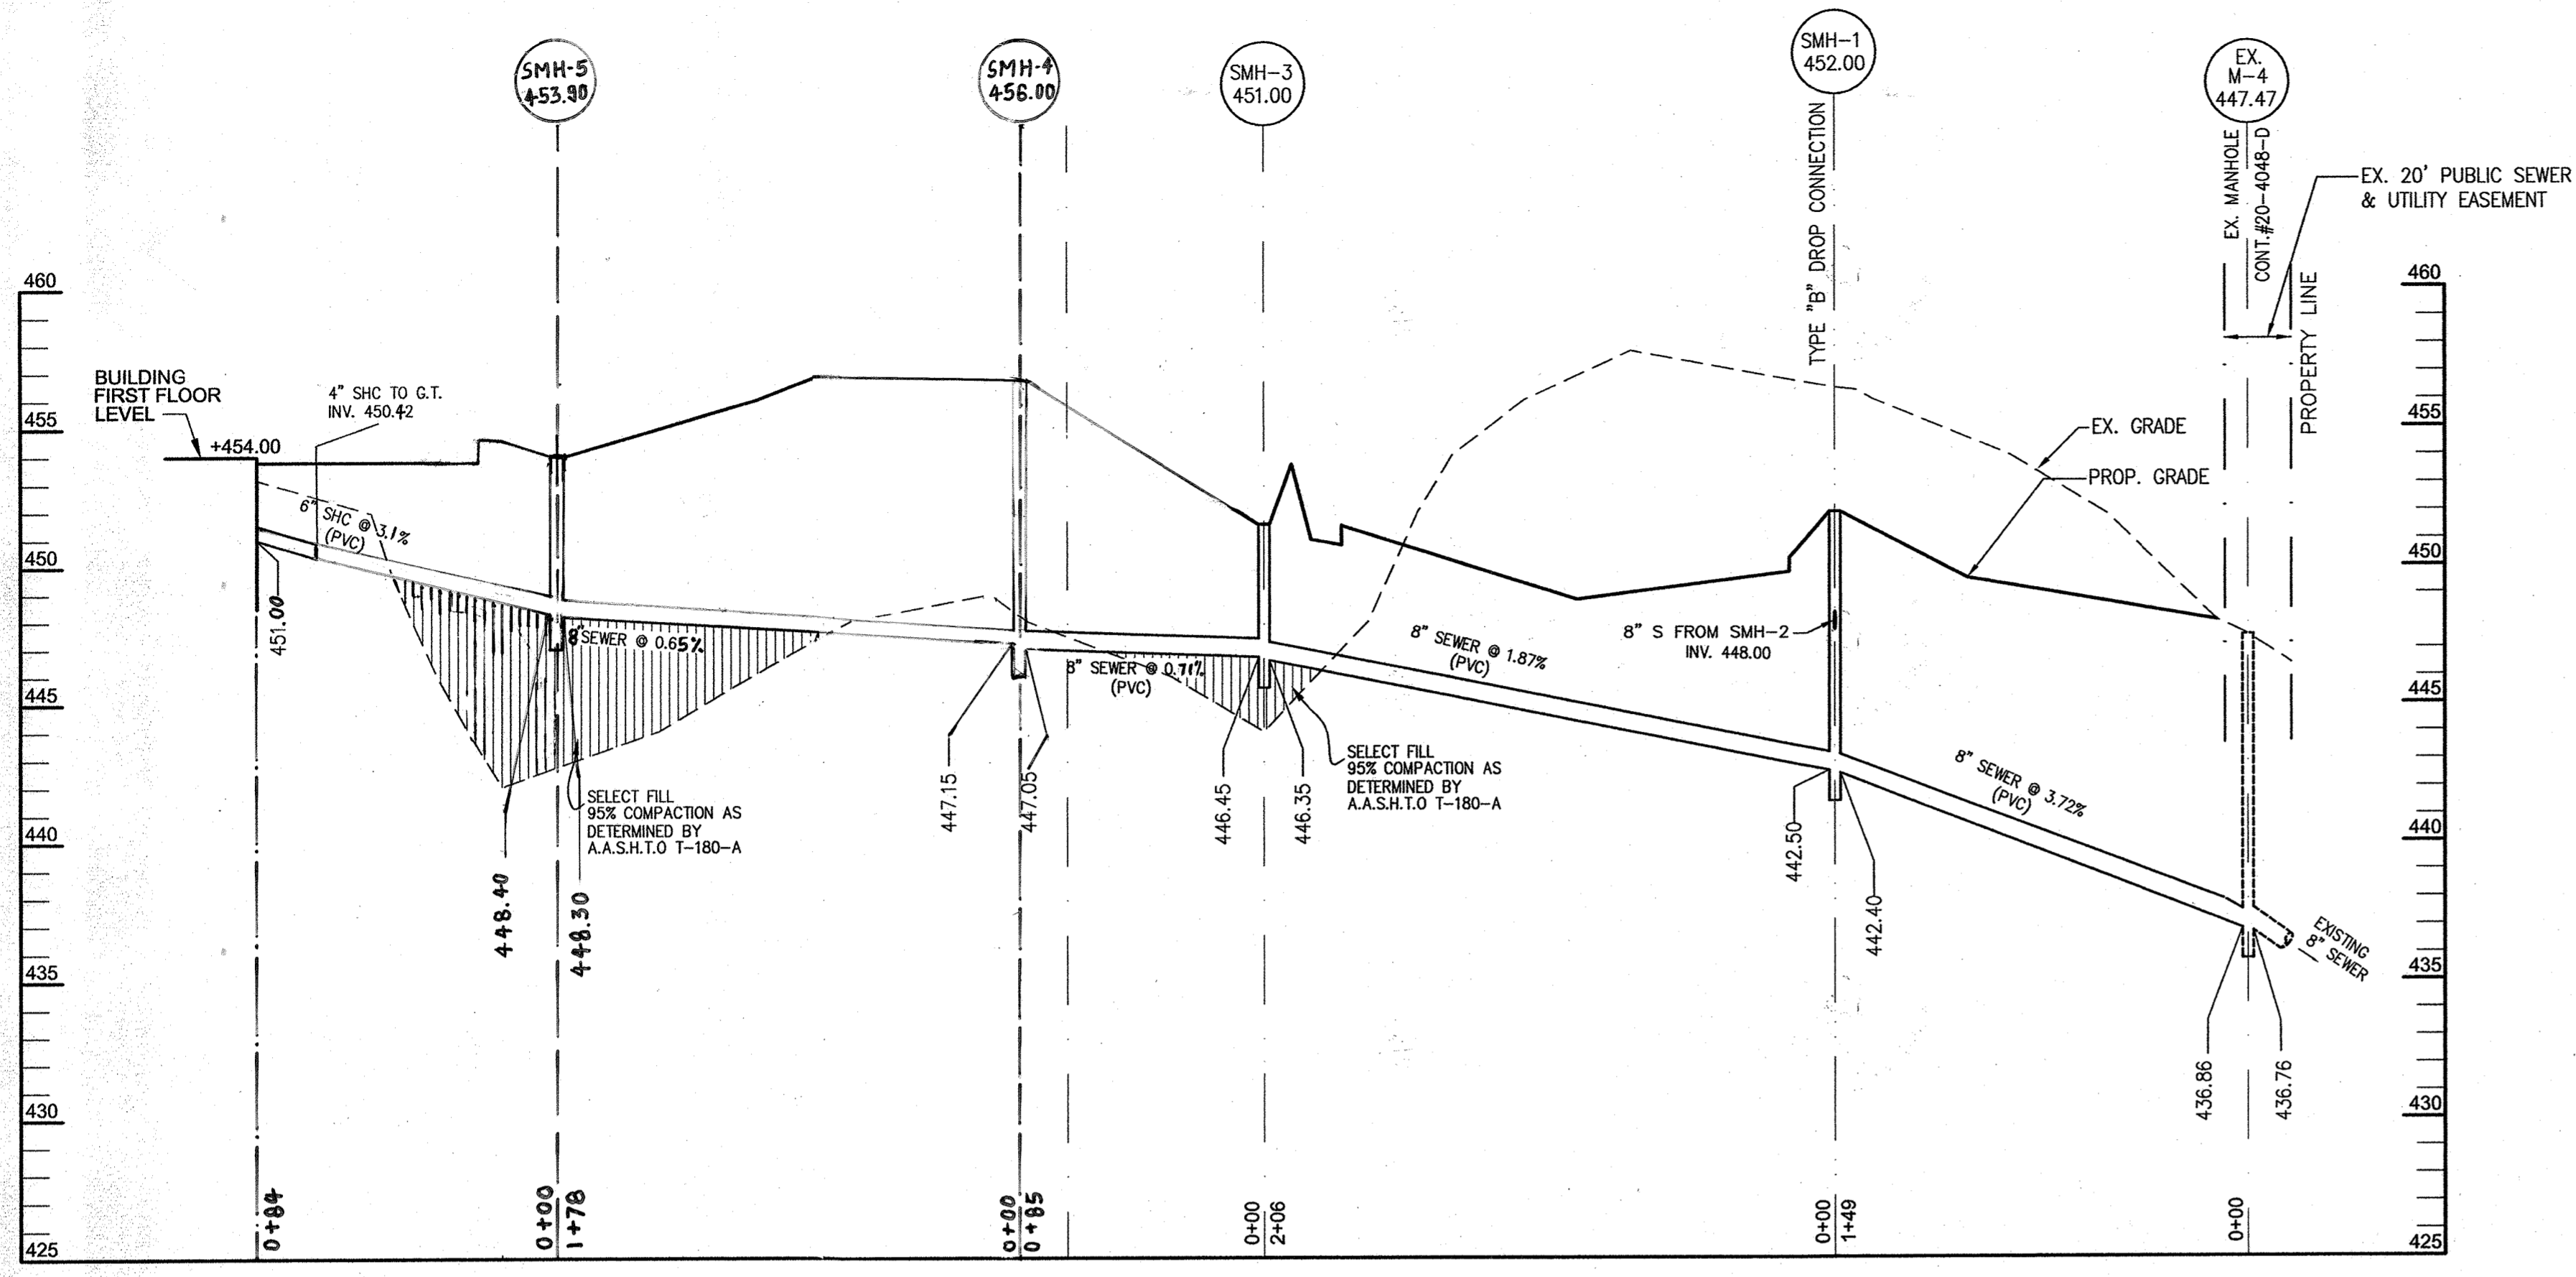

SEWER PROFILE
NURSING HOME SHC TO EX. MANHOLE M-4
SCALE 1"=50' H, 1"=5' V

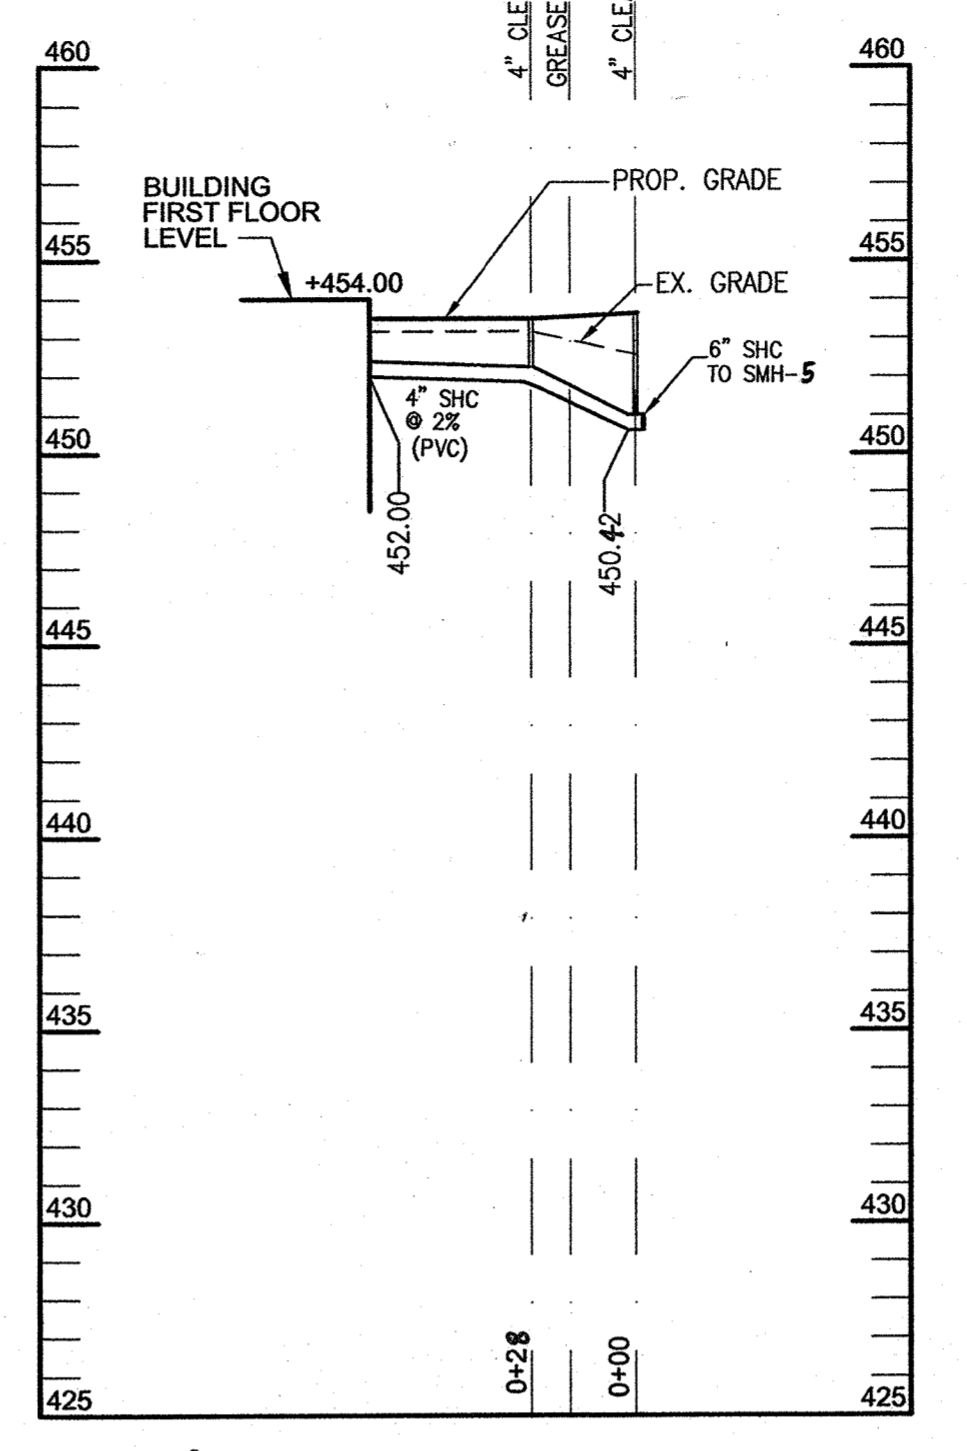

SEWER PROFILE
NURSING HOME SHC TO 6" SEWER SMH-5
SCALE 1"=50' H, 1"=5' V

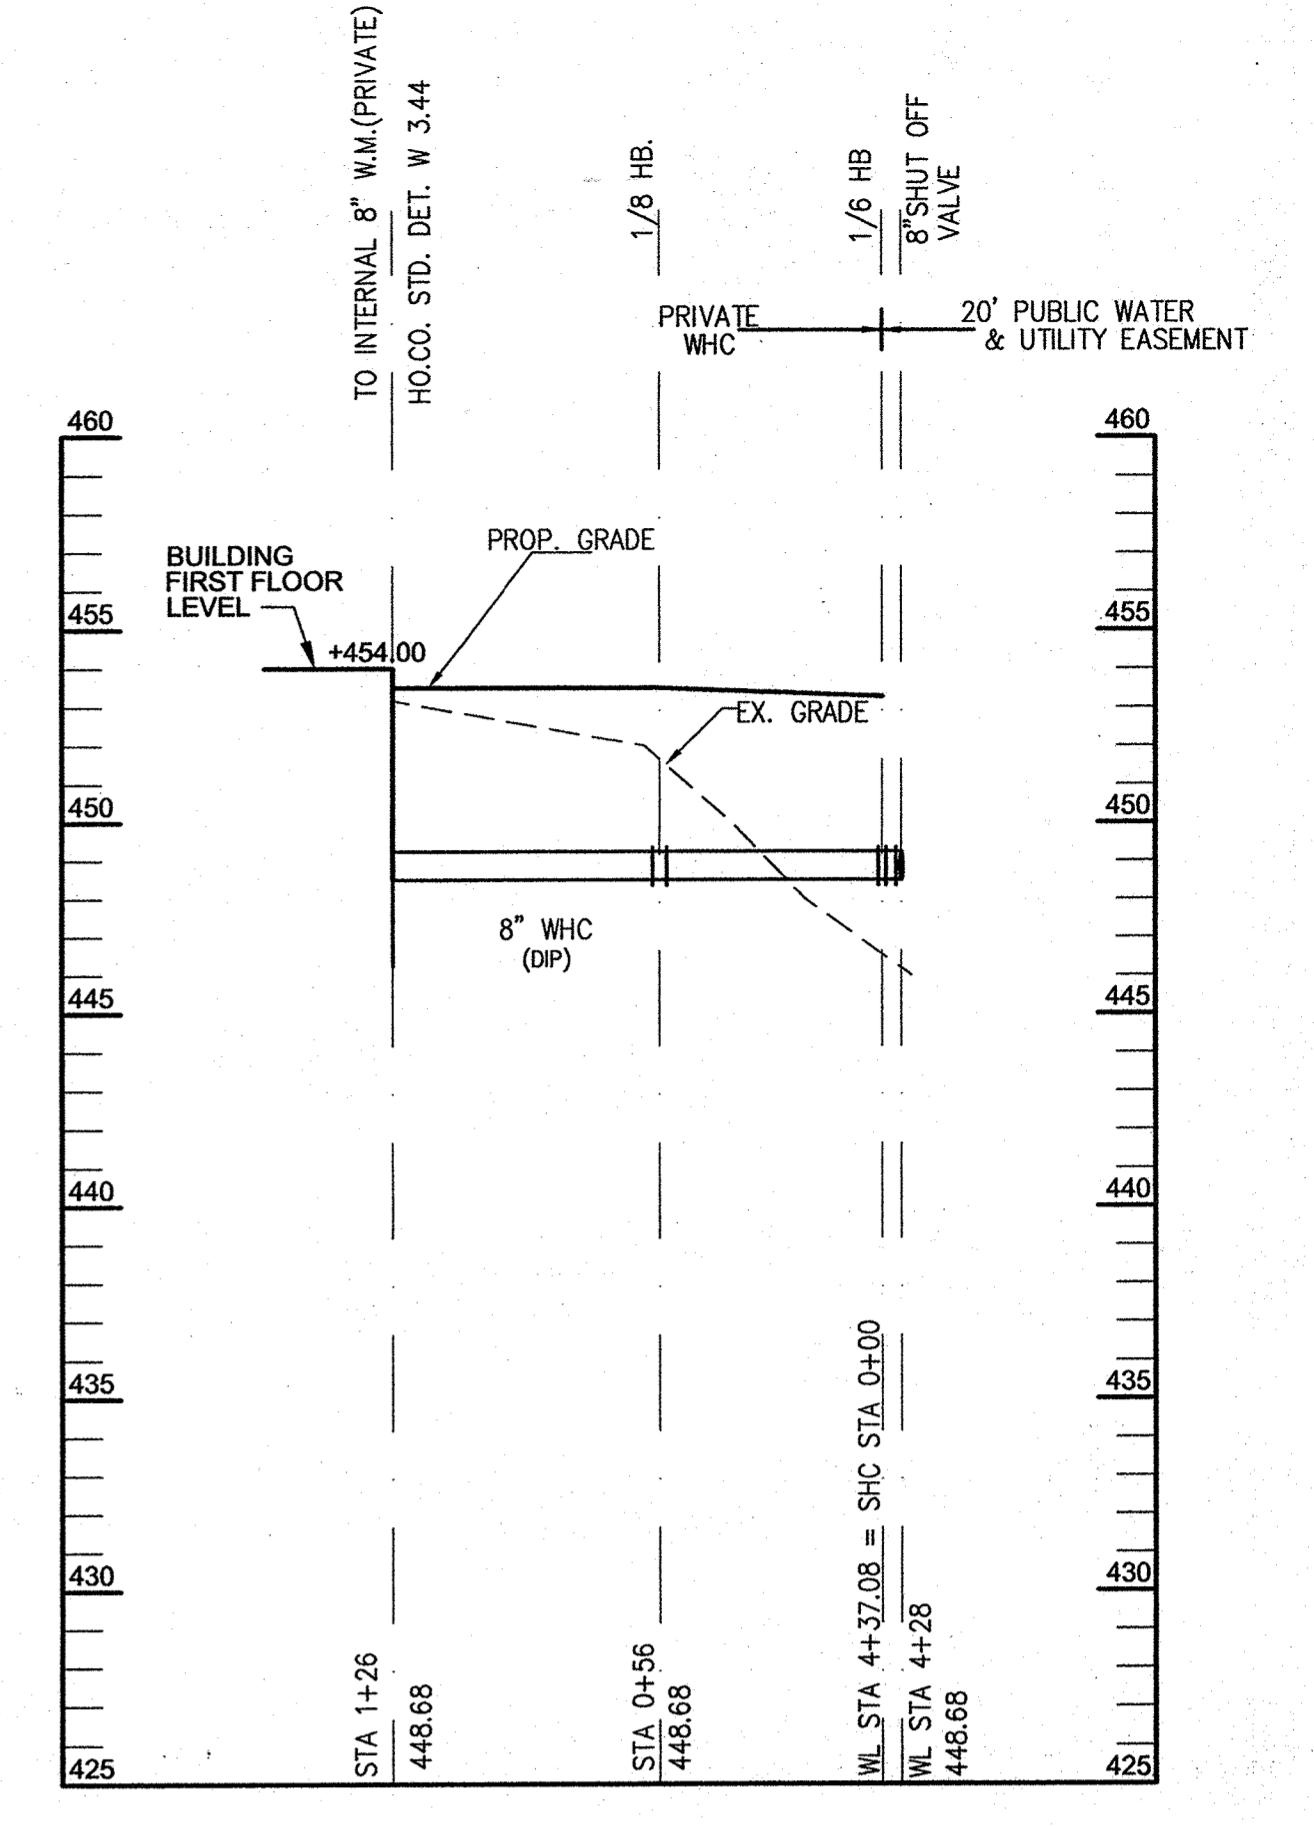


WHC PROFILE
SCALE 1"=50' H, 1"=5' V

SEWER MANHOLES SCHEDULE						
NO.	SYMBOL	TYPE	LOCATION	TOP ELEV.	INV. IN.	INV. OUT.
1	SMH-1	TYPE "B" DROP MANHOLE HO. CO. STD DET S 1.32	N 595,139.49 E 1,340,647.27	452.00	448.00 442.50	442.40
2	SMH-2	PRECAST MH HO. CO. STD DET G 5.12	N 595,321.46 E 1,340,704.53	460.65	456.00	455.90
3	SMH-3	PRECAST MH HO. CO. STD DET G 5.12	N 595,076.19 E 1,340,847.92	451.00	446.45	446.35
4	SMH-4	PRECAST MH HO. CO. STD DET G 5.12	N 595,152.54 E 1,340,884.44	456.00	457.15	447.05
5	SMH-5	PRECAST MH HO. CO. STD DET G 5.12	N 595,178.06 E 1,340,949.35	456.87	447.01	447.51
5	SMH-5	PRECAST MH HO. CO. STD DET G 5.12	N 595,236.46 E 1,341,041.61	453.90	448.40	448.30

APPROVED
PLANNING BOARD
OF HOWARD COUNTY
DATE 3/27/08
[Signature]

APPROVED: DEPARTMENT OF PLANNING AND ZONING
[Signature] Date
Chief, Development Engineering Division
[Signature] Date
Chief, Division of Land Development
[Signature] Date
Director

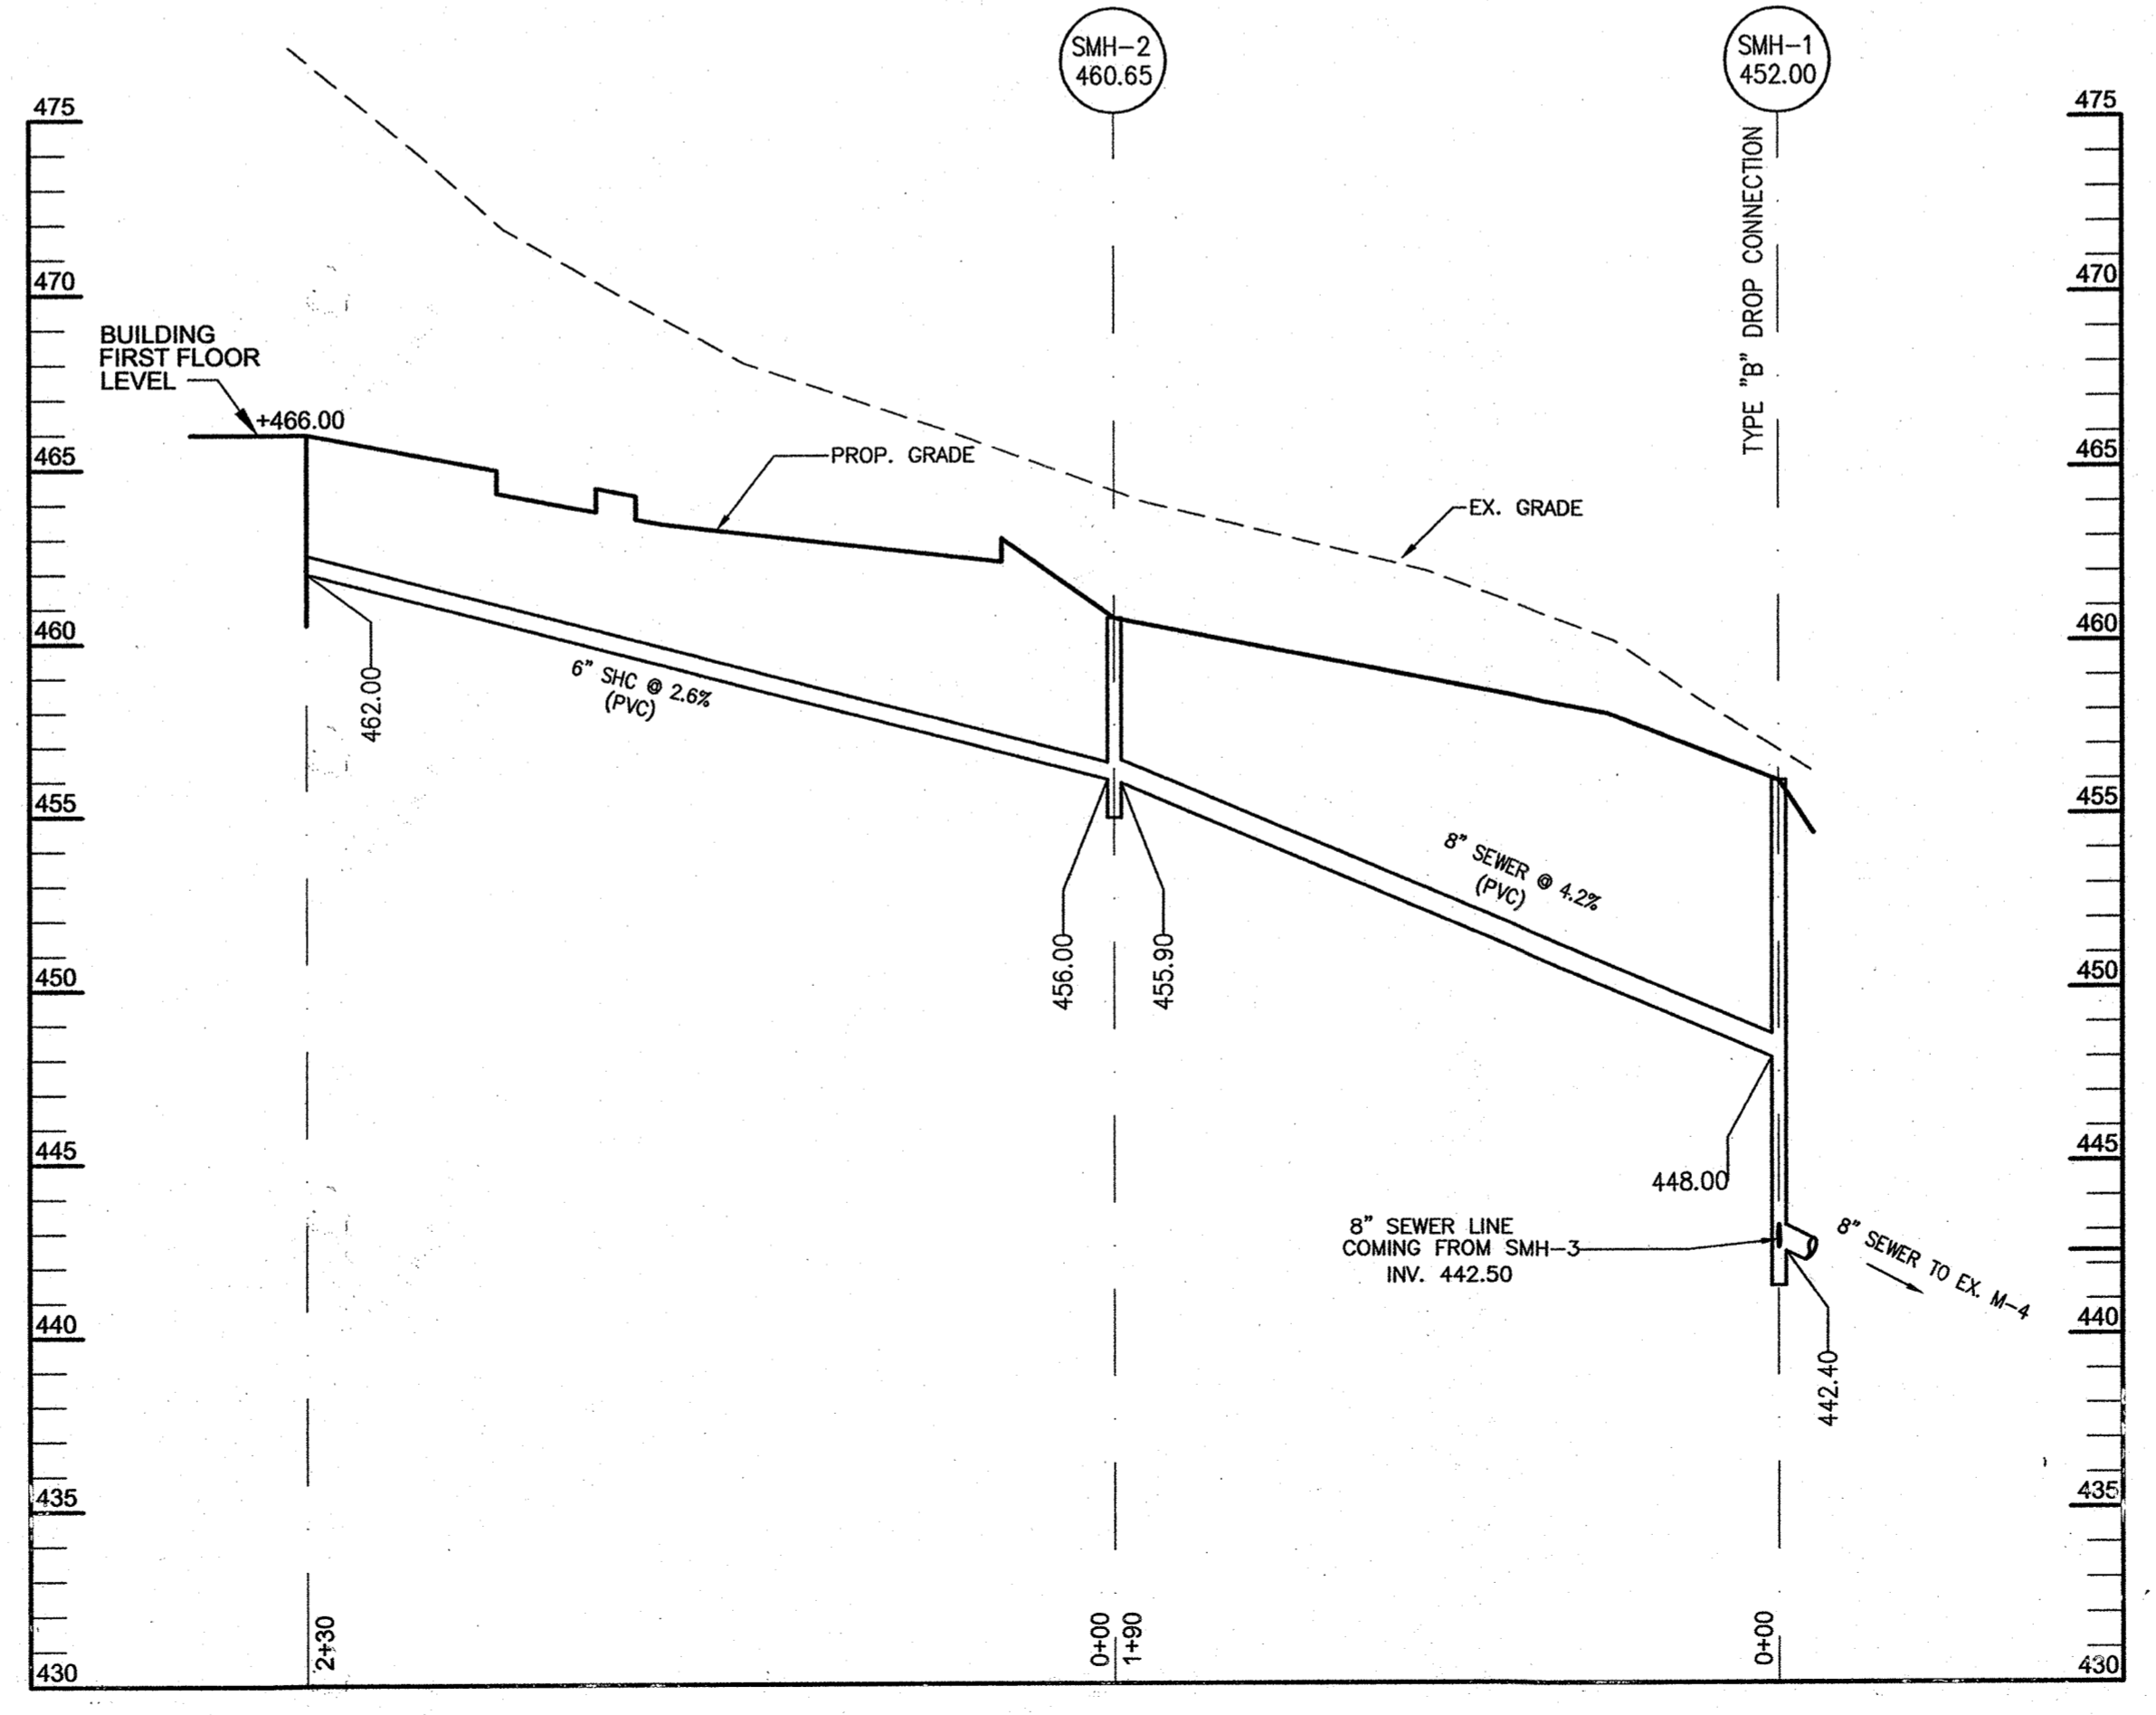

SEWER PROFILE
NURSING HOME SHC TO SMH-1
SCALE 1"=50' H, 1"=5' V

NO.	BY	DATE	REVISION
1	KCB	07/16/08	REVISED SEWER PROFILE FROM SMH 4 TO SMH 5 & SCHEDULE

OWNER
MANGIONE ENTERPRISES OF TURF VALLEY
LIMITED PARTNERSHIP
1205 YORK ROAD, PENTHOUSE
LUTHERVILLE, MARYLAND 21093
PHONE (410) 825-8400

AS-BUILT SEWER PROFILES

TURF VALLEY, LORIE
NURSING HOME & ASSISTED LIVING FACILITY
OAKMONT AT TURF VALLEY
PARCEL Q
PLATS 18773 - 18775
TAX MAP 16 - P/O PARCEL 8- GRID 16 & 17;
POD I per S-86-13 (4th AMENDED)
THIRD ELECTION DISTRICT HOWARD COUNTY, MARYLAND

KCE ENGINEERING, INC.
EXECUTIVE CENTER
3300 NORTH RIDGE ROAD, SUITE 315
ELLCOTT CITY, MARYLAND 21043
PHONE (410) 203-9800 FAX (410) 203-9228

AS-BUILT CERTIFICATION
THERE IS NO "AS-BUILT" INFORMATION PROVIDED ON THIS SHEET
[Signature] DATE 07/23/19
MICHAEL D. ADCOCK, PROFESSIONAL LAND SURVEYOR
MOREG. NO. 21297, EXPIRATION DATE: 06-14-21

Professional Certification. I hereby certify that these documents were prepared or approved by me, and that I am a duly licensed professional engineer under the laws of the State of Maryland, License No. 8818, Expiration Date: 10/17/08.

STATE OF MARYLAND
PROFESSIONAL ENGINEER


DRAWN BY: MG
CHECKED BY: DVK
SCALE: AS SHOWN
DATE: 04/30/2008

SHEET: 15 OF 36

CURVE TABLE					
NO.	ARC LENGTH	CHORD LENGTH	CHORD BEARING	RADIUS	DELTA
C1	125.84'	125.61'	N 74°03'14" W	610.00'	11°49'11"

PROPERTY LINE TABLE		
NO.	LENGTH	BEARING
L1	74.34'	S 42°06'44" E
L2	58.40'	S 46°20'11" E
L3	39.82'	S 11°12'36" W
L4	53.61'	S 07°27'29" E
L5	135.80'	S 12°13'13" W
L6	62.18'	S 23°40'13" W
L7	86.37'	S 33°48'39" W
L8	109.12'	S 48°26'32" W
L9	88.27'	S 71°24'49" W
L10	65.27'	S 45°07'07" W
L11	38.60'	S 25°41'33" W
L12	43.15'	S 54°25'44" W
L13	44.38'	S 21°31'21" W
L14	48.85'	S 29°05'01" W
L15	15.00'	S 10°02'11" W
L16	52.43'	N 33°33'29" W
L17	47.38'	N 33°40'48" W

COORDINATE TABLE		
NO.	NORTHING	EASTING
668	595704.5297	1340842.4238
669	595031.8285	1340601.5238

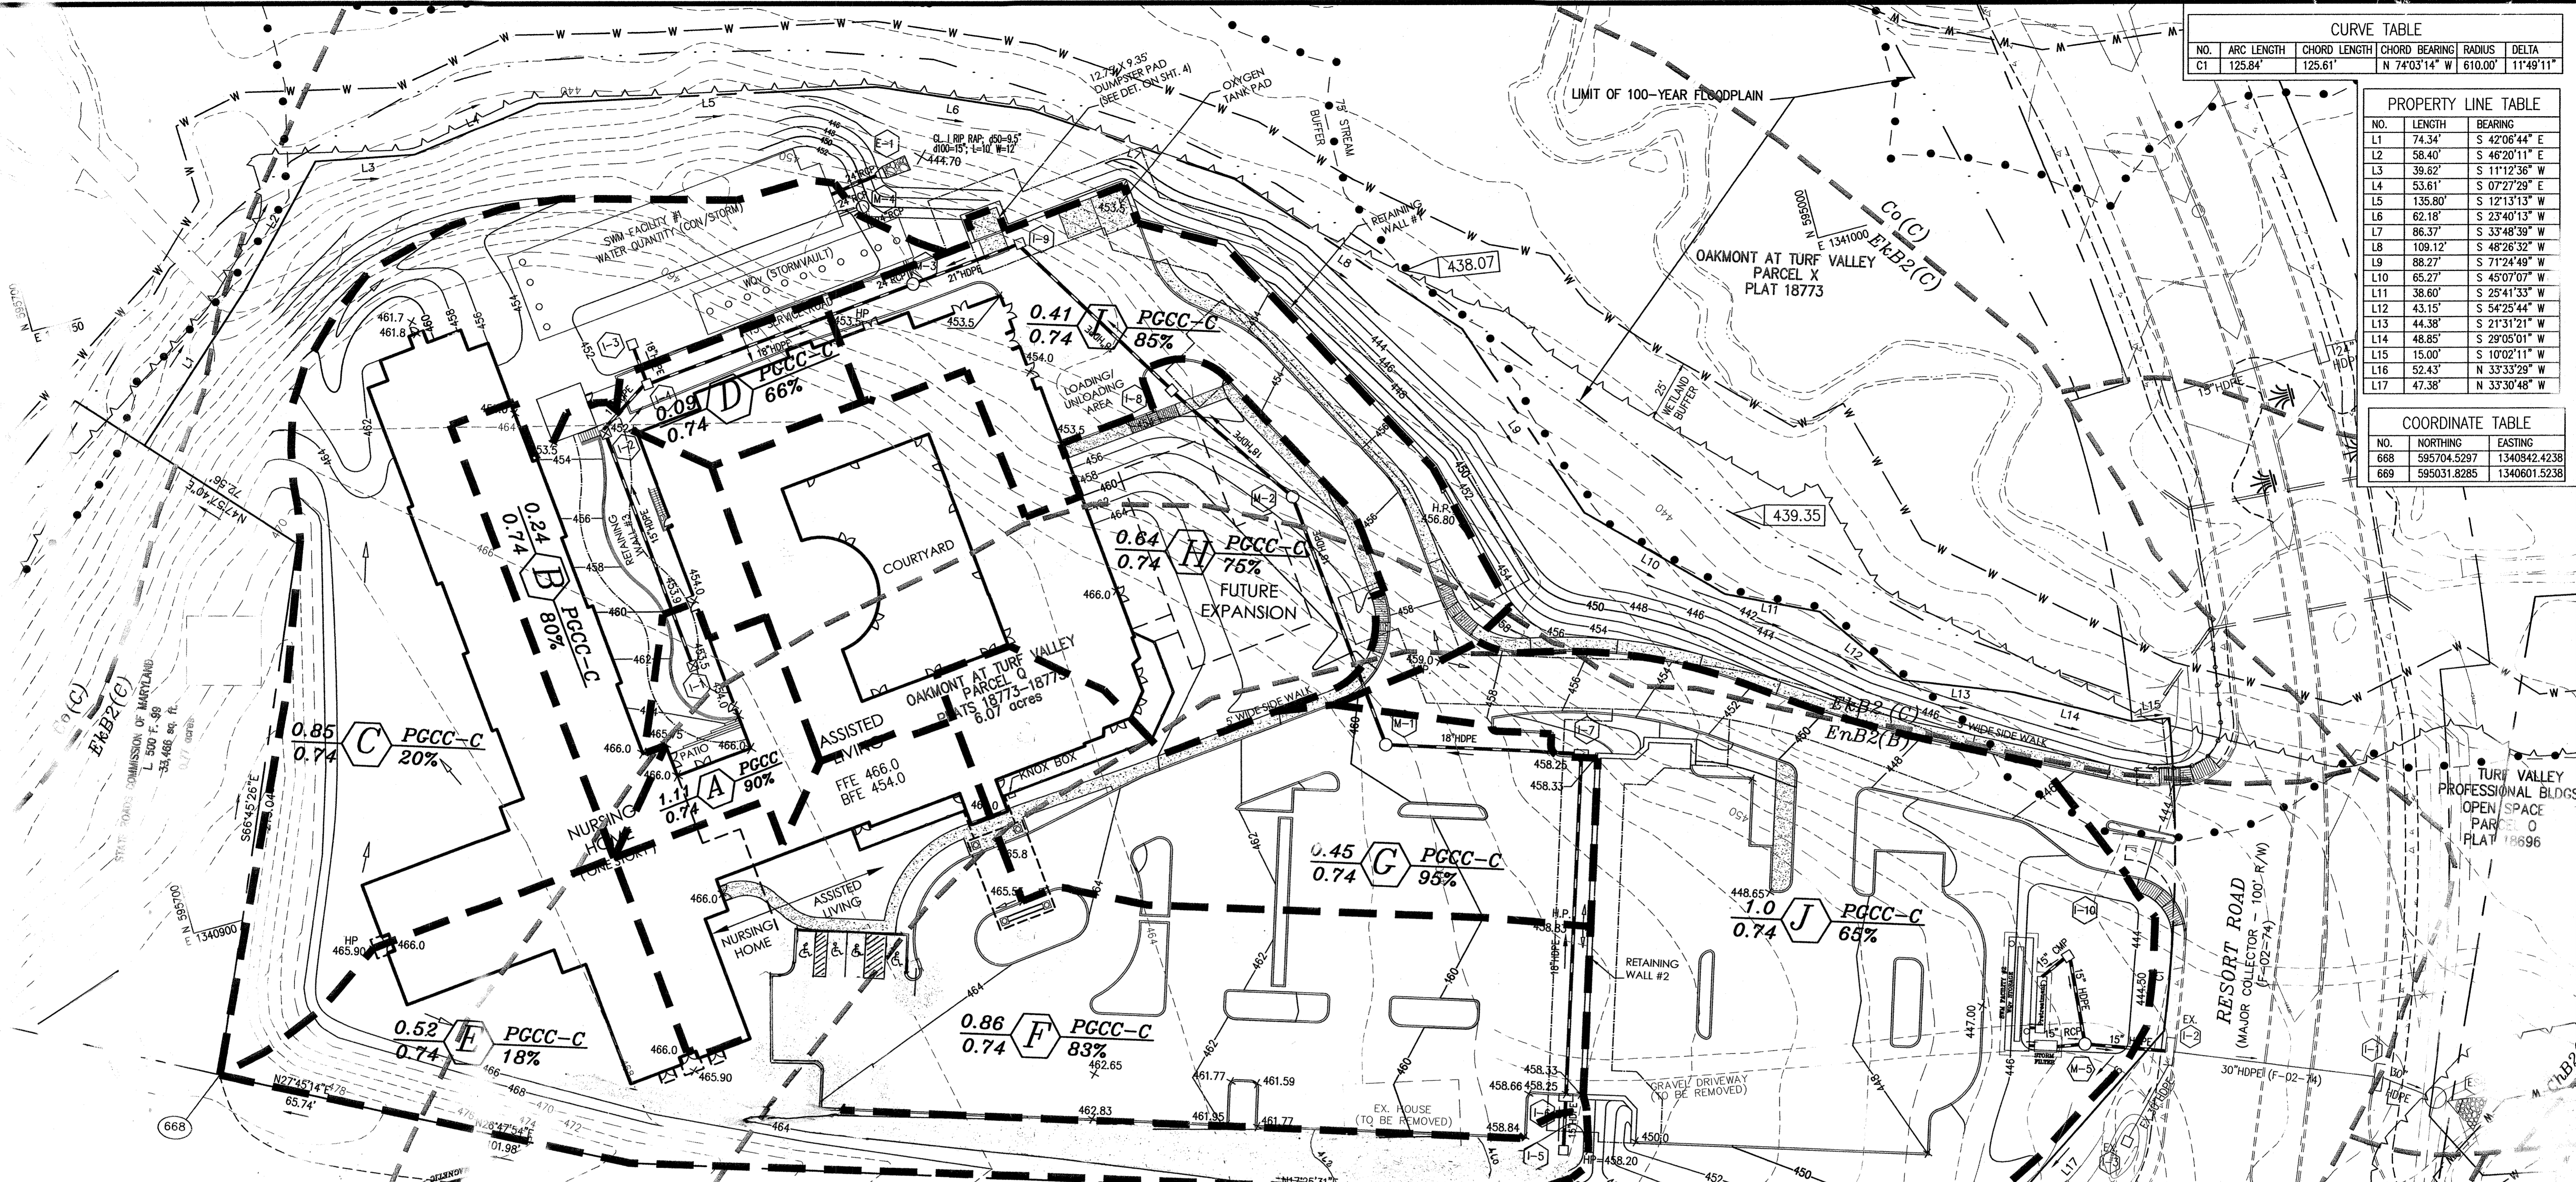

AS-BUILT STORM DRAIN- DRAINAGE AREA MAP

TURF VALLEY, LORIEN
NURSING HOME & ASSISTED LIVING FACILITY
 OAKMONT AT TURF VALLEY
 PARCEL Q
 PLATS 18773 - 18775
 TAX MAP 16 - P/O PARCEL 8- GRID 16 & 17
 POD 1 per S-86-13 (4th AMENDED)
 THIRD ELECTION DISTRICT HOWARD COUNTY, MARYLAND

KCE ENGINEERING, INC.
 EXECUTIVE CENTER
 3300 NORTH RIDGE ROAD, SUITE 315
 ELLICOTT CITY, MARYLAND 21043
 PHONE (410) 203-9800 FAX (410) 203-9228

AS-BUILT CERTIFICATION

I HEREBY CERTIFY, BY MY SEAL, THAT THE CONDITIONS SHOWN ON THIS PLAN WERE CONSTRUCTED TO THE LINES AND GRADES SHOWN ON THIS AS-BUILT PLAN AND MEET THE APPROVED PLANS AND SPECIFICATIONS AND ALSO THAT THESE DOCUMENTS WERE PREPARED BY ME OR UNDER MY RESPONSIBLE CHARGE AND THAT I AM DULY LICENSED PROFESSIONAL LAND SURVEYOR UNDER THE LAWS OF THE STATE OF MARYLAND.

MICHAEL A. ABCOCK, PROFESSIONAL LAND SURVEYOR
 MD REG. NO. 21257, EXPIRATION DATE 06-16-21

LEGEND	
[Symbol]	25% SLOPES
[Symbol]	15% - 24.9% SLOPES
[Symbol]	EX. WETLANDS
[Symbol]	EX. WETLAND BUFFER
[Symbol]	EX. STREAM
[Symbol]	EX. STREAM BUFFER
[Symbol]	EX. 100-YEAR FLOODPLAIN
[Symbol]	SOIL TYPES
[Symbol]	EXISTING EASEMENTS
[Symbol]	EX. WATER

SOIL LEGEND:		
SOIL	TYPE	DESCRIPTION
EkB2	C	ELIOAK SILT LOAM, 3 TO 8% SLOPES, MODERATELY ERODED
EnB2	B	ELSINBORO LOAM, 8 TO 15% SLOPES, MODERATELY ERODED
GIC2	B	GLENELG LOAM, 8 TO 15% SLOPES, MODERATELY ERODED
CO	C	CODRUS SILT LOAM

HOWARD COUNTY SOIL MAP # 9

PROFESSIONAL CERTIFICATION: I HEREBY CERTIFY THAT THESE DOCUMENTS WERE PREPARED OR APPROVED BY ME, AND THAT I AM A DULY LICENSED PROFESSIONAL LAND SURVEYOR UNDER THE LAWS OF THE STATE OF MARYLAND, REG. NO. 21257, EXPIRATION DATE 06-16-2019


STATE OF MARYLAND
 MICHAEL A. ABCOCK
 PROFESSIONAL LAND SURVEYOR

OWNER
 MANGIONE ENTERPRISES OF TURF VALLEY
 LIMITED PARTNERSHIP
 1205 YORK ROAD, PENTHOUSE
 LUTHERVILLE, MARYLAND 21093
 PHONE (410) 825-8400

APPROVED
 PLANNING BOARD
 OF HOWARD COUNTY
 DATE: 3/27/08






5 JUL 4 11/08 REV. SWM 2, STORM DRAIN, GRADING, CURB & PARKING

APPROVED: [Signatures]

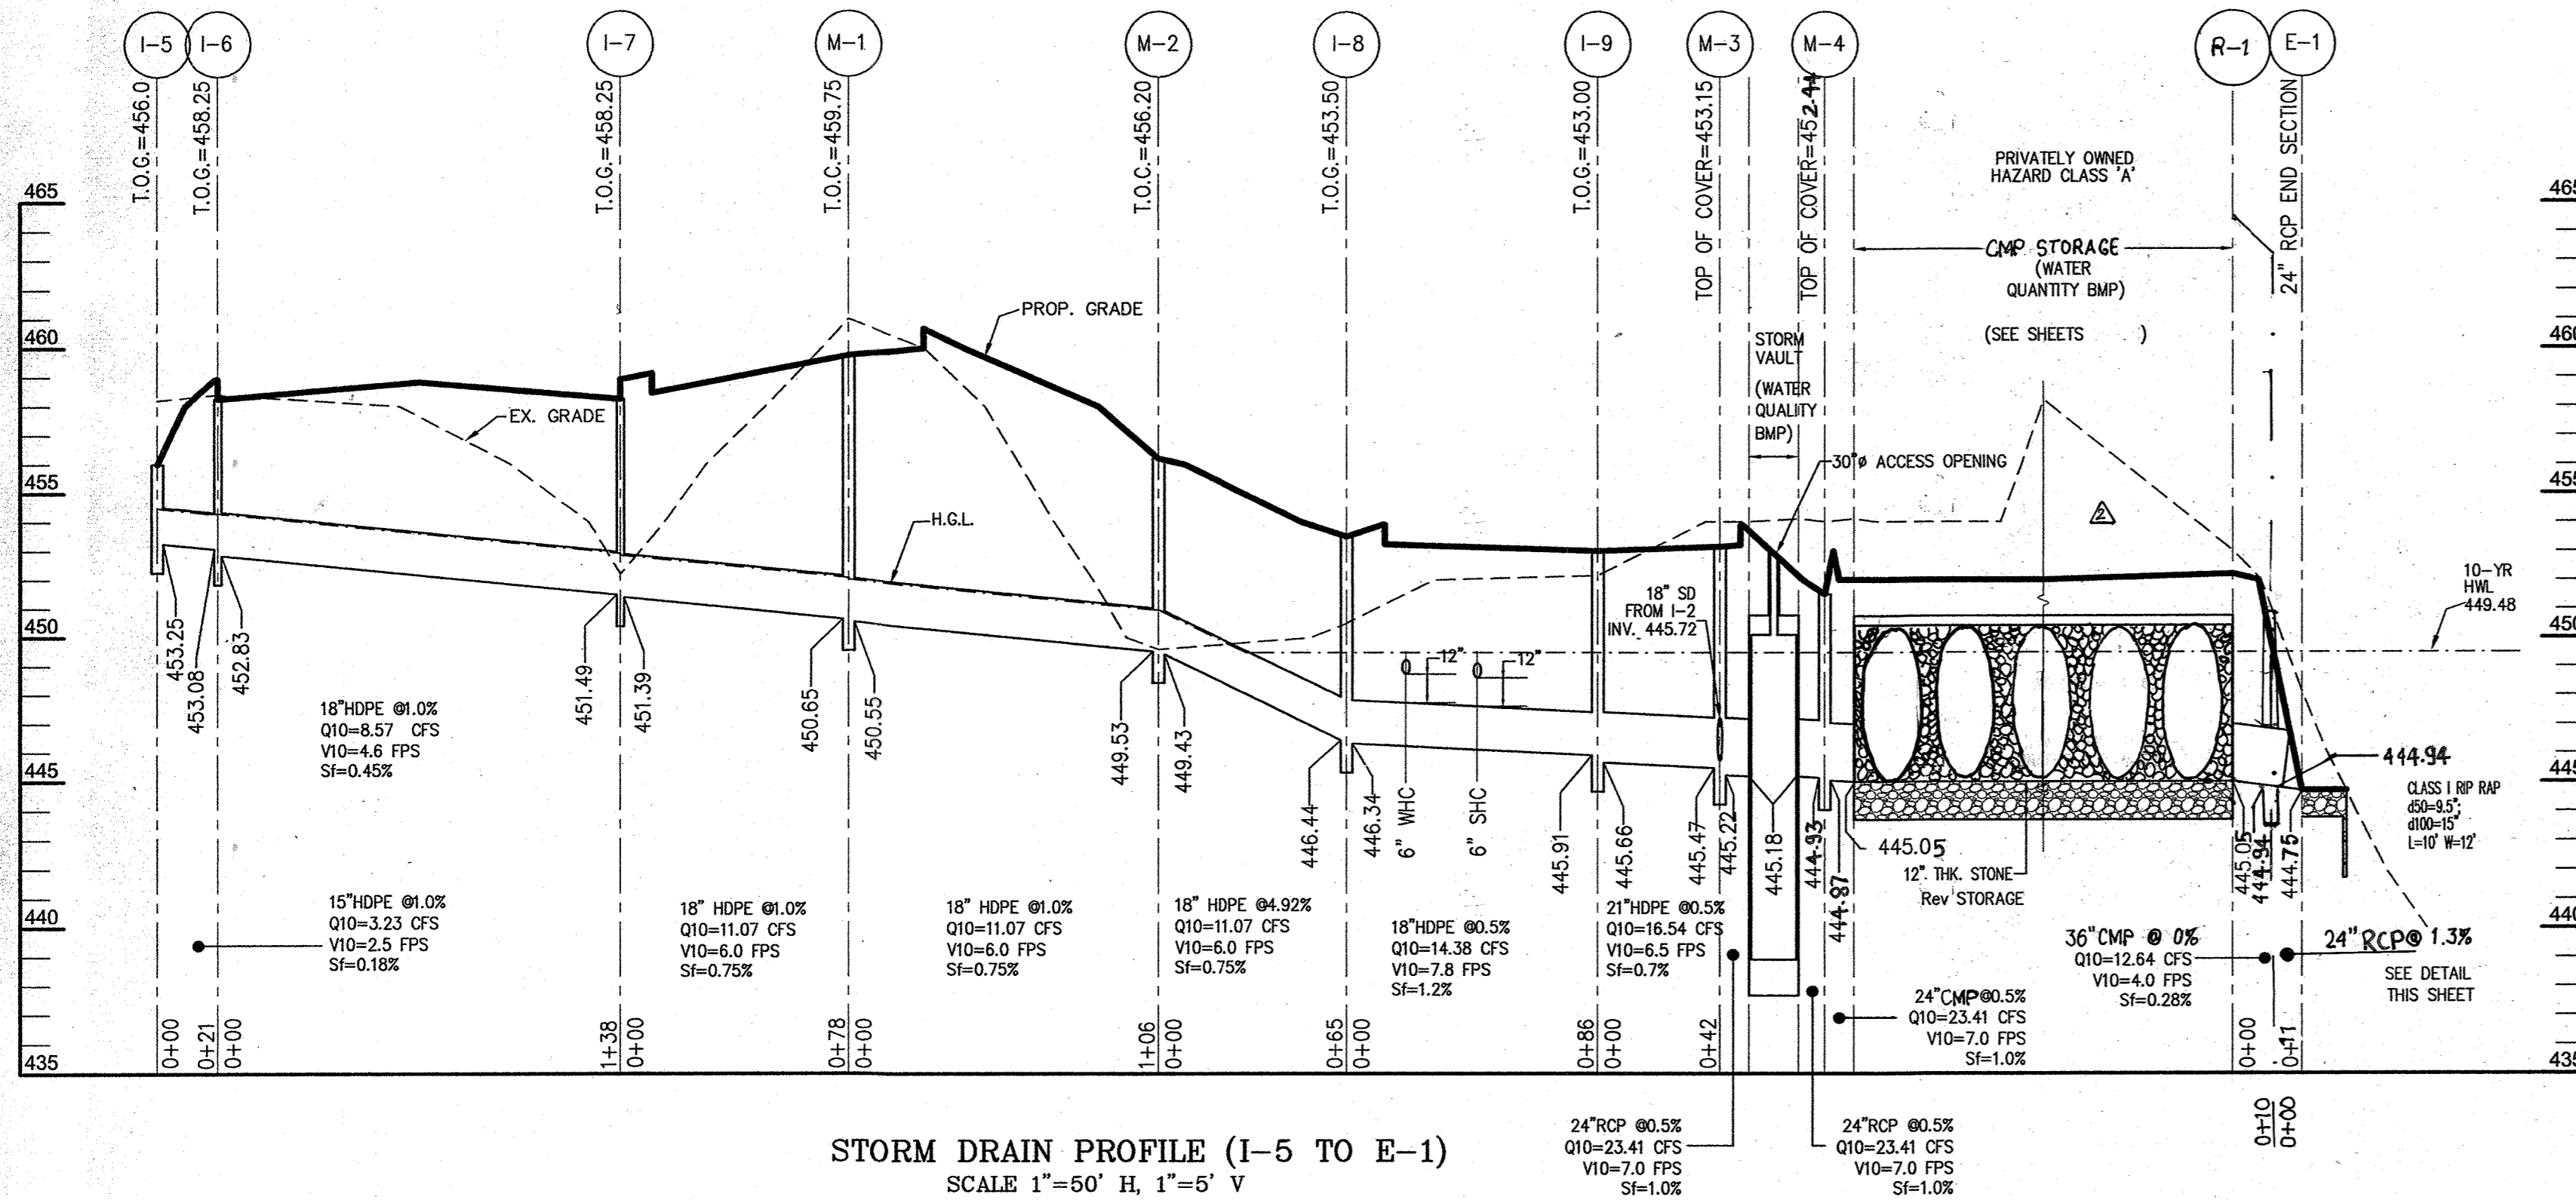

STRUCTURE SCHEDULE							
NO.	TYPE	LOCATION	INV. ELEV. (in)	INV. ELEV. (out)	WIDTH	TOP ELEVATION	STD. DETAIL
I-1	TYPE 'S' INLET	N 595,479.39, E 1,340,951.84	-	450.50		453.50	D 4.22
I-2	TYPE 'S' INLET	N 595,489.14, E 1,341,050.71	449.57	449.47		452.50	D 4.22
I-3	TYPE 'D' INLET	N 595,469.57, E 1,341,082.42	-	448.00		451.00	D 4.11
I-4	TYPE 'S' INLET	N 595,467.90, E 1,341,065.45	447.73	447.63		452.75	D 4.22
I-5	TYPE 'D' INLET	N 595,192.98, E 1,340,673.53	-	453.25		456.00	D 4.11
I-6	A-10 INLET	N 595,186.61, E 1,340,693.58	453.08	452.83	2'-6"	458.25	D 4.04
I-7	A-10 INLET	N 595,144.99, E 1,340,825.24	451.49	451.39	2'-6"	458.25	D 4.04
I-8	TYPE 'S' INLET	N 595,265.71, E 1,341,008.42	446.44	446.34		453.50	D 4.22
I-9	TYPE 'S' INLET	N 595,309.16, E 1,341,081.07	445.91	445.66		453.00	D 4.22
I-10	TYPE 'D' INLET	N 594,968.23, E 1,340,711.01	-	440.33		443.7	D 4.11
M-1	PRECAST CONCRETE MANHOLE	N 595,219.53, E 1,340,848.87	450.65	450.55	5'-0"	459.75	G 5.12
M-2	PRECAST CONCRETE MANHOLE	N 595,229.94, E 1,340,954.51	449.53	449.43	5'-0"	456.20	G 5.12
M-3	PRECAST CONCRETE MANHOLE	N 595,354.61, E 1,341,076.59	445.72	445.22	5'-0"	453.15	G 5.12
M-4	PRECAST CONCRETE MANHOLE	N 595,366.11, E 1,341,111.69	444.93	444.87	5'-0"	452.44	G 5.12
M-5	PRECAST CONCRETE MANHOLE	N 594,980.47, E 1,340,660.21	439.30	437.19	5'-0"	443.90	G 5.12
E-1	24" RCP END SECTION	N 595,349.78, E 1,341,126.71	-	444.75		-	D 5.51
R-1	CONCRETE RISER STR.	N 595,371.56, E 1,341,118.98	444.94	444.94	5'-0"	452.11	-

PIPE SUMMARY		
SIZE	TYPE	LENGTH
15"	HDPE	223'
18"	HDPE	592'
21"	HDPE	42'
24"	RCP	19'
15"	CMP	12'
15"	RCP	10'
24"	AL ₂ CMP	21'
36"	AL ₂ CMP	10'

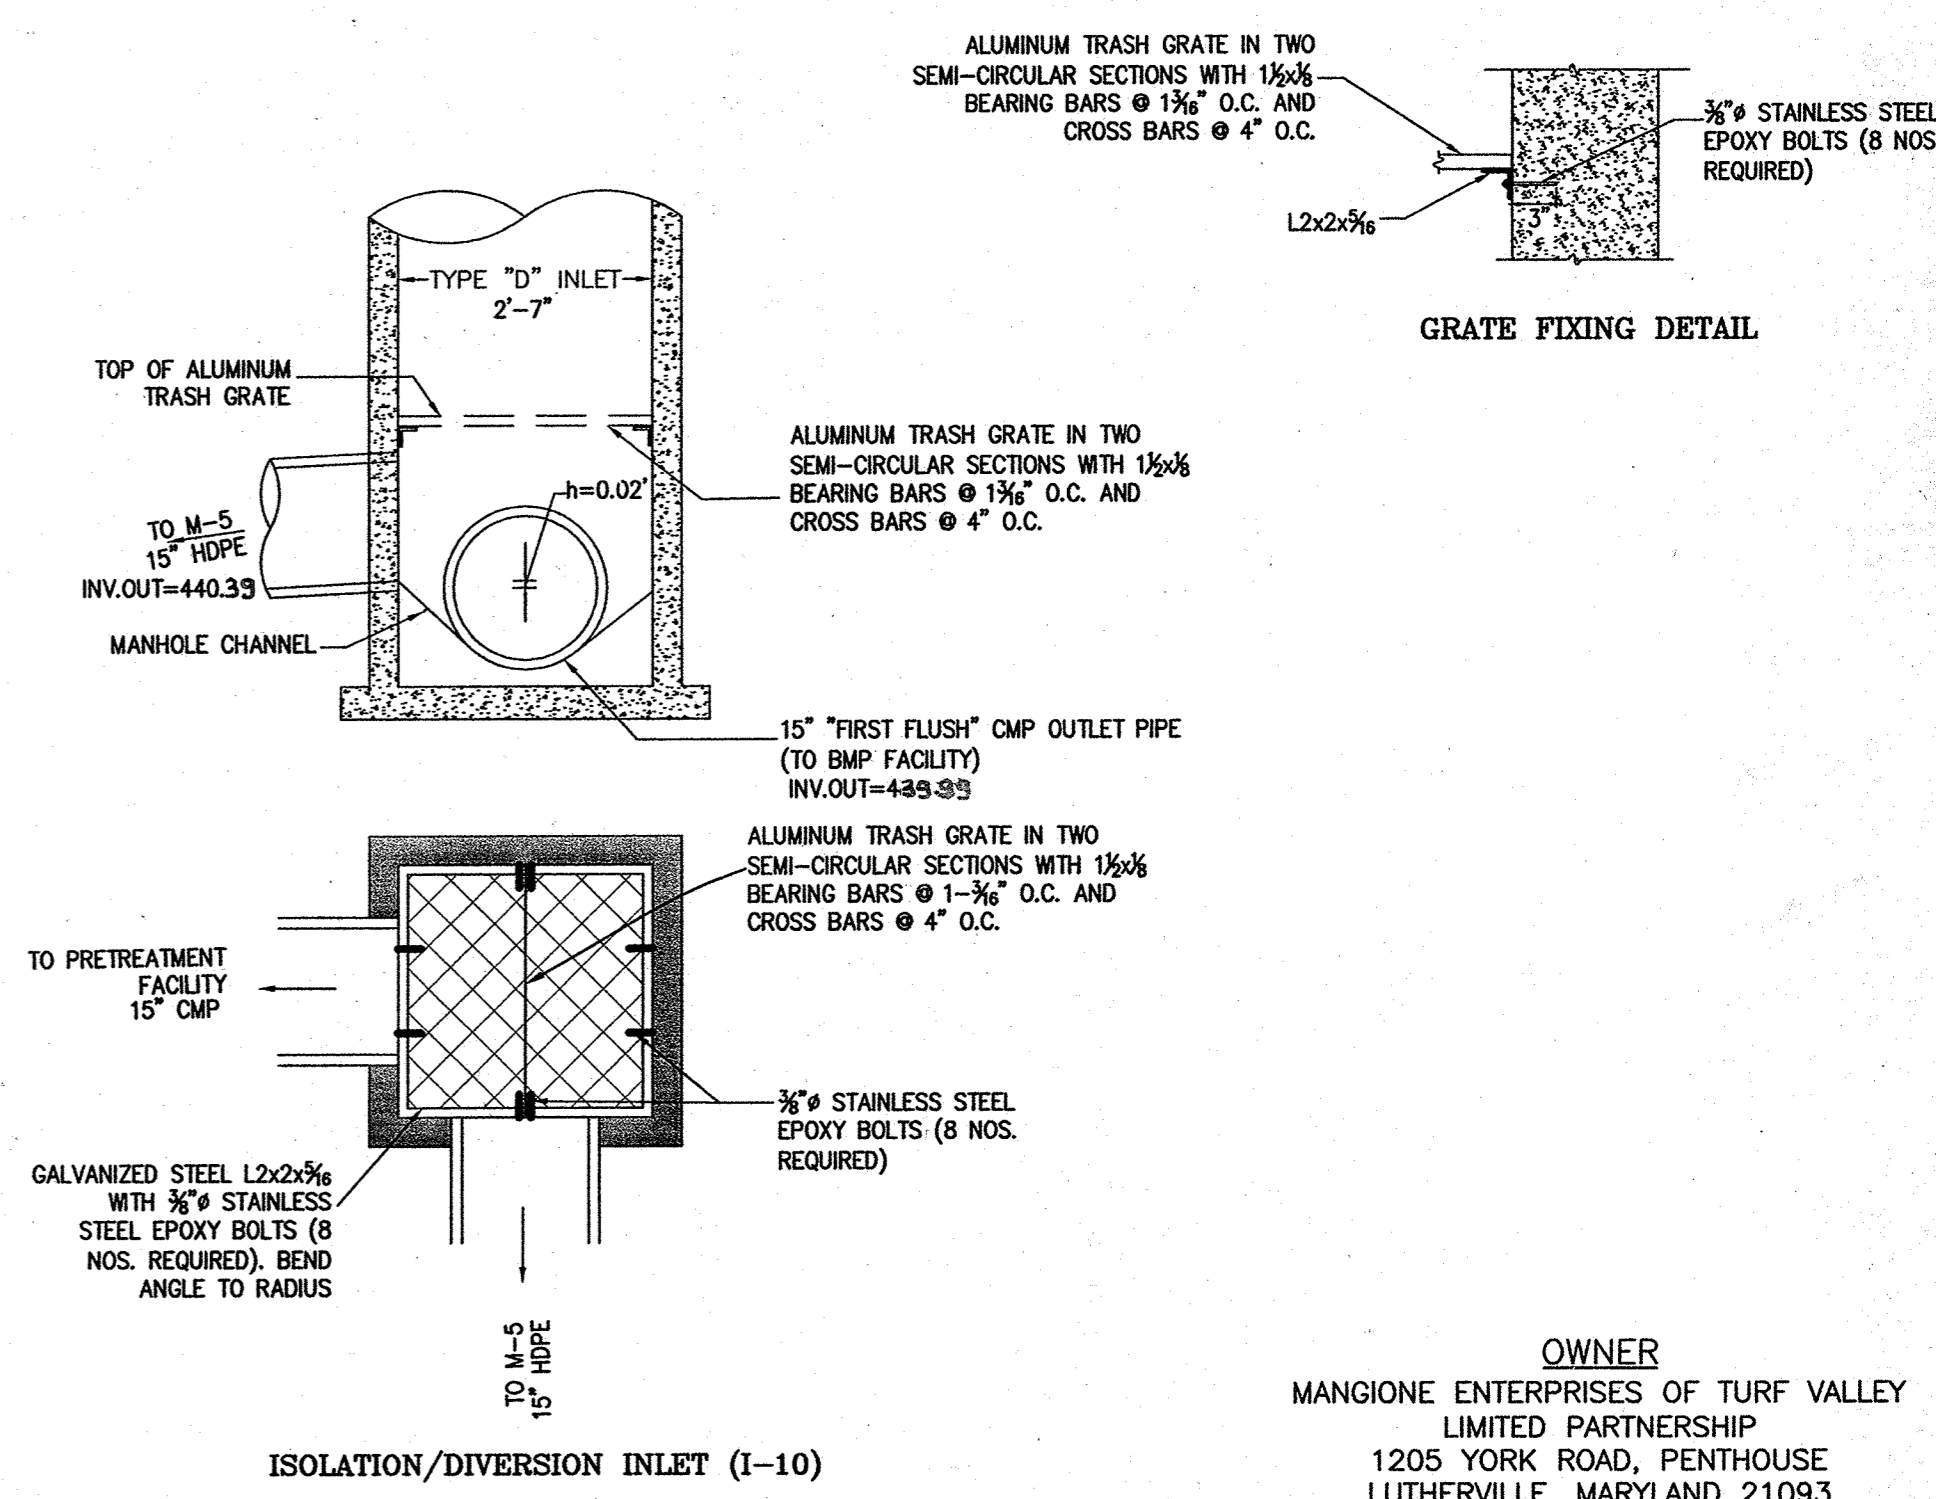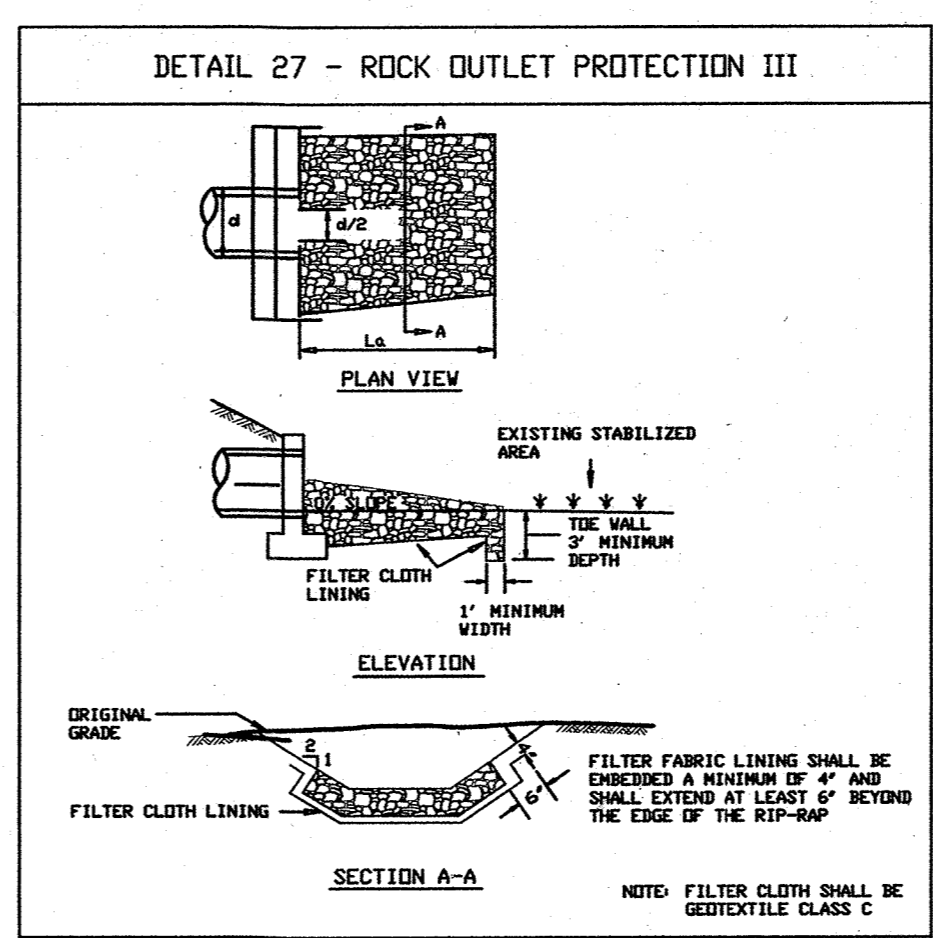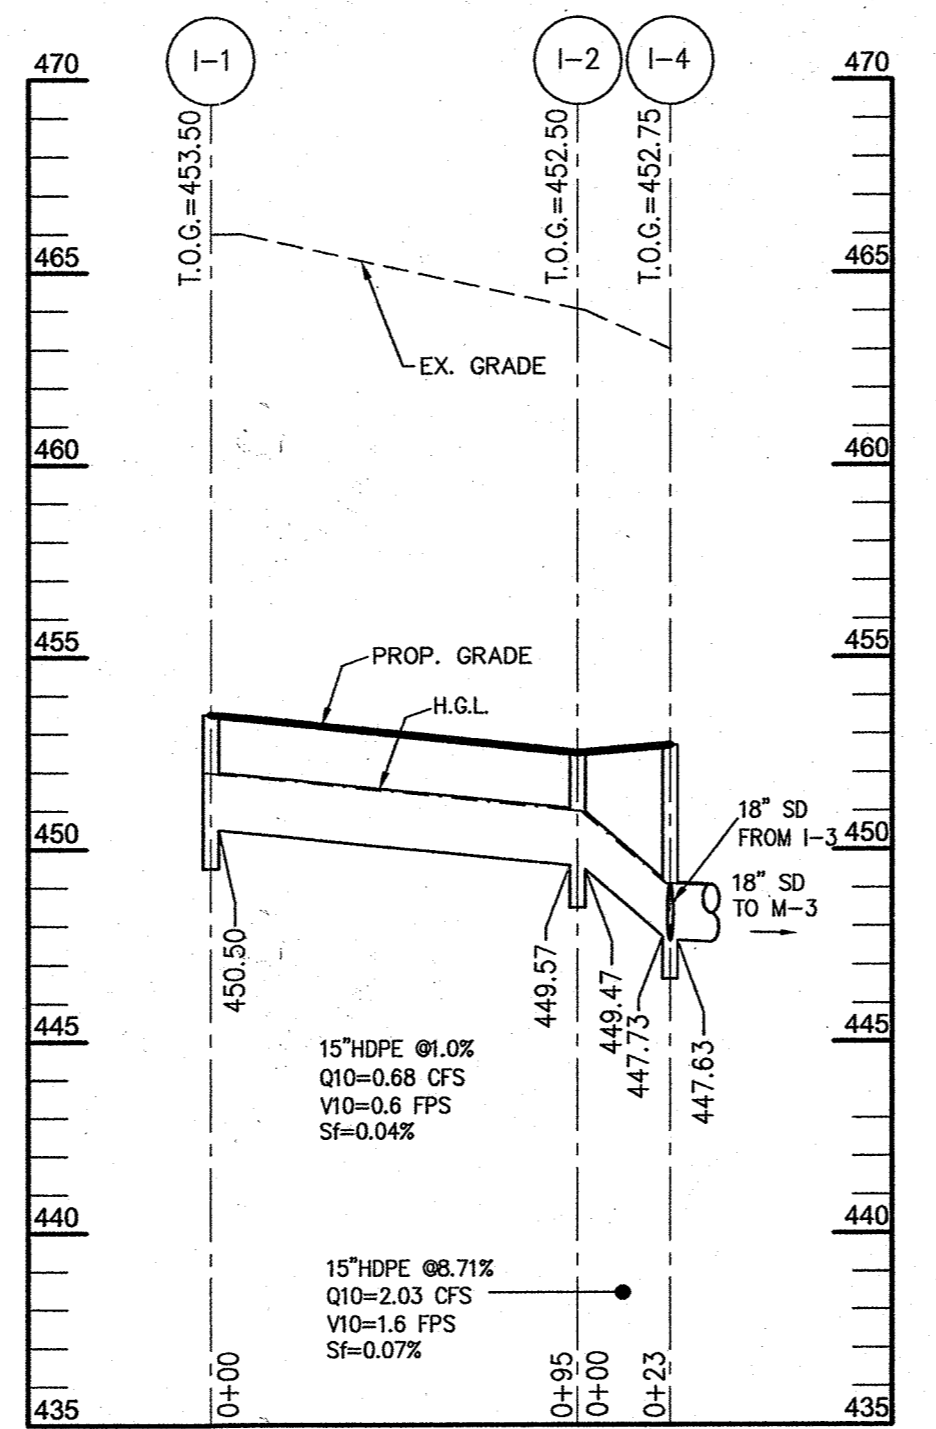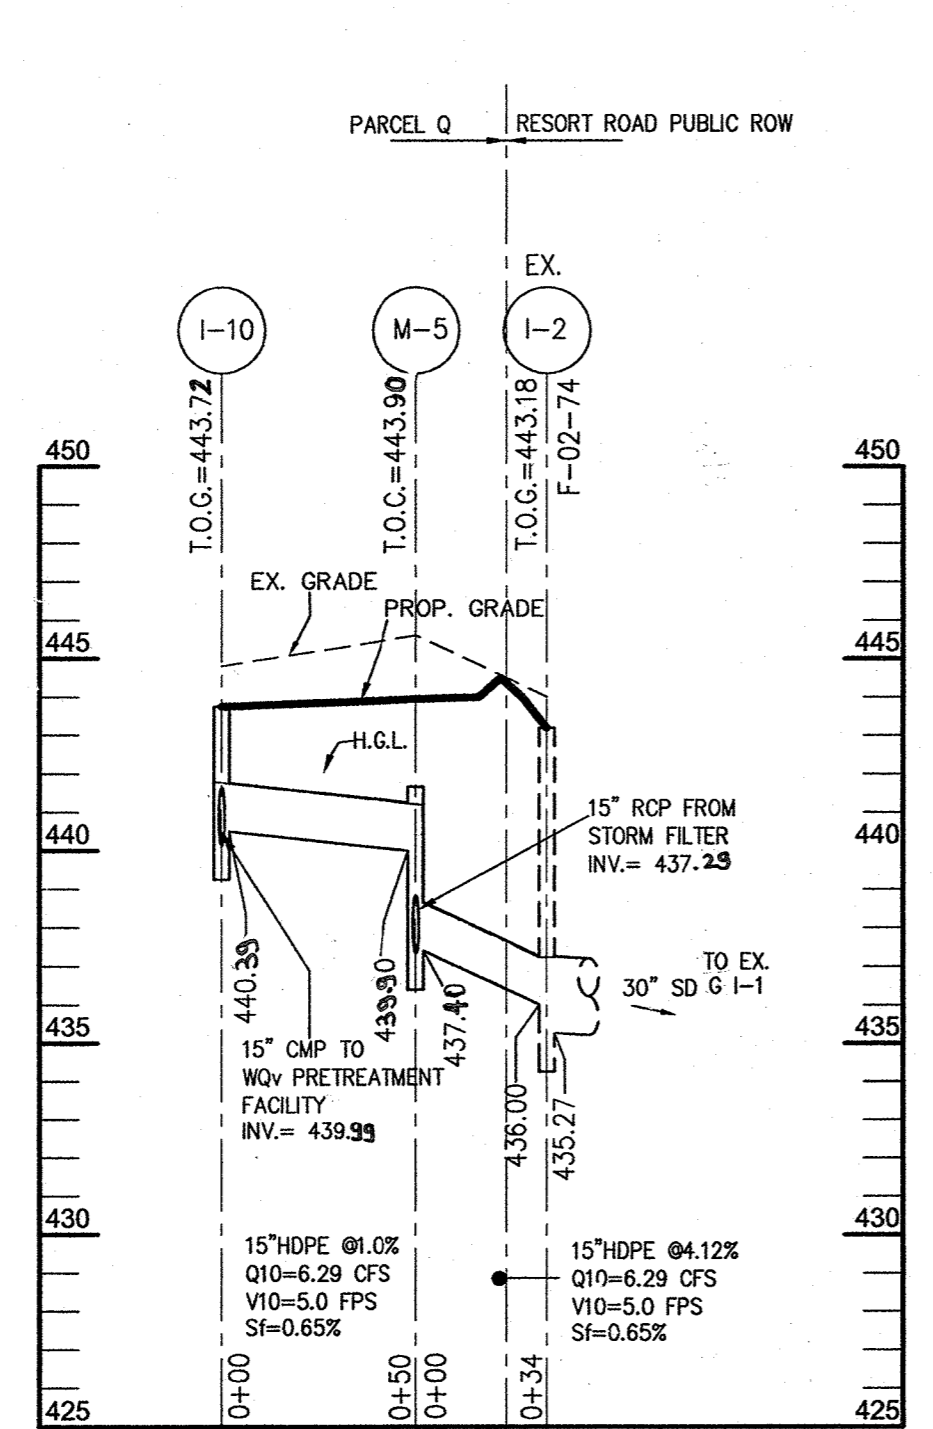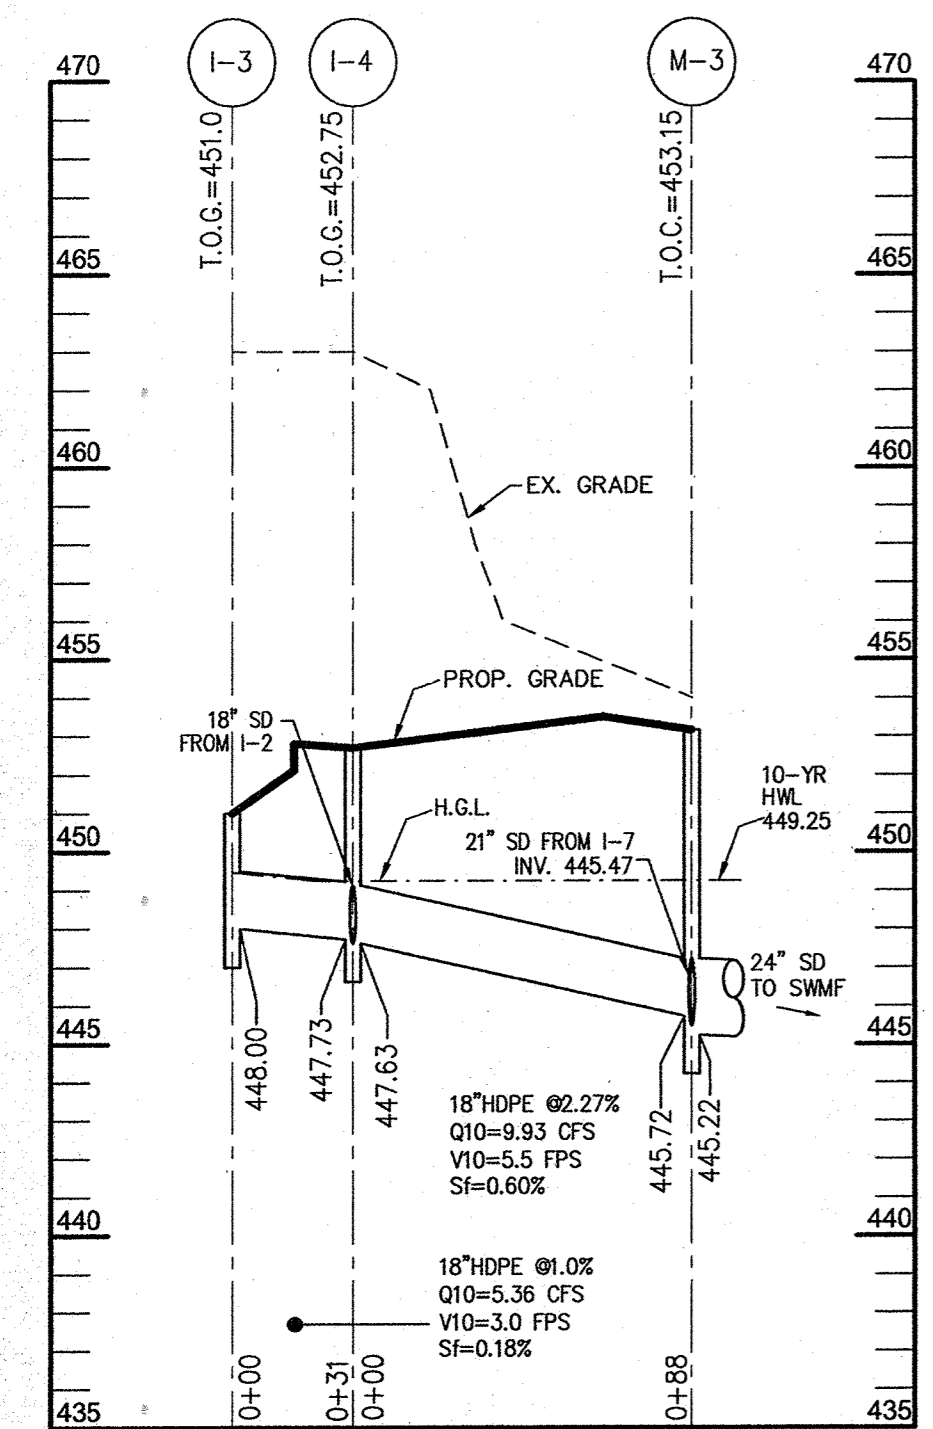

ROCK OUTLET PROTECTION-III

U.S. DEPARTMENT OF AGRICULTURE SOIL CONSERVATION SERVICE PAGE F-18-10A MARYLAND DEPARTMENT OF ENVIRONMENT WATER MANAGEMENT ADMINISTRATION

Construction Specifications

- The subgrade for the filter, rip-rap, or gabion shall be prepared to the required lines and grades. Any fill required in the subgrade shall be compacted to a density of approximately that of the surrounding undisturbed material.
- The rock or gravel shall conform to the specified grading limits when installed respectively in the rip-rap or filter.
- Geotextile shall be protected from punching, cutting, or tearing. Any damage other than an occasional small hole shall be repaired by placing another piece of geotextile over the damaged part or by completely replacing the geotextile. All overlaps whether for repairs or for joining two pieces of geotextile shall be a minimum of one foot.
- Stone for the rip-rap or gabion outlets may be placed by equipment. They shall be constructed to the full course thickness in one operation and in such a manner as to avoid displacement of underlying materials. The stone for rip-rap or gabion outlets shall be delivered and placed in a manner that will ensure that it is reasonably homogeneous with the smaller stones and spalls filling the voids between the larger stones. Rip-rap shall be placed in a manner to prevent damage to the filter blanket or geotextile. Hand placement will be required to the extent necessary to prevent damage to the permanent works.
- The stone shall be placed so that it blends in with the existing ground. If the stone is placed too high then the flow will be forced out of the channel and scour adjacent to the stone will occur.

NO	REVISION	DATE
3	SWM AS-BUILT INFORMATION ADDED	KCE 03/01/10
Δ	REVISED PROFILE I-5 TO E-1, STRUCTURE SCHEDULE, PIPE SIZES	KCE 09/02/08
Δ	REVISED LOCATION OF I-10	KCE 07/16/08

AS-BUILT STORM DRAIN PROFILES & DETAILS

TURF VALLEY, LORIE
NURSING HOME & ASSISTED LIVING FACILITY
OAKMONT AT TURF VALLEY
PARCEL Q
PLATS 18773 - 18775
TAX MAP 16 - P/O PARCEL 8- GRID 16 & 17;
POD 1 per S-86-13 (4th AMENDED)
THIRD ELECTION DISTRICT HOWARD COUNTY, MARYLAND

KCE ENGINEERING, INC.
EXECUTIVE CENTER
3300 NORTH RIDGE ROAD, SUITE 315
ELLCOTT CITY, MARYLAND 21043
PHONE (410) 203-9800 FAX (410) 203-9228

APPROVED
PLANNING BOARD
OF HOWARD COUNTY
DATE 3/27/08

APPROVED: DEPARTMENT OF PLANNING AND ZONING
Chief, Development Engineering Division
Chief, Division of Land Development
Director








AS-BUILT CERTIFICATION
THERE IS NO 'AS-BUILT' INFORMATION PROVIDED ON THIS SHEET.

Professional Certification. I hereby certify that these documents were prepared or approved by me, and that I am a duly licensed professional engineer under the laws of the State of Maryland, License No. 8818, Expiration Date: 10/17/08.

DRAWN BY: MG
CHECKED BY: DVK
SCALE: AS SHOWN
DATE: 04/30/2008

SHEET: 17 OF 36

MICHAEL D. ADCOCK, PROFESSIONAL LAND SURVEYOR
MD REG. NO. 21297, EXPIRATION DATE: 06-16-21

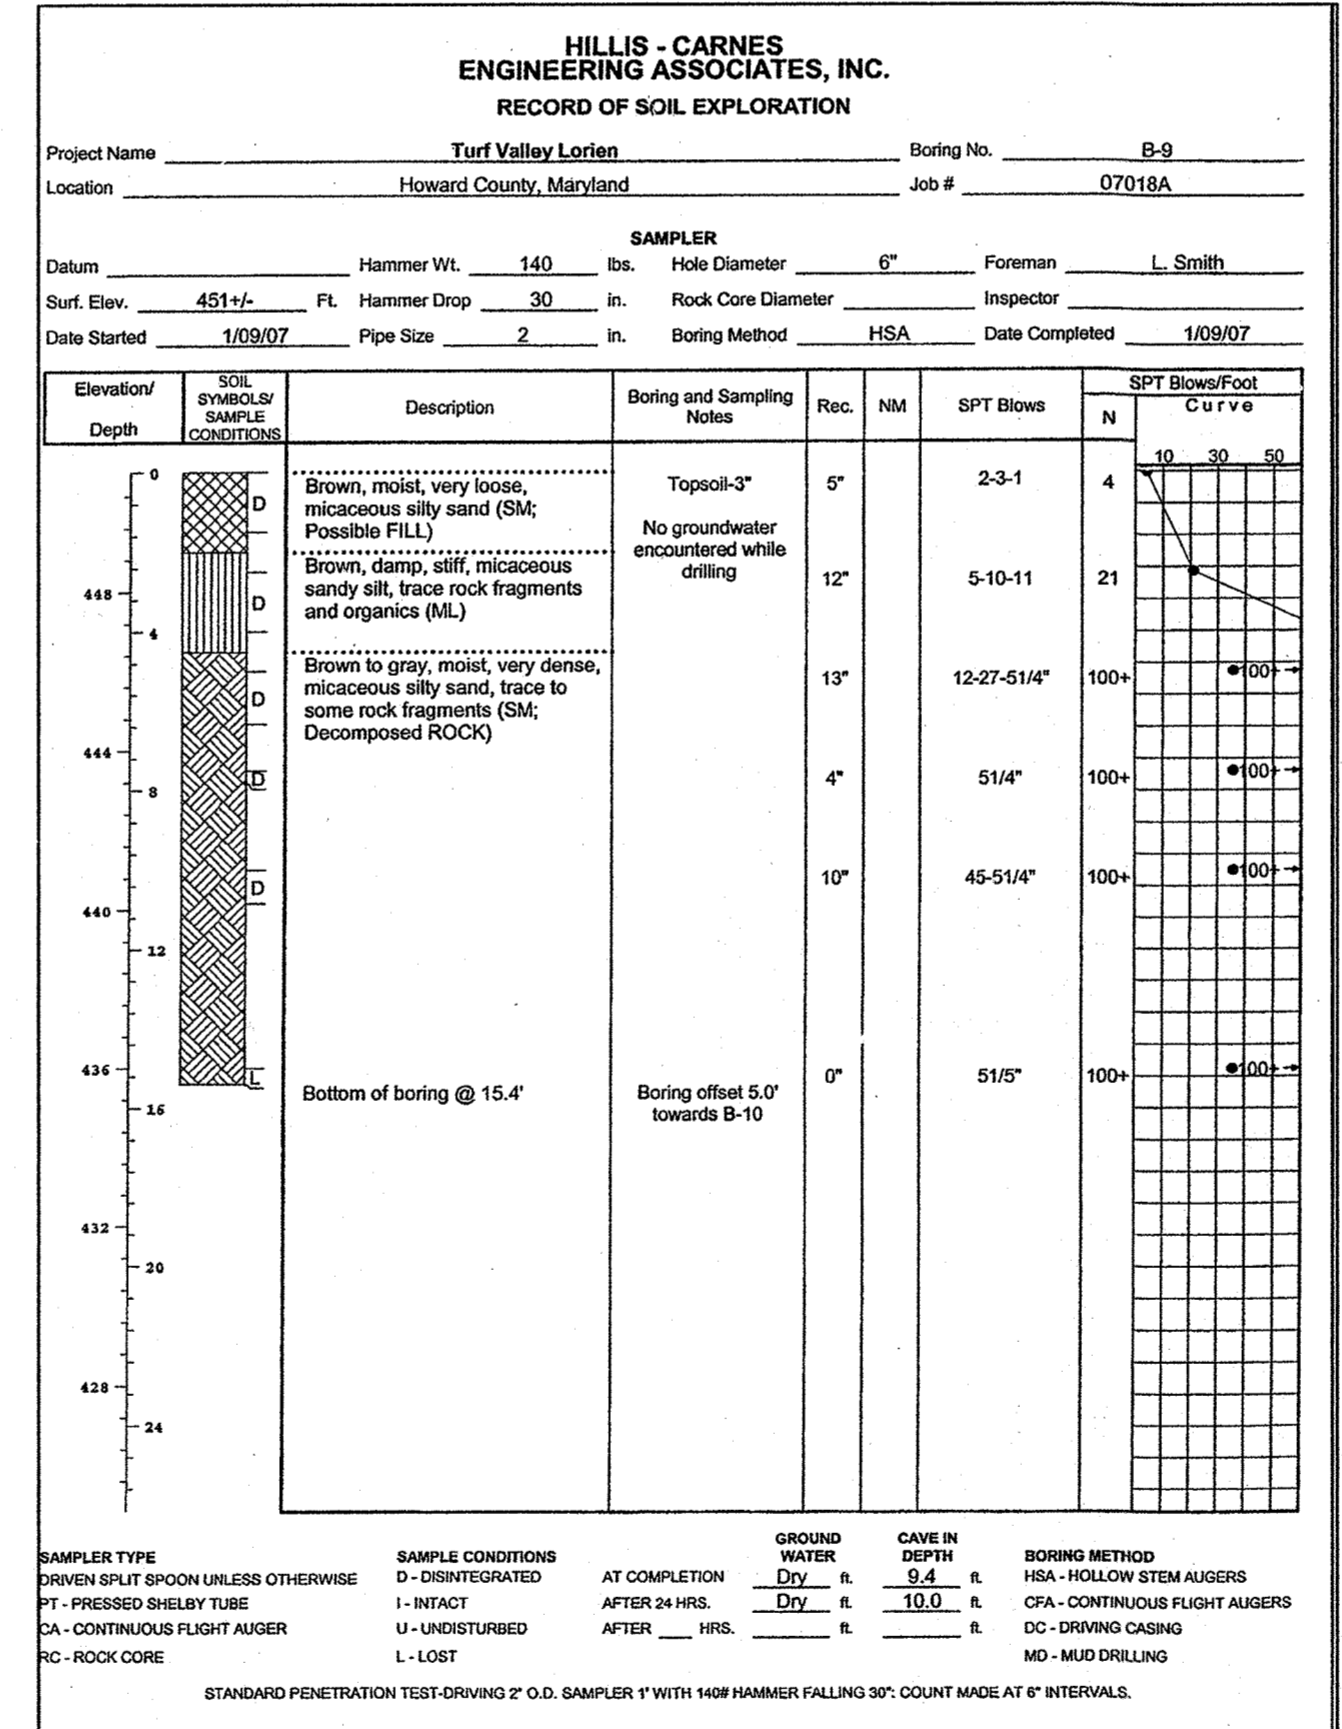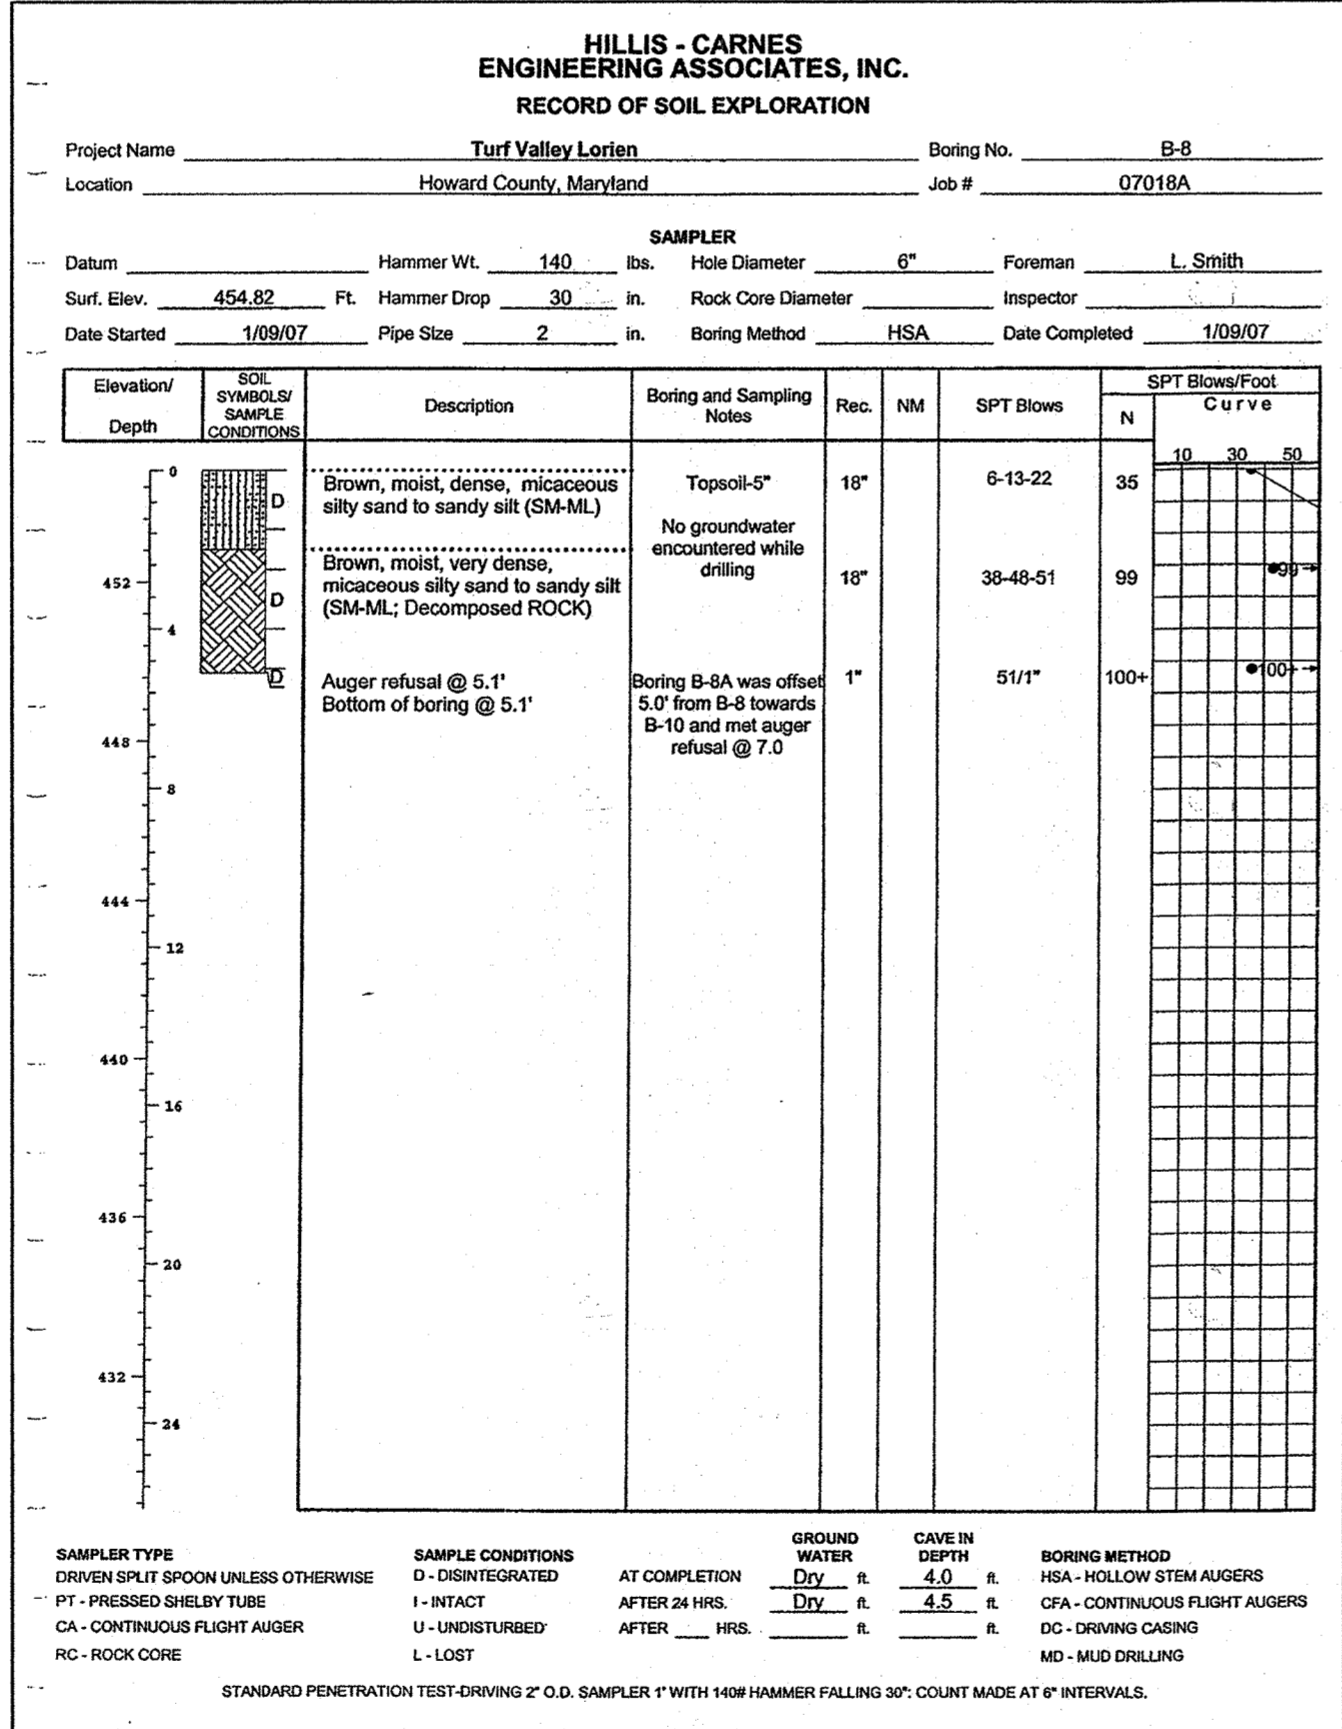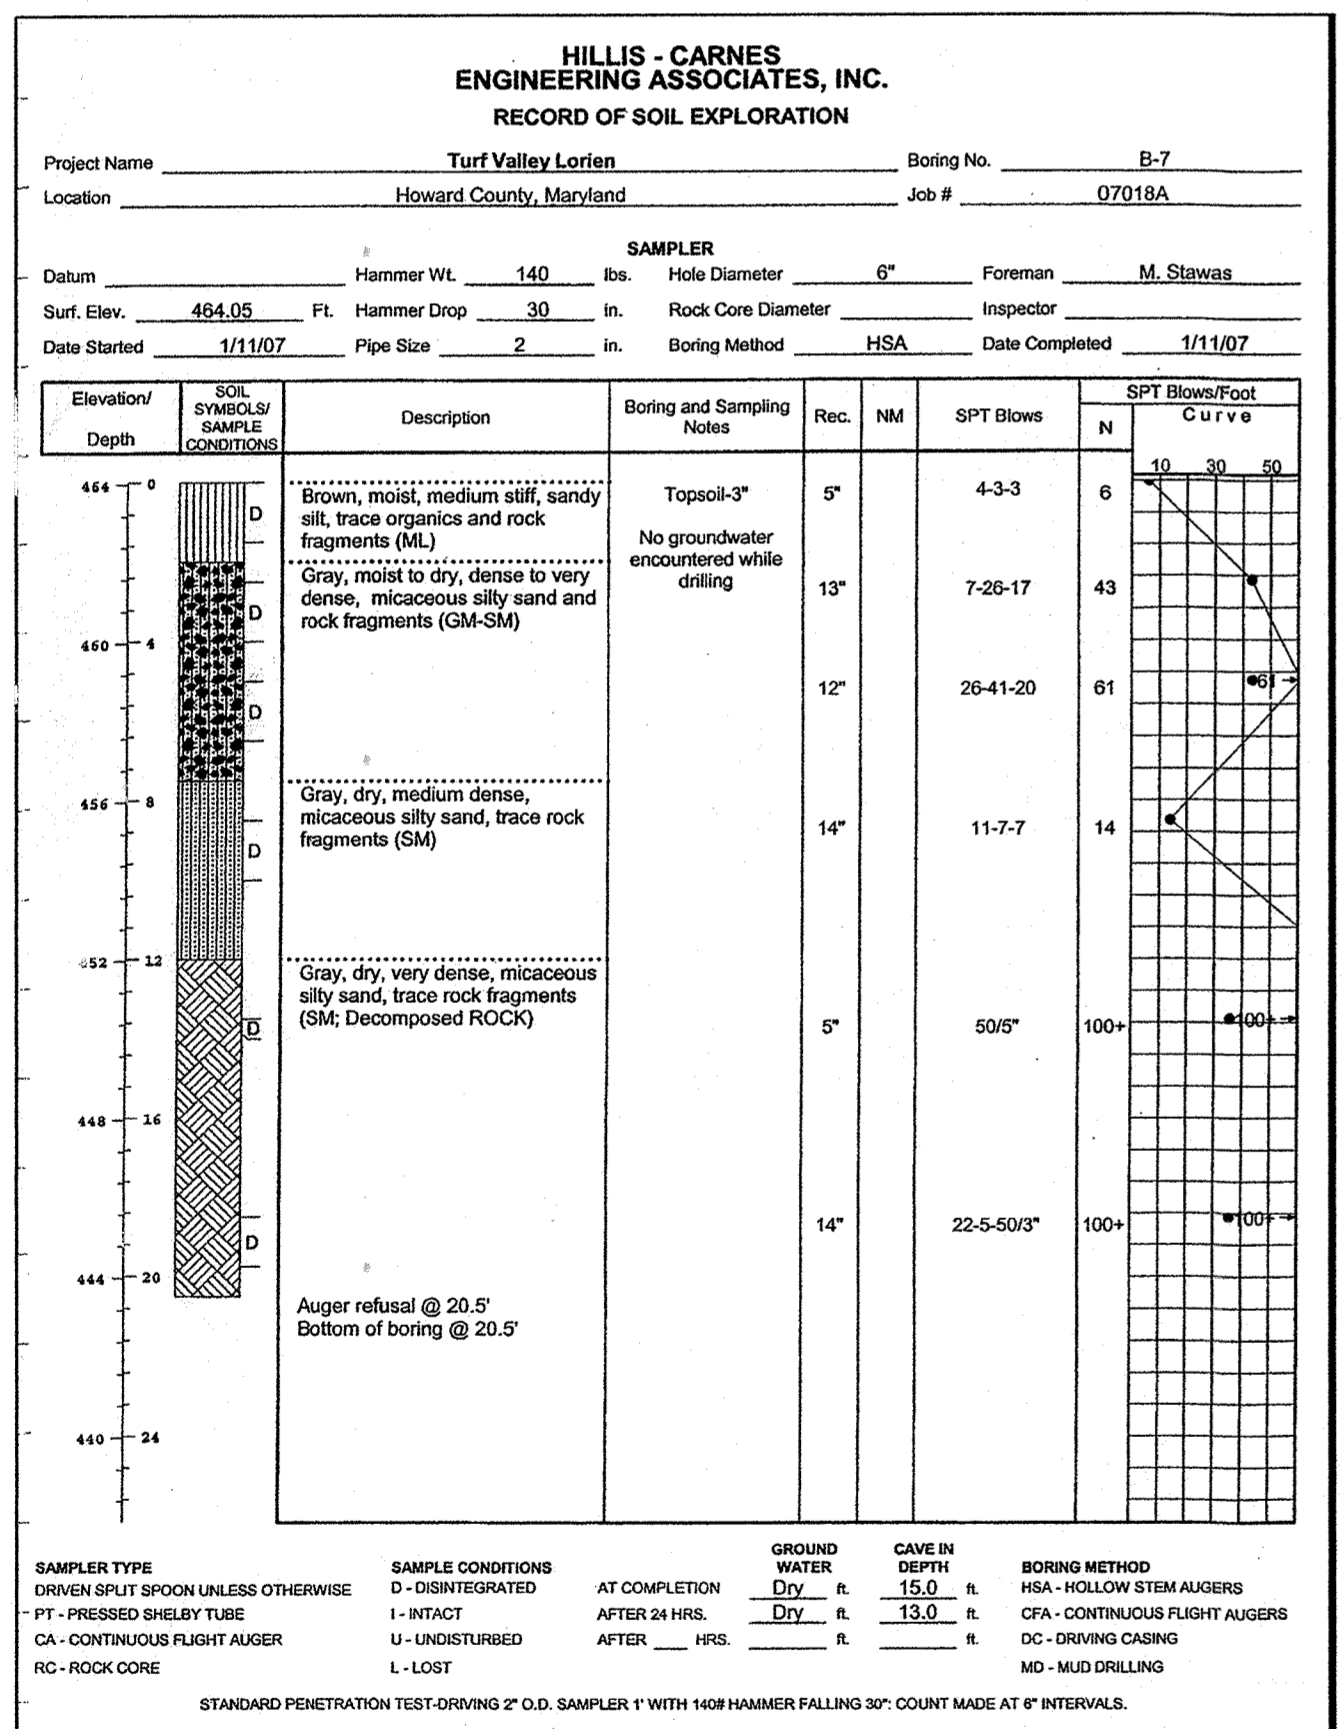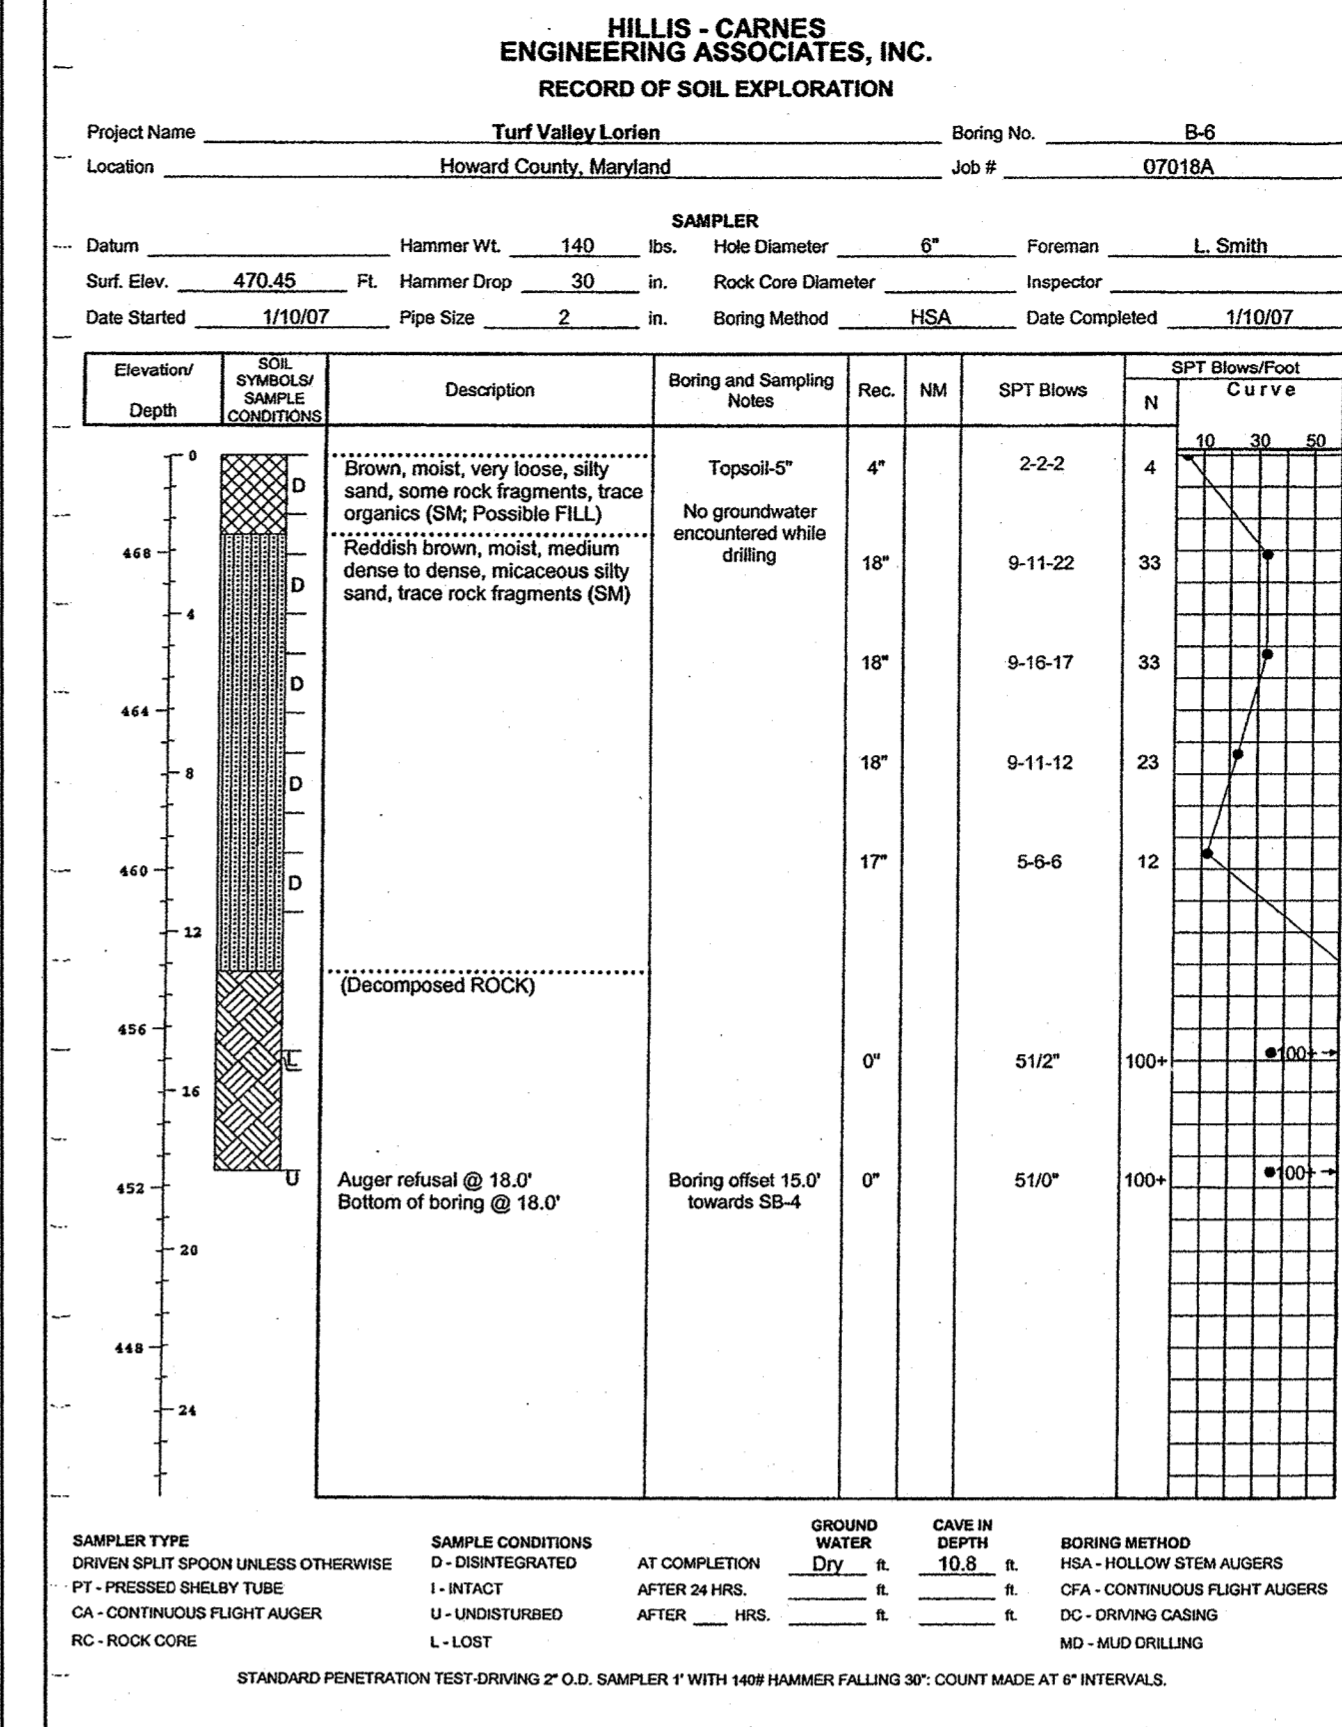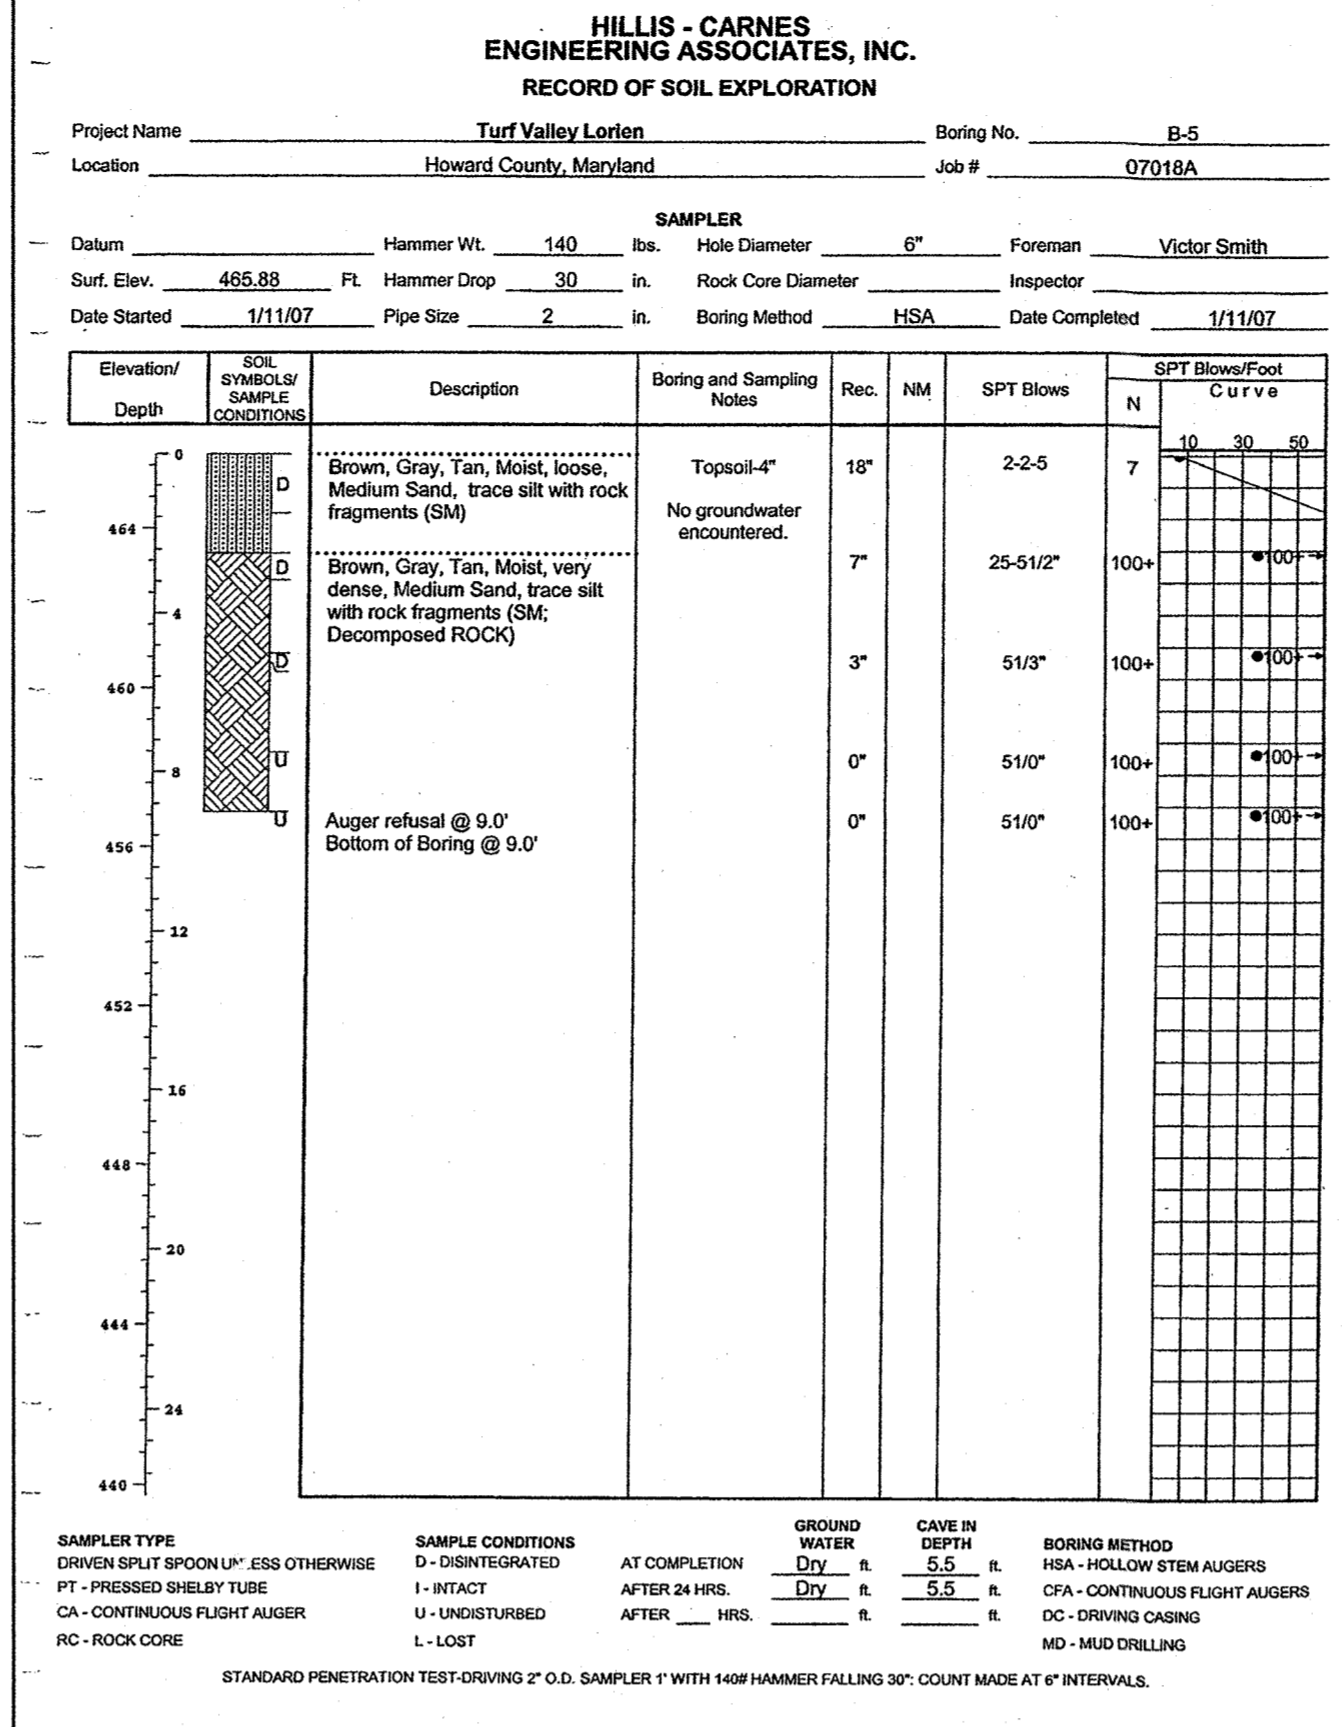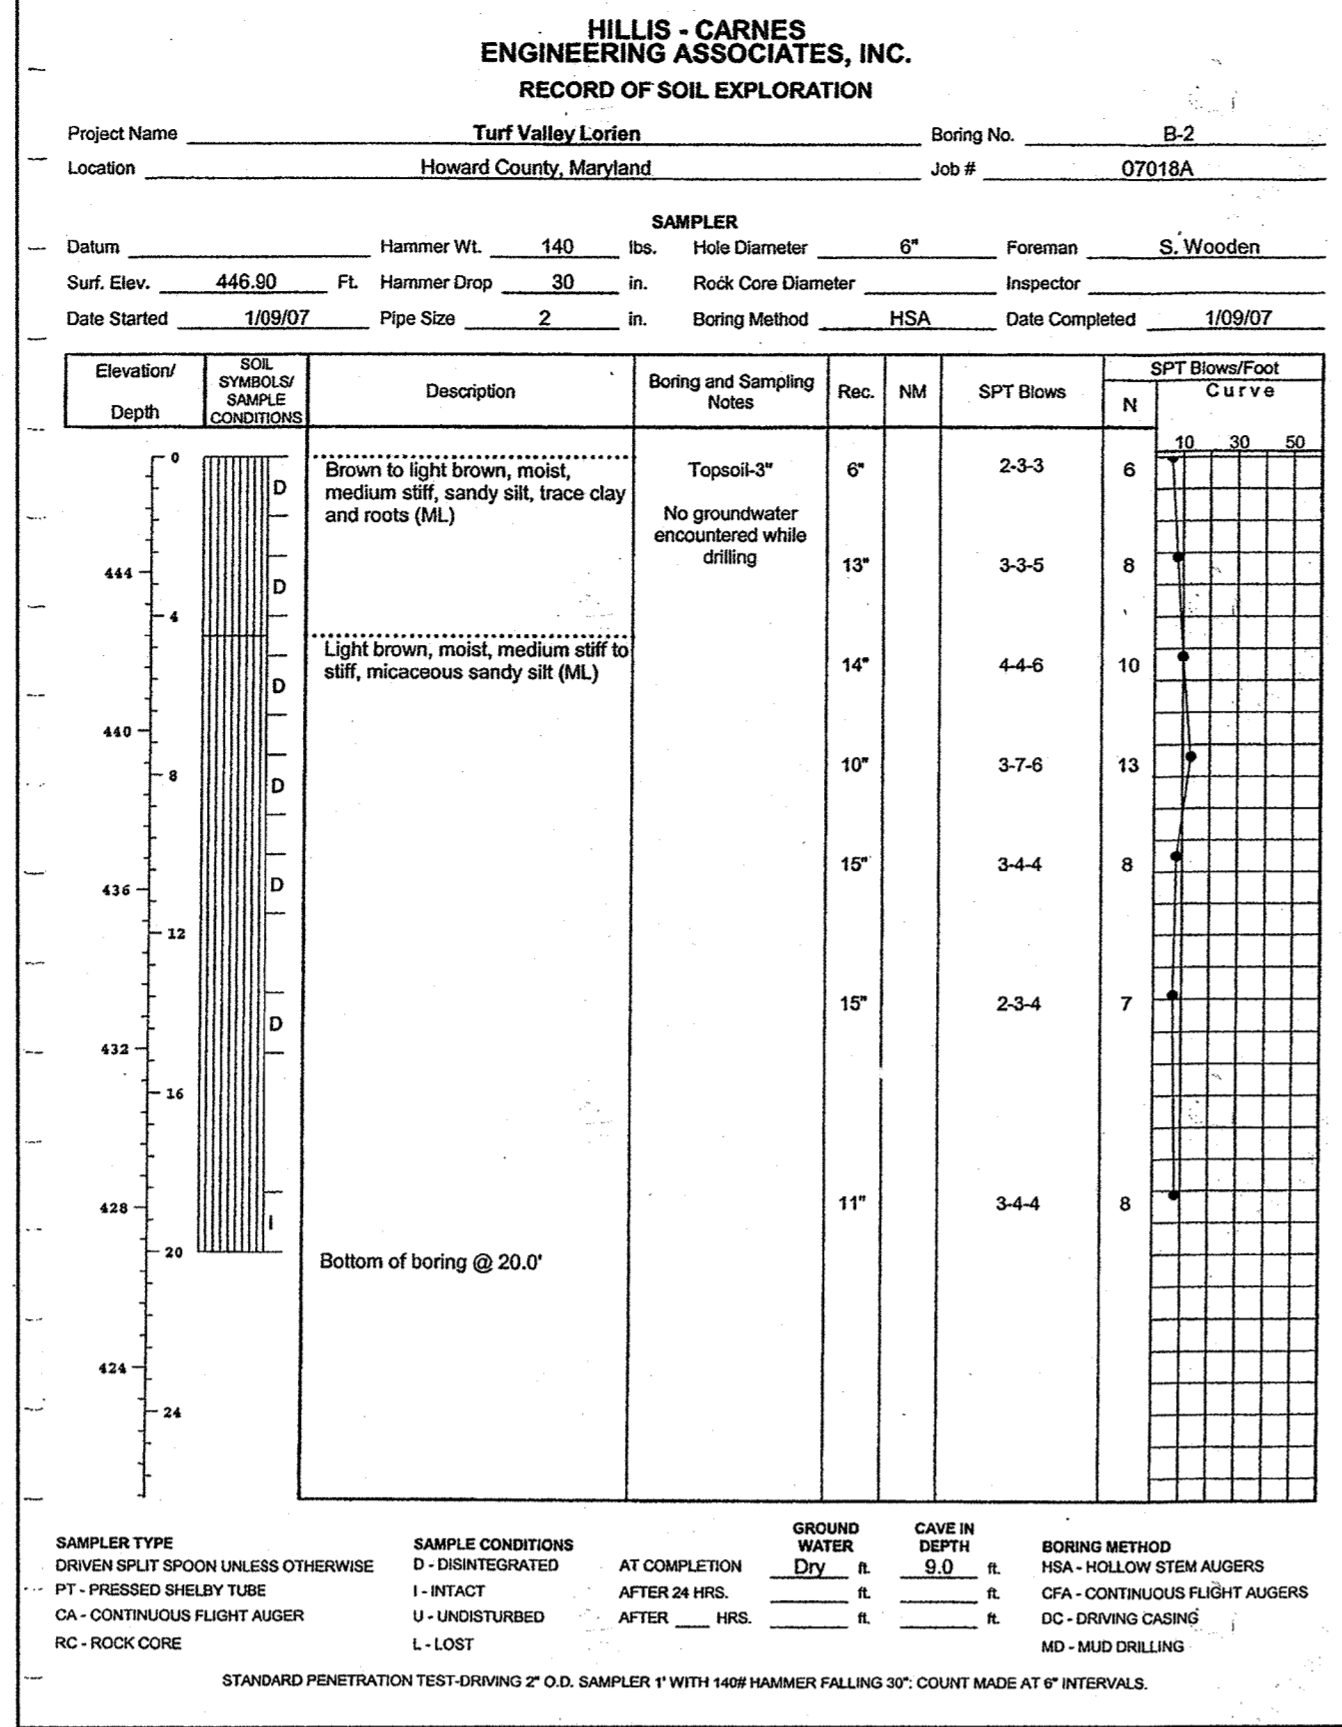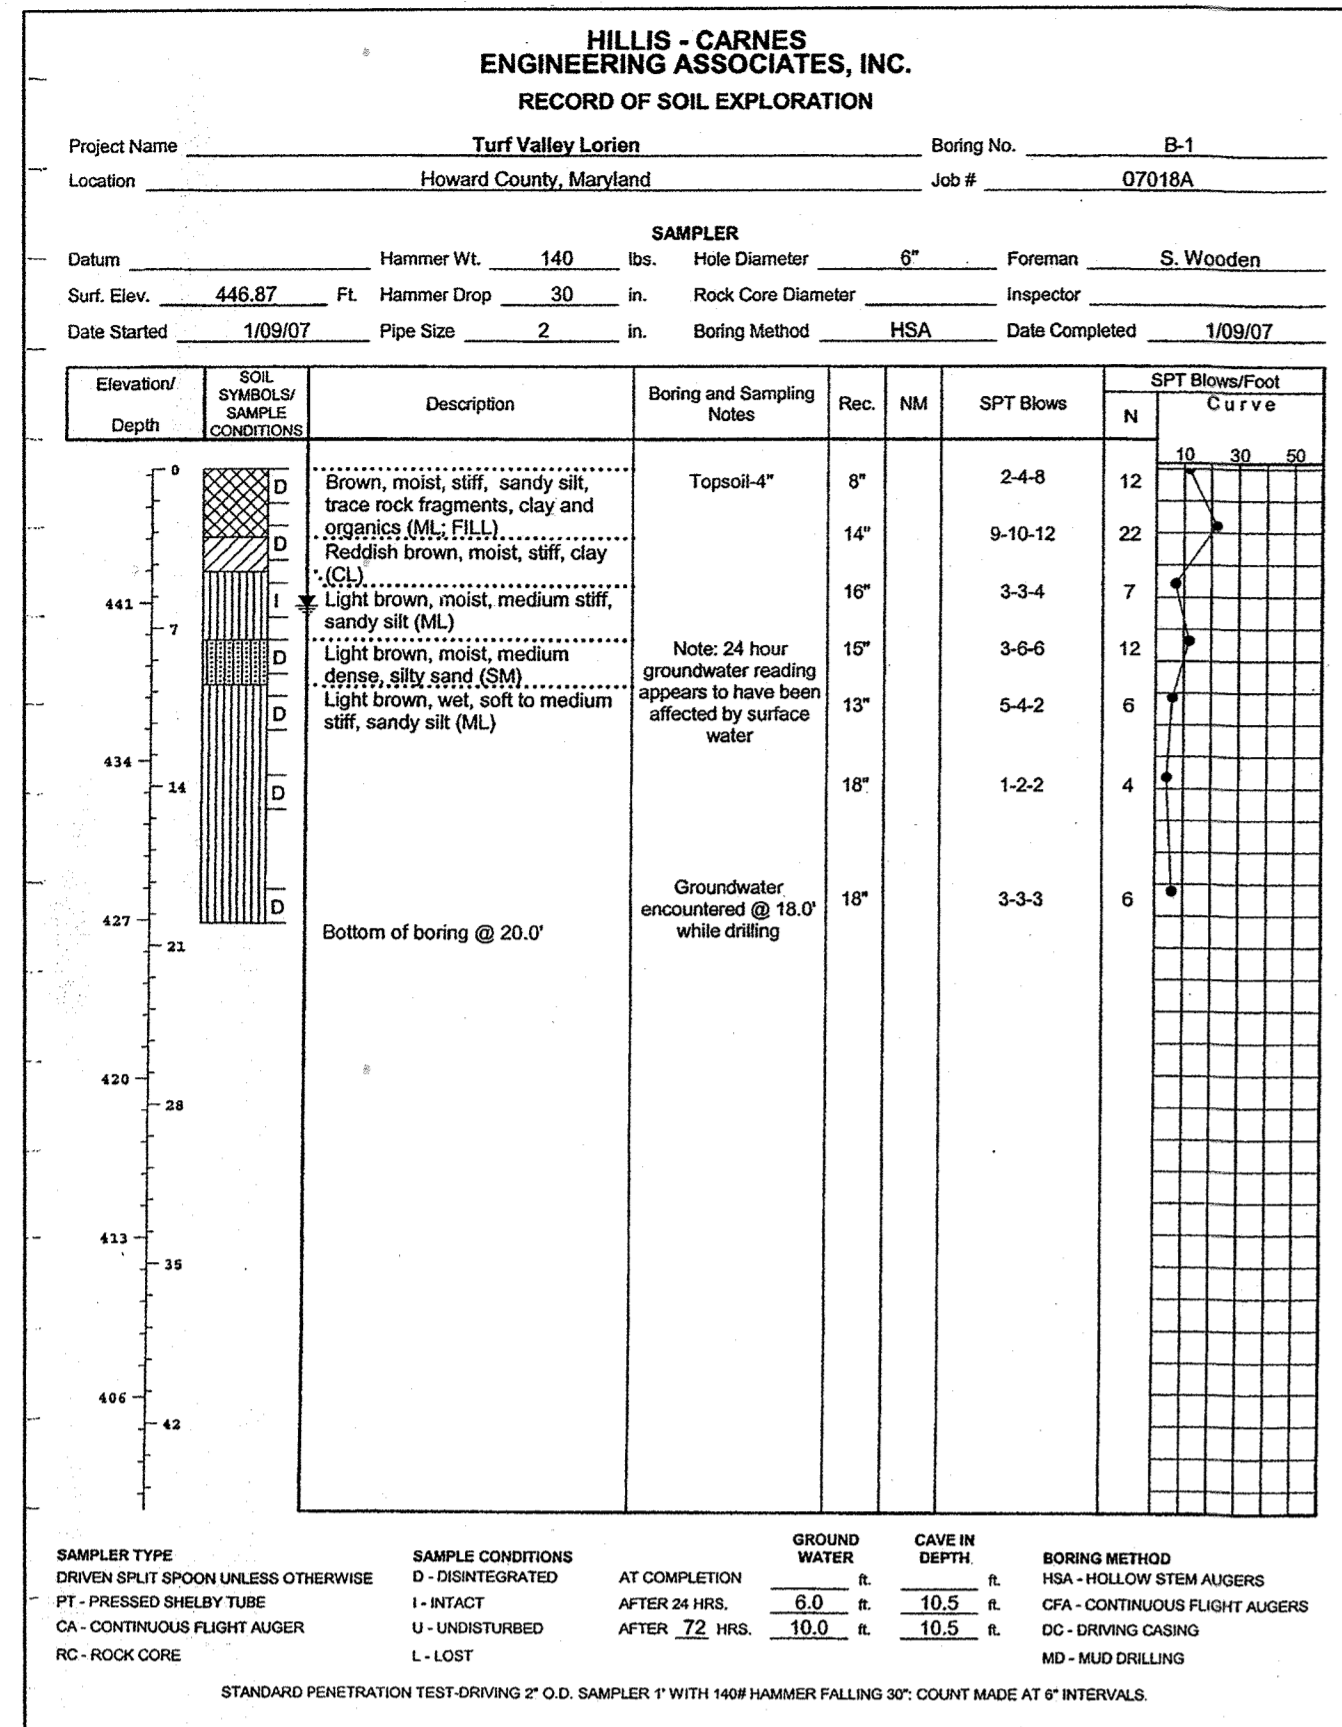

OWNER
 MANGIONE ENTERPRISES OF TURF VALLEY LIMITED PARTNERSHIP
 1205 YORK ROAD, PENTHOUSE LUTHERVILLE, MARYLAND 21093
 PHONE (410) 825-8400

NO	REVISION	DATE

AS-BUILT BORING LOGS

TURF VALLEY, LORIAN NURSING HOME & ASSISTED LIVING FACILITY
 OAKMONT AT TURF VALLEY
 PARCEL Q
 PLATS 18773 - 18775
 TAX MAP 16 - P/O PARCEL 8- GRID 16 & 17;
 POD I per S-86-13 (4th AMENDED)
 THIRD ELECTION DISTRICT HOWARD COUNTY, MARYLAND

KCE ENGINEERING, INC.
 EXECUTIVE CENTER
 3300 NORTH RIDGE ROAD, SUITE 315
 ELLICOTT CITY, MARYLAND 21043
 PHONE (410) 203-9800 FAX (410) 203-9226

APPROVED
 PLANNING BOARD OF HOWARD COUNTY
 DATE 3/27/08
[Signature]

APPROVED: DEPARTMENT OF PLANNING AND ZONING
 Chief, Development Engineering Division [Signature] 6/25/08
 Chief, Division of Land Development [Signature] 6/23/08
 Director [Signature] 6/29/08

AS-BUILT CERTIFICATION
 THERE IS NO "AS-BUILT" INFORMATION PROVIDED ON THIS SHEET.
[Signature] 6/23/08
 MICHAEL D. ARCOCK, PROFESSIONAL LAND SURVEYOR
 MD REG. NO. 21227, EXPIRATION DATE 04-16-21

Professional Certification. I hereby certify that these documents were prepared or approved by me, and that I am a duly licensed professional engineer under the laws of the State of Maryland, License No. 8818, Expiration Date: 10/17/08.

DRAWN BY: MG
 CHECKED BY: DVK
 SCALE: _____
 DATE: 04/30/2008

SHEET: 18 OF 36

BILL OF MATERIALS						
PIECE	QTY	Ø	CORRUGATION	GAGE	FINISH	LENGTH
A	1	66	5X1	16	ALT2	27'-9"
B	1	66	5X1	16	ALT2	34'-11"
C	1	66	5X1	16	ALT2	21'-11"
D	2	66	5X1	16	ALT2	8'-11"
E	1	66	5X1	16	ALT2	22'-2"
F	1	66	5X1	16	ALT2	24'-2"
G	2	66	5X1	16	ALT2	20'-0"
H	18	66	5X1	16	ALT2	24'-0"
J	2	66	5X1	16	ALT2	17'-0"
TOTAL LENGTH						654'-9"

FITTINGS AND MISCELLANEOUS						
PIECE	QTY	Ø	CORRUGATION	GAGE	FINISH	LENGTH
A1	1	36	2 1/2 x 1/2	16	ALT2	TBD
A2	1	36	2 1/2 x 1/2	16	ALT2	10'
A3	1	24	2 1/2 x 1/2	16	ALT2	9.5'

NOTES
GENERAL NOTES:

- This bridge has been designed for general site conditions. The project engineer shall be responsible for the structure's suitability to the existing site conditions and for the hydraulic evaluation -- including scour and confirmation of soil conditions.
- Prior to construction, contractor must verify all elevations shown through the engineer.
- Only CONTECH Stormwater Solutions Inc. the CONSPAN® approved precaster in Maryland may provide the structure designed in accordance with these plans.
- Maximum weight of Precast Unit equals StormVault 22.1 Tons CON/STORM 2.6 Tons
- All debris shall be kept out of the facility during and after construction.

DESIGN DATA

Design Loading:
Vault Units: HS20-44
Design Fill Height: StormVault 10" min. to 2'-0" max.
CON/STORM 1 1/2" min. to 2'-0" max.
from top of crown to top of pavement.
Design Method: Load factor per AASHTO Specification
Assumed net allowable soil bearing pressure: 3000 PSF 1'-9"

Pretreatment Volume Required = 0.026 Ac.ft.
Water Quality Volume Required = 0.21 Ac.ft.
Recharge Volume Required = 0.04 Ac.ft.
Storage Volume Required = 0.3 Ac.ft.

Pretreatment Volume Provided = 1303 cu.ft. (0.03 Ac.ft.)
Water Quality Volume Provided = 9780 cu.ft. (0.22 Ac.ft.)
Recharge Volume Provided = 1899 cu.ft. (0.043 Ac.ft.)
Storage Volume Provided = 23,028 cu.ft. (0.367 Ac.ft.)

*At the time of design, a geotechnical report for the project site was not available. It is the project engineer's, owner's and/or the contractor's responsibility to verify that the actual site conditions at the time of construction are consistent with the assumed allowable soil bearing pressure with a geotechnical investigation from a qualified geotechnical engineer.

MATERIALS

Precast units shall be constructed and installed in accordance with CON/SPAN® Specifications. Concrete for Footings shall have a minimum compressive strength of 4000 psi. Reinforcing steel for footings shall conform to ASTM A615 or A996-Grade 60.

STORMVAULT GENERAL NOTES

- All pipe/structure connections to be fit with water-tight resilient pipe connector. Exact blockout size per manufacturer specifications
- Dimensions and Elevations to be field adjusted to match finished grade
- Orifice protected by Exit Baffle and Trash Rack to prevent blockage
- Maximum HGL Elevation for Stormvault located at T/Inside Arch Elev. 450.50

CON/STORM™ GENERAL NOTES

- All pipe/structure connections to be fit with water-tight resilient pipe connector or grouted & coated with Sikatop Seal 107 waterproofing slurry mortar per manufacturer specifications. Exact blockout size per manufacturer specifications
- Dimensions and Elevations to be field adjusted to match finished grade
- Maximum HGL Elevation for Stormvault located at T/Inside Arch Elev. 450.50
- CON/STORM System To Be Set From North End To South End



NOTE: FOR GENERAL NOTES ASSOCIATED WITH CMP STORAGE SYSTEM, SEE SHEET 24, FOR GENERAL DETAILS, SEE SHEET 25.

APPROVED
PLANNING BOARD
OF HOWARD COUNTY
DATE 3/27/08
[Signature]



Professional Certification: I hereby certify that these documents were prepared or approved by me, and that I am a duly licensed professional engineer under the laws of the State of Maryland, License No. 22201, Expiration Date: 4-30-08.

LOCATION PLAN

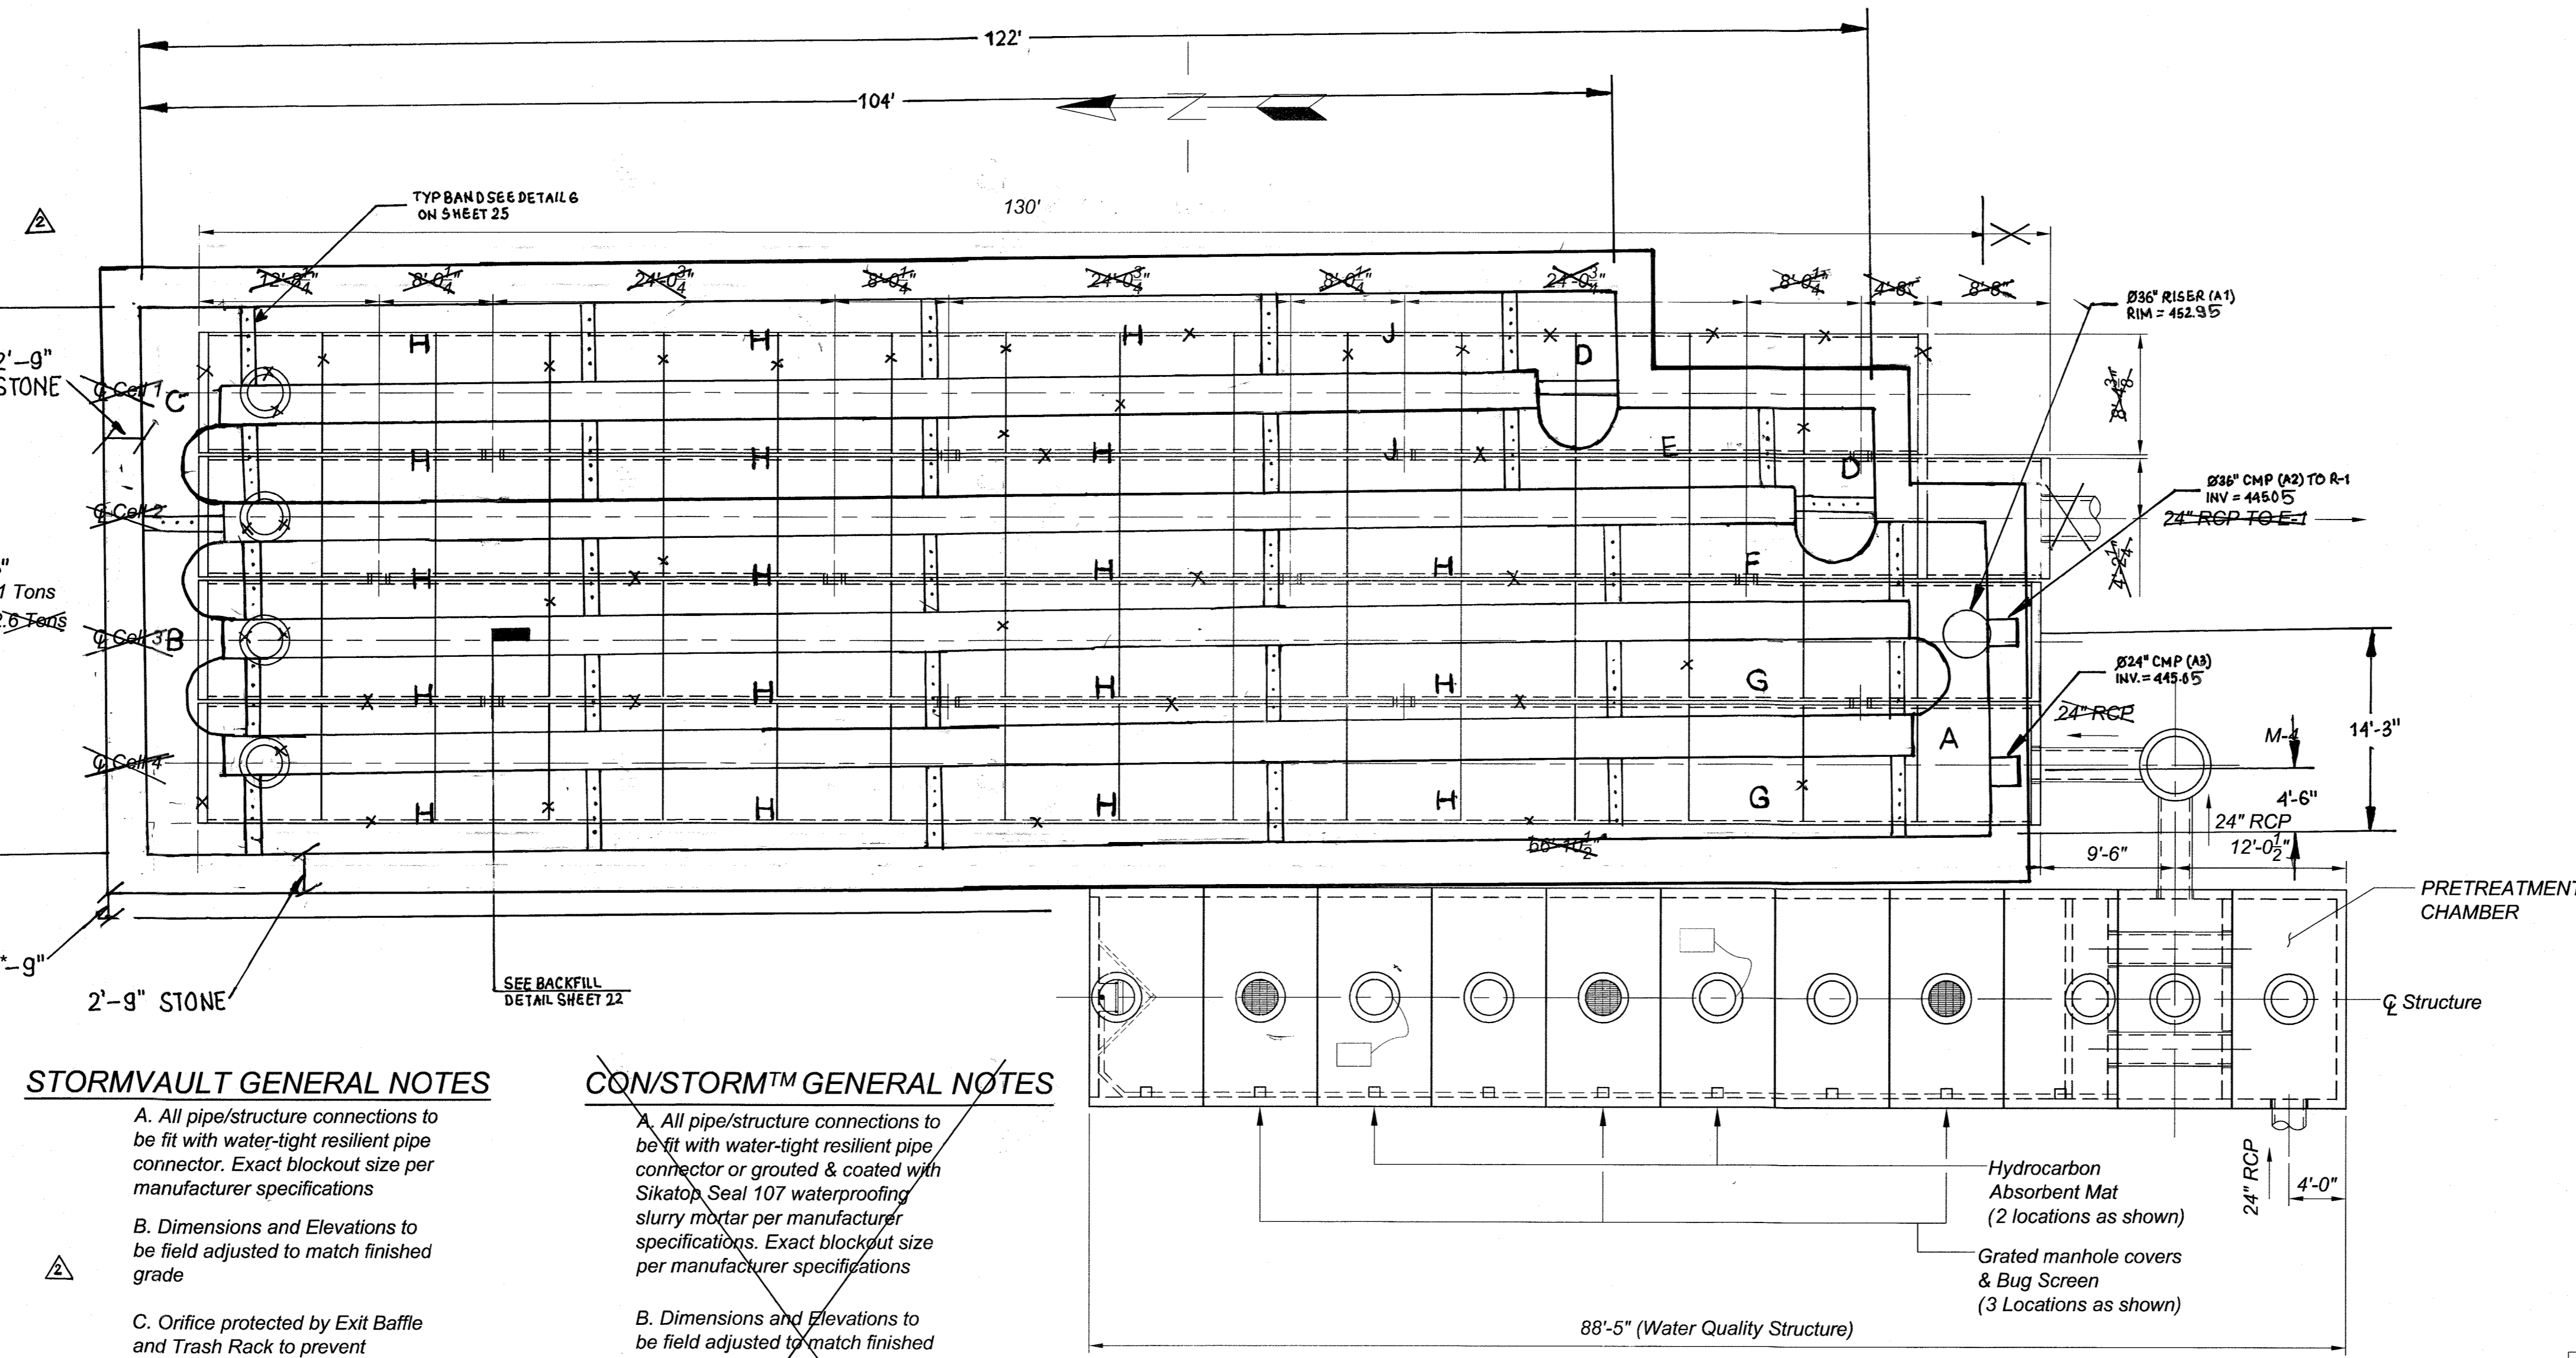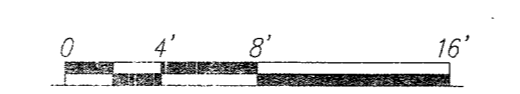

NOTES FOR CMP STORAGE STRUCTURE

- ALL RISER AND STUB DIMENSIONS ARE TO CENTERLINE.
- ALL ELEVATIONS, DIMENSIONS, AND LOCATIONS OF RISERS AND INLETS, SHALL BE VERIFIED BY THE ENGINEER OF RECORD PRIOR TO RELEASING FOR FABRICATION.
- ALL FITTINGS AND REINFORCEMENT COMPLY WITH ASTM A998.
- ALL RISERS AND STUBS ARE 2 1/2 x 1/2 CORRUGATION AND 16 GAGE UNLESS OTHERWISE NOTED.
- RISERS TO BE FIELD TRIMMED TO GRADE.
- PERFORATED SYSTEM.

NO.	BY	DATE	REVISION
1	KCE	09/02/08	REPLACE CON/STORM WITH CMP STORAGE
3	KCE	03/01/10	SWM AS-BUILT INFORMATION ADDED

SWM FACILITY #1 - LOCATION PLAN & GENERAL NOTES
TURF VALLEY, LORIE
NURSING HOME & ASSISTED LIVING FACILITY
AS-BUILT
OAKMONT AT TURF VALLEY
PARCEL Q
PLATS 18773 - 18775
TAX MAP 16 - P/O PARCEL 8- GRID 16 & 17;
POD 1 per S-86-13 (4th AMENDED)
THIRD ELECTION DISTRICT HOWARD COUNTY, MARYLAND

KCE ENGINEERING, INC.
EXECUTIVE CENTER
3300 NORTH RIDGE ROAD, SUITE 315
ELLICOTT CITY, MARYLAND 21043
PHONE (410) 203-9800 FAX (410) 203-9228


AS-BUILT CERTIFICATION

THERE IS NO 'AS-BUILT' INFORMATION PROVIDED ON THIS SHEET.
[Signature]
MICHAEL D. ADCOCK, PROFESSIONAL LAND SURVEYOR
MD REG. NO. 21257, EXPIRATION DATE: 06-16-21



OWNER
MANGIONE ENTERPRISES OF TURF VALLEY
LIMITED PARTNERSHIP
1205 YORK ROAD, PENTHOUSE
LUTHERVILLE, MARYLAND 21093
PHONE (410) 825-8400

DRAWN BY: _____ SHEET: 19
CHECKED BY: _____ OF
SCALE: AS SHOWN 36
DATE: 04/30/2008


APPROVED: DEPARTMENT OF PLANNING AND ZONING
[Signatures and Dates]
Chief, Development Engineering Division
Chief, Division of Land Development
Director

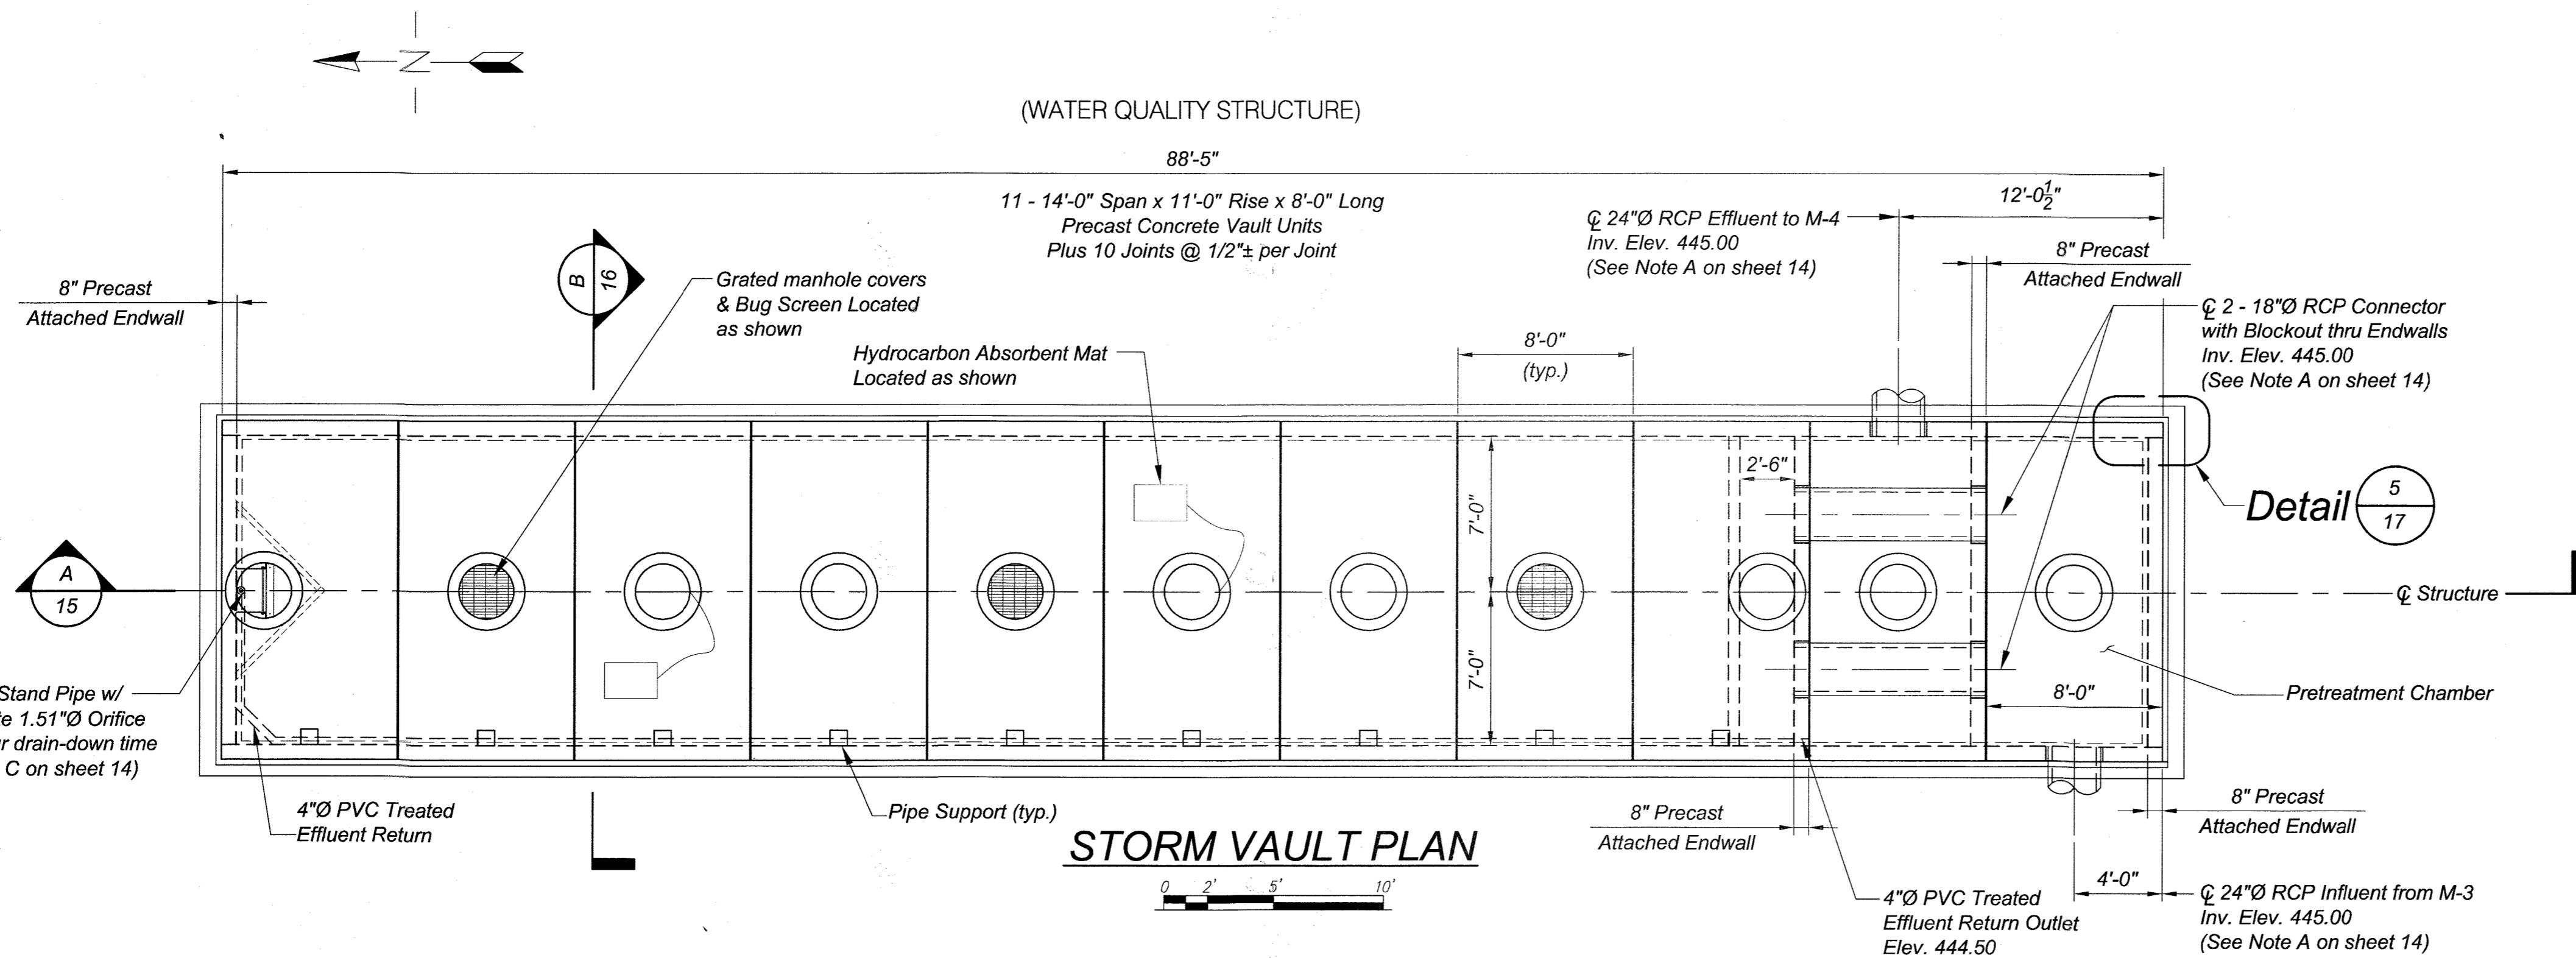

STORM VAULT PLAN

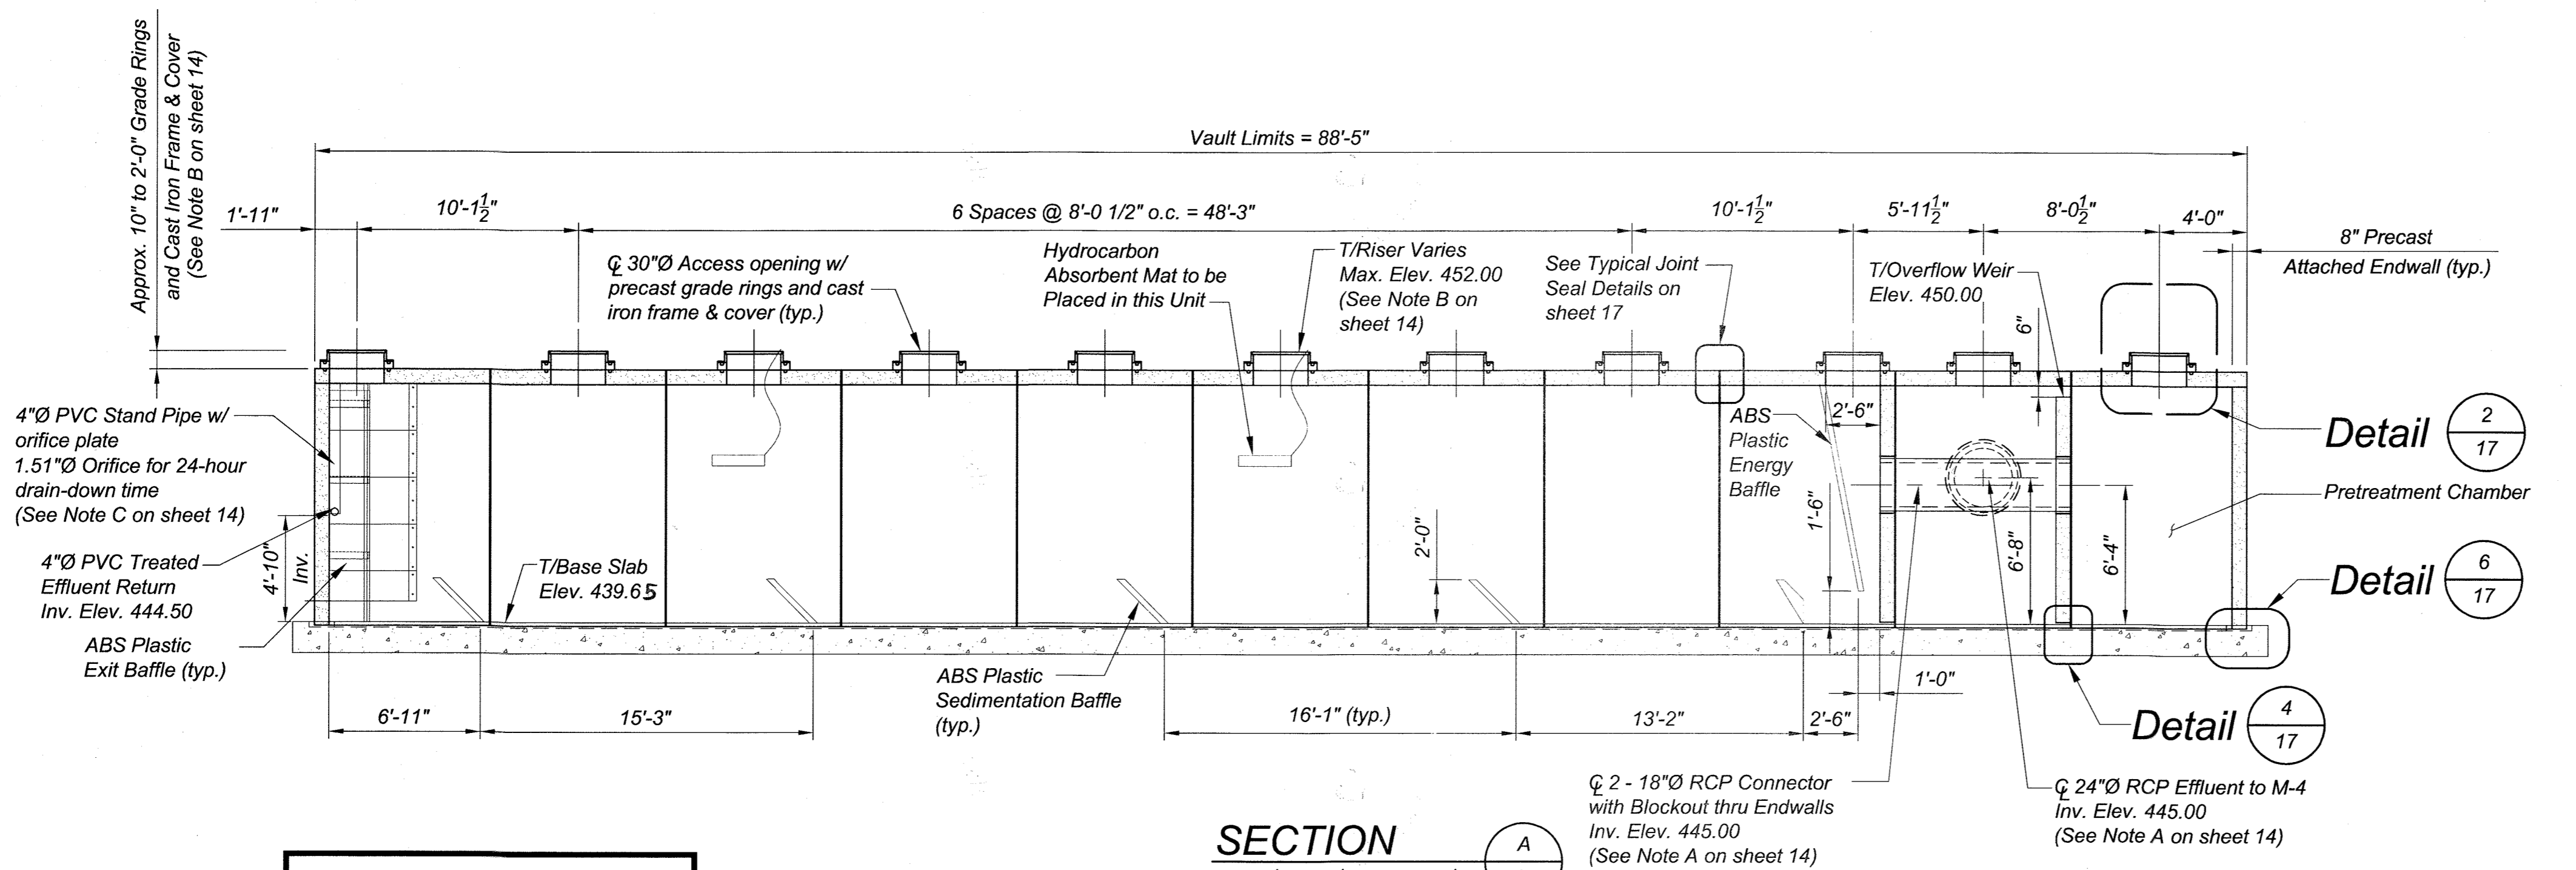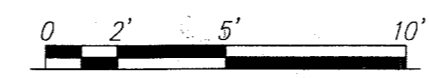

SECTION

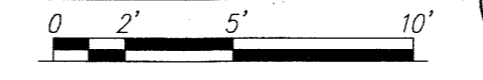

APPROVED
 PLANNING BOARD
 OF HOWARD COUNTY
 DATE 3/27/08
EMM

Thomas J. Brund
 PROFESSIONAL ENGINEER
 No. 22201
 4-30-08

Professional Certification: I hereby certify that these documents were prepared or approved by me, and that I am a duly licensed professional engineer under the laws of the State of Maryland, License No. 22201, Expiration Date: 12-22-08.

AS-BUILT CERTIFICATION

THERE IS NO "AS-BUILT" INFORMATION PROVIDED ON THIS SHEET.

Michael D. Adcock
 MICHAEL D. ADCOCK, PROFESSIONAL LAND SURVEYOR
 MD REG. NO. 21257, EXPIRATION DATE: 06-16-21
 DATE: 07/23/19

OWNER
 MANGIONE ENTERPRISES OF TURF VALLEY
 LIMITED PARTNERSHIP
 1205 YORK ROAD, PENTHOUSE
 LUTHERVILLE, MARYLAND 21093
 PHONE (410) 825-8400


3	SWM AS-BUILT INFORMATION ADDED	KCE	03/01/10
No.	REVISION	BY	DATE

AS-BUILT STORMVAULT PLAN & SECTION
TURF VALLEY, LORIE
NURSING HOME & ASSISTED LIVING FACILITY
 OAKMONT AT TURF VALLEY
 PARCEL Q
 PLATS 18773 - 18775
 TAX MAP 16 - P/O PARCEL 8- GRID 16 & 17;
 POD I per S-86-13 (4th AMENDED)
 THIRD ELECTION DISTRICT HOWARD COUNTY, MARYLAND



KCE ENGINEERING, INC.
 EXECUTIVE CENTER
 3300 NORTH RIDGE ROAD, SUITE 315
 ELLICOTT CITY, MARYLAND 21043
 PHONE (410) 203-9800 FAX (410) 203-9228

APPROVED: DEPARTMENT OF PLANNING AND ZONING
Allen Robinson 6/25/08
 Chief, Development Engineering Division
Cathy Kline 6/23/08
 Chief, Division of Land Development
David A. Taylor 6/23/08
 Director

DRAWN BY: _____ SHEET: 20
 CHECKED BY: _____ OF
 SCALE: AS SHOWN 36
 DATE: 04/30/2008

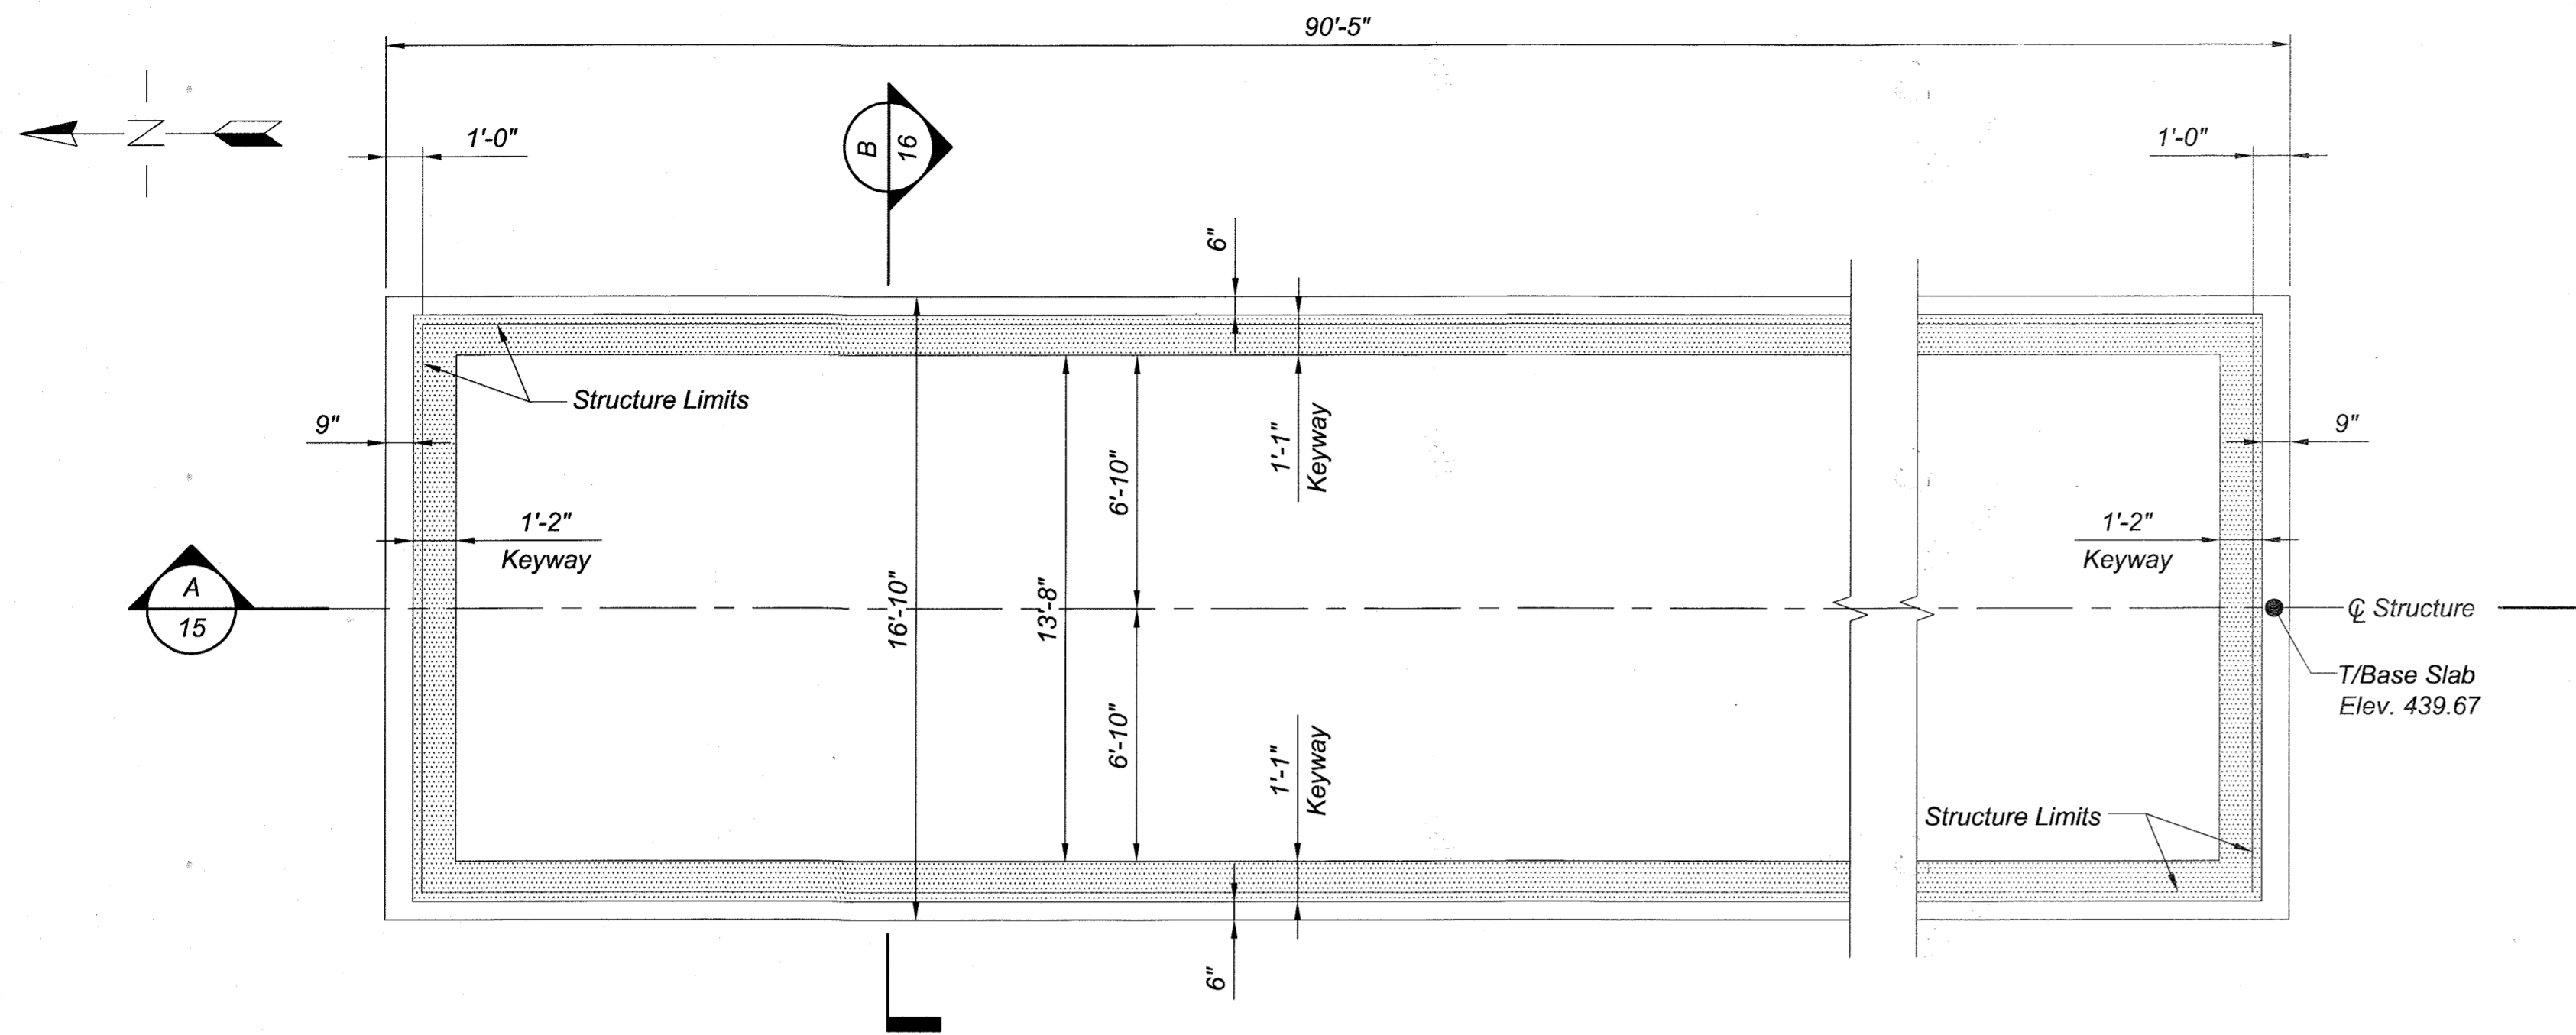


VAULT FOUNDATION PLAN

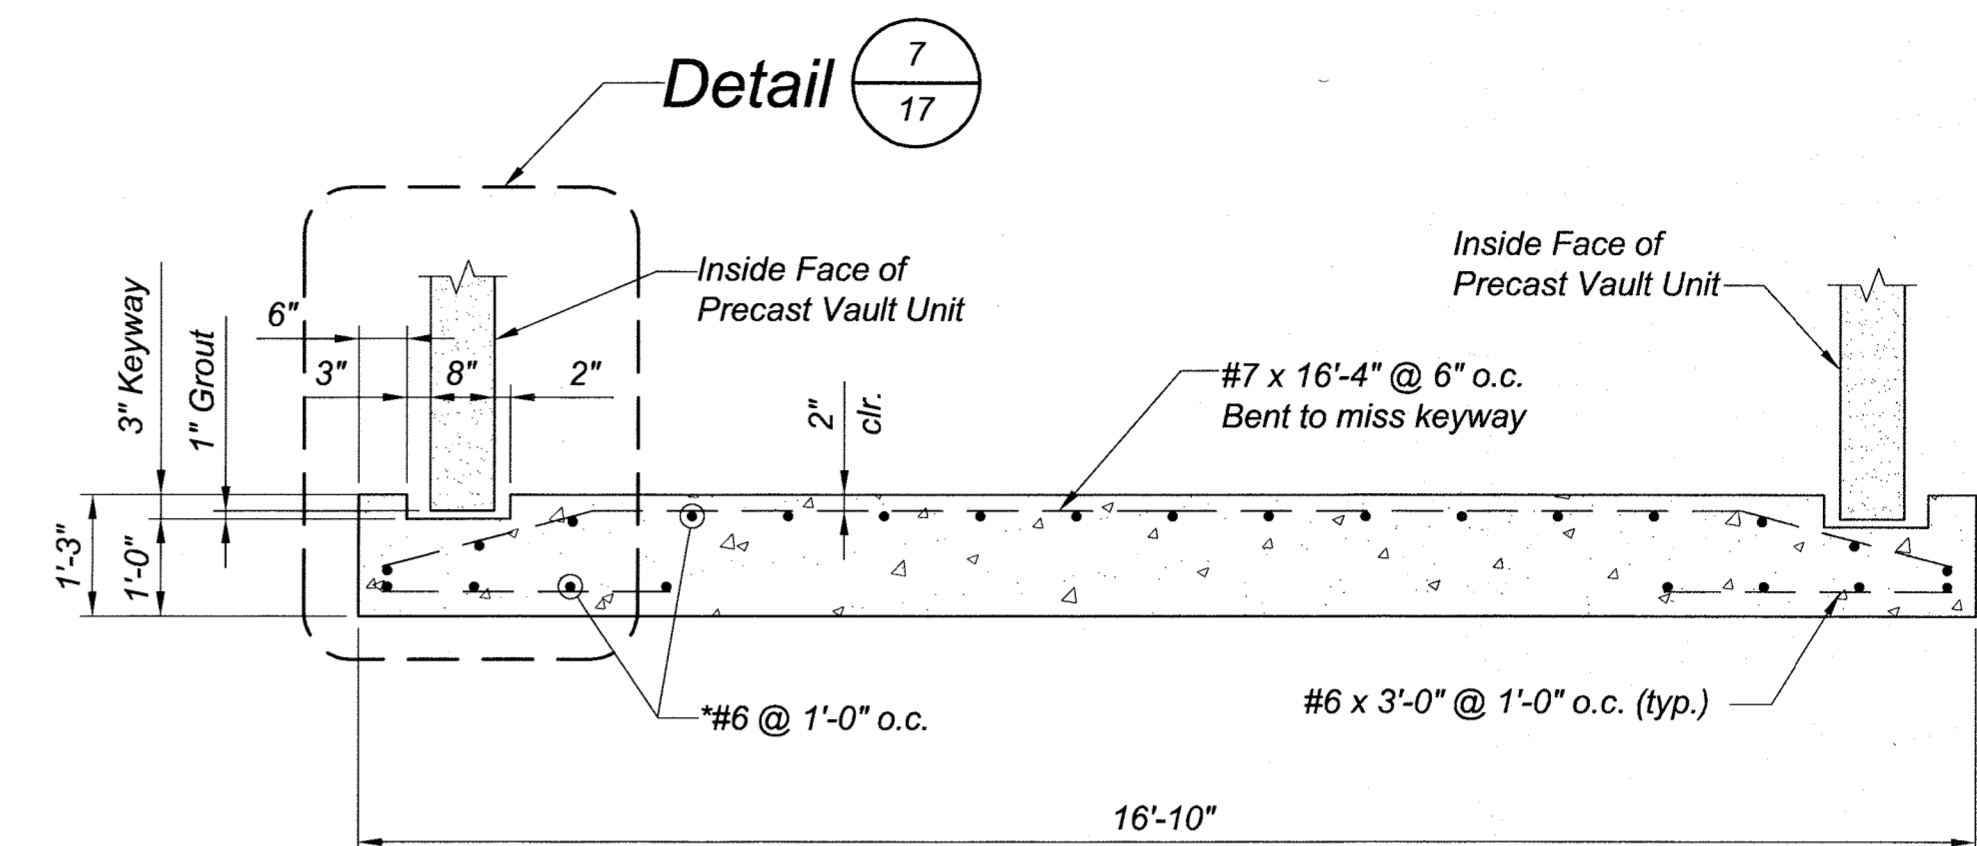
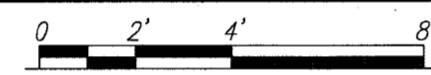


DETAIL 7/17



*Bend all bars to miss keyways

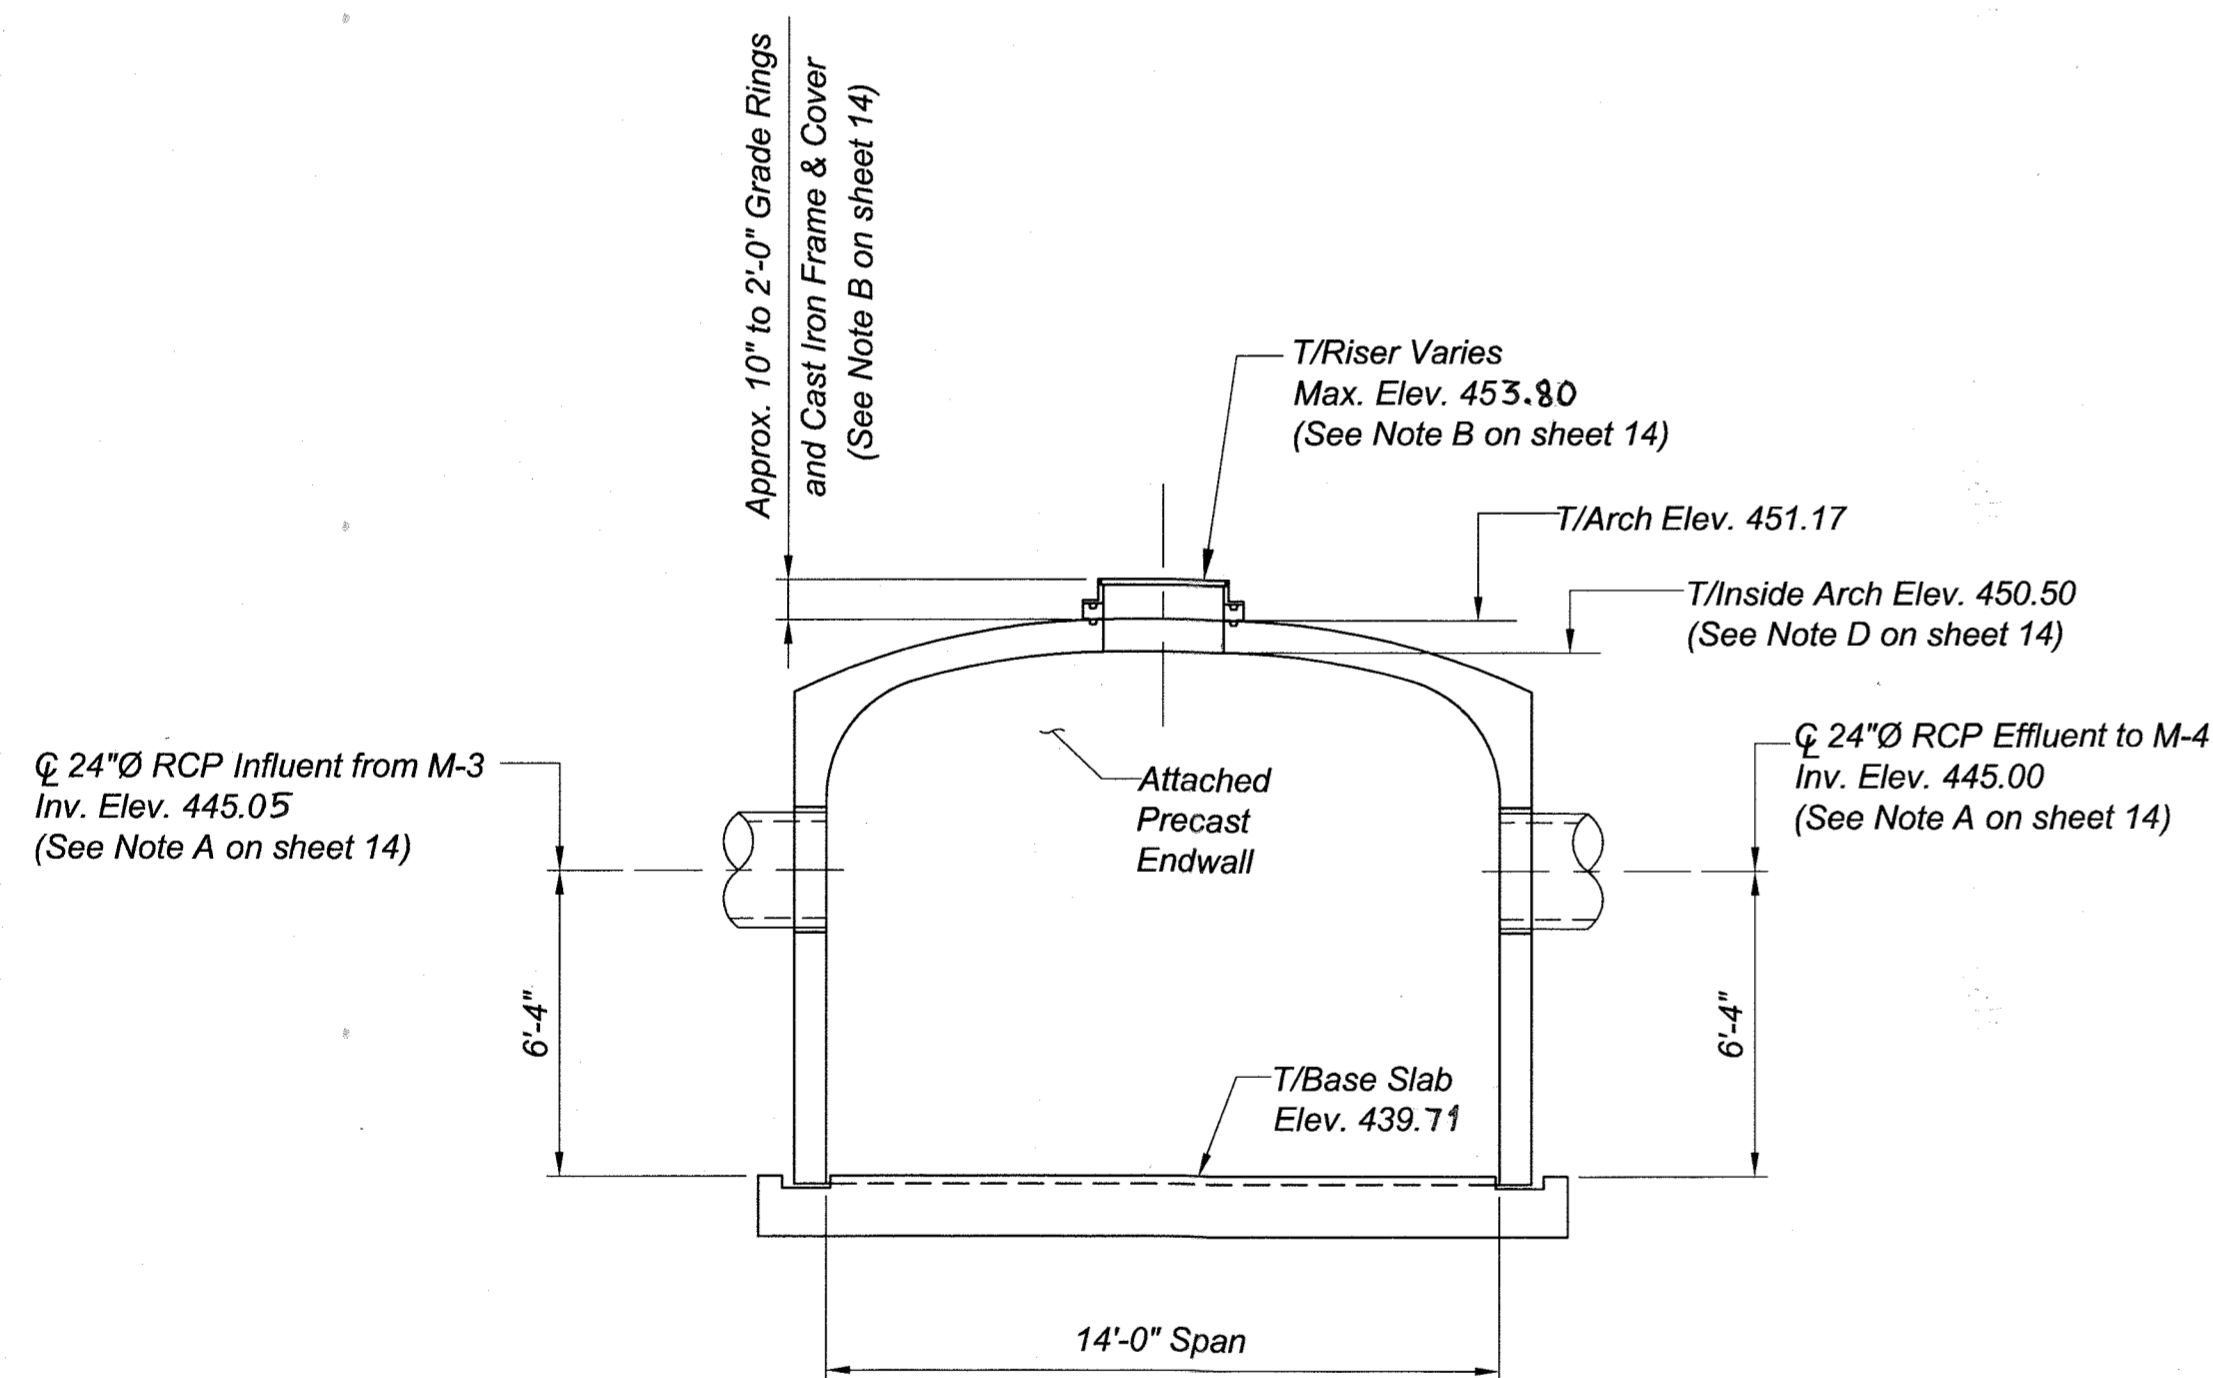


SOUTH END ELEVATION

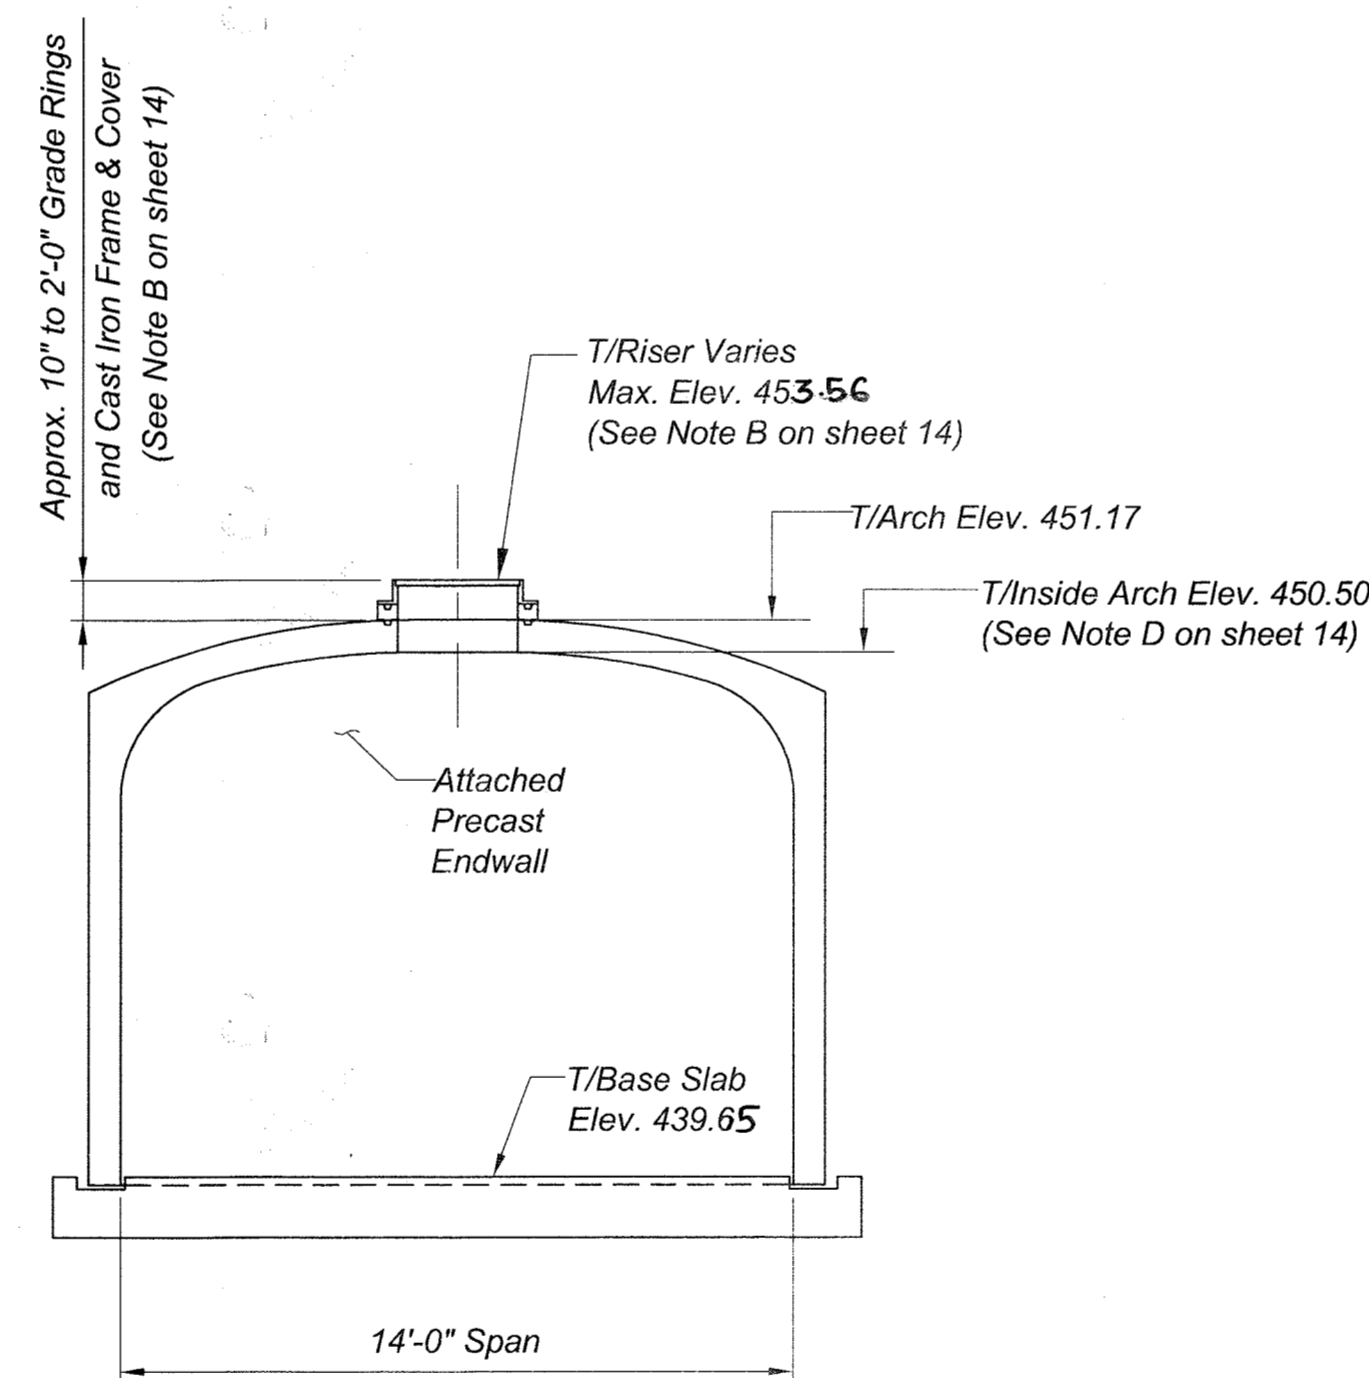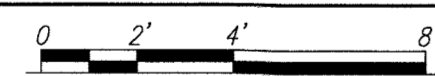

NORTH END ELEVATION

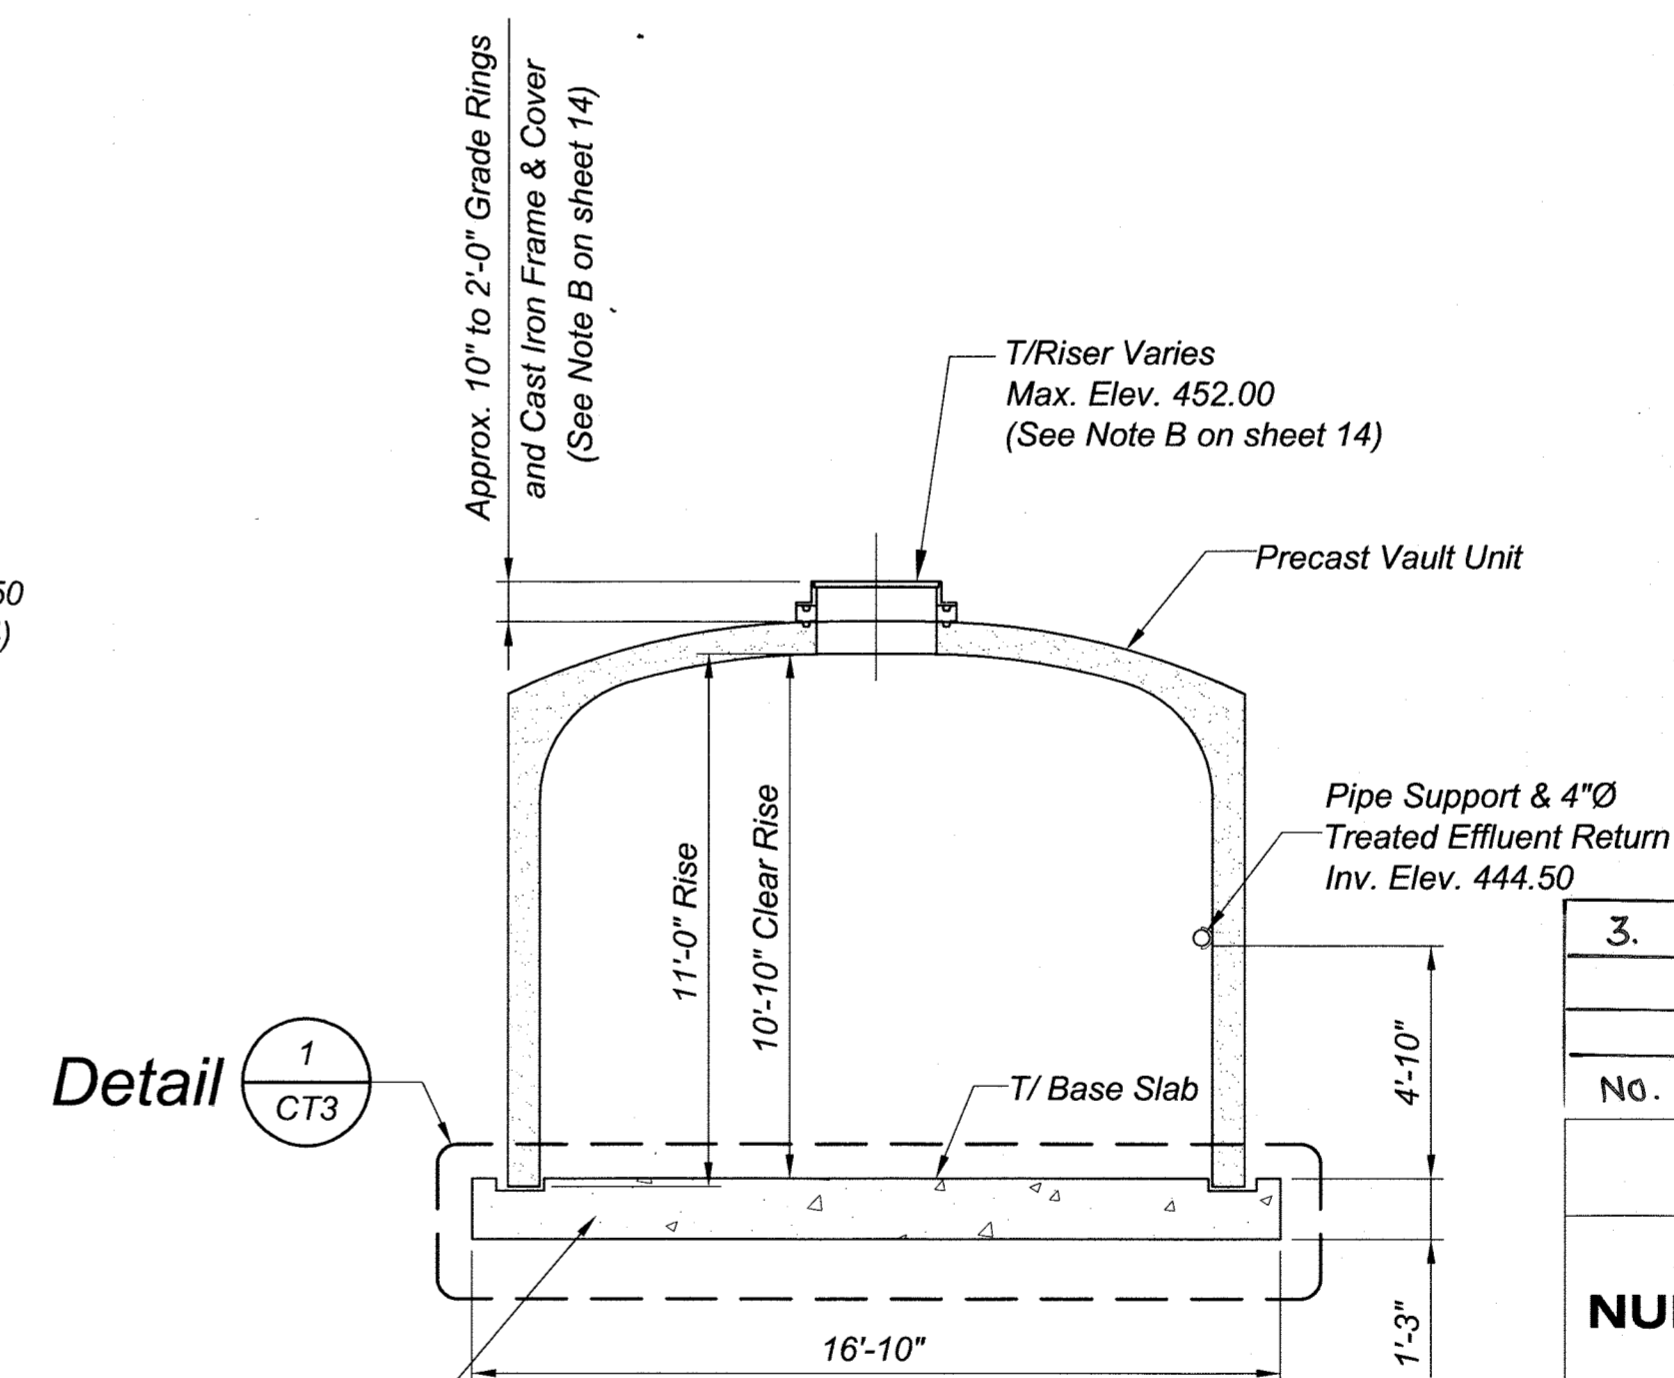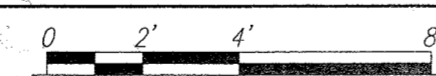

SECTION B

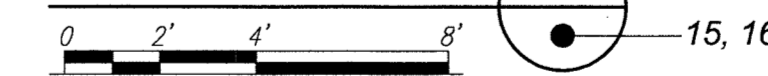


No.	REVISION	BY	DATE
3.	SWM AS-BUILT INFORMATION ADDED	KCE	02/01/10

STORM VAULT FOUNDATION PLAN & DETAILS
TURF VALLEY, LORIE
NURSING HOME & ASSISTED LIVING FACILITY
 AS-BUILT
 OAKMONT AT TURF VALLEY
 PARCEL Q
 PLATS 18773 - 18775
 TAX MAP 16 - P/O PARCEL 8 - GRID 16 & 17;
 POD I per S-86-13 (4th AMENDED)
 THIRD ELECTION DISTRICT HOWARD COUNTY, MARYLAND

KCE ENGINEERING, INC.
 EXECUTIVE CENTER
 3300 NORTH RIDGE ROAD, SUITE 315
 ELLICOTT CITY, MARYLAND 21043
 PHONE (410) 203-9800 FAX (410) 203-9228

APPROVED
 PLANNING BOARD
 OF HOWARD COUNTY
 DATE 3/27/08
[Signature]

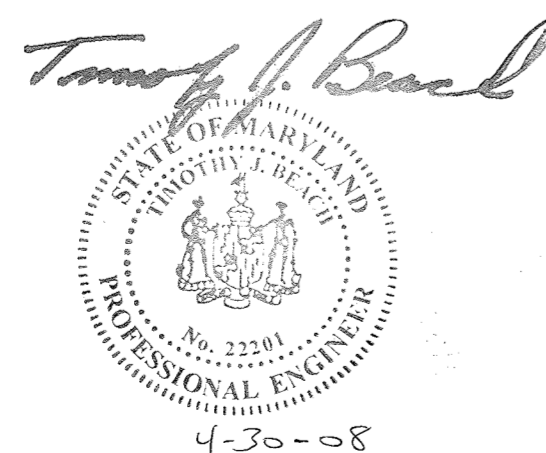

Professional Certification: I hereby certify that these documents were prepared or approved by me, and that I am a duly licensed professional engineer under the laws of the State of Maryland, License No. 22201, Expiration Date: 12-22-08.

AS-BUILT CERTIFICATION










THERE IS NO AS-BUILT INFORMATION PROVIDED ON THIS SHEET.

[Signature] 02/23/10
 MICHAEL D. AD CO. CK., PROFESSIONAL LAND SURVEYOR
 MD REG. NO. 21261, EXPIRATION DATE: 06-14-11

OWNER
 MANGIONE ENTERPRISES OF TURF VALLEY
 LIMITED PARTNERSHIP
 1205 YORK ROAD, PENTHOUSE
 LUTHERVILLE, MARYLAND 21093
 PHONE (410) 825-8400

DRAWN BY: _____ SHEET: **21**
 CHECKED BY: _____ OF
 SCALE: AS SHOWN **36**
 DATE: 04/30/2008

APPROVED: DEPARTMENT OF PLANNING AND ZONING
[Signature] 6/15/08
 Chief, Development Engineering Division
[Signature] 6/27/08
 Chief, Division of Land Development
[Signature] 6/30/08
 Director

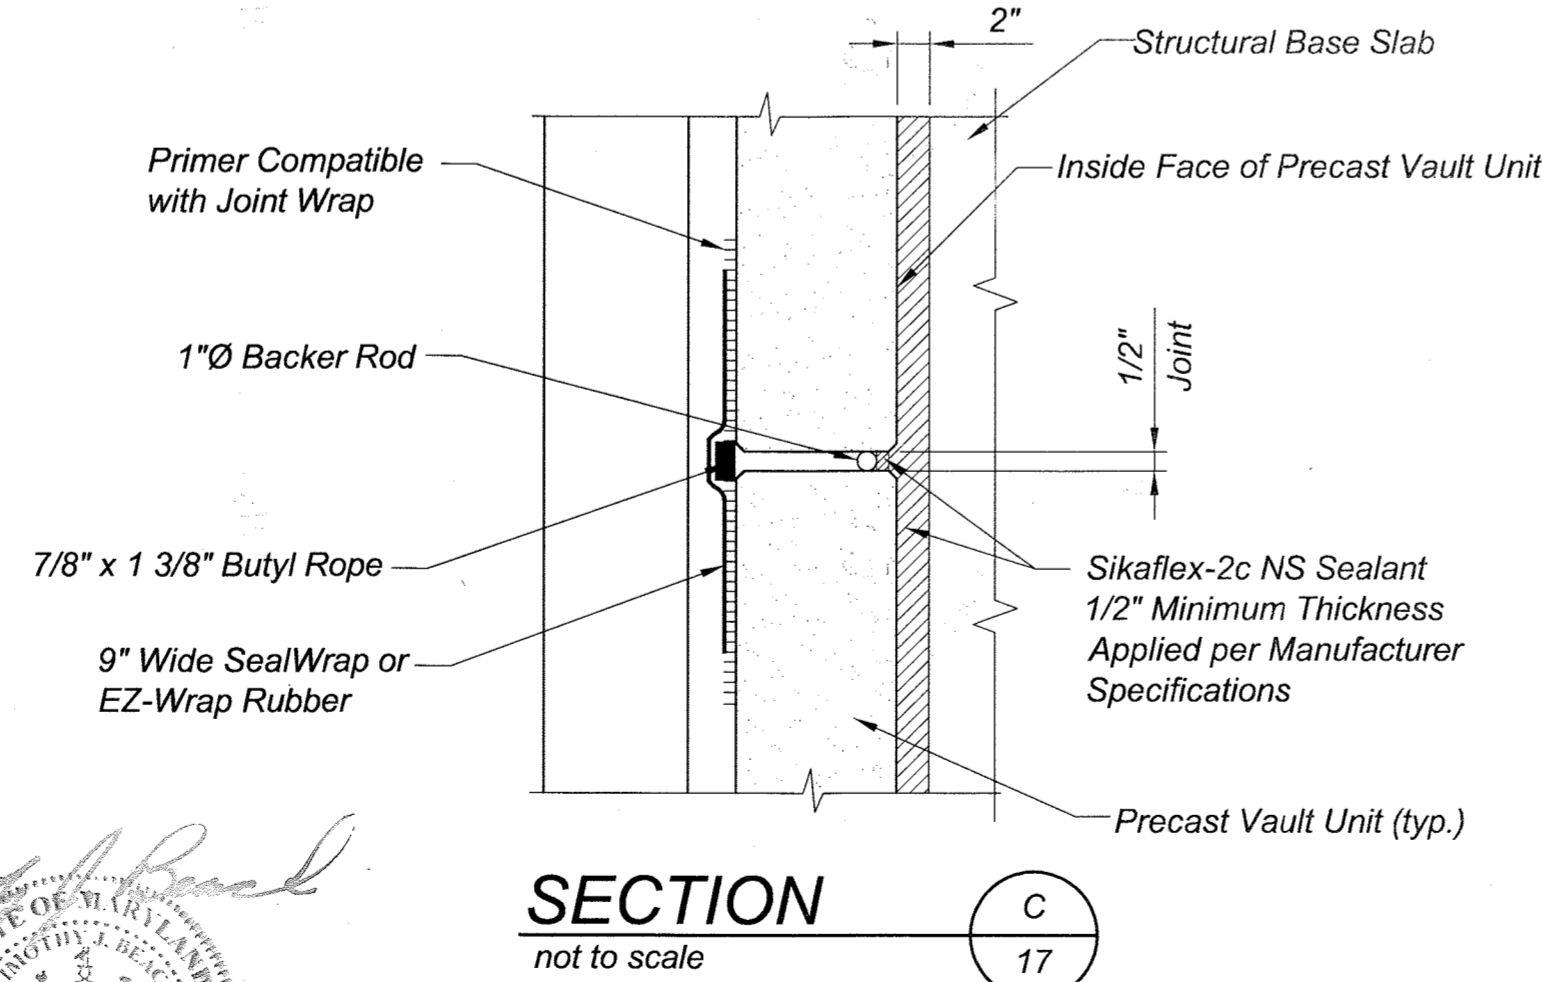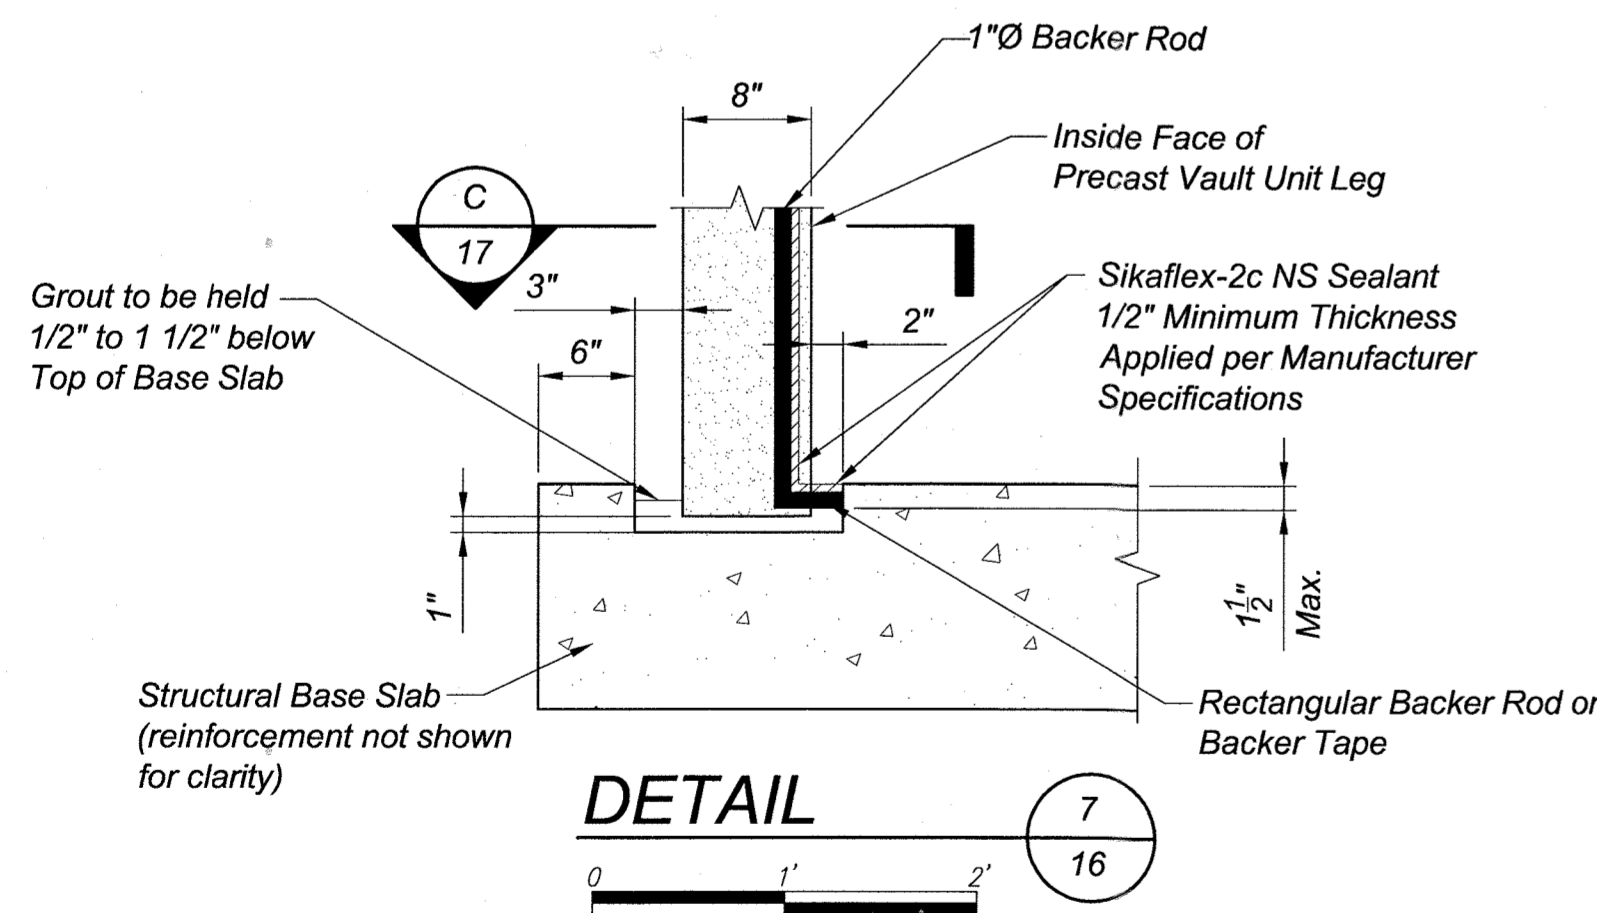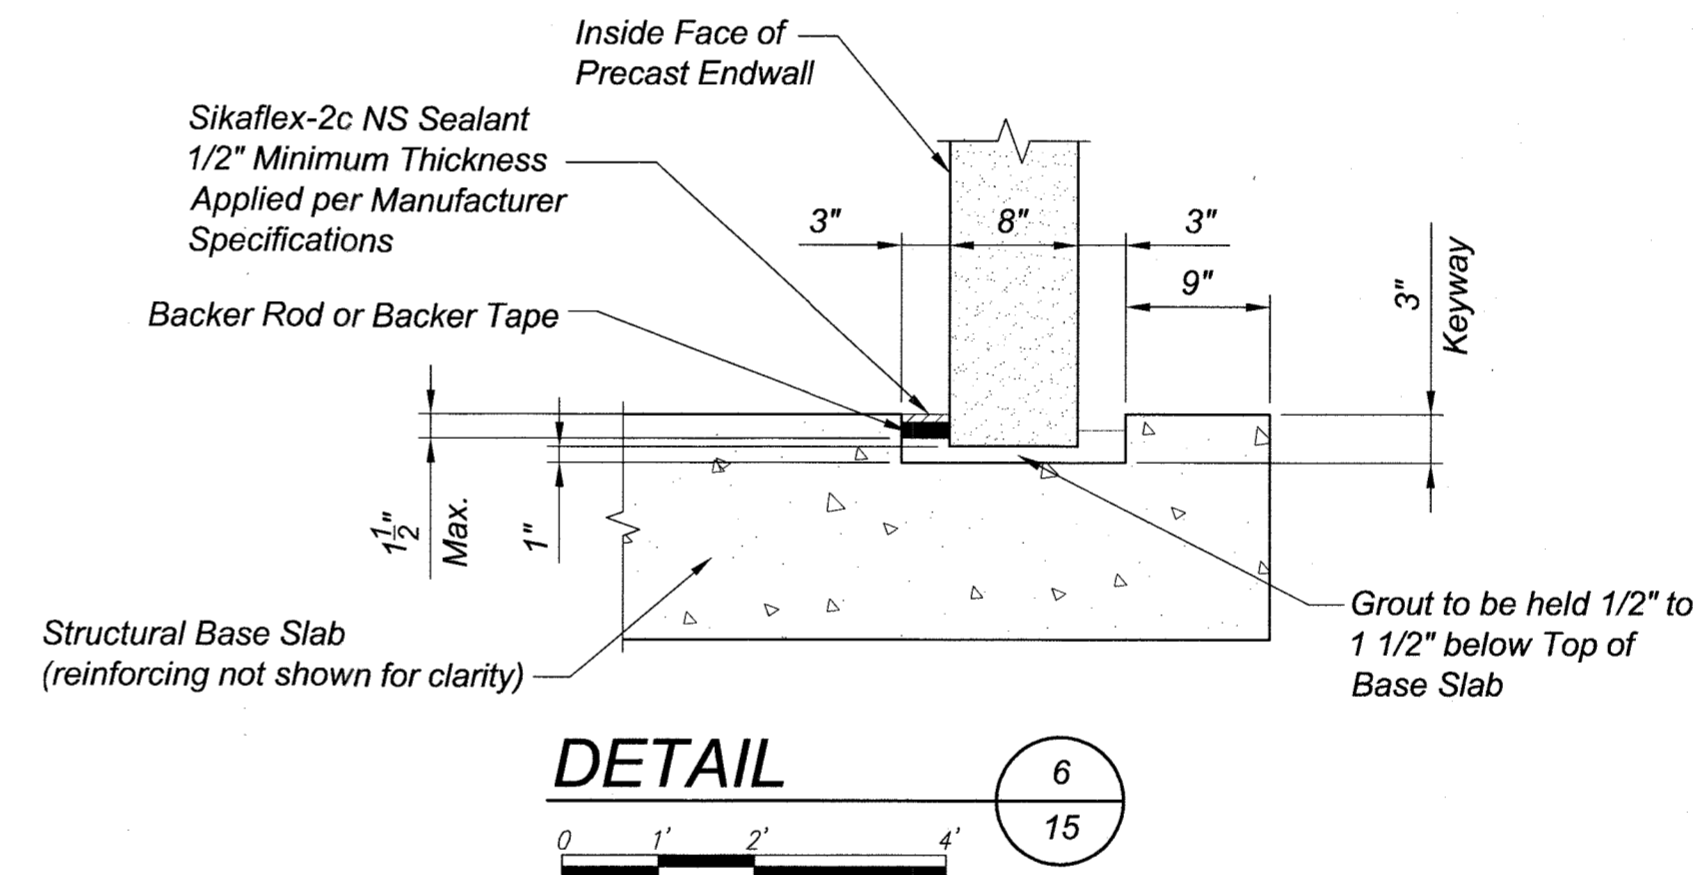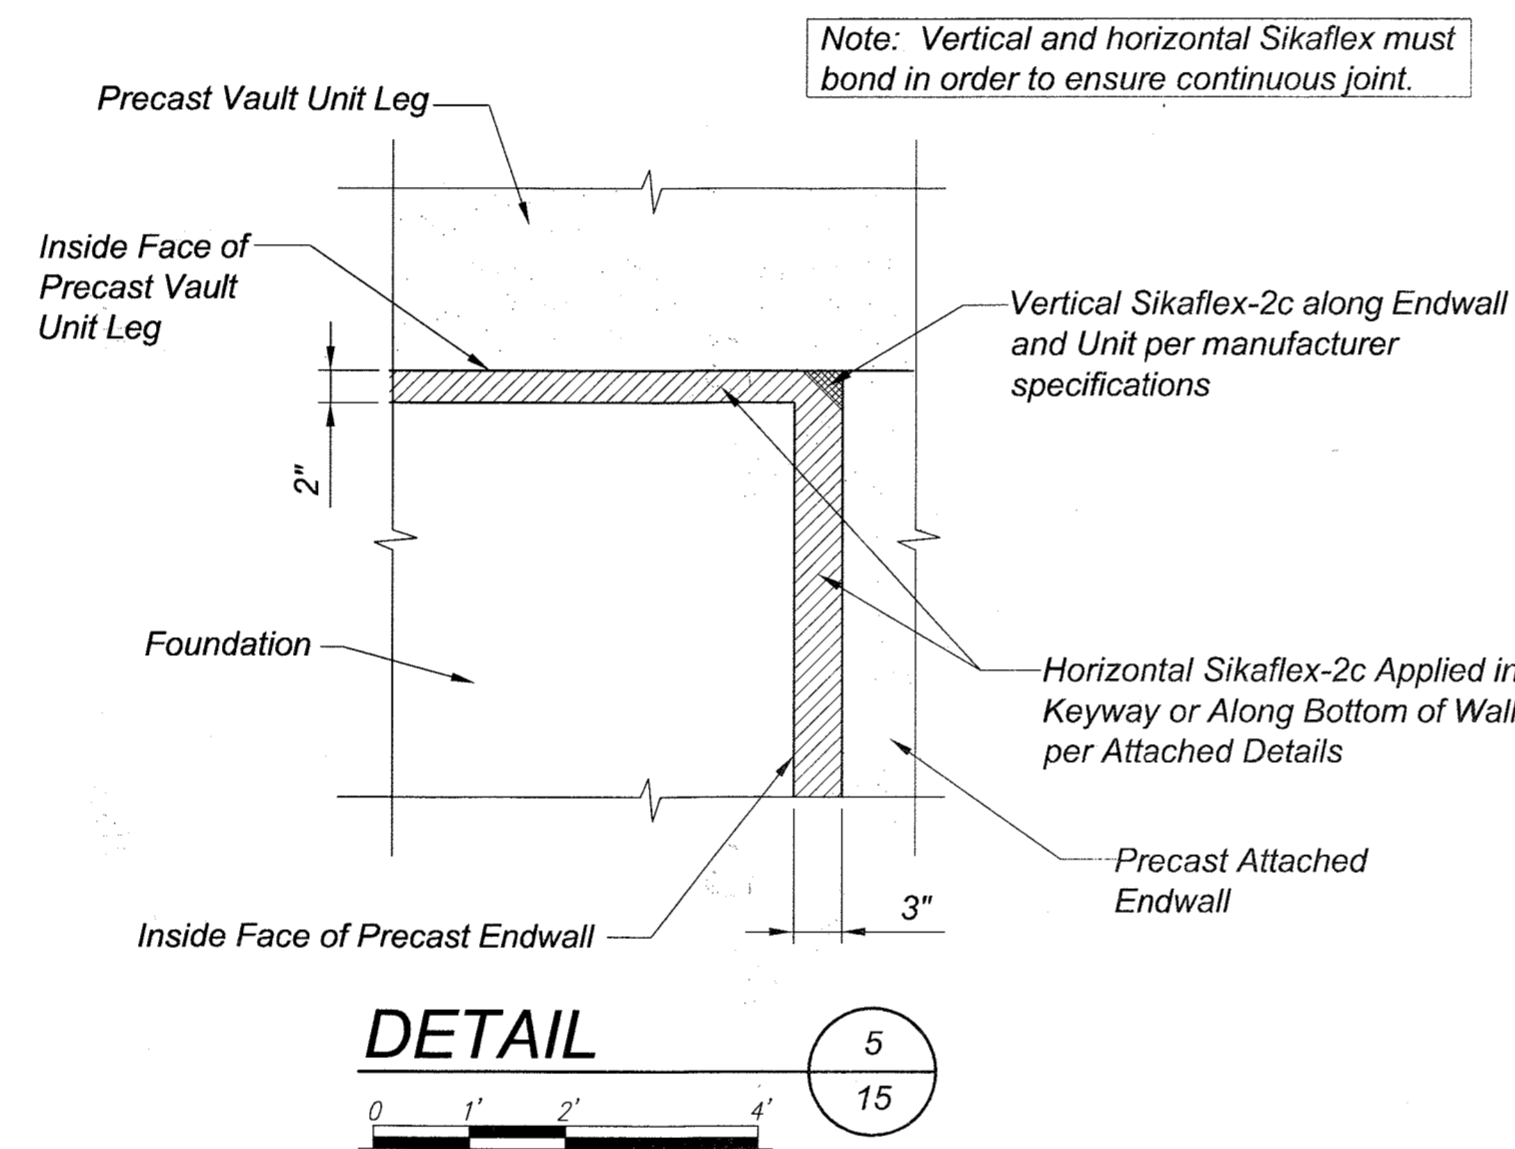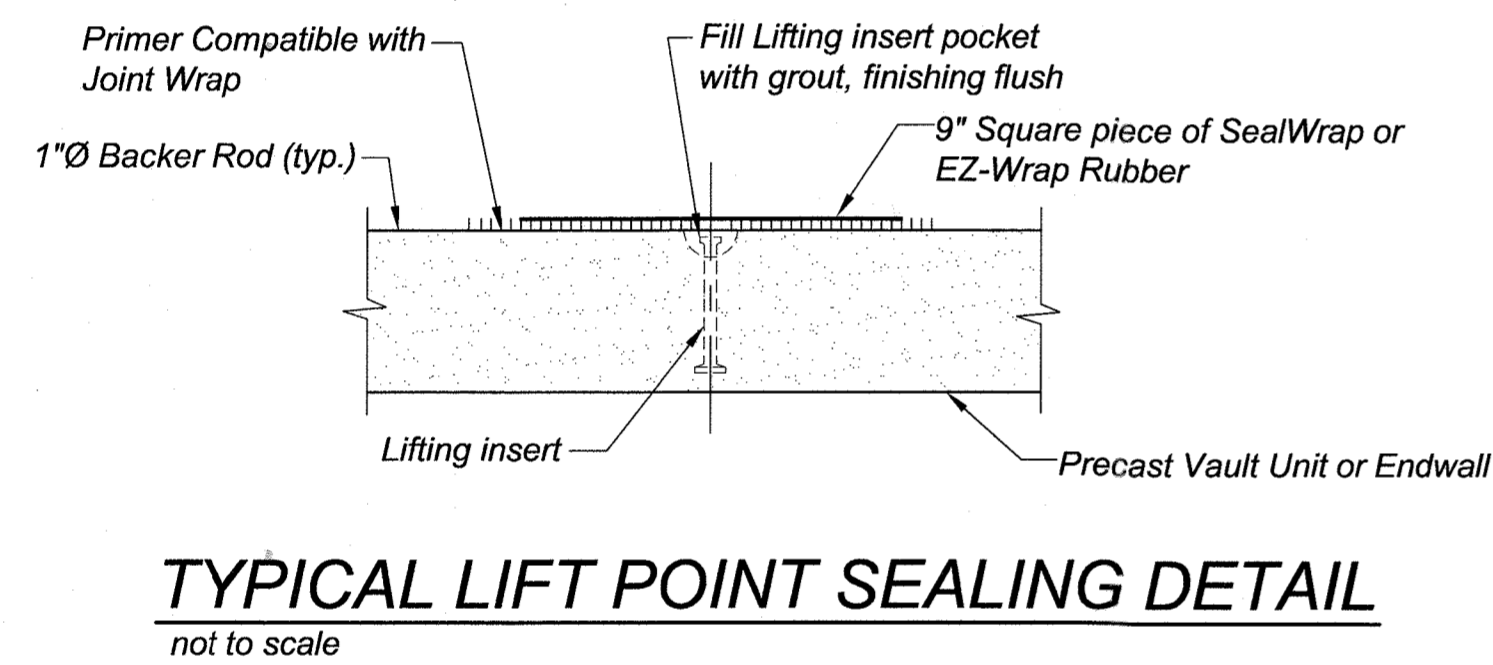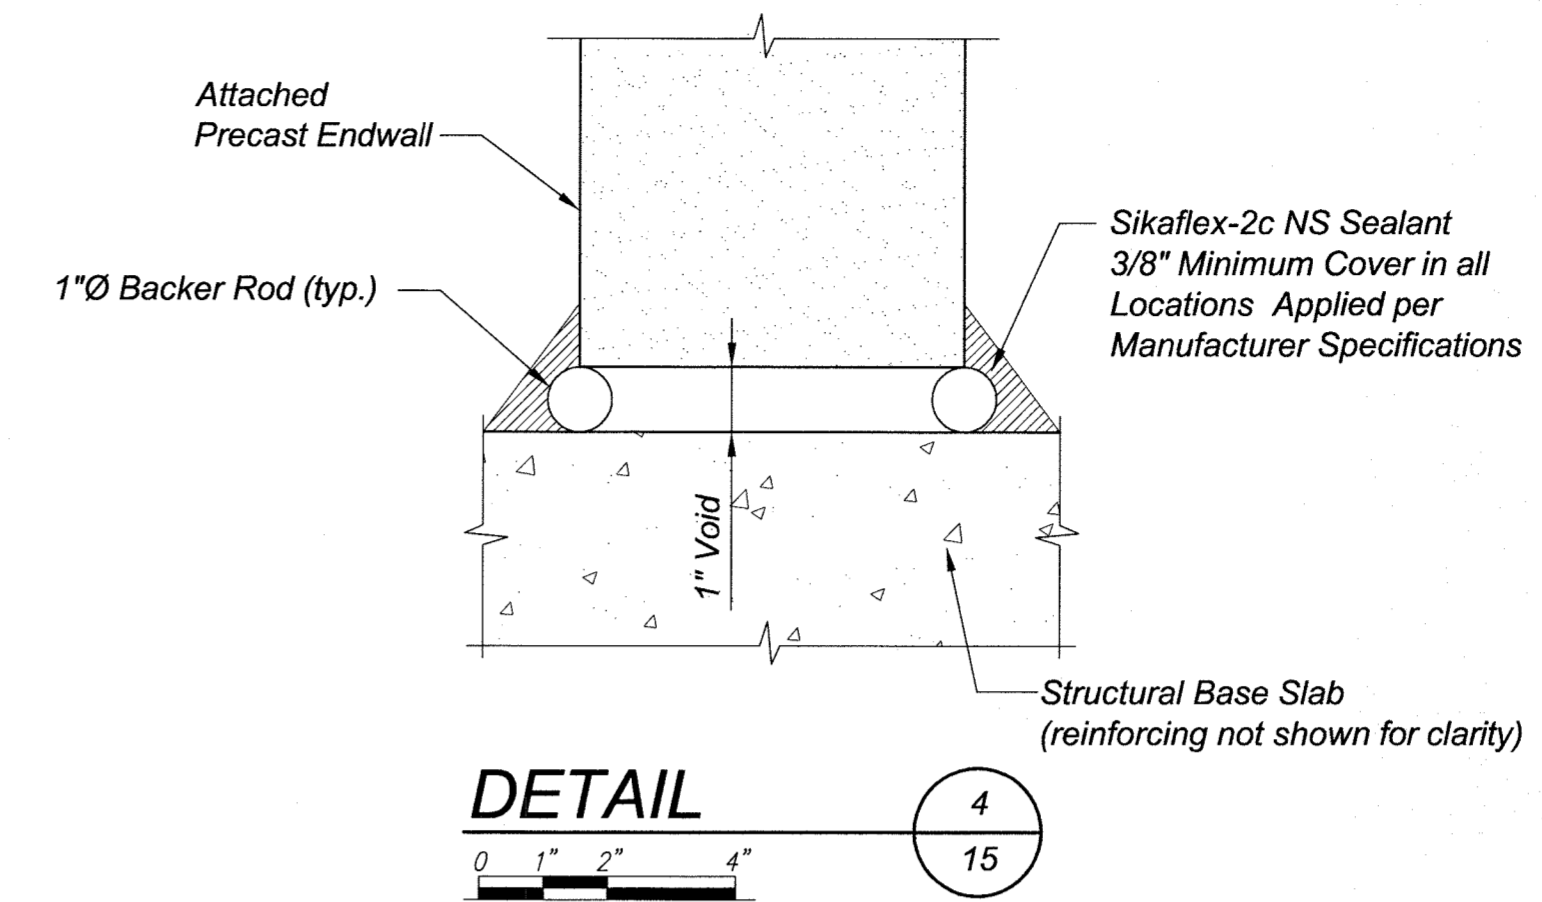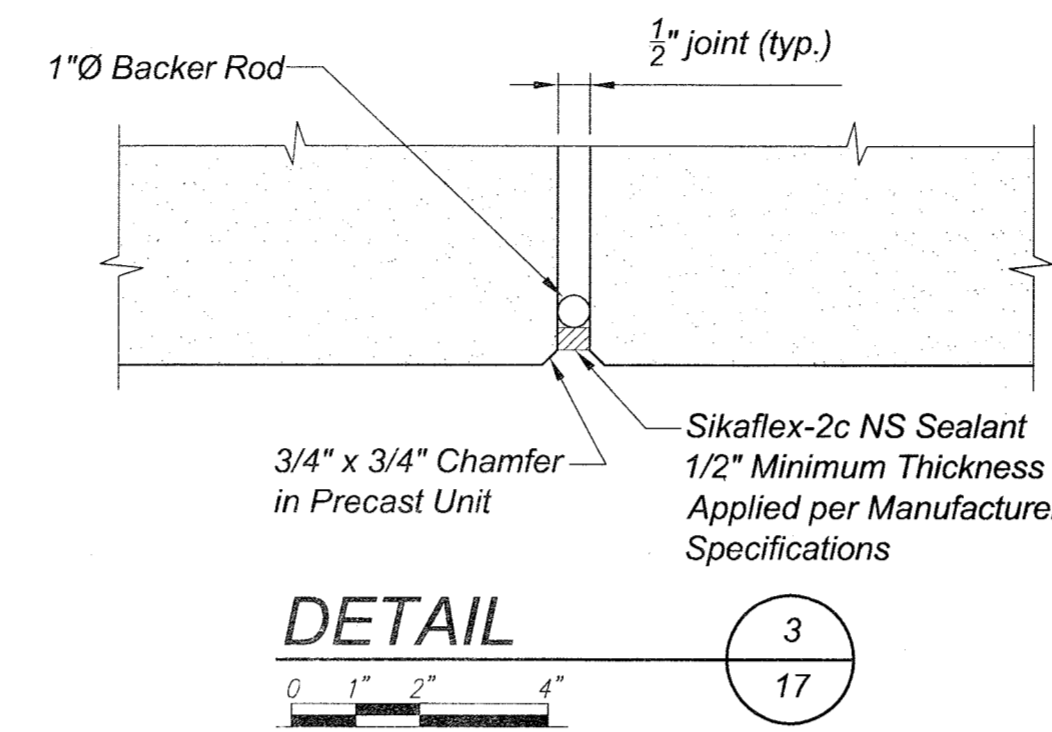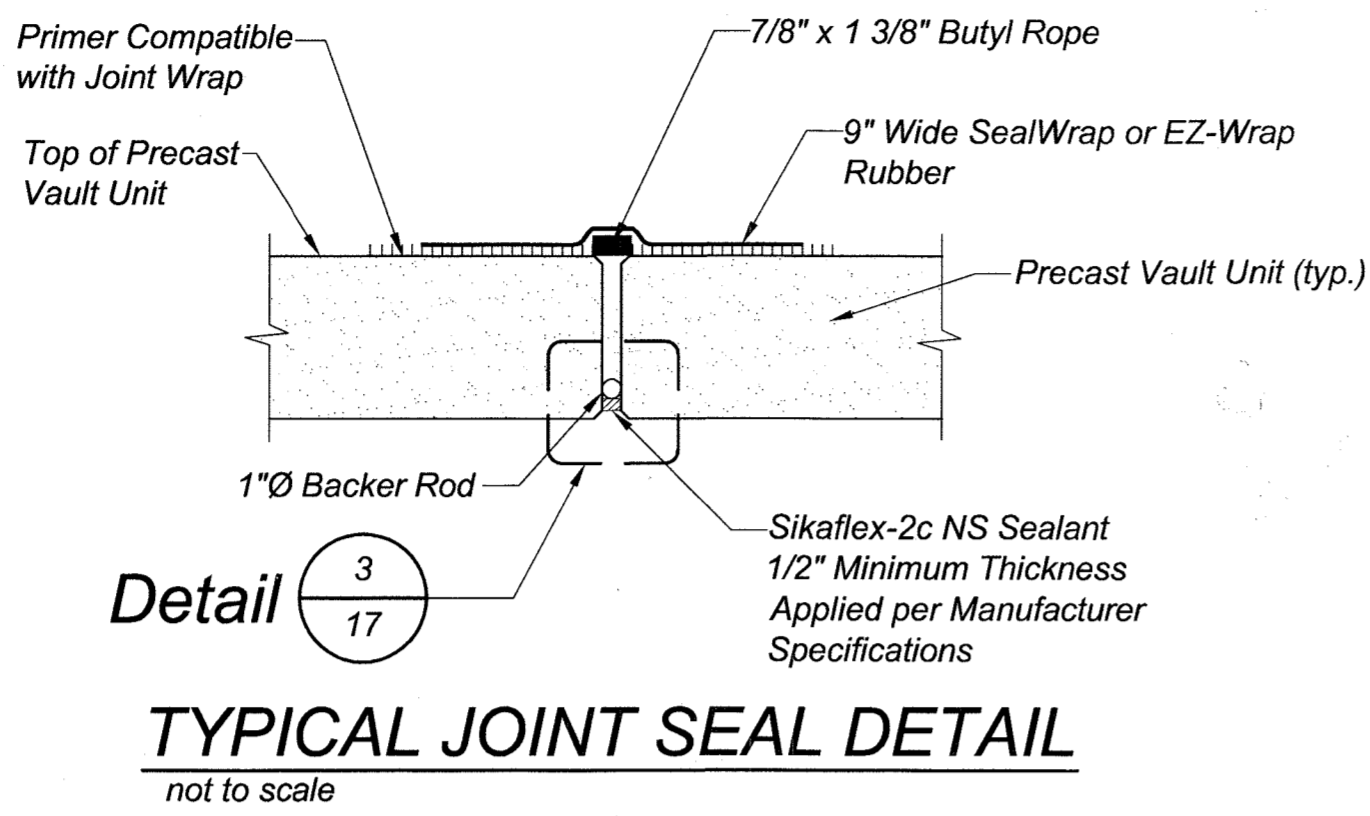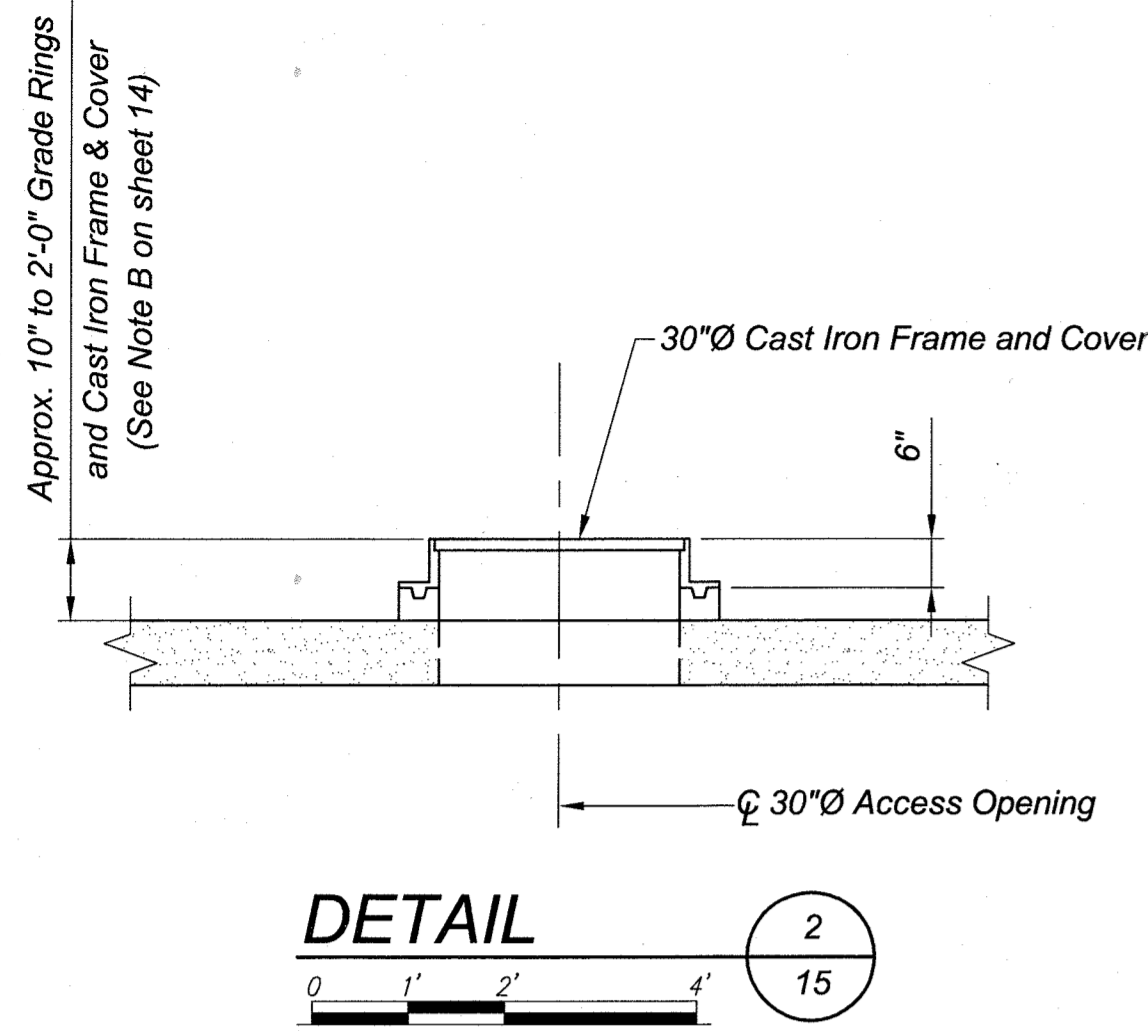

APPROVED
PLANNING BOARD
OF HOWARD COUNTY
DATE 3/27/08



Professional Certification: I hereby certify that these documents were prepared or approved by me, and that I am a duly licensed professional engineer under the laws of the State of Maryland, License No. 22201, Expiration Date: 12-22-08.

AS-BUILT CERTIFICATION

THERE IS NO "AS-BUILT" INFORMATION PROVIDED ON THIS SHEET.

Michael P. Adcock, Professional Land Surveyor
No. 21257, Expiration Date: 04-15-21

OWNER
MANGIONE ENTERPRISES OF TURF VALLEY
LIMITED PARTNERSHIP
1205 YORK ROAD, PENTHOUSE
LUTHERVILLE, MARYLAND 21093
PHONE (410) 825-8400

STORM VAULT DETAILS

TURF VALLEY, LORIE
NURSING HOME & ASSISTED LIVING FACILITY

AS-BUILT

OAKMONT AT TURF VALLEY
PARCEL Q
PLATS 18773 - 18775
TAX MAP 16 - P/O PARCEL 8- GRID 16 & 17;
POD I per S-86-13 (4th AMENDED)
THIRD ELECTION DISTRICT HOWARD COUNTY, MARYLAND

KCE ENGINEERING, INC.
EXECUTIVE CENTER
3300 NORTH RIDGE ROAD, SUITE 315
ELLCOTT CITY, MARYLAND 21043
PHONE (410) 203-9800 FAX (410) 203-9228

APPROVED: DEPARTMENT OF PLANNING AND ZONING

Chief, Development Engineering Division
Date 6/23/08

Chief, Division of Land Development
Date 6/30/08


Director
Date

DRAWN BY: _____ SHEET: 22


CHECKED BY: _____ OF

SCALE: AS SHOWN 36


DATE: 04/30/2008

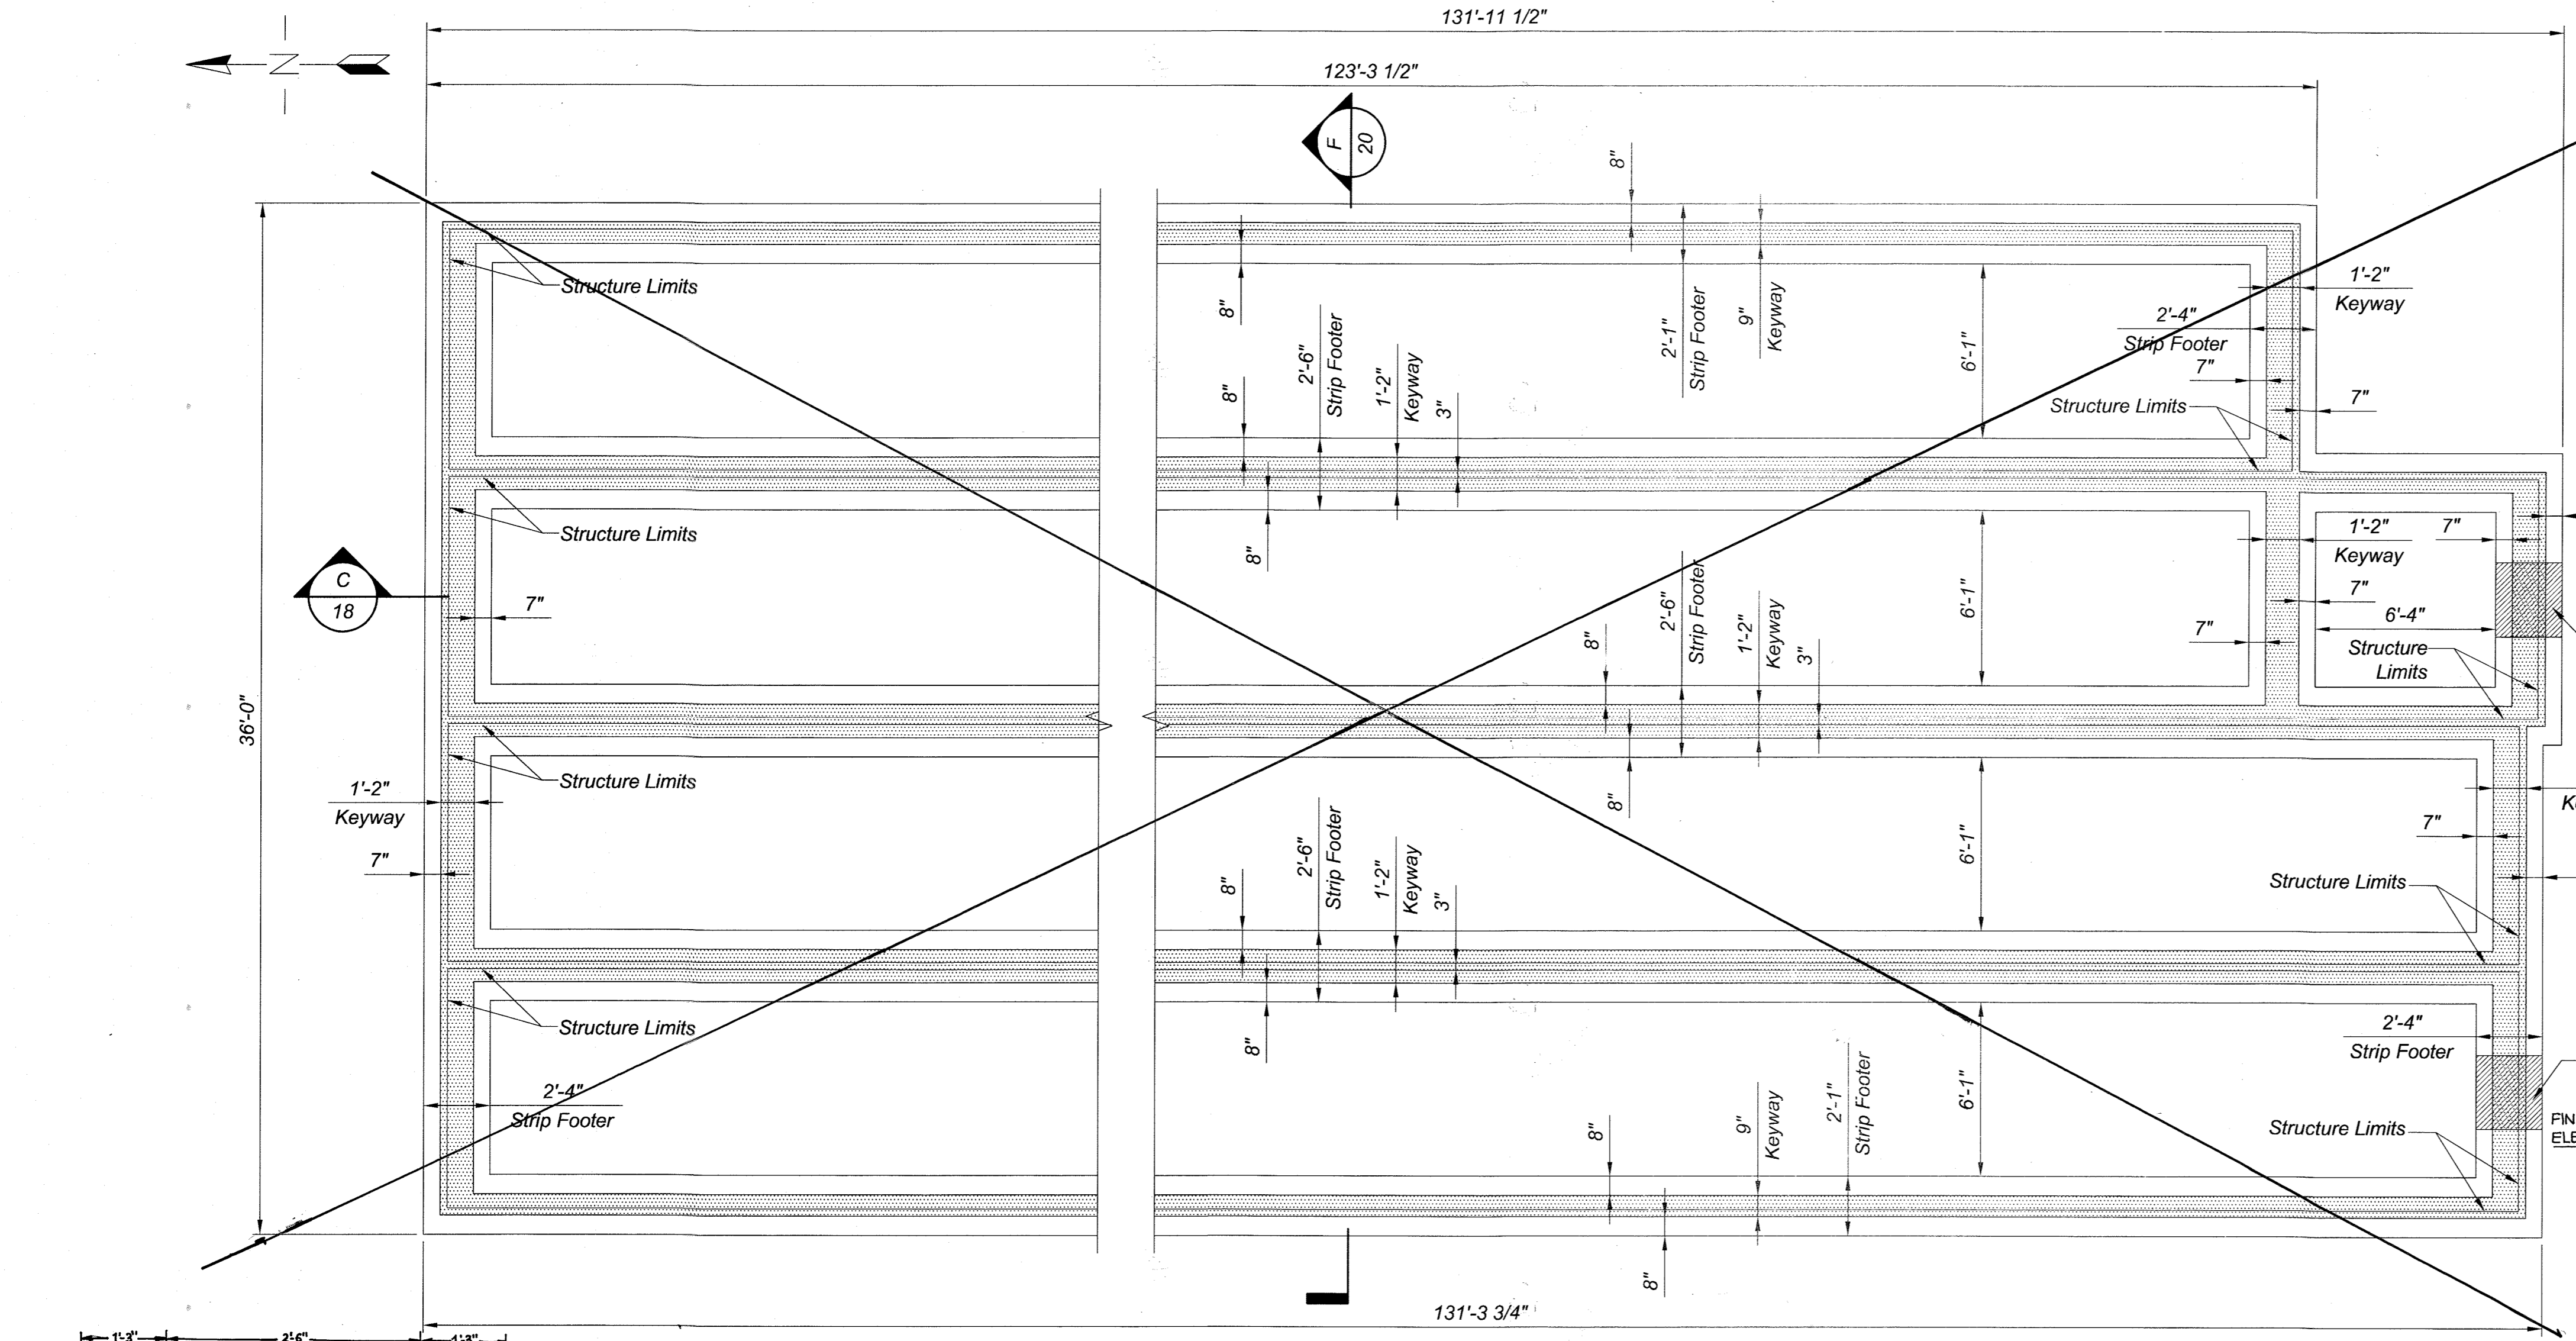



FOUNDATION PLAN
SCALE: N.T.S.

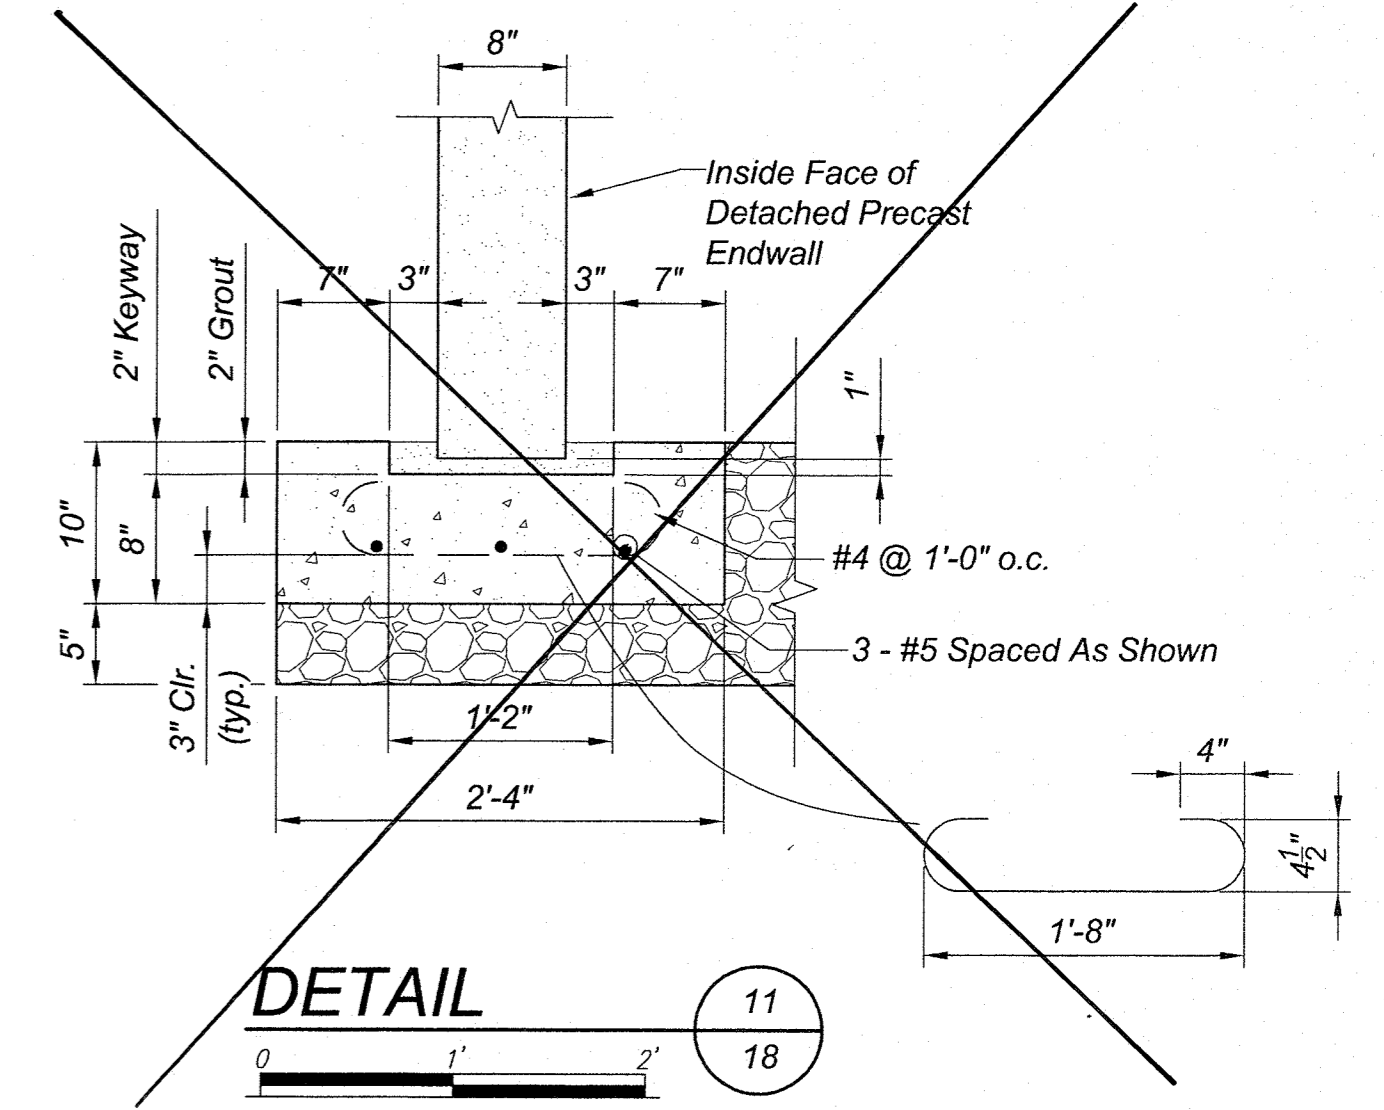


DETAIL 11
SCALE: N.T.S.

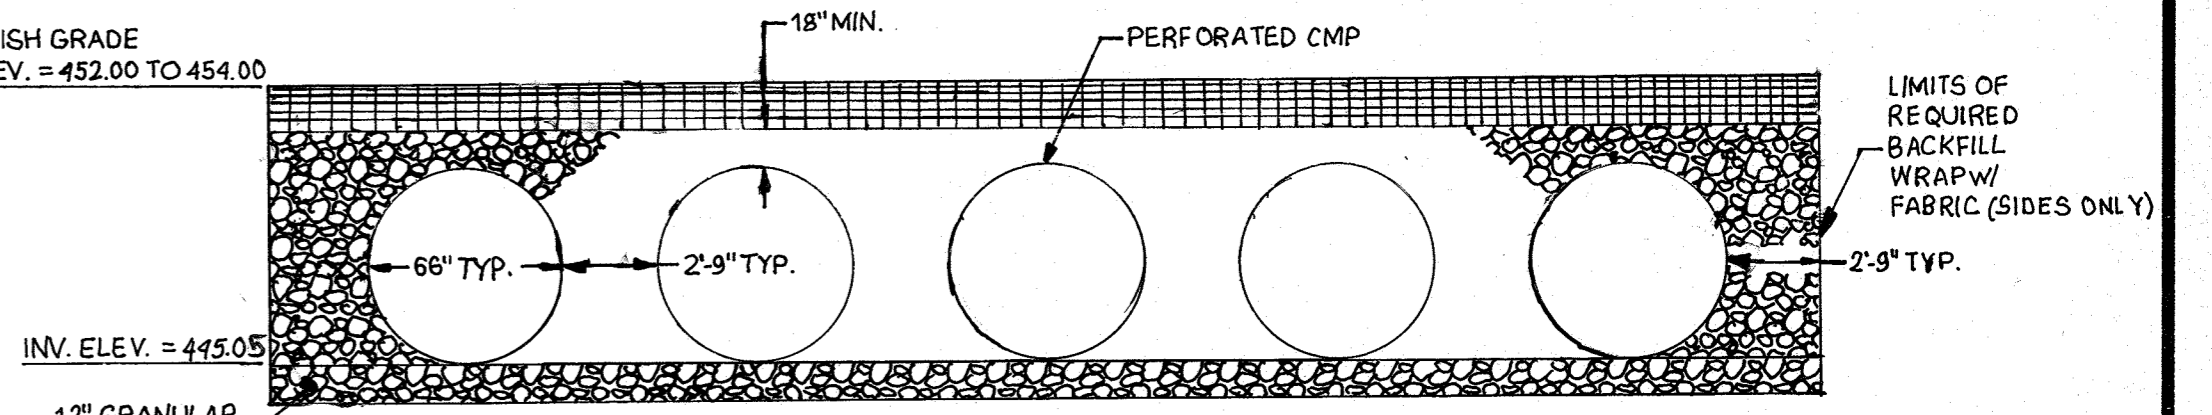


TYPICAL SECTION
SCALE: N.T.S.

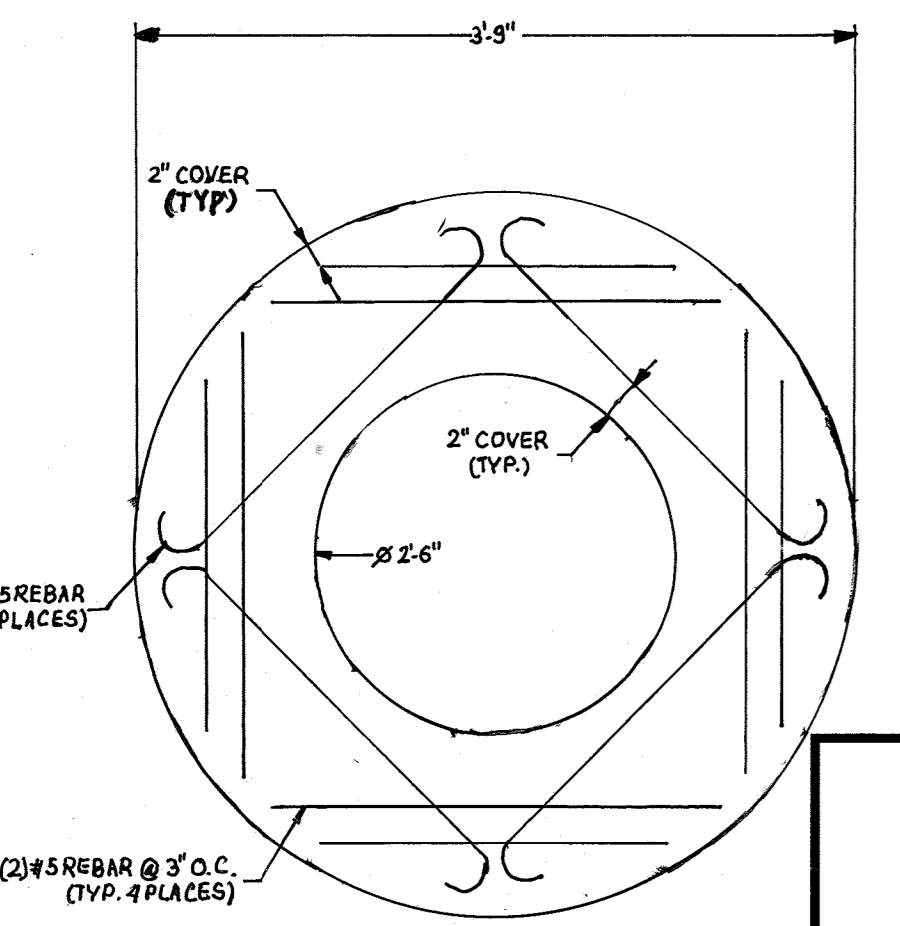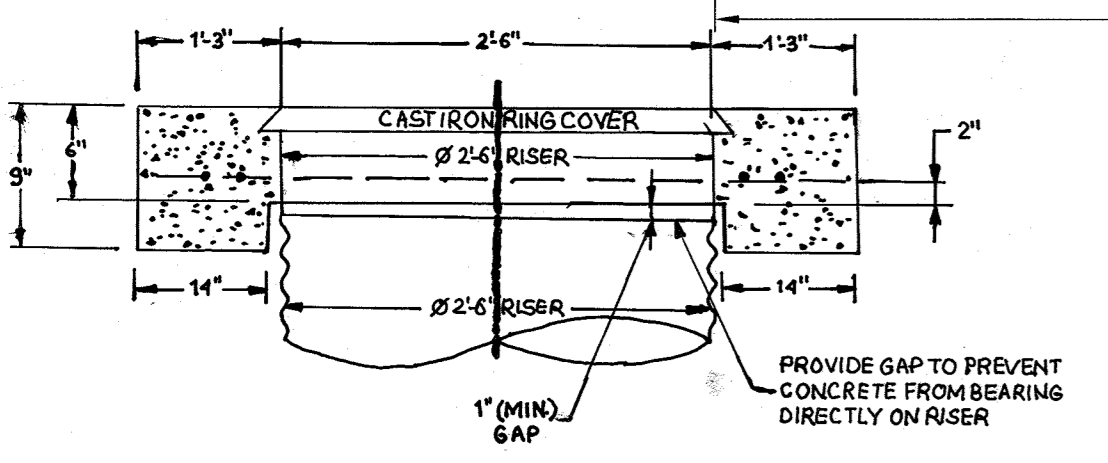

MANHOLE CAP DETAIL (SWM F #1)
SCALE: N.T.S.

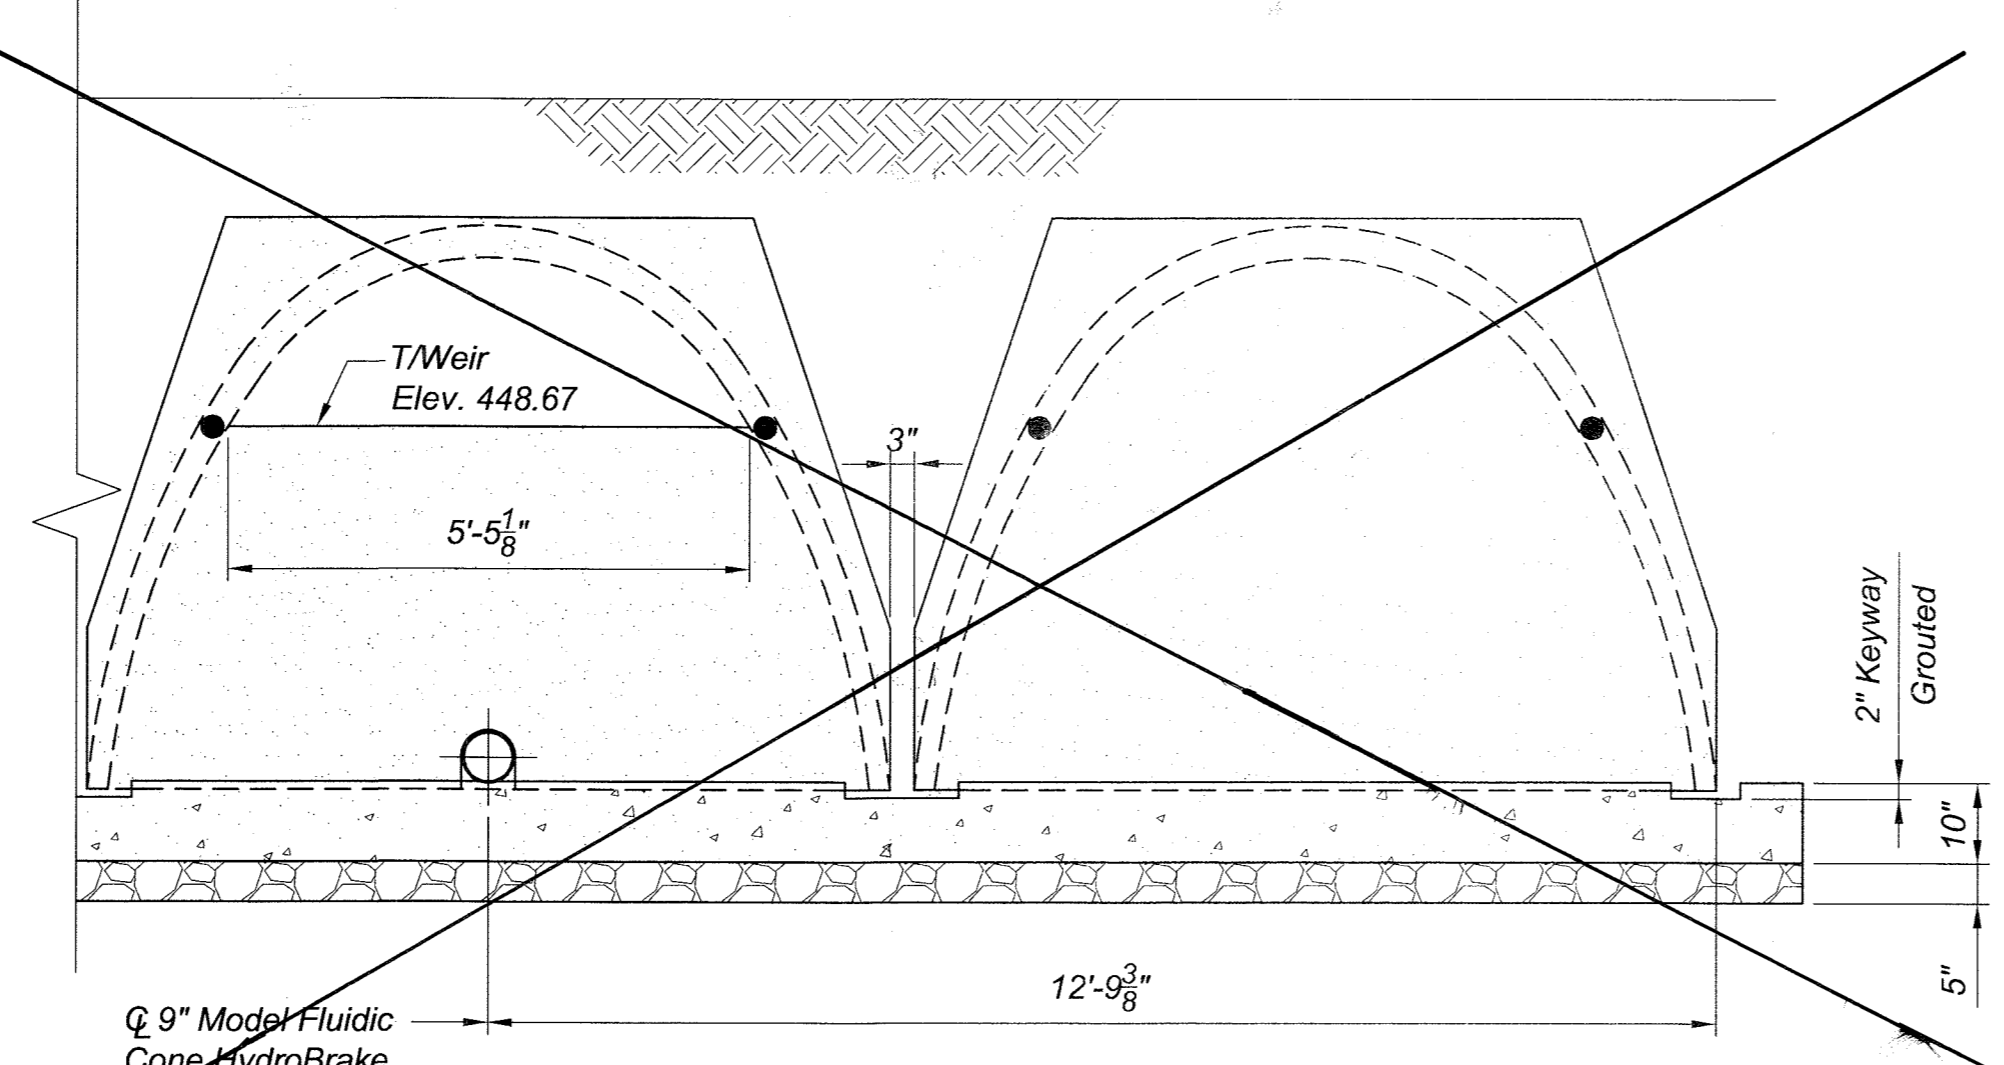

SECTION E
SCALE: N.T.S.

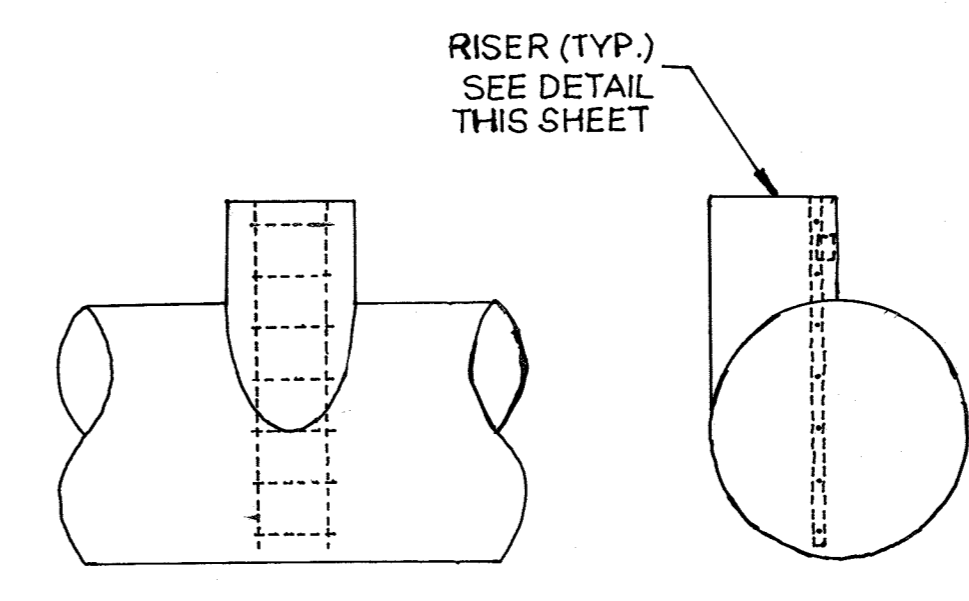

TYPICAL RISER DETAIL
SCALE: N.T.S.

AS-BUILT CERTIFICATION

THERE IS NO "AS-BUILT" INFORMATION PROVIDED ON THIS SHEET.
MICHAEL D. ADLER, PROFESSIONAL LAND SURVEYOR
NO. REG. NO. 11297, EXPIRATION DATE: 06-16-21
DATE: 6/23/19

OWNER
MANGIONE ENTERPRISES OF TURF VALLEY
LIMITED PARTNERSHIP
1205 YORK ROAD, PENTHOUSE
LUTHERVILLE, MARYLAND 21093
PHONE (410) 825-8400

NO.	BY	DATE	REVISION
1	KCE	09/02/08	REPLACE CON/STORM W/ CMP STORAGE
3	KCE	03/01/10	SWM AS-BUILT INFORMATION ADDED


AS-BUILT CMP STORAGE SECTION & DETAILS
TURF VALLEY, LORIE
NURSING HOME & ASSISTED LIVING FACILITY
OAKMONT AT TURF VALLEY
PARCEL Q
PLATS 18773 - 18775
TAX MAP 16 - P/O PARCEL 8- GRID 16 & 17;
POD I per S-86-13 (4th AMENDED)
THIRD ELECTION DISTRICT HOWARD COUNTY, MARYLAND

KCE ENGINEERING, INC.
EXECUTIVE CENTER
3300 NORTH RIDGE ROAD, SUITE 315
ELLICOTT CITY, MARYLAND 21043
PHONE (410) 203-9800 FAX (410) 203-9228

APPROVED: DEPARTMENT OF PLANNING AND ZONING
Chief, Development Engineering Division: 6/25/08
Chief, Division of Land Development: 6/23/08
Director: 6/30/08

APPROVED
PLANNING BOARD
OF HOWARD COUNTY
DATE: 3/27/08

Professional Certification: I hereby certify that these documents were prepared or approved by me, and that I am a duly licensed professional engineer under the laws of the State of Maryland, License No. 22201, Expiration Date: 12-22-08.

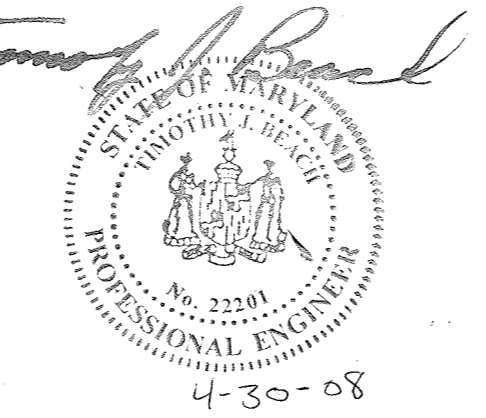

SPECIFICATIONS FOR MANUFACTURE AND INSTALLATION OF CON/SPAN® STORMWATER SYSTEMS

1. DESCRIPTION

This work shall consist of constructing a CONSPAN® vault in accordance with these specifications and in reasonably close conformity with the lines, grades, design and dimensions shown on the plans or as established by the Engineer. In situations where two or more specifications apply to this work, the most stringent requirements shall govern.

2. TYPES

Precast reinforced concrete CONSPAN® vault units manufactured in accordance with this specification shall be designated by span and rise. Precast reinforced concrete CONSPAN® endwalls manufactured in accordance with this specification shall be designated by length and height.

3. MATERIALS - CONCRETE

The concrete for the structures shall be air-entrained when installed in areas subject to freeze-thaw conditions, composed of portland cement, fine and coarse aggregates, admixtures and water. Air-entrained concrete shall contain 6 ± 2 percent air. The air entraining admixture shall conform to ASTM C150.

- 3.1 Portland Cement - Shall conform to the requirements of ASTM Specifications C150-Type I, Type II, or Type III cement.
- 3.2 Coarse Aggregate - Shall consist of stone having a maximum size of 1 inch. Aggregate shall meet requirements for ASTM C33.
- 3.3 Water Reducing Admixture - The manufacturer may submit for approval by the Engineer, a water-reducing admixture for the purpose of increasing workability and reducing the water requirement for the concrete.
- 3.4 Calcium Chloride - The addition to the mix of calcium chloride or admixtures containing calcium chloride will not be permitted.

4. MATERIALS - STEEL REINFORCEMENT AND HARDWARE

All reinforcing steel for the structures shall be fabricated and placed in accordance with the detailed shop drawings submitted by the manufacturer.

- 4.1 Steel Reinforcement - Reinforcement shall consist of welded wire fabric conforming to ASTM Specification A 185 or A 419, or deformed billet steel bars conforming to ASTM Specification A 615, Grade 60. Longitudinal distribution reinforcement may consist of welded wire fabric or deformed billet steel bars.
- 4.2 Hardware:
 - Inserts for endwall connections shall be AISI Type 304 stainless steel, F-58 Expanded Coil inserts as manufactured by Dayton/Richmond Concrete Accessories, Marietta, Ohio, (800) 745-3700. Coil rods and nuts used in endwall connections shall be AISI Type 304 stainless steel. Washers used in endwall connections shall be AISI Type 304 stainless steel plate washers.
 - Reinforcing bar splices shall be made using the Dowel Bar Splicer System as manufactured by Dayton/Richmond Concrete Accessories, Marietta, Ohio, (800) 745-3700, and shall consist of the Dowel Bar Splicer (DB-SAE) and Dowel-In (DI).
 - Ferrule Loop Inserts shall be F-64 Ferrule Loop Inserts as manufactured by Dayton/Richmond Concrete Accessories, Marietta, Ohio, (800) 745-3700.
 - Hook Bolts used in endwall connections shall be ASTM A 307.

5. MANUFACTURE

- 5.1 Mixture - The aggregates, cement and water shall be proportioned and mixed in a batch mixer to produce a homogeneous concrete meeting the strength requirements of this specification. The proportion of portland cement in the mixture shall not be less than 564 pounds (6 sacks) per cubic yard of concrete.
- 5.2 Curing - The precast concrete vault units shall be cured for a sufficient length of time so that the concrete will develop the specified compressive strength in 28 days or less. Any one of the following methods of curing or combinations thereof shall be used:
 - 5.2.1 Steam Curing - The units may be low pressure, steam cured by a system that will maintain a moist atmosphere.
 - 5.2.2 Water Curing - The units may be water cured by any method that will keep the sections moist.
 - 5.2.3 Membrane Curing - A sealing membrane conforming to the requirements of ASTM Specification C 309 may be applied and shall be left intact until the required concrete compressive strength is attained. The concrete temperature at the time of application shall be within ± 10 degrees F of the atmospheric temperature. All surfaces shall be kept moist prior to the application of the compounds and shall be damp when the compound is applied.
- 5.3 Forms - The forms used in manufacture shall be sufficiently rigid and accurate to maintain the structure dimensions within the permissible variations given in Section 7 of these specifications. All casting surfaces shall be of a smooth material.
- 5.4 Handling - Handling devices or holes shall be permitted in each vault unit for the purpose of handling and setting.
- 5.5 Storage - The precast elements shall be stored in such a manner to prevent cracking or damage. The units shall not be moved until the concrete compressive strength has reached a minimum of 2500 psi, and they shall not be stored in an upright position until the concrete compressive strength is a minimum of 4,000 psi.

6. DESIGN

- 6.1 The precast element dimension and reinforcement details shall be as prescribed in the plan and the shop drawings provided by the manufacturer, subject to the provisions of Section 7, below. The minimum concrete compressive strength shall be as shown on the shop drawings. The minimum steel yield strength shall be 60,000 psi, unless otherwise noted on the shop drawings.
- 6.2 The precast elements are designed in accordance with the "Standard Specifications for Highway Bridges" 17th Edition, adopted by the American Association of State Highway and Transportation Officials, 2002. A minimum of one foot of cover above the crown of the vault units is required in the installed condition. (Unless noted otherwise on the shop drawings and designed accordingly.)

APPROVED
PLANNING BOARD
OF HOWARD COUNTY
DATE 3/27/08

Tommy P. Beck
4-30-08

APPROVED: DEPARTMENT OF PLANNING AND ZONING

Chief, Development Engineering Division [Signature] 6/23/08
 Chief, Division of Land Development [Signature] 6/23/08
 Director [Signature] 6/23/08

APPROVED
PLANNING BOARD
OF HOWARD COUNTY
DATE 3/27/08

Professional Certification: I hereby certify that these documents were prepared or approved by me, and that I am a duly licensed professional engineer under the laws of the State of Maryland, License No. 022201, Expiration Date: 12-22-08.

APPROVED
PLANNING BOARD
OF HOWARD COUNTY
DATE 3/27/08

8. TESTING AND INSPECTION

- 8.1 Type of Test Specimen - Concrete compressive strength shall be determined from compression tests made on cylinders or cores. For cylinder testing, a minimum of 4 cylinders shall be taken during each production run. For core testing, one core shall be cut from each of 3 precast elements selected at random from each production group. A production group shall be defined as 15 or fewer vault units (of a particular size), or endwalls in a continuous production run. For each continuous production run, each production group or fraction thereof shall be considered separately for the purpose of testing and acceptance. A production run shall be considered continuous if not interrupted for more than 3 consecutive days.
- 8.2 Compression Testing - Cylinders shall be made and tested as prescribed by the ASTM C 39 Specification. Cores shall be obtained and tested for compressive strength in accordance with the provisions of the ASTM C 497 Specification.
- 8.3 Acceptability of Cylinder Tests - When the average compressive strength of all cylinders tested is equal to or greater than the design compressive strength, and not more than 10% of the cylinders tested have a compressive strength less than the design concrete strength, and no cylinder tested has a compressive strength less than 80% of the design compressive strength, then the lot shall be accepted. When the compressive strength of the cylinders tested does not conform to this acceptance criteria, the acceptability of the lot may be determined as described in section 8.4, below.
- 8.4 Acceptability of Core Tests - The compressive strength of the concrete in each production group as defined in 8.1 is acceptable when the average core test strength is equal to or greater than the design concrete strength. When the compressive strength of the core tested is less than the design concrete strength, the precast element from which that core was taken may be re-cored. When the compressive strength of the re-core is equal to or greater than the design concrete strength, the compressive strength of the concrete in that production group is acceptable.
- 8.4.1 When the compressive strength of any re-core is less than the design concrete strength, the precast element from which that core was taken shall be rejected. Two precast elements from the remainder of the group shall be selected at random and one core shall be taken from each. If the compressive strength of both cores is equal to or greater than the design concrete strength, the compressive strength of the remainder of that group is acceptable. If the compressive strength of either of the two cores tested is less than the design concrete strength, the remainder of the group shall be rejected or, at the option of the manufacturer, each precast element of the remainder of the group shall be cored and accepted individually, and any of these elements that have cores with less than the design concrete strength shall be rejected.
- 8.4.2 Plugging Core Holes - The core holes shall be plugged and sealed by the manufacturer in a manner such that the elements will meet all of the test requirements of this specification. Precast elements so sealed shall be considered satisfactory for use.
- 8.4.3 Test Equipment - Every manufacturer furnishing vault structures under this specification shall furnish all facilities and personnel necessary to carry out the test required.

9. JOINTS

The vault units shall be produced with flat butt ends. The ends of the vault units shall be such that when the sections are laid together they will make a continuous line with a smooth interior free of appreciable irregularities, all compatible with the permissible variations in Section 7, above. The joint width shall not exceed 3/4 inches.

10. WORKMANSHIP AND FINISH

The precast vault units and endwalls shall be substantially free of fractures. The ends of the vault units shall be normal to the walls and centerline of the vault section, within the limits of the variations given in section 7, above, except where beveled ends are specified. The faces of the endwalls and vault units shall be parallel to each other, within the limits of variations given in section 7, above. The surface of the precast elements shall be a smooth steel form or troweled surface. Trapped air pockets causing surface defects shall be considered as part of a smooth, steel form finish.

11. REPAIRS

Precast elements may be repaired, if necessary, because of imperfections in manufacture or handling damage and will be acceptable if, in the opinion of the purchaser, the repairs are sound, properly finished and cured, and the repaired section conforms to the requirements of this specification.

12. INSPECTION

The Precaster shall demonstrate adherence to the standards set forth in the NPCA Quality Control Manual. The Precaster shall meet other Section 16.1 or 16.2.

13. REJECTION

- The precast elements shall be subject to rejection on account of any of the specification requirements. Individual precast elements may be rejected because of any of the following:
- 13.1 Fractures or cracks passing through the wall, except for a single end crack that does not exceed one half the thickness of the wall.
 - 13.2 Defects that indicate proportioning, mixing, and molding not in compliance with Section 5 of these specifications.
 - 13.3 Honeycombed or open texture.
 - 13.4 Damaged ends, where such damage would prevent making a satisfactory joint.

14. MARKING

Each vault unit shall be clearly marked by waterproof paint. The following shall be shown on the inside of the vertical leg of the vault section:
 Vault Span X Vault Rise
 Date of Manufacture
 Name or trademark of the manufacturer

15. CONSTRUCTION REQUIREMENTS

- 15.1 Footings - The vault units and endwalls shall be installed on either precast or cast-in-place concrete footings. The design size and elevation of the footings shall be as determined by the Engineer. A three inch deep keyway shall be formed in the top surface of the vault footings three inches clear of the inside and outside faces of the bridge units, unless specified otherwise on the plans. A keyway is also required in the footings for the endwalls, unless otherwise specified. The footings shall be given a smooth float finish and shall reach a compressive strength of 2,000 psi before placement of the bridge and endwall elements. The completed footing surface shall be constructed in accordance with grades shown on the plans. When tested with a 10 foot straight edge, the surface shall not vary more than 1/4 inch in 10 feet. If a precast concrete footing is used, the contractor shall prepare a 4 inch thick base layer of compacted granular material the full width of the footing prior to placing the precast footing.
- 15.2 Placement of the Vault Units and Endwalls - The vault units and endwalls shall be placed as shown on the Engineer's plan drawings. Special care shall be taken in setting the elements to the line and grade. The vault units and endwalls shall be set on 6" x 6" masonry or steel slabs. A minimum gap of 1/2 inch shall be provided between the footing and the bottom of the unit's vertical legs or the endwall. The gap shall be filled with cement grout. (Portland cement and water or cement mortar composed of Portland cement, sand and water) with a minimum 28-day compressive strength of 3,000 psi. If units have been set with temporary ties (cables, bars, etc.) grout must attain a minimum compressive strength of 1500 psi before ties may be removed.
- 15.3 External Protection of Joints - The joint made by two adjoining vault units shall be covered with a 7/8" x 1/4" perforated bituminous joint sealant and a minimum of a 9 inch wide joint wrap. The surface shall be free of dirt before applying the joint wrap. A primer compatible with the joint wrap to be used shall be applied for a minimum width of one inch on each side of the joint. The external wrap shall be either EC-WRAP RUBBER BY PRESS-SEAL GASKET CORPORATION, SEAL WRAP BY MAR MAC MANUFACTURING CO. INC. or approved equal. The joint shall be covered continuously from the bottom of one vault section leg, across the top of the arch and to the opposite vault section leg. Any laps that result in the joint wrap shall be a minimum of six inches long with the overlap running downhill.
- In addition to the joints between vault units, the joint between the end wall unit and the endwall shall also be sealed as described above. Also, if lift holes are formed in the arch units, they shall be primed and covered with a 9" x 5" square of joint wrap.
- During the backfilling operation, care shall be taken to keep the joint wrap in its proper location over the joint.
- Internal Protection of Joints - Certain vaults may require additional joint protection to ensure that the structure is water-tight. Various joint sealing details including elastomeric, urethane, or liquid sealing may be shown on the plans. Any internal joint sealing shall be performed as indicated on the construction plans.
- 15.4 Backfill - Backfill shall be considered as all replaced excavation and new embankment adjacent to the CONSPAN® vault units and endwalls. The project construction and material specifications which include the specifications for excavation for structures and roadway embankment and embankment construction, shall apply except as modified in this section.
- No backfill shall be placed against any structural elements until they have been approved by the Engineer.
- Backfill against a waterproofed surface shall be placed carefully to avoid damage to the waterproofing material.
- Mechanical tampers or approved compacting equipment shall be used to compact all backfill and embankment immediately adjacent to each side and over the top of each vault unit until it is covered to a minimum depth of one foot, unless the design fill height is less than 1'-0". The backfill within the Critical Backfill Zone (shown in the diagrams below) shall be placed in lifts of eight inches or less (loose depth). Heavy compacting equipment shall not be operated in this area or over the bridge until it is covered to a depth of one foot, unless the design fill height is less than 1'-0".
- Lightweight dozers and graders may be operated over vault units having one foot of compacted cover, but heavy earth moving equipment (larger than a D-4 Dozer weighing in excess of 12 tons and having track pressures of eight psi or greater) shall require two feet of cover unless the design cover is less than two feet. In no case shall equipment operating in excess of the design load (HS20 or HS25) be permitted over the vault units unless approved by CONSPAN®.
- Any additional fill and subsequent excavation required to provide this minimum cover shall be made at no additional cost to the project.
- As a precaution against introducing unbalanced stresses in the wall, when placing backfill at no time shall the difference between the heights of fill on opposite sides of the vault exceed 2'.
- For fill heights over 12 feet, no backfilling may begin until a backfill compaction testing plan has been coordinated with and approved by CONSPAN®. Cost of the backfill compaction testing shall be included in the cost of the precast units. This included cost applies only to projects with fill heights over 12 feet (as measured from top crown of arch to finished grade).

16. QUALITY ASSURANCE

The Precaster shall demonstrate adherence to the standards set forth in the NPCA Quality Control Manual. The Precaster shall meet other Section 16.1 or 16.2.

- 16.1 Certification - The Precaster shall be certified by the Precast/Prestressed Concrete Institute Plant Certification Program or the National Precast Concrete Association's Plant Certification Program prior to and during production of the products covered by this specification.
- 16.2 Qualifications, Testing and Inspection
 - 16.2.1 The Precaster shall have been in the business of producing precast concrete products similar to those specified for a minimum of three years. He shall maintain a permanent quality control department or retain an independent testing agency on a continuing basis. The agency shall issue a report, certified by a licensed engineer, detailing the ability of the Precaster to produce quality products consistent with industry standards.
 - 16.2.2 The Precaster shall show that the following tests are performed in accordance with the ASTM standards indicated. Tests shall be performed for each 150 cubic yards of concrete placed, but not less frequently than once per production run, as follows in 5% of these specifications:

16.2.2.1	Air Content: C231 or C173
16.2.2.2	Compressive Strength: C39, C497
 - 16.2.3 The Precaster shall provide documentation demonstrating compliance with this section to CONSPAN® at regular intervals or upon request.
 - 16.2.4 The Owner may place an inspector in the plant when the products covered by this specification are being manufactured.

17. STORMVAULT® INSPECTION AND MAINTENANCE

The StormVault® Mitigation System by CONSPAN® is specifically designed to treat stormwater runoff to the Maximum Extent Practicable. The StormVault® System is designed to capture and hold floatable debris, free oils and greases, settleable sediments and those dissolved pollutants including metals, nitrates and phosphates, which may adhere or adhere to the surface of sediments and organic debris in stormwater. In order to insure efficient operation and achieve the desired pollutant removal rates, several important inspection and maintenance functions must periodically be performed. The inspection and maintenance are both to be performed during dry periods, in which no flow is entering the StormVault® System and water has returned to the permanent pool elevation. These procedures are described more fully below.

INSPECTION
 The StormVault® Mitigation System by CONSPAN® is to be inspected bi-annually to ensure the system is in proper working order. The twice-yearly observation should require less than four person-hours per visit, but depends upon the size of the StormVault® System. The inspection includes opening each manhole cover and visually inspecting for excess floating debris. The effluent chamber is to be inspected to verify that the control orifice within the standpipe is free of any trash or debris. In addition to the visual inspection, the first several chambers should be probed to gain an estimate of the collected sediment in the bottom of the vault. It is important to record the depths in these chambers to estimate when the next required maintenance should be performed. The removal of collected sediments is to be performed once the average depth in the vault reaches 6 inches. The hydrocarbon mats, which float on the surface of the StormVault® System, are designed to remove free oils and greases from stormwater runoff. The mats are attached to the manhole accesses using a lanyard. These mats must also be inspected as part of the bi-annual cycle. These mats will be a granular solid white when initially installed and will turn darker as they absorb free oils and greases. The mats should be inspected twice yearly to ensure that some white granular portions of the mat remain. The mats may collect some surface sediment; however, only when they change to a solid dark color uniformly throughout the granular medium do they need to be replaced.

MAINTENANCE
 The removal of collected sediments is to be performed once an average depth of 6 inches has been reached in the vault. The hydrocarbon sorbent mats are to be replaced once the mats turn completely dark in color and can no longer absorb any free oils and greases. The maintenance cycle for each StormVault® unit will vary as it is a function of the size, type, and volume of pollutants in the stormwater runoff for that particular site. Previous monitoring and inspection of existing StormVault® units has resulted in a recommended maintenance cycle of 4-5 years for both removal of sediment and replacement of hydrocarbon sorbent mats. A site-specific maintenance cycle can easily be determined by the bi-annual inspections.


Removal of accumulated materials:
 It is recommended that a professional pumping contractor, trained and licensed to remove and dispose of captured sediment material, perform this task. The contractor will lower a nozzle and hose into each chamber and pump the collected material into a vacuum truck. The contractor is to remove only the 6 inches of sediment and not the water in the permanent pool during vacuuming. This will minimize the amount of material, which the contractor must dispose.

Be aware that the captured sediments are by their nature easy to resuspend. Great care shall be taken to prevent any turbulence that may cause mixing and resuspension of the settled materials. The contractor must verify proper disposal with the local jurisdiction. An analysis of the materials may be required before disposal. Because of dilution by the water in the permanent pool, harmful pollutant concentrations are rarely reached.

Replacement of hydrocarbon sorbent mats:
 To remove the mats, locate the lanyard attached to the inside of the access cover and pull them out. Care should be taken in lifting the mats out through the manholes, as the saturated mats can weigh up to the mats' dry weight. The use mats should be disposed of as directed by the local authority. Generally this is in a similar manner used to dispose of drain oil or similar materials. Replace the mats in like fashion by clipping the new mats to the keeper lines. New mats can be obtained by contacting the CONSPAN® office nearest you.

NOTE:
 The StormVault® Mitigation System by CONSPAN® is a confined space and entry is not recommended. Enter only when necessary and with the proper equipment, following OSHA confined space entry procedures.

Group Classification	BACKFILL DESCRIPTION (AASHTO M 145-91)						A-4
	A-1-a	A-1-b	A-3	A-2	A-2-5	A-2-6	
Sieve Analysis, Percent Passing (100% Passing 3" Sieve)							
No. 10	50 max.	50 max.	51 min.				
No. 200	15 max.	25 max.	10 max.	35 max.	35 max.	35 max.	36 min.
Characteristics of Fraction Passing							
No. 40							
Liquid Limit				40 max.	41 min.	40 max.	40 max.
Plasticity Index	6 max.		N.P.	10 max.	10 max.	11 min.	10 max.
Usual Types of Significant Constituent Material	Stone Fragments, Gravel & Sand		Fine Sand	Silty or Clayey Gravel and Sand			Silty Soils
General Rating as Subgrade			Excellent to Good				Fair to Poor

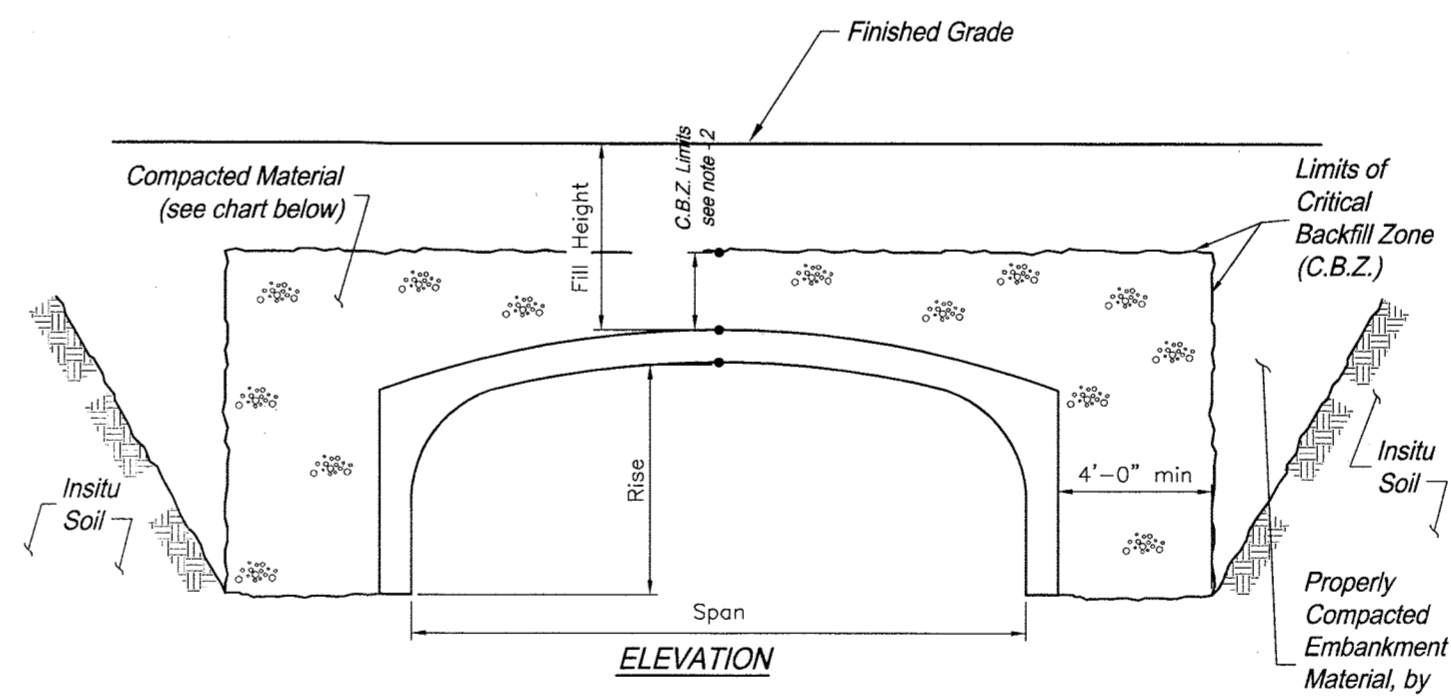

NOTES:
 1. SEE CONSPAN® SPECIFICATIONS SECTION 16.4 FOR BACKFILL SPECIFICATIONS.
 2. FOR FILL HEIGHTS GREATER THAN 2'-0\", C.B.Z. LIMIT SHALL BE 2'-0\"/>

SPAN	FILL HEIGHT	ACCEPTABLE MATERIAL INSIDE C.B.Z.	ACCEPTABLE MATERIAL OUTSIDE C.B.Z.
≤ 24'-0"	≥ 12'-0"	A1, A3	..
≤ 24'-0"	< 12'-0"	A1, A2, A3, A4	..
> 24'-0"	ALL	A1, A3	..

BACKFILL REQUIREMENTS

**EMBANKMENT MATERIAL PER PROJECT SPECIFICATIONS

AS-BUILT CERTIFICATION

THIS IS NO AS-BUILT INFORMATION PROVIDED ON THIS SHEET.

OWNER: MANGIONE ENTERPRISES OF TURF VALLEY LIMITED PARTNERSHIP 1205 YORK ROAD, PENTHOUSE LUTHERVILLE, MARYLAND 21093 PHONE (410) 825-8400


DRAWN BY: _____ SHEET: 24

CHECKED BY: _____ OF _____

SCALE: AS SHOWN SHEET: 36

DATE: 04/30/2008

KCE ENGINEERING, INC. EXECUTIVE CENTER 3300 NORTH RIDGE ROAD, SUITE 315 ELLICOTT CITY, MARYLAND 21043 PHONE (410) 203-9800 FAX (410) 203-9228

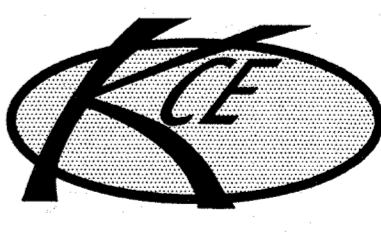

STORMVAULT INSTALLATION SPECIFICATIONS
TURF VALLEY, LORIE
NURSING HOME & ASSISTED LIVING FACILITY
 AS-BUILT OAKMONT AT TURF VALLEY PARCEL Q
 PLATS 18773 - 18775
 TAX MAP 16 - P/O PARCEL 8- GRID 16 & 17;
 POD 1 per S-86-13 (4th AMENDED)
 THIRD ELECTION DISTRICT HOWARD COUNTY, MARYLAND

SPECIFICATIONS FOR MANUFACTURE AND INSTALLATION OF CON/STORM™ VAULT SYSTEMS

1. DESCRIPTION

This work shall consist of constructing a CON/STORM™ vault in accordance with these specifications and in reasonably close conformity with the sizes, grades, design and dimensions shown on the plans as established by the Engineer. In situations where two or more specifications apply to this work, the most stringent requirements shall govern.

2. TYPES

Precast reinforced concrete CON/STORM™ vault units manufactured in accordance with this specification shall be designated by span and rise. Precast reinforced concrete CON/STORM™ endwalls shall be designated by length, height, and thickness.

3. MATERIALS - CONCRETE

The concrete for the vaults shall be air-entrained when installed in areas subject to freeze-thaw conditions, composed of portland cement, fine and coarse aggregates, admixtures and water. Air-entrained concrete shall contain 6 ± 2 percent air. The air-entraining admixture shall conform to ASTM C154.

- 3.1 Portland Cement - Shall conform to the requirements of ASTM Specifications C150-Type I, Type II, or Type III cement.
- 3.2 Coarse Aggregate - Shall consist of stone having a maximum size of 1 inch. Aggregate shall meet requirements for ASTM C33.
- 3.3 Water Reducing Admixture - The manufacturer may submit for approval by the Engineer, a water-reducing admixture for the purpose of increasing workability and reducing the water requirement for the concrete.
- 3.4 Calcium Chloride - The addition to the mix of calcium chloride or admixtures containing calcium chloride will not be permitted.

4. MATERIALS - STEEL REINFORCEMENT AND HARDWARE

All reinforcing steel for the vaults shall be fabricated and placed in accordance with the detailed shop drawings submitted by the manufacturer.

- 4.1 Steel Reinforcement - Reinforcement shall consist of welded wire fabric conforming to ASTM Specification A 185 or A 497, or deformed mild steel bars conforming to ASTM Specification A 615, Grade 60. Longitudinal distribution reinforcement may consist of welded wire fabric or deformed mild steel bars.
- 4.2 Hardware - Vault units and endwalls shall be connected by a single flat coil loop insert and end rod as manufactured by Dayton/Richmond Concrete Assessor in Mansfield, OH (800) 745-3700.
- 4.3 Steel Fiber Reinforcement as manufactured by Polytron or Bekaert shall be Helix or Dramix RC2560 BN, respectively. Minimum dosage as determined through full-scale load testing, shall be located on the shop drawings.

5. MANUFACTURE

- 5.1 Mixture - The aggregates, cement and water shall be proportioned and mixed in a batch mixer to produce a homogeneous concrete meeting the strength requirements of this specification. The proportion of portland cement in the mixture shall not be less than 584 pounds (6 sacks) per cubic yard of concrete.
- 5.2 Consolidation - self compacting concrete shall be used for all CON/STORM™ units. At no time should internal vibration be performed. Precaster may apply external vibration by hand if necessary to assist in consolidation.
- 5.3 Curing - The precast concrete vault shall be cured for a sufficient length of time so that the concrete will develop the specified compressive strength in 28 days or less. Any one of the following methods of curing or combinations thereof shall be used:
 - 5.3.1 Steam Curing - The vaults may be low pressure, steam cured by a system that will maintain a moist atmosphere.
 - 5.3.2 Water Curing - The vaults may be water cured by any method that will keep the sections moist.
 - 5.3.3 Membrane Curing - A sealing membrane conforming to the requirements of ASTM Specification C-309 may be applied and shall be left intact until the required concrete compressive strength is attained. The concrete temperature at the time of application shall be within ± 10 degrees F of the atmospheric temperature. All surfaces shall be kept moist prior to the application of the compounds and shall be damp when the compound is applied.
- 5.4 Forms - the forms used in manufacture shall be sufficiently rigid and accurate to maintain the vault dimensions within the permissible variations given in Section 7 of these specifications. All casting surfaces shall be of a smooth material.
- 5.5 Handling - Handling devices or hoists shall be permitted in each vault for the purpose of handling and setting.
- 5.6 Storage - The precast elements shall be stored in such a manner to prevent cracking or damage. The units shall not be stored until the concrete compressive strength has reached a minimum of 2500 psi, and they shall not be stored in an upright position until the concrete compressive strength is a minimum of 4,000 psi.

6. DESIGN

- 6.1 The precast element dimensions and reinforcement details shall be as prescribed in the plan and shop drawings provided by the manufacturer, subject to the provisions of Section 7, below. The minimum concrete compressive strength shall be as shown on the shop drawings. The minimum steel yield strength shall be 60,000 psi, unless otherwise noted on the shop drawings.
- 6.2 The precast elements are designed in accordance with the "Standard Specifications for Highway Bridges" 17th Edition, adopted by the American Association of State Highway and Transportation Officials, 2002. A minimum of one foot of cover above the crown of the vault units is required in the installed condition. (Unless noted otherwise on the shop drawings and designed accordingly.)

7. PERMISSIBLE VARIATIONS

- 7.1 Vault Units and Endwalls
 - 7.1.1 Internal Dimensions - The internal dimension shall vary not more than 1% from the design dimensions nor more than 1-1/2 inches whichever is less. The haunch dimensions shall vary not more than 3/4 inch from the design dimension.
 - 7.1.2 Slab and Wall Thickness - The slab and wall thickness shall not be less than that shown in the design by more than 1/4 inch. A thickness more than that required in the design shall not be cause for rejection.
 - 7.1.3 Length of Opposite Surfaces - Variations in laying lengths of two opposite surfaces of the vault unit shall not exceed more than 1/2 inch in any section, except where beveled ends for laying of curves are specified by the purchaser.
 - 7.1.4 Area of Reinforcement - The areas of steel reinforcement shall be the design steel areas as shown on the manufacturer's shop drawings. Steel areas greater than those required shall not be cause for rejection. The permissible variation in diameter of any reinforcement shall conform to the tolerances prescribed in the ASTM Specification for that type of reinforcement.

8. TESTING AND INSPECTION

- 8.1 Type of Test Specimen - Concrete compressive strength shall be determined from compressive tests made on cylinders or cores. For cylinder testing, a minimum of 3 cylinders shall be taken during each production run. For core testing, one core shall be cut from each of 3 precast elements selected at random from each production group. A production group shall be defined as 15 or fewer vault units (of a particular size) or endwalls in a continuous production run. For each continuous production run, each production group of 3 specimens shall be considered separately for the purpose of testing and acceptance. A production run shall be considered continuous if not interrupted for more than 3 consecutive days.
- 8.2 Compression Testing - Cylinders shall be made and tested as prescribed by the ASTM C 39 Specification. Cores shall be obtained and tested for compressive strength in accordance with the provisions of the ASTM C497 Specification.
- 8.3 Acceptability of Cylinder Tests - When the average compressive strength of all cylinders tested is equal to or greater than the design compressive strength, and not more than 10% of the cylinders tested have a compressive strength less than the design compressive strength, and no cylinder tested has a compressive strength less than 80% of the design compressive strength, then the lot shall be accepted. When the compressive strength of the cylinders tested does not conform to this acceptance criteria, the acceptability of the lot may be determined as described in section 8.4, below.
- 8.4 Acceptability of Core Tests - The compressive strength of the concrete in each production group as defined in 8.1 is acceptable when the average core test strength is equal to or greater than the design concrete strength. When the compressive strength of the core tested is less than the design concrete strength, the precast element from which that core was taken may be re-cored. When the compressive strength of the re-core is equal to or greater than the design concrete strength, the compressive strength of the concrete in that production group is acceptable.

- 8.4.1 When the compressive strength of any re-core is less than the design concrete strength, the precast element from which that core was taken shall be rejected. Two precast elements from the remainder of the group shall be selected at random and one core shall be taken from each. If the compressive strength of both cores is equal to or greater than the design concrete strength, the compressive strength of the remainder of that group is acceptable. If the compressive strength of either of the two cores tested is less than the design concrete strength, the remainder of the group shall be rejected or, at the option of the manufacturer, each precast element of the remainder of the group shall be re-cored and accepted individually, and any of these elements that have cores with less than the design concrete strength shall be rejected.
- 8.4.2 Plugging Core Holes - The core holes shall be plugged and sealed by the manufacturer in a manner such that the elements will meet all of the test requirements of this specification. Precast elements so sealed shall be considered satisfactory for use.
- 8.4.3 Test Equipment - Every manufacturer furnishing vaults under this specification shall furnish all facilities and personnel necessary to carry out the test required.

- 8.5 Fresh concrete properties - self compacting concrete to be tested by slump flow test and the VSI test per PCI interlink guidelines for the use of self consolidating concrete in PCI member plants.

9. JOINTS

The vault units shall be produced with flat butt ends. The ends of the vault units shall be such that when the sections are laid together they will make a continuous line of with a smooth interior free of appreciable irregularities, all compatible with the permissible variations in Section 7, above. The joint width shall not exceed 3/4 inches.

10. WORKMANSHIP AND FINISH

The vault units and endwalls shall be substantially free of fractures. The ends of the vault units and endwalls shall be normal to the walls and centerline of the vault section, within the limits of the variations given in section 7, above, except where beveled ends are specified. The surface of the precast elements shall be a smooth steel form or troweled surface. Trapped air pockets causing surface defects shall be considered as part of a smooth, steel form finish.

Any additional fill and subsequent excavation required to provide this minimum cover shall be made at no additional cost to the project.

As a precaution against introducing unbalanced stresses in the vault, when placing backfill at no time shall the difference between the heights of fill on opposite sides of the vault exceed 24".

For fill heights over 12 feet, no backfilling may begin until a backfill compaction testing plan has been coordinated with and approved by CONTECH STORMWATER SOLUTIONS. Cost of the backfill compaction testing shall be included in the cost of the precast units. This included cost applies only to projects with fill heights over 12 feet (as measured from top crown of arch to finished grade).

11. REPAIRS

Precast elements may be repaired, if necessary, because of imperfections in manufacture or handling damage and will be acceptable if, in the opinion of the purchaser, the repairs are sound, properly finished and cured, and the repaired section conforms to the requirements of this specification.

12. INSPECTION

The quality of materials, the process of manufacture, and the finished vaults shall be subject to inspection by the purchaser.

13. REJECTION

The precast elements shall be subject to rejection on account of any of the specification requirements. Individual precast elements may be rejected because of any of the following:

- 13.1 Fractures or cracks passing through the wall, except for a single end crack that does not exceed one half the thickness of the wall.
- 13.2 Defects that indicate proportioning, mixing, and molding not in compliance with Section 5 of these specifications.
- 13.3 Honeycombed or open texture.
- 13.4 Damaged ends, where such damage would prevent making a satisfactory joint.

14. MARKING

Each bridge unit shall be clearly marked by waterproof paint. The following shall be shown on the inside of the vertical leg of the bridge section:
Vault Span X Vault Rise
Date of Manufacture
Name or trademark of the manufacturer

15. CONSTRUCTION REQUIREMENTS

- 15.1 Footings - The vault units and endwalls shall be installed on either precast or cast-in-place concrete footings. The design size and elevation of the footings shall be as determined by the Engineer. A keyway shall be formed in the top surface of the vault footings three inches clear of the installed end faces of the vault units, unless specified otherwise on the plans. The footings shall be given a smooth float finish and shall reach a compressive strength of 2,000 psi before placement of the vault and endwall elements. The completed footing surface shall be constructed in accordance with grades shown on the plans. When tested with a 10 foot sliding edge, the surface shall not vary more than 1/4 inch in 10 feet. If a precast concrete footing is used, the contractor shall prepare a 4 inch thick base layer of compacted granular material the full width of the footing prior to placing the precast footing.
- 15.2 Placement of the Vault Units and Endwalls - The vault units and endwalls shall be placed as shown on the Engineer's plan drawings. Special care shall be taken in setting the elements to the true line and grade. The vault units and endwalls shall be set on 6" x 4" rubber or masonite shims. A minimum gap of 1/2 inch shall be provided between the footing and the bottom of the vault unit and endwall. The gap shall be filled with grout. Portland cement and water or cement mortar composed of Portland cement, sand and water) with a minimum 28-day compressive strength of 3000 psi. If units have been set with temporary ties (cable ties, etc.) grout must attain a minimum compressive strength of 4500 psi before ties may be removed.
- 15.3 External Protection of Joints - The butt joint made by two adjoining vault units shall be covered with a 75% x 36" perforated bituminous joint sealant and a minimum of a 9 inch wide joint wrap. The surface shall be free of dirt before applying the joint material. A primer compatible with the joint wrap to be used shall be applied for a minimum width of nine inches on each side of the joint. The external wrap shall be either EZ-WRAP RUBBER by PRESS-SEAL GASKET CORPORATION, SEAL WRAP by MAC MAC MANUFACTURING CO. INC., as shown on the installation drawing, or approved equal. The joint shall be covered continuously from the bottom of one vault section leg, across the top of the arch and to the opposite vault section leg. Any laps that result in the joint wrap shall be a minimum of six inches long with the overlap running downhill.
- In addition to the joints between vault units, the joint between the end vault unit and the endwall shall also be sealed as described above. When precast endwalls are used, the exterior joint between the end vault unit and the endwall shall be sealed with a 2'-0" strip of filter fabric. Also, if lift holes are formed in the arch units, they shall be primed and covered with a 9" x 9" square of joint wrap.
- During the backfilling operation, care shall be taken to keep the joint wrap in its proper location over the joint.
- 15.4 Backfill - Backfill shall be considered as all replaced excavation and new embankment adjacent to the CON/STORM™ vault units and endwalls. The project construction and material specifications which include these specifications for excavation for structures and roadway excavation and embankment construction shall apply except as modified in this section. No backfill shall be placed against any structural elements until they have been approved by the Engineer. Backfill against a waterproofed surface shall be placed carefully to avoid damage to the waterproofing material. Lightweight mechanical tampers or approved compacting equipment shall be used to compact all backfill and embankment immediately adjacent to each side and over the top of each vault unit until it is covered to a minimum depth of one foot, unless the design fill height is less than 1'-0". The backfill within the Critical Backfill Zone (shown in the diagrams below) shall be placed in lifts of eight inches or less (loose depth). Heavy compaction equipment shall not be operated in this area or over the vault unit if it is covered to a depth of two feet, unless the design fill height is less than 2'-0". Lightweight dozers and graders may be operated over bridge units having one foot of compacted cover, but heavy earth moving equipment (larger than a D-4 Dozer weighing in excess of 12 tons and having track pressure of eight psi or greater) shall require two feet of cover unless the design cover is less than two feet. In no case shall equipment operating in excess of the design load (HS20 or HS25) be permitted over the vault units unless approved by CONTECH STORMWATER SOLUTIONS Inc. Any additional fill and subsequent excavation required to provide this minimum cover shall be made at no additional cost to the project.

As a precaution against introducing unbalanced stresses in the vault, when placing backfill at no time shall the difference between the heights of fill on opposite sides of the vault exceed 24".


For fill heights over 12 feet, no backfilling may begin until a backfill compaction testing plan has been coordinated with and approved by CONTECH STORMWATER SOLUTIONS. Cost of the backfill compaction testing shall be included in the cost of the precast units. This included cost applies only to projects with fill heights over 12 feet (as measured from top crown of arch to finished grade).

16. QUALITY ASSURANCE


The Precaster shall demonstrate adherence to the standards set forth in the NPCA Quality Control Manual. The Precaster shall meet either Section 16.1 or 16.2.

- 16.1 Certification - The Precaster shall be certified by the Precast/Prestressed Concrete Institute Plant Certification Program or the National Precast Concrete Association's Plant Certification Program prior to and during production of the products covered by this specification.
- 16.2 Qualifications, Testing and Inspection
 - 16.2.1 The Precaster shall have been in the business of producing precast concrete products similar to those specified for a minimum of three years. He shall maintain a permanent quality control department or retain an independent testing agency on a continuing basis. The agency shall issue a report, certified by a licensed engineer, detailing the ability of the Precaster to produce quality products consistent with industry standards.
 - 16.2.2 The Precaster shall show that the following tests are performed in accordance with the ASTM standards indicated. Tests shall be performed for each 150 cubic yards of concrete placed, but not less frequently than once per production run, as defined in §8 of these specifications.
 - 16.2.2.1 Air Content: C231 or C173
 - 16.2.2.2 Compressive Strength: C39-C497
 - 16.2.2.3 Slump flow spread (SSC mixes only)
 - 16.2.3 The Precaster shall prepare documentation demonstrating compliance with this section to CONTECH BRIDGE SOLUTIONS at regular intervals or upon request.
 - 16.2.4 The Owner may place an inspector in the plant when the products covered by this specification are being manufactured.

BACKFILL DESCRIPTION (AASHTO M 145-91)							
Group Classification	A-1		A-3		A-2		A-4
	A-1-a	A-1-b	A-2-4	A-2-5	A-2-6	A-2-7	
Sieve Analysis, Percent Passing (100% Passing 3" Sieve)							
No. 10	50 max.						
No. 40	30 max.	50 max.	51 min.				
No. 200	15 max.	25 max.	10 max.	35 max.	35 max.	35 max.	36 min.
Characteristics of Fraction Passing							
No. 40							
Liquid Limit	40 max.						
Plasticity Index	N.P.						
Usual Types of Significant Constituent Materials	Stone Fragments, Gravel & Sand		Fine Sand		Silty or Clayey Gravel and Sand		10 max.
General Rating as Subgrade	Excellent to Good						Fair to Poor

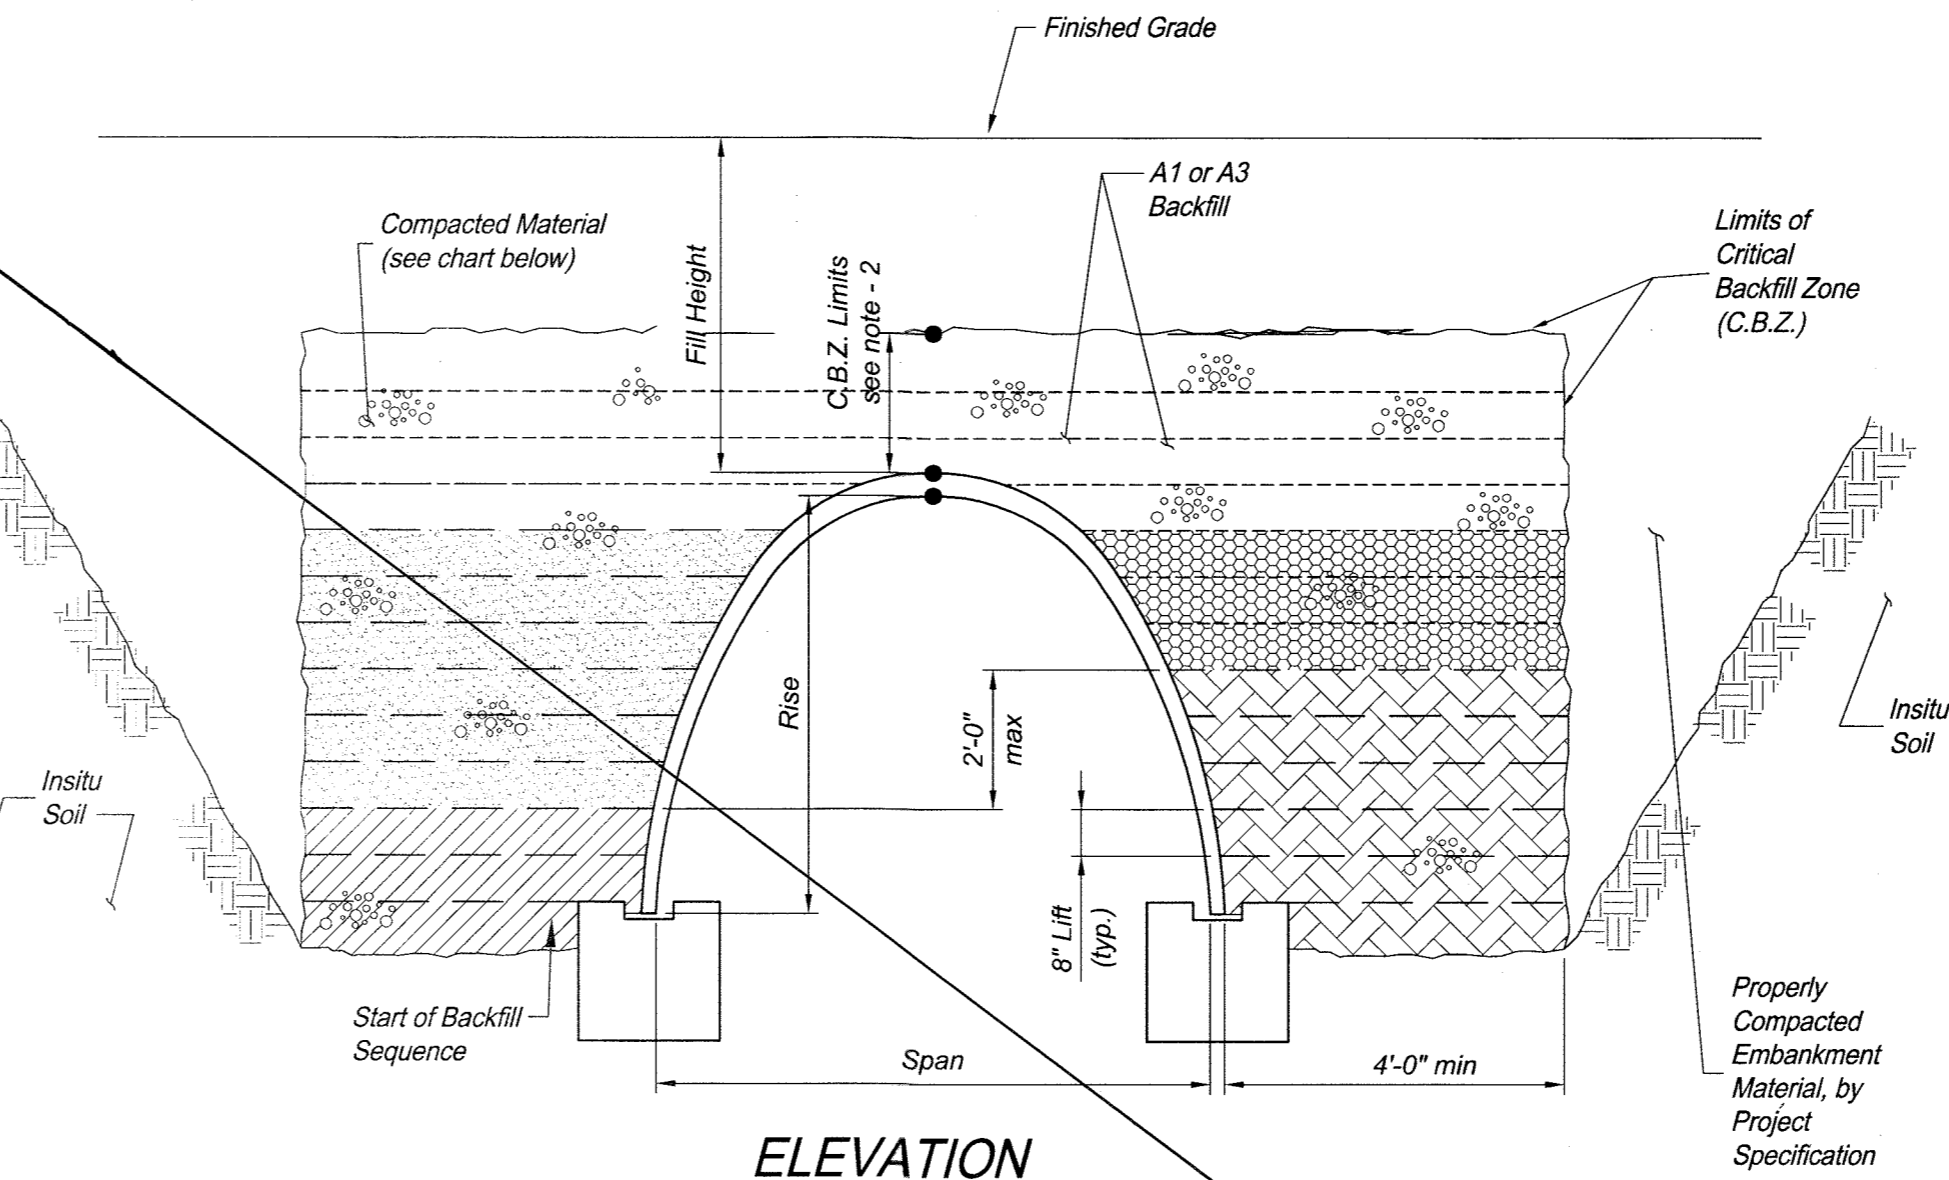

- NOTES**
1. SEE CON/STORM™ SPECIFICATIONS SECTION 15.4 FOR BACKFILL SPECIFICATIONS.
 2. FOR FILL HEIGHTS GREATER THAN 2'-0", C.B.Z. LIMIT SHALL BE 2'-0" ABOVE ARCH CROWN. FOR FILL HEIGHTS LESS THAN 2'-0", THE FINISHED GRADE SHALL BE THE BOUNDARY LINE FOR THE C.B.Z.
 3. BACKFILLING OPERATIONS WITHIN THE C.B.Z. SHALL BE PERFORMED IN LIFTS OF 8" OR LESS (LOOSE DEPTH).
 4. MAXIMUM DRY DENSITY SHALL BE DETERMINED BY AASHTO T-99 OR OTHER APPROVED METHODS.
 5. BACKFILL SHALL BE COMPACTED IN LAYERS UNTIL THE DENSITY IS NOT LESS THAN 95% OF THE MAXIMUM DRY DENSITY.
 6. TO ENSURE BALANCED BACKFILL AND TO AVOID COMPACTION EQUIPMENT IN THE C.B.Z., IT IS RECOMMENDED TO PLACE CRUSHED STONE BETWEEN ADJACENT CELLS WITH BELT CONVEYOR SYSTEMS.

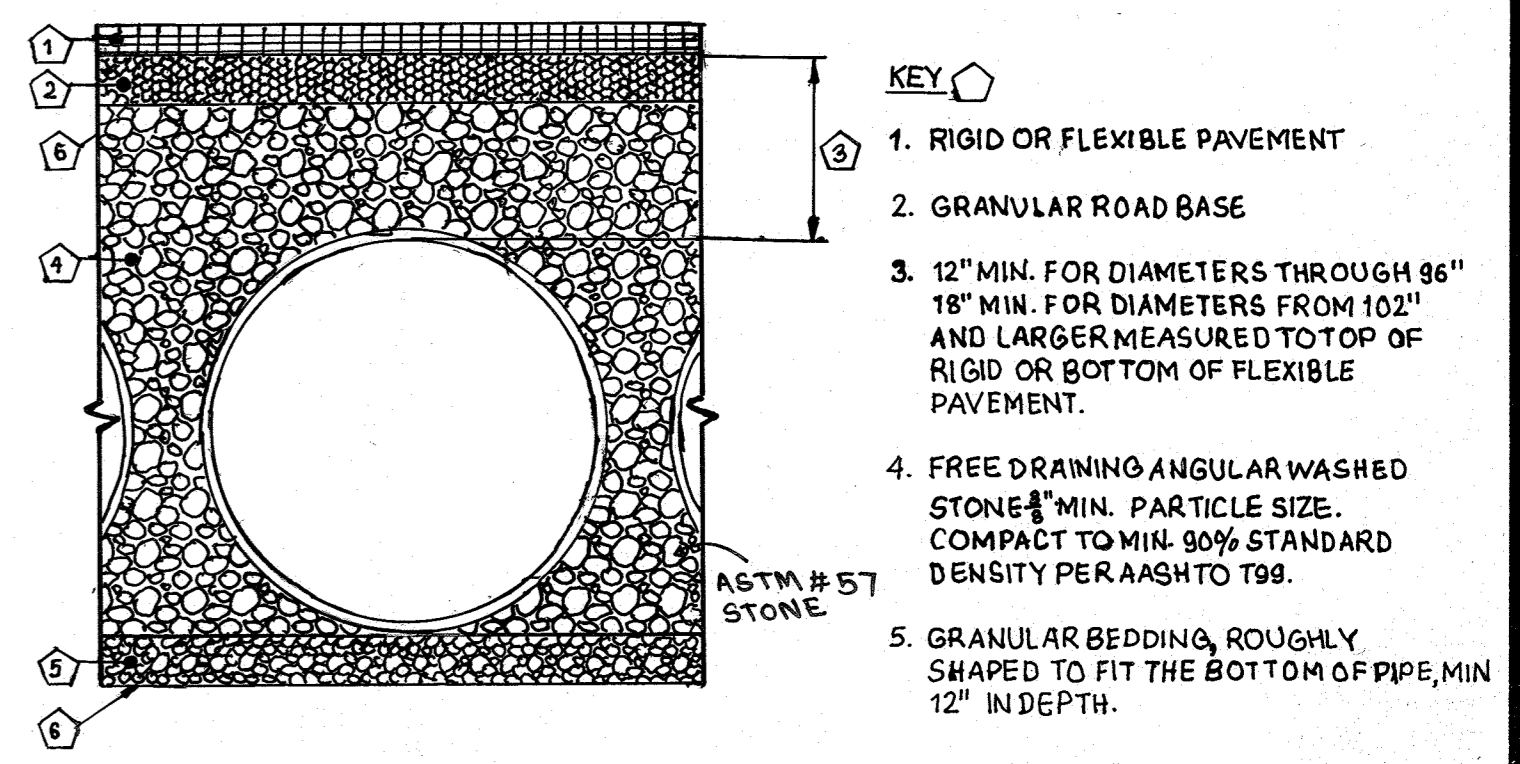

FOUNDATION BEDDING PREPARATION

PRIOR TO PLACING THE BEDDING, THE FOUNDATION MUST BE CONSTRUCTED TO A UNIFORM AND STABLE GRADE. IN THE EVENT THAT UNSUITABLE FOUNDATION MATERIALS ARE ENCOUNTERED DURING EXCAVATION, THEY SHALL BE REMOVED AND BROUGHT BACK TO THE GRADE WITH A FILL MATERIAL AS APPROVED BY THE ENGINEER. ONCE THE FOUNDATION PREPARATION IS COMPLETE, THE 4 INCHES OF A WELL-GRADED GRANULAR MATERIAL SHALL BE PLACED AS THE BEDDING.

BACKFILL

FREE DRAWING ANGULAR WASHED STONE 1/2" MIN. PARTICLE SIZE. COMPACT TO MIN. 90% STANDARD DENSITY PER AASHTO T99 AS APPROVED BY THE ENGINEER (SEE INSTALLATION GUIDELINES). WHEN PLACING THE FIRST LIFTS OF BACKFILL IT IS IMPORTANT TO MAKE SURE THAT THE BACKFILL IS PROPERLY COMPACTED UNDER AND AROUND THE PIPE HAUNCHES. BACKFILL SHALL BE PLACED SUCH THAT THERE IS NO MORE THAN A TWO LIFT (16") DIFFERENTIAL BETWEEN ANY OF THE PIPES AT ANY TIME DURING THE BACKFILL PROCESS. THE BACKFILL SHALL BE ADVANCED ALONG THE LENGTH OF THE DETENTION SYSTEM AT THE SAME RATE TO AVOID DIFFERENTIAL LOADING ON THE PIPE.

OTHER ALTERNATE BACKFILL MATERIAL MAY BE ALLOWED DEPENDING ON SITE SPECIFIC CONDITIONS. REFER TO TYPICAL BACKFILL DETAIL FOR MATERIAL REQUIRED.

BACKFILL DETAIL (SWMF # 1)
SCALE: N.T.S.

NO.	BY	DATE	REVISION
1	KCE	05/02/08	REPLACE CON/STORM WITH CMP 6020R6E
3	KCE	03/01/10	SWM AS-BUILT INFORMATION ADDED

SWMF#1 BACKFILL PLAN

TURF VALLEY, LORIE
NURSING HOME & ASSISTED LIVING FACILITY

AS-BUILT OAKMONT AT TURF VALLEY
PARCEL Q
PLATS 18773 - 18775
TAX MAP 16 - P/O PARCEL 8 - GRID 16 & 17;
POD 1 per S-86-13 (4th AMENDED)
THIRD ELECTION DISTRICT HOWARD COUNTY, MARYLAND

KCE ENGINEERING, INC.

EXECUTIVE CENTER
3300 NORTH RIDGE ROAD, SUITE 315
ELLCOTT CITY, MARYLAND 21043
PHONE (410) 203-9800 FAX (410) 203-9228

APPROVED
PLANNING BOARD
OF HOWARD COUNTY
DATE 3/21/08
EAA

APPROVED: DEPARTMENT OF PLANNING AND ZONING
Chief, Development Engineering Division 4/25/08
Chief, Division of Land Development 6/22/08
Director 6/30/08

Professional Certification: I hereby certify that these documents were prepared or approved by me, and that I am a duly licensed professional engineer under the laws of the State of Maryland, License No. 22201, Expiration Date: 12-22-08.

Professional Engineer
MICHAEL D. ADCOCK
No. 22201
4-30-08








AS-BUILT CERTIFICATION
THERE IS NO "AS-BUILT" INFORMATION PROVIDED ON THIS SHEET.

OWNER
MANGIONE ENTERPRISES OF TURF VALLEY
LIMITED PARTNERSHIP
1205 YORK ROAD, PENTHOUSE
LUTHERVILLE, MARYLAND 21093
PHONE (410) 825-8400

DATE 07/23/19

DRAWN BY: _____ SHEET: 25
CHECKED BY: _____ OF _____
SCALE: AS SHOWN
DATE: 04/30/2008 36

EXAMPLE BACKFILL PLAN FOR CON/STORM™ DETENTION SYSTEMS

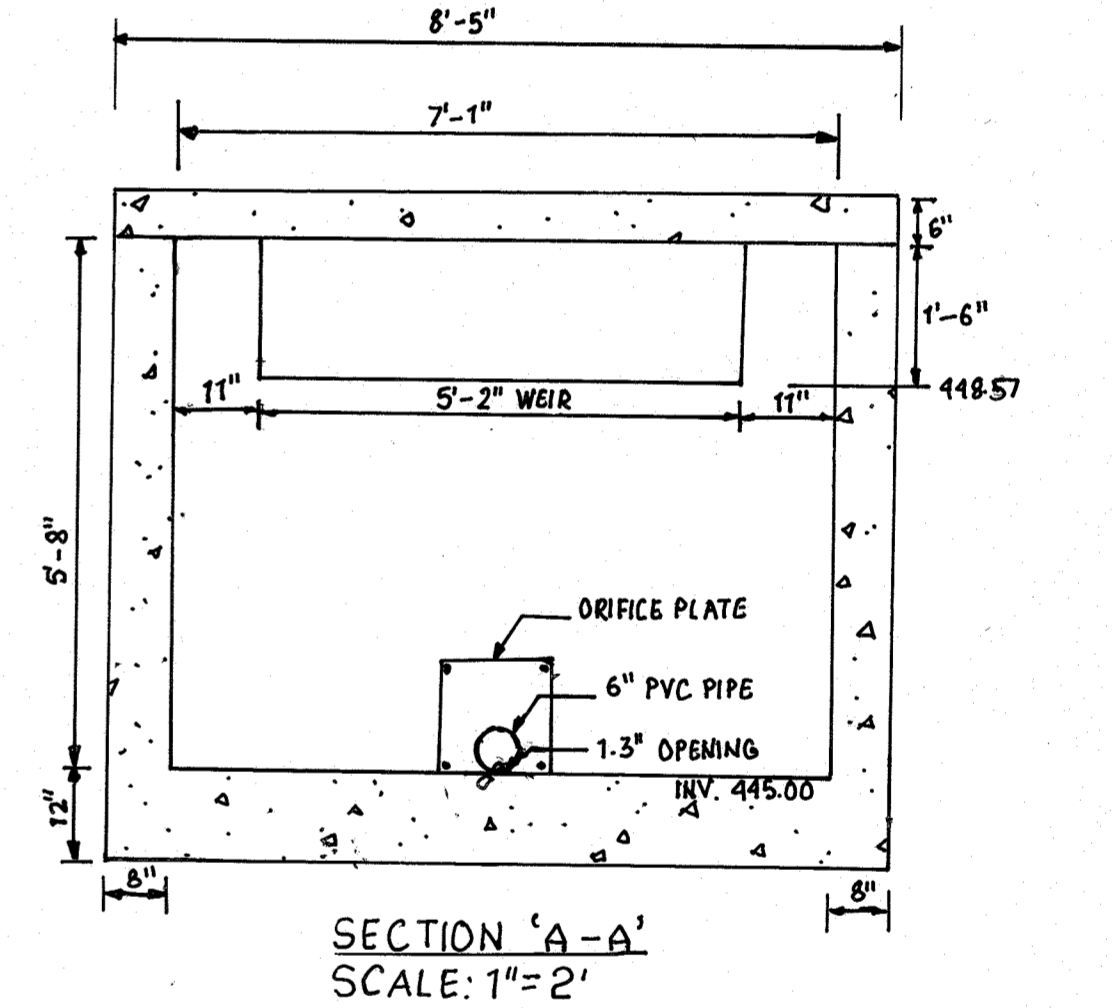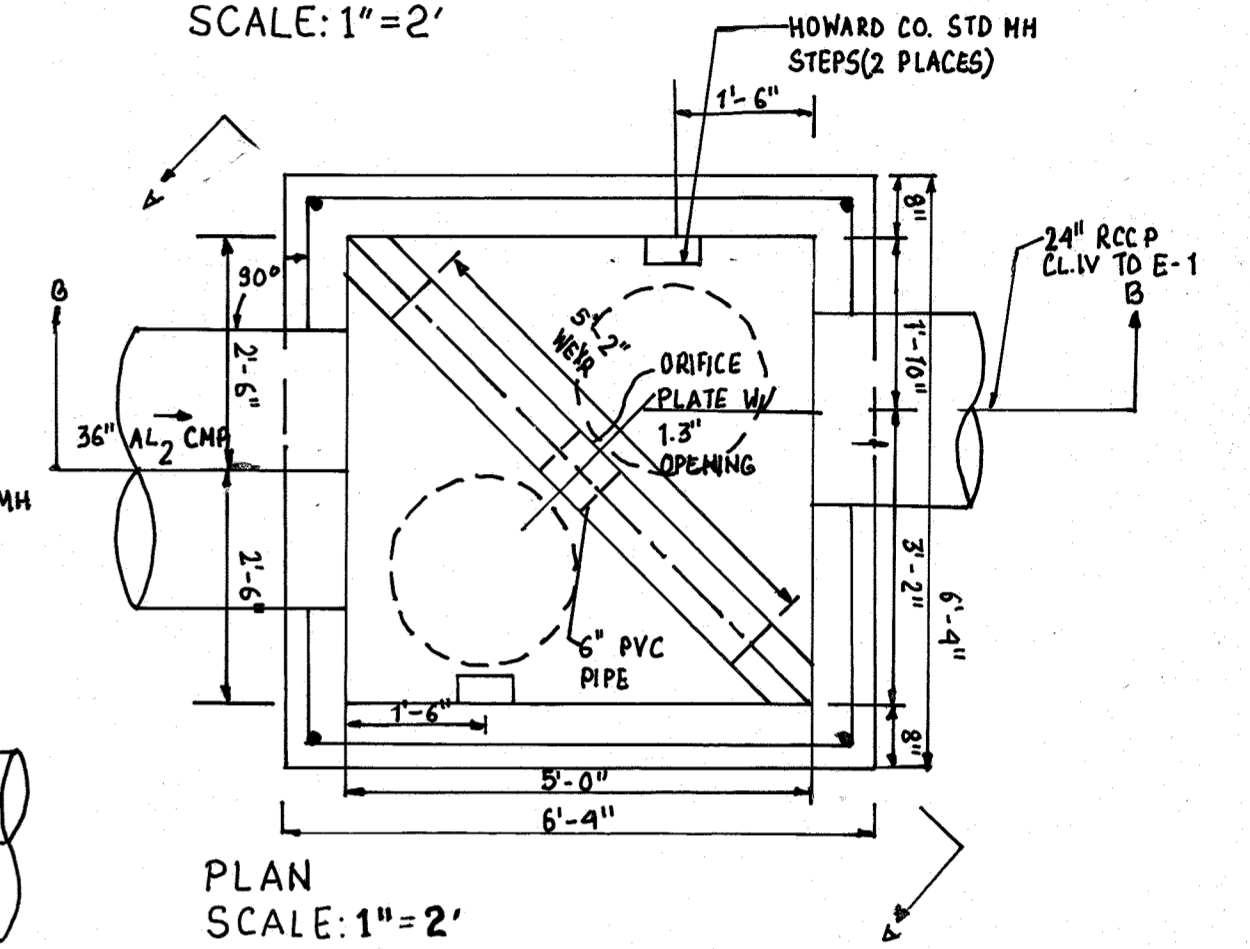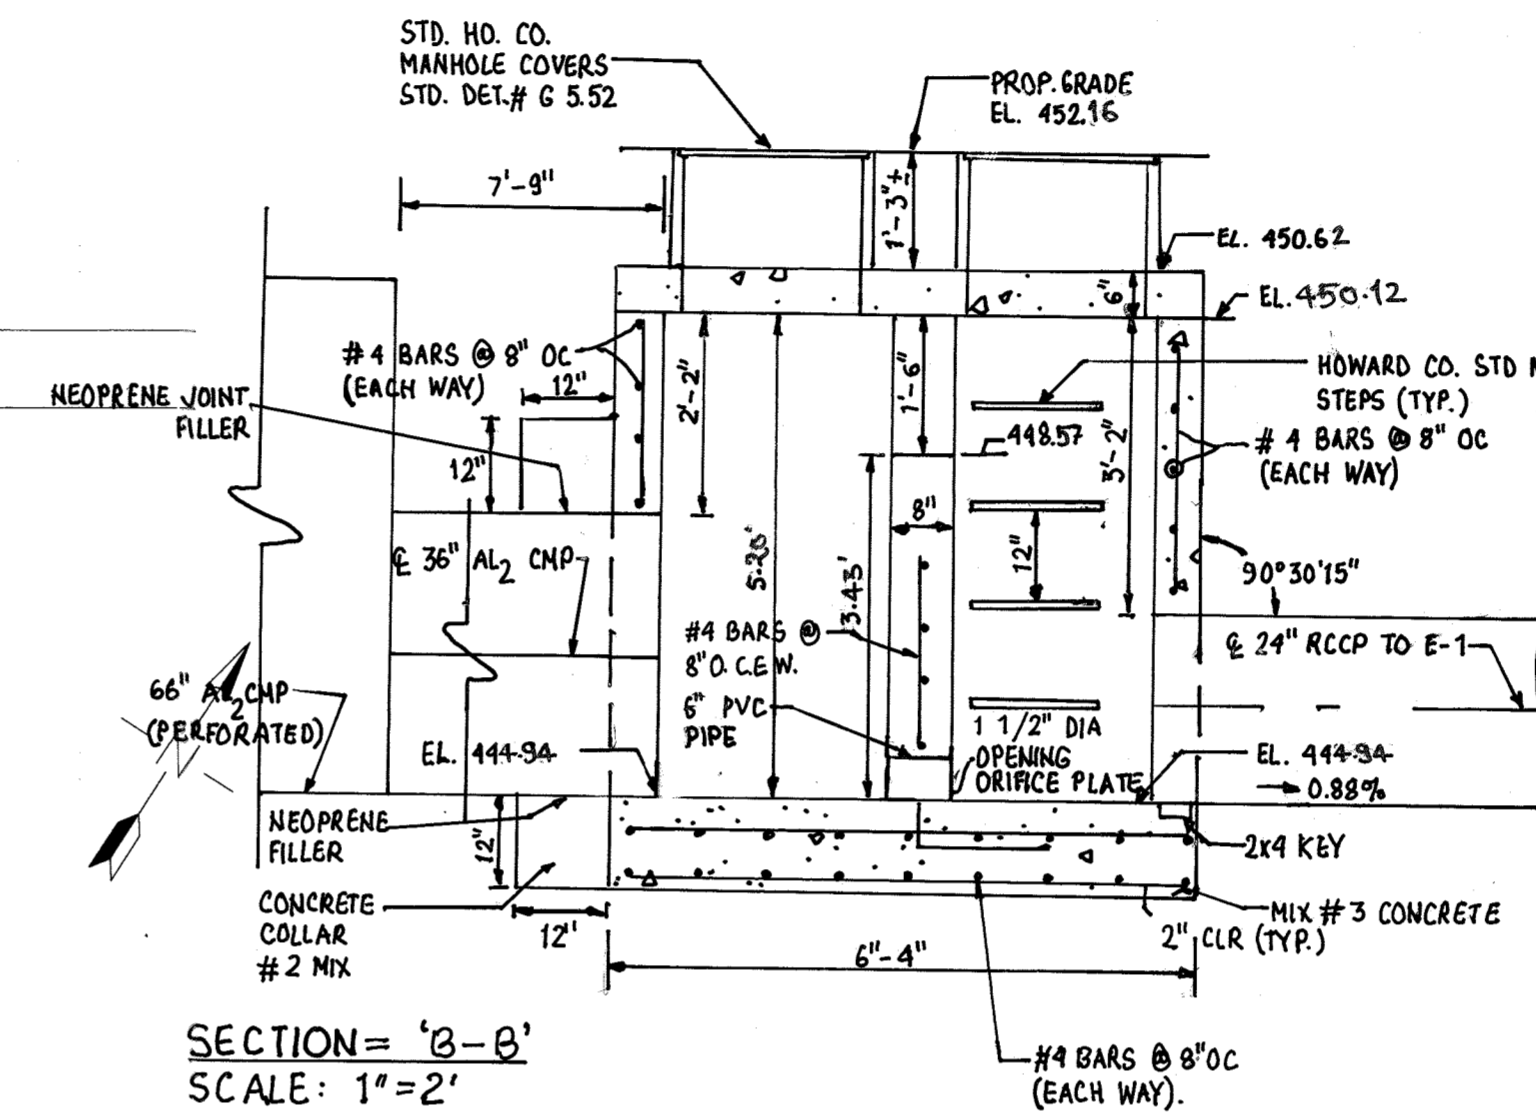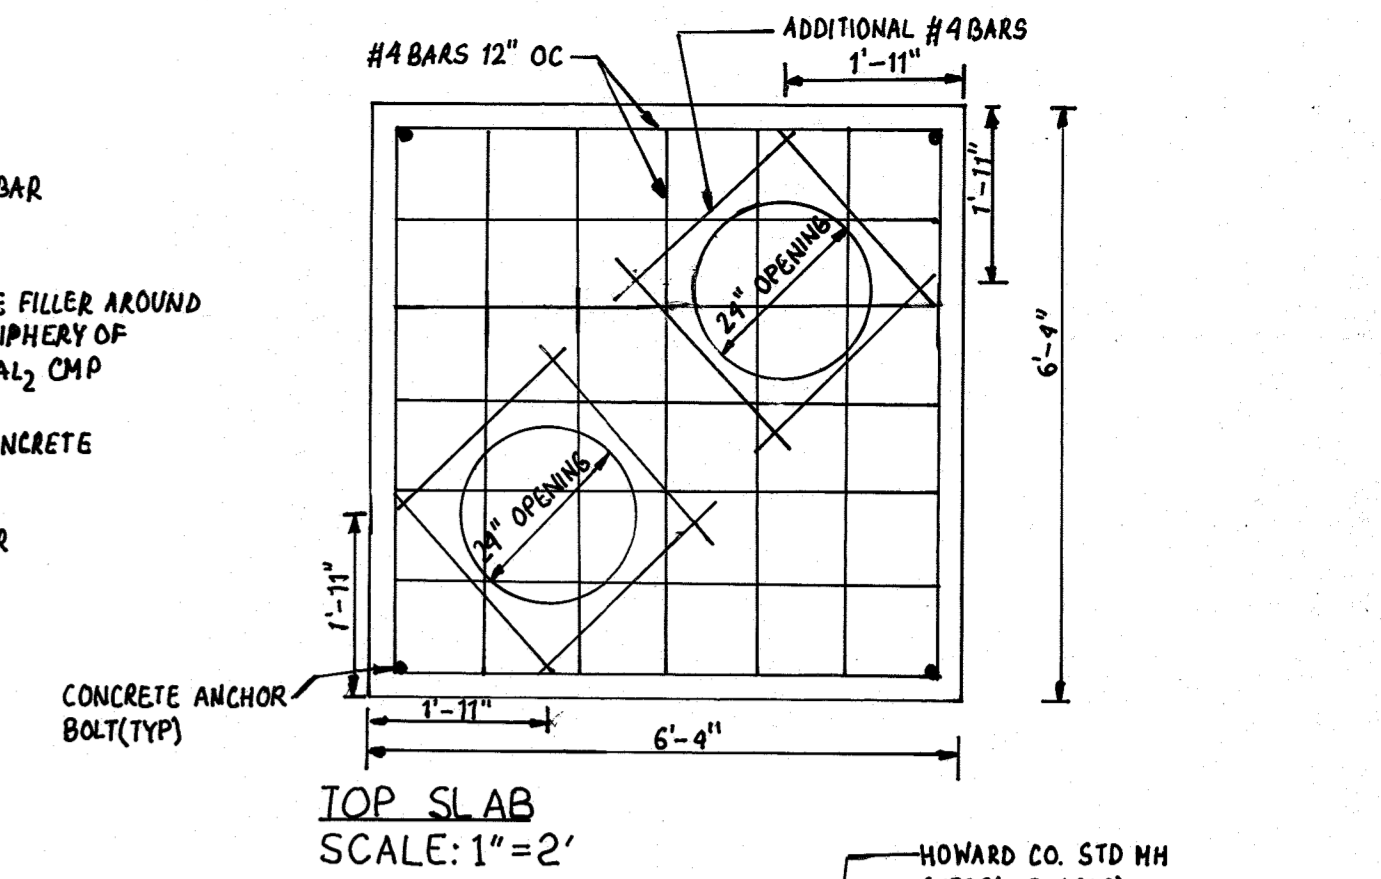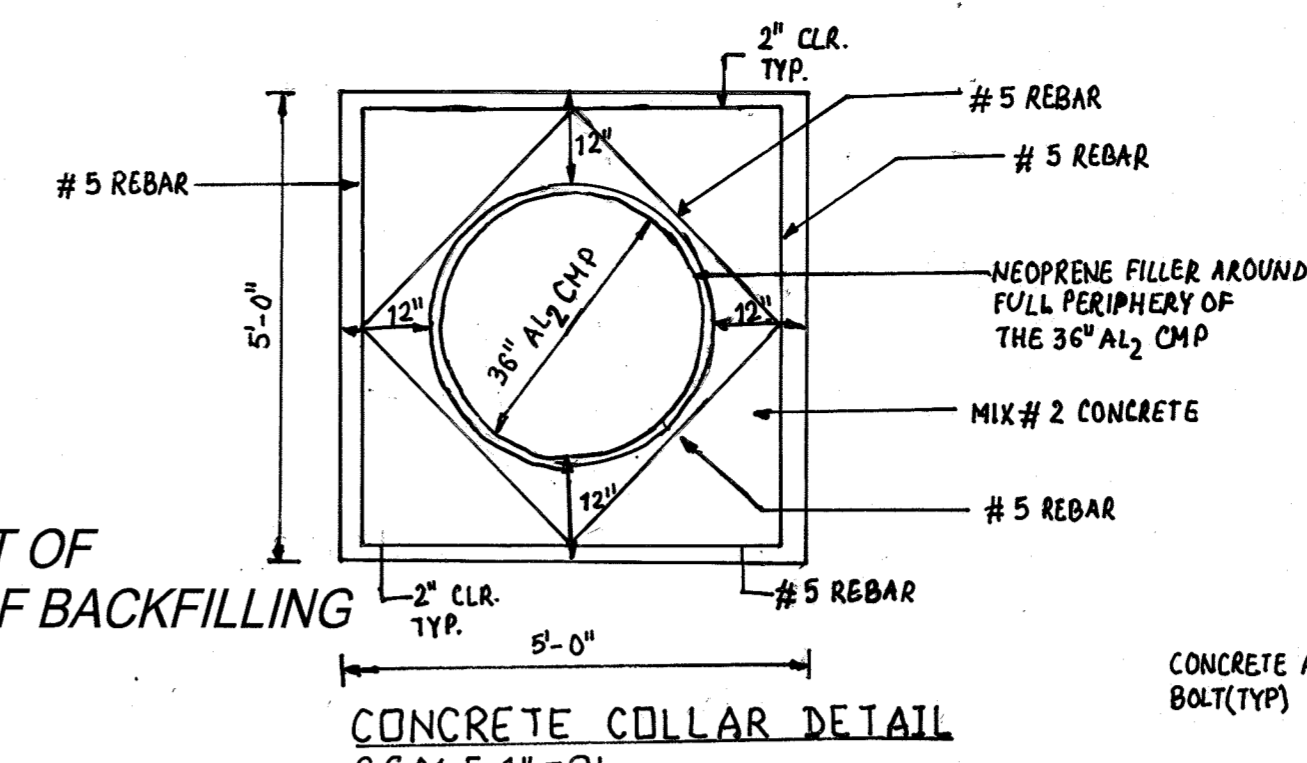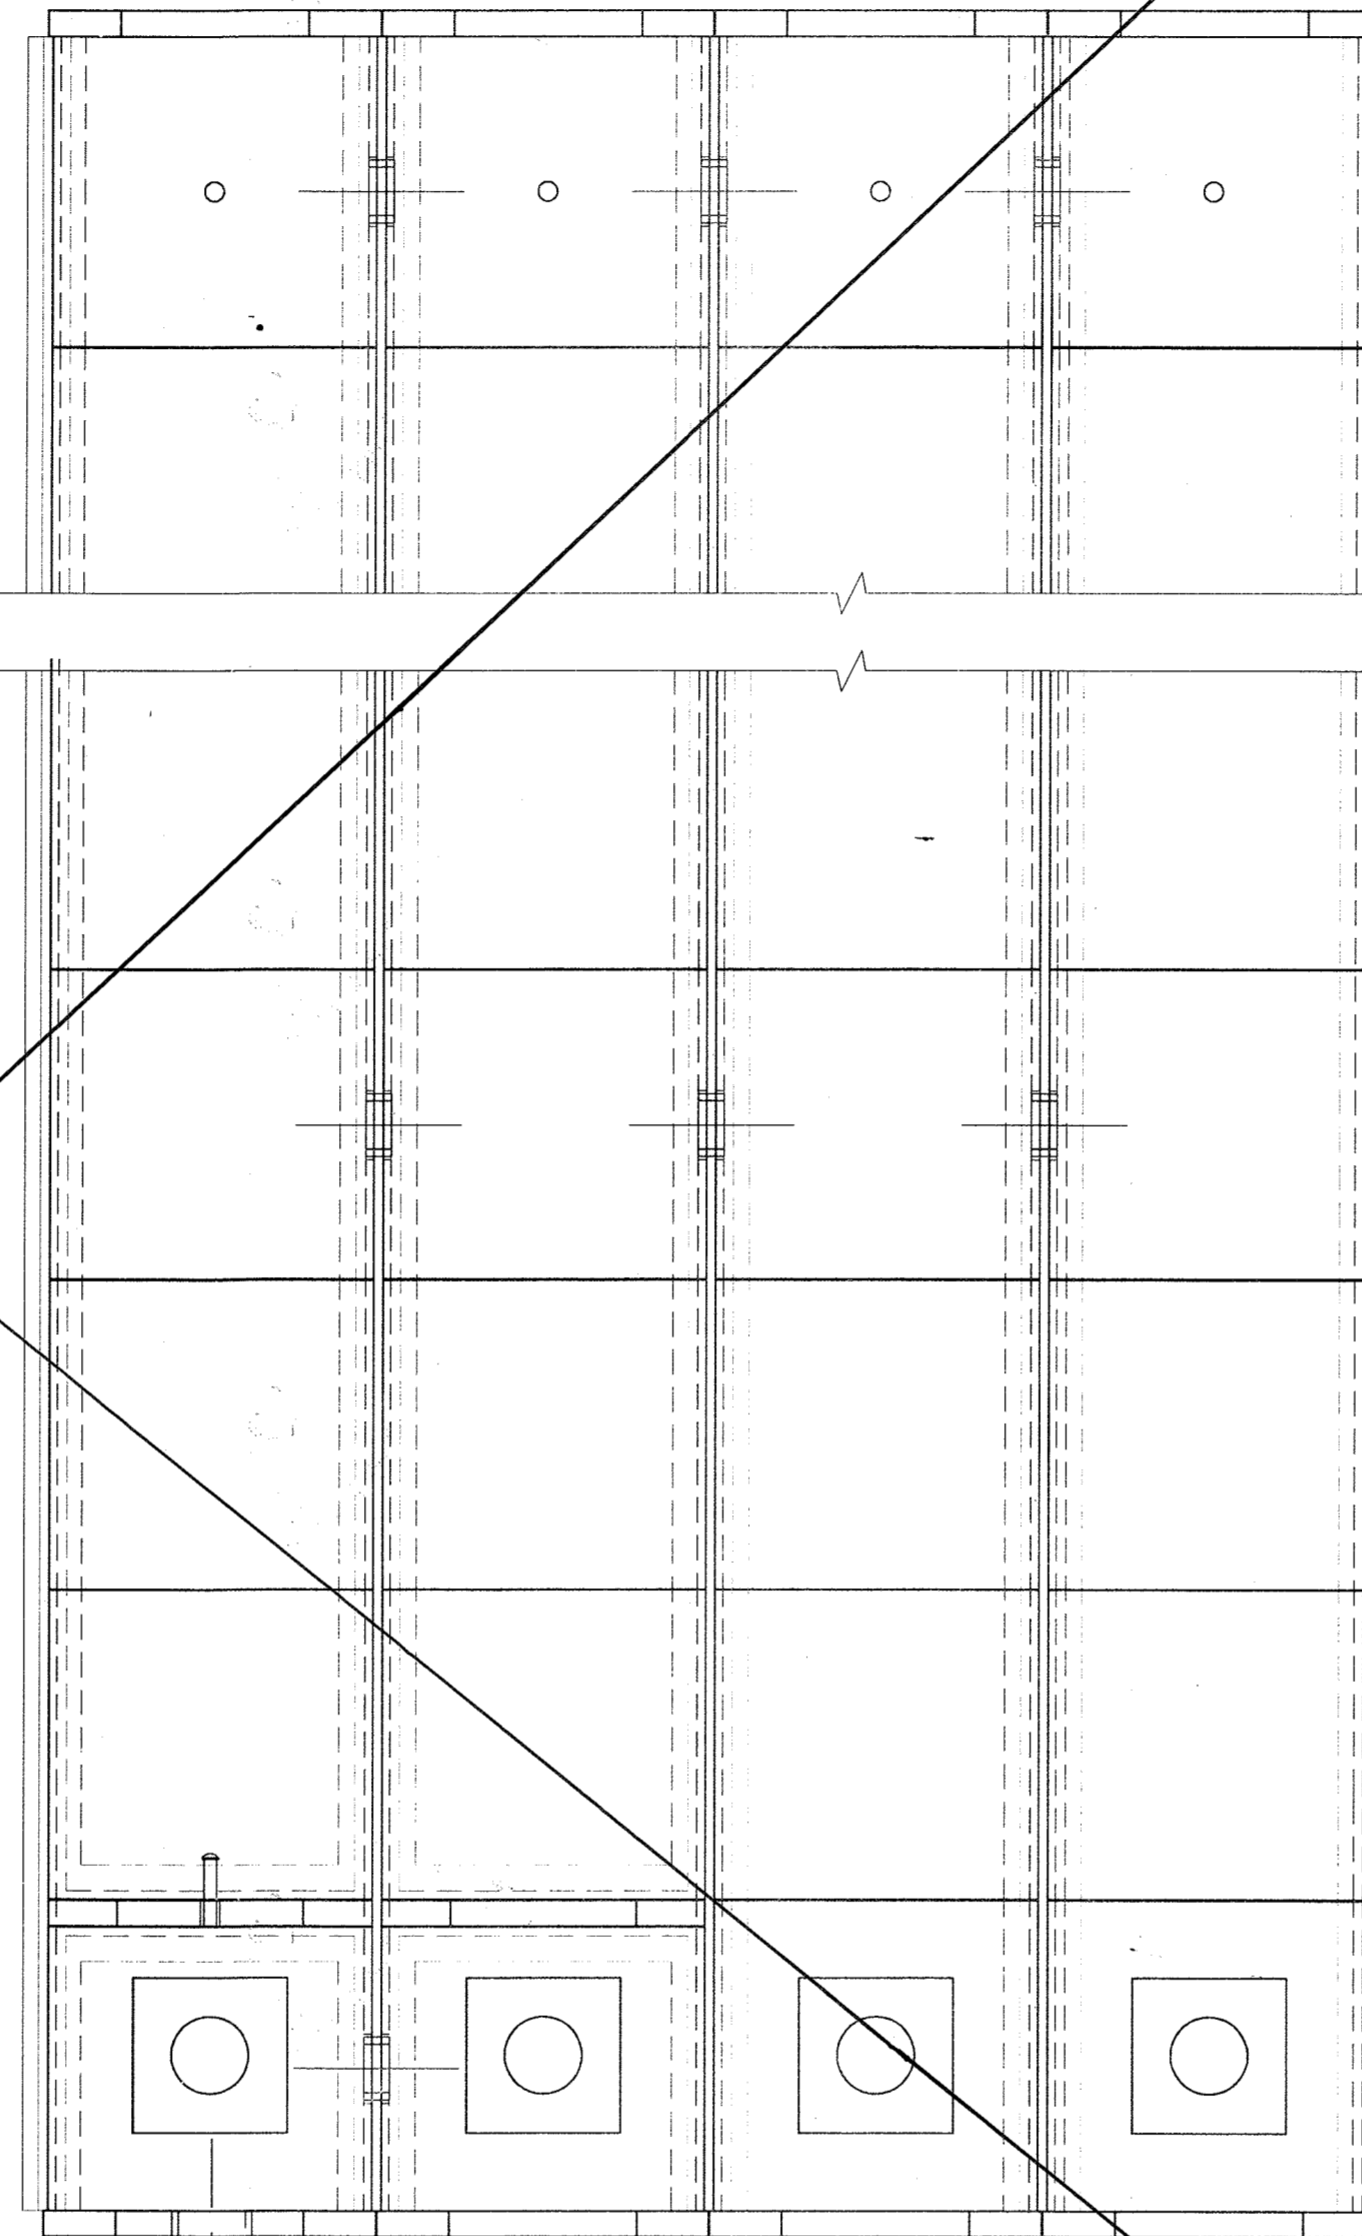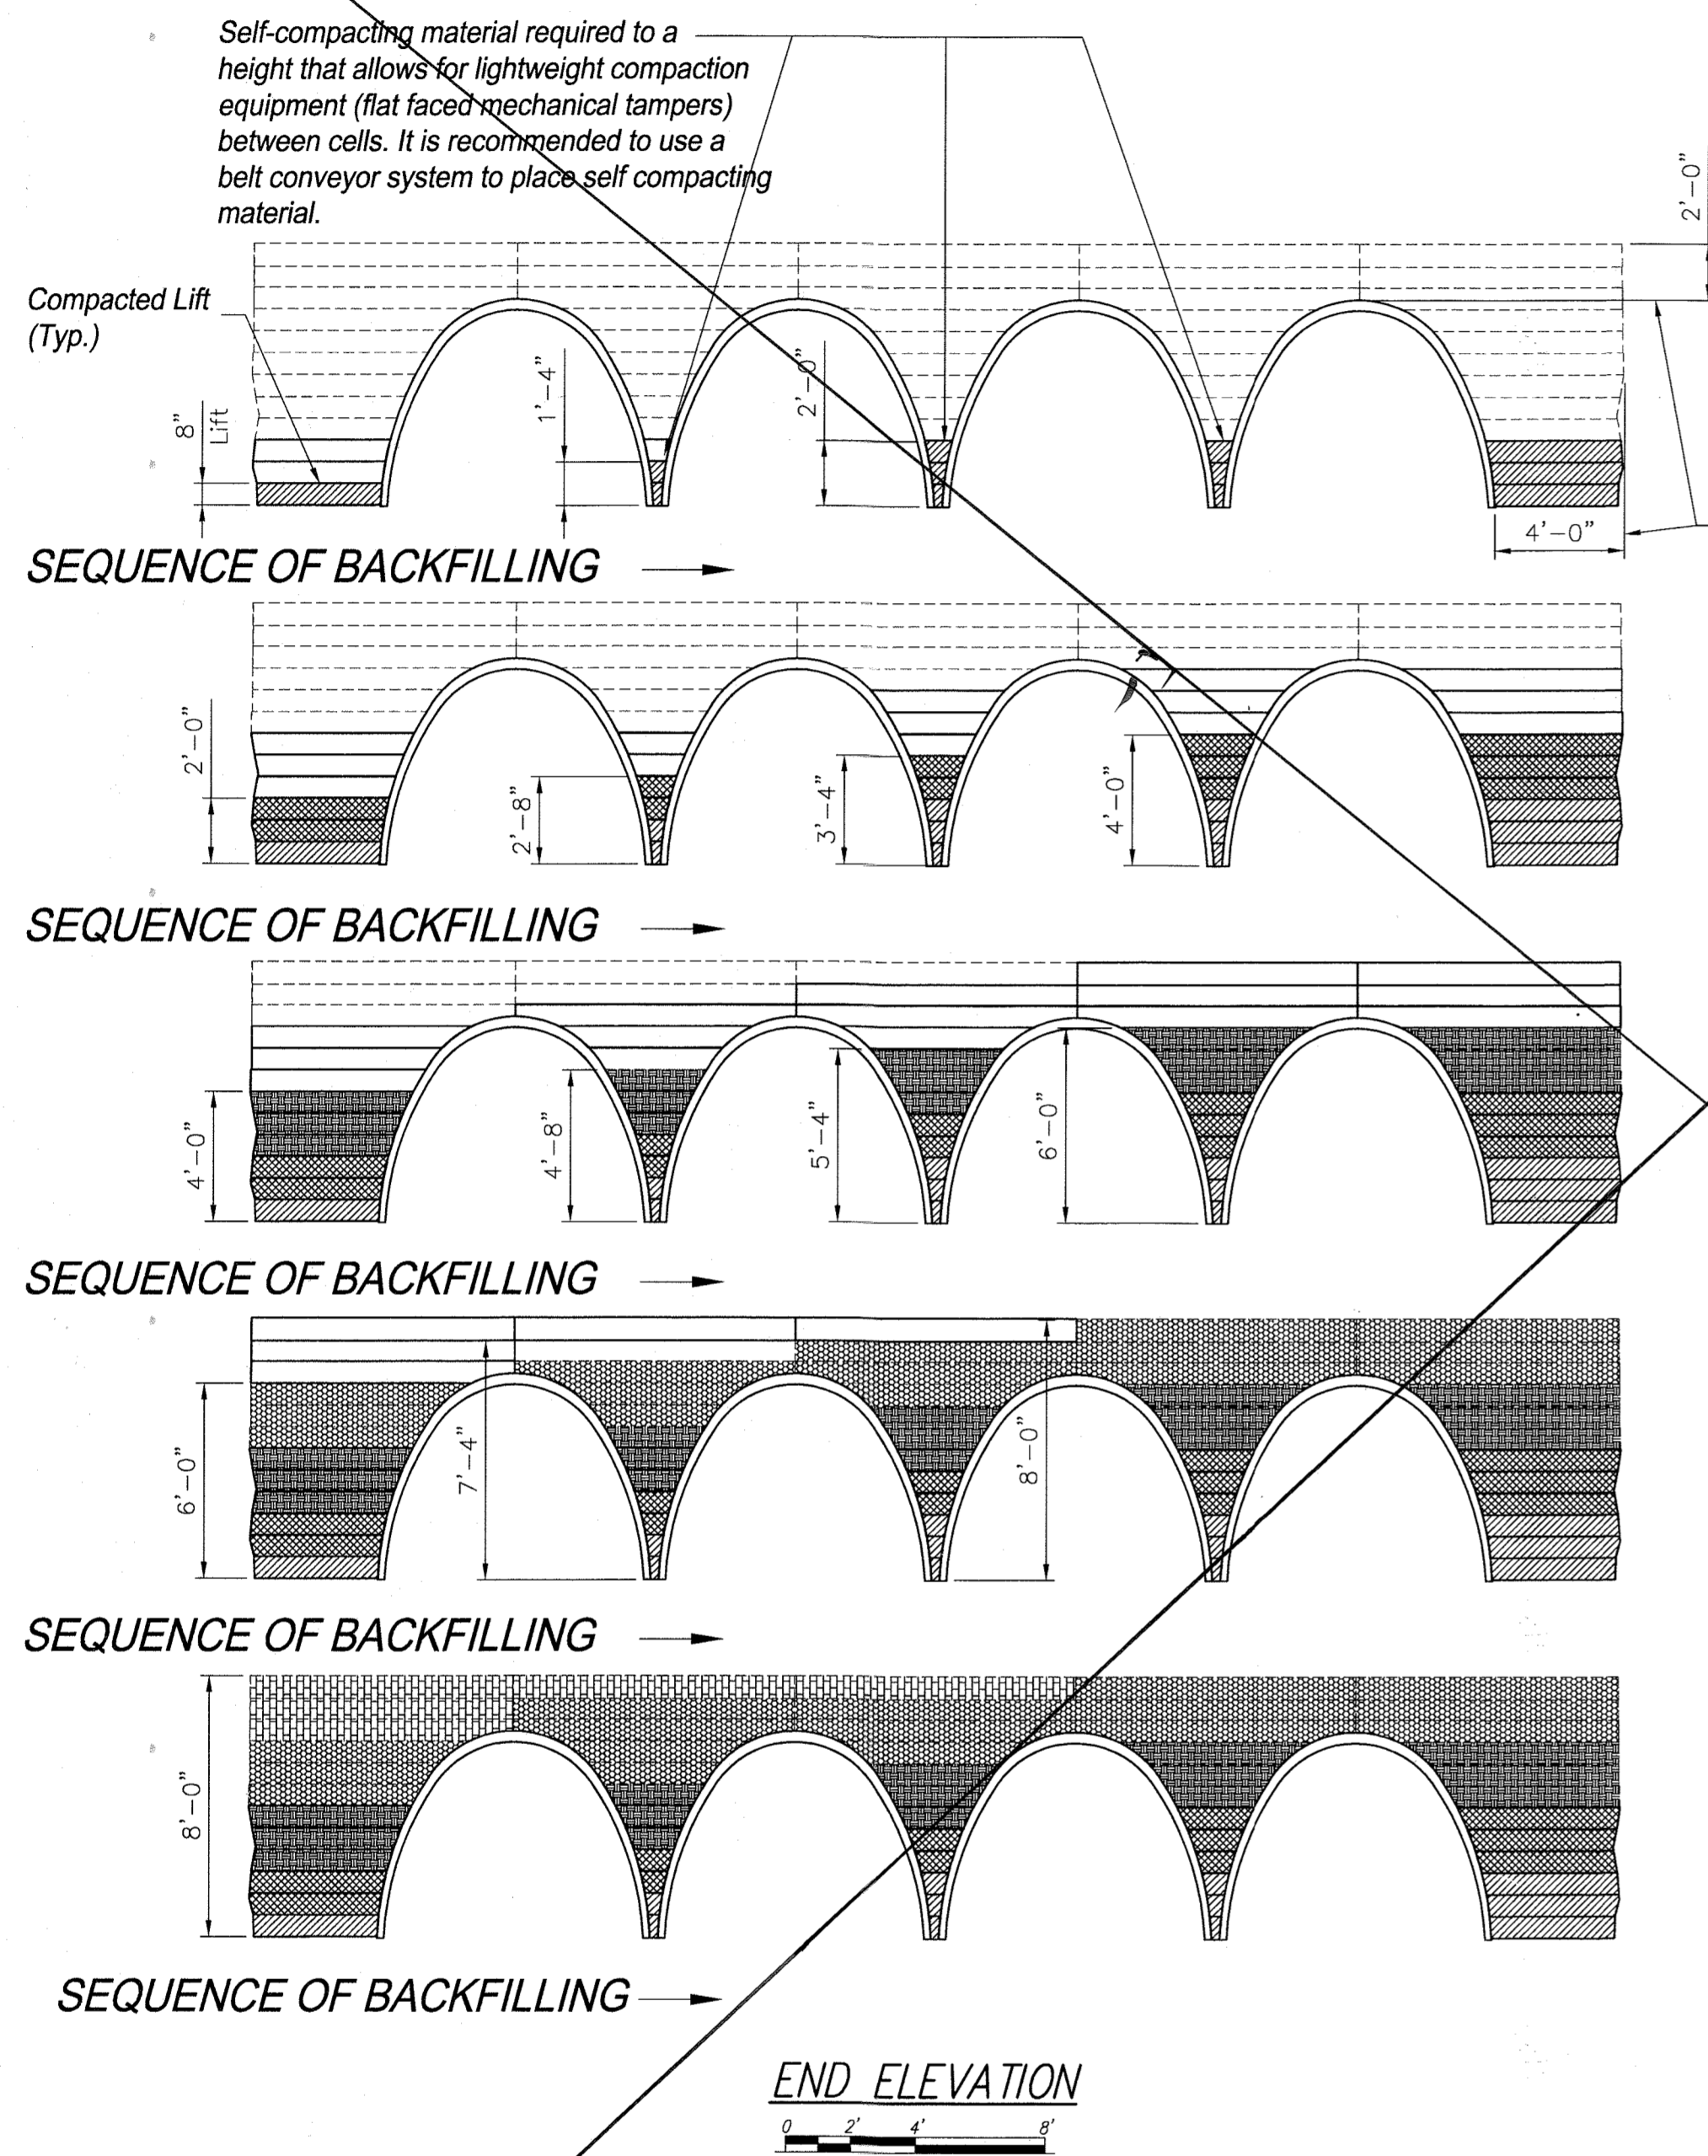

CONSTRUCTION REQUIREMENTS

Backfill - Backfill shall be considered as all replaced excavation and new embankment adjacent to the CON/STORM™ vault units and endwalls. The project construction and material specifications which include the specifications for excavation for structures and roadway excavation and embankment construction, shall apply except as modified in this section.

No backfill shall be placed against any structural elements until they have been approved by the Engineer.

Backfill against a waterproofed surface shall be placed carefully to avoid damage to the waterproofing material.

Mechanical tampers shall be used to compact immediately adjacent to each side and over the top of each vault unit until it is covered to a minimum depth of one foot. Care shall be taken to avoid contact between the structure and compaction equipment at all times. The backfill within the Critical Backfill Zone (CBZ) shall be placed in lifts of eight inches or less (loose depth). Heavy compaction equipment shall not be operated in this area or over the bridge until it is covered to a depth of two feet.

Lightweight dozers and graders may be operated over vault units having one foot of compacted cover, but heavy earth moving equipment (larger than a D-4 Dozer weighing in excess of 12 tons and having track pressures of eight psi or greater) shall require two feet of cover unless the design cover is less than two feet. In no case shall equipment operating in excess of the design load (HS20) be permitted over the vault units unless approved by CONTECH Stormwater Solutions.

Any additional fill and subsequent excavation required to provide this minimum cover shall be made at no additional cost to the project.

As a precaution against introducing unbalanced stresses in the vault, when placing backfill at no time shall the difference between the heights of fill on opposite sides of the vault exceed 24".

AS-BUILT CERTIFICATION

THERE IS NO "AS-BUILT" INFORMATION PROVIDED ON THIS SHEET.

Michael S. Adams
MICHAEL S. ADAMS, PROFESSIONAL LAND SURVEYOR
INCRES. NO. 21257, EXPIRATION DATE: 09-16-21

02/23/10
DATE

NO.	BY	DATE	REVISION
1	KCE	03/02/08	REVISED SHEET TITLE & ADDED DETAILS
3	KCE	02/01/10	SWM AS-BUILT INFORMATION ADDED

OWNER
MANGIONE ENTERPRISES OF TURF VALLEY
LIMITED PARTNERSHIP
1205 YORK ROAD, PENTHOUSE
LUTHERVILLE, MARYLAND 21093
PHONE (410) 825-8400

APPROVED
PLANNING BOARD
OF HOWARD COUNTY
DATE 3/27/08
EAS

Professional Certification: I hereby certify that these documents were prepared or approved by me, and that I am a duly licensed professional engineer under the laws of the State of Maryland, License No. 22201, Expiration Date: 12-22-08.

AS-BUILT STORMWATER MANAGEMENT CONSTRUCTION DETAILS-1
TURF VALLEY, LORIE
NURSING HOME & ASSISTED LIVING FACILITY
OAKMONT AT TURF VALLEY
PARCEL Q
PLATS 18773 - 18775
TAX MAP 16 - P/O PARCEL 8- GRID 16 & 17;
POD 1 per S-86-13 (4th AMENDED)
THIRD ELECTION DISTRICT HOWARD COUNTY, MARYLAND



KCE ENGINEERING, INC.
EXECUTIVE CENTER
3300 NORTH RIDGE ROAD, SUITE 315
ELLCOTT CITY, MARYLAND 21043
PHONE (410) 203-9800 FAX (410) 203-9228

DRAWN BY: _____ SHEET: 26
CHECKED BY: _____ OF
SCALE: AS SHOWN 36
DATE: 04/30/2008

APPROVED: DEPARTMENT OF PLANNING AND ZONING
Chief, Development Engineering Division 6/25/08
Chief, Division of Land Development 6/22/08
Director 6/30/08



60" Ø UNDERGROUND RETENTION SYSTEM TURF VALLEY LORIE - DRAINAGE AREA 2

NOTES:

- 1) ALL ELEVATIONS, DIMENSIONS AND LOCATIONS OF RISERS AND INLETS, SHALL BE VERIFIED BY THE ENGINEER PRIOR TO RELEASING FOR FABRICATION.
- 2) IN SITUATIONS WHERE A FINE-GRAINED BACKFILL MATERIAL IS USED ADJACENT TO THE PIPE SYSTEM, AND ESPECIALLY IN SITUATIONS INVOLVING HIGH GROUNDWATER TABLES, CONSIDERATION SHOULD BE GIVEN TO THE USE OF GASKETED PIPE JOINTS. AT THE VERY LEAST, THE PIPE JOINTS SHOULD BE WRAPPED IN A SUITABLE, NON-WOVEN GEOTEXTILE FABRIC TO PREVENT INFILTRATION OF FINES INTO THE PIPE SYSTEM.
- 3) ALL FITTINGS AND REINFORCEMENT COMPLY WITH ASTM A998.
- 4) SYSTEM MADE FROM: 66" Ø, 5 x 1, ALT2, 16ga., PERFORATED AND NON-PERFORATED CMP.
- 5) MINIMUM COVER HEIGHT FOR PIPE DESCRIBED IN NOTE #4 IS 12".
- 6) CONSIDERATIONS FOR CONSTRUCTION EQUIPMENT LOADS MUST BE TAKEN INTO ACCOUNT. SEE DETAIL 5, SHEET 25.
- 7) ALL PIPE DIMENSIONS ARE SUBJECT TO MANUFACTURERS TOLERANCES.
- 8) ALL RISERS AND STUBS ARE 2 3/8" X 1/2" CORRUGATION AND 16 GAGE, UNLESS OTHERWISE NOTED.
- 9) RISERS TO BE FIELD TRIMMED TO FINAL GRADE.
- 10) SYSTEM IS DESIGNED FOR H20 AND H25 LOADING.

SPECIFICATION FOR CORRUGATED STEEL PIPE-ALUMINIZED TYPE 2 STEEL:

SCOPE:
THIS SPECIFICATION COVERS THE MANUFACTURE AND INSTALLATION OF THE CORRUGATED STEEL PIPE (CSP) DETAILED IN THE PROJECT PLANS.

MATERIAL:
THE ALUMINIZED TYPE 2 STEEL COILS SHALL CONFORM TO THE APPLICABLE REQUIREMENTS OF AASHTO M 274 OR ASTM A 929.

PIPE:
THE CSP SHALL BE MANUFACTURED IN ACCORDANCE WITH THE APPLICABLE REQUIREMENTS OF AASHTO M-36 OR ASTM A760. THE PIPE SIZES, GAUGES AND CORRUGATIONS SHALL BE AS SHOWN ON THE PROJECT PLANS.

ALL FABRICATION OF THE PRODUCT SHALL OCCUR WITHIN THE UNITED STATES.

HANDLING & ASSEMBLY:
SHALL BE IN ACCORDANCE WITH NCSIPA'S (NATIONAL CORRUGATED STEEL PIPE ASSOCIATION) RECOMMENDATIONS.

INSTALLATION:
SHALL BE IN ACCORDANCE WITH AASHTO STANDARD SPECIFICATIONS FOR HIGHWAY BRIDGES, SECTION 26, DIVISION II OR ASTM A 798 AND IN CONFORMANCE WITH THE PROJECT PLANS AND SPECIFICATIONS. IF THERE ARE ANY INCONSISTENCIES OR CONFLICTS THE CONTRACTOR SHOULD DISCUSS AND RESOLVE WITH THE PROJECT ENGINEER.

IT IS ALWAYS THE CONTRACTOR'S RESPONSIBILITY TO FOLLOW OSHA GUIDELINES FOR SAFE PRACTICES.

CONSTRUCTION LOADS:
CONSTRUCTION LOADS MAY BE HIGHER THAN FINAL LOADS. FOLLOW THE MANUFACTURER'S OR NCSIPA GUIDELINES.

INSTALLATION SPECIFICATION

PRE-CONSTRUCTION MEETING

PRIOR TO INSTALLATION OF THE RETENTION SYSTEM A PRE-CONSTRUCTION MEETING SHALL BE CONDUCTED. THOSE REQUIRED TO ATTEND ARE THE SUPPLIER OF THE RETENTION SYSTEM, THE GENERAL CONTRACTOR, SUB CONTRACTORS AND THE ENGINEER.

FOUNDATION/BEDDING PREPARATION

PRIOR TO PLACING THE BEDDING, THE FOUNDATION MUST BE CONSTRUCTED TO A UNIFORM AND STABLE GRADE. IN THE EVENT THAT UNSUITABLE FOUNDATION MATERIALS ARE ENCOUNTERED DURING EXCAVATION, THEY SHALL BE REMOVED AND BROUGHT BACK TO THE GRADE WITH A FILL MATERIAL AS APPROVED BY THE ENGINEER. ONCE THE FOUNDATION PREPARATION IS COMPLETE, THE 4 INCHES OF A WELL-GRADED GRANULAR MATERIAL SHALL BE PLACED AS THE BEDDING.

BACKFILL

THE BACKFILL SHALL BE AN A1, A2 OR A3 GRANULAR FILL PER AASHTO M-145 OR A WELL-GRADED GRANULAR FILL AS APPROVED BY THE ENGINEER (SEE INSTALLATION GUIDELINES). THE MATERIAL SHALL BE PLACED IN 8-INCH LOOSE LIFTS AND COMPACTED TO 90% AASHTO 199 STANDARD PROCTOR DENSITY. WHEN PLACING THE FIRST LIFTS OF BACKFILL IT IS IMPORTANT TO MAKE SURE THAT THE BACKFILL IS PROPERLY COMPACTED UNDER AND AROUND THE PIPE HAUNCHES. BACKFILL SHALL BE PLACED SUCH THAT THERE IS NO MORE THAN A TWO LIFT DIFFERENTIAL BETWEEN ANY OF THE PIPES AT ANY TIME DURING THE BACKFILL PROCESS. THE BACKFILL SHALL BE ADVANCED ALONG THE LENGTH OF THE DETENTION SYSTEM AT THE SAME RATE TO AVOID DIFFERENTIAL LOADING ON THE PIPE.


OTHER ALTERNATE BACKFILL MATERIAL MAY BE ALLOWED DEPENDING ON SITE SPECIFIC CONDITIONS. REFER TO TYPICAL BACKFILL DETAIL WITHIN THIS SET OF PLANS FOR TYPE OF MATERIAL REQUIRED.

MINIMUM COVER

BACKFILL SHALL BE PLACED TO THE PROPER ELEVATION OVER THE SYSTEM AS OUTLINED IN THE PLANS. MINIMUM COVER FOR CONSTRUCTION LOADING NEEDS TO BE DETERMINED BASED ON THE TYPE OF EQUIPMENT THAT IS PLANNED FOR CONSTRUCTION. PROPER COVER FOR CONSTRUCTION EQUIPMENT SHALL BE DETERMINED PRIOR TO THE PRE-CONSTRUCTION MEETING BY THE ENGINEER.

APPROVED:
DEPARTMENT OF PLANNING AND ZONING
[Signature] 6/15/08 Date
Chief, Development Engineering Division
[Signature] 6/27/08 Date
Chief, Division of Land Development
[Signature] 6/30/08 Date
Director

APPROVED
PLANNING BOARD
OF HOWARD COUNTY
DATE 3/26/08
[Signature]

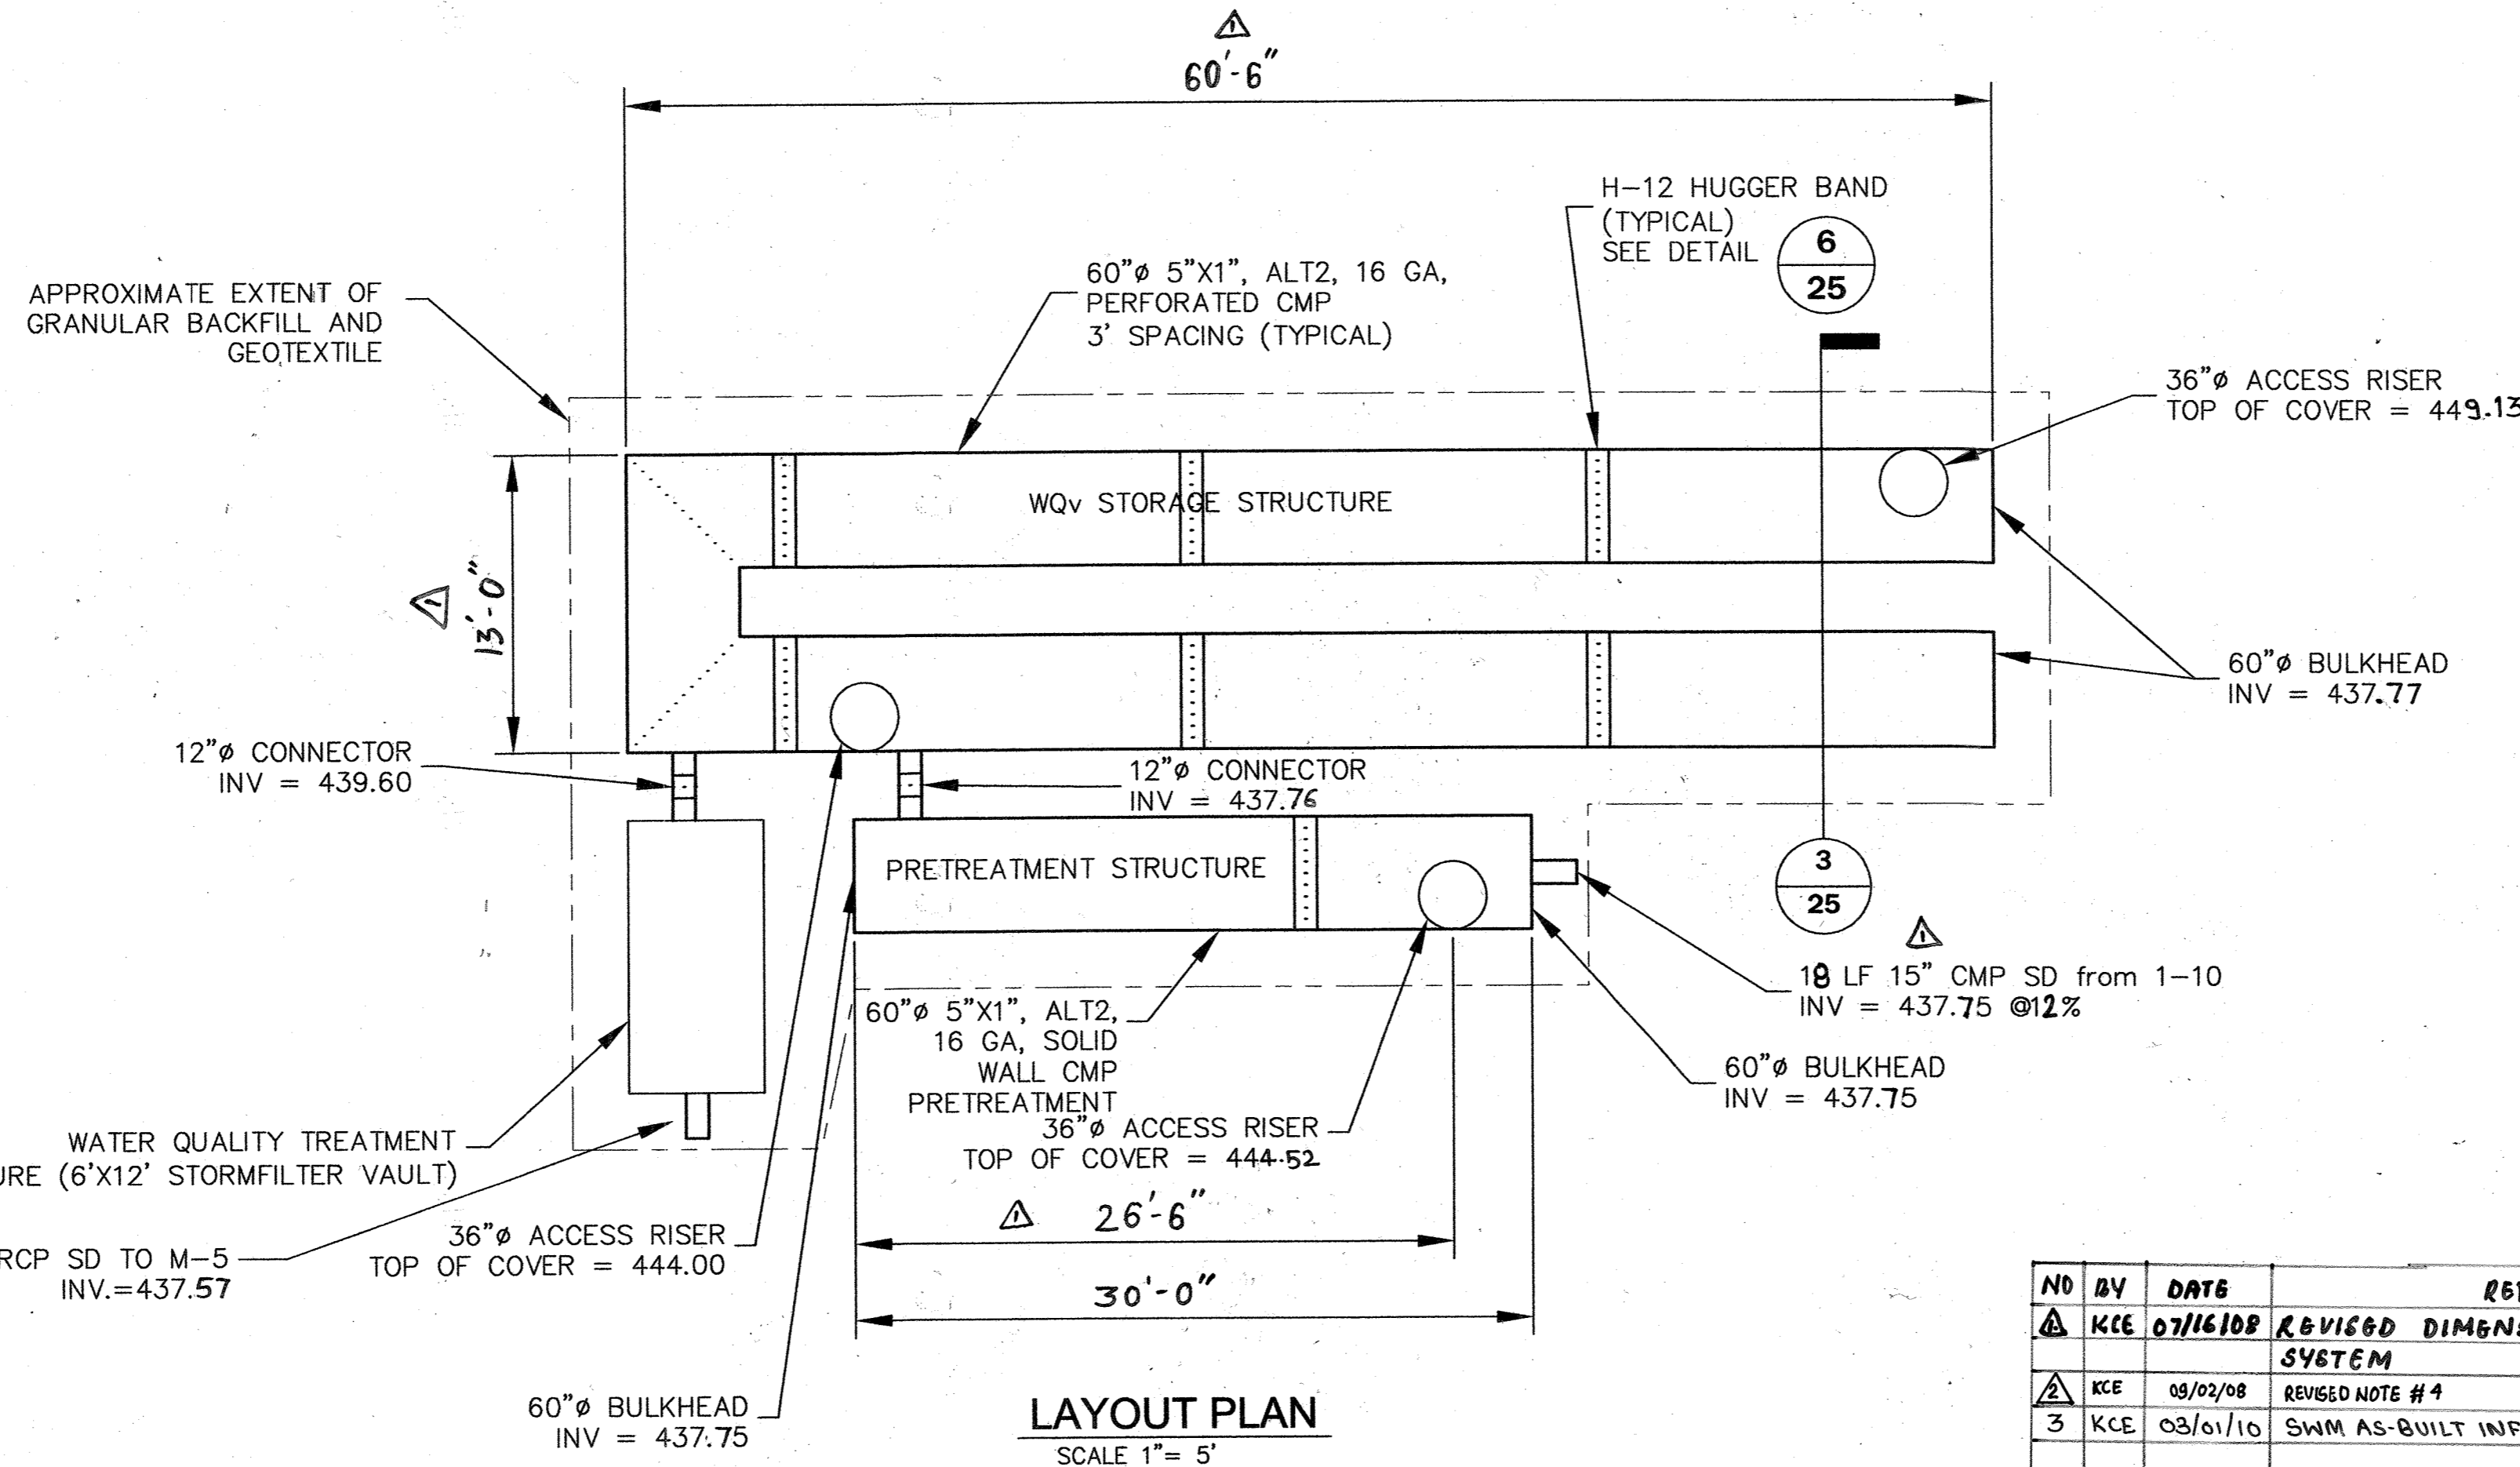

REQUIRED VOLUMES

WQv = 2,309 C.F.
Rev = 479 C.F.
PRETREATMENT = 280 C.F.

PROVIDED VOLUMES

WQv = 2,326 C.F.
STORMFILTER = 212 C.F.
60" PERFORATED SYSTEM = 1,525 C.F.
Rev = 909 C.F.
PRETREATMENT = 589 C.F.

GENERAL NOTES

- 1) VOLUME STORMFILTER BY CONTECH STORMWATER SOLUTIONS, PORTLAND, OREGON (800) 548-4667.
- 2) FILTER CARTRIDGES TO BE SIPHON-ACTED AND SELF-CLEANING. STANDARD DETAIL DRAWING SHOWS MAXIMUM NUMBER OF CARTRIDGES. ACTUAL NUMBER REQUIRED TO BE SPECIFIED ON SITE PLANS OR IN DATA TABLE BELOW.
- 3) PRECAST VAULT TO BE CONSTRUCTED IN ACCORDANCE WITH ASTM C857 AND C858. DETAIL DRAWING REFLECTS DESIGN INTENT ONLY. ACTUAL DIMENSIONS AND CONFIGURATION OF STRUCTURE WILL BE SHOWN ON PRODUCTION SHOP DRAWING.
- 4) STRUCTURE AND ACCESS COVERS TO MEET AASHTO H-20 LOAD RATING.
- 5) VOLUME STORMFILTER REQUIRES 2.0 FEET OF DROP FROM INLET TO OUTLET. IF LESS DROP IS AVAILABLE, CONTACT CONTECH STORMWATER SOLUTIONS.
- 6) INLET AND OUTLET PIPING TO BE SPECIFIED BY ENGINEER AND PROVIDED BY CONTRACTOR. PRECAST VOLUME STORMFILTER VAULT EQUIPPED WITH CAST-IN BOOT CONNECTIONS AT INLET AND OUTLET LOCATIONS FOR WATER-TIGHT CONNECTIONS.
- 7) PROVIDE MINIMUM CLEARANCE FOR MAINTENANCE ACCESS. IF A SHALLOWER SYSTEM IS REQUIRED, CONTACT CONTECH STORMWATER SOLUTIONS FOR OTHER OPTIONS.
- 8) ANTI-FLOTATION BALLAST TO BE SPECIFIED BY ENGINEER AND PROVIDED BY CONTRACTOR, IF REQUIRED. BALLAST TO BE SET ALONG ENTIRE LENGTH OF BOTH SIDES OF THE STRUCTURE.
- 9) ALL STORMFILTERS REQUIRE REGULAR MAINTENANCE. REFER TO OPERATION AND MAINTENANCE GUIDELINES FOR MORE INFORMATION.

AS-BUILT CERTIFICATION

THIS IS NO "AS-BUILT" INFORMATION PROVIDED ON THIS SHEET.
[Signature]
MICHAEL J. ADOCK, PROFESSIONAL LAND SURVEYOR
MD REG. NO. 21257, EXPIRATION DATE: 04-16-21
PRELIMINARY
NOT APPROVED FOR
FABRICATION OR CONSTRUCTION

NOTE:
1. LOCATION OF ALL MANHOLES, STUBS, INLETS, OUTLETS AND OUTLET CONTROL STRUCTURES, TO BE SPECIFIED BY PROJECT ENGINEER OF RECORD PRIOR TO FABRICATION.
2. ALL RECOMMENDED REINFORCING ON THE SYSTEM WILL BE DESIGNED BY MANUFACTURER TO CONFORM TO ASTM A998 AFTER PURCHASE ORDER IS ISSUED.

6' x 12' PRECAST VOLUME STORMFILTER DATA

STRUCTURE ID	SF1
WATER QUALITY VOLUME (ft ³)	2,309
STORAGE IN STORMFILTER (ft ³)	212
# OF CARTRIDGES REQUIRED	10
CARTRIDGE FLOW RATE (1.5 OR 7.5 gpm)	7.5
MEDIA TYPE	XPC59


PIPE DATA:	I.E.	MATERIAL	DIAMETER
INLET PIPE #1	439.6'	CMP	12"
INLET PIPE #2	NA	NA	NA
OUTLET PIPE	437.6'	RCP	15"

RM: 444.00'
444.00' FLOW 444.00'




ANTI-FLOTATION BALLAST	WIDTH	HEIGHT
	NA	NA

NOTES/SPECIAL REQUIREMENTS:

NO	BY	DATE	REVISION
1	KCE	07/16/08	REVISED DIMENSION FOR UNDER GROUND SYSTEM
2	KCE	08/02/08	REVISED NOTE #4
3	KCE	03/01/10	SWM AS-BUILT INFORMATION ADDED

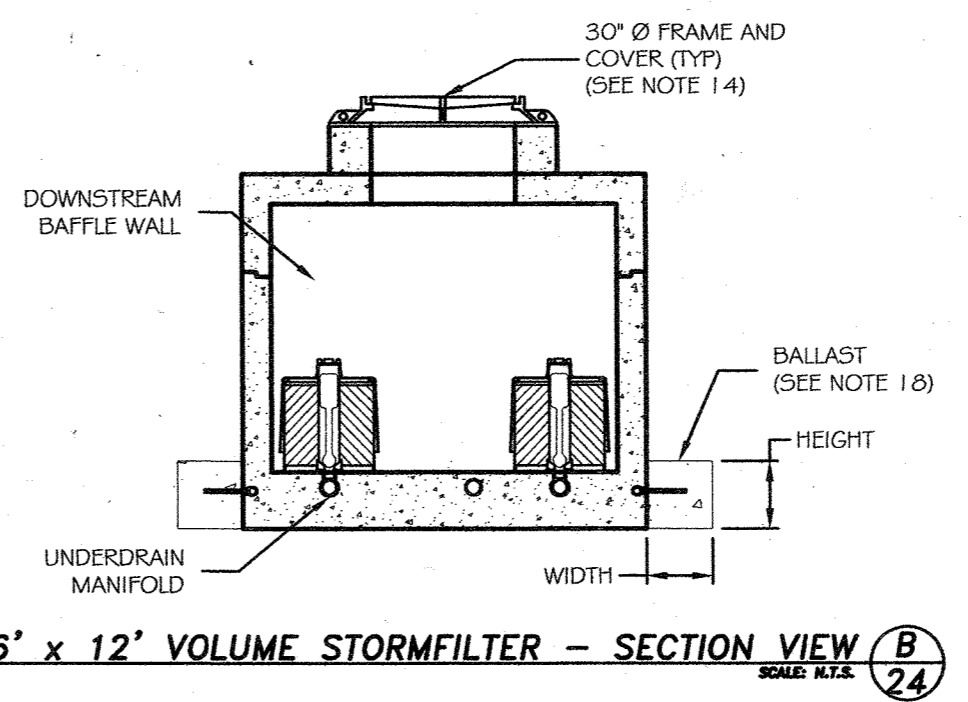

6' x 12' VOLUME STORMFILTER - SECTION VIEW (B)
OWNER:
MANGIONE ENTERPRISES OF TURF VALLEY LIMITED PARTNERSHIP
1205 YORK ROAD, PENTHOUSE
LUTHERVILLE, MARYLAND 21093
PHONE (410) 825-8400

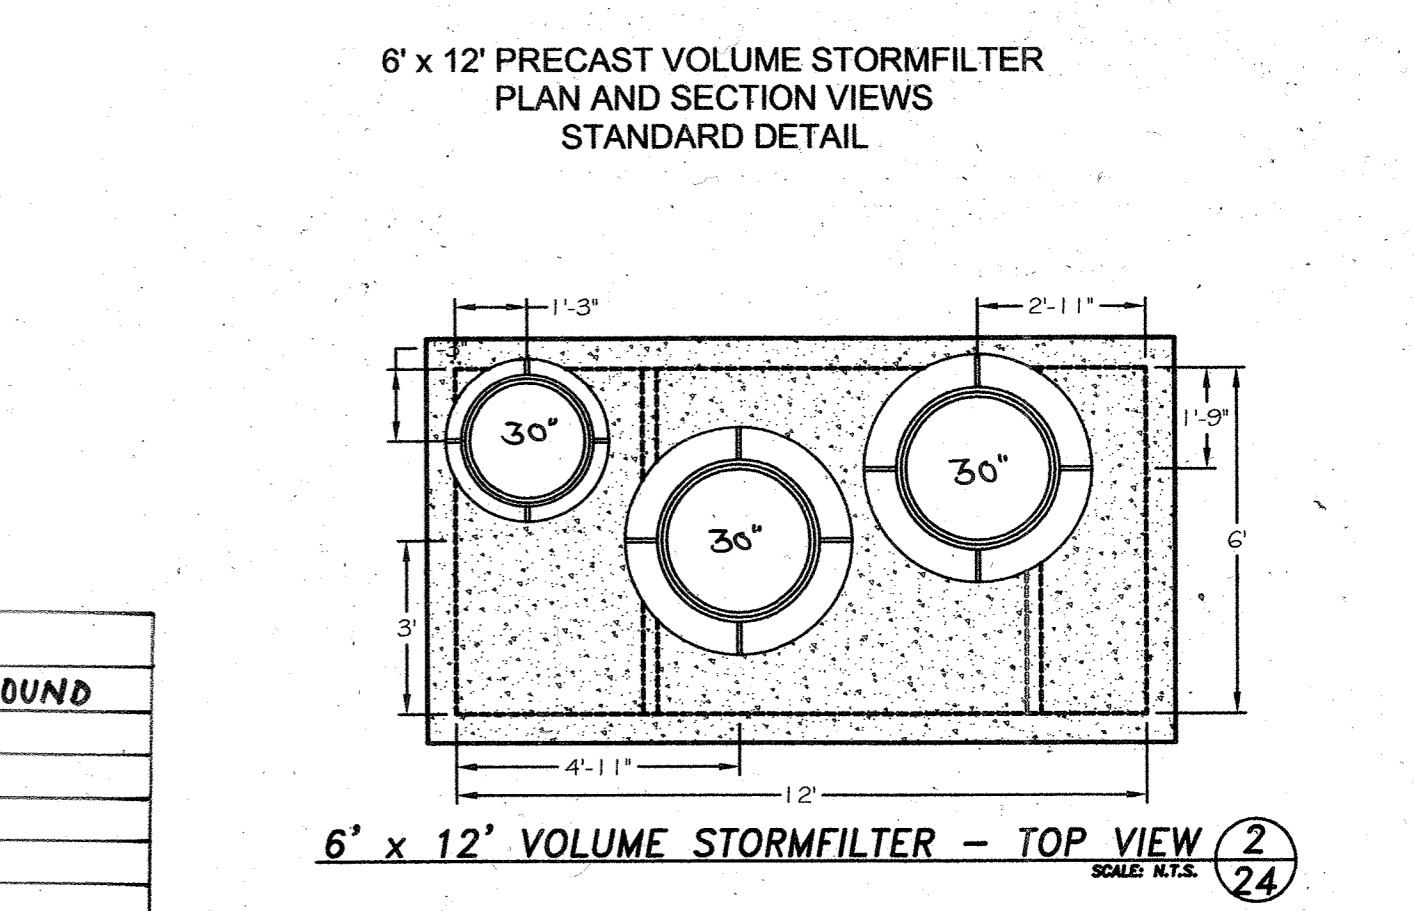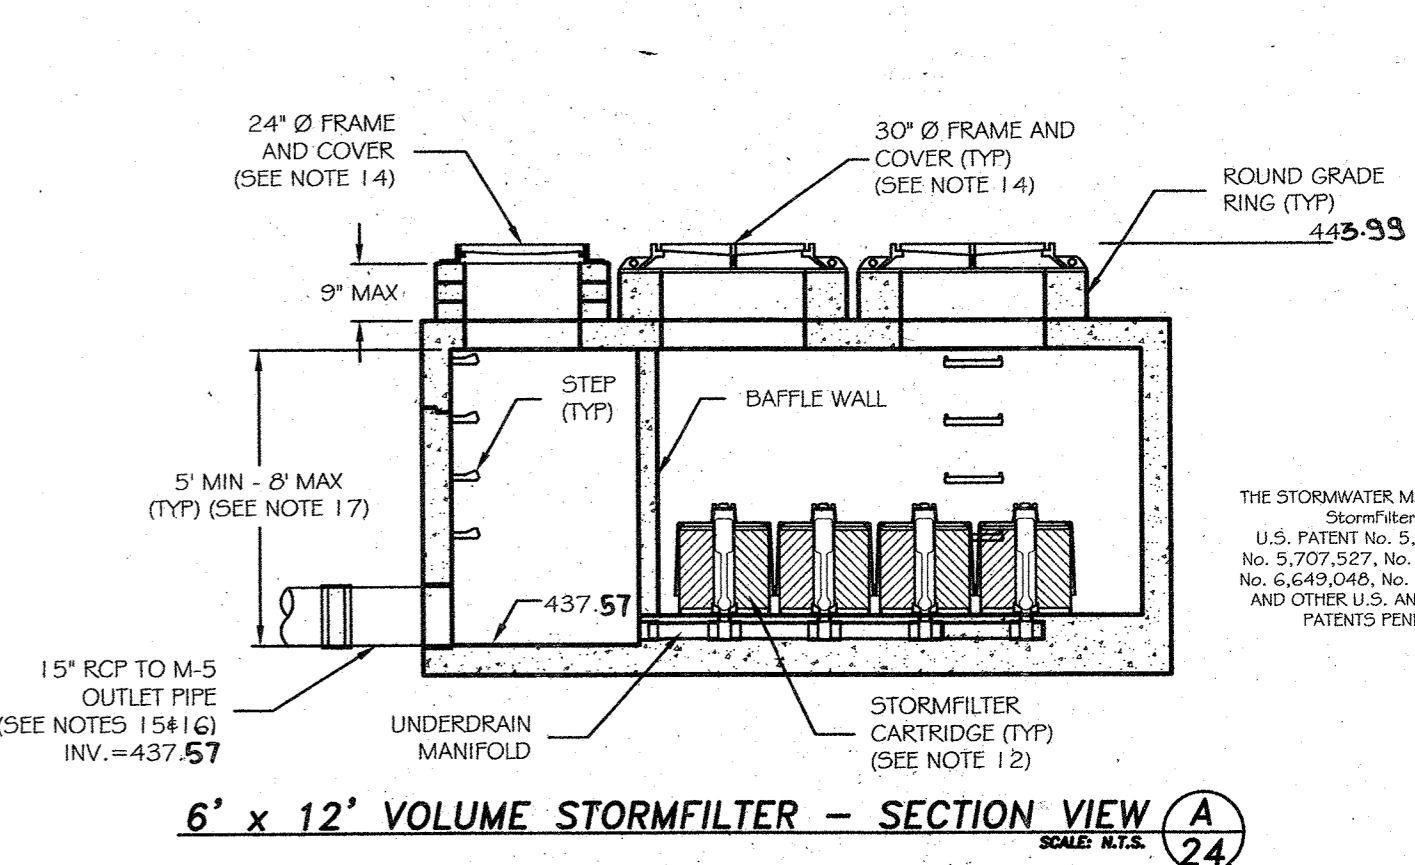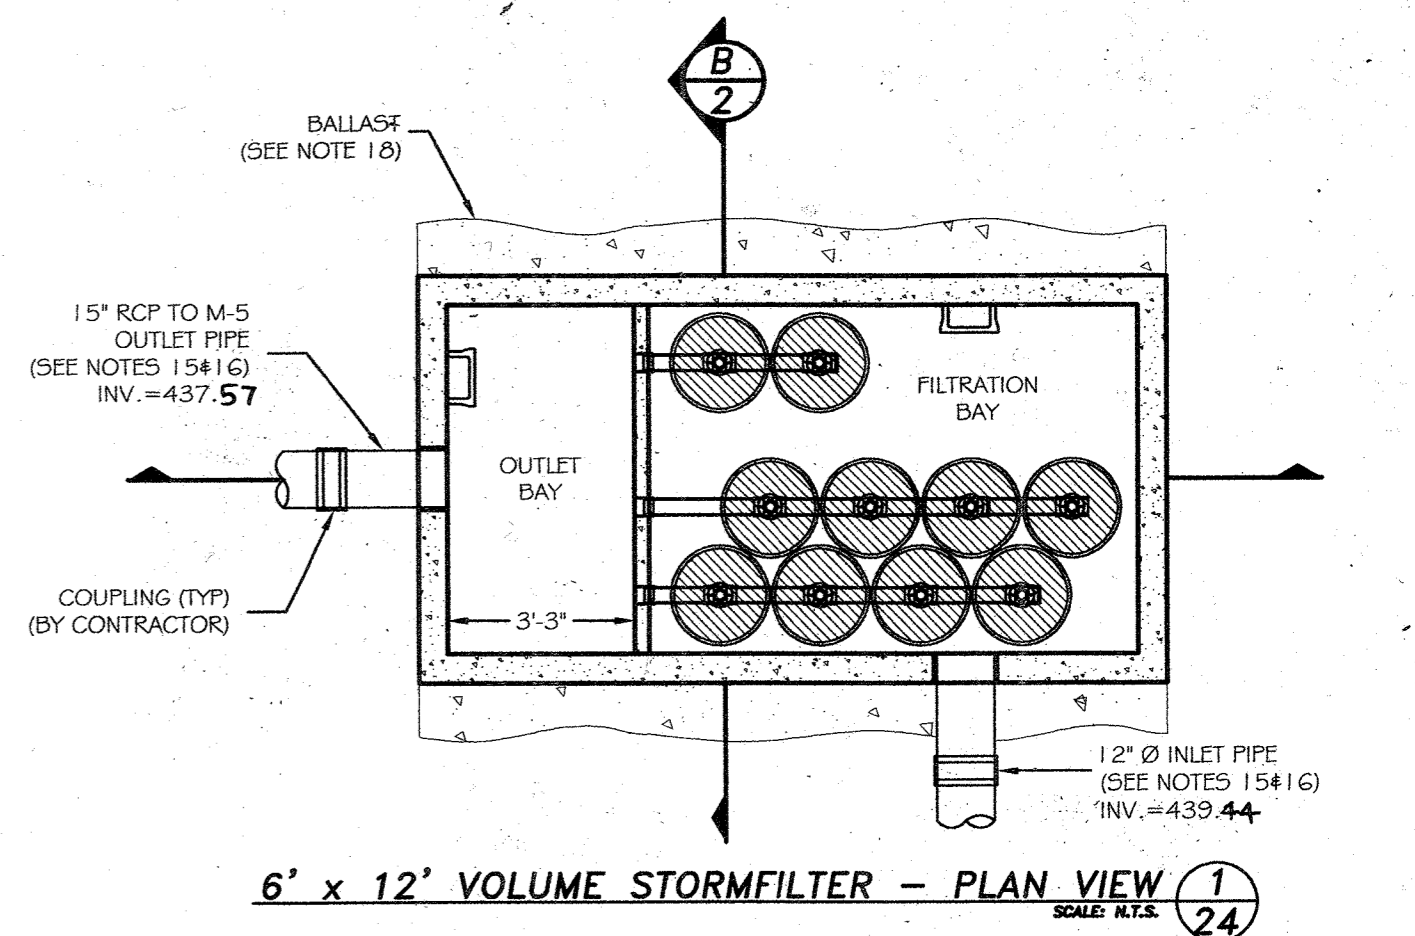


AS-BUILT STORM FILTER LAYOUT PLAN & NOTES
TURF VALLEY, LORIE
NURSING HOME & ASSISTED LIVING FACILITY
OAKMONT AT TURF VALLEY
PARCEL Q
PLATS 18773 - 18775
TAX MAP 16 - P/O PARCEL 8- GRID 16 & 17;
POD 1 per S-86-13 (4th AMENDED)
THIRD ELECTION DISTRICT HOWARD COUNTY, MARYLAND

KCE ENGINEERING, INC.
EXECUTIVE CENTER
3300 NORTH RIDGE ROAD, SUITE 315
ELLICOTT CITY, MARYLAND 21043
PHONE (410) 203-9800 FAX (410) 203-9228

Professional Certification. I hereby certify that these documents were prepared or approved by me, and that I am a duly licensed professional engineer under the laws of the State of Maryland, License No. 8818. Expiration Date: 10/17/08.
DRAWN BY: MG
CHECKED BY: DVK
SCALE: AS SHOWN
DATE: 04/30/2008
SHEET: 27 OF 36





CONTECH ID# 10111

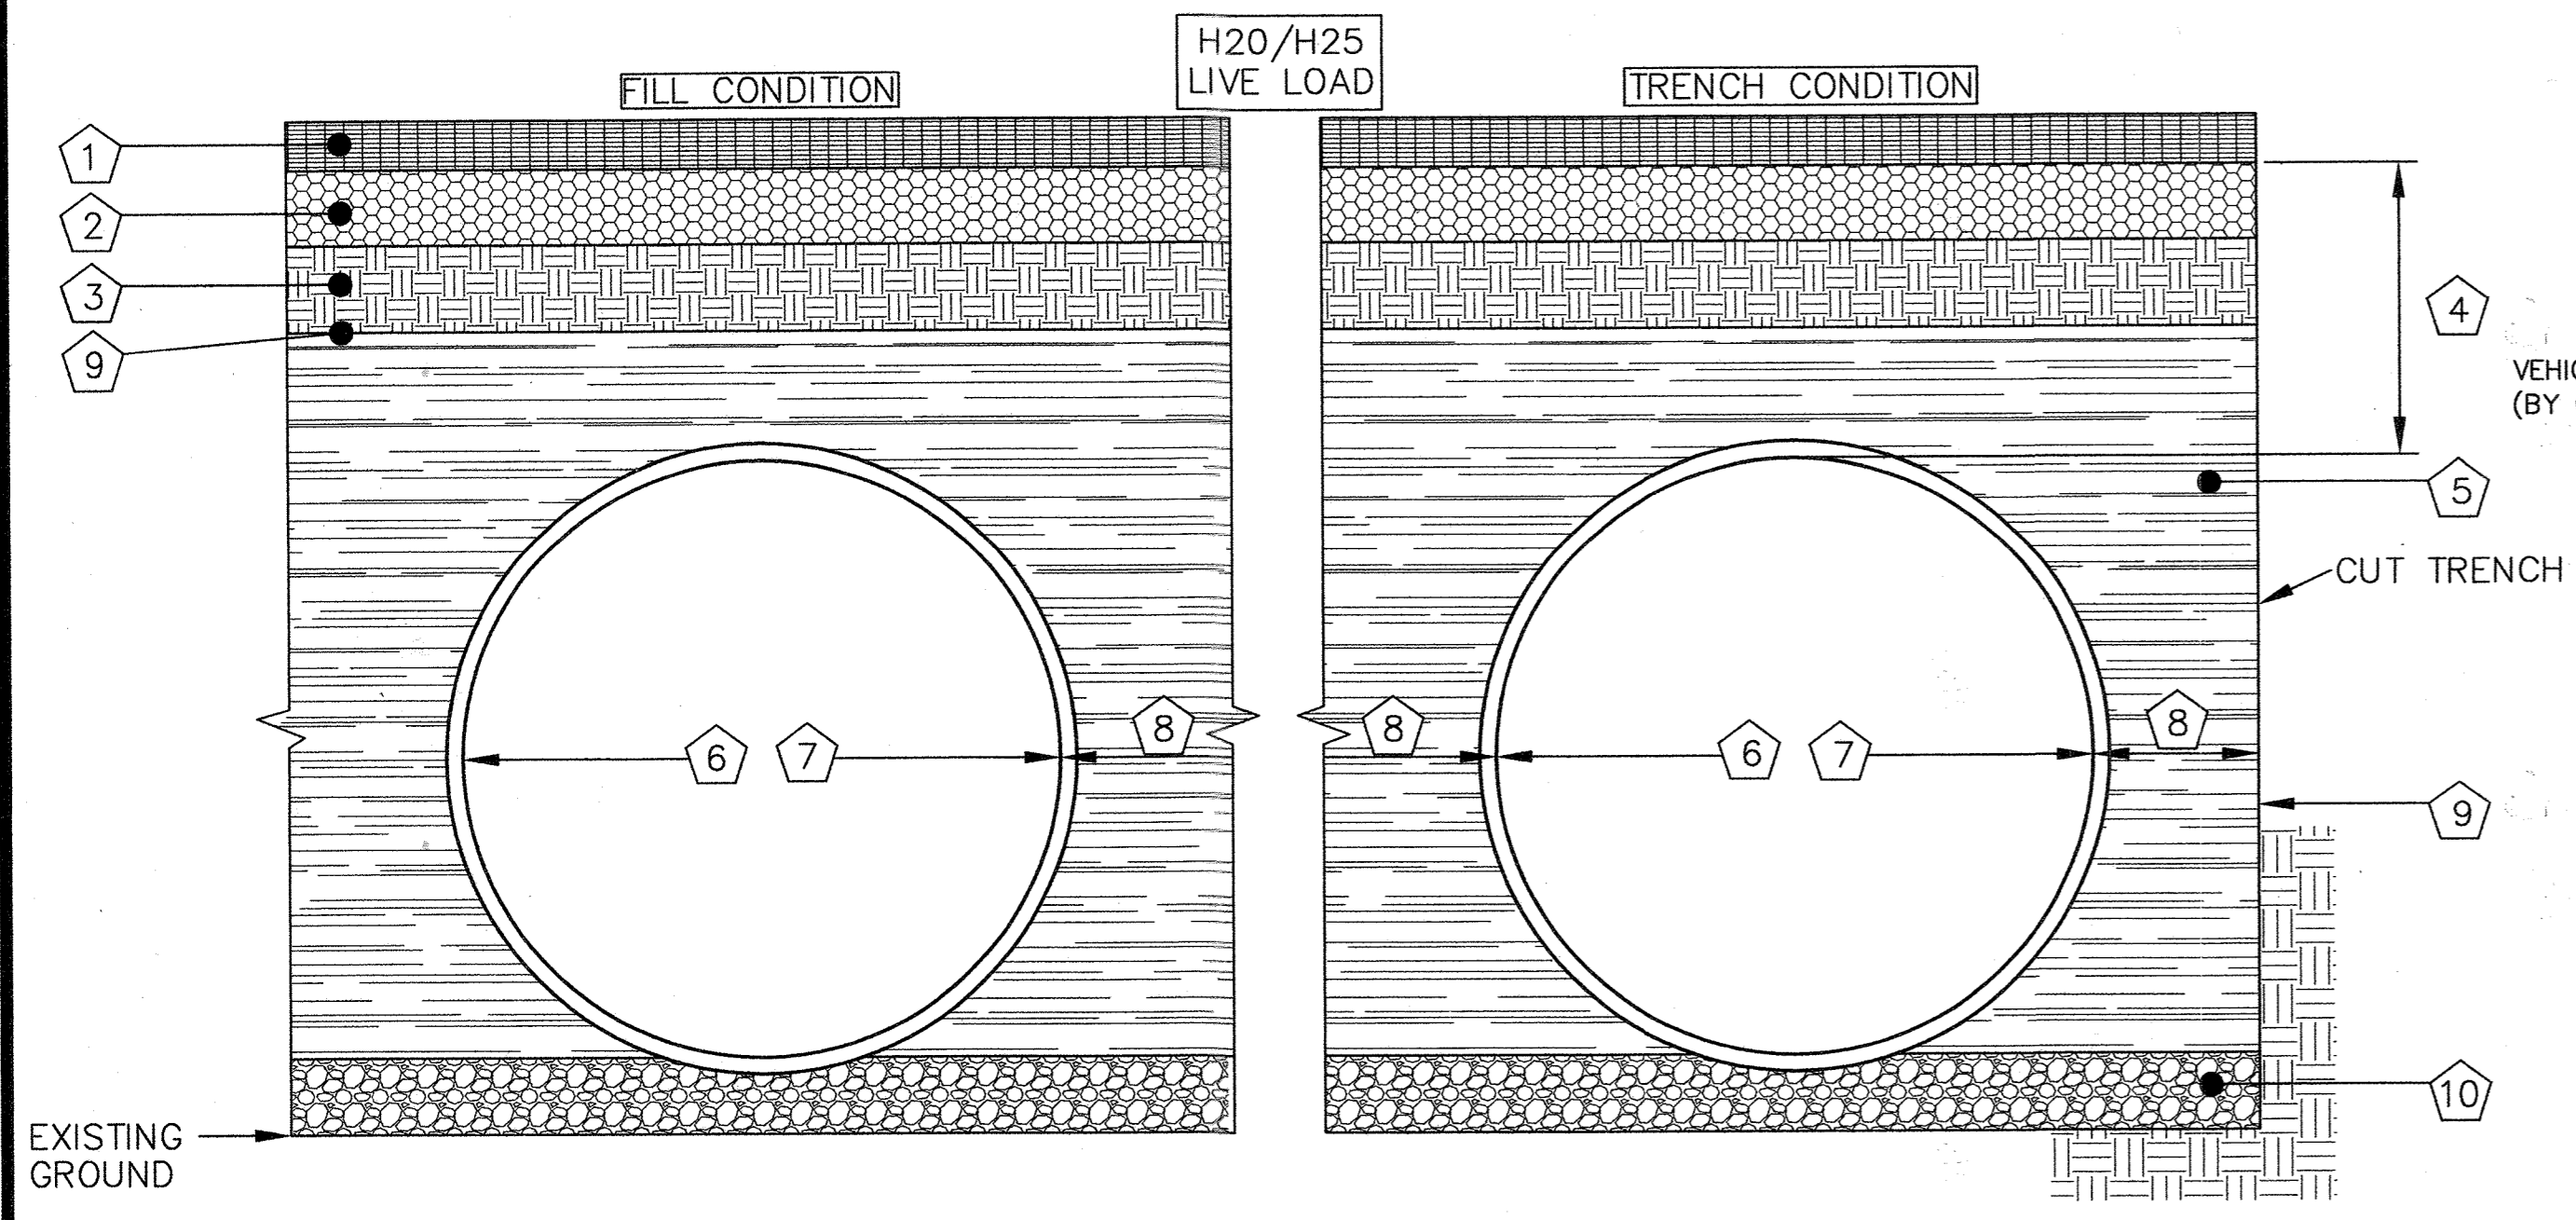


- 1.) RIGID OR FLEXIBLE PAVEMENT
 - 2.) GRANULAR ROAD BASE
 - 3.) NORMAL ROADWAY EMBANKMENT FILL PLACED IN 8" LIFTS AND COMPACTED TO MIN. 90% STANDARD DENSITY PER AASHTO T-99.
 - 4.) 12" MIN. FOR DIAMETERS THROUGH 96" 18" MIN. FOR DIAMETERS FROM 102" AND UP MEASURED FROM TOP OF RIGID OR BOTT. OF FLEXIBLE PAVEMENT.
 - 5.) SELECT GRANULAR FILL PER AASHTO M145 A-1, A-2 OR A-3 OR APPROVED EQUAL. (COMPACTED TO MIN. 90% STANDARD DENSITY PER AASHTO T-99.)
 - 6.) 12"Ø THRU 84"Ø 2 2/3" X 1/2" CSP, GAGE PER AASHTO SECTION 12.
 - 7.) 54"Ø THRU 144"Ø 3" X 1" OR 5" X 1" CSP GAGE PER AASHTO SECTION 12.
 - 8.) STANDARD SPACING IN TABLE, SPECIAL SPACING IS SUBJECT TO APPROVAL BY CONTECH CONSTRUCTION PRODUCTS INC.
- | DIAMETER | REQUIRED SPACING |
|------------|------------------|
| UP TO 24" | 12" |
| 24" - 72" | 1/2 PIPE DIA |
| 72" AND UP | 36" |
- 9.) CONTECH C45 NON-WOVEN GEOTEXTILE AS REQUIRED TO PREVENT SOIL MIGRATION.
 - 10.) RELATIVELY LOOSE GRANULAR BEDDING, ROUGHLY SHAPED TO FIT BOTTOM OF PIPE, 4" TO 6" IN DEPTH. (#57 OR #8 OR OTHER SUITABLE GRANULAR) #57

3
25 SCALE: N.T.S.
BACKFILL DETAIL (SWM F #2)

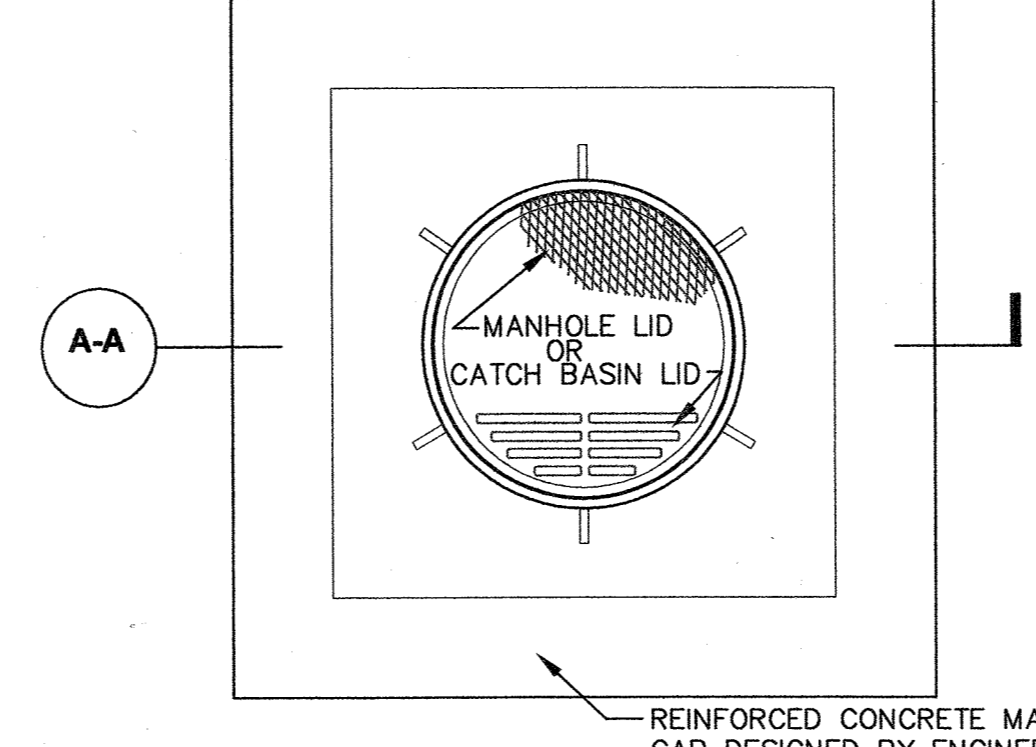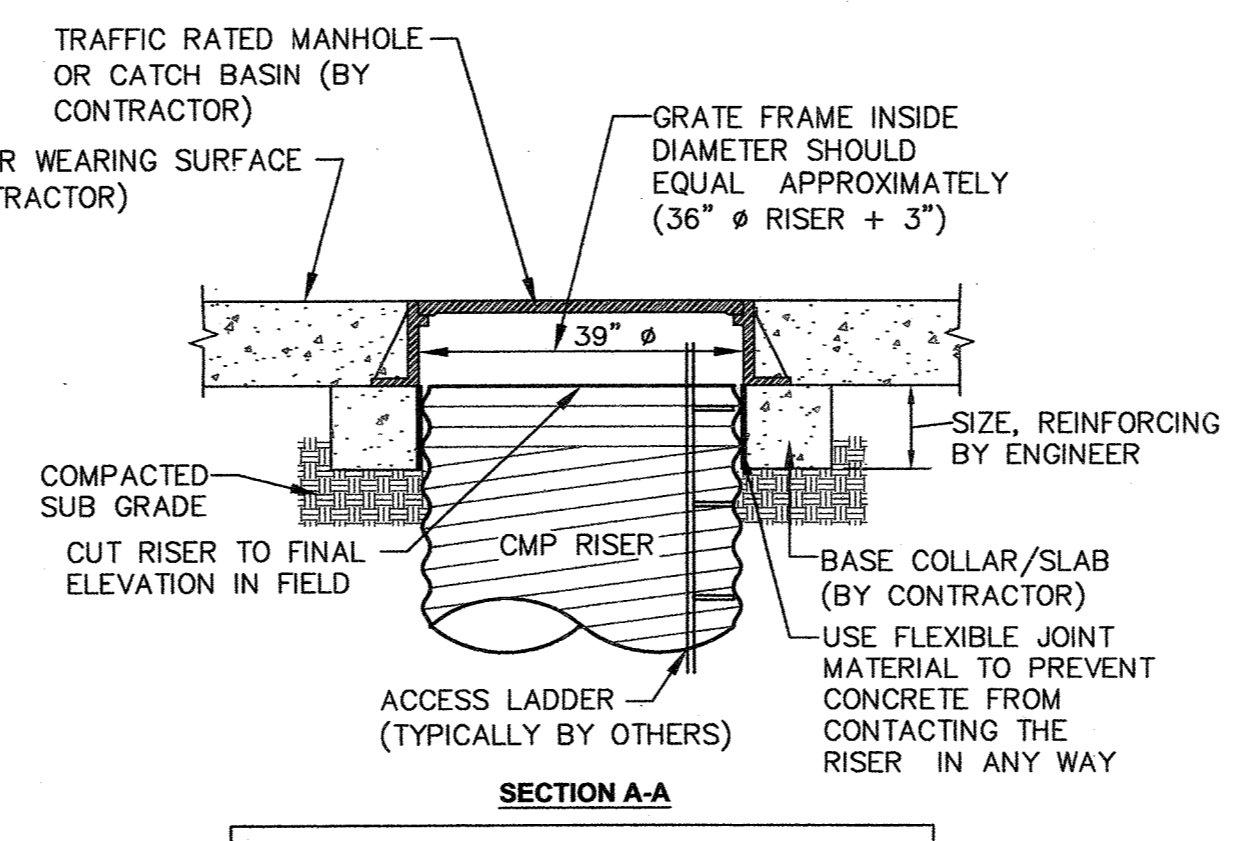

- NOTES:**
1. THE CONCRETE CAP SHALL BE SIZED AND DESIGNED BY OTHERS SO THAT THE LOADS ARE TRANSMITTED TO THE SOIL, AND NOT THE RISER.
 2. THE CONCRETE CAP SHALL BE SIZED TO PROVIDE AN ADEQUATE BOTTOM AREA BASED ON THE ALLOWABLE BEARING CAPACITY OF THE SOIL.
 3. THE FLEXIBLE JOINT MATERIAL (RECYCLED VINYL OR EQ.) TO BE STIFF ENOUGH SO THAT THE CONCRETE CAN NEVER ENGAGE WITH THE RISER CORRUGATIONS.

4
25 SCALE: N.T.S.
MANHOLE CAP DETAIL

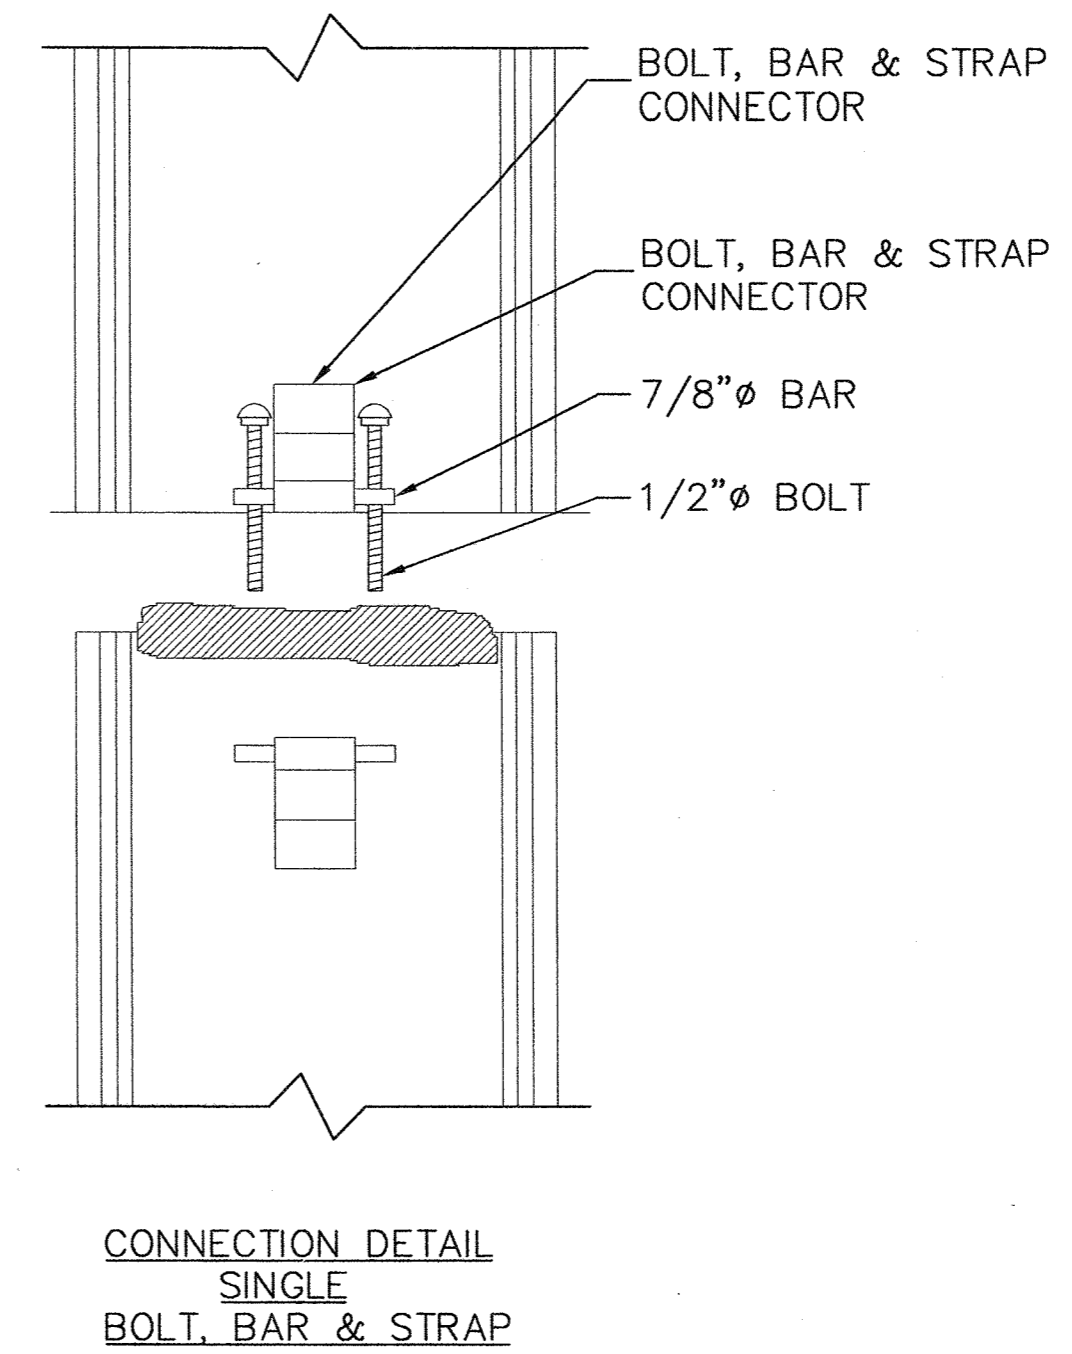


GENERAL NOTES:

1. REFER TO CONTECH BAND SELECTION GUIDE FOR BAND WIDTH, GAGE, AND FASTENER TYPES.
2. BANDS FOR PIPE-ARCH ARE THE SAME AS FOR EQUIVALENT DIAMETER ROUND PIPE.
3. BANDS ARE NORMALLY FURNISHED AS FOLLOWS:
12" THRU 48" 1-PIECE
54" THRU 96" 2-PIECE
102" THRU 144" 3-PIECES.
4. BAND FASTENERS ARE ATTACHED WITH SPOT WELDS, RIVETS OR HAND WELDS. ALL ALUMINUM BANDS, BOTH SINGLE AND DOUBLE BB&S, ARE FURNISHED WITH A 14 GAGE ALUMINUM BACK-UP PLATE WELDED TO THE BAND AND THE STRAP.
5. REROLLED ANNULAR END CORRUGATIONS ARE NORMALLY 2-2/3" X 1/2". DIMENSIONS ARE SUBJECT TO MANUFACTURING TOLERANCES.
6. ORDER SHALL DESIGNATE GASKET OPTION.

NO.	BY	DATE	REVISION
1	KCE	08/01/08	REVISED SHEET TITLE
3	KCE	03/01/10	SWM AS-BUILT INFORMATION ADDED

6
25 SCALE: N.T.S.
H-12 HUGGER BAND DETAIL

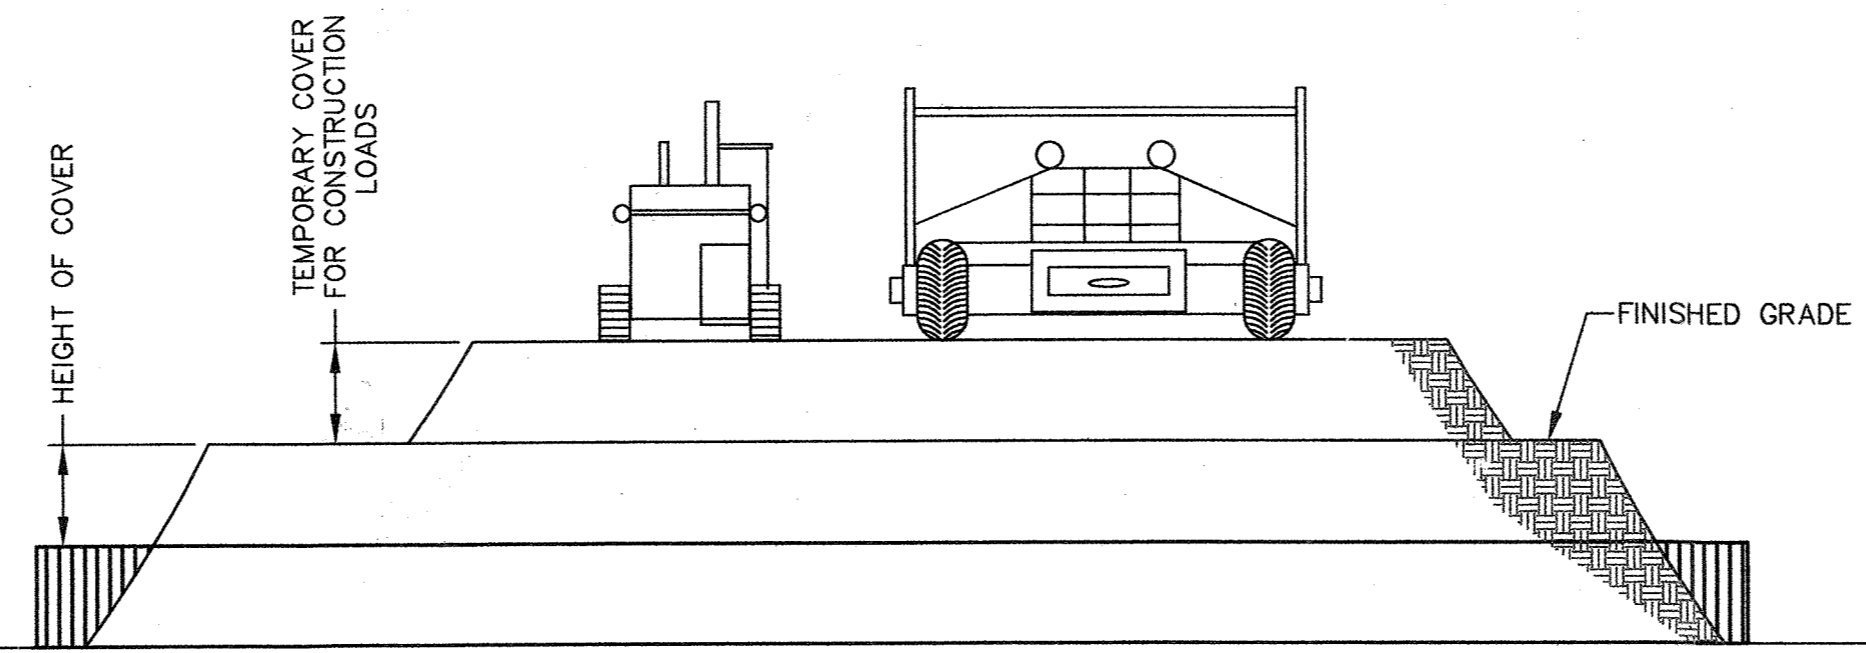

CONSTRUCTION LOADS: FOR TEMPORARY CONSTRUCTION VEHICLE LOADS, AN EXTRA AMOUNT OF COMPACTED COVER MAY BE REQUIRED OVER THE TOP OF THE PIPE. THE HEIGHT-OF-COVER SHALL MEET THE MINIMUM REQUIREMENTS SHOWN IN THE TABLE BELOW. THE USE OF HEAVY CONSTRUCTION EQUIPMENT NECESSITATES GREATER PROTECTION FOR THE PIPE THAN FINISHED GRADE COVER MINIMUMS FOR NORMAL HIGHWAY TRAFFIC.

PIPE SPAN INCHES	AXLE LOADS (kips)			
	18-50	50-75	75-110	110-150
12-42	2.0	2.5	3.0	3.0
48-72	3.0	3.0	3.5	4.0
78-120	3.0	3.5	4.0	4.0
126-144	3.5	4.0	4.5	4.5

*MINIMUM COVER MAY VARY, DEPENDING ON LOCAL CONDITIONS. THE CONTRACTOR MUST PROVIDE THE ADDITIONAL COVER REQUIRED TO AVOID DAMAGE TO THE PIPE. MINIMUM COVER IS MEASURED FROM THE TOP OF THE PIPE TO THE TOP OF THE MAINTAINED CONSTRUCTION ROADWAY SURFACE.

5
25 SCALE: N.T.S.
CONSTRUCTION LOADING DIAGRAM

- NOTE:**
1. LOCATION OF ALL MANHOLES, STUBS, INLETS, OUTLETS AND OUTLET CONTROL STRUCTURES, TO BE SPECIFIED BY PROJECT ENGINEER OF RECORD PRIOR TO FABRICATION.
 2. ALL RECOMMENDED REINFORCING ON THE SYSTEM WILL BE DESIGNED BY MANUFACTURER TO CONFORM TO ASTM A998 AFTER PURCHASE ORDER IS ISSUED.

AS-BUILT CERTIFICATION

THERE IS NO 'AS-BUILT' INFORMATION PROVIDED ON THIS SHEET.

Michael D. Adcock
MICHAEL D. ADCOCK, PROFESSIONAL LAND SURVEYOR
ADDRESS: NO. 01857, EXPIRATION DATE: 04-16-21

07/23/19
DATE

OWNER
MANGIONE ENTERPRISES OF TURF VALLEY
LIMITED PARTNERSHIP
1205 YORK ROAD, PENTHOUSE
LUTHERVILLE, MARYLAND 21093
PHONE (410) 825-8400



CONTECH ID# 10111

PRELIMINARY
NOT APPROVED FOR
FABRICATION OR CONSTRUCTION

APPROVED
PLANNING BOARD
OF HOWARD COUNTY
DATE 3/27/08
BAA

APPROVED: DEPARTMENT OF PLANNING AND ZONING
Michael D. Adcock 6/25/08
Chief, Development Engineering Division
Chris Korte 6/23/08
Chief, Division of Land Development
Barbara A. Leggett 6/29/08
Director

STORMWATER MANAGEMENT CONSTRUCTION DETAILS - II

TURF VALLEY, LORIAN NURSING HOME & ASSISTED LIVING FACILITY
OAKMONT AT TURF VALLEY
AS-BUILT
PARCEL Q
PLATS 18773 - 18775
TAX MAP 16 - P/O PARCEL 8- GRID 16 & 17;
POD I per S-86-13 (4th AMENDED)
THIRD ELECTION DISTRICT HOWARD COUNTY, MARYLAND

KCE ENGINEERING, INC.
EXECUTIVE CENTER
3300 NORTH RIDGE ROAD, SUITE 315
ELLCOTT CITY, MARYLAND 21043
PHONE (410) 203-9800 FAX (410) 203-9228

Professional Certification, I hereby certify that these documents were prepared or approved by me, and that I am a duly licensed professional engineer under the laws of the State of Maryland, License No. 8818, Expiration Date: 10/17/08.

Michael D. Adcock 5/13/08

DRAWN BY: MG
CHECKED BY: DWK
SCALE: AS SHOWN
DATE: 04/30/2008

SHEET: 28 OF 36

MD-378 CONSTRUCTION SPECIFICATIONS

These specifications are appropriate to all ponds within the scope of the Standard for practice MD-378. All references to ASTM and AASHTO specifications apply to the most recent version.

Site Preparation

Areas designated for borrow areas, embankment, and structural works shall be cleared, grubbed and stripped of topsoil. All trees, vegetation, roots and other objectionable material shall be removed. Channel banks and sharp breaks shall be sloped to no steeper than 1:1. All trees shall be cleared and grubbed within 15 feet of the toe of the embankment.

Areas to be covered by the reservoir will be cleared of all trees, brush, logs, fences, rubbish and other objectionable material unless otherwise designated on the plans. Trees, brush, and stumps shall be cut approximately level with the ground surface. For dry stormwater management ponds, a minimum of a 25-foot radius around the inlet structure shall be cleared.

All cleared and grubbed material shall be disposed of outside and below the limits of the dam and reservoir as directed by the owner or his representative. When specified, a sufficient quantity of topsoil will be stockpiled in a suitable location for use on the embankment and other designated areas.

Earth Fill

Material - The fill material shall be taken from approved designated borrow areas. It shall be free of roots, stumps, wood, rubbish, stones greater than 6", frozen or other objectionable materials. Fill material for the center of the embankment, and cut off trench shall conform to Unified Soil Classification GC, SC, CH, or CL and must have at least 30% passing the #200 sieve. Consideration may be given to the use of other materials in the embankment if designed by a geotechnical engineer. Such special designs must have construction supervised by a geotechnical engineer.

Materials used in the outer shell of the embankment must have the capability to support vegetation of the quality required to prevent erosion of the embankment.

Placement - Areas on which fill is to be placed shall be scarified prior to placement of fill. Fill materials shall be placed in maximum 8 inch thick (before compaction) layers which are to be continuous over the entire length of the fill. The most permeable borrow material shall be placed in the downstream portions of the embankment. The principal spillway must be installed concurrently with fill placement and not excavated into the embankment.

Compaction - The movement of the hauling and spreading equipment over the fill shall be controlled so that the entire surface of each lift shall be traversed by not less than one tread track of heavy equipment or compaction shall be achieved by a minimum of four complete passes of a sheepfoot, rubber tired or vibratory roller. Fill material shall contain sufficient moisture such that the required degree of compaction will be obtained with the equipment used. The fill material shall contain sufficient moisture so that if formed into a ball it will not crumble, yet not be so wet that water can be squeezed out. When required by the reviewing agency the minimum required density shall not be less than 95% of maximum dry density with a moisture content within +/-2% of the optimum. Each layer of fill shall be compacted as necessary to obtain that density, and is to be certified by the Engineer at the time of construction. All compaction is to be determined by AASHTO Method T-99 (Standard Proctor).

Cut Off Trench - The cutoff trench shall be excavated into impervious material along or parallel to the centerline of the embankment as shown on the plans. The bottom width of the trench shall be governed by the equipment used for excavation, with the minimum width being four feet. The depth shall be at least four feet below existing grade or as shown on the plans. The side slopes of the trench shall be 1 to 1 or flatter. The backfill shall be compacted with construction equipment, rollers, or hand tampers to assure maximum density and minimum permeability.

Embankment Core - The core shall be parallel to the centerline of the embankment as shown on the plans. The top width of the core shall be a minimum of four feet. The height shall extend up to at least the 10 year water elevation or as shown on the plans. The side slopes shall be 1 to 1 or flatter.

The core shall be compacted with construction equipment, rollers, or hand tampers to assure maximum density and minimum permeability. In addition, the core shall be placed concurrently with the outer shell of the embankment.

Structure Backfill

Backfill adjacent to pipes or structures shall be of the type and quality conforming to that specified for the adjoining fill material. The fill shall be placed in horizontal layers not to exceed four inches in thickness and compacted by hand tampers or other manually directed compaction equipment. The material needs to fill completely all spaces under and adjacent to the pipe. At no time during the backfilling operation shall driven equipment be allowed to operate closer than four feet, measured horizontally, to any part of a structure. Under no circumstances shall a concrete structure or pipe, unless there is a compacted fill of 24" or greater over the structure or pipe. Structure backfill may be flowable fill meeting the requirements of Maryland Department of Transportation, State Highway Administration Standard Specifications for Construction and Materials, Section 313 as modified. The mixture shall have a 100-200 psi; 28 day unconfined compressive strength. The flowable fill shall have a minimum pH of 4.0 and a minimum resistivity of 2,000 ohm-cm. Material shall be placed such that a minimum of 6" (measured perpendicular to the outside of the pipe) of flowable fill shall be under (bedding), over and, on the sides of the pipe. It only needs to extend up to the spring line for rigid conduits. Average slump of the fill shall be 7" to assure flow ability of the material. Adequate measures shall be taken (sandbags, etc.) to prevent floating the pipe. When using flowable fill, all metal pipe shall be bituminous coated. Any adjoining soil fill shall be placed in horizontal layers not to exceed four inches in thickness and compacted by hand tampers or other manually directed compaction equipment. The material shall completely fill all voids adjacent to the flowable fill zone. At no time during the backfilling operation shall driven equipment be allowed to operate closer than four feet, measured horizontally, to any part of a structure. Under no circumstances shall equipment be driven over any part of a structure or pipe unless there is a compacted fill of 24" or greater over the structure or pipe.

Backfill material outside the structural backfill (flowable fill) zone shall be of the type and quality conforming to that specified for the core of the embankment or other embankment materials.

Pipe Conduits

All pipes shall be circular in cross section. **Corrugated Metal Pipe** - All of the following criteria shall apply for corrugated metal pipe:

- 1. Materials - (Polymer Coated steel pipe) Steel pipes with polymeric coatings shall have a minimum coating thickness of 0.01 inch (10 mil) on both sides of the pipe. This pipe and its appurtenances shall conform to the requirements of AASHTO Specifications M-245 & M-246 with watertight coupling bands or flanges. Materials - (Aluminum Coated Steel Pipe) - This pipe and its appurtenances shall conform to the requirements of AASHTO Specification M-274 with watertight coupling bands or flanges. Aluminum Coated Steel Pipe, when used with flow able fill or when soil and/or water conditions warrant for increased durability, shall be fully bituminous coated per requirements of AASHTO Specification M-190 Type A. Any aluminum coating damaged or otherwise removed shall be replaced with cold applied bituminous coating compound. Aluminum surfaces that are to be in contact with concrete shall be painted with one coat of zinc chromate primer or two coats of asphalt. Materials - (Aluminum Pipe) - This pipe and its appurtenances shall conform to the requirements of AASHTO Specification M-196 or M-211 with watertight coupling bands or flanges. Aluminum Pipe, when used with flowable fill or when soil and/or water conditions warrant for increased durability, shall be fully bituminous coated per requirements of AASHTO Specification M-190 Type A. Aluminum surfaces that are to be in contact with concrete shall be painted with one coat of zinc chromate primer or two coats of asphalt. Hot dip galvanized bolts may be used for connections. The pH of the surrounding soils shall be between 4 and 9.
- 2. Coupling bands, anti-seep collars, end sections, etc., must be composed of the same material and coatings as the pipe. Metals must be insulated from dissimilar materials with use of rubber or plastic insulating materials at least 24 mils in thickness.

3. Connections - All connections with pipes must be completely watertight. The drain pipe or barrel connection to the riser shall be welded all around when the pipe and riser are metal. Anti-seep collars shall be connected to the pipe in such a manner as to be completely watertight. Dimple bands are not considered to be watertight.

All connections shall use a rubber or neoprene gasket when joining pipe sections. The end of each pipe shall be re-rolled an adequate number of corrugations to accommodate the bandwidth. The following type connections are acceptable for pipes less than 24 inches in diameter: flanges on both ends of the pipe with a circular 3/8 inch closed cell neoprene gasket, pre-punched to the flange bolt circle, sandwiched between adjacent flanges; a 12-inch wide standard lap type band with 12-inch wide by 3/8-inch thick closed cell circular neoprene gasket; and a 12-inch wide hugger type band with o-ring gaskets having a minimum diameter of 1/2 inch greater than the corrugation depth. Pipes 24 inches in diameter and larger shall be connected by a 24 inch long annular corrugated band using a minimum of 4 (four) rods and lugs, 2 on each connecting pipe end. A 24-inch wide by 3/8-inch thick closed cell circular neoprene gasket will be installed with 12 inches on the end of each pipe. Flanged joints with 3/8 inch closed cell gaskets the full width of the flange is also acceptable. Helically corrugated pipe shall have either continuously welded seams or have lock seams with internal caulking or a neoprene bead.

4. Bedding - The pipe shall be firmly and uniformly bedded throughout its entire length. Where rock or soft, spongy or other unstable soil is encountered, all such material shall be removed and replaced with suitable earth compacted to provide adequate support.

5. Backfilling shall conform to "Structure Backfill".

6. Other details (anti-seep collars, valves, etc.) shall be as shown on the drawings.

Reinforced Concrete Pipe - All of the following criteria shall apply for reinforced concrete pipe:

- 1. Materials - Reinforced concrete pipe shall have bell and spigot joints with rubber gaskets and shall equal or exceed ASTM C-361.
- 2. Bedding - Reinforced concrete pipe conduits shall be laid in a concrete bedding / cradle for

their entire length. This bedding / cradle shall consist of high slump concrete placed under the pipe and up the sides of the pipe at least 50% of its outside diameter with a minimum thickness of 6 inches. Where a concrete cradle is not needed for structural reasons, flowable fill may be used as described in the "Structure Backfill" section of this standard. Gravel bedding is not permitted.

3. Laying pipe - Bell and spigot pipe shall be placed with the bell end upstream. Joints shall be made in accordance with recommendations of the manufacturer of the material. After the joints are sealed for the entire line, the bedding shall be placed so that all spaces under the pipe are filled. Care shall be exercised to prevent any deviation from the original line and grade of the pipe. The first joint must be located within 4 feet from the riser.

4. Backfilling shall conform to "Structure Backfill".

5. Other details (anti-seep collars, valves, etc.) shall be as shown on the drawings.

Plastic Pipe - The following criteria shall apply for plastic pipe:

- 1. Materials - PVC pipe shall be PVC-1120 or PVC-1220 conforming to ASTM D-2241. Corrugated High Density Polyethylene (HDPE) pipe, couplings and fittings shall conform to the following: 4" - 10" inch pipe shall meet the requirements of AASHTO M252 Type S, and 12" through 24" inch shall meet the requirements of AASHTO M294 Type S.
- 2. Joints and connections to anti-seep collars shall be completely watertight.
- 3. Bedding -The pipe shall be firmly and uniformly bedded throughout its entire length. Where rock or soft, spongy or other unstable soil is encountered, all such material shall be removed and replaced with suitable earth compacted to provide adequate support.
- 4. Backfilling shall conform to "Structure Backfill".
- 5. Other details (anti-seep collars, valves, etc.) shall be as shown on the drawings.

Drainage Diaphragms - When a drainage diaphragm is used, a registered professional engineer will supervise the design and construction inspection.

Concrete

Concrete shall meet the requirements of Maryland Department of Transportation, State Highway Administration Standard Specifications for Construction and Materials, Section 414, Mix No.3.

Rock Riprap

Geotextile shall be placed under all riprap and shall meet the requirements of Maryland Department of Transportation, State Highway Administration Standard Specifications for Construction and Materials, Section 921.09, Class C.

Care of Water during Construction

All work on permanent structures shall be carried out in areas free from water. The Contractor shall construct and maintain all temporary dikes, levees, cofferdams, drainage channels, and stream diversions necessary to protect the areas to be occupied by the permanent works. The contractor shall also furnish, install, operate, and maintain all necessary pumping and other equipment required for removal of water from various parts of the work and for maintaining the excavations, foundation, and other parts of the work free from water as required or directed by the engineer for constructing each part of the work. After having served their purpose, all temporary protective works shall be removed or leveled and graded to the extent required to prevent obstruction in any degree whatsoever of the flow of water to the spillway or outlet works and so as not to interfere in any way with the operation or maintenance of the structure. Stream diversions shall be maintained until the full flow can be passed through the permanent works. The removal of water from the required excavation and the foundation shall be accomplished in a manner and to the extent that will maintain stability of the excavated slopes and bottom required excavations and will allow satisfactory performance of all construction operations. During the placing and compacting of material in required excavations, the water level at the locations being refilled shall be maintained below the bottom of the excavation at such locations which may

require draining the water sumps from which the water shall be pumped.

Stabilization

Erosion and Sediment Control

APPROVED PLANNING BOARD OF HOWARD COUNTY DATE 3/27/08 [Signature] [Signature] [Signature]

CONTECH STORMWATER SOLUTIONS. Maintenance Inspection Cleaning AS-BUILT CERTIFICATION

CONTECH STORMWATER SOLUTIONS. Inspection & Maintenance Log

OWNER MANGIONE ENTERPRISES OF TURF VALLEY LIMITED PARTNERSHIP 1205 YORK ROAD, PENTHOUSE LUTHERVILLE, MARYLAND 21093 PHONE (410) 825-8400 AS-BUILT MD-378 CONSTRUCTION SPECIFICATIONS OPERATION & MAINTENANCE SCHEDULE - I TURF VALLEY, LORIE NURSING HOME & ASSISTED LIVING FACILITY OAKMONT AT TURF VALLEY PARCEL Q PLATS 18773 - 18775 TAX MAP 16 - P/O PARCEL 8- GRID 16 & 17; POD 1 per S-86-13 (4th AMENDED) THIRD ELECTION DISTRICT HOWARD COUNTY, MARYLAND KCE ENGINEERING, INC. EXECUTIVE CENTER 3300 NORTH RIDGE ROAD, SUITE 315 ELLICOTT CITY, MARYLAND 21043 PHONE (410) 203-9800 FAX (410) 203-9228

STORMVAULT™ INSPECTION AND MAINTENANCE

The Stormvault™ Mitigation System by CON/SPAN® is specifically designed to treat stormwater runoff to the Maximum Extent Practicable. The Stormvault™ System is designed to capture and hold floatable debris, free oils and greases, settleable sediments and those dissolved pollutants including metals, nitrates and phosphates, which may adsorb or adhere to the surface of sediments and organic debris in stormwater. In order to insure efficient operation and achieve the desired pollutant removal rates, several important inspection and maintenance functions must periodically be performed. The inspection and maintenance are both to be performed during dry periods in which no flow is entering the Stormvault™ System and water has returned to the permanent pool elevation. These procedures are described more fully below.

INSPECTION

The Stormvault™ Mitigation System by CON/SPAN® is to be inspected bi-annually to ensure the system is in proper working order. The twice-yearly observation should consist of no more than four person-hours per visit, but depends upon the size of the Stormvault™ System. The inspection includes opening each manhole cover and visually inspecting for excess floating debris. The effluent chamber is to be inspected to verify that the control office within the standpipe is free of any trash or debris. In addition to the visual inspection, the first several chambers should be probed to gain an estimate of the collected sediment in the bottom of the vault. It is important to record the depth of these chambers to estimate when the next required maintenance should be performed. The removal of collected sediments is to be performed once the average depth of the vault reaches 6 inches. The hydrocarbon mats, which float on the surface of the Stormvault™ System, are designed to remove free oils and greases from stormwater runoff. The mats are attached to the manhole access using a lanyard. The mats within the system are designed site-by-site basis. These mats must be inspected as part of the bi-annual cycle. These mats will be a granular solid white when initially installed and will turn darker as they absorb free oils and greases. The mats should be inspected twice yearly to ensure that some white granular portions of the mat remain. The mats may collect some surface sediment; however, only when they change to a solid dark color uniformly throughout the granular medium do they need to be replaced.

MAINTENANCE

The removal of collected sediments is to be performed once an average depth of 6 inches has been reached in the vault. The hydrocarbon sorbent mats are to be replaced once the mats turn completely dark in color and can no longer absorb any free oils and greases. The maintenance cycle for each Stormvault™ unit will vary as it is a function of the size, type, and volume of pollutants in the stormwater runoff for that particular site. Previous monitoring and investigation of existing Stormvault™ units has resulted in a recommended maintenance cycle of 4-5 years for both removal of sediment and replacement of hydrocarbon sorbent mats. A site-specific maintenance cycle can easily be determined by the bi-annual inspections.

Removal of accumulated materials:

It is recommended that a professional pumping contractor, trained and licensed to remove and dispose of captured sediment material, perform this task. The contractor will lower a nozzle and hose into each chamber and pump the collected material into a vacuum truck. The contractor is to remove only the 6 inches of sediment and not the water in the permanent pool during vacuuming. This will minimize the amount of material which the contractor must dispose.

Be aware that the captured sediments are by their nature easy to resuspend. Great care shall be taken to prevent any turbulence that may cause mixing and resuspension of the settled materials. The contractor must verify proper disposal with the local jurisdiction. An analysis of the materials may be required before disposal. Because of dilution by the water in the permanent pool, harmful pollutant concentrations are rarely reached.

Replacement of hydrocarbon sorbent mats:

To remove the mats, locate the lanyard attached to the inside of the access cover and pull them out. Care should be taken in lifting the mats out through the manholes, as the saturated mats can weigh up to five times as much as new mats. The used mats should be disposed of as directed by the local authority. Generally this is in a similar manner used to dispose of drain-off or similar materials. Replace the mats in like fashion by slipping the new mats to the keeper lines. New mats can be obtained by contacting the CON/SPAN® office nearest you.

NOTE:

The Stormvault™ Mitigation System by CON/SPAN® is a confined space and entry is not recommended. Enter only when necessary and with the proper equipment, following OSHA confined space entry procedures.



Operation and Maintenance

The Stormwater Management StormFilter®

Vault, Cast-In-Place, and Linear Units

Important: These guidelines should be used as a part of your site stormwater management plan.

Description

The Stormwater Management StormFilter® (StormFilter) is a passive, flow-through, stormwater filtration system. The system is comprised of one or more vaults that house rechargeable, media-filled, filter cartridges. The StormFilter works by passing stormwater through the media-filled cartridges, which trap particulates and adsorb materials such as dissolved metals and hydrocarbons. Once filtered through the media, the treated stormwater is directed to a collection pipe or discharged into an open channel drainage way.

The StormFilter is offered in multiple configurations, including vault, linear, catch basin, manhole, and cast-in-place. The vault, linear, manhole, and catch basin models utilize pre-manufactured units to ease the design and installation processes. The cast-in-place units are customized for larger flows and may be either covered or uncovered underground units.

Purpose

The StormFilter is a passive, flow-through, stormwater filtration system designed to improve the quality of stormwater runoff from the urban environment before it enters receiving waterways. It is intended to function as a Best Management Practice (BMP) to meet federal, state, and local

Basic Function

The StormFilter is designed to siphon stormwater runoff through a filter cartridge containing media. A variety of filter media is available and can be customized for each site to target and remove the desired levels of sediments, dissolved phosphorus, dissolved metals, organics, and oil and grease. In many cases, a combination of media is recommended to maximize the effectiveness of the stormwater pollutant removal.

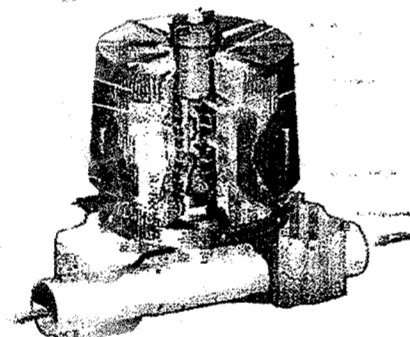


Figure 1. The StormFilter Cartridge

Priming System Function

When stormwater in the StormFilter unit enters a StormFilter cartridge, it percolates horizontally through the cartridge's filter media and collects in the center tube of the cartridge, where the float in the cartridge is in a closed (downward) position.

Water continues to pass through the filter media and into the cartridge's center tube. The air in the cartridge is displaced by the water and purged from beneath the filter hood through the one-way check valve located in the cap. Once the center tube is filled with water (approximately 18 inches deep), there is enough buoyant force on the float to open the float valve and allow the treated water in the center tube to flow into the under-drain manifold. This causes the check valve to close, initiating a siphon that draws polluted water throughout the full surface area and volume of the filter. Thus,

requirements for treating runoff in compliance with the Clean Water Act.

Through independent third party studies, it has been demonstrated that the StormFilter is highly effective for treatment of first flush flows and for treatment of low-paced flows during the latter part of a storm. In general, the StormFilter's efficiency is highest when pollutant concentrations are highest. The primary non-point source pollutants targeted for removal by the StormFilter are: suspended solids (TSS), oil and grease, soluble metals, nutrients, organics, and trash and debris.

Sizing

The StormFilter is sized to treat the peak flow of a water quality design storm. The peak flow is determined from calculations based on the contributing watershed hydrology and from a design storm magnitude set by the local stormwater management agency. The particular size of a StormFilter unit is determined by the number of filter cartridges (see Figure 1) required to treat this peak flow.

The flow rate through each filter cartridge is adjustable, allowing control over the amount of contact time between the influent and the filter media. The maximum flow rate through each cartridge can be adjusted to between 5 and 15 gpm using a calibrated restrictor disc at the base of each filter cartridge. Adjustments to the cartridge flow rate will affect the number of cartridges required to treat the peak flow.

the entire filter cartridge is used to filter water throughout the duration of the storm, regardless of the water surface elevation in the unit. This siphon continues until the water surface elevation drops to the elevation of the hood's scrubbing regulators.

The cartridges are connected to the under-drain manifold with a plastic connector. Since some media used is potentially buoyant, a threaded connector affixed to the under-drain manifold (with glue or other adhesive) is necessary to ensure that the cartridge isn't lifted out of place. For the heavier compost media, a slip connector is used.

The StormFilter is also equipped with flow spreaders that trap floating debris and surface films, even during overflow conditions. Depending on individual site characteristics, some systems are equipped with high and/or base flow bypasses. High flow bypasses are installed when the calculated peak storm event generates a flow that overcomes the overflow capacity of the system. This is especially important for precast systems. Base flow bypasses are sometimes installed to bypass continuous inflows caused by ground water seepage, which usually do not require treatment. All StormFilter units are designed with an overflow. The overflow operates when the inflow rate is greater than the treatment capacity of the filter cartridges.

Ultimately, inspection and maintenance activities should be scheduled based on the historic records and characteristics of an individual StormFilter system. It is recommended that the maintenance agency develop a database to properly manage StormFilter maintenance programs.

Prior to the development of the maintenance database, the following maintenance frequencies should be followed:

Inspection/minor maintenance
 • One time per year
 • After Major Storms

Major maintenance
 • One time per year
 • In the event of a chemical spill

Frequencies should be updated as required.

Maintenance Guidelines

The primary purpose of the StormFilter is to filter out and prevent pollutants from entering our waterways. Like any effective filtration system, periodically these pollutants must be removed to restore the StormFilter to its full efficiency and effectiveness.

Maintenance requirements and frequency are dependent on the pollutant load characteristics of each site.

Maintenance activities may be required in the event of a chemical spill or due to excessive sediment loading from site erosion or extreme storms. It is also good practice to inspect the system after severe storm events.

Types of Maintenance

Presently, procedures have been developed for two levels of maintenance:

- Inspection/minor maintenance
- Major maintenance.

Inspection/minor maintenance activities are combined since minor maintenance does not require special equipment and typically little or no materials are in need of disposal.

Inspection/minor maintenance typically involves:

- Inspection of the vault itself
- Removal of vegetation and trash and debris.

Major maintenance typically includes:

- Cartridge replacement
- Sediment removal

Important: Applicable safety (OSHA) and disposal regulations should be followed during all maintenance activities.

Maintenance Activity Timing

A properly functioning system will remove solids from water by trapping particulates in the porous structure of the filter media. The flow through the system will naturally decrease as more and more solids are trapped. Eventually the flow through the system will be low enough to require replacement of the cartridges. It may be possible to extend the usable span of the cartridges by removing sediment from upstream trapping devices on an as-needed basis in order to prevent material from being re-suspended and discharged to the system.

Site conditions greatly influence maintenance requirements. StormFilter units located in areas with erosion or active construction should be inspected and maintained more often than those in fully stabilized areas.

The maintenance frequency may be adjusted as additional monitoring information becomes available during the inspection program. Areas that develop known problems should be inspected more frequently than areas that demonstrate no problems, particularly after large storms.

Ultimately, inspection and maintenance activities should be scheduled based on the historic records and characteristics of an individual StormFilter system. It is recommended that the maintenance agency develop a database to properly manage StormFilter maintenance programs.

Prior to the development of the maintenance database, the following maintenance frequencies should be followed:

Inspection/minor maintenance
 • One time per year
 • After Major Storms

Major maintenance
 • One time per year
 • In the event of a chemical spill

Frequencies should be updated as required.

Two scheduled inspections/maintenance activities should take place during the year.

First, an inspection/minor maintenance activity should be done. During the minor maintenance activity (routine inspection, debris removal), the need for major maintenance should be determined and, if disposal during major maintenance will be required, samples of the sediments and media should be obtained.

Second, if required, a major maintenance activity (replacement of the filter cartridges and associated sediment removal) should be performed.

In addition to these two scheduled activities, it is important to check the condition of the StormFilter unit after major storms for damage caused by high flows and for high sediment accumulation that may be caused by localized erosion in the drainage area. It may be necessary to adjust the maintenance activity schedule depending on the actual operating conditions encountered by the system.

In general, minor maintenance activities will occur late in the rainy season, and major maintenance will occur in late summer to early fall when flows into the system are not likely to be present.

Maintenance Activity Frequency

The primary factor controlling timing of maintenance for the StormFilter is sedimentation.

Important: This activity will require that workers enter the vault to remove the cartridges from the drainage system.

Method 1:
 a. Using an appropriate sling, attach the cable from the boom, crane, or tripod to the cartridge being removed. Contact CONTECH Stormwater Solutions for specifications on appropriate attachment devices.
 This activity will require that workers enter the vault to remove the cartridges from the drainage system and place them under the vault opening for lifting.
Important: Note that cartridges containing media other than the leaf media require unscrewing from their threaded connectors. Take care not to damage the manifold connectors. This connector should remain installed in the manifold and capped if necessary.
 b. Remove the used cartridges (250 lbs. each) from the vault.
Important: Care must be used to avoid damaging the cartridges during removal and installation. The cost of repairing components damaged during maintenance will be the responsibility of the owner unless CONTECH Stormwater Solutions performs the maintenance activities and damage is not related to discharges to the system.
 c. Set the used cartridge aside or load onto the hauling truck.
 d. Continue steps a through c until all cartridges have been removed.

Method 2:
 a. If applicable, set up safety equipment to protect pedestrians from fall hazards due to open vault doors or when work is being done near walkways or roadways.
 b. Visually inspect the external condition of the unit and take notes concerning defects/problems.

Warning: In the case of a spill, the worker should abort maintenance activities until the proper guidance is obtained. Notify the local hazard control agency and CONTECH Stormwater Solutions immediately.

To conduct an inspection and/or minor maintenance:
Important: Maintenance must be performed by a utility worker familiar with StormFilter units.

1. If applicable, set up safety equipment to protect pedestrians from fall hazards due to open vault doors or when work is being done near walkways or roadways.
 2. Visually inspect the external condition of the unit and take notes concerning defects/problems.

3. Open the doors to the vault and allow the system to air out for 5-10 minutes.
 4. Without entering the vault, inspect the inside of the unit, including components.
 5. Take notes about the external and internal condition of the vault.
 Be sure to record the level of sediment build-up on the floor of the vault, in the forebay, and on top of the cartridges. If flow is occurring, note the level of water and estimate the flow rate per drainage pipe. Record all observations.
 6. Remove large loose debris and trash using a pole with a grapple or net on the end.
 7. Close and fasten the door.
 8. Remove safety equipment.
 9. Make notes about the local drainage area relative to ongoing construction, erosion problems, or high loading of other materials to the system.
Major Maintenance
 Depending on the configuration of the particular system, a worker may be required to enter the vault to perform some tasks.
Important: If vault entry is required, OSHA rules for confined space entry must be followed.
 Filter cartridge replacement should occur during dry weather. It may be necessary to plug the filter inlet pipe if base flows exist. Standing water present in the vault should be regarded as polluted and should be contained during this operation by temporarily capping the manifold connectors.
Important: This activity will require that workers enter the vault to remove the cartridges from the drainage system.
Method 1:
 a. Using an appropriate sling, attach the cable from the boom, crane, or tripod to the cartridge being removed. Contact CONTECH Stormwater Solutions for specifications on appropriate attachment devices.
 This activity will require that workers enter the vault to remove the cartridges from the drainage system and place them under the vault opening for lifting.
Important: Note that cartridges containing media other than the leaf media require unscrewing from their threaded connectors. Take care not to damage the manifold connectors. This connector should remain installed in the manifold and capped if necessary.
 b. Remove the used cartridges (250 lbs. each) from the vault.
Important: Care must be used to avoid damaging the cartridges during removal and installation. The cost of repairing components damaged during maintenance will be the responsibility of the owner unless CONTECH Stormwater Solutions performs the maintenance activities and damage is not related to discharges to the system.
 c. Set the used cartridge aside or load onto the hauling truck.
 d. Continue steps a through c until all cartridges have been removed.
Method 2:
 a. If applicable, set up safety equipment to protect pedestrians from fall hazards due to open vault doors or when work is being done near walkways or roadways.
 b. Visually inspect the external condition of the unit and take notes concerning defects/problems.

Replacement cartridges will be delivered to the site. Information concerning how to obtain the replacement cartridges is available from CONTECH Stormwater Solutions.

Warning: In the case of a spill, the worker should abort maintenance activities until the proper guidance is obtained. Notify the local hazard control agency and CONTECH Stormwater Solutions immediately.

To conduct cartridge replacement and sediment removal maintenance:
 1. If applicable, set up safety equipment to protect pedestrians from fall hazards due to open vault doors or when work is being done near walkways or roadways.
 2. Visually inspect the external condition of the unit and take notes concerning defects/problems.
 3. Open the doors to the vault and allow the system to air out for 5-10 minutes.
 4. Without entering the vault, give the inside of the unit, including components, a general condition inspection.
 5. Make notes about the external and internal condition of the vault.
 Give particular attention to recording the level of sediment build-up on the floor of the vault, in the forebay, and on top of the internal components.
 6. Remove large loose debris and trash using a pole with a grapple or net on the end.
 7. Using a boom, crane, or other device (dolly and ramp), offload the replacement cartridges (up to 150 lbs. each) and set aside.
 8. Remove used cartridges from the vault using one of the following methods:
 a. Unscrew the cartridge cap.
 b. Remove the cartridge hood.
 c. Tip the cartridge on its side.
Important: Note that cartridges containing media other than the leaf media require unscrewing from their threaded connectors. Take care not to damage the manifold connectors. This connector should remain installed in the manifold and capped if necessary.
 d. Empty the cartridge onto the vault floor.
 e. Set the empty, used cartridge aside or load onto the hauling truck.
 f. Continue steps a through e until all cartridges have been removed.
 9. Remove deposited sediment from the floor of the vault and, if large amounts are present, from the forebay. This can usually be accomplished by shoveling the sediment into containers, which, once full, are lifted mechanically from the vault and placed onto the hauling truck. If Method 2 in Step 8 is used to empty the cartridges, or in cases of extreme sediment loading, a vactor truck may be required.
 10. Once the sediments are removed, assess the condition of the vault and the condition of the manifold and connectors. The connectors are short sections of 2-inch schedule 40 PVC, or threaded schedule 80 PVC that should protrude above the floor of the vault.
 a. If required, apply a light coating of FDA approved silicon grease to the outside of the exposed portion of the connectors. This ensures a watertight connection between the cartridge and the drainage pipe.
 b. Replace any damaged connectors.
 11. Using the boom, crane, or tripod, lower and install the new cartridges. Once

again, take care not to damage connections.
 12. Close and fasten the door.
 13. Remove safety equipment.
 14. Make notes about the local drainage area relative to ongoing construction, erosion problems, or high loadings of other materials to the system.
 15. Finally, dispose of the residual materials in accordance with applicable regulations. Make arrangements to return the used cartridges to CONTECH Stormwater Solutions.

Related Maintenance Activities

(Performed on an as-needed basis)
 StormFilter units are often just one of many components in a more comprehensive stormwater drainage and treatment system. The entire system may include catch basins, detention vaults, sedimentation vaults and manholes, detention/retention ponds, swales, artificial wetlands, and other miscellaneous components.
 In order for maintenance of the StormFilter to be successful, it is imperative that all other components be properly maintained. The maintenance/repair of upstream facilities should be carried out prior to StormFilter maintenance activities.
 In addition to considering upstream facilities, it is also important to correct any problems identified in the drainage area. Drainage area concerns may include: erosion problems, heavy oil and grease loading, and discharges of inappropriate materials.

Part of arranging for maintenance to occur should include coordination of disposal of solids (landfill coordination) and liquids (municipal vacuum truck decant facility, local wastewater treatment plant, on-site treatment and discharge).
 Owners should contact the local public works department and inquire about how the department disposes of their street waste residuals. CONTECH Stormwater Solutions will determine disposal methods or reuse of the media contained in the cartridges. If the material has been contaminated with any unusual substance, the cost of special handling and disposal will be the responsibility of the owner.

AS-BUILT CERTIFICATION
 THERE IS NO AS-BUILT INFORMATION PROVIDED ON THIS SHEET.
 MICHAEL D. MCCOY, PROFESSIONAL LAND SURVEYOR
 M.D. REG. NO. 21257, EXPIRATION DATE: 01-31-10
 07/23/19 DATE

AS-BUILT
 OPERATION & MAINTENANCE SCHEDULE - II
TURF VALLEY, LORIE
NURSING HOME & ASSISTED LIVING FACILITY
 OAKMONT AT TURF VALLEY
 PARCEL Q
 PLATS 18773 - 18775
 TAX MAP 16 - P/O PARCEL 8- GRID 16 & 17
 POD I per S-86-13 (4th AMENDED)
 THIRD ELECTION DISTRICT HOWARD COUNTY, MARYLAND

KCE ENGINEERING, INC.
 EXECUTIVE CENTER
 3300 NORTH RIDGE ROAD, SUITE 315
 ELLICOTT CITY, MARYLAND 21043
 PHONE (410) 203-9800 FAX (410) 203-9228

Professional Certification, I hereby certify that these documents were prepared or approved by me, and that I am a duly licensed professional engineer under the laws of the State of Maryland, License No. 8818, Expiration Date: 10/17/08.


DRAWN BY: MG
 CHECKED BY: DVK
 SCALE: N/A
 DATE: 04/30/2008

SHEET: 30 OF 36


APPROVED
 PLANNING BOARD
 OF HOWARD COUNTY
 DATE 3/27/08
 EHA

APPROVED: DEPARTMENT OF PLANNING AND ZONING
 Chief, Development Engineering Division
 Chief, Division of Land Development
 Director

DATE 3/27/08
 DATE 4/30/08

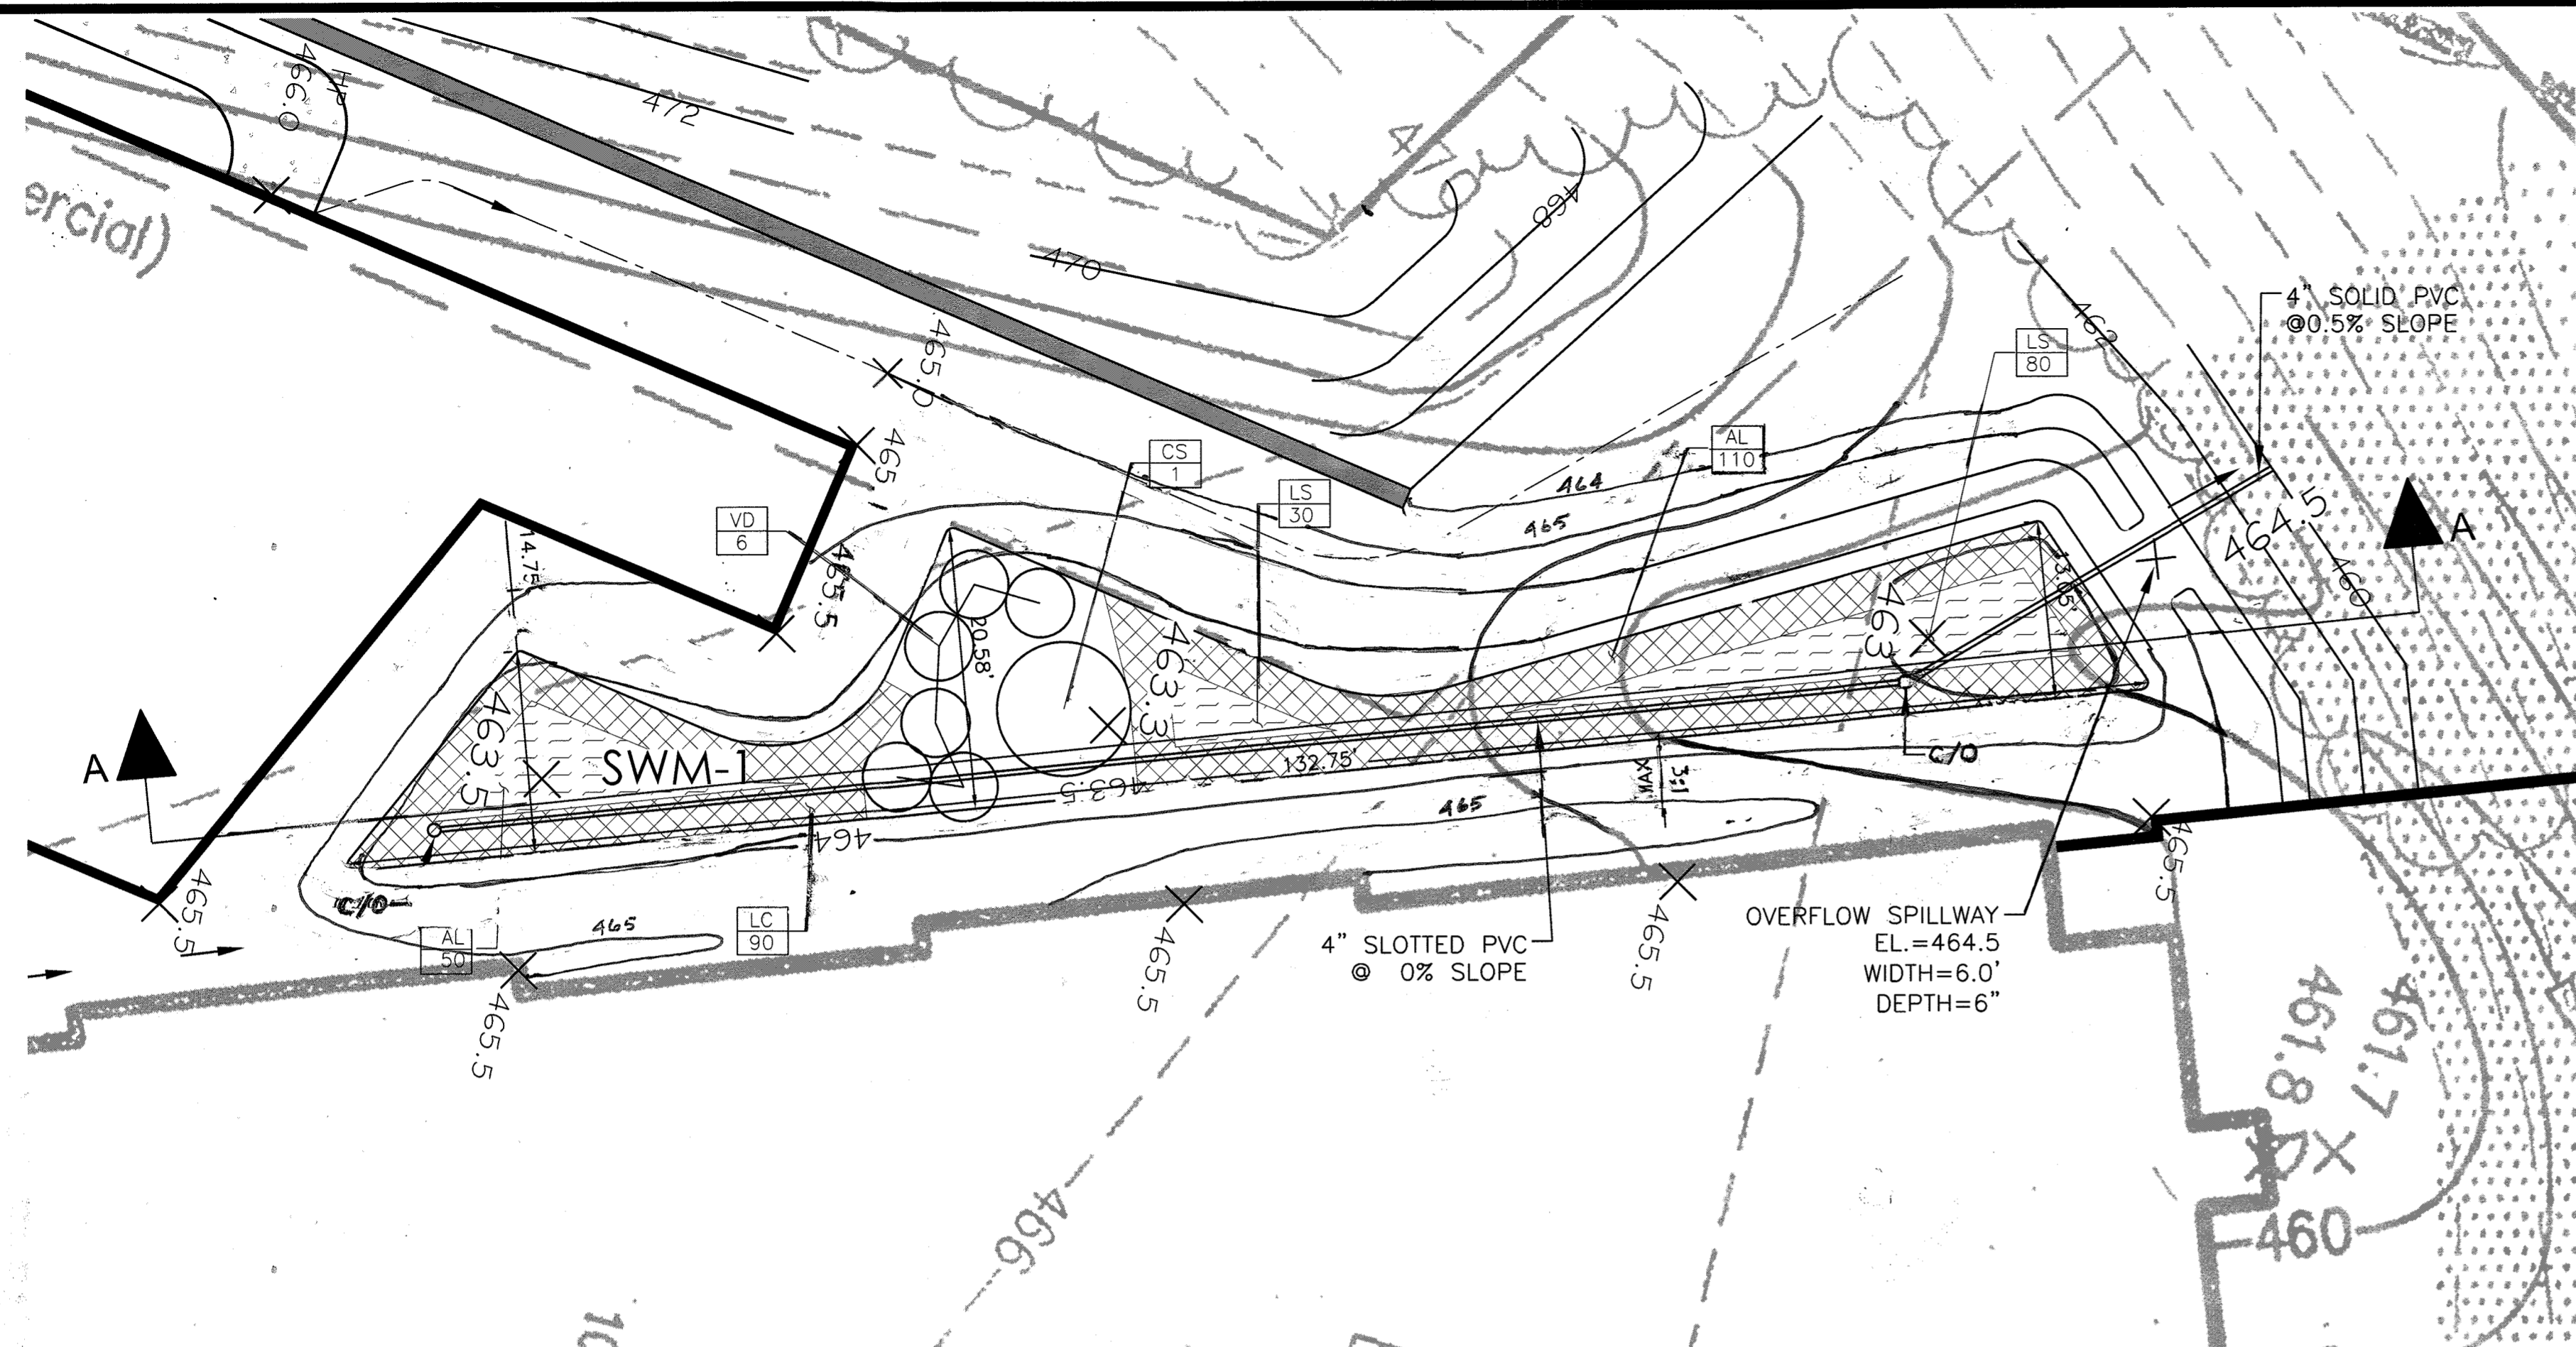

(SWM-1) M-6 MICRO-BIORETENTION FACILITY PLAN
SCALE: 1" = 10'

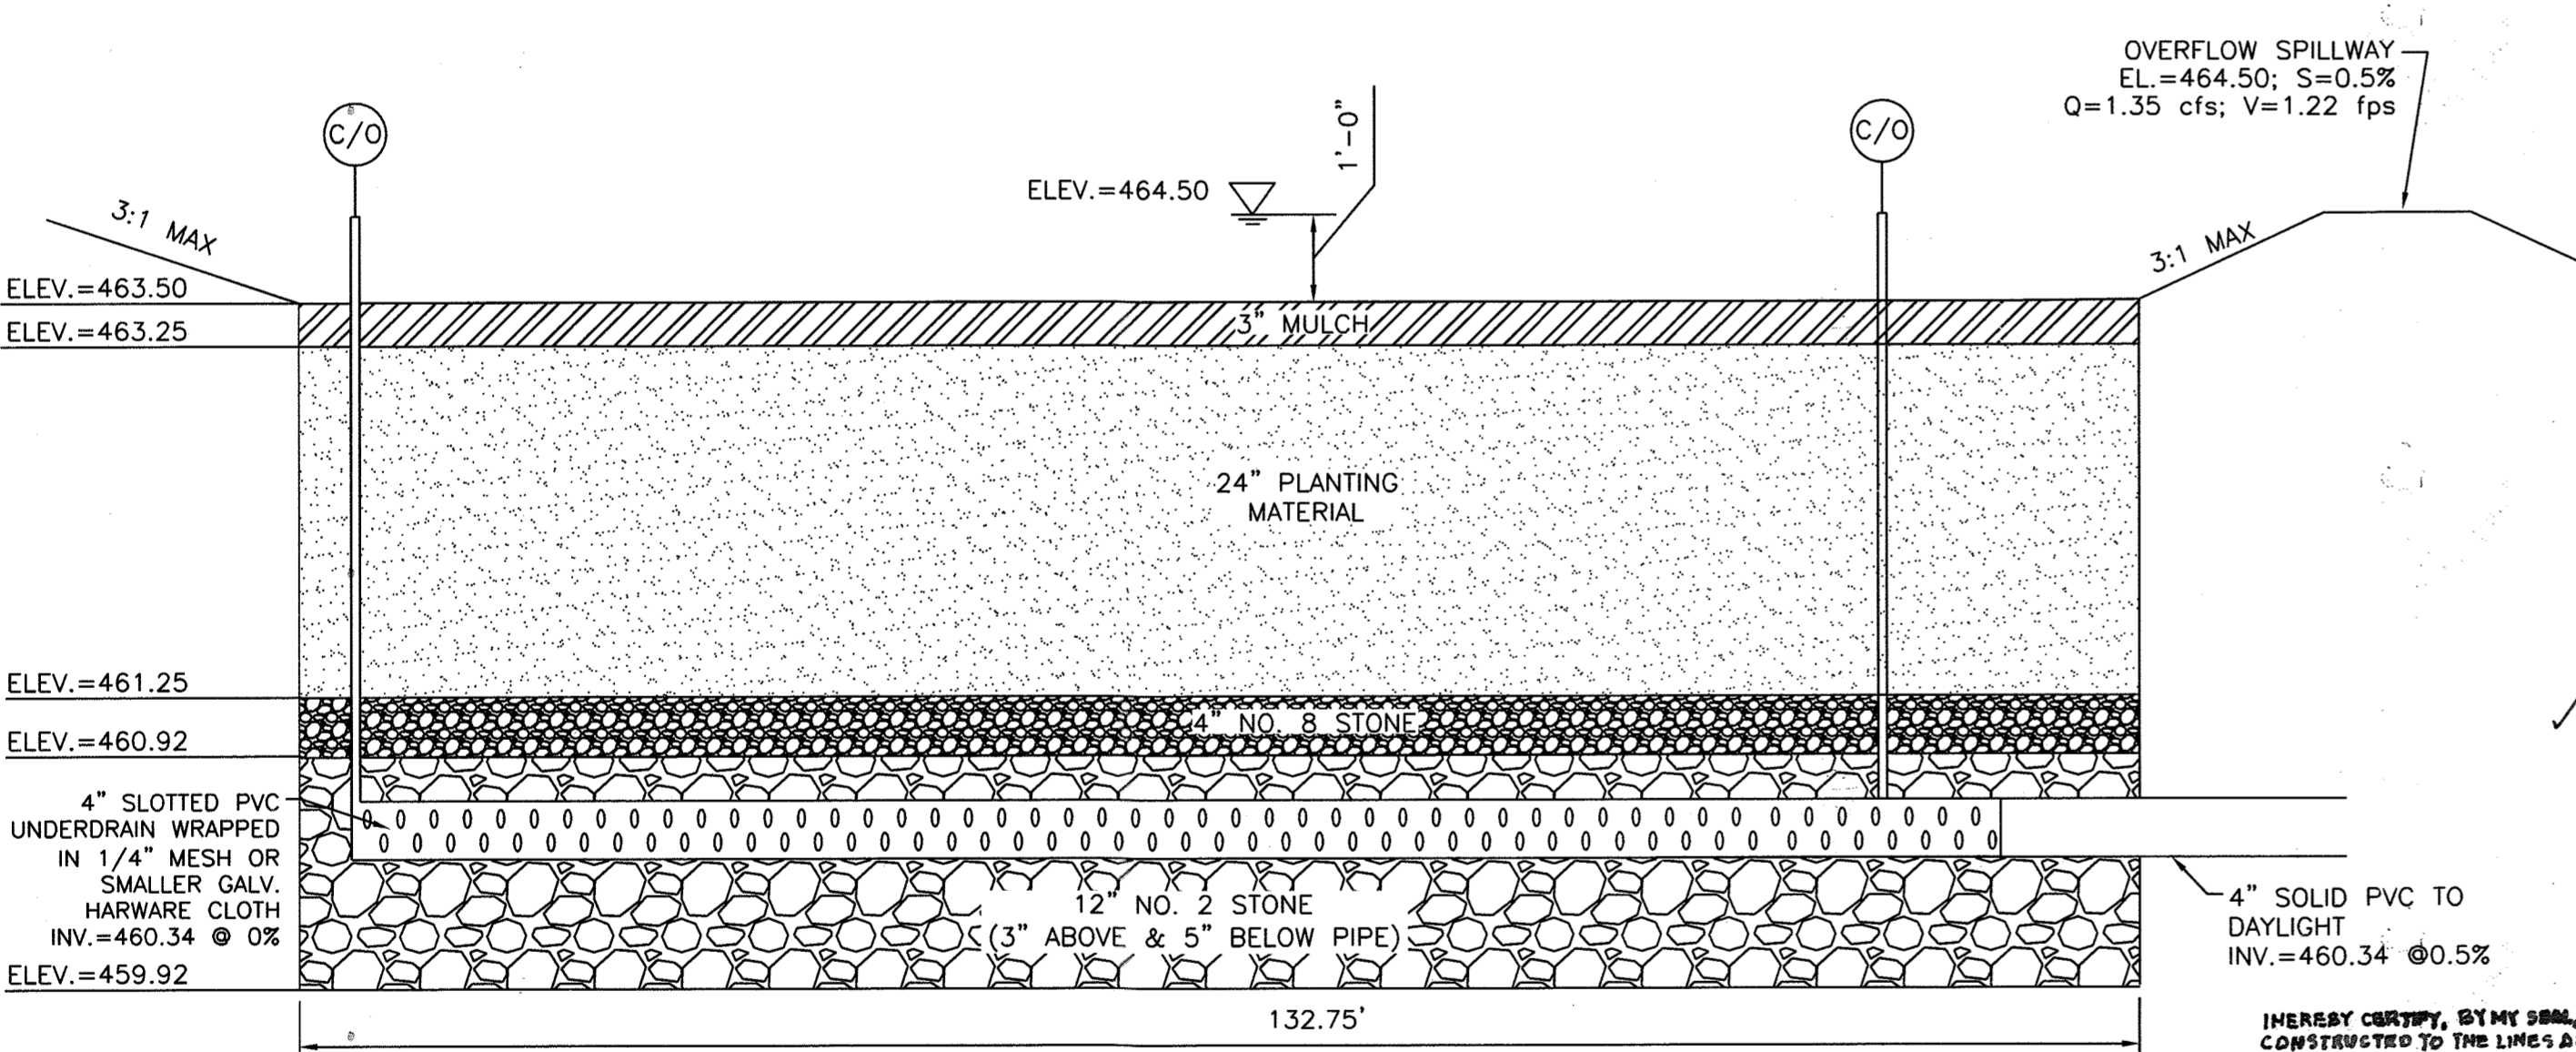

(SWM-1) M-6 MICRO-BIORETENTION FACILITY SECTION A-A
SCALE: NTS

PROFESSIONAL CERTIFICATION: I HEREBY CERTIFY THAT THESE DOCUMENTS WERE PREPARED OR APPROVED BY ME, AND THAT I AM A DULY LICENSED PROFESSIONAL LAND SURVEYOR, UNDER THE LAWS OF THE STATE OF MARYLAND, REG. NO. 21257, EXPIRATION DATE 6-16-2019

APPROVED: DEPARTMENT OF PLANNING AND ZONING
Chief, Development Engineering Division
Chief, Division of Land Development
Director

APPROVED
PLANNING BOARD
OF HOWARD COUNTY
DATE 3/27/2008
9/01/2016

(SWM-1) PLANT SCHEDULE

KEY	QTY	BOTANICAL NAME / COMMON NAME	SIZE	COND.	COMMENTS
SHRUBS					
CS	1	CORNUS SERICEA / REDOSIER DOGWOOD	18" HT.	CONT.	PLANT AT 5' O.C.
VD	6	VIBURNUM DENTATUM 'BLUE MUFFIN' / ARROWWOOD	18" HT.	CONT.	PLANT AT 5' O.C.
PERENNIALS / ORNAMENTAL GRASSES					
AL	160	ASCLEPIAS TUBEROSA / BUTTERFLY MILKWEED	2" HT.	PLUG	PLANT AT 18" O.C.
LC	90	LOBELIA CARDINALIS / CARDINAL FLOWER	2" HT.	PLUG	PLANT AT 18" O.C.
LS	110	LIATRIS SPICATA / BLAZING STAR	2" HT.	PLUG	PLANT AT 18" O.C.


DESIGN SUMMARY

- FACILITY NUMBER: SWM-1
- FACILITY TYPE: M-6 MICRO-BIORETENTION FACILITY
- DRAINAGE AREA: 11,100 SQ. FT.
- BOTTOM ELEVATION: 459.92
- TOP OF BANK ELEVATION: 465.00
- STORAGE VOLUME PROVIDED: 1,300 CU. FT.
- WATER SURFACE ELEVATION: 464.50
- OVERFLOW SPILLWAY: 6' WIDE @ 0.5% SLOPE
- Q=1.35 cfs; V=1.22 fps
- FILTER FABRIC ADDED ON SIDES OF FACILITY ONLY.
- MAINTENANCE RESPONSIBILITY: THIS IS A PRIVATE FACILITY TO BE OWNED & MAINTAINED BY THE OWNER.
- THIS FACILITY IS EXEMPT FROM MD378 GUIDELINES IN THAT THE IMPOUNDED DESIGN HIGHWATER DEPTH IS LESS THAN 3 FEET AT THE EMBANKMENT


DESIGN SUMMARY

- FACILITY NUMBER: SWM-2
- FACILITY TYPE: M-6 MICRO-BIORETENTION FACILITY
- DRAINAGE AREA: 6,000 SQ. FT.
- BOTTOM ELEVATION: 460.22
- TOP OF BANK ELEVATION: 464.80
- STORAGE VOLUME PROVIDED: 550 CU. FT.
- WATER SURFACE ELEVATION: 464.80
- OVERFLOW INLET SIZE & TYPE: 8" NYLOPLAST INLET WITH DOME GRATE
- FILTER FABRIC ADDED ON SIDES OF FACILITY ONLY.
- MAINTENANCE RESPONSIBILITY: THIS IS A PRIVATE FACILITY TO BE OWNED & MAINTAINED BY THE OWNER.
- THIS FACILITY IS EXEMPT FROM MD378 GUIDELINES IN THAT THE IMPOUNDED DESIGN HIGHWATER DEPTH IS LESS THAN 3 FEET AT THE EMBANKMENT

AS-BUILT CERTIFICATION
I HEREBY CERTIFY, BY MY SEAL, THAT THE CONDITIONS SHOWN ON THIS PLAN WERE CONSTRUCTED TO THE LINES AND GRADES SHOWN ON THIS 'AS-BUILT' PLAN AND MEET THE APPROVED PLANS AND SPECIFICATIONS AND ALSO THAT THESE DOCUMENTS WERE PREPARED BY ME OR UNDER MY RESPONSIBILITY. I AM A DULY LICENSED PROFESSIONAL LAND SURVEYOR, UNDER THE LAWS OF THE STATE OF MARYLAND, REG. NO. 21257, EXPIRATION DATE 6-16-2019

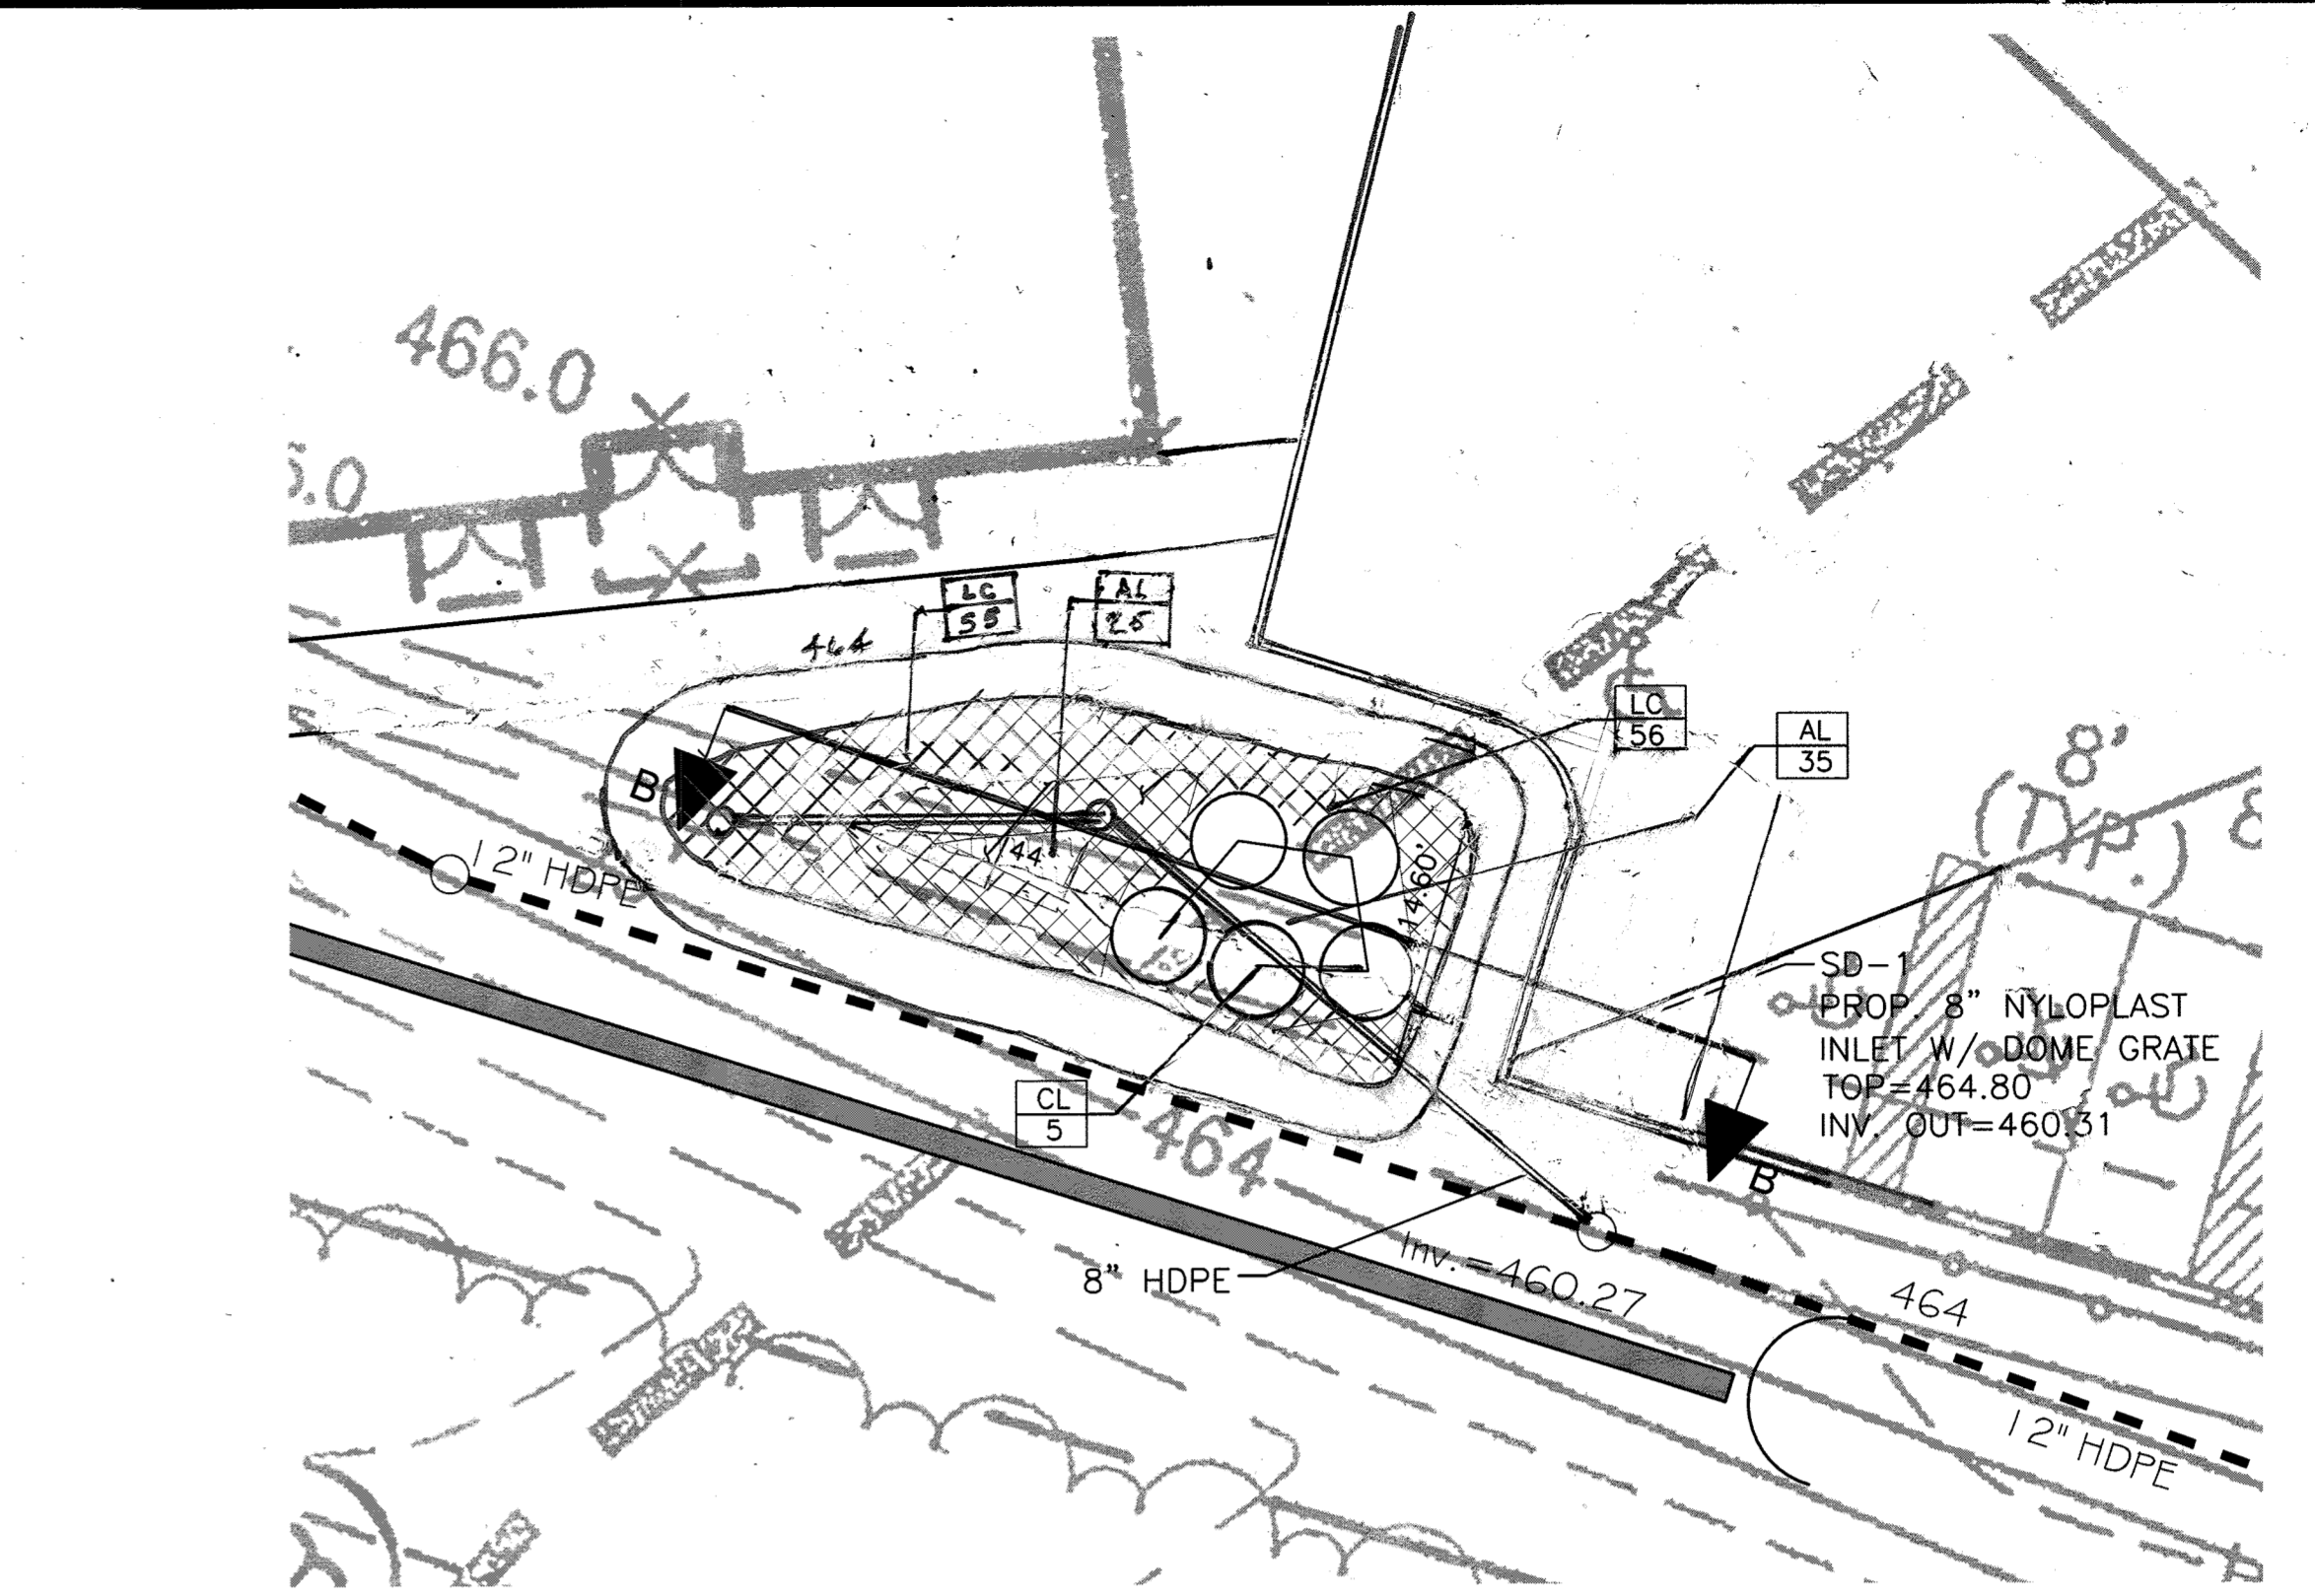


(SWM-2) M-6 MICRO-BIORETENTION FACILITY PLAN
SCALE: 1" = 10'

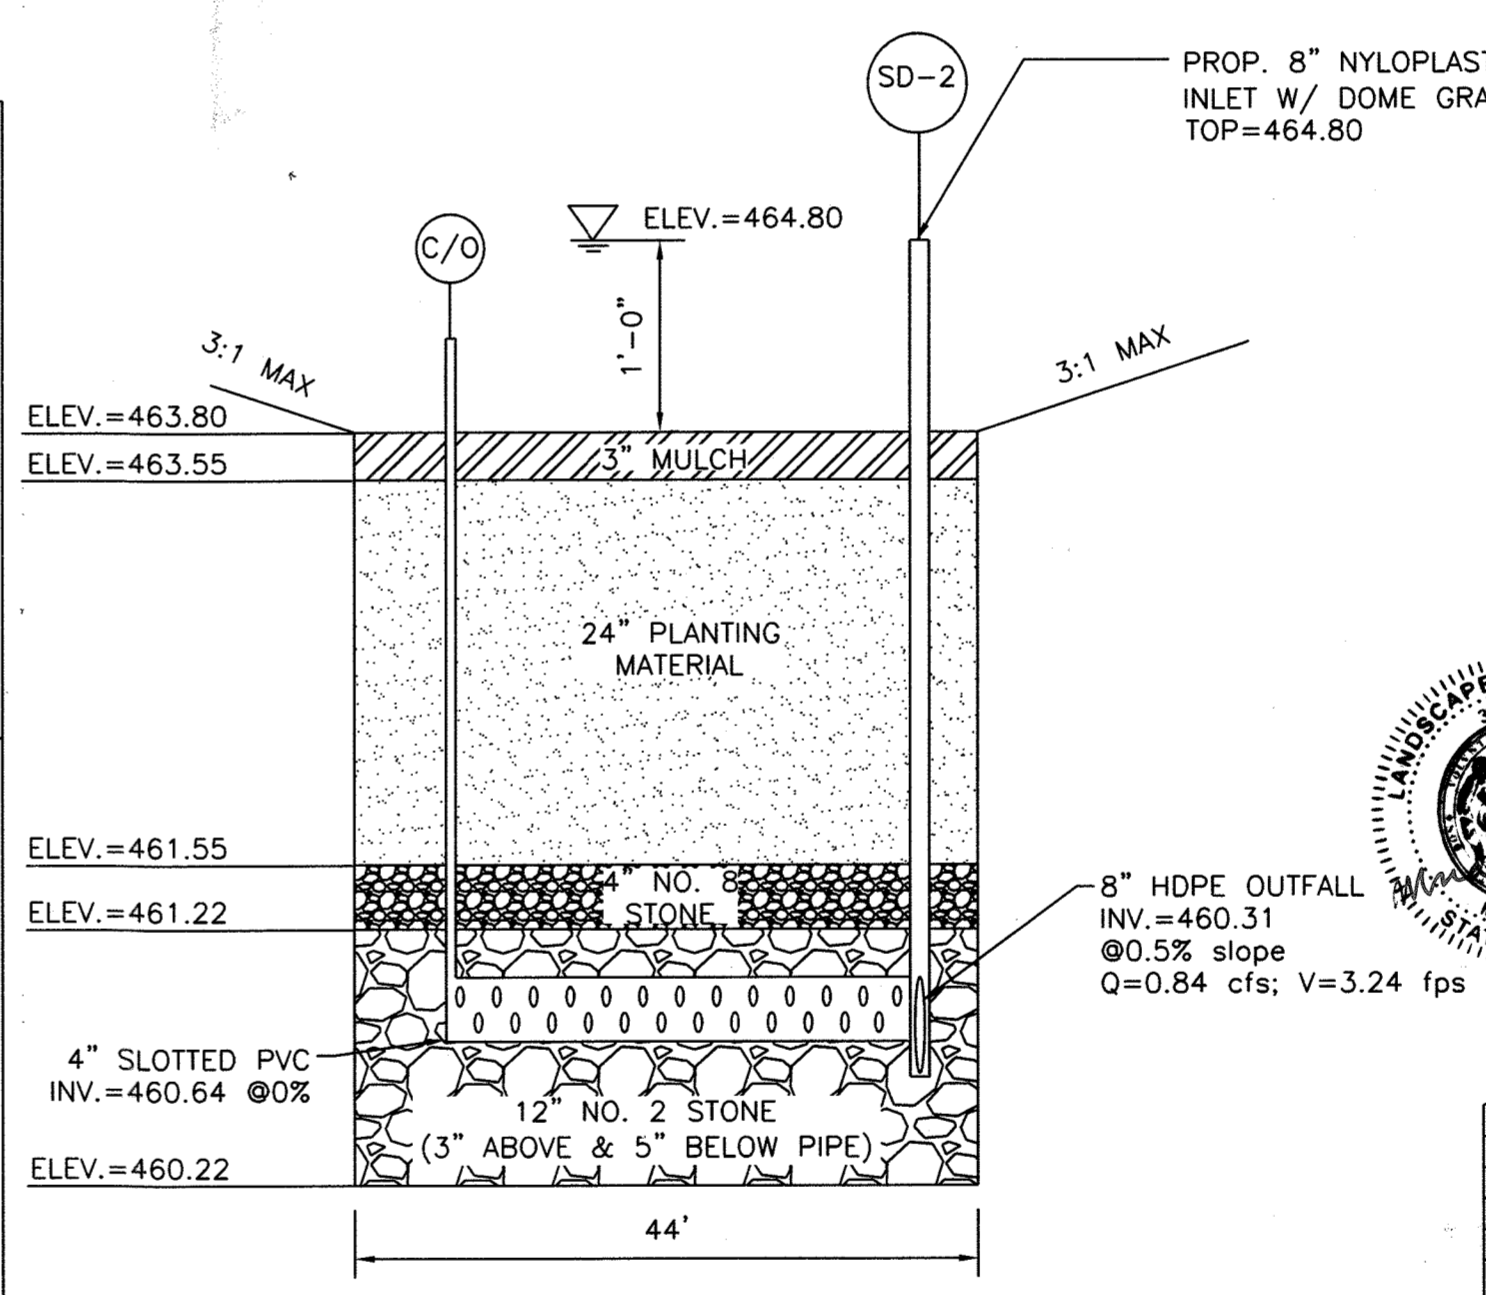

(SWM-2) M-6 MICRO-BIORETENTION FACILITY SECTION B-B
SCALE: NTS

(SWM-2) PLANT SCHEDULE

KEY	QTY	BOTANICAL NAME / COMMON NAME	SIZE	COND.	COMMENTS
PERENNIALS / ORNAMENTAL GRASSES					
AL	60	ASCLEPIAS TUBEROSA / BUTTERFLY MILKWEED	2" HT.	PLUG	PLANT AT 18" O.C.
LC	111	LOBELIA CARDINALIS / CARDINAL FLOWER	2" HT.	PLUG	PLANT AT 18" O.C.
CL	5	CHASMANTHIUM LATIFOLIUM / NORTHERN SEA OATS	1 GAL.	CONT.	PLANT AT 3' O.C.

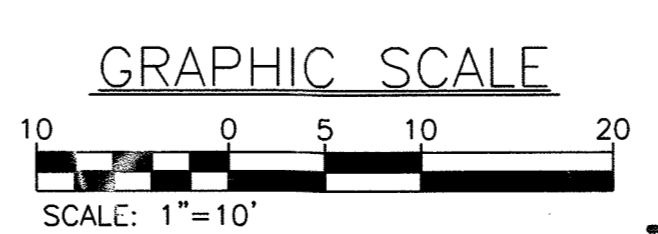

OPERATION AND MAINTENANCE SCHEDULE FOR MICRO-BIORETENTION (M-6)

- The Owner shall maintain the plant material, mulch layer and soil layer annually. Maintenance of mulch and soil is limited to correcting areas of erosion or washout. Any mulch replacement shall be done in the spring. Plant material shall be checked for disease and insect infestation and maintenance will address dead material and pruning. Acceptable replacement plant material is limited to the following: 2000 Maryland Stormwater Design Manual Volume II, Table A.4.1 and 2.
- The Owner shall perform a plant inspection in the spring and in the fall of each year. During the inspection, the Owner shall remove dead and diseased vegetation considered beyond treatment, replace dead plant material with acceptable replacement plant material, treat diseased trees and shrubs, and replace aldehyde stakes and wires.
- The Owner shall inspect the mulch each spring. The mulch shall be replaced every two to three years. The previous mulch layer shall be removed before the new layer is applied.
- The Owner shall correct soil erosion on an as needed basis, with a minimum of once per month and after each heavy storm.

OPERATION AND MAINTENANCE SCHEDULE FOR PRIVATELY OWNED AND MAINTAINED PERMEABLE PAVEMENT (A-2)

- Pavement surfaces should be swept and vacuumed (if porous concrete) to reduce sediment accumulation and ensure continued surface porosity. Sweeping should be performed at least twice annually with a commercial cleaning unit. Washing or compressed air units should not be used to perform surface cleaning. Drainage pipes, inlets, stone edge drains and other structures within or draining to the subbase should be cleaned out at regular intervals.
- Deicers should be used in moderation. Deicers should be non-toxic and be applied either as calcium magnesium acetate or as pretreated salt. Snow plowing should be done carefully with blades set one-inch above the surface. Plowed snow piles and snowmelt should not be directed to permeable pavement.



NO.	REVISION	DATE
1	ADDITION OF BUILDING, SWM FACILITIES, RETAINING WALL AND SERVICE LANE	10/4/2016
2	DELETE PERMEABLE CONCRETE PAVEMENT	2/13/19

AS-BUILT STORMWATER MANAGEMENT DETAILS & SECTIONS
REVISED SITE DEVELOPMENT PLAN
TURF VALLEY, LORIAN
NURSING HOME & ASSISTED LIVING FACILITY
OAKMONT AT TURF VALLEY
PARCEL Q
PLATS 18773 - 18775
TAX MAP 16 - P/O PARCEL 8- GRID 16 & 17;
POD I per S-86-13 (4th AMENDED)
THIRD ELECTION DISTRICT HOWARD COUNTY, MARYLAND




Professional Certification: I hereby certify that these documents were prepared or approved by me, and that I am a duly licensed professional engineer under the laws of the State of Maryland, License No. 8818, Expiration Date: 10/17/18.

ENGINEERS PLANNERS SCIENTISTS CONSTRUCTION MANAGERS
300 North Ridge Road
Suite 315
Baltimore, MD 21286
Phone: (410) 209-9800
Fax: (410) 209-9228
www.kci.com

DRAWN BY: SK
CHECKED BY: DVK
SCALE: AS SHOWN
DATE: 10/4/2016

SHEET: 31 OF 36

NYLOPLAST DRAIN BASIN WITH DOME GRATE

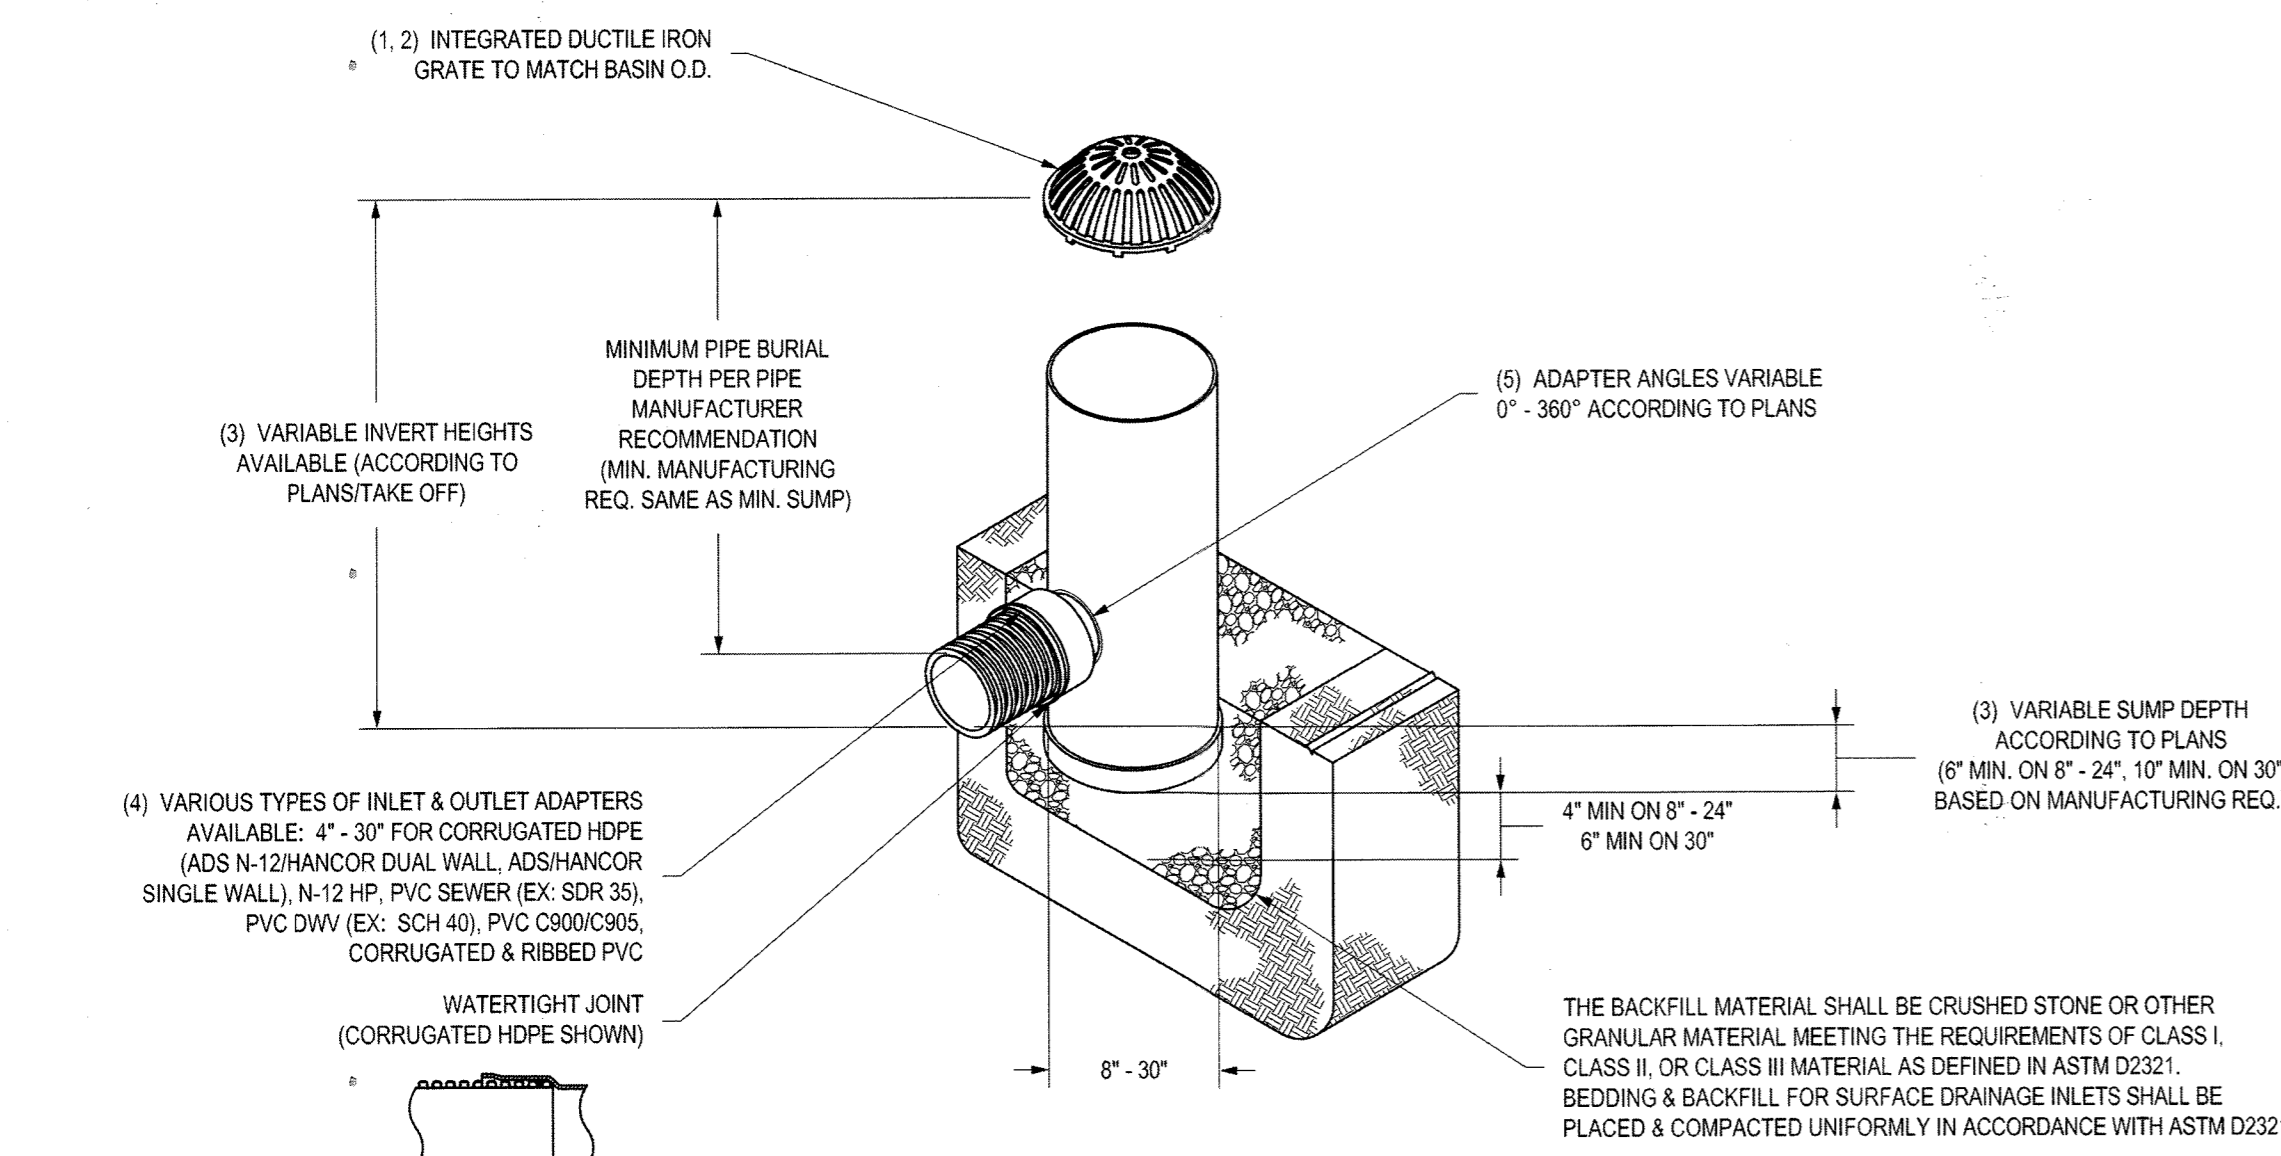


- 8" - 30" DOME GRATES SHALL BE DUCTILE IRON PER ASTM A536 GRADE 70-50-05.
- 8" & 10" DOME GRATES FIT ONTO THE DRAIN BASINS WITH THE USE OF A PVC BODY TOP. SEE DRAWING NO. 7001-110-045.
- DRAIN BASIN TO BE CUSTOM MANUFACTURED ACCORDING TO PLAN DETAILS. RISERS ARE NEEDED FOR BASINS OVER 6" DUE TO SHIPPING RESTRICTIONS. SEE DRAWING NO. 7001-110-065.
- DRAINAGE CONNECTION STUB JOINT TIGHTNESS SHALL CONFORM TO ASTM D3212 FOR CORRUGATED HDPE (ADS N-12) HANCOCK DUAL WALL N-12 HP, & PVC SEWER (4" - 24").
- ADAPTERS CAN BE MOUNTED ON ANY ANGLE 0° TO 360° TO DETERMINE MINIMUM ANGLE BETWEEN ADAPTERS SEE DRAWING NO. 7001-110-012.
- 8" - 30" DOME GRATES HAVE NO LOAD RATING.

THIS PRINT DISCLOSES SUBJECT MATTER IN WHICH NYLOPLAST HAS PROPRIETARY RIGHTS. THE RECEIPT OR POSSESSION OF THIS PRINT DOES NOT CONFER, TRANSFER, OR LICENSE THE USE OF THE DESIGN OR TECHNICAL INFORMATION SHOWN HEREIN. REPRODUCTION OF THIS PRINT OR ANY INFORMATION CONTAINED HEREIN, OR MANUFACTURE OF ANY ARTICLE HEREFROM, FOR THE DISCLOSURE TO OTHERS IS FORBIDDEN, EXCEPT BY SPECIFIC WRITTEN PERMISSION FROM NYLOPLAST.


DRAWN BY	EBC	MATERIAL	3130 VERONA AVE BURLINGAME, CA 94010 PHN (770) 932-2443 FAX (770) 932-2490 www.nyloplast-us.com
DATE	03-25-10	PROJECT NO./NAME	
REVISED BY	NMH	TITLE	DRAIN BASIN WITH DOME GRATE QUICK SPEC INSTALLATION DETAIL
DATE	03-11-16	DWG NO.	7001-110-397
DWG SIZE	A	SCALE	1:40
SHEET	1 OF 1	REV	D

NYLOPLAST DRAIN BASIN WITH DOME GRATE
SCALE - NTS

Part#/Prefix	Product Description	Available Outlets
2812AG_X	12" Custom Basin	4" thru 12"
2815AG_X	15" Custom Basin	4" thru 15"

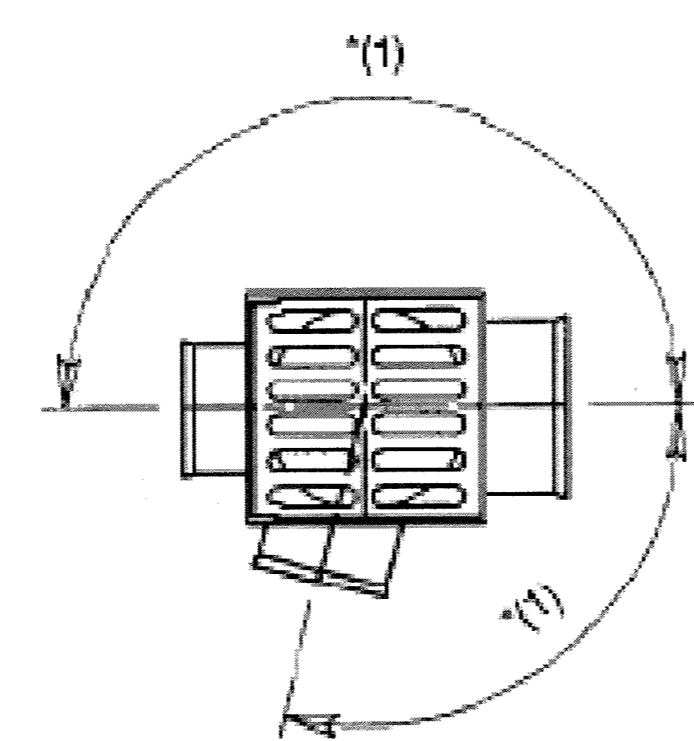


To determine minimum angle between adapters please see chart on page (1).

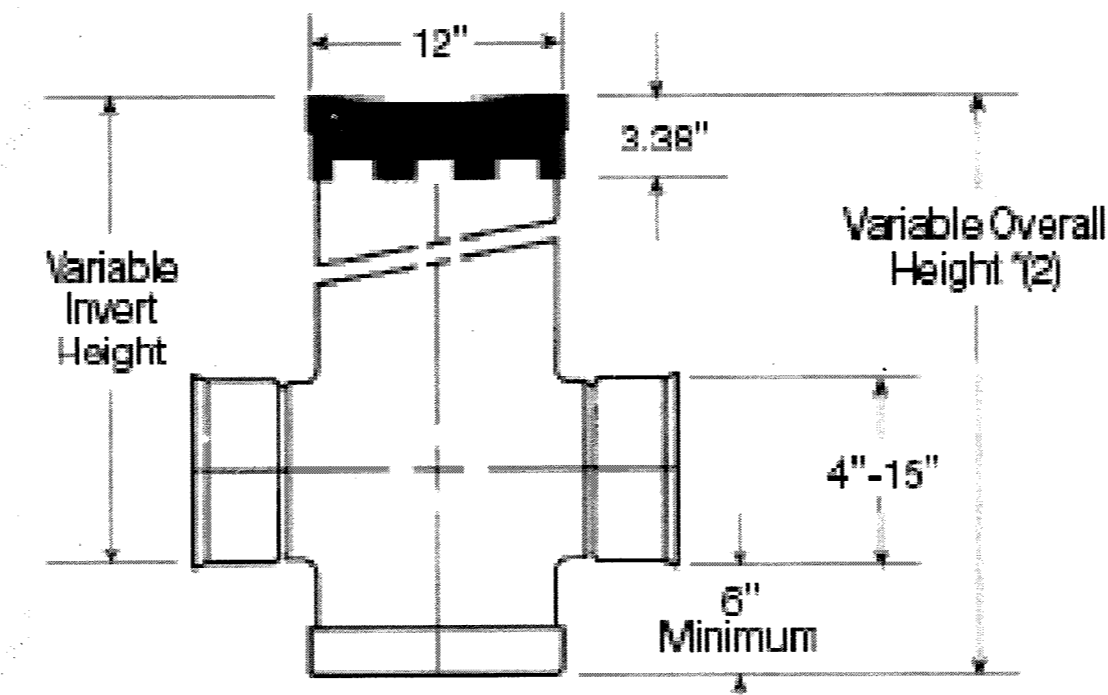

(2) Maximum recommended overall height 10'

12" & 15" Light Duty Bronze Grate Options
(see pg. 22-23)

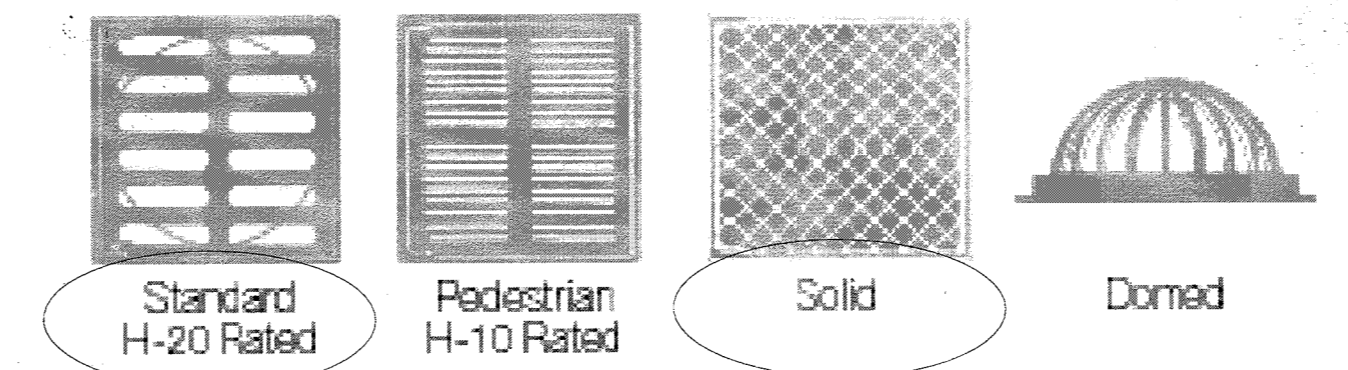


NYLOPLAST INLINE DRAIN INLET
SCALE - NTS

AS-BUILT CERTIFICATION

THIS IS NO "AS-BUILT" INFORMATION PROVIDED ON THIS SHEET.
[Signature] 01/28/19 DATE

NON TRAFFIC INSTALLATION

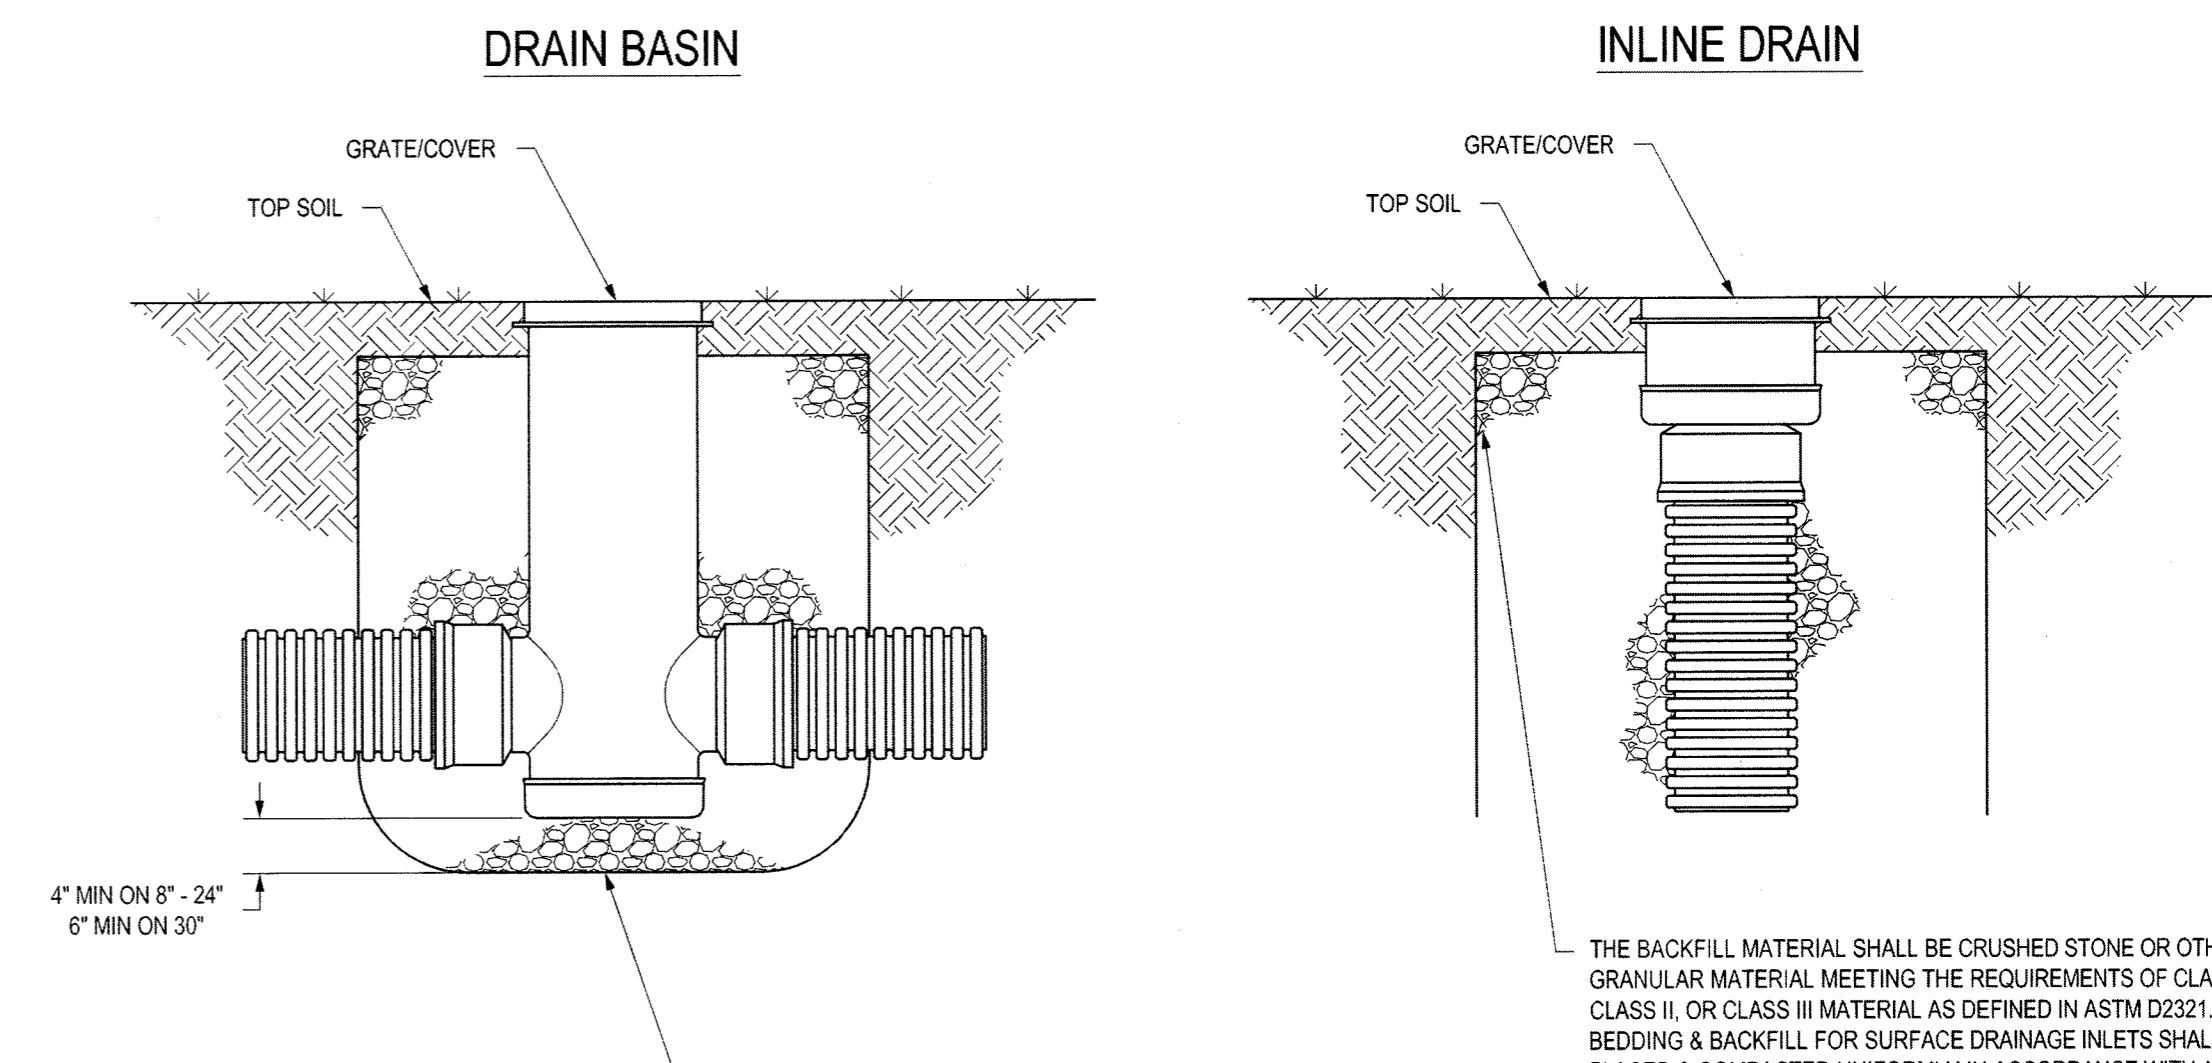



THIS PRINT DISCLOSES SUBJECT MATTER IN WHICH NYLOPLAST HAS PROPRIETARY RIGHTS. THE RECEIPT OR POSSESSION OF THIS PRINT DOES NOT CONFER, TRANSFER, OR LICENSE THE USE OF THE DESIGN OR TECHNICAL INFORMATION SHOWN HEREIN. REPRODUCTION OF THIS PRINT OR ANY INFORMATION CONTAINED HEREIN, OR MANUFACTURE OF ANY ARTICLE HEREFROM, FOR THE DISCLOSURE TO OTHERS IS FORBIDDEN, EXCEPT BY SPECIFIC WRITTEN PERMISSION FROM NYLOPLAST.

DRAWN BY	CJA	MATERIAL	3130 VERONA AVE BURLINGAME, CA 94010 PHN (770) 932-2443 FAX (770) 932-2490 www.nyloplast-us.com
DATE	9-30-09	PROJECT NO./NAME	
REVISED BY	NMH	TITLE	DRAIN BASIN & INLINE DRAIN NON TRAFFIC INSTALLATION
DATE	03-11-16	DWG NO.	7001-110-111
DWG SIZE	A	SCALE	1:25
SHEET	1 OF 1	REV	E


NYLOPLAST INLINE DRAIN AND DRAIN BASIN
SCALE - NTS

Part#/Prefix	Product Description	Available Outlets
2808AG_X	8" Standard Basin*	4" & 6" ONLY max 2 outlets / max height 13"
2810AG_X	10" Standard Basin*	4", 6" & 8" ONLY max 2 outlets / max height 20"
2808AG_X	8" Custom Basin	4" thru 8"
2810AG_X	10" Custom Basin	4" thru 10"


* Fixed height and inverts
All custom & standard basins will have a drop-in grate

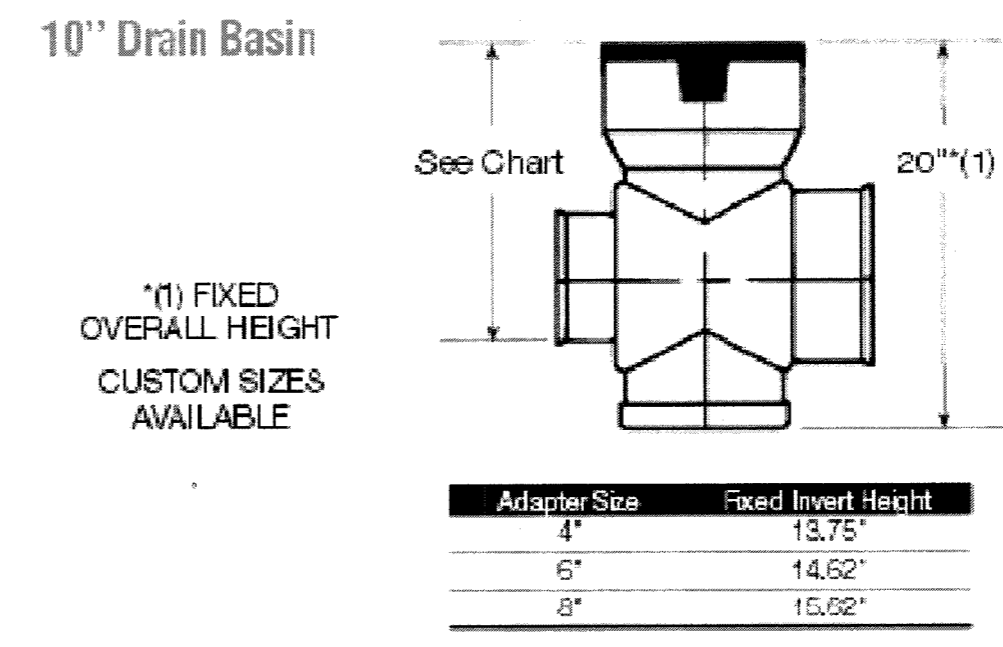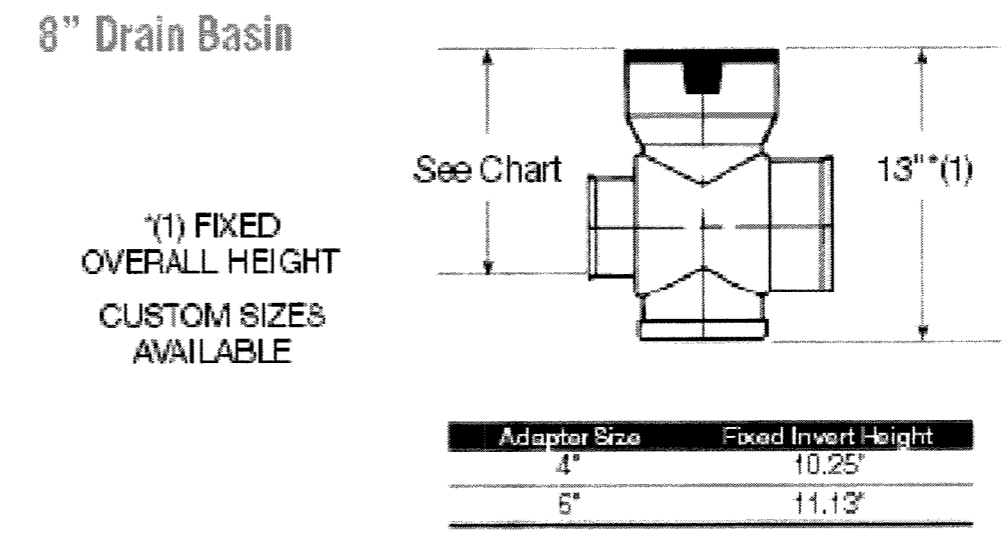

8" & 10" Light Duty Bronze Grate Options
(see pg. 22-23)

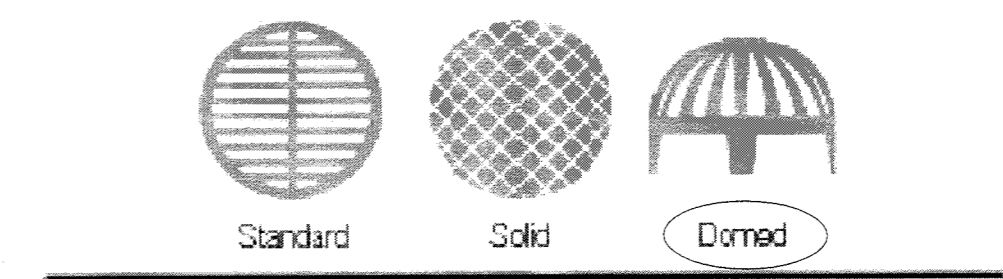

NYLOPLAST DRAIN BASIN (SD-1 & SD-2)
SCALE - NTS

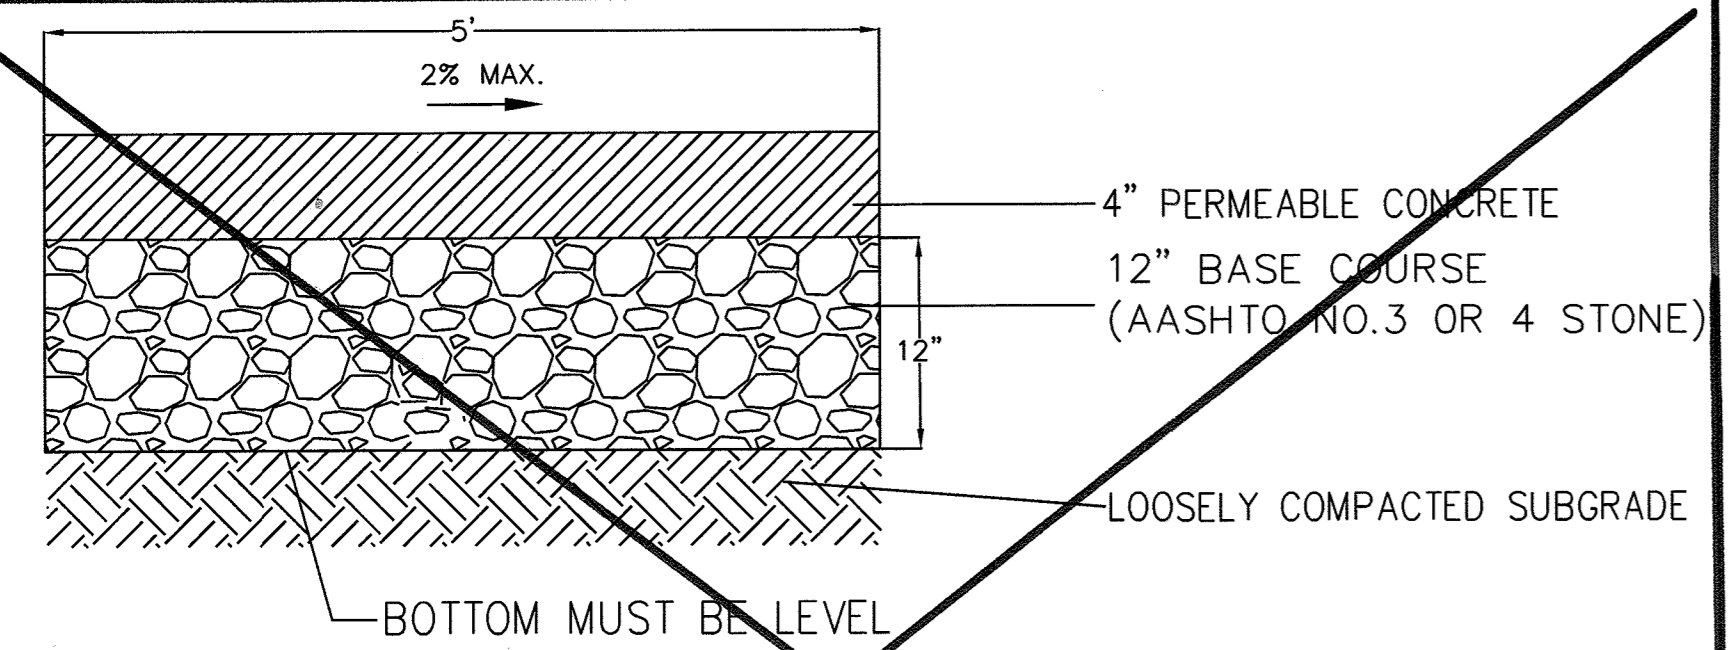

D10 PERMEABLE CONCRETE SIDEWALK
SCALE: NTS

PERMEABLE SIDEWALK CONSTRUCTION NOTES:

- THE BOTTOM OF THE PERMEABLE SIDEWALK SUBBASE MUST BE LEVELED AT 0% SLOPE.
- MATERIAL AND CONSTRUCTION OF PERMEABLE PAVEMENT MUST BE DONE IN ACCORDANCE WITH ACI 522.1.13.
- SUB SOILS SHALL NOT BE COMPACTED DURING CONSTRUCTION OF PROPOSED PERMEABLE PAVEMENTS.

APPROVED: DEPARTMENT OF PLANNING AND ZONING

[Signature] 11-20-14 Date
Chief, Development Engineering Division

[Signature] 12-6-16 Date
Chief, Division of Land Development

[Signature] 12-6-16 Date
Director

APPROVED
PLANNING BOARD
OF HOWARD COUNTY
DATE 3/27/2008
9/01/2016

NO.	REVISION	DATE
1	ADDITION OF BUILDING, SWM FACILITIES, RETAINING WALL AND SERVICE LANE	10/4/2016
2	DELETE PERMEABLE CONCRETE SIDEWALK	2/13/19

AS-BUILT SWM CONSTRUCTION DETAILS

REVISED SITE DEVELOPMENT PLAN
TURF VALLEY, LORIE
NURSING HOME & ASSISTED LIVING FACILITY
OAKMONT AT TURF VALLEY
PARCEL Q
PLATS 18773 - 18775
TAX MAP 16 - P/O PARCEL 8- GRID 16 & 17;
POD I per S-86-13 (4th AMENDED)
THIRD ELECTION DISTRICT HOWARD COUNTY, MARYLAND

KCI TECHNOLOGIES
ENGINEERS
PLANNERS
SCIENTISTS
CONSTRUCTION MANAGERS


3300 North Ridge Road
Suite 315
Ellicott City, MD 21043
Phone (410) 293-9800
Fax (410) 293-9228
www.kci.com

Professional Certification:
I hereby certify that these documents were prepared or approved by me, and that I am a duly licensed professional engineer under the laws of the State of Maryland. License No. 8818, Expiration Date: 10/17/18.

[Signature] 10/26/16

DRAWN BY: SK
CHECKED BY: DVK
SCALE: AS SHOWN
DATE: 10/4/2016

SHEET: 32 OF 36

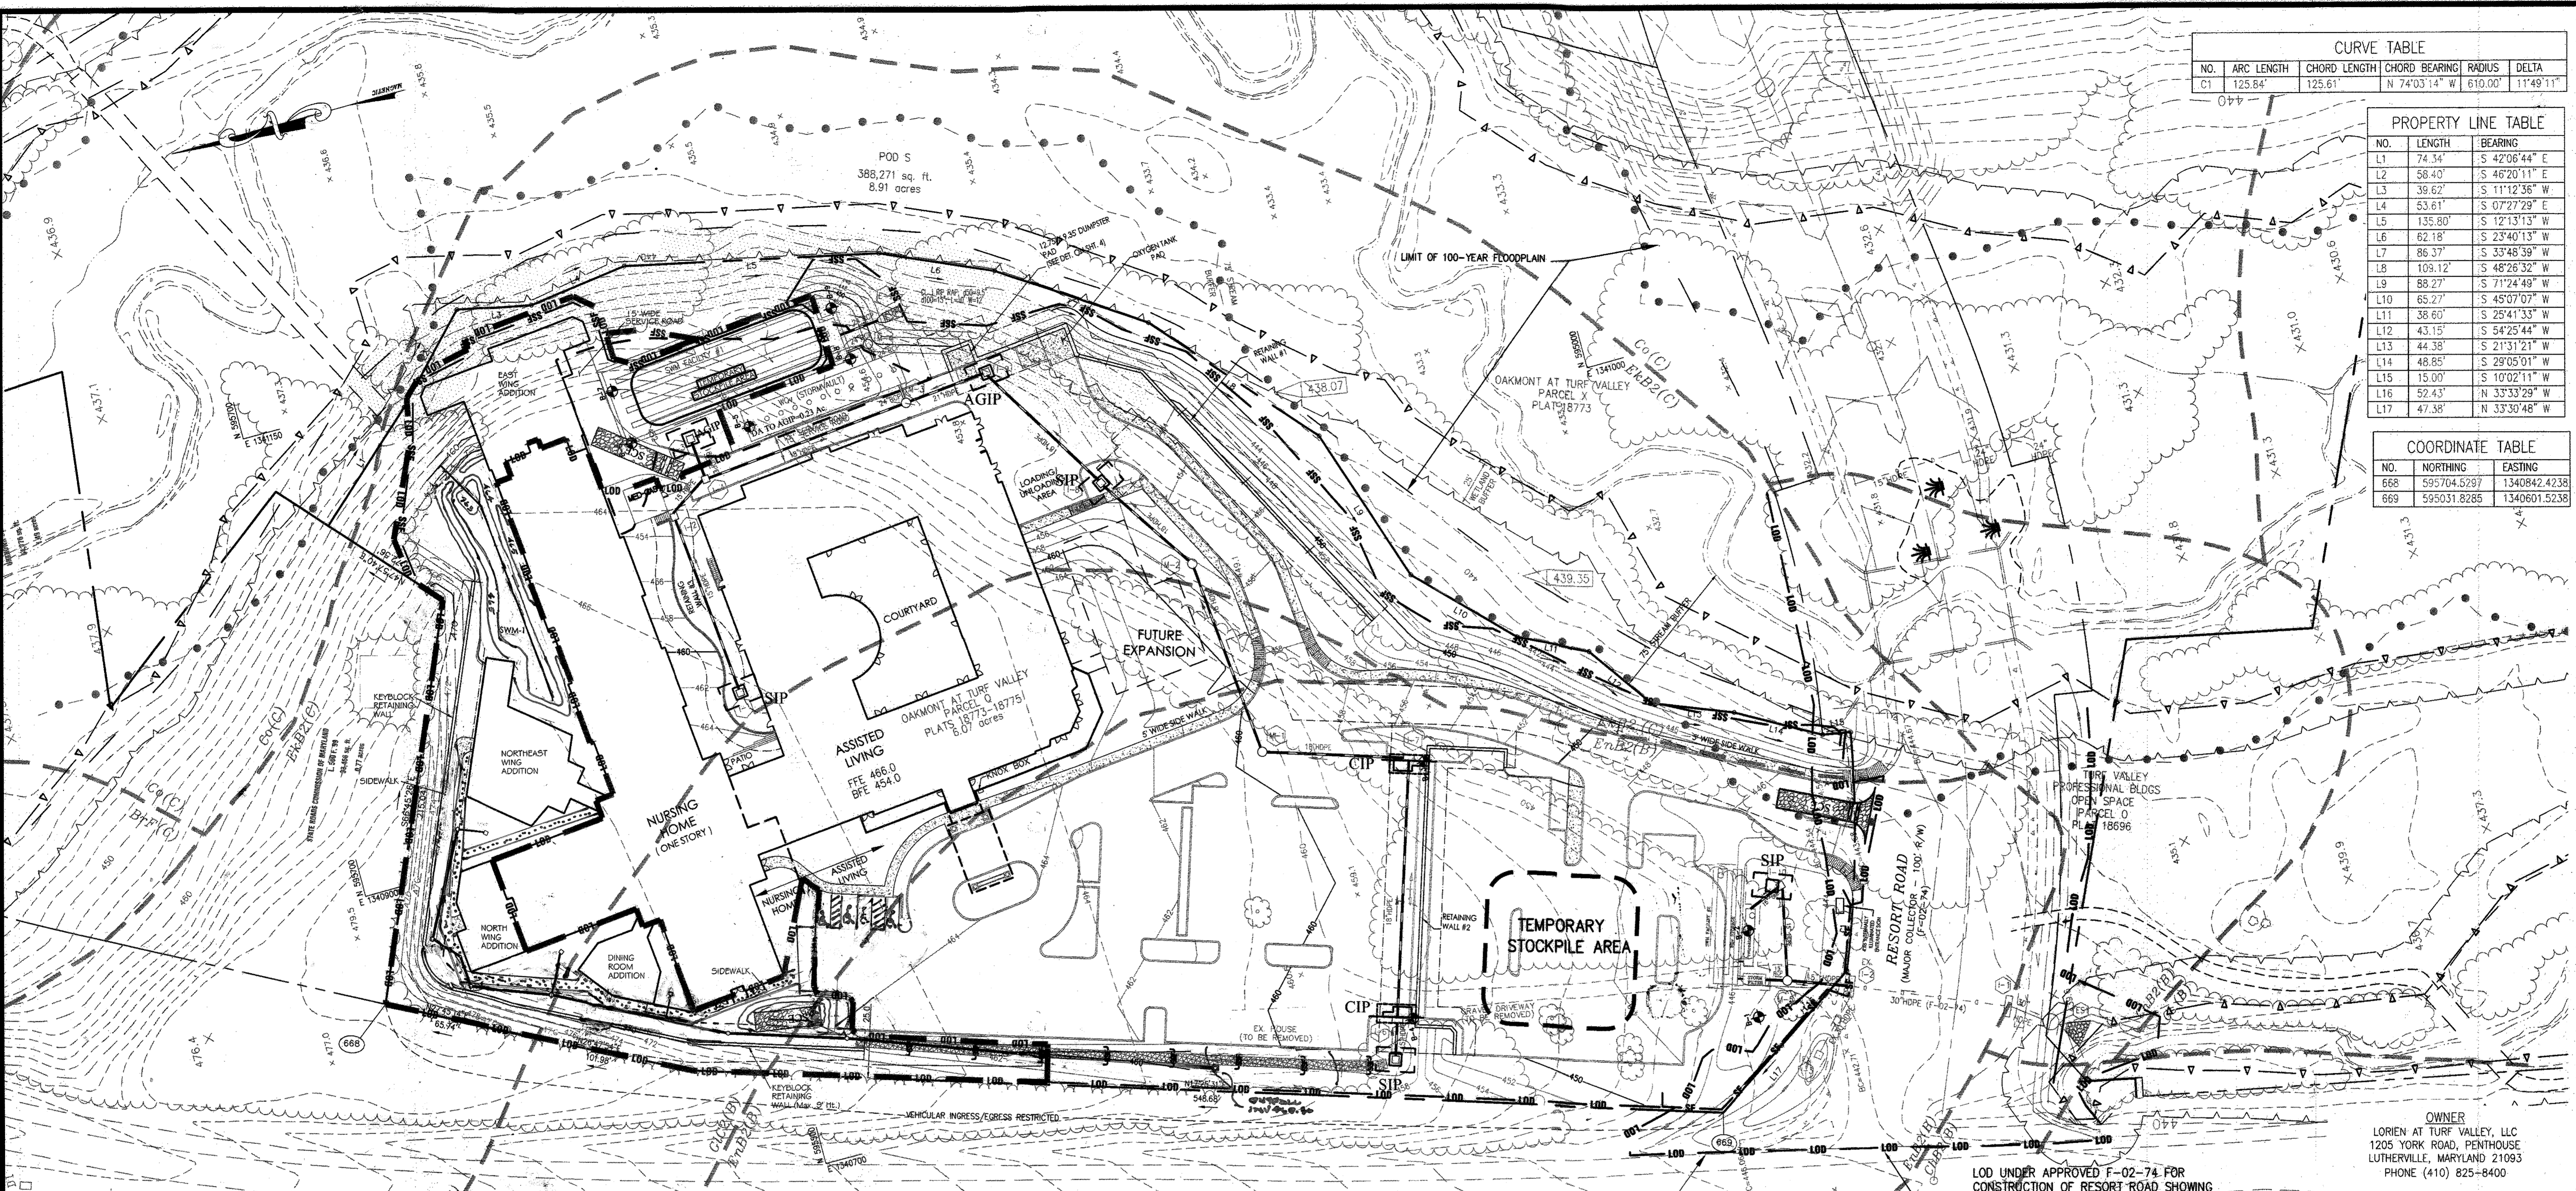

CURVE TABLE

NO.	ARC LENGTH	CHORD LENGTH	CHORD BEARING	RADIUS	DELTA
C1	125.84'	125.61'	N 74°03'14" W	610.00'	11°49'11"

PROPERTY LINE TABLE

NO.	LENGTH	BEARING
L1	74.34'	S 42°06'44" E
L2	56.40'	S 46°20'11" E
L3	39.62'	S 11°12'36" W
L4	53.61'	S 07°27'29" E
L5	135.80'	S 12°13'13" W
L6	62.18'	S 23°40'13" W
L7	86.37'	S 33°48'39" W
L8	109.12'	S 48°28'32" W
L9	88.27'	S 71°24'49" W
L10	65.27'	S 45°07'07" W
L11	38.60'	S 25°41'33" W
L12	43.15'	S 54°25'44" W
L13	44.38'	S 21°31'21" W
L14	48.85'	S 29°05'01" W
L15	15.00'	S 10°02'11" W
L16	52.43'	N 33°33'29" W
L17	47.38'	N 33°30'48" W

COORDINATE TABLE

NO.	NORTHING	EASTING
668	595704.5297	1340842.4238
669	595031.8285	1340601.5238

OWNER
 LORIEN AT TURF VALLEY, LLC
 1205 YORK ROAD, PENTHOUSE
 LUTHERVILLE, MARYLAND 21093
 PHONE (410) 825-8400

AS-BUILT CERTIFICATION
 I HEREBY CERTIFY, BY MY SEAL, THAT THE CONDITIONS SHOWN ON THIS PLAN WERE CONSIDERED TO BE TRUE AND CORRECT AS SHOWN ON THE "AS-BUILT" PLAN AND BEST AVAILABLE PHOTOGRAPHS AND SURVEY DATA AT THE TIME THIS PLAN WAS PREPARED. I AM A LICENSED PROFESSIONAL ENGINEER AND I AM NOT PROVIDING ANY GUARANTEE OR WARRANTY FOR THE ACCURACY OF THE INFORMATION SHOWN ON THIS PLAN.
 [Signature] 11/23/16

SOIL LEGEND:

SOIL	TYPE	DESCRIPTION
EKB2	C	ELIQUAK SILT LOAM, 3 TO 8% SLOPES, MODERATELY ERODED
ENB2	B	ELSINBORO LOAM, 8 TO 15% SLOPES, MODERATELY ERODED
GIC2	B	GLENELG LOAM, 8 TO 15% SLOPES, MODERATELY ERODED
CO	C	CODORUS SILT LOAM

HOWARD COUNTY SOIL MAP # 9

- LEGEND**
- EX. WATER
 - LOD - LIMIT OF DISTURBANCE
 - SF - SILT FENCE
 - SSF - SUPER SILT FENCE
 - CIP - CURB INLET PROTECTION
 - AGIP - AT GRADE INLET PROTECTION
 - EROSION CONTROL MATTING
 - SIP - STANDARD INLET PROTECTION
 - STABILIZATION CONSTRUCTION ENTRANCE (SCE) W/MOUNTABLE BERM
 - 25% SLOPES
 - 15% - 24.9% SLOPES
 - EX. WETLANDS
 - EX. WETLAND BUFFER
 - EX. STREAM
 - EX. STREAM BUFFER
 - EX. 100-YEAR FLOODPLAIN
 - SOIL TYPES
 - EXISTING EASEMENTS

NOTE: TO IMPROVE CLARITY, LIMIT OF DISTURBANCE (LOD) LINE IS NOT SHOWN AT LOCATIONS WHERE SILT FENCE IS USED. IN THESE AREAS, SILT FENCE (SF) LINE ALSO DENOTES THE LIMIT OF DISTURBANCE (LOD).
 CONTRACTOR SHALL INSTALL AND/OR RESET ADDITIONAL LENGTH OF SILT FENCE IF REQUIRED BY THE SEDIMENT CONTROL INSPECTOR.

AS-BUILT SEDIMENT & EROSION CONTROL PLAN

REVISED SITE DEVELOPMENT PLAN
TURF VALLEY, LORIEN
NURSING HOME & ASSISTED LIVING FACILITY

OAKMONT AT TURF VALLEY
 PARCEL O
 PLATS 18773 - 18775
 TAX MAP 16 - P/O PARCEL 8- GRID 16 & 17;
 POD I per S-86-13 (4th AMENDED)
 THIRD ELECTION DISTRICT HOWARD COUNTY, MARYLAND



ENGINEERS
PLANNERS
SCIENTISTS
CONSTRUCTION MANAGERS
KCI TECHNOLOGIES
 3900 North Ridge Road
 Suite 303
 Elkridge City, MD 21043
 Phone (410) 825-8400
 Fax (410) 825-8228
 www.kci.com

DRAWN BY: SK
 CHECKED BY: DVK
 SCALE: 1"=40'
 DATE: 10/4/2016
 SHEET: 33 OF 36

APPROVED
PLANNING BOARD
OF HOWARD COUNTY
 DATE 3/27/2016
 9/6/2016



PROFESSIONAL CERTIFICATION: I HEREBY CERTIFY THAT THESE DOCUMENTS WERE PREPARED OR APPROVED BY ME, AND THAT I AM A DULY LICENSED PROFESSIONAL ENGINEER UNDER THE LAWS OF THE STATE OF MARYLAND, REG. NO. 21267, EXPIRATION DATE 6-16-2019


- 25% SLOPES
- 15% - 24.9% SLOPES
- EX. WETLANDS
- EX. WETLAND BUFFER
- EX. STREAM
- EX. STREAM BUFFER
- EX. 100-YEAR FLOODPLAIN
- SOIL TYPES
- EXISTING EASEMENTS

REVIEWED FOR HOWARD SCD AND MEETS TECHNICAL REQUIREMENTS.
 [Signature] 11/23/16
 U.S. NATURAL RESOURCES CONSERVATION SERVICE
 DATE 11/23/16
 THIS DEVELOPMENT PLAN IS APPROVED FOR SOIL EROSION AND SEDIMENT CONTROL BY THE HOWARD SOIL CONSERVATION DISTRICT.
 [Signature] 11/23/16
 HOWARD SOIL CONSERVATION DISTRICT

ENGINEER'S CERTIFICATE
 I CERTIFY THAT THIS PLAN FOR SEDIMENT AND EROSION CONTROL REPRESENTS A PRACTICAL AND WORKABLE PLAN BASED ON MY PERSONAL KNOWLEDGE OF THE SITE CONDITIONS AND THAT IT WAS PREPARED IN ACCORDANCE WITH THE REQUIREMENTS OF THE HOWARD SOIL CONSERVATION DISTRICT.
 [Signature] 10/26/16
 D. VIR KATHURIA, P.E.

DEVELOPER'S CERTIFICATE
 I HEREBY CERTIFY THAT ALL DEVELOPMENT AND CONSTRUCTION WILL BE DONE ACCORDING TO THIS PLAN FOR SEDIMENT & EROSION CONTROL, AND THAT RESPONSIBLE PERSONNEL INVOLVED IN THE CONSTRUCTION PROJECT WILL HAVE A CERTIFICATE OF ATTENDANCE AT A DEPARTMENT OF THE ENVIRONMENT APPROVED TRAINING PROGRAM FOR THE CONTROL OF SEDIMENT AND EROSION BEFORE BEGINNING THE PROJECT. I ALSO AUTHORIZE PERIODIC ON-SITE INSPECTION BY THE HOWARD SOIL CONSERVATION DISTRICT.
 [Signature] 11/1/16
 LOUIE WANGSONG

APPROVED: DEPARTMENT OF PLANNING AND ZONING
 [Signature] 11/28/16
 Chief, Development Engineering Division
 [Signature] 12-6-16
 Chief, Division of Land Development
 [Signature] 12-6-16
 Director

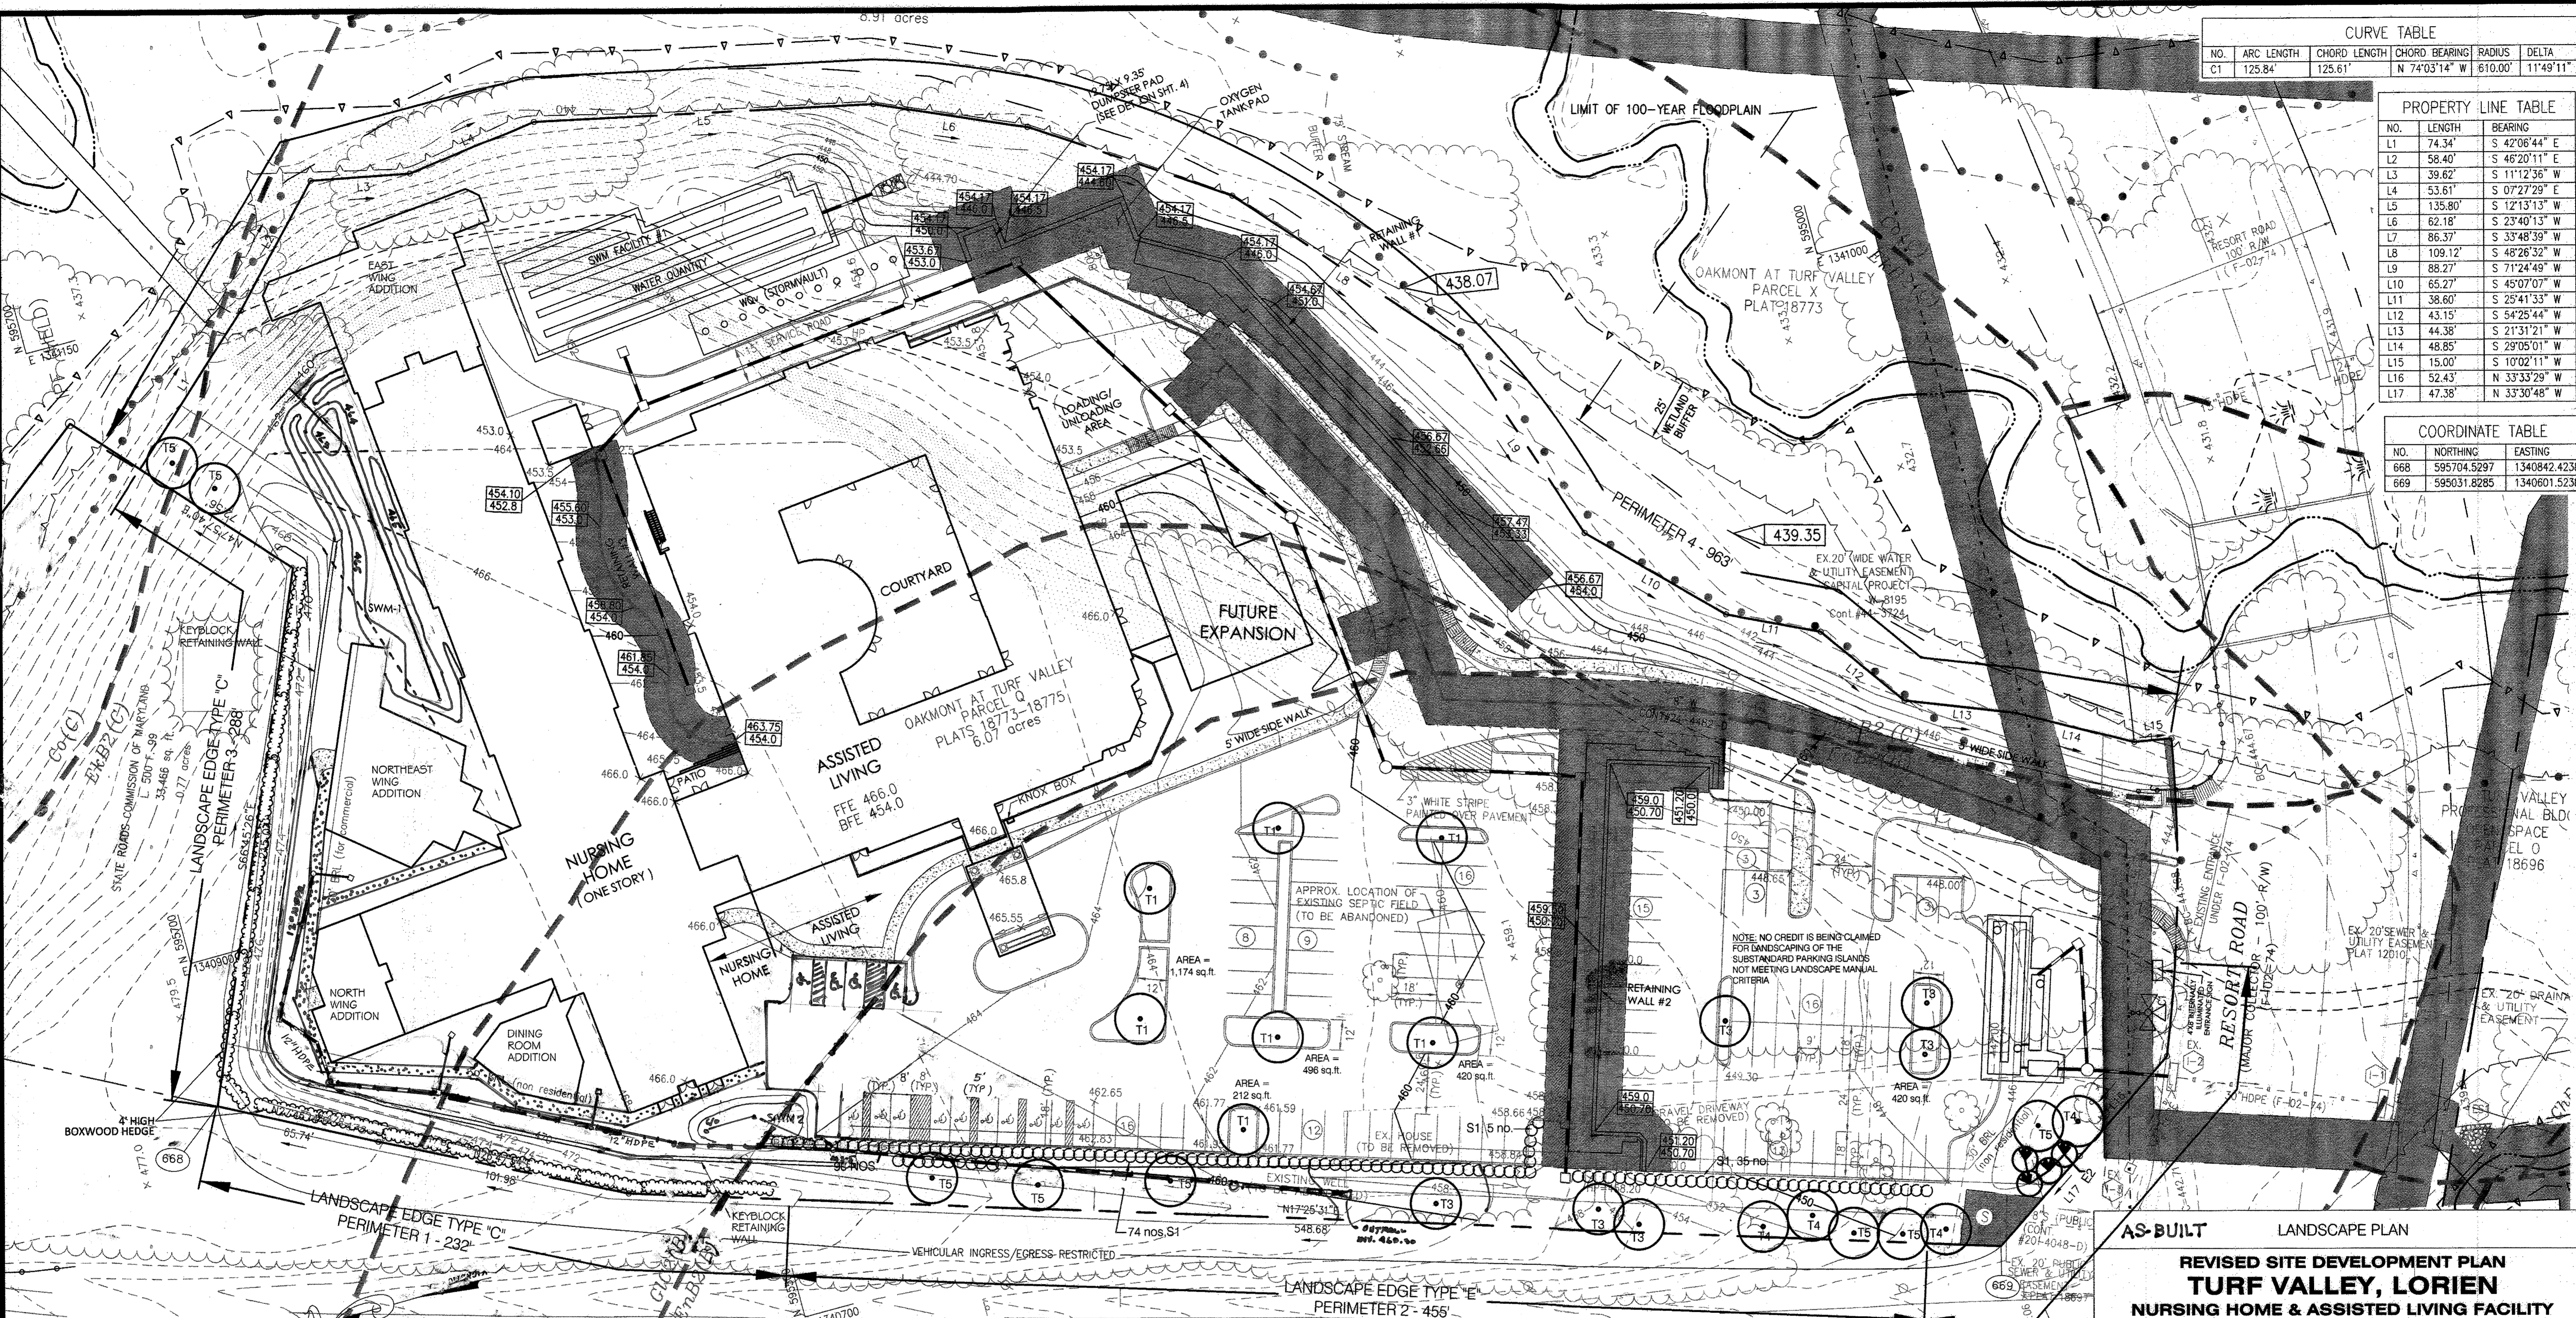

CURVE TABLE					
NO.	ARC LENGTH	CHORD LENGTH	CHORD BEARING	RADIUS	DELTA
C1	125.84'	125.61'	N 74°03'14" W	610.00'	11°49'11"


PROPERTY LINE TABLE		
NO.	LENGTH	BEARING
L1	74.34'	S 42°06'44" E
L2	58.40'	S 46°20'11" E
L3	39.82'	S 11°12'36" W
L4	53.61'	S 07°27'29" E
L5	135.80'	S 12°13'13" W
L6	62.18'	S 23°40'13" W
L7	86.37'	S 33°48'39" W
L8	109.12'	S 48°26'32" W
L9	88.27'	S 71°24'49" W
L10	65.27'	S 45°07'07" W
L11	38.60'	S 25°41'33" W
L12	43.15'	S 54°25'44" W
L13	44.38'	S 21°31'21" W
L14	48.85'	S 29°05'01" W
L15	15.00'	S 10°02'11" W
L16	52.43'	N 33°33'29" W
L17	47.38'	N 33°30'48" W

COORDINATE TABLE		
NO.	NORTHING	EASTING
668	595704.5297	1340842.4238
669	595031.8285	1340601.5238

AS-BUILT CERTIFICATION
 I HEREBY CERTIFY, BY MY SEAL, THAT THE COPYING AND PLOTTING OF THIS PLAN WERE COMPLETED TO THE BEST OF MY KNOWLEDGE AND BELIEF ON THE DATE INDICATED BY THE DATE OF THIS CERTIFICATION AND THAT THE INFORMATION CONTAINED HEREIN IS TRUE AND CORRECT TO THE BEST OF MY KNOWLEDGE AND BELIEF.
 MICHAEL C. ARCO, PROFESSIONAL LAND SURVEYOR
 MD License No. 21227, Expiration Date 6-16-2019

MARRIOTTSVILLE ROAD
 EX. INTERMEDIATE ARTERIAL (ULTIMATE 120' ROW)

PROFESSIONAL CERTIFICATION: I HEREBY CERTIFY THAT THESE DOCUMENTS WERE PREPARED OR APPROVED BY ME, AND THAT I AM A DULY LICENSED PROFESSIONAL LAND SURVEYOR, UNDER THE LAWS OF THE STATE OF MARYLAND, REG. NO. 21227, EXPIRATION DATE 6-16-2019.

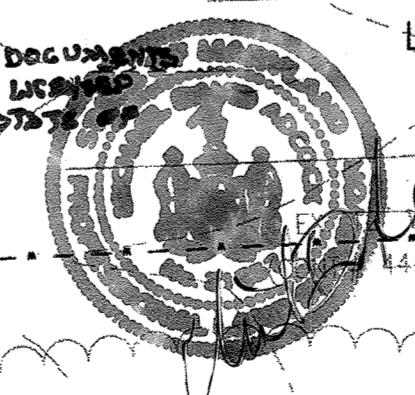

APPROVED
 PLANNING BOARD OF HOWARD COUNTY
 DATE 3/23/2018
 7/01/2016

APPROVED: DEPARTMENT OF PLANNING AND ZONING

11/28/16
 12-6-16
 12-6-16

DEVELOPER'S LANDSCAPE CERTIFICATE
 I CERTIFY THAT THE LANDSCAPING SHOWN ON THIS PLAN WILL BE DONE ACCORDING TO THE PLAN, SECTION 16.124 OF THE HOWARD COUNTY CODE AND THE LANDSCAPE MANUAL. I FURTHER CERTIFY THAT UPON COMPLETION, A LETTER OF LANDSCAPE INSTALLATION, ACCOMPANIED BY AN EXECUTED ONE YEAR GUARANTEE OF PLANT MATERIALS WILL BE SUBMITTED TO THE DEPARTMENT OF PLANNING AND ZONING.

11/1/16
 OWNER/DEVELOPER SIGNATURE DATE

- LEGEND**
- 25% SLOPES
 - 15% - 24.9% SLOPES
 - EX. WETLANDS
 - EX. WETLAND BUFFER
 - EX. STREAM
 - EX. STREAM BUFFER
 - EX. 100-YEAR FLOODPLAIN
 - SOIL TYPES
 - EXISTING EASEMENTS
 - EX. WATER


SOIL LEGEND:

SOIL	TYPE	DESCRIPTION
EkB2	C	ELIOAK SILT LOAM, 3 TO 8% SLOPES, MODERATELY ERODED
EnB2	B	ELISBORO LOAM, 8 TO 15% SLOPES, MODERATELY ERODED
GIC2	B	GLENELG LOAM, 8 TO 15% SLOPES, MODERATELY ERODED
CO	C	CODORUS SILT LOAM

HOWARD COUNTY SOIL MAP # 9

OWNER
 LORIEN AT TURF VALLEY, LLC
 1205 YORK ROAD, PENTHOUSE
 LUTHERVILLE, MARYLAND 21093
 PHONE (410) 825-8400

AS-BUILT LANDSCAPE PLAN
REVISED SITE DEVELOPMENT PLAN
TURF VALLEY, LORIEN
NURSING HOME & ASSISTED LIVING FACILITY
 OAKMONT AT TURF VALLEY
 PARCEL Q
 PLATS 18773 - 18775
 TAX MAP 16 - P/O PARCEL 8- GRID 16 & 17;
 POD I per S-86-13 (4th AMENDED)
 THIRD ELECTION DISTRICT HOWARD COUNTY, MARYLAND

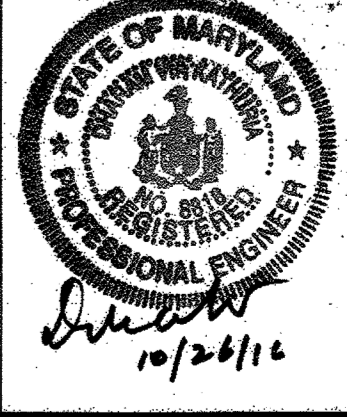

Professional Certification:
 I hereby certify that these documents were prepared or approved by me, and that I am a duly licensed professional engineer under the laws of the State of Maryland, License No. 8818, Expiration Date: 10/17/18.

DRAWN BY: SK
 CHECKED BY: DVK
 SCALE: 1"=30'
 DATE: 10/4/2016

SHEET: 35 OF 36

NOTES

1. NO RARE, THREATENED OR ENDANGERED SPECIES WERE OBSERVED ON THIS SITE.
2. THERE ARE NO ISOLATED FOREST STANDS ON THIS SITE.
3. THIS PLAN HAS BEEN PREPARED IN ACCORDANCE WITH THE PROVISIONS OF SECTION 16.124 OF THE HOWARD COUNTY CODE AND THE LANDSCAPE MANUAL. FINANCIAL SURETY FOR THE PROPOSED LANDSCAPING TO BE POSTED AS PART OF THE DEVELOPER'S AGREEMENT FOR 34 SHADE TREES, 30 EVERGREEN TREES AND 114 SHRUBS IN THE AMOUNT OF \$18,120.
7. CONTRACTOR SHALL VERIFY LOCATION OF ALL UNDERGROUND UTILITIES PRIOR TO DIGGING.
8. FINAL LOCATION OF PLANT MATERIAL MAY NEED TO VARY TO MEET FINAL FIELD CONDITIONS. TREES SHALL NOT BE PLANTED IN THE BOTTOM OF DRAINAGE SWALES.
9. CONTRACTOR SHALL VERIFY PLANT QUANTITIES PRIOR TO BIDDING. IF PLAN DIFFERS FROM LANDSCAPE SCHEDULE, THE PLAN SHALL GOVERN.
10. AT THE TIME OF PLANT INSTALLATION, ALL TREES LISTED AND APPROVED ON THE LANDSCAPE PLAN, SHALL COMPLY WITH THE PROPER HEIGHT REQUIREMENT IN ACCORDANCE WITH THE HOWARD COUNTY LANDSCAPE MANUAL. IN ADDITION, NO SUBSTITUTIONS OR RELOCATIONS OF THE REQUIRED PLANTINGS MAY BE MADE WITHOUT PRIOR REVIEW AND APPROVAL FROM THE DEPARTMENT OF PLANNING AND ZONING. ANY DEVIATIONS FROM THE APPROVED LANDSCAPE PLAN MAY RESULT IN DENIAL OR DELAY IN THE RELEASE OF LANDSCAPE SURETY UNTIL SUCH TIME AS ALL REQUIRED MATERIALS ARE PLANTED AND/OR REVISIONS ARE MADE TO THE PLANS.

PLANT LIST							
KEY	SYMBOL	QTY	BOTANICAL NAME	COMMON NAME	ROOT	SPACING	SIZE
○	T1	10	Sophora japonica	Japanese Pagoda Tree	B&B	As shown on plan	2 1/2"-3" cal.
	T2	3	Gleditsia triacanthos inermis 'Imperial'	Imperial Thornless Honeylocust	B&B	As shown on plan	2 1/2"-3" cal.
	T3	6	Tilia cordata	Little Leaf Linden	B&B	As shown on plan	2 1/2"-3" cal.
	T4	8	Quercus coccinea	Scarlet Oak	B&B	As shown on plan	2 1/2"-3" cal.
	T5	10	Quercus acutissima	Sawtooth Oak	B&B	As shown on plan	2 1/2"-3" cal.
○	E1	6	Pinus strobus	Eastern White Pine	CONT.	As shown on plan	6'-8' ht.
	E2	10	Pinus thunbergiana	Japanese Black Pine	CONT.	As shown on plan	6'-8' ht.
	E3	14	Cupressocyparis leylandi	Leyland Cypress	CONT.	As shown on plan	5'-6' ht.
○	S1	114	Photinia x fraserii	Frasers Photinia	CONT.	4' o.c.	3'-3 1/2' ht.

SCHEDULE A
PERIMETER LANDSCAPE EDGE

Category	Adjacent to Roadways	Parking Lot Perimeter	Adjacent to Perimeter Properties	Internal Perimeter	Adjacent to Eastbound 1-70 ramp
Landscape Type	B	E	C	-	C
Linear Feet of Roadway Frontage/Perimeter	168'	455'	288'	963'	232'
Credit for Existing Vegetation (Yes, No, Linear Feet)	NO	NO	NO	NO	NO
Credit for Wall, Fence or Berm (Yes, No, Linear Feet)	NO	YES 20' (1)	YES HEDGE 20' (2)	NO	YES HEDGE 2 1/2' (2)
Number of Plants Required					
Shade Trees	3	11	7	-	6
Evergreen Trees	4	-	14	-	12
Shrubs	-	109	-	-	-
Number of Plants Provided					
Shade Trees	3	10	2	-	0
Evergreen Trees	4	-	0	-	0
Other Trees (2:1 substitution)	-	-	-	-	-
Shrubs (10:1 substitution)	-	119	-	-	1

- (1) GRADE MORE THAN 2' HIGHER THAN PARKING LOT, SUBSTITUTION CLAIMED FOR 20' OF PERIMETER E
(2) HEDGE (BUXUS MICROPHYLLA/LITTLE LEAF BOXWOOD) 2' TO 2 1/2' HIGH, PLANT 3' APART
NO. OF PLANTS REQUIRED = (20' x 2 1/2') / 3' = 147 PLANTS

SCHEDULE B
PARKING LOT INTERNAL LANDSCAPING


Number of Parking Spaces	133
Number of trees required	7
Number of trees provided	10
Shade trees	
Other trees (2:1 substitution)	

NOTE: NO CREDIT IS BEING CLAIMED FOR LANDSCAPING OF THE SUBSTANDARD PARKING ISLANDS NOT MEETING LANDSCAPE MANUAL CRITERIA.

PERIMETER EDGE SUMMARY


Perimeter	Type	Linear Ft.	Plants Req'd.	Credit for ex. vegetation	Plants provided	Notes
1	C	232'	8 Shade 12 Evergreen	-	0 Shade 0 Evergreen	Adjacent to Roadway
2	E	455'	11 Shade 114 Shrubs	-	10 Shade 119 Shrubs	Parking lot perimeter
3	C	288'	7 Shade 14 Evergreen	-	0 Shade 0 Evergreen	Adjacent to Residential zoning
4	-	963'	-	-	-	Internal landscape edge
5	B	168'	3 Shade 4 Evergreen	-	3 Shade 4 Evergreen	Adjacent to Roadway

Landscape Requirement - 34 Shade trees; 30 Evergreen; 119 shrubs
Banding -
Shrubs: 114 x 30 = \$3,420
Evergreen trees: 30 x 150 = \$4,500
Shade trees: 34 x 300 = \$10,200
Total = \$18,120
Shrubs: 6x30 = \$150
Hedge plants: 147x15 = \$2,205
Total = \$2,355

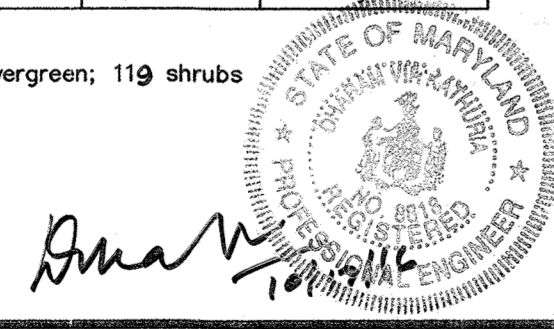


APPROVED
PLANNING BOARD
OF HOWARD COUNTY
DATE 3/27/08
DGA

APPROVED: DEPARTMENT OF PLANNING AND ZONING
Chief, Development Engineering Division: 6/25/08
Chief, Division of Land Development: 6/27/08
Director: 6/30/08

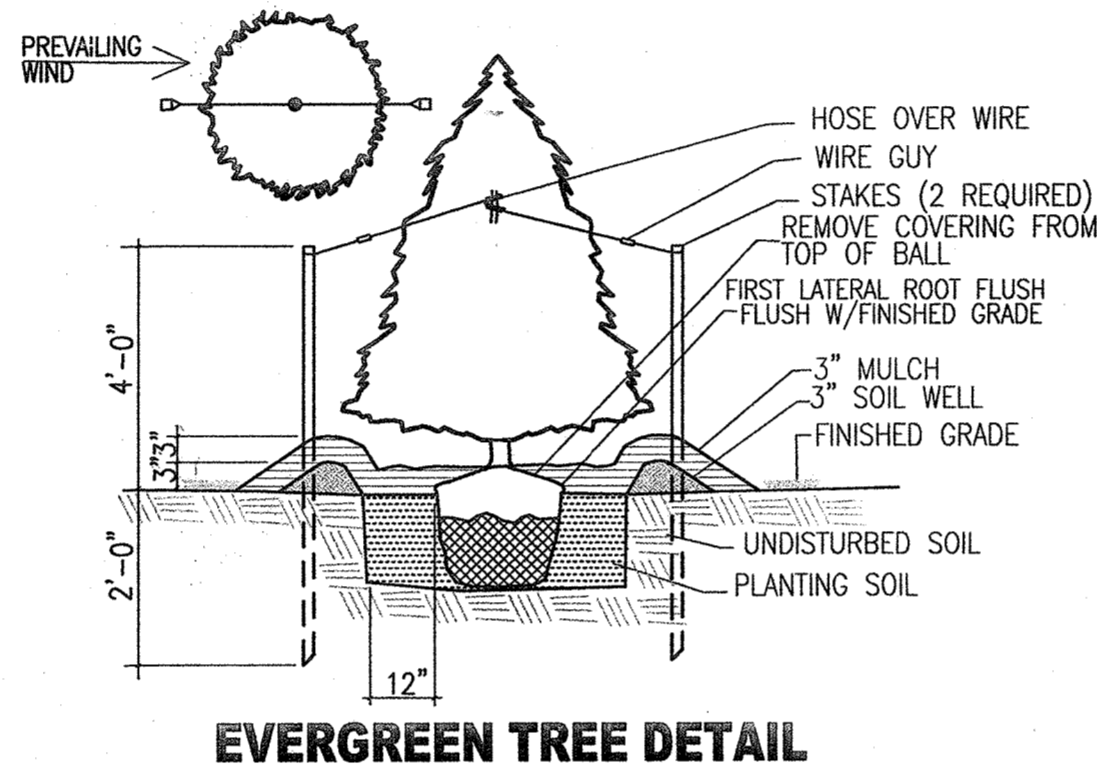


EVERGREEN TREE DETAIL

NOT TO SCALE

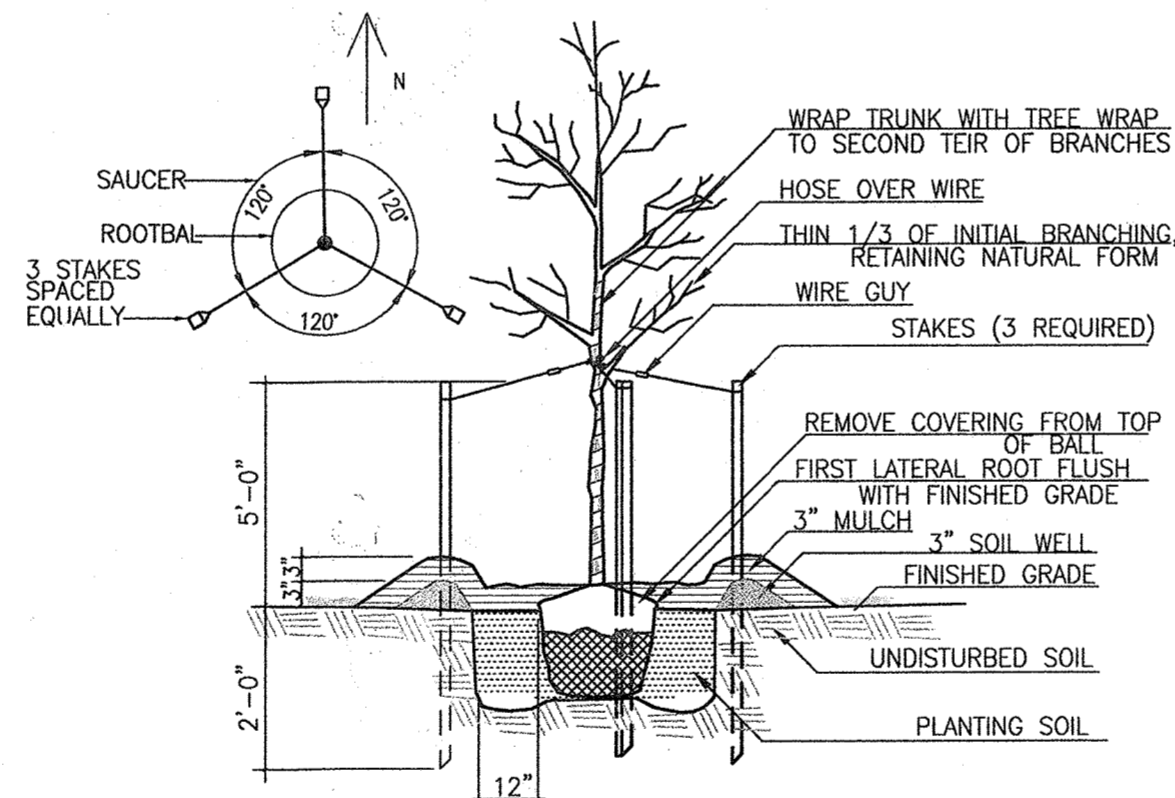

DECIDUOUS TREE DETAIL

NOT TO SCALE

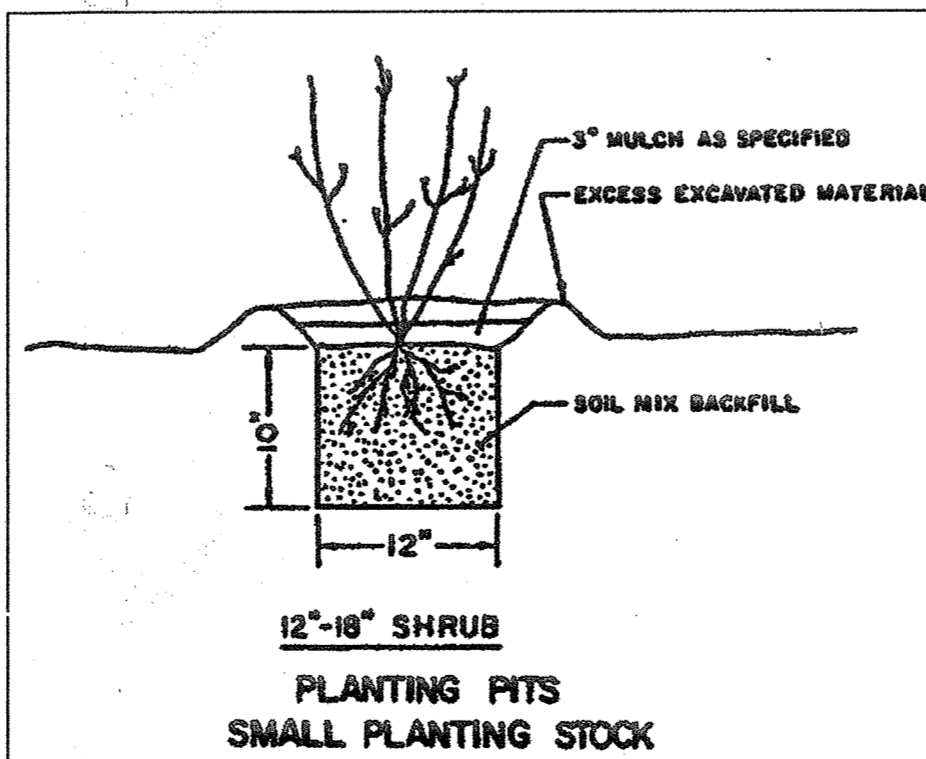

12"-16" SHRUB
PLANTING PITS
SMALL PLANTING STOCK

AS-BUILT CERTIFICATION

THERE IS NO AS-BUILT INFORMATION PROVIDED ON THIS SHEET.

Michael D. McCock, PROFESSIONAL LAND SURVEYOR
MD REG. NO. 21257 EXPIRATION DATE 06-14-21


OWNER

LORIEAN AT TURF VALLEY, LLC
1205 YORK ROAD, PENTHOUSE
LUTHERVILLE, MARYLAND 21093
PHONE (410) 825-8400

AS-BUILT LANDSCAPE DETAILS
TURF VALLEY, LORIEAN
NURSING HOME & ASSISTED LIVING FACILITY
OAKMONT AT TURF VALLEY
PARCEL Q
PLATS 18773 - 18775
TAX MAP 16 - P/O PARCEL 8- GRID 16 & 17;
POD I per S-86-13 (4th AMENDED)
THIRD ELECTION DISTRICT HOWARD COUNTY, MARYLAND

KCE ENGINEERING, INC.
EXECUTIVE CENTER
3300 NORTH RIDGE ROAD, SUITE 315
ELLCOTT CITY, MARYLAND 21043
PHONE (410) 203-9800 FAX (410) 203-9228

"Professional Certification, I hereby certify that these documents were prepared or approved by me, and that I am a duly licensed professional engineer under the laws of the State of Maryland, License No. 8818, Expiration Date: 10/17/2011"

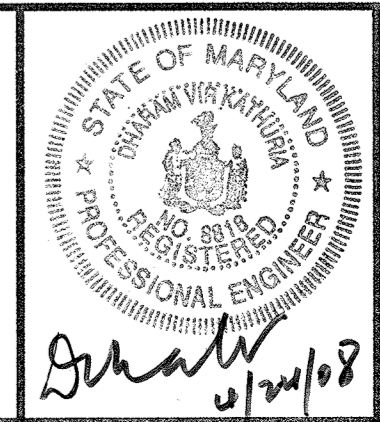

DRAWN BY: MG
CHECKED BY: DVK
SCALE: N/A
DATE: 04/30/2008

SHEET:
36
OF
36