

**GENERAL NOTES**

- SUBJECT PROPERTY IS ZONED "PGCC" PER THE 2020/04 COMPREHENSIVE ZONING PLAN AND THE "COMP. LITE" ZONING AMENDMENTS EFFECTIVE 7/28/06.
- AREA OF PLAN SUBMISSION: 37.50 AC.±
- LIMIT OF DISTURBED AREA: 11.11 AC.±
- EXISTING USE: GOLF COURSE
- PROPOSED USE: STORMWATER MANAGEMENT FACILITIES
- PREVIOUS HOWARD COUNTY FILE NUMBERS: S-8-001, S-11-003, S-8-13, CONTR #44-4480-D, CONTR #24-3447-D, PB-181, PB-224, PB-300, PB-351, PB-365, WP-09-211, WP-10-065, WP-10-112, WP-10-159, WP-11-188, WP-12-129, WP-13-126, F-10-028
- THIS PROPERTY IS WITHIN THE METROPOLITAN DISTRICT.
- SOILS TAKEN FROM WEB SOILS SURVEY, NATIONAL COOPERATIVE SOIL SURVEY WEBSITE ON MAY 20, 2011
- BOUNDARY SURVEY PERFORMED BY WILSON, BOENGER & ASSOCIATES ON OR ABOUT MARCH, 2006
- THE LOT LINES SHOWN HEREON ARE BASED ON TURF VALLEY CLUBHOUSE PHASES (S-08-001) AND I (S-11-003).
- EXISTING TOPOGRAPHY IS BASED ON AN AERIAL SURVEY WITH 2' CONTOURS PREPARED BY WINGS AERIAL MAPPING CO., INC. ON OR ABOUT JANUARY, 2008 AND SUPPLEMENTED WITH FIELD RUN TOPO AS NECESSARY IN THE AREA OF THE SOCCER FIELD, PERFORMED BY BENCHMARK ENGINEERING INC. ON OR ABOUT OCTOBER, 2011 UNDER WP-10-065.
- THE COORDINATES SHOWN HEREON ARE BASED ON THE HOWARD COUNTY GEODETIC CONTROL, WHICH IS BASED ON THE MARYLAND STATE PLANE COORDINATE SYSTEM. HOWARD COUNTY MONUMENTS NUMBERS 161B AND 17AB WERE USED FOR THIS PROJECT.
- THERE ARE NO WETLANDS, STREAMS, FLOODPLAINS, HISTORIC STRUCTURES OR CEMETERIES WITHIN THE PROJECT BOUNDARY.
- WETLAND LIMITS SHOWN ARE BASED ON A STUDY CONDUCTED BY EXPLORATION RESEARCH, INC. AND VERIFIED BY ECOSCIENCE PROFESSIONALS, INC. ON OCTOBER 24, 2007. LIMITS SHOWN ARE IN ACCORDANCE WITH THOSE SHOWN ON THE FOURTH AMENDMENT TO THE TURF VALLEY COMPREHENSIVE SKETCH PLAN (S-8-13, PB 368), APPROVED JULY, 28, 2006.
- THE FLOODPLAIN STUDY FOR THIS PROJECT WAS PREPARED BY BERNARD JOHNSON INCORPORATED, DATED MAY 1986, AND WAS APPROVED BY HOWARD COUNTY UNDER THE LITTLE PATUXENT RIVER WATERSHED MODEL UPDATE ULTIMATE WATERSHED DEVELOPMENT CAPITAL PROJECT D-1065. LIMITS SHOWN ARE IN ACCORDANCE WITH THOSE SHOWN ON THE FOURTH AMENDMENT TO THE TURF VALLEY COMPREHENSIVE SKETCH PLAN (S-8-13, PB 368), APPROVED JULY, 28, 2006. ELEVATIONS HAVE BEEN ADJUSTED TO NAVD 88, AS SHOWN ON SHEETS 3 AND 4.
- NO GRADING, REMOVAL OF VEGETATIVE COVER OR TREES, PAVING AND NEW STRUCTURES SHALL BE PERMITTED WITHIN THE LIMITS OF WETLANDS, STREAMS, OR THEIR REQUIRED BUFFERS, FLOODPLAIN AND FOREST CONSERVATION EASEMENT AREAS AND 100 YEAR FLOODPLAIN.
- THE TRAFFIC STUDY FOR THIS PROJECT WAS PREPARED BY TRAFFIC GROUP, DATED JANUARY 07, 2005 AND WAS APPROVED UNDER THE 4TH AMENDED COMPREHENSIVE SKETCH PLAN ON APRIL 27, 2006.
- A NOISE STUDY IS NOT REQUIRED FOR THIS PROJECT.
- PUBLIC WATER AND PUBLIC SEWER WILL BE USED WITHIN FUTURE DEVELOPMENT OF THIS SITE. PUBLIC WATER WILL BE EXTENDED FROM CONTRACT #44-4480. PUBLIC SEWER WILL BE EXTENDED FROM CONTRACT #24-3447.
- THE CONTRACTOR SHALL NOTIFY THE FOLLOWING UTILITY COMPANIES OR AGENCIES AT LEAST FIVE (5) WORKING DAYS BEFORE STARTING WORK SHOWN ON THESE PLANS:

\* SUBJECT TO NOTE 31, BELOW  
 XX-THE AS-BUILT WAS PERFORMED USING TRAMM-TAPE SURVEY METHODS.

**SITE ANALYSIS DATA SHEET**

ENVIRONMENTAL AREA	SIZE OR USE
TOTAL PROJECT AREA	37.50 ACRES±
LIMIT OF DISTURBANCE	11.11 ACRES±
GREEN OPEN AREA (LAWN)	37.50 ACRES±
IMPERVIOUS AREA (EXISTING)	0.70 ACRES±
PROPOSED SITE USES	SWM FACILITIES
WETLANDS	0.00 ACRES±
WETLAND BUFFERS	0.00 ACRES±
FLOODPLAINS	0.00 ACRES±
FLOODPLAIN BUFFERS	0.00 ACRES±
EXISTING FOREST	12.00 ACRES±
SLOPES GREATER THAN 15%	1.70 ACRES±
HIGHLY ERODIBLE SOILS	7.80 ACRES±

NOTE:  
 1) HIGHLY ERODIBLE SOILS ARE ASSUMED TO BE A "K" VALUE OF 0.37 OR HIGHER.  
 2) HIGHLY ERODIBLE SOILS ARE ASSUMED TO BE A "K" VALUE OF 0.37 OR HIGHER.

# SITE DEVELOPMENT PLANS

## TURF VALLEY


### REGIONAL STORMWATER MANAGEMENT FACILITIES

#### PGCC MULTI-USE SUBDISTRICT

#### HOWARD COUNTY, MARYLAND

**LEGEND**

- EXISTING TREELINE
- EXISTING FLOODPLAIN
- EXISTING STREAMBANK BUFFER
- APPROX. CL STREAM
- EXISTING FENCE
- EXISTING CART PATH

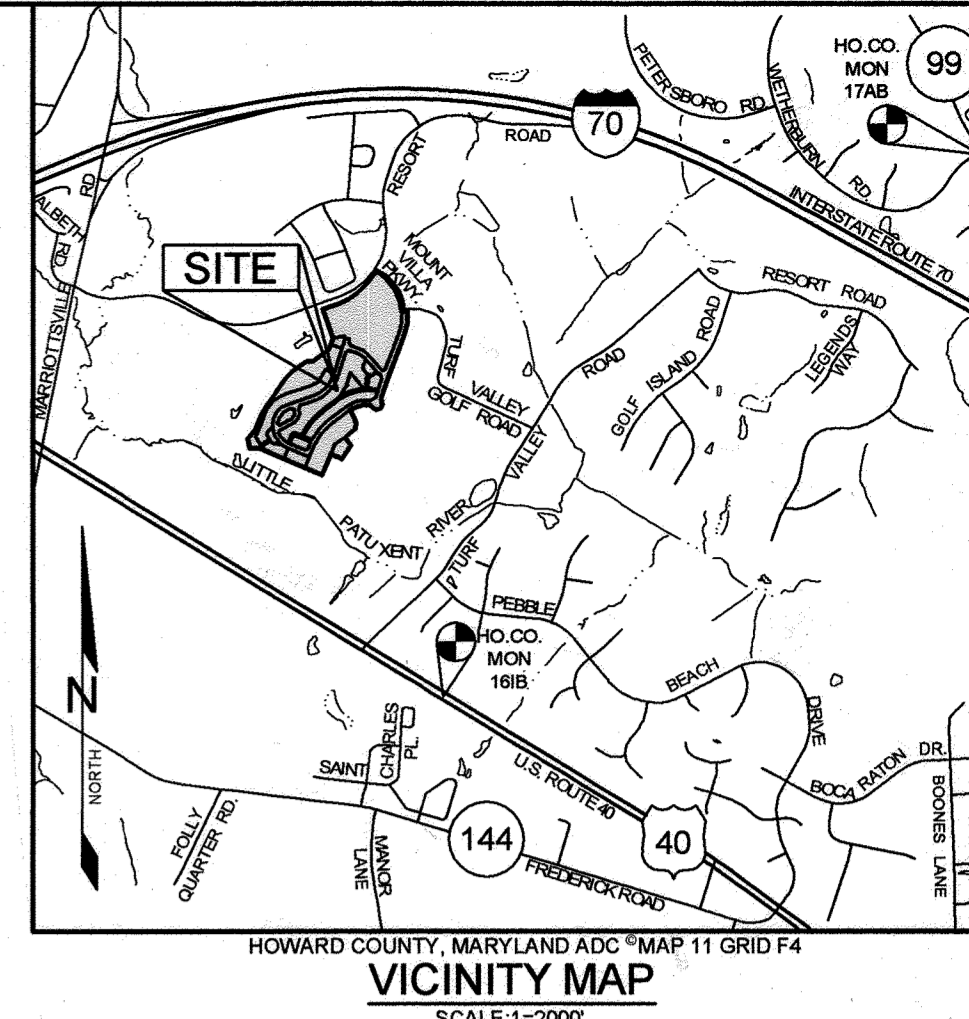

**BENCHMARKS**

NUMBER	NORTHING	EASTING	ELEVATION	DESCRIPTION
161B	590,475.2538	1,344,753.9350	469.892	11.5' SOUTHWEST OF WBL RT. 40, 20.8' WEST OF PK NAIL IN SHOULDER, 86.4' SOUTH OF LAST POST IN GUARDRAIL
17AB	598,435.249	1,349,615.2492	508.469	SE OF INTERSECTION OF RTE. 98 AND WETHERBURN ROAD, 14.8' WEST OF FENCE POST, 35' NE OF MANHOLE

**SITE ANALYSIS DATA CHART**


TOTAL PROJECT AREA	AREA OF SUBMISSION	DISTURBED AREA	PRESENT ZONING
37.50 AC±	37.50 AC±	11.11 AC±	PGCC
PROPOSED USE	FLOOR SPACE PER USE	TOTAL UNITS ALLOWED	TOTAL UNITS PROPOSED
SWM FACILITIES	N/A	N/A	N/A
MAX. # EMPLOYEES/STAFF	PARKING SPACES REQ.	PARKING SPACES PROV.	HC SPACES PROVIDED
N/A	N/A	N/A	N/A
OPEN SPACE REQUIRED	OPEN SPACE PROVIDED	REC. O.S. REQUIRED	REC. O.S. PROVIDED
N/A	N/A	N/A	N/A
BUILDING COVERAGE	FLOOR AREA RATIO	DPZ FILE REFERENCES	SEE GENERAL NOTE #3
N/A	N/A		

**PERMIT INFORMATION CHART**

SUBDIVISION / PROJECT NAME	SECTION / AREA	PARCEL #
TURF VALLEY REGIONAL STORMWATER MANAGEMENT FACILITIES		P/O PARCELS 8 & 394
PLAT OR LF	GRID #	ZONING
L 920, F. 250	16 & 17	PGCC
	TAX MAP #	ELECT. DIS.
	16	THIRD
	CENSUS TRACT	
	6030.00	

**SHEET INDEX**

SHEET NO.	DESCRIPTION
1	COVER SHEET
2	GRADING, SEDIMENT AND EROSION CONTROL PLAN
3	GRADING, SEDIMENT AND EROSION CONTROL PLAN
4	GRADING, SEDIMENT AND EROSION CONTROL PLAN
5	SEDIMENT & EROSION CONTROL NOTES & DETAILS
6	BIORETENTION PLAN & DETAILS
7	EXTENDED DETENTION FACILITY PLAN & DETAILS
8	POND DETAILS
9	DETAILS & STORMDRAIN PROFILES
10	BORING LOGS
11	BIORETENTION PLANTING PLAN & MD 378 POND NOTES
12	STORMWATER MANAGEMENT DETAILS

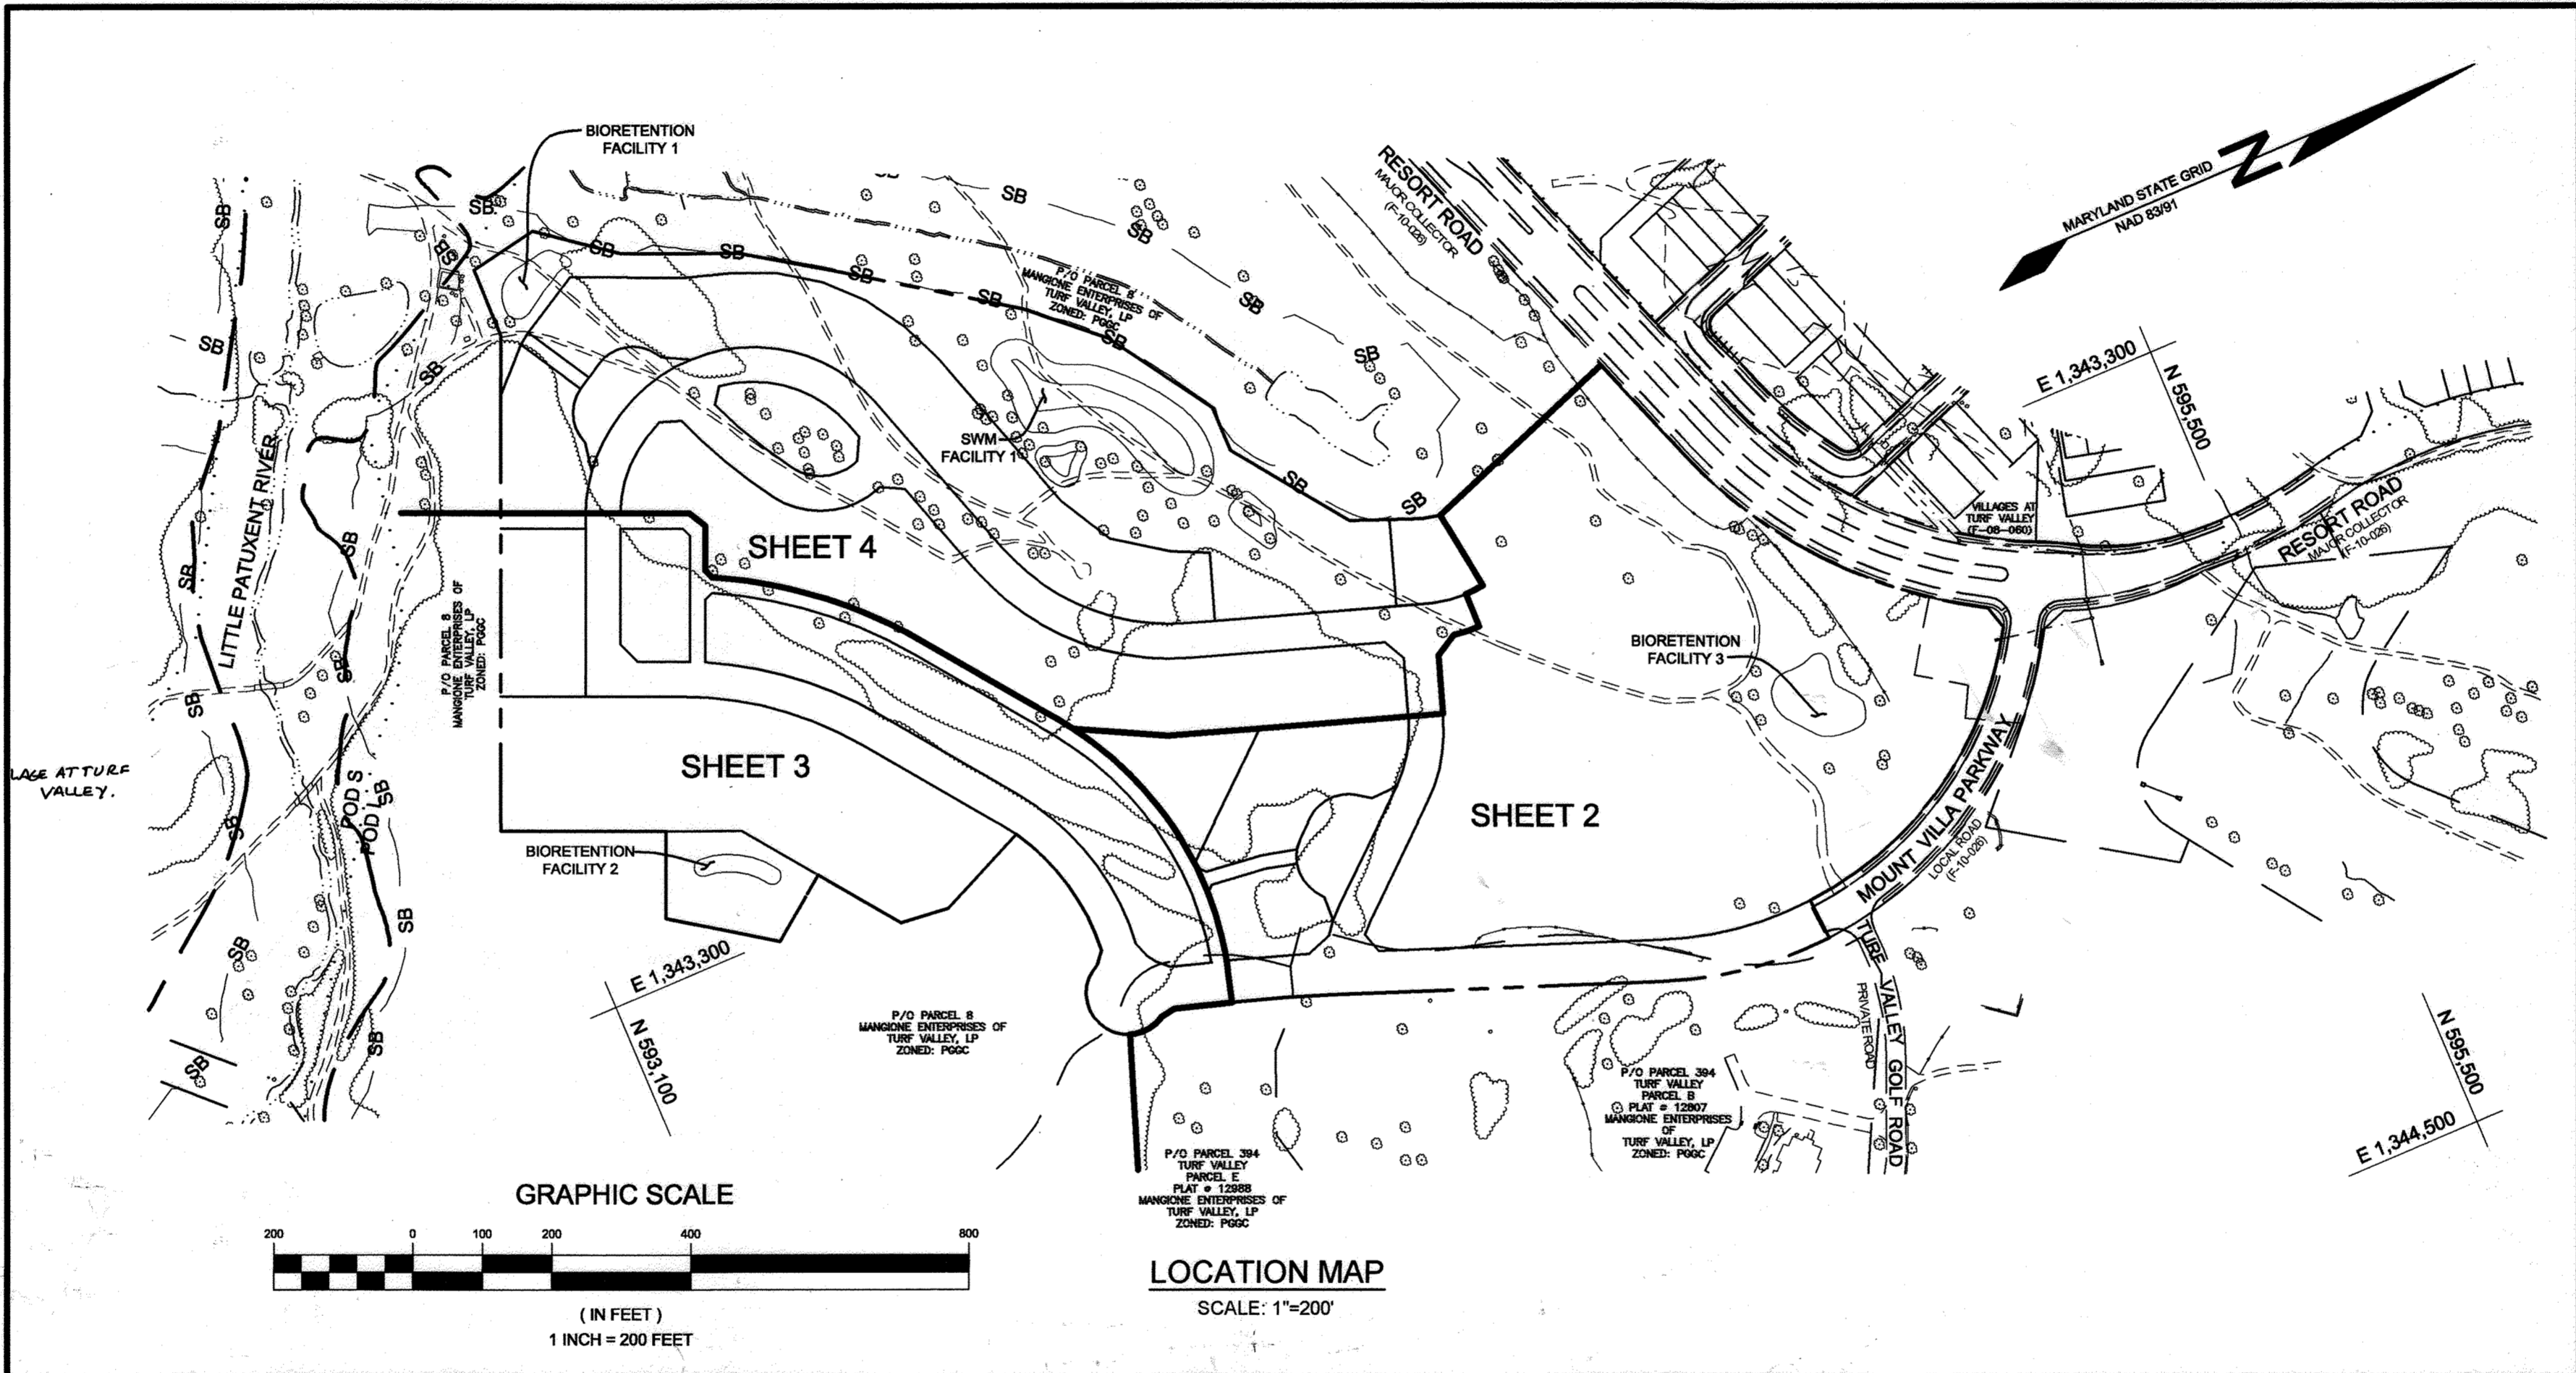

**SOILS LEGEND**


SYMBOL	NAME / DESCRIPTION	GROUP	'K' FACTOR
Co	CODORUS AND HATBORO SILT LOAMS, 0 TO 3 PERCENT SLOPES	C	0.37
GaD	GAILA LOAM, 15 TO 25 PERCENT SLOPES	B	0.24
GgB	GLENELG LOAM, 3 TO 8 PERCENT SLOPES	B	0.20
GgC	GLENELG LOAM, 8 TO 15 PERCENT SLOPES	B	0.20
GmA	GLENELG SILT LOAM, 0 TO 3 PERCENT SLOPES	C	0.37
GmB	GLENELG LOAM, 3 TO 8 PERCENT SLOPES	C	0.37
GmC	GLENELG LOAM, 8 TO 15 PERCENT SLOPES	C	0.37

NOTE:  
 1) SOILS BASED ON WEB SOILS SURVEY, NATIONAL COOPERATIVE SOILS SURVEY  
 2) HIGHLY ERODIBLE SOILS ARE ASSUMED TO BE A "K" VALUE OF 0.37 OR HIGHER.

**AS-BUILT CERTIFICATION**

I HEREBY CERTIFY, BY MY SEAL, THAT THE CONDITIONS SHOWN ON THIS PLAN WERE CONSTRUCTED TO THE LINES AND GRADES SHOWN ON THIS "AS-BUILT" PLAN, AND MEET THE APPROVED PLANS AND SPECIFICATIONS AND ALSO THAT THESE DOCUMENTS WERE PREPARED BY ME OR UNDER MY RESPONSIBLE CHARGE AND THAT I AM A DULY LICENSED PROFESSIONAL LAND SURVEYOR UNDER THE LAWS OF THE STATE OF MARYLAND.

MICHAEL D. ADCOCK, PROFESSIONAL LAND SURVEYOR  
 MD REG. NO. 21287, EXPIRATION DATE: 6/16/23

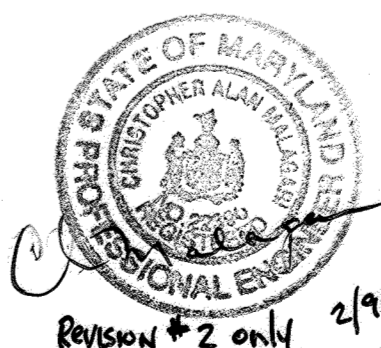

**OWNER/DEVELOPER**

MANGIONE ENTERPRISES OF TURF VALLEY, LP  
 1205 YORK ROAD  
 LUTHERVILLE, MARYLAND 21093  
 410.825.8400

**AS-BUILT**

**COVER SHEET**

**TURF VALLEY**  
 REGIONAL STORMWATER MANAGEMENT FACILITIES  
 PGCC MULTI-USE SUBDISTRICT

TAX MAP 16 GRID 16 & 17 PART OF PARCELS 8 & 394  
 3RD ELECTION DISTRICT HOWARD COUNTY, MARYLAND

**Sill · Adcock & Associates · LLC**  
 Engineers · Surveyors · Planners  
 3300 North Ridge Road, Suite 160  
 Hillcott City, Maryland 21043  
 Phone: 443.325.7682 Fax: 443.325.7685  
 Email: info@silland.com

DESIGN BY: DB  
 DRAWN BY: BK  
 CHECKED BY: PS  
 SCALE: AS SHOWN  
 DATE: APRIL 30, 2013  
 PROJECT #: 06-025  
 SHEET #: 1 of 12

APPROVED: HOWARD COUNTY DEPARTMENT OF PLANNING AND ZONING  
 CHIEF, DEVELOPMENT ENGINEERING DIVISION DATE: 5/21/13  
 CHIEF, DIVISION OF LAND DEVELOPMENT DATE: 5/20/13  
 DIRECTOR DATE: 5/4/13

THESE PLANS FOR SMALL POND CONSTRUCTION, SOIL EROSION AND SEDIMENT CONTROL MEET THE REQUIREMENTS OF THE HOWARD SOIL CONSERVATION DISTRICT.  
 SIGNATURE OF ENGINEER DATE: 4/30/13


ENGINEER'S CERTIFICATE  
 "I CERTIFY THAT THIS PLAN FOR POND CONSTRUCTION, EROSION AND SEDIMENT CONTROL REPRESENTS A PRACTICAL AND WORKABLE PLAN BASED ON MY PERSONAL KNOWLEDGE OF THE SITE CONDITIONS. THIS PLAN WAS PREPARED IN ACCORDANCE WITH THE REQUIREMENTS OF THE HOWARD SOIL CONSERVATION DISTRICT. I HAVE NOTIFIED THE DEVELOPER THAT HE/SHE MUST ENGAGE A REGISTERED PROFESSIONAL ENGINEER TO SUPERVISE POND CONSTRUCTION AND PROVIDE THE HOWARD SOIL CONSERVATION DISTRICT WITH AN "AS-BUILT" PLAN OF THE POND WITHIN 30 DAYS OF COMPLETION."  
 SIGNATURE OF DEVELOPER DATE: 4/30/13

DEVELOPER'S CERTIFICATE  
 "I/WE CERTIFY THAT ALL DEVELOPMENT AND/OR CONSTRUCTION WILL BE DONE ACCORDING TO THESE PLANS, AND THAT ANY RESPONSIBLE PERSONNEL INVOLVED IN THE CONSTRUCTION PROJECT WILL HAVE A CERTIFICATE OF ATTENDANCE AT A DEPARTMENT OF THE ENVIRONMENT APPROVED TRAINING PROGRAM FOR THE CONTROL OF SEDIMENT AND EROSION BEFORE BEGINNING THE PROJECT. I SHALL ENGAGE A REGISTERED PROFESSIONAL ENGINEER TO SUPERVISE POND CONSTRUCTION AND PROVIDE THE HOWARD SOIL CONSERVATION DISTRICT WITH AN "AS-BUILT" PLAN OF THE POND WITHIN 30 DAYS OF COMPLETION. I ALSO AUTHORIZE PERIODIC ON-SITE INSPECTIONS BY THE HOWARD SOIL CONSERVATION DISTRICT."  
 SIGNATURE OF DEVELOPER DATE: 4/30/13

APPROVED  
 PLANNING BOARD OF HOWARD COUNTY  
 DATE: 4/15/13

REVISIONS

NO.	DESCRIPTION	DATE
2	REMOVE DISTURBED AREA TO 11.11 AC (BEZ)	2-9-2017
1	TO ADD ADDITIONAL STOCKPILE AREA	08/21/16

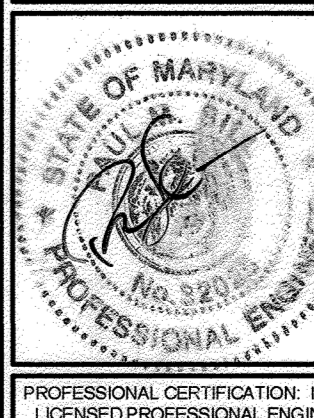



D.A.	WATER QUALITY		RECHARGE		CHANNEL PROTECTION	
	REQUIRED	PROVIDED	REQUIRED	PROVIDED	REQUIRED	PROVIDED
A	2,526cf(1)	5,084cf(1)	558cf(1)	0.988ac(2)	0.0833ac(2)	0.08ac(2)
B	44,562cf(1)	45,084cf(1)	13,151cf(1)	0.02cf(1) *	1.4203ac(2)	1.73ac(2)
C	2,701cf(1)	2,702cf(1)	619cf(1)	3.848cf(1)	0.1276ac(2)	0.0ac(2)
D	3,048cf(1)	3,064cf(1)	797cf(1)	2,760cf(1)	0.0871ac(2)	0.0ac(2)


NOTES:  
 1. WATER QUALITY (WQV) AND RECHARGE (REV) HAVE BEEN CALCULATED FOR THE AREAS SUBJECT TO GRADING AND LAND COVER CHANGE. TREATMENT FOR WQV AND REV WILL BE PROVIDED AS FOLLOWS:  
 DRAINAGE AREA 'A': A BIORETENTION FACILITY (F-6) (BIORETENTION FACILITY 3)  
 DRAINAGE AREA 'B': AN EXTENDED DETENTION WET POND FOR (NOV). FOR (REV) SEE BELOW \*  
 DRAINAGE AREA 'C': A BIORETENTION FACILITY (F-6) (BIORETENTION FACILITY 1)  
 DRAINAGE AREA 'D': A BIORETENTION FACILITY (F-6) (BIORETENTION FACILITY 2)  
 2. CHANNEL PROTECTION HAS BEEN CALCULATED FOR THE AREAS SUBJECT TO GRADING AND LAND COVER CHANGE. TREATMENT FOR CPV WILL BE PROVIDED AS FOLLOWS:  
 DRAINAGE AREA 'A': AN EXTENDED DETENTION WET POND IN AREA-B  
 DRAINAGE AREA 'B': AN EXTENDED DETENTION WET POND  
 DRAINAGE AREA 'C': AN EXTENDED DETENTION WET POND IN AREA-B  
 DRAINAGE AREA 'D': AN EXTENDED DETENTION WET POND IN AREA-B  
 3. OVERBANK FLOOD PROTECTION VOLUME, QP, IS NOT REQUIRED FOR THIS SITE.  
 4. EXTREME FLOOD VOLUME, QF, IS NOT REQUIRED FOR THIS SITE.  
 \* SINCE WE ARE PROVIDING AN EXTENDED DETENTION WET POND AT AREA - B THE RECHARGE VOLUME WILL BE PROPORTIONALLY DISTRIBUTED IN AREAS A, C, AND D

D.A.	P <sub>g</sub>		ESDV		CHANNEL PROTECTION	
	REQUIRED	PROVIDED	REQUIRED	PROVIDED	REQUIRED	PROVIDED
B-1	2.0'	2.0'	1,997 CF (1)	1,980 CF (1)	N/A (3)	N/A (3)


NOTES:  
 1) TREATMENT FOR THE ENVIRONMENTAL SITE DESIGN VOLUMES (ESDV) WILL BE PROVIDED FOR AS FOLLOWS:  
 DRAINAGE AREA B-1: TEMPORARY BIORETENTION FACILITY (F-6)  
 TEMPORARY STORAGE HAS BEEN DESIGNED TO TREAT STORMWATER MANAGEMENT RUNOFF FROM THE MOUNT VILLA PARKWAY EXTENSION (UNDER F-14-096) THIS FLOW UNDER ULTIMATE PROPOSED CONDITIONS WILL BE TREATED IN THE EXTENDED DETENTION FACILITY. WITH THE CONSTRUCTION OF THE EXTENDED DETENTION FACILITY THE TEMPORARY FACILITY WILL BE REMOVED AND FLOW WILL BE DIRECTED TO THE POND.  
 2) CHANNEL PROTECTION IS NOT REQUIRED SINCE ALL ESDV HAVE BEEN TREATED FULLY.  
 3) OVERBANK FLOOD PROTECTION VOLUME, QP, IS NOT REQUIRED FOR THIS SITE.  
 4) EXTREME FLOOD VOLUME, QF, IS NOT REQUIRED FOR THIS SITE.

**LEGEND**

- EXISTING CONTOUR
- EXISTING SPOT ELEVATION
- EXISTING WATER VALVE
- PROPOSED CONTOUR
- PROPOSED SPOT ELEVATION
- DIRECTION OF FLOW
- EXISTING TREES
- EXISTING TREELINE
- PROPOSED TREELINE
- SOIL BOUNDARY
- SLOPES 15.00% TO 24.99%
- SLOPES GREATER THAN 25.00%
- SILT FENCE
- SUPER SILT FENCE
- LIMIT OF DISTURBANCE
- EXISTING SOIL BORING
- PROPOSED EARTH DIKE
- PROPOSED CLEAN WATER EARTH DIKE
- STABILIZED CONSTRUCTION ENTRANCE
- GRASS FILTER STRIP

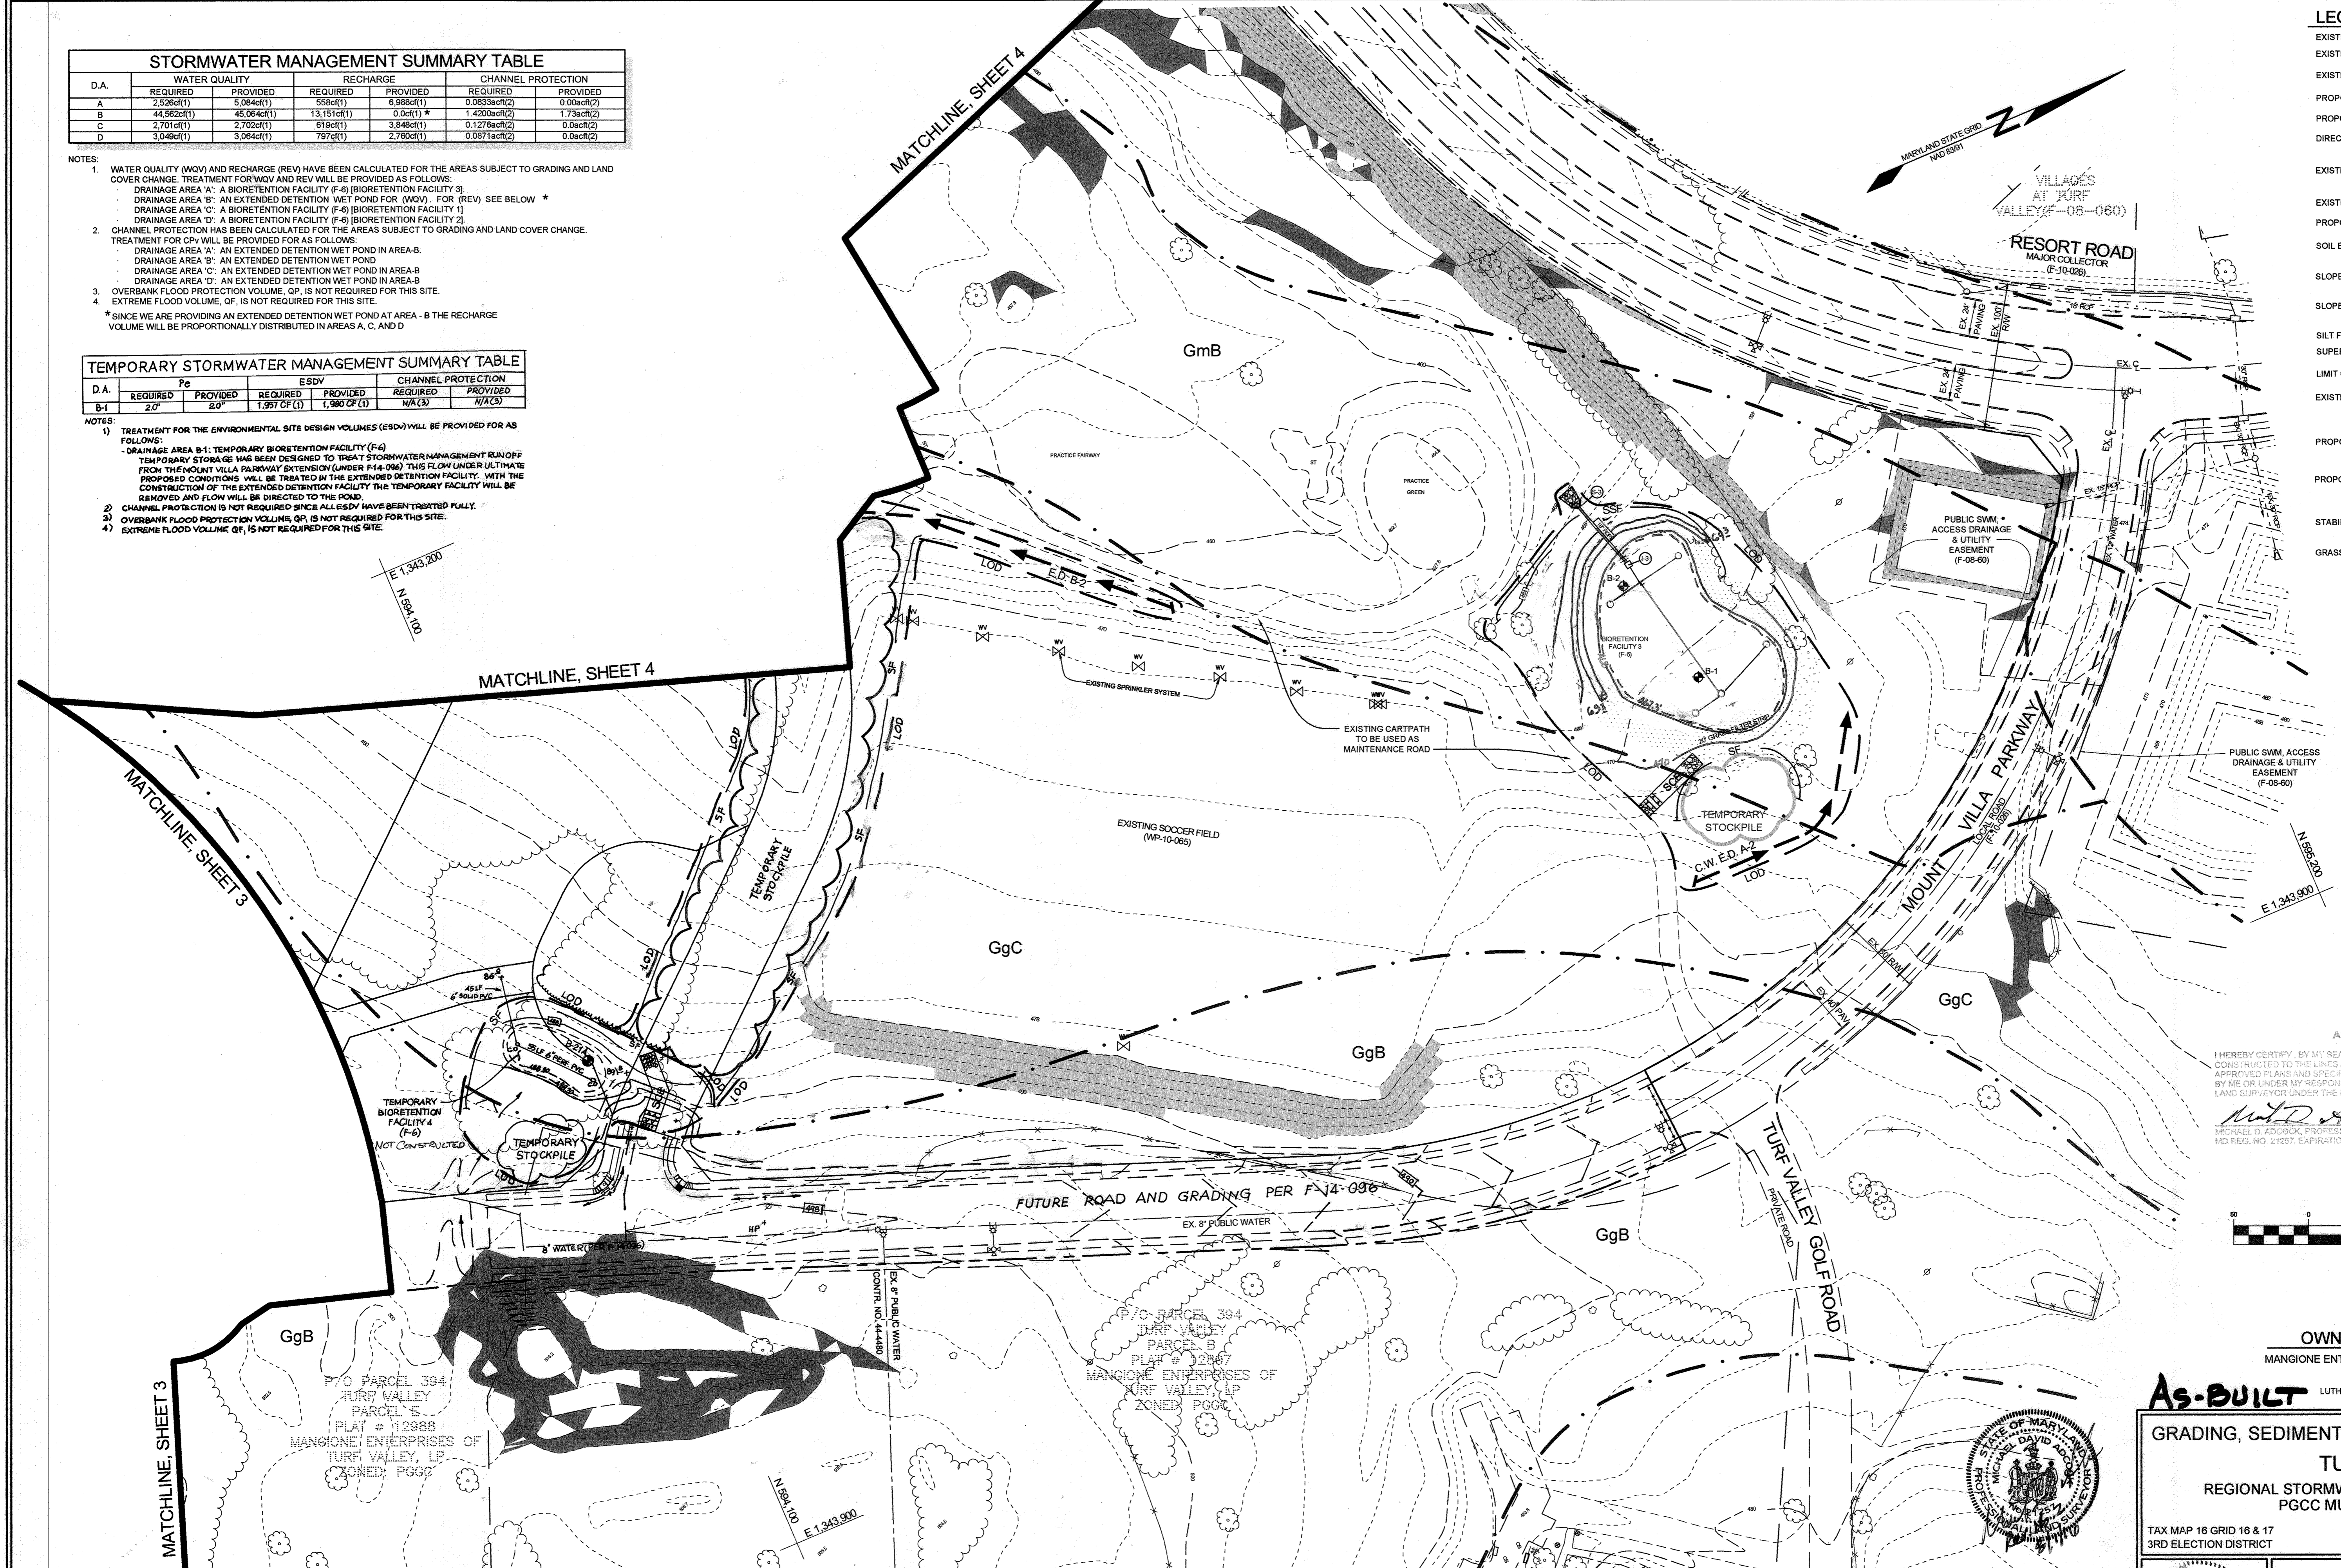

**AS-BUILT CERTIFICATION**  
 I HEREBY CERTIFY, BY MY SEAL, THAT THE CONDITIONS SHOWN ON THIS PLAN WERE CONSTRUCTED TO THE LINES AND GRADES SHOWN ON THE AS-BUILT PLAN AND MEET THE APPROVED PLANS AND SPECIFICATIONS AND ALSO THAT THESE DOCUMENTS WERE PREPARED BY ME OR UNDER MY SUPERVISION AND CHARGE AND THAT I AM A DULY LICENSED PROFESSIONAL LAND SURVEYOR UNDER THE LAWS OF THE STATE OF MARYLAND.  
 MICHAEL D. ADCOCK, PROFESSIONAL LAND SURVEYOR  
 MD REG. NO. 21257, EXPIRATION DATE: 6/16/23  
 DATE: 6/16/23

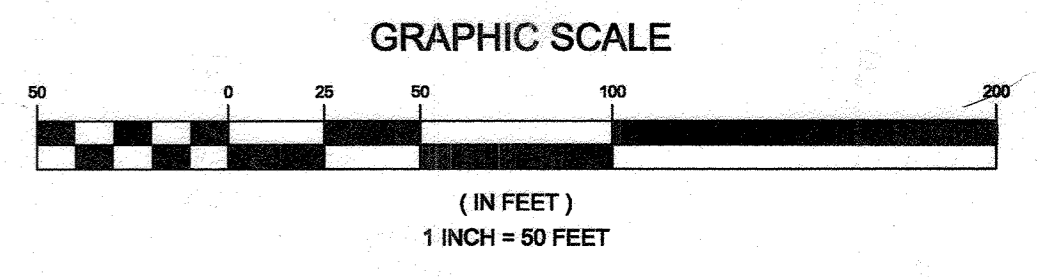

**OWNER/DEVELOPER**  
 MANGIONE ENTERPRISES OF TURF VALLEY, LP  
 LOU MANGIONE  
 1205 YORK ROAD  
 LUTHERVILLE, MARYLAND 21093  
 410.825.9400

**As-BUILT**  
**GRADING, SEDIMENT AND EROSION CONTROL PLAN**  
**TURF VALLEY**  
 REGIONAL STORMWATER MANAGEMENT FACILITIES  
 PGCC MULTI-USE SUBDISTRICT

TAX MAP 16 GRID 16 & 17  
 3RD ELECTION DISTRICT  
 PART OF PARCELS 8 & 394  
 HOWARD COUNTY, MARYLAND

APPROVED: HOWARD COUNTY DEPARTMENT OF PLANNING AND ZONING  
 CHIEF, DEVELOPMENT ENGINEERING DIVISION  
 DATE: 5/2/13

THESE PLANS FOR SMALL POND CONSTRUCTION, SOIL EROSION AND SEDIMENT CONTROL MEET THE REQUIREMENTS OF THE HOWARD SOIL CONSERVATION DISTRICT.  
 DATE: 5/2/13

**ENGINEER'S CERTIFICATE**  
 I CERTIFY THAT THIS PLAN FOR POND CONSTRUCTION, EROSION AND SEDIMENT CONTROL REPRESENTS A PRACTICAL AND WORKABLE PLAN BASED ON MY PERSONAL KNOWLEDGE OF THE SITE CONDITIONS. THIS PLAN WAS PREPARED IN ACCORDANCE WITH THE REQUIREMENTS OF THE HOWARD SOIL CONSERVATION DISTRICT. I HAVE NOTIFIED THE DEVELOPER THAT HE/SHE MUST ENGAGE A REGISTERED PROFESSIONAL ENGINEER TO SUPERVISE POND CONSTRUCTION AND PROVIDE THE HOWARD SOIL CONSERVATION DISTRICT WITH AN "AS-BUILT" PLAN OF THE POND WITHIN 30 DAYS OF COMPLETION.  
 DATE: 4/30/13

**DEVELOPER'S CERTIFICATE**  
 I/WE CERTIFY THAT ALL DEVELOPMENT AND/OR CONSTRUCTION WILL BE DONE ACCORDING TO THESE PLANS, AND THAT ANY RESPONSIBLE PERSONNEL INVOLVED IN THE CONSTRUCTION PROJECT WILL HAVE A CERTIFICATE OF ATTENDANCE AT A DEPARTMENT OF THE ENVIRONMENT APPROVED TRAINING PROGRAM FOR THE CONTROL OF SEDIMENT AND EROSION BEFORE BEGINNING THE PROJECT. I SHALL ENGAGE A REGISTERED PROFESSIONAL ENGINEER TO SUPERVISE POND CONSTRUCTION AND PROVIDE THE HOWARD SOIL CONSERVATION DISTRICT WITH AN "AS-BUILT" PLAN OF THE POND WITHIN 30 DAY OF COMPLETION. I ALSO AUTHORIZE PERIODIC ON-SITE INSPECTIONS BY THE HOWARD SOIL CONSERVATION DISTRICT.  
 DATE: 4/30/13

APPROVED  
 PLANNING BOARD OF HOWARD COUNTY  
 DATE: 04/15/2013

NO.	DESCRIPTION	DATE
2	TO ADD ADDITIONAL STOCKPILE AREA	08/01/16
1	ADD TEMPORARY BIORETENTION FACILITY 4 FOR MOUNT VILLA ROAD CONSTRUCTION	03/19/14



**Sill · Adcock & Associates · LLC**  
 Engineers · Surveyors · Planners  
 3300 North Ridge Road, Suite 160  
 Ellicott City, Maryland 21043  
 Phone: 443.325.7682 Fax: 443.325.7685  
 Email: info@saaml.com

DESIGN BY: DB  
 DRAWN BY: BK  
 CHECKED BY: PS  
 SCALE: 1" = 50'  
 DATE: APRIL 30, 2013  
 PROJECT #: 06-025  
 SHEET #: 2 of 12

PROFESSIONAL CERTIFICATION: I HEREBY CERTIFY THAT THESE DOCUMENTS WERE PREPARED OR APPROVED BY ME, AND THAT I AM A DULY LICENSED PROFESSIONAL ENGINEER UNDER THE LAWS OF THE STATE OF MARYLAND, LICENSE NO. 32023, EXPIRATION DATE: JUNE 20, 2013.



E 1,342,400  
N 692,200

MATCHLINE, SHEET 4

D.A.	WATER QUALITY		RECHARGE		CHANNEL PROTECTION	
	REQUIRED	PROVIDED	REQUIRED	PROVIDED	REQUIRED	PROVIDED
A	2.53ac(1)	5.06ac(1)	55ac(1)	6.98ac(1)	0.063acft(2)	0.00acft(2)
B	44.56ac(1)	45.08ac(1)	13.15ac(1)	0.0cft(1)*	1.420acft(2)	1.73acft(2)
C	2.70cft(1)	2.70cft(1)	619cft(1)	3.848cft(1)	0.1276acft(2)	0.0acft(2)
D	3.048cft(1)	3.064cft(1)	797cft(1)	2.760cft(1)	0.0871acft(2)	0.0acft(2)

- NOTES:
- WATER QUALITY (WQV) AND RECHARGE (REV) HAVE BEEN CALCULATED FOR THE AREAS SUBJECT TO GRADING AND LAND COVER CHANGE. TREATMENT FOR WQV AND REV WILL BE PROVIDED AS FOLLOWS:  
 DRAINAGE AREA 'A': A BIORETENTION FACILITY (F-6) (BIORETENTION FACILITY 3)  
 DRAINAGE AREA 'B': AN EXTENDED DETENTION WET POND FOR (WQV). FOR (REV) SEE BELOW \*  
 DRAINAGE AREA 'C': A BIORETENTION FACILITY (F-6) (BIORETENTION FACILITY 1)  
 DRAINAGE AREA 'D': A BIORETENTION FACILITY (F-6) (BIORETENTION FACILITY 2)
  - CHANNEL PROTECTION HAS BEEN CALCULATED FOR THE AREAS SUBJECT TO GRADING AND LAND COVER CHANGE. TREATMENT FOR CPV WILL BE PROVIDED FOR AS FOLLOWS:  
 DRAINAGE AREA 'A': AN EXTENDED DETENTION WET POND IN AREA-B  
 DRAINAGE AREA 'B': AN EXTENDED DETENTION WET POND  
 DRAINAGE AREA 'C': AN EXTENDED DETENTION WET POND IN AREA-B  
 DRAINAGE AREA 'D': AN EXTENDED DETENTION WET POND IN AREA-B
  - OVERBANK FLOOD PROTECTION VOLUME, QP, IS NOT REQUIRED FOR THIS SITE.
  - EXTREME FLOOD VOLUME, QF, IS NOT REQUIRED FOR THIS SITE.
- \* SINCE WE ARE PROVIDING AN EXTENDED DETENTION WET POND AT AREA - B THE RECHARGE VOLUME WILL BE PROPORTIONALLY DISTRIBUTED IN AREAS A, C, AND D


LEGEND

- EXISTING CONTOUR
- EXISTING SPOT ELEVATION
- PROPOSED CONTOUR
- PROPOSED SPOT ELEVATION
- DIRECTION OF FLOW
- EXISTING TREES
- EXISTING TREELINE
- PROPOSED TREELINE
- SOIL BOUNDARY
- EXISTING STREAM BUFFER
- EXISTING 100 YEAR FLOODPLAIN
- EXISTING 100 YEAR FLOODPLAIN CROSS SECTION
- SLOPES 15.00% TO 24.99%
- SLOPES GREATER THAN 25.00%
- SILT FENCE
- SUPER SILT FENCE
- LIMIT OF DISTURBANCE
- EXISTING SOIL BORING


AS-BUILT CERTIFICATION

I HEREBY CERTIFY, BY MY SEAL, THAT THE CONDITIONS SHOWN ON THIS PLAN WERE CONSTRUCTED TO THE LINES AND GRACES SHOWN ON THIS "AS-BUILT" PLAN, AND MEET THE APPROVED PLANS AND SPECIFICATIONS AND ALSO THAT THESE DOCUMENTS WERE PREPARED BY ME OR UNDER MY RESPONSIBLE CHARGE AND THAT I AM A DULY LICENSED PROFESSIONAL LAND SURVEYOR UNDER THE LAWS OF THE STATE OF MARYLAND.

MICHAEL D. ADCOCK, PROFESSIONAL LAND SURVEYOR  
 MD REG. NO. 21257, EXPIRATION DATE: 06/14/23  
 DATE: 4/1/23

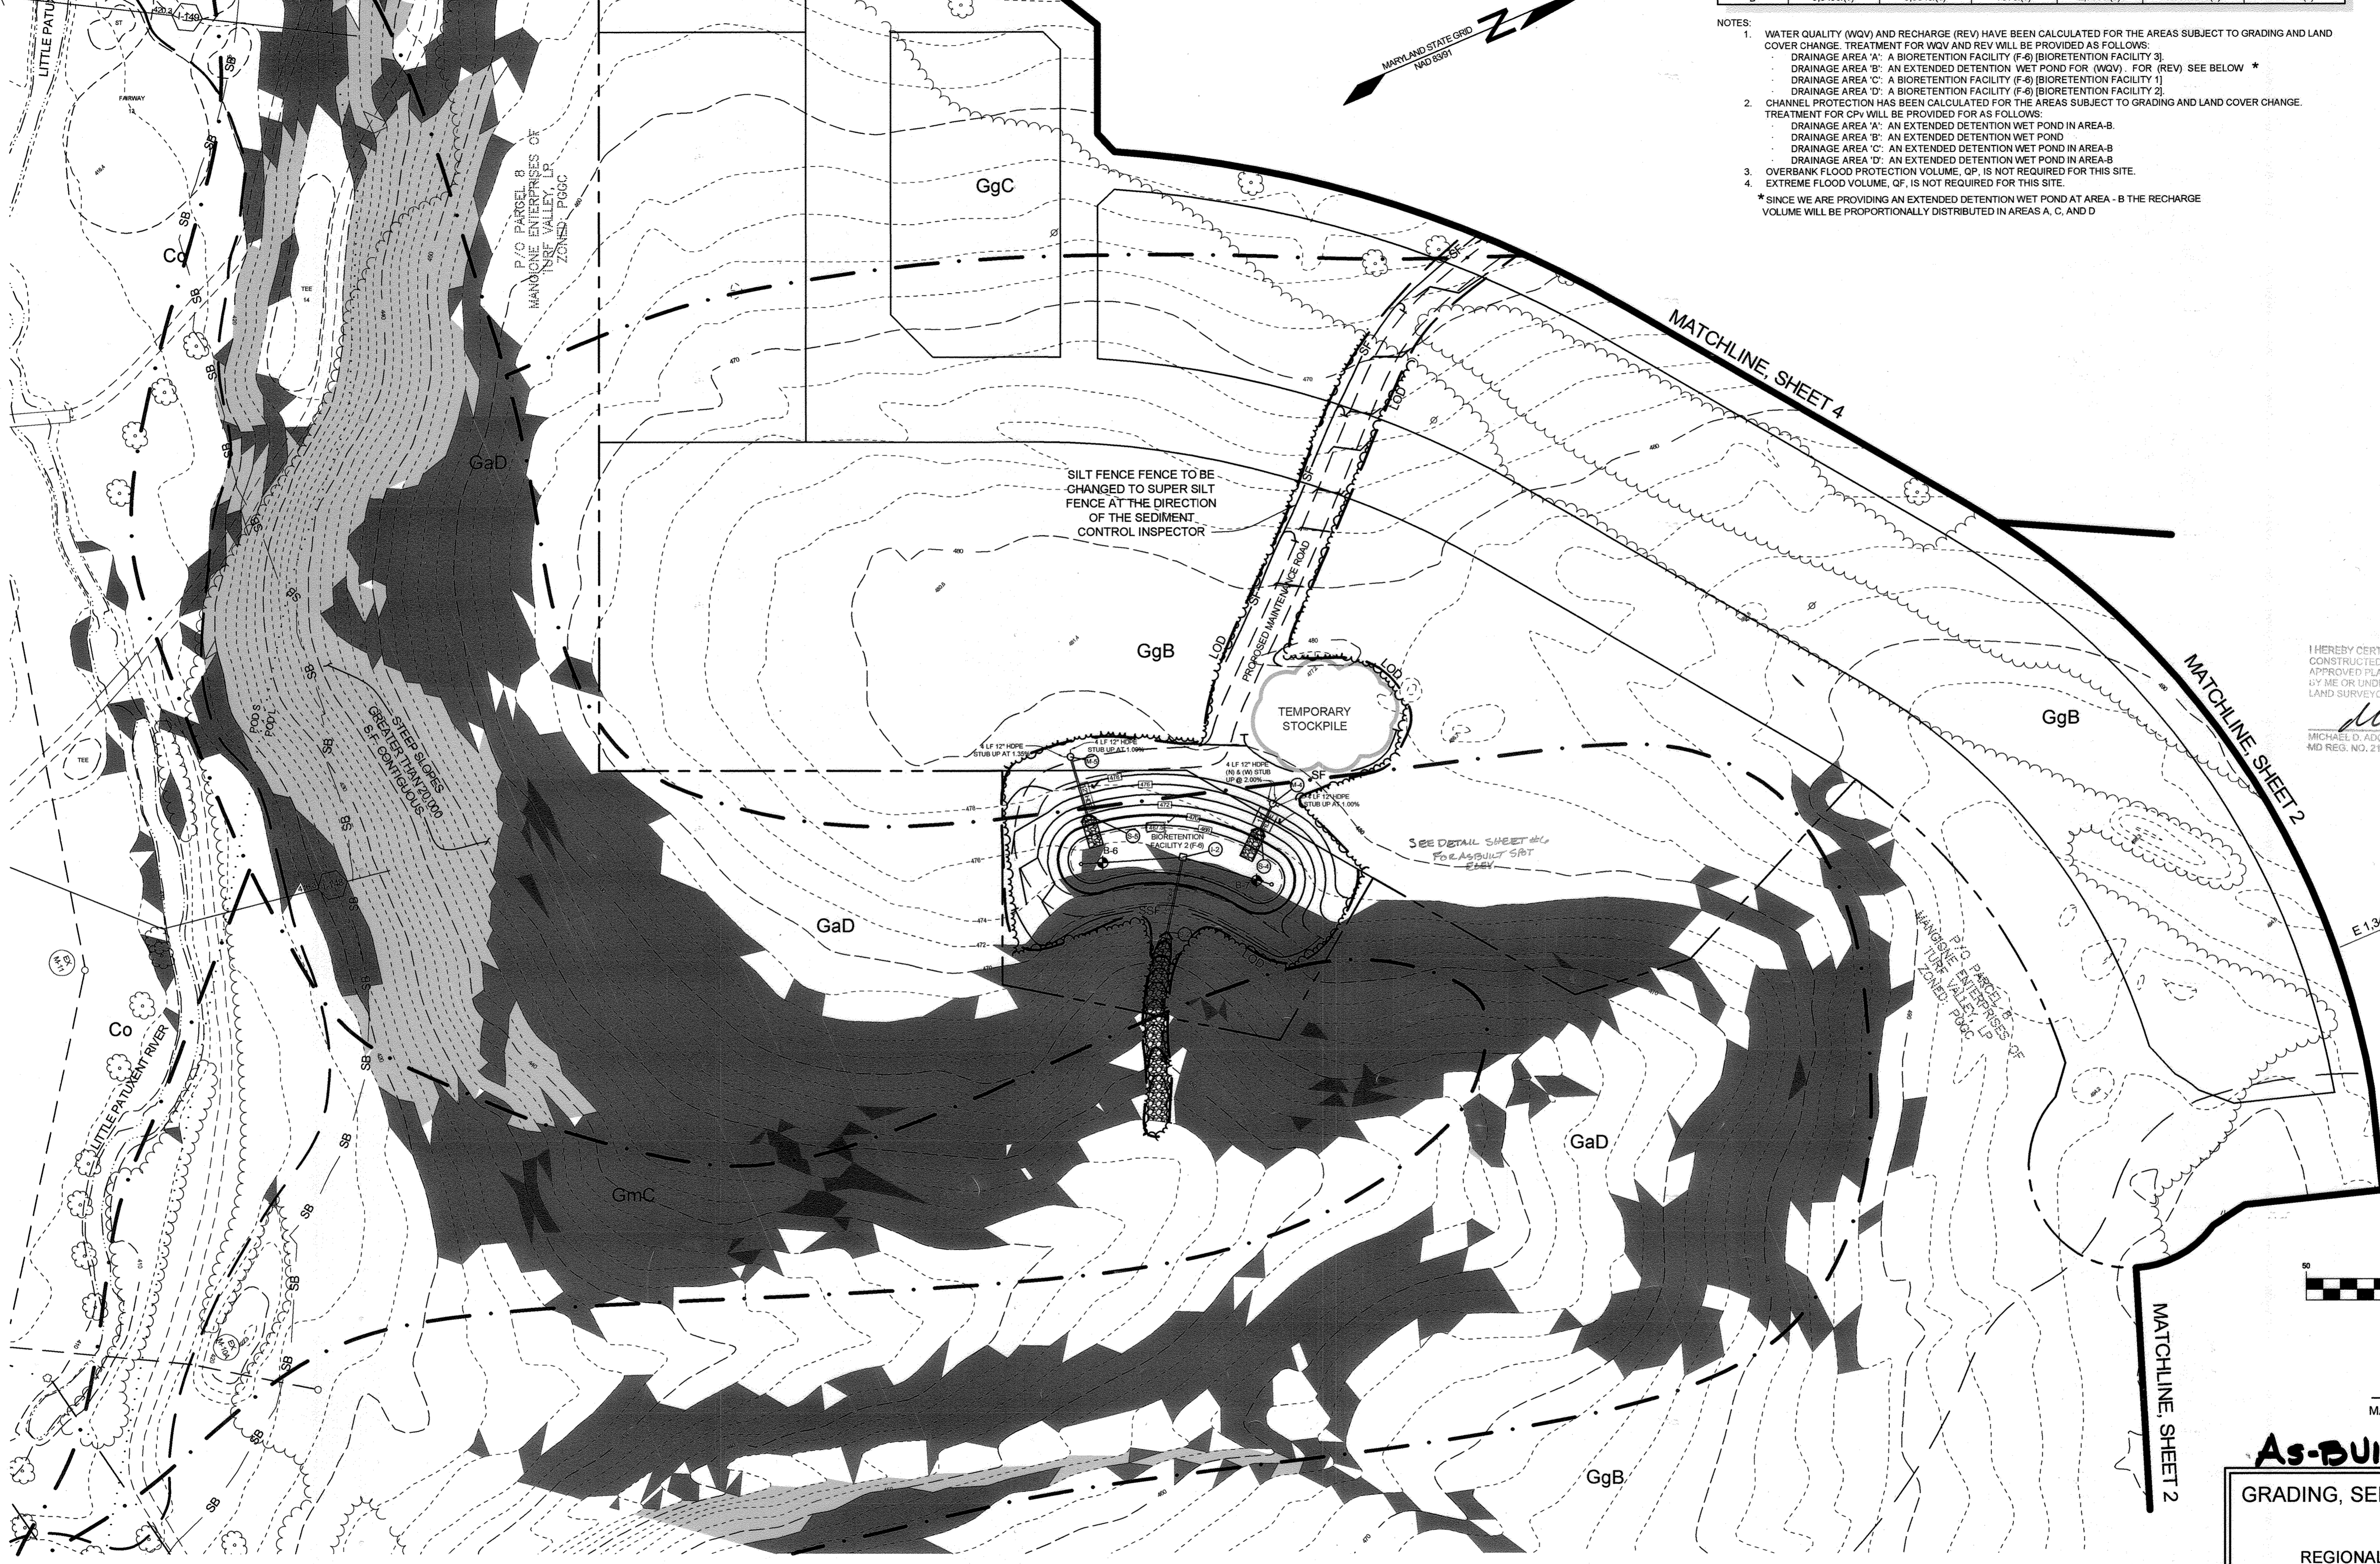

GRAPHIC SCALE

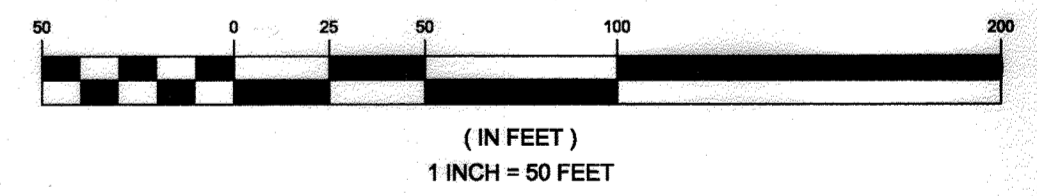

OWNER/DEVELOPER  
 MANGIONE ENTERPRISES OF TURF VALLEY, LP  
 LOU MANGIONE  
 1205 YORK ROAD  
 LUTHERVILLE, MARYLAND 21093  
 410.825.9400

**As-BUILT**

GRADING, SEDIMENT AND EROSION CONTROL PLAN  
 TURF VALLEY  
 REGIONAL STORMWATER MANAGEMENT FACILITIES  
 PGCC MULTI-USE SUBDISTRICT

TAX MAP 16 GRID 16 & 17  
 3RD ELECTION DISTRICT  
 PART OF PARCELS 8 & 394  
 HOWARD COUNTY, MARYLAND

APPROVED: HOWARD COUNTY DEPARTMENT OF PLANNING AND ZONING  
 CHIEF, DEVELOPMENT ENGINEERING DIVISION  
 DATE: 5/2/13


THESE PLANS FOR SMALL POND CONSTRUCTION, SOIL EROSION AND SEDIMENT CONTROL MEET THE REQUIREMENTS OF THE HOWARD SOIL CONSERVATION DISTRICT.  
 SIGNATURE OF ENGINEER: [Signature]  
 DATE: 4/30/13  
 HOWARD SCD

ENGINEERS CERTIFICATE  
 "I CERTIFY THAT THIS PLAN FOR POND CONSTRUCTION, EROSION AND SEDIMENT CONTROL REPRESENTS A PRACTICAL AND WORKABLE PLAN BASED ON MY PERSONAL KNOWLEDGE OF THE SITE CONDITIONS. THIS PLAN WAS PREPARED IN ACCORDANCE WITH THE REQUIREMENTS OF THE HOWARD SOIL CONSERVATION DISTRICT. I HAVE NOTIFIED THE DEVELOPER THAT HE/SHE MUST ENGAGE A REGISTERED PROFESSIONAL ENGINEER TO SUPERVISE POND CONSTRUCTION AND PROVIDE THE HOWARD SOIL CONSERVATION DISTRICT WITH AN "AS-BUILT" PLAN OF THE POND WITHIN 30 DAYS OF COMPLETION."  
 SIGNATURE OF ENGINEER: [Signature]  
 DATE: 4/30/13  
 PAUL M. SILL, P.E.

DEVELOPER'S CERTIFICATE  
 "I/WE CERTIFY THAT ALL DEVELOPMENT AND/OR CONSTRUCTION WILL BE DONE ACCORDING TO THESE PLANS, AND THAT ANY RESPONSIBLE PERSONNEL INVOLVED IN THE CONSTRUCTION PROJECT WILL HAVE A CERTIFICATE OF ATTENDANCE AT A DEPARTMENT OF THE ENVIRONMENT APPROVED TRAINING PROGRAM FOR THE CONTROL OF SEDIMENT AND EROSION BEFORE BEGINNING THE PROJECT. I SHALL ENGAGE A REGISTERED PROFESSIONAL ENGINEER TO SUPERVISE POND CONSTRUCTION AND PROVIDE THE HOWARD SOIL CONSERVATION DISTRICT WITH AN "AS-BUILT" PLAN OF THE POND WITHIN 30 DAYS OF COMPLETION. I ALSO AUTHORIZE PERIODIC ON-SITE INSPECTIONS BY THE HOWARD SOIL CONSERVATION DISTRICT."  
 SIGNATURE OF DEVELOPER: [Signature]  
 DATE: 4/10/13

APPROVED  
 PLANNING BOARD OF HOWARD COUNTY  
 DATE: 04/15/2013  
 [Signature]

NO.	DESCRIPTION	DATE

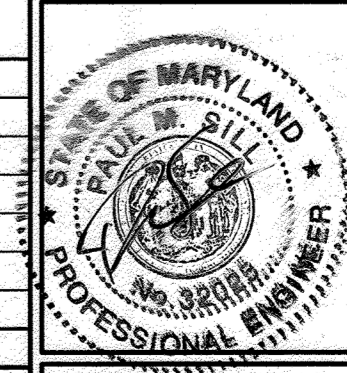


Sill · Adcock & Associates · LLC  
 Engineers · Surveyors · Planners  
 3300 North Ridge Road, Suite 160  
 Ellicott City, Maryland 21043  
 Phone: 443.325.7682 Fax: 443.325.7685  
 Email: info@saaml.com

DESIGN BY: DB  
 DRAWN BY: BK  
 CHECKED BY: PS  
 SCALE: 1" = 50'  
 DATE: APRIL 30, 2013  
 PROJECT #: 06-025  
 SHEET #: 3 of 12

PROFESSIONAL CERTIFICATION: I HEREBY CERTIFY THAT THESE DOCUMENTS WERE PREPARED OR APPROVED BY ME, AND THAT I AM A DULY LICENSED PROFESSIONAL ENGINEER UNDER THE LAWS OF THE STATE OF MARYLAND, LICENSE NO. 32025, EXPIRATION DATE: JUNE 20, 2013




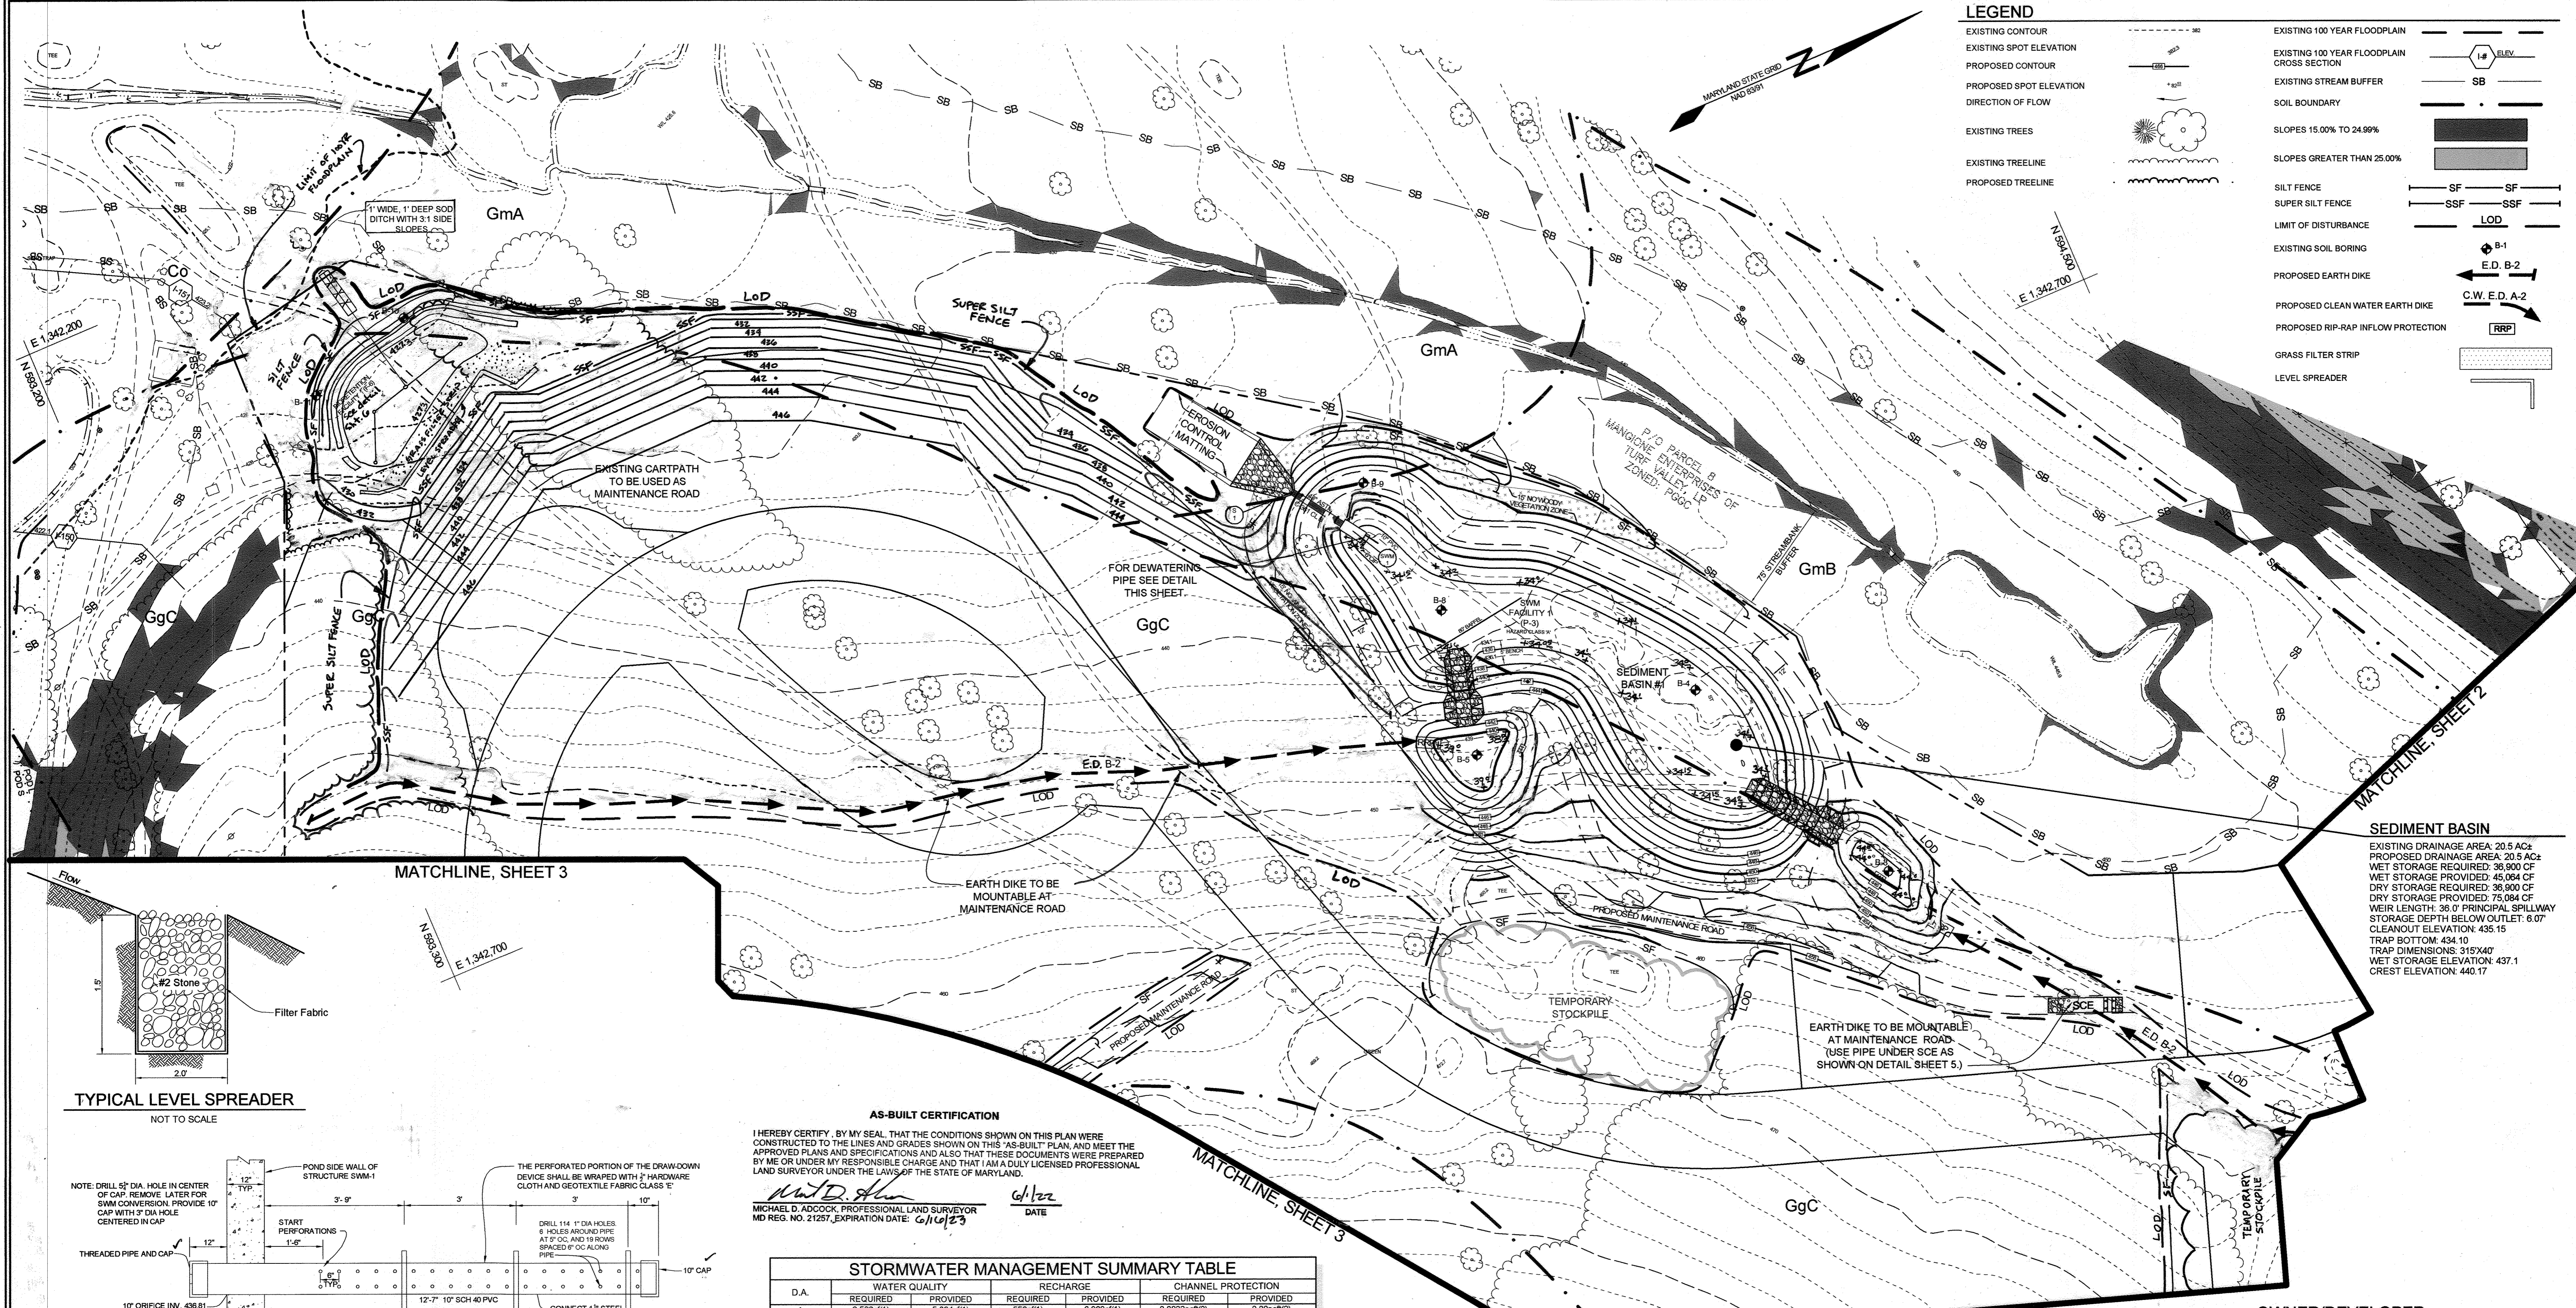


### LEGEND

- EXISTING CONTOUR
- EXISTING SPOT ELEVATION
- PROPOSED CONTOUR
- PROPOSED SPOT ELEVATION
- DIRECTION OF FLOW
- EXISTING TREES
- EXISTING TREELINE
- PROPOSED TREELINE
- EXISTING 100 YEAR FLOODPLAIN
- EXISTING 100 YEAR FLOODPLAIN CROSS SECTION
- EXISTING STREAM BUFFER
- SOIL BOUNDARY
- SLOPES 15.00% TO 24.99%
- SLOPES GREATER THAN 25.00%
- SILT FENCE
- SUPER SILT FENCE
- LIMIT OF DISTURBANCE
- EXISTING SOIL BORING
- PROPOSED EARTH DIKE
- PROPOSED CLEAN WATER EARTH DIKE
- PROPOSED RIP-RAP INFLOW PROTECTION
- GRASS FILTER STRIP
- LEVEL SPREADER

### SEDIMENT BASIN

EXISTING DRAINAGE AREA: 20.5 AC  
 PROPOSED DRAINAGE AREA: 20.5 AC  
 WET STORAGE PROVIDED: 36,900 CF  
 WET STORAGE REQUIRED: 45,084 CF  
 DRY STORAGE PROVIDED: 36,900 CF  
 DRY STORAGE REQUIRED: 75,084 CF  
 WEIR LENGTH: 36.0' PRINCIPAL SPILLWAY  
 STORAGE DEPTH BELOW OUTLET: 6.07'  
 CLEANOUT ELEVATION: 435.15  
 TRAP BOTTOM: 434.10  
 TRAP DIMENSIONS: 31.5" X 40"  
 WET STORAGE ELEVATION: 437.1  
 CREST ELEVATION: 440.17

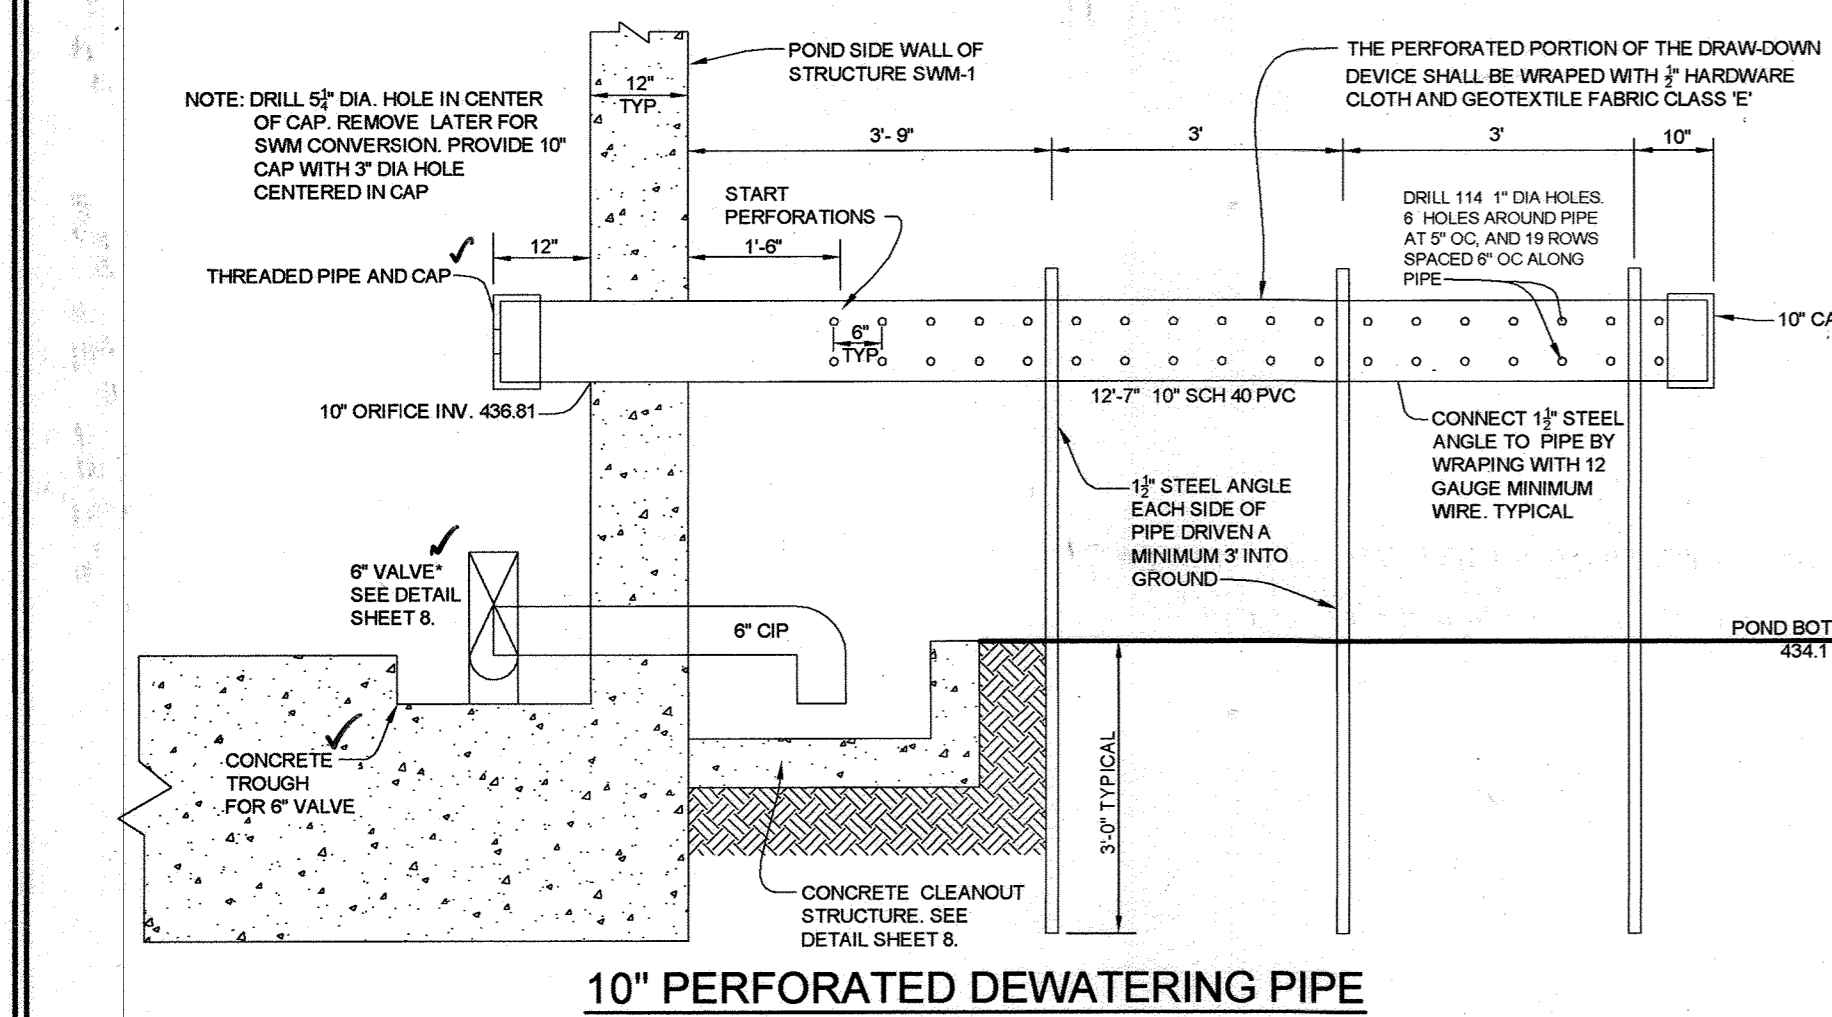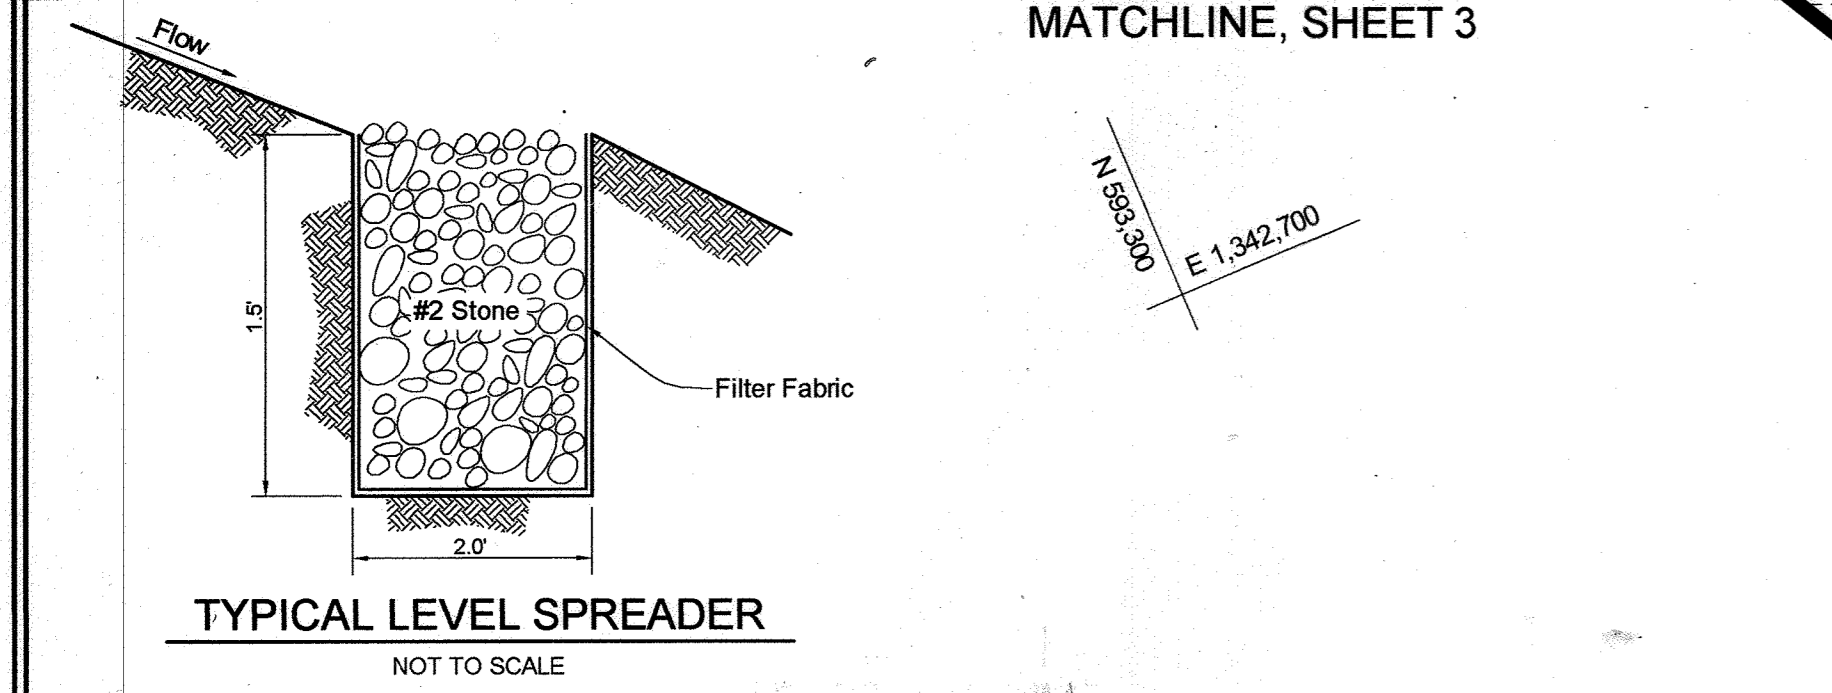

### AS-BUILT CERTIFICATION


I HEREBY CERTIFY, BY MY SEAL, THAT THE CONDITIONS SHOWN ON THIS PLAN WERE CONSTRUCTED TO THE LINES AND GRADES SHOWN ON THIS "AS-BUILT" PLAN, AND MEET THE APPROVED PLANS AND SPECIFICATIONS AND ALSO THAT THESE DOCUMENTS WERE PREPARED BY ME OR UNDER MY RESPONSIBLE CHARGE AND THAT I AM A DULY LICENSED PROFESSIONAL LAND SURVEYOR UNDER THE LAWS OF THE STATE OF MARYLAND.

*Michael D. Adcock* g/l/zc DATE  
 MICHAEL D. ADCOCK, PROFESSIONAL LAND SURVEYOR  
 MD REG. NO. 21257, EXPIRATION DATE: 6/10/23

### STORMWATER MANAGEMENT SUMMARY TABLE

D.A.	WATER QUALITY		RECHARGE		CHANNEL PROTECTION	
	REQUIRED	PROVIDED	REQUIRED	PROVIDED	REQUIRED	PROVIDED
A	2.526c(1)	5.084c(1)	558c(1)	6.988c(1)	0.083ac(2)	0.083ac(2)
B	44.562c(1)	45.064c(1)	13.151c(1)	0.0c(1) *	1.420bc(2)	1.732c(2)
C	2.701c(1)	2.702c(1)	619c(1)	3.848c(1)	0.1276ac(2)	0.0ac(2)
D	3.049c(1)	3.064c(1)	797c(1)	2.760c(1)	0.0871ac(2)	0.0ac(2)

- NOTES:
- WATER QUALITY (WQV) AND RECHARGE (REV) HAVE BEEN CALCULATED FOR THE AREAS SUBJECT TO GRADING AND LAND COVER CHANGE. TREATMENT FOR WQV AND REV WILL BE PROVIDED AS FOLLOWS:  
 DRAINAGE AREA "A": A BIORETENTION FACILITY (F-6) (BIORETENTION FACILITY 3)  
 DRAINAGE AREA "B": AN EXTENDED DETENTION WET POND FOR (WQV). FOR (REV) SEE BELOW \*  
 DRAINAGE AREA "C": A BIORETENTION FACILITY (F-6) (BIORETENTION FACILITY 1)  
 DRAINAGE AREA "D": A BIORETENTION FACILITY (F-6) (BIORETENTION FACILITY 2)
  - CHANNEL PROTECTION HAS BEEN CALCULATED FOR THE AREAS SUBJECT TO GRADING AND LAND COVER CHANGE. TREATMENT FOR CPV WILL BE PROVIDED FOR AS FOLLOWS:  
 DRAINAGE AREA "A": AN EXTENDED DETENTION WET POND IN AREA-B  
 DRAINAGE AREA "B": AN EXTENDED DETENTION WET POND  
 DRAINAGE AREA "C": AN EXTENDED DETENTION WET POND IN AREA-B  
 DRAINAGE AREA "D": AN EXTENDED DETENTION WET POND IN AREA-B
  - OVERBANK FLOOD PROTECTION VOLUME, QP, IS NOT REQUIRED FOR THIS SITE.
  - EXTREME FLOOD PROTECTION, QF, IS NOT REQUIRED FOR THIS SITE.
- \* SINCE WE ARE PROVIDING AN EXTENDED DETENTION WET POND AT AREA - B THE RECHARGE VOLUME WILL BE PROPORTIONALLY DISTRIBUTED IN AREAS A, C, AND D

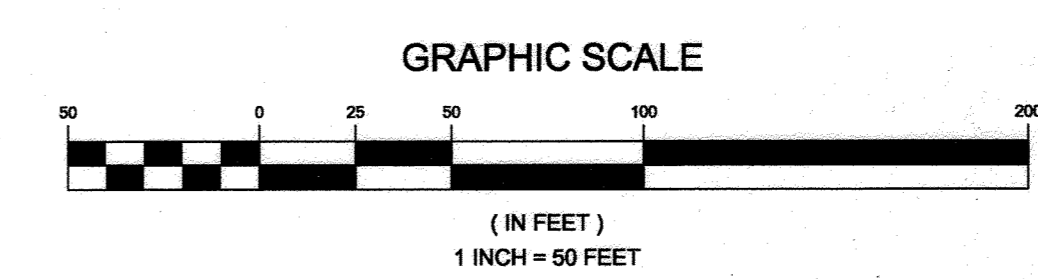

APPROVED: HOWARD COUNTY DEPARTMENT OF PLANNING AND ZONING

*Keith Schuchman* 5/2/13  
 CHIEF, DEVELOPMENT ENGINEERING DIVISION DATE

*Paul M. Sill* 5/2/13  
 CHIEF, DIVISION OF LAND DEVELOPMENT DATE

*Paul M. Sill* 5/2/13  
 DIRECTOR DATE

THESE PLANS FOR SMALL POND CONSTRUCTION, SOIL EROSION AND SEDIMENT CONTROL MEET THE REQUIREMENTS OF THE HOWARD SOIL CONSERVATION DISTRICT.

*Paul M. Sill* 4/30/13  
 HOWARD SCD DATE

### ENGINEERS CERTIFICATE

"I CERTIFY THAT THIS PLAN FOR POND CONSTRUCTION, EROSION AND SEDIMENT CONTROL REPRESENTS A PRACTICAL AND WORKABLE PLAN, AND THAT ANY RESPONSIBLE PERSONNEL INVOLVED IN THE CONSTRUCTION PROJECT WILL HAVE A CERTIFICATE OF ATTENDANCE AT A DEPARTMENT OF THE ENVIRONMENT APPROVED TRAINING PROGRAM FOR THE CONTROL OF SEDIMENT AND EROSION BEFORE BEGINNING THE PROJECT. I SHALL ENGAGE A REGISTERED PROFESSIONAL ENGINEER TO SUPERVISE POND CONSTRUCTION AND PROVIDE THE HOWARD SOIL CONSERVATION DISTRICT WITH AN "AS-BUILT" PLAN OF THE POND WITHIN 30 DAYS OF COMPLETION."

*Paul M. Sill* 4/29/13  
 SIGNATURE OF ENGINEER DATE  
 PAUL M. SILL, P.E.

### DEVELOPER'S CERTIFICATE

"I/WE CERTIFY THAT ALL DEVELOPMENT AND/OR CONSTRUCTION WILL BE DONE ACCORDING TO THESE PLANS, AND THAT ANY RESPONSIBLE PERSONNEL INVOLVED IN THE CONSTRUCTION PROJECT WILL HAVE A CERTIFICATE OF ATTENDANCE AT A DEPARTMENT OF THE ENVIRONMENT APPROVED TRAINING PROGRAM FOR THE CONTROL OF SEDIMENT AND EROSION BEFORE BEGINNING THE PROJECT. I SHALL ENGAGE A REGISTERED PROFESSIONAL ENGINEER TO SUPERVISE POND CONSTRUCTION AND PROVIDE THE HOWARD SOIL CONSERVATION DISTRICT WITH AN "AS-BUILT" PLAN OF THE POND WITHIN 30 DAYS OF COMPLETION. I ALSO AUTHORIZE PERSONNEL ON-SITE INSPECTIONS BY THE HOWARD SOIL CONSERVATION DISTRICT."

*Michael D. Adcock* 4/15/13  
 SIGNATURE OF DEVELOPER DATE

APPROVED  
 PLANNING BOARD OF HOWARD COUNTY

DATE *04/15/2013*

NO.	DESCRIPTION	DATE
2	SHIPT BLDG#1 PER AS-BUILT COND. SHOW LARGE FILL AREA BEHIND E.D. TO BASIN #1. REVISE SED. CONT. ACCORDINGLY.	2/9/2013
1	TO ADD ADDITIONAL STOCKPILE AREA.	08/01/16

### OWNER/DEVELOPER

MANGIONE ENTERPRISES OF TURF VALLEY, LP  
 LOU MANGIONE  
 1205 YORK ROAD  
 LUTHERVILLE, MARYLAND 21093  
 410.825.9400

### As-BUILT

### GRADING, SEDIMENT AND EROSION CONTROL PLAN

### TURF VALLEY

### REGIONAL STORMWATER MANAGEMENT FACILITIES

### PGCC MULTI-USE SUBDISTRICT

TAX MAP 16 GRID 16 & 17  
 3RD ELECTION DISTRICT

PART OF PARCELS 8 & 394  
 HOWARD COUNTY, MARYLAND


### Sill · Adcock & Associates · LLC

Engineers · Surveyors · Planners

3300 North Ridge Road, Suite 160  
 Ellicott City, Maryland 21043  
 Phone: 443.325.7682 Fax: 443.325.7685  
 Email: info@silladcock.com

DESIGN BY: DB  
 DRAWN BY: BK  
 CHECKED BY: PS  
 SCALE: 1" = 50'  
 DATE: APRIL 30, 2013  
 PROJECT #: 06-025  
 SHEET #: 4 of 12



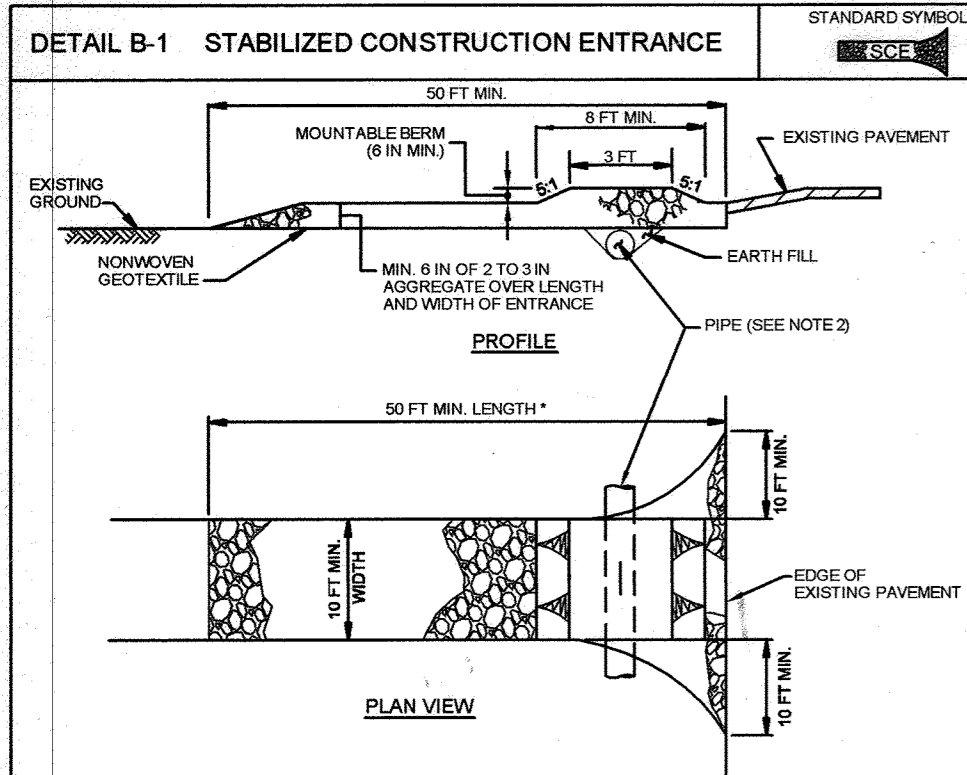


**CONSTRUCTION SPECIFICATIONS**

- PLACE STABILIZED CONSTRUCTION ENTRANCE IN ACCORDANCE WITH THE APPROVED PLAN. VEHICLES MUST TRAVEL OVER THE ENTRANCE LIMIT OF THE SITE. USE MINIMUM LENGTH OF 50 FEET FOR SIGN RESISTANCE (LO). USE MINIMUM WIDTH OF 10 FEET. FLARE SIDE TO FEET MINIMUM AT THE EXISTING ROAD TO PROVIDE TURNING RADIUS.
- PIPE ALONG SURFACE WATER FLOW TO OR DIVERTED TOWARD THE ENTRANCE. MARKING SHOULD BE MADE THROUGH THE ENTRANCE WITH A MOUNTABLE BERM WITH SLOPES AND A MINIMUM OF 12 INCHES OF STONE OVER THE PIPE. PROVIDE PIPE AS SPECIFIED ON APPROVED PLAN. WHEN MOUNTABLE BERMS ARE REQUIRED WHEN SLOPE IS NOT LOCATED AT A HIGH SPOT.
- PREPARE SUBGRADE AND PLACE NONWOVEN GEOTEXTILE, AS SPECIFIED IN SECTION H1 MATERIALS.
- PLACE CRUSHED AGGREGATE (2 TO 3 INCHES IN SIZE) OR EQUIVALENT RECYCLED CONCRETE (WITHOUT REBAR) AT LEAST 8 INCHES DEEP OVER THE LENGTH AND WIDTH OF THE ENTRANCE.
- MAINTAIN ENTRANCE IN A CONDITION THAT MINIMIZES TRACKING OF SEDIMENT. ADD STONE OR MAKE OTHER REPAIRS AS CONDITIONS DEMAND TO MAINTAIN CLEAN SURFACE. MOUNTABLE BERMS AND SPECIFIED DIMENSIONS IMMEDIATELY REMOVE STONE AND/OR SEDIMENT SPILLED, DROPPED, OR TRACKED ONTO ADJACENT ROADWAY BY VACUUMING, SCRAMBLING, AND/OR SWEEPING. WASHING ROADWAY TO REMOVE TRACKED ONTO PAVEMENT IS NOT ACCEPTABLE UNLESS WASH WATER IS DIRECTED TO AN APPROVED SEDIMENT CONTROL PRACTICE.

MARYLAND STANDARDS AND SPECIFICATIONS FOR SOIL EROSION AND SEDIMENT CONTROL

U.S. DEPARTMENT OF AGRICULTURE NATURAL RESOURCES CONSERVATION SERVICE 2011 MARYLAND DEPARTMENT OF ENVIRONMENT AND WATER MANAGEMENT ADMINISTRATION

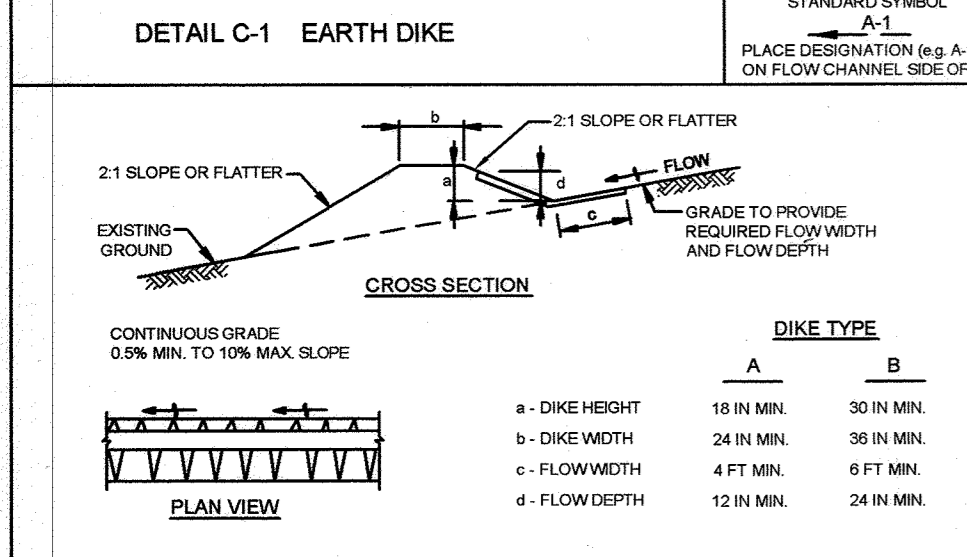


**CONSTRUCTION SPECIFICATIONS**

- USE WOOD POSTS 1 1/2 x 1 1/2 INCH (MINIMUM) SQUARE CUT OF SOUND QUALITY HARDWOOD OR AN ALTERNATIVE TO WOODEN POST USE STANDARD "T" OR "U" SECTION STEEL POSTS WEIGHING NOT LESS THAN 1 POUND PER LINEAL FOOT.
- USE 3/8 INCH MINIMUM POSTS DRIVEN 18 INCH MINIMUM INTO GROUND AND FASTENED NOT FEET APART.
- USE WOVEN SILT FILM GEOTEXTILE AS SPECIFIED IN SECTION H1 MATERIALS AND FASTEN GEOTEXTILE SECURELY TO UPSLOPE SIDE OF FENCE POSTS WITH WIRE TIES OR STAPLES AT TOP AND MID-SECTION.
- PROVIDE MANUFACTURER CERTIFICATION TO THE AUTHORIZED REPRESENTATIVE OF THE INSPECTION/CONSTRUCTION AUTHORITY SHOWING THAT THE GEOTEXTILE USED MEETS THE REQUIREMENTS IN SECTION H1 MATERIALS.
- EMBED GEOTEXTILE A MINIMUM OF 8 INCHES VERTICALLY INTO THE GROUND, BACKFILL AND COMPACT THE SOIL ON BOTH SIDES OF FABRIC.
- WHERE TWO SECTIONS OF GEOTEXTILE ADJOIN, OVERLAP, TWIST, AND STAPLE TO POST IN ACCORDANCE WITH SECTION H1 MATERIALS.
- EXTEND BOTH ENDS OF THE SILT FENCE A MINIMUM OF FIVE HORIZONTAL FEET UPSLOPE AT 45 DEGREES TO THE MAIN FENCE ALIGNMENT TO PREVENT RUNOFF FROM GOING AROUND THE ENDS OF THE SILT FENCE.
- REMOVE ACCUMULATED SEDIMENT AND DEBRIS WHEN BULGES DEVELOP IN SILT FENCE OR WHEN SEDIMENT REACHES 25% OF FENCE HEIGHT. REPLACE GEOTEXTILE IF TORN, IF UNDERMINING OCCURS, REINSTALL FENCE.

MARYLAND STANDARDS AND SPECIFICATIONS FOR SOIL EROSION AND SEDIMENT CONTROL

U.S. DEPARTMENT OF AGRICULTURE NATURAL RESOURCES CONSERVATION SERVICE 2011 MARYLAND DEPARTMENT OF ENVIRONMENT AND WATER MANAGEMENT ADMINISTRATION

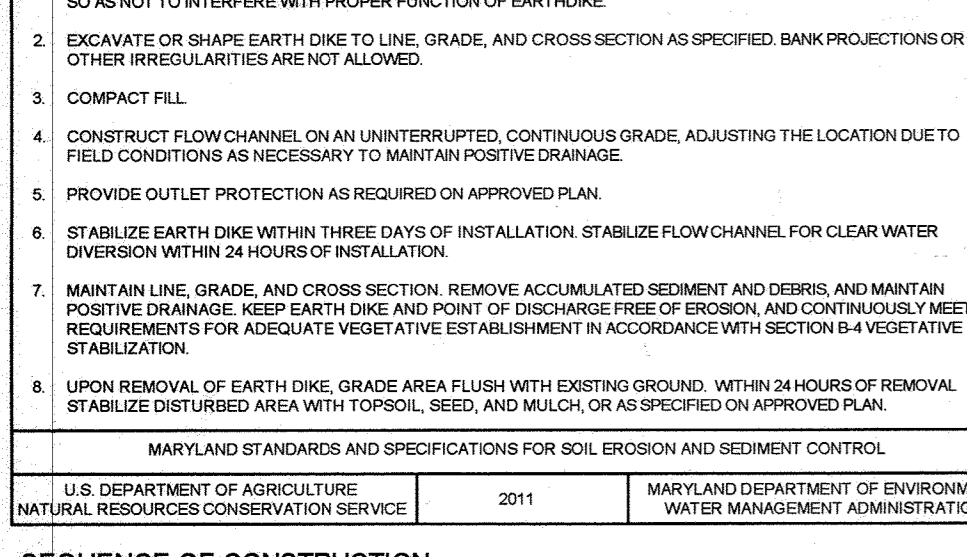

**CONSTRUCTION SPECIFICATIONS**

- REMOVE AND DISPOSE OF ALL TREES, BRUSH, STUMPS, OBSTRUCTIONS, AND OTHER OBJECTIONABLE MATERIAL SO AS NOT TO INTERFERE WITH PROPER FUNCTION OF EARTH DIKE.
- EXCAVATE OR SHAPE EARTH DIKE TO LINE, GRADE, AND CROSS SECTION AS SPECIFIED BANK PROJECTIONS OR OTHER SPECIFICATIONS ARE NOT ALLOWED.
- COMPACT FILL.
- CONSTRUCT FLOW CHANNEL, ON AN UNINTERFERED, CONTINUOUS GRADE, ADJUSTING THE LOCATION DUE TO FIELD CONDITIONS AS NECESSARY TO MAINTAIN POSITIVE DRAINAGE.
- PROVIDE OUTLET PROTECTION AS REQUIRED ON APPROVED PLAN.
- STABILIZE EARTH DIKE WITHIN 24 HOURS OF INSTALLATION. STABILIZE FLOW CHANNEL FOR CLEAR WATER DIVERSION WITHIN 24 HOURS OF INSTALLATION.
- MAINTAIN LINE, GRADE, AND CROSS SECTION. REMOVE ACCUMULATED SEDIMENT AND DEBRIS AND MAINTAIN POSITIVE DRAINAGE. KEEP EARTH DIKE AND CROSS SECTION OPEN AND CONTINUOUSLY MAINTAIN TO MEET REQUIREMENTS FOR ADEQUATE VEGETATIVE ESTABLISHMENT IN ACCORDANCE WITH SECTION 4 VEGETATIVE STABILIZATION.
- UPON REMOVAL OF EARTH DIKE, GRADE AREA FLUSH WITH EXISTING GROUND. WITHIN 24 HOURS OF REMOVAL, STABILIZE DISTURBED AREA WITH TOPSOIL, SEED, AND MULCH, OR AS SPECIFIED ON APPROVED PLAN.

MARYLAND STANDARDS AND SPECIFICATIONS FOR SOIL EROSION AND SEDIMENT CONTROL

U.S. DEPARTMENT OF AGRICULTURE NATURAL RESOURCES CONSERVATION SERVICE 2011 MARYLAND DEPARTMENT OF ENVIRONMENT AND WATER MANAGEMENT ADMINISTRATION

**SEEDING OF CONSTRUCTION**

- OBTAIN GRADING PERMIT. NOTIFY HOWARD COUNTY DEPARTMENT OF INSPECTIONS, LICENSE AND PERMITS AT (410) 313-1880 AT LEAST 24 HOURS BEFORE STARTING ANY WORK.
- INSTALL STABILIZED CONSTRUCTION ENTRANCE, CLEAR AND GRUBS AS NECESSARY FOR THE INSTALLATION OF PERMITTER CONTROLS. (3 DAYS)
- CONSTRUCT EARTH DIKES AND SILT FENCE WHERE SHOWN ON THE PLANS AND STABILIZE. DO NOT INSTALL CLEAR WATER DIKES AT BIOTRENTION FACILITIES 3 AT THIS TIME. (4 DAYS)
- EXCAVATE AND GRADE SEDIMENT BASIN AND FOREBAYS. INSTALL CORE, EMBANKMENT FILT, CONCRETE OUTFALL PIPE, PIPE CIRCLE, ANTI-SEEP COLLAR, CONSTRUCT SWM OUTFALL STRUCTURES 1-1, RIP RAP OUTFALL PROTECTION AND EROSION CONTROL MATTING, CONSTRUCT SWM STRUCTURE SWM-1, INCLUDING 6 POND DRAIN AND VALVE, CONCRETE CLEANOUT STRUCTURE, AND TEMPORARY 10' SEDIMENT CONTROL, DEWATERING DEVICE. (10 WEEKS)
- CONSTRUCT FOREBAY GABION INFLOW STRUCTURES (2 WEEKS)
- EXISTING SOIL APPROVED BY THE GEOTECHNICAL ENGINEER FOR USE AS BIOTRENTION PLANTING SOIL TO BE STOCKPILED SEPARATELY FROM OTHER MATERIAL. IF THIS SOIL IS STOCKPILED FOR MORE THAN TWO WEEKS, SOIL TO BE TURNED OVER. (2 DAYS)
- INSTALL CLEAR WATER DIVERSION DIKES AS SHOWN LOCATED AT BIOTRENTION FACILITIES 3. (3 DAYS)
- GRADE AND CONSTRUCT BIOTRENTION FACILITIES 1, 2, AND 3 INCLUDING ALL PIPE SYSTEMS, INLET STRUCTURES, GRAVEL AND RIP RAP AS SHOWN ON THE PLANS, CONSTRUCT LEVEL SPREADERS AND FILTER STRIPS AND STABILIZE. (3 WEEKS)
- INSTALL ALL PLANT MATERIALS FOR BIOTRENTION PLANTINGS. (3 WEEKS)
- SEDIMENT BASIN NO. 1 TO REMAIN THROUGHOUT THE DEVELOPMENT OF THE TURF VALLEY CLUBHOUSE, PHASE I (S-08-001) AND PHASE II (S-11-003).
- UPON COMPLETION OF THE TURF VALLEY CLUBHOUSE, PHASE I (S-08-001) AND PHASE II (S-11-003), CONVERT BASIN TO THE STORMWATER MANAGEMENT FACILITY #H.
- ON STABILIZATION OF ALL DISTURBED AREAS, INCLUDING MULCHING, AND WITH THE PERMISSION OF THE SEDIMENT CONTROL INSPECTOR, REMOVE SEDIMENT CONTROL MEASURES, EXCEPT EARTH DIKES AND RIP RAP PROTECTION FOR INFLOW CONTROL, INTO THE SEDIMENT BASIN AND STABILIZE ANY REMAINING DISTURBED AREAS. (1 WEEK)

**STANDARD STABILIZATION NOTE**

FOLLOWING INITIAL SOIL DISTURBANCE OR REDISTURBANCE, PERMANENT OR TEMPORARY STABILIZATION MUST BE COMPLETED WITHIN:

- THREE (3) CALENDAR DAYS AS TO THE SURFACE OF ALL PERMETER DIKES, SWALES, DITCHES, PERMETER SLOPES AND ALL SLOPES STEEPER THAN 3 HORIZONTAL TO 1 VERTICAL (3:1), AND
- SEVEN (7) CALENDAR DAYS AS TO ALL OTHER DISTURBED OR GRADED AREAS ON THE PROJECT SITE NOT UNDER ACTIVE GRADING.

DURING GRADING AND AFTER EACH RAINFALL, CONTRACTOR WILL INSPECT AND PROVIDE NECESSARY MAINTENANCE TO THE SEDIMENT CONTROL MEASURES ON THIS PLAN.


APPROVED: HOWARD COUNTY DEPARTMENT OF PLANNING AND ZONING

DATE: 5/2/13

DATE: 5/2/13

DATE: 5/2/13

DATE: 5/2/13

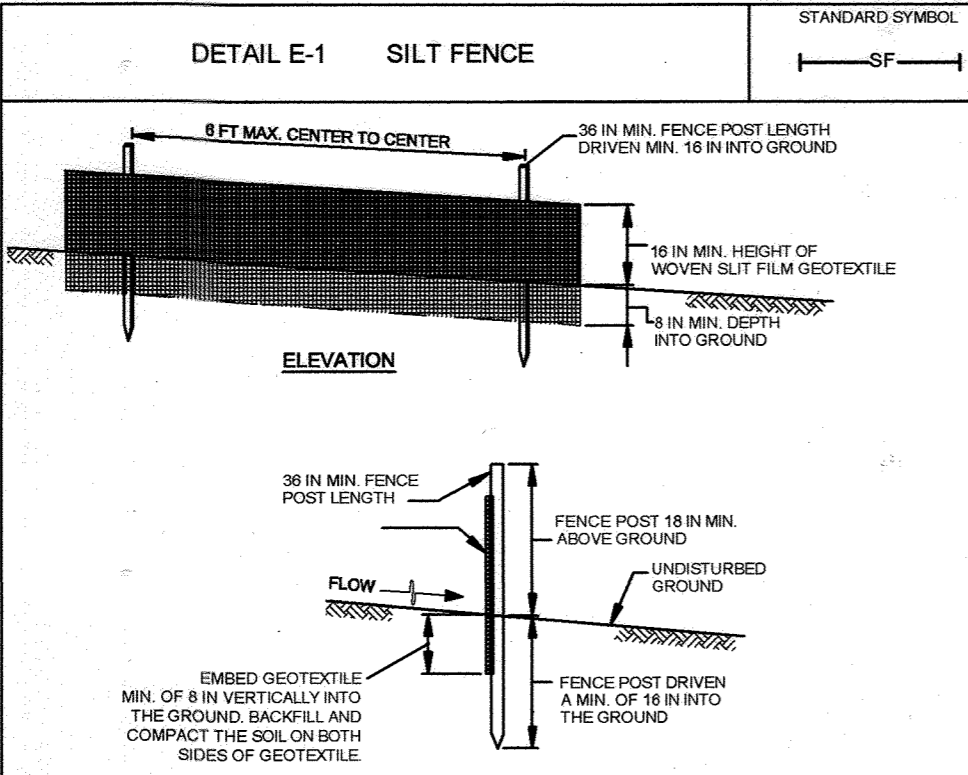


**CONSTRUCTION SPECIFICATIONS**

- PROVIDE NONWOVEN GEOTEXTILE, AS SPECIFIED IN SECTION H1 MATERIALS, UNDER THE BOTTOM AND ALONG SIDES OF ALL RIPRAP.
- CONSTRUCT INFLOW CHANNEL WITH CLASS I RIPRAP OR EQUIVALENT RECYCLED CONCRETE LINING TO A MINIMUM DEPTH OF 18 INCHES (D.D.) AND A 1 FOOT DEEP CHANNEL INFLOW PROTECTION CHANNEL. MUST HAVE A TRIANGULAR CROSS SECTION WITH 2:1 OR FLATTER SIDE SLOPES AND A 4 FOOT MINIMUM BOTTOM WIDTH.
- INSTALL ENTRANCE AND END SECTIONS AS SHOWN ON THE PROFILE.
- BLEND RIPRAP INTO EXISTING GROUND.
- MAINTAIN LINE, GRADE, AND CROSS SECTION. REMOVE ACCUMULATED SEDIMENT AND DEBRIS. KEEP POINTS OF INFLOW AND OUTFLOW FREE OF OBSTRUCTION.

MARYLAND STANDARDS AND SPECIFICATIONS FOR SOIL EROSION AND SEDIMENT CONTROL

U.S. DEPARTMENT OF AGRICULTURE NATURAL RESOURCES CONSERVATION SERVICE 2011 MARYLAND DEPARTMENT OF ENVIRONMENT AND WATER MANAGEMENT ADMINISTRATION

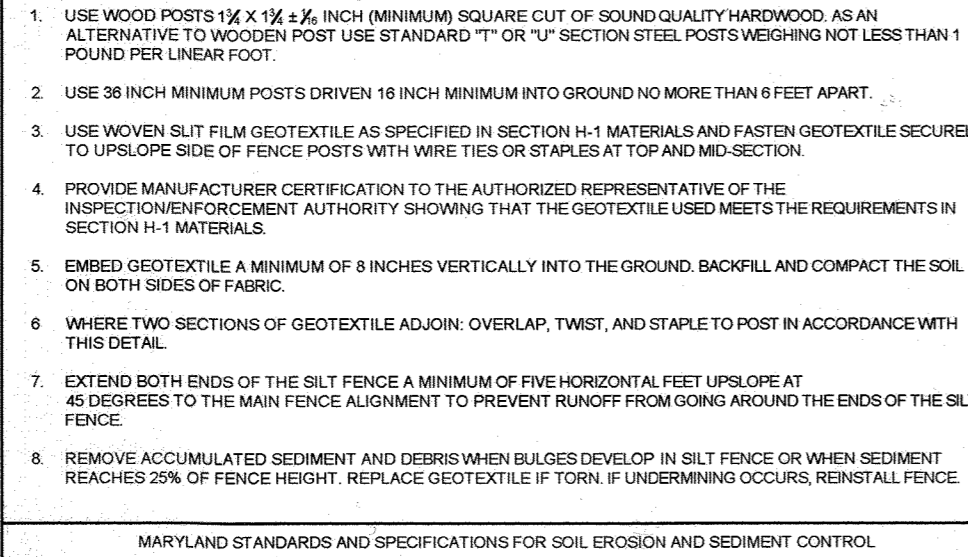


**CONSTRUCTION SPECIFICATIONS**

- USE MATTING THAT HAS A DESIGN VALUE FOR SHEAR STRESS OF 2.0 OR HIGHER THAN THE SHEAR STRESS DETERMINED ON APPROVED PLAN.
- USE PERMANENT SOIL STABILIZATION MATTING MADE OF OPEN WEAVE SYNTHETIC, NONDEGRADABLE FIBERS OR ELEMENTS OF UNIFORM THICKNESS AND DISTRIBUTION THROUGHOUT. CHEMICALS USED IN THE MAT MUST BE NON-LEACHING AND NOT TOXIC TO VEGETATION AND SEED GENERATION AND NON-HARMFUL TO THE SOIL. PRESIDENT, NET WEIGHT MUST BE EXTRUDED PLASTIC WITH A MAXIMUM DISTURBANCE OF 20 INCHES AND SUFFICIENTLY SOFTENED SO SOIL CAN BE MOVED INTO LONGITUDINAL AND TRANSVERSE TRENCHES TO PREVENT SEPARATION OF THE MAT FROM THE SOIL.
- SECURE MATTING USING STAPLES OR WOOD STAPLES. STAPLES MUST BE "T" OR "U" SHAPED STEEL WIRE HAVING A MINIMUM GAUGE OF NO. 14 AND NO. 8 RESPECTIVELY. "T" SHAPED STAPLES MUST BE 1 1/2 TO 1 3/4 INCHES WIDE AND BE A MINIMUM OF 4 INCHES LONG. "U" SHAPED STAPLES MUST HAVE A MINIMUM 1/2 INCH MINIMUM 1 INCH SECONDARY LEG AND MINIMUM 4 INCH LEG. WOOD STAPLES MUST BE ROUND-SHAPED (MIN. 1 1/2 TO 2 INCHES IN LENGTH, 3/4 INCH IN DIAMETER) AND WEAVE SHAPED AT THE BOTTOM.
- PERFORM FINAL GRADING, TOPSOIL APPLICATION, SEEDING PREPARATION, AND PERMANENT SEEDING IN ACCORDANCE WITH SECTION 4. FILL THE MAT VOIDS WITH 48 HOURS OF SOIL OR GRASS MATTING. PRESIDENT, NET WEIGHT MUST BE EXTRUDED PLASTIC WITH A MAXIMUM DISTURBANCE OF 20 INCHES AND SUFFICIENTLY SOFTENED SO SOIL CAN BE MOVED INTO LONGITUDINAL AND TRANSVERSE TRENCHES TO PREVENT SEPARATION OF THE MAT FROM THE SOIL.
- OVERLAP OR ABUT EDGES OF MATTING ROLLS PER MANUFACTURER RECOMMENDATIONS. OVERLAP ROLLS BY 6 INCHES MINIMUM WITH THE UPSTREAM MAT OVERLAPPING ON TOP OF THE DOWNSTREAM MAT.
- KEY IN THE TOP OF SLOPE END OF MAT 6 INCHES (MINIMUM) BY DIGGING A TRENCH, PLACING THE MATTING ROLL END IN THE TRENCH, STAPLING THE MAT IN PLACE, AND TAMPING TO SECURE THE MAT END IN THE TRENCH.
- STAPLE STAKE MAT IN A STAGGERED PATTERN ON A 4 FOOT (MAXIMUM) CENTER-TO-CENTER THROUGHOUT AND 2 FOOT (MAXIMUM) CENTERS ALONG SEAMS, JOINTS, AND ROLL ENDS.
- IF SPECIFIED BY THE DESIGNER OR MANUFACTURER AND DEPENDING ON THE TYPE OF MAT BEING INSTALLED, ONCE THE MAT IS INSTALLED, IT MUST BE TAMPED IN PLACE. FILL THE MAT VOIDS WITH 48 HOURS OF SOIL OR GRASS MATTING. PRESIDENT, NET WEIGHT MUST BE EXTRUDED PLASTIC WITH A MAXIMUM DISTURBANCE OF 20 INCHES AND SUFFICIENTLY SOFTENED SO SOIL CAN BE MOVED INTO LONGITUDINAL AND TRANSVERSE TRENCHES TO PREVENT SEPARATION OF THE MAT FROM THE SOIL.
- ESTABLISH AND MAINTAIN VEGETATION SO THAT REQUIREMENTS FOR ADEQUATE VEGETATIVE ESTABLISHMENT ARE CONTINUOUSLY MET IN ACCORDANCE WITH SECTION 4 VEGETATIVE STABILIZATION.

MARYLAND STANDARDS AND SPECIFICATIONS FOR SOIL EROSION AND SEDIMENT CONTROL

U.S. DEPARTMENT OF AGRICULTURE NATURAL RESOURCES CONSERVATION SERVICE 2011 MARYLAND DEPARTMENT OF ENVIRONMENT AND WATER MANAGEMENT ADMINISTRATION

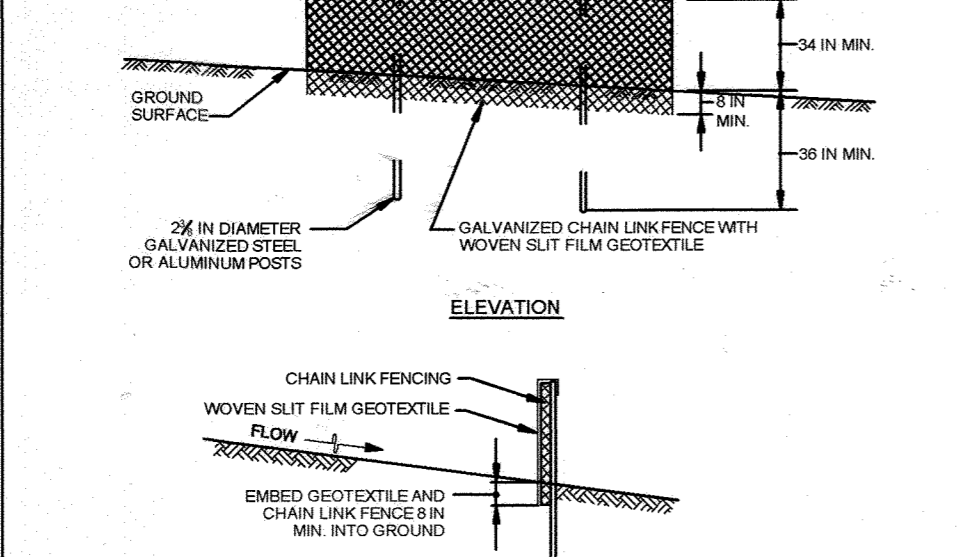

**CONSTRUCTION SPECIFICATIONS**

- INSTALL 24 INCH DIAMETER GALVANNEED STEEL POSTS OF 0.063 INCH WALL THICKNESS AND SIX FOOT LENGTH SPACING NO FURTHER THAN 10 FEET APART. DRIVE THE POSTS A MINIMUM OF 36 INCHES INTO THE GROUND.
- FASTEN 8 GAUGE OR HEAVIER GALVANNEED CHAIN LINK FENCE (2X MINIMUM OPENING) 42 INCHES IN HEIGHT SECURELY TO THE FENCE POSTS WITH WIRE TIES OR HUNG RINGS.
- FASTEN WOVEN SILT FILM GEOTEXTILE AS SPECIFIED IN SECTION H1 MATERIALS, SECURELY TO THE UPSLOPE SIDE OF CHAIN LINK FENCE WITH TIES SPACING EVERY 24 INCHES TO THE TOP AND MID-SECTION. EMBED GEOTEXTILE AND CHAIN LINK FENCE A MINIMUM OF 8 INCHES INTO THE GROUND.
- WHERE ENDS OF THE GEOTEXTILE COME TOGETHER, THE ENDS SHALL BE OVERLAPPED BY 6 INCHES, FOLDED, AND STAPLED TO PREVENT SEDIMENT BY PASS.
- EXTEND BOTH ENDS OF THE SUPER SILT FENCE A MINIMUM OF FIVE HORIZONTAL FEET UPSLOPE AT 45 DEGREES TO THE MAIN FENCE ALIGNMENT TO PREVENT RUNOFF FROM GOING AROUND THE ENDS OF THE SUPER SILT FENCE.
- PROVIDE MANUFACTURER CERTIFICATION TO THE INSPECTION/CONSTRUCTION AUTHORITY SHOWING THAT GEOTEXTILE USED MEETS THE REQUIREMENTS IN SECTION H1 MATERIALS.
- REMOVE ACCUMULATED SEDIMENT AND DEBRIS WHEN BULGES DEVELOP IN FENCE OR WHEN SEDIMENT REACHES 25% OF FENCE HEIGHT. REPLACE GEOTEXTILE IF TORN, IF UNDERMINING OCCURS, REINSTALL FENCE AND GEOTEXTILE.

MARYLAND STANDARDS AND SPECIFICATIONS FOR SOIL EROSION AND SEDIMENT CONTROL

U.S. DEPARTMENT OF AGRICULTURE NATURAL RESOURCES CONSERVATION SERVICE 2011 MARYLAND DEPARTMENT OF ENVIRONMENT AND WATER MANAGEMENT ADMINISTRATION

**TABLE B.5: RECOMMENDED PLANTING DATES FOR PERMANENT COVER IN MARYLAND**

TYPE OF PLANT MATERIAL	PLANT HARDINESS ZONES			
	5b & 6a	6b	7a & 7b	8
SEEDS - COOL-SEASON GRASSES (INCLUDES MIXES WITH FORBS AND/OR LEGUMES)	MAR 15 TO MAY 31 AUG 1 TO SEP 15	MAR 1 TO MAY 15 AUG 1 TO SEP 15	FEB 15 TO APR 30 AUG 15 TO OCT 31 NOV 1 TO NOV 30	
SEEDS - WARM-SEASON COOL-SEASON GRASS MIXES (INCLUDES MIXES WITH FORBS AND/OR LEGUMES)	MAR 15 TO MAY 31 AUG 1 TO SEP 15	MAR 1 TO MAY 15 AUG 1 TO SEP 15	FEB 15 TO APR 30 AUG 15 TO OCT 31 NOV 1 TO NOV 30	
SOO - COOL-SEASON	MAR 15 TO MAY 31 AUG 1 TO SEP 15	MAR 1 TO MAY 15 AUG 1 TO SEP 15	FEB 15 TO APR 30 AUG 15 TO OCT 31 NOV 1 TO NOV 30	
UNROOTED WOODY MATERIALS, BARE-ROOT PLANTS, BULBS, RHIZOMES, CORNUS AND TUBERS	MAR 15 TO MAY 31 AUG 1 TO SEP 15	MAR 1 TO MAY 15 AUG 1 TO SEP 15	FEB 15 TO APR 30 AUG 15 TO OCT 31 NOV 1 TO NOV 30	
CONTAINERIZED STOCK, BALLED-AND-BURLAPPED	MAR 15 TO MAY 31 AUG 1 TO SEP 15	MAR 1 TO MAY 15 AUG 1 TO SEP 15	FEB 15 TO APR 30 AUG 15 TO OCT 31 NOV 1 TO NOV 30	

**NOTES:**


- THE PLANTING DATES LISTED ARE AVERAGES FOR EACH ZONE. THESE DATES MAY REQUIRE ADJUSTMENT TO REFLECT LOCAL CONDITIONS, ESPECIALLY NEAR THE BOUNDARIES OF THE ZONES. WHEN SEEDING TOWARD THE END OF THE LISTED PLANTING DATES, OR WHEN CONDITIONS ARE EXPECTED TO BE LESS THAN OPTIMAL, SELECT AN APPROPRIATE NURSE CROP FROM TABLE B.1 TEMPORARY SEEDING FOR SITE STABILIZATION AND PLANT TOGETHER WITH THE PERMANENT SEEDING MIX.
- WHEN PLANTED DURING THE GROWING SEASON, MOST OF THESE MATERIALS MUST BE PURCHASED AND KEPT IN A DORMANT CONDITION UNTIL PLANTING. BARE-ROOT GRASSES ARE THE EXCEPTION—THEY MAY BE SUPPLIED AS GROWING (NON-DORMANT) PLANTS.
- ADDITIONAL PLANTING DATES FOR THE LOWER COASTAL PLANT, DEPENDENT ON ANNUAL RAINFALL AND TEMPERATURE TRENDS, RECOMMEND ADDING A NURSE CROP, AS NOTED ABOVE, IF PLANTING DURING THIS PERIOD.
- WARM-SEASON GRASSES NEED A SOIL TEMPERATURE OF AT LEAST 50 DEGREES F TO BEGIN TO GERMINATE. IF SOIL TEMPERATURES ARE COLDER THAN 50 DEGREES, OR MOISTURE IS NOT ADEQUATE, THE SEEDS WILL REMAIN DORMANT UNTIL CONDITIONS ARE FAVORABLE. IN GENERAL, PLANTING DURING THE LATTER PORTION OF THIS PERIOD ALLOW MORE TIME FOR WEED EMERGENCE AND WEED CONTROL PRIOR TO PLANTING. WHEN SELECTING A PLANTING DATE, CONSIDER THE NEED FOR WEED CONTROL VS. THE LIKELIHOOD OF HAVING SUFFICIENT MOISTURE FOR LATER PLANTING, ESPECIALLY ON DROUGHTY SITES.
- ADDITIONAL PLANTING DATES DURING WHICH SUPPLEMENTAL WATERING MAY BE NEEDED TO ENSURE PLANT ESTABLISHMENT.
- FRIGHTING AND THAWING OF WET SOILS MAY RESULT IN FROST-HEAVING OF MATERIALS PLANTED IN LATE FALL. IF PLANTS HAVE NOT SUFFICIENTLY ROOTED IN PLACE, SOIL USUALLY NEEDS 4 TO 6 WEEKS TO BECOME SUFFICIENTLY ROOTED. LARGE CONTAINERS ROOTED IN PLACE AND BALLED-AND-BURLAPPED STOCK MAY BE PLANTED INTO THE WINTER MONTHS AS LONG AS THE GROUND IS NOT FROZEN AND SOIL MOISTURE IS ADEQUATE.

**ENGINEERS CERTIFICATE**

I HEREBY CERTIFY THAT THIS PLAN FOR POND CONSTRUCTION, EROSION AND SEDIMENT CONTROL, REPRESENTS A PRACTICAL AND WORKABLE PLAN BASED ON THE PERSONAL KNOWLEDGE OF THE SITE CONDITIONS. THIS PLAN WAS PREPARED IN ACCORDANCE WITH THE REQUIREMENTS OF THE HOWARD COUNTY CONSERVATION DISTRICT. I HAVE NOTIFIED THE DEVELOPER THAT HE/MUST ENGAGE A REGISTERED PROFESSIONAL ENGINEER TO SUPERVISE POND CONSTRUCTION AND PROVIDE THE HOWARD COUNTY CONSERVATION DISTRICT WITH AN "AS-BUILT" PLAN OF THE POND WITHIN 30 DAYS OF COMPLETION.

DATE: 4/30/13

SIGNATURE OF ENGINEER: PAUL M. SILL, P.E.

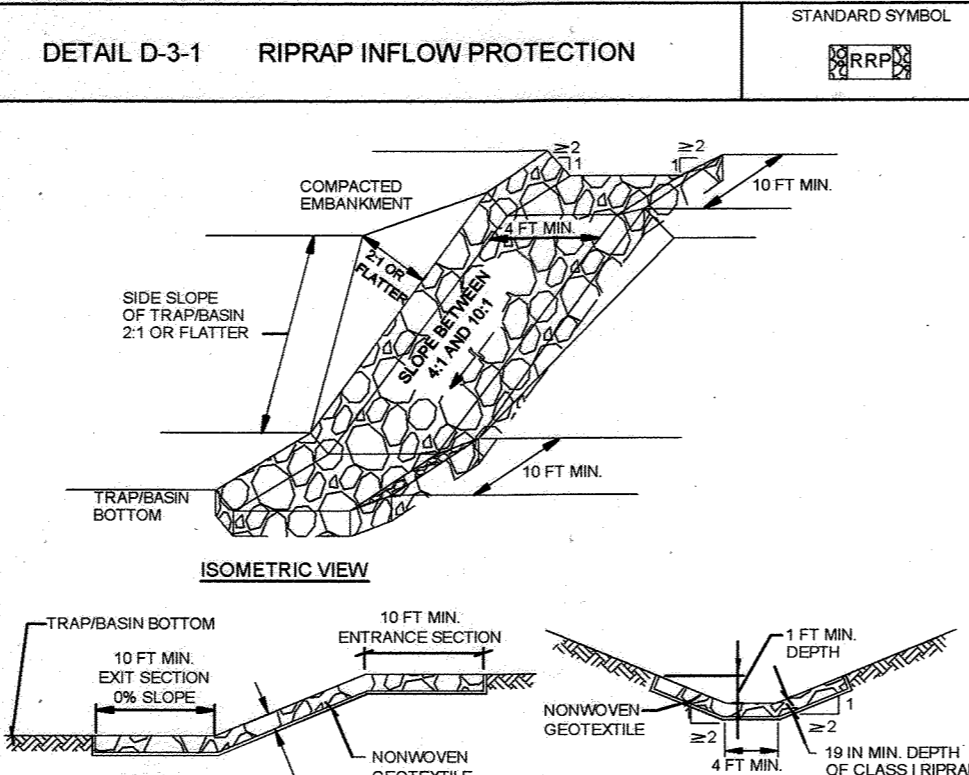


**CONSTRUCTION SPECIFICATIONS**

- RIPRAP AND STONE MUST CONFORM TO THE SPECIFIED CLASS.
- USE NONWOVEN GEOTEXTILE, AS SPECIFIED IN SECTION H1 MATERIALS, AND PROTECT FROM PUNCTURING, CUTTING, OR TEARING FROM ANY SHARPER THAN AN OCCASIONAL SMALL ROCK BY PLACING ANOTHER PIECE OF GEOTEXTILE OVER THE DAMAGED PART OR COMPLETELY REPLACING THE GEOTEXTILE. PROVIDE A MINIMUM OF ONE FOOT OVERLAP FOR EACH JOINT. PROVIDE ONE FOOT OVERLAP FOR EACH JOINT.
- IMPROVE THE SUBGRADE OR BOTTOM OF STONE FILTER. IT TO 10 INCH MINIMUM DEPTH FOR 6 INCH MINIMUM DEPTH RIPRAP TO THE REQUIRED LINES AND SIDES. COMPACT ANY FILL REQUIRED IN THE SUBGRADE TO A COMPACTION LEVEL OF 90 PERCENT OF THE SPECIFIED MATERIAL.
- EXTEND GEOTEXTILE OUT TO FULL CURE THICKNESS IN ONE OPERATION AND IN SUCH A MANNER AS TO AVOID DISPLACEMENT OF UNDERLYING MATERIAL. PLACE STONE FOR RIPRAP IN A MANNER THAT WILL ENSURE THAT IT IS SEATED IN A MANNER TO PREVENT DAMAGE TO THE FILTER BLANKET OR GEOTEXTILE. LEAVE THE EXTENT NEEDED.
- MAINTAIN LINE, GRADE, AND CROSS SECTION. REMOVE ACCUMULATED SEDIMENT AND DEBRIS. KEEP POINTS OF INFLOW AND OUTFLOW FREE OF OBSTRUCTION.

MARYLAND STANDARDS AND SPECIFICATIONS FOR SOIL EROSION AND SEDIMENT CONTROL

U.S. DEPARTMENT OF AGRICULTURE NATURAL RESOURCES CONSERVATION SERVICE 2011 MARYLAND DEPARTMENT OF ENVIRONMENT AND WATER MANAGEMENT ADMINISTRATION

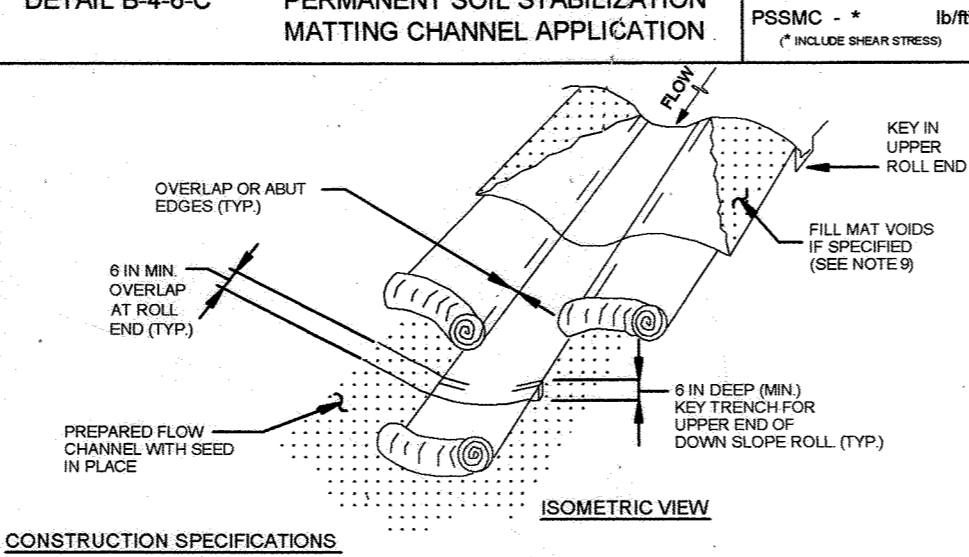


**CONSTRUCTION SPECIFICATIONS**

- USE MATTING THAT HAS A DESIGN VALUE FOR SHEAR STRESS OF 2.0 OR HIGHER THAN THE SHEAR STRESS DETERMINED ON APPROVED PLAN.
- USE PERMANENT SOIL STABILIZATION MATTING MADE OF OPEN WEAVE SYNTHETIC, NONDEGRADABLE FIBERS OR ELEMENTS OF UNIFORM THICKNESS AND DISTRIBUTION THROUGHOUT. CHEMICALS USED IN THE MAT MUST BE NON-LEACHING AND NOT TOXIC TO VEGETATION AND SEED GENERATION AND NON-HARMFUL TO THE SOIL. PRESIDENT, NET WEIGHT MUST BE EXTRUDED PLASTIC WITH A MAXIMUM DISTURBANCE OF 20 INCHES AND SUFFICIENTLY SOFTENED SO SOIL CAN BE MOVED INTO LONGITUDINAL AND TRANSVERSE TRENCHES TO PREVENT SEPARATION OF THE MAT FROM THE SOIL.
- SECURE MATTING USING STAPLES OR WOOD STAPLES. STAPLES MUST BE "T" OR "U" SHAPED STEEL WIRE HAVING A MINIMUM GAUGE OF NO. 14 AND NO. 8 RESPECTIVELY. "T" SHAPED STAPLES MUST BE 1 1/2 TO 1 3/4 INCHES WIDE AND BE A MINIMUM OF 4 INCHES LONG. "U" SHAPED STAPLES MUST HAVE A MINIMUM 1/2 INCH MINIMUM 1 INCH SECONDARY LEG AND MINIMUM 4 INCH LEG. WOOD STAPLES MUST BE ROUND-SHAPED (MIN. 1 1/2 TO 2 INCHES IN LENGTH, 3/4 INCH IN DIAMETER) AND WEAVE SHAPED AT THE BOTTOM.
- PERFORM FINAL GRADING, TOPSOIL APPLICATION, SEEDING PREPARATION, AND PERMANENT SEEDING IN ACCORDANCE WITH SECTION 4. FILL THE MAT VOIDS WITH 48 HOURS OF SOIL OR GRASS MATTING. PRESIDENT, NET WEIGHT MUST BE EXTRUDED PLASTIC WITH A MAXIMUM DISTURBANCE OF 20 INCHES AND SUFFICIENTLY SOFTENED SO SOIL CAN BE MOVED INTO LONGITUDINAL AND TRANSVERSE TRENCHES TO PREVENT SEPARATION OF THE MAT FROM THE SOIL.
- OVERLAP OR ABUT EDGES OF MATTING ROLLS PER MANUFACTURER RECOMMENDATIONS. OVERLAP ROLLS BY 6 INCHES MINIMUM WITH THE UPSTREAM MAT OVERLAPPING ON TOP OF THE DOWNSTREAM MAT.
- KEY IN THE TOP OF SLOPE END OF MAT 6 INCHES (MINIMUM) BY DIGGING A TRENCH, PLACING THE MATTING ROLL END IN THE TRENCH, STAPLING THE MAT IN PLACE, AND TAMPING TO SECURE THE MAT END IN THE TRENCH.
- STAPLE STAKE MAT IN A STAGGERED PATTERN ON A 4 FOOT (MAXIMUM) CENTER-TO-CENTER THROUGHOUT AND 2 FOOT (MAXIMUM) CENTERS ALONG SEAMS, JOINTS, AND ROLL ENDS.
- IF SPECIFIED BY THE DESIGNER OR MANUFACTURER AND DEPENDING ON THE TYPE OF MAT BEING INSTALLED, ONCE THE MAT IS INSTALLED, IT MUST BE TAMPED IN PLACE. FILL THE MAT VOIDS WITH 48 HOURS OF SOIL OR GRASS MATTING. PRESIDENT, NET WEIGHT MUST BE EXTRUDED PLASTIC WITH A MAXIMUM DISTURBANCE OF 20 INCHES AND SUFFICIENTLY SOFTENED SO SOIL CAN BE MOVED INTO LONGITUDINAL AND TRANSVERSE TRENCHES TO PREVENT SEPARATION OF THE MAT FROM THE SOIL.
- ESTABLISH AND MAINTAIN VEGETATION SO THAT REQUIREMENTS FOR ADEQUATE VEGETATIVE ESTABLISHMENT ARE CONTINUOUSLY MET IN ACCORDANCE WITH SECTION 4 VEGETATIVE STABILIZATION.

MARYLAND STANDARDS AND SPECIFICATIONS FOR SOIL EROSION AND SEDIMENT CONTROL

U.S. DEPARTMENT OF AGRICULTURE NATURAL RESOURCES CONSERVATION SERVICE 2011 MARYLAND DEPARTMENT OF ENVIRONMENT AND WATER MANAGEMENT ADMINISTRATION

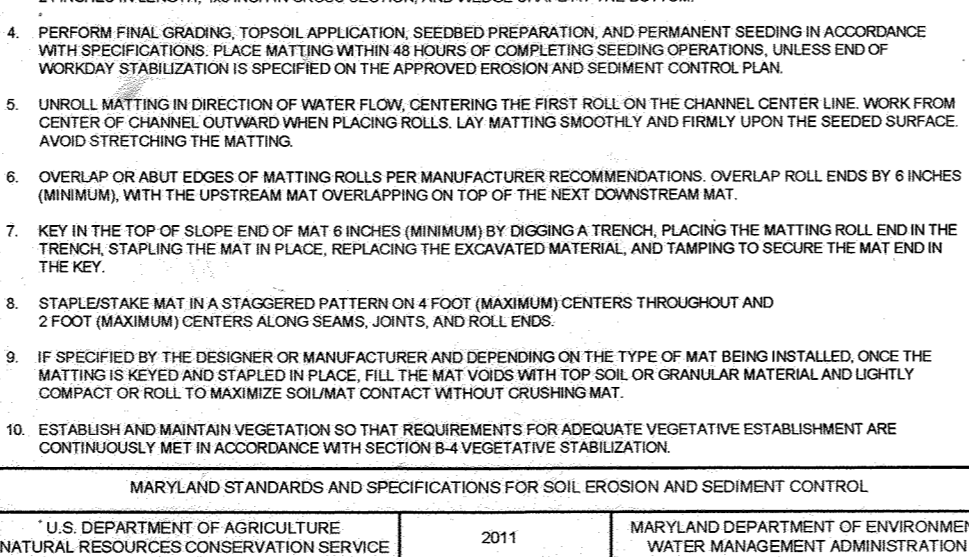

**CONSTRUCTION SPECIFICATIONS**

- INSTALL 24 INCH DIAMETER GALVANNEED STEEL POSTS OF 0.063 INCH WALL THICKNESS AND SIX FOOT LENGTH SPACING NO FURTHER THAN 10 FEET APART. DRIVE THE POSTS A MINIMUM OF 36 INCHES INTO THE GROUND.
- FASTEN 8 GAUGE OR HEAVIER GALVANNEED CHAIN LINK FENCE (2X MINIMUM OPENING) 42 INCHES IN HEIGHT SECURELY TO THE FENCE POSTS WITH WIRE TIES OR HUNG RINGS.
- FASTEN WOVEN SILT FILM GEOTEXTILE AS SPECIFIED IN SECTION H1 MATERIALS, SECURELY TO THE UPSLOPE SIDE OF CHAIN LINK FENCE WITH TIES SPACING EVERY 24 INCHES TO THE TOP AND MID-SECTION. EMBED GEOTEXTILE AND CHAIN LINK FENCE A MINIMUM OF 8 INCHES INTO THE GROUND.
- WHERE ENDS OF THE GEOTEXTILE COME TOGETHER, THE ENDS SHALL BE OVERLAPPED BY 6 INCHES, FOLDED, AND STAPLED TO PREVENT SEDIMENT BY PASS.
- EXTEND BOTH ENDS OF THE SUPER SILT FENCE A MINIMUM OF FIVE HORIZONTAL FEET UPSLOPE AT 45 DEGREES TO THE MAIN FENCE ALIGNMENT TO PREVENT RUNOFF FROM GOING AROUND THE ENDS OF THE SUPER SILT FENCE.
- PROVIDE MANUFACTURER CERTIFICATION TO THE INSPECTION/CONSTRUCTION AUTHORITY SHOWING THAT GEOTEXTILE USED MEETS THE REQUIREMENTS IN SECTION H1 MATERIALS.
- REMOVE ACCUMULATED SEDIMENT AND DEBRIS WHEN BULGES DEVELOP IN FENCE OR WHEN SEDIMENT REACHES 25% OF FENCE HEIGHT. REPLACE GEOTEXTILE IF TORN, IF UNDERMINING OCCURS, REINSTALL FENCE AND GEOTEXTILE.

MARYLAND STANDARDS AND SPECIFICATIONS FOR SOIL EROSION AND SEDIMENT CONTROL

U.S. DEPARTMENT OF AGRICULTURE NATURAL RESOURCES CONSERVATION SERVICE 2011 MARYLAND DEPARTMENT OF ENVIRONMENT AND WATER MANAGEMENT ADMINISTRATION

**TABLE B.1: TEMPORARY SEEDING FOR SITE STABILIZATION**

PLANT SPECIES	SEEDING RATE LB/AC	SEEDING DEPTH INCHES	RECOMMENDED SEEDING DATES BY PLANT HARDINESS ZONE			
			5b & 6a	6b	7a & 7b	8
COOL-SEASON GRASSES	40	1.0	MAR 15 TO MAY 31 AUG 1 TO SEP 15	MAR 1 TO MAY 15 AUG 1 TO SEP 15	FEB 15 TO APR 30 AUG 15 TO OCT 31 NOV 1 TO NOV 30	
ANNUAL RYEGRASS (LALAM PERENNIAL)	40	1.0	MAR 15 TO MAY 31 AUG 1 TO SEP 15	MAR 1 TO MAY 15 AUG 1 TO SEP 15	FEB 15 TO APR 30 AUG 15 TO OCT 31 NOV 1 TO NOV 30	
BARLEY (PERENNIAL VILGARD)	96	2.2	MAR 15 TO MAY 31 AUG 1 TO SEP 15	MAR 1 TO MAY 15 AUG 1 TO SEP 15	FEB 15 TO APR 30 AUG 15 TO OCT 31 NOV 1 TO NOV 30	
OATS (ANNUAL SATIVA)	72	1.7	MAR 15 TO MAY 31 AUG 1 TO SEP 15	MAR 1 TO MAY 15 AUG 1 TO SEP 15	FEB 15 TO APR 30 AUG 15 TO OCT 31 NOV 1 TO NOV 30	
WHEAT (PERENNIAL AESTIVUM)	120	2.9	MAR 15 TO MAY 31 AUG 1 TO SEP 15	MAR 1 TO MAY 15 AUG 1 TO SEP 15	FEB 15 TO APR 30 AUG 15 TO OCT 31 NOV 1 TO NOV 30	
CERIAL RYE (SECALE CERVALE)	112	2.8	MAR 15 TO MAY 31 AUG 1 TO SEP 15	MAR 1 TO MAY 15 AUG 1 TO SEP 15	FEB 15 TO APR 30 AUG 15 TO OCT 31 NOV 1 TO NOV 30	
WARM-SEASON GRASSES	30	0.7	JUN 1 TO JUL 31	MAY 15 TO JUN 30	MAY 15 TO JUN 30	
PEARL MILLET (PERENNIAL GLAUCUM)	20	0.5	JUN 1 TO JUL 31	MAY 15 TO JUN 30	MAY 15 TO JUN 30	

**NOTES:**


- SEEDING RATES FOR THE WARM-SEASON GRASSES ARE IN POUNDS OF LIVE SEED PLUS ACTUAL PLANTING RATES SHALL BE ADJUSTED TO REFLECT PERCENT SEED GERMINATION AND PURITY, AS TESTED. ADJUSTMENTS ARE USUALLY NOT NEEDED FOR THE COOL-SEASON GRASSES. SEEDING RATES LISTED ABOVE ARE FOR TEMPORARY SEEDINGS. WHEN PLANTED ALONE, WHEN PLANTED AS A NURSE CROP WITH PERMANENT SEEDING MIXES, OR WHEN PLANTED WITH PERMANENT SEEDING MIXES, SEEDING RATES SHOULD BE ADJUSTED TO REFLECT PERCENT SEED GERMINATION AND PURITY. FOR SMALLER-SEEDING GRASSES (ANNUAL RYEGRASS, PEARL MILLET, FOXTAIL MILLET), DO NOT EXCEED MORE THAN 8% (BY WEIGHT) OF THE OVERALL PERMANENT SEEDING MIX. CERIAL RYE (SECALE CERVALE) IS A NURSE CROP. SEED AT 10% OF THE SEEDING RATE LISTED ABOVE. OATS ARE THE RECOMMENDED NURSE CROP FOR WARM-SEASON GRASSES.
- FOR SANDY SOILS, PLANT SEEDS AT TWICE THE DEPTH LISTED ABOVE.
- THE PLANTING DATES LISTED ARE AVERAGES FOR EACH ZONE AND MAY REQUIRE ADJUSTMENT TO REFLECT LOCAL CONDITIONS, ESPECIALLY NEAR THE BOUNDARIES OF THE ZONE.

**DEVELOPERS CERTIFICATE**

I HEREBY CERTIFY THAT ALL DEVELOPMENT AND/OR CONSTRUCTION WILL BE DONE IN ACCORDANCE WITH THE REQUIREMENTS OF THE HOWARD COUNTY CONSERVATION DISTRICT. I HAVE NOTIFIED THE DEVELOPER THAT HE/MUST ENGAGE A REGISTERED PROFESSIONAL ENGINEER TO SUPERVISE POND CONSTRUCTION AND PROVIDE THE HOWARD COUNTY CONSERVATION DISTRICT WITH AN "AS-BUILT" PLAN OF THE POND WITHIN 30 DAYS OF COMPLETION.

DATE: 4/15/2013

SIGNATURE OF DEVELOPER: [Signature]

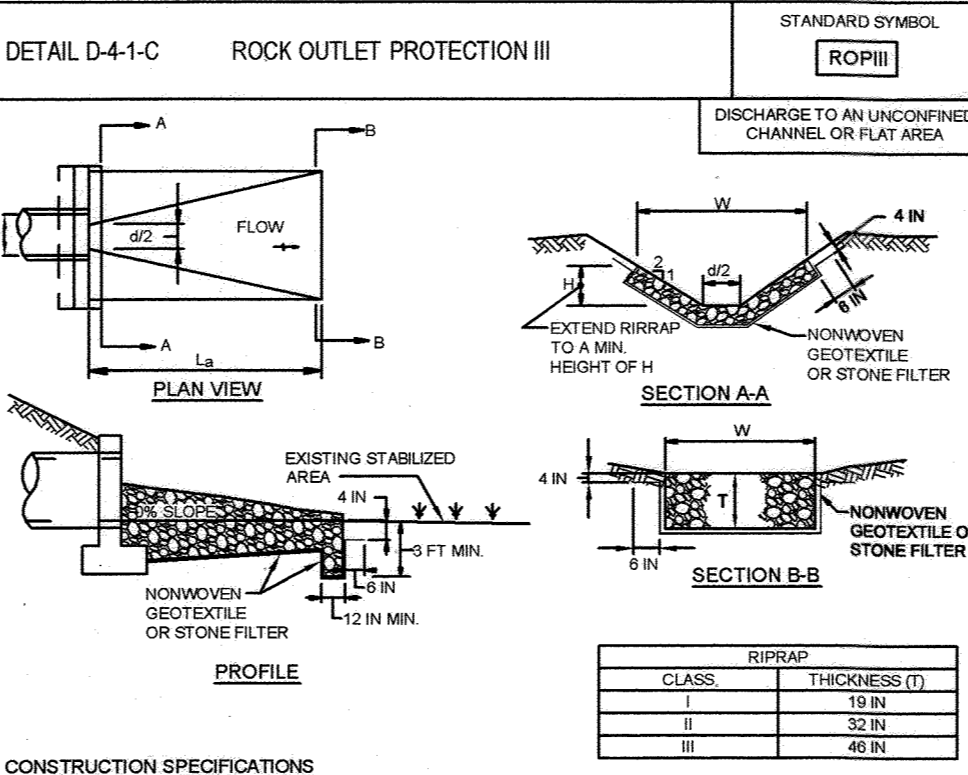


**CONSTRUCTION SPECIFICATIONS**

- RIPRAP AND STONE MUST CONFORM TO THE SPECIFIED CLASS.
- USE NONWOVEN GEOTEXTILE, AS SPECIFIED IN SECTION H1 MATERIALS, AND PROTECT FROM PUNCTURING, CUTTING, OR TEARING FROM ANY SHARPER THAN AN OCCASIONAL SMALL ROCK BY PLACING ANOTHER PIECE OF GEOTEXTILE OVER THE DAMAGED PART OR COMPLETELY REPLACING THE GEOTEXTILE. PROVIDE A MINIMUM OF ONE FOOT OVERLAP FOR EACH JOINT. PROVIDE ONE FOOT OVERLAP FOR EACH JOINT.
- IMPROVE THE SUBGRADE OR BOTTOM OF STONE FILTER. IT TO 10 INCH MINIMUM DEPTH FOR 6 INCH MINIMUM DEPTH RIPRAP TO THE REQUIRED LINES AND SIDES. COMPACT ANY FILL REQUIRED IN THE SUBGRADE TO A COMPACTION LEVEL OF 90 PERCENT OF THE SPECIFIED MATERIAL.
- EXTEND GEOTEXTILE OUT TO FULL CURE THICKNESS IN ONE OPERATION AND IN SUCH A MANNER AS TO AVOID DISPLACEMENT OF UNDERLYING MATERIAL. PLACE STONE FOR RIPRAP IN A MANNER THAT WILL ENSURE THAT IT IS SEATED IN A MANNER TO PREVENT DAMAGE TO THE FILTER BLANKET OR GEOTEXTILE. LEAVE THE EXTENT NEEDED.
- MAINTAIN LINE, GRADE, AND CROSS SECTION. REMOVE ACCUMULATED SEDIMENT AND DEBRIS. KEEP POINTS OF INFLOW AND OUTFLOW FREE OF OBSTRUCTION.

MARYLAND STANDARDS AND SPECIFICATIONS FOR SOIL EROSION AND SEDIMENT CONTROL


U.S. DEPARTMENT OF AGRICULTURE NATURAL RESOURCES CONSERVATION SERVICE 2011 MARYLAND DEPARTMENT OF ENVIRONMENT AND WATER MANAGEMENT ADMINISTRATION

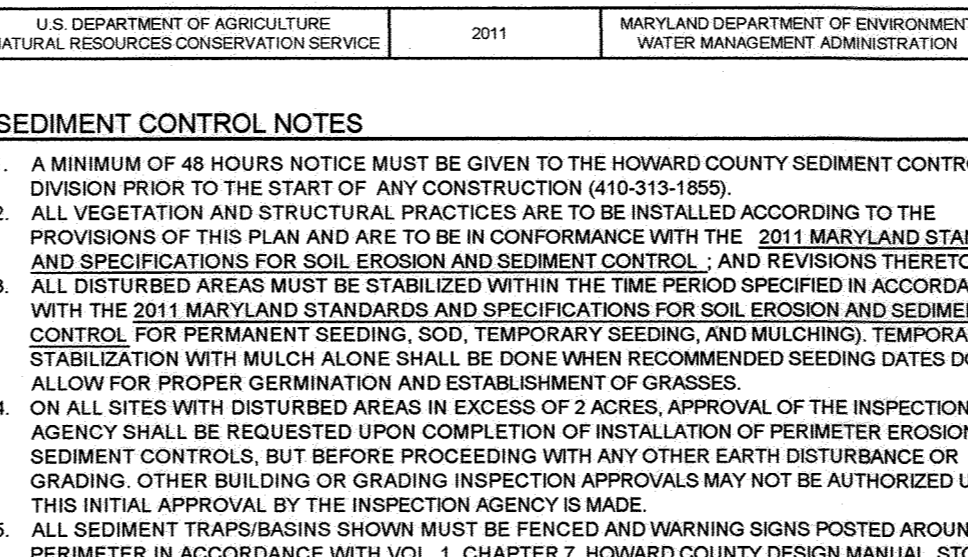


**CONSTRUCTION SPECIFICATIONS**

- USE MATTING THAT HAS A DESIGN VALUE FOR SHEAR STRESS OF 2.0 OR HIGHER THAN THE SHEAR STRESS DETERMINED ON APPROVED PLAN.
- USE PERMANENT SOIL STABILIZATION MATTING MADE OF OPEN WEAVE SYNTHETIC, NONDEGRADABLE FIBERS OR ELEMENTS OF UNIFORM THICKNESS AND DISTRIBUTION THROUGHOUT. CHEMICALS USED IN THE MAT MUST BE NON-LEACHING AND NOT TOXIC TO VEGETATION AND SEED GENERATION AND NON-HARMFUL TO THE SOIL. PRESIDENT, NET WEIGHT MUST BE EXTRUDED PLASTIC WITH A MAXIMUM DISTURBANCE OF 20 INCHES AND SUFFICIENTLY SOFTENED SO SOIL CAN BE MOVED INTO LONGITUDINAL AND TRANSVERSE TRENCHES TO PREVENT SEPARATION OF THE MAT FROM THE SOIL.
- SECURE MATTING USING STAPLES OR WOOD STAPLES. STAPLES MUST BE "T" OR "U" SHAPED STEEL WIRE HAVING A MINIMUM GAUGE OF NO. 14 AND NO. 8 RESPECTIVELY. "T" SHAPED STAPLES MUST BE 1 1/2 TO 1 3/4 INCHES WIDE AND BE A MINIMUM OF 4 INCHES LONG. "U" SHAPED STAPLES MUST HAVE A MINIMUM 1/2 INCH MINIMUM 1 INCH SECONDARY LEG AND MINIMUM 4 INCH LEG. WOOD STAPLES MUST BE ROUND-SHAPED (MIN. 1 1/2 TO 2 INCHES IN LENGTH, 3/4 INCH IN DIAMETER) AND WEAVE SHAPED AT THE BOTTOM.
- PERFORM FINAL GRADING, TOPSOIL APPLICATION, SEEDING PREPARATION, AND PERMANENT SEEDING IN ACCORDANCE WITH SECTION 4. FILL THE MAT VOIDS WITH 48 HOURS OF SOIL OR GRASS MATTING. PRESIDENT, NET WEIGHT MUST BE





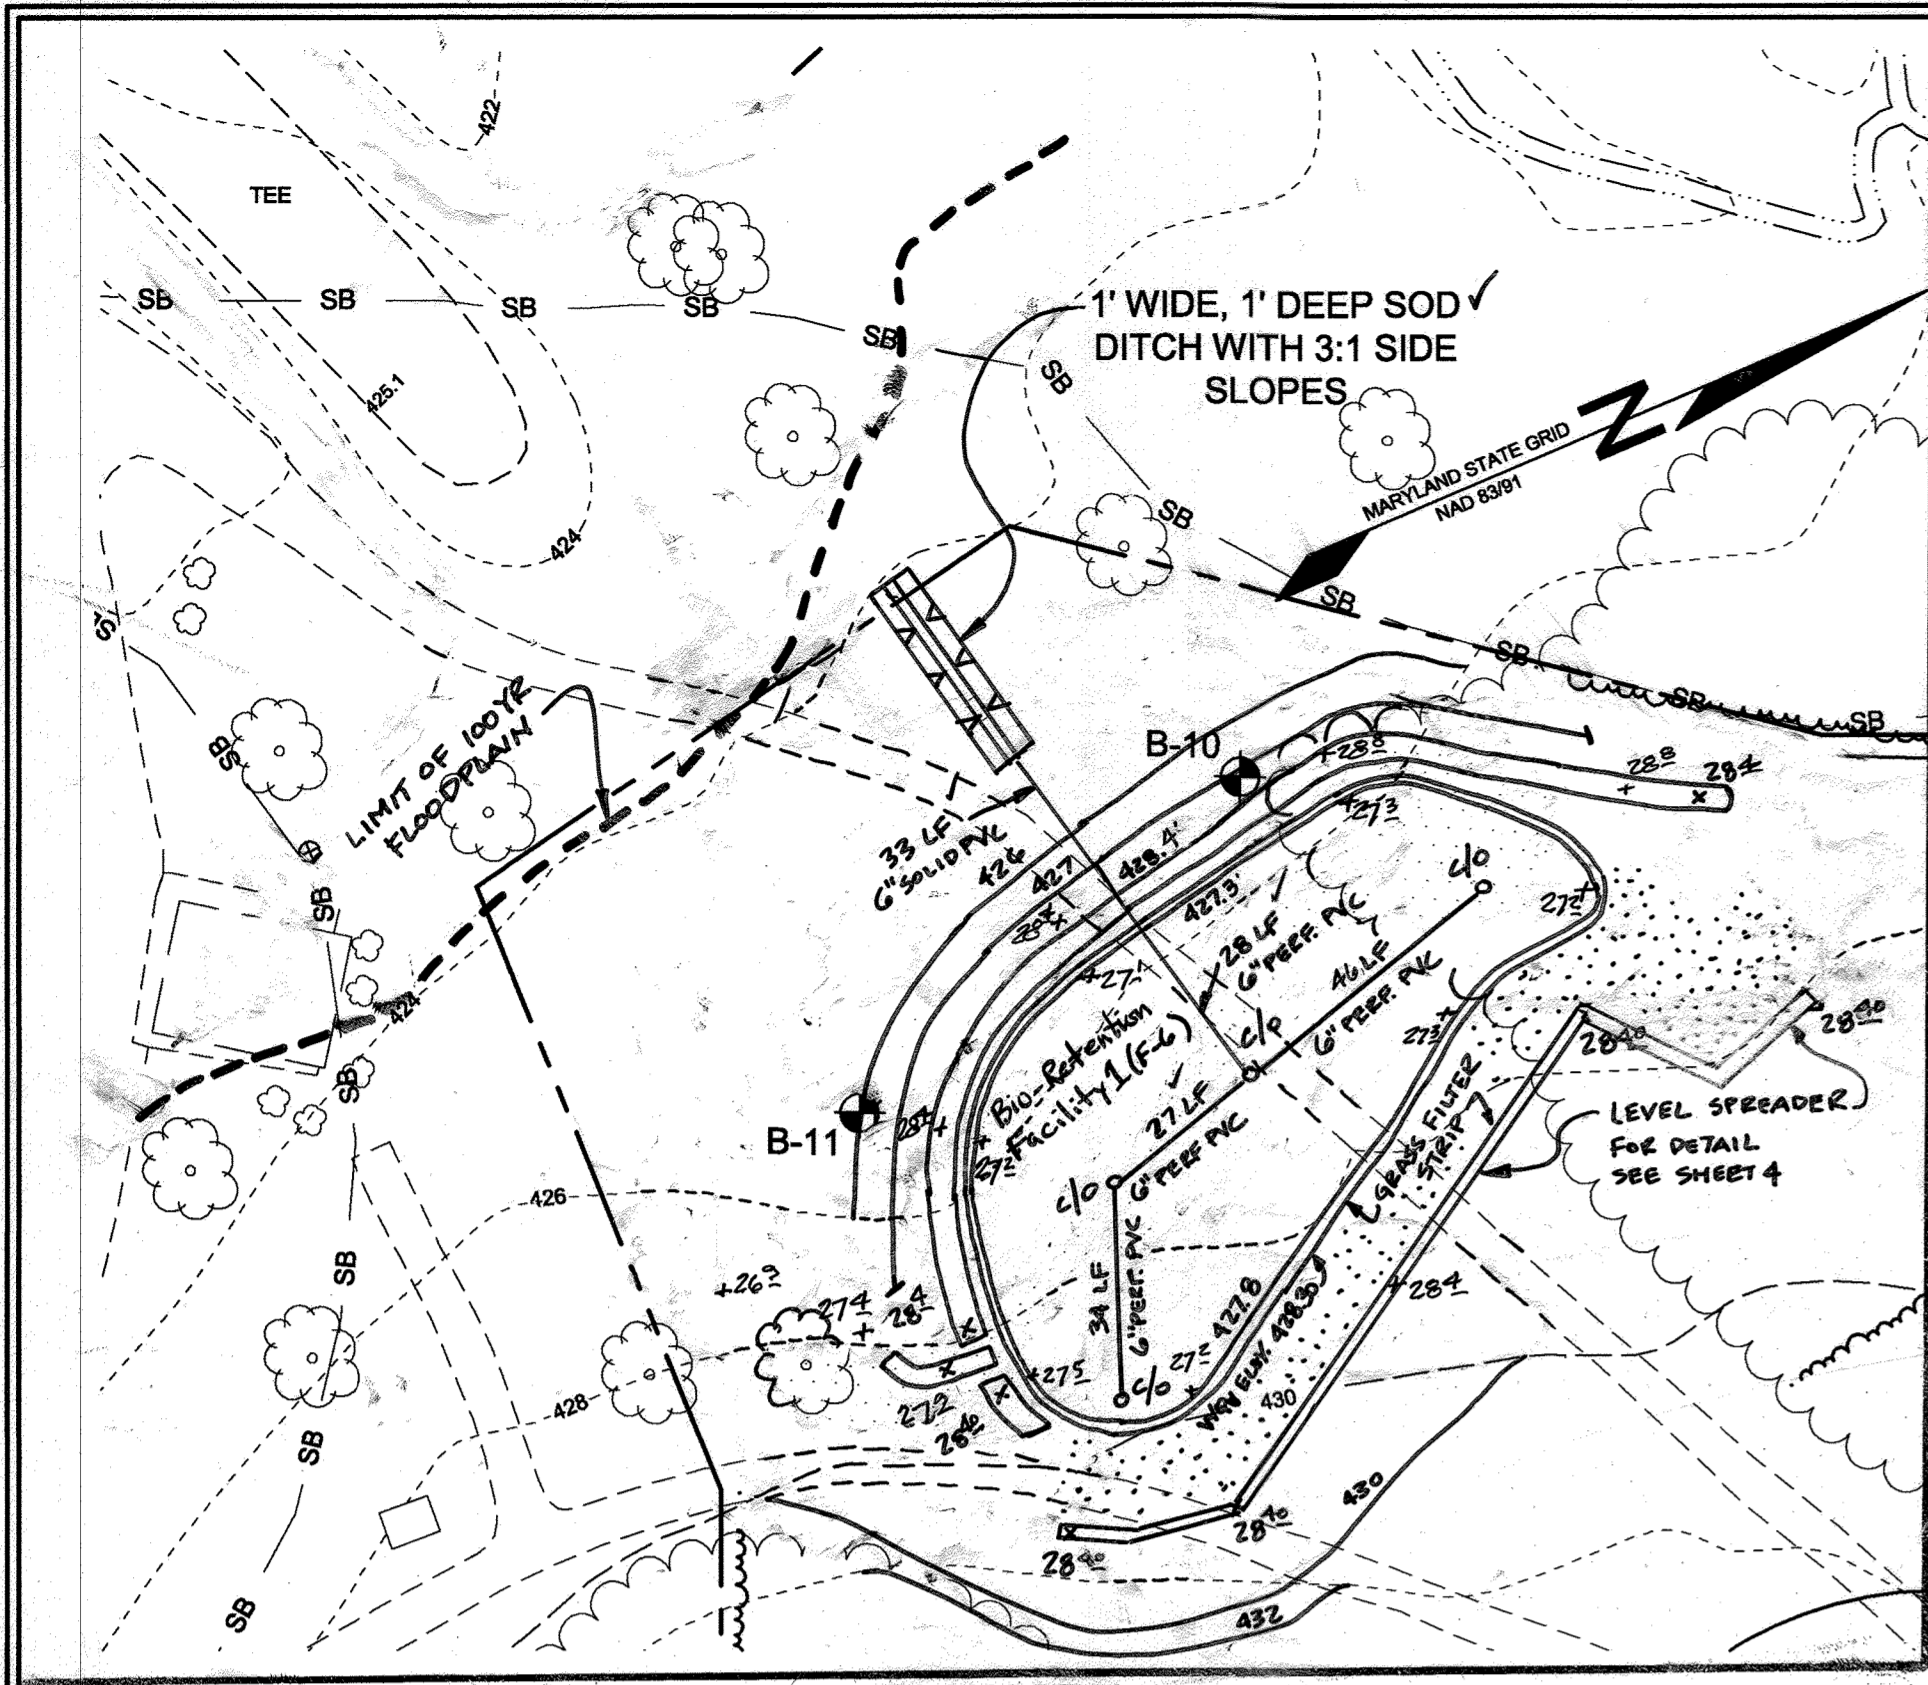

**PLAN VIEW**  
SCALE: 1"=30'

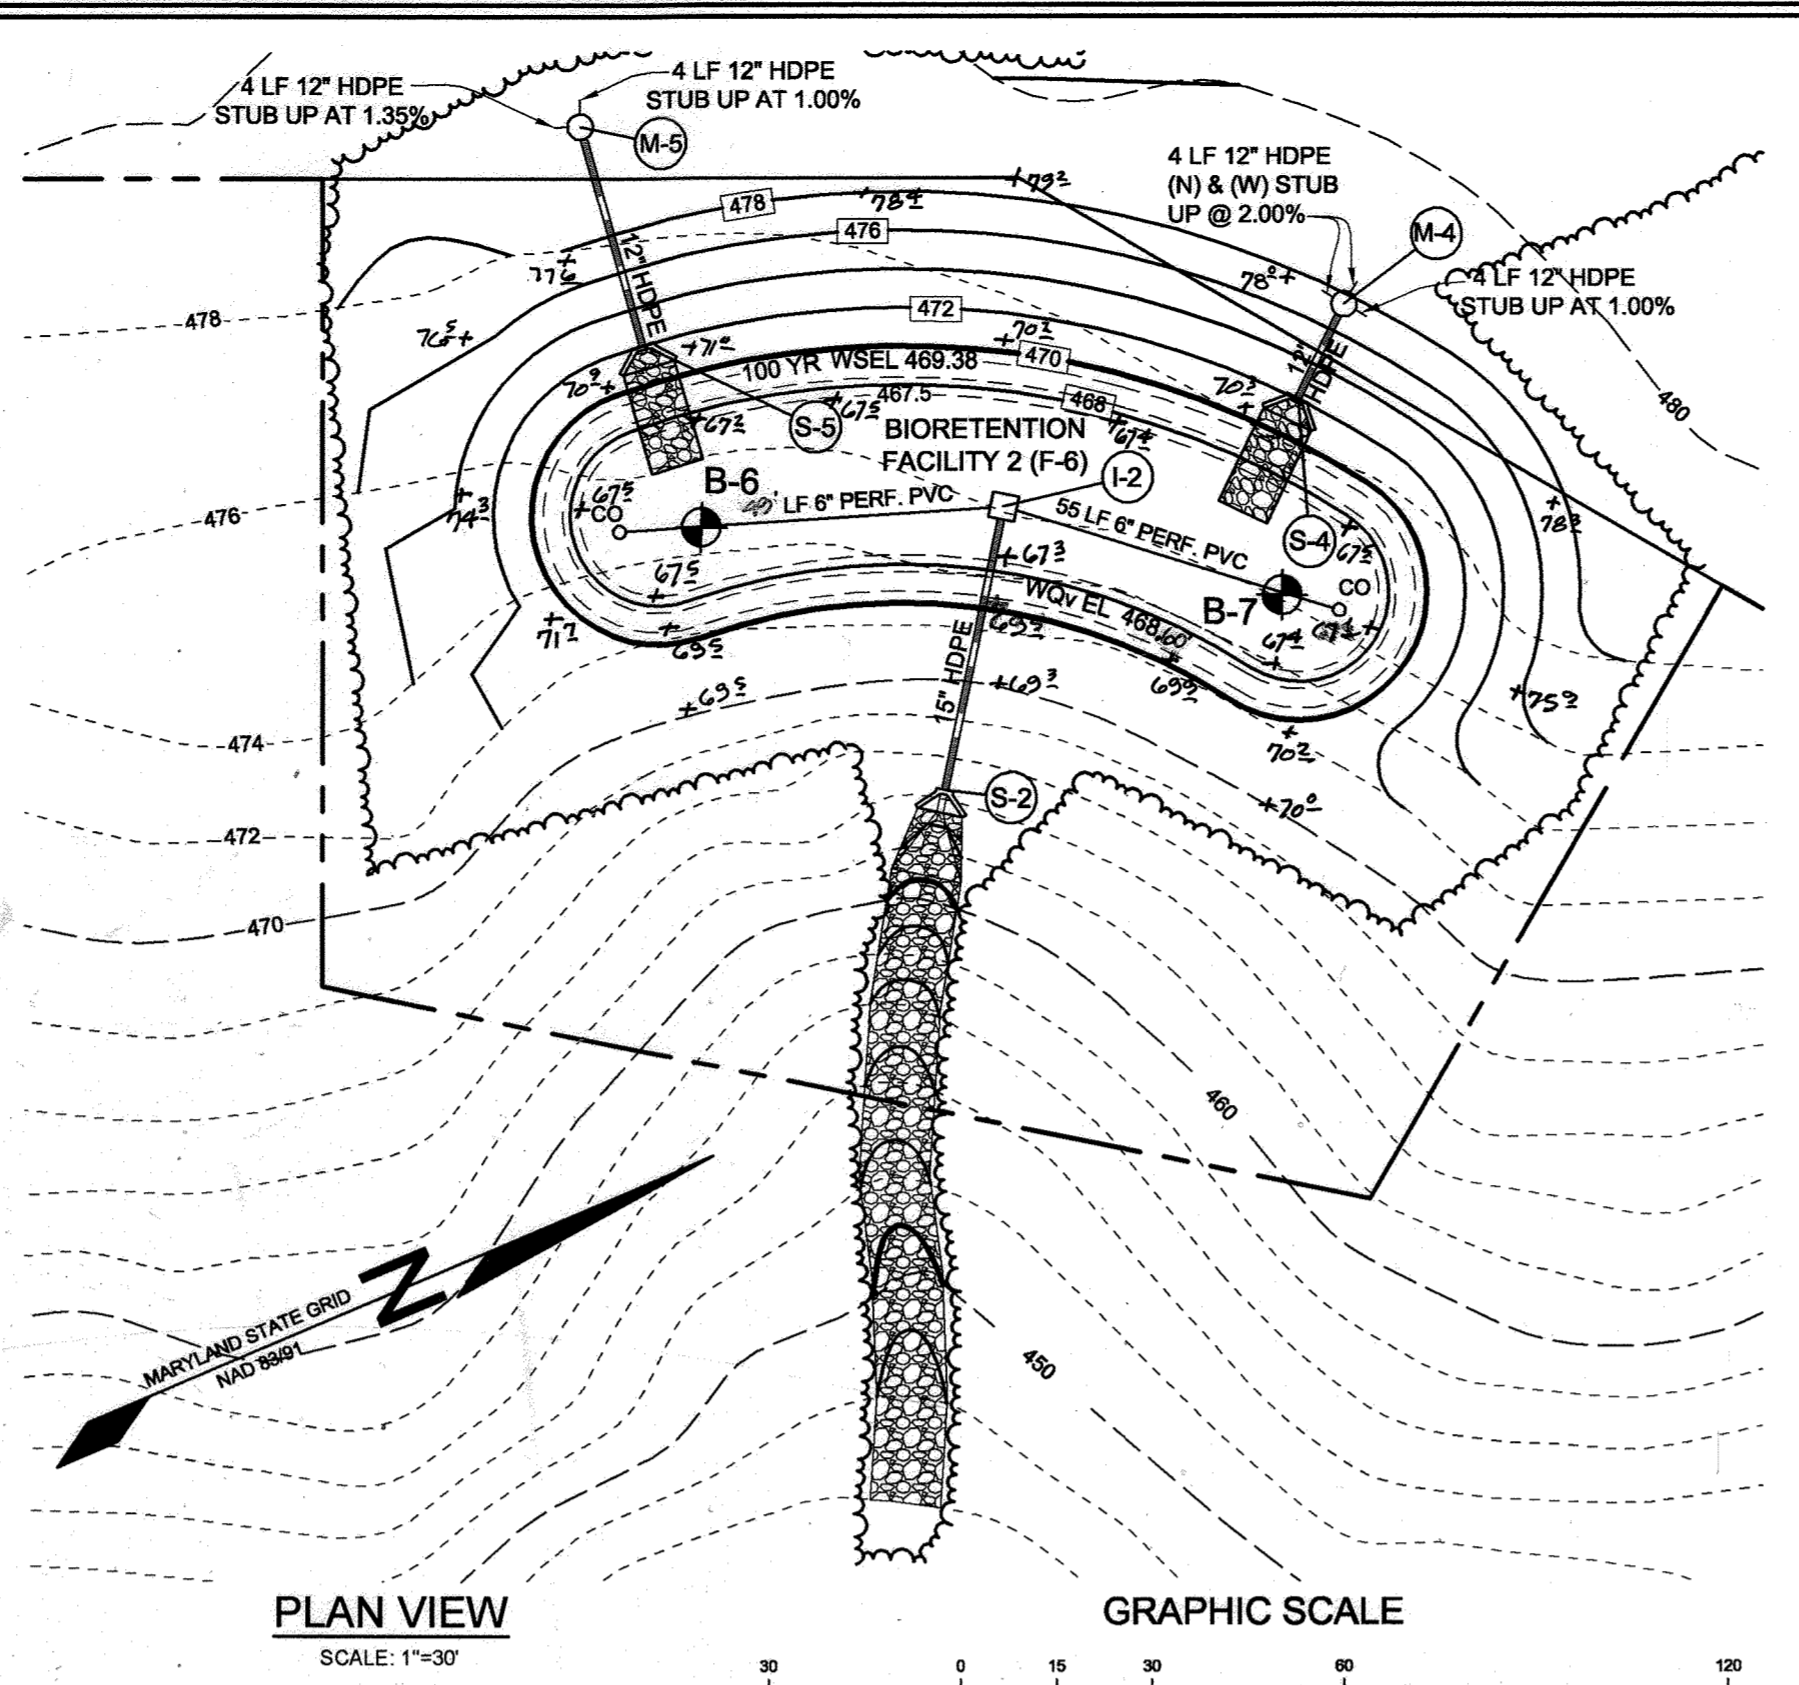

**PLAN VIEW**  
SCALE: 1"=30'

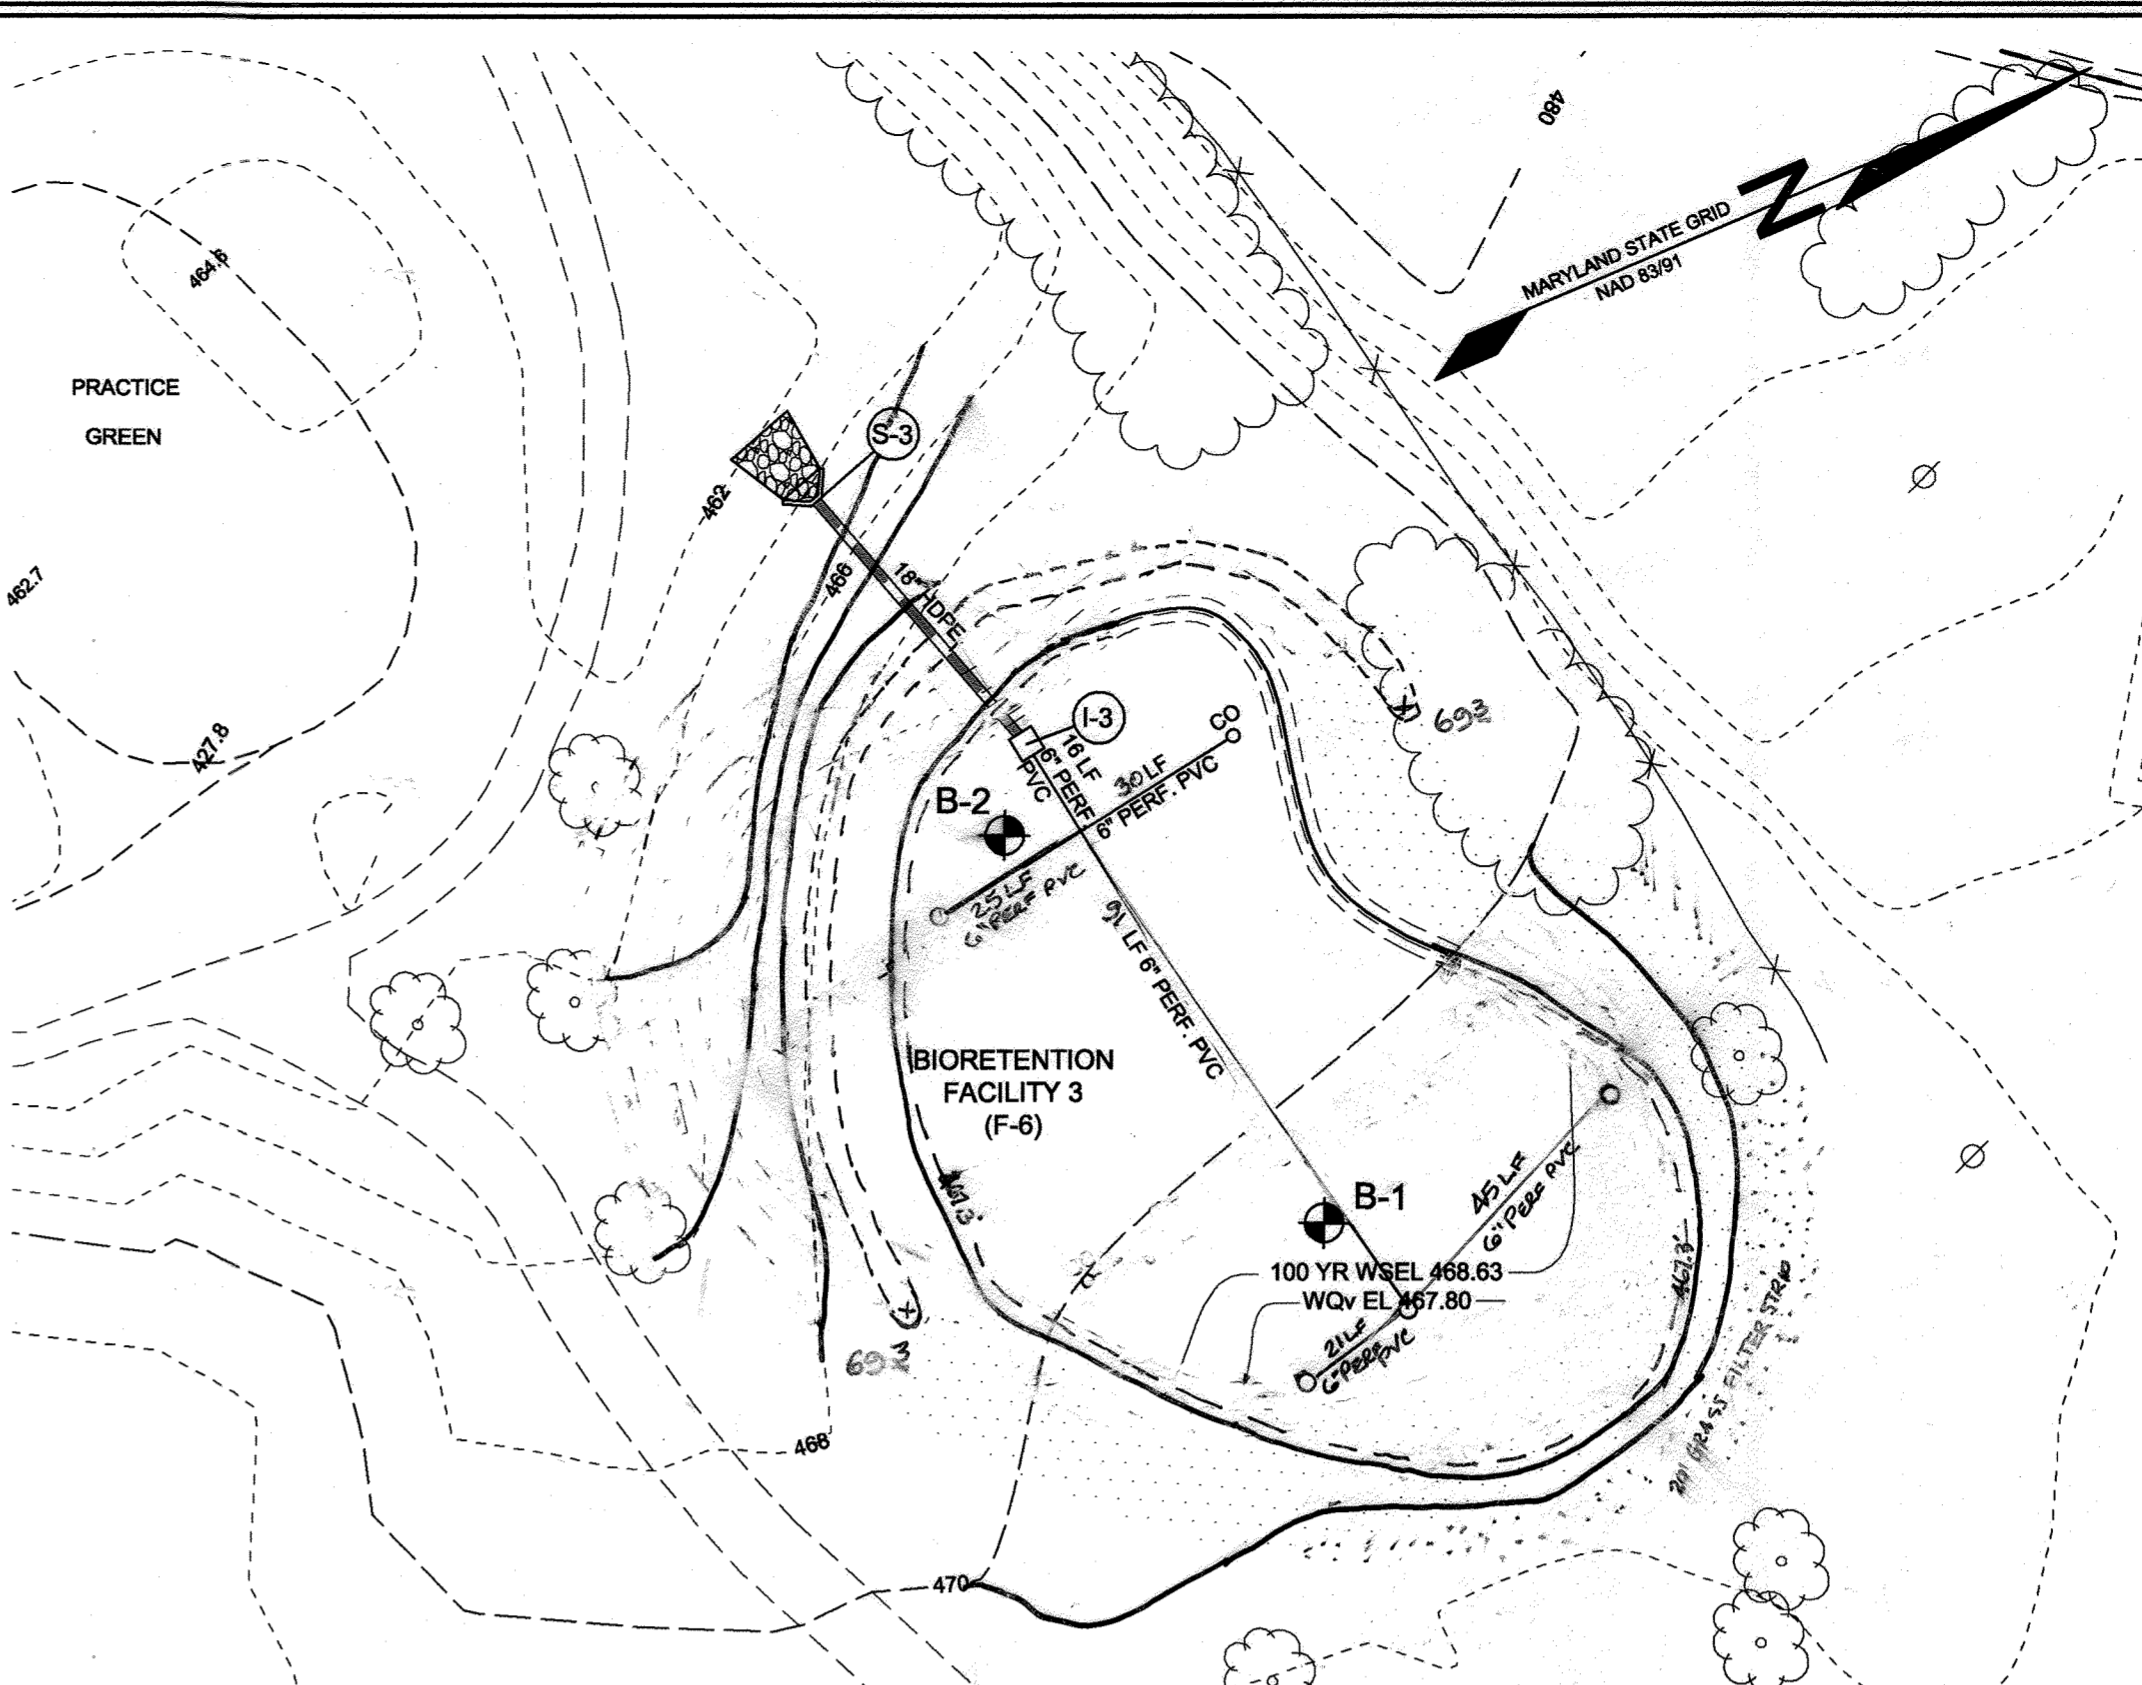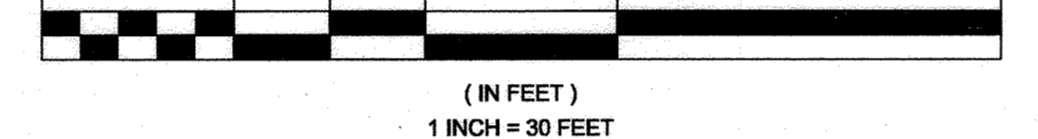

**PLAN VIEW**  
SCALE: 1"=30'


**LEGEND**

- EXISTING CONTOUR
- PROPOSED CONTOUR
- EXISTING SPOT ELEVATION
- PROPOSED SPOT ELEVATION
- DIRECTION OF FLOW
- EXISTING TREELINE
- PROPOSED TREELINE
- EXISTING TREES
- SOIL BOUNDARY
- EXISTING FLOODPLAIN
- EXISTING STREAM BUFFER
- EXISTING SOIL BORING
- GRASS FILTER STRIP
- LEVEL SPREADER


**NOTE:** FACILITY 3 DESIGN AREA = 5,084 S.F.  
AS-BUILT AREA = 5,182 S.F.

**NOTE:** FOR BIORETENTION PLANTING LOCATIONS SEE SHEET 11.


**NOTE:** FOR SWM BORING LOGS SEE SHEET 10.

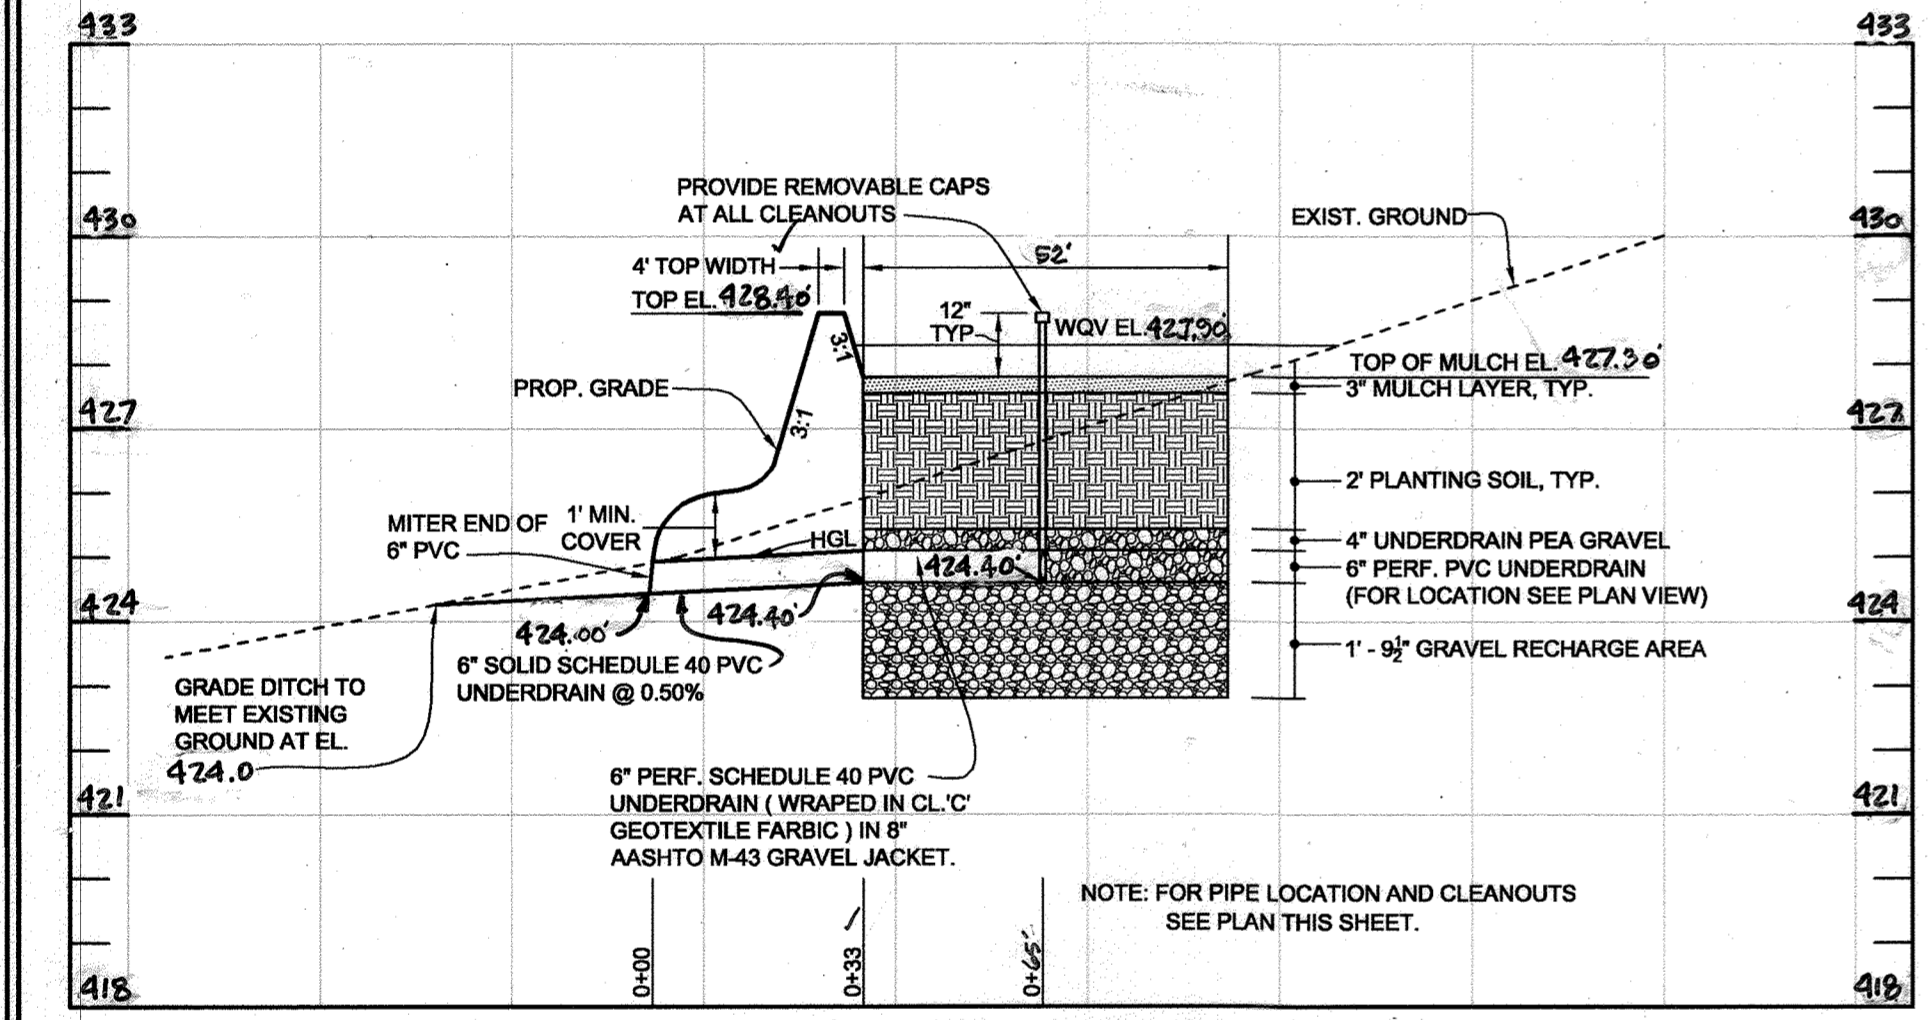

**BIORETENTION FACILITY 1 PROFILE**  
HORIZONTAL SCALE: 1"=30'  
VERTICAL SCALE: 1"=3'

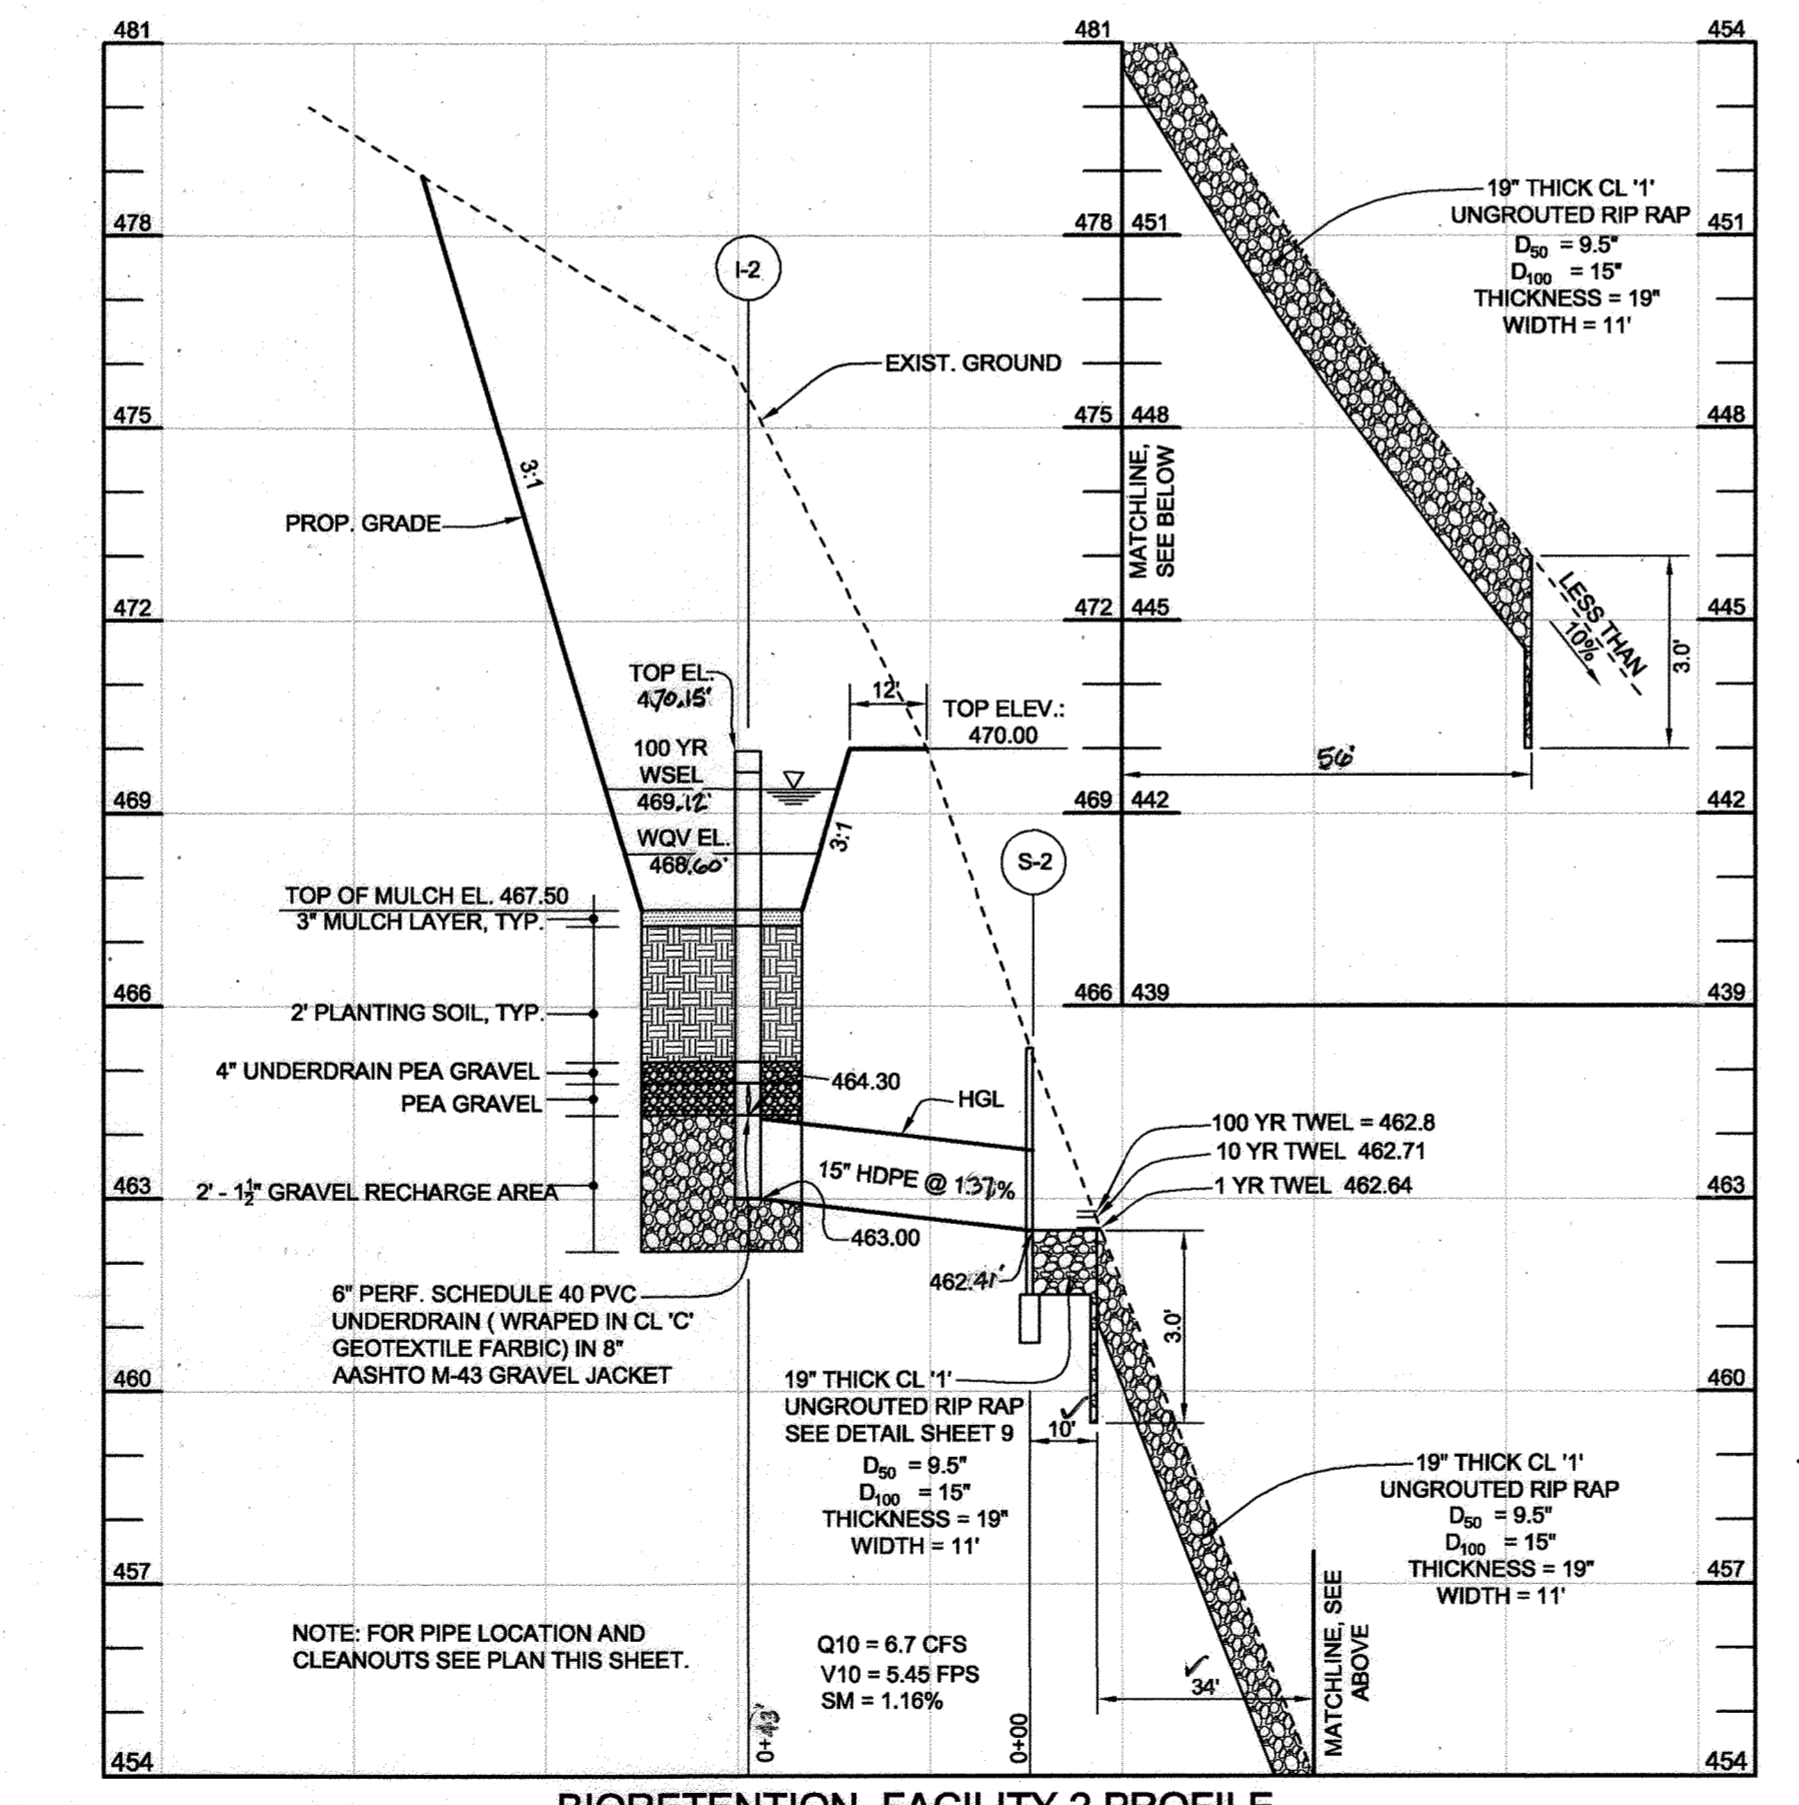

**BIORETENTION FACILITY 2 PROFILE**  
HORIZONTAL SCALE: 1"=30'  
VERTICAL SCALE: 1"=3'

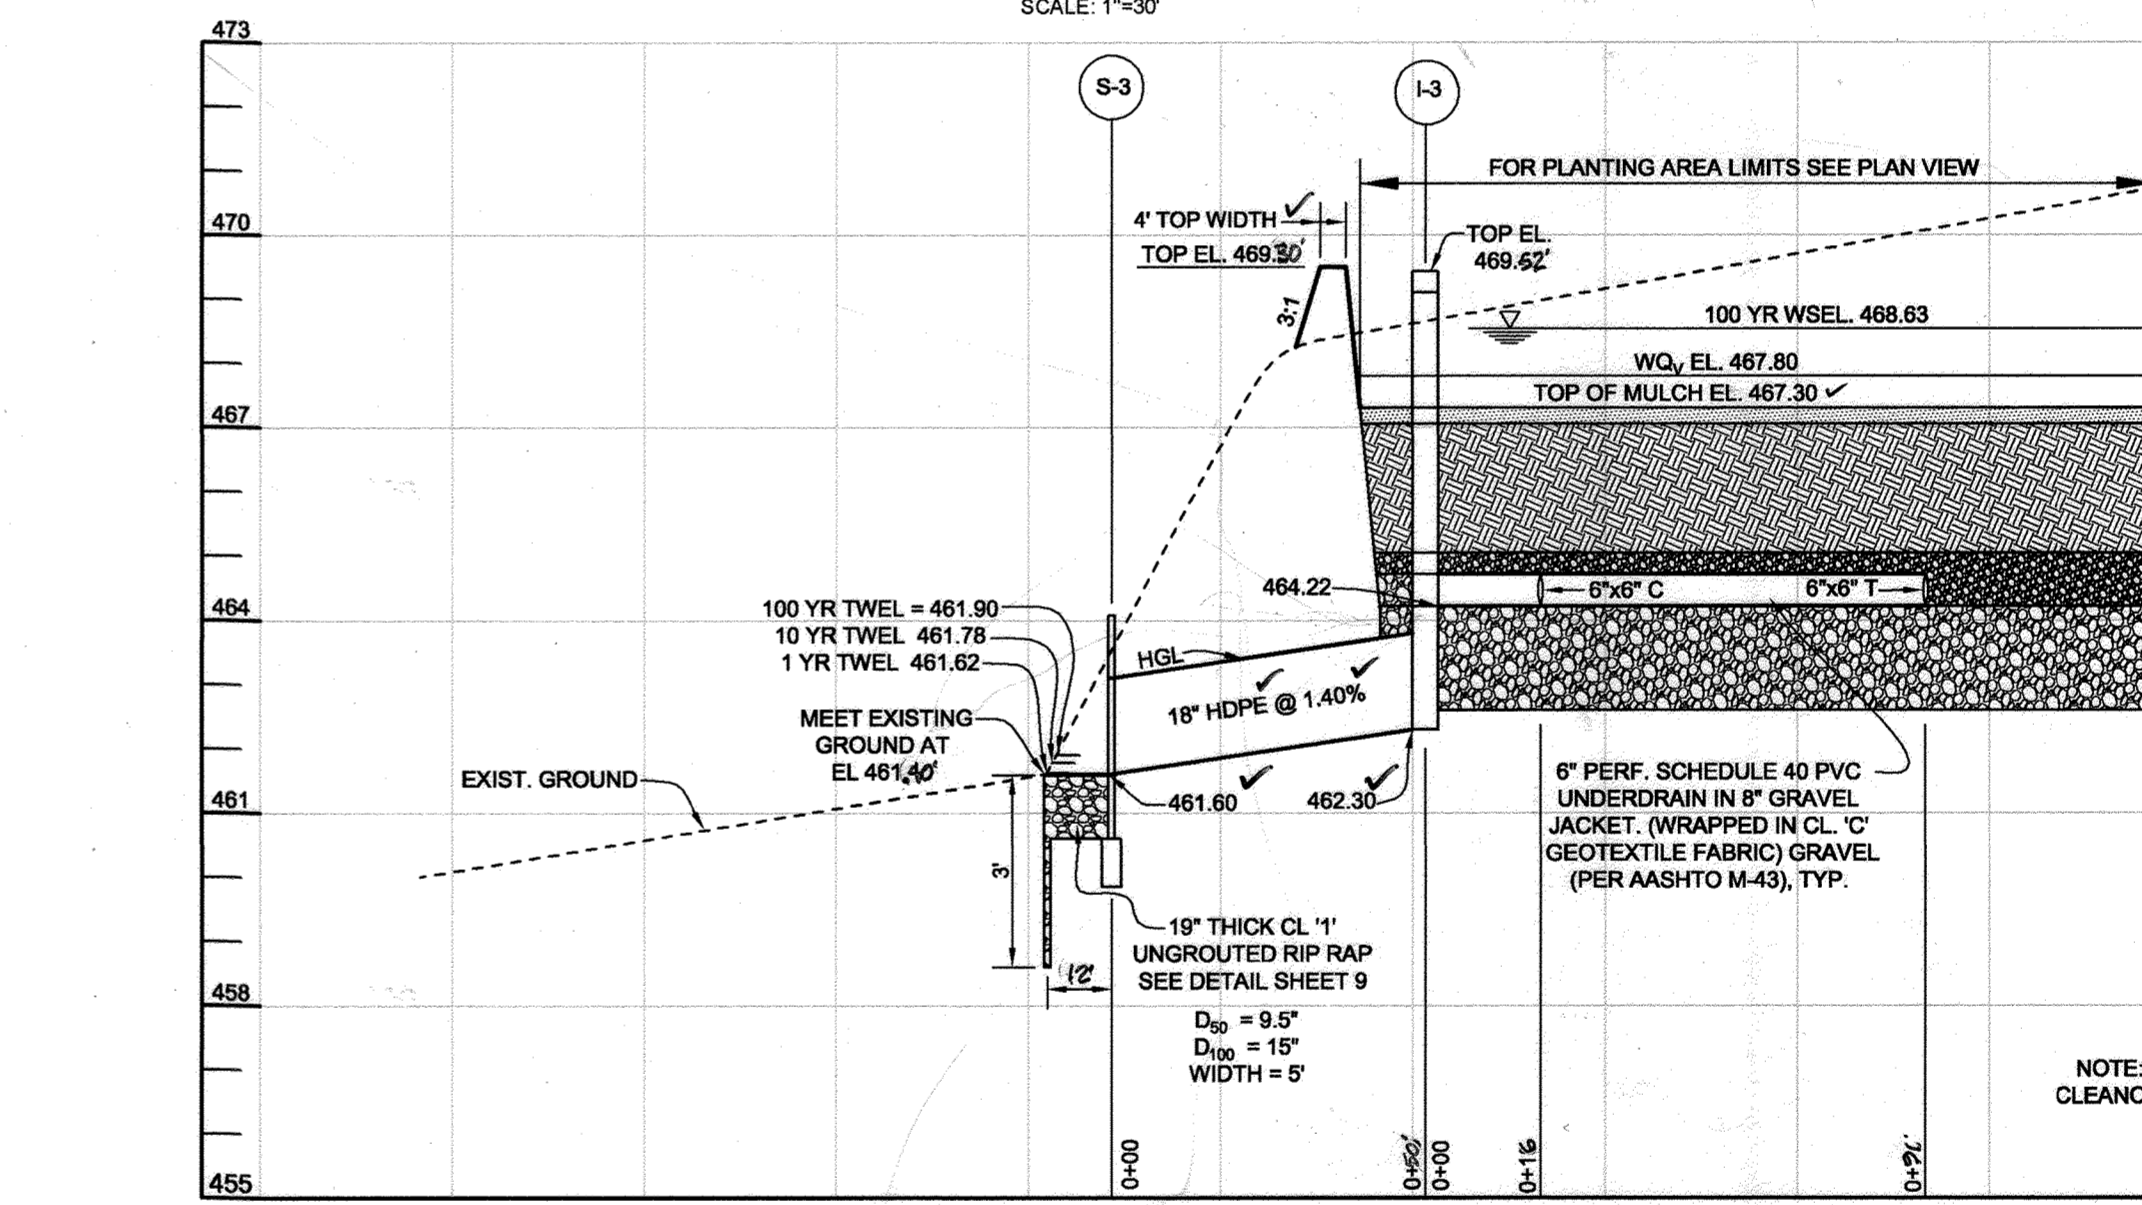

**BIORETENTION FACILITY 3 PROFILE**  
HORIZONTAL SCALE: 1"=30'  
VERTICAL SCALE: 1"=3'

**MATERIALS SPECIFICATIONS FOR BIORETENTION FACILITIES**

MATERIAL	SPECIFICATION	SIZE	NOTES
PLANTINGS	SEE PLANT LIST THIS SHEET	N/A	PLANTINGS ARE SITE-SPECIFIC, SEE PLANT LIST THIS SHEET
PLANTING SOIL (2.0' DEEP)	SAND 35% - 60% SILT 0% - 25% GROUND COMPOST 40%-50%	N/A	EXISTING SOIL SUITABLE TO MEET PLANTING SOIL SPECIFICATIONS TO BE STOCKPILED IN DESIGNATED AREA & SUPPLEMENTED WITH COMPOST AS NECESSARY
MULCH	SHREDDED HARDWOOD		AGED 6 MONTHS, MINIMUM
PEA GRAVEL DIAPHRAGM AND CURTAIN DRAIN, IF REQUIRED	PEA GRAVEL: ASTM-D-448 ORNAMENTAL STONE: WASHED COBBLES	PEA GRAVEL: NO. 6 STONE, 2" TO 5"	
HARDWARE CLOTH	0.035" THICK - 1/4" MESH OR SMALLER GALVANIZED WIRE HARDWARE CLOTH		FOR USE AS A WRAP AROUND PERFORATED UNDERDRAIN PIPING
UNDERDRAIN PEA GRAVEL	# 7 OR # 8 STONE	0.25" TO 0.50"	CLEAN WASHED STONE
UNDERDRAIN GRAVEL	AASHTO M-43	0.375" TO 0.75"	CLEAN WASHED STONE
UNDERDRAIN PIPING	F 788, TYPE PS 28 OR AASHTO M-278	4" TO 6" RIGID SCHEDULE 40 PVC OR SDR35	3/8" PERF. @ 6" ON CENTER, 4 HOLES PER ROW. SLOTTED PIPE MAY BE USED IN-LIEU OF PERFORATED PIPE (HARDWARE CLOTH WRAP NOT REQUIRED). MINIMUM OF 3" OF GRAVEL OVER PIPES; NOT NECESSARY UNDERNEATH PIPES

**BIORETENTION FACILITY 2 PROFILE STRUCTURE SCHEDULE**

NO.	TYPE & OWNERSHIP	LOCATION	TOP ELEV.	INV. IN	INV. OUT	REMARKS
S-1*	TYPE 'A' HEADWALL 48" DIA. PIPE	N 593,950.24 E 1,342,621.15	442.17	433.65	433.79	HO CO DTL D-5.11
SWM-1	MODIFIED A-10 INLET	N 593,978.06 E 1,342,662.07	442.17	434.00	434.00	SPECIAL SEE PLAN
I-2	MODIFIED D-INLET	N 593,342.93 E 1,343,183.77	440.15	464.30	463.00	HO CO DTL D-4.11
S-2	TYPE 'A' HEADWALL 18" DIA. PIPE	N 593,317.21 E 1,343,220.69	462.41	462.41	462.41	HO CO DTL D-5.11
I-3	MODIFIED D-INLET	N 594,862.72 E 1,343,519.45	469.52	464.22	462.30	HO CO DTL D-4.11
S-3	TYPE 'A' HEADWALL 18" DIA. PIPE	N 594,846.90 E 1,343,490.87	469.52	461.54	461.54	HO CO DTL D-5.11
M-4**	STD 4" PRECAST MANHOLE	N 593,402.13 E 1,343,173.14	477.09	469.10	469.00	HO CO DTL G-5.12
S-4	TYPE 'A' HEADWALL 12" DIA. PIPE	N 593,391.38 E 1,343,186.71	468.38	468.38	468.38	MODIFIED HO CO DTL 5.11
M-5**	STD 4" PRECAST MANHOLE	N 593,306.21 E 1,343,103.67	478.54	469.12	469.12	HO CO DTL G-5.12
S-5*	TYPE 'A' HEADWALL 12" DIA. PIPE	N 593,300.81 E 1,343,139.14	468.58	468.58	468.58	MODIFIED HO CO DTL 5.11

**OPERATION AND MAINTENANCE SCHEDULE FOR PRIVATELY OWNED AND MAINTAINED BIORETENTION FACILITIES (F-6)**

- THE OWNER SHALL MAINTAIN THE PLANT MATERIAL, MULCH LAYER AND SOIL LAYER ANNUALLY. MAINTENANCE OF MULCH AND SOIL IS LIMITED TO CORRECTING AREAS OF EROSION OR WASH OUT. ANY MULCH REPLACEMENT SHALL BE DONE IN THE SPRING. PLANT MATERIAL SHALL BE CHECKED FOR DISEASE AND INSECT INFESTATION AND MAINTENANCE WILL ADDRESS DEAD MATERIAL AND PRUNING. ACCEPTABLE REPLACEMENT PLANT MATERIAL IS LIMITED TO THE FOLLOWING: 2000 MARYLAND STORMWATER DESIGN MANUAL, VOLUME II, TABLE A.4.1 AND 2.
- THE OWNER SHALL PERFORM A PLANT INSPECTION IN THE SPRING AND IN THE FALL OF EACH YEAR. DURING THE INSPECTION, THE OWNER SHALL REMOVE DEAD OR DISEASED VEGETATION CONSIDERED BEYOND TREATMENT, REPLACE DEAD PLANT MATERIAL WITH ACCEPTABLE REPLACEMENT PLANT MATERIAL, TREAT DISEASED TREES AND SHRUBS, AND REPLACE ALL DEFICIENT STAKES AND WIRES.
- THE OWNER SHALL INSPECT THE MULCH EACH SPRING. THE MULCH SHALL BE REPLACED EVERY TWO TO THREE YEARS. THE PREVIOUS MULCH LAYER SHALL BE REMOVED BEFORE THE NEW LAYER IS APPLIED.
- THE OWNER SHALL CORRECT SOIL EROSION ON AN AS NEEDED BASIS, WITH A MINIMUM OF ONCE PER MONTH AND AFTER EACH HEAVY STORM.

**AS-BUILT CERTIFICATION**

I HEREBY CERTIFY, BY MY SEAL, THAT THE CONDITIONS SHOWN ON THIS PLAN WERE CONSTRUCTED TO THE LINES AND GRADES SHOWN ON THIS "AS-BUILT" PLAN, AND MEET THE APPROVED PLANS AND SPECIFICATIONS AND ALSO THAT THESE DOCUMENTS WERE PREPARED BY ME OR UNDER MY RESPONSIBLE CHARGE AND THAT I AM A DULY LICENSED PROFESSIONAL LAND SURVEYOR UNDER THE LAWS OF THE STATE OF MARYLAND.

APPROVED: *Michael D. Adcock* 6/10/2013  
MICHAEL D. ADCOCK, PROFESSIONAL LAND SURVEYOR  
MD REG. NO. 21257, EXPIRATION DATE: 6/10/23

**OWNER/DEVELOPER**  
MANGIONE ENTERPRISES OF TURF VALLEY, LP  
LOU MANGIONE  
1205 YORK ROAD  
LUTHERVILLE, MARYLAND 21093  
410.825.8400

APPROVED: HOWARD COUNTY DEPARTMENT OF PLANNING AND ZONING  
CHIEF, DEVELOPMENT ENGINEERING DIVISION  
*5/2/13*  
DATE: 5/2/13

APPROVED: PLANNING BOARD OF HOWARD COUNTY  
DATE: 04/15/2013

**PIPE SCHEDULE**

SIZE	TYPE	LENGTH
48"	RCP ASTM C-361 CL B 25 WITH RUBBER GASKET JOINTS	41 LF
18"	HDPE	49 LF
15"	HDPE	44 LF
12"	HDPE	54 LF
6"	PVC, SOLID	33 LF
6"	PVC, PERFORATED	484 LF

**REVISIONS**

NO.	DESCRIPTION	DATE
1	REVISE LOCATION OF BIO-1 AND RAISE IN ELEVATION BY 1.0 FEET	2-9-2017

**BIORETENTION PLAN & DETAILS**  
TURF VALLEY  
REGIONAL STORMWATER MANAGEMENT FACILITIES  
PGCC MULTI-USE SUBDISTRICT

TAX MAP 16 GRID 16 & 17  
3RD ELECTION DISTRICT

PART OF PARCELS 8 & 394  
HOWARD COUNTY, MARYLAND


**Sill · Adcock & Associates · LLC**  
Engineers · Surveyors · Planners  
3300 North Ridge Road, Suite 160  
Ellicott City, Maryland 21043  
Phone: 443.325.7682 Fax: 443.325.7685  
Email: info@silladcock.com

DESIGN BY: DB  
DRAWN BY: BK  
CHECKED BY: PS  
SCALE: AS SHOWN  
DATE: APRIL 30, 2013  
PROJECT #: 06-025  
SHEET #: 6 OF 12









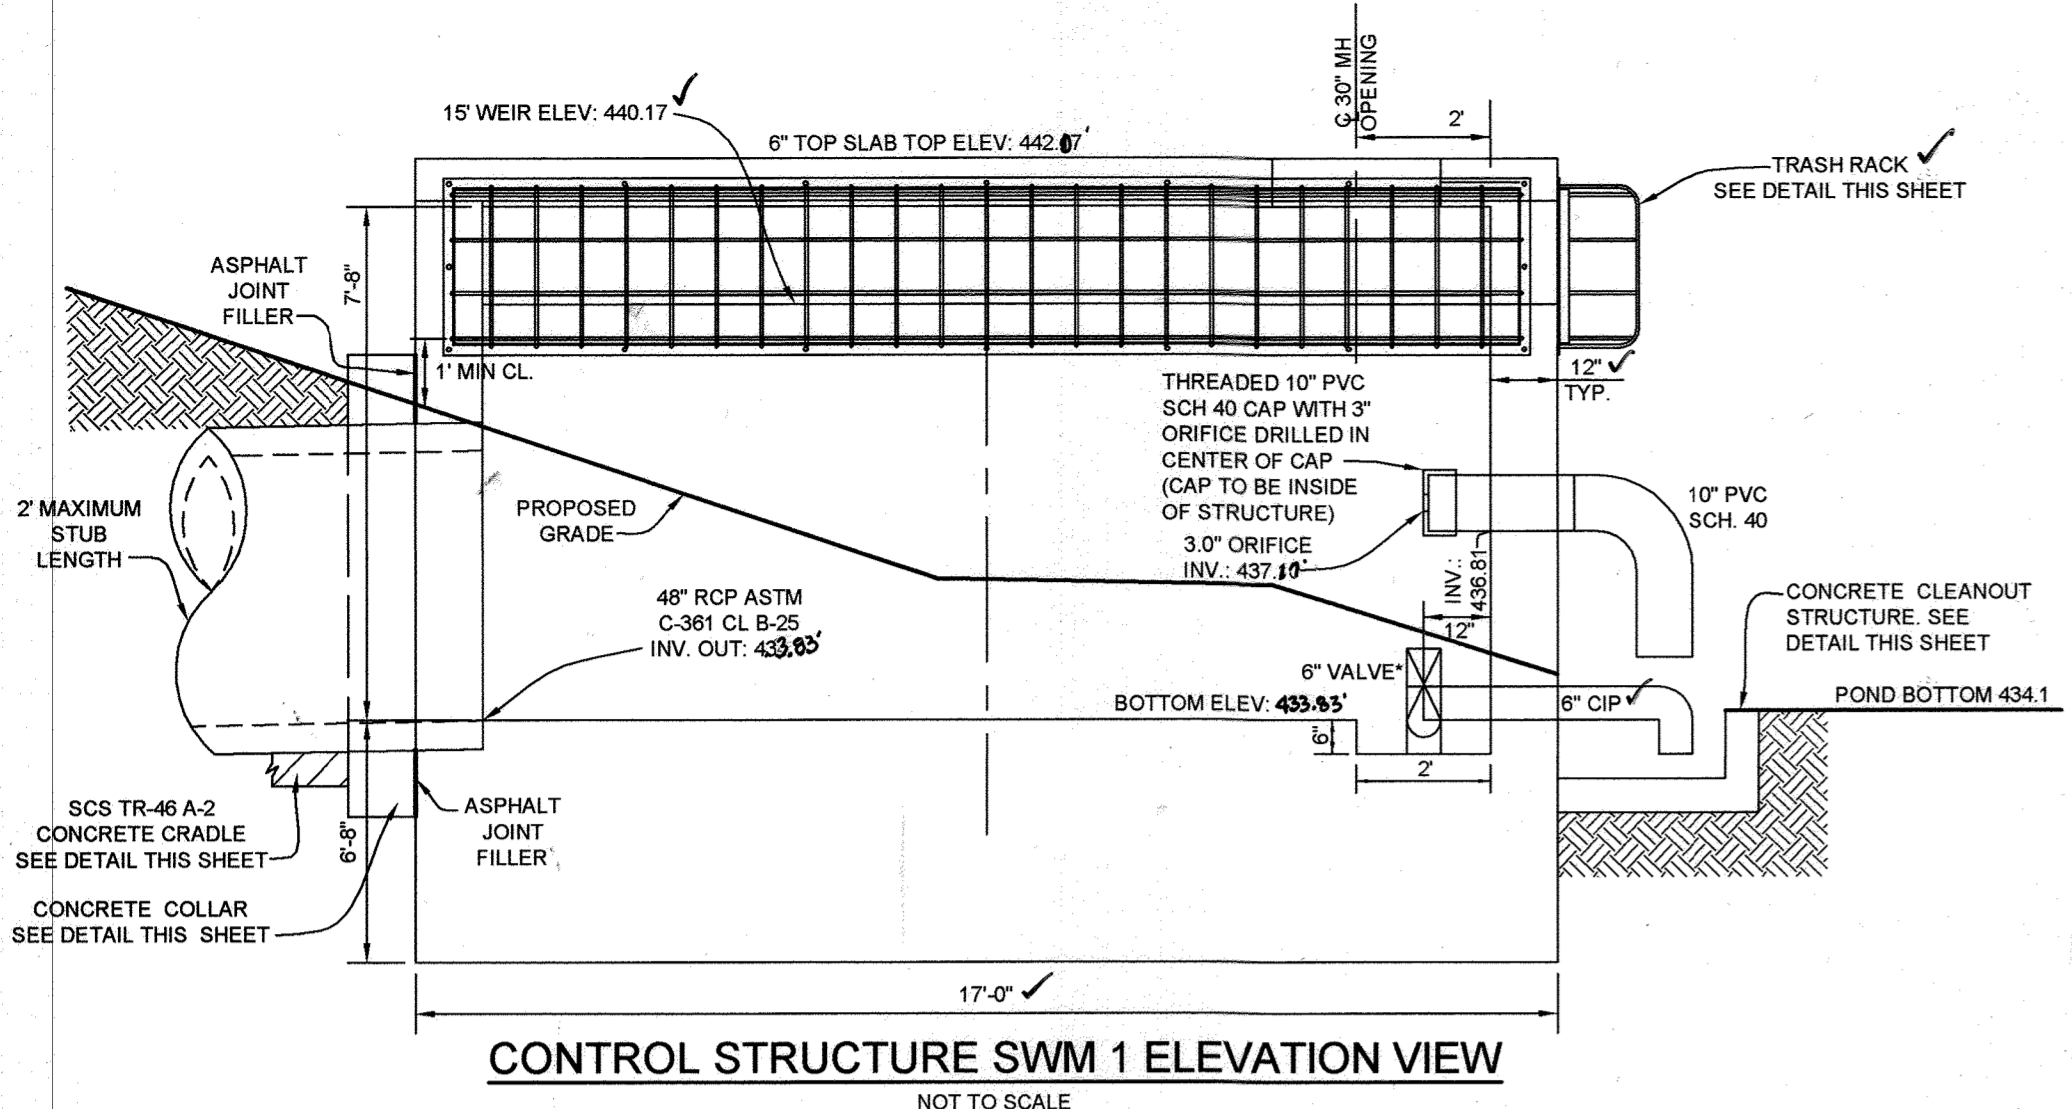


**CONTROL STRUCTURE SWM 1 ELEVATION VIEW**  
NOT TO SCALE

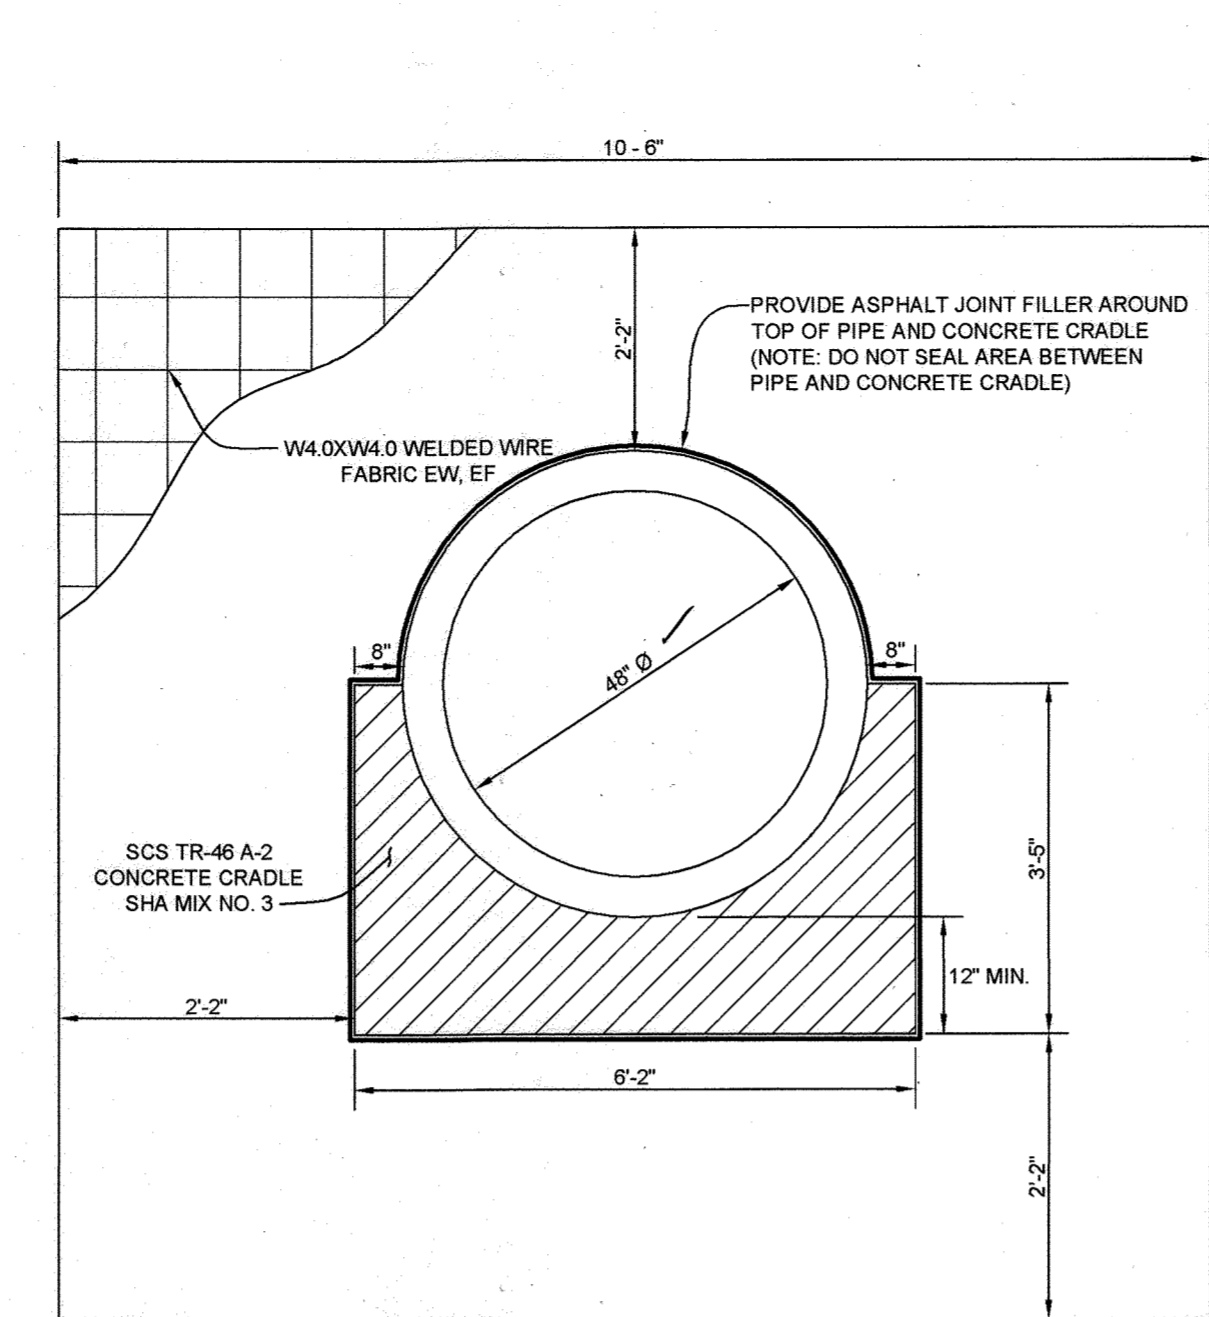

**ANTI SEEP COLLAR AND SCS TR-46 A-2 CONCRETE CRADLE DETAILS**  
NOT TO SCALE

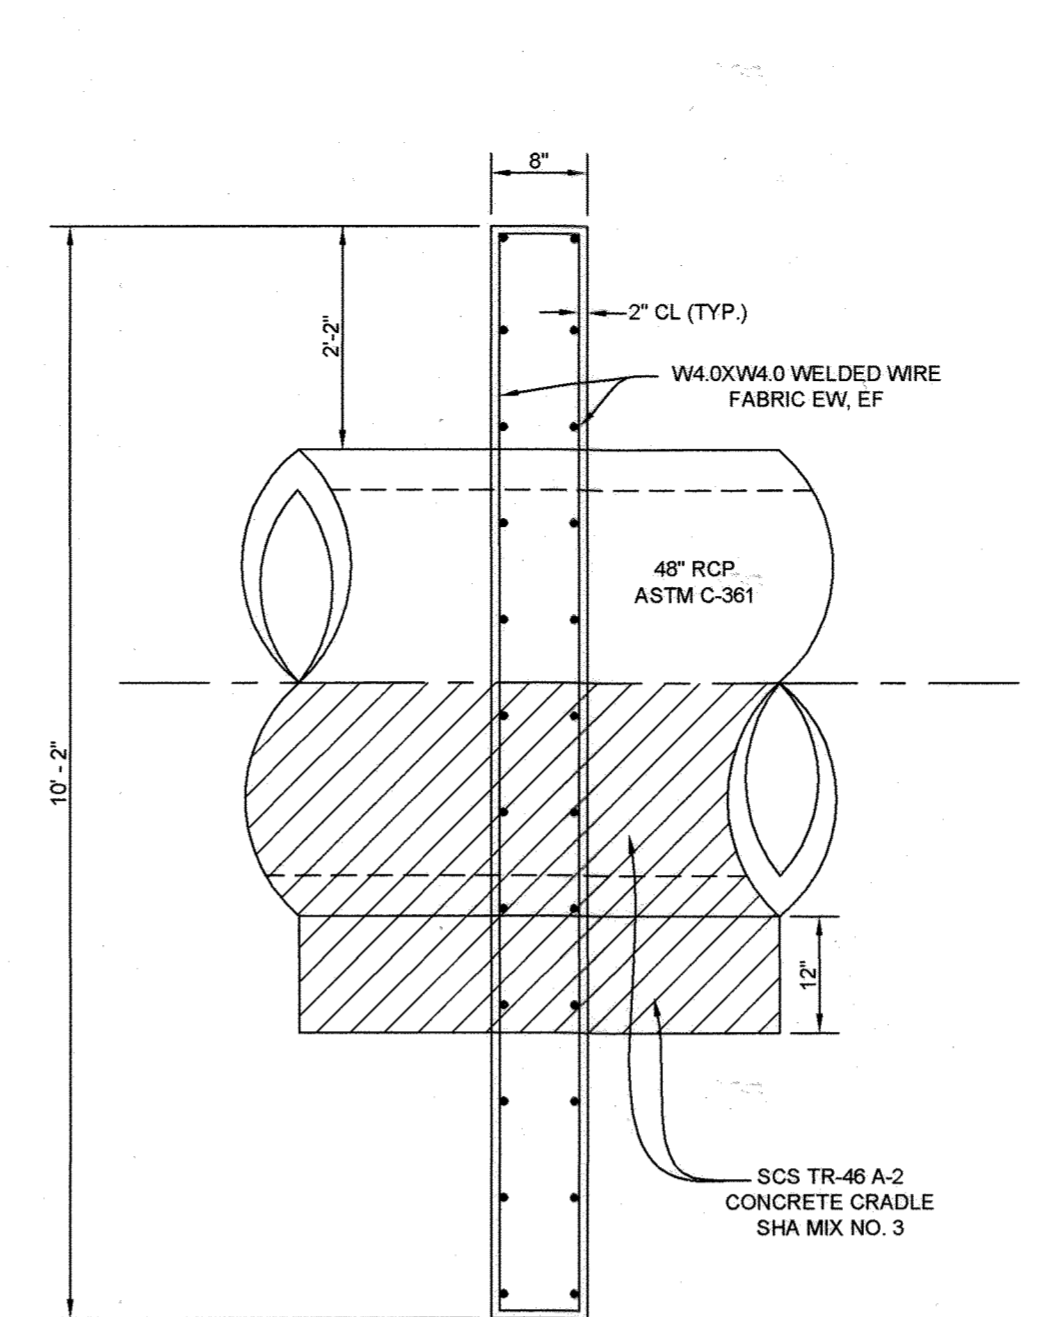


**FRONT VIEW**

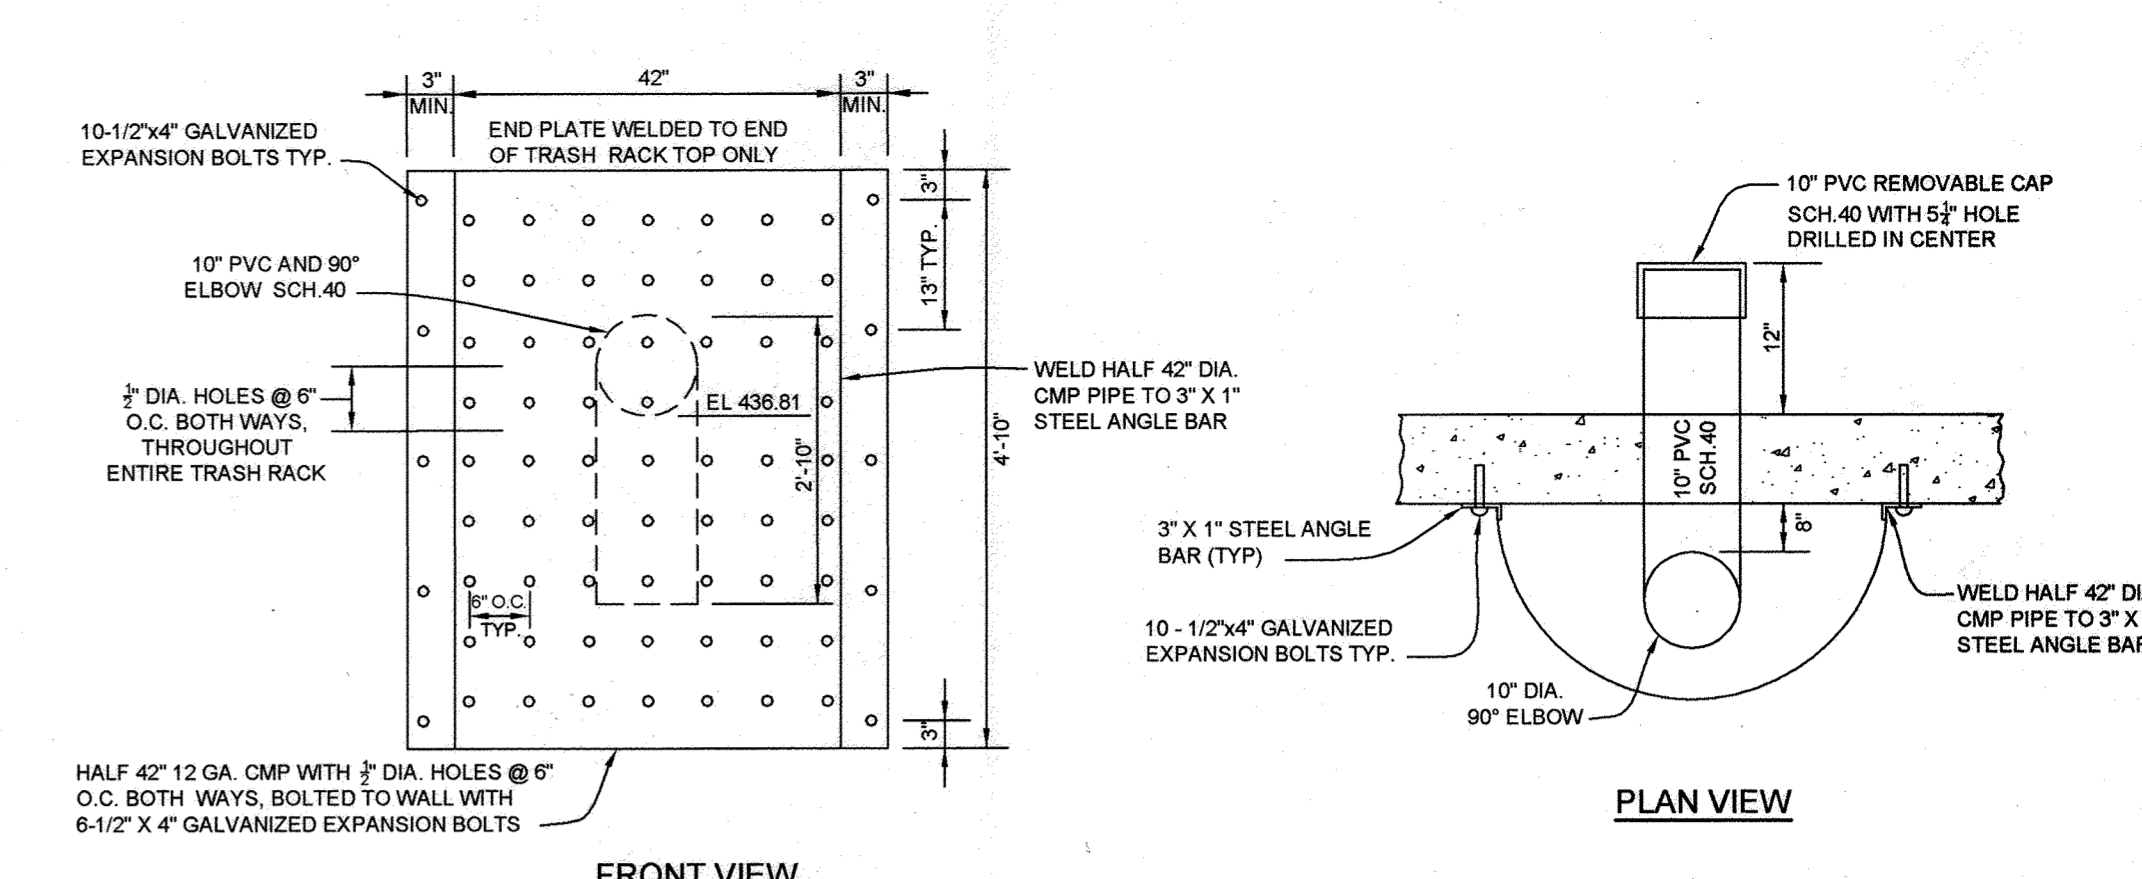


**PLAN VIEW**


**CMP TRASH RACK FOR LOW FLOW ORFICE PROTECTION SWM-1**  
NOT TO SCALE

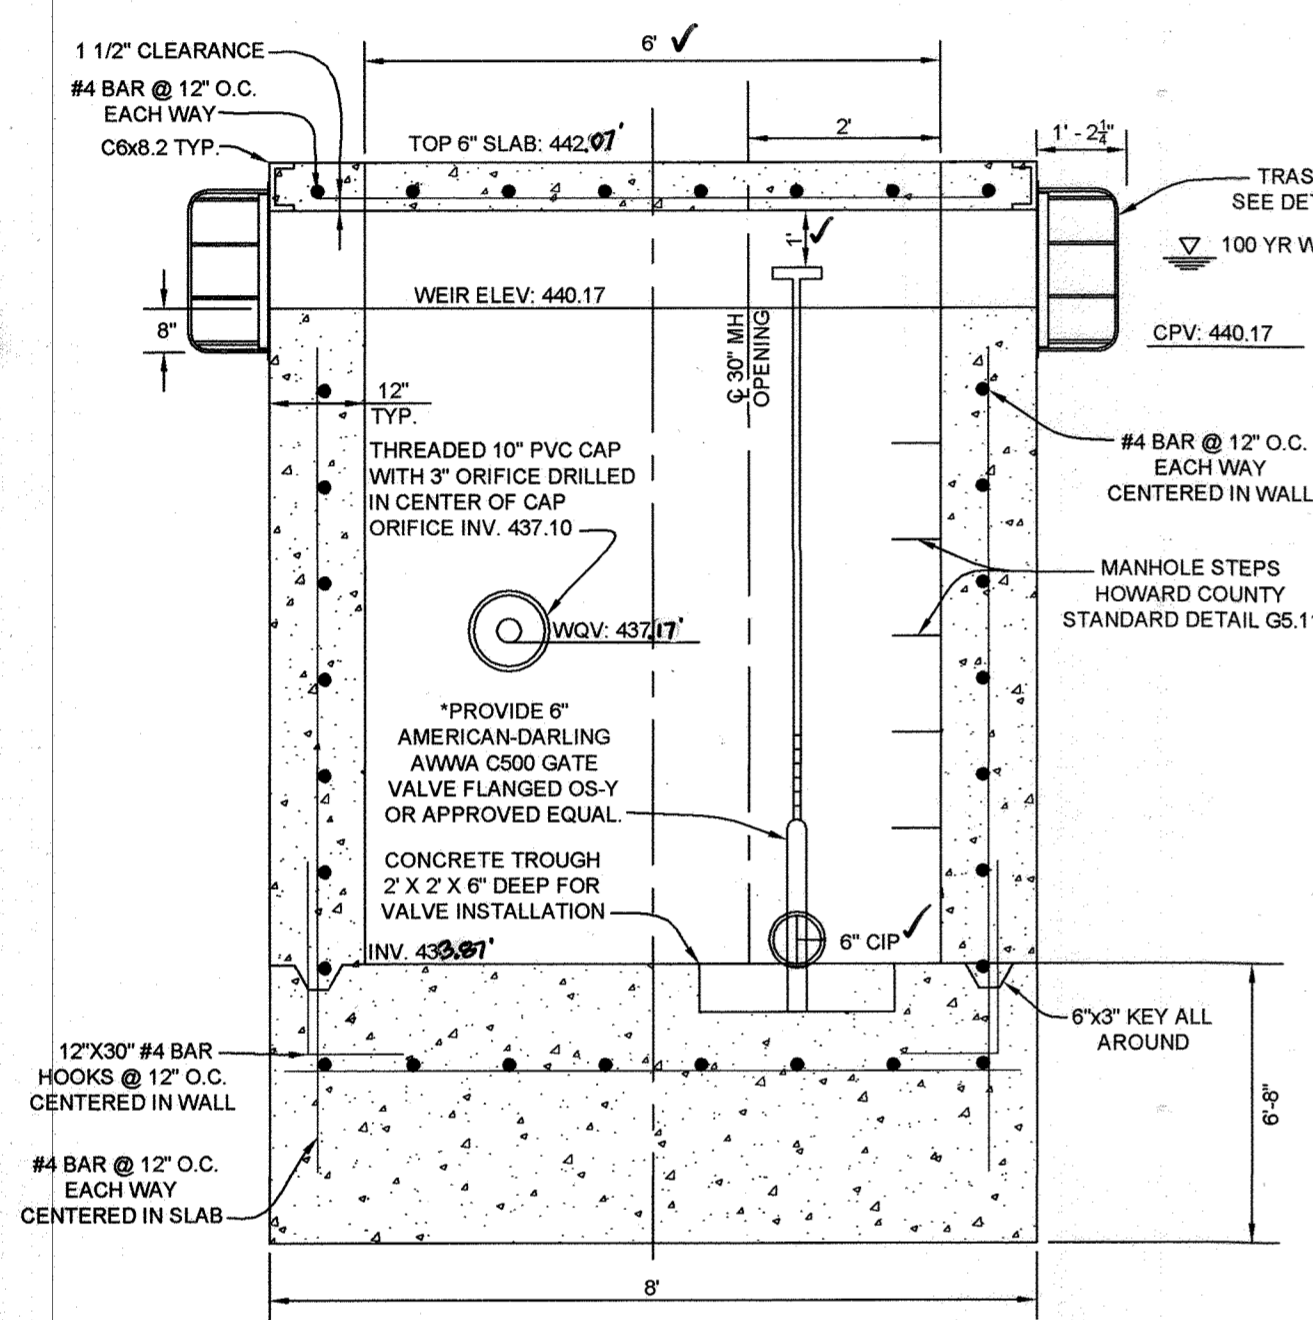


**SECTION 'A-A'**  
NOT TO SCALE

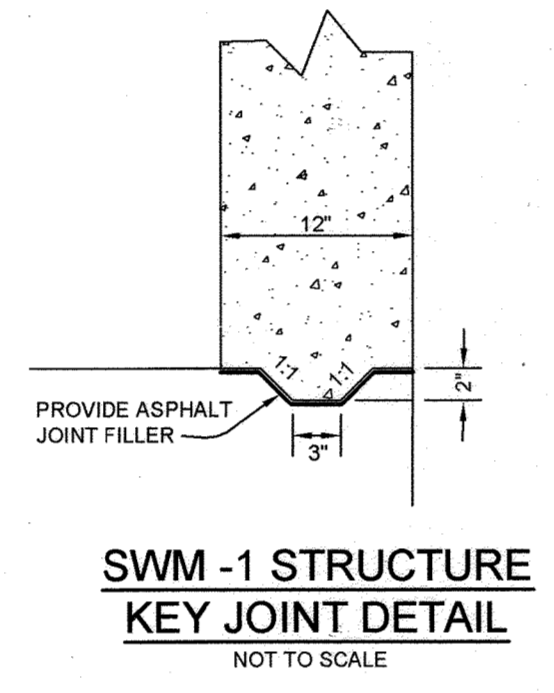


**SWM-1 STRUCTURE KEY JOINT DETAIL**  
NOT TO SCALE

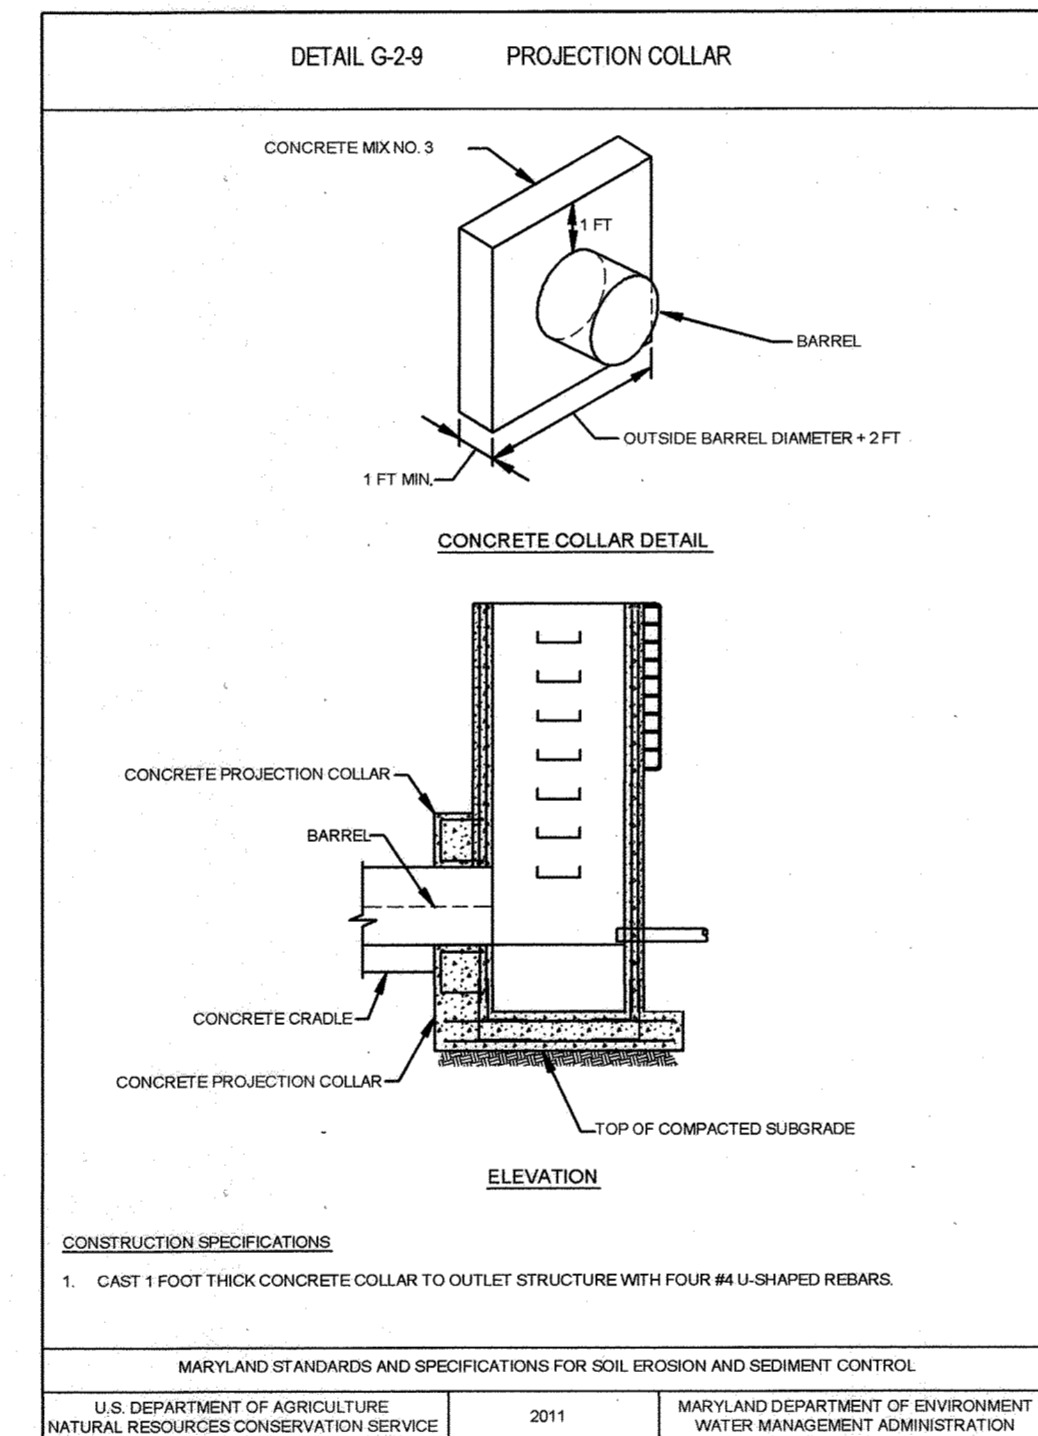

**CONCRETE COLLAR DETAIL**  
NOT TO SCALE

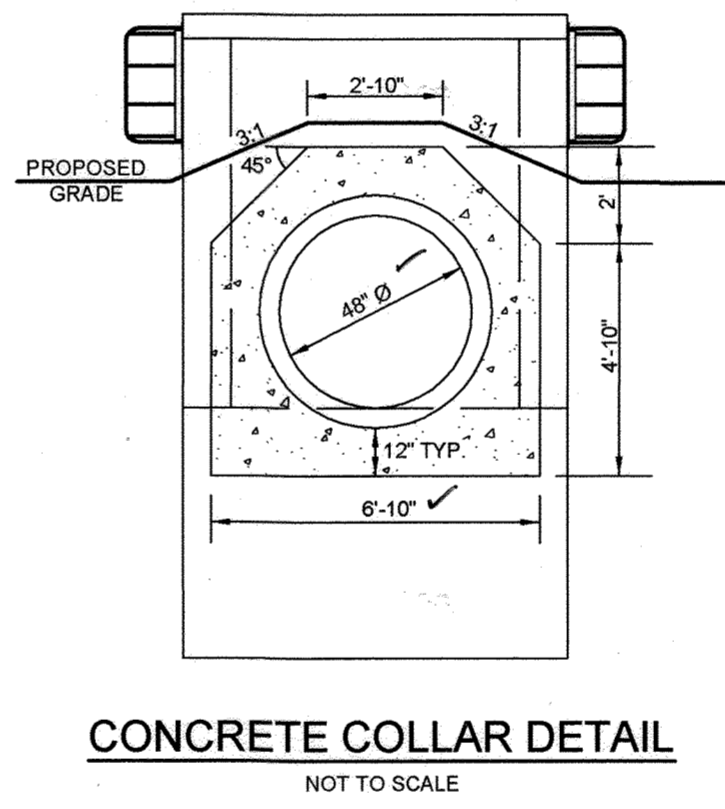


**CONCRETE CLEANOUT STRUCTURE ELEVATION VIEW**  
NOT TO SCALE

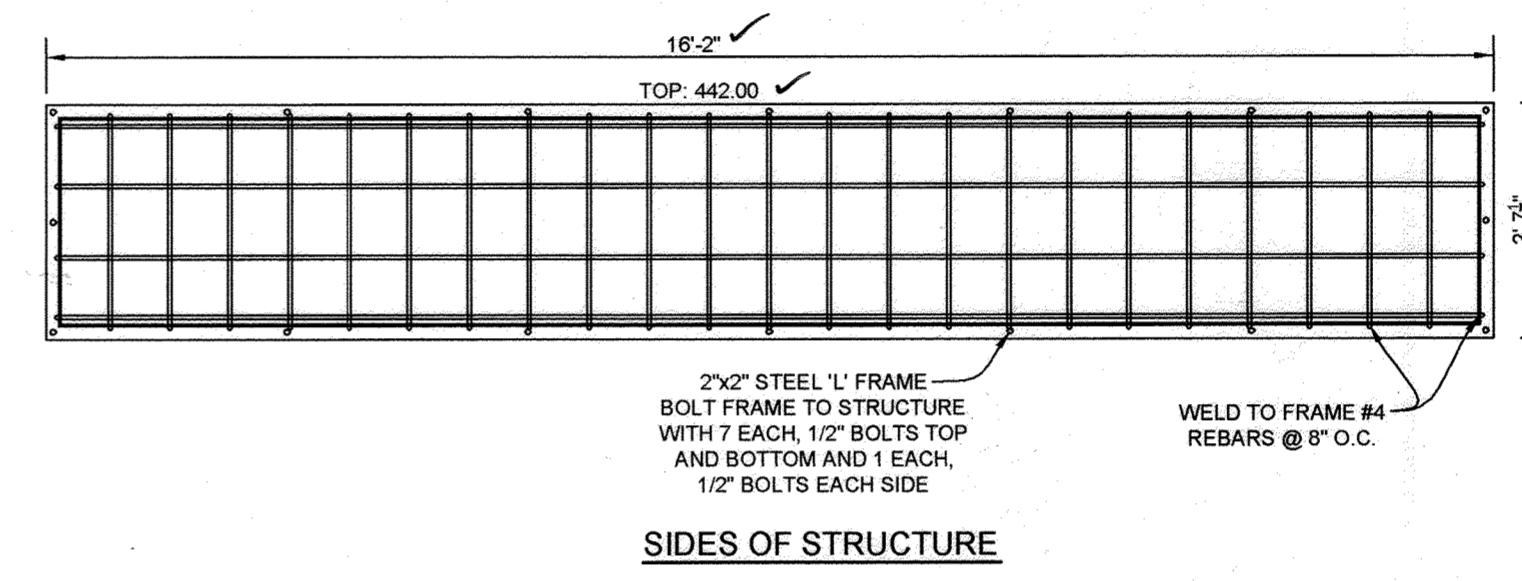


**SIDES OF STRUCTURE**

**TRASH RACK DETAILS**  
NOT TO SCALE


NOTE: GALVANIZE RACK AFTER FABRICATION. RACK TO BE EPOXY COATED AND PAINTED BATTLESHIP GRAY.

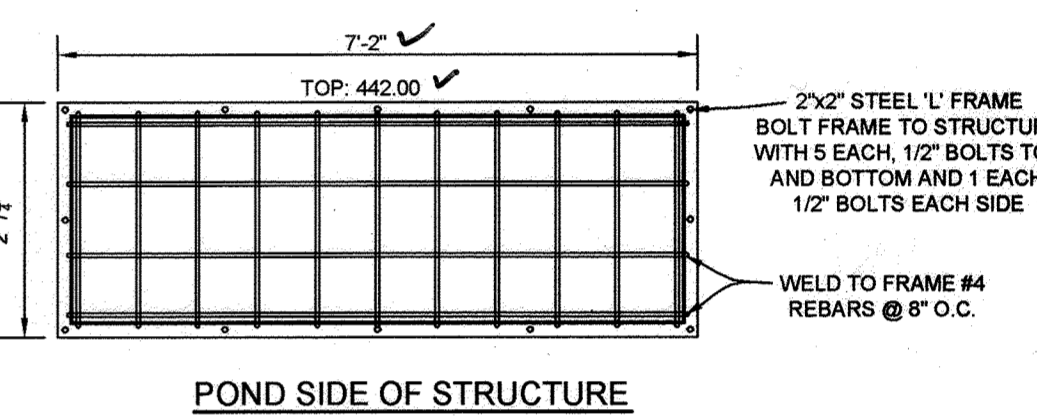

**POND SIDE OF STRUCTURE**

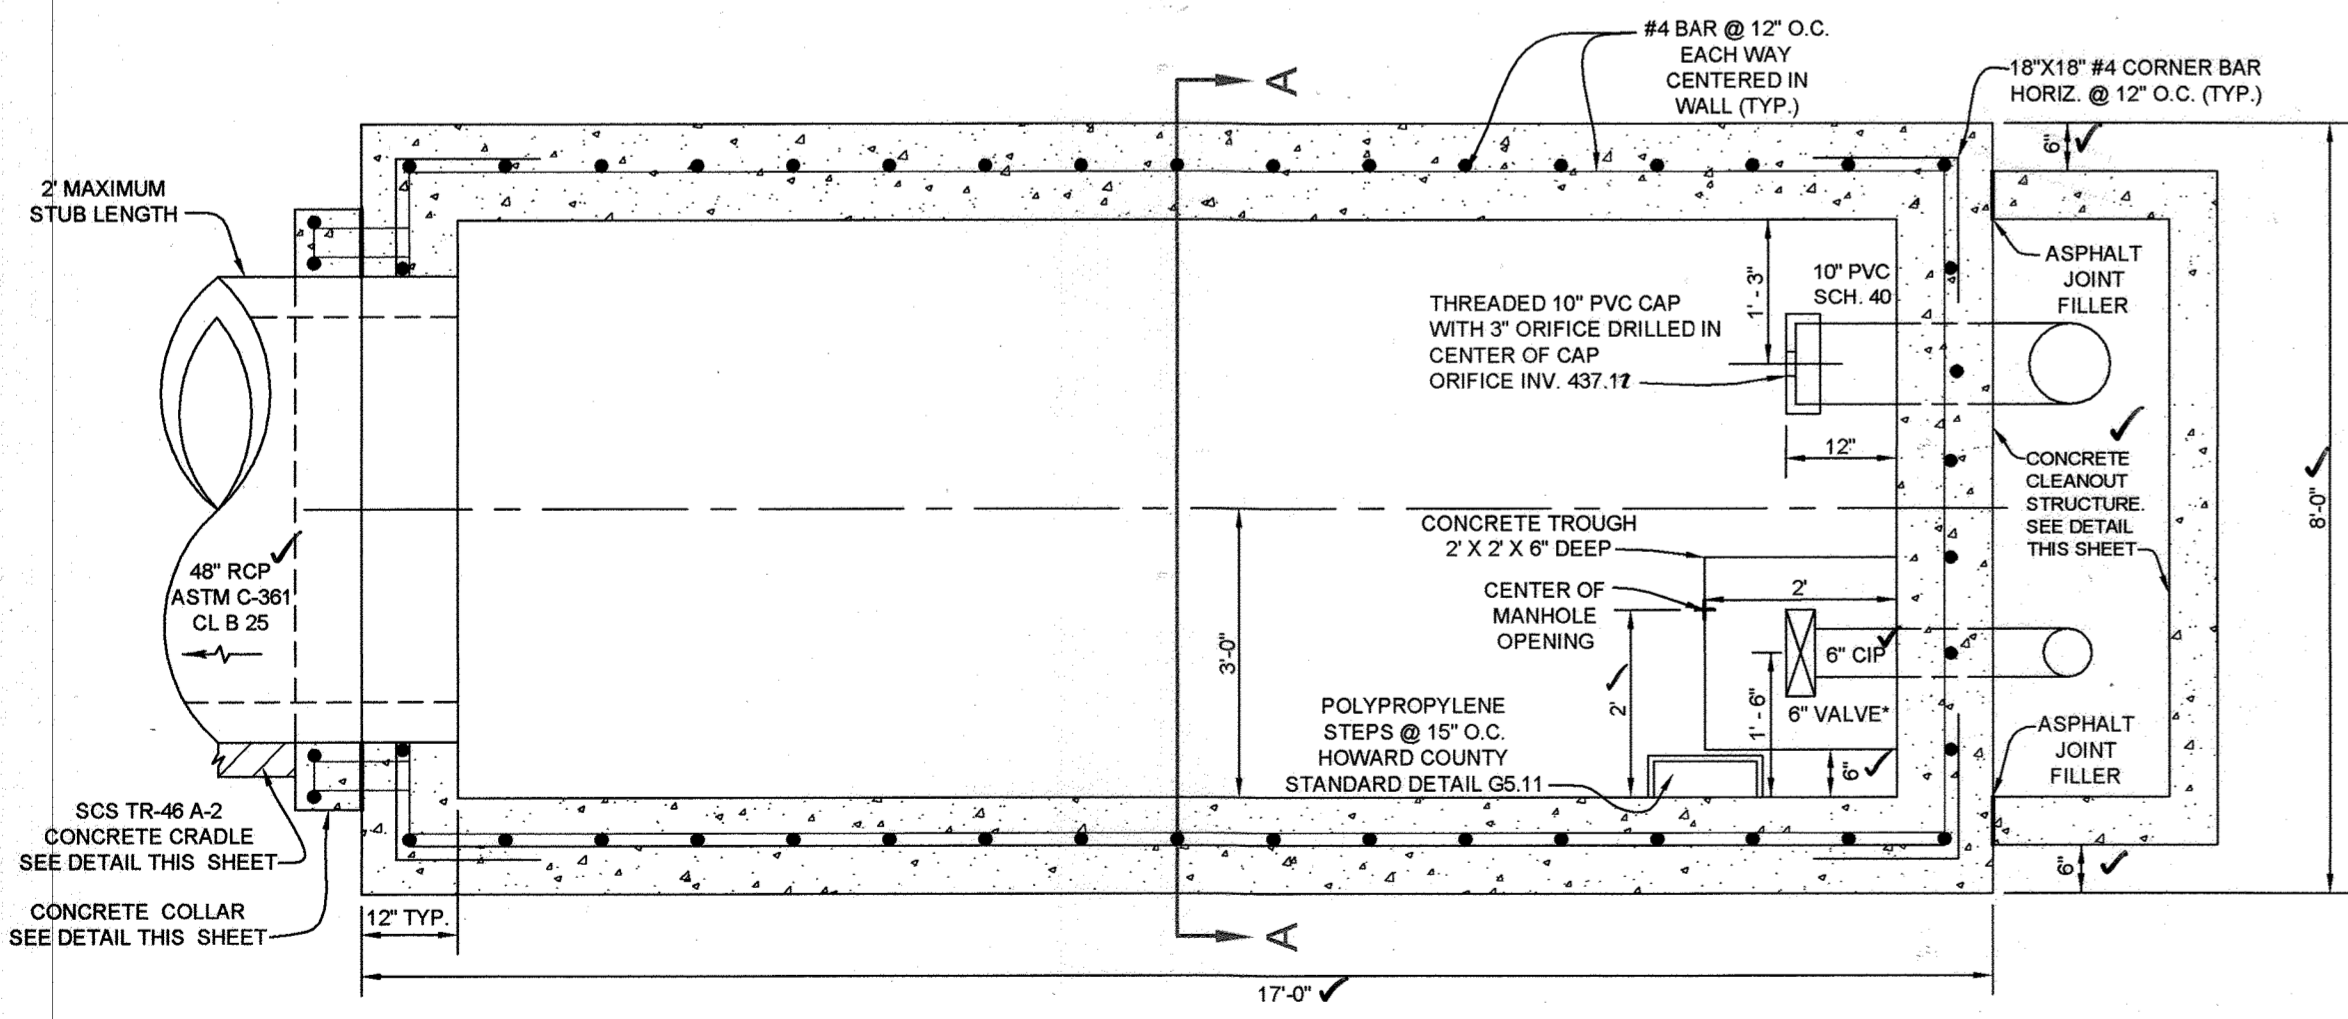

**PLAN VIEW - TOP REMOVED**  
NOT TO SCALE

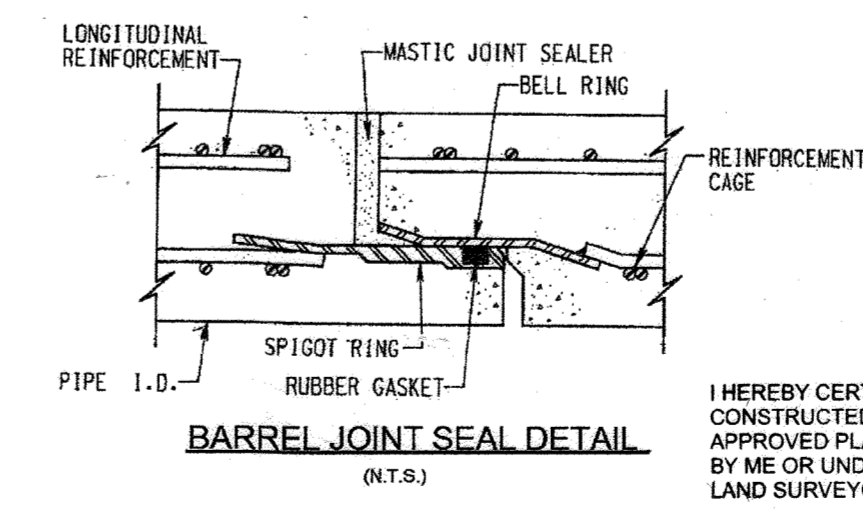

**BARREL JOINT SEAL DETAIL**  
(N.T.S.)

**AS-BUILT CERTIFICATION**  
I HEREBY CERTIFY, BY MY SEAL, THAT THE CONDITIONS SHOWN ON THIS PLAN WERE CONSTRUCTED TO THE LINES AND GRADES SHOWN ON THIS "AS-BUILT" PLAN, AND MEET THE APPROVED PLANS AND SPECIFICATIONS AND ALSO THAT THESE DOCUMENTS WERE PREPARED BY ME OR UNDER MY RESPONSIBLE CHARGE AND THAT I AM A DULY LICENSED PROFESSIONAL LAND SURVEYOR UNDER THE LAWS OF THE STATE OF MARYLAND.  
*Michael D. Adcock*  
MICHAEL D. ADCOCK, PROFESSIONAL LAND SURVEYOR  
MD REG. NO. 21287, EXPIRATION DATE: 6/16/23  
DATE: 04/15/2013

**OWNER/DEVELOPER**  
MANGIONE ENTERPRISES OF TURF VALLEY, LP  
LOU MANGIONE  
1205 YORK ROAD  
LUTHERVILLE, MARYLAND 21083  
410.525.8400

**As-BUILT**  
**POND DETAILS**  
**TURF VALLEY**  
REGIONAL STORMWATER MANAGEMENT FACILITIES  
PGCC MULTI-USE SUBDISTRICT  
TAX MAP 16 GRID 18 & 17 PART OF PARCELS 8 & 394  
3RD ELECTION DISTRICT HOWARD COUNTY, MARYLAND

APPROVED: HOWARD COUNTY DEPARTMENT OF PLANNING AND ZONING  
*John P. ...* 5/2/13  
CHIEF, DEVELOPMENT ENGINEERING DIVISION DATE  
*K. ...* 5/2/13  
CHIEF, DIVISION OF LAND DEVELOPMENT DATE  
*...* 5/2/10  
DIRECTOR DATE

THESE PLANS FOR SMALL POND CONSTRUCTION, SOIL EROSION AND SEDIMENT CONTROL MEET THE REQUIREMENTS OF THE HOWARD SOIL CONSERVATION DISTRICT.  
*Paul M. Sill* 4/30/13  
HOWARD SCD DATE

**ENGINEER'S CERTIFICATE**  
I CERTIFY THAT THIS PLAN FOR POND CONSTRUCTION, EROSION AND SEDIMENT CONTROL REPRESENTS A PRACTICAL AND WORKABLE PLAN BASED ON MY PERSONAL KNOWLEDGE OF THE SITE CONDITIONS. THIS PLAN WAS PREPARED IN ACCORDANCE WITH THE REQUIREMENTS OF THE HOWARD SOIL CONSERVATION DISTRICT. I HAVE NOTIFIED THE DEVELOPER THAT HE/SHE MUST ENGAGE A REGISTERED PROFESSIONAL ENGINEER TO SUPERVISE POND CONSTRUCTION AND PROVIDE THE HOWARD SOIL CONSERVATION DISTRICT WITH AN "AS-BUILT" PLAN OF THE POND WITHIN 30 DAYS OF COMPLETION.  
*Paul M. Sill* 4/29/13  
SIGNATURE OF ENGINEER DATE  
PAUL M. SILL, P.E.








**DEVELOPER'S CERTIFICATE**  
I/WE CERTIFY THAT ALL DEVELOPMENT AND/OR CONSTRUCTION WILL BE DONE ACCORDING TO THESE PLANS, AND THAT ANY RESPONSIBLE PERSONNEL INVOLVED IN THE CONSTRUCTION PROJECT WILL HAVE A CERTIFICATE OF ATTENDANCE AT A DEPARTMENT OF THE ENVIRONMENT APPROVED TRAINING PROGRAM FOR THE CONTROL OF SEDIMENT AND EROSION BEFORE BEGINNING THE PROJECT. I SHALL ENGAGE A REGISTERED PROFESSIONAL ENGINEER TO SUPERVISE POND CONSTRUCTION AND PROVIDE THE HOWARD SOIL CONSERVATION DISTRICT WITH AN "AS-BUILT" PLAN OF THE POND WITHIN 30 DAY OF COMPLETION. ALSO I AUTHORIZE PERIODIC ON-SITE INSPECTIONS BY THE HOWARD SOIL CONSERVATION DISTRICT.  
*...* 4/30/13  
SIGNATURE OF DEVELOPER DATE

APPROVED  
PLANNING BOARD OF HOWARD COUNTY  
DATE: 04/15/2013  
*...*





NO.	DESCRIPTION	DATE

**Sill · Adcock & Associates · LLC**  
Engineers · Surveyors · Planners  
3300 North Ridge Road, Suite 160  
Ellicott City, Maryland 21043  
Phone: 443.325.7682 Fax: 443.325.7685  
Email: info@silladcock.com  
DESIGN BY: DB  
DRAWN BY: BK  
CHECKED BY: PS  
SCALE: AS SHOWN  
DATE: APRIL 30, 2013  
PROJECT #: 06-025  
SHEET #: 8 of 12  
PROFESSIONAL CERTIFICATION: I HEREBY CERTIFY THAT THESE DOCUMENTS WERE PREPARED OR APPROVED BY ME, AND THAT I AM A DULY LICENSED PROFESSIONAL ENGINEER UNDER THE LAWS OF THE STATE OF MARYLAND. LICENSE NO. 32025, EXPIRATION DATE: JUNE 20, 2013



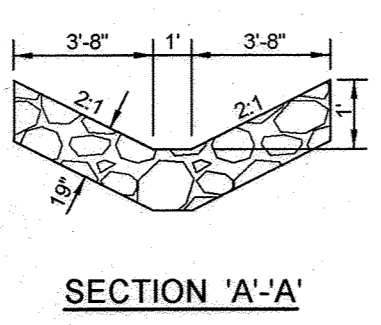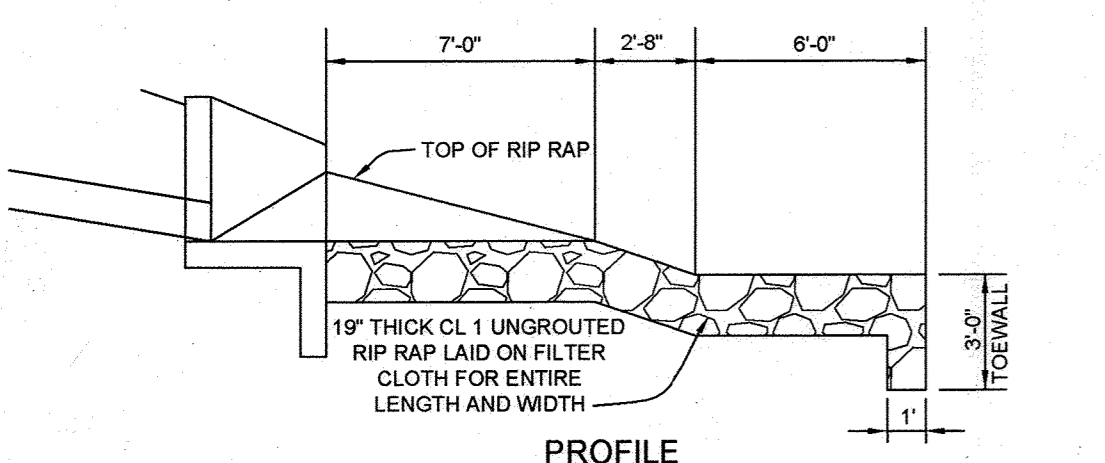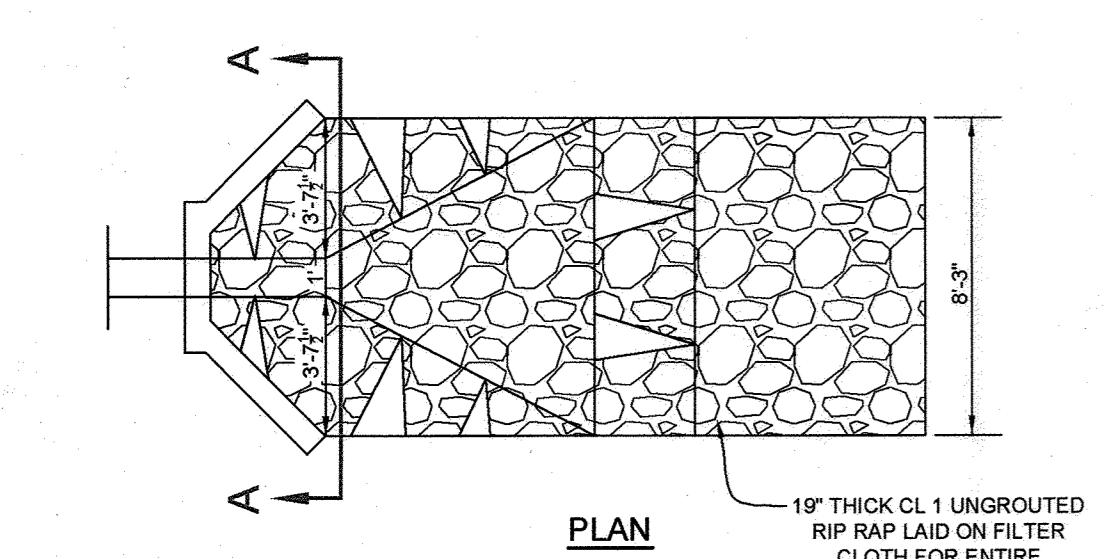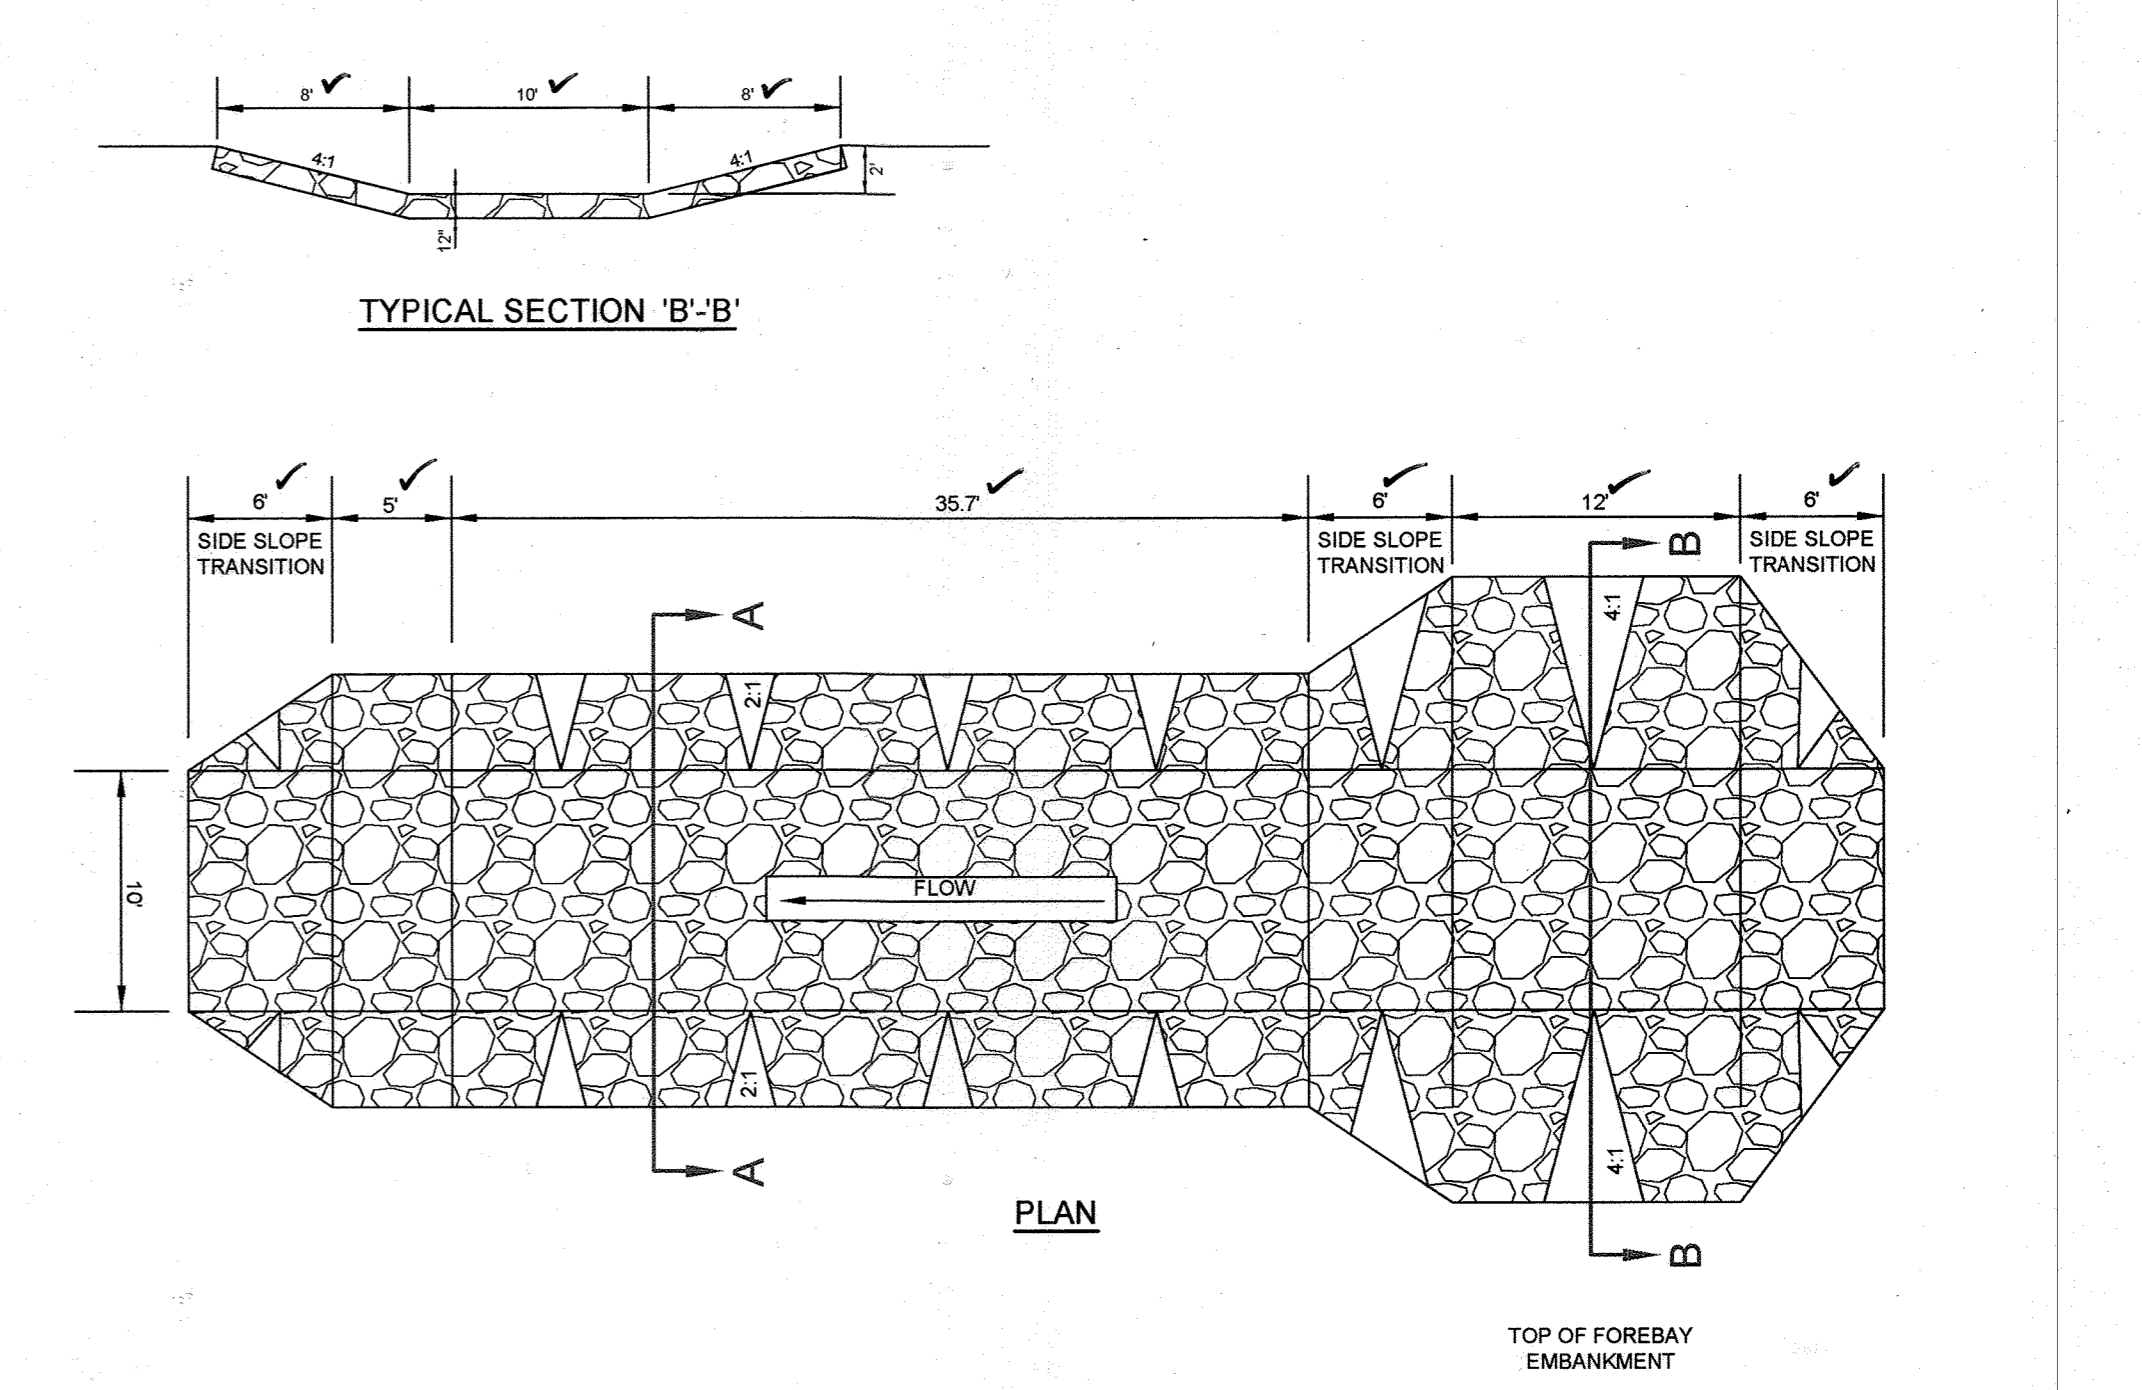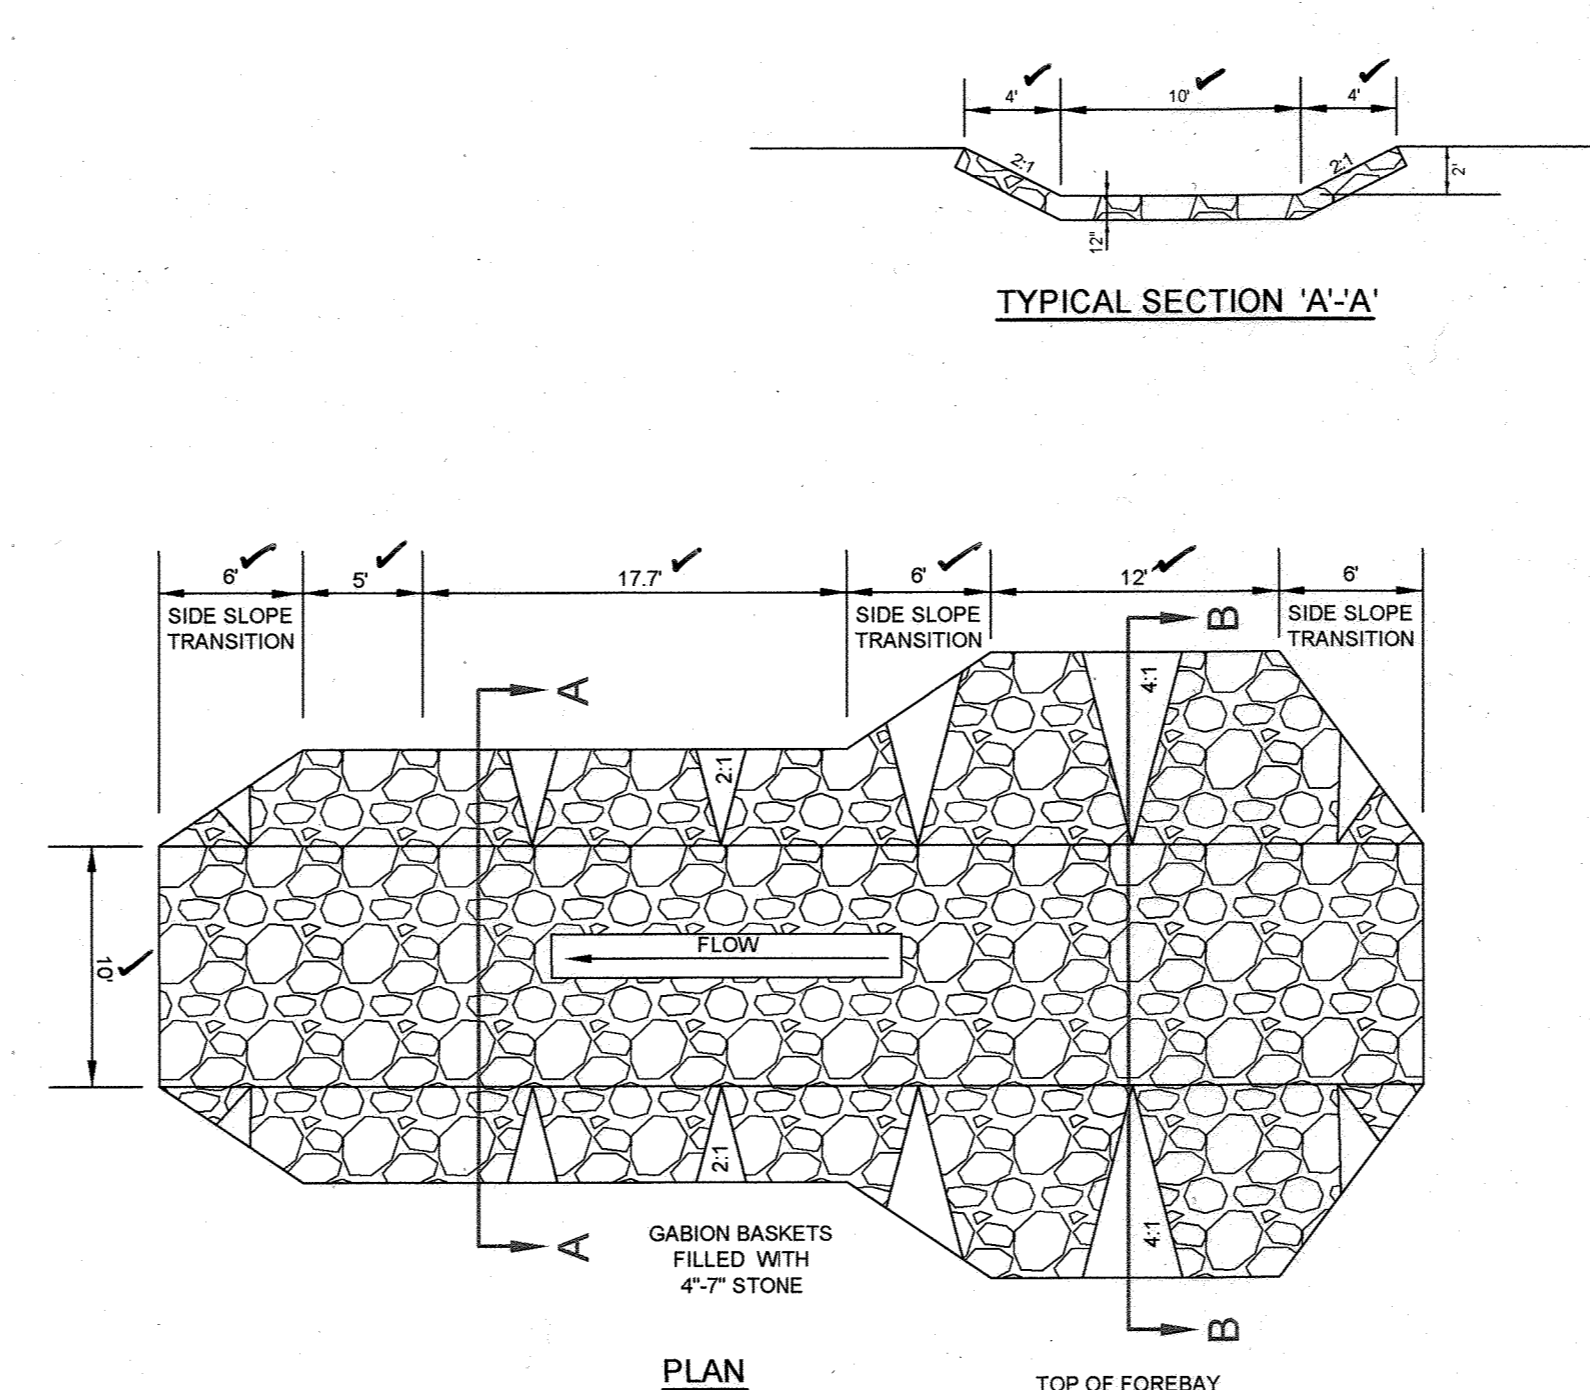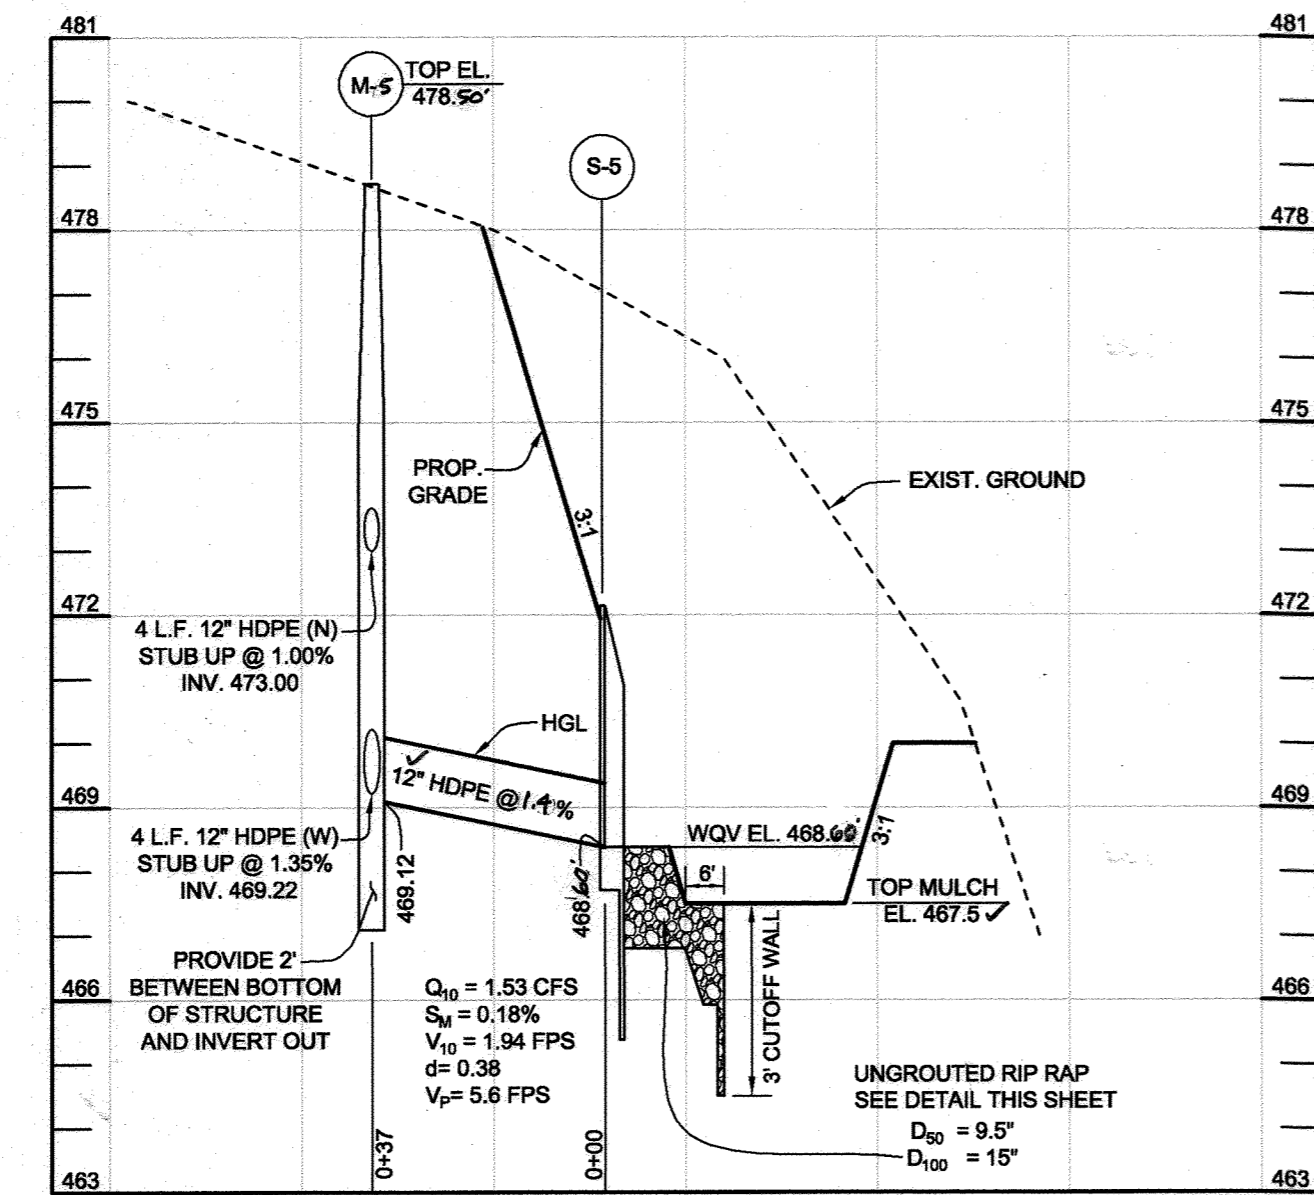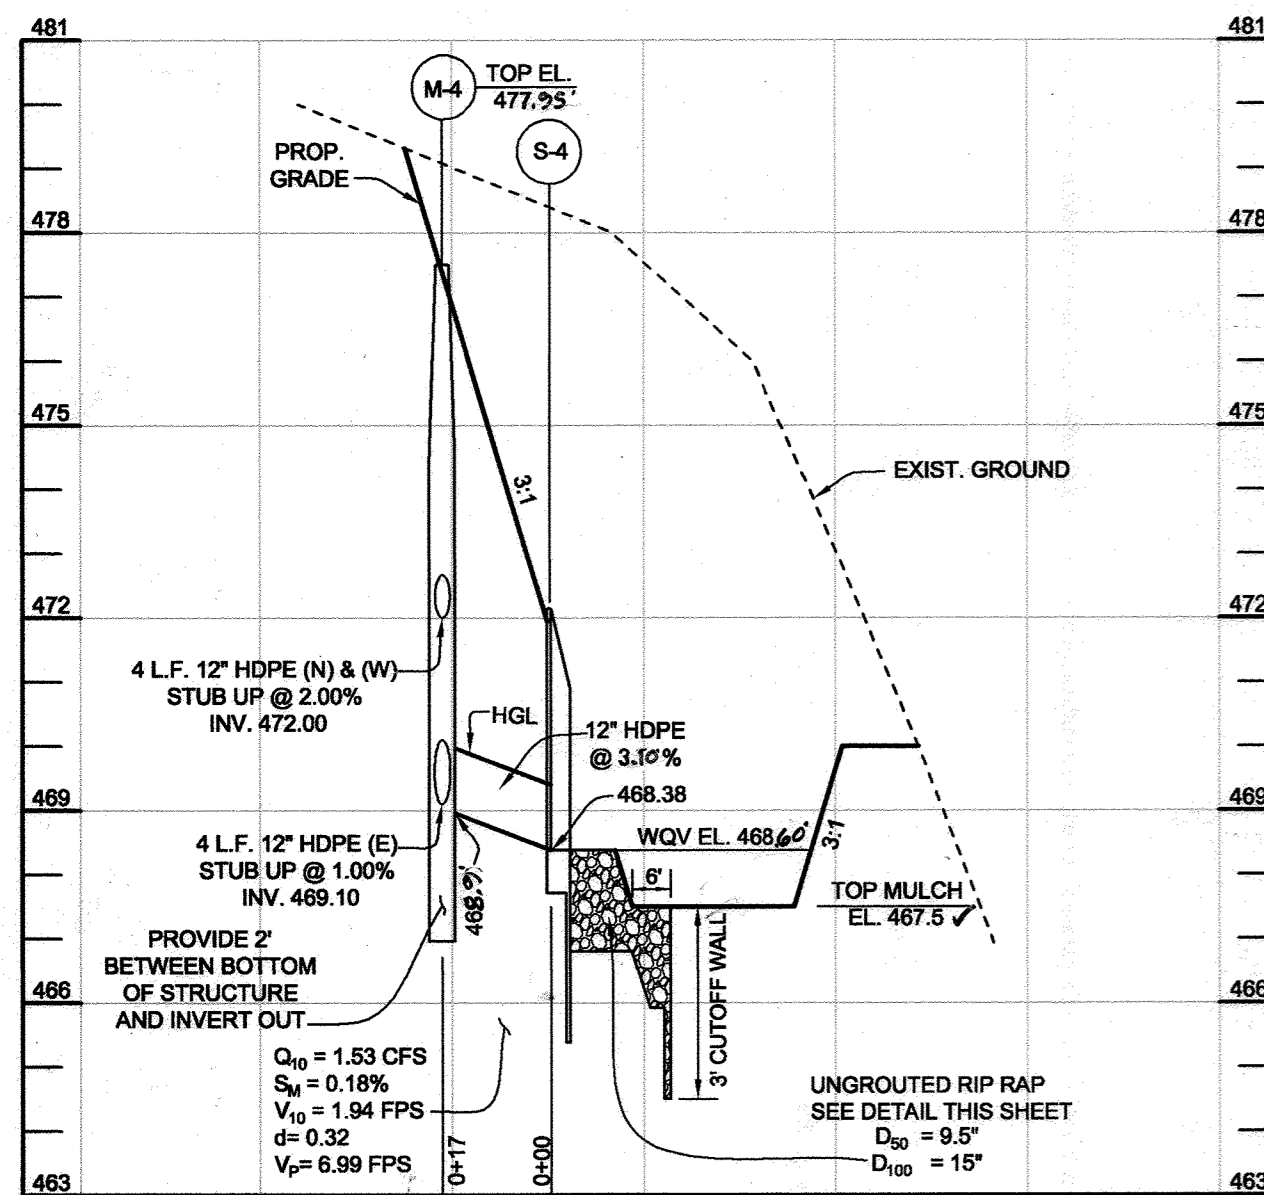

**STRUCTURE S-4 AND S-5 UNGROUTED RIP RAP OUTFALL DETAIL**  
 NOT TO SCALE

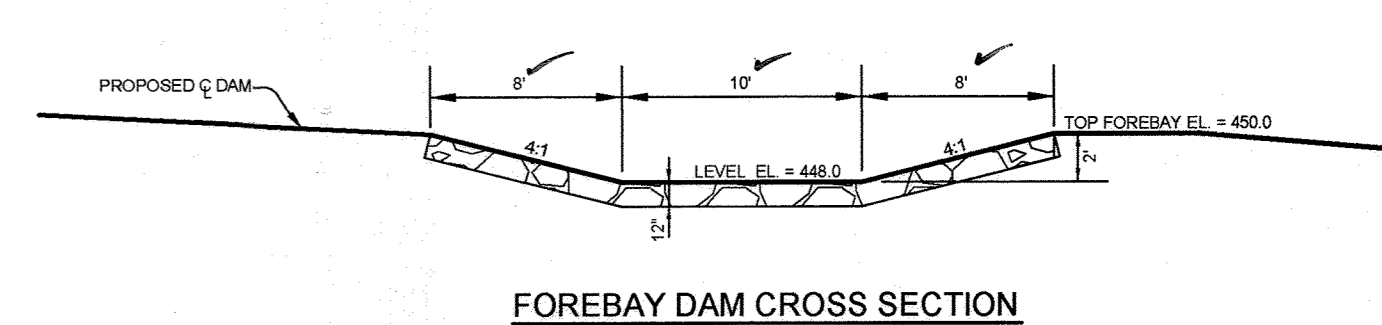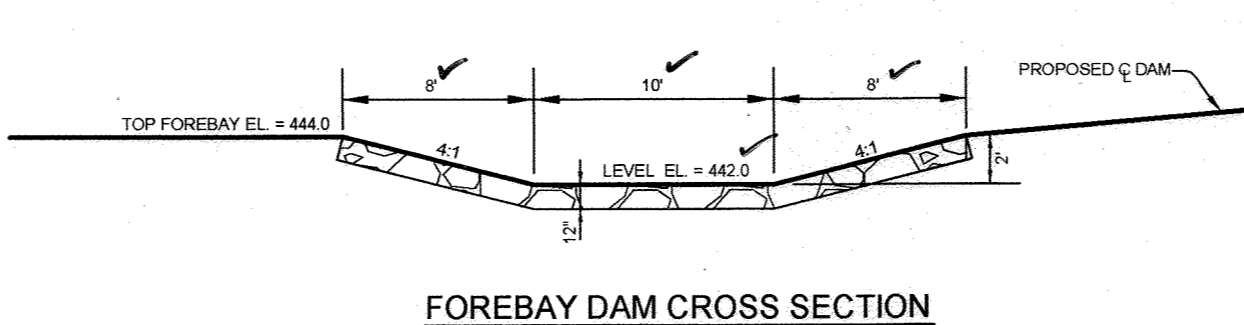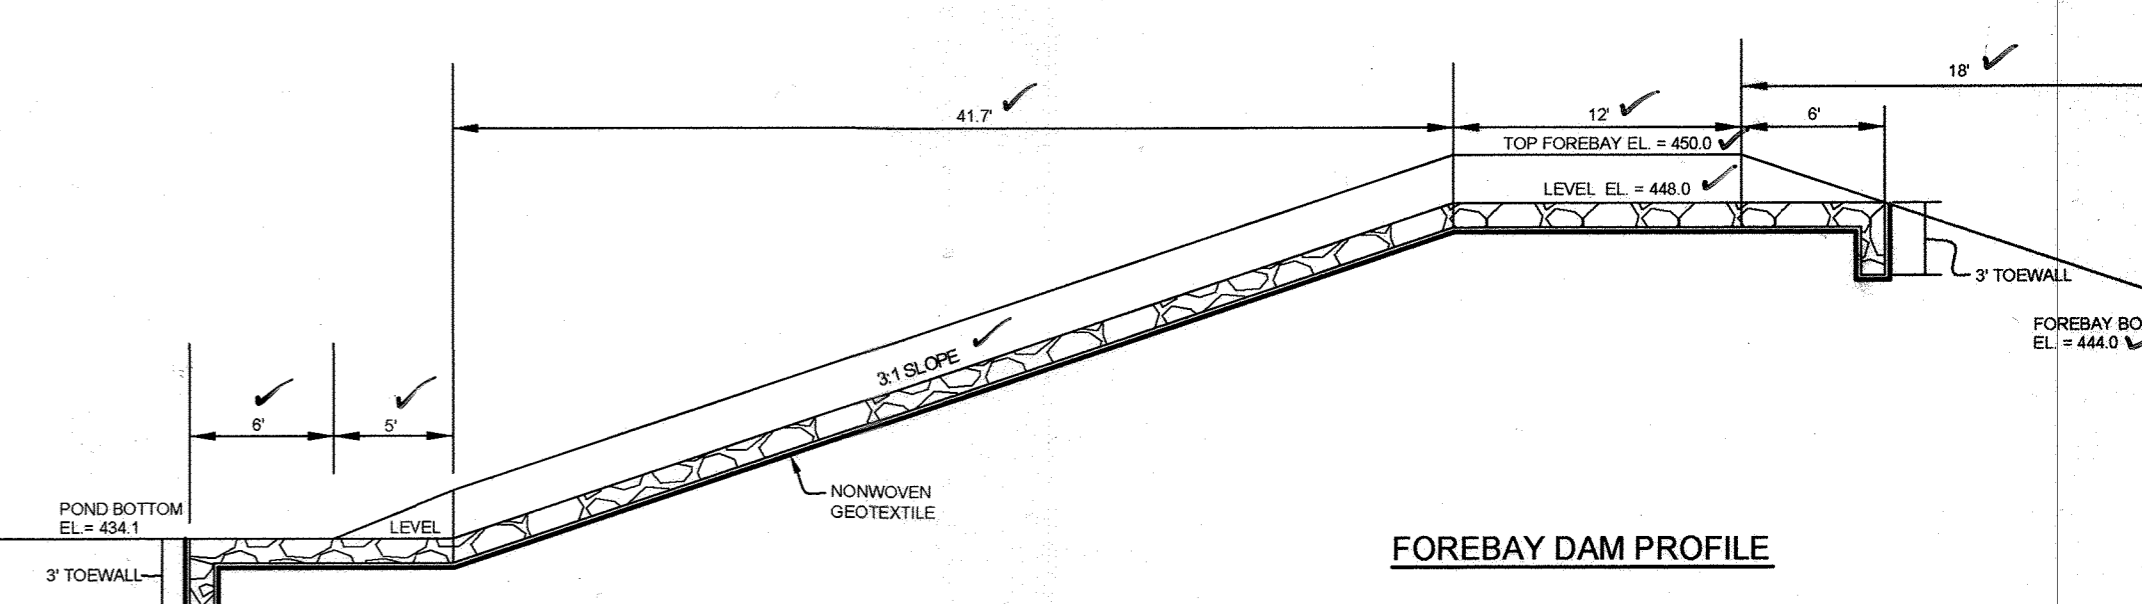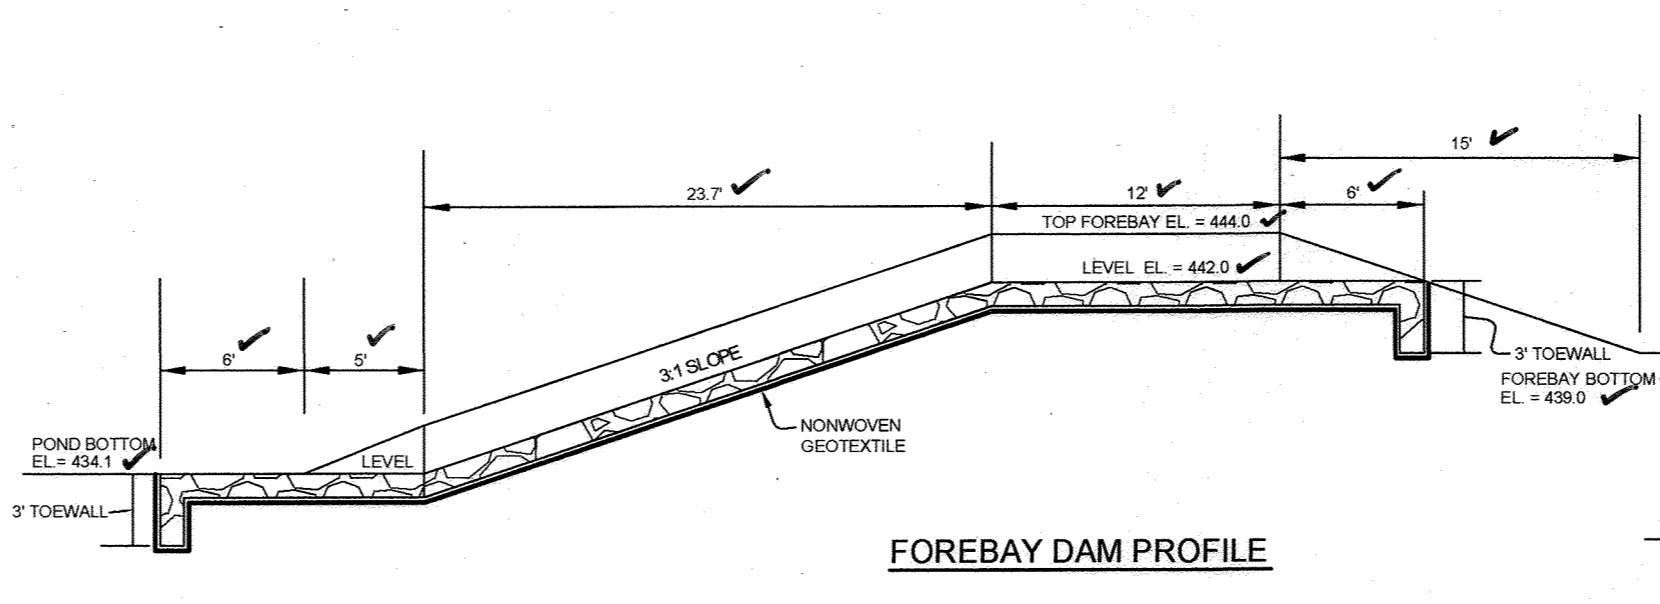



**GABION INFLOW PROTECTION NO. 1 DETAIL**  
 NOT TO SCALE

**GABION INFLOW PROTECTION NO. 2 DETAIL**  
 NOT TO SCALE

**RIP RAP OUTFALL SCHEDULE**

STR.No.	La	D	La+D	H	RIP RAP CL.
SWM-1	28'	48"	32'	28"	CL-1
S-2	10'	12"	11'	15"	CL-1
S-3	11'	18"	12'-6"	18"	CL-1

19" THICK CL 1 UNGROUTED RIP RAP LAID ON FILTER CLOTH FOR ENTIRE LENGTH AND WIDTH  
 $D_{90} = 9.5"$ ,  $D_{100} = 15"$   
 SEE PLAN VIEW SHEETS 2-4

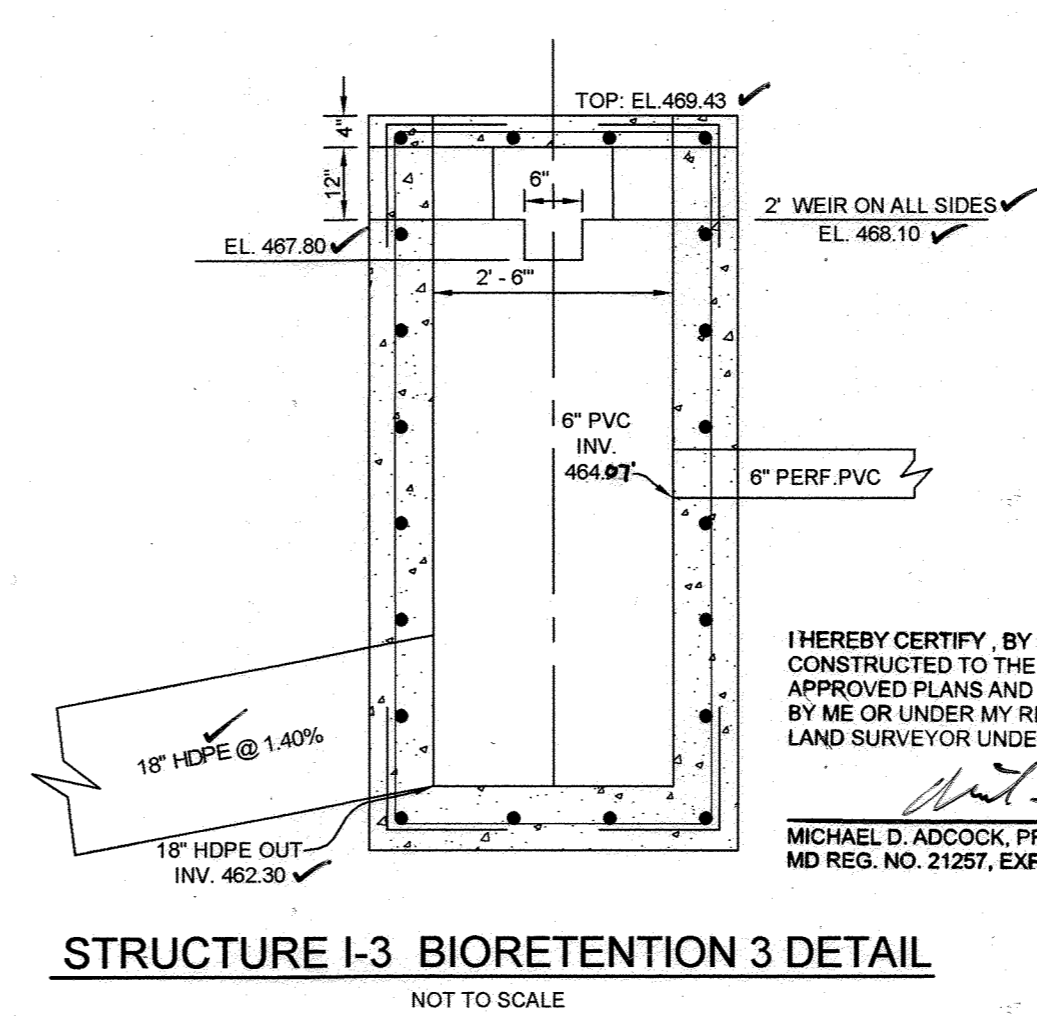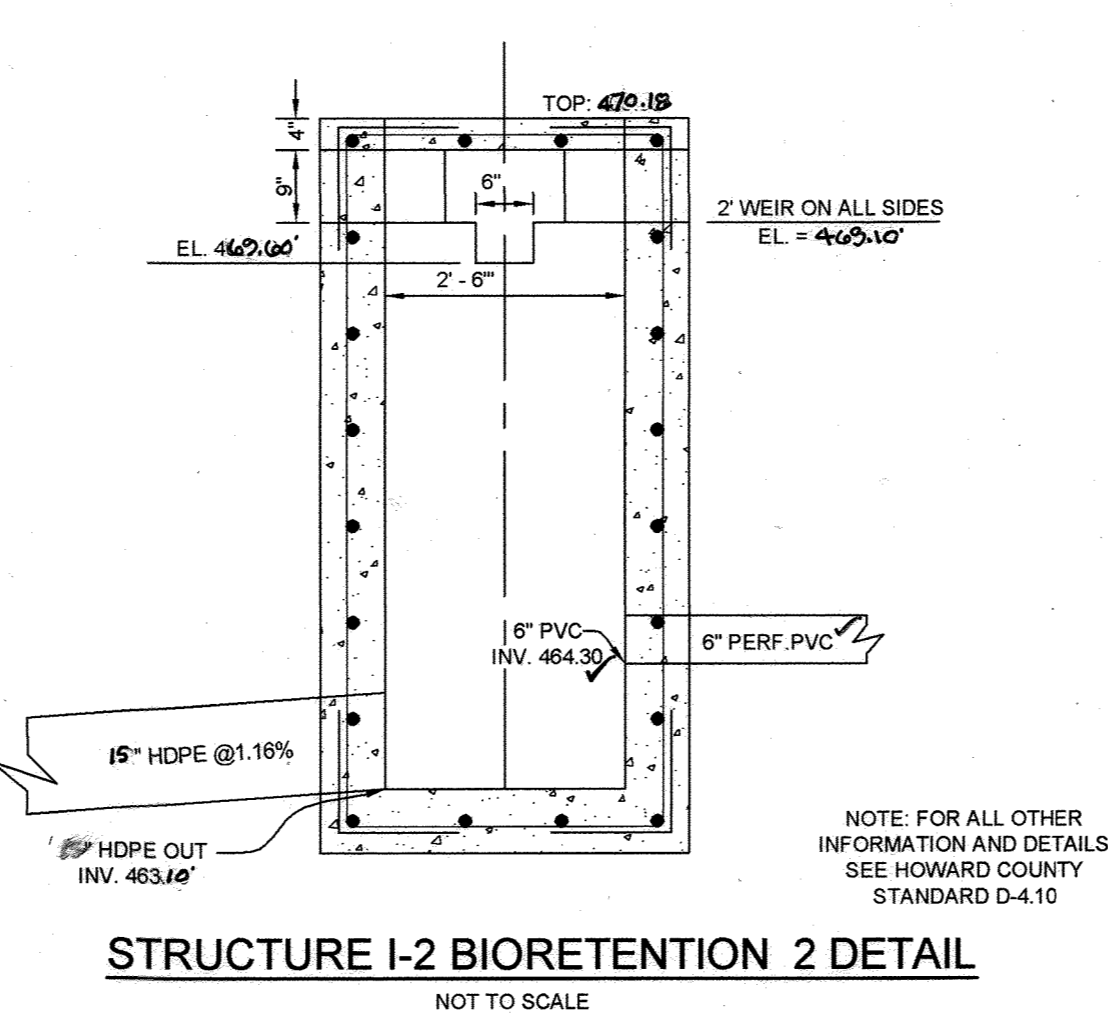

- CONSTRUCTION SPECIFICATIONS:**
- PROVIDE NONWOVEN GEOTEXTILE, AS SPECIFIED IN SECTION H-1 MATERIALS, UNDER THE BOTTOM AND ALONG SIDES OF ALL GABION BASKETS.
  - USE BASKETS MADE OF MINIMUM 11 GAGE WIRE.
  - CONSTRUCT GABION INFLOW PROTECTION BY ARRANGING 12" THICK GABION BASKETS PER MANUFACTURE TO FORM A TRAPEZOIDAL SECTION WITH A 10 FOOT BOTTOM WIDTH 2 FOOT MINIMUM DEPTH. SIDE WALLS AT 2:1 AND 4:1 SLOPES. SEE GABION INFLOW PROTECTION DETAIL ON THE PLANS. FILL GABION BASKETS WITH 4 TO 7 INCH STONE.
  - INSTALL ENTRANCE AND EXIT SECTIONS AS SHOWN ON THE PLANS.
  - INSTALL GABIONS IN ACCORDANCE WITH MANUFACTURER RECOMMENDATIONS.
  - BLEND GABIONS INTO EXISTING GROUND.

**OWNER/DEVELOPER**

MANGIONE ENTERPRISES OF TURF VALLEY, LP  
 LOU MANGIONE  
 1205 YORK ROAD  
 LUTHERVILLE, MARYLAND 21093  
 410.825.8400

**AS-BUILT**

**AS-BUILT CERTIFICATION**

I HEREBY CERTIFY, BY MY SEAL, THAT THE CONDITIONS SHOWN ON THIS PLAN WERE CONSTRUCTED TO THE LINES AND GRADES SHOWN ON THIS "AS-BUILT" PLAN, AND MEET THE APPROVED PLANS AND SPECIFICATIONS AND ALSO THAT THESE DOCUMENTS WERE PREPARED BY ME OR UNDER MY RESPONSIBLE CHARGE AND THAT I AM A DULY LICENSED PROFESSIONAL LAND SURVEYOR UNDER THE LAWS OF THE STATE OF MARYLAND.

MICHAEL D. ADCOCK, PROFESSIONAL LAND SURVEYOR  
 MD REG. NO. 21257, EXPIRATION DATE: 4/14/25

**DETAILS & STORMDRAIN PROFILES**  
**TURF VALLEY**  
 REGIONAL STORMWATER MANAGEMENT FACILITIES  
 PGCC MULTI-USE SUBDISTRICT

TAX MAP 16 GRID 16 & 17  
 3RD ELECTION DISTRICT

STATE OF MARYLAND  
 PROFESSIONAL ENGINEER  
 Sill · Adcock & Associates · LLC  
 Engineers · Surveyors · Planners  
 3300 North Ridge Road, Suite 160  
 Ellicott City, Maryland 21043  
 Phone: 443.325.7682 Fax: 443.325.7685  
 Email: info@silladcock.com

APPROVED: HOWARD COUNTY DEPARTMENT OF PLANNING AND ZONING  
 DATE: 5/2/13

THESE PLANS FOR SMALL POND CONSTRUCTION, SOIL EROSION AND SEDIMENT CONTROL MEET THE REQUIREMENTS OF THE HOWARD SOIL CONSERVATION DISTRICT.  
 DATE: 5/2/13

ENGINEERS CERTIFICATE  
 I CERTIFY THAT THIS PLAN FOR POND CONSTRUCTION, EROSION AND SEDIMENT CONTROL REPRESENTS A PRACTICAL AND WORKABLE PLAN BASED ON MY PERSONAL KNOWLEDGE OF THE SITE CONDITIONS. THIS PLAN WAS PREPARED IN ACCORDANCE WITH THE REQUIREMENTS OF THE HOWARD SOIL CONSERVATION DISTRICT. I HAVE NOTIFIED THE DEVELOPER THAT HE/SHE MUST ENGAGE A REGISTERED PROFESSIONAL ENGINEER TO SUPERVISE POND CONSTRUCTION AND PROVIDE THE HOWARD SOIL CONSERVATION DISTRICT WITH AN "AS-BUILT" PLAN OF THE POND WITHIN 30 DAYS OF COMPLETION.  
 DATE: 5/2/13

DEVELOPER'S CERTIFICATE  
 I HEREBY CERTIFY THAT ALL DEVELOPMENT AND/OR CONSTRUCTION WILL BE DONE ACCORDING TO THESE PLANS, AND THAT ANY RESPONSIBLE PERSONNEL INVOLVED IN THE CONSTRUCTION PROJECT WILL HAVE A CERTIFICATE OF ATTENDANCE AT A DEPARTMENT OF THE ENVIRONMENT APPROVED TRAINING PROGRAM FOR THE CONTROL OF SEDIMENT AND EROSION BEFORE BEGINNING THE PROJECT. I SHALL ENGAGE A REGISTERED PROFESSIONAL ENGINEER TO SUPERVISE POND CONSTRUCTION AND PROVIDE THE HOWARD SOIL CONSERVATION DISTRICT WITH AN "AS-BUILT" PLAN OF THE POND WITHIN 30 DAYS OF COMPLETION. I ALSO AUTHORIZE PERIODIC SITE INSPECTIONS BY THE HOWARD SOIL CONSERVATION DISTRICT.  
 DATE: 5/2/13



APPROVED  
 PLANNING BOARD OF HOWARD COUNTY  
 DATE: 04/15/2013

NO.	DESCRIPTION	DATE







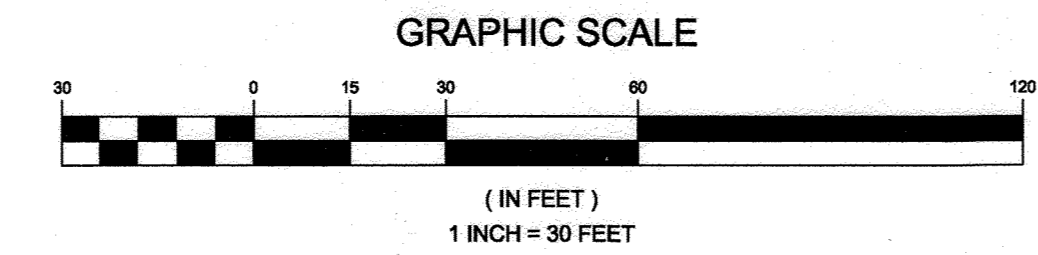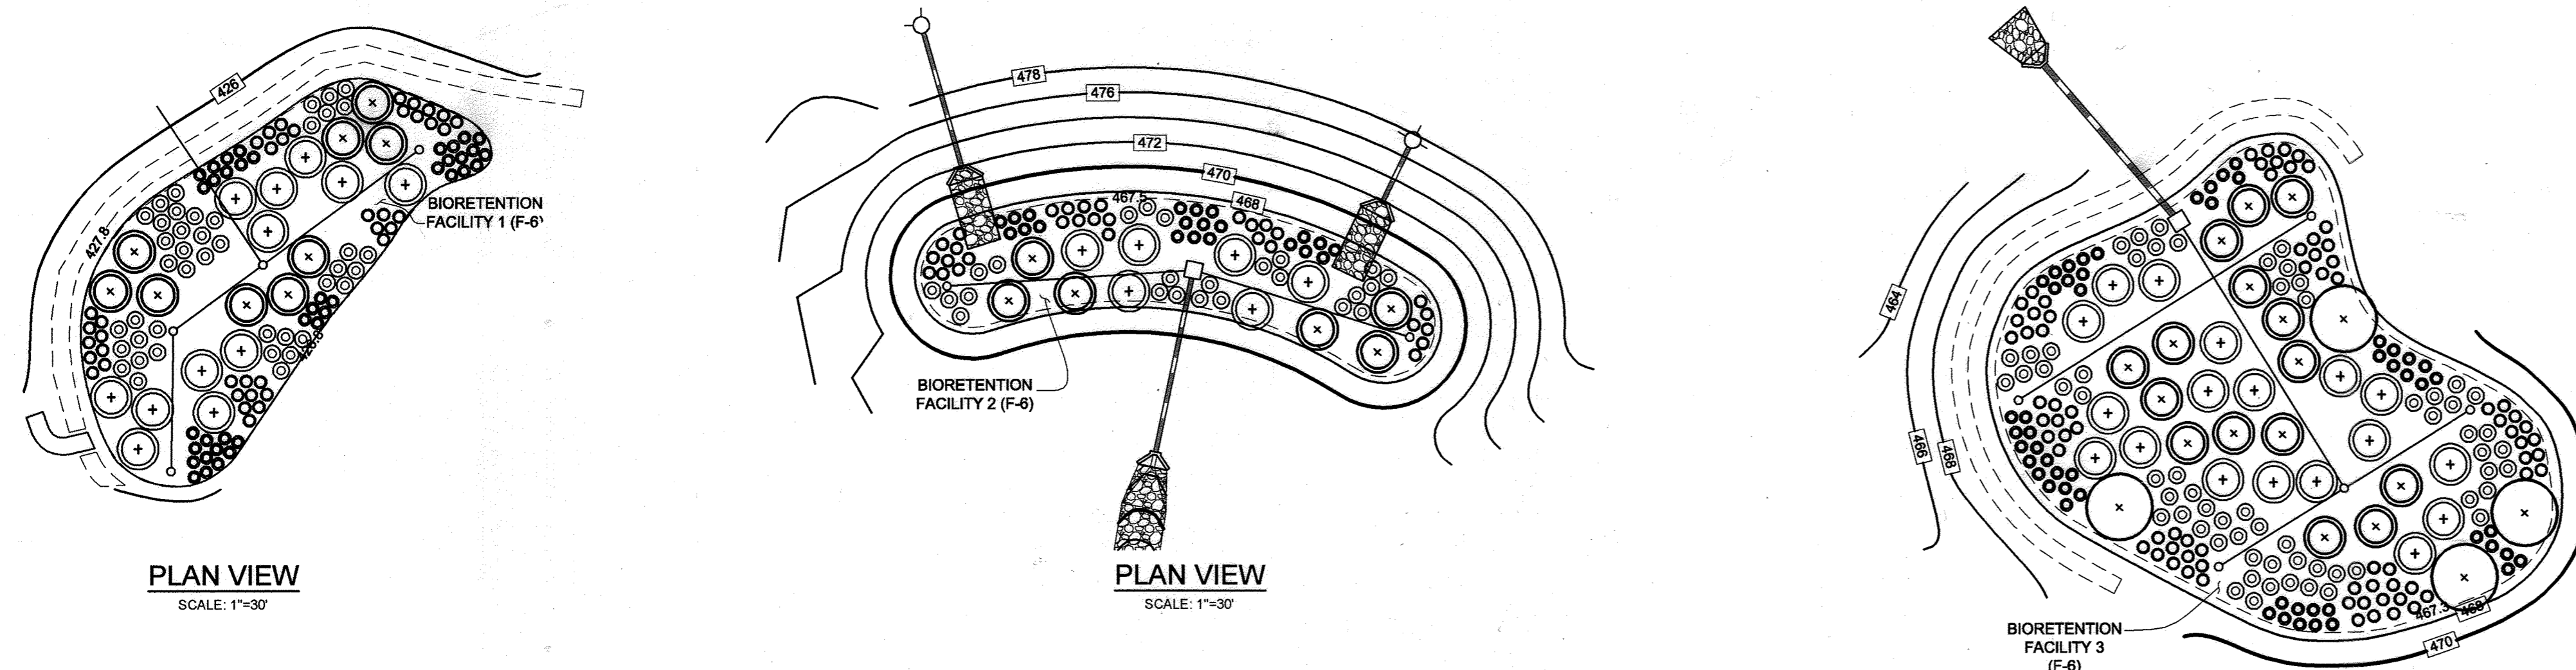

BIORETENTION PLANT LIST										
LEGEND	TREES									
KEY	BOTANICAL NAME	COMMON NAME	SPACING	SIZE	REMARKS	QUANTITY BIO 1	QUANTITY BIO 2	QUANTITY BIO 3		
(X)	ARU	ACER RUBRUM	RED MAPLE	AS SHOWN	1'-1 1/2" CAL.	BB	0	0	4	
SHRUBS										
(*)	CAM	CORNUS AMOMUM	SILKY DOGWOOD	AS SHOWN (MIN. 4" O.C.)	18"-24" HT.	CONT.	9	6	15	
(+)	VDE	VIBURNUM DENTATUM	ARROWWOOD	AS SHOWN (MIN. 10" O.C.)	18"-24" HT.	CONT.	12	6	18	
HERBACEOUS SPECIES										
(O)	EFM	EUPATORIUM FISTULOSUM	JOE-PYE WEED	AS SHOWN (MIN. 4" O.C.)	1 QT./12" HT.	CONT. (3" O.C.)	42	24	63	
(O)	MDI	MONARDA DIDYMA	BEEBALM	AS SHOWN (MIN. 3" O.C.)	1 QT.	CONT.	39	21	54	
(O)	RLA	RUDEBECKIA LACINIATA	TALL CONEFLOWER	AS SHOWN (MIN. 3" O.C.)	1 QT.	CONT.	39	30	75	

NOTE: PLANT MATERIAL MUST COVER 50% OF THE MULCH AREA AT MATURE GROWTH.  
 BIO 1 - BIORETENTION AREA = 5,090 S.F. OR 0.12 AC. PROVIDED: 21 SHRUBS AND 120 HERBACEOUS SPECIES  
 BIO 2 - BIORETENTION AREA = 3,094 S.F. OR 0.07 AC. PROVIDED: 12 SHRUBS AND 75 HERBACEOUS SPECIES  
 BIO 3 - BIORETENTION AREA = 10,090 S.F. OR 0.23 AC. PROVIDED: 4 TREES, 33 SHRUBS AND 192 HERBACEOUS SPECIES

**STORMWATER MANAGEMENT POND CONSTRUCTION SPECIFICATIONS (MD. 378 - JANUARY, 2000)**

**I. SITE PREPARATION**  
 AREAS DESIGNATED FOR BORROW AREAS, EMBANKMENT, AND STRUCTURAL WORKS SHALL BE CLEARED, GRUBBED AND STRIPPED OF TOPSOIL. ALL TREES, VEGETATION, ROOTS AND OTHER OBJECTIONABLE MATERIAL SHALL BE REMOVED. CHANNEL BANKS AND SHARP BREAKS SHALL BE SLOPED TO NO STEEPER THAN 1:1. ALL TREES SHALL BE CLEARED AND GRUBBED WITHIN 15 FEET OF THE TOE OF THE EMBANKMENT.  
 AREAS TO BE COVERED BY THE RESERVOIR WILL BE CLEARED OF ALL TREES, BRUSH, LOGS, FENCES, RUBBISH AND OTHER OBJECTIONABLE MATERIAL UNLESS OTHERWISE DESIGNATED ON THE PLANS. TREES, BRUSH AND STUMPS SHALL BE CUT APPROXIMATELY LEVEL WITH THE GROUND SURFACE. FOR DRY STORMWATER MANAGEMENT PONDS, A MINIMUM OF A 25 FOOT RADIUS AROUND THE INLET STRUCTURE SHALL BE CLEARED.  
 ALL CLEARED AND GRUBBED MATERIAL SHALL BE DISPOSED OF OUTSIDE AND BELOW THE LIMITS OF THE DAM AND RESERVOIR AS DIRECTED BY THE OWNER OR HIS REPRESENTATIVE. WHEN SPECIFIED, A SUFFICIENT QUANTITY OF TOPSOIL WILL BE STOCKPILED IN A SUITABLE LOCATION FOR USE ON THE EMBANKMENT AND OTHER DESIGNATED AREAS.

**II. EARTH FILL**  
**MATERIAL**  
 THE FILL MATERIAL SHALL BE TAKEN FROM APPROVED DESIGNATED BORROW AREAS. IT SHALL BE FREE OF ROOTS, STUMPS, WOOD, RUBBISH, STONES GREATER THAN 6" FROZEN OR OTHER OBJECTIONABLE MATERIALS. FILL MATERIAL FOR THE CENTER OF THE EMBANKMENT AND CUT OFF TRENCH SHALL CONFORM TO UNIFIED SOIL CLASSIFICATION GC, SC, CH, OR CL AND MUST HAVE AT LEAST 30% PASSING THE #200 SIEVE. CONSIDERATION MAY BE GIVEN TO THE USE OF OTHER MATERIALS IN THE EMBANKMENT IF DESIGNED BY A GEOTECHNICAL ENGINEER. SUCH SPECIAL DESIGNS MUST HAVE CONSTRUCTION SUPERVISED BY A GEOTECHNICAL ENGINEER. MATERIAL USED IN THE OUTER SHELL OF THE EMBANKMENT MUST HAVE THE CAPABILITY TO SUPPORT VEGETATION OF THE QUALITY REQUIRED TO PREVENT EROSION OF THE EMBANKMENT.  
**PLACEMENT**  
 AREAS ON WHICH FILL IS TO BE PLACED SHALL BE SCARIFIED PRIOR TO PLACEMENT OF FILL. FILL MATERIALS SHALL BE PLACED IN MAXIMUM 8-INCH THICK (BEFORE COMPACTION) LAYERS WHICH ARE TO BE CONTINUOUS OVER THE ENTIRE LENGTH OF THE FILL. THE MOST PERMEABLE BORROW MATERIAL SHALL BE PLACED IN THE DOWNSTREAM PORTIONS OF THE EMBANKMENT. THE PRINCIPAL SPILLWAY MUST BE INSTALLED CONCURRENTLY WITH FILL PLACEMENT AND NOT EXCAVATED INTO THE EMBANKMENT.  
**COMPACTION**  
 THE MOVEMENT OF THE HAULING AND SPREADING EQUIPMENT OVER THE FILL SHALL BE CONTROLLED SO THAT THE ENTIRE SURFACE OF EACH LIFT SHALL BE TRAVERSED BY NOT LESS THAN ONE TREAD TRACK OF HEAVY EQUIPMENT OR COMPACTION SHALL BE ACHIEVED BY A MINIMUM OF FOUR COMPLETE PASSES OF A SHEEP FOOT, RUBBER TRED OR VIBRATORY ROLLER. FILL MATERIAL SHALL CONTAIN SUFFICIENT MOISTURE SUCH THAT THE REQUIRED DEGREE OF COMPACTION WILL BE OBTAINED WITH THE EQUIPMENT USED. THE FILL MATERIAL SHALL CONTAIN SUFFICIENT MOISTURE SO THAT IF FORMED INTO A BALL, IT WILL NOT CRUMBLE, YET NOT BE SO WET THAT WATER CAN BE SQUEEZED OUT.  
 WHEN REQUIRED BY THE REVIEWING AGENCY, THE MINIMUM REQUIRED DENSITY SHALL NOT BE LESS THAN 95% OF MAXIMUM DRY DENSITY WITH A MOISTURE CONTENT WITHIN ±2% OF THE OPTIMUM. EACH LAYER OF FILL SHALL BE COMPACTED AS NECESSARY TO OBTAIN THAT DENSITY AND IS TO BE CERTIFIED BY AN ENGINEER AT THE TIME OF CONSTRUCTION. ALL COMPACTION IS TO BE DETERMINED BY AASHTO METHOD T-99 (STANDARD PROCTOR).

**CUTOFF TRENCH**  
 THE CUTOFF TRENCH SHALL BE EXCAVATED INTO IMPERVIOUS MATERIAL ALONG OR PARALLEL TO THE CENTERLINE OF THE EMBANKMENT AS SHOWN ON THE PLANS. THE BOTTOM WIDTH OF THE TRENCH SHALL BE GOVERNED BY THE EQUIPMENT USED FOR EXCAVATION WITH THE MINIMUM WIDTH BEING FOUR FEET. THE DEPTH SHALL BE AT LEAST FOUR FEET BELOW EXISTING GRADE OR AS SHOWN ON THE PLANS. THE SIDE SLOPES OF THE TRENCH SHALL BE 1:1 OR FLATTER. THE BACKFILL SHALL BE COMPACTED WITH CONSTRUCTION EQUIPMENT, ROLLERS, OR HAND TAMPERS TO ASSURE MAXIMUM DENSITY AND MINIMUM PERMEABILITY.  
**EMBANKMENT CORE**  
 THE CORE SHALL BE PARALLEL TO THE CENTERLINE OF THE EMBANKMENT AS SHOWN ON THE PLANS. THE TOP WIDTH OF THE CORE SHALL BE A MINIMUM OF FOUR FEET. THE HEIGHT SHALL EXTEND UP TO AT LEAST THE 10 YEAR WATER ELEVATION OR AS SHOWN ON THE PLANS. THE SIDE SLOPES SHALL BE 1:1 OR FLATTER. THE CORE SHALL BE COMPACTED WITH CONSTRUCTION EQUIPMENT, ROLLERS, OR HAND TAMPERS TO ASSURE MAXIMUM DENSITY AND MINIMUM PERMEABILITY. IN ADDITION, THE CORE SHALL BE PLACED CONCURRENTLY WITH THE OUTER SHELL OF THE EMBANKMENT.  
**III. STRUCTURE BACKFILL**  
 BACKFILL ADJACENT TO PIPES OR STRUCTURES SHALL BE OF THE TYPE AND QUALITY CONFORMING TO THAT SPECIFIED FOR THE ADJOINING FILL MATERIAL. THE FILL SHALL BE PLACED IN HORIZONTAL LAYERS NOT TO EXCEED FOUR INCHES IN THICKNESS AND COMPACTED BY HAND TAMPERS OR OTHER MANUALLY DIRECTED COMPACTION EQUIPMENT. THE MATERIAL NEEDS TO FILL COMPLETELY ALL SPACES UNDER AND ADJACENT TO THE PIPE. AT NO TIME DURING THE BACKFILLING OPERATION SHALL DRIVEN EQUIPMENT BE ALLOWED TO OPERATE CLOSER THAN FOUR FEET, MEASURED HORIZONTALLY, TO ANY PART OF A STRUCTURE. UNDER NO CIRCUMSTANCES SHALL EQUIPMENT BE DRIVEN OVER ANY PART OF A CONCRETE STRUCTURE OR PIPE, UNLESS THERE IS A COMPACTED FILL OF 24" OR GREATER OVER THE STRUCTURE OR PIPE.  
 STRUCTURE BACKFILL MAY BE FLOWABLE FILL MEETING THE REQUIREMENTS OF MARYLAND DEPARTMENT OF TRANSPORTATION, STATE HIGHWAY ADMINISTRATION STANDARD SPECIFICATIONS FOR CONSTRUCTION AND MATERIALS, SECTION 313 AS MODIFIED. THE MIXTURE SHALL HAVE A 100-200 PSI, 28 DAY UNCONFINED COMPRESSIVE STRENGTH. THE FLOWABLE FILL SHALL HAVE A MINIMUM PH OF 4.0 AND A MINIMUM RESISTIVITY OF 2,000 OHM-CM. MATERIAL SHALL BE PLACED SUCH THAT A MINIMUM OF 6" (MEASURED PERPENDICULAR TO THE OUTSIDE OF THE PIPE) OF FLOWABLE FILL SHALL BE UNDER (BEDDING), OVER AND ON THE SIDES OF THE PIPE. IT ONLY NEEDS TO EXTEND UP TO THE SPRING LINE FOR RIGID CONDUITS. AVERAGE SLUMP OF THE FILL SHALL BE 7" TO ASSURE FLOWABILITY OF THE MATERIAL. ADEQUATE MEASURES SHALL BE TAKEN (SAND BAGS, ETC.) TO PREVENT FLOATING THE PIPE. WHEN USING FLOWABLE FILL, ALL METAL PIPE SHALL BE BITUMINOUS COATED. ANY ADJOINING SOIL FILL SHALL BE PLACED IN HORIZONTAL LAYERS NOT TO EXCEED FOUR INCHES IN THICKNESS AND COMPACTED BY HAND TAMPERS OR OTHER MANUALLY DIRECTED COMPACTION EQUIPMENT. THE MATERIAL SHALL COMPLETELY FILL ALL VOIDS ADJACENT TO THE FLOWABLE FILL ZONE. AT NO TIME DURING THE BACKFILLING OPERATION SHALL DRIVEN EQUIPMENT BE ALLOWED TO OPERATE CLOSER THAN FOUR FEET, MEASURED HORIZONTALLY, TO ANY PART OF A STRUCTURE. UNDER NO CIRCUMSTANCES SHALL EQUIPMENT BE DRIVEN OVER ANY PART OF A STRUCTURE OR PIPE UNLESS THERE IS A COMPACTED FILL OF 24" OR GREATER OVER THE STRUCTURE OR PIPE. BACKFILL MATERIAL OUTSIDE THE STRUCTURE BACKFILL (FLOWABLE FILL) ZONE SHALL BE OF THE TYPE AND QUALITY CONFORMING TO THAT SPECIFIED FOR THE CORE OF THE EMBANKMENT OR OTHER EMBANKMENT MATERIALS.

**IV. PIPE CONDUITS**  
 ALL PIPES SHALL BE CIRCULAR IN CROSS SECTION.  
**A. CORRUGATED METAL PIPE** - ALL OF THE FOLLOWING CRITERIA SHALL APPLY FOR CORRUGATED METAL PIPE:  
 1. MATERIALS - POLYMER COATED STEEL PIPE.  
 STEEL PIPES WITH POLYMERIC COATINGS SHALL HAVE A MINIMUM COATING THICKNESS OF 0.01 INCH (10 MIL) ON BOTH SIDES OF THE PIPE. THIS PIPE AND ITS APPURTENANCES SHALL CONFORM TO THE REQUIREMENTS OF AASHTO SPECIFICATIONS M-245 & M-246 WITH WATERTIGHT COUPLING BANDS OR FLANGES.  
 MATERIALS - (ALUMINUM COATED STEEL PIPE)  
 THIS PIPE AND ITS APPURTENANCES SHALL CONFORM TO THE REQUIREMENTS OF AASHTO SPECIFICATION M-274 WITH WATERTIGHT COUPLING BANDS OR FLANGES. ALUMINUM COATED STEEL PIPE, WHEN USED WITH FLOWABLE FILL OR WHEN SOIL AND/OR WATER CONDITIONS WARRANT THE NEED FOR INCREASED DURABILITY, SHALL BE FULLY BITUMINOUS COATED PER REQUIREMENTS OF AASHTO SPECIFICATION M-190 TYPE A. ANY ALUMINUM COATING DAMAGED OR OTHERWISE REMOVED SHALL BE REPLACED WITH COLD APPLIED BITUMINOUS COATING COMPOUND. ALUMINUM SURFACES THAT ARE TO BE IN CONTACT WITH CONCRETE SHALL BE PAINTED WITH ONE COAT OF ZINC CHROMATE PRIMER OR TWO COATS OF ASPHALT.  
 MATERIALS - (ALUMINUM PIPE)  
 THIS PIPE AND ITS APPURTENANCES SHALL CONFORM TO THE REQUIREMENTS OF AASHTO SPECIFICATION M-196 OR M-211 WITH WATERTIGHT COUPLING BANDS OR FLANGES. ALUMINUM PIPE, WHEN USED WITH FLOWABLE FILL OR WHEN SOIL AND/OR WATER CONDITIONS WARRANT FOR INCREASED DURABILITY, SHALL BE FULLY BITUMINOUS COATED PER REQUIREMENTS OF AASHTO SPECIFICATION M-190 TYPE A. ALUMINUM SURFACES THAT ARE TO BE IN CONTACT WITH CONCRETE SHALL BE PAINTED WITH ONE COAT OF ZINC CHROMATE PRIMER OR TWO COATS OF ASPHALT. HOT DIP GALVANIZED BOLTS MAY BE USED FOR CONNECTIONS. THE PH OF THE SURROUNDING SOILS SHALL BE BETWEEN 4 AND 9.  
 2. COUPLING BANDS, ANTI-SEEP COLLARS, END SECTIONS, ETC., MUST BE COMPOSED OF THE SAME MATERIAL AS THE PIPE. METALS MUST BE INSULATED FROM DISSIMILAR MATERIALS WITH USE OF RUBBER OR PLASTIC INSULATING MATERIALS AT LEAST 24 MILS IN THICKNESS.  
 3. CONNECTIONS - ALL CONNECTIONS WITH PIPES MUST BE COMPLETELY WATERTIGHT. THE DRAIN PIPE OR BARREL CONNECTION TO THE RISER SHALL BE WELDED ALL AROUND WHEN THE PIPE AND RISER ARE METAL. ANTI-SEEP COLLARS SHALL BE CONNECTED TO THE PIPE IN SUCH A MANNER AS TO BE COMPLETELY WATERTIGHT. DIMPLE BANDS ARE NOT CONSIDERED TO BE WATERTIGHT.  
 ALL CONNECTIONS SHALL USE A RUBBER OR NEOPRENE GASKET WHEN JOINING PIPE SECTIONS. THE END OF EACH PIPE SHALL BE RE-ROLLED AN ADEQUATE NUMBER OF CORRUGATIONS TO ACCOMMODATE THE BAND WIDTH. THE FOLLOWING TYPE CONNECTIONS ARE ACCEPTABLE FOR PIPES LESS THAN 24" IN DIAMETER. FLANGES ON BOTH ENDS OF THE PIPE WITH A CIRCULAR 3/8 INCH CLOSED CELL NEOPRENE GASKET, PRE PUNCHED TO THE FLANGE BOLT CIRCLE, SANDWICHED BETWEEN ADJACENT FLANGES; A 12 INCH WIDE STANDARD LAP BAND WITH 12 INCH WIDE BY 3/8 INCH THICK CLOSED CELL CIRCULAR NEOPRENE GASKET AND A 12 INCH WIDE HUGGER TYPE BAND WITH O-RING GASKETS HAVING A MINIMUM DIAMETER OF 1/2 INCH GREATER THAN THE CORRUGATION DEPTH. PIPES 24 INCHES IN DIAMETER AND LARGER SHALL BE CONNECTED BY A 24 INCH LONG ANNULAR CORRUGATED BAND USING A MINIMUM OF 4 RODS AND LUGS, 2 ON EACH CONNECTING PIPE END. A 24 INCH WIDE BY 3/8 INCH THICK CLOSED CELL CIRCULAR NEOPRENE GASKET WILL BE INSTALLED WITH 12 INCHES ON THE END OF EACH PIPE. FLANGED JOINTS WITH 3/8 INCH CLOSED CELL GASKETS THE FULL WIDTH OF THE FLANGE IS ALSO ACCEPTABLE.  
 HELICALLY CORRUGATED PIPE SHALL HAVE EITHER CONTINUOUSLY WELDED SEAMS OR HAVE LOCK SEAMS WITH INTERNAL CAULKING OR A NEOPRENE BEAD.  
 4. BEDDING - THE PIPE SHALL BE FIRMLY AND UNIFORMLY BEDDED THROUGHOUT ITS ENTIRE LENGTH WHERE ROCK OR SOFT, SPONGY OR OTHER UNSTABLE SOIL IS ENCOUNTERED. ALL SUCH MATERIAL SHALL BE REMOVED AND REPLACED WITH SUITABLE EARTH COMPACTED TO PROVIDE ADEQUATE SUPPORT.  
 5. BACKFILLING SHALL CONFORM TO "STRUCTURE BACKFILL".  
 6. OTHER DETAILS (ANTI-SEEP COLLARS, VALVES, ETC.) SHALL BE AS SHOWN ON THE DRAWINGS.  
**B. REINFORCED CONCRETE PIPE** - ALL OF THE FOLLOWING CRITERIA SHALL APPLY FOR REINFORCED CONCRETE PIPE:  
 1. MATERIALS - REINFORCED CONCRETE PIPE SHALL HAVE BELL AND SPIGOT JOINTS WITH RUBBER GASKETS AND SHALL EQUAL OR EXCEED ASTM DESIGNATION C-361.  
 2. BEDDING - ALL REINFORCED CONCRETE PIPE CONDUITS SHALL BE LAID IN A CONCRETE BEDDING/CRADLE FOR THEIR ENTIRE LENGTH. THIS BEDDING/CRADLE SHALL CONSIST OF HIGH SLUMP CONCRETE PLACED UNDER AND OVER THE SIDES OF THE PIPE AT LEAST 50% OF ITS OUTSIDE DIAMETER WITH A MINIMUM THICKNESS OF 6 INCHES. WHERE A CONCRETE CRADLE IS NOT NEEDED FOR STRUCTURAL REASONS, FLOWABLE FILL MAY BE USED AS DESCRIBED IN THE "STRUCTURE BACKFILL" SECTION OF THIS STANDARD. GRAVEL BEDDING IS NOT PERMITTED.  
 3. LAYING PIPE - BELL AND SPIGOT PIPE SHALL BE PLACED WITH THE BELL END UPSTREAM. JOINTS SHALL BE MADE IN ACCORDANCE WITH RECOMMENDATIONS OF THE MANUFACTURER OF THE MATERIAL. AFTER THE JOINTS ARE SEALED FOR THE ENTIRE LINE, THE BEDDING SHALL BE PLACED SO THAT ALL SPACES UNDER THE PIPE ARE FILLED. CARE SHALL BE EXERCISED TO PREVENT ANY DEVIATION FROM THE ORIGINAL LINE AND GRADE OF THE PIPE. THE FIRST JOINT MUST BE LOCATED WITHIN A FEET FROM THE RISER.  
 4. BACKFILLING SHALL CONFORM TO "STRUCTURE BACKFILL".  
 5. OTHER DETAILS (ANTI-SEEP COLLARS, VALVES, ETC.) SHALL BE AS SHOWN ON THE DRAWINGS.

**C. PLASTIC PIPE** - ALL OF THE FOLLOWING CRITERIA SHALL APPLY FOR PLASTIC PIPE:  
 1. MATERIALS - PVC PIPE SHALL BE PVC-1120 OR PVC-1220 CONFORMING TO ASTM D-1785 OR ASTM D-2241. CORRUGATED HIGH DENSITY POLYETHYLENE (HDPE) PIPE, COUPLINGS AND FITTINGS SHALL CONFORM TO THE FOLLOWING: 4" - 10" PIPE SHALL MEET THE REQUIREMENTS OF AASHTO M-252 TYPE S AND 12" - 24" SHALL MEET THE REQUIREMENTS OF AASHTO M-294 TYPE S.  
 2. JOINTS AND CONNECTIONS TO ANTI-SEEP COLLARS SHALL BE COMPLETELY WATERTIGHT.  
 3. BEDDING - THE PIPE SHALL BE FIRMLY AND UNIFORMLY BEDDED THROUGHOUT ITS ENTIRE LENGTH WHERE ROCK OR SOFT, SPONGY OR OTHER UNSTABLE SOIL IS ENCOUNTERED. ALL SUCH MATERIAL SHALL BE REMOVED AND REPLACED WITH SUITABLE EARTH COMPACTED TO PROVIDE ADEQUATE SUPPORT.  
 4. BACKFILLING SHALL CONFORM TO "STRUCTURE BACKFILL".  
 5. OTHER DETAILS (ANTI-SEEP COLLARS, VALVES, ETC.) SHALL BE AS SHOWN ON THE DRAWINGS.  
**D. DRAINAGE DIAPHRAGMS** - WHEN A DRAINAGE DIAPHRAGM IS USED A REGISTERED PROFESSIONAL ENGINEER WILL SUPERVISE THE DESIGN AND CONSTRUCTION INSPECTION.

**V. CONCRETE**  
 CONCRETE SHALL MEET THE REQUIREMENTS OF MARYLAND DEPARTMENT OF TRANSPORTATION, STATE HIGHWAY ADMINISTRATION STANDARD SPECIFICATIONS FOR CONSTRUCTION AND MATERIALS, SECTION 414, MIX NO. 3.  
**VI. ROCK RIPRAP**  
 ROCK RIPRAP SHALL MEET THE REQUIREMENTS OF MARYLAND DEPARTMENT OF TRANSPORTATION, STATE HIGHWAY ADMINISTRATION STANDARD SPECIFICATIONS FOR CONSTRUCTION AND MATERIALS, SECTION 311.  
 GEOTEXTILE SHALL BE PLACED UNDER ALL RIPRAP AND SHALL MEET THE REQUIREMENTS OF MARYLAND DEPARTMENT OF TRANSPORTATION, STATE HIGHWAY ADMINISTRATION STANDARD SPECIFICATIONS FOR CONSTRUCTION AND MATERIALS, SECTION 921.09, CLASS C.

**VII. CARE OF WATER DURING CONSTRUCTION**  
 ALL WORK ON THE PERMANENT STRUCTURES SHALL BE CARRIED OUT IN AREAS FREE FROM WATER. THE CONTRACTOR SHALL CONSTRUCT AND MAINTAIN ALL TEMPORARY DIKES, LEVEES, COFFERDAMS, DRAINAGE CHANNELS, AND STREAM DIVERSIONS NECESSARY TO PROTECT THE AREAS TO BE OCCUPIED BY THE PERMANENT WORKS. THE CONTRACTOR SHALL ALSO FURNISH, INSTALL, OPERATE AND MAINTAIN ALL NECESSARY PUMPING AND OTHER EQUIPMENT REQUIRED FOR REMOVAL OF WATER FROM THE VARIOUS PARTS OF THE WORK AND FOR MAINTAINING THE EXCAVATIONS, FOUNDATION, AND OTHER PARTS OF THE WORK FREE FROM WATER AS REQUIRED OR DIRECTED BY THE ENGINEER FOR CONSTRUCTING EACH PART OF THE WORK. AFTER HAVING SERVED THEIR PURPOSE, ALL TEMPORARY PROTECTIVE WORKS SHALL BE REMOVED OR LEVELED AND GRADED TO THE EXTENT REQUIRED TO PREVENT OBSTRUCTION IN ANY DEGREE WHAT-SO-EVER OF THE FLOW OF WATER TO THE SPILLWAY OR OUTLET WORKS AND SO AS NOT TO INTERFERE IN ANY WAY WITH THE OPERATION OR MAINTENANCE OF THE STRUCTURE. STREAM DIVERSIONS SHALL BE MAINTAINED UNTIL THE FULL FLOW CAN BE PASSED THROUGH THE PERMANENT WORKS. THE REMOVAL OF WATER FROM THE REQUIRED EXCAVATION AND THE FOUNDATION SHALL BE ACCOMPLISHED IN A MANNER AND TO THE EXTENT THAT WILL MAINTAIN STABILITY OF THE EXCAVATED SLOPES AND BOTTOM OF REQUIRED EXCAVATIONS AND WILL ALLOW SATISFACTORY PERFORMANCE OF ALL CONSTRUCTION OPERATIONS. DURING THE PLACING AND COMPACTING OF MATERIAL IN REQUIRED EXCAVATIONS, THE WATER LEVEL AT THE LOCATIONS BEING REFILLED SHALL BE MAINTAINED BELOW THE BOTTOM OF THE EXCAVATION AT SUCH LOCATIONS WHICH MAY REQUIRE DRAINING THE WATER TO PUMPS FROM WHICH THE WATER SHALL BE PUMPED.  
**VIII. STABILIZATION**  
 ALL BORROW AREAS SHALL BE GRADED TO PROVIDE PROPER DRAINAGE AND LEFT IN A SLIGHTLY CONDITION ALL EXPOSED SURFACES OF THE EMBANKMENT, SPILLWAY, SPOIL AND BORROW AREAS, AND BERMS SHALL BE STABILIZED BY SEEDING, LIMING, FERTILIZING AND MULCHING IN ACCORDANCE WITH THE NATURAL RESOURCES CONSERVATION SERVICE STANDARDS AND SPECIFICATIONS FOR CRITICAL AREA PLANTING (MD-345) OR AS SHOWN ON THE ACCOMPANYING DRAWINGS.

**IX. EROSION AND SEDIMENT CONTROL**  
 CONSTRUCTION OPERATIONS WILL BE CARRIED OUT IN SUCH A MANNER THAT EROSION WILL BE CONTROLLED AND WATER AND AIR POLLUTION MINIMIZED. STATE AND LOCAL LAWS CONCERNING POLLUTION ABATEMENT WILL BE FOLLOWED. CONSTRUCTION PLANS SHALL DETAIL EROSION AND SEDIMENT CONTROL MEASURES.  
**X. STORMWATER MANAGEMENT INSPECTION AND MAINTENANCE SCHEDULE**  
 1. INSPECT ANNUALLY AND AFTER A MAJOR STORM TO ENSURE PROPER OPERATION. WHEN POSSIBLE, INSPECTIONS SHOULD BE CONDUCTED DURING WET WEATHER TO DETERMINE IF THE POND IS FUNCTIONING PROPERLY.  
 2. GRASS ON TOP OF THE EMBANKMENT AND THE SIDE SLOPES ONLY SHALL (AT A MINIMUM) BE MOWED TWICE A YEAR, ONCE IN JUNE AND AGAIN IN SEPTEMBER.  
 3. CLEAN ALL TRASH AND DEBRIS FROM THE POND AND RISER PIPE AREAS.  
 4. REPAIR ANY VISIBLE SIGNS OF EROSION IN THE POND AREA AS WELL AS THE RIP RAP OUTFALL AREA.  
 5. THE DAM INSPECTION CHECKLIST SHALL BE INCLUDED AS PART OF THE OPERATION AND MAINTENANCE PLAN AND PERFORMED AT LEAST ANNUALLY. WRITTEN RECORDS OF MAINTENANCE AND MAJOR REPAIRS NEED TO BE RETAINED IN A FILE. THE ISSUANCE OF A MAINTENANCE AND REPAIR PERMIT FOR ANY REPAIRS OR MAINTENANCE THAT INVOLVES THE MODIFICATION OF THE DAM OR SPILLWAY FROM ITS ORIGINAL DESIGN AND SPECIFICATIONS IS REQUIRED. A PERMIT IS ALSO REQUIRED FOR ANY REPAIRS OR RECONSTRUCTION THAT INVOLVE A SUBSTANTIAL PORTION OF THE STRUCTURE. ALL INDICATED REPAIRS ARE TO BE MADE AS SOON AS PRACTICAL.

**XI. CONSTRUCTION CHECK DATA/AS-BUILT**  
 RECORD ON SURVEY NOTE PAPER, SCS-ENG-28. SURVEY DATA FOR PONDS WILL BE PLOTTED IN RED. ALL CONSTRUCTION INSPECTION VISITS SHALL BE RECORDED ON THE CPA-6 OR APPROPRIATE DOCUMENTATION PAPER. THE DOCUMENTATION SHALL INCLUDE THE DATE, WHO PERFORMED THE INSPECTION, SPECIFICS AS TO WHAT WAS INSPECTED, ALL ALTERNATIVES DISCUSSED AND DECISIONS MADE AND BY WHOM. THE FOLLOWING IS A LIST OF THE MINIMUM DATA NEEDED FOR AS-BUILTS:

1. A PROFILE OF THE TOP OF DAM
2. A CROSS SECTION OF THE EMERGENCY SPILLWAY AT THE CONTROL SECTION
3. A PROFILE ALONG THE CENTERLINE OF THE EMERGENCY SPILLWAY.
4. A PROFILE ALONG THE CENTERLINE OF THE PRINCIPAL SPILLWAY EXTENDING AT LEAST 100 FEET DOWNSTREAM OF FILL
5. THE ELEVATION OF THE PRINCIPAL SPILLWAY CREST.
6. THE ELEVATION OF THE PRINCIPAL SPILLWAY CONDUIT INVERT. (INLET AND OUTLET)
7. THE DIAMETER, LENGTH, THICKNESS AND TYPE OF MATERIAL FOR THE RISER.
8. THE DIAMETER, LENGTH, AND TYPE OF MATERIAL FOR THE CONDUIT.
9. THE SIZE AND TYPE OF ANTI-VORTEX AND TRASH RACK DEVICE AND ITS ELEVATIONS IN RELATION OF THE PRINCIPAL SPILLWAY CREST.
10. THE NUMBER, SIZE, AND LOCATION OF THE ANTI-SEEP COLLARS.
11. THE DIAMETER AND SIZE OF ANY LOW STAGE ORIFICES OR DRAIN PIPES.
12. SHOW THE LENGTH, WIDTH, AND DEPTH OF CONTOURS OF THE POOL AREA SO THAT DESIGN VOLUME CAN BE VERIFIED.
13. NOTES AND MEASUREMENTS TO SHOW THAT ANY SPECIAL DESIGN FEATURES WERE MET.
14. STATEMENT ON SEEDING AND FENCING.
15. NOTES ON SITE CLEANUP AND DISPOSAL.
16. SIGN AND DATE CHECK NOTES TO INCLUDE STATEMENT THAT PRACTICE MEETS OR EXCEEDS PLANS AND SPECIFICATIONS.
17. COMPACTION TEST RESULTS ON ALL FILL PLACEMENT, CERTIFIED BY A PROFESSIONAL ENGINEER.
18. CONCRETE TEST RESULTS. FOR ALL CAST IN PLACE CONCRETE, CERTIFIED BY A PROFESSIONAL ENGINEER.
19. A STATEMENT REGARDING THE STABILITY OF ALL CUT/FILL SLOPES.
20. A STATEMENT REGARDING THE PRESENCE OF SOIL PERMEABILITY, GROUNDWATER AND/OR BEDROCK IN POOL AREA.
21. EVIDENCE THAT THE CUT-OFF/CORE TRENCH WAS INSTALLED PER PLANS AND SPECIFICATIONS.
22. EVIDENCE THAT THE EMERGENCY SPILLWAY AND/OR ACCESS ROAD WAS INSTALLED AS REQUIRED BY PLANS AND SPECIFICATIONS.

**OWNER/DEVELOPER**  
 MANGIONE ENTERPRISES OF TURF VALLEY, LP  
 LOU MANGIONE  
 1205 YORK ROAD  
 LUTHERVILLE, MARYLAND 21093  
 410.825.9400

**AS-BUILT**  
**BIORETENTION PLANTING PLAN & MD 378 POND NOTES**  
**TURF VALLEY**  
 REGIONAL STORMWATER MANAGEMENT FACILITIES  
 PGCC MULTI-USE SUBDISTRICT  
 TAX MAP 16 GRID 16 & 17 PART OF PARCELS 8 & 394  
 3RD ELECTION DISTRICT HOWARD COUNTY, MARYLAND

**AS-BUILT CERTIFICATION**  
 THERE IS NO AS-BUILT INFORMATION ON THIS SHEET.  
*Michael D. Adcock*  
 MICHAEL D. ADCOCK, PROFESSIONAL LAND SURVEYOR DATE: 6/1/13  
 MD REG. NO. 21257, EXPIRATION DATE: 6/16/13

NO.	DESCRIPTION	DATE

**Sill · Adcock & Associates · LLC**  
 Engineers · Surveyors · Planners  
 3300 North Ridge Road, Suite 160  
 Elliot City, Maryland 21043  
 Phone: 443.325.7682 Fax: 443.325.7685  
 Email: info@silladcock.com

DESIGN BY: DB  
 DRAWN BY: BK  
 CHECKED BY: PS  
 SCALE: AS SHOWN  
 DATE: APRIL 30, 2013  
 PROJECT #: 05-025  
 SHEET #: 11 of 12

PROFESSIONAL CERTIFICATION: I HEREBY CERTIFY THAT THESE DOCUMENTS WERE PREPARED OR APPROVED BY ME, AND THAT I AM A DULY LICENSED PROFESSIONAL ENGINEER UNDER THE LAWS OF THE STATE OF MARYLAND, LICENSE NO. 32025, EXPIRATION DATE: JUNE 20, 2013

**APPROVED:** HOWARD COUNTY DEPARTMENT OF PLANNING AND ZONING  
*Howard County* 5/2/13  
 CHIEF, DEVELOPMENT ENGINEERING DIVISION DATE  
*Michael D. Adcock* 5/2/13  
 CHIEF, DIVISION OF LAND DEVELOPMENT DATE  
*Paul M. Sill* 5/4/13  
 DIRECTOR DATE


THESE PLANS FOR SMALL POND CONSTRUCTION, SOIL EROSION AND SEDIMENT CONTROL, MEET THE REQUIREMENTS OF THE HOWARD SOIL CONSERVATION DISTRICT.  
 ENGINEERS CERTIFICATE  
 "I CERTIFY THAT THIS PLAN FOR POND CONSTRUCTION, EROSION AND SEDIMENT CONTROL, REPRESENTS A PRACTICAL AND WORKABLE PLAN BASED ON MY PERSONAL KNOWLEDGE OF THE SITE CONDITIONS. THIS PLAN WAS PREPARED IN ACCORDANCE WITH THE REQUIREMENTS OF THE HOWARD SOIL CONSERVATION DISTRICT. I HAVE NOTIFIED THE DEVELOPER THAT HE/SHE MUST ENGAGE A REGISTERED PROFESSIONAL ENGINEER TO SUPERVISE POND CONSTRUCTION AND PROVIDE THE HOWARD SOIL CONSERVATION DISTRICT WITH AN "AS-BUILT" PLAN OF THE POND WITHIN 30 DAYS OF COMPLETION."  
*Paul M. Sill* 4/30/13  
 SIGNATURE OF ENGINEER DATE  
 PAUL M. SILL, P.E.

DEVELOPER'S CERTIFICATE  
 "I/WE CERTIFY THAT ALL DEVELOPMENT AND/OR CONSTRUCTION WILL BE DONE ACCORDING TO THESE PLANS, AND THAT ANY RESPONSIBLE PERSONNEL INVOLVED IN THE CONSTRUCTION PROJECT WILL HAVE A CERTIFICATE OF ATTENDANCE AT A DEPARTMENT OF THE ENVIRONMENT APPROVED TRAINING PROGRAM FOR THE CONTROL OF SEDIMENT AND EROSION BEFORE BEGINNING THE PROJECT. I/SHALL ENGAGE A REGISTERED PROFESSIONAL ENGINEER TO SUPERVISE POND CONSTRUCTION AND PROVIDE THE HOWARD SOIL CONSERVATION DISTRICT WITH AN "AS-BUILT" PLAN OF THE POND WITHIN 30 DAY OF COMPLETION. I/SHALL ALSO ARRANGE PERIODIC WHITE INSPECTIONS BY THE HOWARD SOIL CONSERVATION DISTRICT."  
*Michael D. Adcock* 4/30/13  
 SIGNATURE OF DEVELOPER DATE


**APPROVED**  
 PLANNING BOARD  
 OF HOWARD COUNTY  
 DATE: 04/15/2013  
*[Signature]*



MATERIALS SPECIFICATIONS FOR TEMPORARY BIORETENTION FACILITY			
MATERIAL	SPECIFICATION	SIZE	NOTES
PLANTINGS	SEE PLANT LIST THIS SHEET	N/A	PLANTINGS ARE SITE-SPECIFIC. SEE PLANT LIST THIS SHEET
PLANTING SOIL (1.0' DEEP)	SAND 35% - 60% SILT 0% - 25% GROUND COMPOST 40%-50%	N/A	EXISTING SOIL SUITABLE TO MEET PLANTING SOIL SPECIFICATIONS TO BE STOCKPILED IN DESIGNATED AREA & SUPPLEMENTED WITH COMPOST AS NECESSARY
MULCH	SHREDDED HARDWOOD		AGED 6 MONTHS, MINIMUM
PEA GRAVEL DIAPHRAGM AND CURTAIN DRAIN, IF REQUIRED	PEA GRAVEL: ASTM-D-448 ORNAMENTAL STONE: WASHED COBBLES	PEA GRAVEL: NO. 6 STONE: 2" TO 5"	
HARDWARE CLOTH	0.035" THICK - 1/4" MESH OR SMALLER GALVANIZED WIRE HARDWARE CLOTH		FOR USE AS A WRAP AROUND PERFORATED UNDERDRAIN PIPING
UNDERDRAIN PEA GRAVEL	#7 OR #8 STONE	0.25" TO 0.50"	CLEAN WASHED STONE
UNDERDRAIN GRAVEL	AASHTO M-43	0.375" TO 0.75"	CLEAN WASHED STONE
UNDERDRAIN PIPING	F 750, TYPE P3 28 OR AASHTO M-278	4" TO 8" RIGID SCHEDULE 40 PVC OR SDR35	- 3/8" PERF. @ 8" ON CENTER, 4 HOLES PER ROW. - SLOTTED PIPE MAY BE USED IN LIEU OF PERFORATED PIPE (HARDWARE CLOTH WRAP NOT REQUIRED) - MINIMUM OF 3" OF GRAVEL OVER PIPES; NOT NECESSARY UNDERNEATH PIPES

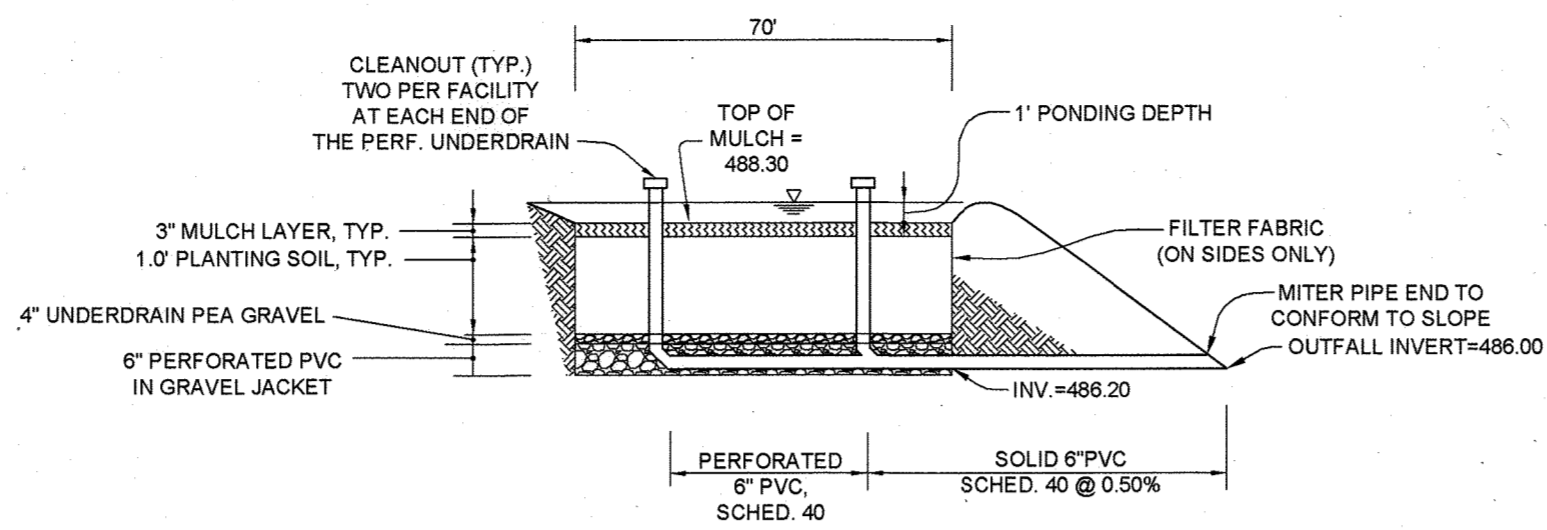

TEMPORARY BIORETENTION FACILITY  
TYPICAL PROFILE  
NOT TO SCALE

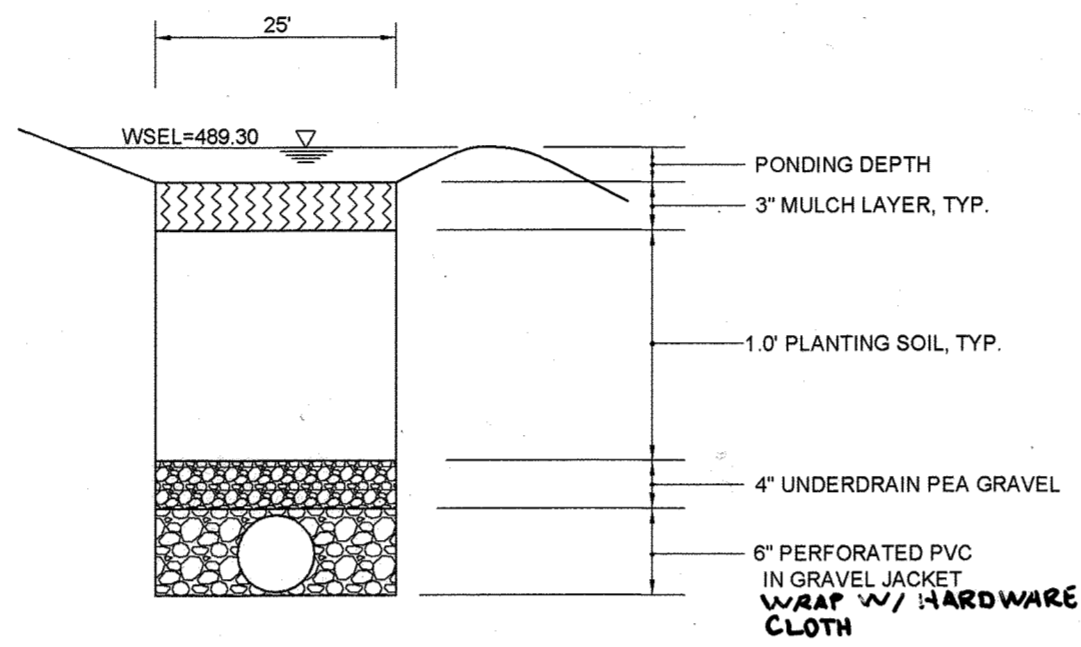

TEMPORARY BIORETENTION FACILITY  
TYPICAL SECTION  
NOT TO SCALE

NOTES:  
• FOR ADDITIONAL INFORMATION, SEE THE 2000 MARYLAND STORMWATER DESIGN MANUAL, VOLUMES I AND II.

OPERATION AND MAINTENANCE SCHEDULE FOR PRIVATELY OWNED AND MAINTAINED BIORETENTION FACILITIES (F-6)

- THE OWNER SHALL MAINTAIN THE PLANT MATERIAL, MULCH LAYER AND SOIL LAYER ANNUALLY. MAINTENANCE OF MULCH AND SOIL IS LIMITED TO CORRECTING AREAS OF EROSION OR WASH OUT. ANY MULCH REPLACEMENT SHALL BE DONE IN THE SPRING. PLANT MATERIAL SHALL BE CHECKED FOR DISEASE AND INSECT INFESTATION AND MAINTENANCE WILL ADDRESS DEAD MATERIAL AND PRUNING. ACCEPTABLE REPLACEMENT PLANT MATERIAL IS LIMITED TO THE FOLLOWING: 2000 MARYLAND STORMWATER DESIGN MANUAL, VOLUME II, TABLE A.4.1 AND 2.
- THE OWNER SHALL PERFORM A PLANT INSPECTION IN THE SPRING AND IN THE FALL OF EACH YEAR. DURING THE INSPECTION, THE OWNER SHALL REMOVE DEAD OR DISEASED VEGETATION CONSIDERED BEYOND TREATMENT, REPLACE DEAD PLANT MATERIAL WITH ACCEPTABLE REPLACEMENT PLANT MATERIAL, TREAT DISEASED TREES AND SHRUBS, AND REPLACE ALL DEFICIENT STAKES AND WIRES.
- THE OWNER SHALL INSPECT THE MULCH EACH SPRING. THE MULCH SHALL BE REPLACED EVERY TWO TO THREE YEARS. THE PREVIOUS MULCH LAYER SHALL BE REMOVED BEFORE THE NEW LAYER IS APPLIED.
- THE OWNER SHALL CORRECT SOIL EROSION ON AN AS NEEDED BASIS, WITH A MINIMUM OF ONCE PER MONTH AND AFTER EACH HEAVY STORM.

TEMPORARY BIORETENTION PLANT LIST						
SHRUBS						
BOTANICAL NAME	COMMON NAME	SPACING	SIZE	REMARKS	QTY	
CORNUS AMOMUM	SILKY DOGWOOD	MIN. 10' O.C.*	18"-24" HT.	CONT.	3	
VIBURNUM DENTATUM	ARROWWOOD	MIN. 10' O.C.*	18"-24" HT.	CONT.	6	
HERBACEOUS SPECIES						
EUPATORIUM FISTULOSUM	JOE-PYE WEED	MIN. 4' O.C.*	1 QT./12" HT.	CONT. (3' O.C.)	9	
RUDEBECKIA LACINIATA	TALL CONEFLOWER	MIN. 3' O.C.*	1 QT.	CONT.	6	


NOTE: PLANT MATERIAL MUST COVER 50% OF THE MULCH AREA AT MATURE GROWTH.  
\*INTERSPERSE PLANTINGS THROUGHOUT BIORETENTION FILTER/MULCH AREA

TEMPORARY STORMWATER MANAGEMENT SUMMARY TABLE						
D.A.	P <sub>6</sub>		ESDV		CHANNEL PROTECTION	
	REQUIRED	PROVIDED	REQUIRED	PROVIDED	REQUIRED	PROVIDED
B-1	2.0'	2.0'	1,957 CF (1)	1,980 CF (1)	N/A (3)	N/A (3)

- NOTES:
- TREATMENT FOR THE ENVIRONMENTAL SITE DESIGN VOLUMES (ESDV) WILL BE PROVIDED FOR AS FOLLOWS:  
- DRAINAGE AREA B-1: TEMPORARY BIORETENTION FACILITY (F-6)
  - CHANNEL PROTECTION IS NOT REQUIRED SINCE ALL ESDV HAVE BEEN TREATED FULLY.
  - OVERBANK FLOOD PROTECTION VOLUME, QP, IS NOT REQUIRED FOR THIS SITE.
  - EXTREME FLOOD VOLUME, QF, IS NOT REQUIRED FOR THIS SITE.

LEGEND

- EXISTING CONTOUR
- EXISTING SPOT ELEVATION
- PROPOSED CONTOUR
- PROPOSED WORK (BY OTHERS)
- PROPOSED SPOT ELEVATION
- DIRECTION OF FLOW
- EXISTING SOIL BORING

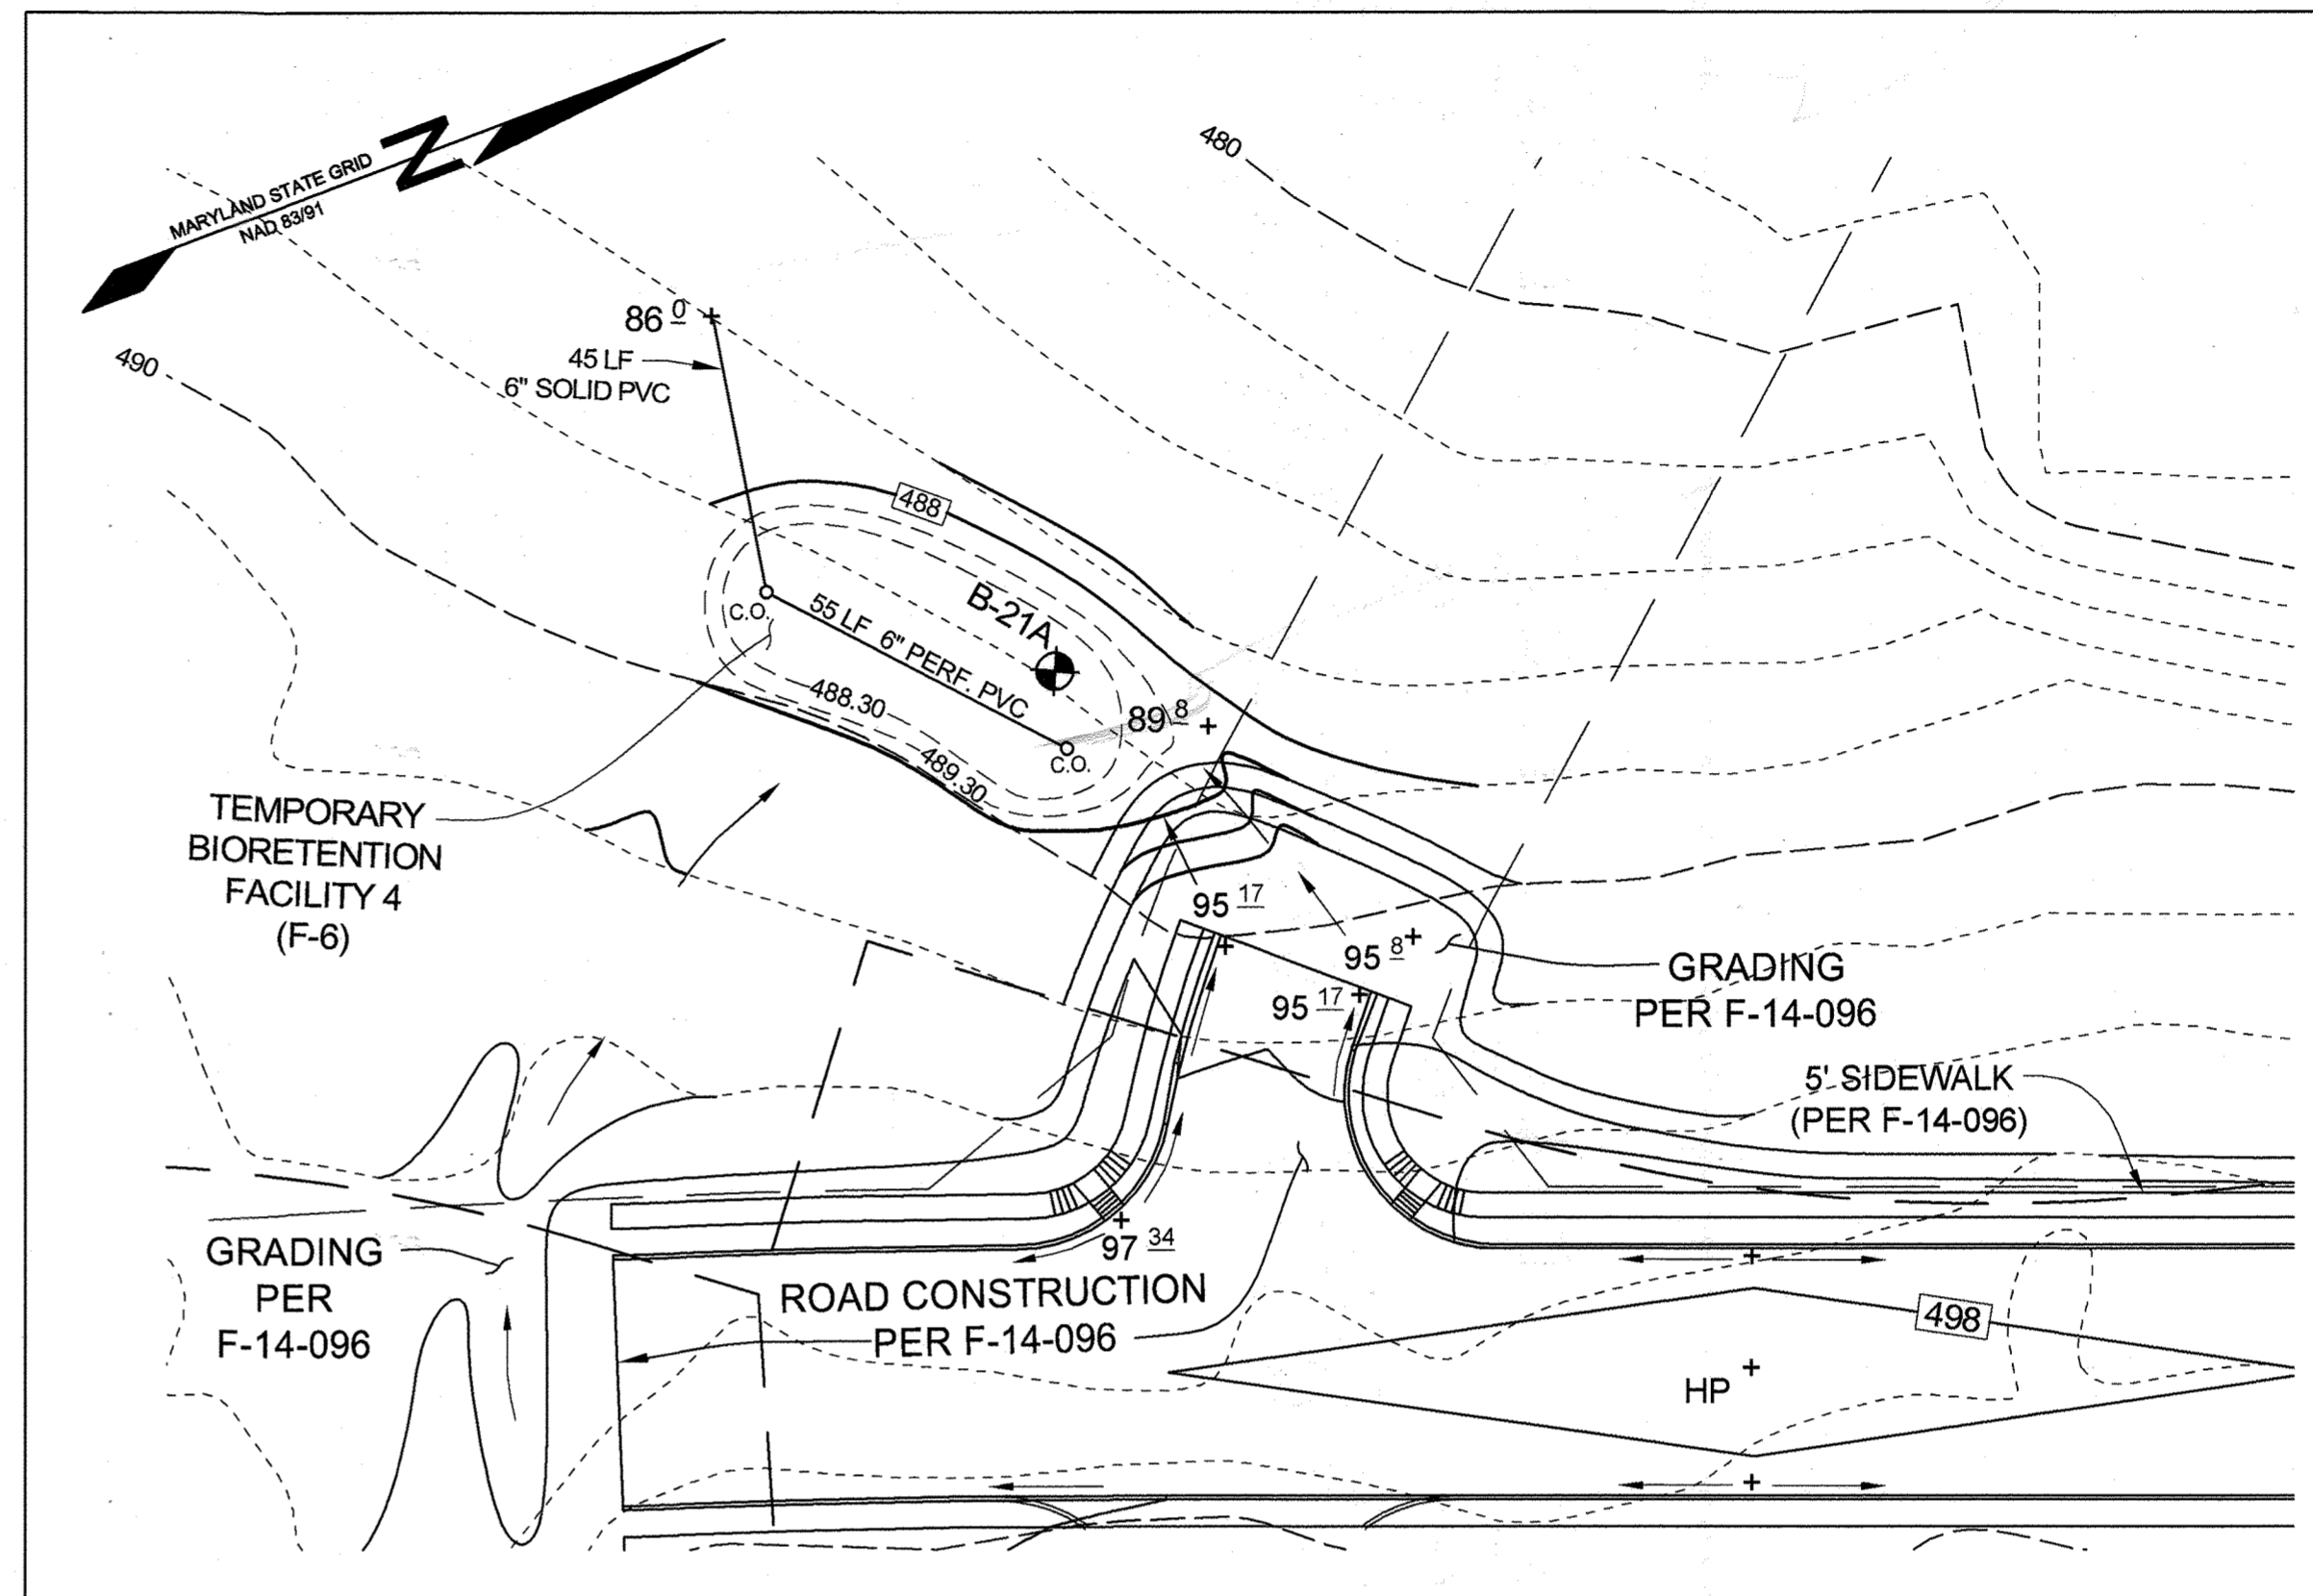

TEMPORARY BIORETENTION FACILITY PLAN VIEW BRAVA COURT  
1"=30'

THE PURPOSE OF THIS ADDITIONAL SHEET IS TO PROVIDE TEMPORARY STORMWATER MANAGEMENT FOR THE CONSTRUCTION OF MOUNT VILLA PARKWAY UNDER F-14-096.

OWNER/DEVELOPER

MANGIONE ENTERPRISES OF TURF VALLEY, LP  
LOU MANGIONE  
1205 YORK ROAD  
LUTHERVILLE, MARYLAND 21093  
410.825.8400

AS-BUILT

AS-BUILT CERTIFICATION

THERE IS NO AS-BUILT INFORMATION ON THIS SHEET.


MICHAEL D. ADCOCK, PROFESSIONAL LAND SURVEYOR  
MD REG. NO. 21257, EXPIRATION DATE: 6/14/23

APPROVED: HOWARD COUNTY DEPARTMENT OF PLANNING AND ZONING  
  
 CHIEF, DEVELOPMENT ENGINEERING DIVISION DATE: 6-26-14  
  
 CHIEF, DIVISION OF LAND DEVELOPMENT DATE: 6-30-14  
  
 DIRECTOR DATE: 6/30/14

APPROVED  
PLANNING BOARD OF HOWARD COUNTY  
DATE: 4/15/13

NO.	DESCRIPTION	DATE
	REVISIONS	

STORMWATER MANAGEMENT DETAILS  
TURF VALLEY  
REGIONAL STORMWATER MANAGEMENT FACILITIES  
PGCC MULTI-USE SUBDISTRICT  
TAX MAP 16 GRID 16 & 17  
3RD ELECTION DISTRICT  
PART OF PARCELS 8 & 394  
HOWARD COUNTY, MARYLAND

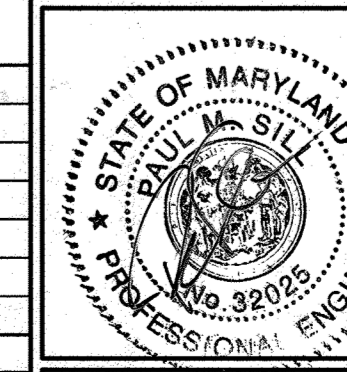

Sill · Adcock & Associates · LLC  
Engineers · Surveyors · Planners  
3300 North Ridge Road, Suite 160  
Cillicott City, Maryland 21043  
Phone: 443.325.7682 Fax: 443.325.7685  
Email: info@silladcock.com

DESIGN BY: DB/BK  
DRAWN BY: BK  
CHECKED BY: PS  
SCALE: AS SHOWN  
DATE: JUNE 23, 2014  
PROJECT #: 06-025  
SHEET #: 12 of 12

PROFESSIONAL CERTIFICATION: I HEREBY CERTIFY THAT THESE DOCUMENTS WERE PREPARED OR APPROVED BY ME, AND THAT I AM A DULY LICENSED PROFESSIONAL ENGINEER UNDER THE LAWS OF THE STATE OF MARYLAND, LICENSE NO. 32025, EXPIRATION DATE: JUNE 20, 2015.