


GENERAL NOTES

- ALL CONSTRUCTION SHALL BE IN ACCORDANCE WITH THE LATEST STANDARDS AND SPECIFICATIONS OF HOWARD COUNTY STANDARDS AND SPECIFICATIONS. ALL WORK AND MATERIALS SHALL COMPLY WITH O.S.H.A. STANDARDS.
- THE CONTRACTOR SHALL NOTIFY MISS UTILITY AT 1-800-257-7777 AT LEAST 48 HOURS PRIOR TO ANY EXCAVATION WORK.
- THE CONTRACTOR IS TO NOTIFY THE FOLLOWING UTILITIES OR AGENCIES AS EARLY AS POSSIBLE BEFORE STARTING WORK. THESE DRAWINGS MISS UTILITY: 1-800-257-7777
VECON: 410-685-0123
BUREAU OF UTILITIES: 410-313-4900
AFC: 410-252-1133
B.G.E.E. (CONSTRUCTION SERVICES): 410-637-8713
B.G.E.E. (EMERGENCY): 410-685-0123
STATE HIGHWAY ADMINISTRATION: 410-531-5533
COLONIA PIPELINE CO.: 410-795-1300
- EXISTING UTILITIES LOCATED FROM ROAD CONSTRUCTION PLANS, FIELD SURVEYS, PUBLIC WATER AND SEWER EXTENSION PLANS AND AVAILABLE RECORD DRAWINGS. APPROXIMATE LOCATION OF EXISTING UTILITIES ARE SHOWN FOR THE CONTRACTOR'S INFORMATION. CONTRACTOR SHALL LOCATE EXISTING UTILITIES AND CONDUCT CONSTRUCTION ACTIVITIES AND TAKE NECESSARY PRECAUTIONS TO PROTECT THE EXISTING UTILITIES AND TO MAINTAIN UNINTERRUPTED SERVICE. ANY DAMAGE INCURRED DUE TO CONTRACTOR'S OPERATION SHALL BE REPAIRED IMMEDIATELY AT THE CONTRACTOR'S EXPENSE.
- THE EXISTING TOPOGRAPHY SHOWN HEREON IS TAKEN FROM A FIELD RUN TOPOGRAPHIC SURVEY PREPARED BY ROBERT H. VOGEL ENGINEERING, INC. DATED JULY, 2006.
- COORDINATES AND ELEVATIONS ARE BASED ON MARYLAND COORDINATE SYSTEM - NAD83(1991) AS PROJECTED BY HOWARD COUNTY GEODETIC CONTROL STATIONS 3513 AND 41CC.
- THE PROPERTY LINE IS SHOWN HEREON IS BASED ON A FIELD-RUN BOUNDARY SURVEY PERFORMED BY ROBERT H. VOGEL ENGINEERING, INC. DATED JULY, 2006.
- ALL ELEVATIONS UNLESS OTHERWISE NOTED.
- THE GEOTECHNICAL ENGINEER TO CONFIRM PAVING SECTION PRIOR TO CONSTRUCTION. ALL PAVING TO BE PAVING MINIMUM HOWARD COUNTY STANDARD P-2 UNLESS OTHERWISE NOTED.
- THE SUBJECT PROPERTY IS ZONED R-12 IN ACCORDANCE WITH THE ZONING REGULATIONS EFFECTIVE ON OCT. 06, 2013, AND IS SUBJECT TO SUBDIVISION AND LAND DEVELOPMENT REGULATIONS EFFECTIVE OCT. 07, 2007 PER COUNCIL BILL 47-2007 & 48-2007. DEVELOPMENT OR CONSTRUCTION ON THIS PROPERTY MUST COMPLY WITH SETBACK AND BUFFER REGULATIONS IN EFFECT AT THE TIME OF SUBMISSION OF THE SITE DEVELOPMENT PLAN, WATER PETITION APPLICATION OR BUILDING/GRADING PERMIT APPLICATIONS.
- WATER AND SEWER TO BE PUBLIC PUBLIC WATER AWARDED THROUGH CONTRACT NO. 24-3265. PUBLIC SEWER AVAILABLE THROUGH CONTRACT NO. 30-3393.
- THIS PROJECT IS LOCATED WITHIN THE METROPOLITAN DISTRICT.
- TO THE BEST OF THE OWNER'S KNOWLEDGE, THERE ARE NO BURIAL GROUNDS, CEMETERIES, OR HISTORIC STRUCTURES LOCATED ON THIS PROPERTY.
- THERE IS NO 100 YEAR FLOODPLAIN OR STEEP SLOPES AREAS ON THIS SITE.
- THE FOREST STAND DELINEATION AND LOCATION OF STREAMS, WETLANDS AND OTHER ENVIRONMENTAL FEATURES WAS PREPARED BY ECO-SCIENCE PROFESSIONALS, INC. DATED SEPTEMBER 12, 2006, UPDATED DECEMBER 2008 AND FEBRUARY 2011.
- THIS PROJECT COMPLIES WITH THE REQUIREMENTS OF SECTION 16.1200 OF THE HOWARD COUNTY CODE FOR FOREST AFFORESTATION THROUGH THE ON-SITE RETENTION OF 0.30 ACRES (13,216 S.F.) UNDER THE TERMS OF DEVELOPER AGREEMENT, SDP-08-083. THE REQUIRED OBLIGATION OF 0.72 ACRES HAS BEEN SATISFIED THROUGH THE PAYMENT OF A FEE-IN-LIEU IN THE AMOUNT OF \$23,522.40 (0.72 x 43560 x \$0.75) TO THE HOWARD COUNTY FOREST CONSERVATION FUND. THE FOREST CONSERVATION OBLIGATION REQUIREMENTS WERE PREVIOUSLY APPROVED UNDER SDP-08-083 (65 LAND) MULTIFLEX UNITS). THE NET TRACT AREA OF 5.0 ACRES INCLUDED ALL OF THE DEVELOPMENT OF PARCEL 153 (3.34 ACRES) AS WELL AS 1.65 ACRES OF ASSOCIATED IMPROVEMENTS ON PARCEL 256 (TEMPLE OF BETH SHALOM, SDP-04-031). THE FOREST CONSERVATION CREDIT FOR THE 1.65 ACRES HAS BEEN TRANSFERRED TO THIS SDP (SDP-16-002) FOR THE INTEGRATED DEVELOPMENT OF SANFORD PLACE AND THE TEMPLE BETH SHALOM.
- A NOISE STUDY WAS PREVIOUSLY PREPARED BY ROBERT H. VOGEL ENGINEERING AND APPROVED WITH SDP-08-083 DATED SEPTEMBER 8, 2008. THE 65DBA NOISE CONTOUR LINE DRAWN ON THIS DEVELOPMENT PLAN IS ADVISORY AS REQUIRED BY THE HOWARD COUNTY DESIGN MANUAL, CHAPTER 15, REVISED FEBRUARY 1992, AND CANNOT BE CONSIDERED TO EXACTLY LOCATE THE 65 DBA NOISE EXPOSURE. THE 65 DBA NOISE LINE WAS ESTABLISHED BY HOWARD COUNTY TO ALERT DEVELOPERS, BUILDERS AND FUTURE RESIDENTS THAT AREAS BEYOND THIS THRESHOLD MAY EXCEED GENERALLY ACCEPTED NOISE LEVELS ESTABLISHED BY THE U.S. DEPARTMENT OF HOUSING AND URBAN DEVELOPMENT.
- HARRIET TUBMAN LANE IS A PUBLIC MAJOR COLLECTOR. ALL PROPOSED STREETS AND DRIVEWAYS SHALL BE PRIVATE.
- STORMWATER MANAGEMENT FOR THIS PROJECT IS BEING PROVIDED BY THE USE OF ENVIRONMENTAL SITE DESIGN UTILIZING NON-STRUCTURAL AND MICRO-SCALE PRACTICES, INCLUDING MICRO-BIORETENTION FACILITIES TO ACCOMMODATE THE TOTAL ESD VOLUME REQUIRED. SWM FACILITIES TO BE PRIVATELY OWNED AND MAINTAINED BY THE H.O.A.
- TRASH AND RECYCLING COLLECTION FACILITIES TO BE PROVIDED BY THE H.O.A.
- THE PROPOSED UNITS WILL HAVE AN AUTOMATIC FIRE PROTECTION SPRINKLER SYSTEM.
- NO GRADING, REMOVAL OF VEGETATIVE COVER OR TREES, PAVING AND NEW STRUCTURES SHALL BE PERMITTED WITHIN THE REQUIRED WETLANDS, STREAMS) OR THEIR BUFFERS, FOREST CONSERVATION AREAS AND 100 YEAR FLOODPLAIN UNLESS ALL REQUIRED PERMITS AND APPROVALS HAVE BEEN OBTAINED.
- ENVIRONMENTAL STUDIES AND REPORTS FOR THIS SITE WERE PREPARED FOR ROBERT H. VOGEL ENGINEERING, INC. BY ECO-SCIENCE PROFESSIONAL, INC. DATED SEPTEMBER 12, 2006, UPDATED DECEMBER 2008 AND FEBRUARY 2011.
- THIS SITE DESIGN PROVIDES THE MINIMUM OF 2.5 PARKING SPACES FOR EACH DWELLING UNIT. SINGLE CAR GARAGES SHALL BE USED FOR PARKING PURPOSES ONLY AND SHALL NOT BE CONVERTED INTO OPEN SPACE OR STORAGE. THE HOUSES GARAGE HAVE BEEN SITED ON THESE LOTS SO THAT A SECOND CAR, IF PARKED IN THE DRIVEWAY, WILL NOT OVERHANG INTO THE PAVED AREA OF THE ADJACENT SIDEWALK STREET. THIS DESIGN PROVIDES A MINIMUM OF FEET AS MEASURED FROM THE GARAGE TO THE EDGE OF THE SIDEWALK. THE ADDITIONAL 0.5 PARKING SPACE PER UNIT IS PROVIDED ON-SITE WITHIN THE 3 PAVED PARKING AREAS.
- REFUSE AND RECYCLING COLLECTION TO BE PRIVATE.
- ANY DAMAGE TO PUBLIC RIGHT-OF-WAY, PAVING, OR EXISTING UTILITIES WILL BE CORRECTED AT THE CONTRACTOR'S EXPENSE.
- ALL REINFORCED CONCRETE FOR STORM DRAIN STRUCTURES SHALL HAVE A MINIMUM OF 28 DAYS STRENGTH OF 3,500 P.S.I.
- TRAFFIC CONTROL AND SIGNING SHALL BE IN ACCORDANCE WITH THE LATEST EDITION OF THE MANUAL ON UNIFORM TRAFFIC CONTROL DEVICES (MUTCD). ALL STREET AND REGULATORY SIGNS SHALL BE IN PLACE PRIOR TO THE PLACEMENT OF ANY ASPHALT.
- ESTIMATES OF EXISTING QUANTITIES SHALL BE CALCULATED BY THE CONTRACTOR.
- SOIL COMPACTION SPECIFICATIONS, REQUIREMENTS, METHODS AND MATERIALS ARE TO BE IN ACCORDANCE WITH THE RECOMMENDATIONS OF THE PROJECT GEOTECHNICAL ENGINEER. GEOTECHNICAL ENGINEER TO CONFIRM ACCEPTABILITY OF PROPOSED PAVING SECTION, BASED ON SOIL TEST PRIOR TO CONSTRUCTION.
- ALL CURB AND GUTTER TO BE HOWARD COUNTY STANDARD DETAIL 3.01 UNLESS OTHERWISE NOTED.
- CONTRACTOR RESPONSIBLE FOR CONSTRUCTING ALL HANDICAP RAMPS AND HANDICAP ACCESS IN ACCORDANCE WITH CURRENT ADA REQUIREMENTS.
- WHERE DRAINAGE FLOWS AWAY FROM CURB, CONTRACTOR TO REVERSE THE GUTTER PAN.
- ALL DIMENSIONS UNLESS OTHERWISE NOTED.
- ALL STORMDRAIN PIPE BEDDING IS TO BE CLASS 'C'.
- ALL BUILDINGS TO HAVE TRASH AND RECYCLING EMPTY DUMP OUT SPLASH BLOCKS. DRAINAGE FROM SPLASH BLOCKS TO BE DIRECTED TOWARD THE SWALES AND/OR PARKING LOT AREAS, WHICH LEADS TO BIORETENTION FACILITIES.
- GEOTECHNICAL REPORT PREPARED BY HILLIS-CARNE ENGINEERING ASSOCIATES, INC., DATED DECEMBER 05, 2007.
- TRAFFIC STUDY PREPARED BY THE TRAFFIC GROUP DATED FEBRUARY 4, 2007.
- THE EXISTING HOUSE AND ALL STRUCTURES WITHIN PARCEL 153 HAS BEEN REMOVED PRIOR TO SUBMISSION OF THE ASSOCIATED FINAL PLAT ORIGINALS IN ACCORDANCE WITH HOWARD COUNTY REGULATIONS.
- THIS PLAN HAS BEEN PREPARED IN ACCORDANCE WITH THE PROVISIONS OF SECTION 16.124 OF THE HOWARD COUNTY CODE AND LANDSCAPE MANUAL AND REQUIRED PERMITS AND APPROVALS FOR THIS SUBDIVISION. FINANCIAL SURETY FOR THE REQUIRED 27 SHADE TREES LANDSCAPING HAS BEEN POSTED AS PART OF THE DEVELOPER AGREEMENT UNDER THIS SITE DEVELOPMENT PLAN IN THE AMOUNT OF \$28,350.00 FOR THE REQUIRED 61 SHADE TREES AND 67 EVERGREENS. FINANCIAL SURETY FOR THE REQUIRED STREET TREE PLANTINGS HAS BEEN POSTED AS PART OF THE DEVELOPER AGREEMENT IN THE AMOUNT OF \$8,000.00 FOR THE REQUIRED 27 SHADE TREES.
- ANY EXISTING STREET TREES DAMAGED OR DESTROYED DURING CONSTRUCTION WILL BE REPLACED BY THE CONTRACTOR.
- THIS PROJECT IS SUBJECT TO COMPLIANCE WITH THE AMENDED FIFTH EDITION OF THE SUBDIVISION AND LAND DEVELOPMENT REGULATIONS. DEVELOPMENT OR CONSTRUCTION ON THIS PROPERTY MUST COMPLY WITH SETBACK AND BUFFER REGULATIONS IN EFFECT AT THE TIME OF SUBMISSION OF THE SITE DEVELOPMENT PLAN, WATER PETITION APPLICATION OR BUILDING/GRADING PERMIT APPLICATIONS.
- ALL SIGN POSTS USED FOR TRAFFIC CONTROL SIGNS INSTALLED IN THE COUNTY RIGHT-OF-WAY SHALL BE MOUNTED ON A 2" GALVANIZED STEEL PERFORATED, SQUARE TUBE POST (1 1/2 GAUGE) INSERTED INTO A 2-1/2" GALVANIZED STEEL, PERFORATED, SQUARE TUBE SLEEVE (12 GAUGE) - 1" LONG. A GALVANIZED STEEL TUBE CAP SHALL BE MOUNTED ON TOP OF EACH SIGN POST.
- ALL EXTERIOR LIGHTING TO COMPLY WITH THE REQUIREMENTS FOUND IN ZONING SECTION 13.4 OF THE HOWARD COUNTY ZONING REGULATIONS. (DETAILS ON SHEET 3)
- LIGHT FIXTURES ON A PROPERTY IN THE R-20 ZONING DISTRICT SHALL BE LIMITED TO 0.1 FOOT CANDLES ALONG THE PROJECT BOUNDARY AND COMPLY WITH ALL REGULATIONS. NO LIGHT SHALL BE EMITTED FROM ANY LIGHT FIXTURE THROUGH A WINDOW, GLASS DOOR OR GLASS PART OF A LAMP AS CERTIFIED BY THE LIGHTING MANUFACTURER, OR AS PROVIDED ON A PHOTOMETRIC TEST PLAN FOR THE SITE. LIGHT FIXTURES WITH THE FOLLOWING CHARACTERISTICS ARE PERMITTED WITHOUT CUTOFF SHIELDS:
A. THE LAMP IS COVERED BY THE FIXTURE AND DOES NOT EXCEED A TOTAL OF MORE THAN 16,000 LUMENS FOR FREESTANDING STRUCTURES, AND 10,000 LUMENS FOR FIXTURES ATTACHED TO STRUCTURES, BASED ON THE MANUFACTURER'S LUMEN RATING FOR THE INITIAL LIGHT OUTPUT OF THE LAMP.
B. THE LAMP IS NO MORE THAN 14 FEET ABOVE GROUND LEVEL FOR FREESTANDING FIXTURES, OR 8 FEET ABOVE GROUND LEVEL FOR FIXTURES ATTACHED TO STRUCTURES.
C. FOR FIXTURES WITH SHIELDS OR OTHER DESIGN FEATURES TO DIRECT THE LIGHT, THE LIGHT IS NOT DIRECTED TOWARDS ADJACENT PROPERTIES OR PUBLIC STREETS.
D. THE SURFACE OF EITHER THE LAMP OR THE FIXTURE ENCLOSING THE LAMP, IS FROSTED OR TRANSLUCENT RATHER THAN TRANSPARENT.
- STREET LIGHT PLACEMENT AND THE TYPE OF FIXTURE AND POLE SHALL BE IN ACCORDANCE WITH THE HOWARD COUNTY DESIGN MANUAL, VOLUME III (GUIDELINES FOR GUIDELINES FOR STREET LIGHTS IN RESIDENTIAL DEVELOPMENTS (JUNE 1993)). A MINIMUM SPACING OF 20' SHALL BE MAINTAINED BETWEEN ANY STREET LIGHT AND ANY TREE.
- THE GRADING AND SEPARATING WALL SHALL COMPLY WITH FEDERAL, STATE, AND LOCAL ACCESSIBILITY REGULATIONS OR GUIDELINES.
- THIS PROJECT IS SUBJECT TO A SHARED ACCESS AND MAINTENANCE AGREEMENT (L-16117/F-001); RECORDED 04/07/15; BY AND BETWEEN BS LAND ACQUISITION (PARCEL 153) AND TEMPLE BETH SHALOM (PARCEL 256, SDP-04-031).
- THIS PLAN IS SUBJECT TO A DESIGN MANUAL WAIVER TO THE FOLLOWING DESIGN MANUAL:
A. DESIGN MANUAL VOLUME II, SECTION 04.15.15.1 TO ALLOW THE SIGHT DISTANCE MEASUREMENT FROM A POINT ON THE CENTERLINE OF THE ACCESS POINT TO THE EDGE OF TRAVEL TO BE REDUCED TO 5'.
B. DESIGN MANUAL VOLUME II, SECTION 04.15.15.2 TO ALLOW THE SIGHT DISTANCE MEASUREMENT FROM A POINT ON THE CENTERLINE OF THE ACCESS POINT TO THE EDGE OF TRAVEL TO BE REDUCED TO 5'.
C. DESIGN MANUAL VOLUME II, SECTION 04.15.15.3 TO ALLOW THE SIGHT DISTANCE MEASUREMENT FROM A POINT ON THE CENTERLINE OF THE ACCESS POINT TO THE EDGE OF TRAVEL TO BE REDUCED TO 5'.
D. DESIGN MANUAL VOLUME II, SECTION 04.15.15.4 TO ALLOW THE SIGHT DISTANCE MEASUREMENT FROM A POINT ON THE CENTERLINE OF THE ACCESS POINT TO THE EDGE OF TRAVEL TO BE REDUCED TO 5'.
E. DESIGN MANUAL VOLUME II, SECTION 04.15.15.5 TO ALLOW THE SIGHT DISTANCE MEASUREMENT FROM A POINT ON THE CENTERLINE OF THE ACCESS POINT TO THE EDGE OF TRAVEL TO BE REDUCED TO 5'.
F. DESIGN MANUAL VOLUME II, SECTION 04.15.15.6 TO ALLOW THE SIGHT DISTANCE MEASUREMENT FROM A POINT ON THE CENTERLINE OF THE ACCESS POINT TO THE EDGE OF TRAVEL TO BE REDUCED TO 5'.
G. DESIGN MANUAL VOLUME II, SECTION 04.15.15.7 TO ALLOW THE SIGHT DISTANCE MEASUREMENT FROM A POINT ON THE CENTERLINE OF THE ACCESS POINT TO THE EDGE OF TRAVEL TO BE REDUCED TO 5'.
H. DESIGN MANUAL VOLUME II, SECTION 04.15.15.8 TO ALLOW THE SIGHT DISTANCE MEASUREMENT FROM A POINT ON THE CENTERLINE OF THE ACCESS POINT TO THE EDGE OF TRAVEL TO BE REDUCED TO 5'.
I. DESIGN MANUAL VOLUME II, SECTION 04.15.15.9 TO ALLOW THE SIGHT DISTANCE MEASUREMENT FROM A POINT ON THE CENTERLINE OF THE ACCESS POINT TO THE EDGE OF TRAVEL TO BE REDUCED TO 5'.
EJ. DESIGN MANUAL VOLUME II, SECTION 04.15.15.140 TO ALLOW THE SIGHT DISTANCE MEASUREMENT FROM A POINT ON THE CENTERLINE OF THE ACCESS POINT TO THE EDGE OF TRAVEL TO BE REDUCED TO 5'.
EK. DESIGN MANUAL VOLUME II, SECTION 04.15.15.141 TO ALLOW THE SIGHT DISTANCE MEASUREMENT FROM A POINT ON THE CENTERLINE OF THE ACCESS POINT TO THE EDGE OF TRAVEL TO BE REDUCED TO 5'.
EL. DESIGN MANUAL

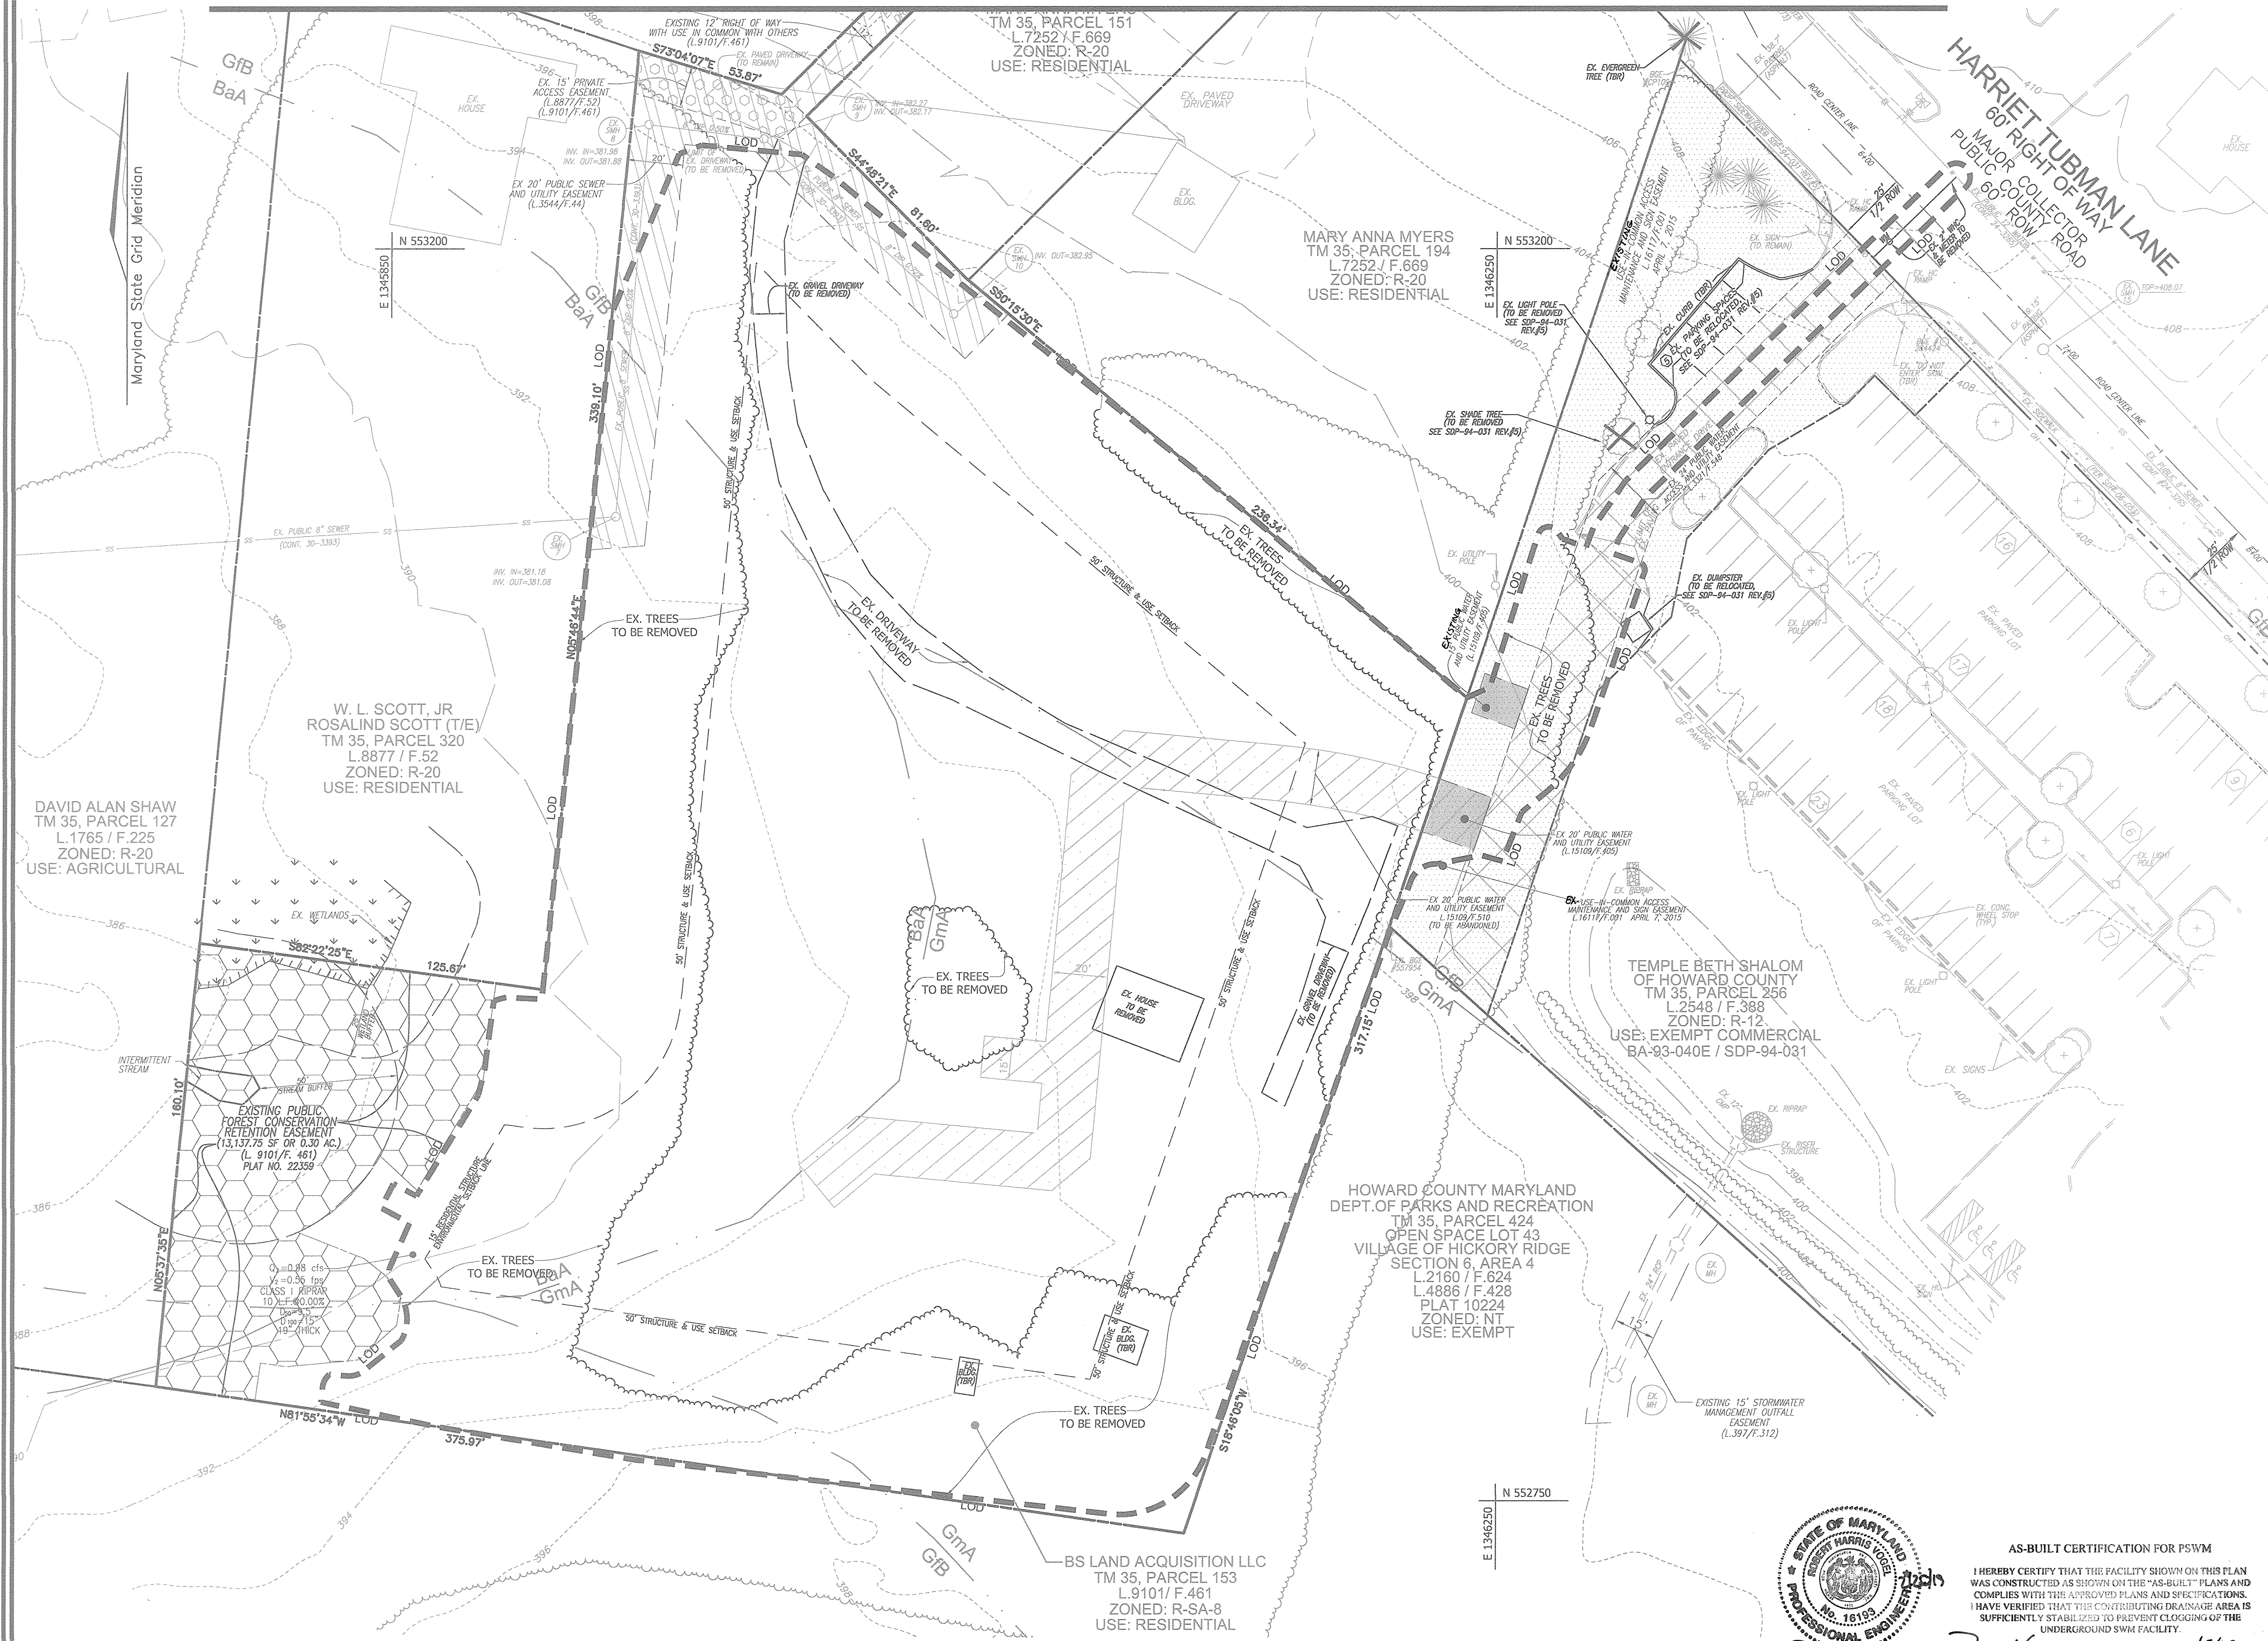

- LEGEND:**
- EXISTING CURB AND GUTTER
 - EXISTING UTILITY POLE
 - ☀ EXISTING LIGHT POLE
 - ☐ EXISTING MAILBOX
 - ☐ EXISTING SIGN
 - EXISTING SANITARY MANHOLE
 - EXISTING SANITARY LINE
 - EXISTING CLEANOUT
 - EXISTING FIRE HYDRANT
 - EXISTING WATER LINE
 - ☀ EXISTING TREES (FIELD LOCATED)
 - ☀ EXISTING TREES (TO BE REMOVED)
 - EXISTING TREELINE (FIELD LOCATED)
 - EXISTING TREELINE (TO BE REMOVED)
 - EXISTING FENCE
 - PROPERTY LINE
 - RIGHT-OF-WAY LINE
 - ADJACENT PROPERTY LINE
 - EXISTING STREAM
 - EXISTING STREAM BUFFER
 - EX. FOREST CONSERVATION "RETENTION" EASEMENT (L. 9101/F. 461) PLAT NO. 22359
 - EXISTING WETLANDS
 - EXISTING 24' PUBLIC WATER ACCESS & UTILITY EASEMENT (L. 3351/F. 546)
 - EXISTING 20' PUBLIC SEWER AND UTIL EASEMENT (L. 3544/F. 44)
 - EXISTING 12' RIGHT OF WAY PRIVATE WATER W/ USE IN COMMON WITH OTHERS (L. 9101/F. 461) (LAST 17/F. 52) (L. 11055/F. 136)
 - EXISTING 15' PRIVATE ACCESS EASEMENT (L. 8877/F. 52) (L. 9101/F. 461)
 - EXISTING JOSEPH'S COMMON ACCESS MAINTENANCE AND SIGN EASEMENT (L. 1617/F. 001)
 - EX. 20' PUBLIC WATER & UTILITY EASEMENT TO BE ABANDONED (L. 15107/F. 510)
 - LIMIT OF DISTURBANCE

OWNER (PARCEL 256)
 TEMPLE BETH SHALOM OF HOWARD COUNTY
 8070 HARRIET TUBMAN LANE
 COLUMBIA, MD. 21044

OWNER (PARCEL 153)
 JOSEPH'S COURTYARD, LLC
 3675 PARK AVENUE #301
 ELLICOTT CITY, MD. 21043
 C/O MICHAEL PFAU
 (410) 480-0023

OWNER/DEVELOPER (PARCEL 153)
 TRINITY HOMES MARYLAND, LLC.
 3675 PARK AVENUE #301
 ELLICOTT CITY, MD. 21043
 C/O MICHAEL PFAU
 (410) 480-0023

NO.	REVISION	DATE

**SITE DEVELOPMENT PLAN
 DEMOLITION PLAN**

JOSEPH'S COURTYARD
 LOTS 1-24 AND OPEN SPACE LOTS 25 AND 26 - USE IN COMMON ACCESS (P.256)
 SINGLE FAMILY ATTACHED AND RELIGIOUS FACILITY (BA-93-040E)
 ZONED: PARCEL 153 (R-SA-8) / PARCEL 256 (R-12) PARCEL 153: PIO 256
 TAX MAP 35 BLOCK 24 L.09101/F.0461/L. 02548/F. 0388 HOWARD COUNTY, MARYLAND
 5TH ELECTION DISTRICT

**ROBERT H. VOGEL
 ENGINEERING, INC.**
 ENGINEERS • SURVEYORS • PLANNERS
 8407 MAIN STREET
 ELLICOTT CITY, MD 21043 TEL: 410.461.7666
 FAX: 410.461.8961

PROFESSIONAL CERTIFICATE

DESIGN BY: RHV/GAH
 DRAWN BY: GAH/KG
 CHECKED BY: RHV
 DATE: MAY 2016
 SCALE: AS SHOWN
 W.O. NO.: 05-84

I HEREBY CERTIFY THAT THESE DOCUMENTS WERE PREPARED OR APPROVED BY ME, AND THAT I AM A FULLY LICENSED PROFESSIONAL ENGINEER UNDER THE LAWS OF THE STATE OF MARYLAND, LICENSE NO. 16193, EXPIRATION DATE 09-27-2018.

2 SHEET OF 14



AS-BUILT CERTIFICATION FOR PSWM

I HEREBY CERTIFY THAT THE FACILITY SHOWN ON THIS PLAN WAS CONSTRUCTED AS SHOWN ON THE "AS-BUILT" PLANS AND COMPLIES WITH THE APPROVED PLANS AND SPECIFICATIONS. I HAVE VERIFIED THAT THE CONTRIBUTING DRAINAGE AREA IS SUFFICIENTLY STABILIZED TO PREVENT CLOGGING OF THE UNDERGROUND SWIM FACILITY.

Robert H. Vogel 16193 2/5/19
 P.E. NAME P.E.# DATE

No AS-BUILT INFORMATION ON THIS SHEET.

APPROVED: HOWARD COUNTY DEPARTMENT OF PLANNING AND ZONING

John E. ...
 CHIEF, DEVELOPMENT ENGINEERING DIVISION HSP DATE 6-1-16

Keith ...
 CHIEF, DIVISION OF LAND DEVELOPMENT DATE 6-28-16


Nathan ...
 DIRECTOR DATE 7-6-16

DEMOLITION PLAN
 SCALE: 1"=30'

SCALE 1"=30'
 15' 0' 30'

LEGEND:

- EXISTING CURB AND GUTTER
- EXISTING UTILITY POLE
- EXISTING LIGHT POLE
- EXISTING MAILBOX
- EXISTING SIGN
- EXISTING SANITARY MANHOLE
- EXISTING SANITARY LINE
- EXISTING CLEANOUT
- EXISTING FIRE HYDRANT
- EXISTING WATER LINE
- EXISTING TREES (FIELD LOCATED)
- EXISTING TREE LINE (FIELD LOCATED)
- PROPERTY LINE
- RIGHT-OF-WAY LINE
- ADJACENT PROPERTY LINE
- EXISTING STREAM
- EXISTING STREAM BUFFER
- PROPOSED CURB AND GUTTER
- PROPOSED CURB TRANSITION
- PROPOSED STORM DRAIN
- PROPOSED STORM DRAIN INLET
- PROP. LIGHT POLE
- PROPOSED FENCE AROUND THE LOT
- PROPOSED TREE LINE
- PROPOSED SIDEWALK
- EX. FOREST CONSERVATION "RETENTION" EASEMENT (L.9101/F.461) (PLAT NO. 22359)
- EXISTING WETLANDS
- EXISTING 24' PUBLIC WATER ACCESS & UTILITY EASEMENT (L.3321/F.648)
- EXISTING 20' PUBLIC SEWER AND UTILITY EASEMENT (L.3544/F.44)
- EXISTING 12' RIGHT OF WAY, PRIVATE WATER & USE IN COMMON WITH OTHERS (L.9101/F.461) (L.8877/F.52) (L.1855/F.136)
- EXISTING 15' PRIVATE ACCESS EASEMENT (L.9101/F.461)
- EXISTING USE-IN-COMMON ACCESS MAINTENANCE AND SIGN EASEMENT (L.16117/F.001)
- RECREATION OPEN SPACE AMENITY AREA
- EXISTING PUBLIC WATER AND UTILITY EASEMENT (L.15108/F.405)
- MICRO-BIOREMEDIATION FACILITIES
- EXISTING 10' PRIVATE DRAINAGE AND UTILITY EASEMENT (PLAT NO. 23834)
- EXISTING VARIABLE WIDTH PUBLIC SEWER, WATER AND UTILITY EASEMENT (PLAT NO. 23834)
- NON-CREDITED OPEN SPACE AREA

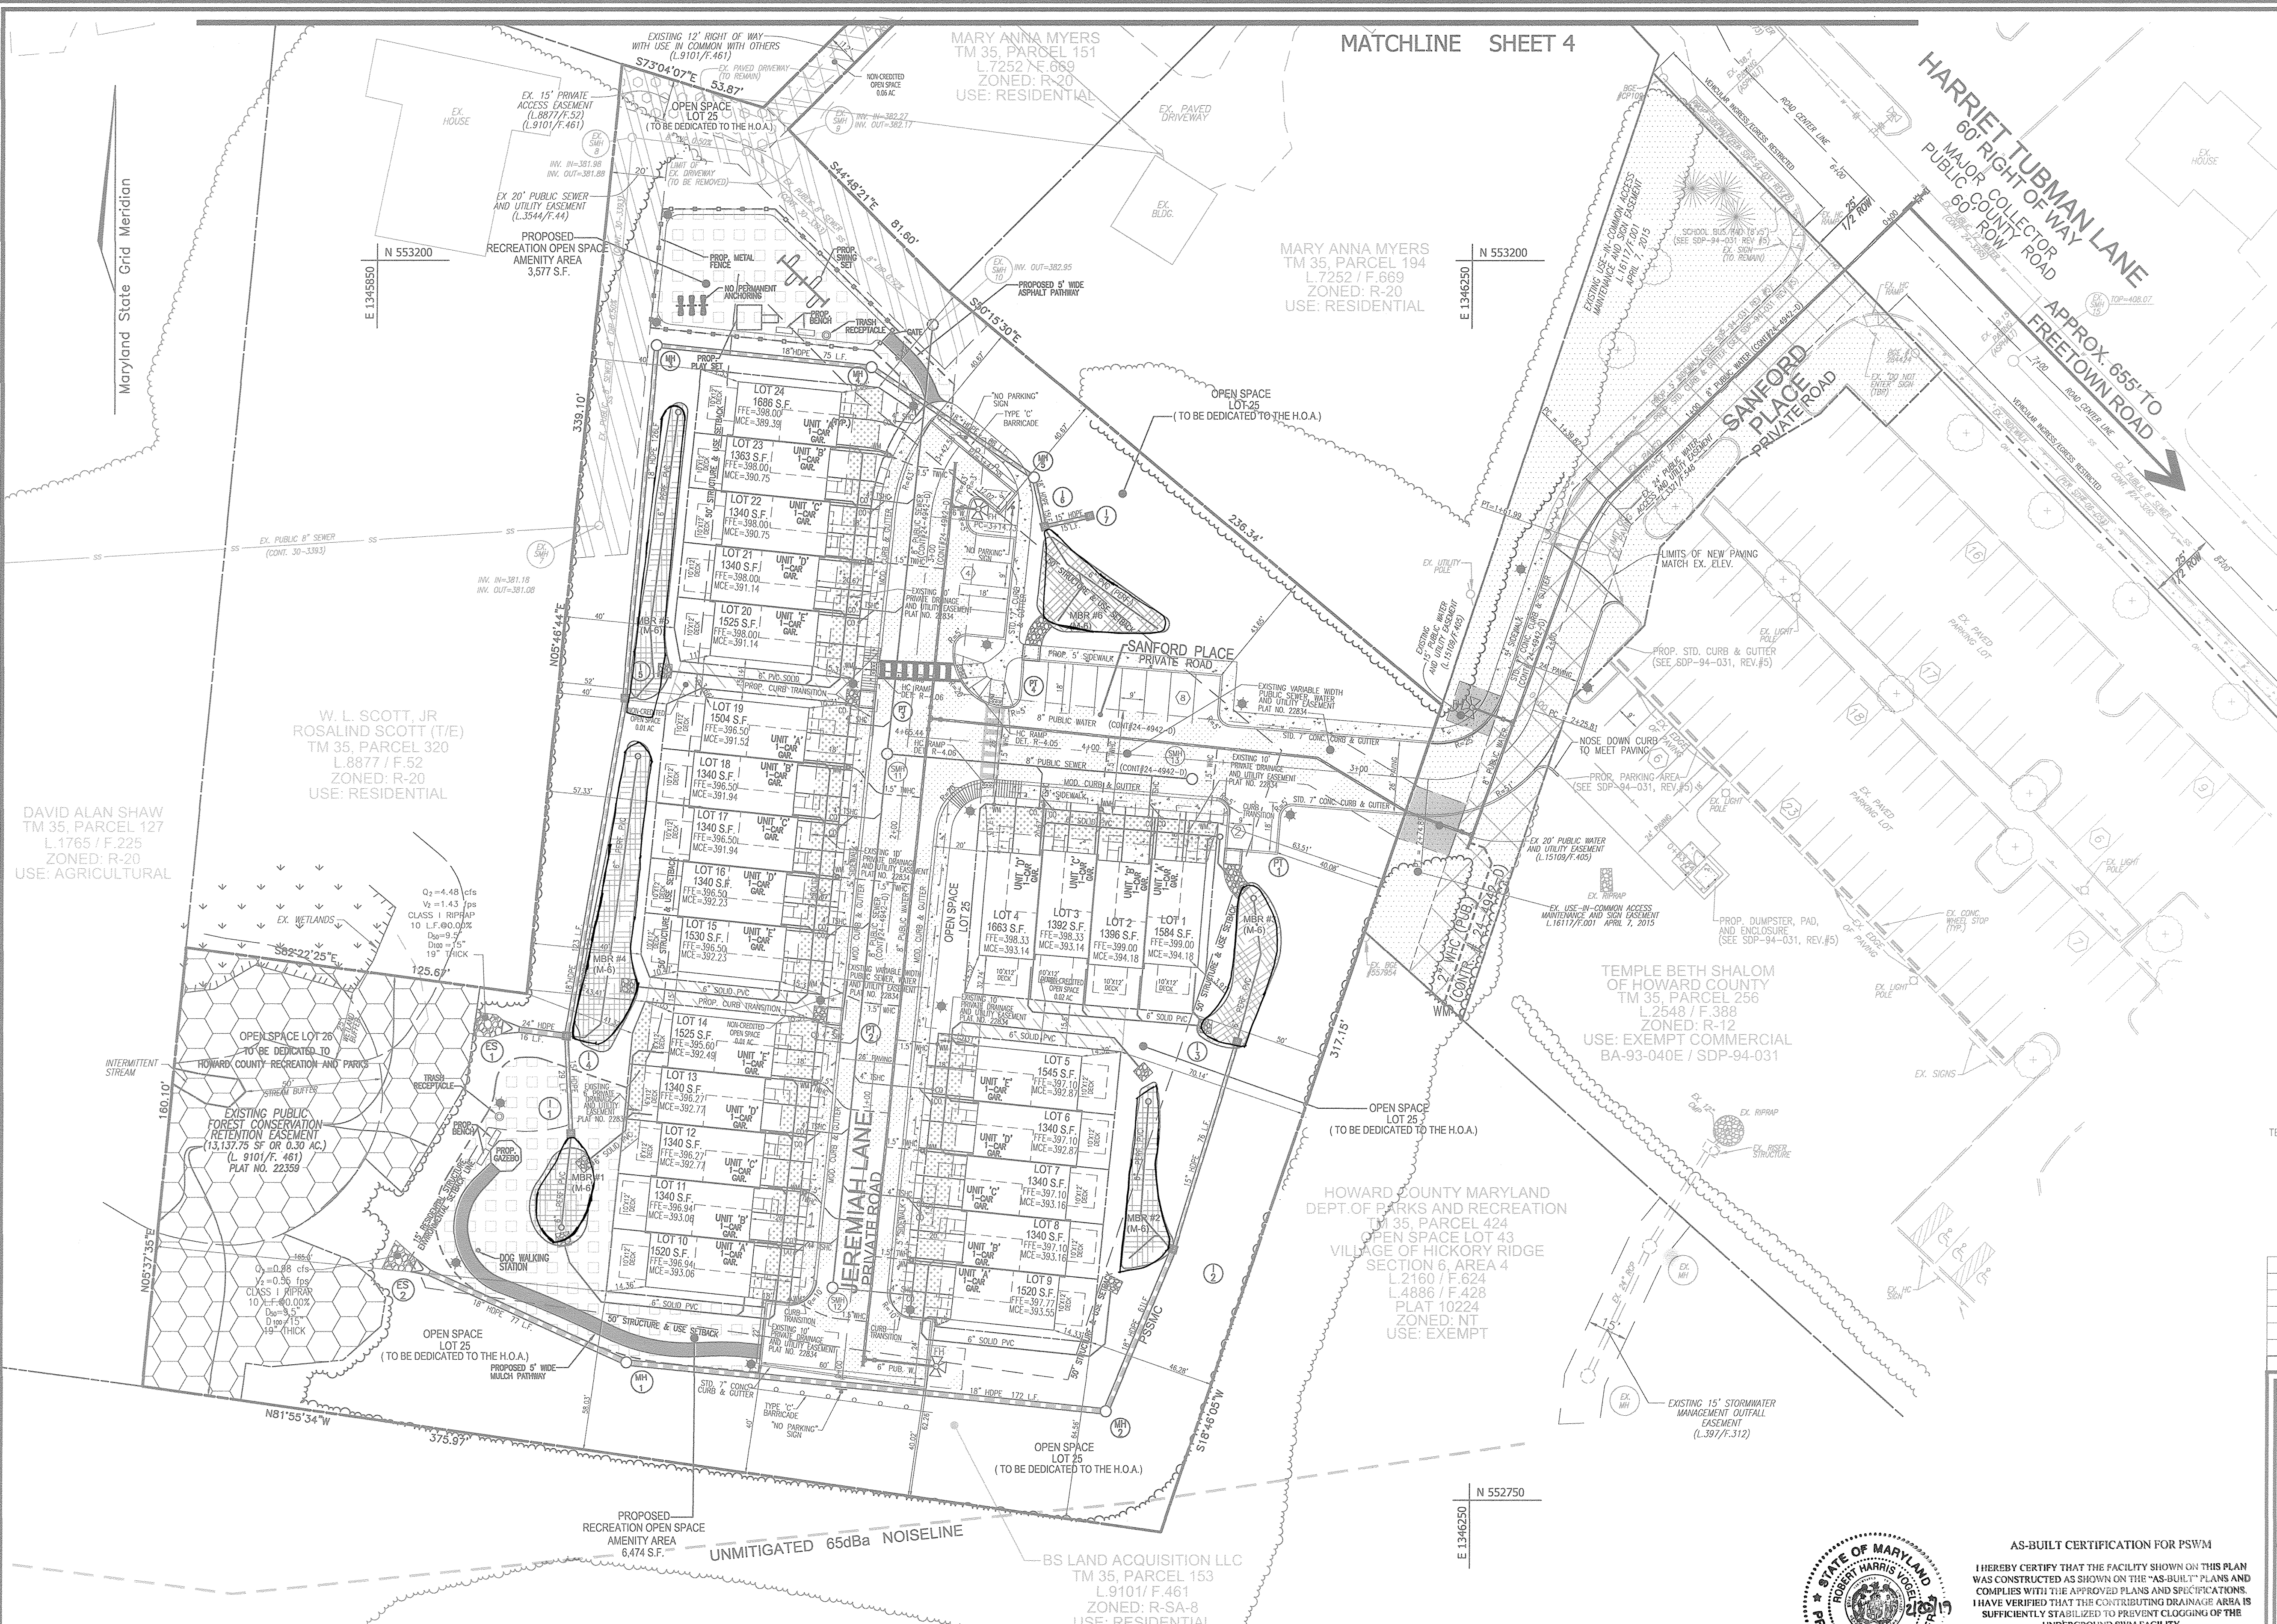



APPROVED: HOWARD COUNTY DEPARTMENT OF PLANNING AND ZONING

Chad Clark 11-29-16
CHIEF, DEVELOPMENT ENGINEERING DIVISION H&P DATE

Katrina 12-05-16
CHIEF, DIVISION OF LAND DEVELOPMENT DATE

W. L. Scott, Jr. 12-5-16
DIRECTOR DATE

PLAN VIEW
SCALE: 1"=30'

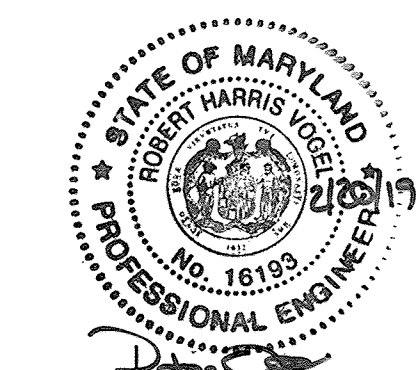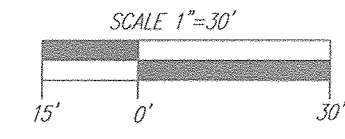

AS-BUILT CERTIFICATION FOR PSWM

I HEREBY CERTIFY THAT THE FACILITY SHOWN ON THIS PLAN WAS CONSTRUCTED AS SHOWN ON THE "AS-BUILT" PLANS AND COMPLIES WITH THE APPROVED PLANS AND SPECIFICATIONS. I HAVE VERIFIED THAT THE CONTRIBUTING DRAINAGE AREA IS SUFFICIENTLY STABILIZED TO PREVENT CLOGGING OF THE UNDERGROUND SWM FACILITY.

Robert H. Vogel 16193 2/5/19
J.E. NAME P.E.# DATE

NO.	REVISION	DATE
1	REVISE PLAN TO ACCOMMODATE BUILDER HOUSE MODEL	10/28/16



REVISED SITE DEVELOPMENT PLAN
SITE LAYOUT PLAN
JOSEPH'S COURTYARD
LOTS 1-24 AND OPEN SPACE LOTS 25 AND 26 - USE IN COMMON ACCESS (P.256)
SINGLE FAMILY ATTACHED AND RELIGIOUS FACILITY (BA-93-40E)
ZONED: PARCEL 153 (R-SA-B) / PARCEL 256 (R-12)
TAX MAP 35 BLOCK 24 L.09101/F.0461/L. 02548/F. 0388 PARCEL 153: PIO 256
5TH ELECTION DISTRICT HOWARD COUNTY, MARYLAND

ROBERT H. VOGEL ENGINEERING, INC.
ENGINEERS • SURVEYORS • PLANNERS
8407 MAIN STREET ELLICOTT CITY, MD 21043 TEL: 410.461.7666 FAX: 410.461.8961

DESIGN BY: RHW/GAH
DRAWN BY: GAH/KG
CHECKED BY: RHW
DATE: MAY 2016
SCALE: AS SHOWN
W.O. NO.: 05-84


PROFESSIONAL CERTIFICATE
I HEREBY CERTIFY THAT THESE DOCUMENTS WERE PREPARED OR APPROVED BY ME, AND THAT I AM A FULLY LICENSED PROFESSIONAL ENGINEER UNDER THE LAWS OF THE STATE OF MARYLAND, LICENSE NO. 16193 EXPIRATION DATE: 09-27-2018

3 SHEET OF 14

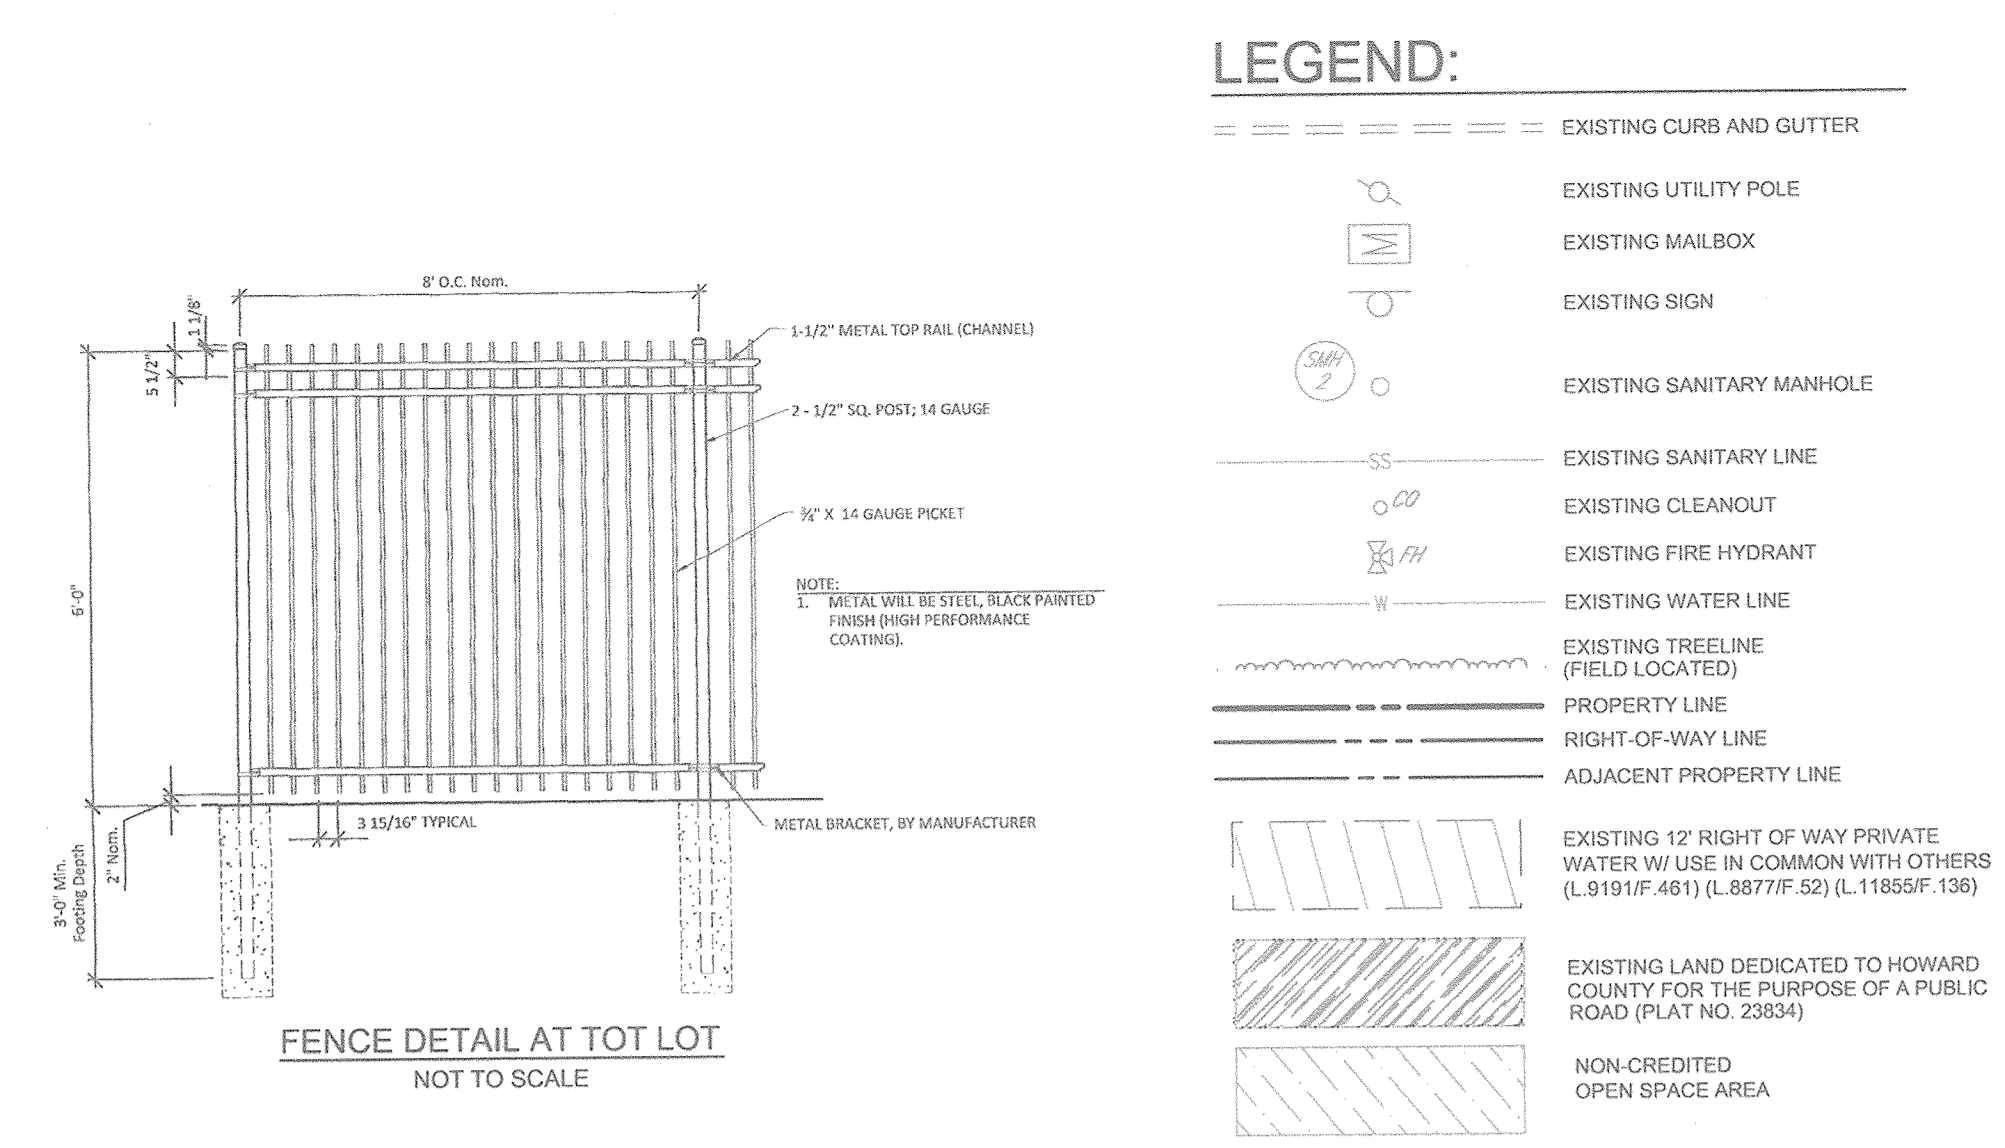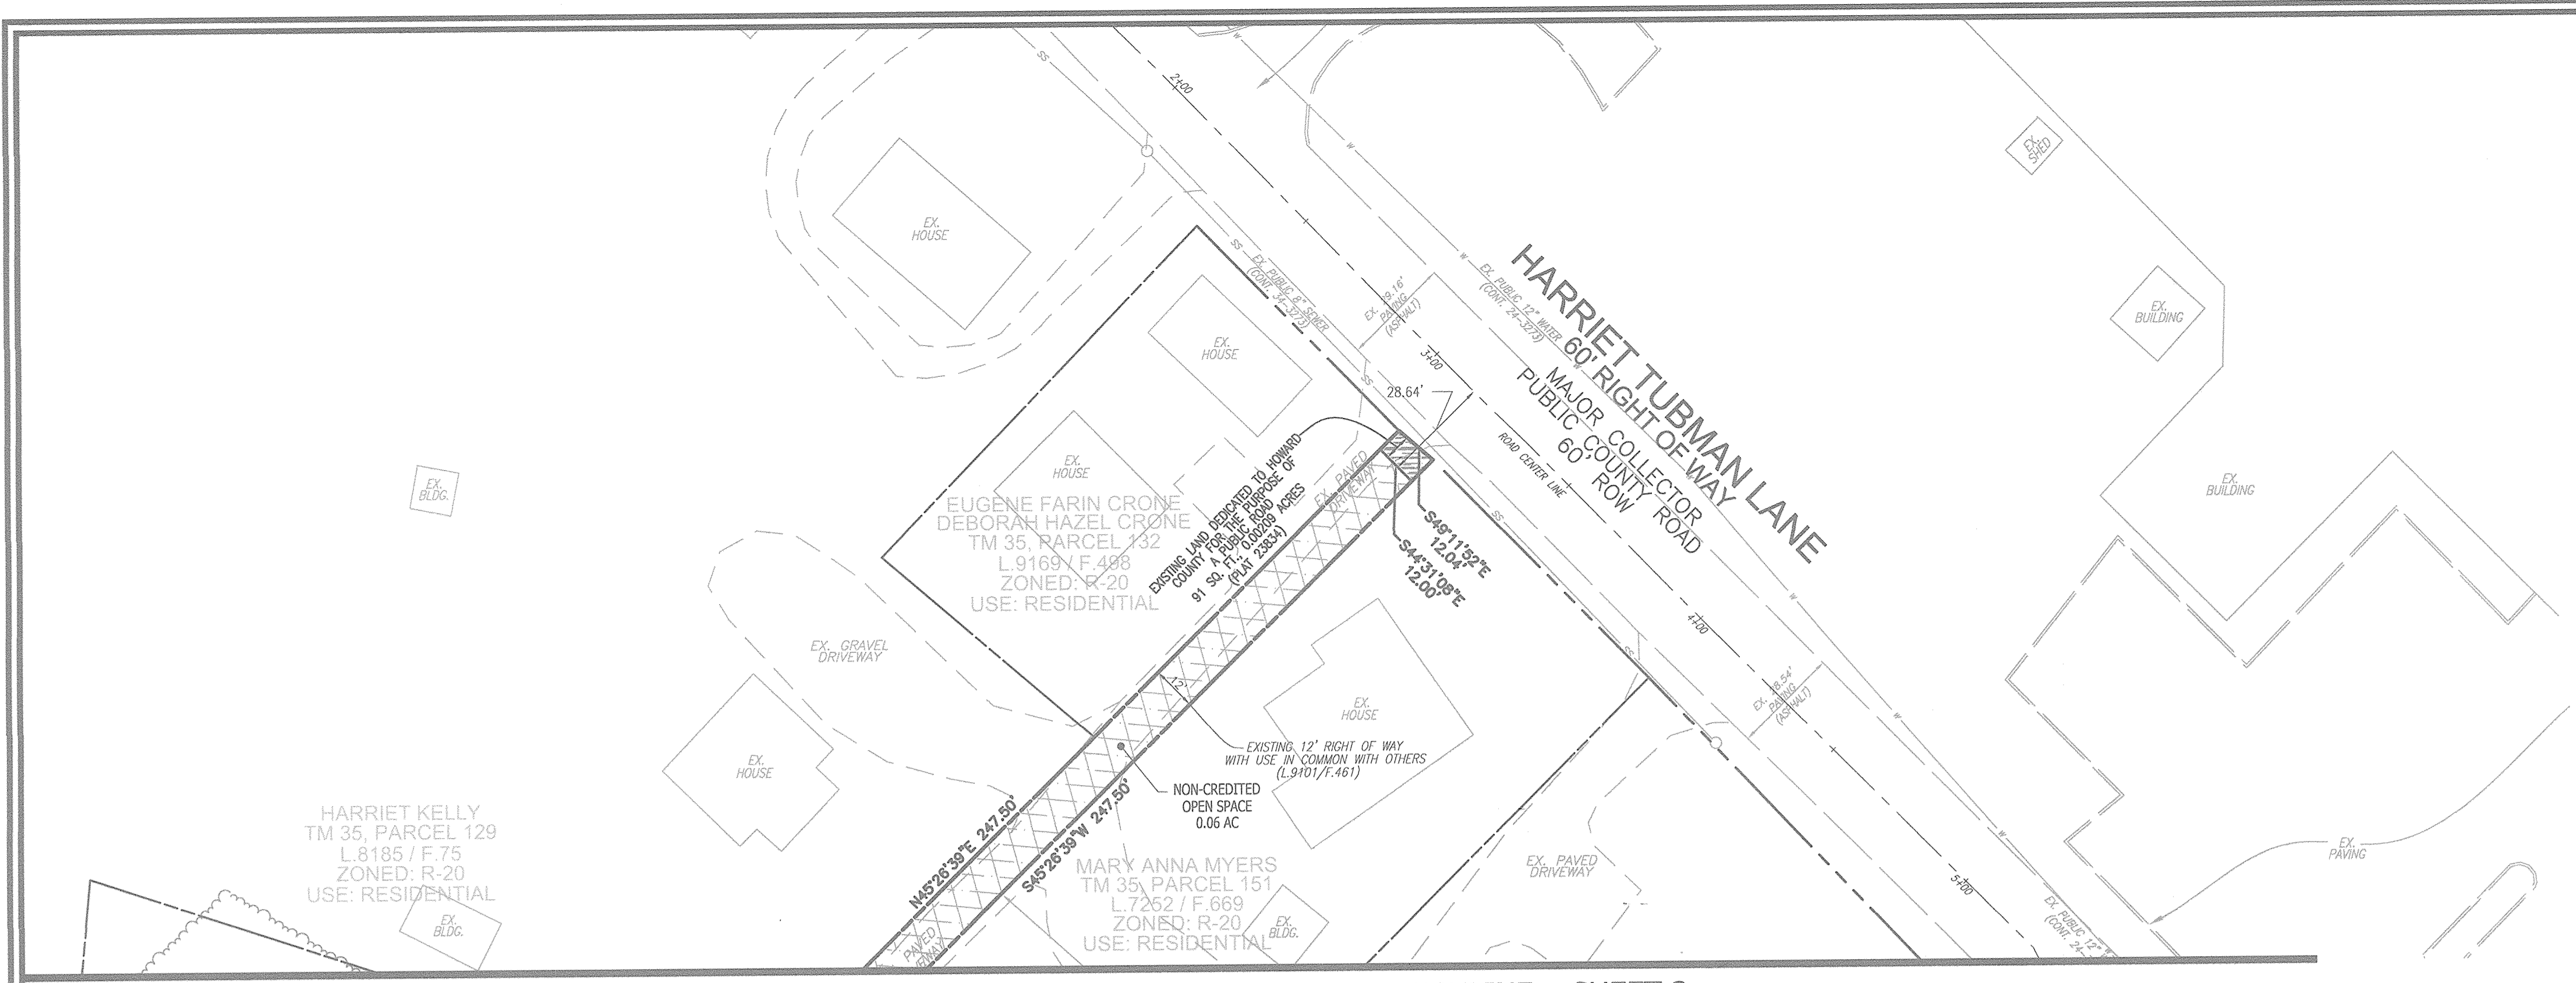


- LEGEND:**
- EXISTING CURB AND GUTTER
 - EXISTING UTILITY POLE
 - EXISTING MAILBOX
 - EXISTING SIGN
 - EXISTING SANITARY MANHOLE
 - EXISTING SANITARY LINE
 - EXISTING CLEANOUT
 - EXISTING FIRE HYDRANT
 - EXISTING WATER LINE
 - EXISTING TREELINE (FIELD LOCATED)
 - PROPERTY LINE
 - RIGHT-OF-WAY LINE
 - ADJACENT PROPERTY LINE
 - EXISTING 12' RIGHT OF WAY PRIVATE WATER W/ USE IN COMMON WITH OTHERS (L.9191/F.481) (L.8877/F.52) (L.11855/F.136)
 - EXISTING LAND DEDICATED TO HOWARD COUNTY FOR THE PURPOSE OF A PUBLIC ROAD (PLAT NO. 23834)
 - NON-CREDITED OPEN SPACE AREA

MATCHLINE SHEET 3
 PLAN VIEW
 SCALE: 1"=30'

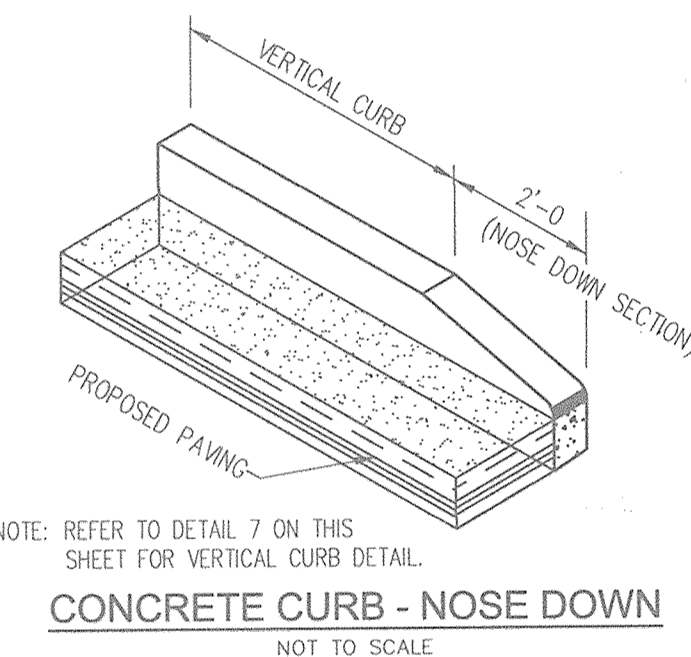


NOTE: REFER TO DETAIL 7 ON THIS SHEET FOR VERTICAL CURB DETAIL.
CONCRETE CURB - NOSE DOWN
 NOT TO SCALE

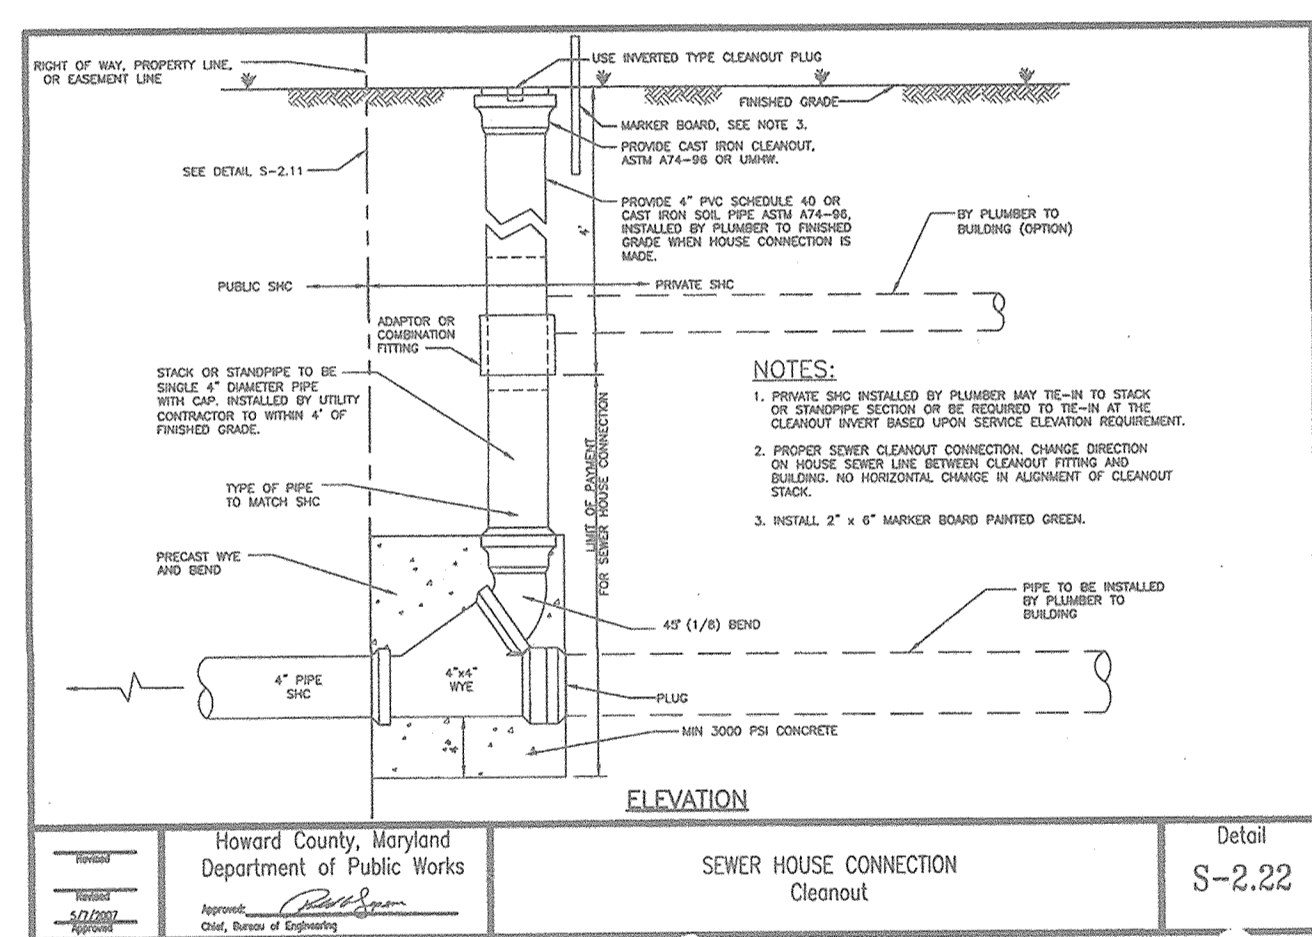

Howard County, Maryland
 Department of Public Works
SEWER HOUSE CONNECTION Cleanout
 Detail S-2.22

SECTION NUMBER	ROAD AND STREET CLASSIFICATION	CALIFORNIA BEARING RATIO (CBR)					
		3 TO 4	5 TO 6	7 TO 8	9 TO 10	11 TO 12	
P-1	PARKING DRIVE	PAVEMENT INTERIOR (INDICES)	1.0	1.5	2.0	2.5	3.0
		MIN. SUPERPAVE FINISH SURFACE (SFS)	1.0	1.5	2.0	2.5	3.0
P-2	PARKING DRIVE	PAVEMENT INTERIOR (INDICES)	1.0	1.5	2.0	2.5	3.0
		MIN. SUPERPAVE FINISH SURFACE (SFS)	1.0	1.5	2.0	2.5	3.0
P-3	RESIDENTIAL AND NON-RESIDENTIAL WITH NO SIDE DRIVE	PAVEMENT INTERIOR (INDICES)	1.0	1.5	2.0	2.5	3.0
		MIN. SUPERPAVE FINISH SURFACE (SFS)	1.0	1.5	2.0	2.5	3.0
P-4	RESIDENTIAL AND NON-RESIDENTIAL WITH SIDE DRIVE	PAVEMENT INTERIOR (INDICES)	1.0	1.5	2.0	2.5	3.0
		MIN. SUPERPAVE FINISH SURFACE (SFS)	1.0	1.5	2.0	2.5	3.0


Howard County, Maryland
 Department of Public Works
PAVING SECTION
 P-1 to P-4
 Detail R-2.01

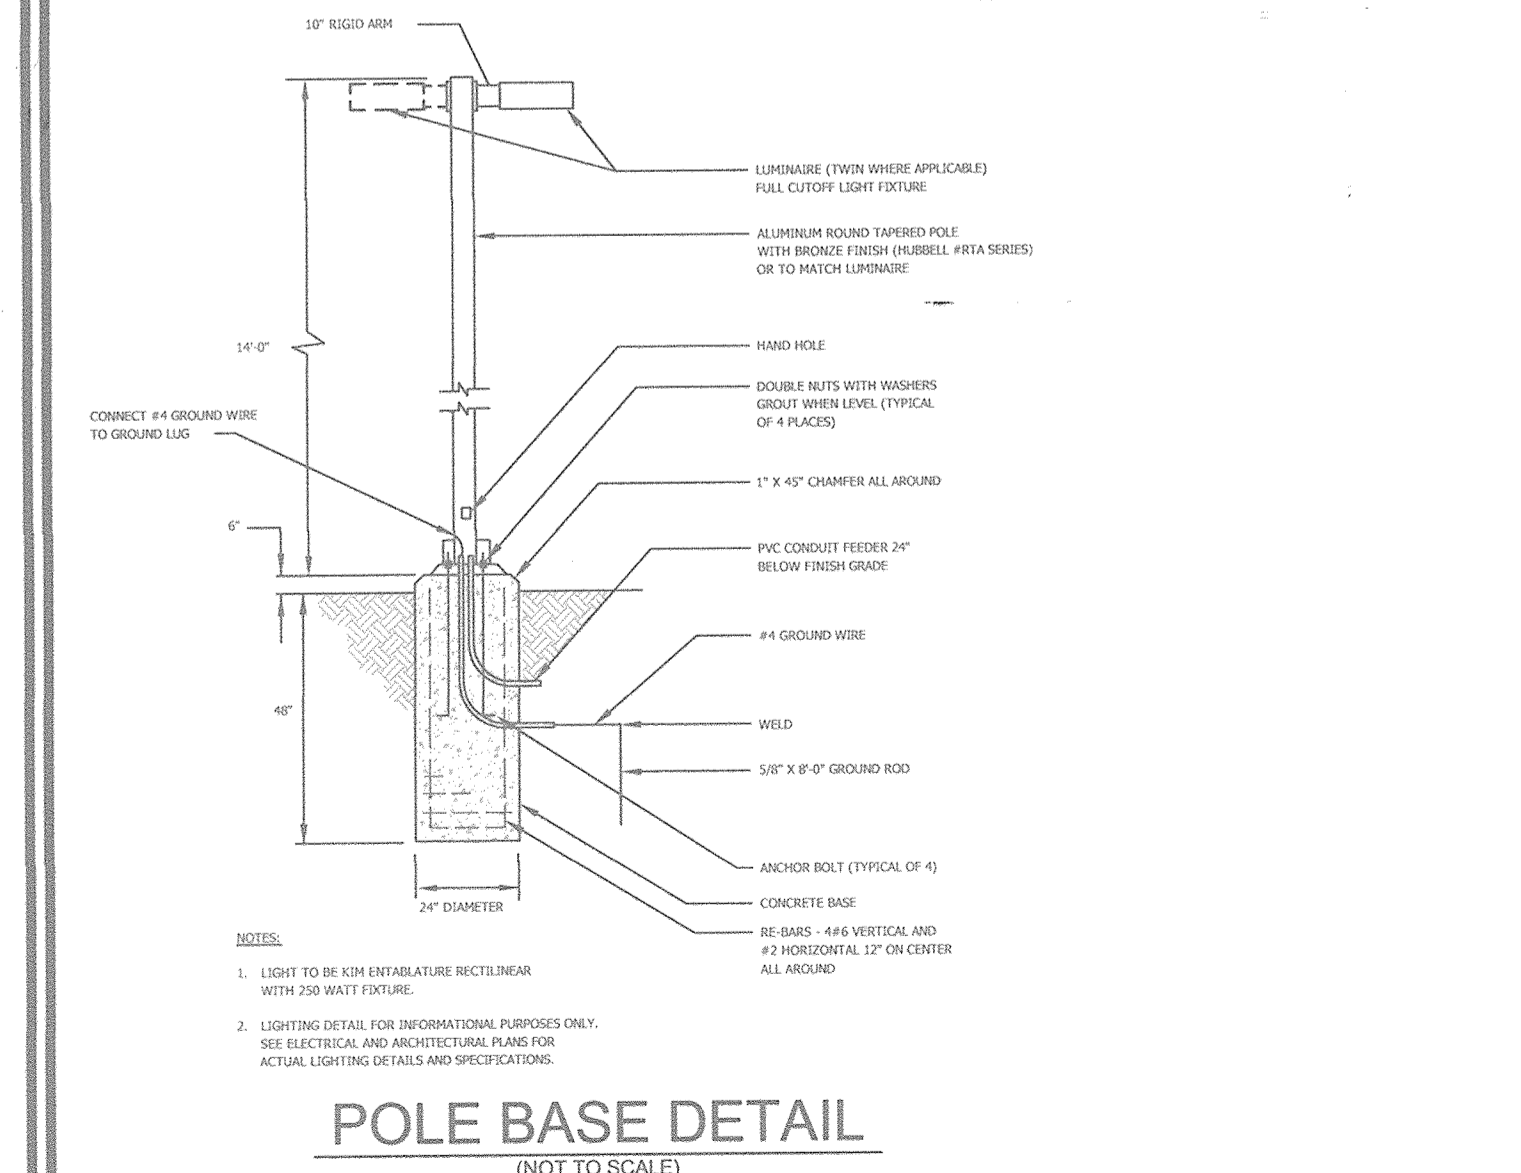


POLE BASE DETAIL
 (NOT TO SCALE)

APPROVED: HOWARD COUNTY DEPARTMENT OF PLANNING AND ZONING

[Signature] 11-29-16
 CHIEF, DEVELOPMENT ENGINEERING DIVISION
 [Signature] 12-05-16
 CHIEF, DIVISION OF LAND DEVELOPMENT
 [Signature] 12-05-16
 DIRECTOR

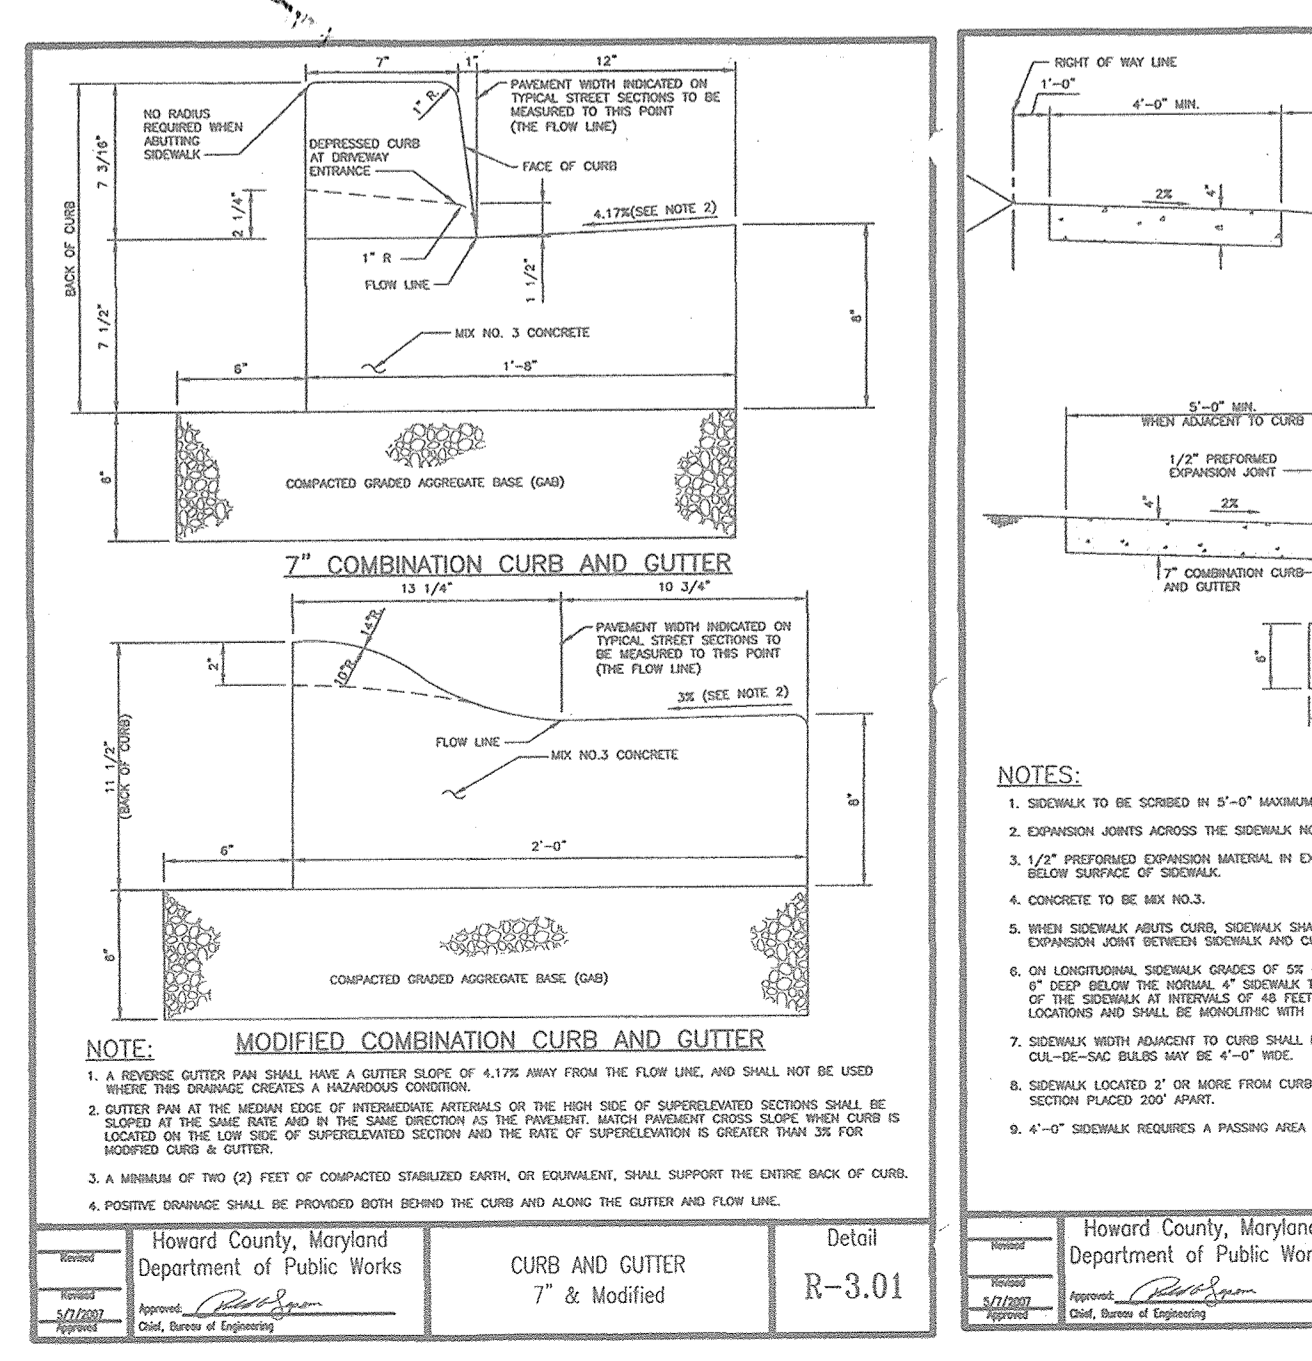


Howard County, Maryland
 Department of Public Works
CURB AND GUTTER
 7" & Modified
 Detail R-3.01

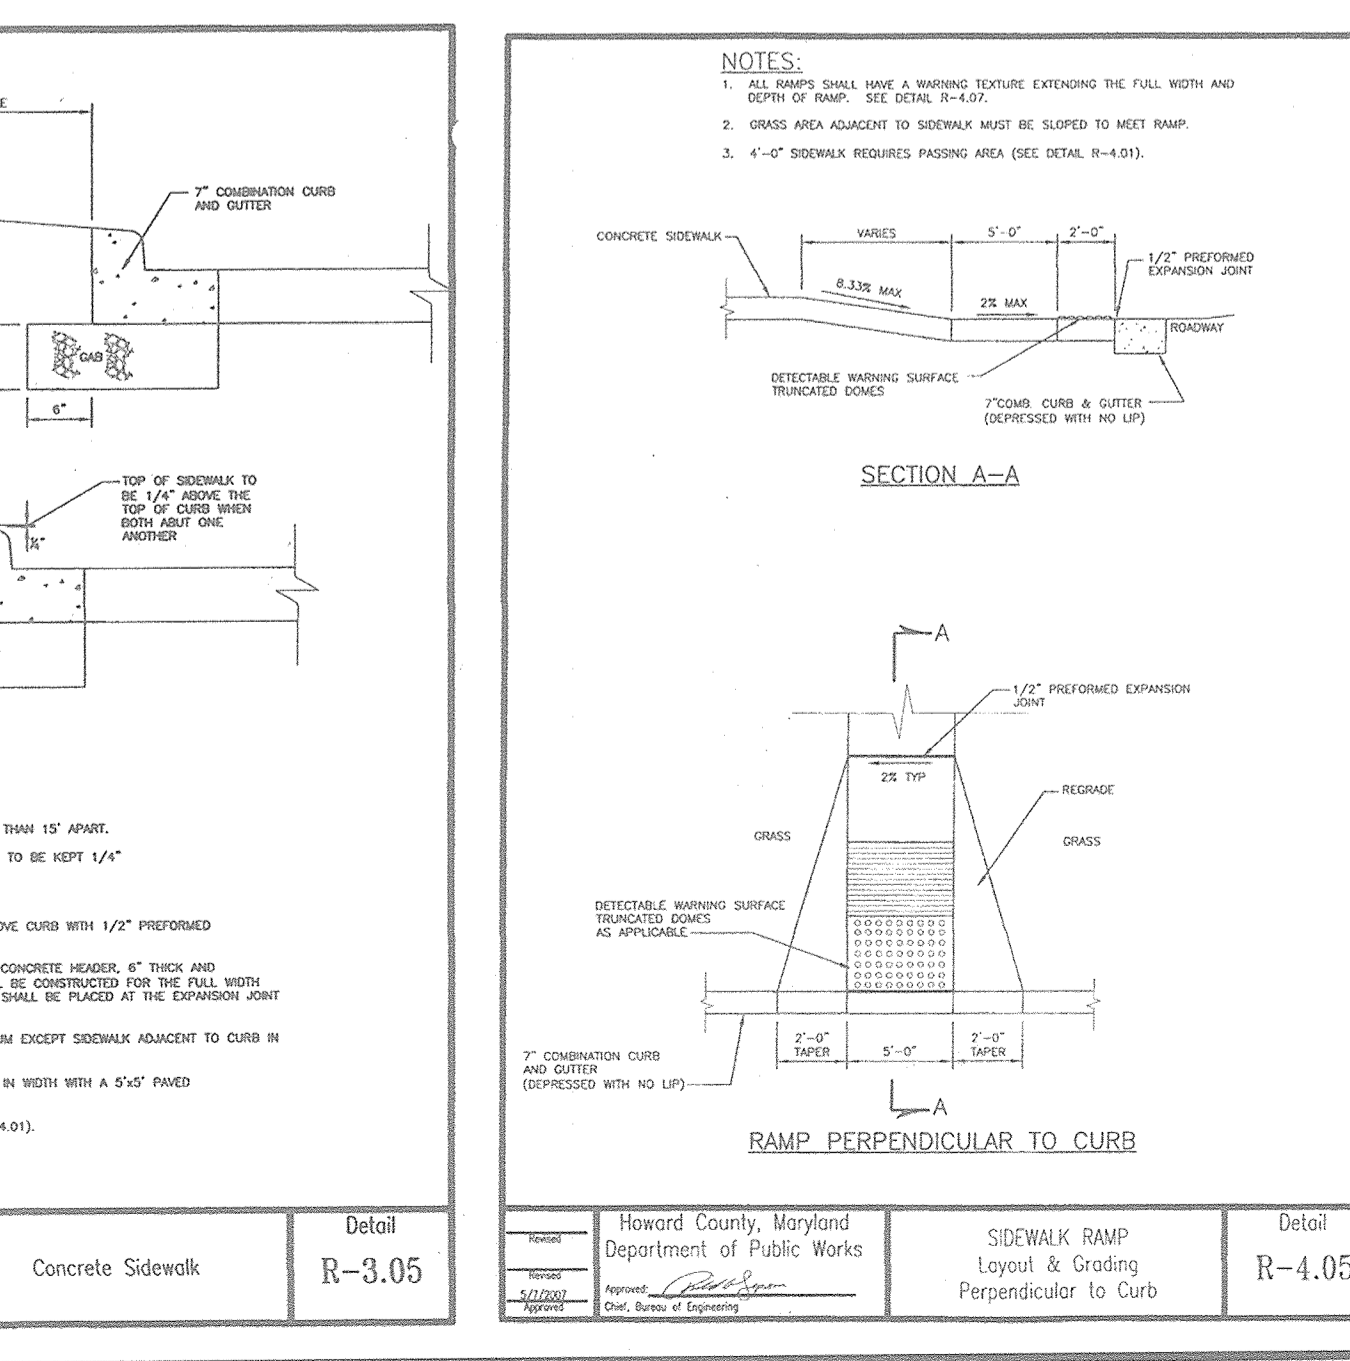

Howard County, Maryland
 Department of Public Works
CONCRETE SIDEWALK
 Detail R-3.05

Howard County, Maryland
 Department of Public Works
SIDEWALK RAMP
 Layout & Grading Perpendicular to Curb
 Detail R-4.05

Howard County, Maryland
 Department of Public Works
SIDEWALK RAMP
 Layout & Grading Parallel to Curb & Thru Median
 Detail R-4.06

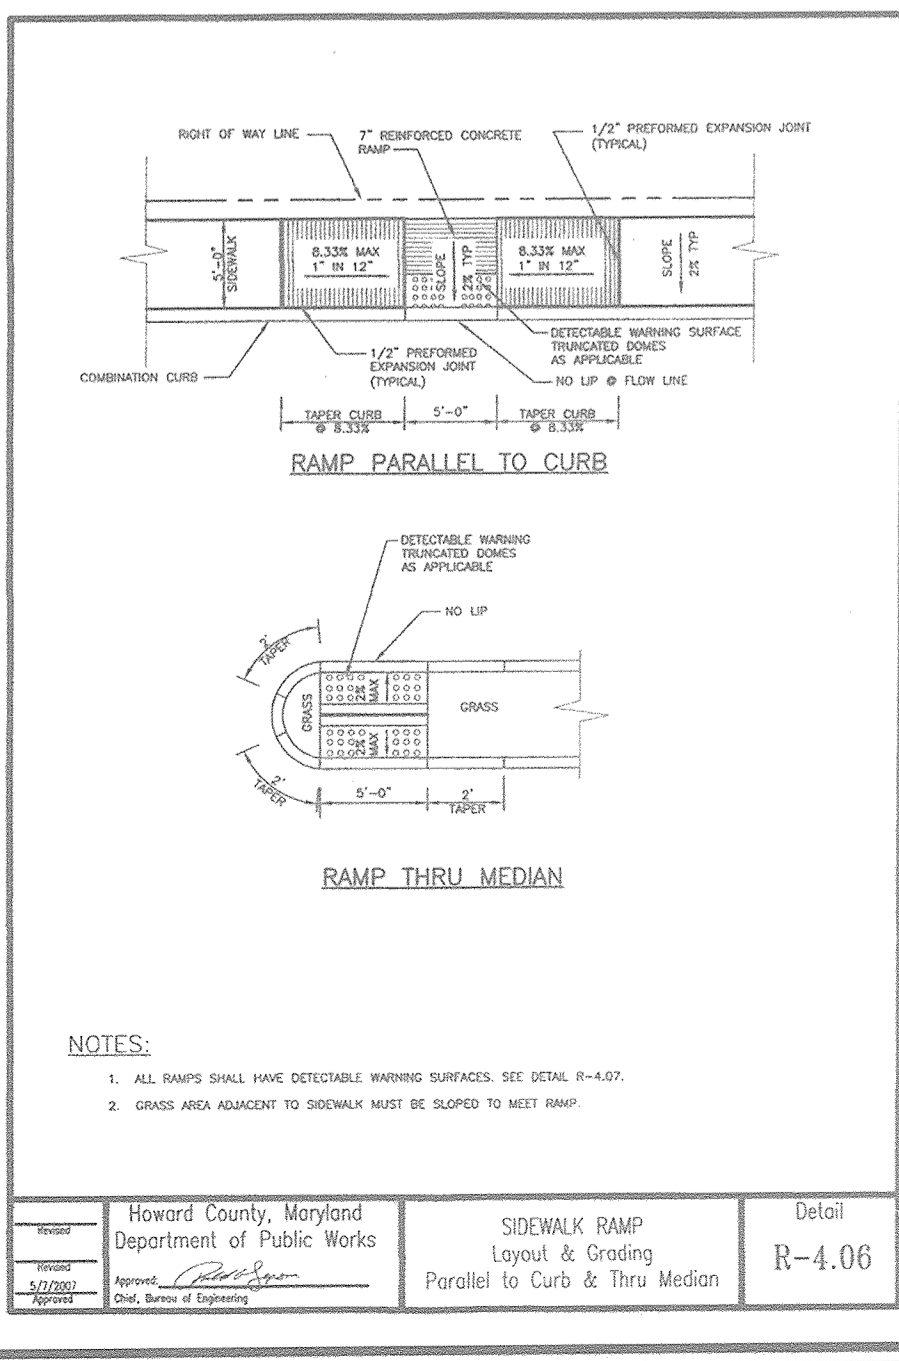

Howard County, Maryland
 Department of Public Works
RAMP PARALLEL TO CURB
 Detail R-4.07

Howard County, Maryland
 Department of Public Works
RAMP THRU MEDIAN
 Detail R-4.08

AS-BUILT CERTIFICATION FOR PSWM

I HEREBY CERTIFY THAT THE FACILITY SHOWN ON THIS PLAN WAS CONSTRUCTED AS SHOWN ON THE "AS-BUILT" PLANS AND COMPLIES WITH THE APPROVED PLANS AND SPECIFICATIONS. I HAVE VERIFIED THAT THE CONTRIBUTING DRAINAGE AREA IS SUFFICIENTLY STABILIZED TO PREVENT CLOGGING OF THE UNDERGROUND SWM FACILITY.

[Signature] 1/19/23 2/15/19
 P.E. NAME P.E. # DATE

NO AS-BUILT INFORMATION ON THIS SHEET

OWNER (PARCEL 256)
 TEMPLE BETH SHALOM OF HOWARD COUNTY
 8070 HARRIET TUBMAN LANE
 COLUMBIA, MD. 21044

OWNER (PARCEL 153)
 JOSEPH'S COURTYARD, LLC
 3675 PARK AVENUE #301
 ELLICOTT CITY, MD. 21043
 C/O MICHAEL PFAU
 (410) 480-0023

OWNER/DEVELOPER (PARCEL 153)
 TRINITY HOMES MARY LAND, LLC
 3675 PARK AVENUE #301
 ELLICOTT CITY, MD. 21043
 C/O MICHAEL PFAU
 (410) 480-0023

NO.	REVISION	DATE
1	REVISE PLAN TO ACCOMMODATE BUILDER HOUSE MODEL	10/28/16

REVISED SITE DEVELOPMENT PLAN
SITE LAYOUT PLAN

JOSEPH'S COURTYARD
 LOTS 1-24 AND OPEN SPACE LOTS 25 AND 26 - USE IN COMMON ACCESS (P.256)
 SINGLE FAMILY ATTACHED AND RELIGIOUS FACILITY (BA-93-40E)
 ZONED: PARCEL 153 (R-SA-8) / PARCEL 256 (R-12)
 L.09101F.0461L.02542/F.0388

TAX MAP 35 BLOCK 24
 5TH ELECTION DISTRICT


ROBERT H. VOGEL, INC.
 ENGINEERS • SURVEYORS • PLANNERS
 8407 MAIN STREET
 ELLICOTT CITY, MD 21043
 TEL: 410.461.7666
 FAX: 410.461.8961

DESIGN BY: RHV/GAH
 DRAWN BY: GAH/KC
 CHECKED BY: RHV
 DATE: MAY 2016
 SCALE: AS SHOWN
 W.O. NO.: 05-84

PROFESSIONAL CERTIFICATE
 I HEREBY CERTIFY THAT THESE DOCUMENTS WERE PREPARED OR APPROVED BY ME, AND THAT I AM A DULY LICENSED PROFESSIONAL ENGINEER UNDER THE LAWS OF THE STATE OF MARYLAND, LICENSE NO. 16193
 EXPIRATION DATE 02-27-2018


[Signature] 10/2/16
 ROBERT H. VOGEL, P.E. No. 16193

4 SHEET OF 14




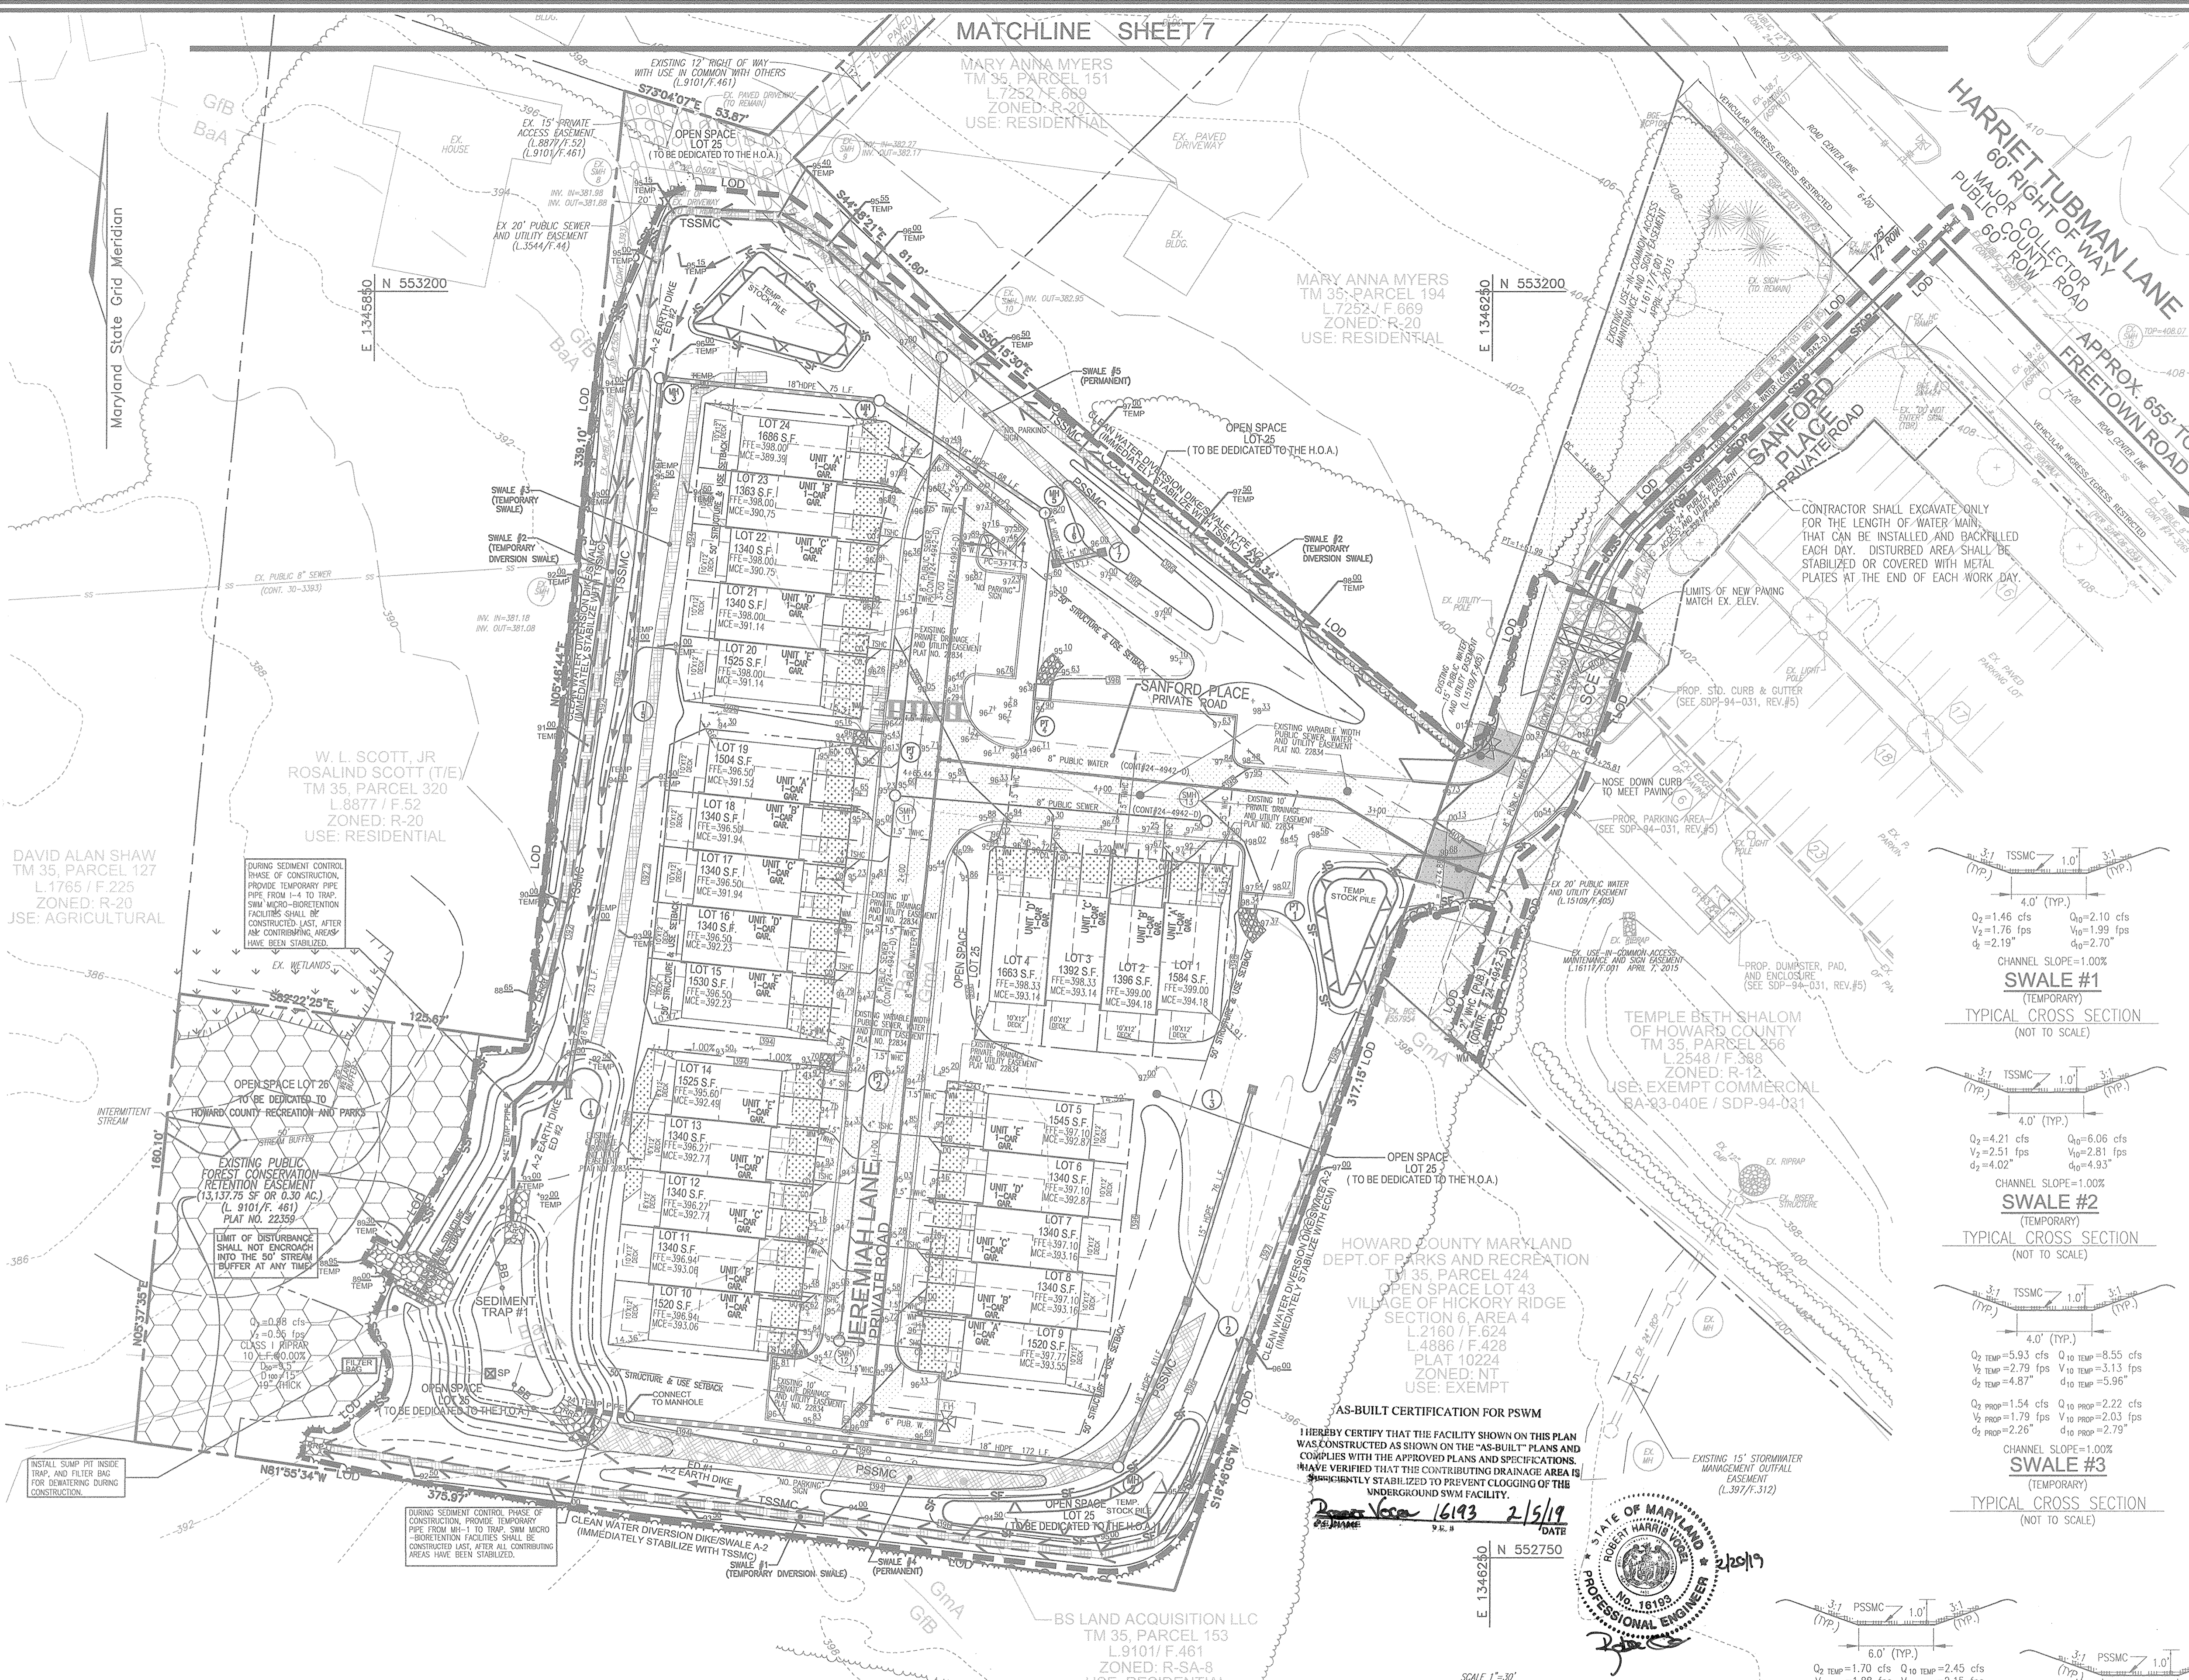


DETAIL G-1-2 STONE/RIPRAP OUTLET SEDIMENT TRAP ST-II

STONE/RIPRAP OUTLET SEDIMENT TRAP ST-II, TRAP NO.	1
DRAINAGE AREA - INITIAL	2.80 ACRES
DRAINAGE AREA - INTERIM	2.80 ACRES
DRAINAGE AREA - FINAL	2.80 ACRES
TOTAL STORAGE REQUIRED	9,360 CF
TOTAL STORAGE PROVIDED	11,263 CF
NET STORAGE PROVIDED	4,680 CF
NET STORAGE REQUIRED	4,680 CF
DRY STORAGE PROVIDED	6,319 CF
EXISTING GROUND ELEVATION AT OUTLET (NET STORAGE ELEVATION)	389.00 FT
TRAP BOTTOM ELEVATION	386.00 FT
TRAP BOTTOM DIMENSIONS	43 x 20 FT x FT
WEIR LENGTH	15 FT
WEIR CREST (DRY STORAGE) ELEVATION	391.00 FT
CLEANOUT ELEVATION	387.50 FT
TOP OF EMBANKMENT ELEVATION	392.00 FT
SIDE SLOPE	3:1 H:V RATIO
EMBANKMENT TOP WIDTH	4 FT
OUTLET PROTECTION - LENGTH	10 FT
OUTLET PROTECTION - DEPTH	19 IN

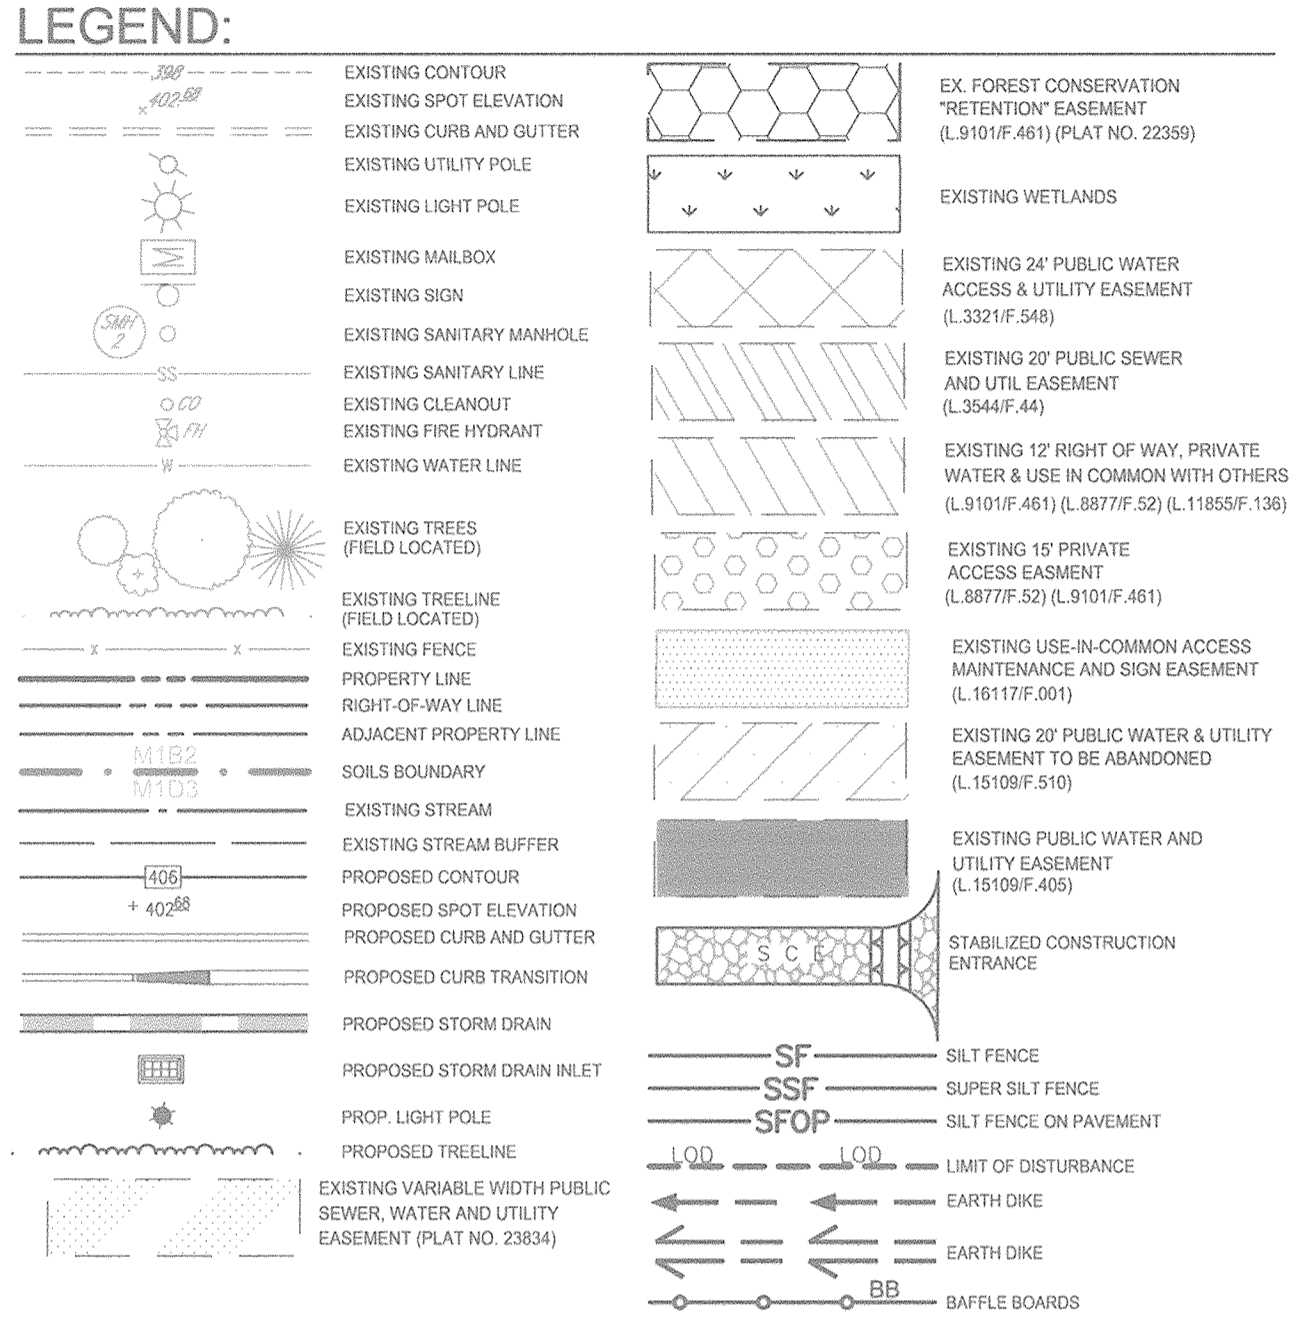



CONTRACTOR SHALL EXCAVATE ONLY FOR THE LENGTH OF WATER MAIN THAT CAN BE INSTALLED AND BACKFILLED EACH DAY. DISTURBED AREA SHALL BE STABILIZED OR COVERED WITH METAL PLATES AT THE END OF EACH WORK DAY.

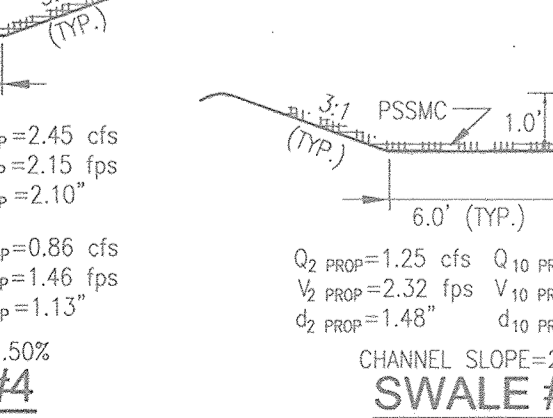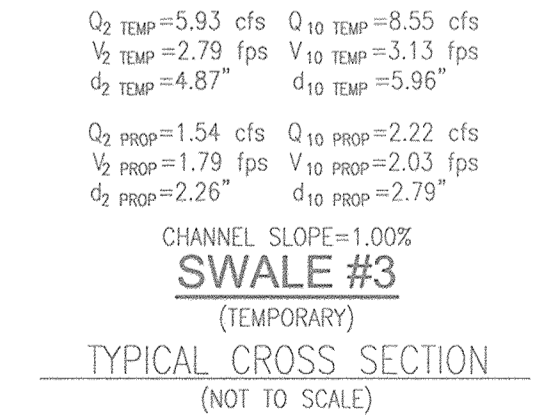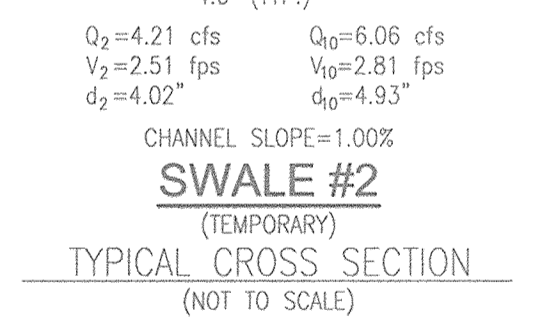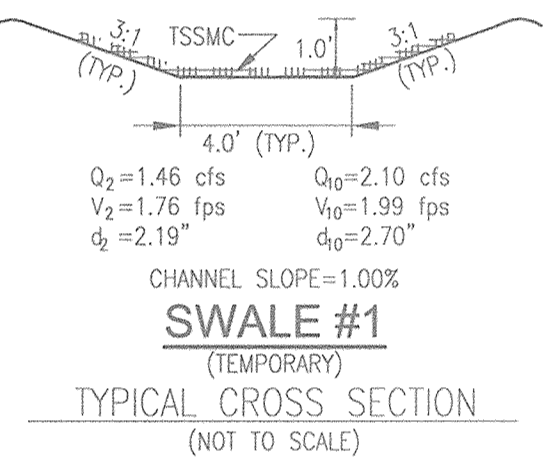

AS-BUILT CERTIFICATION FOR PSSM

I HEREBY CERTIFY THAT THE FACILITY SHOWN ON THIS PLAN WAS CONSTRUCTED AS SHOWN ON THE "AS-BUILT" PLANS AND COMPLIES WITH THE APPROVED PLANS AND SPECIFICATIONS. I HAVE VERIFIED THAT THE CONTRIBUTING DRAINAGE AREA IS PERMANENTLY STABILIZED TO PREVENT CLOGGING OF THE UNDERGROUND SWM FACILITY.

DATE: 1/16/19
 SIGNATURE: [Signature]

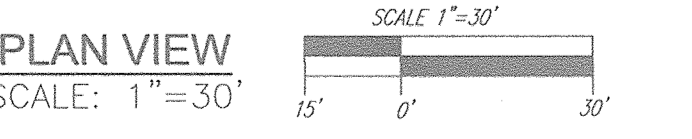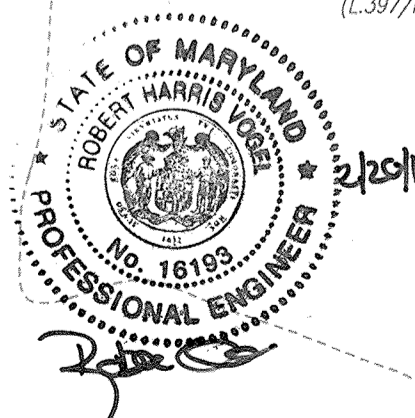

APPROVED: HOWARD COUNTY DEPARTMENT OF PLANNING AND ZONING

Chief, Development Engineering Division: 11-29-16
 Chief, Division of Land Development: 12-5-16
 Director: 12-5-16

OWNER/DEVELOPER CERTIFICATION:
 I HEREBY CERTIFY THAT ANY CLEARING, GRADING, CONSTRUCTION OR DEVELOPMENT WILL BE DONE PURSUANT TO THIS APPROVED EROSION AND SEDIMENT CONTROL PLAN, INCLUDING INSPECTING AND MAINTAINING CONTROLS, AND THAT ALL RESPONSIBLE PERSONNEL INVOLVED IN THE CONSTRUCTION PROJECT WILL HAVE A CERTIFICATE OF ATTENDANCE AT A MARYLAND DEPARTMENT OF THE ENVIRONMENT (MDE) APPROVED TRAINING PROGRAM FOR THE CONTROL OF EROSION AND SEDIMENT PRIOR TO BEGINNING THE PROJECT. I CERTIFY THAT ENTRY FOR PERIODIC ON-SITE EVALUATION BY HOWARD COUNTY, THE HOWARD SOIL CONSERVATION DISTRICT AND/OR MDE.

Signature: [Signature]
 Date: 1/16/19

DESIGNER CERTIFICATION:
 I HEREBY CERTIFY THAT THIS PLAN HAS BEEN DESIGNED IN ACCORDANCE WITH CURRENT MARYLAND EROSION AND SEDIMENT CONTROL LAWS, REGULATIONS, AND STANDARDS, THAT IT REPRESENTS A PRACTICAL AND WORKABLE PLAN BASED ON MY PERSONAL KNOWLEDGE OF THE SITE, AND THAT IT WAS PREPARED IN ACCORDANCE WITH THE REQUIREMENTS OF THE HOWARD SOIL CONSERVATION DISTRICT.

Signature: [Signature]
 Date: 1/16/19

THIS DEVELOPMENT PLAN IS APPROVED FOR SOIL EROSION AND SEDIMENT CONTROL BY THE HOWARD SOIL CONSERVATION DISTRICT.

Signature: [Signature]
 Date: 1/16/19

OWNER (PARCEL 256)
 TEMPLE BETH SHALOM OF HOWARD COUNTY
 8070 HARRIET TUBMAN LANE
 COLUMBIA, MD. 21044

OWNER (PARCEL 153)
 JOSEPH'S COURTYARD, LLC
 3675 PARK AVENUE #301
 ELLICOTT CITY, MD. 21043
 C/O MICHAEL PFAU
 (410) 480-0023

OWNER/DEVELOPER (PARCEL 153)
 TRINITY HOMES MARY LAND, LLC
 3675 PARK AVENUE #301
 ELLICOTT CITY, MD. 21043
 C/O MICHAEL PFAU
 (410) 480-0023

NO.	REVISION	DATE
1	REVISE PLAN TO ACCOMMODATE BUILDER HOUSE MODEL	10/28/16

REVISED SITE DEVELOPMENT PLAN
GRADING, SEDIMENT AND EROSION CONTROL PLAN
STAGE 1
JOSEPH'S COURTYARD
 LOTS 1-24 AND OPEN SPACE LOTS 25 AND 26 - USE IN COMMON ACCESS (P.256)
 SINGLE FAMILY ATTACHED AND RELIGIOUS FACILITY (BA-93-40E)

TAX MAP 35 BLOCK 24 ZONED: PARCEL 153 (R-SA-8) / PARCEL 256 (R-12) / PARCEL 153: PIO 256
 5TH ELECTION DISTRICT L.09101F.0461L. 02548/F. 0388 HOWARD COUNTY, MARYLAND

ROBERT H. VOGEL ENGINEERING, INC.
 ENGINEERS • SURVEYORS • PLANNERS
 8407 MAIN STREET ELLICOTT CITY, MD 21043 TEL: 410.461.7666 FAX: 410.461.8961

PROFESSIONAL CERTIFICATE

I HEREBY CERTIFY THAT THESE DOCUMENTS WERE PREPARED OR APPROVED BY ME, AND THAT I AM A SOIL CONSERVATION DISTRICT REGISTERED PROFESSIONAL ENGINEER UNDER THE LAWS OF THE STATE OF MARYLAND. EXPIRATION DATE: 08-27-2018

DESIGN BY: RHV/GAH
 DRAWN BY: GAH/KG
 CHECKED BY: RHV
 DATE: MAY 2016
 SCALE: AS SHOWN
 W.O. NO.: 05-84

5 SHEET OF 14

MATCHLINE SHEET 7



LEGEND:

[Symbol]	EX. FOREST CONSERVATION RETENTION EASEMENT (L.9101/F.461) (PLAT NO. 22359)	[Symbol]	EXISTING CONTOUR
[Symbol]	EXISTING WETLANDS	[Symbol]	EXISTING CURB AND GUTTER
[Symbol]	EXISTING 24" PUBLIC WATER ACCESS & UTILITY EASEMENT (L.3212/F.548)	[Symbol]	EXISTING UTILITY POLE
[Symbol]	EXISTING 20" PUBLIC SEWER AND UTILITY EASEMENT (L.3244/F.4)	[Symbol]	EXISTING LIGHT POLE
[Symbol]	EXISTING 12" RIGHT OF WAY, PRIVATE WATER & USE IN COMMON WITH OTHERS (L.9101/F.461) (L.8277/F.2) (L.1155/F.138)	[Symbol]	EXISTING MAILBOX
[Symbol]	EXISTING 15" PRIVATE ACCESS EASEMENT (L.8772/F.5) (L.9101/F.461)	[Symbol]	EXISTING SIGN
[Symbol]	EXISTING USE-IN-COMMON ACCESS MAINTENANCE AND SIGN EASEMENT (L.1511/F.001)	[Symbol]	EXISTING SANITARY MANHOLE
[Symbol]	EXISTING 20" PUBLIC WATER & UTILITY EASEMENT TO BE ABANDONED (L.1502/F.510)	[Symbol]	EXISTING SANITARY LINE
[Symbol]	EXISTING PUBLIC WATER AND UTILITY EASEMENT (L.1509/F.465)	[Symbol]	EXISTING CLEANOUT
[Symbol]	STABILIZED CONSTRUCTION ENTRANCE	[Symbol]	EXISTING FIRE HYDRANT
[Symbol]	SILT FENCE	[Symbol]	EXISTING WATER LINE
[Symbol]	SUPER SILT FENCE	[Symbol]	EXISTING TREES (FIELD LOCATED)
[Symbol]	LIMIT OF DISTURBANCE	[Symbol]	EXISTING TREELINE (FIELD LOCATED)
[Symbol]	EARTH DIKE	[Symbol]	PROPOSED FENCE AROUND THE LOT
[Symbol]	EARTH DIKE	[Symbol]	PROPERTY LINE
[Symbol]	TEMPORARY GRADING SPOTS	[Symbol]	RIGHT-OF-WAY LINE
[Symbol]	INLET PROTECTION	[Symbol]	ADJACENT PROPERTY LINE
[Symbol]		[Symbol]	SOILS BOUNDARY
[Symbol]		[Symbol]	EXISTING STREAM
[Symbol]		[Symbol]	EXISTING STREAM BUFFER
[Symbol]		[Symbol]	PROPOSED CONTOUR
[Symbol]		[Symbol]	PROPOSED SPOT ELEVATION
[Symbol]		[Symbol]	PROPOSED CURB AND GUTTER
[Symbol]		[Symbol]	PROPOSED CURB TRANSITION
[Symbol]		[Symbol]	PROPOSED STORM DRAIN
[Symbol]		[Symbol]	PROPOSED STORM DRAIN INLET
[Symbol]		[Symbol]	PROP. LIGHT POLE
[Symbol]		[Symbol]	PROPOSED TREELINE
[Symbol]		[Symbol]	EXISTING 10" PRIVATE DRAINAGE AND UTILITY EASEMENT (PLAT NO. 22834)
[Symbol]		[Symbol]	EXISTING VARIABLE WIDTH PUBLIC SEWER, WATER AND UTILITY EASEMENT (PLAT NO. 22834)

NOTE:
 ALL BUILDINGS TO HAVE ROOF LEADERS WHICH ARE:
 1. PIPED UNDERGROUND TO A MICRO-BIORETENTION AREA.
 2. EMPTIED ONTO SPLASH BLOCKS. DRAINAGE FROM SPLASH BLOCKS TO BE DIRECTED TOWARD THE SWALES AND/OR PARKING LOT AREAS, WHICH DRAIN TO MICRO-BIORETENTION FACILITIES.

OWNER (PARCEL 256)
 TEMPLE BETH SHALOM OF HOWARD COUNTY
 8070 HARRIET TUBMAN LANE
 COLUMBIA, MD. 21044

OWNER/DEVELOPER (PARCEL 153)
 JOSEPH'S COURTYARD, LLC
 3675 PARK AVENUE #301
 ELLICOTT CITY, MD. 21043
 C/O MICHAEL PFUO
 (410) 480-0023

NO.	REVISION	DATE
1	REVISE PLAN TO ACCOMMODATE BUILDER HOUSE MODEL	10/28/16

REVISED SITE DEVELOPMENT PLAN
GRADING, SEDIMENT AND EROSION CONTROL PLAN
STAGE 2
JOSEPH'S COURTYARD
 LOTS 1-24 AND OPEN SPACE LOTS 25 AND 26 - USE IN COMMON ACCESS (P.256)
 SINGLE FAMILY ATTACHED AND RELIGIOUS FACILITY (BA-93-40E)
 TAX MAP 35, BLOCK 24 ZONED: PARCEL 153 (R-SA-8) / PARCEL 256 (R-12)
 L.9101/F.461, L.0254/F.0388 HOWARD COUNTY, MARYLAND

ROBERT H. VOGEL ENGINEERING, INC.
 ENGINEERS • SURVEYORS • PLANNERS
 8407 MAIN STREET
 ELLICOTT CITY, MD 21043
 TEL: 410.461.7666
 FAX: 410.461.8961

PROFESSIONAL CERTIFICATE

I HEREBY CERTIFY THAT THESE DOCUMENTS WERE PREPARED OR APPROVED BY ME AND THAT I AM A DULY LICENSED PROFESSIONAL ENGINEER UNDER THE LAWS OF THE STATE OF MARYLAND, LICENSE NO. 16193, EXPIRATION DATE: 05-27-2016

DESIGN BY: RHW/GAH
 DRAWN BY: GAH/KG
 CHECKED BY: RHW
 DATE: MAY 2016
 SCALE: AS SHOWN
 W.O. NO.: 05-84

6 SHEET OF 14

AS-BUILT CERTIFICATION FOR PSWM
 I HEREBY CERTIFY THAT THE FACILITY SHOWN ON THIS PLAN WAS CONSTRUCTED AS SHOWN ON THE "AS-BUILT" PLANS AND COMPLIES WITH THE APPROVED PLANS AND SPECIFICATIONS. I HAVE VERIFIED THAT THE CONTRIBUTING DRAINAGE AREA IS SUFFICIENTLY STABILIZED TO PREVENT CLOGGING OF THE UNDERGROUND SWM FACILITY.

Robert H. Vogel 16193 2/5/19
 P.E. NAME P.E. # DATE



MAPPED SOILS TYPES - HOWARD COUNTY SOIL MAP #16

SYMBOL NAME / DESCRIPTION	GROUP	HYDRO	HYDRO PERCENT	K FACTOR	PERCENT PERCENT
BaA BAILE SILT LOAN, 0 TO 3 PERCENT SLOPES	D	YES	0.37	NO	NO
GfB GLASTON - URBAN LAND COMPLEX, 0 TO 8 PERCENT SLOPES	A	NO	0.28	NO	NO
GmA GLENMILLE SILT LOAM, 0 TO 3 PERCENT SLOPES	C	NO	0.43	NO	NO

TAKEN FROM: USDA, SCS-WEB SOIL SURVEY, HOWARD COUNTY

NOTE:
 HIGHLY ERODIBLE SOILS ARE THOSE SOILS WITH A SOLE FACTOR GREATER THAN 15 PERCENT OR THOSE SOILS WITH A SOLE ERODIBILITY FACTOR K GREATER THAN 0.35 AND WITH A SOLE FACTOR GREATER THAN 5 PERCENT

NOTE:
 SEE SHEET 5 FOR SEDIMENT TRAP DATA

THIS DEVELOPMENT PLAN IS APPROVED FOR SOIL EROSION AND SEDIMENT CONTROL BY THE HOWARD SOIL CONSERVATION DISTRICT.

John C. Roberts 11/10/16
 HOWARD S.C.D. DATE

DESIGN CERTIFICATION:
 I HEREBY CERTIFY THAT THIS PLAN HAS BEEN DESIGNED IN ACCORDANCE WITH CURRENT MARYLAND EROSION AND SEDIMENT CONTROL LAWS, REGULATIONS, AND STANDARDS, THAT IT REPRESENTS A PRACTICAL AND WORKABLE PLAN BASED ON MY PERSONAL KNOWLEDGE OF THE SITE AND THAT IT WAS PREPARED IN ACCORDANCE WITH THE REQUIREMENTS OF THE HOWARD SOIL CONSERVATION DISTRICT.

Robert H. Vogel 10/31/16
 DESIGNER'S SIGNATURE DATE
 ROBERT H. VOGEL
 M.D. REGISTRATION NO. 16193
 (C.A. R.L.S., OR R.L.A. (circle one))

OWNER/DEVELOPER CERTIFICATION:
 I HEREBY CERTIFY THAT ANY CLEARING, GRADING, CONSTRUCTION OR DEVELOPMENT WILL BE DONE PURSUANT TO THIS APPROVED EROSION AND SEDIMENT CONTROL PLAN, INCLUDING INSPECTING AND MAINTAINING CONTROLS, AND THAT ALL RESPONSIBLE PERSONNEL INVOLVED IN THE CONSTRUCTION PROJECT WILL HAVE A CERTIFICATE OF ATTENDANCE AT A MARYLAND DEPARTMENT OF THE ENVIRONMENT (MDE) APPROVED TRAINING PROGRAM FOR THE CONTROL OF EROSION AND SEDIMENT PRIOR TO BEGINNING THE PROJECT. I CERTIFY RIGHT-OF-CENTRY FOR PERIODIC ON-SITE EVALUATION BY HOWARD COUNTY, THE HOWARD SOIL CONSERVATION DISTRICT AND/OR MDE.


Michael Pfu 11/1/16
 OWNER/DEVELOPER SIGNATURE DATE
 MICHAEL PFU
 PRINTED NAME & TITLE

APPROVED: HOWARD COUNTY DEPARTMENT OF PLANNING AND ZONING








Chad Edwards 11-29-16
 CHIEF, DEVELOPMENT ENGINEERING DIVISION DATE

Natalie Jones 12-5-16
 CHIEF, DIVISION OF LAND DEVELOPMENT DATE

Natalie Jones 12-5-16
 DIRECTOR DATE

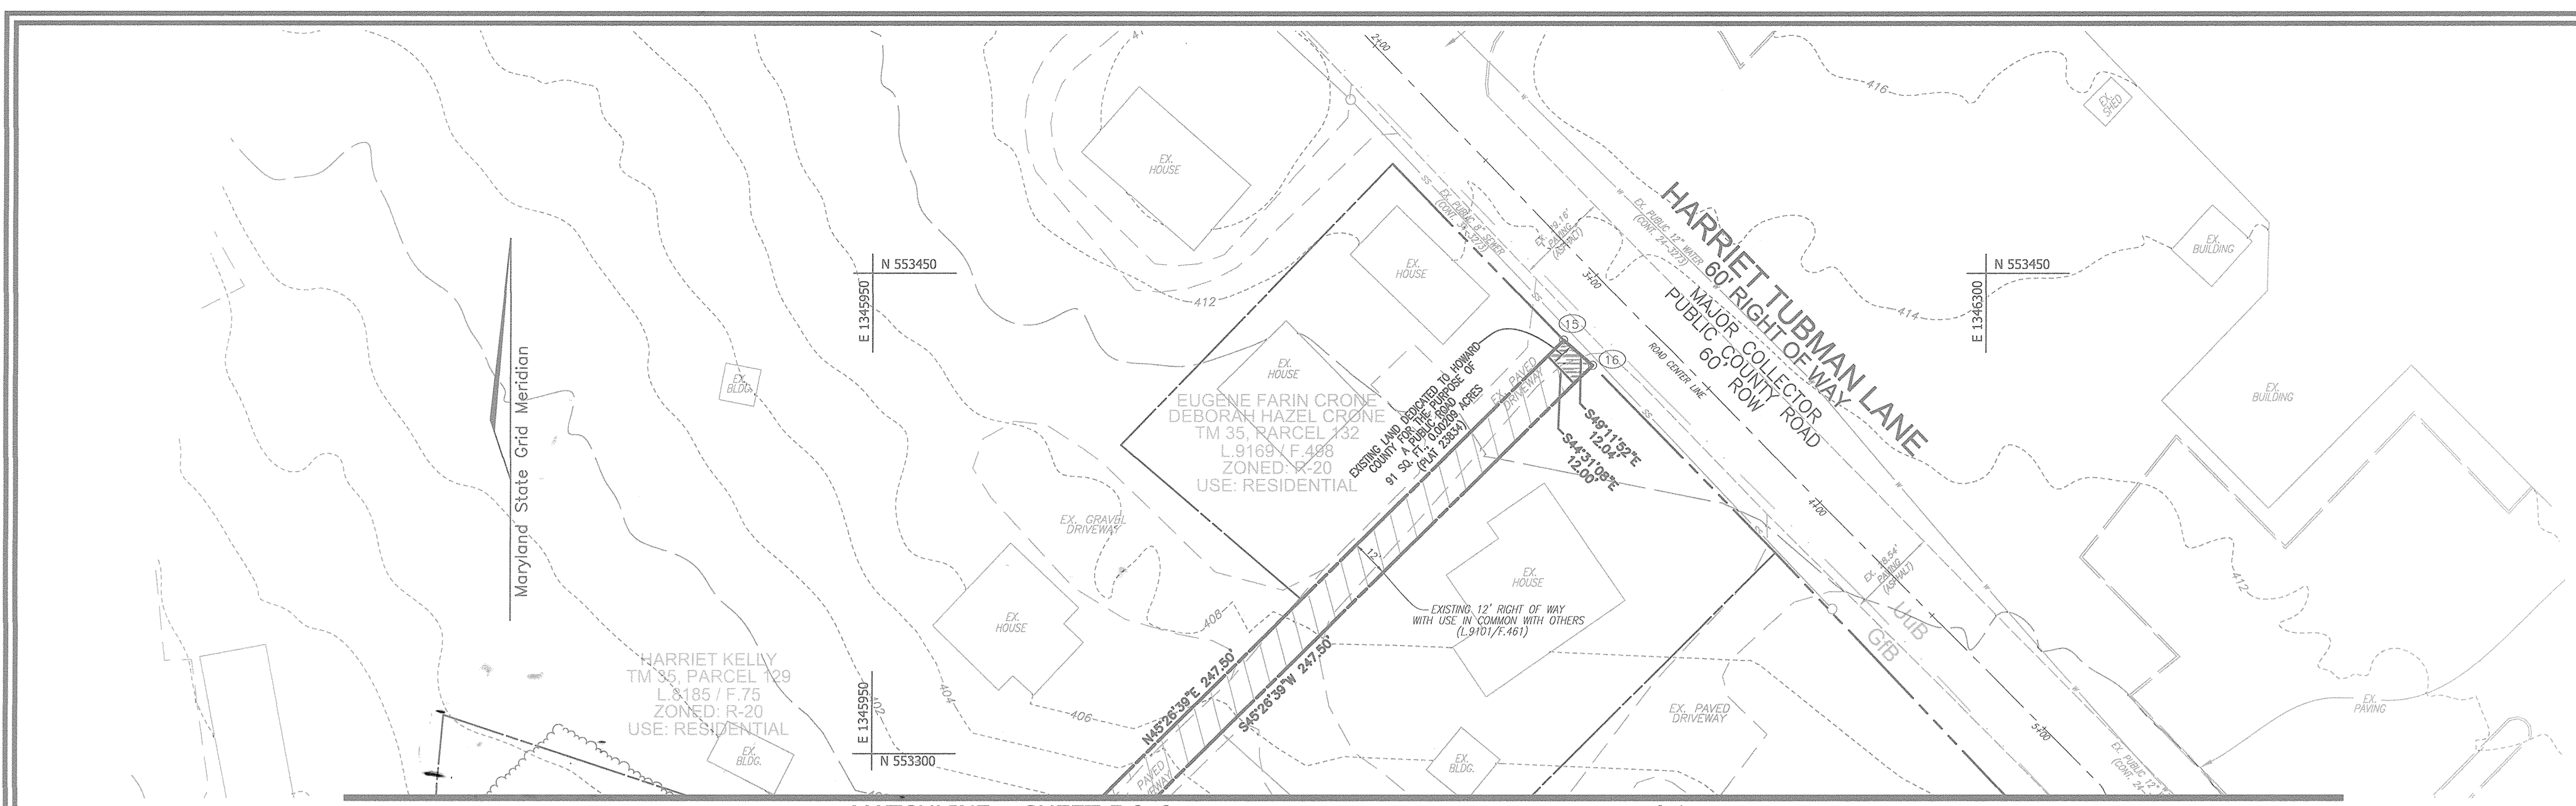

- LEGEND:**
- EXISTING CURB AND GUTTER
 - EXISTING UTILITY POLE
 - EXISTING LIGHT POLE
 - EXISTING MAILBOX
 - EXISTING SIGN
 - EXISTING SANITARY MANHOLE
 - EXISTING SANITARY LINE
 - EXISTING CLEANOUT
 - EXISTING FIRE HYDRANT
 - EXISTING WATER LINE
 - EXISTING TREES (FIELD LOCATED)
 - EXISTING TREE LINE (FIELD LOCATED)
 - EXISTING FENCE
 - PROPERTY LINE
 - RIGHT-OF-WAY LINE
 - ADJACENT PROPERTY LINE
 - EXISTING STREAM
 - EXISTING STREAM BUFFER
 - EXISTING 12' RIGHT OF WAY PRIVATE WATER W/ USE IN COMMON WITH OTHERS (L.919/F.461) (L.867/F.52) (L.1185/F.136)
 - EXISTING LAND DEDICATED TO HOWARD COUNTY FOR THE PURPOSE OF A PUBLIC ROAD (PLAT NO. 23834)
 - NON-CREDITED OPEN SPACE AREA

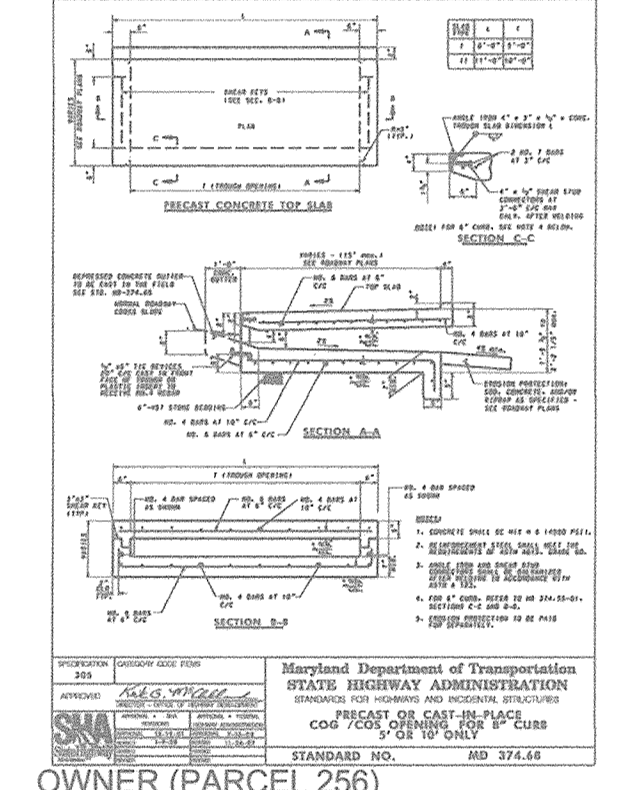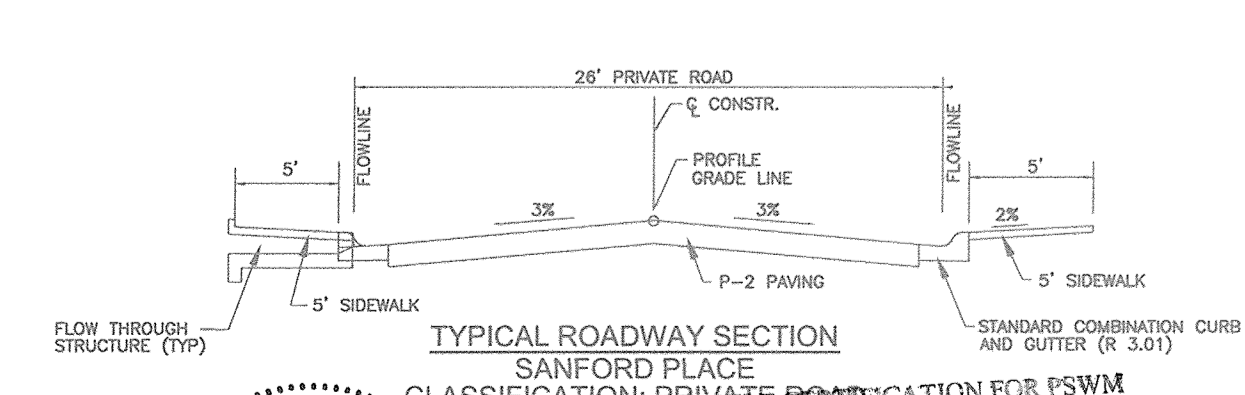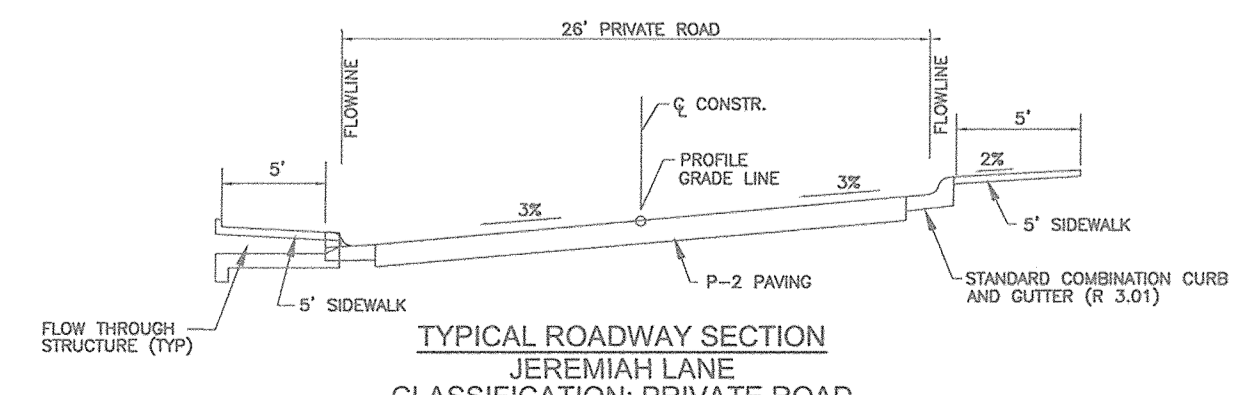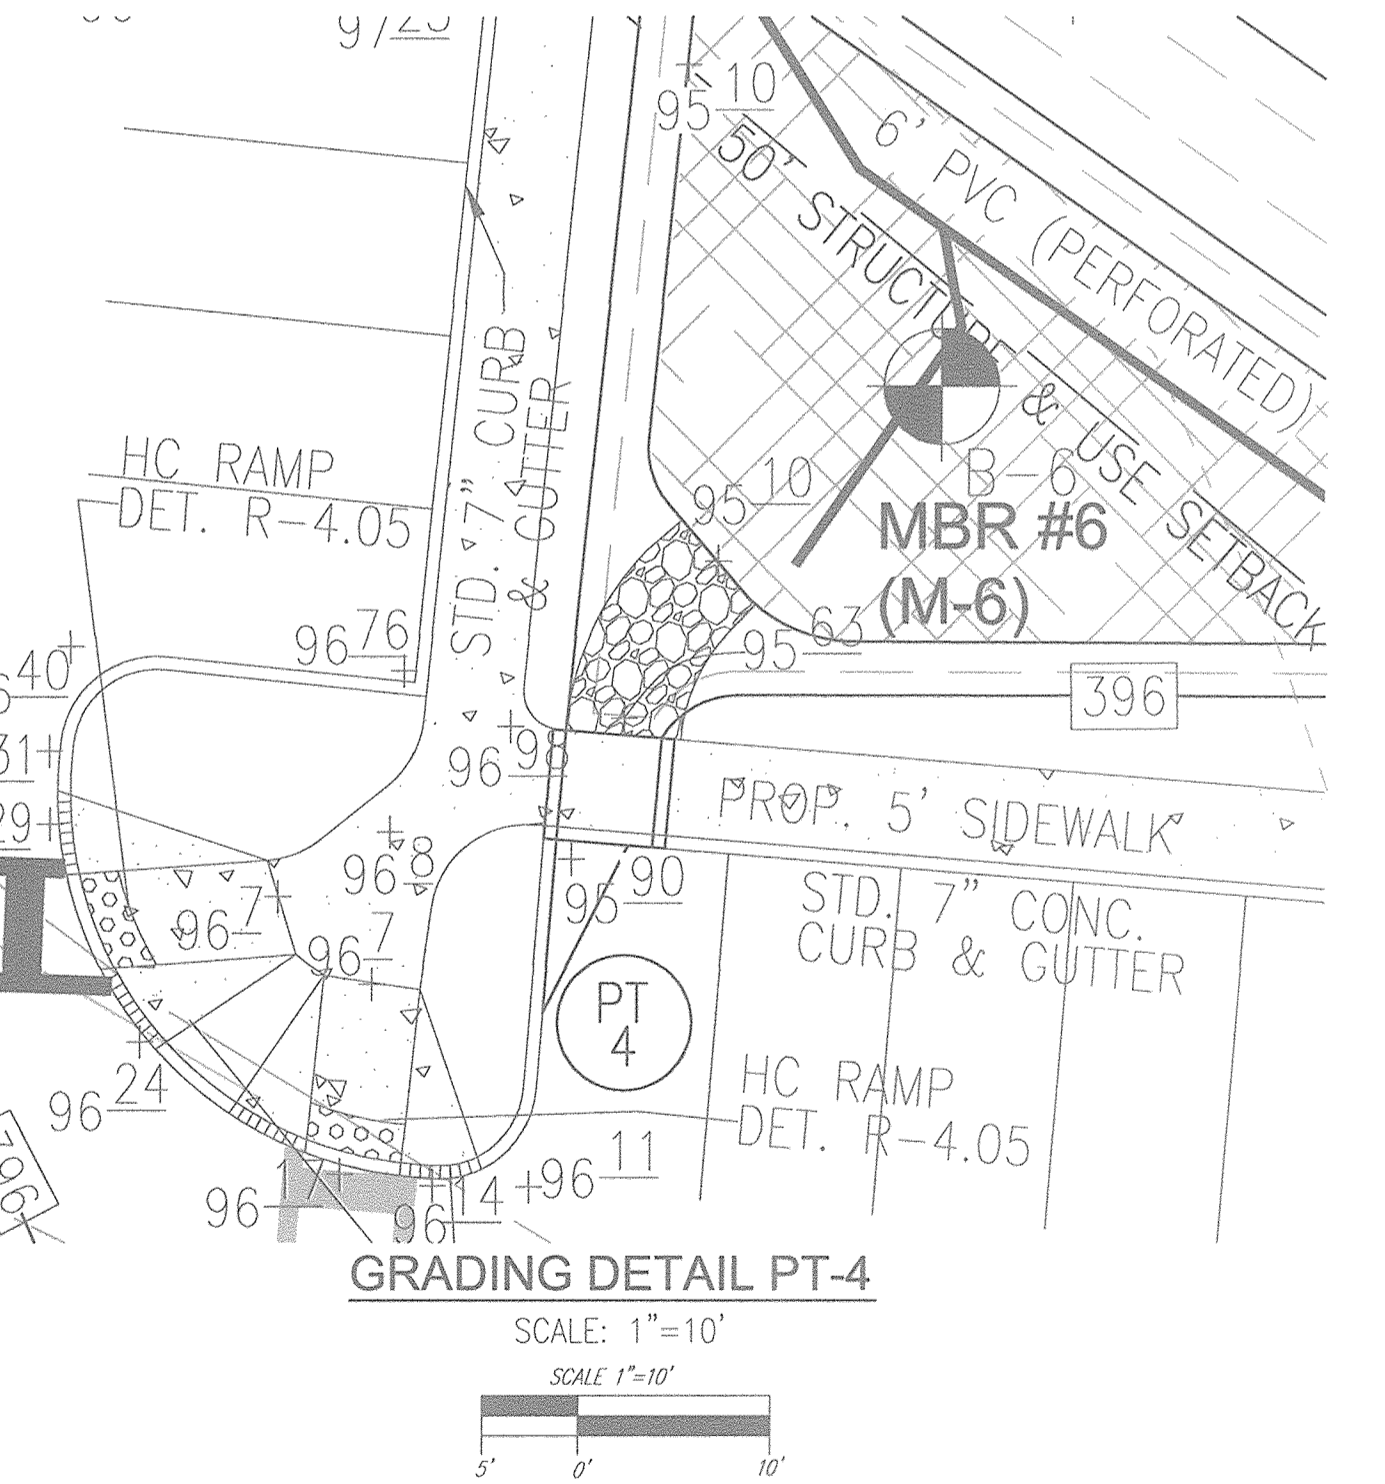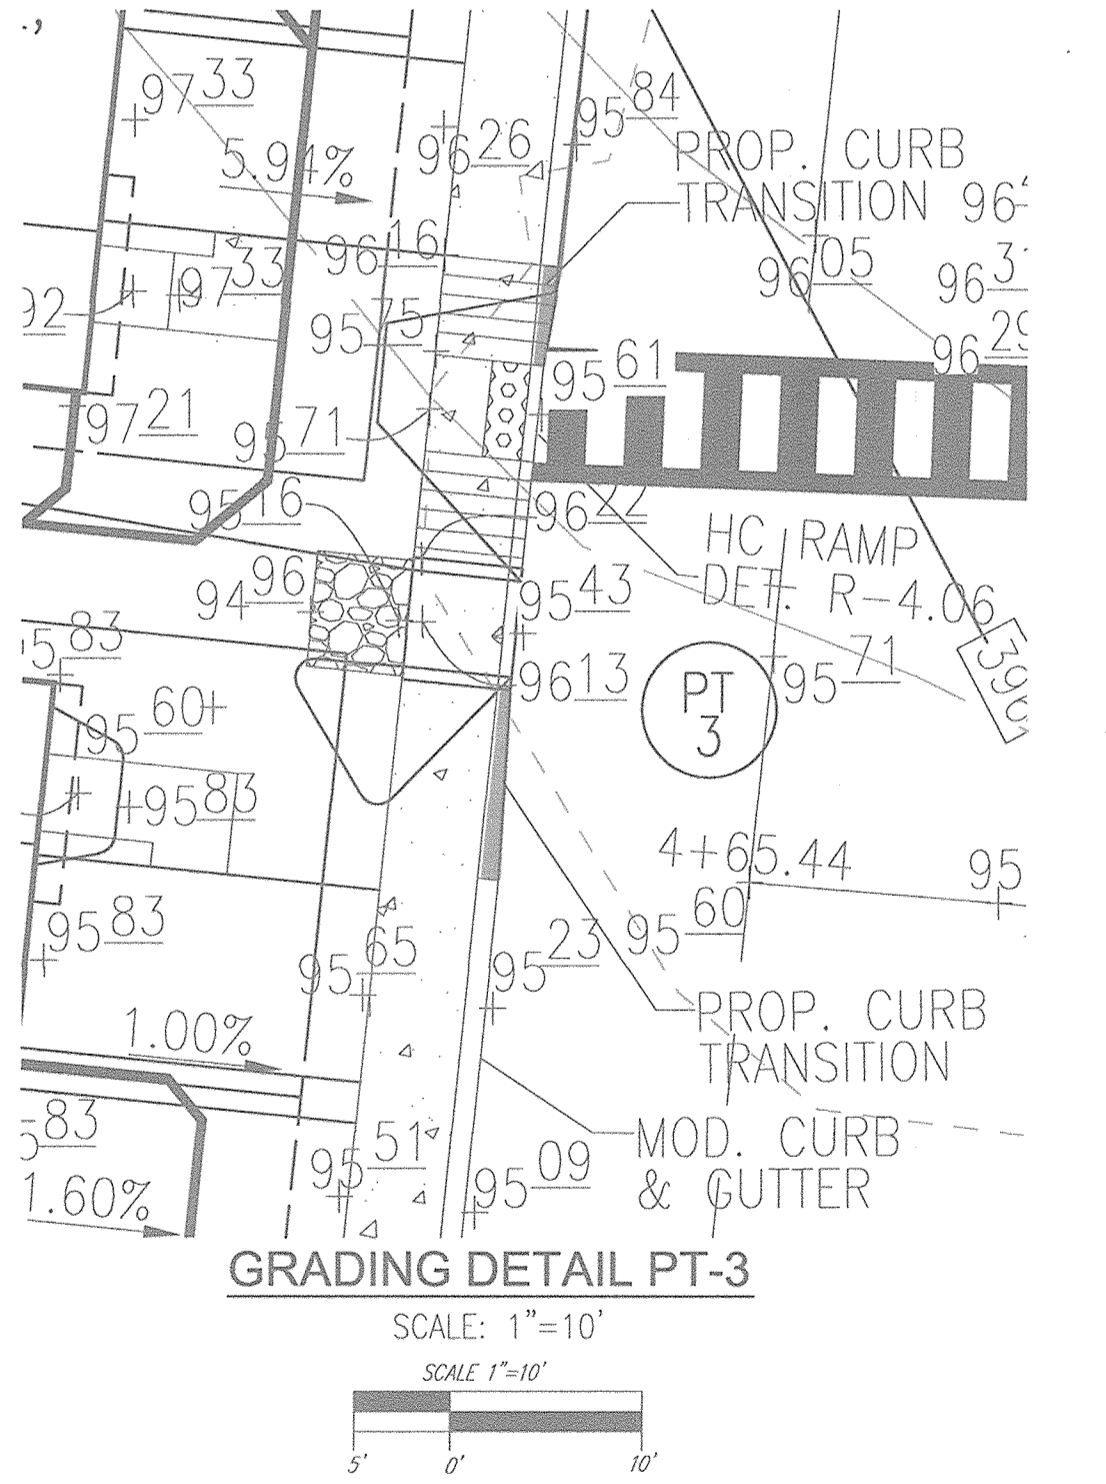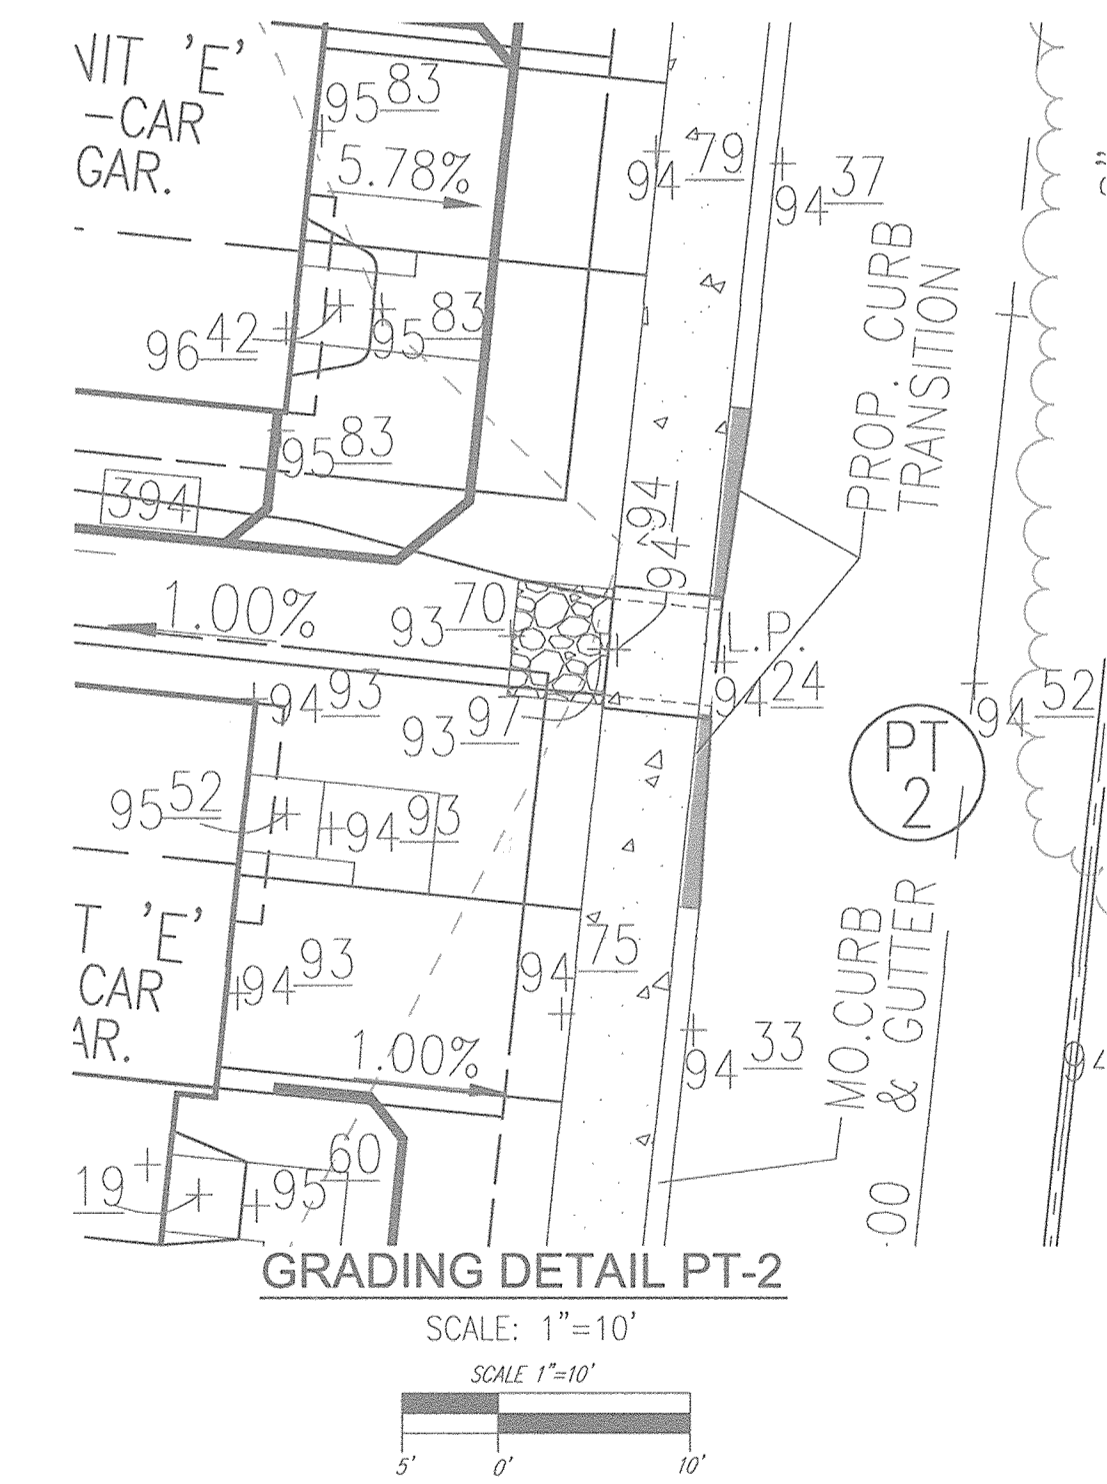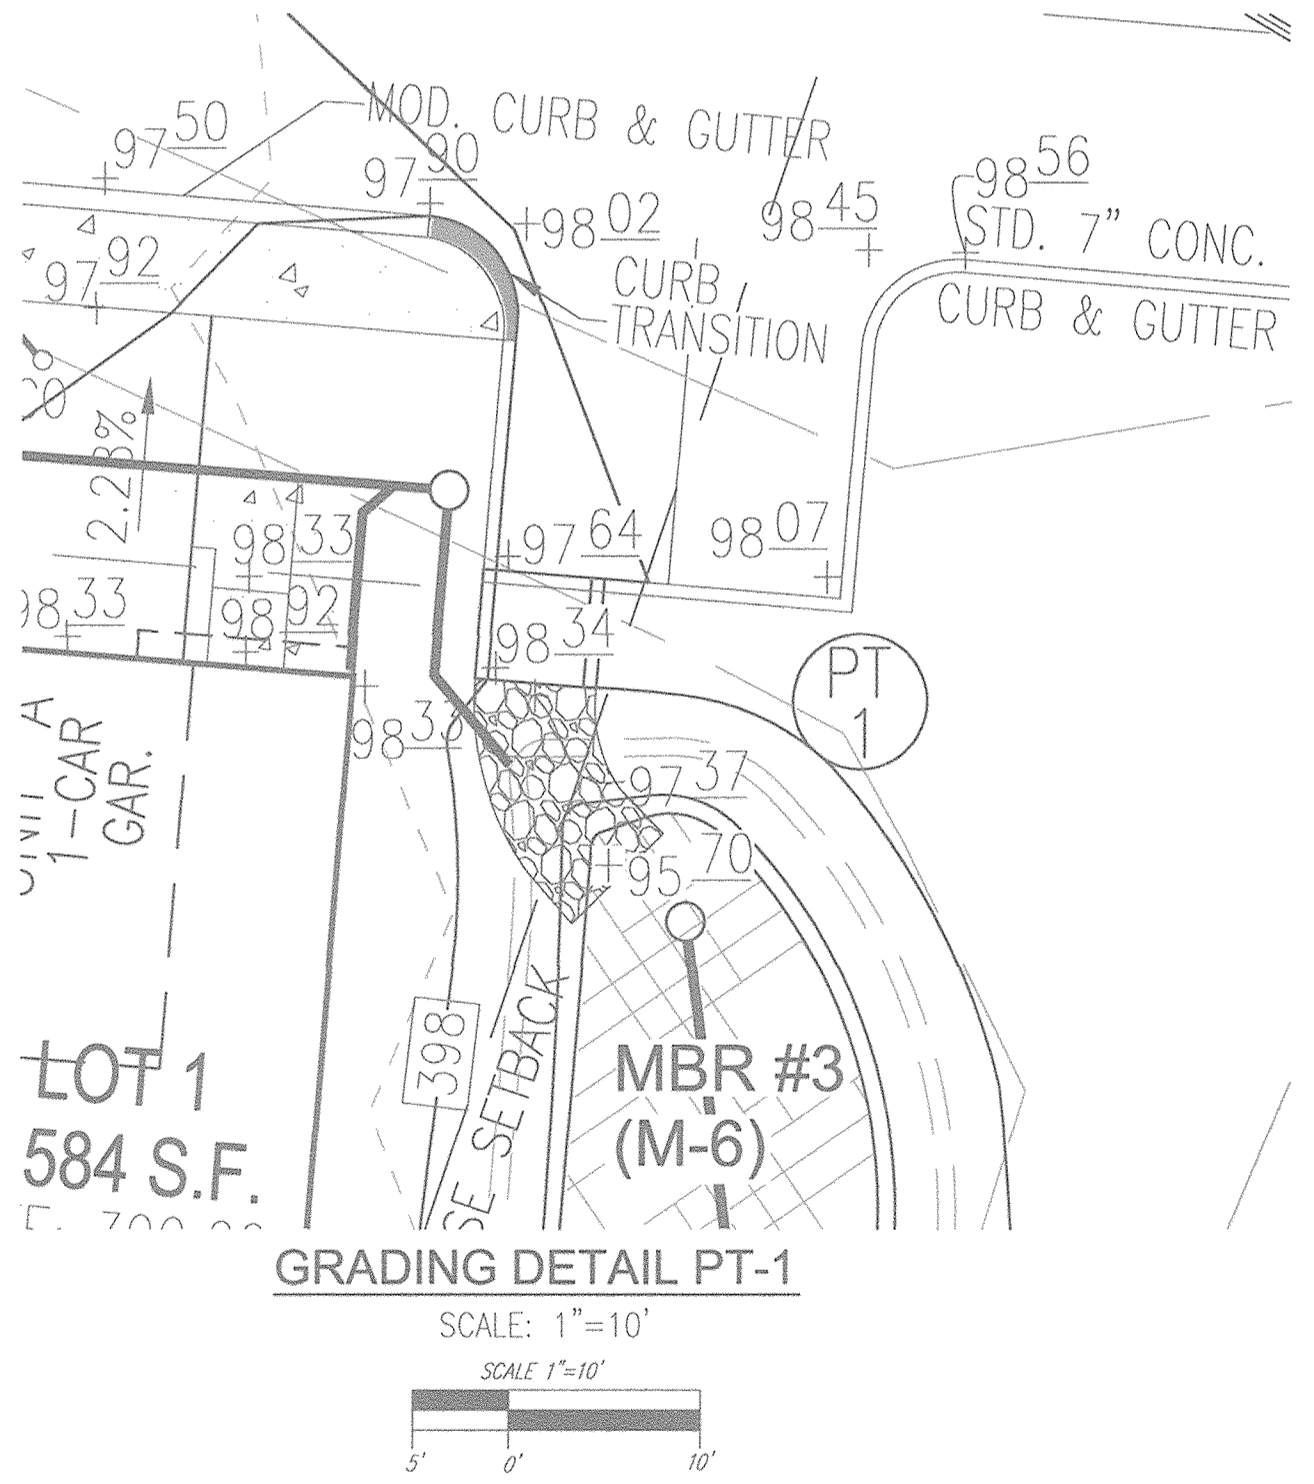

OWNER (PARCEL 256)
TEMPLE BETH SHALOM OF HOWARD COUNTY
8070 HARRIET TUBMAN LANE
COLUMBIA, MD. 21044

OWNER (PARCEL 153)
JOSEPH'S COURTYARD, LLC
3675 PARK AVENUE #301
ELLCOTT CITY, MD. 21043
C/O MICHAEL PFAU
(410) 480-0023

OWNER/DEVELOPER (PARCEL 153)
TRINITY HOMES MARY LAND, LLC.
3675 PARK AVENUE #301
ELLCOTT CITY, MD. 21043
C/O MICHAEL PFAU
(410) 480-0023

NO.	REVISION	DATE
1	REVISE PLAN TO ACCOMMODATE BUILDER HOUSE MODEL	10/28/16

REVISED SITE DEVELOPMENT PLAN
GRADING PLAN
JOSEPH'S COURTYARD
LOTS 1-24 AND OPEN SPACE LOTS 25 AND 26 - USE IN COMMON ACCESS (P.256)
SINGLE FAMILY ATTACHED AND RELIGIOUS FACILITY (BA-93-40E)
TAX MAP 35 BLOCK 24 ZONED: PARCEL 153 (R-SA-8) / PARCEL 256 (R-12) PARCEL 153: PIO 256
5TH ELECTION DISTRICT L.09101/F.0461/L. 02548/F. 0388 HOWARD COUNTY, MARYLAND

ROBERT H. VOGEL ENGINEERING, INC.
ENGINEERS • SURVEYORS • PLANNERS
8407 MAIN STREET
ELLCOTT CITY, MD 21043
TEL: 410.461.7666
FAX: 410.461.8961

APPROVED: HOWARD COUNTY DEPARTMENT OF PLANNING AND ZONING

Robert H. Vogel 11-29-16
CHIEF, DEVELOPMENT ENGINEERING DIVISION HOP DATE

Kate Malone 12-05-16
CHIEF, DIVISION OF LAND DEVELOPMENT GMP DATE

Walter Miller 12-5-16
DIRECTOR DATE

* WHERE MODIFIED CURBING IS PROPOSED, IT SHALL TRANSITION TO STANDARD COMBINATION CURB AND GUTTER (R 3.01) AT ALL INTERSECTIONS.

STATE OF MARYLAND
ROBERT HARRIS VOGEL
No. 16193
PROFESSIONAL ENGINEER

I HEREBY CERTIFY THAT THE FACILITY SHOWN ON THIS PLAN WAS CONSTRUCTED AS SHOWN ON THE "AS-BUILT" PLANS AND COMPLIES WITH THE APPROVED PLANS AND SPECIFICATIONS. I HAVE VERIFIED THAT THE CONTRIBUTING DRAINAGE AREA IS SUFFICIENTLY STABILIZED TO PREVENT CLOGGING OF THE UNDERGROUND SWM FACILITY.

Robert H. Vogel 16193 2/5/19
P.E. # DATE

NO AS-BUILT INFORMATION ON THIS SHEET

DESIGN BY: RHV/GAH
DRAWN BY: GAH/KKG
CHECKED BY: RHV
DATE: MAY 2016
SCALE: AS SHOWN
W.O. NO.: 05-84

I HEREBY CERTIFY THAT THESE DOCUMENTS WERE PREPARED OR APPROVED BY ME AND THAT I AM A DULY LICENSED PROFESSIONAL ENGINEER UNDER THE LAWS OF THE STATE OF MARYLAND, LICENSE NO. 16193, EXPIRATION DATE: 06-27-2016

7 SHEET OF 14

B-4-2 STANDARDS AND SPECIFICATIONS FOR SOIL PREPARATION, TOPSOILING AND SOIL AMENDMENTS

DEFINITION: THE PROCESS OF PREPARING THE SOILS TO SUSTAIN ADEQUATE VEGETATIVE STABILIZATION. PURPOSE: TO PROVIDE A SUITABLE SOIL MEDIUM FOR VEGETATION GROWTH. CONDITIONS WHERE PRACTICE APPLIES: WHERE VEGETATIVE STABILIZATION IS TO BE ESTABLISHED.

B-4-4 STANDARDS AND SPECIFICATIONS FOR TEMPORARY STABILIZATION

DEFINITION: TO STABILIZE DISTURBED SOILS WITH VEGETATION UP TO 6 MONTHS. PURPOSE: TO PROVIDE A SUITABLE SOIL MEDIUM FOR VEGETATION GROWTH. CONDITIONS WHERE PRACTICE APPLIES: EXPOSED SOILS WHERE GROUND COVER IS NEEDED FOR A PERIOD OF 6 MONTHS OR LESS.

B-4-4 STANDARDS AND SPECIFICATIONS FOR STOCKPILE AREA

DEFINITION: A MOUND OR PILE OF SOIL PROTECTION BY APPROPRIATELY DESIGNED EROSION AND SEDIMENT CONTROL MEASURES. PURPOSE: TO PROVIDE A DESIGNATED LOCATION FOR THE TEMPORARY STORAGE OF SOIL THAT CONTROLS THE POTENTIAL FOR EROSION, SEDIMENTATION, AND CHANGES TO DRAINAGE PATTERNS.

B-4-3 STANDARDS AND SPECIFICATIONS FOR SEEDING AND MULCHING

DEFINITION: THE APPLICATION OF SEED AND MULCH TO ESTABLISH VEGETATIVE COVER. PURPOSE: TO PROVIDE DISTURBED SOILS WITH PERMANENT VEGETATION. CONDITIONS WHERE PRACTICE APPLIES: TO THE SURFACE OF ALL PERMANENT CONTOURS, SLOPES, AND ANY DISTURBED AREA NOT UNDER ACTIVE GRADING.

DEFINITION: TO STABILIZE DISTURBED SOILS WITH PERMANENT VEGETATION. PURPOSE: TO PROVIDE LONG-TERM PERENNIAL GRASSES AND LEGUMES TO ESTABLISH PERMANENT GROUND COVER. CONDITIONS WHERE PRACTICE APPLIES: WHERE GROUND COVER IS NEEDED FOR 6 MONTHS OR MORE.

Table B-1: Temporary Seeding for Site Stabilization

Table with 4 columns: Plant Species, Seeding Rate (lb/ac), Seeding Rate (lb/1000 ft²), and Recommended Seeding Dates by Plant Hardiness Zone (4b, 7a, and 7b).

STANDARDS AND SPECIFICATIONS FOR STOCKPILE AREA FOR DUST CONTROL. DEFINITION: THE SUSPENSION OF DUST PARTICLES FROM CONSTRUCTION ACTIVITIES. PURPOSE: TO PREVENT BLOWING AND MOVEMENT OF DUST FROM EXPOSED SOIL SURFACES TO REDUCE ON AND OFF-SITE DAMAGE.

B-4-5 STANDARDS AND SPECIFICATIONS FOR PERMANENT STABILIZATION

DEFINITION: TO STABILIZE DISTURBED SOILS WITH PERMANENT VEGETATION. PURPOSE: TO PROVIDE LONG-TERM PERENNIAL GRASSES AND LEGUMES TO ESTABLISH PERMANENT GROUND COVER. CONDITIONS WHERE PRACTICE APPLIES: WHERE GROUND COVER IS NEEDED FOR 6 MONTHS OR MORE.

DEFINITION: TO STABILIZE DISTURBED SOILS WITH PERMANENT VEGETATION. PURPOSE: TO PROVIDE LONG-TERM PERENNIAL GRASSES AND LEGUMES TO ESTABLISH PERMANENT GROUND COVER. CONDITIONS WHERE PRACTICE APPLIES: WHERE GROUND COVER IS NEEDED FOR 6 MONTHS OR MORE.

PERMANENT SEEDING SUMMARY

Summary table for permanent seeding with columns for Hardness Zone (4b, 7a, 7b), Filler Rate (lb/100-200), and Lime Rate.

TEMPORARY SEEDING SUMMARY



















































Summary table for temporary seeding with columns for Application Rate (lb/ac), Seeding Dates, and Filler/Lime Rates.

TEMPORARY SEEDING SUMMARY

Summary table for temporary seeding with columns for Application Rate (lb/ac), Seeding Dates, and Filler/Lime Rates.

TEMPORARY SEEDING SUMMARY

Summary table for temporary seeding with columns for Application Rate (lb/ac), Seeding Dates, and Filler/Lime Rates.

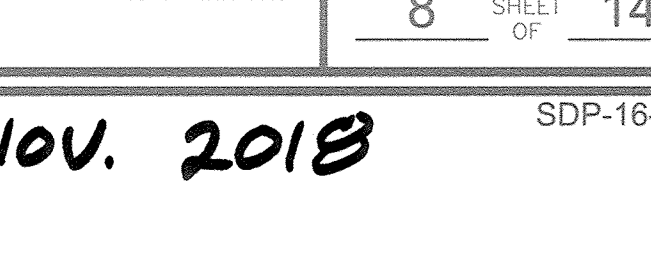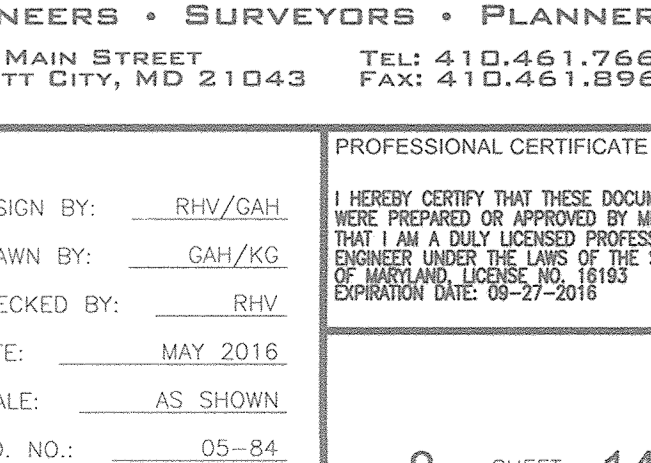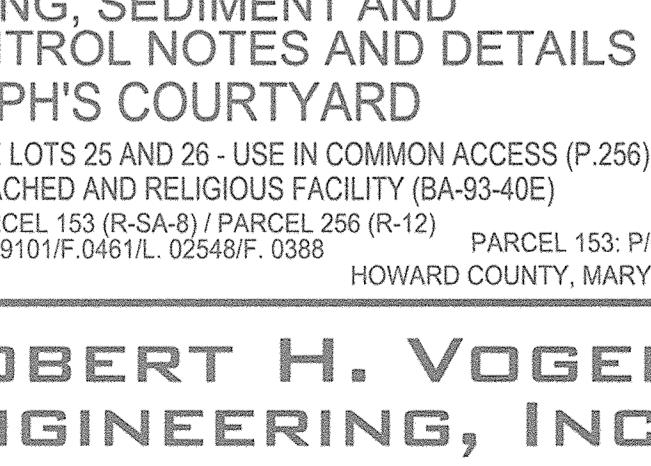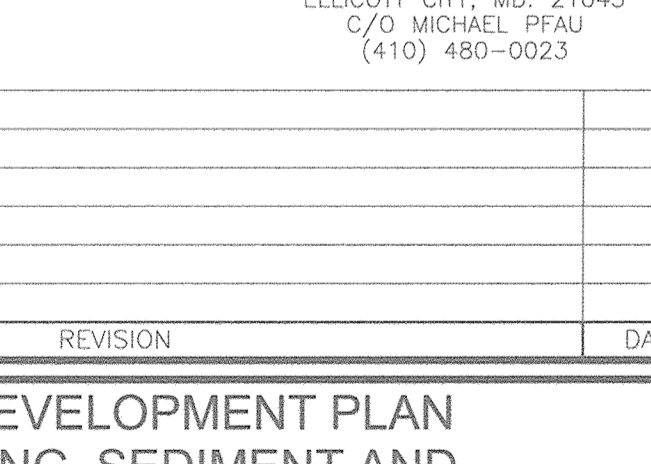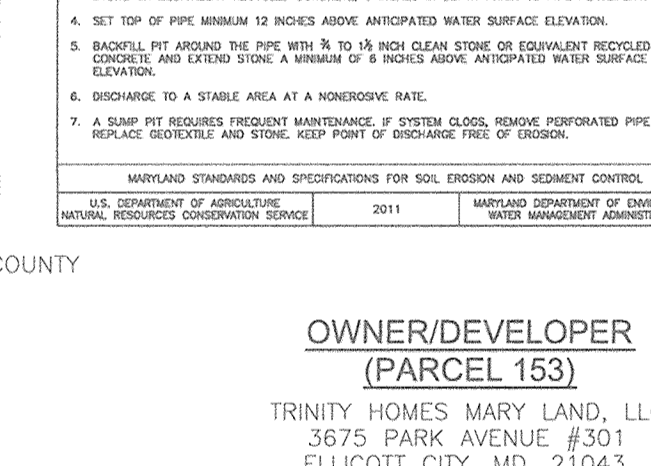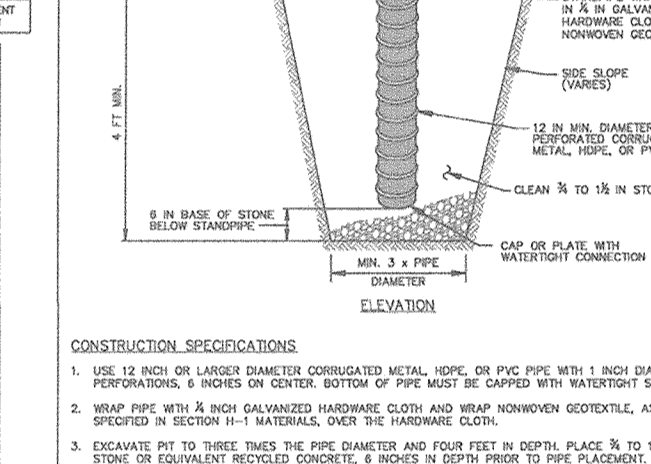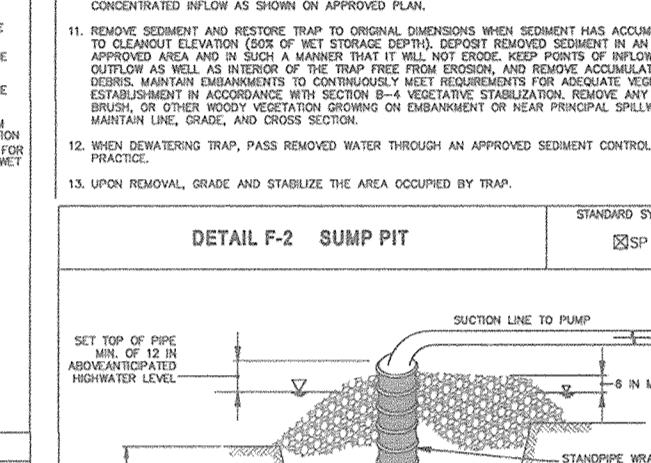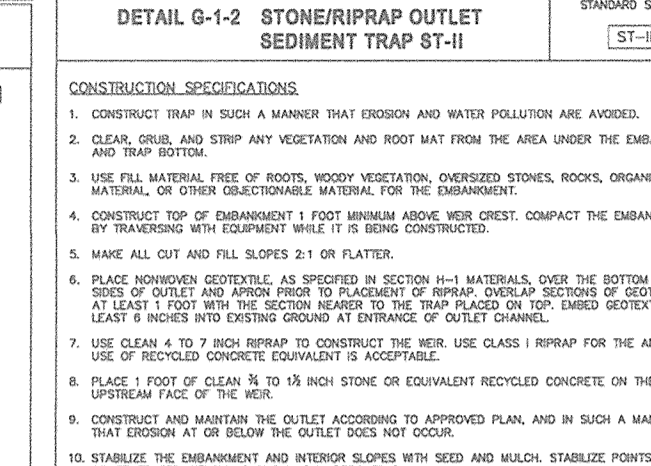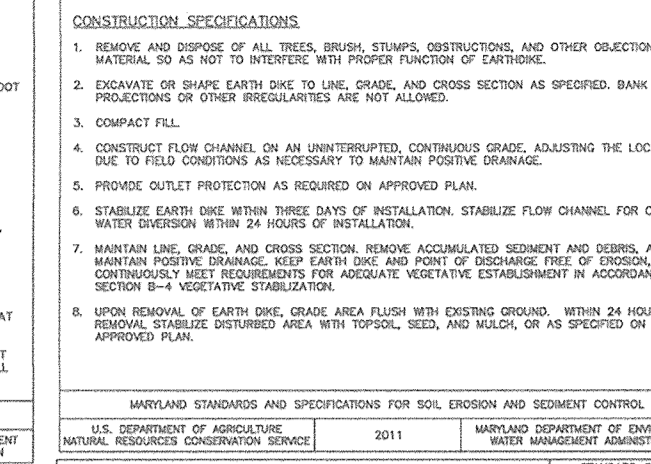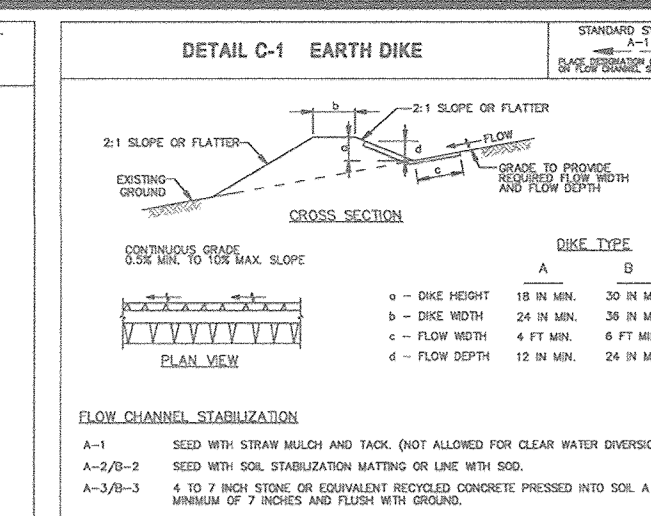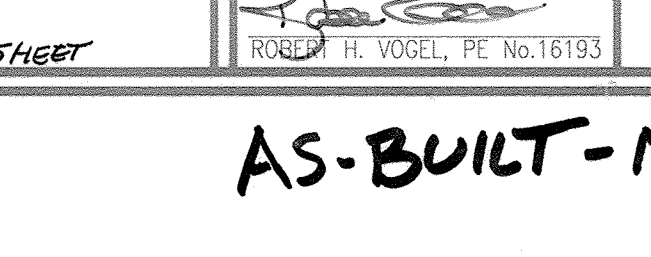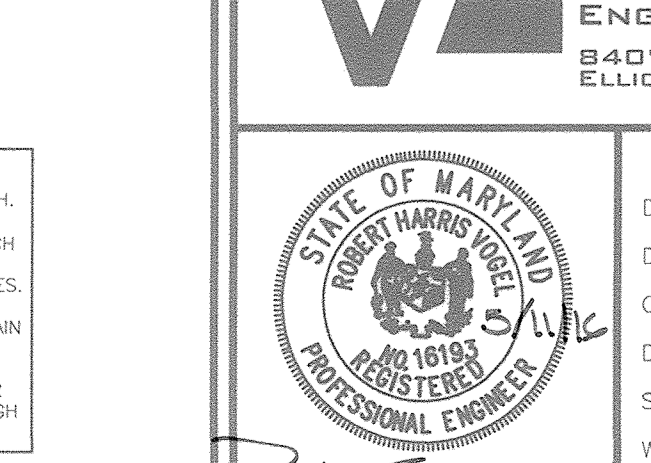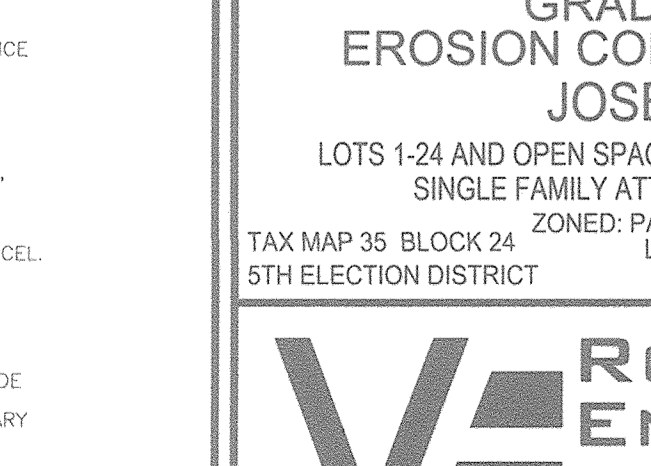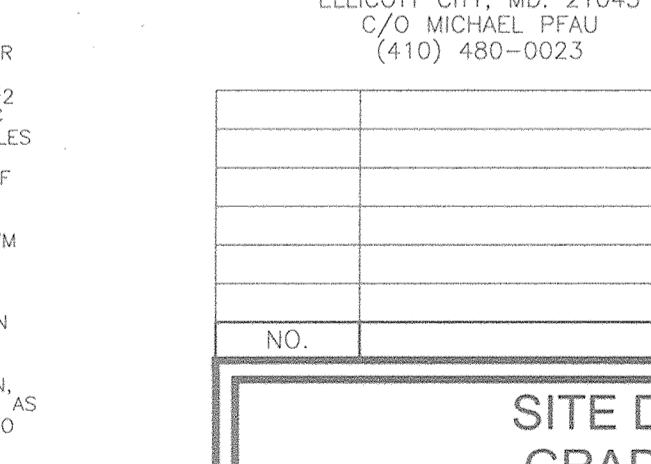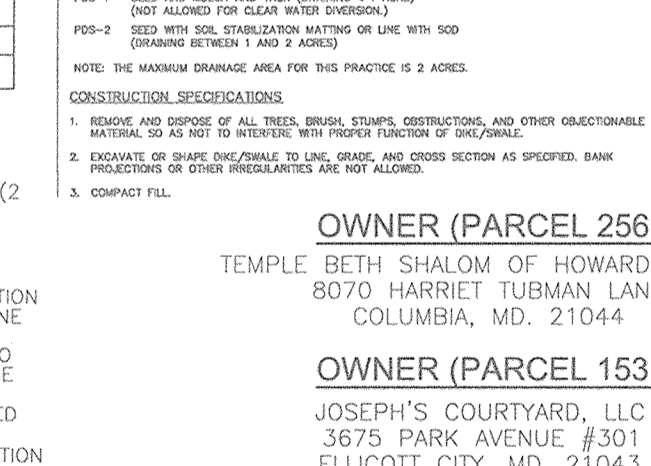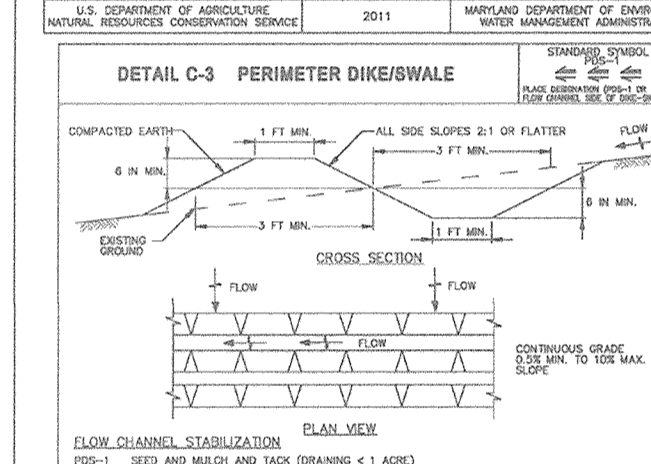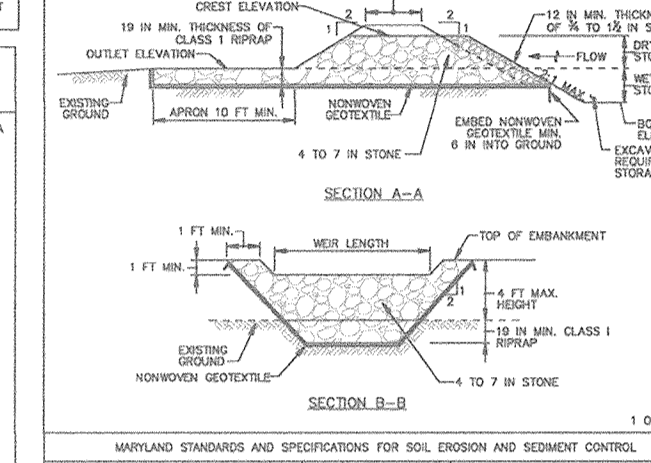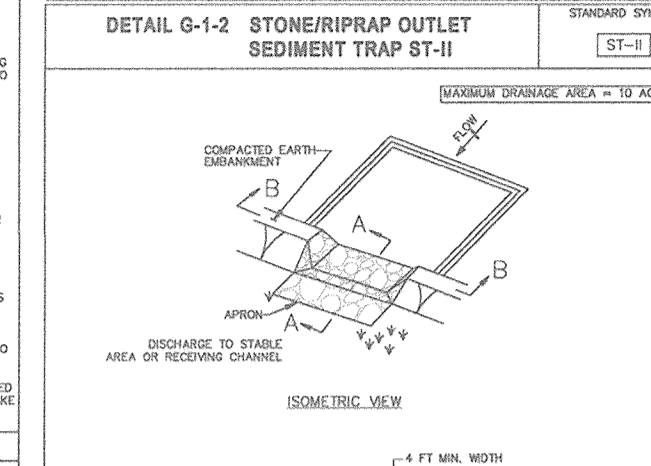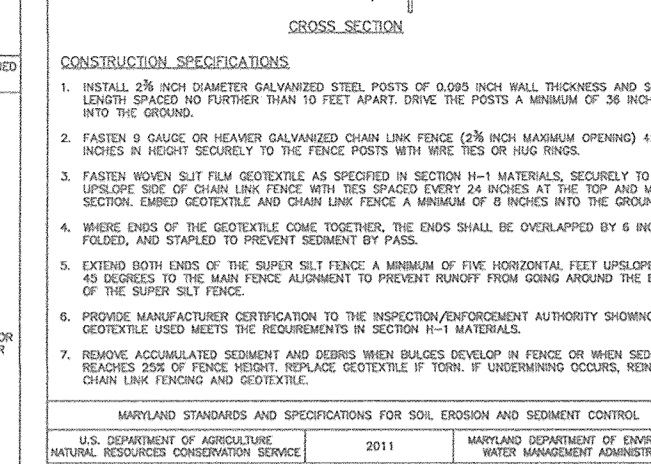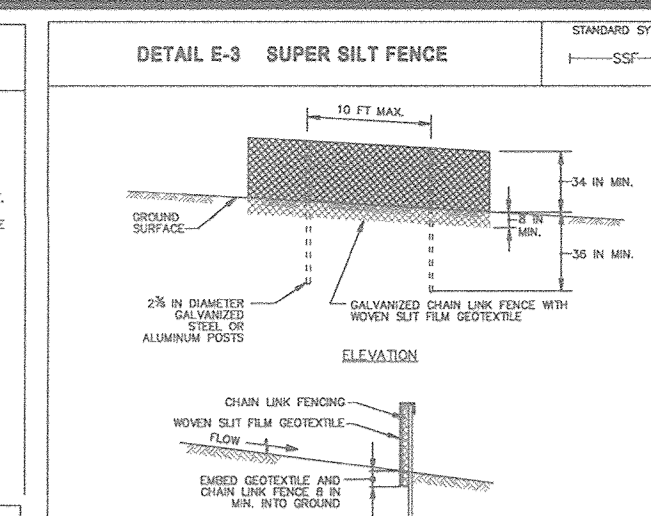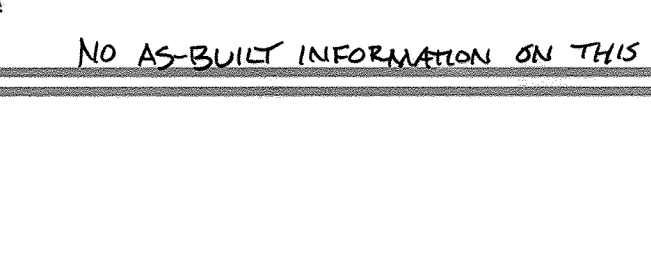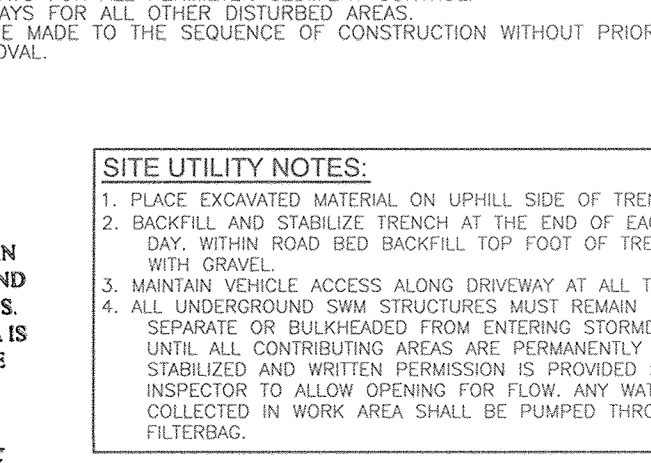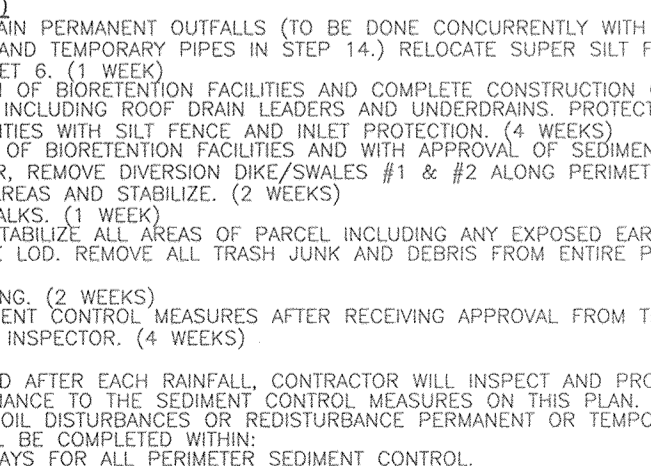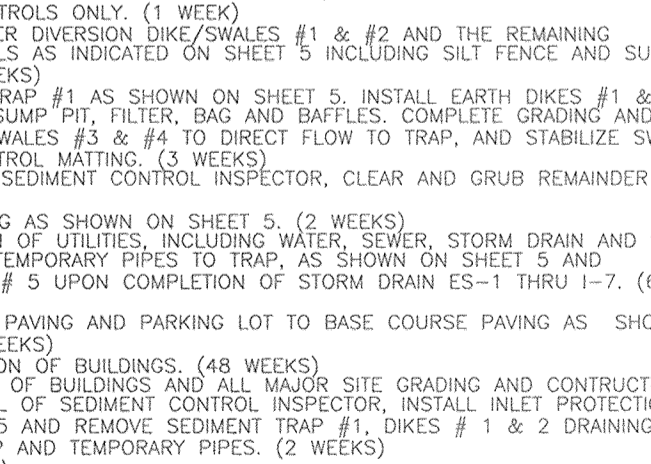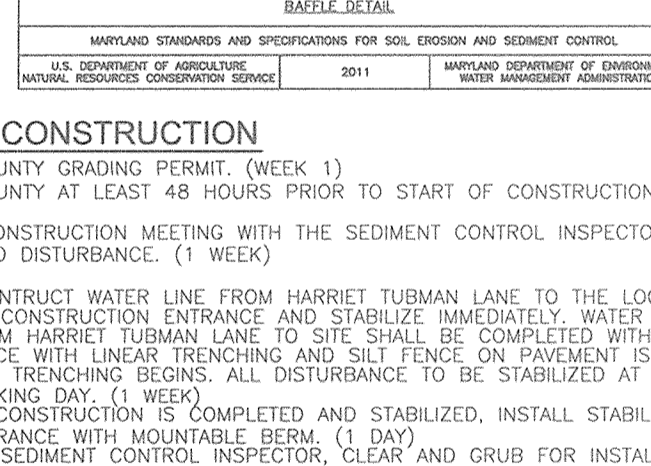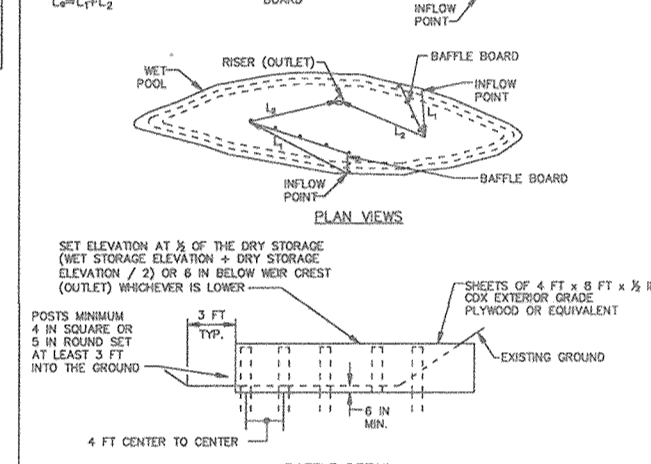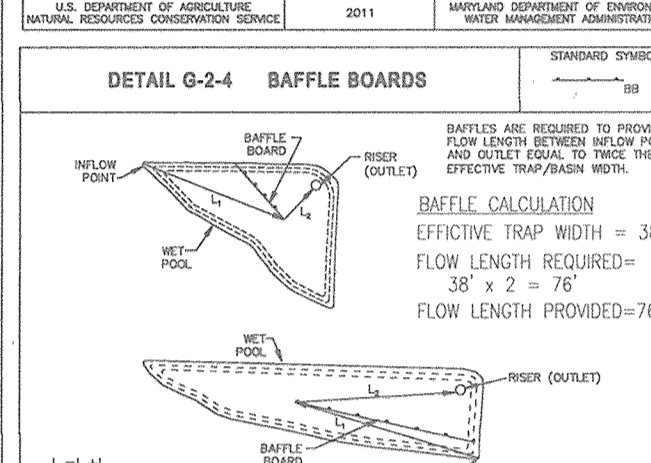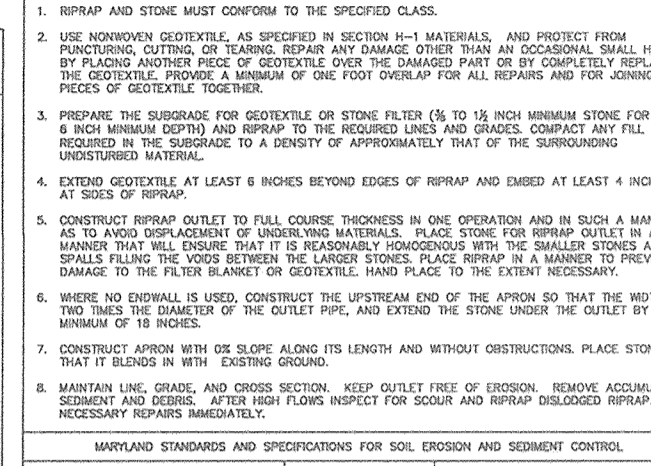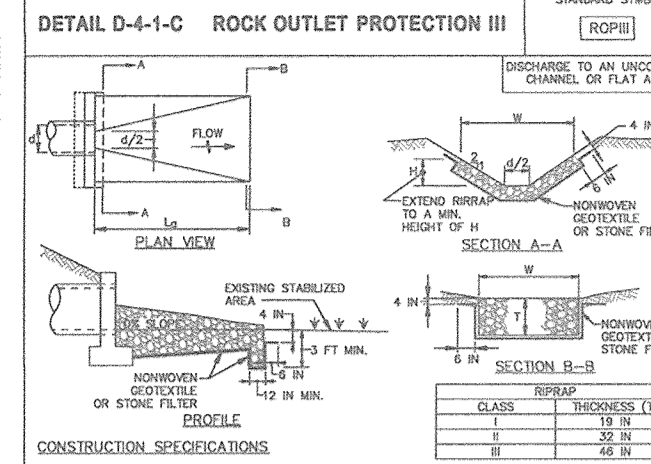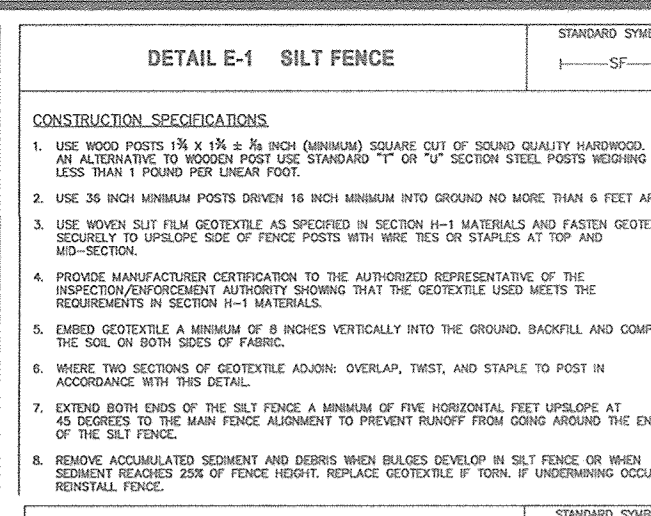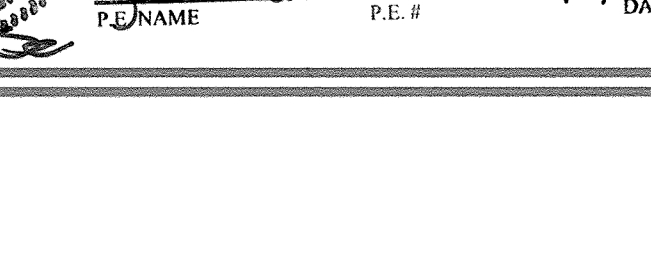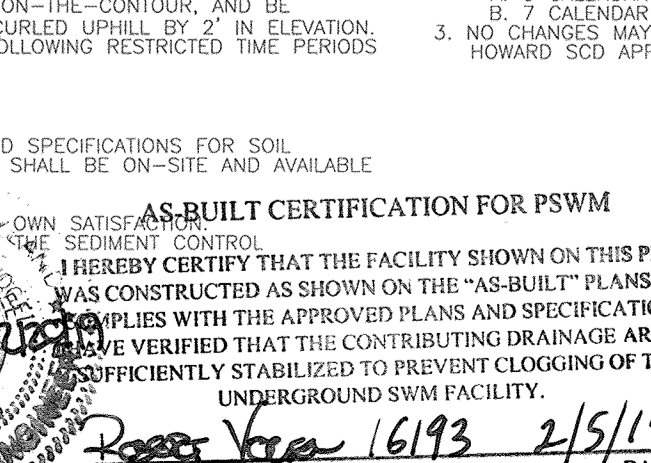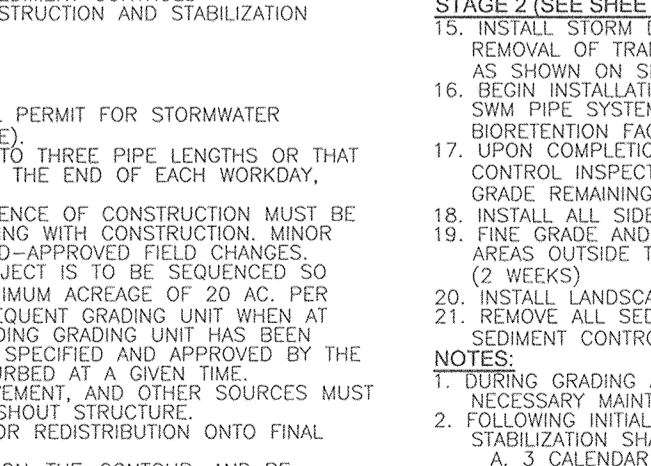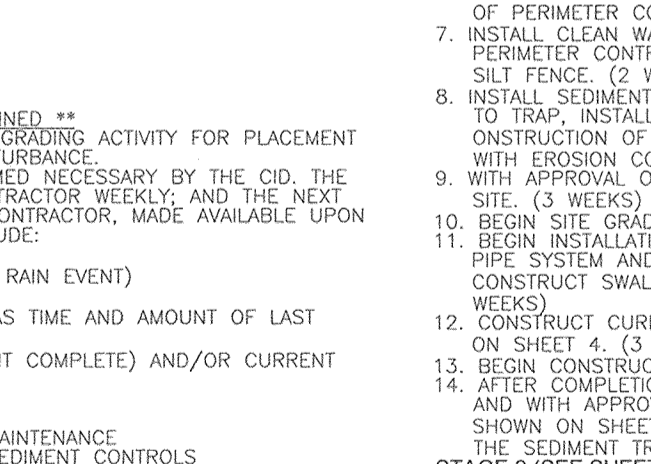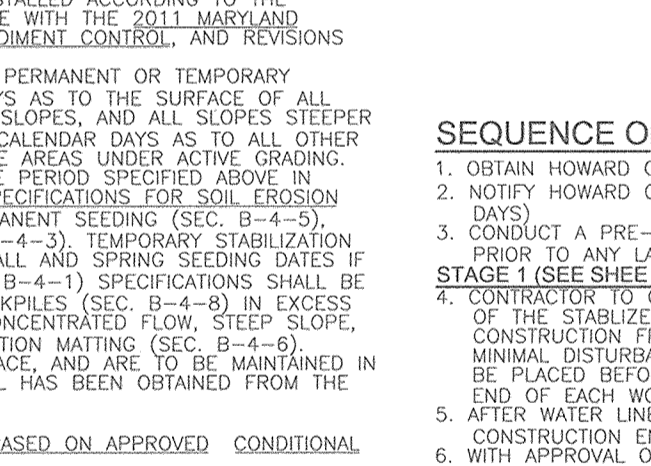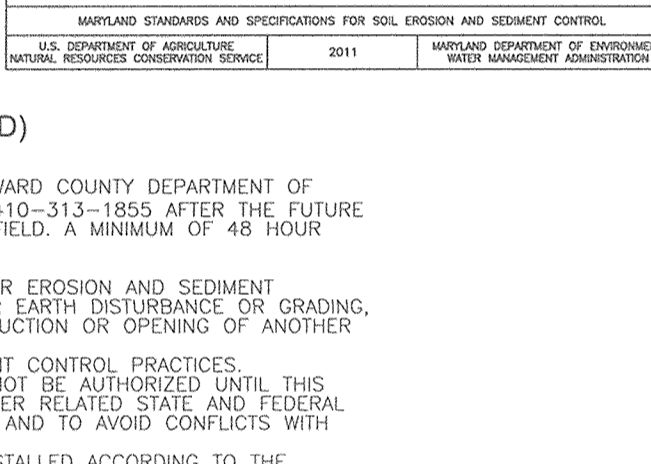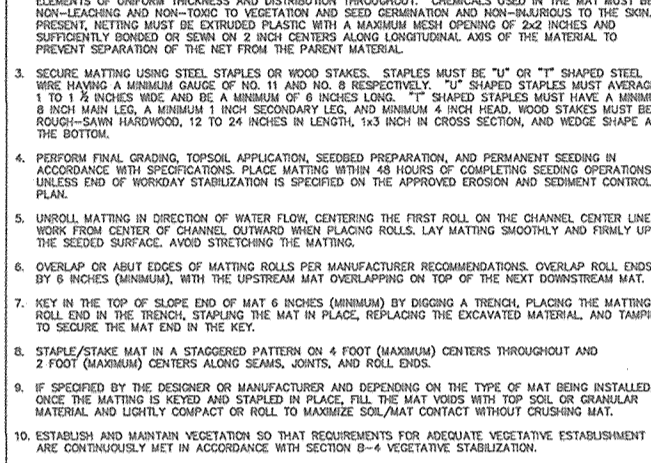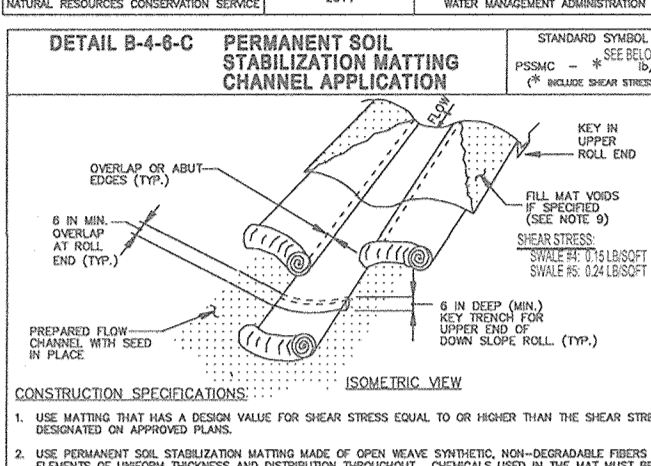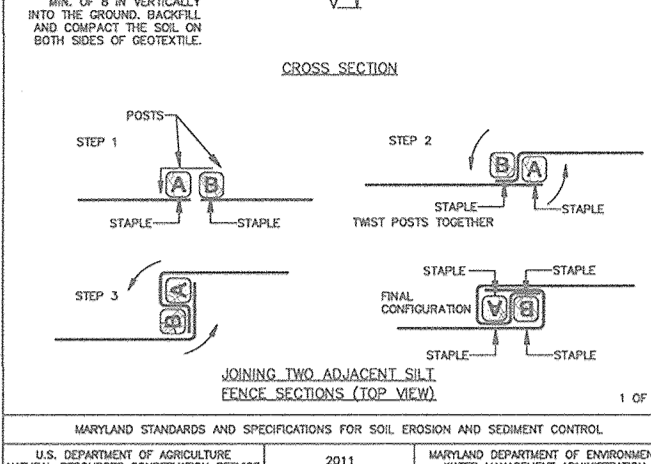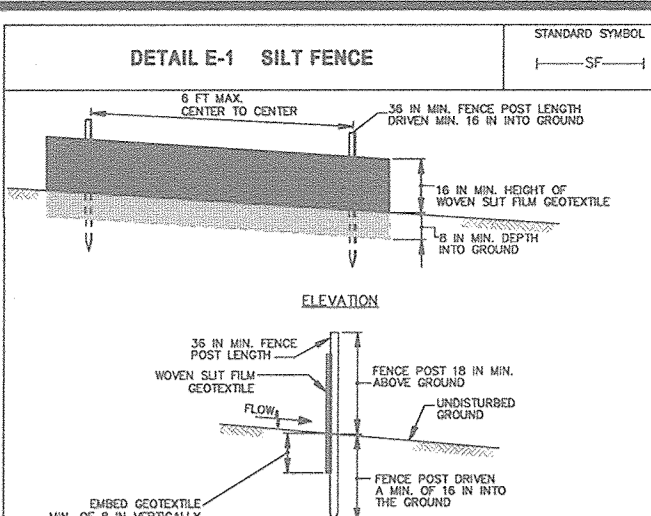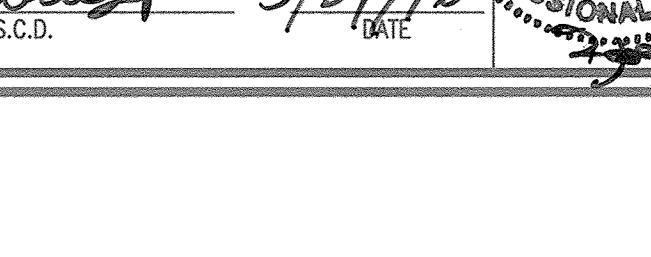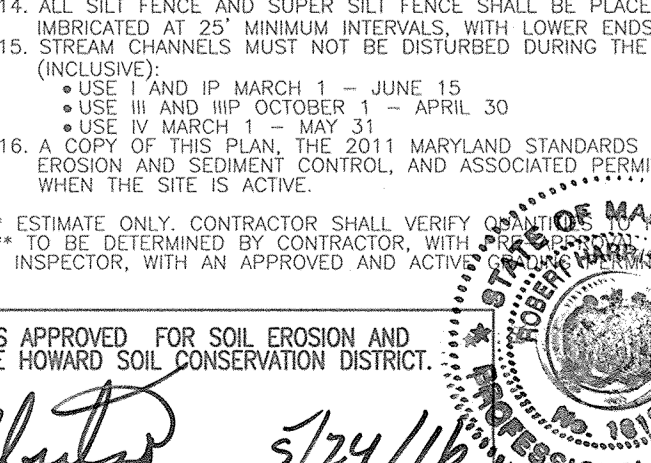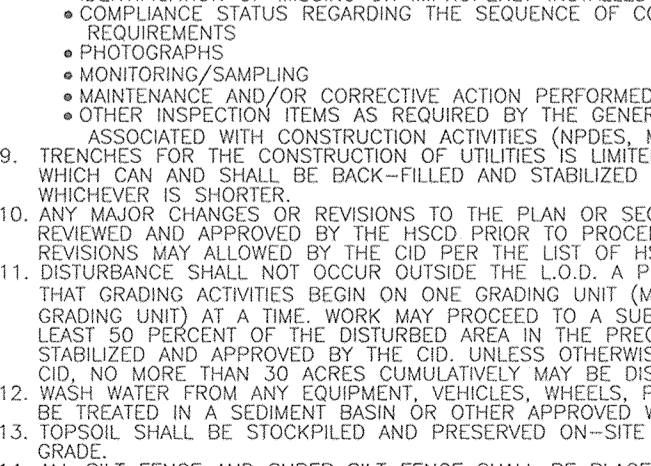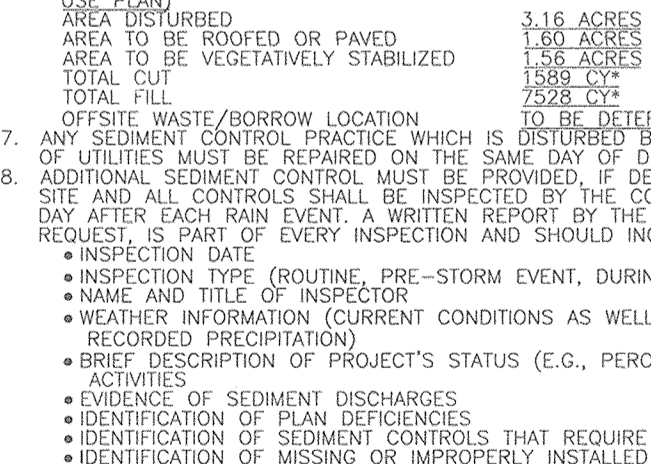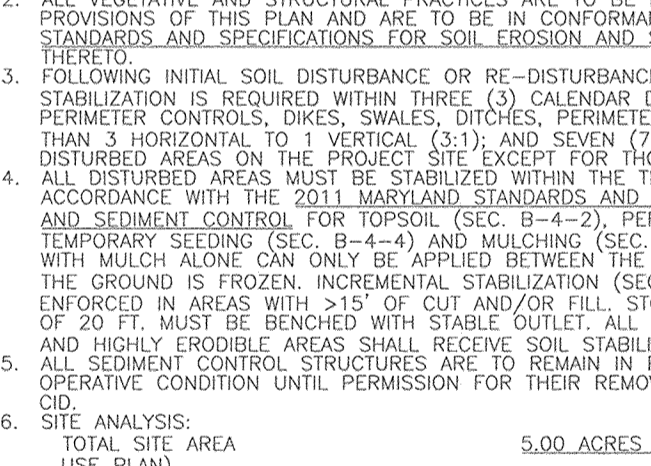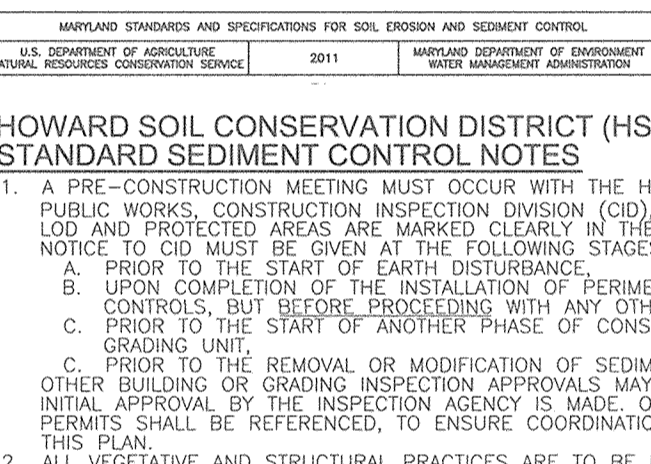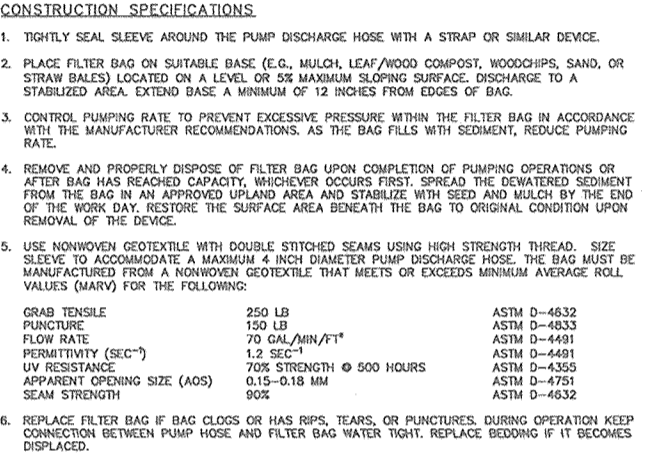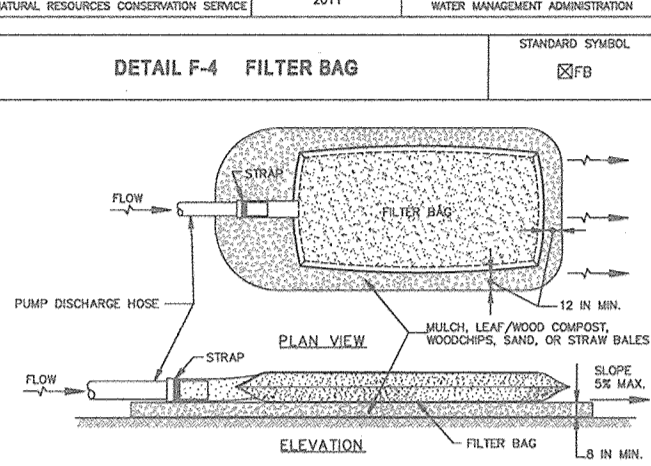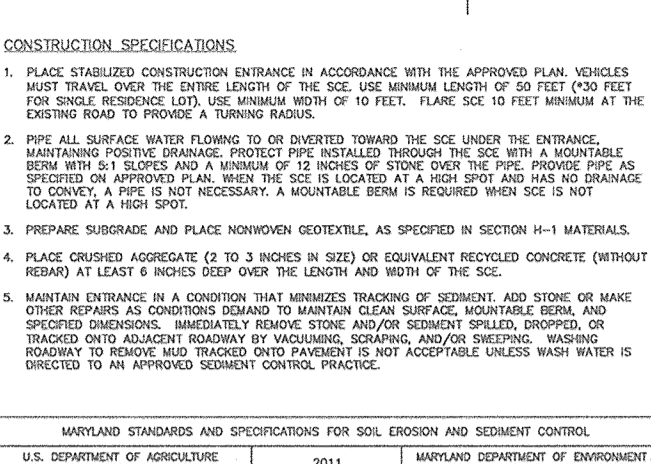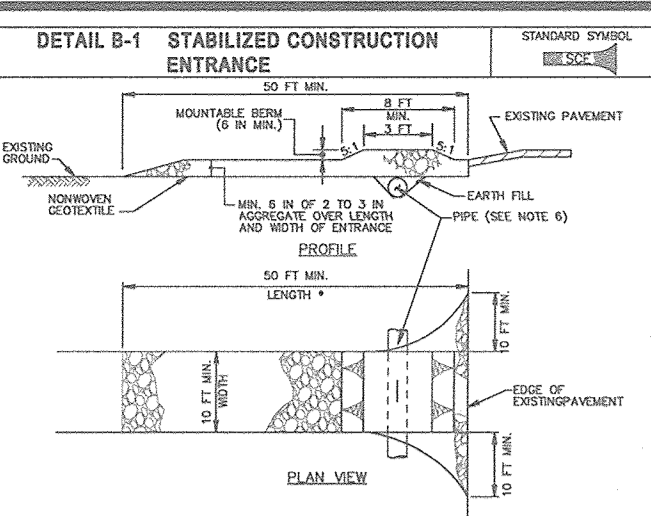

APPROVED: HOWARD COUNTY DEPARTMENT OF PLANNING AND ZONING. Chief, Development Engineering Division. Date: 6-1-16.

BY THE DEVELOPER: [Signature] Date: 6-28-16.

BY THE ENGINEER: [Signature] Date: 6/28/16.

AS-BUILT CERTIFICATION FOR PFSWM. I HEREBY CERTIFY THAT THIS PLAN FOR EROSION AND SEDIMENT CONTROL REPRESENTS A PRACTICAL AND WORKABLE PLAN BASED ON MY PERSONAL KNOWLEDGE OF THE SITE CONDITIONS, AND THAT IT WAS PREPARED IN ACCORDANCE WITH THE REQUIREMENTS OF THE HOWARD COUNTY CONSTRUCTION DISTRICT.

CONSTRUCTION SPECIFICATIONS. 1. OBTAIN HOWARD COUNTY GRADING PERMIT. 2. PRE-CONSTRUCTION MEETING WITH THE SEDIMENT CONTROL INSPECTOR.

OWNER (PARCEL 256). OWNER (PARCEL 153). OWNER (PARCEL 153).

SITE DEVELOPMENT PLAN GRADING, SEDIMENT AND EROSION CONTROL NOTES AND DETAILS. JOSEPH'S COURTYARD.

APPROVED: HOWARD COUNTY DEPARTMENT OF PLANNING AND ZONING.

BY THE DEVELOPER: [Signature] Date: 7-6-16.

BY THE ENGINEER: [Signature] Date: 7/1/16.

AS-BUILT CERTIFICATION FOR PFSWM. I HEREBY CERTIFY THAT THIS PLAN FOR EROSION AND SEDIMENT CONTROL REPRESENTS A PRACTICAL AND WORKABLE PLAN BASED ON MY PERSONAL KNOWLEDGE OF THE SITE CONDITIONS, AND THAT IT WAS PREPARED IN ACCORDANCE WITH THE REQUIREMENTS OF THE HOWARD COUNTY CONSTRUCTION DISTRICT.

CONSTRUCTION SPECIFICATIONS. 1. OBTAIN HOWARD COUNTY GRADING PERMIT. 2. PRE-CONSTRUCTION MEETING WITH THE SEDIMENT CONTROL INSPECTOR.

OWNER (PARCEL 256). OWNER (PARCEL 153). OWNER (PARCEL 153).


SITE DEVELOPMENT PLAN GRADING, SEDIMENT AND EROSION CONTROL NOTES AND DETAILS. JOSEPH'S COURTYARD.




STORM DRAIN DRAINAGE AREA MAP
SCALE: 1"=50'

STRUCTURE SCHEDULE									
STR #	STRUCTURE	NORTHING	EASTING	TOP	INV. IN #1	INV. IN #2	INV. IN #3	INV. OUT	REMARKS/DETAIL #
ES-1	24" CONC. END SECTION	N 552,920.82	E 1,345,902.53	-	388.64	-	-	-	HO. CO. DET. D-5.41
ES-2	18" CONC. END SECTION	N 552,832.48	E 1,345,869.86	-	389.80	-	-	-	HO. CO. DET. D-5.41
I-1	YARD INLET	N 552,883.06	E 1,345,921.42	-	-	-	-	389.80	HO. CO. DET. D-4.14
I-2	YARD INLET	N 552,841.1	E 1,346,141.55	395.30	391.98	391.97	-	391.73	HO. CO. DET. D-4.14
I-3	YARD INLET	N 552,916.42	E 1,346,164.8	396.70	-	-	-	392.37	HO. CO. DET. D-4.14
I-4	YARD INLET	N 552,918.5	E 1,345,919.84	393.20	389.26	389.62	-	388.76	HO. CO. DET. D-4.14
I-5	YARD INLET	N 553,041.11	E 1,345,940.83	394.00	389.98	-	-	389.88	HO. CO. DET. D-4.14
I-6	YARD INLET	N 553,103.49	E 1,346,094.06	395.60	392.02	-	-	391.77	HO. CO. DET. D-4.14
I-7	YARD INLET	N 553,107.28	E 1,346,110.48	395.00	-	-	-	392.50	HO. CO. DET. D-4.14
MH-1	STD. PRECAST MANHOLE	N 552,799.94	E 1,345,941.9	394.15	390.43	-	-	390.33	HO. CO. DET. G-5.12
MH-2	STD. PRECAST MANHOLE	N 552,782.22	E 1,346,117.03	396.00	391.41	-	-	391.31	HO. CO. DET. G-5.12
MH-3	STD. PRECAST MANHOLE	N 553,169.17	E 1,345,952.21	394.71	390.73	-	-	390.63	HO. CO. DET. G-5.12
MH-4	STD. PRECAST MANHOLE	N 553,161.23	E 1,346,030.74	397.20	391.22	-	-	391.12	HO. CO. DET. G-5.12
MH-5	STD. PRECAST MANHOLE	N 553,121.25	E 1,346,090.12	398.20	391.68	-	-	391.58	HO. CO. DET. G-5.12
PT-1	PASS-THRU INLET	N 552,986.53	E 1,346,163.33	398.30	-	-	-	-	DET. MD.374.68, 6.00' L x 5.67' W
PT-2	PASS-THRU INLET	N 552,925.41	E 1,346,020.63	394.84	-	-	-	-	DET. MD.374.68, 6.00' L x 5.67' W
PT-3	PASS-THRU INLET	N 553,040.42	E 1,346,032.27	396.03	-	-	-	-	DET. MD.374.68, 6.00' L x 5.67' W
PT-4	PASS-THRU INLET	N 553,054.77	E 1,346,089.13	396.56	-	-	-	-	DET. MD.374.68, 6.00' L x 5.67' W


PIPE SCHEDULE		
SIZE	TYPE	LENGTH
6"	SOLID PVC	1230
6"	PERFORATED PVC	448
15"	HDPE	95.67
18"	HDPE	746.8
24"	HDPE	23.72

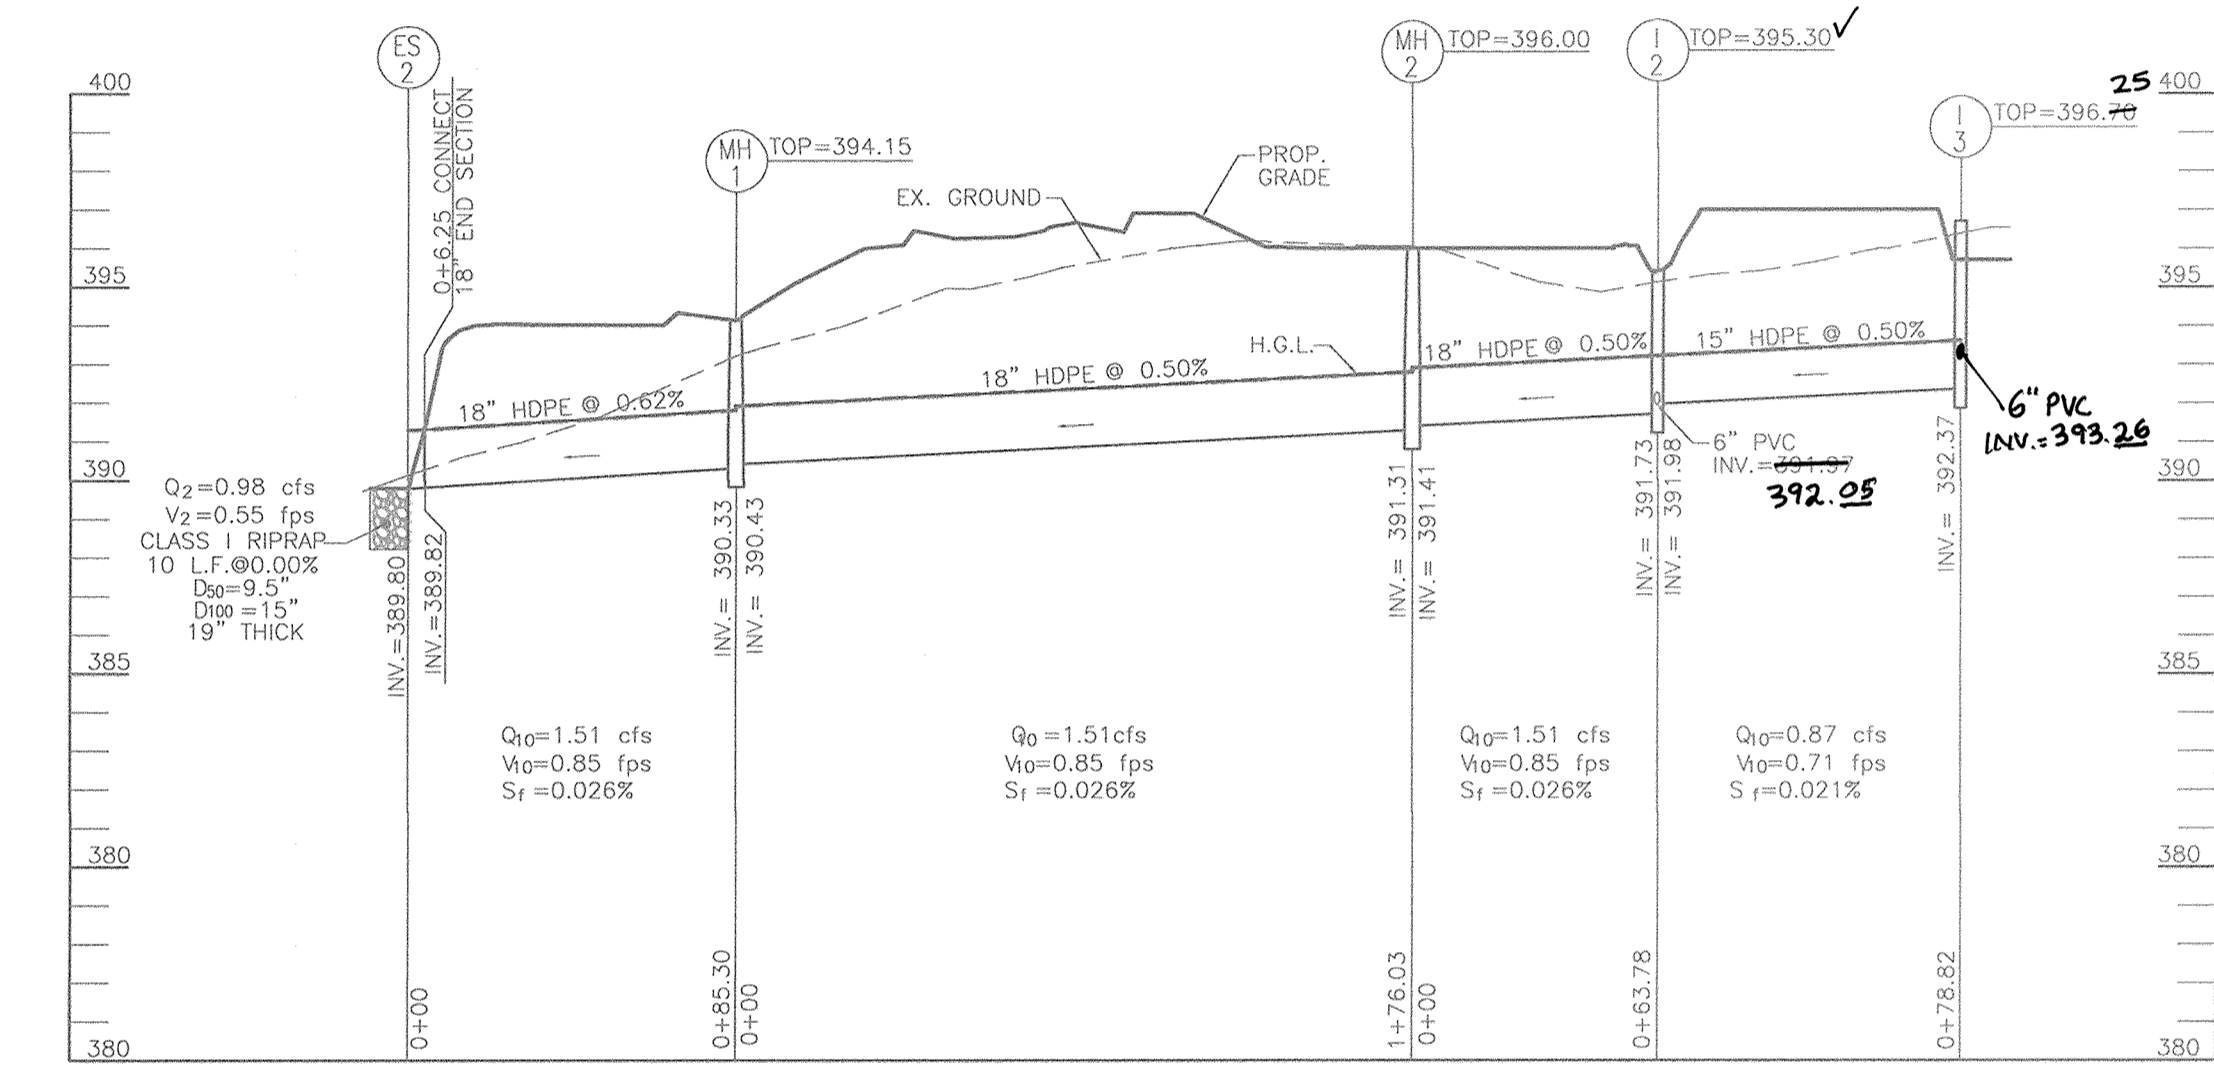


STORM DRAIN PROFILES
SCALE: 1"=50' HORIZ.
1"=5' VERT.

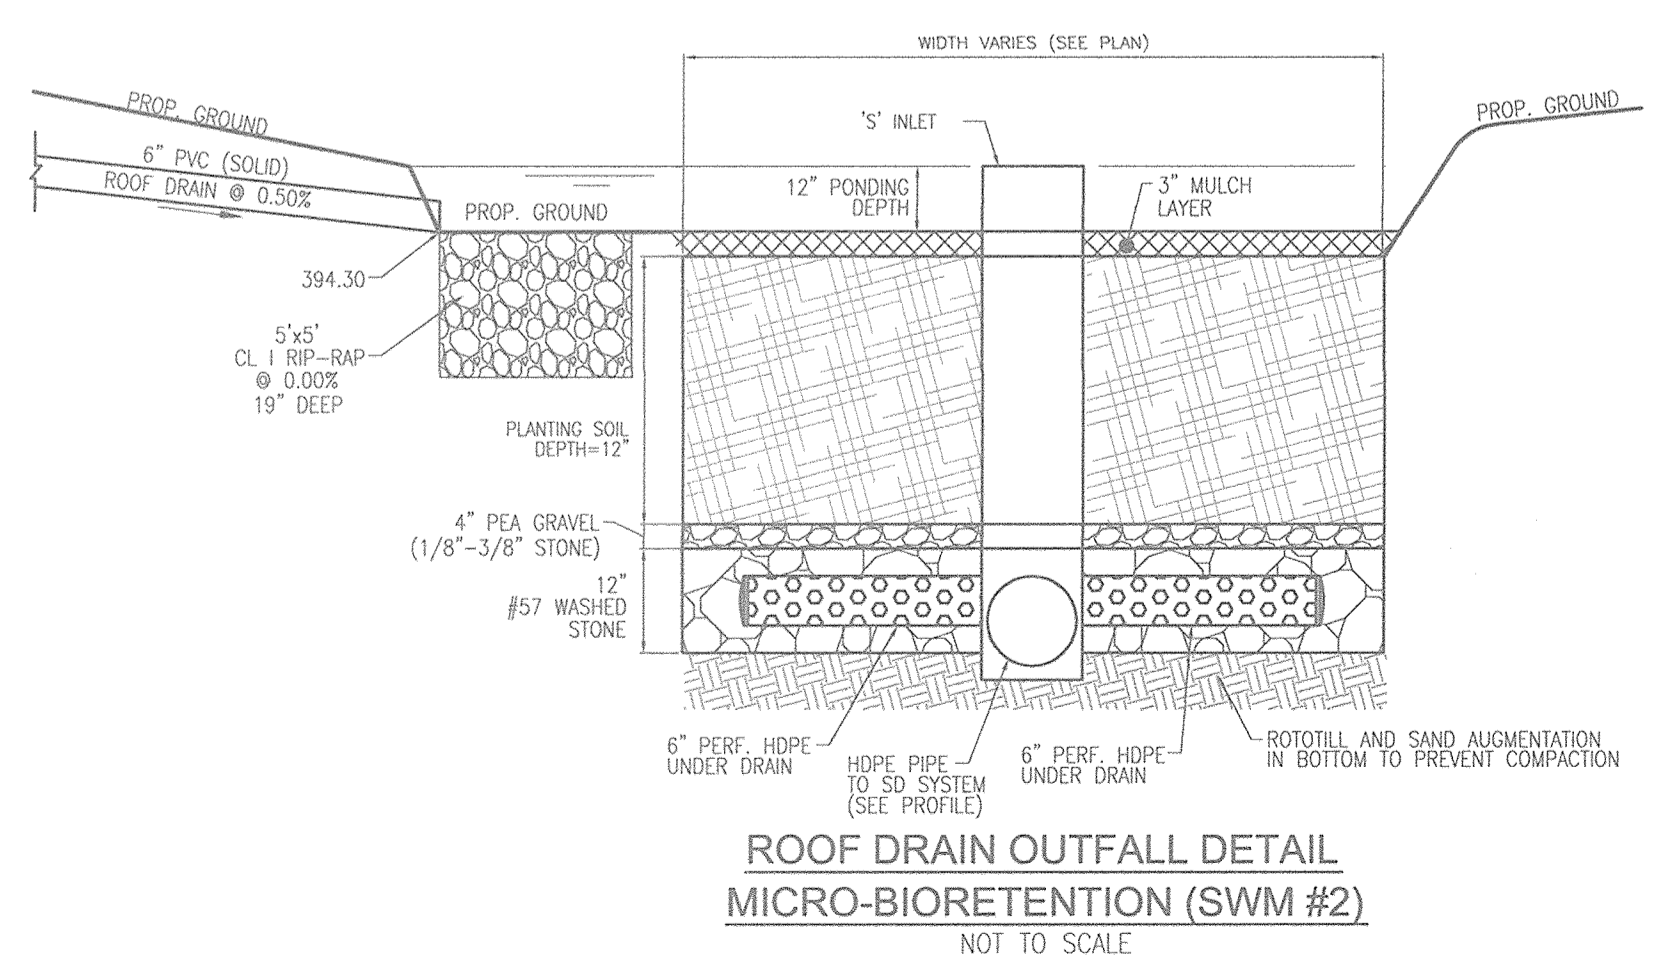

**ROOF DRAIN OUTFALL DETAIL
MICRO-BIORETENTION (SWM #2)**
NOT TO SCALE

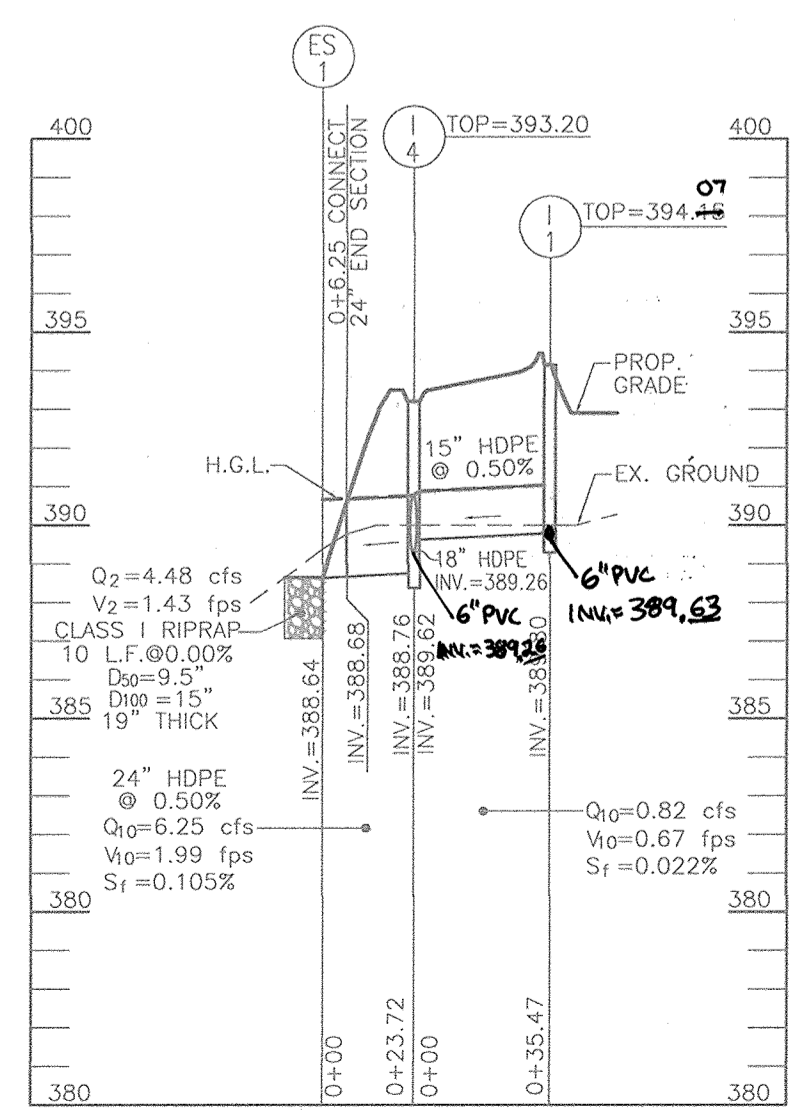

STORM DRAIN PROFILES
SCALE: 1"=50' HORIZ.
1"=5' VERT.

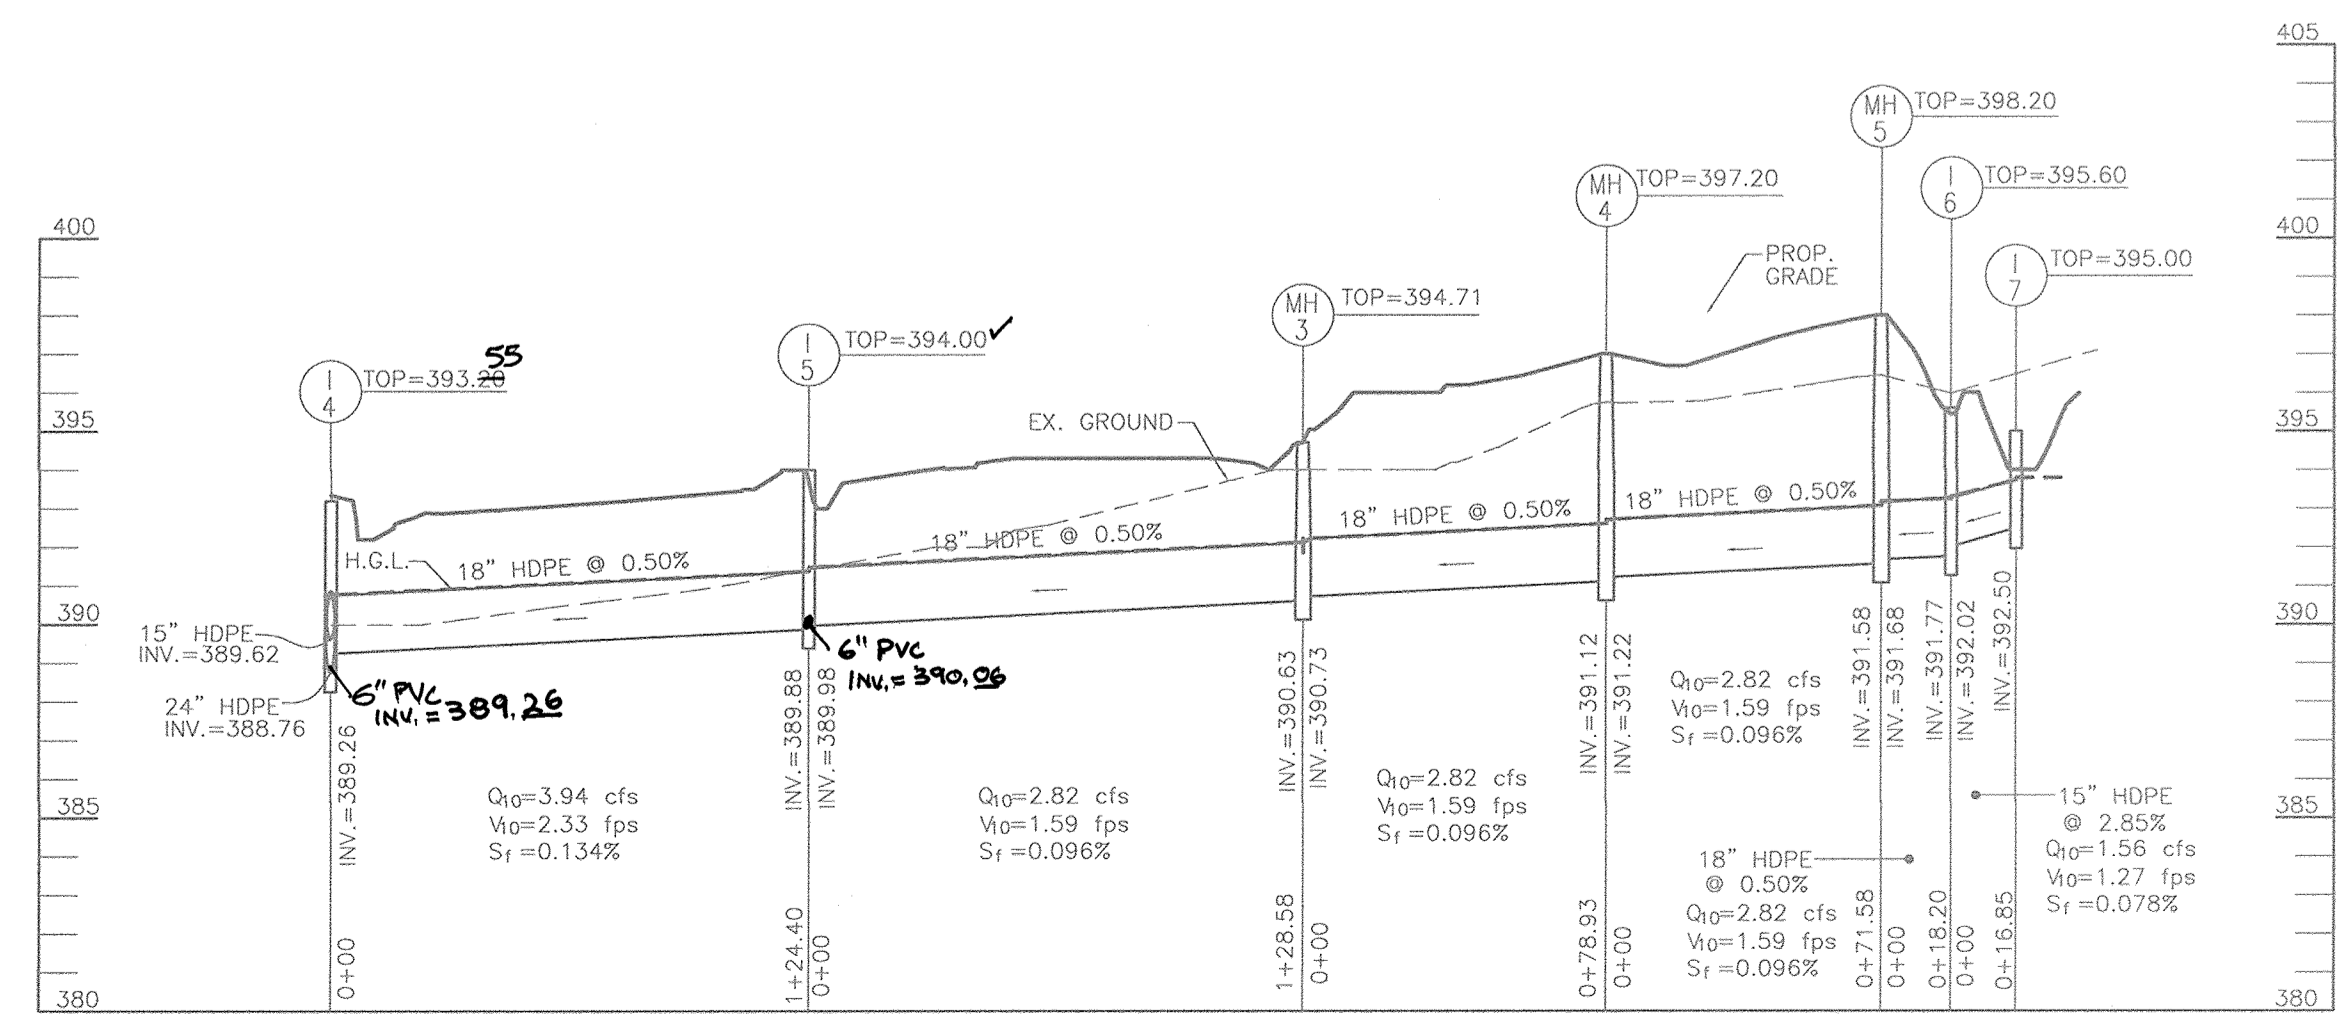

STORM DRAIN PROFILES
SCALE: 1"=50' HORIZ.
1"=5' VERT.

- LEGEND:**
- EXISTING CURB AND GUTTER
 - EXISTING UTILITY POLE
 - EXISTING LIGHT POLE
 - EXISTING MAILBOX
 - EXISTING SIGN
 - EXISTING SANITARY MANHOLE
 - EXISTING SANITARY LINE
 - EXISTING CLEANOUT
 - EXISTING FIRE HYDRANT
 - EXISTING WATER LINE
 - EXISTING TREES (FIELD LOCATED)
 - EXISTING TREELINE (FIELD LOCATED)
 - EXISTING TREELINE (FIELD LOCATED)
 - PROPOSED FENCE AROUND THE TOP LOT
 - PROPERTY LINE
 - RIGHT-OF-WAY LINE
 - ADJACENT PROPERTY LINE
 - EXISTING STREAM
 - EXISTING STREAM BUFFER
 - PROPOSED CURB AND GUTTER
 - PROPOSED CURB TRANSITION
 - PROPOSED STORM DRAIN
 - PROPOSED STORM DRAIN INLET
 - PROPOSED TREETLINE
 - PROPOSED SIDEWALK
 - EX. FOREST CONSERVATION "RETENTION" EASEMENT (L.9101F.461) (PLAT NO. 22359)
 - EXISTING WETLANDS
 - EXISTING 24" PUBLIC WATER ACCESS & UTILITY EASEMENT (L.3321F.548)
 - EXISTING 20" PUBLIC SEWER AND UTILITY EASEMENT (L.3344F.44)
 - EXISTING 12" RIGHT OF WAY, PRIVATE WATER & USE IN COMMON WITH OTHERS (L.9101F.461) (L.8877F.52) (L.11655F.136)
 - EXISTING 15" PRIVATE ACCESS EASEMENT (L.8775F.50) (L.9101F.461)
 - EXISTING USE-IN-COMMON ACCESS MAINTENANCE AND SIGN EASEMENT (L.16117F.001)
 - RECREATION OPEN SPACE AMENITY AREA
 - EXISTING 20" PUBLIC WATER & UTILITY EASEMENT TO BE ABANDONED (L.15109F.510)
 - EXISTING PUBLIC WATER AND UTILITY EASEMENT (L.15109F.405)
 - MICRO-BIORETENTION FACILITIES
 - EXISTING 10" PRIVATE DRAINAGE AND UTILITY EASEMENT (PLAT NO. 23834)
 - DRAINAGE DIVIDE FOR STORM DRAIN
 - DRAINAGE AREA DESIGNATION
 - EXISTING VARIABLE WIDTH PUBLIC SEWER WATER AND UTILITY EASEMENT (PLAT NO. 23834)



AS-BUILT CERTIFICATION FOR PSWM
I HEREBY CERTIFY THAT THE FACILITY SHOWN ON THIS PLAN WAS CONSTRUCTED AS SHOWN ON THE "AS-BUILT" PLANS AND COMPLIES WITH THE APPROVED PLANS AND SPECIFICATIONS. I HAVE VERIFIED THAT THE CONTRIBUTING DRAINAGE AREA IS SUFFICIENTLY STABILIZED TO PREVENT CLOGGING OF THE UNDERGROUND SWM FACILITY.
Robert Vogel 16193 2/5/19
P.E. NAME P.E. # DATE

OWNER (PARCEL 256)
TEMPLE BETH SHALOM OF HOWARD COUNTY
8070 HARRIET TUBMAN LANE
COLUMBIA, MD. 21044


OWNER (PARCEL 153)
JOSEPH'S COURTYARD, LLC
3675 PARK AVENUE #301
ELLCOTT CITY, MD. 21043
C/O MICHAEL PFAU
(410) 480-0023

OWNER/DEVELOPER (PARCEL 153)
TRINITY HOMES MARY LAND, LLC
3675 PARK AVENUE #301
ELLCOTT CITY, MD. 21043
C/O MICHAEL PFAU
(410) 480-0023

NO.	REVISION	DATE
1	REVISE PLAN TO ACCOMMODATE BUILDER HOUSE MODEL	10/25/16

**REVISED SITE DEVELOPMENT PLAN
STORM DRAIN DRAINAGE AREA MAP,
PROFILES AND SCHEDULES
JOSEPH'S COURTYARD**
LOTS 1-24 AND OPEN SPACE LOTS 25 AND 26 - USE IN COMMON ACCESS (P.256)
SINGLE FAMILY ATTACHED AND RELIGIOUS FACILITY (BA-93-40E)
TAX MAP 35 BLOCK 24 ZONED: PARCEL 153 (R-SA-8) / PARCEL 256 (R-12) PARCEL 153: PIO 256
5TH ELECTION DISTRICT L.09101F.0461/L.02548F.0388 HOWARD COUNTY, MARYLAND

**ROBERT H. VOGEL
ENGINEERS • SURVEYORS • PLANNERS**
8407 MAIN STREET
ELLCOTT CITY, MD 21043
TEL: 410.461.7666
FAX: 410.461.8961

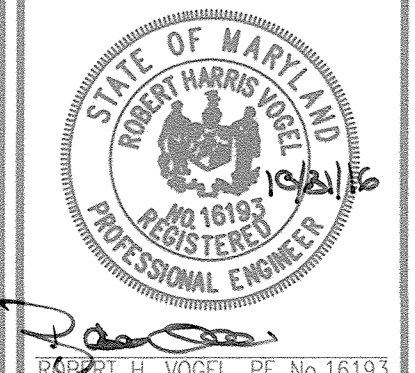

DESIGN BY: RHY/GAH
DRAWN BY: GAH/KG
CHECKED BY: RHY
DATE: MAY 2016
SCALE: AS SHOWN
W.D. NO.: 05-84

PROFESSIONAL CERTIFICATE
I HEREBY CERTIFY THAT THESE DOCUMENTS WERE PREPARED OR APPROVED BY ME, AND THAT I AM A DULY LICENSED PROFESSIONAL ENGINEER UNDER THE LAWS OF THE STATE OF MARYLAND.
EXPIRATION DATE: 06-27-2018

9 SHEET OF 14

AS-BUILT - NOV. 2018



MAPPED SOILS TYPES - HOWARD COUNTY SOIL MAP #16

SYMBOL	NAME / DESCRIPTION	GROUP	HYDRO	PERCENT	K FACTOR	PERM	PROF	STAY	SOIL
BaA	BALDWIN SILT LOAM, 0 TO 3 PERCENT SLOPES	D	YES	0.37	NO	NO	NO	NO	NO
GIB	GLADSTONE - URBAN LAND COMPLEX, 0 TO 8 PERCENT SLOPES	A	NO	0.28	NO	NO	NO	NO	NO
GmA	GLENNVILLE SILT LOAM, 0 TO 3 PERCENT SLOPES	C	NO	0.43	NO	NO	NO	NO	NO

NOTE: TAKEN FROM: USDA, SCS - WEB SOIL SURVEY, HOWARD COUNTY

AS-BUILT CERTIFICATION FOR PSWM

I HEREBY CERTIFY THAT THE FACILITY SHOWN ON THIS PLAN WAS CONSTRUCTED AS SHOWN ON THE "AS-BUILT" PLANS AND COMPLIES WITH THE APPROVED PLANS AND SPECIFICATIONS. I HAVE VERIFIED THAT THE CONTRIBUTING DRAINAGE AREA IS SUFFICIENTLY STABILIZED TO PREVENT CLOGGING OF THE UNDERGROUND SWM FACILITY.

Ross Voeel 16193 2/5/19
P.E. NAME P.E.# DATE

APPROVED: HOWARD COUNTY DEPARTMENT OF PLANNING AND ZONING

Chad Chubb 11-29-16
CHIEF, DEVELOPMENT ENGINEERING DIVISION
DATE

Kurt Salvo 12-05-16
CHIEF, DIVISION OF LAND DEVELOPMENT
DATE

Valerie Taylor 12-05-16
DIRECTOR
DATE

TEST PIT DATA TABLE

BORING #	EXISTING GROUND ELEVATION	DEPTH TO WATER	ELEVATION AT WATER TABLE	MICRO-BIO RETENTION #	ELEVATION AT MBR BOTTOM
B-1	396.56	11'	385.56	3	391.62
B-2	395.03	10'	385.03	2	391.92
B-3	390.38	8'	382.38	1	392.07
B-4	390.62	7'	383.62	4	388.12
B-5	392.77	6.5'	386.27	5	389.92
B-6	395.80	9'	386.8	6	391.02

PROJECT BS LAND DESIGNER RHY/GAH DATE 08/25/16 REV. ROBERT H. VOGEL ENGINEERING, INC.

ENVIRONMENTAL SITE DESIGN PRACTICES VOLUMES PROVIDED

DRAINAGE AREA #	AREA TREATED	FACILITY NUMBER	PERMEABLE PAVEMENT	BIO RETENTION	LANDSCAPE INFILTRATION	GREEN ROOF	BIO SWALES	GRAVEL TRENCH	X	X	ESDV
1	6799	1	0	830	0	0	0	0	0	0	830
2	7897	2	0	830	0	0	0	0	0	0	830
3	11040	3	0	1414	0	0	0	0	0	0	1414
4	33338	4	0	2538	0	0	0	0	0	0	2538
5	17823	5	0	1294	0	0	0	0	0	0	1294
6	9589	6	0	928	0	0	0	0	0	0	928

ESDV REQUIRED: 7802 CF STORAGE, 75% OF ESDV TREATED TOTAL ESDV PROVIDED: 7943

PROJECT: BS LAND

TOTAL AREA: 3.16 AC
TARGET P: 1.72 IN
IMPERVIOUS: 38.38 PERCENT
SITE Rv: 0.40
APPROX SITE ESDV: 7802 CF

DRAINAGE AREA	IMPERVIOUS AREA	GRASS AREA	TOTAL AREA	PERCENT IMPERVIOUS	Rv	ESDV	ESDV TARGET
1	4010	2789	6799	58.98	0.58	329	856
2	4010	3887	7897	50.78	0.51	334	856
3	6576	4464	11040	59.57	0.59	539	1402
4	21353	11983	33336	64.05	0.63	1740	4525
5	9370	8253	17623	53.17	0.53	776	2018
6	7510	2179	9689	77.51	0.75	604	1569

TOTAL AREA: 86384 SF 1.98 AC
TOTAL ESDV: 7943 CF

LEGEND:

- EXISTING CURB AND GUTTER
- EXISTING UTILITY POLE
- EXISTING LIGHT POLE
- EXISTING MAIL BOX
- EXISTING SIGN
- EXISTING SANITARY MANHOLE
- EXISTING SANITARY LINE
- EXISTING CLEANOUT
- EXISTING FIRE HYDRANT
- EXISTING WATER LINE
- EXISTING TREES (FIELD LOCATED)
- EXISTING TREE LINE (FIELD LOCATED)
- PROPOSED FENCE AROUND THE LOT
- PROPERTY LINE
- RIGHT-OF-WAY LINE
- ADJACENT PROPERTY LINE
- EXISTING STREAM
- EXISTING STREAM BUFFER
- PROPOSED CURB AND GUTTER
- PROPOSED CURB TRANSITION
- PROPOSED STORM DRAIN
- PROPOSED STORM DRAIN INLET
- PROPOSED TRENCH
- PROPOSED SIDEWALK
- EX FOREST CONSERVATION "RETENTION" EASEMENT (L.8101/F.461) (PLAT NO. 22359)
- EXISTING WETLANDS (FIELD LOCATED)
- EXISTING 24" PUBLIC WATER ACCESS & UTILITY EASEMENT (L.3321/F.548)
- EXISTING 20" PUBLIC SEWER AND UTILITY EASEMENT (L.3544/F.44)
- EXISTING 12" RIGHT OF WAY PRIVATE WATER & USE IN COMMON WITH OTHERS (L.8101/F.461) (L.8877/F.52) (L.11855/F.138)
- EXISTING 15" PRIVATE ACCESS EASEMENT (L.8877/F.52) (L.8101/F.461)
- EXISTING USE-IN-COMMON ACCESS MAINTENANCE AND SIGN EASEMENT (L.16117/F.001)
- RECREATION OPEN SPACE AMENITY AREA
- EXISTING 20" PUBLIC WATER & UTILITY EASEMENT TO BE ABANDONED (L.15109/F.510)
- EXISTING PUBLIC WATER AND UTILITY EASEMENT (L.15109/F.465)
- MICRO-BIORETENTION FACILITIES
- EXISTING 10" PRIVATE DRAINAGE AND UTILITY EASEMENT (PLAT NO. 23834)
- DRAINAGE DIVIDE FOR SWM
- DRAINAGE AREA DESIGNATION
- EXISTING VARIABLE WIDTH PUBLIC SEWER, WATER AND UTILITY EASEMENT (PLAT NO. 23834)

Table B.4. Construction Specifications for Environmental Site Design Practices

Table B.4.1 Materials Specifications for Micro-Bioretenation, Rain Gardens & Landscape Infiltration:

Material	Specifications	Size	Notes
Planting soil (2" to 4" deep)	see Appendix A, Table A.4	n/a	Planting soil shall be a uniform mix, free of stones, stumps, roots or other similar objects larger than 1/4" diameter.
Organic content	Min. 10% by dry weight (ASTM D 2974)	n/a	Soil shall be a uniform mix, free of stones, stumps, roots or other similar objects larger than 1/4" diameter.
Mulch	shredded hardwood	2" to 4"	Must be clean, free of debris, and shall be replaced every two to three years.
Pea gravel (disinfectant)	pea gravel: ASTM-D-448	NO. 8 OR NO. 9 (1/4" TO 3/8")	Must be clean, free of debris, and shall be replaced every two to three years.
Curtain drain	ornamental stone: washed cobbles	stone: 2" to 5"	Must be clean, free of debris, and shall be replaced every two to three years.
Geotextile	n/a	n/a	Must be clean, free of debris, and shall be replaced every two to three years.
Gravel (underdrains and infiltration basins)	AASHTO M-43	NO. 57 OR NO. 6 (3/8" TO 1/2")	Must be clean, free of debris, and shall be replaced every two to three years.
Underdrain piping	F758, Type PS 28 or AASHTO M-278	4" to 6" rigid schedule 40 PVC or HDPE	Must be clean, free of debris, and shall be replaced every two to three years.
Poured in place concrete (if required)	MSHA Mix No. 3, f _c = 3500 psi @ 28 days, normal weight, air-entrained, conforming to ASTM A615-00	n/a	Must be clean, free of debris, and shall be replaced every two to three years.
Sand	AASHTO M-6 or ASTM-C-33	0.075 to 0.045"	Must be clean, free of debris, and shall be replaced every two to three years.

MICRO-BIORETENTION DATA CHART

MBR Facility	Ponding Depth (ft)	Ponding Elevation (ft)	Top of Plant Mix (ft)	Bottom of Plant Mix (ft)	Depth of Plant Mix (ft)	Bottom of Stone (ft)	Bottom of Invert (ft)	Bottom of Invert (ft)	Bottom of Invert (ft)
#1	1.00	396.07	391.62	391.62	391.62	393.07	393.07	393.07	393.07
#2	1.00	395.39	390.84	390.84	390.84	393.07	393.07	393.07	393.07
#3	1.00	392.25	385.25	385.25	385.25	393.07	393.07	393.07	393.07
#4	1.00	393.00	388.00	388.00	388.00	393.07	393.07	393.07	393.07
#5	1.00	394.00	382.00	382.00	382.00	393.07	393.07	393.07	393.07
#6	0.50	395.00	384.00	384.00	384.00	393.07	393.07	393.07	393.07

APPENDIX B.4.C SPECIFICATIONS FOR MICRO-BIORETENTION, RAIN GARDEN, LANDSCAPE INFILTRATION & INFILTRATION BERMS

1. MATERIAL SPECIFICATIONS


1.1. MATERIAL SPECIFICATIONS

1.2. FILTERING MEDIA OR PLANTING SOIL

1.3. COMPACTION

1.4. UNDERDRAINS

1.5. MISCELLANEOUS

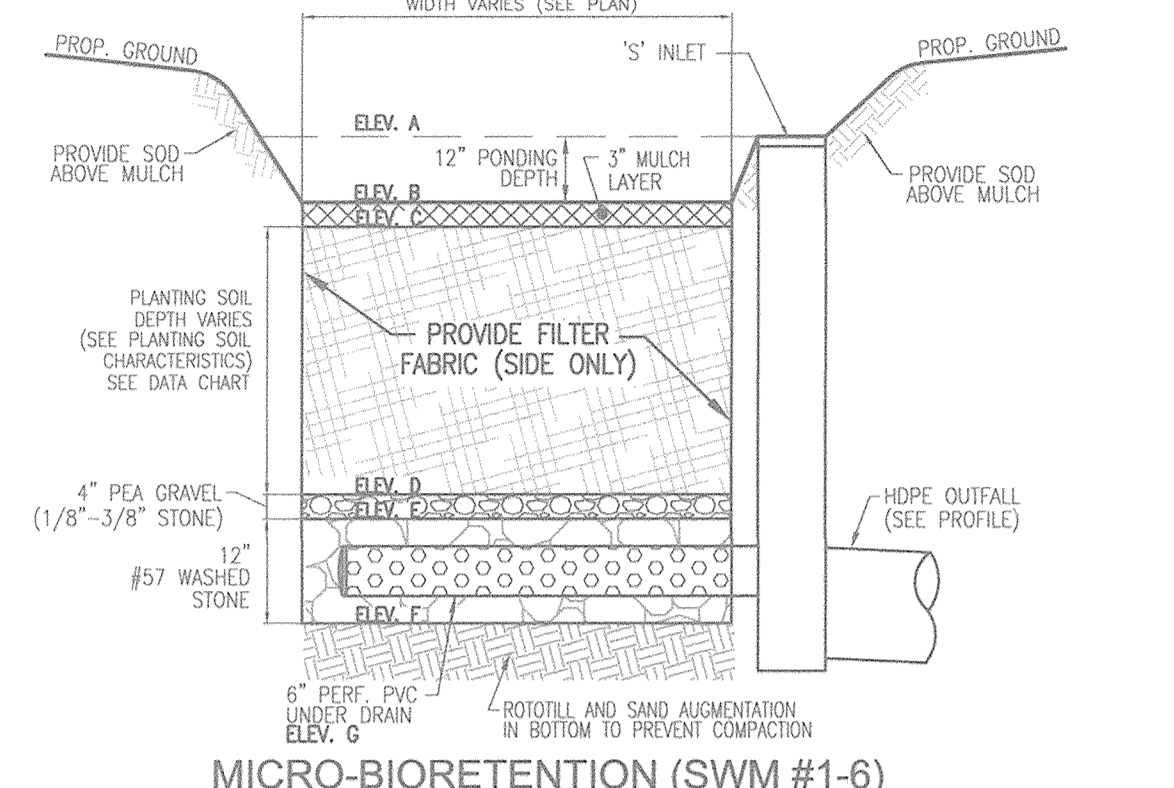

MICRO-BIORETENTION NOTES:

- ONLY THE SIDES OF MICROBIORETENTION ARE TO BE WRAPPED IN FILTER FABRIC. FILTER FABRIC BETWEEN LAYER OR AT THE BOTTOM OF THE MICROBIORETENTION WILL CAUSE THE MBR TO FAIL AND THEREFORE SHALL NOT BE INSTALLED.
- WRAP THE PERFORATED MBR UNDERDRAIN PIPE WITH 1/4" MESH (4x4) OR SMALLER GALVANIZED HARDWARE CLOTH.

OPERATION AND MAINTENANCE SCHEDULE FOR LANDSCAPE INFILTRATION (M-3), MICRO-BIORETENTION (M-6), RAIN GARDENS (M-7), BIORETENTION SWALE (M-8), AND ENHANCED FILTERS (M-9)

- THE OWNER SHALL MAINTAIN THE PLANT MATERIAL, MULCH LAYER AND SOIL LAYER ANNUALLY. MAINTENANCE OF MULCH AND SOIL IS LIMITED TO CORRECTING AREAS OF EROSION OR WASH OUT. ANY MULCH REPLACEMENT SHALL BE DONE IN THE SPRING. PLANT MATERIAL SHALL BE CHECKED FOR DISEASE AND INSECT INFESTATION AND MAINTENANCE WILL ADDRESS DEAD MATERIAL, PRUNING ACCEPTABLE REPLACEMENT PLANT MATERIAL IS LIMITED TO THE FOLLOWING: 2000 MARKLAND STORMWATER DESIGN MANUAL, VOLUME 1, TABLE 4.4.1 AND 2.
- THE OWNER SHALL PERFORM A PLANT IN THE SPRING AND IN THE FALL OF EACH YEAR. DURING THE INSPECTION, THE OWNER SHALL REMOVE DEAD AND DISEASED VEGETATION CONSIDERED BEYOND TREATMENT. REPLACE DEAD PLANT MATERIAL WITH ACCEPTABLE REPLACEMENT PLANT MATERIAL. TREAT DISEASED TREES AND SHRUBS, AND REPLACE ALL DEFICIENT STAKES AND WIRES.
- THE OWNER SHALL PERFORM A PLANT IN THE SPRING AND IN THE FALL OF EACH YEAR. DURING THE INSPECTION, THE OWNER SHALL REMOVE DEAD AND DISEASED VEGETATION CONSIDERED BEYOND TREATMENT. REPLACE DEAD PLANT MATERIAL WITH ACCEPTABLE REPLACEMENT PLANT MATERIAL. TREAT DISEASED TREES AND SHRUBS, AND REPLACE ALL DEFICIENT STAKES AND WIRES.
- THE OWNER SHALL CORRECT SOIL EROSION ON AN AS NEEDED BASIS, WITH A MINIMUM OF ONCE PER MONTH AND AFTER EACH HEAVY STORM.

OWNER (PARCEL 256)
TEMPLE BETH SHALOM OF HOWARD COUNTY
8070 HARRIET TUBMAN LANE
COLUMBIA, MD 21044

OWNER (PARCEL 153)
JOSEPH'S COURTYARD, LLC
3675 PARK AVENUE #301
ELICOTT CITY, MD 21043
C/O MICHAEL PFAU
(410) 480-0023

OWNER/DEVELOPER (PARCEL 153)
TRINITY HOMES MARY LAND, LLC
3675 PARK AVENUE #301
ELICOTT CITY, MD 21043
C/O MICHAEL PFAU
(410) 480-0023

NO.	REVISION	DATE
1	REVISE PLAN TO ACCOMMODATE BUILDER HOUSE MODEL	10/28/16


REVISED SITE DEVELOPMENT PLAN
STORM WATER MANAGEMENT
DRAINAGE AREA MAP, NOTES AND DETAILS
JOSEPH'S COURTYARD
LOTS 1-24 AND OPEN SPACE LOTS 25 AND 26 - USE IN COMMON ACCESS (P.256)
SINGLE FAMILY ATTACHED AND RELIGIOUS FACILITY (BA-93-40E)
TAX MAP 35 BLOCK 24 ZONED: PARCEL 153 (R-SA-8)/ PARCEL 256 (R-12) PARCEL 153: P10 256
5TH ELECTION DISTRICT L.09101/F.0461/L.02549/F.0388 HOWARD COUNTY, MARYLAND

ROBERT H. VOGEL ENGINEERING, INC.
ENGINEERS • SURVEYORS • PLANNERS
8407 MAIN STREET ELICOTT CITY, MD 21043 TEL: 410.461.7666 FAX: 410.461.8961


DESIGN BY: RHY/GAH
DRAWN BY: GAH/KG
CHECKED BY: RHY
DATE: MAY 2016
SCALE: AS SHOWN
W.O. NO.: 05-84

PROFESSIONAL CERTIFICATE
I HEREBY CERTIFY THAT THESE DOCUMENTS WERE PREPARED OR APPROVED BY ME AND THAT I AM A LICENSED PROFESSIONAL ENGINEER UNDER THE LAWS OF THE STATE OF MARYLAND. MY LICENSE NUMBER IS 15193. MY EXPIRATION DATE IS 09-27-2018.


10 SHEET OF 14

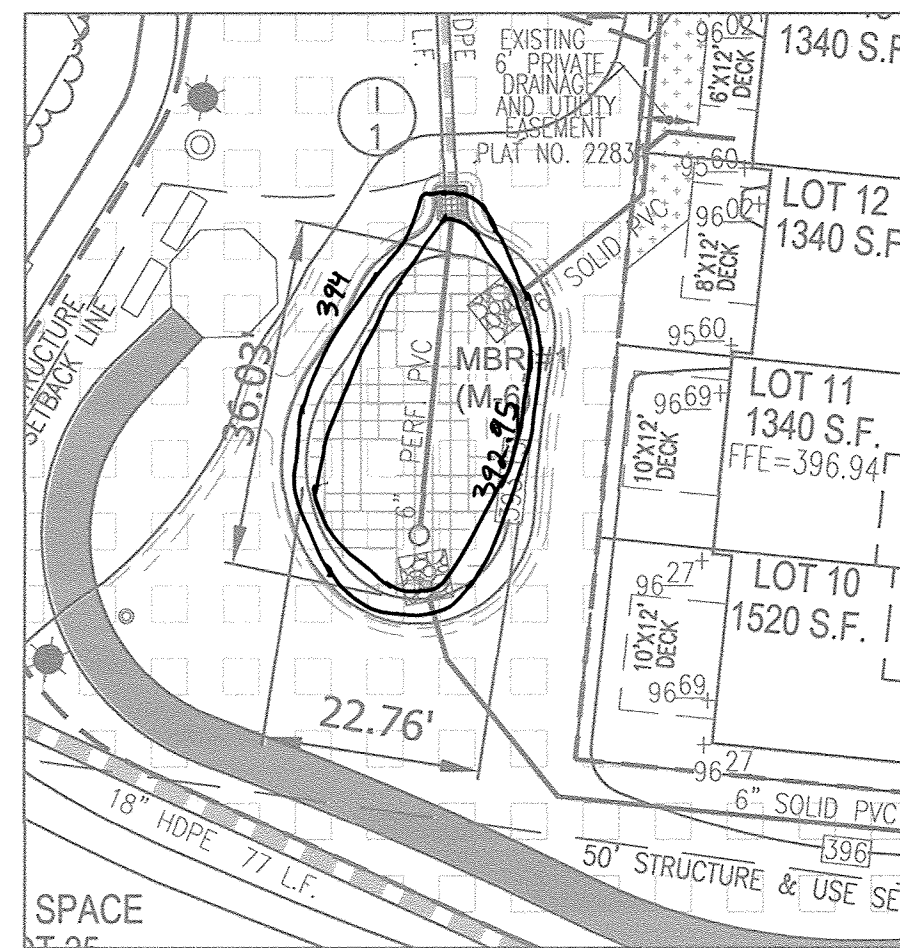


PLAN VIEW MBR #1
SCALE: 1"=20'

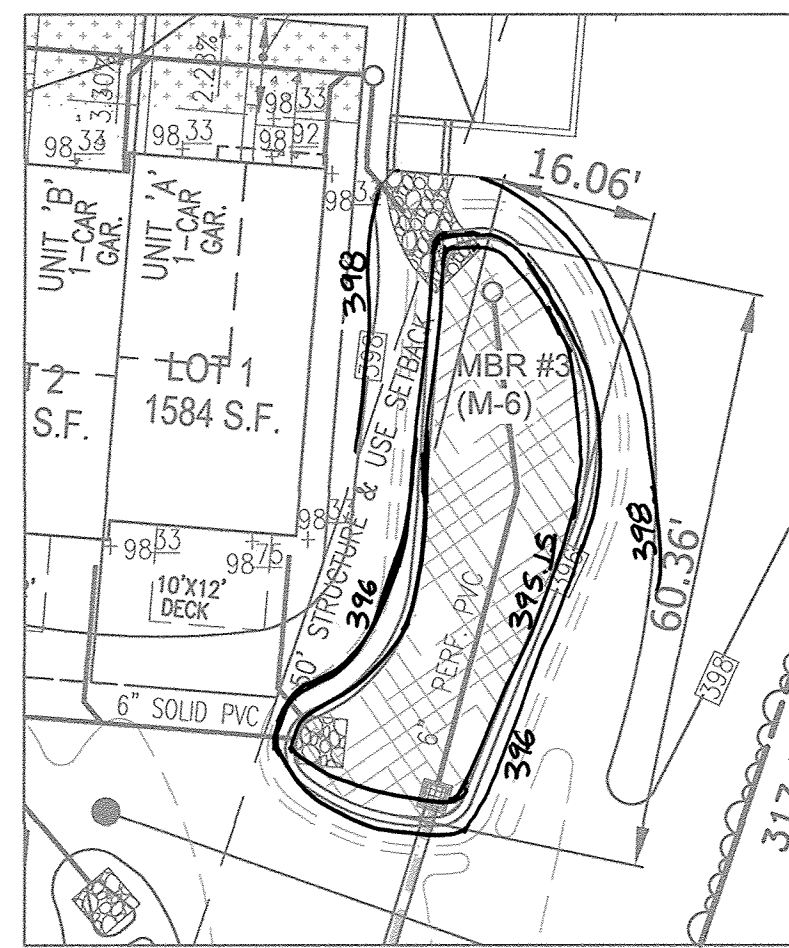


PLAN VIEW MBR #3
SCALE: 1"=20'

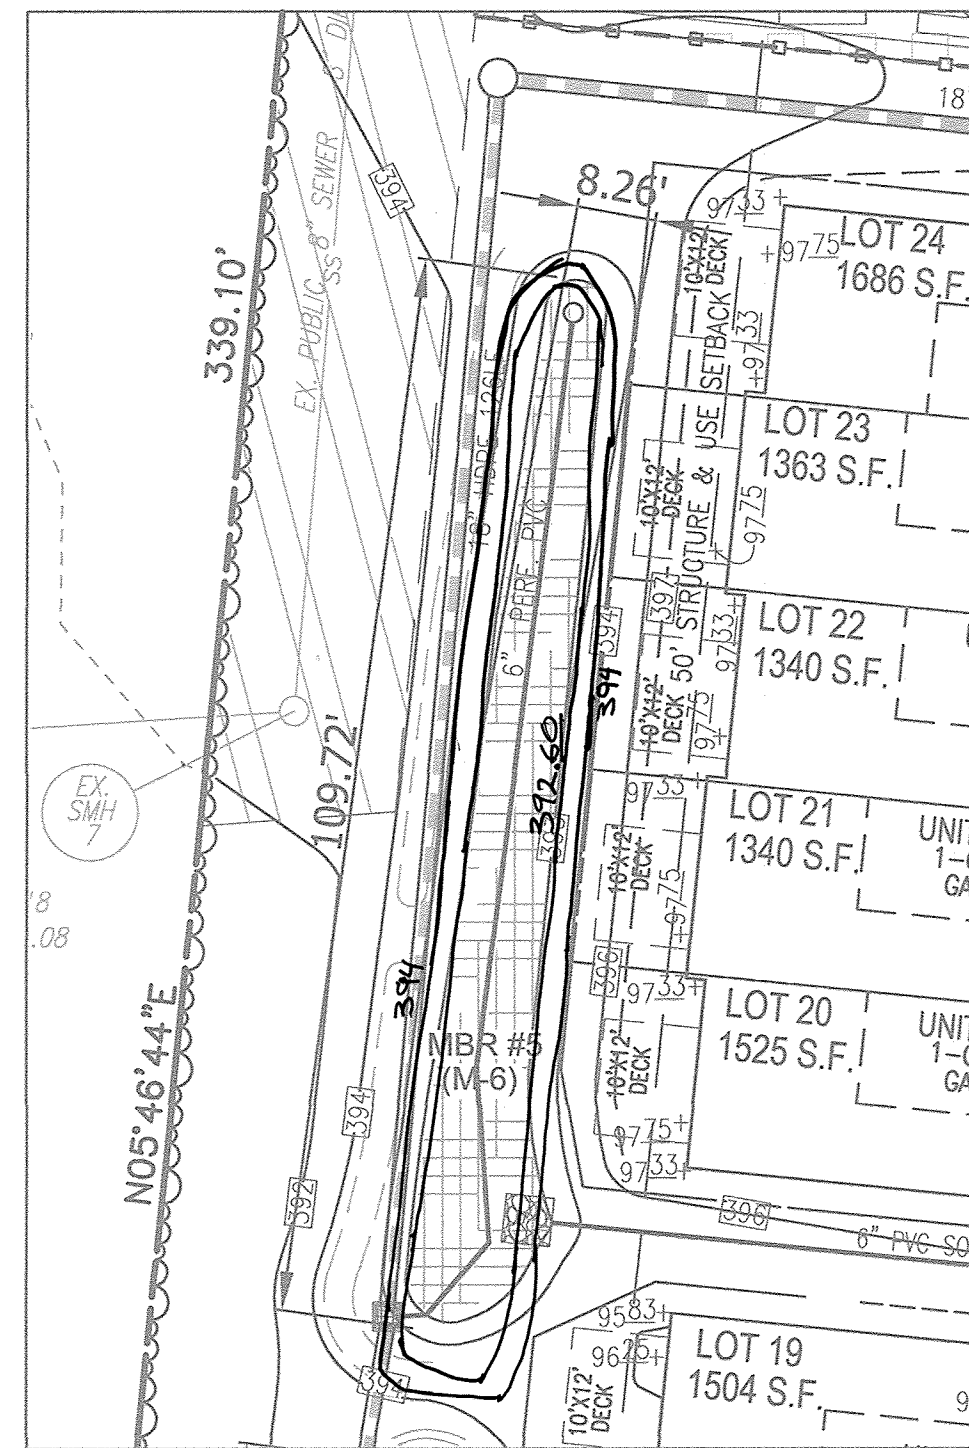


PLAN VIEW MBR #5
SCALE: 1"=20'

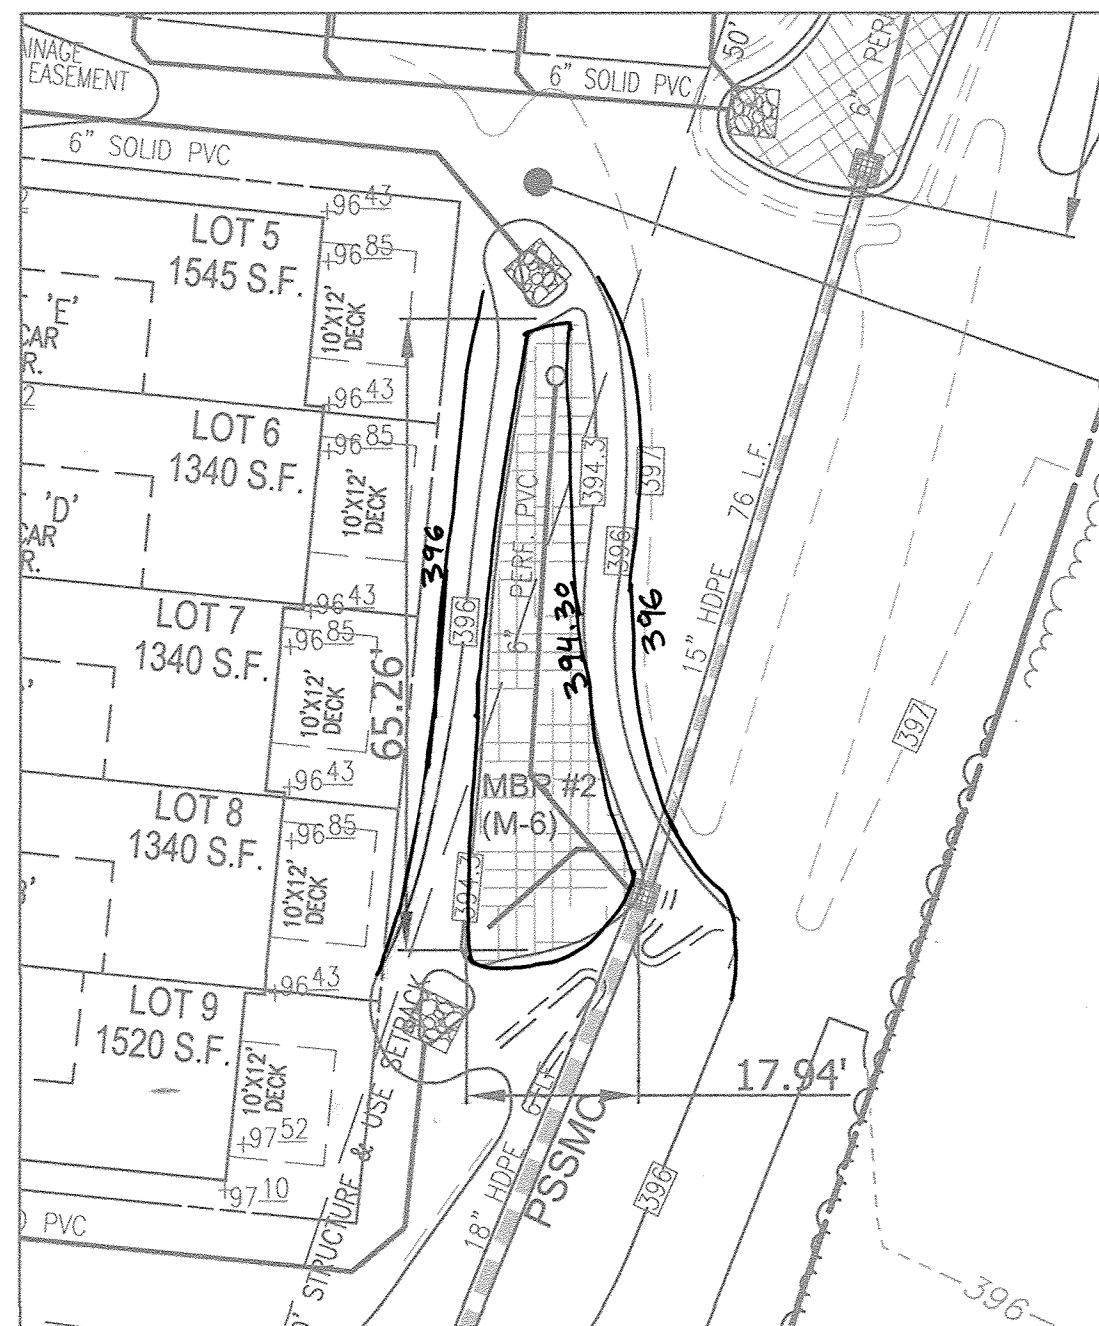

PLAN VIEW MBR #2
SCALE: 1"=20'

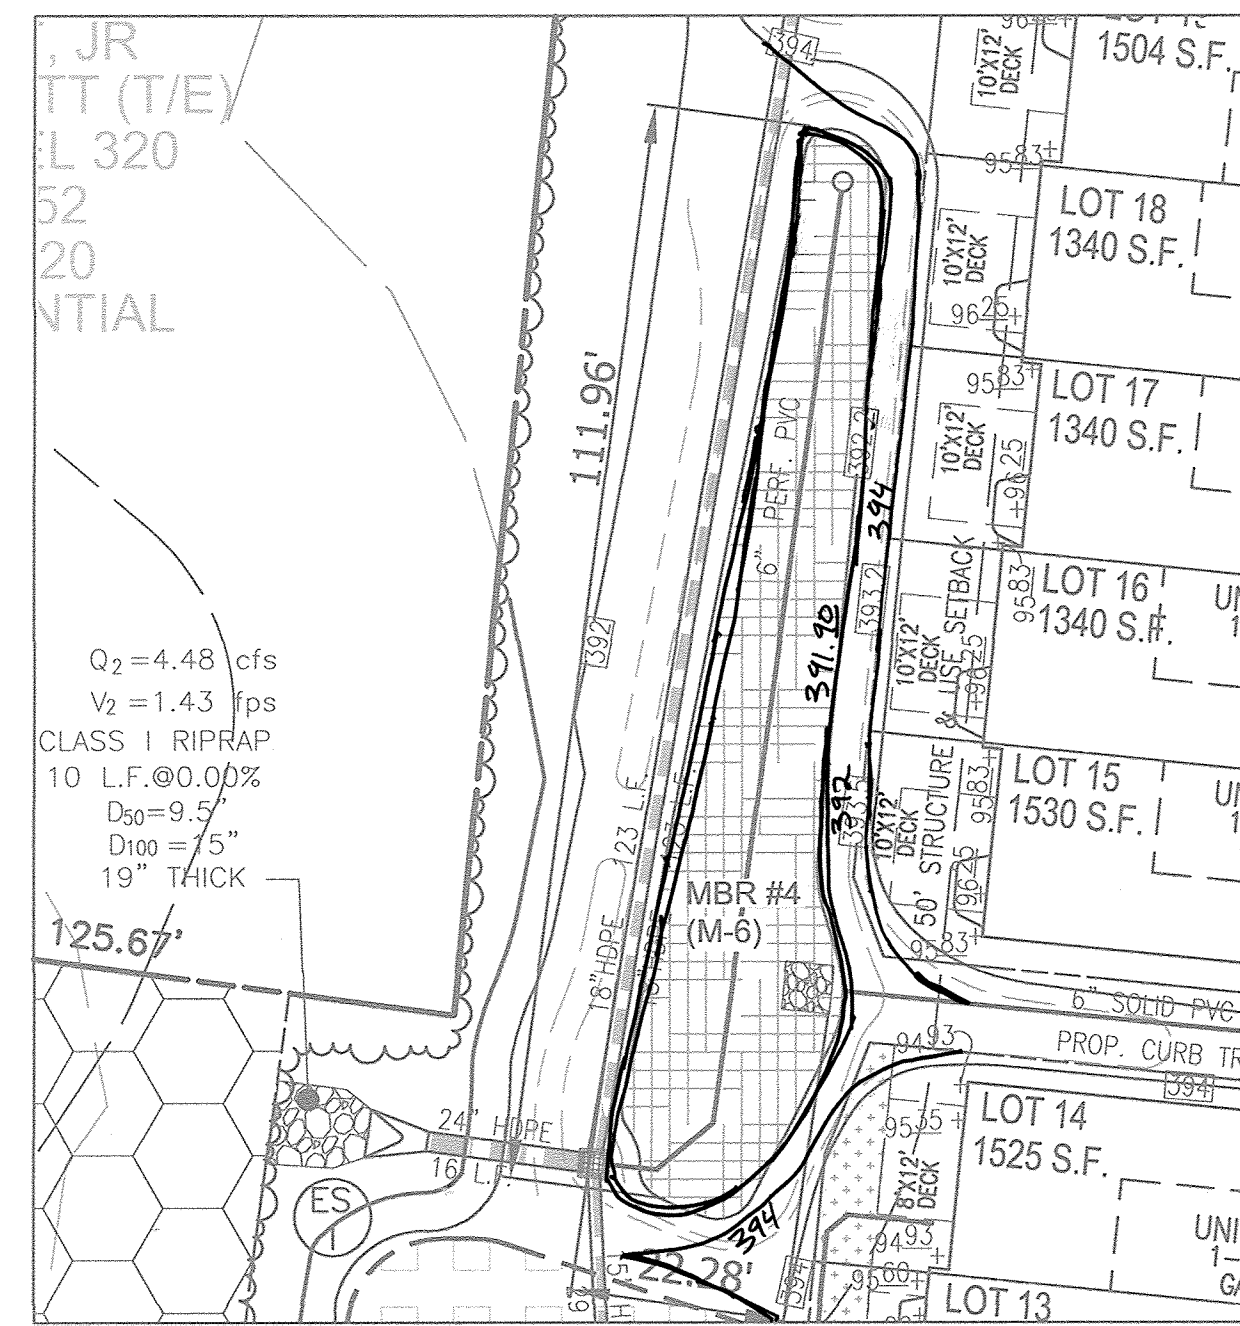

PLAN VIEW MBR #4
SCALE: 1"=20'

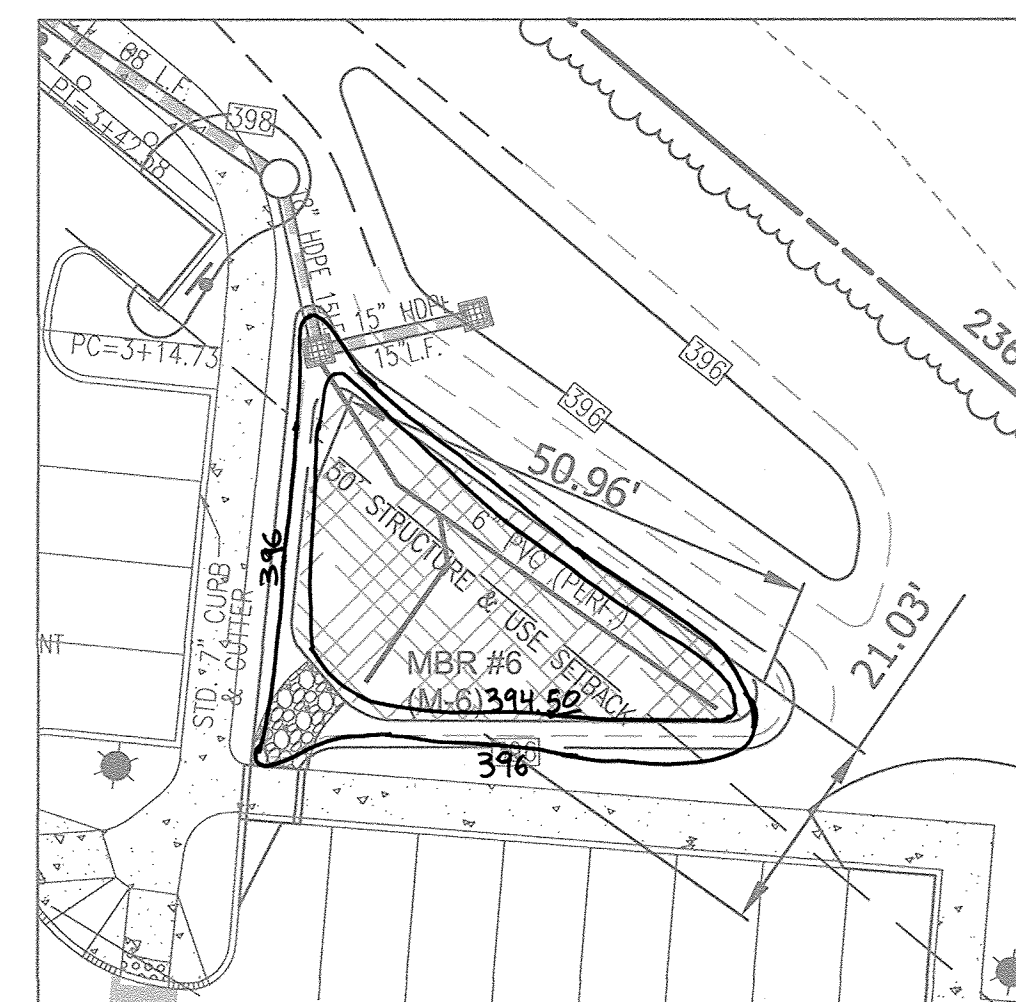

PLAN VIEW MBR #6
SCALE: 1"=20'

LEGEND:

	EXISTING CURB AND GUTTER
	EXISTING UTILITY POLE
	EXISTING LIGHT POLE
	EXISTING SIGN
	EXISTING SANITARY LINE
	EXISTING CLEANOUT (FIELD LOCATED)
	EXISTING TREE LINE (FIELD LOCATED)
	PROPERTY LINE
	RIGHT-OF-WAY LINE
	ADJACENT PROPERTY LINE
	PROPOSED CURB AND GUTTER
	PROPOSED CURB TRANSITION
	PROPOSED STORM DRAIN
	PROPOSED STORM DRAIN INLET
	PROP. LIGHT POLE
	PROPOSED SIDEWALK
	EXISTING 20\"/>
	EXISTING 10\"/>
	RECREATION OPEN SPACE AMENITY AREA




AS-BUILT CERTIFICATION FOR PSWM
 I HEREBY CERTIFY THAT THE FACILITY SHOWN ON THIS PLAN WAS CONSTRUCTED AS SHOWN ON THE "AS-BUILT" PLANS AND COMPLIES WITH THE APPROVED PLANS AND SPECIFICATIONS. I HAVE VERIFIED THAT THE CONTRIBUTING DRAINAGE AREA IS SUFFICIENTLY STABILIZED TO PREVENT CLOGGING OF THE UNDERGROUND SWM FACILITY.
 Robert Vogel 16193 2/5/19
 P.E. NAME P.E.# DATE

OWNER (PARCEL 256)
 TEMPLE BETH SHALOM OF HOWARD COUNTY
 8070 HARRIET TUBMAN LANE
 COLUMBIA, MD. 21044

OWNER/DEVELOPER (PARCEL 153)
 TRINITY HOMES MARY LAND, LLC.
 3675 PARK AVENUE #301
 ELLICOTT CITY, MD. 21043
 C/O MICHAEL PFJAU
 (410) 480-0023

OWNER (PARCEL 153)
 JOSEPH'S COURTYARD, LLC
 3675 PARK AVENUE #301
 ELLICOTT CITY, MD. 21043
 C/O MICHAEL PFJAU
 (410) 480-0023

NO.	REVISION	DATE
1	REVISE PLAN TO ACCOMMODATE BUILDER HOUSE MODEL	10/28/16

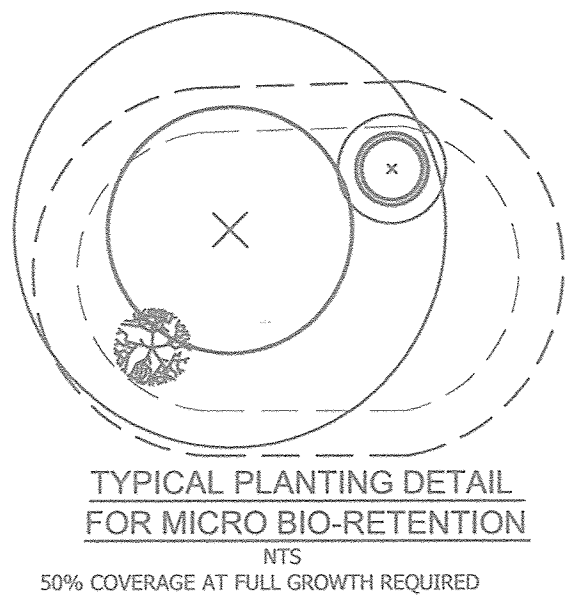

"MICRO-BIORETENTION" PLANTING SCHEDULE NOTES:

1. ALL PLANT MATERIALS SHALL BE FULL AND HEAVY, BE WELL FORMED AND SYMMETRICAL, CONFORM TO THE MOST CURRENT AAN SPECIFICATIONS AND BE INSTALLED IN ACCORDANCE WITH HOWARD COUNTY PLANTING SPECIFICATIONS.
2. CONTRACTOR SHALL VERIFY LOCATION OF ALL UNDERGROUND UTILITIES PRIOR TO DIGGING.
3. FINAL LOCATION OF PLANT MATERIAL MAY NEED TO VARY TO MEET FINAL FIELD CONDITIONS. TREES SHALL NOT BE PLANTED IN THE BOTTOM OF DRAINAGE SWALES.
4. CONTRACTOR SHALL VERIFY PLANT QUANTITIES PRIOR TO BIDDING. IF PLAN DIFFERS FROM LANDSCAPE SCHEDULE, THE PLAN SHALL GOVERN.
5. SEE SHEET 10 FOR TYPICAL PLANTING SPECIFICATIONS AND DETAILS.
6. MICROBIORETENTION AREAS ARE TO BE PLANTED BASED ON A MINIMUM DENSITY OF 1000 STEMS PER PLANTED ACRE (0.229 STEMS PER SQUARE FOOT). ABOVE PLANTING RATIOS ARE TO BE APPLIED TO THE AREAS PROVIDED IN THE ESDv SUMMARY.

SEE SHEET 10 FOR MICRO-BIORETENTION DETAIL AND CONSTRUCTION ELEVATIONS.

MICRO-BIORETENTION PLANTING SCHEDULE				
QTY	BOTANICAL NAME/COMMON NAME	SIZE	REMARKS	
20	LINDERA BENZOIN SPICEBUSH	5 GALLON	CONT	
40	ILEX GLABRA INKBERRY	3 GALLON	CONT	
40	VIBURNUM TRILOBUM AMERICAN Highbush CRANBERRY	3 GALLON	CONT	

SF X 75% X .0229 STEMS PER SQUARE FOOT = PLANTS REQUIRED


MBR FACILITY	SURFACE AREA	REQUIRED PLANTINGS	PLANTINGS
MBR #1	673 SF	12	2 SPICEBUSH 5 INKBERRY 5 AMERICAN Highbush CRANBERRY
MBR #2	704 SF	12	2 SPICEBUSH 5 INKBERRY 5 AMERICAN Highbush CRANBERRY
MBR #3	866 SF	15	3 SPICEBUSH 6 INKBERRY 6 AMERICAN Highbush CRANBERRY
MBR #4	1554 SF	27	7 SPICEBUSH 10 INKBERRY 10 AMERICAN Highbush CRANBERRY
MBR #5	971 SF	17	3 SPICEBUSH 7 INKBERRY 7 AMERICAN Highbush CRANBERRY
MBR #6	959 SF	17	3 SPICEBUSH 7 INKBERRY 7 AMERICAN Highbush CRANBERRY

APPROVED: HOWARD COUNTY DEPARTMENT OF PLANNING AND ZONING

CHIEF, DEVELOPMENT ENGINEERING DIVISION 11-29-16 DATE

 CHIEF, DIVISION OF LAND DEVELOPMENT 12-5-16 DATE

 DIRECTOR 12-5-16 DATE

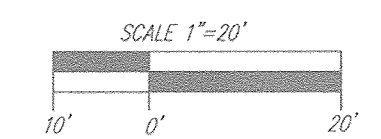

**REVISED SITE DEVELOPMENT PLAN
 STORMWATER MANAGEMENT DETAILS AND
 MICRO-BIORETENTION PLANTING PLANS**
JOSEPH'S COURTYARD
 LOTS 1-24 AND OPEN SPACE LOTS 25 AND 26 - USE IN COMMON ACCESS (P.256)
 SINGLE FAMILY ATTACHED AND RELIGIOUS FACILITY (BA-93-40E)
 TAX MAP 35 BLOCK 24 ZONED: PARCEL 153 (R-SA-8) / PARCEL 256 (R-12) PARCEL 153: PIO 256
 5TH ELECTION DISTRICT L.091011F.0461L.02548/F.0368 HOWARD COUNTY, MARYLAND

**ROBERT H. VOGEL
 ENGINEERS, SURVEYORS, PLANNERS**
 8407 MAIN STREET TEL: 410.461.7566
 ELLICOTT CITY, MD 21043 FAX: 410.461.8961

DESIGN BY: RHV/GAH
 DRAWN BY: GAH/KG
 CHECKED BY: RHV
 DATE: MAY 2016
 SCALE: AS SHOWN
 W.D. NO.: 05-84

PROFESSIONAL CERTIFICATE
 I HEREBY CERTIFY THAT THESE DOCUMENTS WERE PREPARED OR APPROVED BY ME AND THAT I AM A DULY LICENSED PROFESSIONAL ENGINEER UNDER THE LAWS OF THE STATE OF MARYLAND, LICENSE NO. 16193 EXPIRATION DATE: 08-27-2016

11 SHEET OF 14

AS-BUILT - NOV. 2018




FOREST RETENTION AREAS AND NOTES

- FORESTED STREAM AND WETLAND BUFFERS ARE RETAINED IN OPEN SPACE LOTS.
- NO HAZARDOUS OR ENDANGERED SPECIES ARE OBSERVED ON THIS SITE.
- FORESTED AREAS ADJACENT TO FLOODPLAINS AND STREAM BUFFERS ARE SUBSTANTIALLY RETAINED IN OPEN SPACE LOTS.
- CHANGES IN GRADING AND SLOPE WITHIN CONSTRUCTION/INSTALLATION AREAS WILL NOT ADVERSELY AFFECT THE SOILS WITHIN THE FOREST RETENTION AREA. SEDIMENT CONTROL MEASURES WILL BE INSTALLED TO PREVENT SEDIMENT FROM STORMWATER MANAGEMENT FACILITIES. RETAIN SEDIMENT WITHIN THE CONSTRUCTION SITE, AND/OR REDIRECT CLEAN WATER AWAY FROM CONSTRUCTION AREAS.
- THE FOREST CONSERVATION EASEMENT HAS BEEN ESTABLISHED TO FULFILL THE REQUIREMENTS OF SECTION 16.120 OF THE HOWARD COUNTY CODE. NO CLEARING, GRADING OR CONSTRUCTION IS PERMITTED WITHIN THE FOREST CONSERVATION EASEMENT. HOWEVER, FOREST MANAGEMENT PRACTICES AS DEFINED IN THE DEED OF FOREST CONSERVATION EASEMENT ARE ALLOWED.

GENERAL NOTES:

- THIS PLAN HAS BEEN PREPARED IN ACCORDANCE WITH THE PROVISIONS OF SECTION 16.124 OF THE HOWARD COUNTY CODE AND THE LANDSCAPE MANUAL. THE REQUIRED PARKING AND PERIMETER LANDSCAPING WILL BE BONDED PER THIS SUBMISSION.
- FINANCIAL SURETY FOR THE REQUIRED LANDSCAPING HAS BEEN POSTED AS PART OF THE DEVELOPER'S AGREEMENT IN THE AMOUNT OF \$28,350.00 FOR THE REQUIRED 61 SHADE TREES AND 57 EVERGREEN TREES. FINANCIAL SURETY FOR THE REQUIRED STREET TREE HAS BEEN POSTED AS PART OF THE DEVELOPER'S AGREEMENT IN THE AMOUNT OF \$8,100.00 FOR THE REQUIRED 27 SHADE TREES.
- THE OWNER, TENANT AND/OR THEIR AGENTS SHALL BE RESPONSIBLE FOR MAINTENANCE OF THE REQUIRED LANDSCAPING, PLANT MATERIALS, BENCHES, FENCES AND WALLS. ALL PLANT MATERIALS SHALL BE MAINTAINED IN GOOD GROWING CONDITION AND WHEN NECESSARY REPLACED WITH NEW MATERIALS TO ENSURE CONTINUED COMPLIANCE WITH APPLICABLE REGULATIONS. ALL REQUIRED LANDSCAPING SHALL BE PERMANENTLY MAINTAINED IN GOOD CONDITION, AND WHEN NECESSARY, REPAIRED OR REPLACED.
- NO CLEARING OF EXISTING VEGETATION IS PERMITTED WITHIN THE LANDSCAPE EDGE FOR WHICH CREDIT IS BEING TAKEN. HOWEVER, LANDSCAPE MAINTENANCE IS AUTHORIZED.
- AT THE TIME OF INSTALLMENT, ALL SHRUBS AND OTHER PLANTINGS LISTED HERewith AND APPROVED FOR THIS SITE SHALL BE OF THE PROPER HEIGHT REQUIREMENTS IN ACCORDANCE WITH THE HOWARD COUNTY LANDSCAPE MANUAL. IN ADDITION, NO SUBSTITUTIONS OR RELOCATION OF REQUIRED PLANTINGS MAY BE MADE WITHOUT PRIOR REVIEW AND APPROVAL FROM THE DEPARTMENT OF PLANNING AND ZONING. ANY DEVIATION FROM THIS APPROVED LANDSCAPE PLAN MAY RESULT IN DENIAL OR DELAY IN THE RELEASE OF LANDSCAPE FINANCIAL SURETY UNTIL SUCH TIME AS ALL REQUIRED MATERIALS ARE PLANTED AND/OR REVISIONS ARE MADE TO APPLICABLE PLANS AND CERTIFICATES.
- THERE IS NO 100YR FLOODPLAIN ON SITE.
- WETLANDS ARE LOCATED ON SITE IN ACCORDANCE WITH DELINEATION PREPARED BY ECO-SCIENCE PROFESSIONALS, INC., DATED SEPTEMBER 12, 2006.
- NO GRADING, REMOVAL OF VEGETATIVE COVER OR TREES, PAVING AND NEW STRUCTURE SHALL BE PERMITTED WITHIN THE REQUIRED WETLANDS, STREAMS OR THEIR BUFFERS, AND FOREST CONSERVATION EASEMENT AREAS.

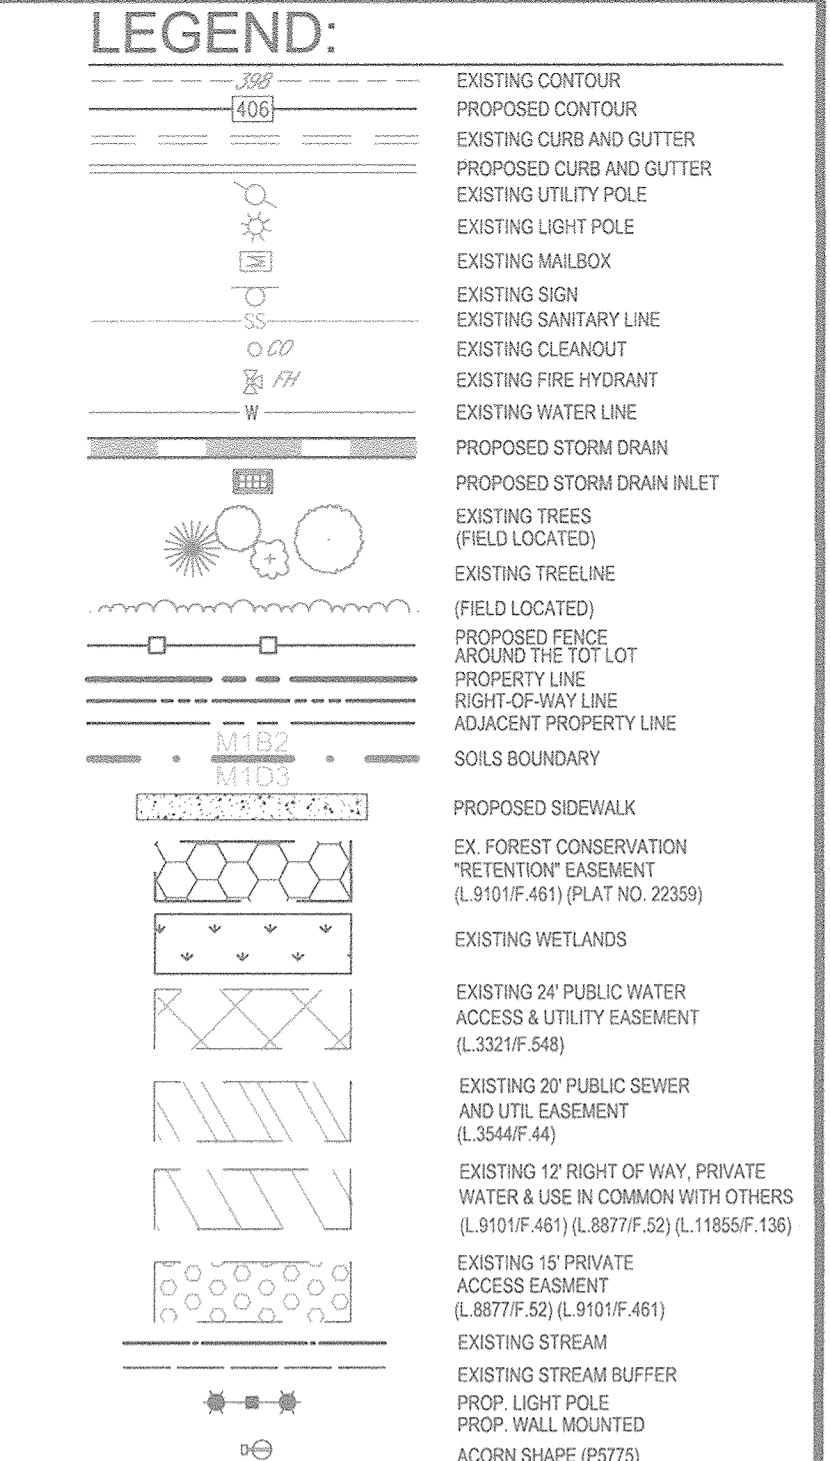

AS-BUILT CERTIFICATION FOR PSWM

I HEREBY CERTIFY THAT THE FACILITY SHOWN ON THIS PLAN WAS CONSTRUCTED AS SHOWN ON THE "AS-BUILT" PLANS AND COMPLIES WITH THE APPROVED PLANS AND SPECIFICATIONS. I HAVE VERIFIED THAT THE CONTRIBUTING DRAINAGE AREA IS SUFFICIENTLY STABILIZED TO PREVENT CLOGGING OF THE UNDERGROUND SWM FACILITY.

[Signature] 6/19/13 2/5/19
P.E. DATE

NO AS-BUILT INFORMATION ON THIS SHEET

SCHEDULE A PERIMETER LANDSCAPE EDGE

CATEGORY	ADJACENT TO ROADWAYS AND PERIMETER PROPERTIES						TOTAL
	1A	1B	2	3	4	6A	
PERIMETER/FRONTAGE DESIGNATION	C	C	C	C	C	C	C
LINEAR FEET OF ROADWAY FRONTAGE/PERIMETER	317	54	339	126	160	376	270
CREDIT FOR EXISTING VEGETATION (YES, NO, LINEAR FEET DESCRIBE BELOW IF NEEDED)	No	No	No	* YES 126 LF	* YES 160 LF	YES 35 LF	**YES 240 LF
CREDIT FOR WALL, FENCE OR BERM (YES, NO, LINEAR FEET DESCRIBE BELOW IF NEEDED)	No	No	No	No	No	No	No
NUMBER OF PLANTS REQUIRED						341	
SHADE TREES	1:40 8	1:40 2	1:40 9	1:40 0	1:40 0	1:40 9	1:40 7
EVERGREEN TREES	1:20 16	1:20 3	1:20 17	1:20 0	1:20 0	1:20 17	1:20 14
NUMBER OF PLANTS PROVIDED						341	
SHADE TREES	8	2	** 7	0	0	** 11	7
EVERGREEN TREES	16	3	12	0	0	22	14
OTHER TREES (2:1 SUBSTITUTION)	-	-	-	-	-	-	0
SHRUBS (10:1 SUBSTITUTION)	-	-	-	-	-	-	0
DESCRIBE PLANT SUBSTITUTION CREDITS BELOW IF NEEDED)							

SCHEDULE B PARKING LOT INTERNAL LANDSCAPING

Number of parking spaces	14
Number of trees required	2
Number of trees provided	2
Shade Trees	2
Other Trees (2:1 Substitution)	0

SCHEDULE C RESIDENTIAL DEVELOPMENT INTERNAL LANDSCAPING

Number of dwelling units	24
Number of trees required (1:1 DU SFA; 1:3 DU APTS)	24
Number of trees provided	24
Shade Trees	24
Other Trees (2:1 Substitution)	-

Forest Conservation Worksheet 2.2

Net Tract Area	A = 5.00
Total Tract Area	B = 0.00
Deductions	C = 5.00
Net Tract Area	
Land Use Category	
ARA	0
MDR	0
IDA	0
HDR	0
MPD	0
CIA	0
Allorestation Threshold (Net Tract Area x 15%)	D = 0.75
Conservation Threshold (Net Tract Area x 20%)	E = 1.00
Existing Forest Cover	F = 0.57
Existing Forest Cover within the Net Tract Area	G = 0.00
Area of Forest Above Conservation Threshold	
Break Even Point	H = 0.57
Break Even Point	I = 0.00
Proposed Forest Clearing	J = 0.27
Total Area of Forest to be Retained	K = 0.30
Total Area of Forest to be Cleared	L = 0.00
Restoration for Clearing Above the Conservation Threshold	M = 0.54
Restoration for Clearing Below the Conservation Threshold	N = 0.00
Credit for Retention above the Conservation Threshold	O = 0.54
Total Restoration Required	P = 0.54
Total Allorestation Required	Q = 0.18
Total Planting Requirement	R = 0.72

Forest Retention Area
DO NOT DISTURB
MACHINERY, DUMPING OR STORAGE OF ANY MATERIALS IS PROHIBITED

NOTE:

- SIGNS TO BE PLACED APPROXIMATELY 50-100 FEET APART. CONDITIONS ON SITE AFFECTING VISIBILITY BY WARRANT PLACING SIGNS CLOSER OR FARTHER APART.
- ATTACHMENT OF SIGNS TO TREES IS PROHIBITED.
- ALL FOREST CONSERVATION SIGNAGE SHALL BE IN PLACE FOR PERPETUITY.

FOREST CONSERVATION AREA SIGNS (FOR A RETENTION EASEMENT)

CONSTRUCTION PERIOD PROTECTION AND MANAGEMENT NOTES FOR FOREST CONSERVATION


PRE-CONSTRUCTION PHASE

- FOR RETENTION AREAS, INSTALL BLAZE ORANGE FENCE AND RETENTION SIGNS BEFORE CONSTRUCTION BEGINS.
- FENCING SHALL BE MAINTAINED IN GOOD CONDITION AND PROMPTLY REPAIRED OR RESTORED AS THE SITUATION WARRANTS.
- A QUALIFIED TREE CARE EXPERT SHALL DETERMINE IF ROOT PRUNING IS REQUIRED ALONG THE LIMIT OF DISTURBANCE. ROOT PRUNING SHALL BE LIMITED TO THE BOTTOM OF DRAINAGE SWALES. ROOT PRUNING SHALL BE LIMITED TO THE BOTTOM OF DRAINAGE SWALES. ROOT PRUNING SHALL BE LIMITED TO THE BOTTOM OF DRAINAGE SWALES. ROOT PRUNING SHALL BE LIMITED TO THE BOTTOM OF DRAINAGE SWALES.

POST-CONSTRUCTION PHASE

- AT THE DIRECTION OF A QUALIFIED TREE CARE EXPERT, DAMAGES TO RETAINED TREES SHALL BE REPAIRED BY THE CONTRACTOR.
- FENCE REMOVAL AND STABILIZATION SHALL BE AS PER THE SEDIMENT AND EROSION CONTROL PLAN.
- DO NOT REMOVE SIGNS.

JOHN CANOLES
DNR QUALIFIED PROFESSIONAL

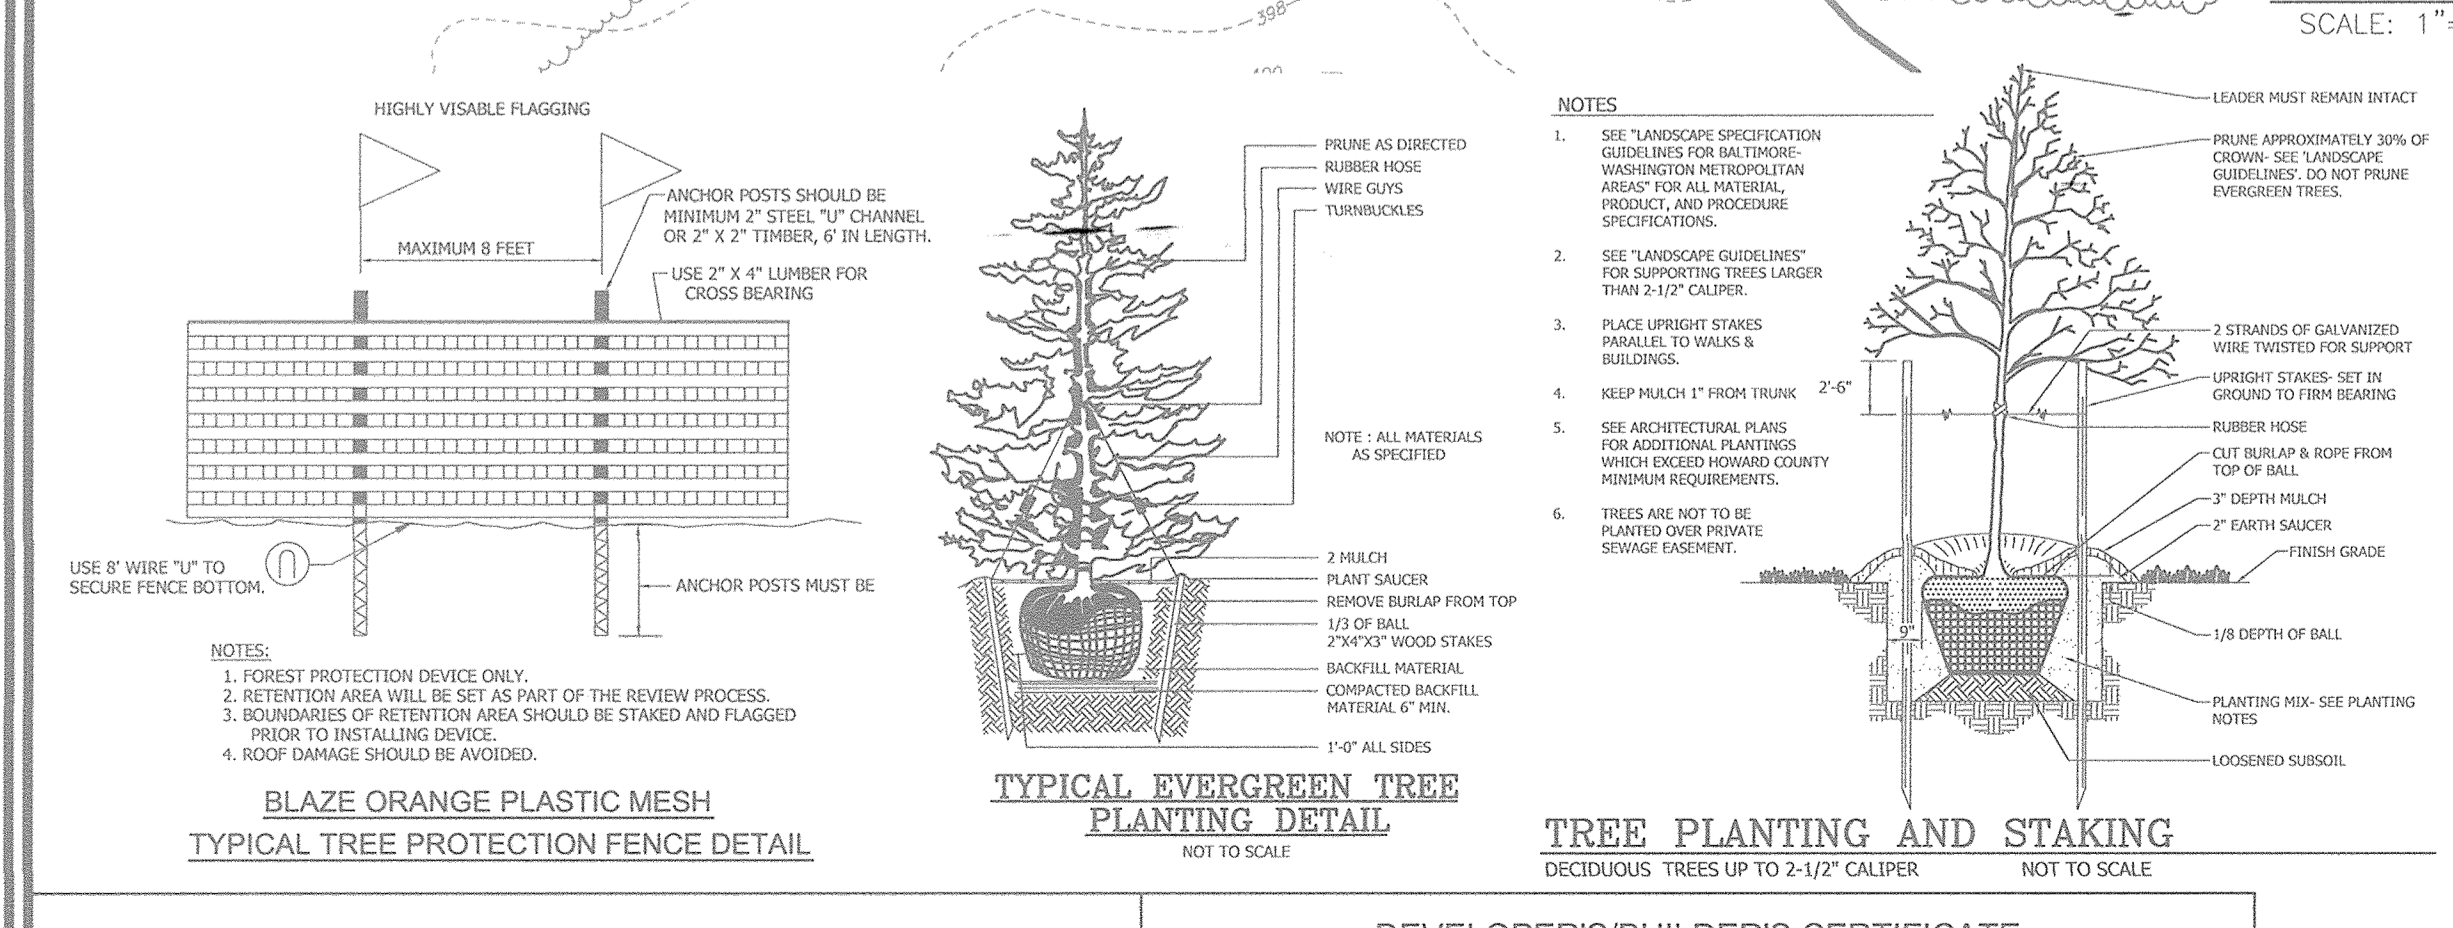

STREET TREE SCHEDULE

ROAD FRONTAGE	1095 LF
TREES REQUIRED	28
TREES PROVIDED	*28

*27 NEW SHADE TREES AND 1 EXISTING SHADE TREE TO REMAIN

LANDSCAPE SCHEDULE

KEY	QUAN.	BOTANICAL NAME	SIZE	CAT
AR	35	ACER RUBRUM OCTOBER GLORY RED MAPLE	2 1/2"-3" CAL.	B & B
ZS	2	ZELKOVA SERRATA 'VILLAGE GREEN'	2 1/2"-3" CAL.	B & B
PY	24	PRUNUS YEDOENSIS/ YOSHINO CHERRY	1 1/2"-2" CAL.	B & B
GT	3	QUERUS ILEX/IMPERIAL THORNLESS HONEY LOCUST	1 1/2"-2" CAL.	B & B
PS	67	PINUS STROBUS EASTERN WHITE PINE	6'-8" HT.	B & B
AB	12	ACER RUBRUM 'BOWHALL' BOWHALL RED MAPLE	2 1/2"-3" CAL.	B & B
CB	12	CARPINUS BETULUS 'FASTIGIATA' FASTIGIATE EUROPEAN HORNBEAM	1 1/2"-2" CAL.	B & B

*There is one existing Shade Tree to remain which will count towards total of 89 shade trees provided.

LANDSCAPE SCHEDULE NOTE:

- ALL PLANT MATERIALS SHALL BE FULL AND HEAVY, WELL FORMED AND SYMMETRICAL, CONFORM TO THE MOST CURRENT ANS SPECIFICATIONS AND BE INSTALLED IN ACCORDANCE WITH HRD PLANTING SPECIFICATIONS.
- CONTRACTOR SHALL VERIFY LOCATION OF ALL UNDERGROUND UTILITIES PRIOR TO DIGGING.
- FINAL LOCATION OF PLANT MATERIAL MAY NEED TO VARY TO MEET FINAL FIELD CONDITIONS. TREES SHALL NOT BE PLANTED IN THE BOTTOM OF DRAINAGE SWALES.
- CONTRACTOR SHALL VERIFY PLANT QUANTITIES PRIOR TO BIDDING. IF PLAN DIFFERS FROM LANDSCAPE SCHEDULE, THE PLAN SHALL GOVERN.

APPROVED: HOWARD COUNTY DEPARTMENT OF PLANNING AND ZONING

[Signature] 11-29-16
CHIEF, DEVELOPMENT ENGINEERING DIVISION

[Signature] 12-5-16
CHIEF, DIVISION OF LAND DEVELOPMENT

[Signature] 12-5-16
DIRECTOR

DEVELOPER'S/BUILDER'S CERTIFICATE

I/WE CERTIFY THAT THE LANDSCAPING SHOWN ON THIS PLAN WILL BE DONE ACCORDING TO THE PLAN, SECTION 16.124 OF THE HOWARD COUNTY SUBDIVISION AND THE LAND DEVELOPMENT REGULATIONS AND THE LANDSCAPE MANUAL. I/WE FURTHER CERTIFY THAT UPON COMPLETION, A LETTER OF NOTICE, ACCOMPANIED BY AN EXECUTED ONE-YEAR GUARANTEE OF PLANT MATERIALS, WILL BE SUBMITTED TO THE DEPARTMENT OF PLANNING AND ZONING.

[Signature] 11/1/16
DEVELOPER/BUILDER

OWNER (PARCEL 256)
TEMPLE BETH SHALOM OF HOWARD COUNTY
8070 HARRIET TUBMAN LANE
COLUMBIA, MD. 21044

OWNER (PARCEL 153)
JOSEPH'S COURTYARD, LLC
3675 PARK AVENUE #301
ELLCOTT CITY, MD. 21043
C/O MICHAEL PFAU
(410) 480-0023

OWNER/DEVELOPER (PARCEL 153)
TRINITY HOMES MARYLAND, LLC.
3675 PARK AVENUE #301
ELLCOTT CITY, MD. 21043
C/O MICHAEL PFAU
(410) 480-0023

Forest Conservation Worksheet 2.2

1	REVISE PLAN TO ACCOMMODATE BUILDER HOUSE MODEL	10/28/16
NO.	REVISION	DATE

REVISED SITE DEVELOPMENT PLAN
FOREST CONSERVATION AND LANDSCAPE PLAN
JOSEPH'S COURTYARD
LOTS 1-24 AND OPEN SPACE LOTS 25 AND 26 - USE IN COMMON ACCESS (P.256)
SINGLE FAMILY ATTACHED AND RELIGIOUS FACILITY (BA-93-40E)
TAX MAP 35 BLOCK 24 ZONED: PARCEL 153 (R-SA-8) / PARCEL 256 (R-12) PARCEL 153: P10 256
5TH ELECTION DISTRICT L09101/F.0461/L. 02548/F. 0388 HOWARD COUNTY, MARYLAND


ROBERT H. VOGEL ENGINEERING, INC.
ENGINEERS • SURVEYORS • PLANNERS
8407 MAIN STREET
ELLCOTT CITY, MD 21043
TEL: 410.461.7666
FAX: 410.461.8961

DESIGN BY: RHV/GAH
DRAWN BY: GAH/KG
CHECKED BY: RHV
DATE: MAY 2016
SCALE: AS SHOWN
W.O. NO.: 05-84

PROFESSIONAL CERTIFICATE
I HEREBY CERTIFY THAT THESE DOCUMENTS WERE PREPARED OR APPROVED BY ME, AND THAT I AM A DULY LICENSED PROFESSIONAL ENGINEER UNDER THE LAWS OF THE STATE OF MARYLAND. MY LICENSE NUMBER IS 16193. EXPIRATION DATE 09-27-2018.

[Signature] 12/5/16
ROBERT H. VOGEL, P.E. No. 16193

12 SHEET OF 14

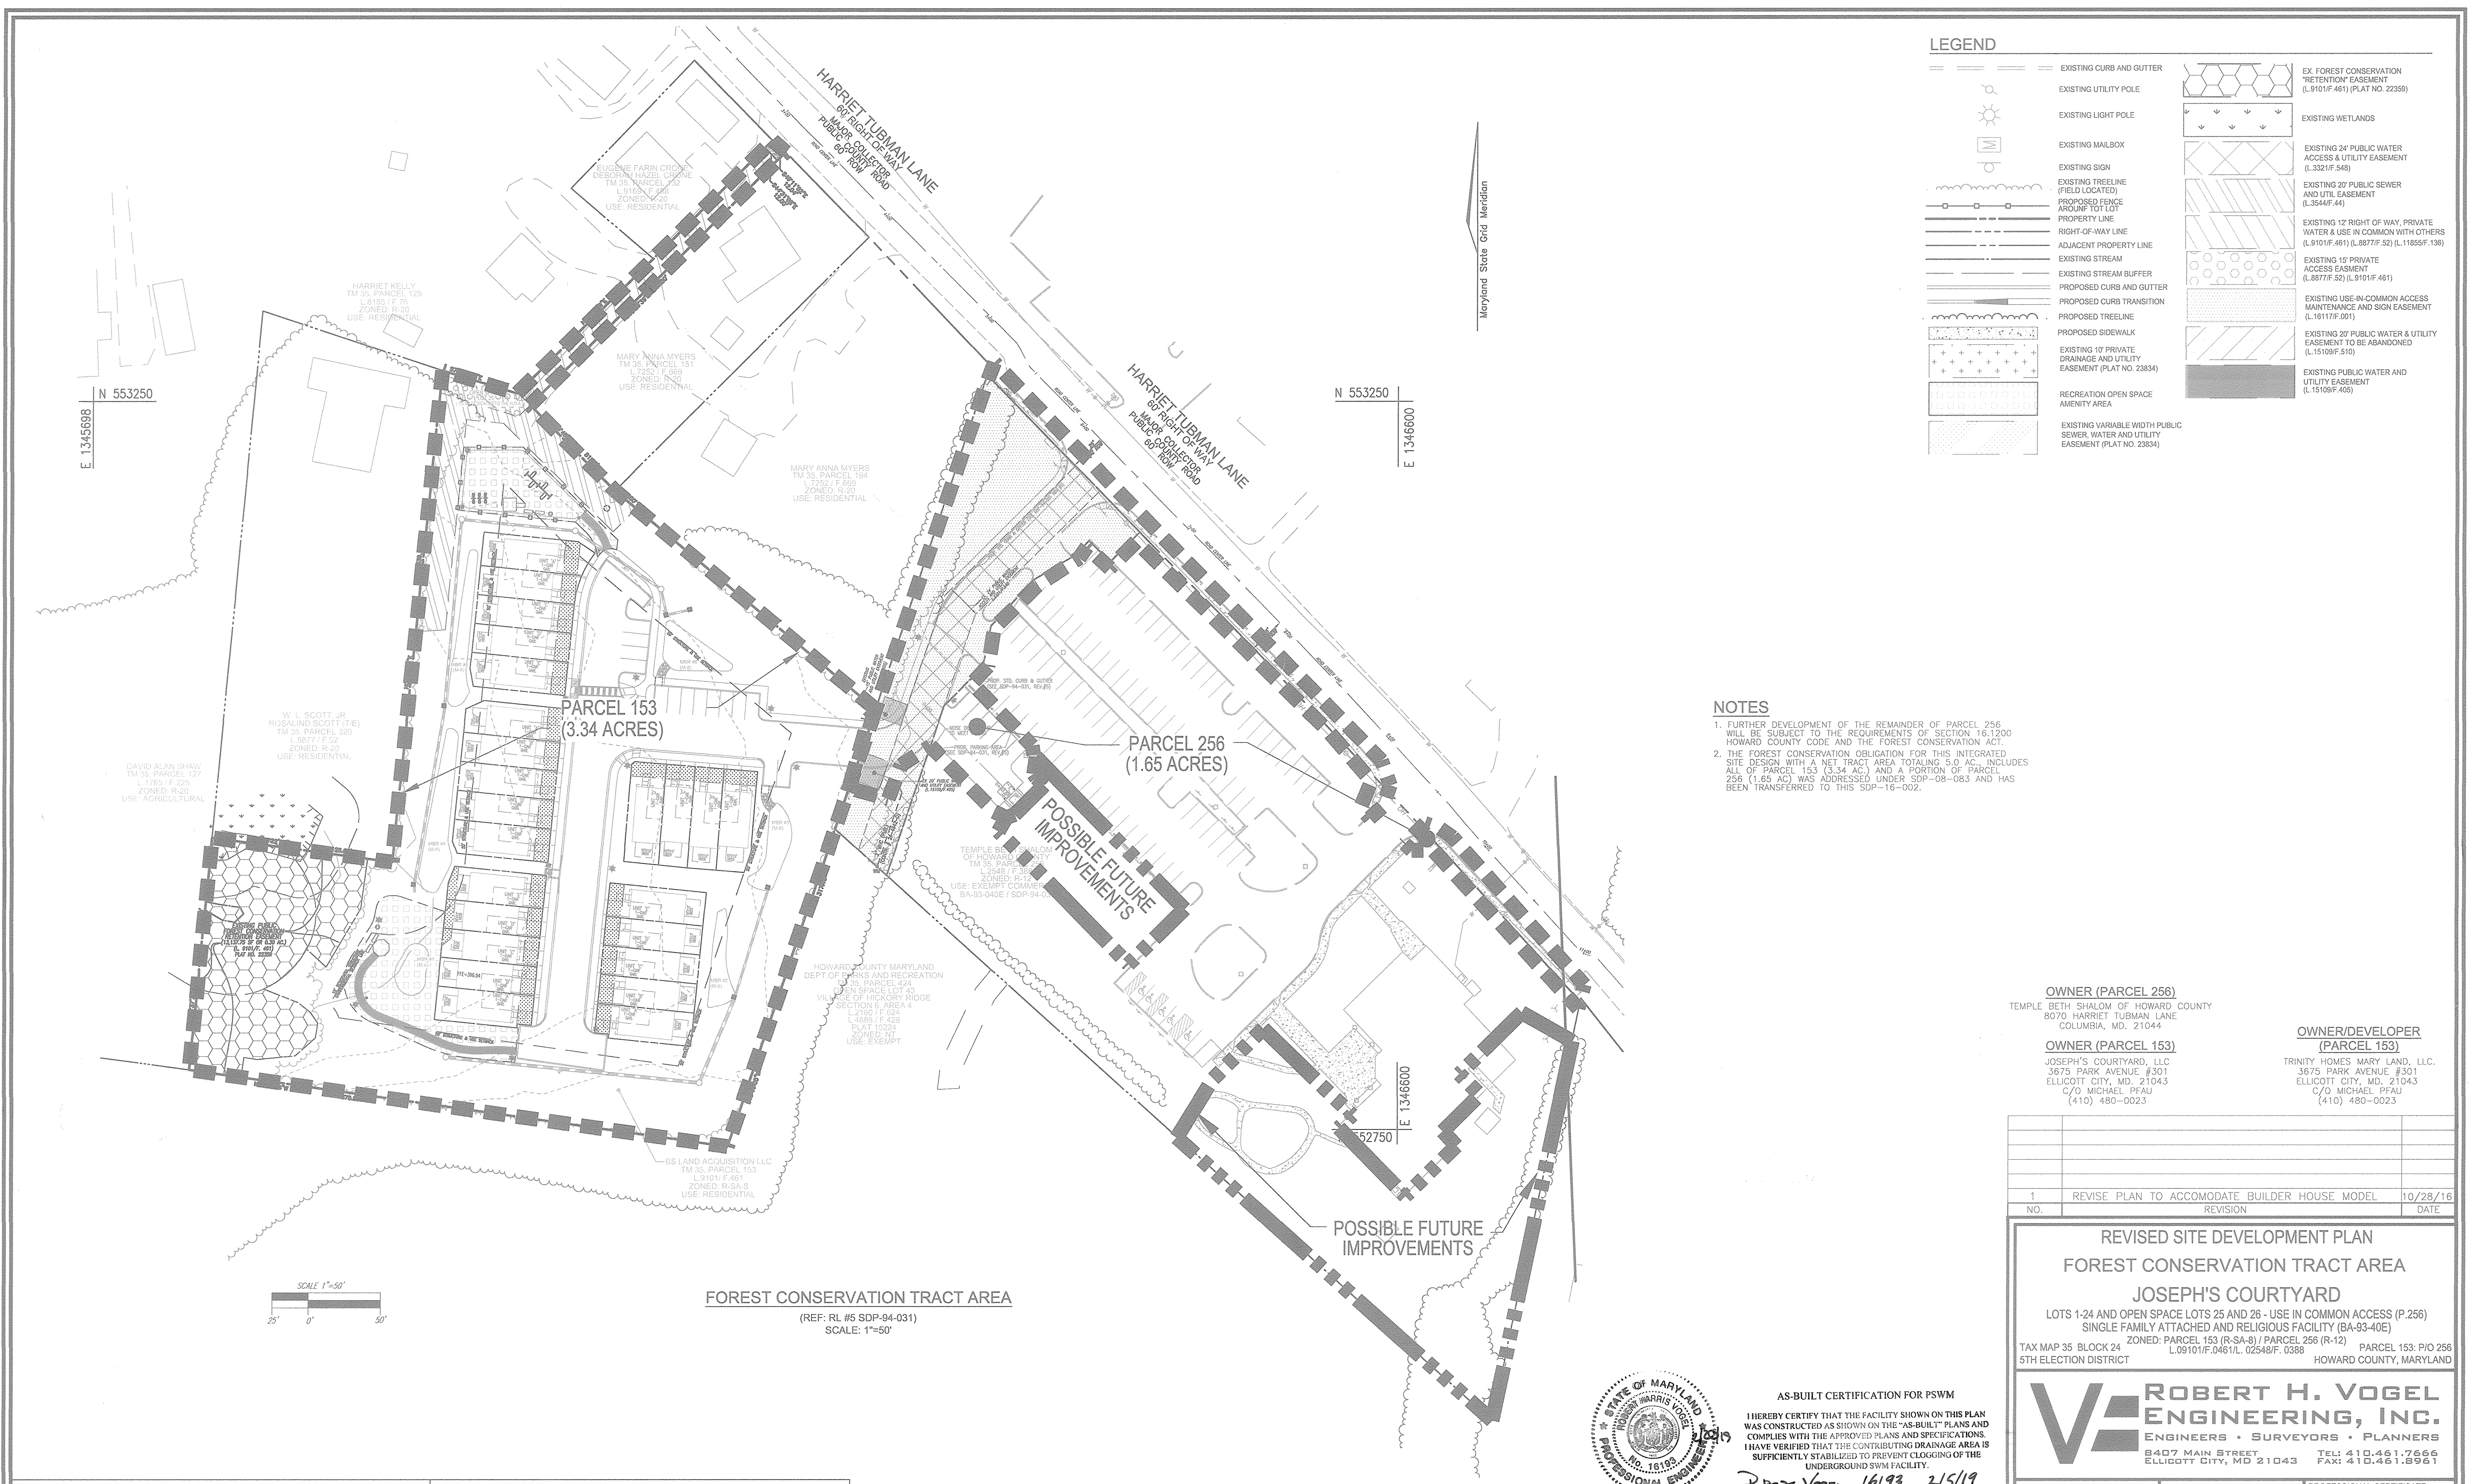

LEGEND

EXISTING CURB AND GUTTER	EXISTING UTILITY POLE	EXISTING WETLANDS
EXISTING LIGHT POLE	EXISTING MAILBOX	EXISTING 24" PUBLIC WATER ACCESS & UTILITY EASEMENT (L.3321/F.548)
EXISTING SIGN	EXISTING TREELINE (FIELD LOCATED)	EXISTING 20" PUBLIC SEWER AND UTL. EASEMENT (L.3544/F.44)
PROPOSED FENCE	PROPOSED FENCE	EXISTING 12' RIGHT OF WAY, PRIVATE WATER & USE IN COMMON WITH OTHERS (L.9101/F.461) (L.8877/F.52) (L.11855/F.138)
PROPERTY LINE	RIGHT-OF-WAY LINE	EXISTING 15' PRIVATE ACCESS EASEMENT (L.8877/F.52) (L.9101/F.461)
ADJACENT PROPERTY LINE	EXISTING STREAM	EXISTING USE-IN-COMMON ACCESS MAINTENANCE AND SIGN EASEMENT (L.16117/F.001)
EXISTING STREAM BUFFER	PROPOSED CURB AND GUTTER	EXISTING 20" PUBLIC WATER & UTILITY EASEMENT TO BE ABANDONED (L.15108/F.510)
PROPOSED CURB TRANSITION	PROPOSED CURB TRANSITION	EXISTING PUBLIC WATER AND UTILITY EASEMENT (L.15108/F.405)
PROPOSED TREELINE	PROPOSED SIDEWALK	
EXISTING 10' PRIVATE DRAINAGE AND UTILITY EASEMENT (PLAT NO. 23834)	EXISTING 10' PRIVATE DRAINAGE AND UTILITY EASEMENT (PLAT NO. 23834)	
RECREATION OPEN SPACE AMENITY AREA	EXISTING VARIABLE WIDTH PUBLIC SEWER WATER AND UTILITY EASEMENT (PLAT NO. 23834)	

NOTES

- FURTHER DEVELOPMENT OF THE REMAINDER OF PARCEL 256 WILL BE SUBJECT TO THE REQUIREMENTS OF SECTION 16.1200 HOWARD COUNTY CODE AND THE FOREST CONSERVATION ACT.
- THE FOREST CONSERVATION OBLIGATION FOR THIS INTEGRATED SITE DESIGN WITH A NET TRACT AREA TOTALING 5.0 AC. INCLUDES ALL OF PARCEL 153 (3.34 AC.) AND A PORTION OF PARCEL 256 (1.65 AC.) WAS ADDRESSED UNDER SDP-08-083 AND HAS BEEN TRANSFERRED TO THIS SDP-16-002.

OWNER (PARCEL 256)
 TEMPLE BETH SHALOM OF HOWARD COUNTY
 8070 HARRIET TUBMAN LANE
 COLUMBIA, MD. 21044


OWNER (PARCEL 153)
 JOSEPH'S COURTYARD, LLC
 3675 PARK AVENUE #301
 ELLICOTT CITY, MD. 21043
 C/O MICHAEL PFAU
 (410) 480-0023

OWNER/DEVELOPER (PARCEL 153)
 TRINITY HOMES MARYLAND, LLC.
 3675 PARK AVENUE #301
 ELLICOTT CITY, MD. 21043
 C/O MICHAEL PFAU
 (410) 480-0023

1	REVISE PLAN TO ACCOMMODATE BUILDER HOUSE MODEL	10/28/16
NO.	REVISION	DATE

REVISED SITE DEVELOPMENT PLAN
FOREST CONSERVATION TRACT AREA
JOSEPH'S COURTYARD
 LOTS 1-24 AND OPEN SPACE LOTS 25 AND 26 - USE IN COMMON ACCESS (P.256)
 SINGLE FAMILY ATTACHED AND RELIGIOUS FACILITY (BA-93-40E)
 ZONED: PARCEL 153 (R-SA-8) / PARCEL 256 (R-12)
 TAX MAP 35 BLOCK 24 L.09101/F.0461/L. 02548/F. 0388 PARCEL 153: PIO 256
 5TH ELECTION DISTRICT HOWARD COUNTY, MARYLAND

ROBERT H. VOGEL ENGINEERING, INC.
 ENGINEERS • SURVEYORS • PLANNERS
 8407 MAIN STREET ELLICOTT CITY, MD 21043
 TEL: 410.461.7666 FAX: 410.461.8961

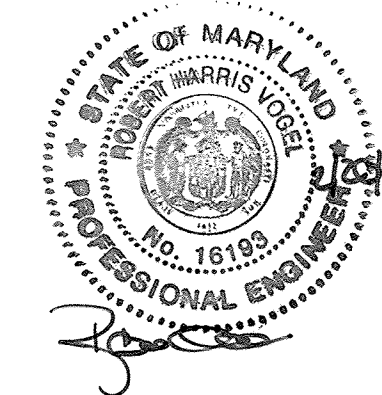

AS-BUILT CERTIFICATION FOR PSWM
 I HEREBY CERTIFY THAT THE FACILITY SHOWN ON THIS PLAN WAS CONSTRUCTED AS SHOWN ON THE "AS-BUILT" PLANS AND COMPLIES WITH THE APPROVED PLANS AND SPECIFICATIONS. I HAVE VERIFIED THAT THE CONTRIBUTING DRAINAGE AREA IS SUFFICIENTLY STABILIZED TO PREVENT CLOGGING OF THE UNDERGROUND SWM FACILITY.
 Robert H. Vogel 16193 2/5/19
 J.E. NAME P.E.# DATE

John Canoles
 DNR QUALIFIED PROFESSIONAL

DESIGN BY: RHV/GAH	PROFESSIONAL CERTIFICATE
DRAWN BY: GAH/KG	I HEREBY CERTIFY THAT THESE DOCUMENTS WERE PREPARED OR APPROVED BY ME, AND THAT I AM A DULY LICENSED PROFESSIONAL ENGINEER UNDER THE LAWS OF THE STATE OF MARYLAND. LICENSE NO. 16193 EXPIRATION DATE 08-27-2018
CHECKED BY: RHV	
DATE: MAY 2016	
SCALE: AS SHOWN	
W.O. NO.: 05-84	
	13 SHEET OF 14

APPROVED: HOWARD COUNTY DEPARTMENT OF PLANNING AND ZONING

Chief, Development Engineering Division
 11-29-16
 DATE

Chief, Division of Land Development
 12-05-16
 DATE










Director
 12-5-16
 DATE

DEVELOPER'S/BUILDER'S CERTIFICATE

I/WE CERTIFY THAT THE LANDSCAPING SHOWN ON THIS PLAN WILL BE DONE ACCORDING TO THE PLAN, SECTION 16.124 OF THE HOWARD COUNTY SUBDIVISION AND THE LAND DEVELOPMENT REGULATIONS AND THE LANDSCAPE MANUAL. I/WE FURTHER CERTIFY THAT UPON COMPLETION, A LETTER OF NOTICE, ACCOMPANIED BY AN EXECUTED ONE YEAR GUARANTEE OF PLANT MATERIALS, WILL BE SUBMITTED TO THE DEPARTMENT OF PLANNING AND ZONING.

Michael Pfauf
 DEVELOPER/BUILDER
 11/1/16
 DATE

NO AS-BUILT INFORMATION ON THIS SHEET

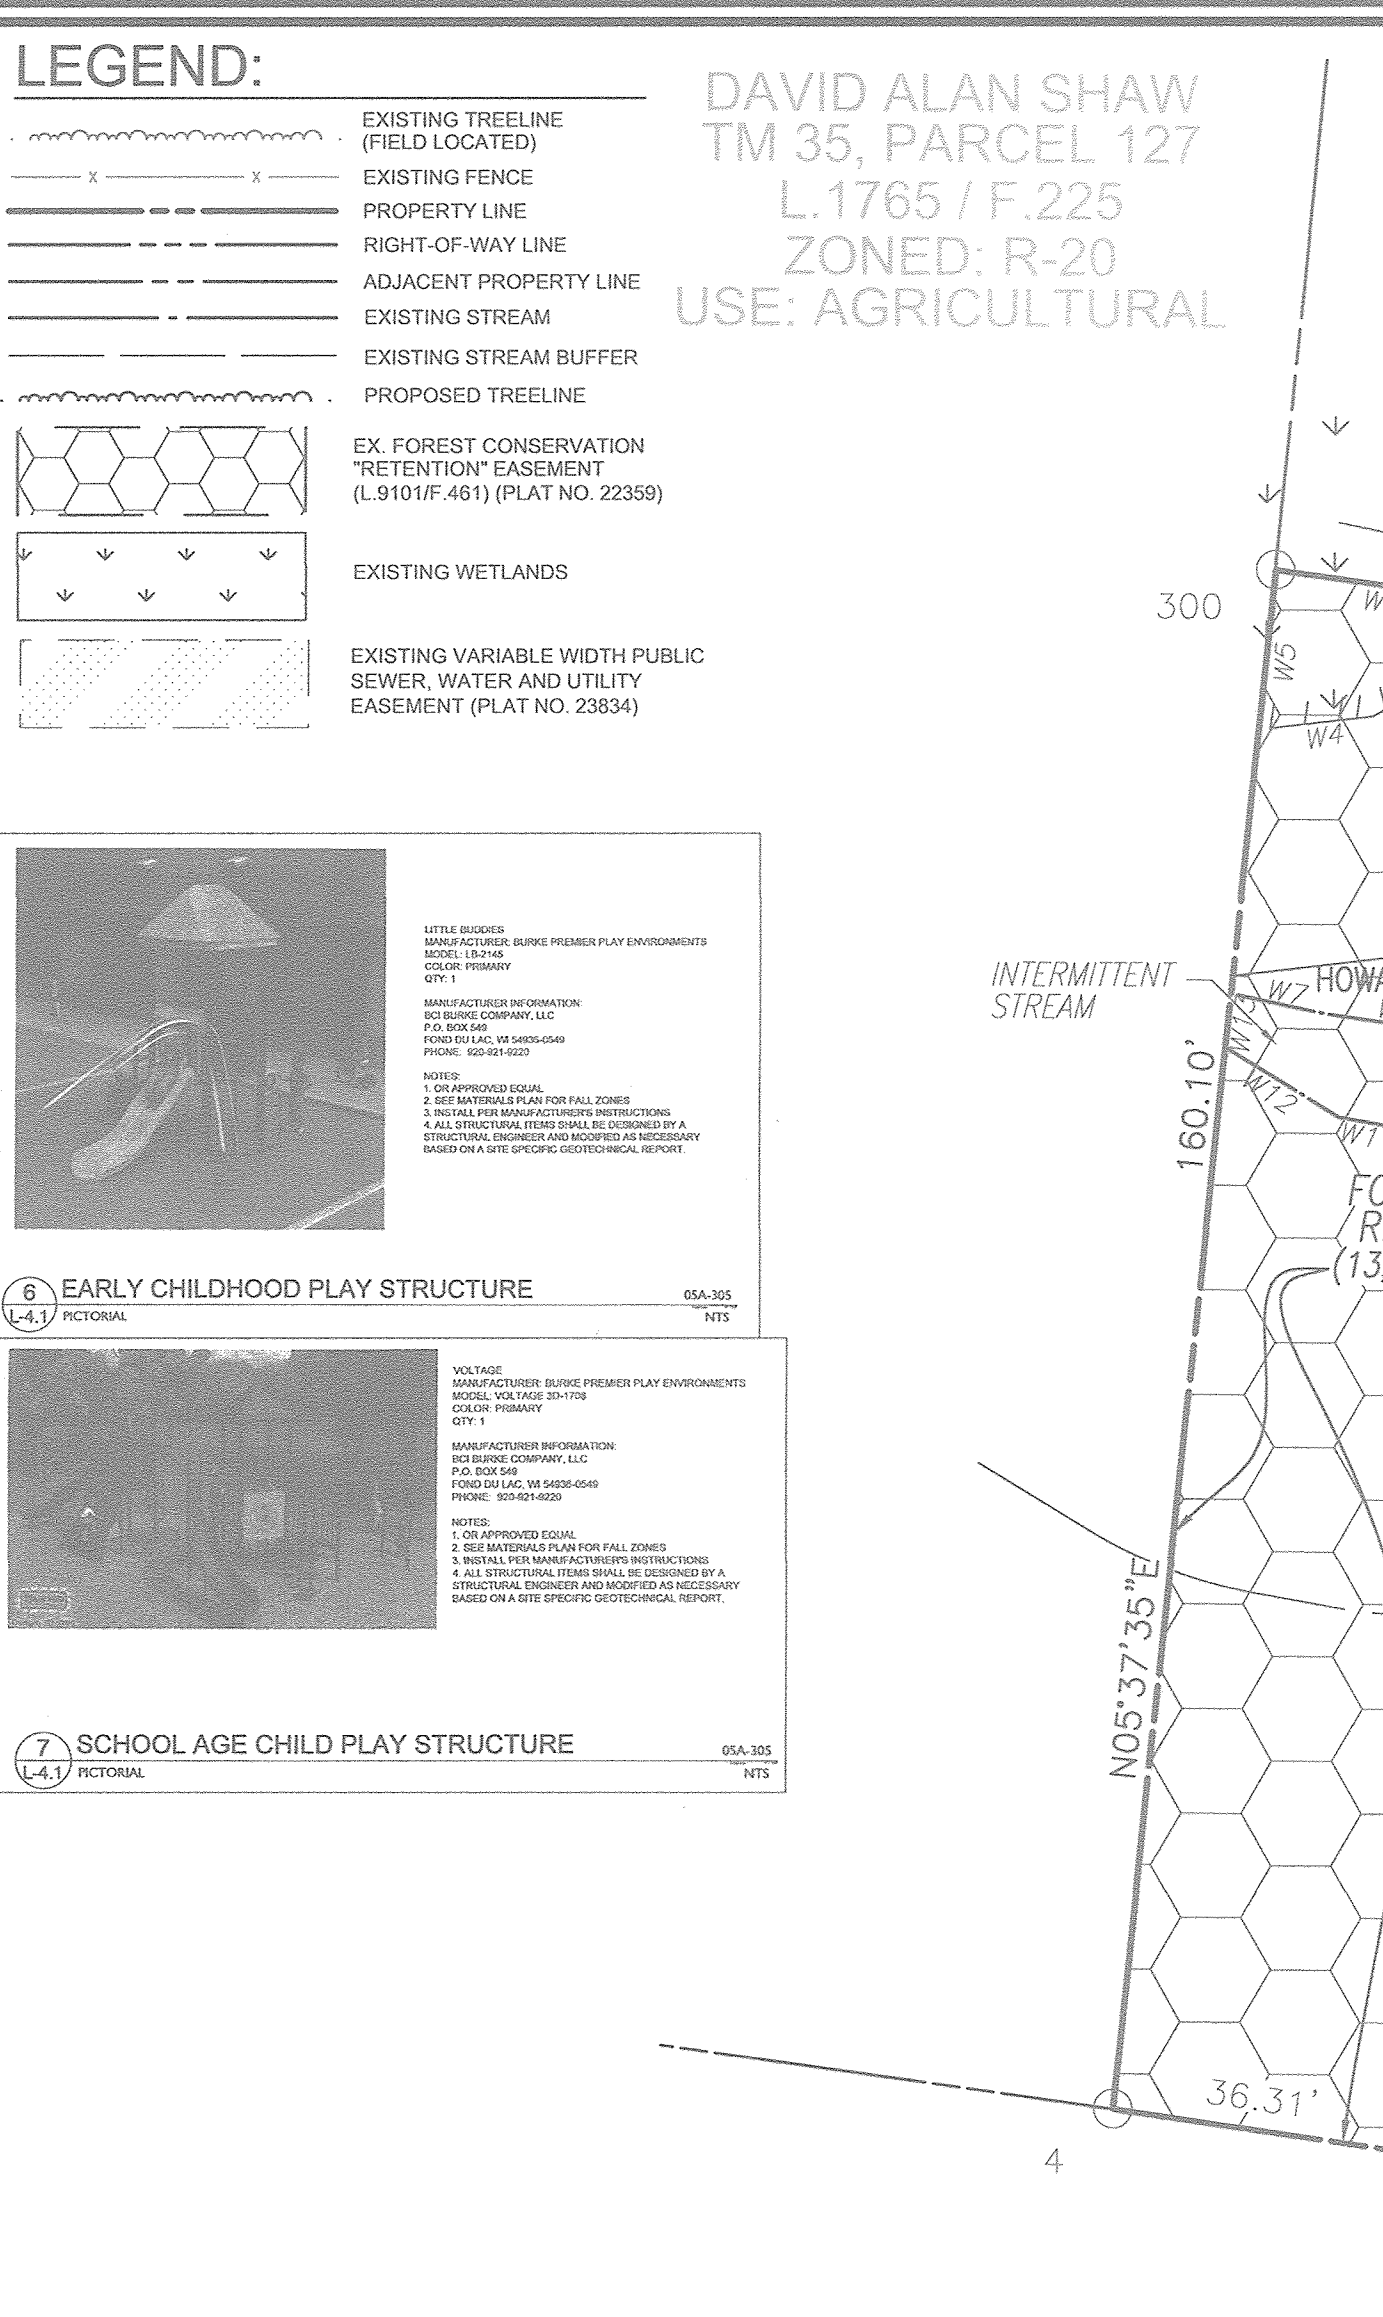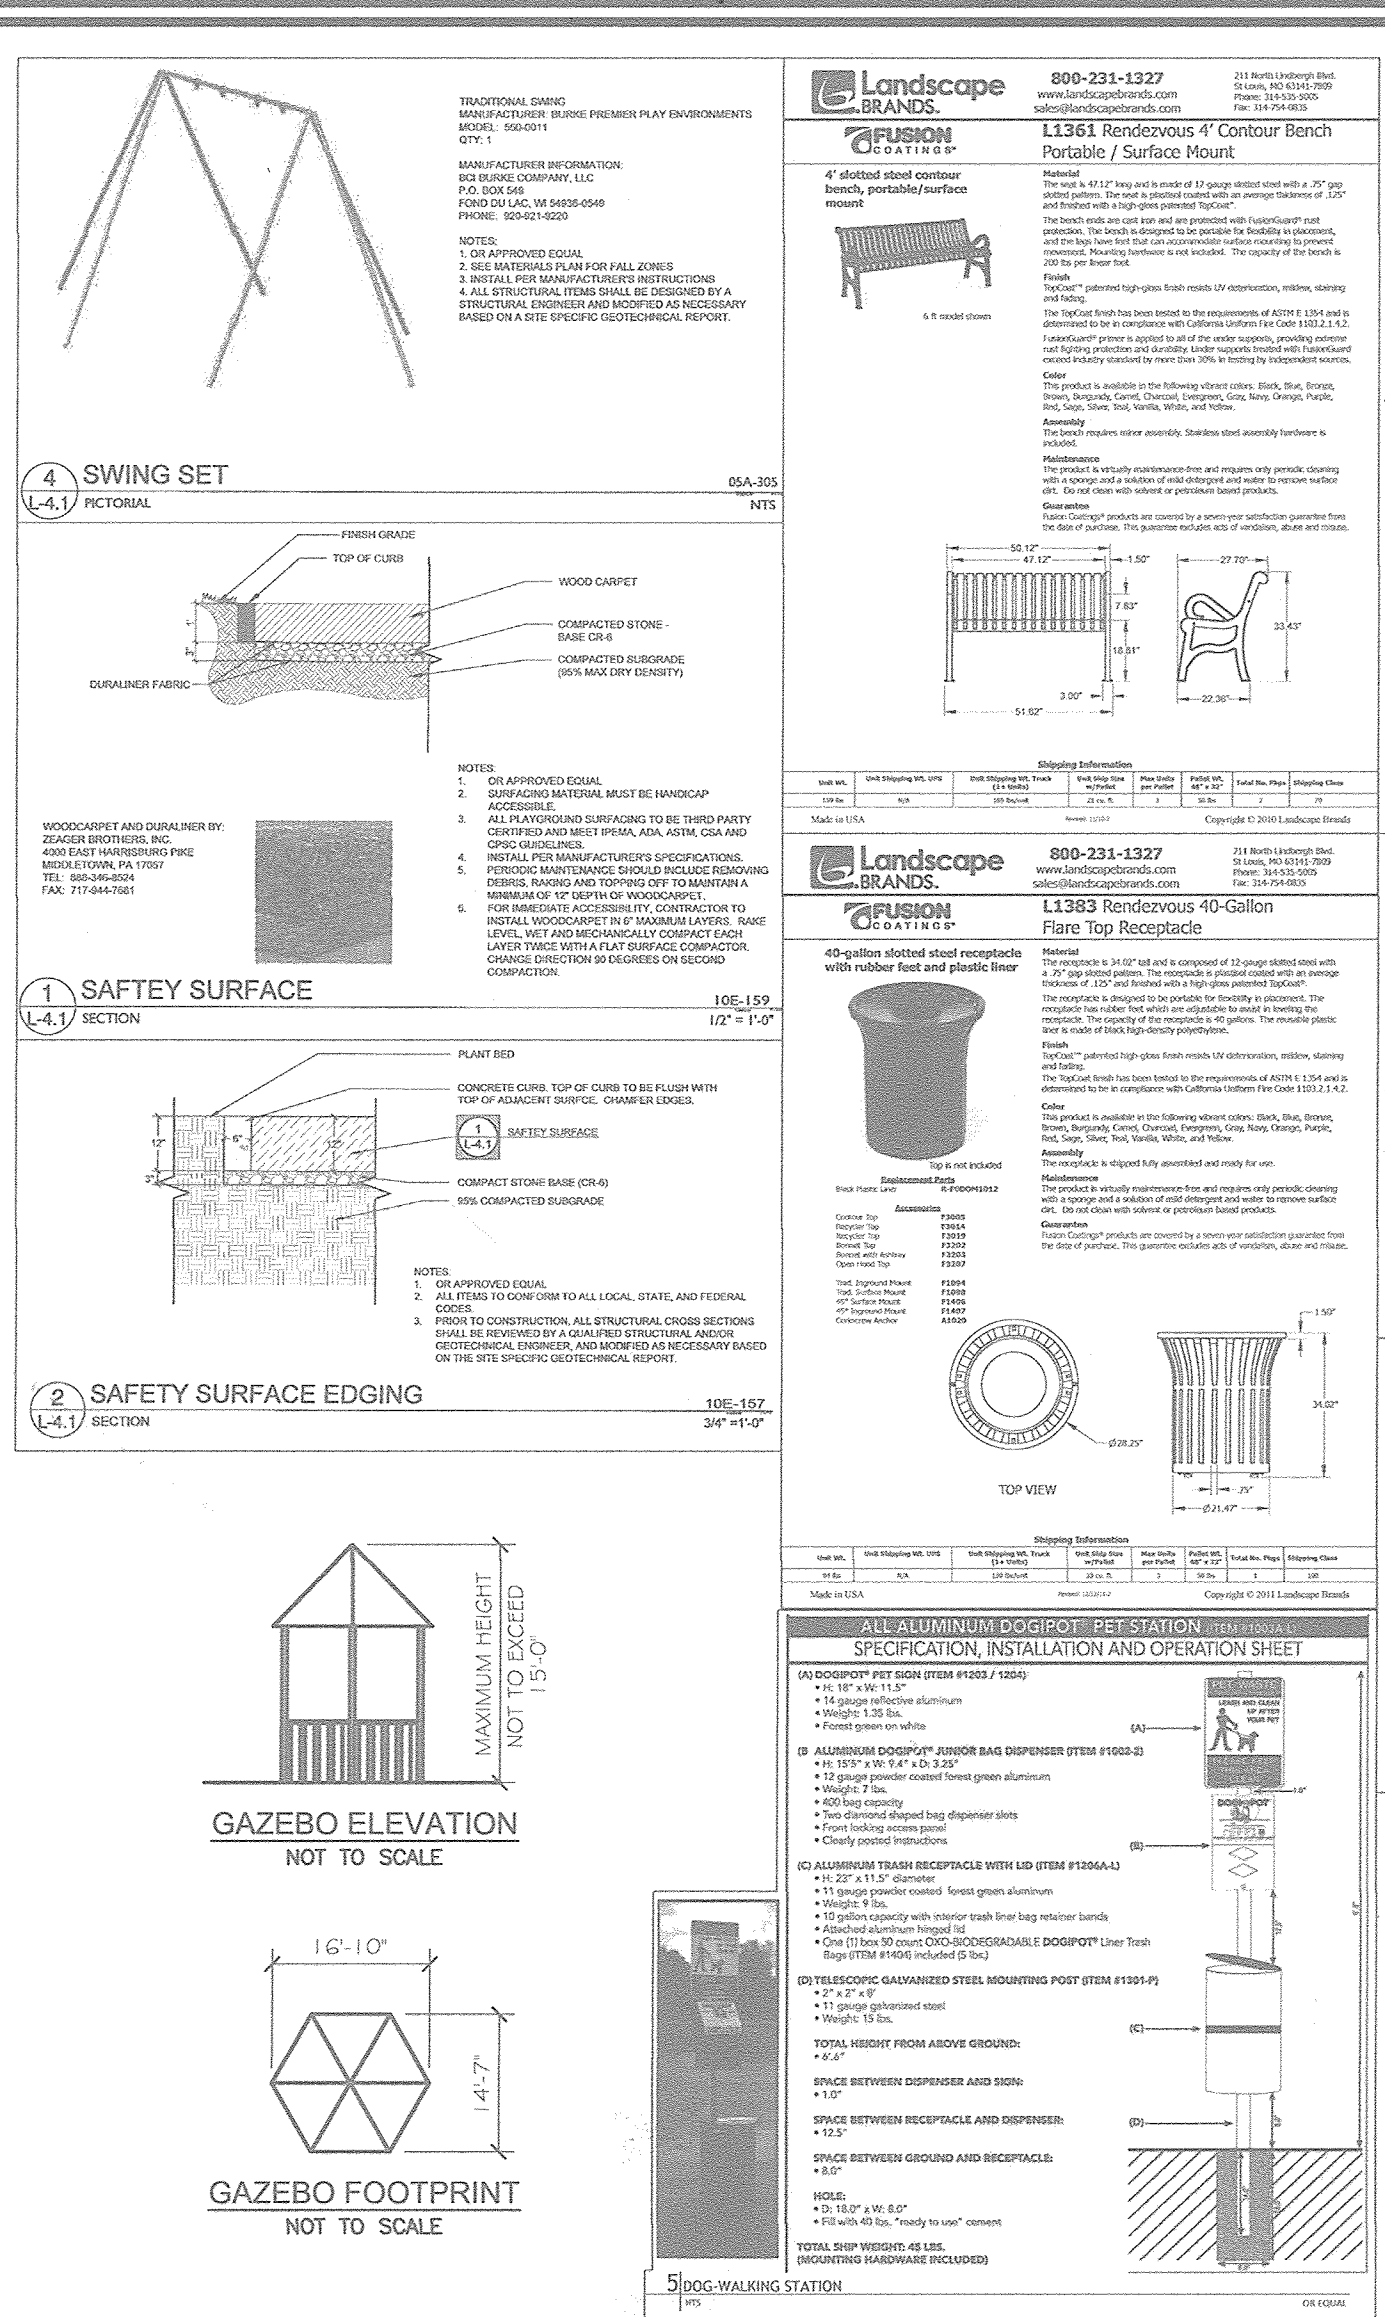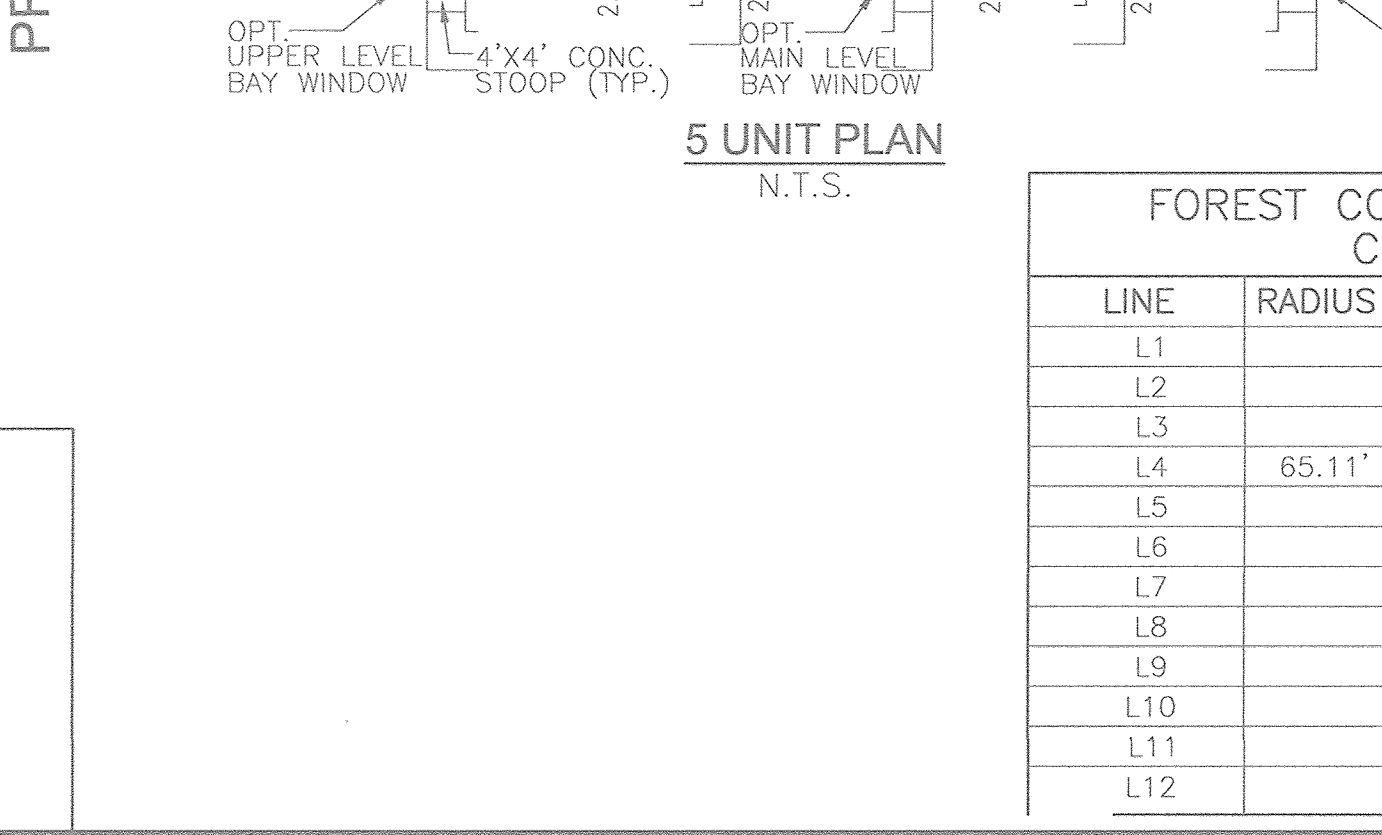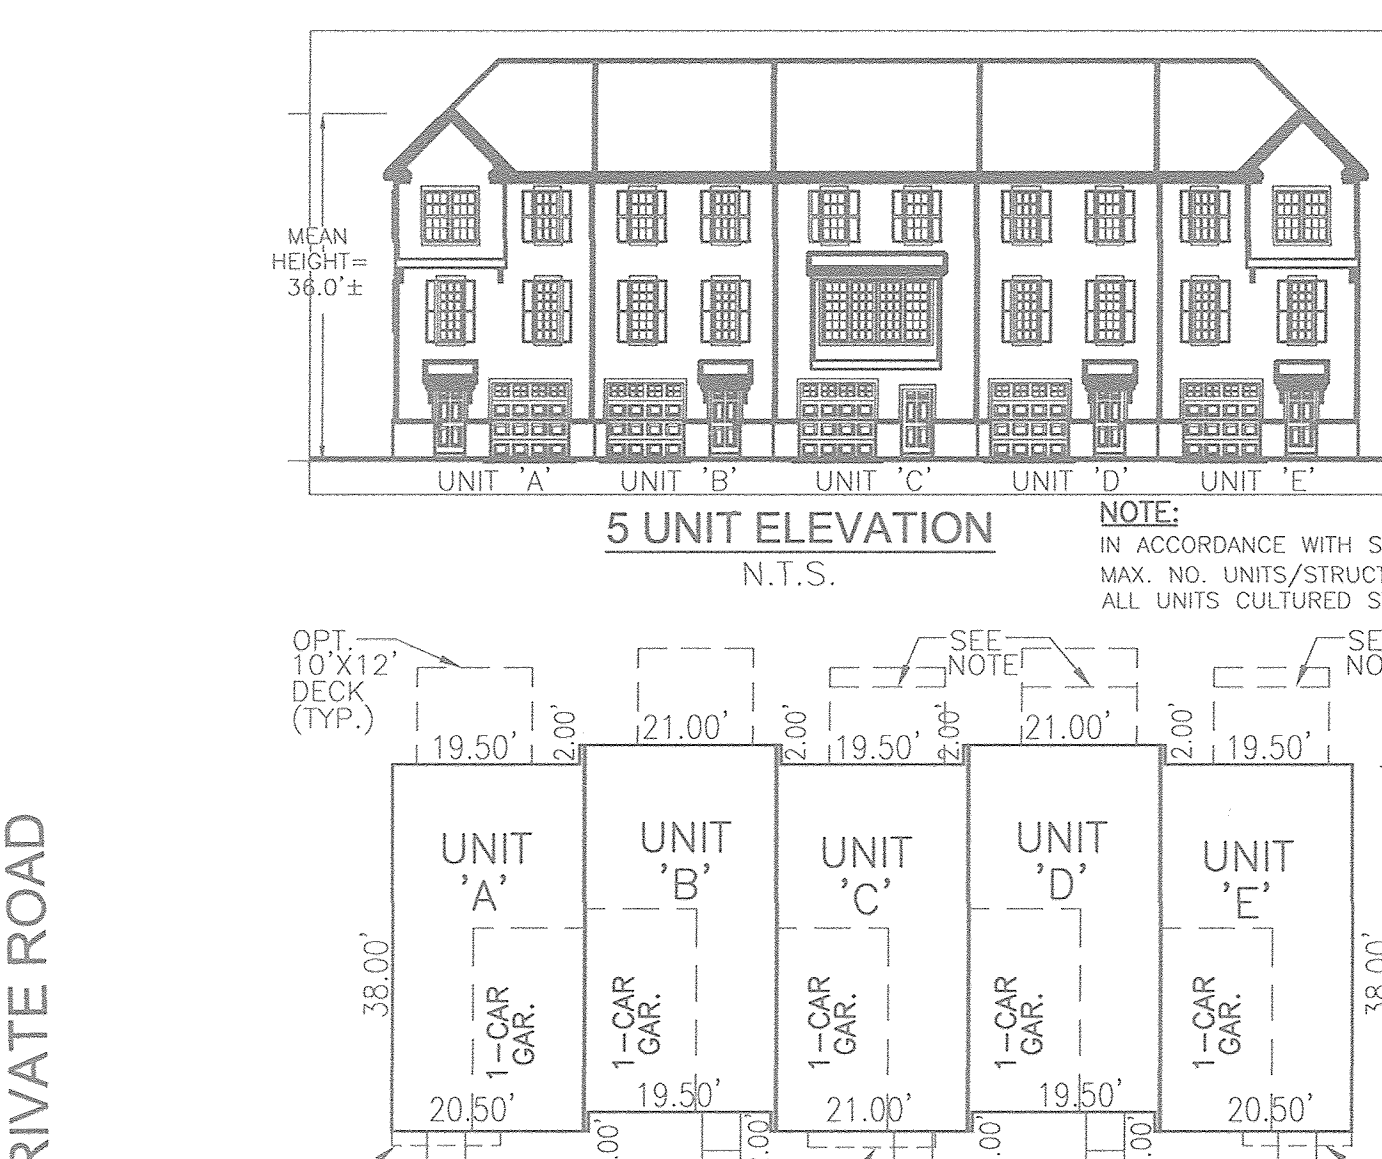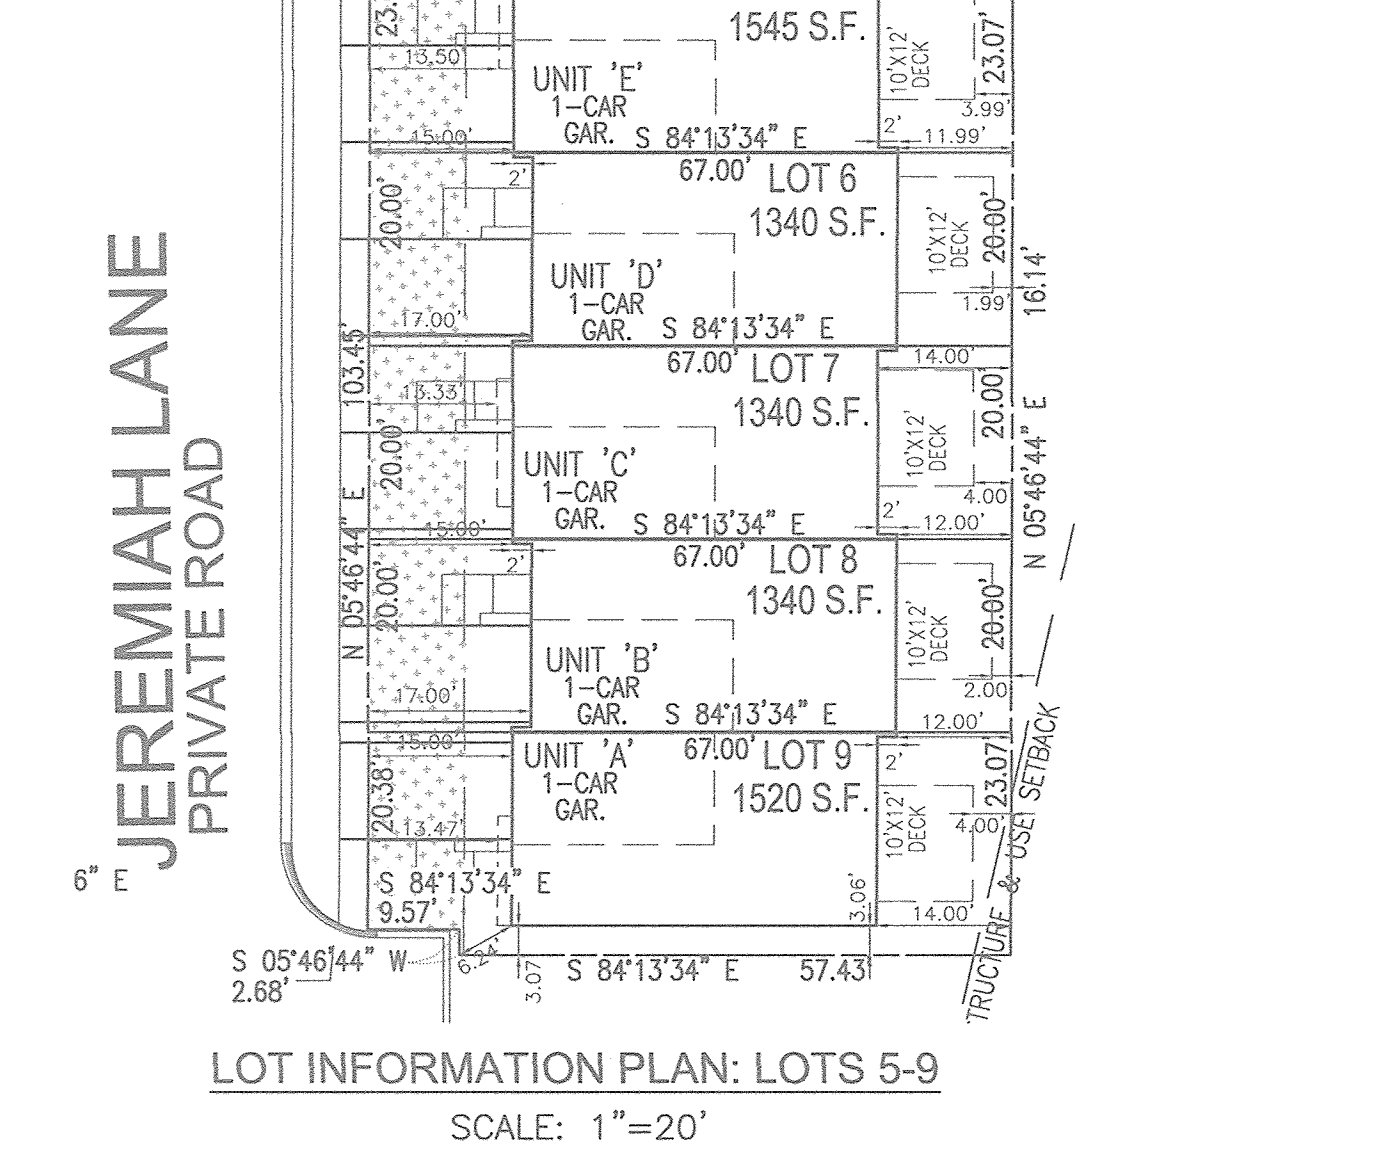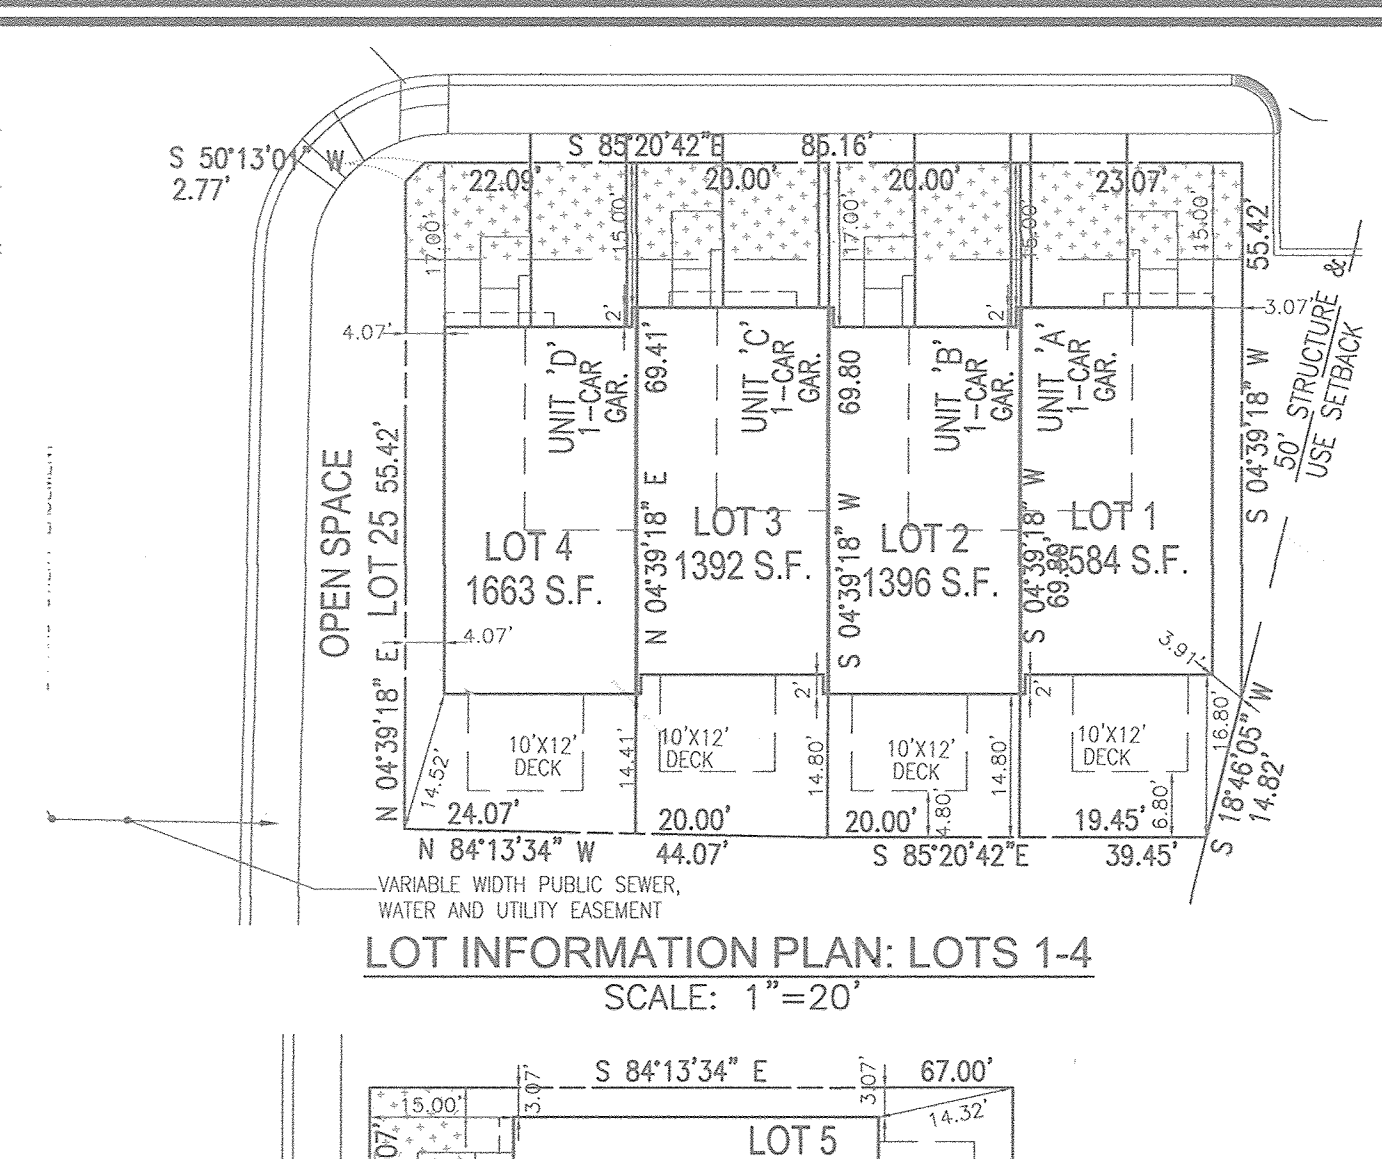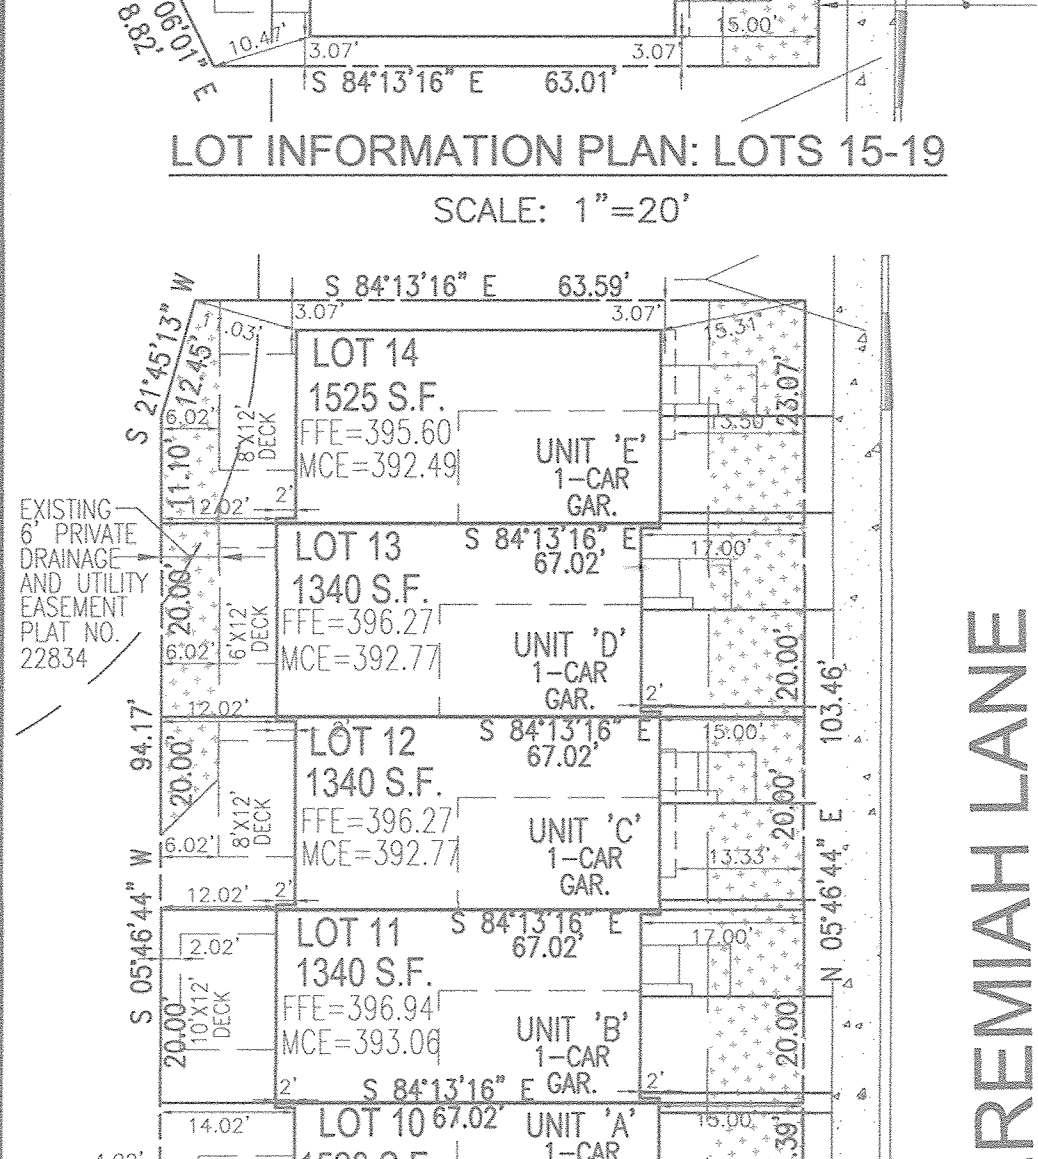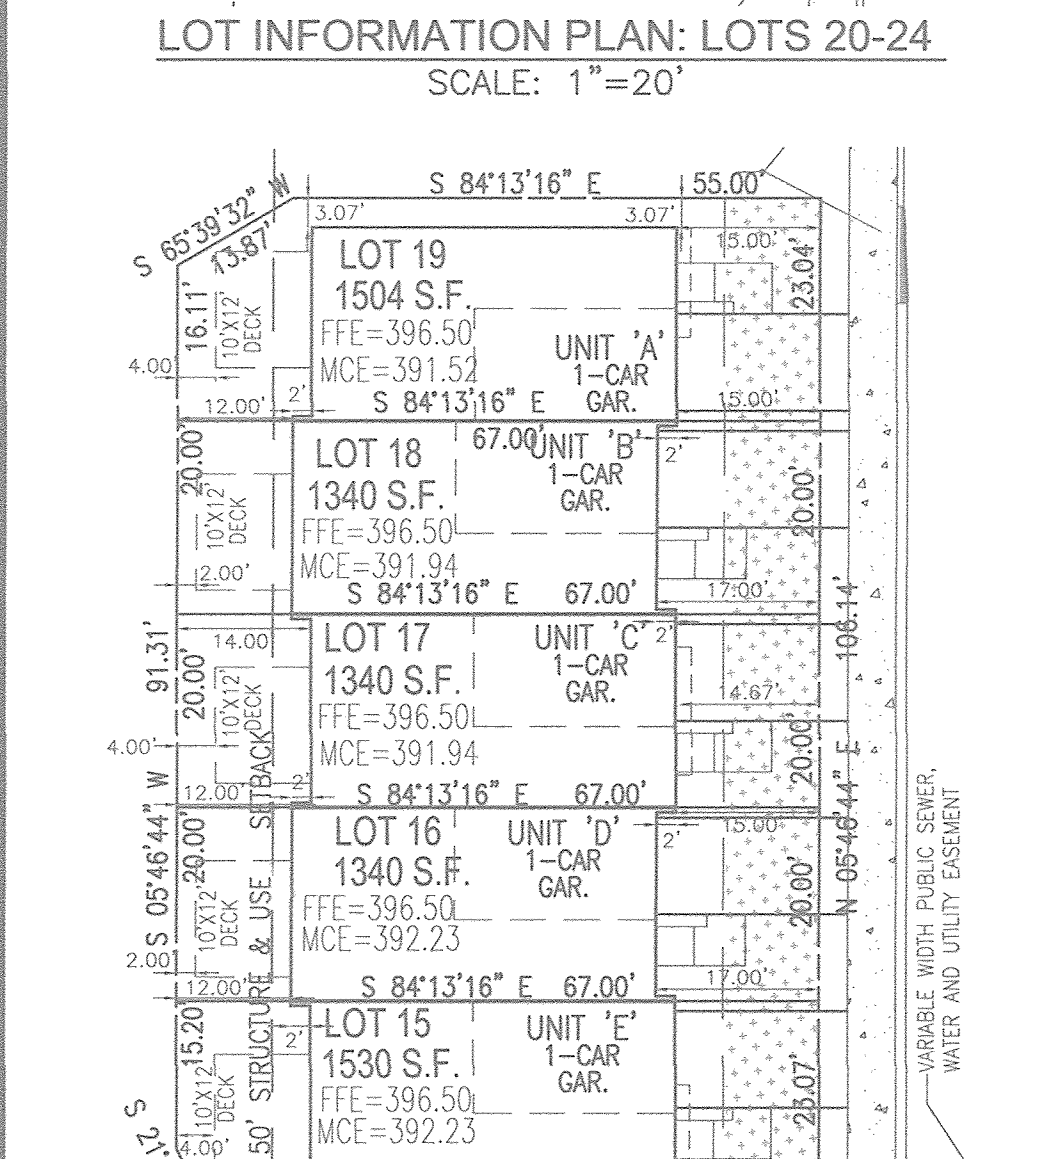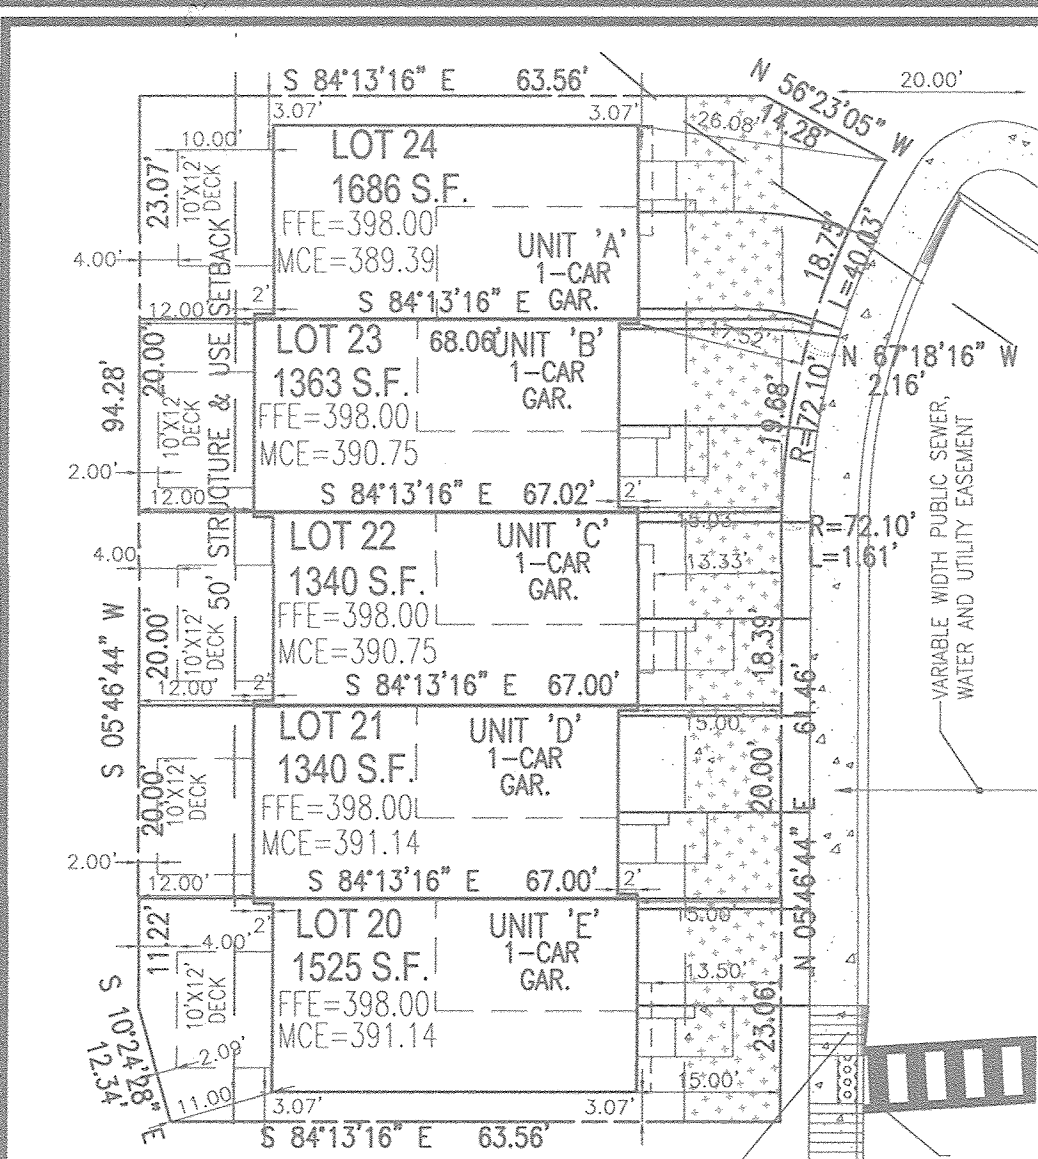

FOREST CONSERVATION EASEMENT COURSE TABLE

LINE	RADIUS	LENGTH	BEARING	LENGTH
L1			S 07°37'35" W	35.00'
L2			S 30°49'41" W	46.36'
L3			N 47°20'35" W	18.24'
L4	65.11'	41.27'	S 47°34'28" W	40.58'
L5			S 68°40'20" E	25.83'
L6			S 51°44'36" E	10.48'
L7			S 34°48'52" E	9.21'
L8			S 08°56'51" W	10.20'
L9			S 48°25'31" W	18.63'
L10			S 84°49'59" W	26.42'
L11			N 81°55'34" W	9.25'
L12			S 08°04'26" W	13.70'

WETLAND LINE TABLE


LINE	BEARING	DISTANCE
W-1	S33°23'01" W	8.95'
W-2	N74°27'04" W	37.07'
W-3	S59°35'33" W	17.16'
W-4	S82°02'21" W	12.14'
W-5	N05°37'34" E	16.80'
W-6	S82°22'25" E	66.42'
W-7	S78°14'15" E	9.30'
W-8	S82°07'36" E	14.08'
W-9	S28°28'51" E	5.04'
W-10	S46°53'45" W	8.49'
W-11	N80°08'47" W	8.77'
W-12	N58°59'18" W	13.37'
W-13	N08°31'27" E	5.73'

LOT COVERAGE MATRIX

LOT NO.	LOT AREA	BASIC BLDG AREA	% BLDG COVERAGE
1	1,584 S.F.	760 S.F.	47.98
2	1,396 S.F.	760 S.F.	54.44
3	1,392 S.F.	760 S.F.	54.60
4	1,663 S.F.	760 S.F.	45.70
5	1,545 S.F.	760 S.F.	49.19
6	1,340 S.F.	760 S.F.	56.72
7	1,340 S.F.	760 S.F.	56.72
8	1,340 S.F.	760 S.F.	56.72
9	1,520 S.F.	760 S.F.	50.00
10	1,520 S.F.	760 S.F.	50.00
11	1,340 S.F.	760 S.F.	56.72
12	1,340 S.F.	760 S.F.	56.72
13	1,340 S.F.	760 S.F.	56.72
14	1,525 S.F.	760 S.F.	49.84
15	1,530 S.F.	760 S.F.	49.67
16	1,340 S.F.	760 S.F.	56.72
17	1,340 S.F.	760 S.F.	56.72
18	1,340 S.F.	760 S.F.	56.72
19	1,504 S.F.	760 S.F.	50.53
20	1,525 S.F.	760 S.F.	49.84
21	1,340 S.F.	760 S.F.	56.72
22	1,340 S.F.	760 S.F.	56.72
23	1,363 S.F.	760 S.F.	55.76
24	1,686 S.F.	760 S.F.	45.08

REVISIONS

NO.	REVISION	DATE
1	REVISE PLAN TO ACCOMMODATE BUILDER HOUSE MODEL	10/28/16
	REVISION	

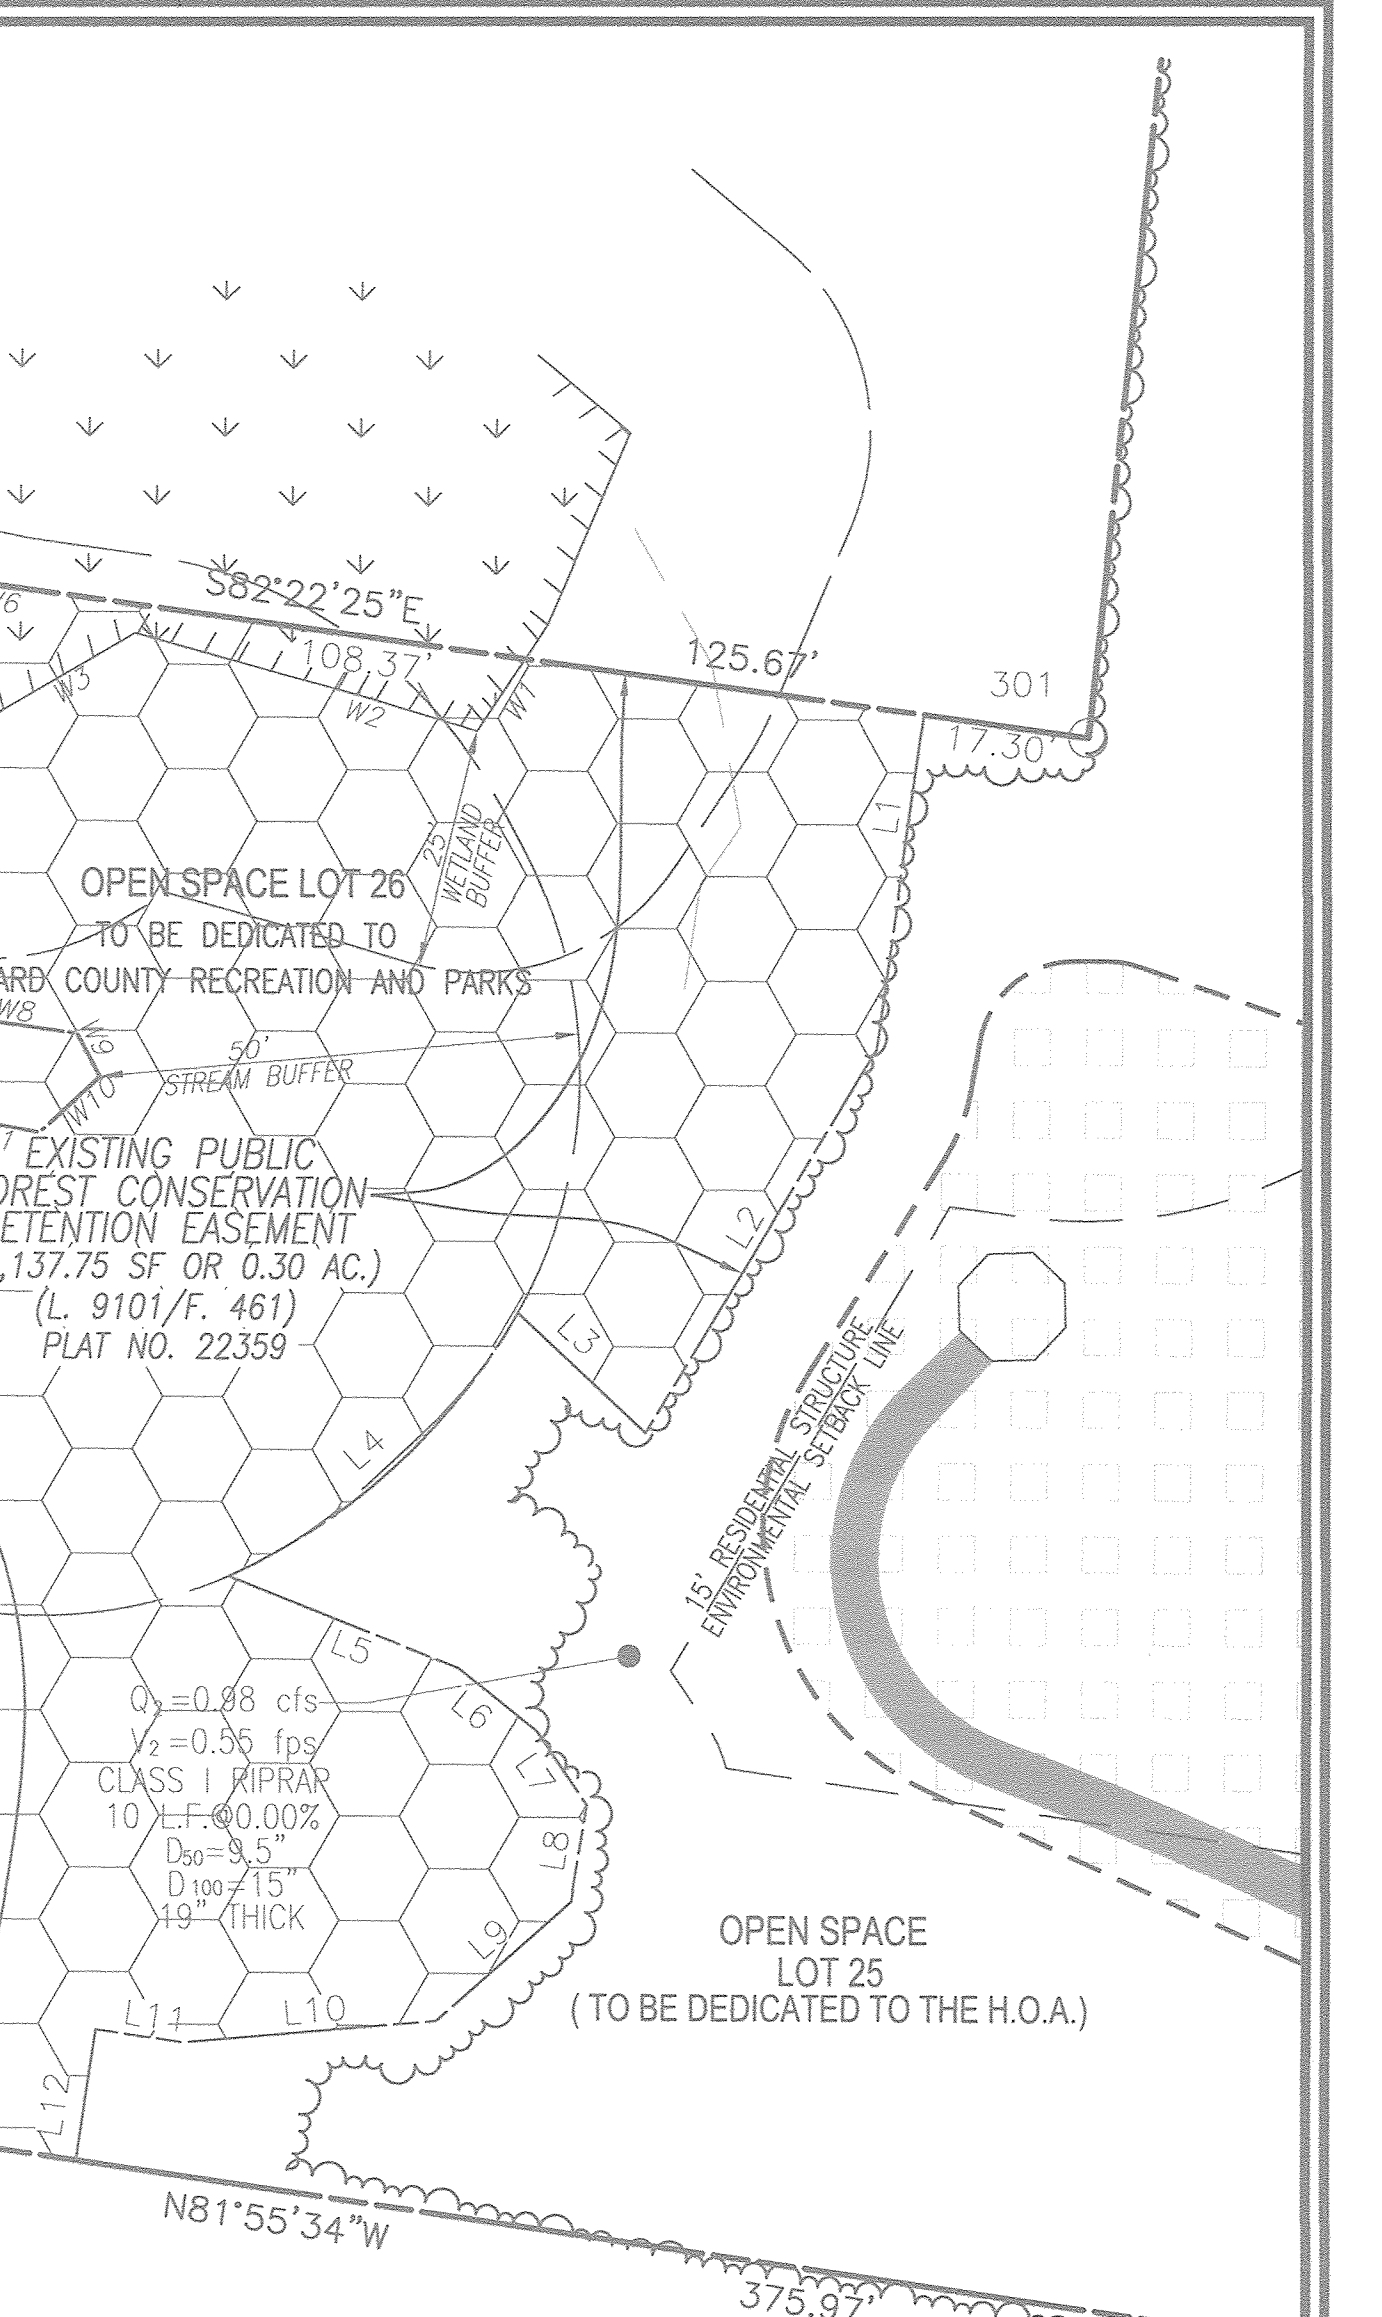

OWNER (PARCEL 256)
TEMPLE BETH SHALOM OF HOWARD COUNTY
8070 HARRIET TUBMAN LANE
COLUMBIA, MD, 21044

OWNER (PARCEL 153)
JOSEPH'S COURTYARD, LLC
3675 PARK AVENUE #301
ELICOTT CITY, MD, 21043
C/O MICHAEL PFUHL
(410) 480-0023

OWNER/DEVELOPER (PARCEL 153)
TRINITY HOMES MARY LAND, LLC.
3675 PARK AVENUE #301
ELICOTT CITY, MD, 21043
C/O MICHAEL PFUHL
(410) 480-0023

ROBERT H. VOGEL ENGINEERING, INC.
ENGINEERS • SURVEYORS • PLANNERS
8407 MAIN STREET
ELICOTT CITY, MD 21043
TEL: 410.461.7666
FAX: 410.461.8961

DESIGN BY: RHW/GAH
DRAWN BY: GAH/KC
CHECKED BY: RHW
DATE: MAY 2016
SCALE: AS SHOWN
W.O. NO.: 05-84

PROFESSIONAL CERTIFICATE
I HEREBY CERTIFY THAT THESE DOCUMENTS WERE PREPARED OR APPROVED BY ME, AND THAT I AM A FULLY LICENSED PROFESSIONAL ENGINEER UNDER THE LAWS OF THE STATE OF MARYLAND, LICENSE NO. 16193, EXPIRATION DATE 05-27-2018.

14 SHEET OF 14

APPROVED: HOWARD COUNTY DEPARTMENT OF PLANNING AND ZONING

[Signature] 11-29-16
CHIEF, DEVELOPMENT ENGINEERING DIVISION

[Signature] 12-05-16
CHIEF, DIVISION OF LAND DEVELOPMENT

[Signature] 12-05-16
DIRECTOR