

SHEET INDEX

NO	DESCRIPTION	NO	DESCRIPTION
1	COVER SHEET	23	SUBMERGED GRAVEL WETLANDS DETAILS
2	OVERALL PLAN	24	UNDERGROUND SWM DETAILS
3	EXISTING CONDITIONS PLAN	25	STORMWATER MANAGEMENT POND 1 DETAILS
4	SITE DEVELOPMENT PLAN	26	STORMWATER MANAGEMENT DETAILS
5	GRADING AND SEDIMENT CONTROL PLAN - PHASE I	27	STORMWATER MANAGEMENT DETAILS
6	GRADING AND SEDIMENT CONTROL PLAN - PHASE I	28	STORMWATER MANAGEMENT DETAILS
7	SEDIMENT CONTROL DETAILS	29	PAVING, STRIPING, AND SIGNAGE PLAN
8	GRADING AND SEDIMENT CONTROL PLAN - PHASE II	30	FOREST CONSERVATION PLAN
9	GRADING AND SEDIMENT CONTROL PLAN - PHASE III	31	FOREST CONSERVATION PLAN, NOTES AND DETAILS
10	SEDIMENT CONTROL NOTES	32	LANDSCAPE PLAN
11	SEDIMENT CONTROL DETAILS	33	LANDSCAPE PLAN
12	SEDIMENT CONTROL DETAILS	34	LANDSCAPE NOTES AND DETAILS
13	SEDIMENT CONTROL DETAILS	35	SOIL BORING LOGS
14	SITE DETAILS	36	SOIL BORING LOGS
15	UTILITY PLAN	37	ARCHITECTURAL ELEVATIONS & RETAINING WALL SECTIONS
16	STORM DRAIN DRAINAGE AREA MAP	38	RETAINING WALL PLAN
17	STORM DRAIN PROFILES AND SCHEDULES	39	RETAINING WALL DETAILS
18	STORM DRAIN PROFILES AND SCHEDULES	40	RETAINING WALL DETAILS
19	PRIVATE UTILITY PROFILES AND SCHEDULES	41	RETAINING WALL NOTES AND SPECIFICATIONS
20	STORMWATER MANAGEMENT PLAN	42	LIGHTING PLAN
21	MICRO-BIORETENTION DETAILS	43	LIGHTING DETAILS
22	STORMWATER MANAGEMENT DETAILS		


GENERAL NOTES

- ALL CONSTRUCTION SHALL BE IN ACCORDANCE WITH THE LATEST STANDARDS AND SPECIFICATIONS OF HOWARD COUNTY PLUS MSHA STANDARDS AND SPECIFICATIONS, IF APPLICABLE.
- THE CONTRACTOR SHALL NOTIFY "MISS UTILITY" AT 1-800-257-7777 AT LEAST 48 HOURS PRIOR TO ANY EXCAVATION WORK BEING DONE.
- ALL PLAN DIMENSIONS ARE TO FACE OF CURB UNLESS OTHERWISE NOTED.
- THE EXISTING TOPOGRAPHY IS PROVIDED BY AN AERIAL SURVEY BY MAPPING RESOURCE GROUP, INC., DATED FEBRUARY 2016, AND HAS BEEN SUPPLEMENTED BY COUNTY GIS INFORMATION.
- THE BOUNDARY SURVEY IS PROVIDED BY AN ALTA TITLE SURVEY BY PENNONI ASSOCIATES, INC., DATED FEBRUARY 2016, AND HAS BEEN SUPPLEMENTED BY COUNTY GIS INFORMATION.
- THE COORDINATES SHOWN HEREON ARE BASED UPON THE HOWARD COUNTY GEODETIC CONTROL WHICH IS BASED UPON THE MARYLAND STATE PLANE COORDINATE SYSTEM NAD 83/91. HOWARD COUNTY MONUMENT NOS. 0043 AND 3808 WERE USED FOR THIS PROJECT.
- WATER IS PUBLIC, CONTRACT 14-4679.
- SEWER IS PUBLIC, CONTRACT 580-S-A.
- APPROXIMATE LOCATION OF EXISTING UTILITIES ARE SHOWN. THE CONTRACTOR SHALL TAKE ALL NECESSARY PRECAUTIONS TO PROTECT THE EXISTING UTILITIES AND MAINTAIN UNINTERRUPTED SERVICE. ANY DAMAGE INCURRED DUE TO CONTRACTOR'S OPERATION SHALL BE REPAIRED IMMEDIATELY AT THE CONTRACTOR'S EXPENSE. EXISTING UTILITIES ARE SHOWN BASED ON THE BEST AVAILABLE INFORMATION.
- THE FLOODPLAIN SHOWN IS FROM A FLOODPLAIN STUDY PERFORMED FOR CAPITAL PROJECT J 4148.
- WETLANDS SHOWN ARE FROM URS MEMORANDUM DATED JULY 27, 2015 TO HOWARD COUNTY DEPARTMENT OF PUBLIC WORKS, AND A SUPPLEMENTAL REPORT PREPARED BY BRAYHILL, LLC DATED MARCH 1, 2016.
- SUBJECT PROPERTY ZONED M-2 PER THE OCTOBER 6, 2013 COMPREHENSIVE ZONING PLAN.
- ALL ELEVATIONS SHOWN ARE BASED NAVD88.
- ALL LIGHTING IS TO BE DIRECTED/REFLECTED DOWNWARD AWAY FROM ADJACENT PUBLIC ROADS AND RESIDENTIALLY ZONED PROPERTIES IN ACCORDANCE WITH SECTION 134.0 OF THE HOWARD COUNTY ZONING REGULATIONS. LIGHT TRESPASS ONTO ANY PROPERTY ZONED R-12 SHALL BE LIMITED TO 0.1 FOOT CANDLES.
- A TRAFFIC STUDY WAS PERFORMED BY TRAFFIC CONCEPTS DATED APRIL 2016, AND WAS APPROVED ON MARCH 9, 2017.
- NO BUILDINGS OR STRUCTURES EXIST ON THE PROPERTY.
- BASED ON AVAILABLE COUNTY MAPS AND RECORDS, THERE ARE NO HISTORIC STRUCTURES OR KNOWN CEMETERIES LOCATED ON THE SUBJECT PROPERTY.
- APPLICABLE DPZ FILE REFERENCES: ECP-16-056, F-16-105, F-17-068.
- NO GRADING, REMOVAL OF VEGETATIVE COVER OR TREES, PAVING AND NEW STRUCTURES SHALL BE PERMITTED WITHIN THE LIMITS OF WETLANDS, STREAMS, OR THEIR REQUIRED BUFFERS, FLOODPLAIN AND FOREST CONSERVATION AREAS, EXCEPT AS SHOWN ON THIS PLAN AS ESSENTIAL DISTURBANCE AND APPROVED BY HOWARD COUNTY AND MDE. ESSENTIAL DISTURBANCES FOR THIS PROJECT INCLUDE THE TEMPORARY DISTURBANCE OF APPROXIMATELY 5,950 FOR THE CONNECTION OF SEWER TO AN EXISTING SEWER MAIN. ADDITIONALLY THE PROJECT WILL ENTAIL THE CROSSING BENEATH A STREAM, FLOODPLAIN, AND WETLAND SYSTEM WITH A SEWER MAIN VIA JACK AND BORE CONSTRUCTION. NO IMPACTS TO THE STREAM, FLOODPLAIN, AND WETLANDS ARE PROPOSED AS THIS CONSTRUCTION WILL PASS UNDERNEATH THE STREAM AND ALL DISTURBANCE WILL BE LOCATED OUTSIDE OF THE FLOODPLAIN LIMITS.
- FOREST CONSERVATION FOR THIS PROJECT HAS BEEN PROVIDED THROUGH THE RETENTION OF 2.67 ACRES OF ON-SITE FOREST AND THE PURCHASE OF CREDITS FOR 2.23 ACRES OF FOREST IN AN OFFSITE BANK. THE BANK IS KNOWN AS SDP-16-029, AFS FARM AND/OR F-13-070 QUARTZ HILL III. THE FOREST CONSERVATION EASEMENT HAS BEEN ESTABLISHED TO FULFILL THE REQUIREMENTS OF SECTION 16.1200 OF THE HOWARD COUNTY CODE AND FOREST CONSERVATION ACT. NO CLEARING, GRADING, OR CONSTRUCTION IS PERMITTED WITHIN THE FOREST CONSERVATION EASEMENT, HOWEVER FOREST MANAGEMENT PRACTICES AS DEFINED IN THE DEED OF FOREST CONSERVATION EASEMENT ARE ALLOWED.
- THIS PLAN HAS BEEN PREPARED IN ACCORDANCE WITH THE PROVISIONS OF SECTION 16.124 OF THE HOWARD COUNTY CODE AND LANDSCAPE MANUAL. LANDSCAPE PLANTINGS FOR 43 SHADE TREES AND 16 EVERGREEN TREES HAVE BEEN PROVIDED UNDER THIS PLAN. A FINANCIAL SURETY IN THE AMOUNT OF \$15,300 MUST BE POSTED WITH THE DEVELOPER AGREEMENT FOR THIS PROJECT.
- STORMWATER MANAGEMENT FOR THIS PROJECT WILL BE PROVIDED BY THREE (3) MICRO-BIORETENTION FACILITIES, A GRASS SWALE, A SUBMERGED GRAVEL WETLAND, A DRY EXTENDED DETENTION POND, AND AN UNDERGROUND SWM FACILITY. SWM FACILITIES WILL HANDLE 10 AND 100 YEAR STORM EVENTS. ALL SWM DEVICES WILL BE PRIVATELY OWNED AND MAINTAINED.
- A NOISE STUDY IS NOT REQUIRED FOR THIS PROJECT.
- A GEOTECHNICAL REPORT WAS PREPARED FOR THIS PROJECT BY PENNONI ASSOCIATED DATED JANUARY 2017.
- A FOREST STAND DELINEATION FOR THIS PROPERTY WAS COMPLETED BY PENNONI ASSOCIATES, INC. AND APPROVED ON SEPTEMBER 2, 2016.
- THE CONTRACTOR SHALL TEST PIT EXISTING UTILITIES AT LEAST (5) DAYS BEFORE STARTING WORK SHOWN ON THESE DRAWINGS.
- CONTRACTOR IS SOLELY RESPONSIBLE FOR CONSTRUCTION MEANS, METHODS, TECHNIQUES, SEQUENCES, PROCEDURES, AND SAFETY PRECAUTIONS AND PROGRAMS. THE CONTRACTOR SHALL FOLLOW THE SEQUENCE OF CONSTRUCTION OUTLINED IN THESE PLANS.
- PIPE SHALL NOT BE INSTALLED BY THE CONTRACTOR UNTIL THE LENGTH CALLED FOR AT EACH STATION HAS BEEN APPROVED BY THE ENGINEER IN THE FIELD.

SITE DEVELOPMENT PLAN

TERRAPIN COMMERCE CENTER - BUILDING A

DORSEY RUN ROAD 1ST ELECTION DISTRICT HOWARD COUNTY, MARYLAND

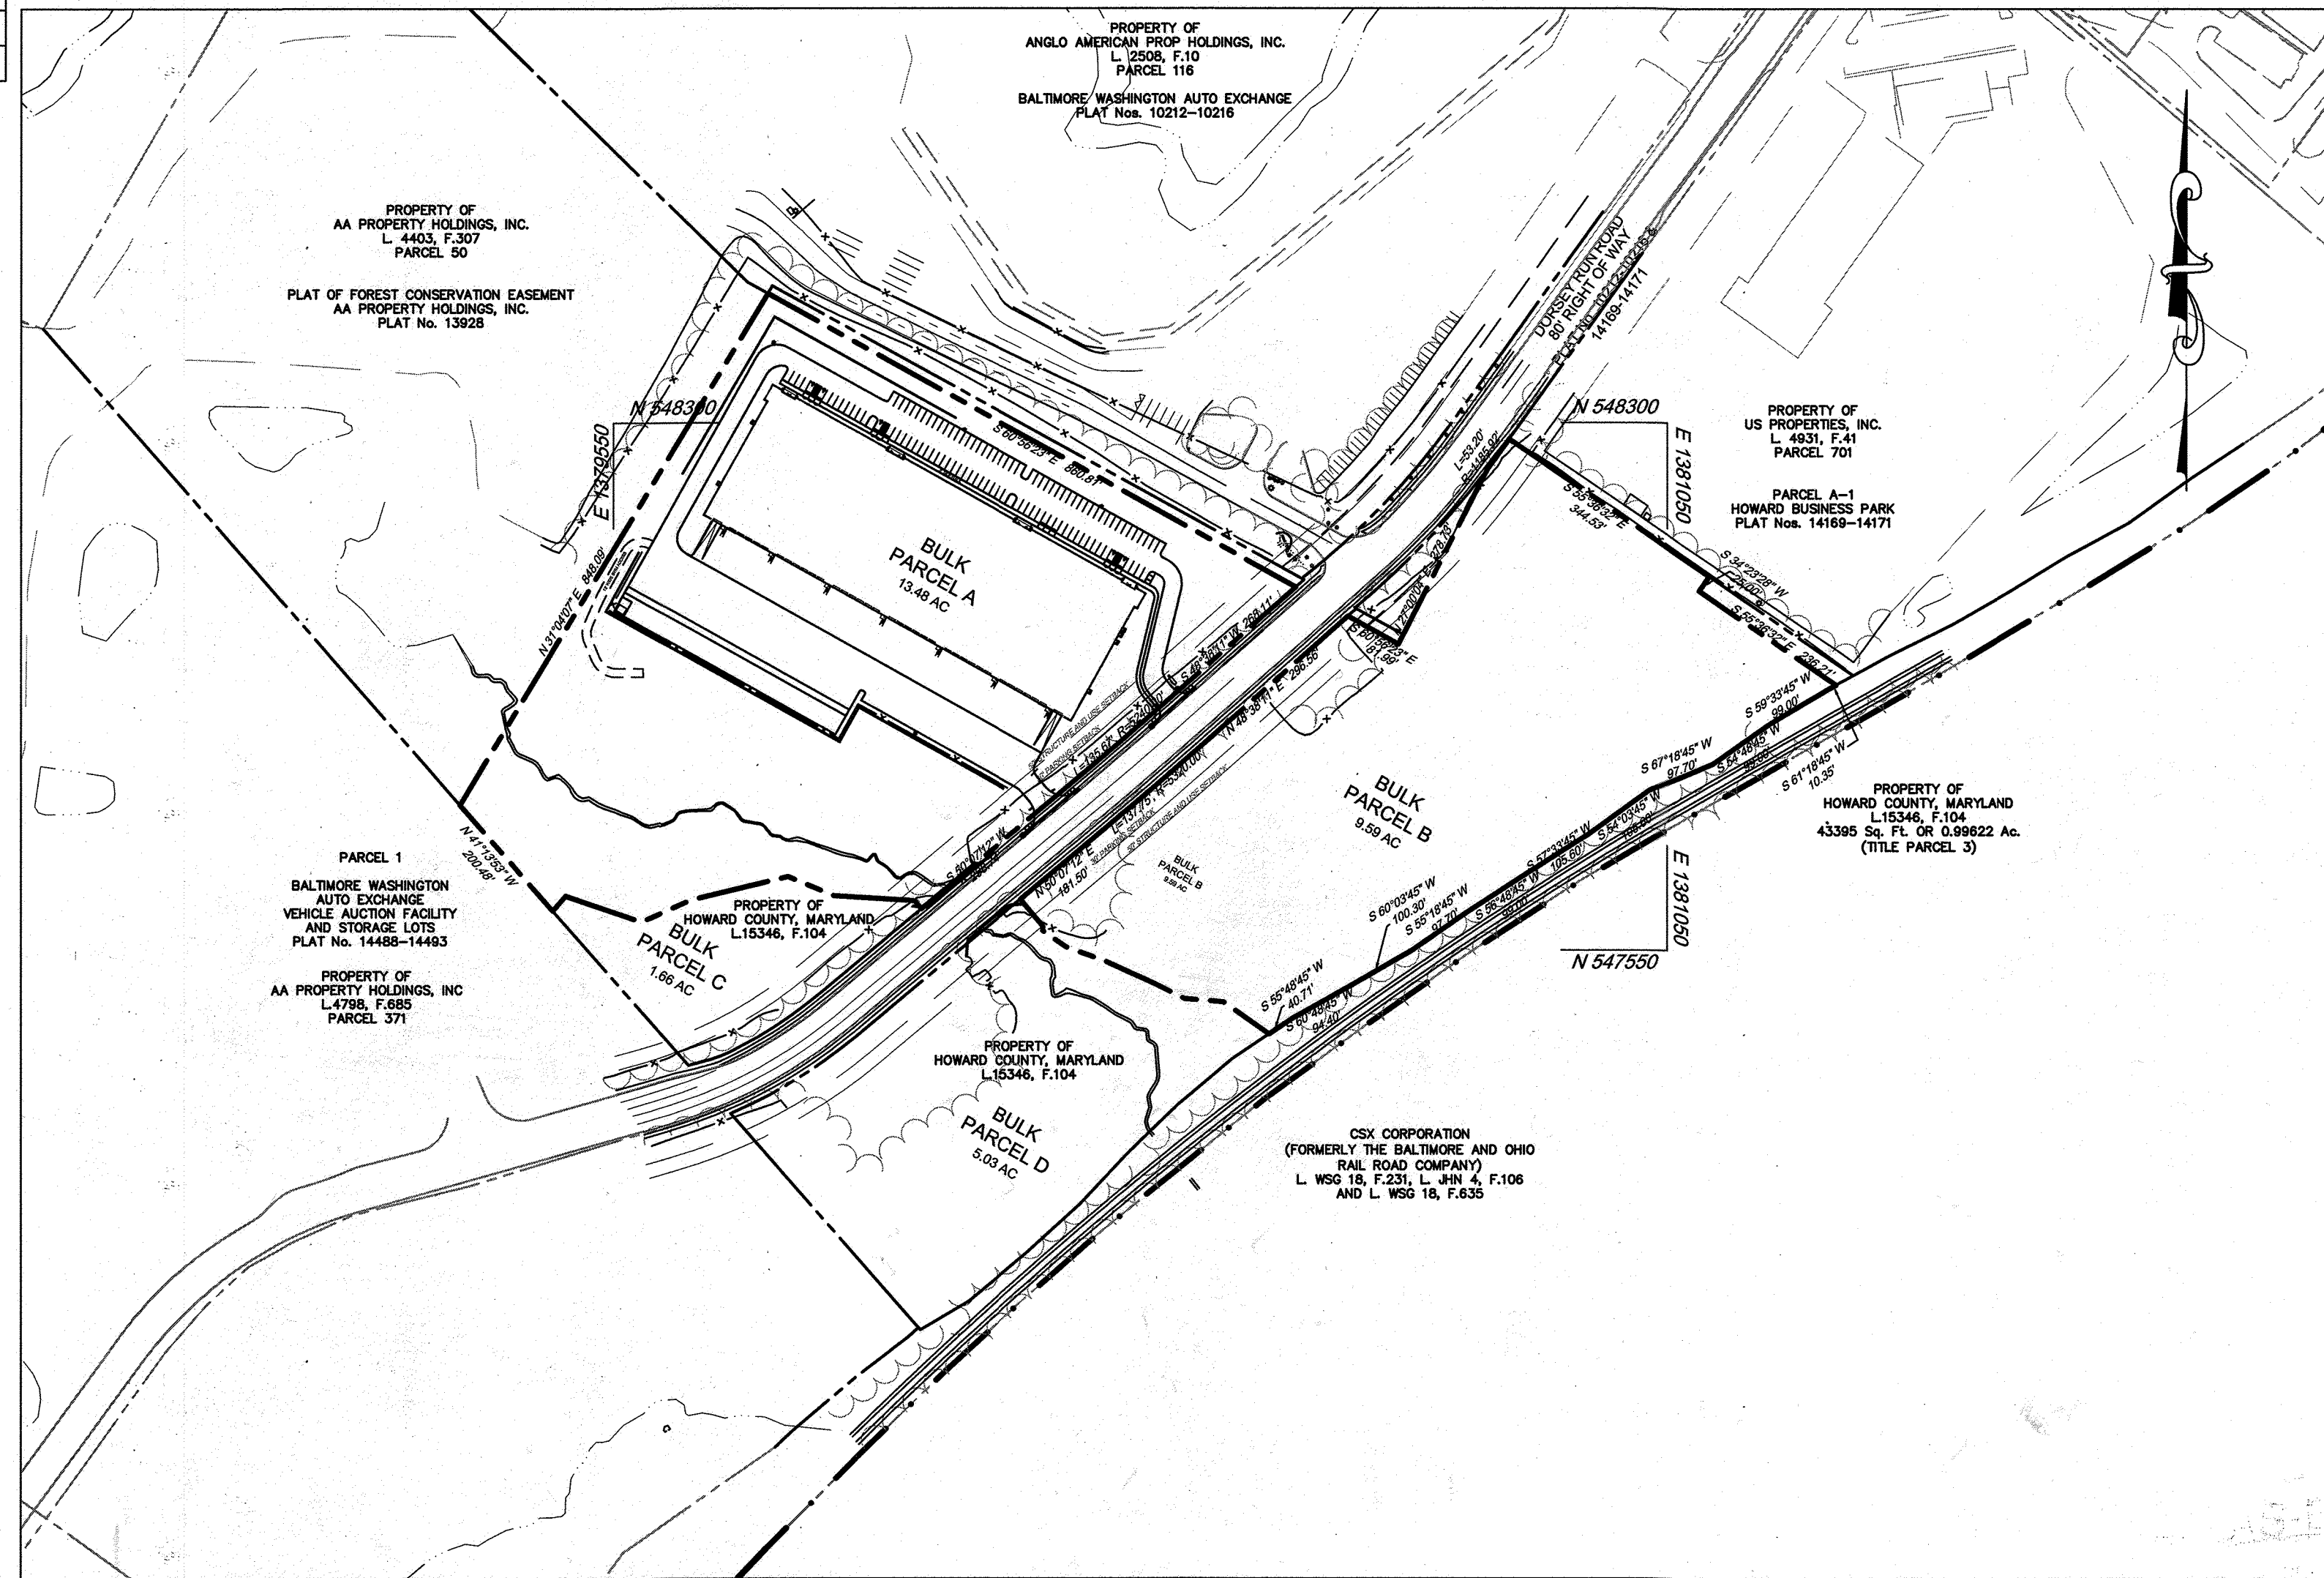

LOCATION PLAN

SCALE: 1" = 200'



- NO PIPE SHALL BE LAID UNLESS LINES OF EXCAVATION HAVE BEEN BROUGHT WITHIN 6" OF FINISHED GRADE.
- ALL PIPE ELEVATIONS SHOWN ARE INVERT ELEVATIONS.
- PROFILE STATIONS SHALL BE ADJUSTED AS NECESSARY TO CONFORM TO PLAN DIMENSIONS.
- ALL FILL AREAS WITHIN ROADWAY AND UNDER STRUCTURES TO BE COMPACTED TO A MINIMUM OF 95% COMPACTION OF AASHTO T180.
- AN ACCESSIBLE ROUTE SHALL BE PROVIDED BETWEEN HANDICAPPED PARKING OR PUBLIC RIGHT OF WAYS TO THE MAIN BUILDING ENTRANCE IN ACCORDANCE WITH CURRENT ADA AND LOCAL STANDARDS. ALL HANDICAPPED RAMPS SHALL BE CONSTRUCTED ACCORDING TO CURRENT ADA AND LOCAL STANDARDS. EXCEPT AS SUPERSEDED IN CURRENT ADA AND LOCAL STANDARDS THE FOLLOWING SHALL APPLY:
 - MAXIMUM SIDEWALK CROSS SLOPES SHALL BE 2%.
 - A MINIMUM 5'x5' LANDING AREA WITH A MAXIMUM SLOPE IN ANY DIRECTION OF 2% SHALL BE PROVIDED AT ALL CHANGES IN DIRECTION, TOPS AND BOTTOMS OF RAMPS, AND BUILDING EGRESS POINTS.
 - ALL HANDICAPPED PARKING SHALL BE SLOPED NO GREATER THAN 2% IN ANY DIRECTION, INCLUDING A 5' WIDE AREA BEHIND THE PARKING SPACES.
 - AN ACCESS ROUTE FROM THE PARKING SPACE(S) TO THE MAIN BUILDING ENTRANCE SHALL BE PROVIDED. ALL SLOPES ALONG THE DIRECTION OF TRAVEL SHALL NOT EXCEED 1:20 UNLESS THEY FALL UNDER CONDITION B) ABOVE. SLOPES IN EXCESS OF 1:20 EXCEPT FOR CURB RAMPS, REQUIRE A HANDRAIL MEETING ADA REQUIREMENTS. SEE SHEET 38 FOR DETAIL OF HANDICAPPED PARKING.
- THIS PROJECT IS SUBJECT TO COMPLIANCE WITH THE AMENDED FIFTH EDITION OF THE SUBDIVISION AND LAND DEVELOPMENT REGULATIONS. DEVELOPMENT OR CONSTRUCTION ON THIS PROPERTY MUST COMPLY WITH SETBACK AND BUFFER REGULATIONS IN EFFECT AT THE TIME OF SUBMISSION OF THE SITE DEVELOPMENT PLAN, WAIVER PETITION APPLICATION OR BUILDING/GRADING PERMIT APPLICATIONS.

- THE FOLLOWING DESIGN MANUAL WAIVERS HAVE BEEN APPROVED FOR THIS PROJECT:
 - CONSTRUCTION OF A RETAINING WALL IN FILL - WAIVER FROM SECTION 3.4.A.2.a OF THE HOWARD COUNTY DESIGN MANUAL VOLUME III, APPROVED ON FEBRUARY 16, 2017
 - USE OF ALTERNATE INSTALLATION TECHNOLOGY FOR SEWER MAIN INSTALLATION - SECTION 5.14 OF THE HOWARD COUNTY DESIGN MANUAL VOLUME II, APPROVED ON FEBRUARY 23, 2017
 - USE OF STOPPING SIGHT DISTANCE IN LIEU OF INTERSECTION SIGHT DISTANCE - SECTION 2.5.9 OF THE HOWARD COUNTY DESIGN MANUAL VOLUME III, APPROVED ON MAY 26, 2017.
 - REDUCTION OF INTERSECTION SPACING - SECTION 2.6.D OF THE HOWARD COUNTY DESIGN MANUAL VOLUME III, APPROVED ON MAY 26, 2017. INTERSECTION SPACING WAS REDUCED FROM 250' TO 198'.
- A PERMIT HAS BEEN ISSUED BY THE ARMY CORPS OF ENGINEERS (PERMIT # 2016-62029-M39) AND THE MARYLAND DEPARTMENT OF THE ENVIRONMENT (PERMIT # 201662029/16-NI-3361) FOR DISTURBANCE IN THE FLOODPLAIN ASSOCIATED WITH THE SEWER MAIN EXTENSION.

AS-BUILT CERTIFICATION

I HEREBY CERTIFY BY MY SEAL THAT THE FACILITY SHOWN ON THIS PLAN WERE CONSTRUCTED AS SHOWN ON THE "AS-BUILT" PLANS MEETS THE APPROVED PLANS AND SPECIFICATIONS.

Sharon K. Cruz 3/6/2016
 PRINTED NAME MID. P.E. NO.
 SIGNATURE DATE

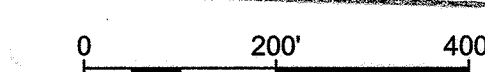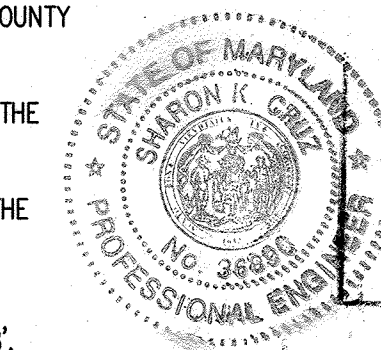


ADDRESS CHART

PARCEL NUMBER	STREET ADDRESS
51	7200 DORSEY RUN ROAD

SUBDIVISION NAME	SECT./AREA	PARCEL BUILDABLE BULK
PARCEL 'A'	-	PARCEL 'A'
PLAT NO. OR L.F.	GRID #	ZONING
24363 - 24366	11	M-2
TAX MAP NO.	43	ELECT. DIST.
		1
		CENSUS TRACT
		601203

SITE ANALYSIS DATA

AREA OF SITE: 13.48 ACRES (587,102 SF)
 LIMIT OF DISTURBANCE: 11.26 ACRES (490,340 SF)
 PRESENT ZONING: M-2 (INDUSTRIAL)
 EXISTING USE: VACANT, WOODED LOT
 PROPOSED USE: WAREHOUSE
 EXISTING FLOOR AREA: 0 SF
 PROPOSED FLOOR AREA: ±126,000 SF
 MAXIMUM # OF EMPLOYEES: UNKNOWN AT THIS TIME
 PARKING REQUIRED: 95 SPACES (0.75 SPACES/1,000 SF)
 PARKING PROPOSED: 108 SPACES
 AREA OF WETLANDS: 2.59 ACRES (104,236 SF)
 AREA OF WETLAND BUFFERS: 0.76 ACRES (33,197 SF)
 AREA OF FLOODPLAIN: 0.58 ACRES (25,229 SF)
 EXISTING FOREST AREA: 12.70 ACRES (553,041 SF)
 AREA OF FOREST WITHIN LOD: 10.80 ACRES (470,485 SF)
 AREA OF STEEP SLOPES:
 15%-25%: ±0.00 ACRES (±00,000 SF)
 25%+: ±0.00 ACRES (±00,000 SF)
 AREA OF ERODIBLE SOILS: ±0.00 ACRES (±0 SF)
 IMPERVIOUS AREA:
 EXISTING: ±0.00 SF
 PROPOSED: ±280,860 SF
 ZONE M-2 SETBACKS:
 FROM EXTERNAL PUBLIC STREET RIGHT-OF-WAY: 50 FEET
 PARKING USES FROM EXTERNAL PUBLIC STREET RIGHT-OF-WAY: 30 FEET
 FROM INTERNAL PUBLIC STREET RIGHT-OF-WAY: 50 FEET
 PARKING USES FROM INTERNAL PUBLIC STREET RIGHT-OF-WAY: 10 FEET
 FROM ANY RESIDENTIAL DISTRICT: 150 FEET
 FROM RESIDENTIAL USES IN A CAC OR TOD DISTRICT: 100 FEET
 ZONE M-2 BUILDING HEIGHT:
 STRUCTURE WITH MINIMUM SETBACK: 50 FEET
 STRUCTURE WITH AN ADDITIONAL 1 FOOT IN HEIGHT FOR EVERY 2 FEET OF SETBACK ABOVE THE MINIMUM: 100 FEET
 BUILDING HEIGHT PROPOSED: 38'

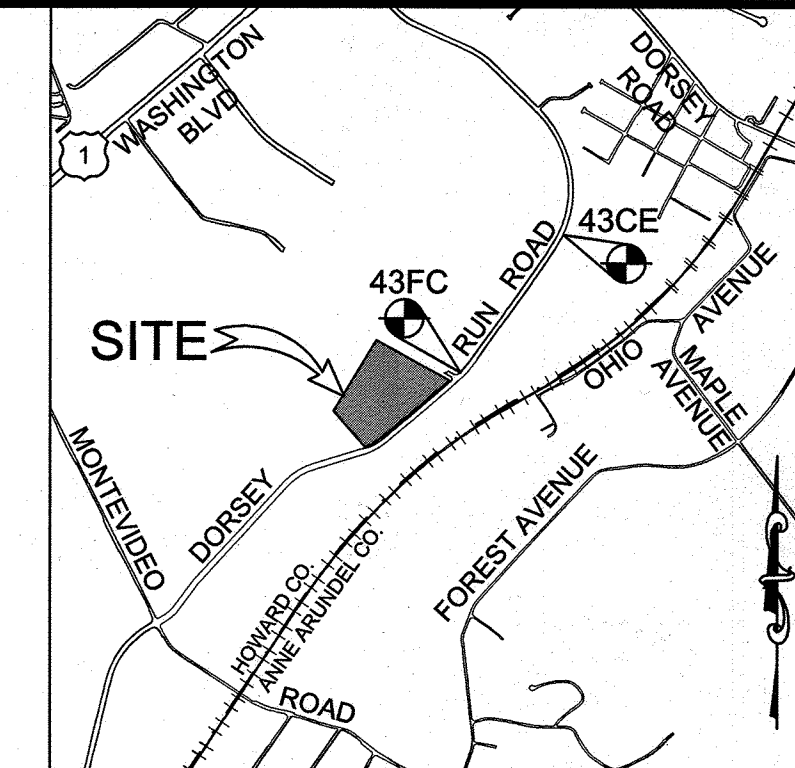

VICINITY MAP
 SCALE: 1" = 2,000'
 HOWARD COUNTY
 ADC MAP 35 GRID A7
 ADC MAP USE LICENSE #3652

BENCHMARKS
 HOWARD COUNTY SURVEY CONTROL: 43CE
 ELEVATION 199.143
 N 549,595.935 E 1,381,719.608
 LOCATION IS 9' FROM FACE OF CURB ALONG DORSEY RUN ROAD.
 HOWARD COUNTY SURVEY CONTROL: 43FC
 ELEVATION 157.533
 N 548,199.445 E 1,380,681.244
 LOCATION IS 3.1' FROM FACE OF CURB ALONG DORSEY RUN ROAD.

APPROVED: DEPARTMENT OF PLANNING AND ZONING

Sharon K. Cruz 9-21-17
 CHIEF, DEVELOPMENT ENGINEERING DIVISION DATE

Vest Redwood 9-27-17
 CHIEF, DIVISION OF LAND DEVELOPMENT DATE

Nickie J. J. 10-2-17
 DIRECTOR DATE

1920/23 Parking Lot Improvements BH

DATE	NO.	REVISION	BY

DEVELOPER: DCT INDUSTRIAL
 12011 GUILFORD ROAD
 SUITE 102
 ANNAPOLIS JUNCTION, MD 20701
 ATTN: FRED FERRARO
 PHONE: 410-645-5020

OWNER: DCT MEARS LLC
 12011 GUILFORD ROAD
 SUITE 102
 ANNAPOLIS JUNCTION, MD 20701
 ATTN: FRED FERRARO
 PHONE: 410-645-5020

PROJECT: TERRAPIN COMMERCE CENTER


AREA: TAX MAP 43, PARCEL 51 LOT PAR A PLAT 23793 ZONED M-2
 GRID NO. 11 1st ELECTION DISTRICT
 7200 DORSEY RUN ROAD
 ELK RIDGE, MARYLAND 21075
 HOWARD COUNTY, MARYLAND

TITLE: COVER SHEET

Pennonni Associates Inc.
 Engineers - Surveyors - Planners
 Landscape Architects


8818 Centre Park Drive, Suite 200 Columbia, MD 21045
 T 410.997.8900 F 410.997.9282

DESIGNED BY: PJS
 DRAWN BY: AGS/JSN
 PROJECT NO: DCT11601
 DATE: JUNE 23, 2017
 SCALE: 1" = 200'
 DRAWING NO. 1 OF 43

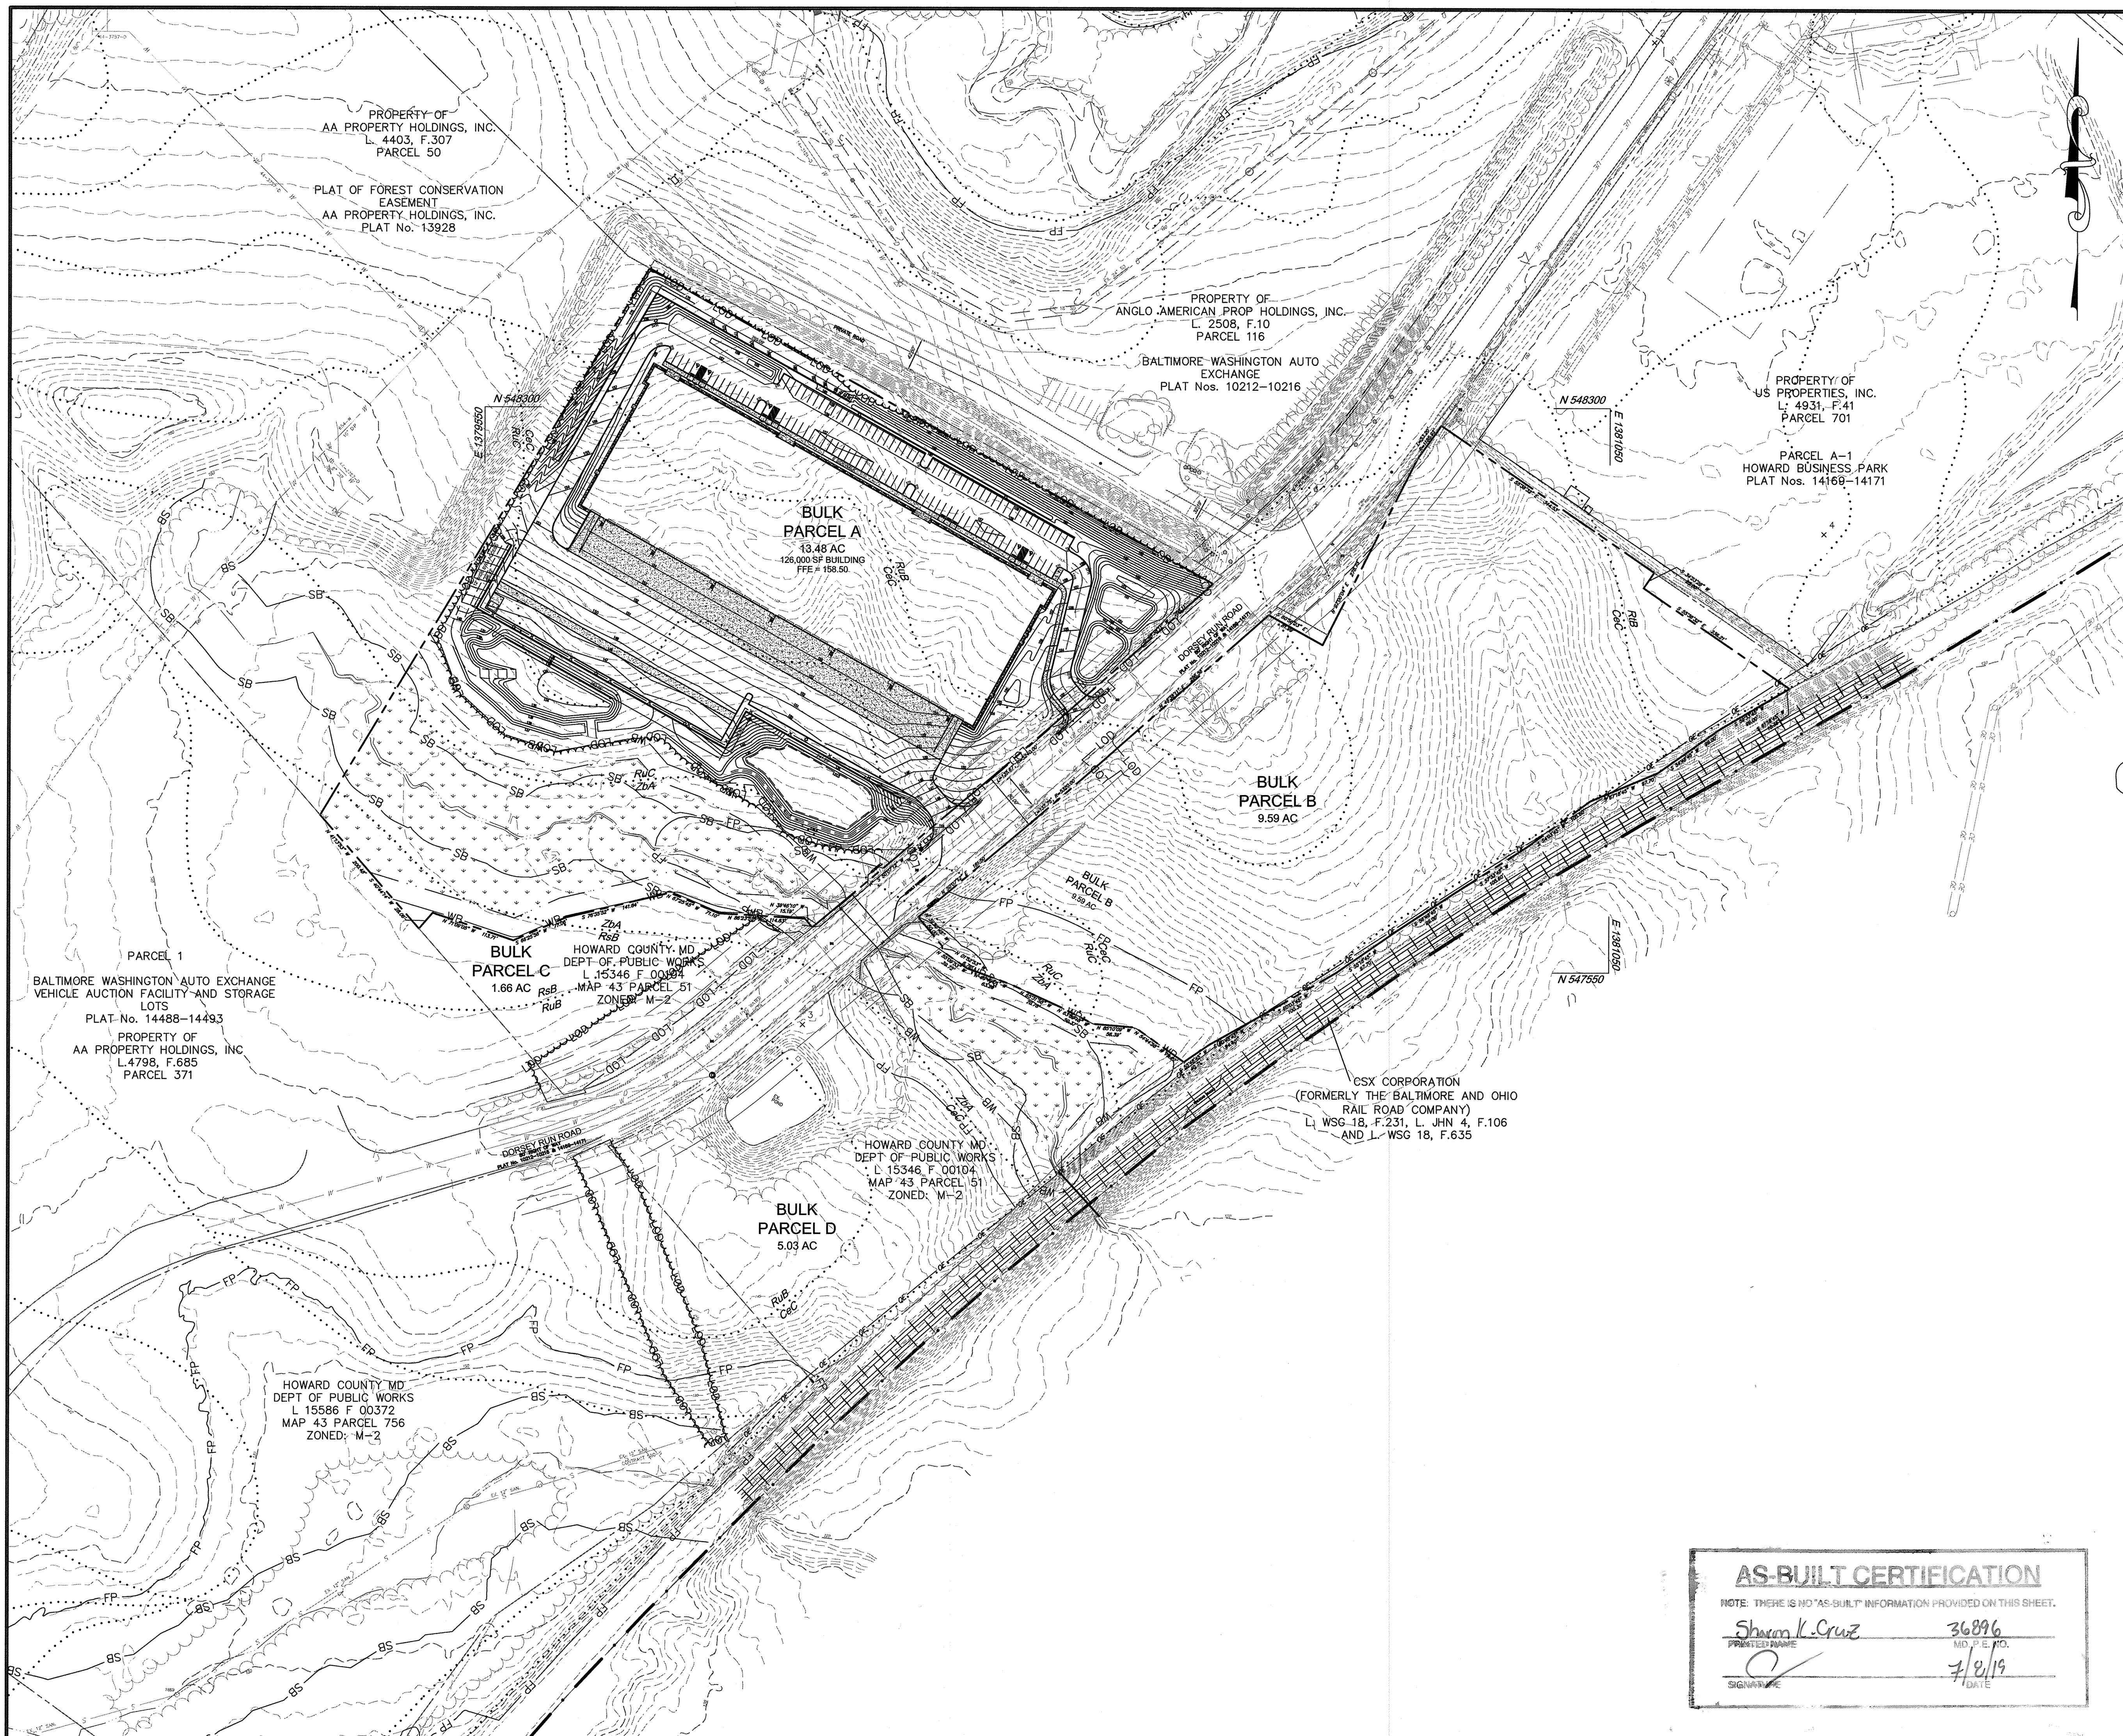

LEGEND

PROPERTY LINE AND RIGHT-OF-WAY	
EXISTING BUILDING	
EXISTING 1' CONTOUR	
EXISTING 5' CONTOUR	
EXISTING TREE LINE	
EXISTING SOILS	
EXISTING WATER	
EXISTING SEWER	
EXISTING OVERHEAD ELECTRICAL	
EXISTING UNDERGROUND ELECTRICAL	
EXISTING STORM DRAIN	
EXISTING STREAM	
EXISTING FLOODPLAIN	
EXISTING WETLANDS	
EXISTING WETLAND BUFFER	
PROPOSED 1' CONTOUR	
PROPOSED 5' CONTOUR	
PROP. CONCRETE SIDEWALK	

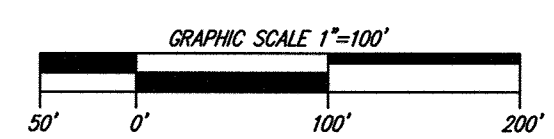

APPROVED : DEPARTMENT OF PLANNING AND ZONING

	9.21.17
CHIEF, DEVELOPMENT ENGINEERING DIVISION	DATE
	9.27.17
CHIEF, DIVISION OF LAND DEVELOPMENT	DATE
	10-2-17
DIRECTOR	DATE

DATE	NO.	REVISION	BY
DEVELOPER			
DCT INDUSTRIAL 12011 GUILFORD ROAD SUITE 102 ANNAPOLIS JUNCTION, MD. 20701 ATTN: FRED FERRARO PHONE: 410-645-5020			
OWNER			
DCT MEARS LLC 12011 GUILFORD ROAD SUITE 102 ANNAPOLIS JUNCTION, MD. 20701 ATTN: FRED FERRARO PHONE: 410-645-5020			
PROJECT			
TERRAPIN COMMERCE CENTER			
AREA			
TAX MAP 43, PARCEL 51 LOT PAR A PLAT 23793 ZONED M-2 GRID NO. 11 1st ELECTION DISTRICT 7200 DORSEY RUN ROAD ELKRIDGE, MARYLAND 21075 HOWARD COUNTY, MARYLAND			
TITLE			
OVERALL PLAN			

Pennoni Associates Inc.
Engineers • Surveyors • Planners
Landscape Architects

8818 Centre Park Drive, Suite 200 Columbia, MD 21045
T 410.997.8900 F 410.997.9282


AS-BUILT CERTIFICATION

NOTE: THERE IS NO "AS-BUILT" INFORMATION PROVIDED ON THIS SHEET.

36896
PRINTED NAME MD. P.E. NO.
 7/8/19
SIGNATURE DATE


SEAL

	DESIGNED BY : PJS
	DRAWN BY : AGS/JSN
	PROJECT NO : DCT1601
	DATE : JUNE 23, 2017
	SCALE : 1" = 100'
	DRAWING NO. 2 OF 43

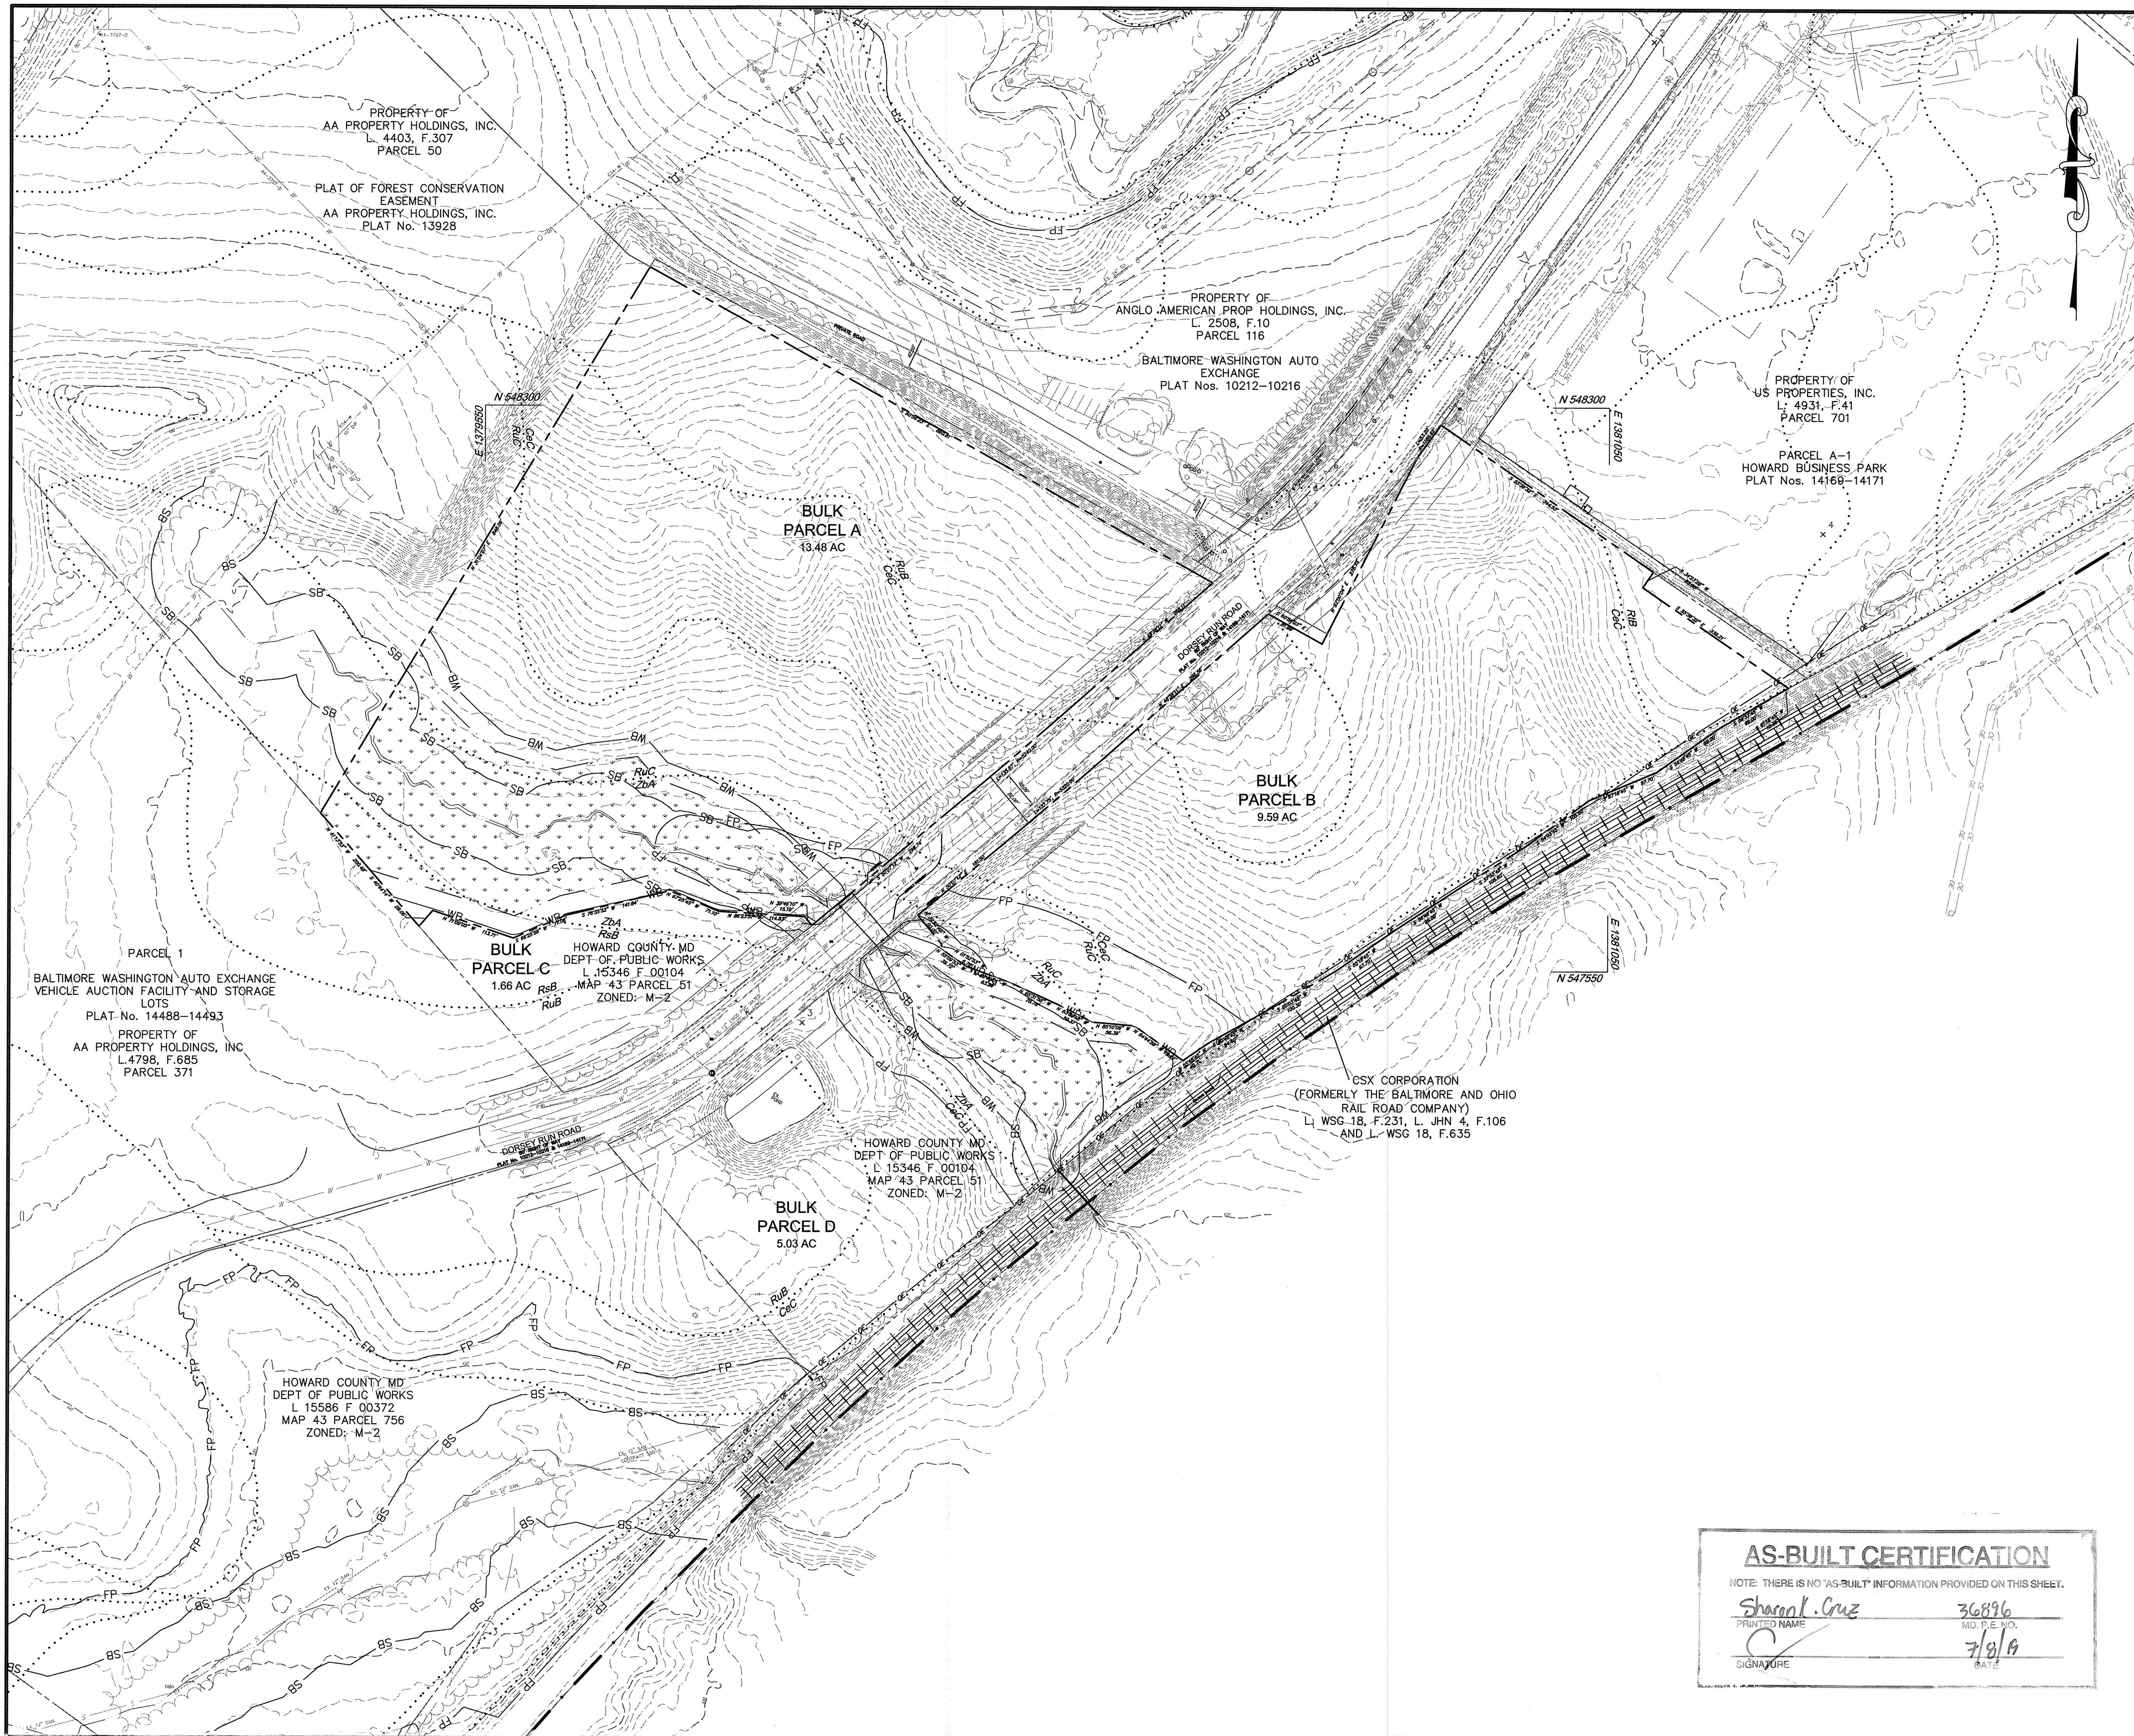

LEGEND

- PROPERTY LINE AND RIGHT-OF-WAY
- EXISTING BUILDING
- EXISTING 1' CONTOUR
- EXISTING 5' CONTOUR
- EXISTING TREE LINE
- EXISTING SOILS
- EXISTING WATER
- EXISTING SEWER
- EXISTING OVERHEAD ELECTRICAL
- EXISTING UNDERGROUND ELECTRICAL
- EXISTING STORM DRAIN
- EXISTING STREAM
- EXISTING STREAM BUFFER
- EXISTING FLOODPLAIN
- EXISTING WETLANDS
- EXISTING WETLAND BUFFER
- EXISTING RAILROAD TRACKS

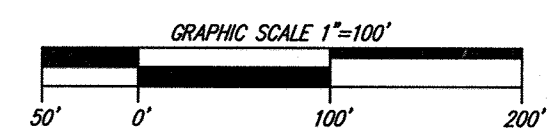

APPROVED : DEPARTMENT OF PLANNING AND ZONING

	9-21-17
CHIEF, DEVELOPMENT ENGINEERING DIVISION	DATE
	9-27-17
CHIEF, DIVISION OF LAND DEVELOPMENT	DATE
	10-2-17
DIRECTOR	DATE

DATE	NO.	REVISION	BY
DEVELOPER			
DCT INDUSTRIAL 12011 GUILFORD ROAD SUITE 102 ANNAPOLIS JUNCTION, MD 20701 ATTN: FRED FERRARO PHONE: 410-645-5020			

OWNER	DCT MEARS LLC 12011 GUILFORD ROAD SUITE 102 ANNAPOLIS JUNCTION, MD 20701 ATTN: FRED FERRARO PHONE: 410-645-5020
-------	--

PROJECT	TERRAPIN COMMERCE CENTER
---------	--------------------------

AREA	TAX MAP 43, PARCEL 51 LOT PAR A PLAT 23793 ZONED M-2 GRID NO. 11 1st ELECTION DISTRICT 7200 DORSEY RUN ROAD ELKRIDGE, MARYLAND 21075 HOWARD COUNTY, MARYLAND
------	--

TITLE	EXISTING CONDITIONS PLAN
-------	--------------------------

Pennoni Associates Inc.
 Engineers • Surveyors • Planners
 Landscape Architects
 8818 Centre Park Drive, Suite 200 Columbia, MD 21045
 T 410.997.8900 F 410.997.9282

AS-BUILT CERTIFICATION

NOTE: THERE IS NO "AS-BUILT" INFORMATION PROVIDED ON THIS SHEET.

	36896
PRINTED NAME	MD. P.E. NO.
	7/9/19
SIGNATURE	DATE

DESIGNED BY:	DATE:
PJS	JUNE 23, 2017
DRAWN BY:	SCALE:
AGS/JSN	1" = 100'
PROJECT NO.:	DRAWING NO.:
DCT1601	3 OF 43

Schedule	Symbol	Label	Quantity	Manufacturer	Catalog Number	Description	Number Lamps	Filename	Lumens Per Lamp	Light Loss Factor
B	[Symbol]	29	1	Visonare Lighting LLC	VLX-1-T4-96C-7-4K-UVV	38 in. L x 17 in. W x 10 in. H	1	VLX_1_T4_96C_7_4K_E	23484	0.9
C	[Symbol]	4	1	Visonare Lighting LLC	VLX-1-T4-96C-5-4K-UVV	38 in. L x 17 in. W x 10 in. H	1	VLX_1_T4_96C_5_4K_E	18632	0.9

SYMBOL	DESCRIPTION
[Symbol]	PROPOSED SIGN
[Symbol]	PROPOSED SPEED BUMP
[Symbol]	PROPOSED CROSSWALK
[Symbol]	PROPOSED CONCRETE
[Symbol]	PROPOSED PARKING COUNT

ZONING INFORMATION


LOCATION: ELKRIDGE, HOWARD COUNTY, MARYLAND

ZONE: MANUFACTURING HEAVY (M-2)

EXISTING/PROPOSED USE: MANUFACTURING, WAREHOUSING, INDUSTRIAL BUSINESS (PERMITTED USE)

EXISTING PARKING SPACES: 109


PROPOSED PARKING SPACES: 120

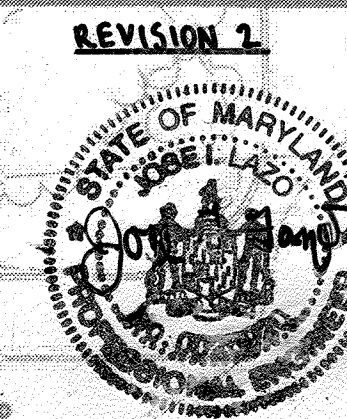

REVISION 2

Professional Certification: I HEREBY CERTIFY THAT THESE DOCUMENTS WERE PREPARED OR APPROVED BY ME, AND THAT I AM A DULY LICENSED PROFESSIONAL ENGINEER UNDER THE LAWS OF THE STATE OF MARYLAND, LICENSE NO. 26920, EXPIRATION DATE: JULY 16, 2021.

Redline Plan Purpose:
 1. Modify sections of two (2) trailer aprons to eliminate excess cross slope adjacent to drive aisle.
 2. Revised canopy dimensions.

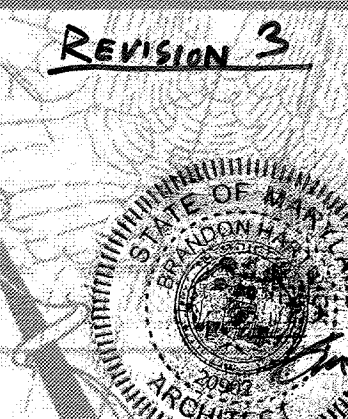


REVISION 3




Professional Certification: I HEREBY CERTIFY THAT THESE DOCUMENTS WERE PREPARED OR APPROVED BY ME, AND THAT I AM A DULY LICENSED ARCHITECT IN THE STATE OF MARYLAND, LICENSE NO. 20904.

Redline Plan Purpose:
 The LOD of 1,345 sq. ft. is less than 5,000 sq. ft. therefore, is exempt from providing stormwater management. Any future increase where the cumulative LOD exceeds 5,000 sq. ft. will require that stormwater management be provided.

SYMBOL	DESCRIPTION
[Symbol]	PROPERTY LINE AND RIGHT-OF-WAY
[Symbol]	EXISTING 1" CONTOUR
[Symbol]	EXISTING 5" CONTOUR
[Symbol]	EXISTING TREE LINE
[Symbol]	EXISTING SOILS
[Symbol]	EXISTING WATER
[Symbol]	EXISTING SEWER
[Symbol]	EXISTING OVERHEAD ELECTRICAL
[Symbol]	EXISTING UNDERGROUND ELECTRICAL
[Symbol]	EXISTING STORM DRAIN
[Symbol]	EXISTING STREAM
[Symbol]	EXISTING FLOODPLAIN
[Symbol]	EXISTING WETLANDS
[Symbol]	EXISTING WETLAND BUFFER
[Symbol]	PROPOSED MICRO-BIORETENTION FACILITY
[Symbol]	PROPOSED STORM DRAIN
[Symbol]	PROPOSED WATER
[Symbol]	PROPOSED SEWER
[Symbol]	PROP. CONCRETE SIDEWALK
[Symbol]	PROPOSED TREE LINE

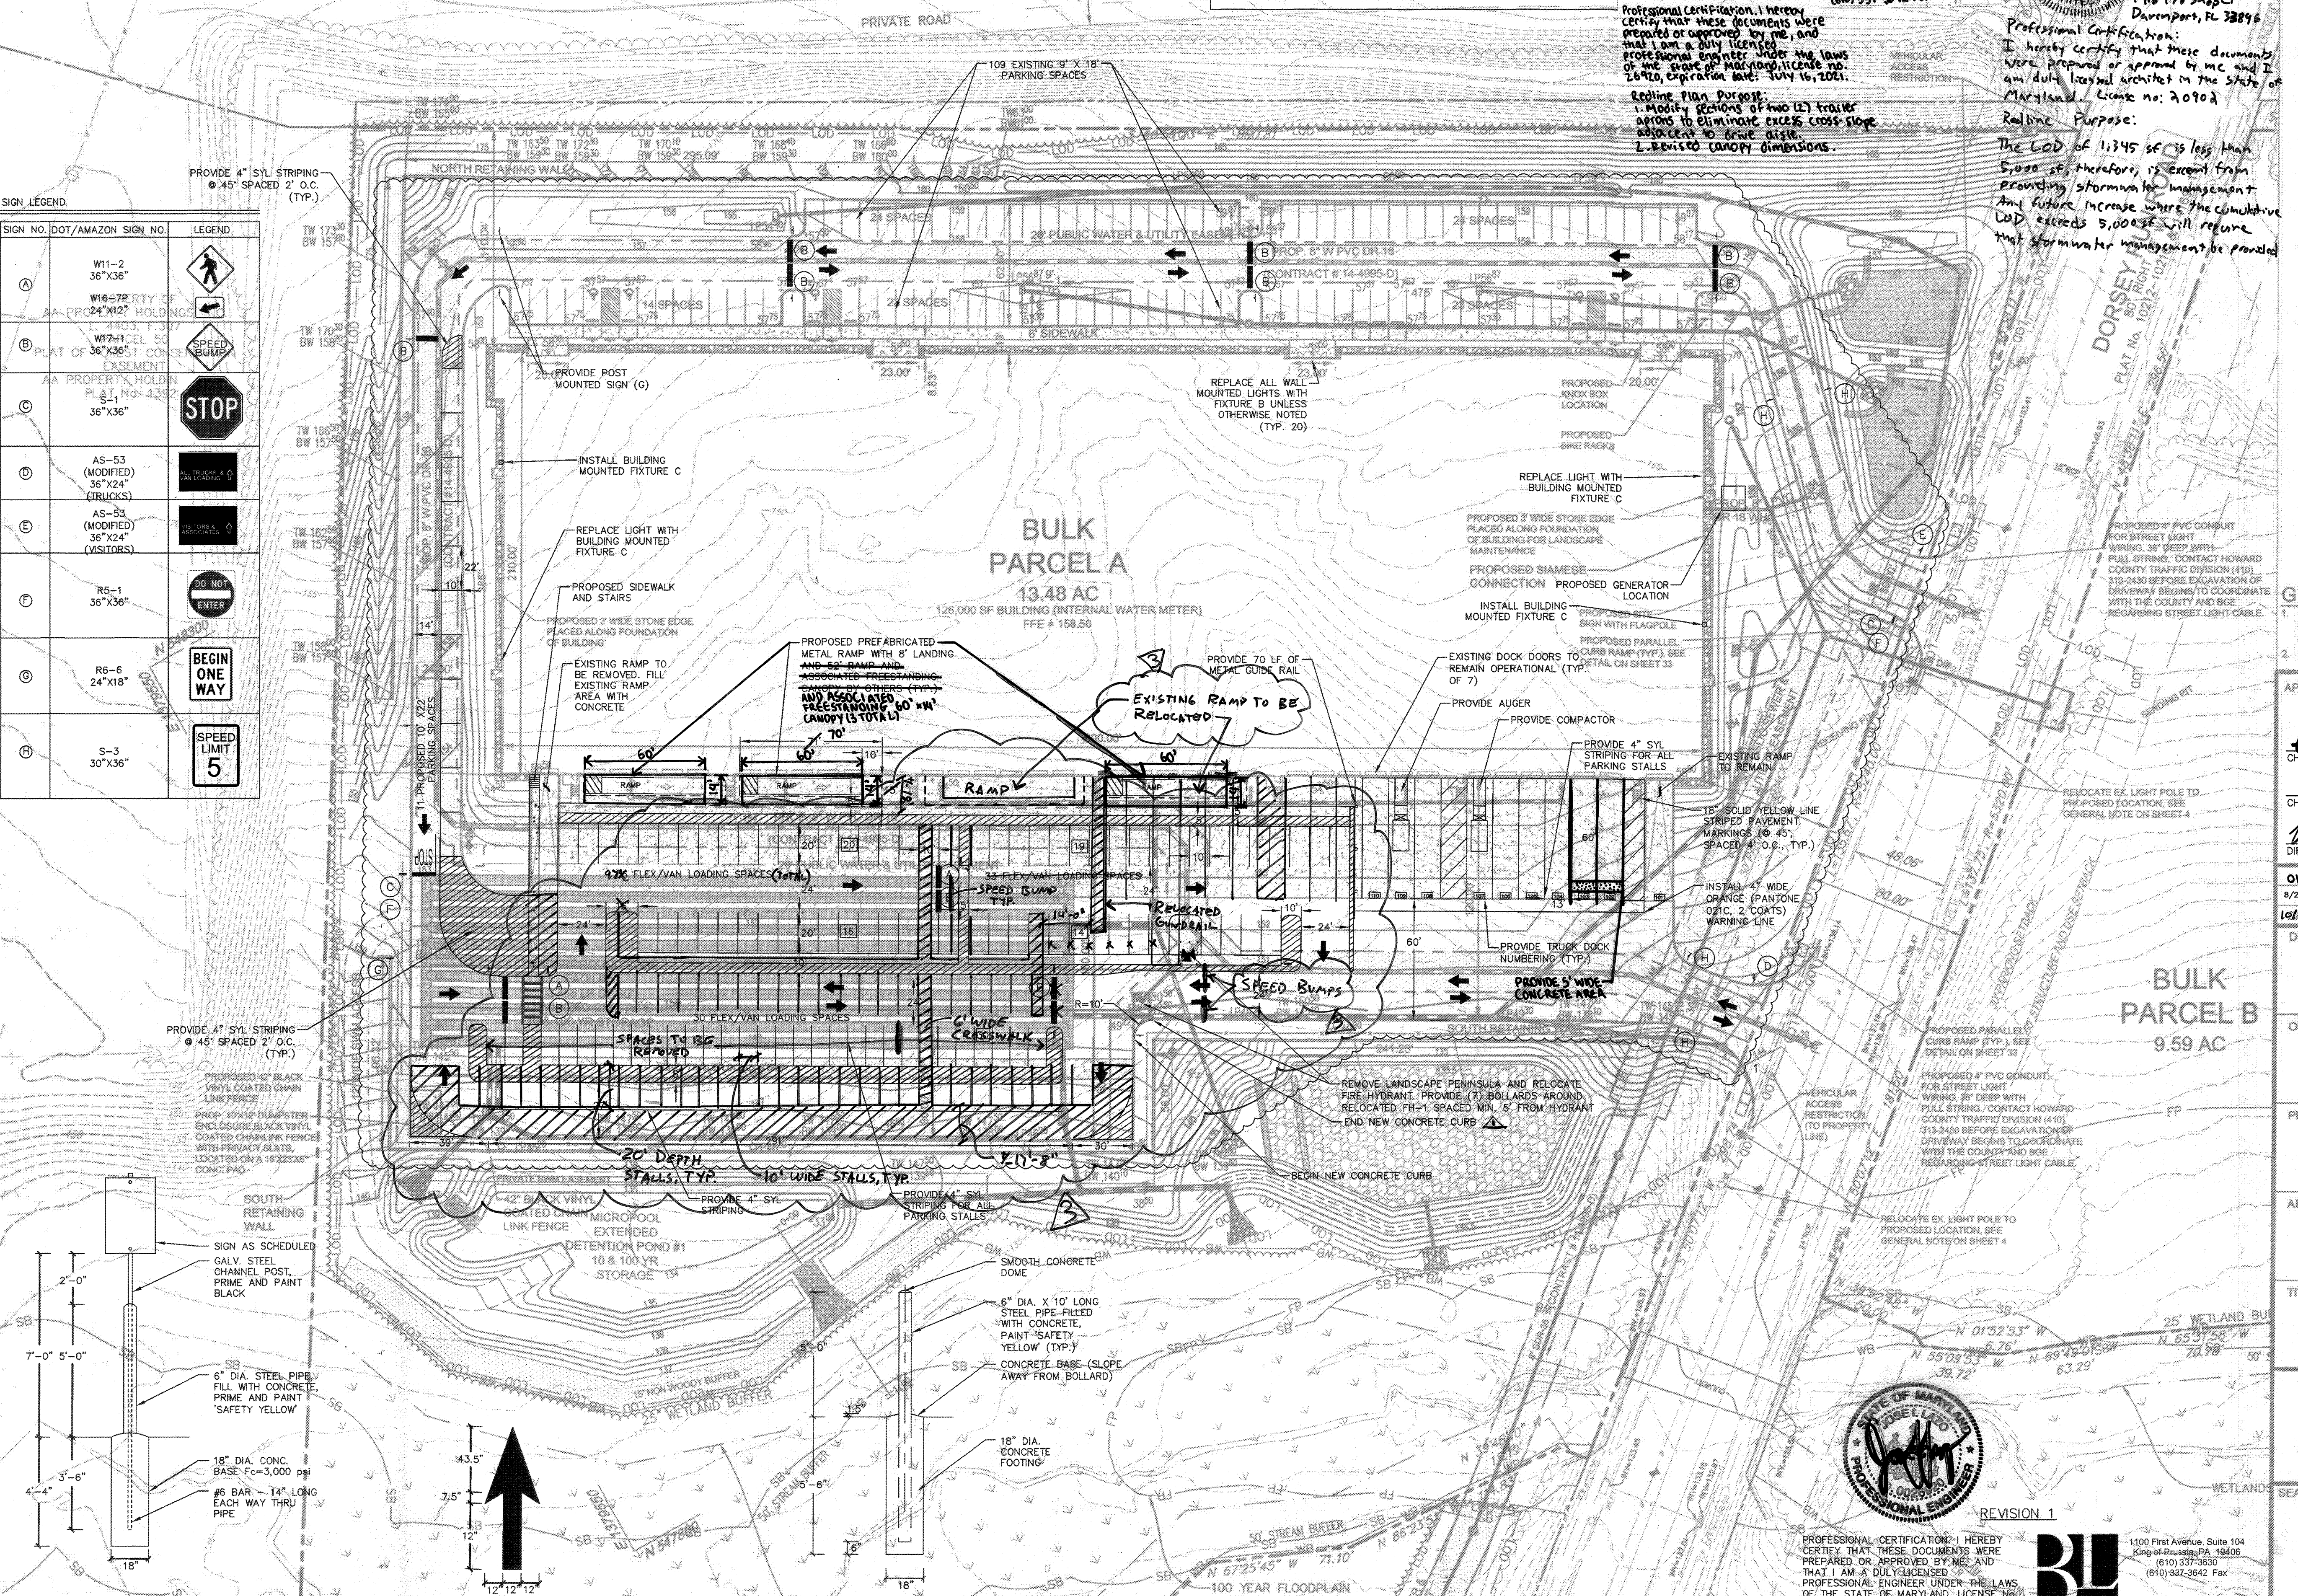

SIGN NO./DOT/AMAZON SIGN NO.	LEGEND
(A) W11-2 36"x36"	[Symbol]
(B) W17-1 36"x36"	[Symbol]
(C) AA PROPERTY HOLDING PLAT NO. 138 36"x36"	[Symbol]
(D) AS-53 (MODIFIED) 36"x24" (TRUCKS)	[Symbol]
(E) AS-53 (MODIFIED) 36"x24" (VISITORS)	[Symbol]
(F) R5-1 36"x36"	[Symbol]
(G) R6-6 24"x18"	[Symbol]
(H) S-3 30"x36"	[Symbol]

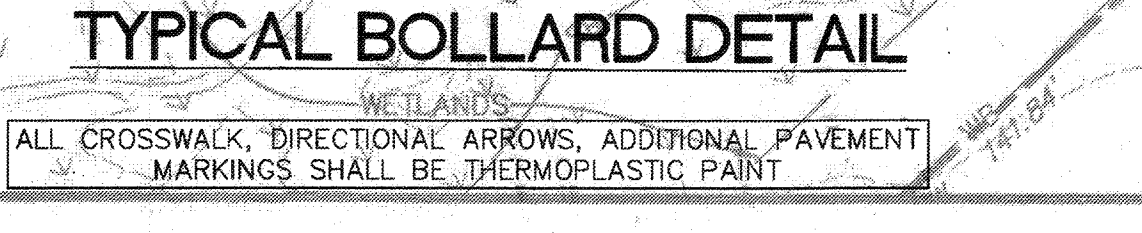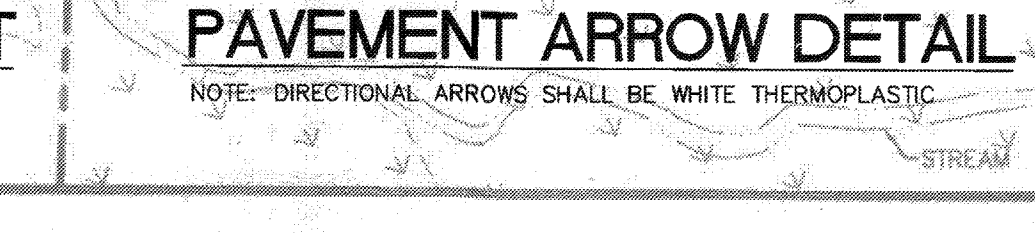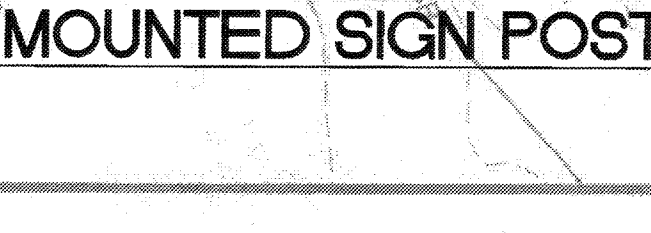

GENERAL NOTE

- HOWARD COUNTY WILL RELOCATE THE EXISTING STREET LIGHTS. CONTACT THE HOWARD COUNTY TRAFFIC DIVISION AT 410-343-2400 TO COORDINATE RELOCATIONS AND INSTALLATION OF STREET LIGHT CONDUITS.
- REFER TO SHEET 29 FOR TRAFFIC CONTROL DETAILS.

APPROVED: DEPARTMENT OF PLANNING AND ZONING

[Signature] 10-11-19
 CHIEF, DEVELOPMENT ENGINEERING DIVISION JP DATE

[Signature] 10-18-19
 CHIEF, DIVISION OF LAND DEVELOPMENT NH DATE

[Signature] 10-18-19
 DIRECTOR DATE

NO.	DESCRIPTION	DATE
01/27/19	2 Modification of trailer docks	BL
8/28/19	1 LOT STRIPING AND RELOCATION OF FIRE HYDRANT	BL
10/17/19	13 PARKING LOT IMPROVEMENTS	BL

DEVELOPER: DCT INDUSTRIAL
 12011 GUILFORD ROAD, SUITE 102
 ANNAPOLIS JUNCTION, MD 20701
 ATTN: FRED FERRARO
 PHONE: 410-645-5020

OWNER: DCT MEARS LLC
 12011 GUILFORD ROAD, SUITE 102
 ANNAPOLIS JUNCTION, MD 20701
 ATTN: FRED FERRARO
 PHONE: 410-645-5020


PROJECT: TERRAPIN COMMERCE CENTER

AREA: TAX MAP 43, PARCEL 51 LOT PAR A PLAT 23793 ZONED M-2
 GRID NO. 11 1st ELECTION DISTRICT
 7200 DORSEY RUN ROAD
 ELKRIDGE, MARYLAND 21075
 HOWARD COUNTY, MARYLAND

TITLE: REVISED SITE DEVELOPMENT PLAN

Pennoni Associates Inc.
 Engineers - Surveyors - Planners
 Landscape Architects
 8818 Centre Park Drive, Suite 200 Columbia, MD 21045
 T 410.997.8900 F 410.997.9282


DESIGNED BY: FJS
 DRAWN BY: AGS/JSN
 PROJECT NO.: DCT1601
 DATE: JUNE 23, 2017
 SCALE: 1" = 40'
 DRAWING NO. 4 OF 43

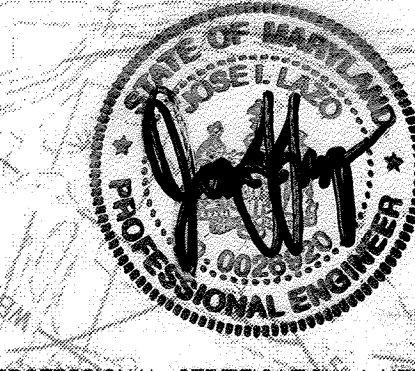

REVISION 1


PROFESSIONAL CERTIFICATION: I HEREBY CERTIFY THAT THESE DOCUMENTS WERE PREPARED OR APPROVED BY ME, AND THAT I AM A DULY LICENSED PROFESSIONAL ENGINEER UNDER THE LAWS OF THE STATE OF MARYLAND, LICENSE NO. 26920, EXPIRATION DATE: JULY 16, 2021.

Redline Plan Purpose:
 1. RELOCATE EXISTING FIRE HYDRANT FH-1 AND REMOVE ASSOCIATED LANDSCAPE ISLAND.
 2. RESTRICT EXISTING TRUCK COURTS FOR NEW VAN TRAFFIC CIRCULATION AND VAN LOADING.

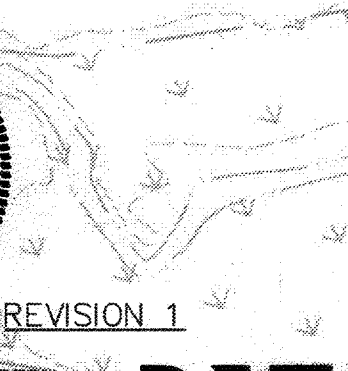

BL Companies

1100 First Avenue, Suite 104
 King of Prussia, PA 19406
 (610) 337-3630
 (610) 347-3642 Fax

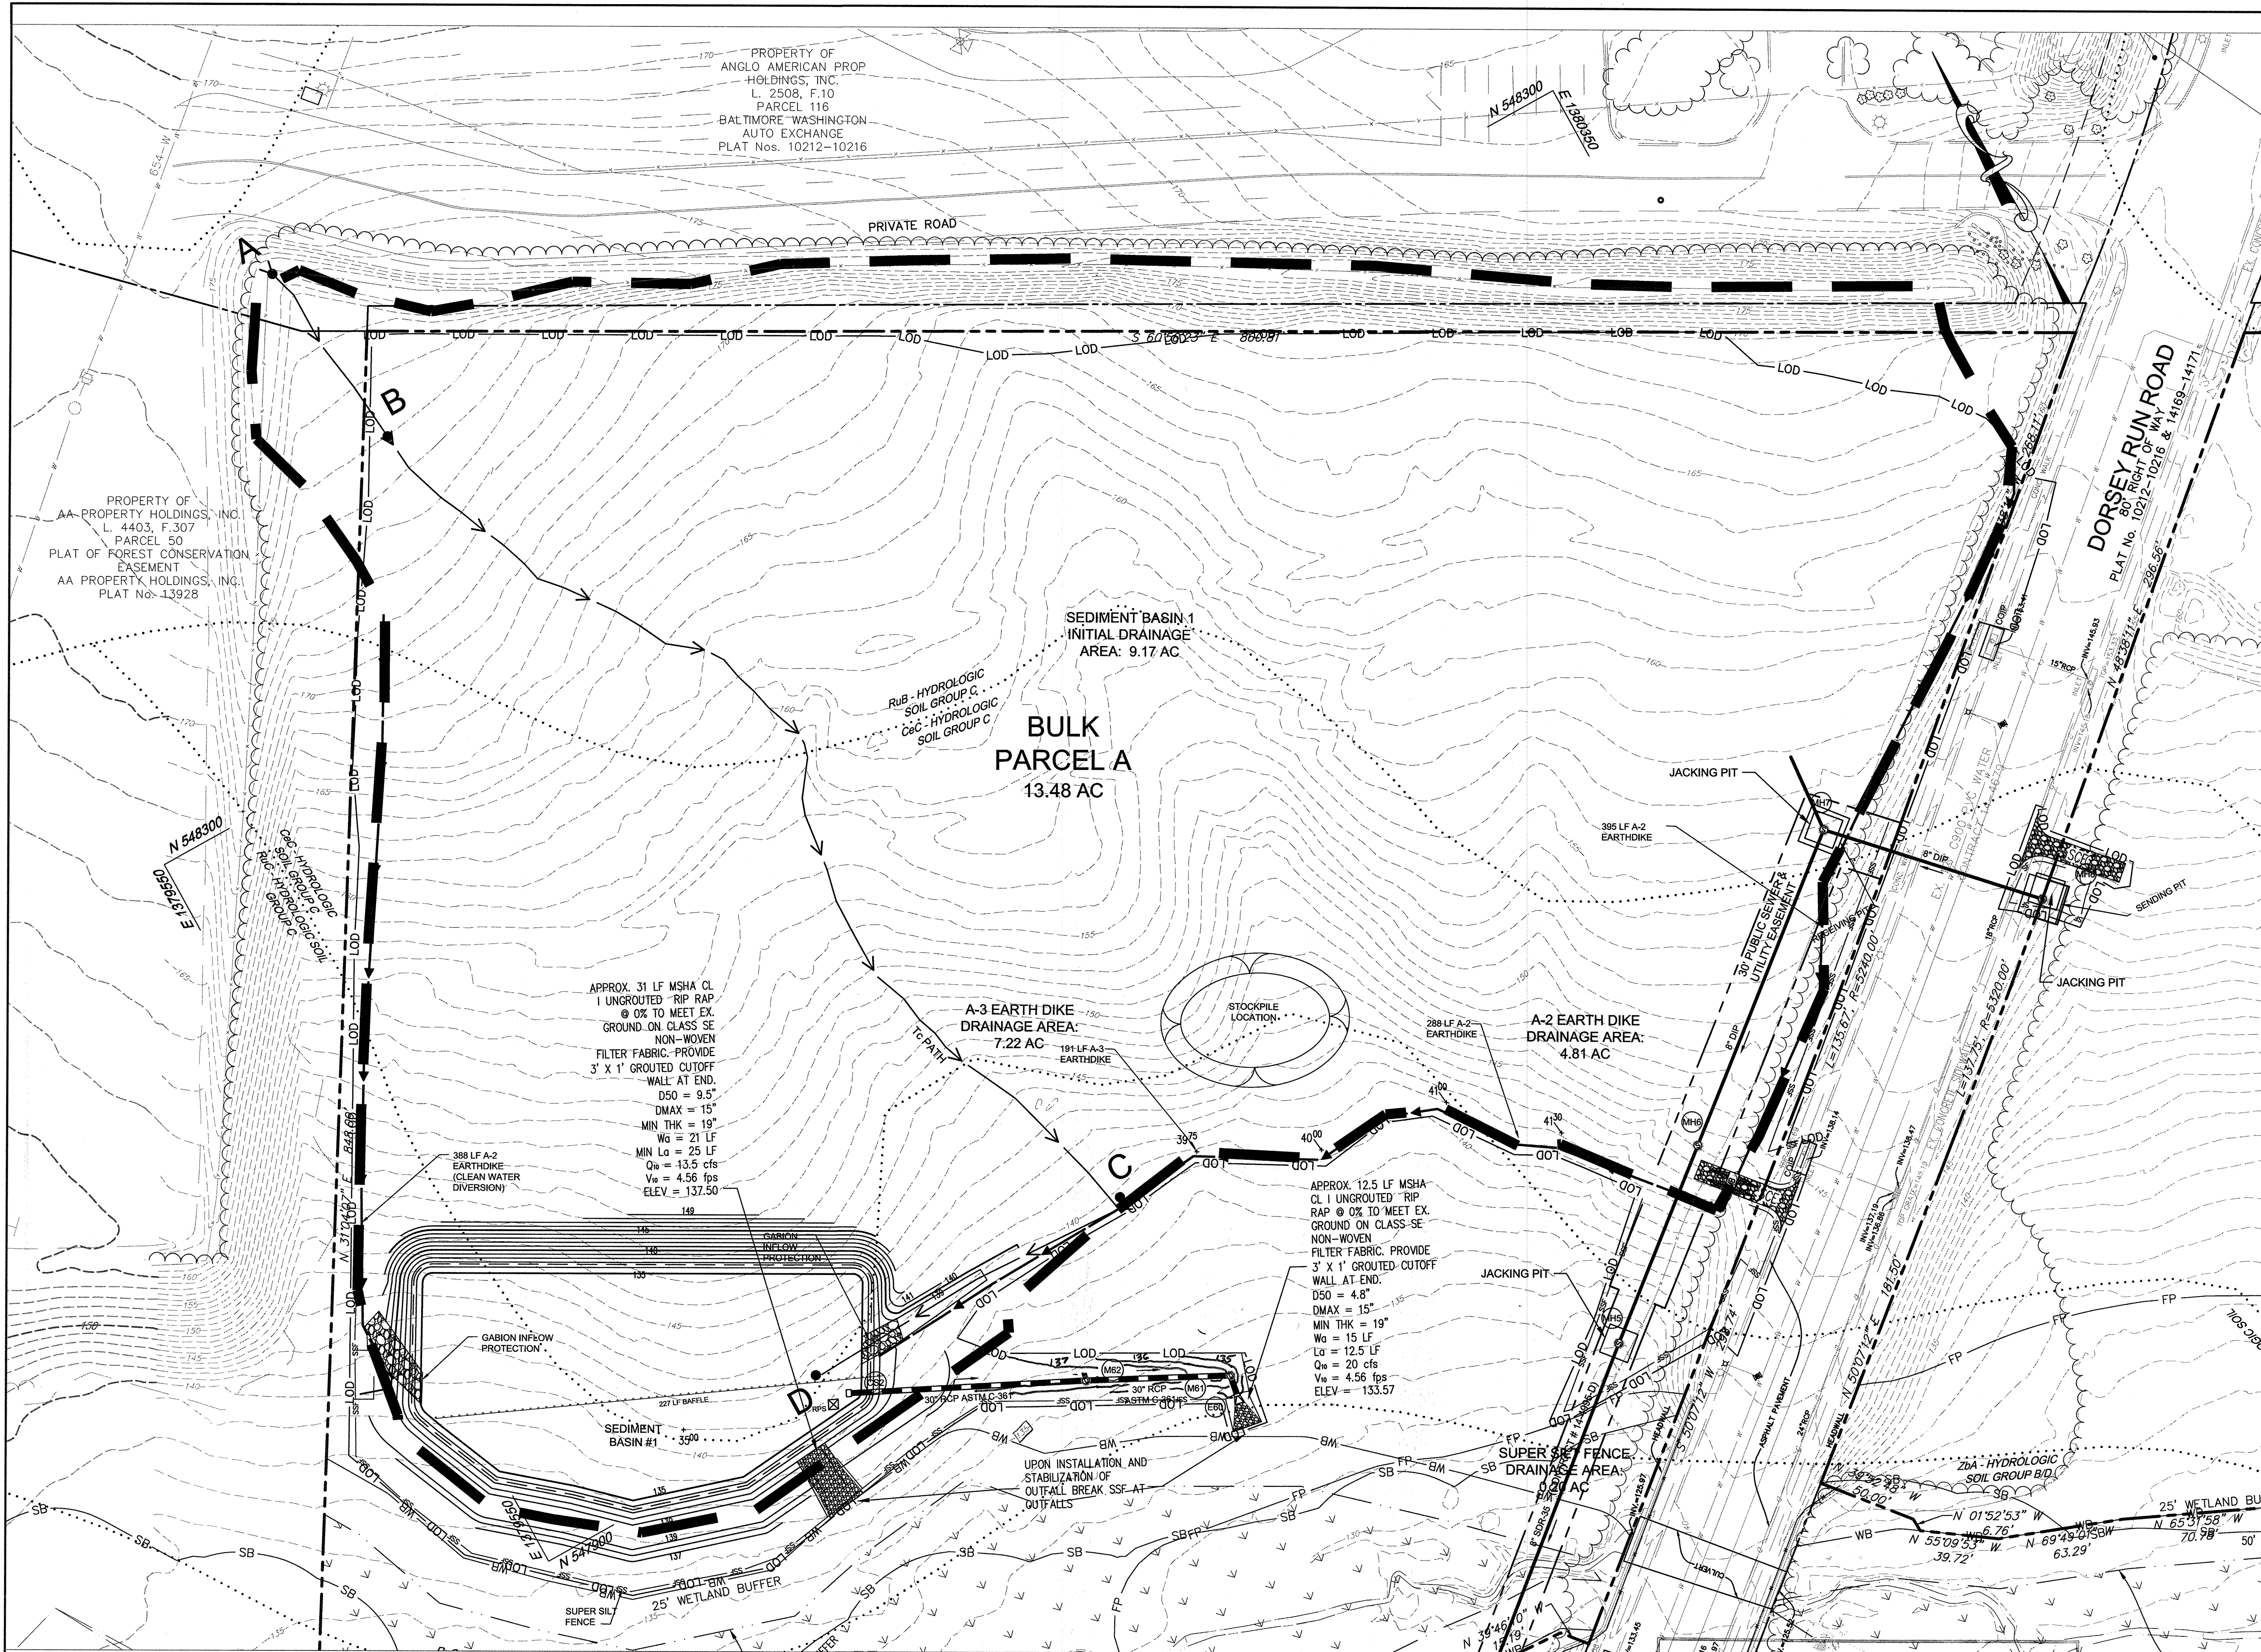

BASIN CONSTRUCTION MAY NOT BEGIN UNTIL ALL MATERIALS FOR CONSTRUCTION OF BASIN ARE ON SITE.
 ALL BASIN CONSTRUCTION SHALL BE INSPECTED BY THE HOWARD COUNTY INSPECTOR.

ENGINEER'S CERTIFICATE
 I HEREBY CERTIFY THAT THIS PLAN HAS BEEN DESIGNED IN ACCORDANCE WITH CURRENT MARYLAND EROSION AND SEDIMENT CONTROL LAWS, REGULATIONS, AND STANDARDS. THAT IT REPRESENTS A PRACTICAL AND WORKABLE PLAN BASED ON MY PERSONAL KNOWLEDGE OF THE SITE, AND THAT IT WAS PREPARED IN ACCORDANCE WITH THE REQUIREMENTS OF THE HOWARD SOIL CONSERVATION DISTRICT.

SIGNATURE OF ENGINEER (PRINT NAME BELOW SIGNATURE) *Sharon L. Cruz* DATE *8/21/17*

DEVELOPER'S CERTIFICATE
 I HEREBY CERTIFY THAT ANY CLEARING, GRADING, CONSTRUCTION, OR DEVELOPMENT WILL BE DONE PURSUANT TO THIS APPROVED EROSION AND SEDIMENT CONTROL PLAN, INCLUDING INSPECTING AND MAINTAINING CONTROLS, AND THAT THE RESPONSIBLE PERSONNEL INVOLVED IN THE CONSTRUCTION PROJECT WILL HAVE A CERTIFICATE OF TRAINING AT A MARYLAND DEPARTMENT OF THE ENVIRONMENT APPROVED TRAINING PROGRAM FOR THE CONTROL ON EROSION AND SEDIMENT PRIOR TO BEGINNING THE PROJECT. I CERTIFY RIGHT-OF-ENTRY FOR PERIODIC ON-SITE EVALUATION BY HOWARD COUNTY, THE HOWARD SOIL CONSERVATION DISTRICT AND/OR MDE.

SIGNATURE OF DEVELOPER (PRINT NAME BELOW SIGNATURE) *Jacqueline Carbone* DATE *8/1/17*

THIS PLAN IS APPROVED FOR SOIL EROSION AND SEDIMENT CONTROL BY THE HOWARD SOIL CONSERVATION DISTRICT.

John R. Polite DATE *8/30/17*
 HOWARD SOIL CONSERVATION DISTRICT

APPROVED: DEPARTMENT OF PLANNING AND ZONING
John R. Polite DATE *8-21-17*
 CHIEF, DEVELOPMENT ENGINEERING DIVISION
Kathleen L. Lamm DATE *9-27-17*
 CHIEF, DIVISION OF LAND DEVELOPMENT
Valerie J. Jaffe DATE *10-2-17*
 DIRECTOR

DATE	NO.	REVISION	BY

DEVELOPER: DCT INDUSTRIAL
 12011 GUILFORD ROAD
 SUITE 102
 ANNAPOLIS JUNCTION, MD 20701
 ATTN: FRED FERRARO
 PHONE: 410-645-5020

OWNER: DCT MEARS LLC
 12011 GUILFORD ROAD
 SUITE 102
 ANNAPOLIS JUNCTION, MD 20701
 ATTN: FRED FERRARO
 PHONE: 410-645-5020

PROJECT: TERRAPIN COMMERCE CENTER

AREA: TAX MAP 43, PARCEL 51 LOT PAR A PLAT 23793 ZONED M-2
 GRID NO. 11 1st ELECTION DISTRICT
 7200 DORSEY RUN ROAD
 ELKRIDGE, MARYLAND 21075
 HOWARD COUNTY, MARYLAND

TITLE: GRADING AND SEDIMENT CONTROL PLAN - PHASE I

Pennoni Associates Inc.
 Engineers • Surveyors • Planners
 Landscape Architects
 8818 Centre Park Drive, Suite 200 Columbia, MD 21045
 T 410.997.8900 F 410.997.9282

SEAL: PROFESSIONAL ENGINEER, STATE OF MARYLAND, LICENSE NO. 3086, EXPIRES 12/31/2019

DESIGNED BY: PJS
 DRAWN BY: AGS/JSN
 PROJECT NO.: DCT1601
 DATE: JUNE 23, 2017
 SCALE: 1" = 40'
 DRAWING NO.: 5 OF 43

LEGEND

PROPERTY LINE AND RIGHT-OF-WAY
 EXISTING 1' CONTOUR
 EXISTING 5' CONTOUR
 EXISTING TREE LINE
 EXISTING SOILS
 PROPOSED 1' CONTOUR
 PROPOSED 5' CONTOUR
 PROPOSED SPOT ELEVATION
 PROPOSED STORM DRAIN

PROPOSED TREE LINE
 PROPOSED SILT FENCE
 PROPOSED SUPER SILT FENCE
 PROPOSED STABILIZED CONSTRUCTION ENTRANCE

MATCHLINE - SEE SHEET 6


DRAINAGE AREA
 PROPOSED EARTH DIKE
 REMOVABLE PUMPING STATION
 COMBINATION INLET PROTECTION

STANDARD INLET PROTECTION
 GABION INFLOW PROTECTION
 STOCKPILE

AS-BUILT CERTIFICATION
 NOTE: THERE IS NO "AS-BUILT" INFORMATION PROVIDED ON THIS SHEET.
Sharon L. Cruz 36896
 PRINTED NAME MD #5 NO.
 SIGNATURE DATE *7/20/19*

0 40' 80'

MATCHLINE - SEE SHEET 5

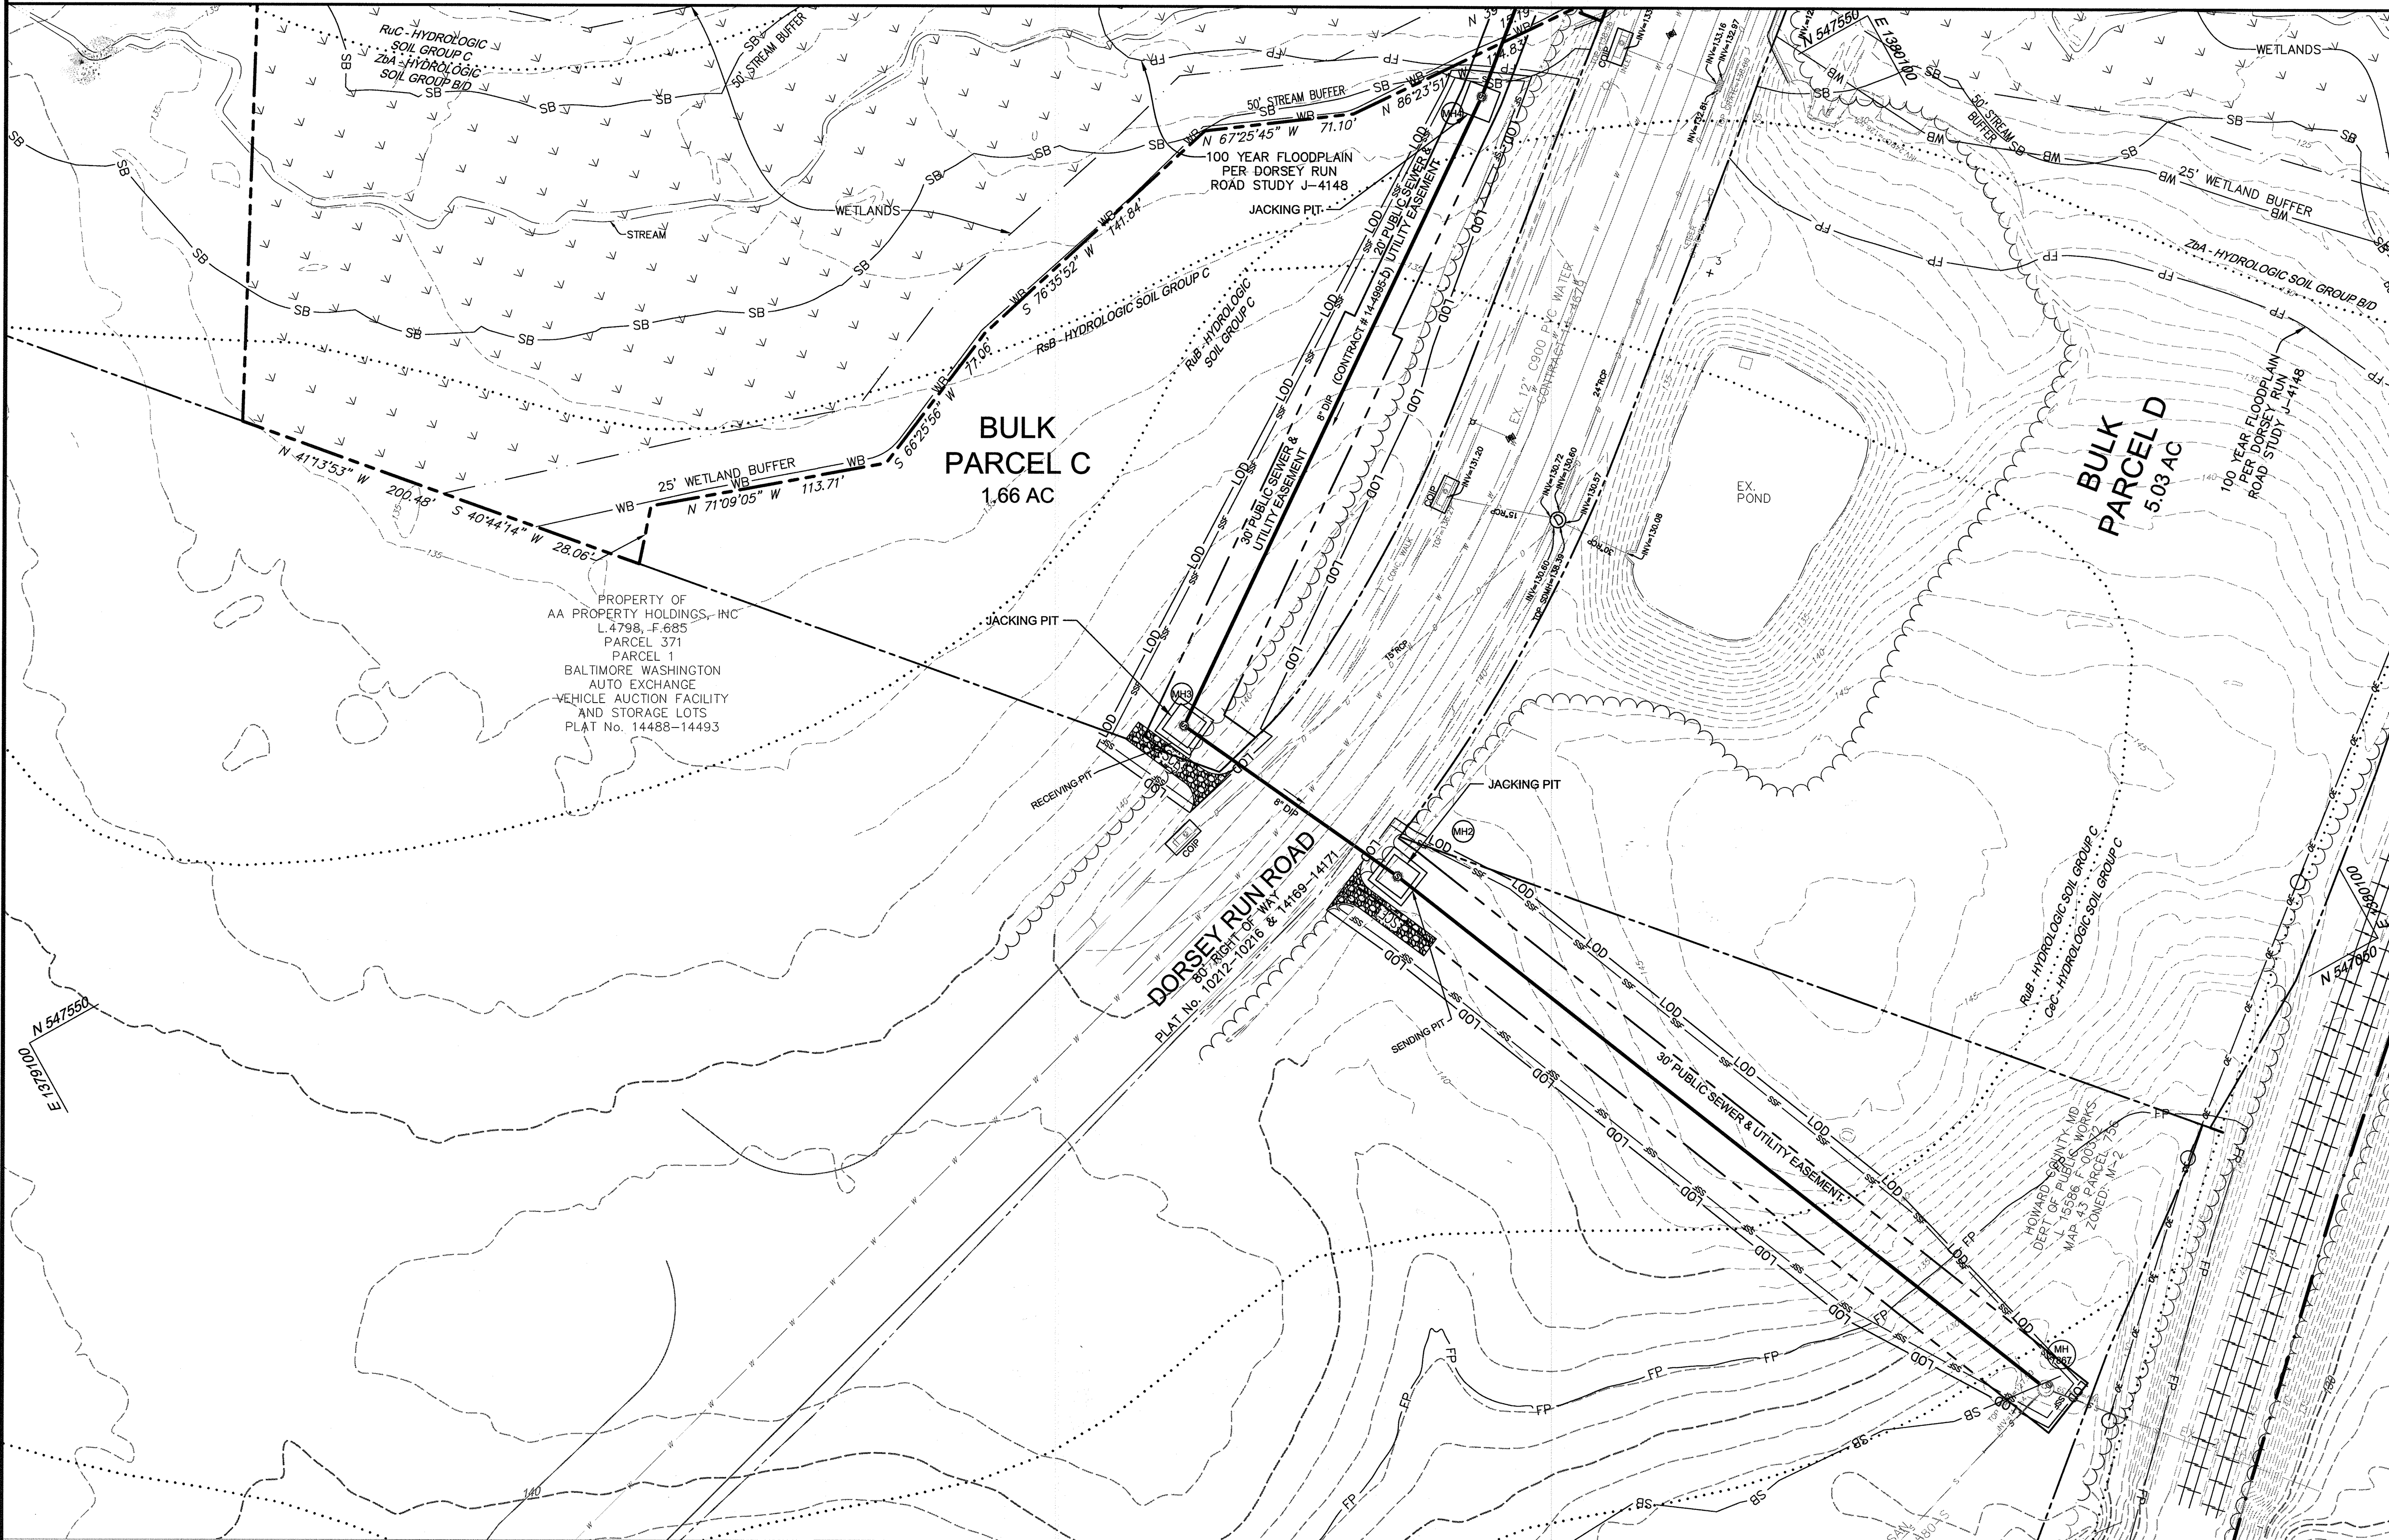

LEGEND

SEE 'GRADING AND SEDIMENT CONTROL PLAN - PHASE I' FOR LEGEND

ENGINEER'S CERTIFICATE
 I HEREBY CERTIFY THAT THIS PLAN HAS BEEN DESIGNED IN ACCORDANCE WITH CURRENT MARYLAND EROSION AND SEDIMENT CONTROL LAWS, REGULATIONS, AND STANDARDS, THAT IT REPRESENTS A PRACTICAL AND WORKABLE PLAN BASED ON MY PERSONAL KNOWLEDGE OF THE SITE, AND THAT IT WAS PREPARED IN ACCORDANCE WITH THE REQUIREMENTS OF THE HOWARD SOIL CONSERVATION DISTRICT.

Sharon L. Cave 8/22/17
 SIGNATURE OF ENGINEER (PRINT NAME BELOW SIGNATURE) DATE

DEVELOPER'S CERTIFICATE
 I/WE HEREBY CERTIFY THAT ANY CLEARING, GRADING, CONSTRUCTION, OR DEVELOPMENT WILL BE DONE PURSUANT TO THIS APPROVED EROSION AND SEDIMENT CONTROL PLAN, INCLUDING INSPECTING AND MAINTAINING CONTROLS, AND THAT THE RESPONSIBLE PERSONNEL INVOLVED IN THE CONSTRUCTION PROJECT WILL HAVE A CERTIFICATE OF TRAINING AT A MARYLAND DEPARTMENT OF THE ENVIRONMENT APPROVED TRAINING PROGRAM FOR THE CONTROL ON EROSION AND SEDIMENT PRIOR TO BEGINNING THE PROJECT. I CERTIFY RIGHT-OF-ENTRY FOR PERIODIC ON-SITE EVALUATION BY HOWARD COUNTY, THE HOWARD SOIL CONSERVATION DISTRICT AND/OR MDE.

Jaqueline Carbone 8/1/17
 SIGNATURE OF DEVELOPER (PRINT NAME BELOW SIGNATURE) DATE

THIS PLAN IS APPROVED FOR SOIL EROSION AND SEDIMENT CONTROL BY THE HOWARD SOIL CONSERVATION DISTRICT.

John R. Robinson 8/30/17
 HOWARD SOIL CONSERVATION DISTRICT DATE

APPROVED: DEPARTMENT OF PLANNING AND ZONING

John R. Robinson 9-21-17
 CHIEF, DEVELOPMENT ENGINEERING DIVISION DATE

Vestil Salas 9-27-17
 CHIEF, DIVISION OF LAND DEVELOPMENT DATE

William J. J. J. 10-2-17
 DIRECTOR DATE

DATE	NO.	REVISION	BY

DEVELOPER
 DCT INDUSTRIAL
 12011 GUILFORD ROAD
 SUITE 102
 ANNAPOLIS JUNCTION, MD 20701
 ATTN: FRED FERRARO
 PHONE: 410-645-5020

OWNER
 DCT MEARS LLC
 12011 GUILFORD ROAD
 SUITE 102
 ANNAPOLIS JUNCTION, MD 20701
 ATTN: FRED FERRARO
 PHONE: 410-645-5020

PROJECT
 TERRAPIN COMMERCE CENTER

AREA
 TAX MAP 43, PARCEL 51 LOT PAR A PLAT 23793 ZONED M-2
 GRID NO. 11 1st ELECTION DISTRICT
 7200 DORSEY RUN ROAD
 ELKRIDGE, MARYLAND 21075
 HOWARD COUNTY, MARYLAND

TITLE
 GRADING AND SEDIMENT CONTROL PLAN - PHASE I

Seal: Pennoni Associates Inc. Engineers • Surveyors • Planners Landscape Architects
 8818 Centre Park Drive, Suite 200 Columbia, MD 21045
 T 410.997.8900 F 410.997.9282


DESIGNED BY: PJS
DRAWN BY: AGS/JSN
PROJECT NO.: DCT11601
DATE: JUNE 23, 2017
SCALE: 1" = 40'
DRAWING NO.: 6 OF 43


SOILS CHART

MAP SYMBOL	NAME	STRUCTURAL LIMITATIONS DWELLINGS W/ BASEMENTS	EROSION HAZARD	HYDRIC (Y/N)	SLOPE (%)	SOIL GROUP	Kw FACTOR
CcC	CHILLUM LOAM	VERY LIMITED	SLIGHT	N	5-10	C	0.43
RsB	RUSSET FINE SANDY LOAM	VERY LIMITED	SLIGHT	N	2-5	C	0.28
RiB	RUSSET-ALLOWAY-HAMBROOK COMPLEX	SOMEWHAT LIMITED	SLIGHT	Y	0-5	C	0.28
RuB	RUSSET AND BELTSVILLE SOILS	NOT LIMITED	SLIGHT	N	2-5	C	0.28
RuC	RUSSET AND BELTSVILLE SOILS	VERY LIMITED	SLIGHT	Y	5-10	C	0.28
ZbA	ZEKIAH AND ISSUE SOILS	NOT RATED	SLIGHT	N	0-2, FREQUENTLY FLOODED	BD	0.32


SOURCE: NATURAL RESOURCES CONSERVATION SERVICE WEB SOIL SURVEY AND HOWARD SOIL CONSERVATION DISTRICT SOIL MAP NUMBER 25

AS-BUILT CERTIFICATION
 NOTE: THERE IS NO 'AS-BUILT' INFORMATION PROVIDED ON THIS SHEET.
Sharon L. Cave 36896
 PRINTED NAME MD P.E. NO.
 SIGNATURE DATE

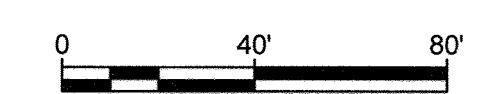

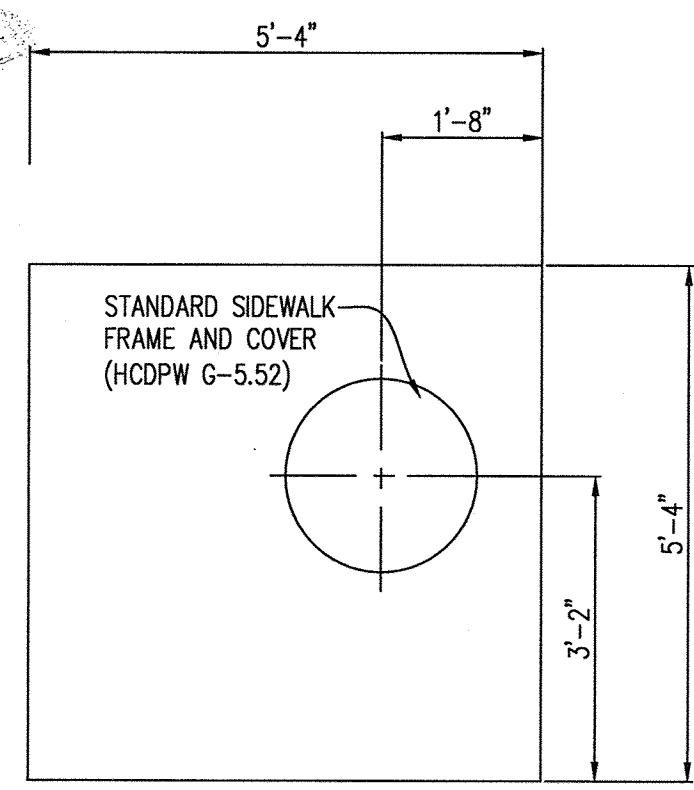


TOP SLAB
SCALE 1/2"

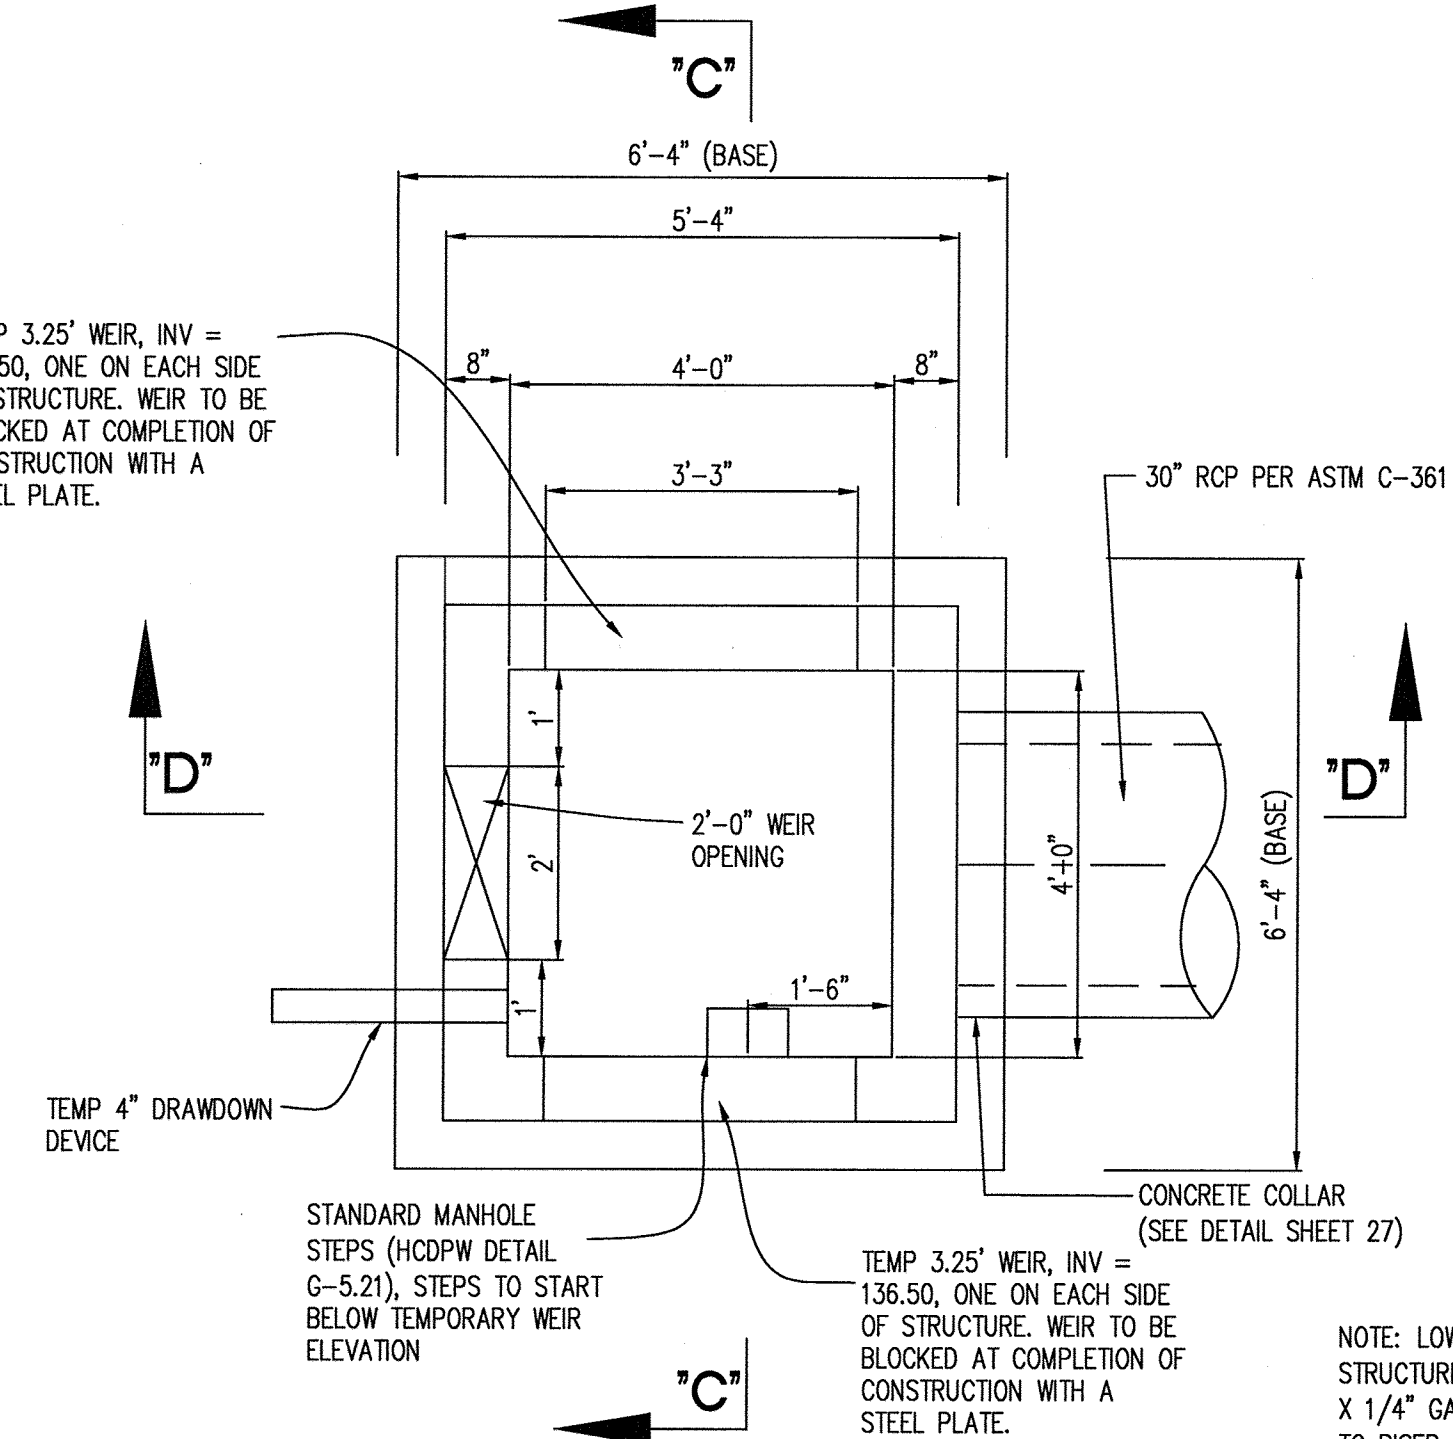


PLAN SECTION
TOP SLAB REMOVED
SCALE 1/2"

POND 1 CONCRETE RISER DETAIL
STRUCTURE CS2
SCALE 1/2"


SEDIMENT BASIN # 1	
NOTE: POND 1 IS TO BE USED AS A SEDIMENT BASIN	
EX. DRAINAGE AREA	= 9.17 AC
INTERM DRAINAGE AREA	= 9.40 AC
DEV. DRAINAGE AREA	= 9.40 AC
STORAGE REQUIRED (3,600 cu.ft./Ac.)	
REQUIRED VOLUME WET	= 16,920 CF
REQUIRED VOLUME DRY	= 16,920 CF
TOTAL VOLUME	= 33,840 CF
STORAGE PROVIDED	
PROVIDED VOLUME WET	= 17,680 CF
PROVIDED VOLUME DRY	= 82,109 CF
TOTAL VOLUME	= 99,789 CF
STORAGE DEPTH	
MINIMUM BOTTOM ELEVATION	= 135.00
BOTTOM DIMENSIONS	= 174' X 249'
RISER DIAMETER	= 4'X4'
RISER CREST ELEVATION	= 136.50
BARREL DIAMETER	= 30"
BARREL LENGTH	= 117 LF
BARREL INVERTS	
UPSTREAM	= 134.34
DOWNSTREAM	= 134.00
TRASH RACK DIAMETER	= N/A
CLEAN OUT ELEVATION	= 135.40
PERMANENT POOL WSEL	= 135.80
DESIGN TOP OF EMBANKMENT EL.	= 139.00
CONSTRUCTED TOP OF EMBANKMENT EL.	= 139.20
EMERGENCY SPILLWAY CREST EL.	= 137.50
EMERGENCY SPILLWAY WIDTH	= 8'

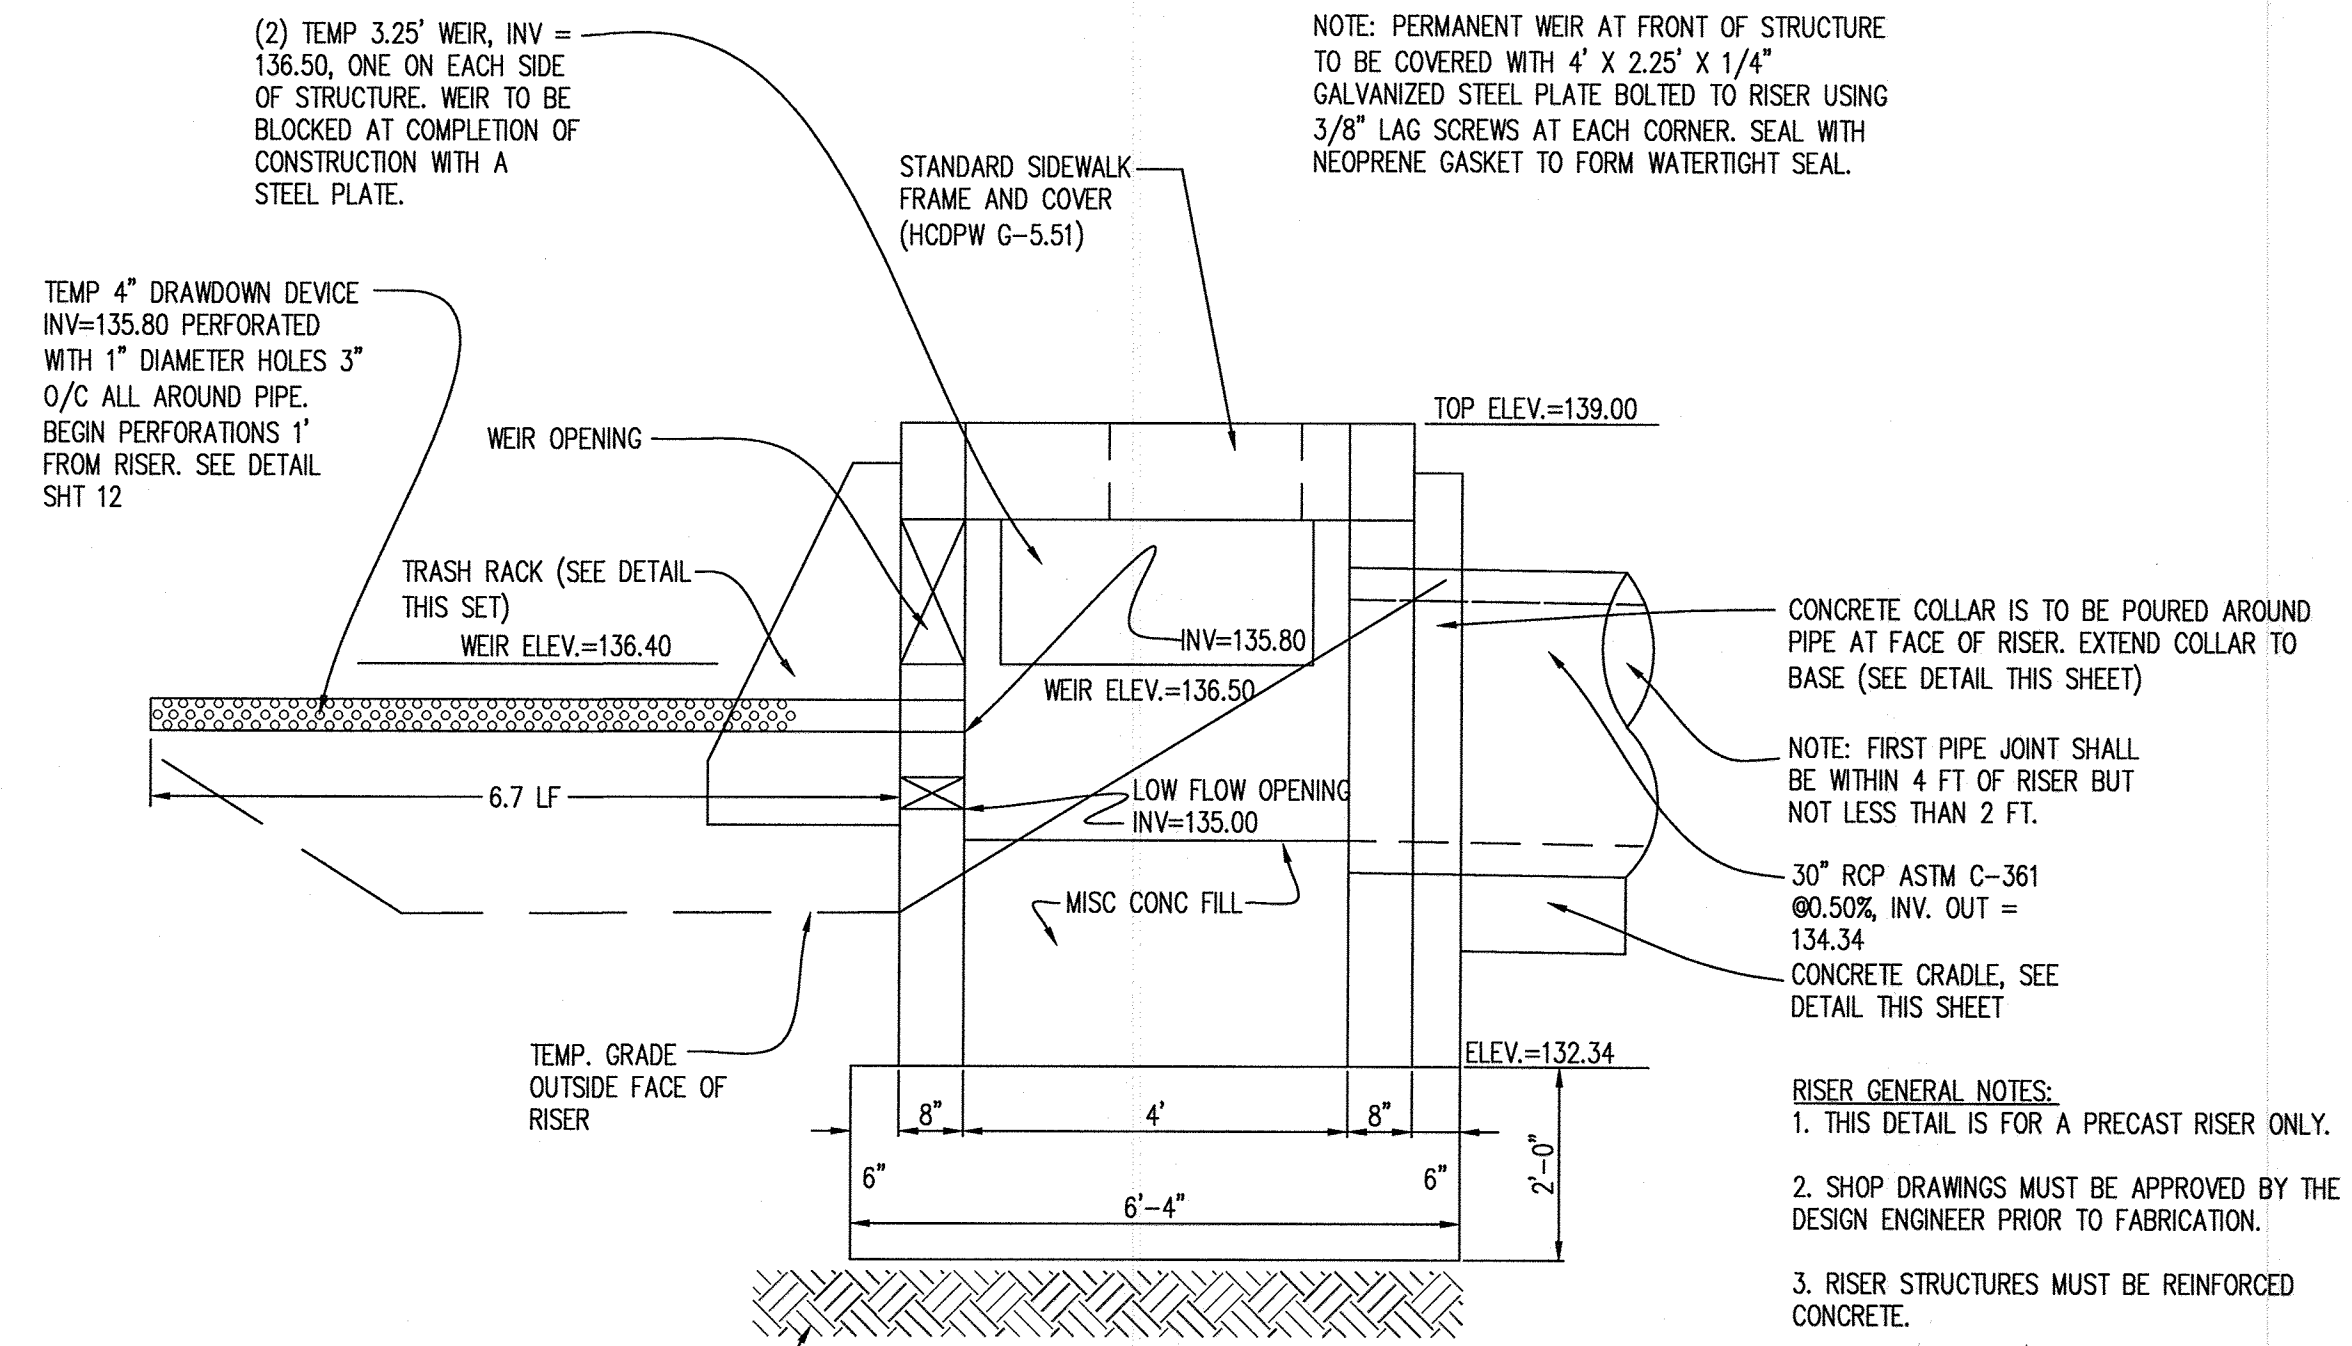

SECTION "D-D"
SCALE 1/2"

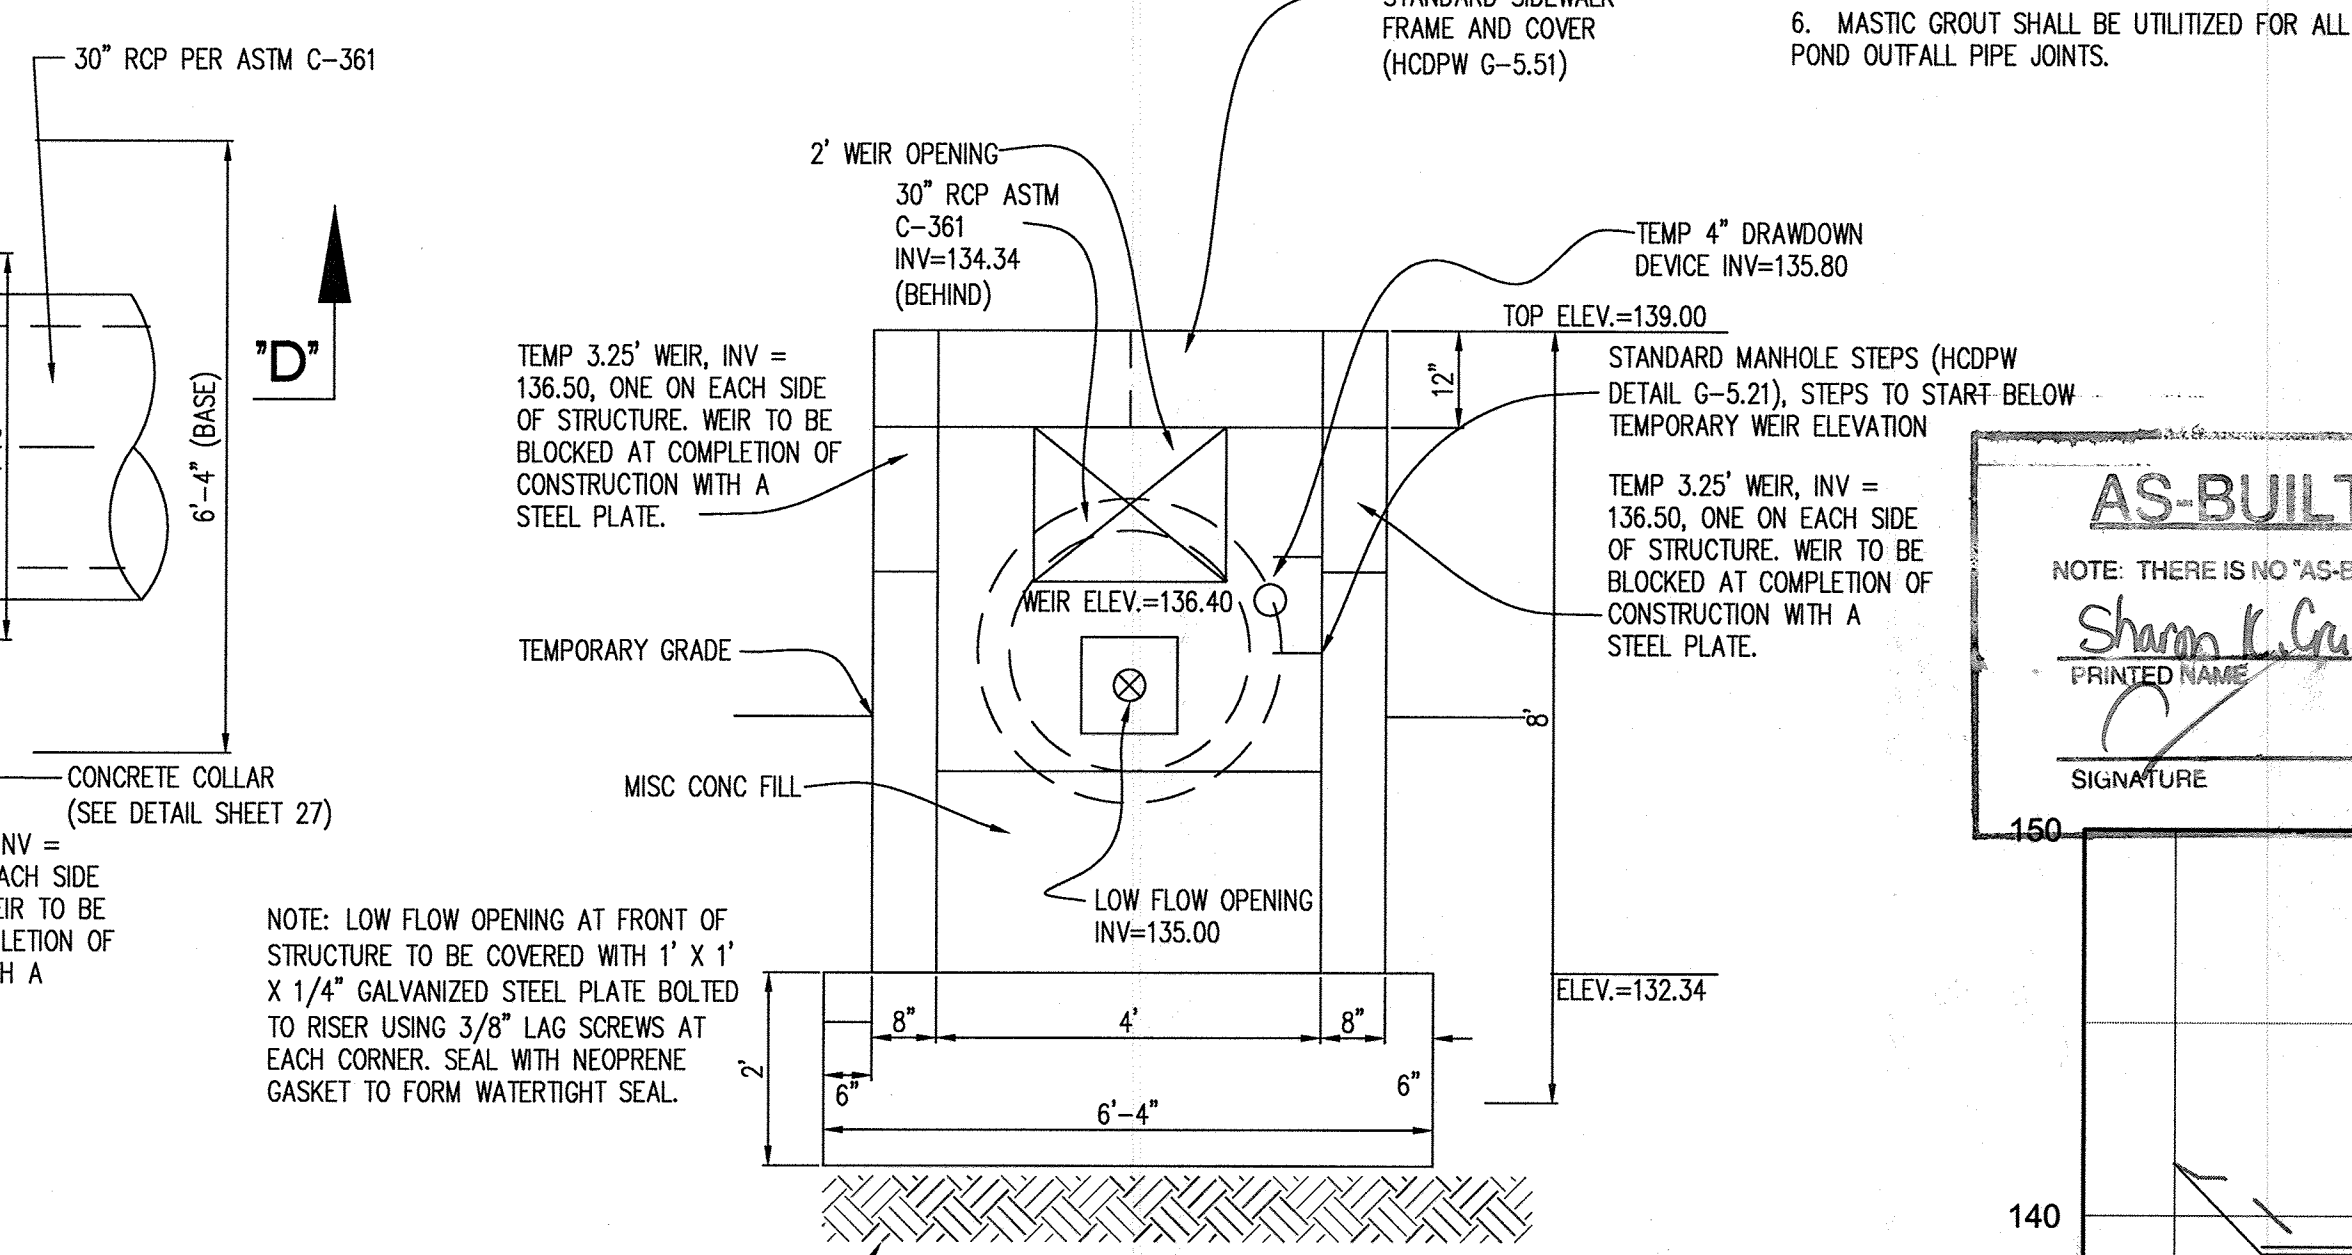

SECTION "C-C"
SCALE 1/2"

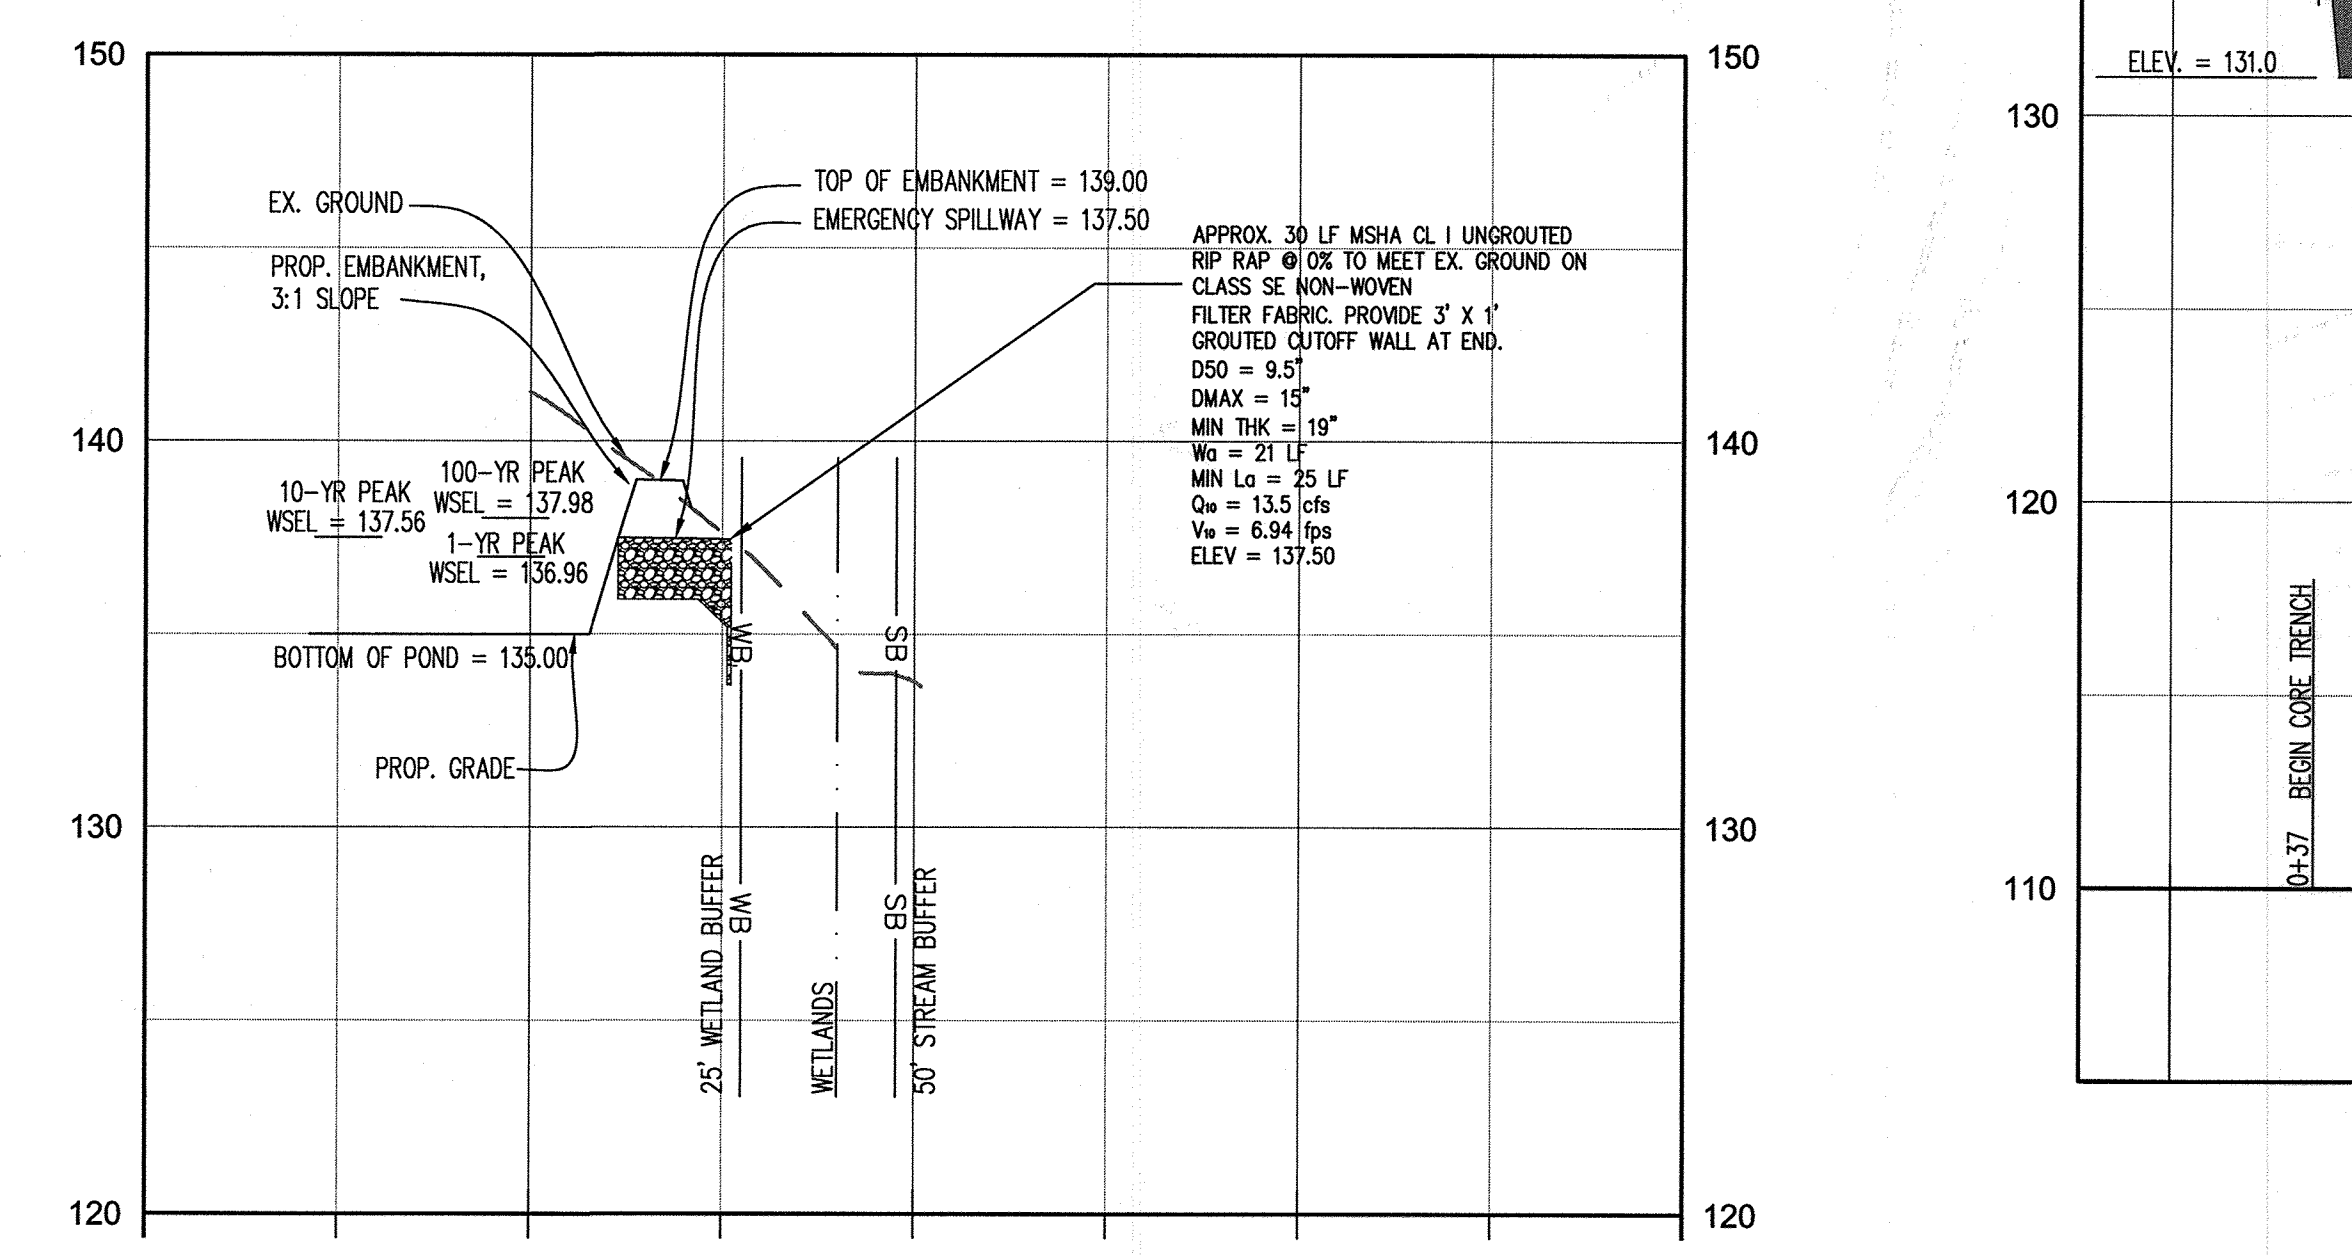


SEDIMENT BASIN # 1 EMERGENCY SPILLWAY PROFILE
HORIZONTAL SCALE: 1" = 50'
VERTICAL SCALE: 1" = 5'

NOTE: PERMANENT WEIR AT FRONT OF STRUCTURE TO BE COVERED WITH 4' X 2.25' X 1/4" GALVANIZED STEEL PLATE BOLTED TO RISER USING 3/8" LAG SCREWS AT EACH CORNER. SEAL WITH NEOPRENE GASKET TO FORM WATERTIGHT SEAL.


NOTE: FIRST PIPE JOINT SHALL BE WITHIN 4 FT OF RISER BUT NOT LESS THAN 2 FT.
30" RCP ASTM C-361 @ 0.50% INV. OUT = 134.34
CONCRETE CRADLE, SEE DETAIL THIS SHEET

RISER GENERAL NOTES:
1. THIS DETAIL IS FOR A PRECAST RISER ONLY.
2. SHOP DRAWINGS MUST BE APPROVED BY THE DESIGN ENGINEER PRIOR TO FABRICATION.
3. RISER STRUCTURES MUST BE REINFORCED CONCRETE.
4. ALL CONNECTIONS SHALL BE WATERTIGHT.
5. ALL CONCRETE SHALL BE SHA MIX No. 3
6. MASTIC GROUT SHALL BE UTILIZED FOR ALL POND OUTFALL PIPE JOINTS.

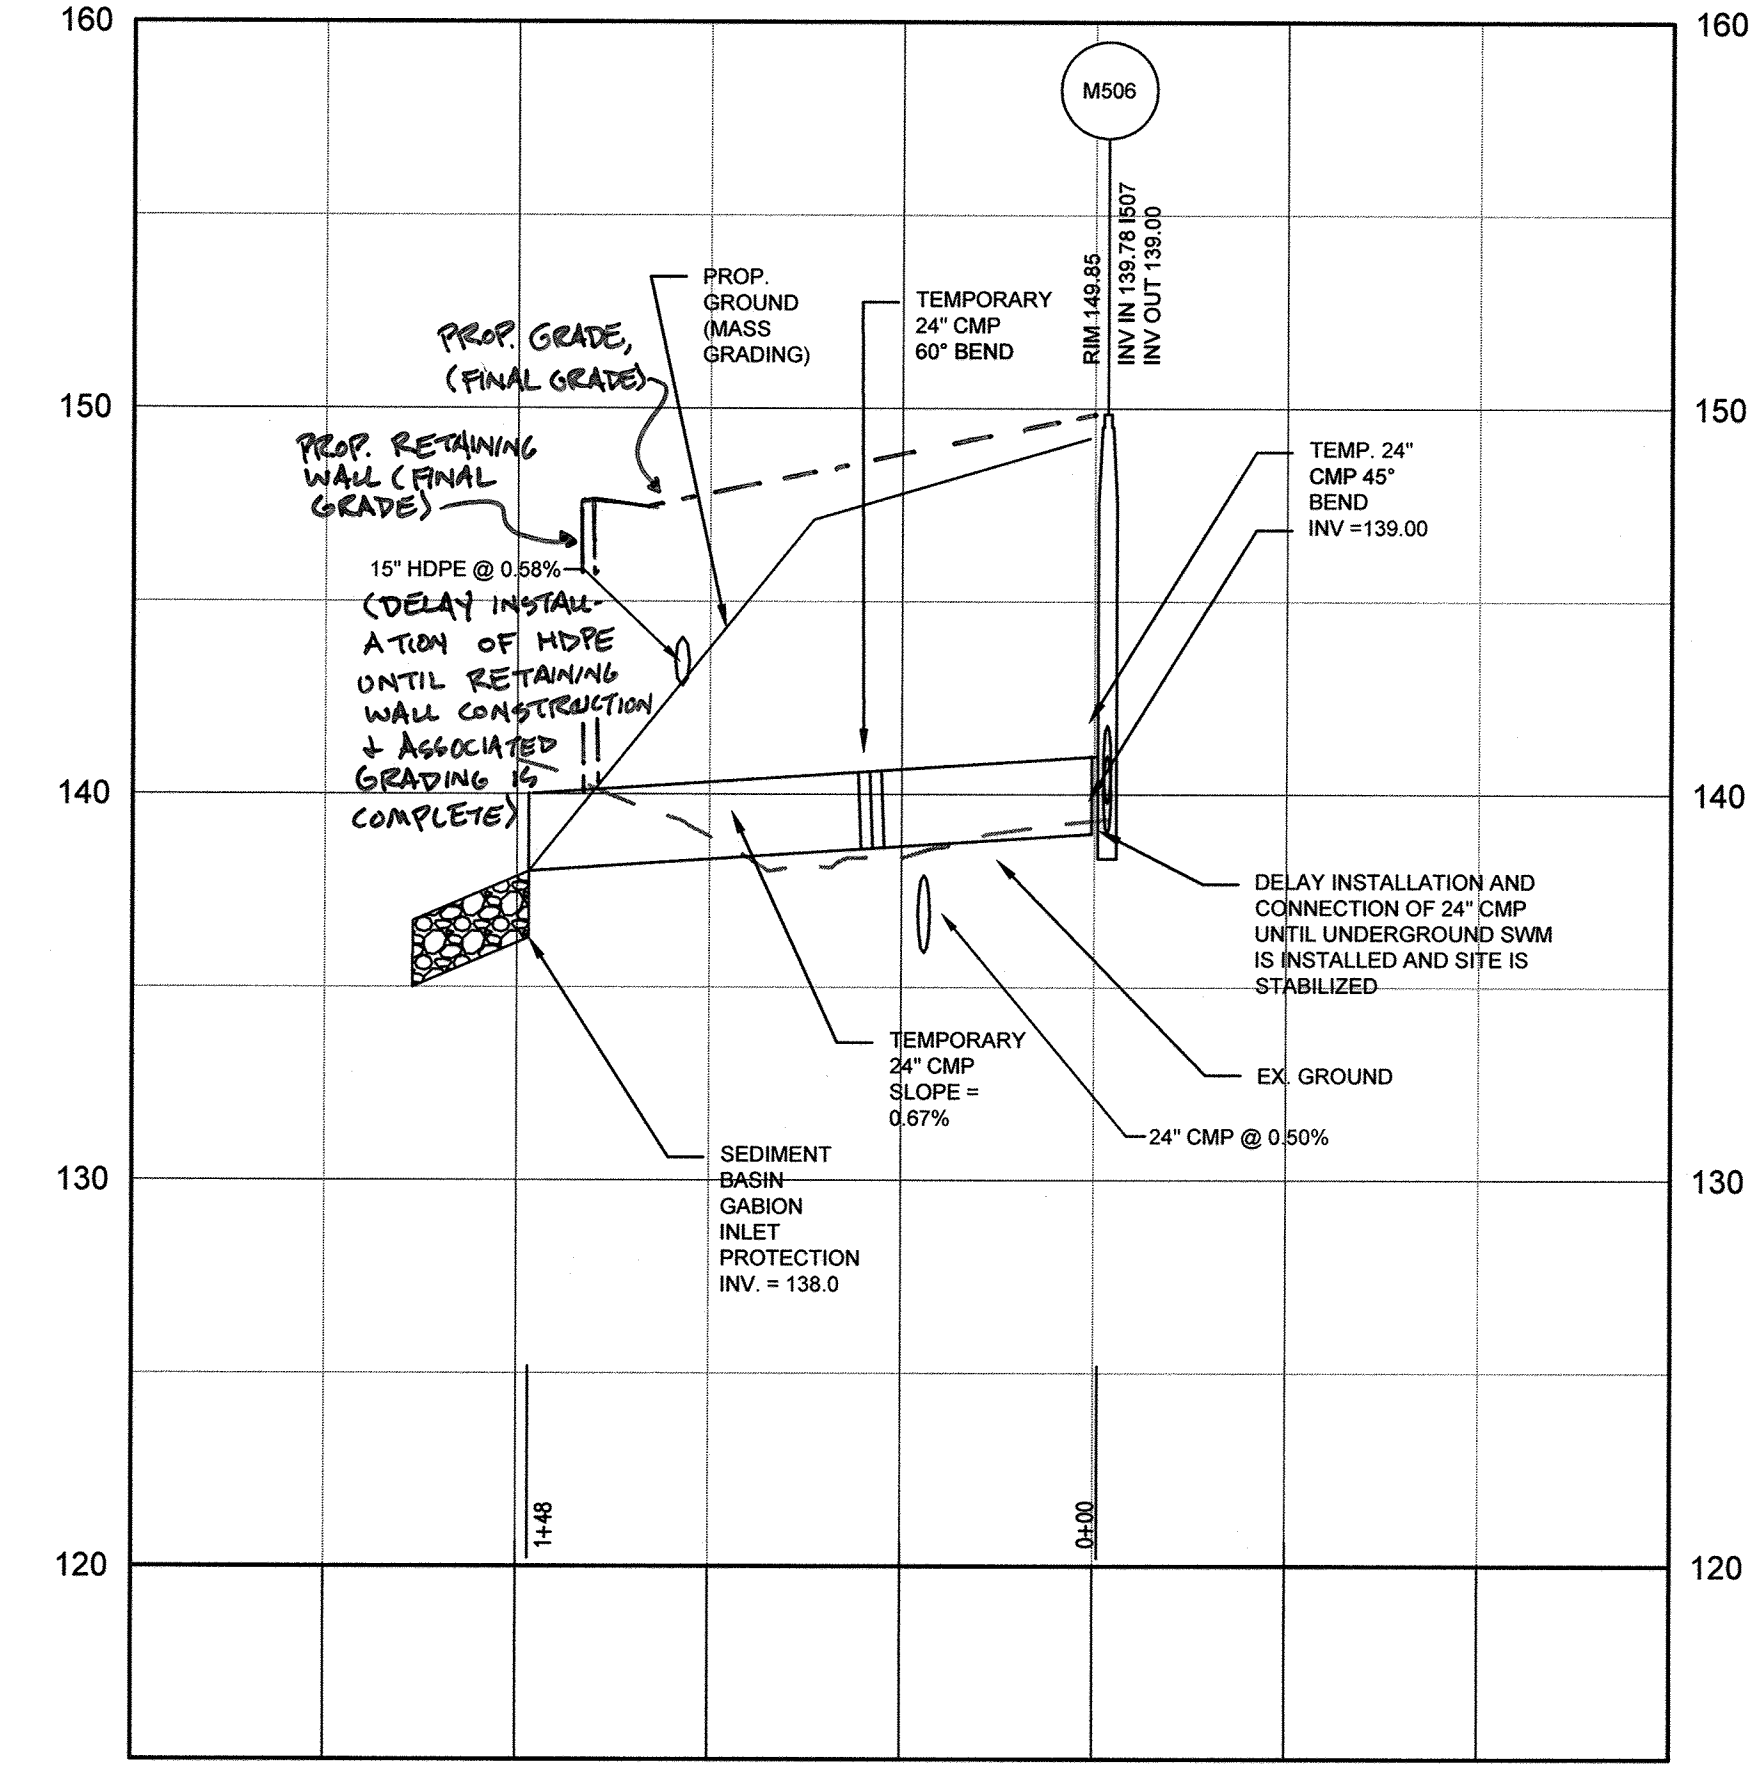

TEMP 24 CMP STORM DRAIN
HORIZONTAL SCALE: 1" = 50'
VERTICAL SCALE: 1" = 5'

AS-BUILT CERTIFICATION
NOTE: THERE IS NO "AS-BUILT" INFORMATION PROVIDED ON THIS SHEET.
Shawn K. Guiz
PRINTED NAME
36896
NO. P.E. NO.
7/8/19
DATE
SIGNATURE

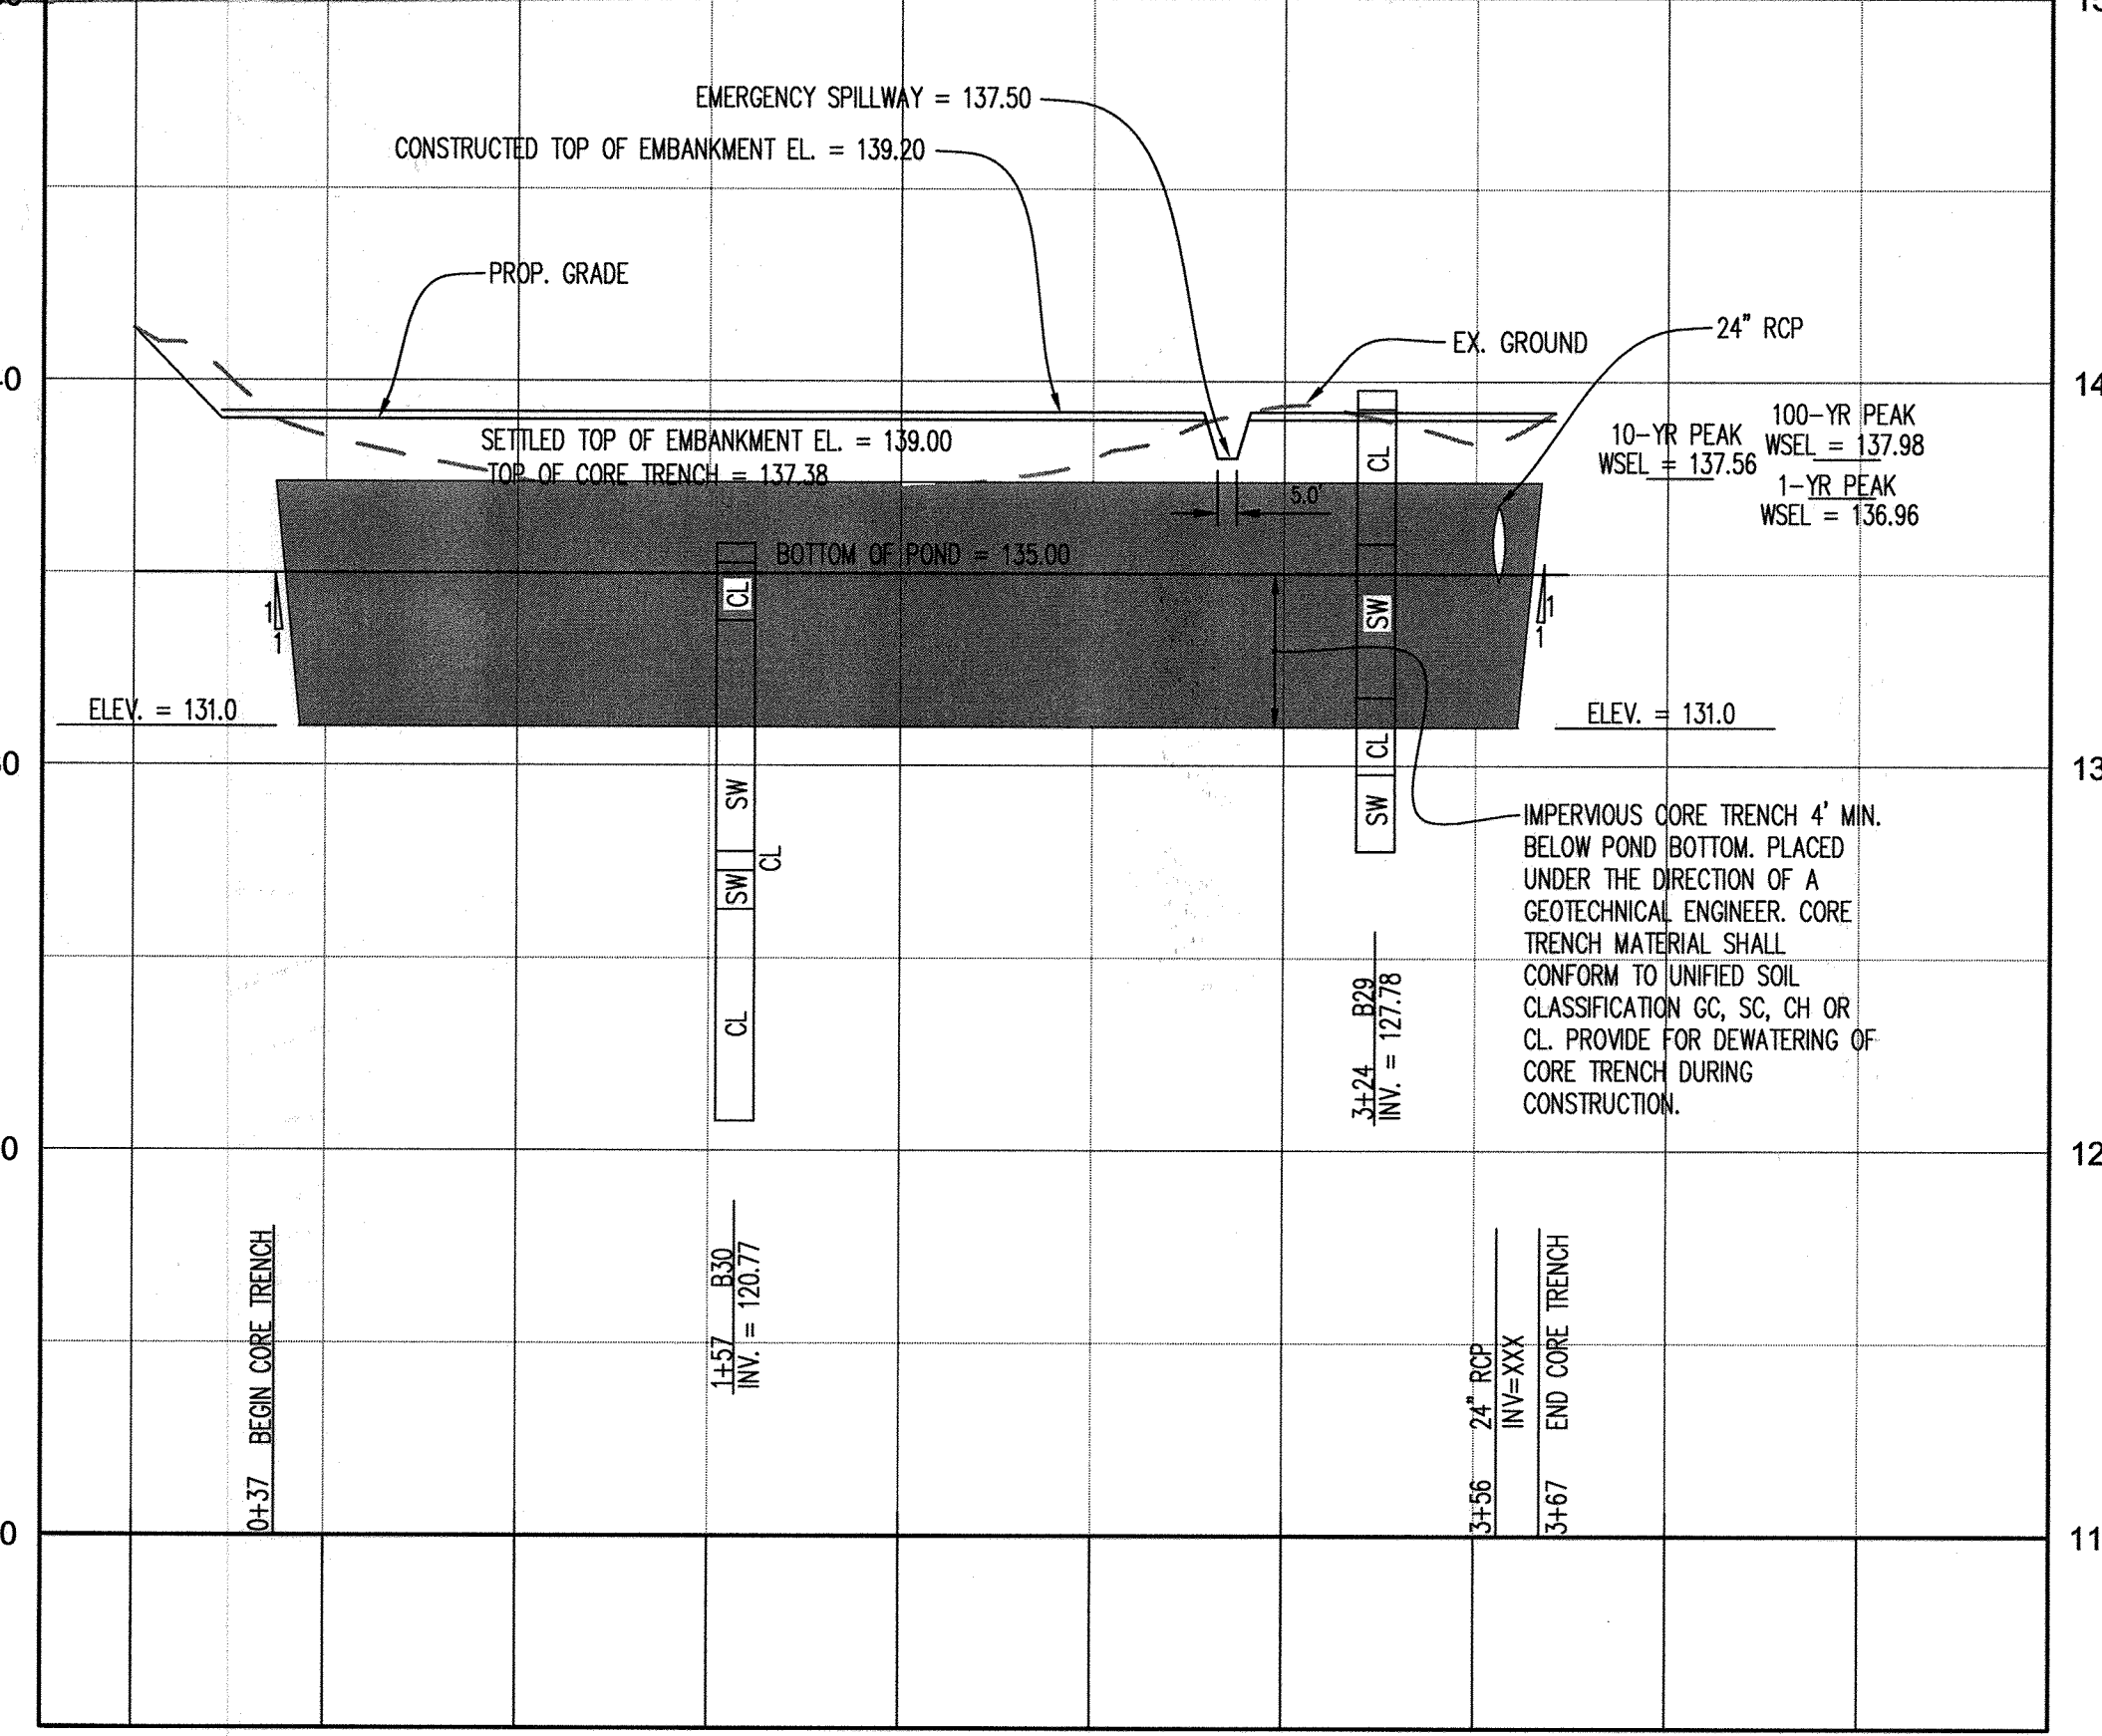

SEDIMENT BASIN # 1 CENTERLINE EMBANKMENT PROFILE

HORIZONTAL SCALE: 1" = 50'
VERTICAL SCALE: 1" = 5'

SEDIMENT BAFFLES-BASIN 1

SURFACE AREA OF BASIN AT RISER CREST = 24,116 SF
 $We = (AREA/2)^{1/2}$
 $We = (17,635/2)^{1/2} = 110 FT$
 $Le = \text{REQUIRED BAFFLE LENGTH}$
 $Le = 2(110) = 220 FT$
 PROVIDED BAFFLE LENGTH = 227 FT
 PROVIDED BAFFLE LENGTH IS GREATER THAN REQUIRED BAFFLE LENGTH, THEREFORE BAFFLE DESIGN REQUIREMENTS ARE MET

ENGINEER'S CERTIFICATE
I HEREBY CERTIFY THAT THIS PLAN HAS BEEN DESIGNED IN ACCORDANCE WITH CURRENT MARYLAND EROSION AND SEDIMENT CONTROL LAWS, REGULATIONS, AND STANDARDS, THAT IT REPRESENTS A PRACTICAL AND WORKABLE PLAN BASED ON MY PERSONAL KNOWLEDGE OF THE SITE, AND THAT IT WAS PREPARED IN ACCORDANCE WITH THE REQUIREMENTS OF THE HOWARD SOIL CONSERVATION DISTRICT.

Signature of Engineer: *Shawn K. Guiz*
DATE: 8/1/17

DEVELOPER'S CERTIFICATE
I/WE HEREBY CERTIFY THAT ANY CLEARING, GRADING, CONSTRUCTION, OR DEVELOPMENT WILL BE DONE PURSUANT TO THIS APPROVED EROSION AND SEDIMENT CONTROL PLAN, INCLUDING INSPECTING AND MAINTAINING CONTROLS, AND THAT THE RESPONSIBLE PERSONNEL INVOLVED IN THE CONSTRUCTION PROJECT WILL HAVE A CERTIFICATE OF TRAINING AT A MARYLAND DEPARTMENT OF THE ENVIRONMENT APPROVED TRAINING PROGRAM FOR THE CONTROL OF EROSION AND SEDIMENT PRIOR TO BEGINNING THE PROJECT. I CERTIFY RIGHT-OF-ENTRY FOR PERIODIC ON-SITE EVALUATION BY HOWARD COUNTY, THE HOWARD SOIL CONSERVATION DISTRICT AND/OR MDE.

Signature of Developer: *Jacqueline Carbone*
DATE: 8/1/17

THIS PLAN IS APPROVED FOR SOIL EROSION AND SEDIMENT CONTROL BY THE HOWARD SOIL CONSERVATION DISTRICT.

Signature: *John R. Robertson*
HOWARD SOIL CONSERVATION DISTRICT
DATE: 8/30/17

APPROVED: DEPARTMENT OF PLANNING AND ZONING
 Signature: *Paul Clark*
CHIEF, DEVELOPMENT ENGINEERING DIVISION
DATE: 9-22-17
 Signature: *Kate S. D...*
CHIEF, DIVISION OF LAND DEVELOPMENT
DATE: 9-27-17
 Signature: *Valaris J...*
DIRECTOR
DATE: 10-2-17

DATE	NO.	REVISION	BY

DEVELOPER: DCT INDUSTRIAL
12011 GUILFORD ROAD
SUITE 102
ANNAPOLIS JUNCTION, MD 20701
ATTN: FRED FERRARO
PHONE: 410-645-5020

OWNER: DCT MEARS LLC
12011 GUILFORD ROAD
SUITE 102
ANNAPOLIS JUNCTION, MD 20701
ATTN: FRED FERRARO
PHONE: 410-645-5020


PROJECT: TERRAPIN COMMERCE CENTER

AREA: TAX MAP 43, PARCEL 51 LOT PAR A PLAT 23793 ZONED M-2
GRID NO. 11 1st ELECTION DISTRICT
7200 DORSEY IRUN ROAD
ELKRIDGE, MARYLAND 21075
HOWARD COUNTY, MARYLAND

SEDIMENT CONTROL DETAILS

Pennoni Associates Inc.
Engineers • Surveyors • Planners
Landscape Architects
8818 Centre Park Drive, Suite 200 Columbia, MD 21045
T 410.997.8900 F 410.997.9282


DESIGNED BY: PJS
DRAWN BY: AGS/JSN
PROJECT NO: DCT1601
DATE: JUNE 23, 2017
SCALE: AS SHOWN
DRAWING NO. 7 OF 43

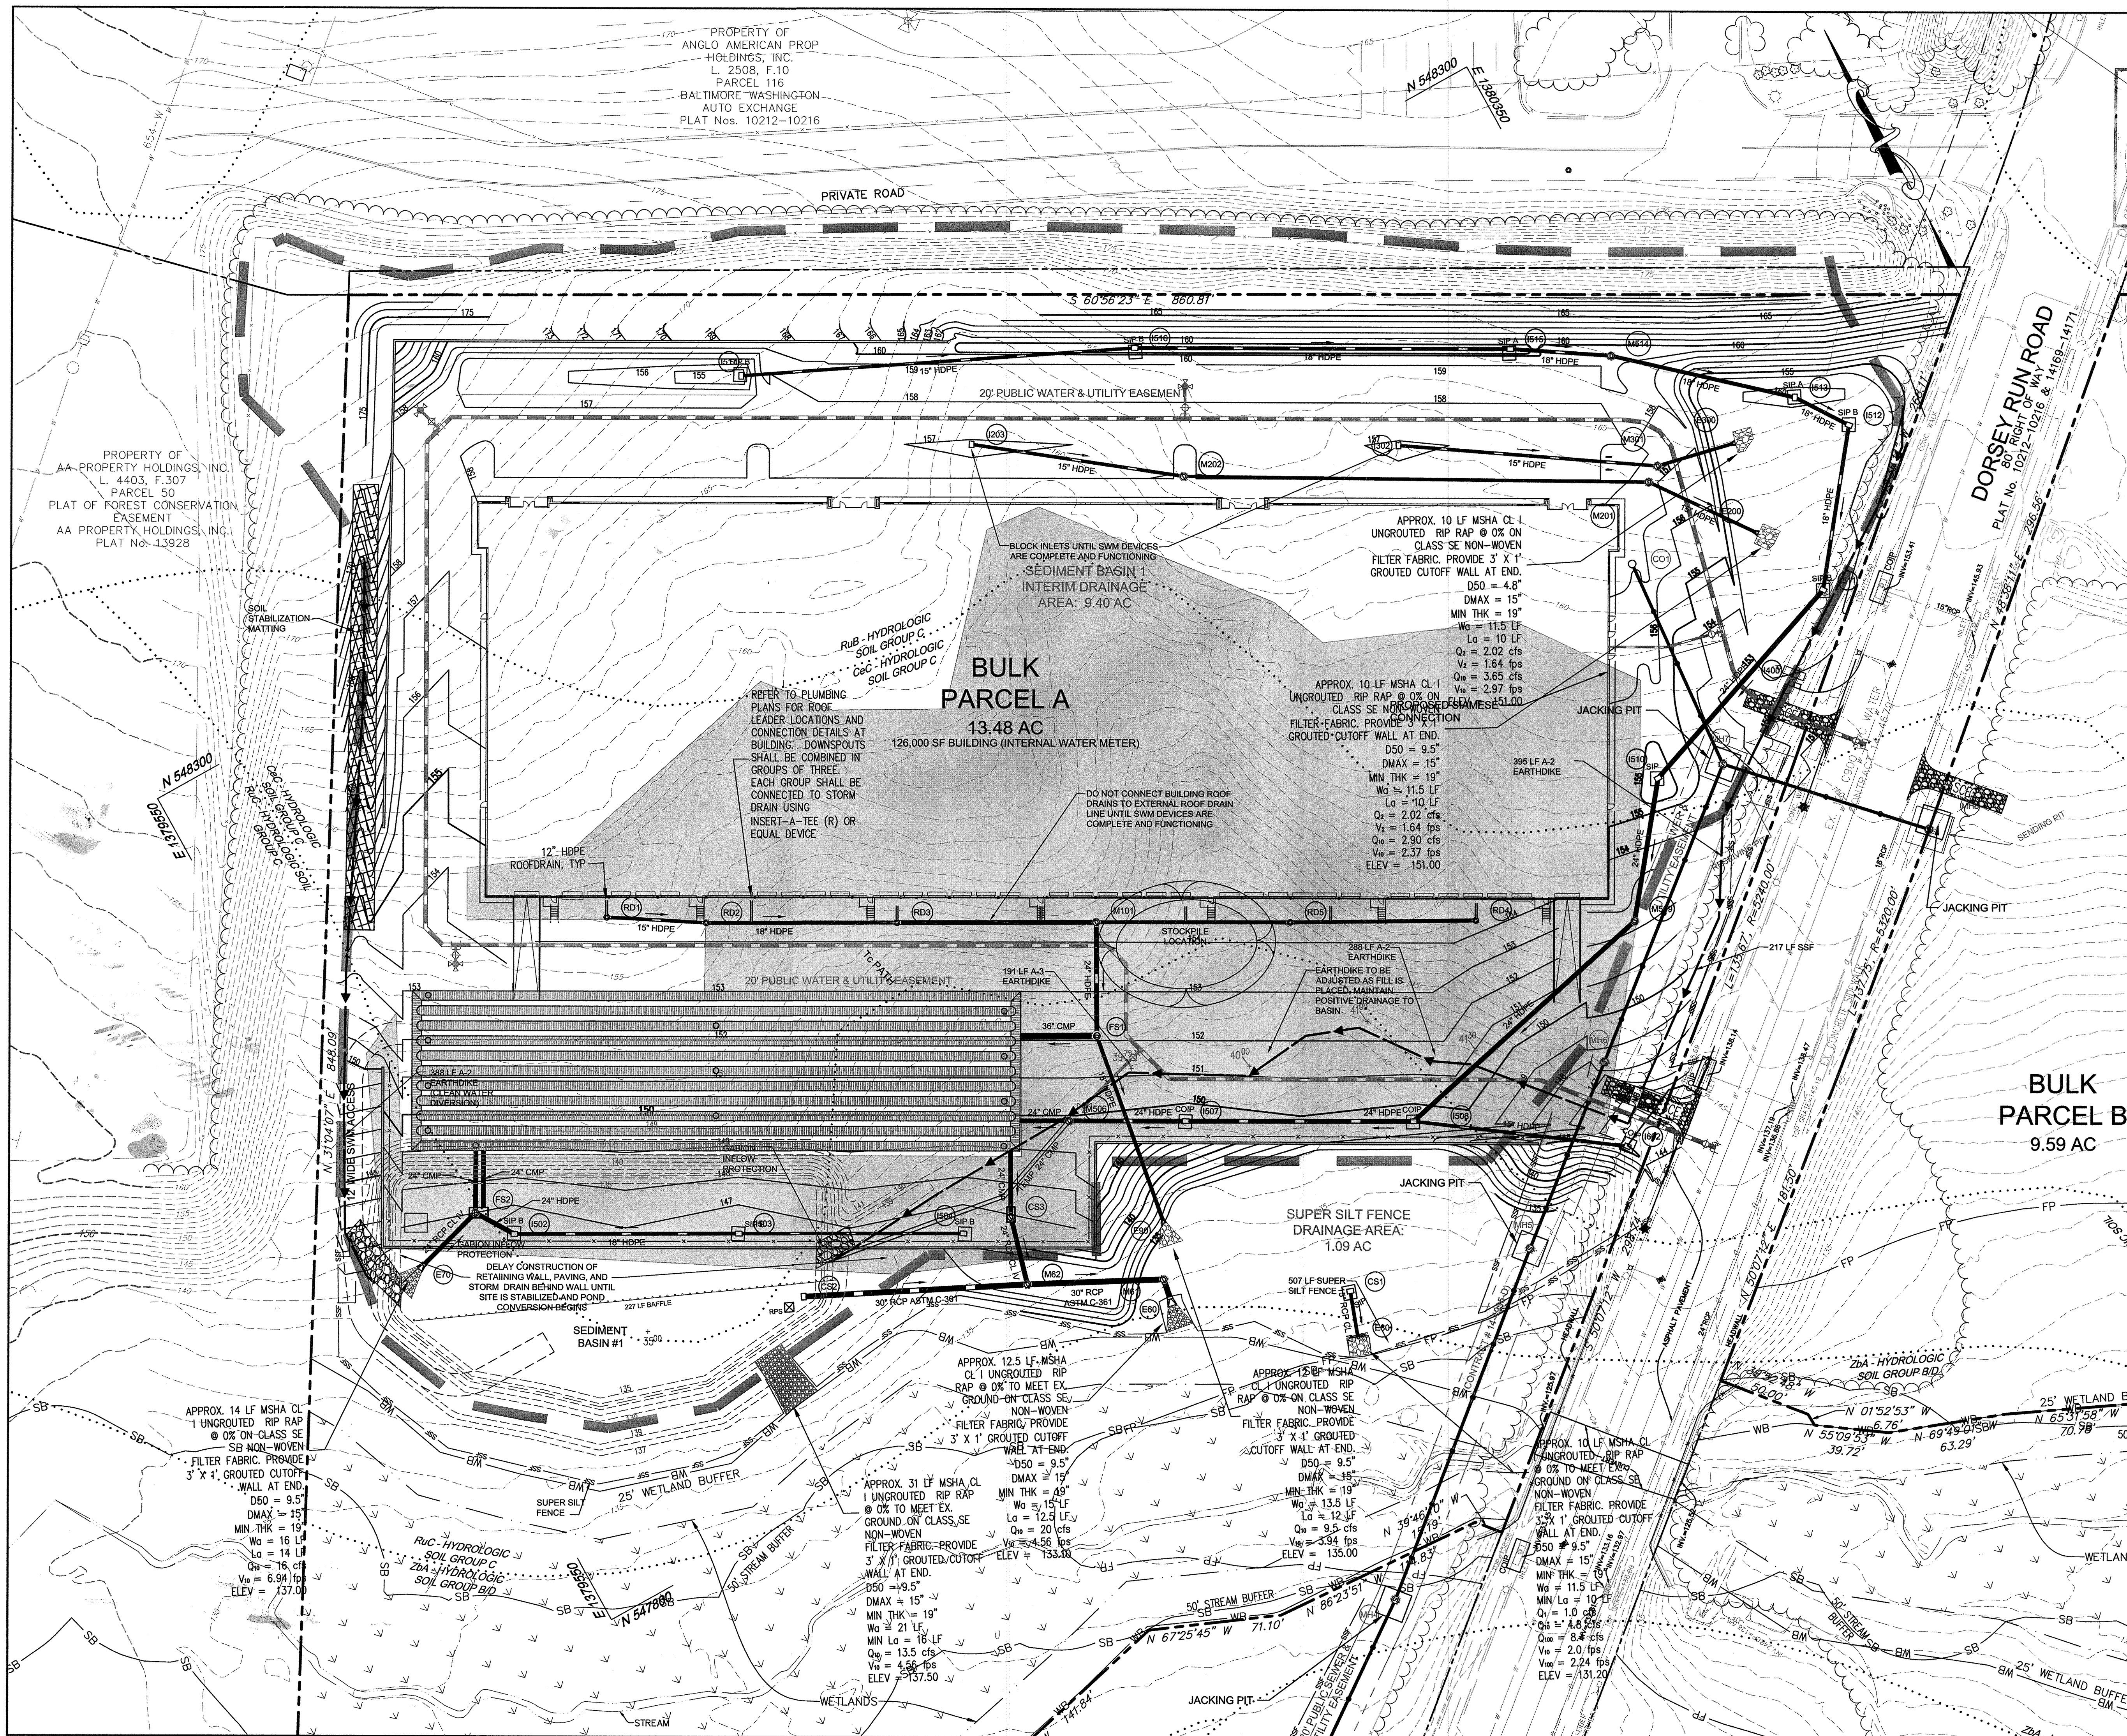

LEGEND
 SEE "GRADING AND SEDIMENT CONTROL PLAN - PHASE I" FOR LEGEND

AS-BUILT CERTIFICATION
 NOTE: THERE IS NO "AS-BUILT" INFORMATION PROVIDED ON THIS SHEET.

Signature: *Sharon L. Cruz* Date: 8/19/17
 MD. P.E. NO.: 36996

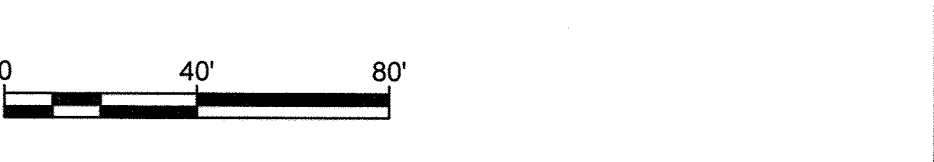

ENGINEER'S CERTIFICATE
 I HEREBY CERTIFY THAT THIS PLAN HAS BEEN DESIGNED IN ACCORDANCE WITH ALL APPLICABLE FEDERAL, STATE, AND LOCAL LAWS, REGULATIONS, AND STANDARDS, THAT IT REPRESENTS A PRACTICAL AND WORKABLE PLAN BASED ON MY PERSONAL KNOWLEDGE OF THE SITE, AND THAT IT WAS PREPARED IN ACCORDANCE WITH THE REQUIREMENTS OF THE HOWARD SOIL CONSERVATION DISTRICT.

Signature: *Sharon L. Cruz* Date: 8/20/17
 MD. P.E. NO.: 36996

DEVELOPER'S CERTIFICATE
 I HEREBY CERTIFY THAT ANY CLEARING, GRADING, CONSTRUCTION, OR DEVELOPMENT WILL BE DONE PURSUANT TO THIS APPROVED EROSION AND SEDIMENT CONTROL PLAN, INCLUDING INSPECTING AND MAINTAINING CONTROLS, AND THAT THE RESPONSIBLE PERSONNEL INVOLVED IN THE CONSTRUCTION PROJECT WILL HAVE A CERTIFICATE OF TRAINING AT A MARYLAND DEPARTMENT OF THE ENVIRONMENT APPROVED TRAINING PROGRAM FOR THE CONTROL ON EROSION AND SEDIMENT PRIOR TO BEGINNING THE PROJECT. I CERTIFY RIGHT-OF-ENTRY FOR PERIODIC ON-SITE EVALUATION BY HOWARD COUNTY, THE HOWARD SOIL CONSERVATION DISTRICT AND/OR MDE.

Signature: *Jacqueline Carbone* Date: 8/1/17
 MD. P.E. NO.: 36996

THIS PLAN IS APPROVED FOR SOIL EROSION AND SEDIMENT CONTROL BY THE HOWARD SOIL CONSERVATION DISTRICT.

Signature: *John R. Robertson* Date: 8/30/17
 HOWARD SOIL CONSERVATION DISTRICT

APPROVED: DEPARTMENT OF PLANNING AND ZONING

Signature: *David Palmer* Date: 9-22-17
 CHIEF, DEVELOPMENT ENGINEERING DIVISION

Signature: *Walter S. D'Amico* Date: 9-27-17
 CHIEF, DIVISION OF LAND DEVELOPMENT

Signature: *Walter S. D'Amico* Date: 10-2-17
 DIRECTOR

DATE	NO.	REVISION	BY
DEVELOPER			
DCT INDUSTRIAL 12011 GUILFORD ROAD SUITE 102 ANNAPOLIS JUNCTION, MD 20701 ATTN: FRED FERRARO PHONE: 410-645-5020			
OWNER			
DCT MEARS LLC 12011 GUILFORD ROAD SUITE 102 ANNAPOLIS JUNCTION, MD 20701 ATTN: FRED FERRARO PHONE: 410-645-5020			
PROJECT			
TERRAPIN COMMERCE CENTER			
AREA			
TAX MAP 43, PARCEL 51 LOT PAR A PLAT 23793 ZONED M-2 GRID NO. 11 1st ELECTION DISTRICT 7200 DORSEY RUN ROAD ELKRIDGE, MARYLAND 21075 HOWARD COUNTY, MARYLAND			

TITLE
 GRADING AND SEDIMENT CONTROL PLAN - PHASE II


Pennoni
 Pennoni Associates Inc.
 Engineers • Surveyors • Planners
 Landscape Architects

8818 Centre Park Drive, Suite 200 Columbia, MD 21045
 T 410.997.8900 F 410.997.9282

SEAL:

BY: *Sharon L. Cruz* Date: 8/22/17

DESIGNED BY: PJS
 DRAWN BY: AGS/JSN
 PROJECT NO.: DCTI1601
 DATE: JUNE 23, 2017
 SCALE: 1" = 40'
 DRAWING NO.: 8 OF 43

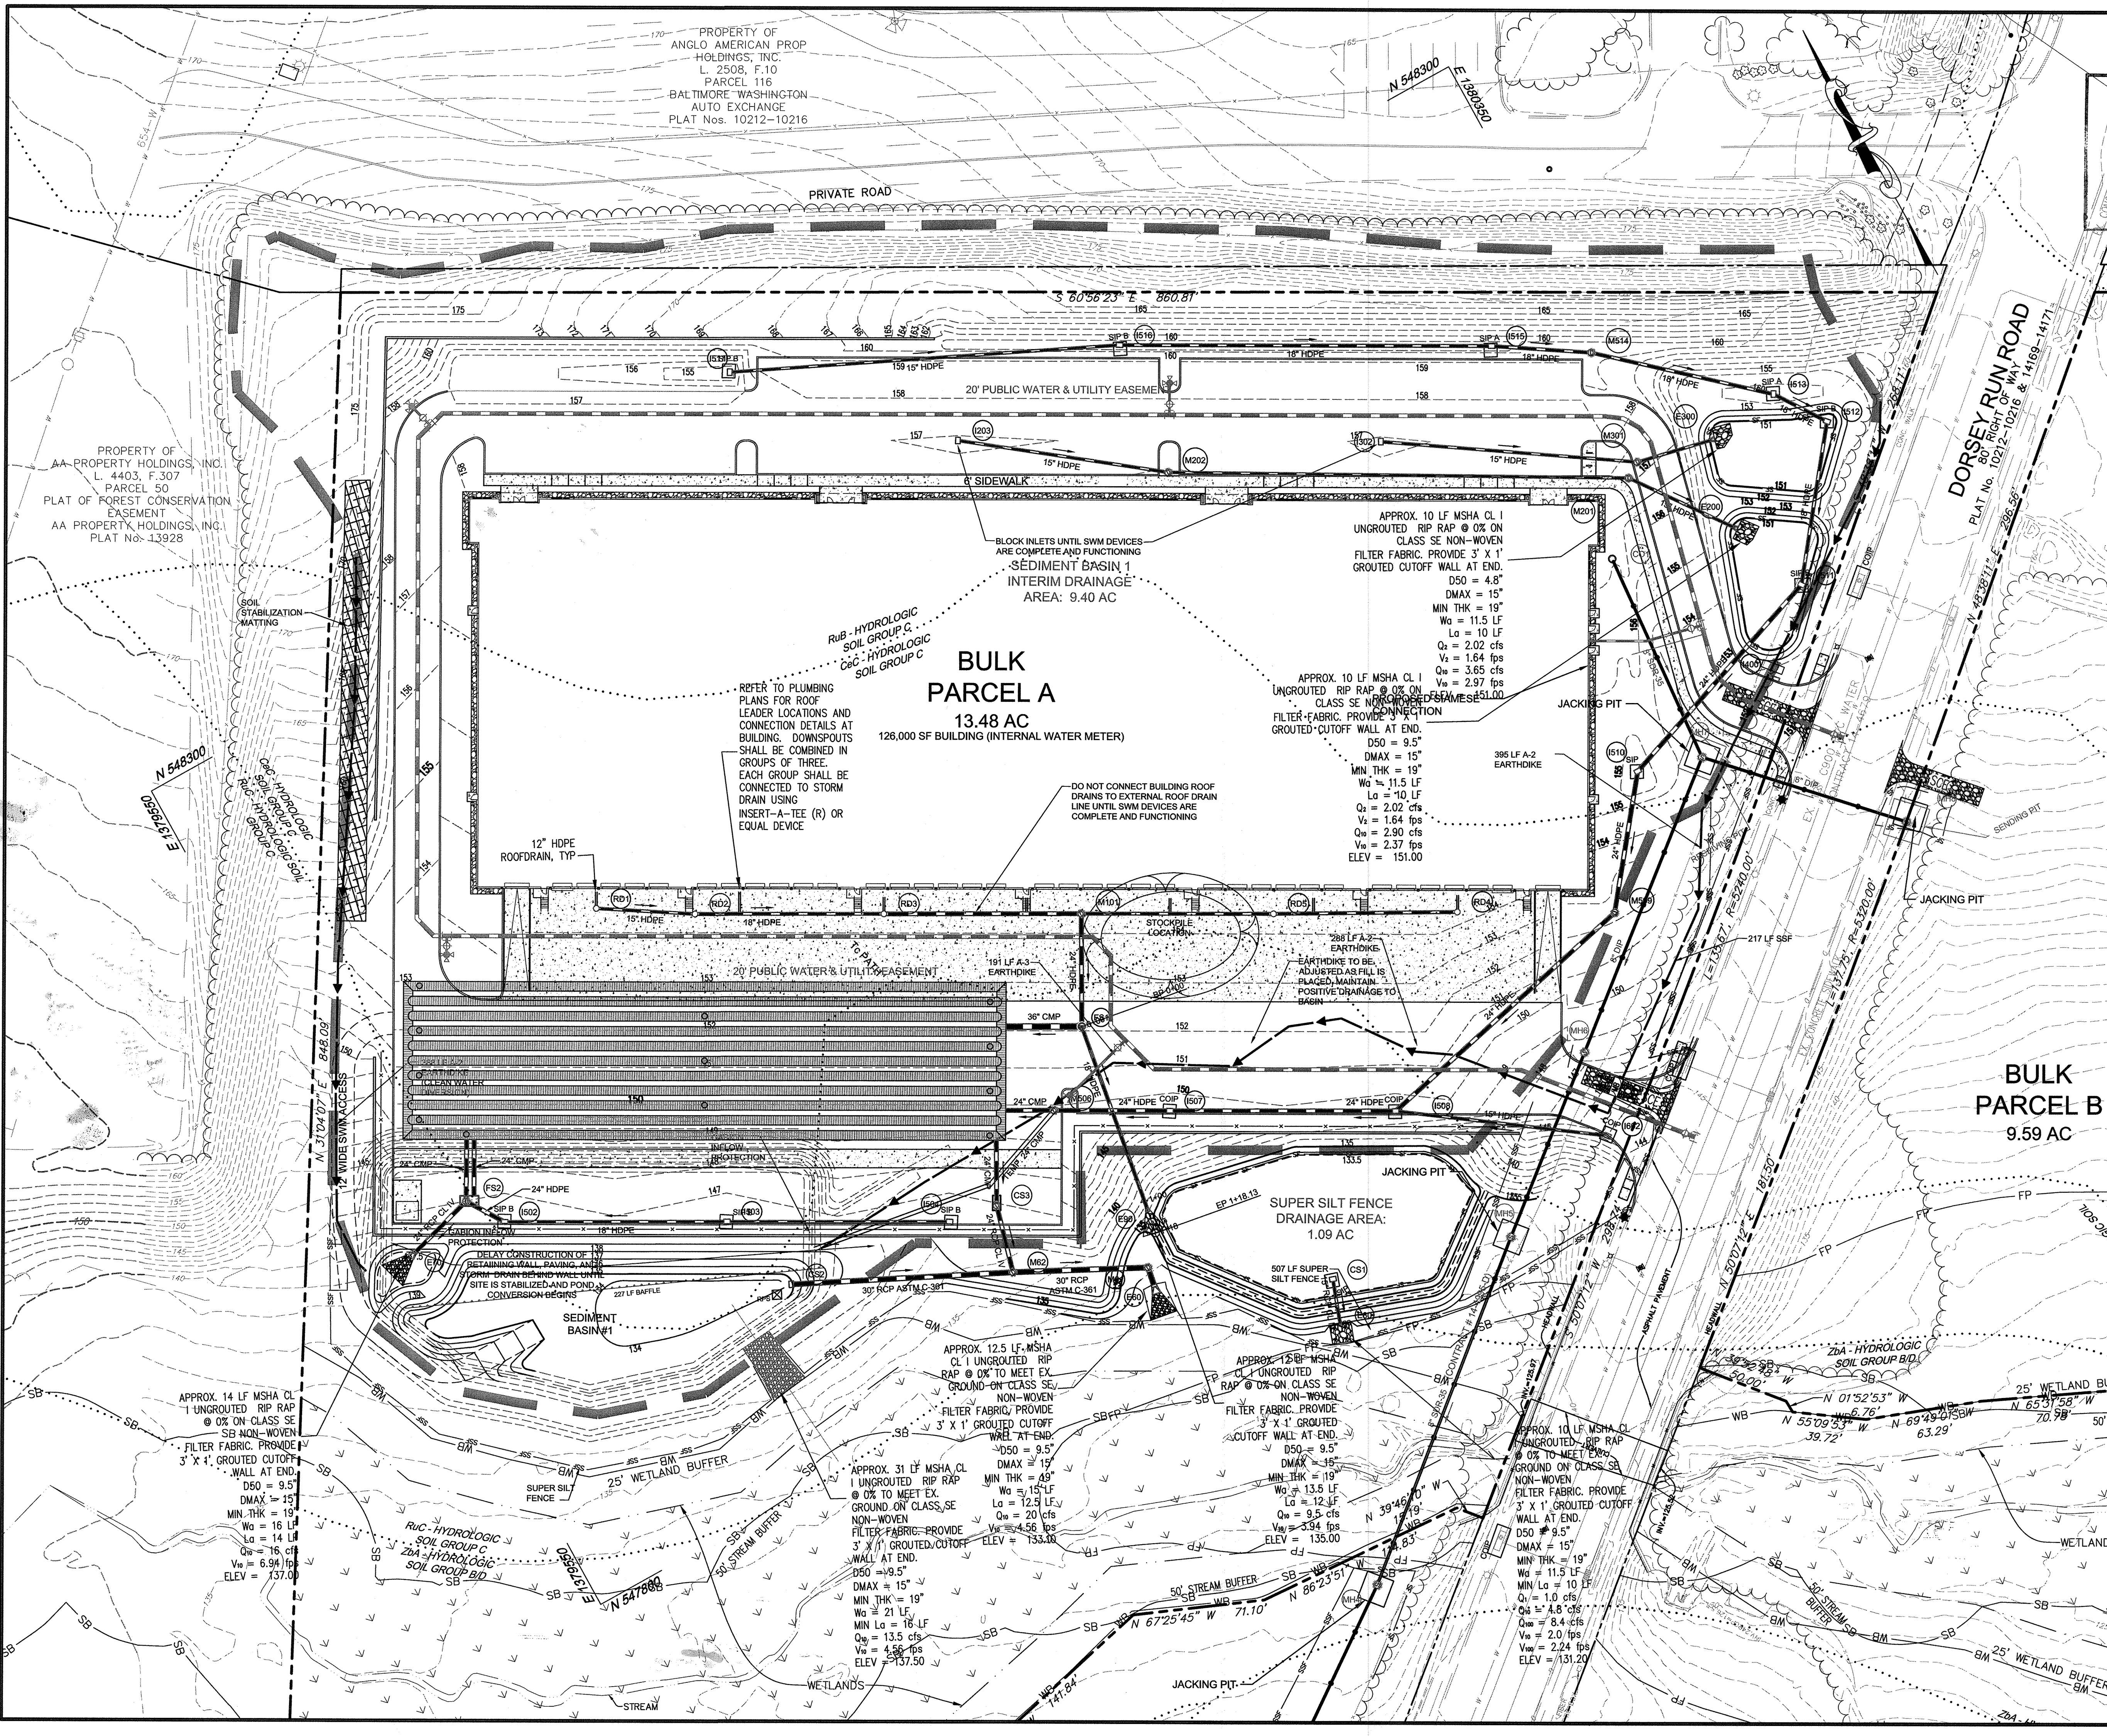

LEGEND
SEE 'GRADING AND SEDIMENT CONTROL PLAN - PHASE I' FOR LEGEND

AS-BUILT CERTIFICATION
NOTE: THERE IS NO 'AS-BUILT' INFORMATION PROVIDED ON THIS SHEET.

PRINTED NAME: *Shawn Cruz* 36996 MD. P.E. NO.
SIGNATURE: *Shawn Cruz* 7/27/19 DATE

ENGINEER'S CERTIFICATE
I HEREBY CERTIFY THAT THIS PLAN HAS BEEN DESIGNED IN ACCORDANCE WITH CURRENT MARYLAND EROSION AND SEDIMENT CONTROL LAWS, REGULATIONS, AND STANDARDS, THAT IT REPRESENTS A PRACTICAL AND WORKABLE PLAN BASED ON MY PERSONAL KNOWLEDGE OF THE SITE, AND THAT IT WAS PREPARED IN ACCORDANCE WITH THE REQUIREMENTS OF THE HOWARD SOIL CONSERVATION DISTRICT.

SIGNATURE OF ENGINEER: *Shawn Cruz* (PRINT NAME BELOW SIGNATURE) DATE: 8/1/17

DEVELOPER'S CERTIFICATE
I/WE HEREBY CERTIFY THAT ANY CLEARING, GRADING, CONSTRUCTION, OR DEVELOPMENT WILL BE DONE PURSUANT TO THIS APPROVED EROSION AND SEDIMENT CONTROL PLAN, INCLUDING INSPECTING AND MAINTAINING CONTROLS, AND THAT THE RESPONSIBLE PERSONNEL INVOLVED IN THE CONSTRUCTION PROJECT WILL HAVE A CERTIFICATE OF TRAINING AT A MARYLAND DEPARTMENT OF THE ENVIRONMENT APPROVED TRAINING PROGRAM FOR THE CONTROL ON EROSION AND SEDIMENT PRIOR TO BEGINNING THE PROJECT. I CERTIFY RIGHT-OF-ENTRY FOR PERIODIC ON-SITE EVALUATION BY HOWARD COUNTY, THE HOWARD SOIL CONSERVATION DISTRICT AND/OR MDE.

SIGNATURE OF DEVELOPER: *Jacqueline Carbone* (PRINT NAME BELOW SIGNATURE) DATE: 8/1/17

THIS PLAN IS APPROVED FOR SOIL EROSION AND SEDIMENT CONTROL BY THE HOWARD SOIL CONSERVATION DISTRICT.

SIGNATURE: *John R. Robertson* (PRINT NAME BELOW SIGNATURE) DATE: 8/30/17
HOWARD SOIL CONSERVATION DISTRICT

APPROVED: DEPARTMENT OF PLANNING AND ZONING
SIGNATURE: *David E. ...* DATE: 9-22-17
CHIEF, DEVELOPMENT ENGINEERING DIVISION

SIGNATURE: *West ...* DATE: 9-27-17
CHIEF, DIVISION OF LAND DEVELOPMENT

SIGNATURE: *Walter ...* DATE: 10-2-17
DIRECTOR

DATE	NO.	REVISION	BY
		DCT INDUSTRIAL 12011 GUILFORD ROAD SUITE 102 ANNAPOLIS JUNCTION, MD 20701 ATTN: FRED FERRARO PHONE: 410-645-5020	
		DCT MEARS LLC 12011 GUILFORD ROAD SUITE 102 ANNAPOLIS JUNCTION, MD 20701 ATTN: FRED FERRARO PHONE: 410-645-5020	
		TERRAPIN COMMERCE CENTER	
		TAX MAP 43, PARCEL 51 LOT PAR A PLAT 23785 ZONED M-2 GRID NO. 11 1st ELECTION DISTRICT 7200 DORSEY RUN ROAD ELKRIDGE, MARYLAND 21075 HOWARD COUNTY, MARYLAND	
		GRADING AND SEDIMENT CONTROL PLAN - PHASE III	

Pennoni Associates Inc.
Pennoni Engineers • Surveyors • Planners
Landscape Architects

8818 Centre Park Drive, Suite 200 Columbia, MD 21045
T 410.997.8900 F 410.997.9282

DESIGNED BY: PJS
DRAWN BY: AGS/JSN
PROJECT NO.: DCT1801
DATE: JUNE 23, 2017
SCALE: 1" = 40'
DRAWING NO. 9 OF 43

SDP-17-030

B-4-2 STANDARDS AND SPECIFICATIONS FOR SOIL PREPARATION, TOPSOILING, AND SOIL AMENDMENTS

DEFINITION
THE PROCESS OF PREPARING THE SOILS TO SUSTAIN ADEQUATE VEGETATIVE STABILIZATION.

PURPOSE
TO PROVIDE A SUITABLE SOIL MEDIUM FOR VEGETATIVE GROWTH.

CONDITIONS WHERE PRACTICE APPLIES
WHERE VEGETATIVE STABILIZATION IS TO BE ESTABLISHED.

CRITERIA

- A. SOIL PREPARATION**
- TEMPORARY STABILIZATION**
 - SEEDBED PREPARATION CONSISTS OF LOOSENING SOIL TO A DEPTH OF 3 TO 5 INCHES BY MEANS OF SUITABLE AGRICULTURAL OR CONSTRUCTION EQUIPMENT, SUCH AS DISC HARROWS OR CHISEL PLOWS OR RIPPER MOUNTED ON CONSTRUCTION EQUIPMENT. AFTER THE SOIL IS LOOSEND, IT MUST NOT BE ROLLED OR DRAGGED SMOOTH BUT LEFT IN THE ROUGHENED CONDITION. SLOPES 3:1 OR FLATTER ARE TO BE TRACKED WITH RIDGES RUNNING PARALLEL TO THE CONTOUR OF THE SLOPE.
 - APPLY FERTILIZER AND LIME AS PRESCRIBED ON THE PLANS.
 - INCORPORATE LIME AND FERTILIZER INTO THE TOP 3 TO 5 INCHES OF SOIL BY DISKING OR OTHER SUITABLE MEANS.
 - PERMANENT STABILIZATION**
 - A SOIL TEST IS REQUIRED FOR ANY EARTH DISTURBANCE OF 5 ACRES OR MORE. THE MINIMUM SOIL CONDITIONS REQUIRED FOR PERMANENT VEGETATIVE ESTABLISHMENT ARE:
 - SOIL PH BETWEEN 6.0 AND 7.0.
 - SOLUBLE SALTS LESS THAN 500 PARTS PER MILLION (PPM).
 - SOIL CONTAINS LESS THAN 40 PERCENT CLAY BUT ENOUGH FINE GRAINED MATERIAL (GREATER THAN 30 PERCENT SILT PLUS CLAY) TO PROVIDE THE CAPACITY TO HOLD A MODERATE AMOUNT OF MOISTURE. AN EXCEPTION: IF LOVEGRASS WILL BE PLANTED, THEN A SANDY SOIL (LESS THAN 30 PERCENT SILT PLUS CLAY) WOULD BE ACCEPTABLE.
 - SOIL CONTAINS 1.5 PERCENT MINIMUM ORGANIC MATTER BY WEIGHT.
 - SOIL CONTAINS SUFFICIENT PORE SPACE TO PERMIT ADEQUATE ROOT PENETRATION.
 - APPLICATION OF AMENDMENTS OR TOPSOIL IS REQUIRED IF ON-SITE SOILS DO NOT MEET THE ABOVE CONDITIONS.
 - GRADED AREAS MUST BE MAINTAINED IN A TRUE AND EVEN GRADE AS SPECIFIED ON THE APPROVED PLAN, THEN SCARIFIED OR OTHERWISE LOOSEND TO A DEPTH OF 3 TO 5 INCHES.
 - APPLY SOIL AMENDMENTS AS SPECIFIED ON THE APPROVED PLAN OR AS INDICATED BY THE RESULTS OF A SOIL TEST.
 - MIX SOIL AMENDMENTS INTO THE TOP 3 TO 5 INCHES OF SOIL BY DISKING OR OTHER SUITABLE MEANS. RAKE LAWN AREAS TO SMOOTH THE SURFACE, REMOVE LARGE OBJECTS LIKE STONES AND BRANCHES, AND READY THE AREA FOR SEED APPLICATION. LOOSEN SURFACE SOIL BY DRAGGING WITH A HEAVY CHAIN OR OTHER EQUIPMENT TO ROUGHEN THE SURFACE WHERE SITE CONDITIONS WILL NOT PERMIT NORMAL SEEDBED PREPARATION. TRACK SLOPES 3:1 OR FLATTER WITH TRACKED EQUIPMENT LEAVING THE SOIL IN AN IRREGULAR CONDITION WITH RIDGES RUNNING PARALLEL TO THE CONTOUR OF THE SLOPE. LEAVE THE TOP 1 TO 3 INCHES OF SOIL LOOSE AND FRABLE. SEEDBED LOOSENING MAY BE UNNECESSARY ON NEWLY DISTURBED AREAS.

- B. TOPSOILING**
- TOPSOIL IS PLACED OVER PREPARED SUBSOIL PRIOR TO ESTABLISHMENT OF PERMANENT VEGETATION. THE PURPOSE IS TO PROVIDE A SUITABLE SOIL MEDIUM FOR VEGETATIVE GROWTH. SOILS OF CONCERN HAVE LOW MOISTURE CONTENT, LOW NUTRIENT LEVELS, LOW PH, MATERIALS TOXIC TO PLANTS, AND/OR UNACCEPTABLE SOIL GRADATION.
 - TOPSOIL SALVAGED FROM AN EXISTING SITE MAY BE USED PROVIDED IT MEETS THE STANDARDS AS SET FORTH IN THESE SPECIFICATIONS. TYPICALLY, THE DEPTH OF TOPSOIL TO BE SALVAGED FOR A GIVEN SOIL TYPE CAN BE FOUND IN THE REPRESENTATIVE SOIL PROFILE SECTION IN THE SOIL SURVEY PUBLISHED BY USDA-NRCS.
 - TOPSOILING IS LIMITED TO AREAS HAVING 2:1 OR FLATTER SLOPES WHERE:
 - THE TEXTURE OF THE EXPOSED SUBSOIL/PARENT MATERIAL IS NOT ADEQUATE TO PRODUCE VEGETATIVE GROWTH.
 - THE SOIL MATERIAL IS SO SHALLOW THAT THE ROOTING ZONE IS NOT DEEP ENOUGH TO SUPPORT PLANTS OR FURNISH CONTINUING SUPPLIES OF MOISTURE AND PLANT NUTRIENTS.
 - THE ORIGINAL SOIL TO BE VEGETATED CONTAINS MATERIAL TOXIC TO PLANT GROWTH.
 - THE SOIL IS SO ACIDIC THAT TREATMENT WITH LIMESTONE IS NOT FEASIBLE.
 - AREAS HAVING SLOPES STEEPER THAN 2:1 REQUIRE SPECIAL CONSIDERATION AND DESIGN.
 - TOPSOIL SPECIFICATIONS: SOIL TO BE USED AS TOPSOIL MUST MEET THE FOLLOWING CRITERIA:
 - TOPSOIL MUST BE A LOAM, SANDY LOAM, CLAY LOAM, SILT LOAM, SANDY CLAY LOAM, OR LOAMY SAND. OTHER SOILS MAY BE USED IF RECOMMENDED BY AN AGRONOMIST OR SOIL SCIENTIST AND APPROVED BY THE APPROPRIATE APPROVAL AUTHORITY. TOPSOIL MUST NOT BE A MIXTURE OF CONTRASTING TEXTURED SUBSOILS AND MUST CONTAIN LESS THAN 5 PERCENT BY VOLUME OF ONIERS, STONES, SLAG, COARSE FRAGMENTS, GRAVEL, STICKS, ROOTS, TRASH, OR OTHER MATERIALS LARGER THAN 1 1/2 INCHES IN DIAMETER.
 - TOPSOIL MUST BE FREE OF NOXIOUS PLANTS OR PLANT PARTS SUCH AS BERMUDA GRASS, QUACK GRASS, JOHNSON GRASS, NUT SEDGE, POISON IVY, THISTLE, OR OTHERS AS SPECIFIED.
 - TOPSOIL SUBSTITUTES OR AMENDMENTS, AS RECOMMENDED BY A QUALIFIED AGRONOMIST OR SOIL SCIENTIST AND APPROVED BY THE APPROPRIATE APPROVAL AUTHORITY, MAY BE USED IN LIEU OF NATURAL TOPSOIL.
 - TOPSOIL APPLICATION
 - EROSION AND SEDIMENT CONTROL PRACTICES MUST BE MAINTAINED WHEN APPLYING TOPSOIL.
 - UNIFORMLY DISTRIBUTE TOPSOIL IN A 5 TO 8 INCH LAYER AND LIGHTLY COMPACT TO A MINIMUM THICKNESS OF 4 INCHES. SPREADING IS TO BE PERFORMED IN SUCH A MANNER THAT SOODING OR SEEDING CAN PROCEED WITH A MINIMUM OF

ADDITIONAL SOIL PREPARATION AND TILLAGE. ANY IRREGULARITIES IN THE SURFACE RESULTING FROM TOPSOILING OR OTHER OPERATIONS MUST BE CORRECTED IN ORDER TO PREVENT THE FORMATION OF DEPRESSIONS OR WATER POCKETS.

- TOPSOIL MUST NOT BE PLACED IF THE TOPSOIL OR SUBSOIL IS IN A FROZEN OR MUDDY CONDITION, WHEN THE SUBSOIL IS EXCESSIVELY WET OR IN A CONDITION THAT MAY OTHERWISE BE DETRIMENTAL TO PROPER GRADING AND SEEDBED PREPARATION.
- SOIL AMENDMENTS (FERTILIZER AND LIME SPECIFICATIONS)
 - SOIL TESTS MUST BE PERFORMED TO DETERMINE THE EXACT RATIOS AND APPLICATION RATES FOR BOTH LIME AND FERTILIZER ON SITES HAVING DISTURBED AREAS OF 5 ACRES OR MORE. SOIL ANALYSIS MAY BE PERFORMED BY A RECOGNIZED PRIVATE OR COMMERCIAL LABORATORY. SOIL SAMPLES TAKEN FOR ENGINEERING PURPOSES MAY ALSO BE USED FOR CHEMICAL ANALYSES.
 - FERTILIZERS MUST BE UNIFORM IN COMPOSITION, FREE FLOWING AND SUITABLE FOR ACCURATE APPLICATION BY APPROPRIATE EQUIPMENT. MANURE MAY BE SUBSTITUTED FOR FERTILIZER WITH PRIOR APPROVAL FROM THE APPROPRIATE APPROVAL AUTHORITY. FERTILIZERS MUST ALL BE DELIVERED TO THE SITE FULLY LABELED ACCORDING TO THE APPLICABLE LAWS AND MUST BEAR THE NAME, TRADE NAME OR TRADEMARK AND WARRANTY OF THE PRODUCER.
 - LIME MATERIALS MUST BE GROUND LIMESTONE (HYDRATED OR BURNT LIME MAY BE SUBSTITUTED EXCEPT WHEN HYDROSEEDING) WHICH CONTAINS AT LEAST 50 PERCENT TOTAL OXIDES (CALCIUM OXIDE PLUS MAGNESIUM OXIDE). LIMESTONE MUST BE GROUND TO SUCH FINENESS THAT AT LEAST 50 PERCENT WILL PASS THROUGH A #100 MESH SIEVE AND 98 TO 100 PERCENT WILL PASS THROUGH A #20 MESH SIEVE.
 - LIME AND FERTILIZER ARE TO BE EVENLY DISTRIBUTED AND INCORPORATED INTO THE TOP 3 TO 5 INCHES OF SOIL BY DISKING OR OTHER SUITABLE MEANS.
 - WHERE THE SUBSOIL IS EITHER HIGHLY ACIDIC OR COMPOSED OF HEAVY CLAYS, SPREAD GROUND LIMESTONE AT THE RATE OF 4 TO 8 TONS/ACRE (200-400 POUNDS PER 1,000 SQUARE FEET) PRIOR TO THE PLACEMENT OF TOPSOIL.

B-4-3 STANDARDS AND SPECIFICATIONS FOR SEEDING AND MULCHING

DEFINITION
THE APPLICATION OF SEED AND MULCH TO ESTABLISH VEGETATIVE COVER.

PURPOSE
TO PROTECT DISTURBED SOILS FROM EROSION DURING AND AT THE END OF CONSTRUCTION.

CONDITIONS WHERE PRACTICE APPLIES
TO THE SURFACE OF ALL PERIMETER CONTROLS, SLOPES, AND ANY DISTURBED AREA NOT UNDER ACTIVE GRADING.

CRITERIA

- A. SEEDING**
- SPECIFICATIONS**
 - ALL SEED MUST MEET THE REQUIREMENTS OF THE MARYLAND STATE SEED LAW. ALL SEED MUST BE SUBJECT TO RE-TESTING BY A RECOGNIZED SEED LABORATORY. ALL SEED USED MUST HAVE BEEN TESTED WITHIN THE 6 MONTHS IMMEDIATELY PRECEDING THE DATE OF SOWING SUCH MATERIAL ON ANY PROJECT. REFER TO TABLE B.4 REGARDING THE QUALITY OF SEED. SEED TAGS MUST BE AVAILABLE UPON REQUEST TO THE INSPECTOR TO VERIFY TYPE OF SEED AND SEEDING RATE.
 - MULCH ALONE MAY BE APPLIED BETWEEN THE FALL AND SPRING SEEDING DATES ONLY IF THE GROUND IS FROZEN. THE APPROPRIATE SEEDING MIXTURE MUST BE APPLIED WHEN THE GROUND THAWS.
 - INOCULANTS: THE INOCULANT FOR TREATING LEGUME SEED IN THE SEED MIXTURES MUST BE A PURE CULTURE OF NITROGEN FIXING BACTERIA PREPARED SPECIFICALLY FOR THE SPECIES. INOCULANTS MUST NOT BE USED LATER THAN THE DATE INDICATED ON THE CONTAINER. ADD FRESH INOCULANTS AS DIRECTED ON THE PACKAGE. USE FOUR TIMES THE RECOMMENDED RATE WHEN HYDROSEEDING. NOTE: IT IS VERY IMPORTANT TO KEEP INOCULANT AS COOL AS POSSIBLE UNTIL USED. TEMPERATURES ABOVE 75 TO 80 DEGREES FAHRENHEIT CAN WEAKEN BACTERIA AND MAKE THE INOCULANT LESS EFFECTIVE.
 - SOD OR SEED MUST NOT BE PLACED ON SOIL WHICH HAS BEEN TREATED WITH SOIL STERILANTS OR CHEMICALS USED FOR WEED CONTROL UNTIL SUFFICIENT TIME HAS ELAPSED (14 DAYS MIN.) TO PERMIT DISSIPATION OF PHYTO-TOXIC MATERIALS.
 - APPLICATION**
 - DRY SEEDING: THIS INCLUDES USE OF CONVENTIONAL DROP OR BROADCAST SPREADERS.
 - INCORPORATE SEED INTO THE SUBSOIL AT THE RATES PRESCRIBED ON TEMPORARY SEEDING TABLE B.1, PERMANENT SEEDING TABLE B.3, OR SITE-SPECIFIC SEEDING SUMMARIES.
 - APPLY SEED IN TWO DIRECTIONS, PERPENDICULAR TO EACH OTHER. APPLY HALF THE SEEDING RATE IN EACH DIRECTION. ROLL THE SEEDING AREA WITH A WEIGHTED ROLLER TO PROVIDE GOOD SEED TO SOIL CONTACT.
 - DRILL OR CULTIPACKER SEEDING: MECHANIZED SEEDERS THAT APPLY AND COVER SEED WITH SOIL.
 - CULTIPACKING SEEDERS ARE REQUIRED TO BURY THE SEED IN SUCH A FASHION AS TO PROVIDE AT LEAST 1/4 INCH OF SOIL COVERING. SEEDBED MUST BE FIRM AFTER PLANTING.
 - APPLY SEED IN TWO DIRECTIONS, PERPENDICULAR TO EACH OTHER. APPLY HALF THE SEEDING RATE IN EACH DIRECTION.
 - HYDROSEEDING: APPLY SEED UNIFORMLY WITH HYDROSEEDER (SLURRY INCLUDES SEED AND FERTILIZER).
 - IF FERTILIZER IS BEING APPLIED AT THE TIME OF SEEDING, THE APPLICATION RATES SHOULD NOT EXCEED THE FOLLOWING: NITROGEN, 100 POUNDS PER ACRE; TOTAL OF SOLUBLE NITROGEN, P205 (PHOSPHOROUS), 200 POUNDS PER ACRE; K2O (POTASSIUM), 200 POUNDS PER ACRE.
 - MIX SEED AND FERTILIZER ON SITE AND SEED IMMEDIATELY AND WITHOUT INTERRUPTION.
 - WHEN HYDROSEEDING DO NOT INCORPORATE SEED INTO THE SOIL.

B-4-4 STANDARDS AND SPECIFICATIONS FOR TEMPORARY STABILIZATION

DEFINITION
TO STABILIZE DISTURBED SOILS WITH VEGETATION FOR UP TO 6 MONTHS.

PURPOSE
TO USE FAST GROWING VEGETATION THAT PROVIDES COVER ON DISTURBED SOILS.

CONDITIONS WHERE PRACTICE APPLIES
EXPOSED SOILS WHERE GROUND COVER IS NEEDED FOR A PERIOD OF 6 MONTHS OR LESS. FOR LONGER DURATION OF TIME, PERMANENT STABILIZATION PRACTICES ARE REQUIRED.

CRITERIA

- SELECT ONE OR MORE OF THE SPECIES OR SEED MIXTURES LISTED IN TABLE B.1 FOR THE APPROPRIATE PLANT HARDNESS ZONE (FROM FIGURE B.3), AND ENTER THEM IN THE TEMPORARY SEEDING SUMMARY BELOW ALONG WITH APPLICATION RATES, SEEDING DATES AND SEEDING DEPTHS. IF THIS SUMMARY IS NOT PUT ON THE PLAN AND COMPLETED, THEN TABLE B.1 PLUS FERTILIZER AND LIME RATES MUST BE PUT ON THE PLAN.
 - FOR SITES HAVING SOIL TESTS PERFORMED, USE AND SHOW THE RECOMMENDED RATES BY THE TESTING AGENCY. SOIL TESTS ARE NOT REQUIRED FOR TEMPORARY SEEDING.
 - WHEN STABILIZATION IS REQUIRED OUTSIDE OF A SEEDING SEASON, APPLY SEED AND MULCH OR STRAW MULCH ALONE AS PRESCRIBED IN SECTION B-4-3.A.1.B AND MAINTAIN UNTIL THE NEXT SEEDING SEASON.
- TEMPORARY SEEDING SUMMARY**
- | No. | Hardness Zone (from Figure B.3):
Seed Mixture (from Table B.1): | | Fertilizer Rate (10-20-20) | Lime Rate |
|-----|--|----------------------------|----------------------------|--------------------|
| | Species | Application Rate (lb/acre) | | |
| 1 | ANNUAL RYEGRASS | 40 | | |
| 2 | BARLEY | 96 | 436 lb/acre | 2 tons/acre |
| 3 | OATS | 72 | (10 lb/1000 sq ft) | (90 lb/1000 sq ft) |
| 4 | PEARL MILLET | 20 | | |
- DEFINITION**
TO STABILIZE DISTURBED SOILS WITH PERMANENT VEGETATION.
- CRITERIA**
- MULCH MATERIALS (IN ORDER OF PREFERENCE)
 - STRAW CONSISTING OF THOROUGHLY THRESHED WHEAT, RYE, OAT, OR BARLEY AND REASONABLY BRIGHT IN COLOR. STRAW IS TO BE FREE OF NOXIOUS WEED SEEDS AS SPECIFIED IN THE MARYLAND SEED LAW AND NOT MUSTY, MOULDY, CAKED, DECAYED, OR EXCESSIVELY DUSTY. NOTE: USE ONLY STERILE STRAW MULCH IN AREAS WHERE ONE SPECIES OF GRASS IS DESIRED.
 - WOOD CELLULOSE FIBER MULCH (WCFM) CONSISTING OF SPECIALLY PREPARED WOOD CELLULOSE PROCESSED INTO A UNIFORM FIBROUS PHYSICAL STATE.
 - WCFM IS TO BE DYED GREEN OR CONTAIN A GREEN DYE IN THE PACKAGE THAT WILL PROVIDE AN APPROPRIATE COLOR TO FACILITATE VISUAL INSPECTION OF THE UNIFORMLY SPREAD SLURRY.
 - WCFM, INCLUDING DYE, MUST CONTAIN NO GERMINATION OR GROWTH INHIBITING FACTORS.
 - WCFM MATERIALS ARE TO BE MANUFACTURED AND PROCESSED IN SUCH A MANNER THAT THE WOOD CELLULOSE FIBER MULCH WILL REMAIN IN UNIFORM SUSPENSION IN WATER UNDER AGITATION AND WILL BLEND WITH SEED, FERTILIZER AND OTHER ADDITIVES TO FORM A HOMOGENEOUS SLURRY. THE MULCH MATERIAL MUST FORM A BLOTTER-LIKE GROUND COVER, ON APPLICATION, HAVING MOISTURE ABSORPTION AND PERCOLATION PROPERTIES AND MUST COVER AND HOLD GRASS SEED IN CONTACT WITH THE SOIL WITHOUT INHIBITING THE GROWTH OF THE GRASS SEEDLINGS.
 - WCFM MATERIAL MUST NOT CONTAIN ELEMENTS OR COMPOUNDS AT CONCENTRATION LEVELS THAT WILL BE PHYTO-TOXIC.
 - WCFM MUST CONFORM TO THE FOLLOWING PHYSICAL REQUIREMENTS: FIBER LENGTH OF APPROXIMATELY 10 MILLIMETERS, DIAMETER APPROXIMATELY 1 MILLIMETER, PH RANGE OF 4.0 TO 8.5, ASH CONTENT OF 1.6 PERCENT MAXIMUM AND WATER HOLDING CAPACITY OF 90 PERCENT MINIMUM.

- PURPOSE**
TO USE LONG-LIVED PERENNIAL GRASSES AND LEGUMES TO ESTABLISH PERMANENT GROUND COVER ON DISTURBED SOILS. **CONDITIONS WHERE PRACTICE APPLIES**
EXPOSED SOILS WHERE GROUND COVER IS NEEDED FOR 6 MONTHS OR MORE.
- CRITERIA**
- A. SEED MIXTURES**
- GENERAL USE**
 - SELECT ONE OR MORE OF THE SPECIES OR MIXTURES LISTED IN TABLE B.3 FOR THE APPROPRIATE PLANT HARDNESS ZONE (FROM FIGURE B.3) AND BASED ON THE SITE CONDITION OR PURPOSE FOUND ON TABLE B.2. ENTER SELECTED MIXTURE(S), APPLICATION RATES, AND SEEDING DATES IN THE PERMANENT SEEDING SUMMARY. THE SUMMARY IS TO BE PLACED ON THE PLAN.
 - ADDITIONAL PLANTING SPECIFICATIONS FOR EXCEPTIONAL SITES SUCH AS SHOULDER, STREAM BANKS, OR DUNES OR FOR SPECIAL PURPOSES SUCH AS WILDLIFE OR AESTHETIC TREATMENT MAY BE FOUND IN USDA-NRCS TECHNICAL FIELD OFFICE GUIDE, SECTION 342 - CRITICAL AREA PLANTING.
 - FOR SITES HAVING DISTURBED AREA OVER 5 ACRES, USE AND SHOW THE RATES RECOMMENDED BY THE SOIL TESTING AGENCY.
 - FOR AREAS RECEIVING LOW MAINTENANCE, APPLY UREA FORM FERTILIZER (46-0-0) AT 3 1/2 POUNDS PER 1000 SQUARE FEET (150 POUNDS PER ACRE) AT THE TIME OF SEEDING IN ADDITION TO THE SOIL AMENDMENTS SHOWN IN THE PERMANENT SEEDING SUMMARY.
 - TURFGRASS MIXTURES**
 - AREAS WHERE TURFGRASS MAY BE DESIRED INCLUDE LAWNS, PARKS, PLAYGROUNDS, AND COMMERCIAL SITES WHICH WILL RECEIVE A MEDIUM TO HIGH LEVEL OF MAINTENANCE.
 - SELECT ONE OR MORE OF THE SPECIES OR MIXTURES LISTED BELOW BASED ON THE SITE CONDITIONS OR PURPOSE. ENTER SELECTED MIXTURE(S), APPLICATION RATES, AND SEEDING DATES IN THE PERMANENT SEEDING SUMMARY. THE SUMMARY IS TO BE PLACED ON THE PLAN.
 - KENTUCKY BLUEGRASS: FULL SUN MIXTURE: FOR USE IN AREAS THAT RECEIVE INTENSIVE MANAGEMENT. IRRIGATION REQUIRED IN THE AREAS OF CENTRAL MARYLAND AND EASTERN SHORE. RECOMMENDED CERTIFIED KENTUCKY BLUEGRASS CULTIVARS SEEDING RATE: 1.5 TO 2.0 POUNDS PER 1000 SQUARE FEET. CHOOSE A MINIMUM OF THREE KENTUCKY BLUEGRASS CULTIVARS WITH EACH RANGING FROM 10 TO 35 PERCENT OF THE TOTAL MIXTURE BY WEIGHT.
 - KENTUCKY BLUEGRASS/PERENNIAL RYE: FULL SUN MIXTURE: FOR USE IN FULL SUN AREAS WHERE RAPID ESTABLISHMENT IS NECESSARY AND WHEN TURF WILL RECEIVE MEDIUM TO INTENSIVE MANAGEMENT. CERTIFIED PERENNIAL RYEGRASS CULTIVARS/CERTIFIED KENTUCKY BLUEGRASS SEEDING RATE: 2 POUNDS MIXTURE PER 1000 SQUARE FEET. CHOOSE A MINIMUM OF THREE KENTUCKY BLUEGRASS CULTIVARS WITH EACH RANGING FROM 10 TO 35 PERCENT OF THE TOTAL MIXTURE BY WEIGHT.
 - TALL FESCUE/KENTUCKY BLUEGRASS: FULL SUN MIXTURE: FOR USE IN DROUGHT PRONE AREAS AND/OR FOR AREAS RECEIVING LOW TO MEDIUM MANAGEMENT IN FULL SUN TO MEDIUM SHADE. RECOMMENDED MIXTURE INCLUDES: CERTIFIED TALL FESCUE CULTIVARS 95 TO 100 PERCENT, CERTIFIED KENTUCKY BLUEGRASS CULTIVARS 0 TO 5 PERCENT. SEEDING RATE: 1.5 TO 8 POUNDS PER 1000 SQUARE FEET. ONE OR MORE CULTIVARS MAY BE BLENDED.
 - KENTUCKY BLUEGRASS/FINE FESCUE: SHADE MIXTURE: FOR USE IN AREAS WITH SHADE IN BLUEGRASS LAWNS. FOR ESTABLISHMENT IN HIGH QUALITY, INTENSIVELY MANAGED TURF AREA. MIXTURE INCLUDES: CERTIFIED KENTUCKY BLUEGRASS CULTIVARS 30 TO 40 PERCENT AND CERTIFIED FINE FESCUE AND 60 TO 70 PERCENT. SEEDING RATE: 1 1/2 TO 3 POUNDS PER 1000 SQUARE FEET.

- NOTES:**
SELECT TURFGRASS VARIETIES FROM THOSE LISTED IN THE MOST CURRENT UNIVERSITY OF MARYLAND PUBLICATION, AGRONOMY MEMO #77, "TURFGRASS CULTIVAR RECOMMENDATIONS FOR MARYLAND"
- CHOOSE CERTIFIED MATERIAL. CERTIFIED MATERIAL IS THE BEST GUARANTEE OF CULTIVAR PURITY. THE CERTIFICATION PROGRAM OF THE MARYLAND DEPARTMENT OF AGRICULTURE, TURF AND SEED SECTION, PROVIDES A RELIABLE MEANS OF CONSUMER PROTECTION AND ASSURES A PURE GENETIC LINE.
- IDEAL TIMES OF SEEDING FOR TURF GRASS MIXTURES**
WESTERN MD: MARCH 15 TO JUNE 1, AUGUST 1 TO OCTOBER 1 (HARDNESS ZONES: 5B, 6A)
CENTRAL MD: MARCH 1 TO MAY 15, AUGUST 15 TO OCTOBER 15 (HARDNESS ZONES: 6B)
SOUTHERN MD, EASTERN SHORE: MARCH 1 TO MAY 15, AUGUST 15 TO OCTOBER 15 (HARDNESS ZONES: 7A, 7B)
- DILL AREAS TO RECEIVE SEED BY DISKING OR OTHER APPROVED METHODS TO A TILL DEPTH OF 2 TO 4 INCHES, LEVEL AND RAKE THE AREAS TO PREPARE A PROPER SEEDBED. REMOVE STONES AND DEBRIS OVER 1 1/2 INCHES IN DIAMETER. THE RESULTING SEEDBED MUST BE IN SUCH CONDITION THAT FUTURE MOWING OF GRASSES WILL POSE NO DIFFICULTY.
- IF SOIL MOISTURE IS DEFICIENT, SUPPLY NEW SEEDINGS WITH ADEQUATE WATER FOR PLANT GROWTH (1/2 TO 1 INCH EVERY 3 TO 4 DAYS DEPENDING ON SOIL TEXTURE) UNTIL THEY ARE FIRMLY ESTABLISHED. THIS IS ESPECIALLY TRUE WHEN SEEDINGS ARE MADE LATE IN THE PLANTING SEASON, IN ABNORMALLY DRY OR HOT SEASONS, OR ON ADVERSE SITES.

B-4-5 STANDARDS AND SPECIFICATIONS FOR PERMANENT STABILIZATION

DEFINITION
TO STABILIZE DISTURBED SOILS WITH PERMANENT VEGETATION.

PURPOSE
TO USE FAST GROWING VEGETATION THAT PROVIDES COVER ON DISTURBED SOILS.

CONDITIONS WHERE PRACTICE APPLIES
EXPOSED SOILS WHERE GROUND COVER IS NEEDED FOR A PERIOD OF 6 MONTHS OR MORE.

CRITERIA

- GENERAL SPECIFICATIONS
 - CLASS OF TURFGRASS SOD MUST BE MARYLAND STATE CERTIFIED. SOD LABELS MUST BE MADE AVAILABLE TO THE JOB FOREMAN AND INSPECTOR.
 - SOD MUST BE MACHINE CUT AT A UNIFORM SOIL THICKNESS OF 3/4 INCH, PLUS OR MINUS 1/4 INCH, AT THE TIME OF CUTTING. MEASUREMENT FOR THICKNESS MUST EXCLUDE TOP GROWTH AND THATCH. BROKEN PADS AND TORN OR UNEVEN ENDS WILL NOT BE ACCEPTABLE.
 - STANDARD SIZE SECTIONS OF SOD MUST BE STRONG ENOUGH TO SUPPORT THEIR

PURPOSE
TO USE LONG-LIVED PERENNIAL GRASSES AND LEGUMES TO ESTABLISH PERMANENT GROUND COVER ON DISTURBED SOILS. **CONDITIONS WHERE PRACTICE APPLIES**
EXPOSED SOILS WHERE GROUND COVER IS NEEDED FOR 6 MONTHS OR MORE.

CRITERIA

- A. SEED MIXTURES**
- GENERAL USE**
 - SELECT ONE OR MORE OF THE SPECIES OR MIXTURES LISTED IN TABLE B.3 FOR THE APPROPRIATE PLANT HARDNESS ZONE (FROM FIGURE B.3) AND BASED ON THE SITE CONDITION OR PURPOSE FOUND ON TABLE B.2. ENTER SELECTED MIXTURE(S), APPLICATION RATES, AND SEEDING DATES IN THE PERMANENT SEEDING SUMMARY. THE SUMMARY IS TO BE PLACED ON THE PLAN.
 - ADDITIONAL PLANTING SPECIFICATIONS FOR EXCEPTIONAL SITES SUCH AS SHOULDER, STREAM BANKS, OR DUNES OR FOR SPECIAL PURPOSES SUCH AS WILDLIFE OR AESTHETIC TREATMENT MAY BE FOUND IN USDA-NRCS TECHNICAL FIELD OFFICE GUIDE, SECTION 342 - CRITICAL AREA PLANTING.
 - FOR SITES HAVING DISTURBED AREA OVER 5 ACRES, USE AND SHOW THE RATES RECOMMENDED BY THE SOIL TESTING AGENCY.
 - FOR AREAS RECEIVING LOW MAINTENANCE, APPLY UREA FORM FERTILIZER (46-0-0) AT 3 1/2 POUNDS PER 1000 SQUARE FEET (150 POUNDS PER ACRE) AT THE TIME OF SEEDING IN ADDITION TO THE SOIL AMENDMENTS SHOWN IN THE PERMANENT SEEDING SUMMARY.
 - TURFGRASS MIXTURES**
 - AREAS WHERE TURFGRASS MAY BE DESIRED INCLUDE LAWNS, PARKS, PLAYGROUNDS, AND COMMERCIAL SITES WHICH WILL RECEIVE A MEDIUM TO HIGH LEVEL OF MAINTENANCE.
 - SELECT ONE OR MORE OF THE SPECIES OR MIXTURES LISTED BELOW BASED ON THE SITE CONDITIONS OR PURPOSE. ENTER SELECTED MIXTURE(S), APPLICATION RATES, AND SEEDING DATES IN THE PERMANENT SEEDING SUMMARY. THE SUMMARY IS TO BE PLACED ON THE PLAN.
 - KENTUCKY BLUEGRASS: FULL SUN MIXTURE: FOR USE IN AREAS THAT RECEIVE INTENSIVE MANAGEMENT. IRRIGATION REQUIRED IN THE AREAS OF CENTRAL MARYLAND AND EASTERN SHORE. RECOMMENDED CERTIFIED KENTUCKY BLUEGRASS CULTIVARS SEEDING RATE: 1.5 TO 2.0 POUNDS PER 1000 SQUARE FEET. CHOOSE A MINIMUM OF THREE KENTUCKY BLUEGRASS CULTIVARS WITH EACH RANGING FROM 10 TO 35 PERCENT OF THE TOTAL MIXTURE BY WEIGHT.
 - KENTUCKY BLUEGRASS/PERENNIAL RYE: FULL SUN MIXTURE: FOR USE IN FULL SUN AREAS WHERE RAPID ESTABLISHMENT IS NECESSARY AND WHEN TURF WILL RECEIVE MEDIUM TO INTENSIVE MANAGEMENT. CERTIFIED PERENNIAL RYEGRASS CULTIVARS/CERTIFIED KENTUCKY BLUEGRASS SEEDING RATE: 2 POUNDS MIXTURE PER 1000 SQUARE FEET. CHOOSE A MINIMUM OF THREE KENTUCKY BLUEGRASS CULTIVARS WITH EACH RANGING FROM 10 TO 35 PERCENT OF THE TOTAL MIXTURE BY WEIGHT.
 - TALL FESCUE/KENTUCKY BLUEGRASS: FULL SUN MIXTURE: FOR USE IN DROUGHT PRONE AREAS AND/OR FOR AREAS RECEIVING LOW TO MEDIUM MANAGEMENT IN FULL SUN TO MEDIUM SHADE. RECOMMENDED MIXTURE INCLUDES: CERTIFIED TALL FESCUE CULTIVARS 95 TO 100 PERCENT, CERTIFIED KENTUCKY BLUEGRASS CULTIVARS 0 TO 5 PERCENT. SEEDING RATE: 1.5 TO 8 POUNDS PER 1000 SQUARE FEET. ONE OR MORE CULTIVARS MAY BE BLENDED.
 - KENTUCKY BLUEGRASS/FINE FESCUE: SHADE MIXTURE: FOR USE IN AREAS WITH SHADE IN BLUEGRASS LAWNS. FOR ESTABLISHMENT IN HIGH QUALITY, INTENSIVELY MANAGED TURF AREA. MIXTURE INCLUDES: CERTIFIED KENTUCKY BLUEGRASS CULTIVARS 30 TO 40 PERCENT AND CERTIFIED FINE FESCUE AND 60 TO 70 PERCENT. SEEDING RATE: 1 1/2 TO 3 POUNDS PER 1000 SQUARE FEET.

- NOTES:**
SELECT TURFGRASS VARIETIES FROM THOSE LISTED IN THE MOST CURRENT UNIVERSITY OF MARYLAND PUBLICATION, AGRONOMY MEMO #77, "TURFGRASS CULTIVAR RECOMMENDATIONS FOR MARYLAND"
- CHOOSE CERTIFIED MATERIAL. CERTIFIED MATERIAL IS THE BEST GUARANTEE OF CULTIVAR PURITY. THE CERTIFICATION PROGRAM OF THE MARYLAND DEPARTMENT OF AGRICULTURE, TURF AND SEED SECTION, PROVIDES A RELIABLE MEANS OF CONSUMER PROTECTION AND ASSURES A PURE GENETIC LINE.
- IDEAL TIMES OF SEEDING FOR TURF GRASS MIXTURES**
WESTERN MD: MARCH 15 TO JUNE 1, AUGUST 1 TO OCTOBER 1 (HARDNESS ZONES: 5B, 6A)
CENTRAL MD: MARCH 1 TO MAY 15, AUGUST 15 TO OCTOBER 15 (HARDNESS ZONES: 6B)
SOUTHERN MD, EASTERN SHORE: MARCH 1 TO MAY 15, AUGUST 15 TO OCTOBER 15 (HARDNESS ZONES: 7A, 7B)
- DILL AREAS TO RECEIVE SEED BY DISKING OR OTHER APPROVED METHODS TO A TILL DEPTH OF 2 TO 4 INCHES, LEVEL AND RAKE THE AREAS TO PREPARE A PROPER SEEDBED. REMOVE STONES AND DEBRIS OVER 1 1/2 INCHES IN DIAMETER. THE RESULTING SEEDBED MUST BE IN SUCH CONDITION THAT FUTURE MOWING OF GRASSES WILL POSE NO DIFFICULTY.
- IF SOIL MOISTURE IS DEFICIENT, SUPPLY NEW SEEDINGS WITH ADEQUATE WATER FOR PLANT GROWTH (1/2 TO 1 INCH EVERY 3 TO 4 DAYS DEPENDING ON SOIL TEXTURE) UNTIL THEY ARE FIRMLY ESTABLISHED. THIS IS ESPECIALLY TRUE WHEN SEEDINGS ARE MADE LATE IN THE PLANTING SEASON, IN ABNORMALLY DRY OR HOT SEASONS, OR ON ADVERSE SITES.

B-4-4 STANDARDS AND SPECIFICATIONS FOR TEMPORARY STABILIZATION

DEFINITION
TO STABILIZE DISTURBED SOILS WITH VEGETATION FOR UP TO 6 MONTHS.

PURPOSE
TO USE FAST GROWING VEGETATION THAT PROVIDES COVER ON DISTURBED SOILS.

CONDITIONS WHERE PRACTICE APPLIES
EXPOSED SOILS WHERE GROUND COVER IS NEEDED FOR A PERIOD OF 6 MONTHS OR LESS. FOR LONGER DURATION OF TIME, PERMANENT STABILIZATION PRACTICES ARE REQUIRED.

CRITERIA

- GENERAL SPECIFICATIONS
 - CLASS OF TURFGRASS SOD MUST BE MARYLAND STATE CERTIFIED. SOD LABELS MUST BE MADE AVAILABLE TO THE JOB FOREMAN AND INSPECTOR.
 - SOD MUST BE MACHINE CUT AT A UNIFORM SOIL THICKNESS OF 3/4 INCH, PLUS OR MINUS 1/4 INCH, AT THE TIME OF CUTTING. MEASUREMENT FOR THICKNESS MUST EXCLUDE TOP GROWTH AND THATCH. BROKEN PADS AND TORN OR UNEVEN ENDS WILL NOT BE ACCEPTABLE.
 - STANDARD SIZE SECTIONS OF SOD MUST BE STRONG ENOUGH TO SUPPORT THEIR

PURPOSE
TO USE LONG-LIVED PERENNIAL GRASSES AND LEGUMES TO ESTABLISH PERMANENT GROUND COVER ON DISTURBED SOILS. **CONDITIONS WHERE PRACTICE APPLIES**
EXPOSED SOILS WHERE GROUND COVER IS NEEDED FOR 6 MONTHS OR MORE.

CRITERIA

- A. SEED MIXTURES**
- GENERAL USE**
 - SELECT ONE OR MORE OF THE SPECIES OR MIXTURES LISTED IN TABLE B.3 FOR THE APPROPRIATE PLANT HARDNESS ZONE (FROM FIGURE B.3) AND BASED ON THE SITE CONDITION OR PURPOSE FOUND ON TABLE B.2. ENTER SELECTED MIXTURE(S), APPLICATION RATES, AND SEEDING DATES IN THE PERMANENT SEEDING SUMMARY. THE SUMMARY IS TO BE PLACED ON THE PLAN.
 - ADDITIONAL PLANTING SPECIFICATIONS FOR EXCEPTIONAL SITES SUCH AS SHOULDER, STREAM BANKS, OR DUNES OR FOR SPECIAL PURPOSES SUCH AS WILDLIFE OR AESTHETIC TREATMENT MAY BE FOUND IN USDA-NRCS TECHNICAL FIELD OFFICE GUIDE, SECTION 342 - CRITICAL AREA PLANTING.
 - FOR SITES HAVING DISTURBED AREA OVER 5 ACRES, USE AND SHOW THE RATES RECOMMENDED BY THE SOIL TESTING AGENCY.
 - FOR AREAS RECEIVING LOW MAINTENANCE, APPLY UREA FORM FERTILIZER (46-0-0) AT 3 1/2 POUNDS PER 1000 SQUARE FEET (150 POUNDS PER ACRE) AT THE TIME OF SEEDING IN ADDITION TO THE SOIL AMENDMENTS SHOWN IN THE PERMANENT SEEDING SUMMARY.
 - TURFGRASS MIXTURES**
 - AREAS WHERE TURFGRASS MAY BE DESIRED INCLUDE LAWNS, PARKS, PLAYGROUNDS, AND COMMERCIAL SITES WHICH WILL RECEIVE A MEDIUM TO HIGH LEVEL OF MAINTENANCE.
 - SELECT ONE OR MORE OF THE SPECIES OR MIXTURES LISTED BELOW BASED ON THE SITE CONDITIONS OR PURPOSE. ENTER SELECTED MIXTURE(S), APPLICATION RATES, AND SEEDING DATES IN THE PERMANENT SEEDING SUMMARY. THE SUMMARY IS TO BE PLACED ON THE PLAN.
 - KENTUCKY BLUEGRASS: FULL SUN MIXTURE: FOR USE IN AREAS THAT RECEIVE INTENSIVE MANAGEMENT. IRRIGATION REQUIRED IN THE AREAS OF CENTRAL MARYLAND AND EASTERN SHORE. RECOMMENDED CERTIFIED KENTUCKY BLUEGRASS CULTIVARS SEEDING RATE: 1.5 TO 2.0 POUNDS PER 1000 SQUARE FEET. CHOOSE A MINIMUM OF THREE KENTUCKY BLUEGRASS CULTIVARS WITH EACH RANGING FROM 10 TO 35 PERCENT OF THE TOTAL MIXTURE BY WEIGHT.
 - KENTUCKY BLUEGRASS/PERENNIAL RYE: FULL SUN MIXTURE: FOR USE IN FULL SUN AREAS WHERE RAPID ESTABLISHMENT IS NECESSARY AND WHEN TURF WILL RECEIVE MEDIUM TO INTENSIVE MANAGEMENT. CERTIFIED PERENNIAL RYEGRASS CULTIVARS/CERTIFIED KENTUCKY BLUEGRASS SEEDING RATE: 2 POUNDS MIXTURE PER 1000 SQUARE FEET. CHOOSE A MINIMUM OF THREE KENTUCKY BLUEGRASS CULTIVARS WITH EACH RANGING FROM 10 TO 35 PERCENT OF THE TOTAL MIXTURE BY WEIGHT.
 - TALL FESCUE/KENTUCKY BLUEGRASS: FULL SUN MIXTURE: FOR USE IN DROUGHT PRONE AREAS AND/OR FOR AREAS RECEIVING LOW TO MEDIUM MANAGEMENT IN FULL SUN TO MEDIUM SHADE. RECOMMENDED MIXTURE INCLUDES: CERTIFIED TALL FESCUE CULTIVARS 95 TO 100 PERCENT, CERTIFIED KENTUCKY BLUEGRASS CULTIVARS 0 TO 5 PERCENT. SEEDING RATE: 1.5 TO 8 POUNDS PER 1000 SQUARE FEET. ONE OR MORE CULTIVARS MAY BE BLENDED.
 - KENTUCKY BLUEGRASS/FINE FESCUE: SHADE MIXTURE: FOR USE IN AREAS WITH SHADE IN BLUEGRASS LAWNS. FOR ESTABLISHMENT IN HIGH QUALITY, INTENSIVELY MANAGED TURF AREA. MIXTURE INCLUDES: CERTIFIED KENTUCKY BLUEGRASS CULTIVARS 30 TO 40 PERCENT AND CERTIFIED FINE FESCUE AND 60 TO 70 PERCENT. SEEDING RATE: 1 1/2 TO 3 POUNDS PER 1000 SQUARE FEET.

- NOTES:**
SELECT TURFGRASS VARIETIES FROM THOSE LISTED IN THE MOST CURRENT UNIVERSITY OF MARYLAND PUBLICATION, AGRONOMY MEMO #77, "TURFGRASS CULTIVAR RECOMMENDATIONS FOR MARYLAND"
- CHOOSE CERTIFIED MATERIAL. CERTIFIED MATERIAL IS THE BEST GUARANTEE OF CULTIVAR PURITY. THE CERTIFICATION PROGRAM OF THE MARYLAND DEPARTMENT OF AGRICULTURE, TURF AND SEED SECTION, PROVIDES A RELIABLE MEANS OF CONSUMER PROTECTION AND ASSURES A PURE GENETIC LINE.
- IDEAL TIMES OF SEEDING FOR TURF GRASS MIXTURES**
WESTERN MD: MARCH 15 TO JUNE 1, AUGUST 1 TO OCTOBER 1 (HARDNESS ZONES: 5B, 6A)
CENTRAL MD: MARCH 1 TO MAY 15, AUGUST 15 TO OCTOBER 15 (HARDNESS ZONES: 6B)
SOUTHERN MD, EASTERN SHORE: MARCH 1 TO MAY 15, AUGUST 15 TO OCTOBER 15 (HARDNESS ZONES: 7A, 7B)
- DILL AREAS TO RECEIVE SEED BY DISKING OR OTHER APPROVED METHODS TO A TILL DEPTH OF 2 TO 4 INCHES, LEVEL AND RAKE THE AREAS TO PREPARE A PROPER SEEDBED. REMOVE STONES AND DEBRIS OVER 1 1/2 INCHES IN DIAMETER. THE RESULTING SEEDBED MUST BE IN SUCH CONDITION THAT FUTURE MOWING OF GRASSES WILL POSE NO DIFFICULTY.
- IF SOIL MOISTURE IS DEFICIENT, SUPPLY NEW SEEDINGS WITH ADEQUATE WATER FOR PLANT GROWTH (1/2 TO 1 INCH EVERY 3 TO 4 DAYS DEPENDING ON SOIL TEXTURE) UNTIL THEY ARE FIRMLY ESTABLISHED. THIS IS ESPECIALLY TRUE WHEN SEEDINGS ARE MADE LATE IN THE PLANTING SEASON, IN ABNORMALLY DRY OR HOT SEASONS, OR ON ADVERSE SITES.

B-4-4 STANDARDS AND SPECIFICATIONS FOR TEMPORARY STABILIZATION

DEFINITION
TO STABILIZE DISTURBED SOILS WITH VEGETATION FOR UP TO 6 MONTHS.

PURPOSE
TO USE FAST GROWING VEGETATION THAT PROVIDES COVER ON DISTURBED SOILS.

CONDITIONS WHERE PRACTICE APPLIES
EXPOSED SOILS WHERE GROUND COVER IS NEEDED FOR A PERIOD OF 6 MONTHS OR LESS. FOR LONGER DURATION OF TIME, PERMANENT STABILIZATION PRACTICES ARE REQUIRED.

CRITERIA

- GENERAL SPECIFICATIONS
 - CLASS OF TURFGRASS SOD MUST BE MARYLAND STATE CERTIFIED. SOD LABELS MUST BE MADE AVAILABLE TO THE JOB FOREMAN AND INSPECTOR.
 - SOD MUST BE MACHINE CUT AT A UNIFORM SOIL THICKNESS OF 3/4 INCH, PLUS OR MINUS 1/4 INCH, AT THE TIME OF CUTTING. MEASUREMENT FOR THICKNESS MUST EXCLUDE TOP GROWTH AND THATCH. BROKEN PADS AND TORN OR UNEVEN ENDS WILL NOT BE ACCEPTABLE.
 - STANDARD SIZE SECTIONS OF SOD MUST BE STRONG ENOUGH TO SUPPORT THEIR









MAINTENANCE

TO PROVIDE A DESIGNATED LOCATION FOR THE TEMPORARY STORAGE OF SOIL THAT CONTROLS THE POTENTIAL FOR EROSION, SEDIMENTATION, AND CHANGES TO DRAINAGE PATTERNS.

STOCKPILE AREAS ARE UTILIZED WHEN IT IS NECESSARY TO SALVAGE AND STORE SOIL FOR LATER USE.

THE STOCKPILE AREA MUST CONTINUOUSLY MEET THE REQUIREMENTS FOR ADEQUATE VEGETATIVE ESTABLISHMENT IN ACCORDANCE WITH SECTION B-4 VEGETATIVE STABILIZATION. SOIL SLOPES MUST BE MAINTAINED AT NO STEEPER THAN A 2:1 RATIO. THE STOCKPILE AREA MUST BE KEPT FREE OF EROSION. IF THE VERTICAL HEIGHT OF A STOCKPILE EXCEEDS 20 FEET FOR 2:1 SLOPES, 30 FEET FOR 3:1 SLOPES, OR 40 FEET FOR 4:1 SLOPES, BENCHING MUST BE PROVIDED IN ACCORDANCE WITH SECTION B-3 LAND GRADING.

NOTE TO CONTRACTOR
ALL SEDIMENT CONTROLS SHALL BE INSTALLED IN ACCORDANCE WITH THESE PLANS AND THE MDE INSPECTOR. ALL SEDIMENT CONTROL REQUIREMENTS SHALL BE STRICTLY ENFORCED.
ALL CONTROLS INTERCEPTED BY UTILITY

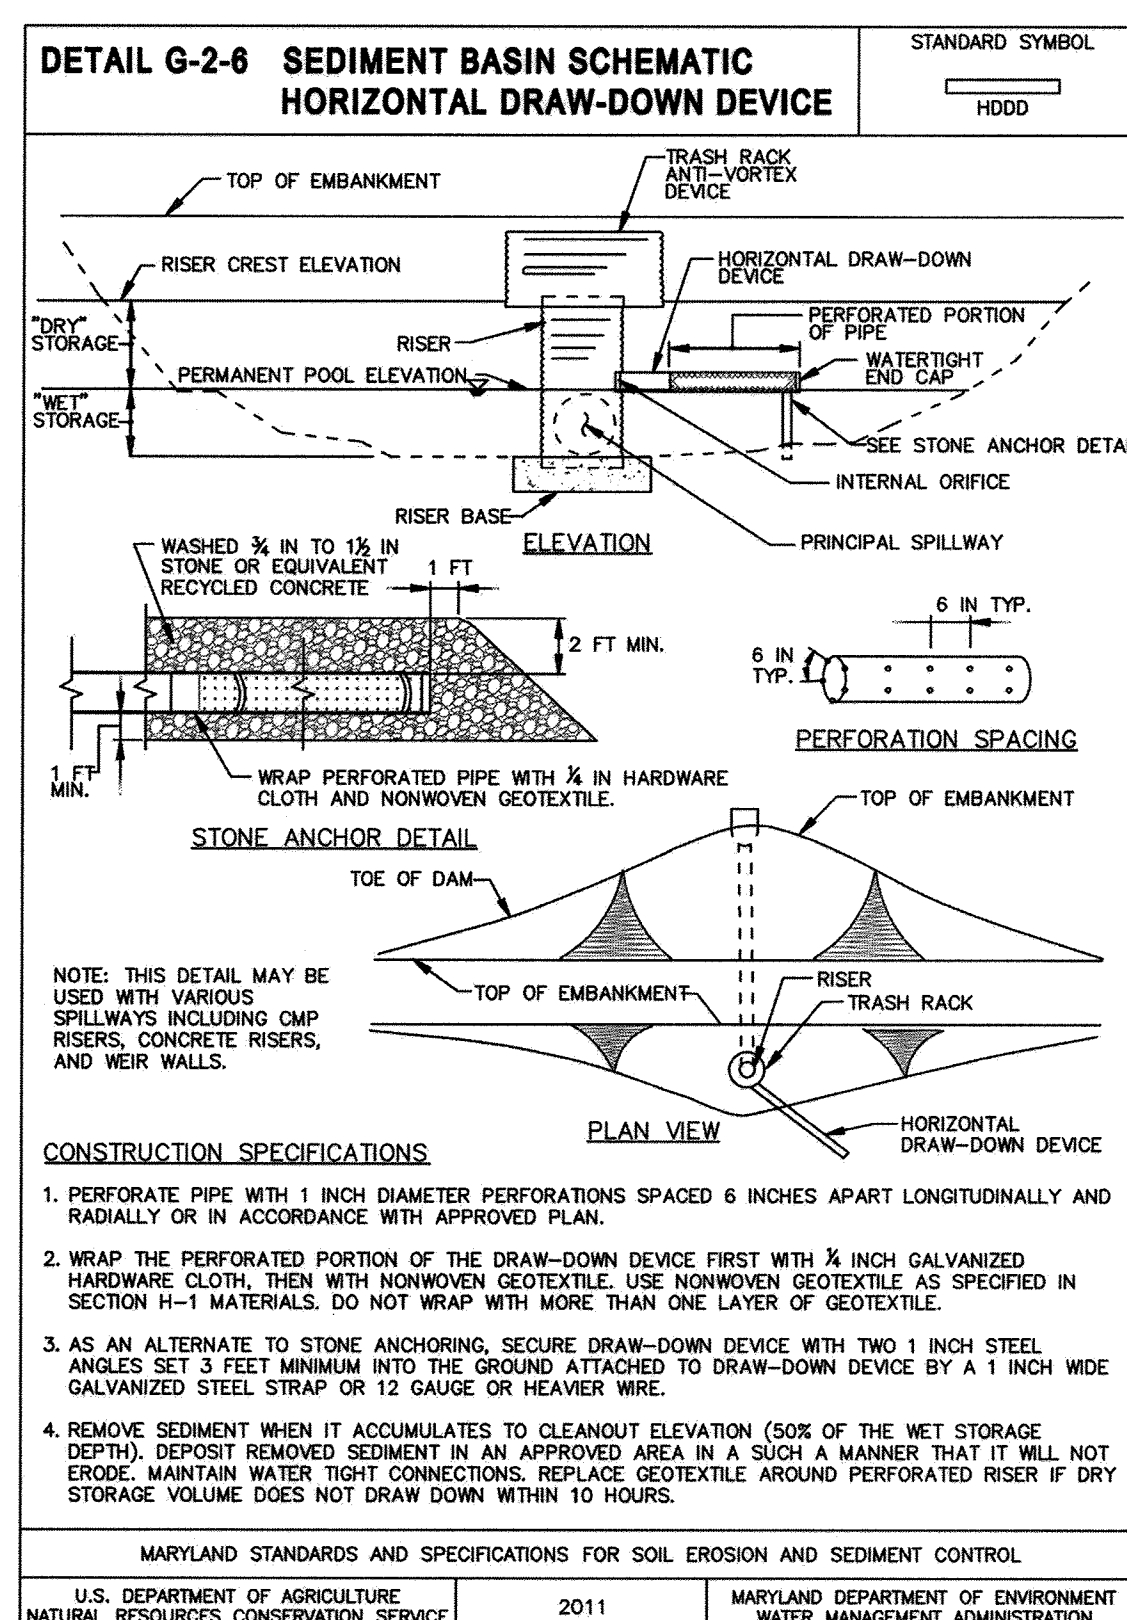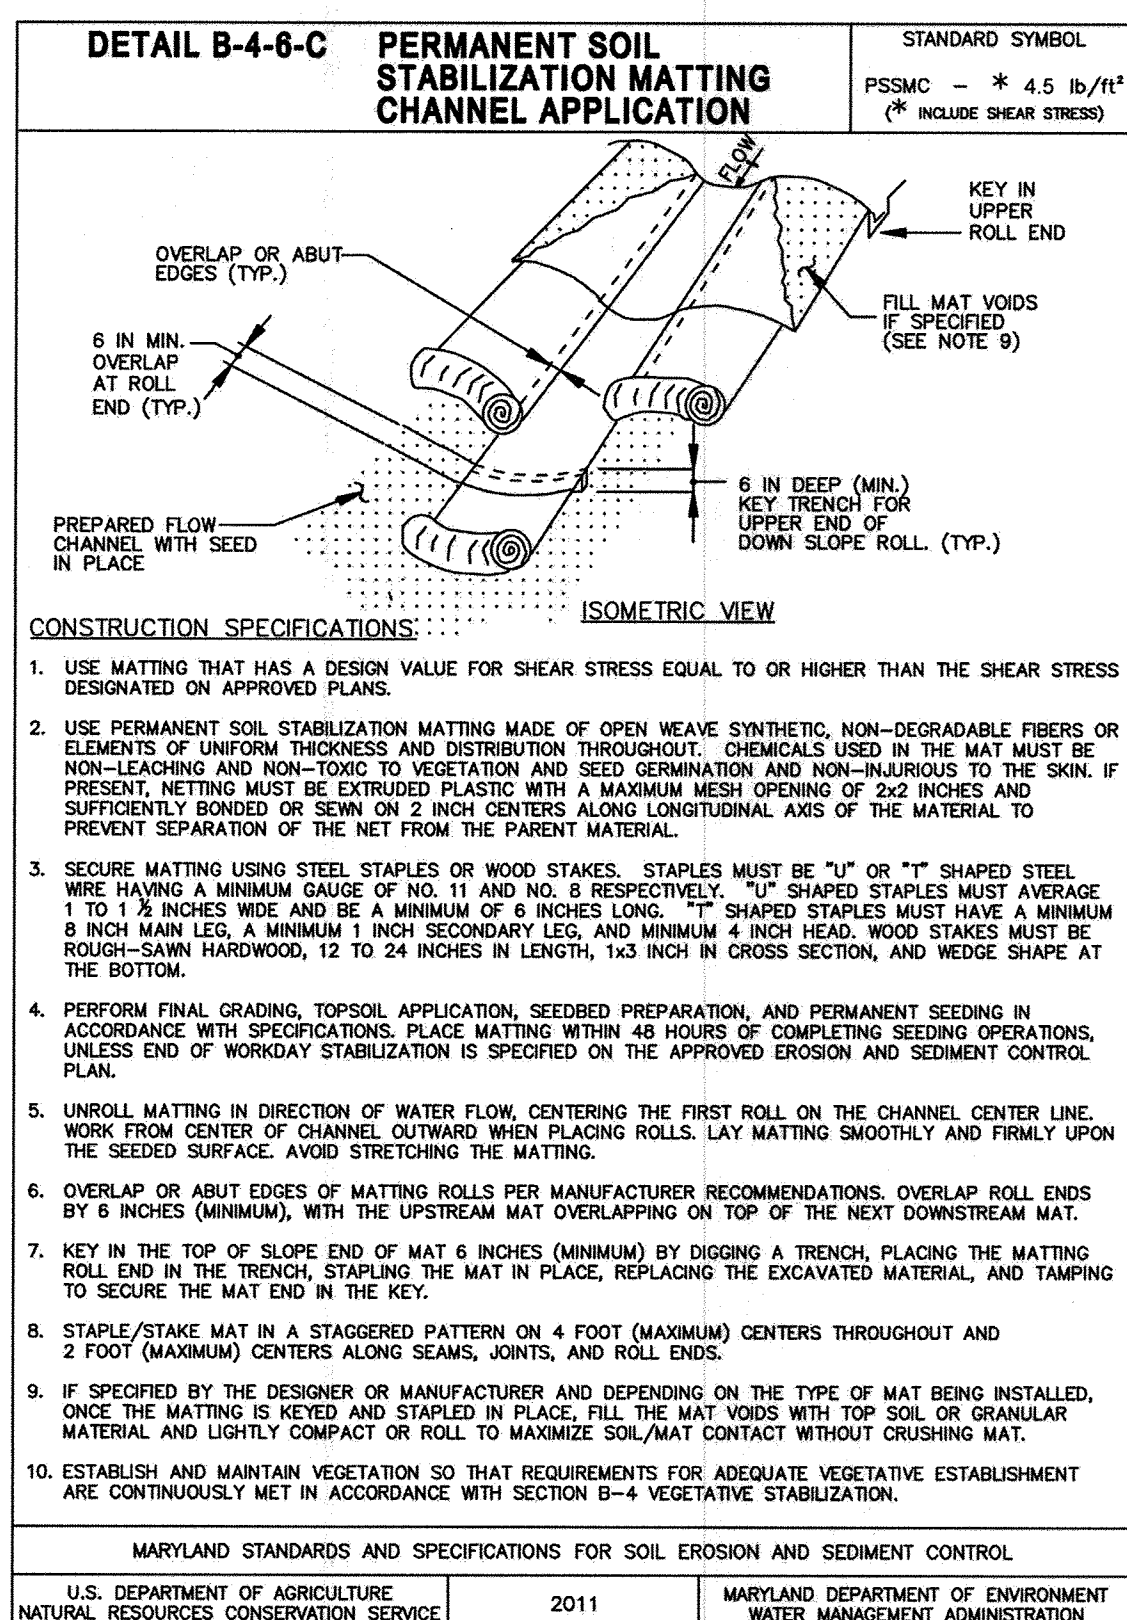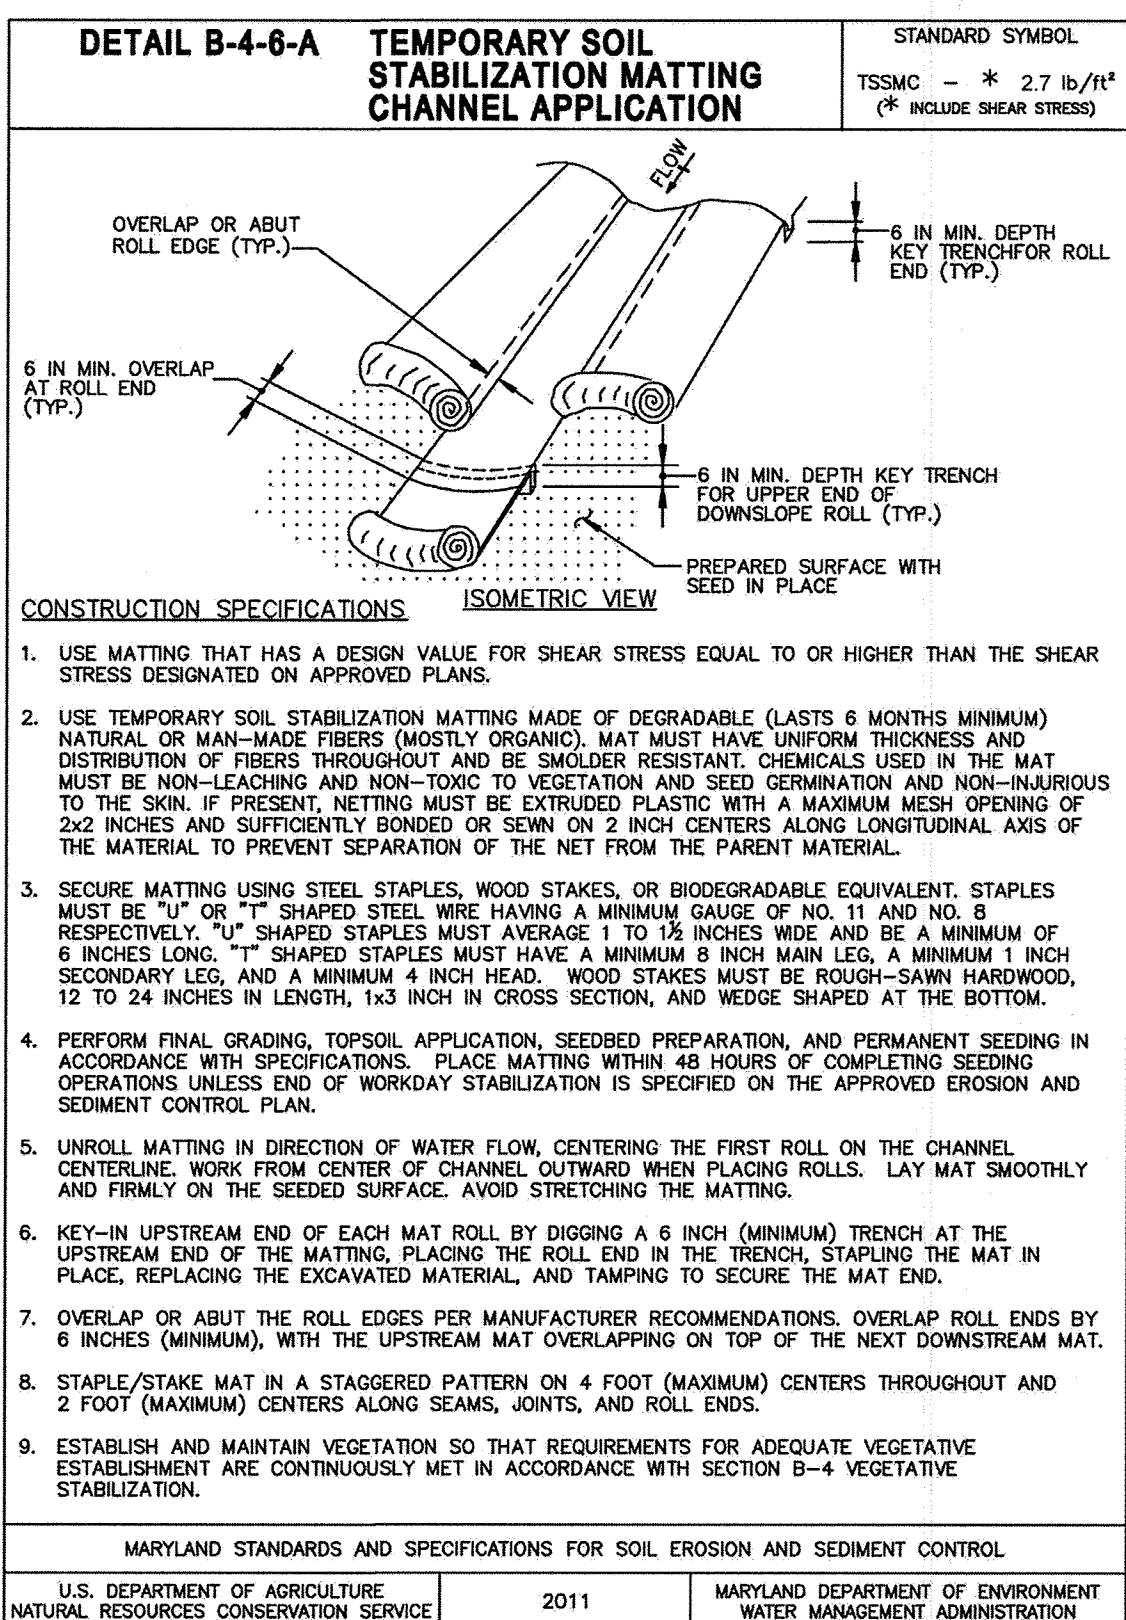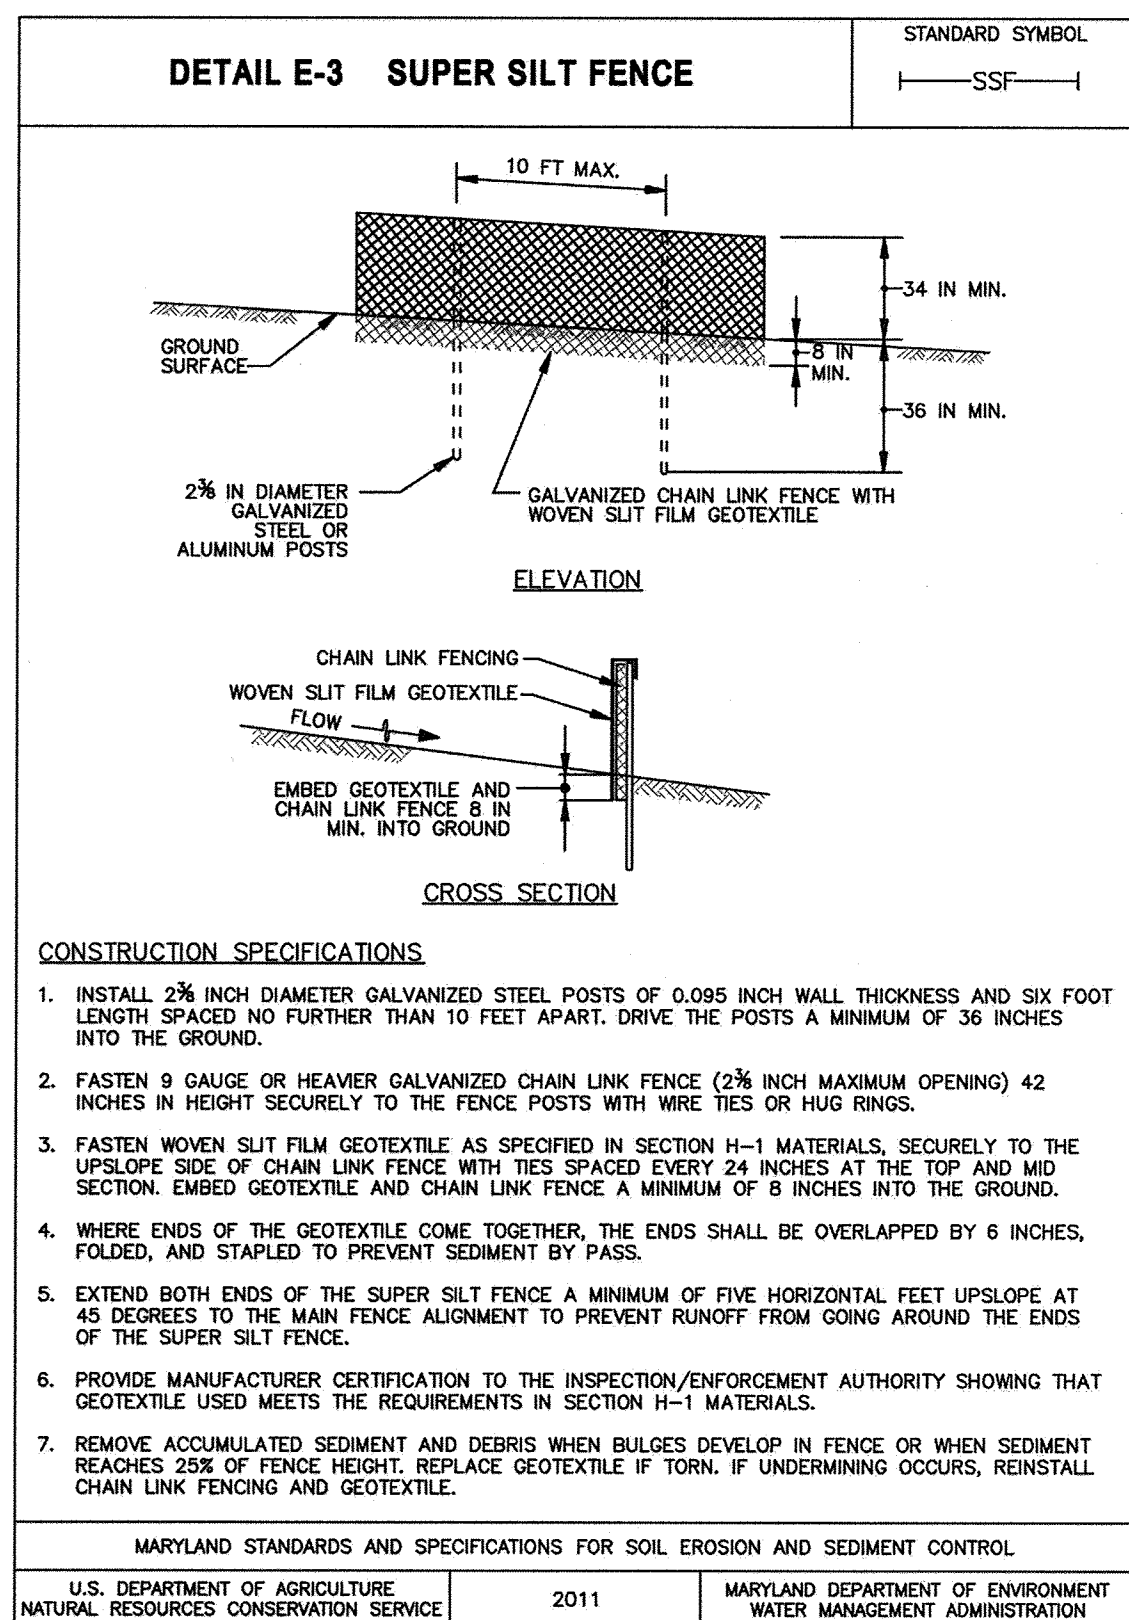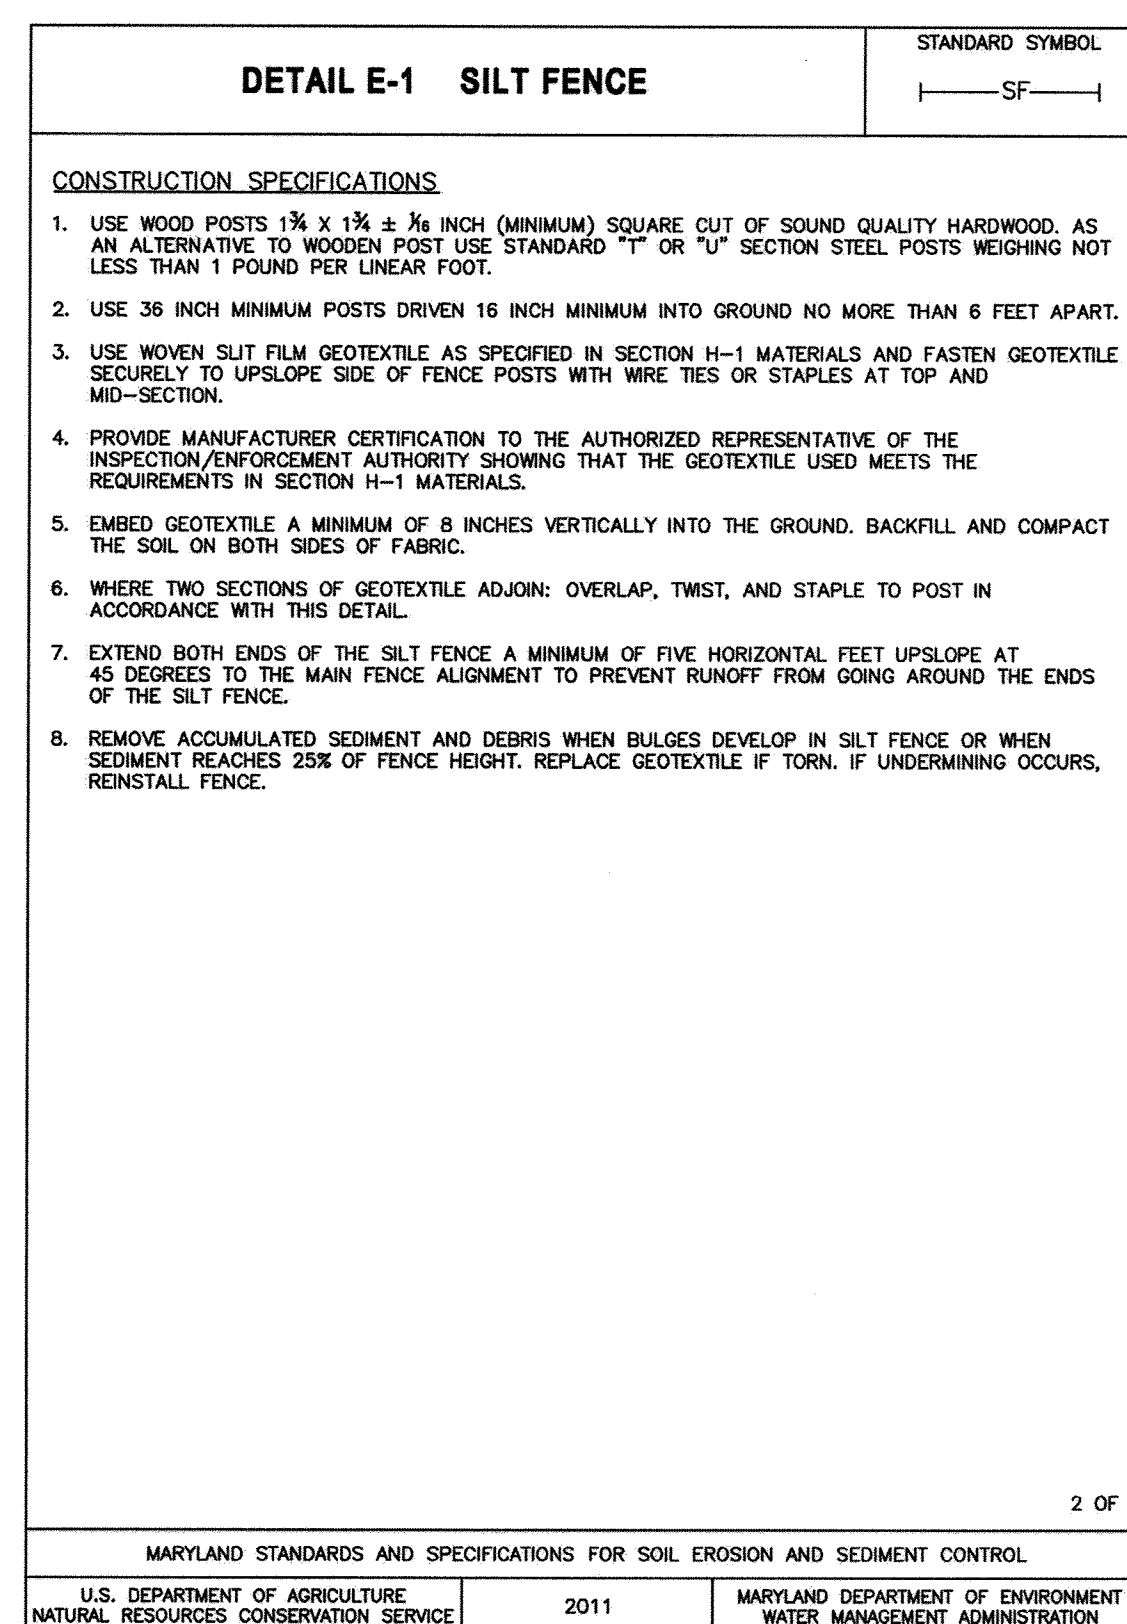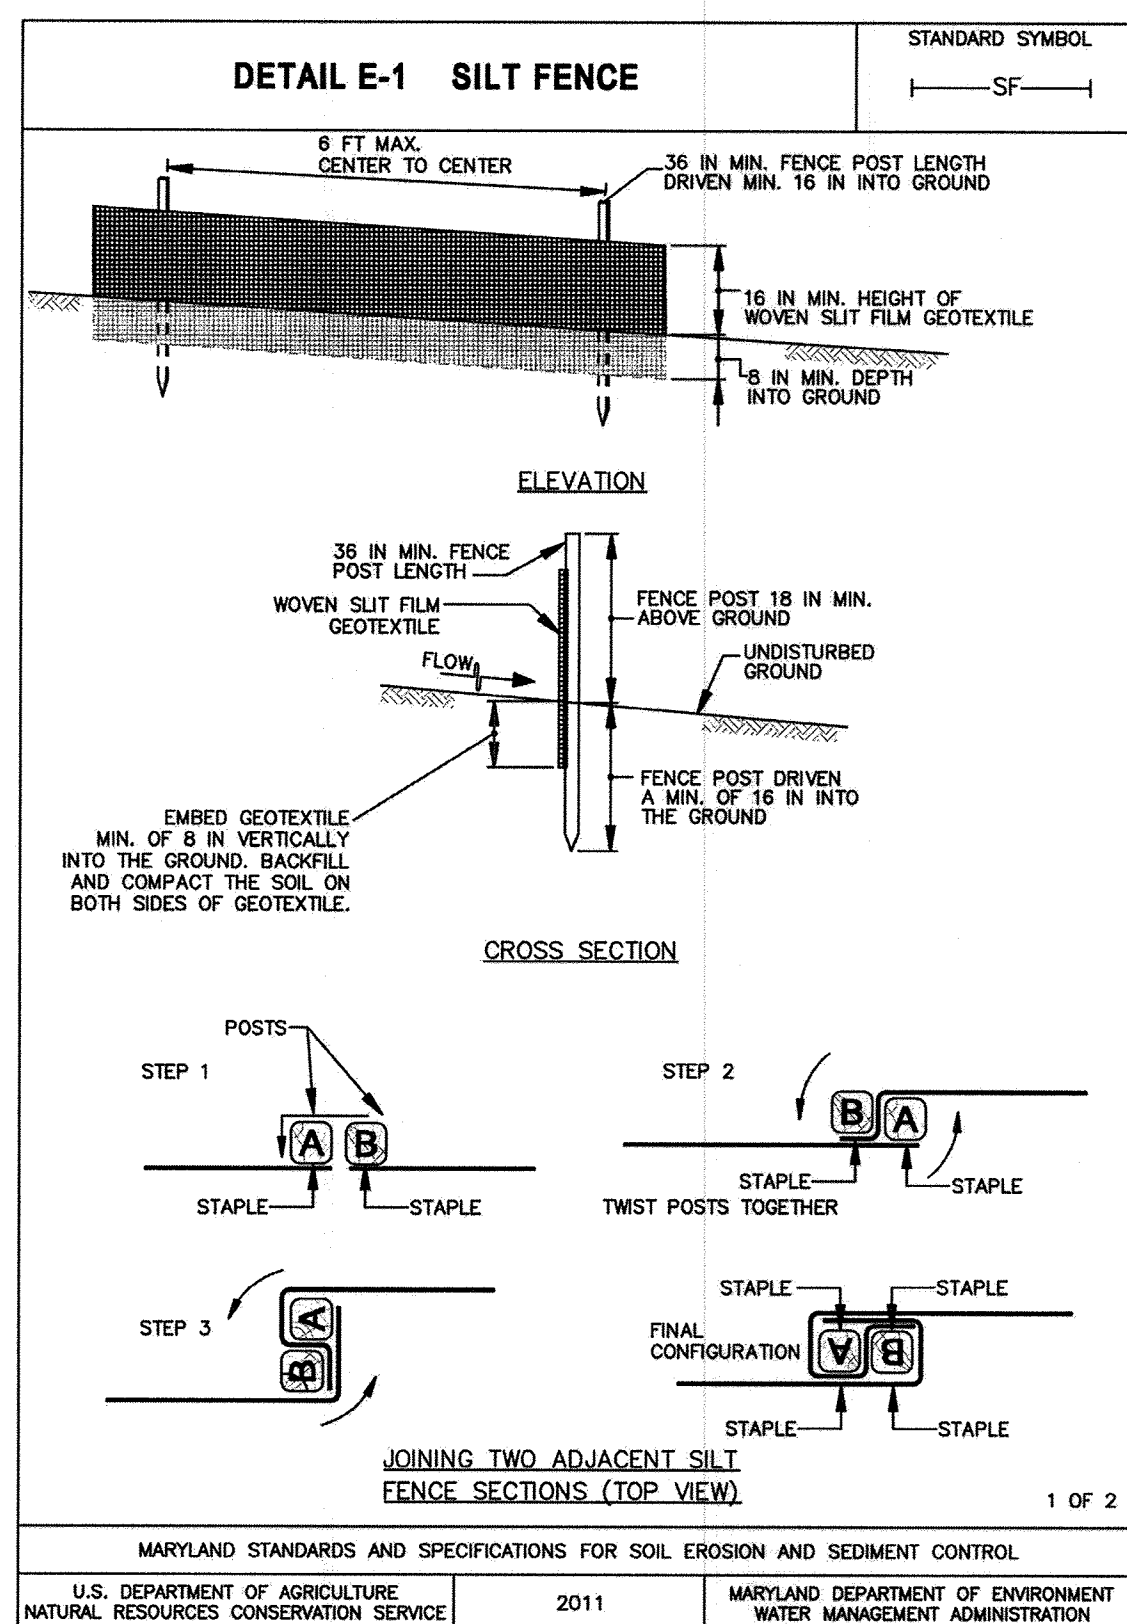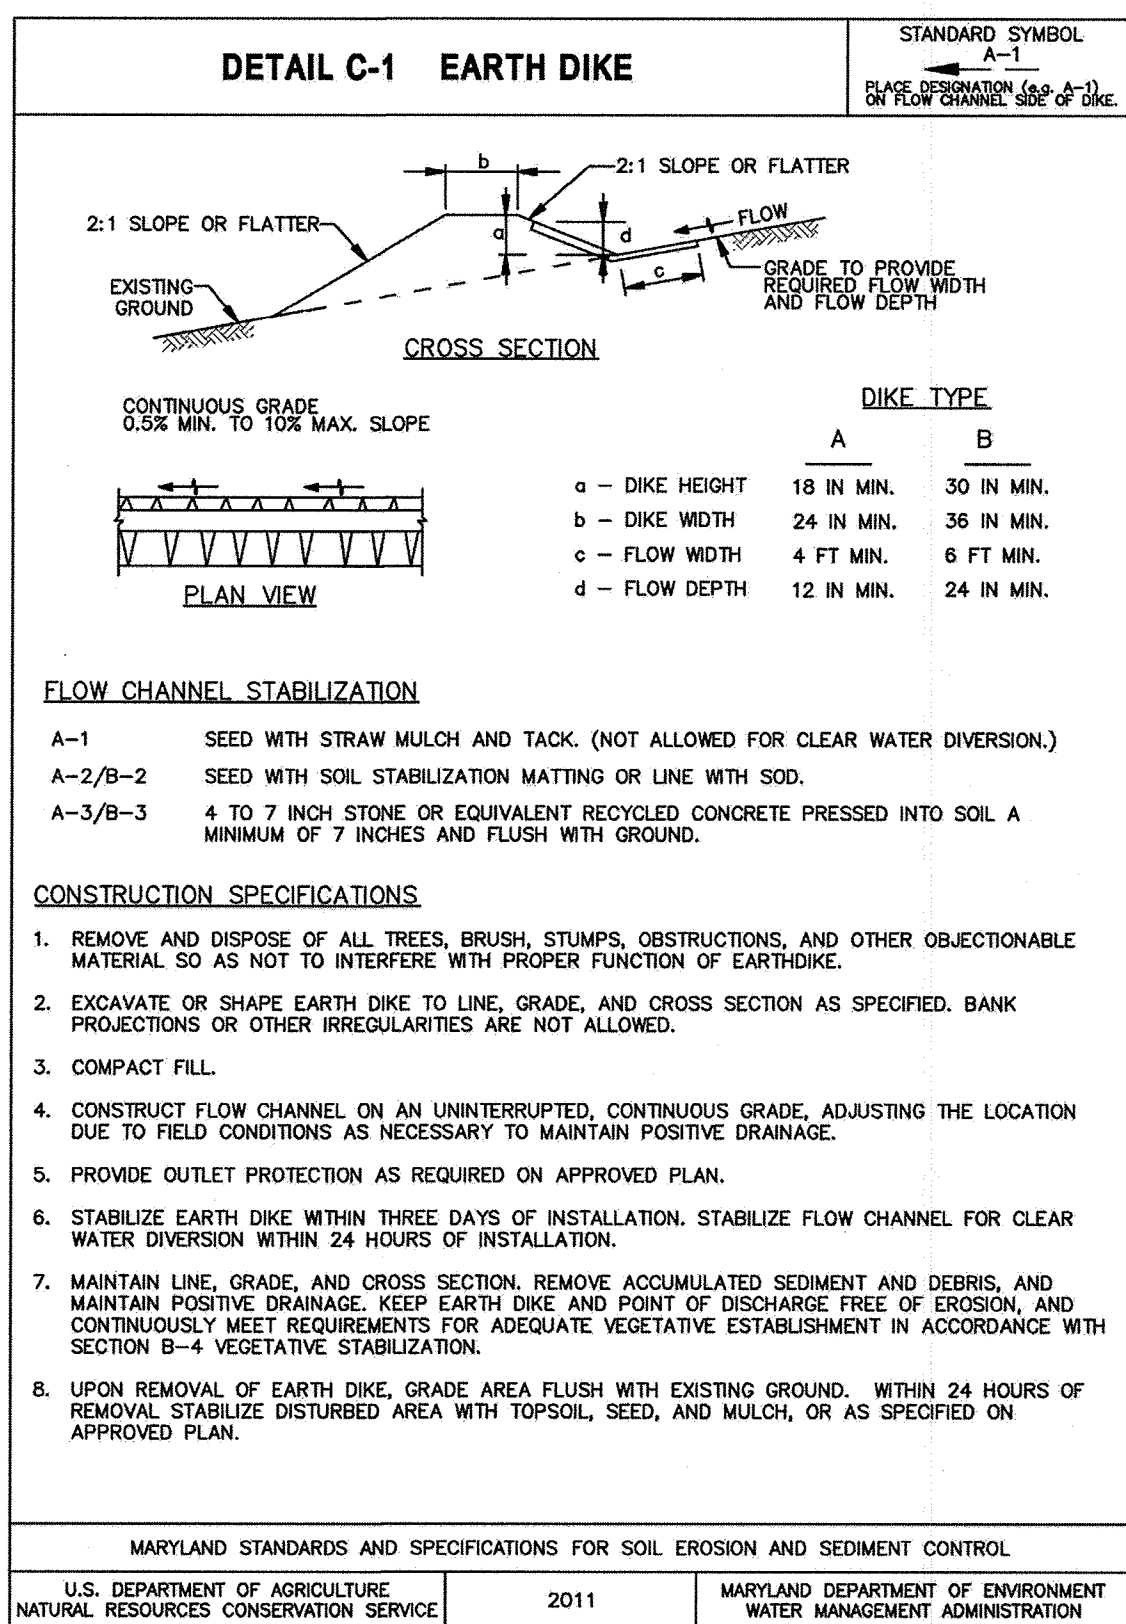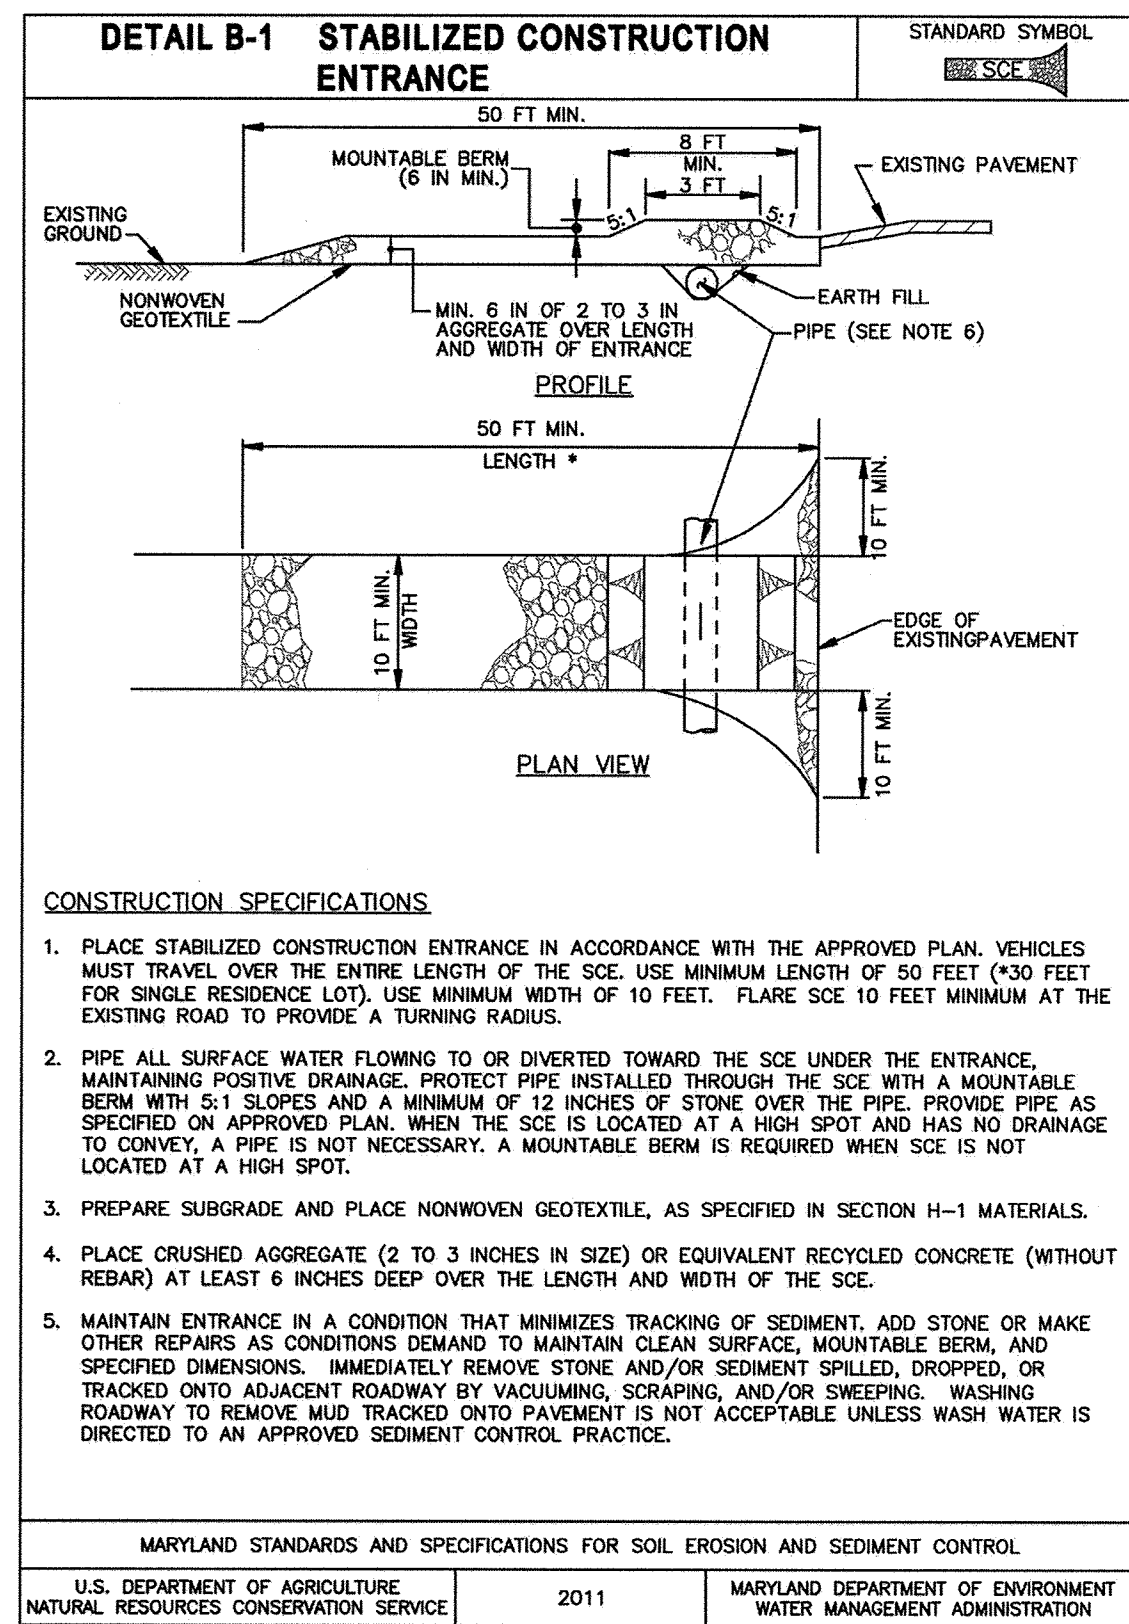

ENGINEER'S CERTIFICATE
I HEREBY CERTIFY THAT THIS PLAN HAS BEEN DESIGNED IN ACCORDANCE WITH CURRENT MARYLAND EROSION AND SEDIMENT CONTROL LAWS, REGULATIONS, AND STANDARDS. THAT IT REPRESENTS A PRACTICAL AND WORKABLE PLAN BASED ON MY PERSONAL KNOWLEDGE OF THE SITE, AND THAT IT WAS PREPARED IN ACCORDANCE WITH THE REQUIREMENTS OF THE HOWARD SOIL CONSERVATION DISTRICT.

SIGNATURE OF ENGINEER: *Sharon L. Cruz* DATE: 8/1/17

DEVELOPER'S CERTIFICATE
I/WE HEREBY CERTIFY THAT ANY CLEARING, GRADING, CONSTRUCTION, OR DEVELOPMENT WILL BE DONE PURSUANT TO THIS APPROVED EROSION AND SEDIMENT CONTROL PLAN, INCLUDING INSPECTING AND MAINTAINING CONTROLS, AND THAT THE RESPONSIBLE PERSONNEL INVOLVED IN THE CONSTRUCTION PROJECT WILL HAVE A CERTIFICATE OF TRAINING AT A MARYLAND DEPARTMENT OF THE ENVIRONMENT APPROVED TRAINING PROGRAM FOR THE CONTROL ON EROSION AND SEDIMENT PRIOR TO BEGINNING THE PROJECT. I CERTIFY RIGHT-OF-ENTRY FOR PERIODIC ON-SITE EVALUATION BY HOWARD COUNTY, THE HOWARD SOIL CONSERVATION DISTRICT AND/OR MDE.

SIGNATURE OF DEVELOPER: *Jacqueline Carbone* DATE: 8/1/17

THIS PLAN IS APPROVED FOR SOIL EROSION AND SEDIMENT CONTROL BY THE HOWARD SOIL CONSERVATION DISTRICT.

SIGNATURE OF APPROVER: *John R. Robertson* DATE: 8/30/17

APPROVED: DEPARTMENT OF PLANNING AND ZONING

CHIEF, DEVELOPMENT ENGINEERING DIVISION DATE: 9-21-17

CHIEF, DIVISION OF LAND DEVELOPMENT DATE: 9-27-17

DIRECTOR DATE: 10-2-17

DATE	NO.	REVISION	BY
		DCT INDUSTRIAL	

DEVELOPER: DCT INDUSTRIAL
12011 GUILFORD ROAD
SUITE 102
ANNAPOLIS JUNCTION, MD 20701
ATTN: FRED FERRARO
PHONE: 410-645-5020

OWNER: DCT MEARS LLC
12011 GUILFORD ROAD
SUITE 102
ANNAPOLIS JUNCTION, MD 20701
ATTN: FRED FERRARO
PHONE: 410-645-5020

PROJECT: TERRAPIN COMMERCE CENTER

AREA: TAX MAP 43, PARCEL 51 LOT PAR A PLAT 23783 ZONED M-2
GRID NO. 11 181 ELECTON DISTRICT
7200 DORSEY RUN ROAD
ELKRIDGE, MARYLAND 21075
HOWARD COUNTY, MARYLAND









TITLE: SEDIMENT CONTROL DETAILS

Pennoni Associates Inc.
Engineers • Surveyors • Planners
Landscape Architects

8818 Centre Park Drive, Suite 200 Columbia, MD 21045
T 410.997.8900 F 410.997.9282

DESIGNED BY:	PJS
DRAWN BY:	AGS/JSN
PROJECT NO.:	DCT1601
DATE:	JUNE 23, 2017
SCALE:	AS SHOWN
DRAWING NO.:	11 OF 43

AS-BUILT CERTIFICATION
NOTE: THERE IS NO "AS-BUILT" INFORMATION PROVIDED ON THIS SHEET.
Signature: *Sharon L. Cruz* DATE: 8/29/16
PRINTED NAME: Sharon L. Cruz MD, P.E., No. 71819
SIGNATURE: *Sharon L. Cruz* DATE: 8/29/16

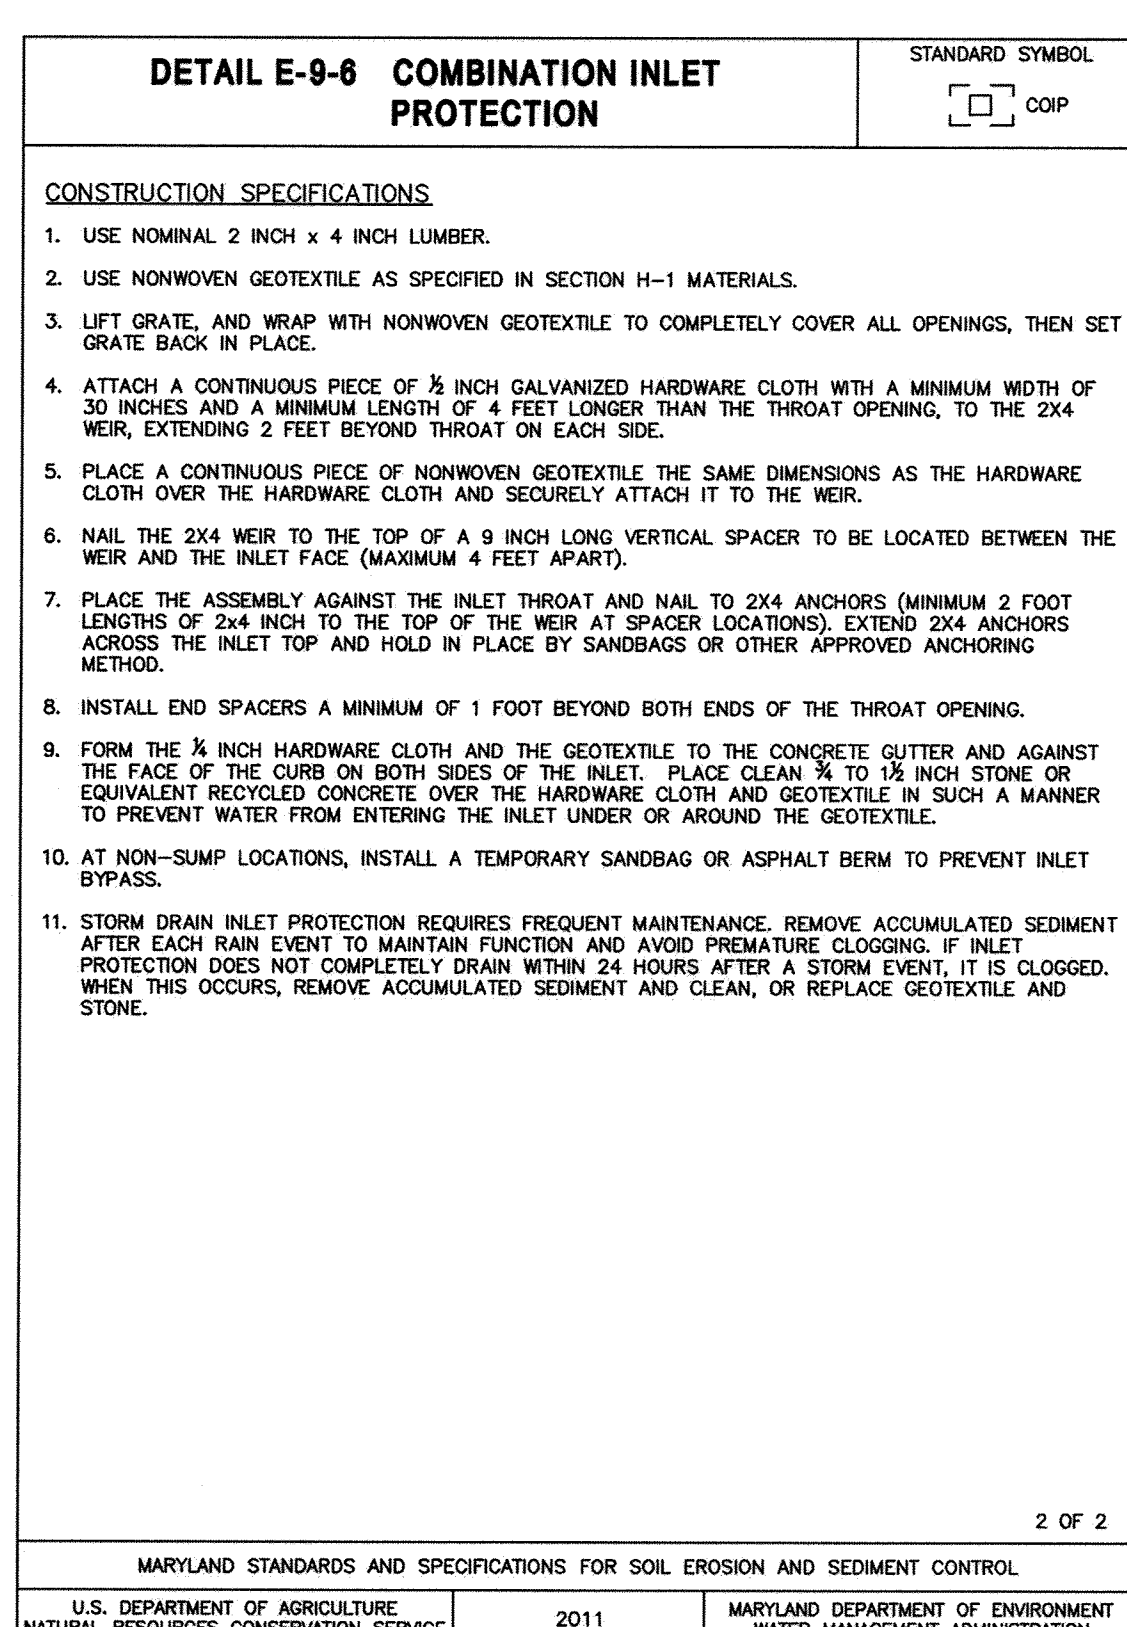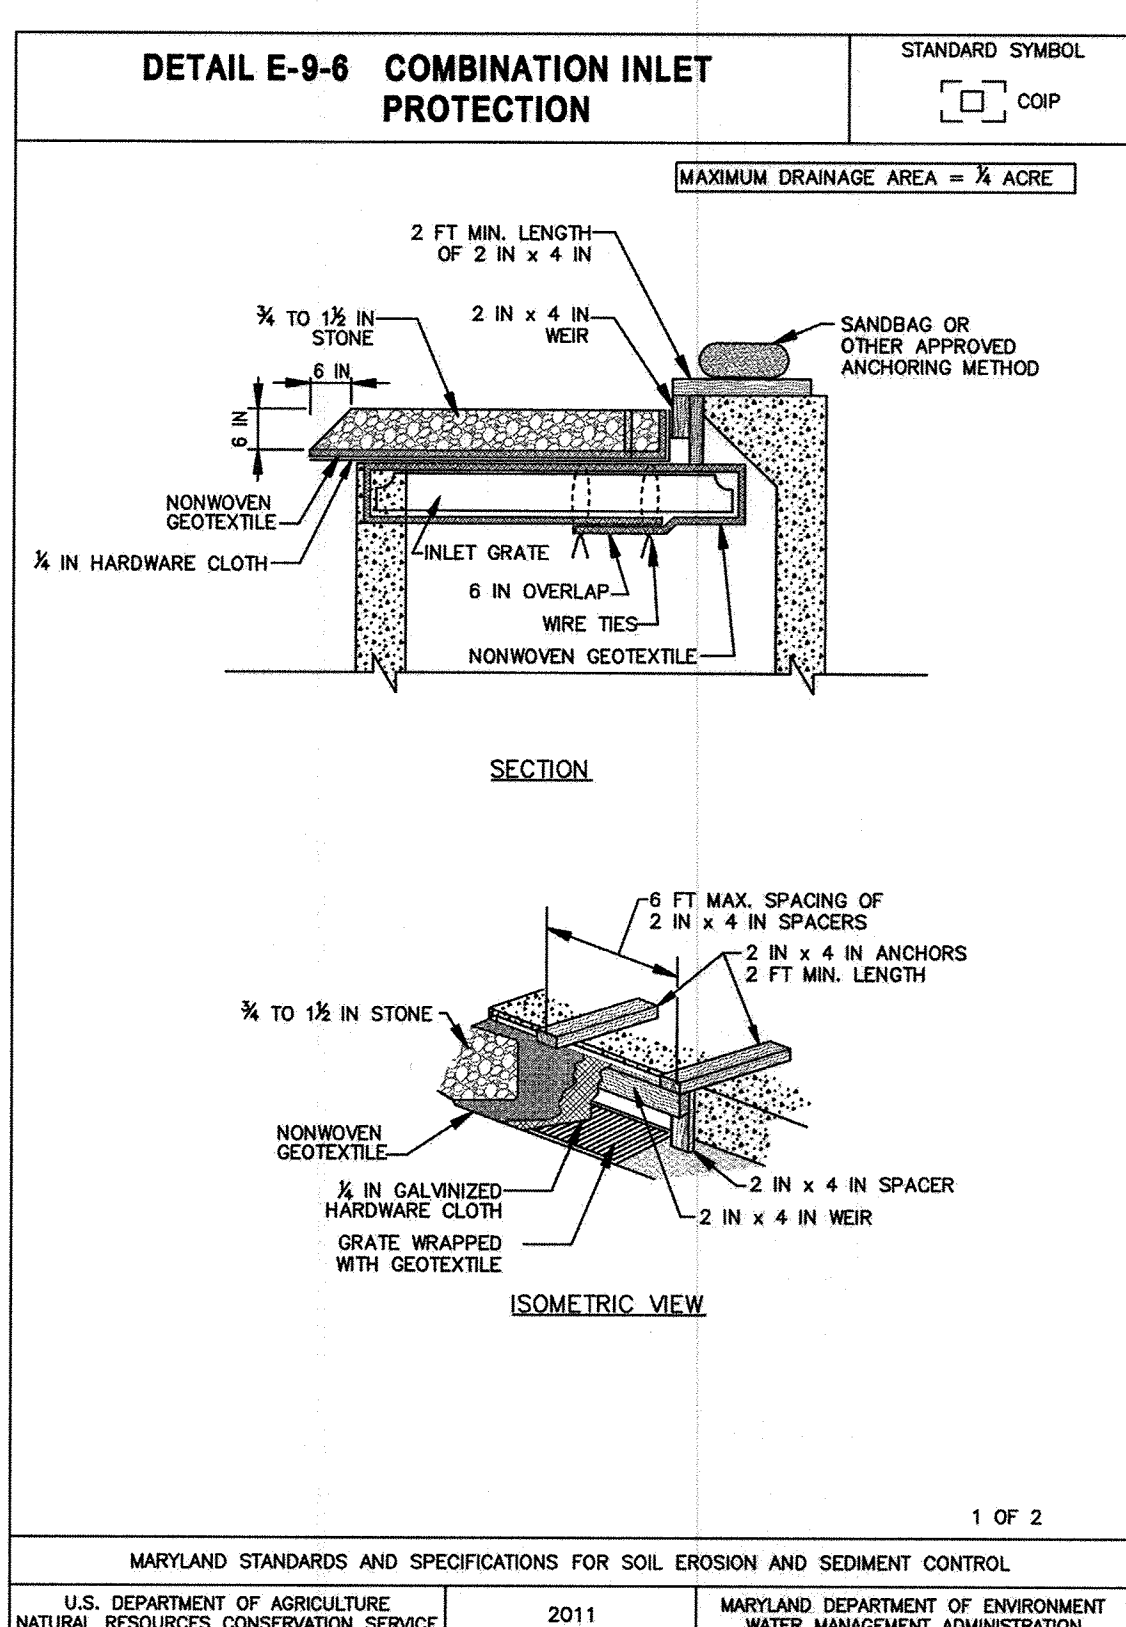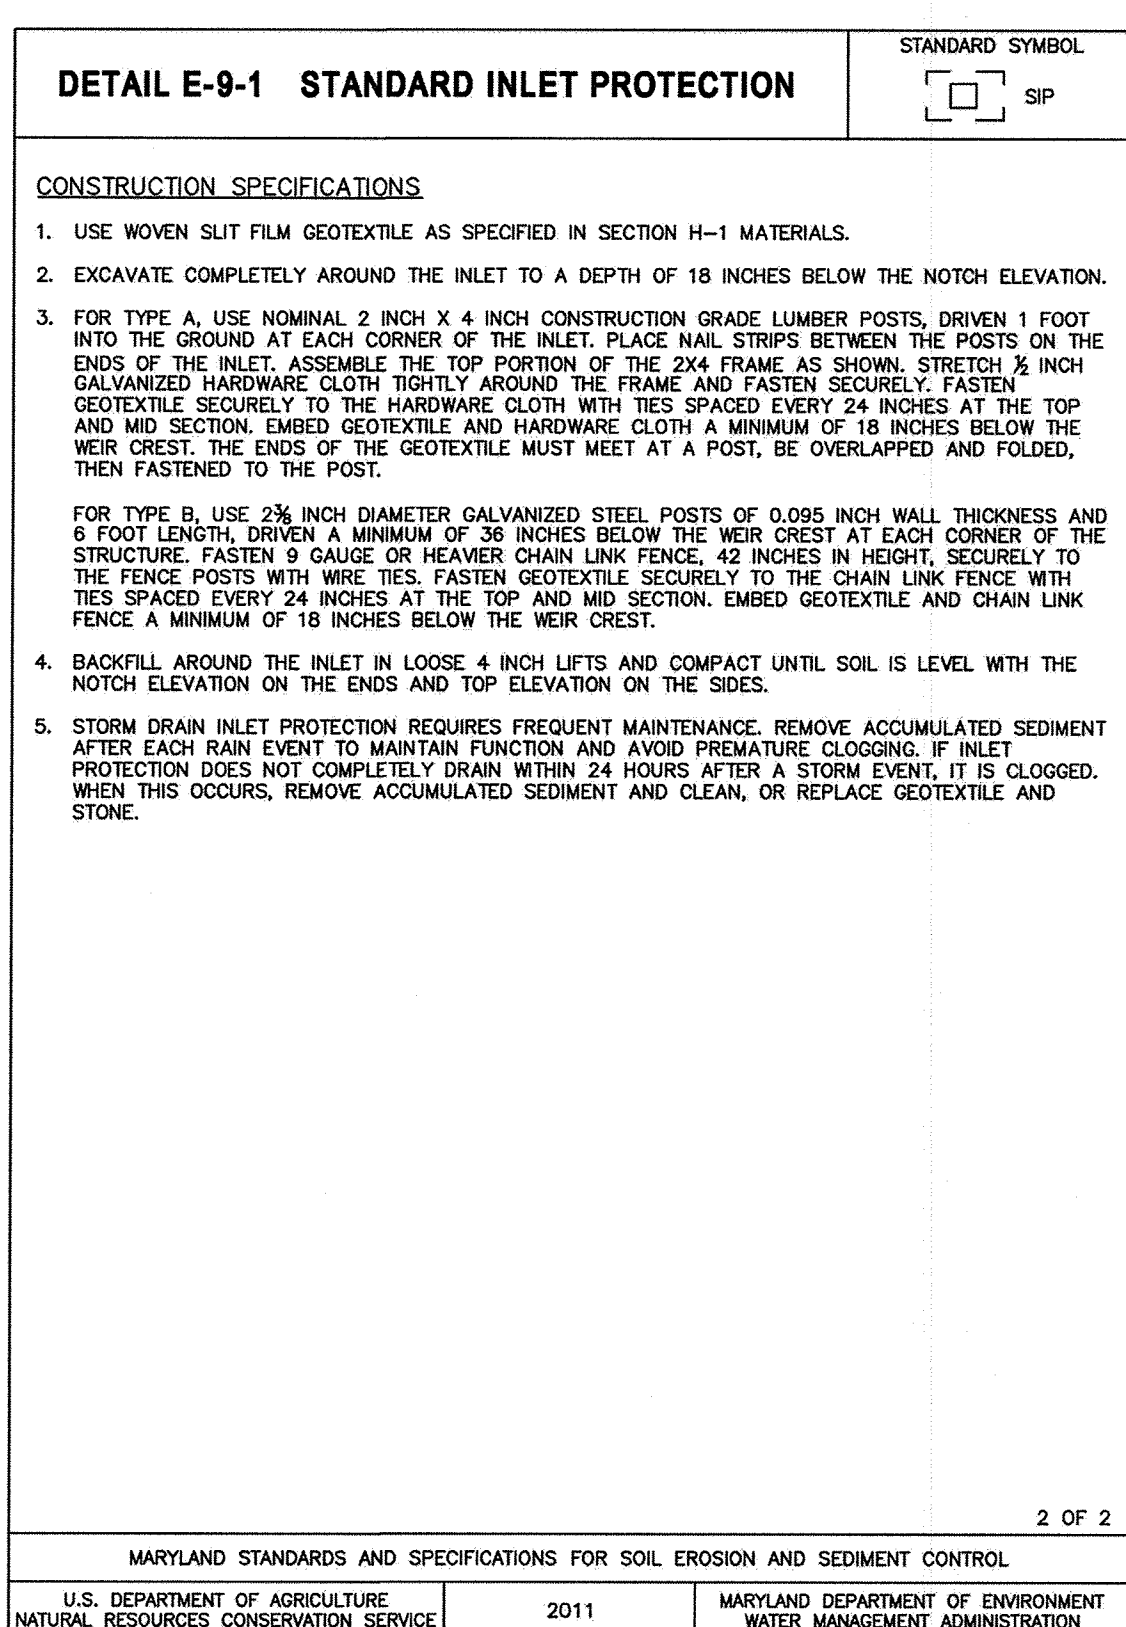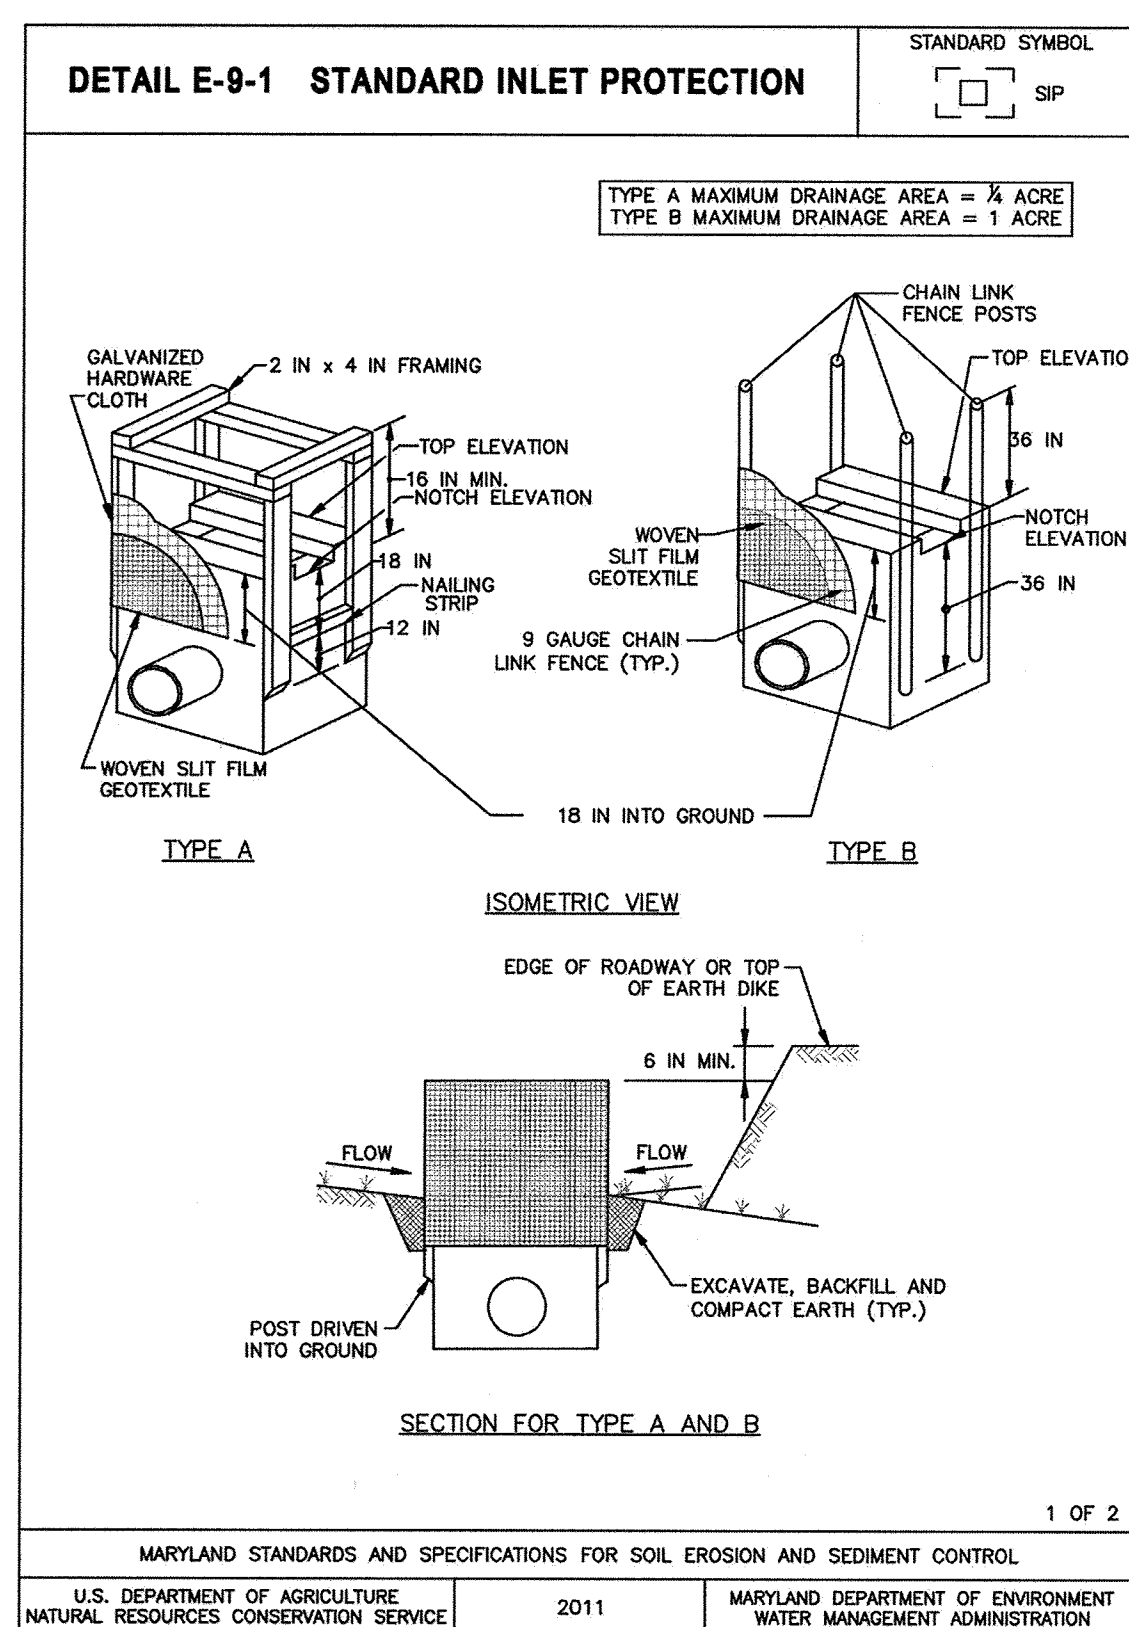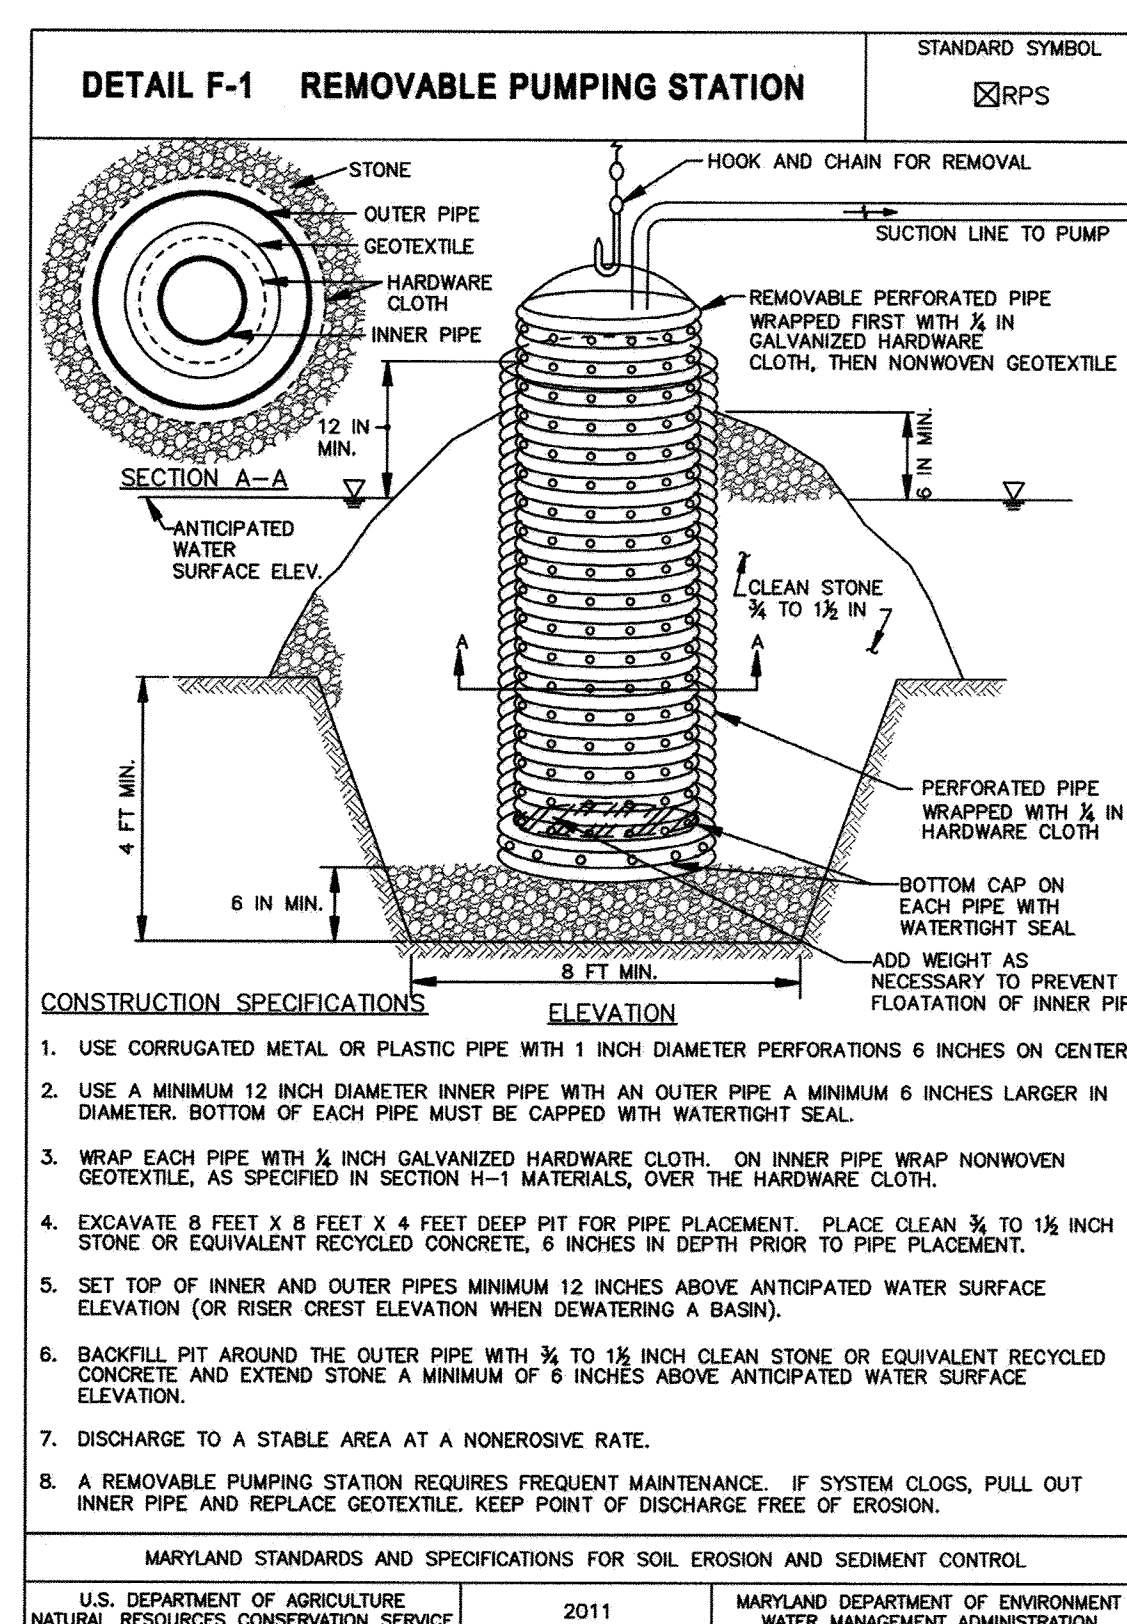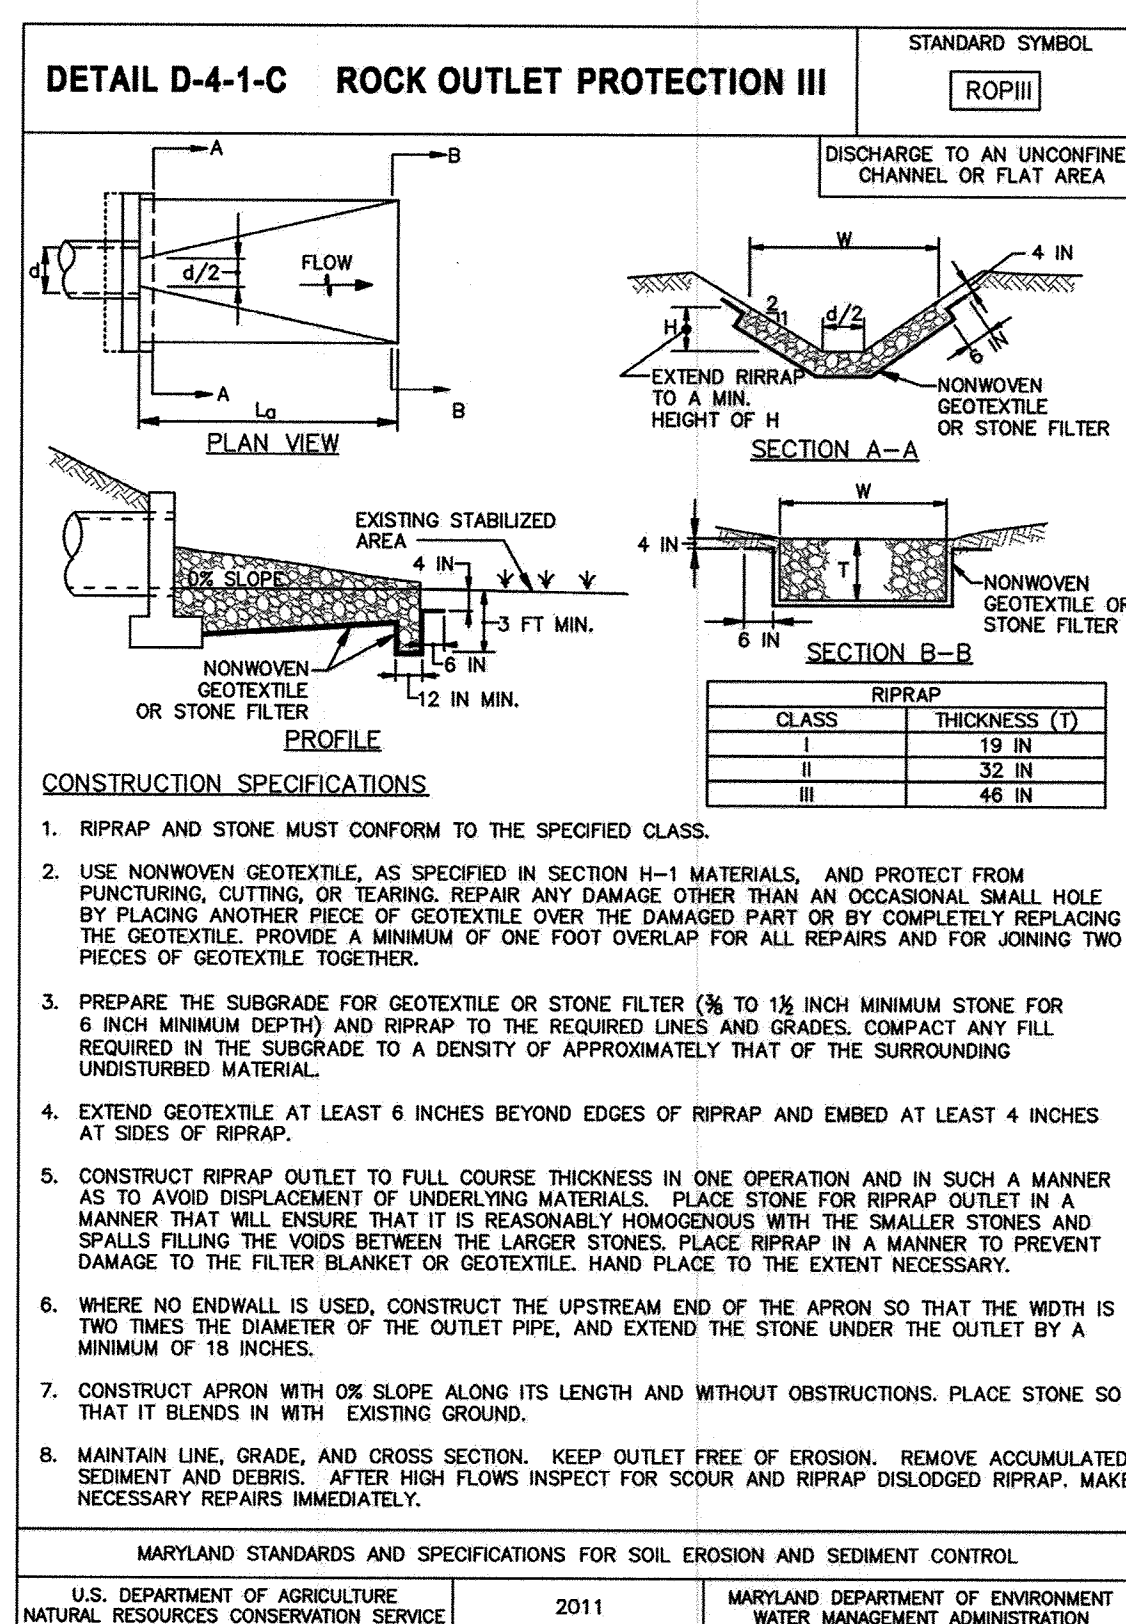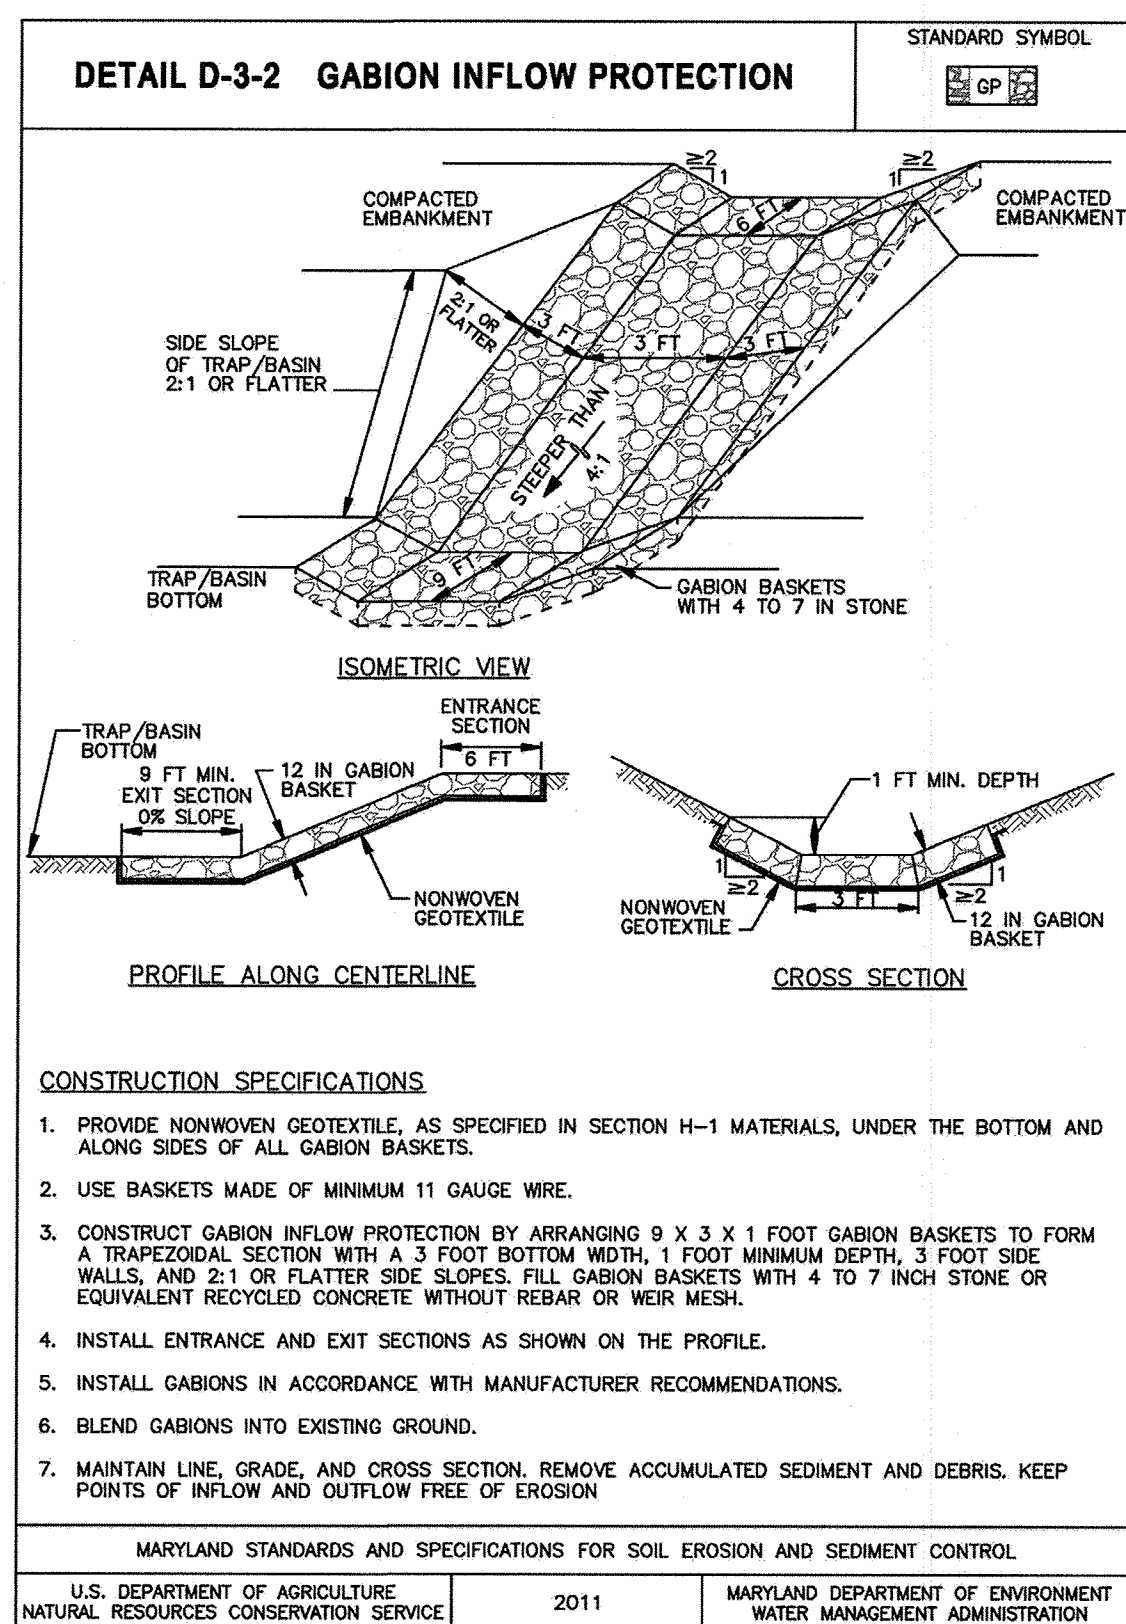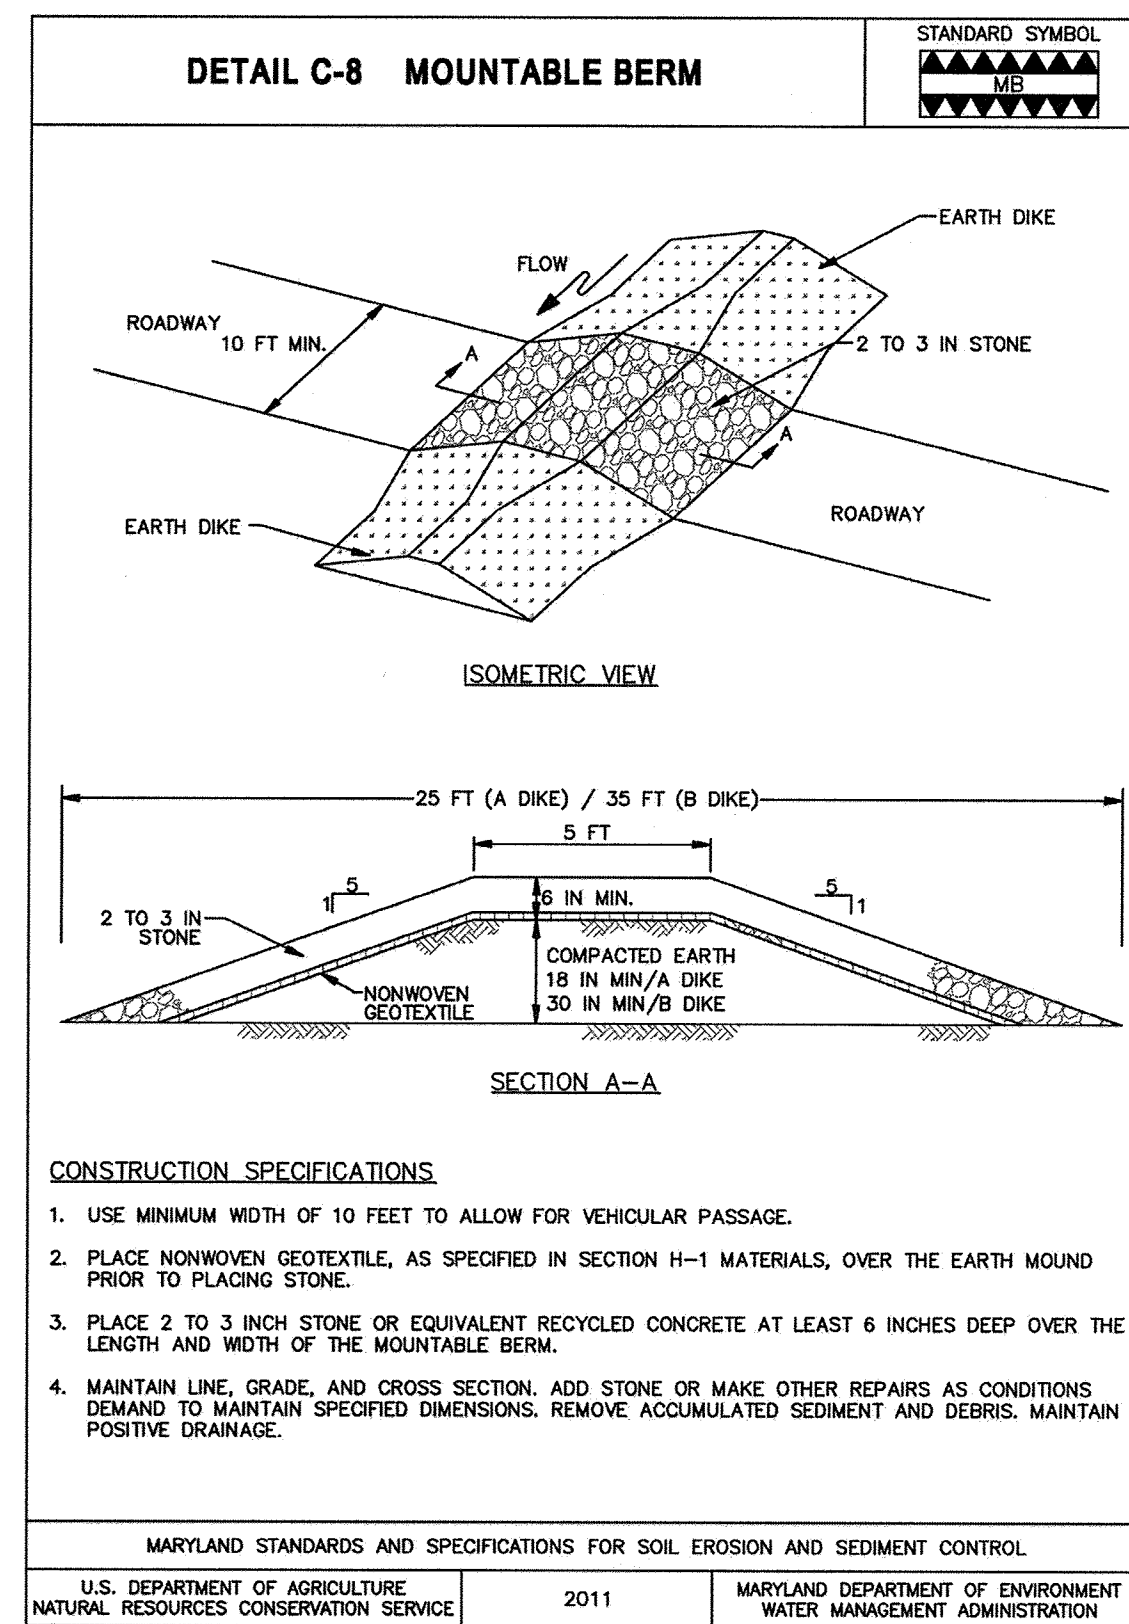

ENGINEER'S CERTIFICATE
I HEREBY CERTIFY THAT THIS PLAN HAS BEEN DESIGNED IN ACCORDANCE WITH CURRENT MARYLAND EROSION AND SEDIMENT CONTROL LAWS, REGULATIONS, AND STANDARDS, THAT IT REPRESENTS A PRACTICAL AND WORKABLE PLAN BASED ON MY PERSONAL KNOWLEDGE OF THE SITE, AND THAT IT WAS PREPARED IN ACCORDANCE WITH THE REQUIREMENTS OF THE HOWARD SOIL CONSERVATION DISTRICT.

SIGNATURE OF ENGINEER: *Sharon K. Cruz* 8/21/17
DATE

DEVELOPER'S CERTIFICATE
I/WE HEREBY CERTIFY THAT ANY CLEARING, GRADING, CONSTRUCTION, OR DEVELOPMENT WILL BE DONE PURSUANT TO THIS APPROVED EROSION AND SEDIMENT CONTROL PLAN, INCLUDING INSPECTING AND MAINTAINING CONTROLS, AND THAT THE RESPONSIBLE PERSONNEL INVOLVED IN THE CONSTRUCTION PROJECT WILL HAVE A CERTIFICATE OF TRAINING AT A MARYLAND DEPARTMENT OF THE ENVIRONMENT APPROVED TRAINING PROGRAM FOR THE CONTROL ON EROSION AND SEDIMENT PRIOR TO BEGINNING THE PROJECT. I CERTIFY RIGHT-OF-ENTRY FOR PERIODIC ON-SITE EVALUATION BY HOWARD COUNTY, THE HOWARD SOIL CONSERVATION DISTRICT AND/OR MDE.

SIGNATURE OF DEVELOPER: *Jacqueline Carbone* 8/1/17
DATE

THIS PLAN IS APPROVED FOR SOIL EROSION AND SEDIMENT CONTROL BY THE HOWARD SOIL CONSERVATION DISTRICT.

SIGNATURE OF APPROVED: *John R. Robertson* 8/31/17
DATE

APPROVED: DEPARTMENT OF PLANNING AND ZONING
CHIEF, DEVELOPMENT ENGINEERING DIVISION: *David G. Smith* 9-21-17
DATE
CHIEF, DIVISION OF LAND DEVELOPMENT: *Karl Shalinski* 9-27-17
DATE
DIRECTOR: *William J. J. J.* 10-2-17
DATE

DATE	NO.	REVISION	BY
		DCI INDUSTRIAL SUITE 102 12011 GUILFORD ROAD ANNAPOLIS JUNCTION, MD 20701 ATTN: FRED FERRARO PHONE: 410-645-5020	
		DCI MEARS LLC 12011 GUILFORD ROAD SUITE 102 ANNAPOLIS JUNCTION, MD 20701 ATTN: FRED FERRARO PHONE: 410-645-5020	
		TERRAPIN COMMERCE CENTER	
		TAX MAP 43, PARCEL 51 LOT PAR A PLAT 23783 ZONED M-2 GRID NO. 11 1st ELECTION DISTRICT 7200 DORSEY RUN ROAD ELKRIDGE, MARYLAND 21075 HOWARD COUNTY, MARYLAND	

TITLE
SEDIMENT CONTROL DETAILS

Pennoni Associates Inc.
Engineers • Surveyors • Planners
Landscape Architects
8818 Centre Park Drive, Suite 200 Columbia, MD 21045
T 410.997.8900 F 410.997.9282

DESIGNED BY: PJS
DRAWN BY: AGS/JSN
PROJECT NO.: DCT11601
DATE: JUNE 23, 2017
SCALE: AS SHOWN
DRAWING NO. 12 OF 43

AS-BUILT CERTIFICATION
NOTE: THERE IS NO "AS-BUILT" INFORMATION PROVIDED ON THIS SHEET.
PRINTED NAME: *Sharon K. Cruz* 36896 MD P.E. NO.
SIGNATURE: *[Signature]* 7/21/19 DATE

CONSTRUCTION SPECIFICATIONS

These specifications are appropriate to all ponds within the scope of the Standard for practice MD-378. All references to ASTM and AASHTO specifications apply to the most recent version.

Site Preparation

Areas designated for borrow areas, embankment, and structural works shall be cleared, grubbed and stripped of topsoil. All trees, vegetation, roots and other objectionable material shall be removed. Channel banks and sharp breaks shall be sloped to no steeper than 1:1. All trees shall be cleared and grubbed within 15 feet of the toe of the embankment.

Areas to be covered by the reservoir will be cleared of all trees, brush, logs, fences, rubbish and other objectionable material unless otherwise designated on the plans. Trees, brush, stumps shall be cut approximately level with the ground surface. For dry stormwater management ponds, a minimum of a 25-foot radius around the inlet structure shall be cleared.

All cleared and grubbed material shall be disposed of outside and below the limits of the dam and reservoir as directed by the owner or his representative. When specified, a sufficient quantity of topsoil will be stockpiled in a suitable location for use on the embankment and other designated areas.

Earth Fill

Material - The fill material shall be taken from approved designated borrow areas. It shall be free of roots, stumps, wood, rubbish, stones greater than 6", frozen or other objectionable materials. Fill material for the center of the embankment, and cut off trench shall conform to Unified Soil Classification GC, SC, CH, or CL and must have at least 30% passing the #200 sieve. Consideration may be given to the use of other materials in the embankment if designed by a geotechnical engineer. Such special designs must have construction supervised by a geotechnical engineer.

Materials used in the outer shell of the embankment must have the capability to support vegetation of the quality required to prevent erosion of the embankment.

Placement - Areas on which fill is to be placed shall be scarified prior to placement of fill. Fill materials shall be placed in maximum 8 inch thick (before compaction) layers which are to be continuous over the entire length of the fill. The most permeable borrow material shall be placed in the downstream portions of the embankment. The principal spillway must be installed concurrently with fill placement and not excavated into the embankment.

Compaction - The movement of the hauling and spreading equipment over the fill shall be controlled so that the entire surface of each lift shall be traversed by not less than one track of heavy equipment or compaction shall be achieved by a minimum of four complete passes of a sheepsfoot, rubber tired or vibratory roller. Fill material shall contain sufficient moisture such that the required degree of compaction will be obtained with the equipment used. The fill material shall contain sufficient moisture so that if formed into a ball it will not crumble, yet not be so wet that water can be squeezed out.

When required by the reviewing agency the minimum required density shall not be less than 95% of maximum dry density with a moisture content within +/- 2% of the optimum. Each layer of fill shall be compacted as necessary to obtain that density, and is to be certified by the Engineer at the time of construction. All compaction is to be determined by AASHTO Method T-99 (Standard Proctor).

Cut Off Trench - The cutoff trench shall be excavated into impervious material along or parallel to the centerline of the embankment as shown on the plans. The bottom width of the trench shall be governed by the equipment used for excavation, with the minimum width being four feet. The depth shall be at least four feet below existing grade or as shown on the plans. The side slopes of the trench shall be 1 to 1 or flatter. The backfill shall be compacted with construction equipment, roller.

etc.) to prevent floating the pipe. When using flowable fill, all metal pipe shall be bituminous coated. Any adjoining soil fill shall be placed in horizontal layers not to exceed four inches in thickness and compacted by hand tampers or other manually directed compaction equipment. The material shall completely fill all voids adjacent to the flowable fill zone. At no time during the backfilling operation shall driven equipment be allowed to operate closer than four feet, measured horizontally, to any part of a structure. Under no circumstances shall equipment be driven over any part of a structure or pipe unless there is a compacted fill of 24" or greater over the structure or pipe. Backfill material outside the structural backfill (flowable fill) zone shall be of the type and quality conforming to that specified for the core of the embankment or other embankment materials.

Embankment Core - The core shall be parallel to the centerline of the embankment as shown on the plans. The top width of the core shall be a minimum of four feet. The height shall extend up to at least the 10 year water elevation or as shown on the plans. The side slopes shall be 1 to 1 or flatter. The core shall be compacted with construction equipment, rollers, or hand tampers to assure maximum density and minimum permeability. In addition, the core shall be placed concurrently with the outer shell of the embankment into the embankment.

Structure Backfill

Backfill adjacent to pipes or structures shall be of the type and quality conforming to that specified for the adjoining fill material. The fill shall be placed in horizontal layers not to exceed four inches in thickness and compacted by hand tampers or other manually directed compaction equipment. The material needs to fill completely all spaces under and adjacent to the pipe. At no time during the backfilling operation shall driven equipment be allowed to operate closer than four feet, measured horizontally, to any part of a structure. Under no circumstances shall equipment be driven over any part of a concrete structure or pipe, unless there is a compacted fill of 24" or greater over the structure or pipe.

Structure backfill may be flowable fill meeting the requirements of Maryland Department of Transportation, State Highway Administration Standard Specifications for Construction and Materials, Section 313 as modified. The mixture shall have a 100-200 psi, 28 day unconfined compressive strength. The flowable fill shall have a minimum pH of 4.0 and a minimum resistivity of 2,000 ohm-cm. Material shall be placed such that a minimum of 6" (measured perpendicular to the outside of the pipe) of flowable fill shall be under (bedding), over and, on the sides of the pipe. It only needs to extend up to the spring line for rigid conduits. Average slump of the fill shall be 7" to assure flowability of the material. Adequate measures shall be taken (sand bags,

with one coat of zinc chromate primer or two coats of asphalt. Materials - (Aluminum Pipe) - This pipe and its appurtenances shall conform to the requirements of AASHTO Specification M-196 or M-211 with watertight coupling bands or flanges. Aluminum Pipe, when used with flowable fill or when soil and/or water conditions warrant for increased durability, shall be fully bituminous coated per requirements of AASHTO Specification M-190 Type A. Aluminum surfaces that are to be in contact with concrete shall be painted with one coat of zinc chromate primer or two coats of asphalt. Hot dip galvanized bolts may be used for connections. The pH of the surrounding soils shall be between 4 and 9.

Pipe Conduits

All pipes shall be circular in cross section.

Corrugated Metal Pipe - All of the following criteria shall apply for corrugated metal pipe:

- 1. Materials - (Polymer Coated steel pipe) - Steel pipes with polymeric coatings shall have a minimum coating thickness of 0.01 inch (10 mil) on both sides of the pipe. This pipe and its appurtenances shall conform to the requirements of AASHTO Specifications M-245 & M-246 with watertight coupling bands or flanges.

Materials - (Aluminum Coated Steel Pipe) - This pipe and its appurtenances shall conform to the requirements of AASHTO Specification M-274 with watertight coupling bands or flanges. Aluminum Coated Steel Pipe, when used with flowable fill or when soil and/or water conditions warrant the need for increased durability, shall be fully bituminous coated per requirements of AASHTO Specification M-190 Type A. Any aluminum coating damaged or otherwise removed shall be replaced with cold applied bituminous coating compound. Aluminum surfaces that are to be in contact with concrete shall be painted

of 1/2 inch greater than the corrugation depth. Pipes 24 inches in diameter and larger shall be connected by a 24 inch long annular corrugated band using a minimum of 4 (four) rods and lugs, 2 on each connecting pipe end. A 24-inch wide by 3/8-inch thick closed cell circular neoprene gasket will be installed with 12 inches on the end of each pipe. Flanged joints with 3/8 inch closed cell gaskets the full width of the flange is also acceptable.

Helically corrugated pipe shall have either continuously welded seams or have lock seams with internal caulking or a neoprene bead. Bedding - The pipe shall be firmly and uniformly bedded throughout its entire length. Where rock or soft, spongy or other unstable soil is encountered, all such material shall be removed and replaced with suitable earth compacted to provide adequate support.

Backfilling shall conform to "Structure Backfill".

- 5. Other details (anti-seep collars, valves, etc.) shall be as shown on the drawings. Plastic Pipe - The following criteria shall apply for plastic pipe: 1. Materials - PVC pipe shall be PVC-1120 or PVC-1220 conforming to ASTM D-1785 or ASTM D-2241. Corrugated High Density Polyethylene (HDPE) pipe, couplings and fittings shall conform to the following: 4" - 10" inch pipe shall meet the requirements of AASHTO M252 Type S, and 12" through 24" inch shall meet the requirements of AASHTO M294 Type S.

Reinforced Concrete Pipe - All of the following criteria shall apply for reinforced concrete pipe: 1. Materials - Reinforced concrete pipe shall have bell and spigot joints with rubber gaskets and shall equal or exceed ASTM C-361. 2. Bedding - Reinforced concrete pipe conduits shall be laid in a concrete bedding / cradle for their entire length. This bedding / cradle shall consist of high slump concrete placed under the pipe and up the sides of the pipe at least 50% of its outside diameter with a minimum thickness of 6 inches. Where a concrete grade is not needed for structural reasons, flowable fill may be used as described in the "Structure Backfill" section of this standard. Gravel bedding is not permitted.

Drainage Diaphragms - When a drainage diaphragm is used, a registered professional engineer will supervise the design and construction inspection.

Concrete shall meet the requirements of Maryland Department of Transportation, State Highway Administration Standard Specifications for Construction and Materials, Section 902.10, Mix No. 3. Rock Riprap shall meet the requirements of Maryland Department of Transportation, State Highway Administration Standard Specifications for Construction and Materials, Section 311. Geotextile shall be placed under all riprap and shall meet the requirements of Maryland Department of Transportation, State Highway Administration Standard Specifications for Construction and Materials, Section 921.09, Class SE (Non-Woven).

Care of Water during Construction

All work on permanent structures shall be carried out in areas free from water. The Contractor shall construct and maintain all temporary dikes, levees, cofferdams, drainage channels, and stream diversions necessary to protect the areas to be occupied by the permanent works. The Contractor shall also furnish, install, operate, and maintain all necessary pumping and other equipment required for removal of water from various parts of the work and for maintaining the excavations, foundation, and other parts of the work free from water as required or directed by the engineer for constructing each part of the work. After having served their purpose, all temporary protective works shall be removed or leveled and graded to the extent required to prevent obstruction in any degree whatsoever of the flow of water to the spillway or outlet works and so as not to interfere in any way with the operation or maintenance of the structure. Stream diversions shall be maintained until the full flow can be passed through the permanent works. The removal of water from the required excavation and the foundation shall be accomplished in a manner and to the extent that will maintain stability of the excavated slopes and bottom required excavations and will allow satisfactory per-

structures, pipe and materials must be on site prior to proceeding with step 8. A. INSTALL SUPER SILT FENCE ALONG DOWNSTREAM TOE OF EMBANKMENT. OBTAIN PERMISSION FROM INSPECTOR BEFORE PROCEEDING. (1 DAY) B. CLEAR POND AREA AND STRIP TOPSOIL FOR POND AREA AND STOCKPILE OUTSIDE OF EMBANKMENT AREA. (2 DAYS) C. GRADE A SMALL AREA TO BOTTOM ELEVATION OF POND AND INSTALL A REMOVABLE PUMPING STATION TO BE USED TO DRAIN THE WORK AREA DURING CONSTRUCTION. DIRECT FLOWS TO THE PUMP STATION. (1 DAY) D. CONSTRUCT THE CUT-OFF TRENCH. CUTOFF AND CORE TRENCH BACKFILL MATERIAL IS TO MEET THE SPECIFICATIONS OF MD-378 CRITERIA AND IS TO BE PLACED UNDER THE SUPERVISION OF A LICENSED GEOTECHNICAL ENGINEER. (2 DAYS) E. CONSTRUCT RIP RAP OUTFALL, BARREL, CONCRETE GRADLE, ANTI SEEP COLLAR, AND RISER STRUCTURE. CONCRETE COLLARS ARE TO BE CAST IN PLACE. ALL INSTALLATION IS TO BE OBSERVED BY PENNONI ENGINEER. (3 DAYS) F. CONSTRUCT EMBANKMENT IN 8' LIFTS, USING 4" LIFTS WITHIN 5' HORIZONTALLY OF BARREL OR RISER. CONSTRUCT CORE. (4 DAYS) G. GRADE CHECK AND PERMANENTLY STABILIZE EMBANKMENT. (1 DAY) H. INSTALL TEMPORARY DRAINAGE DEVICE. (1 DAY) I. EXCAVATE SEDIMENT BASIN STORAGE AREA AS SHOWN ON SEDIMENT CONTROL PLAN SHEET 5. INSTALL BAFFLE BOARDS. (5 DAYS) J. UPON COMPLETION OF BASIN, STABILIZE WITH TEMPORARY SEEDING. (1 DAY) K. OBTAIN INSPECTOR'S APPROVAL BEFORE PROCEEDING FURTHER. (1 DAY)

PHASE 2 - BUILDING A MASS GRADING 10. WITH APPROVAL OF SEDIMENT CONTROL INSPECTOR, BEGIN CLEARING AND GRADING. FOLLOW DUST CONTROL PRACTICES PER MDE DETAIL. AS GRADING PROCEEDS, CONSTRUCT SITE RETAINING WALLS, DELAY CONSTRUCTION OF RETAINING WALL, PAVEMENT, AND STORM DRAIN FROM 1504 TO FS2 IMMEDIATELY ADJACENT TO BASIN UNTIL SITE IS STABILIZED AND POND CONVERSION IS UNDERWAY. MAINTAIN FLOWS TO SEDIMENT BASIN DURING GRADING. (3 MONTHS) 11. WITH COMPLETION OF BUILDING PAD, BEGIN BUILDING CONSTRUCTION. (3 MONTHS) 12. UPON ESTABLISHMENT OF SUBGRADE, INSTALL WATER MAIN, PRIVATE SANITARY CONNECTIONS, WATER & SEWER HOUSE CONNECTIONS, AND STORM DRAIN. ANY CONTROLS INTERCEPTED BY UTILITY INSTALLATION ARE TO BE REPAIRED THE SAME DAY. INSTALL TEMPORARY 24" CMP PIPE FROM MS06 TO BASIN TO DIRECT FLOWS TO SEDIMENT BASIN. BLOCK OPENINGS FROM MS06 TO UNDERGROUND SWM SYSTEM. DO NOT CONNECT BUILDING ROOF DRAINS TO EXTERNAL ROOF DRAIN UNTIL SWM FACILITIES ARE FUNCTIONAL. BLOCK INLETS I002 AND I202 UNTIL MB#1 AND MB#2 ARE COMPLETE. MAINTAIN FLOWS TO SEDIMENT BASIN DURING UTILITY CONSTRUCTION. (1 MONTH) 13. INSTALL UNDERGROUND SWM SYSTEM AND OUTFALL FROM CS3 TO M61. CONTACT PENNONI ENGINEER TO OBSERVE INSTALLATION OF SWM FACILITIES. DO NOT CONNECT UNDERGROUND SWM SYSTEM TO STORM DRAIN UNTIL POND CONVERSION AND SITE STABILIZATION. (2 WEEKS) 14. MAINTAIN FLOWS TO SEDIMENT BASIN THROUGHOUT PHASE 2. PHASE 3 - FINAL GRADING 15. WITH COMPLETION OF SUBGRADE AND UTILITY INSTALLATION, INSTALL CURB AND GUTTER. BEGIN PARKING LOT CONSTRUCTION. CONSTRUCT THE STONE SUBGRADE OF THE ASPHALT AND CONCRETE PAVEMENT ON THE SITE. (15 DAYS) 16. INSTALL ASPHALT AND CONCRETE PAVEMENT. (5 DAYS) 17. PERFORM FINE GRADING, CONSTRUCT SIDEWALKS, AND ANY OTHER CONSTRUCTION ACTIVITY. MAINTAIN FLOWS TO SEDIMENT BASIN DURING FINE GRADING AND PAVING OPERATIONS. (28 DAYS) 18. STABILIZE ALL DISTURBED AREAS. (1 DAY) 19. BEGIN POND CONVERSION AND FINAL POND GRADING TO ALLOW THE CONSTRUCTION RETAINING WALL, PAVEMENT, AND STORM DRAIN FROM STRUCTURE 1504 TO FS1. REMOVE TEMPORARY 24" CMP UPON COMPLETION OF STORM DRAIN. (2 WEEKS) 20. CONSTRUCT MICRO BIORETENTION FACILITIES AND SUBMERGED GRAVEL WETLAND AND ALL ASSOCIATED UNDERDRAIN/OVERDRAINS. CONTACT PENNONI ENGINEER TO OBSERVE INSTALLATION OF SWM FACILITIES. UPON INSTALLATION OF FILTER MEDIA, INSTALL SILT FENCE AROUND FACILITIES, AND INLET PROTECTION AT OVERFLOW INLETS. (3 WEEKS) 21. WITH APPROVAL OF THE INSPECTOR, FLUSH STORM DRAIN AND CONVERT BASIN. MUCK OUT BASIN AND COMPLETE BASIN REGARDING BASED ON FINAL GRADING PLAN. REMOVE DRAINAGE DEVICE AND REMOVAL PUMPING STATION. INSTALL LOW FLOW PIPE AND TRASH RACKS. REMOVE BLOCKING FROM ALL INLETS AND STRUCTURES. (5 DAYS) 22. COMPLETE PAVING AND LANDSCAPING ON THE SITE. (2 WEEKS) 23. UPON PERMISSION OF COUNTY SEDIMENT CONTROL INSPECTOR, REMOVE ALL REMAINING SEDIMENT CONTROL DEVICES AND STABILIZE DISTURBED AREAS IN ACCORDANCE WITH PERMANENT SEEDING NOTES. (2 DAYS)

PHASE 3 - FINAL GRADING

6. SITE ANALYSIS: TOTAL AREA OF SITE: 13.50 ACRES AREA DISTURBED: 9.70 ACRES AREA TO BE ROOFED OR PAVED: 6.50 ACRES AREA TO BE VEGETATIVELY STABILIZED: 3.20 ACRES TOTAL CUT: 32,167 CU. YDS. TOTAL FILL: 34,638 CU. YDS. 7. ANY SEDIMENT CONTROL PRACTICE WHICH IS DISTURBED BY GRADING ACTIVITY FOR PLACEMENT OF UTILITIES MUST BE REPAIRED ON THE SAME DAY OF DISTURBANCE. 8. ADDITIONAL SEDIMENT CONTROL MUST BE PROVIDED, IF DEEMED NECESSARY BY THE CD. THE SITE AND ALL CONTROLS SHALL BE INSPECTED BY THE CONTRACTOR WEEKLY, AND THE NEXT DAY AFTER EACH RAIN EVENT. A WRITTEN REPORT BY THE CONTRACTOR, MADE AVAILABLE UPON REQUEST, IS PART OF EVERY INSPECTION AND SHOULD INCLUDE: • INSPECTION DATE • INSPECTION TYPE (ROUTINE, PRE-STORM EVENT, DURING RAIN EVENT) • NAME AND TITLE OF INSPECTOR • WEATHER INFORMATION (CURRENT CONDITIONS AS WELL AS TIME AND AMOUNT OF LAST RECORDED PRECIPITATION) • BRIEF DESCRIPTION OF PROJECT'S STATUS (E.G., PERCENT COMPLETE) AND/OR CURRENT ACTIVITIES • EVIDENCE OF SEDIMENT DISCHARGES • IDENTIFICATION OF PLAN DEFICIENCIES • IDENTIFICATION OF SEDIMENT CONTROLS THAT REQUIRE MAINTENANCE • IDENTIFICATION OF MISSING OR IMPROPERLY INSTALLED SEDIMENT CONTROLS • COMPLIANCE STATUS REGARDING THE SEQUENCE OF CONSTRUCTION AND STABILIZATION REQUIREMENTS • PHOTOGRAPHS • MONITORING/SAMPLING • MAINTENANCE AND/OR CORRECTIVE ACTION PERFORMED • OTHER INSPECTION ITEMS AS REQUIRED BY THE GENERAL PERMIT FOR STORMWATER ASSOCIATED WITH CONSTRUCTION ACTIVITIES (NPDES, MDE). 9. TRENCHES FOR THE CONSTRUCTION OF UTILITIES IS LIMITED TO THREE PIPE LENGTHS OR THAT WHICH CAN AND SHALL BE BACK-FILLED AND STABILIZED BY THE END OF EACH WORKDAY, WHICHEVER IS SHORTER. 10. ANY MAJOR CHANGES OR REVISIONS TO THE PLAN OR SEQUENCE OF CONSTRUCTION MUST BE REVIEWED AND APPROVED BY THE HSCD PRIOR TO PROCEEDING WITH CONSTRUCTION. MINOR REVISIONS MAY ALLOWED BY THE CD PER THE LIST OF HSCD-APPROVED FIELD CHANGES. 11. DISTURBANCE SHALL NOT OCCUR OUTSIDE THE L.O.D. A PROJECT IS TO BE SEQUENCED SO THAT GRADING ACTIVITIES BEGON ON ONE GRADING UNIT (MAXIMUM ACREAGE OF 20 AC. PER GRADING UNIT) AT A TIME. WORK MAY PROCEED TO A SUBSEQUENT GRADING UNIT WHEN AT LEAST 50 PERCENT OF THE DISTURBED AREA IN THE PRECEDING GRADING UNIT HAS BEEN STABILIZED AND APPROVED BY THE CD. UNLESS OTHERWISE SPECIFIED AND APPROVED BY HSCD, NO MORE THAN 30 ACRES CUMULATIVELY MAY BE DISTURBED AT A GIVEN TIME. 12. WASH WATER FROM ANY EQUIPMENT, VEHICLES, WHEELS, PAVEMENT, AND OTHER SOURCES MUST BE TREATED IN A SEDIMENT BASIN OR OTHER APPROVED WASHOUT STRUCTURE. 13. TOPSOIL SHALL BE STOCKPILED AND PRESERVED ON-SITE FOR REDISTRIBUTION ONTO FINAL GRADE. 14. ALL SILT FENCE AND SUPER SILT FENCE SHALL BE PLACED ON-THE-CONTOUR, AND BE IMBERICATED AT 25' MINIMUM INTERVALS, WITH LOWER ENDS CURLED UPHILL BY 2' IN ELEVATION. 15. STREAM CHANNELS MUST NOT BE DISTURBED DURING THE FOLLOWING RESTRICTED TIME PERIODS (INCLUSIVE): • USE I AND IP MARCH 1 - JUNE 15 • USE III AND IIP OCTOBER 1 - APRIL 30 • USE IV MARCH 1 - MAY 31 16. A COPY OF THIS PLAN, THE 2011 MARYLAND STANDARDS AND SPECIFICATIONS FOR SOIL EROSION AND SEDIMENT CONTROL, AND ASSOCIATED PERMITS SHALL BE ON-SITE AND AVAILABLE WHEN THE SITE IS ACTIVE.

AS-BUILT CERTIFICATION

NOTE: THERE IS NO "AS-BUILT" INFORMATION PROVIDED ON THIS SHEET. Sharon L. Cruz 36896 MD.P.E. NO. 7/20/19 DATE

ENGINEER'S CERTIFICATE

I HEREBY CERTIFY THAT THIS PLAN HAS BEEN DESIGNED IN ACCORDANCE WITH CURRENT MARYLAND EROSION AND SEDIMENT CONTROL LAWS, REGULATIONS, AND STANDARDS, THAT IT REPRESENTS A PRACTICAL AND WORKABLE PLAN BASED ON MY PERSONAL KNOWLEDGE OF THE SITE, AND THAT IT WAS PREPARED IN ACCORDANCE WITH THE REQUIREMENTS OF THE HOWARD SOIL CONSERVATION DISTRICT.

DEVELOPER'S CERTIFICATE

I HAVE HEREBY CERTIFY THAT ANY CLEARING, GRADING, CONSTRUCTION, OR DEVELOPMENT WILL BE DONE PURSUANT TO THIS APPROVED EROSION AND SEDIMENT CONTROL PLAN, INCLUDING INSPECTING AND MAINTAINING CONTROLS, AND THAT THE RESPONSIBLE PERSONNEL INVOLVED IN THE CONSTRUCTION PROJECT WILL HAVE A CERTIFICATE OF TRAINING AT A MARYLAND DEPARTMENT OF THE ENVIRONMENT APPROVED TRAINING PROGRAM FOR THE CONTROL ON EROSION AND SEDIMENT PRIOR TO BEGINNING THE PROJECT. I CERTIFY RIGHT-OF-ENTRY FOR PERIODIC ON-SITE EVALUATION BY HOWARD COUNTY, THE HOWARD SOIL CONSERVATION DISTRICT AND/OR MDE.

formance of all construction operations. During the placing and compacting of material in required excavations, the water level at the locations being refilled shall be maintained below the bottom of the excavation at such locations which may require draining the water stems from which the water shall be pumped.

Stabilization


All borrow areas shall be graded to provide proper drainage and left in a slightly condition. All exposed surfaces of the embankment, spillway, spoil and borrow areas, and berms shall be stabilized by seeding, liming, fertilizing and mulching in accordance with the Natural Resources Conservation Service Standards and Specifications for Critical Area Planting (MD-342) or as shown on the accompanying drawings.

Erosion and Sediment Control

Construction operations will be carried out in such a manner that erosion will be controlled and water and air pollution minimized. State and local laws concerning pollution abatement will be followed. Construction plans shall detail erosion and sediment control measures.

OPERATION AND MAINTENANCE


An operation and maintenance plan in accordance with Local or State Regulations will be prepared for all ponds. As a minimum, the dam inspection checklist located in Appendix A shall be included as part of the operation and maintenance plan and performed at least annually. Written records of maintenance and major repairs needs to be retained in a file. The issuance of a Maintenance and Repair Permit for any repairs or maintenance that involves the modification of the dam or spillway from its original design and specifications is required. A permit is also required for any repairs or reconstruction that involve a substantial portion of the structure. All indicated repairs are to be made as soon as practical.

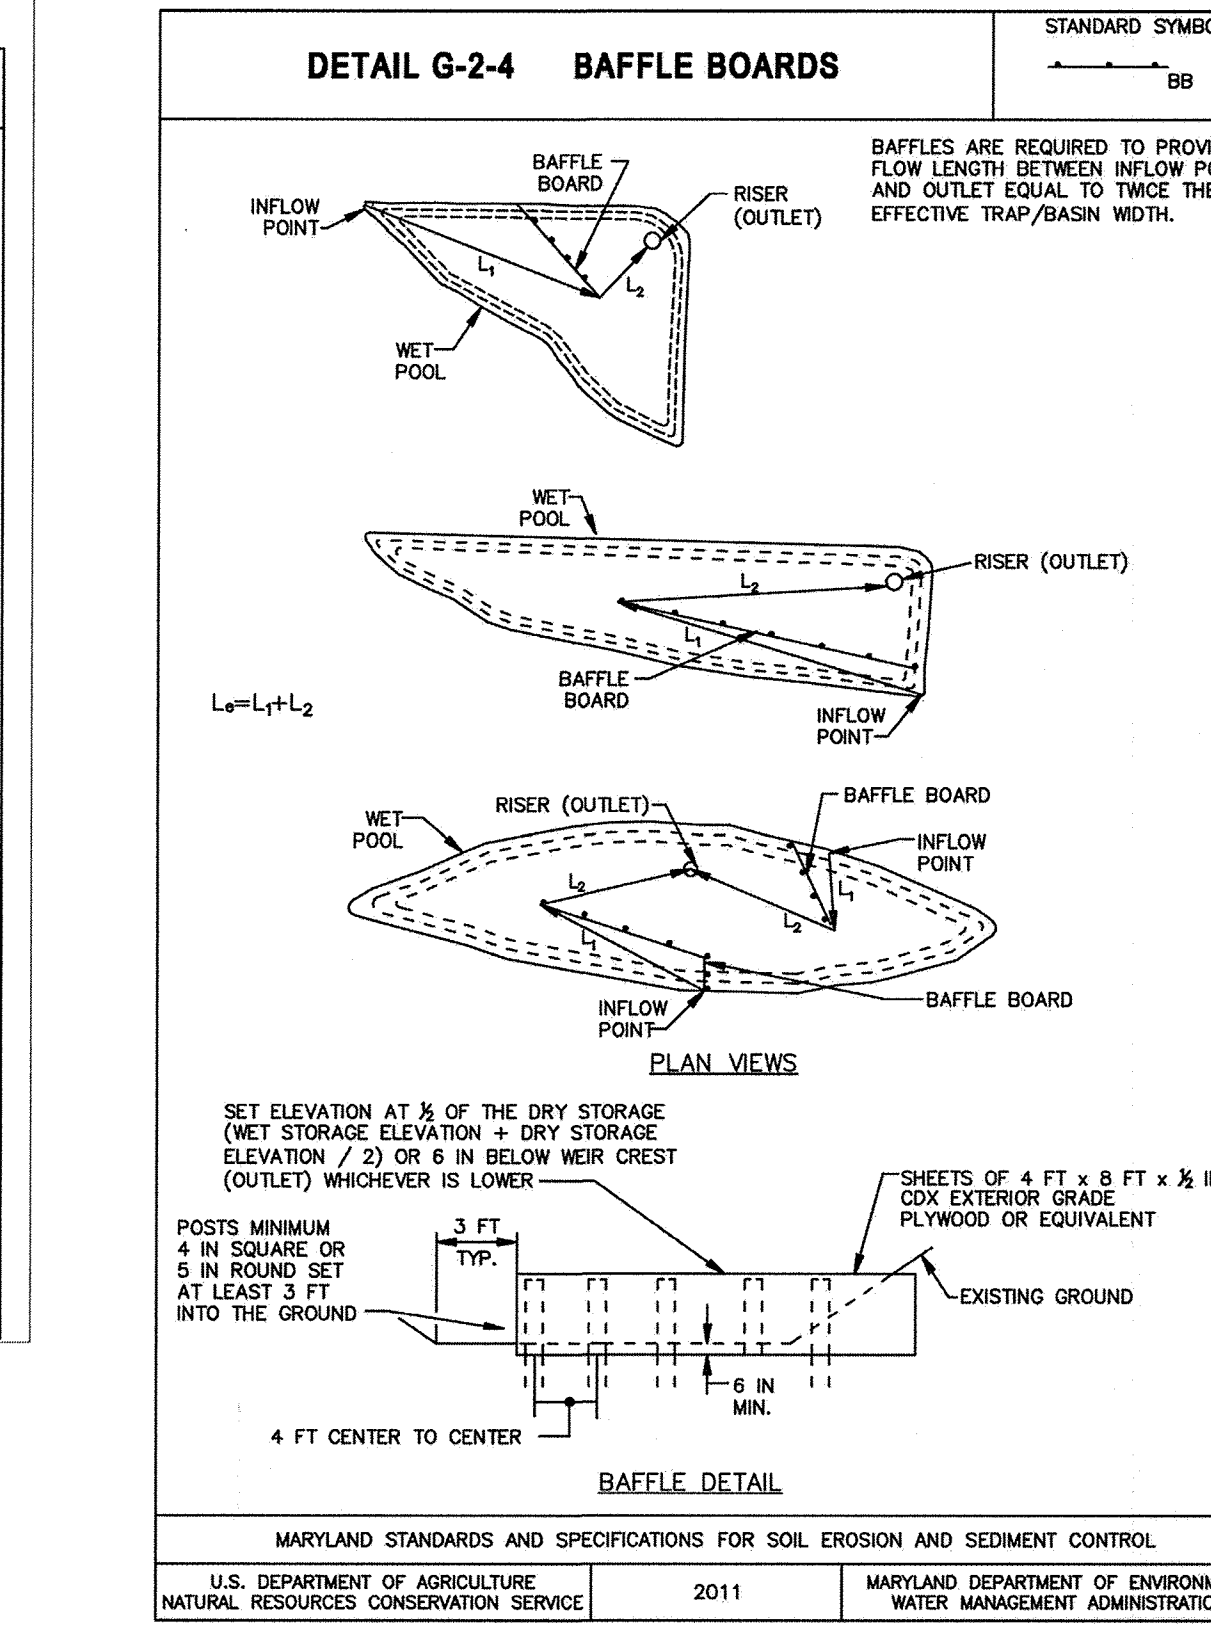

MARYLAND STANDARDS AND SPECIFICATIONS FOR SOIL EROSION AND SEDIMENT CONTROL. U.S. DEPARTMENT OF AGRICULTURE NATURAL RESOURCES CONSERVATION SERVICE 2011 MARYLAND DEPARTMENT OF ENVIRONMENT WATER MANAGEMENT ADMINISTRATION

- STRUCTURES, PIPE AND MATERIALS MUST BE ON SITE PRIOR TO PROCEEDING WITH STEP 8. A. INSTALL SUPER SILT FENCE ALONG DOWNSTREAM TOE OF EMBANKMENT. OBTAIN PERMISSION FROM INSPECTOR BEFORE PROCEEDING. (1 DAY) B. CLEAR POND AREA AND STRIP TOPSOIL FOR POND AREA AND STOCKPILE OUTSIDE OF EMBANKMENT AREA. (2 DAYS) C. GRADE A SMALL AREA TO BOTTOM ELEVATION OF POND AND INSTALL A REMOVABLE PUMPING STATION TO BE USED TO DRAIN THE WORK AREA DURING CONSTRUCTION. DIRECT FLOWS TO THE PUMP STATION. (1 DAY) D. CONSTRUCT THE CUT-OFF TRENCH. CUTOFF AND CORE TRENCH BACKFILL MATERIAL IS TO MEET THE SPECIFICATIONS OF MD-378 CRITERIA AND IS TO BE PLACED UNDER THE SUPERVISION OF A LICENSED GEOTECHNICAL ENGINEER. (2 DAYS) E. CONSTRUCT RIP RAP OUTFALL, BARREL, CONCRETE GRADLE, ANTI SEEP COLLAR, AND RISER STRUCTURE. CONCRETE COLLARS ARE TO BE CAST IN PLACE. ALL INSTALLATION IS TO BE OBSERVED BY PENNONI ENGINEER. (3 DAYS) F. CONSTRUCT EMBANKMENT IN 8' LIFTS, USING 4" LIFTS WITHIN 5' HORIZONTALLY OF BARREL OR RISER. CONSTRUCT CORE. (4 DAYS) G. GRADE CHECK AND PERMANENTLY STABILIZE EMBANKMENT. (1 DAY) H. INSTALL TEMPORARY DRAINAGE DEVICE. (1 DAY) I. EXCAVATE SEDIMENT BASIN STORAGE AREA AS SHOWN ON SEDIMENT CONTROL PLAN SHEET 5. INSTALL BAFFLE BOARDS. (5 DAYS) J. UPON COMPLETION OF BASIN, STABILIZE WITH TEMPORARY SEEDING. (1 DAY) K. OBTAIN INSPECTOR'S APPROVAL BEFORE PROCEEDING FURTHER. (1 DAY) 9. UPON COMPLETION OF THE SEDIMENT BASIN INSTALL EXTERIORS DRAINING TO SEDIMENT BASIN. (3 DAYS) PHASE 2 - BUILDING A MASS GRADING 10. WITH APPROVAL OF SEDIMENT CONTROL INSPECTOR, BEGIN CLEARING AND GRADING. FOLLOW DUST CONTROL PRACTICES PER MDE DETAIL. AS GRADING PROCEEDS, CONSTRUCT SITE RETAINING WALLS, DELAY CONSTRUCTION OF RETAINING WALL, PAVEMENT, AND STORM DRAIN FROM 1504 TO FS2 IMMEDIATELY ADJACENT TO BASIN UNTIL SITE IS STABILIZED AND POND CONVERSION IS UNDERWAY. MAINTAIN FLOWS TO SEDIMENT BASIN DURING GRADING. (3 MONTHS) 11. WITH COMPLETION OF BUILDING PAD, BEGIN BUILDING CONSTRUCTION. (3 MONTHS) 12. UPON ESTABLISHMENT OF SUBGRADE, INSTALL WATER MAIN, PRIVATE SANITARY CONNECTIONS, WATER & SEWER HOUSE CONNECTIONS, AND STORM DRAIN. ANY CONTROLS INTERCEPTED BY UTILITY INSTALLATION ARE TO BE REPAIRED THE SAME DAY. INSTALL TEMPORARY 24" CMP PIPE FROM MS06 TO BASIN TO DIRECT FLOWS TO SEDIMENT BASIN. BLOCK OPENINGS FROM MS06 TO UNDERGROUND SWM SYSTEM. DO NOT CONNECT BUILDING ROOF DRAINS TO EXTERNAL ROOF DRAIN UNTIL SWM FACILITIES ARE FUNCTIONAL. BLOCK INLETS I002 AND I202 UNTIL MB#1 AND MB#2 ARE COMPLETE. MAINTAIN FLOWS TO SEDIMENT BASIN DURING UTILITY CONSTRUCTION. (1 MONTH) 13. INSTALL UNDERGROUND SWM SYSTEM AND OUTFALL FROM CS3 TO M61. CONTACT PENNONI ENGINEER TO OBSERVE INSTALLATION OF SWM FACILITIES. DO NOT CONNECT UNDERGROUND SWM SYSTEM TO STORM DRAIN UNTIL POND CONVERSION AND SITE STABILIZATION. (2 WEEKS) 14. MAINTAIN FLOWS TO SEDIMENT BASIN THROUGHOUT PHASE 2. PHASE 3 - FINAL GRADING 15. WITH COMPLETION OF SUBGRADE AND UTILITY INSTALLATION, INSTALL CURB AND GUTTER. BEGIN PARKING LOT CONSTRUCTION. CONSTRUCT THE STONE SUBGRADE OF THE ASPHALT AND CONCRETE PAVEMENT ON THE SITE. (15 DAYS) 16. INSTALL ASPHALT AND CONCRETE PAVEMENT. (5 DAYS) 17. PERFORM FINE GRADING, CONSTRUCT SIDEWALKS, AND ANY OTHER CONSTRUCTION ACTIVITY. MAINTAIN FLOWS TO SEDIMENT BASIN DURING FINE GRADING AND PAVING OPERATIONS. (28 DAYS) 18. STABILIZE ALL DISTURBED AREAS. (1 DAY) 19. BEGIN POND CONVERSION AND FINAL POND GRADING TO ALLOW THE CONSTRUCTION RETAINING WALL, PAVEMENT, AND STORM DRAIN FROM STRUCTURE 1504 TO FS1. REMOVE TEMPORARY 24" CMP UPON COMPLETION OF STORM DRAIN. (2 WEEKS) 20. CONSTRUCT MICRO BIORETENTION FACILITIES AND SUBMERGED GRAVEL WETLAND AND ALL ASSOCIATED UNDERDRAIN/OVERDRAINS. CONTACT PENNONI ENGINEER TO OBSERVE INSTALLATION OF SWM FACILITIES. UPON INSTALLATION OF FILTER MEDIA, INSTALL SILT FENCE AROUND FACILITIES, AND INLET PROTECTION AT OVERFLOW INLETS. (3 WEEKS) 21. WITH APPROVAL OF THE INSPECTOR, FLUSH STORM DRAIN AND CONVERT BASIN. MUCK OUT BASIN AND COMPLETE BASIN REGARDING BASED ON FINAL GRADING PLAN. REMOVE DRAINAGE DEVICE AND REMOVAL PUMPING STATION. INSTALL LOW FLOW PIPE AND TRASH RACKS. REMOVE BLOCKING FROM ALL INLETS AND STRUCTURES. (5 DAYS) 22. COMPLETE PAVING AND LANDSCAPING ON THE SITE. (2 WEEKS) 23. UPON PERMISSION OF COUNTY SEDIMENT CONTROL INSPECTOR, REMOVE ALL REMAINING SEDIMENT CONTROL DEVICES AND STABILIZE DISTURBED AREAS IN ACCORDANCE WITH PERMANENT SEEDING NOTES. (2 DAYS)

- SEQUENCE OF CONSTRUCTION 1. OBTAIN GRADING PERMIT. (1 DAY) 2. STAKEOUT LIMITS OF DISTURBANCE. (1 DAY) 3. CONDUCT A PRE-CONSTRUCTION MEETING WITH COUNTY INSPECTOR. (1 DAY) PHASE 1 - SEWER OUTFALL 4. INSTALL STABILIZED CONSTRUCTION ENTRANCES. CLEAR AND GRUB AS NECESSARY TO INSTALL PERIMETER SUPER SILT FENCES FOR SEWER CONSTRUCTION. (1 WEEK) 5. INSTALL SEWER OUTFALL (MH7867 TO MH8). (2 WEEKS) 6. UPON COMPLETION OF SEWER CONSTRUCTION, STABILIZE ALL DISTURBED AREAS. WITH STABILIZATION OF DISTURBED AREAS, AND APPROVAL OF SEDIMENT CONTROL INSPECTOR, REMOVE SEDIMENT CONTROLS. 7. CONCURRENT WITH SEWER INSTALLATION, INSTALL REMAINING STABILIZED CONSTRUCTION ENTRANCES. CLEAR AND GRUB AS NECESSARY TO INSTALL PERIMETER SUPER SILT FENCES AND PERIMETER EARTH DIKES FOR CLEAN WATER DIVERSION (1 WEEK) 8. UPON APPROVAL OF PERIMETER CONTROL INSTALLATION BY COUNTY INSPECTOR, INSTALL SEDIMENT BASIN. ALL BASIN

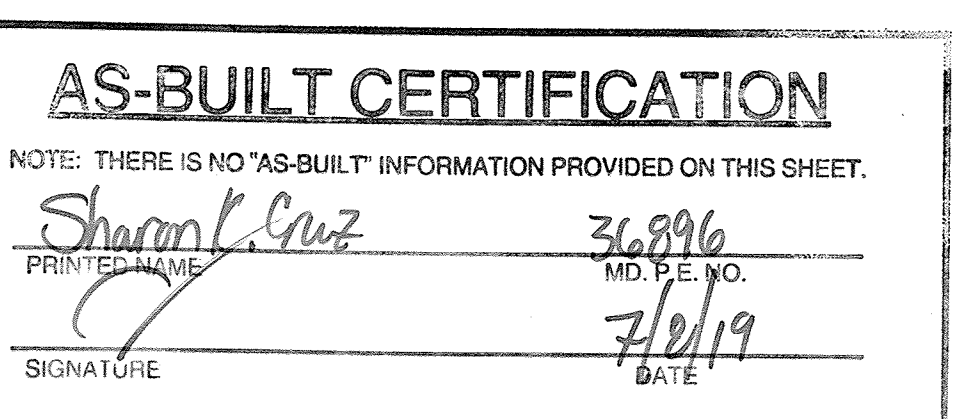


ENGINEER'S CERTIFICATE and DEVELOPER'S CERTIFICATE sections with signatures of Sharon L. Cruz and Jacqueline Carbone, dated 8/1/17.


Table with columns: DATE, NO., REVISION, BY. Includes entries for DCT INDUSTRIAL, ANNAPOLIS JUNCTION, MD 20701, and DCT MEARS LLC.

Table with columns: DEVELOPER, OWNER, PROJECT, AREA, TITLE. Includes information for TERRAPIN COMMERCE CENTER and SEDIMENT CONTROL DETAILS.


SEDIMENT CONTROL DETAILS section including Pennoni Associates Inc. logo, address (8818 Centre Park Drive, Suite 200 Columbia, MD 21045), phone (410.997.8900), fax (410.997.9282), and design information (DESIGNED BY: PJS, DRAWN BY: AGS/JSN, PROJECT NO: DCT1601, DATE: JUNE 23, 2017, SCALE: AS SHOWN, DRAWING NO. 13 OF 43).

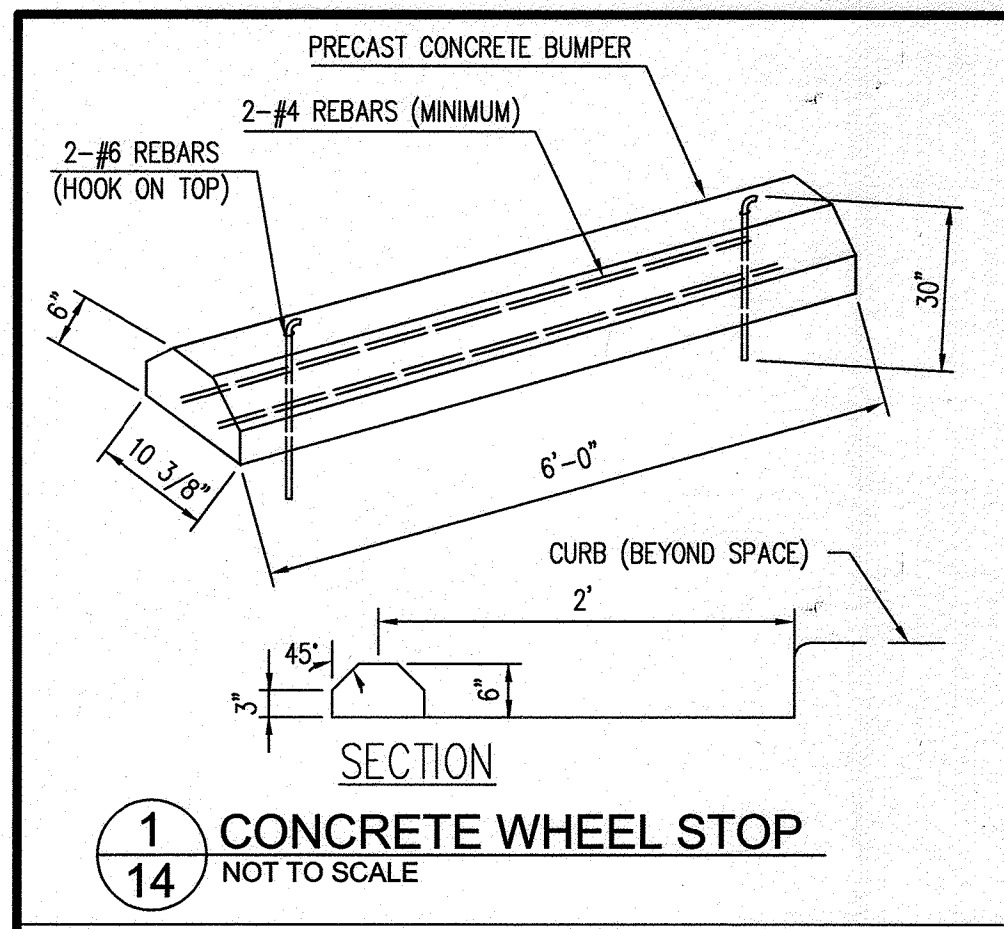

1 CONCRETE WHEEL STOP
14 NOT TO SCALE
HC DPW STD. R-3.02

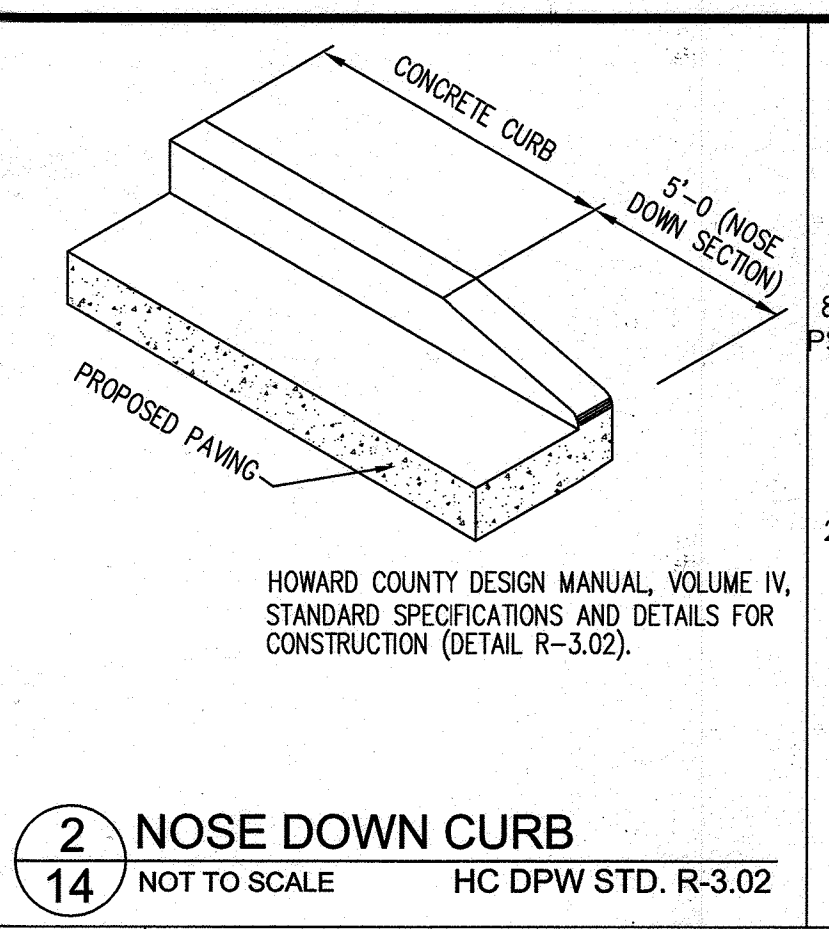


2 NOSE DOWN CURB
14 NOT TO SCALE
HC DPW STD. R-3.02

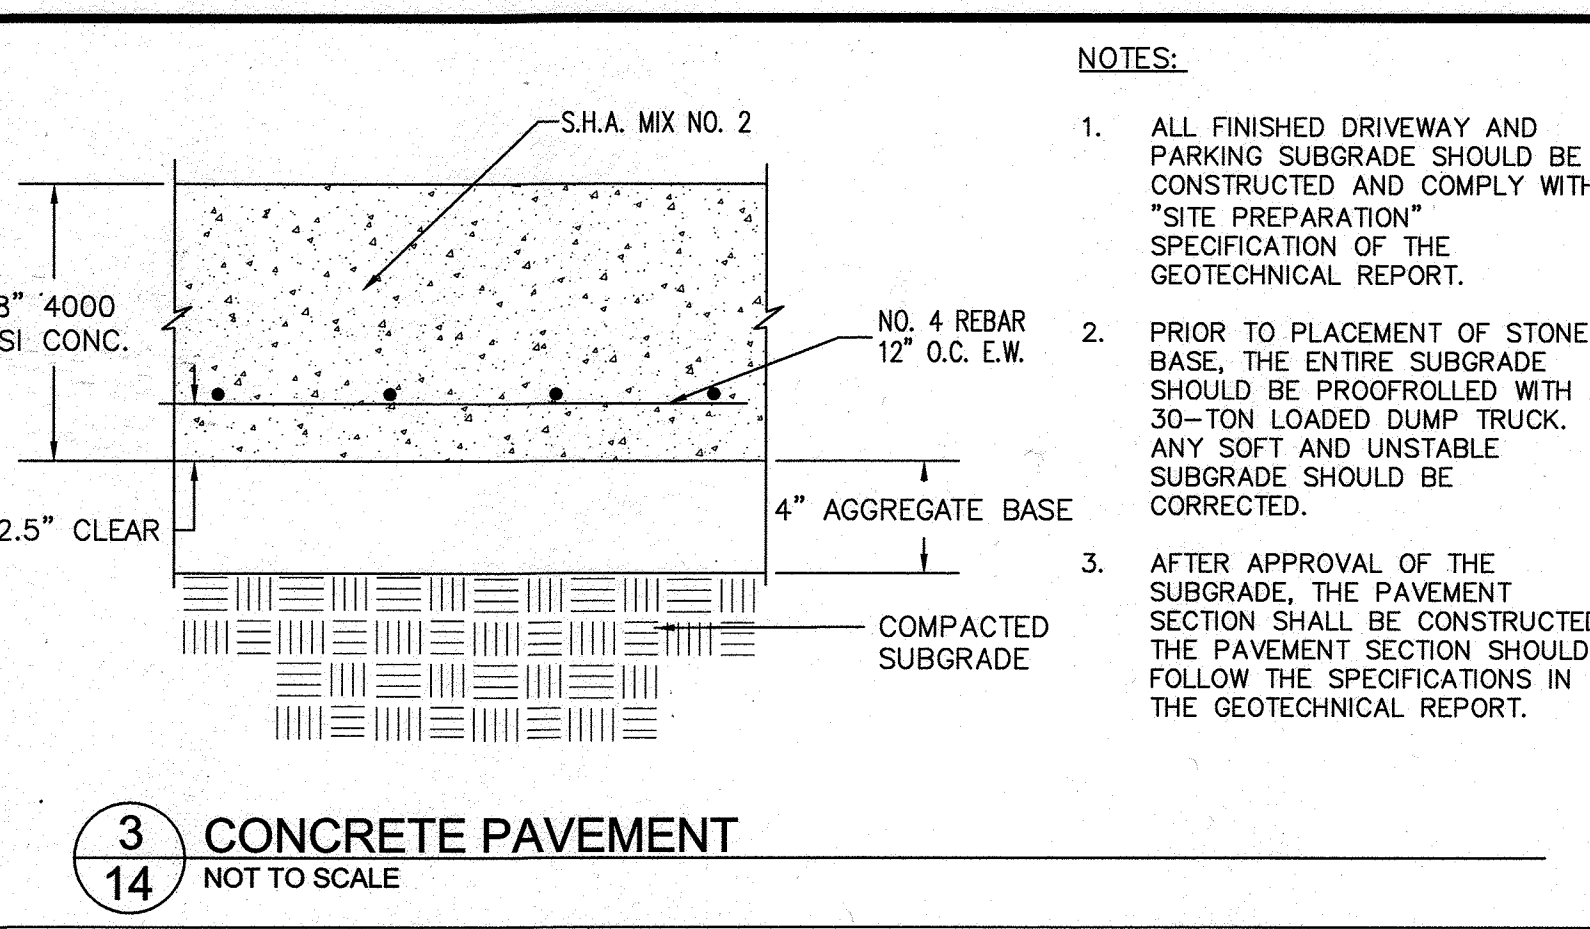


3 CONCRETE PAVEMENT
14 NOT TO SCALE

NOTES:


- ALL FINISHED DRIVEWAY AND PARKING SUBGRADE SHOULD BE CONSTRUCTED AND COMPLY WITH "SITE PREPARATION" SPECIFICATION OF THE GEOTECHNICAL REPORT.
- PRIOR TO PLACEMENT OF STONE BASE, THE ENTIRE SUBGRADE SHOULD BE PROOFROLLED WITH A 30-TON LOADED DUMP TRUCK. ANY SOFT AND UNSTABLE SUBGRADE SHOULD BE CORRECTED.
- AFTER APPROVAL OF THE SUBGRADE, THE PAVEMENT SECTION SHALL BE CONSTRUCTED. THE PAVEMENT SECTION SHOULD FOLLOW THE SPECIFICATIONS IN THE GEOTECHNICAL REPORT.

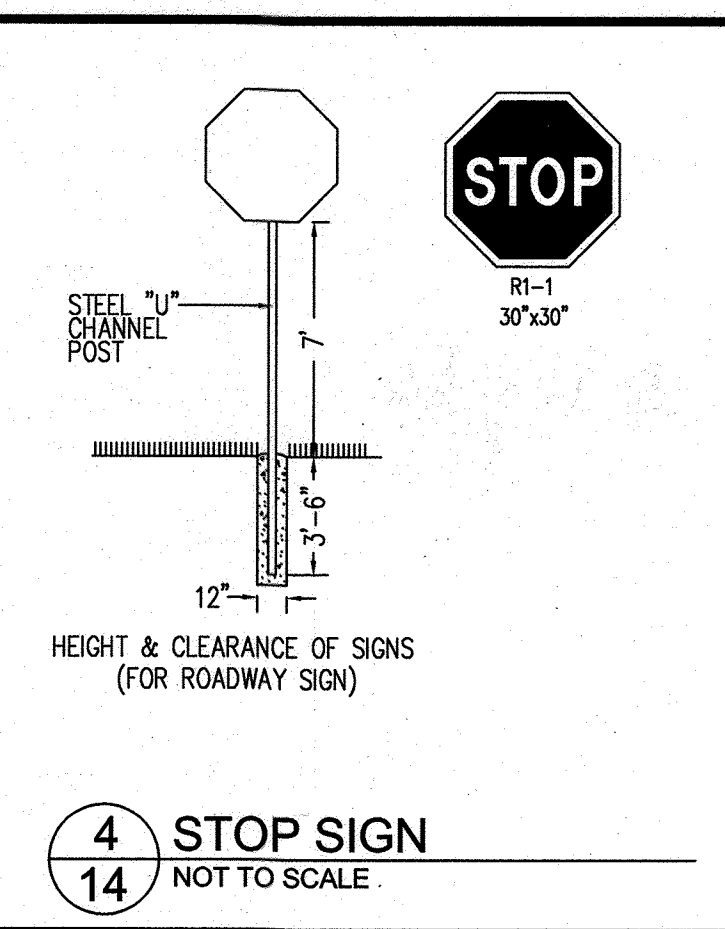


4 STOP SIGN
14 NOT TO SCALE

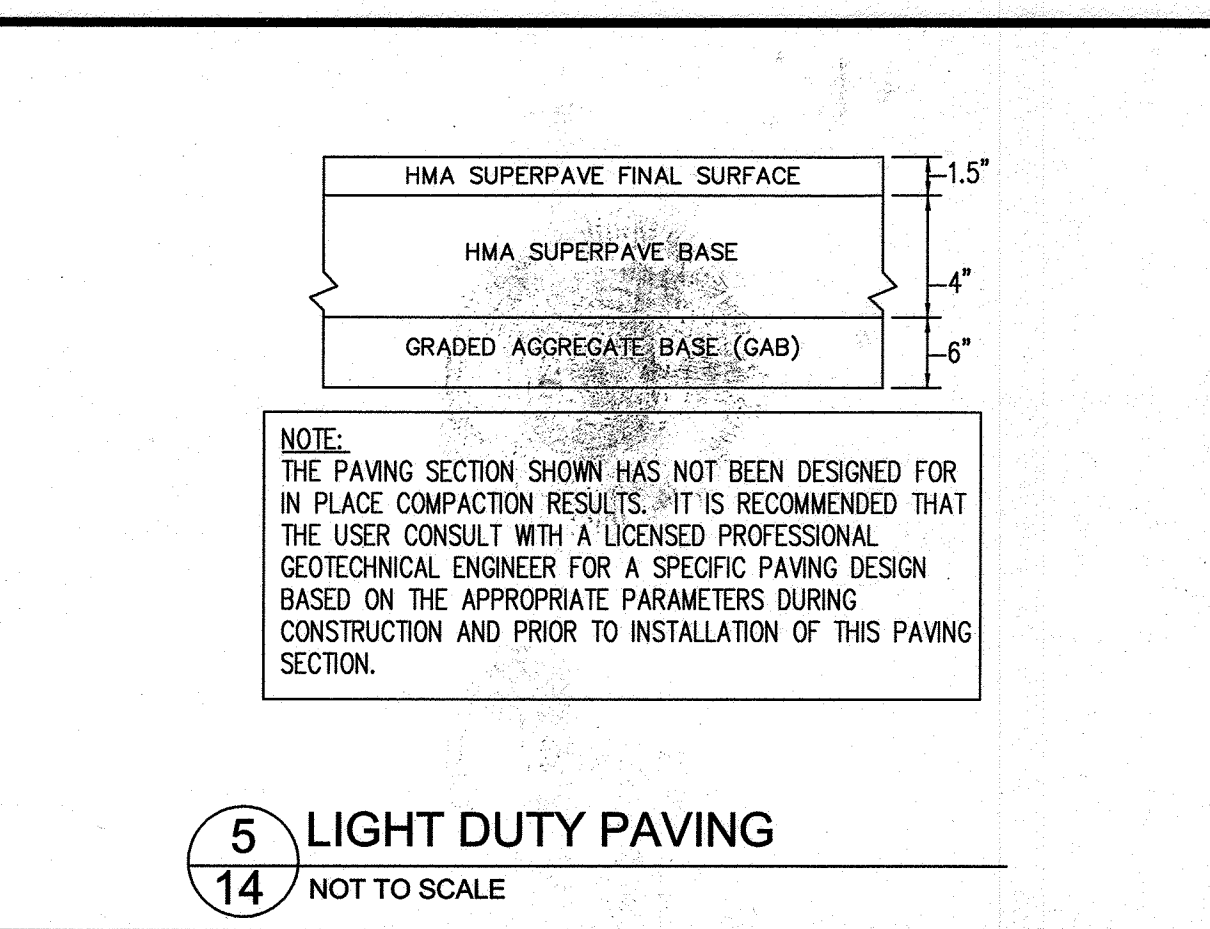


5 LIGHT DUTY PAVING
14 NOT TO SCALE

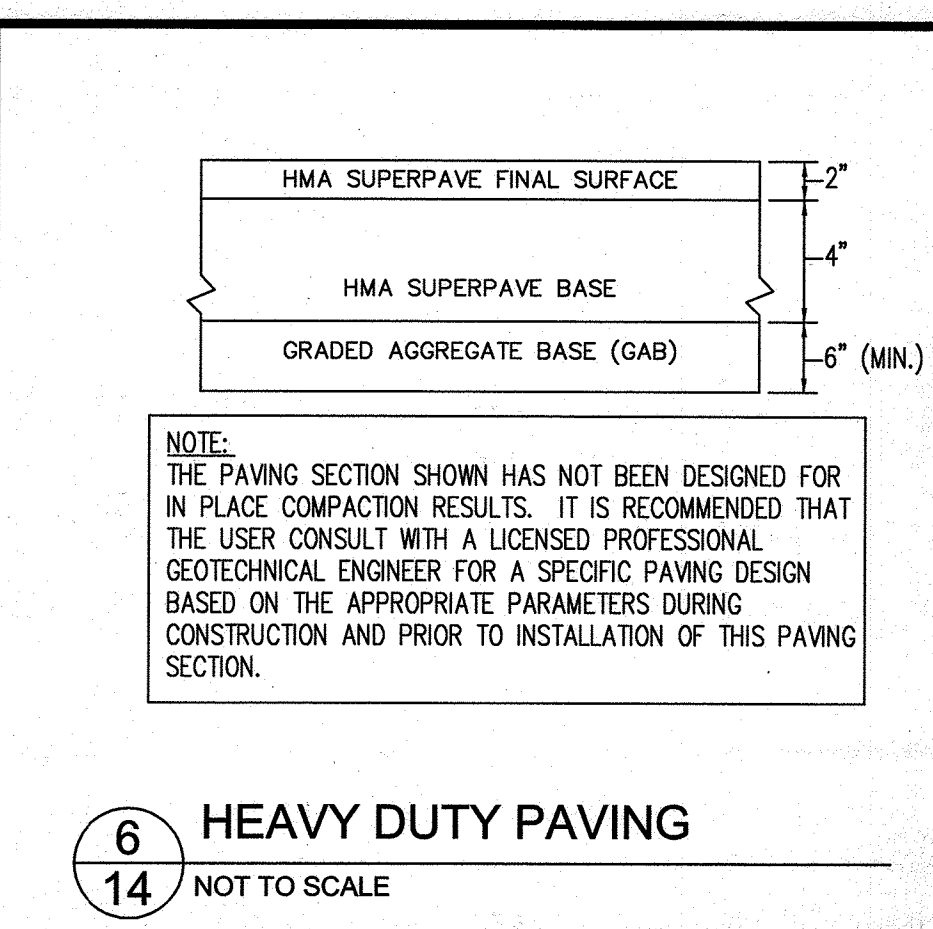


6 HEAVY DUTY PAVING
14 NOT TO SCALE

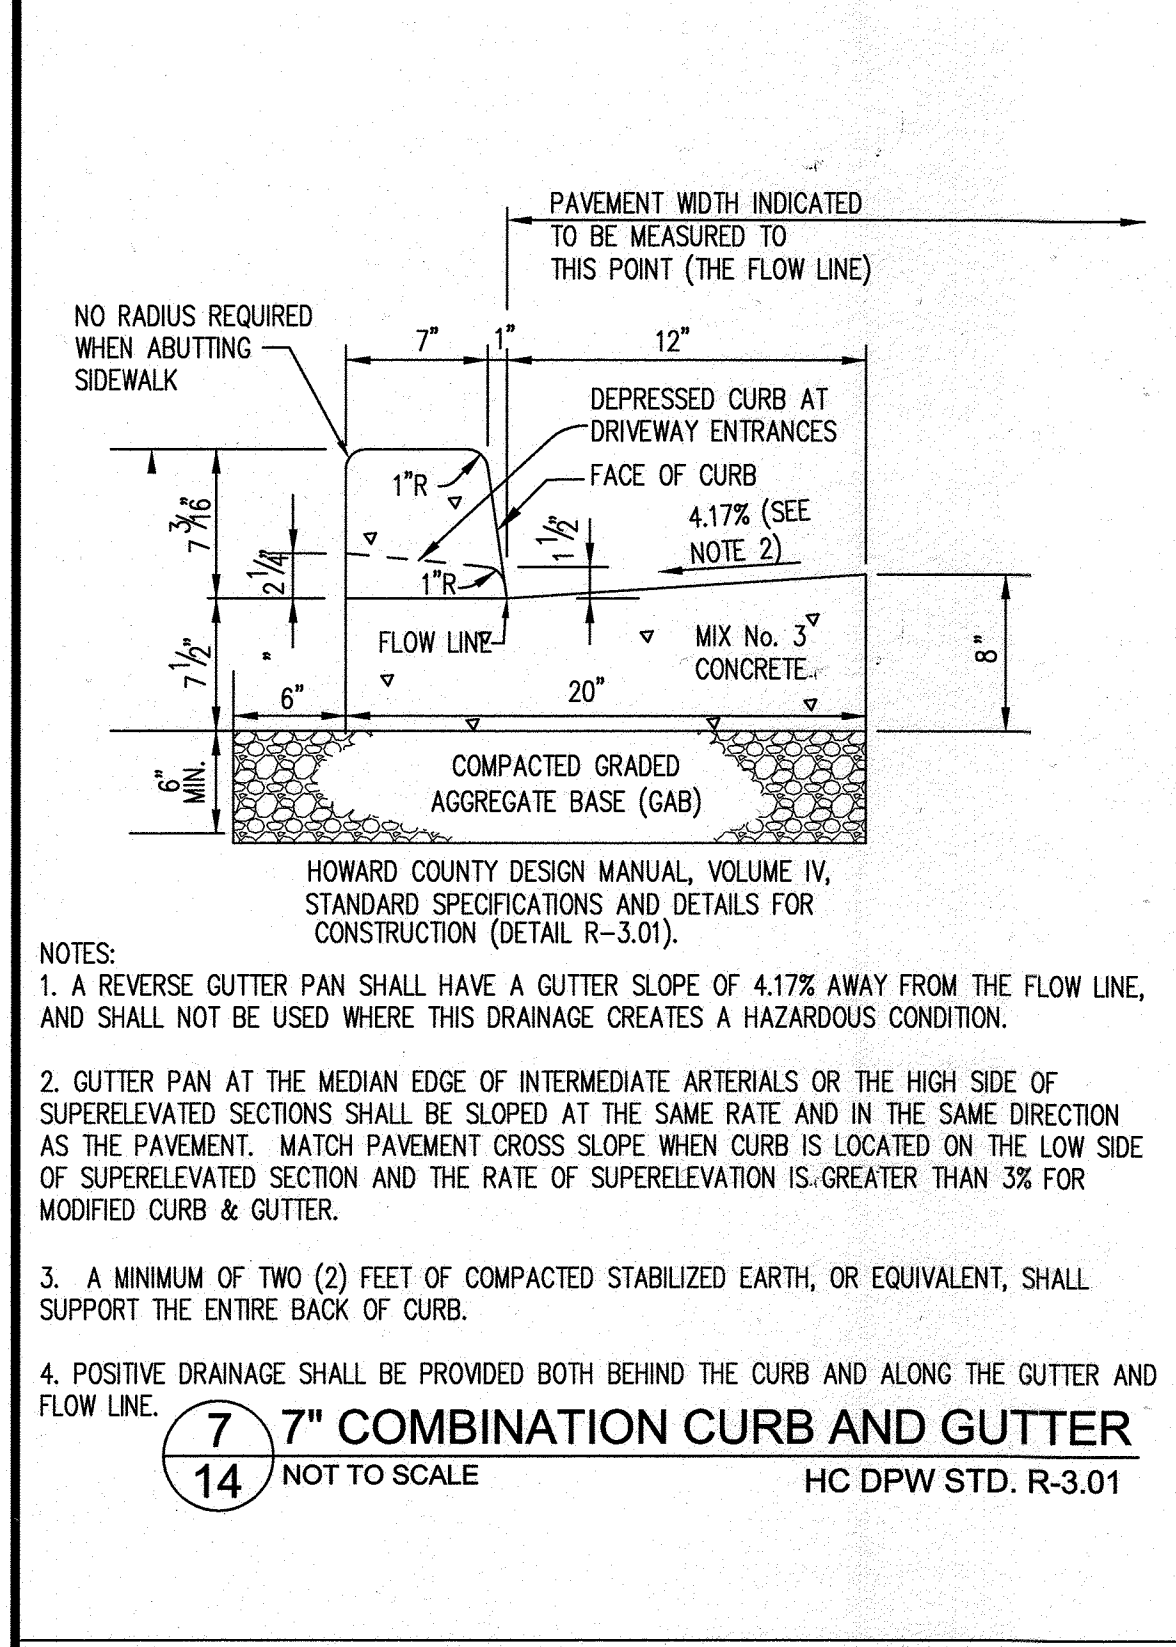


7 7\"/>

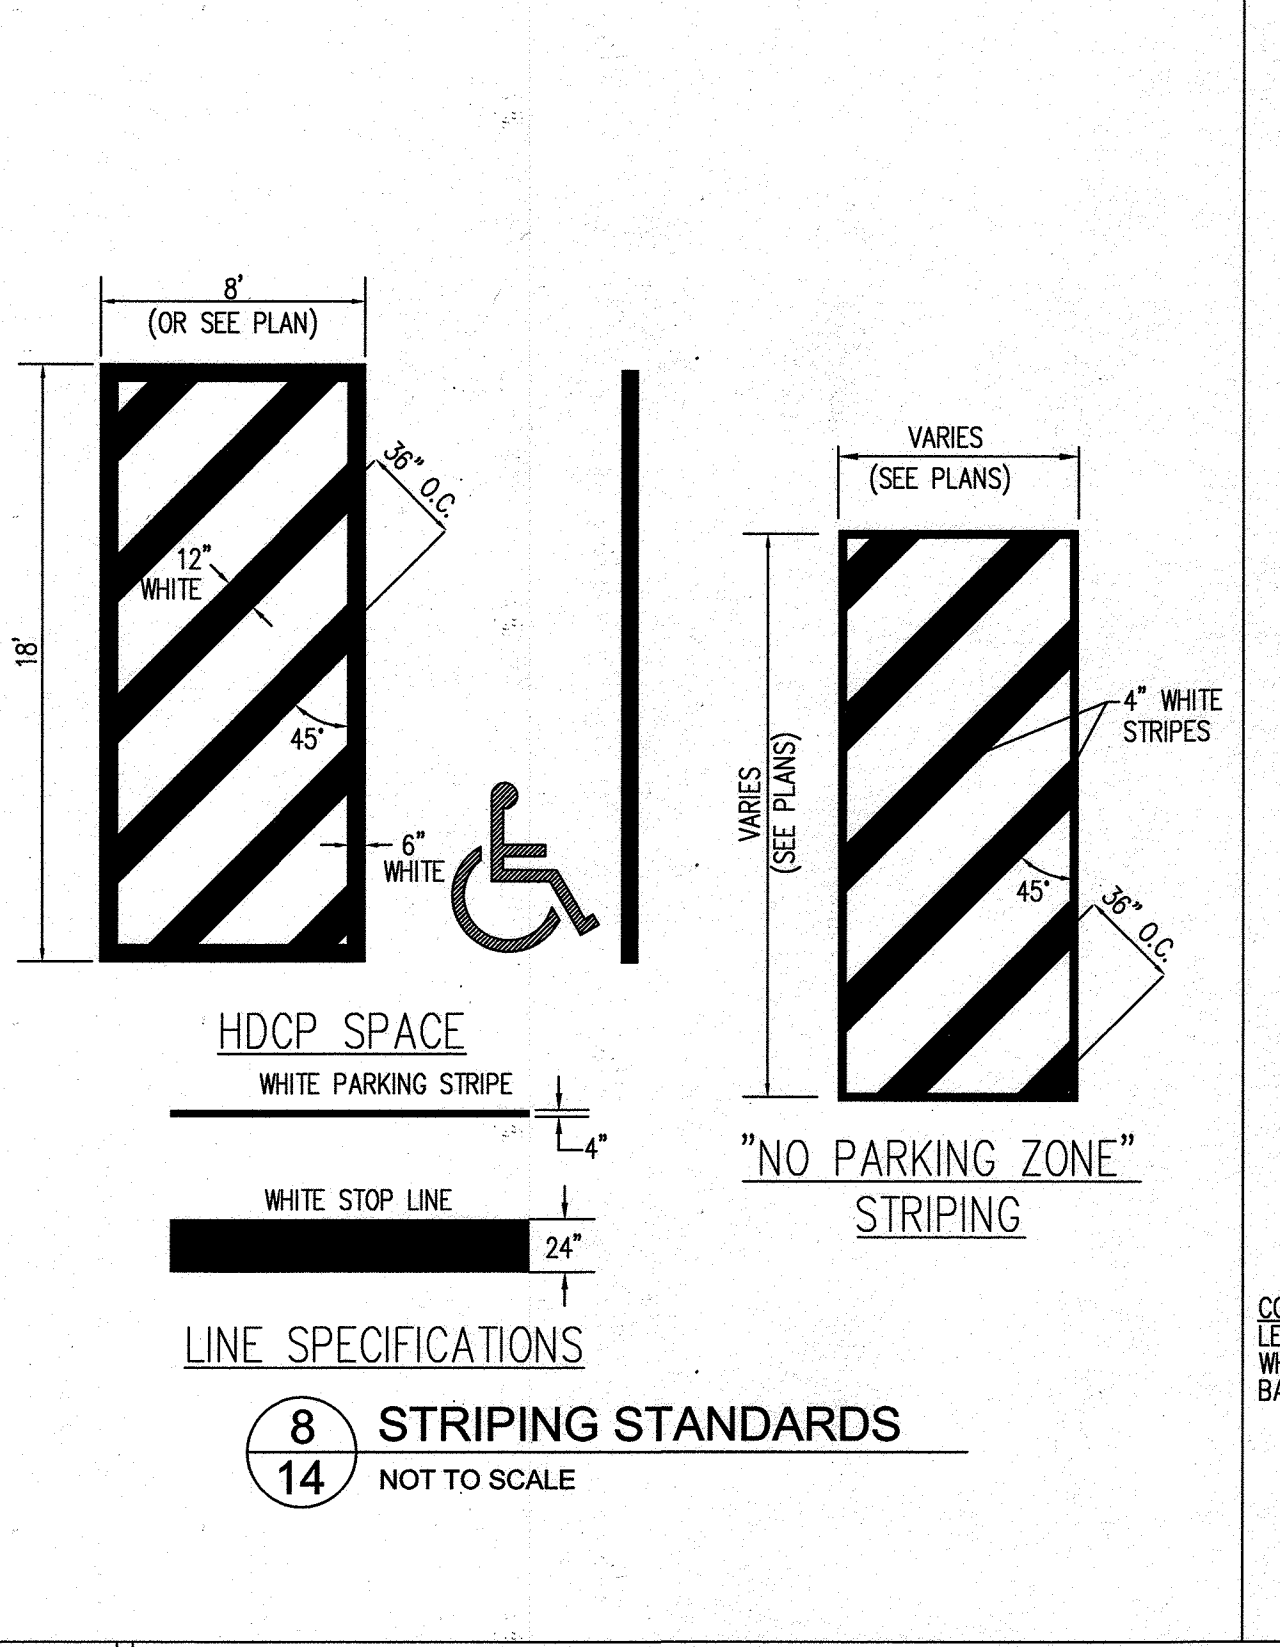


8 STRIPING STANDARDS
14 NOT TO SCALE

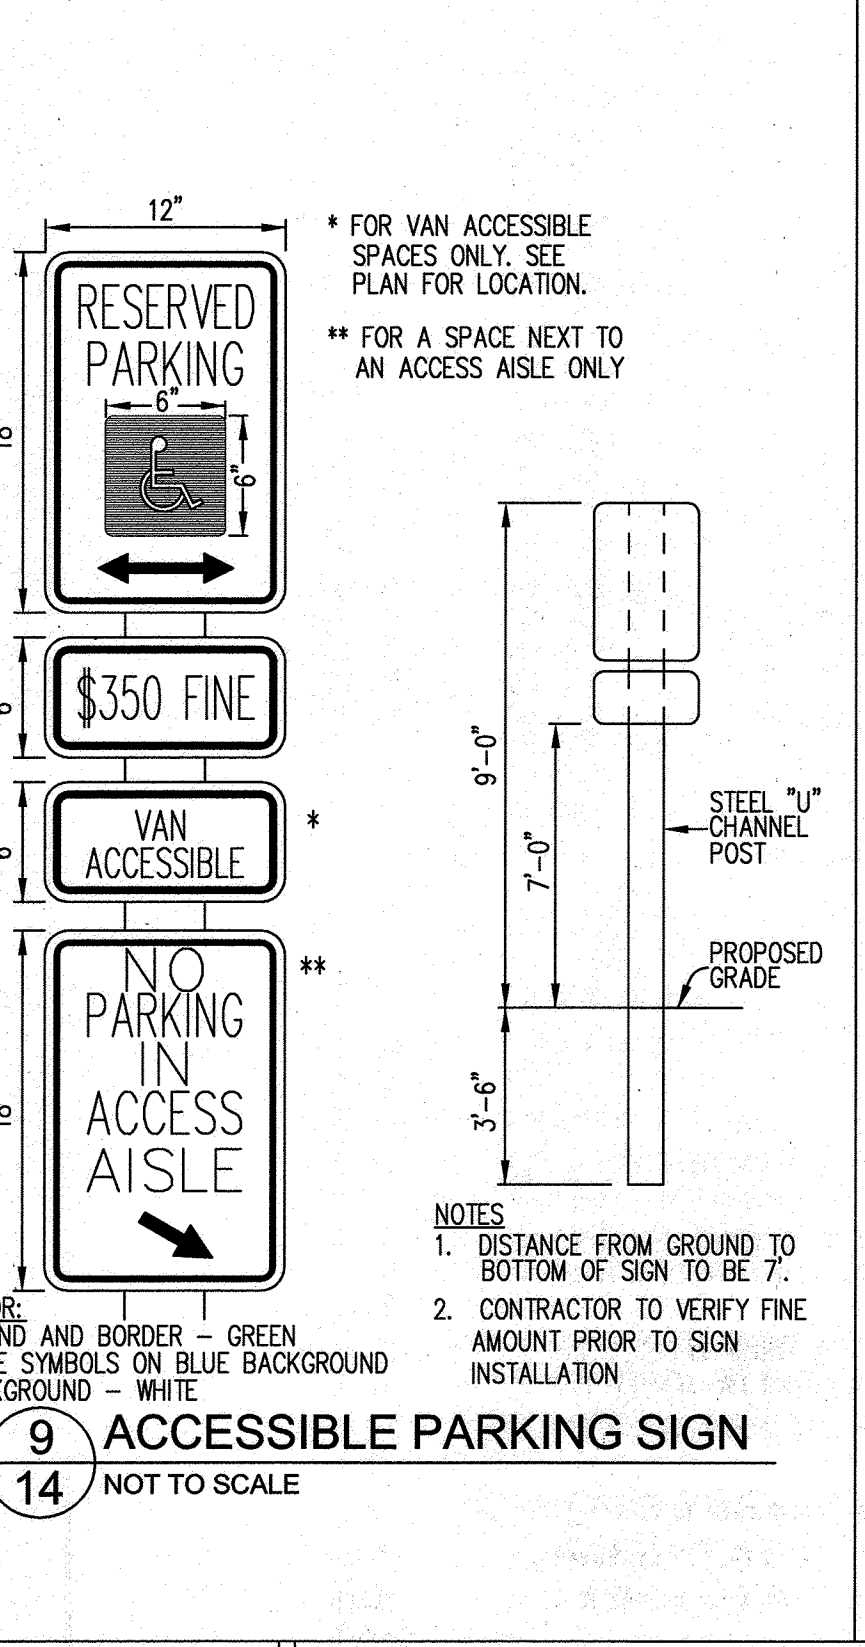


9 ACCESSIBLE PARKING SIGN
14 NOT TO SCALE

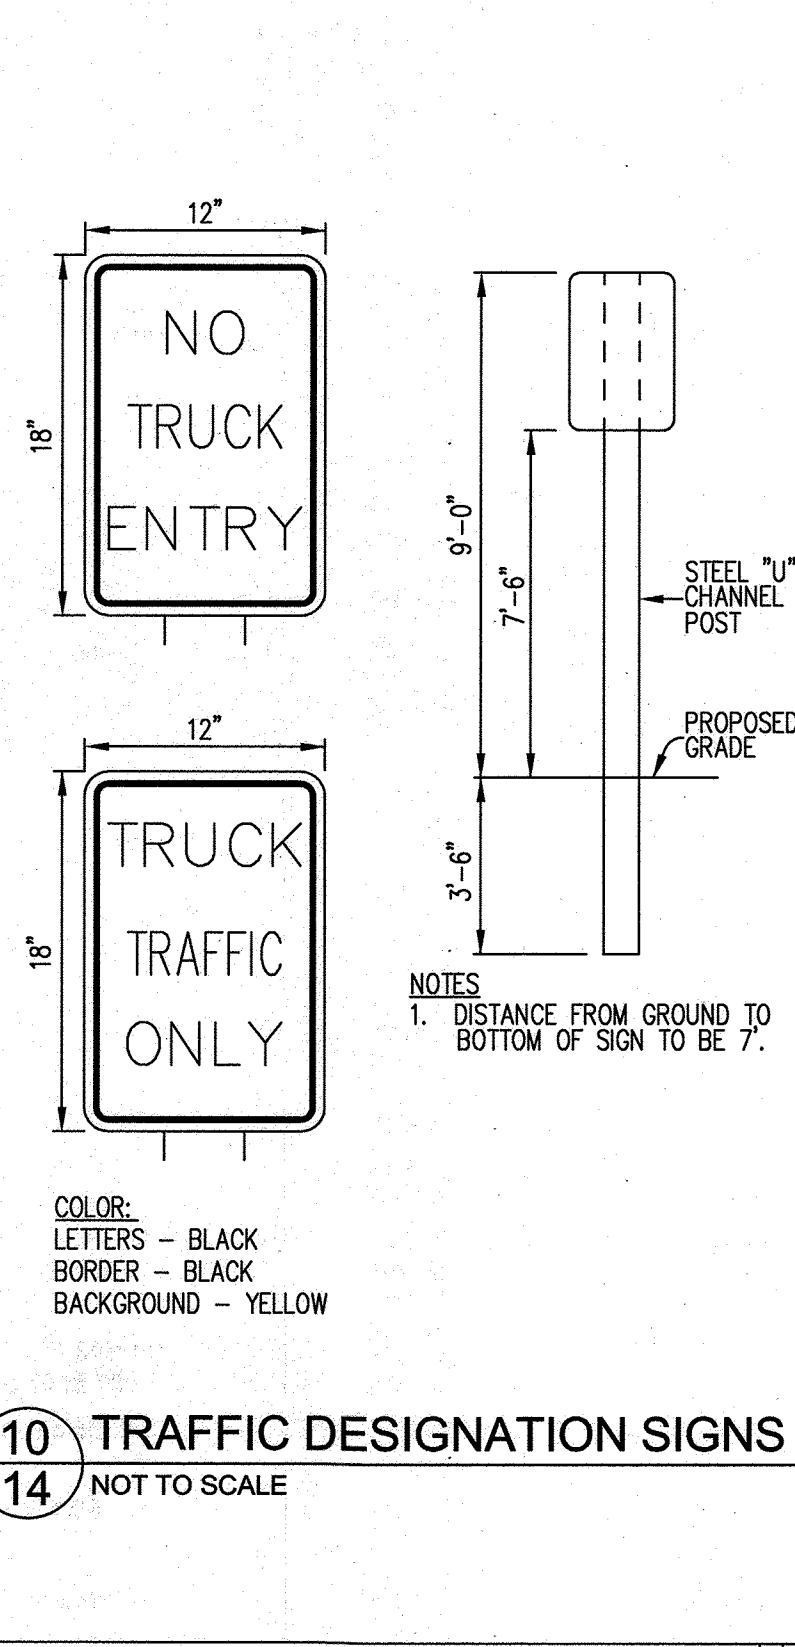

10 TRAFFIC DESIGNATION SIGNS
14 NOT TO SCALE

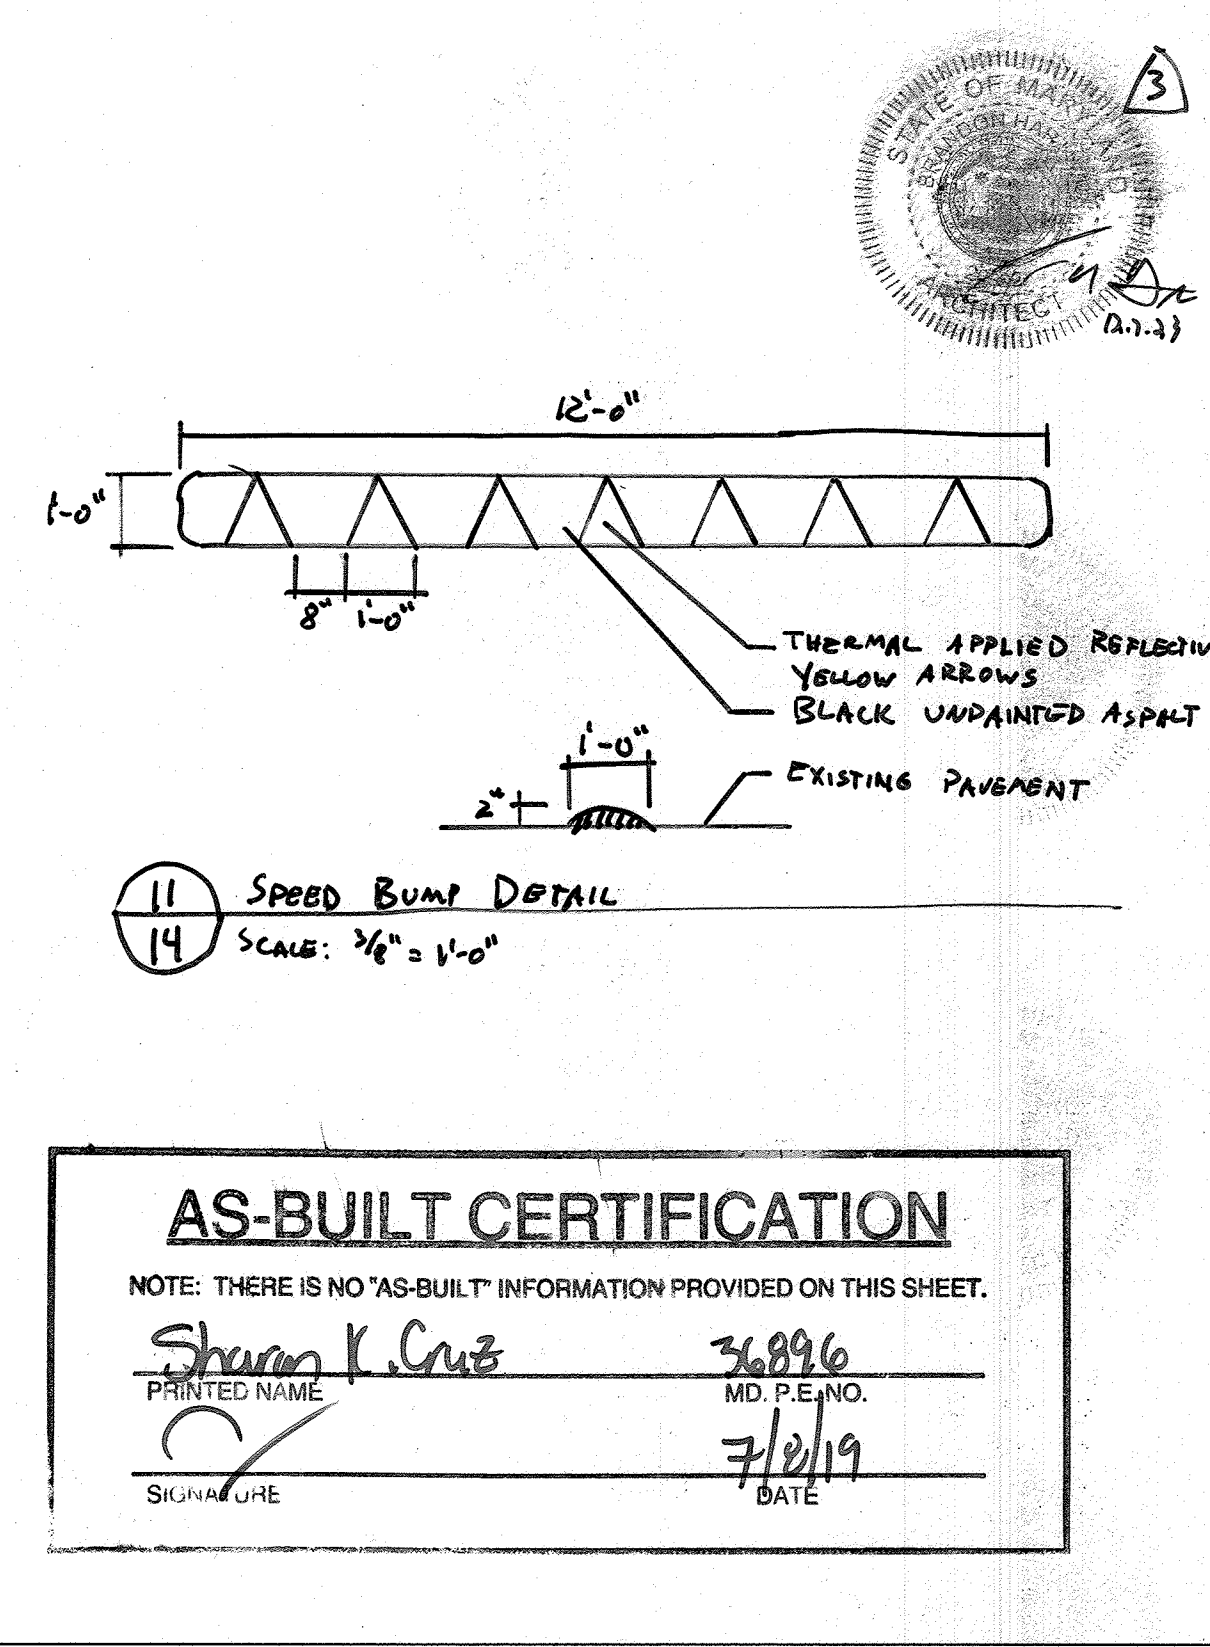

11 SPEED BUMP DETAIL
14 SCALE: 3/4\"/>

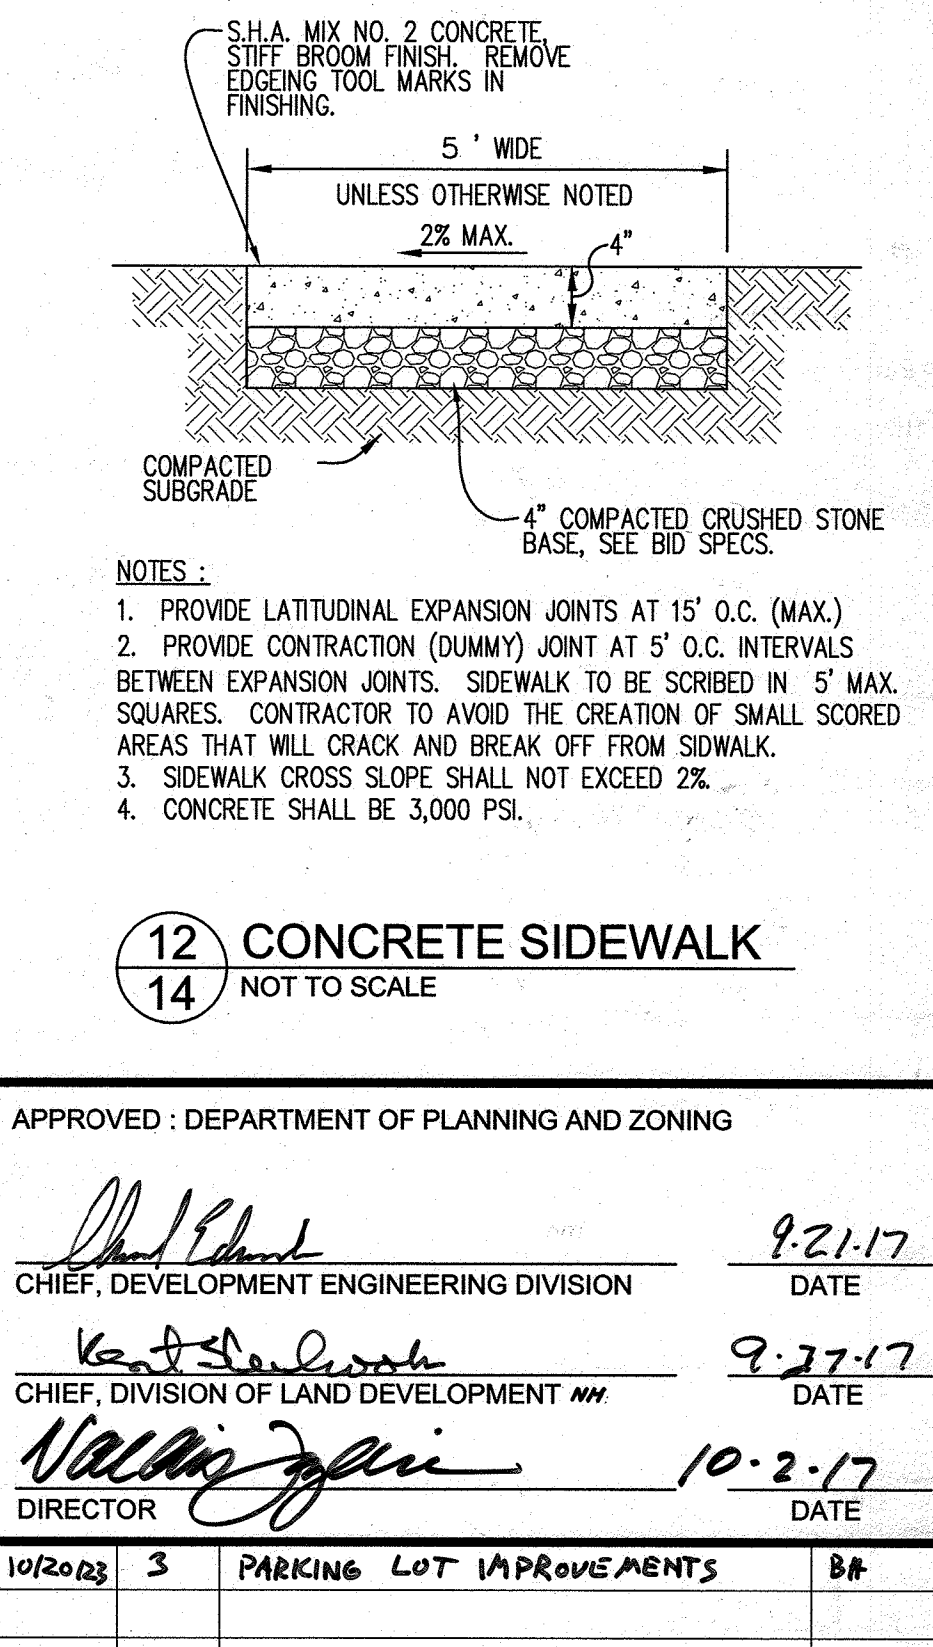

12 CONCRETE SIDEWALK
14 NOT TO SCALE

AS-BUILT CERTIFICATION

NOTE: THERE IS NO "AS-BUILT" INFORMATION PROVIDED ON THIS SHEET.

Sharon K. Cruz 36896
PRINTED NAME MD. P.E./NO.

7/2/19
SIGNATURE DATE


APPROVED: DEPARTMENT OF PLANNING AND ZONING

Chief, Development Engineering Division 9-21-17
DATE


Chief, Division of Land Development 9-27-17
DATE

Director 10-2-17
DATE


NO.	REVISION	BY
102023	3	PARKING LOT IMPROVEMENTS

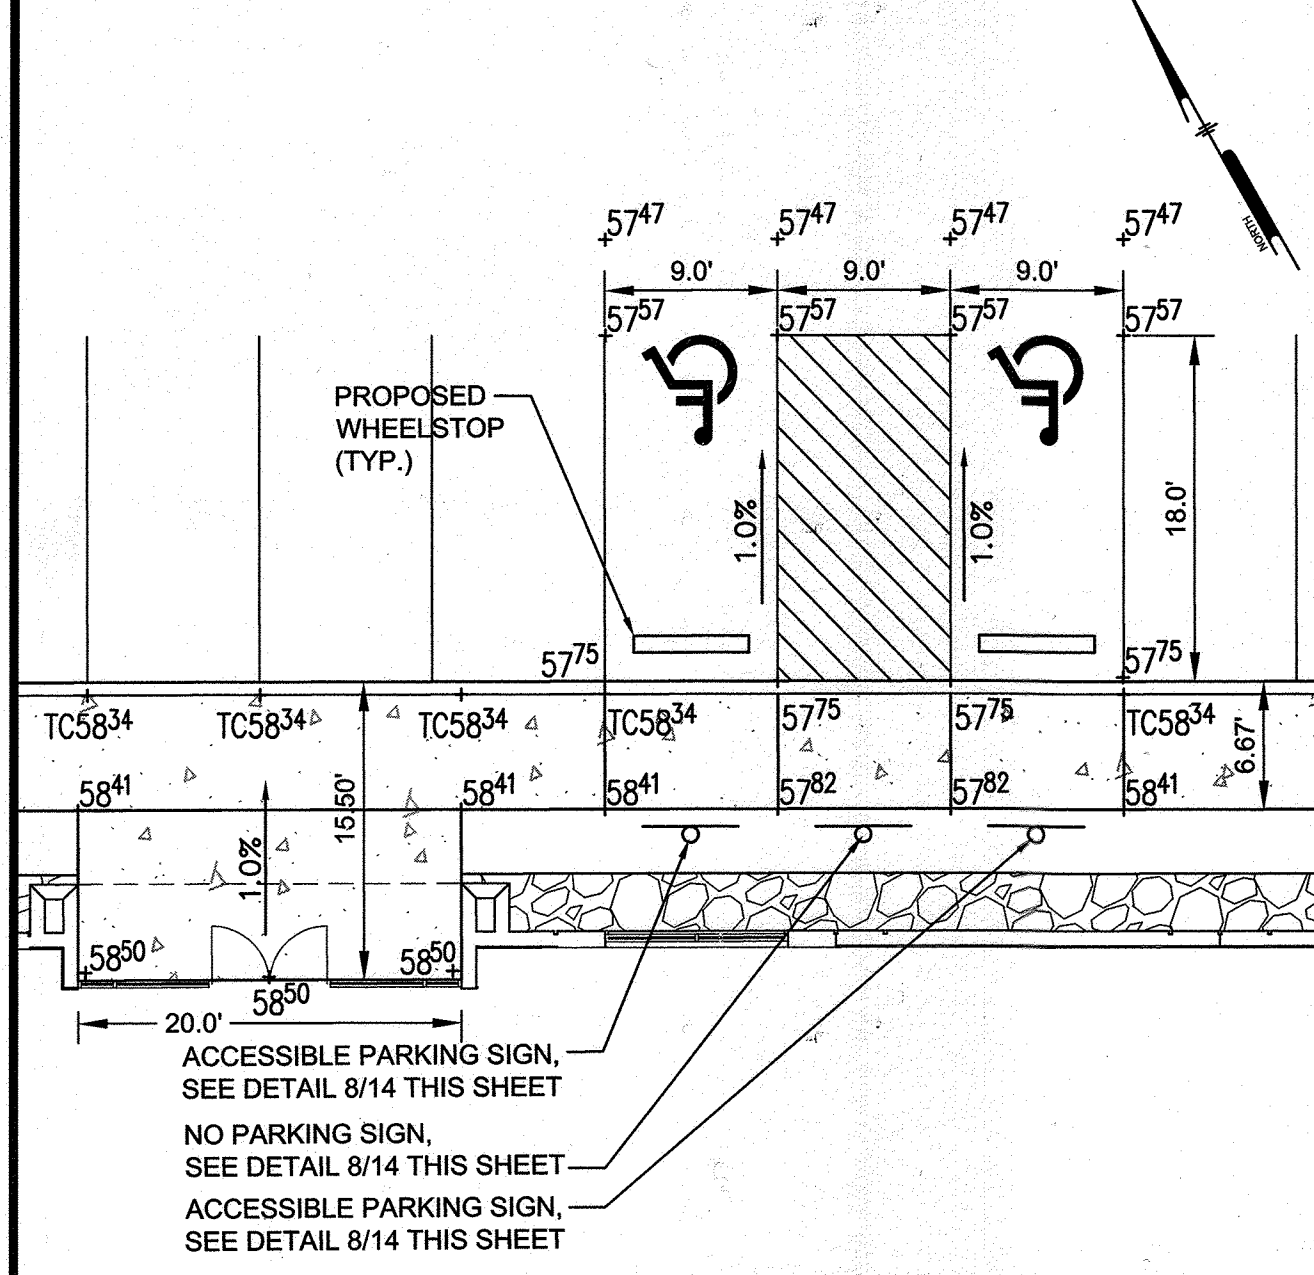


13 ACCESSIBLE PARKING
14 SCALE: 1\"/>

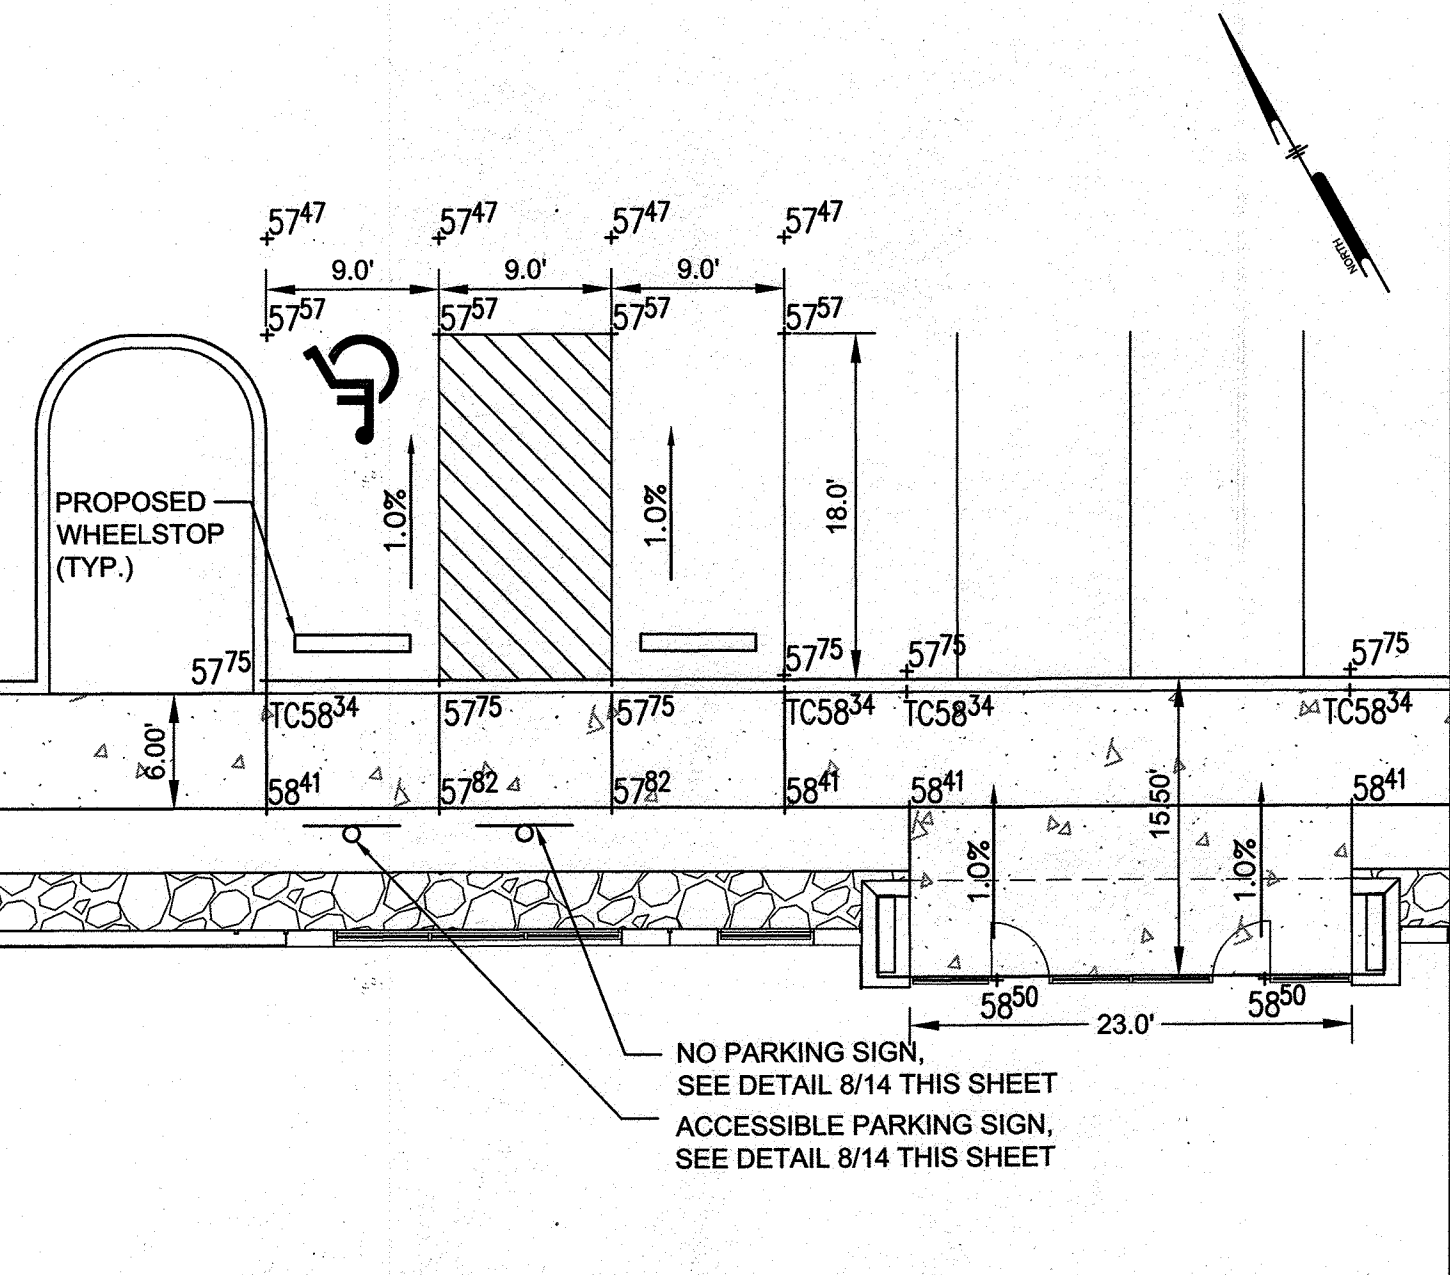

14 ACCESSIBLE PARKING
14 SCALE: 1\"/>

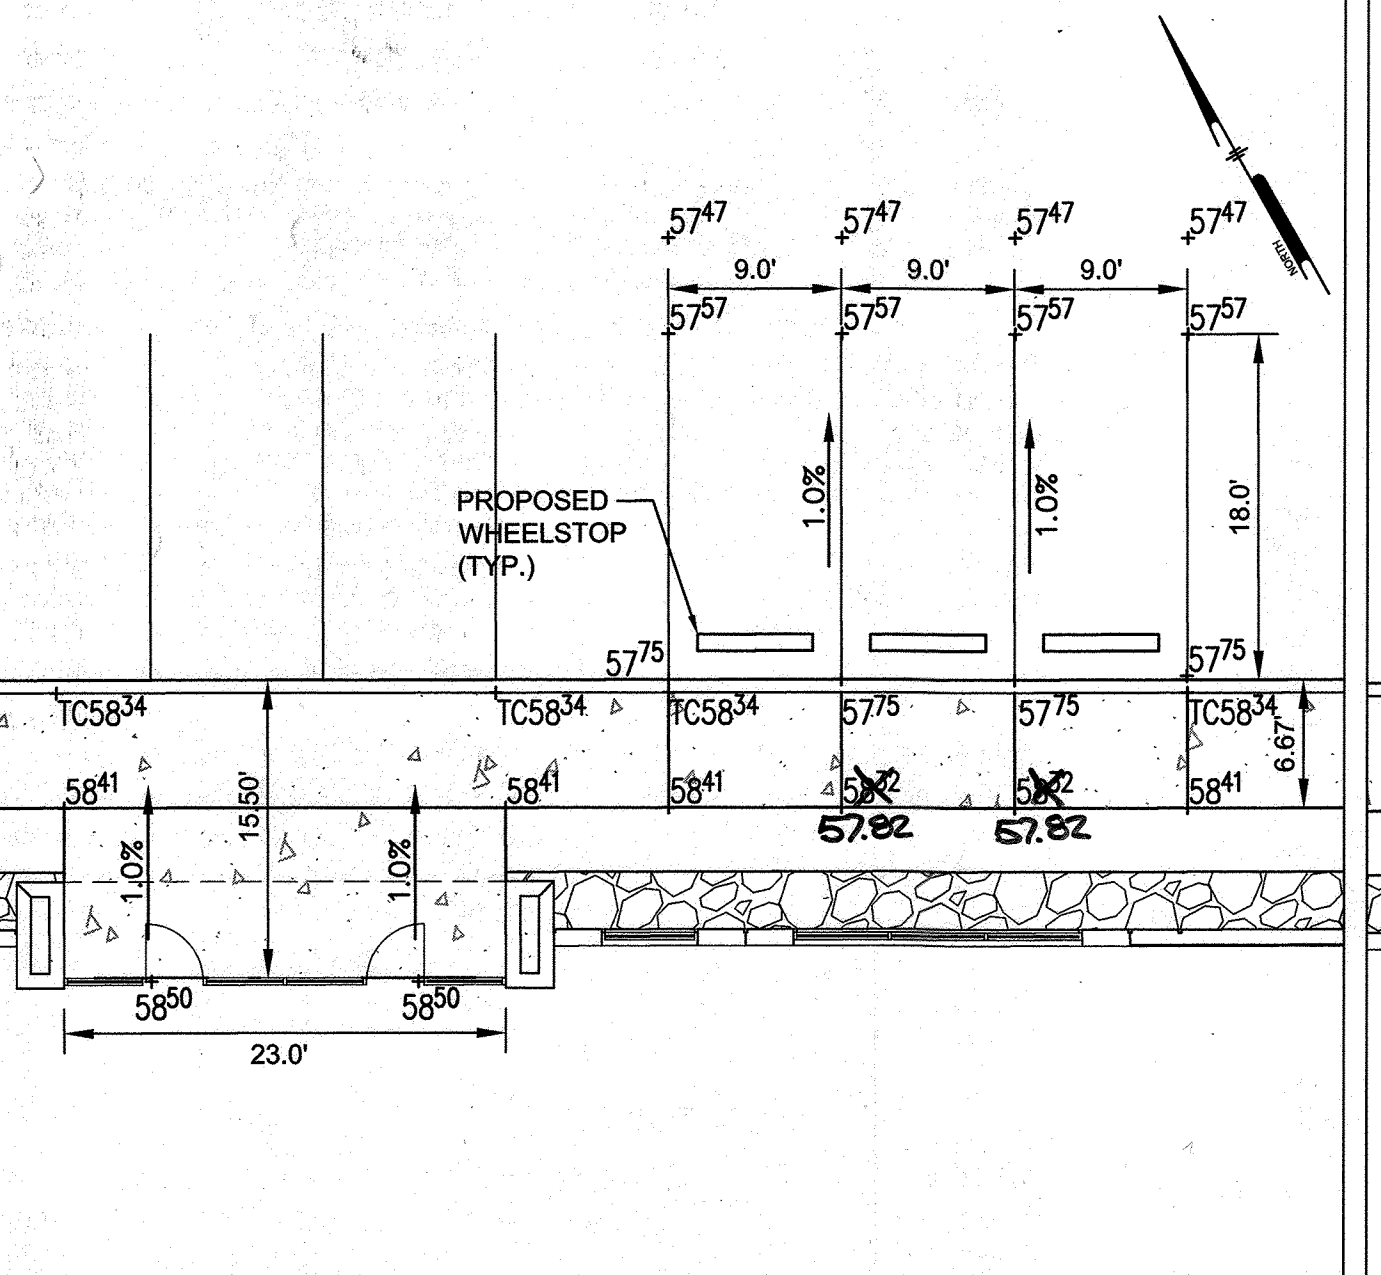

15 POTENTIAL ACCESSIBLE PARKING
14 SCALE: 1\"/>

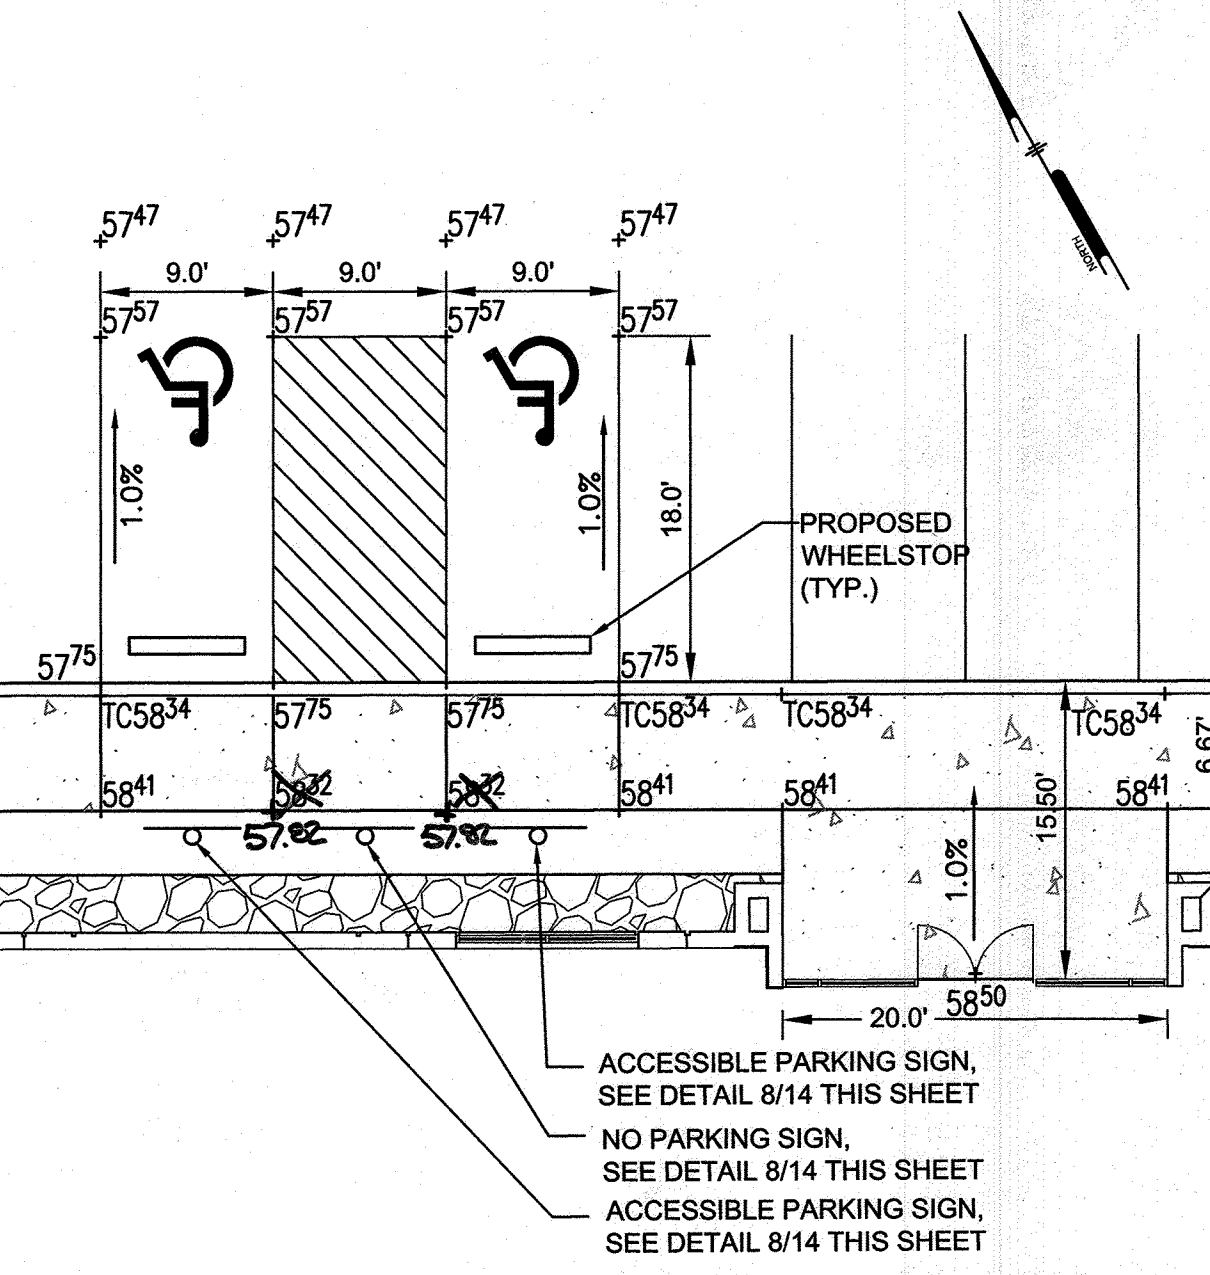

16 ACCESSIBLE PARKING
14 SCALE: 1\"/>

ACCESSIBILITY NOTES:

- ACCESSIBLE ROUTE SHALL BE PROVIDED BETWEEN HANDICAPPED PARKING OR PUBLIC RIGHT OF WAYS TO THE MAIN BUILDING ENTRANCE IN ACCORDANCE WITH CURRENT ADA AND LOCAL STANDARDS. ALL HANDICAPPED RAMPS SHALL BE CONSTRUCTED ACCORDING TO CURRENT ADA AND LOCAL STANDARDS, EXCEPT AS SUPERSEDED IN CURRENT ADA AND LOCAL STANDARDS THE FOLLOWING SHALL APPLY:
 - MAXIMUM SIDEWALK CROSS SLOPES SHALL BE 2%.
 - A MINIMUM 5' X 5' LANDING AREA WITH A MAXIMUM SLOPE IN ANY DIRECTION OF 2% SHALL BE PROVIDED AT ALL CHANGES IN DIRECTION, TOPS AND BOTTOMS OF RAMPS, AND BUILDING EGRESS POINTS.
 - ALL HANDICAPPED PARKING SHALL BE SLOPED NO GREATER THAN 2% IN ANY DIRECTION, INCLUDING A 5' WIDE AREA BEHIND THE PARKING SPACES.
 - AN ACCESS ROUTE FROM THE PARKING SPACE(S) TO THE MAIN BUILDING ENTRANCE SHALL BE PROVIDED. ALL SLOPES ALONG THE DIRECTION OF TRAVEL SHALL NOT EXCEED 1:20 UNLESS THEY FALL UNDER CONDITION B) ABOVE. SLOPES IN EXCESS OF 1:20 EXCEPT FOR CURB RAMPS, REQUIRE A HANDRAIL MEETING ADA REQUIREMENTS.

TERRAPIN COMMERCE CENTER

AREA: TAX MAP 43, PARCEL 51 LOT PAR A PLAT 23793 ZONED M-2 GRID NO. 11 1st ELECTION DISTRICT 7200 DORSEY RUN ROAD ELK RIDGE, MARYLAND 21075 HOWARD COUNTY, MARYLAND

TITLE: SITE DETAILS

Pennoi Associates Inc.
Engineers • Surveyors • Planners
Landscape Architects


8818 Centre Park Drive, Suite 200 Columbia, MD 21045
T 410.997.8900 F 410.997.9282

DESIGNED BY: PJS
DRAWN BY: AGS/JSN
PROJECT NO: DCT11601
DATE: JUNE 23, 2017
SCALE: AS SHOWN
DRAWING NO. 14 OF 43

PROPERTY OF
ANGLO AMERICAN PROP
HOLDINGS, INC.
L. 2508, F.10
PARCEL 116
BALTIMORE WASHINGTON
AUTO EXCHANGE
PLAT Nos. 10212-10216

PROPERTY OF
AA PROPERTY HOLDINGS, INC.
L. 4403, F.307
PARCEL 50
PLAT OF FOREST CONSERVATION
EASEMENT
AA PROPERTY HOLDINGS, INC.
PLAT No. 13928

LEGEND	
PROPERTY LINE AND RIGHT-OF-WAY	---
PROPOSED STORM DRAIN	—●—
PROPOSED WATER	—○—
PROPOSED FIRE HYDRANT	⊕
PROPOSED SEWER	—S—

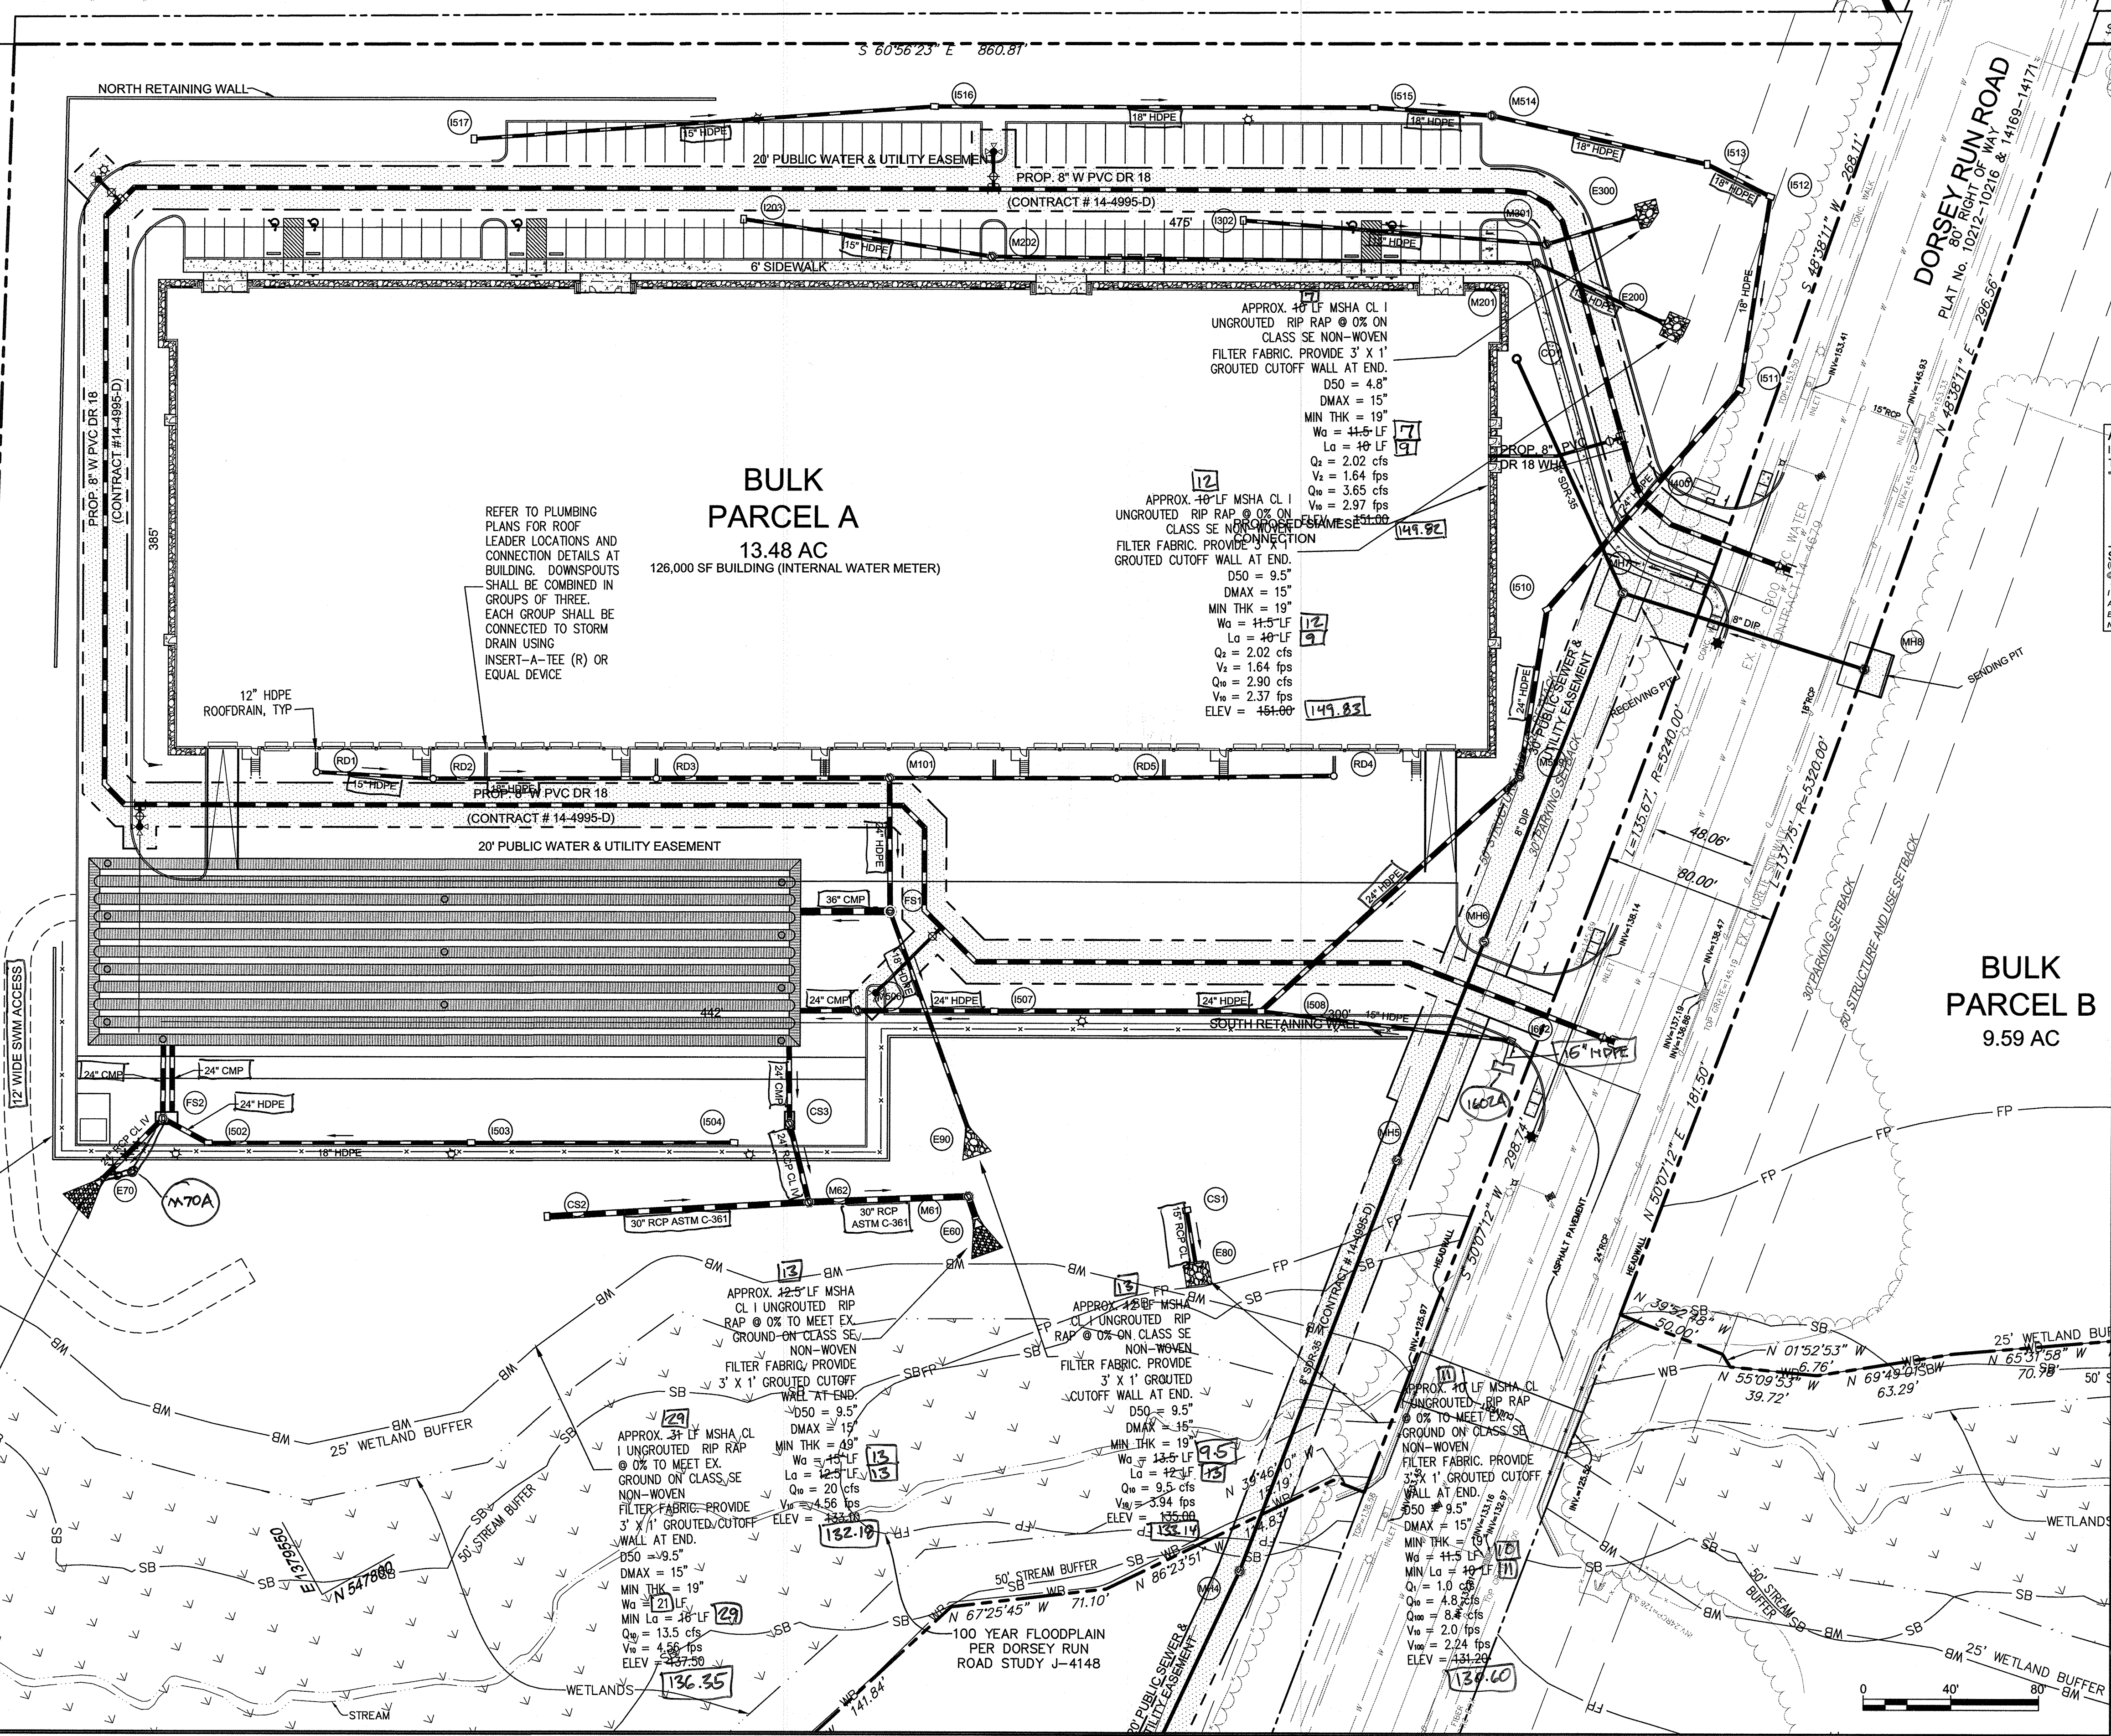

BULK PARCEL A
13.48 AC
126,000 SF BUILDING (INTERNAL WATER METER)

BULK PARCEL B
9.59 AC

AS-BUILT CERTIFICATION
I HEREBY CERTIFY, BY MY SEAL, THAT TO THE BEST OF MY KNOWLEDGE AND BELIEF THE FACILITIES SHOWN ON THIS PLAN WERE CONSTRUCTED AS SHOWN ON THIS "AS-BUILT" PLAN AND MEET THE APPROVED PLANS AND SPECIFICATIONS.


SIGNATURE OF ENGINEER: *Therese Cruz*
DATE: 7/8/19
PE # 36696
STATE OF MARYLAND PROFESSIONAL ENGINEER

APPROVED: DEPARTMENT OF PLANNING AND ZONING	
<i>Chief Development Engineering Division</i>	9-21-17
DATE	
<i>Chief, Division of Land Development</i>	9-27-17
DATE	
<i>Director</i>	10-2-17
DATE	

DATE	NO.	REVISION	BY
DEVELOPER			
DCT INDUSTRIAL 12011 GUILFORD ROAD SUITE 102 ANNAPOLIS JUNCTION, MD 20701 ATTN: FRED FERRARO PHONE: 410-645-5020			
OWNER			
DCT MEARS LLC 12011 GUILFORD ROAD SUITE 102 ANNAPOLIS JUNCTION, MD 20701 ATTN: FRED FERRARO PHONE: 410-645-5020			
PROJECT			
TERRAPIN COMMERCE CENTER			
AREA			
TAX MAP 43, PARCEL 51 LOT PAR A PLAT 23793 ZONED M-2 GRID NO. 11 1st ELECTION DISTRICT 7200 DORSEY RUN ROAD ELKRIDGE, MARYLAND 21075 HOWARD COUNTY, MARYLAND			
TITLE			
UTILITY PLAN AS-BUILT			

Pennoni Associates Inc.
Engineers • Surveyors • Planners
Landscape Architects
8818 Centre Park Drive, Suite 200 Columbia, MD 21045
T 410.997.8900 F 410.997.9282

DESIGNED BY: PJS
DRAWN BY: AGS/JSN
PROJECT NO.: DCT11601
DATE: JUNE 23, 2017
SCALE: 1" = 40'
DRAWING NO.: 15 OF 43

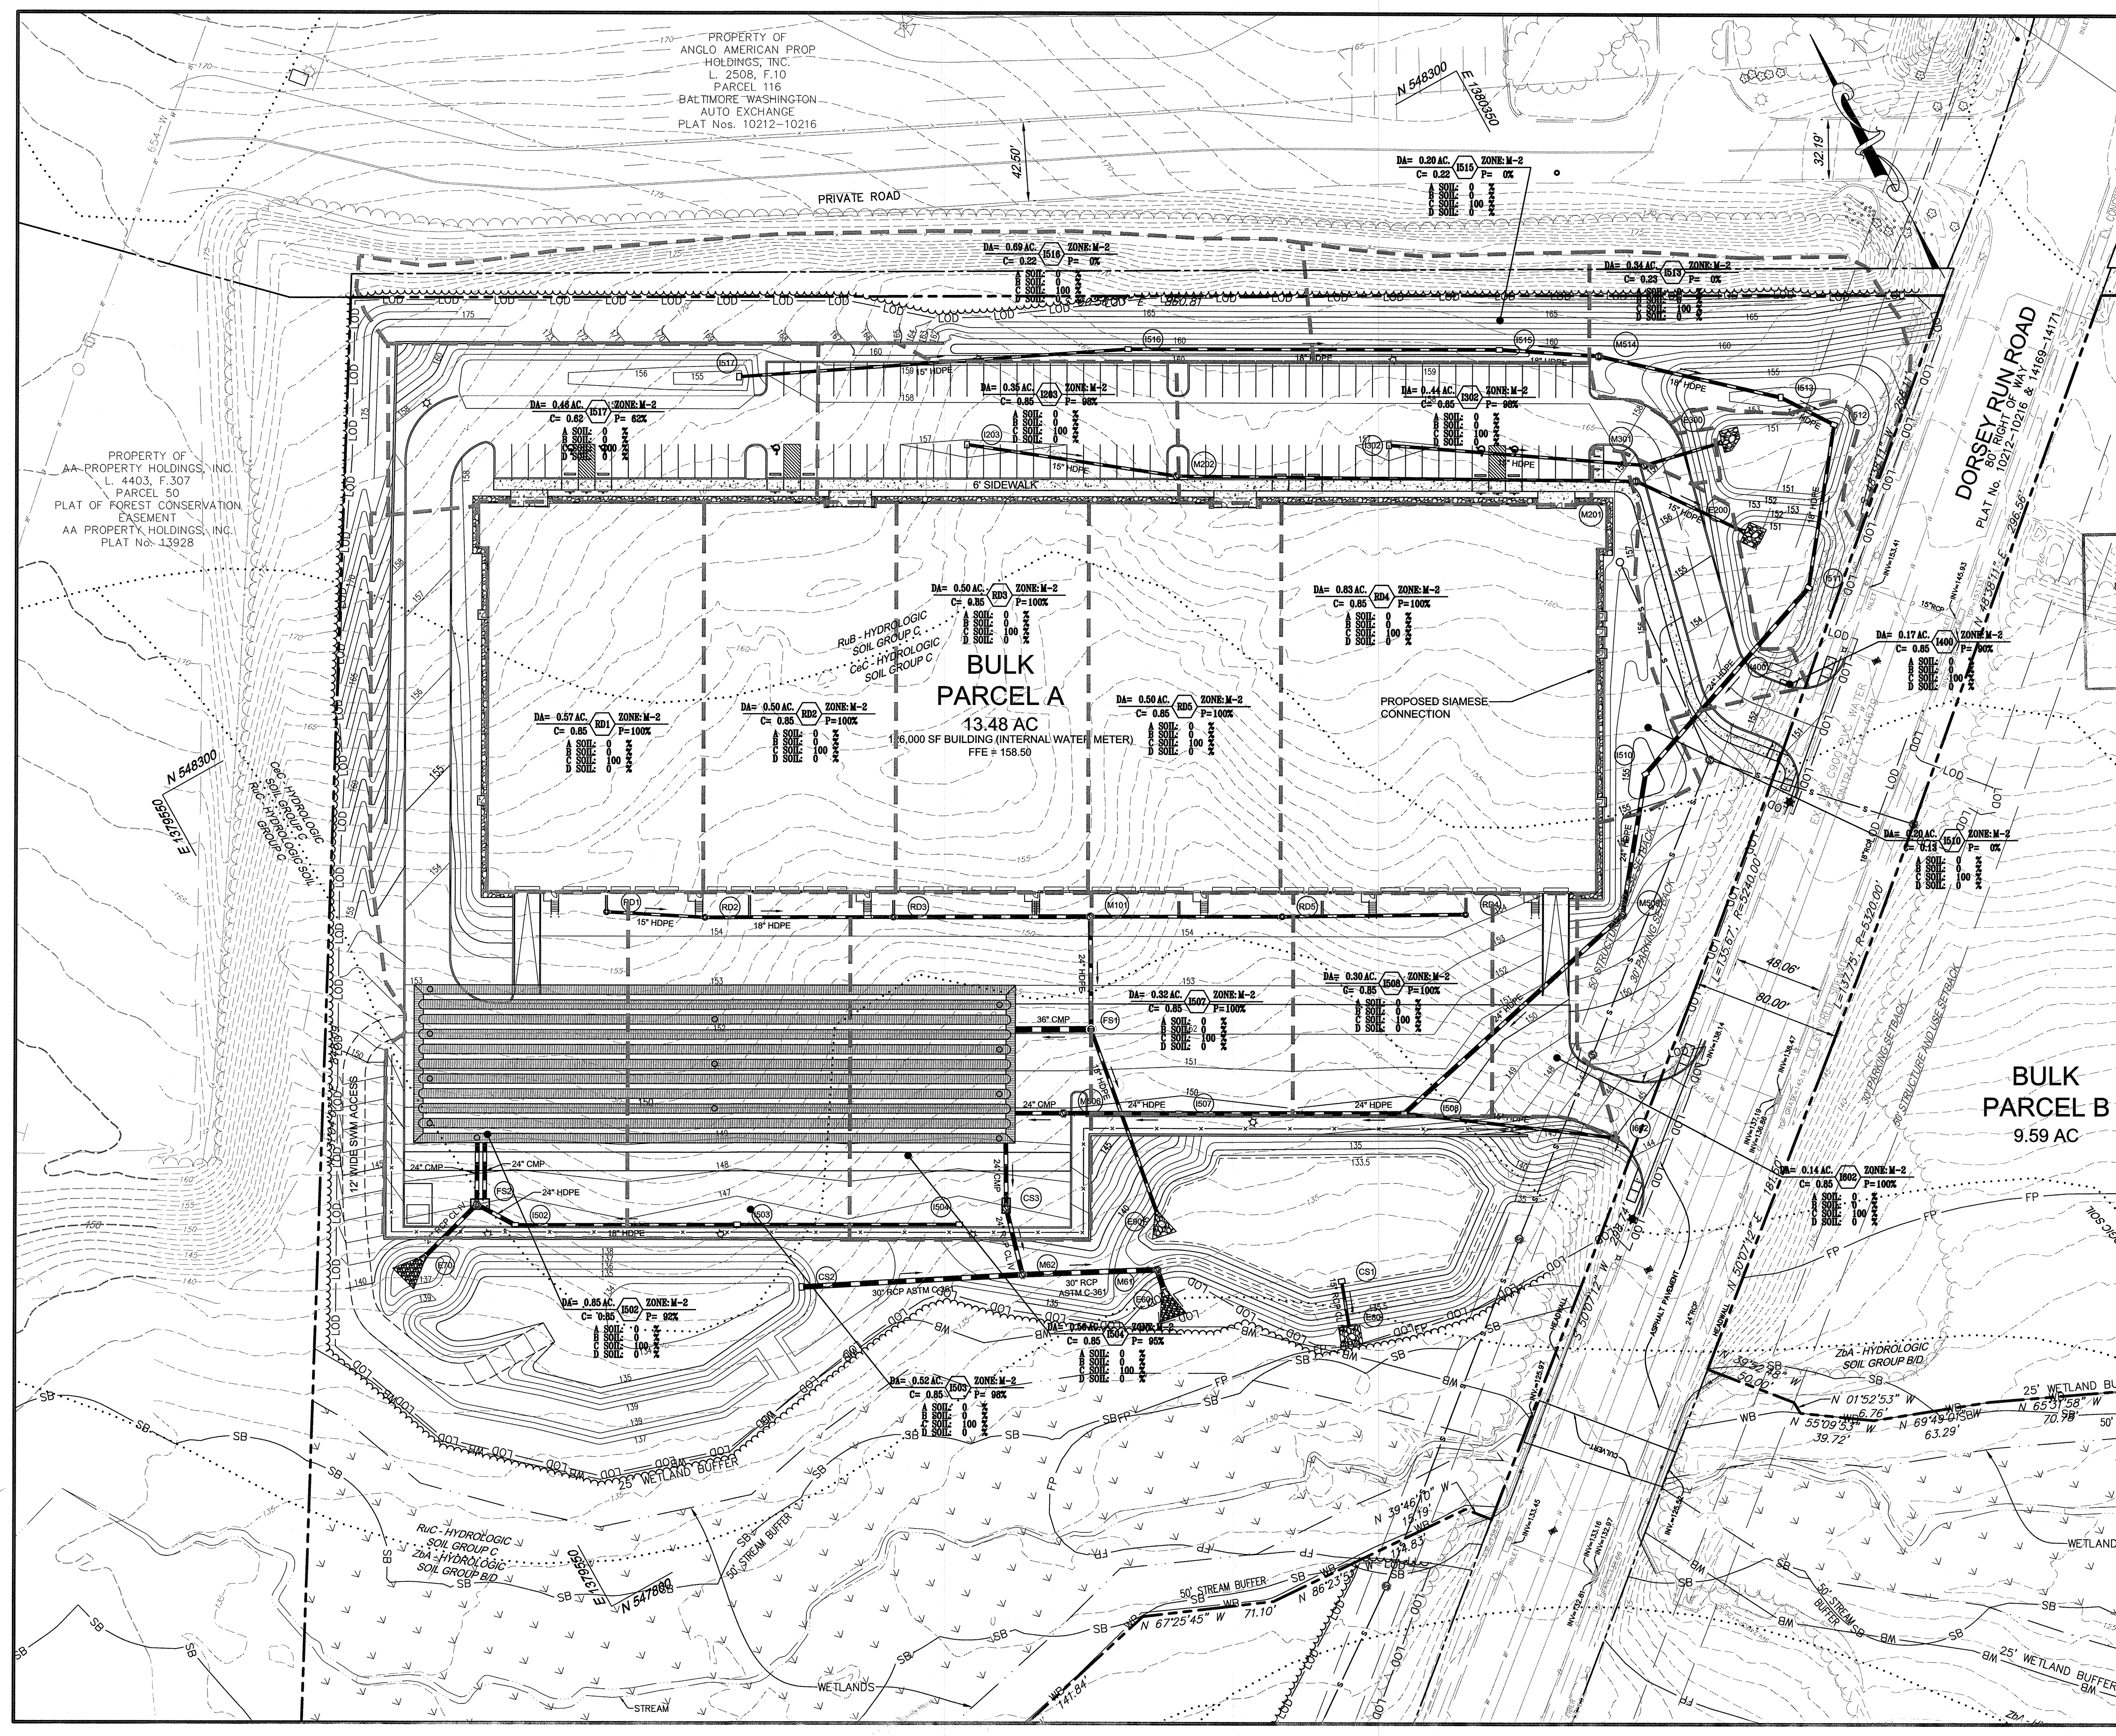


LEGEND

PROPERTY LINE AND RIGHT-OF-WAY	---
EXISTING 1' CONTOUR	-----
EXISTING 5' CONTOUR	-----
EXISTING SOILS	RUB
PROPOSED 1' CONTOUR	-----
PROPOSED 5' CONTOUR	-----
PROPOSED SPOT ELEVATION	56.96'
PROPOSED STORM DRAIN	---
PROPOSED TREE LINE	---
DRAINAGE AREA	---

AS-BUILT CERTIFICATION

NOTE: THERE IS NO "AS-BUILT" INFORMATION PROVIDED ON THIS SHEET.

Sharon K. Cruz 3/8/19
 PRINTED NAME ID. P.E. NO. DATE
 SIGNATURE

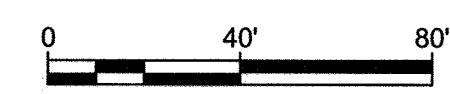

APPROVED: DEPARTMENT OF PLANNING AND ZONING

<i>[Signature]</i>	9-21-17
CHIEF, DEVELOPMENT ENGINEERING DIVISION	DATE
<i>[Signature]</i>	9-27-17
CHIEF, DIVISION OF LAND DEVELOPMENT	DATE
<i>[Signature]</i>	10-2-17
DIRECTOR	DATE

DATE	NO.	REVISION	BY
		DCT INDUSTRIAL 12011 GUILFORD ROAD SUITE 102 ANNAPOLIS JUNCTION, MD 20701 ATTN: FRED FERRARO PHONE: 410-645-5020	
		DCT MEARS LLC 12011 GUILFORD ROAD SUITE 102 ANNAPOLIS JUNCTION, MD 20701 ATTN: FRED FERRARO PHONE: 410-645-5020	

DEVELOPER

OWNER

PROJECT
TERRAPIN COMMERCE CENTER

AREA
TAX MAP 43, PARCEL 51 LOT PAR A PLAT 23793 ZONED M-2
GRID NO. 11 1st ELECTION DISTRICT
7200 DORSEY RUN ROAD
ELKRIDGE, MARYLAND 21075
HOWARD COUNTY, MARYLAND


TITLE
STORM DRAIN DRAINAGE AREA MAP

Pennoni Associates Inc.
 Engineers • Surveyors • Planners
 Landscape Architects
 8818 Centre Park Drive, Suite 200 Columbia, MD 21045
 T 410.997.8900 F 410.997.9282

DESIGNED BY: PJS
 DRAWN BY: AGS/JSN
 PROJECT NO: DCT11601
 DATE: JUNE 23, 2017
 SCALE: 1" = 40'
 DRAWING NO. 16 OF 43

BY: *[Signature]*


PROFESSIONAL CERTIFICATION, I HEREBY CERTIFY THAT THESE DOCUMENTS WERE PREPARED OR APPROVED BY ME, AND THAT I AM A FULLY LICENSED PROFESSIONAL ENGINEER UNDER THE LAWS OF THE STATE OF MARYLAND, LICENSE NO. 3696, EXPIRATION DATE: 5/2022

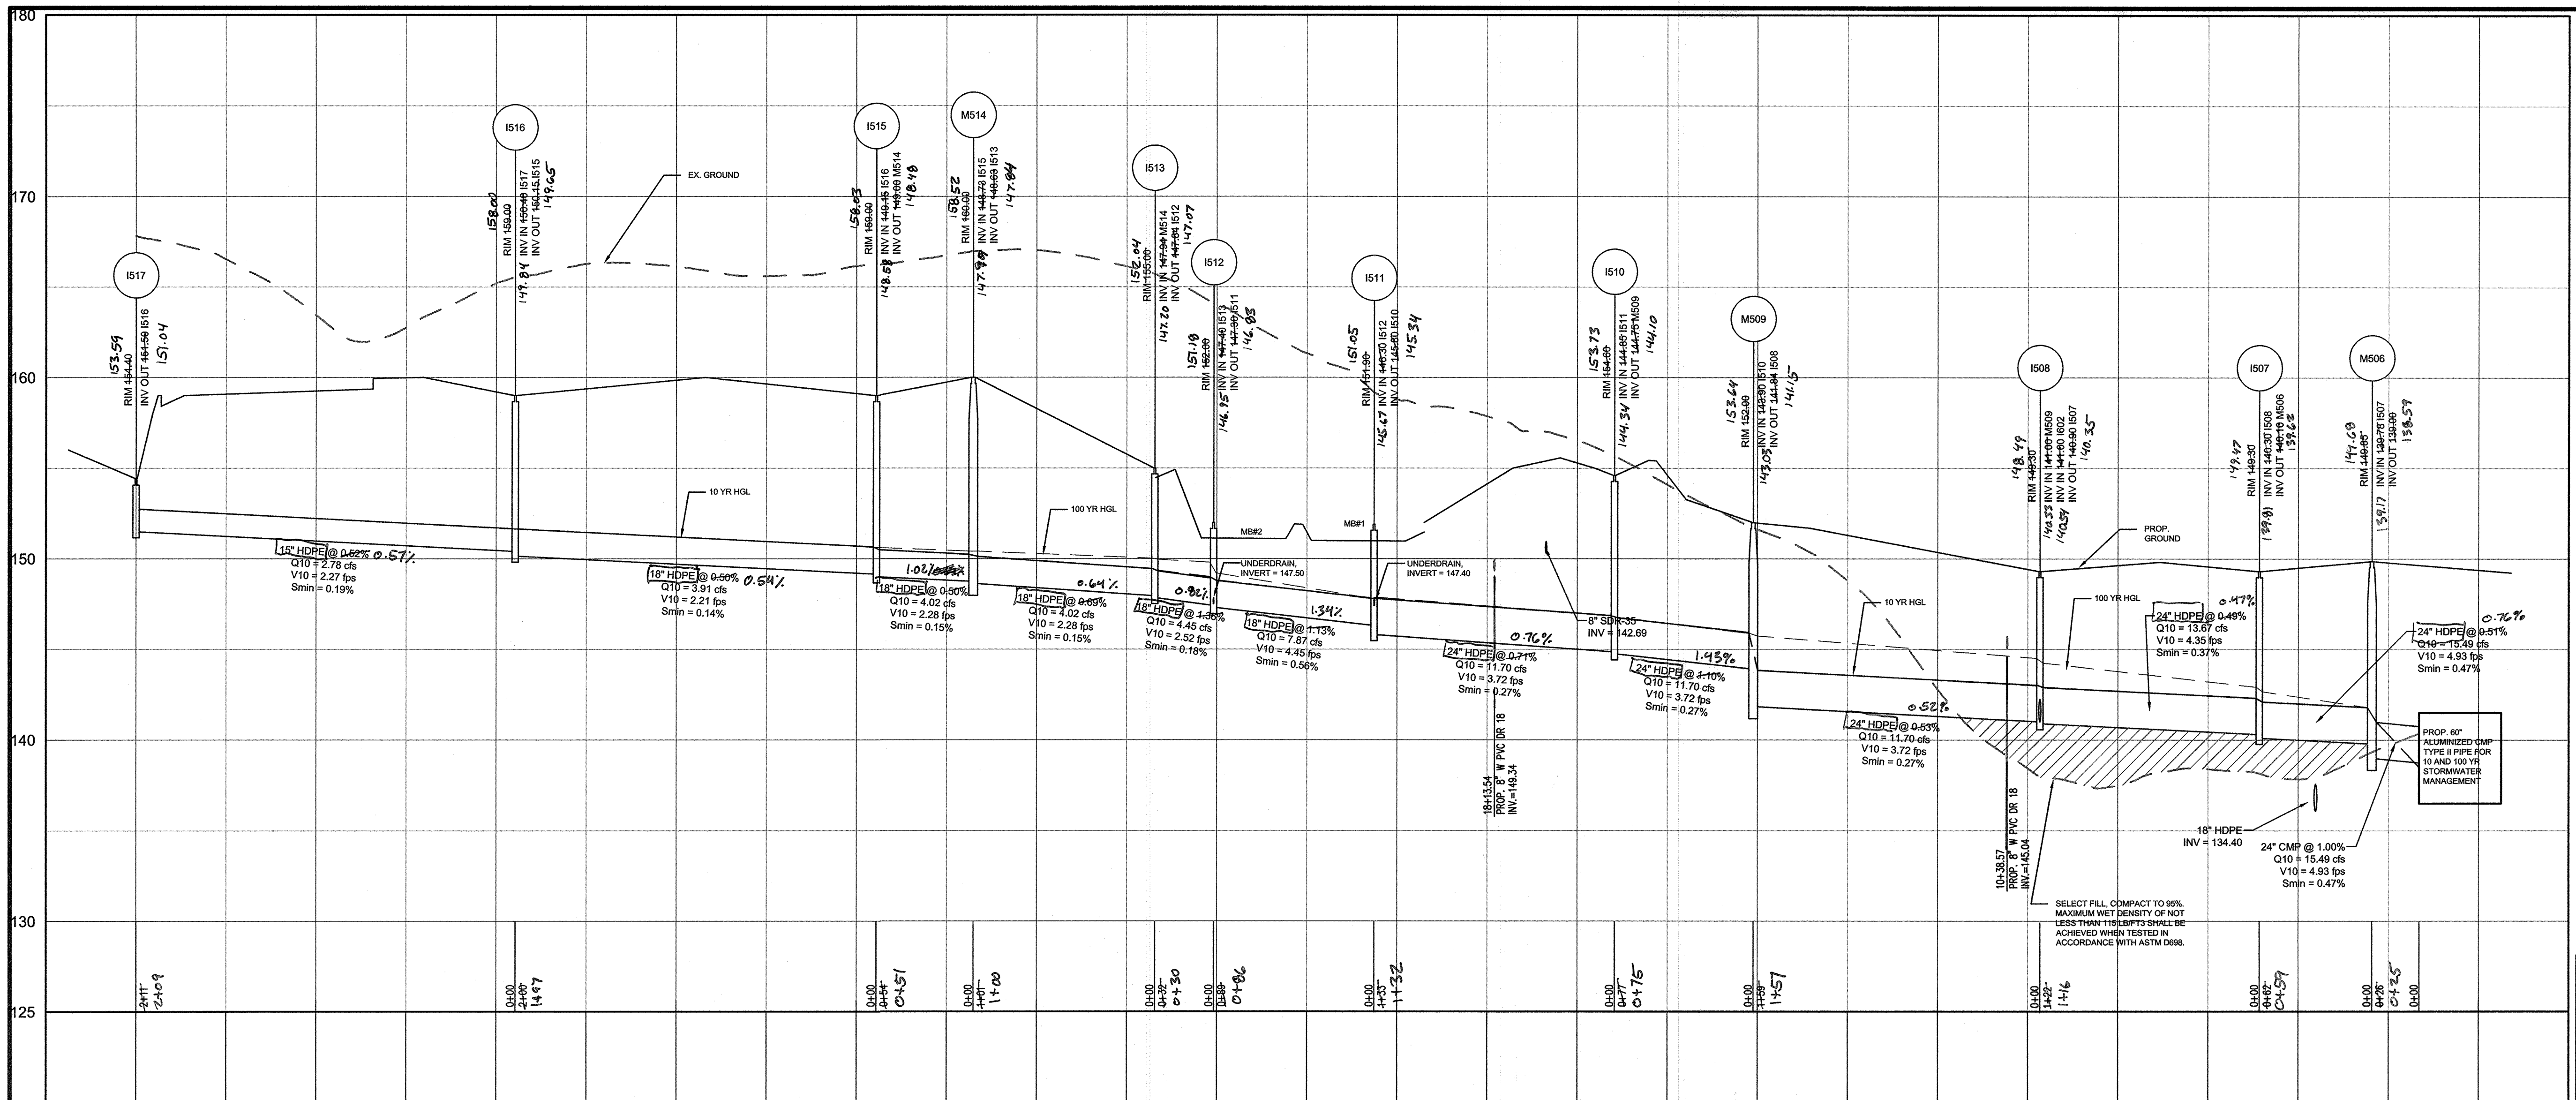

I517 TO M506
 HORIZONTAL SCALE: 1" = 50'
 VERTICAL SCALE: 1" = 5'

ID	RIM ELEVATION	INV IN (FROM)	INV OUT (TO)	TYPE	LOCATION (NORTHING/EASTING)
CS1	134.47		134.47 (15" RCP CL IV) E80	YARD INLET, D-4.14	547760.8645, 1379979.8054
CS2	139.05		134.75 (30" RCP CL IV) M62	CONTROL STRUCTURE, SEE SWM DETAILS	547900.1476, 1379723.0888
CS3	146.57	135.57 (24" CMP @ 0.29%)	134.00 (24" RCP CL IV) M62	CONTROL STRUCTURE, SEE SWM DETAILS	547883.2473, 1379840.3293
E60	135.21	132.71 (30" RCP CL IV @ 0.50%) M61		30" CONC. FES, D-5.51	547804.9327, 1379893.7792
E70	138.27	136.30 (24" RCP CL IV @ 2.45%) FS2		24" HDPE FLARED END SECTION	548014.0747, 1379554.6248
E80	133.59	131.27 (15" RCP CL IV @ 0.75%) CS1		CONC. ENDWALL, D-5.21	547737.3994, 1379971.3161
E90	136.53	134.53 (18" HDPE @ 1.93%) FS1		15" HDPE FLARED END SECTION	547842.9365, 1379910.5244
E00	161.83	160.56 (15" HDPE @ 0.59%) M201		15" HDPE FLARED END SECTION	548009.2330, 1380364.2639
E300	151.74	150.64 (15" HDPE @ 5.25%) M301		18" HDPE FLARED END SECTION	548055.9757, 1380376.0475
FS1	151.74	144.50 (24" HDPE @ 1.05%) M101	136.42 (18" HDPE) E90 136.54 (36" CMP)	60" FLOWSPLITTER MH, G-5.13, SEE SWM DETAILS	547945.1406, 1379927.1574
FS2	146.75	139.59 (24" HDPE @ 1.30%) I502	132.00 (24" RCP CL IV) E70 137.82 (24" CMP)	48" MH	548024.5245, 1379591.4671
I203	136.45		132.85 (15" HDPE) M202	A-5 INLET, D-4.01	548252.8496, 1380021.4608
I302	156.45		152.52 (15" HDPE) M301	A-5 INLET, D-4.01	548141.5970, 1380220.4780
I400	151.75			4" WIDE CURB SLOT	547926.3787, 1380364.6085
I502	145.92	140.38 (18" HDPE @ 1.00%) I503	139.84 (24" HDPE) FS2	WR INLET, D-4.35	548004.6574, 1379604.2048
I503	145.93	141.80 (15" HDPE @ 0.58%) I504	144.42 (18" HDPE) I502	WR INLET, D-4.35	547946.4172, 1379709.1232
I504	145.93		142.18 (15" HDPE) I503	WR INLET, D-4.35	547887.9809, 13799813.9222
I507	149.47	139.81 (24" HDPE @ 0.49%) I508	139.62 (24" HDPE) M506	A-5 INLET, D-4.01	547882.3712, 1379946.6485
I508	146.99	140.33 (24" HDPE @ 0.53%) M509 140.54 (15" HDPE @ 0.50%) I602	140.35 (24" HDPE) I507	A-5 INLET, D-4.01	547823.1663, 1380022.9684
I510	153.73	144.34 (24" HDPE @ 0.71%) I511	144.10 (24" HDPE) M509	YARD INLET, D-4.14	547919.5086, 1380255.8808
I511	161.05	145.57 (18" HDPE @ 1.13%) I512	145.34 (24" HDPE) I510	YARD INLET, D-4.14	547964.2116, 1380381.3792
I512	161.16	146.95 (18" HDPE @ 1.36%) I513	146.83 (18" HDPE) I511	YARD INLET, D-4.14	548034.2721, 1380436.0099
I513	152.04	147.80 (18" HDPE @ 0.89%) M514	147.07 (18" HDPE) I512	YARD INLET, D-4.14	548061.1313, 1380417.9253

ID	RIM ELEVATION	INV IN (FROM)	INV OUT (TO)	TYPE	LOCATION (NORTHING/EASTING)
I515	158.03	148.58 (18" HDPE @ 0.50%) I516	146.46 (18" HDPE) M514	YARD INLET, D-4.14	548157.4707, 1380297.5337
I516	158.06	149.84 (15" HDPE @ 0.52%) I517	149.45 (18" HDPE) I515	YARD INLET, D-4.14	548255.2943, 1380122.4506
I517	153.39		151.04 (15" HDPE) I516	YARD INLET, D-4.14	548344.7047, 1379931.6663
I602	144.61		140.49 (15" HDPE) I508	A-5 INLET	547756.0300, 1380146.2888
M61	138.39	132.98 (30" RCP CL IV @ 0.50%) M62	132.74 (30" RCP CL IV) E60	48" MH	547814.5104, 1379895.5329
M62	138.82	135.26 (30" RCP CL IV @ 0.50%) CS2 133.82 (24" RCP CL IV @ 0.55%) CS3	132.22 (30" RCP CL IV) M61	48" MH	547847.6740, 1379830.6436
M101	153.66	148.97 (24" HDPE @ 0.50%) RD3 148.81 (18" HDPE @ 1.16%) RD5	145.19 (24" HDPE) FS1	48" MH, G-5.12	547998.2164, 1379956.2889
M201	167.71	150.86 (15" HDPE @ 0.48%) M202	150.76 (15" HDPE) E200	48" MH, G-5.12	548059.6115, 1380327.8852
M202	157.50	152.19 (15" HDPE @ 0.50%) I203	152.12 (15" HDPE) M201	48" MH, G-5.12	548182.8420, 1380112.2876
M301	156.95	152.75 (15" HDPE @ 0.50%) I302	152.70 (15" HDPE) E300	48" MH, G-5.12	548064.9154, 1380336.0632
M506	149.68	139.17 (24" HDPE @ 0.51%) I507	139.59 (24" CMP)	96" 48" MH, G-5.12	547912.8372, 1379892.1789
M509	159.64	143.03 (24" HDPE @ 1.10%) I510	141.15 (24" HDPE) I508	48" MH, G-5.12	547859.0951, 1380207.9009
M514	156.52	147.96 (18" HDPE @ 0.50%) I515	147.84 (18" HDPE) I513	48" MH, G-5.12	548128.2288, 1380342.8336
RD1	153.49		150.54 (15" HDPE) RD2	18" NYLOPLAST DRAIN BASIN WITH SOLID COVER	548128.0192, 1379729.1903
RD2	153.62	150.11 (15" HDPE @ 0.94%) RD1	150.00 (18" HDPE) RD3	18" NYLOPLAST DRAIN BASIN WITH SOLID COVER	548099.5093, 1379774.1950
RD3	153.65	149.15 (18" HDPE @ 0.80%) RD2	145.90 (24" HDPE) M101	18" NYLOPLAST DRAIN BASIN WITH SOLID COVER	548049.9180, 1379863.1750
RD4	153.85		150.40 (18" HDPE) RD5	18" NYLOPLAST DRAIN BASIN WITH SOLID COVER	547900.6018, 1380133.9193
RD5	153.68	149.79 (18" HDPE @ 0.71%) RD4	149.71 (18" HDPE) M101	18" NYLOPLAST DRAIN BASIN WITH SOLID COVER	547947.8480, 1380046.8061
M70A	142.06	136.33 (24" RCP)	136.30 (24" RCP)	48" MH	

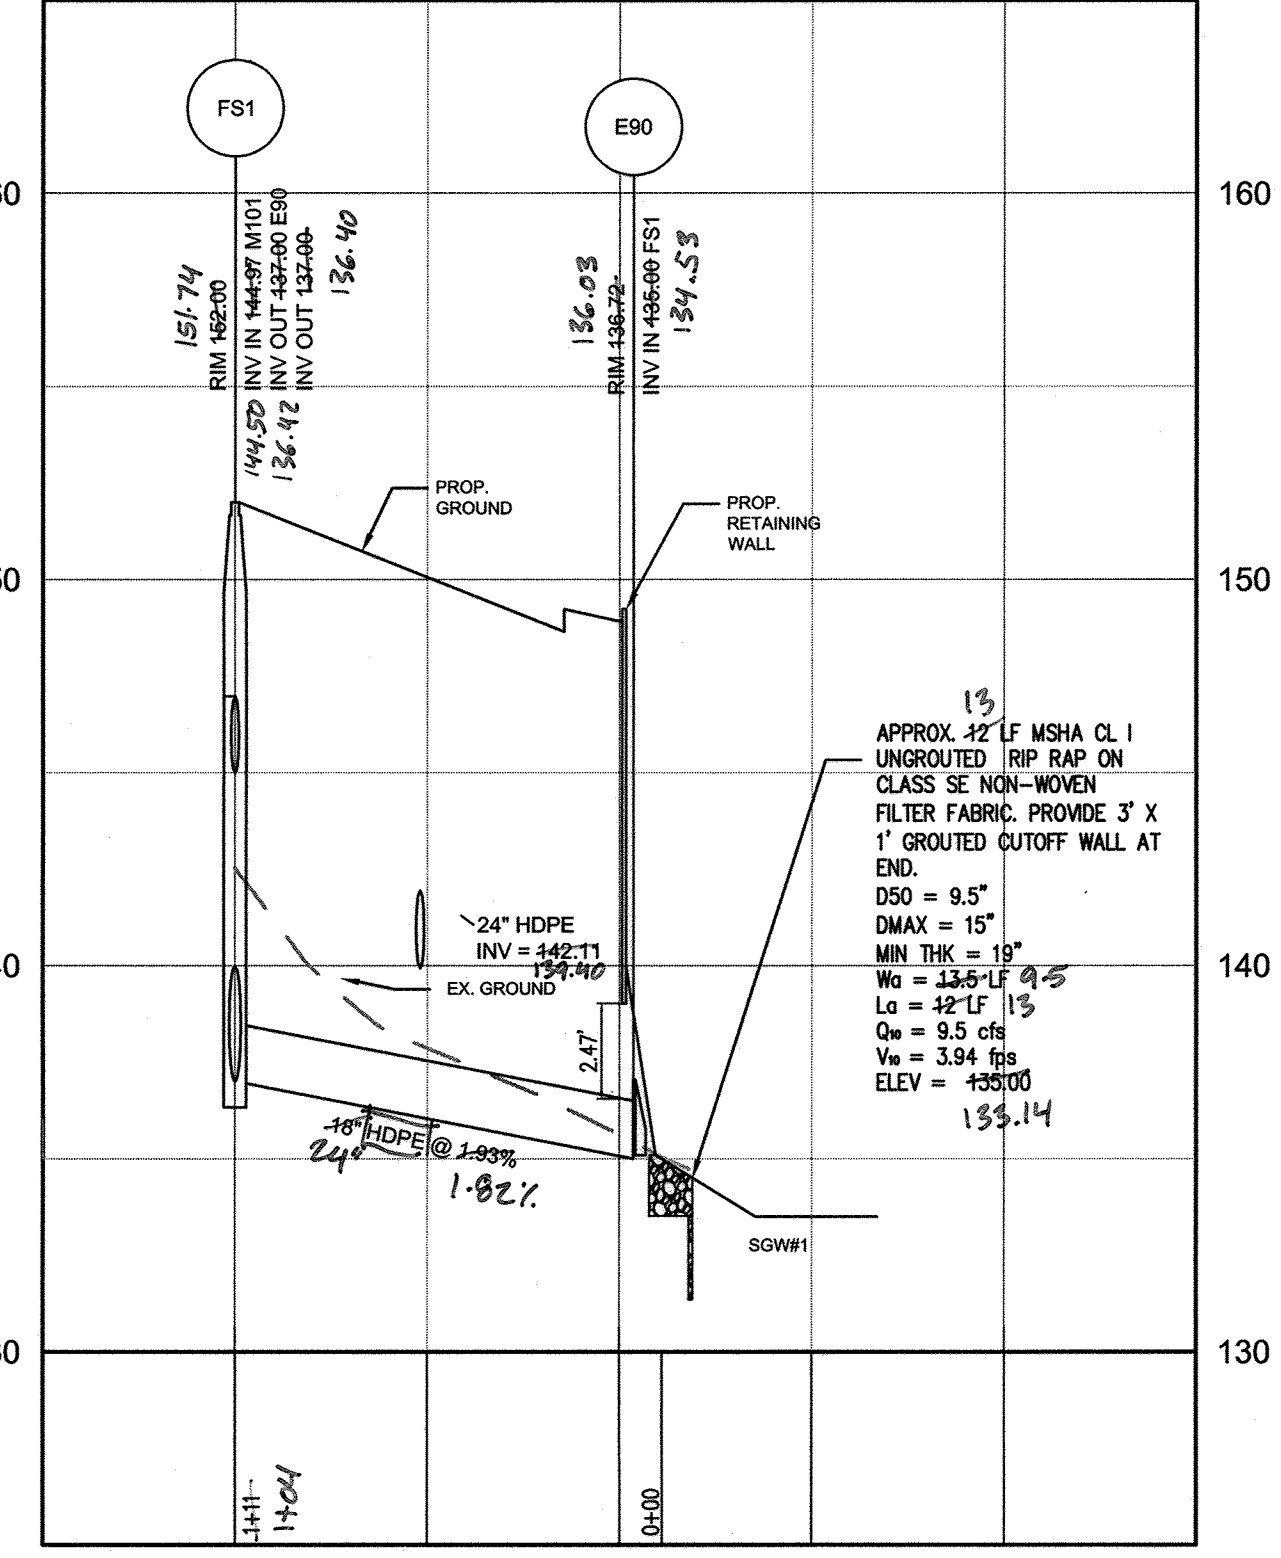

FS1 TO E90
 HORIZONTAL SCALE: 1" = 50'
 VERTICAL SCALE: 1" = 5'



AS-BUILT CERTIFICATION
 I HEREBY CERTIFY, BY MY SEAL, THAT TO THE BEST OF MY KNOWLEDGE AND BELIEF THE FACILITIES SHOWN ON THIS PLAN WERE CONSTRUCTED AS SHOWN ON THIS "AS-BUILT" PLAN AND MEET THE APPROVED PLANS AND SPECIFICATIONS.

Signature: *Sham C. Cruz* DATE: 7/6/19
 PE # 36896

I HEREBY CERTIFY THAT THESE DOCUMENTS WERE PREPARED OR APPROVED BY ME, AND THAT I AM A DULY LICENSED PROFESSIONAL ENGINEER UNDER THE LAWS OF THE STATE OF MARYLAND, LICENSE NO. 36896, EXPIRATION DATE: 2-15-21

APPROVED: DEPARTMENT OF PLANNING AND ZONING


Sham C. Cruz 9-21-17
 CHIEF, DEVELOPMENT ENGINEERING DIVISION DATE

Vicki Seaton 9-27-17
 CHIEF, DIVISION OF LAND DEVELOPMENT DATE


Walter J. J. J. 10-2-17
 DIRECTOR DATE

DATE	NO.	REVISION	BY
DEVELOPER: DCT INDUSTRIAL 12011 GUILFORD ROAD SUITE 102 ANNAPOLIS JUNCTION, MD 20701 ATTN: FRED FERRARO PHONE: 410-645-5020			
OWNER: DCT MEARS LLC 12011 GUILFORD ROAD SUITE 102 ANNAPOLIS JUNCTION, MD 20701 ATTN: FRED FERRARO PHONE: 410-645-5020			
PROJECT: TERRAPIN COMMERCE CENTER			
AREA: TAX MAP 43, PARCEL 51 LOT PAR A PLAT 23793 ZONED M-2 GRID NO. 11 1st ELECTION DISTRICT 7200 DORSEY RUN ROAD ELKRIDGE, MARYLAND 21075 HOWARD COUNTY, MARYLAND			
TITLE: STORM DRAIN PROFILES AND SCHEDULES AS-BUILT			
Pennon! Pennoni Associates Inc. Engineers • Surveyors • Planners Landscape Architects			
8818 Centre Park Drive, Suite 200 Columbia, MD 21045 T 410.997.8900 F 410.997.9282			


DESIGNED BY: PJS
 DRAWN BY: AGS/JSN
 PROJECT NO.: DCT11601
 DATE: JUNE 23, 2017
 SCALE: AS SHOWN
 DRAWING NO. 17 OF 43

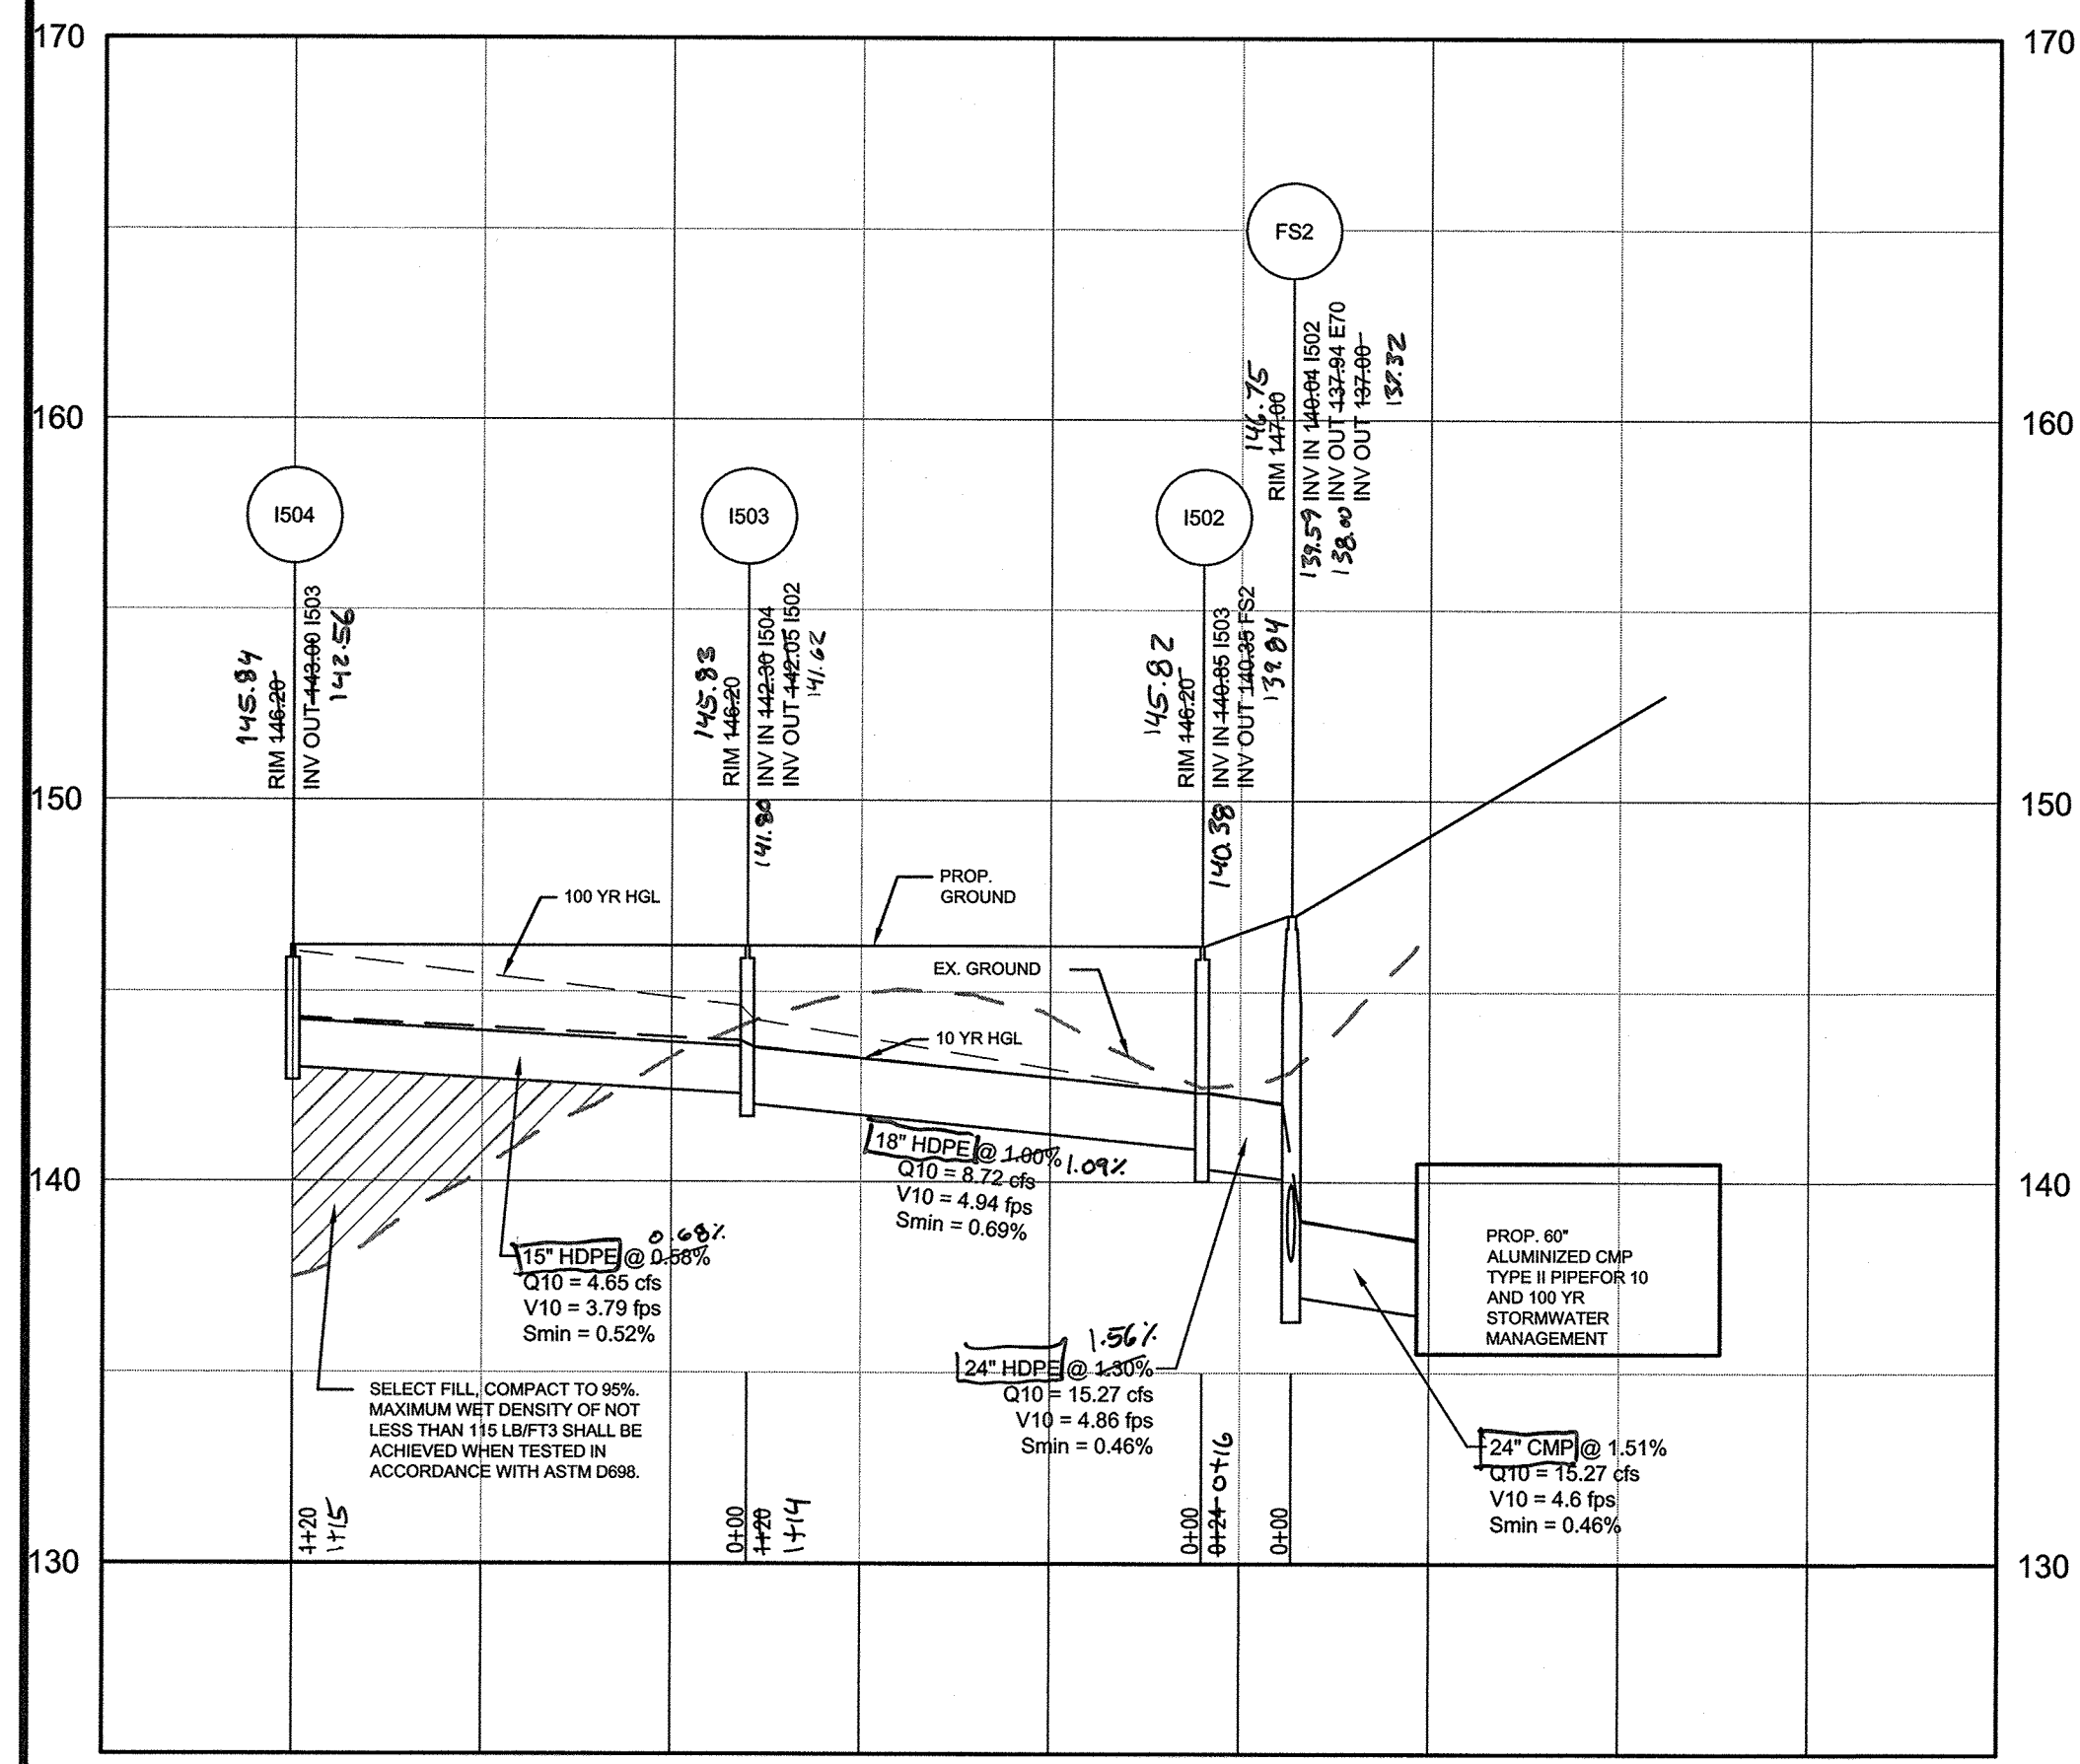


I504 TO FS2
HORIZONTAL SCALE: 1" = 50'
VERTICAL SCALE: 1" = 5'

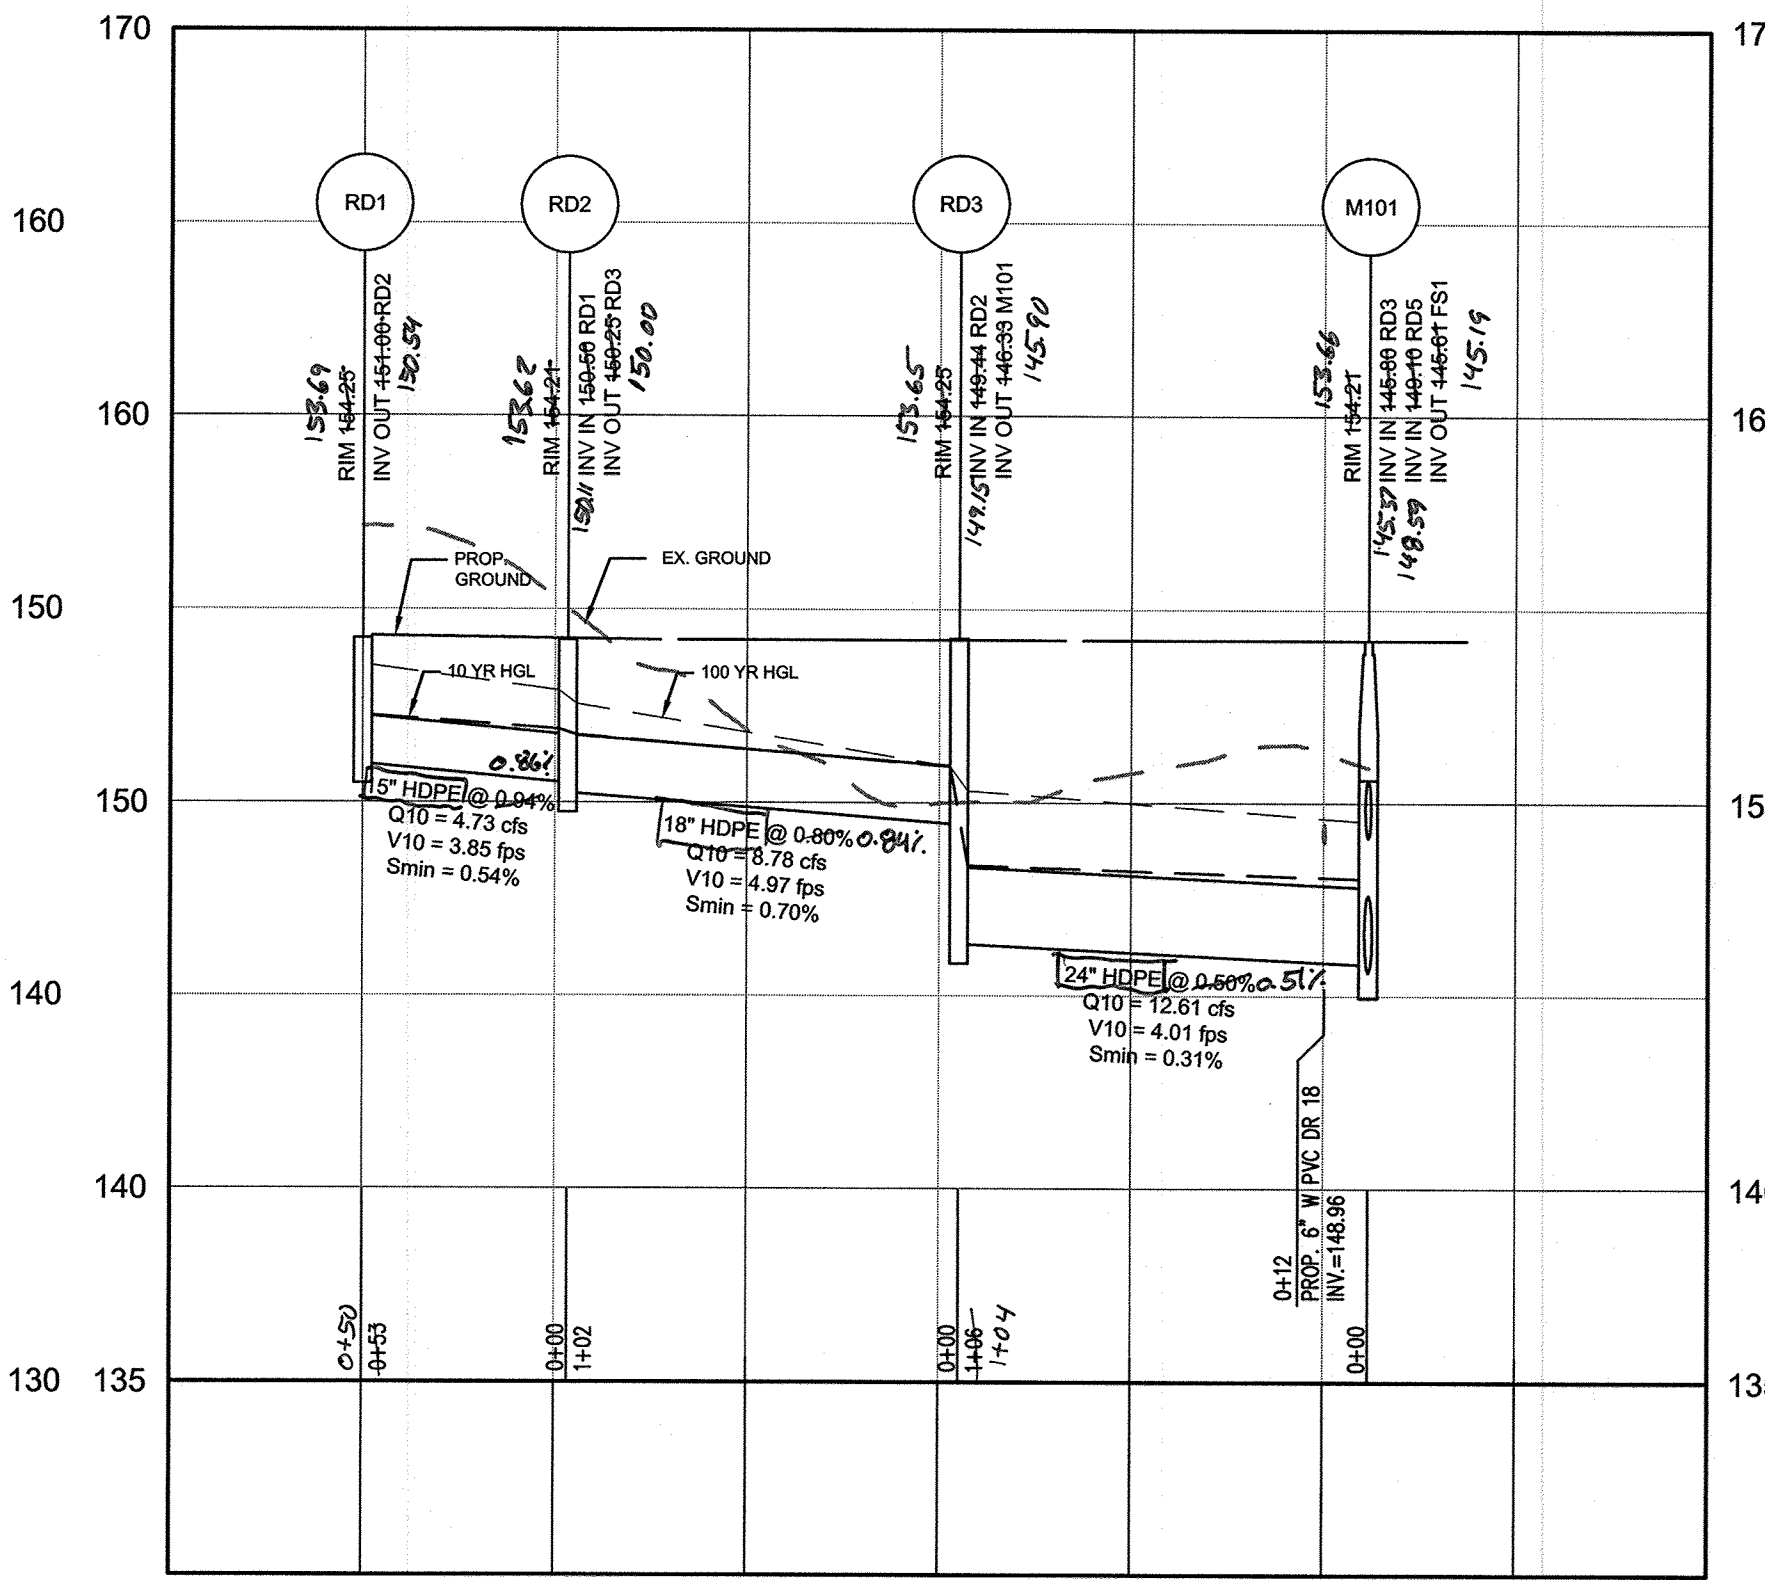


RD1 TO M101
HORIZONTAL SCALE: 1" = 50'
VERTICAL SCALE: 1" = 5'

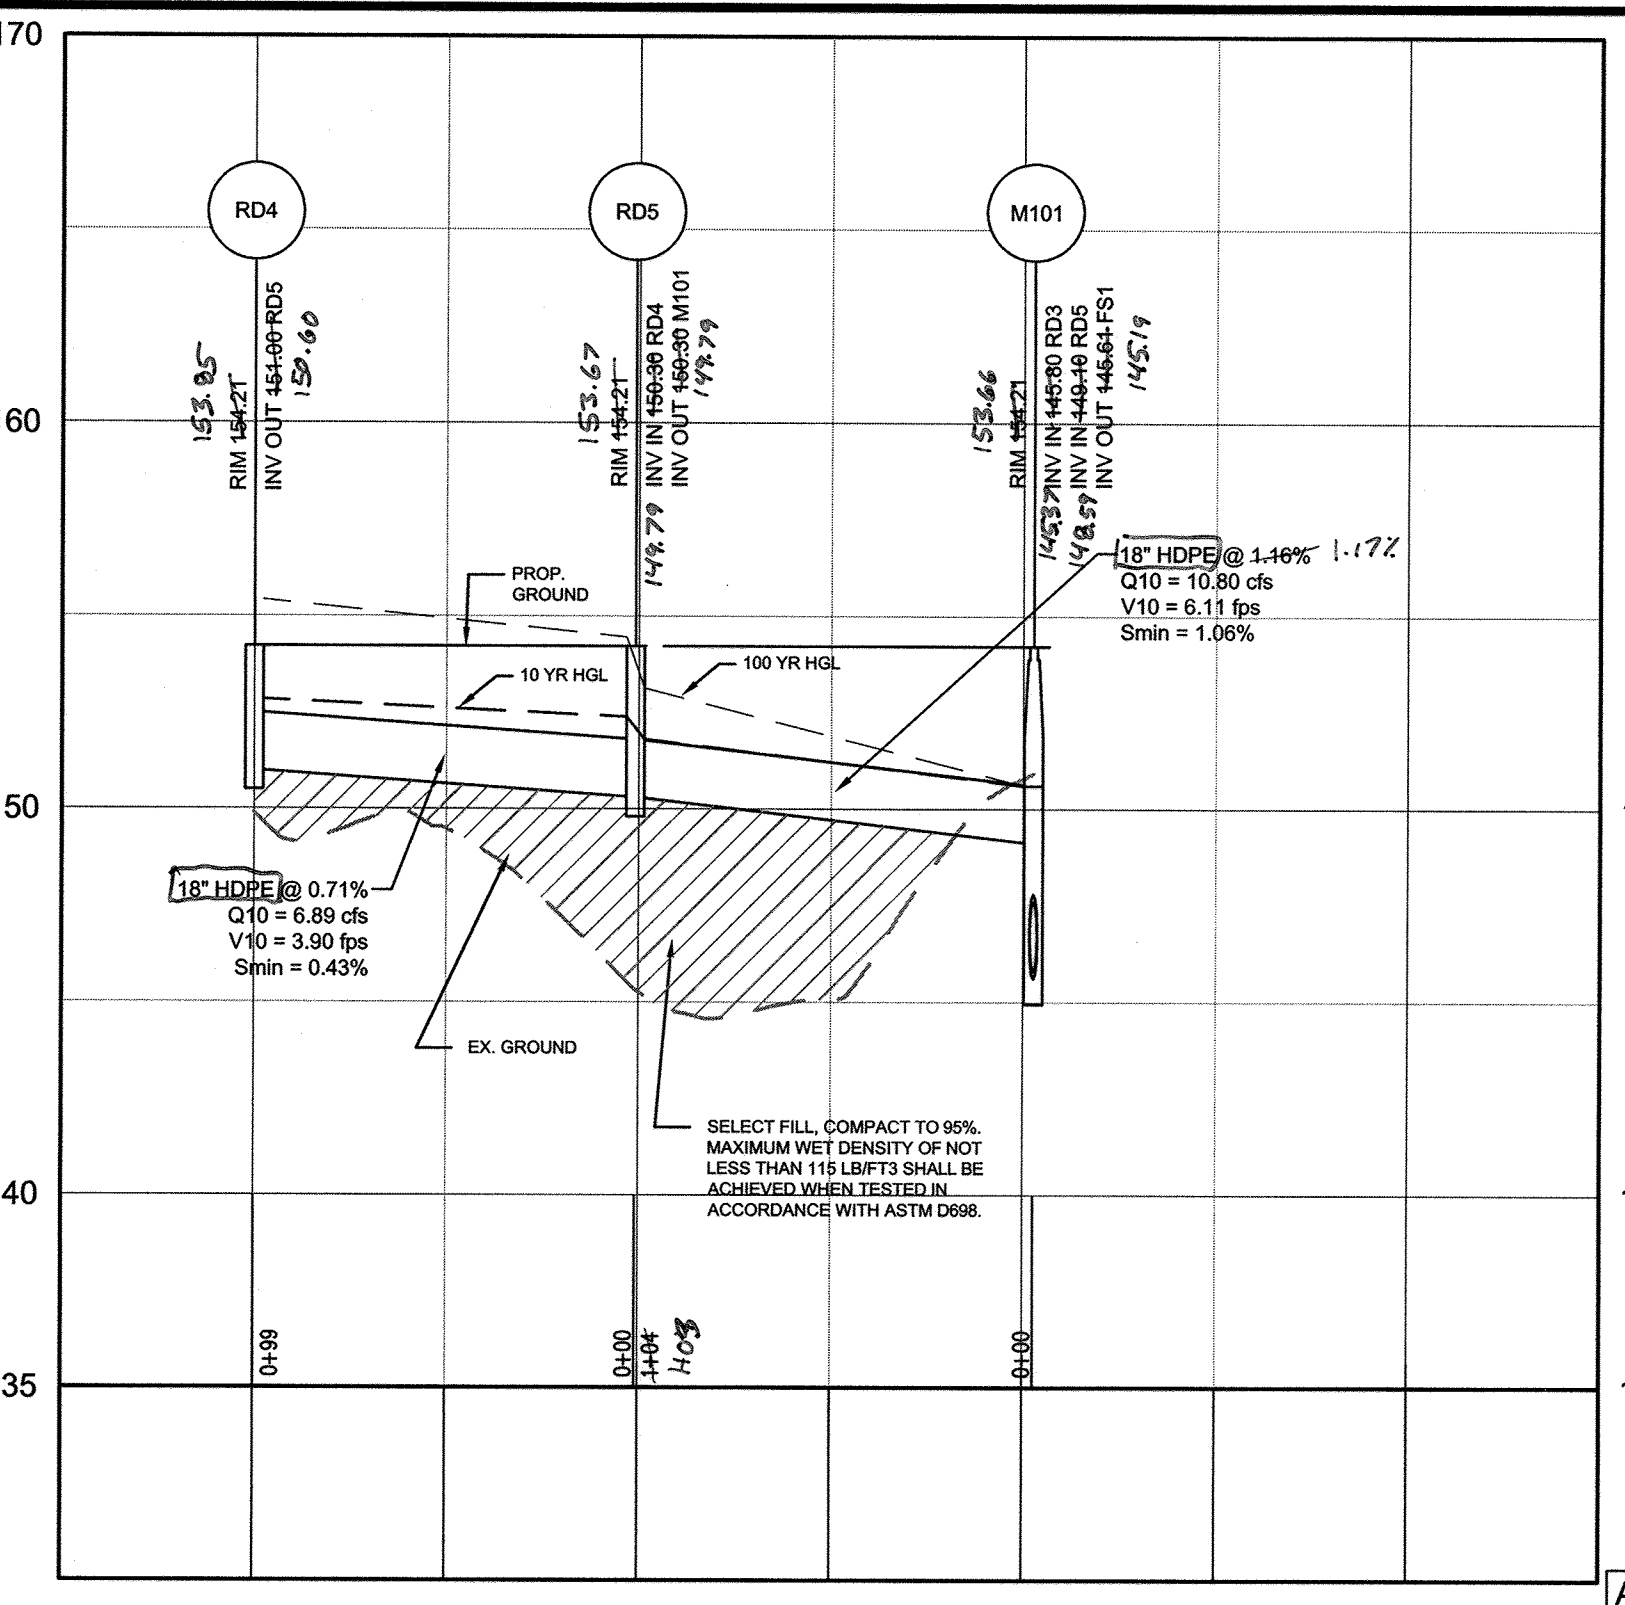


RD4 TO M101
HORIZONTAL SCALE: 1" = 50'
VERTICAL SCALE: 1" = 5'

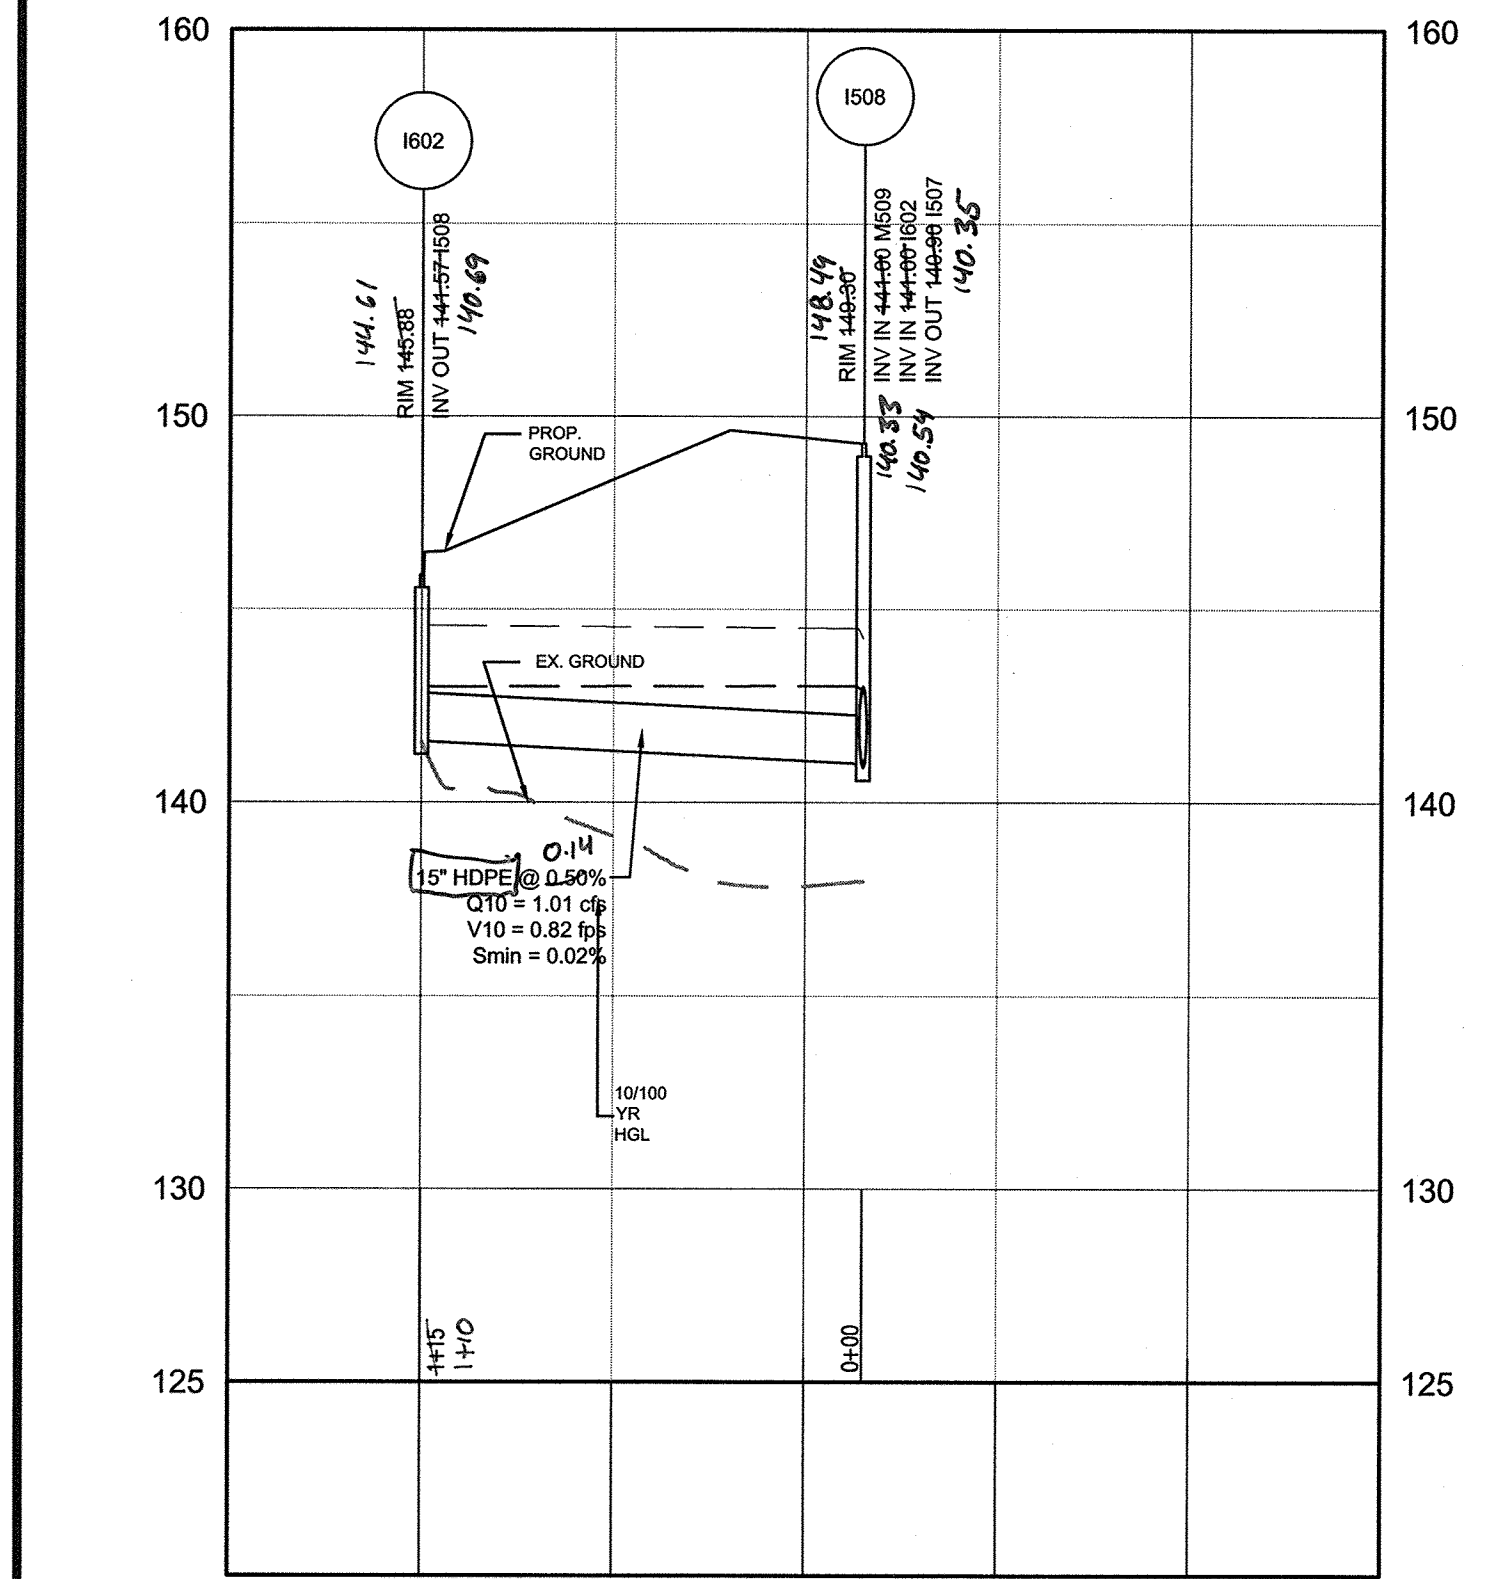

I602 TO E600
HORIZONTAL SCALE: 1" = 50'
VERTICAL SCALE: 1" = 5'

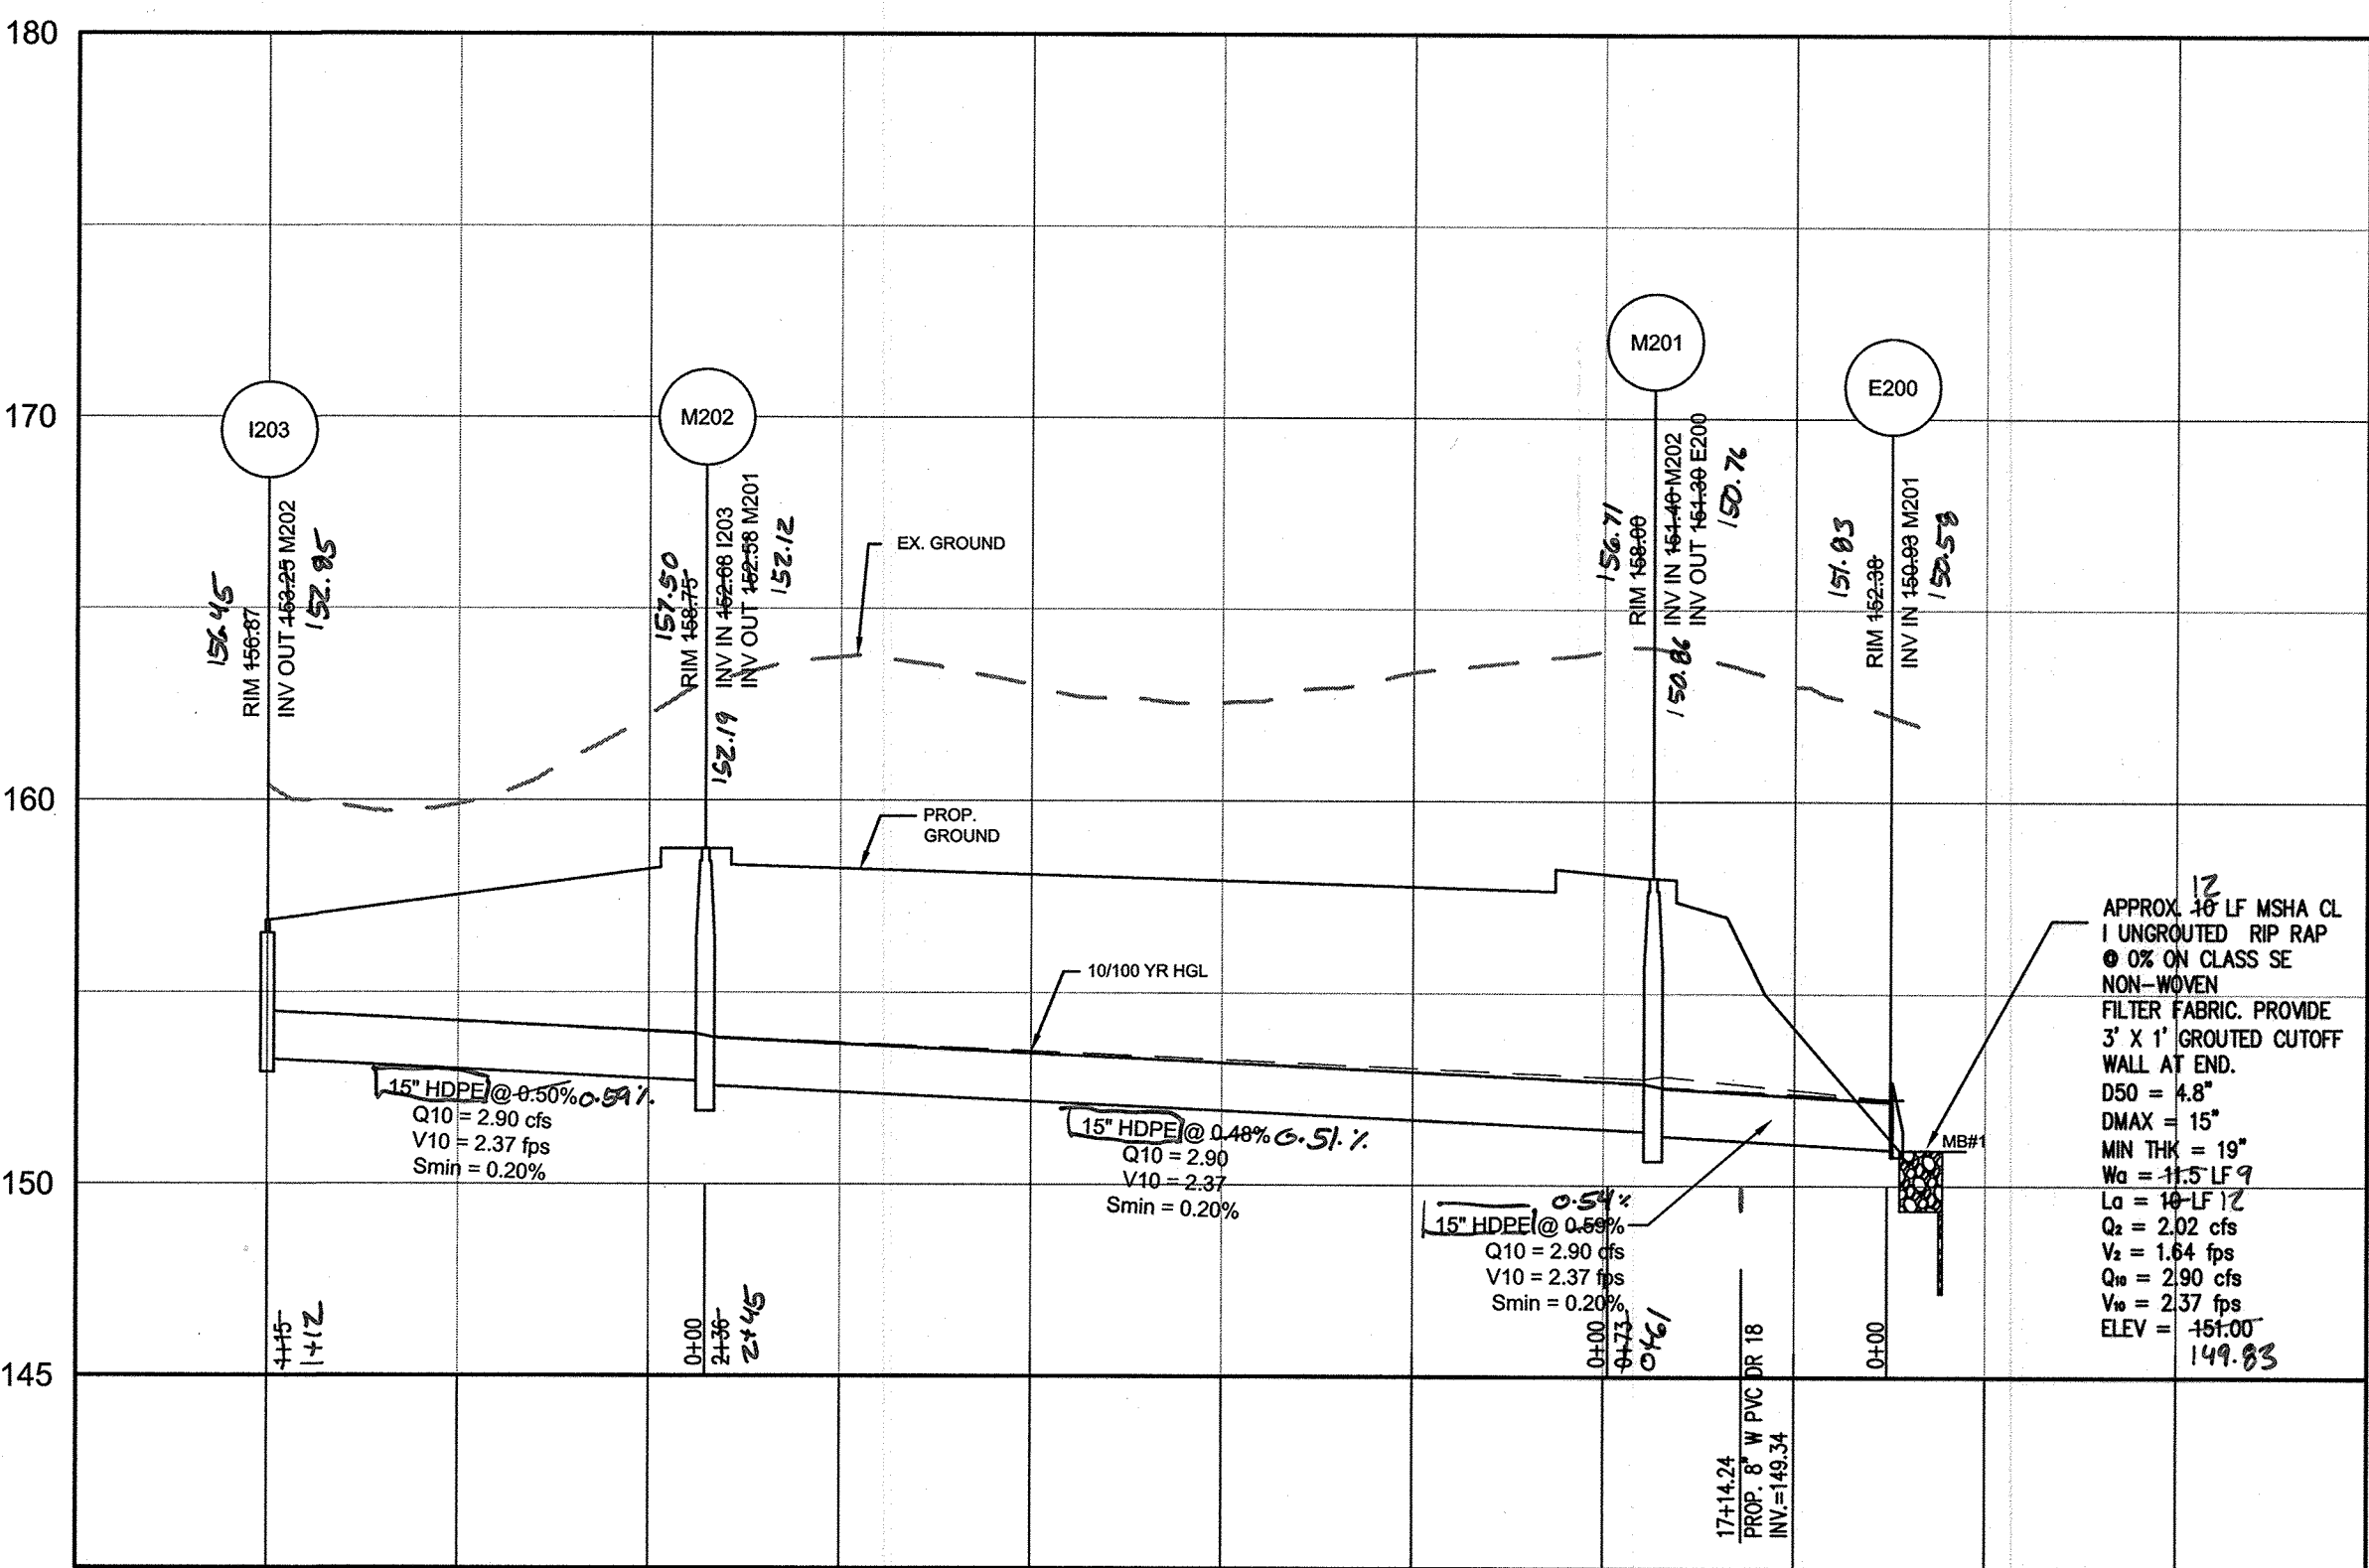

I203 TO E200
HORIZONTAL SCALE: 1" = 50'
VERTICAL SCALE: 1" = 5'

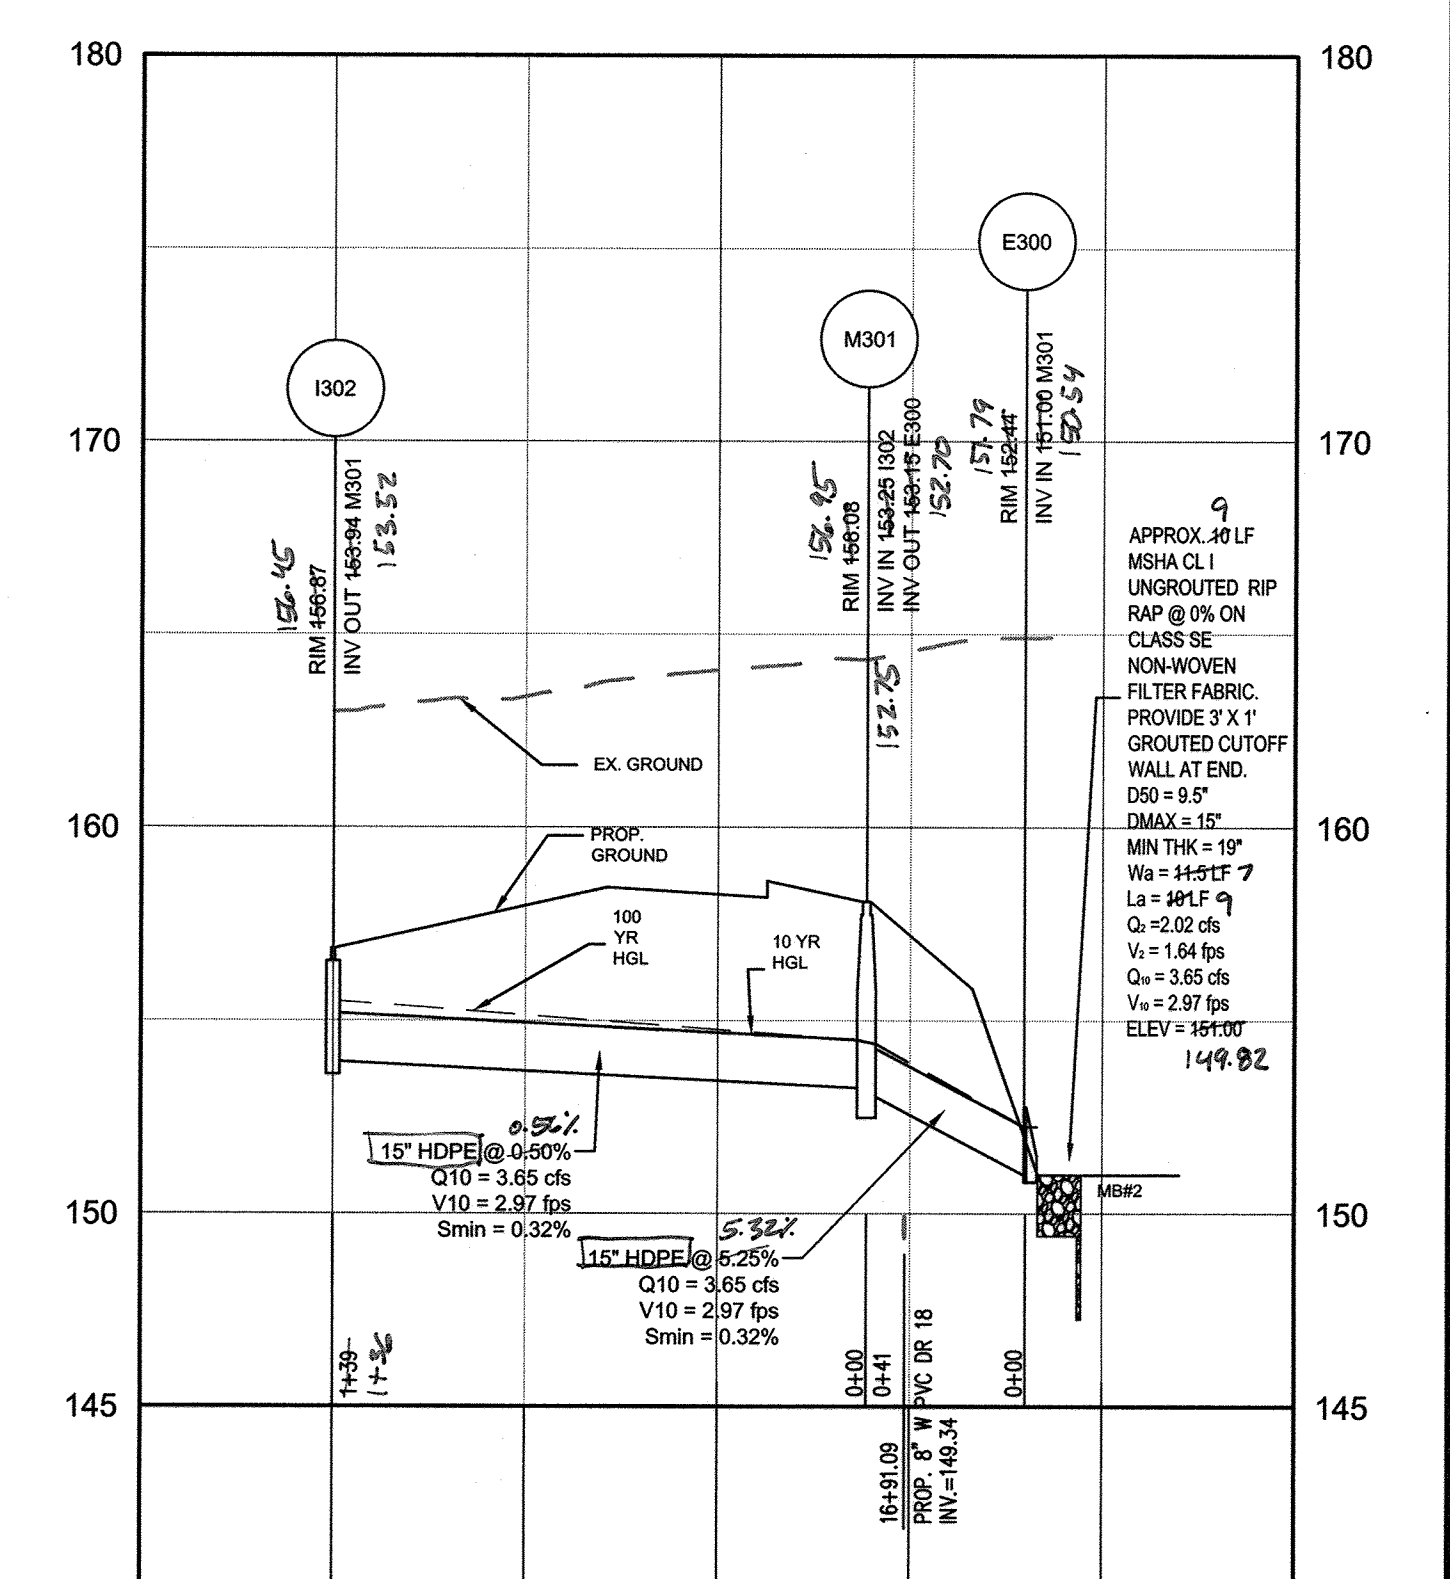

I302 TO E300
HORIZONTAL SCALE: 1" = 50'
VERTICAL SCALE: 1" = 5'

AS-BUILT CERTIFICATION
I HEREBY CERTIFY, BY MY SEAL, THAT TO THE BEST OF MY KNOWLEDGE AND BELIEF THE FACILITIES SHOWN ON THIS PLAN WERE CONSTRUCTED AS SHOWN ON THIS "AS-BUILT" PLAN AND MEET THE APPROVED PLANS AND SPECIFICATIONS.

SIGNATURE OF ENGINEER: *[Signature]* DATE: 7/2/19
 PRINT NAME BELOW SIGNATURE: *[Name]* PE # 36876
 I HEREBY CERTIFY THAT THESE DOCUMENTS WERE PREPARED OR APPROVED BY ME, AND THAT I AM A DULY LICENSED PROFESSIONAL ENGINEER UNDER THE LAWS OF THE STATE OF MARYLAND, LICENSE NO. 36876, EXPIRATION DATE: 8-15-21

APPROVED: DEPARTMENT OF PLANNING AND ZONING

Chief, Development Engineering Division: *[Signature]* DATE: 9-21-17
 Chief, Division of Land Development: *[Signature]* DATE: 9-27-17
 Director: *[Signature]* DATE: 10-2-17

DATE	NO.	REVISION	BY
DEVELOPER: DCT INDUSTRIAL 12011 GUILFORD ROAD SUITE 102 ANNAPOLIS, JUNCTION, MD 20701 ATTN: FRED FERRARO PHONE: 410-645-5020			
OWNER: DCT MEARS LLC 12011 GUILFORD ROAD SUITE 102 ANNAPOLIS, JUNCTION, MD 20701 ATTN: FRED FERRARO PHONE: 410-645-5020			
PROJECT: TERRAPIN COMMERCE CENTER			
AREA: TAX MAP 43, PARCEL 51 LOT PAR A PLAT 23793 ZONED M-2 GRID NO. 11 1st ELECTION DISTRICT 7200 DORSEY RUN ROAD ELKRIDGE, MARYLAND 21075 HOWARD COUNTY, MARYLAND			
TITLE: STORM DRAIN PROFILES AND SCHEDULES AS-BUILT			
Pennoni Associates Inc. Engineers - Surveyors - Planners Landscape Architects 8818 Centre Park Drive, Suite 200 Columbia, MD 21045 T 410.997.8900 F 410.997.9282			

DESIGNED BY: PJS
 DRAWN BY: AGS/JSN
 PROJECT NO: DCT1601
 DATE: JUNE 23, 2017
 SCALE: AS SHOWN
 DRAWING NO. 18 OF 43

STORM DRAIN PIPE SCHEDULE						
ID	INV OUT	INV IN	DIAMETER (in)	MATERIAL	LENGTH (ft)	SLOPE
FS2 TO UG	137.00	136.50	24"	CMP	30'	1.86%
UG TO CS3	136.00	135.90	24"	CMP	35'	0.29%
CS1 TO E80	131.18	131.00	15"	RCP CL IV	25'	0.75%
CS2 TO M62	134.34	133.74	30"	RCP CL IV	120'	0.50%
CS3 TO M62	134.40	134.20	24"	RCP CL IV	37'	0.55%
FS1 TO UG	137.00	136.50	36"	CMP	41'	1.23%
FS1 TO E90	137.00	135.00	18"	HDPE	104'	1.93%
FS2 TO UG	137.00	136.50	24"	CMP	33'	1.51%
FS2 TO E70	137.84	137.00	24"	RCP CL IV	38'	2.45%
I203 TO M202	153.25	152.68	15"	HDPE	115'	0.50%
I302 TO M301	153.94	153.25	15"	HDPE	139'	0.50%
I502 TO FS2	140.35	140.04	24"	HDPE	24'	1.30%
I502 TO I503	140.85	142.05	18"	HDPE	120'	1.00%
I504 TO I503	143.00	142.30	15"	HDPE	120'	0.58%
I507 TO M508	140.10	139.78	24"	HDPE	62'	0.51%
I508 TO I507	140.90	140.30	24"	HDPE	122'	0.49%
I510 TO M509	144.75	143.90	24"	HDPE	77'	1.10%
I511 TO I510	145.80	144.85	24"	HDPE	133'	0.71%
I512 TO I511	147.30	146.30	18"	HDPE	89'	1.13%
I513 TO I512	147.84	147.40	18"	HDPE	32'	1.36%


STORM DRAIN PIPE SCHEDULE						
ID	INV OUT	INV IN	DIAMETER (in)	MATERIAL	LENGTH (ft)	SLOPE
I515 TO M514	149.00	148.73	18"	HDPE	54'	0.50%
I516 TO I515	150.15	149.15	18"	HDPE	201'	0.50%
I517 TO I516	151.50	150.40	25"	HDPE	211'	0.52%
I602 TO I508	141.57	141.00	15"	HDPE	115'	0.50%
M61 TO E60	133.15	133.10	30"	RCP CL IV	10'	0.50%
M62 TO M61	133.61	133.25	30"	RCP CL IV	73'	0.50%
M101 TO FS1	145.61	144.97	24"	HDPE	61'	1.05%
M101 TO RD5	149.10	150.30	18"	HDPE	104'	1.16%
M201 TO E200	151.30	150.93	15"	HDPE	62'	0.59%
M202 TO M201	152.58	151.40	15"	HDPE	248'	0.48%
M301 TO E300	153.15	151.00	15"	HDPE	41'	5.25%
M506 TO UG	139.00	138.74	24"	CMP	26'	1.00%
M509 TO I508	141.84	141.00	24"	HDPE	159'	0.53%
M514 TO I513	148.63	147.94	18"	HDPE	101'	0.69%
RD1 TO RD2	151.00	150.50	15"	HDPE	53'	0.94%
RD2 TO RD3	150.25	149.44	18"	HDPE	102'	0.80%
RD3 TO M101	146.33	145.80	24"	HDPE	106'	0.50%
RD5 TO RD4	150.30	151.00	18"	HDPE	99'	0.71%

WATER/SEWER PIPE SCHEDULE		
SIZE	TYPE	LINEAR FOOTAGE
8"	PVC SDR-35	117
8"	C900 PVC	25


STORM DRAIN PIPE SCHEDULE		
SIZE	TYPE	LINEAR FOOTAGE
6"	PVC	30
6"	PERFORATED PVC	200
4"	PERFORATED PVC	167
15"	RCP CL IV	18
24"	RCP CL IV	75
30"	RCP CL IV	203
15"	HDPE	1,112
18"	HDPE	901
24"	HDPE	744
60"	ALUMINIZED CMP - 10 GAUGE	3,465
24"	ALUMINIZED CMP - 10 GAUGE	124
36"	ALUMINIZED CMP - 10 GAUGE	41

NOTES:


- 1) ALL STRUCTURES ARE HOWARD COUNTY STANDARDS UNLESS NOTED OTHERWISE. CONTRACTOR MAY USE PRECAST STRUCTURE WHERE AVAILABLE TO MEET THE STANDARD STRUCTURE SPECIFIED.
- 2) STATIONS ARE GIVEN TO CENTER OF STRUCTURE AT FACE OF CURB FOR CURB INLETS AND TO CENTER OF STRUCTURE FOR ALL OTHER STRUCTURES.
- 3) ELEVATIONS ARE GIVEN TO TOP OF CURB FOR CURB INLETS, TOP OF GRATE FOR GRATE INLETS AND TOP OF LID FOR MANHOLES.
- 4) PIPE LENGTHS ARE GIVEN TO THE CENTER OF THE STRUCTURE. CONTRACTOR SHALL ADJUST LENGTH TO OBTAIN ACTUAL PIPE LENGTHS.
- 5) ALL CLEANOUTS LOCATED IN PAVEMENT AREAS SHALL BE TRAFFIC BEARING.
- 6) THE PIPE SCHEDULE IS GIVEN FOR REFERENCE. IN THE EVENT OF A DISCREPANCY BETWEEN THE PIPE SCHEDULE AND THE PLAN, THE INFORMATION ON THE PLAN SHALL TAKE PRIORITY.

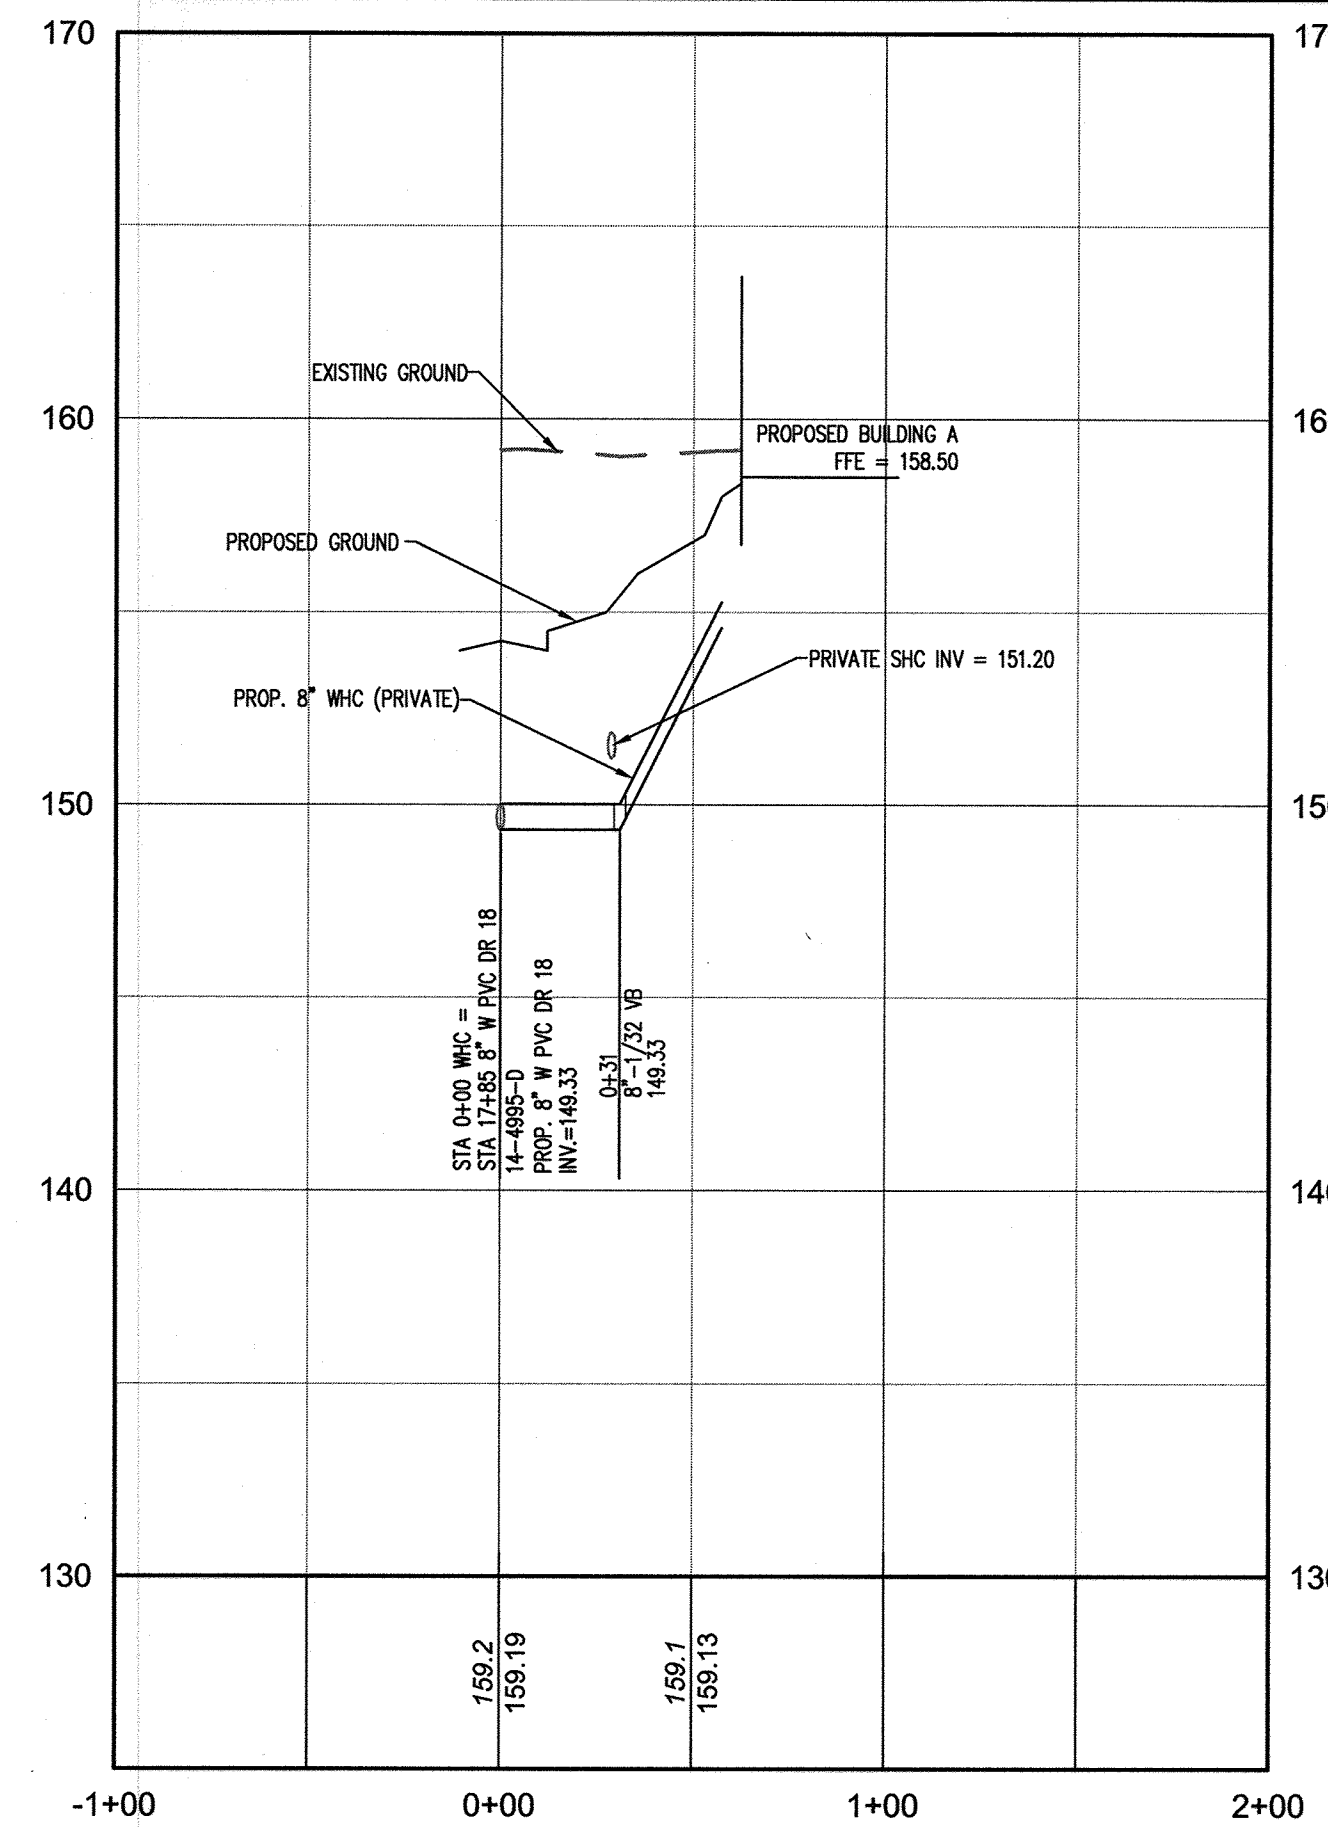

WATER HOUSE CONNECTION
HORIZONTAL SCALE: 1" = 50'
VERTICAL SCALE: 1" = 5'

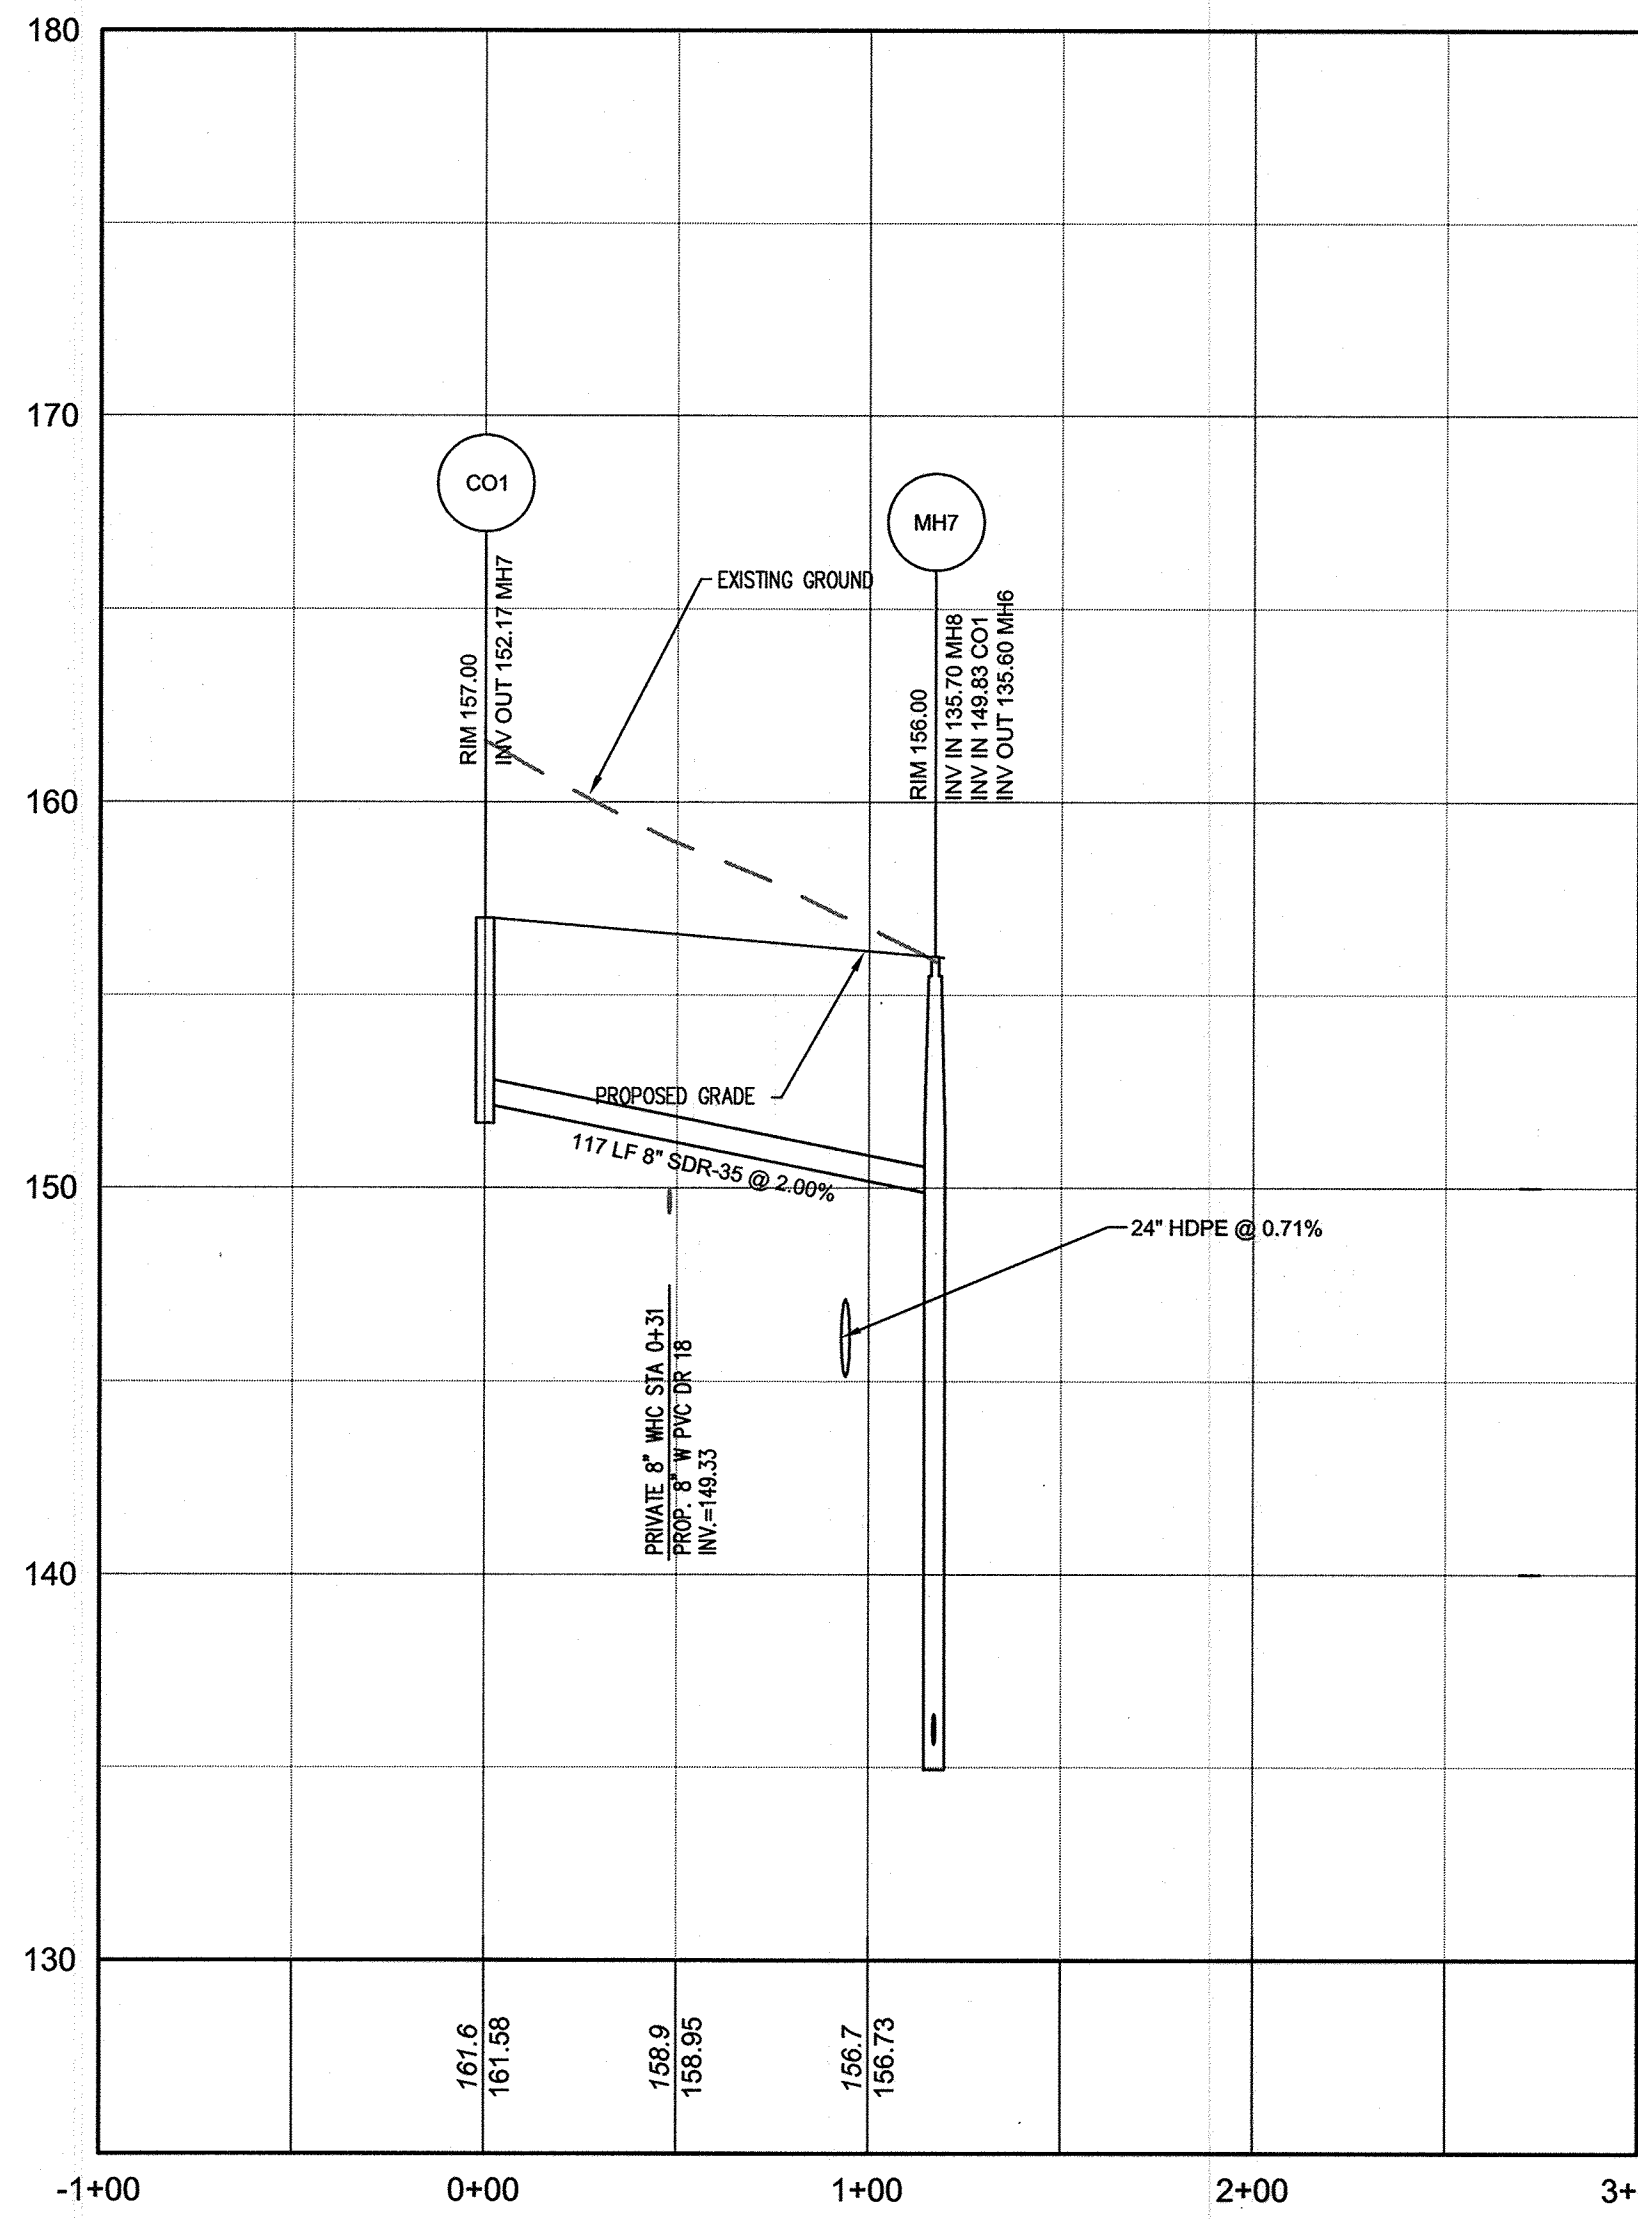

PRIVATE SEWER
HORIZONTAL SCALE: 1" = 50'
VERTICAL SCALE: 1" = 5'

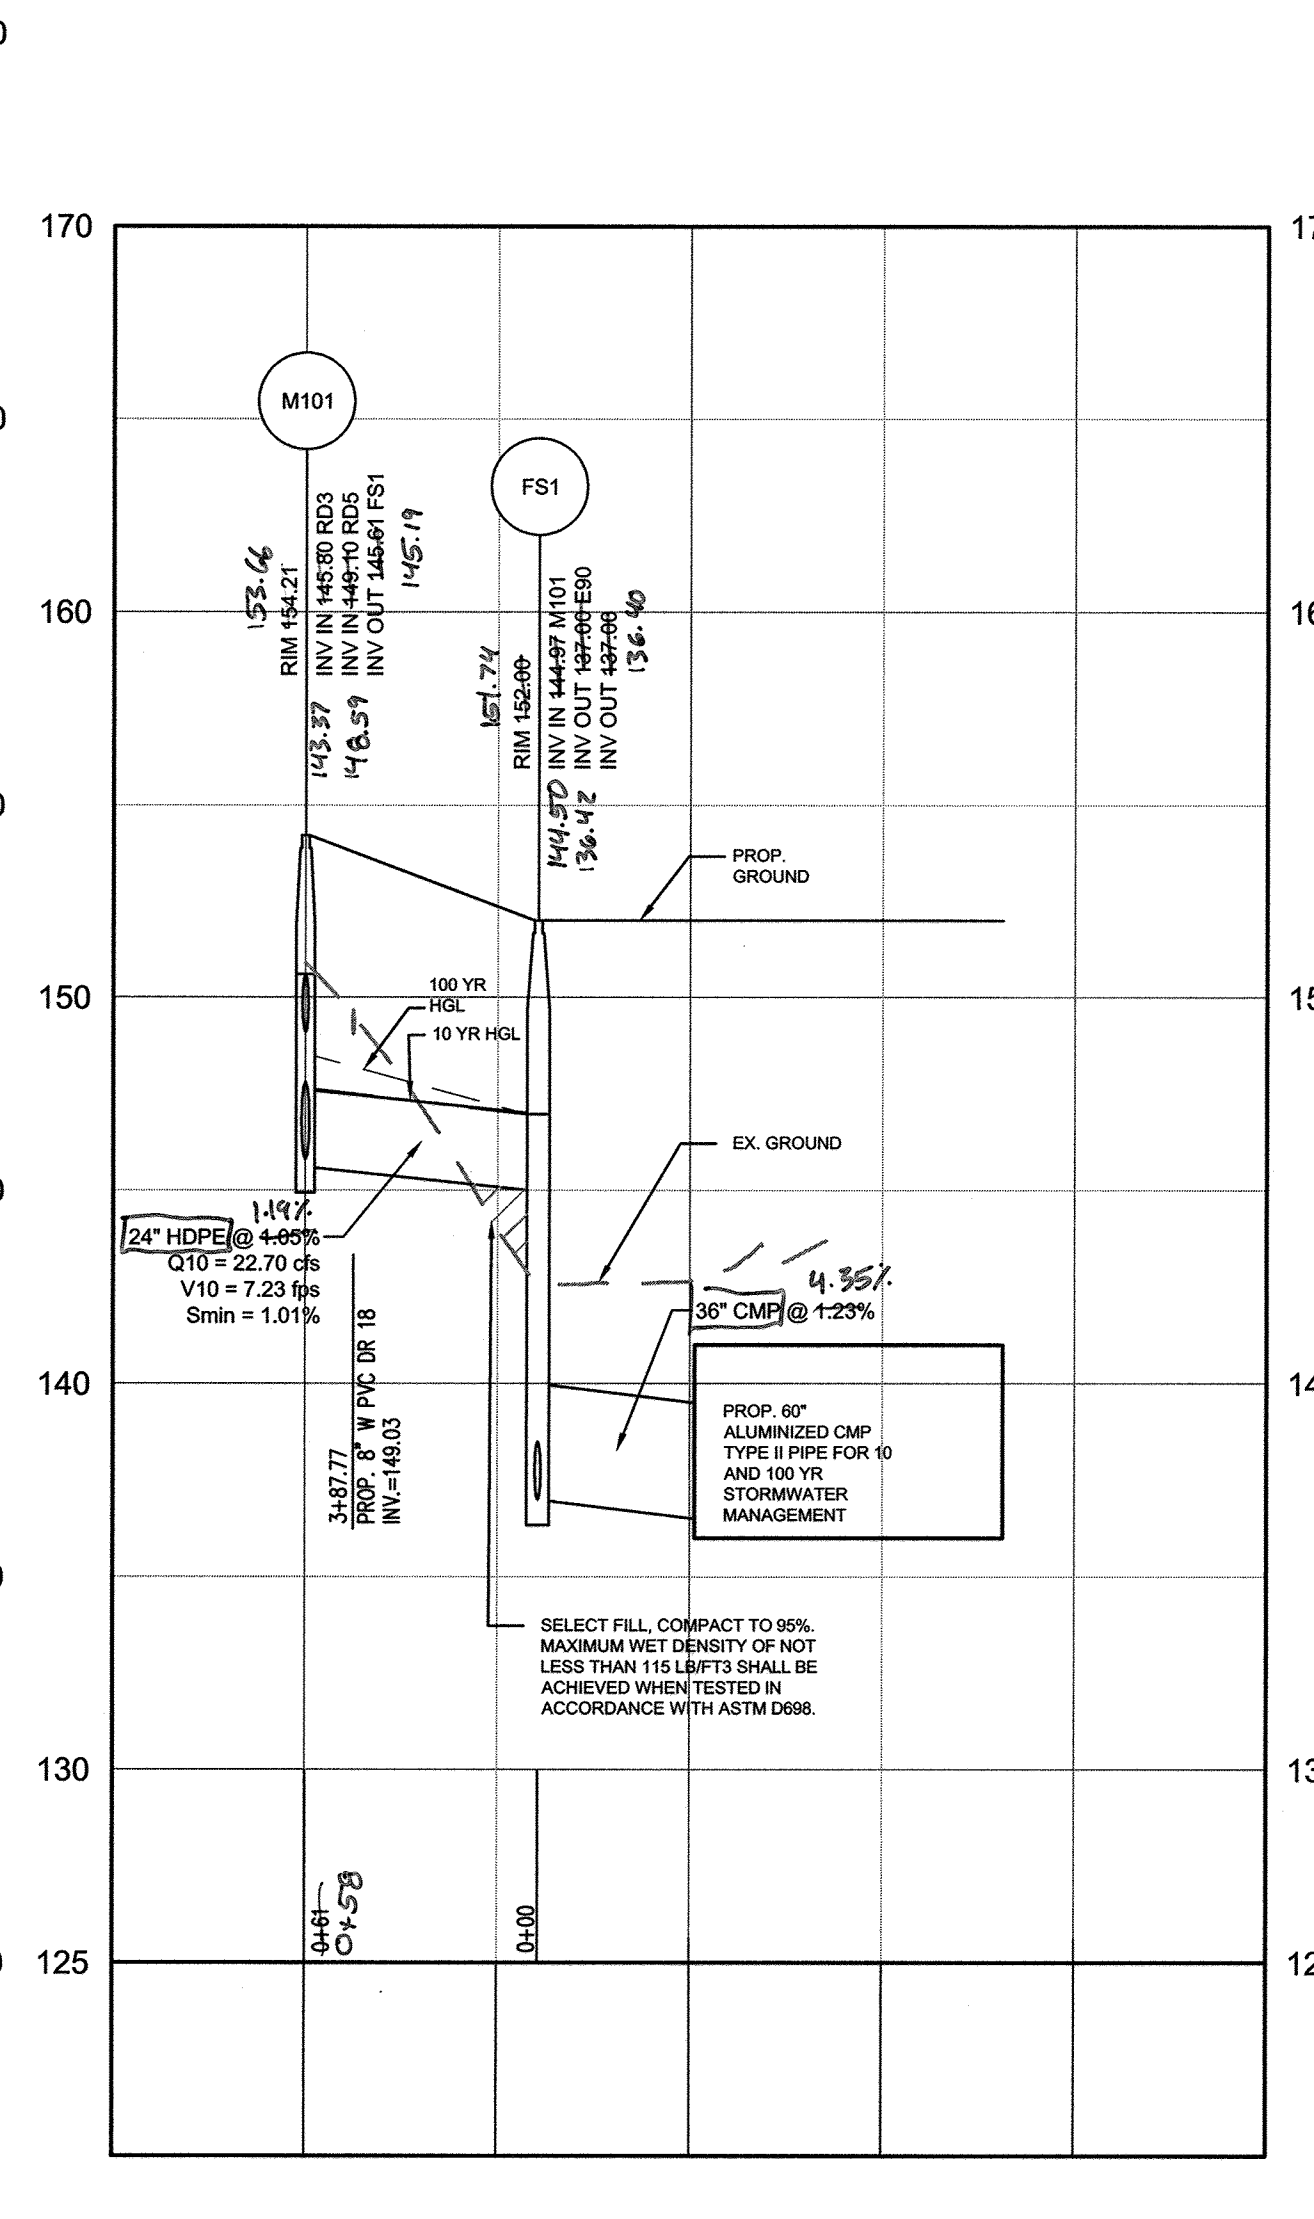

M101 TO UG SWM 3+00
HORIZONTAL SCALE: 1" = 50'
VERTICAL SCALE: 1" = 5'

NYLOPLAST DRAIN BASIN WITH STANDARD GRATE

(1, 2) INTEGRATED DUCTILE IRON FRAME & GRATE TO MATCH BASIN O.D.

(3) VARIABLE INVERT HEIGHTS AVAILABLE (ACCORDING TO PLANS/TAKE OFF)

(4) VARIOUS TYPES OF INLET & OUTLET ADAPTERS AVAILABLE: 4" - 30" FOR CORRUGATED HDPE (ADS IN 2-HANDED DUAL WALL, ADS-HANDED SINGLE WALL), 1/2-12 HP, PVC SEWER (EX: SDR 35), PVC DWV (EX: SCH 40), PVC C900/C905, CORRUGATED & RIBBED PVC

(5) ADAPTER ANGLES VARIABLE 0° - 360° ACCORDING TO PLANS

(6, 7) TRAFFIC LOADS: CONCRETE SLAB DIMENSIONS ARE FOR GUIDELINE PURPOSES ONLY. ACTUAL CONCRETE SLAB MUST BE DESIGNED TAKING INTO CONSIDERATION LOCAL SOIL CONDITIONS, TRAFFIC LOADING, & OTHER APPLICABLE DESIGN FACTORS. SEE DRAWING NO. 7001-110-111 FOR NON TRAFFIC INSTALLATION.

(8) VARIABLE SUMP DEPTH ACCORDING TO PLANS (6" MIN. ON 8" x 24", 10" MIN. ON 30" BASED ON MANUFACTURING REQ.)

THE BACKFILL MATERIAL SHALL BE CRUSHED STONE OR OTHER GRANULAR MATERIAL MEETING THE REQUIREMENTS OF CLASS I OR CLASS II MATERIAL, AS DEFINED IN ASTM D2221. BEDDING & BACKFILL FOR SURFACE DRAINAGE INLETS SHALL BE WELL PLACED & COMPACTED UNIFORMLY IN ACCORDANCE WITH ASTM D2221.

1 - 8" x 30" STANDARD GRATES SHALL BE DUCTILE IRON PER ASTM A536 GRADE 704046.

2 - 12" x 30" FRAMES SHALL BE DUCTILE IRON PER ASTM A536 GRADE 704046. 8" & 10" STANDARD GRATES FIT DIRECTLY ONTO DRAIN BASIN WITH THE USE OF A PVC BODY TOP. SEE DRAWING NO. 7001-110-110.

3 - DRAIN BASIN TO BE CUSTOM MANUFACTURED ACCORDING TO PLAN DETAILS. RISERS ARE REQUIRED FOR BASINS OVER 84" DUE TO SHIPPING RESTRICTIONS. SEE DRAWING NO. 7001-110-110.

4 - DRAINAGE CONNECTION STUB JOINT TIGHTNESS SHALL CONFORM TO ASTM D2221 FOR CORRUGATED HDPE (ADS IN 2-HANDED DUAL WALL), 1/2-12 HP, & PVC SEWER 1/2" - 24".

5 - ADAPTERS CAN BE MOUNTED ON ANY ANGLE 0° TO 360°. TO DETERMINE MINIMUM ANGLE BETWEEN ADAPTERS SEE DRAWING NO. 7001-110-112.

6 - 12" x 30" STANDARD GRATES SHALL MEET #40 LOAD RATING.

7 - IF A 10" STANDARD GRATE IS RATED FOR LIGHT DUTY APPLICATIONS, ONLY NO CONCRETE COLLAR IS NEEDED FOR LIGHT DUTY RATING.

THIS PRINT ENCLOSURE SUBJECT MATTER IN WHICH NYLOPLAST HAS PROPRIETARY RIGHTS. THE RECEIPT OR POSSESSION OF THIS PRINT DOES NOT CONFER, TRANSFER, OR LICENSE THE USE OF THE DESIGN OR TECHNICAL INFORMATION SHOWN HEREIN. REPRODUCTION OF THIS PRINT OR ANY INFORMATION CONTAINED HEREIN, OR MANUFACTURE OF ANY ARTICLE HEREFROM FOR THE ENCLOSURE TO OTHERS IS FORBIDDEN, EXCEPT BY SPECIFIC WRITTEN PERMISSION FROM NYLOPLAST.

DESIGNED BY: EBC
DATE: 1-23-06
REVIEWED BY: CCA
DATE: 12-29-11
DWG SIZE: A
SCALE: 1/4" = 1'-0"
SHEET: 1 OF 1
DWG NO.: 7001-110-144
REV: G

Nyloplast
3130 VERONA AVE
BURLINGTON, MA 01803
PHONE: (781) 322-2440
FAX: (781) 322-2409
WWW.NYLOPLAST.COM

TITLE: DRAIN BASIN WITH STANDARD GRATE
QUICK SPEC INSTALLATION DETAIL

AS-BUILT CERTIFICATION
I HEREBY CERTIFY, BY MY SEAL, THAT TO THE BEST OF MY KNOWLEDGE AND BELIEF THE FACILITIES SHOWN ON THIS PLAN WERE CONSTRUCTED AS SHOWN ON THIS "AS-BUILT" PLAN AND MEET THE APPROVED PLANS AND SPECIFICATIONS.

SIGNATURE OF ENGINEER: *Shawn K. Cruz*
DATE: 7/8/19
PE # 36896

STATE OF MARYLAND PROFESSIONAL ENGINEER
NO. 38950 EXPIRATION DATE: 2-15-21

APPROVED: DEPARTMENT OF PLANNING AND ZONING

Shawn K. Cruz 9-21-17
CHIEF, DEVELOPMENT ENGINEERING DIVISION DATE

Walter J. Jaffe 9-28-17
CHIEF, DIVISION OF LAND DEVELOPMENT DATE

Walter J. Jaffe 10-2-17
DIRECTOR DATE

DATE	NO.	REVISION	BY

DEVELOPER: DCT INDUSTRIAL
12011 GUILFORD ROAD
SUITE 102
ANNAPOLIS JUNCTION, MD 20701
ATTN: FRED FERRARO
PHONE: 410-645-5020

OWNER: DCT MEARS LLC
12011 GUILFORD ROAD
SUITE 102
ANNAPOLIS JUNCTION, MD 20701
ATTN: FRED FERRARO
PHONE: 410-645-5020

PROJECT: TERRAPIN COMMERCE CENTER

AREA: TAX MAP 43, PARCEL 51 LOT PAR A PLAT 23793 ZONED M-2
GRID NO. 11 1st ELECTION DISTRICT
7200 DORSEY RUN ROAD
ELKDRIDGE, MARYLAND 21075
HOWARD COUNTY, MARYLAND


TITLE: PRIVATE UTILITY PROFILES AND SCHEDULES AS-BUILT

Pennoni Associates Inc.
Engineers • Surveyors • Planners
Landscape Architects

8818 Centre Park Drive, Suite 200 Columbia, MD 21045
T 410.997.8900 F 410.997.9282

DESIGNED BY: PJS
DRAWN BY: AGS/JSN
PROJECT NO.: DCT11601
DATE: JUNE 23, 2017
SCALE: AS SHOWN
DRAWING NO. 19 OF 43

BY: *Shawn K. Cruz*
STATE OF MARYLAND PROFESSIONAL ENGINEER UNDER THE LAWS OF THE STATE OF MARYLAND, LICENSE NO. 36896, EXPIRES 2-15-21

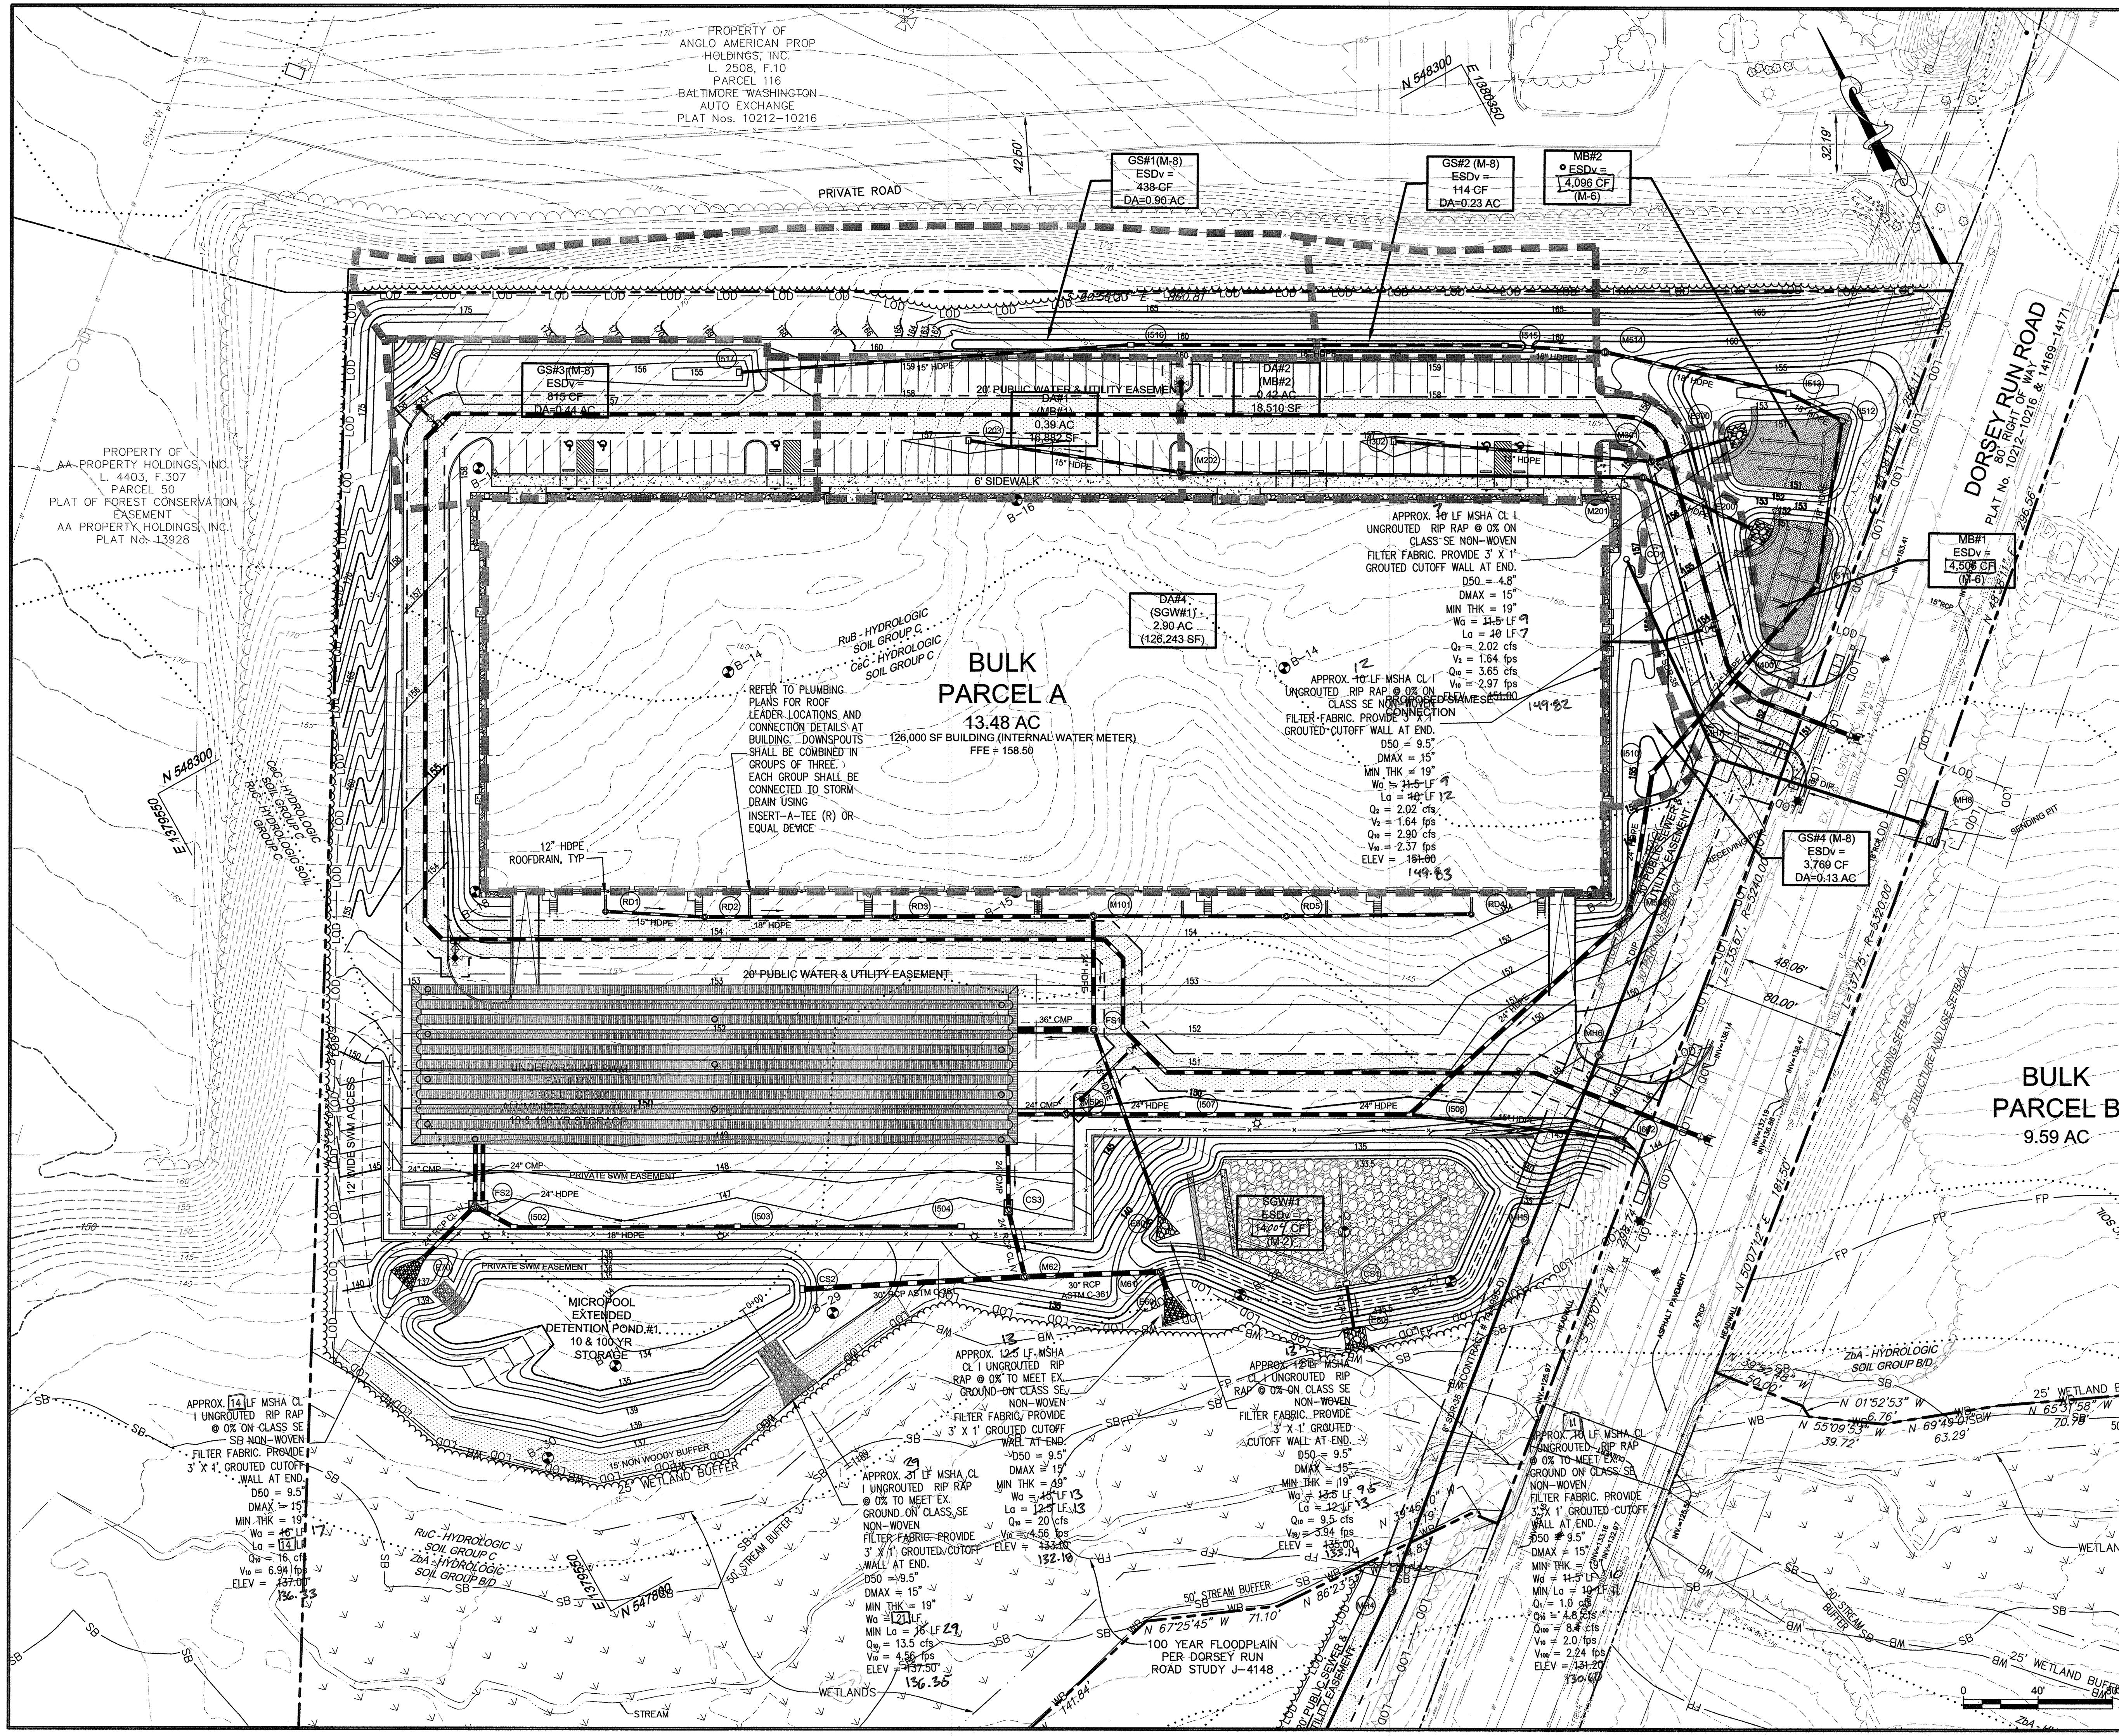

LEGEND

PROPERTY LINE AND RIGHT-OF-WAY	---
EXISTING 1' CONTOUR	-----
EXISTING 5' CONTOUR	-----
EXISTING TREE LINE	~ ~ ~ ~ ~
EXISTING SOILS
EXISTING WATER	~~~~~
EXISTING SEWER	---S---
EXISTING OVERHEAD ELECTRICAL	---O---
EXISTING UNDERGROUND ELECTRICAL	---U---
EXISTING STORM DRAIN	---D---
EXISTING STREAM	~~~~~
PROPOSED 1' CONTOUR	-----
PROPOSED 5' CONTOUR	-----
PROPOSED MICRO-BIORETENTION FACILITY	[Symbol]
PROPOSED STORM DRAIN	---D---
PROPOSED WATER	~~~~~
PROP. CONCRETE SIDEWALK	[Symbol]
PROPOSED TREE LINE	~ ~ ~ ~ ~
SOIL BORING	⊙ B-14
DRAINAGE AREA	---DA---

AS-BUILT CERTIFICATION
 I HEREBY CERTIFY, BY MY SEAL, THAT TO THE BEST OF MY KNOWLEDGE AND BELIEF THE FACILITIES SHOWN ON THIS PLAN WERE CONSTRUCTED AS SHOWN ON THIS "AS-BUILT" PLAN AND MEET THE APPROVED PLANS AND SPECIFICATIONS.

STATE OF MARYLAND
 PROFESSIONAL ENGINEER
 No. 36896
 DATE: 7/19/19
 SIGNATURE OF ENGINEER: [Signature]
 DATE: 3/6/19

APPROVED: DEPARTMENT OF PLANNING AND ZONING

DATE: 9-21-17
 DATE: 9-27-17
 DATE: 10-2-17

DATE	NO.	REVISION	BY
		DCT INDUSTRIAL	
		12011 GUILFORD ROAD	
		SUITE 102	
		ANNAPOLIS JUNCTION, MD 20701	
		ATTN: FRED FERRARO	
		PHONE: 410-645-5020	

OWNER: DCT MEARS LLC
 12011 GUILFORD ROAD
 SUITE 102
 ANNAPOLIS JUNCTION, MD 20701
 PHONE: 410-645-5020

PROJECT: **TERRAPIN COMMERCE CENTER**

AREA: TAX MAP 43, PARCEL 51 LOT PAR A PLAT 23793 ZONED M-2
 GRID NO. 11 1st ELECTION DISTRICT
 7200 DORSEY RUN ROAD
 ELK RIDGE, MARYLAND 21075
 HOWARD COUNTY, MARYLAND


TITLE: **STORMWATER MANAGEMENT PLAN AS-BUILT**

Pennoni Associates Inc.
 Engineers - Surveyors - Planners
 Landscape Architects

8818 Centre Park Drive, Suite 200 Columbia, MD 21045
 T 410.997.8900 F 410.997.9282

DESIGNED BY: PJS
DRAWN BY: AGS/JSN
PROJECT NO: DCT11601
DATE: JUNE 23, 2017
SCALE: 1" = 40'
DRAWING NO. 20 OF 43


SDP-17-030

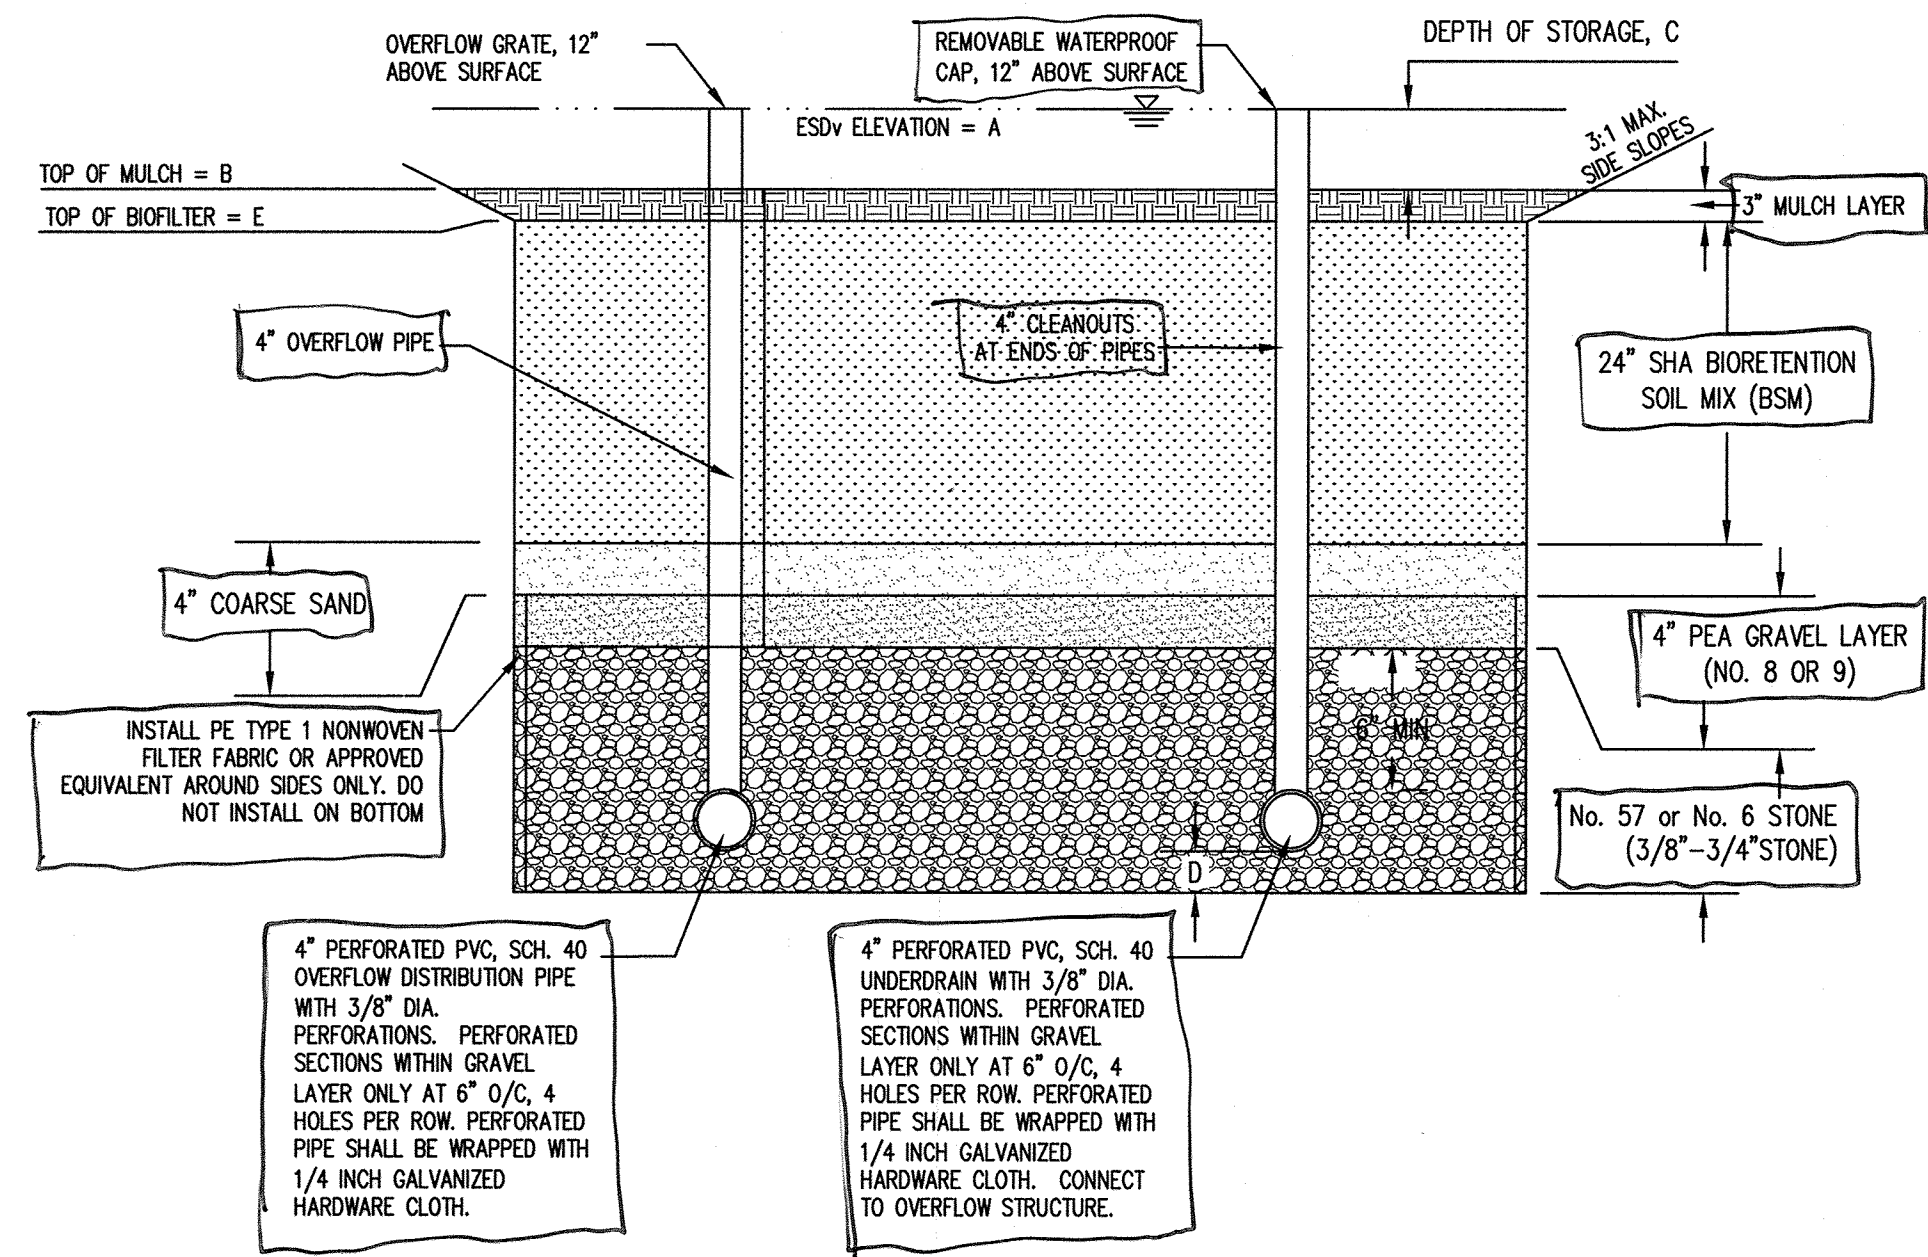


1 MICROBIORETENTION TYPICAL SECTION
21 NOT TO SCALE

OPERATION AND MAINTENANCE SCHEDULE FOR MICRO-BIORETENTION (M-6)

- ANNUAL MAINTENANCE OF PLANT MATERIAL, MULCH LAYER AND SOIL LAYER IS REQUIRED. MAINTENANCE OF MULCH AND SOIL IS LIMITED TO CORRECTING AREAS OF EROSION OR WASH OUT. ANY MULCH REPLACEMENT SHALL BE DONE IN THE SPRING. PLANT MATERIAL SHALL BE CHECKED FOR DISEASE AND INSECT INFESTATION AND MAINTENANCE WILL ADDRESS DEAD MATERIAL AND PRUNING. ACCEPTABLE REPLACEMENT PLANT MATERIAL IS LIMITED TO THE FOLLOWING: 2000 MARYLAND STORMWATER DESIGN MANUAL VOLUME II, TABLE A.4.1 AND 2.
- SCHEDULE OF PLANT INSPECTION WILL BE TWICE A YEAR IN SPRING AND FALL. THIS INSPECTION WILL INCLUDE REMOVAL OF DEAD AND DISEASED VEGETATION CONSIDERED BEYOND TREATMENT, TREATMENT OF ALL DISEASED TREES AND SHRUBS AND REPLACEMENT OF ALL DEFICIENT STAKES AND WIRES.
- MULCH SHALL BE INSPECTED EACH SPRING. REMOVE PREVIOUS MULCH LAYER BEFORE APPLYING NEW LAYER ONCE EVERY 2 TO 3 YEARS.
- SOIL EROSION TO BE ADDRESSED ON AN AS NEEDED BASIS, WITH A MINIMUM OF ONCE PER MONTH AND AFTER HEAVY STORM EVENTS.

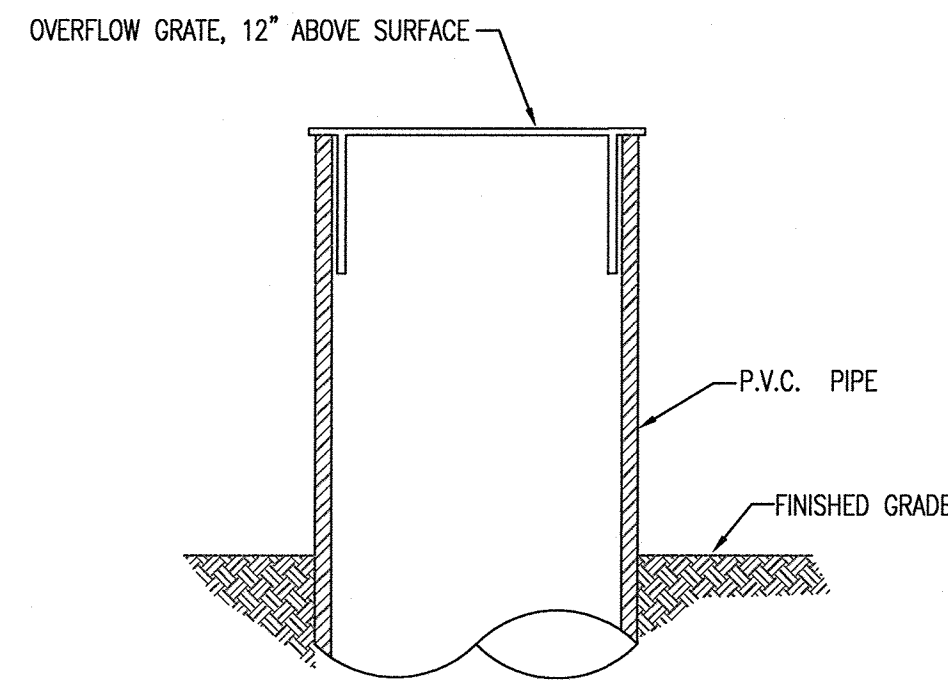

7 OVERFLOW GRATE
21 NOT TO SCALE

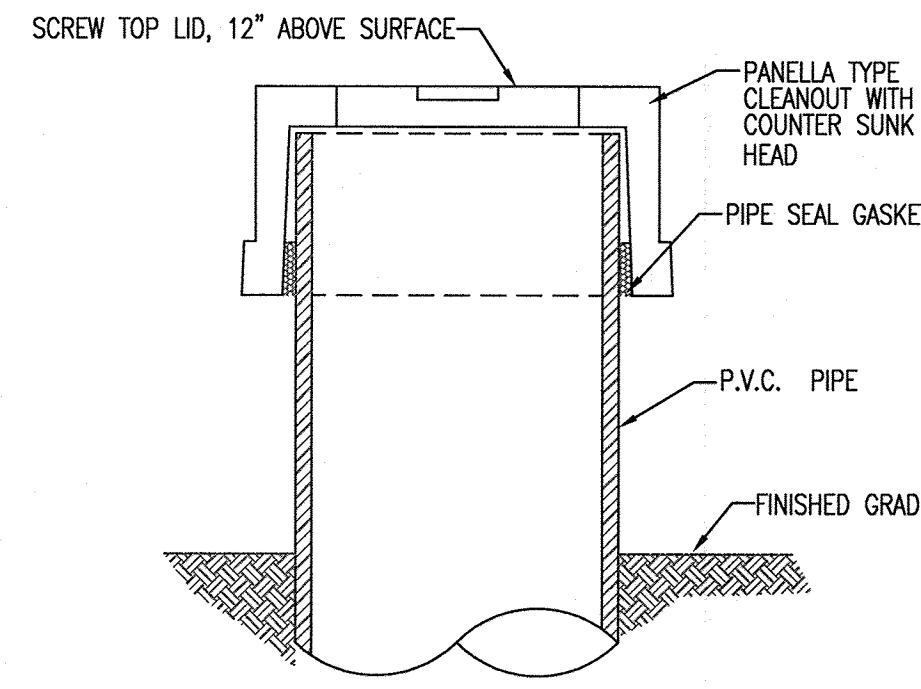


6 CLEAN-OUT OBSERVATION WELL CAP
21 NOT TO SCALE

ESDv SUMMARY TABLE			
ESDv REQUIRED	ESDv REQUIRED TO MEET Cp	ESDv REQUIRED TO MEET Wqv	ESDv PROVIDED
44,256 cf	44,649 cf	22,128 cf	24,171 cf
			AS-BUILT 23,816 CF

ESDv DEVICE SUMMARY TABLE			
TREATMENT	ESDv REQUIRED TO MEET Cp	ESDv REQUIRED TO MEET Wqv	ESDv PROVIDED
SUBMERGED GRAVEL WETLAND 1	26,984 cf	9,994 cf	14,356 cf
GRASS SWALES	4,357 cf	1,614 cf	1,212 cf
MICRO-BIORETENTION 1	4,506 cf	1,669 cf	4,506 cf
MICRO-BIORETENTION 2	4,096 cf	1,517 cf	4,096 cf
TOTAL			24,171 cf
			AS-BUILT 23,816 CF

AS-BUILT
23,816 CF

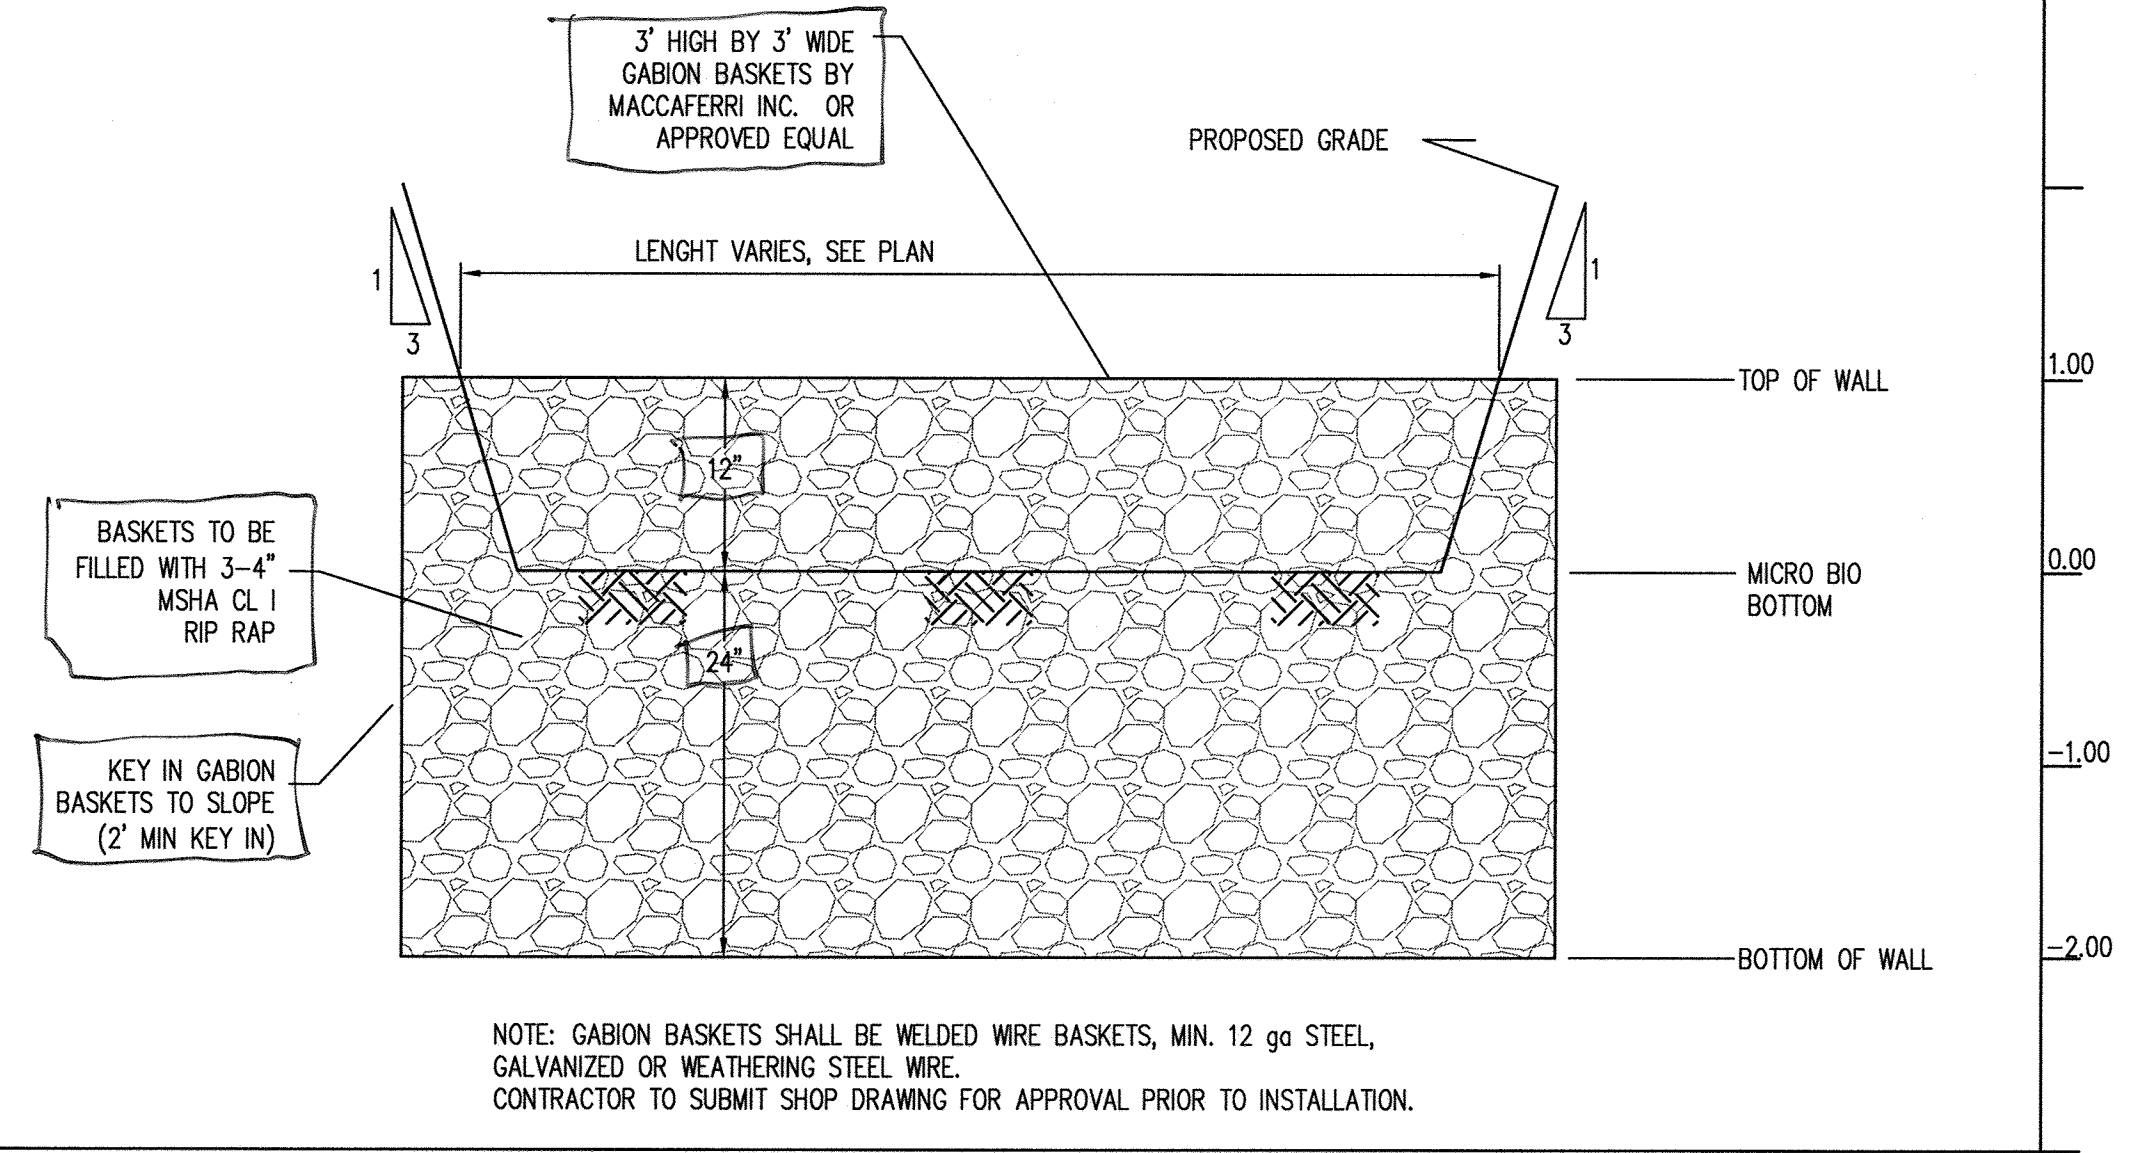

MICROBIO GABION WALL DETAIL

SCALE: HOR: 1"=10'
VERT: 1"=1'

MICROBIORETENTION SPECIFICATIONS

- THE UNDERDRAIN PIPE MUST BE 4-INCH DIAMETER SCHEDULE 40 OR STRONGER PERFORATED PVC PIPE AT 0.00% SLOPE. THREE INCHES OF GRAVEL MUST BE PLACED UNDER THE PIPE, WITH A MINIMUM OF 6 INCHES OF GRAVEL OVER THE PIPE. PERFORATIONS MUST BE 3/8 INCH IN DIAMETER AND MUST BE LOCATED 4 INCHES ON CENTER, EVERY 90 DEGREES AROUND THE PIPE. PERFORATED PIPE MUST BEGIN AT LEAST 5 FT. INSIDE THE FILTER MEDIA. FILTER FABRIC MUST NOT BE WRAPPED AROUND THE UNDERDRAIN PIPE.
- 4 INCH CLEAN-OUTS SHOULD BE USED. CLEANOUTS FOR EACH PIPE SHOULD EXTEND 12 INCHES ABOVE THE TOP OF THE PLANTING MEDIA AND HAVE A REMOVABLE CAP. OVERFLOW PIPES SHALL HAVE A REMOVABLE RATE THAT FITS SNUGLY INSIDE THE PIPE.
- THE GRAVEL LAYER SURROUNDING THE UNDERDRAIN PIPES MUST MEET MSHA SIZE #57 (TABLE 901A), AND MUST PROVIDE A MINIMUM OF 6 INCHES COVER OVER THE PIPE, AND MINIMUM 3 INCHES UNDER THE PIPE. NO GEOTEXTILE OR FILTER FABRIC IS ALLOWED ANYWHERE WITHIN THE FILTER MEDIA (STONE OR SAND).
- A MINIMUM 4-INCH FINE AGGREGATE SAND LAYER SHALL BE PROVIDED BELOW THE SOIL FILTER/PLANTING MEDIA. THE SAND MUST BE ASTM C33 FINE AGGREGATE SAND. MANUFACTURED SAND OR STONE DUST IS NOT ACCEPTABLE.
- A MINIMUM 4-INCH PEA GRAVEL LAYER SHALL BE PROVIDED BETWEEN THE SAND AND THE STONE.
- THE PLANTING MEDIA MIX SHALL MEET SHA BIORETENTION SOIL MIX STANDARDS. THE SOIL SHALL MEET THE FOLLOWING MINIMUM CRITERIA: A HOMOGENEOUS MIXTURE COMPOSED OF 5 PARTS COARSE SAND, 3 PARTS BASE SOIL, AND 2 PARTS FINE BARK. THE SOIL SHALL BE FREE OF STONES, STUMPS, ROOTS OR OTHER SIMILAR OBJECTS LARGER THAN 2 INCHES. THE PLANTING MATERIAL SHALL BE FLOODED AFTER PLACEMENT. ANY SETTLEMENT THAT OCCURS SHALL BE FILLED BACK TO THE DESIGN ELEVATION.
- THE SURFACE MULCH LAYER WILL CONSIST OF STANDARD FINE SHREDDED AGED HARDWOOD MULCH. THE MULCH SHOULD BE UNIFORMLY TO A DEPTH OF 3 INCHES. YEARLY REPLISHING MAY BE NECESSARY. PINE BARK IS NOT ACCEPTABLE.

AS-BUILT CERTIFICATION
I HEREBY CERTIFY, BY MY SEAL, THAT TO THE BEST OF MY KNOWLEDGE AND BELIEF THE FACILITIES SHOWN ON THIS PLAN WERE CONSTRUCTED AS SHOWN ON THIS "AS-BUILT" PLAN AND MEET THE APPROVED PLANS AND SPECIFICATIONS.

SIGNATURE OF ENGINEER: *Sharon L. Cruse* DATE: 7/1/19
 PROFESSIONAL ENGINEER NO. 36896 EXPIRATION DATE: 2-15-21

APPROVED: DEPARTMENT OF PLANNING AND ZONING

Chief, Development Engineering Division: *Sharon L. Cruse* DATE: 9-21-17
 Chief, Division of Land Development: *Walter J. Zepke* DATE: 9-22-17
 Director: *Walter J. Zepke* DATE: 10-2-17

DEVELOPER: DCT INDUSTRIAL
12011 GUILFORD ROAD
SUITE 102
ANNAPOLIS JUNCTION, MD 20701
ATTN: FRED FERRARO
PHONE: 410-645-5020

OWNER: DCT MEARS LLC
12011 GUILFORD ROAD
ANNAPOLIS JUNCTION, MD 20701
ATTN: FRED FERRARO
PHONE: 410-645-5020

PROJECT: TERRAPIN COMMERCE CENTER

AREA: TAX MAP 43, PARCEL 51 LOT PAR A PLAT 23793 ZONED M-2
GRID NO. 11 1st ELECTION DISTRICT
7200 DORSEY RUN ROAD
ELKRIDGE, MARYLAND 21075
HOWARD COUNTY, MARYLAND

TITLE: MICRO-BIORETENTION DETAILS
AS-BUILT

Pennoni Associates Inc.
Engineers • Surveyors • Planners
Landscape Architects

8818 Centre Park Drive, Suite 200 Columbia, MD 21045
T 410.997.8900 F 410.997.9282

MICRO-BIORETENTION SEQUENCE OF CONSTRUCTION

- DO NOT BEGIN BIURETENTION INSTALLATION UNTIL SITE UPSTREAM OF MICRO-BIURETENTION IS STABILIZED AND FINE GRADING HAS BEEN COMPLETED.
- EXCAVATE MICRO-BIURETENTION. CONSTRUCTION SHALL BE PERFORMED WITH LIGHTWEIGHT, WIDE-TRACKED EQUIPMENT TO MINIMIZE DISTURBANCE AND COMPACTION. EXCAVATED MATERIALS SHALL BE PLACED IN A CONTAINED AREA. (1 DAY)
- PLACE STONE AND UNDERDRAINS. (1 DAY)
- PLACE SAND LAYER IN LIFTS OF THREE INCHES. (0.5 DAY)
- PLACE PLANTING SOIL AND OBSERVATION WELLS. (1 DAY)
- PLACE MULCH. (0.5 DAY)
- INSTALL PLANT MATERIAL. (1 DAY)
- STABILIZE MICRO-BIURETENTION AREA. (0.5 DAY)


SAND SPECIFICATIONS

WASHED ASTM C33 FINE AGGREGATE CONCRETE SAND IS UTILIZED FOR STORMWATER MANAGEMENT APPLICATIONS. IN ADDITION TO THE ASTM C-33 SPECIFICATION, SAND MUST MEET ALL OF THE FOLLOWING CONDITIONS.


- SAND MUST MEET GRADATION REQUIREMENTS FOR ASTM C-33 FINE AGGREGATE CONCRETE SAND. AASHTO M-6 GRADATION IS ALSO ACCEPTABLE.
- SAND MUST BE SILICA BASED. NO LIMESTONE BASED PRODUCTS MAY BE USED. IF THE MATERIAL IS WHITE OR GRAY IN COLOR, IT IS PROBABLY NOT ACCEPTABLE.
- SAND MUST BE CLEAN. NATURAL, UNWASHED SAND DEPOSITS MAY NOT BE USED. LIKEWISE, SAND THAT HAS BECOME CONTAMINATED BY IMPROPER STORAGE OR INSTALLATION PRACTICES WILL BE REJECTED.
- MANUFACTURED SAND OR STONE DUST IS NOT ACCEPTABLE UNDER ANY CIRCUMSTANCE.

MICRO-BIURETENTION DESIGN DATA		AS-BUILT		
	1	2		
A	151.90	152.00	150.70	150.92
B	151.00	150.90	150.14	150.25
C	12"	12"	6.75'	6'
D	30"	29"		
E	150.65	150.75	149.89	150.00
SURFACE AREA AT 'E' (SF)	2,131	1,978	2,072	1,963
OVERFLOW STRUCTURE	1511	1512		
OVERFLOW RIM ELEVATION	151.90	152.00	151.05	151.20
UNDERDRAIN INVERT	147.40	147.50	146.97	146.89

MICRO-BIURETENTION #1 AND #2 PLANT SCHEDULE				
SYMBOL	QTY.	SCIENTIFIC/COMMON NAME	SIZE	REMARKS
AA	24	ARONIA ARBUTIFOLIA 'BRILLIANTISSIMA' RED CHOKEBERRY	3 GAL.	CONT. AS SHOWN
FG	14	FOTHERGILLA GARDENII 'MT. AIRY' MT. AIRY DWARF FOTHERGILLA	3 GAL.	CONT. AS SHOWN
IT	30	ITEA VIRGINICA 'HENRY'S GARNET' HENRY'S GARNET VIRGINIA SWEETSPICE	18-24" HT.	CONT. AS SHOWN
CE	687	CAREX 'EVERGOLD' EVERGOLD SEDGE	1 QUART	CONT. 18" ON CENTER
EP	191	EUPATORIUM PURPUREUM JOE PYE WEED	1 QUART	CONT. 18" ON CENTER
IS	669	IRIS VERSICOLOR 'BLUE FLAG' BLUE FLAG IRIS	1 QUART	CONT. 18" ON CENTER
RL	560	RUDBECKIA LACINATA 'GOLDQUELLE' GOLDQUELLE CONEFLOWER	1 QUART	CONT. 18" ON CENTER

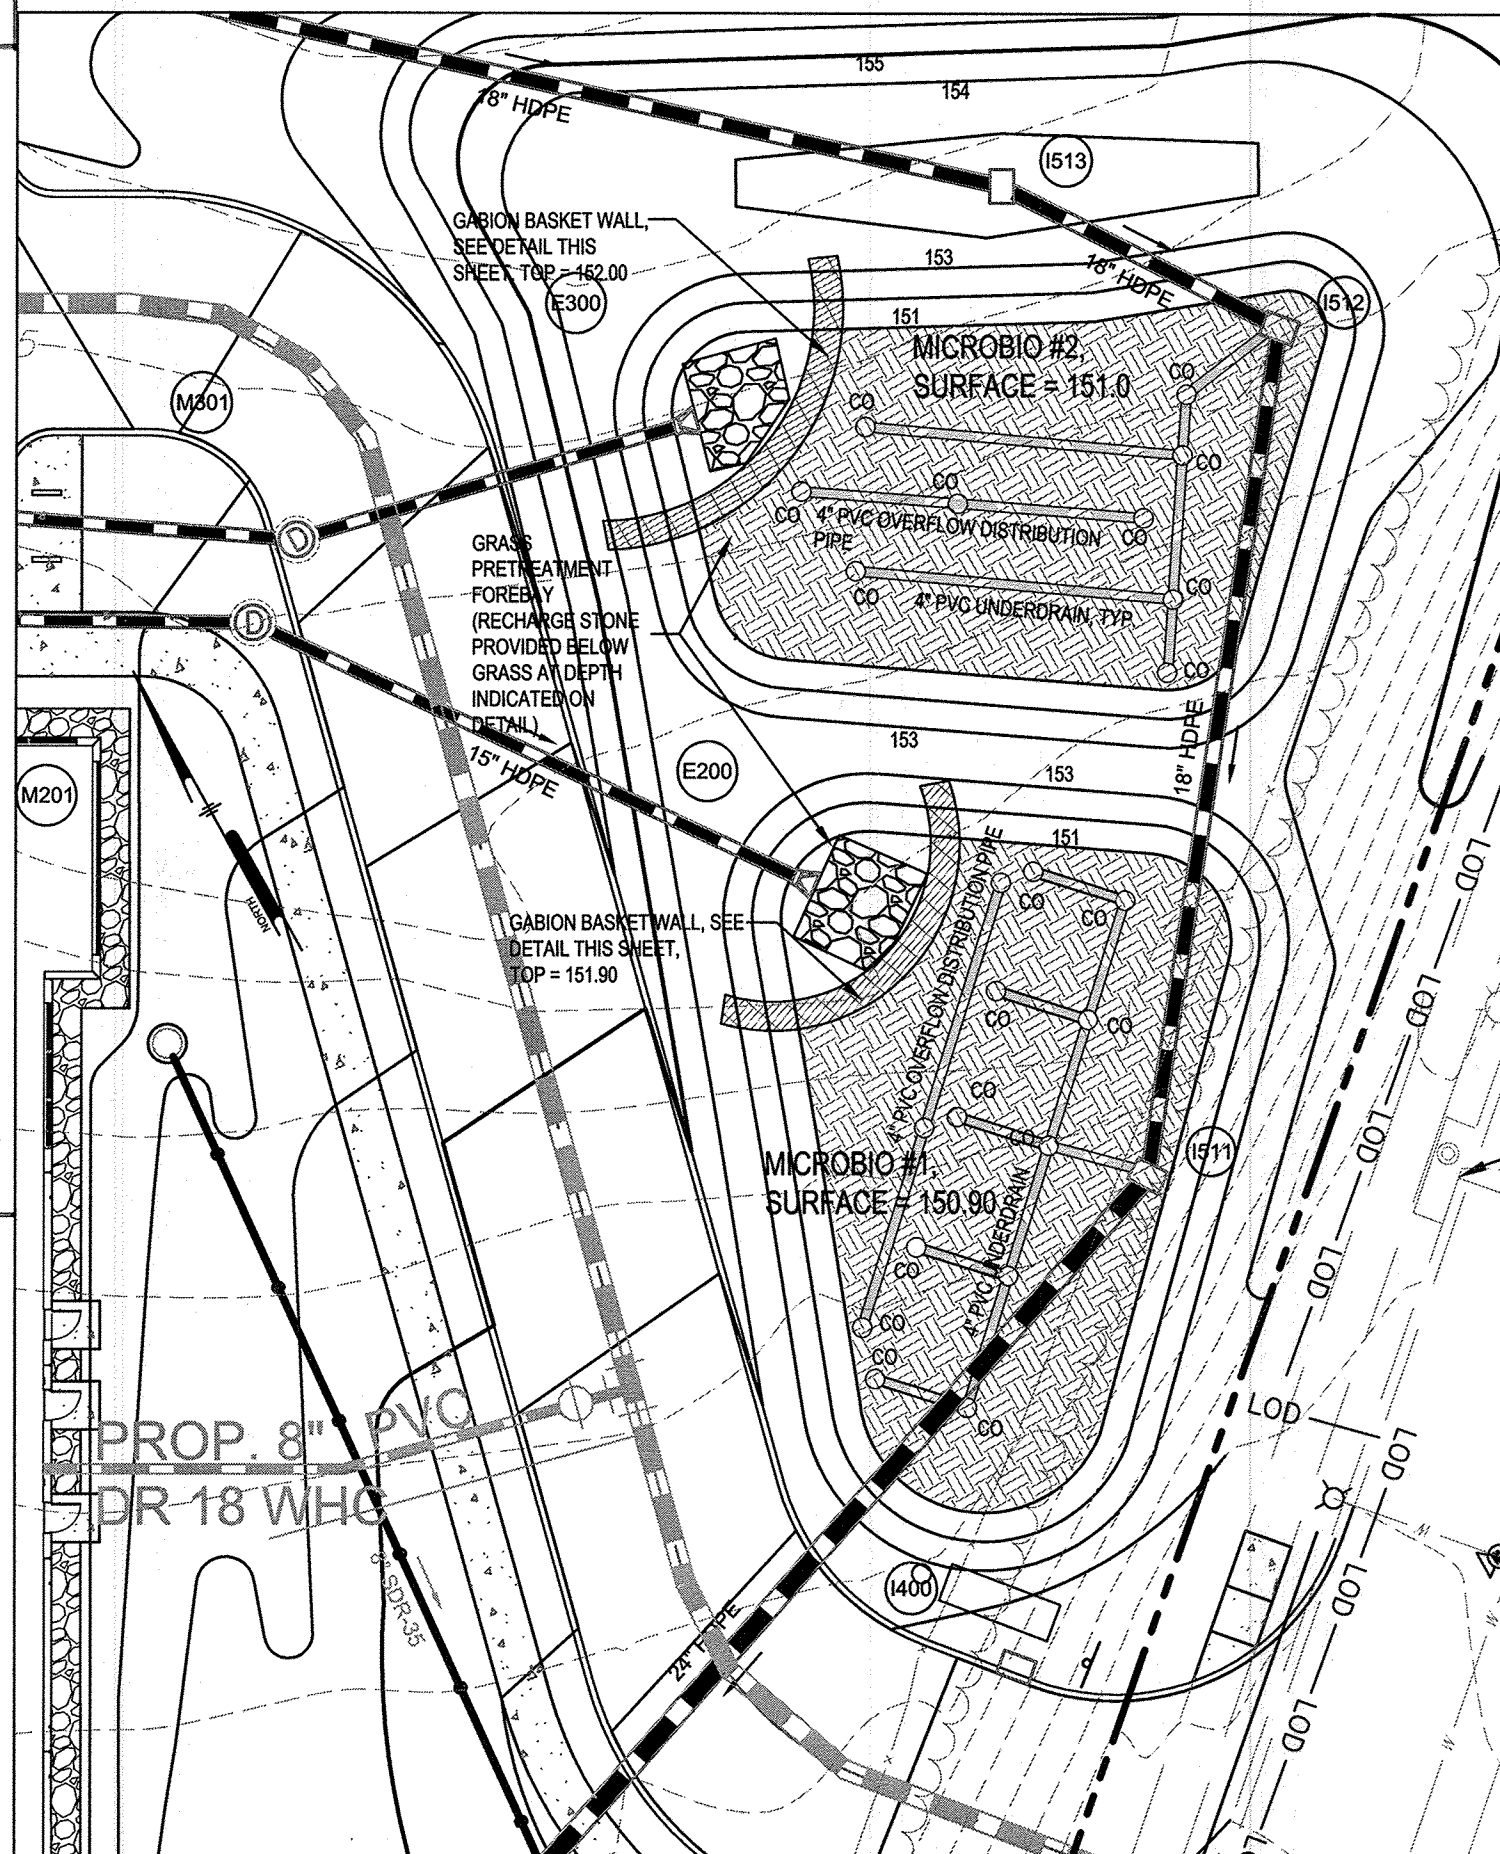


MICRO-BIURETENTION #1 & #2 DETAIL PLAN
SCALE: 1"=20'

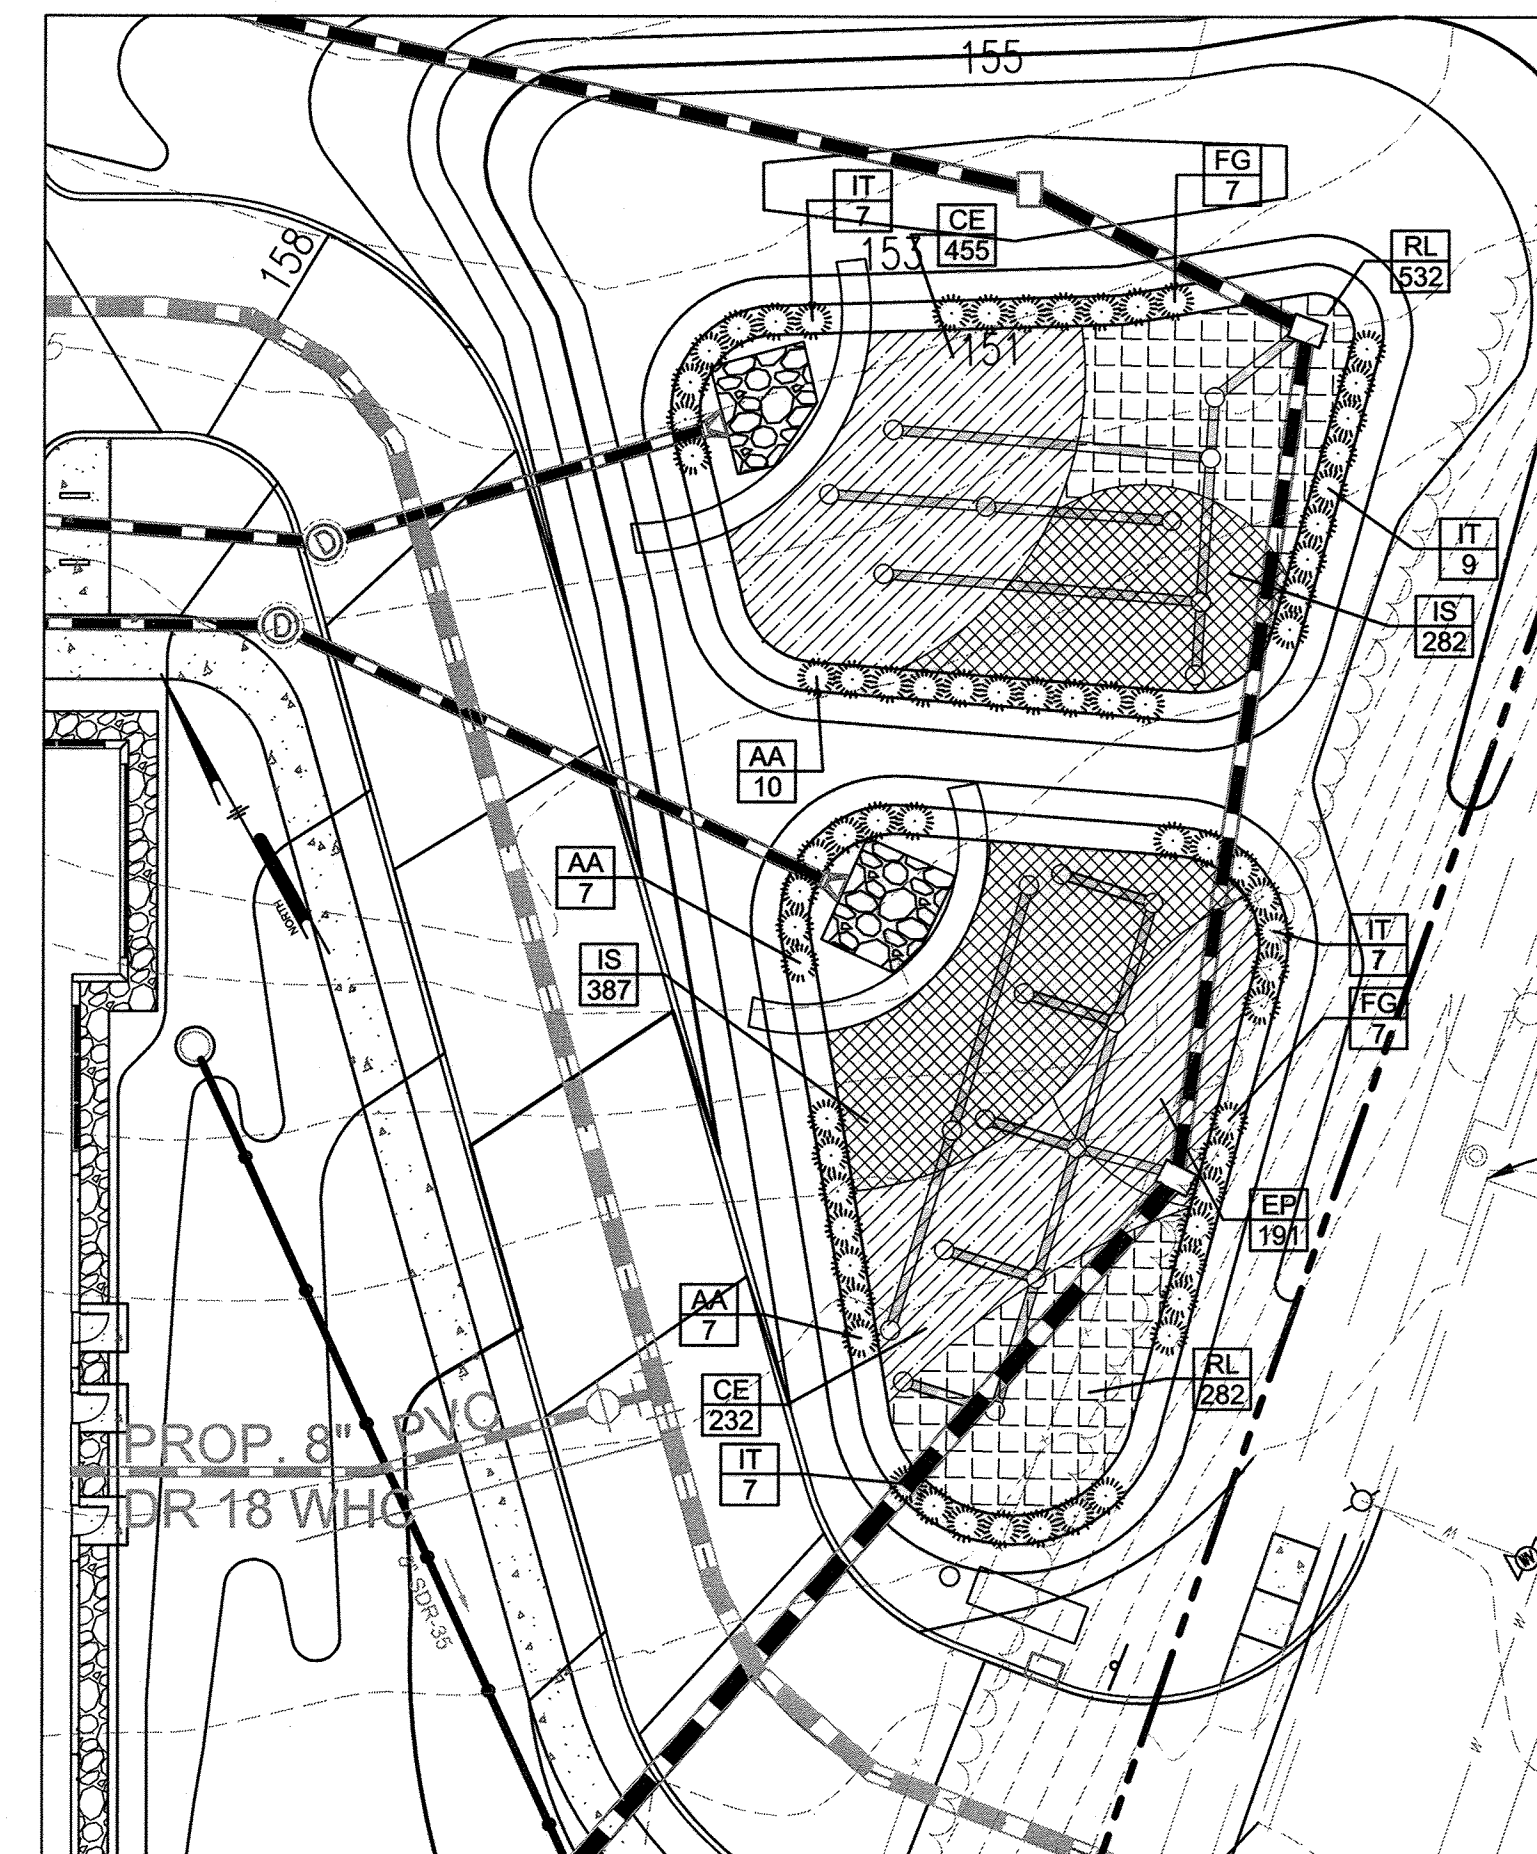


MICRO-BIURETENTION #1 & #2 LANDSCAPE PLAN
SCALE: 1"=20'

DESIGNED BY: PJS
 DRAWN BY: AGS/JSN
 PROJECT NO: DCT1601
 DATE: JUNE 23, 2017
 SCALE: AS SHOWN
 DRAWING NO: 21 OF 43

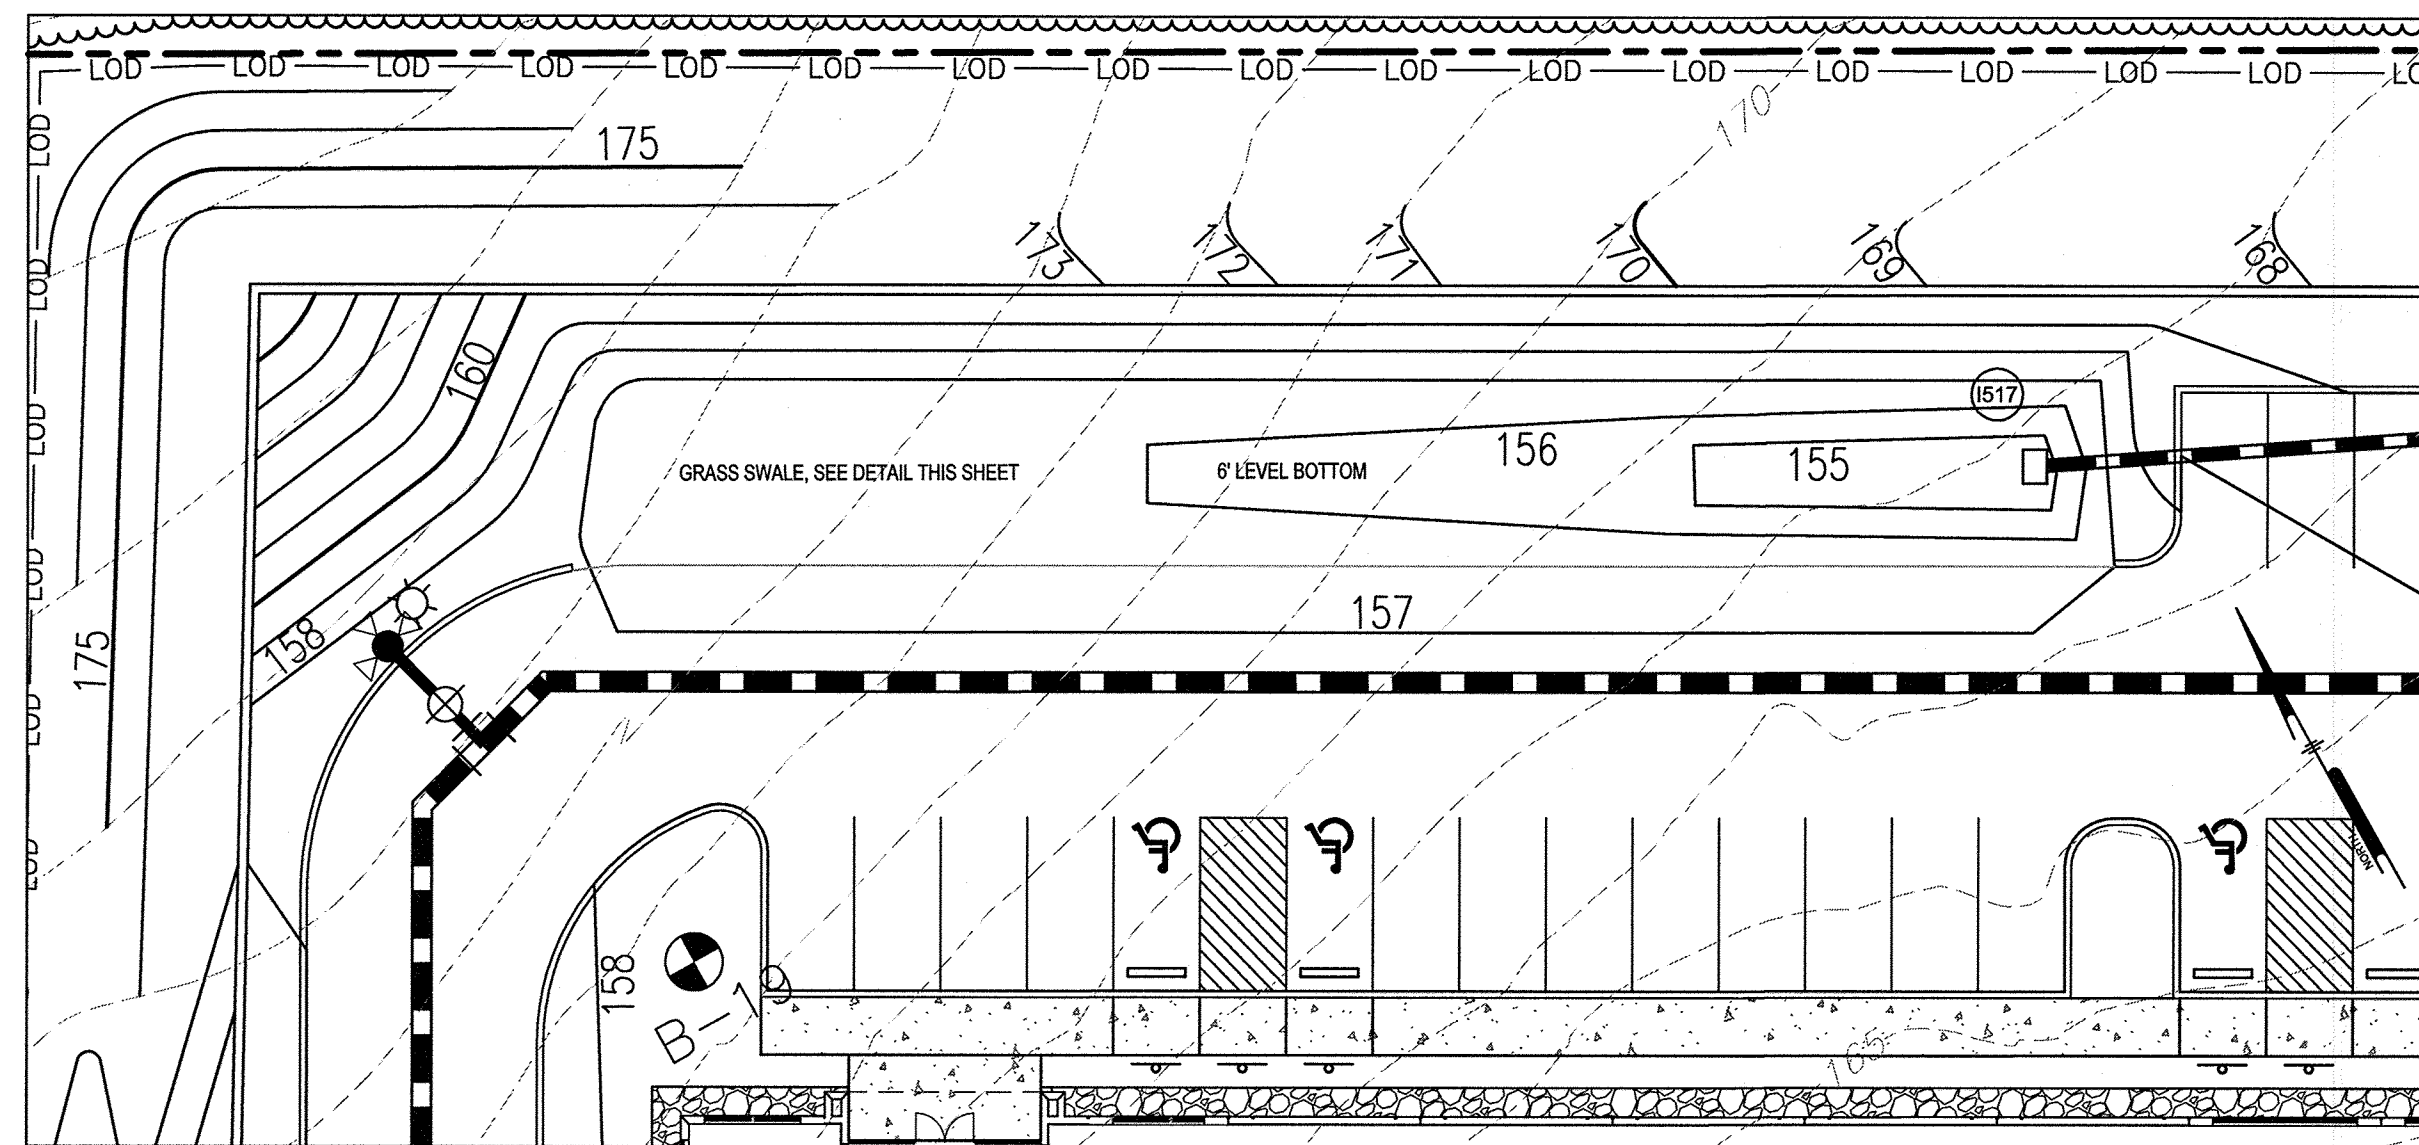


GRASS SWALE #3 DETAIL PLAN
SCALE: 1"=20'

STORMWATER MANAGEMENT POND #1 PLANT SCHEDULE					
SYMBOL	QTY.	SCIENTIFIC/ COMMON NAME	SIZE	ROOT	REMARKS
EP	850	EUPATORIUM PURPUREUM JOE PYE WEED	1 QUART	CONT.	12" ON CENTER
IS	790	IRIS VERSICOLOR 'BLUE FLAG' BLUE FLAG IRIS	1 QUART	CONT.	12" ON CENTER
LC	710	LOBELIA CARDINALIS CARDINAL FLOWER	1 QUART	CONT.	12" ON CENTER

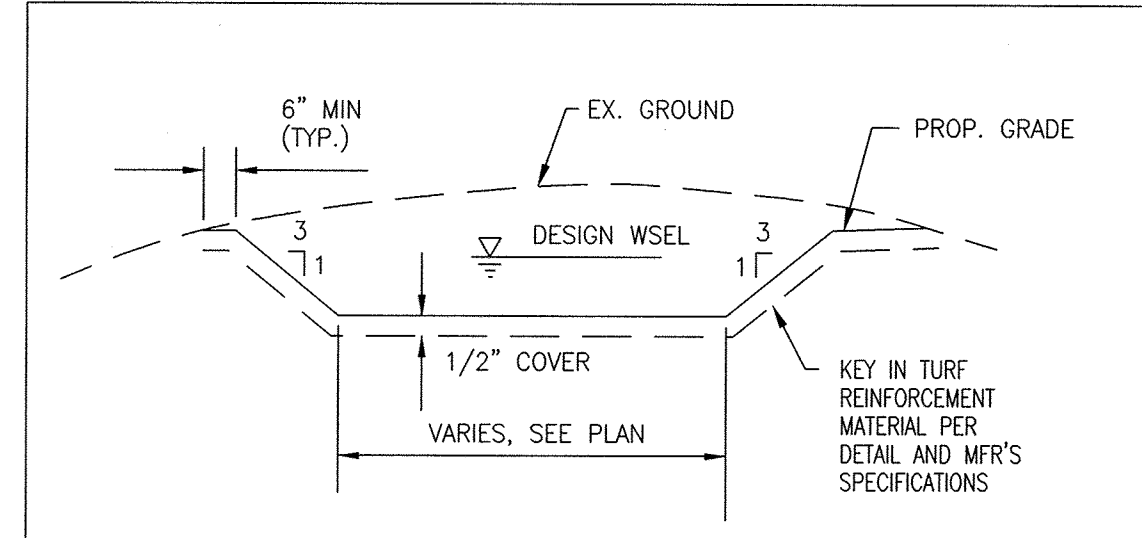


- NOTES
- INSTALL THE MATERIAL PER THE MANUFACTURER'S INSTRUCTIONS INCLUDING SURFACE PREPARATION AND STAPLING. IT IS VERY IMPORTANT THAT THE MATERIAL BE INSTALLED IN GOOD CONTACT WITH THE GROUND WITH NO WRINKLES OR VOID SPACES BELOW THE FABRIC. STAPLES MUST BE PLACED IN A DIAMOND PATTERN APPROXIMATELY 18" APART.
 - FILL VOIDS IN THE MATERIAL WITH TOPSOIL BEFORE SODDING OR SEEDING DO NOT PLACE MORE THAN ONE HALF INCH (1/2") OF TOPSOIL OVER THE MATERIAL. THE MATERIAL MUST BE WITHIN THE ROOT ZONE FOR IT TO FUNCTION PROPERLY.
 - MATERIAL MUST BE ENKAMAT 7010, ENKAMAT 7020, TENSAR TM-3000, PYRAMAT, OR OTHER MCDPS APPROVED EQUIVALENT. TO BE CONSIDERED AS AN EQUIVALENT, THE MATERIAL MUST BE A SINGLE BONDED TURF REINFORCEMENT MATERIAL.
 - TURF REINFORCEMENT IS NOT MEANT TO SERVE AS AN EROSION CONTROL MAT. IF NECESSARY, A BIODEGRADABLE MATERIAL SUCH AS EXVELSIOR MAY BE PLACED OVER THE PREPARED SEED BED TO HOLD THE SEED IN PLACE. THE PURPOSE OF THE TURF REINFORCEMENT MATERIAL IS TO ADD STRENGTH TO THE ROOT SYSTEM AFTER GERMINATION.

GRASS SWALE TYPICAL SECTION
NOT TO SCALE

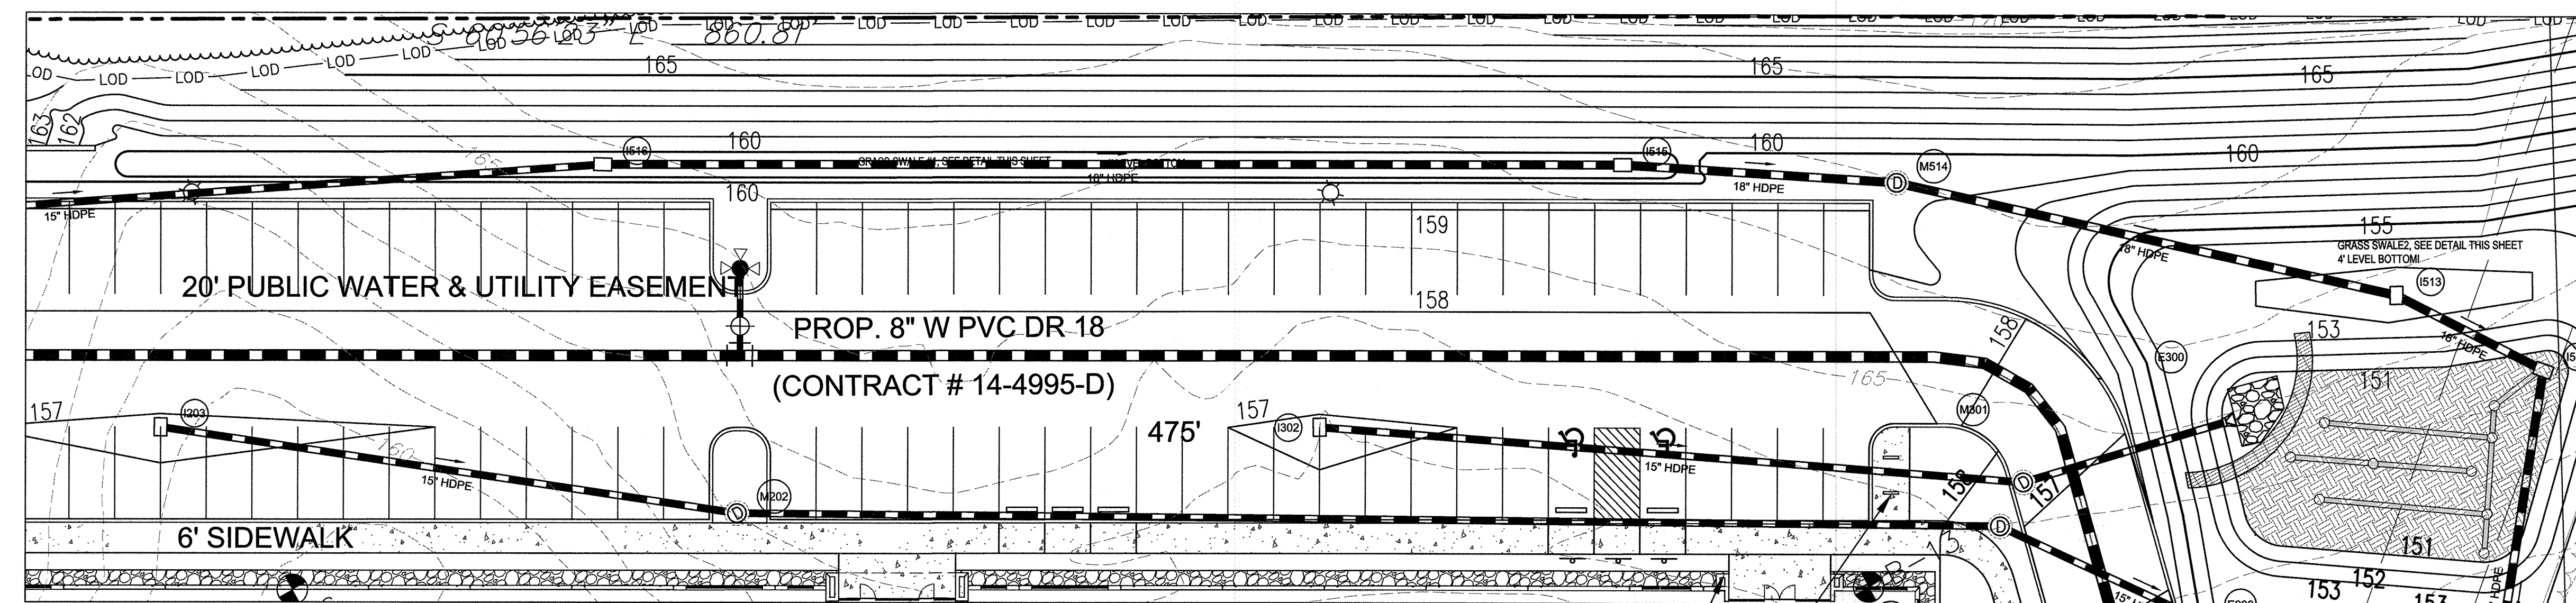

GRASS SWALE #1 & 2 DETAIL PLAN
SCALE: 1"=20'

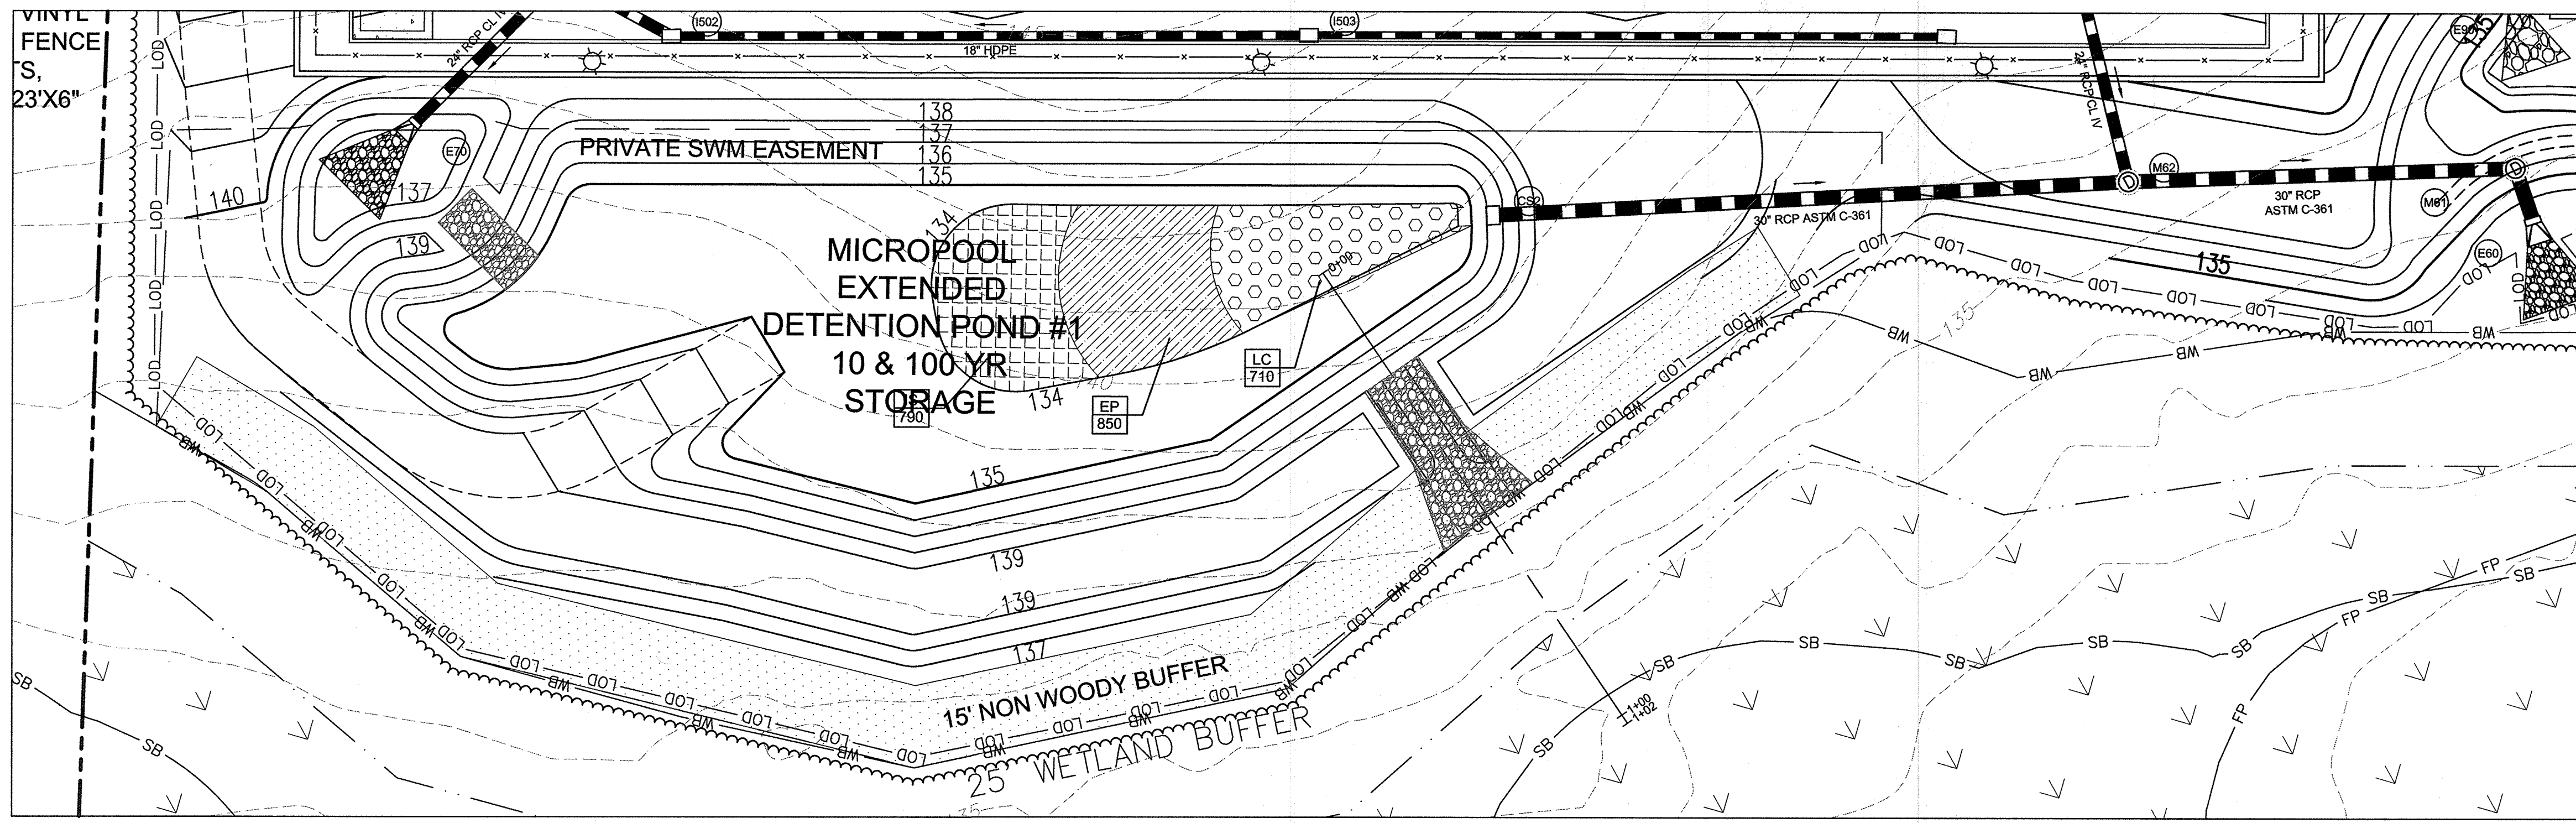

STORMWATER MANAGEMENT POND #1 LANDSCAPE PLAN
SCALE: 1"=20'

AS-BUILT CERTIFICATION
I HEREBY CERTIFY, BY MY SEAL, THAT TO THE BEST OF MY KNOWLEDGE AND BELIEF THE FACILITIES SHOWN ON THIS PLAN WERE CONSTRUCTED AS SHOWN ON THIS "AS-BUILT" PLAN AND MEET THE APPROVED PLANS AND SPECIFICATIONS.

SIGNATURE OF ENGINEER: *John C. Cruz* DATE: 7/21/19
 I HEREBY CERTIFY THAT THESE DOCUMENTS WERE PREPARED OR APPROVED BY ME AND THAT I AM A DULY LICENSED PROFESSIONAL ENGINEER UNDER THE LAWS OF THE STATE OF MARYLAND, LICENSE NO. 36896, EXPIRATION DATE 2-15-21

APPROVED: DEPARTMENT OF PLANNING AND ZONING

Chief, Development Engineering Division: *David E. ...* DATE: 9-21-17
 Chief, Division of Land Development: *Veronica ...* DATE: 9-27-17
 Director: *William ...* DATE: 10-2-17

DATE	NO.	REVISION	BY
DEVELOPER: DCT INDUSTRIAL 12011 GUILFORD ROAD SUITE 102 ANNAPOLIS JUNCTION, MD 20701 ATTN: FRED FERRARO PHONE: 410-645-5020			
OWNER: DCT MEARS LLC 12011 GUILFORD ROAD SUITE 102 ANNAPOLIS JUNCTION, MD 20701 ATTN: FRED FERRARO PHONE: 410-645-5020			
PROJECT: TERRAPIN COMMERCE CENTER			
AREA: TAX MAP 43, PARCEL 51 LOT PAR A PLAT 23793 ZONED M-2 GRID NO. 11 1st ELECTION DISTRICT 7200 DORSEY RUN ROAD ELKRIDGE, MARYLAND 21075 HOWARD COUNTY, MARYLAND			
TITLE: STORMWATER MANAGEMENT DETAILS AS-BUILT			

Pennon Pennoni Associates Inc.
Engineers • Surveyors • Planners
Landscape Architects

8818 Centre Park Drive, Suite 200 Columbia, MD 21045
T 410.997.8900 F 410.997.9282

SEAL: *John C. Cruz*

DESIGNED BY: PJS
 DRAWN BY: AGS/JSN
 PROJECT NO: DCT11601
 DATE: JUNE 23, 2017
 SCALE: AS SHOWN
 DRAWING NO. 22 OF 43

GRAVEL WETLAND SEQUENCE OF CONSTRUCTION


- DO NOT BEGIN GRAVEL WETLAND INSTALLATION UNTIL SITE UPSTREAM OF GRAVEL WETLAND IS STABILIZED AND FINE GRADING HAS BEEN COMPLETED.
- EXCAVATE GRAVEL WETLAND. WETLAND CONSTRUCTION SHALL BE PERFORMED WITH LIGHTWEIGHT, WIDE-TRACKED EQUIPMENT TO MINIMIZE DISTURBANCE AND COMPACTION. EXCAVATED MATERIALS SHALL BE PLACED IN A CONTAINED AREA. ANY PUMPING OPERATIONS SHALL DISCHARGE FILTERED WATER TO A STABLE OUTLET. (1 DAY)
- PLACE STONE, OBSERVATION WELL AND UNDERDRAINS. (1 DAY)
- PLACE PLANTING SOIL. (0.5 DAY)
- INSTALL PLANT MATERIAL. (1 DAY)
- STABILIZE GRAVEL WETLAND AREA. (0.5 DAY)

GRAVEL WETLAND OPERATION AND MAINTENANCE SCHEDULE


- ANNUAL MAINTENANCE OF PLANT MATERIAL, MULCH LAYER AND SOIL LAYER IS REQUIRED. MAINTENANCE OF MULCH AND SOIL IS LIMITED TO CORRECTING AREAS OF EROSION OR WASH OUT. ANY MULCH REPLACEMENT SHALL BE DONE IN THE SPRING. PLANT MATERIAL SHALL BE CHECKED FOR DISEASE AND PRUNING. INFESTATION AND MAINTENANCE WILL ADDRESS DEAD MATERIAL AND PRUNING.
- SCHEDULE OF PLANTING INSPECTION WILL BE TWICE A YEAR IN SPRING AND FALL. THIS INSPECTION WILL INCLUDE REMOVAL OF DEAD AND DISEASE VEGETATION CONSIDERED BEYOND TREATMENT, TREATMENT OF ALL DISEASED TREES AND SHRUBS AND REPLACEMENT OF ALL DEFICIENT STAKES AND WIRES.
- SOIL EROSION TO BE ADDRESSED ON AN AS NEEDED BASIS, WITH A MINIMUM OF ONCE A MONTH AND AFTER HEAVY STORMS.

GRAVEL WETLAND SPECIFICATIONS


- THE UNDERDRAIN PIPE MUST BE 6-INCH DIAMETER SCHEDULE 40 OR STRONGER PERFORATED PVC PIPE AT 0.00% SLOPE. THREE INCHES OF GRAVEL MUST BE PLACED UNDER THE PIPE. PERFORATIONS MUST BE 3/8 INCH IN DIAMETER AND MUST BE LOCATED 4 INCHES ON CENTER, EVERY 90 DEGREES AROUND THE PIPE. PERFORATED PIPE MUST BEGIN AT LEAST 5 FT. INSIDE THE FILTER MEDIA. FILTER FABRIC MUST NOT BE WRAPPED AROUND THE UNDERDRAIN PIPE.
- 6" INCH CLEAN-OUTS SHOULD BE USED. CLEANOUTS FOR EACH PIPE SHOULD EXTEND 6 INCHES ABOVE THE TOP OF THE PLANTING MEDIA AND HAVE A REMOVABLE CAP.
- THE GRAVEL LAYER SURROUNDING THE UNDERDRAIN PIPES MUST BE CLEAN, WASHED ROUNDED BANK RUN GRAVEL ASTM D448 SIZE #6, AND A MINIMUM OF 3 INCHES UNDER THE PIPE. NO GEOTEXTILE OR FILTER FABRIC IS ALLOWED ANYWHERE WITHIN THE FILTER MEDIA.
- THE UNDERDRAIN SHALL BE TURNED UP INSIDE THE OUTFALL STRUCTURE AS SHOWN ON THE OUTFALL STRUCTURE DETAILS AT THE ELEVATION SHOWN. THE UNDERDRAIN WITHIN THE OUTFALL STRUCTURE SHALL BE SOLID PVC.
- THE PLANTING MEDIA SHALL CONFORM TO MDE SPECIFICATIONS AS SHOWN IN APPENDIX B3 OF THE MARYLAND STORMWATER DESIGN MANUAL, VOL. 1 & II. THE SOIL SHALL BE FREE OF STONES, STUMPS, ROOTS OR OTHER SIMILAR OBJECTS LARGER THAN 2 INCHES. THE FIRST LAYER OF THE PLANTING MEDIA SHALL BE LIGHTLY TILLED TO MIX IT INTO THE SAND LAYER, SO NOT TO CREATE A DEFINITIVE BOUNDARY. THE PLANTING MATERIAL SHALL BE FLOODED AFTER PLACEMENT. ANY SETTLEMENT THAT OCCURS SHALL BE FILLED BACK TO THE DESIGN ELEVATION.

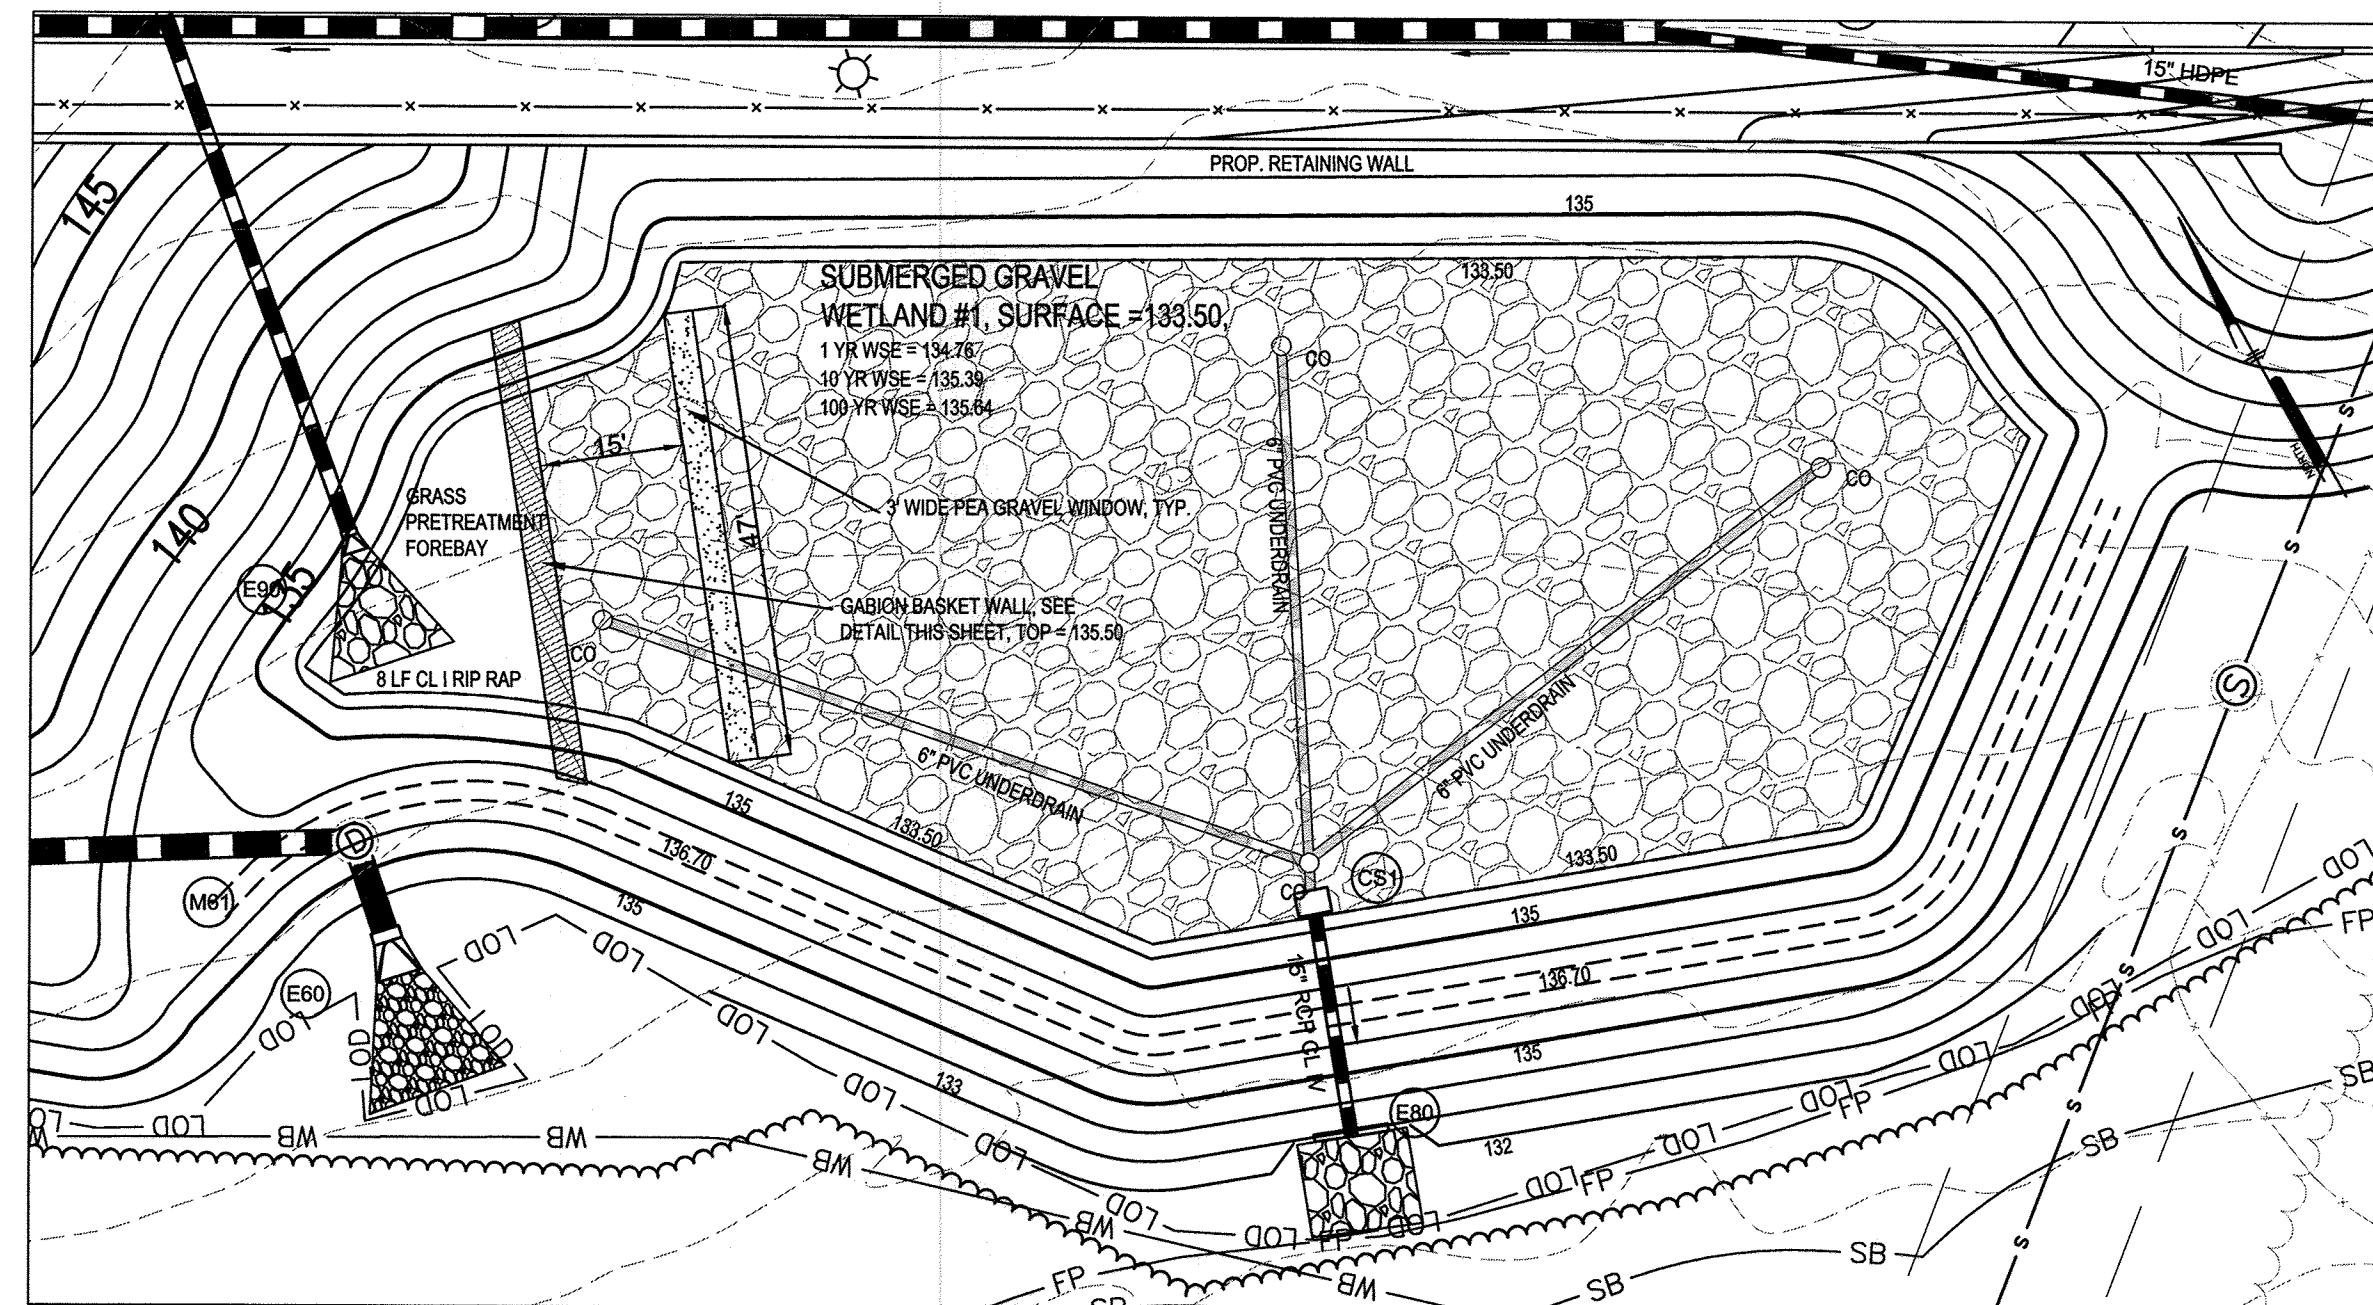


SUBMERGED GRAVEL WETLANDS DETAIL PLAN
SCALE: 1"=20'

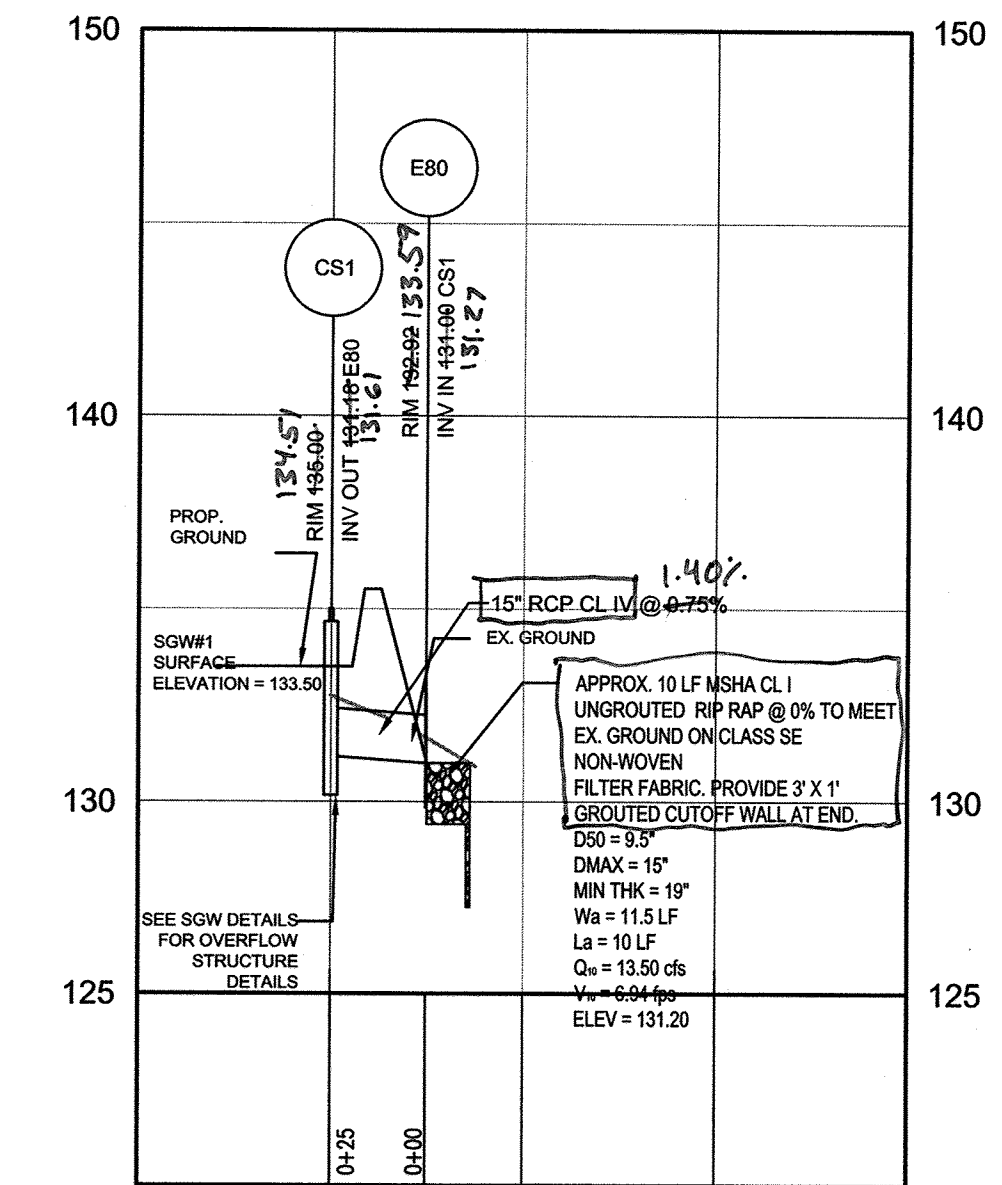

CS1 TO E80
HORIZONTAL SCALE: 1" = 50'
VERTICAL SCALE: 1" = 5'

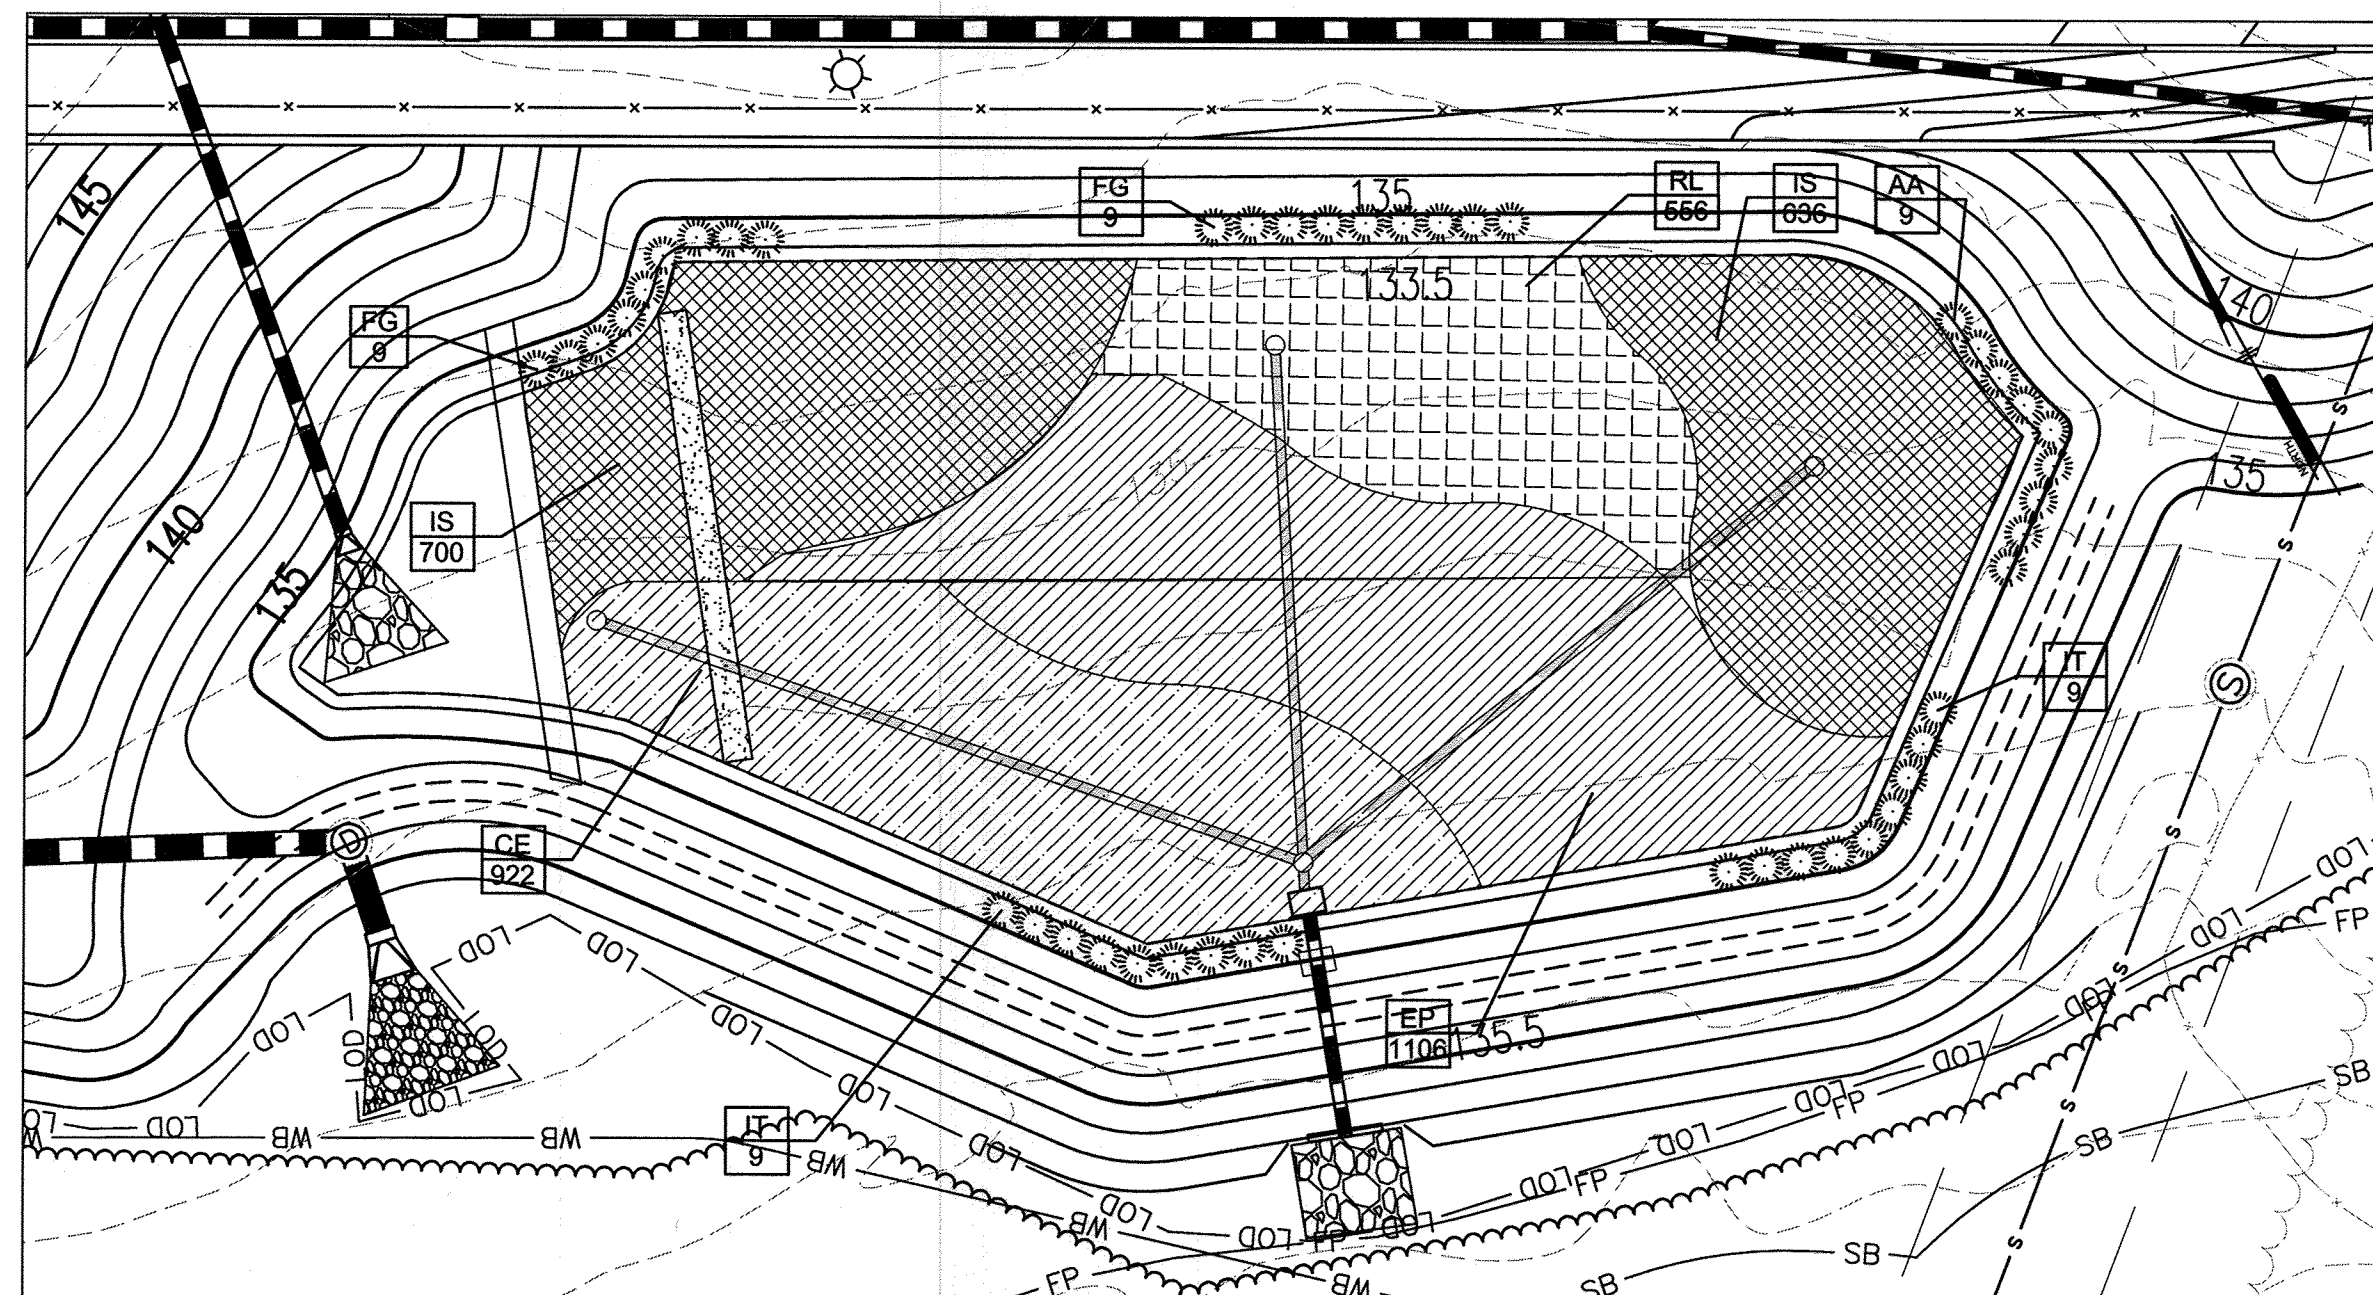

SUBMERGED GRAVEL WETLANDS LANDSCAPE PLAN
SCALE: 1"=20'

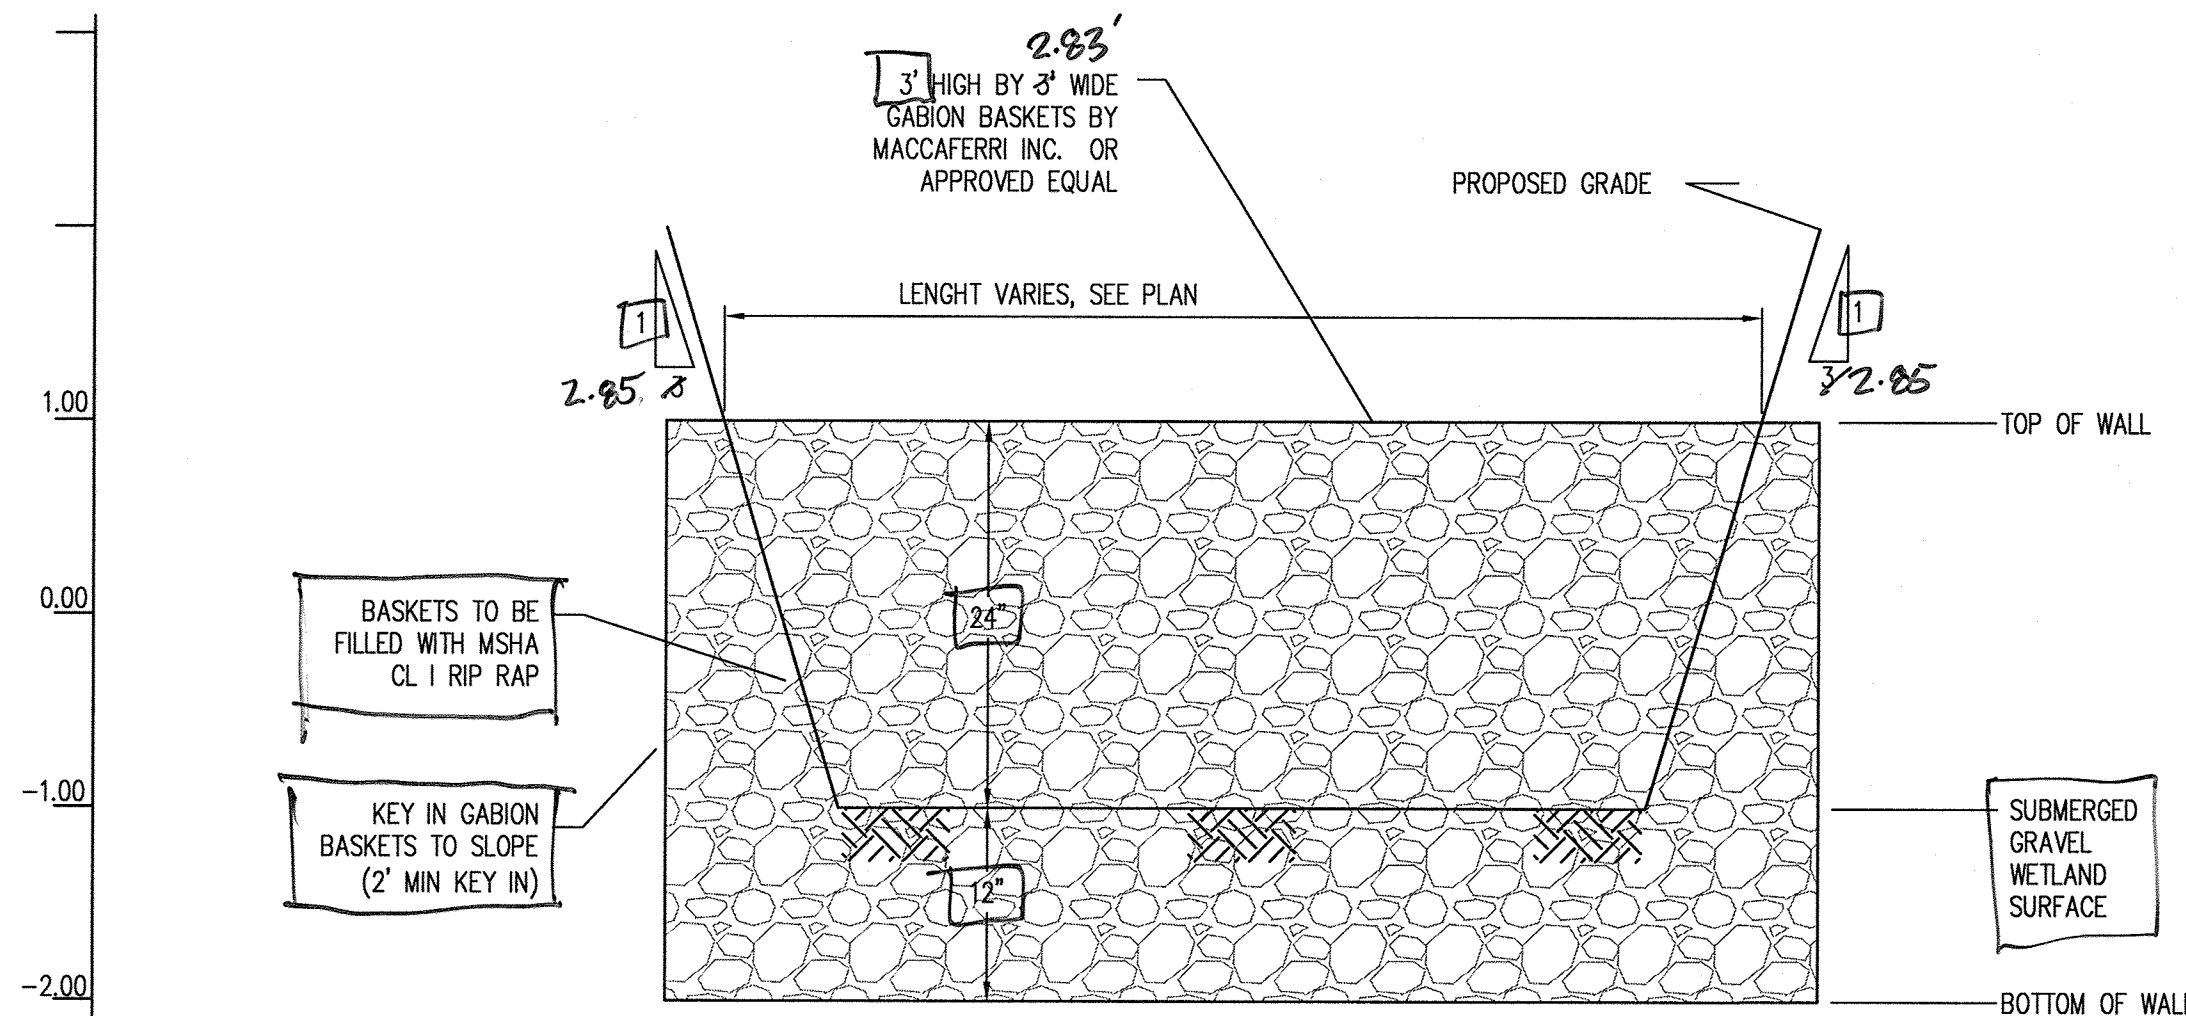

SUBMERGED GRAVEL WETLAND GABION WALL DETAIL
SCALE: HOR: 1"=10'
VERT: 1"=1'

AS-BUILT CERTIFICATION
I HEREBY CERTIFY, BY MY SEAL, THAT TO THE BEST OF MY KNOWLEDGE AND BELIEF THE FACILITIES SHOWN ON THIS PLAN WERE CONSTRUCTED AS SHOWN ON THIS "AS-BUILT" PLAN AND MEET THE APPROVED PLANS AND SPECIFICATIONS.

SIGNATURE OF ENGINEER: *Sharon K. Gorman* DATE: 7/6/19
PE # 36896

STATE OF MARYLAND PROFESSIONAL ENGINEER

APPROVED: DEPARTMENT OF PLANNING AND ZONING

DATE: 9-22-17
DATE: 9-27-17
DATE: 10-2-17

DEVELOPER: DCT INDUSTRIAL, 12011 GUILFORD ROAD, SUITE 102, ANNAPOLIS JUNCTION, MD 20701

OWNER: DCT MEARS LLC, 12011 GUILFORD ROAD, SUITE 102, ANNAPOLIS JUNCTION, MD 20701


PROJECT: TERRAPIN COMMERCE CENTER

AREA: TAX MAP 43, PARCEL 51 LOT PAR A PLAT 23793 ZONED M-2


TITLE: SUBMERGED GRAVEL WETLANDS DETAILS AS-BUILT

Pennoni Associates Inc. Engineers - Surveyors - Planners
8818 Centre Park Drive, Suite 200 Columbia, MD 21045
T 410.997.8900 F 410.997.9282

DESIGNED BY: PJS
DRAWN BY: AGS/JSN
PROJECT NO: DCT1601
DATE: JUNE 23, 2017
SCALE: AS SHOWN
DRAWING NO. 23 OF 43

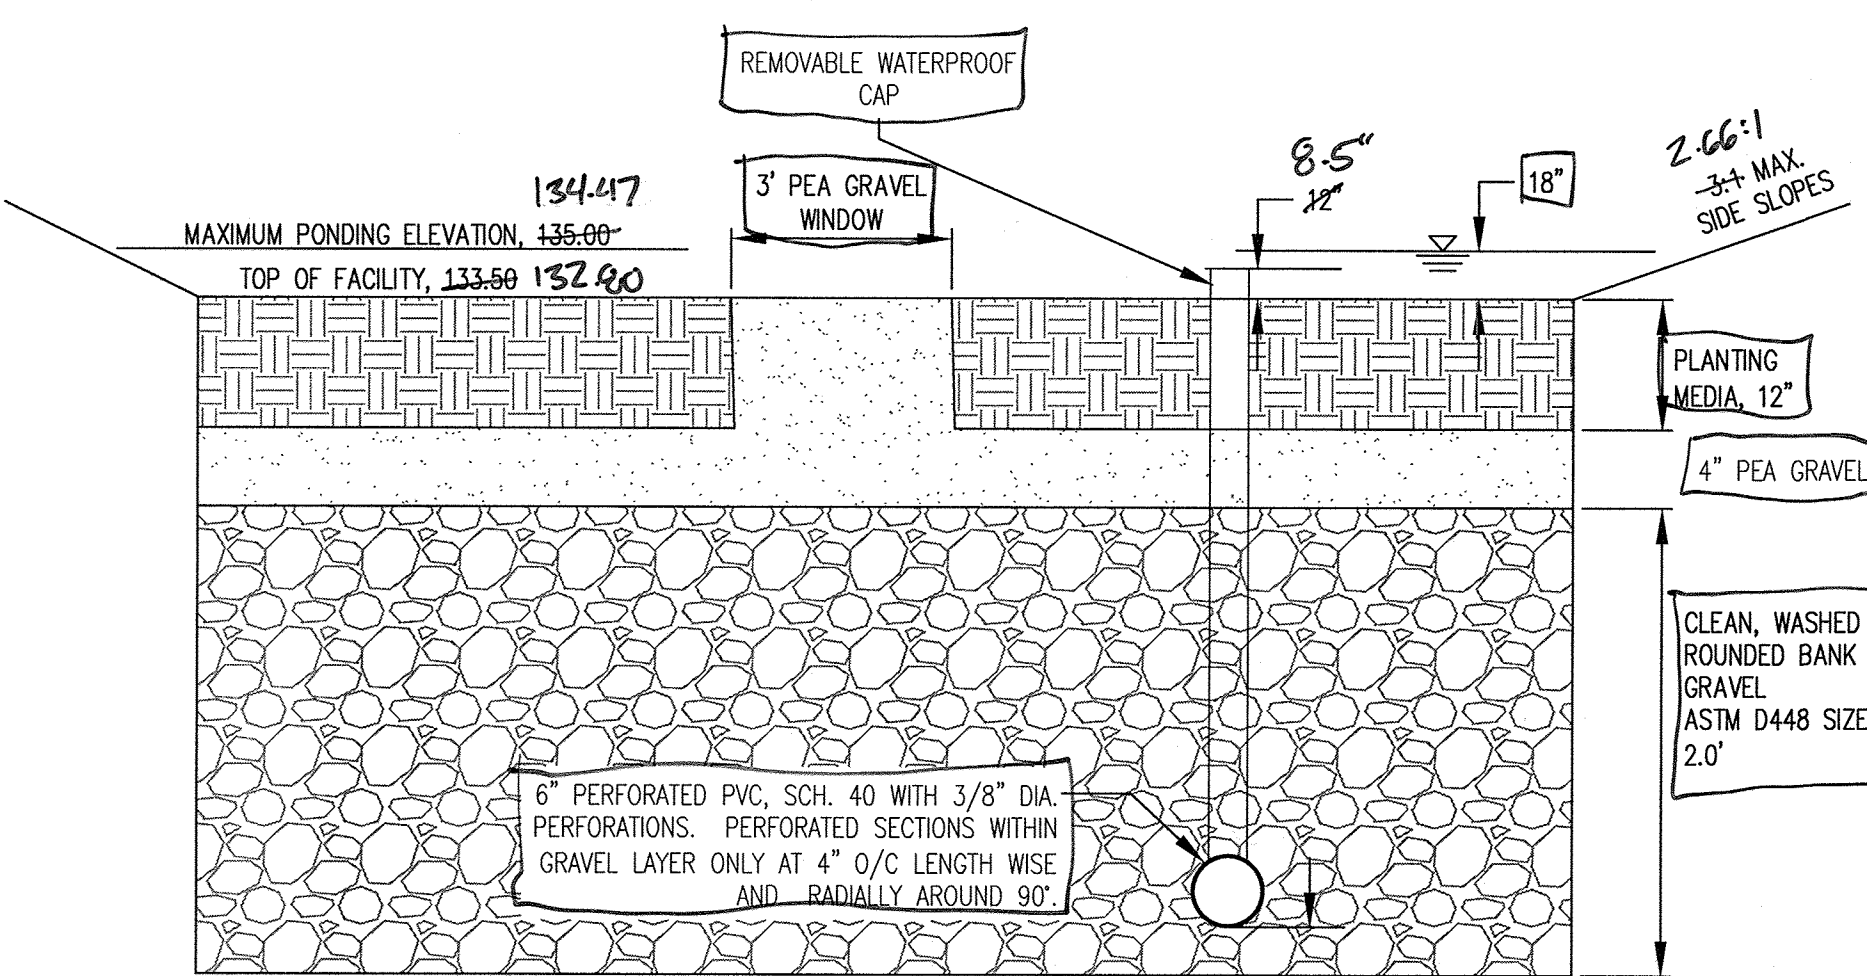

SUBMERGED GRAVEL WETLAND TYPICAL SECTION
NOT TO SCALE

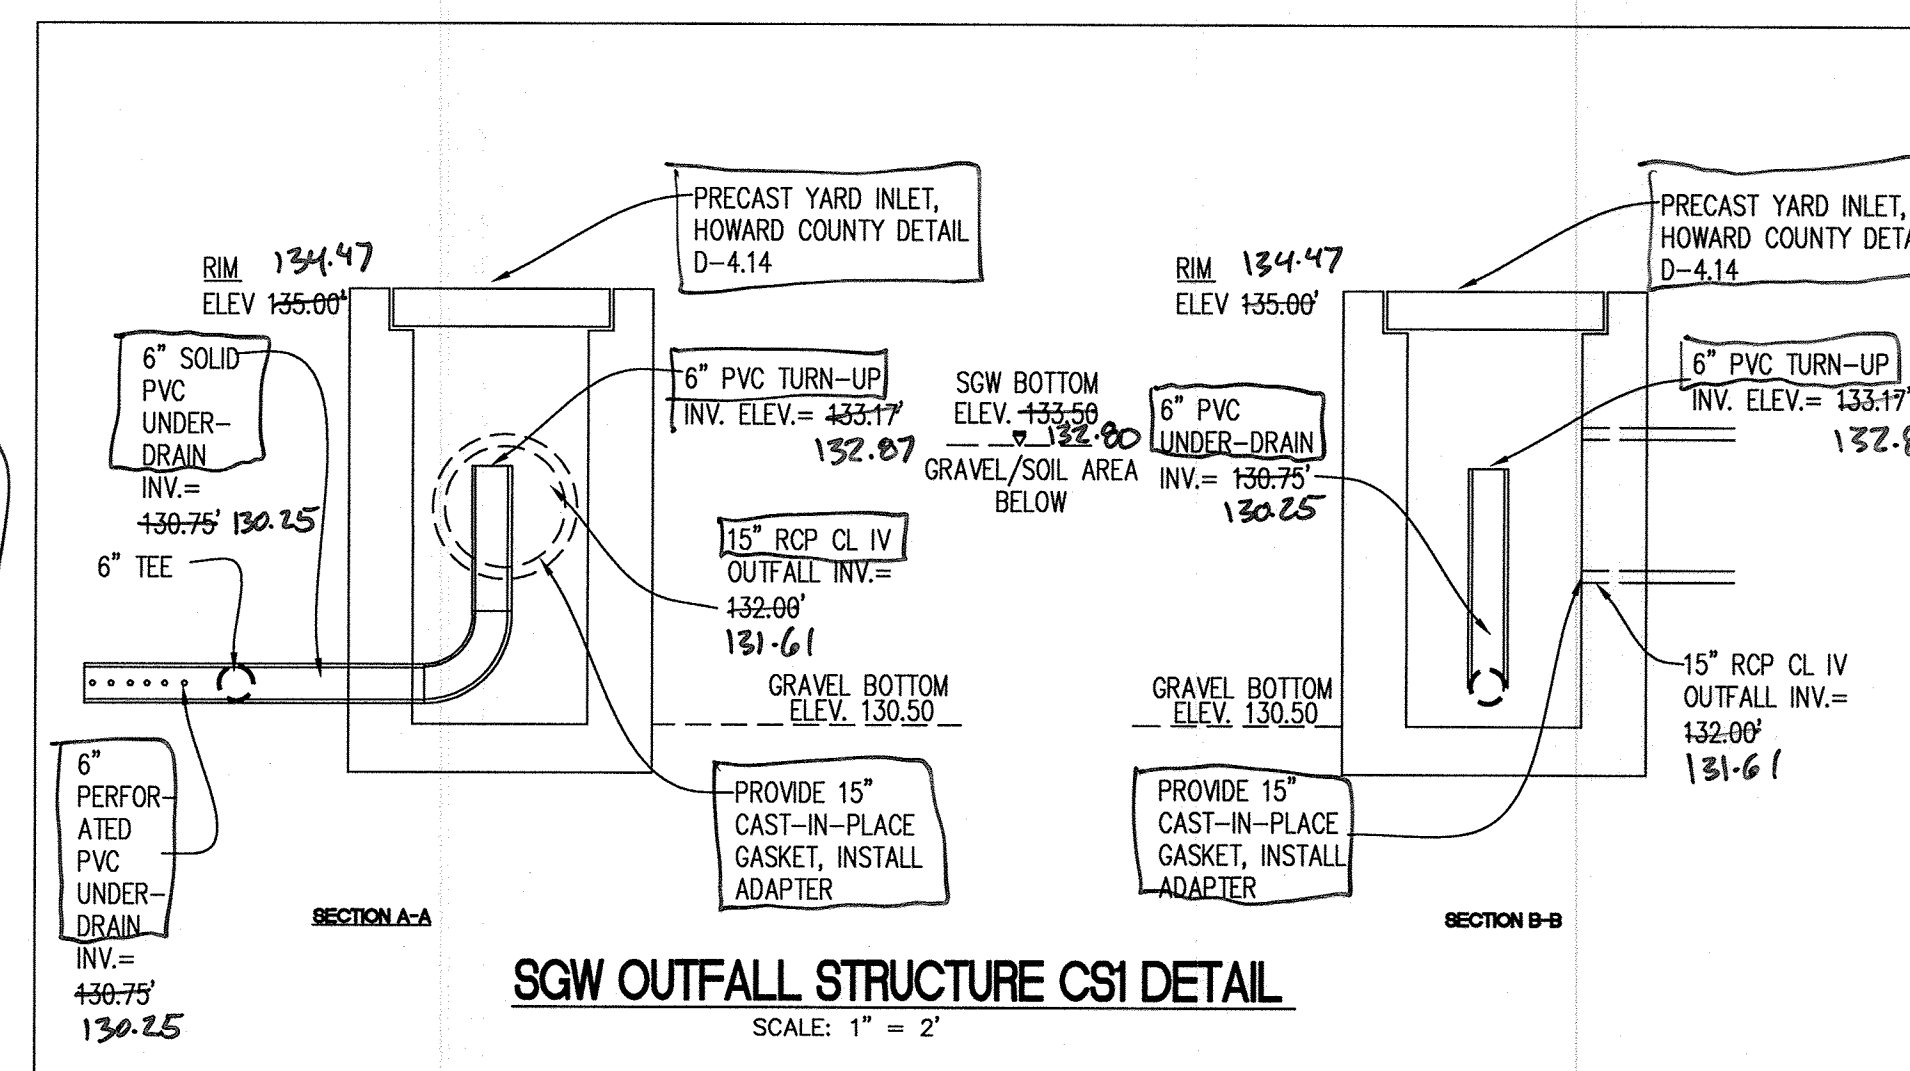


SGW OUTFALL STRUCTURE CS1 DETAIL
SCALE: 1" = 2'

SUBMERGED GRAVEL WETLANDS PLANT SCHEDULE

SYMBOL	QTY.	SCIENTIFIC/COMMON NAME	SIZE	ROOT	REMARKS
AA	9	ARONIA ARBUTIFOLIA 'BRILLIANTISSIMA' RED CHOKEBERRY	3 GAL.	CONT.	AS SHOWN
FG	18	FOTHERGILLA GARDENII 'MT. AIRY' MT. AIRY DWARF FOTHERGILLA	3 GAL.	CONT.	AS SHOWN
IT	18	ITEA VIRGINICA 'HENRY'S GARNET' BLUE FLAG IRIS HENRY'S GARNET VIRGINIA SWEETSPIRE	18-24" HT.	CONT.	AS SHOWN
CE	922	CAREX 'EVERGOLD' EVERGOLD SEDGE	1 QUART	CONT.	18" ON CENTER
EP	1106	EUPATORIUM PURPUREUM JOE PYE WEED	1 QUART	CONT.	18" ON CENTER
IS	1336	IRIS VERSICOLOR 'BLUE FLAG' BLUE FLAG IRIS	1 QUART	CONT.	18" ON CENTER
RL	556	RUDBECKIA LACINIATA 'GOLDQUELLE' GOLDQUELLE CONEFLOWER	1 QUART	CONT.	18" ON CENTER

P:\PRODUCTS\CONTRACTS\1615-COMMERCIAL\1615-030 SDP-17-030.DWG - PROPERTY RECORDS - DEVELOPMENT PERMITS - BUILDING - 11/07/2017 10:59:23

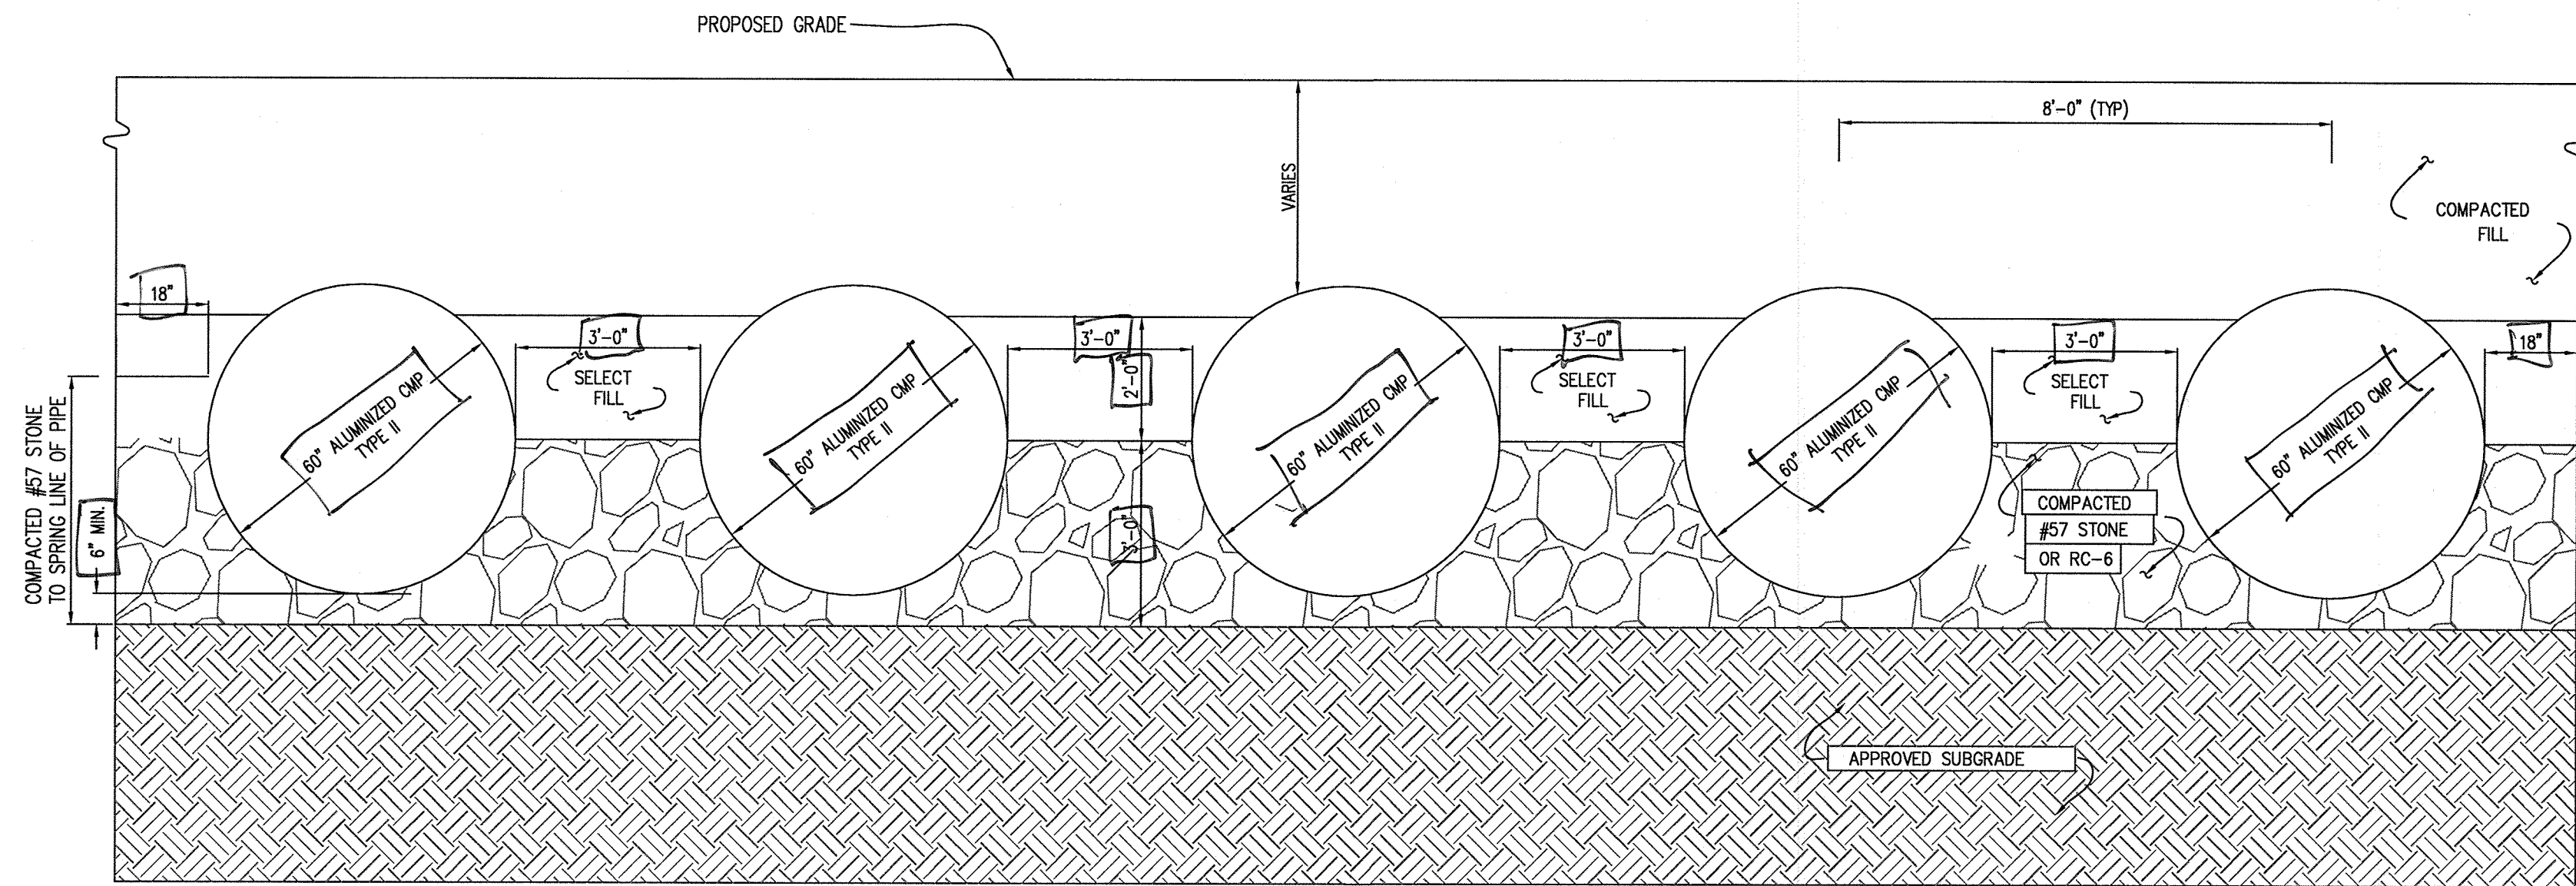

NOTE: SEE PLAN VIEW FOR NUMBER OF PIPES

UNDERGROUND WATER QUANTITY STORAGE PIPES
TYPICAL SECTION
SCALE: 1"=2'

ALL PIPE ENDS MUST BE MATCHED AND NUMBERED BY THE MANUFACTURER

▽ 100 YR WSEL = 139.91
▽ 10 YR WSEL = 138.97
▽ 1 YR WSEL = 137.60

UNDERGROUND STORMWATER MANAGEMENT CONSTRUCTION SPECIFICATIONS

A. SITE PREPARATION

AREAS UNDER THE CULVERTS AND STRUCTURAL WORKS SHALL BE CLEARED, GRUBBED, AND THE TOPSOIL STRIPPED TO REMOVE ALL TREES, VEGETATION, ROOTS, OR OTHER OBJECTIONABLE MATERIAL.

B. SPECIFICATION FOR CORRUGATED STEEL PIPE

DESCRIPTION:

THE ALUMINIZED CMP TYPE II CORRUGATED STEEL SHALL BE FABRICATED IN ACCORDANCE WITH AASHTO DESIGNATION M-274 FROM A BASE METAL MANUFACTURED IN ACCORDANCE WITH ASTM A-525 COATED UNIFORMLY ON BOTH SIDES WITH 1.00 OZ./SQ.FT. OF PURE ALUMINUM.

MATERIAL:

THE 60" DIAMETER CORRUGATED METAL PIPE SHALL BE OF THE CORRUGATION DESIGN AND GAGE INDICATED. THE STEEL PIPE, COUPLERS AND FITTINGS SHALL CONFORM TO THE REQUIREMENTS OF AASHTO M-36 WITH THE PIPE HAVING A 5"X1" CORRUGATION PROFILE AND SHALL BE A MINIMUM 10 GAGE. THE COUPLING BANDS SHALL BE THE SAME MATERIAL AS THE PIPE AND SHALL BE A MINIMUM OF 24 INCHES WIDE. THE CORRUGATED METAL PIPE SHALL BE MANUFACTURED WITH CONTINUOUS LOCKSEAM OR BUTT WELDED HELICAL CORRUGATIONS AND HAVING NO LESS THAN TWO ANNUAL CORRUGATIONS REROLLED AT BOTH ENDS OF ANY LENGTH OF PIPE. COUPLING BANDS SHALL BE FORMED WITH TWO CORRUGATIONS THAT ARE SPACED TO PROVIDE SEATING IN THE SECOND REROLLED CORRUGATION OF EACH PIPE END, AND PIPE ENDS SHALL BE MATCHED AND NUMBERED. ALL ALUMINIZED SURFACES THAT WILL BE IN CONTACT WITH CONCRETE SHALL BE PAINTED WITH ONE COAT OF ZINC CHROMATE PRIMER.

C. INSTALLATION

THE CORRUGATED METAL PIPE SHALL BE HANDLED IN A MANNER NOT TO DAMAGE THE PIPE OR COATING. BEDDING AND BACKFILL MATERIAL SHALL BE SELECTED, GRANULAR MATERIAL AND SHALL BE FREE OF ROCKS AND HARD CLODS LARGER THAN 3-INCHES IN SIZE. THE BEDDING AND BACKFILL MATERIAL SHALL BE CAREFULLY PLACED AND CONSOLIDATED EVENLY ON BOTH SIDES OF THE PIPE IN MAXIMUM 8-INCH LOOSE LIFTS. THE PH OF THE SURROUNDING SOIL SHALL BE LESS THAN (9) AND GREATER THAN (4).

THE MATERIAL MUST COMPLETELY FILL ALL SPACES UNDER AND ADJACENT TO THE STRUCTURE OR PIPE. AT NO TIME DURING THE BACKFILLING OPERATION SHALL DRIVEN EQUIPMENT BE ALLOWED TO OPERATE CLOSER THAN FOUR FEET, MEASURED HORIZONTALLY, TO ANY PART OF THE STRUCTURE. UNDER NO CIRCUMSTANCES SHALL THE CONTRACTOR DRIVE EQUIPMENT OVER A CONCRETE STRUCTURE OR PIPE UNLESS THERE IS A COMPACTED FILL OF 24-INCHES OR GREATER OVER THE STRUCTURE OR PIPE.


CONTRACTOR SHALL BE RESPONSIBLE FOR PROVIDING ADEQUATE SHORING OF TRENCH WALLS TO PREVENT FAILURE DURING CONSTRUCTION.

D. CONNECTIONS

ALL CONNECTIONS SHALL BE COMPLETELY WATERTIGHT. THIS INCLUDES ALL ENDCAPS, PIPES, CONNECTIONS TO AND FROM CONCRETE CONTROL STRUCTURE AND ALL CONNECTIONS FROM STORM DRAINAGE SYSTEM. SEE MATERIAL SPECIFICATIONS ABOVE.


GENERAL NOTES:

1. ALL CONSTRUCTION SHALL MEET HOWARD COUNTY AND MARYLAND STATE HIGHWAY ADMINISTRATION STANDARDS AND SPECIFICATIONS.
2. CONCRETE STRENGTH SHALL BE 4,000 PSI MIN. AT 28 DAYS.
3. REINFORCEMENT SHALL BE CLEAN AND FREE OF RUST AND MEET ASTM-615 GRADE 60.
4. ALL REINFORCEMENT SHALL HAVE 2" MIN. COVER.
5. CONTRACTOR SHALL SUBMIT SHOP DRAWINGS TO THE ENGINEER FOR REVIEW PRIOR TO FABRICATION.
6. THE STRUCTURE FOUNDATION AND PIPE BEDDING SHALL BE APPROVED BY THE GEOTECHNICAL ENGINEER PRIOR TO INSTALLATION.
7. CMP PIPE INSTALLATION PER MANUFACTURER'S RECOMMENDATION.
8. CONTRACTOR SHALL EXERCISE CARE DURING CONSTRUCTION SO AS NOT TO DAMAGE UNDERGROUND S.W.M.F. ANY DAMAGE TO CMP, MANHOLES, ETC. SHALL BE REPAIRED BY CONTRACTOR AT HIS/HER EXPENSE TO SATISFACTION OF ENGINEER.
9. ALL DEBRIS SHALL BE KEPT OUT OF THE FACILITY DURING AND AFTER CONSTRUCTION.

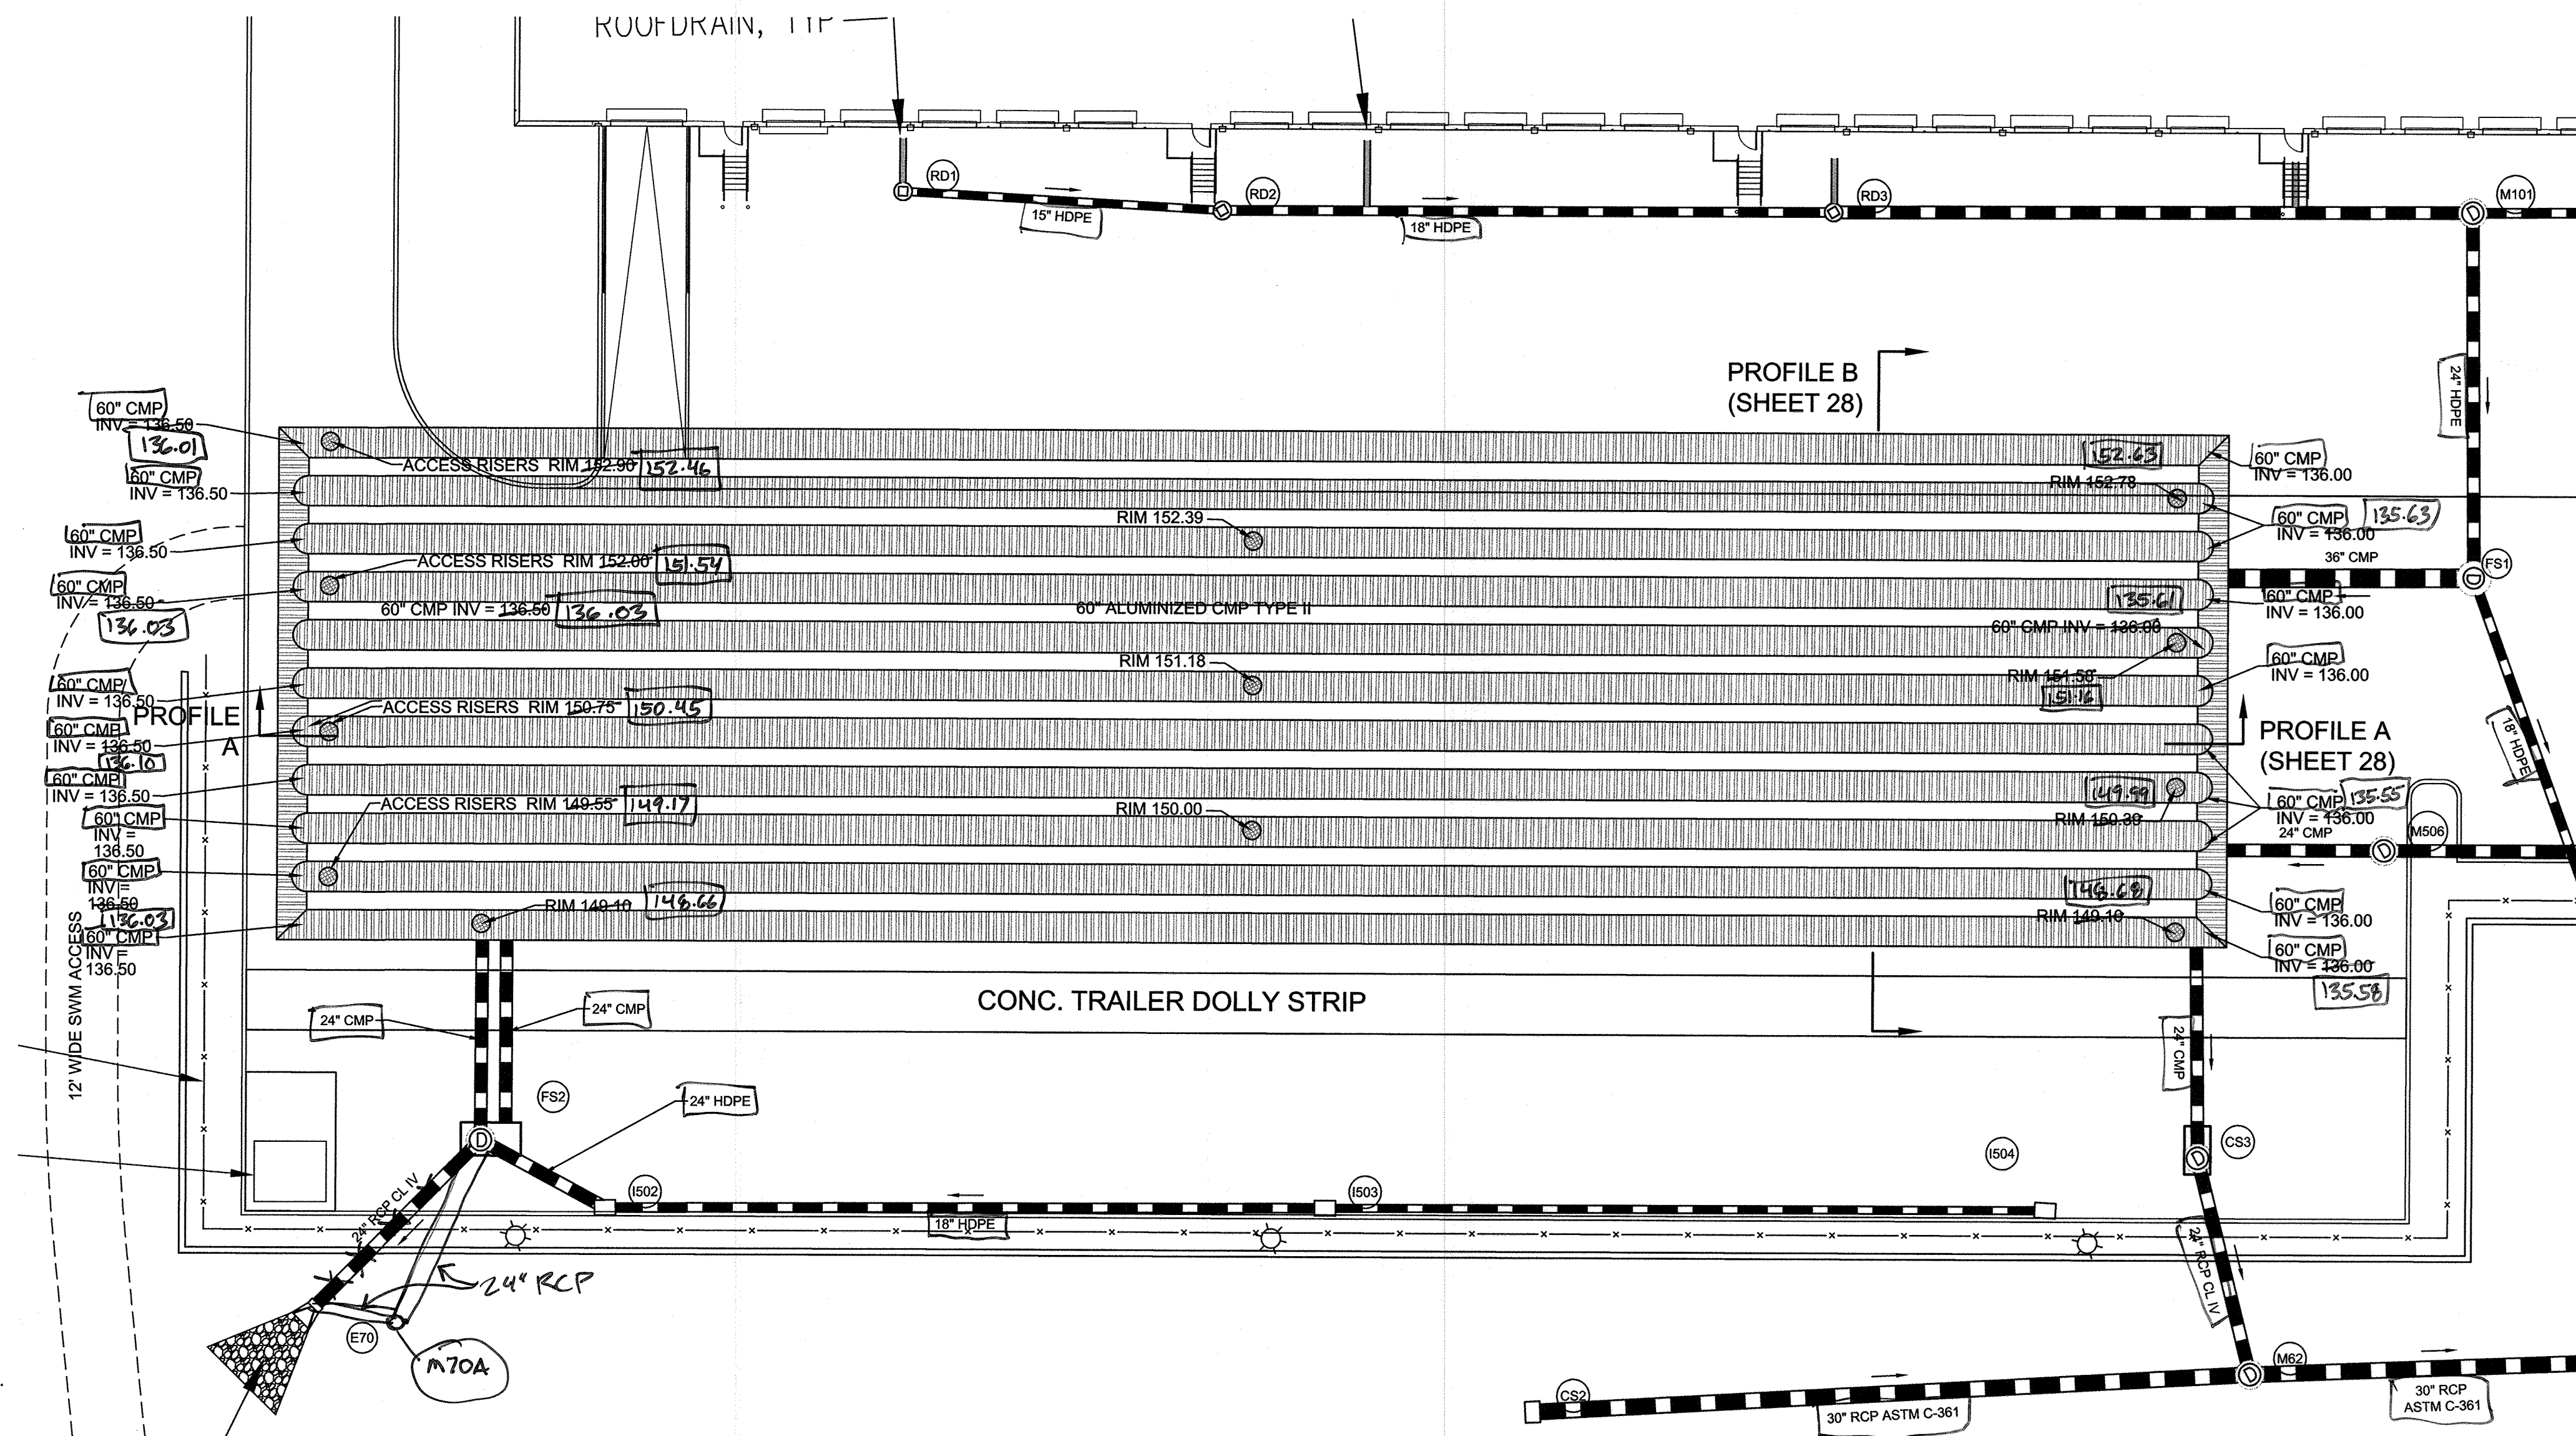


UNDERGROUND STORMWATER MANAGEMENT FACILITY PLAN


1"=20'

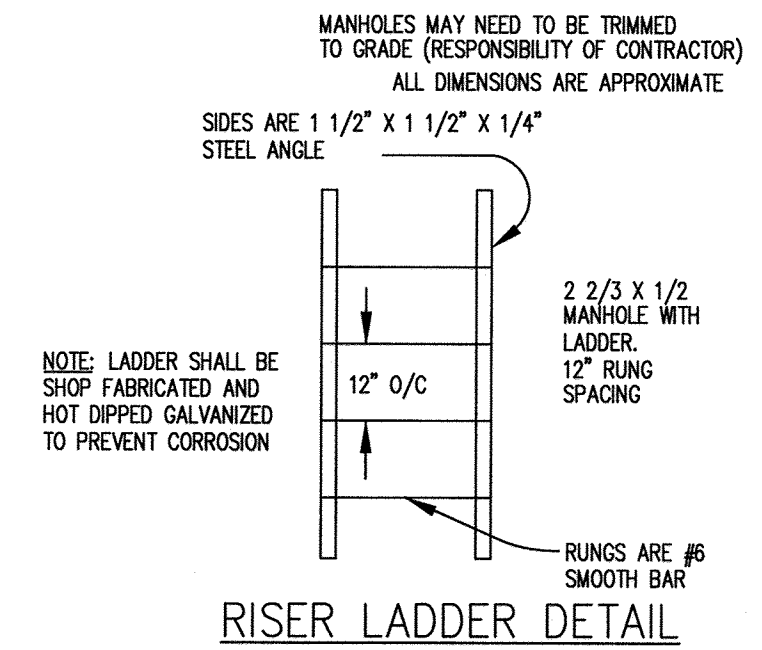


RISER LADDER DETAIL
NOT TO SCALE

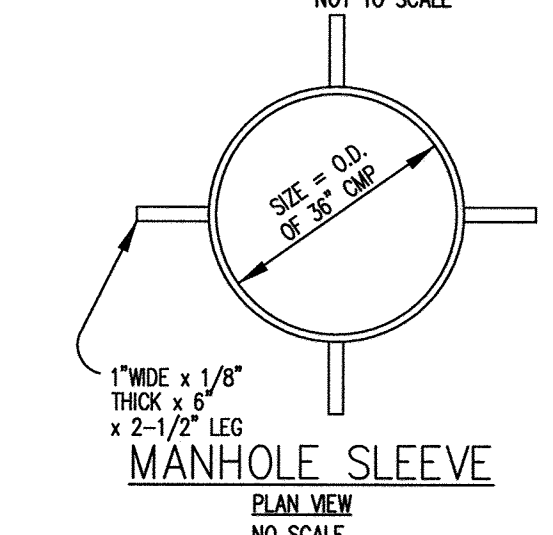


MANHOLE SLEEVE
PLAN VIEW
NO SCALE

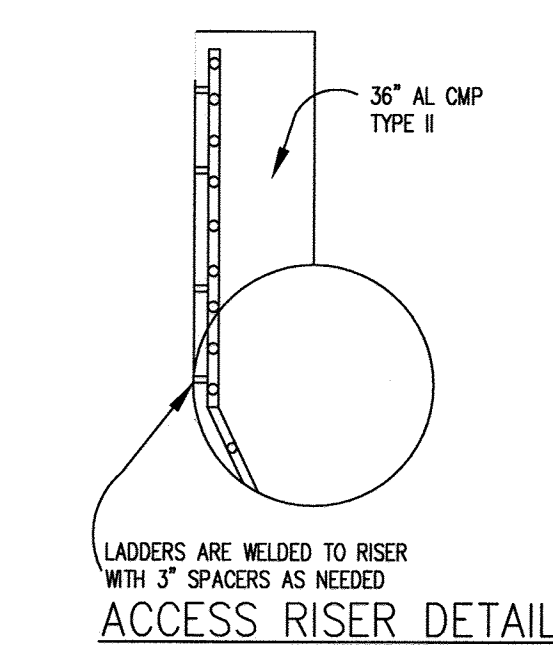


ACCESS RISER DETAIL
NOT TO SCALE

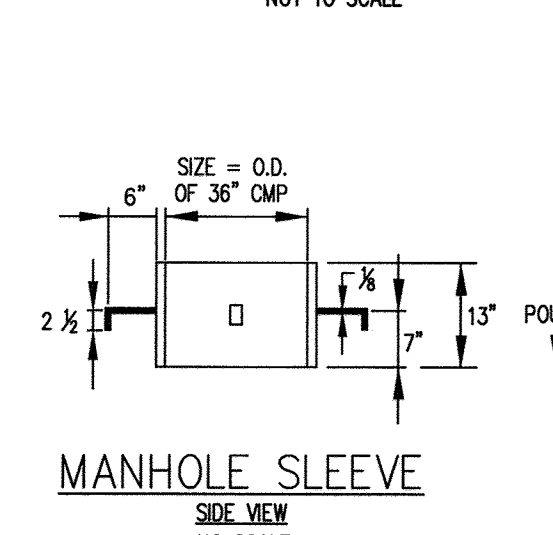

MANHOLE SLEEVE
SIDE VIEW
NO SCALE

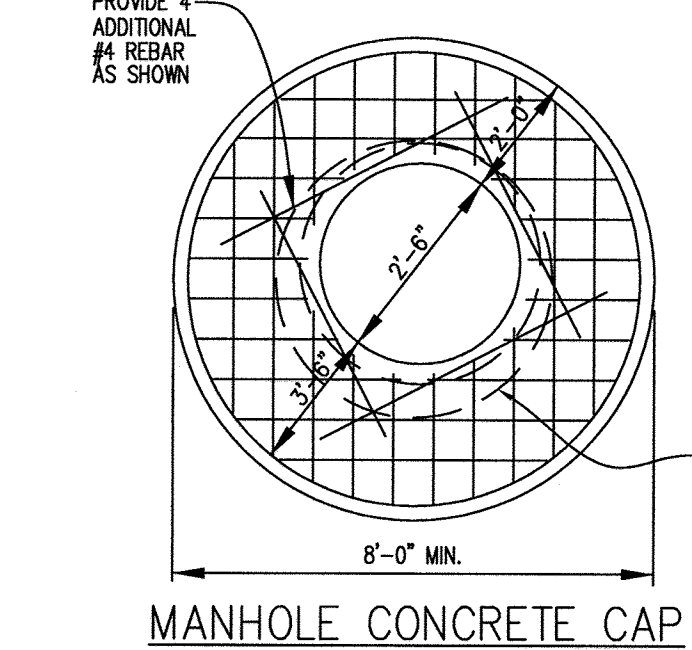

MANHOLE CONCRETE CAP
NOT TO SCALE

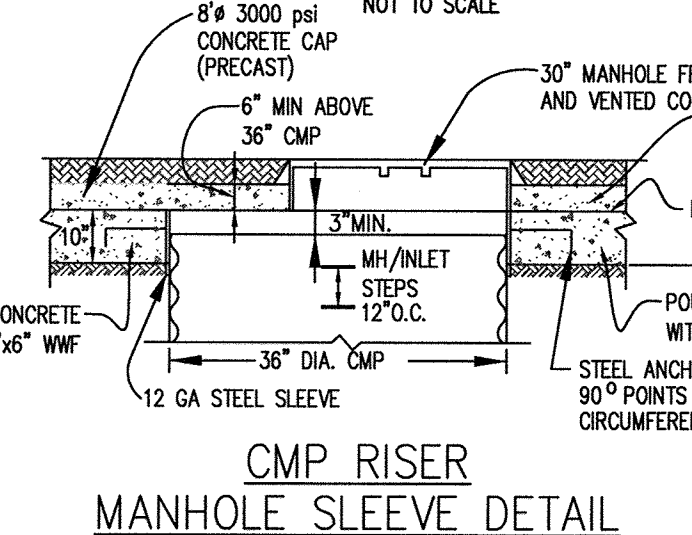

CMP RISER
MANHOLE SLEEVE DETAIL
NO SCALE

AS-BUILT CERTIFICATION
I HEREBY CERTIFY, BY MY SEAL, THAT TO THE BEST OF MY KNOWLEDGE AND BELIEF THE FACILITIES SHOWN ON THIS PLAN WERE CONSTRUCTED AS SHOWN ON THIS "AS-BUILT" PLAN AND MEET THE APPROVED PLANS AND SPECIFICATIONS.

SIGNATURE OF ENGINEER: *Dr. J. L. ...* DATE: 7/1/19
PE # 36916

STATE OF MARYLAND PROFESSIONAL ENGINEER

APPROVED: DEPARTMENT OF PLANNING AND ZONING

DATE	NO.	REVISION	BY

DEVELOPER: DCT INDUSTRIAL, 12011 GUILFORD ROAD, SUITE 102, ANNAPOLIS JUNCTION, MD 20701, ATTN: FRED FERRARO, PHONE: 410-645-5020

OWNER: DCT MEARS LLC, 12011 GUILFORD ROAD, SUITE 102, ANNAPOLIS JUNCTION, MD 20701, ATTN: FRED FERRARO, PHONE: 410-645-5020

PROJECT: TERRAPIN COMMERCE CENTER


AREA: TAX MAP 43, PARCEL 51 LOT PAR A PLAT 23793 ZONED M-2 GRID NO. 11 1st ELECTION DISTRICT 7200 DORSEY RUN ROAD ELKCRIDGE, MARYLAND 21075 HOWARD COUNTY, MARYLAND

TITLE: UNDERGROUND SWM DETAILS AS-BUILT


Penncol Associates Inc. Engineers • Surveyors • Planners Landscape Architects
8818 Centre Park Drive, Suite 200 Columbia, MD 21045 T 410.997.8900 F 410.997.9282

DESIGNED BY: PJS
DRAWN BY: AGS/JSN
PROJECT NO: DCT11601
DATE: JUNE 23, 2017
SCALE: AS SHOWN
DRAWING NO: 24 OF 43

SEAL: PROFESSIONAL ENGINEER, STATE OF MARYLAND, LICENSE NO. 36916, EXPIRATION DATE: 2-15-21

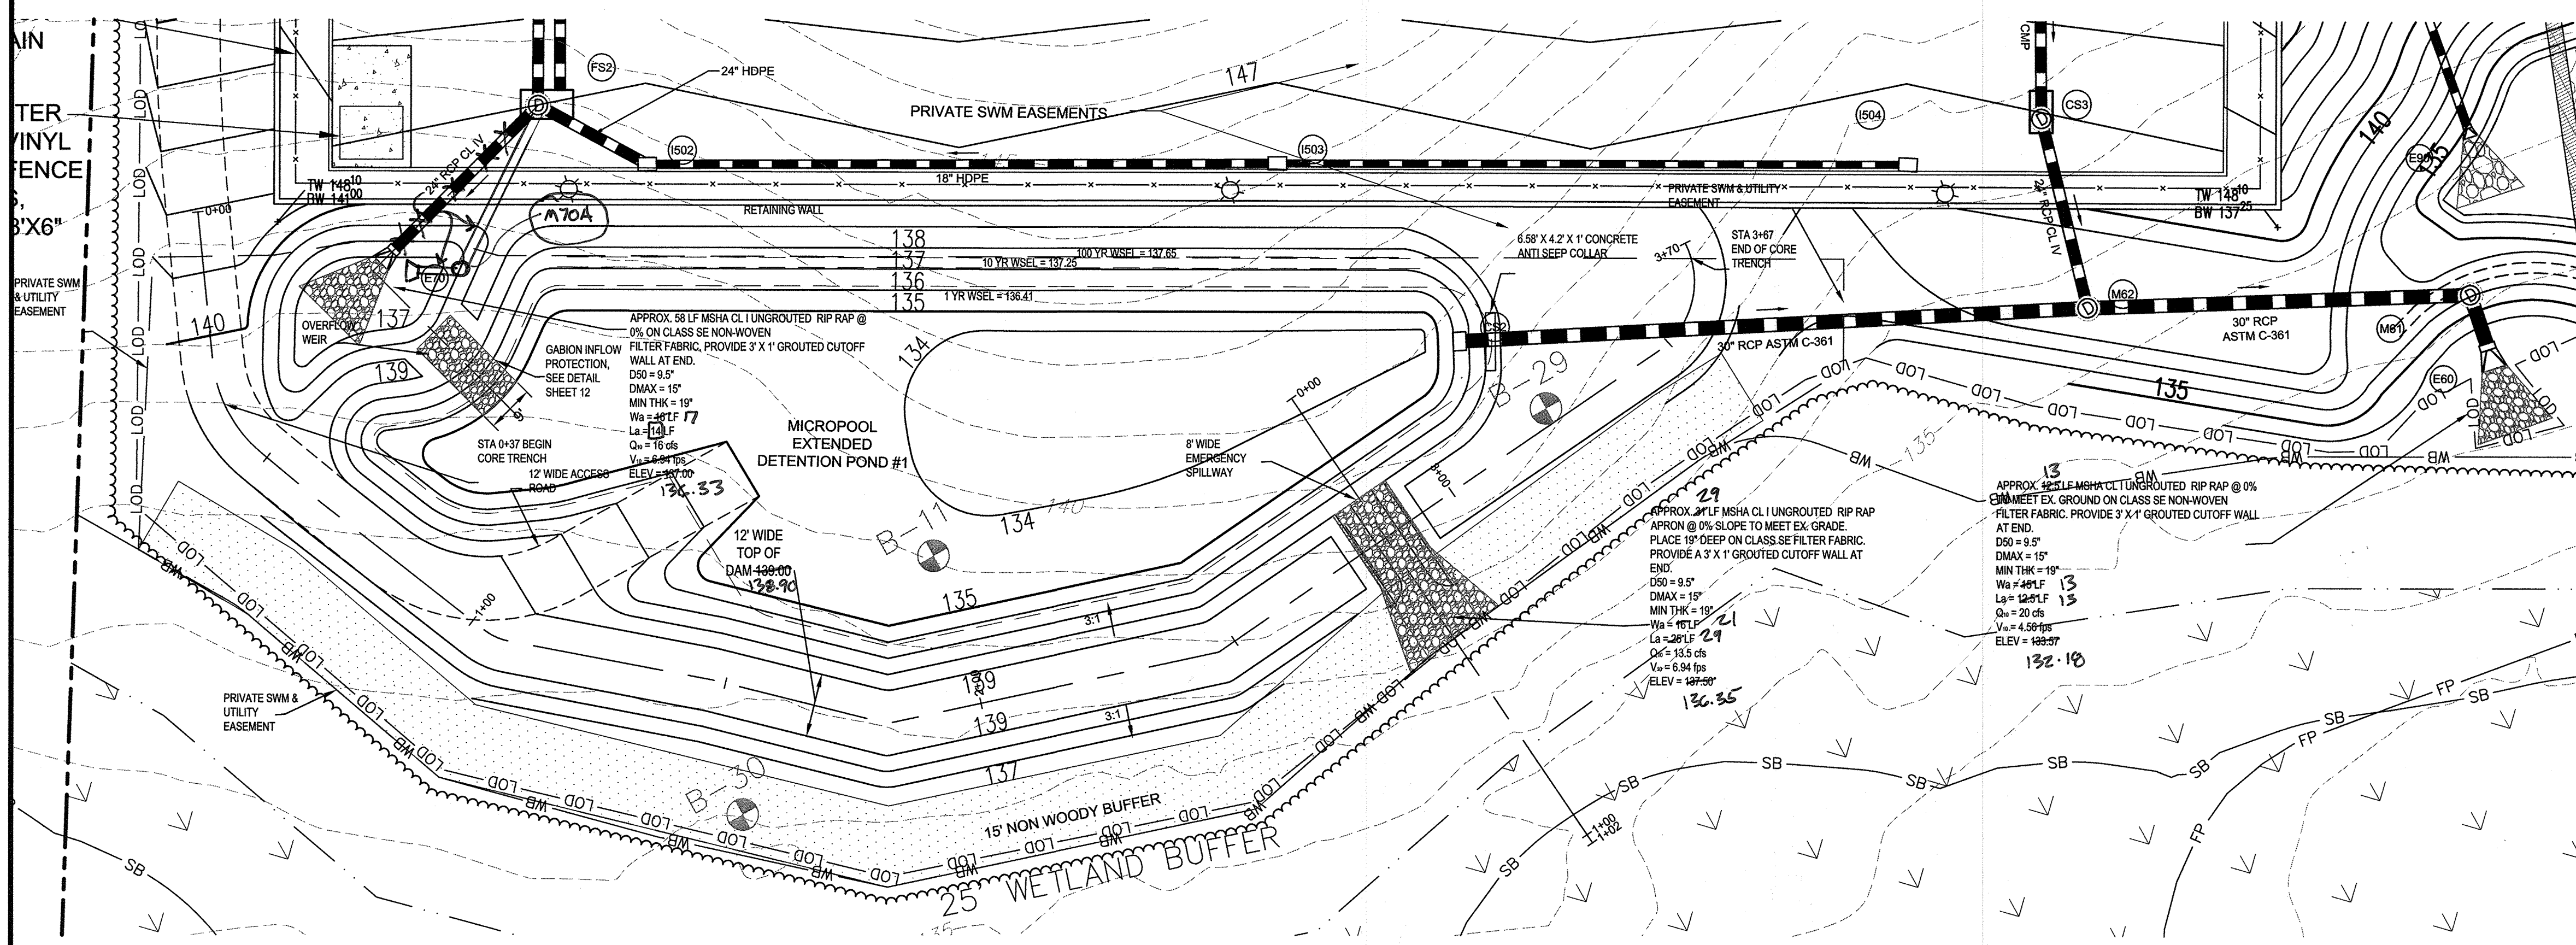

POND PLAN
1"=20'

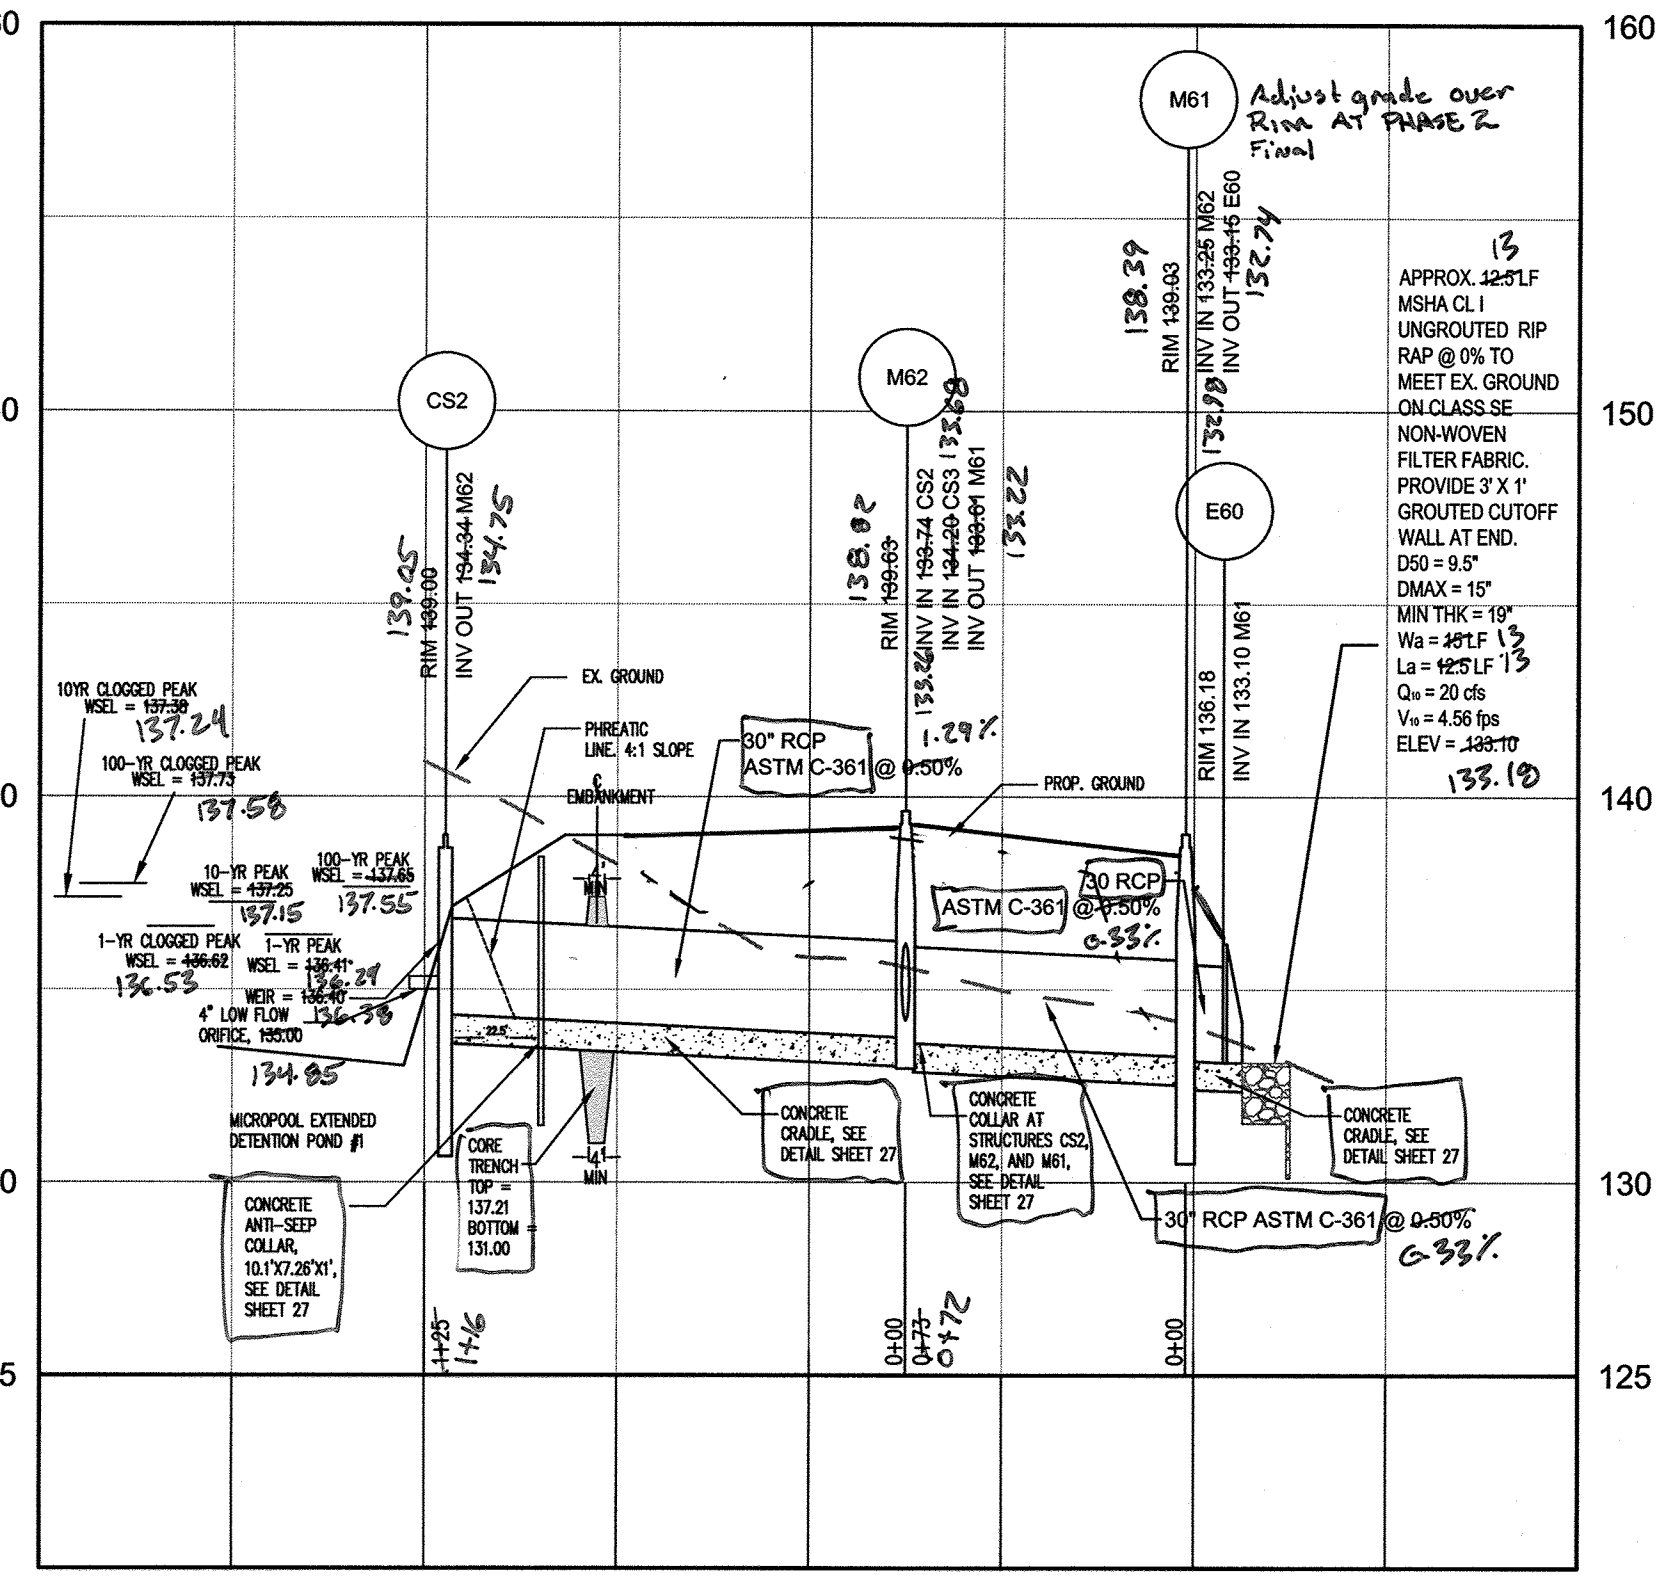

CS2 TO E60 (POND OUTFALL)
HORIZONTAL SCALE: 1" = 50'
VERTICAL SCALE: 1" = 5'

AS-BUILT CERTIFICATION
I HEREBY CERTIFY, BY MY SEAL, THAT TO THE BEST OF MY KNOWLEDGE AND BELIEF THE FACILITIES SHOWN ON THIS PLAN WERE CONSTRUCTED AS SHOWN ON THIS "AS-BUILT" PLAN AND MEET THE APPROVED PLANS AND SPECIFICATIONS.

SIGNATURE OF ENGINEER
Shamir K. Cruz
DATE: 7/8/19
PE # 36096


STATE OF MARYLAND
SHAMIR K. CRUZ
PROFESSIONAL ENGINEER
NO. 38950
EXPIRES 12-15-21

APPROVED: DEPARTMENT OF PLANNING AND ZONING


Shamir K. Cruz
CHIEF, DEVELOPMENT ENGINEERING DIVISION
DATE: 9-22-17

West Sheehan
CHIEF, DIVISION OF LAND DEVELOPMENT
DATE: 9-27-17


Nadine J. J...
DIRECTOR
DATE: 10-2-17

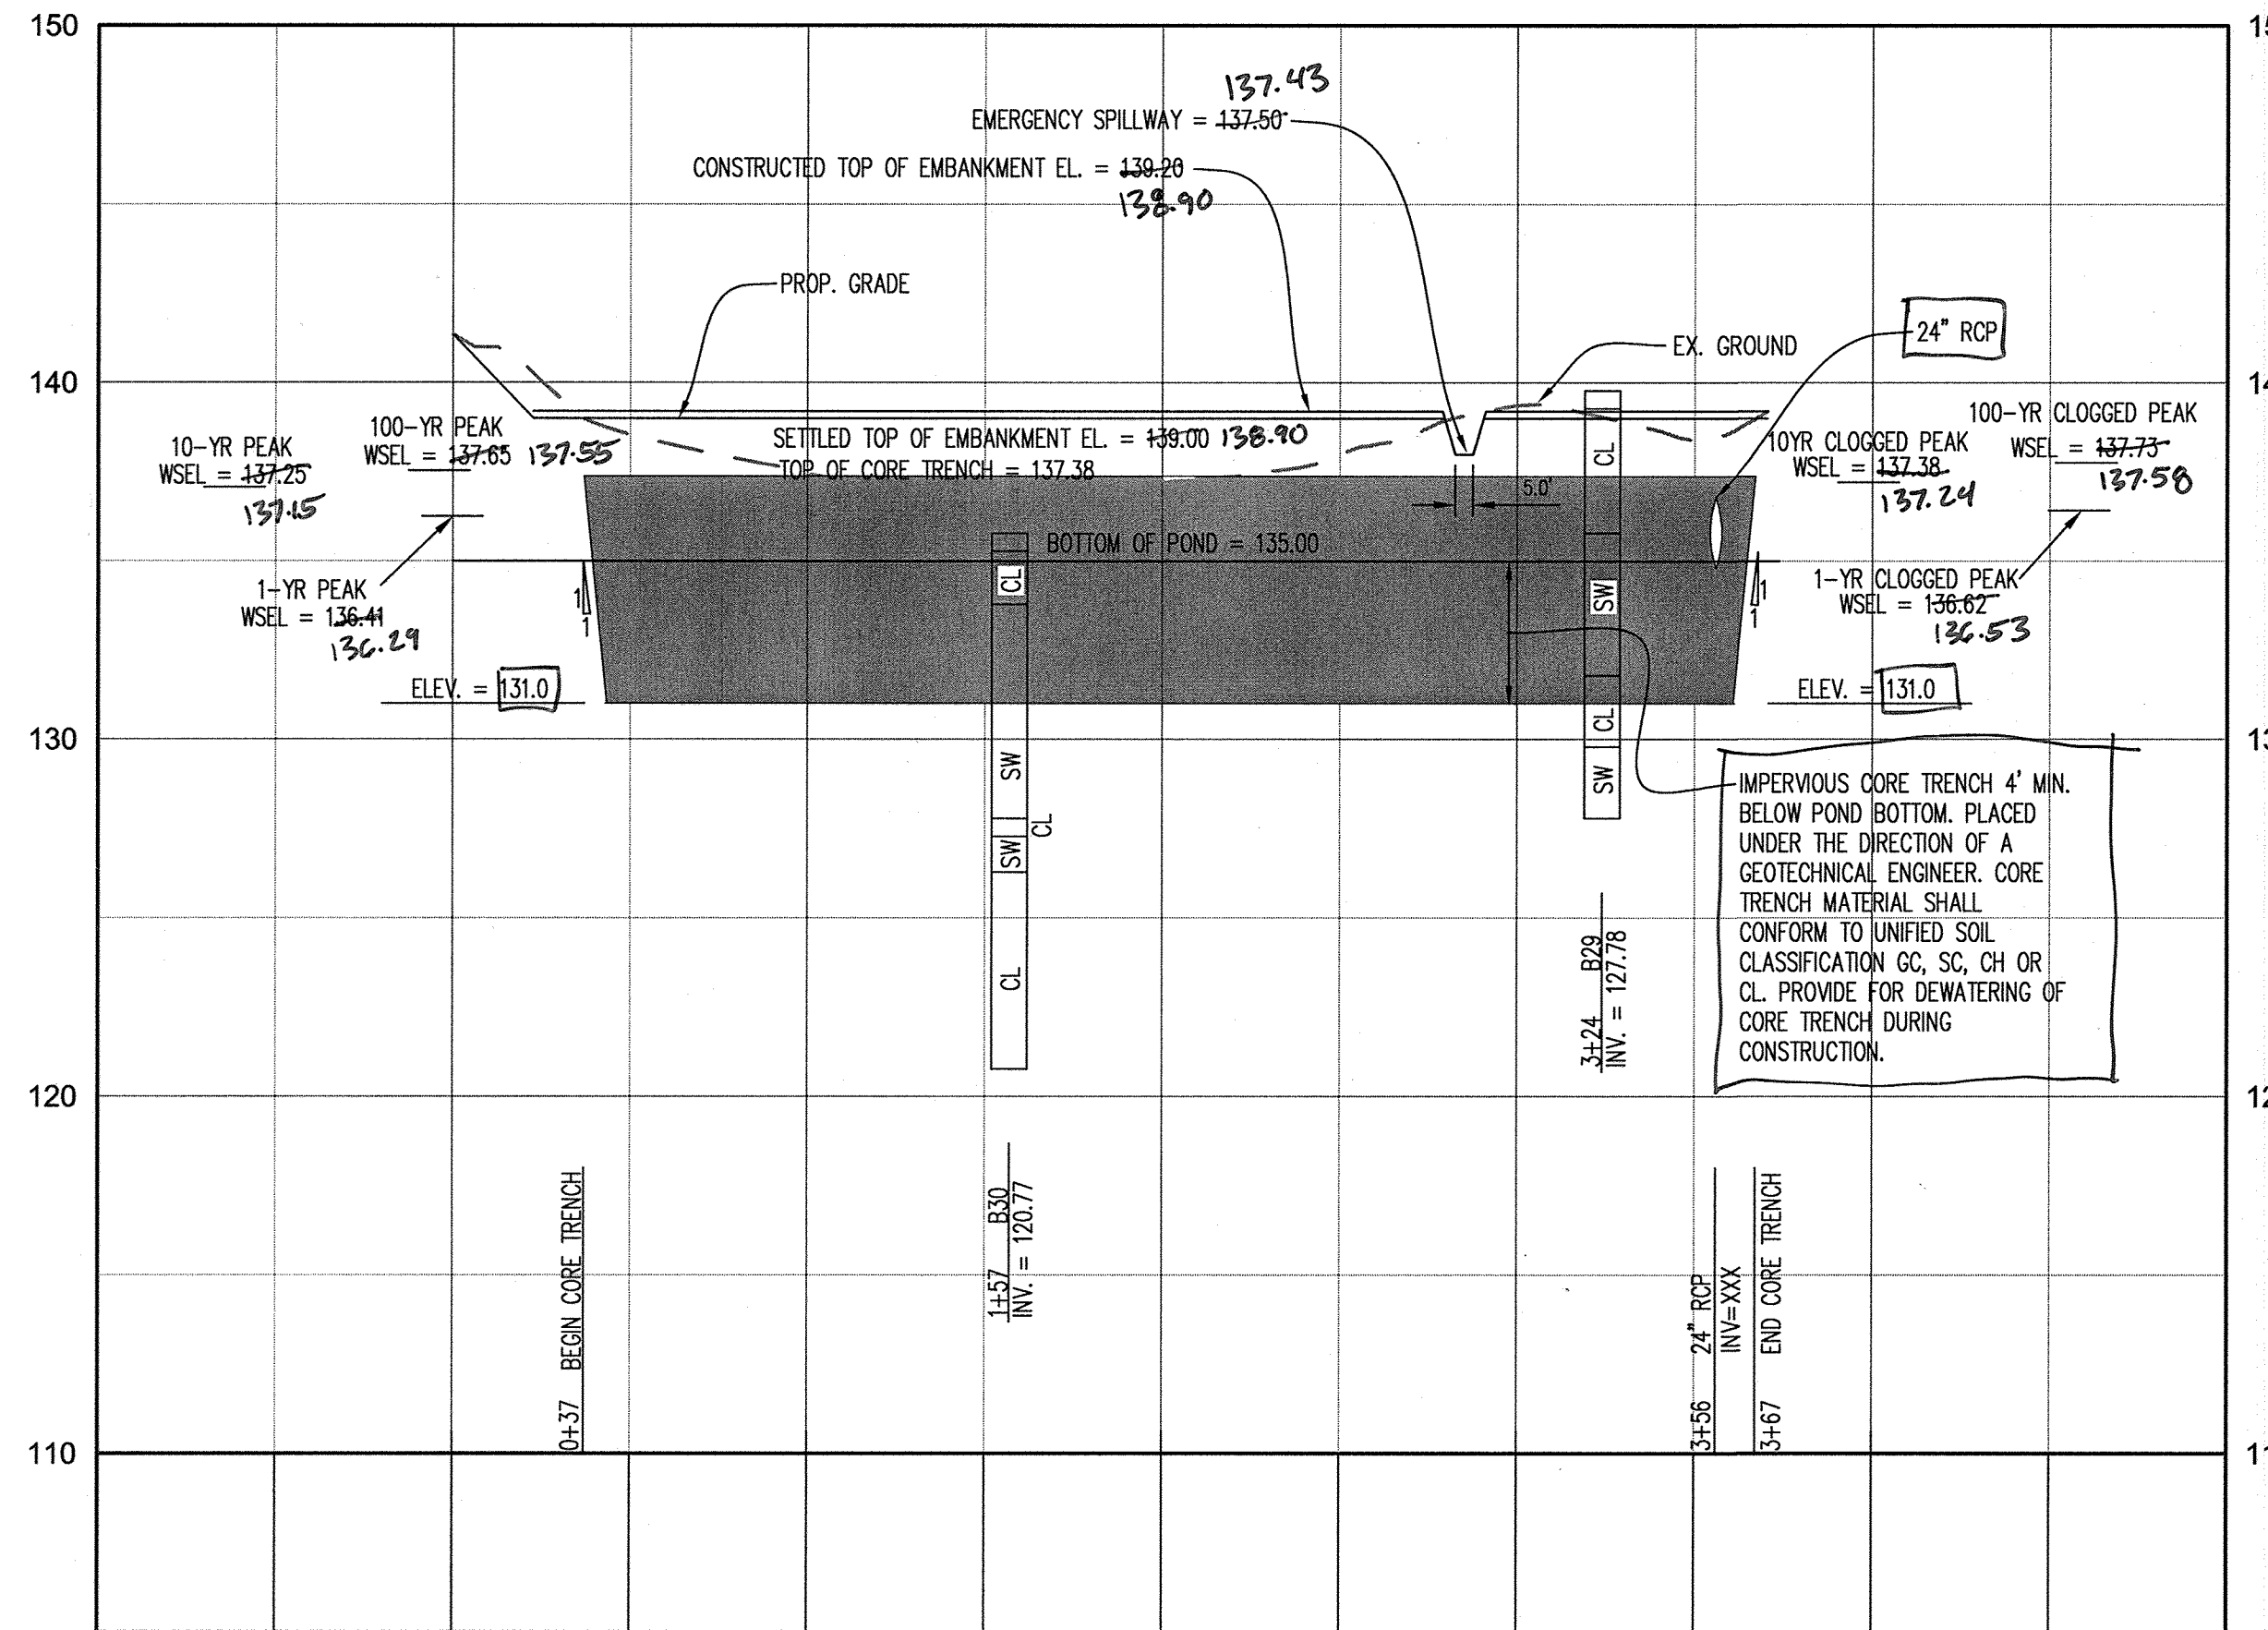

SWAMP POND 1 CENTERLINE EMBANKMENT PROFILE
HORIZONTAL SCALE: 1" = 50'
VERTICAL SCALE: 1" = 5'

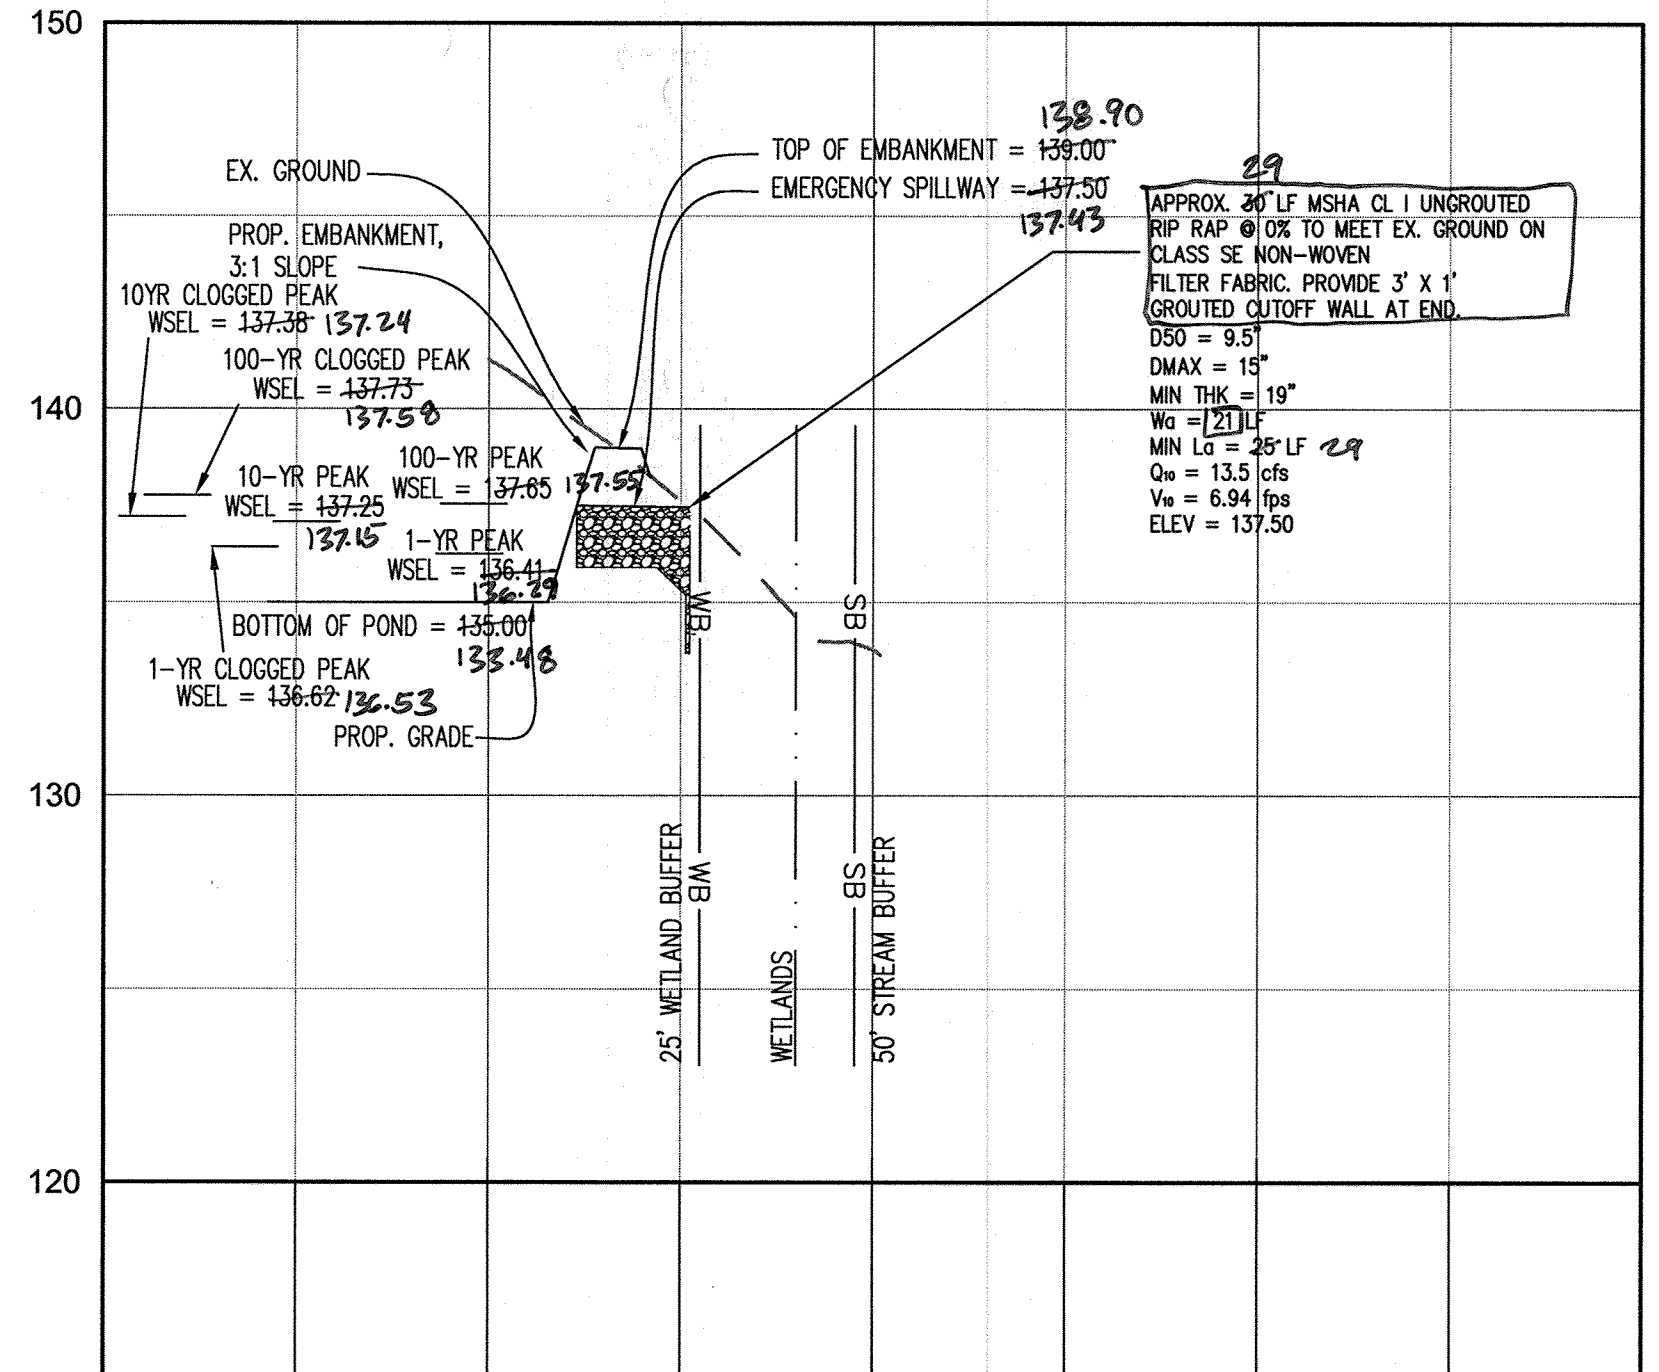

POND 1 EMERGENCY SPILLWAY
HORIZONTAL SCALE: 1" = 50'
VERTICAL SCALE: 1" = 5'

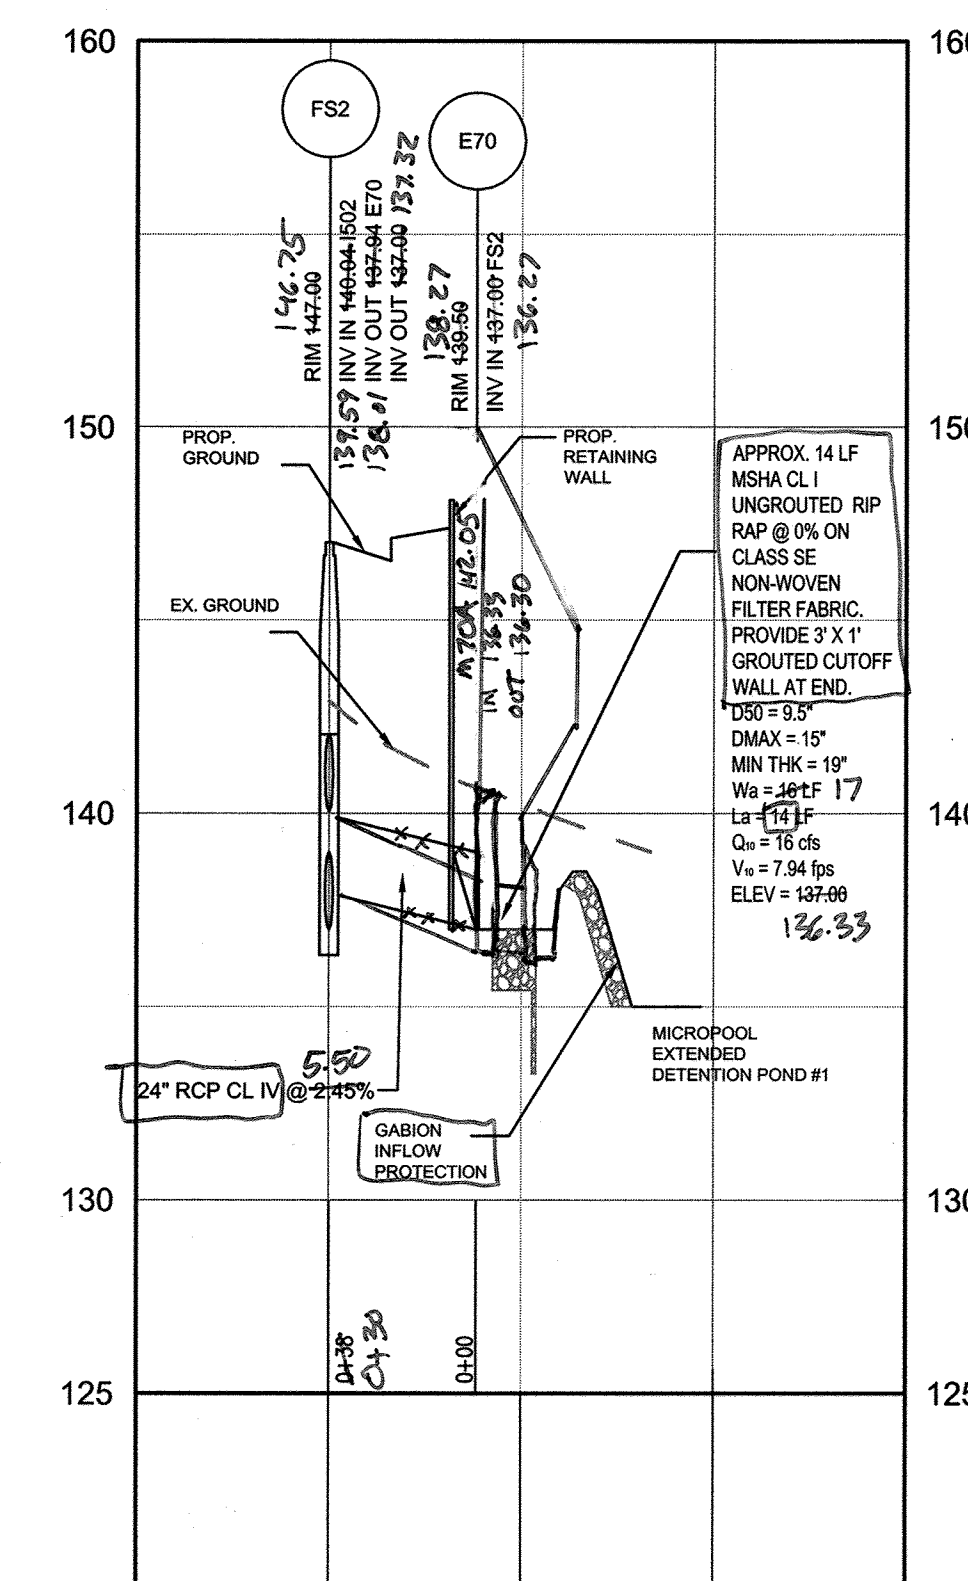


FS2 TO E70
HORIZONTAL SCALE: 1" = 50'
VERTICAL SCALE: 1" = 5'

DATE	NO.	REVISION	BY
DEVELOPER			
DCT INDUSTRIAL 12011 GUILFORD ROAD SUITE 102 ANNAPOLIS JUNCTION, MD 20701 ATTN: FRED FERRARO PHONE: 410-645-5020			
OWNER			
DCT MEARS LLC 12011 GUILFORD ROAD SUITE 102 ANNAPOLIS JUNCTION, MD 20701 ATTN: FRED FERRARO PHONE: 410-645-5020			
PROJECT			
TERRAPIN COMMERCE CENTER			
AREA			
TAX MAP 43, PARCEL 51 LOT PAR A PLAT 23793 ZONED M-2 GRID NO. 11 1st ELECTION DISTRICT 7200 DORSEY RUN ROAD ELKRIDGE, MARYLAND 21075 HOWARD COUNTY, MARYLAND			
TITLE			
STORMWATER MANAGEMENT POND 1 DETAILS AS-BUILT			
Pennoni Associates Inc. Engineers • Surveyors • Planners Landscape Architects 8818 Centre Park Drive, Suite 200 Columbia, MD 21045 T 410.997.8900 F 410.997.9282			
SEAL			
DESIGNED BY: PJS			
DRAWN BY: AGS/JSN			
PROJECT NO: DCT1601			
DATE: JUNE 23, 2017			
SCALE: AS SHOWN			
DRAWING NO. 25 OF 43			

GENERAL NOTES FOR TRASH RACK (CS3)

1. STEEL TO CONFORM TO ASTM A-36.
2. ALL SURFACES OF TRASH RACK(S) MUST BE HOT DIPPED GALVANIZED AFTER FABRICATION.
3. TRASH RACK TO BE FASTENED TO WALL WITH 1/2" MASONRY ANCHORS. TRASH RACK TO BE REMOVABLE.
4. TRASH RACK TO BE HORIZONTALLY CENTERED OVER OPENING.
5. FABRICATOR MAY MODIFY COMPONENTS OF TRASH RACK FRAME TO IMPROVE CONSTRUCTABILITY OF TRASH RACK. SHOP DRAWINGS SHOWING MODIFICATIONS MUST BE APPROVED BY BALTIMORE COUNTY DEPRM PRIOR TO FABRICATION.

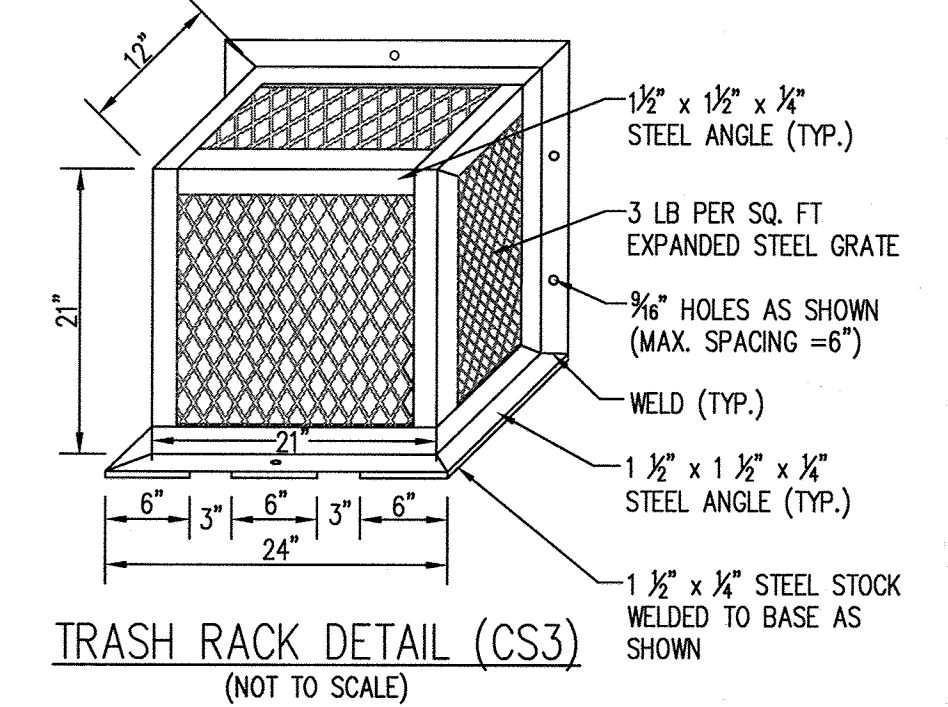

AS-BUILT CERTIFICATION
 I HEREBY CERTIFY, BY MY SEAL, THAT TO THE BEST OF MY KNOWLEDGE AND BELIEF THE FACILITIES SHOWN ON THIS PLAN WERE CONSTRUCTED AS SHOWN ON THIS "AS-BUILT" PLAN AND MEET THE APPROVED PLANS AND SPECIFICATIONS.

DATE: 7/2/19
 SIGNATURE OF ENGINEER: [Signature]
 PE # 36896

I HEREBY CERTIFY THAT THESE DOCUMENTS WERE PREPARED OR APPROVED BY ME, AND THAT I AM A DULY LICENSED PROFESSIONAL ENGINEER UNDER THE LAWS OF THE STATE OF MARYLAND, LICENSE NO. 36896, EXPIRATION DATE: 2-15-21.

STATE OF MARYLAND PROFESSIONAL ENGINEER

APPROVED: DEPARTMENT OF PLANNING AND ZONING


DATE	NO.	REVISION	BY

CHIEF, DEVELOPMENT ENGINEERING DIVISION: [Signature] DATE: 4-21-17
 CHIEF, DIVISION OF LAND DEVELOPMENT: [Signature] DATE: 9-27-17
 DIRECTOR: [Signature] DATE: 10-2-17

DEVELOPER	DCT INDUSTRIAL 12011 GUILFORD ROAD SUITE 102 ANNAPOLIS JUNCTION, MD 20701 ATTN: FRED FERRARO PHONE: 410-645-5020
OWNER	DCT MEARS LLC 12011 GUILFORD ROAD SUITE 102 ANNAPOLIS JUNCTION, MD 20701 ATTN: FRED FERRARO PHONE: 410-645-5020
PROJECT	TERRAPIN COMMERCE CENTER
AREA	TAX MAP 43, PARCEL 51 LOT PAR A PLAT 23793 ZONED M-2 GRID NO. 11 1st ELECTION DISTRICT 7200 DORSEY RUN ROAD ELK RIDGE, MARYLAND 21075 HOWARD COUNTY, MARYLAND
TITLE	STORMWATER MANAGEMENT DETAILS AS-BUILT
	Pennoni Associates Inc. Engineers • Surveyors • Planners Landscape Architects
	8818 Centre Park Drive, Suite 200 Columbia, MD 21045 T 410.997.8900 F 410.997.9282


SEAL: [Professional Engineer Seal]

DESIGNED BY:	PJS
DRAWN BY:	AGS/JSN
PROJECT NO.:	DCT11601
DATE:	JUNE 23, 2017
SCALE:	AS SHOWN
DRAWING NO.:	26 OF 43

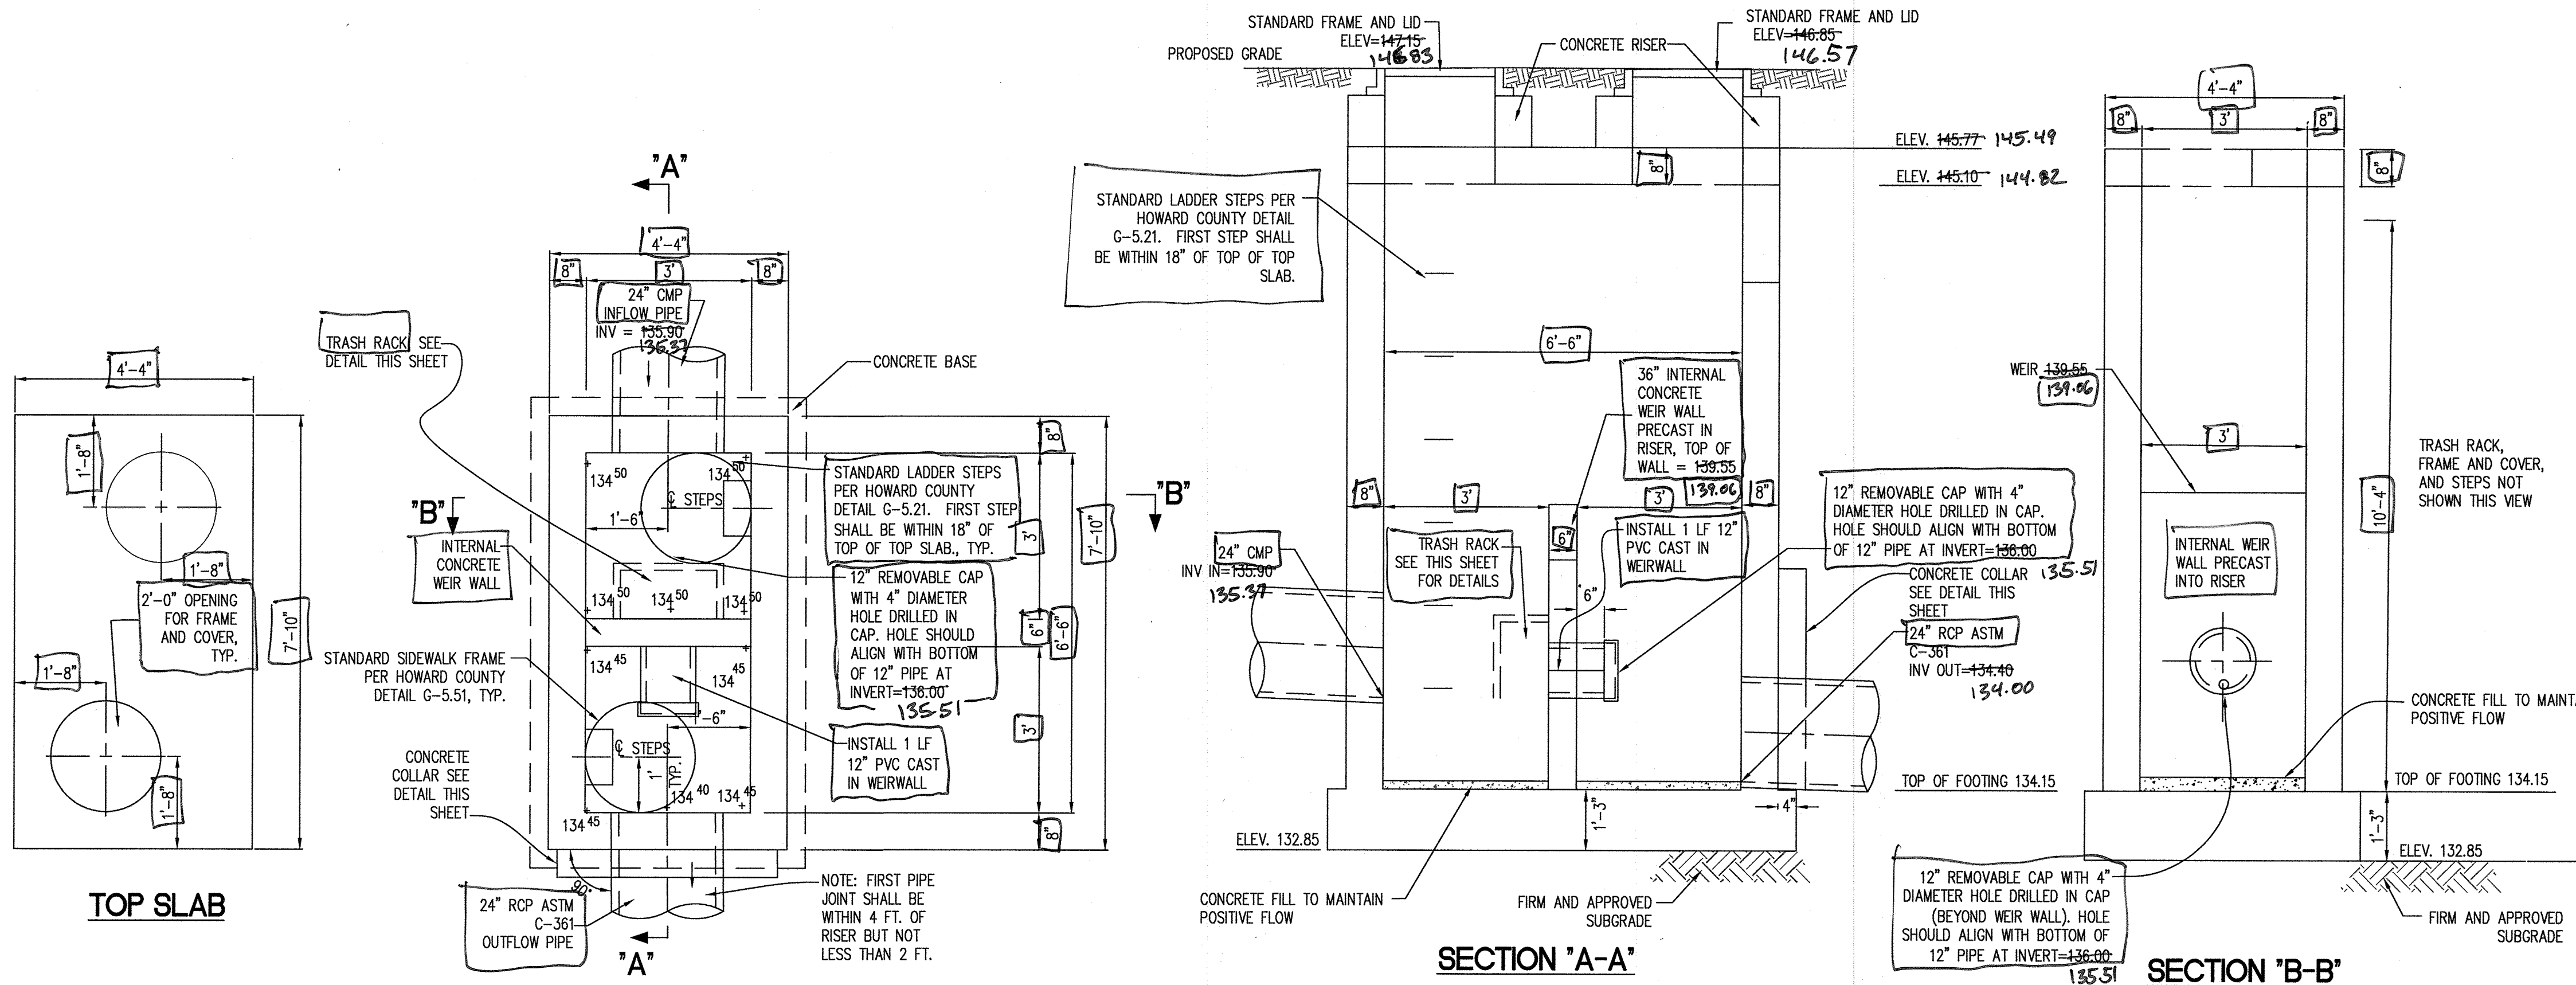


CONTROL STRUCTURE DETAIL CS3
 SCALE: 1"=2"

PRECAST RISER NOTE:
 SHOP DRAWING FOR PRE-CAST CONCRETE RISERS WITH SUPPORTING STRUCTURAL COMPUTATIONS (SIGNED AND SEALED BY A MARYLAND REGISTERED PROFESSIONAL ENGINEER) MEETING ASTM REQUIREMENTS FOR PRE-CAST STRUCTURES MUST BE SUBMITTED TO THE ENGINEER, AND THE APPROVING AGENCY (HOWARD COUNTY DEPARTMENT OF PUBLIC WORKS AND TRANSPORTATION) FOR APPROVAL PRIOR TO FABRICATION. IF ANY STRUCTURE DIMENSIONS VARY FROM WHAT WAS ORIGINALLY REVIEWED/APPROVED, THEN THE HYDRAULICS, FLOTATION AND STRUCTURAL INTEGRITY WILL HAVE TO BE RE-ANALYZED. ALL JOINTS AND CONNECTIONS MUST BE WATERTIGHT. THE METHOD OF ACHIEVING WATERTIGHT SEAL BETWEEN THE RISER STRUCTURE, AND ALL CONDUITS (I.E., BARREL AND LOW FLOW PIPES) SHALL BE APPROVED BY THE ENGINEER IN CHARGE, AND DPWT PRIOR TO FABRICATION.

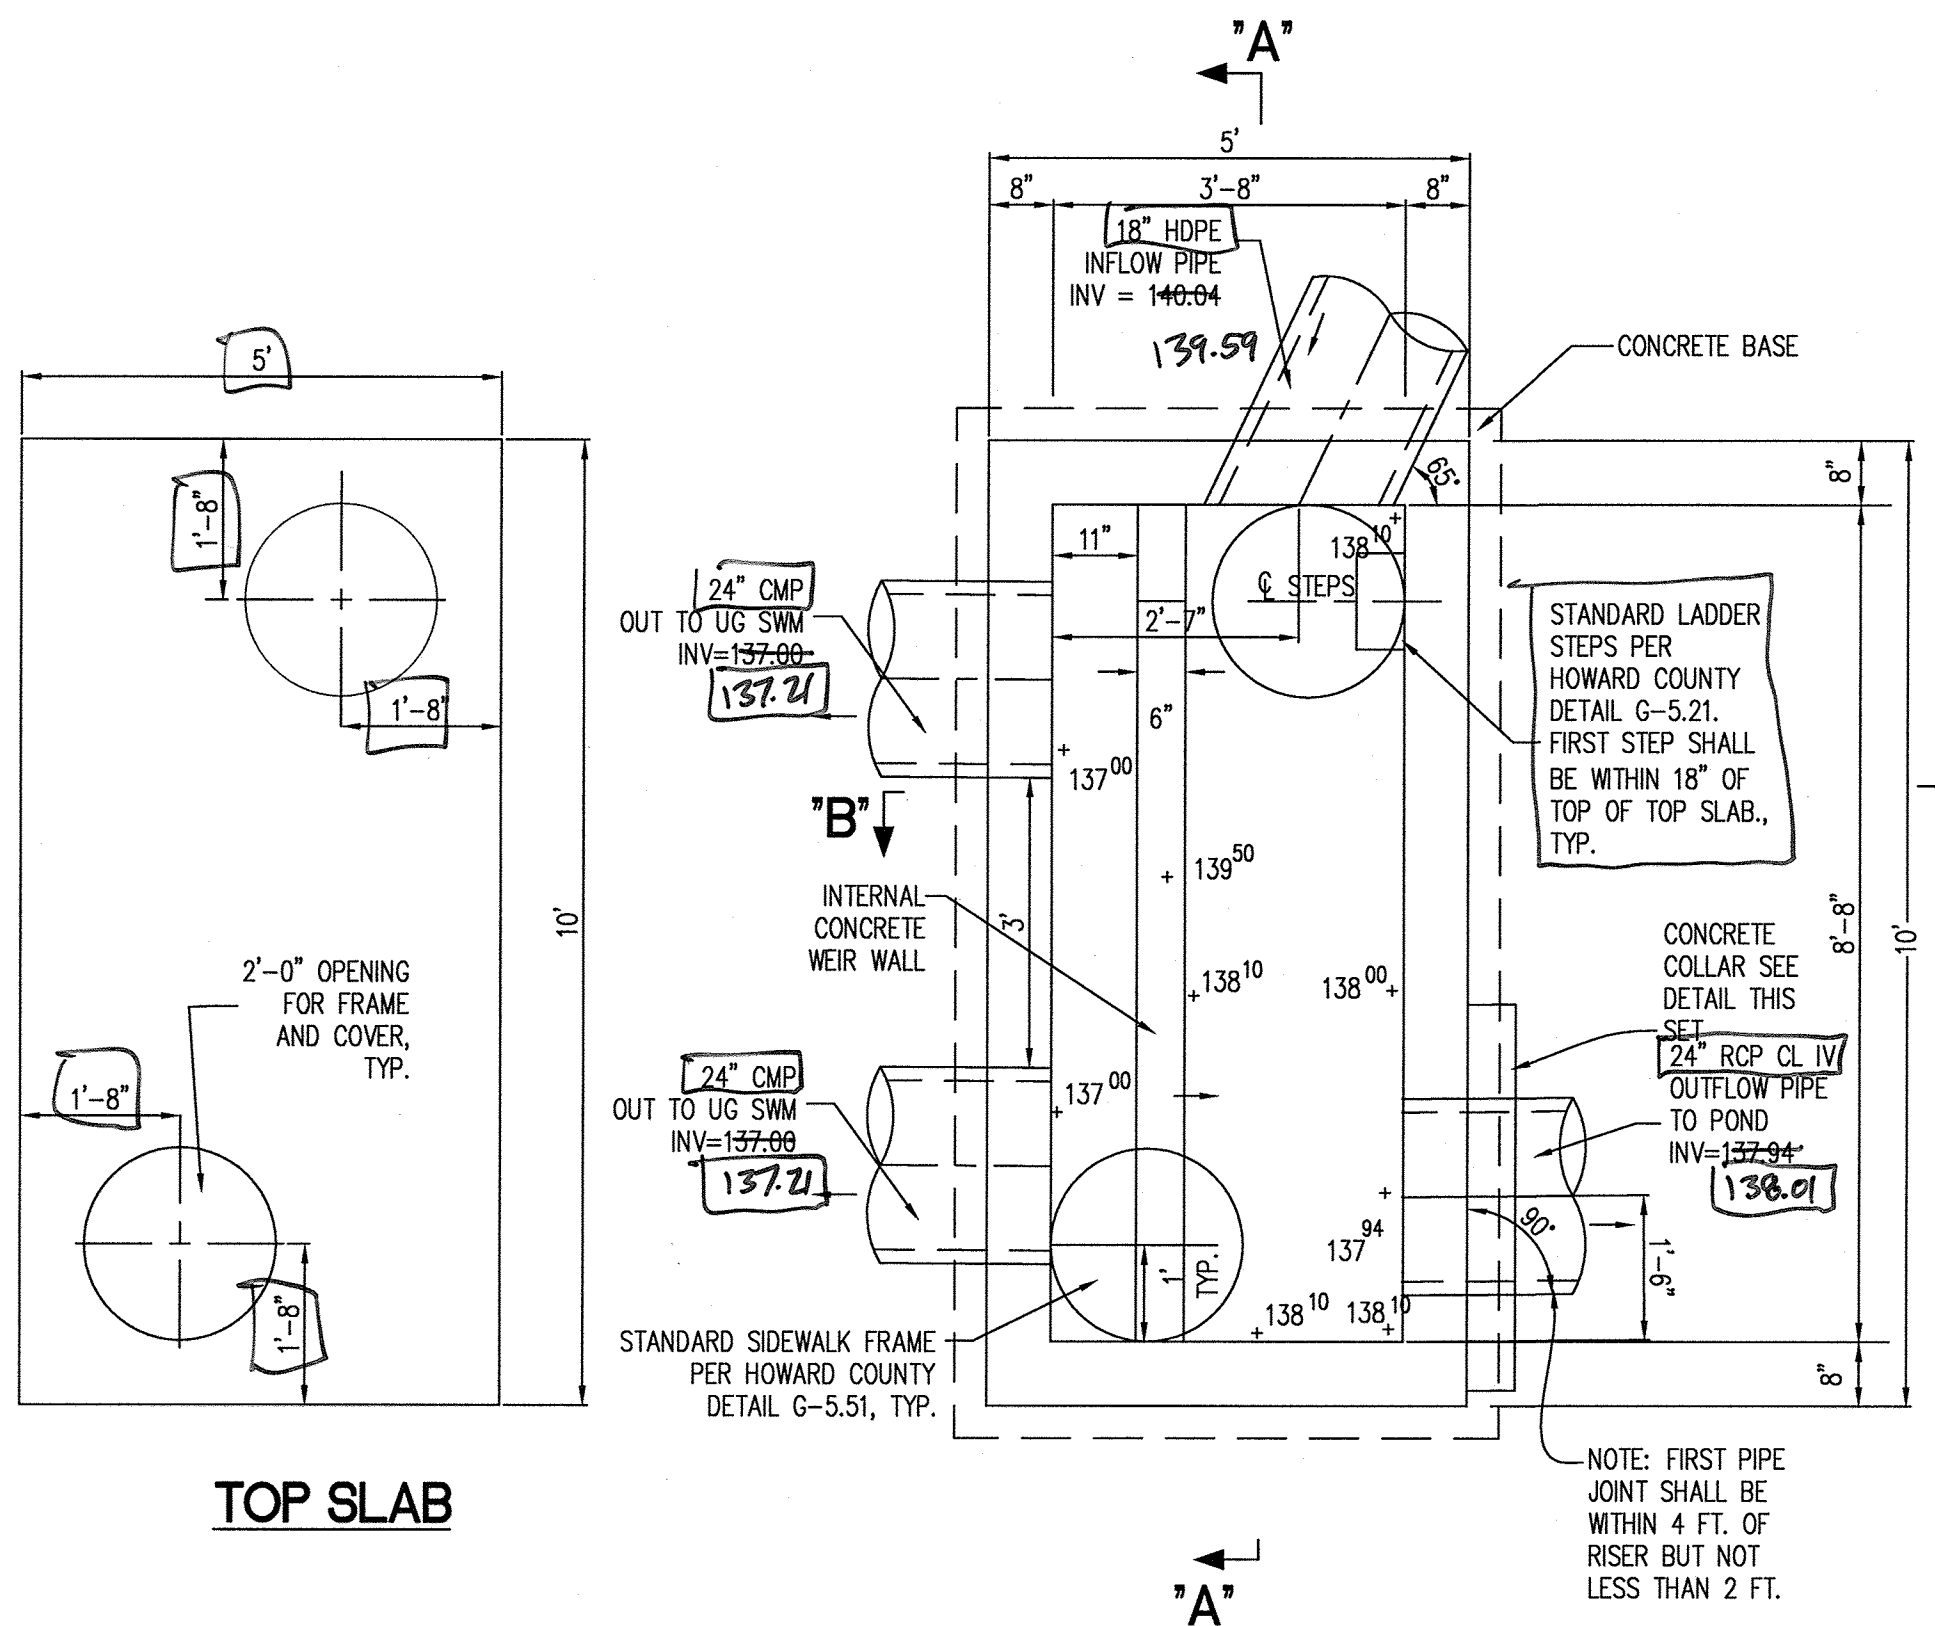

PLAN SECTION - TOP SLAB REMOVED












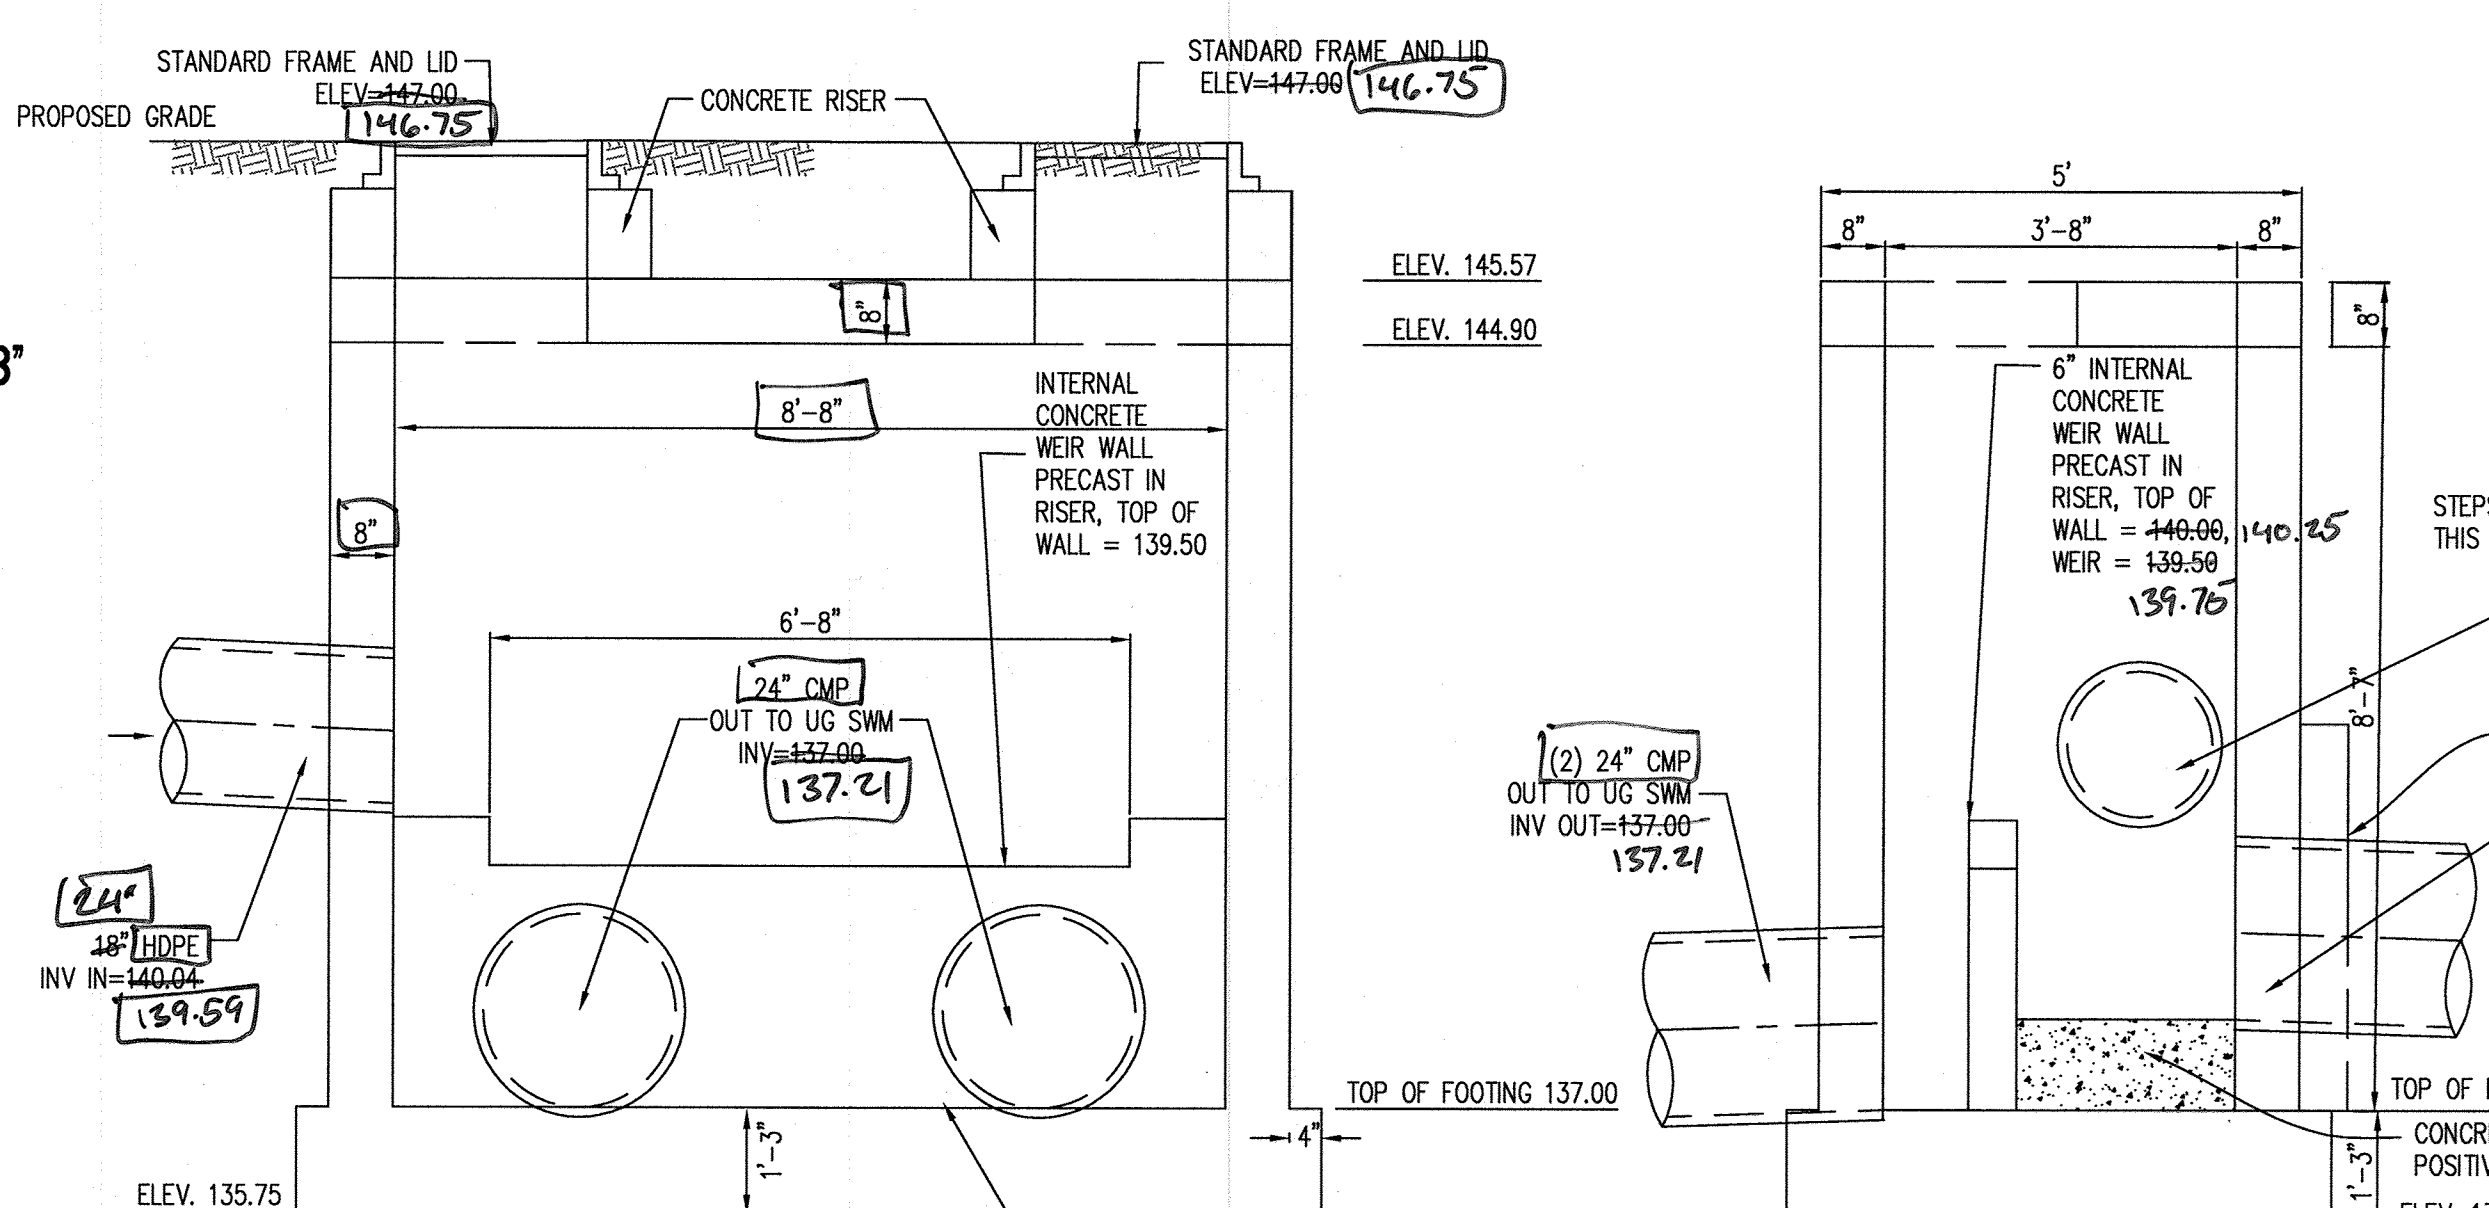


SECTION 'A-A'

SECTION 'B-B'

CONTROL STRUCTURE DETAIL FS2
 SCALE: 1"=2"

PLAN SECTION - TOP SLAB REMOVED

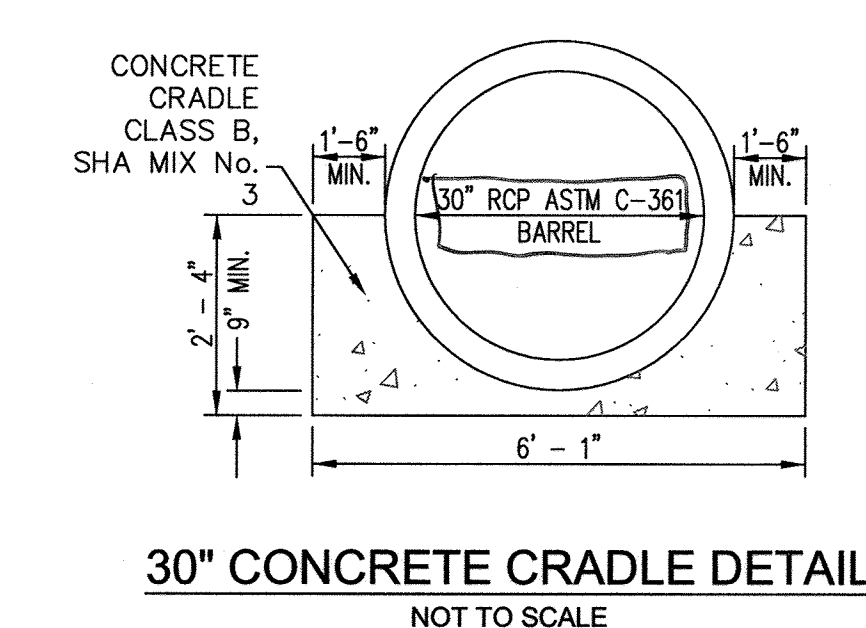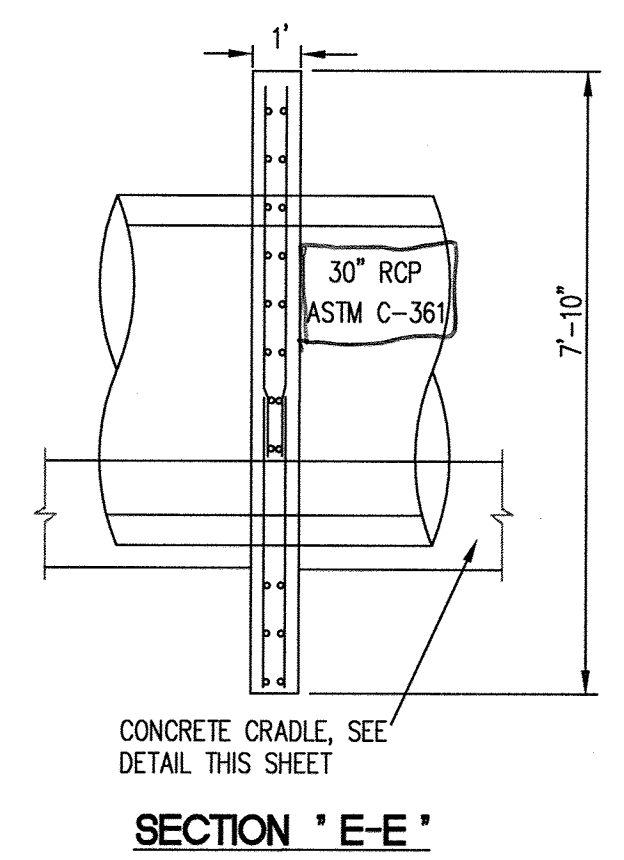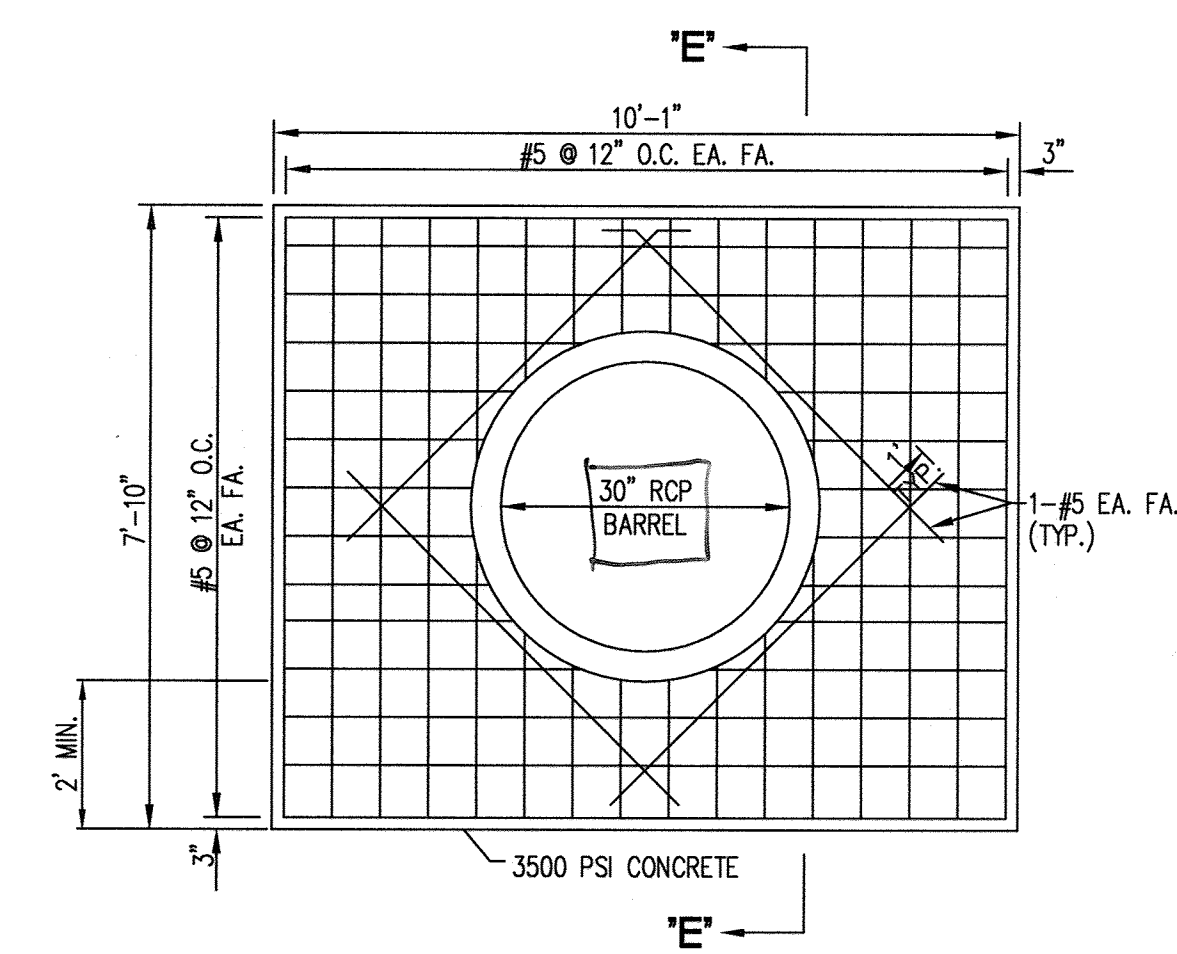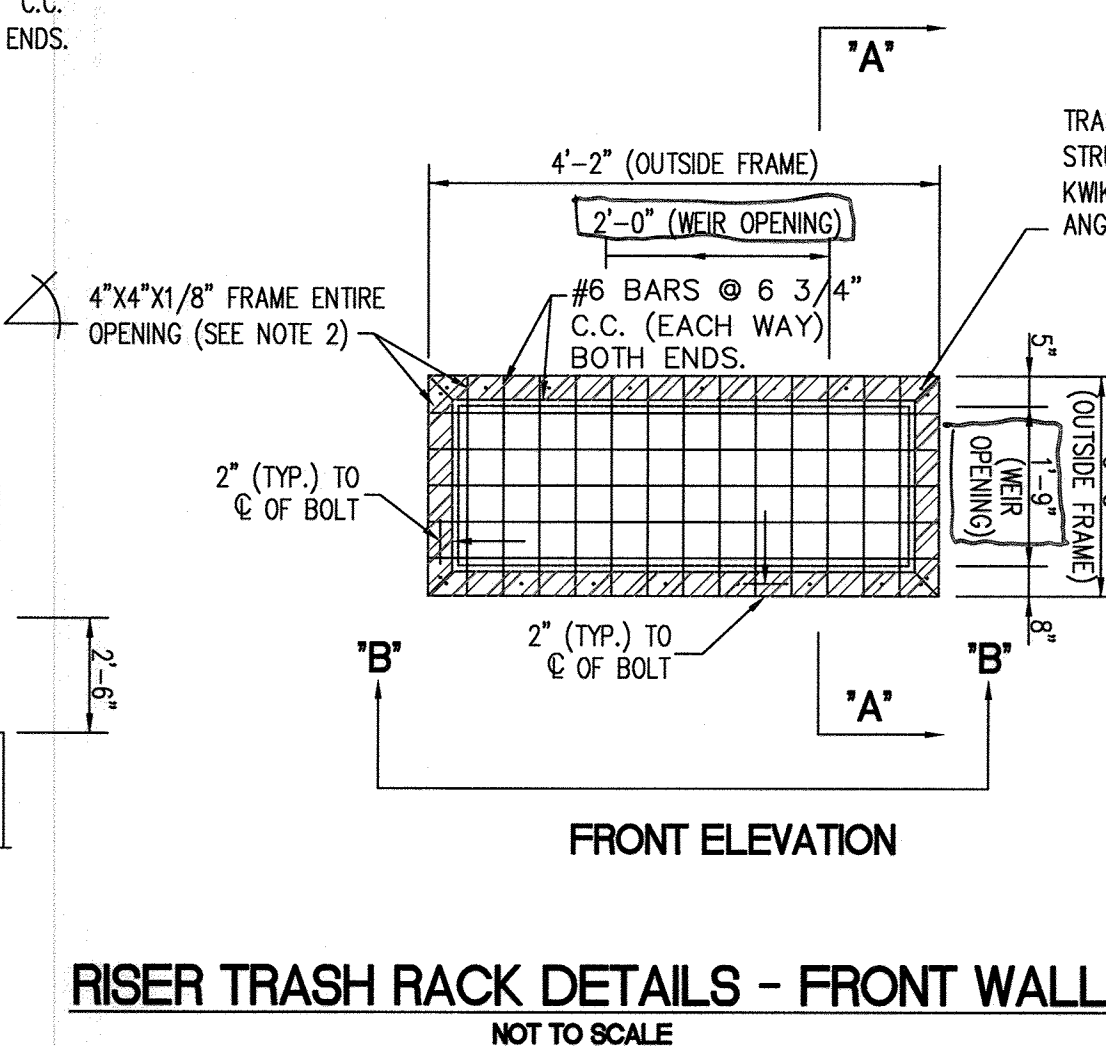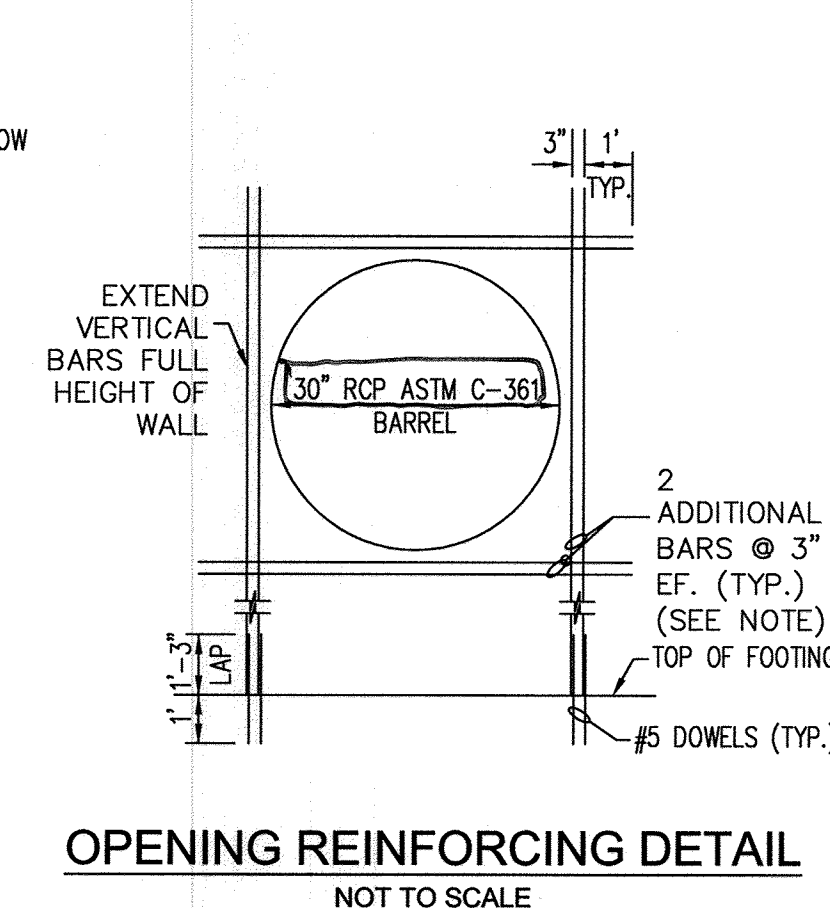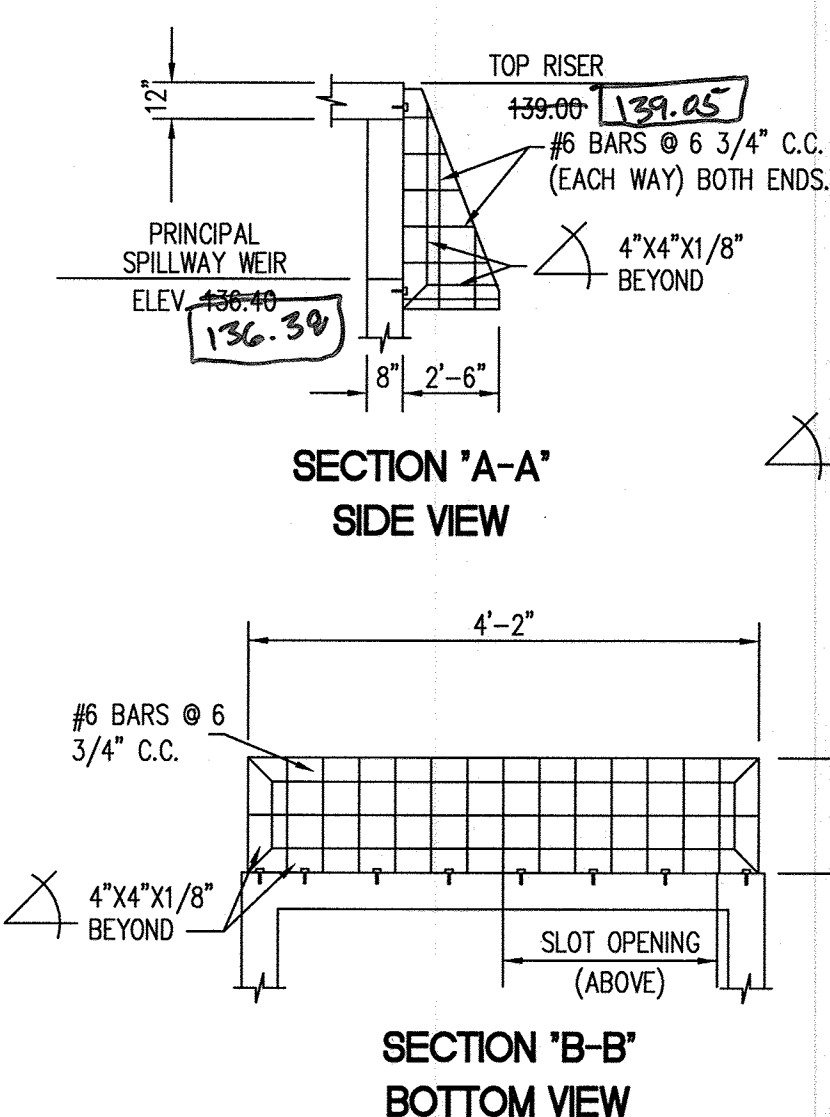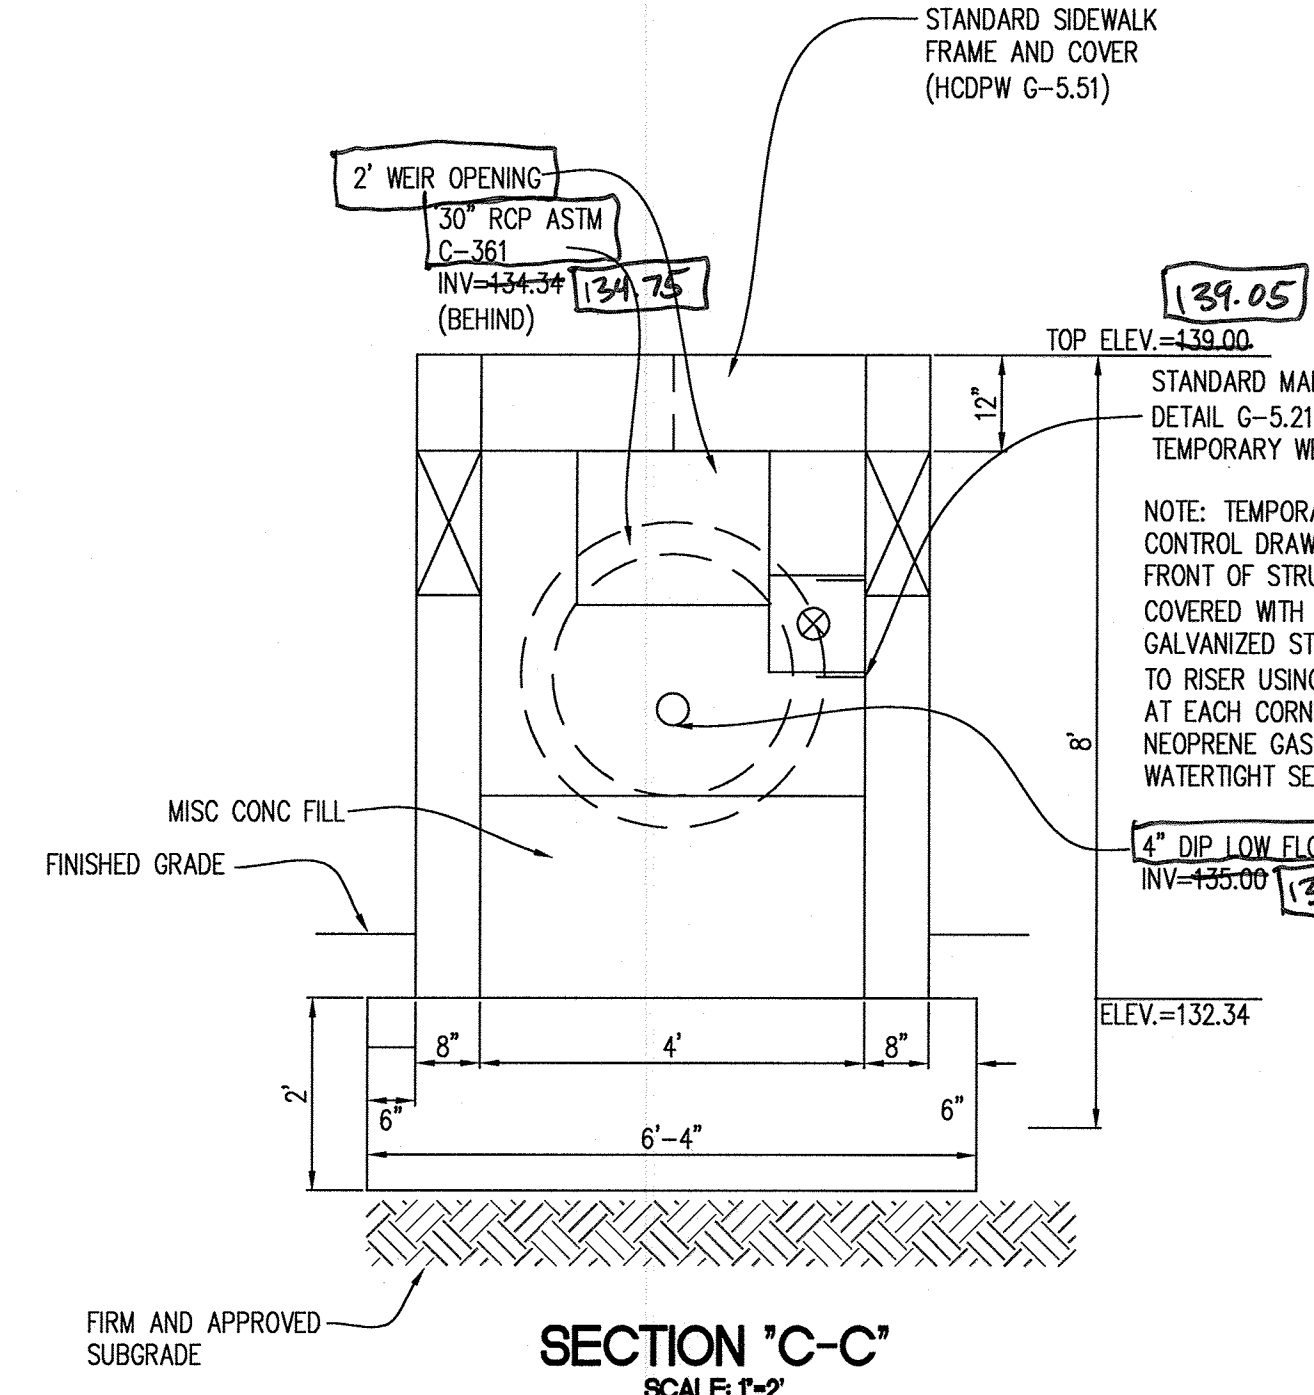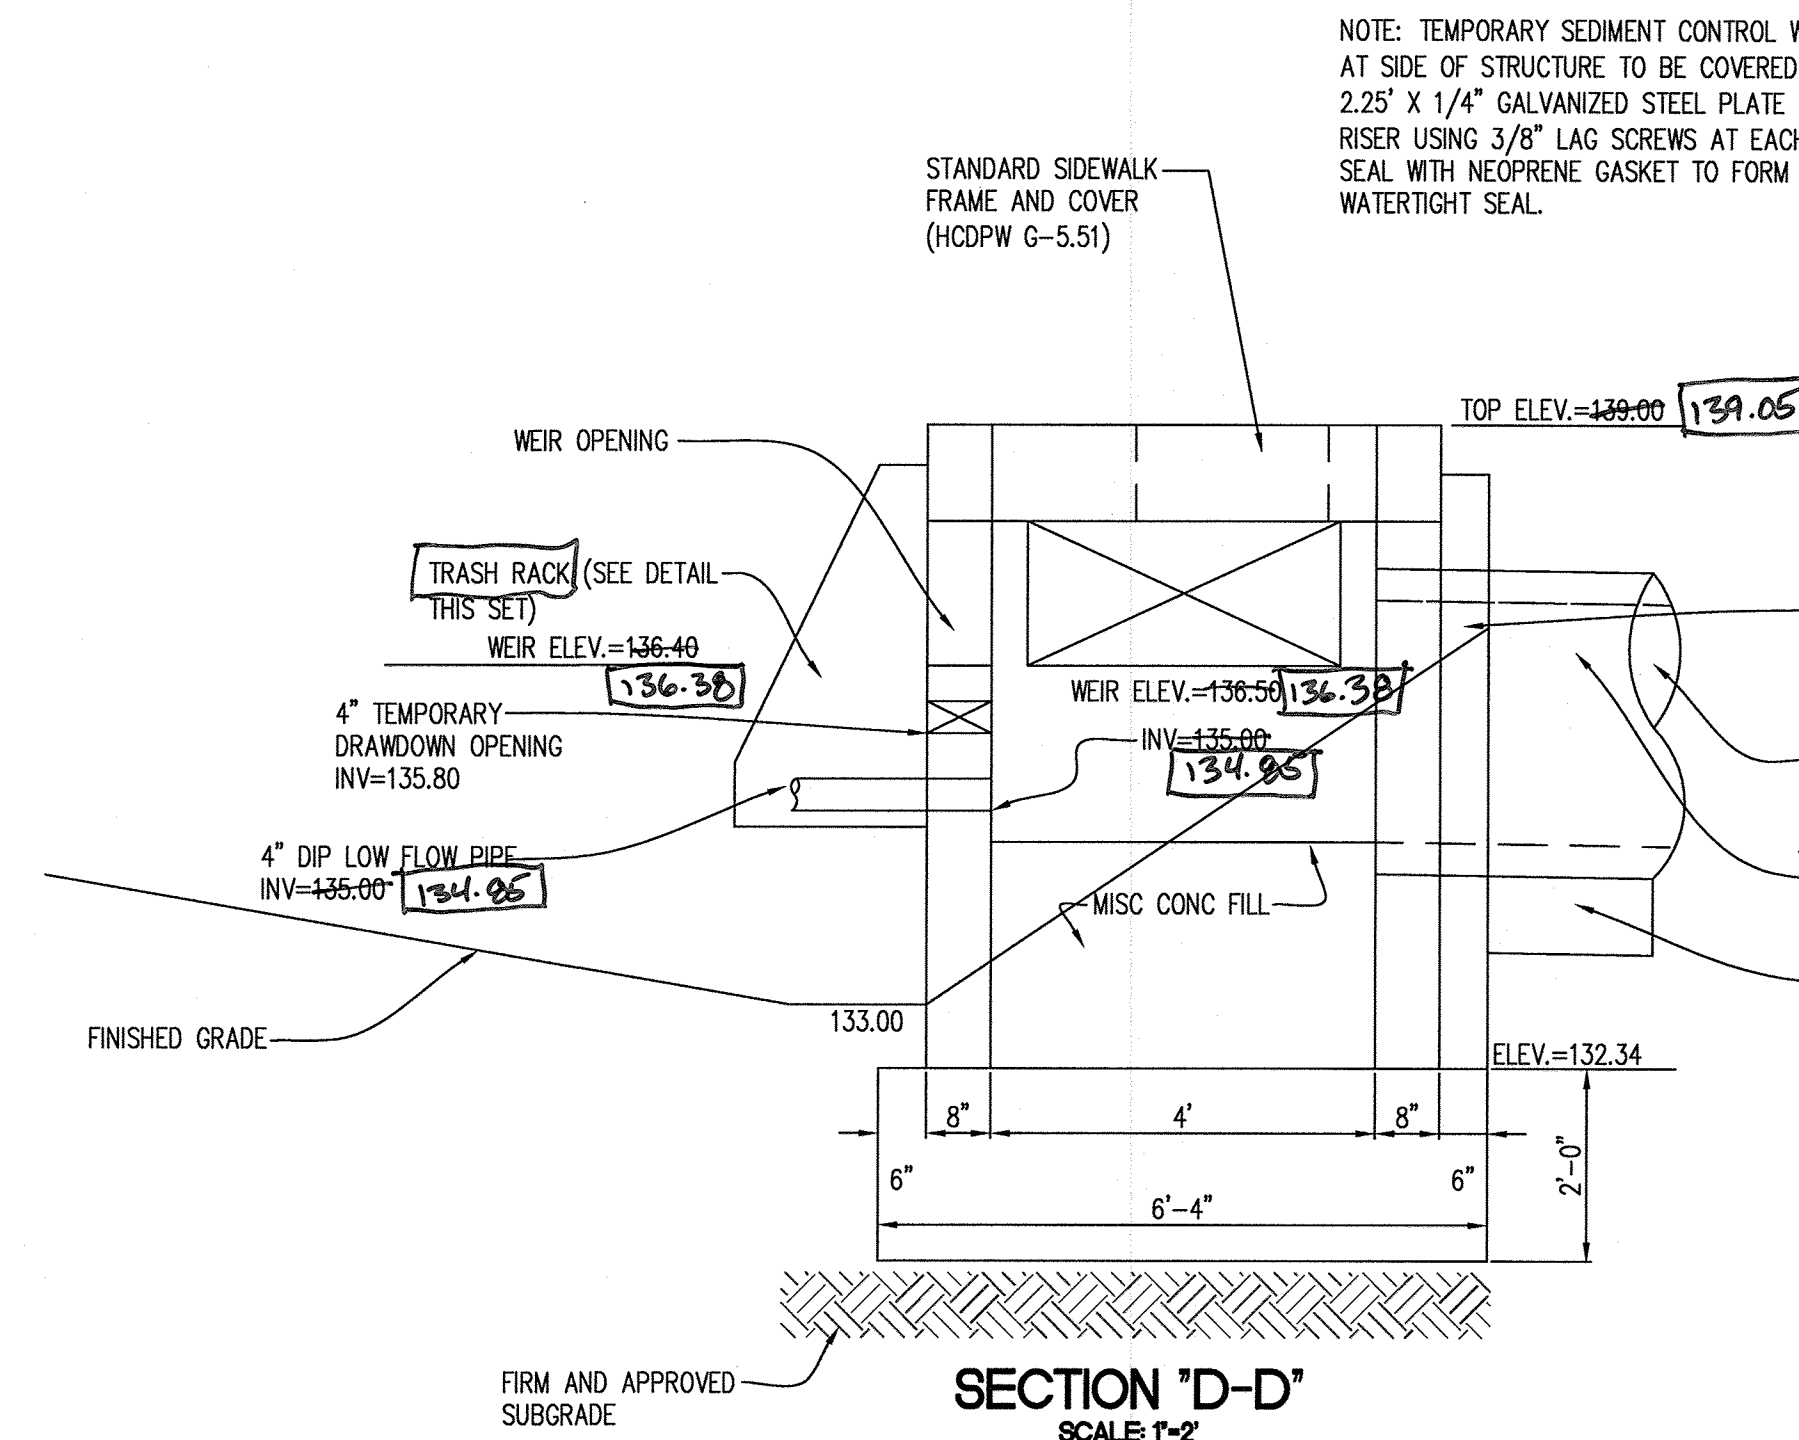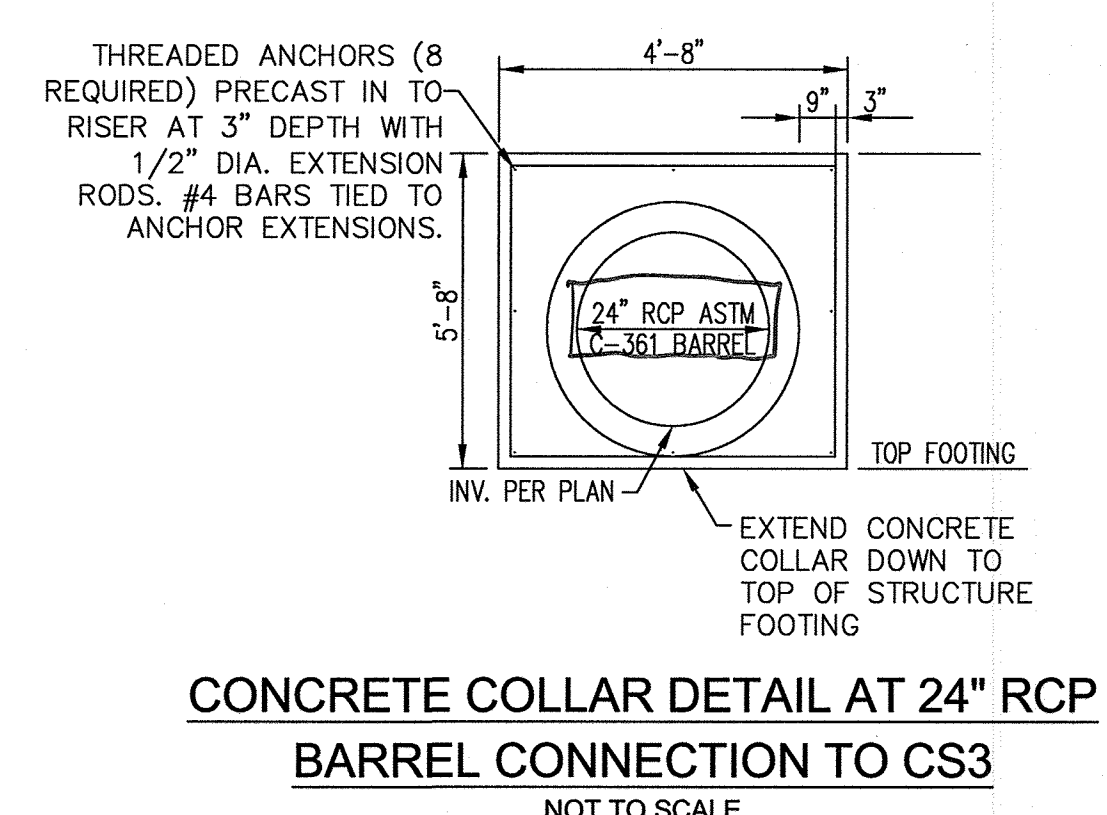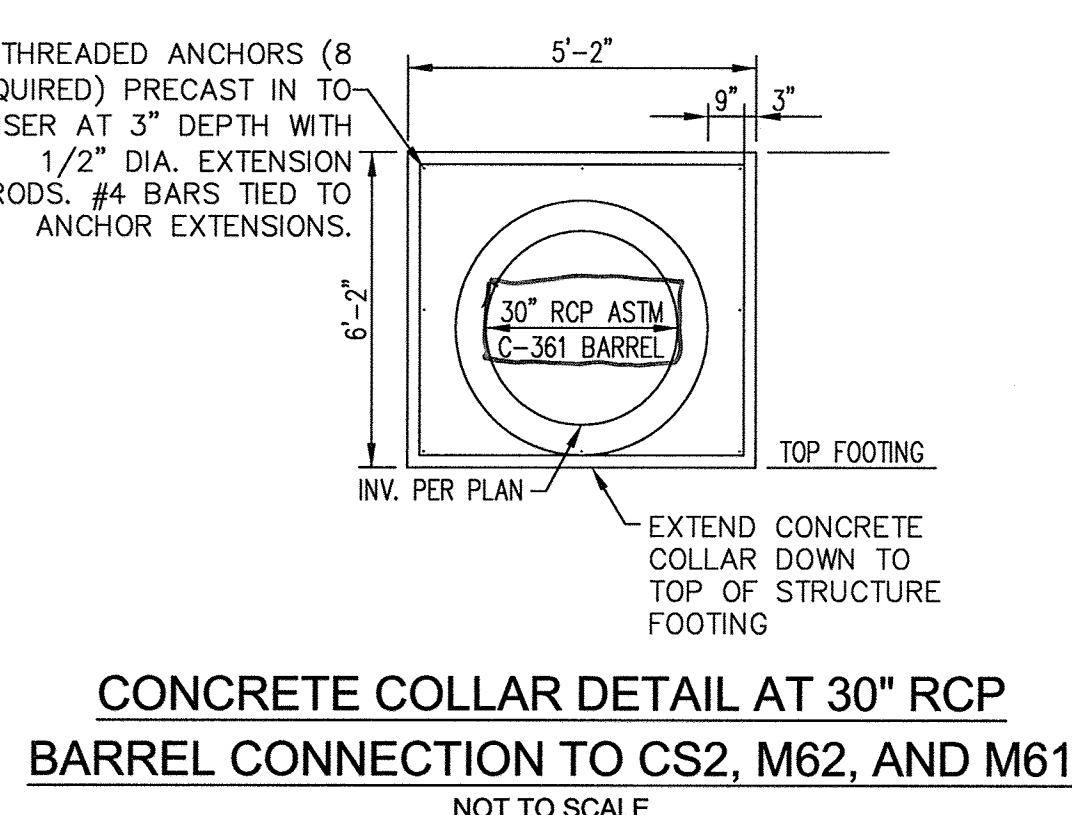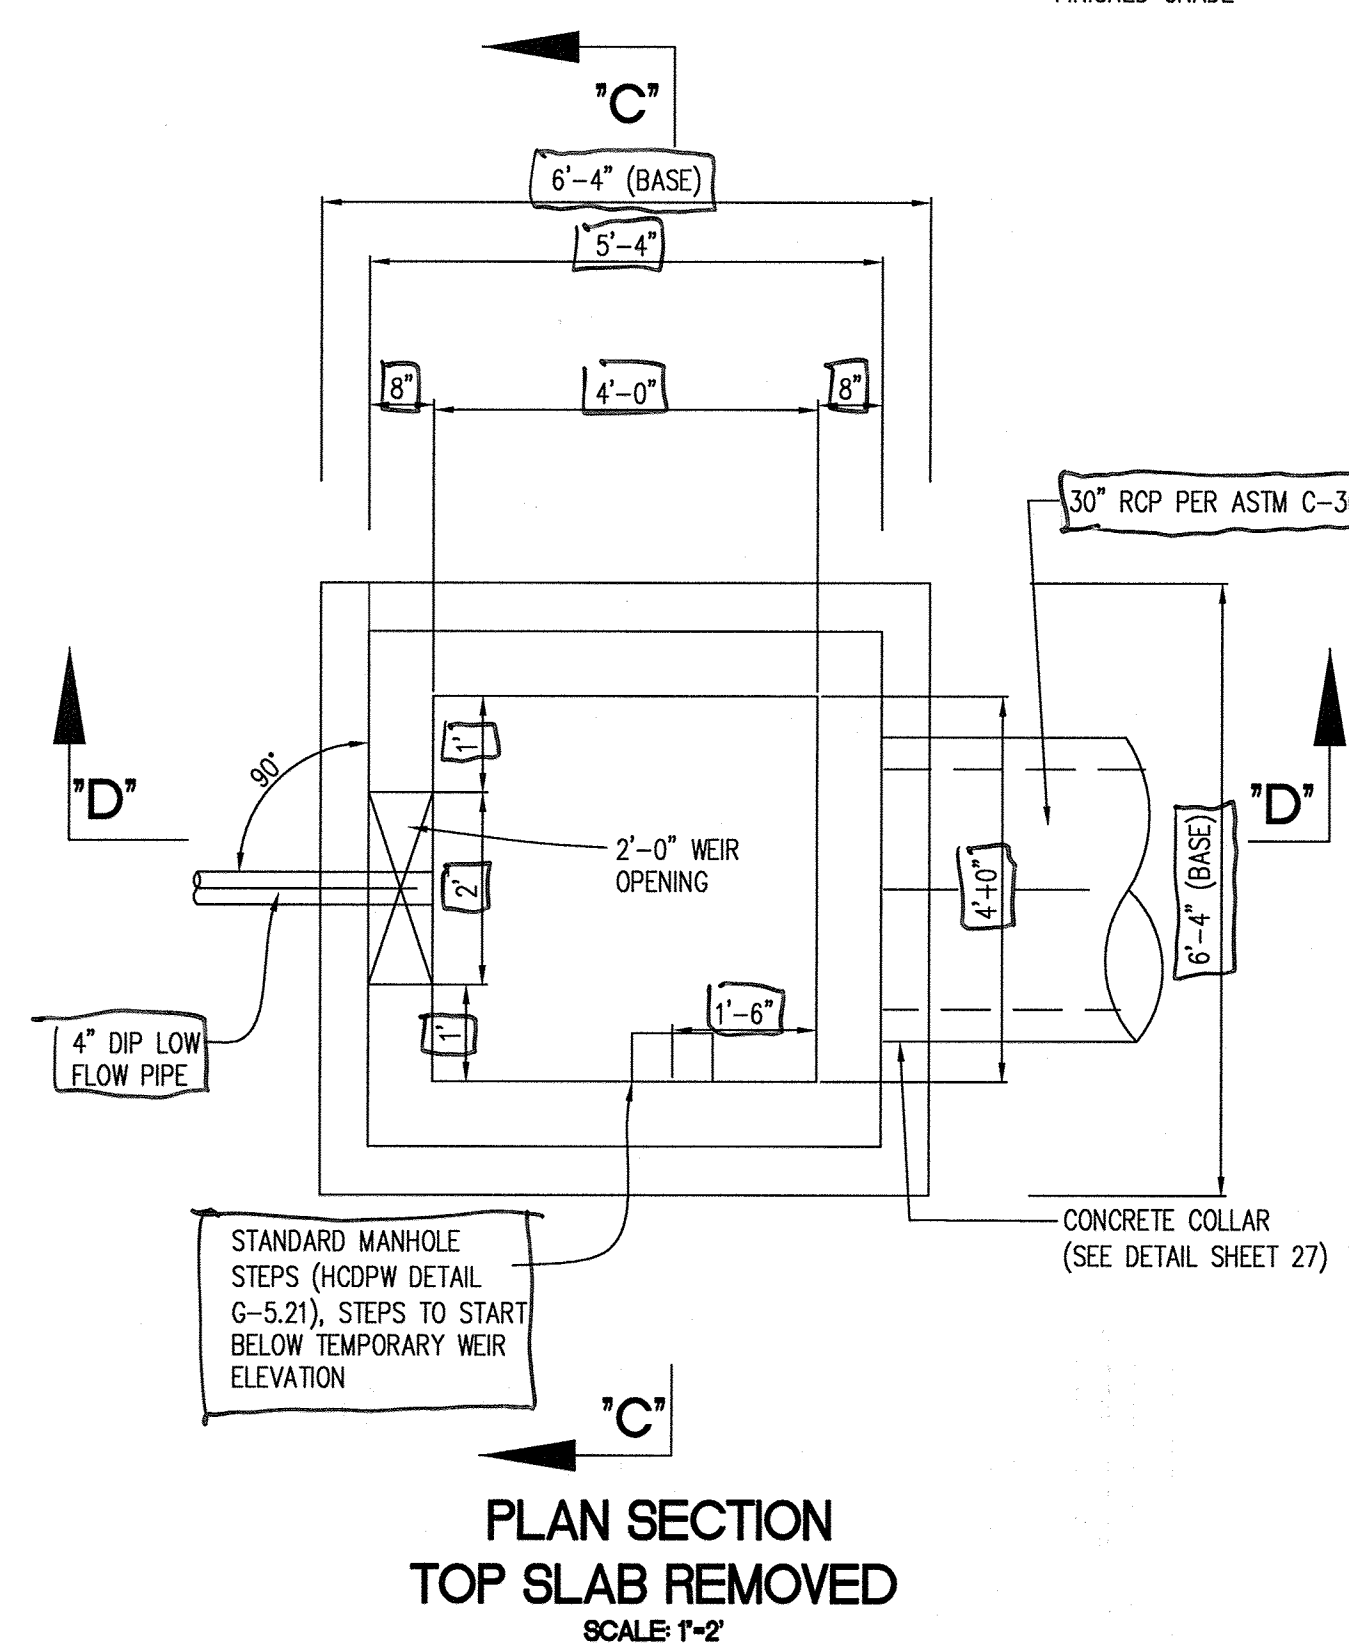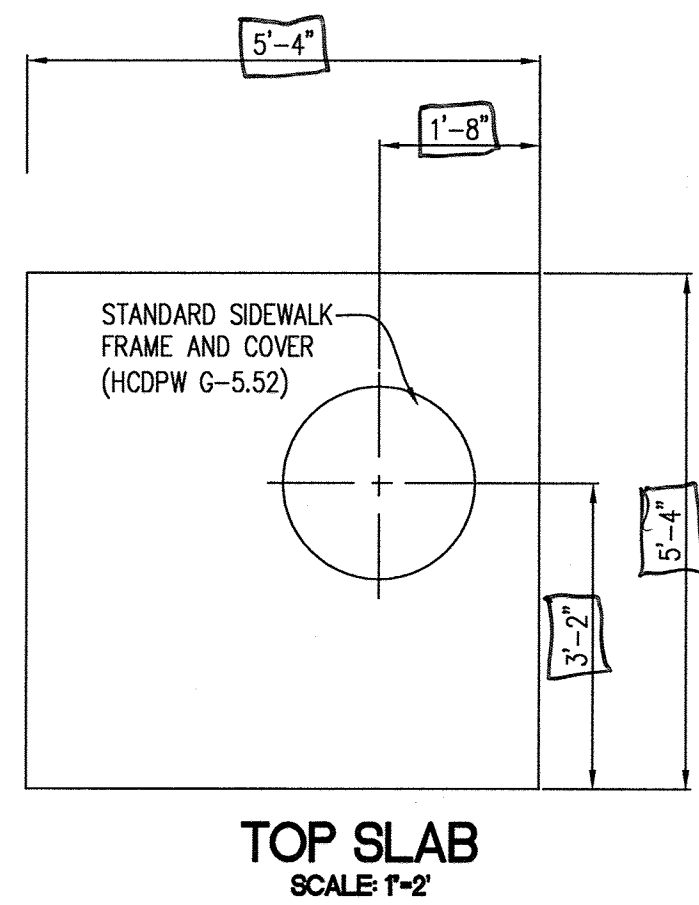

NOTE: TEMPORARY SEDIMENT CONTROL WEIRS (2) AT SIDE OF STRUCTURE TO BE COVERED WITH 4' X 2.25' X 1/4' GALVANIZED STEEL PLATE BOLTED TO RISER USING 3/8" LAG SCREWS AT EACH CORNER. SEAL WITH NEOPRENE GASKET TO FORM WATERTIGHT SEAL.

CONCRETE COLLAR IS TO BE POURED AROUND PIPE AT FACE OF RISER. EXTEND COLLAR TO BASE (SEE DETAIL THIS SHEET)

NOTE: FIRST PIPE JOINT SHALL BE WITHIN 4 FT OF RISER BUT NOT LESS THAN 2 FT.

RISER GENERAL NOTES:

1. THIS DETAIL IS FOR A PRECAST RISER ONLY.
2. SHOP DRAWINGS MUST BE APPROVED BY THE DESIGN ENGINEER PRIOR TO FABRICATION.
3. RISER STRUCTURES MUST BE REINFORCED CONCRETE.
4. ALL CONNECTIONS SHALL BE WATERTIGHT.
5. ALL CONCRETE SHALL BE SHA MIX No. 3
6. MASTIC GROUT SHALL BE UTILIZED FOR ALL POND OUTFALL PIPE JOINTS.

NOTE: TEMPORARY SEDIMENT CONTROL DRAWDOWN DEVICE AT FRONT OF STRUCTURE TO BE COVERED WITH 1' X 1' X 1/4' GALVANIZED STEEL PLATE BOLTED TO RISER USING 3/8" LAG SCREWS AT EACH CORNER. SEAL WITH NEOPRENE GASKET TO FORM WATERTIGHT SEAL.

REMOVABLE TRASH RACK NOTES:

1. ENTIRE TRASH RACK MUST BE HOT DIPPED GALVANIZED AFTER CONSTRUCTION.
2. BUTT WELD FRAME ANGLE, FILLET WELD BARS TO ANGLE FRAME.
3. PROVIDE 1/4" FILLET WELD AT BAR CROSSINGS.
4. ANGLE FRAMES AND BARS SHALL BE FABRICATED USING ASTM A-36 STEEL.
5. TRASH RACK SHALL BE MOUNTED TO RISER WITH 1/2" DIA. STAINLESS STEEL HEX HEAD BOLTS.
6. HORIZONTAL BARS TO BE BEHIND VERTICAL BARS.
7. TRASH RACK SHALL BE PAINTED BATTLESHIP GREY.

AS-BUILT CERTIFICATION

I HEREBY CERTIFY, BY MY SEAL, THAT TO THE BEST OF MY KNOWLEDGE AND BELIEF THE FACILITIES SHOWN ON THIS PLAN WERE CONSTRUCTED AS SHOWN ON THIS "AS-BUILT" PLAN AND MEET THE APPROVED PLANS AND SPECIFICATIONS.

SIGNATURE OF ENGINEER: *[Signature]* DATE: 7/11/19

STATE OF MARYLAND PROFESSIONAL ENGINEER: *[Seal]*

APPROVED: DEPARTMENT OF PLANNING AND ZONING


CHIEF, DEVELOPMENT ENGINEERING DIVISION	9-21-17
DATE	
CHIEF, DIVISION OF LAND DEVELOPMENT	9-27-17
DATE	
DIRECTOR	10-2-17
DATE	

DATE	NO.	REVISION	BY
DEVELOPER			
DCT INDUSTRIAL			
12011 GUILFORD ROAD			
SUITE 102			
ANNAPOLIS JUNCTION, MD 20701			
ATTN: FRED FERRARO			
PHONE: 410-645-5020			
OWNER			
DCT MEARS LLC			
12011 GUILFORD ROAD			
SUITE 102			
ANNAPOLIS JUNCTION, MD 20701			
ATTN: FRED FERRARO			
PHONE: 410-645-5020			
PROJECT			
TERRAPIN COMMERCE CENTER			
AREA			
TAX MAP 43, PARCEL 51 LOT PAR A PLAT 23793 ZONED M-2			
GRID NO. 11 1st ELECTION DISTRICT			
7200 DORSEY RUN ROAD			
ELKRIDGE, MARYLAND 21075			
HOWARD COUNTY, MARYLAND			
TITLE			
STORMWATER MANAGEMENT			
AS-BUILT			

Pennoni Associates Inc.
Engineers - Surveyors - Planners
Landscape Architects


8818 Centre Park Drive, Suite 200 Columbia, MD 21045
T 410.997.8900 F 410.997.9282

DESIGNED BY: PJS
DRAWN BY: AGS/JSN
PROJECT NO: DCT11601
DATE: JUNE 23, 2017
SCALE: AS SHOWN
DRAWING NO. 27 OF 43

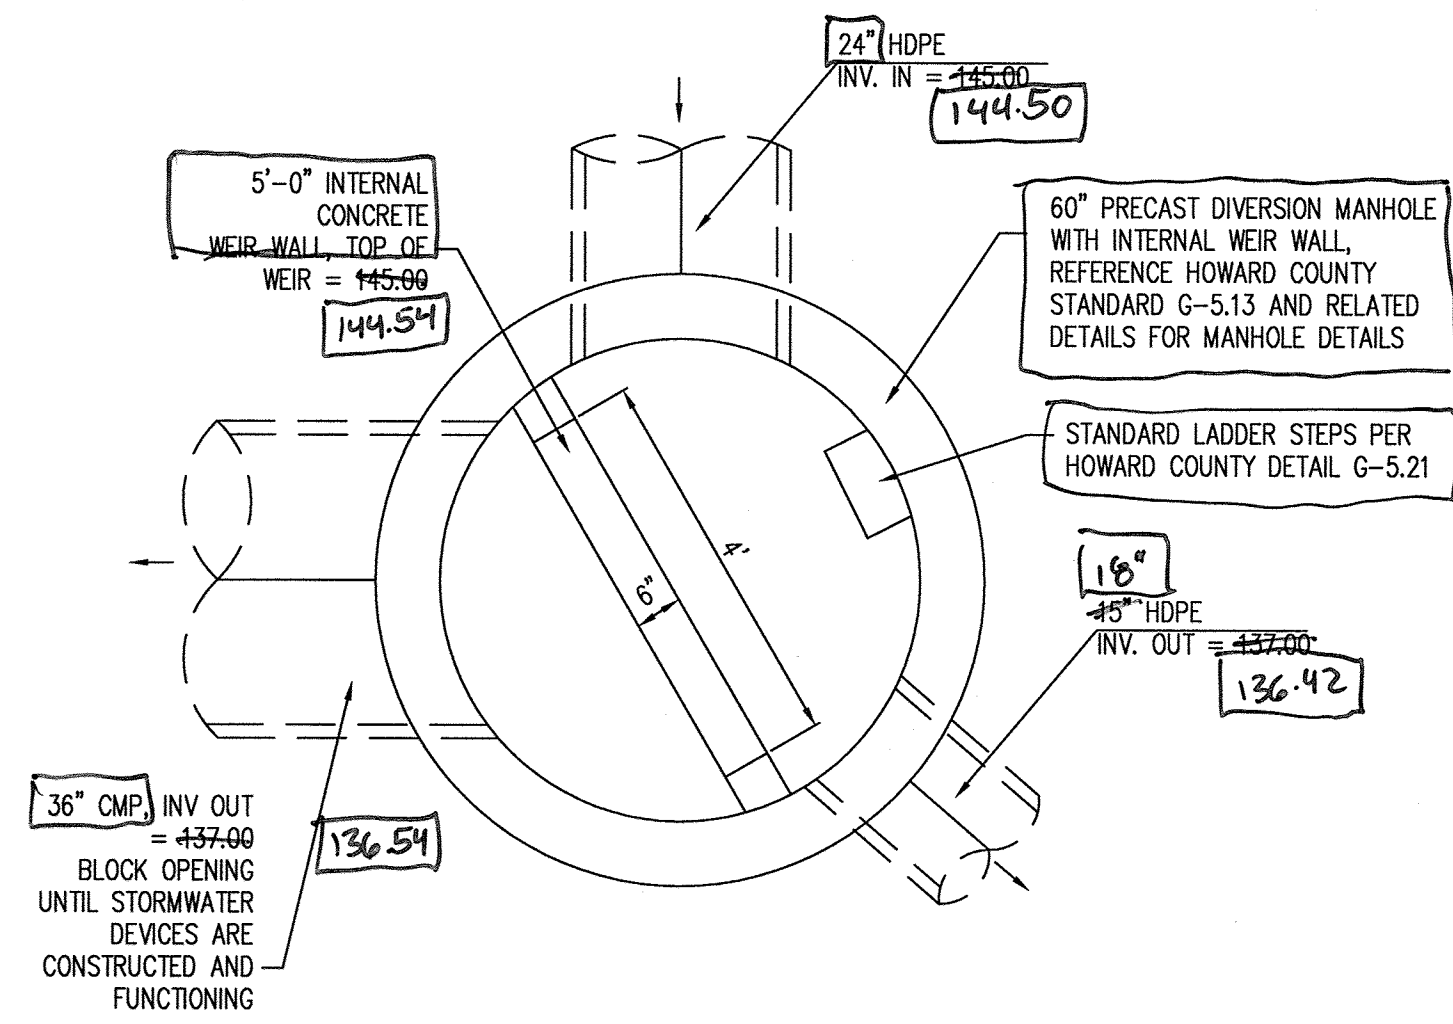


PLAN SECTION
SCALE: 1"=2'

FLOW SPLITTER MANHOLE DETAIL STRUCTURE FS-1

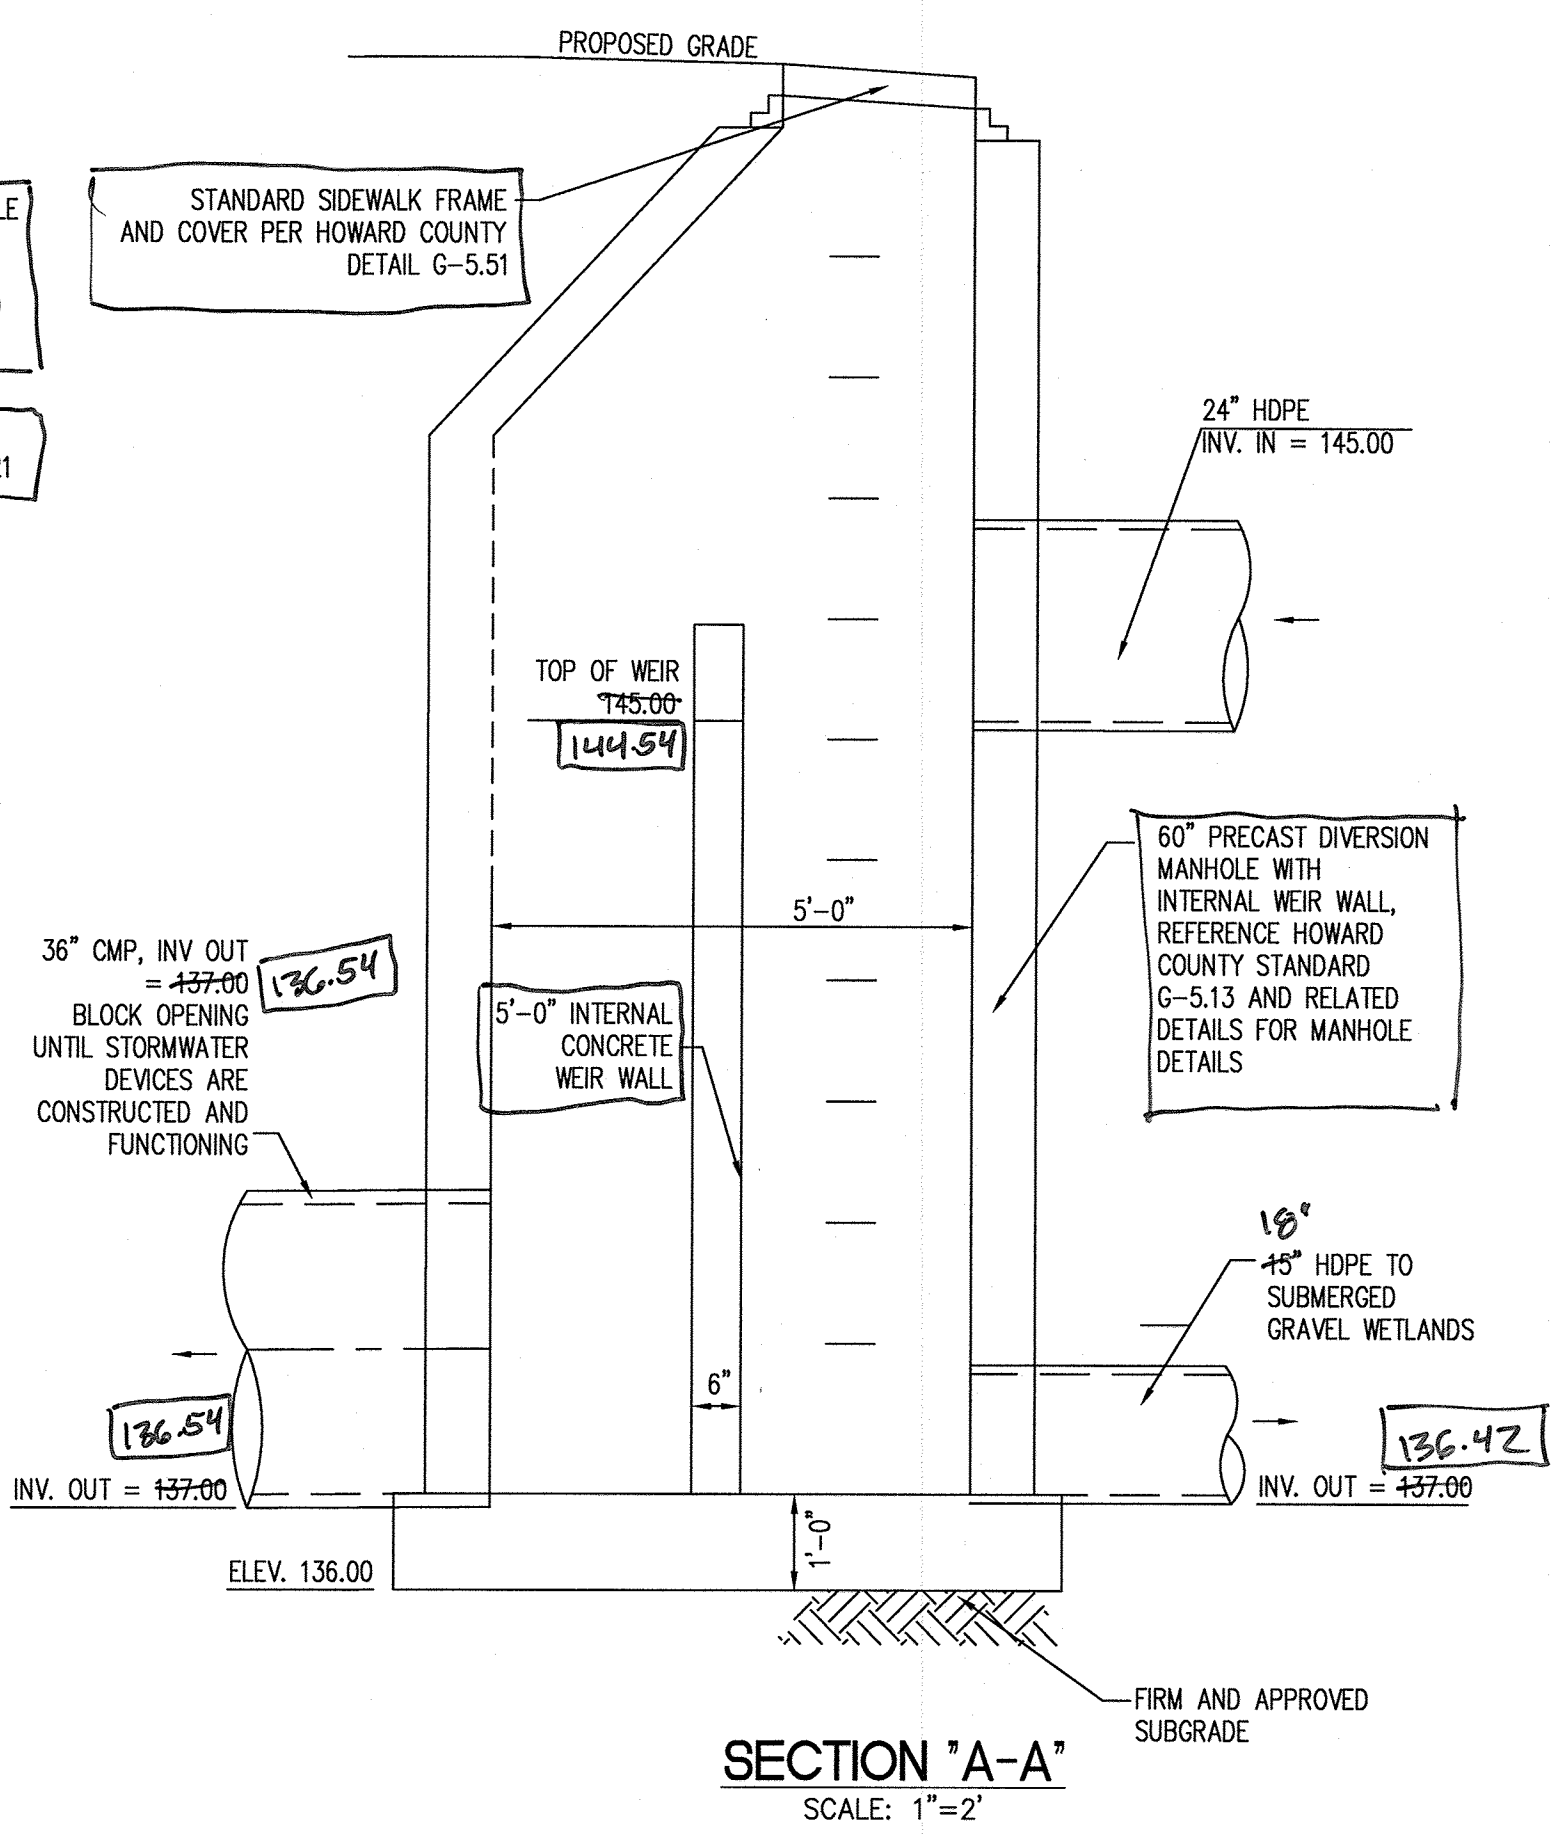


SECTION 'A-A'
SCALE: 1"=2'


PRECAST RISER NOTE:
SHOP DRAWING FOR PRE-CAST CONCRETE RISERS WITH SUPPORTING STRUCTURAL COMPUTATIONS (SIGNED AND SEALED BY A MARYLAND REGISTERED PROFESSIONAL ENGINEER) MEETING ASTM REQUIREMENTS FOR PRE-CAST STRUCTURES MUST BE SUBMITTED TO THE ENGINEER, FOR APPROVAL PRIOR TO FABRICATION. IF ANY STRUCTURE DIMENSIONS VARY FROM WHAT WAS ORIGINALLY REVIEWED/APPROVED, THEN THE HYDRAULICS, FLOTATION AND STRUCTURAL INTEGRITY WILL HAVE TO BE RE-ANALYZED. ALL JOINTS AND CONNECTIONS MUST BE WATER-TIGHT. THE METHOD OF ACHIEVING WATER-TIGHT SEAL BETWEEN THE RISER STRUCTURE, AND ALL CONDUITS (I.E., BARREL AND LOW FLOW PIPES) SHALL BE APPROVED BY THE ENGINEER IN CHARGE PRIOR TO FABRICATION.

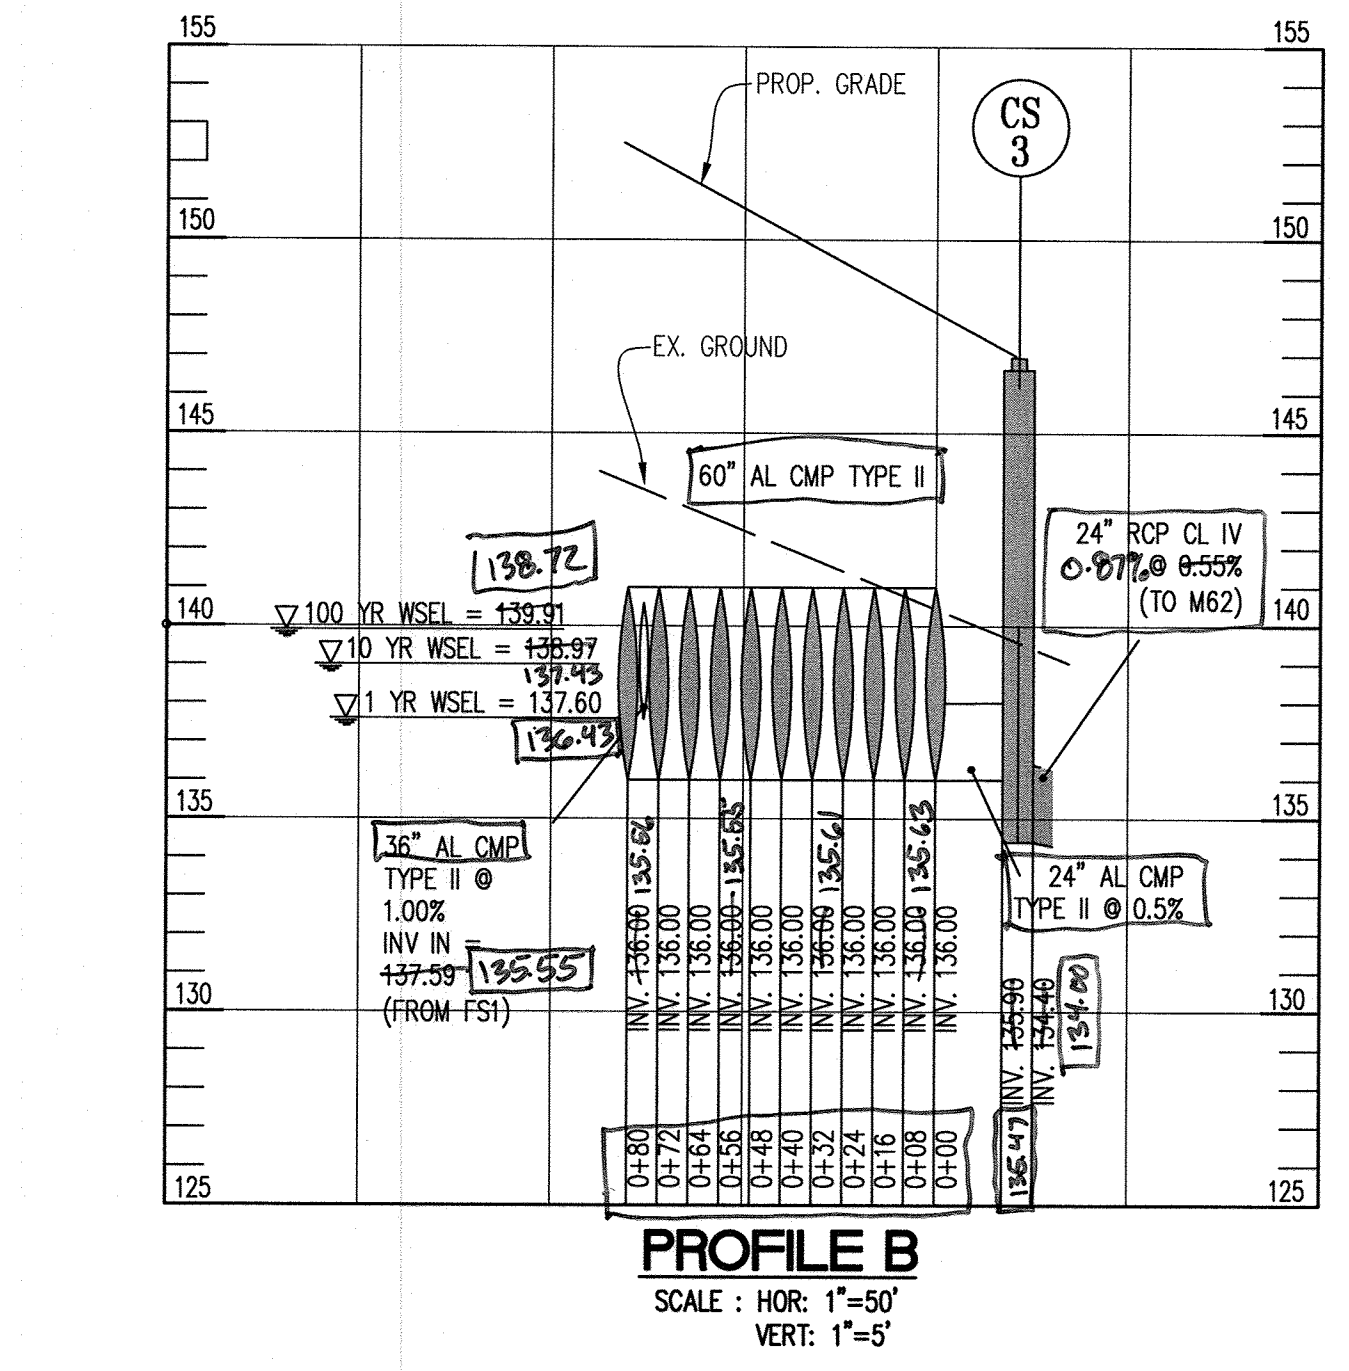

PROFILE B
SCALE: HOR: 1"=50'
VERT: 1"=5'

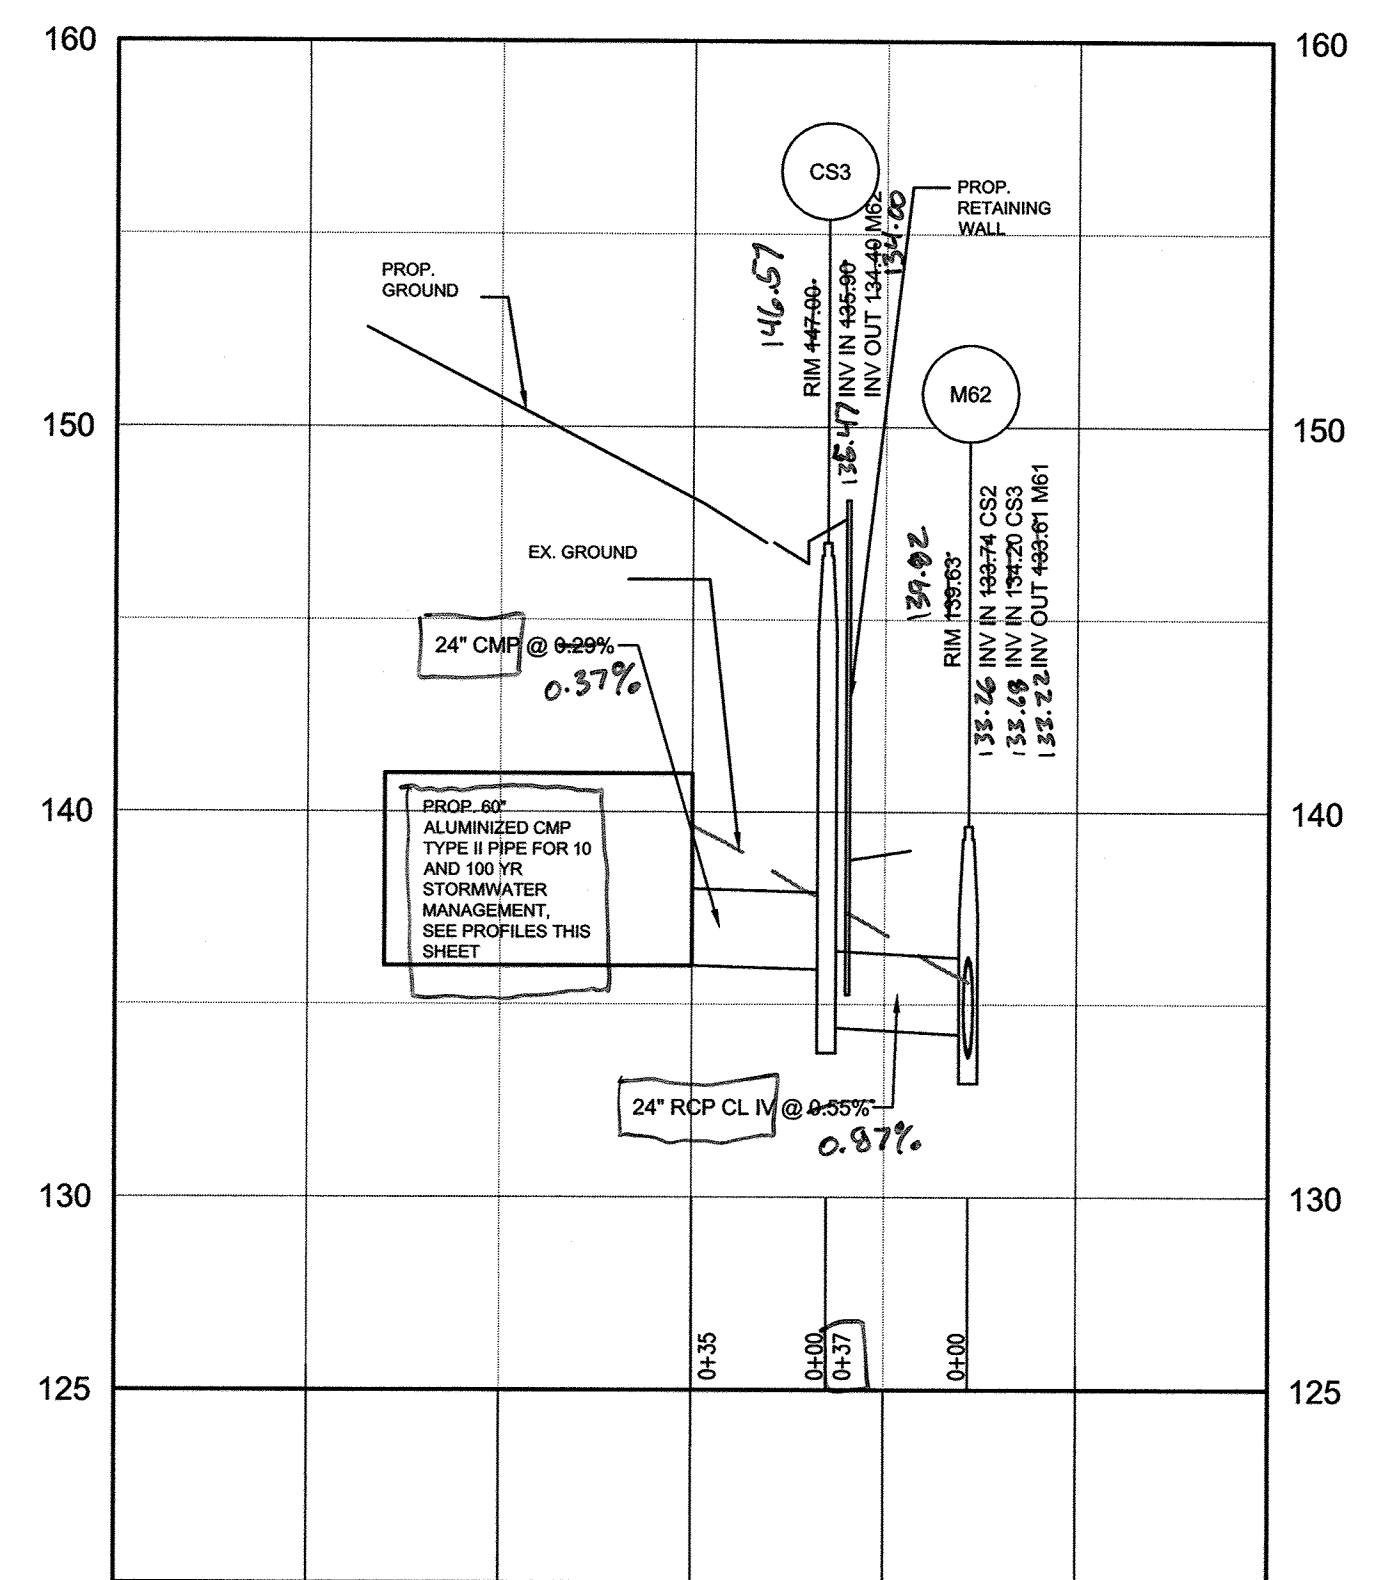

CS3 TO M62 (UNDERGROUND SWM OUTFALL)
HORIZONTAL SCALE: 1" = 50'
VERTICAL SCALE: 1" = 5'

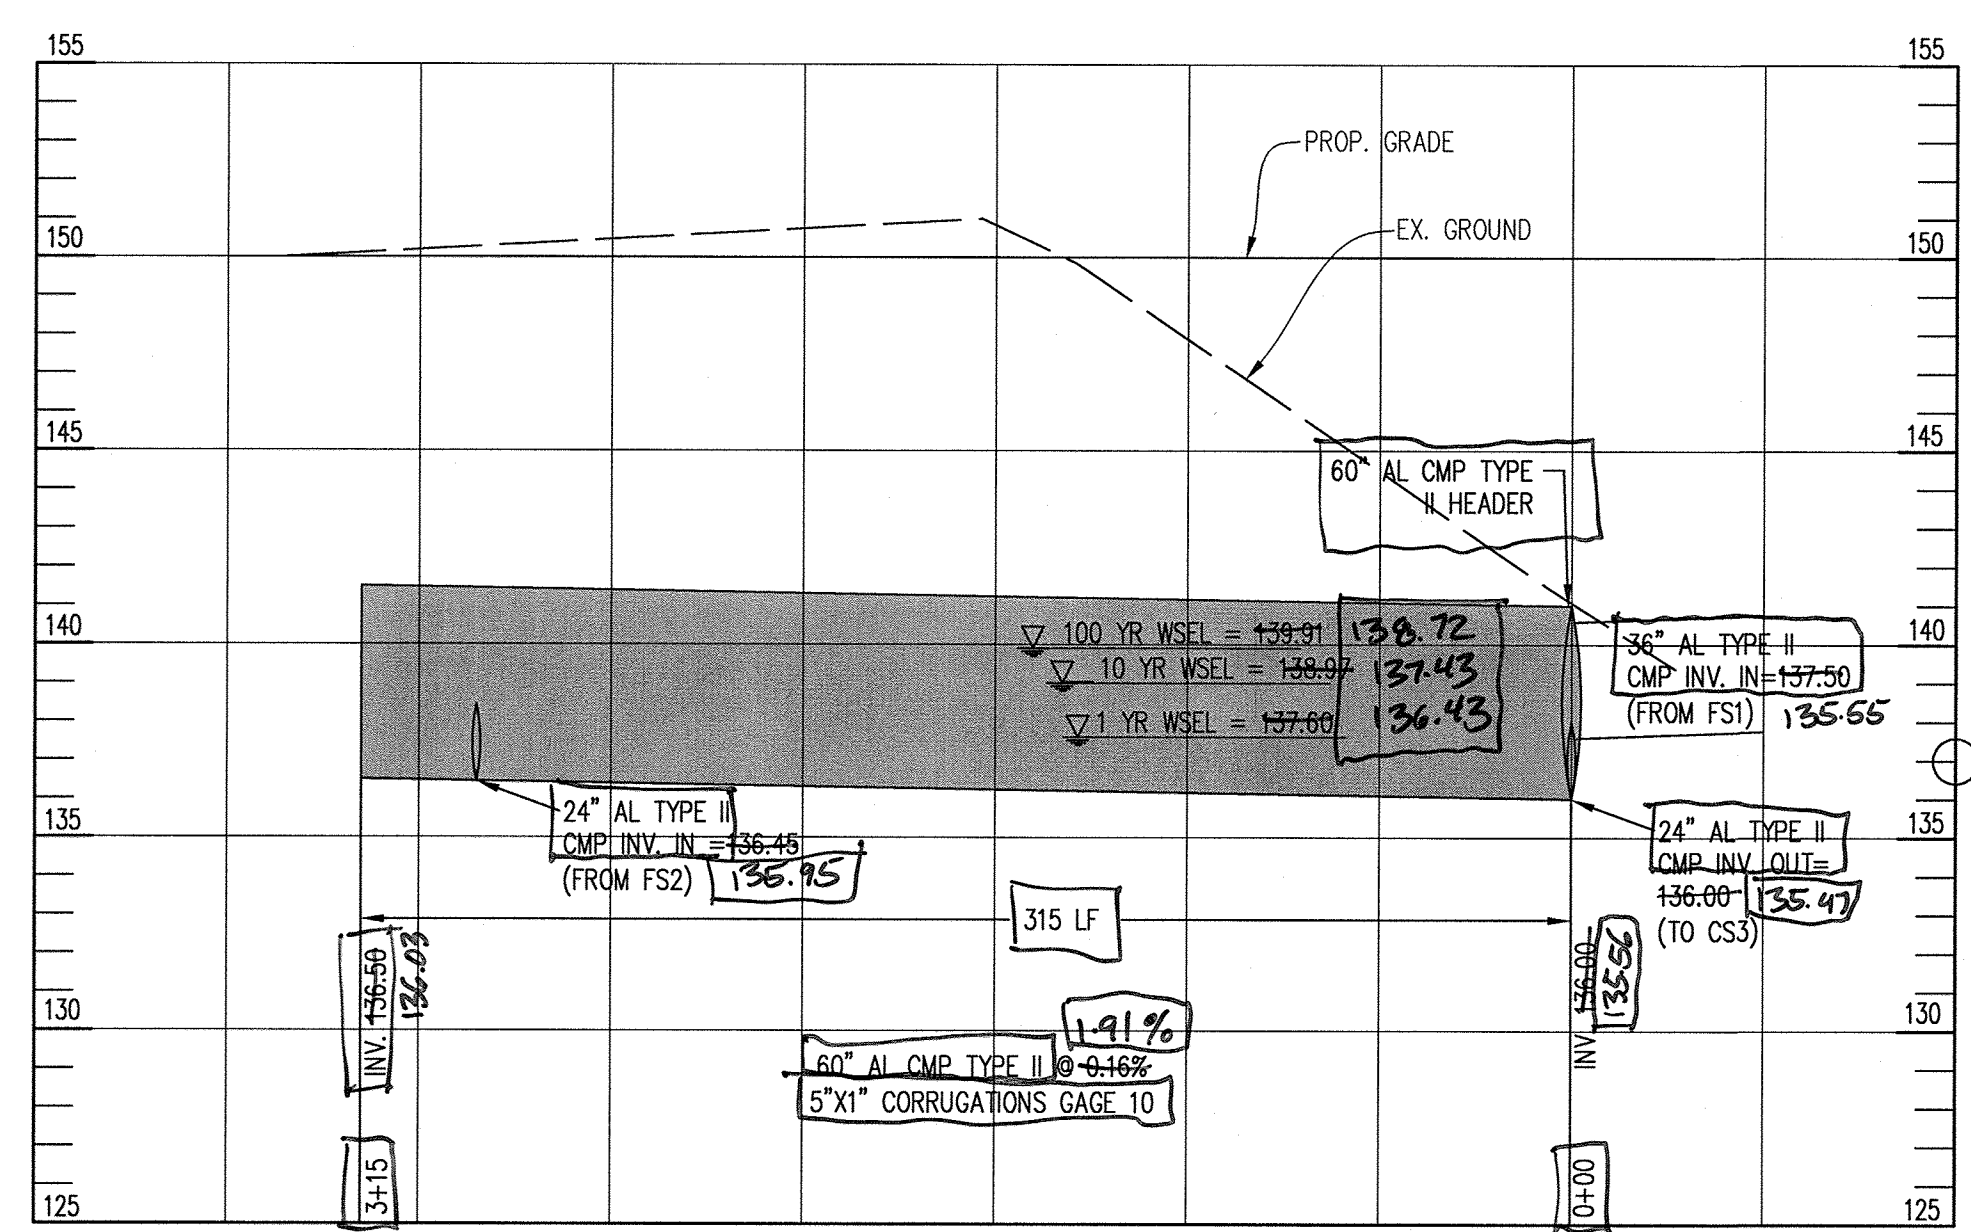

PROFILE A
SCALE: HOR: 1"=50'
VERT: 1"=5'

5.8. STORMWATER MANAGEMENT PONDS

WE UNDERSTAND THAT THE PONDS ARE DESIGNED AS DRY PONDS. THE PONDS WILL REQUIRE DESIGN AND CONSTRUCTION IN ACCORDANCE WITH NRCS - MD CODE NO. 378 POND STANDARDS/SPECIFICATIONS.

5.8.1 SUBGRADE PREPARATION

SUBGRADE AREAS OF FILL EMBANKMENTS SHOULD BE CLEARED OF TREES, LOGS, STUMPS, ROOTS, BRUSH, BOULDERS, SOIL, AND RUBBISH PRIOR TO FILL PLACEMENT. THE FOUNDATION AREA SHOULD BE THOROUGHLY SCARIFIED BEFORE PLACEMENT OF FILL TO ALLOW FOR BONDING OF THE FILL TO THE FOUNDATION.

5.8.2 EMBANKMENT

FOR PORTIONS OF THE EMBANKMENT TO BE CONSTRUCTED IN FILL CONDITIONS, NEAR SURFACE SOILS OF STRATA A AND B CAN BE REUSED FOR EMBANKMENT CONSTRUCTION, PROVIDED ALL ORGANICS AND DEBRIS LARGER THAN 3 INCHES IN ITS GREATEST DIMENSION BE REMOVED PRIOR TO REUSE. IF NECESSARY, IMPORTED FILL SHOULD CONSIST OF WELL-GRADED MATERIAL WITH A MAXIMUM PARTICLE SIZE LESS THAN 3 INCHES, NOT MORE THAN 20 PERCENT PASSING THE NO. 200 SIEVE AND HAVE A PLASTICITY INDEX (PI) NOT GREATER THAN 8 PERCENT.

NEW FILLS CONSISTING OF ON-SITE SOIL (STRATA A AND B) OR IMPORTED GRANULAR SOIL SHOULD BE PLACED IN LAYERS NOT EXCEEDING 10 IN. LOOSE MEASURE. THIS CRITERION MUST BE ADJUSTED BY THE GEOTECHNICAL ENGINEER IN THE FIELD DEPENDING ON THE CONDITIONS PRESENT AT THE TIME OF CONSTRUCTION, ON THE COMPACTION EQUIPMENT USED, AND ON THE FILL MATERIAL SELECTED. FILL PLACED WITHIN THE EMBANKMENT SHOULD BE COMPACTED TO AT LEAST 98 PERCENT OF THE LABORATORY DETERMINED MAXIMUM DRY DENSITY, ASTM D 698, WHEN SMALL HAND OPERATED COMPACTION EQUIPMENT IS USED AND TO AT LEAST 95 PERCENT OF THE LABORATORY DETERMINED DRY DENSITY, ASTM D 1557, WHEN SELF-PROPELLED, HEAVY DUTY COMPACTION EQUIPMENT IS USED.

SPECIFICATIONS SHOULD INDICATE THAT THE PERCENTAGE OF MAXIMUM DRY DENSITY ATTAINED IN THE FIELD IS NOT THE ONLY CRITERIA TO BE USED FOR ASSESSING FILL COMPACTION. OBSERVATION OF THE BEHAVIOR OF THE FILL UNDER THE LOADS OF CONSTRUCTION EQUIPMENT SHOULD BE USED. IF THE TEST RESULTS INDICATE THAT THE PERCENTAGE OF COMPACTION IS BEING ACHIEVED, BUT THE SOIL MASS IS MOVING UNDER THE EQUIPMENT, PLACEMENT OF ADDITIONAL FILL SHOULD NOT BE CONTINUED UNTIL THE MOVEMENT IS STABILIZED. OTHERWISE, SETTLEMENT OF THE FILL MAY OCCUR.

5.8.3 CUTOFF TRENCH AND IMPERVIOUS CORE

CUTOFF TRENCHES AND IMPERVIOUS CORES SHOULD BE CONSTRUCTED IN ACCORDANCE WITH NRCS - MD CODE NO. 378 POND STANDARDS/SPECIFICATIONS. TO PREVENT HORIZONTAL SEEPAGE THROUGH NEWLY COMPACTED FILL OR STATA A AND B SOILS THAT MAY BE EXPOSED ALONG THE SIDE SLOPES, WE RECOMMEND THAT A COMPACTED CLAY CUTOFF TRENCH AND IMPERVIOUS CORE BE UTILIZED. WE RECOMMEND THAT THE CUTOFF TRENCH BE PROVIDED A MINIMUM OF 4 FEET BELOW THE ENTIRE LENGTH OF THE DAM AND SHOULD BE LOCATED AT OR UPSTREAM FROM THE CENTERLINE OF THE DAM. THE CUTOFF SHOULD HAVE A BOTTOM WIDTH ADEQUATE TO ACCOMMODATE THE EQUIPMENT USED FOR EXCAVATION, BACKFILL, AND COMPACTION OPERATIONS, WITH THE MINIMUM WIDTH BEING 4 FEET AND SIDE SLOPES NO STEEPER THAN ONE HORIZONTAL TO ONE VERTICAL. THE IMPERVIOUS CORE SHOULD BE CONSTRUCTED WITHIN THE EMBANKMENT AT OR UPSTREAM FROM THE CENTERLINE OF THE DAM AND EXTEND UP TO THE ABUTMENTS TO THE 10-YEAR WATER SURFACE ELEVATION. THE IMPERVIOUS CORE SHOULD EXTEND VERTICALLY FROM THE CUTOFF TRENCH UP TO THE 10-YEAR WATER SURFACE ELEVATION THROUGHOUT THE EMBANKMENT.

THE MATERIALS SHOULD CONSIST OF CLAY COMPACTED TO AT LEAST 98 PERCENT OF THE LABORATORY DETERMINED MAXIMUM DRY DENSITY, ASTM D 698, WHEN SMALL HAND OPERATED COMPACTION EQUIPMENT IS USED AND TO AT LEAST 95 PERCENT OF THE LABORATORY DETERMINED DRY DENSITY, ASTM D 1557, WHEN SELF-PROPELLED, HEAVY DUTY COMPACTION EQUIPMENT IS USED. THE ON-SITE CLAY MATERIAL (STRATUM A) APPEARS BE SUITABLE FOR USE AS A CUTOFF TRENCH AND IMPERVIOUS CORE PROVIDED THAT THE MATERIAL IS WITHIN THE REQUIRED MOISTURE CONTENT RANGE TO ACHIEVE THE SPECIFIED COMPACTION AND HAS A MINIMUM PLASTICITY INDEX OF 6. HOWEVER, CONDITIONING OF THE ON-SITE SOILS MAY BE PROHIBITIVELY TIME CONSUMING OR COSTLY, WARRANTING IMPORTING OF OFF-SITE CLAY.

FILL LAYERS SHOULD BE PROPERLY ROUGHENED OR SCARIFIED USING A SHEEPSFOOT ROLLER OR SIMILAR EQUIPMENT PRIOR TO THE PLACEMENT OF THE NEXT LIFT OF FILL. ALTHOUGH IT IS DESIRABLE TO SEAL FILL OPERATIONS ON A DAILY BASIS USING A STEEL DRUM OR RUBBER TIRE ROLLER, THESE SURFACES SHOULD BE SCARIFIED THE FOLLOWING DAY PRIOR TO FILL ACTIVITIES TO MINIMIZE THE CREATION OF PLANES OF SEEPAGE WITHIN THE EMBANKMENT STRUCTURE.

AS-BUILT CERTIFICATION
I HEREBY CERTIFY, BY MY SEAL, THAT TO THE BEST OF MY KNOWLEDGE AND BELIEF THE FACILITIES SHOWN ON THIS PLAN WERE CONSTRUCTED AS SHOWN ON THIS "AS-BUILT" PLAN AND MEET THE APPROVED PLANS AND SPECIFICATIONS.

SIGNATURE OF ENGINEER
[Signature]
DATE: 7/21/19
PE # 36096

STATE OF MARYLAND PROFESSIONAL ENGINEERING
[Seal]

OPERATION AND MAINTENANCE SCHEDULE FOR PRIVATELY OWNED AND MAINTAINED STORMWATER PONDS (P-1 THROUGH P-5)

- ROUTINE MAINTENANCE:**
1. FACILITY SHALL BE INSPECTED ANNUALLY AND AFTER MAJOR STORMS. INSPECTIONS SHALL BE PERFORMED DURING WET WEATHER TO DETERMINE IF THE POND IS FUNCTIONING PROPERLY.
 2. TOP AND SIDE SLOPES OF THE EMBANKMENT SHALL BE MOWED A MINIMUM OF TWO (2) TIMES PER YEAR, ONCE IN JUNE AND ONCE IN SEPTEMBER. OTHER SIDE SLOPES AND MAINTENANCE ACCESS SHALL BE MOWED AS NEEDED.
 3. DEBRIS AND LITTER SHALL BE REMOVED DURING REGULAR MOWING OPERATIONS AND AS NEEDED.
 4. VISIBLE SIGNS OF EROSION IN THE POND AS WELL AS THE RIPRAP OR GABION OUTLET AREA SHALL BE REPAIRED AS SOON AS IT IS NOTICED.
- NON-ROUTINE MAINTENANCE:**
1. STRUCTURAL COMPONENTS OF THE POND SUCH AS THE DAM, THE RISER, AND THE PIPES SHALL BE REPAIRED UPON THE DETECTION OF ANY DAMAGE. THE COMPONENTS SHALL BE INSPECTED DURING ROUTINE MAINTENANCE OPERATIONS.
 2. SEDIMENT SHALL BE REMOVED FROM THE POND, AND FOREBAY, NO LATER THAN WHEN THE CAPACITY OF THE POND, OR FOREBAY, IS HALF FULL OF SEDIMENT, OR, WHEN DEEMED NECESSARY FOR AESTHETIC REASONS, UPON APPROVAL FROM THE DEPARTMENT OF PUBLIC WORKS.

APPROVED: DEPARTMENT OF PLANNING AND ZONING

[Signature]
CHIEF, DEVELOPMENT ENGINEERING DIVISION
DATE: 9-21-17

[Signature]
CHIEF, DIVISION OF LAND DEVELOPMENT
DATE: 9-27-17

[Signature]
DIRECTOR
DATE: 10-2-17


DATE	NO.	REVISION	BY
DEVELOPER			
DCT INDUSTRIAL 12011 GUILFORD ROAD SUITE 102 ANNAPOLIS JUNCTION, MD 20701 ATTN: FRED FERRARO PHONE: 410-645-5020			
OWNER			
DCT MEARS LLC 12011 GUILFORD ROAD SUITE 102 ANNAPOLIS JUNCTION, MD 20701 ATTN: FRED FERRARO PHONE: 410-645-5020			
PROJECT			
TERRAPIN COMMERCE CENTER			
AREA			
TAX MAP 43, PARCEL 51 LOT PAR A PLAT 23793 ZONED M-2 GRID NO. 11 1st ELECTION DISTRICT 7200 DORSEY RUN ROAD ELKRIDGE, MARYLAND 21075 HOWARD COUNTY, MARYLAND			
TITLE			
STORMWATER MANAGEMENT DETAILS AS-BUILT			
Pennoni Associates Inc. Engineers - Surveyors - Planners Landscape Architects			
8818 Centre Park Drive, Suite 200 Columbia, MD 21045 T 410.997.8900 F 410.997.9282			

SEAL

DESIGNED BY: PJS
DRAWN BY: AGS/JSN
PROJECT NO: DCT11601
DATE: JUNE 23, 2017
SCALE: AS SHOWN
DRAWING NO. 28 OF 43

BY: [Signature]
PROFESSIONAL CERTIFICATION: I HEREBY CERTIFY THAT THESE DOCUMENTS WERE PREPARED OR APPROVED BY ME AND THAT I AM A DULY LICENSED PROFESSIONAL ENGINEER UNDER THE LAWS OF THE STATE OF MARYLAND, LICENSE NO. 36096, EXPIRATION DATE: 2-15-21

PROPERTY OF
AA PROPERTY HOLDINGS, INC.
L. 4403, F. 307
PARCEL 50
PLAT OF FOREST CONSERVATION
EASEMENT
AA PROPERTY HOLDINGS, INC.
PLAT No. 13928

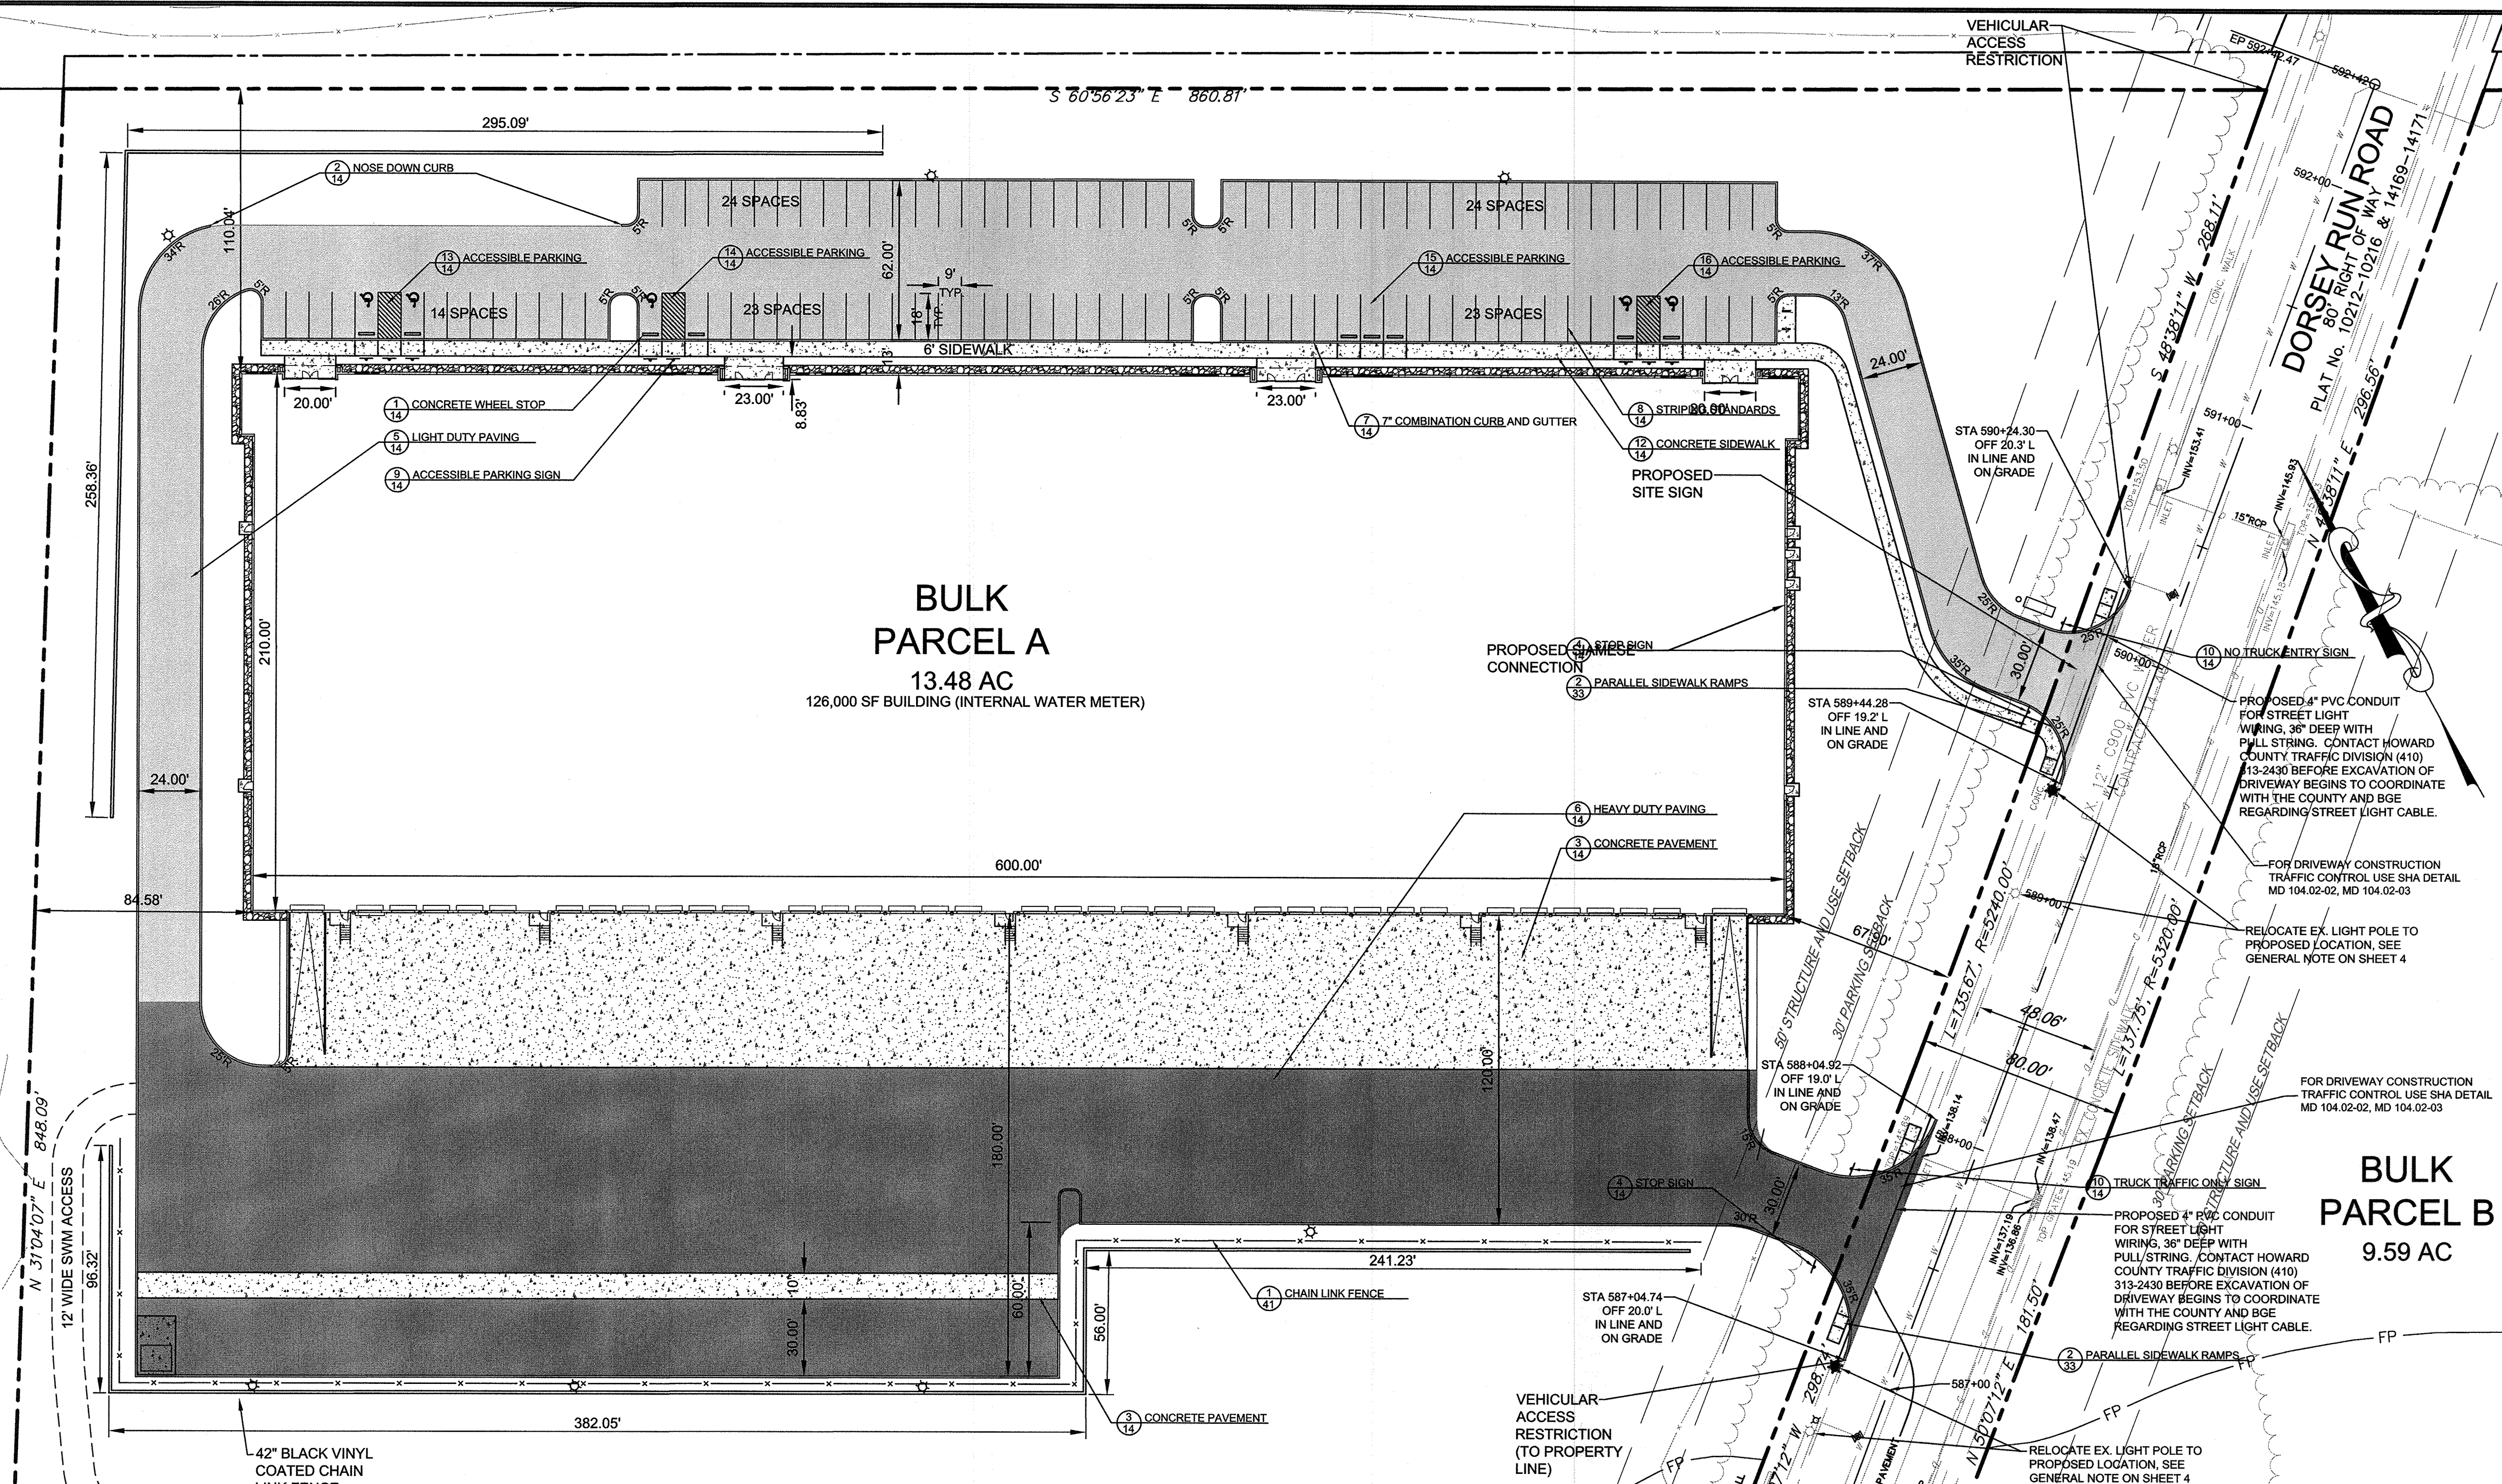

LEGEND

PROPERTY LINE AND RIGHT-OF-WAY	
PROP. CONCRETE SIDEWALK	
PROP. CONCRETE PAVEMENT	
PROP. P-3 PAVING	
PROP. P-5 PAVING	

**BULK
PARCEL A**
13.48 AC
126,000 SF BUILDING (INTERNAL WATER METER)

**BULK
PARCEL B**
9.59 AC

APPROVED: DEPARTMENT OF PLANNING AND ZONING

	9-21-17
CHIEF, DEVELOPMENT ENGINEERING DIVISION	DATE
	9-27-17
CHIEF, DIVISION OF LAND DEVELOPMENT	DATE
	10-2-17
DIRECTOR	DATE

DATE	NO.	REVISION	BY

DEVELOPER: DCT INDUSTRIAL
12011 GUILFORD ROAD
SUITE 102
ANNAPOLIS JUNCTION, MD 20701
ATTN: FRED FERRARO
PHONE: 410-645-5020

OWNER: DCT MEARS LLC
12011 GUILFORD ROAD
SUITE 102
ANNAPOLIS JUNCTION, MD 20701
ATTN: FRED FERRARO
PHONE: 410-645-5020

PROJECT: **TERRAPIN COMMERCE CENTER**




AREA: TAX MAP 43, PARCEL 51 LOT PAR A PLAT 23793 ZONED M-2
GRID NO. 11 1st ELECTION DISTRICT
7200 DORSEY RUN ROAD
ELKRIDGE, MARYLAND 21075
HOWARD COUNTY, MARYLAND

TITLE: **PAVING, STRIPING, AND SIGNAGE PLAN**

Pennoni Associates Inc.
Engineers • Surveyors • Planners
Landscape Architects

8818 Centre Park Drive, Suite 200 Columbia, MD 21045
T 410.997.8900 F 410.997.9282

DESIGNED BY: PJS
DRAWN BY: AGS/JSN
PROJECT NO: DCT1601
DATE: JUNE 23, 2017
SCALE: 1" = 40'
DRAWING NO. 29 OF 43

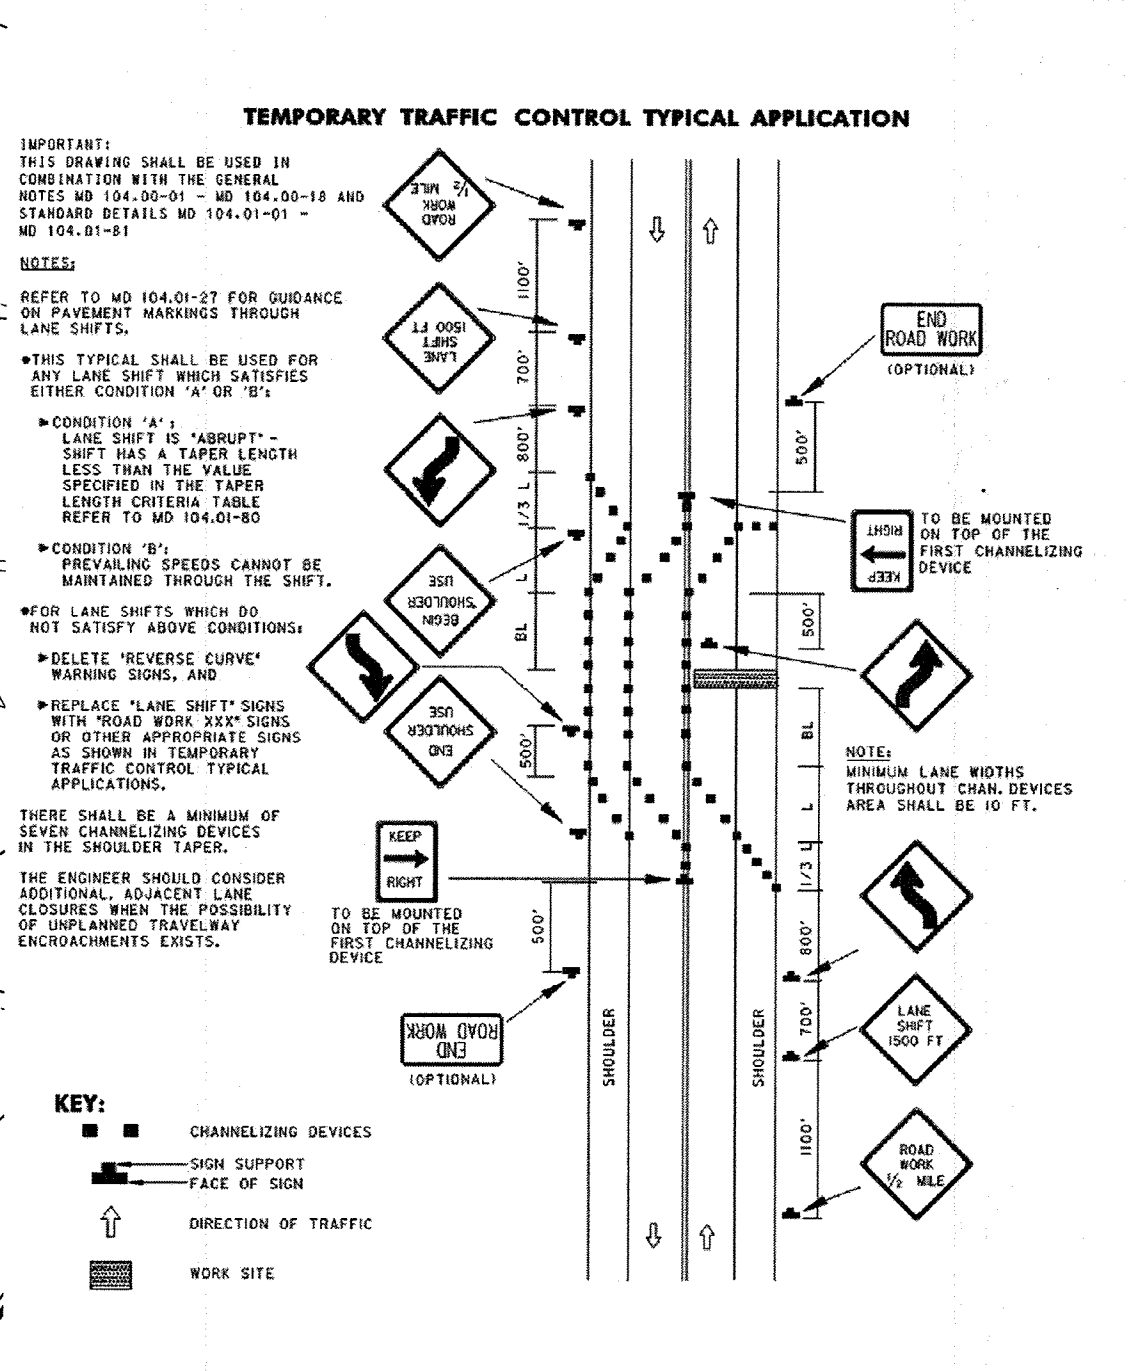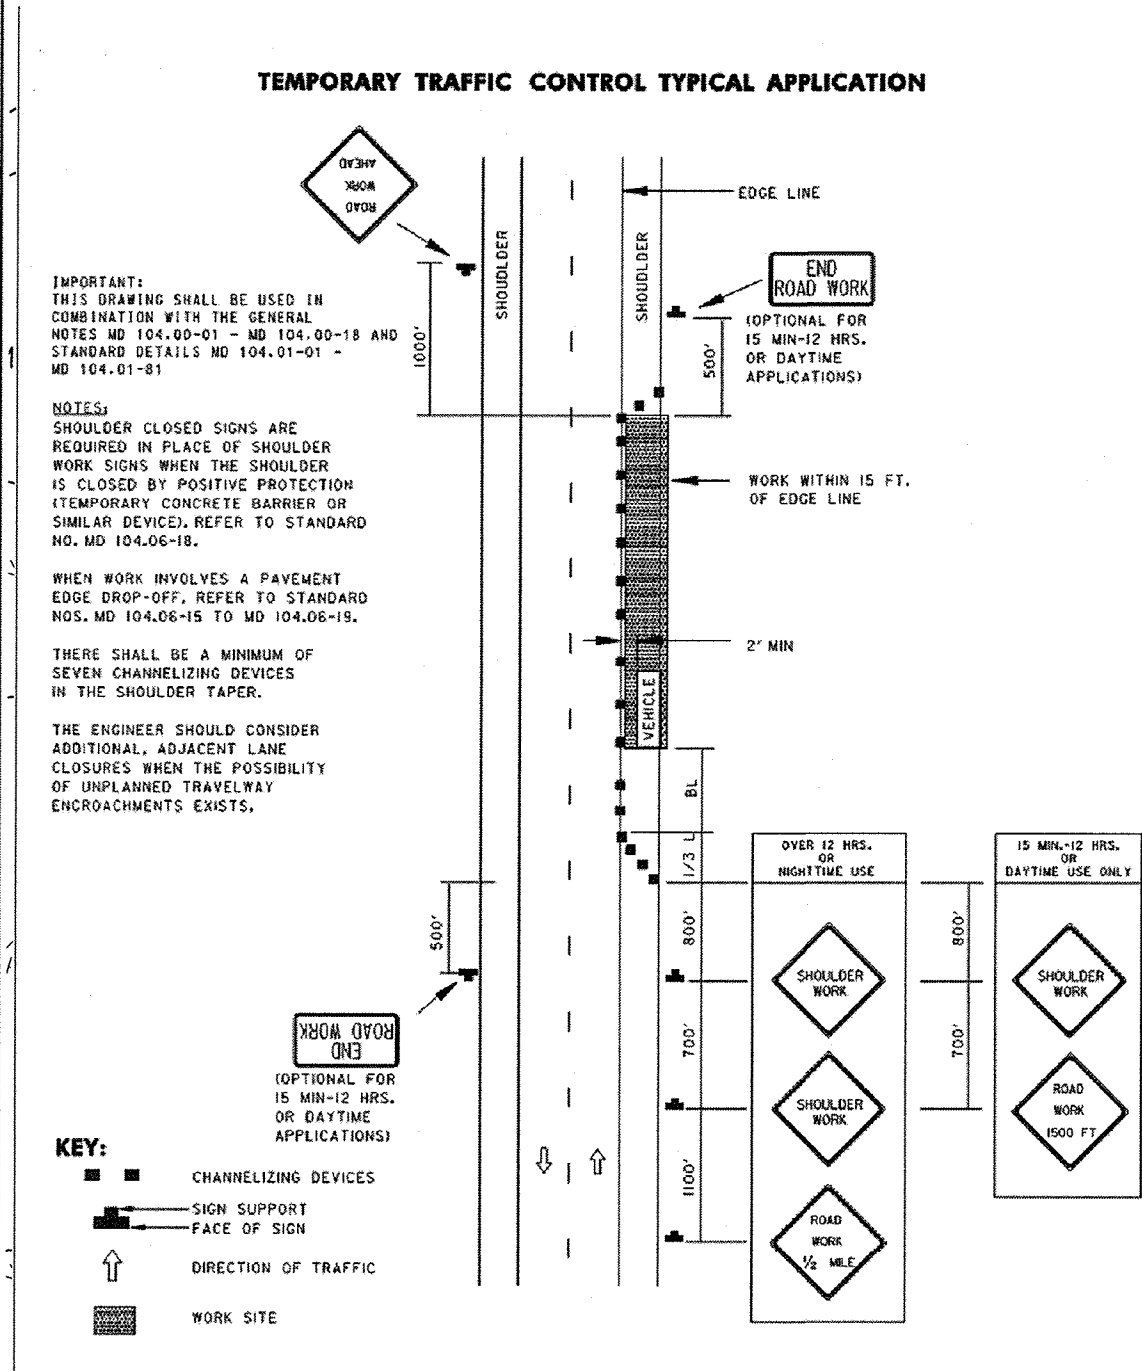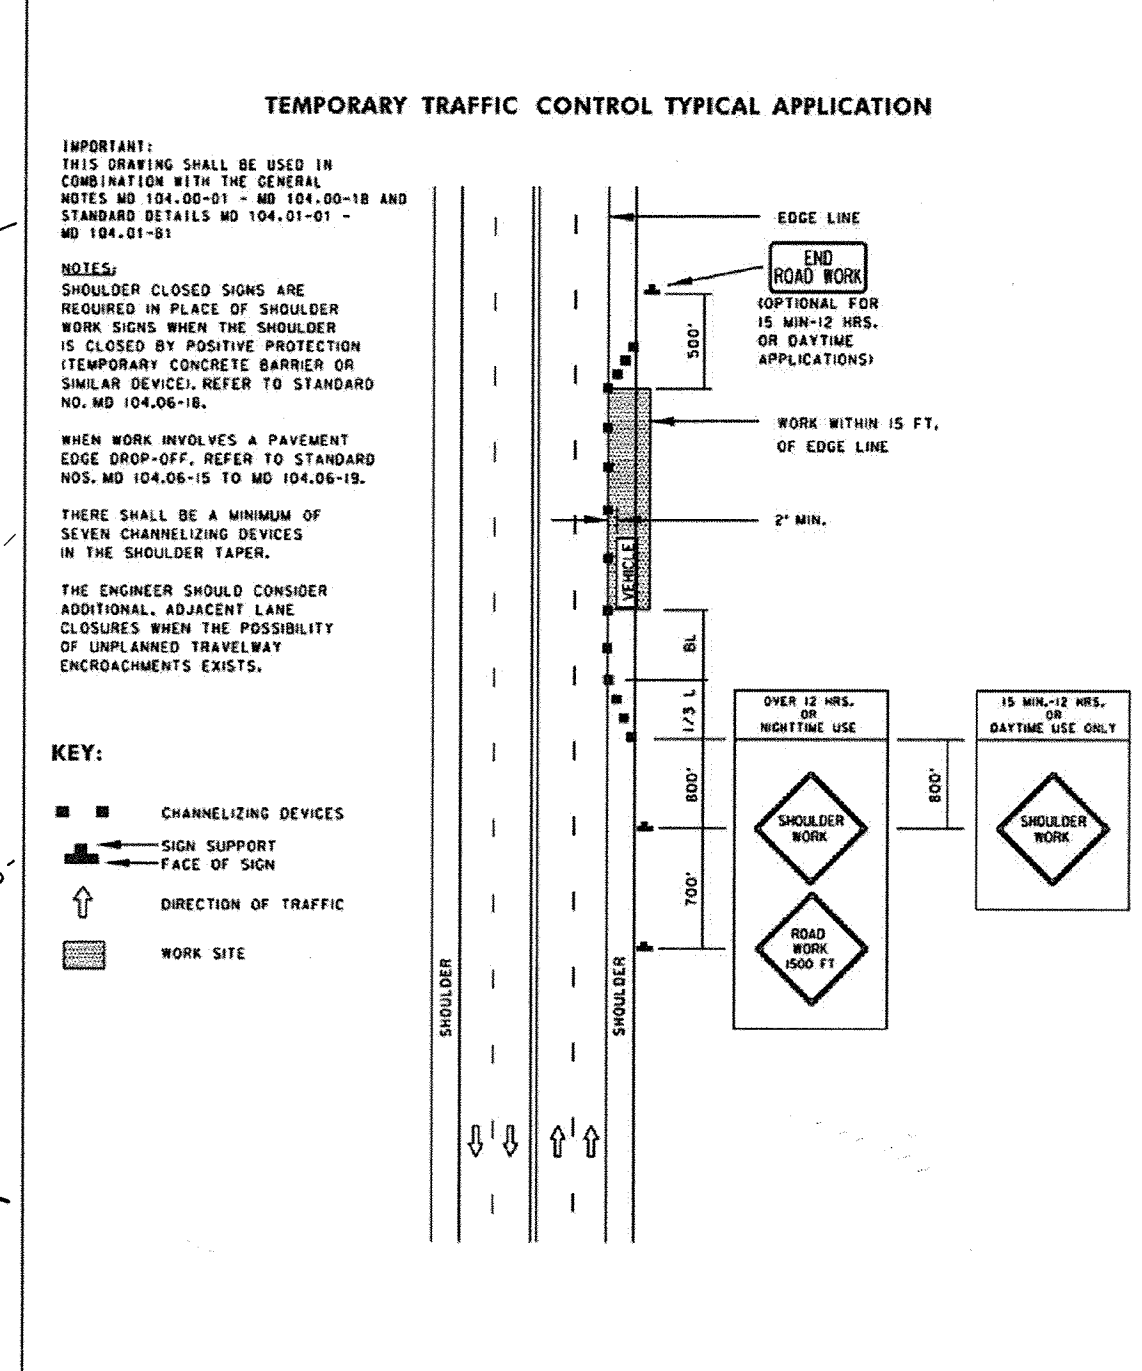

SPECIFICATION 104
APPROVED:

Maryland Department of Transportation
STATE HIGHWAY ADMINISTRATION
STANDARDS FOR HIGHWAYS AND INCIDENTAL STRUCTURES
**SHOULDER WORK/MULTILANE UNDIV.
EQU/LESS THAN 40 MPH**
STANDARD NO. MD 104.03-02

SPECIFICATION 104
APPROVED:

Maryland Department of Transportation
STATE HIGHWAY ADMINISTRATION
STANDARDS FOR HIGHWAYS AND INCIDENTAL STRUCTURES
**SHOULDER WORK /2-LANE, 2-WAY
GREATER THAN 40 MPH**
STANDARD NO. MD 104.02-01

SPECIFICATION 104
APPROVED:

Maryland Department of Transportation
STATE HIGHWAY ADMINISTRATION
STANDARDS FOR HIGHWAYS AND INCIDENTAL STRUCTURES
**LANE SHIFT RIGHT OR LEFT SIDE/2-LANE,
2-WAY GREATER THAN 40 MPH/15 MIN -
12 HRS. OR DAYTIME ONLY**
STANDARD NO. MD 104.02-03

AS-BUILT CERTIFICATION

NOTE: THERE IS NO "AS-BUILT" INFORMATION PROVIDED ON THIS SHEET.

PRINTED NAME: Sharon H. Cruz
MD P.E. NO.: 36896
DATE: 7/8/19



BY:


DESIGNED BY: PJS
DRAWN BY: AGS/JSN
PROJECT NO: DCT1601
DATE: JUNE 23, 2017
SCALE: 1" = 40'
DRAWING NO. 29 OF 43

PROPERTY OF
ANGLO AMERICAN PROP
HOLDINGS, INC.
L. 2508, F.10
PARCEL 116
BALTIMORE WASHINGTON
AUTO EXCHANGE
PLAT Nos. 10212-10216

PROPERTY OF
AA PROPERTY HOLDINGS, INC.
L. 4403, F.307
PARCEL 50
PLAT OF FOREST CONSERVATION
EASEMENT
AA PROPERTY HOLDINGS, INC.
PLAT No. 13928

LEGEND	
PROPERTY LINE AND RIGHT-OF-WAY	---
EXISTING 1' CONTOUR	-----154-----
EXISTING 5' CONTOUR	-----155-----
EXISTING TREE LINERUB.....
EXISTING SOILSRUB.....
EXISTING WETLANDSWB.....
EXISTING WETLAND BUFFER	WB
EXISTING STORM DRAIN	-----164-----
PROPOSED 1' CONTOUR	-----165-----
PROPOSED 5' CONTOUR	-----165-----
PROPOSED MICRO-BIORETENTION FACILITY	
PROPOSED TREE LINERUB.....
PROPOSED STORM DRAIN	-----164-----
PROPOSED TREE PROTECTION FENCE	-----164-----
CREDITED FOREST CONSERVATION EASEMENT	+++++
NON-CREDITED FOREST CONSERVATION EASEMENTRUB.....
PROPOSED FOREST CONSERVATION SIGNRUB.....

AS-BUILT CERTIFICATION
NOTE: THERE IS NO "AS-BUILT" INFORMATION PROVIDED ON THIS SHEET.
Shawn L. Cruz 36896
PRINTED NAME MD, P.E. NO.
7/2/19 DATE
SIGNATURE

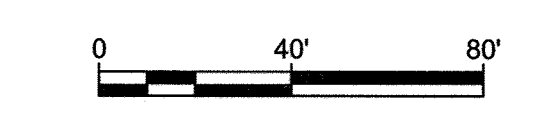

APPROVED: DEPARTMENT OF PLANNING AND ZONING

 CHIEF, DEVELOPMENT ENGINEERING DIVISION 9-21-17 DATE

 CHIEF, DIVISION OF LAND DEVELOPMENT 9-27-17 DATE

 DIRECTOR 10-2-17 DATE

DATE	NO.	REVISION	BY

DEVELOPER: DCT INDUSTRIAL, 12011 GUILFORD ROAD, SUITE 102, ANNAPOLIS, JUNCTION, MD 20701, ATTN: FRED FERRARO, PHONE: 410-645-5020

OWNER: DCT MEARS LLC, 12011 GUILFORD ROAD, SUITE 102, ANNAPOLIS, JUNCTION, MD 20701, ATTN: FRED FERRARO, PHONE: 410-645-5020

PROJECT: TERRAPIN COMMERCE CENTER

AREA: TAX MAP 43, PARCEL 51 LOT PAR A PLAT 23793 ZONED M-2, GRID NO. 11 1st ELECTION DISTRICT, 7200 DORSEY RUN ROAD, ELKRIDGE, MARYLAND 21075, HOWARD COUNTY, MARYLAND


TITLE: FOREST CONSERVATION PLAN

Pennoni Associates Inc.


 Engineers • Surveyors • Planners
 Landscape Architects
 8818 Centre Park Drive, Suite 200 Columbia, MD 21045
 T 410.997.8900 F 410.997.9282

DESIGNED BY: PJS
 DRAWN BY: AGS/JSN
 PROJECT NO: DCT11601
 DATE: JUNE 23, 2017
 SCALE: 1" = 40'
 DRAWING NO. 30 OF 43

PETER J. STONE #3068

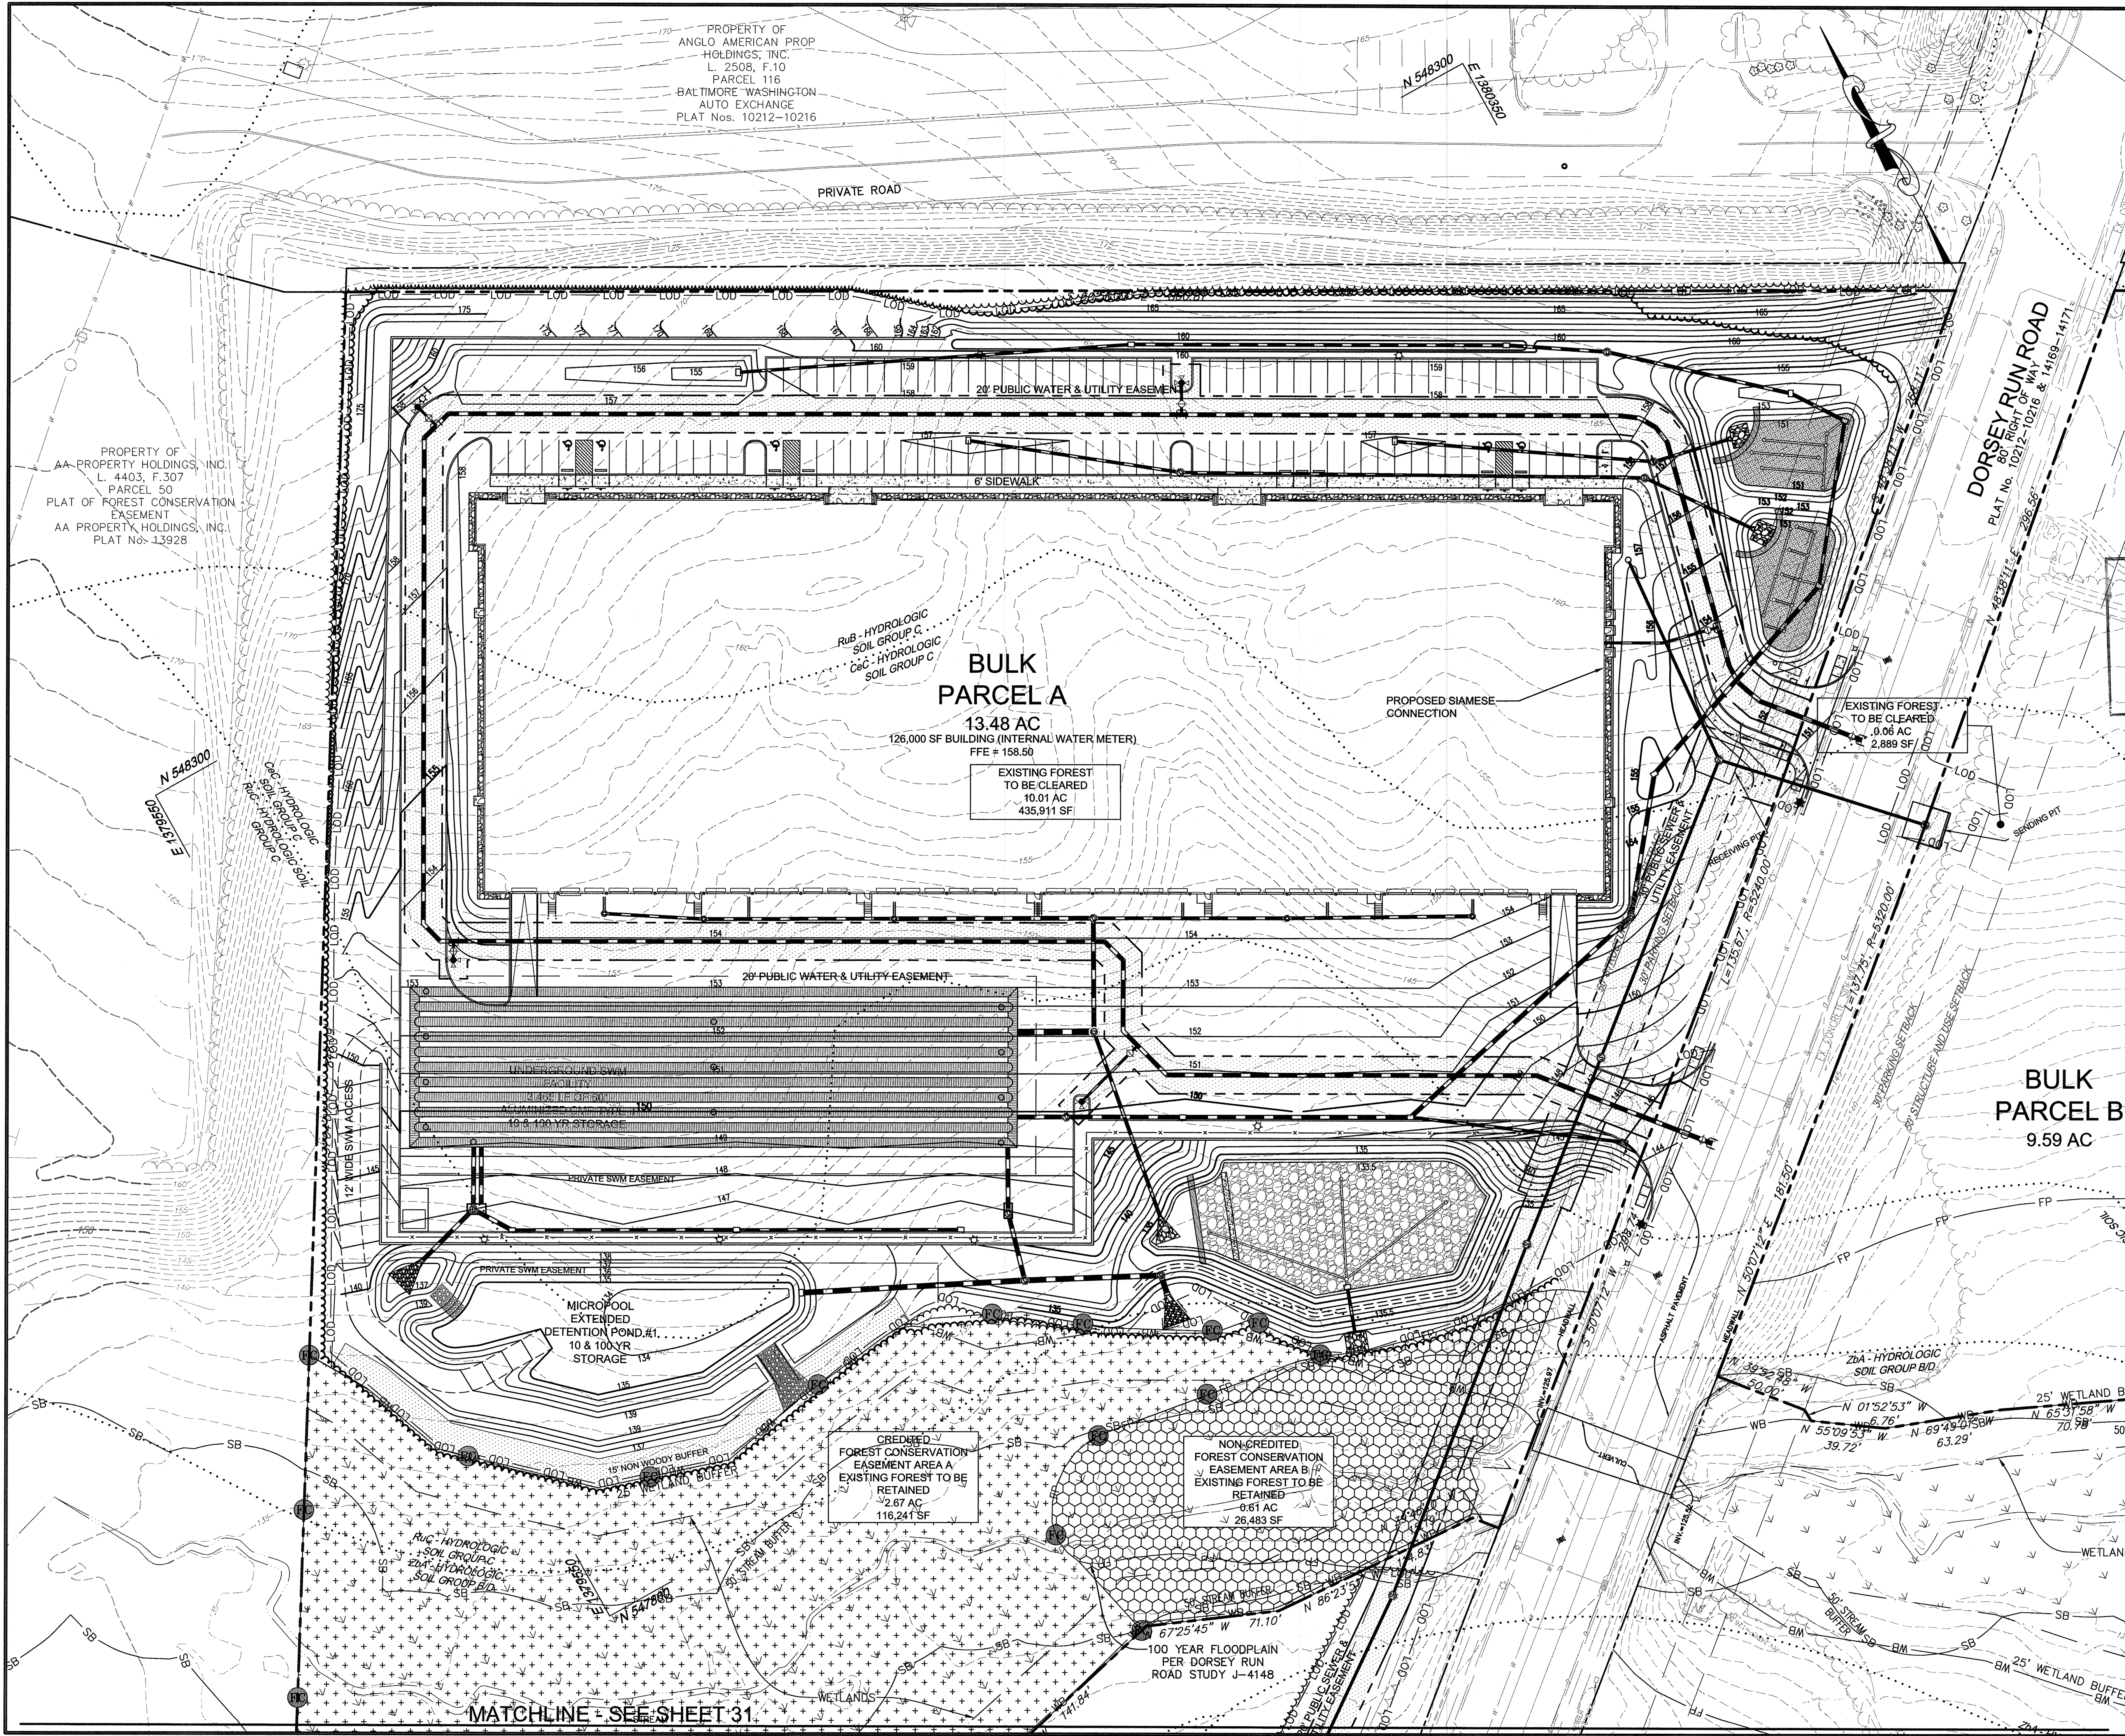

MATCHLINE - SEE SHEET 31

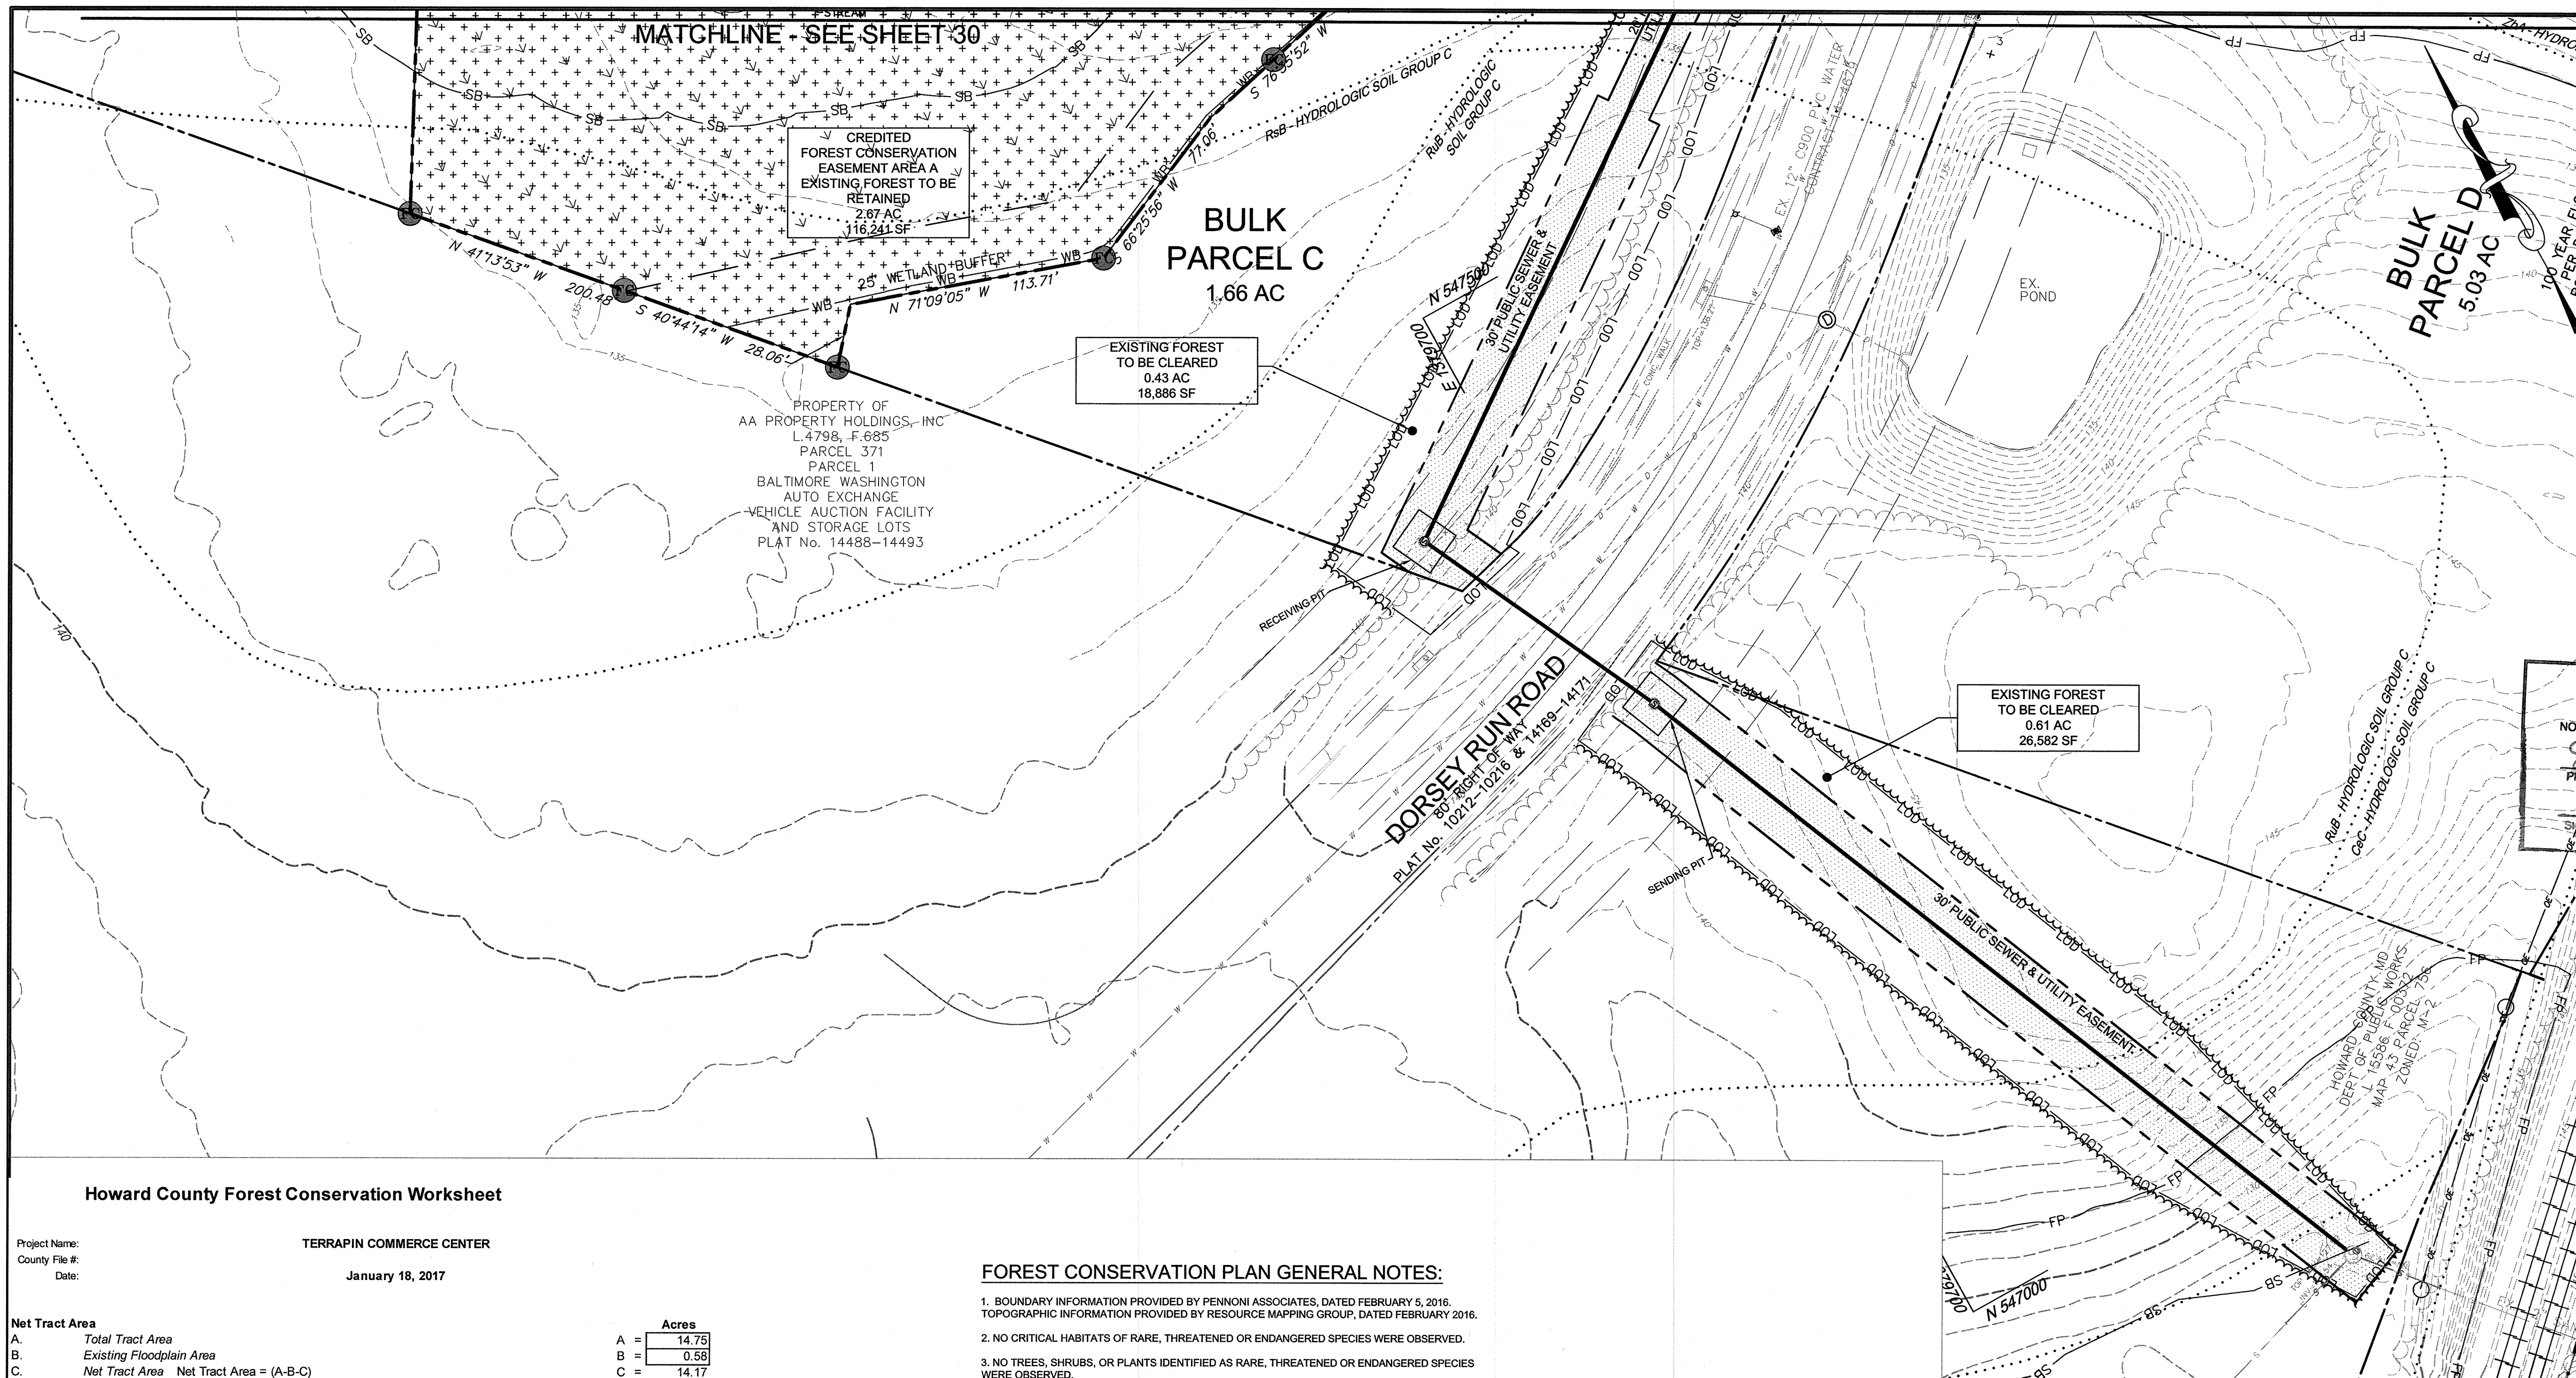

LEGEND


PROPERTY LINE AND RIGHT-OF-WAY	---
EXISTING 1' CONTOUR	---154---
EXISTING 5' CONTOUR	---155---
EXISTING TREE LINE	~~~~~
EXISTING SOILSRsb.....
EXISTING WETLANDSWB.....
EXISTING WETLAND BUFFER	WB
EXISTING STORM DRAIN	164
PROPOSED 1' CONTOUR	165
PROPOSED 5' CONTOUR	165
PROPOSED MICRO-BIORETENTION FACILITY	[Symbol]
PROPOSED TREE LINE	~~~~~
PROPOSED STORM DRAIN	---
PROPOSED TREE PROTECTION FENCE	--- ---
PROP. FOREST CONSERVATION EASEMENT	[Symbol]
PROPOSED FOREST CONSERVATION SIGN	[Symbol]

AS-BUILT CERTIFICATION

NOTE: THERE IS NO "AS-BUILT" INFORMATION PROVIDED ON THIS SHEET.

PRINTED NAME: Sharon E. Cruz 36996 MD. P.E. NO.

SIGNATURE: [Signature] 7/2/19 DATE

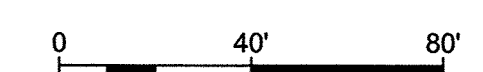

APPROVED: DEPARTMENT OF PLANNING AND ZONING

Chief, Development Engineering Division	9-21-17
Chief, Division of Land Development	9-27-17
Director	10-2-17

DATE	NO.	REVISION	BY
		DCT INDUSTRIAL	
		12011 GUILFORD ROAD	
		SUITE 102	
		ANNAPOLIS JUNCTION, MD 20701	
		ATTN: FRED FERRARO	
		PHONE: 410-645-5020	

OWNER	DCT MEARS LLC
	12011 GUILFORD ROAD
	SUITE 102
	ANNAPOLIS JUNCTION, MD 20701
	ATTN: FRED FERRARO
	PHONE: 410-645-5020

PROJECT	TERRAPIN COMMERCE CENTER
AREA	TAX MAP 43, PARCEL 51 LOT PAR A, PLAT 23793 ZONED M-2
	GRID NO. 11 1st ELECTRIC DISTRICT
	7200 DORSEY RUN ROAD
	ELKRIDGE, MARYLAND 21075
	HOWARD COUNTY, MARYLAND

TITLE: **FOREST CONSERVATION PLAN, NOTES AND DETAILS**

Pennoni Associates Inc.
Engineers • Surveyors • Planners
Landscape Architects

8818 Centre Park Drive, Suite 200 Columbia, MD 21045
T 410.997.8900 F 410.997.9282

DESIGNED BY:	PJS
DRAWN BY:	AGS/JSN
PROJECT NO.:	DCT11601
DATE:	JUNE 23, 2017
SCALE:	1" = 40'
DRAWING NO.:	31 OF 43

Howard County Forest Conservation Worksheet

Project Name: **TERRAPIN COMMERCE CENTER**
County File #: _____
Date: **January 18, 2017**


	A	B	C	D	E	F	G	H	I	J	K	L	M	N	P	Q	R
Net Tract Area																	
A. Total Tract Area	14.75																
B. Existing Floodplain Area	0.58																
C. Net Tract Area	14.17																
Land Use Category: Industrial Development Area																	
D. Afforestation Threshold (Net Tract Area X 15%)	2.13																
E. Conservation Threshold (Net Tract Area X 15%)	2.13																
Existing Forest Cover																	
F. Existing Forest Cover within the Net Tract Area	13.78																
G. Area of Forest Above Conservation Threshold	11.65																
H. Break Even Point	4.46																
I. Forest Clearing Permitted Without Mitigation	9.32																
Proposed Forest Clearing																	
J. Total Area of Forest to be Cleared	11.11																
K. Total Area of Forest to be Retained	2.67																
Planting Requirements																	
L. Reforestation for Clearing Above the Conservation Threshold	2.78																
M. Reforestation for Clearing Below the Conservation Threshold	0.00																
N. Credit for Retention Above the Conservation Threshold	0.54																
P. Total Reforestation Required P = L + M - N	2.23																
Q. Total Afforestation Required	0.00																
R. Total Planting Requirement R = P + Q	2.23																

FOREST CONSERVATION PLAN GENERAL NOTES:

- BOUNDARY INFORMATION PROVIDED BY PENNONI ASSOCIATES, DATED FEBRUARY 8, 2016. TOPOGRAPHIC INFORMATION PROVIDED BY RESOURCE MAPPING GROUP, DATED FEBRUARY 2016.
- NO CRITICAL HABITATS OF RARE, THREATENED OR ENDANGERED SPECIES WERE OBSERVED.
- NO TREES, SHRUBS, OR PLANTS IDENTIFIED AS RARE, THREATENED OR ENDANGERED SPECIES WERE OBSERVED.
- THERE ARE NO KNOWN CEMETERIES OR BURIAL PLOTS LOCATED ON THE SITE.
- THERE ARE NO STRUCTURES PRESENT ON THE SITE.
- THE SOILS ON SITE ARE CHILLUM LOAM (5-10% SLOPES) - CcC, RUSSET FINE SANDY LOAM (2-5% SLOPES) - RbB, RUSSET AND BELTSVILLE SOILS (2-5% SLOPES) - RbB, RUSSET AND BELTSVILLE SOILS (5-10% SLOPES) - RbC, AND ZEKIAH AND ISSUE SOILS (0-2% SLOPES) - ZbA ACCORDING TO THE NATURAL RESOURCES CONSERVATION SERVICE WEB SOIL SURVEY.
- A FOREST STAND DELINEATION FOR THIS PROPERTY WAS COMPLETED BY PENNONI ASSOCIATES, INC. AND APPROVED ON SEPTEMBER 2, 2016 (SEE FILE # ECP-16-086).
- THE HOWARD COUNTY FOREST CONSERVATION MANUAL SUPERCEDES ANY DISCREPANCIES BETWEEN THE MANUAL AND THESE PLANS.
- THIS PROJECT COMPLIES WITH THE REQUIREMENTS OF SECTION 16.1200 OF THE HOWARD COUNTY CODE FOR FOREST CONSERVATION.
- THIS PROJECT COMPLIES WITH THE REQUIREMENTS OF SECTION 16.1200 OF THE HOWARD COUNTY CODE FOR FOREST CONSERVATION BY 2.67 ACRES OF ON-SITE RETENTION AND THE PURCHASE OF CREDITS FOR 2.23 ACRES OF FOREST IN AN OFFSITE BANK. THE BANK IS KNOWN AS SDP-16-029, AFS FARM AND/OR P-13-070 QUARTZ HILL III.
- THE FOREST CONSERVATION EASEMENT HAS BEEN ESTABLISHED TO FULFILL THE REQUIREMENTS OF SECTION 16.1200 OF THE HOWARD COUNTY CODE AND FOREST CONSERVATION ACT. NO CLEARING, GRADING, OR CONSTRUCTION IS PERMITTED WITHIN THE FOREST CONSERVATION EASEMENT, HOWEVER FOREST MANAGEMENT PRACTICES AS DEFINED IN THE DEED OF FOREST CONSERVATION EASEMENT ARE ALLOWED.

FOREST CONSERVATION EASEMENT TABLE


CONSERVATION TYPE	AREA	ACRES	SF
ON-SITE RETENTION	A	2.67	116,241
TOTAL RETENTION		2.67	116,241

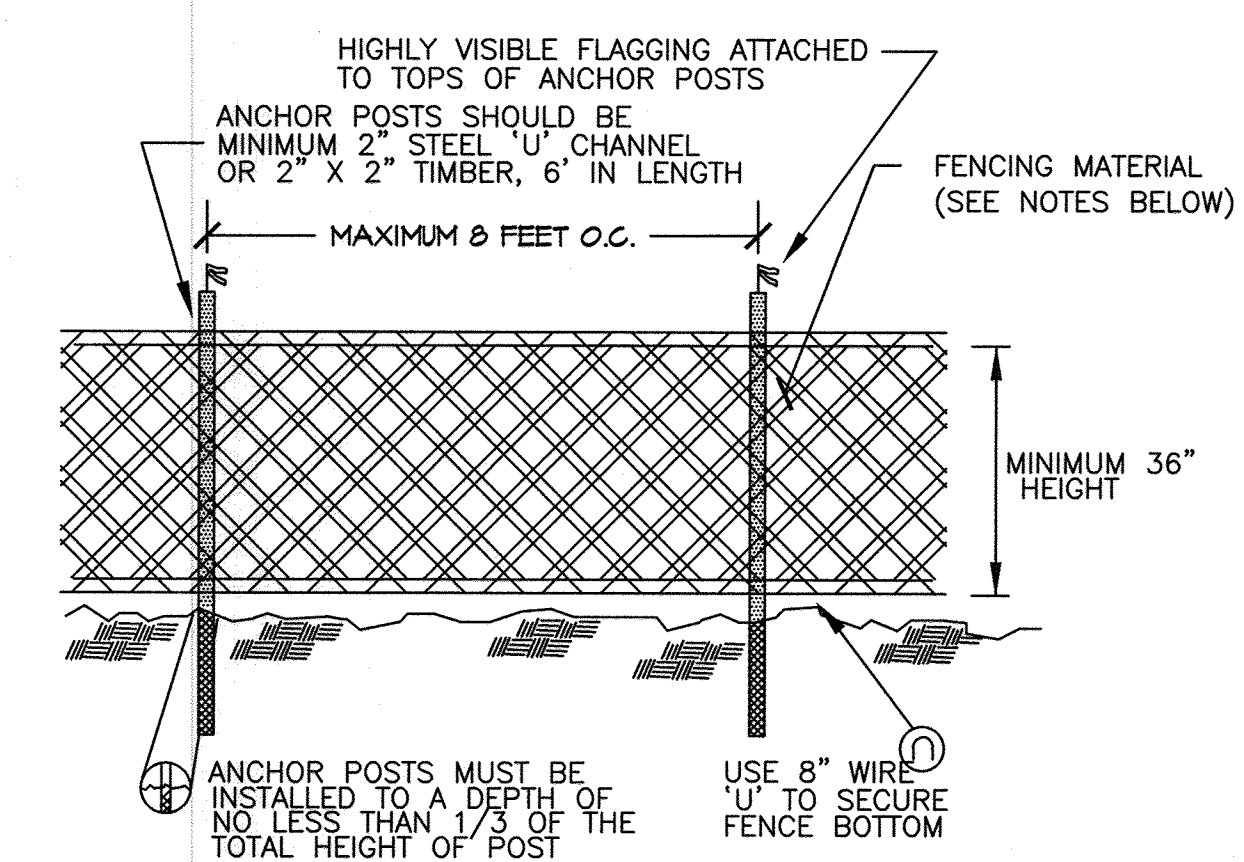

- NOTES:
- BLAZE ORANGE MESH OR SUPER SILT FENCE FOR TREE PROTECTION DEVICE, ONLY.
 - BOUNDARIES OF PROTECTION AREA WILL BE ESTABLISHED PRIOR TO GRADING AND SEDIMENT CONTROL.
 - AVOID DAMAGE TO CRITICAL ROOT ZONE. DO NOT DAMAGE OR SEVER LARGE ROOTS WHEN INSTALLING POSTS.
 - FENCING SHALL BE MAINTAINED THROUGHOUT CONSTRUCTION.

TREE PROTECTION FENCING


NOT TO SCALE

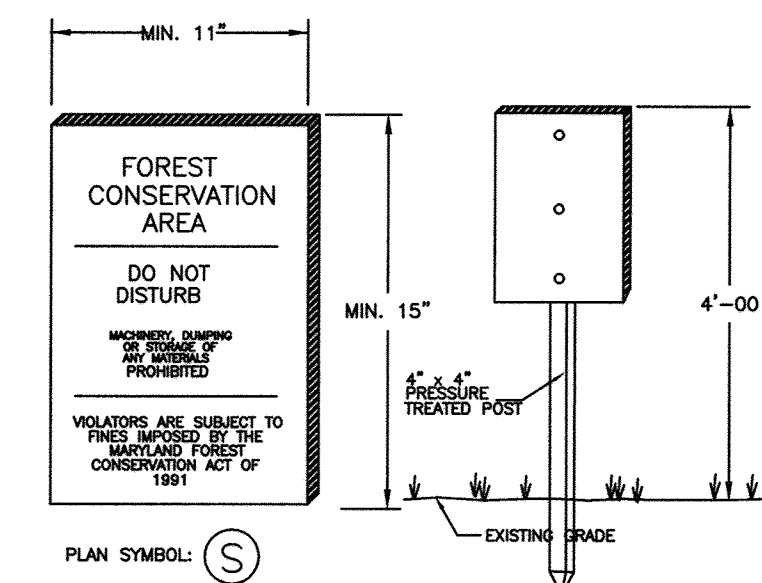


- NOTES:
- SIGNAGE SHALL BE LOCATED ON FOREST CONSERVATION / REFORESTATION / AFFORESTATION EASEMENT BORDER.
 - SEE PLAN FOR SPACING.

FOREST CONSERVATION & REFORESTATION SIGN DETAIL

NOT TO SCALE

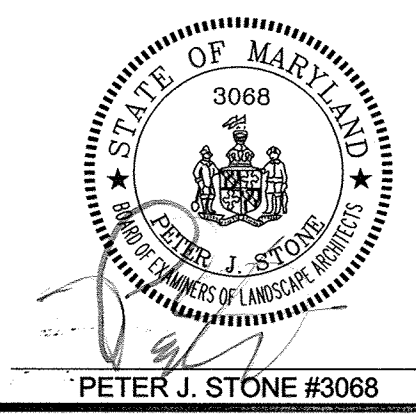

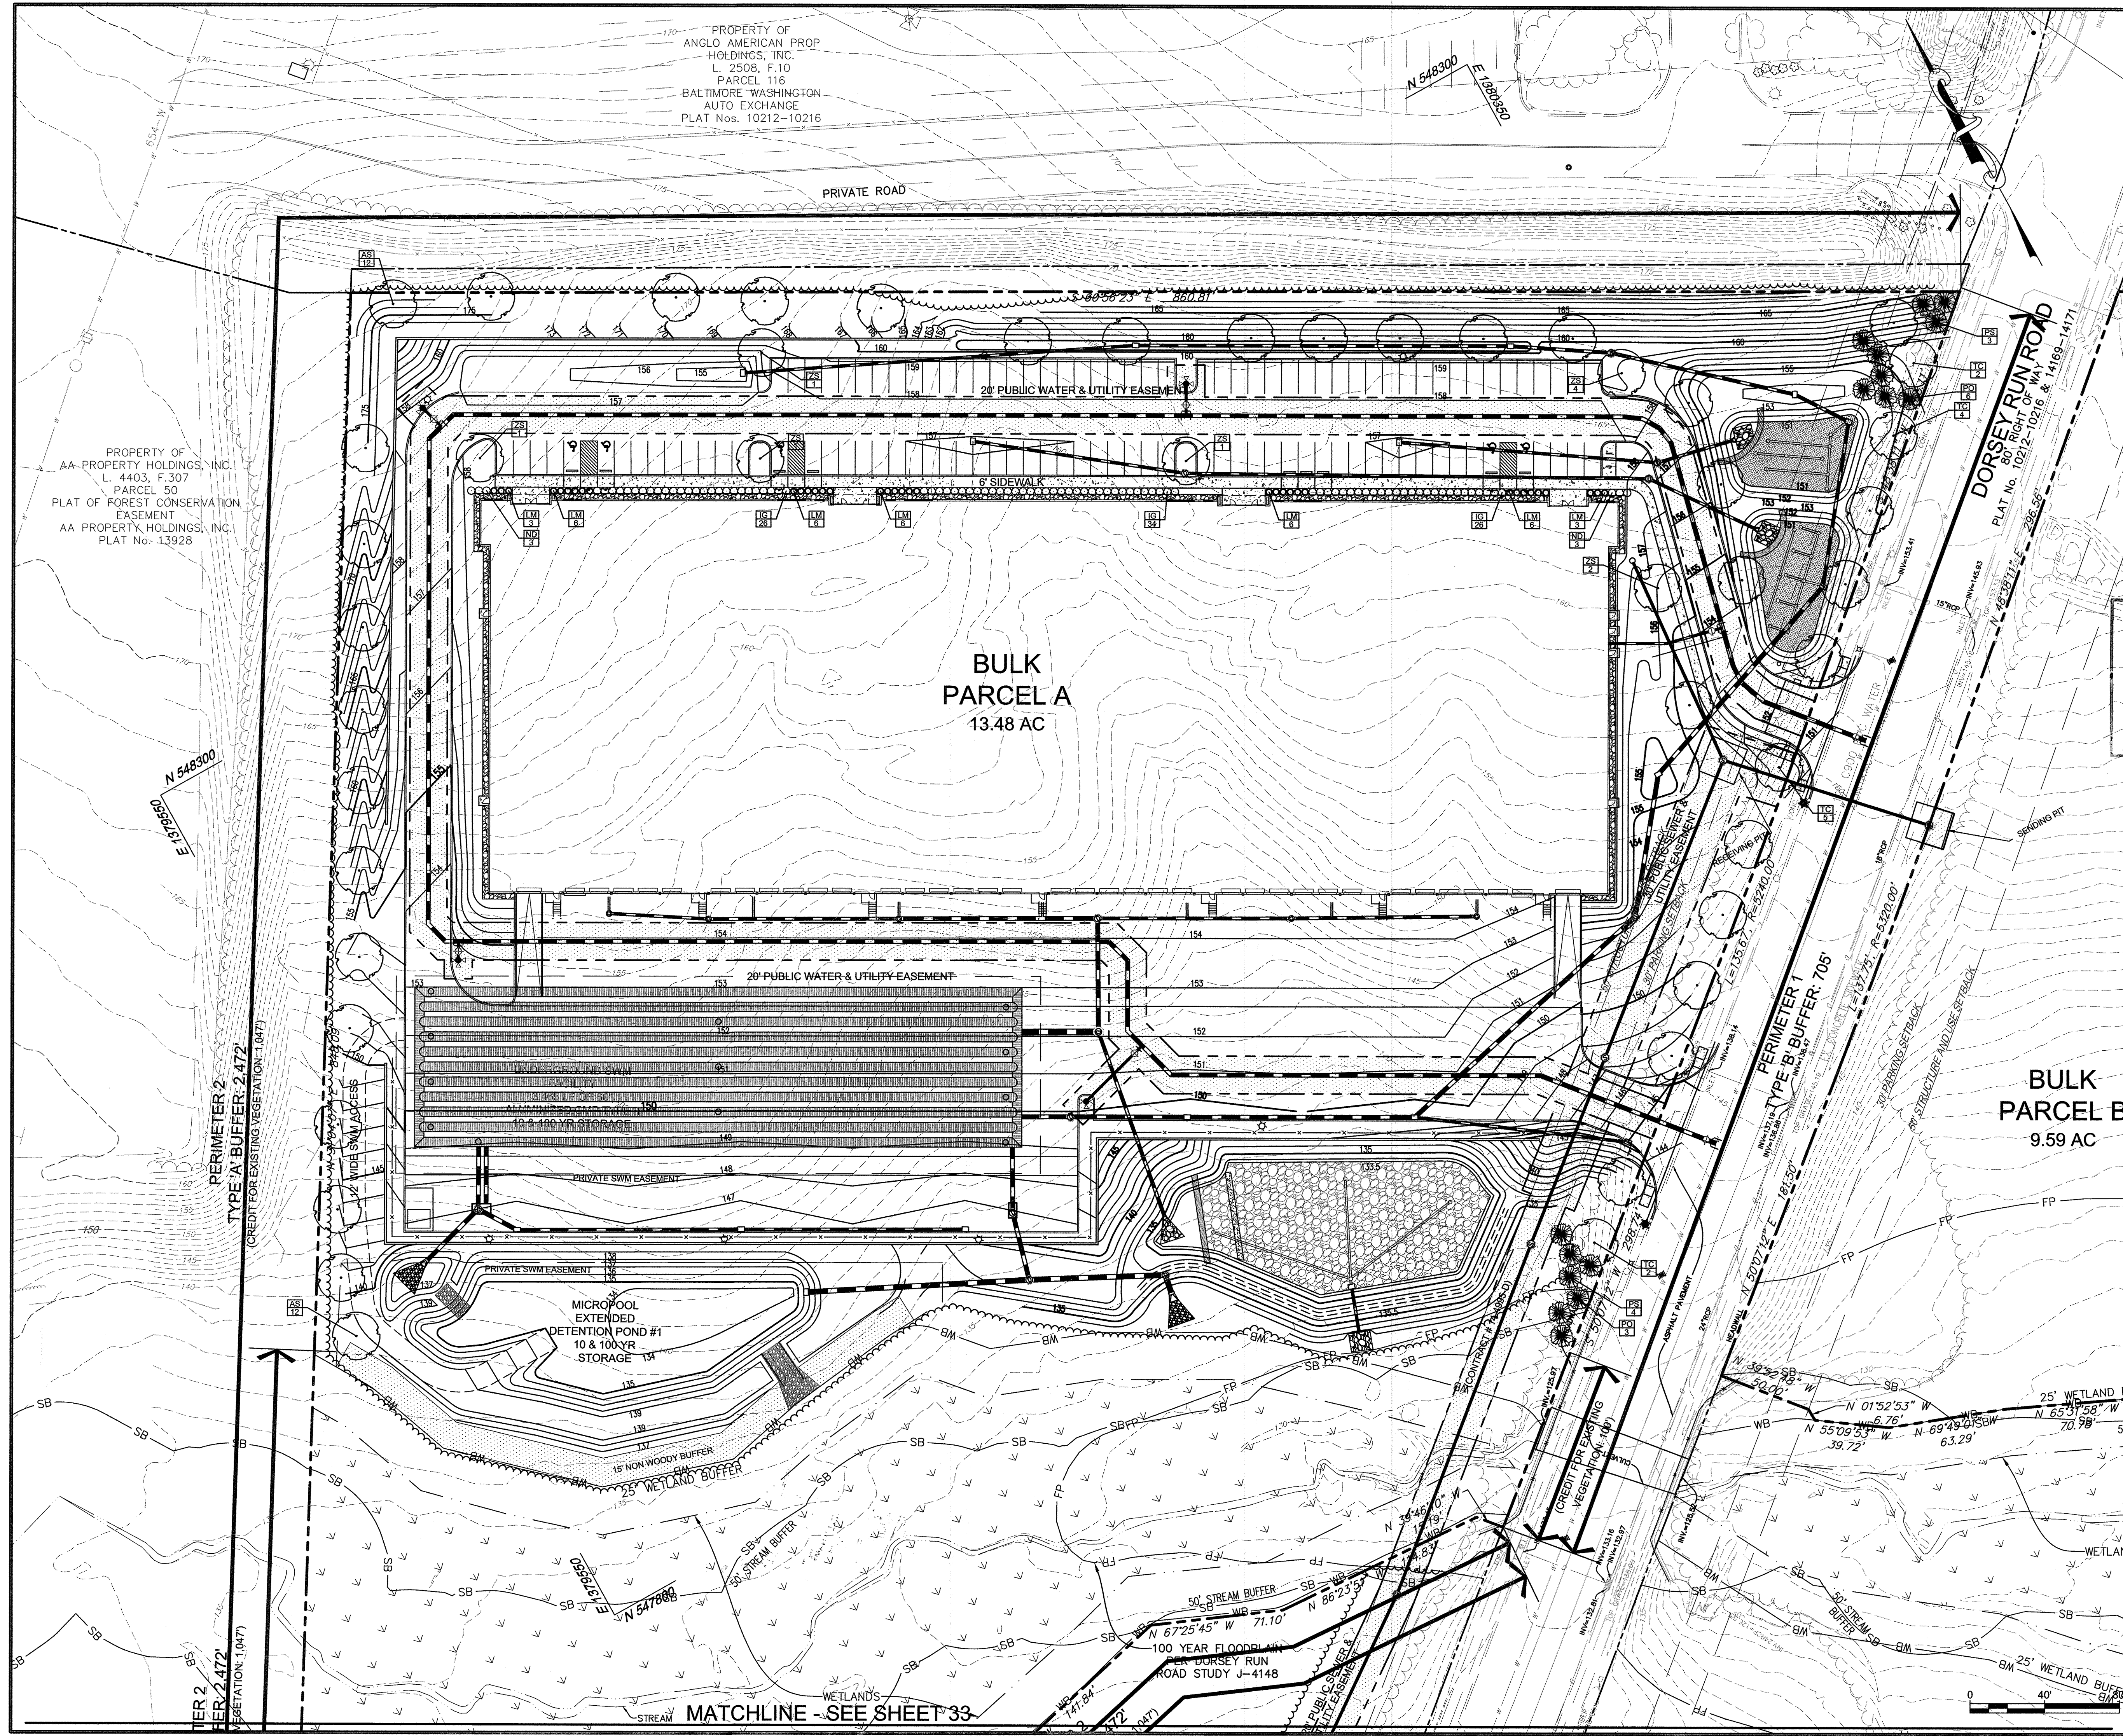

LEGEND

PROPOSED TREE LINE	
PROPOSED SHADE TREE	
PROPOSED EVERGREEN TREE	
PROPOSED SHRUBS	

AS-BUILT CERTIFICATION

NOTE: THERE IS NO "AS-BUILT" INFORMATION PROVIDED ON THIS SHEET.

PRINTED NAME: Sharon L. Cruz MD. P.E. NO.: 36896

SIGNATURE: DATE: 7/2/19

APPROVED: DEPARTMENT OF PLANNING AND ZONING

	9-21-17
CHIEF, DEVELOPMENT ENGINEERING DIVISION	DATE
	9-27-17
CHIEF, DIVISION OF LAND DEVELOPMENT	DATE
	10-2-17
DIRECTOR	DATE

DATE	NO.	REVISION	BY
DEVELOPER			
DCT INDUSTRIAL 12011 GUILFORD ROAD SUITE 102 ANNAPOLIS JUNCTION, MD 20701 ATTN: FRED FERRARO PHONE: 410-645-5020			
OWNER			
DCT MEARS LLC 12011 GUILFORD ROAD SUITE 102 ANNAPOLIS JUNCTION, MD 20701 ATTN: FRED FERRARO PHONE: 410-645-5020			
PROJECT			
TERRAPIN COMMERCE CENTER			
AREA			
TAX MAP 43, PARCEL 51 LOT PAR A PLAT 23793 ZONED M-2 GRID NO. 11 1st ELECTION DISTRICT 7200 DORSEY RUN ROAD ELKRIDGE, MARYLAND 21075 HOWARD COUNTY, MARYLAND			
TITLE			
LANDSCAPE PLAN			

Pennoni Pennoni Associates Inc.
Engineers • Surveyors • Planners
Landscape Architects

8818 Centre Park Drive, Suite 200 Columbia, MD 21045
T 410.997.8900 F 410.997.9282

DESIGNED BY: PJS
DRAWN BY: AGS/JSN
PROJECT NO: DCT11601
DATE: JUNE 23, 2017
SCALE: 1" = 40'
DRAWING NO. 32 OF 43

STATE OF MARYLAND
PETER J. STONE #3068

PLANT SCHEDULE					
SYMBOL	QTY.	SCIENTIFIC/ COMMON NAME	SIZE	ROOT	REMARKS
SHADE TREES					
AS	24	ACER SACCHARUM 'GREEN MOUNTAIN' GREEN MOUNTAIN SUGAR MAPLE	2.5-3" CAL.	B&B	AS SHOWN
TC	13	TILIA CORDATA 'GREENSPIRE' GREENSPIRE LITTLELEAF LINDEN	2.5-3" CAL.	B&B	AS SHOWN
ZS	10	ZELKOVA SERRATA 'VILLAGE GREEN' VILLAGE GREEN JAPANESE ZELKOVA	2.5-3" CAL.	B&B	AS SHOWN
EVERGREEN TREES					
PS	7	PINUS STROBUS EASTERN WHITE PINE	6-8" HT.	B&B	AS SHOWN
PO	9	PICEA OMORIKA SERBIAN SPRUCE	6-8" HT.	B&B	AS SHOWN
SHRUBS					
IG	85	ILEX GLABRA 'SHAMROCK' INKBERRY	18-24" HT.	B&B	AS SHOWN
LM	36	LIRIOPE MUSCARI BIG BLUE LIRIOPE	1 GAL.	CONT.	AS SHOWN
ND	6	MANDINA DOMESTICA SACRED BAMBOO	18-24" HT.	B&B	AS SHOWN

SCHEDULE A - PERIMETER LANDSCAPE EDGE		
	ADJACENT TO ROADWAYS	ADJACENT TO PERIMETER PROPERTIES
PERIMETER	1	2
LANDSCAPE TYPE	B	A
LINEAR FEET OF ROADWAY FRONTAGE/ PERIMETER	705' ±	2,472' ±
CREDIT FOR EXISTING VEGETATION (YES, NO, LINEAR FEET) (DESCRIBE BELOW IF NEEDED)	YES 100'	YES 1,047'
CREDIT FOR WALL, FENCE, BERM OR DRIVE AISLE (YES/NO/LINEAR FEET)	NO	NO
LINEAR FEET REMAINING	605' ±	1,425' ±
NUMBER OF PLANTS REQUIRED		
SHADE TREES	13	24
EVERGREEN TREES	16	0
SHRUBS	0	0
NUMBER OF PLANTS PROVIDED		
SHADE TREES	13	24
EVERGREEN TREES	16	0
SMALL FLOWERING TREES	0	0
SHRUBS	0	0

SCHEDULE B - PARKING LOT INTERNAL LANDSCAPING	
PARKING LOT	1
NUMBER OF PARKING SPACES	111
NUMBER OF SHADE TREES REQUIRED (1/20 SPACES)	6
NUMBER OF TREES PROVIDED	
SHADE TREES	6
OTHER TREES (2:1 SUBSTITUTION)	0
NUMBER OF ISLANDS PROVIDED	4

PLANTING SPECIFICATIONS

- Plants, related material, and operations shall meet the detailed description, as given on the plans and as described herein. Where discrepancies exist between Standards & Guidelines referenced within these specifications and the Howard County Landscape Manual, the latter takes precedence.
- All plant material, unless otherwise specified, that is not nursery grown, uniformly branched, does not have a vigorous root system, and does not conform to the most recent edition of the American Association of Nurserymen (AAN) Standards will be rejected. Plant material that is not healthy, vigorous, free from defects, decay, disfiguring roots, sunscald injuries, abrasions of the bark, plant disease, insect pest eggs, borers and all forms of insect infestations or objectionable disfigurements will be rejected. Plant material that is weak or which has been cut back from larger grades to meet specified requirements will be rejected. Trees with forked leaders will be rejected. All B & B plants shall be freshly dug; no healed-in plants or plants from cold storage will be accepted.
- Unless otherwise specified, all general conditions, planting operations, details and planting specifications shall conform to the most recent edition of the "Landscape Specification Guidelines" by the Landscape Contractors Association of MD, DC, & VA", (hereinafter "Landscape Guidelines") approved by the Landscape Contractors Association of Metropolitan Washington and the Potomac Chapter of the American Society of Landscape Architects.
- Contractor shall guarantee all plant material for a period of one year after date of acceptance in accordance with the appropriate section on the Landscape Guidelines. Contractor's attention is directed to the maintenance requirements found within the one year specifications including watering and replacement of specified plant material.
- Contractor shall be responsible for notifying all relevant and appropriate utility companies, utility contractors, and "Miss Utility" a minimum of 48 hours prior to the beginning of any work. Contractor may make minor adjustments in spacing and location of plant material to avoid conflicts with utilities. Major changes will require the approval of the landscape architect. Damage to existing structure and utilities shall be repaired at the expense of the Contractor.
- Protection of existing vegetation to remain shall be accomplished via the temporary installation of 4 foot high snow fence at the drip line, see detail.
- Contractor is responsible for installing all material in the proper planting season for each plant type. All planting is to be completed within growing season of completion of site construction. Do not plant Pinus strobus or Xcupressocyparis leylandii between November 15 and March 15. Landscape plants are not to be installed before site is graded to final grade.
- Contractor to regrade, fine grade, sod, hydroseed and straw mulch all areas disturbed by their work.
- Bid shall be based on actual site conditions. No extra payment shall be made for work arising from actual site conditions differing from those indicated on drawings and specifications.
- Plant quantities are provided for the convenience of the contractor only. If discrepancies exist between quantities shown on plan and those shown on the plant list, the quantities on the plan take precedence. Where discrepancies on the plan exist between the symbols and the callout leader, the number of symbols take precedence.
- All shrubs and groundcover areas shall be planted in continuous planting beds, prepared as specified, unless otherwise indicated on plans. (See Specification 13). Beds to be mulched with minimum 2" and maximum 3" of composted, double-shredded hardwood mulch throughout.
- Positive drainage shall be maintained on planting beds (minimum 2 percent slope).
- Bed preparation shall be as follows: Till into a minimum depth of 6" 1 yard of Compro or Leafgro per 200 SF of planting bed, and 1 yard of topsoil per 100 SF of bed. Add 3 lbs of standard 5-10-5 fertilizer per cubic yard of planting mix and till. Ericaceous plants (Azaleas, Rhododendrons, etc.): top dress after planting with iron sulfate or comparable product according to package directions. Taxus baccata 'Repandens' (English weeping yews): Top dress after planting with 1/4 to 1/2 cup lime each.
- Planting mix: For trees not in a prepared bed, mix 50% Compro or Leafgro with 50% soil from tree hole to use as backfill, see tree planting detail.
- Weed & insect control: Incorporate a pre-emergent herbicide into the planting bed following recommended rates on the label. For tree planting, apply a pre-emergent on top of soil and root ball before mulching. Caution: For areas to be planted with a ground cover, be sure to carefully check the chemical used to assure its adaptability to the specific groundcover to be treated. Maintain the mulch weed-free for the extent of the warranty period. Under no circumstances is a pesticide containing chlorpyrifos to be used as a means of pest control.
- Water: All plant material planted shall be watered thoroughly the day of planting. All plant material not yet planted shall be properly protected from drying out until planted. At a minimum, water unplanted plant material daily and as necessary to avoid desiccation.
- Pruning: Do not heavily prune trees and shrubs at planting. Prune only broken, dead, or diseased branches.
- All areas within contract limits disturbed during or prior to construction not designated to receive plants and mulch shall be fine graded, grass seed planted, and covered with straw mulch.

GENERAL NOTES:

- THIS PLAN HAS BEEN PREPARED IN ACCORDANCE WITH THE PROVISIONS OF SECTION 16.124 OF THE HOWARD COUNTY CODE AND THE LANDSCAPE MANUAL.
- FINANCIAL SURETY FOR THE REQUIRED LANDSCAPING MUST BE POSTED AS PART OF THE DEVELOPER'S AGREEMENT IN THE AMOUNT OF \$15,300.00.
43 SHADE TREES @ \$300 = \$12,900.00
0 ORNAMENTAL TREES @ \$150 = \$0
16 EVERGREEN TREES @ \$150 = \$2,400
0 SHRUBS @ \$30 = \$0
- THIS PLAN IS FOR LANDSCAPING PURPOSES ONLY.
- CONTRACTOR IS SOLELY RESPONSIBLE FOR CONSTRUCTION MEANS, METHODS, TECHNIQUES, SEQUENCES, PROCEDURES, AND SAFETY PRECAUTIONS AND PROGRAMS.
- ALL MATERIAL SELECTED SHALL BE EQUAL TO OR BETTER THAN THE REQUIREMENTS OF THE "USA STANDARD FOR NURSERY STOCK", LATEST EDITION, AS PUBLISHED BY THE AMERICAN ASSOCIATION OF NURSERYMEN.
- ALL MATERIAL SHALL BE PLANTED IN ACCORDANCE WITH THE MINIMUM GUIDELINES PUBLISHED IN THE LATEST EDITION OF "LANDSCAPE SPECIFICATION GUIDELINES" PUBLISHED BY THE LANDSCAPE CONTRACTORS ASSOCIATION.
- AT THE TIME OF INSTALLATION, ALL SHRUBS AND OTHER PLANTINGS SHALL BE OF THE PROPER HEIGHT AND/OR SPREAD REQUIREMENTS IN ACCORDANCE WITH THIS PLAN AND THE HOWARD COUNTY LANDSCAPE MANUAL.
- NO SUBSTITUTIONS OR RELOCATION OF PLANTS MAY BE MADE WITHOUT PRIOR APPROVAL FROM THE DEPARTMENT OF PLANNING AND ZONING OF HOWARD COUNTY. ANY DEVIATION FROM THIS LANDSCAPE PLAN WILL RESULT IN A REQUIREMENT FOR SUBMITTAL OF AN OFFICIAL "REDLINE REVISION" TO THE SITE DEVELOPMENT PLAN(S) AND/OR DENIAL IN THE RELEASE OF LANDSCAPE SURETY.

DEVELOPER'S/BUILDER'S CERTIFICATE:

I/WE CERTIFY THAT THE LANDSCAPING SHOWN ON THIS PLAN WILL BE DONE ACCORDING TO THE PLAN, SECTION 16.124 OF THE HOWARD COUNTY CODE AND THE HOWARD COUNTY LANDSCAPE MANUAL. I/WE FURTHER CERTIFY THAT UPON COMPLETION, A LETTER OF LANDSCAPE INSTALLATION, ACCOMPANIED BY AN EXECUTED ONE YEAR GUARANTEE OF PLANT MATERIALS, WILL BE SUBMITTED TO THE DEPARTMENT OF PLANNING AND ZONING.

Jacqueline Carlone 8/1/17
SIGNATURE DATE

NOTES:

- DO NOT HEAVILY PRUNE THE TREE AT PLANTING. PRUNE ONLY CROSSOVER LIMBS, CO-DOMINANT LEADERS, AND BROKEN OR DEAD BRANCHES. SOME INTERIOR THIGS AND LATERAL BRANCHES MAY BE PRUNED; HOWEVER, DO NOT REMOVE THE TERMINAL BUDS OF BRANCHES THAT EXTEND TO THE EDGE OF THE CROWN.
- STAKE TREES ONLY IF RECOMMENDED ON THE PLANT SCHEDULE OR UPON THE APPROVAL OF THE LANDSCAPE ARCHITECT. STAKING DETAIL SHOWN ONLY IF RECOMMENDED.


B&B TREES: D16 PLANTING PIT TWICE AS WIDE AS THE DIAMETER OF THE TOP OF THE ROOT BALL WITH A MINIMUM PLANTING PIT DIAMETER OF 5'.

CONTAINERIZED TREES: D16 PLANTING PIT TWO AND A HALF TIMES AS WIDE AS THE DIAMETER OF THE CONTAINER WITH A MINIMUM PLANTING PIT DIAMETER OF 30". REMOVE CONTAINER JUST BEFORE PLANTING. INSPECT HEALTH OF ROOTS. REJECT MATERIAL WITH UNHEALTHY OR INSUFFICIENT ROOTS. REMOVE ALL THINE, ROPE, WIRE, AND BURLAP FROM TOP OF ROOT BALL. DO NOT REMOVE WIRE BASKET. BEND TOP OF WIRE BASKET DOWN INTO PLANTING PIT.

CONSTRUCT 3" SAUCER ALL AROUND PLANTING HOLE. FLOOD WITH WATER TWICE WITHIN 24 HOURS.

BACKFILL WITH PLANTING MIX (SEE PLANTING SPECIFICATIONS). TAMP SOIL AROUND ROOT BALL BASE FIRMLY WITH FOOT PRESSURE SO THAT ROOT BALL DOES NOT SHIFT.

PLACE ROOT BALL ON UNEXCAVATED OR COMPACTED SOIL.

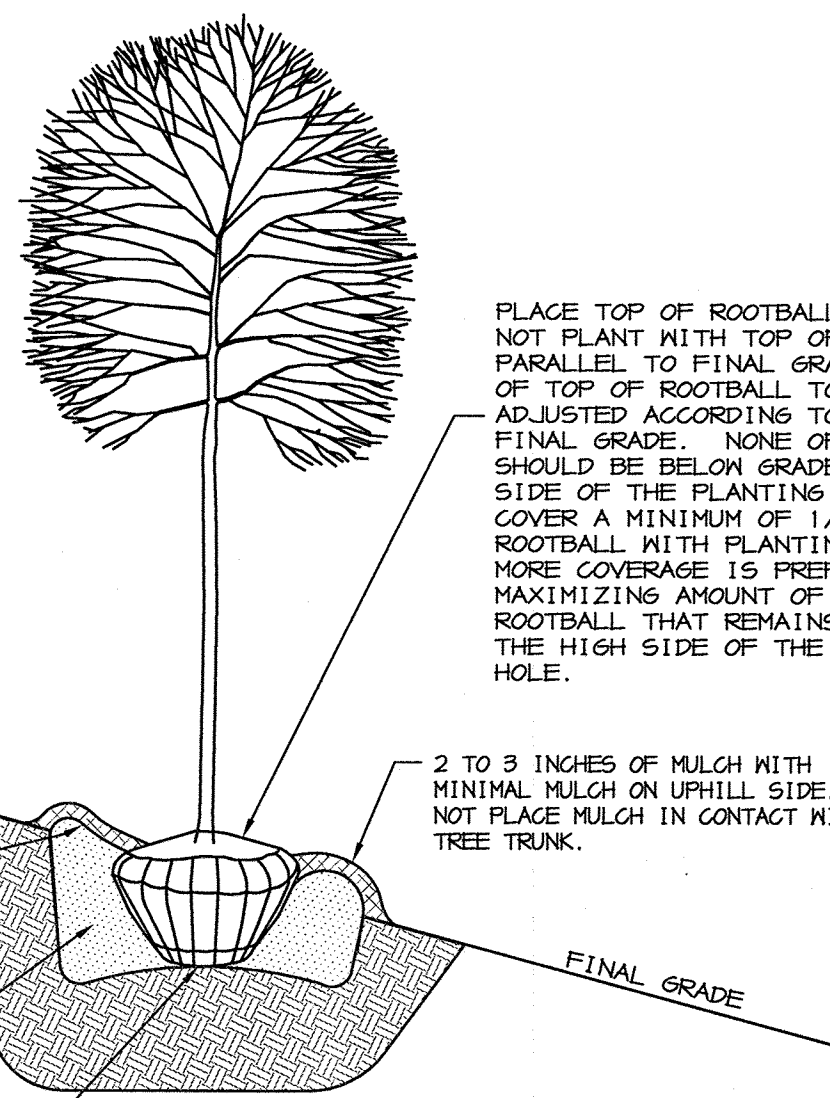


1 DECIDUOUS B&B AND CONTAINERIZED TREE PLANTING DETAIL FOR STEEP SLOPES
26 NOT TO SCALE

NOTES:

- SELECT ONLY NURSERY STOCK WITH A SINGLE LEADER UNLESS OTHERWISE SPECIFIED ON PLAN. PLANTS WITH CO-DOMINANT LEADERS, MISSING, OR DAMAGED LEADERS SHALL BE REJECTED.
- STAKE TREES AS SHOWN.
- D16 PLANTING PIT TWICE AS WIDE AS THE DIAMETER OF THE TOP OF THE ROOT BALL WITH A MINIMUM PLANTING PIT DIAMETER OF 5'.
- CONTRACTOR TO REMOVE AND GRADE OUT PLANTING SAUCER AT END OF ONE YEAR MAINTENANCE PERIOD. AREA AROUND TREES SHALL BE GRADED SMOOTH TO ELIMINATE MOUNDING. CONTRACTOR TO REMULCH AREA AROUND TREE WHEN GRADING IS COMPLETE.

CONSTRUCT 3" SAUCER ALL AROUND PLANTING HOLE. FLOOD WITH WATER TWICE WITHIN 24 HOURS.

BACKFILL WITH PLANTING MIX (SEE PLANTING SPECIFICATIONS). TAMP SOIL AROUND ROOT BALL BASE FIRMLY WITH FOOT PRESSURE SO THAT ROOT BALL DOES NOT SHIFT.

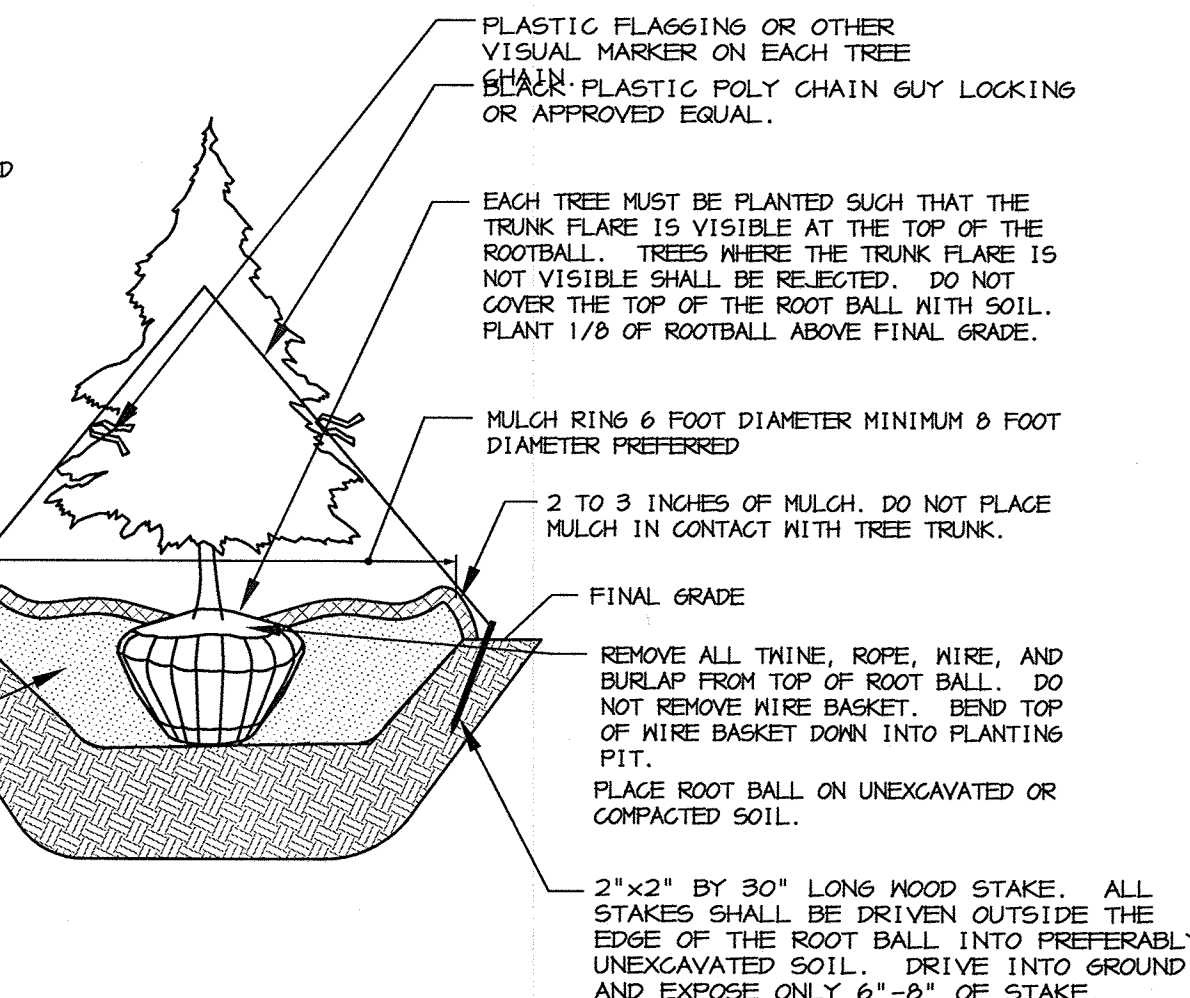


3 EVERGREEN B&B TREE PLANTING DETAIL
26 NOT TO SCALE


NOTES:

- DO NOT HEAVILY PRUNE THE TREE AT PLANTING. PRUNE ONLY CROSSOVER LIMBS, CO-DOMINANT LEADERS, AND BROKEN OR DEAD BRANCHES. SOME INTERIOR THIGS AND LATERAL BRANCHES MAY BE PRUNED; HOWEVER, DO NOT REMOVE THE TERMINAL BUDS OF BRANCHES THAT EXTEND TO THE EDGE OF THE CROWN.
- STAKE TREES AS SHOWN.
- D16 PLANTING PIT TWICE AS WIDE AS THE DIAMETER OF THE TOP OF THE ROOT BALL WITH A MINIMUM PLANTING PIT DIAMETER OF 5'.
- TIGHTEN GUYS ONLY ENOUGH TO KEEP FROM SLIPPING. ALLOW FOR SOME TRUNK MOVEMENT. GUYS SHALL BE LONG ENOUGH TO ACCOMMODATE 1.5 IN. OF GROWTH AND BUFFER ALL BRANCHES.
- TUCK ANY LOOSE ENDS OF THE GUY SO THAT NO LOOSE ENDS ARE EXPOSED.
- CONTRACTOR TO REMOVE AND GRADE OUT PLANTING SAUCER AT END OF ONE YEAR MAINTENANCE PERIOD. AREA AROUND TREES SHALL BE GRADED SMOOTH TO ELIMINATE MOUNDING. CONTRACTOR TO REMULCH AREA AROUND TREE WHEN GRADING IS COMPLETE.

INSTALL TWO STAKES ON OPPOSITE SIDES OF TREE, PARALLEL TO THE DIRECTION OF THE PREVAILING WINTER WINDS, UNLESS OTHERWISE DIRECTED BY LANDSCAPE ARCHITECT. ALL STAKES SHALL BE DRIVEN OUTSIDE THE EDGE OF THE ROOT BALL INTO PREFERABLY UNEXCAVATED SOIL.

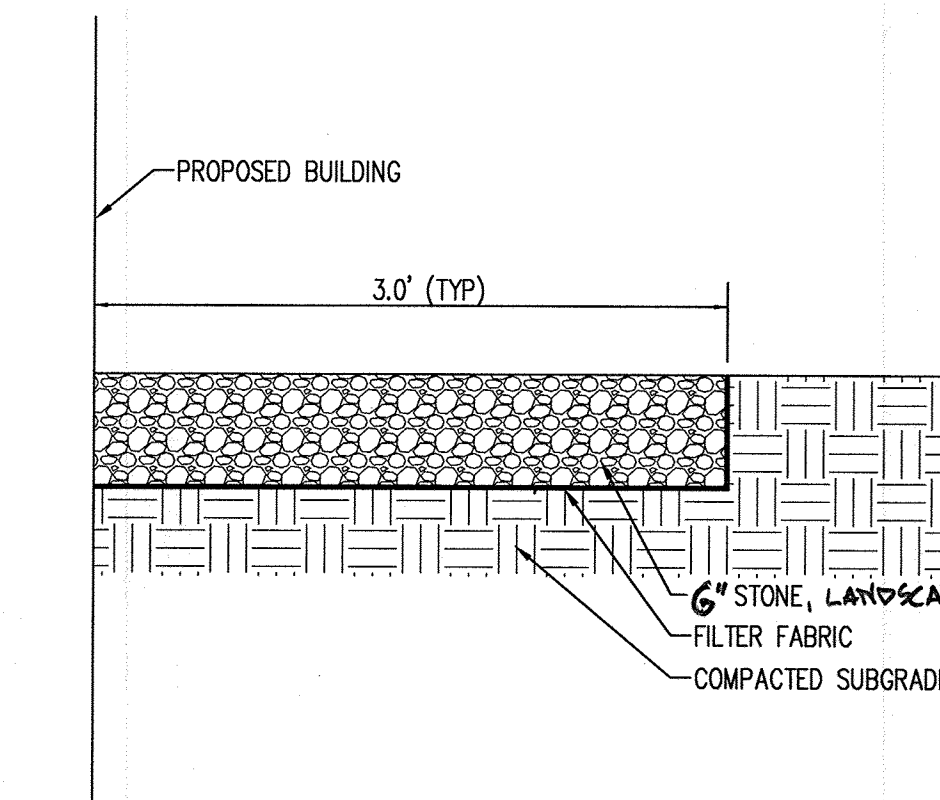

2 BUILDING FOUNDATION STONE
26 NOT TO SCALE

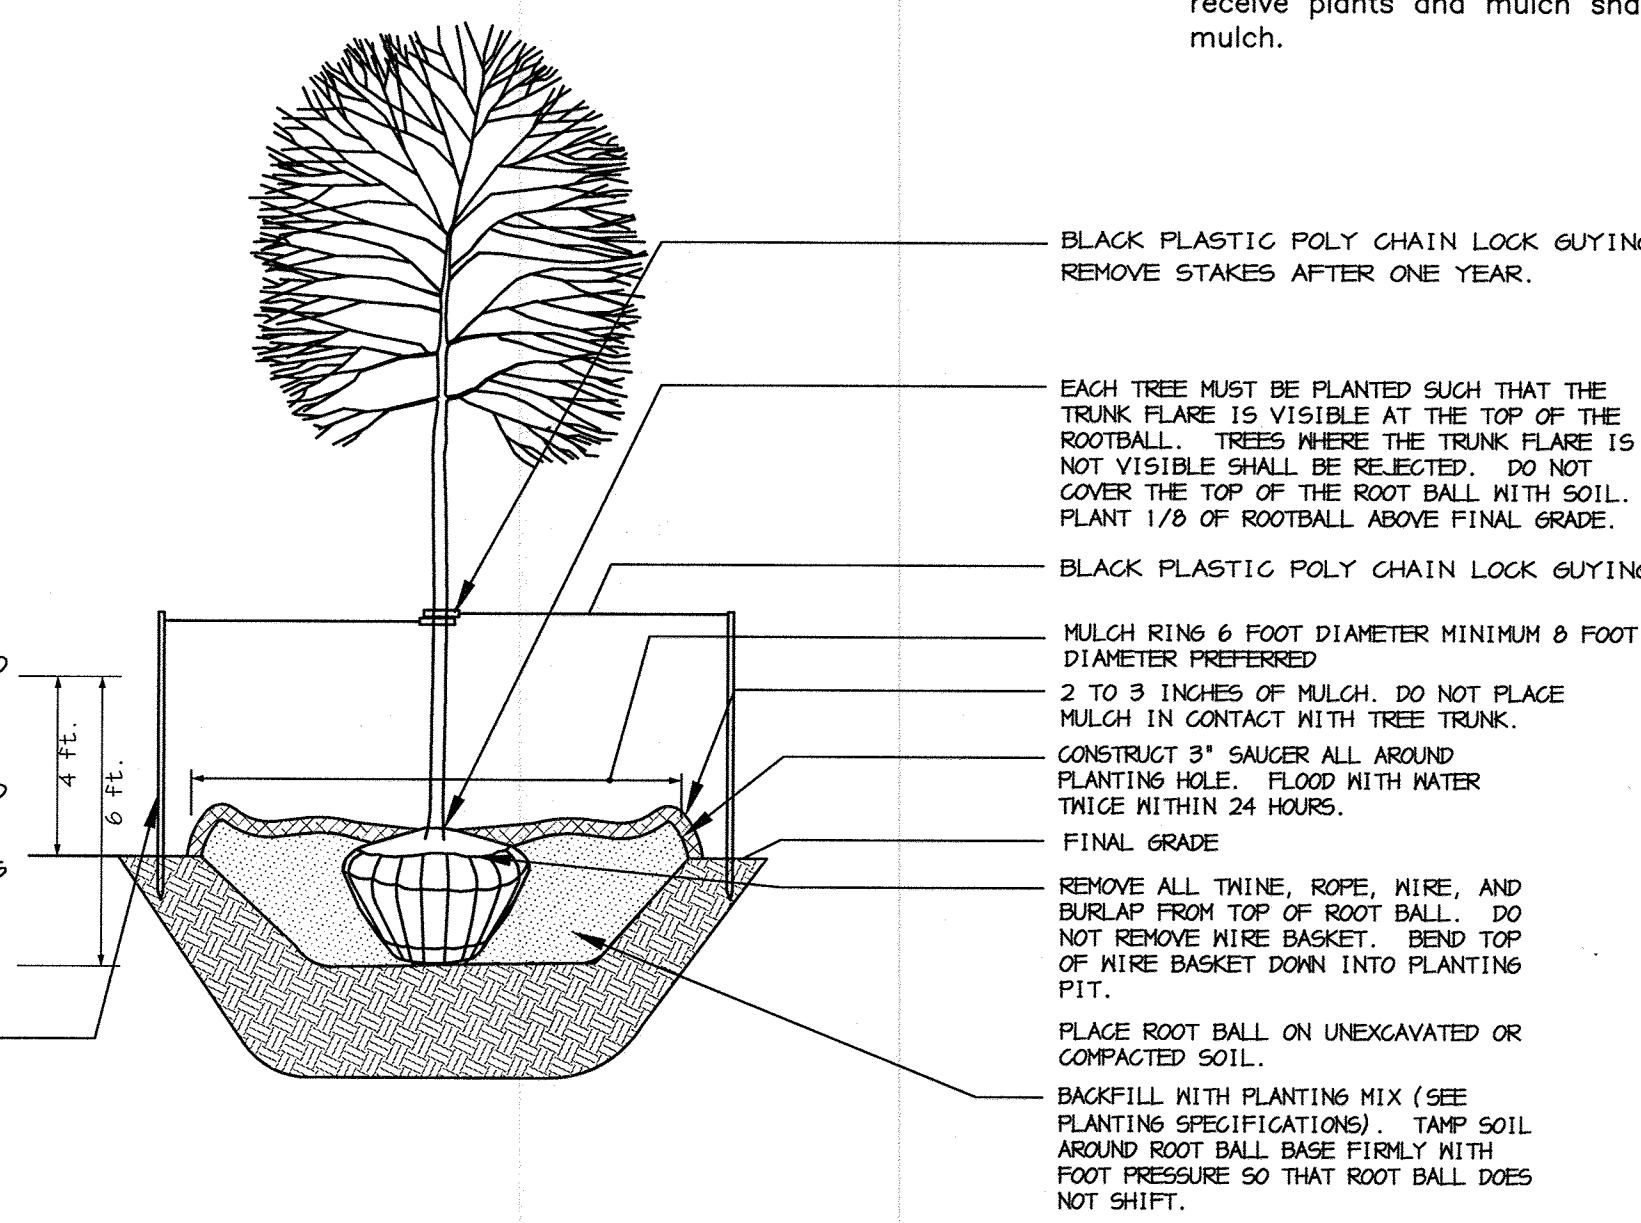

4 DECIDUOUS B&B TREE PLANTING DETAIL (TREES 3" CAL. OR SMALLER)
26 NOT TO SCALE

AS-BUILT CERTIFICATION
NOTE: THERE IS NO "AS-BUILT" INFORMATION PROVIDED ON THIS SHEET.
Sharon L. Cruz 3/6/16
PRINTED NAME MD P.E. NO.
7/8/19
SIGNATURE DATE

APPROVED: DEPARTMENT OF PLANNING AND ZONING

Sharon L. Cruz 9-21-17
CHIEF, DEVELOPMENT ENGINEERING DIVISION DATE

Katrina J. Smith 9-27-17
CHIEF, DIVISION OF LAND DEVELOPMENT DATE

William J. Griffin 10-2-17
DIRECTOR DATE

DATE	NO.	REVISION	BY

DEVELOPER: DCT INDUSTRIAL
12011 GULFROAD ROAD
SUITE 102
ANNAPOLIS JUNCTION, MD 20701
ATTN: FRED FERRARO
PHONE: 410-645-5020

OWNER: DCT MEARS LLC
12011 GULFROAD ROAD
SUITE 102
ANNAPOLIS JUNCTION, MD 20701
ATTN: FRED FERRARO
PHONE: 410-645-5020

PROJECT: TERRAPIN COMMERCE CENTER

AREA: TAX MAP 43, PARCEL 51 LOT PAR A PLAT 23793 ZONED M-2
GRID NO. 11 1st ELECTION DISTRICT
7200 DORSEY RUN ROAD
ELKRIDGE, MARYLAND 21075
HOWARD COUNTY, MARYLAND

TITLE: LANDSCAPE NOTES AND DETAILS

Pennoni Associates Inc.
Pennoni Engineers • Surveyors • Planners
Landscape Architects
8818 Centre Park Drive, Suite 200 Columbia, MD 21045
T 410.997.8900 F 410.997.9282

8-22-17
DESIGNED BY: PJS
DRAWN BY: AGS/JSN
PROJECT NO: DCT11601
DATE: JUNE 23, 2017
SCALE: AS SHOWN
DRAWING NO. 34 OF 43

PETER J. STONE #3068

PROJECT: Mears Property		PROJECT NO.: DCT11501		
PROJECT LOCATION: Elbridge, MD		ELEVATION: +133.138 NAVD83		
DRILLING FIRM: Connolly and Associates		LOGGED BY: S. Cuccorra		
FOREMAN: Tom Chas		DATE STARTED: 05-05-16		
DRILLING METHOD: HSA Auger 3 1/2"		DATE COMPLETED: 05-05-16		
DEPTH TO WATER: INITIAL: 7' NE AFTER 24 HOURS: * NM CAVING: C 8				
Description	Depth (feet)	Stratum	Blow Counts	Remarks
7" TOPSOIL	0-0.3	T		
Tan CLAY, little fine sand, little organics	0.3-1.0	S-1	10	1-WOH-1-2
Gray CLAY, little fine sand	1.0-1.5	A	16	3-4-6-7
Gray CLAY, and fine to medium to coarse sand, trace fine gravel	1.5-5.0	S-3	16	3-4-11-7
Gray fine to medium SAND, some to little silt	5.0-6.0	B	14	3-3-8-13
Tan to brown fine to medium SAND, little to some silt	6.0-8.0	S-4	15	6-8-20-31
Orange to gray CLAY, some fine sand	8.0-10.0	C	16	2-3-4-5
Boring terminated at 10 ft.				

PAGE 1 of 1

PROJECT: Mears Property		PROJECT NO.: DCT11501		
PROJECT LOCATION: Elbridge, MD		ELEVATION: +139.256 NAVD83		
DRILLING FIRM: Connolly and Associates		LOGGED BY: S. Cuccorra		
FOREMAN: Tom Chas		DATE STARTED: 05-05-16		
DRILLING METHOD: HSA Auger 3 1/2"		DATE COMPLETED: 05-05-16		
DEPTH TO WATER: INITIAL: 7.5' NE AFTER 24 HOURS: * NM CAVING: C 5				
Description	Depth (feet)	Stratum	Blow Counts	Remarks
4" TOPSOIL	0-0.3	T		
Tan to brown CLAY, little fine sand	0.3-1.0	S-1	14	1-1-2-2
Tan to white CLAY, and fine sand	1.0-1.5	A	15	3-4-3-3
Black to gray CLAY, some fine to medium sand	1.5-4.5	S-3	20	3-4-4-5
Brown to yellow medium to fine SAND, trace silt	4.5-6.0	S-4	24	6-8-20-31
Medium to coarse to fine SAND, trace silt, trace fine gravel	6.0-8.0	B	24	4-8-8-11
Orange medium to coarse to fine SAND, trace silt (wet)	8.0-10.0	S-6	20	
Boring terminated at 10 ft.				

PAGE 1 of 1

PROJECT: Mears Property		PROJECT NO.: DCT11501		
PROJECT LOCATION: Elbridge, MD		ELEVATION: +150.068 NAVD83		
DRILLING FIRM: Connolly and Associates		LOGGED BY: S. Cuccorra		
FOREMAN: Tom Chas		DATE STARTED: 05-04-16		
DRILLING METHOD: HSA Auger 3 1/2"		DATE COMPLETED: 05-04-16		
DEPTH TO WATER: INITIAL: 13' NE AFTER 24 HOURS: * NM CAVING: C 10				
Description	Depth (feet)	Stratum	Blow Counts	Remarks
4" TOPSOIL	0-0.3	T		
Red to tan CLAY, trace fine sand	0.3-1.0	S-1	12	1-1-2-3
Red to tan CLAY, some fine to medium to coarse sand, trace fine gravel	1.0-1.5	A	18	3-6-7-8
Red to tan to gray CLAY, some fine sand	1.5-4.5	S-3	24	4-8-9-10
Reddish black CLAY, little fine sand	4.5-6.0	S-4	24	5-7-8-13
Tannish gray to orange fine SAND, little to some silt, trace fine gravel	6.0-8.0	S-5	18	11-11-11-9
Brown to black medium to coarse to fine SAND, little to trace silt	8.0-10.0	S-6	18	
Medium to coarse to fine SAND, trace fine gravel, trace silt (wet)	10.0-12.0	B	24	4-12-19-33
Yellow to tan medium to coarse to fine SAND, little fine gravel, trace silt	12.0-14.0	S-7	24	5-8-16-13
Boring terminated at 20 ft.				

PAGE 1 of 1

PROJECT: Mears Property		PROJECT NO.: DCT11501		
PROJECT LOCATION: Elbridge, MD		ELEVATION: +163.208 NAVD83		
DRILLING FIRM: Connolly and Associates		LOGGED BY: S. Cuccorra		
FOREMAN: Tom Chas		DATE STARTED: 05-04-16		
DRILLING METHOD: HSA Auger 3 1/2"		DATE COMPLETED: 05-04-16		
DEPTH TO WATER: INITIAL: 7' NE AFTER 24 HOURS: * NM CAVING: C 30.5				
Description	Depth (feet)	Stratum	Blow Counts	Remarks
6" TOPSOIL	0-0.6	T		
Tan to brown SILT, little fine sand	0.6-1.0	S-1	18	1-1-1-2
Brown CLAY, some fine sand	1.0-1.5	A	24	3-5-10-10
Brown CLAY, and fine sand	1.5-2.0	S-3	20	2-5-7-9
Grayish tan CLAY, trace fine sand (moist)	2.0-3.0	S-4	24	5-10-15-13
Yellow medium to coarse to fine SAND, trace fine gravel, trace silt	3.0-4.0	B	24	
Gray CLAY, trace fine to medium to coarse sand (high plasticity)	4.0-14.75	C	24	3-10-11-23
Gray to tan medium to fine SAND, trace silt	14.75-17.0	S-5	24	
Brown to red to black medium to coarse to fine SAND, trace silt	17.0-18.0	S-6	12	12-50-9"
Tan to gray medium to coarse to fine SAND, some to little fine gravel, little silt	18.0-20.0	S-7	20	4-8-20-35
Boring terminated at 25 ft.				

PAGE 1 of 1

PROJECT: Mears Property		PROJECT NO.: DCT11501		
PROJECT LOCATION: Elbridge, MD		ELEVATION: +157.808 NAVD83		
DRILLING FIRM: Connolly and Associates		LOGGED BY: S. Cuccorra		
FOREMAN: Tom Chas		DATE STARTED: 05-05-16		
DRILLING METHOD: HSA Auger 3 1/2"		DATE COMPLETED: 05-05-16		
DEPTH TO WATER: INITIAL: 19' NE AFTER 24 HOURS: * NM CAVING: C 28				
Description	Depth (feet)	Stratum	Blow Counts	Remarks
4" TOPSOIL	0-0.3	T		
Tan CLAY, trace fine sand	0.3-1.0	S-1	24	1-1-3-3
Orange to tan CLAY, and fine to medium to coarse sand, trace fine gravel	1.0-1.5	A	17	3-4-4-6
Orange to tan CLAY, and fine to medium to coarse sand, trace fine gravel	1.5-2.0	S-3	17	2-2-5-7
White medium to fine SAND, trace to little silt	2.0-4.0	S-4	18	4-12-19-14
Orange to yellow medium to coarse to fine SAND, trace fine gravel, trace silt (moist to wet)	4.0-10.0	S-5	20	10-35-37-29
Orange to yellow medium to coarse to fine SAND, trace fine gravel, trace silt (wet)	10.0-13.0	S-6	13	13-18-17-20
Gray CLAY, and fine to medium sand	13.0-18.0	S-7	16	5-6-9-6
SAPROLITE: Gray fine to medium sand, little silt	18.0-20.0	S-8	6	7-4-6-40
SAPROLITE: Gray fine to medium sand, trace silt	20.0-24.0	D	4	504"

PAGE 1 of 2

PROJECT: Mears Property		PROJECT NO.: DCT11501		
PROJECT LOCATION: Elbridge, MD		ELEVATION: +152.778 NAVD83		
DRILLING FIRM: Connolly and Associates		LOGGED BY: S. Cuccorra		
FOREMAN: Tom Chas		DATE STARTED: 05-05-16		
DRILLING METHOD: HSA Auger 3 1/2"		DATE COMPLETED: 05-05-16		
DEPTH TO WATER: INITIAL: 7' NE AFTER 24 HOURS: * NM CAVING: C 13				
Description	Depth (feet)	Stratum	Blow Counts	Remarks
2" TOPSOIL	0-0.2	T		
Tan CLAY, and fine sand	0.2-1.0	S-1	24	1-4-4-5
Tan medium to fine SAND, little to trace silt	1.0-1.5	S-2	16	4-4-5-9
Tan to brown medium to coarse to fine SAND, little silt, trace fine gravel	1.5-4.0	S-3	20	7-10-12-14
White medium to fine SAND, trace to little silt	4.0-8.0	S-4	24	3-8-15-45
Medium to coarse to fine SAND, some coarse to fine gravel, trace silt	8.0-11.0	S-5	18	11-18-18-20
Boring terminated at 15 ft.				

PAGE 1 of 1

PROJECT: Mears Property		PROJECT NO.: DCT11501		
PROJECT LOCATION: Elbridge, MD		ELEVATION: +158.618 NAVD83		
DRILLING FIRM: Connolly and Associates		LOGGED BY: S. Cuccorra		
FOREMAN: Tom Chas		DATE STARTED: 05-04-16		
DRILLING METHOD: HSA Auger 3 1/2"		DATE COMPLETED: 05-04-16		
DEPTH TO WATER: INITIAL: 7' NE AFTER 24 HOURS: * NM CAVING: C 18				
Description	Depth (feet)	Stratum	Blow Counts	Remarks
5" TOPSOIL	0-0.5	T		
Brown CLAY, some to little fine sand	0.5-1.0	S-1	18	1-1-1-2
Brown CLAY, trace fine sand	1.0-1.5	A	14	1-2-3-4
Brown fine to medium SAND, little silt	1.5-2.0	S-3	15	3-5-8-4
Purple to yellow CLAY, trace fine to medium to coarse sand	2.0-4.0	S-4	18	3-4-8-11
White to gray CLAY, trace fine sand	4.0-8.0	S-5	18	14-44-50-5"
Medium to coarse to fine SAND, some to little fine gravel, trace silt	8.0-10.0	S-6	18	16-32-50-5"
Gray to light brown coarse to medium to fine SAND, little to some fine gravel, trace silt, trace coarse gravel	10.0-12.0	B	18	
SAPROLITE: Gray fine to medium sand, some silt	12.0-18.0	D	24	8-10-15-16
Boring terminated at 20 ft.				

PAGE 1 of 1

PROJECT: Mears Property		PROJECT NO.: DCT11501		
PROJECT LOCATION: Elbridge, MD		ELEVATION: +160.418 NAVD83		
DRILLING FIRM: Connolly and Associates		LOGGED BY: S. Cuccorra		
FOREMAN: Tom Chas		DATE STARTED: 05-04-16		
DRILLING METHOD: HSA Auger 3 1/2"		DATE COMPLETED: 05-04-16		
DEPTH TO WATER: INITIAL: 7' NE AFTER 24 HOURS: * NM CAVING: C 16.9				
Description	Depth (feet)	Stratum	Blow Counts	Remarks
4" TOPSOIL	0-0.3	T		
Tan to brown to gray CLAY, little fine sand	0.3-1.0	S-1	18	1-1-3-8
Yellow to tan to white medium to fine to coarse SAND, some clay, trace fine gravel, trace mica	1.0-1.5	A	18	5-8-8-13
Gray fine to medium SAND, little silt	1.5-2.0	S-3	14	13-16-50-5"
Purple CLAY, some fine to medium sand	2.0-3.0	S-4	24	8-10-16-32
Yellow to tan medium to coarse to fine SAND, trace silt, trace mica	3.0-13.0	S-5	17	8-20-18-31
Gray CLAY, trace fine sand	13.0-19.0	S-6	18	4-13-18-15
Boring terminated at 20 ft.				

PAGE 1 of 1

APPROVED: DEPARTMENT OF PLANNING AND ZONING

[Signature] 9-21-17
 CHIEF, DEVELOPMENT ENGINEERING DIVISION DATE

[Signature] 9-27-17
 CHIEF, DIVISION OF LAND DEVELOPMENT DATE

[Signature] 10-2-17
 DIRECTOR DATE

DATE	NO.	REVISION	BY

DEVELOPER: DCT INDUSTRIAL
 12011 GUILFORD ROAD
 SUITE 102
 ANNAPOLIS, JUNCTION, MD 20701
 ATTN: FRED FERRARO
 PHONE: 410-645-5020

OWNER: DCT MEARS LLC
 12011 GUILFORD ROAD
 SUITE 102
 ANNAPOLIS, JUNCTION, MD 20701
 ATTN: FRED FERRARO
 PHONE: 410-645-5020

PROJECT: TERRAPIN COMMERCE CENTER

AREA: TAX MAP 43, PARCEL 51 LOT PAR A PLAT 23793 ZONED M-2
 GRID NO. 11 1st ELECTION DISTRICT
 7200 DORSEY RUN ROAD
 ELKRIDGE, MARYLAND 21075
 HOWARD COUNTY, MARYLAND

TITLE: SOIL BORING LOGS

Pennoni Associates Inc.
 Engineers - Surveyors - Planners
 Landscape Architects

8818 Centre Park Drive, Suite 200 Columbia, MD 21045
 T 410.997.8900 F 410.997.9282

DESIGNED BY: PJS
 DRAWN BY: AGSJSN
 PROJECT NO.: DCT11601
 DATE: JUNE 23, 2017
 SCALE: AS SHOWN
 DRAWING NO. 35 OF 43

AS-BUILT CERTIFICATION

NOTE: THERE IS NO "AS-BUILT" INFORMATION PROVIDED ON THIS SHEET.

[Signature] 3/6/19
 PRINTED NAME MD. P.E. NO. DATE



PROJECT: Mears Projects		PROJECT NO.: DCT11501	
PROJECT LOCATION: Elkridge, MD		ELEVATION: +2171.578 NAVD83	
DRILLING FIRM: Connelly & Associates		LOGGED BY: S. Cuccorra	
FOREMAN: Tom Chew		DATE STARTED: 05-04-16	
DRILLING METHOD: HSA Auger 3 1/2"		DATE COMPLETED: 05-05-16	
DEPTH TO WATER: INITIAL: # NE AFTER 24 HOURS: # NM CAVING: C NM		LOG OF BORING No. B-18	
0	4" TOPSOIL		
0.35	Yellow to tan CLAY, little fine sand, trace mica	S-1	20 1-1-3-4
4.6-10-12	Yellow to tan CLAY, some fine to medium to coarse sand, trace fine gravel	S-2	9 4-6-10-12
5	Tan to brown fine to medium SAND, little to trace clay	S-3	24 3-7-18-10
11.24-38-31		S-4	18 11-24-38-31
13	Tan medium to coarse to fine SAND, trace clay, trace fine gravel	S-6	21 13-42-48-48
19	Brown medium to fine sand, some silt, some fine gravel, trace mica	S-6	20 21-26-16-10
20	Gray to brown CLAY, and fine sand, trace mica		
20	Boring terminated at 20 ft.		

PAGE 1 of 1

PROJECT: Mears Projects		PROJECT NO.: DCT11501	
PROJECT LOCATION: Elkridge, MD		ELEVATION: +2171.578 NAVD83	
DRILLING FIRM: Connelly & Associates		LOGGED BY: S. Cuccorra	
FOREMAN: Tom Chew		DATE STARTED: 05-04-16	
DRILLING METHOD: HSA Auger 3 1/2"		DATE COMPLETED: 05-04-16	
DEPTH TO WATER: INITIAL: # 31 AFTER 24 HOURS: # NM CAVING: C 27.5		LOG OF BORING No. B-19	
0	5" TOPSOIL		
0.42	Tan to brown CLAY, trace fine sand (moist)	S-1	18 1-1-2-3
8.8-11-12		S-2	24 8-8-11-12
11.9-13-18	Purple to brown to gray CLAY, some to little fine sand	S-3	24 11-9-13-18
13.14-21-26	Gray to brown fine to medium SAND, some silt	S-4	22 13-14-21-26
15	Tan to brown medium to coarse to fine SAND, some fine gravel, trace silt	S-6	15 11-24-30-35
18	Gray CLAY, trace fine sand	S-6	20 5-10-12-10
18	Yellow to tan fine to medium to coarse SAND, and silt	S-7	18 5-8-11-13
18	Gray CLAY, little fine sand, trace fine gravel	S-8	22 10-13-18-18
18	Gray fine to medium to coarse SAND, some to little silt	S-8	24 7-17-25-27
18		S-10	18 17-24-50-5
18		S-11	5 50'5"
18	SAPROLITE: Gray fine to medium sand, trace clay		

PAGE 1 of 2

PROJECT: Mears Projects		PROJECT NO.: DCT11501	
PROJECT LOCATION: Elkridge, MD		ELEVATION: +2171.578 NAVD83	
DRILLING FIRM: Connelly & Associates		LOGGED BY: S. Cuccorra	
FOREMAN: Tom Chew		DATE STARTED: 05-04-16	
DRILLING METHOD: HSA Auger 3 1/2"		DATE COMPLETED: 05-04-16	
DEPTH TO WATER: INITIAL: # 31 AFTER 24 HOURS: # NM CAVING: C 27.5		LOG OF BORING No. B-19	
0	SAPROLITE: Gray fine to medium sand, trace clay		
0	Boring terminated at 40 ft.		

PAGE 2 of 2

PROJECT: Terrain Commerce Center		PROJECT NO.: DCT11601	
PROJECT LOCATION: Dorsey Run Road, Howard County, MD		ELEVATION: 131.93 ft. NAVD83	
DRILLING FIRM: Connelly & Associates		LOGGED BY: C. Bagher	
FOREMAN: Ron Mena		DATE STARTED: 12/9/16	
DRILLING METHOD: 3 1/4 HSA		DATE COMPLETED: 12/9/16	
DEPTH TO WATER: INITIAL: # NE AFTER 24 HOURS: # NM CAVING: C 8 ft.		LOG OF BORING No. B-27	
0	6" TOPSOIL		
0.5	Light brown to gray silty CLAY, trace fine sand	S-1	23 2-2-4-8
6	Gray to orange fine to coarse SAND, trace gravel, little silty clay	S-2	20 9-14-17-19
6		S-3	24 6-7-6-10
6	Blue to green silty CLAY, some to and fine sand	S-4	11 8-7-7-9
6.33		S-6	20 8-10-12-10
6.33		S-6	17 6-7-12-11
6.33	Boring terminated at 12 ft.		

PAGE 1 of 1

PROJECT: Terrain Commerce Center		PROJECT NO.: DCT11601	
PROJECT LOCATION: Dorsey Run Road, Howard County, MD		ELEVATION: 132.42 ft. NAVD83	
DRILLING FIRM: Connelly & Associates		LOGGED BY: C. Bagher	
FOREMAN: Ron Mena		DATE STARTED: 12/9/16	
DRILLING METHOD: 3 1/4 HSA		DATE COMPLETED: 12/9/16	
DEPTH TO WATER: INITIAL: # NE AFTER 24 HOURS: # NM CAVING: C 12 ft.		LOG OF BORING No. B-28	
0	5" TOPSOIL		
0.42	Brown to gray to orange silty CLAY, trace fine sand	S-1	20 2-2-3-6
4.7-11-19		S-2	18 4-7-11-19
4.6-7-8	Gray silty CLAY, trace fine sand	S-3	24 4-6-7-8
2-4-6-8	Blue to green silty CLAY, trace to little fine sand	S-4	6 2-4-6-8
4.7-9-9		S-4	19 4-7-9-9
15-15-31-26	Blue to green to gray to red to brown silty CLAY	S-6	22 15-15-31-26
15	Boring terminated at 15 ft.		

PAGE 1 of 1

PROJECT: Terrain Commerce Center		PROJECT NO.: DCT11601	
PROJECT LOCATION: Dorsey Run Road, Howard County, MD		ELEVATION: 130.78 ft. NAVD83	
DRILLING FIRM: Connelly & Associates		LOGGED BY: C. Bagher	
FOREMAN: Ron Mena		DATE STARTED: 12/9/16	
DRILLING METHOD: 3 1/4 HSA		DATE COMPLETED: 12/9/16	
DEPTH TO WATER: INITIAL: # 10 ft. AFTER 24 HOURS: # NM CAVING: C 10 ft.		LOG OF BORING No. B-29	
0	3" TOPSOIL		
0.28	Orange to brown silty CLAY and fine SAND	S-1	23 1-2-4-8
5.8-12-17	Red to brown silty CLAY and fine SAND, trace fine gravel	S-2	12 5-8-12-17
2-2-1-2	Red to brown fine to medium SAND and silty CLAY, little fine gravel	S-3	7 2-2-1-2
15-17-14-16	Red to brown fine to coarse SAND, little to some fine to coarse gravel, trace silty clay	S-4	20 15-17-14-16
4-8-6-6	Tan to orange medium to fine SAND, trace silty clay	S-5	10 4-8-6-6
14-12-28-24	Gray CLAY and orange medium to coarse SAND, trace coarse gravel (moist)	S-6	24 14-12-28-24
14-12-28-24	Gray medium to coarse to fine SAND, little fine to coarse gravel, trace clay	S-6	24 14-12-28-24
14	Boring terminated at 12 ft.		

PAGE 1 of 1

PROJECT: Terrain Commerce Center		PROJECT NO.: DCT11601	
PROJECT LOCATION: Dorsey Run Road, Howard County, MD		ELEVATION: 135.77 ft. NAVD83	
DRILLING FIRM: Connelly & Associates		LOGGED BY: C. Bagher	
FOREMAN: Ron Mena		DATE STARTED: 12/9/16	
DRILLING METHOD: 3 1/4 HSA		DATE COMPLETED: 12/9/16	
DEPTH TO WATER: INITIAL: # 7.6 ft. AFTER 24 HOURS: # NM CAVING: C 13 ft.		LOG OF BORING No. B-30	
0	6" TOPSOIL		
0.35	Gray silty CLAY	S-1	21 2-2-2-2
4.5-7-8	Gray fine to medium to coarse SAND, little clay, trace silt	S-2	15 4-5-7-8
6-8-7-9	Orange to gray fine to medium to coarse SAND, little silty clay	S-3	10 6-8-7-9
9-9-5-7	Gray CLAY, little fine to coarse sand	S-5	22 9-9-5-7
14-16-21-28	Orange to brown to black coarse SAND, some silty clay, little fine to coarse gravel	S-6	18 14-16-21-28
14-16-21-28	Blue to green silty CLAY, little to and fine sand	S-6	18 14-16-21-28
15	Boring terminated at 15 ft.		

PAGE 1 of 1

PROJECT: Terrain Commerce Center		PROJECT NO.: DCT11601	
PROJECT LOCATION: Dorsey Run Road, Howard County, MD		ELEVATION: 139.11 ft. NAVD83	
DRILLING FIRM: Connelly & Associates		LOGGED BY: C. Bagher	
FOREMAN: Ron Mena		DATE STARTED: 12/9/16	
DRILLING METHOD: 3 1/4 HSA		DATE COMPLETED: 12/9/16	
DEPTH TO WATER: INITIAL: # 13 ft. AFTER 24 HOURS: # NM CAVING: C 21 ft.		LOG OF BORING No. B-31	
0	4" TOPSOIL		
0.35	Red to brown silty CLAY (dry to moist)	S-1	18 3-3-5
7-16-25		S-2	17 12-28-38
7-16-25		S-3	6 7-16-25
10-17-13	Orange to brown coarse to medium SAND, trace silty clay, trace mica (damp)	S-4	16 10-17-13
18-19-16	Gray coarse to medium SAND and GRAVEL, little silty clay, trace mica (wet)	S-5	24 18-19-16
3-3-7-13	Gray to green to blue silty CLAY, trace fine sand (damp)	S-6	12 3-3-7-13
2-WOH-14-39	Blue to gray silty CLAY, little fine sand	S-7	10 2-WOH-14-39
25	Boring terminated at 25 ft.		

PAGE 1 of 1

APPROVED: DEPARTMENT OF PLANNING AND ZONING

David Clark 9-21-17
CHIEF, DEVELOPMENT ENGINEERING DIVISION DATE

Kurt S. DeLoach 9-27-17
CHIEF, DIVISION OF LAND DEVELOPMENT DATE

William J. Griffin 10-2-17
DIRECTOR DATE

DEVELOPER

DCT INDUSTRIAL
12011 GUILFORD ROAD
SUITE 102
ANNAPOLIS JUNCTION, MD 20701
ATTN: FRED FERRARO
PHONE: 410-645-5020

OWNER

DCT MEARS LLC
12011 GUILFORD ROAD
SUITE 102
ANNAPOLIS JUNCTION, MD 20701
ATTN: FRED FERRARO
PHONE: 410-645-5020

PROJECT

TERRAPIN COMMERCE CENTER

AREA

TAX MAP 43, PARCEL 51 LOT PAR A PLAT 23793 ZONED M-2
GRID NO. 11 1st ELECTION DISTRICT
7200 DORSEY RUN ROAD
ELK RIDGE, MARYLAND 21075
HOWARD COUNTY, MARYLAND

TITLE

SOIL BORING LOGS

Pennoni Associates Inc.
Engineers • Surveyors • Planners
Landscape Architects


8818 Centre Park Drive, Suite 200 Columbia, MD 21045
T 410.997.8900 F 410.997.9282





DESIGNED BY: PJS
DRAWN BY: AGS/JSN
PROJECT NO.: DCT11601
DATE: JUNE 23, 2017
SCALE: AS SHOWN
DRAWING NO. 36 OF 43

AS-BUILT CERTIFICATION

NOTE: THERE IS NO "AS-BUILT" INFORMATION PROVIDED ON THIS SHEET.

Sharon L. Cruz 3/6/2016
PRINTED NAME MD, P.E. NO.
Sharon L. Cruz 7/2/19
SIGNATURE DATE

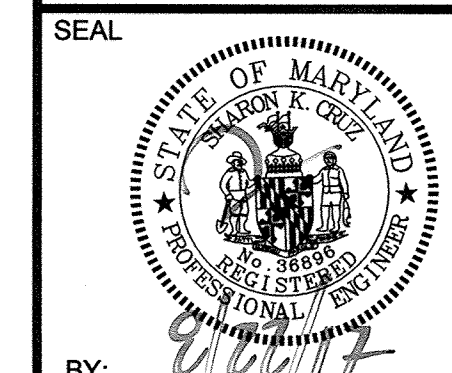

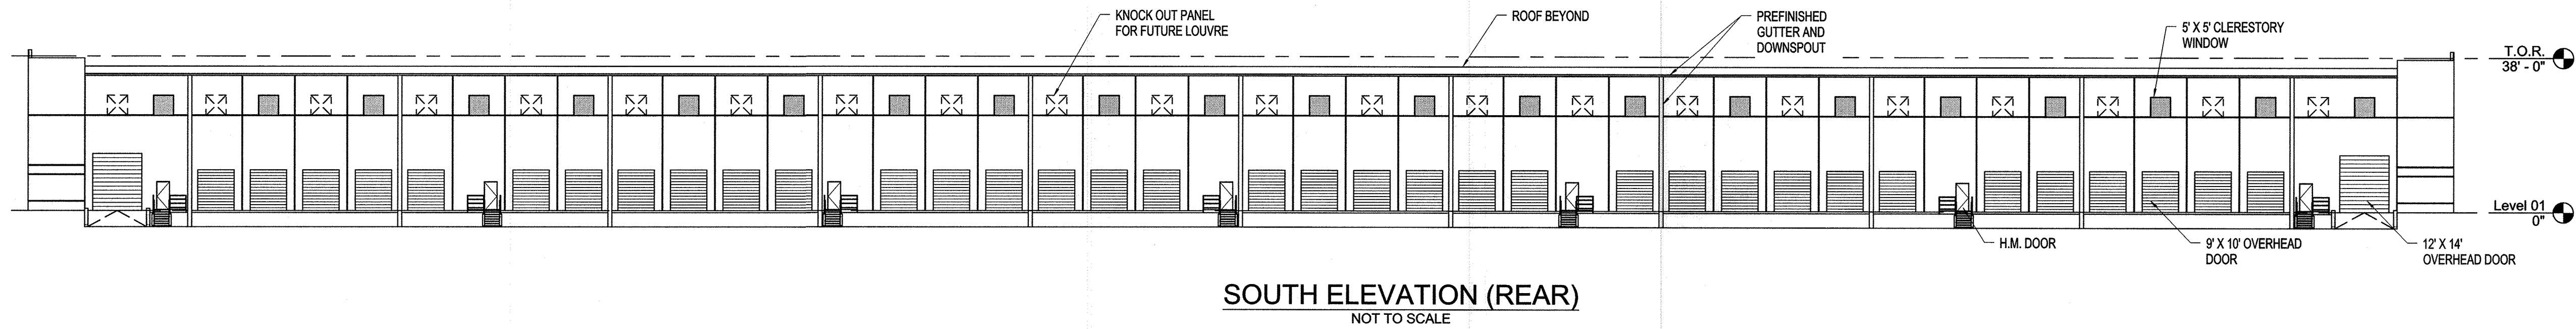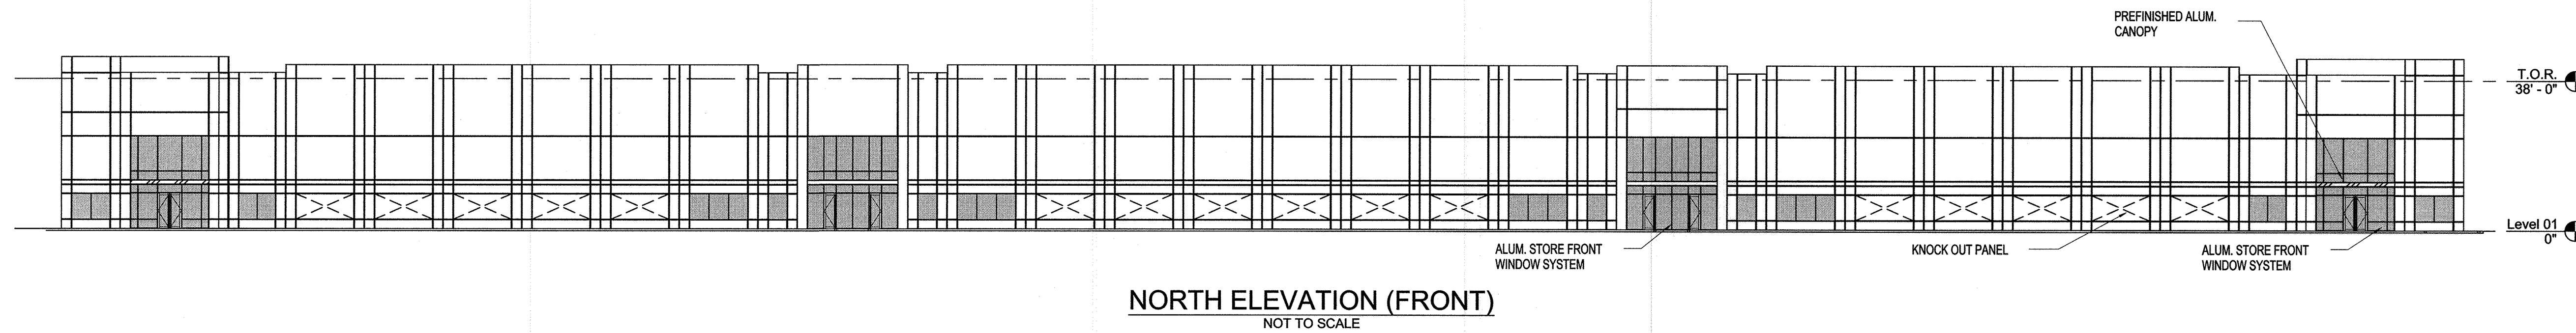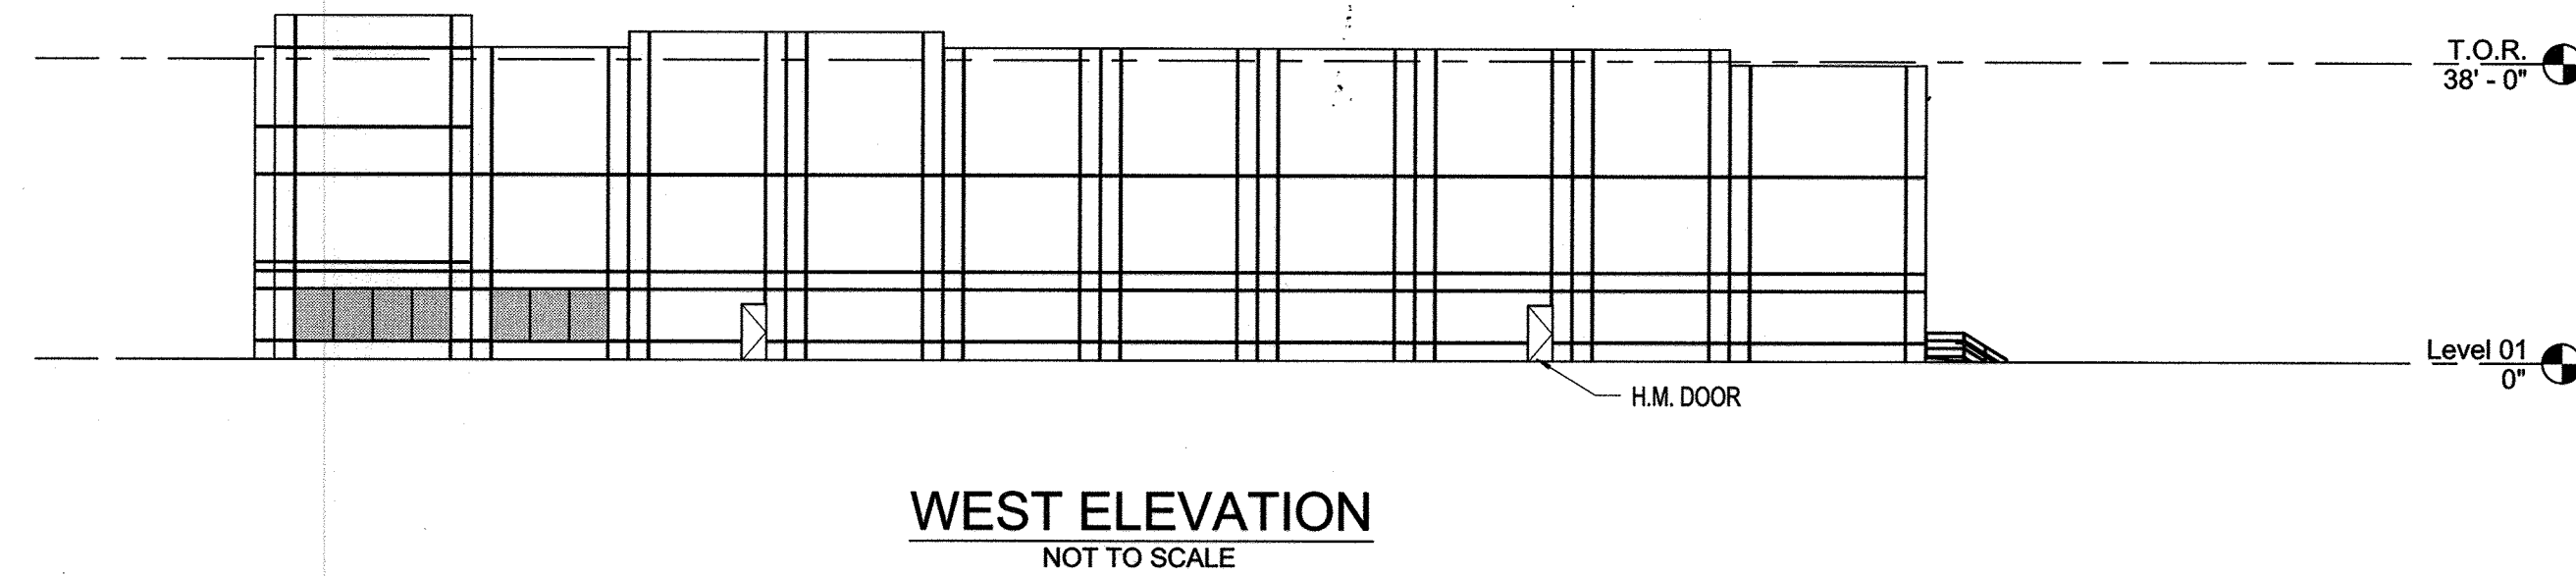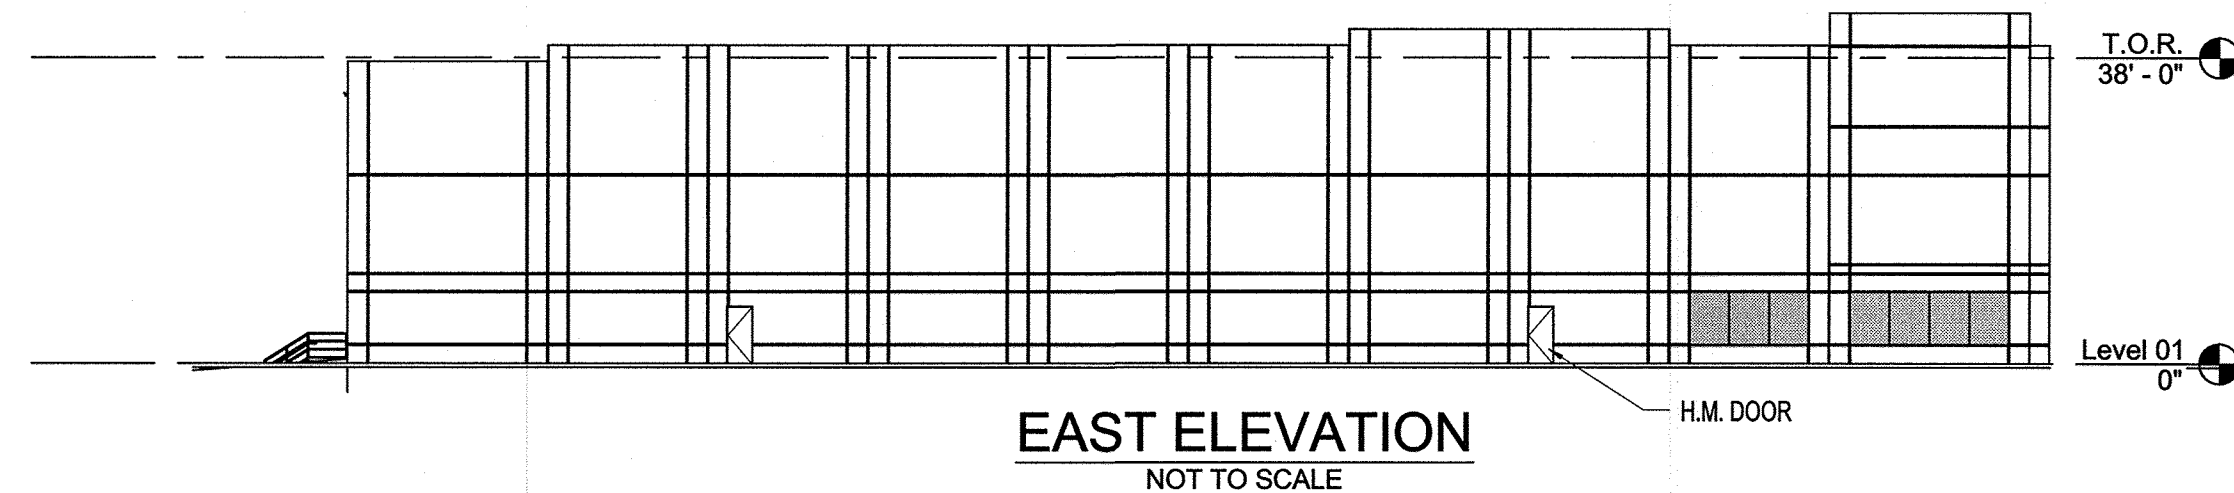

APPROVED: DEPARTMENT OF PLANNING AND ZONING	
<i>Sharon K. Cruz</i>	9-13-17
CHIEF, DEVELOPMENT ENGINEERING DIVISION	DATE
<i>Fred Ferraro</i>	9-27-17
CHIEF, DIVISION OF LAND DEVELOPMENT	DATE
<i>Walter J. Jaffe</i>	10-2-17
DIRECTOR	DATE

DATE	NO.	REVISION	BY
DEVELOPER DCT INDUSTRIAL 12011 GUILFORD ROAD SUITE 102 ANNAPOLIS JUNCTION, MD 20701 ATTN: FRED FERRARO PHONE: 410-645-5020			
OWNER DCT MEARS LLC 12011 GUILFORD ROAD SUITE 102 ANNAPOLIS JUNCTION, MD 20701 ATTN: FRED FERRARO PHONE: 410-645-5020			
PROJECT TERRAPIN COMMERCE CENTER			
AREA TAX MAP 43, PARCEL 51 LOT PAR A PLAT 23793 ZONED M-2 GRID NO. 11 1st ELECTION DISTRICT 7200 DORSEY RUN ROAD ELKRIDGE, MARYLAND 21075 HOWARD COUNTY, MARYLAND			
TITLE ARCHITECTURAL ELEVATIONS			

Pennoni Pennoni Associates Inc.
Engineers • Surveyors • Planners
Landscape Architects
8818 Centre Park Drive, Suite 200 Columbia, MD 21045
T 410.997.8900 F 410.997.9282

AS-BUILT CERTIFICATION
NOTE: THERE IS NO "AS-BUILT" INFORMATION PROVIDED ON THIS SHEET.
Sharon K. Cruz 36896
PRINTED NAME MD. P.E. NO.
[Signature] 7/2/19
SIGNATURE DATE

	DESIGNED BY: PJS
	DRAWN BY: AGS/JSN
	PROJECT NO: DCT11601
	DATE: JUNE 23, 2017
	SCALE: NOT TO SCALE
BY: <i>[Signature]</i>	DRAWING NO. <u>37</u> OF <u>43</u>

SEGMENTAL RETAINING WALL SPECIFICATIONS

PART 1 - GENERAL

1.1 WORK INCLUDES

WORK INCLUDES FURNISHING AND INSTALLING SEGMENTAL RETAINING WALL UNITS, GEGRID REINFORCEMENT, WALL FILL, AND BACKFILL TO THE LINES AND GRADES SHOWN ON THE CONSTRUCTION DRAWINGS PRODUCED BY PENNON ASSOCIATES, INC. AND AS SPECIFIED HEREIN. THE CONTRACT ALSO INCLUDES THE FURNISHING AND INSTALLING OF ALL APPROPRIATE MATERIALS, EQUIPMENT, AND LABOR REQUIRED FOR CONSTRUCTION OF THE GEGRID REINFORCED, SEGMENTAL RETAINING WALL. THE GEOTECHNICAL EXPLORATION FOR THIS SITE WAS PERFORMED BY PENNON ASSOCIATES, INC., AS SUMMARIZED IN THEIR REPORT DATED JUNE 2, 2016.

1.2 REFERENCE STANDARDS

- A. ASTM C80-75 (1981 REV.) - HOLLOW LOAD BEARING MASONRY UNITS
- B. ASTM C140-75 (1981 REV.) - SAMPLING AND TESTING CONCRETE MASONRY UNITS
- C. ASTM C145-75 (1981 REV.) - SOLID LOAD BEARING CONCRETE MASONRY UNITS
- D. GEOTECHNICAL RESEARCH INSTITUTE (GRI), GR-604 - DETERMINATION OF LONG TERM DESIGN STRENGTH OF GEORGRIDS
- E. ASTM D 838 - TEST METHOD FOR TENSILE PROPERTIES OF PLASTIC
- F. ASTM D 1248 - SPECIFICATION FOR POLYETHYLENE PLASTICS MOLING AND EXTENSION MATERIALS
- G. ASTM D 4218 - TEST METHOD FOR CARBON BLACK CONTENT IN POLYETHYLENE COMPOUNDS BY THE MAUFFLE FURNACE TECHNIQUE
- H. ASTM D 3034 - SPECIFICATION FOR POLYVINYL CHLORIDE (PVC) PIPE
- I. ASTM C 1372 - SPECIFICATIONS FOR SEGMENTAL RETAINING WALL UNITS.

1.3 DELIVERY, STORAGE AND HANDLING

- A. CONTRACTOR SHALL CHECK THE MATERIALS UPON DELIVERY TO ENSURE THAT THE PROPER MATERIAL HAS BEEN RECEIVED.
- B. CONTRACTOR SHALL PREVENT EXCESSIVE MOISTURE, WET CEMENT, EPOXY, AND LIKE MATERIALS WHICH MAY AFFIX THEMSELVES FROM COMING IN CONTACT WITH THE MATERIALS.
- C. CONTRACTOR SHALL PROTECT THE MATERIALS FROM DAMAGE. DAMAGED MATERIAL SHALL NOT BE INCORPORATED INTO THE REINFORCED RETAINING WALL.
- D. GEORGRIDS SHALL BE STORED ABOVE -20°F

1.4 SUBMITTALS/CERTIFICATION

THE CONTRACTOR SHALL SUBMIT A MANUFACTURER'S CERTIFICATION, PRIOR TO THE START OF THE WORK, THAT THE RETAINING WALL SYSTEM COMPONENTS MEET THE REQUIREMENTS OF ASTM C 1372 AND OTHER REQUIREMENTS SPECIFIED HEREIN. THIS CERTIFICATION SHOULD BE PROVIDED TO THE GEOTECHNICAL ENGINEER FOR REVIEW AND APPROVAL, PRIOR TO WALL CONSTRUCTION.

PART 2 - PRODUCTS

2.1 DEFINITIONS

- A. GEGRID IS A HIGH DENSITY POLYETHYLENE, POLYESTER, OR POLYPROPYLENE GRID, SPECIFICALLY FABRICATED FOR USE AS A SOIL REINFORCEMENT.
- B. CONCRETE RETAINING WALL UNITS ARE AS DETAIL ON THE DRAWINGS AND AS SPECIFIED HEREIN.
- C. BACKFILL IS THE SOIL WHICH IS USED AS FILL FOR THE REINFORCED WALL MASS.
- D. FOUNDATION SOIL IS THE IN-SITU SOIL OR CONTROLLED COMPACTED FILL PLACED BELOW THE BOTTOM OF THE RETAINING WALL AND GEGRID ZONE.

2.2 MATERIALS

THE CONTRACTOR SHALL SUBMIT MANUFACTURER'S CATALOG AND SAMPLES OF THE PROPOSED MATERIALS FOR APPROVAL BY THE PROJECT GEOTECHNICAL ENGINEER A MINIMUM OF SEVEN DAYS BEFORE THE START OF CONSTRUCTION. MATERIALS SHALL BE TRANSPORTED TO THE SITE ONLY AFTER APPROVAL OF THE PROPOSED MATERIALS BY THE PROJECT GEOTECHNICAL ENGINEER.

A. CONCRETE UNITS

- 1. MASONRY UNITS SHALL BE KEYSTONE COMPAC III UNITS. SUBSTITUTION OF OTHER CONCRETE UNITS MAY BE ALLOWED WITH THE PRIOR APPROVAL OF THE GEOTECHNICAL ENGINEER.
- 2. CONCRETE WALL UNITS SHALL HAVE A MINIMUM 28 DAY COMPRESSIVE STRENGTH OF 3000 PSI, IN ACCORDANCE WITH ASTM C-90. THE CONCRETE SHALL HAVE ADEQUATE FREEZE/THAW PROTECTION WITH A MAXIMUM MOISTURE ABSORPTION OF 6 PERCENT.
- 3. MODULAR CONCRETE MATERIALS SHALL CONFORM TO THE REQUIREMENTS OF ASTM C 1372 - STANDARD SPECIFICATIONS FOR SEGMENTAL RETAINING WALL UNITS.
- 4. THE UNITS SHALL PASS 100 FREEZE/THAW CYCLES IN WATER WITH LESS THAN 1% WEIGHT LOSS IN ACCORDANCE WITH ASTM C 1372.
- 5. EXTERIOR DIMENSIONS MAY VARY. UNITS ARE REQUIRED TO HAVE A MINIMUM OF 1.0 SQUARE FOOT OF FACE AREA EACH.
- 6. UNITS SHALL HAVE ANGLED SIDES AND BE CAPABLE OF ATTAINING CONCAVE AND CONVEX ALIGNMENT CURVES IN ACCORDANCE WITH MANUFACTURER'S RECOMMENDATIONS.
- 7. UNITS SHALL BE INTERLOCKED WITH NON-CORROSIVE REINFORCED FIBERGLASS PINS.
- 8. UNITS SHALL BE INTERLOCKED AS TO PROVIDE A MAXIMUM OF 1.25-INCH OF SETBACK PER BLOCK.

B. LEVELING PAD

MATERIAL FOR LEVELING PAD/FOOTING SHALL CONSIST OF COMPACTED FREE-DRAINING COARSE AGGREGATES MEETING THE REQUIREMENTS OF ASTM #57 STONE. A COMPACTED LEVELING PAD A MINIMUM OF 6 INCHES THICK AND 24 INCHES WIDE IS REQUIRED.

C. FIBERGLASS CONNECTING PINS

- 1. THE MOST ISOPHTHALIC POLYESTER RESIN FULTRUDED FIBERGLASS REINFORCEMENT RODS, A MINIMUM ONE-HALF INCH IN DIAMETER.
- 2. PINS SHALL HAVE A MINIMUM FLEXURAL STRENGTH OF 126,000 PSI AND SHORT BEAM SHEAR OF 8,400 PSI.
- 3. FOR SUBSTITUTION OF CONCRETE UNITS, USE OF OTHER COMPATIBLE CONNECTOR SYSTEMS MAY BE ALLOWED WITH THE PRIOR APPROVAL OF THE GEOTECHNICAL ENGINEER.

D. GEGRID

- 1. GEOTECHNICAL REINFORCEMENT SHALL CONSIST OF HIGH PERFORMANCE WOVEN POLYESTER GEORGRIDS MANUFACTURED BY TENAX INTERNATIONAL FOR SOIL REINFORCEMENT APPLICATIONS. THE TYPE, STRENGTH AND PLACEMENT LOCATION OF THE REINFORCING GEOTECHNICAL SHALL BE AS SHOWN ON THE PLANS. DETAILED TEST DATA SHALL BE SUBMITTED TO THE ENGINEER FOR APPROVAL PRIOR TO CONSTRUCTION AND SHALL INCLUDE TENSILE STRENGTH (ASTM D 4535 OR ASTM D 6537), CREEP (ASTM D 5622), SITE DAMAGE AND DURABILITY (GR-604), PULLOUT (ASTM D 4796), AND CONNECTION (ASTM D6638) TEST DATA.
- 2. INCLUDED WITH THE TEST DATA SHALL BE A REPORT THAT WILL SHOW THAT THE MW91 3XT SHALL HAVE AN ULTIMATE TENSILE STRENGTH OF 3,500 POUNDS PER LINEAR FOOT (MARV), A LONG-TERM DESIGN STRENGTH OF 1,918 POUNDS PER LINEAR FOOT, IN ACCORDANCE WITH ASTM D 6637 AND A JUNCTION STRENGTH OF 975 POUNDS PER LINEAR FOOT (MARV) IN ACCORDANCE WITH GRI-622.
- 3. INCLUDED WITH THE TEST DATA SHALL BE A REPORT THAT WILL SHOW THAT THE MW91 5XT SHALL HAVE AN ULTIMATE TENSILE STRENGTH OF 4,700 POUNDS PER LINEAR FOOT (MARV), A LONG-TERM DESIGN STRENGTH OF 2,575 POUNDS PER LINEAR FOOT, IN ACCORDANCE WITH ASTM D 6637 AND A JUNCTION STRENGTH OF 1,408 POUNDS PER LINEAR FOOT (MARV) IN ACCORDANCE WITH GRI-622.
- 4. TYPE OF FENCING SELECTED BY THE OWNER/DEVELOPER MAY INTERFERE WITH GEGRID REINFORCEMENT. INSTALL SONOTUBES CONCURRENTLY WITH GEGRID AND FILL PLACEMENT TO AVOID CONTACTS OR DAMAGE TO GEGRID. OWNER SHALL SELECT FENCING PRIOR TO START OF WALL CONSTRUCTION SO WALL AND FENCE CONTRACTORS CAN COORDINATE INSTALLATION.

E. REINFORCED ZONE

CONTROLLED FILL SOIL SHALL MEET THE REQUIREMENTS OF ASHTO GROUP CLASSIFICATION OF A-2-4 OR MORE GRANULAR. IF ADEQUATE QUANTITIES ARE NOT AVAILABLE ON-SITE, IMPORTED BACKFILL SHALL MEET THE ABOVE REQUIREMENTS AND SHOULD BE APPROVED BY G.T.A. BACKFILL MATERIAL AT 1-1502, 1-503, AND 1-504 SHALL BE CR6 OR R06 FOR THE FULL WIDTH AND HEIGHT OF EACH INLET AS DETAILED IN THE DRAWINGS.

F. RETAINED FILL AND STRUCTURAL FILL

CONTROLLED FILL SOILS TO BE PLACED OUTSIDE THE REINFORCED BACKFILL AREA AND WHERE SPECIFIED SHALL CONSIST OF ON-SITE OR IMPORTED SOILS MEETING THE REQUIREMENTS OF USCS M, SM, OR ML. ALL FILL MATERIALS PROPOSED TO BE PLACED BEHIND THE REINFORCED BACKFILL SHALL BE PLACED AS CONTROLLED FILL COMPACTED TO 92 PERCENT OF THE MAXIMUM DRY DENSITY IN ACCORDANCE WITH THE MODIFIED PROCTOR, ASTM D-1557.

G. UNIT FILL / DRAINAGE LAYER

THE UNIT FILL AND DRAINAGE LAYER SHALL CONSIST OF ASTM #57 STONE AND BE PLACED WITHIN THE BLOCK AS UNIT FILL AND BEHIND THE BLOCK AS THE DRAINAGE LAYER WITH A MINIMUM THICKNESS OF 12 INCHES.

H. DRAINAGE PIPE

THE DRAINAGE PIPES SHALL BE PERFORATED HDPE OR SOLID PVC PIPE AS INDICATED.

I. FILTER FABRIC

FILTER FABRIC SHALL BE NON-WOVEN, POLYPROPYLENE GEOTEXTILE, 140# MANUFACTURED BY NICOLLON MW91 GROUP OR APPROVED EQUIVALENT.

J. SLEEVE-IT OR SONOTUBE

SLEEVE-IT OR SONOTUBE SHALL BE INSTALLED DURING WALL CONSTRUCTION AT FENCE POST HOLDERS AT 8 FEET ON CENTER UNLESS OTHERWISE SPECIFIED BY THE FENCE DESIGNER/INSTALLER.

K. DRAINAGE COMPOSITE

THE DRAINAGE GEOTECHNOLOGICAL SHOULD BE DRAINAGE 700 DOUBLE SIDED MANUFACTURED BY TENAX CORPORATION, OR APPROVED EQUIVALENT

PART 3 - EXECUTION

A. EARTHWORK

- 1. THE CONTRACTOR SHALL EXCAVATE TO THE LINES AND GRADES SHOWN ON THE CONSTRUCTION DRAWINGS. UNDER NO CIRCUMSTANCES SHOULD THE EXCAVATION LINES AND GRADES BE EXCEEDED, EXCEPT WITH OWNER'S APPROVAL. THE CONTRACTOR SHALL PROTECT THE EXCAVATION FROM SLOUGHING BY EXCAVATING TO THE APPROPRIATE GRADE FOR THE OPEN SOIL TYPE AND COVERING THE EXCAVATED FACE WITH THE STONE DRAINAGE LAYER.
- 2. THE BOTTOM OF WALL EXCAVATION SHALL BE SLOPED AT A MINIMUM GRADE OF 2% TOWARDS THE WALL FACE.
- 3. THE CONTRACTOR IS RESPONSIBLE FOR STABILITY OF ALL EXCAVATION AND SLOPES REQUIRED TO CONSTRUCT THE WALL. FROM ALL EXCAVATION IN ACCORDANCE WITH THE APPLICABLE OSHA AND COUNTY STANDARDS.
- 4. PRIOR TO RETAINING WALL CONSTRUCTION AND THE PLACEMENT OF FILL, ALL TOPSOIL SHALL BE STRIPPED AND REMOVED FROM THE WALL AREA.
- 5. INSTALL ALL UTILITIES WITHIN 20 FEET OF WALL FACE CONCURRENTLY WITH WALL CONSTRUCTION.
- 6. PRIOR TO WALL CONSTRUCTION INSTALL STORM DRAIN RUN FROM F52 TO E70 AND CS3 TO M62 INCLUDING THE ASSOCIATED PIPE.
- 7. CONCURRENTLY WITH WALL CONSTRUCTION, INSTALL STORM DRAIN FROM F52 TO E70 AND ASSOCIATED PIPE. PIPE SHALL BE BACKFILLED WITH #57 STONE. STONE SPACING SHALL BE 12 INCHES ON EACH SIDE OF THE CONCRETE COLLARS. CUT AND GROUT BLOCKS USING GROUT WITH A MINIMUM 28-DAY STRENGTH OF 3,000 PSI. ALLOW GROUTED BLOCKS TO CURE FOR A MINIMUM OF 3 DAYS PRIOR TO CONTINUING WALL CONSTRUCTION AT THIS LOCATION.
- 8. UTILITY TRENCH BACKFILL SHALL BE PERFORMED AS SPECIFIED IN PART 3, ITEM F.
- 9. CONCURRENTLY WITH WALL CONSTRUCTION, INSTALL FS2, E70, AND ASSOCIATED PIPE. CUT AND GROUTED BLOCKS AS WHERE PIPE INTERSECTS WALL FACE AND AS DETAILED IN THE DRAWINGS. GROUT SHALL HAVE A MINIMUM 28-DAY STRENGTH OF 3,000 PSI AND SHALL BE ALLOWED TO CURE FOR A MINIMUM OF 3 DAYS BEFORE WALL CONSTRUCTION CAN CONTINUE AROUND GROUTED AREAS.

B. FOUNDATION SUBGRADE PREPARATION

- 1. FOUNDATION SOIL SHALL BE EXCAVATED AS REQUIRED FOR INSTALLATION OF LEVELING PAD, GEGRID, STRUCTURAL FILL, AND OTHER ELEMENTS AND AS SHOWN ON THE CONSTRUCTION DRAWINGS.
- 2. THE EXPOSED SUBGRADE SHALL BE THOROUGHLY PROFILESOLLED. THE SURFICIAL SOFT/LOOSE SOILS, AND TOPSOIL SHALL BE REMOVED TO A STABLE SUBGRADE AS DIRECTED BY G.T.A.
- 3. ALL FILL REQUIRED TO ACHIEVE THE WALL BOTTOM ELEVATION SHALL CONSIST OF STRUCTURAL FILL THAT MEETS THE REQUIREMENTS OF PART 2, ITEM E. THE FILL SHALL BE PREPARED, PLACED, COMPACTED, AND TESTED IN ACCORDANCE WITH PART 3, ITEM F. PLACEMENT OF STRUCTURAL FILL SHALL NOT PROCEED UNTIL THE SUBGRADE HAS BEEN APPROVED BY G.T.A.
- 4. FOUNDATION SOIL SHOULD BE EXAMINED BY G.T.A. TO ASSURE THAT THE ACTUAL FOUNDATION SOIL STRENGTH MEETS OR EXCEEDS ASSUMED DESIGN STRENGTH. SOILS NOT MEETING REQUIRED STRENGTH SHOULD BE REMOVED AND REPLACED WITH CONTROLLED, COMPACTED MATERIAL.
- 5. ALLOWABLE BEARING PRESSURE FOR NATURAL, AND CONTROLLED, COMPACTED STRUCTURAL FILL SHALL BE AS SPECIFIED IN PART 5, FOUNDATION SOIL.

C. LEVELING PAD

- 1. THE LEVELING PAD SHALL BE PLACED AS SHOWN ON THE CONSTRUCTION DRAWINGS WITH A MINIMUM THICKNESS OF 6 INCHES AND 24 INCHES WIDE.
- 2. BELOW THE PROPOSED CONCRETE COLLARS OR GROUTED BLOCKS, INSTALL A LEVELING PAD WITH A MINIMUM THICKNESS OF 6 INCHES AND ENSURE THAT THE STONE EXTENDS A MINIMUM OF 6 INCHES ON EACH SIDE OF THE CONCRETE COLLARS.
- 3. LEVELING PAD MATERIALS SHALL BE INSTALLED ON UNDISTURBED IN-SITU SOILS OR CONTROLLED, COMPACTED BACKFILL.
- 4. LEVELING PAD SHALL BE PREPARED TO ENSURE COMPLETE CONTACT OF RETAINING WALL UNIT WITH BASE. GAPS SHALL NOT BE ALLOWED.
- 5. THE LEVELING PAD SHALL BE CONSTRUCTED WITH THE MATERIALS DESCRIBED IN PART 2.

D. UNIT INSTALLATION

- 1. FIRST COURSE OF CONCRETE WALL UNITS SHALL BE PLACED ON THE LEVELING PAD. THE UNITS SHALL BE CHECKED FOR LEVEL AND ALIGNMENT. THE FIRST COURSE IS THE MOST IMPORTANT TO PROVIDE ACCURATE AND ACCEPTABLE RESULTS.
- 2. ENSURE THAT UNITS ARE IN FULL CONTACT WITH BASE.
- 3. UNITS ARE PLACED SIDE BY SIDE FOR FULL LENGTH OF WALL ALIGNMENT. ALIGNMENT MAY BE DONE BY MEANS OF A STRING LINE OR OFFSET FROM BASE LINE.
- 4. INSTALL FIBERGLASS CONNECTING PINS.
- 5. LAY UP EACH COURSE ENSURING THAT THE CONNECTING PINS ARE INSERTED THROUGH FRONT SLOT OF THE UNIT, AND INTO THE RECEIVING SLOT IN THE COURSE BELOW. REPEAT PROCEDURE TO THE EXTENT OF WALL HEIGHT.
- 6. AT THE END OF EACH COURSE WHERE THE WALL CHANGES ELEVATION, UNITS SHALL BE TURNED INTO THE BACKFILL. UNITS SHALL BE LAD AS TO CREATE THE MINIMUM RADIUS POSSIBLE, UNLESS OTHERWISE SHOWN ON THE DRAWINGS. A MINIMUM OF ONE UNIT SHALL BE INSTALLED INTO THE GROUT. ONLY THE FRONT FACE OF THE UNITS SHALL BE VISIBLE FROM THE SIDE OF THE WALL.
- 7. CAP UNITS SHALL BE INSTALLED AND BONDED WITH CONSTRUCTION ADHESIVE OR EPOXY CEMENT AS REQUIRED BY MANUFACTURER.
- 8. CONTRACTOR SHALL PROVIDE POSITIVE DRAINAGE FOR THE BACK OF THE RETAINING WALL DURING CONSTRUCTION.

E. GEGRID INSTALLATION

- 1. THE GEGRID SOIL REINFORCEMENT SHALL BE LAD HORIZONTALLY ON COMPACTED BACKFILL AND CONNECTED TO THE CONCRETE WALL UNITS. HOOK GRID OVER THE FIBERGLASS CONNECTING PIN, WALL, AND ANCHOR BEFORE BACKFILL IS PLACED ON THE GEGRID.
- 2. SLACK IN THE GEGRID AT THE WALL UNIT CONNECTIONS SHALL BE REMOVED IN A MANNER, AND TO SUCH A DEGREE, AS APPROVED BY THE ENGINEER.
- 3. GEGRID SHALL BE LAD AT THE PROPER ELEVATION AND ORIENTATION AS SHOWN ON THE CONSTRUCTION DRAWINGS OR AS DIRECTED BY THE ENGINEER.
- 4. CORRECT ORIENTATION (ROLL DIRECTION) OF THE GEGRID SHALL BE VERIFIED BY THE CONTRACTOR.
- 5. GEGRID SHALL BE SECURED IN-PLACE WITH STAPLES, PINS, SAND BAGS, OR BACKFILL AS REQUIRED BY FILL PLACEMENT PROCEDURES, OR WEATHER CONDITIONS, OR AS DIRECTED BY THE ENGINEER.
- 6. OVERLAPS:
 - a. UNUSUAL GEGRID DOES NOT NEED TO BE OVERLAPPED IN THE ACROSS THE ROLL DIRECTION, EXCEPT TO CONTAIN THE FILL AT THE SLOPE FACE WHEN WRAP-AROUND FACING IS USED. UNUSUAL GRID SHOULD BE OVERLAPPED 48" IN THE ROLLED DIRECTION.
 - b. A LAYER OF SOIL A MINIMUM OF 4 INCHES IN THICKNESS SHALL BE SPREAD BETWEEN UNUSUAL GEGRID LAYERS IN THE AREA TO BE OVERLAPPED, OR AS DIRECTED.

F. PLACEMENT OF FILL AND BACKFILL

- 1. FILL MATERIALS SHALL BE PLACED IN LIFTS NOT EXCEEDING 8 INCHES IN LOOSE THICKNESS.
- 2. AT THE TIME OF COMPACTION, FILL MATERIALS SHALL BE WITHIN -2% TO +4% OF THE OPTIMUM MOISTURE CONTENT, AND SHALL BE COMPACTED TO A MINIMUM OF 92% OF THE MAXIMUM DRY DENSITY AS DETERMINED IN ACCORDANCE WITH ASTM SPECIFICATION D-1557, THE MODIFIED PROCTOR METHOD.
- 3. BACKFILL SHALL BE PLACED, SPREAD, AND COMPACTED IN SUCH A MANNER THAT MINIMIZES THE DEVELOPMENT OF WHEELRIMS AND/OR IMBEDMENT OF THE GEGRID. PLACE BACKFILL FROM FRONT OF GEGRID AND STOP TO BACK OF GEGRID.
- 4. THE LEFT OF BACKFILL IMMEDIATELY BELOW A LAYER OF GEGRID SHALL BE SCARIFIED TO A DEPTH OF 2 INCHES IMMEDIATELY AFTER COMPLETION OF LIFT COMPACTION. THE GEGRID SHALL BE PLACED AND THE SUBSEQUENT LIFT OF SOIL PLACED AND COMPACTED THE SAME DAY AS THE UNDERLYING LIFT IS SCARIFIED.
- 5. ONLY HAND-OPERATED COMPACTION EQUIPMENT SHALL BE ALLOWED WITHIN 4 FEET OF THE WALL FACE.
- 6. BACKFILL SHALL BE PLACED FROM THE WALL OUTWARD TO ENSURE THAT THE GEGRID REMAINS TAUT.
- 7. TRACKED CONSTRUCTION EQUIPMENT SHALL NOT BE OPERATED WITHIN THE REINFORCED ZONE BEHIND THE WALL.
- 8. RUBBER-TIRED EQUIPMENT MAY PASS OVER THE GEGRID REINFORCEMENT AT SLOW SPEEDS, LESS THAN 10 MPH. SLOTTED BRAKING AND SHARP TURNING SHOULD BE AVOIDED.
- 9. ALL FILL AND BACKFILL OPERATIONS SHALL BE OBSERVED ON A FULL-TIME BASIS BY A QUALIFIED SOIL TECHNICIAN TO DETERMINE IF MINIMUM COMPACTION REQUIREMENTS ARE BEING MET AND THAT MATERIALS MEETING OR EXCEEDING THE SPECIFICATION REQUIREMENTS ARE USED.
- 10. IN-PLACE DENSITY TESTS SHALL BE PERFORMED WITH A MINIMUM OF 1 TEST PER 2,000 SQUARE FEET OF FILL AREA FOR EACH LIFT OF FILL PLACED. THE ELEVATION AND LOCATION OF THE TESTS SHALL BE CLEARLY IDENTIFIED AT THE TIME OF FILL PLACEMENT.
- 11. THE BACKFILL MATRIX MUST BE CONSTRUCTED SO THAT FINE GRAIN SOILS DO NOT TRAP WATER.

G. DRAINAGE

- 1. DRAINAGE FILL SHALL BE PLACED BEHIND THE WALL TO THE LIMITS SHOWN. THE DRAINAGE FILL SHALL BE A MINIMUM OF 12-INCHES THICK AND SHALL MEET THE REQUIREMENTS OF ASTM #57 STONE. THE DRAINAGE FILL SHALL BE WRAPPED IN FILTER FABRIC (MARV 140# OR EQUIV.) AS SHOWN ON THE DRAWINGS.
- 2. AT WALL #2, WRAP ALL #57 STONE WITH FILTER FABRIC BELOW EL. 138 FROM STA. 6+00 TO STA. 7+67.
- 3. POSITIVE DRAINAGE SHALL BE MAINTAINED DURING AND AFTER CONSTRUCTION. SOILS WITHIN THE REINFORCED ZONE THAT BECOME WET DURING CONSTRUCTION SHALL BE DRIED OR REMOVED.
- 4. INSTALL THE PERFORATED DRAINAGE PIPES, LATERAL DRAINAGE PIPES, AND DRAINAGE GEOTECHNOLOGICAL, IF REQUIRED, INCREMENTALLY ALONG WITH THE INSTALLATION OF CONCRETE UNITS AND PLACEMENT OF FILL.

H. FENCING

Note: SLEEVE-IT OR SONOTUBE SHALL BE INSTALLED BEHIND THE BLOCK CELLS AT 8 FEET ON CENTER. SLEEVE-ITS OR SONOTUBES SHALL BE FILLED WITH SHARP CORNERED CONCRETE TO A MIN. DENSITY OF 28%. CRUSHED STONE OR 2000 PSI 2 unreinforced concrete.

PART 4 - CONSTRUCTION OBSERVATION AND TESTING

- A. THE RETAINING WALL SHOULD ONLY BE CONSTRUCTED UNDER THE OBSERVATION OF G.T.A TO CONFIRM THAT THE SOIL AND MATERIALS USED DURING CONSTRUCTION MEET THE REQUIREMENTS SPECIFIED HEREIN. IF G.T.A IS NOT CONTRACTED TO PROVIDE CONSTRUCTION OBSERVATION AND TESTING SERVICES DURING WALL CONSTRUCTION, G.T.A IS RELEASED OF ALL RESPONSIBILITY FOR THE PERFORMANCE OF THE WALL.
- B. THE REQUIRED BEARING PRESSURE BEHIND THE FOOTING OF THE WALL SHALL BE VERIFIED IN THE FIELD BY A CERTIFIED SOILS TECHNICIAN. TESTING DOCUMENTATION MUST BE PROVIDED TO THE GEOTECHNICAL ENGINEER PRIOR TO THE START OF WALL CONSTRUCTION. THE REQUIRED TESTING PROCEDURE SHALL BE THE DYNAMIC CONE PENETROMETER (DCP) TEST ASTM SP-309.
- C. THE SUFFICIENCY OF FILL MATERIAL SHALL BE CONFIRMED BY THE ON-SITE SOILS TECHNICIAN.

PART 5 - DESIGN PARAMETERS

WALL #1	WALL #2	
MAXIMUM EXPOSED WALL HEIGHT (FT.):	15.0	14.8
ANGLE OF FACE (DEG.):	NEAR VERTICAL	8
BLOCK EMBEDEDMENT (FT.):	VARIES	8
MAXIMUM TOE SLOPE ANGLE (DEG.):	8	18.4
MAXIMUM TOE SLOPE ANGLE (DEG.):	26.6	18.4
REINFORCED FILL ZONE		
DENSITY OF BACKFILL (PCF):	130	130
PHI (DEG.):	32	32
COHESION (PSF):	0	0

RETAINED ZONE		
DENSITY (PCF):	125	125
PHI (DEG.):	28	28
COHESION (PSF):	0	0
FOUNDATION SOIL		
DENSITY (PCF):	125	125
PHI (DEG.):	28	28
COHESION (PSF):	0	0
LEVELING PAD MATERIAL:	NO. 57 STONE	
ALLOWABLE BEARING PRESSURE (PSF):	2,500	
MODULAR BLOCK DATA		
KEYSTONE BLOCKS:	COMPAC III UNITS	
KEYSTONE CAP BLOCKS:	4" HIGH CAP UNITS	
UNIT FILL:	AGGREGATE, AASHTO NO. 57	


GEGRID DATA		
GEGRID TYPE:	MW91 3XT AND 5XT	
COVERAGE OF GEORGRIDS:	100	
WALL/SOIL INTERACTION COEFFICIENT:	0.8	
DIRECT SHEAR COEFFICIENT:	0.8	
CONSTRUCTION DAMAGE BASED ON:	CRUSHED STONE	
GEGRID LENGTH (FT.):	4 TO 13 FEET	
GEOTEXTILE:	MW91 140 #, OR APPROVED EQUIVALENT	

PART 6 - DESIGN CRITERIA


- 1. DESIGN PARAMETERS
 - a. MIN. F.S. FOR SLIDING: 1.5
 - b. MIN. F.S. FOR OVERTURNING: 2.0
 - c. MIN. F.S. FOR UNCERTAINTIES: 1.5
 - d. MIN. F.S. FOR GLOBAL STABILITY: 1.3
- 2. GEGRID INSTALLATION DAMAGE REDUCTION FACTOR: 1.15
- 3. GEGRID DURABILITY REDUCTION FACTOR: 1.1
- 4. GEGRID OVERALL SAFETY FACTOR: 2.0
- 5. MIN. F.S. FOR BEARING: 1.5

PART 7 - CONSTRUCTION SEQUENCE



- A. OBTAIN BUILDING PERMITS AND INSTALL SEDIMENT AND EROSION CONTROL DEVICES.
- B. GRADE AREAS BELOW AND BEHIND THE WALLS.
- C. INSTALL STORM DRAIN RUNS FROM CS3 TO M62 AND FS1 TO E70 PRIOR TO WALL CONSTRUCTION AND BACKFILL IN ACCORDANCE WITH PART 3, ITEM F AND AS DETAILED IN THE DRAWINGS.
- D. INSTALL STORM DRAIN RUN FROM FS2 TO E70 CONCURRENTLY WITH WALL CONSTRUCTION. CUT AND GROUT BLOCK WHERE PIPE INTERSECTS WALL FACE. GROUT SHALL HAVE A MINIMUM 28-DAY STRENGTH OF 3,000 PSI. GROUT SHALL CURE A MINIMUM OF 3 DAYS BEFORE CONTINUING WALL CONSTRUCTION.
- E. CONSTRUCT LEVELING PAD.
- F. CONSTRUCT WALL INCLUDING BLOCK, GEGRID, AND REINFORCED FILL.
- G. INSTALL SLEEVE-ITS OR SONOTUBES BEHIND THE BLOCK CELLS AS DETAILED. SONOTUBES OR SLEEVE-ITS SHALL BE INSTALLED WITH A MINIMUM DEPTH OF 28 INCHES AND BACKFILLED WITH GROUT OR CONCRETE.
- H. INSTALL CAP UNITS.

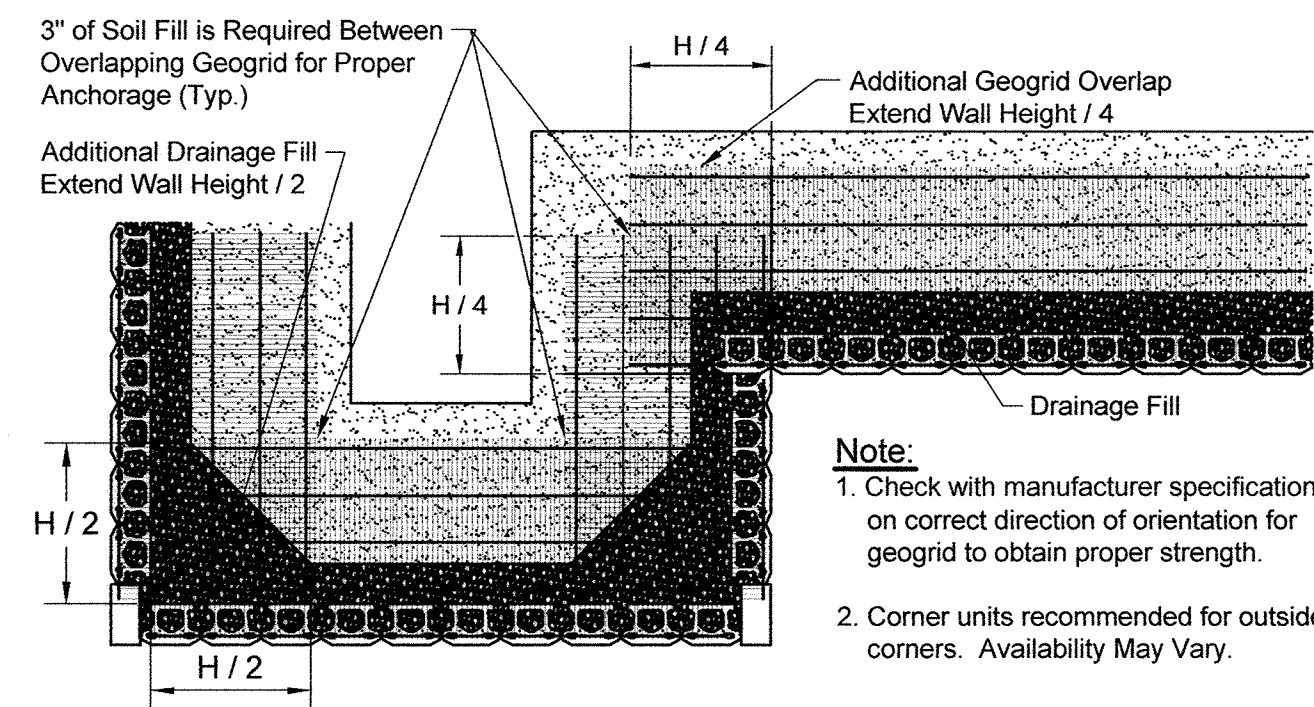


GEORGRID INSTALLATION AT CORNERS
SCALE AS SHOWN

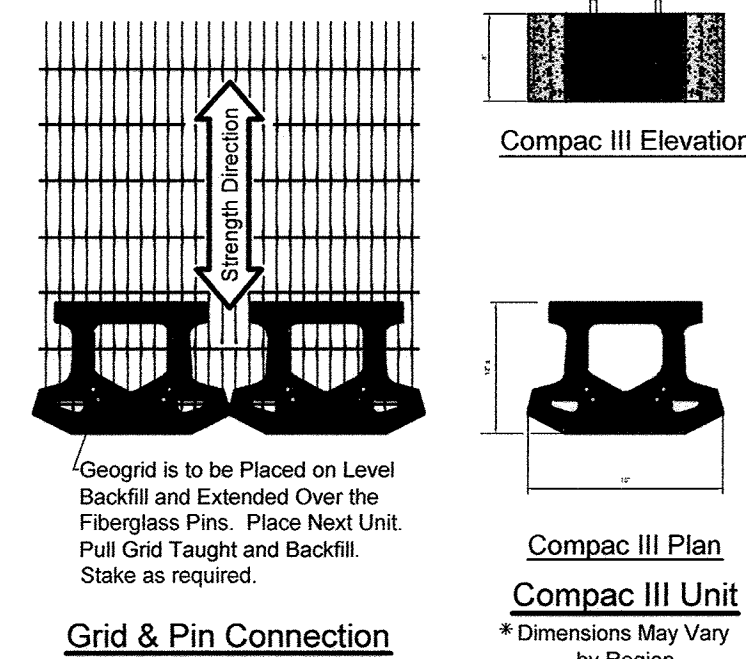

Grid & Pin Connection

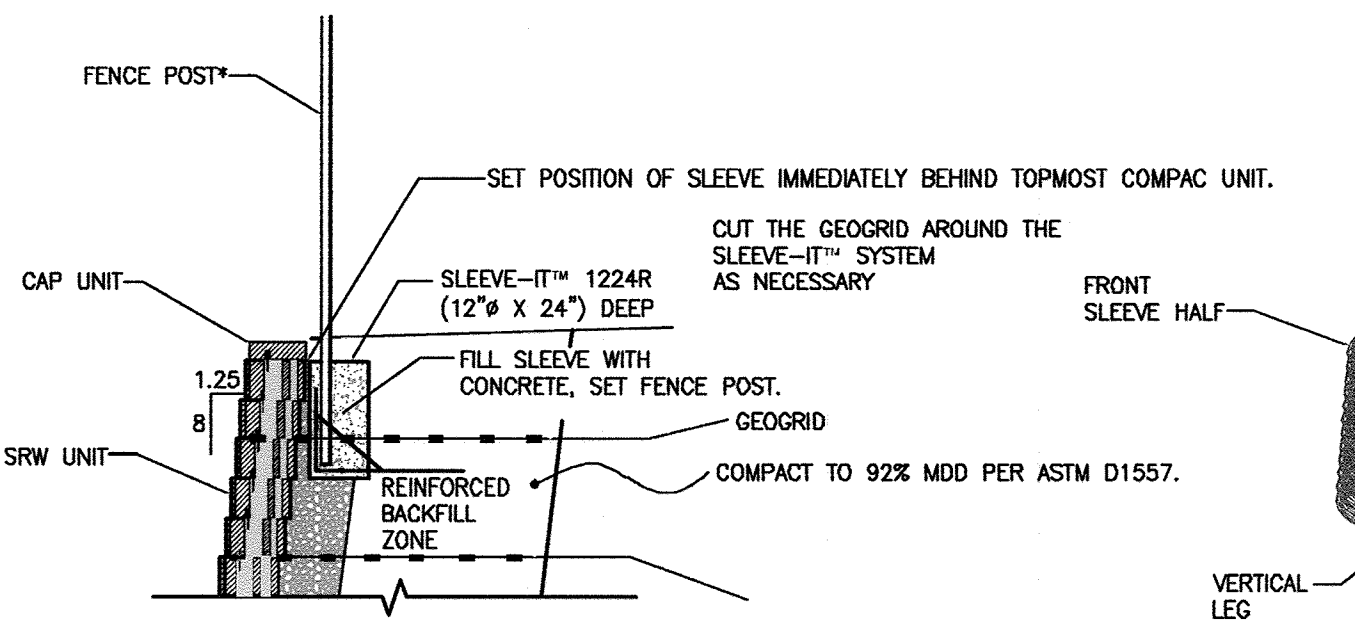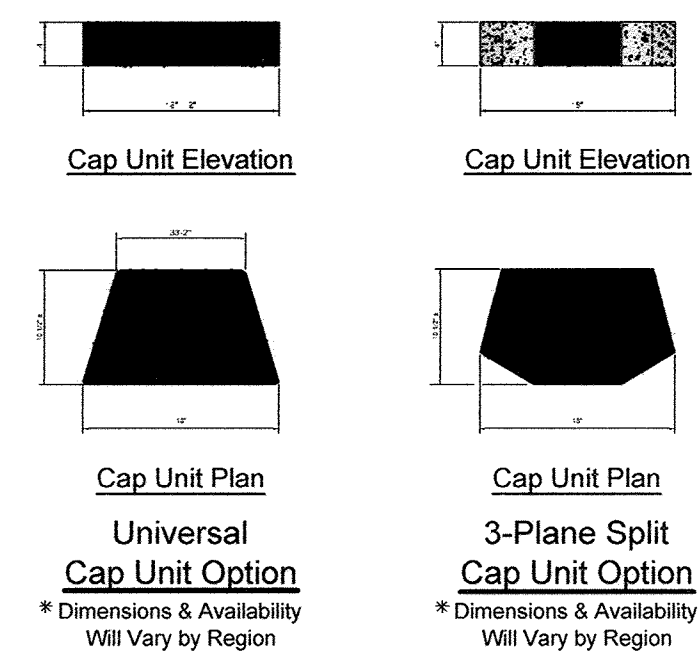

DETAIL OF FENCE POST INSTALLATION USING SLEEVE-IT™ 1224R
NOT TO SCALE

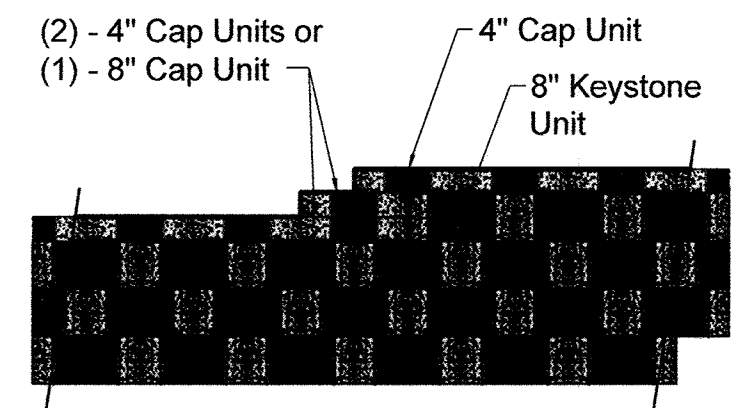

Note: 1. Secure all cap units with Keystone Kapeal or equal.



Top of Wall Steps

AS-BUILT CERTIFICATION

NOTE: THERE IS NO "AS-BUILT" INFORMATION PROVIDED ON THIS SHEET.

Sharon L. Cruz 36896
PRINTED NAME MD. P.E. NO.

[Signature] 7/2/19
SIGNATURE DATE

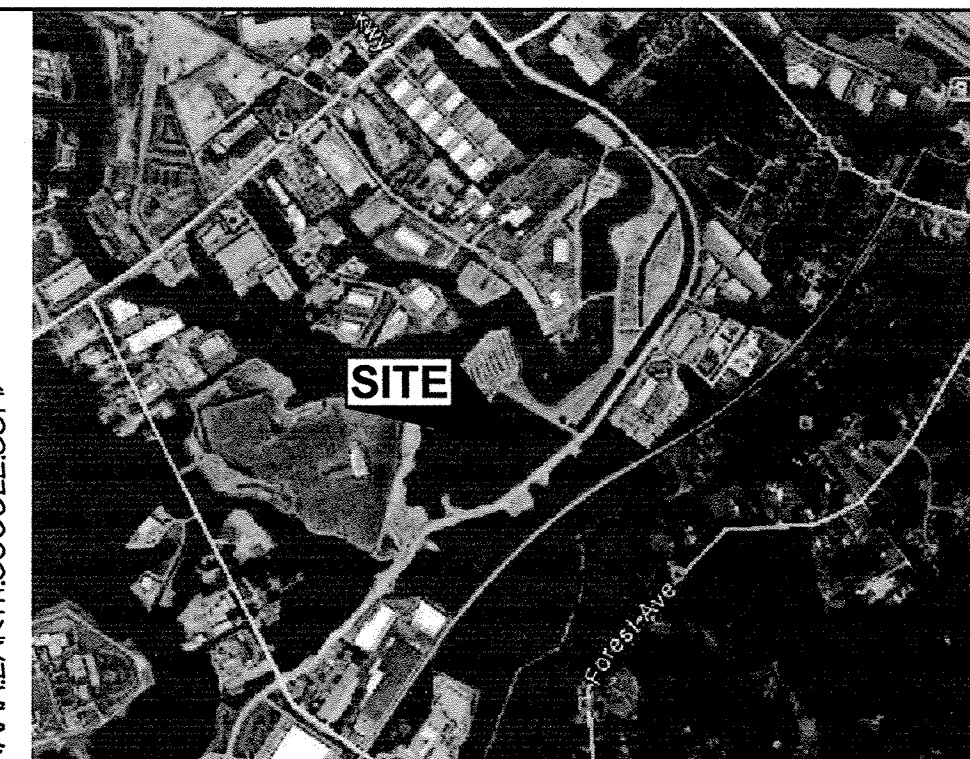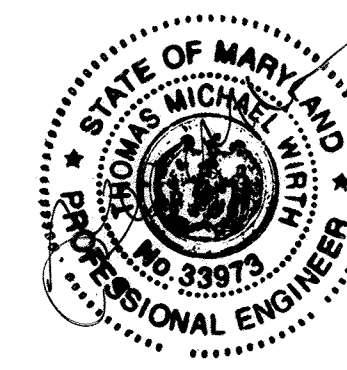

SOURCE: PLAN ADAPTED FROM A 2016 AERIAL PHOTOGRAPH OF HOWARD COUNTY, MARYLAND MAINTAINED BY GOOGLE EARTH. WWW.EARTH.GOOGLE.COM

VICINITY MAP
SCALE: 1" = 2000'

APPROVED: DEPARTMENT OF PLANNING AND ZONING

<i>[Signature]</i>	9-13-17
CHIEF, DEVELOPMENT ENGINEERING DIVISION	DATE
<i>[Signature]</i>	9-27-17
CHIEF, DIVISION OF LAND DEVELOPMENT	DATE
<i>[Signature]</i>	10-2-17
DIRECTOR	DATE

8/23/17	2	REVISED TITLE BLOCK	TMW
8/15/17	1	REVISED WALL #2	TMW
DATE	NO.	REVISION	BY
DEVELOPER: DCT INDUSTRIAL 12011 GUILFORD ROAD SUITE 102 ANNAPOLIS JUNCTION, MD 20701 ATTN: FRED FERRARO PHONE: 410-645-5020			
OWNER: DCT MEARS LLC 12011 GUILFORD ROAD SUITE 102 ANNAPOLIS JUNCTION, MD 20701 ATTN: FRED FERRARO PHONE: 410-645-5020			

PROJECT
TERRAPIN COMMERCE CENTER


AREA: TAX MAP 43, PARCEL 51 LOT PAR A PLAT 23793 ZONED M-2
GRID NO. 11 1st ELECTION DISTRICT
7200 DORSEY RUN ROAD
ELKRIDGE, MARYLAND 21075
HOWARD COUNTY, MARYLAND

TITLE
NOTES AND DETAILS


GEO-TECHNOLOGY ASSOCIATES, INC.
GEOTECHNICAL AND ENVIRONMENTAL CONSULTANTS
3445-A BOX HILL CORPORATE CENTER DRIVE
ABINGDON, MARYLAND 21009
410-515-9446
FAX: 410-515-4895
WWW.GTAENG.COM
© 2017 GEO-TECHNOLOGY ASSOCIATES, INC.

DESIGNED BY: EBC
DRAWN BY: KDJ/EBC
PROJECT NO: DCT11601
DATE: JUNE 2017
SCALE: AS SHOWN
DRAWING NO. 38 OF 43


GEO-TECHNOLOGY ASSOCIATES, INC.

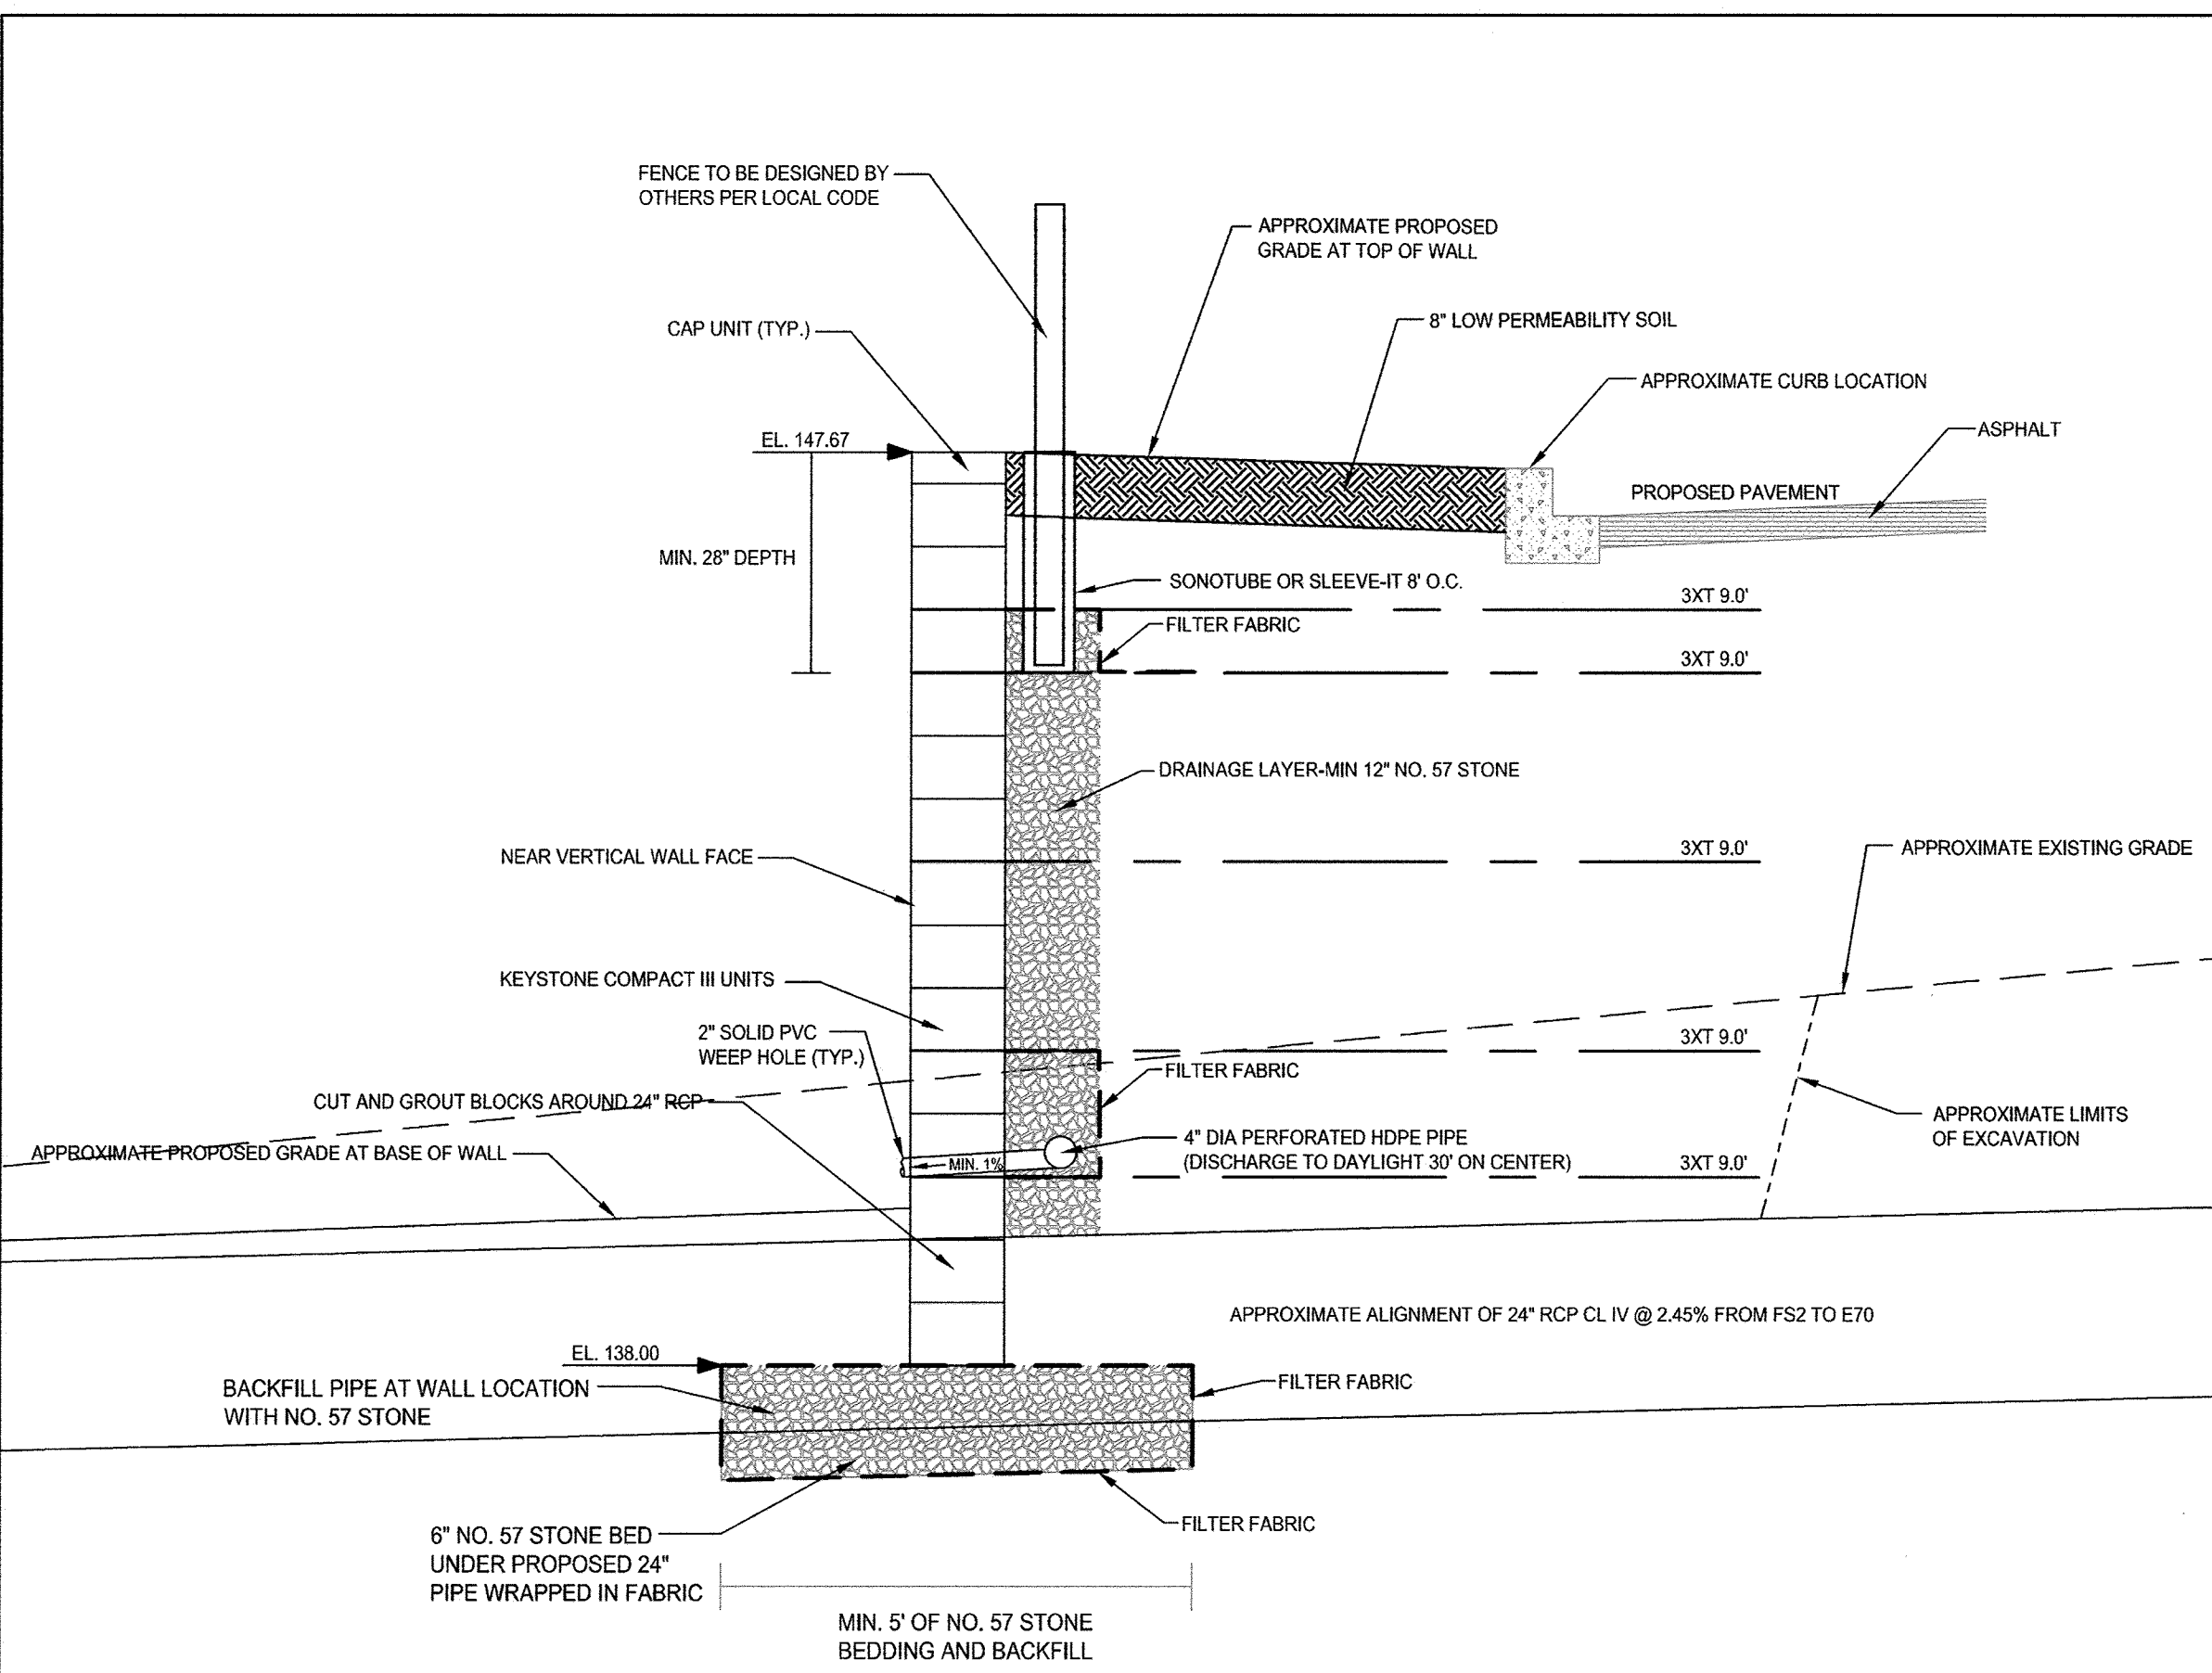


RETAINING WALL #2 CROSS SECTION VIEW @ STA. 1+27.70
SCALE: NOT TO SCALE

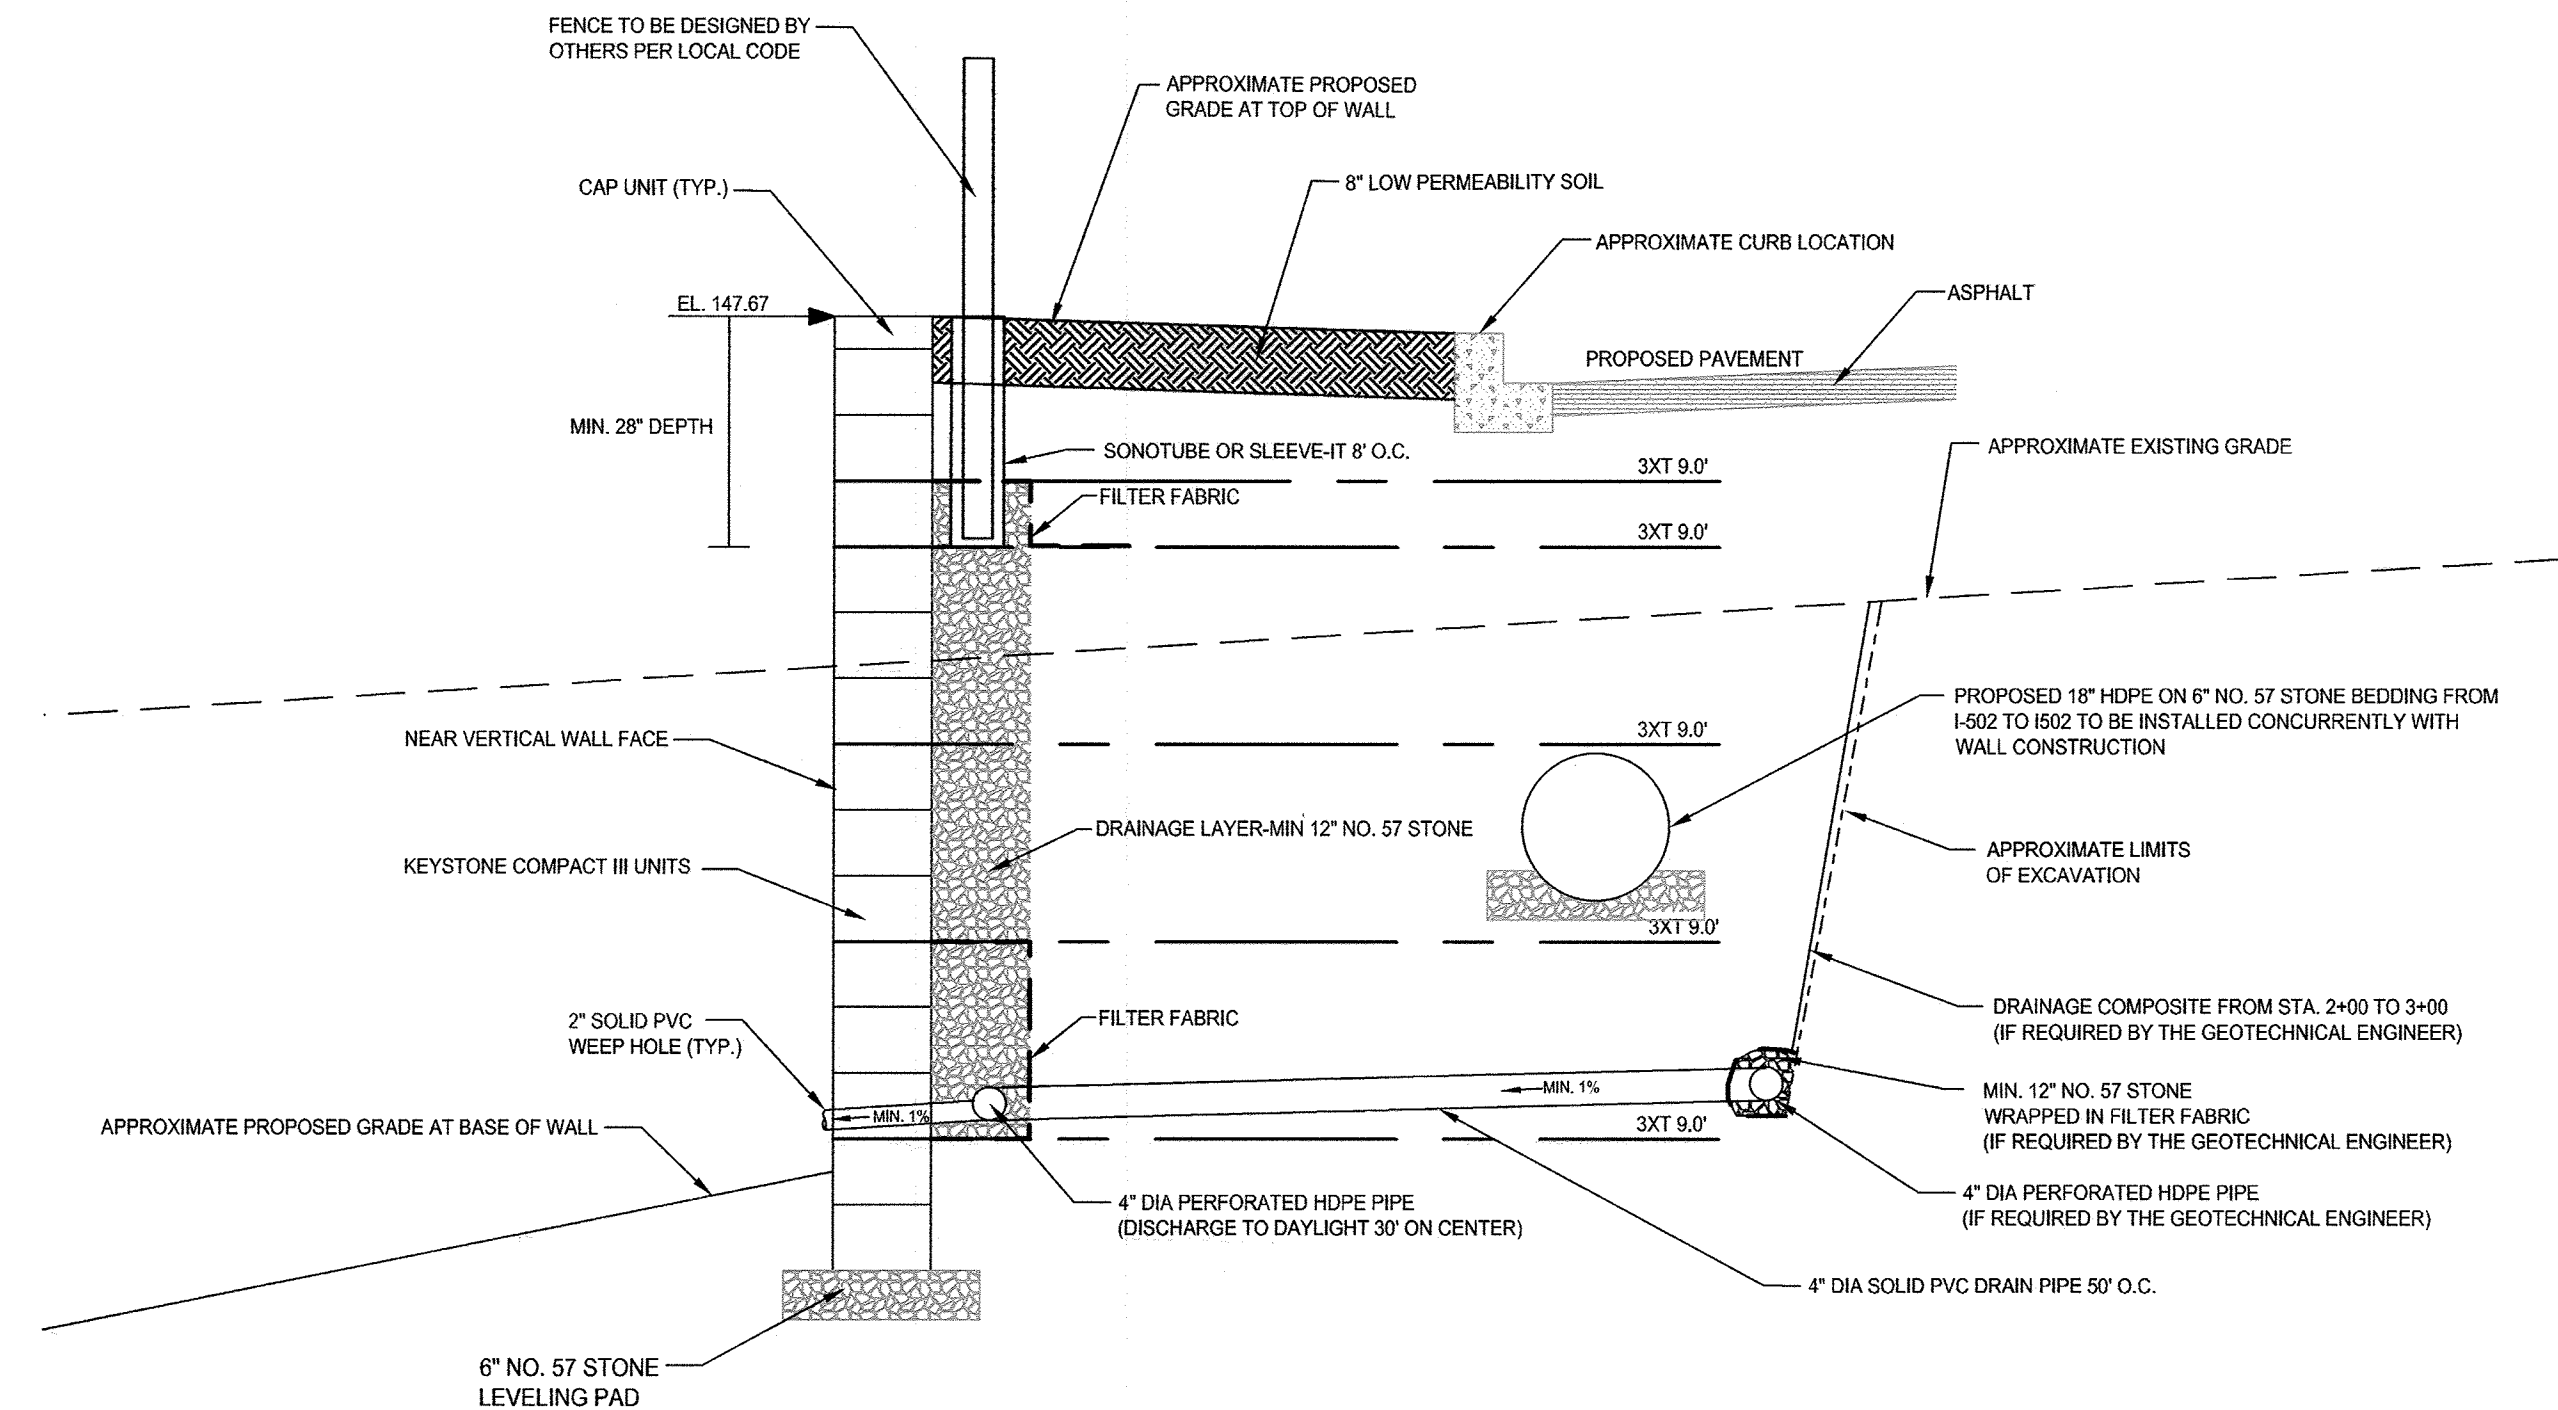


RETAINING WALL #2 CROSS SECTION VIEW @ STA. 2+50
SCALE: NOT TO SCALE

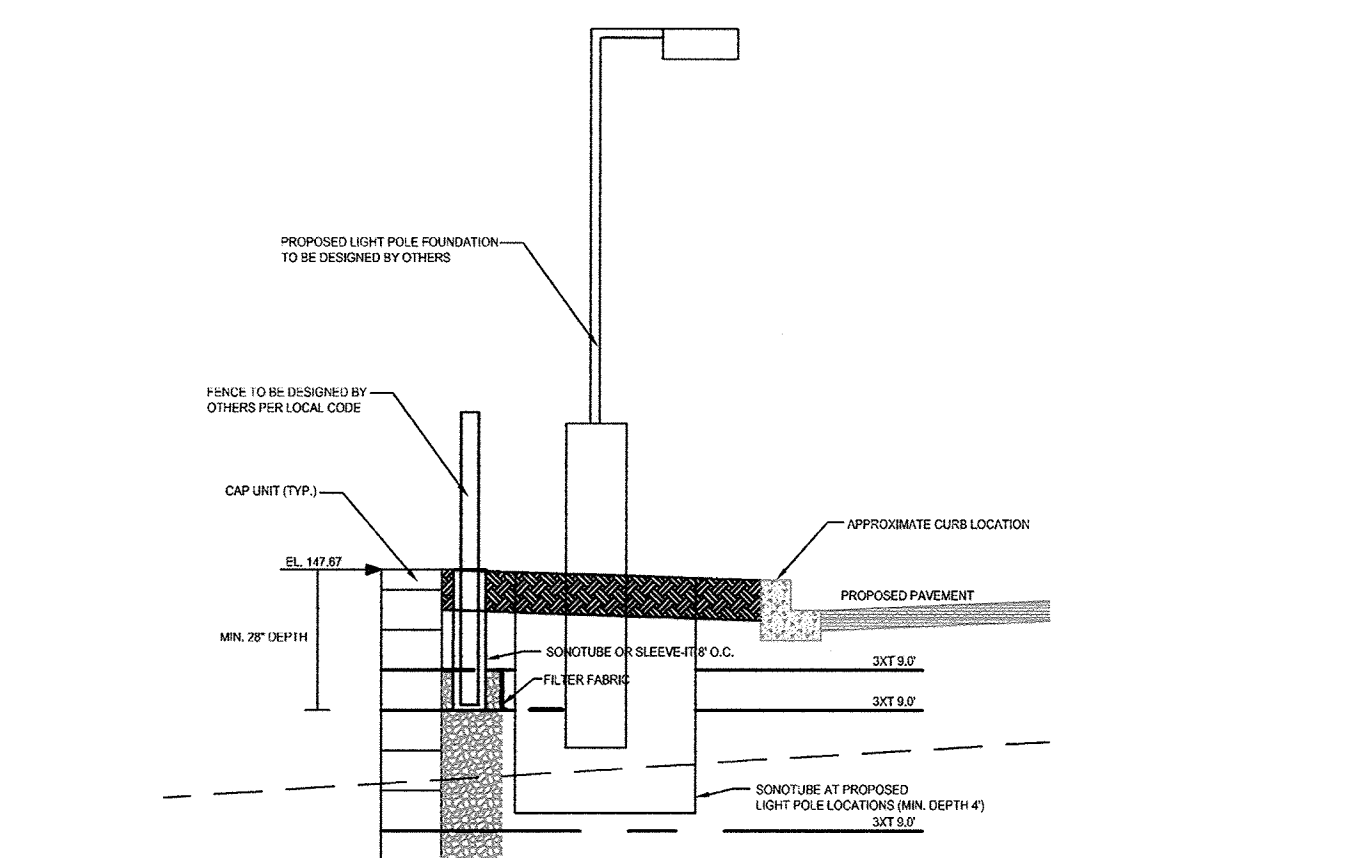


RETAINING WALL #2 CROSS SECTION VIEW @ LIGHT POLE LOCATIONS (SEE BELOW)
SCALE: NOT TO SCALE

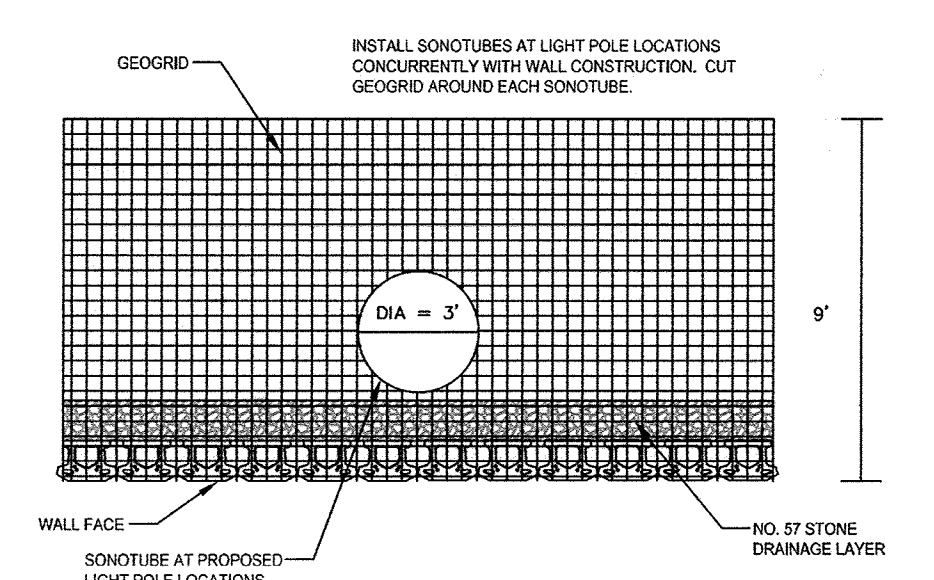

SONOTUBE INSTALLATION AT LIGHT POLE LOCATIONS (TYP.)
SCALE: NOT TO SCALE

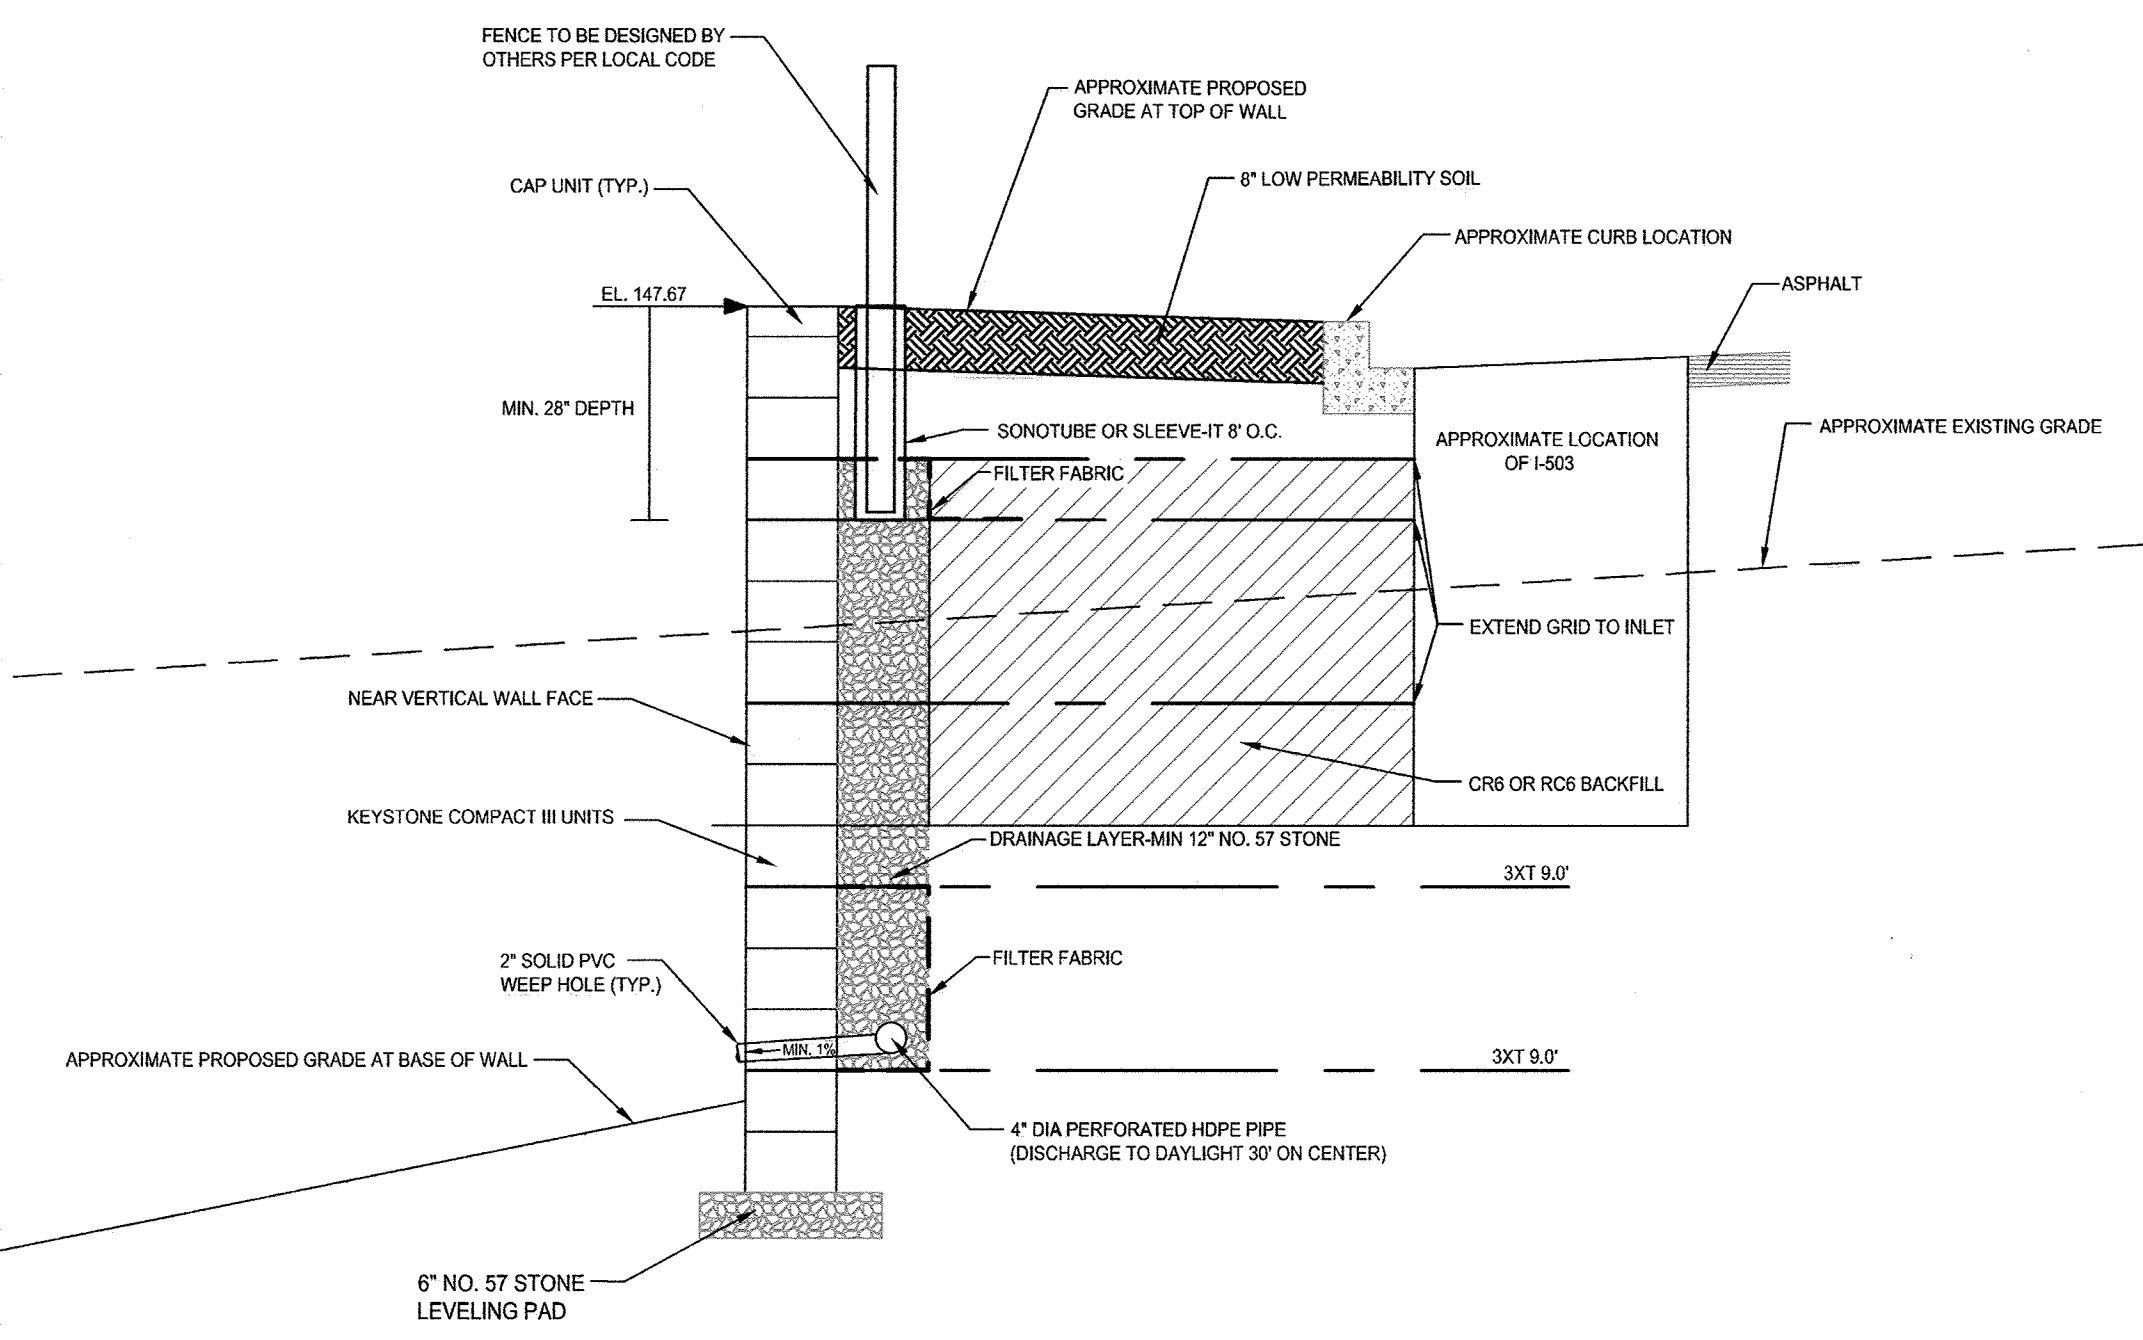


RETAINING WALL #2 CROSS SECTION VIEW @ STA. 2+87
SCALE: NOT TO SCALE

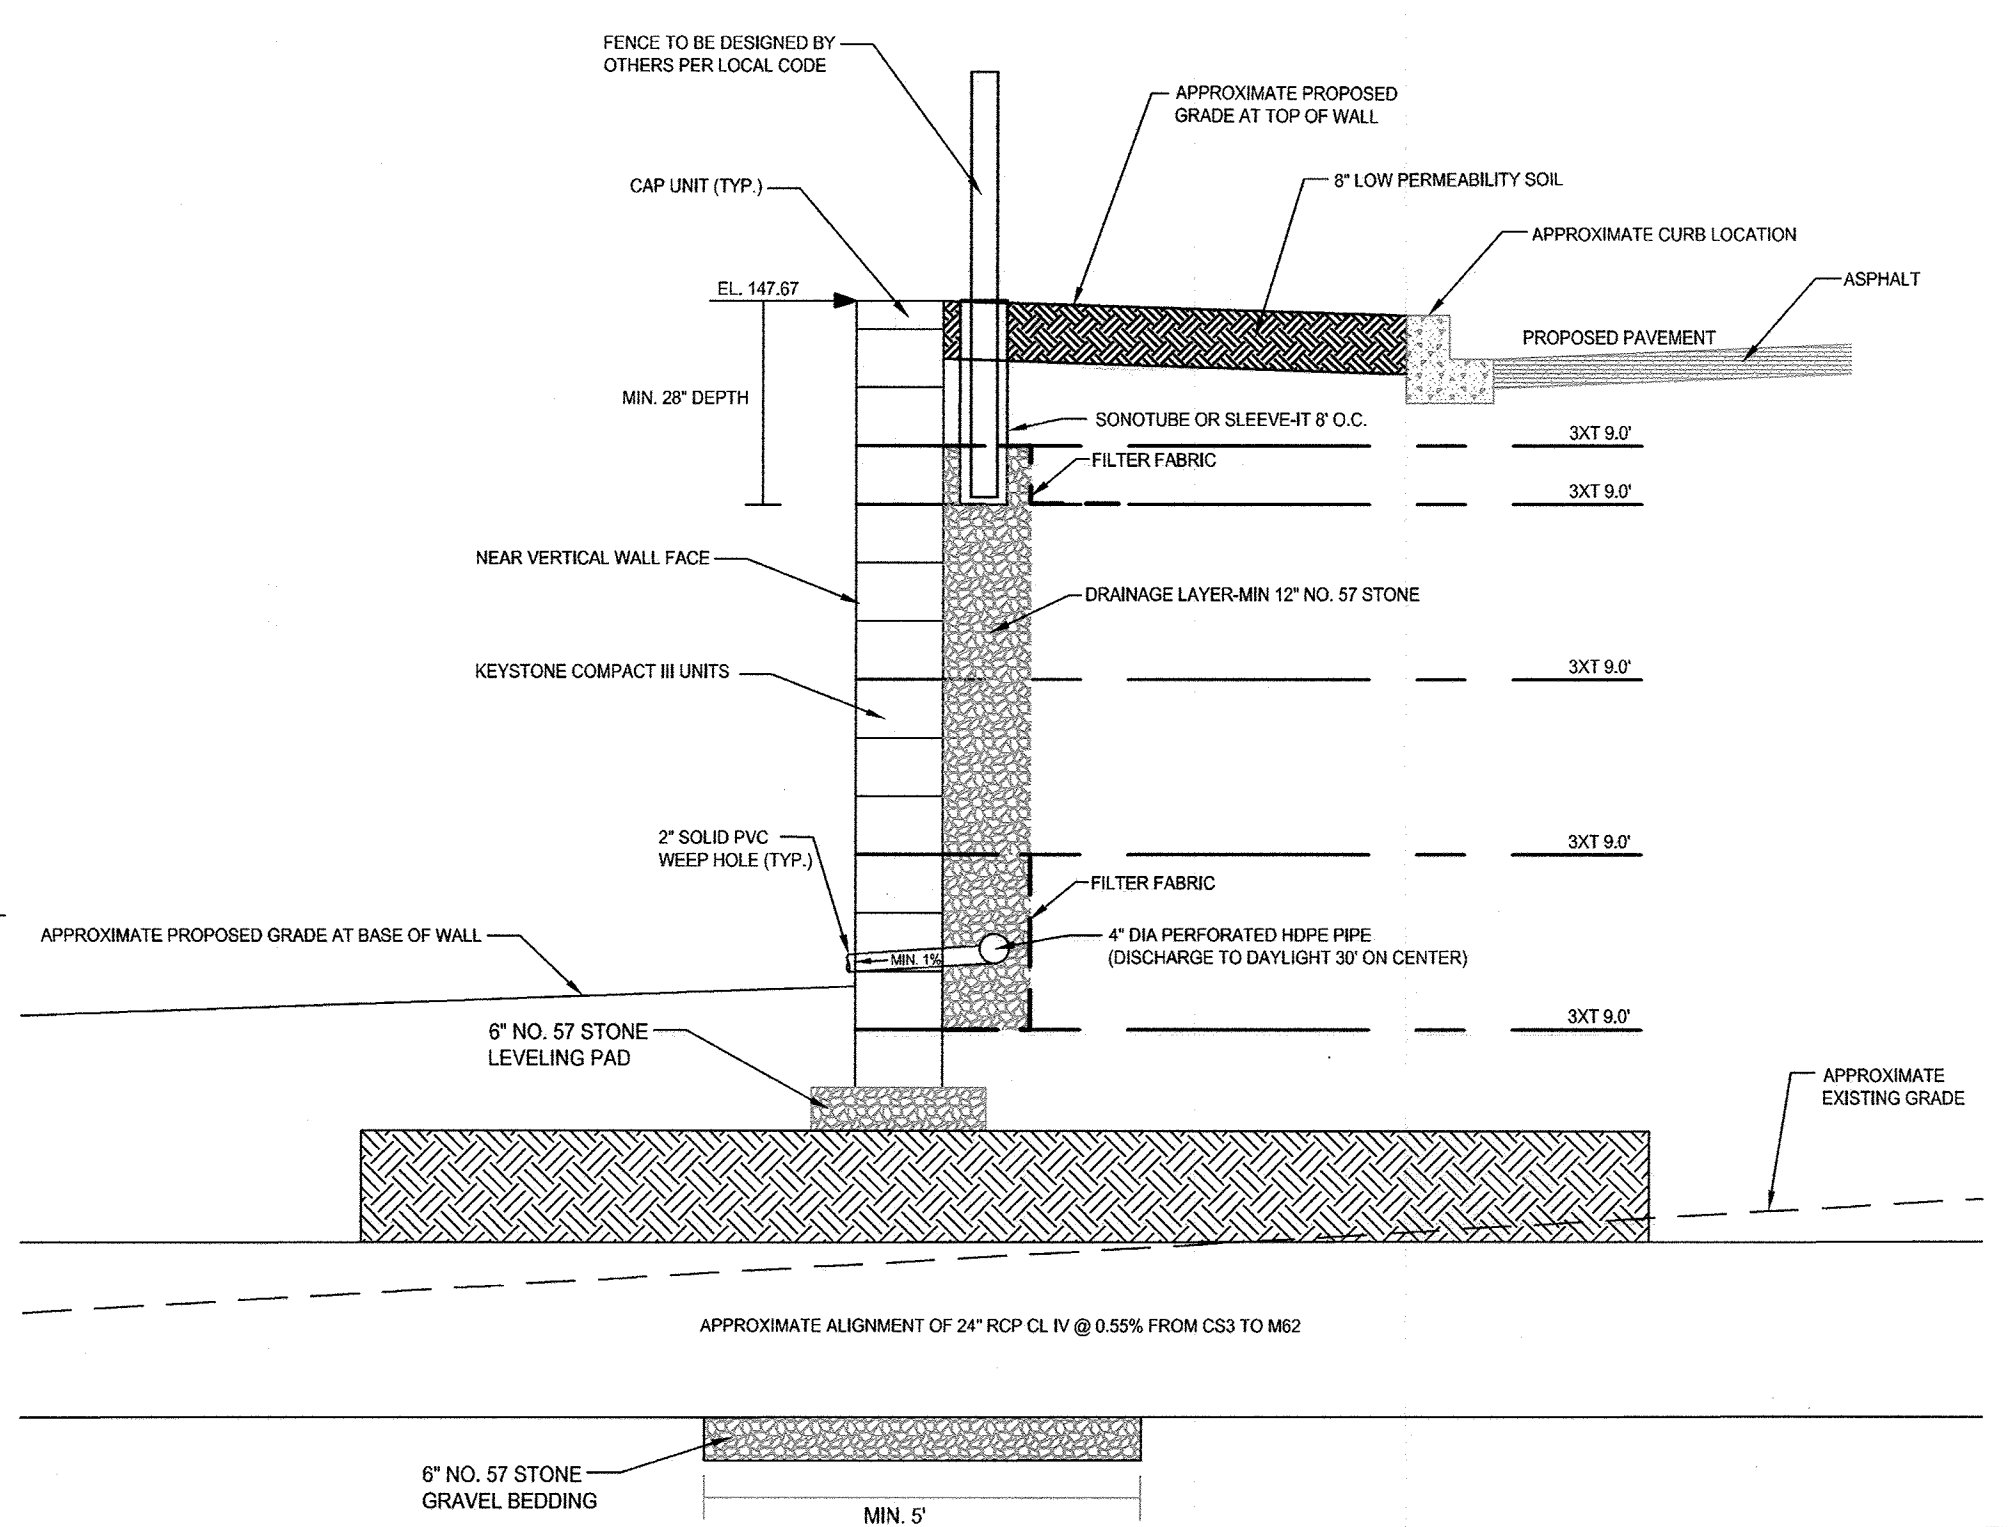

RETAINING WALL #2 CROSS SECTION VIEW @ STA. 4+37
SCALE: NOT TO SCALE

LEGEND
STRUCTURAL BACKFILL PLACED IN ACCORDANCE WITH PART 3, ITEM F OF THE "NOTES AND DETAILS" PAGE

AS-BUILT CERTIFICATION
NOTE: THERE IS NO "AS-BUILT" INFORMATION PROVIDED ON THIS SHEET.
Shawn L. Cruz 36896
PRINTED NAME M.D. FILE NO.
7/2/19 DATE
SIGNATURE

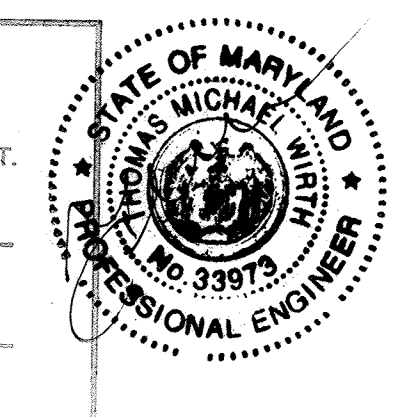

APPROVED : DEPARTMENT OF PLANNING AND ZONING			
<i>Shawn L. Cruz</i>			9-13-17
CHIEF, DEVELOPMENT ENGINEERING DIVISION			DATE
<i>Kevin S. Deane</i>			9-27-17
CHIEF, DIVISION OF LAND DEVELOPMENT			DATE
<i>Walter J. Jolly</i>			10-2-17
DIRECTOR			DATE
8/23/17	2	REVISED TITLE BLOCK	TMW
8/15/17	1	REVISED WALL #2	TMW
DATE	NO.	REVISION	BY

DEVELOPER
DCT INDUSTRIAL
12011 GUILFORD ROAD
SUITE 102
ANNAPOLIS JUNCTION, MD 20701
ATTN: FRED FERRARO
PHONE: 410-645-5020

OWNER
DCT MEARS LLC
12011 GUILFORD ROAD
SUITE 102
ANNAPOLIS JUNCTION, MD 20701
ATTN: FRED FERRARO
PHONE: 410-645-5020

PROJECT
TERRAPIN COMMERCE CENTER

AREA
TAX MAP 43, PARCEL 51 LOT PAR A PLAT 23793 ZONED M-2
GRID NO. 11 1st ELECTION DISTRICT
7200 DORSEY RUN ROAD
ELK RIDGE, MARYLAND 21075
HOWARD COUNTY, MARYLAND

TITLE
RETAINING WALL #2 CROSS SECTION VIEWS AND DETAILS

GEO-TECHNOLOGY ASSOCIATES, INC.
GEOTECHNICAL AND ENVIRONMENTAL CONSULTANTS
3445-A BOX HILL CORPORATE CENTER DRIVE
ABINGDON, MARYLAND 21009
410-515-9446
FAX: 410-515-4895
WWW.GTAENG.COM
© 2017 GEO-TECHNOLOGY ASSOCIATES, INC.

DESIGNED BY : PJS
DRAWN BY : AGS/JSN
PROJECT NO : DCT11601
DATE : JUNE 23, 2017
SCALE : AS SHOWN
DRAWING NO. 41 OF 43



PROPERTY OF
ANGLO AMERICAN PROP
HOLDINGS, INC.
L. 2508, F.10
PARCEL 116
BALTIMORE WASHINGTON
AUTO EXCHANGE
PLAT Nos. 10212-10216

PROPERTY OF
AA PROPERTY HOLDINGS, INC.
L. 4403, F.307
PARCEL 50
PLAT OF FOREST CONSERVATION
EASEMENT
AA PROPERTY HOLDINGS, INC.
PLAT No. 13928

PRIVATE ROAD

N 548300
E 1289300

N 548300
E 1302600

**BULK
PARCEL A**
13.48 AC
126,000 SF BUILDING (INTERNAL WATER METER)

PROPOSED SIAMESE
CONNECTION

DORSEY RUN ROAD
80' RIGHT OF WAY
PLAT No. 10212-10216 & 1416B-14171
L 4838711, E 238287

PROPOSED 4" PVC CONDUIT
FOR STREET LIGHT
WIRING, 36" DEEP WITH
PULL STRING. CONTACT HOWARD
COUNTY TRAFFIC DIVISION (410)
313-2430 BEFORE EXCAVATION OF
DRIVEWAY BEGINS TO COORDINATE
WITH THE COUNTY AND BGE
REGARDING STREET LIGHT CABLE

PROP. HOWARD COUNTY
STREET LIGHT

RELOCATE EX LIGHT POLE TO
PROPOSED LOCATION, SEE
GENERAL NOTE ON SHEET 4

**BULK
PARCEL B**
9.59 AC

PROPOSED 4" PVC CONDUIT
FOR STREET LIGHT
WIRING, 36" DEEP WITH
PULL STRING. CONTACT HOWARD
COUNTY TRAFFIC DIVISION (410)
313-2430 BEFORE EXCAVATION OF
DRIVEWAY BEGINS TO COORDINATE
WITH THE COUNTY AND BGE
REGARDING STREET LIGHT CABLE

RELOCATE EX LIGHT POLE TO
PROPOSED LOCATION, SEE
GENERAL NOTE ON SHEET 4

LEGEND	
PROPERTY LINE AND RIGHT-OF-WAY	---
PROPOSED POLE (ON-SITE) MOUNTED LIGHT	☆
PROPOSED BUILDING MOUNTED LIGHT	
PROPOSED HOWARD COUNTY STREET LIGHT	⊙
PROPOSED SHADE TREE	○
PROPOSED EVERGREEN TREE	⊗
PROPOSED SHRUBS	⊕

AS-BUILT CERTIFICATION

NOTE: THERE IS NO "AS-BUILT" INFORMATION PROVIDED ON THIS SHEET.

Sharon L. Cruz 3/6/2019
PRINTED NAME MD. P.E. NO.
SIGNATURE DATE

APPROVED: DEPARTMENT OF PLANNING AND ZONING

Chief, Development Engineering Division 9-21-17
DATE
Chief, Division of Land Development 9-22-17
DATE
Director 10-8-17
DATE

DATE	NO.	REVISION	BY

DEVELOPER DCT INDUSTRIAL
12011 GUILFORD ROAD
SUITE 102
ANNAPOLIS JUNCTION, MD 20701
ATTN: FRED FERRARO
PHONE: 410-645-5020

OWNER DCT MEARS LLC
12011 GUILFORD ROAD
SUITE 102
ANNAPOLIS JUNCTION, MD 20701
ATTN: FRED FERRARO
PHONE: 410-645-5020

PROJECT **TERRAPIN COMMERCE CENTER**

AREA TAX MAP 43, PARCEL 51 LOT PAR A PLAT 23793 ZONED M-2
GRID NO. 11 1st ELECTION DISTRICT
7200 DORSEY RUN ROAD
ELKRIDGE, MARYLAND 21075
HOWARD COUNTY, MARYLAND

TITLE LIGHTING PLAN

Pennoni Associates Inc.
Engineers • Surveyors • Planners
Landscape Architects

8818 Centre Park Drive, Suite 200 Columbia, MD 21045
T 410.997.8900 F 410.997.9282

8-23-17

DESIGNED BY: PJS
DRAWN BY: AGS/JSN
PROJECT NO: DCT11601
DATE: JUNE 23, 2017
SCALE: 1" = 40'
DRAWING NO. 42 OF 43

