

| SHEET INDEX | |
|-------------|--|
| NO. | DESCRIPTION |
| 1 | SITE DEVELOPMENT AND GRADING PLAN |
| 2 | SEDIMENT & EROSION CONTROL PLAN |
| 3 | SEDIMENT & EROSION CONTROL NOTES AND DETAILS |
| 4 | STORMWATER MANAGEMENT PLAN AND DETAILS |

| SITE PRACTICES CHART | | | |
|----------------------|------------------------|-----------|-------------------|
| LOT | ADDRESS | MBR (M-6) | RAIN BARREL (M-1) |
| 540 | 6338-A BEECHFIELD AVE. | 1" | 1 |
| 541 | 6338-B BEECHFIELD AVE. | 1" | 1 |

* MBR-1 on lots 540 and 541 is shared

SITE DEVELOPMENT PLAN HARWOOD PARK

LOTS 540-541, PLAT BOOK 60 PAGE 115

1st ELECTION DISTRICT HOWARD COUNTY, MARYLAND

AS-BUILT CERTIFICATION
I hereby certify, to the best of my knowledge and belief the facilities shown on this "AS-BUILT" Plan meet the Approved Plans and Specifications


Donald Mason, P.E.

Date: 4-14-23

Professional Certification. I hereby certify that these documents were prepared or approved by me, and that I am a duly licensed professional engineer under the laws of the State of Maryland.

License No. 21443, Expiration Date: 12-31-24

| BENCH MARKS | |
|--|-----------------|
| HO. CO. #3805 (NAD '83) | ELEV. 193.71 |
| STAMPED DISC ON CONCRETE MONUMENT BEING 38.8 SOUTH EAST OF A FIRE HYDRANT, 5.6' NORTH OF THE EXISTING CONCRETE CURB ALONG NORTH SIDE OF WASHINGTON BLVD (RT.1) | |
| N 558,378.581 | E 1,386,524.195 |
| HO. CO. #3806 (NAD '83) | ELEV. 175.23 |
| STAMPED DISC ON CONCRETE MONUMENT BEING 44' SOUTHWEST OF A LIGHT POLE & 148' NORTH OF THE GATE AT ATLANTIC SUPPLY CO. | |
| N 557,155.459 | E 1,384,992.262 |

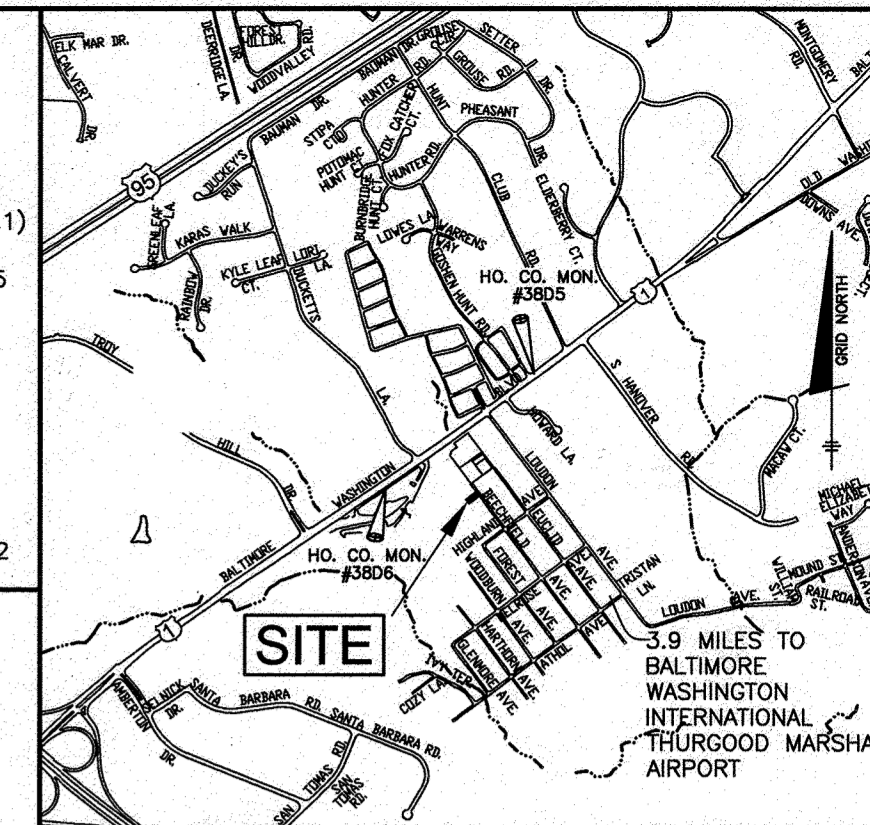

GENERAL NOTES

- SUBJECT PROPERTY IS ZONED R-12 PER THE 10-6-2013 COMPREHENSIVE ZONING PLAN.
- THIS PROJECT IS SUBJECT TO THE AMENDED FIFTH EDITION OF THE SUBDIVISION AND LAND DEVELOPMENT REGULATIONS, DATED OCTOBER 7, 2007.
- PROJECT LIMITS ARE BASED ON A BOUNDARY SURVEY PERFORMED BY BENCHMARK ENGINEERING, INC., ON OR ABOUT APRIL 2015.
- TOPOGRAPHY SHOWN HEREON IS BASED ON A FIELD RUN SURVEY PREPARED BY BENCHMARK ENGINEERING, INC., DATED APRIL 2015, CONTOUR INTERVAL IS 2'.
- THE COORDINATES SHOWN HEREON ARE BASED UPON THE HOWARD COUNTY GEODETIC CONTROL WHICH IS BASED UPON THE MARYLAND STATE PLANE COORDINATE SYSTEM. HOWARD COUNTY MONUMENTS 3805 & 3806 WERE USED FOR THIS PROJECT.
- NO GRADING, REMOVAL OF VEGETATIVE COVER OR TREES, PAVING AND NEW STRUCTURES SHALL BE PERMITTED WITHIN THE LIMITS OF WETLANDS, STREAM(S), OR THEIR REQUIRED BUFFERS, FLOODPLAIN AND FOREST CONSERVATION EASEMENT AREAS.
- THERE ARE NO STEEP SLOPES (25% OR GREATER) IN EXCESS OF 20,000 SF ON THIS SITE.
- THERE IS NO NEED FOR A FLOOD STUDY FOR THIS PROJECT. THERE ARE NO FLOODPLAINS, STREAMS OR WETLANDS LOCATED ON-SITE.
- TO THE BEST OF OUR KNOWLEDGE THERE ARE NO CEMETERIES OR HISTORIC STRUCTURES LOCATED ON THIS SITE.
- A NOISE STUDY IS NOT REQUIRED FOR THIS PLAN.
- THIS SITE IS LOCATED WITHIN THE METROPOLITAN DISTRICT AND THE PLANNED SERVICE AREA. WATER AND SEWER WILL BE PUBLIC CONNECTIONS PROPOSED TO CONTRACT W-108-3-34740.
- THE SITE AREA IS LESS THAN 20,000 SF. THEREFORE, THE SITE SHALL BE EXEMPT FROM THE REQUIREMENTS OF SECTION 16.1200 OF THE HOWARD COUNTY CODE FOR FOREST CONSERVATION PER SECTION 16.1202(B)(1)(i) OF THE SUBDIVISION REGULATIONS FOR DEVELOPMENT ON LAND WHICH IS LESS THAN 40,000 SF IN SIZE.
- PREVIOUS DPZ FILES: P.B. 60 PG. 115
- THIS SUBDIVISION WAS CREATED PRIOR TO THE EFFECTIVE DATE OF THE 1993 EDITION OF THE SUBDIVISION AND LAND DEVELOPMENT REGULATIONS AND THE ENACTMENT OF THE LANDSCAPE MANUAL AND IS THEREFORE EXEMPT FROM THE PERIMETER LANDSCAPE REQUIREMENT.
- DRIVEWAYS SHALL BE PROVIDED PRIOR TO RESIDENTIAL OCCUPANCY TO INSURE SAFE ACCESS FOR FIRE AND EMERGENCY VEHICLES PER THE FOLLOWING MINIMUM REQUIREMENTS:
A) WIDTH - 12' (16' SERVING MORE THAN ONE RESIDENCE).
B) SURFACE - 6" OF COMPACT CRUSHER RUN BASE WITH TAR AND CHIP COATING (1-1/2" MIN.).
C) GEOMETRY - MAXIMUM 15% GRADE, MAXIMUM 10% GRADE CHANGE AND MINIMUM 45' TURNING RADIUS.
D) STRUCTURES (CULVERTS/BRIDGES) - CAPABLE OF SUPPORTING 25 GROSS TONS (H25 LOADING).
E) DRAINAGE ELEMENTS - CAPABLE OF SAFELY PASSING 100 YEAR FLOODPLAIN WITH NO MORE THAN 1 FOOT DEPTH OVER DRIVEWAY.
F) STRUCTURE CLEARANCES - MINIMUM 12 FEET.
G) MAINTENANCE - SUFFICIENT TO INSURE ALL WEATHER USE.
- IN ACCORDANCE WITH SECTION 128 OF THE HOWARD COUNTY ZONING REGULATIONS, BAY WINDOWS, CHIMNEYS, OR EXTERIOR STAIRWAYS NOT MORE THAN 16 FEET IN WIDTH MAY PROJECT NOT MORE THAN 4 FEET INTO ANY SETBACKS, PORCHES OR DECKS, OPEN OR ENCLOSED, MAY PROJECT NOT MORE THAN 10 FEET INTO THE FRONT OR REAR YARD SETBACK.
- A PRE-SUBMISSION COMMUNITY MEETING FOR THIS PROJECT IS NOT REQUIRED.
- THE CONTRACTOR SHALL NOTIFY THE DEPARTMENT OF PUBLIC WORKS/BUREAU OF ENGINEERING/CONSTRUCTION INSPECTION DIVISION AT (410) 313-1880 AT LEAST FIVE (5) WORKING DAYS PRIOR TO THE START OF WORK.
- THE CONTRACTOR SHALL NOTIFY "MISS UTILITY" AT 1-800-257-7777 AT LEAST 48 HOURS PRIOR TO ANY EXCAVATION WORK BEING DONE.
- EXISTING UTILITIES SHOWN ARE BASED ON A FIELD SURVEY, HOWARD COUNTY GIS, AND INFORMATION OF RECORD.
- ANY DAMAGE TO THE COUNTY'S RIGHT-OF-WAY SHALL BE CORRECTED AT THE BUILDER'S EXPENSE. CONTRACTOR SHALL ADJUST ELEVATIONS OF STRUCTURES AS NECESSARY.
- SHC SHALL BE THE RESPONSIBILITY OF THE OWNER.
- STORMWATER MANAGEMENT METHODS WERE DESIGNED BASED ON THE 2000 MARYLAND STORMWATER DESIGN MANUAL, VOLUMES I AND II. TREATMENT IS PROVIDED USING ENVIRONMENTAL SITE DESIGN METHODS, INCLUDING MICRO-BIORETENTION PRACTICE (M-6) AND RAIN BARRELS (M-1). THE FACILITIES SHALL BE OWNED AND MAINTAINED BY THE LOT OWNER.
- BRL INDICATES ZONING RESTRICTION LINE, OTHER RESTRICTIONS MAY APPLY.
- ALL CONSTRUCTION SHALL BE IN ACCORDANCE WITH THE LATEST STANDARDS AND SPECIFICATIONS OF HOWARD COUNTY.
- THE STAKING OF FOUNDATIONS PRIOR TO CONSTRUCTION TO ENSURE COMPLIANCE WITH REGULATORY BUILDING RESTRICTION LINES IS RECOMMENDED.
- THE SUBJECT PROPERTY IS LOCATED WITHIN THE BWI AIRPORT ZONING DISTRICT. AIRPORT ZONING PERMITS No. 18-130 (LOTS 540 AND 541) WERE ISSUED ON JUNE 16, 2018.
- THIS PROJECT SHALL COMPLY WITH THE MARYLAND AVIATION ADMINISTRATION'S VEGETATIVE ESTABLISHMENT DETAILS AND SPECIFICATIONS FOR PROJECTS WITHIN 4 MILES OF THE BALTIMORE WASHINGTON INTERNATIONAL AIRPORT, DATED JULY 1, 2004.
- THE SINGLE CAR GARAGE FOR EACH DWELLING UNIT SHALL BE USED FOR PARKING PURPOSES ONLY AND SHALL NOT BE CONNECTED INTO LIVING SPACE OR STORAGE SPACE. THE REQUIRED 2.5 PARKING SPACES HAS BEEN SATISFIED BY PROVIDING ONE (1) CAR GARAGE PARKING SPACE AND TWO (2) DRIVEWAY PARKING SPACES FOR EACH SINGLE FAMILY ATTACHED UNIT.
- SEWER HOUSE CONNECTION DESIGN MANUAL WAIVER HAS BEEN APPROVED BY A LETTER DATED JULY 3, 2018 FOR LOT 541 DUE TO THE LACK OF SERVICE BY GRAVITY FOR THE CELLAR.
- TEMPORARY OR PERMANENT SEEDING AND STABILIZATION IS TO BE PERFORMED AT THE DIRECTION OF THE SEDIMENT CONTROL INSPECTOR OR AT THE TIME FRAME PROVIDED WITHIN THE 2011 MD STANDARDS & SPECIFICATIONS FOR SOIL EROSION AND SEDIMENT CONTROL, WHICHEVER IS MORE STRINGENT.

LEGEND

| | |
|-------------------------|------|
| LIMIT OF SUBMISSION | --- |
| ADJACENT PROPERTIES | --- |
| LOT BOUNDARIES | --- |
| EXISTING CONTOURS | -10- |
| PROPOSED CONTOURS | -10- |
| EXISTING STRUCTURES | --- |
| PROPOSED STRUCTURE | --- |
| PROPOSED RETAINING WALL | --- |
| PAVEMENT OVERLAY | --- |

SITE ANALYSIS DATA CHART

- | | |
|--|---|
| A) TOTAL PROJECT AREA | 0.14 AC. |
| B) AREA OF THIS PLAN SUBMISSION | 0.14 AC. |
| C) APPROXIMATE LIMIT OF DISTURBANCE | 0.14 AC. |
| D) PRESENT ZONING: | R-12 |
| E) PROPOSED USE OF SITE: | RESIDENTIAL SINGLE FAMILY SEMI-DETACHED |
| F) TOTAL NUMBER OF UNITS ALLOWED AS SHOWN ON FINAL PLAT(S) | 2 |
| G) TOTAL NUMBER OF UNITS PROPOSED | 2 |
| H) REQUIRE PARKING PER UNIT: | 2.5 SPACES |
| I) PROVIDED PARKING PER UNIT: | 3 (1 GARAGE AND 2 DRIVEWAY) |
| J) APPLICABLE DPZ FILE REFERENCES: | P.B. 60, PG. 115 |
| K) PROPOSED WATER AND SEWER SYSTEMS: | <input checked="" type="checkbox"/> PUBLIC <input type="checkbox"/> PRIVATE |

| ADDRESS CHART | |
|---------------|------------------------|
| LOT No. | ADDRESS |
| 540 | 6338-A BEECHFIELD AVE. |
| 541 | 6338-B BEECHFIELD AVE. |

| SHC CHART | | | | | |
|------------|---------------|----------------------|--------|-----|------------|
| Lot Number | Invert @ main | Invert @ R/W or esmt | MCE | DHC | Notes |
| 540 | 154.98 | 155.20 | 159.50 | No | SHC @ 2.0% |
| 541 | 157.62 | 157.85 | 162.15 | No | SHC @ 2.0% |

| SOILS LEGEND | | | |
|----------------------|---|-----------|--|
| MAP SYMBOL/SOIL TYPE | MAPPING UNIT | Kw FACTOR | |
| UcB | D Urban land-Chillum-Beltville complex, 0 to 5 percent slopes | 0.37 | |


APPROVED: DEPARTMENT OF PLANNING AND ZONING

Kest Sladovick 10-12-18
CHIEF, DIVISION OF LAND DEVELOPMENT

Chad Clark 10-9-18
CHIEF, DEVELOPMENT ENGINEERING DIVISION

William J. Allen 10-15-18
DIRECTOR

PLAN VIEW GRAPHIC SCALE

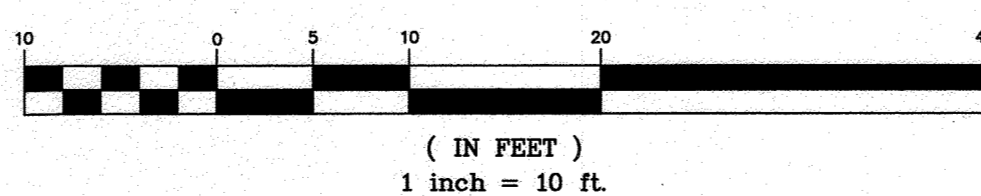

MODERATE INCOME HOUSING UNITS (MIHU) ALLOCATION EXEMPTIONS TRACKING

| | |
|---|----|
| Total Number of Lots/Units Proposed | 2 |
| Number of MIHU Required | 0 |
| Number of MIHU Provided Onsite (exempt from APFO allocations) | 0 |
| Number of APFO Allocations Required (remaining lots/units) | 0 |
| MIHU Fee-in-Lieu (indicate lot/unit numbers) | NA |

*Development consists of two lots previously recorded per plat 60/115

PERMIT INFORMATION CHART

| SUBDIVISION NAME: | | SECTION/AREA: | LOT | PARCEL # |
|--------------------------|-------------|---------------|--------------|--|
| HARWOOD PARK | | N/A | LOTS 540-541 | 873 |
| PLAT No. PB 60 FOLIO 115 | GRID No. 13 | ZONE R-12 | TAX MAP 38 | ELECTION DISTRICT 1ST CENSUS TRACT 6012.04 |


| REVISION | |
|----------|------|
| NO. | DATE |
| | |

BENCHMARK ENGINEERING, INC.
ENGINEERS & LAND SURVEYORS & PLANNERS
8480 BALTIMORE NATIONAL PIKE SUITE 315 & ELLICOTT CITY, MARYLAND 21043
(410) 465-4100 (F) 410-465-6644
WWW.BEI-CIVILENGINEERING.COM

OWNER/DEVELOPER: TSZ PROPERTIES 10382 BALTIMORE NATIONAL PIKE ELLICOTT CITY, MARYLAND 21042 410-465-4103 c/o STEPHANIE PORTA

HARWOOD PARK
LOTS 540-541
PLAT BOOK 60 FOLIO 115
SINGLE FAMILY SEMI-DETACHED DUPLEX UNITS
TAX MAP: 38 GRID: 13 PARCEL: 873
ZONED: R-12
BEECHFIELD AVENUE
ELECTION DISTRICT NO. 1, HOWARD COUNTY, MARYLAND
SITE DEVELOPMENT AND GRADING PLAN

DATE: JUNE, 2018 BEI PROJECT NO. 2565
SCALE: 1" = 10' SHEET 1 OF 4

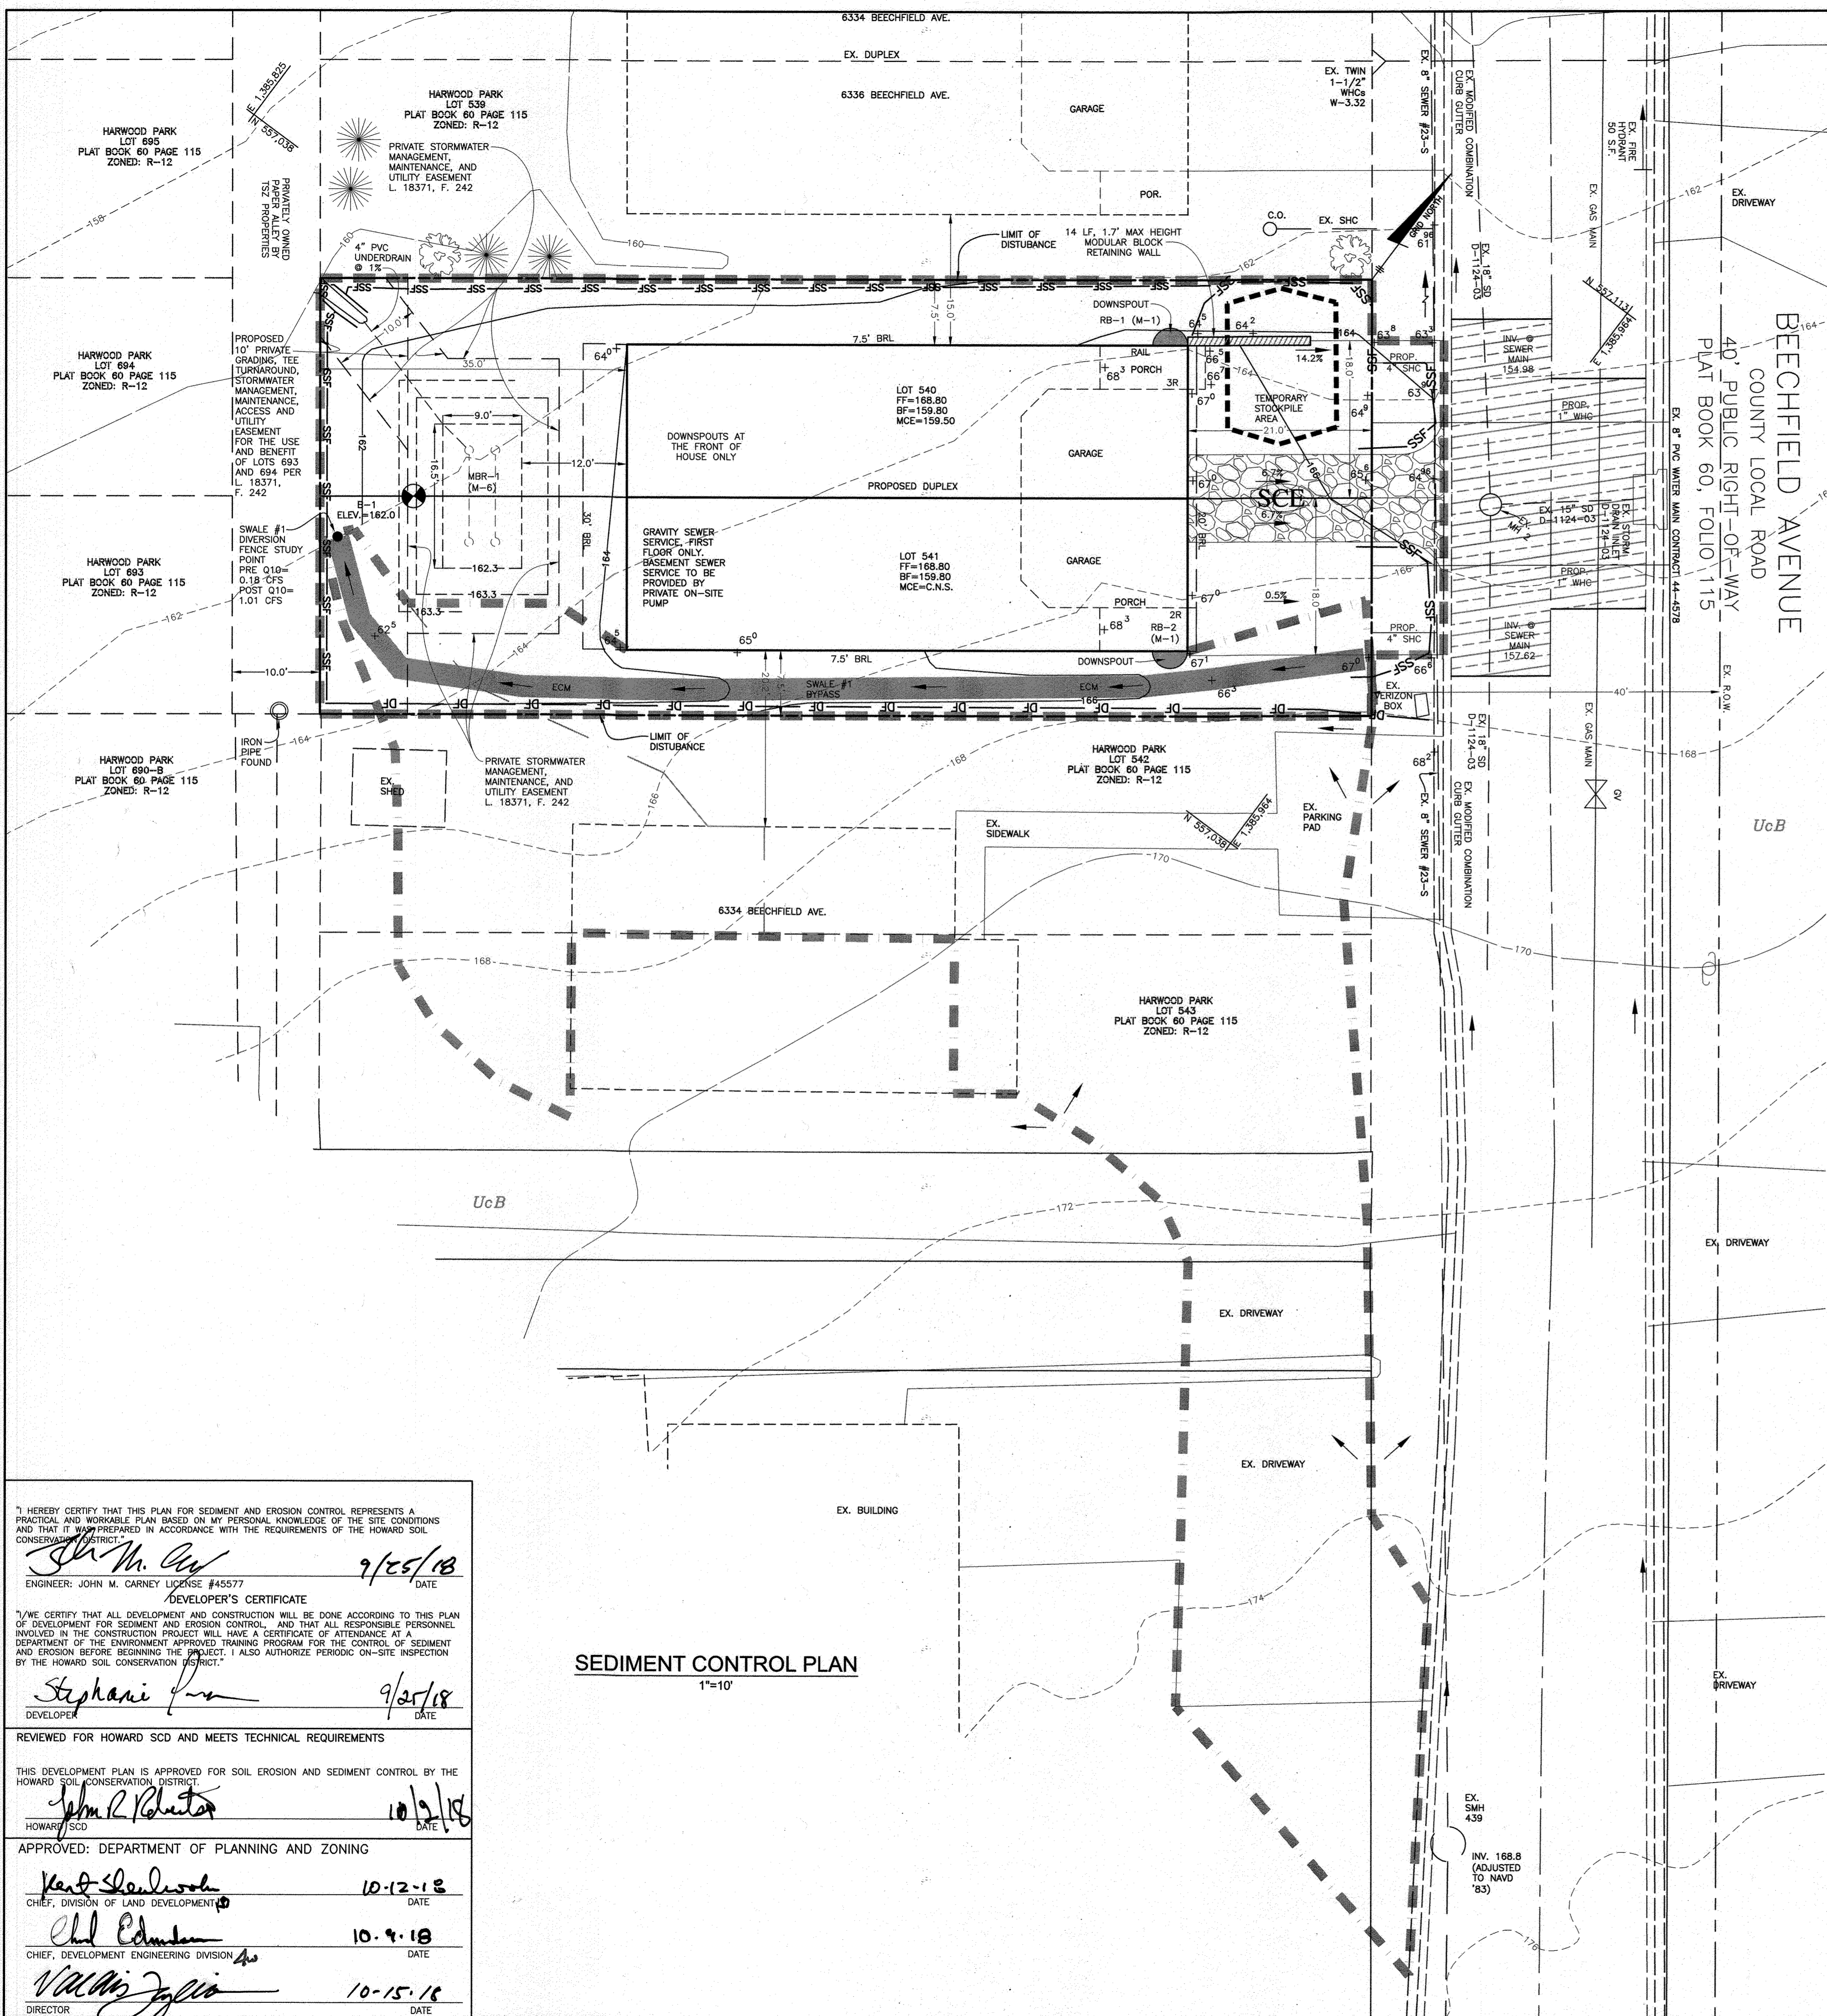

LEGEND

- LIMIT OF SUBMISSION
- ADJACENT PROPERTIES
- LOT BOUNDARIES
- EXISTING CONTOURS
- PROPOSED CONTOURS
- EXISTING STRUCTURES
- PROPOSED STRUCTURE
- PROPOSED RETAINING WALL
- LIMIT OF DISTURBANCE
- SILT FENCE
- SUPER-SILT FENCE
- DIVERSION FENCE
- SWALE DRAINAGE AREA
- ROOF DRAINAGE AREA
- PAVEMENT OVERLAY

Table B.3: Recommended Planting Dates for Permanent Cover in Maryland

| Type of Plant Material | Plant Hardiness Zones | | |
|--|--|--|--|
| | 5b and 6a | 6b | 7a and 7b |
| Seeds - Cool-Season Grasses (includes mixes with forbs and/or legumes) | Mar 15 to May 31 Aug 1 to Sep 30 | Mar 1 to May 15 Aug 1 to Oct 15 | Feb 15 to Apr 30 Aug 15 to Oct 31 Nov 1 to Nov 30 |
| Seeds - Warm-Season/Cool-Season Grass Mixes (includes mixes with forbs and/or legumes) | Mar 15 to May 31** Jun 1 to Jun 15* | Mar 1 to May 15** May 16 to Jun 15* | Feb 15 to Apr 30** May 1 to May 31* |
| Sod - Cool-Season | Mar 15 to May 31 Jun 1 to Aug 31* | Mar 1 to May 15 May 16 to Sep 14** Sep 1 to Nov 15** | Feb 15 to Apr 30 May 1 to Sep 30** Oct 1 to Dec 1** |
| Unrooted Woody Materials; Bare-Root Plants; Bulbs, Rhizomes, Corms, and Tubers | Mar 15 to May 31 Jun 1 to Jun 30* | Mar 1 to May 15 May 16 to Jun 30* | Feb 15 to Apr 30 May 1 to Jun 30* |
| Containerized Stock; Balled-and-Burlapped Stock | Mar 15 to May 31 Jun 1 to Jun 30* | Mar 1 to May 15 May 16 to Jun 30** Sep 1 to Nov 30** | Feb 15 to Apr 30 May 1 to Jun 30** Oct 1 to Dec 15** |

Table B.3 Notes:


- The planting dates listed are averages for each zone. These dates may require adjustment to reflect local conditions, especially near the boundaries of the zones. When seeding toward the end of the listed planting dates, or when conditions are expected to be less than optimal, select an appropriate nurse crop from Table 1 and plant with the permanent seeding mix. (See Table B.2, Note 1, for more information.)
- When planted during the growing season, most of these materials must be purchased and kept in a dormant condition until planting. Bare-root grasses are the exception—they may be supplied as growing (non-dormant) plants.
 - Additional planting dates for the lower Coastal Plain, dependent on annual rainfall and temperature trends. Recommend adding a nurse crop, as noted above, if planting during this period.
 - Warm-season grasses need a soil temperature of at least 50 degrees F in order to germinate. If soil temperatures are colder than 50 degrees, or moisture is not adequate, the seeds will remain dormant until conditions are favorable. In general, planting during the later portion of this period allows more time for weed emergence and weed control prior to planting. When selecting a planting date, consider the need for weed control vs. the likelihood of having sufficient moisture for later plantings, especially on drygully sites.
 - Additional planting dates during which supplemental watering may be needed to ensure plant establishment.
 - Frequent freezing and thawing of wet soils may result in frost-heaving of materials planted in late fall. If plants have not sufficiently rooted in place, soil usually needs 4 to 6 weeks to become sufficiently rooted. Large containerized and balled-and-burlapped stock may be planted into the winter months as long as the ground is not frozen and soil moisture is adequate.

Table B.1: Temporary Seeding for Site Stabilization

| Plant Species | Seeding Rate ^{1/} lb/acre | Seeding Depth (inches) | Recommended Seeding Dates by Plant Hardiness Zone ^{2/} | | |
|---|---------------------------------------|---------------------------|---|----------------------------------|------------------------------------|
| | | | 5b and 6a | 6b | 7a and 7b |
| Cool-Season Grasses | | | | | |
| Annual Ryegrass (<i>Lolium perenne</i> esp. <i>multiflorum</i>) | 40 | 1.0 | Mar 15 to May 31; Aug 1 to Sep 30 | Mar 1 to May 15; Aug 1 to Oct 15 | Feb 15 to Apr 30; Aug 15 to Nov 30 |
| Barley (<i>Hordeum vulgare</i>) | 96 | 2.2 | Mar 15 to May 31; Aug 1 to Sep 30 | Mar 1 to May 15; Aug 1 to Oct 15 | Feb 15 to Apr 30; Aug 15 to Nov 30 |
| Oats (<i>Avena sativa</i>) | 72 | 1.7 | Mar 15 to May 31; Aug 1 to Sep 30 | Mar 1 to May 15; Aug 1 to Oct 15 | Feb 15 to Apr 30; Aug 15 to Nov 30 |
| Wheat (<i>Triticum aestivum</i>) | 120 | 2.8 | Mar 15 to May 31; Aug 1 to Sep 30 | Mar 1 to May 15; Aug 1 to Oct 15 | Feb 15 to Apr 30; Aug 15 to Nov 30 |
| Cereal Rye (<i>Sorghum arvense</i>) | 112 | 2.8 | Mar 15 to May 31; Aug 1 to Oct 31 | Mar 1 to May 15; Aug 1 to Nov 15 | Feb 15 to Apr 30; Aug 15 to Dec 15 |
| Warm-Season Grasses | | | | | |
| Foxtail Millet (<i>Setaria italica</i>) | 30 | 0.7 | Jun 1 to Jul 31 | May 16 to Jul 31 | May 1 to Aug 14 |
| Pearl Millet (<i>Pennisetum glaucum</i>) | 20 | 0.5 | Jun 1 to Jul 31 | May 16 to Jul 31 | May 1 to Aug 14 |

NOTES:

- Seeding rates for the warm-season grasses are in pounds of Pure Live Seed (PLS). Annual planting rates shall be adjusted to reflect percent seed germination and purity, as noted. Adjustments are usually not needed for the cool-season grasses.
- Seeding rates listed above are for temporary seedings, when planted alone. When planted as a nurse crop with permanent seed mixes, use 1/3 of the seeding rate listed above for barley, oats, and wheat. For mulch-needed grasses (annual ryegrass, pearl millet, foxtail millet), do not exceed more than 75% by weight of the overall permanent seeding mix. Cereal rye generally should not be used as a nurse crop, unless planting will occur in very late fall beyond the seeding dates for other temporary seedings. Cereal rye has allelopathic properties that inhibit the germination and growth of other plants. It must be used as a nurse crop, seeds at 1/3 of the rate listed above.
- Oats are the recommended nurse crop for warm-season grasses.
- For sandy soils, plant seeds at twice the depth listed above.
- The planting dates listed are averages for each zone and may require adjustment to reflect local conditions, especially near the boundaries of the zone.

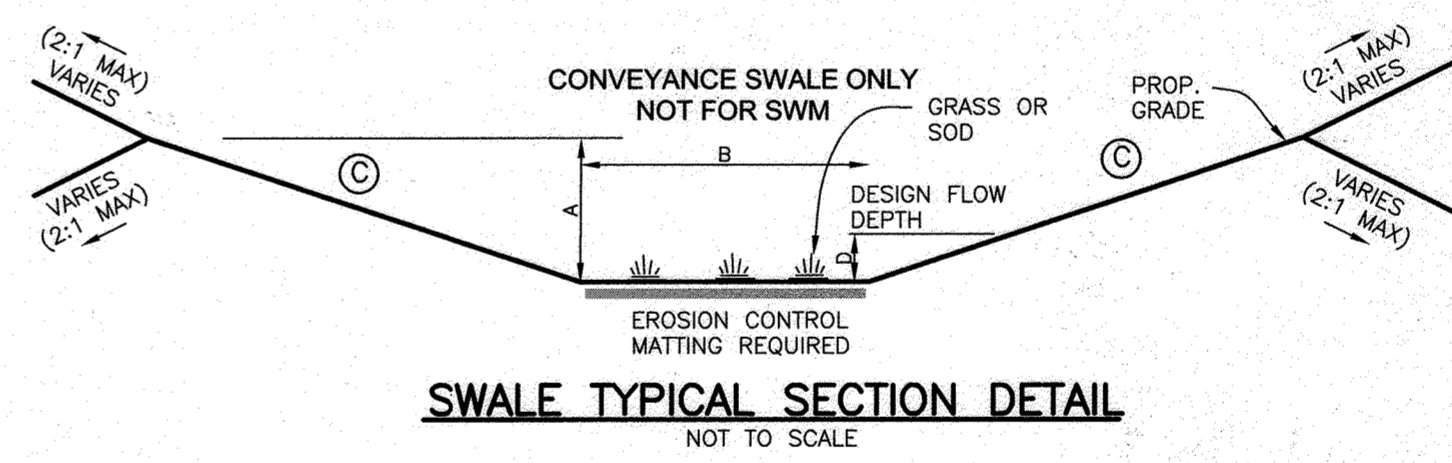

SWALE #1

| | |
|-------------|-------|
| A | 1.0' |
| B | 1.0' |
| C | 2.1' |
| D | 0.24' |
| SLOPE | 4.0% |
| BOTTOM DIMS | |
| LENGTH | 125' |
| WIDTH | 1.0' |


STORM Q (RUNOFF) VELOCITY
 2 YR 0.59 CFS 2.41 FPS
 10 YR 1.01 CFS 2.84 FPS

GRASS SWALE DESIGN TABLES

NOTE: ELEVATIONS LISTED IN CHART ARE ELEVATIONS AT BOTTOM OF THE SWALES. THESE SWALES DO NOT PROVIDE STORMWATER MANAGEMENT.

SWALE #1

| | |
|------|-----------|
| AREA | 0.163 AC |
| I2 | 4.5 IN/HR |
| I10 | 6.6 IN/HR |
| Q2 | 0.59 CFS |
| Q10 | 1.01 CFS |

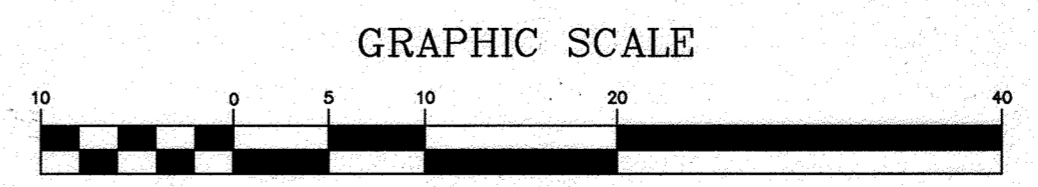


SOILS LEGEND

| MAP SYMBOL | SOIL TYPE | MAPPING UNIT | Kw FACTOR |
|------------|-----------|--|-----------|
| UcB | D | Urban land—Chillum—Beltsville complex, 0 to 5 percent slopes | 0.37 |

USDA - NRCS WEBSITE - SOIL SURVEY MAP NO. 25 - NO HYDRIC SOILS

"NO AS-BUILT INFORMATION IS PROVIDED ON THIS SHEET"

Professional Certification. I hereby certify that these documents were prepared or approved by me, and that I am a duly licensed professional engineer under the laws of the State of Maryland.
 License No. 21443, Expiration Date: 12-21-24

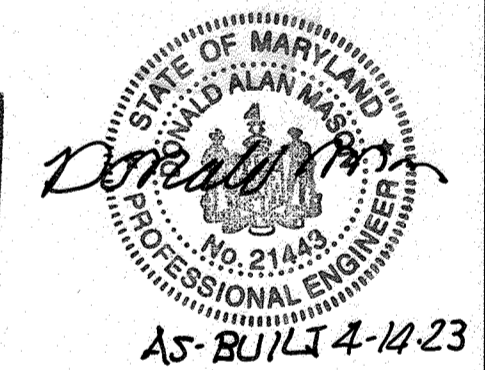

I HEREBY CERTIFY THAT THIS PLAN FOR SEDIMENT AND EROSION CONTROL REPRESENTS A PRACTICAL AND WORKABLE PLAN BASED ON MY PERSONAL KNOWLEDGE OF THE SITE CONDITIONS AND THAT IT WAS PREPARED IN ACCORDANCE WITH THE REQUIREMENTS OF THE HOWARD SOIL CONSERVATION DISTRICT.

John M. Carney
 ENGINEER: JOHN M. CARNEY LICENSE #45577
 DEVELOPER'S CERTIFICATE
 DATE: 9/25/18

Stephanie Porta
 DEVELOPER
 DATE: 9/25/18

REVIEWED FOR HOWARD SCD AND MEETS TECHNICAL REQUIREMENTS

John R. Roberts
 HOWARD SCD
 DATE: 10/2/18

APPROVED: DEPARTMENT OF PLANNING AND ZONING

Keith Shankwood
 CHIEF, DIVISION OF LAND DEVELOPMENT
 DATE: 10-12-18

Chad Edmister
 CHIEF, DEVELOPMENT ENGINEERING DIVISION
 DATE: 10-9-18

Valerie Zappia
 DIRECTOR
 DATE: 10-15-18

SEDIMENT CONTROL PLAN
 1"=10'

NO. DATE REVISION

Professional Certification. I hereby certify that these documents were prepared or approved by me, and that I am a duly licensed professional engineer under the laws of the State of Maryland. License #5577, Expiration Date: 06-08-2020.

BENCHMARK ENGINEERS & LAND SURVEYORS & PLANNERS ENGINEERING, INC.
 8480 BALTIMORE NATIONAL PIKE & SUITE 315 & ELLICOTT CITY, MARYLAND 21043
 (7) 410-465-4100 (F) 410-465-4044
 WWW.BEI-CIVILENGINEERING.COM

OWNER/DEVELOPER: TSZ PROPERTIES
 10382 BALTIMORE NATIONAL PIKE ELLICOTT CITY, MARYLAND 21042
 410-465-4103
 c/o STEPHANIE PORTA

HARWOOD PARK
 LOTS 540-541
 PLAT BOOK 60 FOLIO 115
 SINGLE FAMILY SEMI-DETACHED DUPLEX UNITS
 TAX MAP: 38 GRID: 13 PARCEL: 873
 ZONED: R-12
 ELECTION DISTRICT NO. 1, HOWARD COUNTY, MARYLAND

SEDIMENT & EROSION CONTROL PLAN


DATE: JUNE, 2018 BEI PROJECT NO. 2565
 SCALE: 1" = 10' SHEET 2 OF 4

LEGEND

- LIMIT OF SUBMISSION
- ADJACENT PROPERTIES
- LOT BOUNDARIES
- EXISTING CONTOURS
- PROPOSED CONTOURS
- EXISTING STRUCTURES
- PROPOSED STRUCTURE
- PROPOSED RETAINING WALL
- ROOF DRAINAGE AREA
- PAVEMENT OVERLAY

OPERATION AND MAINTENANCE SCHEDULE FOR PRIVATELY OWNED AND MAINTAINED (M-3) LANDSCAPE INFILTRATION (M-6) MICRO-BIORETENTION

- The Owner shall maintain the plant material, mulch layer and soil layer annually. Maintenance of mulch and soil is limited to correcting areas of erosion or wash out. Any mulch replacement shall be done in the spring. Plant material shall be checked for disease and insect infestation and maintenance will address dead material and pruning. Acceptable replacement plant material is limited to the following: 2000 Maryland Stormwater Design Manual Volume II, Table A.4.1 and 2.
- The Owner shall perform a plant inspection in the spring and in the fall of each year. During the inspection, the Owner shall remove dead and diseased vegetation considered beyond treatment, replace dead plant material with acceptable replacement plant material, treat diseased trees and shrubs, and replace all deficient stakes and wires.
- The Owner shall inspect the mulch each spring. The mulch shall be replaced every two to three years. The previous mulch layer shall be removed the new layer is applied.
- The Owner shall correct soil erosion on an as needed basis, with a minimum of once per month and after each heavy storm.

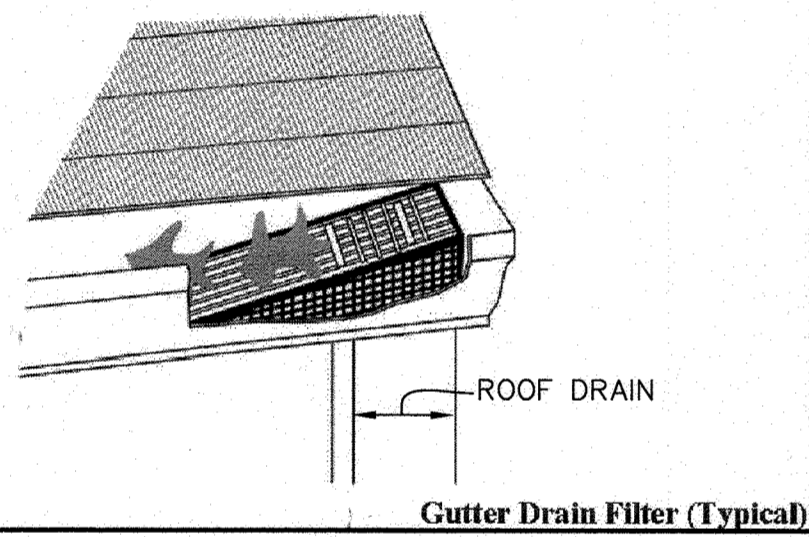

OR EQUIVALENT GUTTER GUARD

Appendix B.4. Construction Specifications for Environmental Site Design Practices

Table B.4.1 Materials Specifications for Micro-Bioretentation, Rain Gardens & Landscape Infiltration

| Material | Specification | Size | Notes |
|---|---|--|--|
| Plantings | see Appendix A, Table A.4 | n/a | plantings are site-specific |
| Planting soil [2' to 4' deep] | loamy sand (60 - 65%) & compost (35 - 40%) or sandy loam (30%), coarse sand (30%) & compost (40%) | n/a | USDA soil types loamy sand or sandy loam; clay content < 5% |
| Organic content | Min. 10% by dry weight (ASTM D 2974) | | |
| Mulch | shredded hardwood | | aged 6 months, minimum; no pine or wood chips |
| Pea gravel diaphragm | pea gravel: ASTM-D-448 | NO. 8 OR NO. 9 (1.8" TO 3/8") | |
| Curtain drain | ornamental stone: washed cobbles | stone: 2" to 5" | |
| Geotextile | | n/a | PE Type 1 nonwoven |
| Gravel (underdrains and infiltration berms) | AASHTO M-43 | NO. 57 OR NO. 6 AGGREGATE (3/8" to 3/4") | |
| Underdrain piping | F 758, Type PS 28 or AASHTO M-278 | 4" to 6" rigid schedule 40 PVC or SDR35 | Slotted or perforated pipe; 3/8" perf. @ 6" on center, 4 holes per row; minimum of 3" of gravel over pipes; not necessary underneath pipes. Perforated pipe shall be wrapped with 1/4-inch galvanized hardware cloth |
| Poured in place concrete (if required) | MSHA Mix No. 3; $F_c = 3500$ psi @ 28 days, normal weight, air-entrained; reinforcing to meet ASTM-615-60 | n/a | on-site testing of poured-in-place concrete required: 28 day strength and slump test; all concrete design (cast-in-place or pre-cast) not using previously approved State or local standards requires design drawings sealed and approved by a professional structural engineer licensed in the State of Maryland - design to include meeting ACI Code 350.R/89; vertical loading [H-10 or H-20]; allowable horizontal loading (based on soil pressures); and analysis of potential cracking |
| Sand | AASHTO-M-6 or ASTM-C-33 | 0.02" to 0.04" | Sand substitutions such as Diabase and Graystone (AASHTO) #10 are not acceptable. No calcium carbonated or dolomitic sand substitutions are acceptable. No "rock dust" can be used for sand. |

APPROVED: DEPARTMENT OF PLANNING AND ZONING

Keith S. ... 10-12-18
 CHIEF, DIVISION OF LAND DEVELOPMENT
Paul ... 10-9-18
 CHIEF, DEVELOPMENT ENGINEERING DIVISION
William ... 10-15-18
 DIRECTOR

ESD STORMWATER MANAGEMENT SUMMARY TABLE

| Practice | # | DA to practice | Imp Area to practice | Q _{0.98} = 0.98 inches | | ESD _{0.98} = 490 cfs | | R _{0.54} = 0.54 | | REV | Ownership |
|----------------------|----------|----------------|----------------------|---------------------------------|----------|-------------------------------|------------|--------------------------|-------------|-----------|-----------|
| | | | | Required | Provided | 2% DA? | Required | Provided | Pe Provided | | |
| MBR-1 | (M-6) #1 | 2,711 | 2,240 | | | 323 | 326 | | | 83 | Private |
| RB-1 | (M-1) #1 | 1,120 | 1,120 | | | 160 | 7 | | | | Private |
| RB-2 | (M-1) #2 | 1,120 | 1,120 | | | 160 | 7 | | | | Private |
| Total Treated | | 2,711 | 2,240 | | | 323 | 340 | 1.2 | 16 | 83 | |
| Site Total | | 5,993 | 3,293 | | | | | | | | |

OR EQUIVALENT GUTTER GUARD


STORMWATER MANAGEMENT PLAN VIEW

GRAPHIC SCALE



Rain Barrel (M-1) Dimension Chart

| Drywell Designation | Volume Provided (gal) | Volume Provided (CF) | Grade |
|---------------------|-----------------------|----------------------|-------|
| RB-1 | 50.00 | 6.68 | 164.5 |
| RB-2 | 50.00 | 6.68 | 167.1 |

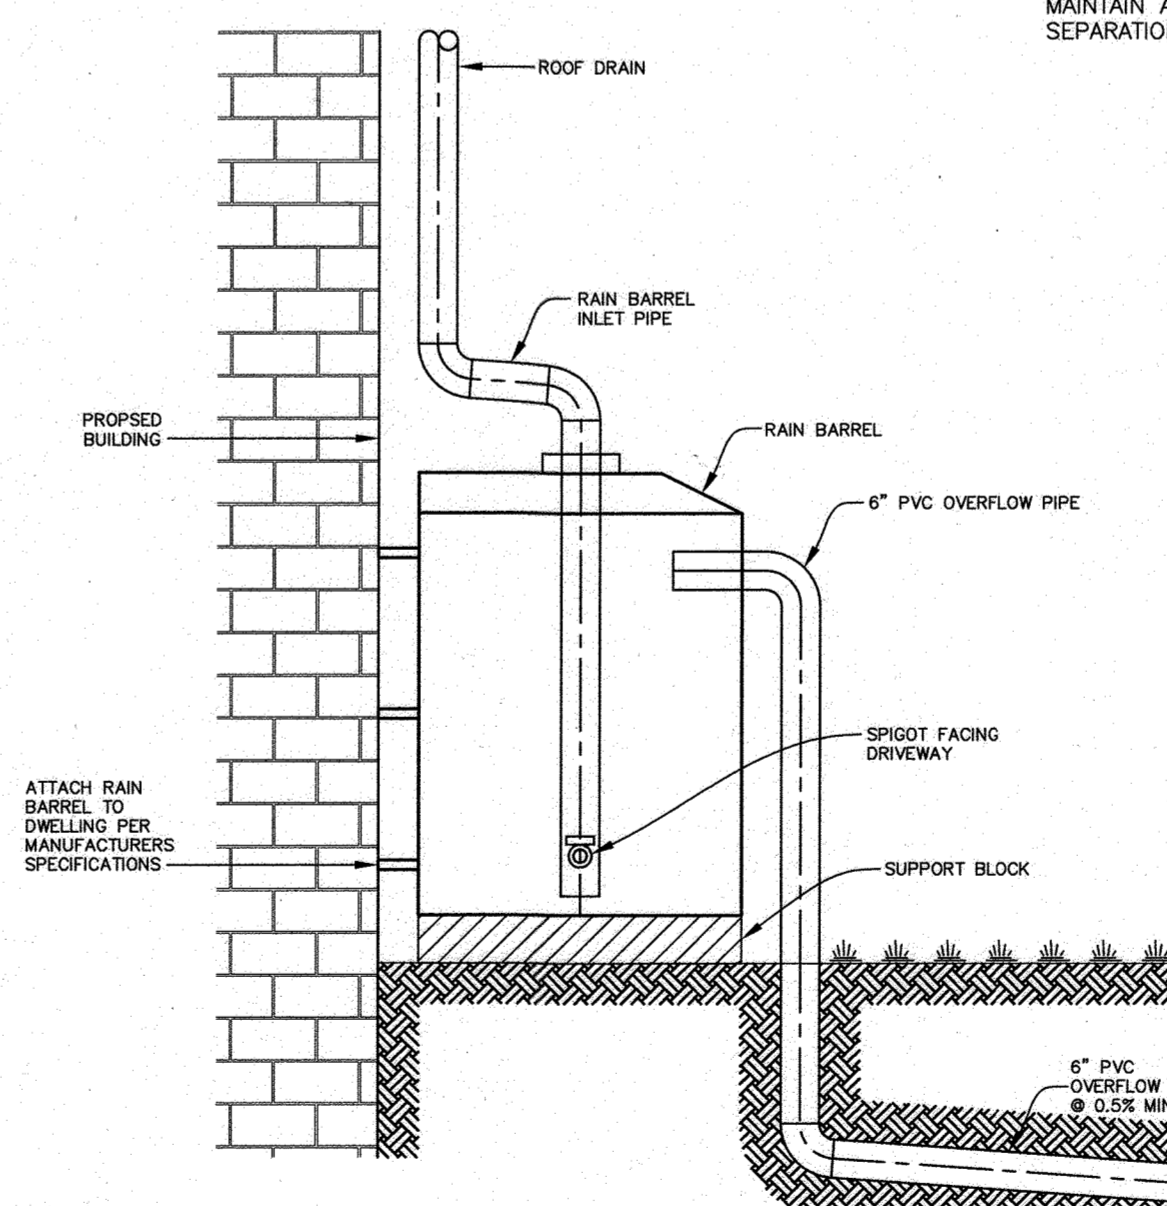

OPERATION & MAINTENANCE SCHEDULE FOR PRIVATELY OWNED & MAINTAINED RAINWATER HARVESTING (M-1)

- The Owner shall empty barrels on a monthly basis and clean barrel with a hose.
- The Owner shall verify integrity of leaf screens, gutters, downspouts, spigots, and mosquito screens, and clean and remove any debris.
- The Owner shall replace damaged components as needed.
- The Owner shall disconnect the barrel prior to winter, or allow the barrel to drain by bottom spigot during the winter season.


AS-BUILT CERTIFICATION

I hereby certify, by my seal, that to the best of my knowledge and belief the facilities shown on this "AS-BUILT" Plan meet the Approved Plans and Specifications

Donald Mason, P.E.

Date: 4-14-23

Professional Certification. I hereby certify that these documents were prepared or approved by me, and that I am a duly licensed professional engineer under the laws of the State of Maryland.
 License No. 21443 Expiration Date: 12-21-24

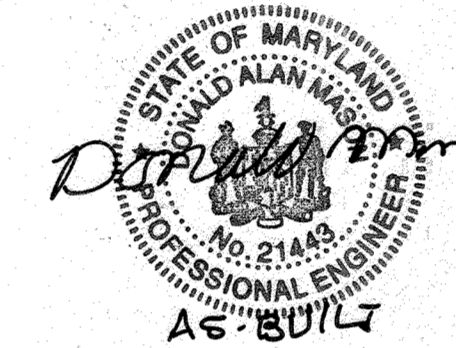


UNDERDRAIN, OVERFLOW AND OUTFALL NOTES

- THE LAST CLEAN-OUT LOCATION WITHIN EACH MICRO-BIORETENTION FACILITY SHALL BE FITTED WITH A NON-CLOGGING SURFACE DRAIN (EXAMPLE: 4" ABS ROOF DRAIN W/CAST ALUMINUM DOME) AT THE POND SURFACE ELEVATION INDICATED IN THE CORRESPONDING TABLE ELEV. 2.
- THE PVC WITHIN THE FACILITY SHALL BE PERFORATED.
- THE UNDER-DRAIN AND PIPE TO OUTFALL SHALL BE INSTALLED TO A MINIMUM DEPTH OF 2' BELOW FINISHED GRADE AND SHALL MAINTAIN A MINIMUM 1% SLOPE AND MAINTAIN A MINIMUM OF 1' OF SEPARATION AT ALL CROSSINGS.

MICRO-BIORETENTION DESIGN TABLES



MBR-1

| | |
|------------------------|--------|
| ELEV. 1 | 163.30 |
| ELEV. 2 | 163.00 |
| ELEV. 3 | 162.30 |
| ELEV. 4 | 162.05 |
| ELEV. 5 | 160.95 |
| ELEV. 6 | 160.62 |
| ELEV. 7 | 160.42 |
| ELEV. 8 | 158.72 |
| SURFACE AREA: 148.5 SF | |

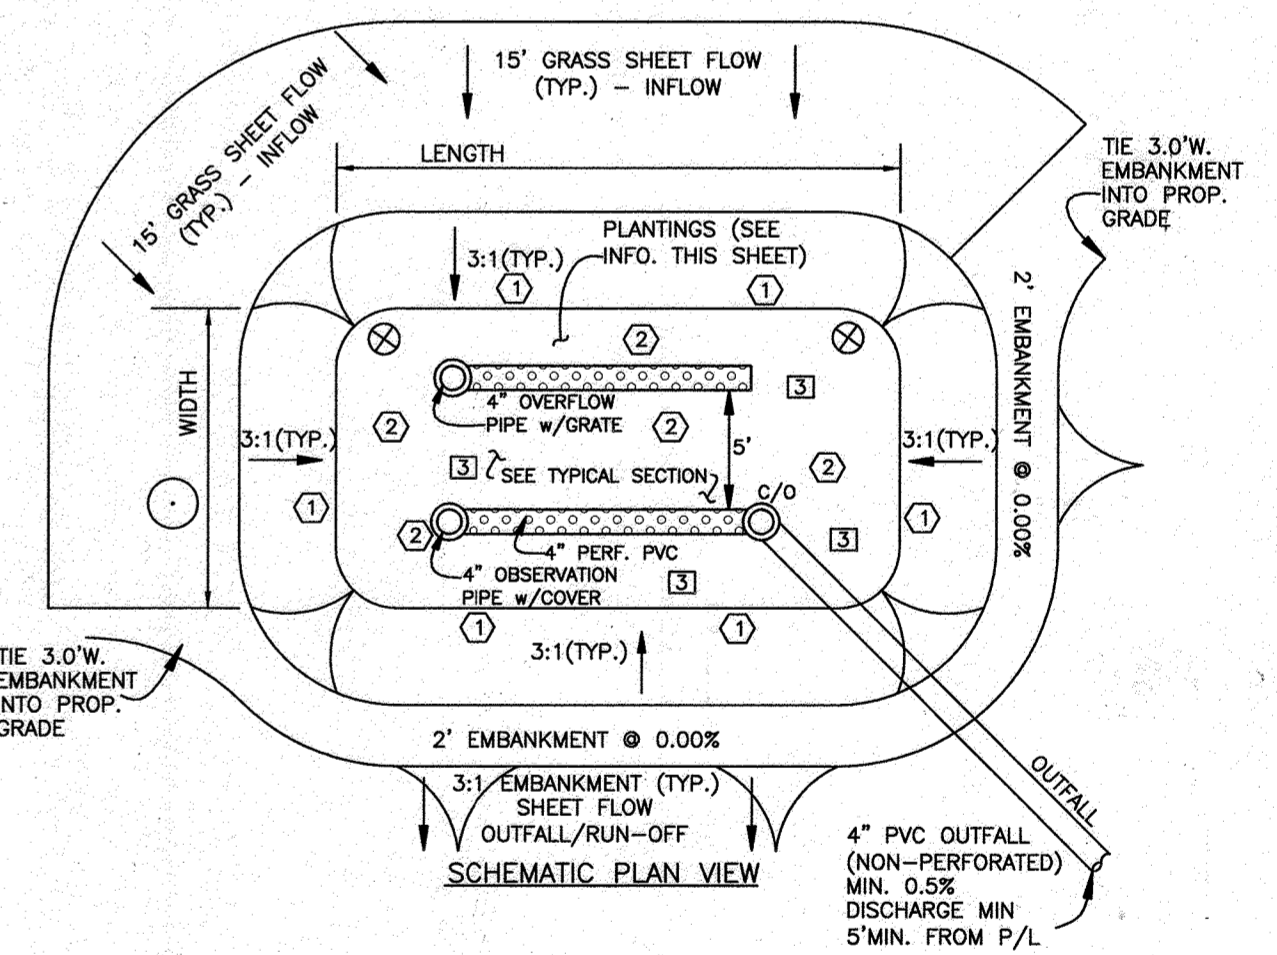

TYPICAL MICRO-BIORETENTION DETAILS

NOT TO SCALE

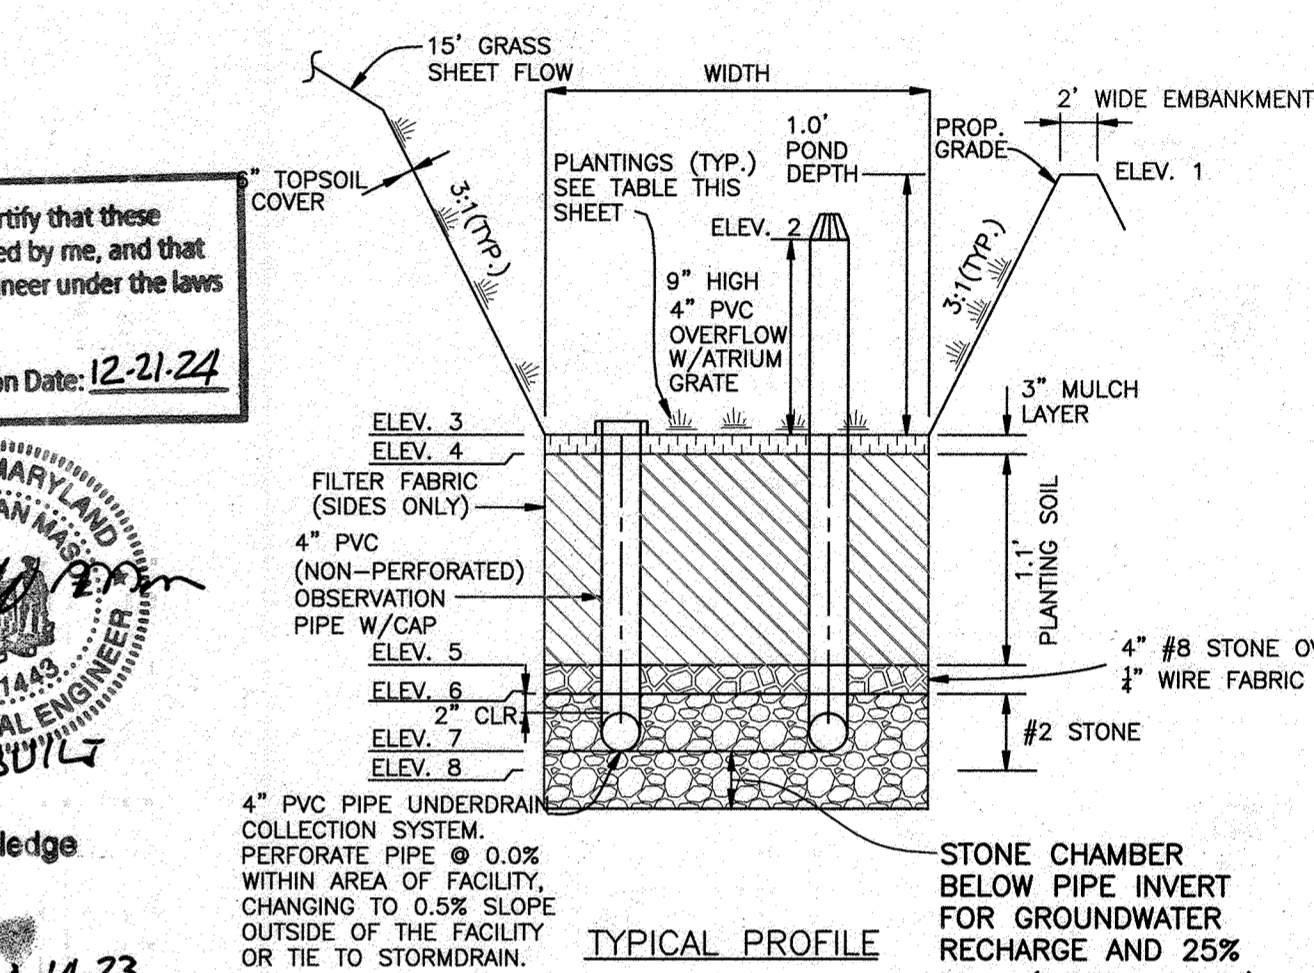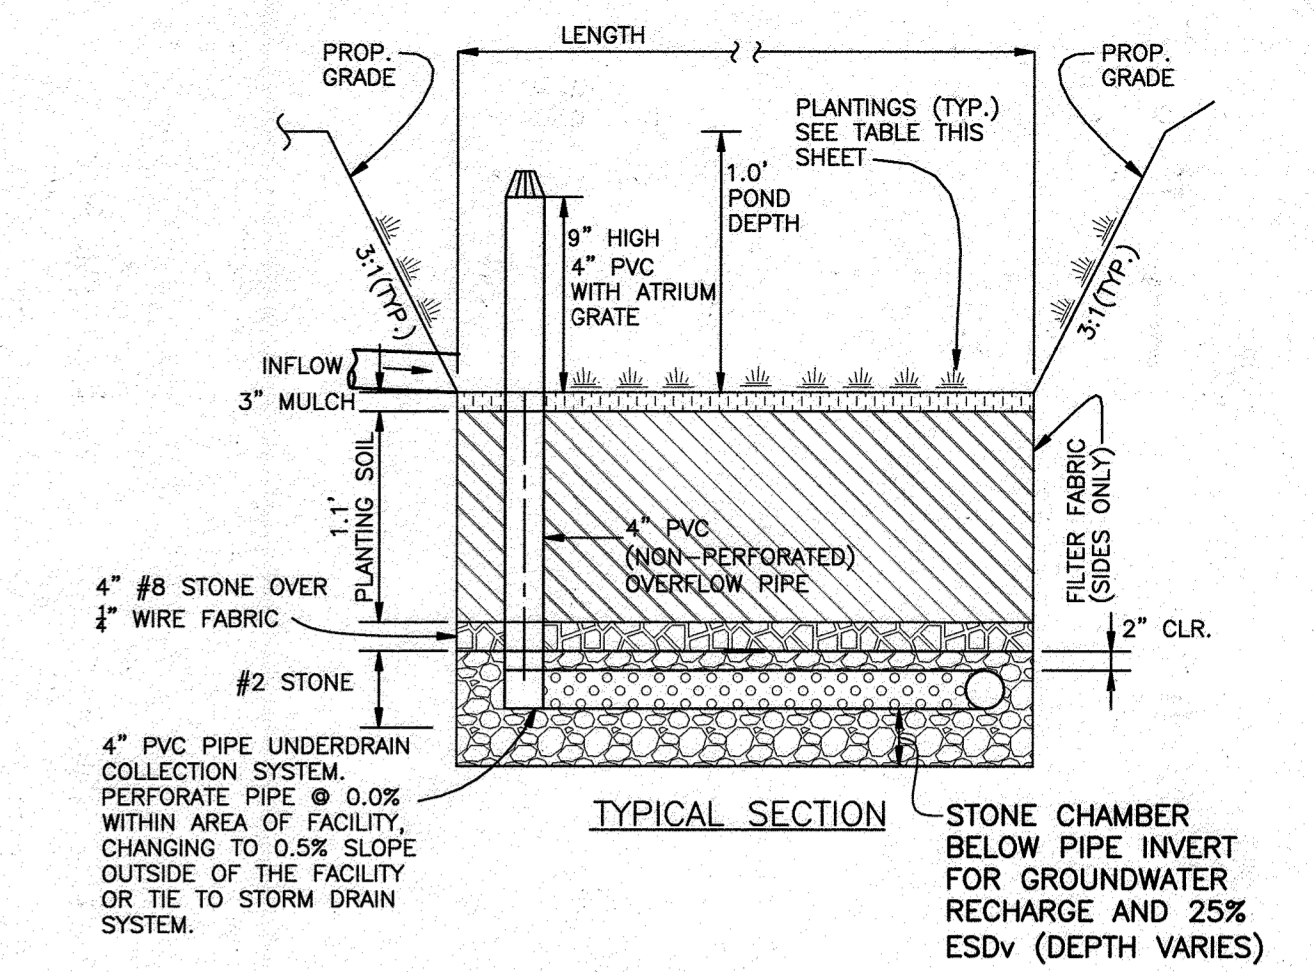

Professional Certification. I hereby certify that these documents were prepared or approved by me, and that I am a duly licensed professional engineer under the laws of the State of Maryland.
 License #5572 Expiration Date: 06-09-2020.

BENCHMARK ENGINEERING, INC.
 ENGINEERS & LAND SURVEYORS & PLANNERS
 8480 BALTIMORE NATIONAL PIKE & SUITE 315 & ELLICOTT CITY, MARYLAND 21043
 (P) 410-465-4103 (F) 410-465-6644
 WWW.BE1-CVLENGINEERING.COM

9/25/18

OWNER/DEVELOPER: TSZ PROPERTIES, 10382 BALTIMORE NATIONAL PIKE, ELLICOTT CITY, MARYLAND 21042, 410-465-4103, c/o STEPHANIE PORTA

HARWOOD PARK
 LOTS 540-541
 PLAT BOOK 60 FOLIO 115
 SINGLE FAMILY SEMI-DETACHED DUPLEX UNITS
 TAX MAP: 38 ZONED: R-12 PARCEL: 873
 BEECHFIELD AVENUE
 ELECTION DISTRICT NO. 1, HOWARD COUNTY, MARYLAND
STORMWATER MANAGEMENT PLAN AND NOTES

DATE: JUNE, 2018 BEI PROJECT NO. 2565
 SCALE: 1" = 10' SHEET 4 OF 4