


FANNIE SARBESMAN  
W.H.H 433/732


PHILLIP L. CURLEY  
320/452

FANNIE SARBESMAN  
433/732

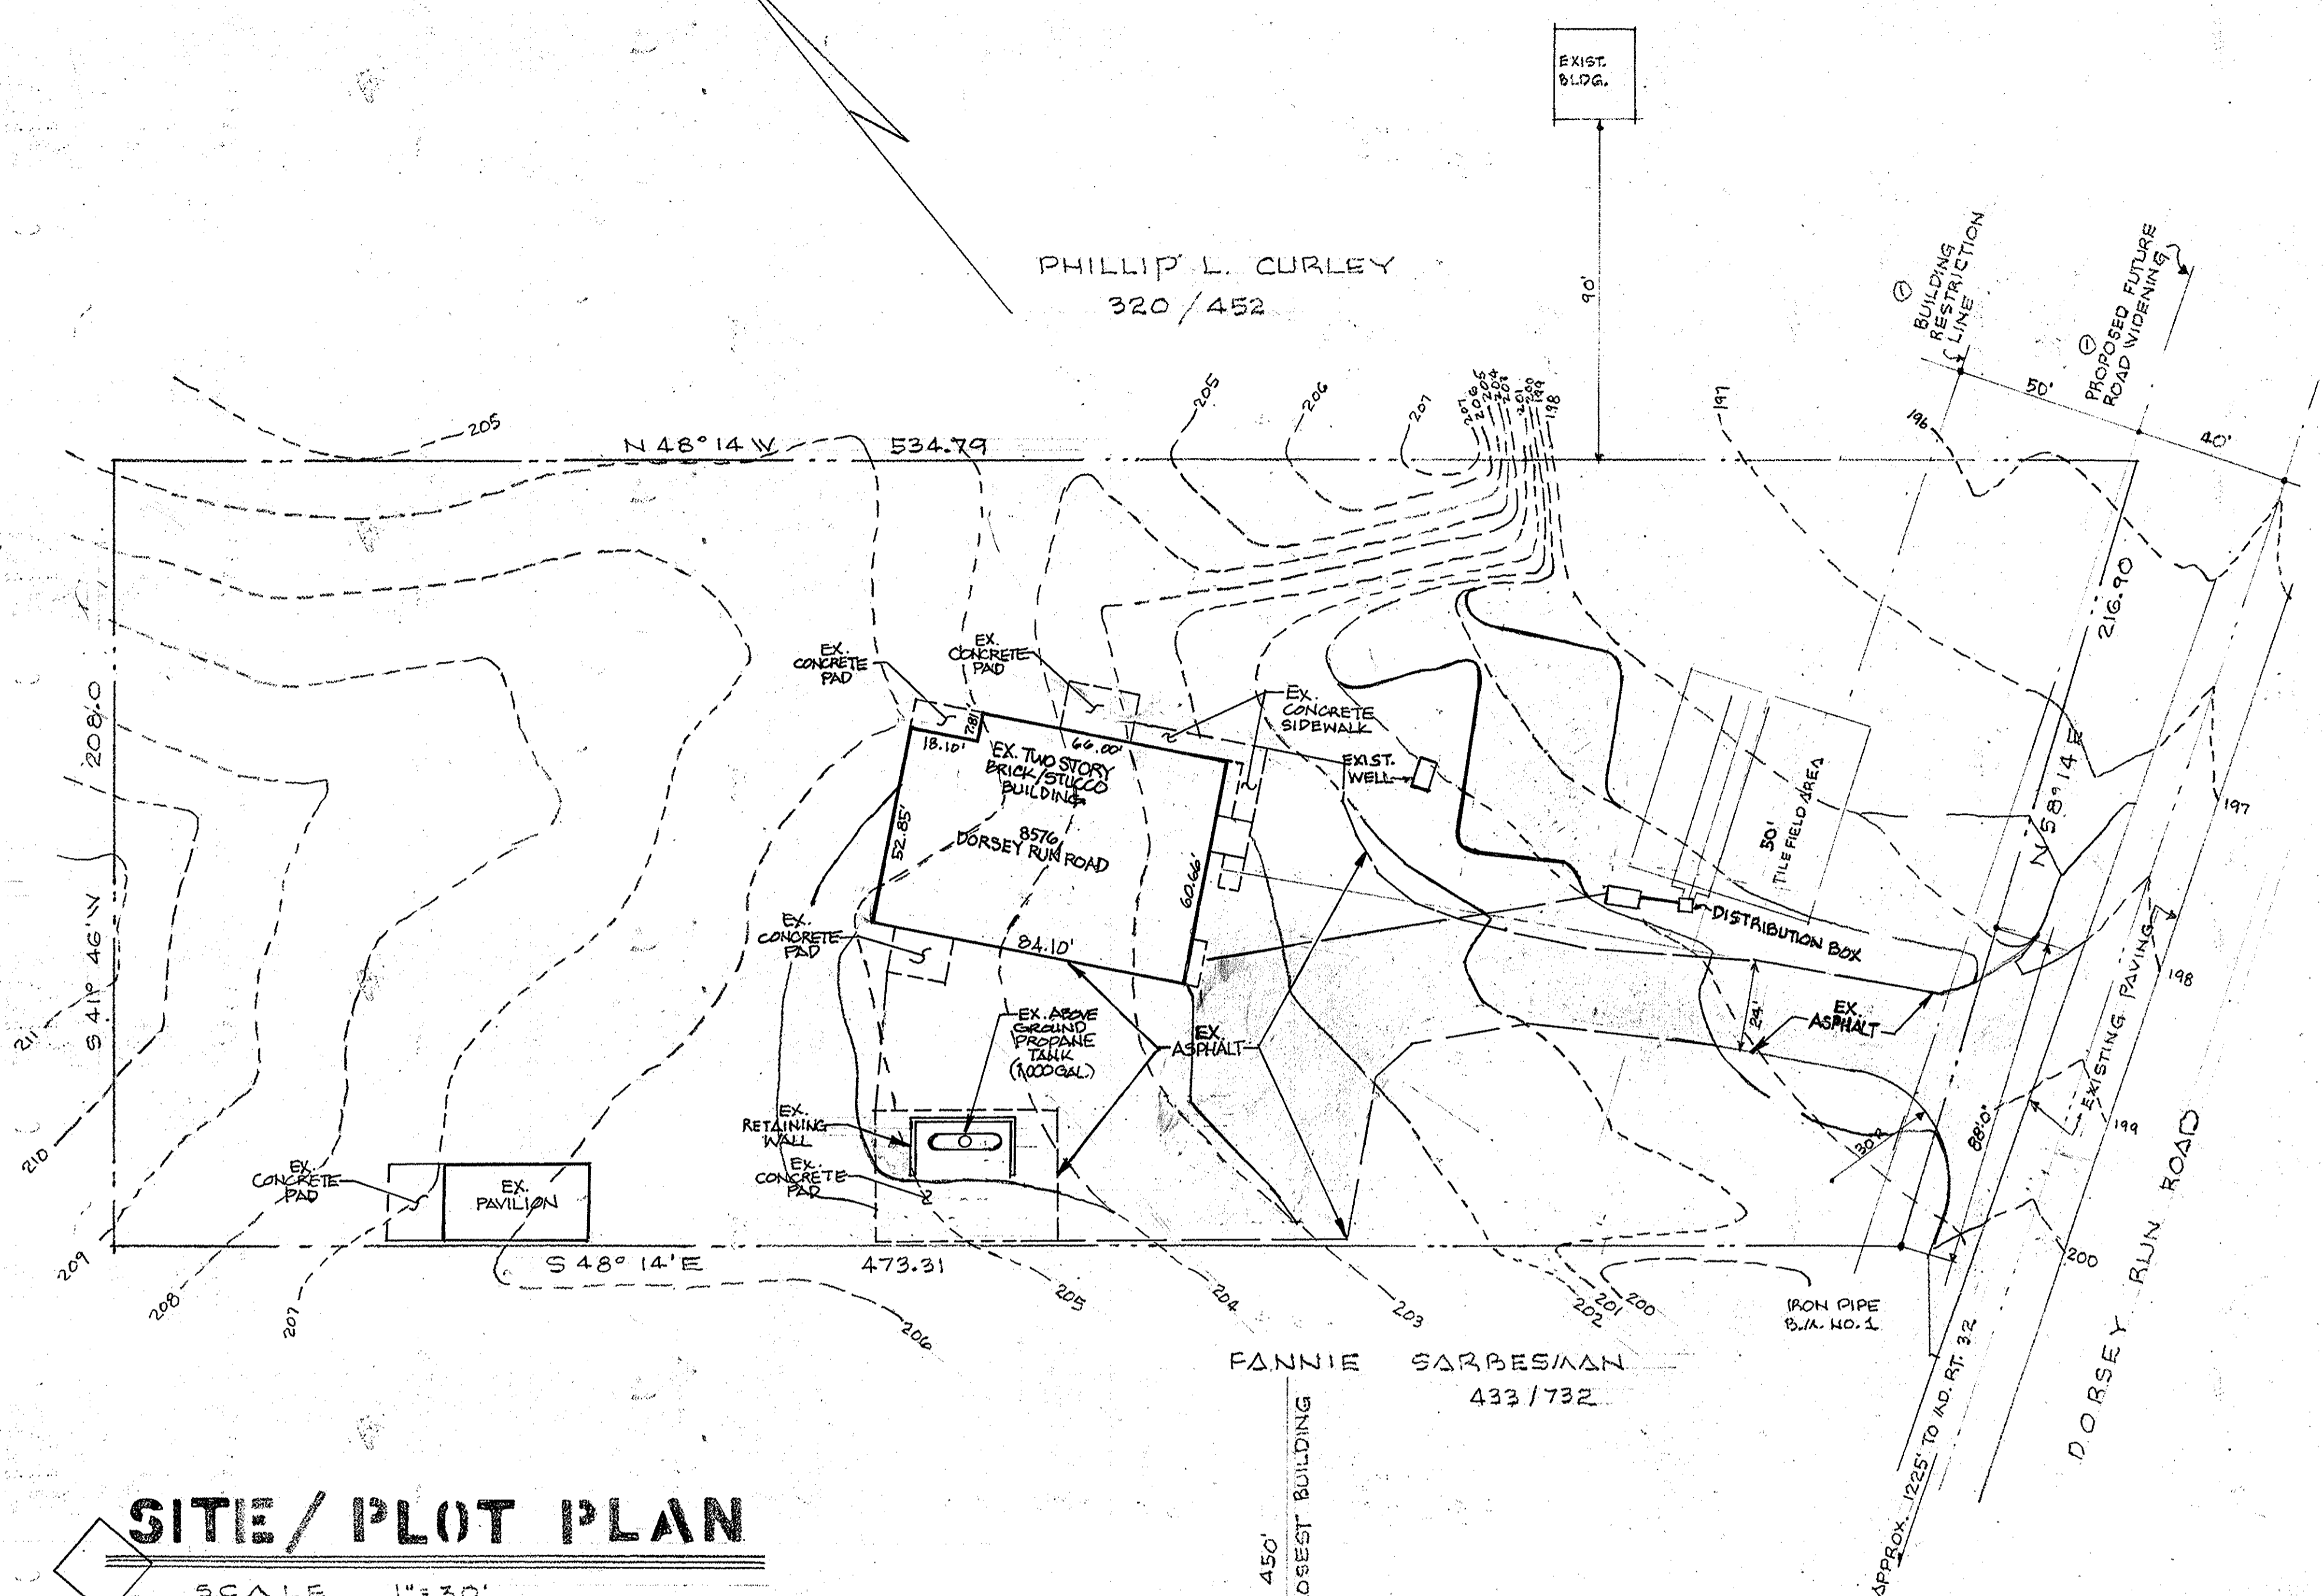

**SITE/ PLOT PLAN**

SCALE 1" = 30'

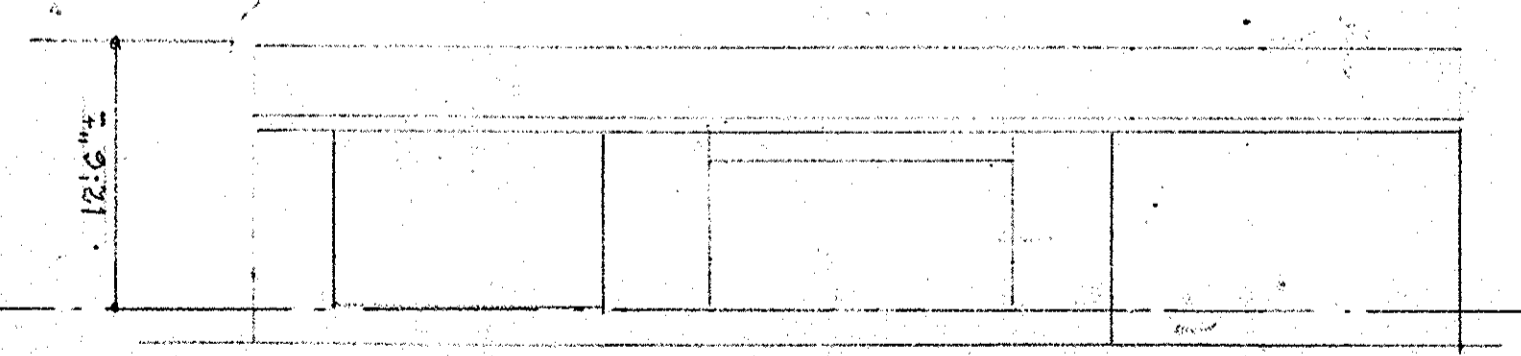

SCHEMATIC PROFILE  
NOT TO SCALE

SEPTIC SYSTEM  
750 GALLON TANK  
TILE FIELD (3-50' LONG LINES)  
3' WIDE TRENCH MAX. DEPTH 2.5' FROM ORIG. GROUND  
AREA FOR TILE FIELD AS SHOWN

AREA	2.407 Δ
ZONING	M-2
NUMBER OF EMPLOYEES	5
TOTAL FLOOR SPACE OF OFFICE	1341 #
NUMBER OF PARKING SPACES	5
<b>TAX MAP 48- PARCEL 21</b>	

ALL SWALES SHALL BE SODDED AND TAMPED AND ALL SLOPES SHALL BE SEEDED OR SODDED IN CONJUNCTION WITH THE HOWARD COUNTY SOIL CONSERVATION SERVICE AND THE HOWARD COUNTY PLANNING COMMISSION

NO SIGNS PROPOSED ON THIS SITE AND NO FENCES OR WALLS SHALL BE CONSTRUCTED ON THIS SITE

① DRIVEWAY ENTRANCE TO BE CONSTRUCTED IN ACCORDANCE WITH DG, D7, OR D8 HOWARD COUNTY ROAD CONSTRUCTION CODE & STANDARD SPECIFICATION PAGE 61 TO 63

PURPOSE NOTE:  
THE PURPOSE OF THIS REDLINE IS TO ADD A 1,000 GALLON PROpane TANK AND UPDATE SITE FEATURES.

NOTE: REDLINE APPROVED ON 09/22/15 EXHAUSTED THE 5,000 SF OF REDLINE IMPERVIOUS IMPROVEMENT WITH NO SWM REQUIREMENT. ANY FURTHER REDLINE IMPERVIOUS AREA WILL BE SUBJECT TO ESD.

NO.	REVISION DESCRIPTION	DATE
1	ADD PROpane TANK & UPDATE SITE PLAN	09/22/15

THIS DEVELOPMENT PLAN IS APPROVED FOR SOIL EROSION AND SEDIMENT CONTROL BY THE HOWARD SOIL CONSERVATION DISTRICT.

REVIEWED: *Elmer J. Jones* 11/20/70  
DIST. CONSERVATIONIST DATE

APPROVED: *Robert B. Campbell* Nov. 20, 1970  
HOWARD SOIL CONSERVATION DISTRICT DATE

**APPROVED**  
DIVISION OF  
LAND DEVELOPMENT  
OFFICE OF  
PLANNING AND ZONING  
OF HOWARD COUNTY  
DATE: NOV 10 1970  
*JHCF*



① REVISED NOV. 10, 1970

**OFFICE BUILDING**  
**SEABOARD FOUNDATIONS**

323 OLD DORSEY RUN ROAD  
6TH ELECTION DISTRICT HOWARD COUNTY, MARYLAND

SCALE: AS SHOWN DATE: 10/5/70

michael A. asimenos architect  
600 tolna street balto. md.

S/1