
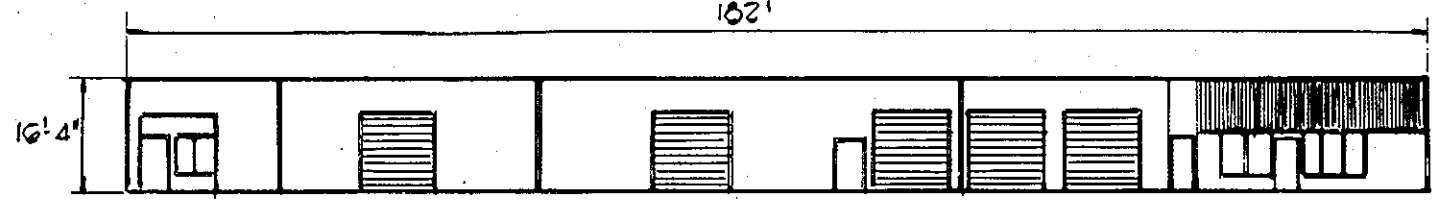
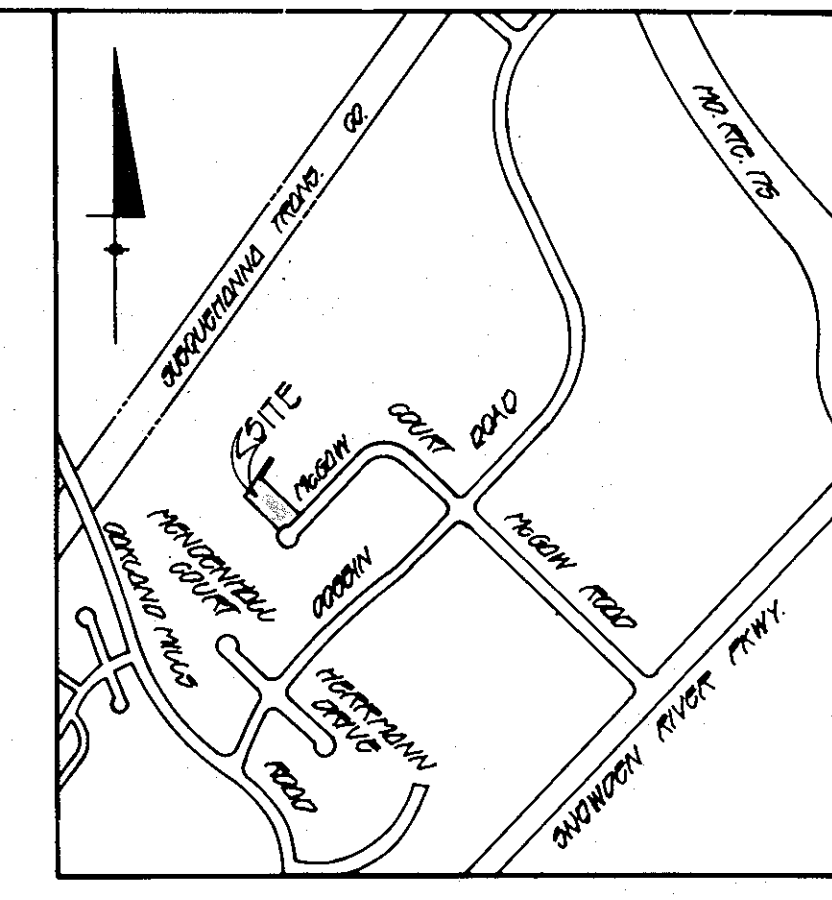


APPROVED HOWARD COUNTY OFFICE OF PLANNING AND ZONING
William J. Harpelle 4-28-82
 DIRECTOR, PLANNING AND ZONING

APPROVED HOWARD COUNTY DEPARTMENT OF PUBLIC WORKS FOR PUBLIC WATER, PUBLIC SEWERAGE AND STREET DRAINAGE SYSTEMS AND SIGNS
Mark F. Nunnally 4-26-82
 DIRECTOR, PUBLIC WORKS

APPROVED HOWARD COUNTY DEPARTMENT OF PUBLIC HEALTH FOR PUBLIC WATER AND PUBLIC SEWERAGE SYSTEMS
John P. ... 4-27-82
 COUNTY HEALTH OFFICER


No.	Revision	Date
1	Added 8" Security Fence & details	3/16/04
2	Added Paving, Sidewalk, Planters & Revised H.C. Striping	8/4/09
3	INDICATE REINSTALLATION OF PRIVATE WATER MAIN & PRIVATE FIRE HYDRANTS	10/21/09

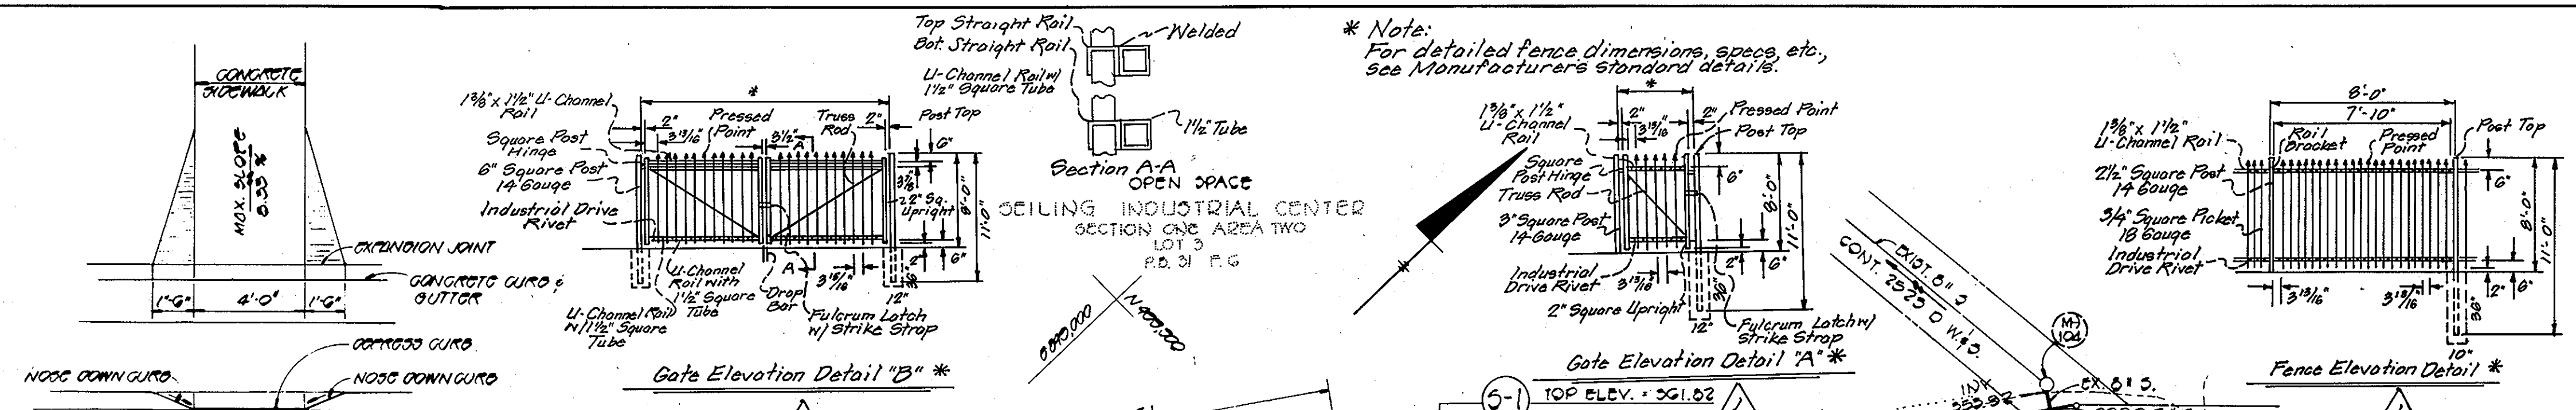


SCHEMATIC BUILDING PROFILE
NO SCALE

- LEGEND**
- BITUMINOUS CONCRETE PAVING
 - NORMAL SLOPE ON GUTTER SECTION
 - REVERSE SLOPE ON GUTTER SECTION
 - CONCRETE SIDEWALK
 - SECURITY FENCE


- GENERAL NOTES**
- TOTAL AREA OF PARCEL E-1 - 1.645 AC.±
 - PRESENT ZONING NEW TOWN EMPLOYMENT CENTER, FOR DEVELOPMENT PHASE CRITERIA SEE PHASE 128-A-1 RECORDED AS PLAT 3054 A-206.
 - PARCEL E-1 IS RECORDED AS PLAT 5030.
 - PARKING DATA
 - USE - OFFICE AND WAREHOUSE
 - NUMBER OF PARKING SPACES PROVIDED - 19
 - TOTAL NUMBER OF INDUSTRIAL EMPLOYEES - 20
 - NUMBER OF PARKING SPACES REQUIRED = 1 SPACE/2 EMPLOYEES = 10 SPACES
 - OFFICE USE AREA - 1936^{sq} 2 SPACES REQUIRED/1000^{sq} = 4 SPACES
 - NUMBER OF PARKING SPACES REQUIRED = 14
 - TOTAL NUMBER OF HANDICAPPED SPACES REQUIRED - 2
 - TOTAL NUMBER OF HANDICAPPED SPACES PROVIDED - 2
 - PARKING SPACES TO BE DELINEATED BY SOLID WHITE 6" PAINTED LINES.
 - ALL PAVING AND STORM DRAIN CONSTRUCTION SHALL BE IN ACCORDANCE WITH THE HOWARD COUNTY ROAD CONSTRUCTION CODE AND STANDARD SPECIFICATIONS.
 - EXISTING UTILITIES SHOWN HEREON HAVE BEEN LOCATED FROM FIELD AND OFFICE INFORMATION. THE CONTRACTOR SHALL DETERMINE THE EXACT LOCATION OF EXISTING UTILITIES TO HIS OWN SATISFACTION BEFORE MAKING ANY CONNECTION THERETO OR EXCAVATING IN THE AREA THEREOF.
 - THE CONTRACTOR SHALL NOTIFY MISS UTILITY AT 559-0100 A MINIMUM OF THREE DAYS PRIOR TO BEGINNING ANY CONSTRUCTION SHOWN HEREON.
 - THE PROPERTY IS LOCATED ON TAX MAP 36, PARCEL 366.
 - COVERAGE
 - TOTAL AREA OF PARCEL - 1.645 AC.±
 - TOTAL BUILDING COVERAGE - 19,960^{sq}± OR 28% OF SITE.
 - THE CONTRACTOR SHALL NOTIFY THE HOWARD COUNTY CONSTRUCTION INSPECTION/SURVEY DIVISION 24 HOURS PRIOR TO COMMENCEMENT OF WORK AT 992-2418.
 - HANDICAPPED FACILITIES TO BE CONSTRUCTED IN ACCORDANCE WITH THE "DESIGN OF BARRIER FREE FACILITIES" AND THE "MARYLAND BUILDING CODE FOR THE HANDICAPPED AND AGED"
 - THE SANITARY SEWER LINE AND CONNECTIONS SHALL BE OF A MATERIAL AS SPECIFIED UNDER ARTICLE 37.06 SECTION 37.06-2 IN VOLUME 4 (STANDARD SPECIFICATIONS AND DETAILS FOR CONSTRUCTION).
 - SEE DRAWINGS S2.11 AND S3.21 IN VOLUME 4 (STANDARD SPECIFICATIONS AND DETAILS FOR CONSTRUCTION) FOR THE PROPOSED 6" SEWER CONNECTION AND MAIN LINE CLEAN OUT. BY LETTER DATED OCTOBER 14, 2009, MS. RON LEBSON, CHIEF, BUREAU OF ENGINEERING, APPROVED A WATER TO THE HOWARD COUNTY TREATMENT PLANT, VOLUME II, WATER & SEWER, ALLOWING THE INSTALLATION OF A PRIVATE WATER MAIN & PRIVATE FIRE HYDRANT.

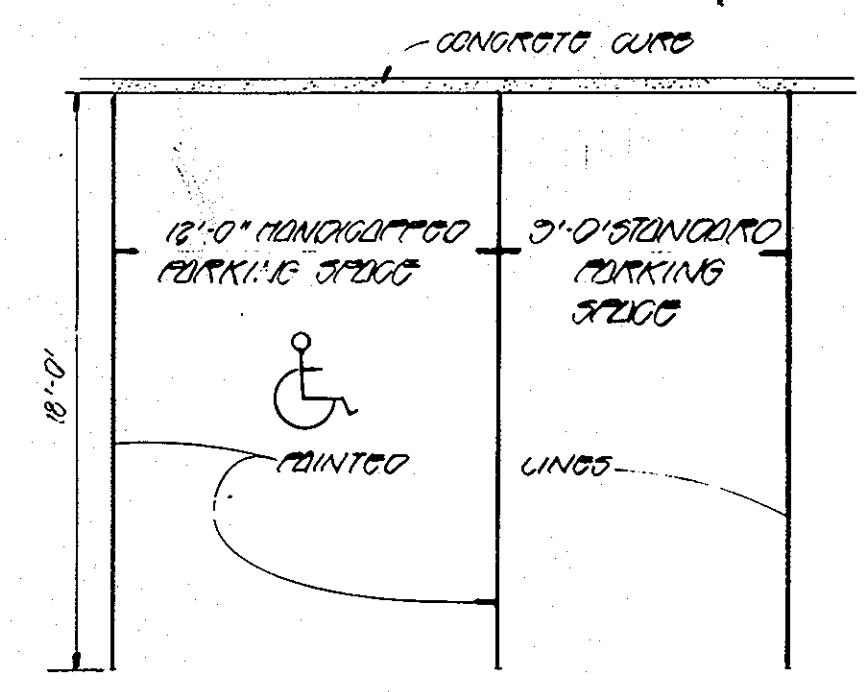


TYPICAL PARKING SPACE
NO SCALE

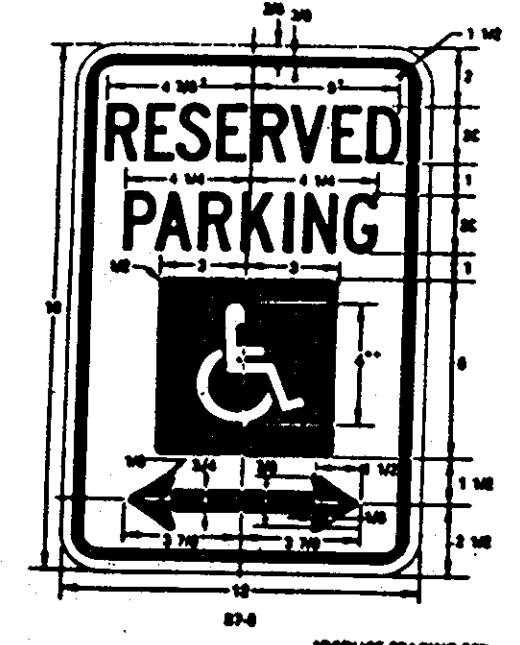


HANDICAPPED SIGN DETAIL
NO SCALE

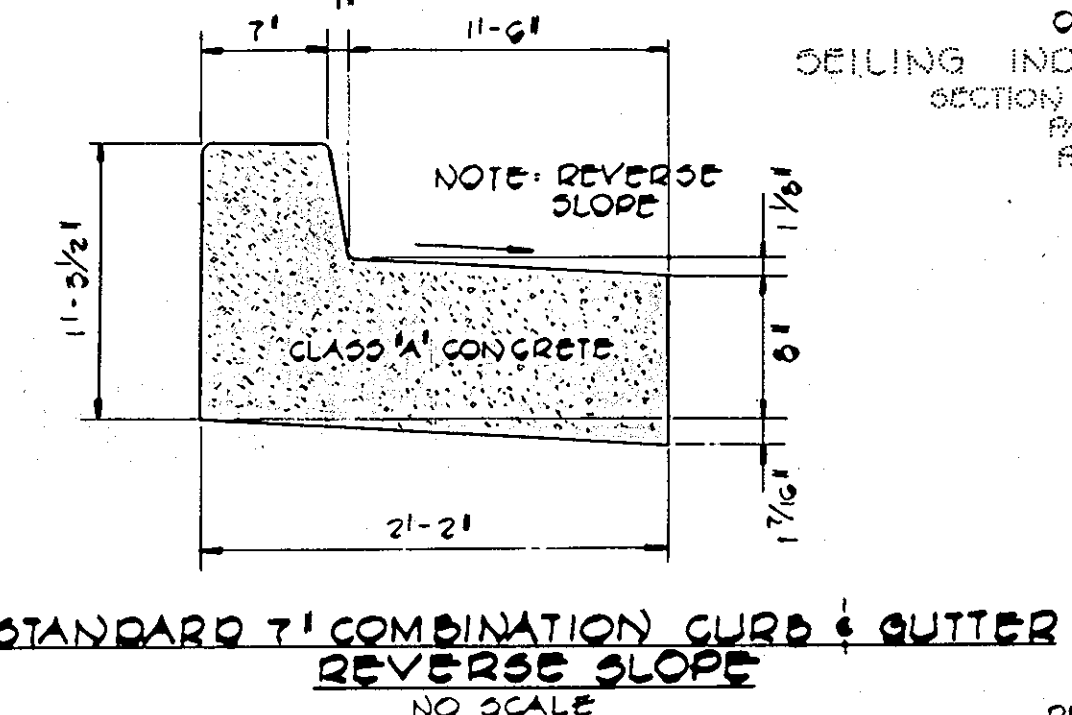

STANDARD 7' COMBINATION CURB & GUTTER
REVERSE SLOPE
NO SCALE

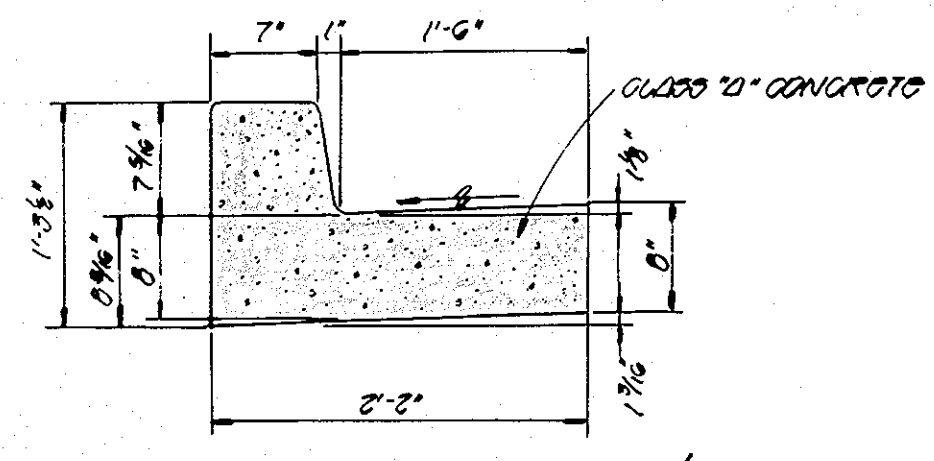


STANDARD 7' COMBINATION CURB & GUTTER
NO SCALE

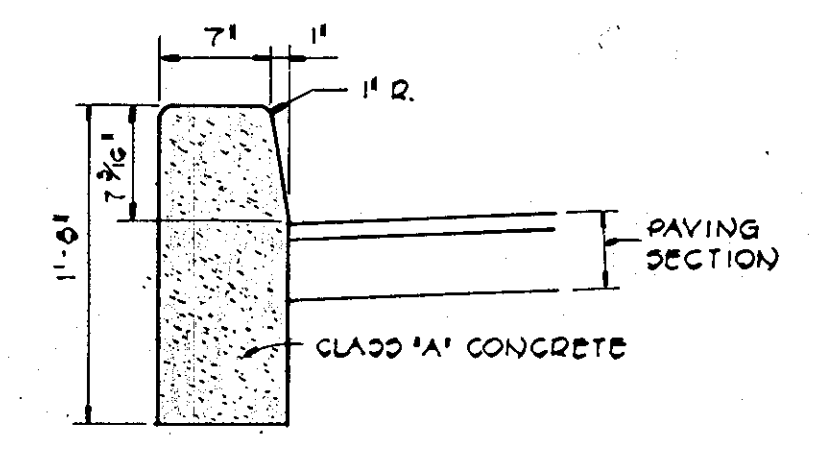

STANDARD BARRIER CURB
NO SCALE

AS BUILT FOR NEW 8" VALVE
 8" VALVE TO EX. FIRE HYDRANT ACROSS MCGAW COURT = 62'
 8" VALVE TO EX. CURB STOP FOR 2" WHC = 8'
 8" VALVE TO FRAME & COVER/TOP OF DETECTOR VAULT = 7'

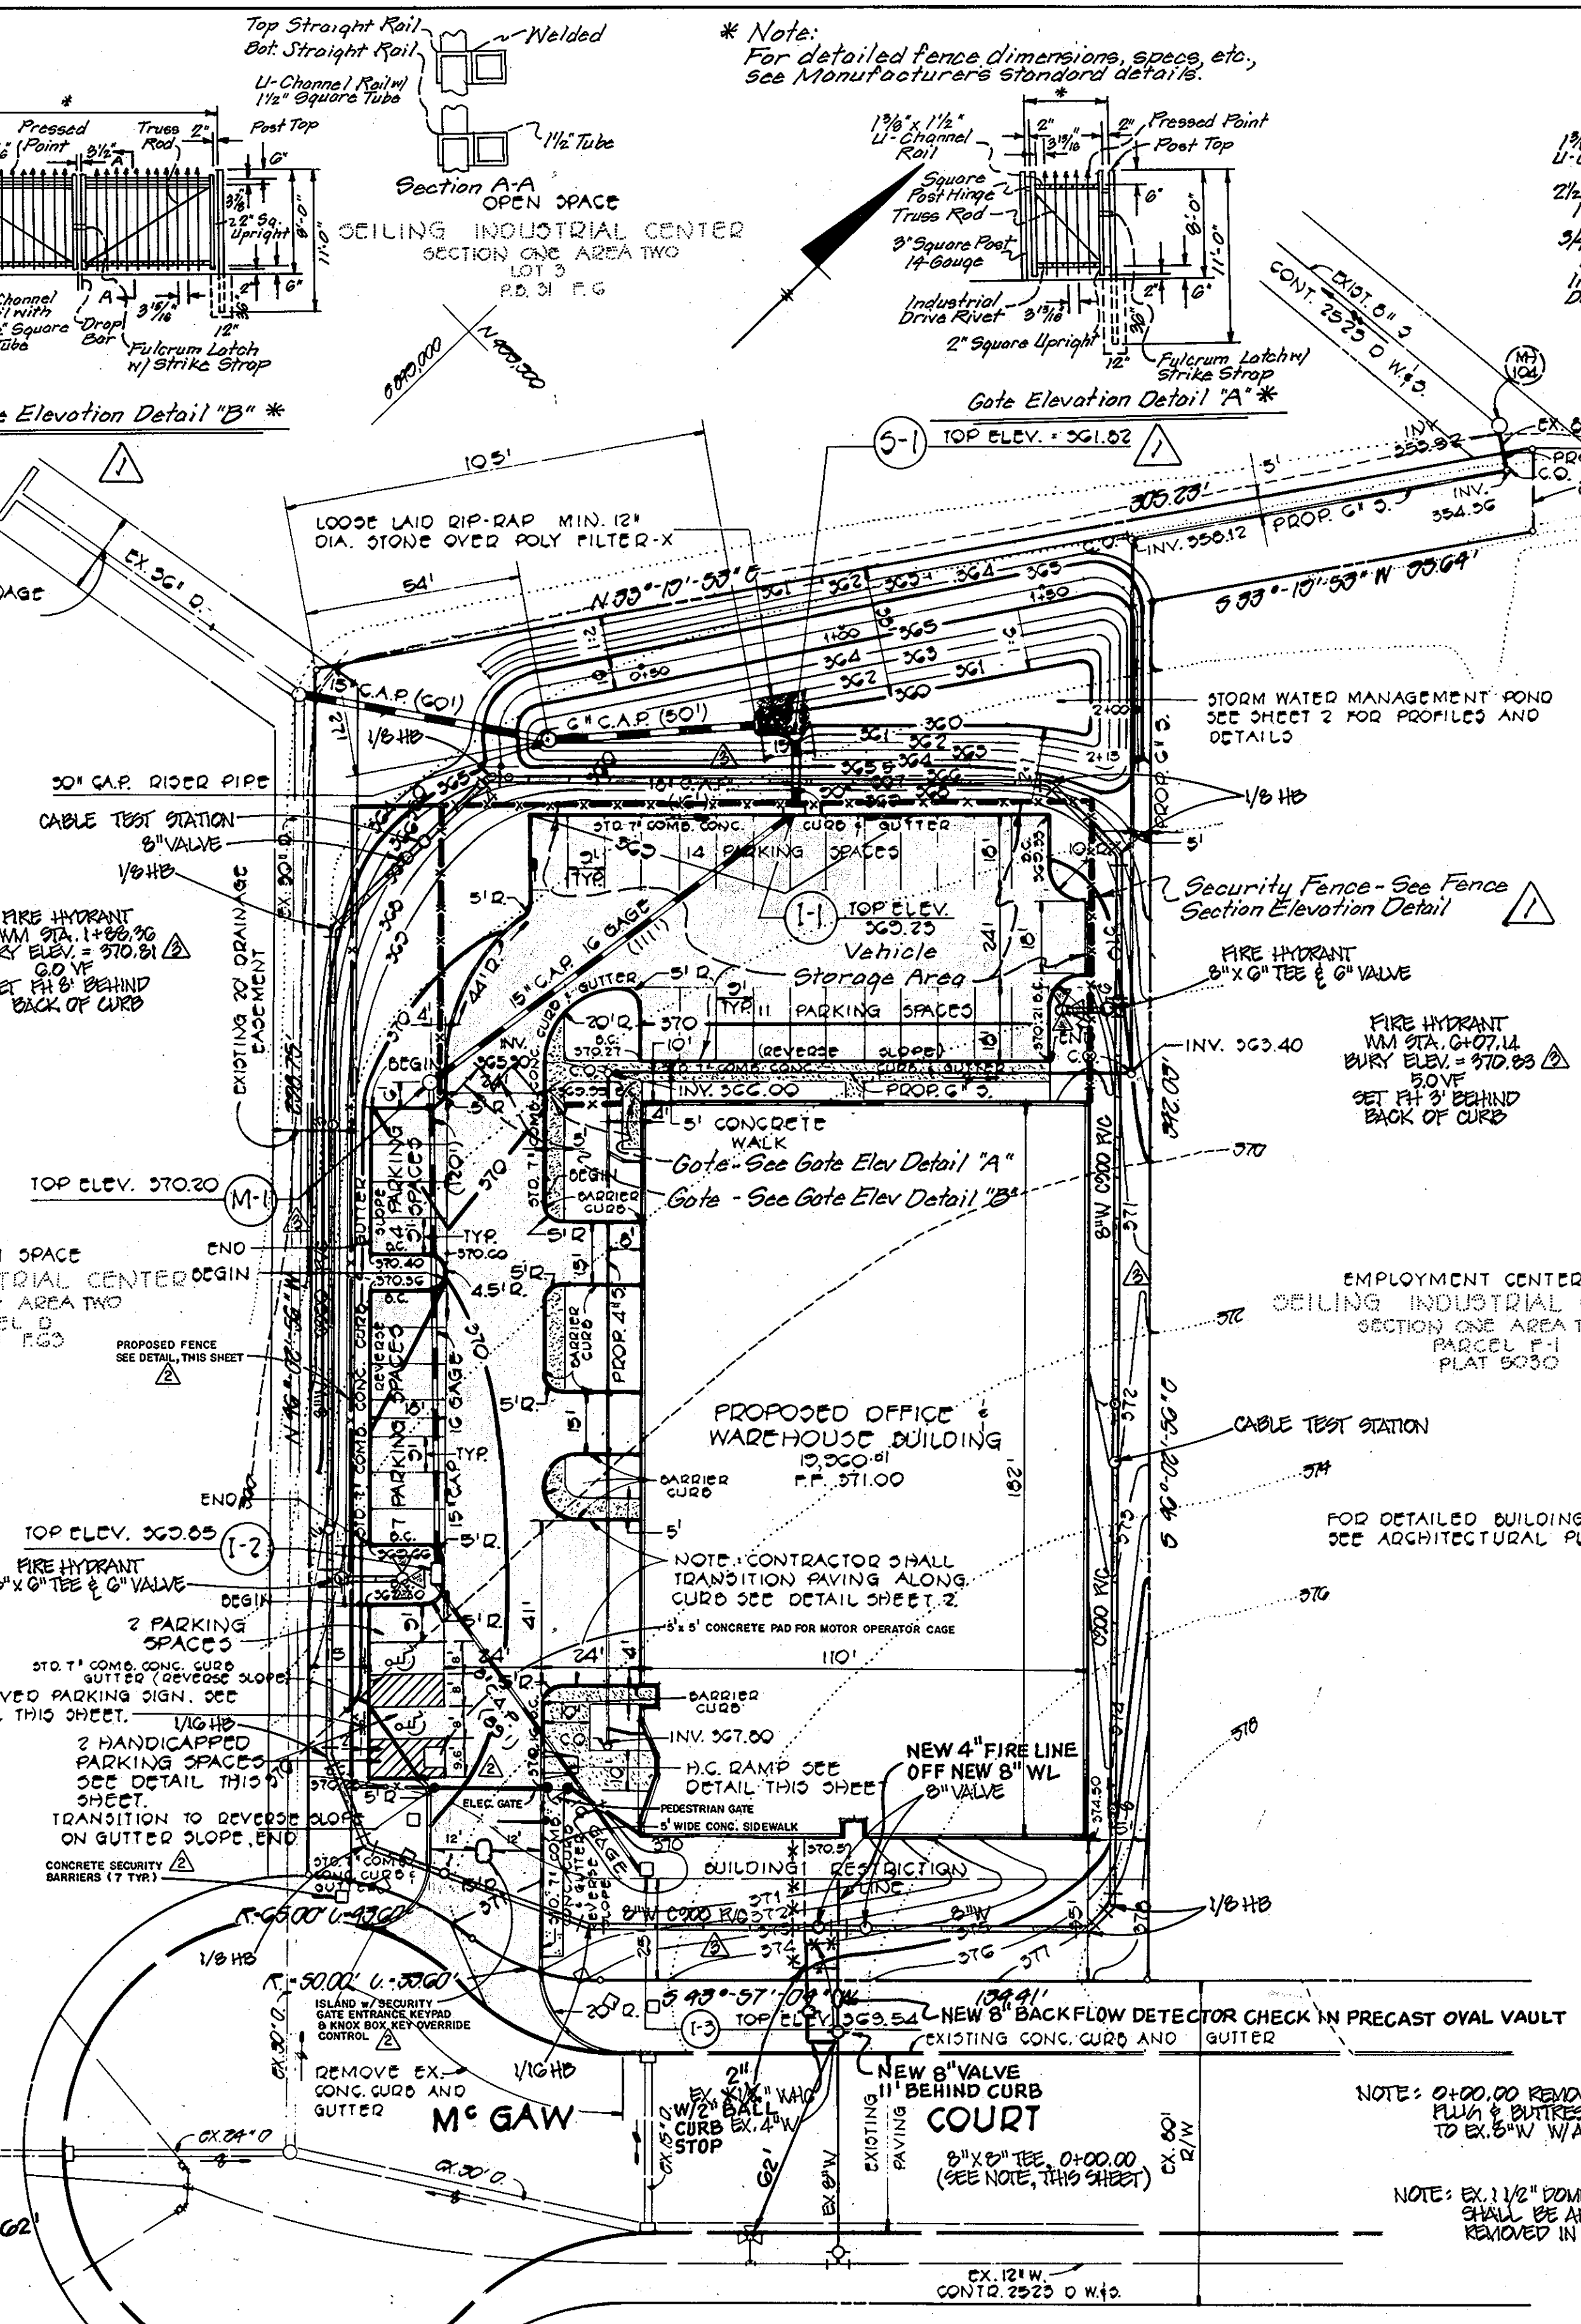

APPROVED
 PLANNING BOARD
 OF HOWARD COUNTY
 DATE 4-7-82

SITE DEVELOPMENT
 GRADING PLAN

AS BUILT
 DATE: FEBRUARY 2010

DATA BASE INC.
 PARCEL E-1
 CEILING INDUSTRIAL CENTER
 SECTION ONE
 AREA TWO
 SIXTH ELECTION DISTRICT
 FEBRUARY 5, 1982
 SHEET 1 OF 4

STATE OF MARYLAND
 PAUL W. KRIBBEL 10/20/09
 PAUL W. KRIBBEL P.E. REVISION

STATE OF MARYLAND
 CAROL A. COLLINS 2/22/12
 CAROL A. COLLINS P.E.

STATE OF MARYLAND
 REVISION 9/15/09

OWNER & DEVELOPER
 COAST CONSTRUCTION COMPANY
 632 S.W. 145 RD
 PO BOX 66473
 SEATTLE, WASHINGTON 98106













DEVELOPER'S CERTIFICATE
 "I HEREBY CERTIFY THAT ALL DEVELOPMENT AND/OR CONSTRUCTION WILL BE DONE ACCORDING TO THESE PLANS, AND THAT ANY RESPONSIBLE PERSONNEL INVOLVED IN THE CONSTRUCTION PROJECT WILL HAVE A CERTIFICATE OF ATTENDANCE AT A DEPARTMENT OF NATURAL RESOURCES APPROVED TRAINING PROGRAM FOR THE CONTROL OF SEDIMENT AND EROSION BEFORE BEGINNING THE PROJECT. I WILL PROVIDE THE HOWARD SOIL CONSERVATION DISTRICT WITH AN AS-BUILT PLAN OF THE POND WITHIN 30 DAYS OF COMPLETION."
 SIGNATURE OF DEVELOPER: Carol Collins
 DATE: 3/18/12

ENGINEER'S CERTIFICATE
 "I CERTIFY THAT THIS PLAN FOR POND CONSTRUCTION, EROSION AND SEDIMENT CONTROL, REPRESENTS A PRACTICAL AND WORKABLE PLAN BASED ON MY PERSONAL KNOWLEDGE OF THE SITE CONDITIONS. THIS PLAN WAS PREPARED IN ACCORDANCE WITH THE REQUIREMENTS OF THE HOWARD SOIL CONSERVATION DISTRICT. I HAVE NOTIFIED THE DEVELOPER THAT HE MUST PROVIDE THE HOWARD SOIL CONSERVATION DISTRICT WITH AN "AS BUILT" PLAN OF THE POND WITHIN 30 DAYS OF COMPLETION."
 SIGNATURE OF ENGINEER: Carol Collins
 DATE: 3/18/12

THESE PLANS HAVE BEEN REVIEWED FOR THE HOWARD SOIL CONSERVATION DISTRICT AND MEET THE TECHNICAL REQUIREMENTS FOR SMALL POND CONSTRUCTION, SOIL EROSION AND SEDIMENT CONTROL.
 SIGNATURE OF SOIL CONSERVATION SERVICE: James M. Nelson
 DATE: 4/16/12

THESE PLANS FOR SMALL POND CONSTRUCTION, SOIL EROSION AND SEDIMENT CONTROL MEET THE REQUIREMENTS OF THE HOWARD SOIL CONSERVATION DISTRICT.
 SIGNATURE OF HOWARD SOIL CONSERVATION DISTRICT: Robert W. Ziskin
 DATE: 4/16/12

STRUCTURE SCHEDULE					
NO	TYPE	INVERT IN	INVERT OUT	TOP ELEV.	REMARKS
I-1	A-5	362.66	362.41	362.23	DRAWING 90-4.01
I-2	A-5	-	363.27	363.85	DRAWING 90-4.01
M-1	A-1 MANHOLE	364.04	363.73	370.20	DRAWING 90-3.01
2-1	STANDARD METAL END SECTION	-	360.92	361.82	DRAWING 90-3.01
I-3	YARD INLET	-	366.00	363.45	DRAWING 90-4.14

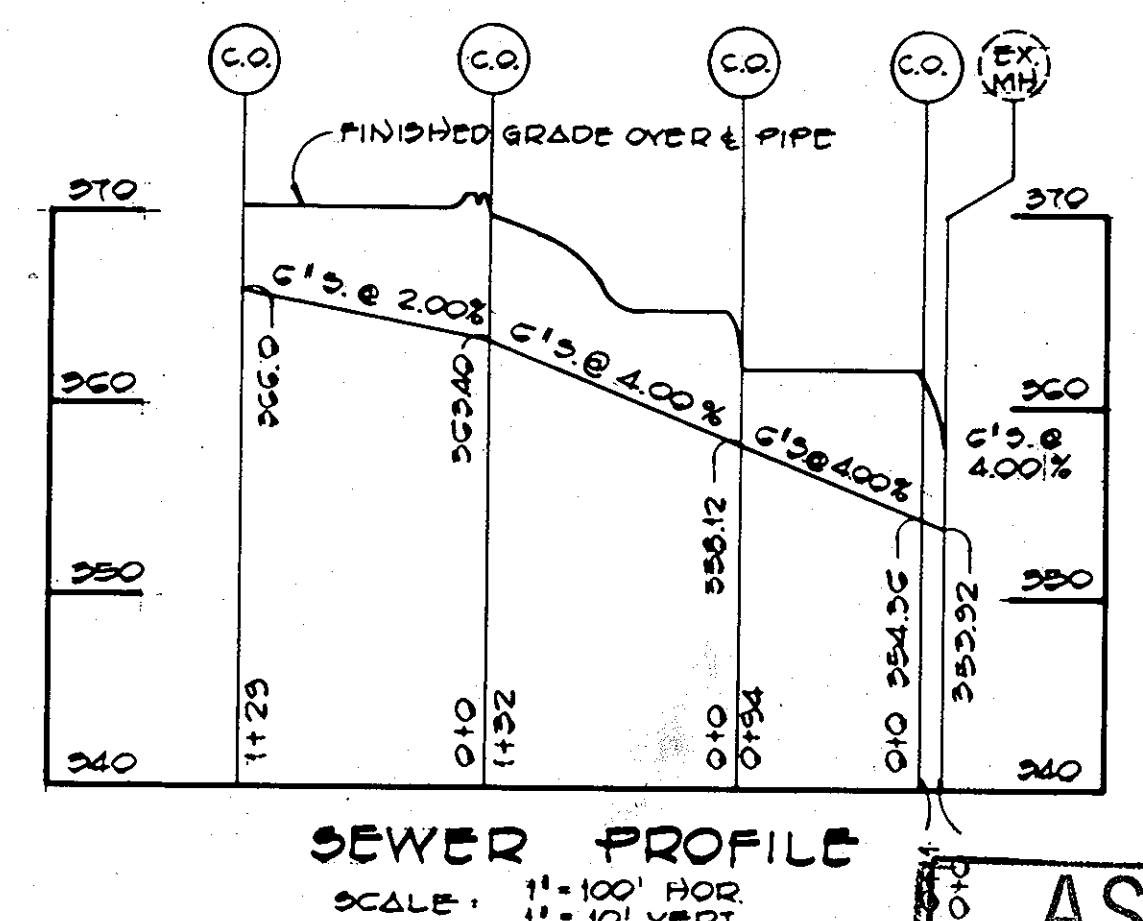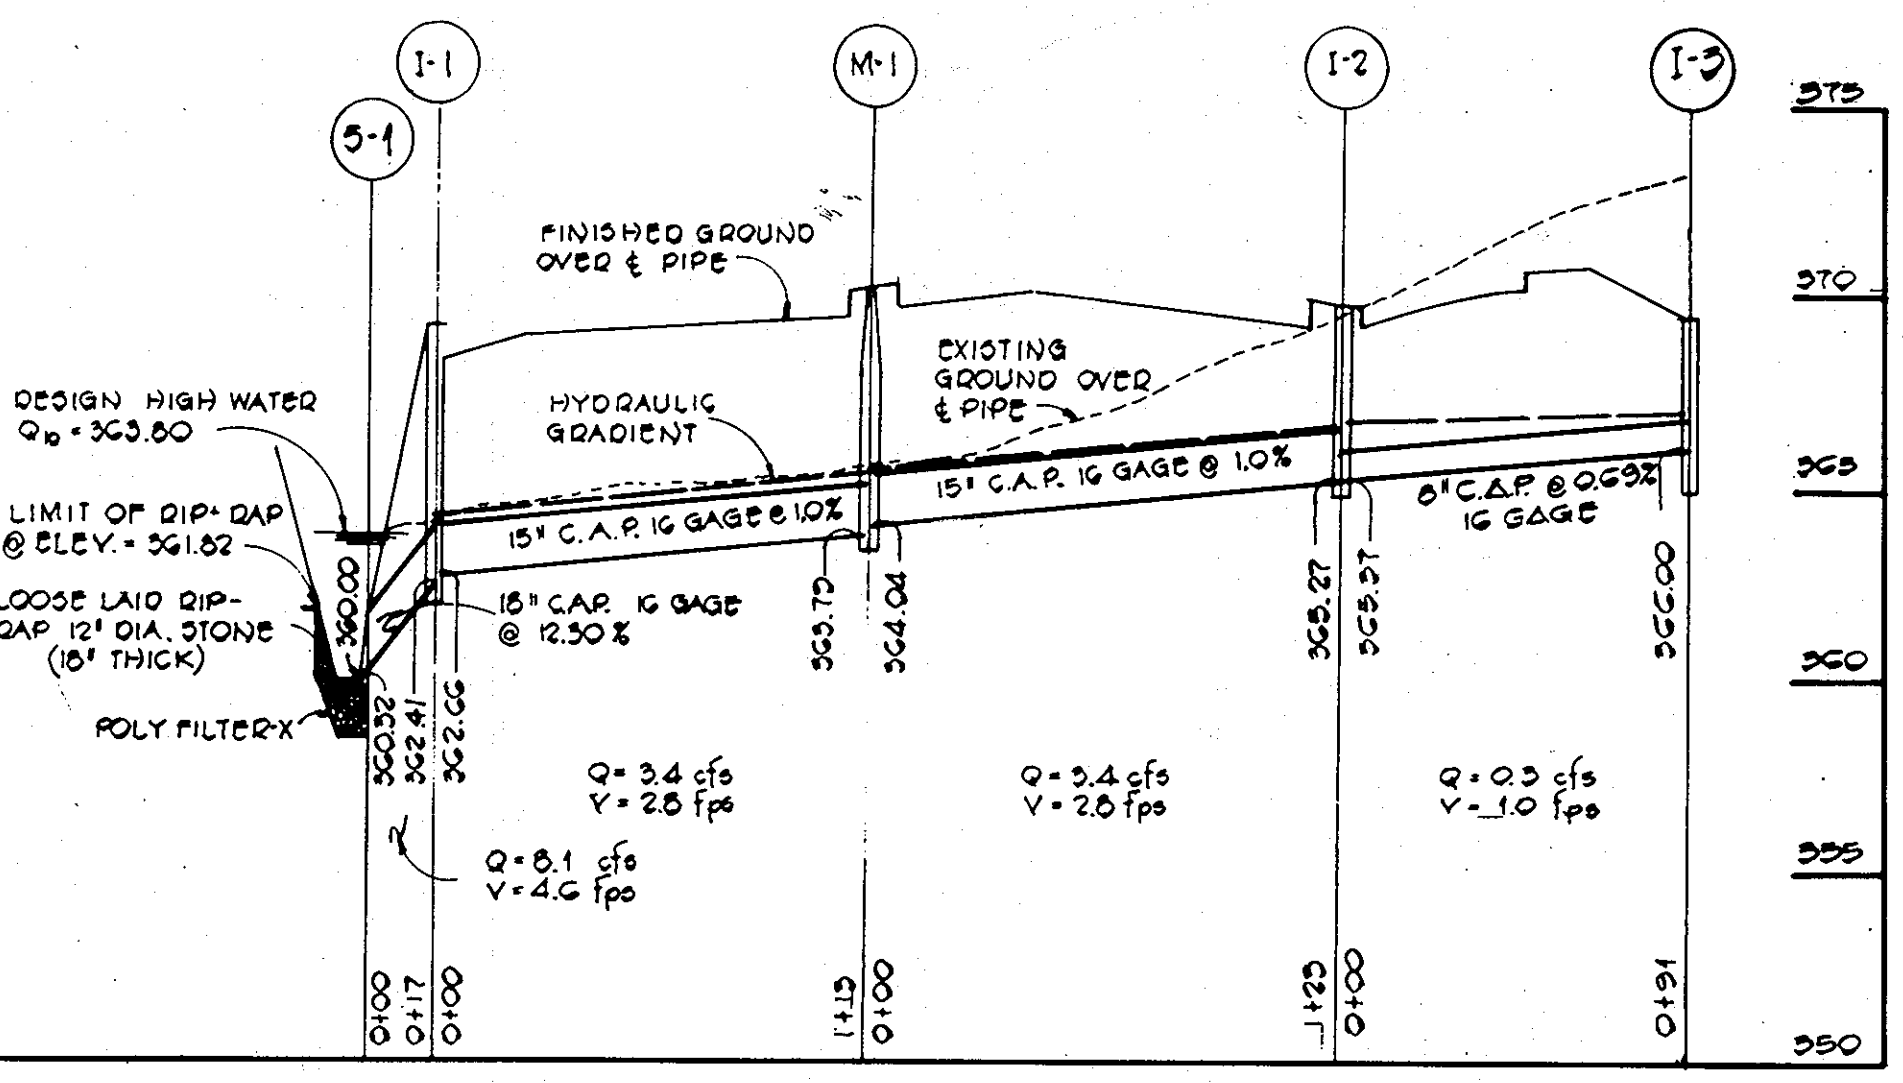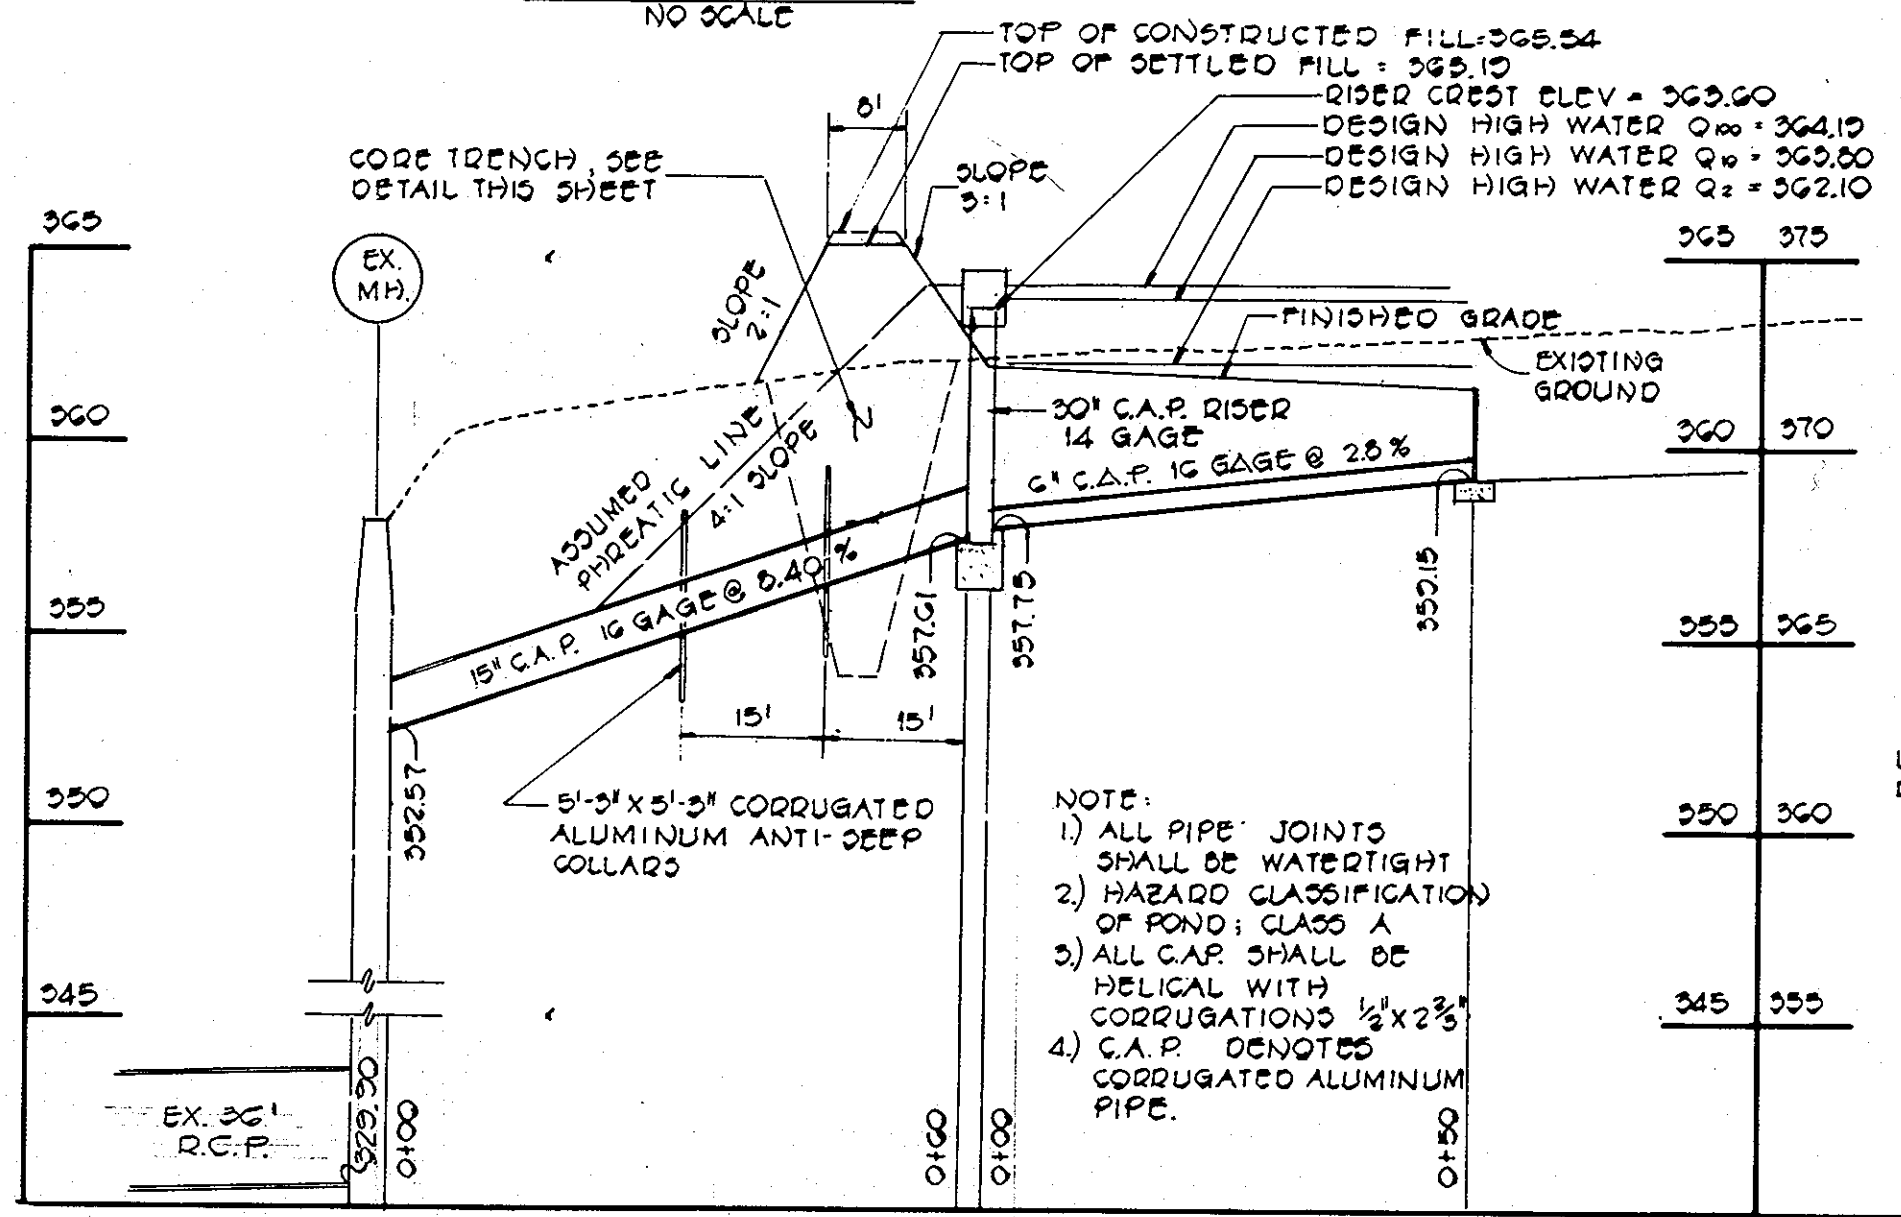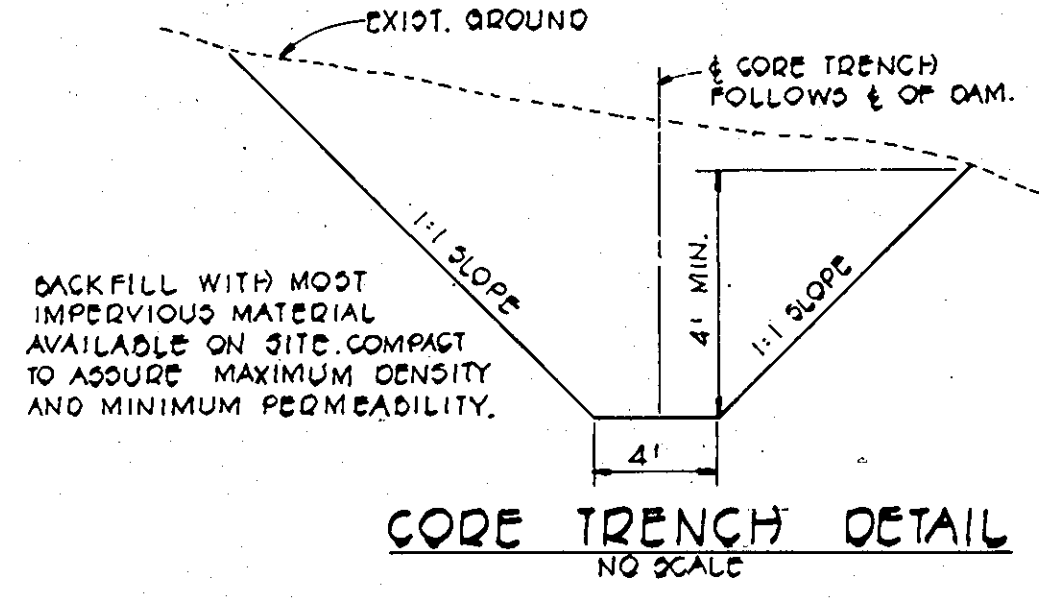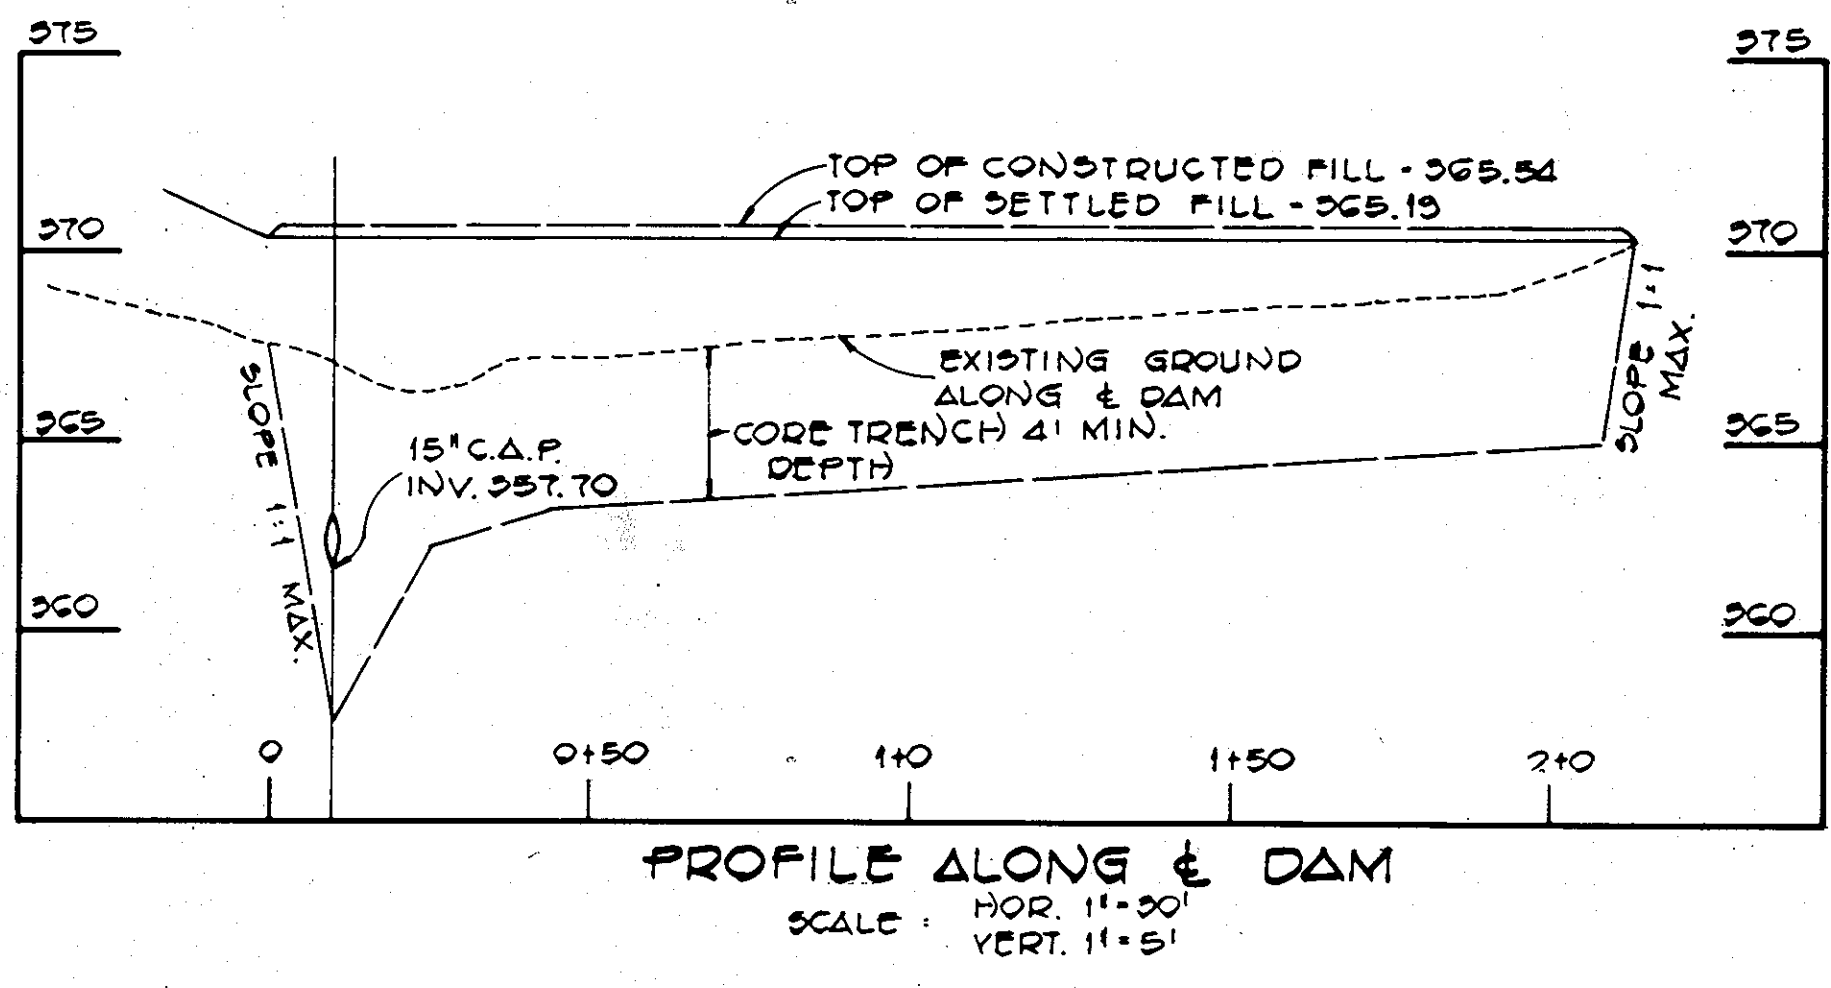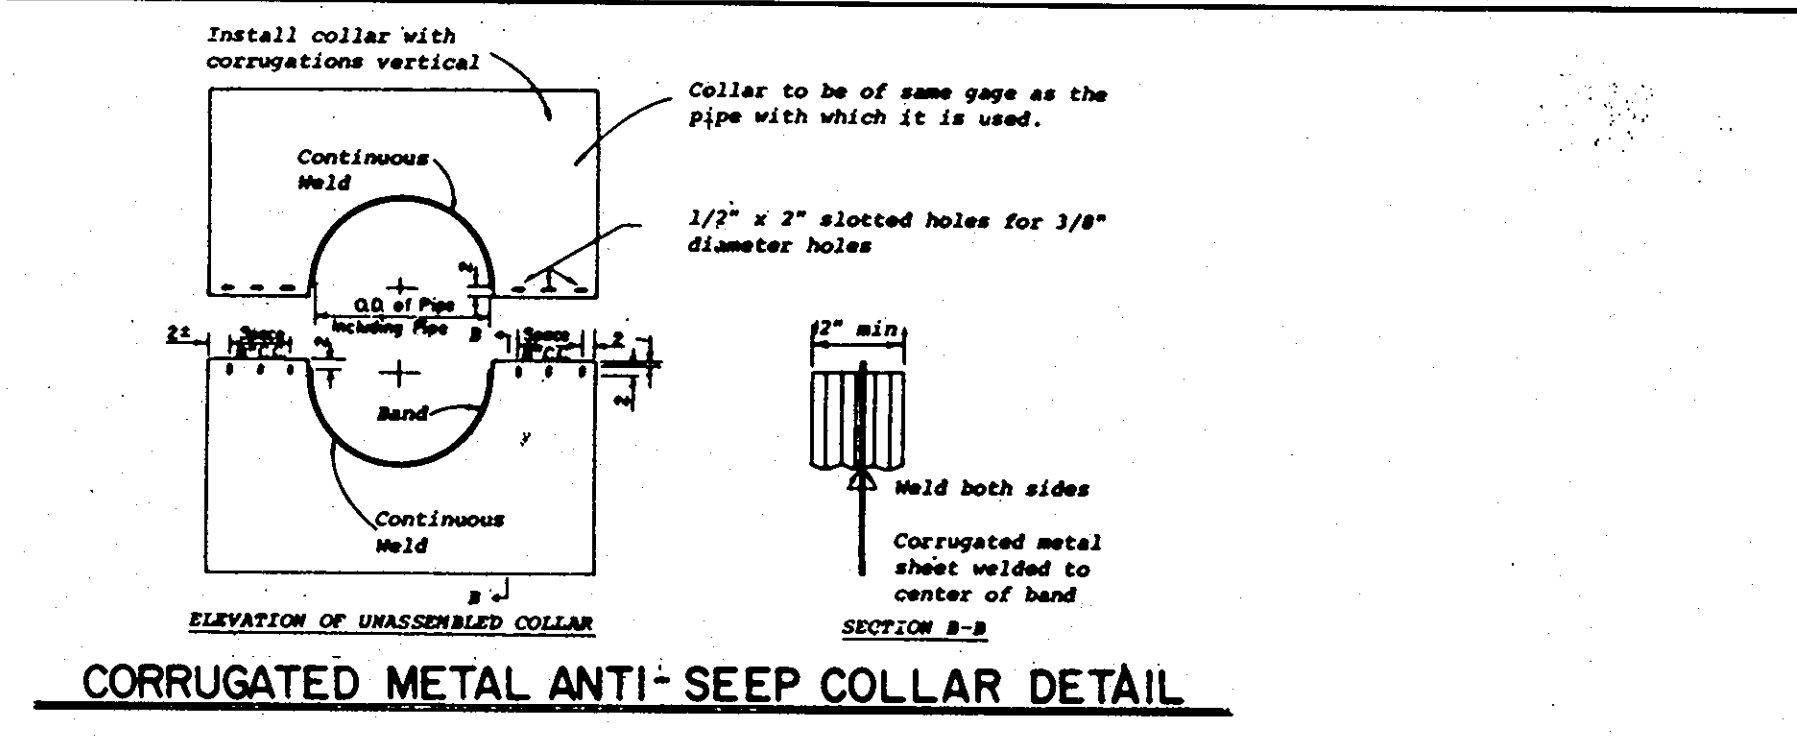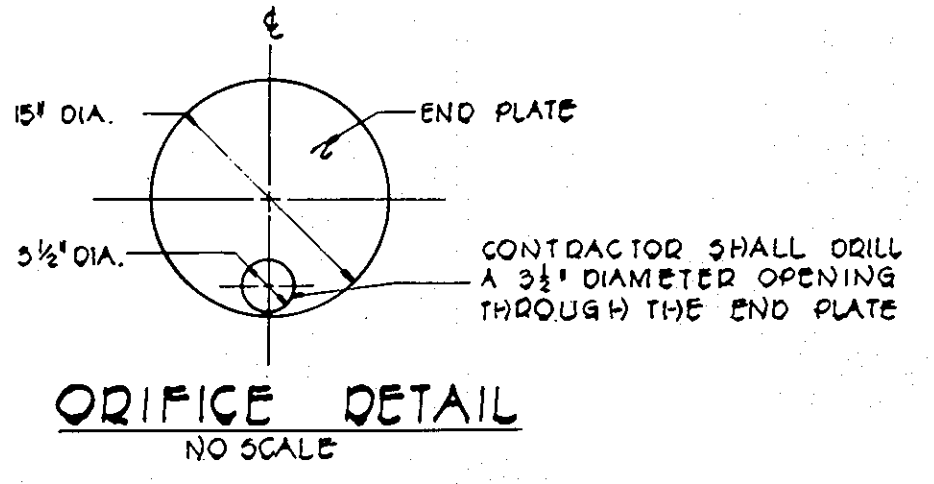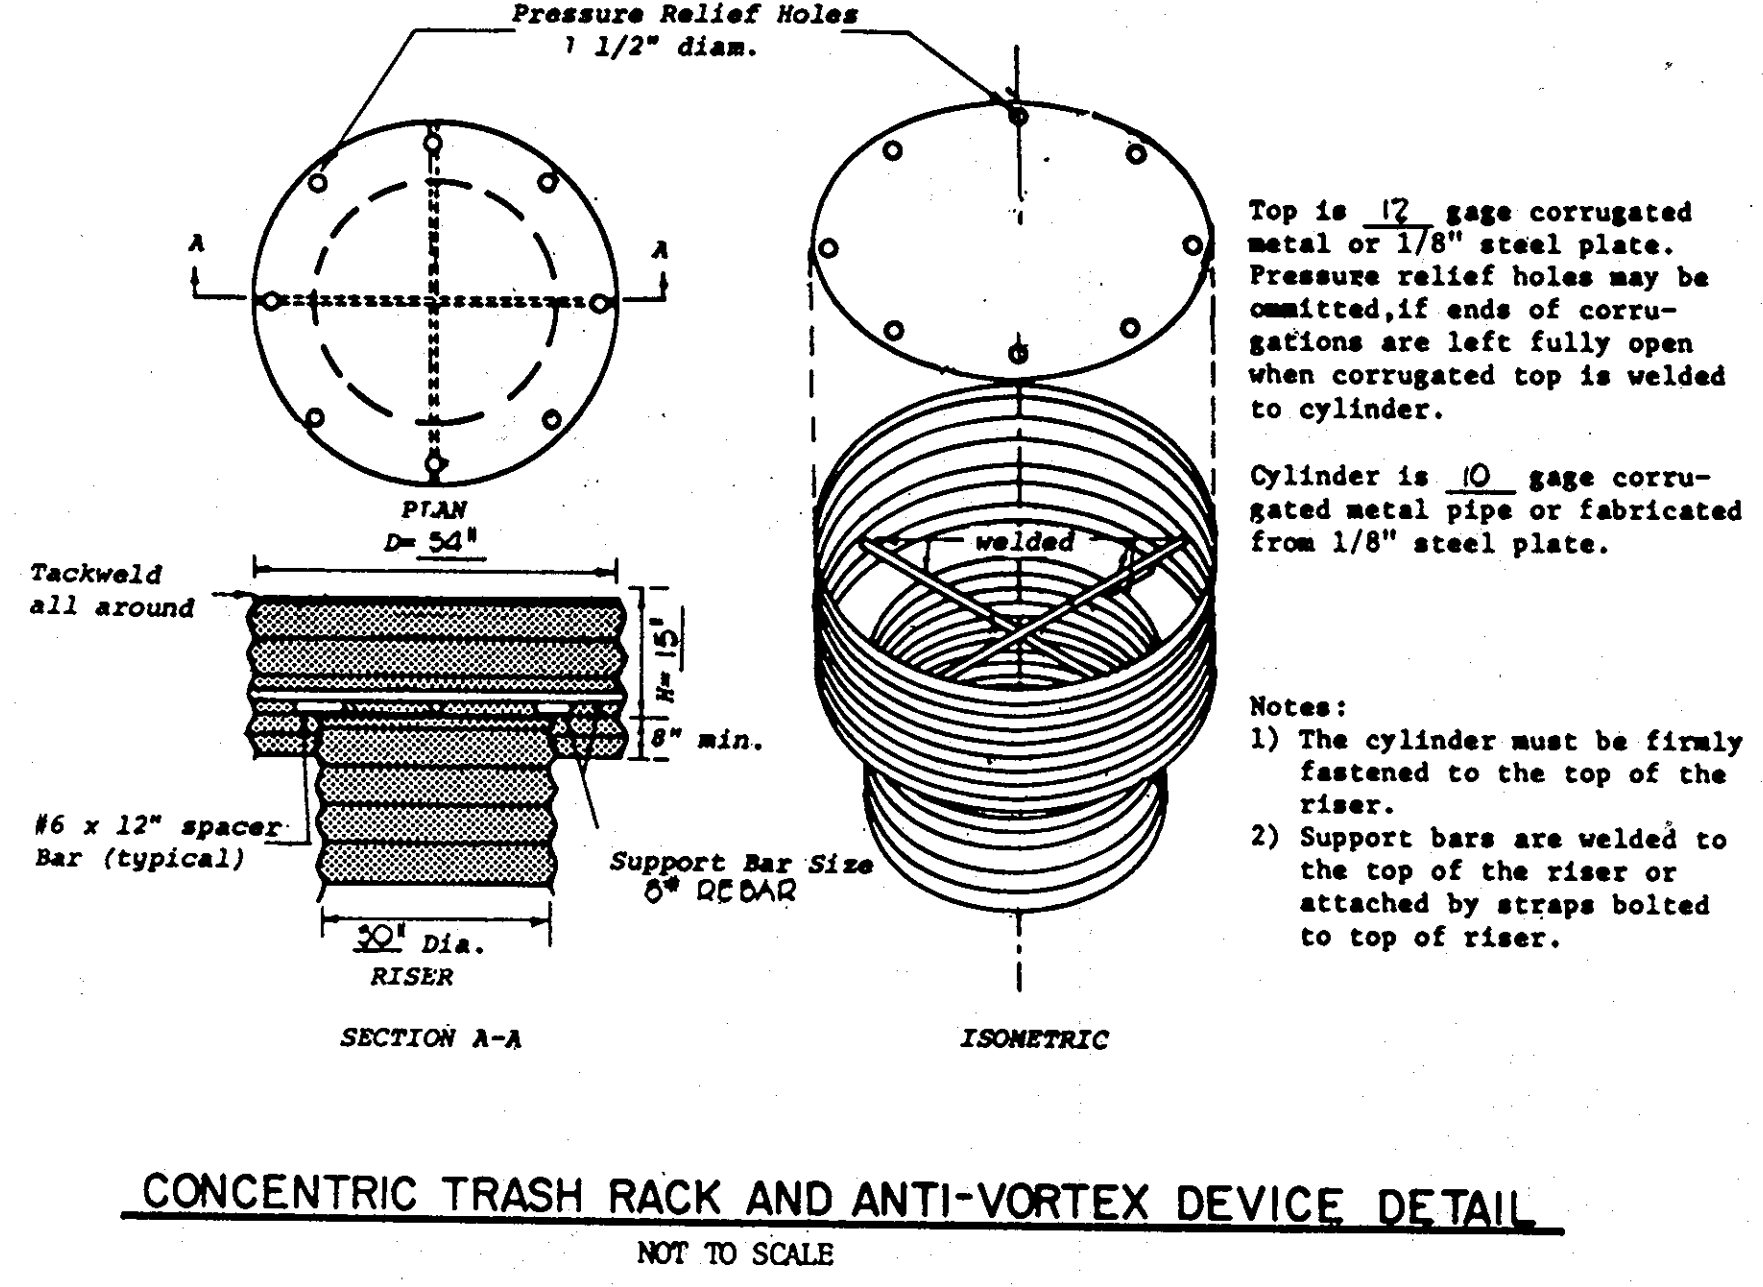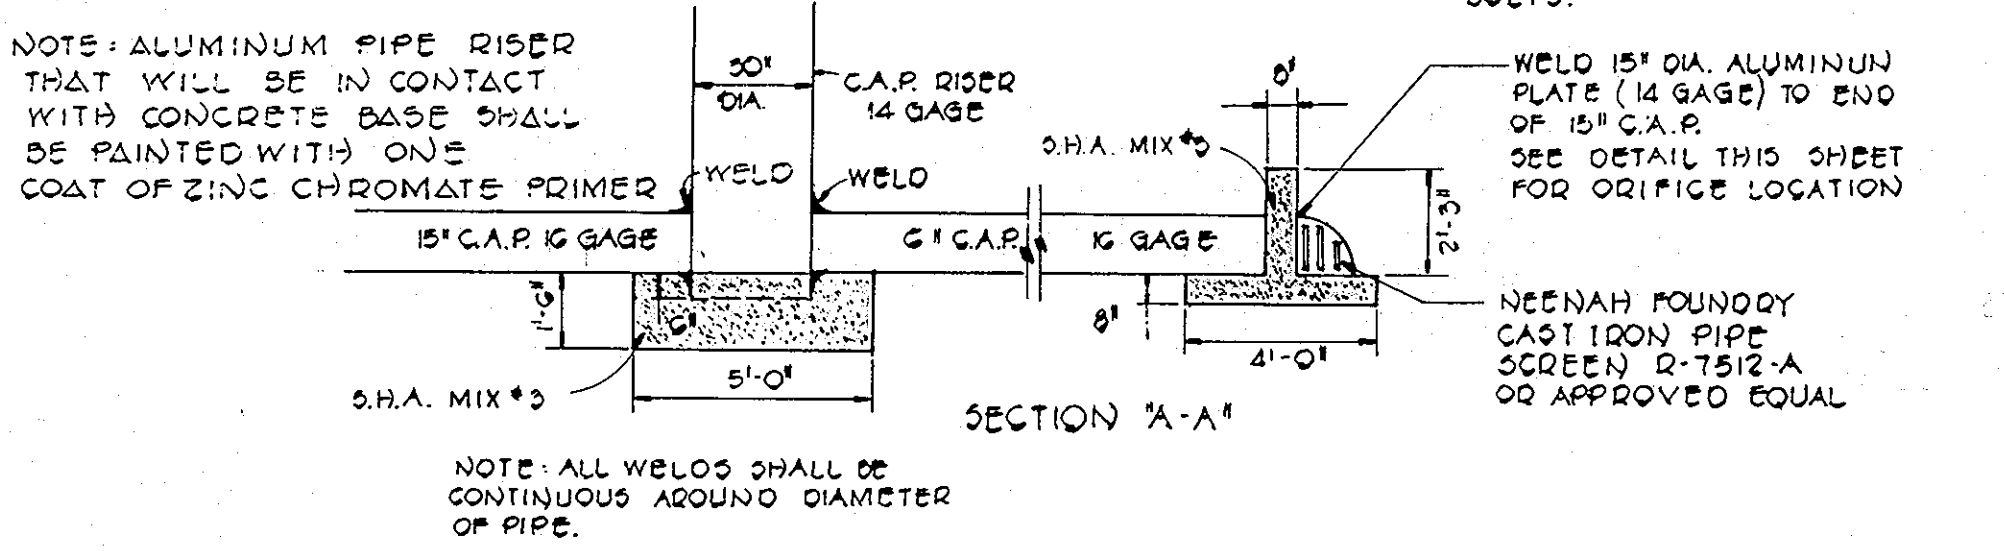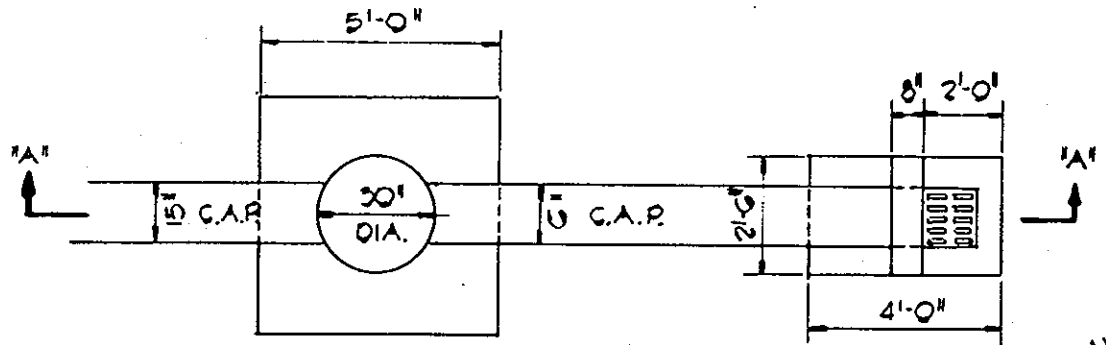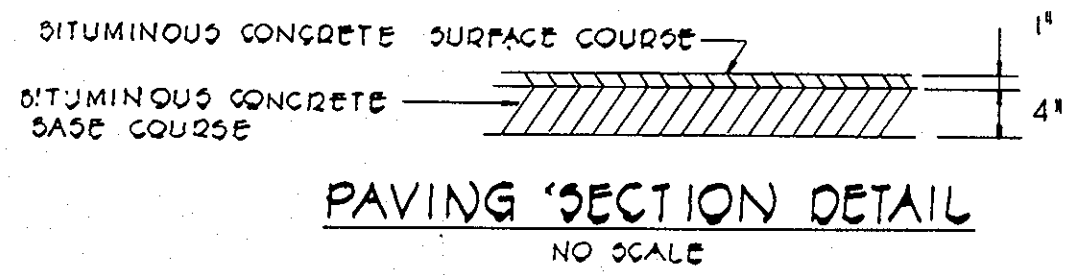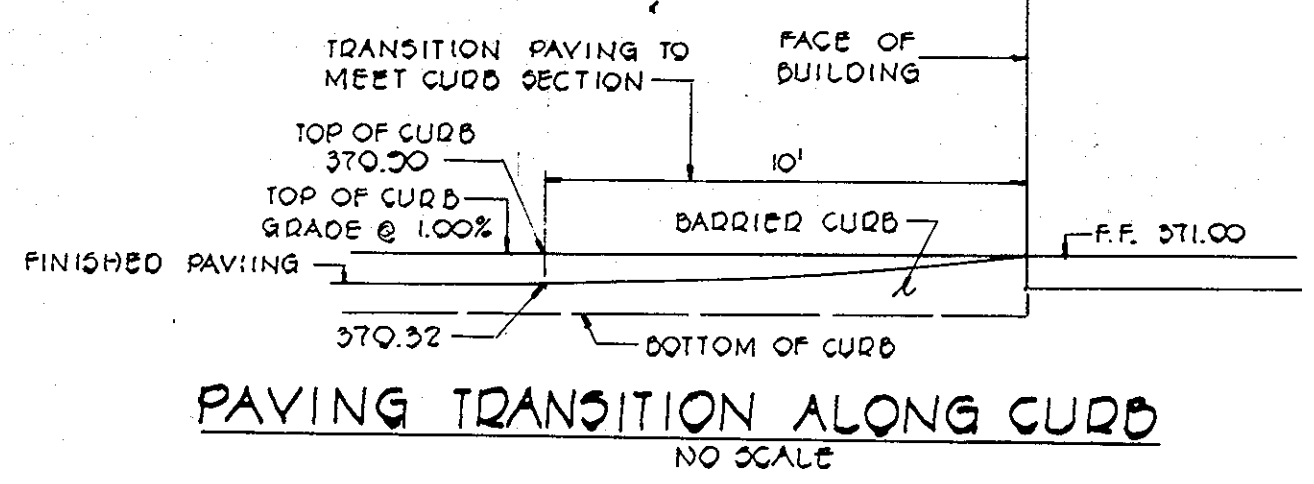

STORM WATER MANAGEMENT POND SPECIFICATIONS

- SITE PREPARATION**
Areas under the embankment and structural works shall be cleared, grubbed and the topsoil stripped to remove all trees, vegetation, roots or other objectionable material. To facilitate clean out and restoration, it is recommended that the permanent pool area be cleared of all brush and trees.
- EARTH FILL**
The fill material shall be taken from approved designated borrow area or areas. It shall be free from roots, stumps, wood, rubbish, over-size stones, frozen or other objectionable materials. The embankment shall be constructed to an elevation which provides for anticipated settlement to the design elevation. The fill height all along the length of the embankment shall be increased at least 5 percent above the design elevation (including freeboard) unless otherwise shown on the plans.
Placement
Areas on which fill is to be placed shall be scarified prior to placement of fill. Fill materials shall be placed in 8-inch maximum thickness (before compaction) layers which are to be continuous over the entire length of the fill. The most porous borrow material shall be placed in the downstream portions of the embankment.
Compaction
95% of Standard Proctor by A.S.T.M. 698
Core Trench
Where specified, a core trench shall be excavated along or parallel to the centerline of the embankment as shown on the plans. The bottom width of the trench shall be governed by the equipment used for excavation, with the minimum width being four feet. The depth shall be at least four feet or as shown on the plans. The side slopes of the trench shall be 1 to 1 or flatter. The backfill material for the core trench shall be the most impervious material available and shall be compacted with equipment or rollers to assure maximum density and minimum permeability.
- STRUCTURAL BACKFILL**
Backfill material shall be of the type and quality conforming to that specified for the adjoining fill material. The fill shall be placed in horizontal layers not to exceed four inches in thickness and compacted by hand tampers or other compaction equipment. The material needs to fill completely all spaces under and adjacent to the pipe. At no time during the backfilling operation shall driven equipment be allowed to operate closer than four feet, measured horizontally, to any part of a structure. Under no circumstances shall the contractor drive equipment over any part of a concrete structure or pipe unless there is a compacted fill of twenty-four inches or greater over the structure or pipe.


- PIPE CONDUITS**
A. CORRUGATED METAL PIPE
1. Materials - Aluminum Pipe - This pipe and its appurtenances shall conform to the requirements of AASHTO Specification M-196 or M-211, with watertight coupling bands.
2. Connections - All connections with pipes must be completely watertight. The drain pipe or barrel connection to the control structure shall be mortared all around. Watertight coupling bands shall be used at all joints. Anti-seep collars shall be connected to the pipe in such a manner as to be completely watertight.
3. Bedding - The pipe shall be firmly and uniformly bedded throughout its entire length. Where rock or soft, spongy or other unstable soil is encountered, all such material shall be removed and replaced with suitable earth compacted to provide adequate support.
4. Laying pipe - The pipe shall be placed with inside circumferential laps pointing downstream and with the longitudinal laps at the sides.
5. Backfilling shall conform to structural backfill as shown above.
6. Other details (anti-seep collars, valves, etc.) shall be as shown on the drawings.
- CONCRETE**
Concrete shall meet minimum requirements set forth in Maryland State Highway Administration Specifications for Materials, Highways, Bridges, and Incidental Structures, Article 20.07 (Portland Cement Concrete Mixtures), Mix No. 3.
- STABILIZATION**
All borrow areas shall be graded to provide proper drainage and left in a slightly condition. All exposed surfaces of the embankment, spillway and borrow areas shall be stabilized by seeding and applying straw mulch in accordance with Standards and Specifications for Soil Erosion and Sediment Control in Urbanizing Areas immediately after finish grading.
All exposed areas of the embankment and pond shall be stabilized by:
a. Spreading 4" topsoil
b. Working in 1 ton of ground limestone and 1,000 pounds of 10-10-10 fertilizer per acre.
c. Seed with 40 lbs./acre of "Kentucky 31" tall fescue, and 15 lbs./acre of Crownvetch inoculated.
d. Mulch with 1-1/2 tons straw per acre.
e. Tie down mulch with emulsified asphalt @ 348 gallons/acre.

APPROVED
PLANNING BOARD
OF HOWARD COUNTY
DATE 4-7-82
JMM

STORM DRAIN PROFILES & DETAILS

AS BUILT
DATE: FEBRUARY 2010

DATA BASE INC.
PARCEL E-1
CEILING INDUSTRIAL CENTER
SECTION ONE AREA TWO
SIXTH ELECTION DISTRICT HOWARD COUNTY MARYLAND
FEBRUARY 5, 1982 SHEET 2 OF 4

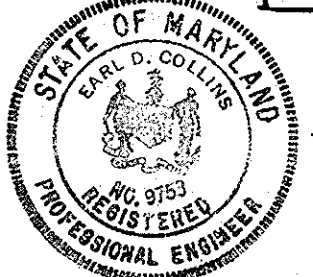

FISHER, COLLINS AND CARTER, INC.
CONSULTING ENGINEERS AND LAND SURVEYORS
8388 COURT AVENUE
ELLCOTT CITY, MARYLAND 21043

APPROVED: HOWARD COUNTY OFFICE OF PLANNING AND ZONING
THOMAS J. HANIGL 4-28-82
DIRECTOR, PLANNING AND ZONING

APPROVED: HOWARD COUNTY DEPARTMENT OF PUBLIC WORKS FOR PUBLIC WATER, PUBLIC SEWERAGE AND STORM DRAINAGE SYSTEMS AND ROADS.
JOHN F. NIMMAY 4-26-82
DIRECTOR, PUBLIC WORKS

THESE PLANS FOR SMALL POND CONSTRUCTION, SOIL EROSION AND SEDIMENT CONTROL MEET THE REQUIREMENTS OF THE HOWARD SOIL CONSERVATION DISTRICT.
HOWARD SOIL CONSERVATION DISTRICT 4/12/82

APPROVED: HOWARD COUNTY HEALTH DEPARTMENT FOR PUBLIC WATER AND PUBLIC SEWERAGE SYSTEMS.
JAYM B. BAYNE 4-27-82
COUNTY HEALTH OFFICER

THESE PLANS HAVE BEEN REVIEWED FOR THE HOWARD SOIL CONSERVATION DISTRICT AND MEET THE TECHNICAL REQUIREMENTS FOR SMALL POND CONSTRUCTION, SOIL EROSION AND SEDIMENT CONTROL.
HOWARD SOIL CONSERVATION DISTRICT 4/12/82

APPROVED: HOWARD COUNTY OFFICE OF PLANNING AND ZONING
Thomas H. Harris 4-28-82
 DIRECTOR, PLANNING AND ZONING





APPROVED: HOWARD COUNTY OFFICE OF PUBLIC WORKS FOR PUBLIC UTILITIES, PUBLIC POWER AND STORM DRAINAGE SYSTEMS AND ROADS
Henry F. Nemmy 4-26-82
 DIRECTOR, PUBLIC WORKS

APPROVED: HOWARD COUNTY HEALTH DEPARTMENT FOR PUBLIC UTILITIES AND PUBLIC POWER AND STORM DRAINAGE SYSTEMS AND ROADS
James J. Ryan 4-26-82
 CHIEF, BUREAU OF ENGINEERING









APPROVED: HOWARD COUNTY SOIL CONSERVATION DISTRICT FOR SOIL EROSION AND SEDIMENT CONTROL
Robert Ziehm 4/12/82
 DISTRICT COORDINATOR, HOWARD COUNTY SOIL CONSERVATION DISTRICT

APPROVED: HOWARD COUNTY SOIL CONSERVATION DISTRICT AND MEETS TECHNICAL REQUIREMENTS
Robert Ziehm 4/12/82
 U.S. SOIL CONSERVATION DISTRICT

No.	Revisions	Date
1	Added Sidewalk, Planters & Revised H.C. Striping	8/14/09
2	INDICATE INSTALLATION OF REMOTE POWER MAIN & PROTECT FIRE HYDRANTS	10/2/09
3	ADD NOTE REGARDING SILT FENCE AS REQUIRED FOR PERMANENT CURB	10/2/09

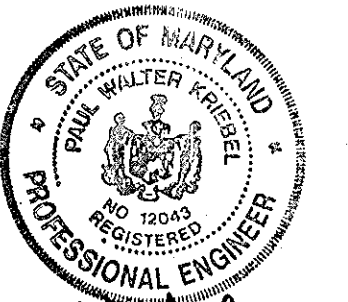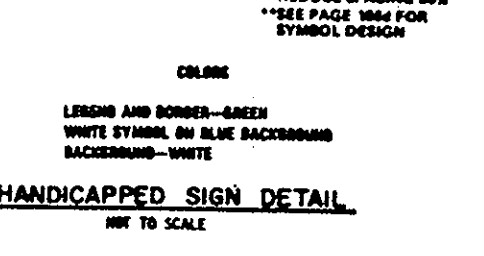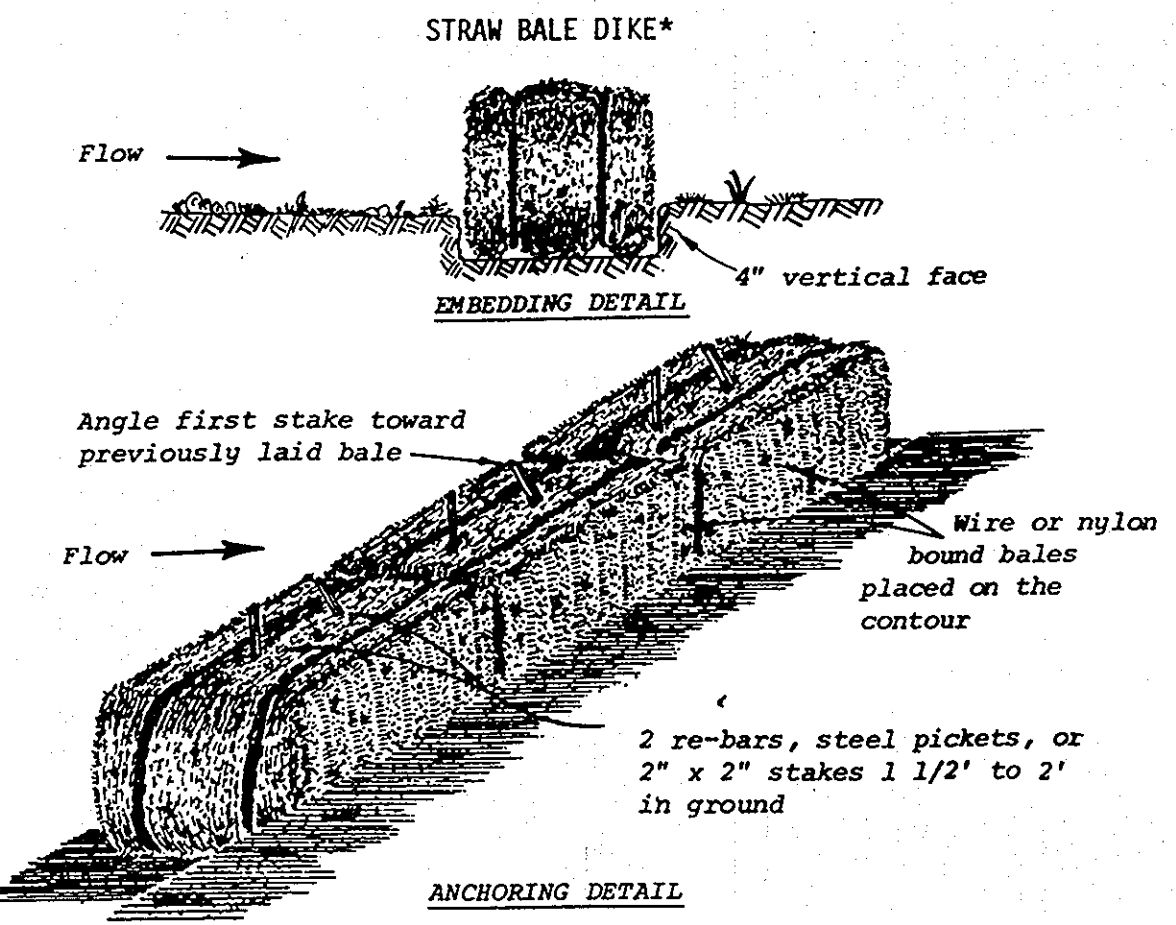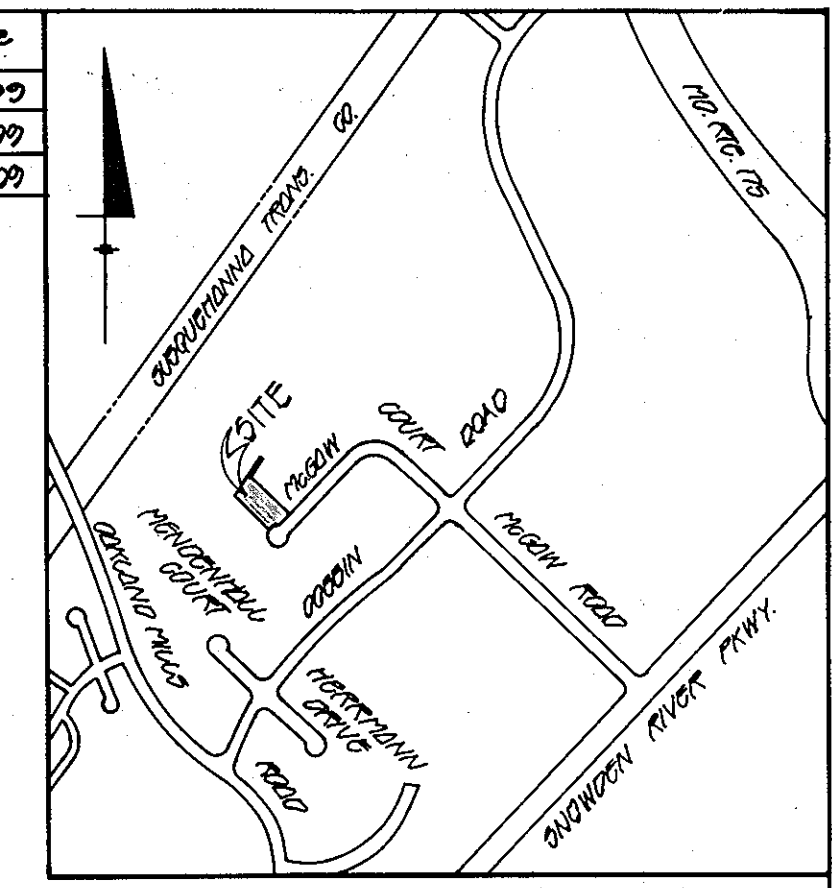


Paul W. Kriebel 10/22/09
 PAUL W. KRIEBEL FOR REGISTRATION

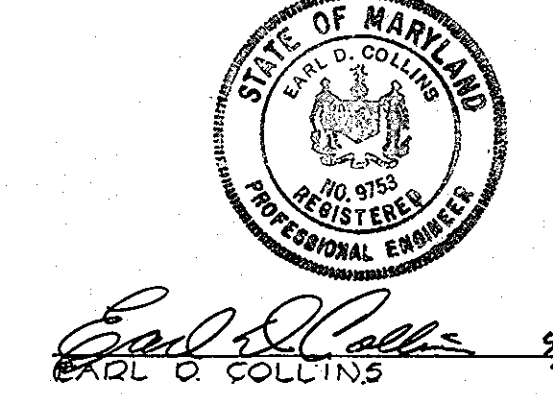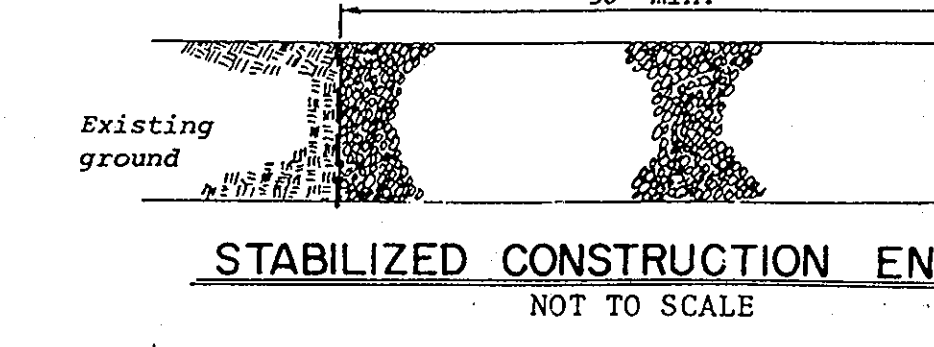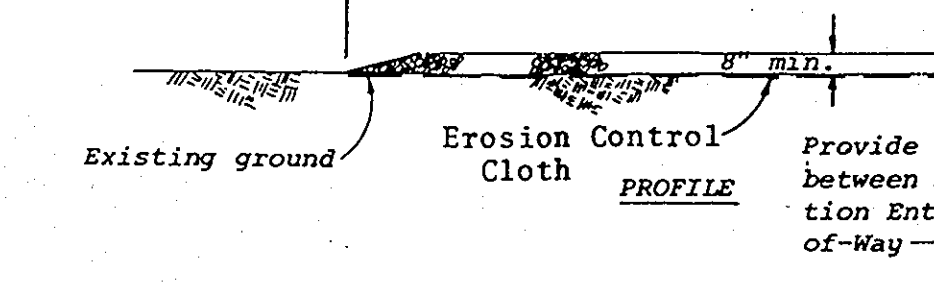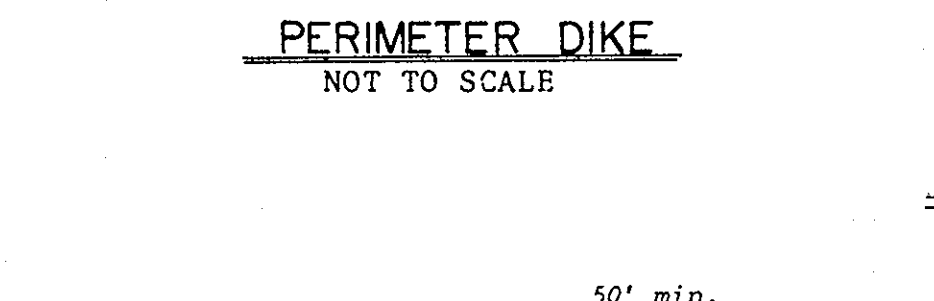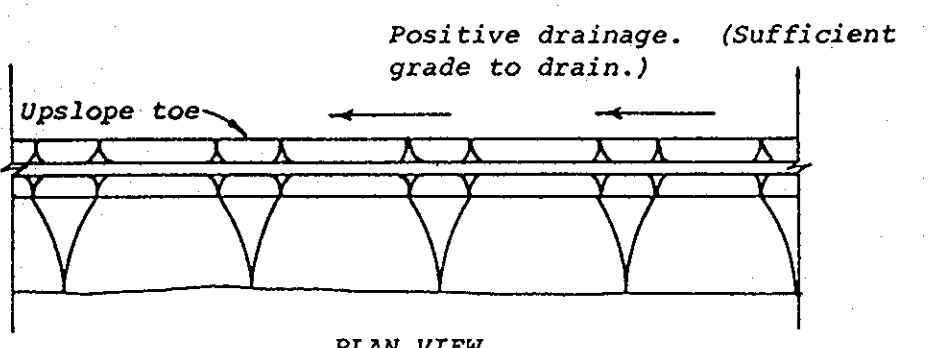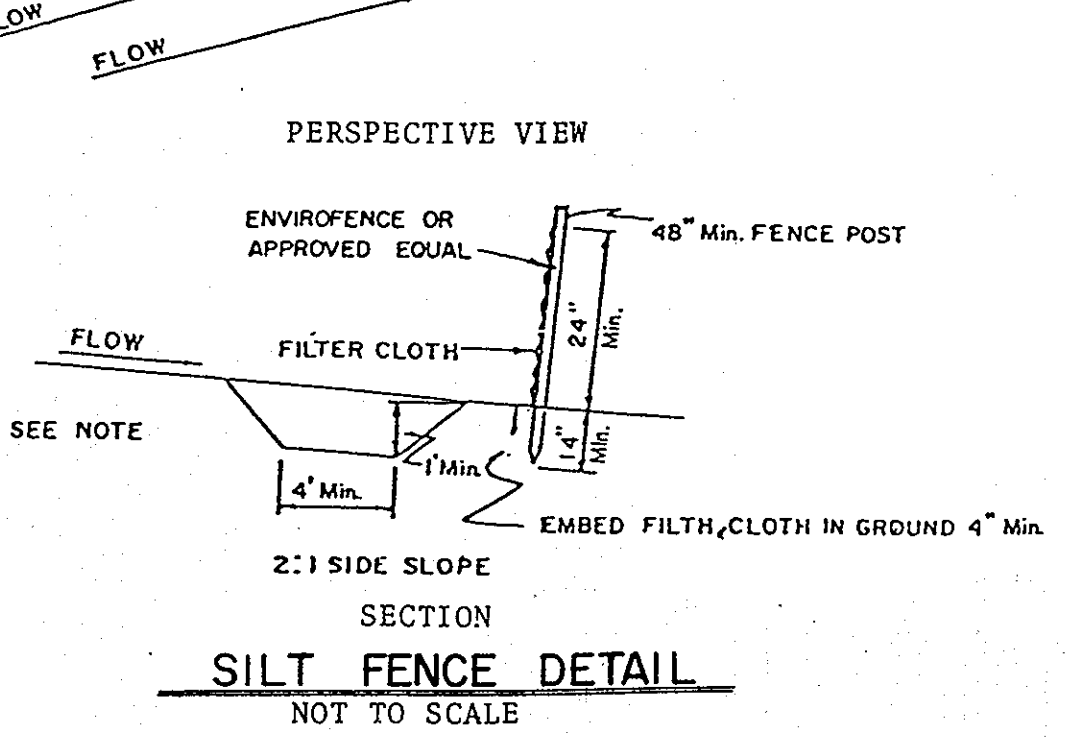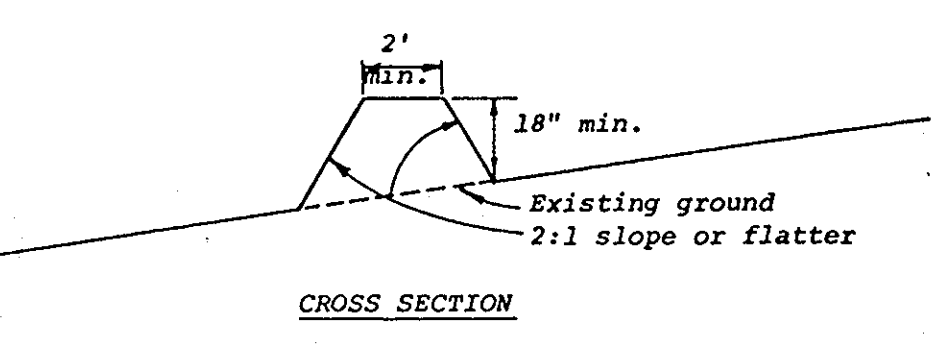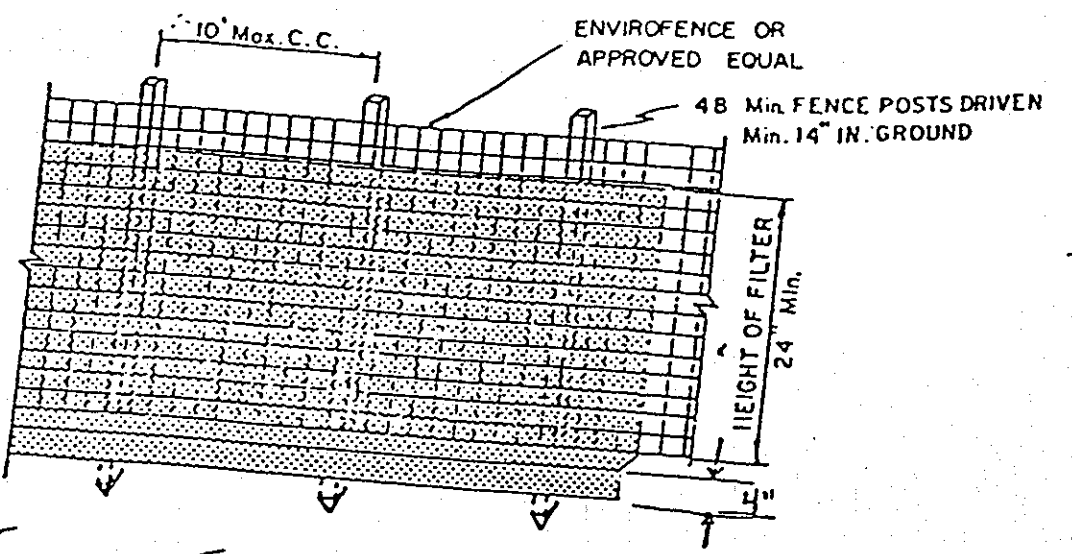

Earl G. Collins 4/14/09
 EARL G. COLLINS
 FLETCHER COLLINGS AND GORTON, INC.
 CONSULTING ENGINEERS AND LAND SURVEYORS
 8800 COURT AVENUE
 CUMMERTOWN, MARYLAND 21033
 410-2995

OWNER & DEVELOPER
 COAST CONSTRUCTION COMPANY
 652 D.W. 145 RD
 P.O. BOX 66475
 SEATTLE, WASHINGTON 98166

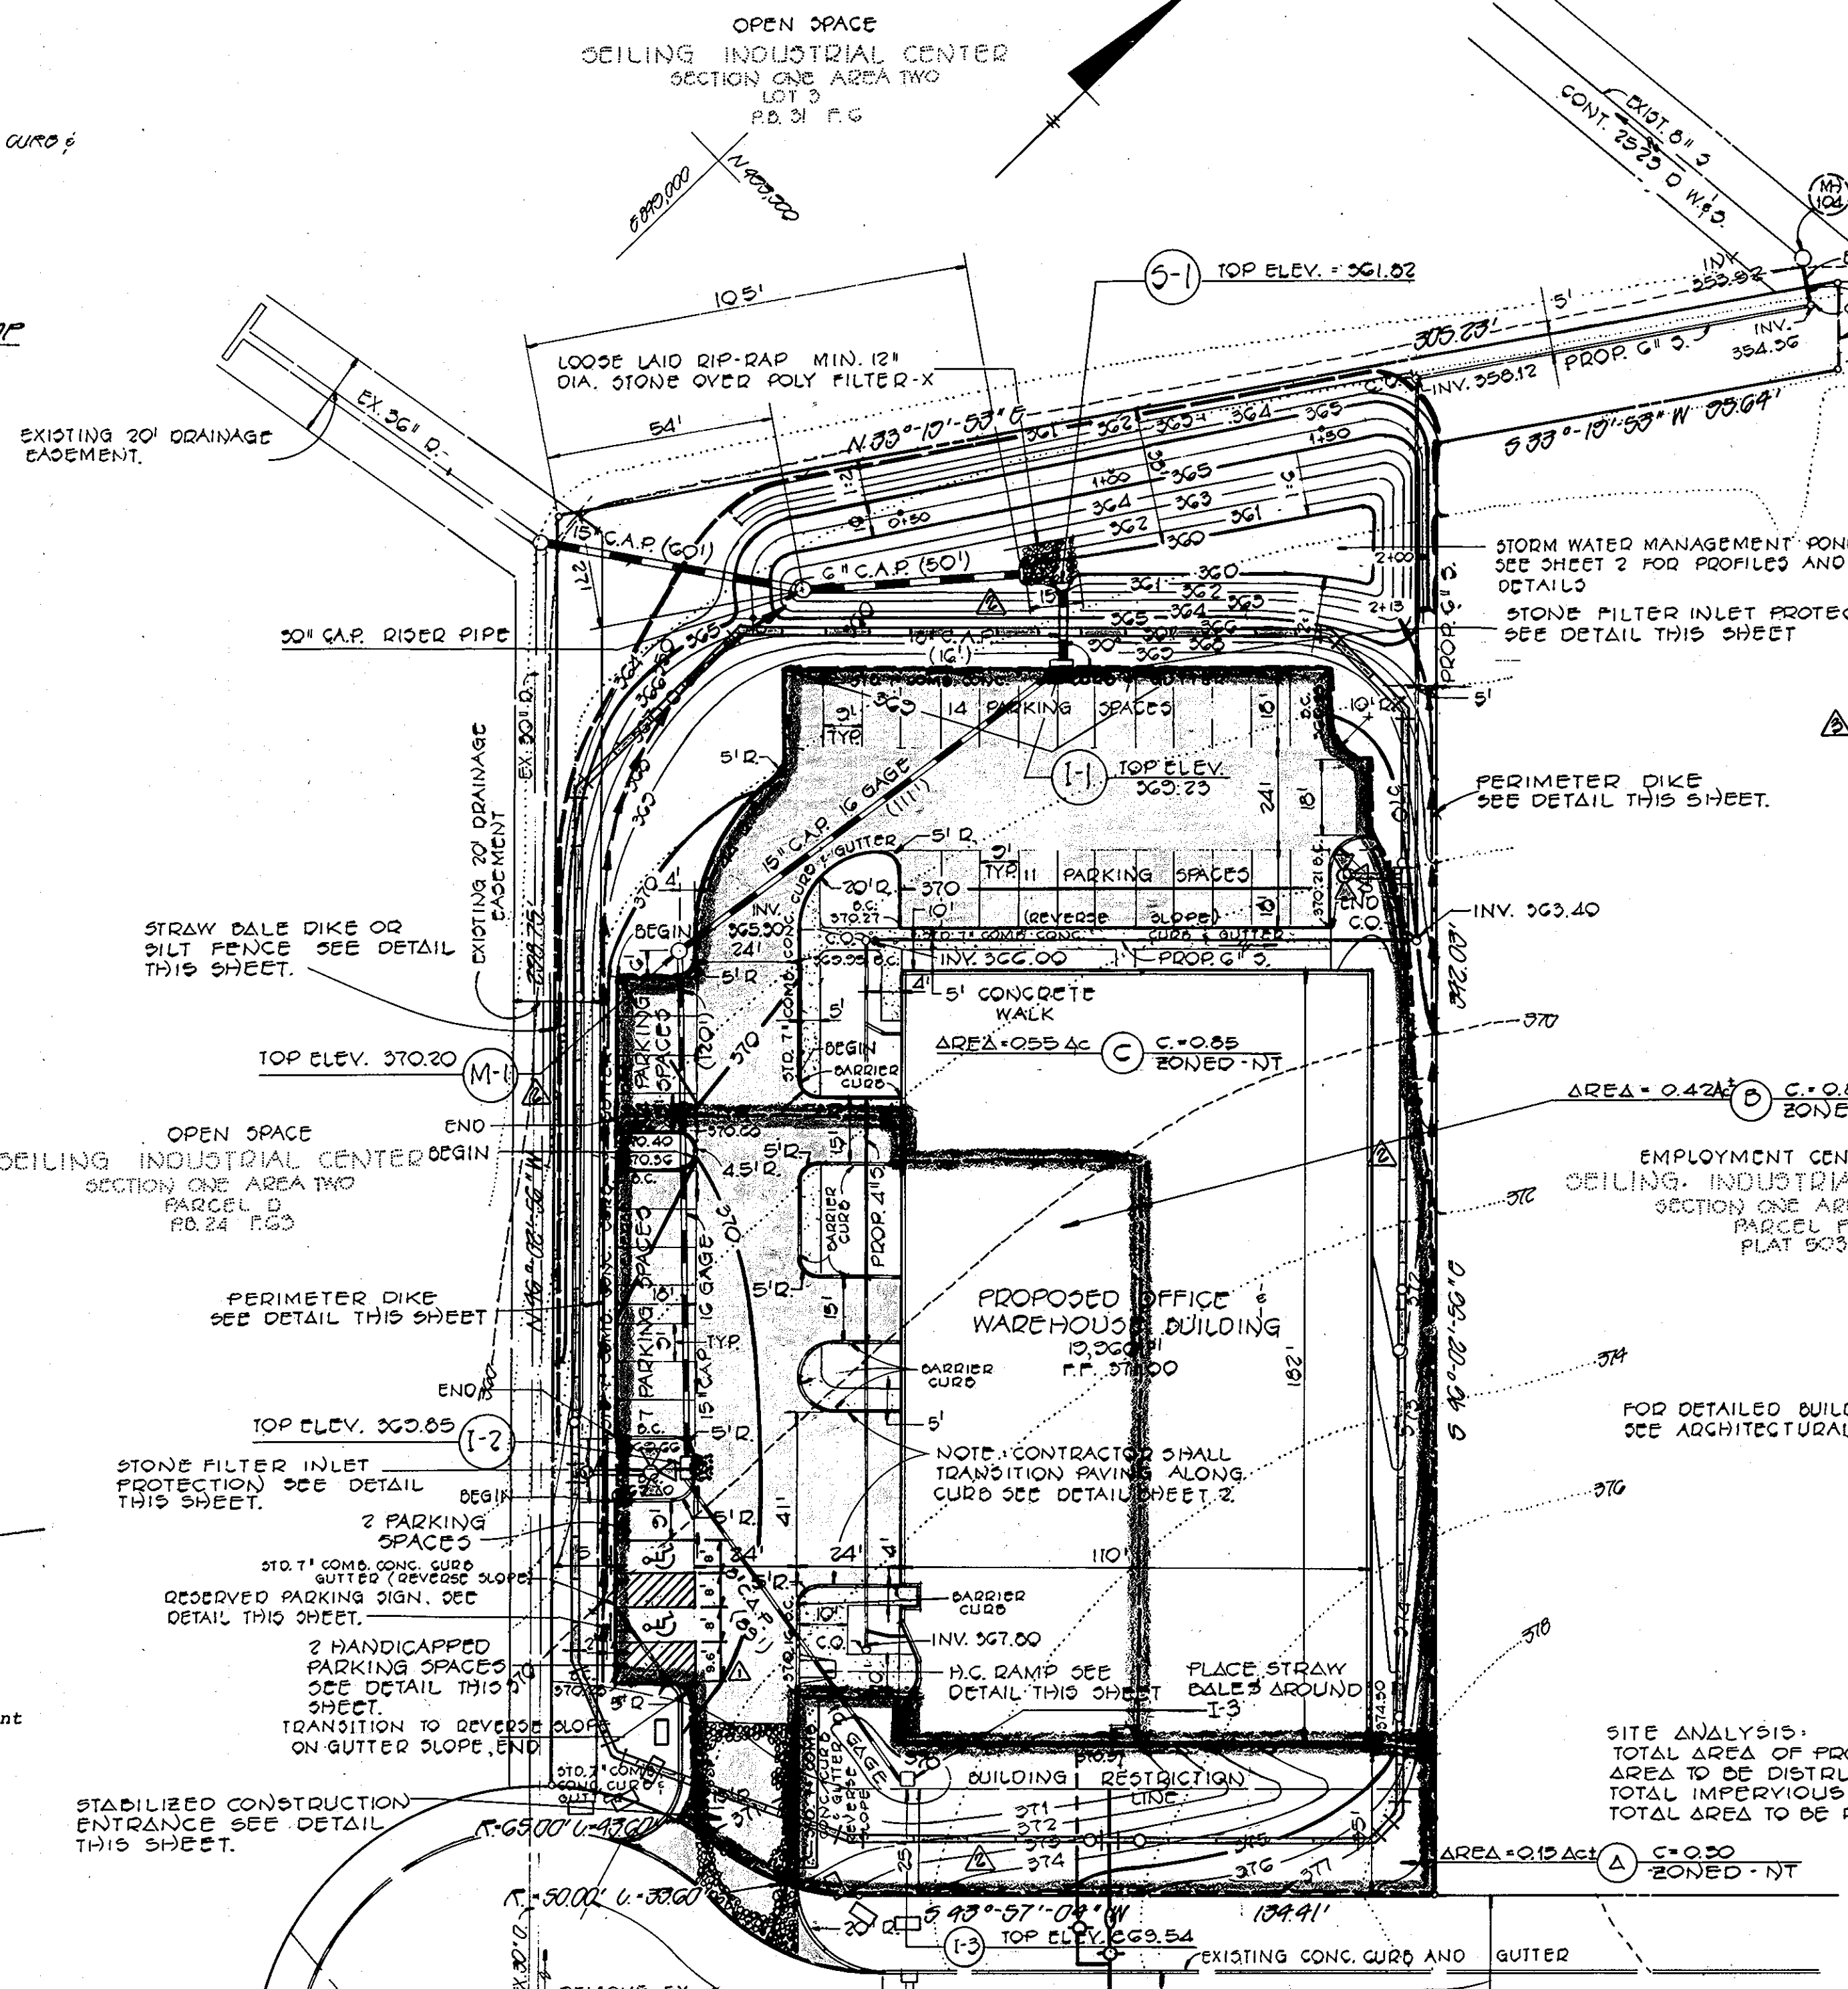

- SEDIMENT CONTROL NOTES
- Specifications for the Sediment Control Details shown hereon are included in the U.S.D.A. Soil Conservation Service "Standards and Specifications for Soil Erosion and Sediment Control in Developing Areas."
 - The developer shall notify the Howard County Office of Inspection and Permits at least 24 hours prior to beginning any construction shown hereon (892-2433).
 - Sediment control structures to be constructed prior to any on-site grading or disturbance to any existing surface material, and are to be stabilized as soon as constructed.
 - All sediment control structures to remain in place until permission for their removal has been obtained from the Howard County Office of Inspection and Permits. (892-2433).
 - All graded areas not to be sodded shall be stabilized by seeding and mulching in accordance with the following:
 - Site Preparation
 - Harrow or disc in areas proposed to be seeded the following materials
 - Pulverized limestone at 2 tons/acre.
 - Commercial fertilizer 10-10-10 at 3/4 tons/acre.
 - Super phosphate at 600 lbs./acre.
 - Seeding
 - Sow the following seed mixture at the rate of 200 lbs./acre with a mechanical spreader.
 - Temporary: Italian or Perennial Rye Grass
 - Permanent: 40% Marion Blue Grass, 40% South Dakota Blue Grass and 20% Penn Lawn Creeping Fescue.
 - The seeded area shall then be raked with a York Rake (a minimum of 2 passes) covered and compacted with Cultipacker or other approved method.
 - Mulching
 - Seeded areas shall be uniformly mulched immediately after seeding with unweathered small grain straw at the rate of 1 1/2 - 2 tons/acre.
 - Tie mulch down with liquid asphalt at 0.04 gal./s.y. or emulsified asphalt at 0.04 gal./s.y. or mulch netting.

- CONSTRUCTION SEQUENCE
- OBTAIN GRADING AND BUILDING PERMIT.
 - CONSTRUCT STONE CONSTRUCTION ENTRANCE.
 - CONSTRUCT STORM WATER MANAGEMENT POND AND STABILIZE USING TEMPORARY SEEDING.
 - THE ORIFICE AT THE 6" C.A.P. SHALL BE BLOCKED IN ACCORDANCE WITH THE DETAIL ON THIS SHEET. THE ORIFICE SHALL REMAIN BLOCKED UNTIL SUCH TIME WHEN THE SEDIMENT BASIN TRANSITIONS TO FUNCTION AS A STORM WATER MANAGEMENT POND.
 - INSTALL PERIMETER DIKES, STRAW BALE DIKES AND SILT FENCE.
 - GRADE SITE TO SUBGRADE.
 - CONSTRUCT BUILDING AND STORM DRAIN SYSTEM.
 - INSTALL INLET PROTECTION DEVICES AT I-1, I-2 AND I-3.
 - INSTALL CONCRETE CURB AND LAY BASE COURSE.
 - DURING CONSTRUCTION, SEDIMENT SHALL BE REMOVED FROM THE SEDIMENT BASIN WHEN THE CLEANOUT ELEVATION 360.8 HAS BEEN REACHED.
 - AFTER EACH RAINFALL, THE CONTRACTOR SHALL INSPECT AND PROVIDE NECESSARY MAINTENANCE ON THE SEDIMENT AND EROSION CONTROL STRUCTURES SHOWN HEREON.
 - THE SEDIMENT BASIN SHALL BE DEWATERED BY PUMPING.
 - THE SEDIMENT FROM THE BASIN SHALL BE PLACED ON THE SLOPES BEHIND THE CURB AND STABILIZED WITH PERMANENT SEEDING.
 - THE STORM WATER MANAGEMENT POND SHALL BE GRADED IN ACCORDANCE WITH SHEET ONE AND STABILIZED IN ACCORDANCE WITH THE PERMANENT SEEDING SPECIFICATIONS. INSTALL RIP RAP AS SHOWN ON SHEET ONE.
 - REMOVE PERIMETER DIKES AND STABILIZE WITH PERMANENT SEEDING.
 - REMOVE STONE CONSTRUCTION ENTRANCE.
 - CLEAN BASE COURSE, APPLY TACK COAT TO BASE COURSE AND LAY SURFACE COURSE.
 - ALL DISTURBED AREAS DUE TO REMOVAL OF SEDIMENT CONTROL MEASURES SHALL BE GRADED AND STABILIZED BY PERMANENT SEEDING.



APPROVED
 PLANNING BOARD
 OF HOWARD COUNTY
 DATE 4-7-82

DRAINAGE AREA MAP
 SEDIMENT CONTROL PLAN

AS BUILT
 DATE: FEBRUARY 2010











PARCEL E-1
 CEILING INDUSTRIAL CENTER
 SECTION ONE
 AREA TWO
 HOWARD COUNTY, MARYLAND.
 SHEET 3 OF 4

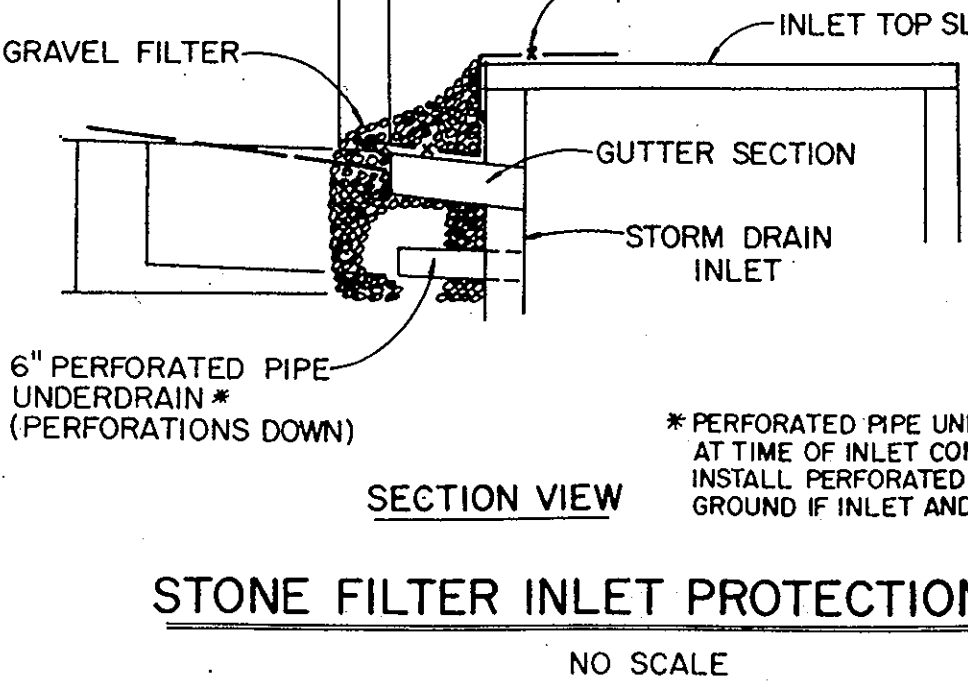
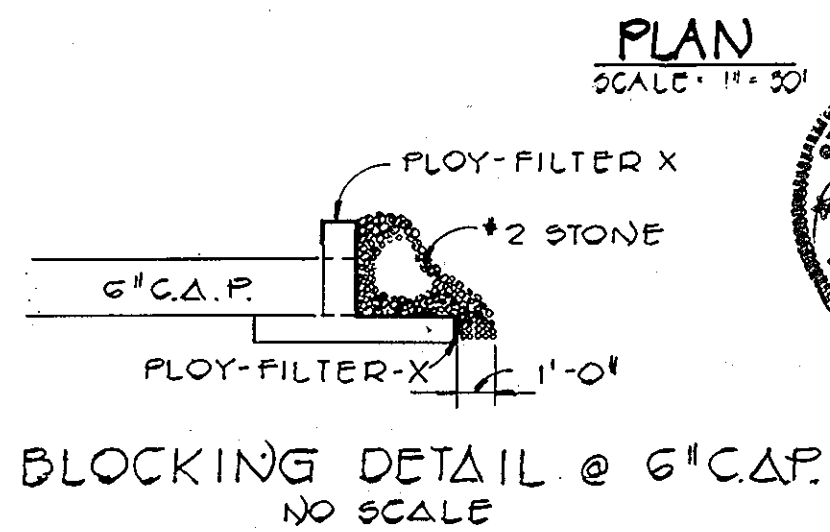


APPROVED - HOWARD COUNTY OFFICE OF PLANNING AND ZONING
4-28-82
 APPROVED - HOWARD COUNTY DEPARTMENT OF PUBLIC WORKS FOR PUBLIC WATER, PUBLIC SEWERAGE AND STREET DRAINAGE SYSTEMS AND NOTES
4-28-82
 APPROVED - HOWARD COUNTY HEALTH DEPARTMENT FOR PUBLIC WATER AND PUBLIC SEWERAGE SYSTEMS
4-21-82


No.	Revisions	Date
1	Added sidewalk, Planters & Revised H.C. Striping	8/4/09
2	INDICATE INSTALLATION OF PRIVATE 8" WATER MAIN & PRIVATE FIRE HYDRANT, ADD ASSOCIATED PRIVATE 8" WATER MAIN PROFILE & ADD ASSOCIATED WATER MAIN TABULATION CHART	10/21/09

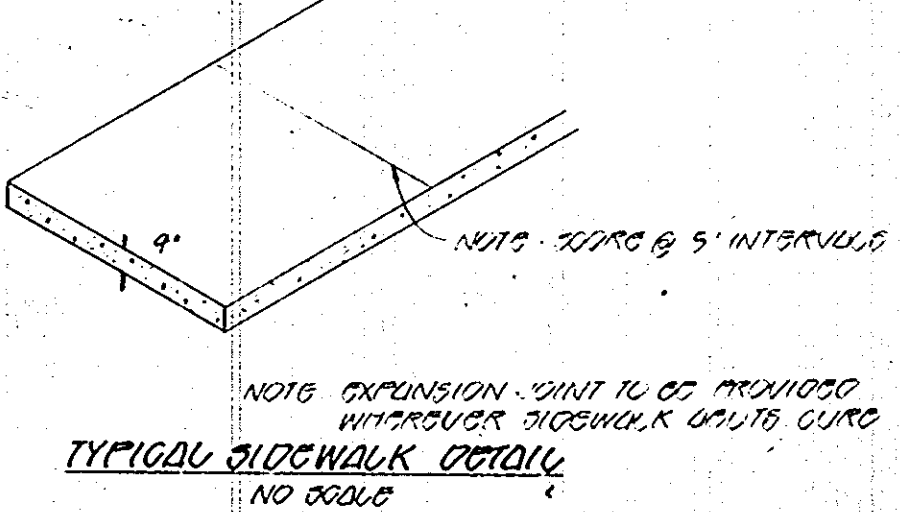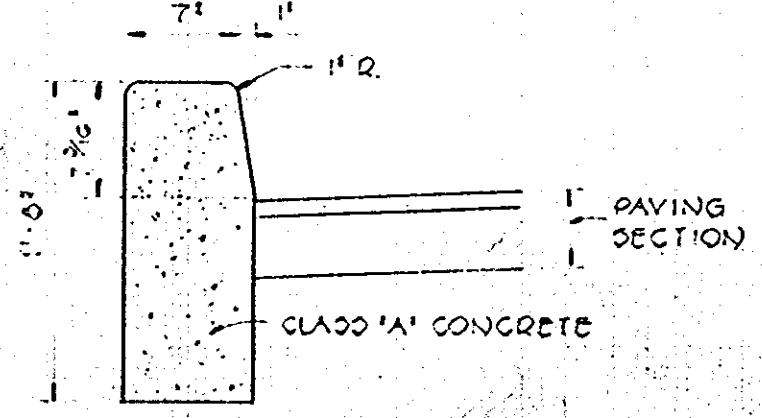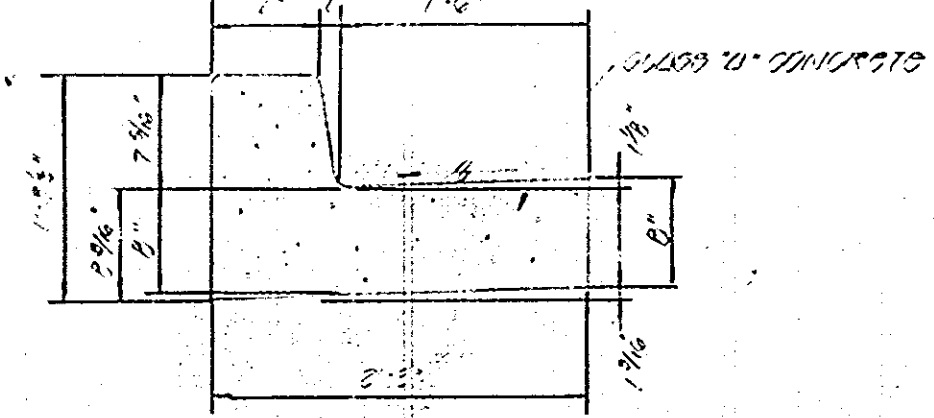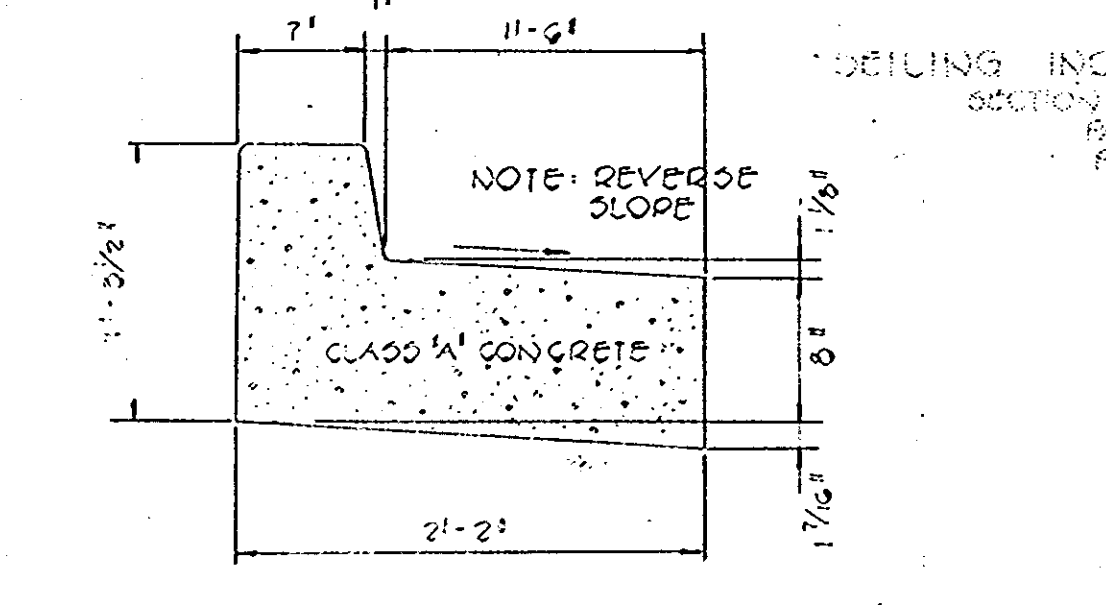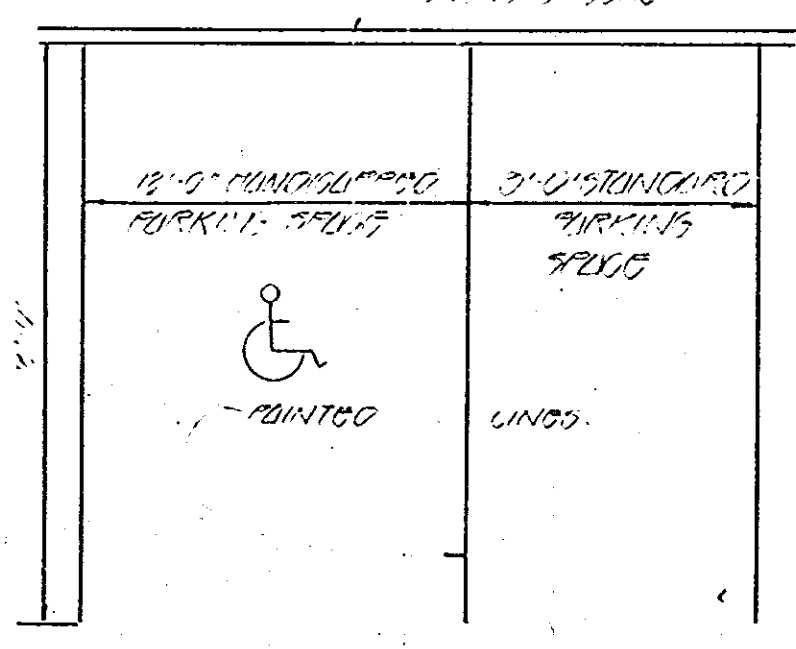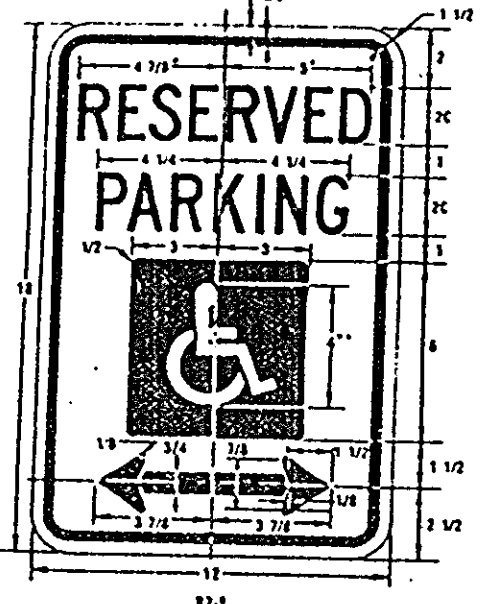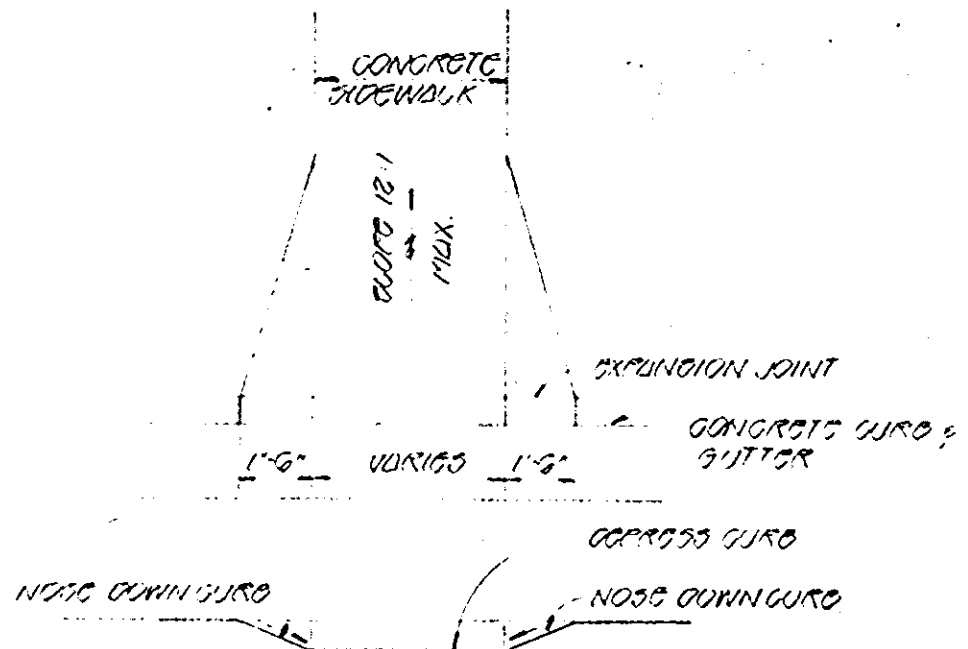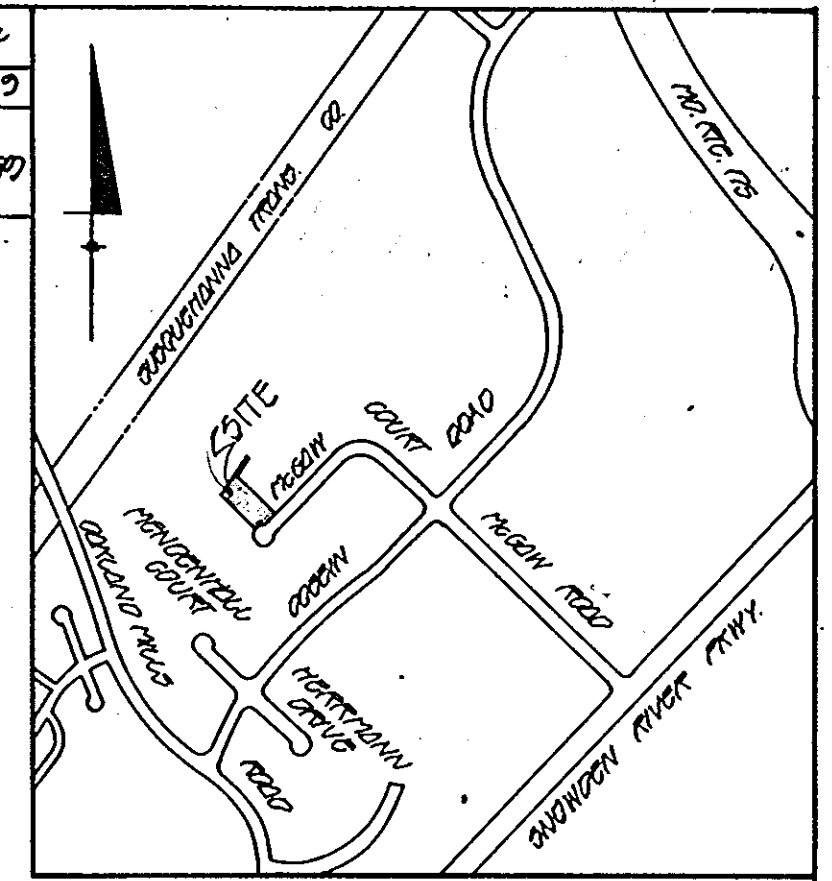

M.W. STA.	APPURTENANCE	NOTHING	EXISTING
0+00.00	8" VALVE	554445.40	136798.01
0+02.00	1 1/2" H.A.	554441.09	136793.94
0+20.25	1 1/2" H.A.	554374.77	136872.00
1+43.24	1 1/2" H.A.	554383.93	136849.05
1+60.36	8" VALVE	554433.06	136860.00
3+40.00	1 1/2" H.A.	554325.22	136803.09
3+71.00	8" VALVE	554390.41	136802.63
3+80.00	CABLE TEST STATION	554301.18	136771.60
4+01.50	1 1/2" H.A.	554377.98	136852.12
5+39.23	1 1/2" H.A.	554877.07	136897.67
5+41.20	1 1/2" H.A.	554877.53	136882.73
6+02.50	8" VALVE	554681.01	136850.30
7+10.00	CABLE TEST STATION	554572.39	136771.65
8+10.00	1 1/2" H.A.	554577.18	136805.74
9+32.50	1 1/2" H.A.	554406.02	136803.93
9+48.00	8" VALVE	554445.72	136772.17
9+52.00	8" VALVE	554445.40	136768.01

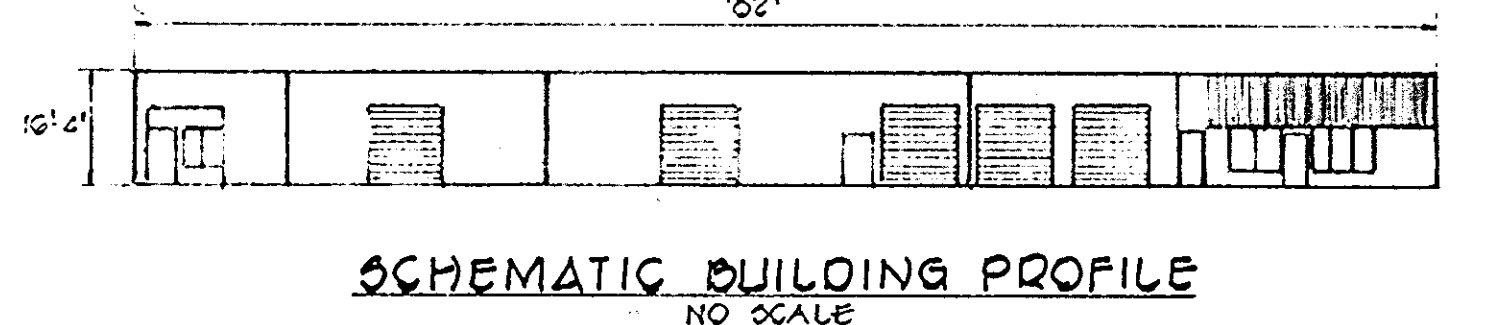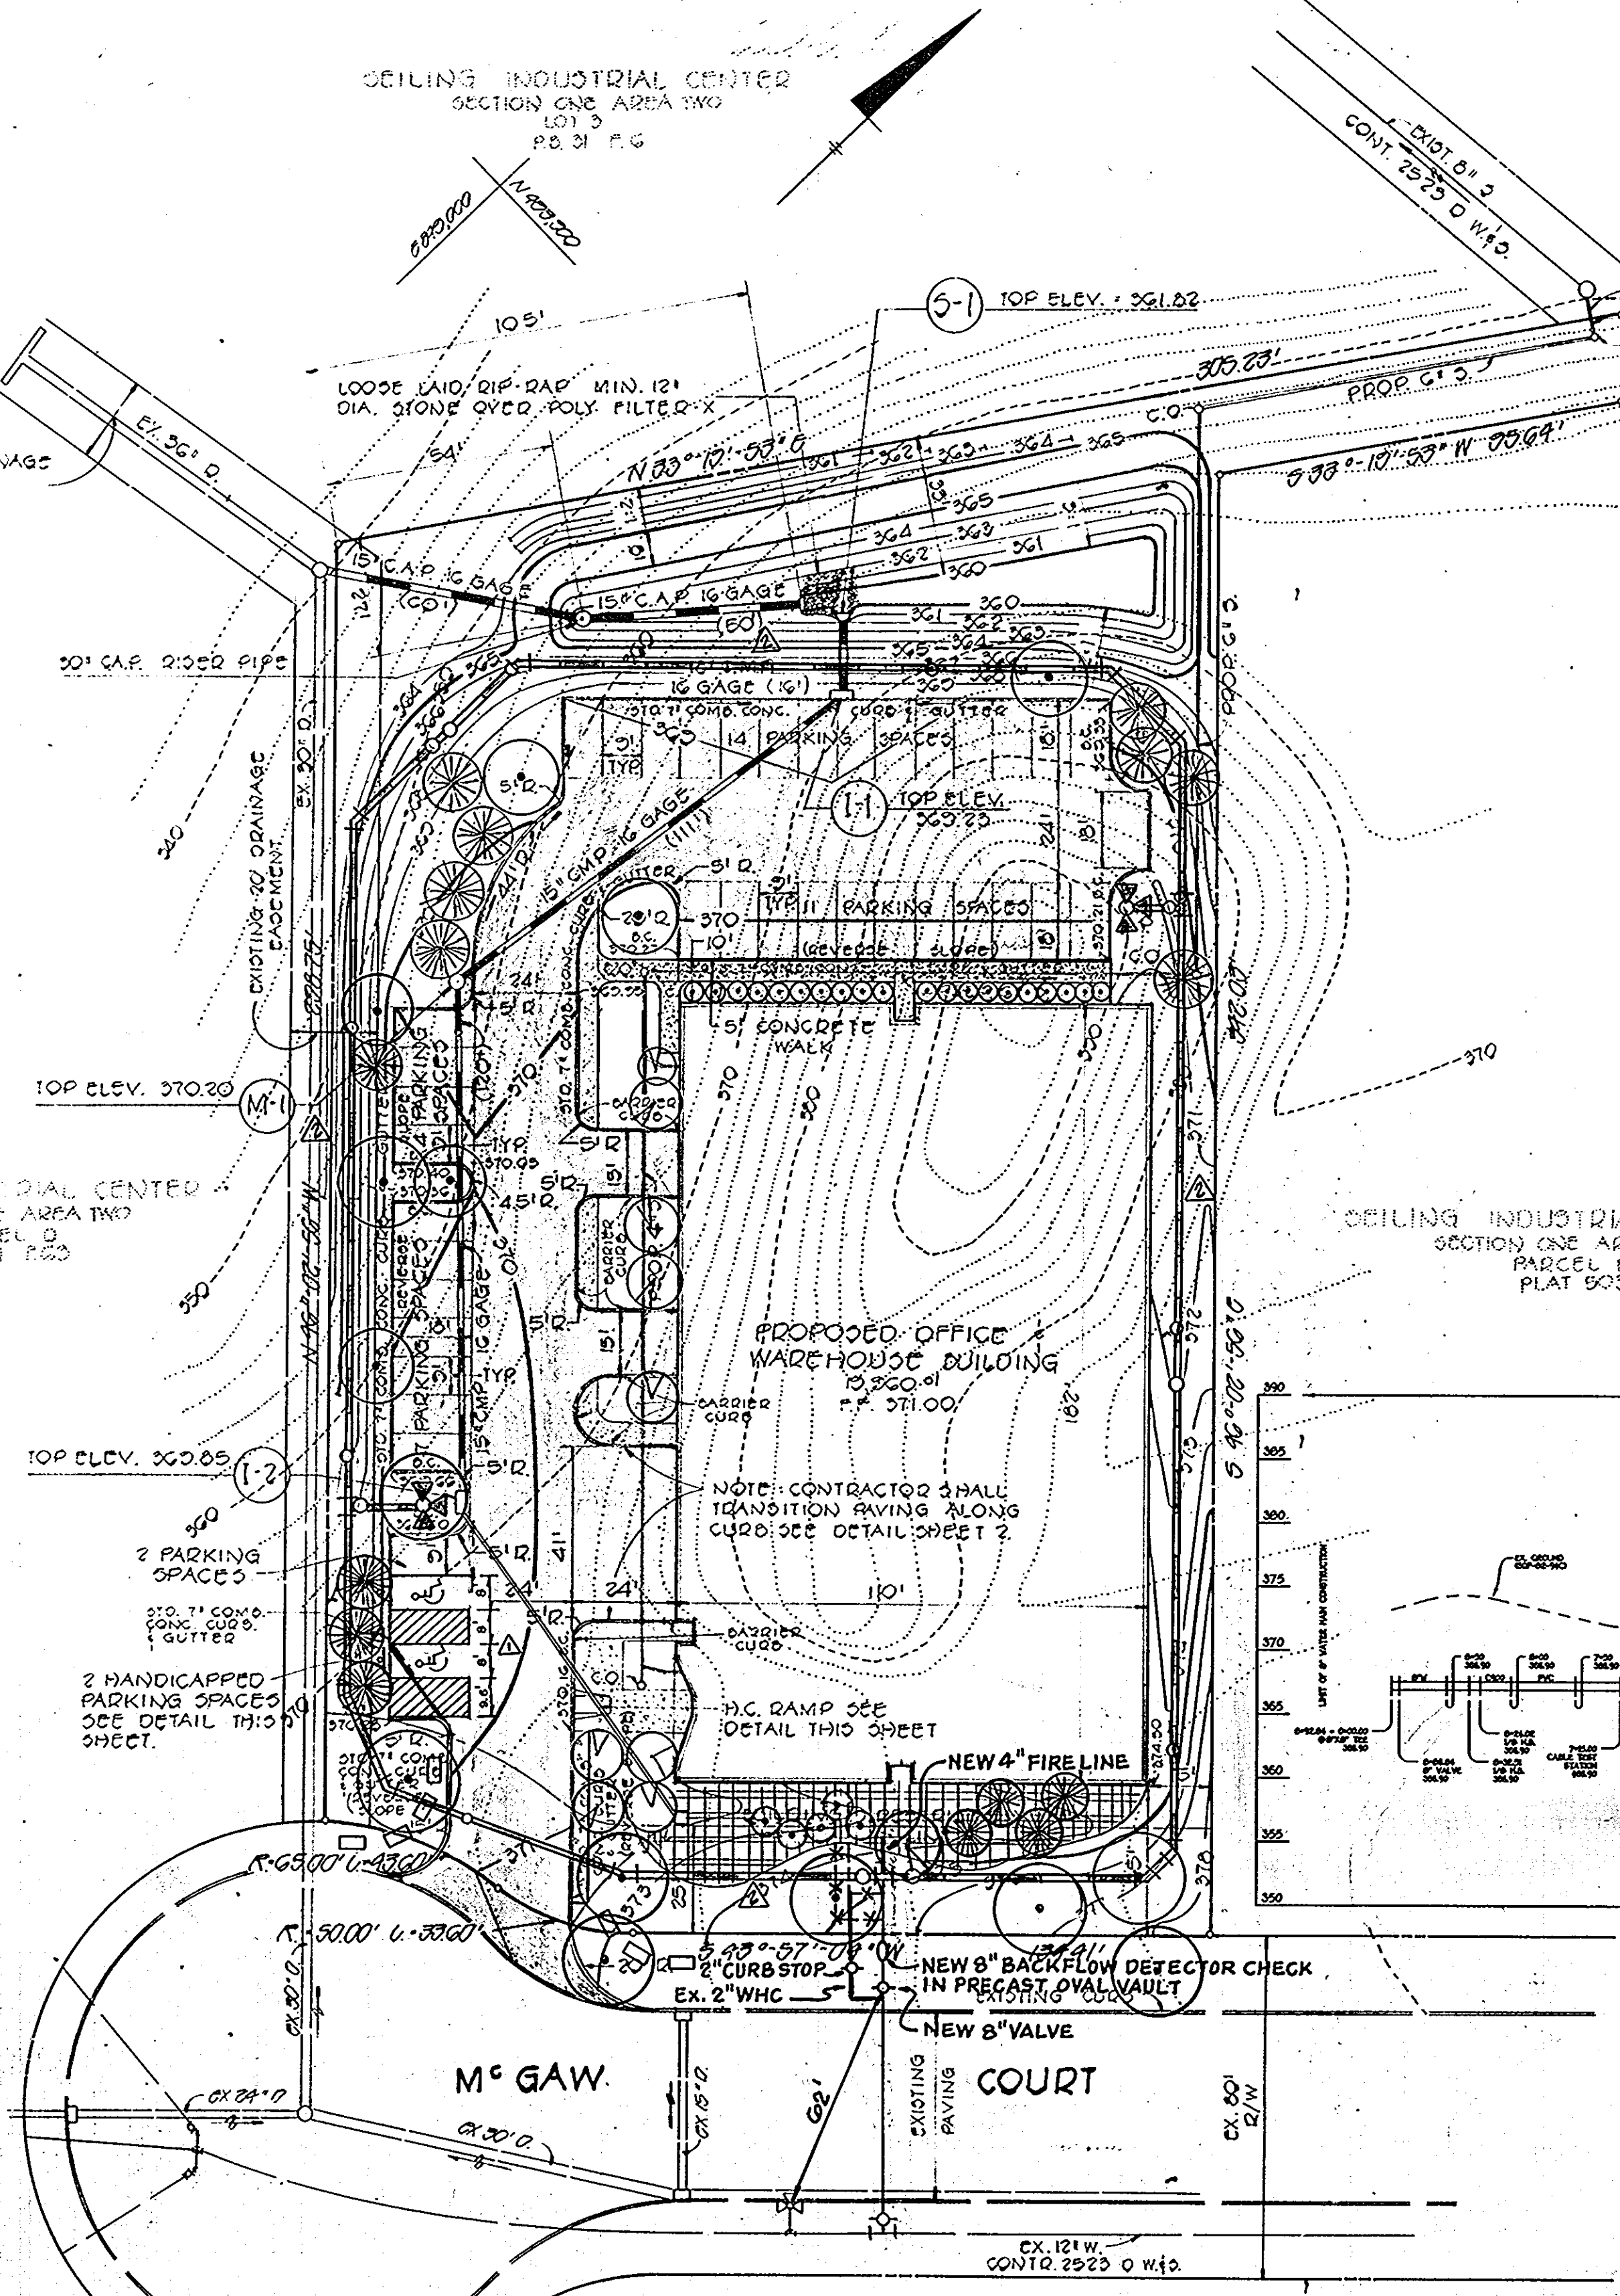

- OVERHEAD CANOPY TREE 2 1/2' - 3' CAL., 12' - 14' HT. PIN OAK OR SWEETGUM
- INTERMEDIATE FOCUS TREE 2 1/2' CAL., 8' - 10' HT. KWANZEN CHERRY
- EVERGREEN 6' - 8' HT. AUSTRIAN / RED PINE
- SHRUBS
- GROUND COVER WINTERCREEPER IVY

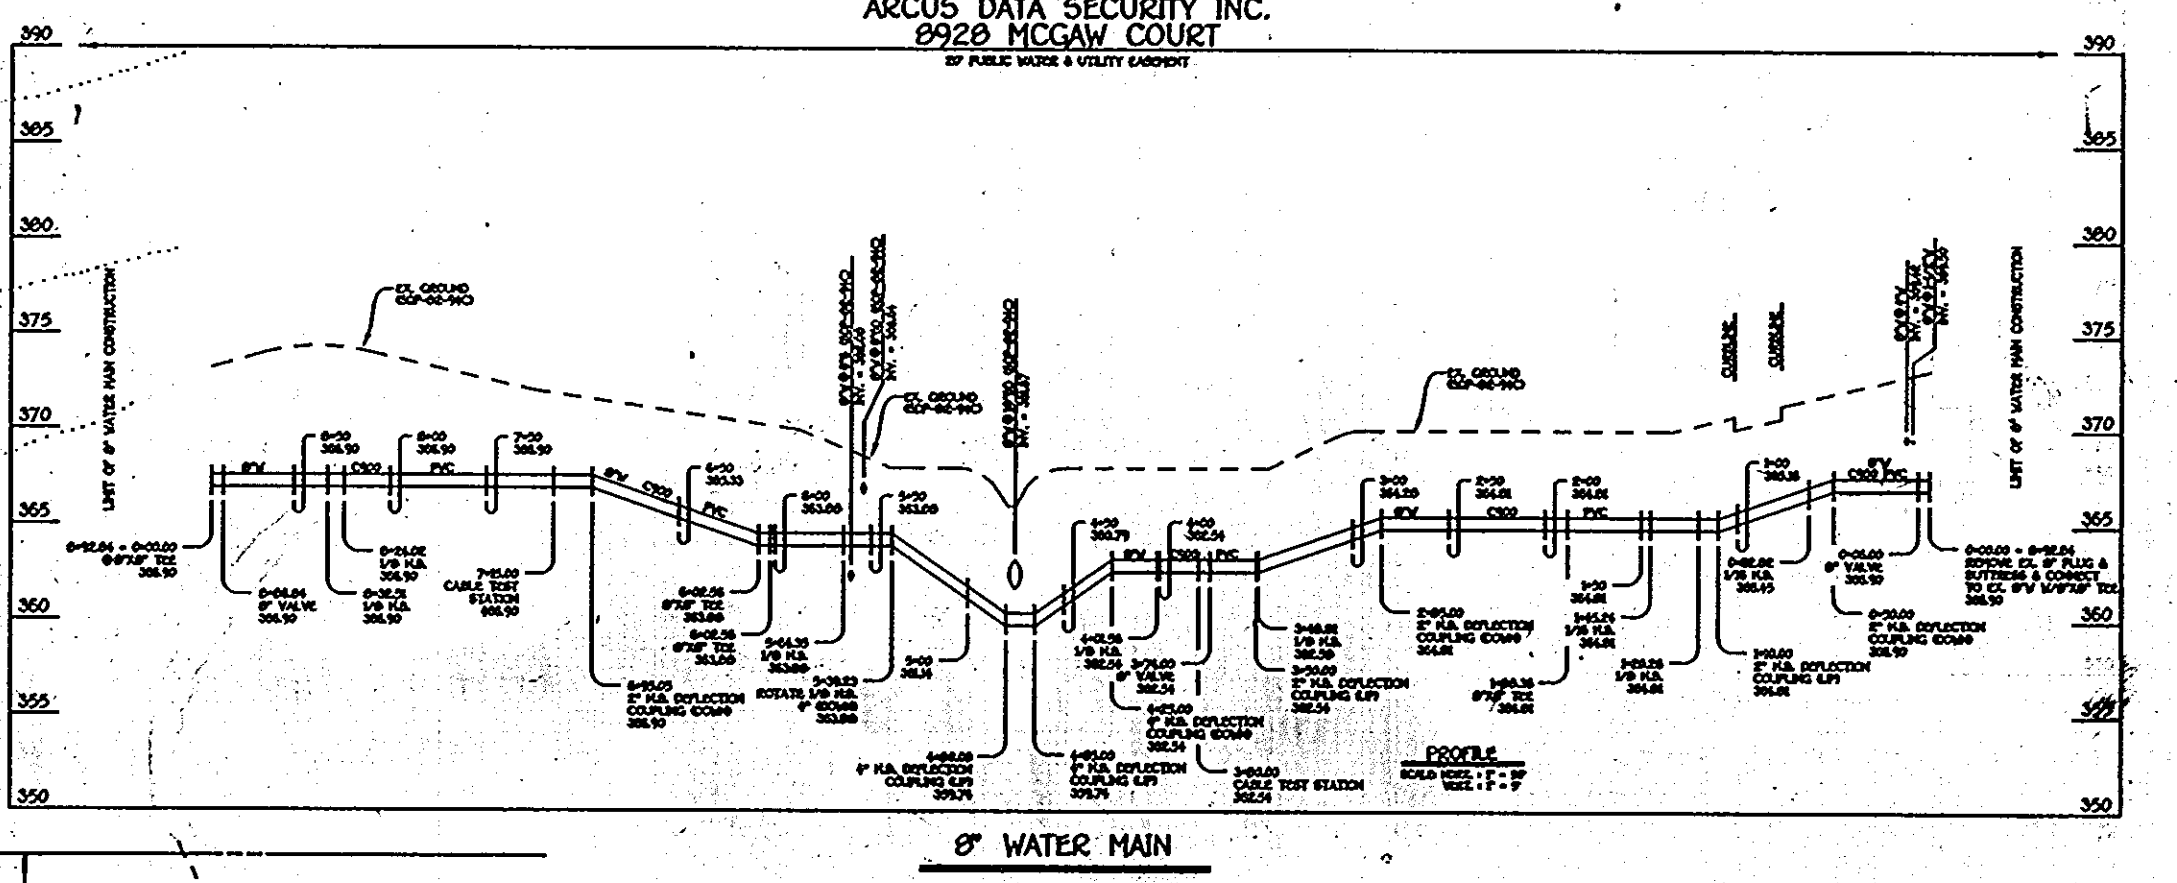

APPROVED
 PLANNING BOARD
 OF HOWARD COUNTY
 DATE **4-7-82**

LANDSCAPE PLAN
 WATER MAIN PROFILE & WATER MAIN TABULATION CHART

AS BUILT
 DATE: FEBRUARY 2010



DATA BASE INC.

PARCEL E-1
 CEILING INDUSTRIAL CENTER
 SECTION ONE
 AREA TWO
 SIXTH ELECTION DISTRICT
 FEBRUARY 5, 1982
 SHEET 4 OF 4

AS BUILT FOR NEW 8" VALVE
 8" VALVE TO EX. FIRE HYDRANT ACROSS MCGAW COURT = 62'
 8" VALVE TO EX. CURB STOP FOR 2" WHC = 8'
 8" VALVE TO FRAME & COVER/TOP OF DETECTOR VAULT = 7'

EARL O. COLLINS
 DATE: 2-15-82
 EARL O. COLLINS AND GORTER INC.
 CONSULTING ENGINEERS AND LAND SURVEYORS
 1800 QUINCY AVENUE
 CUMMERTOWN, MARYLAND 21033
 461-2055

OWNER
 DEVELOPER
 COAST CONSTRUCTION COMPANY
 692 2ND AVE SW
 PO BOX 66475
 SEATTLE, WASHINGTON 98106

REVISION 10/21/09