


GENERAL NOTE: 5.C.


BAY#	AREA (SF)	USE CATEGORY	PARKING REQUIREMENT PER USE	PARKING REQUIRED	NOTES
1-2	5,218	Light Manufacturing	5(c) 2 SPACES/1000	10.44	
3	2,609	Warehouse Food Dist.	5(a) 0.75 SPACES/1000	1.96	
4	2,609	Athletic Center (Gym)	6(a) 10 SPACES/1000sq of assembly area	26.09	CHANGE OF USE
5	2,609	Warehouse General	5(a) 0.75 SPACES/1000	1.96	Vacant
6	2,609	Warehouse General	5(a) 0.75 SPACES/1000	1.96	Vacant
7	2,609	Warehouse General	5(a) 0.75 SPACES/1000	1.96	
8	2,609	Warehouse General	5(a) 0.75 SPACES/1000	1.96	
9	2,609	Warehouse General	5(a) 0.75 SPACES/1000	1.96	
10-11	5,218	Light Manufacturing	5(c) 2 SPACES/1000	10.44	
Parking Required				60.82 (Use 61 spaces)	

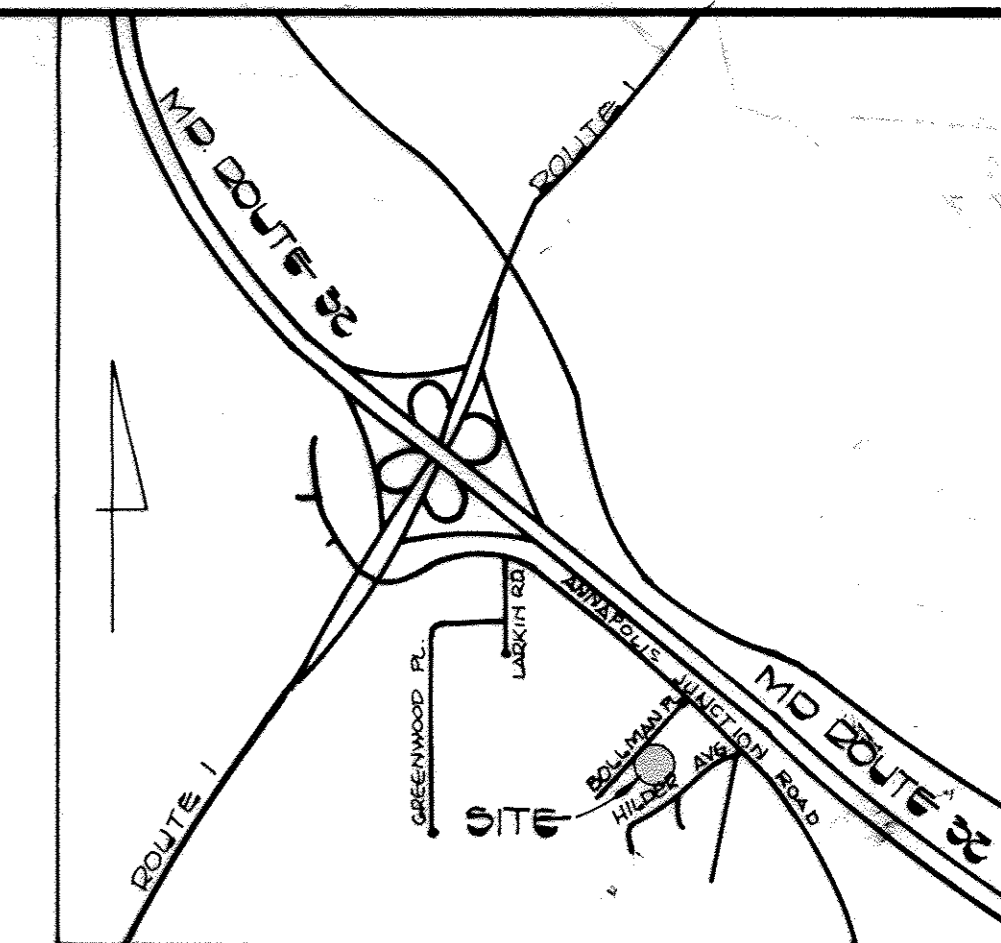


VICINITY MAP  
SCALE: 1" = 2000'

GENERAL NOTES:

- TOTAL AREA OF PARCEL: 2.80 AC. +
- PRESENT ZONING: M-2 (MANUFACTURING - HEAVY)
- PROPERTY IS RECORDED AS PLAT NO. 5988
- PROPERTY IS SHOWN ON TAX MAP 43, PART OF PARCEL 18
- PARKING DATA:
  - INTENDED USE OF STRUCTURE: WAREHOUSES
  - TOTAL AREA OF BUILDING: 28,700 S.F. + OR 0.66 AC. + (24%)
  - SEE PARKING DATA TABLE THIS SHEET.
- TOTAL NUMBER OF SPACES PROVIDED: 67 SPACES
  - REGULAR SPACES: 64
  - HANDICAPPED SPACES: 3
- OPEN SPACE (GREEN AREA): 0.96 AC. + (35%)
- THE CONTRACTOR SHALL NOTIFY THE HOWARD COUNTY CONSTRUCTION INSPECTION/SURVEY DIVISION 24 HOURS PRIOR TO COMMENCEMENT OF WORK AT 792-7272.
- HANDICAPPED FACILITIES TO BE CONSTRUCTED IN ACCORDANCE WITH THE "DESIGN OF BARRIER FREE FACILITIES" AND THE "MARYLAND BUILDING CODE FOR THE HANDICAPPED AND AGED."
- ALL PAVING AND STORM DRAIN CONSTRUCTION SHALL BE IN ACCORDANCE WITH THE HOWARD COUNTY ROAD CONSTRUCTION CODE AND STANDARD SPECIFICATIONS.
- EXISTING UTILITIES SHOWN HEREON HAVE BEEN LOCATED FROM FIELD AND OFFICE INFORMATION. THE CONTRACTOR SHALL DETERMINE THE EXACT LOCATION OF EXISTING UTILITIES TO HIS OWN SATISFACTION BEFORE MAKING ANY CONNECTION THERETO OR EXCAVATING IN THE AREA THEREOF.
- THE CONTRACTOR SHALL NOTIFY MISS UTILITY 559-0100 A MINIMUM OF THREE DAYS PRIOR TO BEGINNING ANY CONSTRUCTION SHOWN HEREON.
- SEE ARCHITECTURAL DRAWINGS FOR BUILDING DIMENSIONS.
- STORMWATER MANAGEMENT HAS BEEN PROVIDED UNDER F 82-43

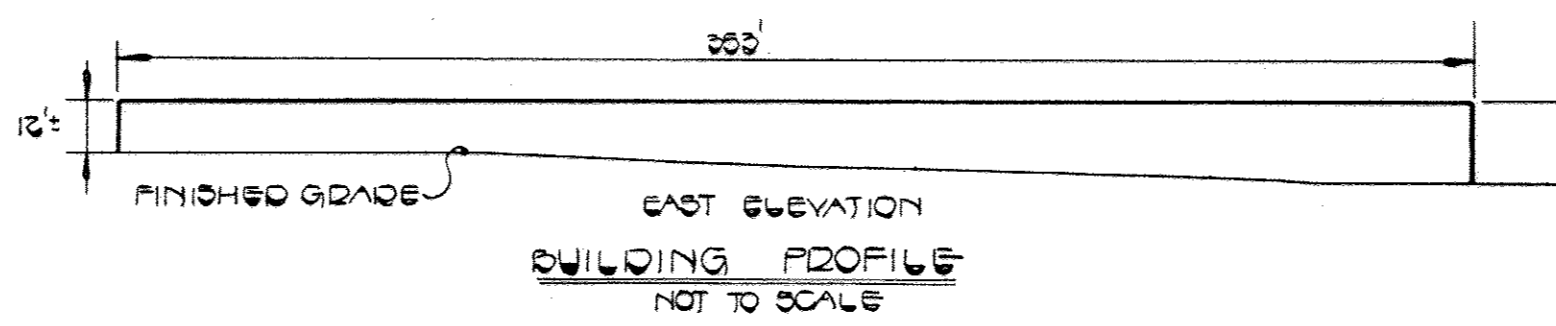

CORRIDOR INDUSTRIAL CENTER  
SECTION 2  
PARCEL D-2  
PLAT 5070  
ZONED: M-2

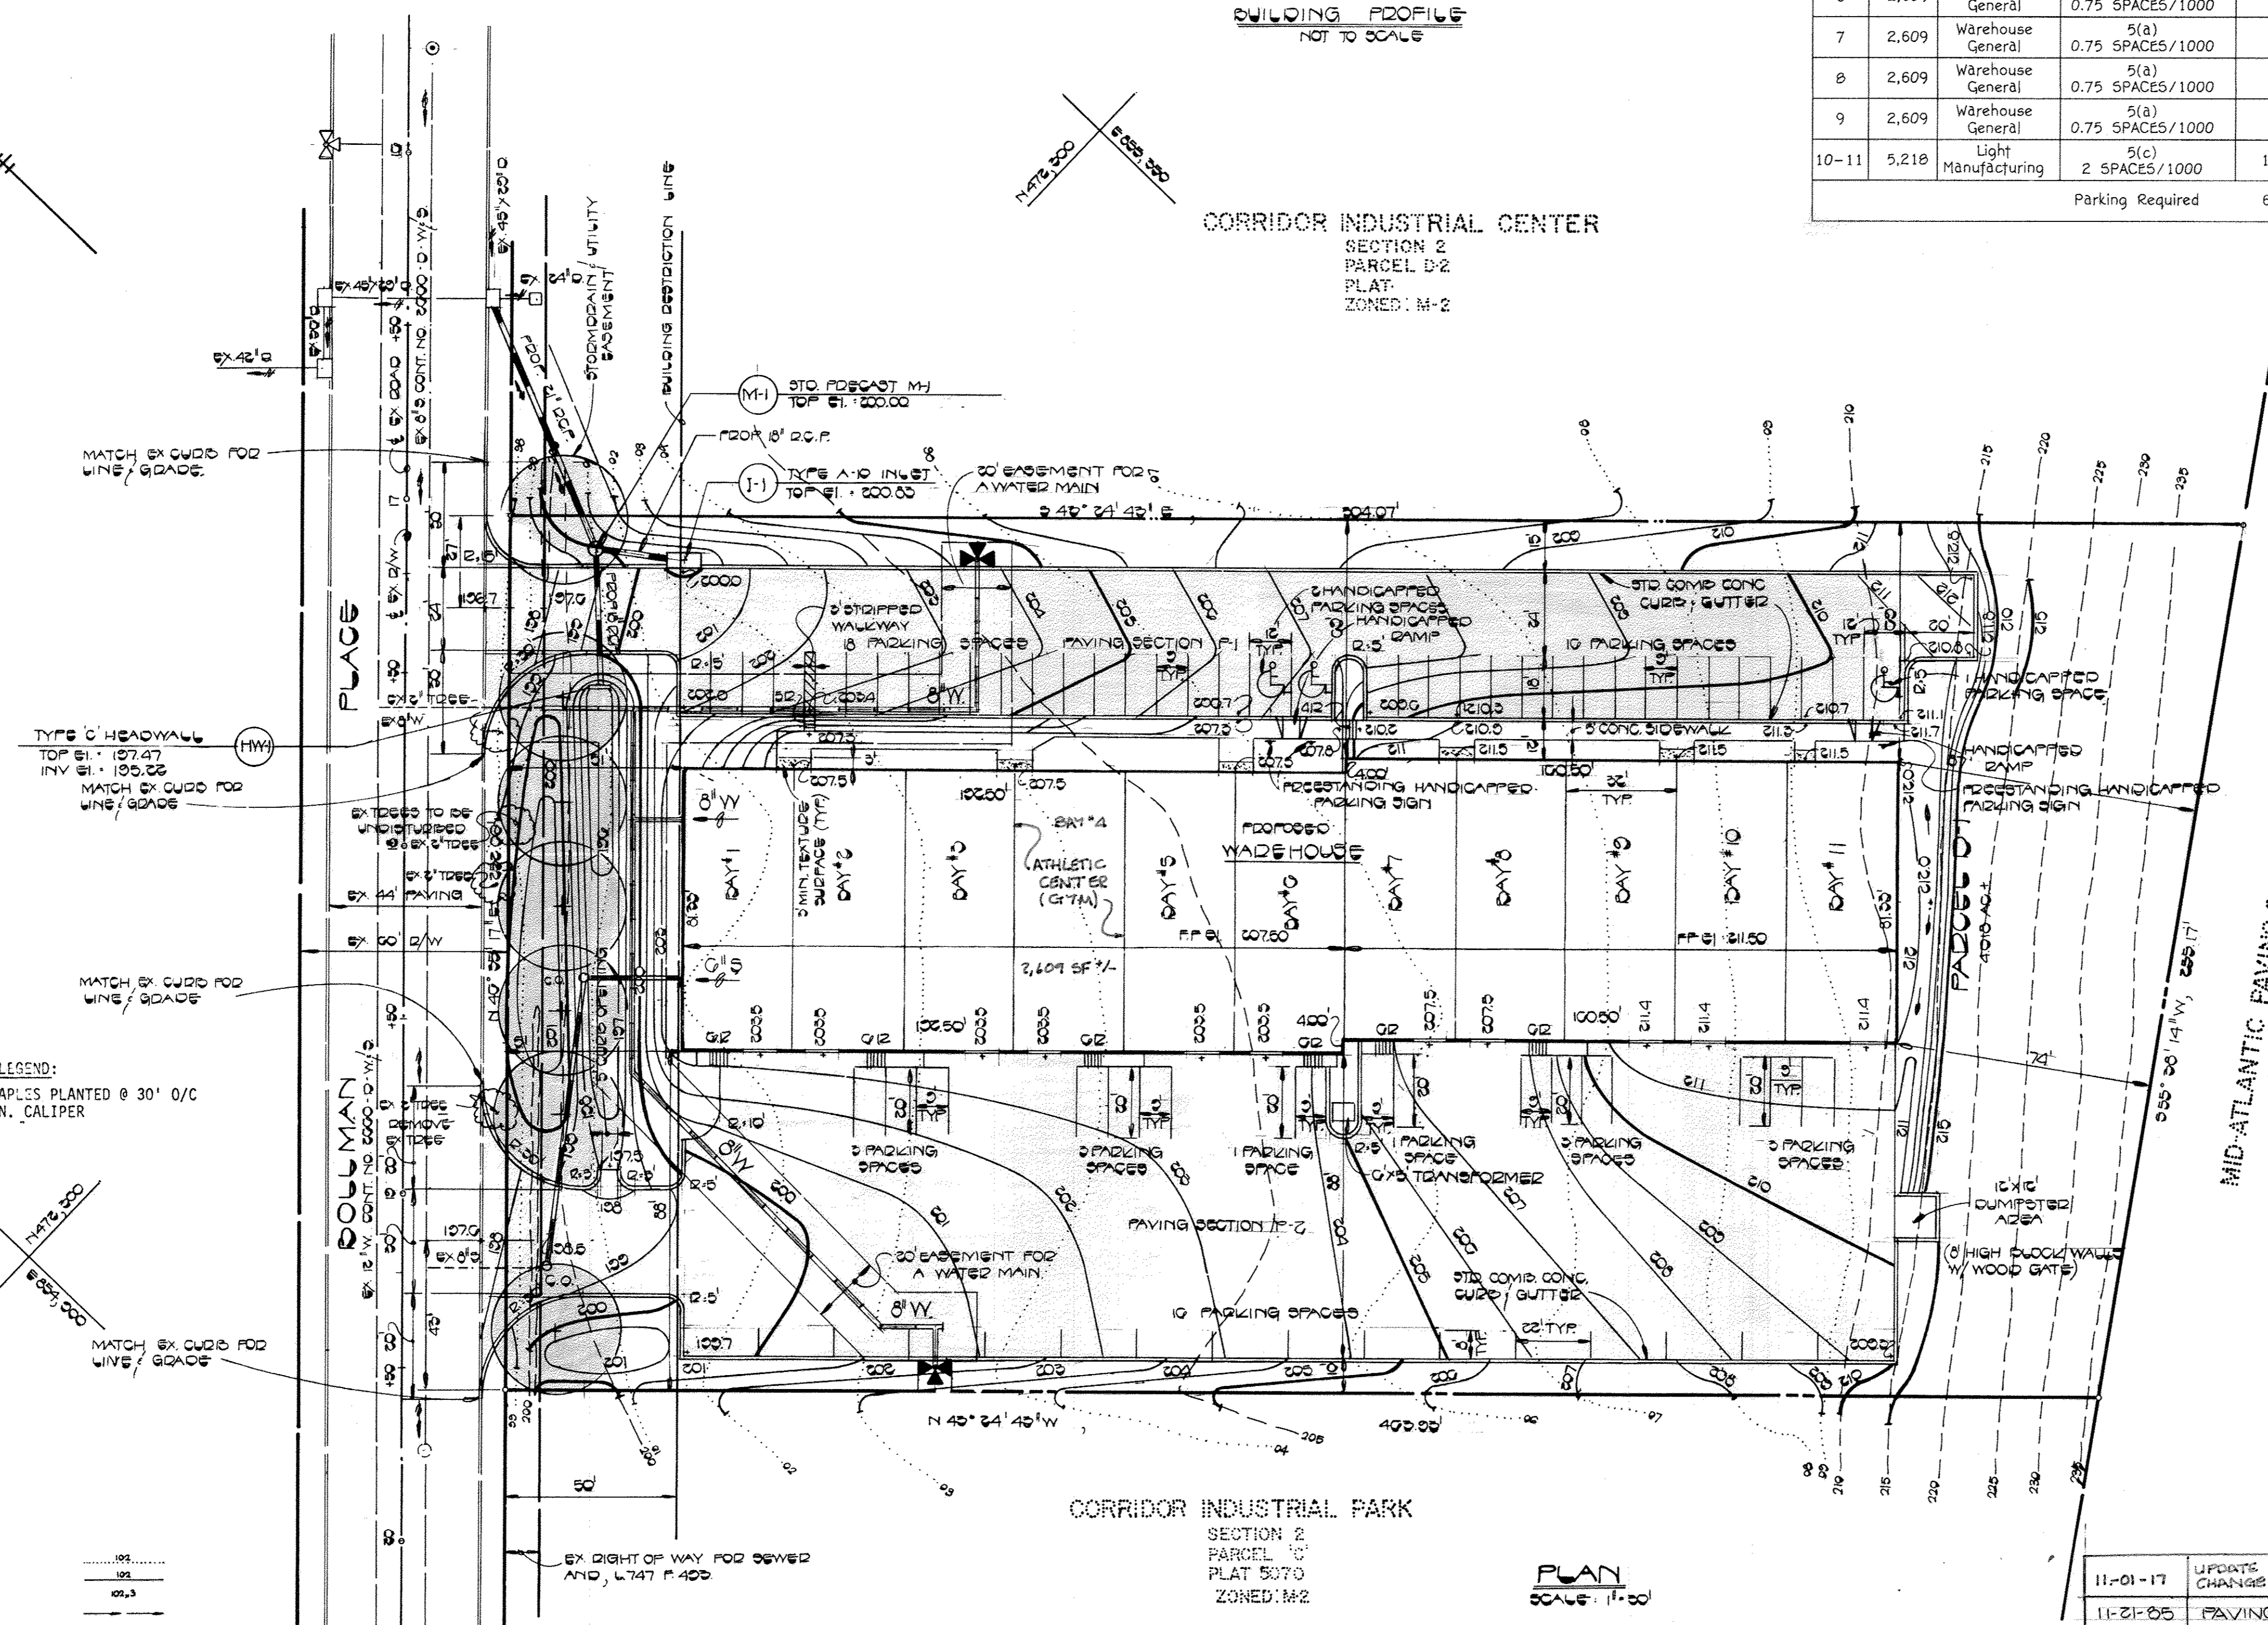

LANDSCAPE LEGEND:  
7 SUGAR MAPLES PLANTED @ 30' O/C  
2 1/2" MIN. CALIPER

LEGEND  
EXISTING CONTOUR (1' INTERVAL)  
PROPOSED CONTOUR (1' INTERVAL)  
SPOT ELEVATION  
DRAINAGE FLOW  
RETAINING WALL  
EX. WOODS TO BE SAVED  
STRAW BALE DIKE (S.B.D.)  
SILT FENCE (S.F.)  
STABILIZED CONSTRUCTION ENTRANCE (S.C.E.)  
PERIMETER DIKE (P.D.)

OWNER/DEVELOPER  
QUINCY DEVELOPMENT CO., INC.  
5051 WHETSTONE ROAD  
COLUMBIA, MARYLAND 21044  
(301) 995-0649

DATE	DESCRIPTION
11-01-87	UPDATE PARKING DATA FOR TENANT CHANGE IN USE
11-21-85	PAVING SECTION P-3 TO P-2
11-21-85	CURB RADII FROM 30' TO 5' @ ENTRANCE
DATE	DESCRIPTION
REVISIONS	

D-1	8725	ROWMAN PLACE
PARCEL #	STREET ADDRESS	
ADDRESS CHART		

APPROVED  
DIVISION OF LAND DEVELOPMENT &  
ZONING ADMINISTRATION  
HOWARD COUNTY, MARYLAND  
DATE 7-31-84



FISHER, COLLINS & CARTER, INC.  
CIVIL ENGINEERS & LAND SURVEYORS  
8388 COURT AVE.  
ELLCOTT CITY, MD. 21043  
(301) 461-2855

ENGINEER'S CERTIFICATE  
I HEREBY CERTIFY THAT THIS PLAN FOR EROSION AND SEDIMENT CONTROL REPRESENTS A PRACTICAL AND WORKABLE PLAN BASED ON MY PERSONAL KNOWLEDGE OF THE SITE CONDITIONS AND THAT IT WAS PREPARED IN ACCORDANCE WITH THE REQUIREMENTS OF THE HOWARD SOIL CONSERVATION DISTRICT.

Charles J. Conard  
SIGNATURE OF ENGINEER  
4/21/84  
DATE

DEVELOPER'S CERTIFICATE  
"I/WE CERTIFY THAT ALL DEVELOPMENT AND CONSTRUCTION WILL BE DONE ACCORDING TO THIS PLAN OF DEVELOPMENT AND PLAN FOR EROSION AND SEDIMENT CONTROL AND THAT ALL RESPONSIBLE PERSONNEL INVOLVED IN THE CONSTRUCTION PROJECT WILL HAVE A CERTIFICATE OF ATTENDANCE AT A DEPARTMENT OF NATURAL RESOURCES APPROVED TRAINING PROGRAM FOR THE CONTROL OF SEDIMENT AND EROSION BEFORE BEGINNING THE PROJECT. I ALSO AUTHORIZE PERIODIC ON-SITE INSPECTION BY THE HOWARD SOIL CONSERVATION DISTRICT OR THEIR AUTHORIZED AGENTS, AS ARE DEEMED NECESSARY."

Chris J. Quinn  
SIGNATURE OF DEVELOPER  
6/20/84  
DATE

REVIEWED FOR HOWARD COUNTY SOIL CONSERVATION DISTRICT AND MEETS TECHNICAL REQUIREMENTS.

M.H.S. Sills  
U.S. SOIL CONSERVATION SERVICE  
9/18/84  
DATE

THIS DEVELOPMENT IS APPROVED FOR EROSION AND SEDIMENT CONTROL BY THE HOWARD SOIL CONSERVATION DISTRICT.

Approved: Stephen R. Shuler  
9/17/84  
DATE  
HOWARD SOIL CONSERVATION DISTRICT

APPROVED: OFFICE OF PLANNING AND ZONING

John J. Hanish  
PLANNING DIRECTOR  
11-19-84  
DATE

John J. Munchman  
CHIEF, DIVISION OF LAND DEVELOPMENT AND ZONING ADMINISTRATION  
11-16-84  
DATE

APPROVED: HOWARD COUNTY HEALTH DEPARTMENT FOR PUBLIC WATER AND SEWERAGE SYSTEMS.

John J. Hanish  
HEALTH OFFICER  
DATE

APPROVED: DEPARTMENT OF PUBLIC WORKS FOR PUBLIC WATER AND SEWER AND STORM DRAINAGE SYSTEMS AND ROADS.

John J. Hanish  
DIRECTOR, PUBLIC WORKS  
11-14-84  
DATE

John J. Hanish  
CHIEF, BUREAU OF ENGINEERING  
11-14-84  
DATE

SUBDIVISION NAME	SECTION/AREA	TAX / ZONE MAP	ELEC. DIST.	CENSUS TR.
CORRIDOR INDUSTRIAL PARK	2 / P-D-1	48	61h	6064
PLAT NO. / BLOCK No.	ZONE	MAP	ELEC. DIST.	CENSUS TR.
13 / M-2	48	61h	6064	
WATER CODE	SEWER CODE			
C-04	4100000			

SITE DEVELOPMENT PLAN  
CORRIDOR INDUSTRIAL PARK  
SECTION 2  
PARCEL D-1  
6th ELECTION DISTRICT  
HOWARD COUNTY, MD.  
SCALE: AS SHOWN DATE: JUNE 18, 1984  
SHEET 1 OF 3  
REVISED: AUGUST 6, 1984







