


VICINITY MAP  
SCALE: 1"=1200'

GENERAL NOTES:

- TOTAL NUMBER OF LOTS: 7
- TOTAL AREA OF LOTS: 2.32 AC.
- PRESENT ZONING: R-20
- PROPERTY IS LOCATED ON TAX MAP 46, PART OF PARCEL 197.
- THE CONTRACTOR SHALL NOTIFY THE HOWARD COUNTY CONSTRUCTION INSPECTION/PERMITS DIVISION 24 HOURS PRIOR TO COMMENCEMENT OF WORK AT 992-2455.
- ALL PAVING AND STORM DRAIN CONSTRUCTION SHALL BE IN ACCORDANCE WITH THE HOWARD COUNTY ROAD CONSTRUCTION CODE AND STANDARD SPECIFICATIONS.
- EXISTING UTILITIES SHOWN HEREON HAVE BEEN LOCATED FROM FIELD AND OFFICE INFORMATION. THE CONTRACTOR SHALL DETERMINE THE EXACT LOCATION OF EXISTING UTILITIES TO HIS OWN SATISFACTION BEFORE MAKING ANY CONNECTION THERETO OR EXCAVATING IN THE AREA THEREOF.
- THE CONTRACTOR SHALL NOTIFY MISS UTILITY 559-0100 A MINIMUM OF THREE DAYS PRIOR TO BEGINNING ANY CONSTRUCTION SHOWN HEREON.
- SEE ARCHITECTURAL DRAWINGS FOR BUILDING DIMENSIONS.
- STORM WATER MANAGEMENT HAS BEEN PROVIDED FOR THIS PROJECT UNDER F-85-157.

NOTE:

SEDIMENT CONTROL FOR THESE LOTS WILL BE PROVIDED BY UTILIZING THE STORM WATER MANAGEMENT POND (NOW BEING TEMPORARILY USED AS AN EXISTING SEDIMENT BASIN) SEE PLANS F-85-157. IN THE EVENT THAT THE SEDIMENT BASIN IS CONVERTED INTO A PERMANENT STORM WATER MANAGEMENT POND BEFORE ALL DISTURBED AREAS INVOLVED WITH THE CONSTRUCTION OF THE DWELLINGS ON THESE LOTS, A SEDIMENT CONTROL PLAN FOR THESE LOTS MUST BE SUBMITTED AND APPROVED BY THE HOWARD SOIL CONSERVATION DISTRICT.

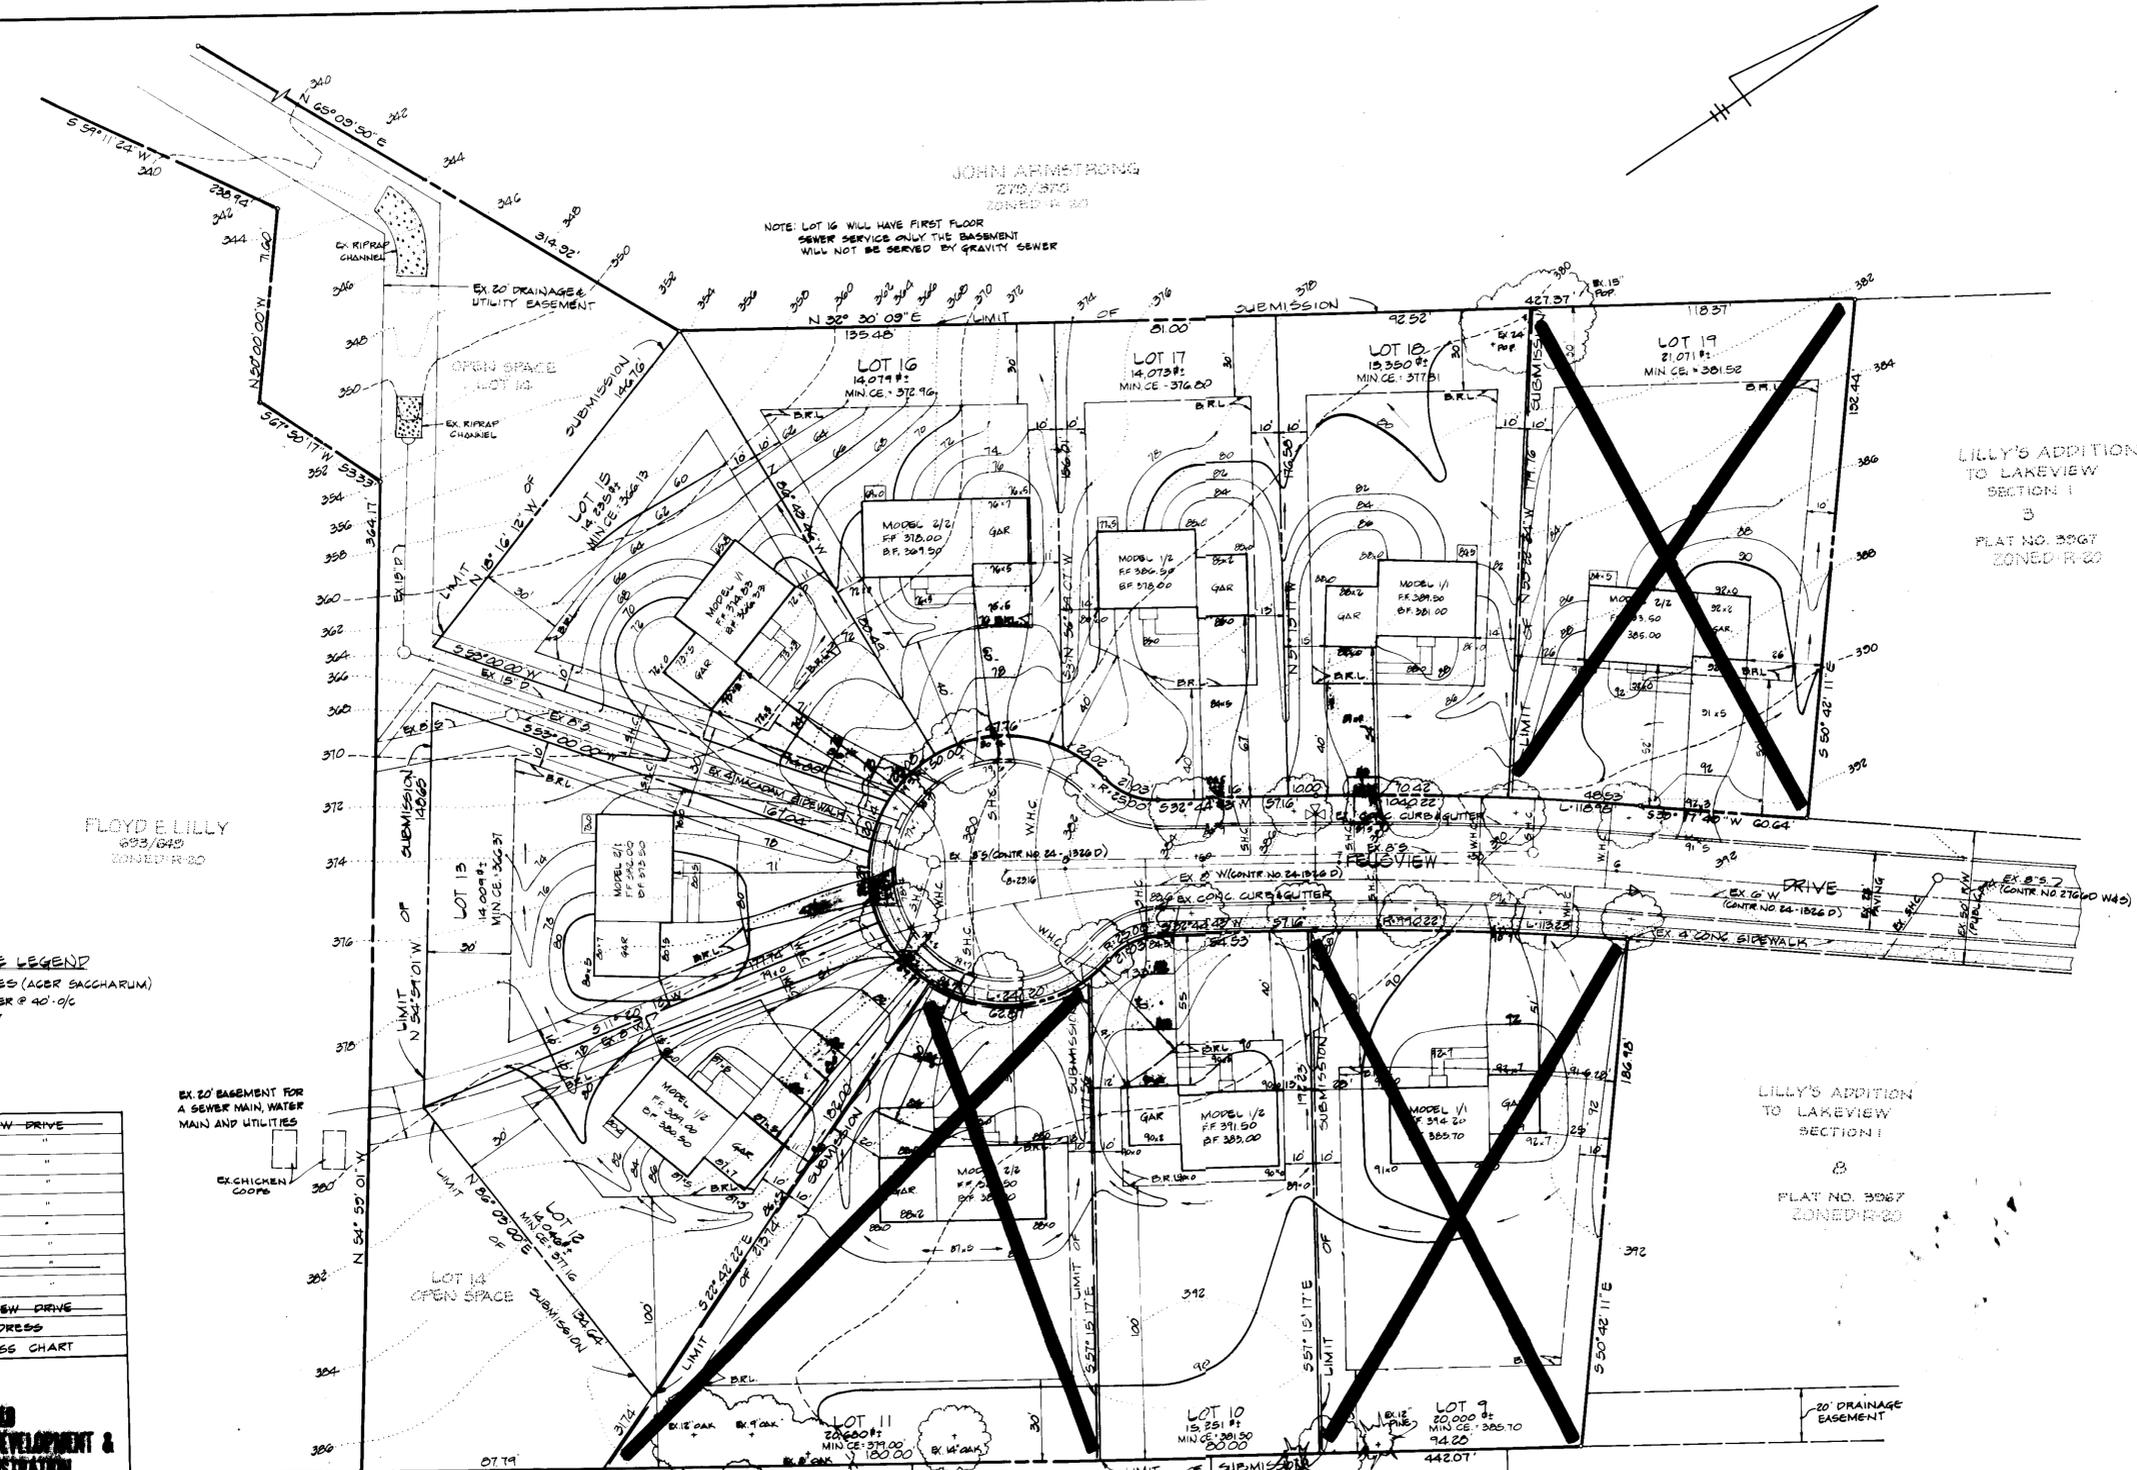

JOHN ARMSTRONG  
270,570  
ZONED R-20

NOTE: LOT 16 WILL HAVE FIRST FLOOR SEWER SERVICE ONLY THE BASEMENT WILL NOT BE SERVED BY GRAVITY SEWER

FLOYD E LILLY  
683/643  
ZONED R-20

LANDSCAPE LEGEND  
SUGAR MAPLES (AGER SACCHARUM)  
2 1/2" DIA. SAU PER @ 40'-0" C  
PER F-85-157

LOT NO	ADDRESS
19	6466 FELSVIEW DRIVE
18	6472 "
17	6476 "
16	6480 "
15	6484 "
14	6487 "
13	6493 "
12	6499 "
11	6504 "
10	6510 "
9	6511 FELSVIEW DRIVE

APPROVED  
DIVISION OF LAND DEVELOPMENT &  
ZONING ADMINISTRATION  
HOWARD COUNTY, MARYLAND  
DATE 10-18-85

*Charles Carter*  
ENGINEER

OWNER/DEVELOPER  
FLOYD E LILLY  
304 MONTGOMERY STREET  
LAUREL, MARYLAND 20810

SITE DEVELOPMENT PLAN

LILLY'S ADDITION TO LAKEVIEW

SECTION 2  
LOT 10, 12, 13 AND LOTS 15-18  
TAX MAP NO 46 PARCEL NO. 197  
6TH ELECTION DISTRICT  
HOWARD COUNTY, MD  
REVISED OCTOBER 24, 1985  
SCALE: 1"=30'  
SHEET 1 OF 3 SEPTEMBER 13, 1985

ENGINEER'S CERTIFICATE

I HEREBY CERTIFY THAT THIS PLAN FOR EROSION AND SEDIMENT CONTROL REPRESENTS A PRACTICAL AND WORKABLE PLAN BASED ON MY PERSONAL KNOWLEDGE OF THE SITE CONDITIONS AND THAT IT WAS PREPARED IN ACCORDANCE WITH THE REQUIREMENTS OF THE HOWARD SOIL CONSERVATION DISTRICT.

FISHER, COLLINS & CARTER, INC.  
CIVIL ENGINEERS & LAND SURVEYORS  
8388 COURT AVE.  
ELLICOTT CITY, MD. 21043  
(301) 461-2855

*Charles Carter*  
SIGNATURE OF ENGINEER  
10/25/85  
DATE

DEVELOPER'S CERTIFICATE

"I/WE CERTIFY THAT ALL DEVELOPMENT AND CONSTRUCTION WILL BE DONE ACCORDING TO THIS PLAN OF DEVELOPMENT AND PLAN FOR EROSION AND SEDIMENT CONTROL AND THAT ALL RESPONSIBLE PERSONNEL INVOLVED IN THE CONSTRUCTION PROJECT WILL HAVE A CERTIFICATE OF ATTENDANCE AT A DEPARTMENT OF NATURAL RESOURCES APPROVED TRAINING PROGRAM FOR THE CONTROL OF SEDIMENT AND EROSION BEFORE BEGINNING THE PROJECT. I ALSO AUTHORIZE PERIODIC ONSITE INSPECTION BY THE HOWARD SOIL CONSERVATION DISTRICT OR THEIR AUTHORIZED AGENTS, AS ARE DEEMED NECESSARY."

*Floyd E Lilly*  
SIGNATURE OF DEVELOPER  
9/20/85  
DATE

REVIEWED FOR HOWARD SOIL CONSERVATION DISTRICT AND MEETS TECHNICAL REQUIREMENTS

*Stephen M. Healy*  
U.S. SOIL CONSERVATION SERVICE  
DATE 10/30/85  
THIS DEVELOPMENT IS APPROVED FOR EROSION AND SEDIMENT CONTROL BY THE HOWARD SOIL CONSERVATION DISTRICT.  
APPROVED:  
*Stephen M. Healy*  
DATE 10/30/85  
HOWARD SOIL CONSERVATION DISTRICT

APPROVED: OFFICE OF PLANNING AND ZONING

*William M. Murchison*  
PLANNING DIRECTOR  
DATE 11-4-85  
CHIEF, DIVISION OF LAND DEVELOPMENT AND ZONING ADMINISTRATION

APPROVED: HOWARD COUNTY HEALTH DEPARTMENT FOR PUBLIC WATER AND SEWERAGE SYSTEMS


*Joseph Boylen*  
HEALTH OFFICER  
DATE 11-1-85

APPROVED: DEPARTMENT OF PUBLIC WORKS FOR PUBLIC WATER & SEWER AND STORM DRAINAGE SYSTEMS AND ROADS.

*William E. Murchison*  
DIRECTOR OF PUBLIC WORKS  
DATE 11-21-85  
*William E. Murchison*  
CHIEF, BUREAU OF ENGINEERING  
DATE 10/27/85

PLAT NO.	BLOCK NO.	ZONE	TAX/ZONE	ELEC. DIST.	CENSUS TR.
6400	18	R 20	46	6th	6062


WATER CODE 14  
SEWER CODE 7450000

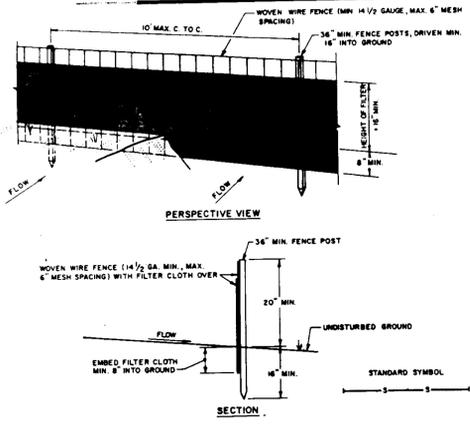


CONSTRUCTION NOTES FOR FABRICATED SILT FENCE

1. WOVEN WIRE FENCE TO BE FASTENED SECURELY TO FENCE POSTS WITH WIRE TIES OR STAPLES.
  2. FILTER CLOTH TO BE FASTENED SECURELY TO WOVEN WIRE FENCE WITH TIES SPACED EVERY 24" AT TOP AND MID SECTION.
  3. WHEN TWO SECTIONS OF FILTER CLOTH ADJOIN EACH OTHER THEY SHALL BE OVERLAPPED BY SIX INCHES AND FOLDED.
  4. MAINTENANCE SHALL BE PERFORMED AS NEEDED AND MATERIAL REMOVED WHEN "BULGES" DEVELOP IN THE SILT FENCE.
- POSTS: STEEL EITHER T OR U TYPE OR 2" HARDWOOD  
 FENCE: WOVEN WIRE, 1/2 GA. 4" MAX. MESH OPENING  
 FILTER CLOTH: FILTER X, TURF, LINO, STABIL-LINKA LINO OR APPROVED EQUAL  
 PREFABRICATED UNIT: GEOFAB, ENVIROFENCE, OR APPROVED EQUAL

**SILT FENCE**  
NOT TO SCALE

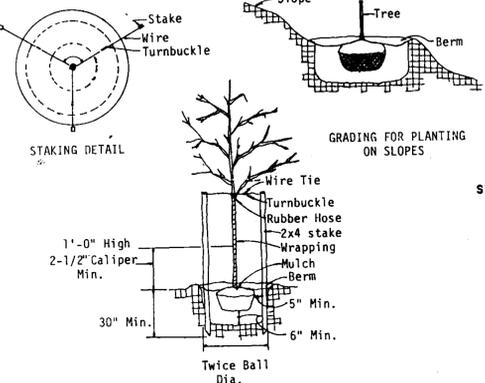


Note: Remove Burlap from Top 1/3 of Ball  
**TREE PLANTING**  
NOT TO SCALE

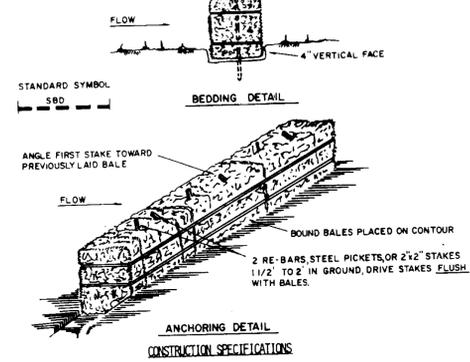

**CONSTRUCTION SPECIFICATIONS**

1. BALES SHALL BE PLACED AT THE TOE OF A SLOPE OR ON THE CONTOUR AND IN A ROW WITH ENDS TIGHTLY ADJUTING THE ADJACENT BALES.
2. EACH BALE SHALL BE EMBEDDED IN THE SOIL A MINIMUM OF (4) INCHES, AND PLACED SO THE BINDINGS ARE HORIZONTAL.
3. BALES SHALL BE SECURELY ANCHORED IN PLACE BY EITHER TWO STAKES OR RE-BARS DRIVEN THROUGH THE BALES. THE FIRST STAKE IN EACH BALE SHALL BE DRIVEN TOWARD THE PREVIOUSLY LAID BALE AT AN ANGLE TO FORCE THE BALES TOGETHER. STAKES SHALL BE DRIVEN FLUSH WITH THE BALE.
4. INSPECTION SHALL BE FREQUENT AND REPAIR REPLACEMENT SHALL BE MADE PROMPTLY AS NEEDED.
5. BALES SHALL BE REMOVED WHEN THEY HAVE SERVED THEIR USEFULNESS SO AS NOT TO BLOCK OR IMPEDE STORM FLOW OR DRAINAGE.


**STRAW BALE DIKE**  
NOT TO SCALE

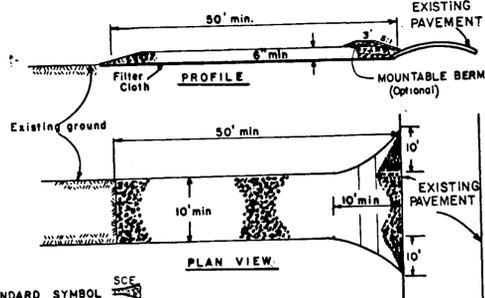

**CONSTRUCTION SPECIFICATIONS**

1. Stone Size - Use 2" stone, or reclaimed or recycled concrete equivalent.
2. Length - As required, but not less than 50 feet (except on a single residential lot where a 30 foot minimum length would apply).
3. Thickness - Not less than six (6) inches.
4. Width - Ten (10) foot minimum, but not less than the full width at points where ingress or egress occurs.
5. Filter Cloth - Will be placed over the entire area prior to placing of stone. Filter will not be required on a single family residence lot.
6. Surface Water - All surface water flowing or diverted toward construction entrances shall be piped across the entrance. If piping is impractical, a mountable berm with 5:1 slopes will be permitted.
7. Maintenance - The entrance shall be maintained in a condition which will prevent tracking or flowing of sediment onto public rights-of-way. This may require periodic top dressing with additional stone as conditions demand and repair and/or cleanout of any measures used to trap sediment. All sediment spilled, dropped, washed or tracked onto public rights-of-way must be removed immediately.
8. Washing - Wheels shall be cleaned to remove sediment prior to entrance onto public rights-of-way. When washing is required, it shall be done on an area stabilized with stone and which drains into an approved sediment trapping device.
9. Periodic inspection and needed maintenance shall be provided after each rain.

**STABILIZED CONSTRUCTION ENTRANCE**  
NOT TO SCALE

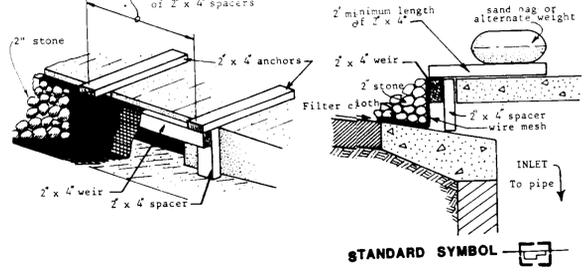


**Construction Specifications**

1. Materials
- A. Wooden frame is to be constructed of 2" x 4" construction grade lumber.
- B. Wire mesh must be of sufficient strength to support filter fabric, and stone for curb inlets, with water fully impounded against it.
- C. Filter cloth must be of a type approved for this purpose; resistant to sunlight with sieve size, E08, 40-85, to allow sufficient passage of water and removal of sediment.
4. Stone is to be 2" in size and clean, since fines would clog the cloth.
5. The assembly shall be placed so that the end spacers are a minimum 1' beyond both ends of the throat opening.
6. Form the wire mesh and filter cloth to the concrete gutter and against the face of curb on both sides of the inlet. Place clean 2" stone over the wire mesh and filter fabric in such a manner as to prevent water from entering the inlet under or around the filter cloth.
7. This type of protection must be inspected frequently and the filter cloth and stone replaced when clogged with sediment.
8. Assure that storm flow does not bypass inlet by installing temporary earth or asphalt dikes directing flow into inlet.


**Curb Inlet Protection**

1. Attach a continuous piece of wire mesh (30" min. width by throat length plus 4") to the 2" x 4" weir (measuring throat length plus 2") as shown on the standard drawing.
2. Place a piece of approved filter cloth (40-85 sieve) of the same dimensions as the wire mesh over the wire mesh and securely attach to the 2" x 4" weir.
3. Securely nail the 2" x 4" weir to 9" long vertical spacers to be located between the weir and inlet face (max. 6' apart).
4. Place the assembly against the inlet throat and nail (minimum 2' lengths of 2" x 4" anchors shall extend across the inlet top and be held in place by sandbags or alternate weight.


**INLET PROTECTION**  
NOT TO SCALE

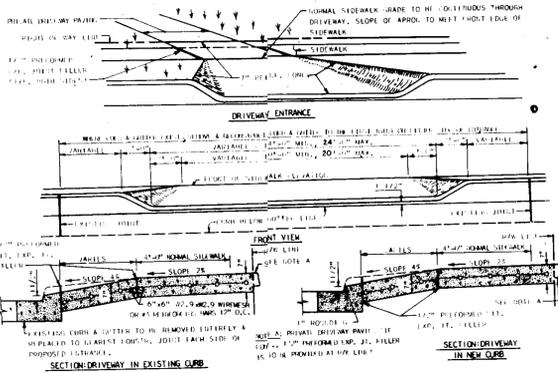

**RESIDENTIAL DRIVEWAY ENTRANCE**  
NOT TO SCALE

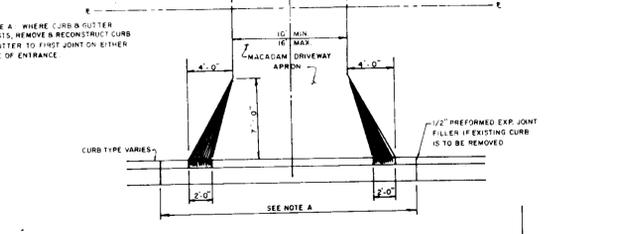

**RESIDENTIAL DRIVEWAY ENTRANCE WITHOUT SIDEWALK**  
NOT TO SCALE

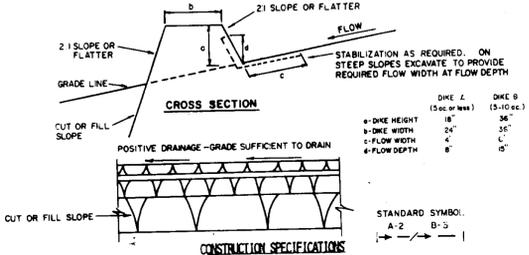

**CONSTRUCTION SPECIFICATIONS**



1. All dikes shall be compacted by earth-moving equipment.
2. All dikes shall have positive drainage to an outlet.
3. Top width may be wider and side slopes may be flatter if desired to facilitate crossing by construction traffic.
4. Field location should be adjusted as needed to utilize a stabilized safe outlet.
5. Earth dikes shall have an outlet that functions with a minimum of erosion. Runoff shall be conveyed to a sediment trapping device such as a sediment trap or sediment basin where either the dike channel or the drainage area above the dike are not adequately stabilized.
6. Stabilization shall be: (A) IN ACCORDANCE WITH STANDARD SPECIFICATIONS FOR SEED AND STRAW MULCH OR STRAW MULCH IF NOT IN SEEDING SEASON, (B) FLOW CHANNEL AS PER THE CHART BELOW.

**FLOW CHANNEL STABILIZATION**

TYPE OF TREATMENT	CHANNEL GRADE	DIKE A	DIKE B
1	5-3 OR	SEED AND STRAW MULCH	SEED AND STRAW MULCH
2	3.1-5 OR	SEED AND STRAW MULCH	SEED USING JUTE, OR EXCELSTOR; SO; 2" STONE
3	5.1-8 OR	SEED WITH JUTE, OR SO; 2" STONE	LINED RIP-RAP 4-8"
4	8.1-20 OR	LINED RIP-RAP 4-8"	ENGINEERING DESIGN

A. STONE TO BE 2 INCH STONE, OR RECYCLED CONCRETE EQUIVALENT, IN A LAYER AT LEAST 3 INCHES IN THICKNESS AND BE PRESSED INTO THE SOIL WITH CONSTRUCTION EQUIPMENT.  
 B. RIP-RAP TO BE 4-8 INCHES IN A LAYER AT LEAST 8 INCHES THICKNESS AND PRESSED INTO THE SOIL.  
 C. APPROVED EQUIVALENTS CAN BE SUBSTITUTED FOR ANY OF THE ABOVE MATERIALS.  
 7. PERIODIC INSPECTION AND REQUIRED MAINTENANCE MUST BE PROVIDED AFTER EACH RAIN EVENT.

**EARTH DIKE**  
NOT TO SCALE

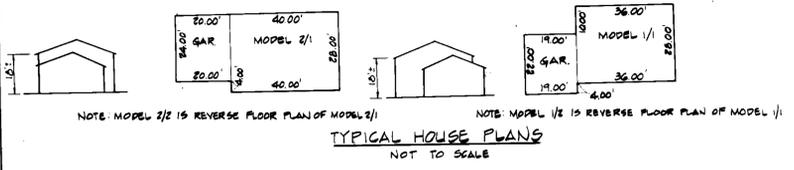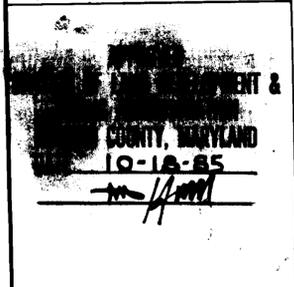

**TYPICAL HOUSE PLANS**  
NOT TO SCALE

**FISHER, COLLINS & CARTER, INC.**  
CIVIL ENGINEERS & LAND SURVEYORS  
8388 COURT AVENUE  
ELLCOTT CITY, MARYLAND 21043  
(301) 461-2855

**ENGINEER'S CERTIFICATE**  
I HEREBY CERTIFY THAT THIS PLAN FOR EROSION AND SEDIMENT CONTROL REPRESENTS A PRACTICAL AND WORKABLE PLAN BASED ON MY PERSONAL KNOWLEDGE OF THE SITE CONDITIONS AND THAT IT WAS PREPARED IN ACCORDANCE WITH THE REQUIREMENTS OF THE HOWARD SOIL CONSERVATION DISTRICT.

*Chad Lamb*  
SIGNATURE OF ENGINEER  
10/26/85  
DATE

**DEVELOPER'S CERTIFICATE**  
"I/WE CERTIFY THAT ALL DEVELOPMENT AND CONSTRUCTION WILL BE DONE ACCORDING TO THIS PLAN OF DEVELOPMENT AND PLAN FOR EROSION AND SEDIMENT CONTROL AND THAT ALL RESPONSIBLE PERSONNEL INVOLVED IN THE CONSTRUCTION PROJECT WILL HAVE A CERTIFICATE OF ATTENDANCE AT A DEPARTMENT OF NATURAL RESOURCES APPROVED TRAINING PROGRAM FOR THE CONTROL OF SEDIMENT AND EROSION BEFORE BEGINNING THE PROJECT. I ALSO AUTHORIZE PERIODIC ON-SITE INSPECTION BY THE HOWARD SOIL CONSERVATION DISTRICT OR THEIR AUTHORIZED AGENTS, AS ARE DEEMED NECESSARY."

*John A. Lamb*  
SIGNATURE OF DEVELOPER  
9/26/85  
DATE

REVIEWED FOR HOWARD SOIL CONSERVATION DISTRICT AND MEETS TECHNICAL REQUIREMENTS  
*James M. Hahn* 10/30/85  
U.S. SOIL CONSERVATION SERVICE DATE

THIS DEVELOPMENT IS APPROVED FOR EROSION AND SEDIMENT CONTROL BY THE HOWARD SOIL CONSERVATION DISTRICT.  
*Stephen A. Hahn* 10/30/85  
DISTRICT DATE  
HOWARD SOIL CONSERVATION DISTRICT

APPROVED: OFFICE OF PLANNING AND ZONING  
*Thomas A. Hahn* 10-4-85  
PLANNING DIRECTOR DATE

APPROVED: DIVISION OF LAND DEVELOPMENT AND ZONING ADMINISTRATION  
*John W. Hahn* 11-4-85  
CHIEF, DIVISION OF LAND DEVELOPMENT AND ZONING ADMINISTRATION DATE

APPROVED: HOWARD COUNTY HEALTH DEPARTMENT FOR PUBLIC WATER AND SEWERAGE SYSTEMS  
*Joseph B. Jones* 11-1-85  
HEALTH OFFICER DATE

APPROVED: DEPARTMENT OF PUBLIC WORKS FOR PUBLIC WATER & SEWER AND STORM DRAINAGE SYSTEMS AND ROADS.  
*William H. Jones* 10-31-85  
DIRECTOR (PUBLIC WORKS) DATE

*William H. Jones* 10-29-85  
CHIEF, BUREAU OF ENGINEERING DATE


SUBDIVISION	SECTION	LOT NO.
LILLY'S ADDITION TO LAKEVIEW	2	10, 12, 13 & 15-18
PLAT NO. 6400	BLOCK NO. 18	ZONE TAX/ZONE 46
WATER CODE	ELEC. DIST. 6th	CENSUS TR. 6002
	SEWER CODE	7450000

**NOTES AND DETAILS**  
**LILLY'S ADDITION TO LAKEVIEW**  
 SECTION 2  
 LOT 10, 12, 13 AND LOTS 15-18  
 TAX MAP NO. 46 PARCEL NO. 197  
 6TH ELECTION DISTRICT  
 HOWARD COUNTY MD  
 REVISED: OCTOBER 24, 1985  
 SCALE AS SHOWN SHEET 2 OF 3  
 SEPTEMBER 13, 1985



OWNER/DEVELOPER  
 FLOYD E. LILLY  
 304 MONTGOMERY STREET  
 LAUREL, MARYLAND 20810

NOTE:  
 SEDIMENT CONTROL FOR THESE LOTS WILL BE PROVIDED BY UTILIZING THE STORM WATER MANAGEMENT POND (NOW BEING TEMPORARILY USED AS AN EXISTING SEDIMENT BASIN) SEE PLANS F-85-157. IN THE EVENT THAT THE SEDIMENT BASIN IS CONVERTED INTO A PERMANENT STORM WATER MANAGEMENT POND BEFORE ALL DISTURBED AREAS INVOLVED WITH THE CONSTRUCTION OF THE DWELLINGS ON THESE LOTS, A SEDIMENT CONTROL PLAN FOR THESE LOTS MUST BE SUBMITTED AND APPROVED BY THE HOWARD SOIL CONSERVATION DISTRICT.

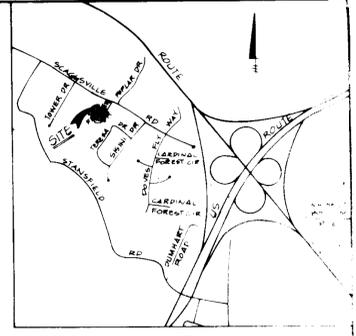


**PERMANENT SEEDING NOTES:**  
 APPLY TO GRADED OR CLEARED AREA NOT SUBJECT TO IMMEDIATE FURTHER DISTURBANCE WHERE A PERMANENT LONG-LIVED VEGETATIVE COVER IS NEEDED.  
 SEEDING PREPARATION: LOOSEN UPPER THREE-INCHES OF SOIL BY RAKING, DISCING OR OTHER ACCEPTABLE MEANS BEFORE SEEDING.  
 SOIL AMENDMENTS: IN LIEU OF SOIL TEST RECOMMENDATIONS, USE ONE OF THE FOLLOWING SCHEDULES:  
 1) PREFERRED: APPLY 2 TONS PER ACRE DOLOMITIC LIMESTONE (92 LBS/1000 SQUARE FT.) AND 600 LBS PER ACRE 10-10-10 FERTILIZER (14 LBS/1000 SQ. FT.) BEFORE SEEDING. HARROW OR DISC INTO UPPER THREE-INCHES OF SOIL AT TIME OF SEEDING. APPLY 400 LBS. PER ACRE 30-0-0 UREAFORM FERTILIZER (9 LBS/1000 SQ. FT.).  
 2) ACCEPTABLE: APPLY 2 TONS PER ACRE DOLOMITIC LIMESTONE (92 LBS/1000 SQ. FT.) AND 1000 LBS PER ACRE 10-10-10 FERTILIZER (22 LBS/1000 SQ. FT.) BEFORE SEEDING. HARROW OR DISC INTO UPPER THREE-INCHES OF SOIL.  
 SEEDING: FOR PERIODS MARCH 1 THRU APRIL 30 AND AUGUST 1 THRU OCTOBER 15, SEED WITH 60 LBS PER ACRE (1.4 LBS/1000 SQ. FT.) OF KENTUCKY 31 TALL FESCUE. FOR THE PERIOD MAY 1 THRU JULY 31, SEED WITH 60 LBS KENTUCKY 31 TALL FESCUE PER ACRE AND 2 LBS PER ACRE (.05 LBS/1000 SQ. FT.) OF HEATING LONGSSIS. DURING THE PERIOD OF OCTOBER 16 THRU FEBRUARY 28, PROTECT SITE BY: OPTION (1) 2 TONS PER ACRE OF WELL ANCHORED STRAW MULCH AND SEED AS SOON AS POSSIBLE IN THE SPRING. OPTION (2) USE SOIL OPTION (3) SEED WITH 60 LBS/ACRE KENTUCKY 31 TALL FESCUE AND MULCH WITH 2 TONS/ACRE WELL ANCHORED STRAW.  
 MULCHING: APPLY 1 1/2 TO 2 TONS PER ACRE (70 TO 90 LBS/1000 SQ. FT.) OF UNROTTED SMALL GREEN STRAW IMMEDIATELY AFTER SEEDING. ANCHOR MULCH IMMEDIATELY AFTER APPLICATION USING MULCH ANCHORING TOOL OR 218 GALLONS PER ACRE (5 GAL/1000 SQ. FT.) OF EMULSIFIED ASPHALT ON FLAT AREAS. ON SLOPES 8 FEET OR HIGHER, USE 348 GALLONS PER ACRE (8 GAL/1000 SQ. FT.) FOR ANCHORING.  
 MAINTENANCE: INSPECT ALL SEEDING AREAS AND MAKE NEEDED REPAIRS, REPLACEMENTS AND RESEEDING.  
**TEMPORARY SEEDING NOTES:**  
 APPLY TO GRADED OR CLEARED AREAS LIKELY TO BE REDISTURBED WHERE A SHORT-TERM VEGETATIVE COVER IS NEEDED.  
 SEEDING PREPARATION: LOOSEN UPPER THREE-INCHES OF SOIL BY RAKING, DISCING OR OTHER ACCEPTABLE MEANS BEFORE SEEDING.  
 SOIL AMENDMENTS: APPLY 600 LBS PER ACRE 10-10-10 FERTILIZER (14 LBS/1000 SQ. FT.)  
 SEEDING: FOR PERIODS MARCH 1 THRU APRIL 30 AND FROM AUGUST 15 THRU NOVEMBER 15, SEED WITH 10 LBS PER ACRE OF ANNUAL RYE (3.2 LBS/1000 SQ. FT.). FOR THE PERIOD MAY 1 THRU AUGUST 14, SEED WITH 3 LBS PER ACRE OF MIXING LONGSSIS (1.0 LBS/1000 SQ. FT.). FOR THE PERIOD NOVEMBER 16 THRU FEBRUARY 28, PROTECT SITE BY APPLYING 2 TONS PER ACRE OF WELL ANCHORED STRAW MULCH AND SEED AS SOON AS POSSIBLE IN THE SPRING, OR USE SOIL.  
 MULCHING: APPLY 1 1/2 TO 2 TONS PER ACRE (70 TO 90 LBS/1000 SQ. FT.) OF UNROTTED SMALL GREEN STRAW IMMEDIATELY AFTER SEEDING. ANCHOR MULCH IMMEDIATELY AFTER APPLICATION USING MULCH ANCHORING TOOL OR 218 GAL. PER ACRE (5 GAL/1000 SQ. FT.) OF EMULSIFIED ASPHALT ON FLAT AREAS. ON SLOPES, 8 FT. OR HIGHER, USE 348 GAL PER ACRE (8 GAL/1000 SQ. FT.) FOR ANCHORING.  
 REFER TO THE 1983 MARYLAND STANDARDS AND SPECIFICATIONS FOR SOIL EROSION AND SEDIMENT CONTROL FOR RATE AND METHODS NOT COVERED.

**LANDSCAPE LEGEND**  
 SUGAR MAPLES (ACER SACCHARUM)  
 2 1/2" MIN. CALIPER @ 40'-06"  
 PER F-85-157

14	ANTI-FELLSVIEW DRIVE
8	2676
17	2676
6	2620
13	2624
5	2627
12	2623
11	2627
10	2675
9	ANTI-FELLSVIEW DRIVE

LOT NO.	ADDRESS
14	ANTI-FELLSVIEW DRIVE
8	2676
17	2676
6	2620
13	2624
5	2627
12	2623
11	2627
10	2675
9	ANTI-FELLSVIEW DRIVE

**APPROVED**  
 DIVISION OF LAND DEVELOPMENT &  
 ZONING ADMINISTRATION  
 HOWARD COUNTY, MARYLAND  
 DATE 10-18-85

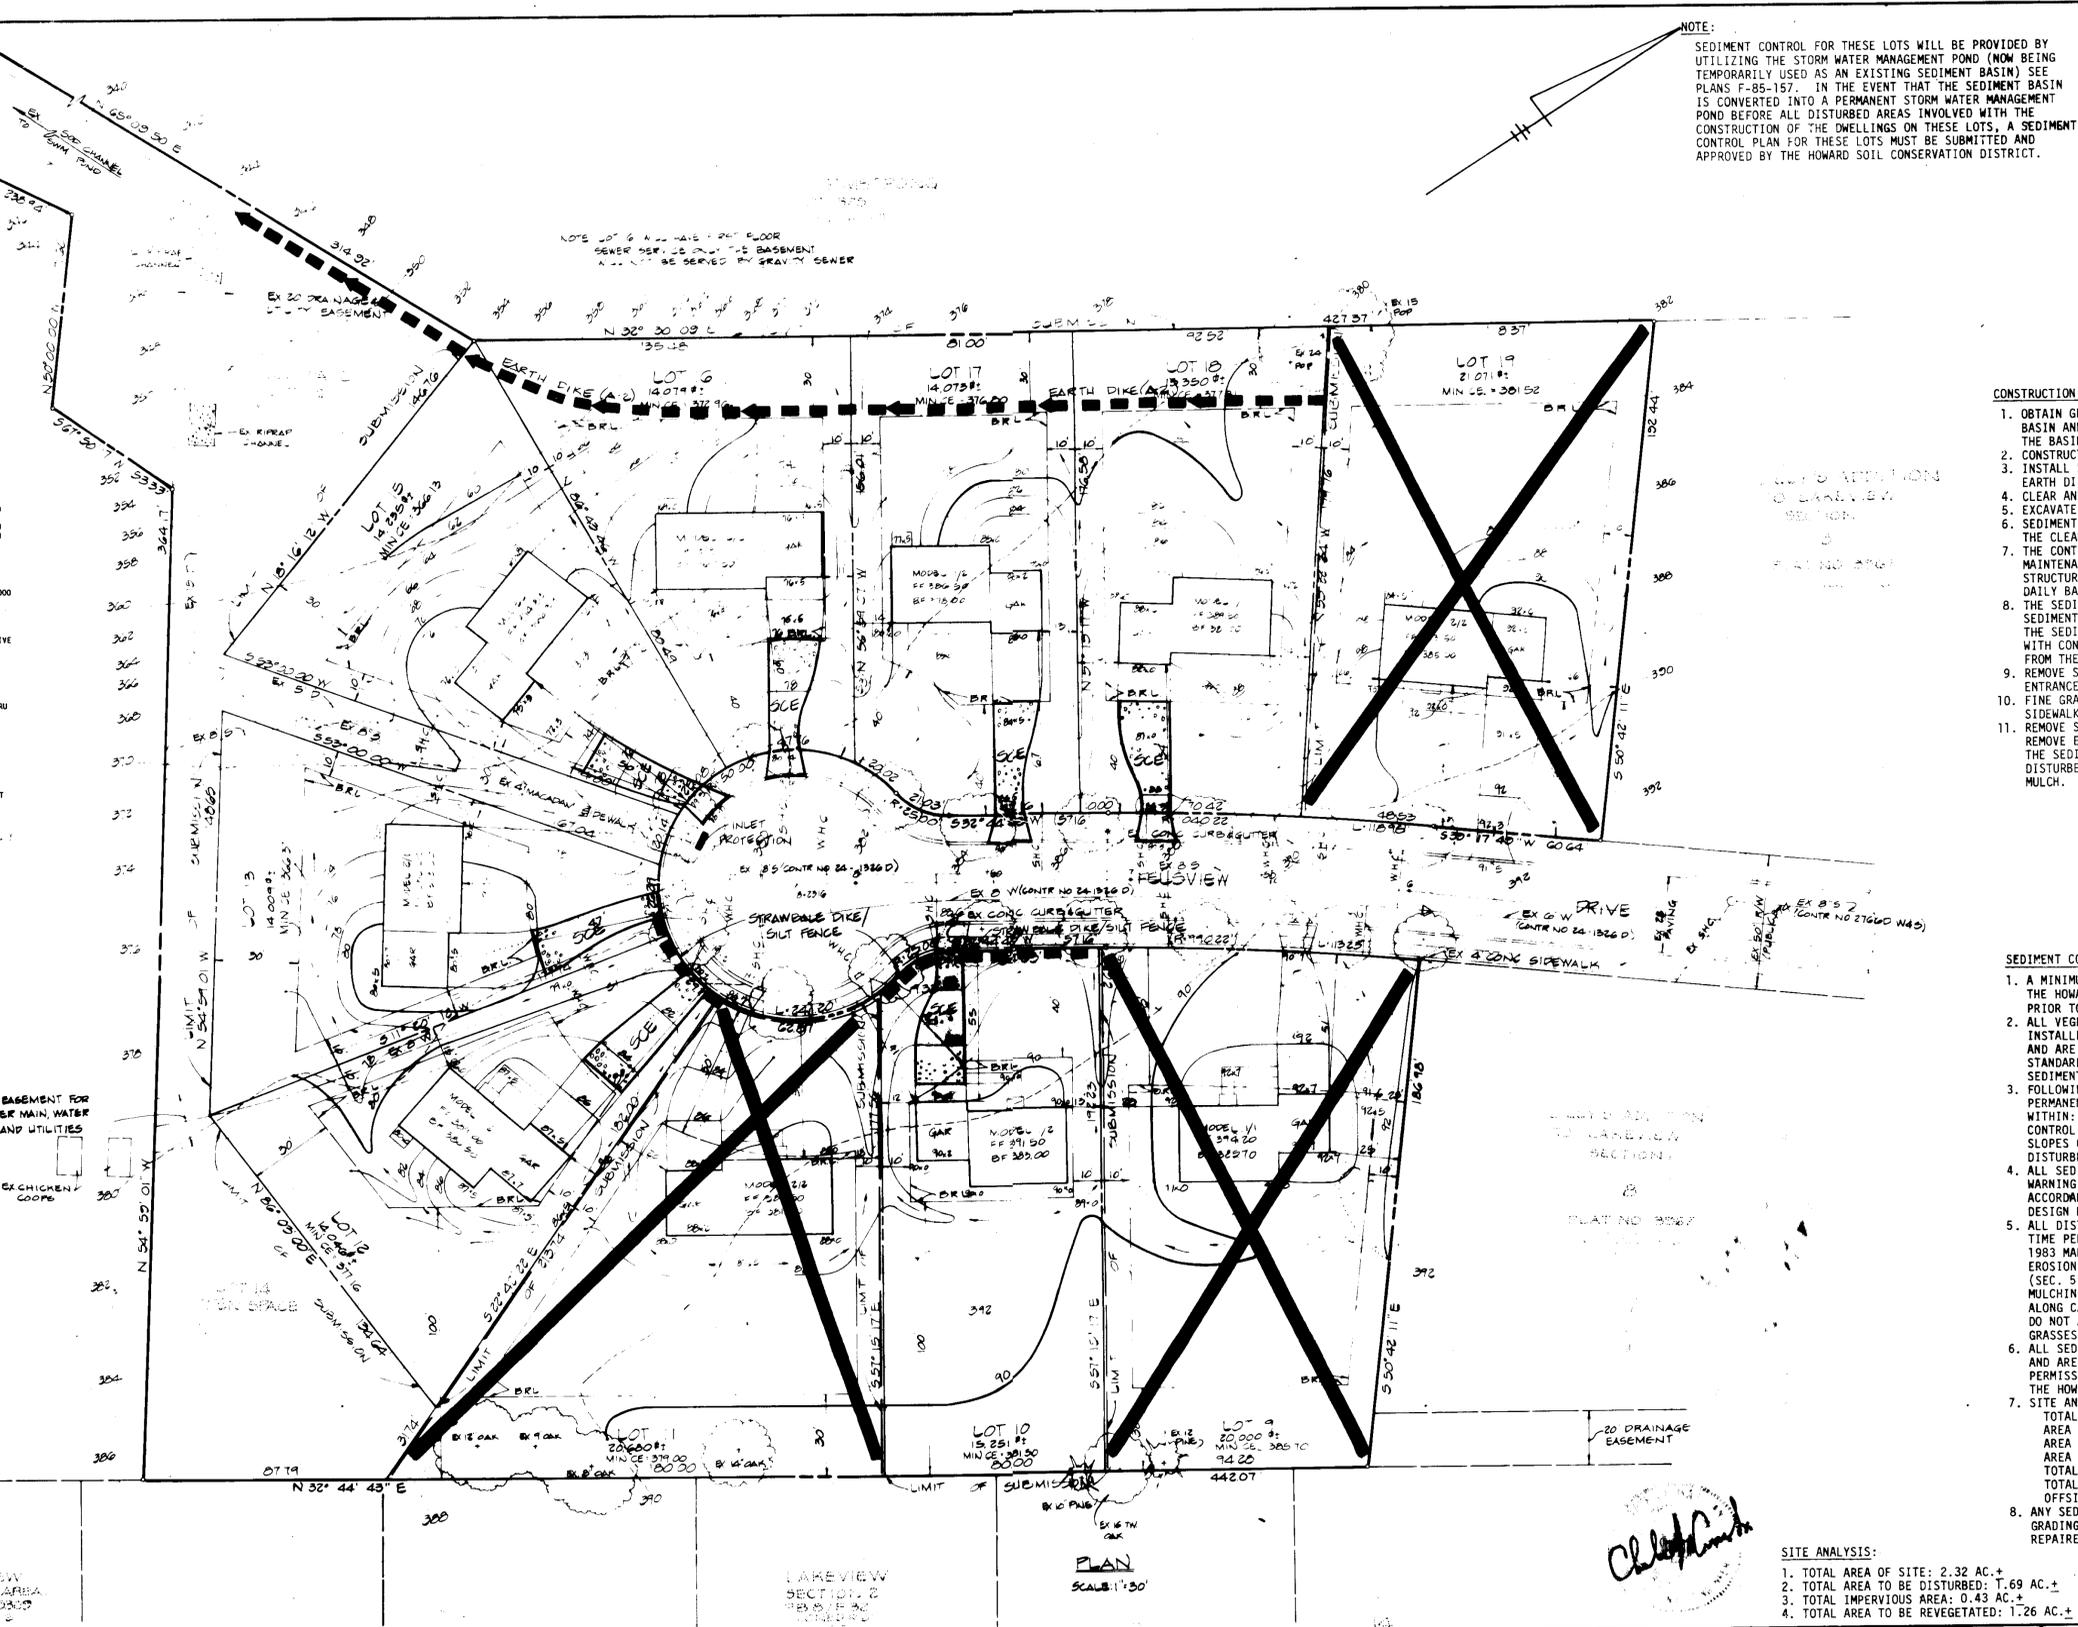

- CONSTRUCTION SEQUENCE:**
- OBTAIN GRADING PERMIT. INSPECT EXISTING SEDIMENT BASIN AND MAKE ANY NECESSARY REPAIRS OR MAINTENANCE TO THE BASIN PRIOR TO BEGINNING ANY WORK SHOWN HEREON.
  - CONSTRUCT STONE CONSTRUCTION ENTRANCE FOR LOTS.
  - INSTALL STRAW BALE DIKE OR SILT FENCE ON LOTS. CONSTRUCT EARTH DIKE ALONG REAR OF LOTS 15-18.
  - CLEAR AND GRUB HOUSE SITES TO SUBGRADE.
  - EXCAVATE FOR FOUNDATIONS AND BEGIN HOUSE CONSTRUCTION.
  - SEDIMENT SHALL BE REMOVED FROM THE SEDIMENT BASIN WHEN THE CLEANOUT ELEVATION HAS BEEN REACHED.
  - THE CONTRACTOR SHALL INSPECT AND PROVIDE NECESSARY MAINTENANCE ON THE SEDIMENT AND EROSION CONTROL STRUCTURES SHOWN HEREON, AFTER EACH RAINFALL AND ON A DAILY BASIS.
  - THE SEDIMENT BASIN SHALL BE DETERMINED BY PUMPING. THE SEDIMENT FROM THE BASIN SHALL BE PLACED UP-GRADE FROM THE SEDIMENT BASIN IN SUCH A MANNER AS NOT TO INTERFERE WITH CONSTRUCTION OPERATIONS OR CAUSE EROSION DOWNGRADE FROM THE SEDIMENT BASIN.
  - REMOVE SEDIMENT FROM ROADWAYS AND DRESS STONE CONSTRUCTION ENTRANCE AS REQUIRED.
  - FINE GRADE LOTS AND STABILIZE. INSTALL DRIVEWAYS AND SIDEWALKS.
  - REMOVE STRAW BALE DIKE OR SILT FENCE AND STABILIZE. REMOVE EARTH DIKE AFTER PERMISSION HAS BEEN GIVEN BY THE SEDIMENT CONTROL INSPECTOR AND STABILIZE REMAINING DISTURBED AREA WITH PERMANENT SEEDING MIXTURE AND STRAW MULCH.

- SEDIMENT CONTROL NOTES:**
- A MINIMUM OF 24 HOURS NOTICE MUST BE GIVEN TO THE HOWARD COUNTY OFFICE OF INSPECTION AND PERMITS PRIOR TO THE START OF ANY CONSTRUCTION. (992-2437)
  - ALL VEGETATIVE AND STRUCTURAL PRACTICES ARE TO BE INSTALLED ACCORDING TO THE PROVISIONS OF THIS PLAN AND ARE TO BE IN CONFORMANCE WITH THE 1983 MARYLAND STANDARDS AND SPECIFICATIONS FOR SOIL EROSION AND SEDIMENT CONTROL.
  - FOLLOWING INITIAL SOIL DISTURBANCE OR REDISTURBANCE, PERMANENT OR TEMPORARY STABILIZATION SHALL BE COMPLETED WITHIN: A) 7 CALENDAR DAYS FOR ALL PERIMETER SEDIMENT CONTROL STRUCTURES, DIKES, PERIMETER SLOPES AND ALL SLOPES GREATER THAN 3:1, B) 14 DAYS AS TO ALL OTHER DISTURBED OR GRADED AREAS ON THE PROJECT SITE.
  - ALL SEDIMENT TRAPS/BASINS SHOWN MUST BE FENCED AND WARNING SIGNS POSTED AROUND THEIR PERIMETER IN ACCORDANCE WITH VOL. 1, CHAPTER 12, OF THE HOWARD COUNTY DESIGN MANUAL, STORM DRAINAGE.
  - ALL DISTURBED AREAS MUST BE STABILIZED WITHIN THE TIME PERIOD SPECIFIED ABOVE IN ACCORDANCE WITH THE 1983 MARYLAND STANDARDS AND SPECIFICATIONS FOR SOIL EROSION AND SEDIMENT CONTROL FOR PERMANENT SEEDINGS (SEC. 51) AND (SEC. 52). TEMPORARY SEEDING (SEC. 50) AND MULCHING (SEC. 52). TEMPORARY STABILIZATION WITH MULCH ALONG CAN ONLY BE DONE WHEN RECOMMENDED SEEDING DATES DO NOT ALLOW FOR PROPER GERMINATION AND ESTABLISHMENT OF GRASSES.
  - ALL SEDIMENT CONTROL STRUCTURES ARE TO REMAIN IN PLACE AND ARE TO BE MAINTAINED IN OPERATIVE CONDITION UNTIL PERMISSION FOR THEIR REMOVAL HAS BEEN OBTAINED FROM THE HOWARD COUNTY SEDIMENT CONTROL INSPECTOR.
  - SITE ANALYSIS:  
 TOTAL AREA OF SITE 2.32 ACRES  
 AREA DISTURBED 1.61 ACRES  
 AREA TO BE ROOFED OR PAVED 0.43 ACRES  
 AREA TO BE VEGETATIVELY STABILIZED 1.26 ACRES  
 TOTAL CUT 4000 CU. YDS.  
 TOTAL FILL 4000 CU. YDS.  
 OFFSITE WASTE/BORROW AREA LOCATION BALANCED SITE  
 ANY SEDIMENT CONTROL PRACTICE WHICH IS DISTURBED BY GRADING ACTIVITY FOR PLACEMENT OF UTILITIES MUST BE REPAIRED ON THE SAME DAY OF DISTURBANCE.

**SITE ANALYSIS:**  
 1. TOTAL AREA OF SITE: 2.32 AC. ±  
 2. TOTAL AREA TO BE DISTURBED: 1.69 AC. ±  
 3. TOTAL IMPERVIOUS AREA: 0.43 AC. ±  
 4. TOTAL AREA TO BE REVEGETATED: 1.26 AC. ±

**OWNER/DEVELOPER**  
 304 MONTGOMERY STREET  
 LAUREL, MARYLAND 20800

**FISHER, COLLINS & CARTER, INC.**  
 CIVIL ENGINEERS & LAND SURVEYORS  
 1388 COURT AVE.  
 ELLICOTT CITY, MD. 21043  
 (301) 461-2855

**ENGINEER'S CERTIFICATE**  
 I HEREBY CERTIFY THAT THIS PLAN FOR EROSION AND SEDIMENT CONTROL REPRESENTS A PRACTICAL AND WORKABLE PLAN BASED ON MY PERSONAL KNOWLEDGE OF THE SITE CONDITIONS AND THAT IT WAS PREPARED IN ACCORDANCE WITH THE REQUIREMENTS OF THE HOWARD SOIL CONSERVATION DISTRICT.

*Charles J. Carter*  
 SIGNATURE OF ENGINEER  
 10/25/85  
 DATE

**DEVELOPER'S CERTIFICATE**  
 I/WE CERTIFY THAT ALL DEVELOPMENT AND CONSTRUCTION WILL BE DONE ACCORDING TO THIS PLAN OF DEVELOPMENT AND PLAN FOR EROSION AND SEDIMENT CONTROL AND THAT ALL RESPONSIBLE PERSONNEL INVOLVED IN THE CONSTRUCTION PROJECT WILL HAVE A CERTIFICATE OF ATTENDANCE AT A DEPARTMENT OF NATURAL RESOURCES APPROVED TRAINING PROGRAM FOR THE CONTROL OF SEDIMENT AND EROSION BEFORE BEGINNING THE PROJECT. I ALSO AUTHORIZE PERIODIC ONSITE INSPECTION BY THE HOWARD SOIL CONSERVATION DISTRICT OR THEIR AUTHORIZED AGENTS, AS ARE DEEMED NECESSARY.

*L. E. Lilly*  
 SIGNATURE OF DEVELOPER  
 9/28/85  
 DATE

**REVIEWED BY HOWARD SOIL CONSERVATION DISTRICT AND MEETS TECHNICAL REQUIREMENTS**

*Thomas M. Helm*  
 U.S. SOIL CONSERVATION SERVICE  
 10/30/85  
 DATE

THIS DEVELOPMENT IS APPROVED FOR EROSION AND SEDIMENT CONTROL BY THE HOWARD SOIL CONSERVATION DISTRICT.

*Stephen A. Guler*  
 DISTRICT ENGINEER  
 10/30/85  
 DATE

**APPROVED: OFFICE OF PLANNING AND ZONING**

*Thomas G. Harvay*  
 PLANNING DIRECTOR  
 11-7-85  
 DATE

*William M. Harvay*  
 CHIEF, DIVISION OF LAND DEVELOPMENT AND ZONING ADMINISTRATION  
 11-4-85  
 DATE

APPROVED: HOWARD COUNTY HEALTH DEPARTMENT FOR PUBLIC WATER AND SEWERAGE SYSTEMS

*Joseph J. Brown*  
 HEALTH OFFICER  
 11-1-85  
 DATE

**APPROVED: DEPARTMENT OF PUBLIC WORKS FOR PUBLIC WATER & SEWER AND STORM DRAINAGE SYSTEMS AND ROADS**

*James F. Nimmer*  
 DIRECTOR, PUBLIC WORKS  
 10-15-85  
 DATE

*Michael H. ...*  
 CHIEF, BUREAU OF ENGINEERING  
 11-3-85  
 DATE

SUBDIVISION	SECTION	LOT NO.
LILLY'S ADDITION TO LAKEVIEW	2	10, 12, 13 AND LOTS 15-19 AND LOTS 18-19
PLAT NO. 6400	BLOCK NO. 1B	TAX/ZONE
		R. 20 46
WATER CODE E 19	ELEC. DIST. 6th	CENSUS TR. 6062
	SEWER CODE	7450000

**SEDIMENT CONTROL PLAN**

**LILLY'S ADDITION TO LAKEVIEW**

SECTION 2  
 LOTS 10, 12, 13 AND LOTS 15-19

TAX MAP NO. 46 PARCEL NO. 197

LOT 10 ELECTION DISTRICT

HOWARD COUNTY, MD.  
 REVISION: OCTOBER 24, 1985

SCALE: 1"=30'  
 SHEET 203  
 SEPTEMBER 3, 1985

SCP 80-74