




SDP-70-0

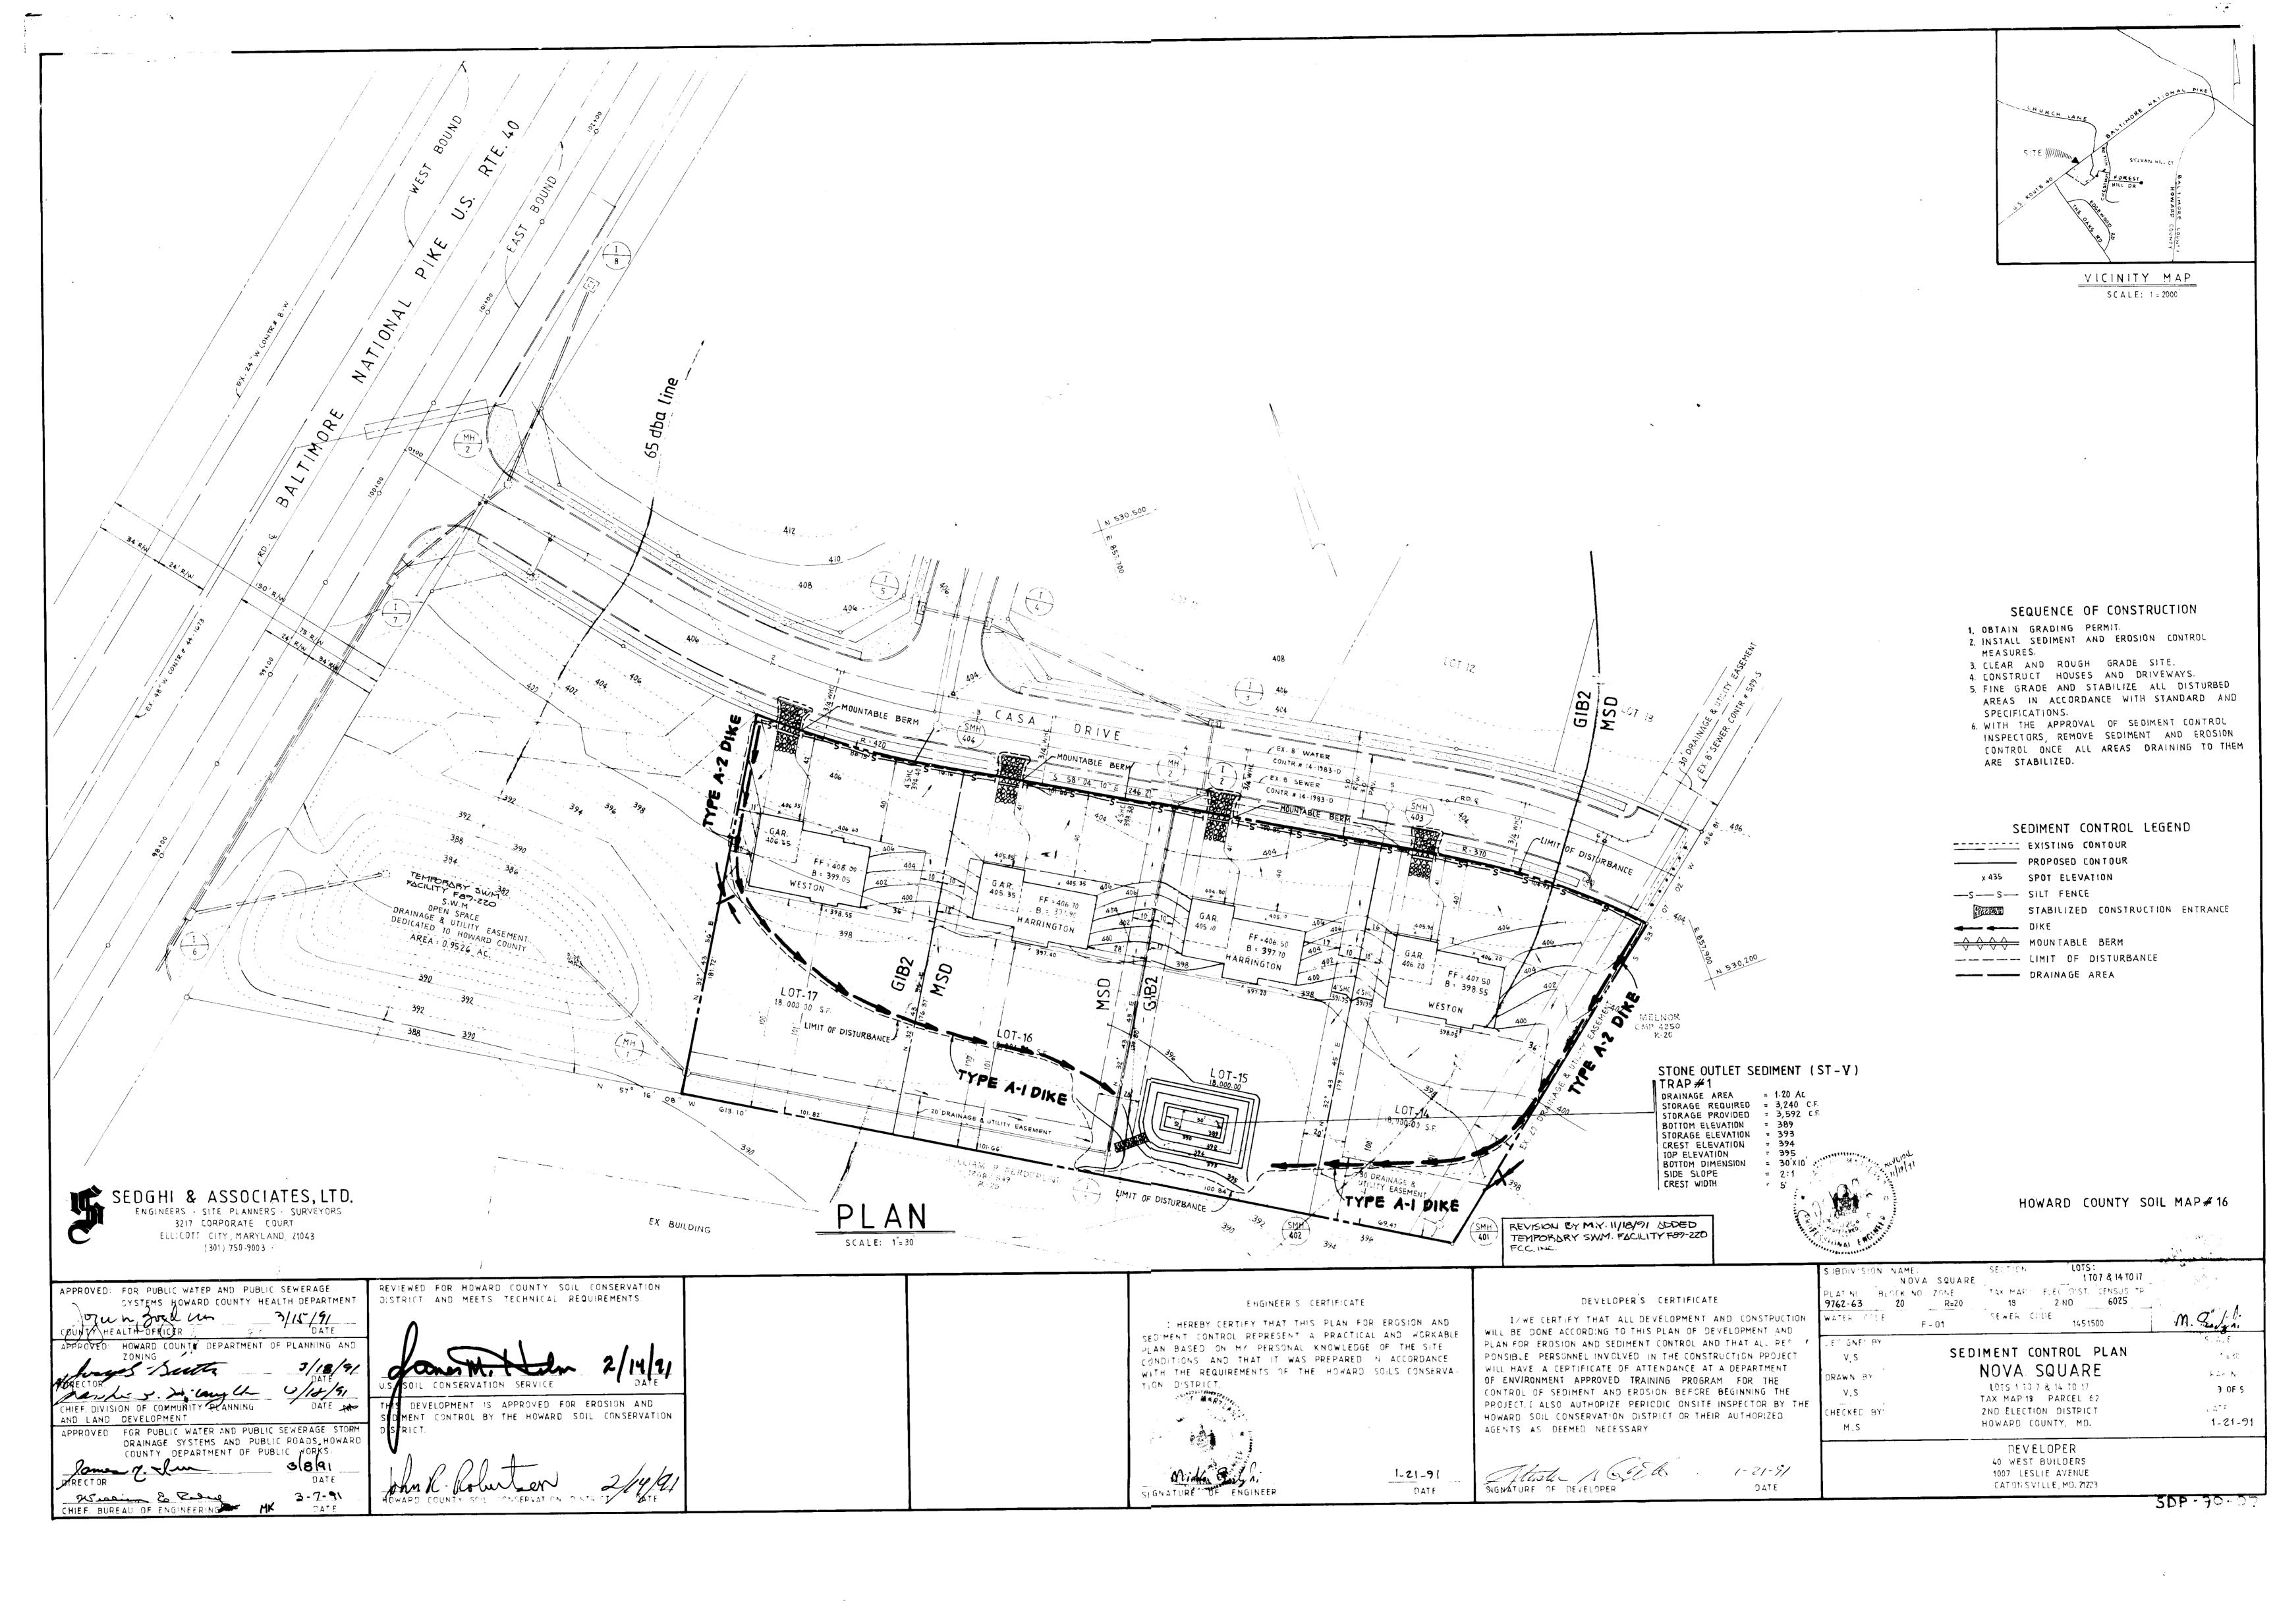

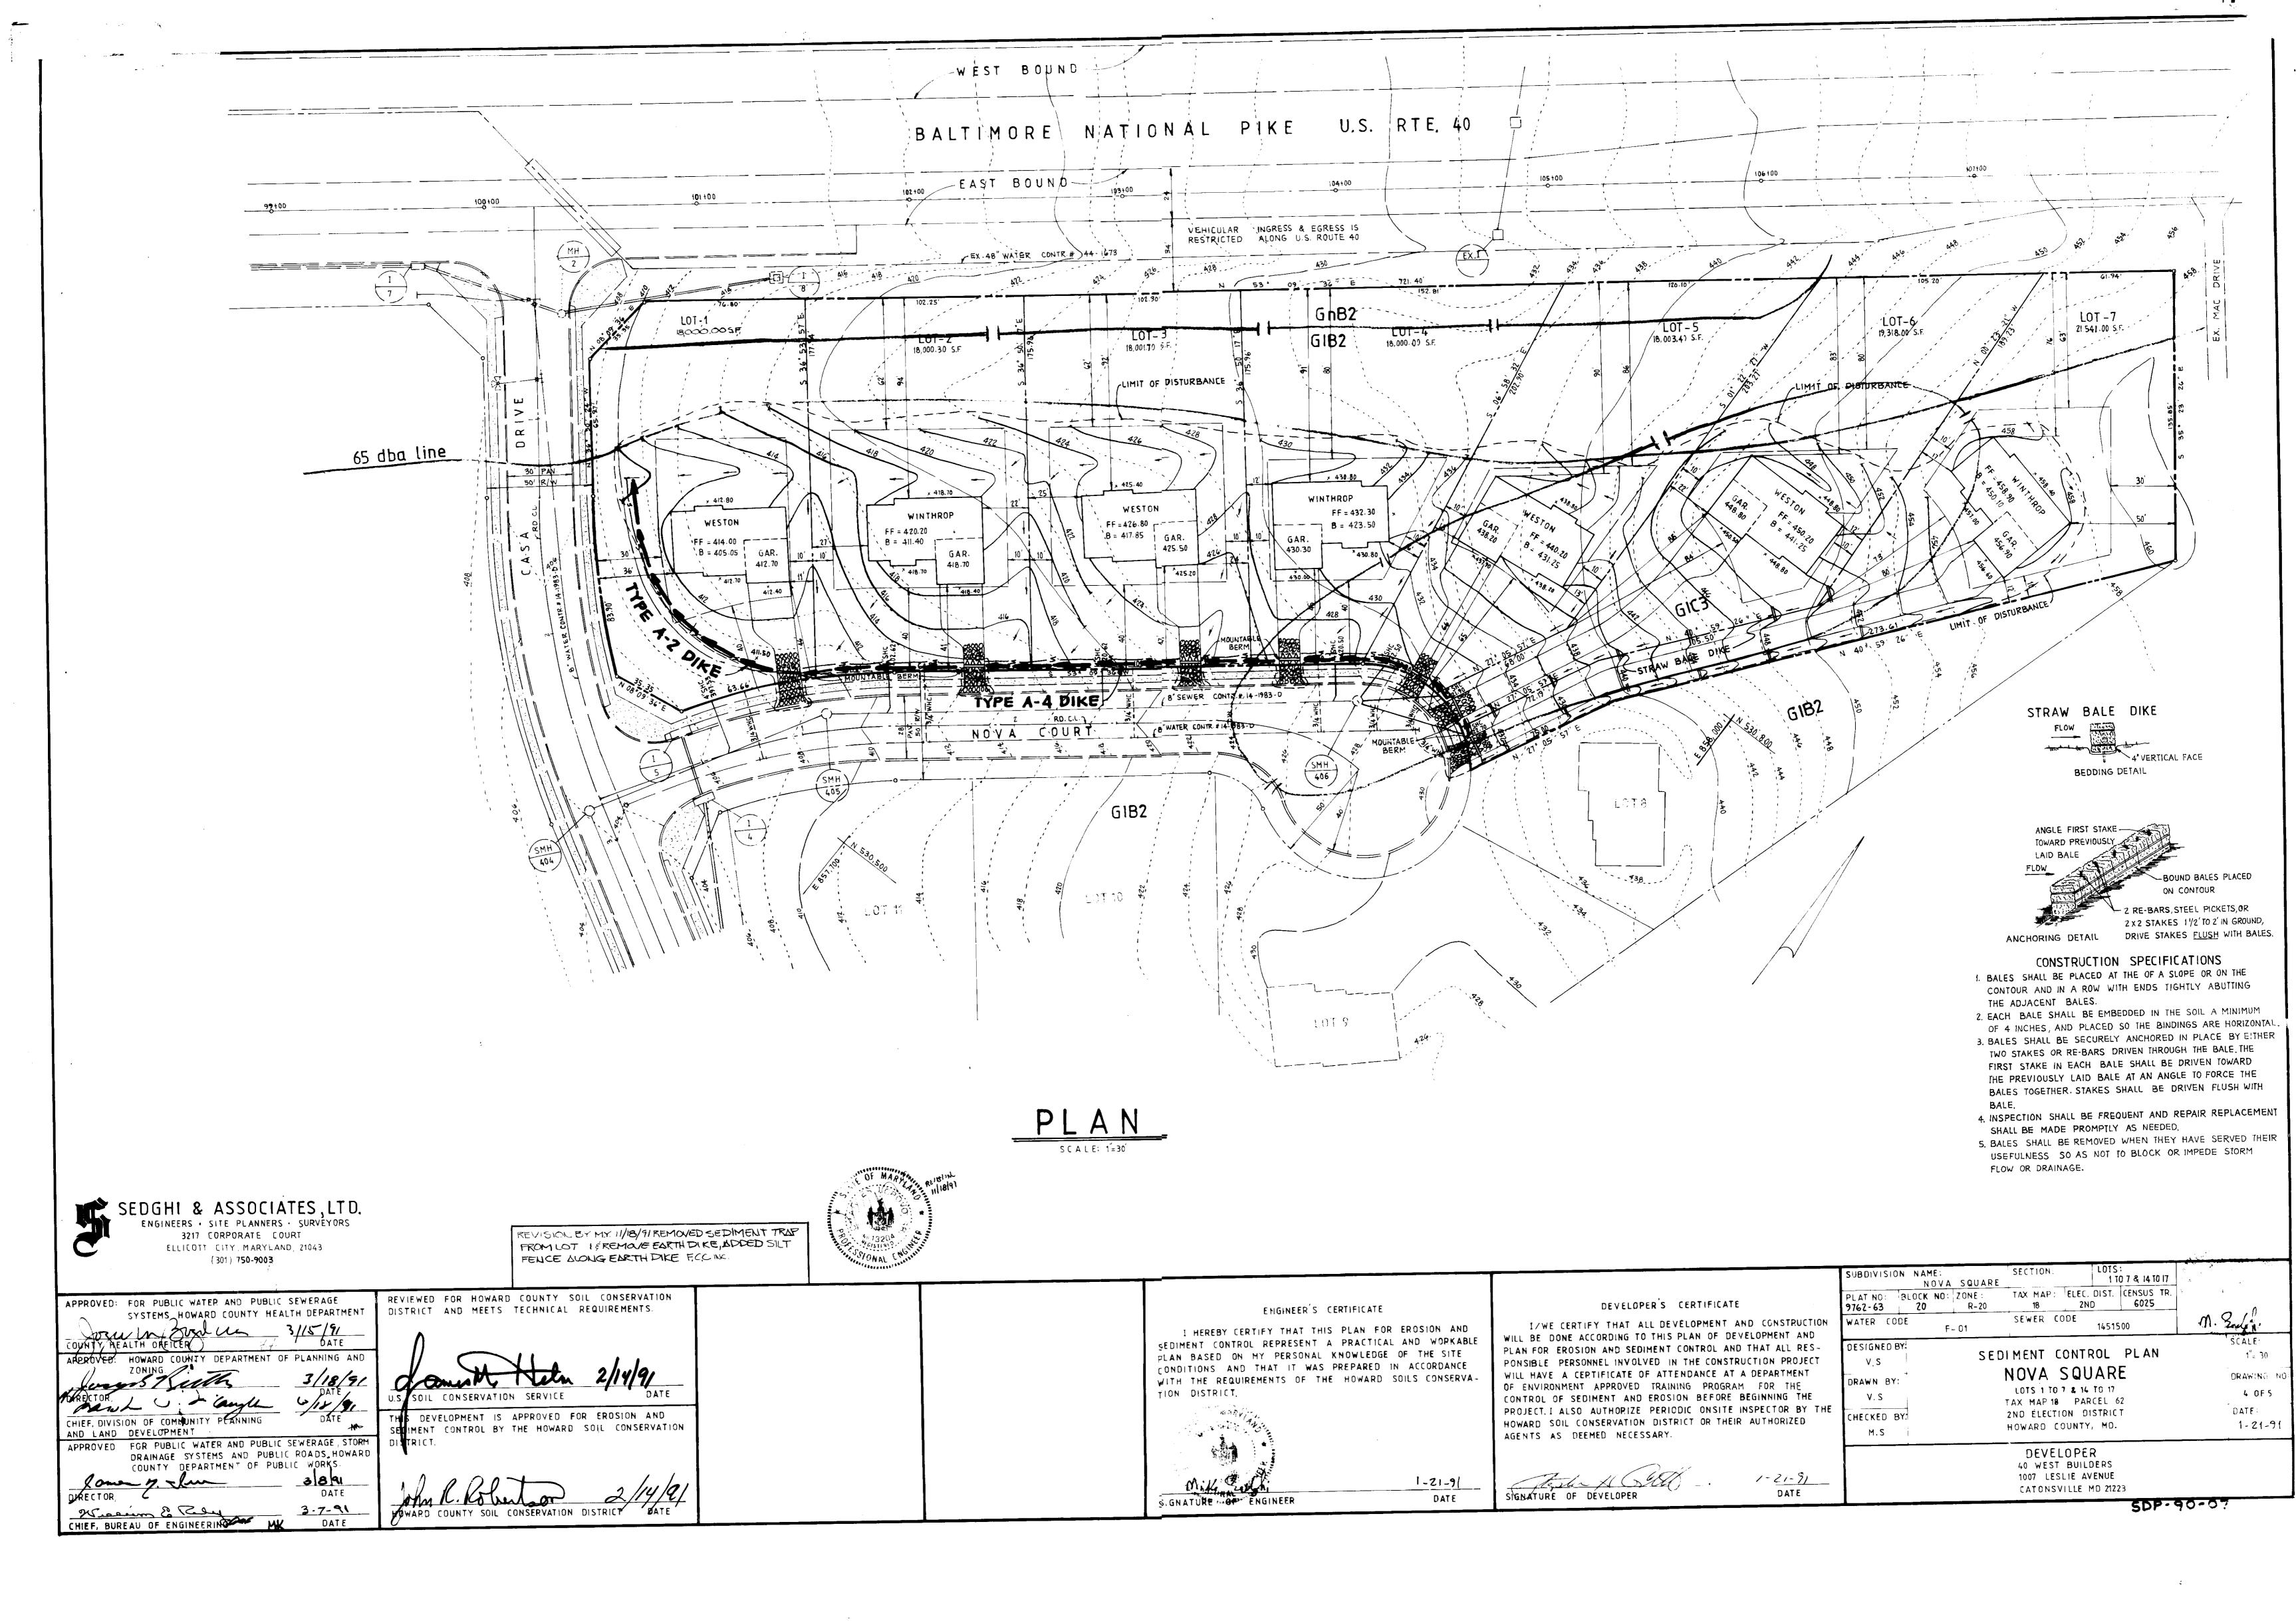

#### CONSTRUCTION SPECIFICATIONS

- 1. Stone Size Use 2° stone, or reclaimed or recycled concrete equivalent. 2. Length - As required, but not less than 50 feet (except on a single resi-
- dence lot where a 30 foot minimum length would apply).
- Thickness Not less than six (6) inches. 4. Width - Ten (10) foot minimum, but not less than the full width at
- points where ingress or egress occurs. 5. Filter Cloth - Will be placed over the entire area prior to placing of atone
- Filter will not be required on a single family residence lot. 6. Surface Water - All surface water flowing or diverted toward construction entrances shall be piped across the entrance. If piping is impractical,
- a mountable berm with 5:1 slopes will be permitted. 7. Maintenance - The entrance shall be maintained in a condition which will prevent tracking or flowing of sediment onto public rights-of-way. This may require periodic top dressing with additional stone as conditions demand and repair and/or cleanout of any measures used to trap sediment. All sediment spilled, dropped, washed or tracked onto public rights-of-way must
- be removed immediately. 8. Washing - Wheels shall be cleaned to remove sediment prior to entrance onto public rights-of-way. When washing is required, it shall be done on an area stabilized with stone and which drains into an approved sediment trapping
- 9. Periodic inspection and needed maintenance shall be provided after each rain.

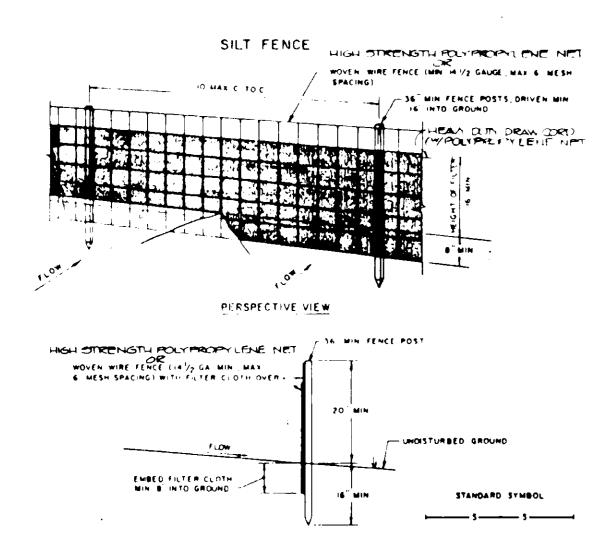

SECTION

CONSTRUCTION HOLDS FOR EAST, A TEX SILL FEACE POSTS STEEL EITHER TO THE MIN (Actual) 1 WOVEN WIRE FERRE OF BE FASTENED IT WELLY C FENLE POSTS WETH WIRE TIES OF STAPLES FDICE HOVEN WIRE, 14 bx  $2^{-1}$  leter culth to be rastened securely t WEVEN WIRE FENCE WITH THE' SPACEO EVERY 24" AT TOP AND MID SECTION HIGH STRENGTH POLY-PROPYLENE NETTING 3. WHEN THO SECTIONS OF FILTER WHOTH CLOTH: FILTER X,
MIRAFI JOUX, STABILINKA TIHON OR APPROVED
EQUAL ADJOIN EACH OTHER THEY SHALL BE OVER LAPPED BY STY INCHES AND FOLDED 4 MAINTENANCE SHALL BE PERFORMED AS . MEEDED AND MATERIAL REMOVED HEEN ENVIROPENCE, OR AFPROVED "BULGES" DEVELOP IN THE SILT FENCE

PERMANENT SELDING NOTES

APPLY TO GRADED OR CLEARED AREA NOT SUBJECT TO IMMEDIATE FUTURE DISTURBANCE WHERE A PERMANENT LONG-LIVED VEGETATIVE COVER IS NEEDED. Seedbed Preparation: Lonson upper 3 inches of soil by raking, discing or other acceptable means before seeding, if not previously loosened.

Soil Amendments: IN LIEU OF SOIL TEST RECOMMENDATIONS, USE ONE OF THE

- FOLLOWING SCHEDULES. 1.) Preferred - Apply 2 tons per acre dolomitic limestone (92 lbs./1000 square ft.) and 600 lbs. per acre 10-10-10 fertilizer (14 lbs./1000 sq. ft.) before seeding. Harrow or disc into upper three inches of soil. At time of seeding, apply 400 lbs. per acre 30-0-0 uresform fertilizer (91bs./1000 sq. fl.)
- 2.) Acceptable Apply 2 tone per acre dolomitic limestone (92 lbs./1000 sq.ft.) and 1000 lbs. per acre 10-10-10 fertilizer (23 lbs./1000 sq. ft.) before seeding. Harrow or disc into upper three inches of soil.

Seeding - For the pariods March 1 thru April 30, and August 1 thru October 15, seed with 60 lbs. per acre (1.4 lbs./1000 sq. ft.: of Kentucky 31 Tall Feacue. For the period May 1 thru July 31, seed with 60 los. Kentucky 31 Tall Feacue per acre and 2 lbs. per acre (.05 lbs./1000 so, it.) of weeping lovegrass. During the period of October 16 thru Fedruary 28, protect site by: Option (1) 2 tons per acre of well anchored straw mulch and seed as soon as possible in the spring. Option (2) Use sod. Option (3) Seed with 60 lbs./scre Kentucky 31 Tell Feacus and mulch with 2 tons/acre well anchored straw.

Hulching - Apply 1/2 to 2 tons per acre (70 to 90 lbs./1000 sq.ft.) of unrotted small grain strew immediately after sending. Anchor mulch immediately after application using mulch anchoring tool or 218 gallons per acre ( 5 gal./1000 sq.ft:) of emulaified asphalt on flat areas. On slopes 8 feet or higher, use 348 gallons per scre (8 gal./1300 sq. ft.) for anchoring.

Maintenance - Inspect all second areas and make needed repairs, replacements and reseedings.

TEMPORARY SEEDING NOTES APPLY TO GRADED OR CLEARED AREA LIKELY TO BE REDISTORBED WHERE A STORT-TERM VEGETATIVE COVER 15 NEEDED.


Seedbed Preparation: Loosen upper 3 inches of soil by raking, discing or other acceptable means before seeding, if not previously loosened.

Soil Amendments: Apply 60 lbs. per acre 10-10-10 fertilizer (14 lbs./1000 sq.ft.)

Saeding: For pericis Narch 1 thru April 38 and from August 15 thru November 15, seed with 2% bu, per acre of annual ryu (3.2 lbs./1000 eq.ft.). For the period May 1 thru August 14, seed with 3 lbs. per acre of weeping lovegrass (.07 lbs./ 1000 sq.ft.). For the period November 16 thru February 28, protect site by applying 2 tons per acre of well anchored straw mulch and seed as soon as possible in the spring, or use soul.

Mulching: Apply 1% to 2 tons per acce (70 to 90 lbs./1000 sq.ft.) of unratted small grain straw immediately after seeding. Anchor mulch immediately after application using mulch anchoring tool or 218 gal. per acro (5 gal./1000 sq.ft.) of emulsified asphalt on flat areas. On slopes, 8 ft. or higher, use 348 gal. per acre (8 gal./ 1000 sq.ft.) for amchoring.

REFER TO THE 1783 MD. STANDARD AND SPECIFICATIONS FOR SOIL EROSION AND SEDIMENT CONTROL FOR RATE AND METHODS NOT COVERED.

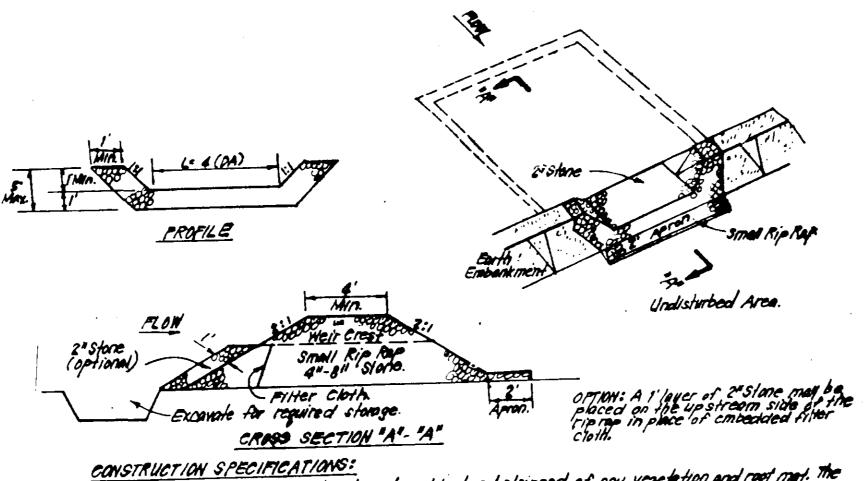

h Arm under embankment shall be cleared, grubbed and stripped of any vegetation and root met. The 2. The fill material for the embantment shall be free of rooks and other woody vegetation as well as over 2.' The fill meterial for the embankment shall be free of rooks and other woody vegetation as well as over street states, rocks organic meterial or other objectionable material. The embankment shall be compacted by traversing with compacted in the superior while it is being constructed.

3. All cut and fill slopes shall be 251 or flatter.

4. The stone used in the outlet shall be small rip-rop 4°-5° along with 1' thickness of 2° appreciate placed on the up-grade side an the small rip roop or embadded filter cloth in the rip roop and on the property of the trap accumulated to 12 the design depth of the trap accumulated to 12 the design depth of the trap.

6. The otherwise shall be inspected after each room and repairs made as needed.

7. Construction operations shall be corried out in such a manner than erosion and water pollution is a construction operations shall be corried out in such a manner than erosion and water pollution is a construction operations. 7. Construction operations shall be carried out in such a manner than erosion and water pollution is. 8. The structure shall be removed and the area stabilized when the drainage area has been properly

STONE OUTLET SEDIMENT TRAP (S.O.ST.) ST.Y.

APPROVED: FOR PUBLIC WATER AND PUBLIC SEWERAGE SYSTEMS, Reviewed for HOWARD HOWARD COUNTY HEALTH DEPARTMENT COONTY PEALTH OF PUER APPROVED HOWARD COUNTY DEPT. OF PLANNING & ZONING U.S. SOIL CONSERVATION SERVICE 3/18/9/ THIS DEVELOPMENT PLAN IS APPROVED CHIEF DIVISION OF COMMENTY PLANNINGDATE FOR SOIL EROSION AND SEDIMENT & LAND DEVELOPMENT CONTROL BY HOWARD COUNTY SOIL APPROVED FOR PUBLIC WATER AND PUBLIC SEWERAGE. CONSERVATION DISTRICT. STORM DRAINAGE SYSTEMS AND PUBLIC ROADS HOWARD COUNTY DEPARTMENT OF PUBLIC WORKS Maseum & Kale

HOF BUREAU OF ENGINEERING

DEVELOPER'S / BUILDER'S CERTIFICATE 1/WE CERTIFY THAT ALL DEVELOPMENT AND CONSTRUCTION WILL BE DONE ACCORD ING TO THIS PLAN OF DEVELOPMENT AND PLAN FOR EROSION AND SEDIMENT CON-TROL AND THAT ALL RESPONSIBLE PERSONNEL INVOLVED IN THE CONSTRUCTION PROJECT WILL HAVE A CERTIFICATE OF ATTENDANCE AT A DEPT. OF ENVIRONMENT APPROVED TRAINING PROGRAM FOR THE CONTROL OF SEDIMENT AND EROSION BEFORE BEGINNING THE PROJECT. I ALSO AUTHORIZE PERIODIC ON-SITE INSPECTION BY THE HOWARD COUNTY SOIL CONSERVATION DISTRICT OR THEIR AUTHORIZED AGENTS, AS ARE DEEMED NECESSARY.

17 67 6 5 DATE DEVELOPER / BUILDER

#### STANDARD AND SPECIFICATIONS POR VECETATIVE STABILIZATION WITH SOS

### SPECIFICATIONS

- 1. Class of turfgrass sod shall be Maryland or Virginia State Certified, or Maryland or Virginia State appreved and.
- 2. Sod shall be machine cut at a uniform soil thickness of 3/4 inch, plus or minus 1/4 inch, at the tire of cutting. Measurement for thickness shall exclude top growth and thatch.
- 3. Standard size sections of tod thall be strong enough to support their own weight and retain their size and shape when suspended vertically with a fire grasp on the upper 10 percent of the section.
- 4. Individual pieces of sod shall be cut to the suppliers width and length. Maximum allowable deviation from standard widths and lengths shall be 5 percent. Broken pads and torn or uneven ends will not be acceptable.
- 5. Sod shall not be harvested or transplanted when moisture content (excessively dry or wet) may adversely affect its survival.
- 6. Sod shall be harvested, delivered and installed within a period of 36 hours. Sod not transplanted within this period shall be inspected and approved prior to its installation.

## I. Site Preparation

Fertilizer and lime application rates shall be determined by soil tests. Under unusual circumstances where there is insufficient time for a complete soil test, fertilizer and lime materials may be applied in amounts shown under B, below.

- A. Prior to sodding, the surface shall be cleared of all trash. debris, and of all roots, brush, wire, grade stakes and other objects that would interfere with planting, fertilizing or maintenance operations.
- B. Where the soil is said or composed of heavy clays, ground limestone shall be spread at the rate of 2 tons/acre or 100 pounds per 1,000 square feet. In all soils 1,000 pounds per acre or 25 pounds per 1,000 square feet of 10-10-10 fertiliser or equivalent shall be uniformly applied and mixed into the top 3 inches of soil with the required line.
- C. All areas receiving sod shall be uniformily fine graded Hard-packed earth shall be scarefied prior to placement of sod.

#### SEDEPENT CONTROL NOTES

- 1) A minimum of 14 hours natice must be given to the Howard County Office of Imprection and Fermite priority the start of any construction. (991-2437)
- 2) All engetative mid structural practices are to bo installed according to the provisions of this plan and are to be in conformance with the 1983 HARYLAND STANDARDS AND SPECIFICATIONS FOR SOLL ERGSION AND SERIMENT CONTROL.
- 3) Following inities will disturbence or redisturbence, permenent or temperary stabilization shall be completed withint a) 7 calendar days for all perimeter sediment control structures, dikes, perimeter slopes and all slopes greater than 3:1, b) 14 days of to all other disturbed or graded areas on the project site.
- 4) All sediment traps/basins shown must be funced and warning signs posted around their perimeter in accordance with Vol. 1, Chaper 12, of the HOHARD COUNTY DESIGN MANUAL, Storm Drainege.
- 5) All disturbed areas must be stabilised within the time poriod specified above in accordance with the 1983 MARYLAND STANDARDS AND SPECIFICATIONS FOR BUIL EROSION AND SEDIMENT COMEROL for permanent seedings (Sec. 51) sod (Sec. 54), tamporary seeding (Sec. 50) and mulching (Sec. 52.) Temporary stabilization with mulch slone can only be done when recommended seeding dates do not allow for propur germination and establishment of grasses.
- 6) All sediment control atructures are to remain in place and are to be maintained in operative condition until permission for their removal has been obtained from the Howard County Sediment Control Inspector
- 7) Sita Analysis: 4.18 Acres 3:03 Acres Total Area of Site Area Disturbed Area to be roofed or paved \_ 0.65 Acres Area to be vegetatively stabilized 2.38 Acres 1000 Cu. yde Total Cut Total Fill Offsite waste/borrew area location
- (8) Any mediment control practice which is disturbed by grading activity for placement of utilities must be repaired on the same day of disturbance.
- 9) Additional sediment control must be provided, if deemed necessary by the Howard County DPW sediment control

Inspector.

- 10) On all sites with disturbed areas in excess of 2 acres, approval of the inspection agency shall be requested upon completion of installation of perimeter erosion and sediment controls, but before proceeding with any other earth disturbance or grading. Other building or grading inspection approvals may not be authorized until this initial approval by the inspection agency is made.
- 11) It houses are to be constructed on in "An-Bold" beals, at random, Single Lot Sediment Control as shown below shall be implemented. 11/
- 12) All pipes to be blocked at the end of each day (see detail
- 13) The total amount of straw bale dikes/wilt fence equals 2300 L.E.

ENGINEER'S CERTIFICATE HEREBY CERTIFY THAT THIS PLAN FOR EROSION AND SEDIMENT CONTROL REPRESENTS A PRACTICAL AND WORK-ABLE PLAN BASED ON MY PERSONAL KNOWLEDGE OF THE SITE CONDITIONS AND THAT IT WAS PREPARED IN ACCORDANCE WITH THE REQUIREMENTS OF THE HOWARD COUNTY SOIL CONSERVATION DISTRICT.



1-21-91


## GENERAL MOTES

- 1) Refer to "1983 Maryland Standards and Specifications for Soil Erosion and Sediment Control for Standard details and detailed specifications of each practice specified heasin.
- 2) with the approval of the sediment control inspector, minor field adjustments can and will be made to insure the control of any sediment. Changes in sediment control practices sequine prior approved of the sediment County Soil Conservation District. control inspector and the
- At the end of each working day, all sediment control practices will be inspected and left in operational condition.
- 4) Following initial soil disturbance or redisturbance, permanent or temporary stabilization shall be completed within: a.) seven calendar days as to the surface of all perimeter controls, dikes, swales, ditches, perimeter stopes, and all slupes greater than 3 horizontal to 1 vertical (3:1) and b.) fourteen days as to all other disturbed or graded areas on the project site.
- Any change to the grading proposed on this plan requires re-submission to County Soil Conservation District for approval.
- 6) Dust control will be provided for all disturbed areas. Refer to 1983 Haryland Standards and Specifications for Soil Erosion and Sediment Control, pp 6201 and 62.02 for acceptable methods and specifications for dust control.
- 7) Any variation from the sequence of operations stated on this plan requires the approval of the sediment control inspector and the County Soil Conservation District prior to the initiation of the change.
- 8) Excess cut or borrow material shall go to or come from, respectively, a site with an approved sediment control plan.

# The following item may be used as applicable:

9) Refer to "Maryland's Guidelines to Waterway Construction" by the Water Resources Administration (WRA), dated January, 1986 for standard details and detailed specifications of each practice specified herein for waterway CORSTRUCTION.



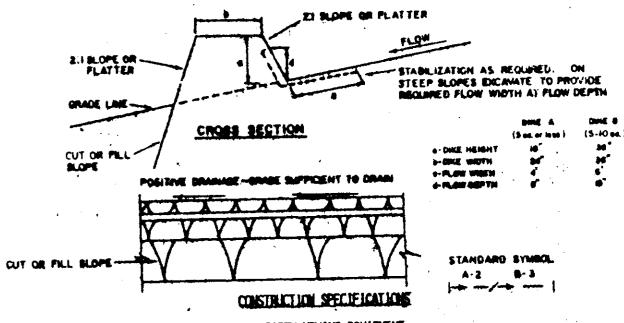

- ALL DIKES SHALL BE COMPACTED BY EARTH-HOVING EQUIPMENT. ALL DIKES SHALL HAVE POSITIVE DRAINAGE TO AN OUTLET!
  TOP WINTH MAY BE WIDER AND SIDE SLOPES MAY BE PLATTER IF DESIRED TO FACILITATE
- CROSSING BY CONSTRUCTION TRAFFIC.
  FIELD LOCATION BHOULD BE ADJUSTED AS NEEDED TO UTILIZE A STABILIZED SAFE OUTLET.
  EARTH DIKES SHALL HAVE AN OUTLET THAT PUNCTIONS WITH A MUNIMUM OF EROSION. HUNOFF
  BHALL BE CONNEYED TO A SEDIMENT TRAFFING DEVICE SUCH AS A SEDIMENT TRAF OR SEDIMENT
  BASIN WHERE EITHER THE DIES COMPREL OR THE DRABME AND ABOVE THE DAME ARE NOT
- ADEQUATELY STABILIZED:

  STABILIZATION SHALL BE! (A) IN ACCOMPANCE WITH STANDARD SPECIFICATIONS FOR SEED AND STRAIN MALCH CR STRAIN MALCH (F NOT IN SEEDING SEASON, (B) FLOW COMPANEL AS PER THE CHART SELDM;

## FLOW CHANNEL STABILIZATION

-			
TYPE OF IREADMENT	CHANEL	DIFA	DIVER
1	.5-3.0 <b>%</b>	SEED AND STRUM MALCH	SEED AND STRAIN MULCH
2	3.1-5.0%	SEED AND STRAY MALCH	SEED USING JUTE, OR EXCELSION, SOD; 2" STONE
3	5.1-8.0K	SEED WITH JUTE, OR SOD!	LINED RIP-RAP 4-8"
4	8.1-20%	LINED RIP-RAP 4-8"	EMERICANIAN DERIGH
A. Stone to	DE 2 INCH STONE	OR RECYCLED CONCRETE BOUTVAL	ENT, IN A LAYER AT LEAST 3

INCHES IN THICOMESS AND BE PRESSED INTO THE SOIL WITH CONSTRUCTION EQUIPMENT.

B. RIP-RAP TO BE 4-8 INCHES IN A LAYER AT LEAST B INCHES THICOMESS AND PRESSED INTO

THE SOIL.
APPROVED EQUIVALENTS CAN BE SUBSTITUTED FOR ANY OF THE ABOVE MATERIALS. PERIODIC IMPRECTION AND REQUIRED MAINTENANCE MUST BE PROVIDED AFTER EACH RAIN EVENT.

> EARTH DIKE NO SCALE

> > M. Longai

