


SHEET INDEX	
NO.	DESCRIPTION
1	TITLE SHEET
2	SITE DEVELOPMENT PLAN
3	SEDIMENT CONTROL PLAN & DETAILS AND DRAINAGE AREA MAP
4	STORM DRAIN PROFILES & DETAILS
5	SWM NOTES & DETAILS
6	LANDSCAPE PLAN


# SITE DEVELOPMENT PLAN HILLCROFT PROFESSIONAL CENTER VILLAGE OF OWEN BROWN SECTION 5 AREA 1 6TH ELECTION DISTRICT HOWARD COUNTY, MARYLAND

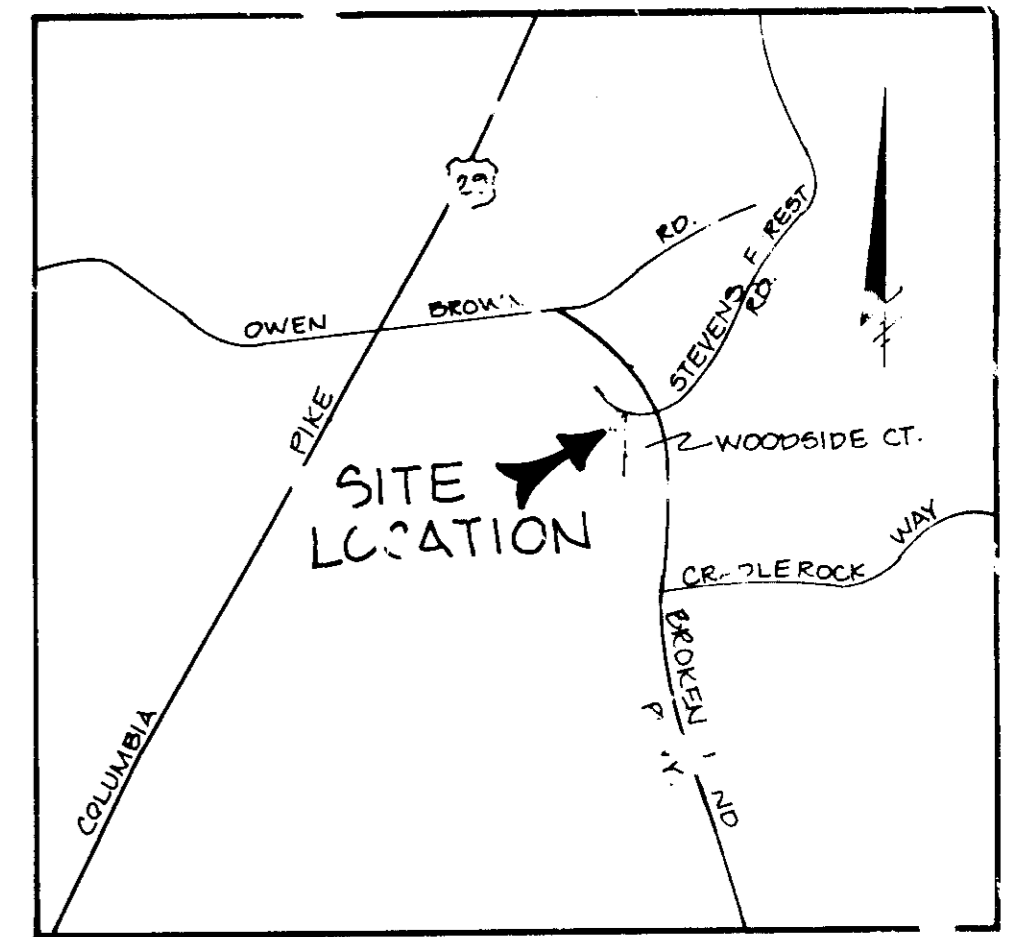

**VICINITY MAP**  
SCALE: 1"=2000'

### GENERAL NOTES

- ALL WATER LINES SHALL BE CONSTRUCTED A MINIMUM OF 42" COVER BELOW FINISHED GRADE.
- ALL WORK SHALL BE PERFORMED IN ACCORDANCE WITH THE HOWARD COUNTY DESIGN MANUAL, VOLUME IV, I.E., STANDARD SPECIFICATIONS AND DETAILS FOR CONSTRUCTION.
- APPROXIMATE LOCATION OF EXISTING UTILITIES ARE SHOWN FROM BEST AVAILABLE INFORMATION. THE CONTRACTOR SHALL TAKE ALL NECESSARY PRECAUTIONS TO PROTECT THE EXISTING UTILITIES AND MAINTAIN UNINTERRUPTED SERVICE. ANY DAMAGE INCURRED DUE TO CONTRACTOR'S OPERATION SHALL BE REPAIRED IMMEDIATELY AT THE CONTRACTOR'S EXPENSE.
- THE CONTRACTOR SHALL TEST PIT EXISTING UTILITIES AT LEAST FIVE (5) DAYS BEFORE STARTING WORK SHOWN ON THESE DRAWINGS TO VERIFY THEIR LOCATION AND ELEVATION. THE CONTRACTOR SHALL NOTIFY THE ENGINEER IMMEDIATELY IF LOCATION OF UTILITIES IS OTHER THAN SHOWN.
- CONTRACTOR TO NOTIFY THE FOLLOWING UTILITIES OR AGENCIES AT LEAST FIVE DAYS BEFORE STARTING WORK SHOWN ON THESE DRAWINGS:  
 MISS UTILITY 1-800-257-7777  
 CAP TELEPHONE COMPANY 725-9976  
 HOWARD COUNTY BUREAU OF UTILITIES 992-2366  
 AT&T CABLE LOCATION DIVISION 393-3553  
 BALTIMORE GAS & ELECTRIC COMPANY 685-0123  
 STATE HIGHWAY ADMINISTRATION 531-5533  
 HOWARD COUNTY CONSTRUCTION/INSPECTION SURVEY DIVISION (24 HOURS NOTICE PRIOR TO COMMENCEMENT OF WORK) 792-7272
- ALL INLETS SHALL BE CONSTRUCTED IN ACCORDANCE WITH HOWARD COUNTY STANDARDS.
- ALL PIPE ELEVATIONS SHOWN ARE INVERT ELEVATIONS.
- THE CONTRACTOR SHALL PROVIDE A JOINT IN ALL SEWER MAINS WITHIN 2'-0" OF EXTERIOR MANHOLE WALLS.
- PROFILE STATIONS SHALL BE ADJUSTED AS NECESSARY TO CONFORM TO PL. DIMENSIONS.
- NO PIPE SHALL BE LAID UNTIL LINES OF EXCAVATION HAVE BEEN BROUGHT TO SURFACE.
- TOPO TAKEN FROM FIELD RUN SURVEY DATED OCTOBER, 1989 BY RIEMER, MUEGGE AND ASSOCIATES.
- ALL PLAN DIMENSIONS ARE TO FACE OF CURB UNLESS OTHERWISE NOTED.
- ALL STORM DRAIN PIPE BIDDING SHALL BE AS SHOWN IN DETAIL G-01 (TRENCH IN ROCK OR TRENCH IN EARTH AS DETERMINED BY FIELD CONDITIONS) IN VOL. IV OF HOWARD COUNTY DESIGN MANUAL UNLESS OTHERWISE DIRECTED BY THE ENGINEER OR AS SHOWN ON THE DRAWINGS.
- THE DEVELOPER IS RESPONSIBLE FOR THE ACQUISITION OF ALL EASEMENTS, RIGHTS AND/OR RIGHTS-OF-WAY THAT MAY BE REQUIRED FOR THE SEDIMENT AND EROSION CONTROL PRACTICES, STORM WATER MANAGEMENT PRACTICES AND THE DISCHARGE OF STORM WATER INTO OR ACROSS ADJACENT OR DOWNSTREAM PROPERTIES INCLUDED IN THIS PLAN. HE IS ALSO RESPONSIBLE FOR THE ACQUISITION OF ALL EASEMENTS RIGHTS AND/OR WORK ON ADJACENT PROPERTIES INCLUDED IN THIS PLAN.
- THE OWNER SHALL PROVIDE A SEPARATE AND INDEPENDENT SEWER CONNECTION FOR EACH TENANT OR OCCUPANT OF ANY BUILDING, SHOWN ON THIS SITE DEVELOPMENT PLAN, WHO WILL DISCHARGE NON-DOMESTIC WASTE TO THE PUBLIC SEWERAGE SYSTEM IF THIS WASTE IS REGULATED UNDER SECTION 18.122A OF THE HOWARD COUNTY CODE. EACH SEPARATE AND INDEPENDENT SEWER CONNECTION SHALL INCLUDE A STANDARD MANHOLE AND OTHER WASTE PRETREATMENT DEVICES AS REQUIRED AND APPROVED BY HOWARD COUNTY. WASTE LINES ON THE INTERIOR OF THE BUILDING SHALL BE DESIGNED, CONSTRUCTED OR MODIFIED SUCH THAT NON-DOMESTIC WASTE WILL BE DISCHARGED TO THE SEPARATE AND INDEPENDENT SEWER CONNECTION. NO TENANT OR OCCUPANT OF ANY BUILDING SHOWN ON THIS SITE DEVELOPMENT PLAN SHALL DISCHARGE REGULATED NON-DOMESTIC WASTE TO THE PUBLIC SEWERAGE SYSTEM PRIOR TO INSTALLATION OF THE SEPARATE AND INDEPENDENT SEWER CONNECTION AND RELATED INTERIOR WASTE LINES. THE ABOVE REQUIREMENTS SHALL APPLY TO ALL INITIAL AND FUTURE OCCUPANTS OR TENANTS.
- PER A FIELD INVESTIGATION BY THE RIEMER, MUEGGE & ASSOC. STAFF ENVIRONMENTALIST, THERE ARE NO WETLANDS ON SITE.
- SEE DEVELOPMENT OF PLANNING AND ZONING FILE NUMBERS: FDP-149-A1, FDP-110
- WF-05-88 APPROVED 1 JULY 1989 TO WAIVE SECTION 10.156 (K) OF THE SUBDIVISION REGULATIONS.

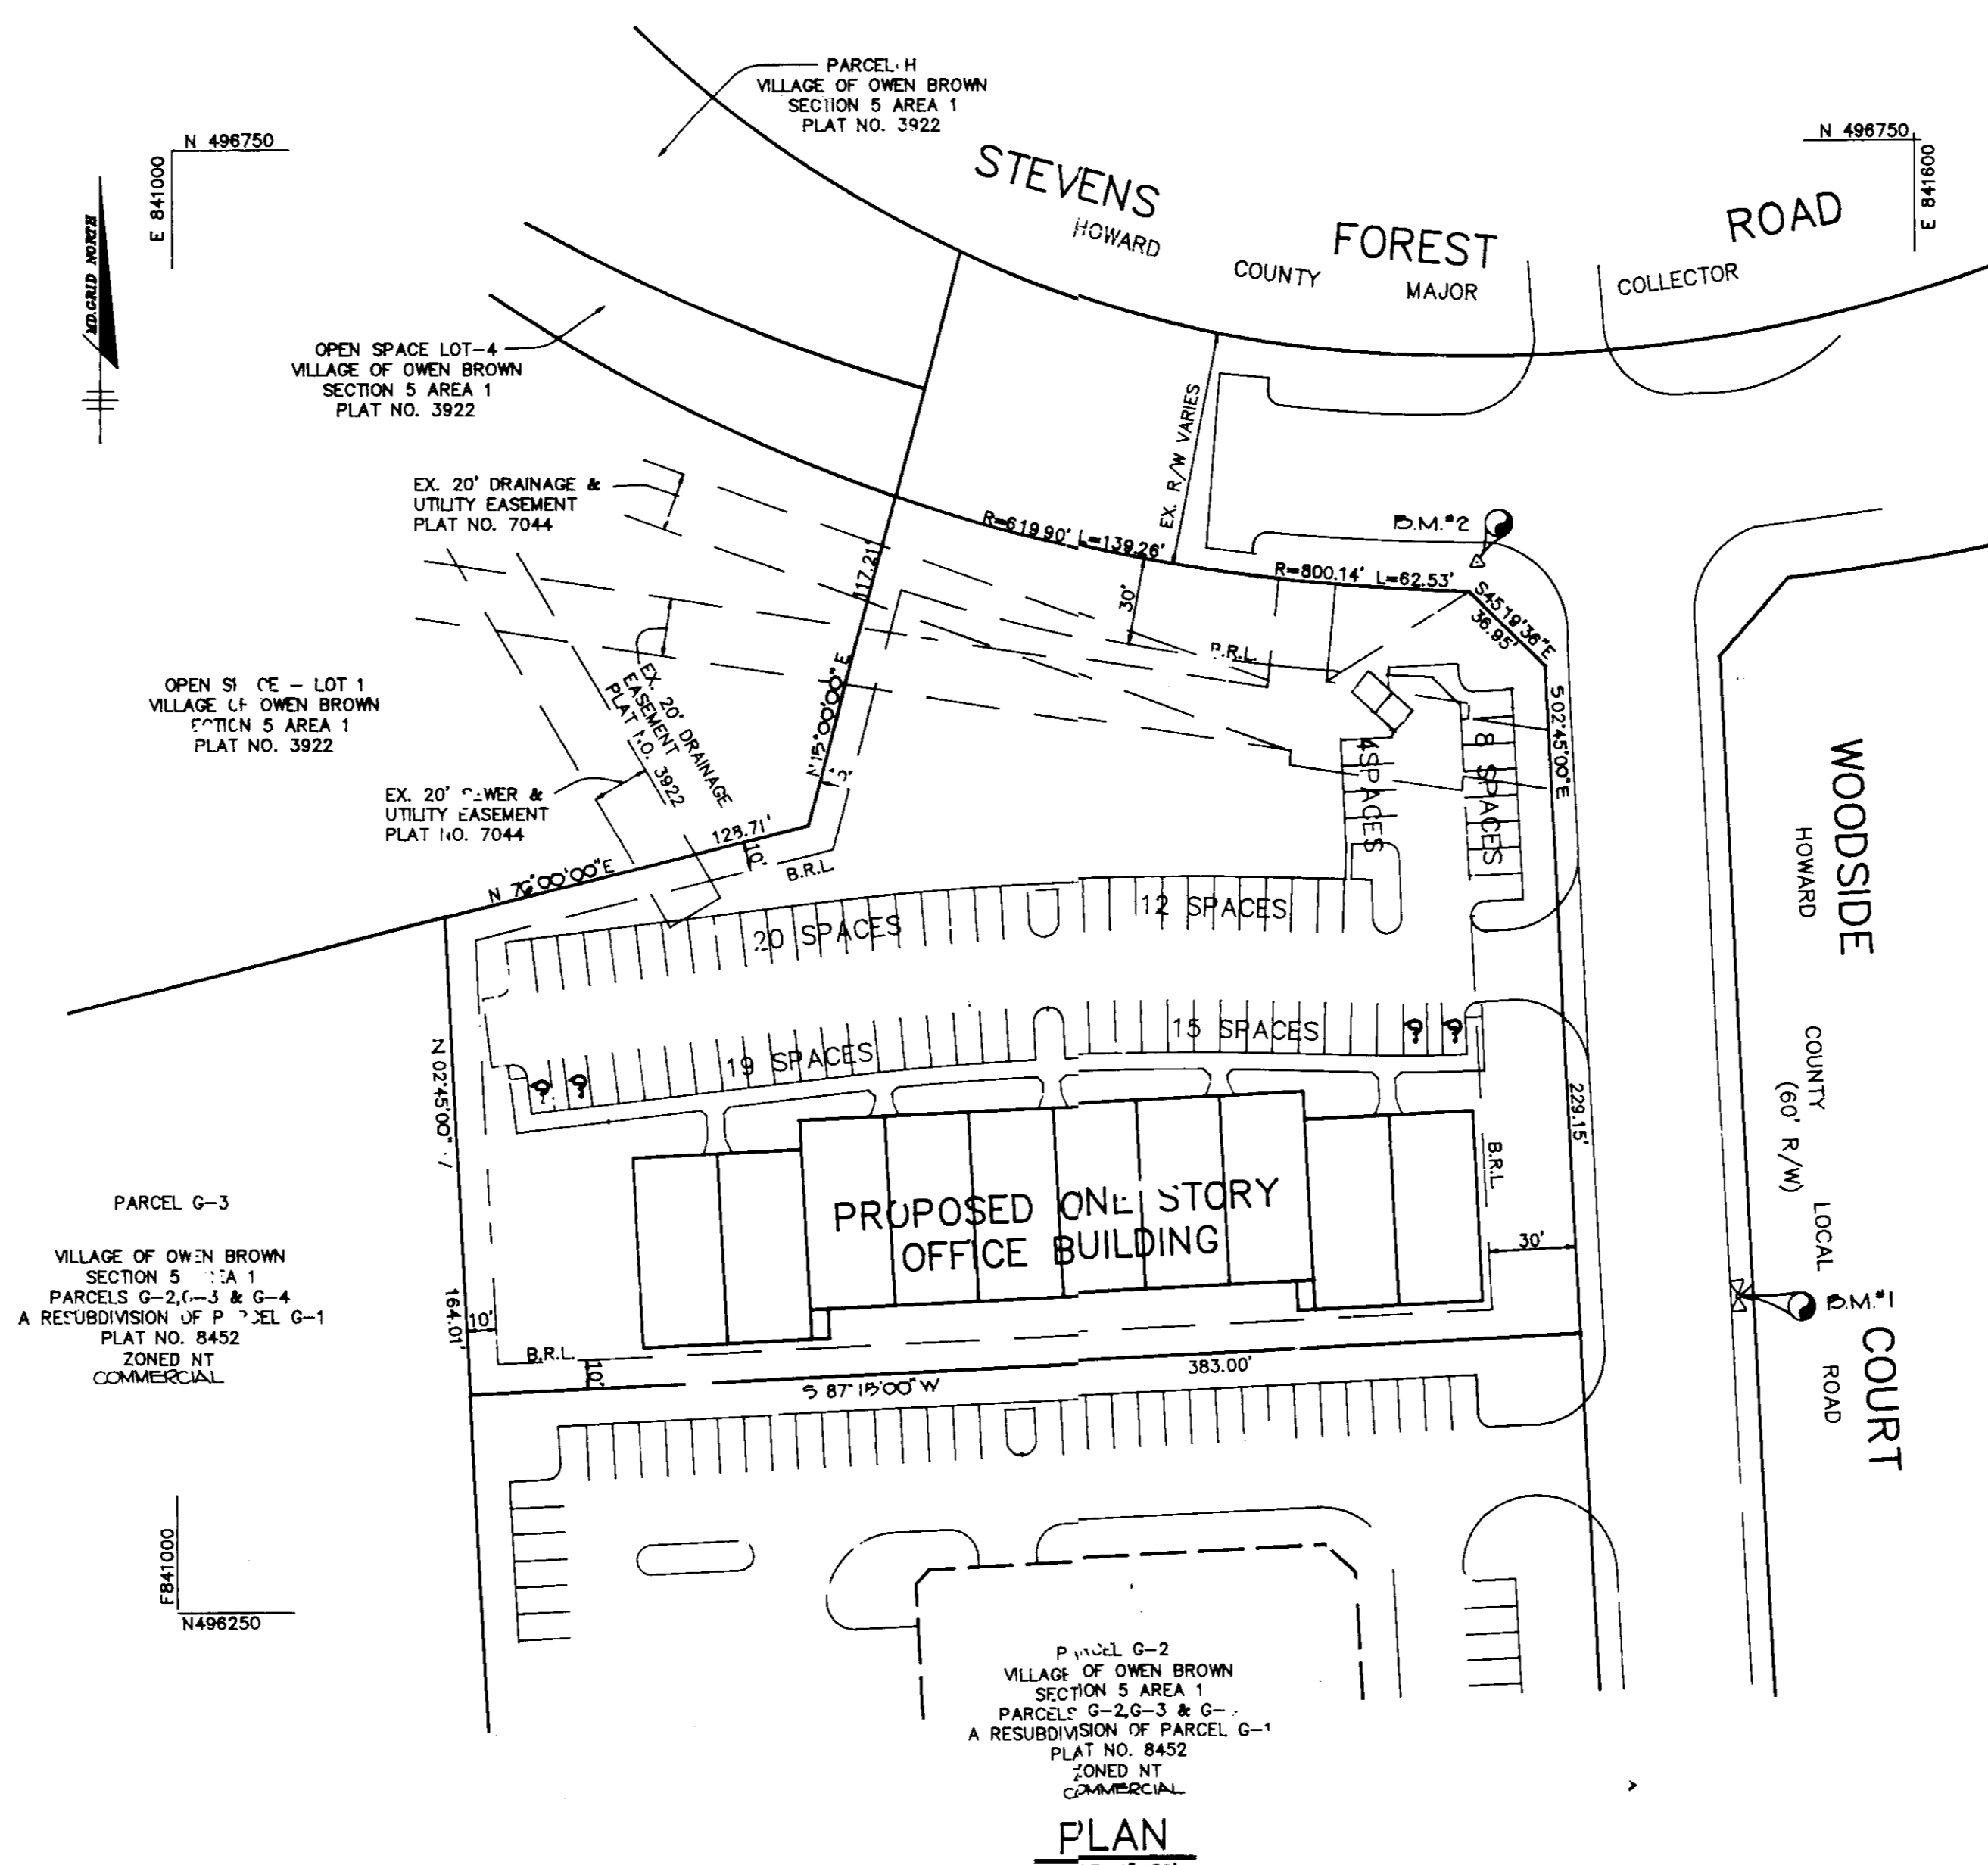


### SITE TABULATION

AREA OF PROPERTY.....2.083 ACRES  
 PRESENT ZONING.....NT (COMM.)  
 PROPOSED USE.....OFFICE BUILDING - 1 STORY  
 BUILDING AREA.....18,850 SQ.FT.  
 BUILDING COVERAGE  
 OF SITE.....20.7 %  
 PARKING REQUIRED.....2 SP/1000 SF N.L.A.  
 TOTAL PARKING REQUIRED.. 38 SPACES  
 TOTAL PARKING PROVIDED.. 78 SPACES (INCL. 4 HAND)  
 TOTAL PARKING AREA.....0.54 AC. (23,675 SF.)  
 LANDSCAPED ISLANDS  
 REQUIRED (0%).....0 AC. (0 SF.)  
 PROVIDED (53%).....0.09 AC. (1243 SF.)  
 OPEN SPACE:  
 REQUIRED (0%).....0 AC. (0 SF.)  
 PROVIDED (53%).....1.11 AC. (48,210 SF.)

THE PARKING SPACES REQUIRED AND PROVIDED ON THIS SITE DEVELOPMENT PLAN ARE FOR OFFICE USE ONLY AND ANY CONVERSION OF THE USE IN THE FUTURE IS SUBJECT TO THE PARKING REQUIREMENTS OF FINAL DEVELOPMENT PLAN PHASE 149-A-1.

**BENCH MARKS**  
 B.M.#1 ELEV. 342.97  
 TOP OF EX. FIRE HYDRANT, EAST SIDE OF WOODSIDE COURT  
 B.M.#2 ELEV. 341.86  
 HUB # TACK SET @ NORTHEAST CORNER OF PROPERTY (TRANSVERSE STA. # 700)

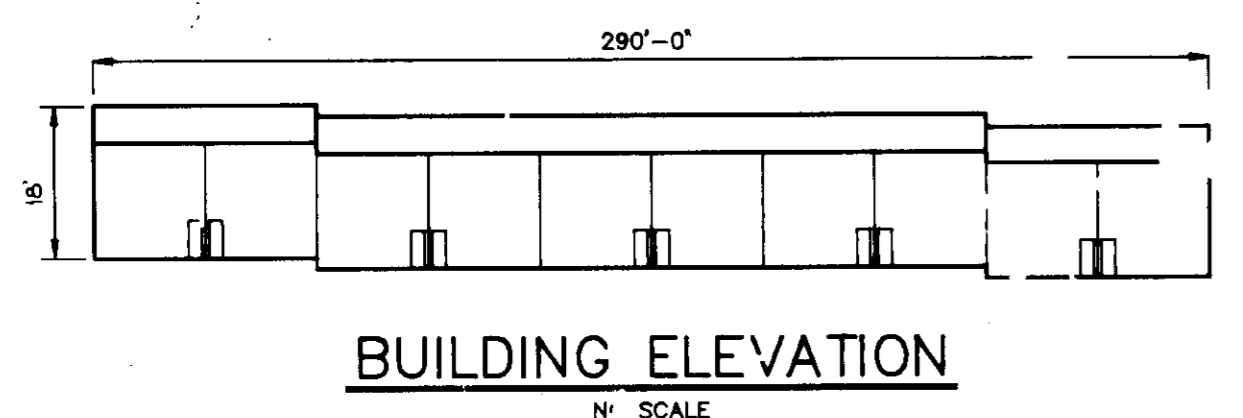



**BUILDING ELEVATION**  
N SCALE

ADDRESS CHART		VILLAGE OF OWEN BROWN		LOT/PARCEL #	
LOT NUMBER	STREET ADDRESS	LOT #	BLOCK #	ZONE	PARCEL #
PARCEL G-4	6200 WOODSIDE COURT	14	NT	36	6TH G0G1.02

**APPROVED**  
PLANNING BOARD  
of HOWARD COUNTY  
DATE: 11 April 1990

AS BUILT CERTIFICATE	
ARTHUR E. MUEGGE #8707	DATE
APPROVED: FOR PUBLIC WATER AND PUBLIC SEWERAGE SYSTEMS, HOWARD COUNTY HEALTH DEPARTMENT.	9/23/93
APPROVED: HOWARD COUNTY DEPARTMENT OF PLANNING AND ZONING.	10/13/93
APPROVED: FOR PUBLIC WATER, PUBLIC SEWERAGE, STORM DRAINAGE SYSTEMS AND PUBLIC ROADS.	9/21/93
DATE NO.	REVISION
OWNER/DEVELOPER:	JEROME M. WILLIAMS 8055-F COLUMBIA 100 PARKWAY COLUMBIA, MD. 21046
PROJECT:	HILLCROFT PROFESSIONAL CENTER AN OFFICE BUILDING
AREA:	VILLAGE OF OWEN BROWN SEC. 5 AREA 1 PARCEL G-4 - A RESUB. OF PARCEL G-1 PLAT NO. 8452 6TH ELECTION DISTRICT HOWARD COUNTY, MARYL.
TITLE:	TITLE SHEET
RIEMER, MUEGGE & ASSOCIATES, INC.	A Land Planning, Engineering and Consulting Firm 3105 North Ridge Road Ellicott City, Maryland 21043 301-461-2690 FAX: 301-750-3176
DATE: 9-23-93	DESIGNED BY: D.D.S.
	DRAWN BY: CADD
	PROJECT NO: 66402
	DATE: SEPTEMBER 2, 1993
	SCALE: AS SHOWN
	DR. WING NO. 10

MAY 1990 - BLUEPRINT CO. INC. 720007

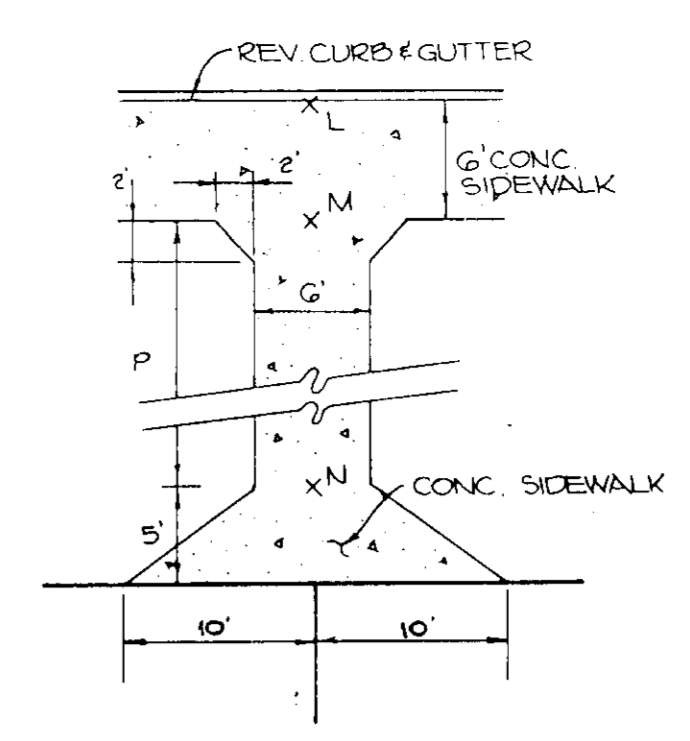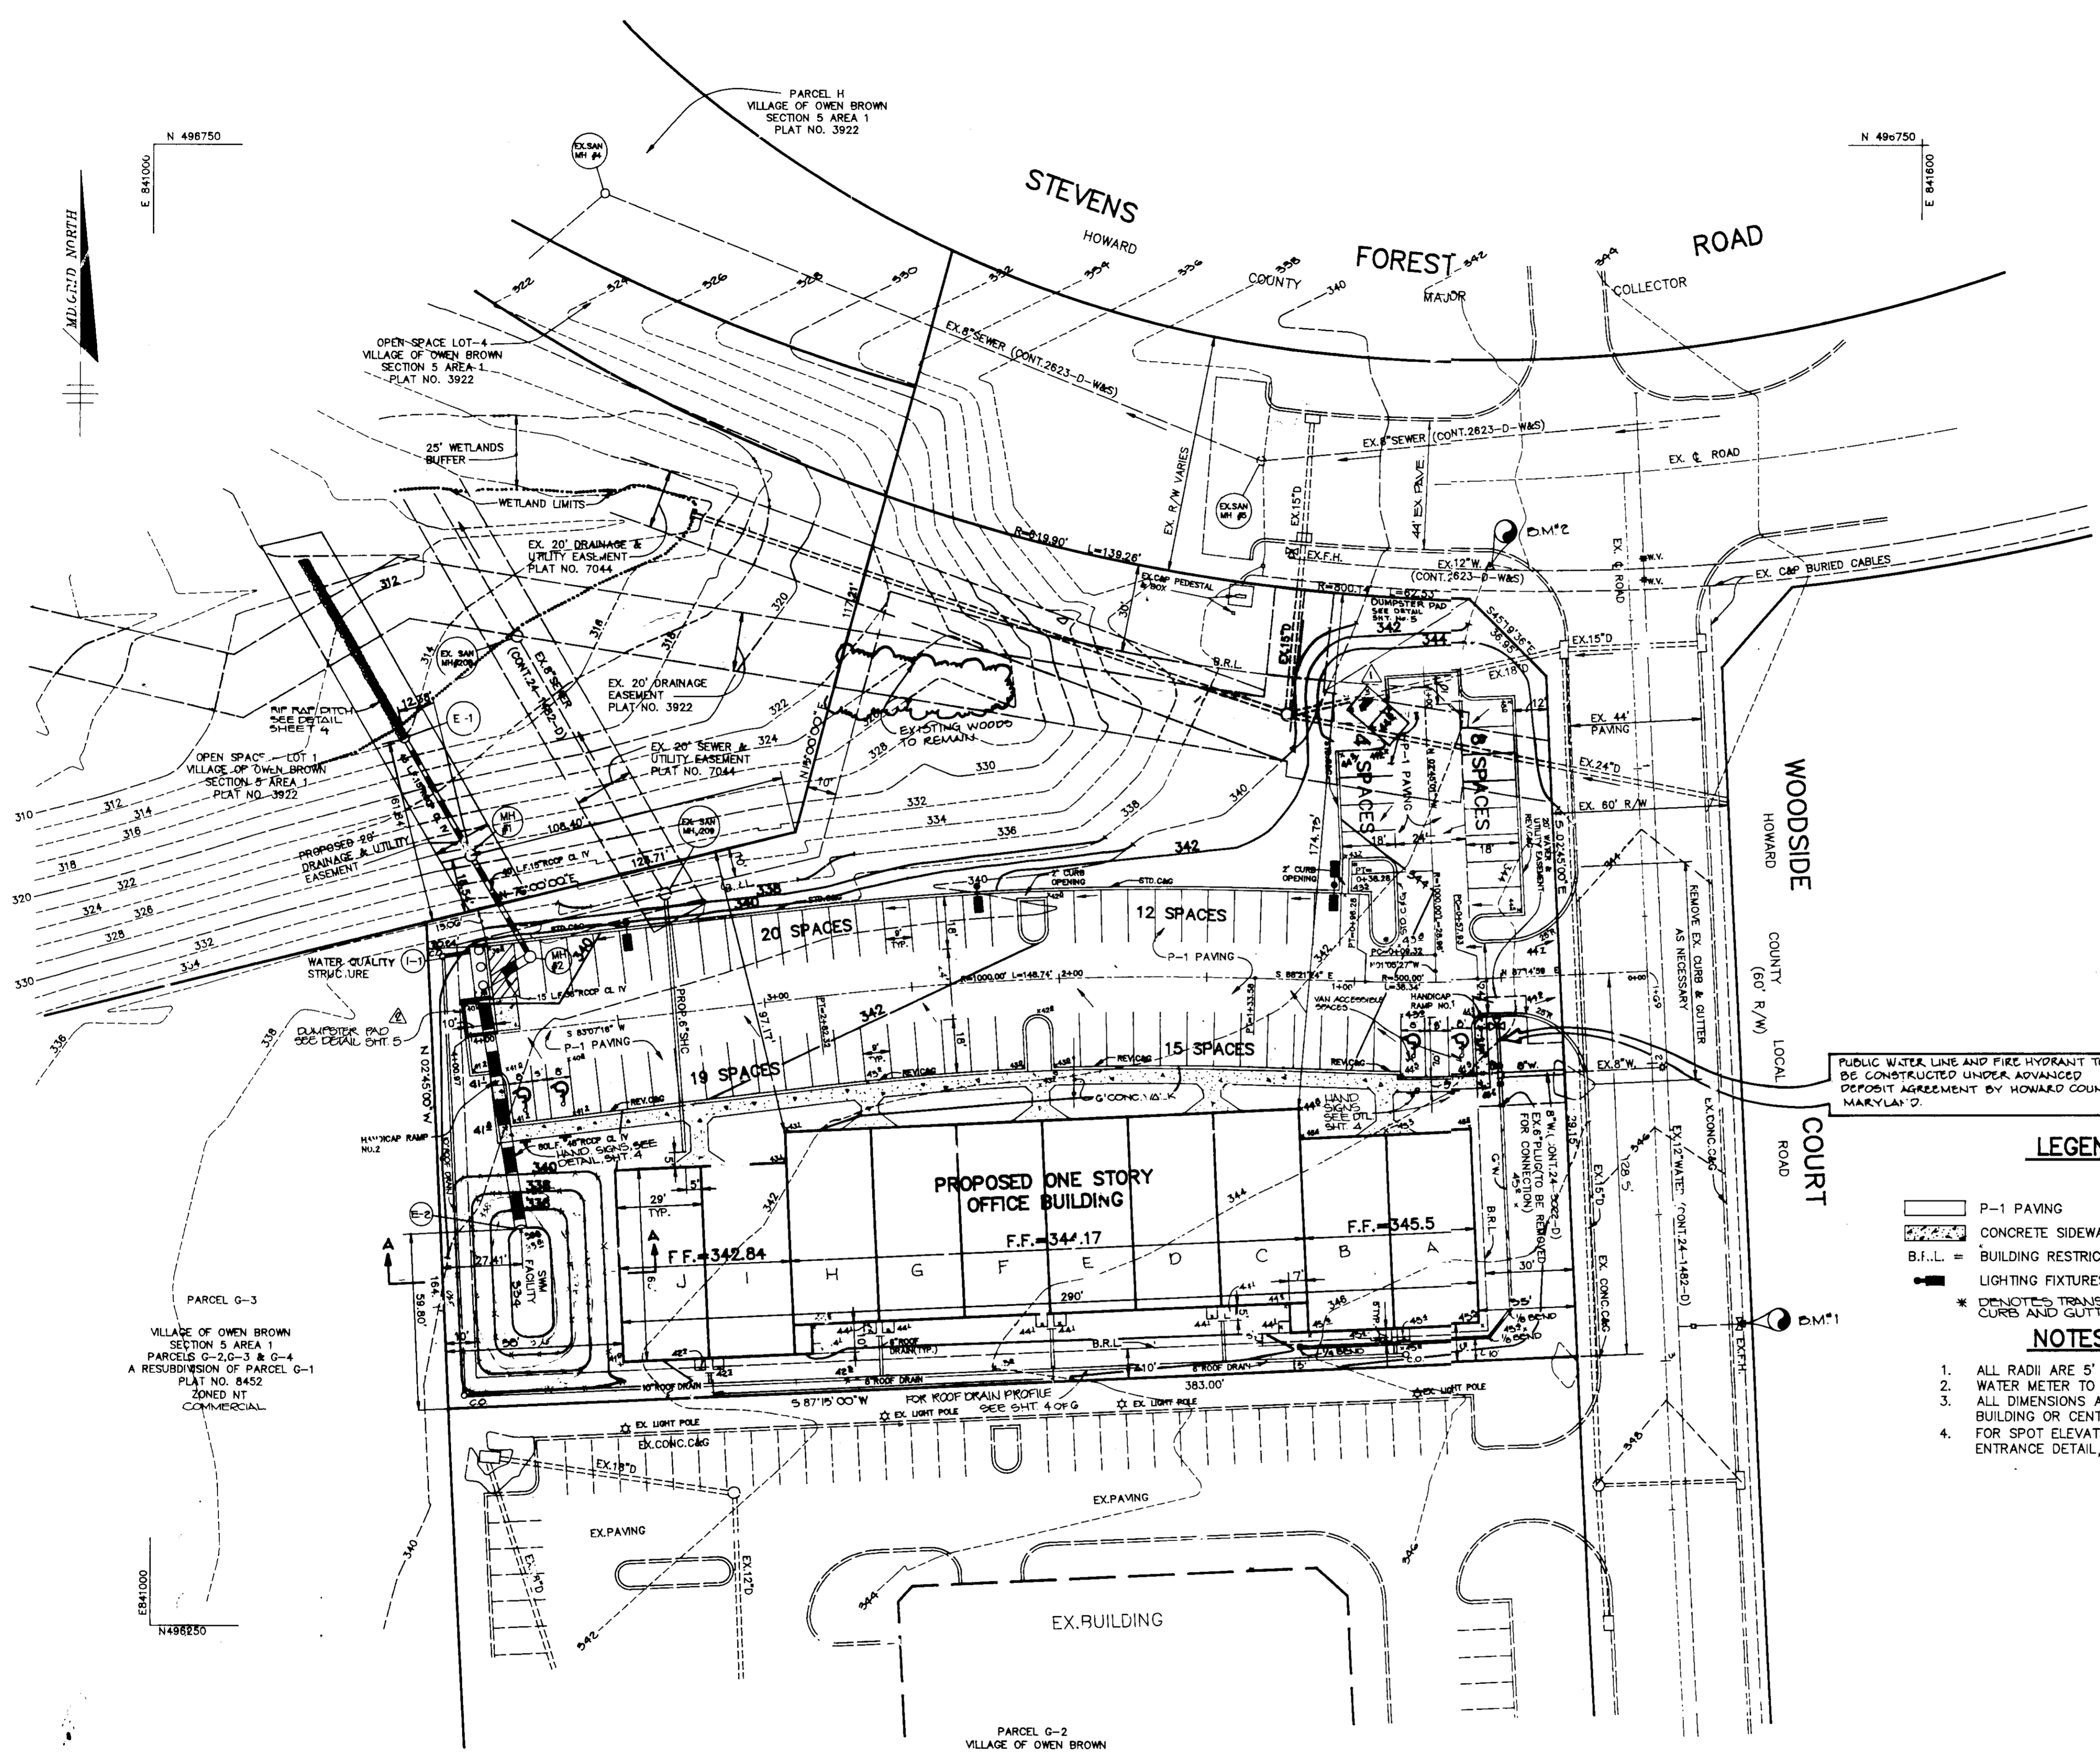

ENTRANCE TO BUILDINGS	L(T.C.)	M	N	P
A & B	42.0	42.0	42.0	10'
C & D	43.0	43.0	44.0	4'
E & F	43.0	43.0	44.0	5'
G & H	44.0	44.0	44.1	4'
I & J	44.0	44.0	45.1	0'

**SIDEWALK ENTRANCE DETAIL**  
NO SCALE

PUBLIC WATER LINE AND FIRE HYDRANT TO BE CONSTRUCTED UNDER ADVANCED DEPOSIT AGREEMENT BY HOWARD COUNTY, MARYLAND.

**LEGEND**

- P-1 PAVING
- CONCRETE SIDEWALK
- B.R.L. = BUILDING RESTRICTION LINE
- LIGHTING FIXTURES (SEE DETAIL SHEET 4)
- DENOTES TRANSITION FROM REVERSE TO STANDARD CURB AND GUTTER

**NOTES**

1. ALL RADII ARE 5' UNLESS OTHERWISE NOTED
2. WATER METER TO BE FOS INSIDE SETTING
3. ALL DIMENSIONS ARE FACE OF CURB, FACE OF BUILDING OR CENTERLINE
4. FOR SPOT ELEVATIONS FOR ENTRANCES, SEE ENTRANCE DETAIL, SHEET 4

**PLAN**  
SCALE: 1"=30'

**AS BUILT CERTIFICATE**

J. Savelle  
JAYKING & ASSOCIATES, INC.  
ARTHUR E. MUEGGE #8701 DATE

APPROVED: FOR PUBLIC WATER AND PUBLIC SEWERAGE SYSTEMS, HOWARD COUNTY HEALTH DEPARTMENT.

*John E. ...* 9/23/93  
COUNTY HEALTH OFFICER DATE

APPROVED: HOWARD COUNTY DEPARTMENT OF PLANNING AND ZONING.

*...* 10/13/93  
DIRECTOR DATE

APPROVED: FOR PUBLIC WATER, PUBLIC SEWERAGE, STORM DRAINAGE SYSTEMS AND PUBLIC ROADS.

*Gina ...* 10/13/93  
CHIEF, DIVISION OF LAND DEVELOPMENT AND RESEARCH DATE

APPROVED: FOR PUBLIC WATER, PUBLIC SEWERAGE, STORM DRAINAGE SYSTEMS AND PUBLIC ROADS.

*...* 9/21/93  
DIRECTOR DATE

*...* 9/20/93  
CHIEF, BUREAU OF ENGINEERING DATE

DATE	NO	REVISION
12/20/00	1	ADDED DUMPSTER PAD
4/15/94	2	ADDED DUMPSTER PAD, REMOVED 2 PARKING SPACES, REVERSED (REVERSED ORDR) BLDG. LETTERS.

OWNER/DEVELOPER  
JEROME M. WILLIAMS  
2000 F. COLUMBIA 100 PARKWAY  
COLL ABIA, MD. 21045

PROJECT: HILLCROFT PROFESSIONAL CENTER  
AN OFFICE BUILDING



AREA: VILLAGE OF OWEN BROWN, SEC. 5 AREA 1  
PARCEL G-4 - A RESUB. OF PARCEL G-1 PLAT NO. 8452  
6th ELECTION DISTRICT HOWARD COUNTY, MARYLAND

TITLE: SITE DEVELOPMENT PLAN


RIEMER MUEGGE & ASSOCIATES, INC.  
A Land Planning, Engineering and Consulting Firm  
3105 North Ridge Road Ellicott City, Maryland 21043  
301-461-2690 FAX: 301-750-3176

APPROVED  
PLANNING BOARD  
of HOWARD COUNTY  
DATE 11 APR 1990

DATE	DESIGNED BY	DRAWN BY	PROJECT NO.	DATE	SCALE	DRAWING NO.
9/2/93	...	...	G-102	SEPTEMBER 2, 1993	AS SHOWN	2-0-2

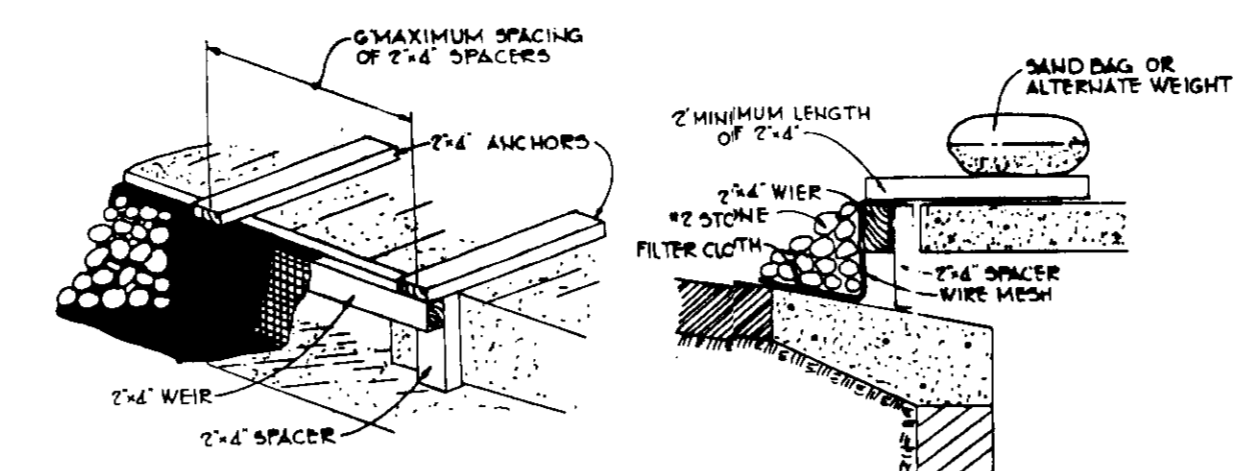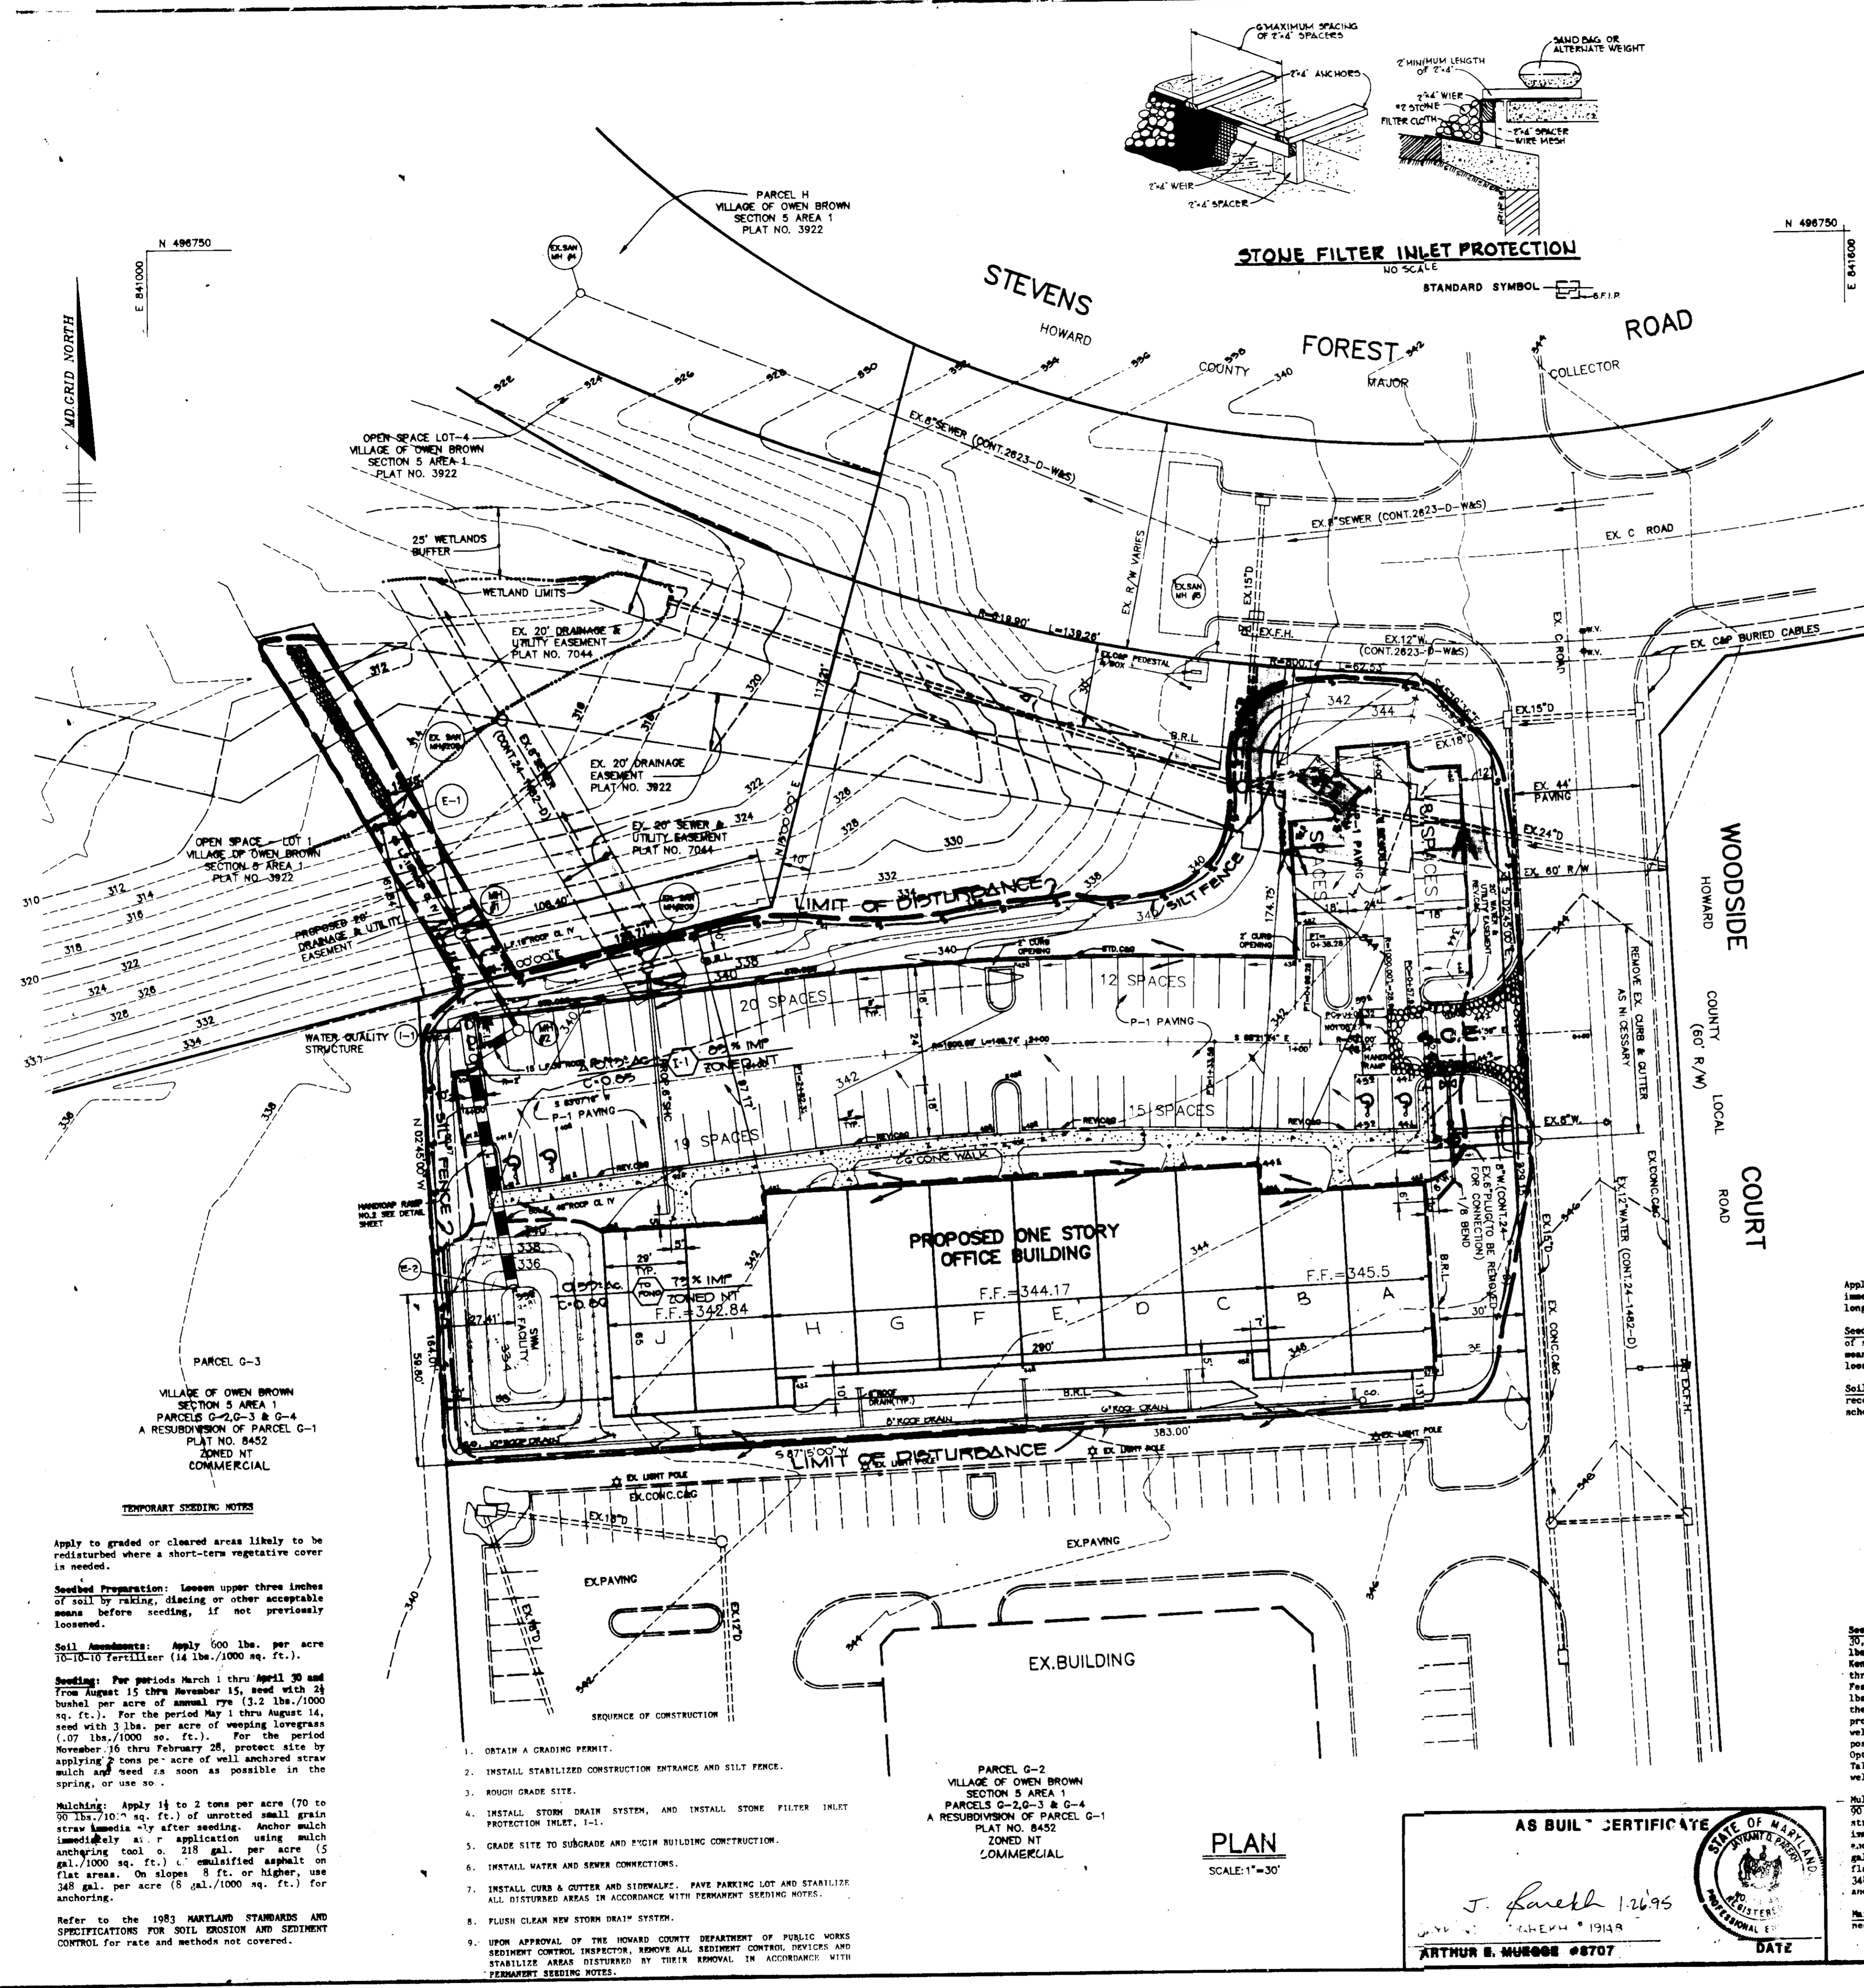


STONE FILTER INLET PROTECTION  
NO SCALE

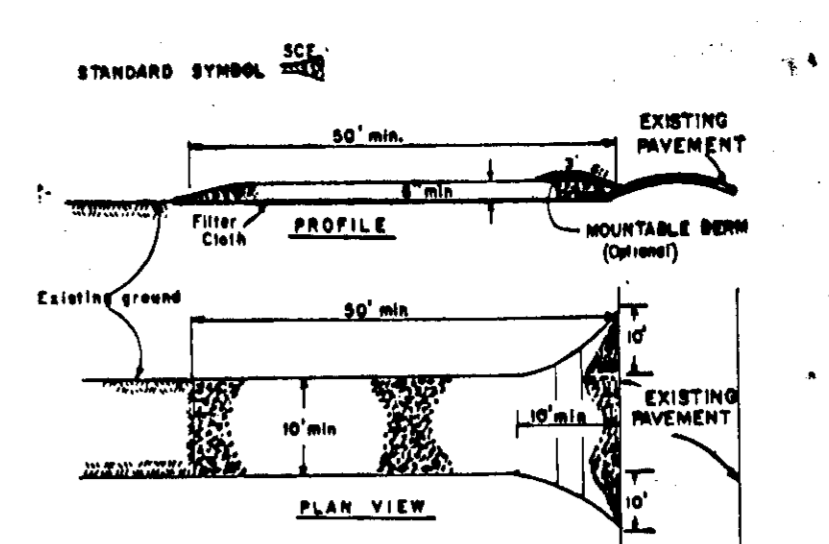

STABILIZED CONSTRUCTION ENTRANCE  
NO SCALE

- CONSTRUCTION SPECIFICATIONS**
- Stone size - Use 3" stone, or crushed or recycled concrete equivalent.
  - Length - No exception, but not less than 50 feet (except on a slope less than 2:1 where a 30 foot minimum length would apply).
  - Thickness - Not less than 18" (6" inches).
  - Width - 7' to 18' foot minimum, but not less than the full width at points where layout or ground occurs.
  - Filter Cloth - Will be placed over the entire area prior to placing of stone. Filter will not be placed on a slope less than 2:1.
  - Surface Water - All surface water flowing or directed toward construction entrance shall be placed over the entrance. If placing is impractical, entrance shall be placed over the entrance. If placing is impractical, entrance shall be placed over the entrance.
  - Maintenance - The entrance shall be maintained in condition which will prevent tracking of sediment onto public rights-of-way. This may require periodic top dressing with additional stone. This may also require periodic cleaning of any material used to top sediment. All sediment spilled, dropped, washed or tracked onto public rights-of-way must be removed immediately.
  - Washing - Trucks will be cleaned to remove sediment prior to entrance onto public rights-of-way. When washing is required, it shall be done on an area stabilized with stone and which drains into an approved sediment trapping device.
  - Periodic inspection and needed maintenance shall be provided after each rain.

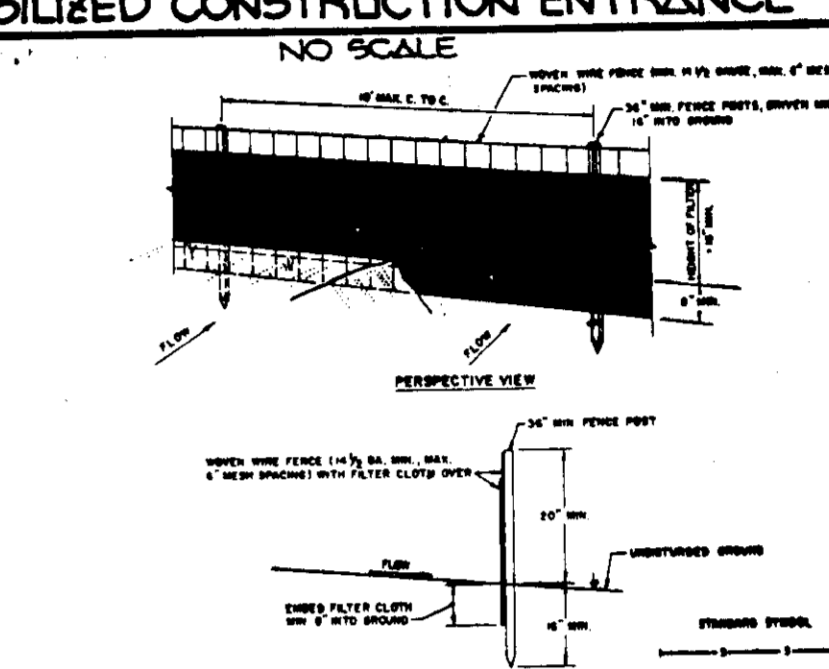

SILT FENCE  
NO SCALE

- CONSTRUCTION AIDS FOR EROSION CONTROL**
- Apply 200 lbs per acre of limestone (92 lbs/1000 sq ft) before seeding. Harrow or disc into upper three inches of soil. At time of seeding, apply 400 lbs per acre 30-0-0 urea-form fertilizer (9 lbs/1000 sq ft).
  - Apply 1 1/2 to 2 tons per acre (70 to 90 lbs/1000 sq ft.) of untreated small grain straw immediately after seeding. Anchor mulch immediately at application using mulch anchoring tool or 218 gal. per acre (5 gal./1000 sq. ft.) of emulsified asphalt on flat areas. On slopes 8 feet or higher, use 348 gal. per acre (6 gal./1000 sq. ft.) for anchoring.
  - Maintenance: 1. Inspect all seeded areas and make needed repairs, re-seeds and reseedings.

**PERMANENT SEEDING NOTES**

Apply to graded or cleared areas not subject to immediate further disturbance where a permanent long-lived vegetative cover is needed.

**Seeded Preparation:** Loosen upper three inches of soil by raking, discing or other acceptable means before seeding, if not previously loosened.

**Soil Amendments:** In lieu of soil test recommendations, use one of the following schedules:

- Preferred - Apply 2 tons per acre dolomitic limestone (92 lbs/1000 sq ft) and 600 lbs per acre 10-10-10 fertilizer (14 lbs/1000 sq ft) before seeding. Harrow or disc into upper three inches of soil. At time of seeding, apply 400 lbs per acre 30-0-0 urea-form fertilizer (9 lbs/1000 sq ft).
- Acceptable - Apply 2 tons per acre dolomitic limestone (92 lbs/1000 sq ft) and 1000 lbs per acre 10-10-10 fertilizer (23 lbs/1000 sq ft) before seeding. Harrow or disc into upper three inches of soil.

**Seeding:** For the periods March 1 thru April 30 and August 1 thru October 15, seed with 60 lbs. per acre (1.4 lbs./1000 sq. ft.) of Kentucky 31 Tall Fescue. For the period May 1 thru July 31, seed with 60 lbs Kentucky 31 Tall Fescue per acre; and 2 lbs per acre (.05 lbs/1000 sq ft) of weeping lovegrass. During the period of October 16 thru February 28, protect site by: (option 1) 2 tons per acre of well-anchored straw mulch and seed as soon as possible in the spring. Option (2) Use seed. Option (2) Seed with 60 lbs/acre Kentucky 31 Tall Fescue and mulch with 2 tons/acre well-anchored straw.

**Mulching:** Apply 1 1/2 to 2 tons per acre (70 to 90 lbs/1000 sq. ft.) of untreated small grain straw immediately after seeding. Anchor mulch immediately after application using mulch anchoring tool or 218 gallons per acre (5 gal./1000 sq. ft.) of emulsified asphalt on flat areas. On slopes 8 feet or higher, use 348 gallons per acre (6 gal./1000 sq. ft.) for anchoring.

**Maintenance:** 1. Inspect all seeded areas and make needed repairs, re-seeds and reseedings.

BY THE DEVELOPER:

"I CERTIFY THAT ALL DEVELOPMENT AND/OR CONSTRUCTION WILL BE DONE ACCORDING TO THESE PLANS, AND THAT ANY RESPONSIBLE PERSONNEL INVOLVED IN THE CONSTRUCTION PROJECT WILL HAVE A CERTIFICATE OF ATTENDANCE AT A DEPARTMENT OF NATURAL RESOURCES APPROVED TRAINING PROGRAM FOR THE CONTROL OF SEDIMENT AND EROSION BEFORE BEGINNING THE PROJECT. I WILL PROVIDE THE HOWARD SOIL CONSERVATION DISTRICT WITH AN "AS-BUILT" PLAN OF THE POND WITHIN 30 DAYS OF COMPLETION. I ALSO AUTHORIZE PERIODIC ON-SITE INSPECTIONS BY THE HOWARD SOIL CONSERVATION DISTRICT."

*James M. Williams* 9/2/93  
DEVELOPER DATE

BY THE ENGINEER:

"I CERTIFY THAT THIS PLAN FOR POND CONSTRUCTION, EROSION AND SEDIMENT CONTROL REPRESENTS A PRACTICAL AND WORKABLE PLAN BASED ON MY PERSONAL KNOWLEDGE OF THE SITE CONDITIONS. THIS PLAN WAS PREPARED IN ACCORDANCE WITH THE REQUIREMENTS OF THE HOWARD SOIL CONSERVATION DISTRICT. I HAVE NOTIFIED THE DEVELOPER THAT HE MUST PROVIDE THE HOWARD SOIL CONSERVATION DISTRICT WITH AN "AS-BUILT" PLAN OF THE POND WITHIN 30 DAYS OF COMPLETION."

*Arthur E. Muegge* 11/4/89  
ENGINEER DATE

THESE PLANS HAVE BEEN REVIEWED FOR THE HOWARD SOIL CONSERVATION DISTRICT AND MEET THE TECHNICAL REQUIREMENTS FOR SMALL POND CONSTRUCTION, SOIL EROSION AND SEDIMENT CONTROL.

*Edward J. Hines* 9/15/92  
U.S. SOIL CONSERVATION SERVICE DATE

THESE PLANS FOR SMALL POND CONSTRUCTION, SOIL EROSION AND SEDIMENT CONTROL MEET THE REQUIREMENTS OF THE HOWARD SOIL CONSERVATION DISTRICT.

APPROVED *John L. Robertson* 9/15/93  
HOWARD S.C.D. DATE

APPROVED: FOR PUBLIC WATER AND PUBLIC SEWERAGE SYSTEMS, HOWARD COUNTY HEALTH DEPARTMENT.

*Joseph D. Ballew* 9-21-93  
COUNTY HEALTH OFFICER DATE

APPROVED: HOWARD COUNTY DEPARTMENT OF PLANNING AND ZONING.

*Joseph D. Ballew* 10/13/93  
DIRECTOR DATE

*Gina J. Williams* 10/13/93  
CHIEF, DIVISION OF LAND DEVELOPMENT AND RESEARCH DATE

APPROVED: FOR PUBLIC WATER, PUBLIC SEWERAGE, STORM DRAINAGE SYSTEMS AND PUBLIC ROADS.

HOWARD COUNTY DEPARTMENT OF PUBLIC WORKS

*James J. Shaw* 9-20-93  
INSPECTOR DATE

*Robert J. Seaman* 9/20/93  
DATE, BUREAU OF ENGINEERING DATE

4/15/94 1 ADDED DUMPSTER, REMOVED 2 PARKING SPACES, REVISED SIGN LETTERS.

OWNER/DEVELOPER: JEROME M. WILLIAMS  
8000-F COLUMBIA 100 PARKWAY  
COLUMBIA, MD. 21045

PROJECT: HILLCROFT PROFESSIONAL CENTER  
AN OFFICE BUILDING

AREA: VILLAGE OF OWEN BROWN, SEC. 5 AREA 1  
PARCELS G-4-A, RESUBDIVISION OF PARCEL G-1 PLAT NO. 8452  
62<sup>ND</sup> ELECTION DISTRICT, HOWARD COUNTY, MARYLAND

TITLE: SEDIMENT CONTROL PLAN & DETAILS AND DRAINAGE AREA MAP

RIEMER MUEGGE & ASSOCIATES, INC.  
A Land Planning, Engineering and Consulting Firm  
3105 North Ridge Road Ellicott City, Maryland 21043  
301-461-2690 FAX: 301-750-3176

9-2-93 DATE








DESIGNED BY: P.B.S.  
DRAWN BY: CADD/M.K.  
PROJECT NO: 60402  
DATE: SEPTEMBER 2, 1993  
SCALE: AS SHOWN  
DRAWING NO: 3-6-93

APPROVED PLANNING BOARD OF HOWARD COUNTY  
DATE: 11 April 1990

*Arthur E. Muegge* 12/6/95  
ARTHUR E. MUEGGE #8707 DATE

STATE OF MARYLAND  
REGISTERED PROFESSIONAL ENGINEER  
ARTHUR E. MUEGGE #8707

SDP 90-105

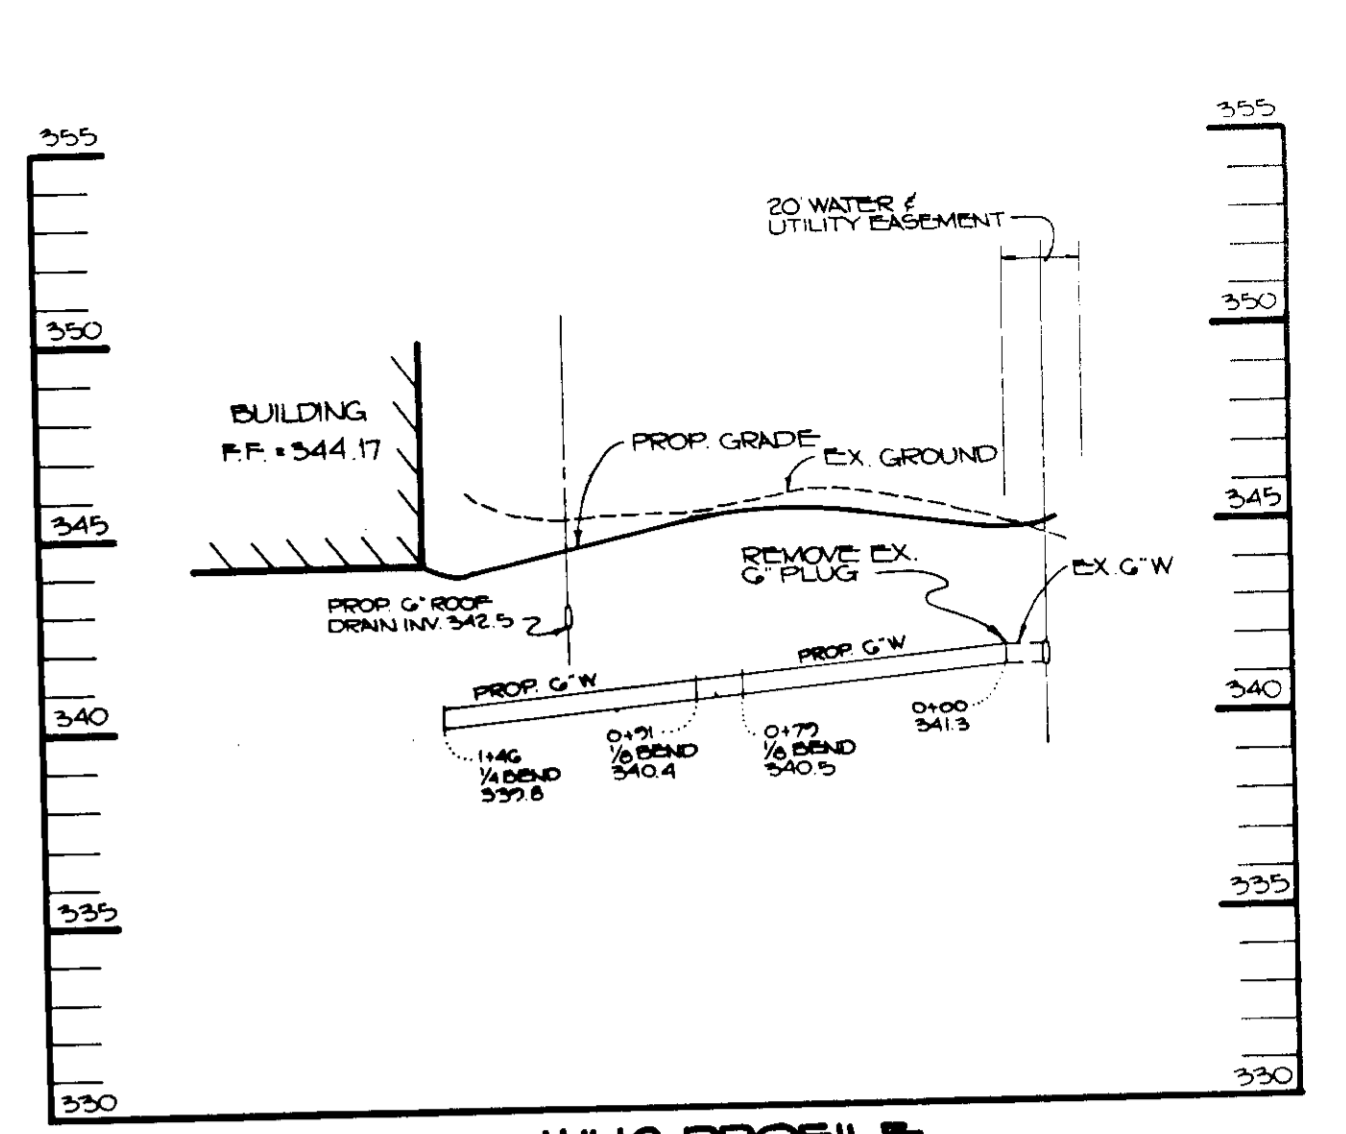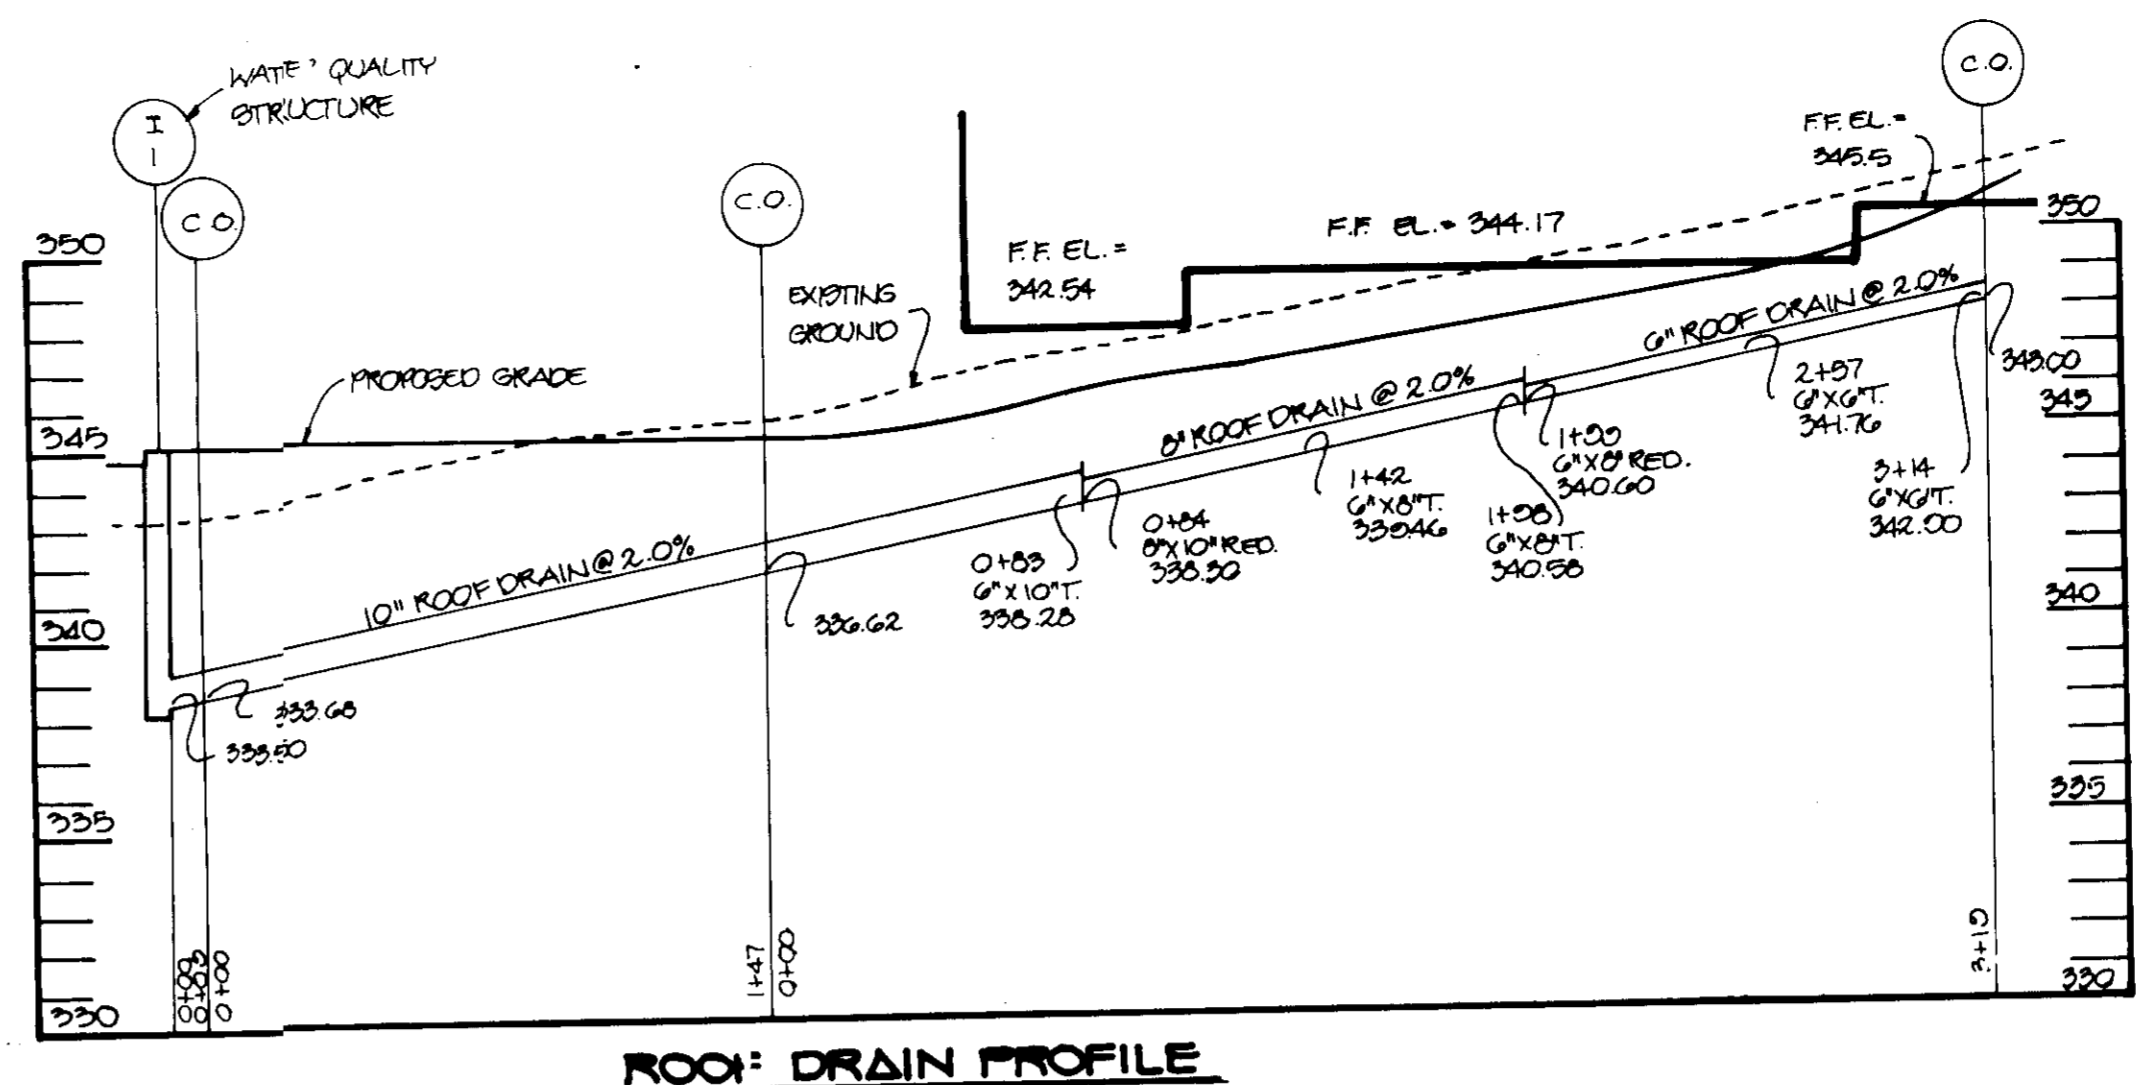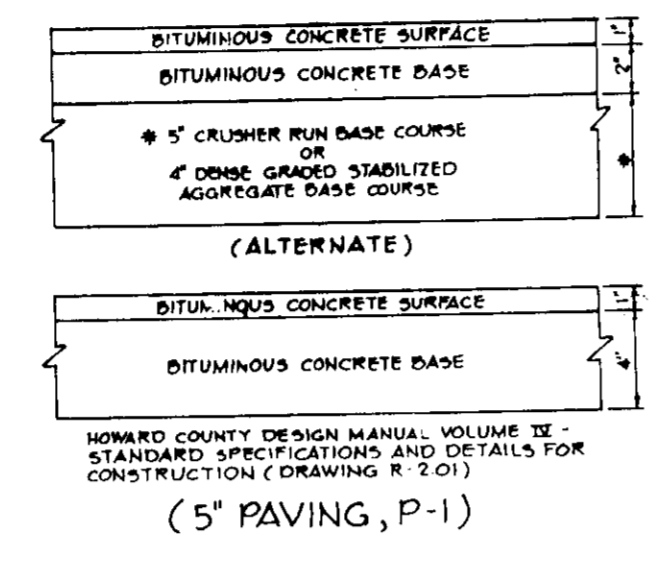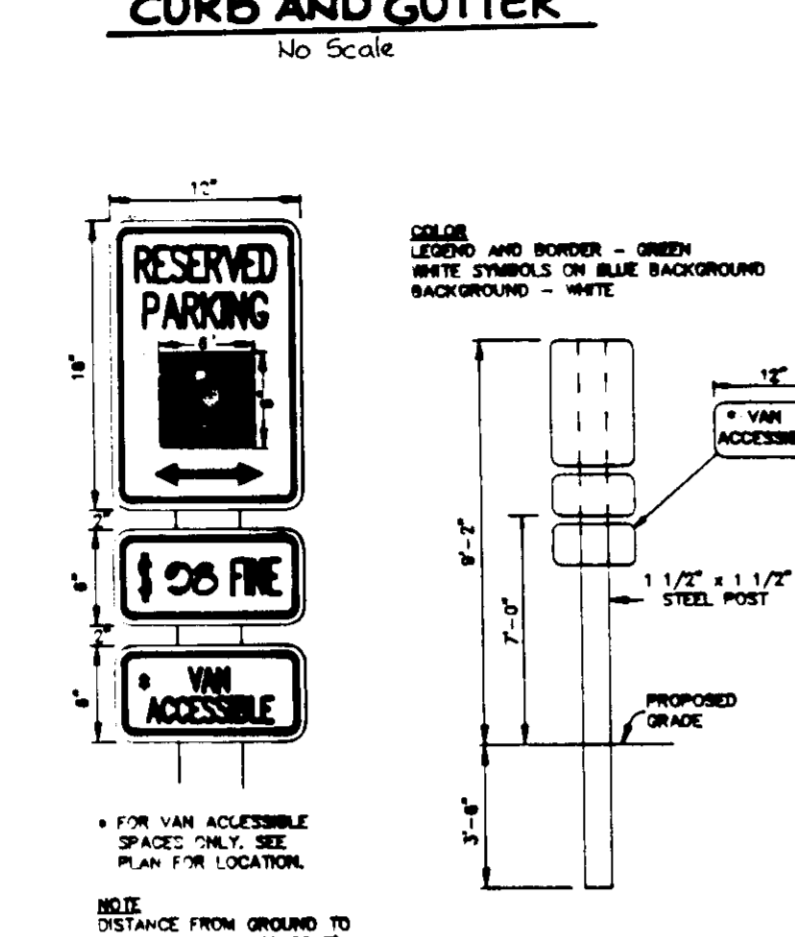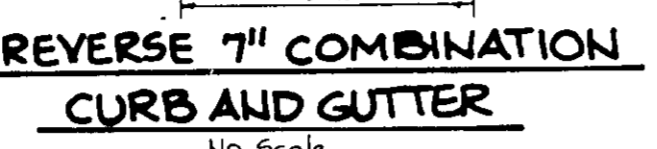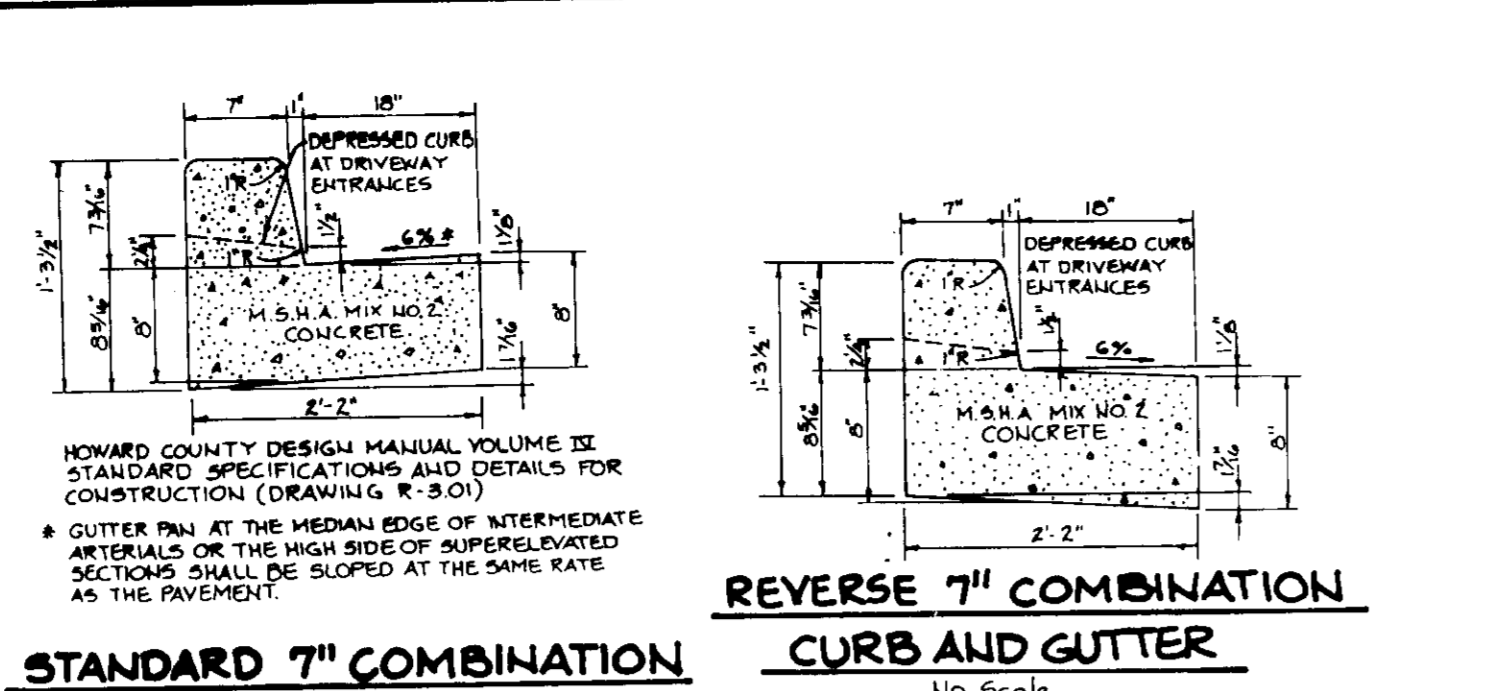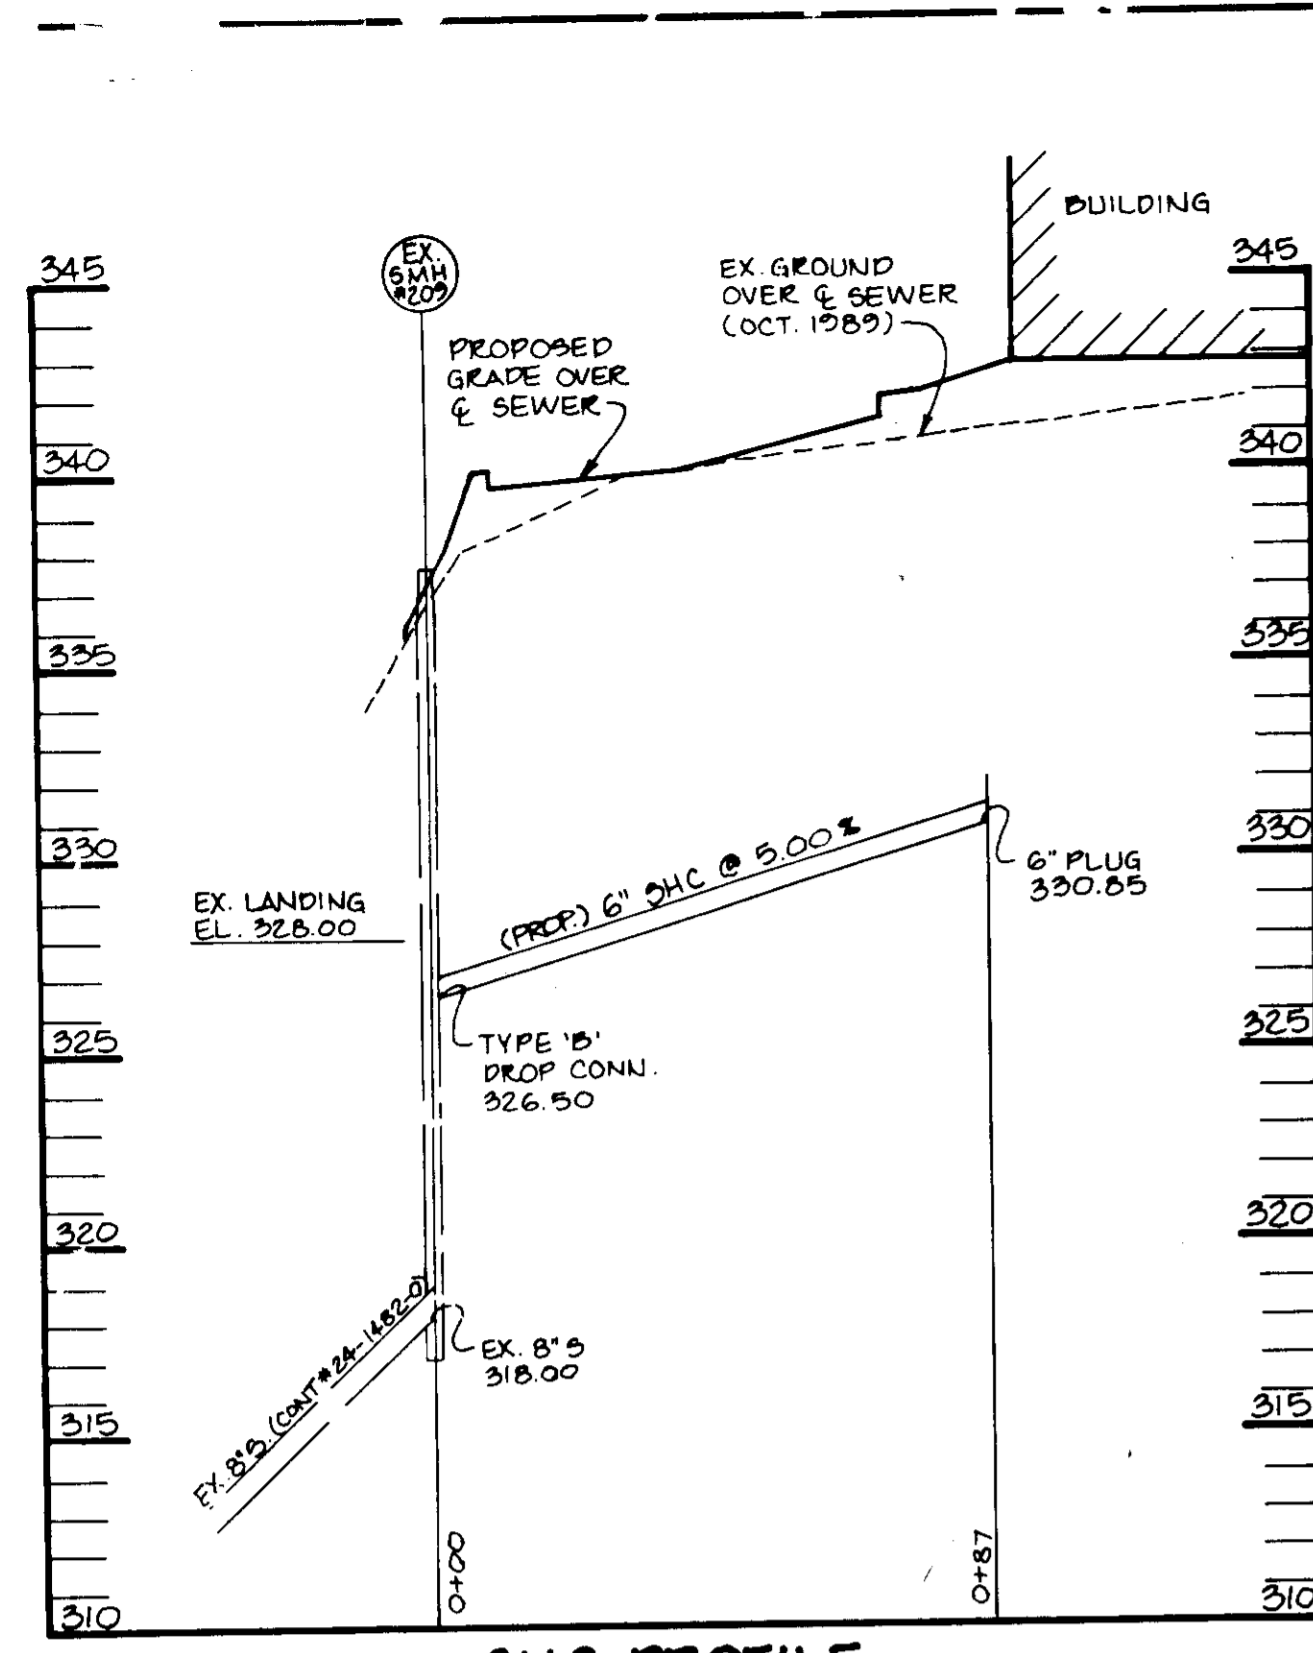

SHC PROFILE  
SCALE: HOR. 1"=50'  
VERT. 1"=5'



HANDICAP SIGN DETAIL  
NO SCALE

SIDEWALK DETAIL  
NO SCALE





RIP RAP DETAIL  
NO SCALE

ROOF DRAIN PROFILE  
SCALE: HOR. 1"=50'  
VERT. 1"=5'

WHC PROFILE  
SCALE: HOR. 1"=50'  
VERT. 1"=5'

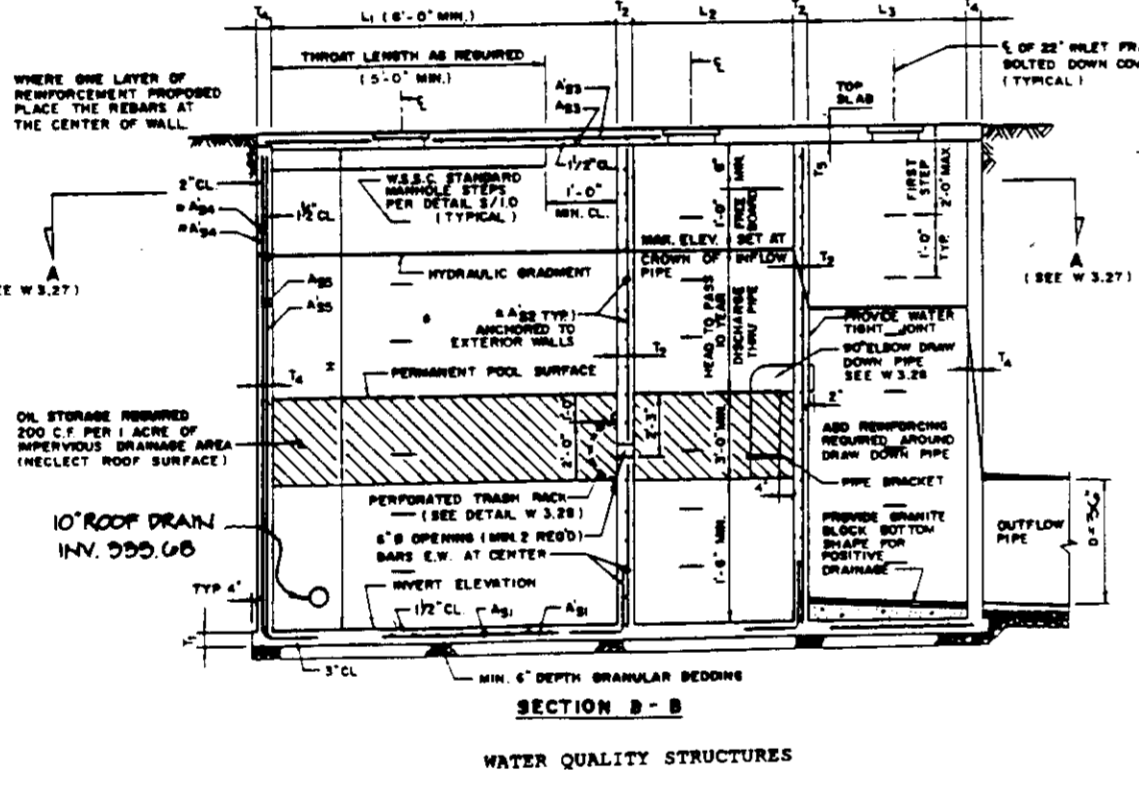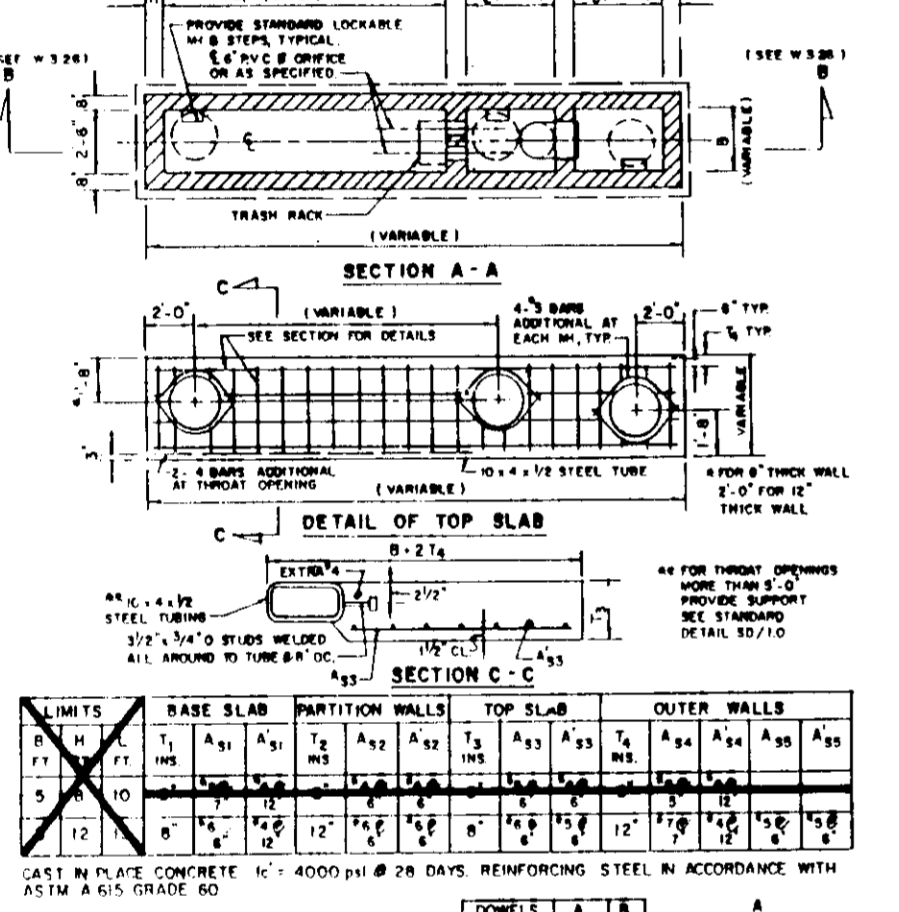


STRUCT. NUMBER	PAVED AREA (SQ. FT.)	NO. OF TRAP	NO. OF STORAGE	NO. OF INLET	NO. OF OUTLET	NO. OF CLEANOUT	FLOOR FINISH	WALL FINISH	TOP SLAB ELEV.	OFFICE	SIZE			
I-1	0.61	122	195	6'-0"	4'-0"	4'-0"	3'-2.50	2'-10"	5'-7.00	5'-0"	340.40	340.10	4	10'

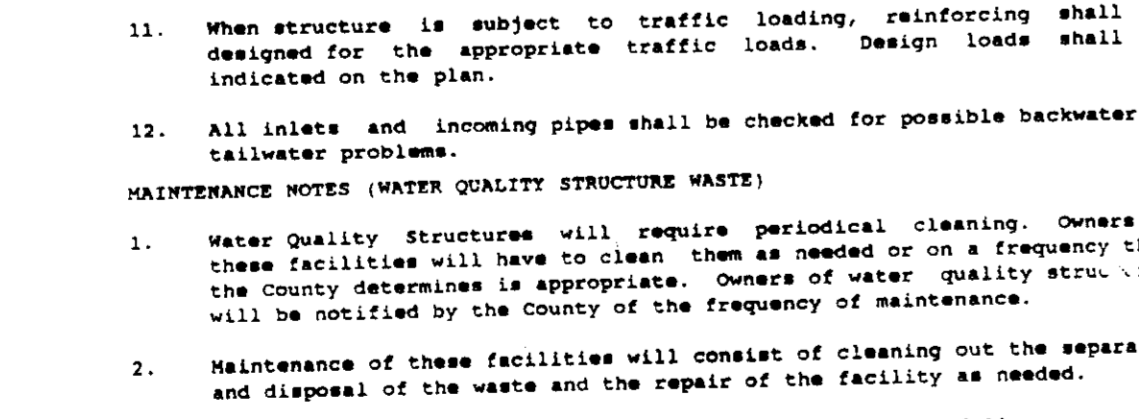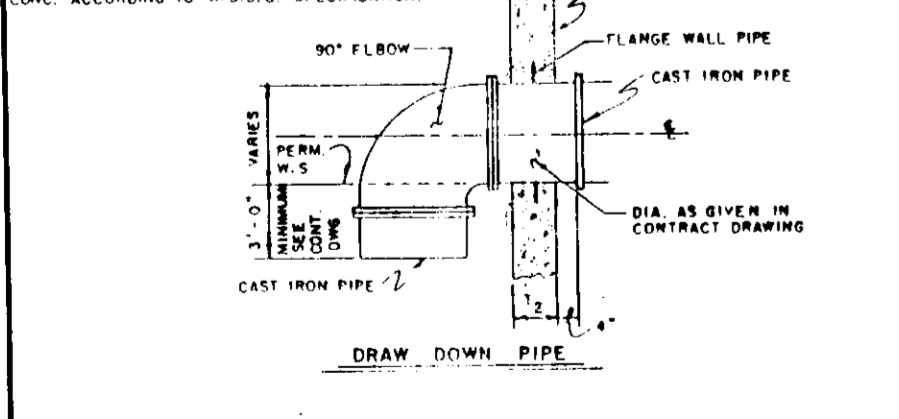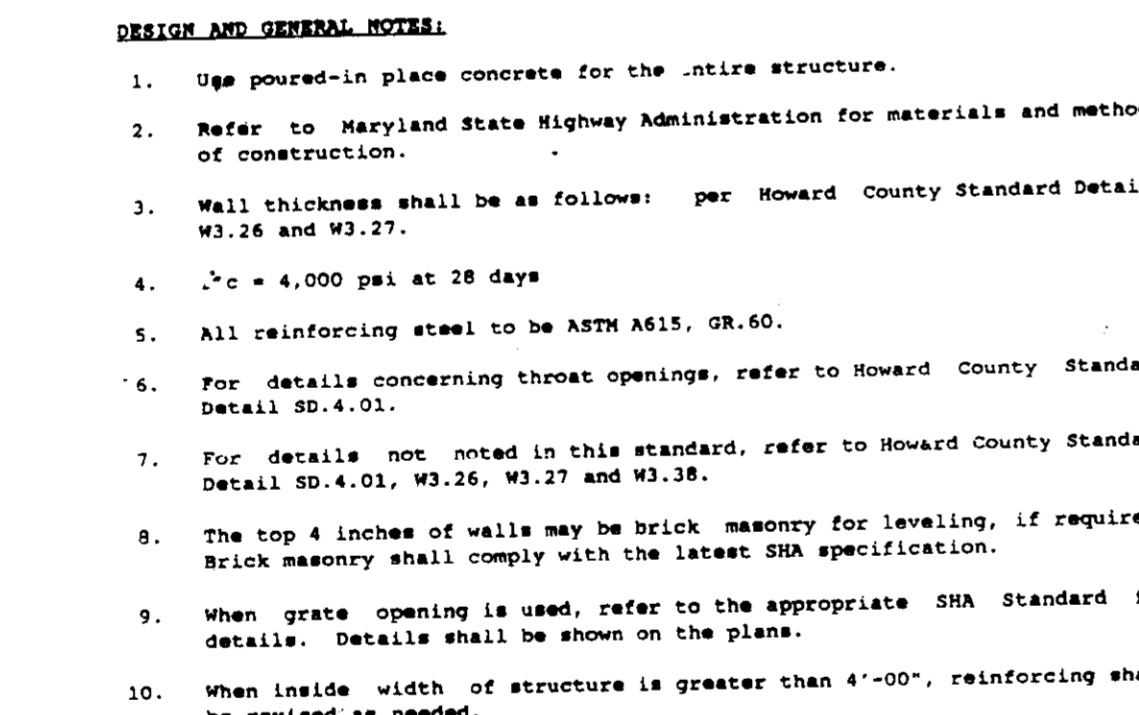
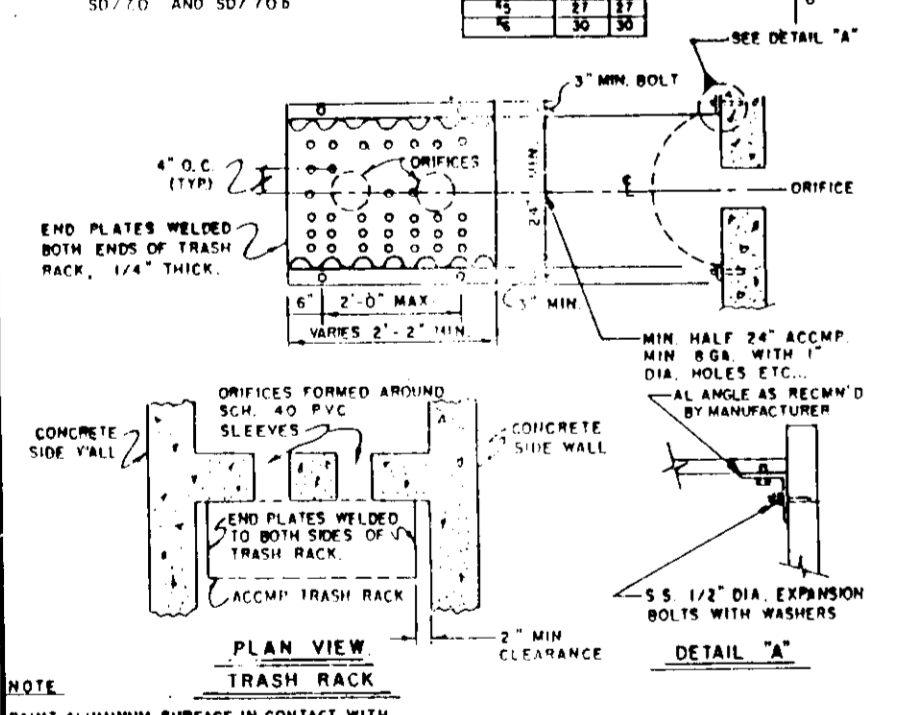


- INSPECTION NOTES:**
- Prior to start of construction on water quality structures, the Howard County Department of Public Works Inspector must be called 48 hours in advance at 792-2630.
  - The Howard County Department of Public Works Inspector must be notified (792-2630) at each of the following stages:
    - Approval of subgrade for footings.
    - Footings formed and steel set prior to pouring.
    - Structure sides formed and steel set prior to pouring.
    - Prior to top slab and manholes being set, Howard County Department of Public Works Inspector must check structure and all debris and silt in structure removed.
    - When site is permanently stabilized and sediment control measures to protect inlet are to be removed.

- DESIGN AND GENERAL NOTES:**
- Use poured-in place concrete for the entire structure.
  - Refer to Maryland State Highway Administration for materials and methods of construction.
  - Wall thickness shall be as follows: per Howard County Standard Details W3.26 and W3.27.
  - $f'_c = 4,000$  psi at 28 days.
  - All reinforcing steel to be ASTM A615, GR. 60.
  - For details concerning throat openings, refer to Howard County Standard Detail SD.4.01.
  - For details not noted in this standard, refer to Howard County Standard Detail SD.4.01, W3.26, W3.27 and W3.38.
  - The top 4 inches of walls may be brick masonry for leveling, if required. Brick masonry shall comply with the latest SHS specification.
  - When grate opening is used, refer to the appropriate SHS Standard for details. Details shall be shown on the plans.
  - When inside width of structure is greater than 4'-00", reinforcing shall be revised as needed.
  - When structure is subject to traffic loading, reinforcing shall be designed for the appropriate traffic loads. Design loads shall be indicated on the plan.
  - All inlets and incoming pipes shall be checked for possible backwater or tailwater problems.
- MAINTENANCE NOTES (WATER QUALITY STRUCTURE WASTE):**
- Water Quality Structures will require periodical cleaning. Owners of these facilities will have to clean them as needed or on a frequency that the County determines is appropriate. Owners of water quality structures will be notified by the County of the frequency of maintenance.
  - Maintenance of these facilities will consist of cleaning out the separator and disposal of the waste and the repair of the facility as needed.
  - The disposal of the liquid and solid matter should be as follows:
    - All liquid material in the separator inlet shall be pumped into a suitable tank truck and disposed of at an approved sanitary district discharge manhole or be taken to an approved sewage treatment plant for discharge.
    - The solid material shall be landfilled in an approved sanitary landfill.
  - The inlet pipes, trash racks, grates, and structural parts shall be repaired as needed.
- CONSTRUCTION NOTES:**
- Silt and debris shall not be allowed to enter the structures until contributing drainage areas have been permanently stabilized.
  - All openings to structures shall be protected with the appropriate sediment control measures during construction.

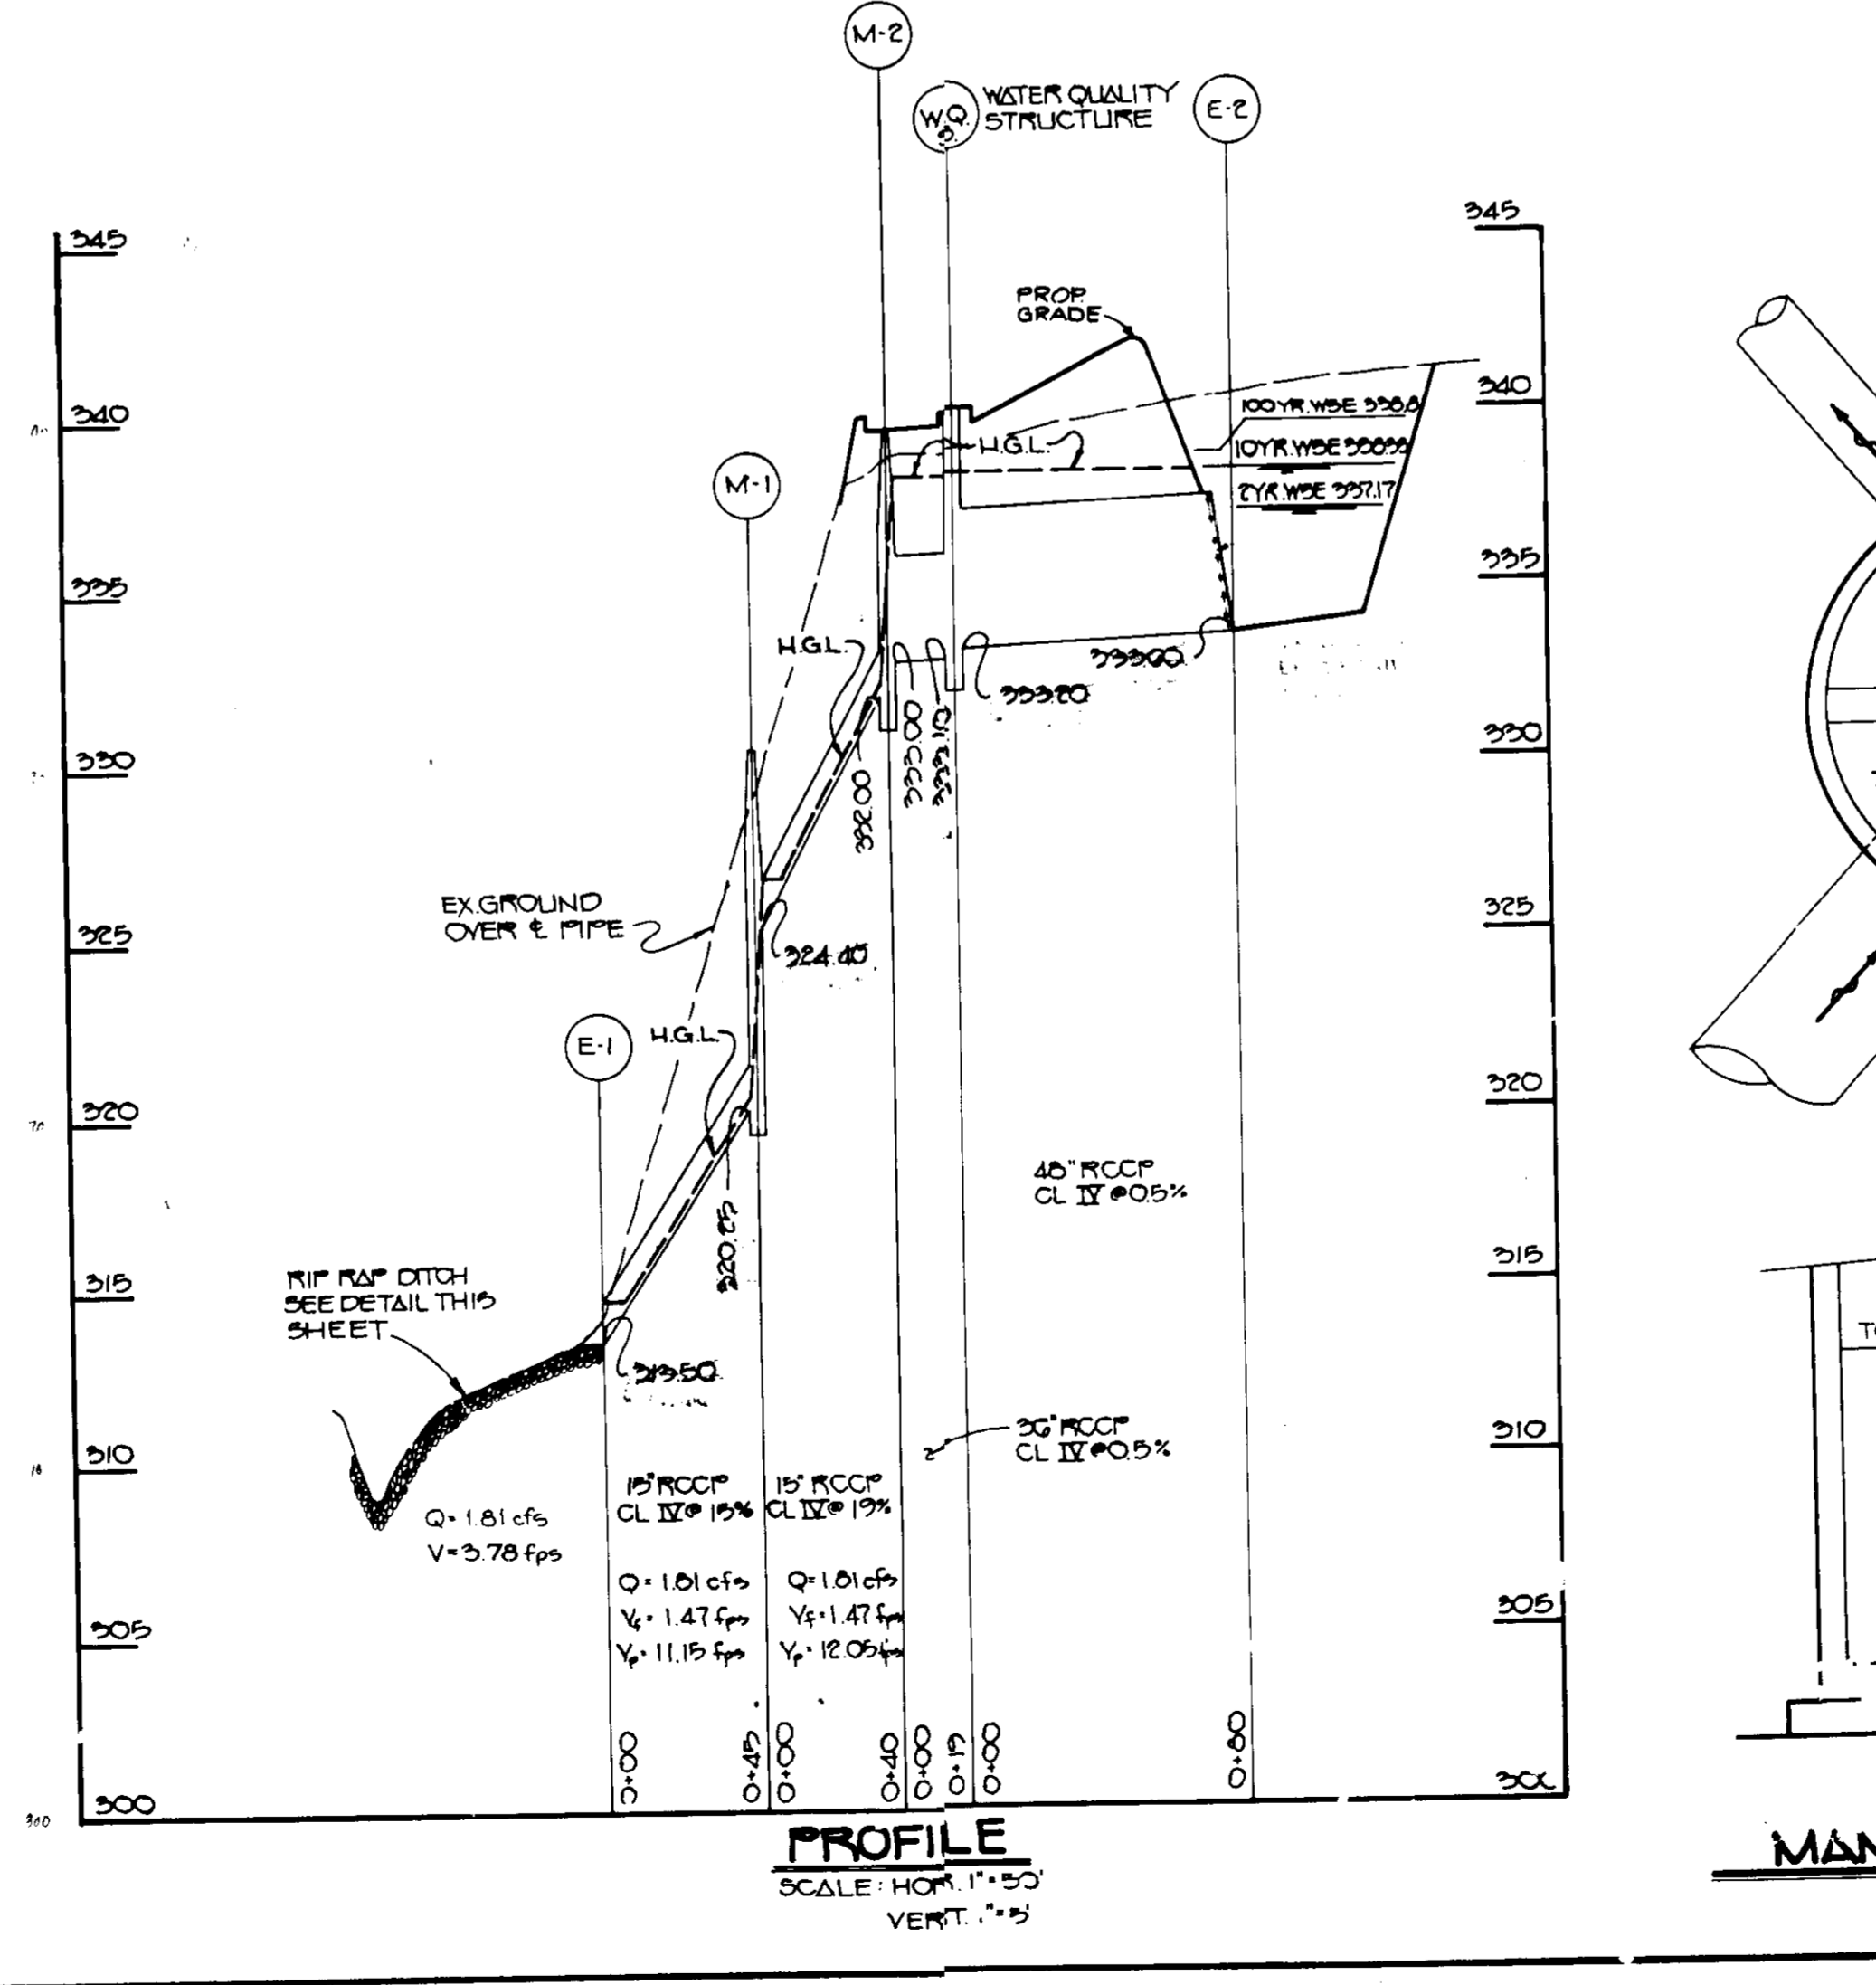


PROFILE  
SCALE: HOR. 1"=50'  
VERT. 1"=5'

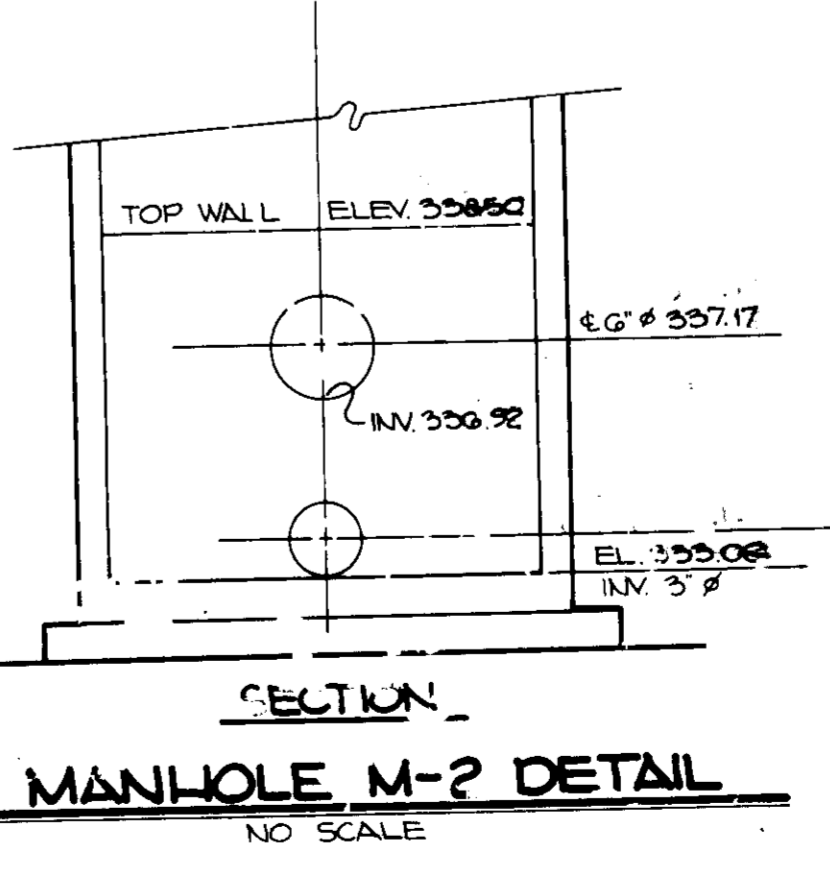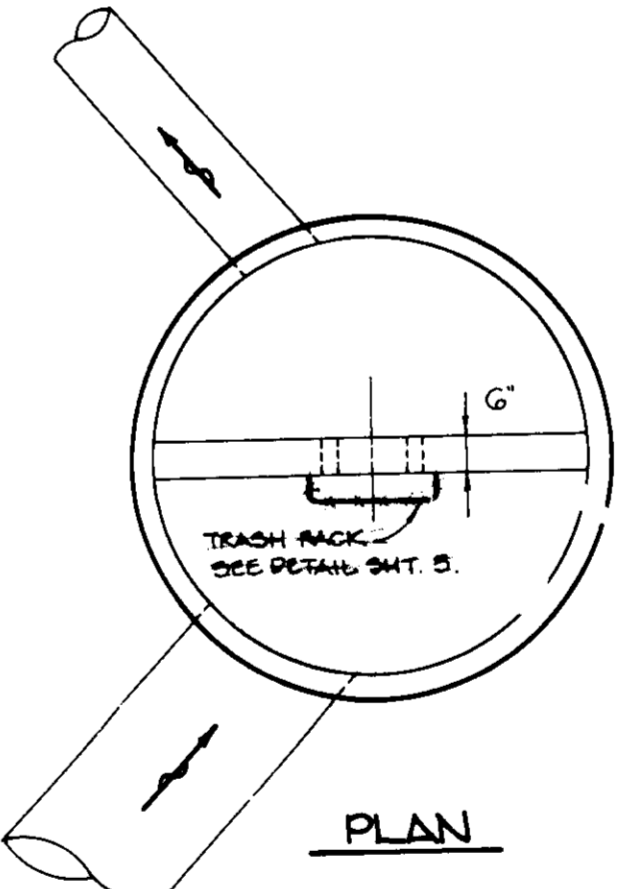

MANHOLE M-2 DETAIL  
NO SCALE

- ALL LIGHT FIXTURES TO BE SINGLE LUMINAIRE 400 WATT MERCURY TYPE WITH METAL POLES AND DIRECTED DOWNWARD.
- LOCATIONS OF LIGHT FIXTURES ARE ON THE PLAN AND ARE SHOWN THUS:
- LIGHTS TO BE MODEL II TYPE AS MANUFACTURED BY MOLCAST OR APPROVED EQUAL.
- POLE AND FIXTURE TO HAVE BLACK POLYESTER ENAMEL FINISH.
- POLE TO BE LOCATED 3' BACK FROM BACK OF CURB.

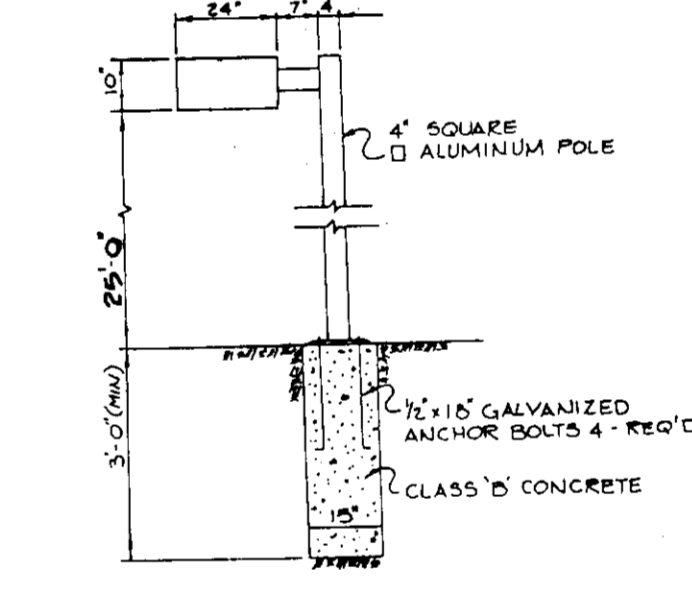

LIGHT POLE DETAIL  
NO SCALE

NO.	TYPE	LOCATION	INV. IN	INV. OUT	TOP ELEV.	REMARKS
I-1	WATER QUALITY STRUCTURE	SEE PLAN	333.20	339.10	340.10	SEE DETAIL, THIS SHEET
E-1	15" CONC. END SECTION	SEE PLAN	---	313.30	---	HO. CO. STD. DETAIL SD 5.52
E-2	48" CONC. END SECTION	SEE PLAN	333.60	---	---	HO. CO. STD. DETAIL SD 5.52
M-1	STD. 4' PRECAST	SEE PLAN	324.40	320.25	330.40	HO. CO. STD. DETAIL G 5.12
M-2	STD. 5' PRECAST	SEE PLAN	333.00	332.00	339.60	SEE DETAIL THIS SHEET & HO. CO. STD. DETAIL G 5.15

**AS BUILT CERTIFICATE**

J. Farrell 1/26/95  
DATE

ARTHUR E. MUEGGE #9707  
DATE

APPROVED: FOR PUBLIC WATER AND PUBLIC SEWERAGE SYSTEMS, HOWARD COUNTY HEALTH DEPARTMENT.

*Joseph E. Muegge* 9-23-92  
COUNTY HEALTH OFFICER DATE

APPROVED: HOWARD COUNTY DEPARTMENT OF PLANNING AND ZONING.

*Joseph E. Muegge* 10/13/93  
DIRECTOR DATE

APPROVED: DIVISION OF LAND DEVELOPMENT AND RESEARCH.

*Gina Surrency* 10/13/93  
CHIEF, DIVISION OF LAND DEVELOPMENT AND RESEARCH DATE

APPROVED: FOR PUBLIC WATER, PUBLIC SEWERAGE, STORM DRAINAGE SYSTEMS AND PUBLIC ROADS.

HOWARD COUNTY DEPARTMENT OF PUBLIC WORKS

*Camryn M. Lewis* 9-23-93  
DIRECTOR DATE

APPROVED: BUREAU OF ENGINEERING.

*Arthur E. Muegge* 9/20/93  
CHIEF, BUREAU OF ENGINEERING DATE

DATE	NO.	REVISION

OWNER/DEVELOPER:  
JEROME M. WILLIAMS  
8035 F. COLUMBIA 100 PARKWAY  
COLUMBIA, MD. 21045

PROJECT: HILLCROFT PROFESSIONAL CENTER AN OFFICE BUILDING

AREA: VILLAGE OF OPEN BROWN SEC. 5 AREA 1  
PARCEL G-4-A1 SUB. OF PARCEL G-1 PLAT NO. 8420  
6TH ELECTION DISTRICT HOWARD COUNTY, MARYLAND

TITLE: STORM DRAIN PROFILE AND DETAILS

RIEMER MUEGGE & ASSOCIATES, INC.  
A Land Planning, Engineering and Consulting Firm  
3105 North Ridge Road Ellicott City, Maryland 21043  
301-461-2630 FAX: 301-750-3176

APPROVED PLANNING BOARD OF HOWARD COUNTY  
DATE 11 April 1990

DESIGNED BY: D.B.S.  
DRAWN BY: CADD/M.K.  
PROJECT NO: 86402  
DATE: SEPTEMBER 2, 1993  
SCALE: AS SHOWN  
DRAWING NO. 4 OF 9

These specifications are appropriate to ponds within the scope of the Standard for practice 378.

**I. SITE PREPARATION**  
Areas designated for borrow areas, embankment, and structural works shall be cleared, grubbed and stripped of vegetation. All trees, vegetation, roots and other objectionable material shall be removed. Channel banks and sharp breaks shall be sloped to no steeper than 1:1.

Areas to be covered by the pond of reservoir will be cleared of all trees, brush, logs, fences, rubbish and other objectionable material unless otherwise designated on the plans. Trees, brush and stumps shall be cut approximately level with the ground surface.

All cleared and grubbed material shall be disposed of outside and below the limits of the dam and reservoir as directed by the owner or his representative. When specified, a sufficient quantity of topsoil will be stockpiled in a suitable location for use on the embankment and other designated areas.

**II. EARTH FILL**

**Material**  
The fill material shall be taken from approved designated borrow areas or areas. It shall be free of roots, stumps, wood, rubbish, over-size stones, frozen or other objectionable materials. The embankment shall be constructed to an elevation which provides for anticipated settlement to the design elevation. The fill height shall be the length of the embankment shall be increased above the design elevation (including freeboard) as shown on the plans.

**Placement**  
Areas on which fill is to be placed shall be scarified prior to placement of fill. Fill material shall be placed in 8-inch maximum thickness (before compaction) layers which are to be continuous over the entire length of the fill. The most porous borrow material shall be placed in the downstream portions of the embankment.

**Compaction**  
The movement of the hauling and spreading equipment over the fill shall be controlled so that the entire surface of each lift shall be traversed by not less than one tread track of the equipment or compaction shall be achieved by a minimum of four complete passes of a sheepsfoot, rubber tired or vibratory roller. Fill material shall contain sufficient moisture such that the required degree of compaction can be obtained with the equipment used.

Where a minimum required density is specified, each layer of fill shall be compacted as necessary to obtain that density and is to be certified by the Engineer.

**Cutoff Trench**

Where specified, a cutoff trench shall be excavated along or parallel to the centerline of the embankment as shown on the plans. The bottom width of the trench shall be as shown on the drawings, with the minimum width being four feet. The depth shall be at least four feet or as shown on the plans. The side slopes of a trench shall be 1 to 1 or flatter. The backfill material for the cutoff trench shall be the most impervious material available and shall be compacted with equipment or rollers to assure maximum density and minimum permeability.

**III. STRUCTURAL BACKFILL**

Backfill material shall be of the type and quality conforming to that specified for the adjoining fill material. The fill shall be placed in horizontal layers not to exceed four inches in thickness and compacted by hand tampers or other compaction equipment. The material needs to fill completely all spaces under and adjacent to the pipe. At no time during the backfilling operation shall driven equipment be allowed to operate closer than four feet, measured horizontally, to any part of a structure. Under no circumstances shall equipment be driven over any part of a concrete structure or pipe unless there is a compacted fill of twenty-four inches or greater over the structure or pipe.

**IV. PIPE CONDUITS**

All pipes shall be circular in cross section.

**A. Corrugated Metal Pipe**

- Materials - (Steel Pipe)** - This pipe and its appurtenances shall be galvanized and fully bituminous coated and shall conform to the requirements of ASTM Specification A-131 Type A with watertight coupling bands. Any bituminous coating damaged or otherwise removed shall be replaced with cold applied bituminous coating compound.
- Connections** - All connections with pipes must be completely watertight. The drain pipe or barrel connection to the riser shall be welded all around where the pipe and riser are metal. Watertight coupling bands or flanges shall be used at all joints. Antiseep collars shall be connected to the pipe in such a manner as to the completely watertight. Diaple bands are not considered to be watertight.
- Bedding** - The pipe shall be firmly and uniformly bedded throughout its entire length. Where rock or other unstable soil is encountered, all such material shall be removed and replaced with suitable earth compacted to provide adequate support.
- Laying pipe** - The pipe shall be placed with inside circumferential laps pointing downstream and with the longitudinal laps at the sides.
- Backfilling** shall conform to structural backfill as shown above.
- Other details (anti-seep collars, valves, etc.) shall be as shown on the drawings.

**B. Reinforced Concrete Pipe**

- Materials** - Reinforced concrete pipe shall have a rubber gasket joint and shall equal or exceed ASTM Specification C-301. An approved equivalent is ANMA Specification C-301.
- Bedding** - All reinforced concrete pipe conduits shall be laid in a concrete bedding for their entire length. This bedding shall consist of high slump concrete placed under the pipe and up the sides of the pipe at least 10% of its outside diameter with a minimum thickness of 3", or as shown on the drawings.
- Laying pipe** - Bell and spigot pipe shall be placed with the bell end upstream. Joints shall be made in accordance with recommendations of the manufacturer of the material. After the joints are sealed for the entire line, the bedding shall be placed so that all spaces under the pipe are filled. Care shall be exercised to prevent any deviation from the original line and grade of the pipe.
- Backfilling** shall conform to structural backfill as shown above.
- Other details (anti-seep collars, valves, etc.) shall be as shown on the drawings.
- For pipes of other materials, specific specifications shall be shown on the drawings.

**V. CONCRETE**

**1. Materials**

a. **Cement** - Normal Portland cement shall conform to the latest ASTM Specification C-150.

b. **Water** - The water used in concrete shall be clean, free from oil, acid, alkali, scales, organic matter or other objectionable substances.

c. **Sand** - The sand used in concrete shall be clean, hard, strong and durable, and shall be well graded with 100 percent passing a one-quarter inch sieve. Lightweight sand shall not be used.

d. **Coarse Aggregate** - The coarse aggregate shall be clean, hard, strong and durable, and free from clay or silt. It shall be well graded with a maximum size of one and one-half (1-1/2) inches.

e. **Reinforcing Steel** - The reinforcing steel shall be deformed bars of intermediate grade miller steel or rail steel conforming to ASTM Specification A-615.

2. **Design Mix** - The concrete shall be mixed in the following proportions, measured by weight. The water-cement ratio shall be 5/7 1/2 to 6 U.S. Gallons of water per 94 pound bag of cement. The proportion of materials for the trial mix shall be 1:2:3-1/2. The combination of aggregates may be adjusted to produce a plastic and workable mix that will not produce hairiness in placing or honeycombing in the structure.

3. **Mixing** - The concrete ingredients shall be mixed in batch mixers until the mixture is homogeneous and of uniform consistency. The mixing of each batch shall continue for not less than 90 and one-half minutes after all the ingredients, except the full amount of water, are in the mixer. The minimum mixing time is predicated on proper control of the speed of rotation of the mixer and of the introduction of the materials, including water, into the mixer. Water shall be added prior to, during, and following the mixer-charging operations. Excessive overmixing requiring the addition of water to preserve the required concrete consistency shall not be permitted. Truck mixing will be allowed provided that the use of this method shall cause no violation of any applicable provisions of the specifications given here.

4. **Forms** - The forms shall have sufficient strength and rigidity to hold the concrete and to withstand the necessary pressure, tamping, and vibration without deflection from the prescribed lines. They shall be mortar-tight and constructed so that they can be removed without hammering or prying against the concrete.

The inside of forms shall be oiled with a non-staining mineral oil or thoroughly wetted before concrete is placed.

Forms may be removed 24 hours after the placement of concrete. All wire ties and other devices used shall be recessed from the surface of the concrete.

5. **Reinforcing Steel** - All reinforcing material shall be free of dirt, rust, scale, oil, paint or any other coatings. The steel shall be accurately placed and securely tied into position so that no movement of the steel will occur during placement of concrete.

6. **Consolidating** - Concrete shall be consolidated with internal type mechanical vibrators. Vibration shall be supplemented by spading and hand tamping as necessary to insure smooth and dense concrete along form surfaces, in corners, and around embedded items.

7. **Finishing** - Defective concrete, honeycombed areas, voids left by the removal of tie rods, ridges on all concrete surfaces permanently exposed to view or exposed to water on the finished structure, shall be repaired immediately after the removal of forms. All voids shall be reamed and completely filled with dry-patching mortar.

8. **Protection and Curing** - Exposed surfaces of concrete shall be protected from the direct rays of the sun for at least the first three (3) days. All concrete shall be kept continuously moist for at least ten (10) days after being placed. Moisture may be applied by spraying or sprinkling as necessary to prevent the concrete from drying. Concrete shall not be exposed to freezing during the curing period. Curing compounds may also be used.


**9. Placing Temperature** - Concrete may not be placed at temperatures below 32° F with the temperature falling, or 36° with the temperature rising.

**VI. STABILIZATION**


All borrow areas shall be graded to provide proper drainage and left in a slightly condition. All exposed surfaces of the embankment, spillway, spill and borrow areas, and borrow shall be stabilized by seeding, liming, fertilizing and mulching (if required) in accordance with the vegetative treatment specifications or as shown on the accompanying drawings.

**VII. EROSION AND SEDIMENT CONTROL**


Construction operations will be carried out in such a manner that erosion will be controlled and water and air pollution minimized. State and local laws concerning pollution abatement will be followed. Construction plans shall detail erosion and sediment control measures to be employed during the construction process.

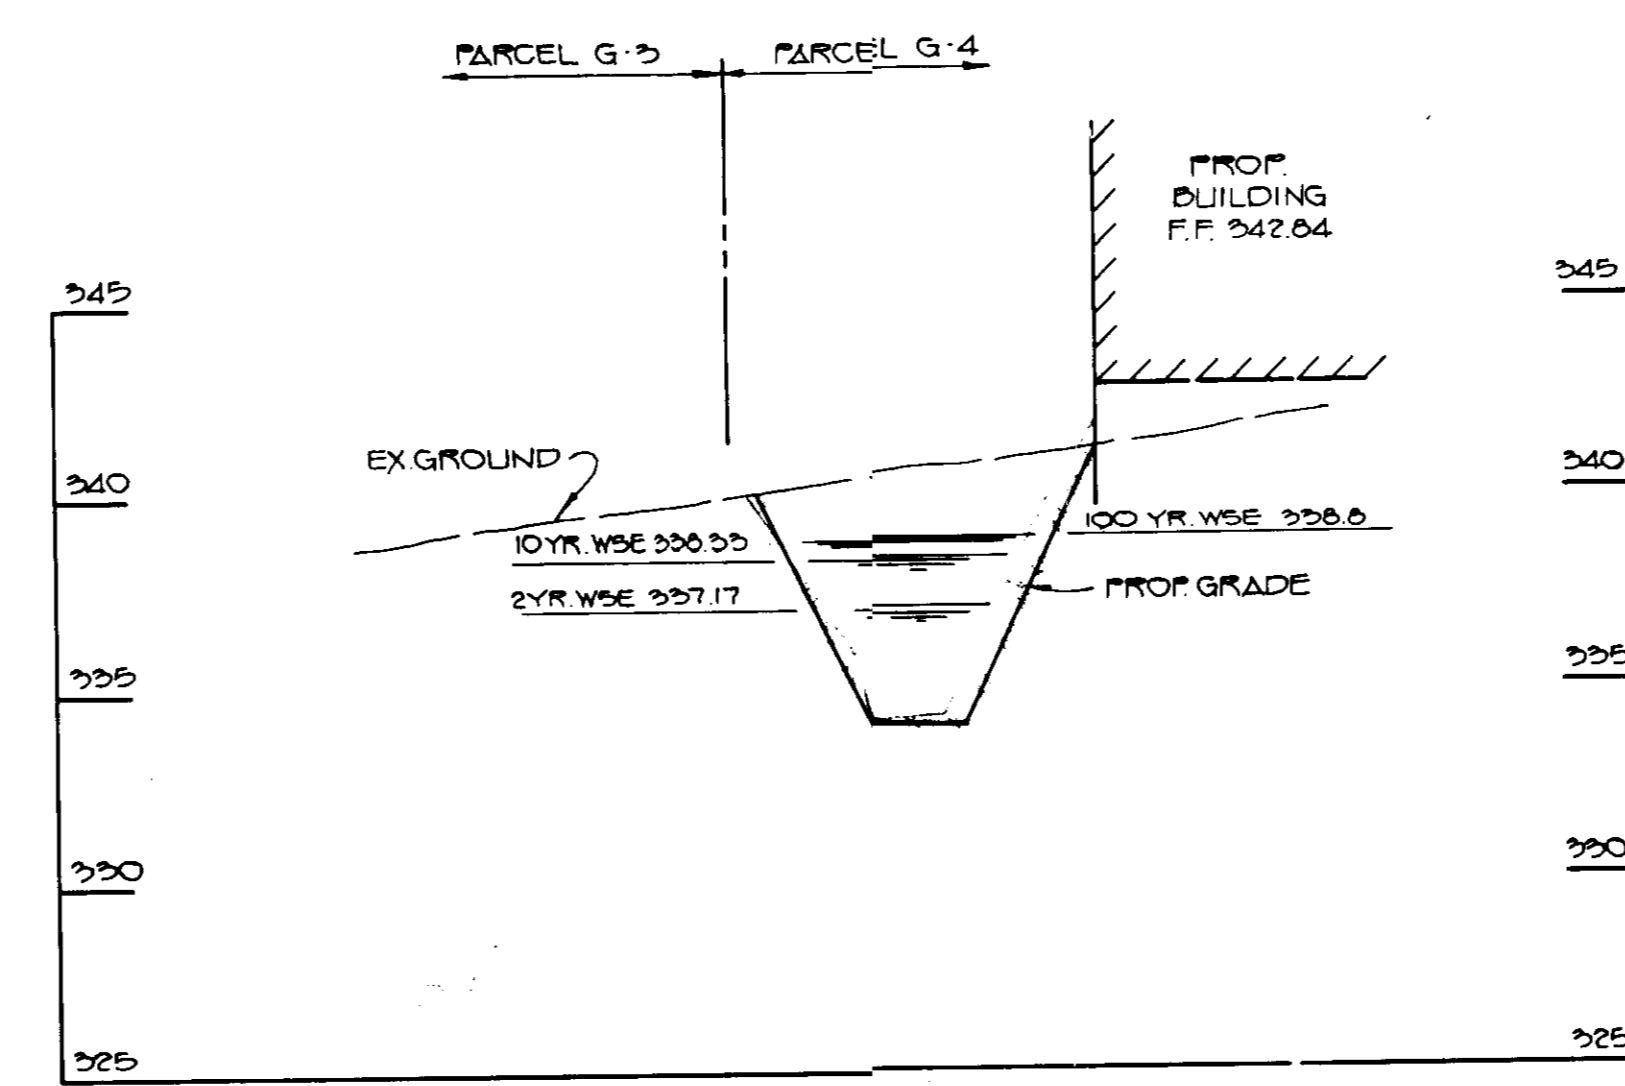


**SECTION A-A**  
SCALE: HORIZ. 1" = 50'  
VERT. 1" = 5'

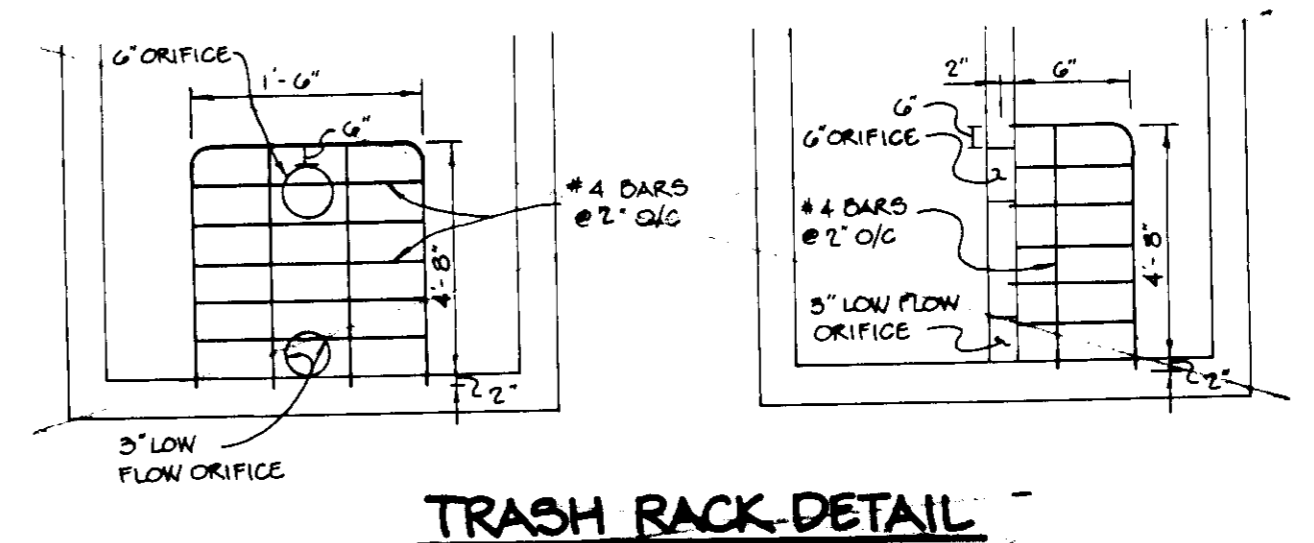


**TRASH RACK DETAIL**  
NO SCALE

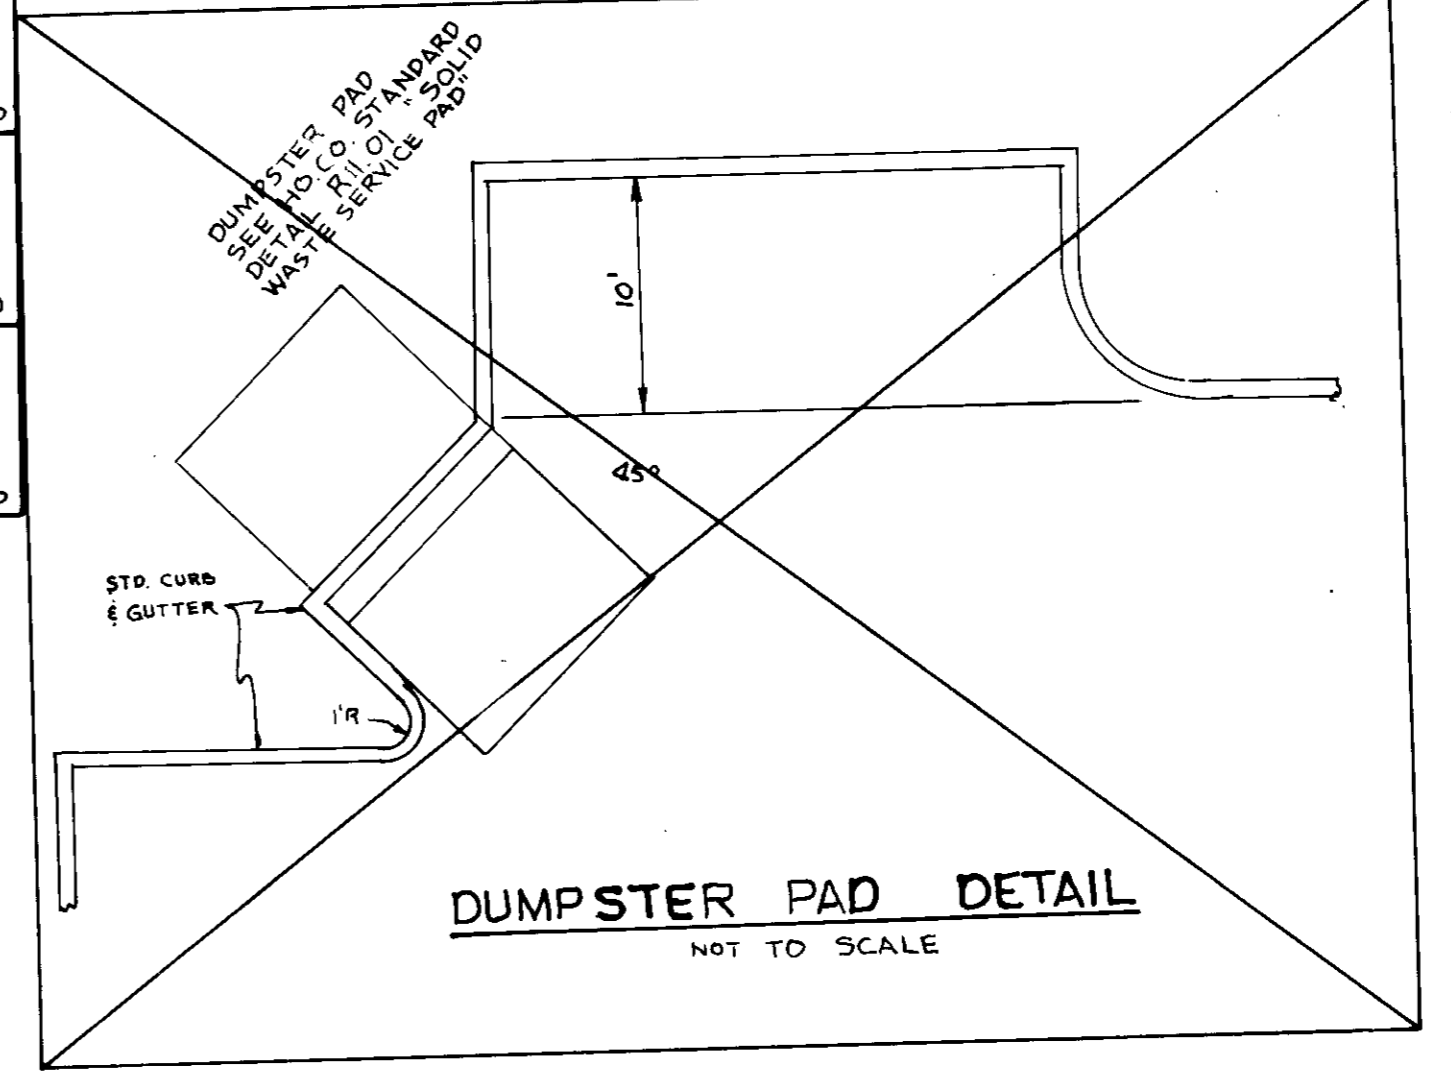

**DUMPSTER PAD DETAIL**  
NOT TO SCALE

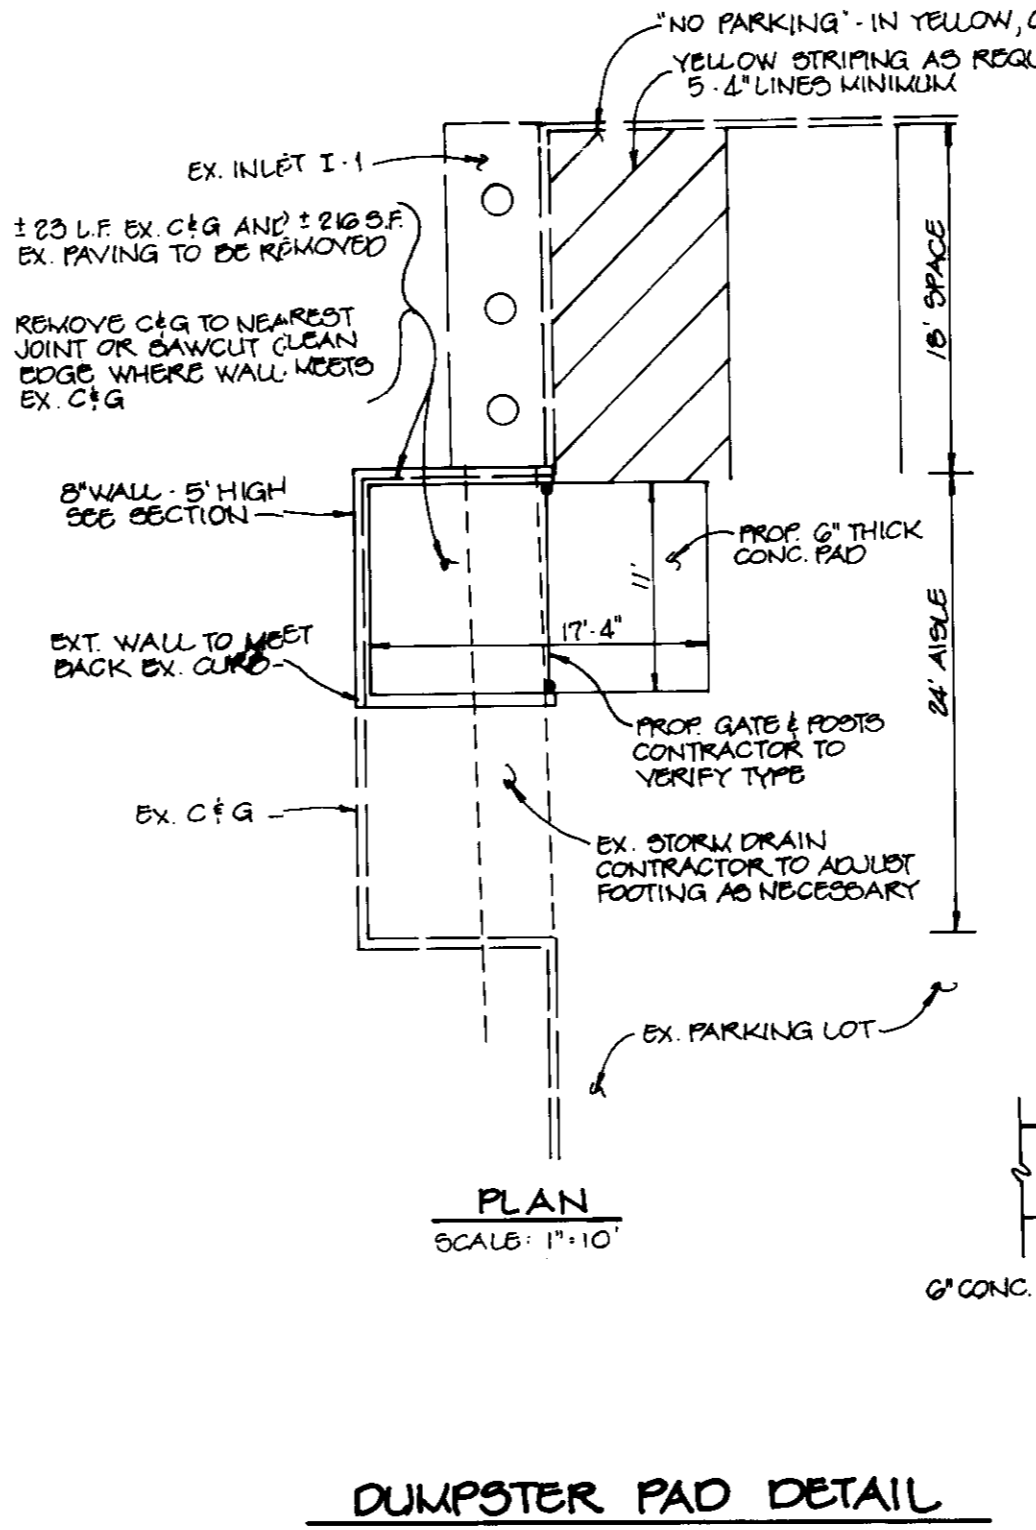

**DUMPSTER PAD DETAIL**

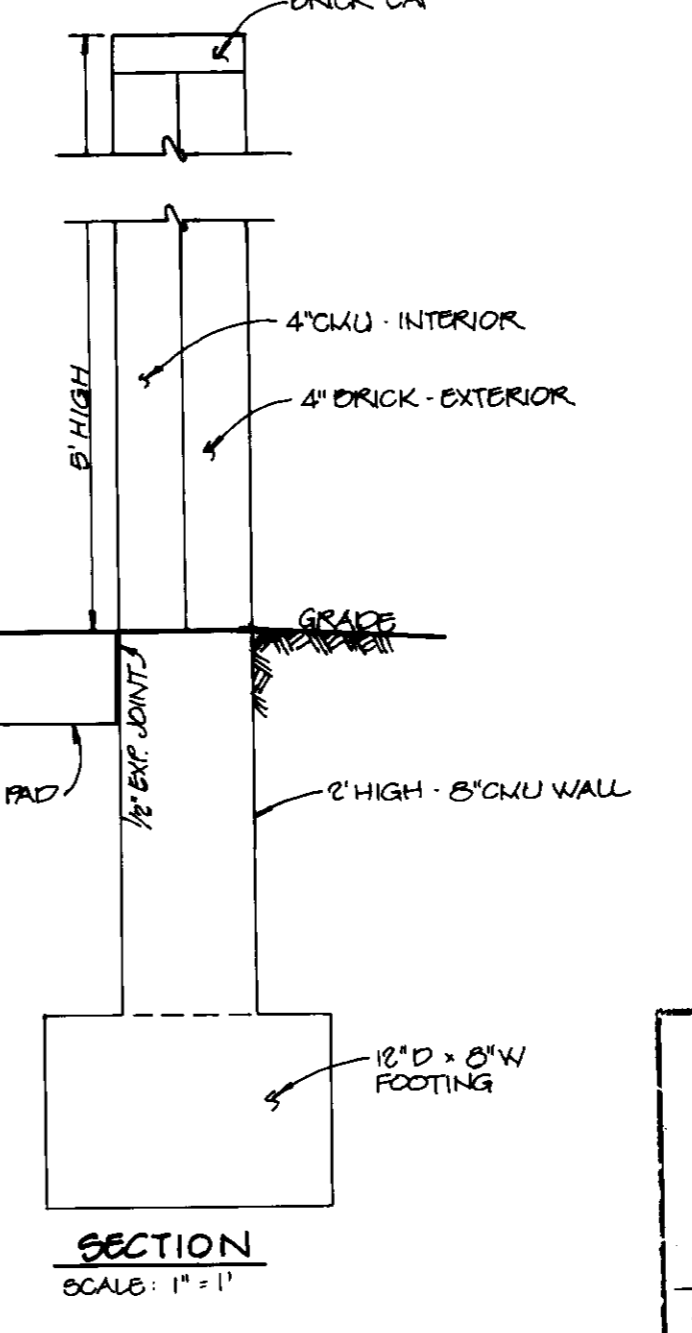

**SECTION**  
SCALE: 1" = 1'

**APPROVED**  
PLANNING BOARD  
of HOWARD COUNTY  
DATE: 11 April 1990

AS BUILT CERTIFICATE  
J. Farrell 12/95  
ARTHUR E. MUEGGE #8707 DATE

BY THE DEVELOPER:  
"I CERTIFY THAT ALL DEVELOPMENT AND/OR CONSTRUCTION WILL BE DONE ACCORDING TO THESE PLANS, AND THAT ANY RESPONSIBLE PERSONNEL INVOLVED IN THE CONSTRUCTION PROJECT WILL HAVE A CERTIFICATE OF ATTENDANCE AT A DEPARTMENT OF NATURAL RESOURCES APPROVED TRAINING PROGRAM FOR THE CONTROL OF SEDIMENT AND EROSION BEFORE BEGINNING THE PROJECT. I WILL PROVIDE THE HOWARD SOIL CONSERVATION DISTRICT WITH AN 'AS-BUILT' PLAN OF THE POND WITHIN 30 DAYS OF COMPLETION. I ALSO AUTHORIZE PERIODIC ON-SITE INSPECTIONS BY THE HOWARD SOIL CONSERVATION DISTRICT."  
Jerome M. Williams 9/2/93  
DEVELOPER DATE

BY THE ENGINEER:  
"I CERTIFY THAT THIS PLAN FOR POND CONSTRUCTION, EROSION AND SEDIMENT CONTROL REPRESENTS A PRACTICAL AND WORKABLE PLAN BASED ON MY PERSONAL KNOWLEDGE OF THE SITE CONDITIONS. THIS PLAN WAS PREPARED IN ACCORDANCE WITH THE REQUIREMENTS OF THE HOWARD SOIL CONSERVATION DISTRICT. I HAVE NOTIFIED THE DEVELOPER THAT HE MUST PROVIDE THE HOWARD SOIL CONSERVATION DISTRICT WITH AN 'AS-BUILT' PLAN OF THE POND WITHIN 30 DAYS OF COMPLETION."  
Arthur E. Muegge 10/13/93  
ENGINEER DATE

THESE PLANS HAVE BEEN REVIEWED FOR THE HOWARD SOIL CONSERVATION DISTRICT AND MEET THE TECHNICAL REQUIREMENTS FOR SMALL POND CONSTRUCTION, SOIL EROSION AND SEDIMENT CONTROL.

APPROVED: 9/2/93  
S.O.S. SOIL CONSERVATION SERVICE DATE

THESE PLANS FOR SMALL POND CONSTRUCTION, SOIL EROSION AND SEDIMENT CONTROL MEET THE REQUIREMENTS OF THE HOWARD SOIL CONSERVATION DISTRICT.

APPROVED: 9/15/93  
HOWARD S.C.D. DATE

APPROVED: FOR PUBLIC WATER AND PUBLIC SEWERAGE SYSTEMS, HOWARD COUNTY HEALTH DEPARTMENT.  
Joseph B. Bode 9/23/93  
COUNTY HEALTH OFFICER DATE

APPROVED: HOWARD COUNTY DEPARTMENT OF PLANNING AND ZONING.

APPROVED: 10/13/93  
DIRECTOR DATE

APPROVED: 10/13/93  
CHIEF, DIVISION OF LAND DEVELOPMENT AND RESEARCH DATE

APPROVED: FOR PUBLIC WATER, PUBLIC SEWERAGE, STORAGE DRAINAGE SYSTEMS AND PUBLIC ROADS.

HOWARD COUNTY DEPARTMENT OF PUBLIC WORKS  
APPROVED: 9/2/93  
DIRECTOR DATE

APPROVED: 9/20/93  
CHIEF, BUREAU OF ENGINEERING DATE

12/22/93	2	ADDED DUMPSTER PAD DETAIL
4/15/94	1	ADDED DUMPSTER PAD DETAIL
DATE	NO.	REVISION

OWNER/DEVELOPER  
JEROME M. WILLIAMS  
8005-F COLUMBIA 100 PARKWAY  
COLUMBIA, MD. 21045

PROJECT: HILLCROFT PROFESSIONAL CENTER  
3 OFFICE BUILDING  
AREA VILLAGE OF OWEN BROWN SEC. 5 AREA 1  
PARCEL G-4 & RESUB OF PARCEL G-1 PLAT NO. 0452  
G-3 ELECTION DISTRICT HOWARD COUNTY MARYLAND

TITLE: S.W.M. NOTES & DETAILS



RIEMER MUEGGE & ASSOCIATES, INC.  
A Land Planning, Engineering and Consulting Firm  
3105 North Ridge Road Ellicott City, Maryland 21043  
301-461-2050 FAX: 301-750-3176

DATE: 9/2/93


DESIGNED BY: DBS  
DRAWN BY: RMA  
PROJECT NO: 06402  
DATE: SEPTEMBER 2, 1993  
SCALE: AS SHOWN  
DRAWING NO. 508

SDP 90-100

N 486750  
E 841000  
MD CRD NORTH

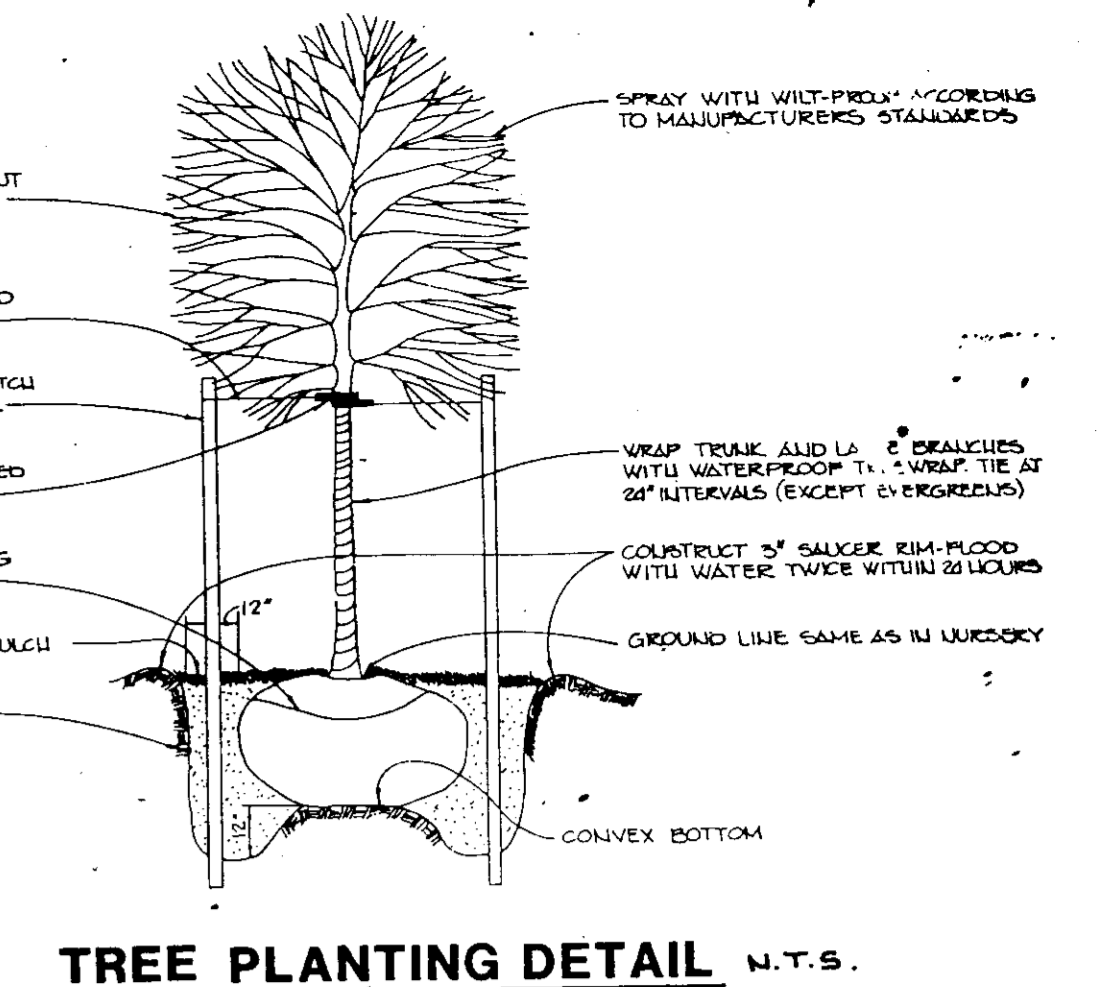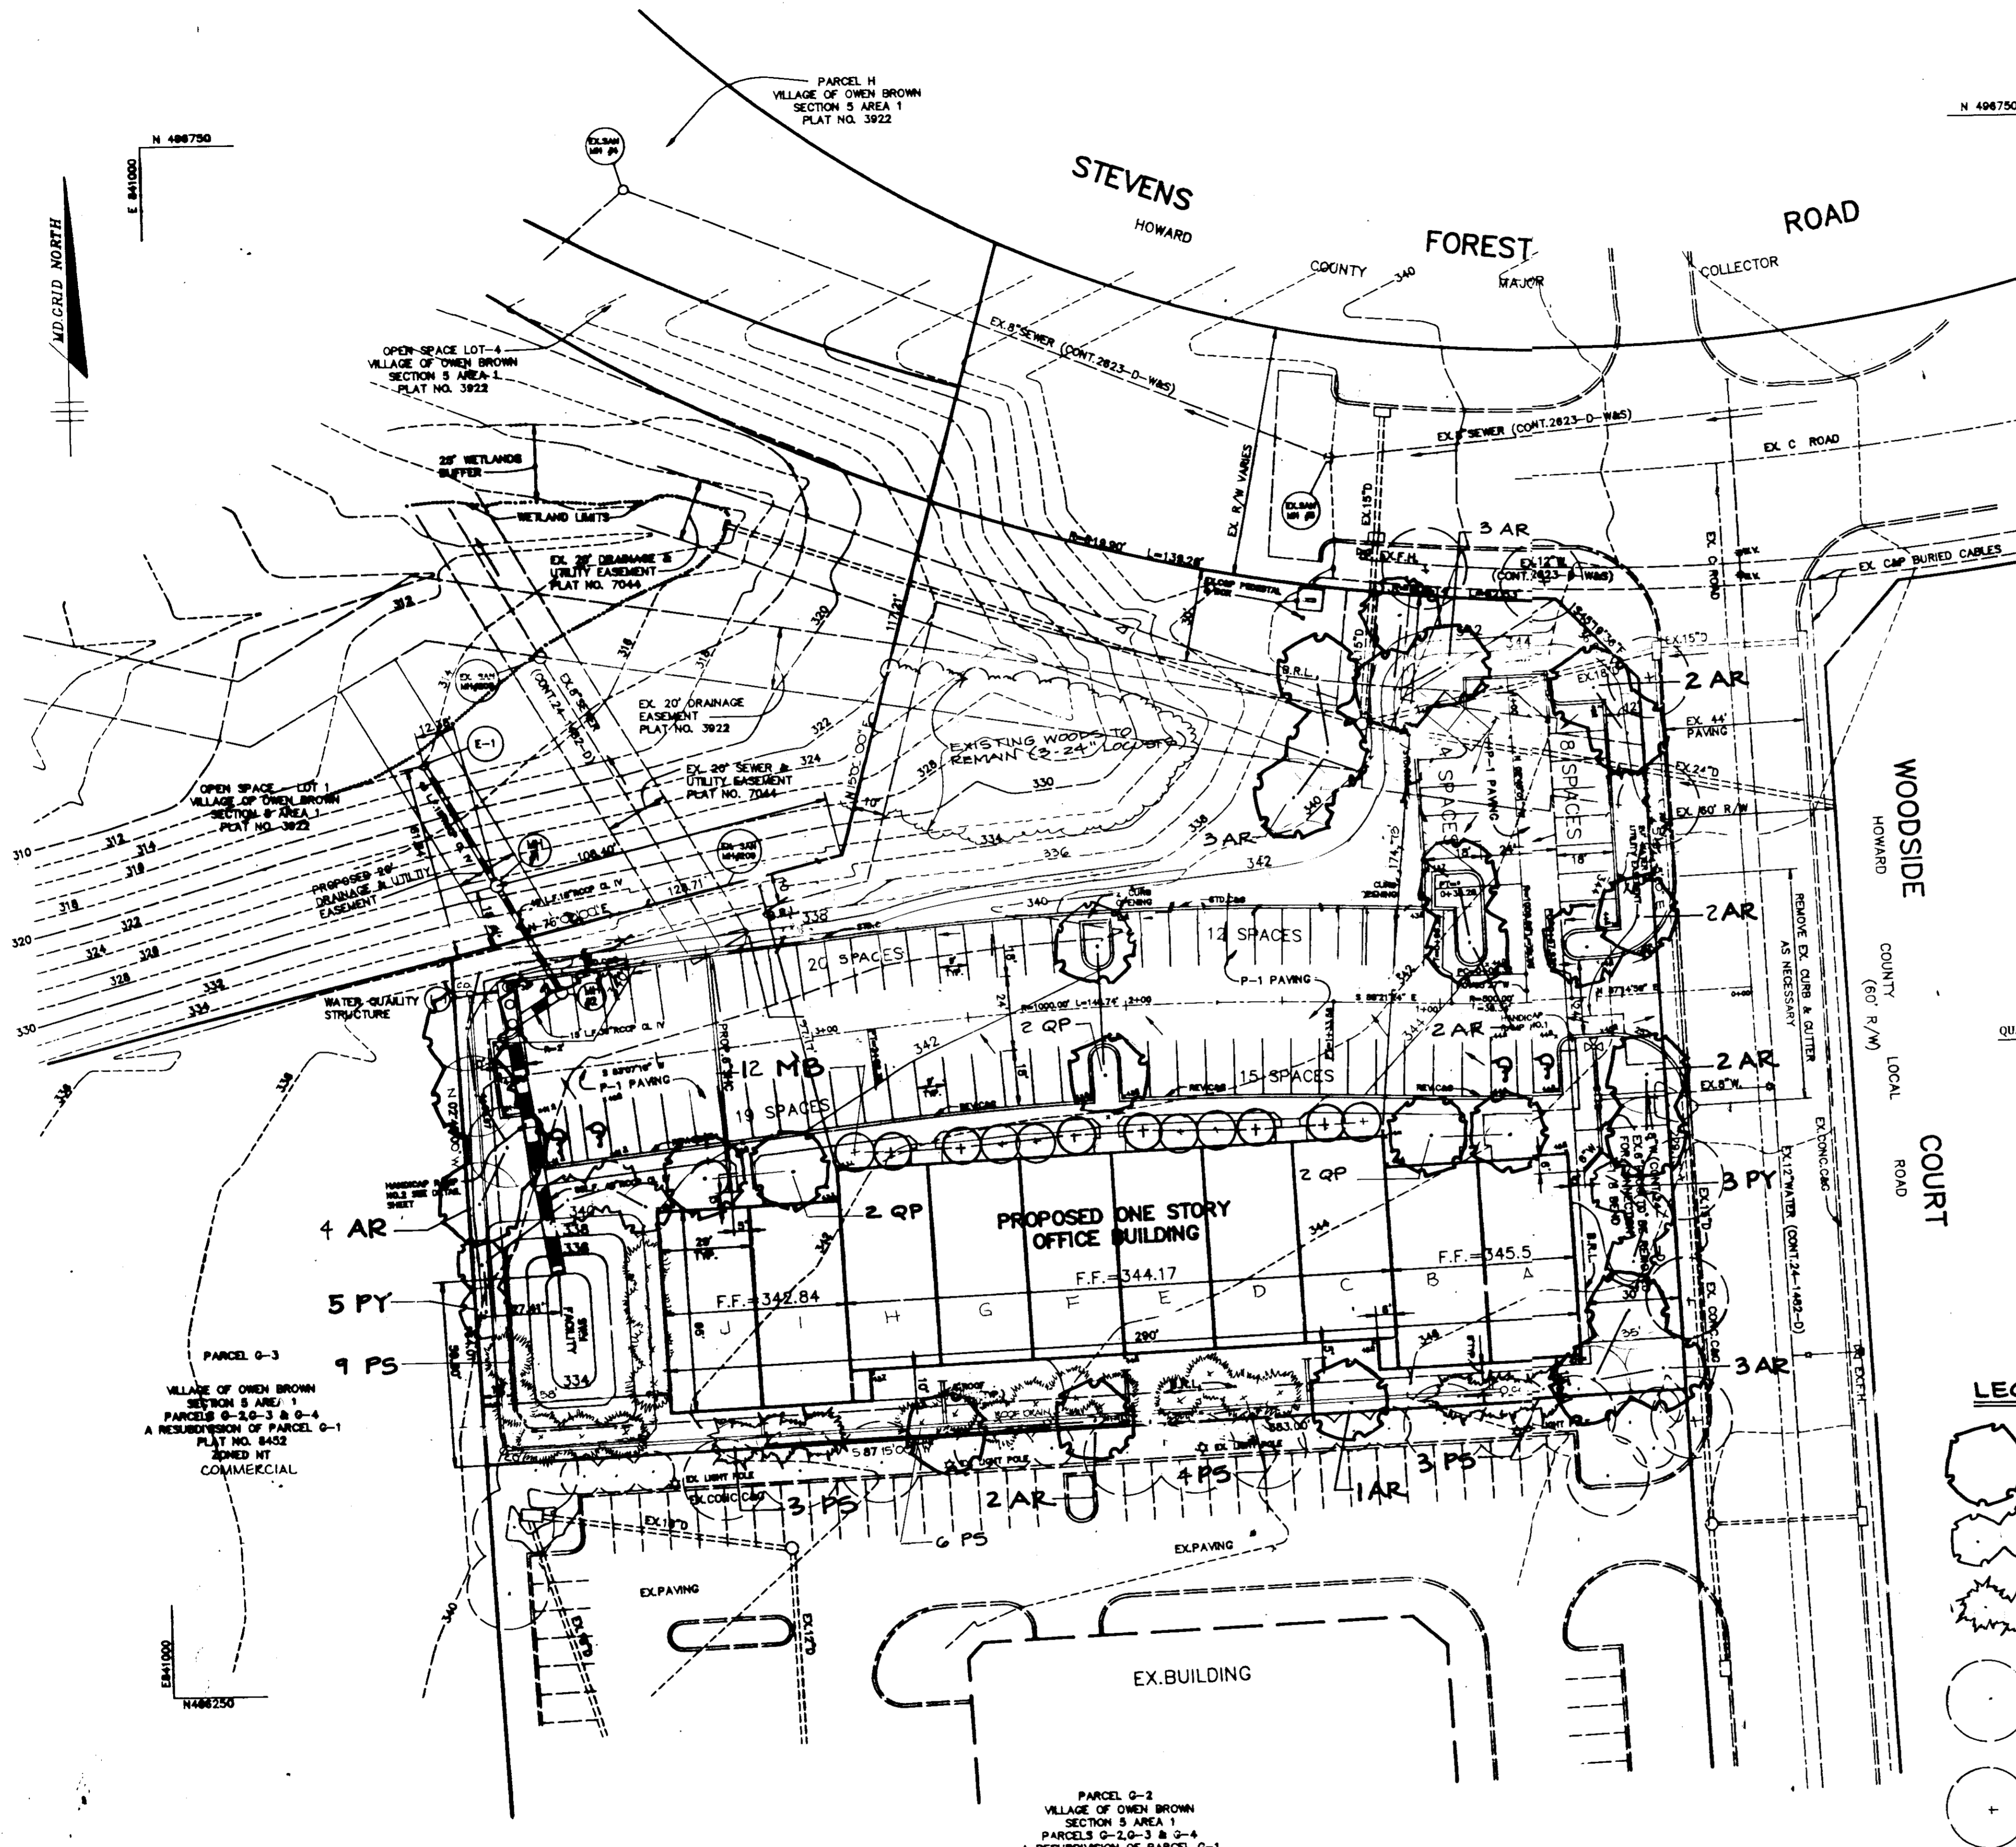

TREE PLANTING DETAIL N.T.S.

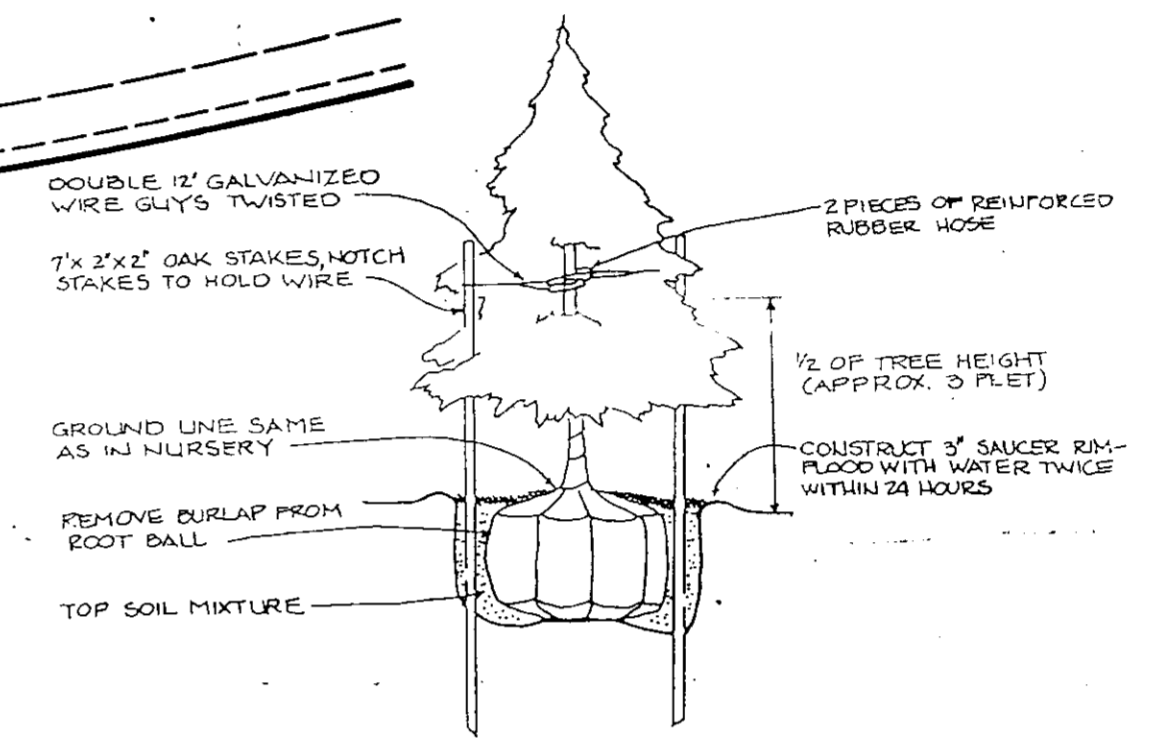

EVERGREEN PLANTING DETAIL N.T.S.

PLANT LIST

QUANTITY	KEY	NAME	SIZE	REMARKS
24	AR	ACER RUBRUM 'October Glory' October Glory Red Maple	2 1/2-3" Cal. 12-14' Ht.	B & B Full crown
12	MB	MALUS BACCATA 'Columnaris' Columnar Siberian Crabapple	2-2 1/2" Cal. 8-10' Ht.	B & B
25	PS	PINUS STROBUS White Pine	2-2 1/2" Cal. 6-8' Ht.	B & B Natural
8	PY	PRUNUS YEDOENSIS Yoshino Cherry	2-2 1/2" Cal. 8-10' Ht.	B & B
6	QP	QUERCUS PALUSTRIS Pin Oak	2 1/2-3" Cal. 12-14' Ht.	B & B Full Crown

LEGEND

- PROPOSED SHADE TREE
- PROPOSED FLOWERING TREE
- PROPOSED EVERGREEN
- EX. TREES - ADJACENT SITE
- STREET TREE PER ROAD DRAWINGS

NOTE: THIS PLAN HAS BEEN PREPARED IN ACCORDANCE WITH SECTION 10-104 OF THE HOWARD COUNTY CODE AND THE LANDSCAPE MANUAL FOR NEW TOWN ALTERNATIVE COMPLIANCE.

FINANCIAL SURETY FOR THE PROVIDED 7% LANDSCAPE TREES IN THE AMOUNT OF \$12,800.00 IS PART OF THE GRADING AGREEMENT.

APPROVED  
PLANNING DEPARTMENT  
of HOWARD COUNTY  
April 11, 1990

10/14/94	3	REV. PLANT LIST & PLAN
DATE	NO.	REVISION
<b>AS BUILT CERTIFICATE</b>		
ARTHUR E. MUEGGE #8707		DATE
APPROVED: FOR PUBLIC WATER AND PUBLIC SEWERAGE SYSTEMS, HOWARD COUNTY HEALTH DEPARTMENT.		
<i>Joseph G. Miller</i>	5-23-93	DATE
APPROVED: HOWARD COUNTY DEPARTMENT OF PLANNING AND ZONING.		
<i>Joseph G. Miller</i>	10/13/93	DATE
<i>Jim Johnson</i>	10/13/93	DATE
APPROVED: FOR PUBLIC WATER, PUBLIC SEWERAGE, STORM DRAINAGE SYSTEMS AND PUBLIC ROADS.		
HOWARD COUNTY DEPARTMENT OF PUBLIC WORKS		
<i>Camryn Johnson</i>	9-21-93	DATE
<i>Paul J. Johnson</i>	9/20/93	DATE
4/15/94	2	ADDED DUMPSTER PAD, REMOVED 2 PRE-EXISTING TREES
4/30/93	1	REV. PLANT LIST
DATE	NO.	REVISION
OWNER/DEVELOPER		
JEROME WILLIAMS 2005 F COLUMBIA 100 PARKWAY COLUMBIA, MD 21045		
PROJECT: HILLCROFT PROFESSIONAL CENTER (AN OFFICE BUILDING)		
AREA: VILLAGE OF OWEN BROWN SEC. 5 AREA 1 PARCEL 6-4-A REMOVAL OF PARCEL E-1 PLAT NO. 8452 6th ELECTION DISTRICT HOWARD COUNTY, MARYLAND		
TITLE: <b>LANDSCAPE PLAN</b>		
RIEMER MUEGGE & ASSOCIATES, INC. A Land Planning, Engineering and Consulting Firm 3105 North Ridge Road Ellicott City, Maryland 21043 301-461-2600 FAX: 301-750-3176		
3-6-93		DATE
DESIGNED BY: Z.L.K.		
DRAWN BY: Z.L.K.		
PROJECT NO: 66402		
DATE: SEPTEMBER 8, 1993		
SCALE: AS SHOWN		
DRAWING NO. G-100		

PARCEL G-2  
VILLAGE OF OWEN BROWN  
SECTION 5 AREA 1  
PARCELS G-2, G-3 & G-4  
A RESUBDIVISION OF PARCEL G-1  
PLAT NO. 8452  
ZONED NT  
COMMERCIAL

PLAN  
SCALE: 1"=30'