
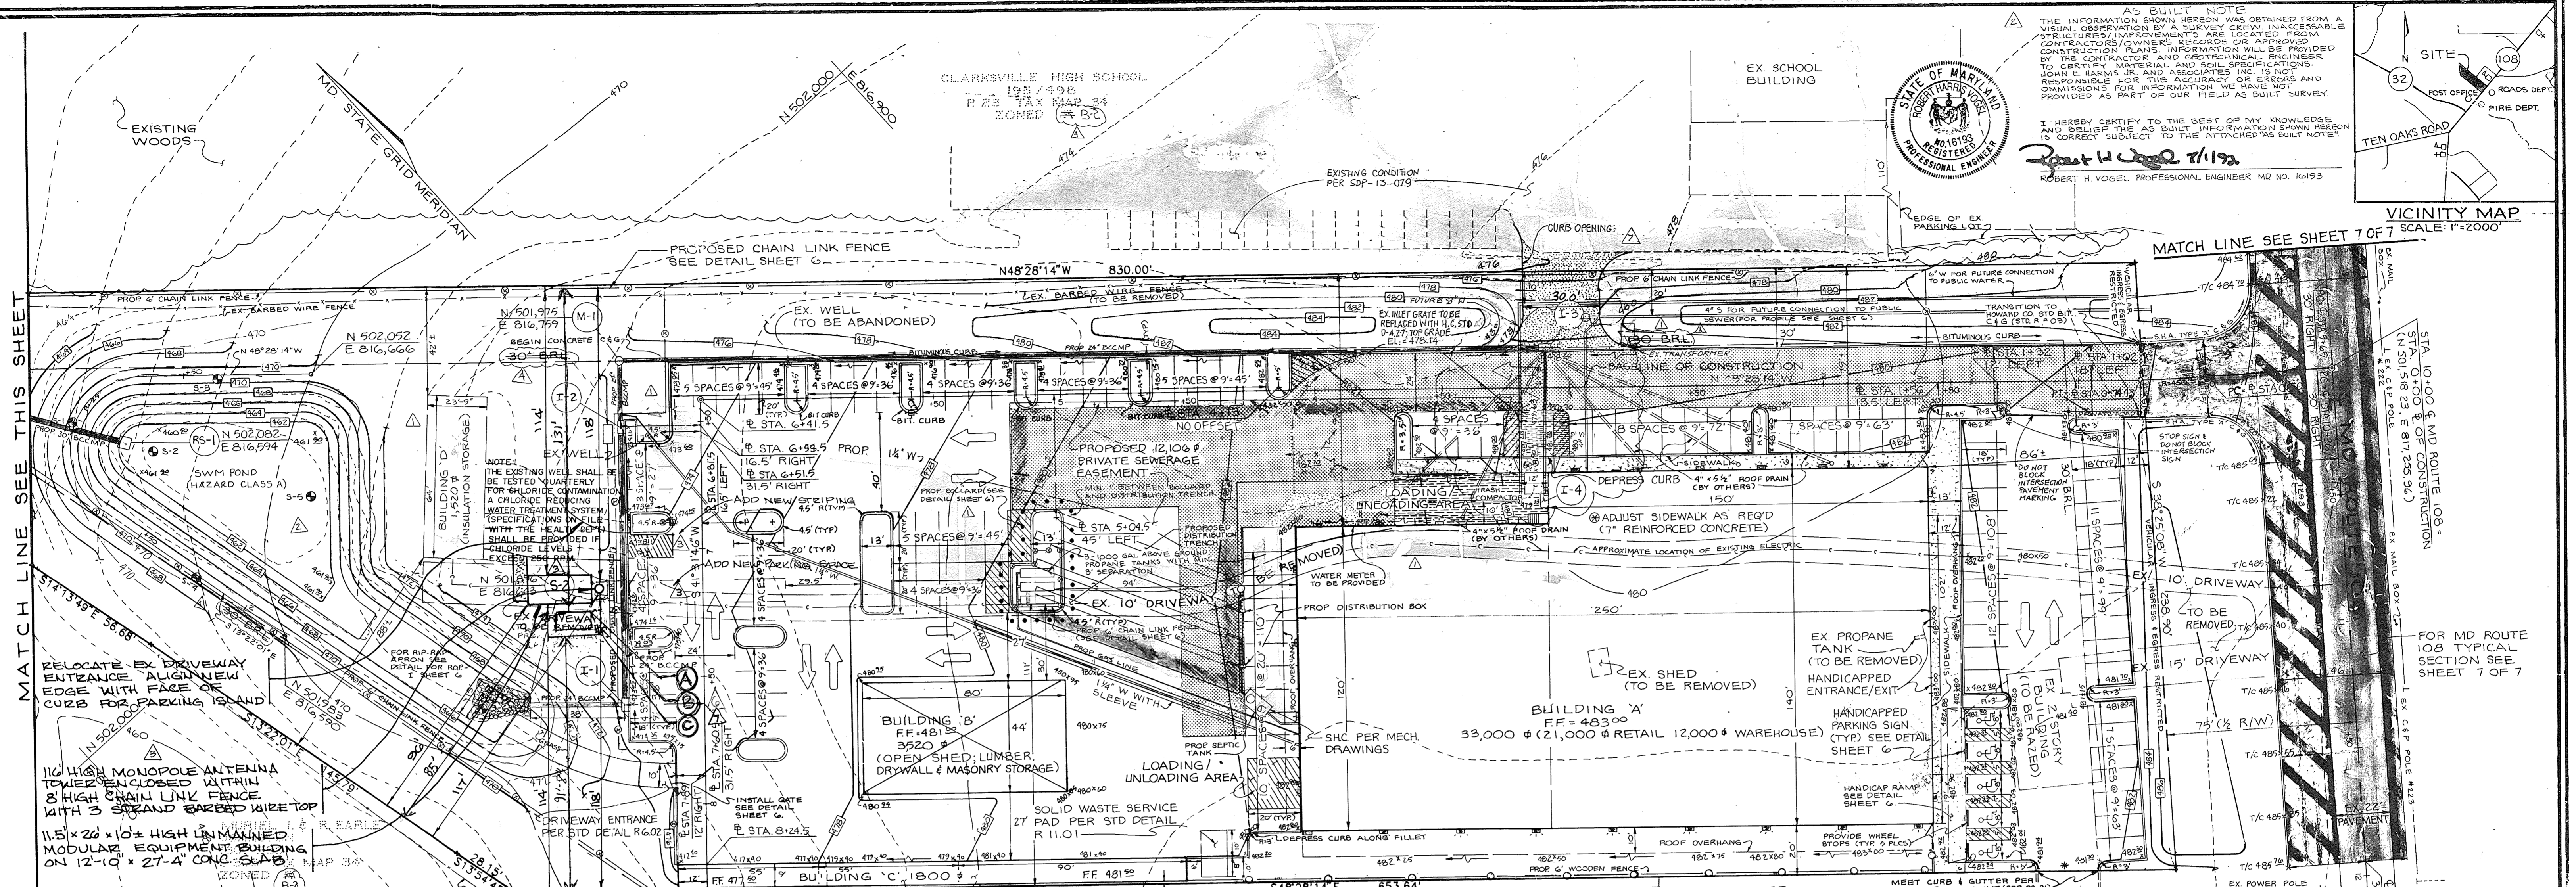


**AS BUILT NOTE**  
 THE INFORMATION SHOWN HEREON WAS OBTAINED FROM A VISUAL OBSERVATION BY A SURVEY CREW IN ACCESSIBLE STRUCTURES/IMPROVEMENTS ARE LOCATED FROM CONSTRUCTION PLANS. INFORMATION WILL BE PROVIDED TO THE CONTRACTOR AND GEOTECHNICAL ENGINEER TO CERTIFY MATERIAL AND SOIL SPECIFICATIONS. JOHN E. HARMS, JR. AND ASSOCIATES, INC. IS NOT RESPONSIBLE FOR THE ACCURACY OF ERRORS AND OMISSIONS FOR INFORMATION WE HAVE NOT PROVIDED AS PART OF OUR FIELD AS BUILT SURVEY.

I HEREBY CERTIFY TO THE BEST OF MY KNOWLEDGE AND BELIEF THAT THE INFORMATION SHOWN HEREON IS CORRECT SUBJECT TO THE ATTACHED "AS BUILT NOTE".

*Robert H. Vogel 7/1/92*  
 ROBERT H. VOGEL, PROFESSIONAL ENGINEER MD NO. 16193

STATE OF MARYLAND  
 REGISTERED PROFESSIONAL ENGINEER  
 NO. 16193

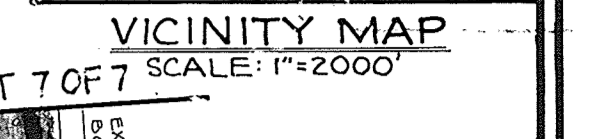

**REVISIONS BY:**

- A NEW 12x17 CONCRETE EQUIPMENT PAD WITH CANOPY
- B NEW 25'3" x 20'8" FENCED COMPOUND
- C NEW ELECTRICAL SERVICE FRAME

REVISIONS BY: *Robert J. Laska*, ARCHITECT


REVISIONS BY: *Marc A. Marzullo*, PE, COMMUNICATION SERVICES, INC.

- GENERAL NOTES**
- A variance has been granted by the Maryland Department of the Environment to allow buildings within 10 feet of the sewage disposal system to be constructed.
  - Maximum sewage design flow allocation is 1,000 gallons per day.
  - Water and sewer facilities are private.
  - Storm drainage system and stormwater management facility are private.
  - Road network and parking lot outside Maryland Route 108 right of way are private. Site entrance within Maryland Route 108 right of way is a public way.
  - All work shall be performed in accordance with the Howard County Design Manual Volume IV - Standard Specifications and Details for Construction.
  - Approximate location of existing utilities are shown. The contractor shall take all necessary precautions to protect the existing utilities and maintain uninterrupted service. Any damage incurred due to contractor's operation shall be repaired immediately at the contractor's expense.
  - Contractor to notify the following utilities or agencies at least five days before starting work on these drawings: MISS UTILITY 1-800-297-7777; C & P Telephone Company 992-2366; Howard County Bureau of Utilities 992-2366; AT&T Cable Location Division 393-3553; Baltimore Gas and Electric Company 685-0123; State Highway Administration 531-5533; Howard County Construction/Inspection Survey Division 992-2417/2418.
  - The property boundary shown hereon was taken from subdivision plat number F-90-199 recorded.
  - Minimum setbacks shown are in accordance with those established on subdivision plat number F-90-199.
  - Estimates of earthwork quantities are provided solely for the purpose of calculating permit fees. Since final earthwork quantities are based on many conditions over which Harms and Associates has no control including accuracy of standard methods of calculations, variability of soils, allowable survey and construction tolerances, and compaction ratios, Harms and Associates does not guarantee the accuracy of these estimates.
  - Existing topography was provided from a field survey provided by JOHN E. HARMS, JR. and Associates, Inc. (DATE MAY 1990).
  - Corrugated metal pipe sections will be joined with a single or two piece corrugated band with a watertight neoprene gasket. Displaced band connectors will not be permitted.
  - ALL CURB TO BE HOWARD COUNTY STANDARD CORNER CURB AND GUTTER UNLESS OTHERWISE NOTED.

**SHEET INDEX**

SHEET	DESCRIPTION
1	SITE DEVELOPMENT PLAN REV
2	DRAINAGE AREA MAP AND STORM DRAIN PROFILES
3	STORMWATER MANAGEMENT SPECIFICATIONS AND DETAILS
4	SEDIMENT AND EROSION CONTROL PLAN REV
5	LANDSCAPING PLAN
6	MISCELLANEOUS DETAILS
7	PRIVATE SEWER PROFILES AND MISCELLANEOUS DETAILS

- GENERAL NOTES (CONT)**
- WP-91-29, A WAIVER PETITION TO ALLOW ACCESS ONTO A MINOR ARTERIAL HIGHWAY FOR COMMERCIAL ZONED PROPERTY WAS GRANTED 10-22-90.
  - A FIELD OBSERVATION WAS CONDUCTED TO VERIFY THAT NO WETLANDS ARE ON SITE.
  - THE SOIL BORING PROFILES AND GEOTECHNICAL INFORMATION WAS TAKEN FROM A REPORT PROVIDED BY HERBST & ASSOCIATES.
  - ALL EXTERIOR LIGHTING FIXTURES SHALL BE DIRECTED/REFLECTED AWAY FROM ALL ADJACENT PUBLIC ROADS AND RESIDENTIAL ZONING DISTRICTS.
- SITE ANALYSIS**
- A. AREA OF PARCEL: 4.486 AC 195,411 sq
  - B. PRESENT ZONING: B-2
  - C. PROPOSED USE OF STRUCTURE: BLDG. A - HARDWARE RETAIL, WAREHOUSE; BLDG. B & C - STORAGE
  - D. FLOOR SPACE: BLDG. A: 21,000 sq RETAIL, 12,000 sq WAREHOUSE; BLDG. B: 3,200 sq (OPEN STORAGE AREA); BLDG. C: 1,800 sq (OPEN STORAGE AREA); BLDG. D: 1,520 sq (WAREHOUSE)
  - E. MAX. NUMBER OF EMPLOYEES: 15
  - F. NUMBER OF PARKING SPACES REQUIRED: 113 (5 HANDICAPPED) 1 PER 200 sq RETAIL (105); 1 PER 2 EMPLOYEES WAREHOUSE (8)
  - G. NUMBER OF PARKING SPACES PROVIDED: 113 (5 HANDICAPPED)
  - H. OPEN SPACE AREA TO REMAIN ON SITE: 1,180 sq, 26.3% OF NET AREA
  - I. BUILDING COVERAGE OF SITE: 3,200 sq, 71.3% OF GROSS AREA (SEE BELOW)
  - J. AREA OF LANDSCAPED ISLAND: 4,265 sq, 94.7% OF PARKING AREA
  - K. AREA OF PARKING LOT: 78,029 sq
  - L. AREA OF LANDSCAPED ISLAND: 4,265 sq, 20.5% OF GROSS AREA (SEE BELOW)

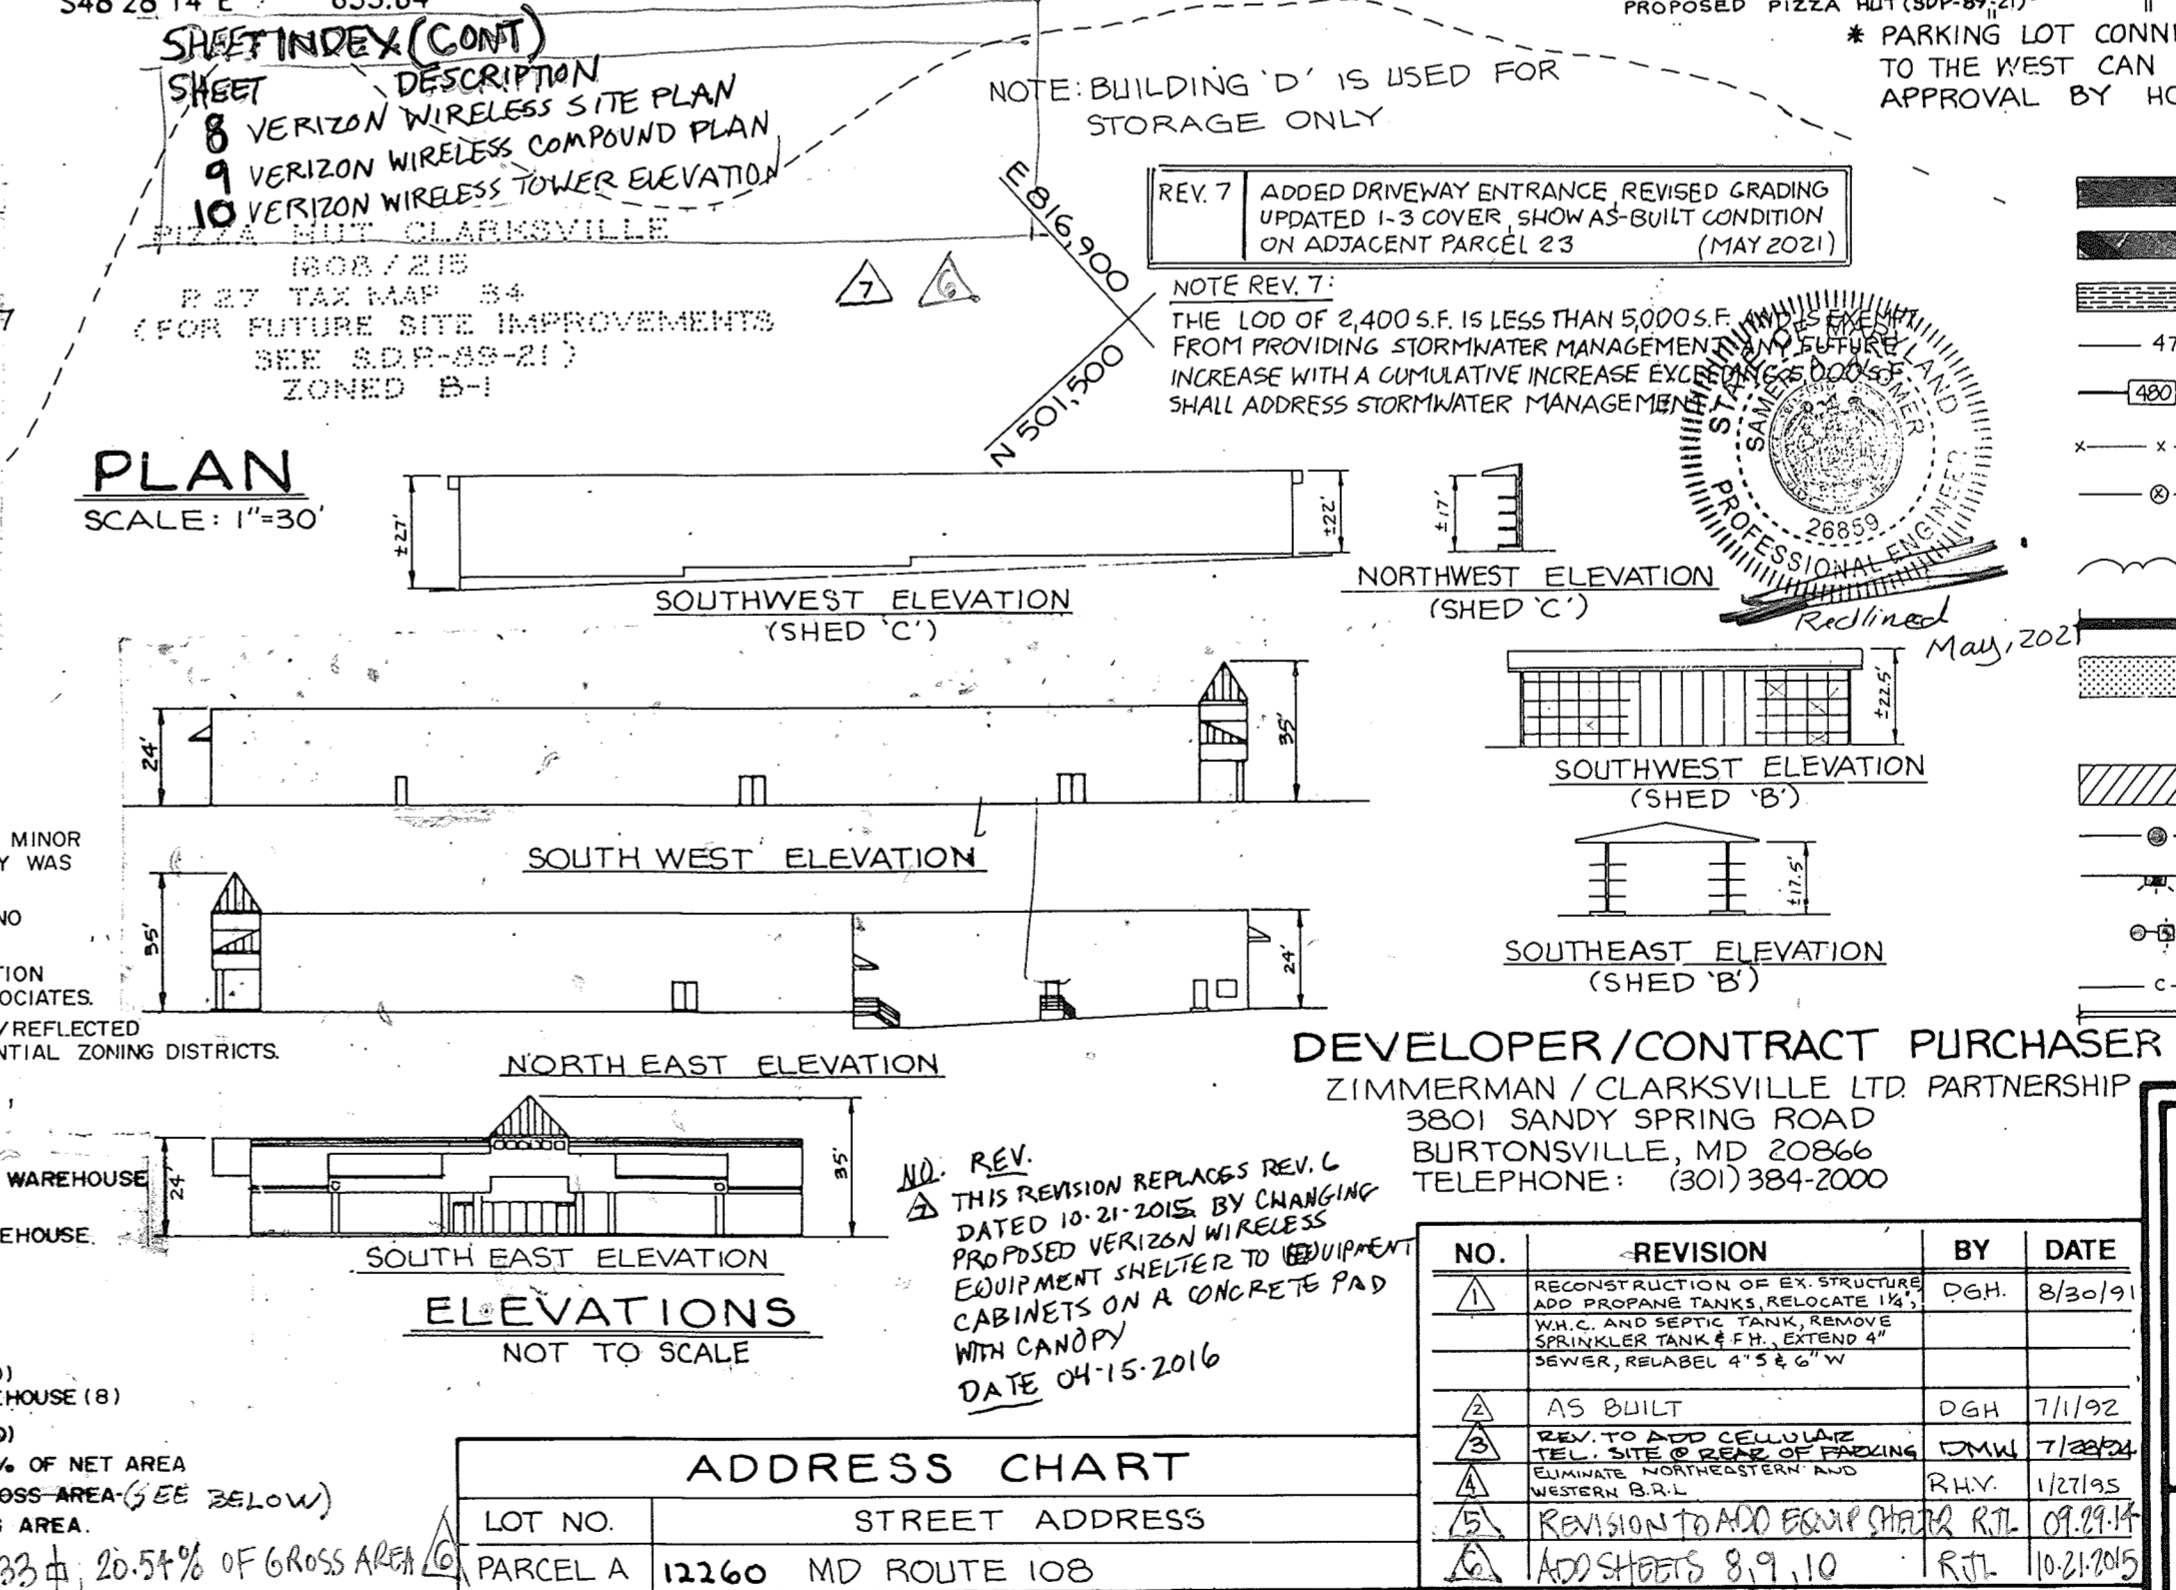

**LEGEND**

- SURFACE OVERLAY
- FULL DEPTH PAVING
- 8" REINFORCED CONCRETE
- EXISTING CONTOUR
- PROPOSED CONTOUR
- EXISTING FENCE
- PROPOSED 6' CHAIN LINK FENCE
- EXISTING TREE LINE
- PROPOSED STORM DRAIN
- P-3 PAVING SECTION, SEE DETAIL SHEET G (ALL OTHER PAVING OUTSIDE R/W USE P-2 PAVING SECTION)
- PARKING LOT STRIPING (NO PARKING AREA)
- PROPOSED 6' WOODEN FENCE
- PROPOSED LIGHTING FIXTURE
- PROPOSED LIGHTING FIXTURE
- APPROXIMATE LOCATION OF EXISTING UNDERGROUND ELECTRIC
- PROPOSED WATER LINE

**DEVELOPER/CONTRACT PURCHASER**  
 ZIMMERMAN / CLARKSVILLE LTD PARTNERSHIP  
 3801 SANDY SPRING ROAD  
 BURTNSVILLE, MD 20866  
 TELEPHONE: (301) 384-2000

**SITE DEVELOPMENT PLAN**  
**ZIMMERMAN AND SONS**  
 HOME IMPROVEMENT CENTER + TRUCK CENTER  
 REFERENCE F-90-199 AND WP-91-29  
 TAX MAP 34 PARCEL 358 LOT 3  
 5TH ELECTION DISTRICT HOWARD COUNTY, MARYLAND

**JOHN E. HARMS, JR. AND ASSOCIATES, INC.**  
 CONSULTING ENGINEERS - PLANNERS - SURVEYORS  
 8808 CENTRE PARK DRIVE COLUMBIA, MARYLAND 21045 TELEPHONE (301) 740-8200

**ENGINEER'S CERTIFICATE**

"I CERTIFY THAT THIS PLAN FOR POND CONSTRUCTION, EROSION AND SEDIMENT CONTROL REPRESENTS A PRACTICAL AND WORKABLE PLAN BASED ON MY PERSONAL KNOWLEDGE OF THE SITE CONDITIONS. THIS PLAN WAS PREPARED IN ACCORDANCE WITH THE REQUIREMENTS OF THE HOWARD SOIL CONSERVATION DISTRICT. I HAVE NOTIFIED THE DEVELOPER THAT HE MUST PROVIDE THE HOWARD SOIL CONSERVATION DISTRICT WITH AN "AS-BUILT" PLAN OF THE POND WITHIN 30 DAYS OF COMPLETION."

*Robert H. Vogel* 4/15/91  
 SIGNATURE OF ENGINEER DATE

**DEVELOPER'S CERTIFICATE**

"I CERTIFY THAT ALL DEVELOPMENT AND/OR CONSTRUCTION WILL BE DONE ACCORDING TO THESE PLANS, AND THAT ANY RESPONSIBLE PERSONNEL INVOLVED IN THE CONSTRUCTION PROJECT WILL HAVE A CERTIFICATE OF ATTENDANCE AT A DEPARTMENT OF ENVIRONMENT APPROVED TRAINING PROGRAM FOR THE CONTROL OF SEDIMENT AND EROSION BEFORE BEGINNING THE PROJECT. I WILL PROVIDE THE HOWARD SOIL CONSERVATION DISTRICT WITH AN "AS-BUILT" PLAN OF THE POND WITHIN 30 DAYS OF COMPLETION. I ALSO AUTHORIZE PERIODIC ON-SITE INSPECTION BY THE HOWARD SOIL CONSERVATION DISTRICT."

*Robert J. Laska* 5/1/91  
 SIGNATURE OF DEVELOPER DATE

**APPROVED: HOWARD COUNTY DEPARTMENT OF PLANNING AND ZONING**

*James B. Smith* 4/4/91  
 DIRECTOR DATE

**APPROVED: FOR PRIVATE WATER AND PRIVATE SEWERAGE SYSTEMS**  
 HOWARD COUNTY HEALTH DEPARTMENT

*James M. Boyd* 5/10/91  
 COUNTY HEALTH OFFICER DATE

**APPROVED: FOR STORM DRAINAGE SYSTEMS AND PUBLIC ROADS.**  
 HOWARD COUNTY DEPARTMENT OF PUBLIC WORKS

*James M. Boyd* 5/23/91  
 DIRECTOR DATE

**APPROVED: CHIEF, BUREAU OF ENGINEERING**

*William B. Cole* 5-23-91  
 CHIEF, BUREAU OF ENGINEERING DATE

NO.	REVISION	BY	DATE
1	RECONSTRUCTION OF EX. STRUCTURE AND PROPANE TANKS, RELocate 12" W.P. AND 4" ELECTRIC SERVICE TO SPRINKLER TANK #1, EXTEND 4" SERVICE TO TANK #2, 4" x 6" W	DGH	8/30/91
2	AS BUILT	DGH	7/1/92
3	REV. TO CORRECT CELLULOSIC CELLULOSE SITE OF RECORD DRAWING	RLW	7/28/92
4	REV. TO CORRECT CELLULOSIC CELLULOSE SITE OF RECORD DRAWING	RLW	10/21/92
5	REVISION TO A20 BSM CHINA RTR	RLW	09/24/94
6	ADD SHEETS 8, 9, 10	RLW	10/21/95

SUBMISSION NAME	SECTION/AREA	PARCEL NUMBER
ZIMMERMAN AND SONS	N/A	PARCEL A

PLAT NO.	BLOCK NO.	ZONE	TAX/ZONE	ELECT. DIST.	CENSUS TR.
9893	6	B-2	34	5th	6051

PRIVATE	PRIVATE
WATER CODE	SEWER CODE


DESIGNED BY: I.A.B.  
 DRAWN BY: D.G.H.  
 CHECKED BY: R.H.V.  
 DATE: 6/20/90  
 SCALE: AS SHOWN  
 W.O. NO.: 45-90-004A

10 SHEET OF 17





STRUCTURE		SCHEDULE		REMARKS
NO.	TYPE	TOP ELEV.	INV. IN.	
I-1	A-5 INLET	474.25**	466.50	S.D. 4.01 *
I-2	A-5 INLET	473.85**	468.00	S.D. 4.01 *
I-3	S COMBINATION INLET	478.14 *	474.60	S.D. 4.27 *
I-4	NEENAH R 4990BX	479.13	N/A	476.00 OR EQUIVALENT
S-1	27 B.C.C.M.P. END SECTION	N/A	466.00	N/A S.D. 5.61 *
S-2	TYPE 'C' ENDWALL (24")	N/A	465.00	N/A S.D. 5.21 *
RS-1	STORMWATER MANAGEMENT RELEASE STRUCTURE	469.35	N/A	460.50 SEE DETAIL, SHEET 3
M-1	STD. PRECAST MANHOLE	477.00	468.50	468.40 G 5.11 *

\* HOWARD COUNTY STANDARD DETAIL.  
\*\* TOP OF CURB ELEVATION

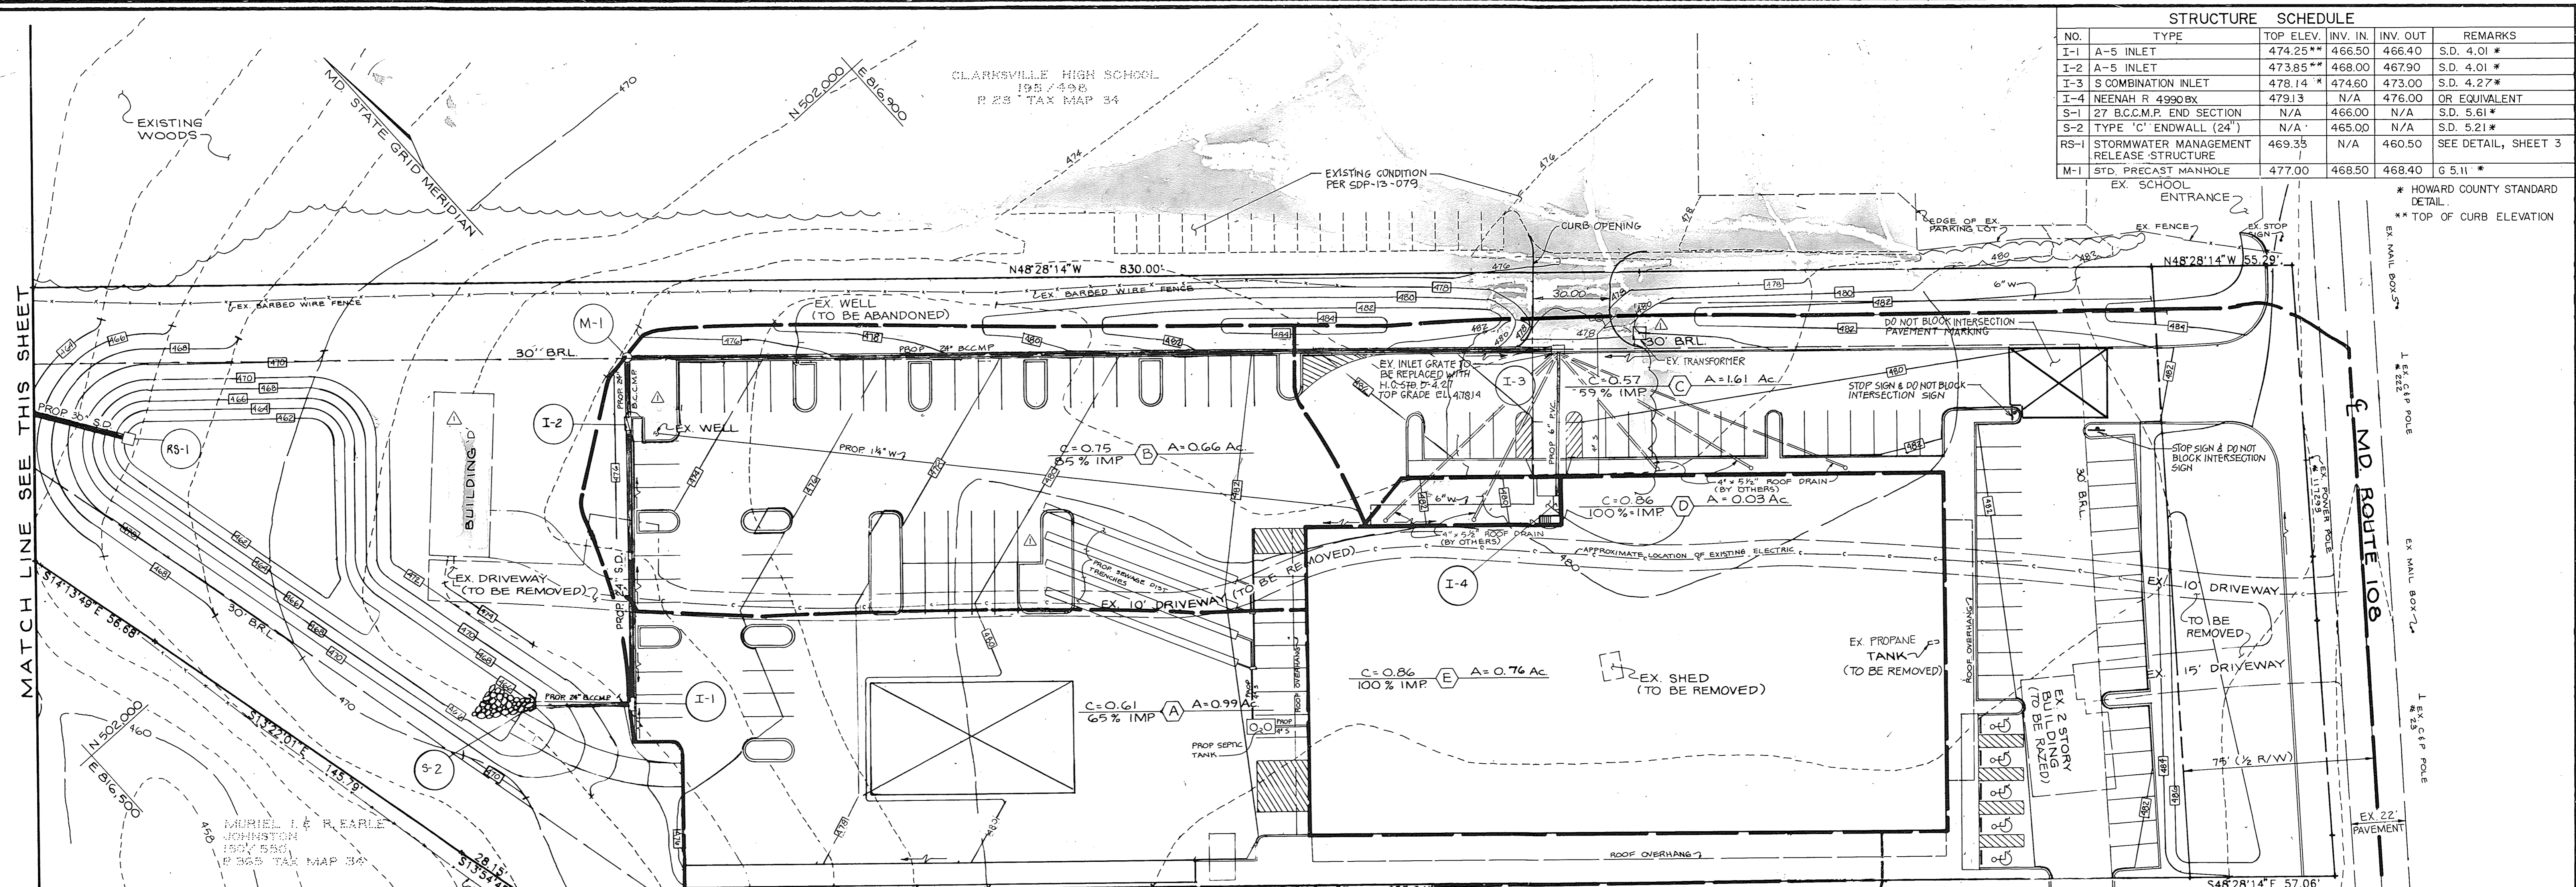

SEE OFF-SITE DRAINAGE AREA


**DRAINAGE AREA MAP**  
SCALE: 1" = 30'

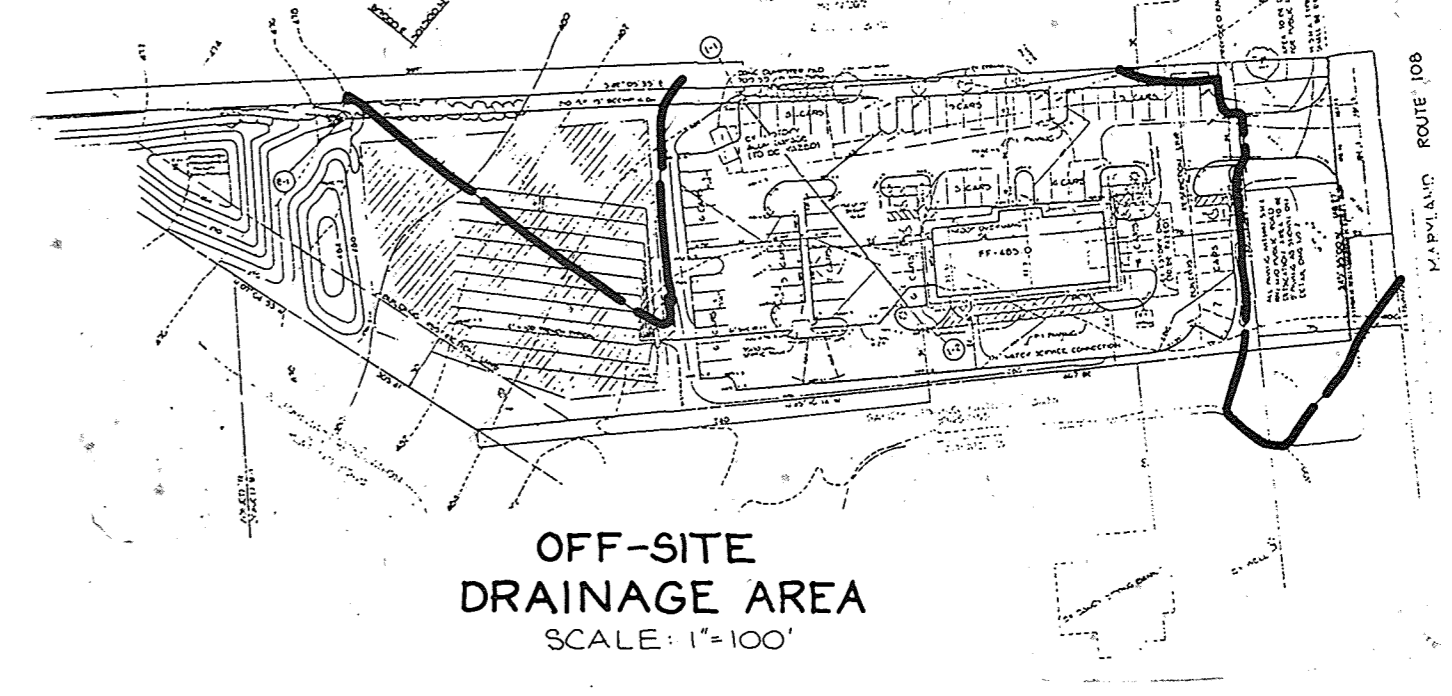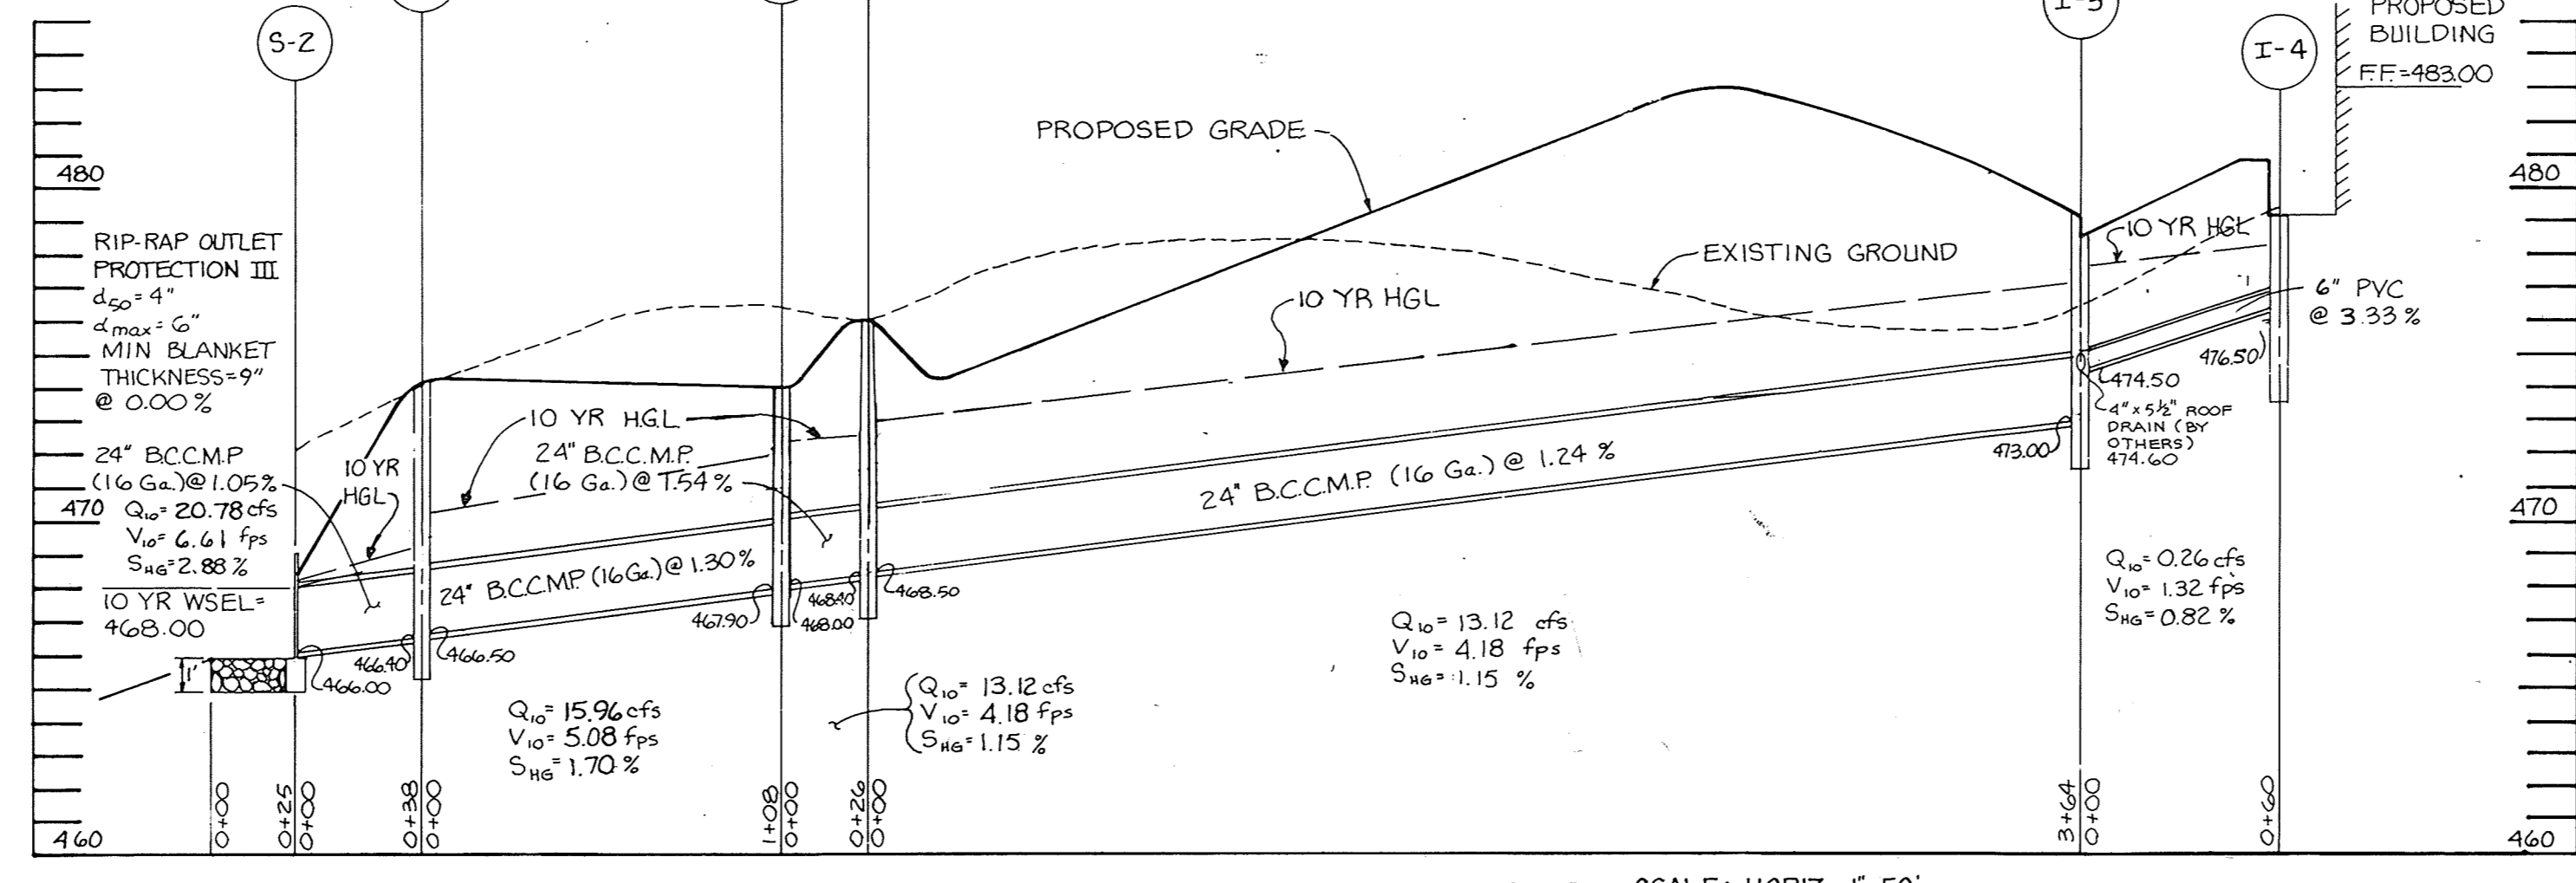

DEVELOPER/CONTRACT PURCHASER  
ZIMMERMAN CLARKSVILLE LTD. PARTNERSHIP  
3801 SANDY SPRING ROAD  
BURTONSVILLE, MD, 20866  
TELEPHONE: (301) 384-2000

**DRAINAGE AREA MAP & STORM DRAIN PROFILE**  
**ZIMMERMAN AND SONS**  
HOME IMPROVEMENT CENTER + TRUCK WASH COMPOUND  
REFERENCE F-90-199 AND WP-91-29  
TAX MAP 34 PARCEL 358 LOT 3  
5TH ELECTION DISTRICT HOWARD COUNTY, MARYLAND

**JOHN E. HARMS, JR. AND ASSOCIATES, INC.**  
CONSULTING ENGINEERS - PLANNERS - SURVEYORS  
8808 CENTRE PARK DRIVE SUITE 110  
COLUMBIA, MARYLAND 21045 TELEPHONE (301) 740-5800

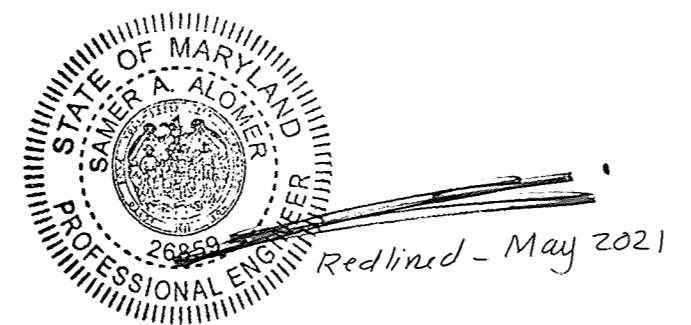

NO.	REVISION	BY	DATE
1	RECONSTRUCTION OF EX. STRUCTURE REMOVE P.U. EXTEND AT SEWER	DGH	07/09/91
2	ADD COMMENTS 8.9.10	RAL	10/21/95
3	THIS REVISION REQUIRES REV. DATE 10-21-95. ALL APPROVED PROPOSED VENTON WELLS EQUIPMENT TO BE 24" B.C.C.M.P. CONCRETE WITH NICKEL CAST IRON	MAAM	04/15/96

APPROVED: HOWARD COUNTY DEPARTMENT OF PLANNING AND ZONING  
*James D. Butler* 6/4/91  
DIRECTOR DATE  
*James D. Butler* 6/1/91  
CHIEF, DIVISION OF COMMUNITY PLANNING AND LAND DEVELOPMENT DATE  
APPROVED: FOR STORM DRAINAGE SYSTEMS AND PUBLIC ROADS.  
HOWARD COUNTY DEPARTMENT OF PUBLIC WORKS  
*James D. Butler* 5/23/91  
DIRECTOR DATE  
*William E. Reed* 5/23/91  
CHIEF, BUREAU OF ENGINEERING DATE

APPROVED: FOR PRIVATE WATER AND PRIVATE SEWERAGE SYSTEMS  
HOWARD COUNTY HEALTH DEPARTMENT  
*James M. Boyd* 5/10/91  
COUNTY HEALTH OFFICER DATE

DESIGNED BY: I.A.B.  
DRAWN BY: D.G.H./J.U.T.  
CHECKED BY: R.H.V.  
DATE: 6/25/90  
SCALE: AS SHOWN  
W.O. NO.: 45-90-004A  
2 SHEET OF 10



STORMWATER MANAGEMENT POND CONSTRUCTION SPECIFICATIONS

I. SITE PREPARATION

AREAS DESIGNATED FOR BORROW AREAS, EMBANKMENT, AND STRUCTURAL WORKS SHALL BE CLEARED, GRUBBED AND STRIPPED TOPSOIL, TREES, VEGETATION, ROOTS AND OTHER OBJECTIONABLE MATERIAL SHALL BE REMOVED. CHANNEL BANKS AND SHARP BREAKS SHALL BE SLOPED TO NO STEEPER THAN 1:1.

AREAS TO BE COVERED BY THE POND OR RESERVOIR SHALL BE CLEARED OF ALL TREES, BRUSH, LOGS, FENCES, RUBBISH AND OTHER OBJECTIONABLE MATERIALS UNLESS OTHERWISE DESIGNATED ON THE PLANS. TREES, BRUSH AND STUMPS SHALL BE CUT APPROXIMATELY LEVEL WITH THE GROUND SURFACE.

ALL CLEARED AND GRUBBED MATERIAL SHALL BE DISPOSED OF OUTSIDE AND BELOW THE LIMITS OF THE DAM AND RESERVOIR AS DIRECTED BY THE OWNER OR HIS REPRESENTATIVE. WHEN SPECIFIED, A SUFFICIENT QUANTITY OF TOP SOIL WILL BE STOCKPILED IN A SUITABLE LOCATION FOR USE ON THE EMBANKMENT AND OTHER DESIGNATED AREAS.

II. EARTH FILL

**MATERIAL**

THE FILL MATERIAL SHALL BE TAKEN FROM APPROVED DESIGNATED BORROW AREA OR AREAS. IT SHALL BE FREE OF ROOTS, STUMPS, RUBBISH, OVERSIZE STONES, FROZEN OR OTHER OBJECTIONABLE MATERIALS. THE EMBANKMENT SHALL BE CONSTRUCTED TO AN ELEVATION WHICH PROVIDES FOR ANTICIPATED SETTLEMENT TO THE DESIGN ELEVATION. THE FILL HEIGHT ALONG THE LENGTH OF THE EMBANKMENT SHALL BE INCREASED ABOVE THE DESIGN ELEVATION (INCLUDING FREEBOARD) AS SHOWN ON THE PLANS.

**PLACEMENT**

AREAS ON WHICH FILL IS TO BE PLACED SHALL BE SCARIFIED PRIOR TO PLACEMENT OF FILL. FILL MATERIALS SHALL BE PLACED IN 8-INCH MAXIMUM THICKNESS (BEFORE COMPACTION) LAYERS CONTINUOUSLY OVER THE ENTIRE LENGTH OF THE FILL. THE MOST POROUS BORROW MATERIAL SHALL BE PLACED IN THE DOWNSTREAM PORTIONS OF THE EMBANKMENT.

**COMPACTION**

THE MOVEMENT OF THE HAULING AND SPREADING EQUIPMENT OVER THE FILL SHALL BE CONTROLLED SO THAT THE ENTIRE SURFACE OF EACH LIFT SHALL BE TRAVERSED BY NOT LESS THAN ONE TREAD TRACK OF THE EQUIPMENT. COMPACTION SHALL BE ACHIEVED BY A MINIMUM OF FOUR COMPLETE PASSES OF A SHEEPSFOOT, RUBBER TIRE OR VIBRATORY ROLLER. FILL MATERIAL SHALL CONTAIN SUFFICIENT MOISTURE SUCH THAT THE REQUIRED DEGREE OF COMPACTION CAN BE OBTAINED WITH THE EQUIPMENT USED.

WHERE A MINIMUM REQUIRED DENSITY IS SPECIFIED, EACH LAYER OF FILL SHALL BE COMPACTED AS NECESSARY TO OBTAIN THAT DENSITY AND IS TO BE CERTIFIED BY THE ENGINEER.

**CUTOFF TRENCH**

WHERE SPECIFIED, A CUT-OFF TRENCH SHALL BE EXCAVATED ALONG OR PARALLEL TO THE CENTERLINE OF THE EMBANKMENT AS SHOWN ON THE PLANS. THE BOTTOM WIDTH OF THE TRENCH SHALL BE AS SHOWN ON THE DRAWINGS, WITH THE MINIMUM WIDTH BEING FOUR FEET. THE DEPTH SHALL BE AT LEAST FOUR FEET OR AS SHOWN ON THE PLANS. THE SIDES OF THE TRENCH SHALL BE 1 TO 1 OR FLATTER. THE BACKFILL MATERIAL FOR THE CUTOFF TRENCH SHALL BE THE MOST IMPERVIOUS MATERIAL AVAILABLE AND SHALL BE COMPACTED WITH EQUIPMENT OR ROLLERS TO ASSURE MAXIMUM DENSITY AND MINIMUM PERMEABILITY.

**III. STRUCTURAL BACKFILL**

BACKFILL MATERIAL SHALL BE OF THE TYPE AND QUANTITY CONFORMING TO THAT SPECIFIED FOR THE ADJOINING FILL MATERIAL. THE FILL SHALL BE PLACED IN HORIZONTAL LAYERS NOT TO EXCEED FOUR INCHES IN THICKNESS AND COMPACTED BY HAND TAMPERS OR OTHER COMPACTION EQUIPMENT. THE MATERIAL SHALL FILL COMPLETELY ALL SPACES UNDER AND ADJACENT TO THE PIPE. AT NO TIME DURING THE BACKFILLING OPERATION SHALL DRIVEN EQUIPMENT BE ALLOWED TO OPERATE CLOSER THAN FOUR FEET, MEASURED HORIZONTALLY, TO ANY PART OF A STRUCTURE. UNDER NO CIRCUMSTANCES SHALL EQUIPMENT BE DRIVEN OVER ANY PART OF A CONCRETE STRUCTURE OR PIPE UNLESS THERE IS A COMPACTED FILL OF TWENTY-FOUR INCHES OR GREATER OVER THE STRUCTURE OR PIPE.

IV. PIPE CONDUITS

- ALL PIPES SHALL BE CIRCULAR IN CROSS SECTION.
- A. CORRUGATED METAL PIPE**
- MATERIALS** - (STEEL PIPE) - THIS PIPE AND ITS APPURTENANCES SHALL BE GALVANIZED AT FULLY BITUMINOUS COATED AND SHALL CONFORM TO THE REQUIREMENTS OF AASHTO SPECIFICATION M-180 TYPE A WITH WATER TIGHT COUPLING BANDS. ANY BITUMINOUS COATING DAMAGED OR OTHERWISE REMOVED SHALL BE REPLACED WITH COLD APPLIED BITUMINOUS COATING COMPOUND.
  - STEEL PIPES WITH POLYMERIC COATING** SHALL HAVE A MINIMUM COATING THICKNESS OF 0.01 INCH (10 MIL) ON BOTH SIDES OF THE PIPE. THE FOLLOWING COATINGS ARE COMMERCIALY AVAILABLE: NEXON, PLASTI-COTE, BLACK-LAD, AND BETH-CO-LOY. COATED CORRUGATED STEEL PIPE SHALL MEET THE REQUIREMENTS OF AASHTO M-245 AND M-246.
  - CONNECTIONS** - ALL CONNECTIONS WITH PIPES MUST BE COMPLETELY WATER TIGHT. THE DRAIN PIPE OR BARREL CONNECTION TO THE RISER SHALL BE WELDED ALL AROUND WHEN THE PIPE AND RISER ARE METAL. WATER TIGHT COUPLING BANDS OR FLANGES SHALL BE USED AT ALL JOINTS. ANTI-SEEP COLLARS SHALL BE CONNECTED TO THE PIPE IN SUCH A MANNER AS TO BE COMPLETELY WATER TIGHT. DIPLE BANDS ARE NOT CONSIDERED TO BE WATER TIGHT.
  - BEDDING** - THE PIPE SHALL BE FIRMLY AND UNIFORMLY BEDDED THROUGHOUT ITS ENTIRE LENGTH. WHERE ROCK OR SOFT, SPONGY OR OTHER UNSTABLE SOIL IS ENCOUNTERED, ALL SUCH MATERIAL SHALL BE REMOVED AND REPLACED WITH SUITABLE EARTH COMPACTED TO PROVIDE ADEQUATE SUPPORT.
  - LAYING PIPE** - THE PIPE SHALL BE SET WITH INSIDE CIRCUMFERENTIAL LAPS POINTING DOWNSTREAM AND WITH THE LONGITUDINAL LAPS AT THE SIDES.
  - BACKFILLING** SHALL CONFORM TO STRUCTURAL BACKFILL AS SHOWN ABOVE.

V. CONCRETE

A. MATERIALS

- CEMENT** - NORMAL PORTLAND CEMENT SHALL CONFORM TO THE LATEST ASTM SPECIFICATIONS C-150.
- WATER** - THE WATER USED IN CONCRETE SHALL BE CLEAN, FREE FROM OIL, ACID, ALKALI, SCALES, ORGANIC MATTER OR OTHER OBJECTIONABLE SUBSTANCES.
- SAND** - THE SAND USED IN CONCRETE SHALL BE CLEAN, HARD, STRONG AND DURABLE, AND SHALL BE WELL GRADED WITH 100 PERCENT PASSING A ONE-QUARTER INCH SIEVE. LIMESTONE SAND SHALL NOT BE USED.
- COARSE AGGREGATE** - THE COARSE AGGREGATE SHALL BE CLEAN, HARD, STRONG AND DURABLE, AND FREE FROM CLAY OR DIRT. IT SHALL BE WELL GRADED WITH A MAXIMUM SIZE OF ONE AND ONE-HALF (1-1/2) INCHES.
- REINFORCING STEEL** - THE REINFORCING STEEL SHALL BE DEFORMED BARS OF INTERMEDIATE GRADE BILLET STEEL OR RAIL STEEL CONFORMING TO ASTM SPECIFICATION A-165.

**B. DESIGN MIX** - THE CONCRETE SHALL BE MIXED IN THE FOLLOWING PROPORTIONS, MEASURED BY WEIGHT. THE WATER-CEMENT RATIO SHALL BE 5-1/2 TO 6 U.S. GALLONS OF WATER PER 94 POUND BAG OF CEMENT. THE PROPORTION OF MATERIALS FOR THE TRIAL MIX SHALL BE 1:2.3-1/2. THE COMBINATION OF AGGREGATES MAY BE ADJUSTED TO PRODUCE A PLASTIC AND WORKABLE MIX THAT WILL NOT PRODUCE HARSHNESS IN PLACING OR HONEYCOMBING IN THE STRUCTURE.

**C. MIXING** - THE CONCRETE INGREDIENTS SHALL BE MIXED IN BATCH MIXERS UNTIL THE MIXTURE IS HOMOGENEOUS AND OF UNIFORM CONSISTENCY. THE MIXING OF EACH BATCH SHALL CONTINUE FOR NOT LESS THAN ONE AND ONE-HALF MINUTES AFTER ALL THE INGREDIENTS EXCEPT THE FULL AMOUNT OF WATER ARE IN THE MIXER. THE MINIMUM MIXING TIME IS PREDICTED ON PROPER CONTROL OF THE SPEED OF ROTATION OF THE MIXER AND OF THE INTRODUCTION OF THE MATERIALS, INCLUDING WATER, INTO THE MIXER. THE MIXER SHALL BE STOPPED PRIOR TO DUMPING, AND FOLLOWING THE MIXER-CHARGING OPERATIONS, EXCESSIVE OVERMIXING REQUIRING THE ADDITION OF WATER TO PRESERVE THE REQUIRED CONCRETE CONSISTENCY SHALL NOT BE PERMITTED. TRUCK MIXING WILL BE ALLOWED PROVIDED THAT THE USE OF THIS METHOD SHALL CAUSE NO VIOLATION OF ANY APPLICABLE PROVISIONS OF THE SPECIFICATIONS GIVEN HERE.

**D. FORMS** - THE FORMS SHALL HAVE SUFFICIENT STRENGTH AND RIGIDITY TO HOLD THE CONCRETE AND TO WITHSTAND THE NECESSARY PRESSURE, TAMPING, AND VIBRATION WITHOUT DEFLECTION FROM THE PRESCRIBED LINES. THEY SHALL BE MORTAR-TIGHT AND CONSTRUCTED SO THAT THEY CAN BE REMOVED WITHOUT HAMMERING OR PRYING AGAINST THE CONCRETE. THE INSIDE OF FORMS SHALL BE OILED WITH NON-STAINING MINERAL OIL OR THOROUGHLY WETTED BEFORE CONCRETE IS PLACED.

FORMS MAY BE REMOVED 24 HOURS AFTER THE PLACEMENT OF CONCRETE. ALL WIRE TIES AND OTHER DEVICES USED SHALL BE RECESSED FROM THE SURFACE OF THE CONCRETE.

**E. REINFORCING STEEL** - ALL REINFORCING MATERIAL SHALL BE FREE OF DIRT, RUST, SCALE, OIL, PAINT OR ANY OTHER COATINGS. THE STEEL SHALL BE ACCURATELY PLACED AND SECURELY TIED TOGETHER INTO POSITION SO THAT NO MOVEMENT OF THE STEEL WILL OCCUR DURING PLACEMENT OF CONCRETE.

**F. CONSOLIDATING** - CONCRETE SHALL BE CONSOLIDATED WITH INTERNAL TYPE MECHANICAL VIBRATORS. VIBRATION SHALL BE SUPPLEMENTED BY SPADING AND HAND TAMPING AS NECESSARY TO INSURE SMOOTH AND DENSE CONCRETE ALONG FORM SURFACES, IN CORNERS, AND AROUND EMBEDDED ITEMS.

**G. FINISHING** - DEFECTIVE CONCRETE, HONEYCOMBED AREAS, VOIDS LEFT BY THE REMOVAL OF THE FORMS, RIDGES ON ALL CONCRETE SURFACES PERMANENTLY EXPOSED TO VIEW OR EXPOSED TO WATER ON THE FINISHED STRUCTURE, SHALL BE REPAIRED IMMEDIATELY AFTER THE REMOVAL OF THE FORMS. ALL VOIDS SHALL BE REAMED AND COMPLETELY FILLED WITH DRY-FINISHING MORTAR.

**H. PROTECTION AND CURING** - EXPOSED SURFACES OF CONCRETE SHALL BE PROTECTED FROM THE DIRECT RAYS OF THE SUN FOR AT LEAST THE FIRST THREE (3) DAYS. ALL CONCRETE SHALL BE KEPT CONTINUOUSLY MOIST FOR AT LEAST TEN (10) DAYS AFTER BEING PLACED. MOISTURE MAY BE APPLIED BY SPRAYING OR SPRINKLING AS NECESSARY TO PREVENT THE CONCRETE FROM DRYING. CONCRETE SHALL NOT BE EXPOSED TO FREEZING DURING THE CURING PERIOD. CURING COMPOUNDS MAY ALSO BE USED.

**I. PLACING TEMPERATURE** - CONCRETE MAY NOT BE PLACED AT TEMPERATURE BELOW 37 DEGREES F WITH THE TEMPERATURE FALLING, OR 34 DEGREES F WITH THE TEMPERATURE RISING.

**VI. STABILIZATION**

ALL BORROW AREAS SHALL BE GRADED TO PROVIDE PROPER DRAINAGE AND LEFT IN A SLIGHTLY CONDITION. ALL EXPOSED SURFACES OF THE EMBANKMENT, SPILLWAY, SPOIL AND BORROW AREAS, AND BERMS SHALL BE STABILIZED BY SEEDING, LIMING, FERTILIZING AND MULCHING (IF REQUIRED) IN ACCORDANCE WITH THE VEGETATIVE TREATMENT SPECIFICATIONS.

**VII. EROSION AND SEDIMENT CONTROL**

CONSTRUCTION OPERATIONS WILL BE CARRIED OUT IN SUCH A MANNER THAT EROSION WILL BE CONTROLLED AND WATER AND AIR POLLUTION MINIMIZED. STATE AND LOCAL LAWS CONCERNING POLLUTION ABATEMENT SHALL BE FOLLOWED. DETAIL OF EROSION AND SEDIMENT CONTROL MEASURES TO BE EMPLOYED DURING THE CONSTRUCTION PROCESS SHALL BE IN ACCORDANCE WITH EROSION AND SEDIMENT CONTROL PLANS FOR THIS PROJECT.

THE CONSTRUCTION OF ALL INFILTRATION BASINS SHOULD COMPLY WITH THE CRITERIA SET FORTH IN THE MARYLAND SOIL CONSERVATION DISTRICT'S STANDARDS AND SPECIFICATIONS 37B-PONDS DATED JULY, 1981 OR SUBSEQUENT REVISIONS AND THE ADDITIONAL CRITERIA PROVIDED BELOW.

3.2.6.1 SCHEDULE

THE SEQUENCE OF VARIOUS PHASES OF BASIN CONSTRUCTION SHALL BE COORDINATED WITH THE OVERALL PROJECT CONSTRUCTION SCHEDULE. A PROGRAM SHALL SCHEDULE ROUGH EXCAVATION OF THE BASIN WITH THE ROUGH GRADING PHASE OF THE PROJECT TO PERMIT USE OF THE MATERIAL AS FILL IN EARTHWORK AREAS. THE PARTIALLY EXCAVATED BASIN SHALL SERVE AS A SEDIMENTATION BASIN IN ORDER TO ASSIST IN EROSION AND SEDIMENT CONTROL DURING CONSTRUCTION. HOWEVER, BASINS NEAR FINAL STAGES OF EXCAVATION SHOULD NEVER BE USED PREMATURELY FOR RUNOFF DISPOSAL. DRAINAGE FROM UNTREATED, FRESHLY CONSTRUCTED SLOPES WITHIN THE WATERSHED AREA WOULD LOAD THE NEWLY FORMED BASIN WITH A HEAVY CONCENTRATION OF FINE SEDIMENT. THIS COULD SERIOUSLY IMPAIR THE NATURAL INFILTRATION CHARACTERISTICS OF THE BASIN FLOOR. FINAL GRADE OF AN INFILTRATION BASIN SHALL NOT BE ATTAINED UNTIL AFTER ITS USE AS A SEDIMENT CONTROL BASIN IS COMPLETE.

SPECIFICATIONS FOR BASIN CONSTRUCTION SHOULD STATE: (1) THE EARLIEST POINT IN PROGRESS WHEN STORM DRAINAGE MAY BE DIRECTION TO THE BASIN, AND (2) THE MEANS BY WHICH THIS DELAY IN USE IS TO BE ACCOMPLISHED. DUE TO THE WIDE VARIETY OF CONDITIONS ENCOUNTERED AMONG PROJECTS, EACH SHOULD BE SEPARATELY EVALUATED IN ORDER TO POSTPONE USE AS IS REASONABLY POSSIBLE.

**3.2.6.2 EXCAVATION**

INITIAL BASIN EXCAVATION SHALL BE CARRIED TO WITHIN 1 FOOT OF THE FINAL DEFERRED UNTIL ALL DISTURBED AREAS ON THE WATERSHED HAVE BEEN ESTABLISHED OR PROTECTED. THE FINAL PHASE EXCAVATION SHOULD REMOVE ALL ACCUMULATED SEDIMENT. RELATIVELY TRACKED EQUIPMENT IS RECOMMENDED FOR THIS OPERATION TO AVOID COMPACTION OF THE BASIN FLOOR. AFTER THE FINAL GRADING IS COMPLETED, THE BASIN FLOOR SHOULD BE DEEPLY TILLED BY MEANS OF ROTARY TILLERS OR DISC BARROWS TO PROVIDE A WELL-SERATED, HIGHLY POROUS SURFACE TEXTURE.

**3.2.6.3 LINING MATERIAL**

INFILTRATION BASINS MAY BE LINED WITH A 6- TO 12-INCH LAYER OF FILTER MATERIAL SUCH AS COARSE SAND TO HELP PREVENT THE BUILDUP OF IMPERVIOUS DEPOSITS ON THE SOIL SURFACE. THE FILTER LAYER CAN BE REPLACED OR CLEANED WHEN IT BECOMES CLOGGED. WHEN A 6-INCH LAYER OF COARSE ORGANIC MATERIAL IS SPECIFIED FOR DISCING (SUCH AS HULLS, LEAVES, STEMS, ETC.) OR SPADING INTO THE BASIN FLOOR TO INCREASE THE PERMEABILITY OF THE SOILS, THE BASIN FLOOR SHOULD BE SOMER OR NUNDATED FOR A BRIEF PERIOD, THEN ALLOWED TO DRY SUBSEQUENT TO THIS OPERATION. THIS INDUCES THE ORGANIC MATERIAL TO DECAY RAPIDLY, LOOSENING THE UPPER SOIL LAYER.

ESTABLISHING DENSE VEGETATION ON THE BASIN SIDE SLOPES AND FLOOR IS REQUIRED. A DENSE VEGETATIVE STAND WILL NOT ONLY PREVENT EROSION AND SLOUGHING, BUT WILL ALSO PROVIDE A NATURAL MEANS OF MAINTAINING RELATIVELY HIGH INFILTRATION RATES. EROSION PROTECTION OF INFLOW POINTS TO THE BASIN SHALL ALSO BE PROVIDED. REMOVAL OF ACCUMULATED SEDIMENT IS A PROBLEM ONLY AT THE BASIN FLOOR. LITTLE MAINTENANCE IS NORMALLY REQUIRED TO MAINTAIN THE INFILTRATION CAPACITY OF SLOPE AREAS.

SELECTION OF SUITABLE VEGETATIVE MATERIALS FOR THE SIDE SLOPE AND ALL OTHER AREAS TO BE STABILIZED WITH VEGETATION AND APPLICATION OF REQUIRED FERTILIZER AND MULCHES SHALL BE DONE IN ACCORDANCE WITH THE MARYLAND STANDARDS AND SPECIFICATIONS FOR SOIL EROSION AND SEDIMENT CONTROL. LOCAL EXTENSION AGENCIES SHOULD ALSO BE CONSULTED.

3.2.1 MAINTENANCE

**3.2.7.1 INSPECTION SCHEDULE**

DRAINAGE SYSTEMS MUST BE INSPECTED ON A ROUTINE BASIS TO ENSURE THAT THEY ARE FUNCTIONING PROPERLY. INSPECTIONS CAN BE ON A SEMIANNUAL BASIS BUT SHOULD ALWAYS BE CONDUCTED FOLLOWING MAJOR STORMS.

(A) PURPOSES - IT IS NECESSARY TO RESTORE THE NATURAL INFILTRATION CAPACITY BY OVERCOMING THE EFFECTS OF SURFACE COMPACTION, AND TO CONTROL WEED GROWTH ON THE BASIN FLOOR.







(B) TECHNIQUE - ROTARY TILLERS OR DISC BARROWS WILL NORMALLY SERVE THIS PURPOSE. LIGHT TRACTORS SHALL BE EMPLOYED FOR THESE OPERATIONS. IN THE EVENT THAT HEAVY EQUIPMENT HAS CAUSED DEEPER THAN NORMAL COMPACTION OF THE SURFACE, THESE OPERATIONS SHALL BE PRECEDED BY DEEP PLOWING. IN ITS FINAL CONDITION AFTER TILLING, THE BASIN FLOOR SHALL BE LEVEL, SMOOTH AND FREE OF RIDGES AND FURROWS TO EASE FUTURE REMOVAL OF SEDIMENT AND MINIMIZE THE MATERIAL TO BE REMOVED DURING FUTURE CLEANING OPERATIONS. A LEVELLING DRAG, TOWED BEHIND THE EQUIPMENT ON THE LAST PASS, WILL ACCOMPLISH THIS.

(C) FREQUENCY IN THE SPRING, THE BASIN SURFACE IS USUALLY QUITE POROUS DUE TO THE EFFECTS OF FROST AND SUBSEQUENT THAWING. THE INFILTRATION CAPACITY DIMINISHES RAPIDLY THEREAFTER. TO ENHANCE INFILTRATION CAPACITY, TILLING SHALL BE THROUGH ONCE EACH SEASON, FROM LATE JUNE THROUGH SEPTEMBER. TO CONTROL VEGETATIVE GROWTH, AN ADDITIONAL LIGHT TILLAGE MAY BE ADVISABLE DURING THE GROWING SEASON. PRECULTIVATION TILLING SHALL BE PERMITTED TO AVOID ANY POSSIBILITY OF WORKING SEDIMENT ACCUMULATIONS INTO THE BASIN FLOOR AS A PART OF LIGHT CULTIVATION FOR THE PURPOSE OF WEED CONTROL. IT IS THEREFORE STRESSED AGAIN THAT ANY CULTIVATION OR TILLING OPERATION BE PRECEDED IN ALL CASES BY CAREFUL SEDIMENT REMOVAL.

3.2.7.5 SIDE SLOPE MAINTENANCE

(A) PURPOSE - TO PROMOTE A DENSE TURF WITH EXTENSIVE ROOT GROWTH THEREBY ENHANCING INFILTRATION THROUGH THE SOLE SURFACE AND PREVENT WEEDS FROM GRADUALLY TAKING OVER THE SLOPE AREAS.

(B) FREQUENCY - GRASSES OF THE FESCUE FAMILY ARE REQUIRED FOR SEEDING PRIMARILY DUE TO THEIR ADAPTABILITY TO DRY SANDY SOILS, DROUGHT RESISTANCE, HARDINESS AND ABILITY TO WITHSTAND BRIT. THE USE OF FESCUE WILL ALSO PERMIT LONG INTERVALS BETWEEN MOWINGS. THIS IS IMPORTANT DUE TO THE RELATIVELY STEEP SLOPES WHICH MAKE MOWING DIFFICULT. MOWING TWICE A YEAR, ONCE IN JUNE AND AGAIN IN SEPTEMBER IS GENERALLY SATISFACTORY. REFERTILIZATION WITH 10-6-4 RATIO FERTILIZER AT A RATE OF 500 POUNDS PER ACRE (11 POUNDS PER 1,000 SQUARE FEET) MAY BE REQUIRED THE SECOND YEAR AFTER SEEDING.

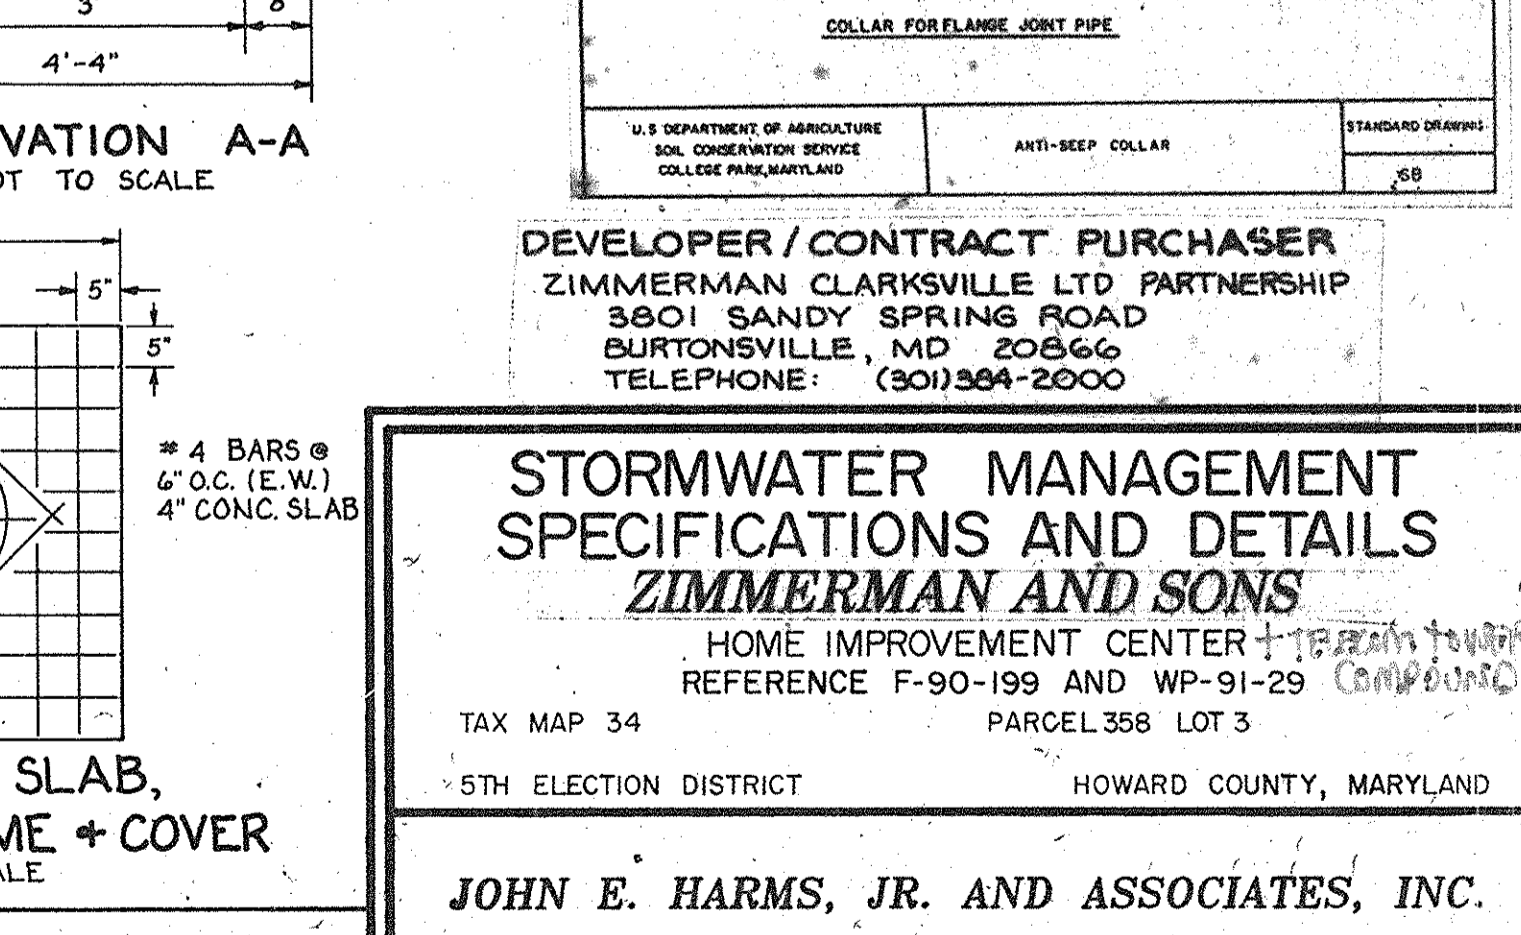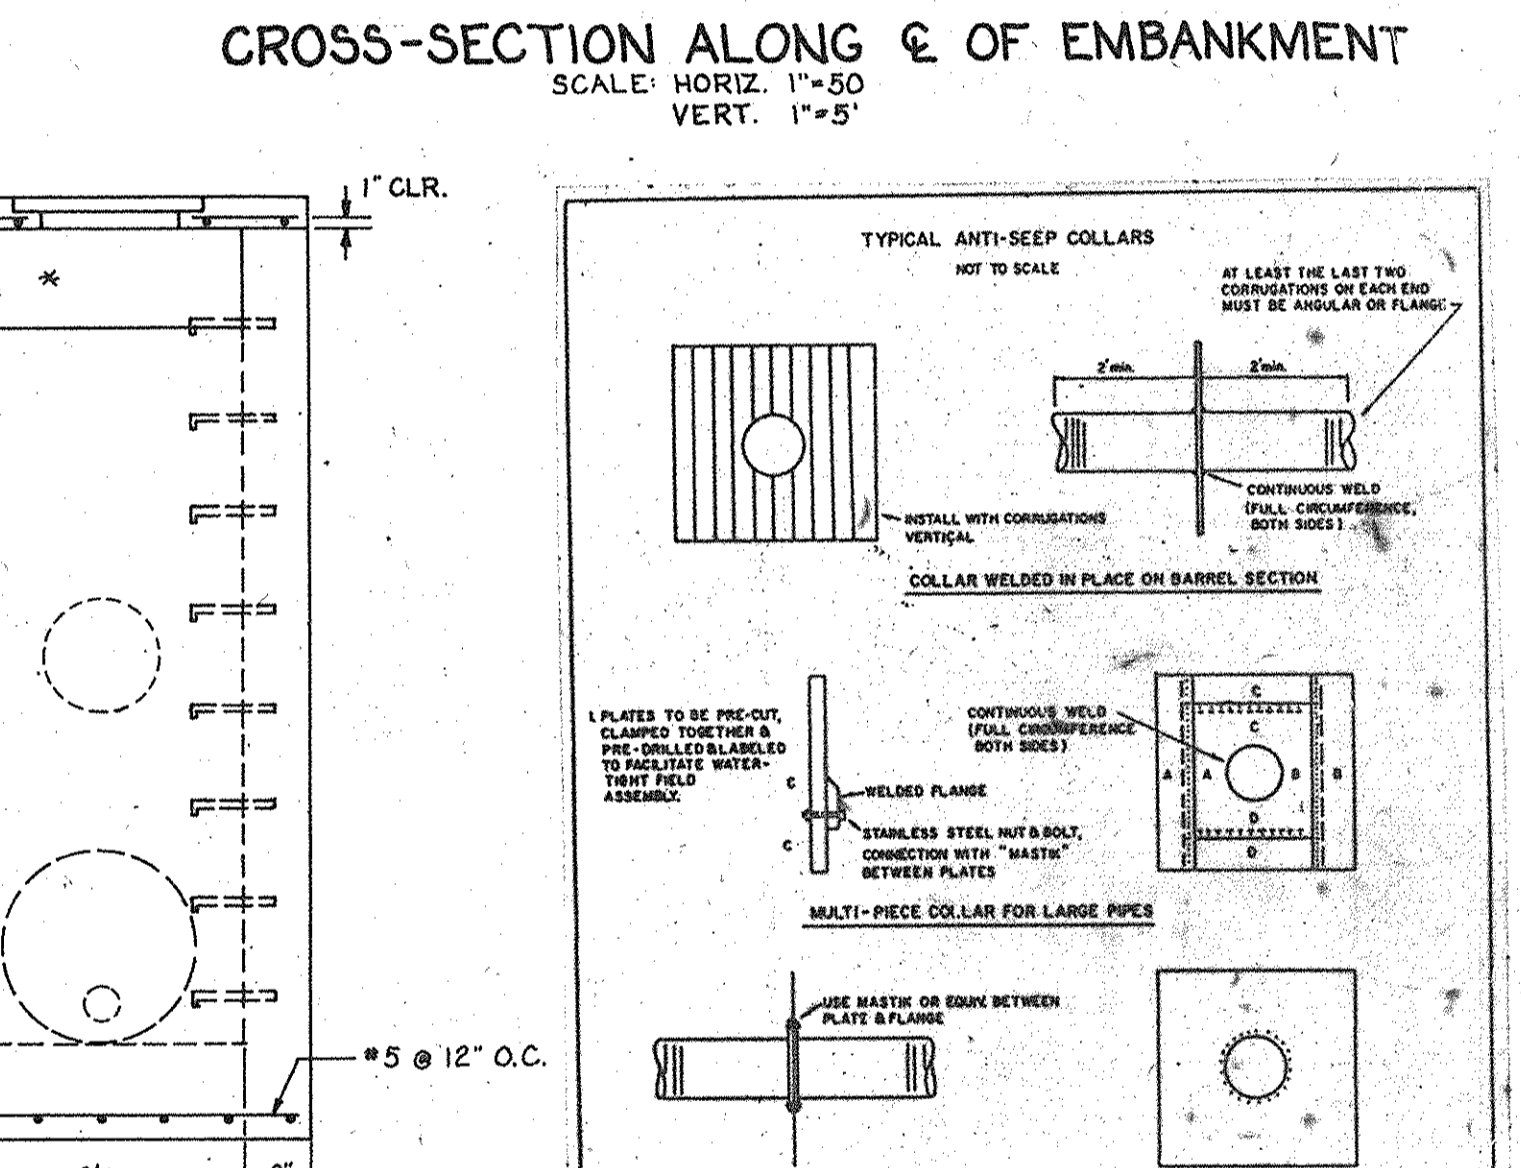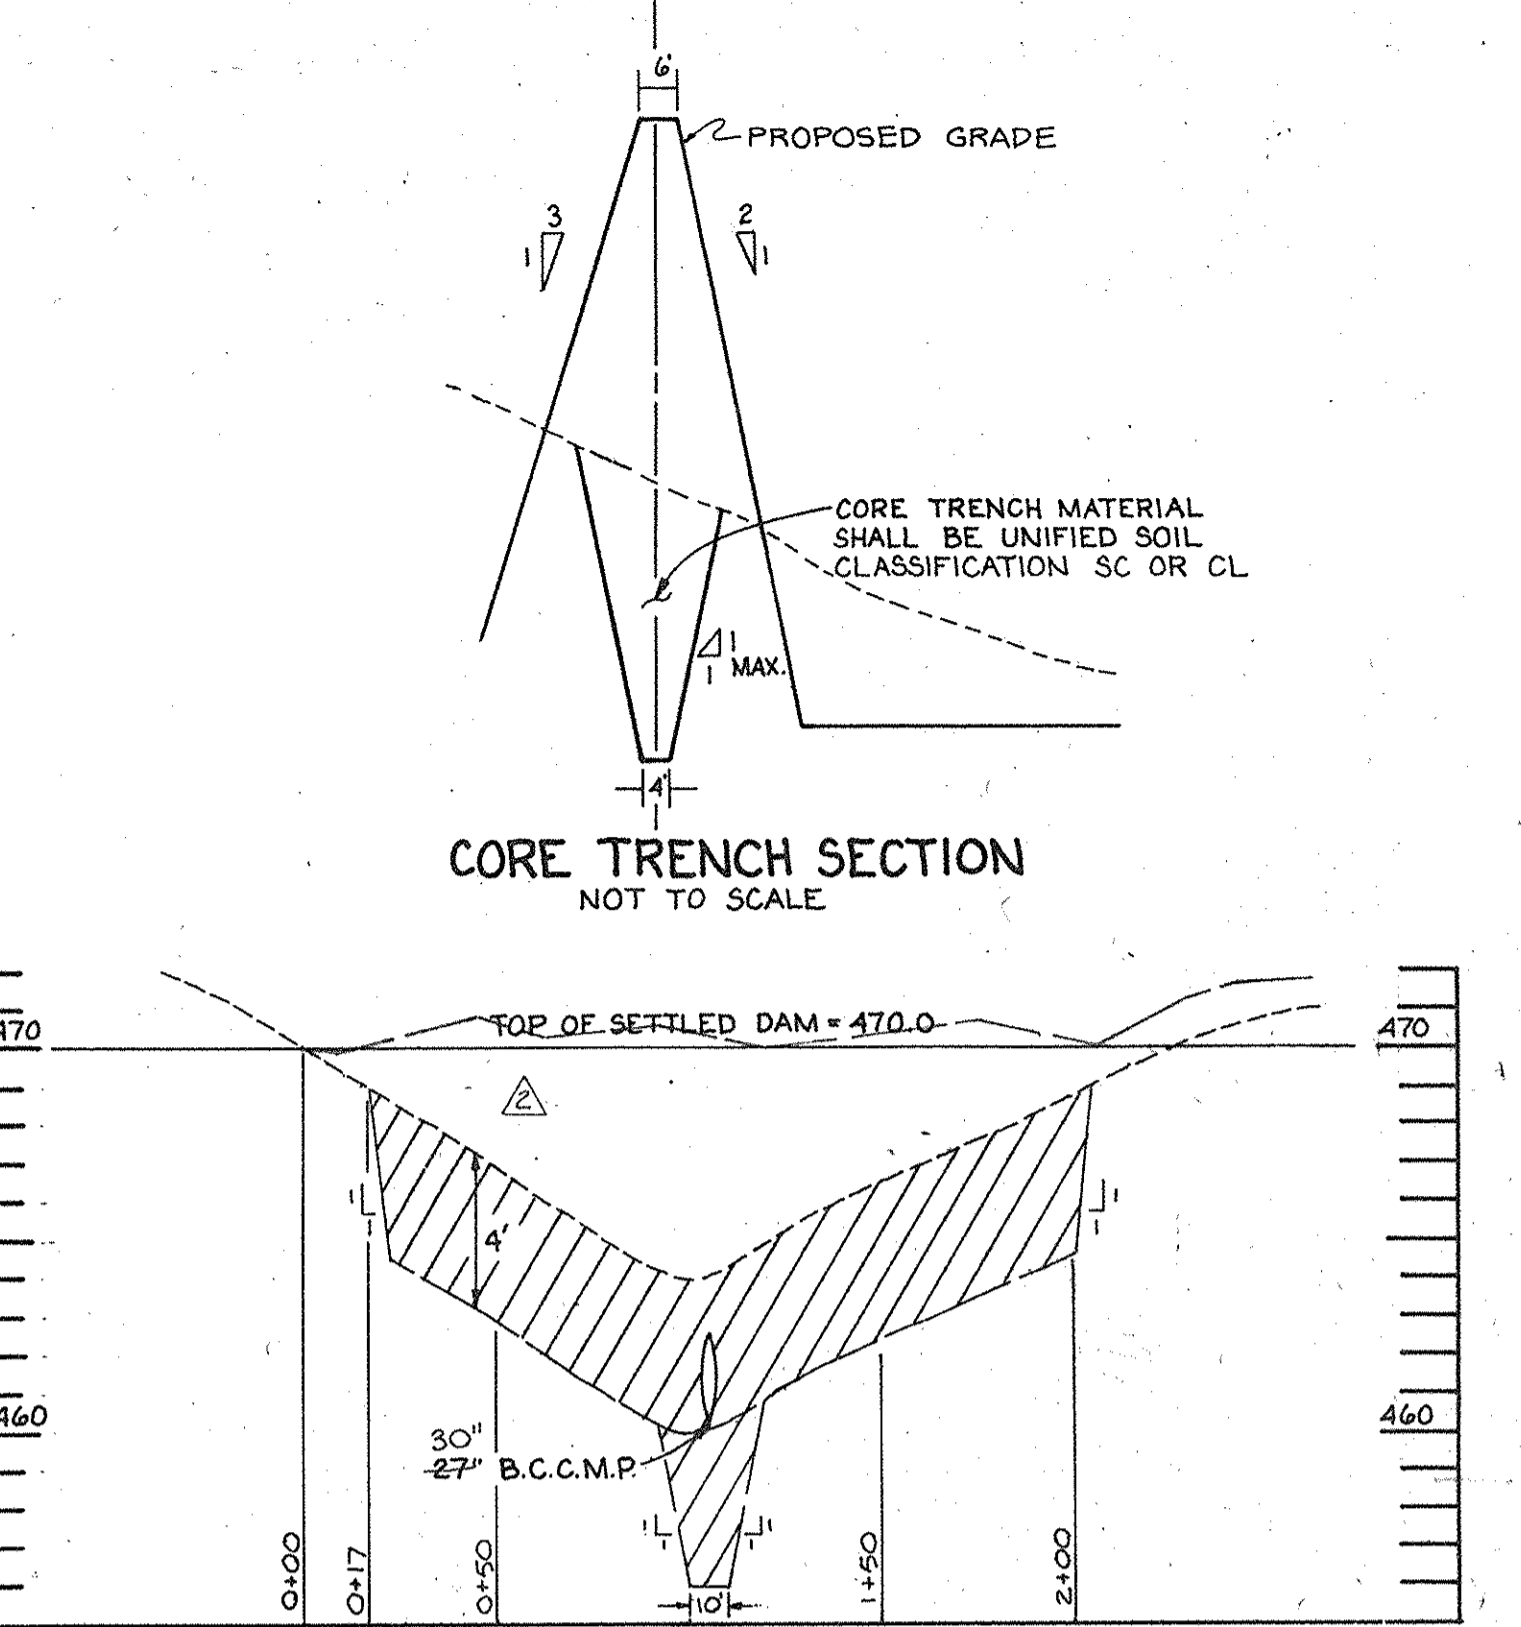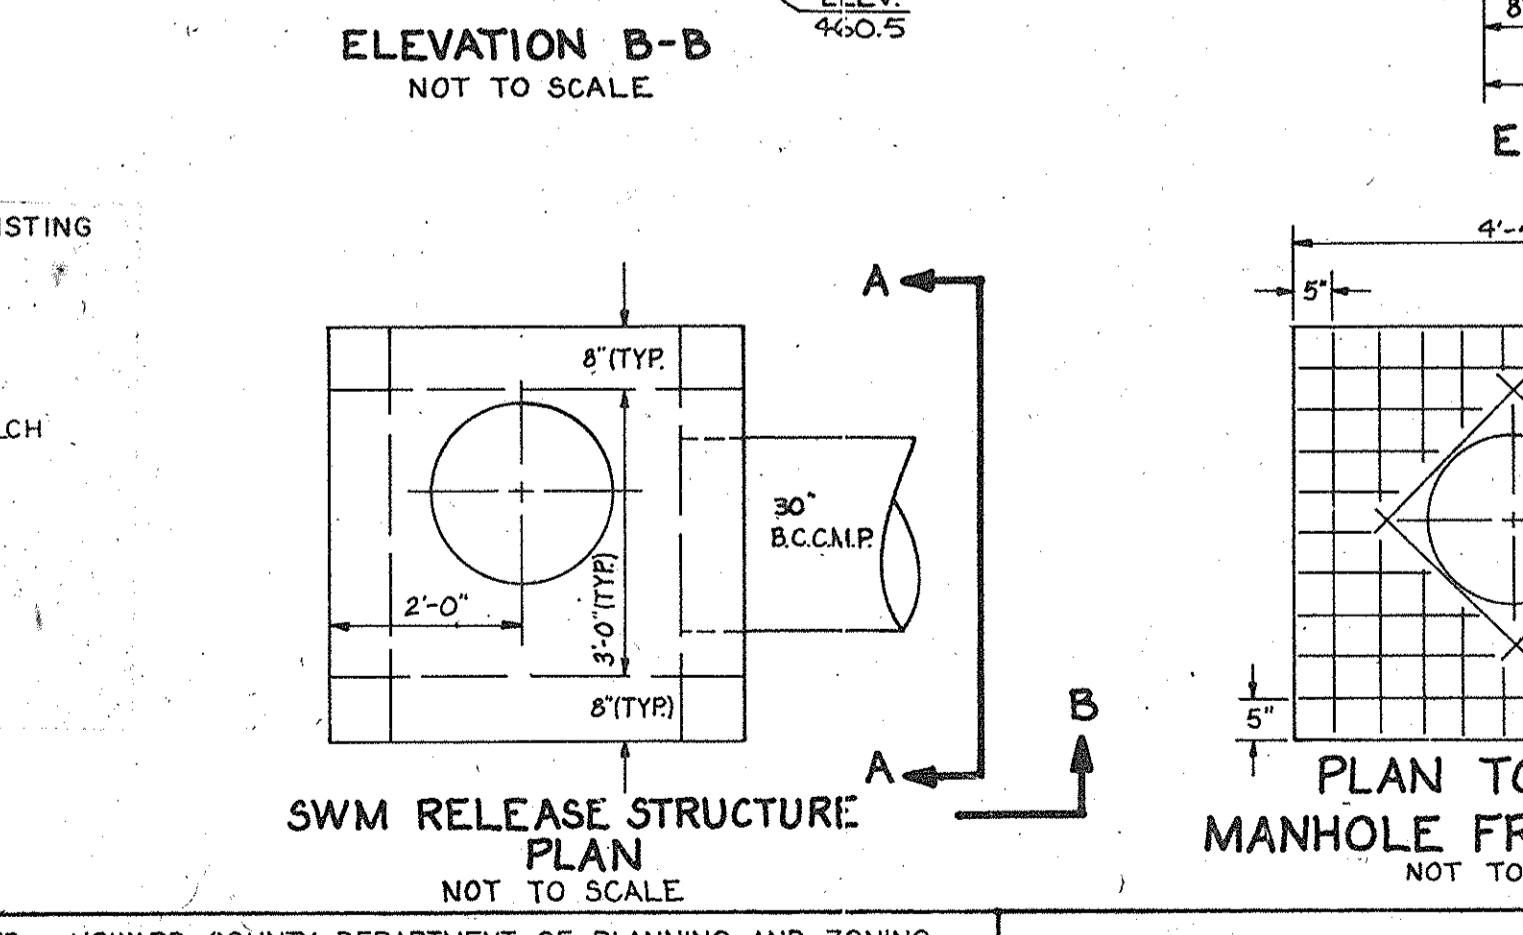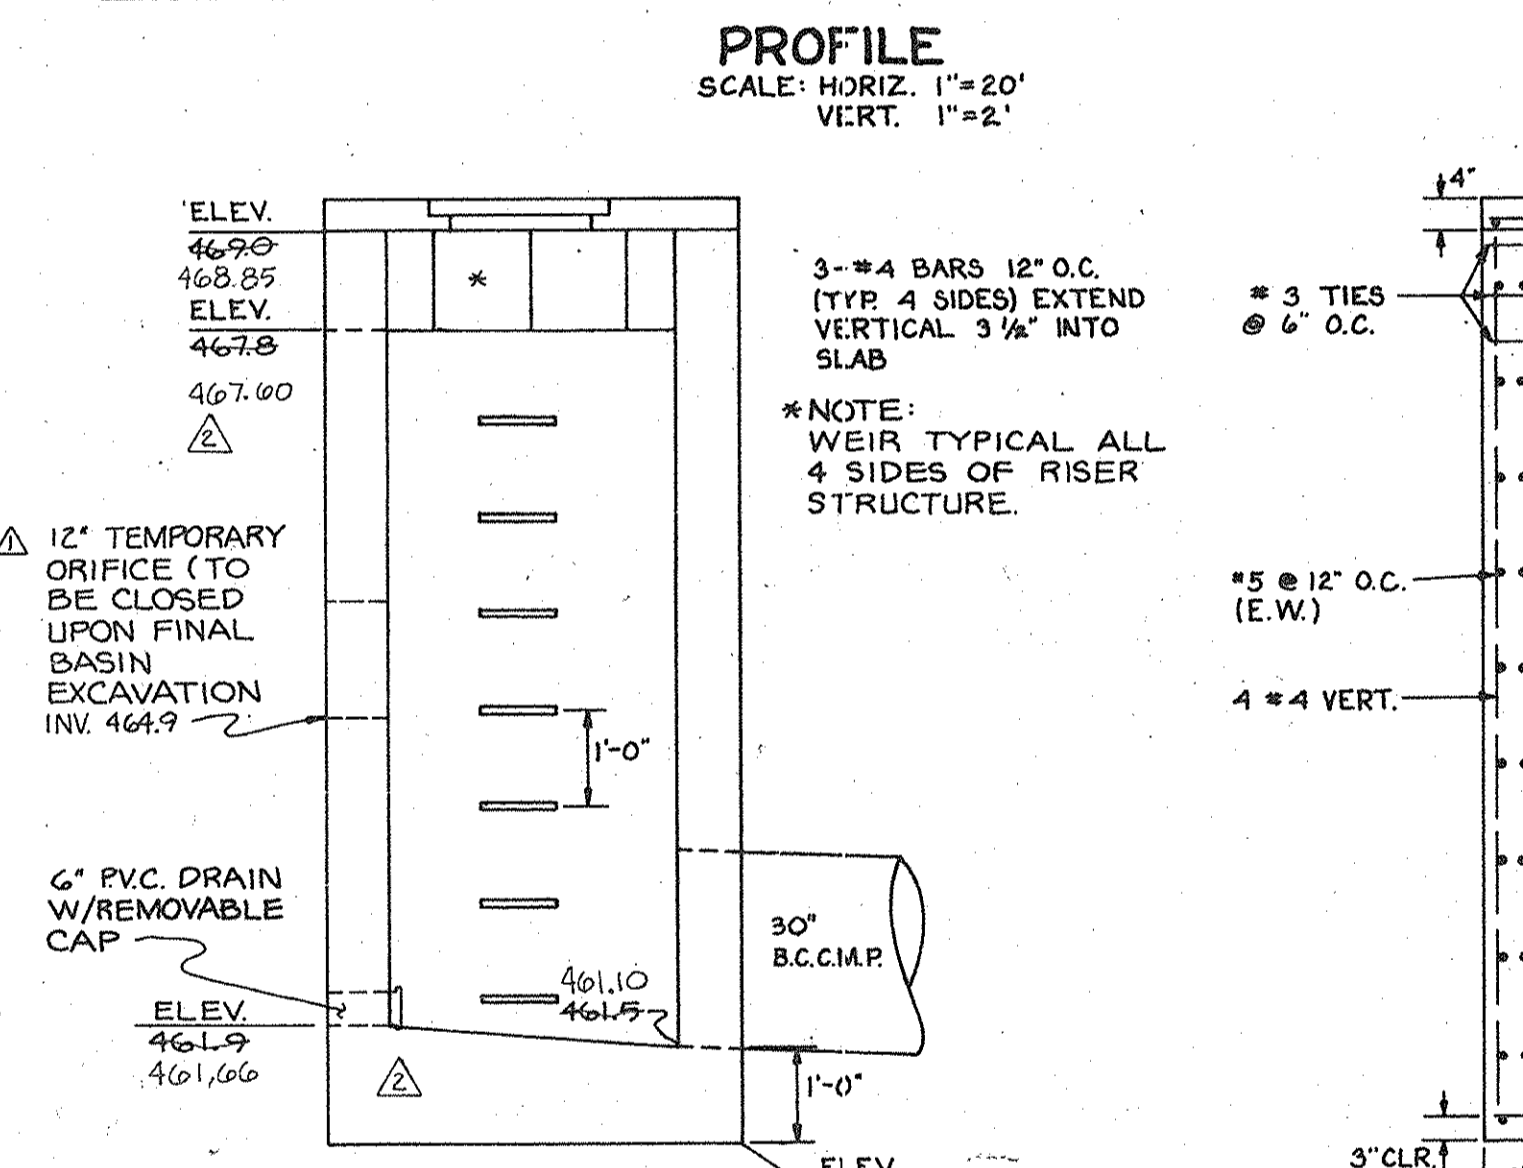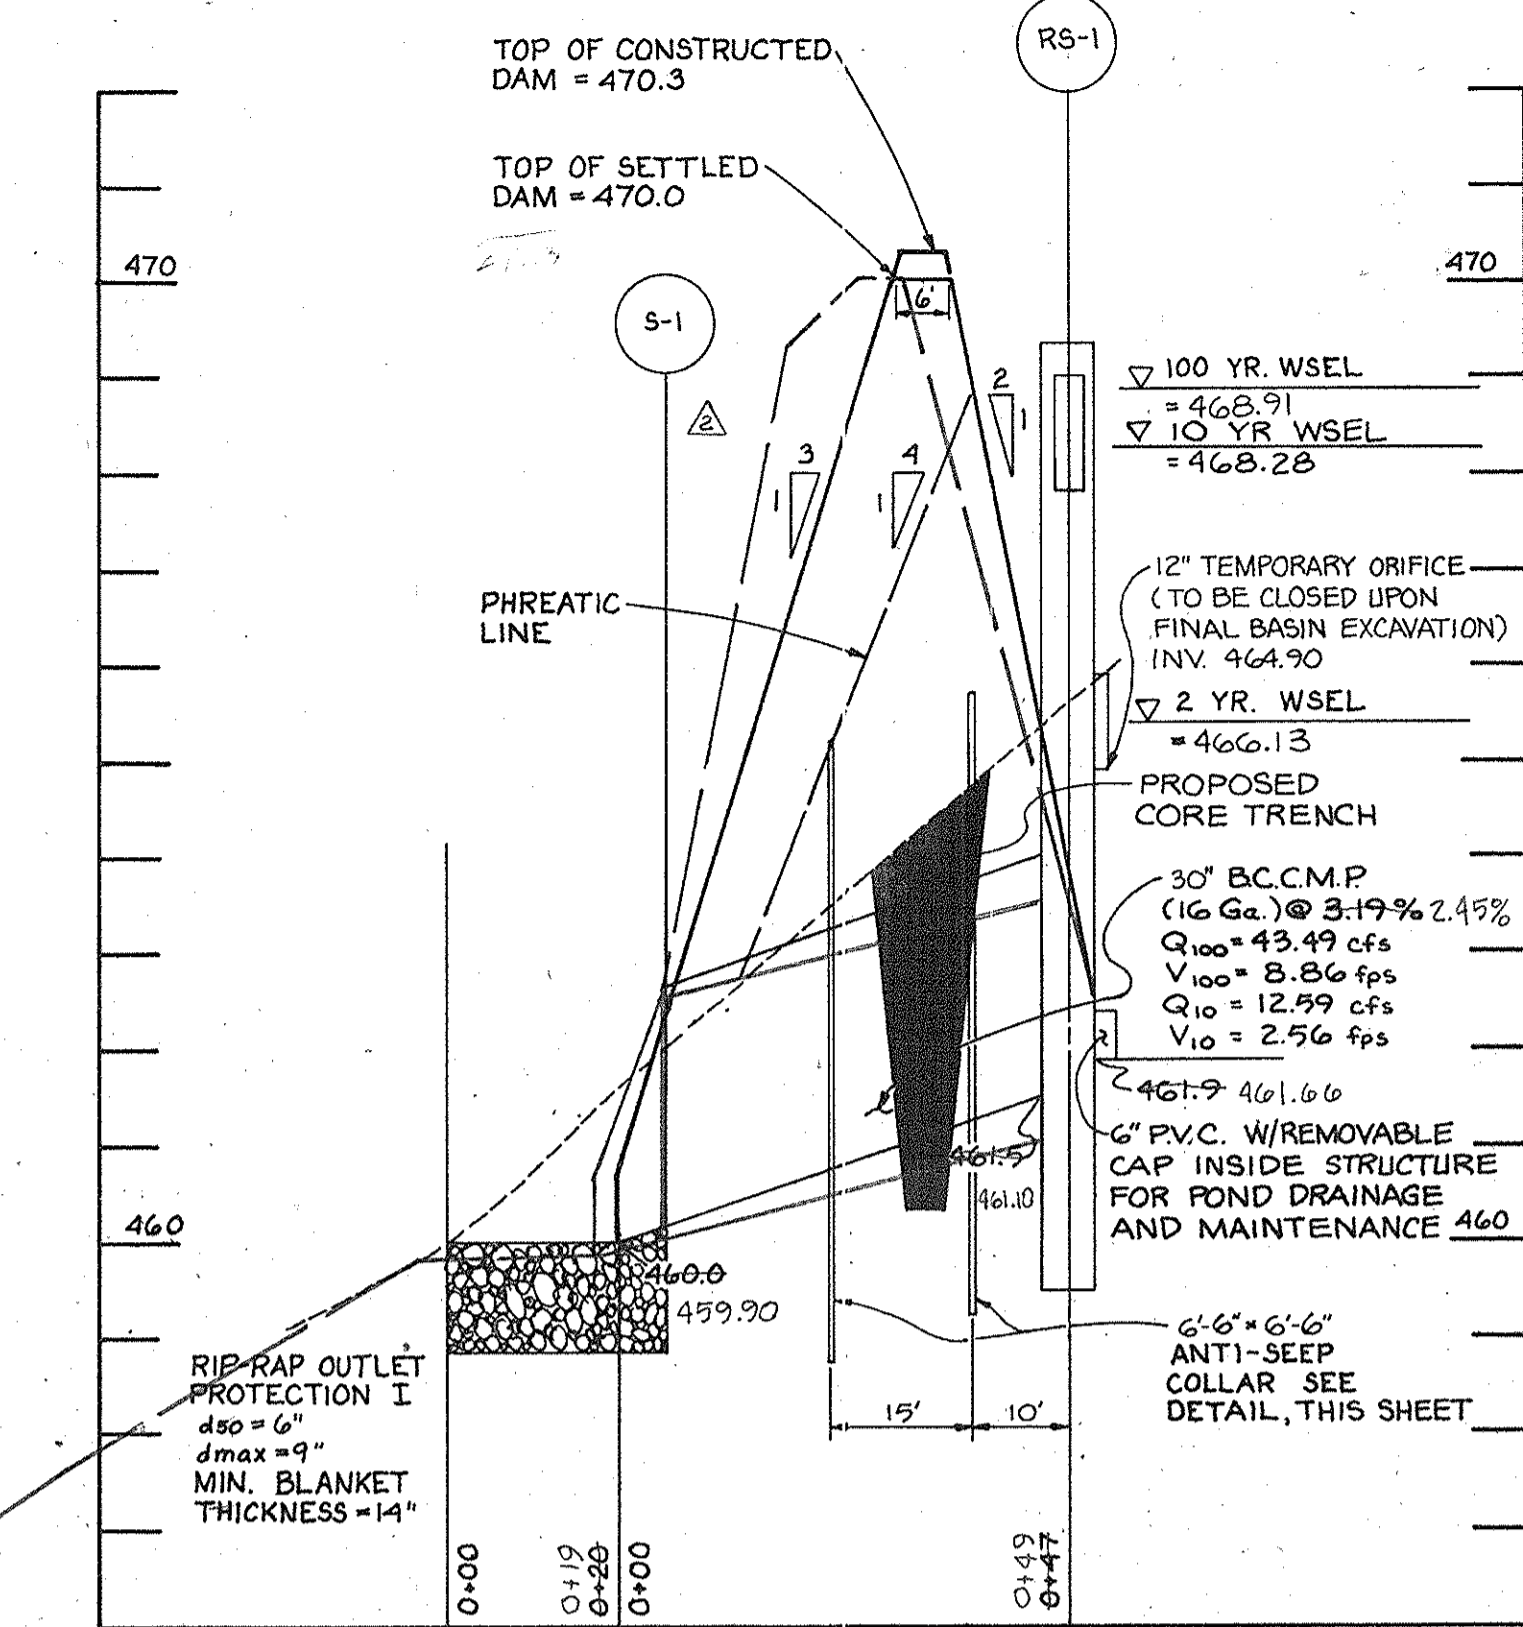

NOTE: S.W.M. POND IS HAZARD CLASS 'A'.

AS BUILT NOTE

THE INFORMATION SHOWN HEREON WAS OBTAINED FROM A VISUAL OBSERVATION BY A SURVEY CREW INACCESSIBLE STRUCTURES IMPROVED FROM THE CONTRACTOR'S OWNERS RECORDS OR APPROVED CONSTRUCTION PLANS. INFORMATION WILL BE PROVIDED BY THE CONTRACTOR AND/OR REGISTERED PROFESSIONAL ENGINEER FOR THE ACCURACY OF ERRORS AND OMISSIONS FOR INFORMATION WE HAVE NOT PROVIDED AS PART OF OUR FIELD AS BUILT SURVEY.

I HEREBY CERTIFY TO THE BEST OF MY KNOWLEDGE AND BELIEF THE AS BUILT INFORMATION SHOWN HEREON IS CORRECT SUBJECT TO THE ATTACHED 'AS BUILT' NOTES.

NO.	REVISION	BY	DATE
1	AS BUILT	DGH	7/1/92
2	ADD SHEET 9.0.10	RAL	10.15.92
3	THIS IS A 2-DAY PERMIT		
4	PROVIDE PERMIT INFORMATION		
5	EQUIPMENT CALIBRATED ON 7/1/92		

**ENGINEER'S CERTIFICATE**

I CERTIFY THAT THIS PLAN FOR POND CONSTRUCTION, EROSION AND SEDIMENT CONTROL REPRESENTS A PRACTICAL AND WORKABLE PLAN BASED ON MY PERSONAL KNOWLEDGE OF THE SITE CONDITIONS. THIS PLAN WAS PREPARED IN ACCORDANCE WITH THE REQUIREMENTS OF THE HOWARD SOIL CONSERVATION DISTRICT. I HAVE NOTIFIED THE DEVELOPER THAT HE MUST PROVIDE THE HOWARD SOIL CONSERVATION DISTRICT WITH AN "AS-BUILT" PLAN OF THE POND WITHIN 30 DAYS OF COMPLETION.

Signature: Robert L. Uggel  
DATE: 4/5/91

**DEVELOPER'S CERTIFICATE**

I CERTIFY THAT ALL DEVELOPMENT AND/OR CONSTRUCTION WILL BE DONE ACCORDING TO THESE PLANS, AND THAT ANY RESPONSIBLE PERSONNEL INVOLVED IN THE CONSTRUCTION PROJECT WILL HAVE A CERTIFICATE OF ATTENDANCE AT A DEPARTMENT OF ENVIRONMENT APPROVED TRAINING PROGRAM FOR THE CONTROL OF SEDIMENT AND EROSION BEFORE BEGINNING THE PROJECT. I WILL PROVIDE THE HOWARD SOIL CONSERVATION DISTRICT WITH AN "AS-BUILT" PLAN OF THE POND WITHIN 30 DAYS OF COMPLETION. I ALSO AUTHORIZE PERIODIC ON-SITE INSPECTION BY THE HOWARD SOIL CONSERVATION DISTRICT.

Signature: Robert J. Zimmermann  
DATE: 4/5/91

THESE PLANS HAVE BEEN REVIEWED FOR THE HOWARD SOIL CONSERVATION DISTRICT AND MEET THE TECHNICAL REQUIREMENTS FOR SMALL POND CONSTRUCTION, SOIL EROSION AND SEDIMENT CONTROL.

Signature: Robert J. Zimmermann  
DATE: 5/11/91

APPROVED: HOWARD COUNTY DEPARTMENT OF PLANNING AND ZONING

Signature: [Signature]  
DATE: 5/11/91

APPROVED: STORM DRAINAGE SYSTEMS AND PUBLIC WORKS

Signature: [Signature]  
DATE: 5-23-91

APPROVED: FOR PRIVATE WATER AND PRIVATE SEWERAGE SYSTEMS

Signature: [Signature]  
DATE: 5/10/91

Signature: [Signature]  
DATE: 5/10/91

DEVELOPER / CONTRACT PURCHASER

ZIMMERMAN CLARKSVILLE LTD PARTNERSHIP  
3801 SANDY SPRING ROAD  
BURTONSVILLE, MD 20866  
TELEPHONE: (301)564-2000

**STORMWATER MANAGEMENT SPECIFICATIONS AND DETAILS**

ZIMMERMAN AND SONS

HOME IMPROVEMENT CENTER

REFERENCE F-90-199 AND WP-91-29

TAX MAP 34 PARCEL 358 LOT 3

5TH ELECTION DISTRICT HOWARD COUNTY, MARYLAND

**JOHN E. HARMS, JR. AND ASSOCIATES, INC.**

CONSULTING ENGINEERS - PLANNERS - SURVEYORS


8808 CENTRE PARK DRIVE  
COLUMBIA, MARYLAND 21046

TELEPHONE (301) 740-6300

DESIGNED BY: T.A.B.  
DRAWN BY: J.J.T.  
CHECKED BY: R.H.V.  
DATE: 6/25/90  
SCALE: AS SHOWN  
W.O. NO. 45-90-004A

3 SHEET OF 10



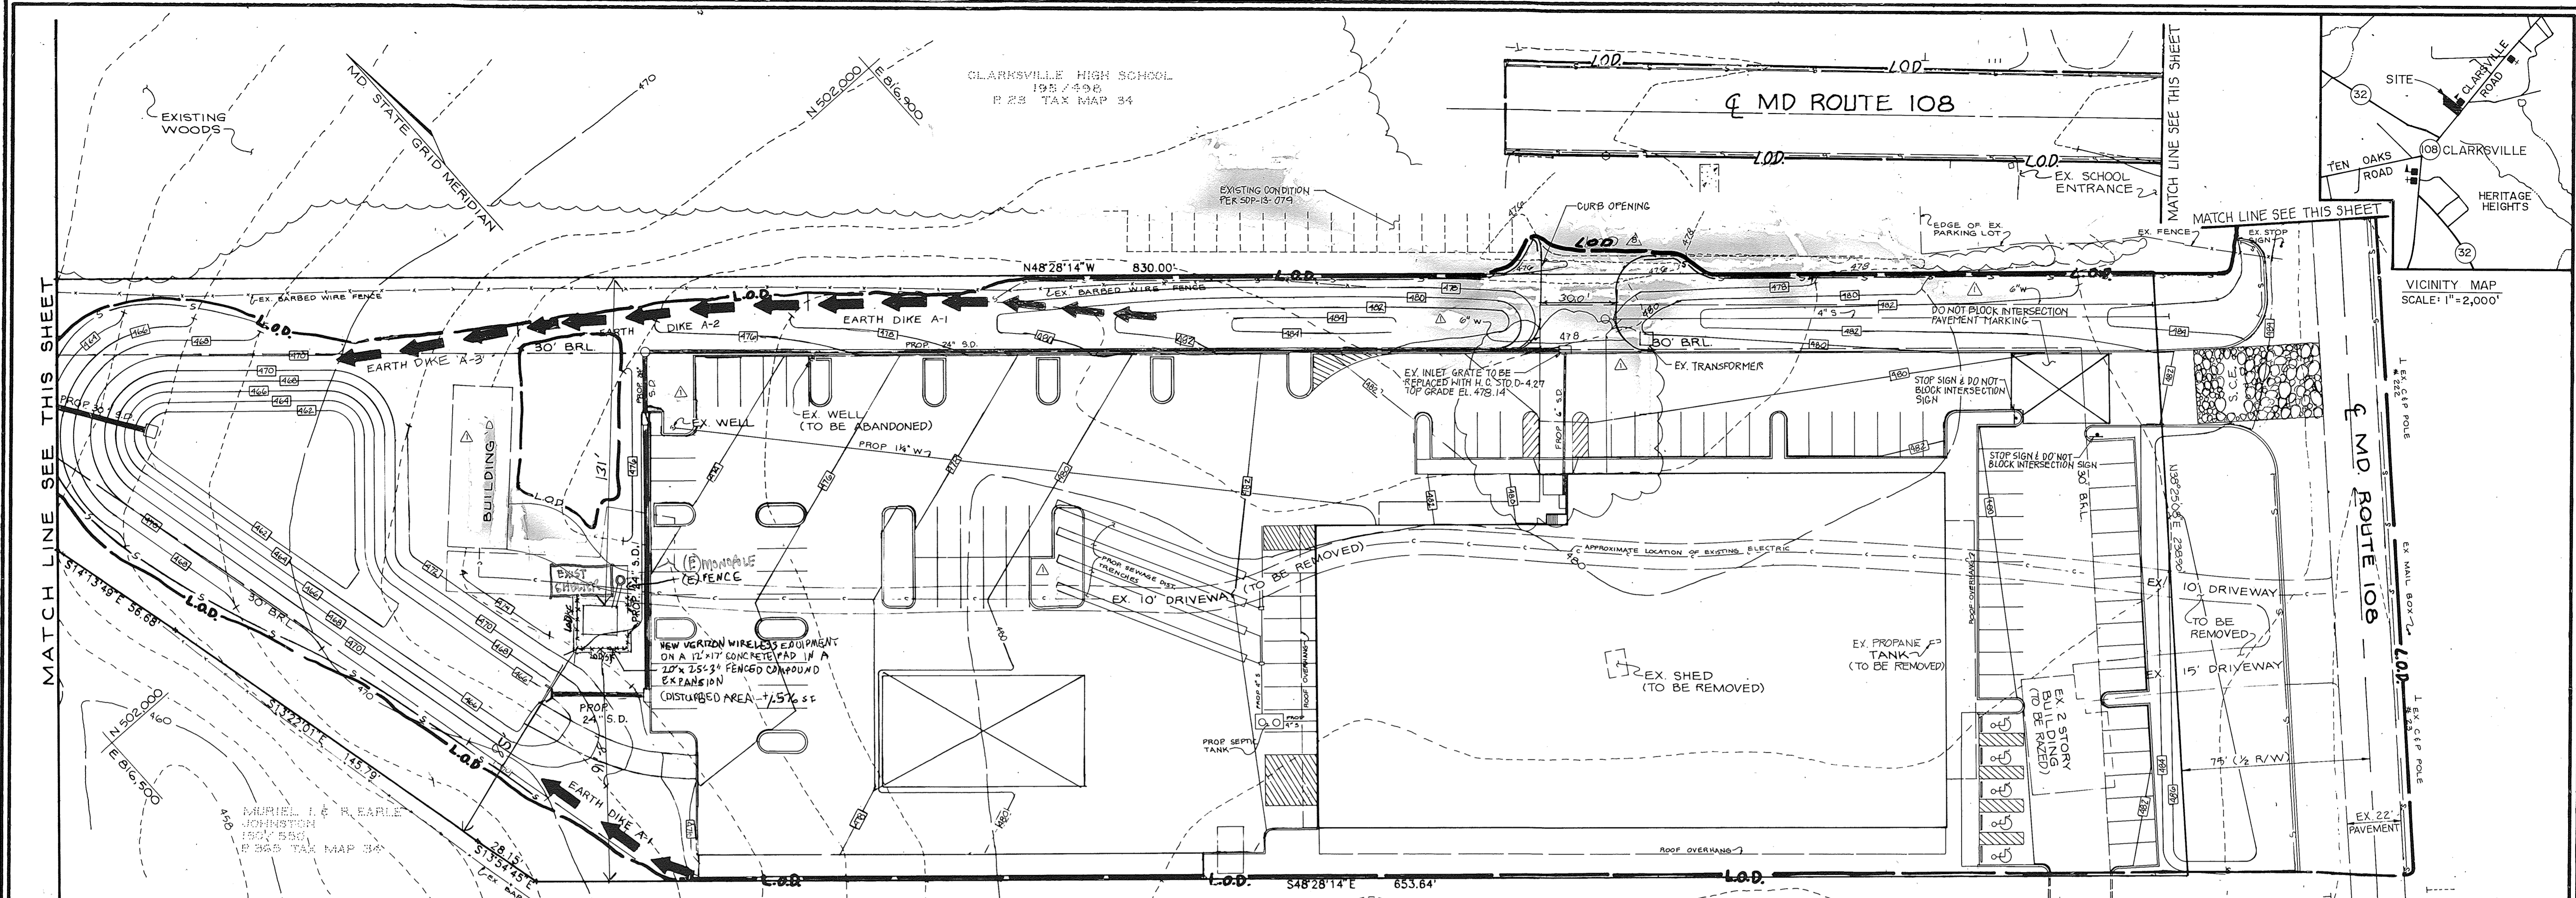

PLAN  
SCALE: 1"=30'

SEDIMENT CONTROL NOTES

- 1) A minimum of 24 hours notice must be given to the Howard County Office of Inspection and Permits prior to the start of any construction. (992-2437)
- 2) All vegetative and structural practices are to be installed according to the provisions of this plan and are to be in conformance with the 1983 MARYLAND STANDARDS AND SPECIFICATIONS FOR SOIL EROSION AND SEDIMENT CONTROL.
- 3) Following initial soil disturbance or redistribution, permanent or temporary stabilization shall be completed within: a) 7 calendar days for all perimeter sediment control structures, dikes, perimeter slopes and all slopes greater than 3:1, b) 14 days as to all other disturbed or graded areas on the project site.
- 4) All sediment traps/basins shown must be fenced and warning signs posted around their perimeter in accordance with Vol. 1, Chapter 12, of the HOWARD COUNTY DESIGN MANUAL, Storm Drainage.
- 5) All disturbed areas must be stabilized within the time period specified above in accordance with the 1983 MARYLAND STANDARDS AND SPECIFICATIONS FOR SOIL EROSION AND SEDIMENT CONTROL for permanent seedings (Sec. 51) and (Sec. 54), temporary seedings (Sec. 50) and mulching (Sec. 52). Temporary stabilization with mulch alone can only be done when recommended seeding rates do not allow for proper germination and establishment of grasses.
- 6) All sediment control structures are to remain in place and are to be maintained in operative condition until permission for their removal has been obtained from the Howard County Sediment Control Inspector.
- 7) Site Analysis:
 

	ON SITE	OFF SITE	TOTAL
Total Area of Site	4.49	0.74	5.23
Area Disturbed	4.16	0.74	4.90
Area to be roofed or paved	2.67	0.54	3.21
Area to be vegetatively stabilized	1.49	0.20	1.69
Total Cut	6.500	0.00	6.500
Total Fill	6.500	0.00	6.500
Offsite waste/borrow area location	N/A		
- 8) Any sediment control practice which is disturbed by grading activity for placement of utilities must be repaired on the same day of disturbance.

PERMANENT SEEDING NOTES

Apply to graded or cleared areas not subject to immediate further disturbance where a permanent long-lived vegetative cover is needed.

**Seedbed Preparation:** Loosen upper three inches of soil by raking, discing or other acceptable means before seeding, if not previously loosened.

**Soil Amendments:** In lieu of soil test recommendations, use one of the following schedules.

- 1) Preferred -- Apply 2 tons per acre dolomitic limestone (92 lbs/1000 square ft) and 600 lbs per acre 10-10-10 fertilizer (14 lbs/1000 sq ft) before seeding. Harrow or disc into upper three inches of soil. At time of seeding, apply 400 lbs per acre 30-0-0 ureaform fertilizer (9 lbs/1000 sq ft).
- 2) Acceptable -- Apply 2 tons per acre dolomitic limestone (92 lbs/1000 square ft) and 1000 lbs per acre 10-10-10 fertilizer (23 lbs/1000 sq ft) before seeding. Harrow or disc into upper three inches of soil.

**Seeding -** For the periods March 1 thru April 30, and August 1 thru October 15, seed with 60 lbs per acre (1.4 lbs/1000 sq ft) of Kentucky 31 Tall Fescue. For the period May 1 thru July 31, seed with 60 lbs Kentucky 31 Tall Fescue per acre and 2 lbs per acre (0.05 lbs/1000 sq ft) of weeping lovegrass. During the period of October 16 thru February 28, protect site by: Option (1) 2 tons per acre of well anchored straw mulch and seed as soon as possible in the spring. Option (2) Use sod. Option (3) Seed with 60 lbs/acre Kentucky 31 Tall Fescue and mulch with 2 tons/acre well anchored straw.

**Mulching -** Apply 1 1/2 to 2 tons per acre (70 to 90 lbs/1000 sq ft) of unrotted small grain straw immediately after seeding. Anchor mulch immediately after application using mulch anchoring tool or 218 gallons per acre (5 gal/1000 sq ft) of emulsified asphalt on flat areas. On slopes 8 feet or higher, use 348 gallons per acre (8 gal/1000 sq ft) for anchoring.

**Maintenance -** Inspect all seeded areas and make needed repairs, replacements and reseedings.

TEMPORARY SEEDING NOTES

Apply to graded or cleared areas likely to be redisturbed where a short-term vegetative cover is needed.

**Seedbed Preparation:** Loosen upper three inches of soil by raking, discing or other acceptable means before seeding, if not previously loosened.


**Soil Amendments:** Apply 60 lbs per acre 10-10-10 fertilizer (14 lbs/1000 sq ft).

**Seeding:** For periods March 1 thru April 30 and from August 15 thru November 15, seed with 2 1/2 bushel per acre of annual ryegrass (3.2 lbs/1000 sq ft). For the period May 1 thru August 14, seed with 3 lbs per acre of weeping lovegrass (.07 lbs/1000 sq ft). For the period November 16 thru February 28, protect site by applying 2 tons per acre of well anchored straw mulch and seed as soon as possible in the spring, or use sod.

**Mulching:** Apply 1 1/2 to 2 tons per acre (70 to 90 lbs/1000 sq ft) of unrotted small grain straw immediately after seeding. Anchor mulch immediately after application using mulch anchoring tool or 218 gal per acre (5 gal/1000 sq ft) of emulsified asphalt on flat areas. On slopes 8 ft or higher, use 348 gal per acre (8 gal/1000 sq ft) for anchoring.

Refer to the 1983 MARYLAND STANDARDS AND SPECIFICATIONS FOR SOIL EROSION AND SEDIMENT CONTROL for rate and methods not covered.

LEGEND

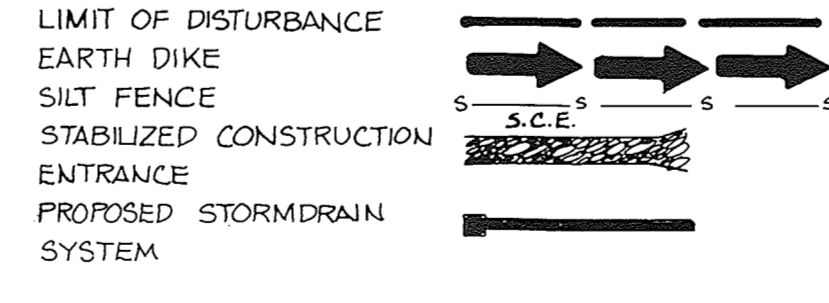

SEQUENCE OF CONSTRUCTION

1. Obtain grading permit.
2. Notify Howard County Bureau of Inspection and Permits (992-2437) at least 24 hours before starting work.
3. Construct stabilized Construction Entrance.
4. Install perimeter sediment control measures.
5. Construct RS-1 and stormwater management outfall S-1.
6. Construct infiltration basin. Initial basin excavation of stormwater management facility shall be made to elevation 463.00. Temporary 12" orifice shall be constructed at this time.
7. Clear, grub and rough grade site.
8. Begin construction of buildings A, B, and C.
9. Construct sewage disposal system and water service for Building A.
10. Construct storm drainage system.
11. Construct parking lot and improvements to Maryland Route 108.
12. Upon stabilization of contributing drainage area to infiltration basin, excavation of pond shall be made to finished bottom elevation 461.90 and temporary 12" orifice shall be plugged.
13. During grading and after each rainfall, the contractor shall inspect and provide necessary maintenance on the sediment and erosion control measures shown herein.
14. During grading, sediment shall be removed from the sediment traps when the cleanout elevation has been reached.
15. Following initial soil disturbance or redistribution, permanent or temporary stabilization shall be completed within:
  - A. 7 calendar days for all perimeter sediment control structures, dikes, swales, ditch perimeter slopes and all slopes greater than 3:1.
  - B. 14 days for all other disturbed areas.
16. With the approval of the Sediment Control Inspector, remove all sediment control structures.



NO.	REVISION	BY	DATE
1	RECONSTRUCTION OF EX STRUCTURE, REMOVE EXISTING 4" R/W ISLANDS AND 6" W, REV ISLANDS	OGH	8/20/91
2	ADD DRIVEWAY ENTRANCE REVISED GRADING UPDATED 1:3 COVER SHOW AS-BUILT CONDITIONS ON ADJACENT PARCEL E3 (MAY 2021)	OGH	10/24/15
3	THIS REVISION REPLACES REV 10 PROPOSED PERIMETER WIRELESS EQUIPMENT CABINETS ON A CONCRETE PAD WITH CARRY	OGH	04/15/20


DEVELOPER / CONTRACT PURCHASER  
ZIMMERMAN CLARKSVILLE LTD PARTNERSHIP  
3601 SANDY SPRING ROAD  
BURTONSVILLE, MD 20866  
TELEPHONE: (301)384-2000

SEDIMENT AND EROSION CONTROL PLAN  
ZIMMERMAN AND SONS  
HOME IMPROVEMENT CENTER + TRANSFORM THINKERS  
REFERENCE F-90-199 AND WP-91-29

TAX MAP 34 PARCEL 358 LOT 3  
5TH ELECTION DISTRICT HOWARD COUNTY, MARYLAND

JOHN E. HARMS, JR. AND ASSOCIATES, INC.  
CONSULTING ENGINEERS - PLANNERS - SURVEYORS

8008 CENTRE PARK DRIVE  
COLUMBIA, MARYLAND 21045  
SUITE 110  
TELEPHONE (301) 740-8200

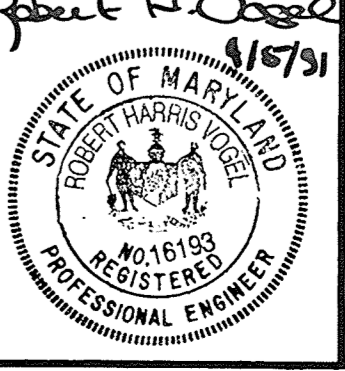

DESIGNED BY: J.A.B.  
DRAWN BY: J.J.T.  
CHECKED BY: R.H.V.  
DATE: 6/25/90  
SCALE: 1"=30'  
W.O. NO.: 45-90-004A  
4 SHEET OF 10

ENGINEER'S CERTIFICATE  
"I CERTIFY THAT THIS PLAN FOR POND CONSTRUCTION, EROSION AND SEDIMENT CONTROL REPRESENTS A PRACTICAL AND WORKABLE PLAN BASED ON MY PERSONAL KNOWLEDGE OF THE SITE CONDITIONS. THIS PLAN WAS PREPARED IN ACCORDANCE WITH THE REQUIREMENTS OF THE HOWARD SOIL CONSERVATION DISTRICT. I HAVE NOTIFIED THE DEVELOPER THAT HE MUST PROVIDE THE HOWARD SOIL CONSERVATION DISTRICT WITH AN "AS-BUILT" PLAN OF THE POND WITHIN 30 DAYS OF COMPLETION."

Robert H. Harms, Jr.  
SIGNATURE OF ENGINEER  
6/25/91  
DATE

DEVELOPER'S CERTIFICATE  
"I CERTIFY THAT ALL DEVELOPMENT AND/OR CONSTRUCTION WILL BE DONE ACCORDING TO THESE PLANS, AND THAT ANY RESPONSIBLE PERSONNEL INVOLVED IN THE CONSTRUCTION PROJECT WILL HAVE A CERTIFICATE OF ATTENDANCE AT A DEPARTMENT OF ENVIRONMENT APPROVED TRAINING PROGRAM FOR THE CONTROL OF SEDIMENT AND EROSION BEFORE BEGINNING THE PROJECT. I WILL PROVIDE THE HOWARD SOIL CONSERVATION DISTRICT WITH AN "AS-BUILT" PLAN OF THE POND WITHIN 30 DAYS OF COMPLETION. I ALSO AUTHORIZE PERIODIC ON-SITE INSPECTION BY THE HOWARD SOIL CONSERVATION DISTRICT."

Robert H. Harms, Jr.  
SIGNATURE OF DEVELOPER  
4/25/91  
DATE

THESE PLANS HAVE BEEN REVIEWED FOR THE HOWARD SOIL CONSERVATION DISTRICT AND MEET THE TECHNICAL REQUIREMENTS FOR SMALL POND CONSTRUCTION, SOIL EROSION AND SEDIMENT CONTROL.

Robert H. Harms, Jr. 5/1/91  
DATE

THESE PLANS FOR SMALL POND CONSTRUCTION, SOIL EROSION AND SEDIMENT CONTROL MEET THE REQUIREMENTS OF THE HOWARD SOIL CONSERVATION DISTRICT.

Robert H. Harms, Jr. 5/1/91  
DATE

APPROVED: HOWARD COUNTY DEPARTMENT OF PLANNING AND ZONING

James M. Boyd 6/4/91  
DIRECTOR DATE

James M. Boyd 6/6/91  
CHIEF, DIVISION OF COMMUNITY PLANNING AND LAND DEVELOPMENT DATE

APPROVED: FOR STORM DRAINAGE SYSTEMS AND PUBLIC ROADS. HOWARD COUNTY DEPARTMENT OF PUBLIC WORKS





























James M. Boyd 5/23/91  
DIRECTOR DATE

James M. Boyd 5/23/91  
CHIEF, BUREAU OF ENGINEERING DATE

APPROVED: FOR PRIVATE WATER AND PRIVATE SEWERAGE SYSTEMS. HOWARD COUNTY HEALTH DEPARTMENT

James M. Boyd 5/10/91  
COUNTY HEALTH OFFICER DATE



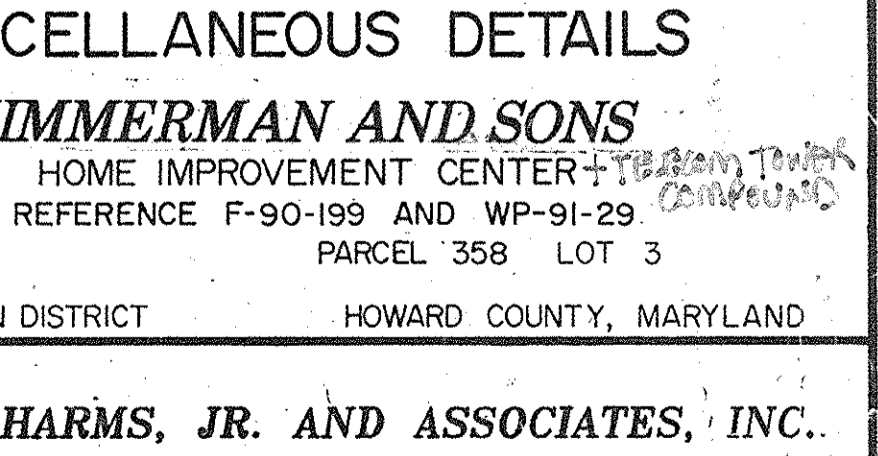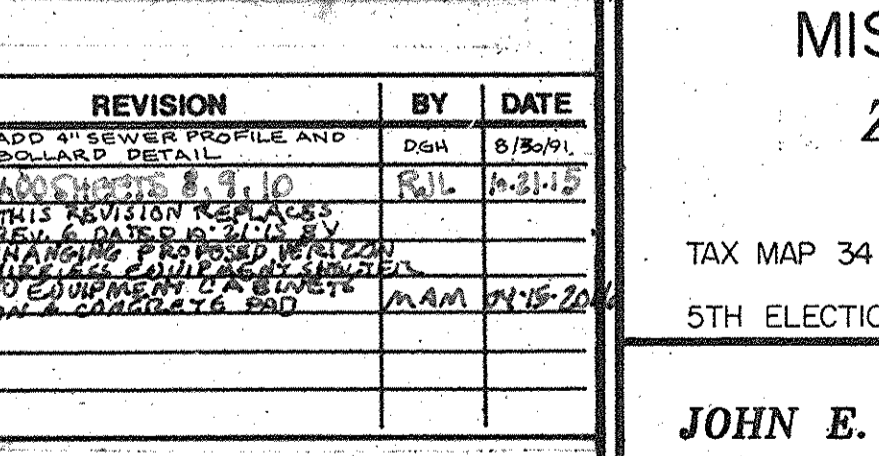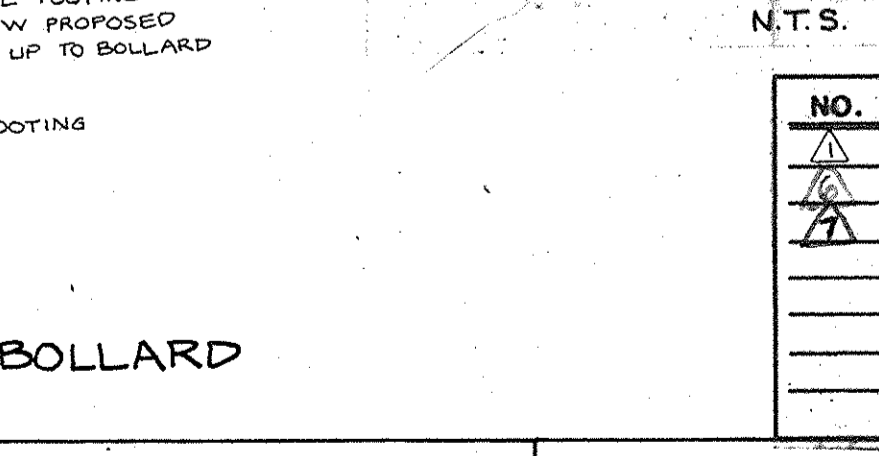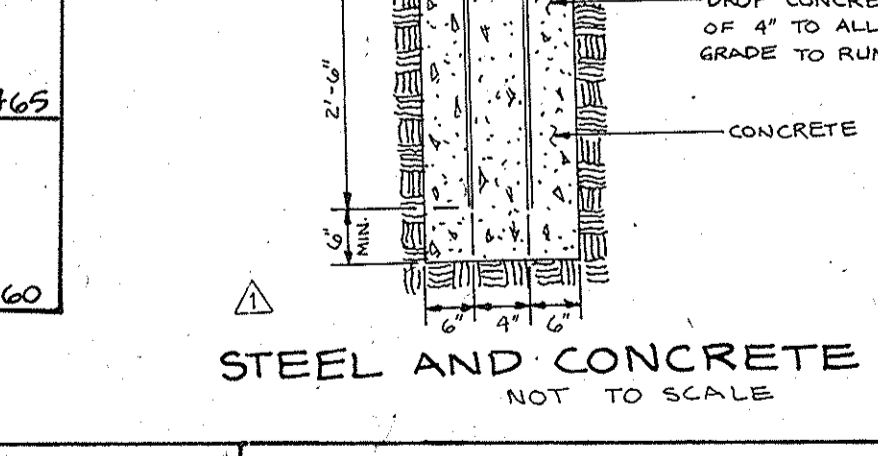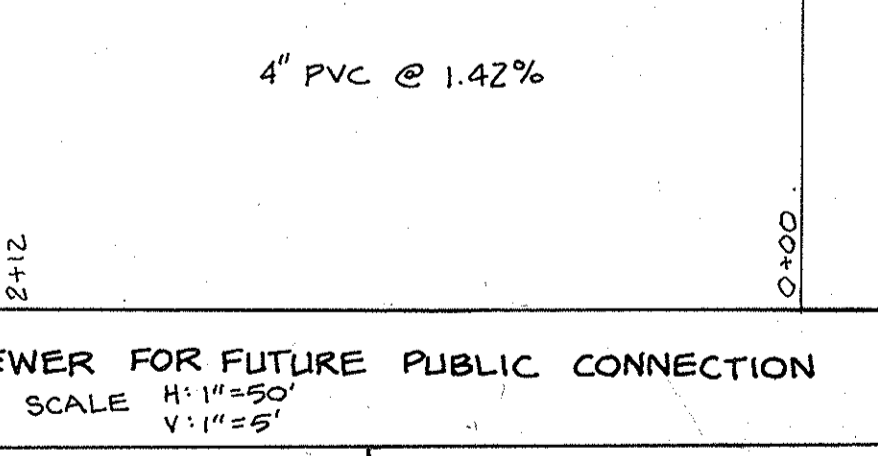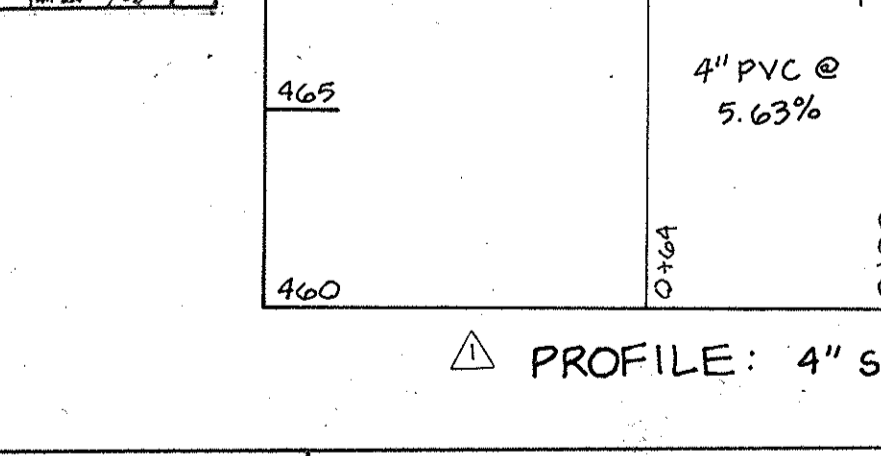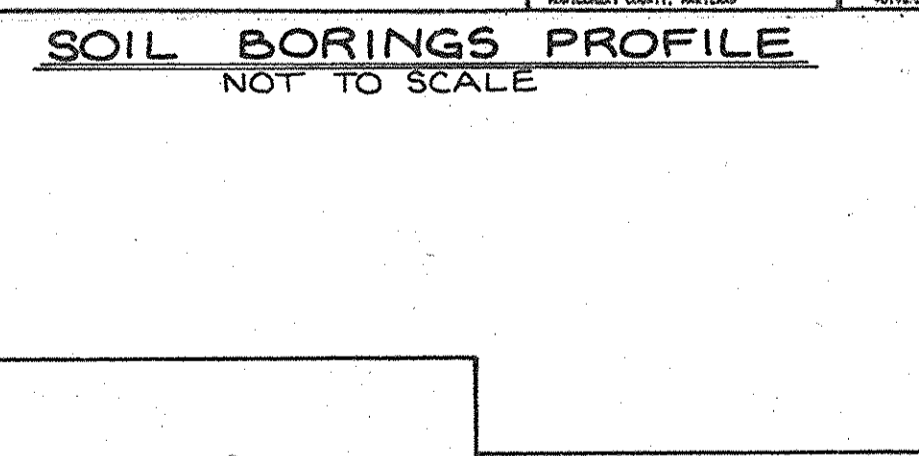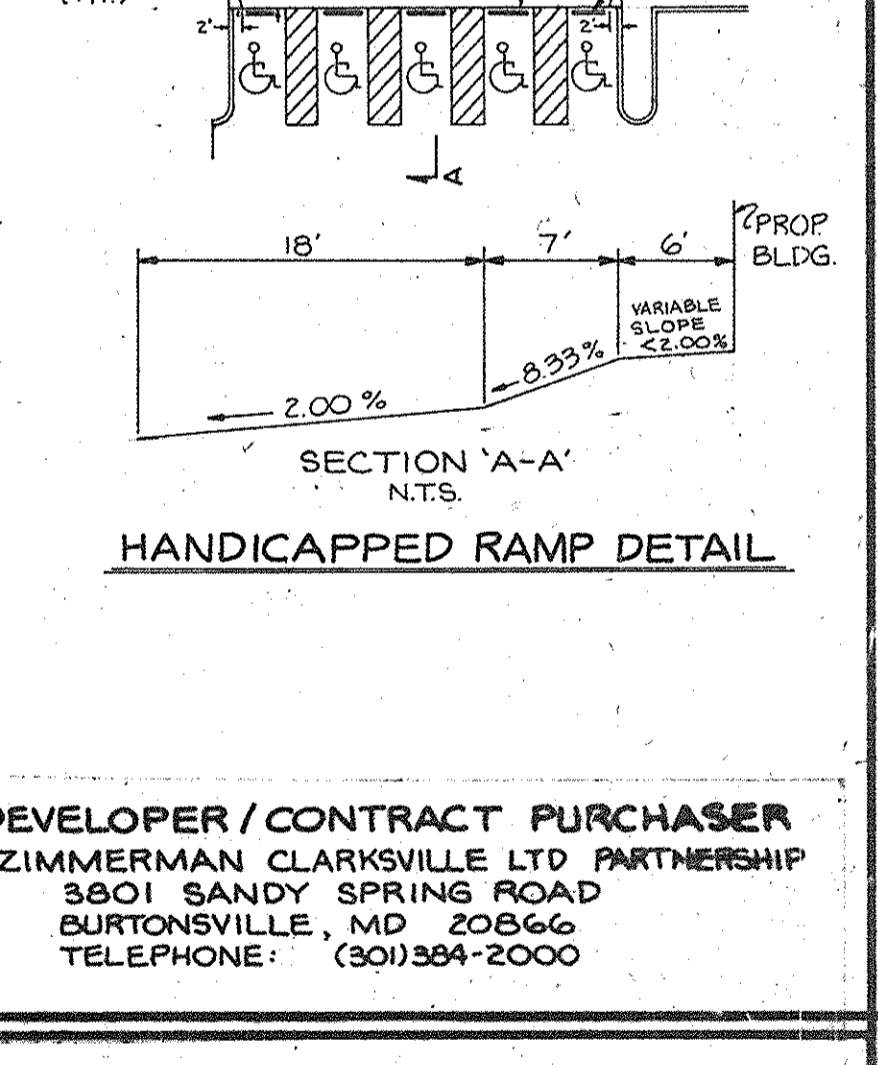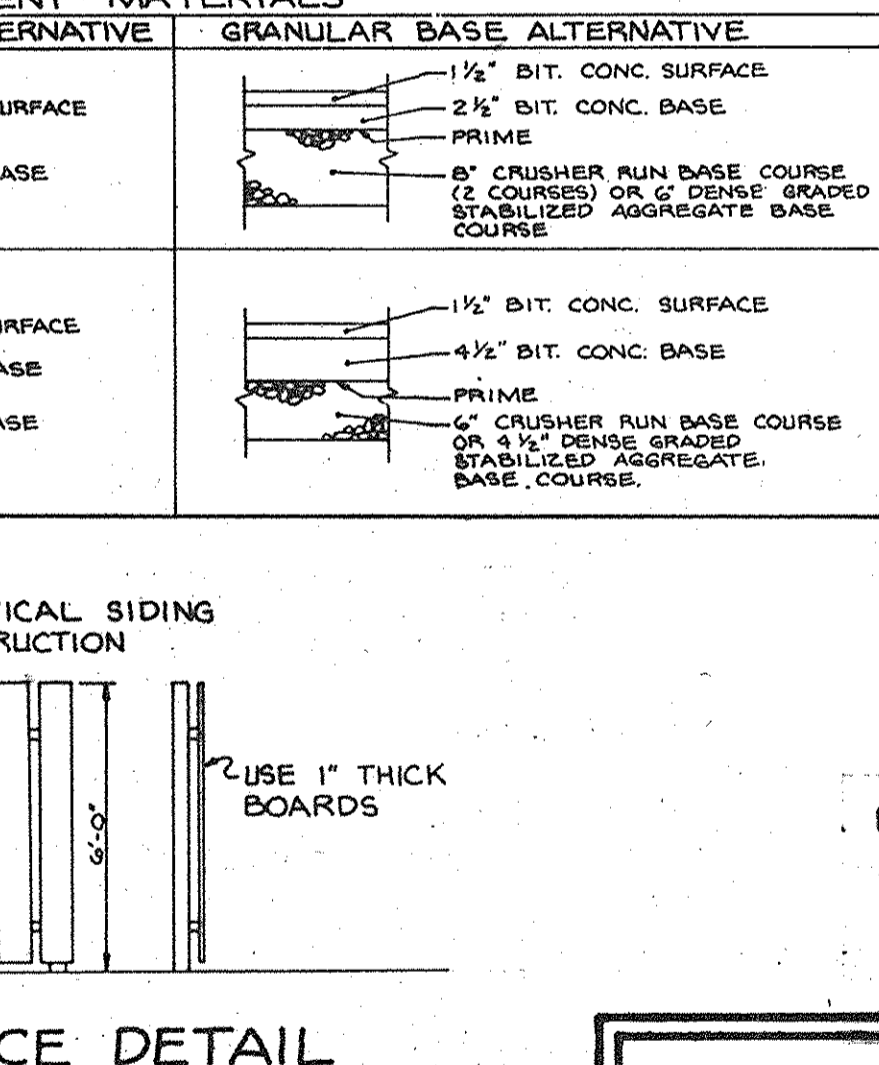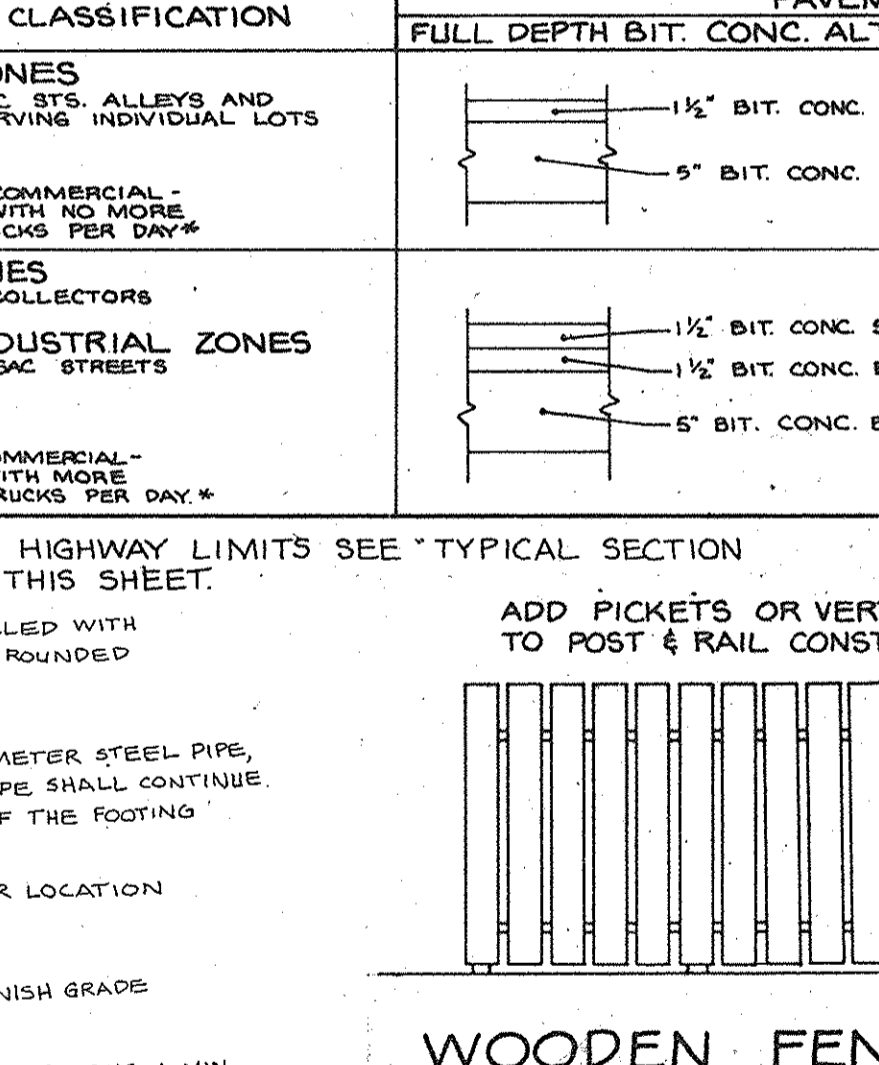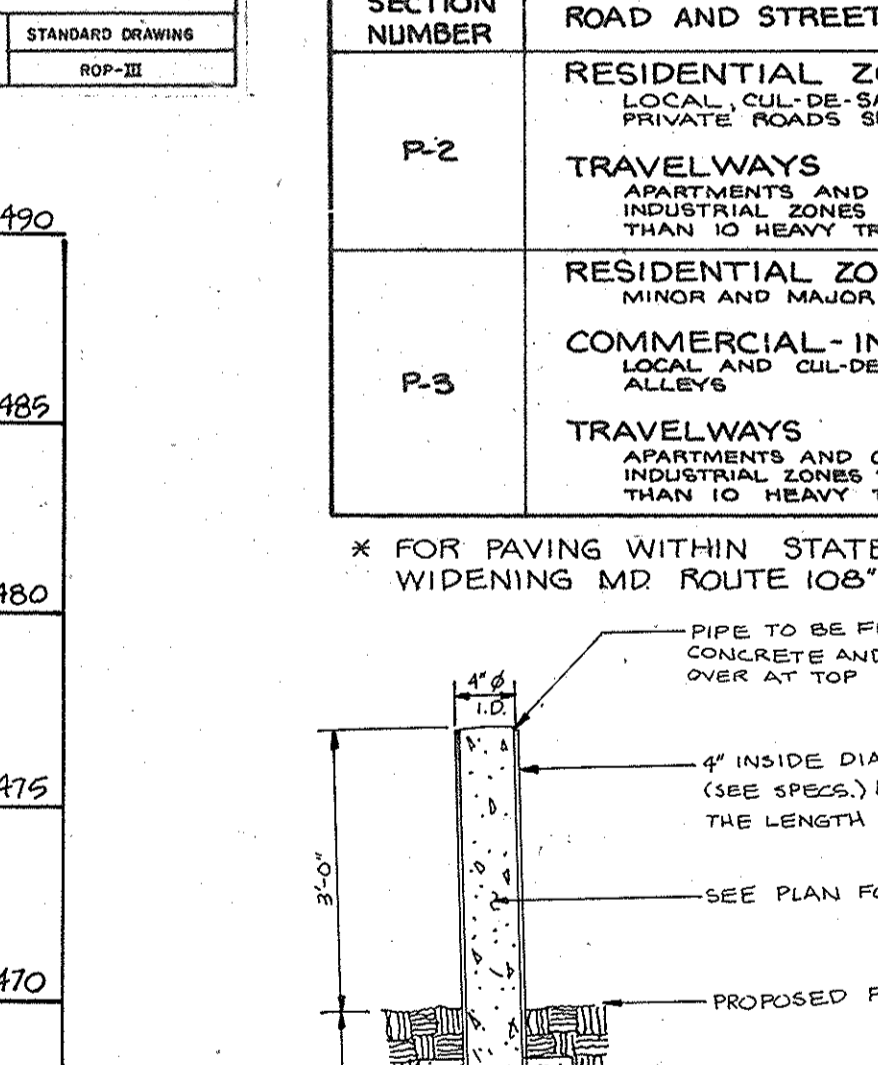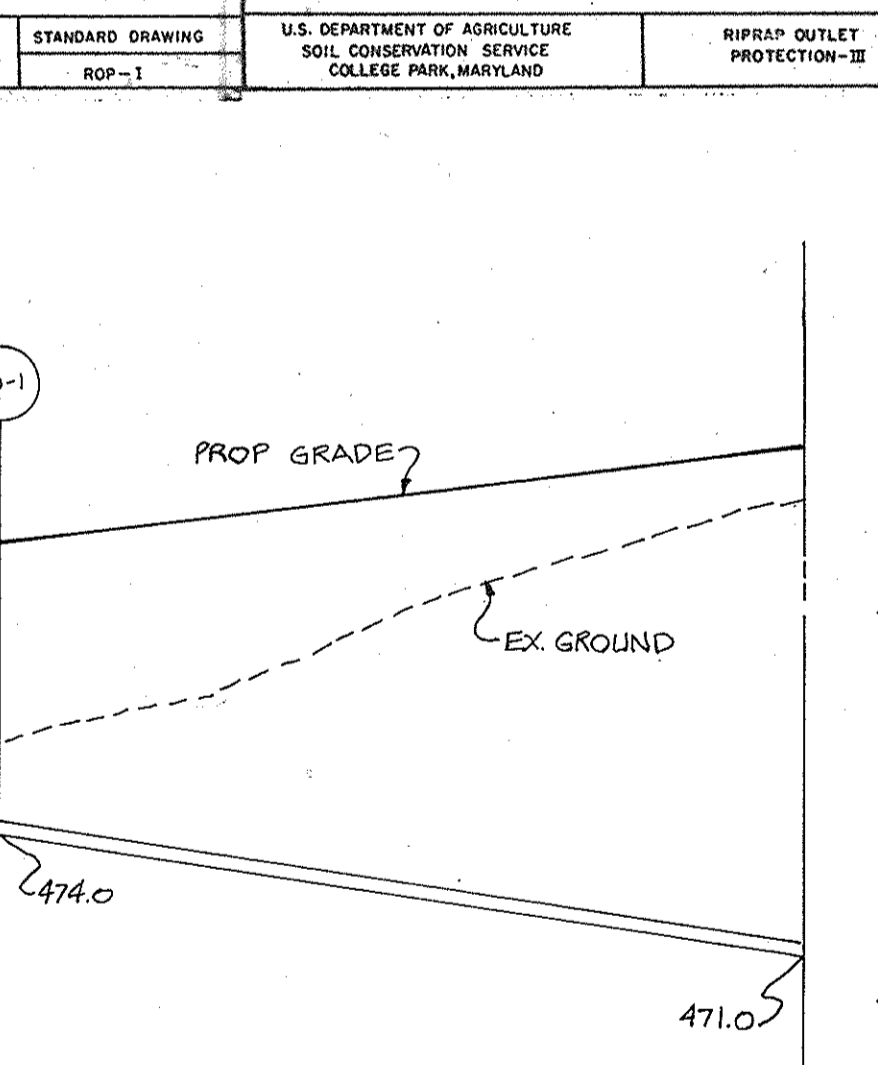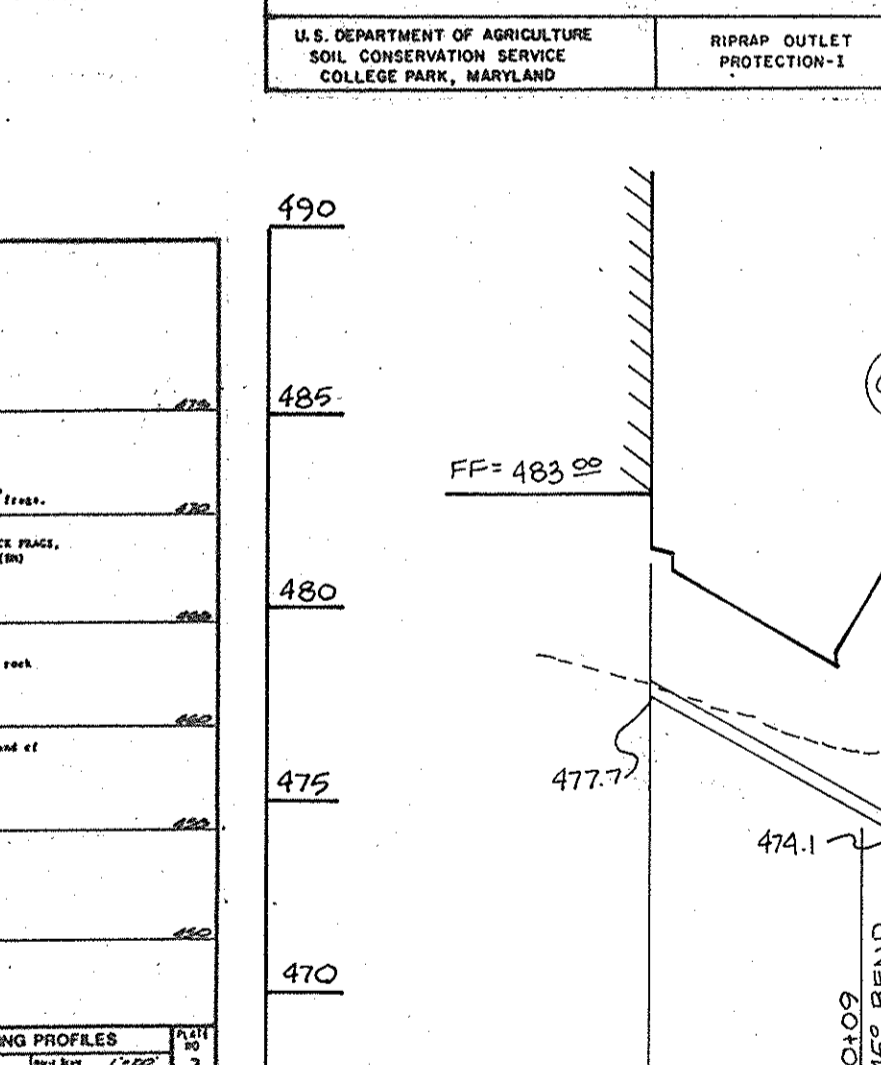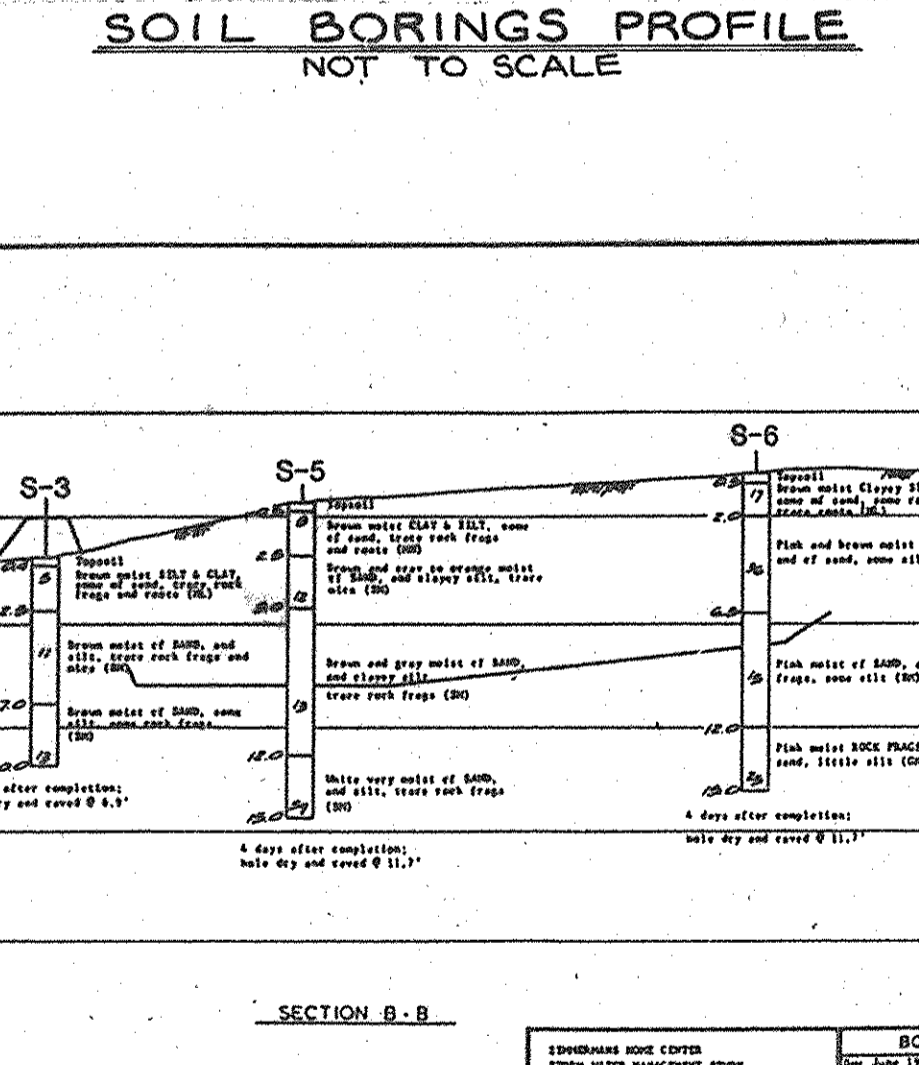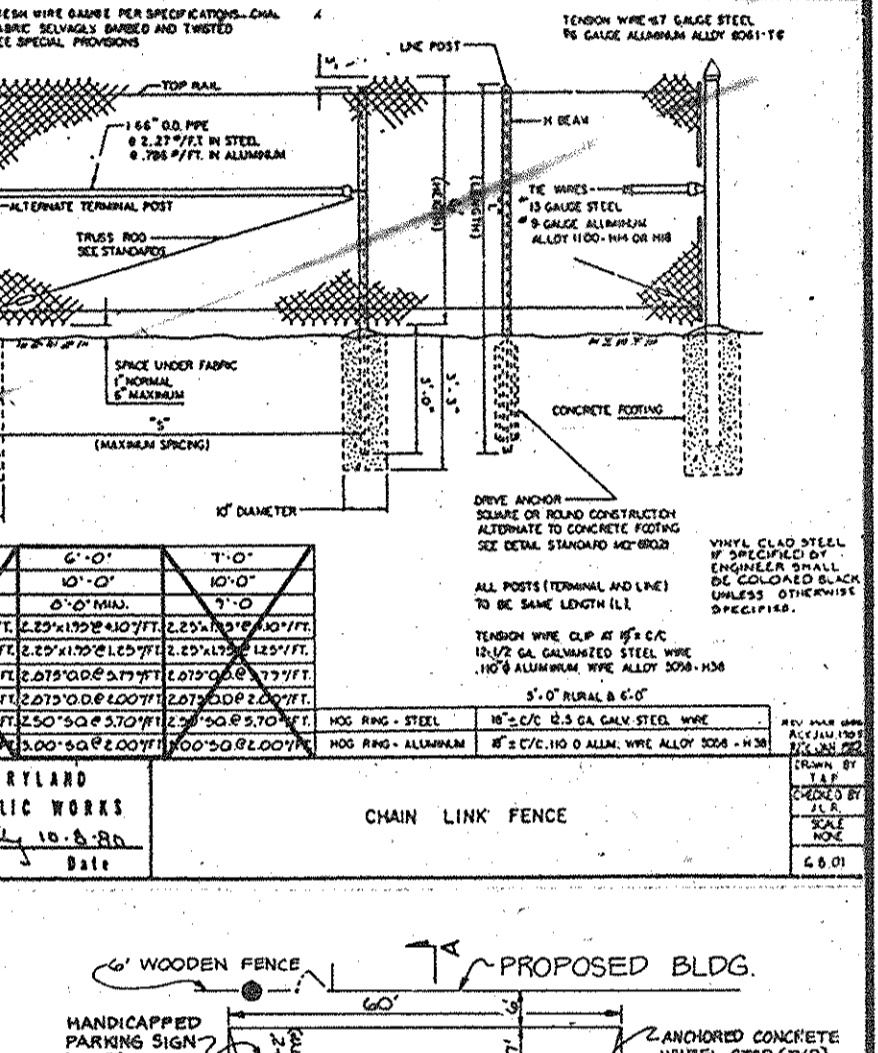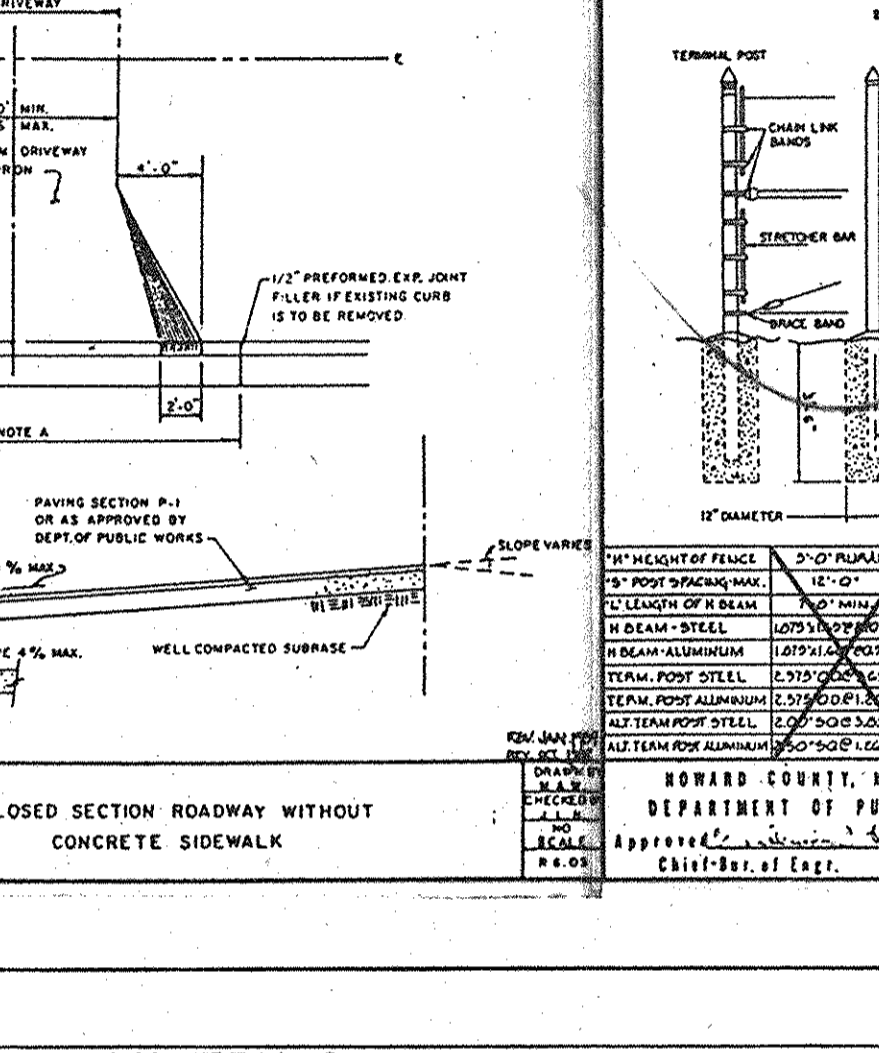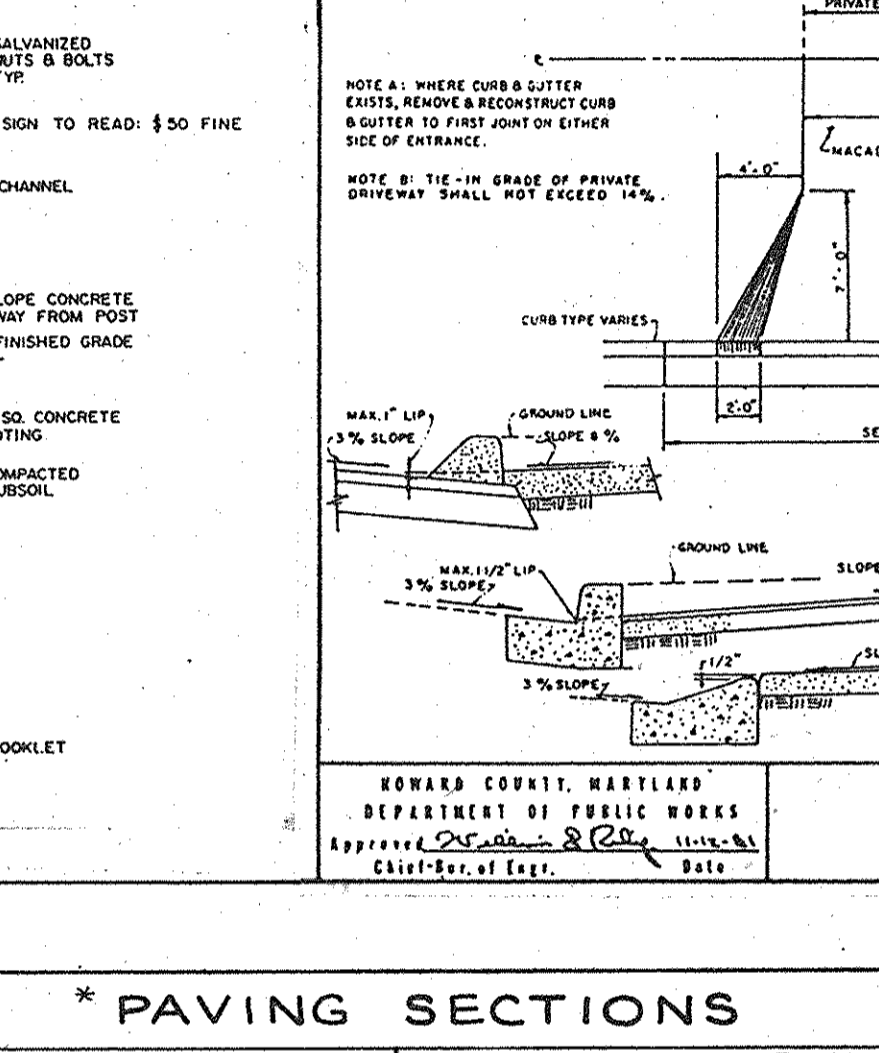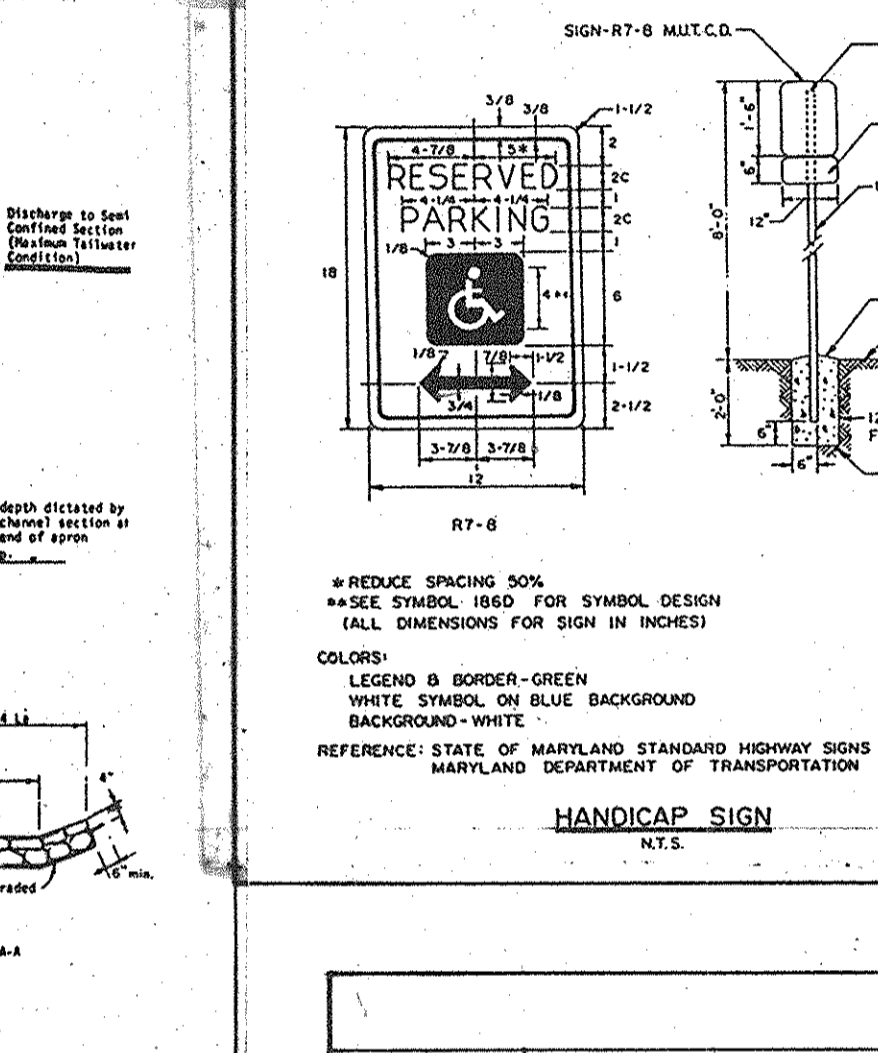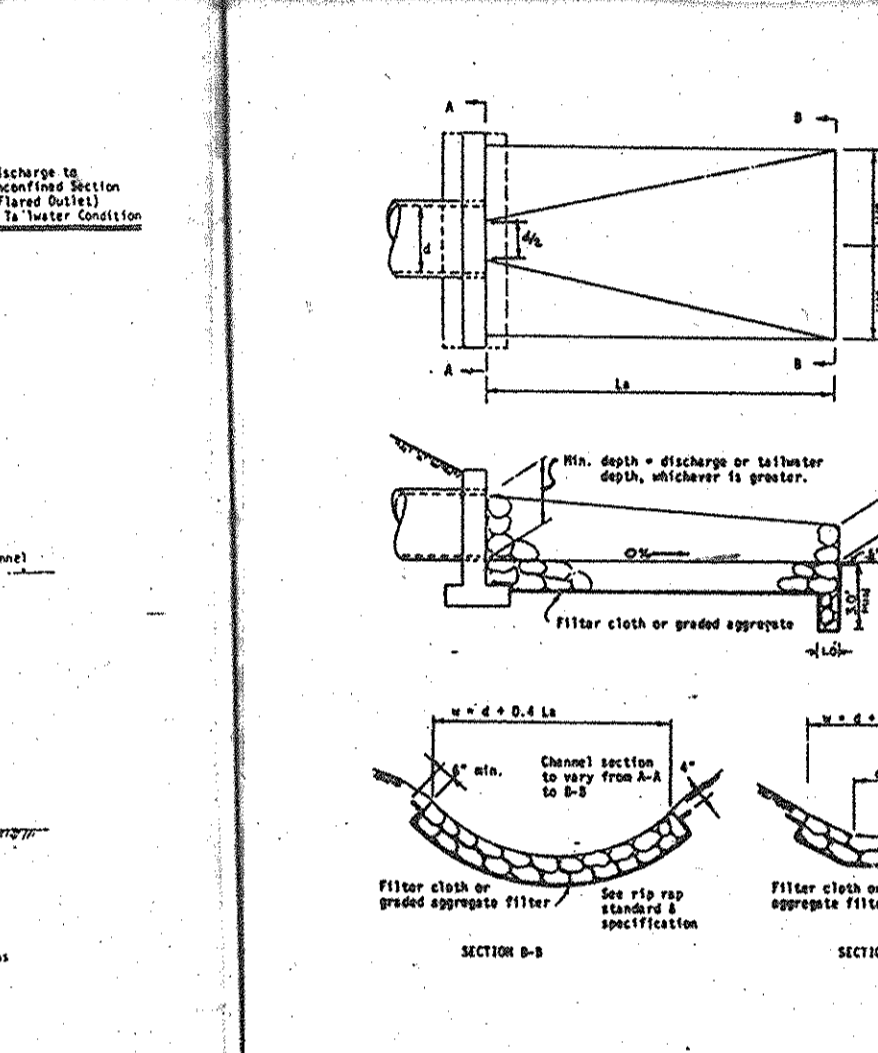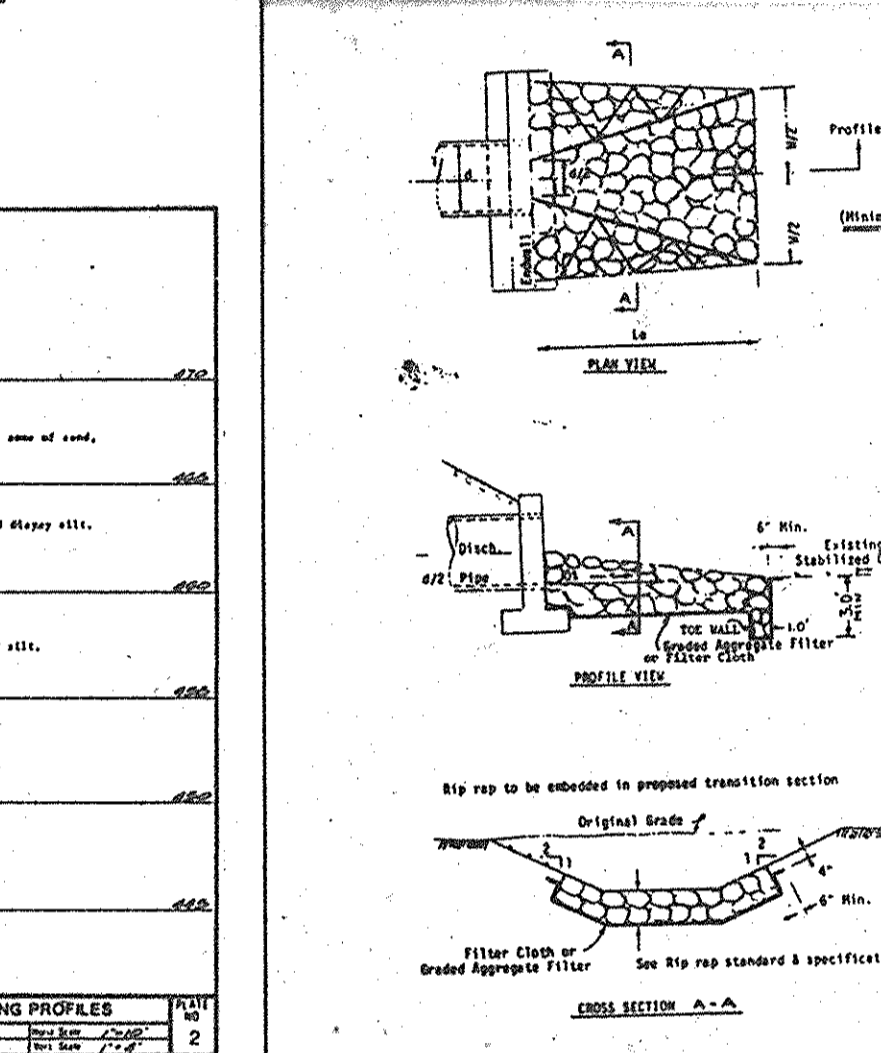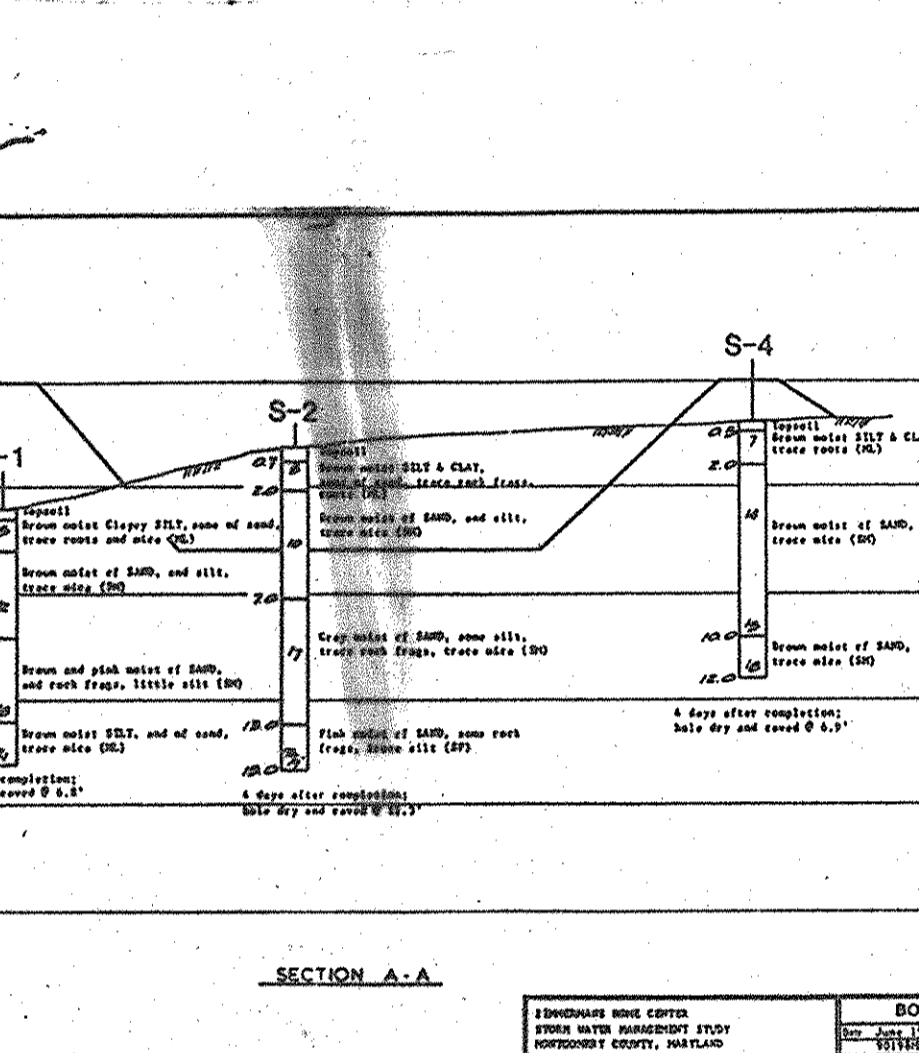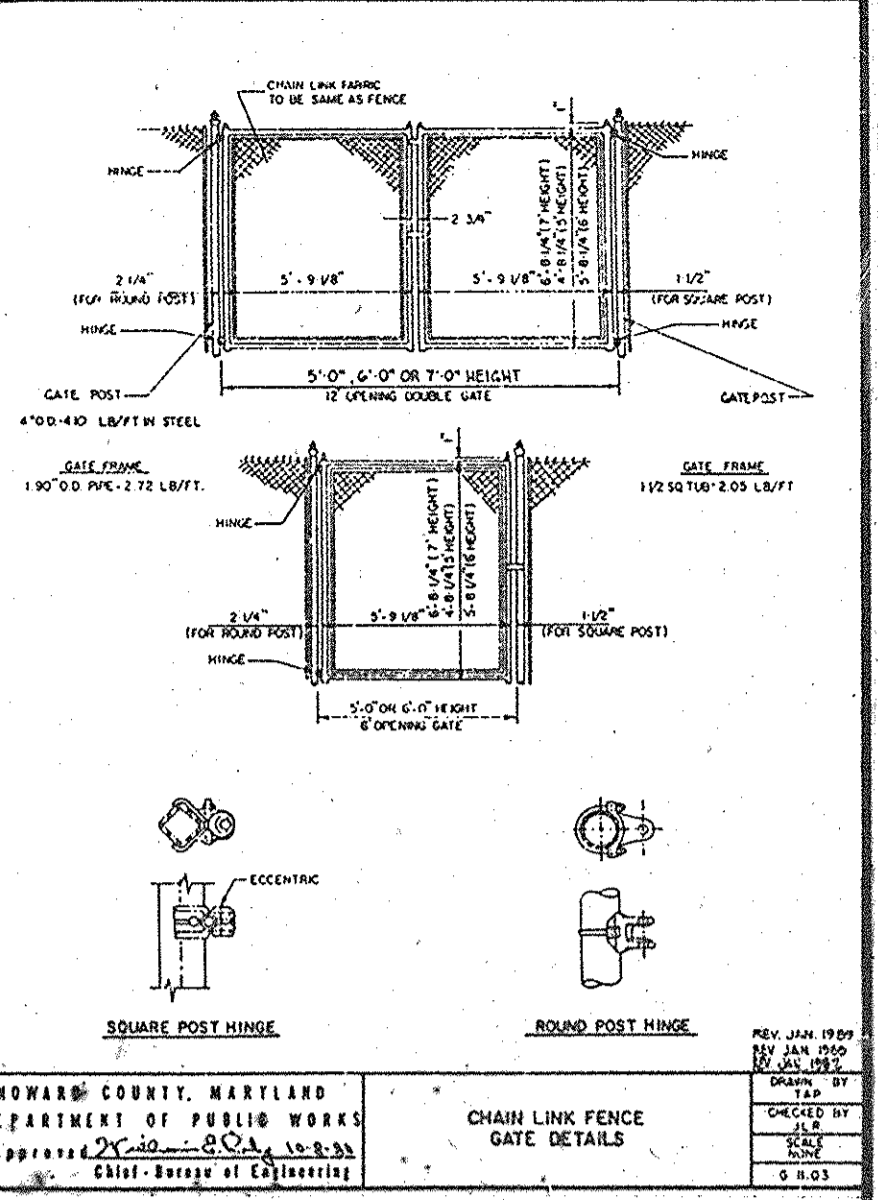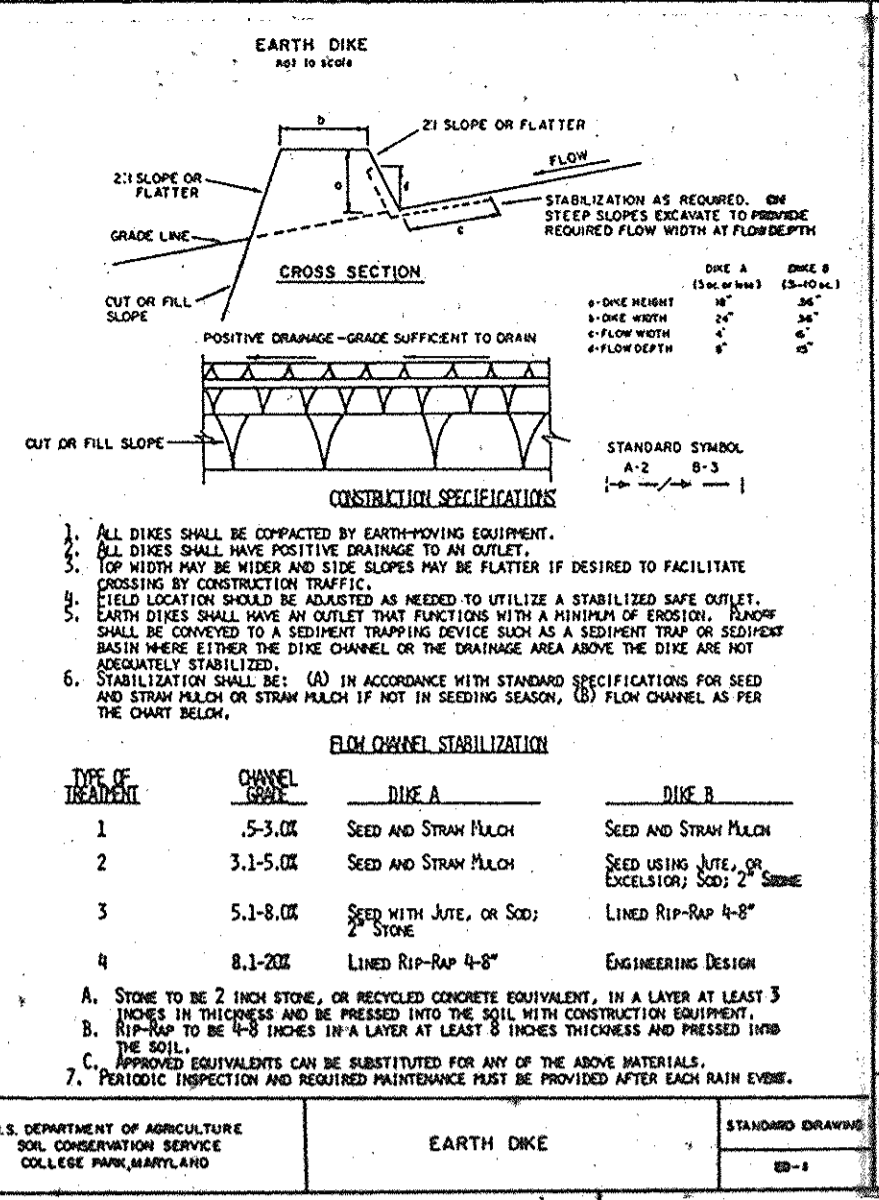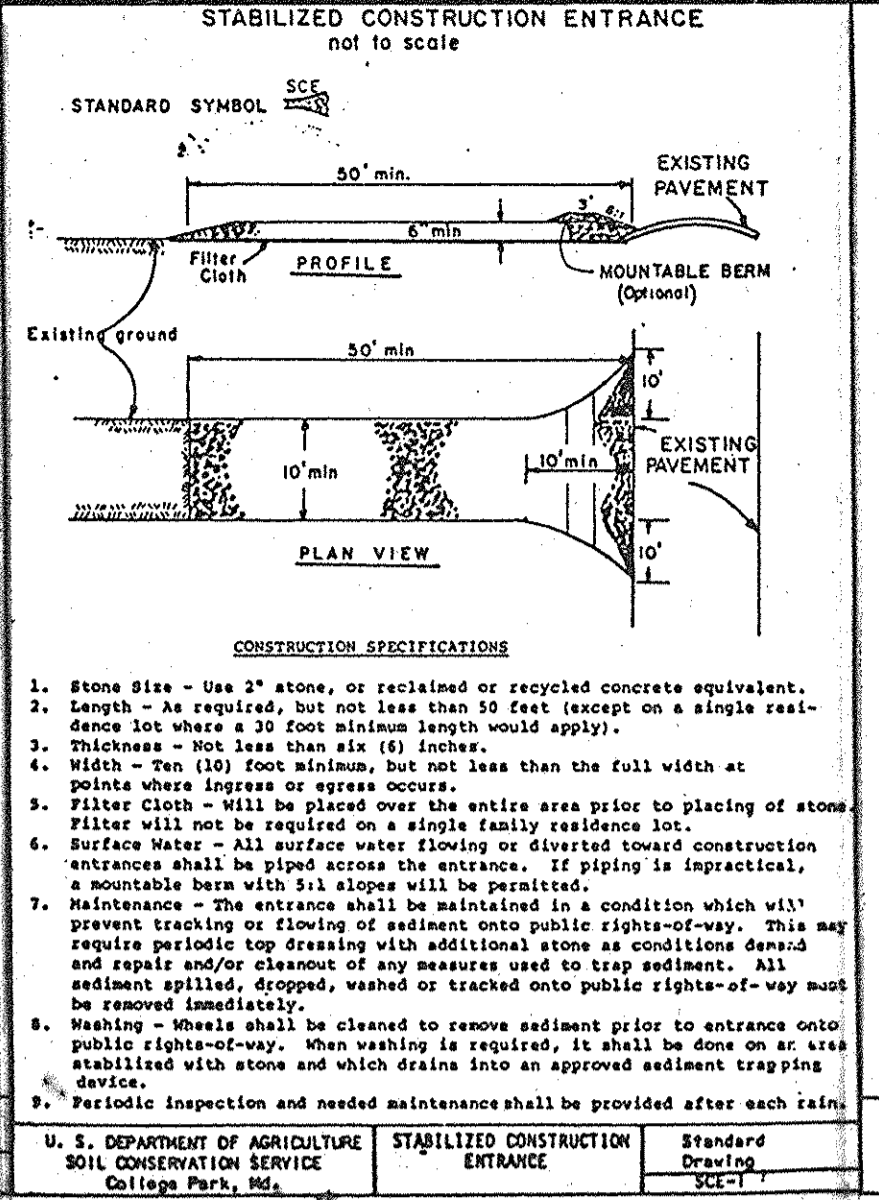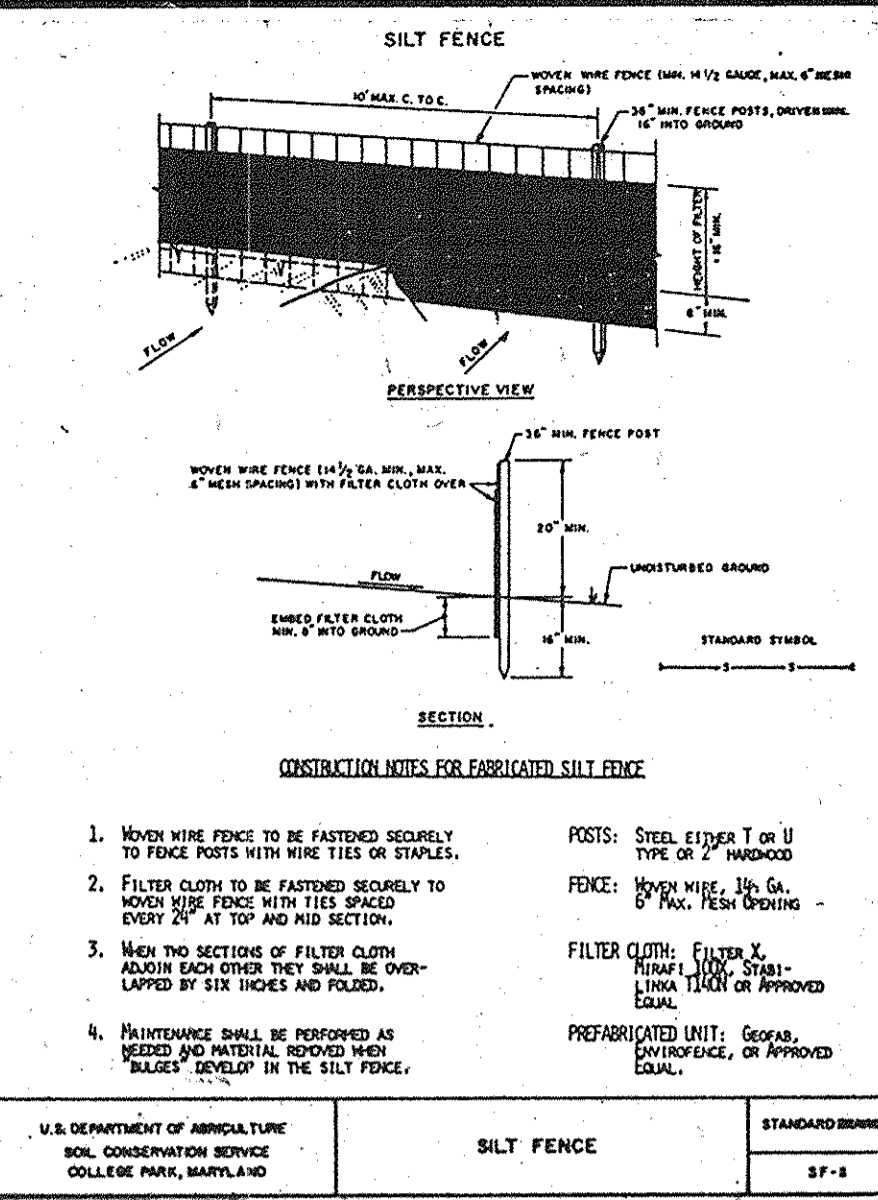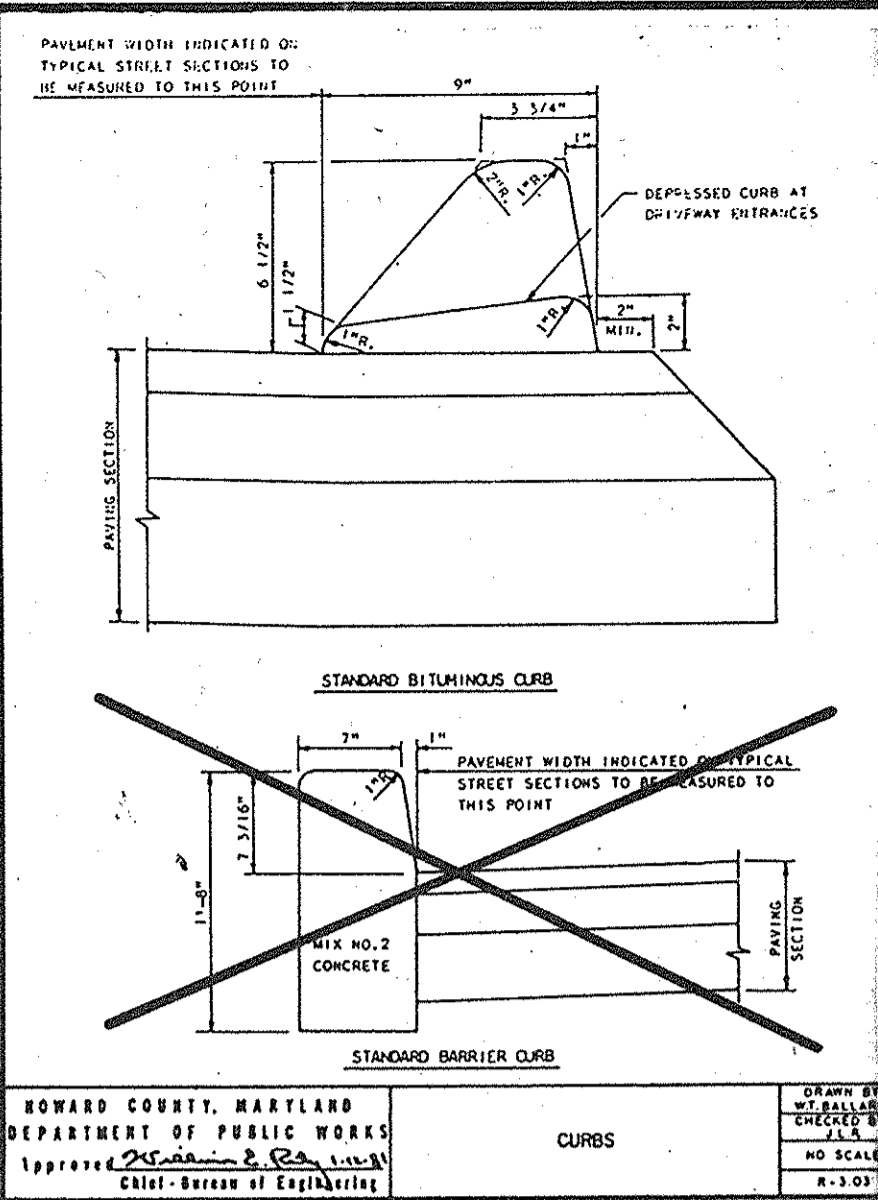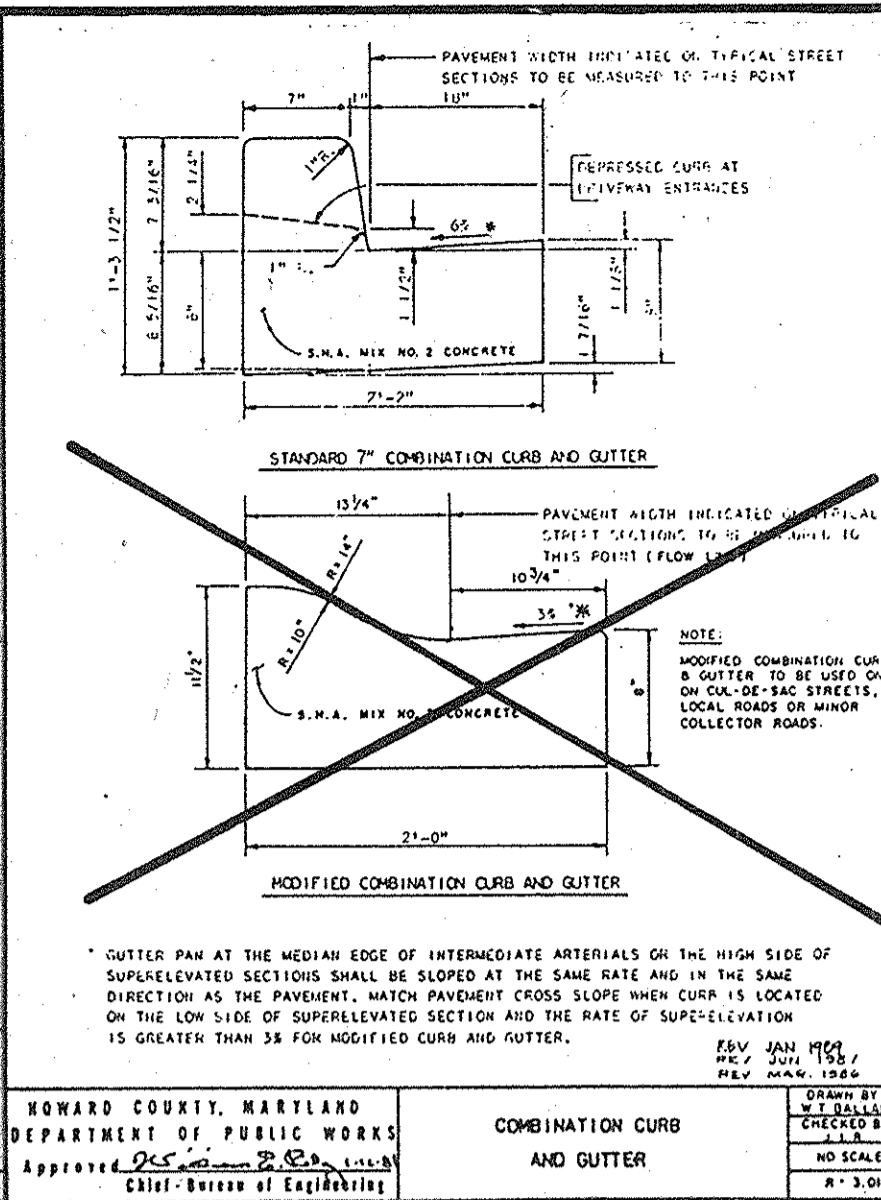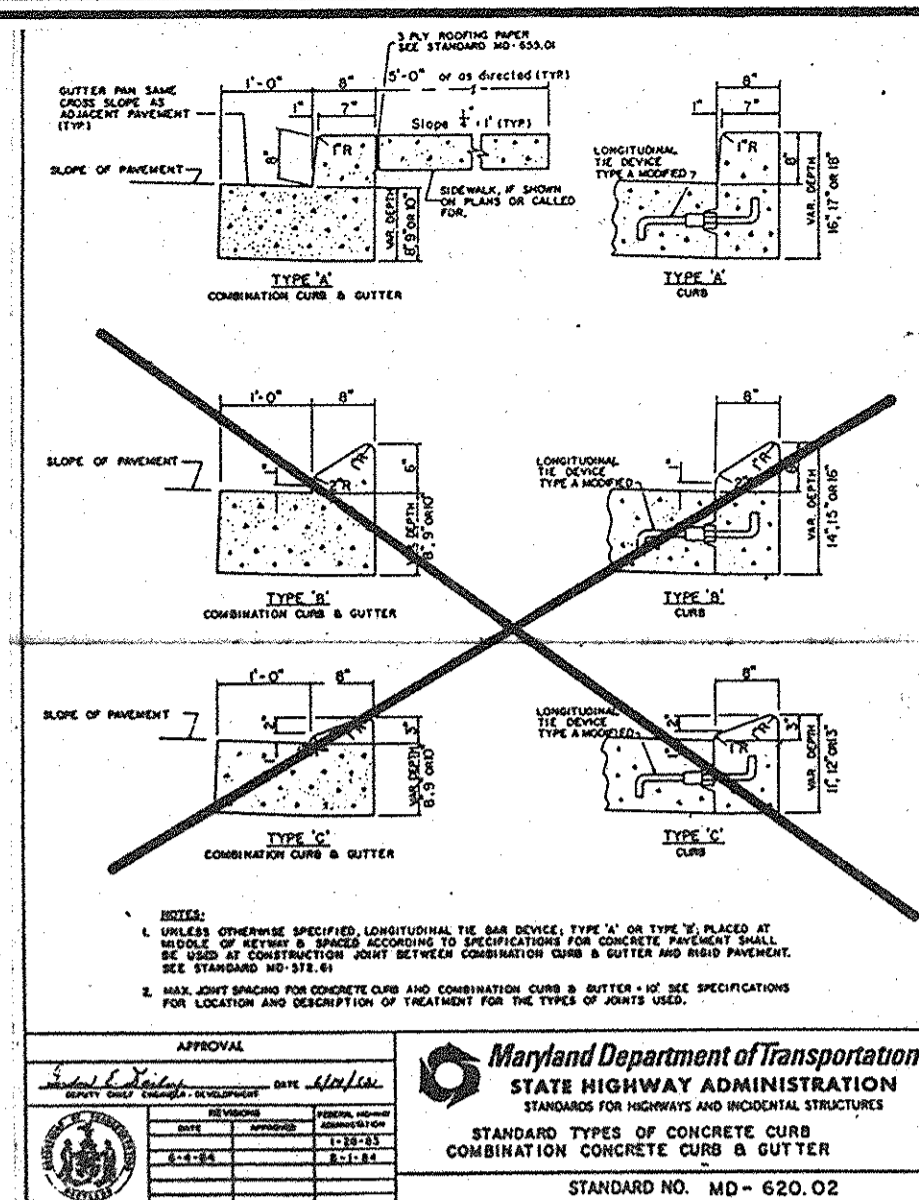

**ENGINEER'S CERTIFICATE**  
 I CERTIFY THAT THIS PLAN FOR POND CONSTRUCTION, EROSION AND SEDIMENT CONTROL REPRESENTS A PRACTICAL AND WORKABLE PLAN BASED ON MY PERSONAL KNOWLEDGE OF THE SITE CONDITIONS. THIS PLAN WAS PREPARED IN ACCORDANCE WITH THE REQUIREMENTS OF THE HOWARD SOIL CONSERVATION DISTRICT. I HAVE NOTIFIED THE DEVELOPER THAT HE MUST PROVIDE THE HOWARD SOIL CONSERVATION DISTRICT WITH AN "AS-BUILT" PLAN OF THE POND WITHIN 30 DAYS OF COMPLETION.

Robert W. Vogel 4/15/91  
 SIGNATURE OF ENGINEER DATE

**DEVELOPER'S CERTIFICATE**  
 I CERTIFY THAT ALL DEVELOPMENT AND/OR CONSTRUCTION WILL BE DONE ACCORDING TO THESE PLANS, AND THAT ANY RESPONSIBLE PERSONNEL INVOLVED IN THE CONSTRUCTION PROJECT WILL HAVE A CERTIFICATE OF ATTENDANCE AT A DEPARTMENT OF ENVIRONMENT APPROVED TRAINING PROGRAM FOR THE CONTROL OF SEDIMENT AND EROSION BEFORE BEGINNING THE PROJECT. I WILL PROVIDE THE HOWARD SOIL CONSERVATION DISTRICT WITH AN "AS-BUILT" PLAN OF THE POND WITHIN 30 DAYS OF COMPLETION. I ALSO AUTHORIZE PERIODIC ON-SITE INSPECTION BY THE HOWARD SOIL CONSERVATION DISTRICT.

Robert Zimmerman 4/27/91  
 SIGNATURE OF DEVELOPER DATE

THESE PLANS HAVE BEEN REVIEWED FOR THE HOWARD SOIL CONSERVATION DISTRICT AND MEET THE TECHNICAL REQUIREMENTS FOR SMALL POND CONSTRUCTION, SOIL EROSION AND SEDIMENT CONTROL.

Robert W. Vogel 5/1/91  
 U.S. SOIL CONSERVATION SERVICE DATE

THESE PLANS FOR SMALL POND CONSTRUCTION, SOIL EROSION AND SEDIMENT CONTROL MEET THE REQUIREMENTS OF THE HOWARD SOIL CONSERVATION DISTRICT.

Robert W. Vogel 5/1/91  
 HOWARD S.C.D. DATE

APPROVED: HOWARD COUNTY DEPARTMENT OF PLANNING AND ZONING

James S. Hester 6/4/91  
 DIRECTOR DATE

James S. Hester 6/10/91  
 CHIEF, DIVISION OF COMMUNITY PLANNING AND LAND DEVELOPMENT DATE

APPROVED: FOR PUBLIC WATER AND PUBLIC SEWERAGE STORM DRAINAGE SYSTEMS AND PUBLIC ROADS

James S. Hester 6/10/91  
 DIRECTOR DATE

James S. Hester 6/10/91  
 CHIEF, BUREAU OF ENGINEERING DATE

APPROVED: FOR PUBLIC WATER AND PUBLIC SEWERAGE SYSTEMS

James M. Boyd 5/10/91  
 COUNTY HEALTH OFFICER DATE

**MISCELLANEOUS DETAILS**

ZIMMERMAN AND SONS  
 HOME IMPROVEMENT CENTER  
 REFERENCE F-90-199 AND WP-91-29

TAX MAP 34 PARCEL 358 LOT 3  
 5TH ELECTION DISTRICT HOWARD COUNTY, MARYLAND

JOHN E. HARMS, JR. AND ASSOCIATES, INC.  
 CONSULTING ENGINEERS - PLANNERS - SURVEYORS

8008 CENTRAL PARK DRIVE SUITE 110  
 COLUMBIA, MARYLAND 21045 TELEPHONE (301) 740-5200




DESIGNED BY: TAB  
 DRAWN BY: D.G.H.  
 CHECKED BY: R.H.V.  
 DATE: 6/25/90  
 SCALE: AS SHOWN  
 W.O. NO.: 45-90-004A

6 SHEET OF 10

SDP 90-220





PRECAST SEPTIC TANK, ST 5 X 10 - 15, 1,500 GAL./HEAVY DUTY.

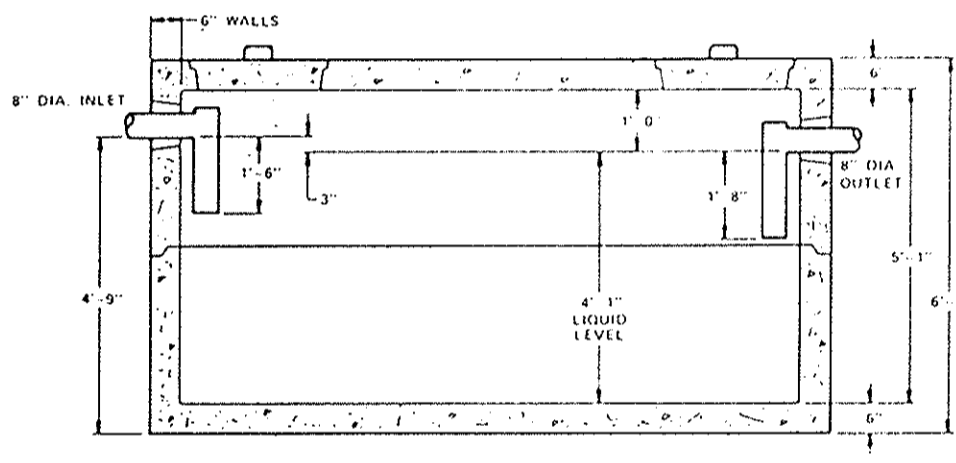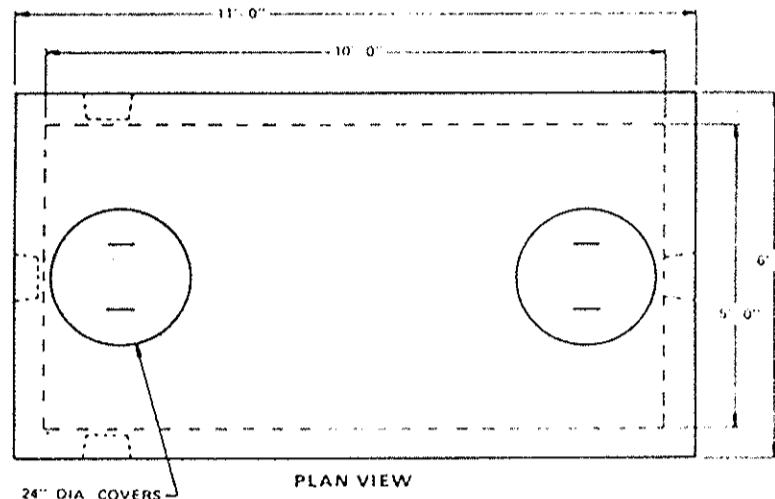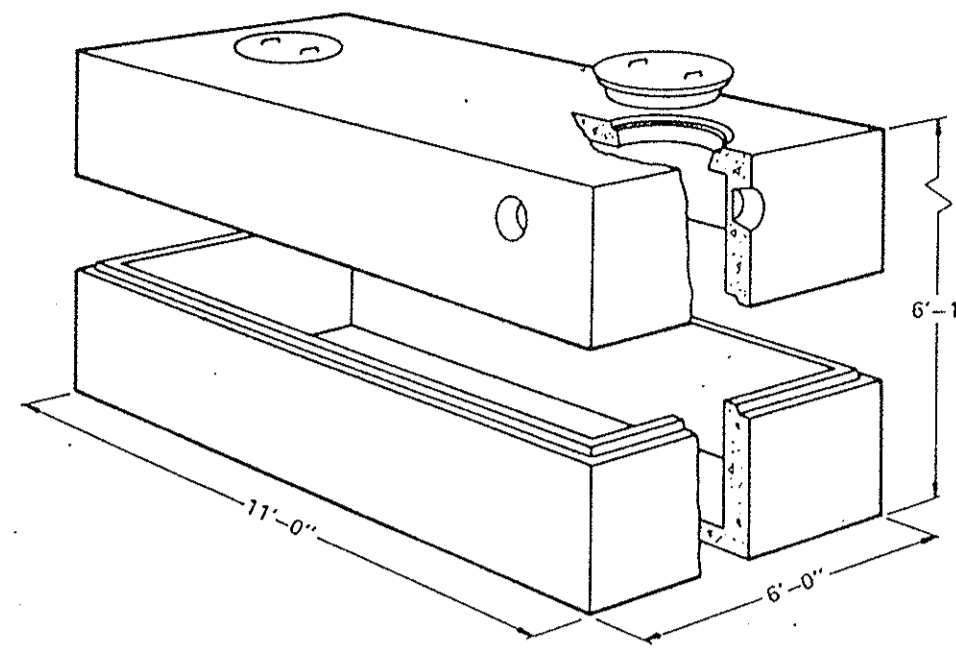

SPECIFICATIONS

CONCRETE MINIMUM STRENGTH - 5,000 P.S.I. @ 28 DAYS  
 STEEL REINFORCEMENT - ASTM A-615-79, GRADE 60, 1" MIN. COVER  
 DESIGN LOADING - AASHTO HS20-44  
 EARTH COVER - 0 TO 5 FEET  
 WATER TABLE - 3/4 FEET BELOW FINISH GRADE  
 CONSTRUCTION JOINT - SEALED WITH 1" DIA. BUTYL RUBBER OR EQUIVALENT  
 TEES - PROVIDED AND INSTALLED BY OTHERS


SEPTIC TANK DETAIL  
N.T.S.

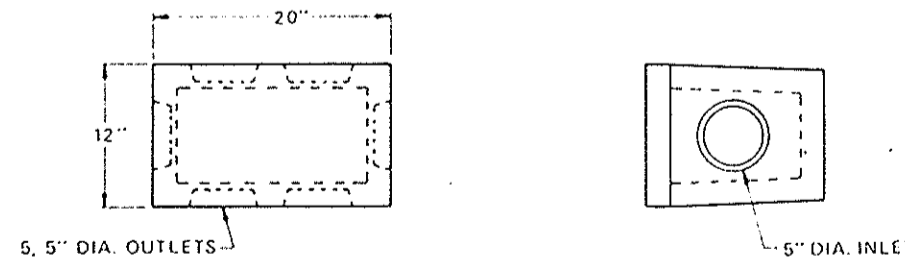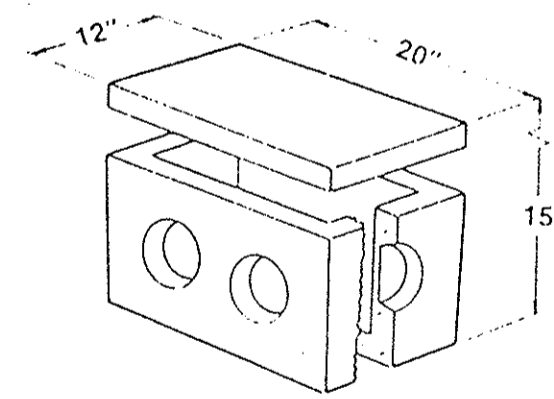


SPECIFICATIONS

Concrete Minimum Strength - 4,000 P.S.I. @ 28 Days  
 Steel Reinforcement - ASTM A-615-75, Grade 60, 1" Min. Cover

DISTRIBUTION BOX DETAIL  
N.T.S.

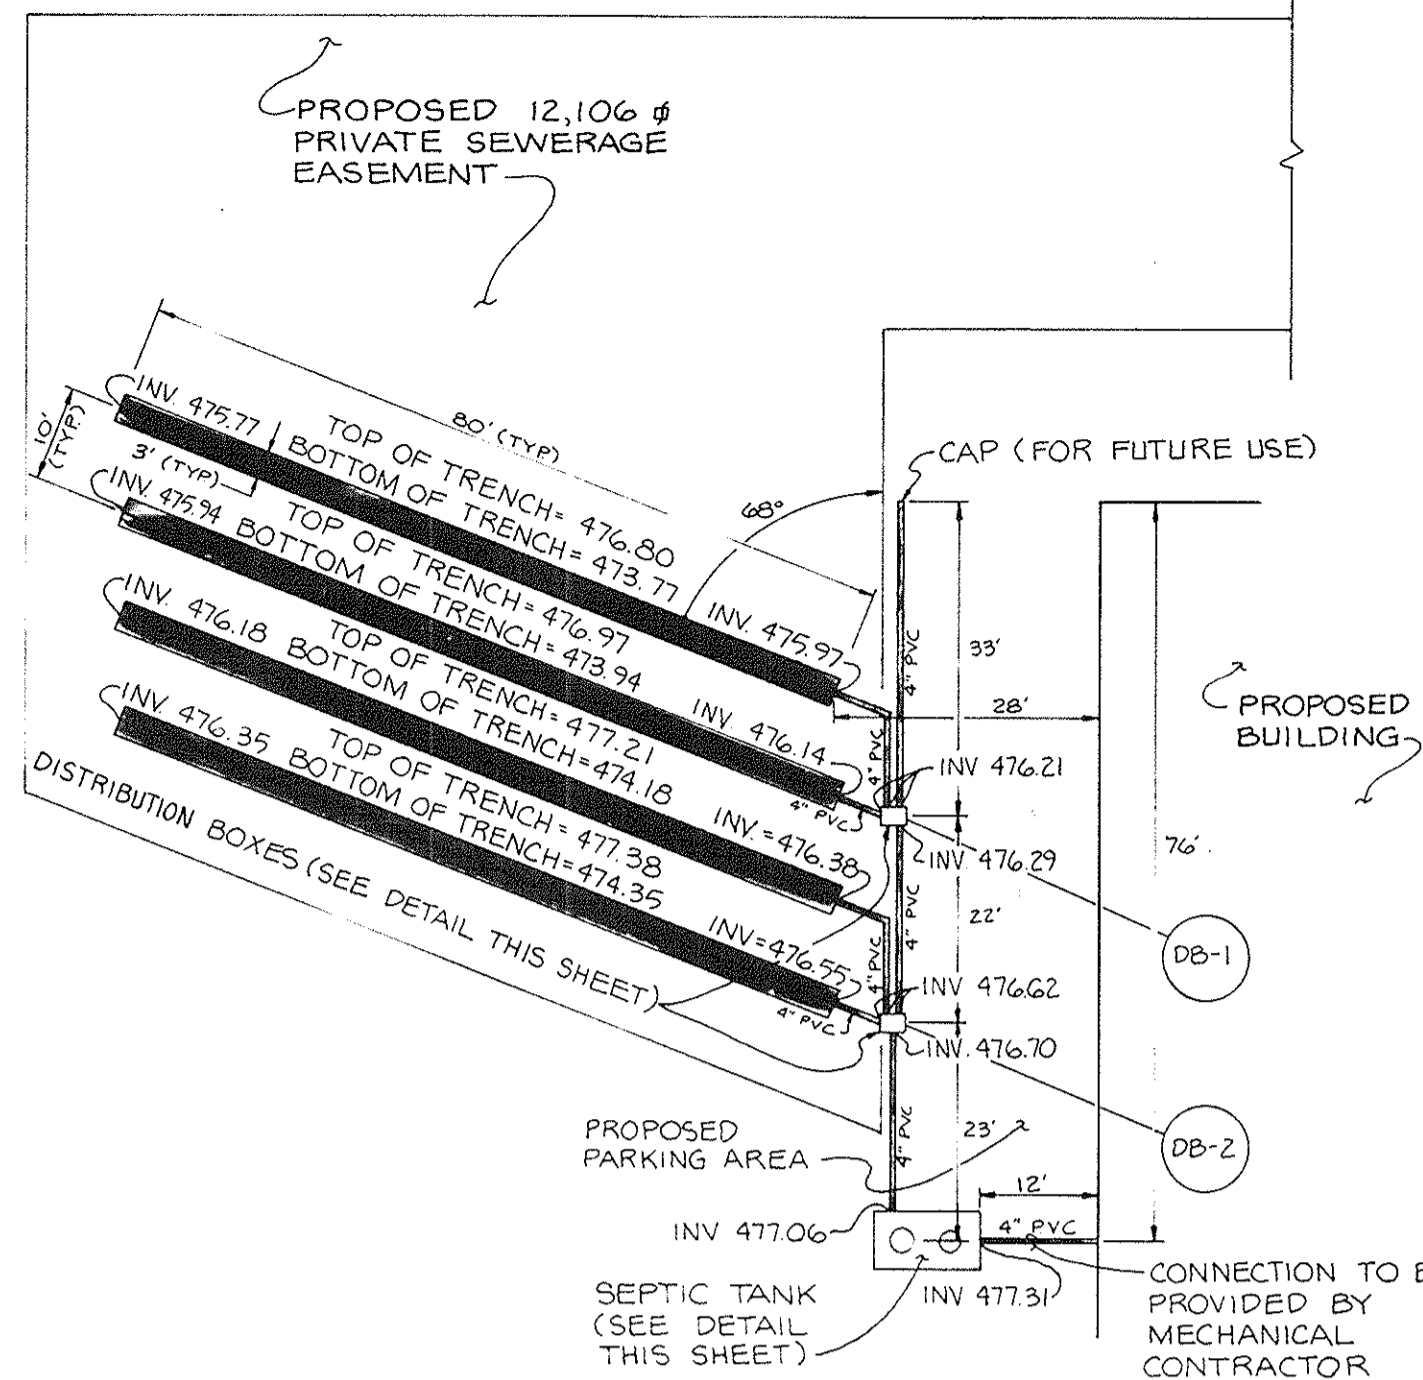


SCHMATIC SEWER LAYOUT  
SCALE: 1"=20'

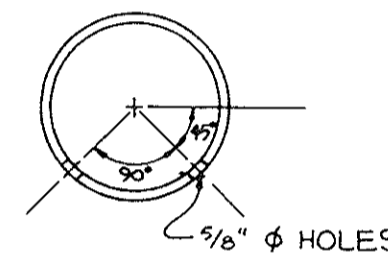


4" PERFORATED PVC SECTION  
N.T.S.

TRENCH CONSTRUCTION NOTES


- TRENCHES SHALL BE EXCAVATED USING A BACKHOE OR A WHEEL OR LADDER TYPE TRENCHER. FRONT-END LOADERS OR BULLDOZERS SHOULD NOT BE USED FOR TRENCH EXCAVATION.
- EXCAVATED MATERIALS FROM THE TRENCHES SHALL BE PLACED AT A SUFFICIENT DISTANCE DOWNSLOPE OF THE TRENCHES TO AVOID MIGRATION OF SOILS BACK INTO THE TRENCH.
- WORK SHALL BE SCHEDULED SUCH THAT THE TRENCHES CAN BE COVERED IN ONE DAY TO PREVENT WINDBLOWN OR WATERBORNE SEDIMENT FROM ENTERING THE TRENCH.
- THE FIELD ENGINEER SHALL VERIFY THE CONSTRUCTED ELEVATIONS OF THE TRENCHES TO ENSURE A MINIMUM 3' FOOT COVER IS PROVIDED.
- UPON COMPLETION OF TRENCH EXCAVATION AND PRIOR TO PLACEMENT OF PAVING, HEAVY CONSTRUCTION EQUIPMENT TRAFFIC SHALL BE DIVERTED FROM THE TRENCHES AND ADJACENT AREA.

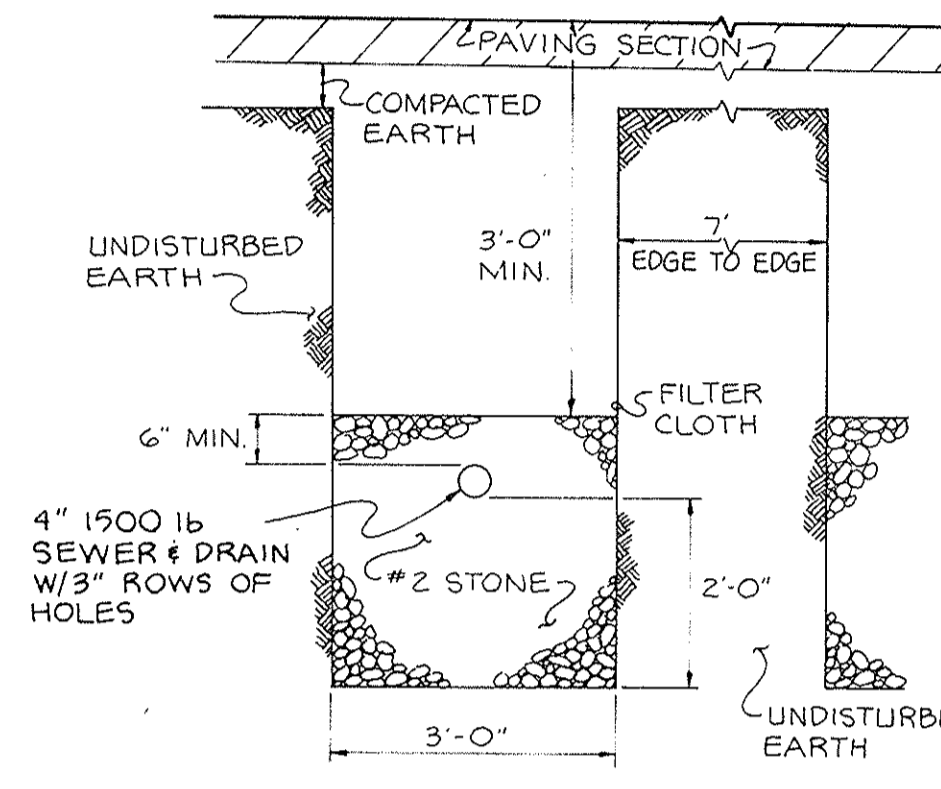


TYPICAL SEPTIC SYSTEM TRENCH DETAIL  
N.T.S.

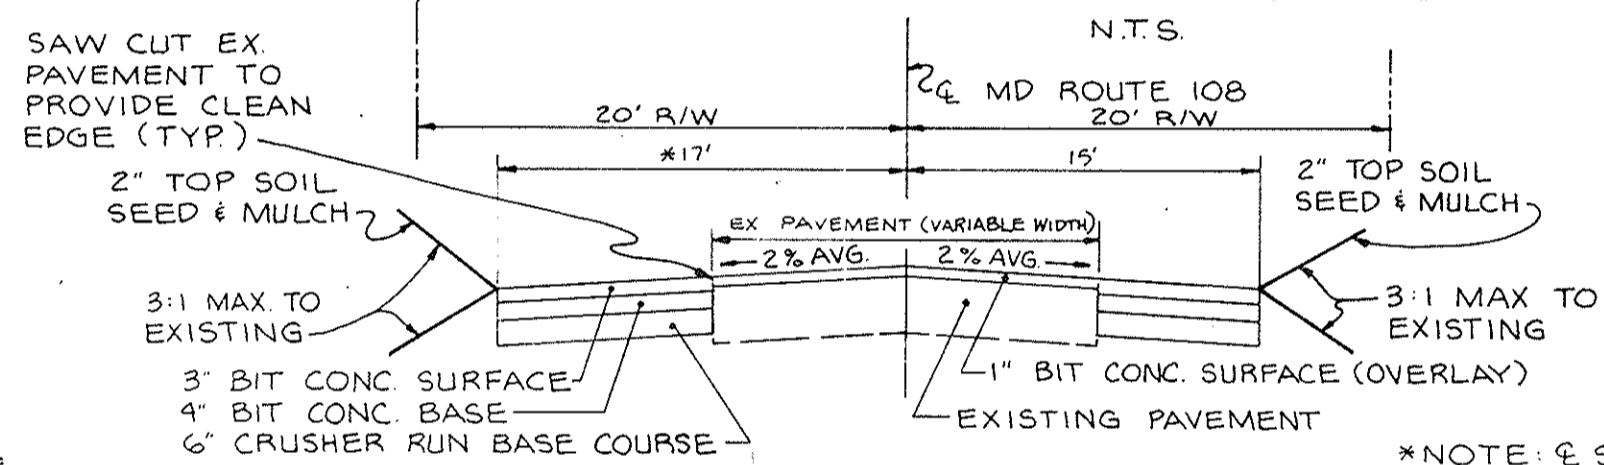


TYPICAL SECTION WIDENING MD ROUTE 108  
 ± STA. 7+22 RT TO ± STA. 9+37 RT  
 ± STA. 7+22 LT TO ± STA. 9+52 LT  
 NOT TO SCALE

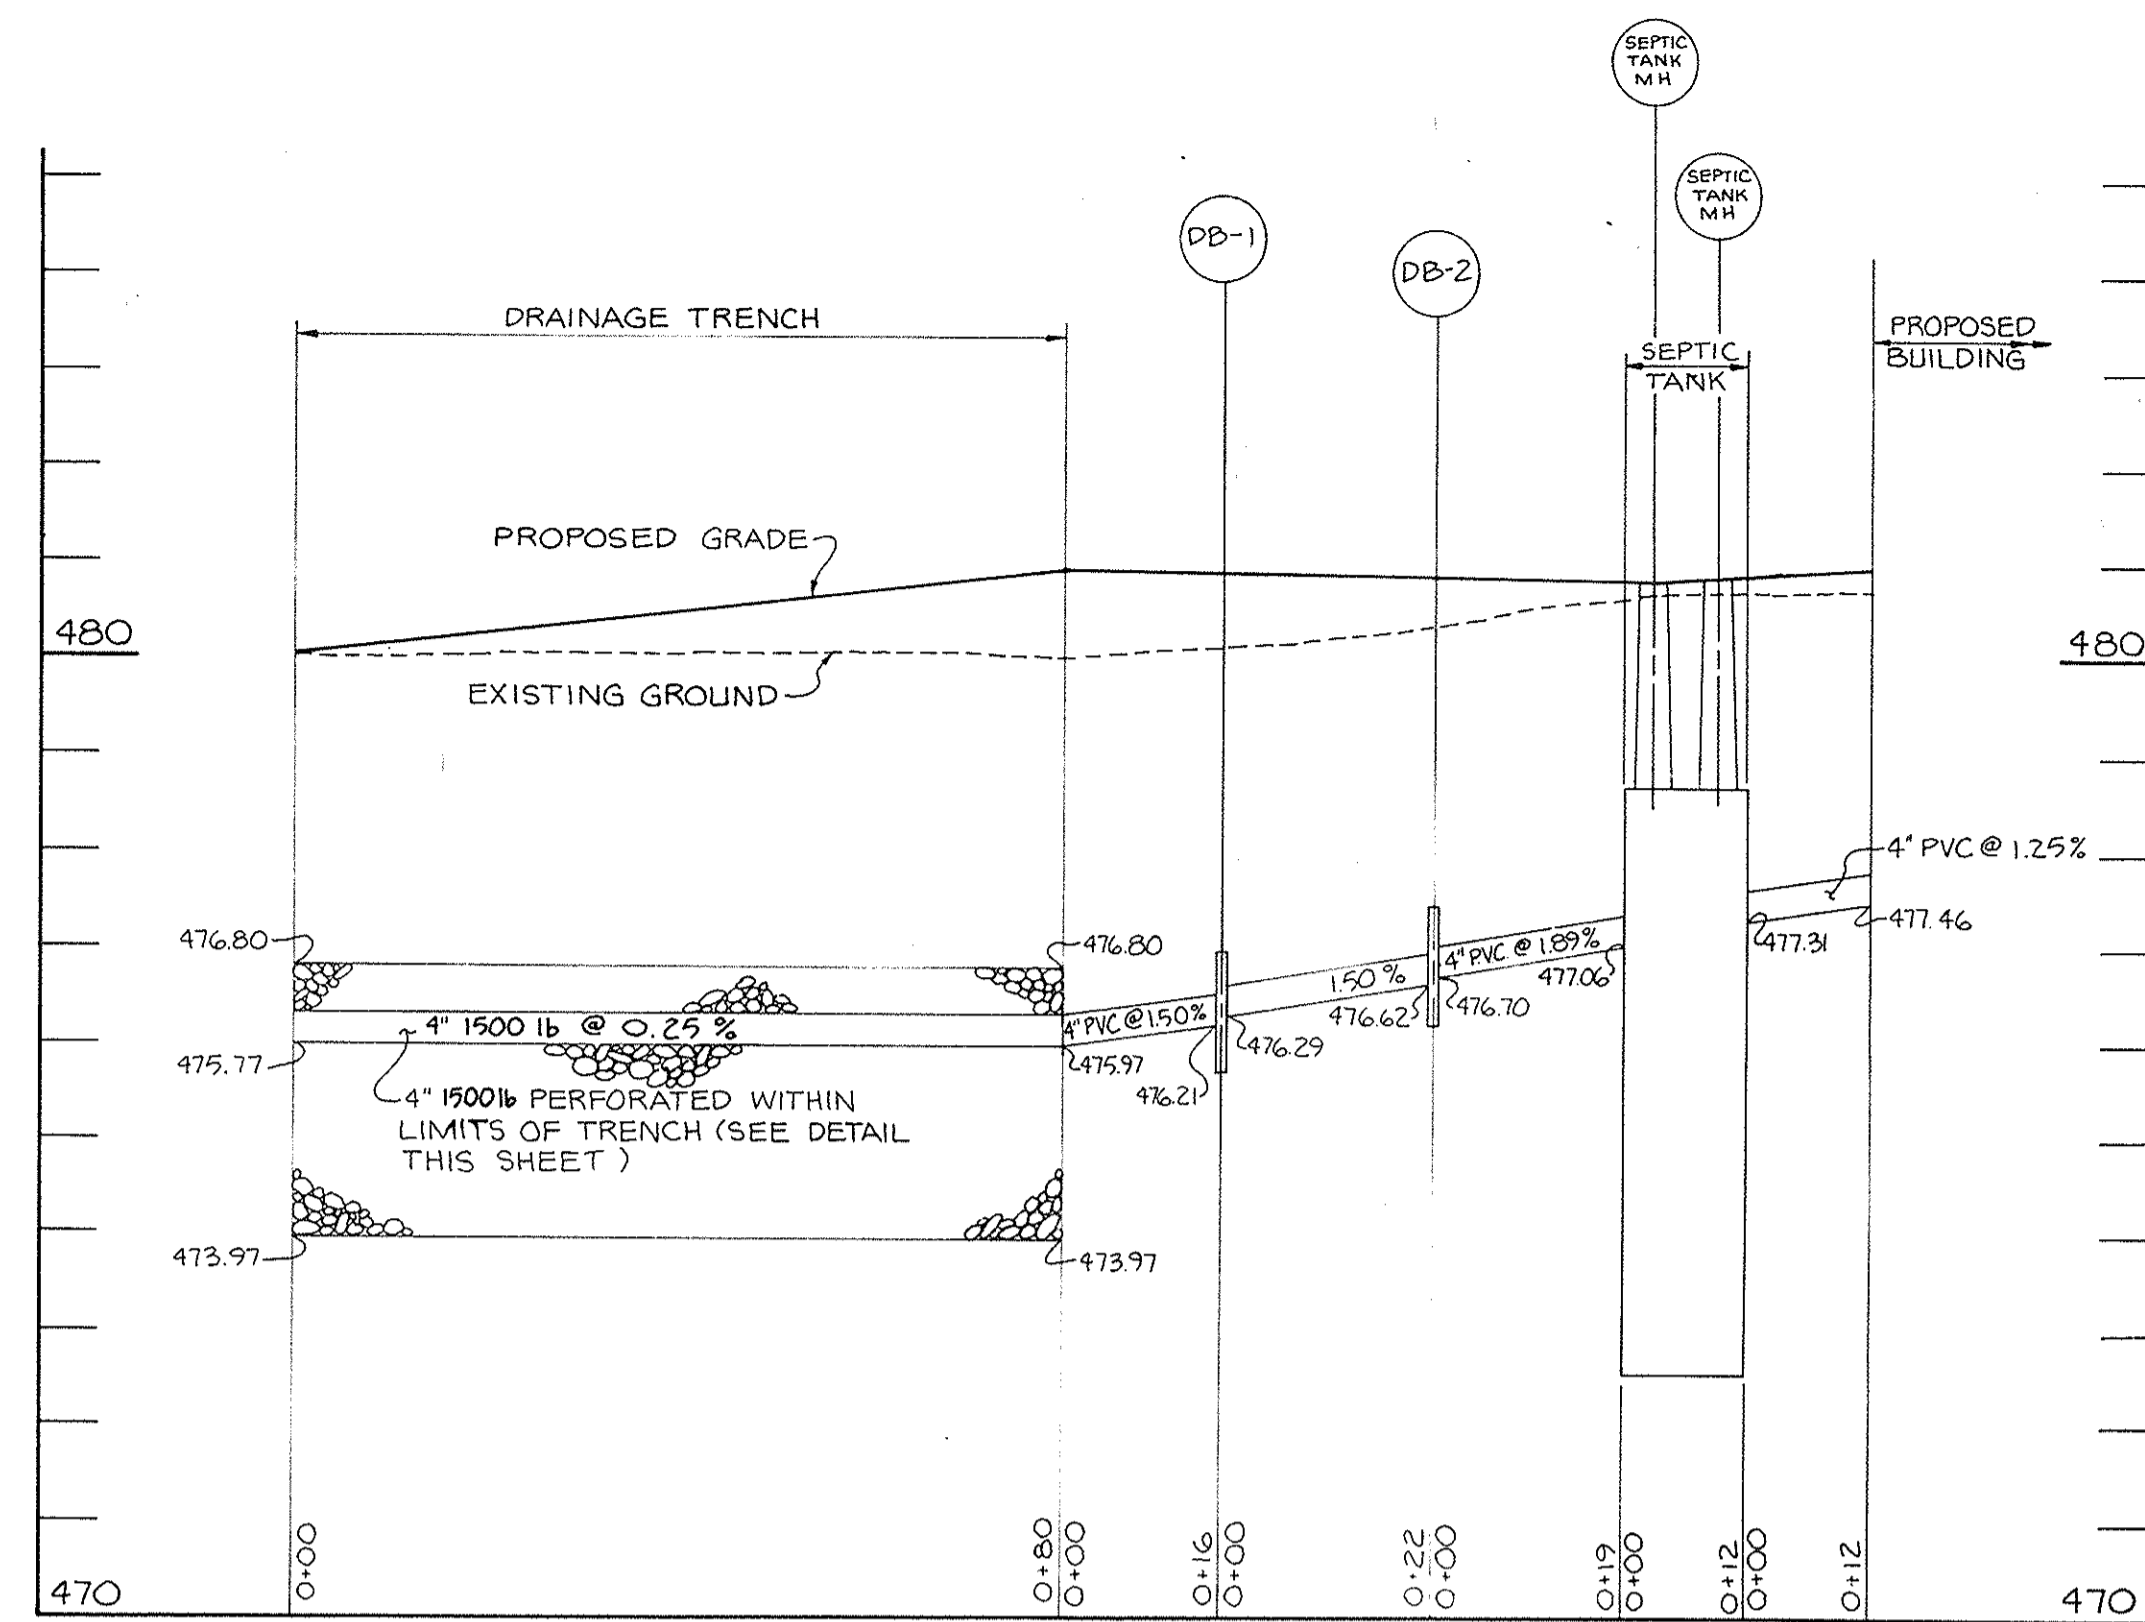

TYPICAL SEPTIC SYSTEM PROFILE  
SCALE: VERT. 1"=2' HORIZ. 1"=20'

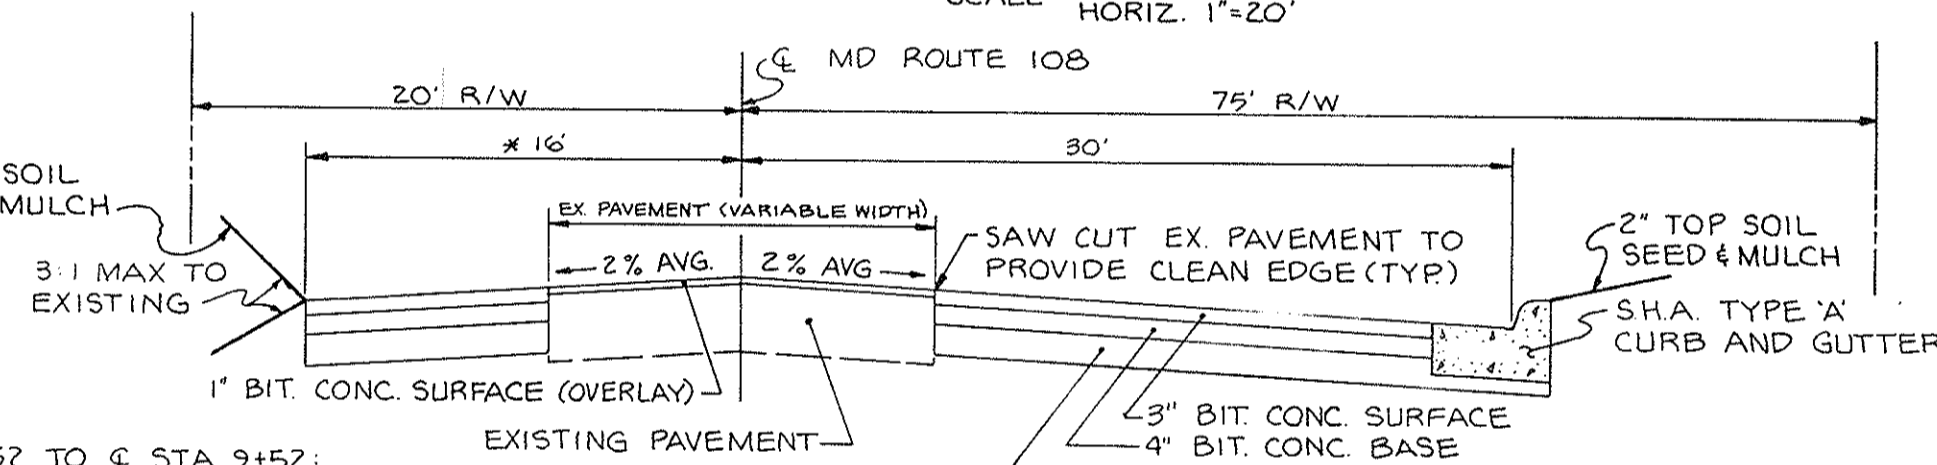

TYPICAL SECTION WIDENING MD ROUTE 108  
 ± STA. 9+37 RT TO ± STA. 11+95 RT  
 ± STA. 9+52 LT TO ± STA. 11+95 LT

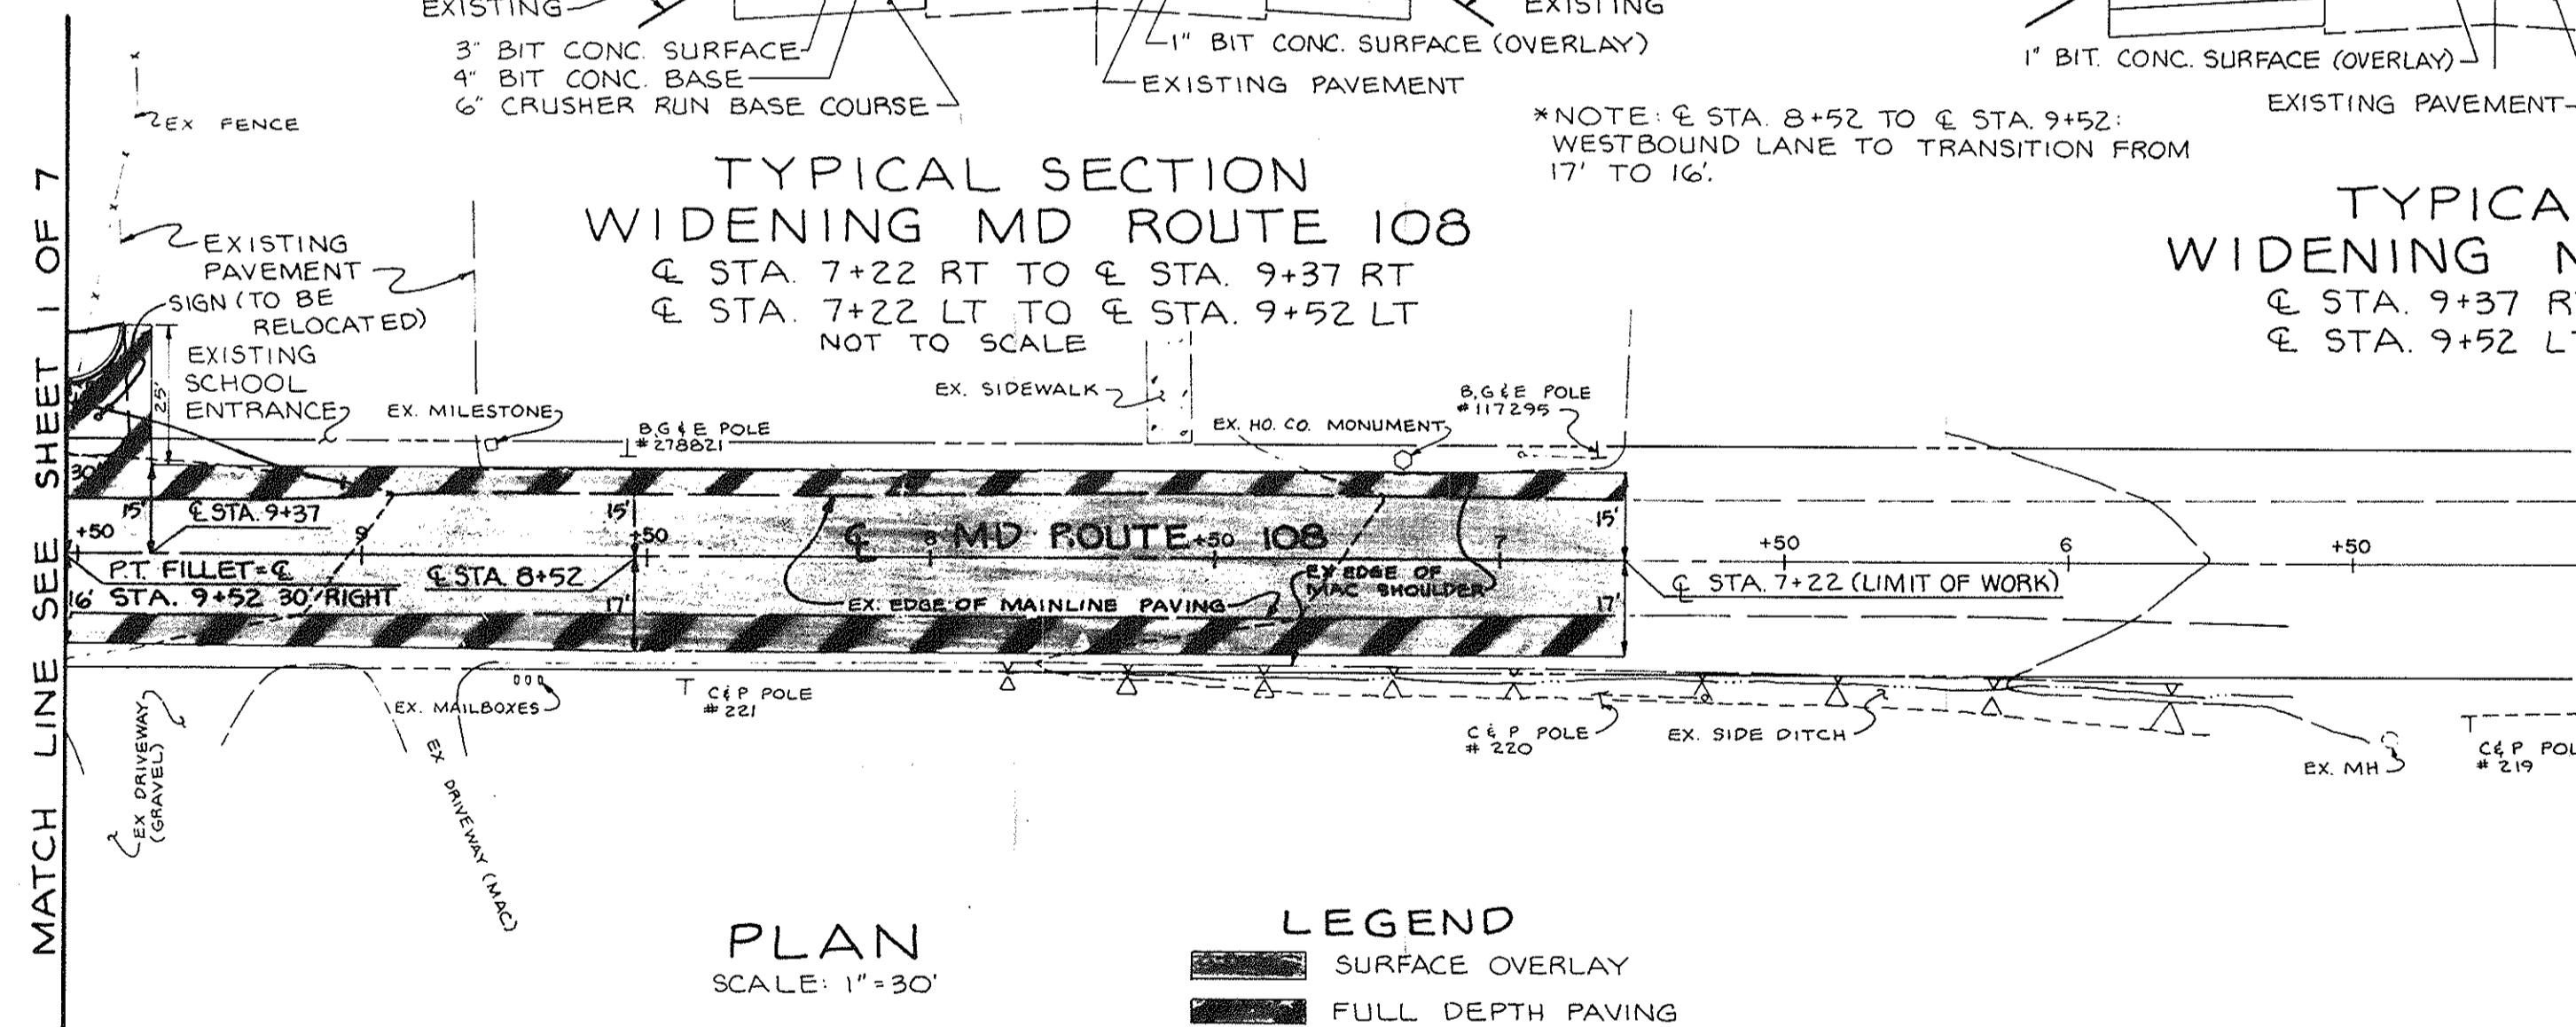

PLAN  
SCALE: 1"=30'

LEGEND  
 [Pattern] SURFACE OVERLAY  
 [Pattern] FULL DEPTH PAVING

APPROVED: HOWARD COUNTY DEPARTMENT OF PLANNING AND ZONING

*James R. Butler* 6/14/91  
 DIRECTOR DATE  
*Charles J. Drayton* 6/15/91  
 CHIEF, DIVISION OF COMMUNITY PLANNING AND LAND DEVELOPMENT DATE

APPROVED: FOR STORM DRAINAGE SYSTEMS AND PUBLIC ROADS. HOWARD COUNTY DEPARTMENT OF PUBLIC WORKS

*James J. Lewis* 5/22/91  
 DIRECTOR DATE  
*William S. Davis* 5/23/91  
 CHIEF, BUREAU OF ENGINEERING DATE

APPROVED: FOR PRIVATE WATER AND PRIVATE SEWERAGE SYSTEMS HOWARD COUNTY HEALTH DEPARTMENT

*George M. Bayland* per *J. M. Smith* 5/10/91  
 COUNTY HEALTH OFFICER DATE

NO.	REVISION	BY	DATE
1	ADD SHEETS 8 & 10	RLL	10-24-90
2	THIS TRENCH REPAIRS		
3	RE-CHANGED 10-24-90		
4	RE-CHANGED 10-24-90		
5	RE-CHANGED 10-24-90		
6	RE-CHANGED 10-24-90		
7	RE-CHANGED 10-24-90		
8	RE-CHANGED 10-24-90		
9	RE-CHANGED 10-24-90		
10	RE-CHANGED 10-24-90		

PRIVATE SEWER PROFILES & MISCELLANEOUS DETAILS  
**ZIMMERMAN AND SONS**  
 HOME IMPROVEMENT CENTER  
 REFERENCE F-90-199 AND WP-91-29  
 TAX MAP 34 PARCEL 358 LOT 3  
 5TH ELECTION DISTRICT HOWARD COUNTY, MARYLAND

**JOHN E. HARMS JR. AND ASSOCIATES INC.**  
 CONSULTING ENGINEERS - PLANNERS - SURVEYORS




2 CENTRE PARK COLUMBIA, MARYLAND 21045 8808 CENTRE PARK DRIVE SUITE 110 TELEPHONE (301) 740-5200

DESIGNED BY: T.A.B.  
 DRAWN BY: D.G.H.  
 CHECKED BY: R.H.V.  
 DATE: 10/5/90  
 SCALE: AS SHOWN  
 W.O. NO. 45-90-004A




**SITE INFORMATION**

- 1.) SITE NAME: GREAT STAR  
SEARCH RING: ATC ID 305180
- 2.) THIS IS NOT A BOUNDARY SURVEY AND IS NOT TO BE USED FOR THE TRANSFER OF PROPERTY.
- 3.) THE SUBJECT PARCEL INFORMATION:  
OWNER: KENDALL FAMILY LLC  
PREMISES ADDRESS: 12660 CLARKSVILLE PIKE  
CLARKSVILLE, MD 21029  
  
MAILING ADDRESS: 12660 CLARKSVILLE PIKE  
CLARKSVILLE, MD 21029  
  
COUNTY: HOWARD COUNTY  
MAP: 0034 PARCEL: 0025  
DISTRICT: 05 ACCOUNT: 358051

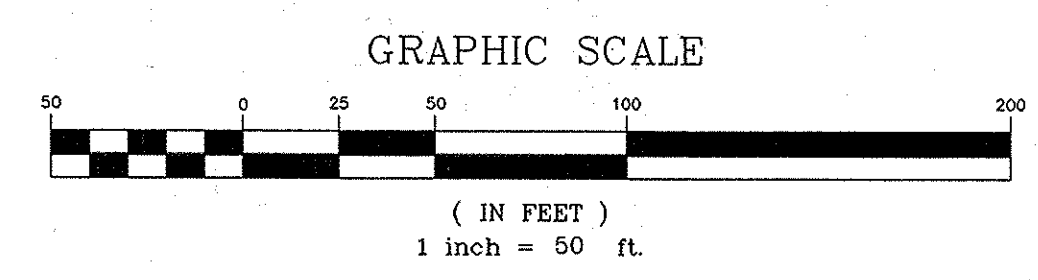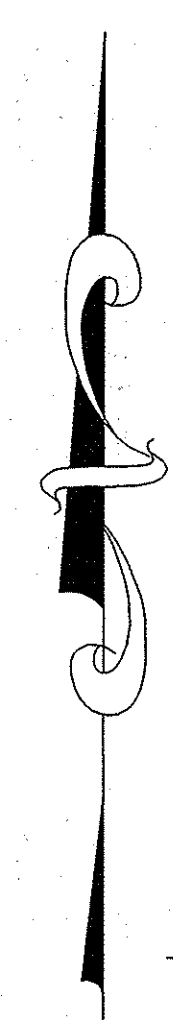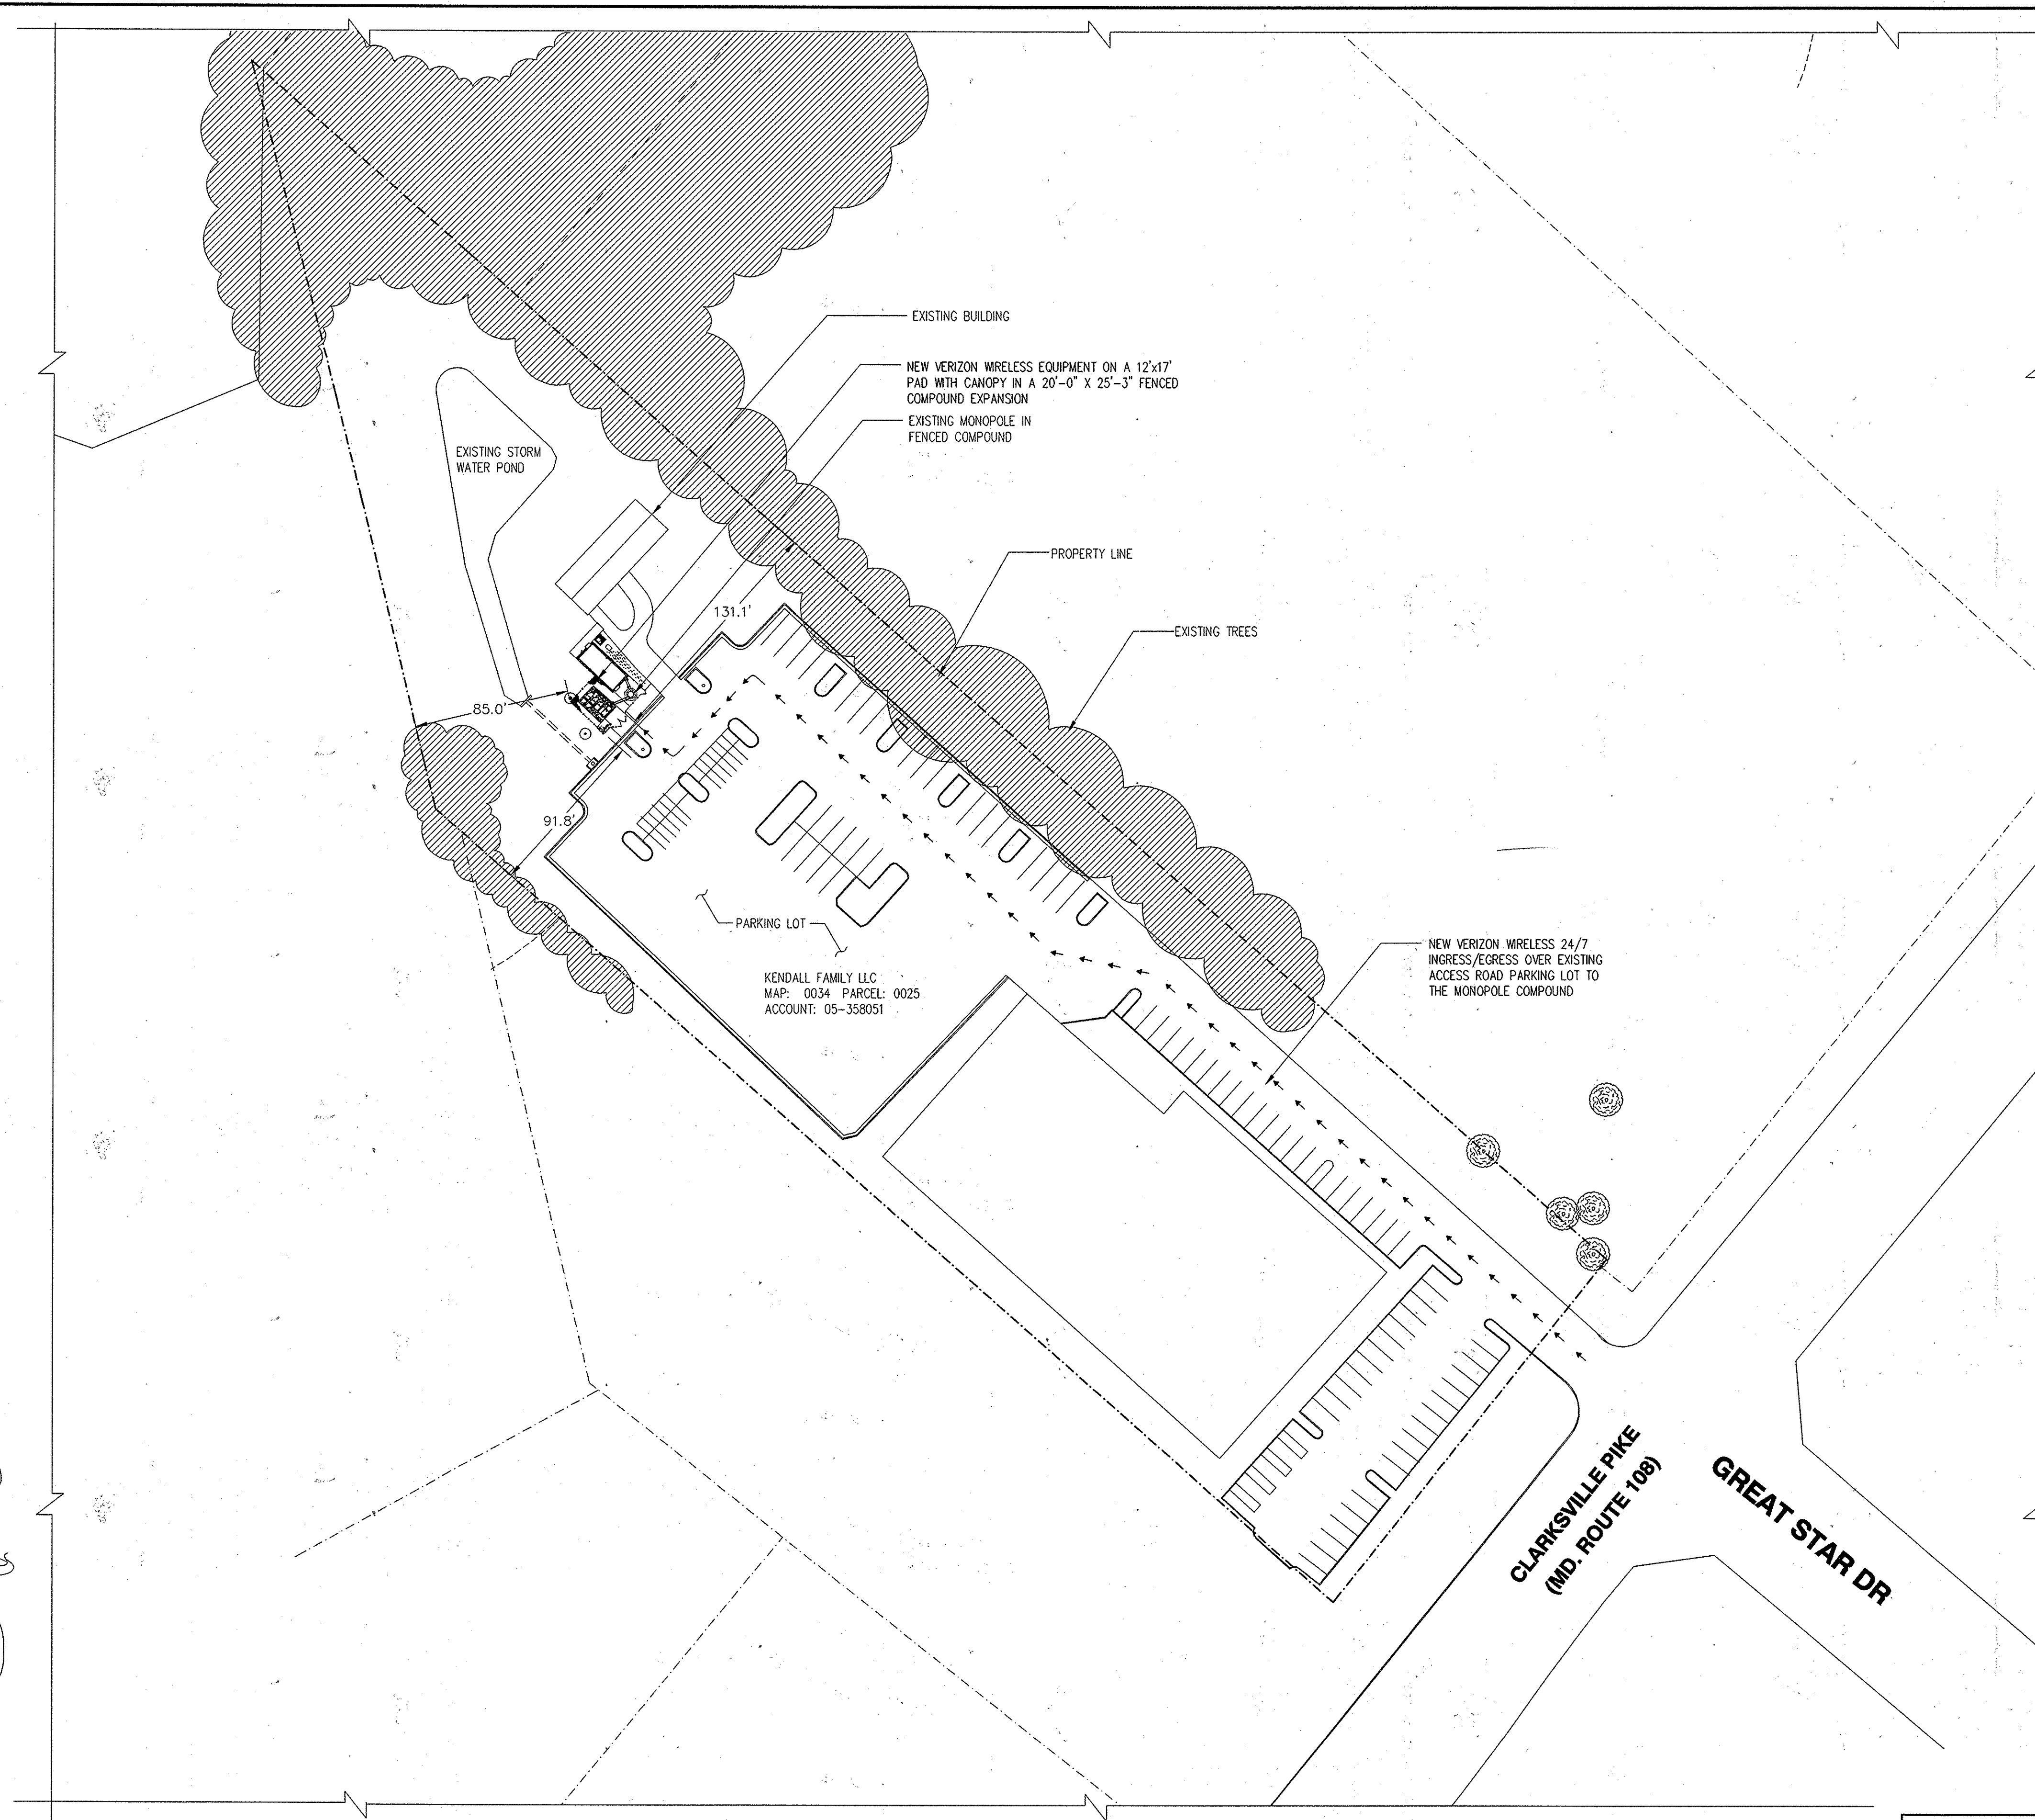



**SITE PLAN**  
SCALE: 1" = 50'-0"  
TRUE NORTH

APPROVALS			
APPROVED:	DEPARTMENT OF PLANNING AND ZONING		
<i>[Signature]</i>		DATE	6-7-16
CHIEF, DEPARTMENT ENGINEERING DIVISION		DATE	6-9-16
<i>[Signature]</i>		DATE	6-9-16
CHIEF, DIVISION OF LAND DEVELOPMENT		DATE	
<i>[Signature]</i>		DATE	

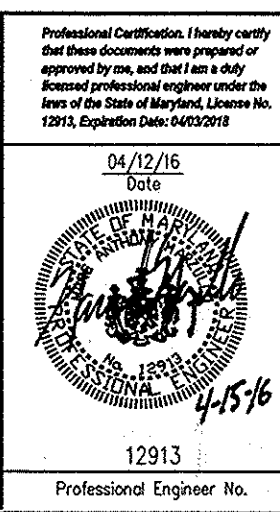

04-12-16	7	REVISE VERIZON WIRELESS EQUIPMENT SHELTER TO EQUIPMENT CABINETS WITH CANOPY AND GENERATOR IN NEW EXPANDED EQUIPMENT COMPOUND (NOTE: THIS REV. 7 REPLACES REV. 6 DATED 10/21/15)
Date	No.	Revision Description
SITE DEVELOPMENT PLAN - ZIMMERMAN AND SONS HOME IMPROVEMENT CENTER AND TELECOMMUNICATIONS TOWER COMPOUND REFERENCE F-90-199 AND WP-91-29		
OWNER: KENDALL FAMILY LLC 12660 CLARKSVILLE PIKE CLARKSVILLE, MD 21029	DEVELOPER: VERIZON WIRELESS 3500 MONROE BLVD LAUREL, MD 20725	
entrex COMMUNICATIONS SERVICES, INC. 6000 Rockledge Drive, Suite 550 Bethesda, MD 20817 PHONE: (301)468-0900 FAX: (301)468-0901		
Subdivision Name	Section/Arts	Lot/Parcel #
LIBER: 974	SRD: 6	34
ZONING: 359	Zone: 34	Elect. Dist: 0
WATER CODE:		Contour Foot:
<b>SITE PLAN</b> Des. By M.A. Scale: Enflex Proj. No.: 1102.320 Dwn. By M.A. Date: 04-08-16 Chk. By M.M. Approved: M.M.		
<b>8 of 10</b>		



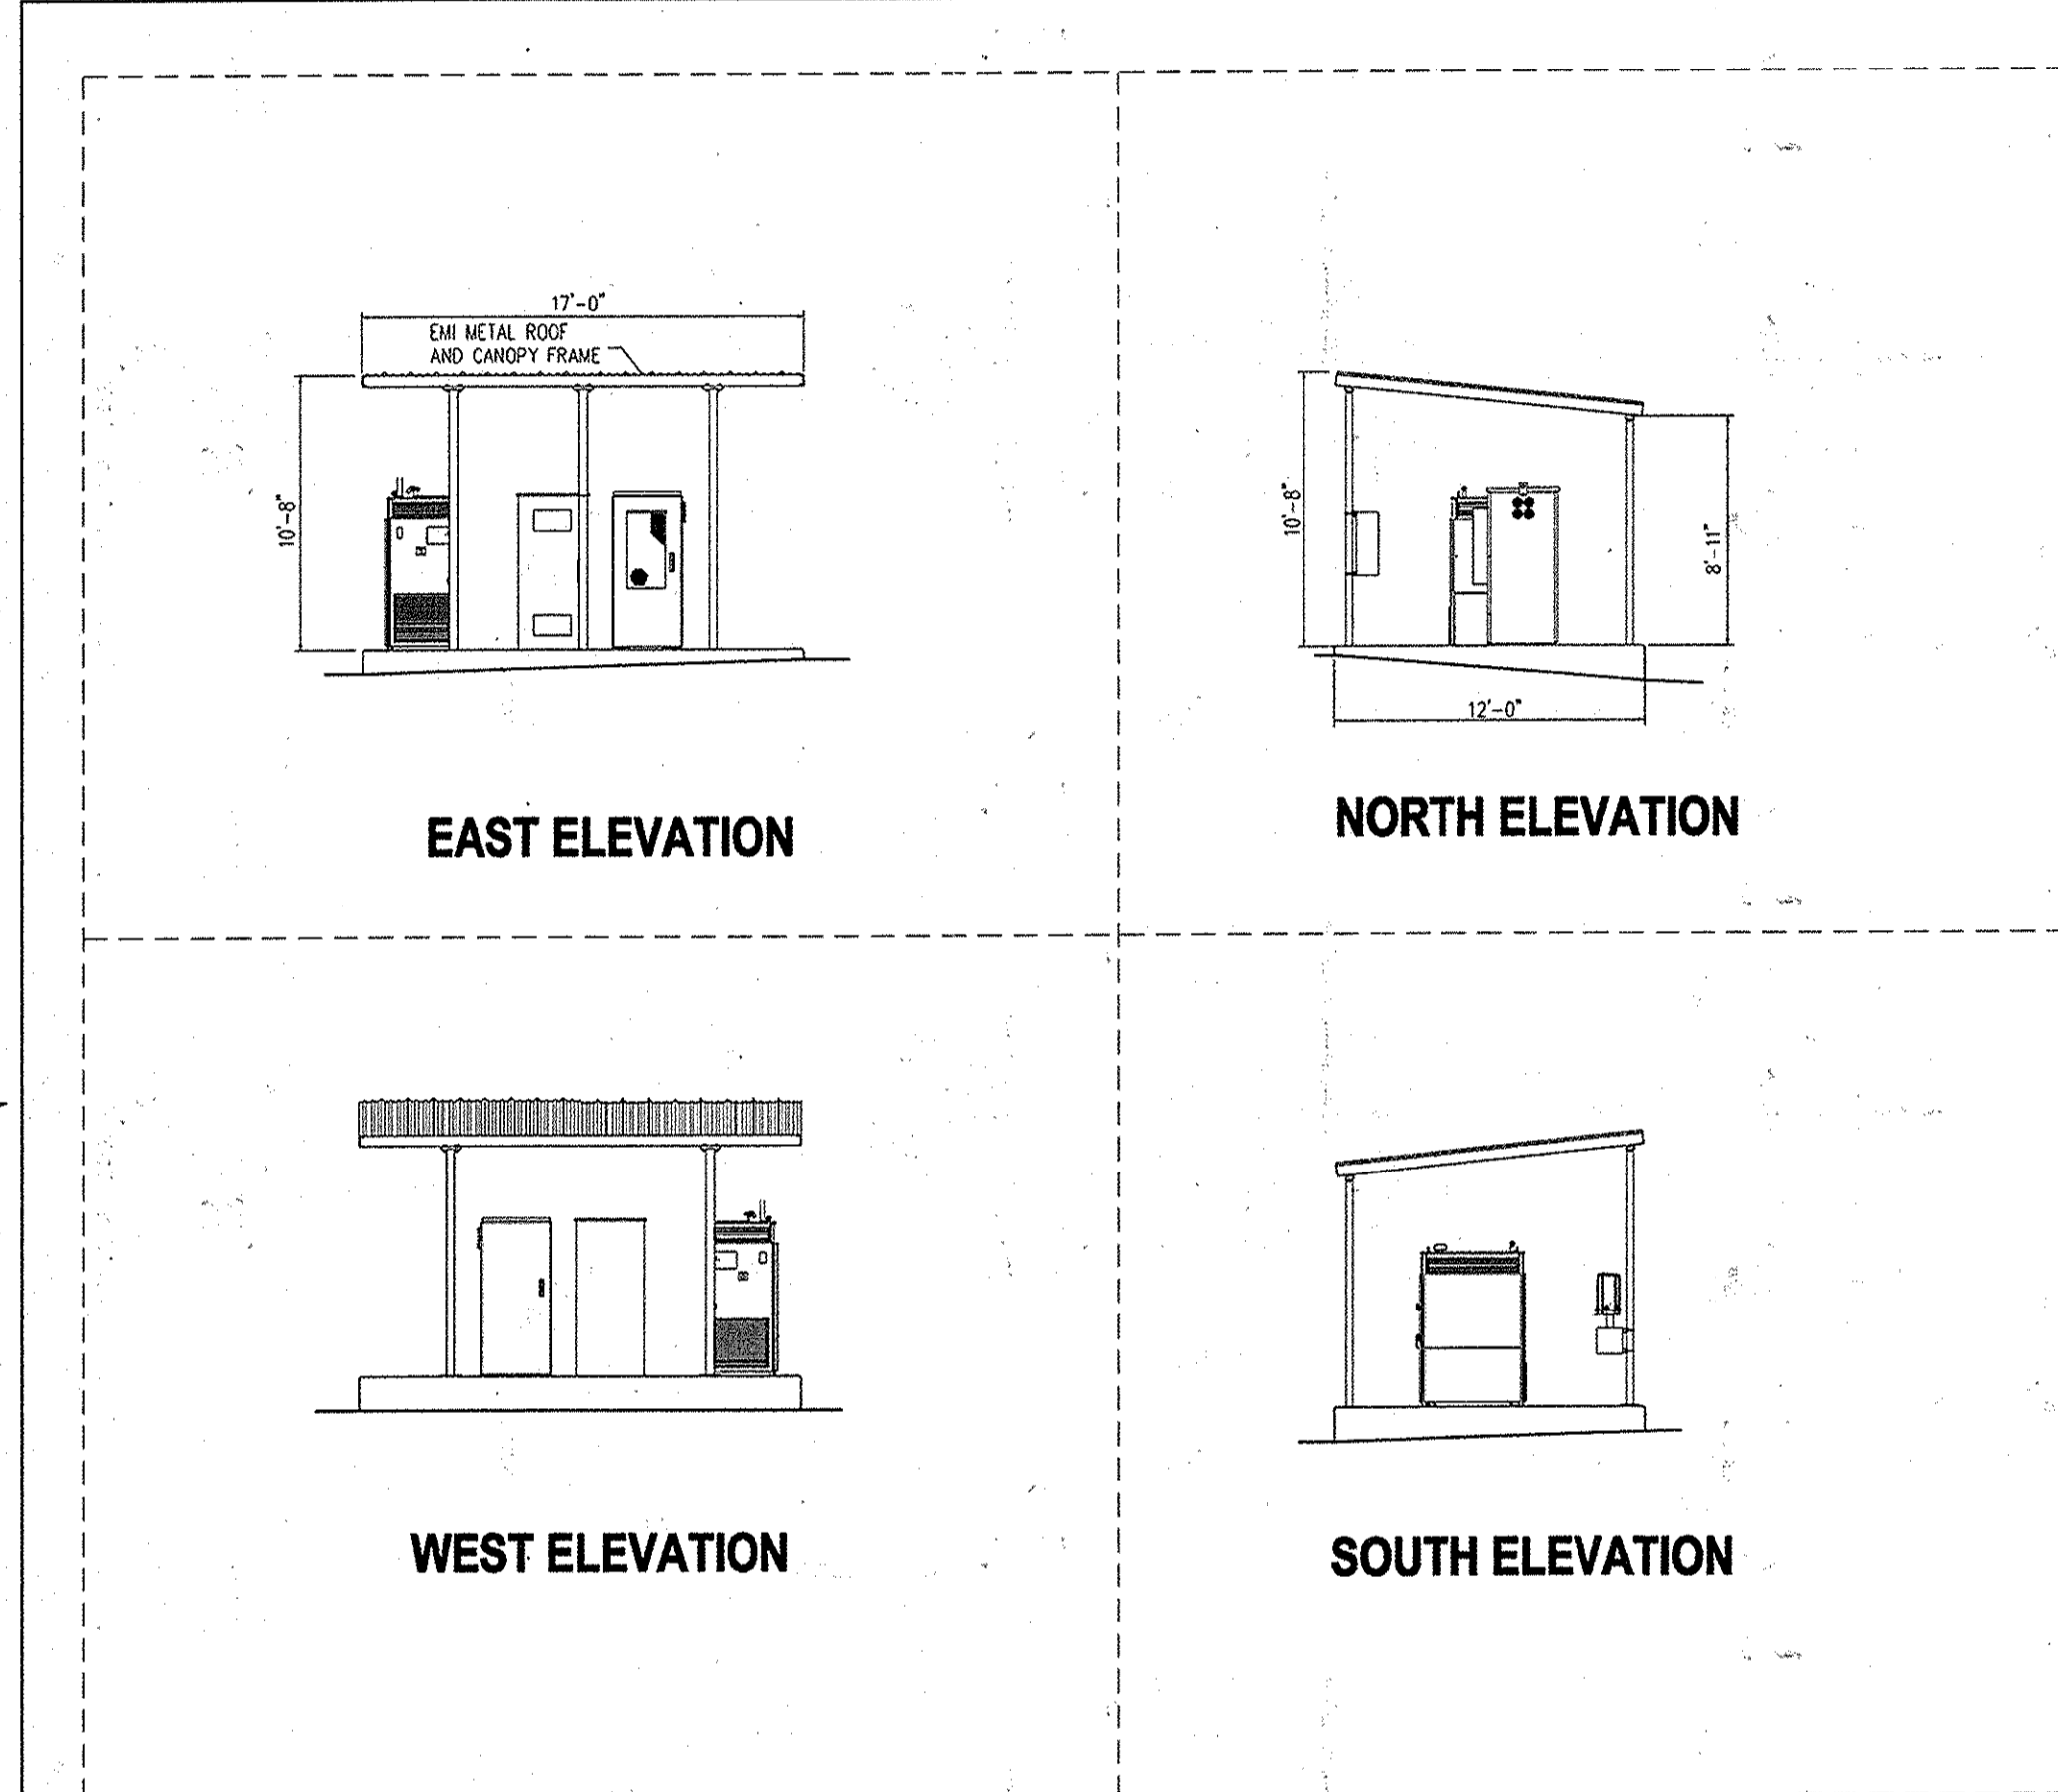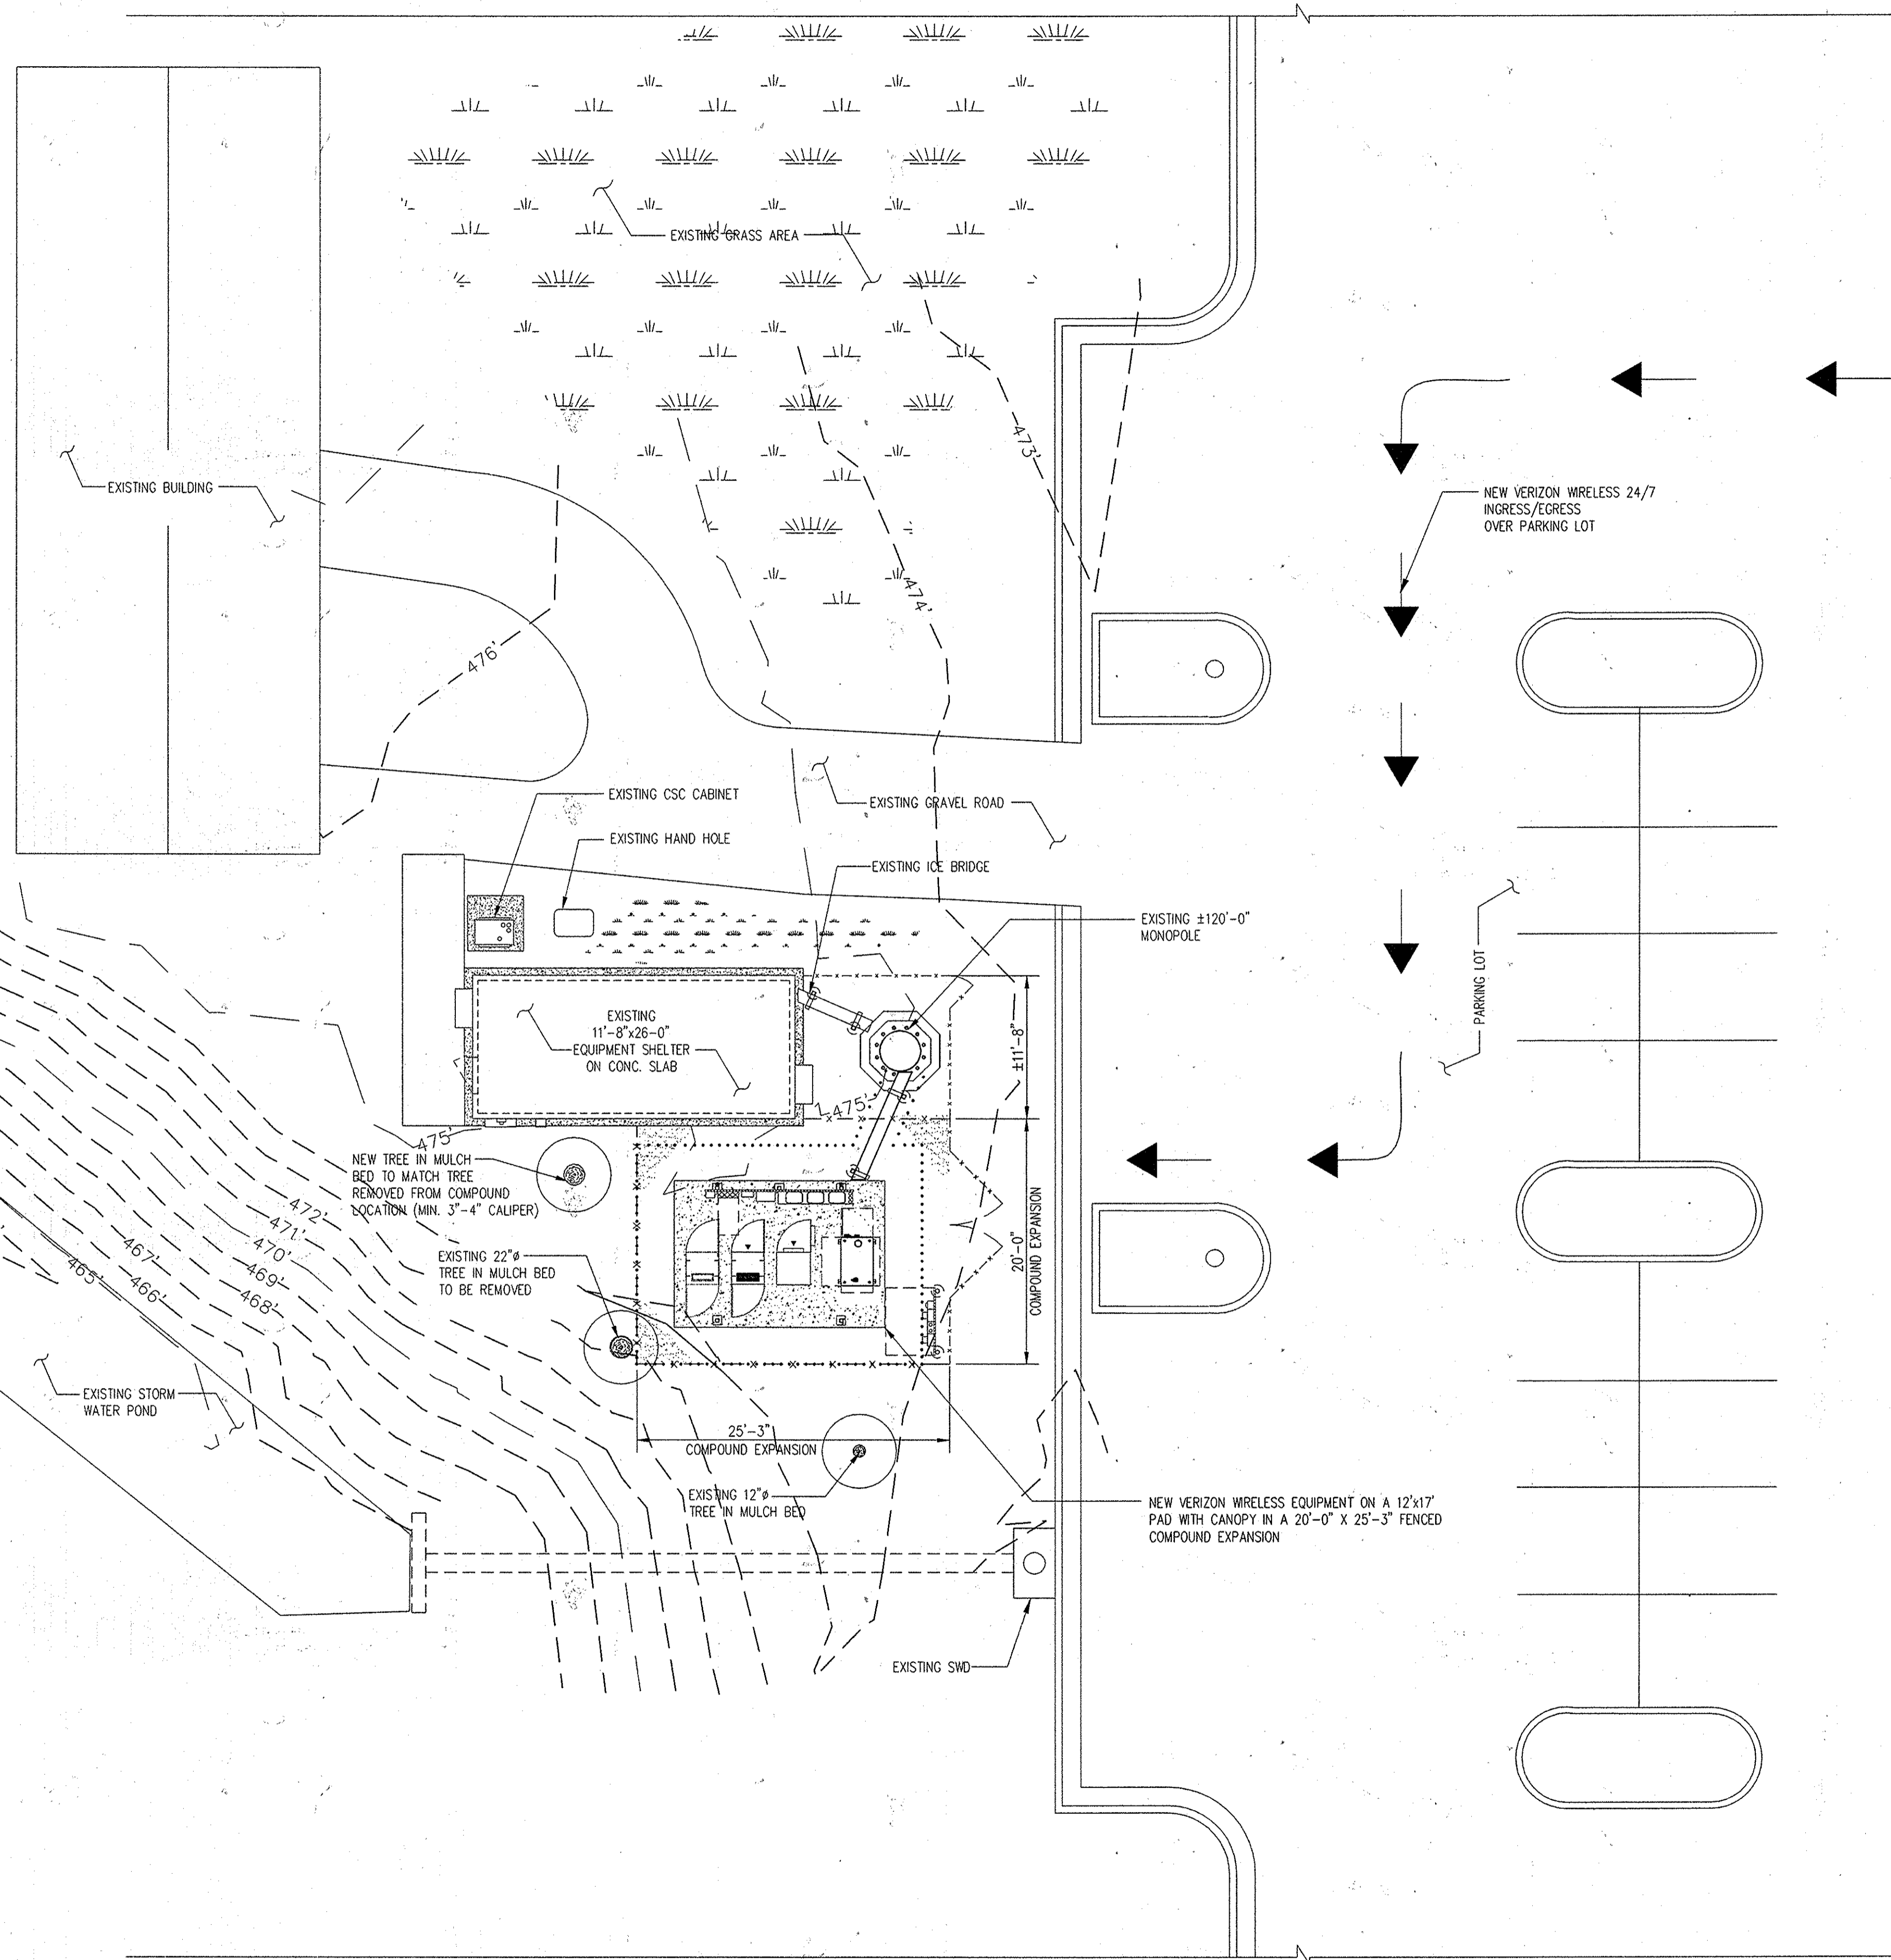


CANOPY DETAILS (N.T.S.)

**PARTIAL SITE PLAN**  
SCALE: 1/8"=1'-0"

TRUE NORTH


**APPROVALS**

APPROVED: <i>[Signature]</i>	DEPARTMENT OF PLANNING AND ZONING	DATE: 6-7-16
CHIEF, DEVELOPMENT ENGINEERING DIVISION		
CHIEF, OFFICE OF LAND DEVELOPMENT		DATE: 6-9-16
<i>[Signature]</i>		DATE: 6-9-16
DIRECTOR		

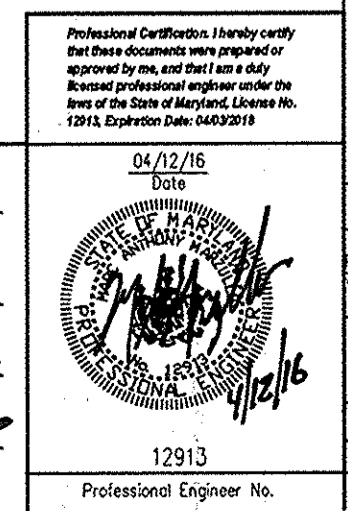


Date:	04-12-16	7	REVISION VERIZON WIRELESS EQUIPMENT SHELTER TO EQUIPMENT CABINETS WITH CANOPY AND GENERATOR IN NEW EXPANDED EQUIPMENT COMPOUND. (NOTE: THIS REV. 7 REPLACES REV. 6 DATED 10/21/15)
<p><b>SITE DEVELOPMENT PLAN</b> ZIMMERMAN AND SONS HOME IMPROVEMENT CENTER AND TELECOMMUNICATIONS TOWER COMPOUND REFERENCE F-90-189 AND WIP-01-29</p>			
OWNER:	DEVELOPER:		
RENDAL FAMILY LLC 12840 CLIPSHALL PIKE CLARKSVILLE, MD 21029	VERIZON WIRELESS 7600 HOWELL BLVD LAZEL, MD 20722		
<p><b>entrex</b> communication services, inc. 6600 Rockledge Drive, Suite 500 Baltimore, MD 21287 PHONE: (410) 488-0980 FAX: (410) 488-0991</p>			
Subdivision Name:	Section/Area:	Lot/Parcel #:	
USDC: 9774	M/A	Block: 25	
2000-359	6	Zone: 107/zone misc	Elect. Dis: 5
WATER CODE			
<p><b>PARTIAL SITE PLAN</b></p>			
Des. By:	M.A.	Scale:	Entrex Proj. No.: 1102.320
Drn. By:	M.A.	Date: 04-08-16	
Chk. By:	M.M.	Approved: M.L.	<b>9 of 10</b>



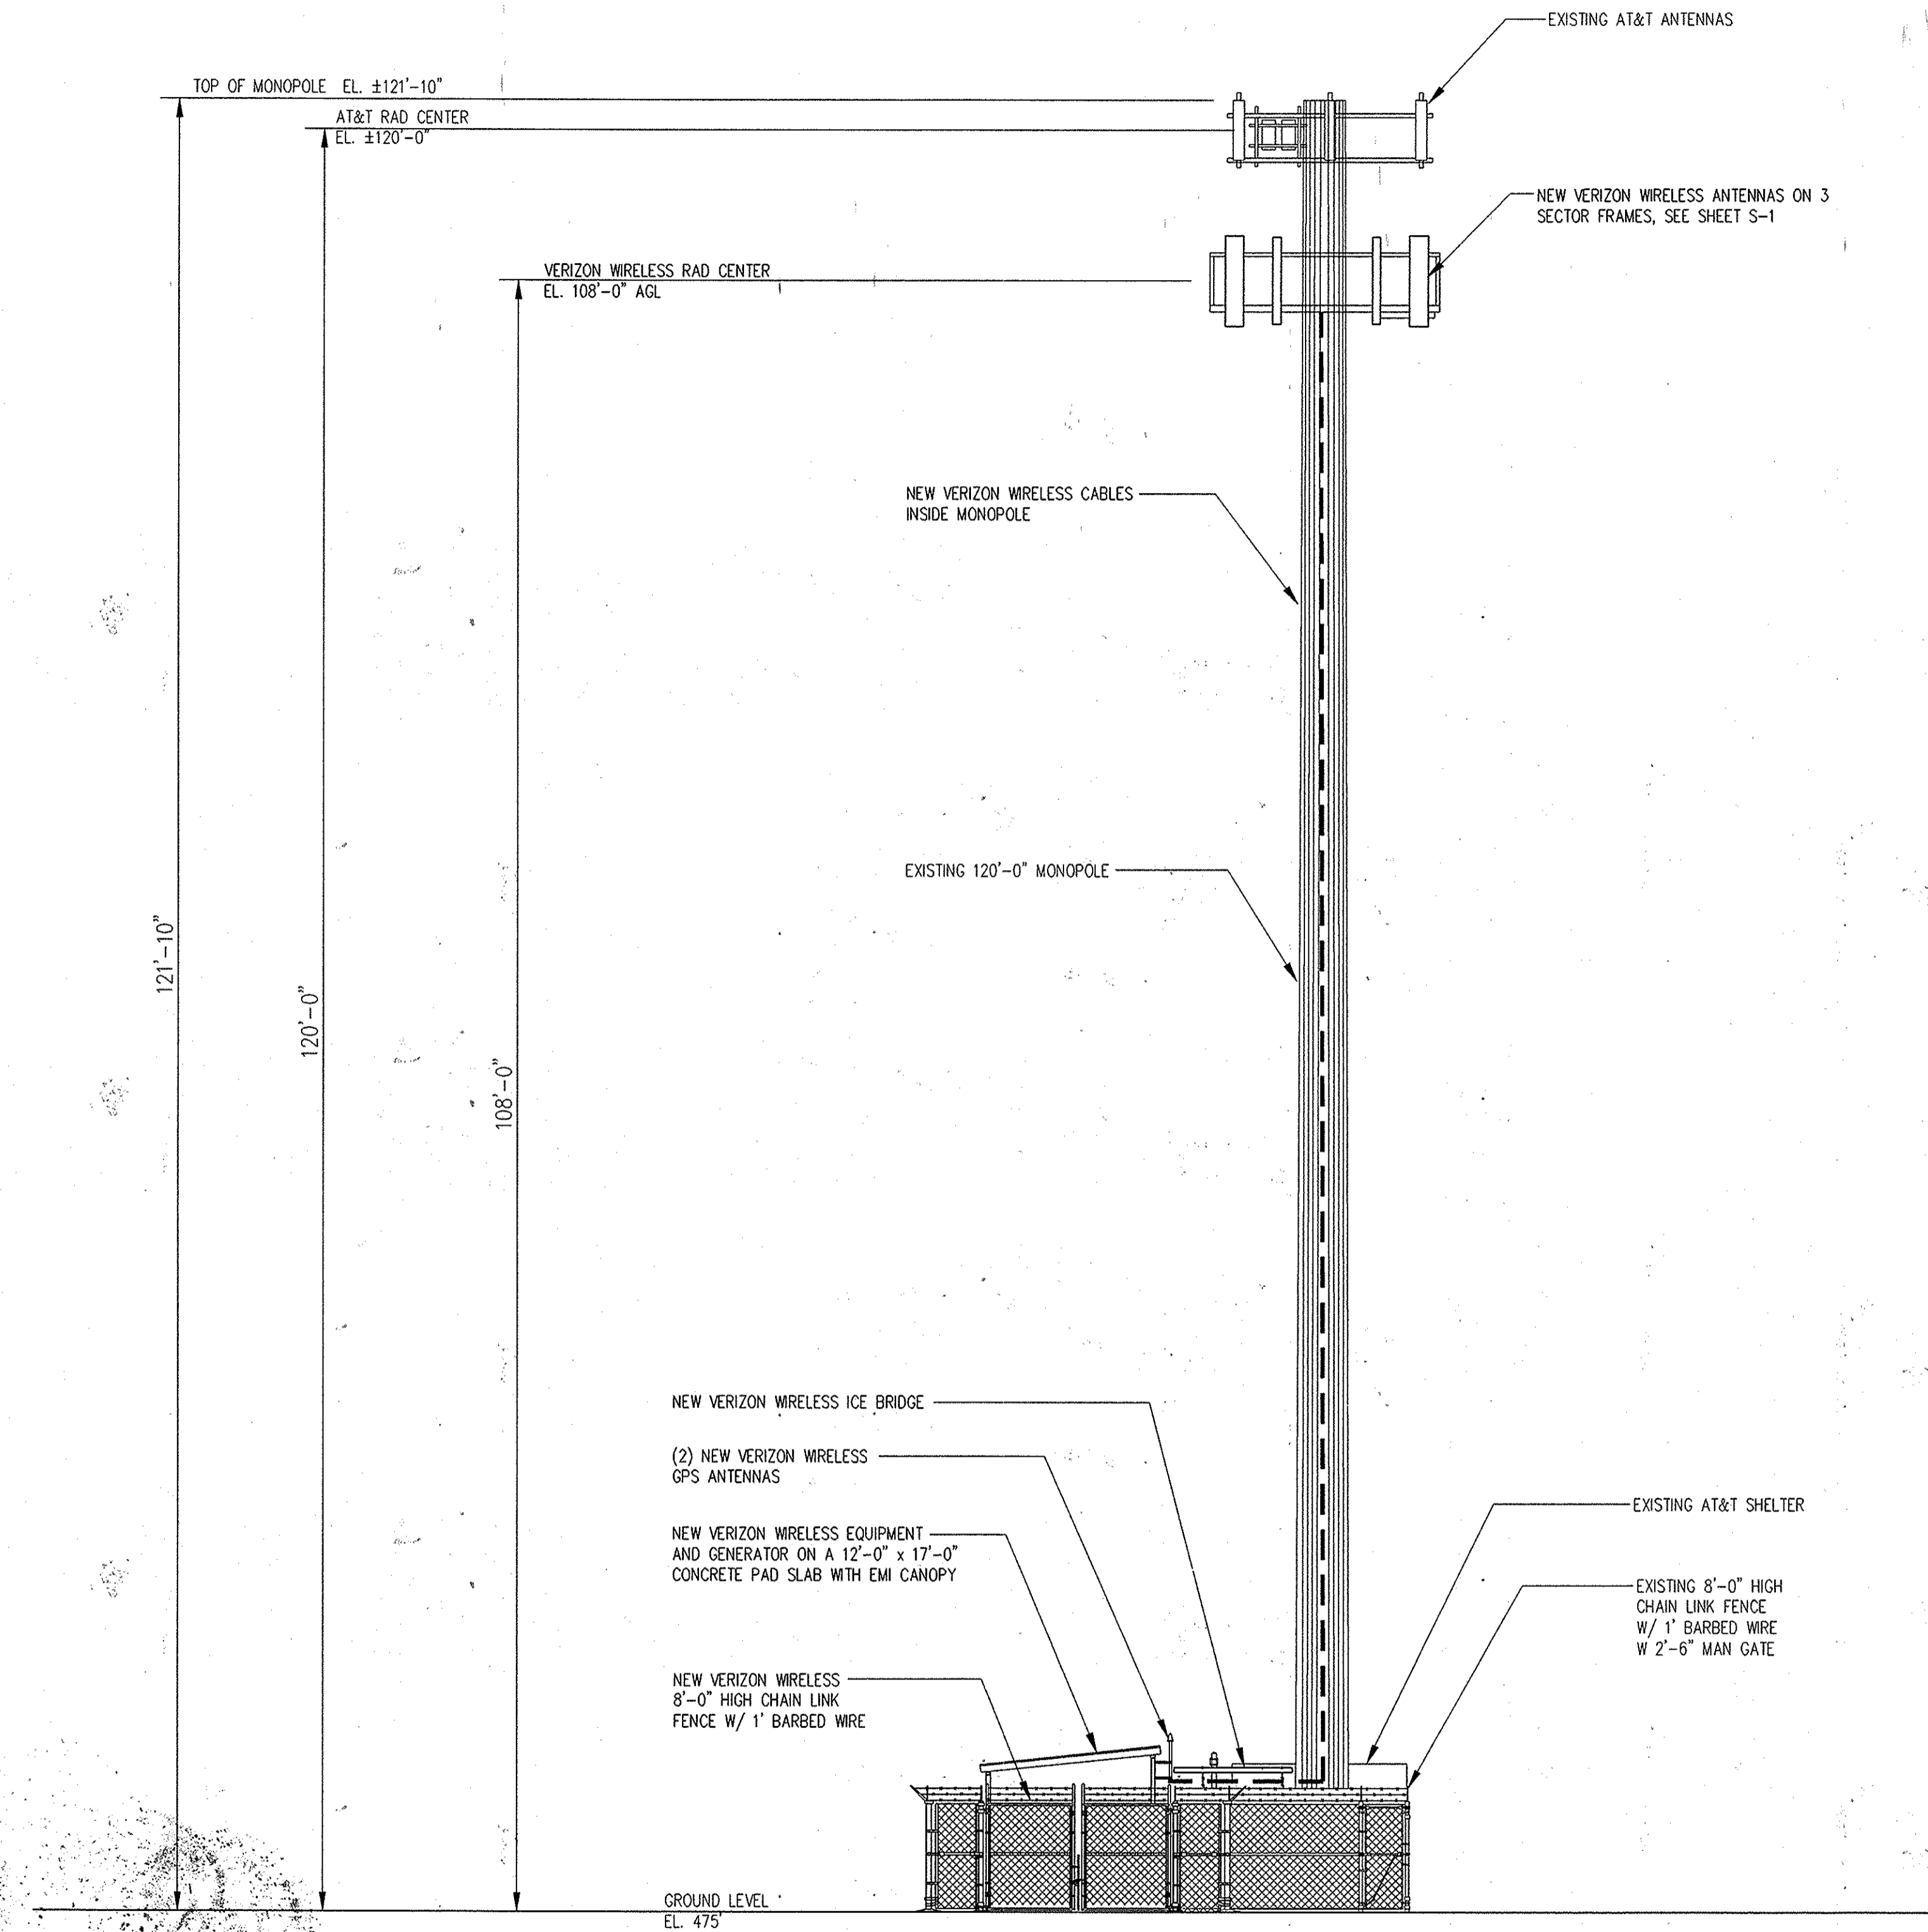

**MONOPOLE ELEVATION**  
SCALE: 1/8"=1'-0"

04-12-16	7	REVISE VERIZON WIRELESS EQUIPMENT SHELTER TO EQUIPMENT CABINETS WITH CANOPY AND GENERATOR IN NEW EXPANDED EQUIPMENT COMPOUND (NOTE: THIS REV. 7 REPLACES REV. 6 DATED 10/21/15)
Date:	No.	Revision Description
<b>SITE DEVELOPMENT PLAN</b> <b>ZIMMERMAN AND SONS</b> <b>HOME IMPROVEMENT CENTER AND</b> <b>TELECOMMUNICATIONS TOWER COMPOUND</b> <b>REFERENCE F-90-199 AND WP-91-29</b>		
OWNER: ZIMMERMANN & SONS, LLC 17660 CLAYVILLE CLAYVILLE, MD 20729	DEVELOPER: WIRELESS 1600 MONROE LARK, MD 20725	

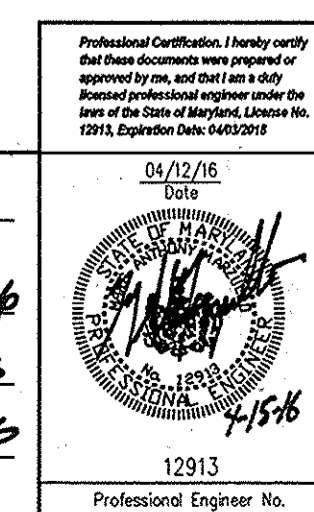

APPROVALS			
APPROVED:	DEPARTMENT OF PLANNING AND ZONING		
<i>[Signature]</i>		DATE: 6-7-16	
DESIGNED BY:		DATE: 6-9-16	
<i>[Signature]</i>		DATE: 6-9-16	
CHECKED BY:		DATE:	
<i>[Signature]</i>		DATE:	

6600 Roadside Drive, Suite 550 Bethesda, MD 20817 PHONE: (301) 248-0900 FAX: (301) 248-0901	1600 MONROE LARK, MD 20725
Subdivision Name: _____ Section/Area: _____ Lot/Parcel #: _____	LIBR: 374 ZONE: 6 DIST: 34 WATER CODE: _____
<b>MONOPOLE ELEVATION</b>	
Dis. By: M.A. Date: 04-08-16	Scale: _____ Approved: M.A.
10 of 10	