

GENERAL NOTES - NON-RESIDENTIAL
SITE DEVELOPMENT PLAN

- ALL CONSTRUCTION SHALL BE IN ACCORDANCE WITH THE LATEST STANDARDS AND SPECIFICATIONS OF HOWARD COUNTY PLUS MSHA STANDARDS AND SPECIFICATIONS IF APPLICABLE.
- THE CONTRACTOR SHALL NOTIFY THE DEPARTMENT OF PUBLIC WORKS/BUREAU OF ENGINEERING/CONSTRUCTION INSPECTION DIVISION AT (410) 313-1880 AT LEAST FIVE (5) WORKING DAYS PRIOR TO THE START OF WORK.
- IF REQUIRED FOR THIS PROJECT, TRAFFIC DEVICES, MARKINGS AND SIGNING SHALL BE IN ACCORDANCE WITH THE LATEST EDITION OF THE MANUAL OF UNIFORM TRAFFIC CONTROL DEVICES (MUTCD). ALL STREET AND REGULATORY SIGNS SHALL BE IN PLACE PRIOR TO THE PLACEMENT OF ANY ASPHALT.
- THE EXISTING TOPOGRAPHY IS TAKEN FROM AERIAL SURVEY WITH ONE FOOT CONTOUR INTERVALS PREPARED BY HOWARD COUNTY, DATED DECEMBER 2008.
- THE COORDINATES SHOWN HEREON ARE BASED UPON THE HOWARD COUNTY GEODETIC CONTROL WHICH IS BASED UPON THE MARYLAND STATE PLANE COORDINANCE SYSTEM. CONTROL FOR THIS PROJECT IS PROVIDED BY HOWARD COUNTY DEPARTMENT OF PUBLIC WORKS FIELD MONUMENTATION.
- STORMWATER MANAGEMENT (ESD) MEASURES ARE PROVIDED THROUGH THE USE OF A BIO-SWALE, CISTERN AND GRASS CHANNELS. MANAGEMENT OF THE 10 YR. 24-HOUR STORM HAS BEEN PROVIDED UNDER SDP-97-128.
- EXISTING UTILITIES ARE BASED ON "AS-BUILT" DRAWINGS.
- THERE IS NO FLOODPLAIN ON THIS SITE.
- THERE IS NO WETLANDS ON THIS SITE.
- NO TRAFFIC STUDY IS REQUIRED FOR THIS PROJECT.
- THERE ARE NO DESIGN MANUAL WAIVERS PLANNED FOR THIS PROJECT IN REGARDS TO ENVIRONMENTAL DISTURBANCES.
- FOREST CONSERVATION OBLIGATIONS HAVE BEEN PREVIOUSLY ADDRESSED BY SDP-97-128, ALPHA RIDGE LANDFILL.

INSTALL SOIL STABILIZATION MATTING
STA. 100+80 TO 101+15, LT. (GRASS CHANNEL NO. 2) 170 S.Y.
STA. 101+11 TO 101+41.5, LT. (GRASS CHANNEL NO. 1) 198 S.Y.
STA. 100+80 TO, RT. TO 104+85, LT. (GRASS CHANNEL NO. 3&5) 1130 S.Y.
STA. 100+54.5, RT. TO 105+26, LT. (GRASS CHANNEL NO. 4) 550 S.Y.
STA. 101+64 TO 102+01, LT. 70 S.Y.
STA. 104+34 TO 104+80, LT. 80 S.Y.

INSTALL TRENCH DRAIN
(SEE PLAN AND DETAIL, SHEET CO-3)
STA. 101+65.9 TO 102+00.9, 58' LT. 35 L.F.
STA. 101+65.9 TO 102+00.9, 87' LT. 35 L.F.

CONSTRUCTION BIO-SWALE SECTION
STA. 102+07.5 TO 104+44.5, 117.5' LT. 237 L.F.
(SEE DETAILS, SHEET CO-4)

INSTALL HARDWOOD MULCH (BIO-SWALE) 3' DEPTH
STA. 104+45 TO 102+08, LT. 18 C.Y.

INSTALL CLASS I RIPRAP OUTLET PROTECTION (19" DEPTH)
(SEE RIPRAP CONTROL TABLE)
STA. 100+27 TO 100+76, LT. 85 S.Y.

INSTALL TURFGRASS SOD
STA. 101+86 TO 104+51, LT. (BIO-SWALE) 380 S.Y.
STA. 100+14 TO 100+55.5, RT. 110 S.Y.

DIVERSION BERM/SWALE
CONSTRUCTION TO REPLACE
GRASS CHANNEL NO. 4

GRASS CHANNEL
NOT CONSTRUCTED

- LEGEND
- HOT MIX ASPHALT PAVEMENT
 - CONCRETE PAVEMENT
 - SOIL STABILIZATION MATTING
 - MULCH
 - TURFGRASS SOD
 - CLASS I RIPRAP/GABION WEIR
 - BORING LOCATION

- SITE ANALYSIS DATA
- TAX MAP: 10 & 16
 - PARCEL NO'S: 54, 253, 220 & 11
 - ELECTION DISTRICT: 3
 - ZONING: PEC
 - AREA OF PROJECT: 3.04 AC.
 - AREA OF WETLANDS: 0.0 AC.
 - AREA OF WETLAND BUFFER: 0.0 AC.
 - AREA OF FLOODPLAIN: 0.0 AC.
 - AREA OF STREAM BUFFER: 0.0 AC.
 - AREA OF STEEP SLOPES: 0.0 AC.
 - (SITE PREVIOUSLY MASS GRADED)
 - AREA OF FOREST: 0.0 AC.
 - AREA OF DISTURBANCE: 3.04 AC.
 - AREA OF NEW IMPERVIOUS: 0.87 AC.
 - AREA OF REDEVELOPMENT: 0.02 AC.
 - AREA OF IMPERVIOUS REMOVED: 0.0 AC.
 - SITE HAS BEEN PREVIOUSLY MASS GRADED.
- ORIGINAL SOILS IN AREA ARE CHESTER, HYDROLOGIC CLASS B, BASED ON THE 1988 SOIL SURVEY FOR HOWARD COUNTY.

APPROVED: DEPARTMENT OF PLANNING AND ZONING

Charles S. Nolan, P.E. 3/14/12
DATE


3-29-12
DATE

4-02-12
DATE

7/4/12
DATE

"PROFESSIONAL CERTIFICATION. I HEREBY CERTIFY THESE DOCUMENTS ARE PREPARED OR APPROVED BY ME, AND THAT I AM A DULY LICENSED PROFESSIONAL ENGINEER UNDER THE LAWS OF THE STATE OF MARYLAND, LICENSE NO. 15212, EXPIRATION DATE: 12/24/2012."

NOTE: FOR REPAIR OF EQUIPMENT ACCESS ROAD DISTURBANCE SEE GRAVEL PAVING REPAIR SECTION ON SHEET CO-2

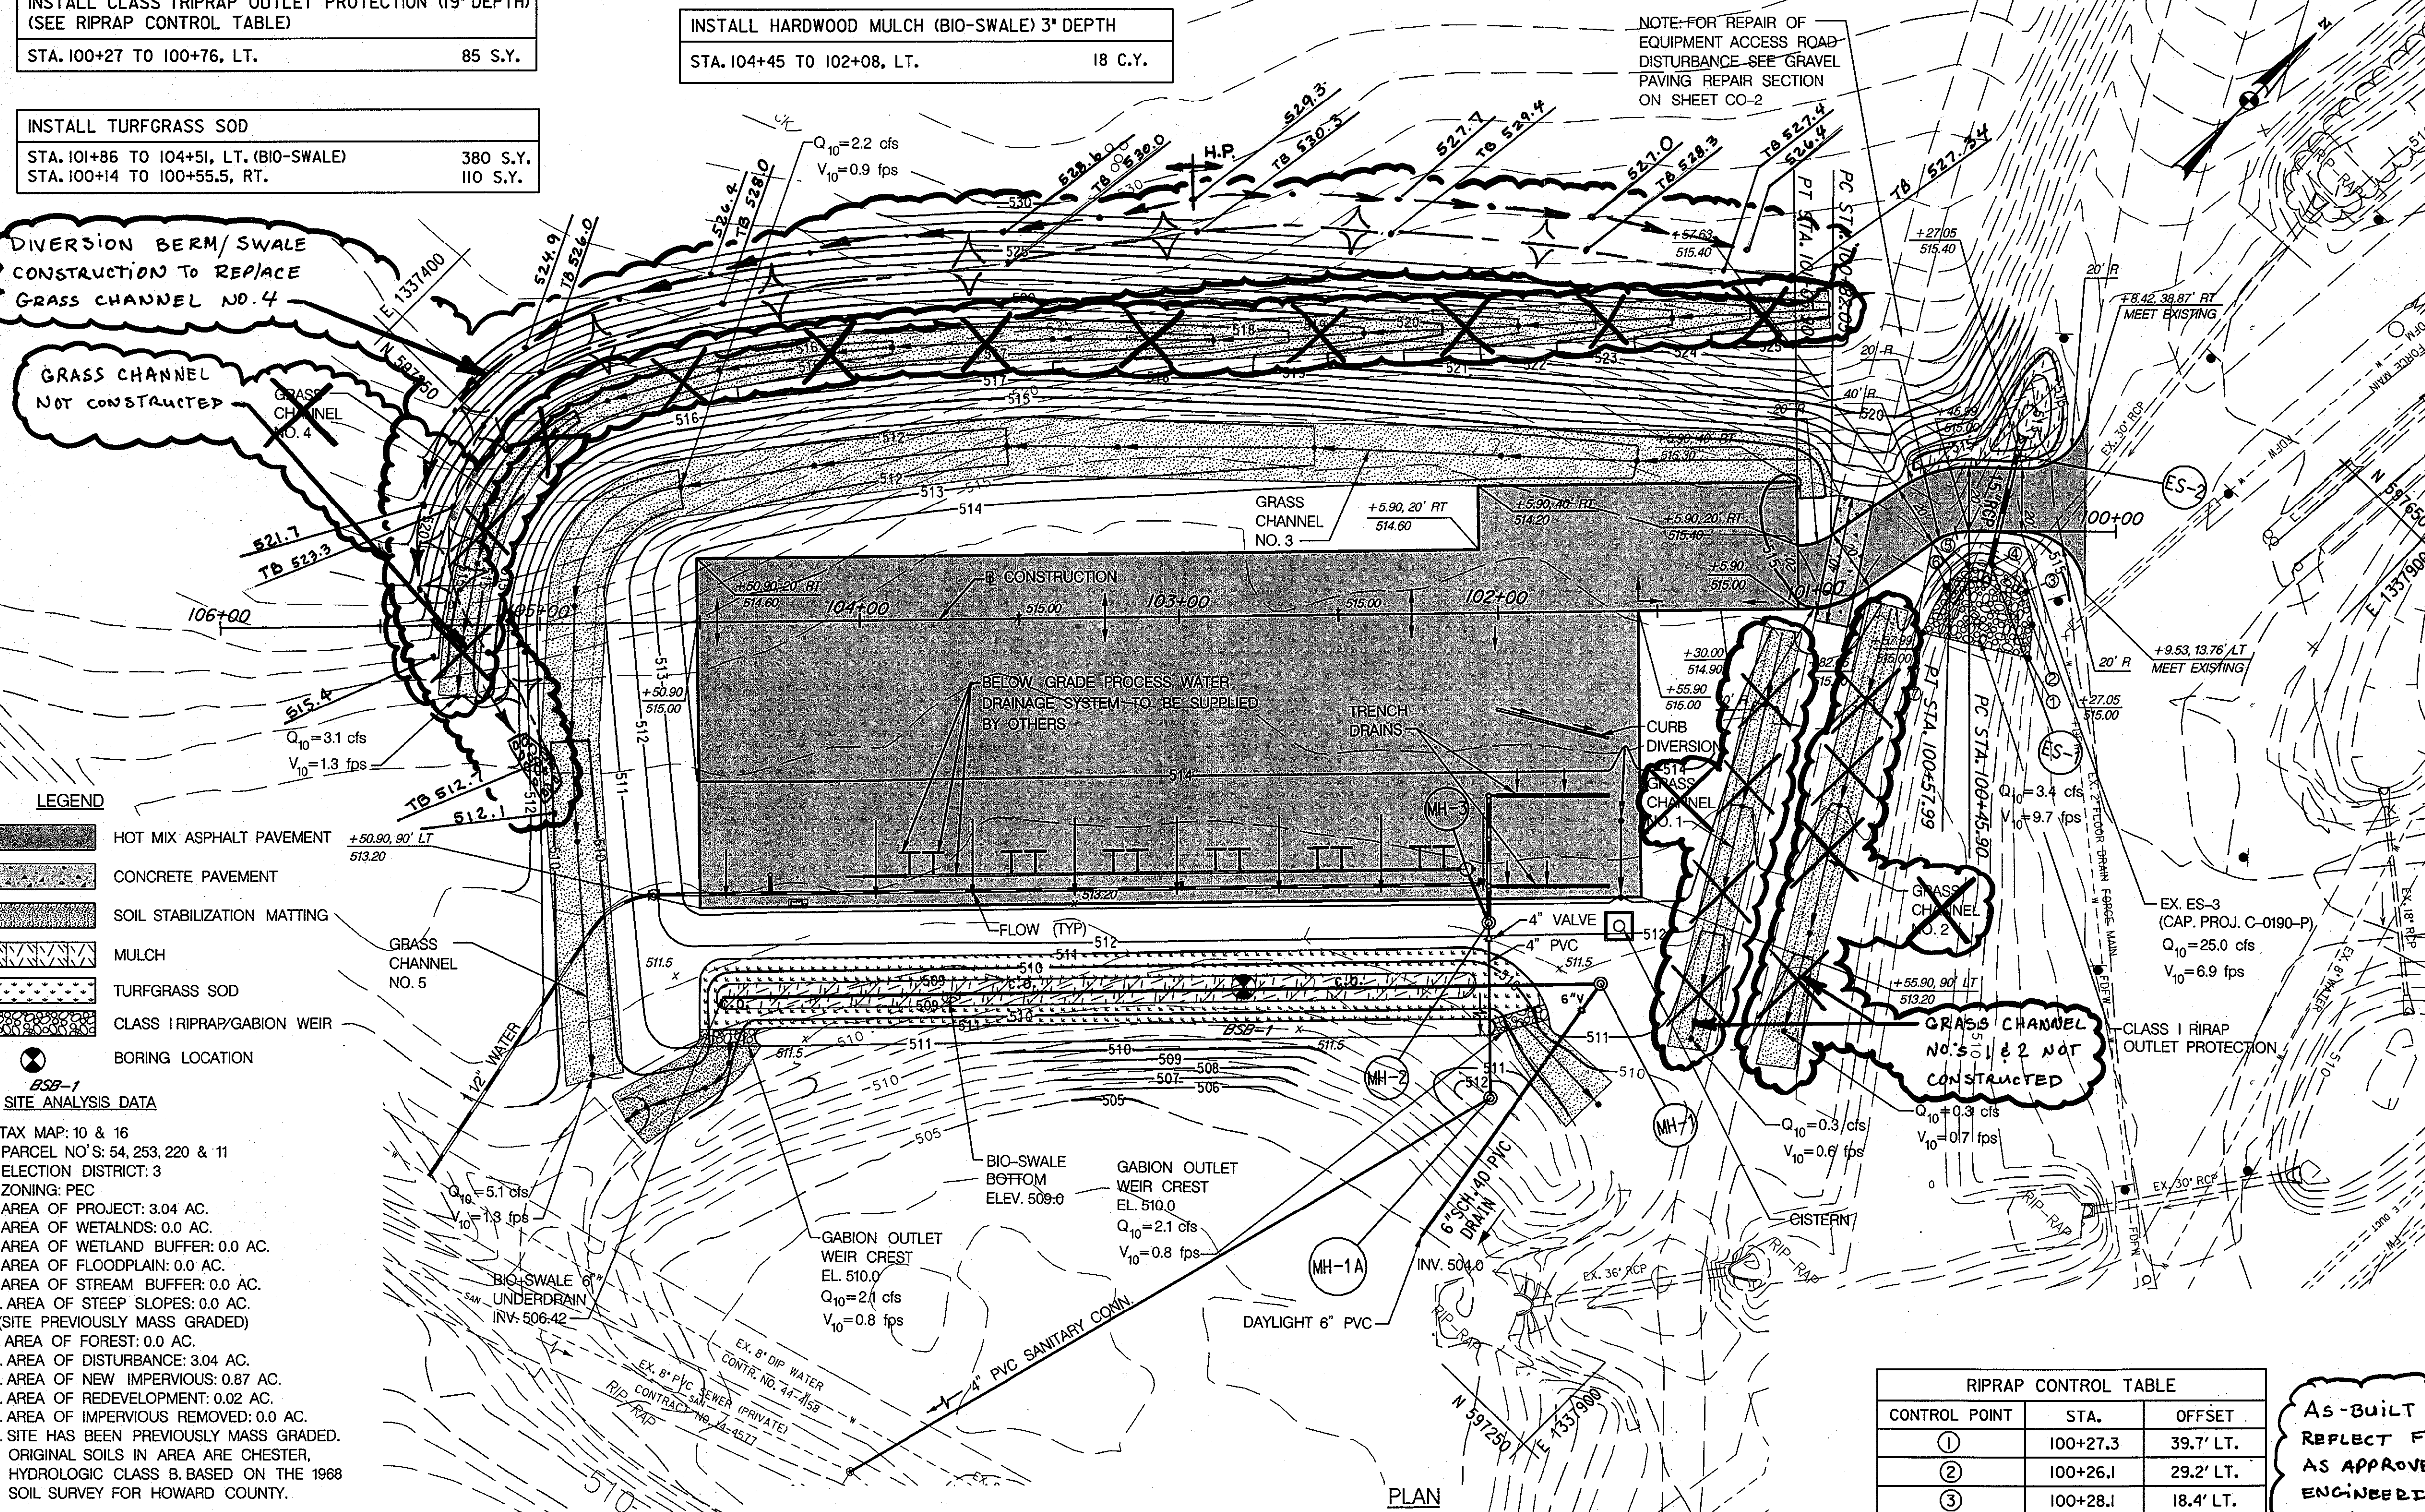


INSTALL HOT MIX ASPHALT CURB DIVERSION (HO. CO. DETAIL R-3.03)
STA. 101+65.9 40' LT. TO 102+00, 30' LT. 36 L.F.

INSTALL GABION WEIR (BIO-SWALE)
(SEE DETAILS, SHEET CO-4)
STA. 100+94, 128' LT. 2 C.Y.
STA. 104+41.5, 131.5' LT. 2 C.Y.

CONSTRUCT HOT MIX ASPHALT PAVEMENT SECTION
(SEE PAVEMENT SECTION DETAIL, SHEET CO-2) 36,293 S.F.

CONSTRUCT CONCRETE PAVEMENT SECTION
(SEE PAVEMENT SECTION LOCATION PLAN & DETAIL, SHEET CO-2) 420 S.F.

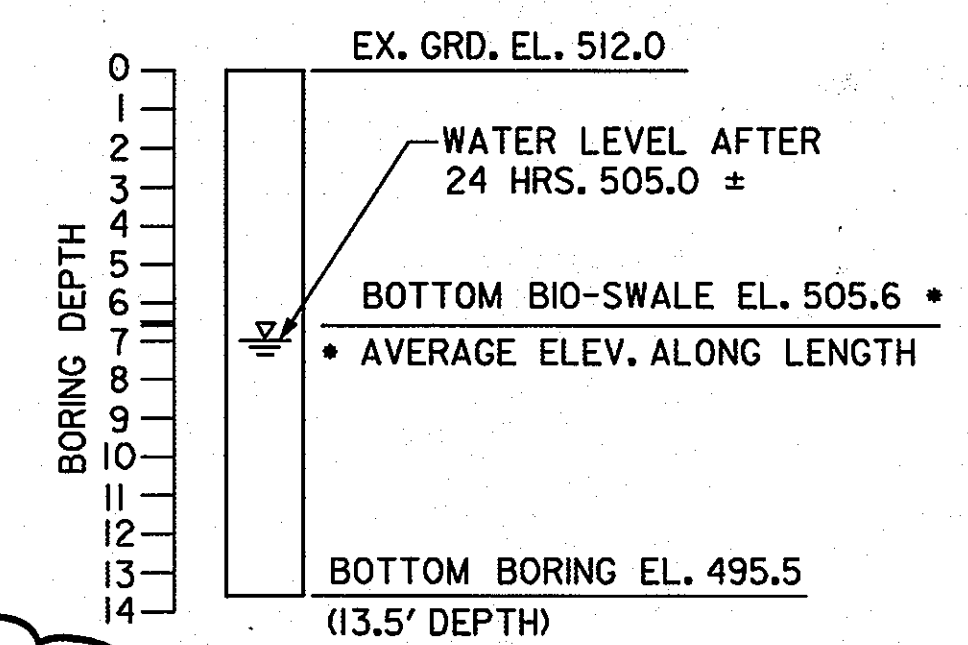

LOCATION: N 597,291.0
E 1,337,736.0
BORING DUG 1/8/12
BSB-1 BORING LOG

RIPRAP CONTROL TABLE

CONTROL POINT	STA.	OFFSET
①	100+27.3	39.7' LT.
②	100+26.1	29.2' LT.
③	100+28.1	18.4' LT.
④	100+37.8	10.9' LT.
⑤	100+46.5	10.2' LT.
⑥	100+62.3	13.5' LT.
⑦	100+76.6	21.3' LT.

AS-BUILT INFORMATION SHOWN REFLECT FIELD CONDITION CHANGES AS APPROVED BY THE DEVELOPMENT ENGINEERING DIVISION (DED) BY EMAIL DATED JULY 18, 2013.

PURPOSE STATEMENT
THE PURPOSE OF THIS REVISION TO SDP-97-128 IS TO INCORPORATE THE CONSTRUCTION OF THE AERATED STATIC PILE COMPOST FACILITY ON THE GROUNDS OF THE ALPHA RIDGE LANDFILL.

SUBDIVISION NAME ALPHA RIDGE SOLID WASTE MANAGEMENT CENTER	LOT/PARCEL 54, 253, 220, 11	ZONE PEC	TAX / ZONE MAP 10 & 16
LIBER / FOLIO 10-847606 16-879215 10-897314	SEWER CODE PRIVATE, EXISTING	CENSUS TR. 60-30	

DEPARTMENT OF PUBLIC WORKS
HOWARD COUNTY, MARYLAND

3/15/12
DATE

3/13/12
DATE

NOLAN Associates, Inc.
Engineers - Civil/Structural/Inspections
4785 Dorsey Hall Drive
Suite 124
Ellicott City, Maryland 21042
Phone: (410) 995-3851 Fax: (410) 995-1283



DES: GWF	
DRN: JRW	
CHK:	
DATE: MARCH 2012	
BY NO.	REVISION
DATE	600' SCALE MAP NO. 16 BLOCK NO. 8

SITE DEVELOPMENT PLAN





ALPHA RIDGE LANDFILL
AERATED STATIC PILE COMPOST FACILITY
CAPITAL PROJECT NO. C-0299
TAX MAP 10 & 16. PARCEL NUMBERS 54, 253, 220 & 11
ELECTION DISTRICT NO. 3 HOWARD COUNTY, MARYLAND

SCALE: AS SHOWN
SHEET CO-1 OF 9 TOTAL OF 98

GRASS CHANNEL SCHEDULE						
GRASS CHANNEL	BOTTOM WIDTH	SIDE SLOPES	Q ₁₀ (cfs)	V ₁₀ (cfs)	FLOW DEPTH (ft)	WIDTH OF SSM
NO. 1	7 ft	3:1	0.3	0.6	0.1	13'
NO. 2	4 ft	3:1	0.3	0.7	0.1	10'
NO. 3	12 ft	3:1 (MAX)	2.2	0.9	0.2	18'
NO. 4	4 ft	3:1	3.1	1.3	0.5	10'
NO. 5	12 ft	3:1 (MAX)	5.1	1.3	0.3	18'

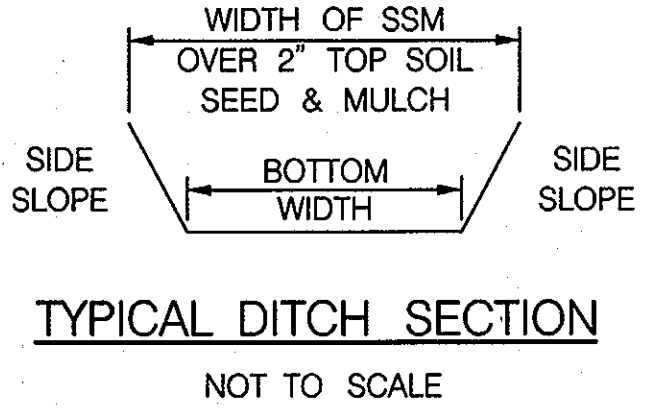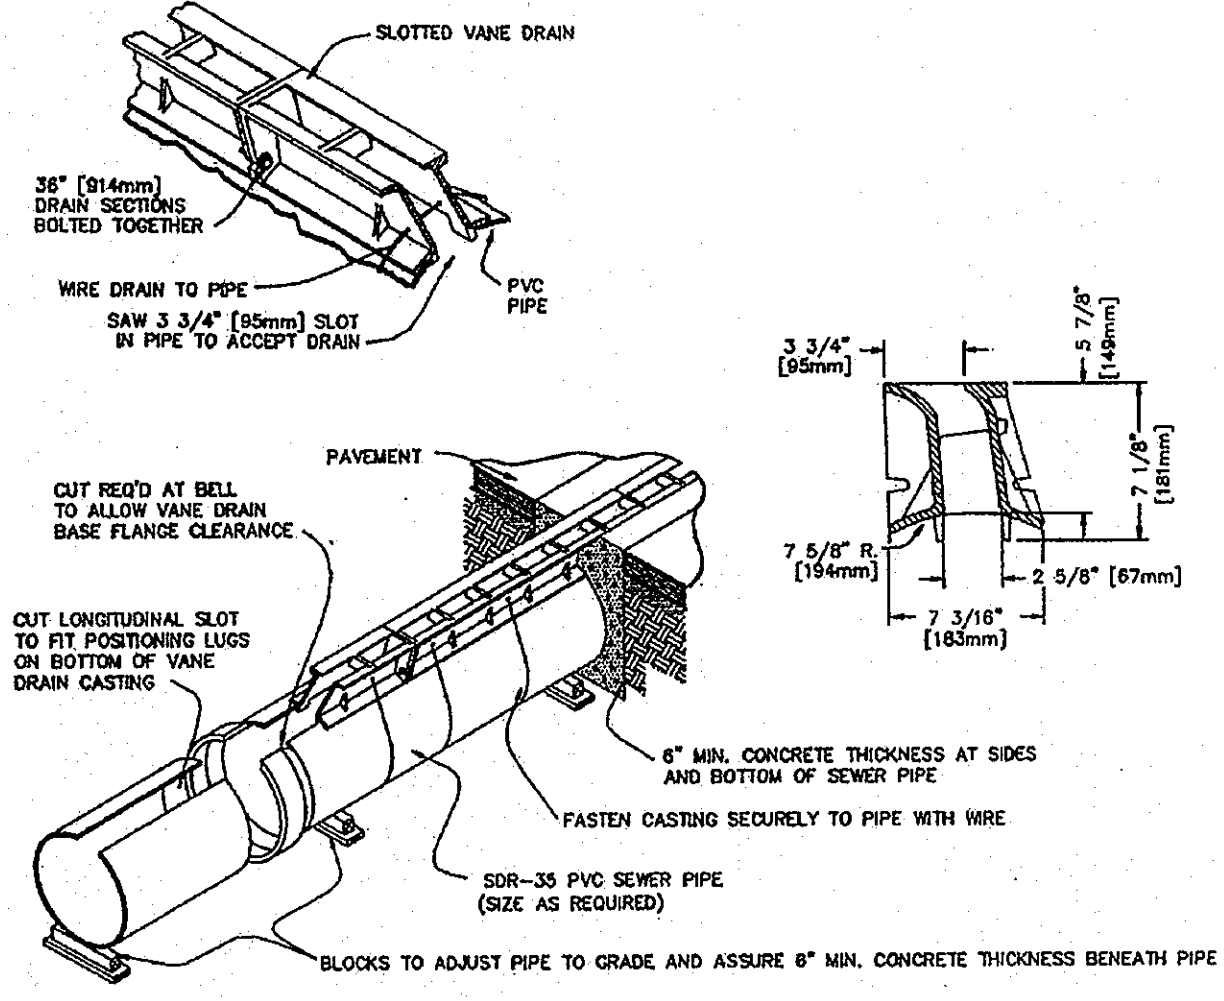

- NOTES:
- TRENCH DRAIN TO BE NEENAH FOUNDRY TYPE R-3599-A OR APPROVED EQUAL.
 - PIPE SIZE TO BE 12-INCH PVC SCH 40.

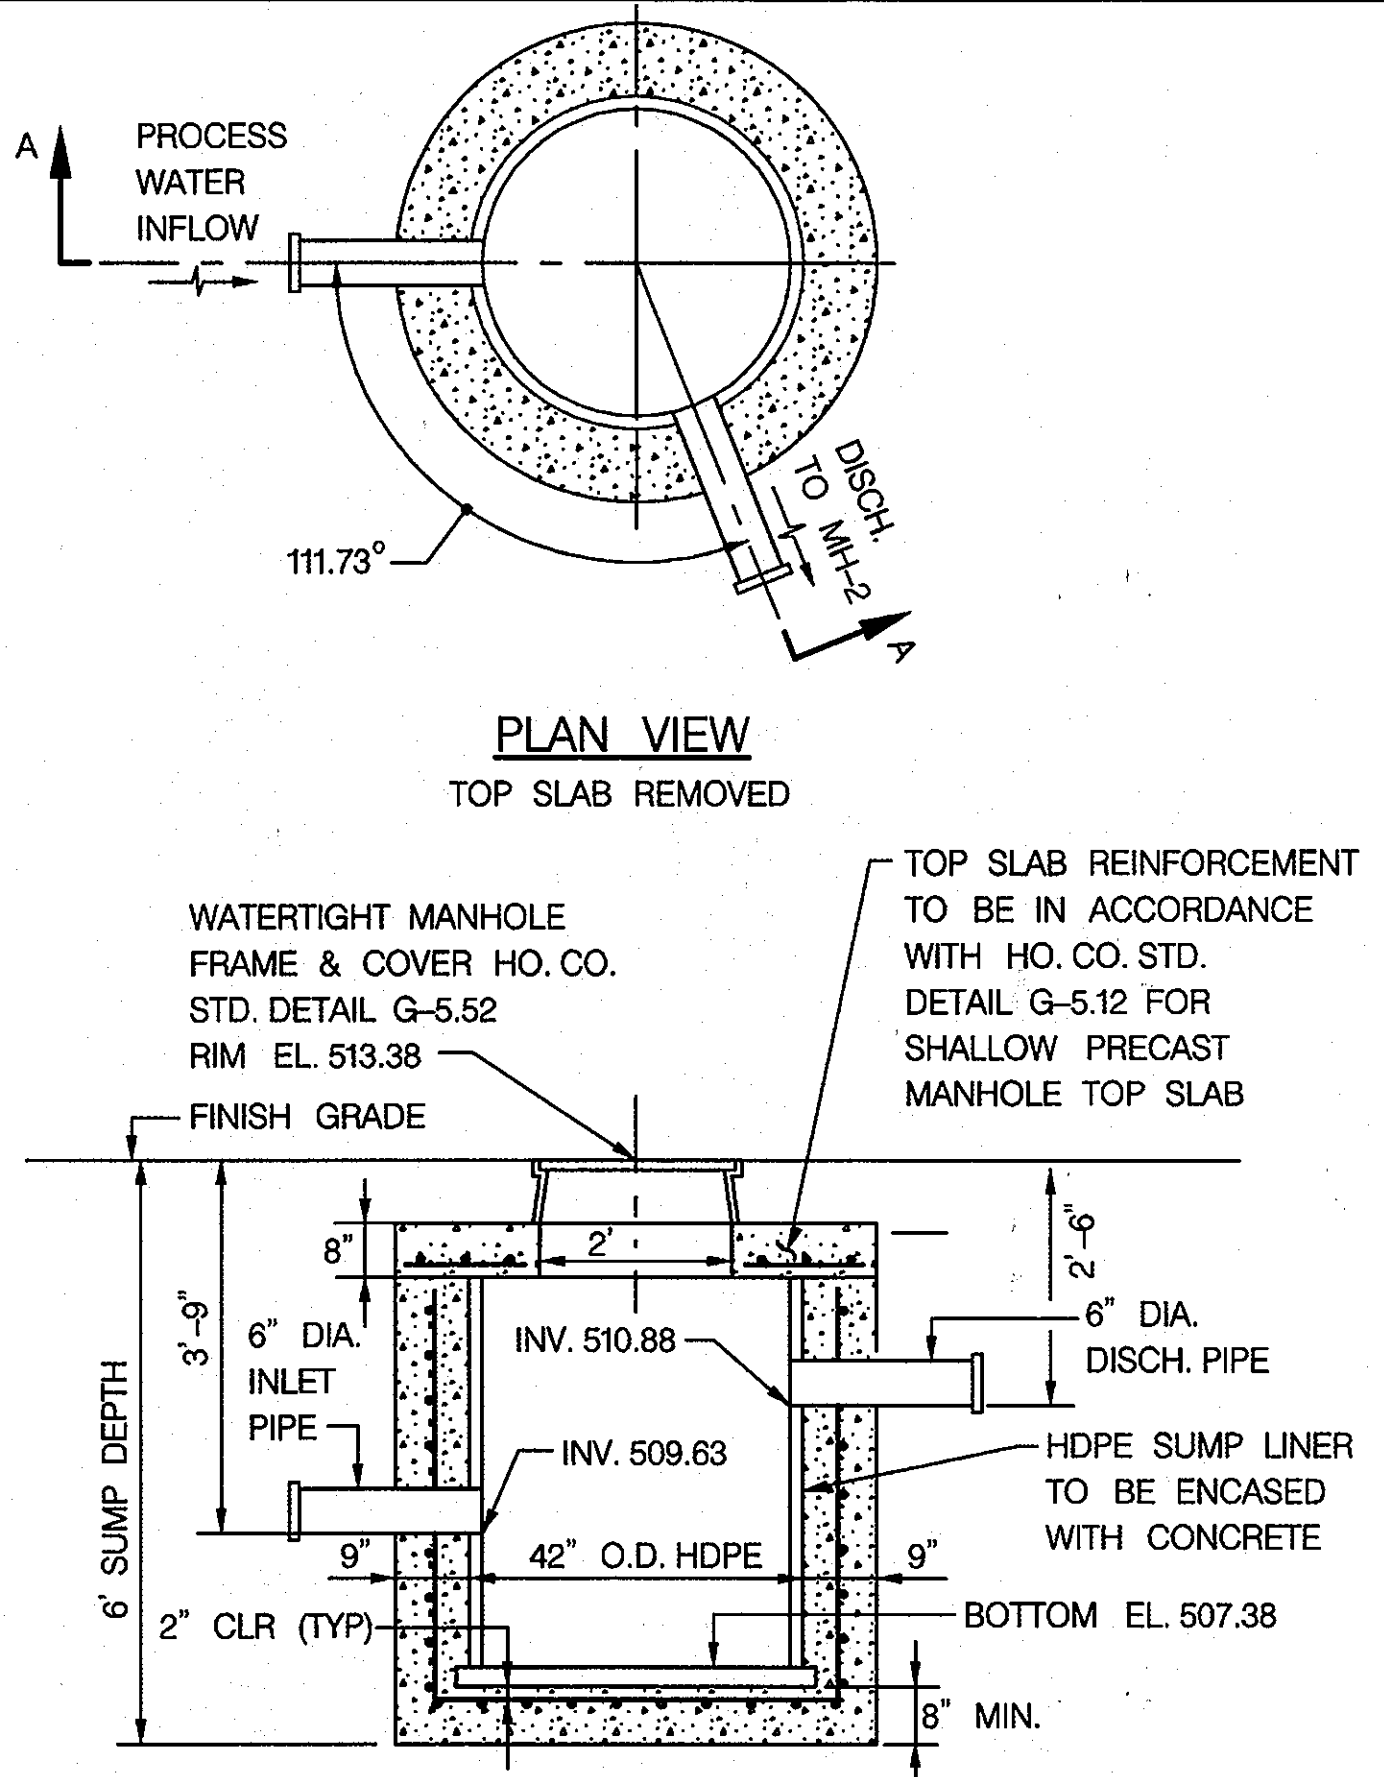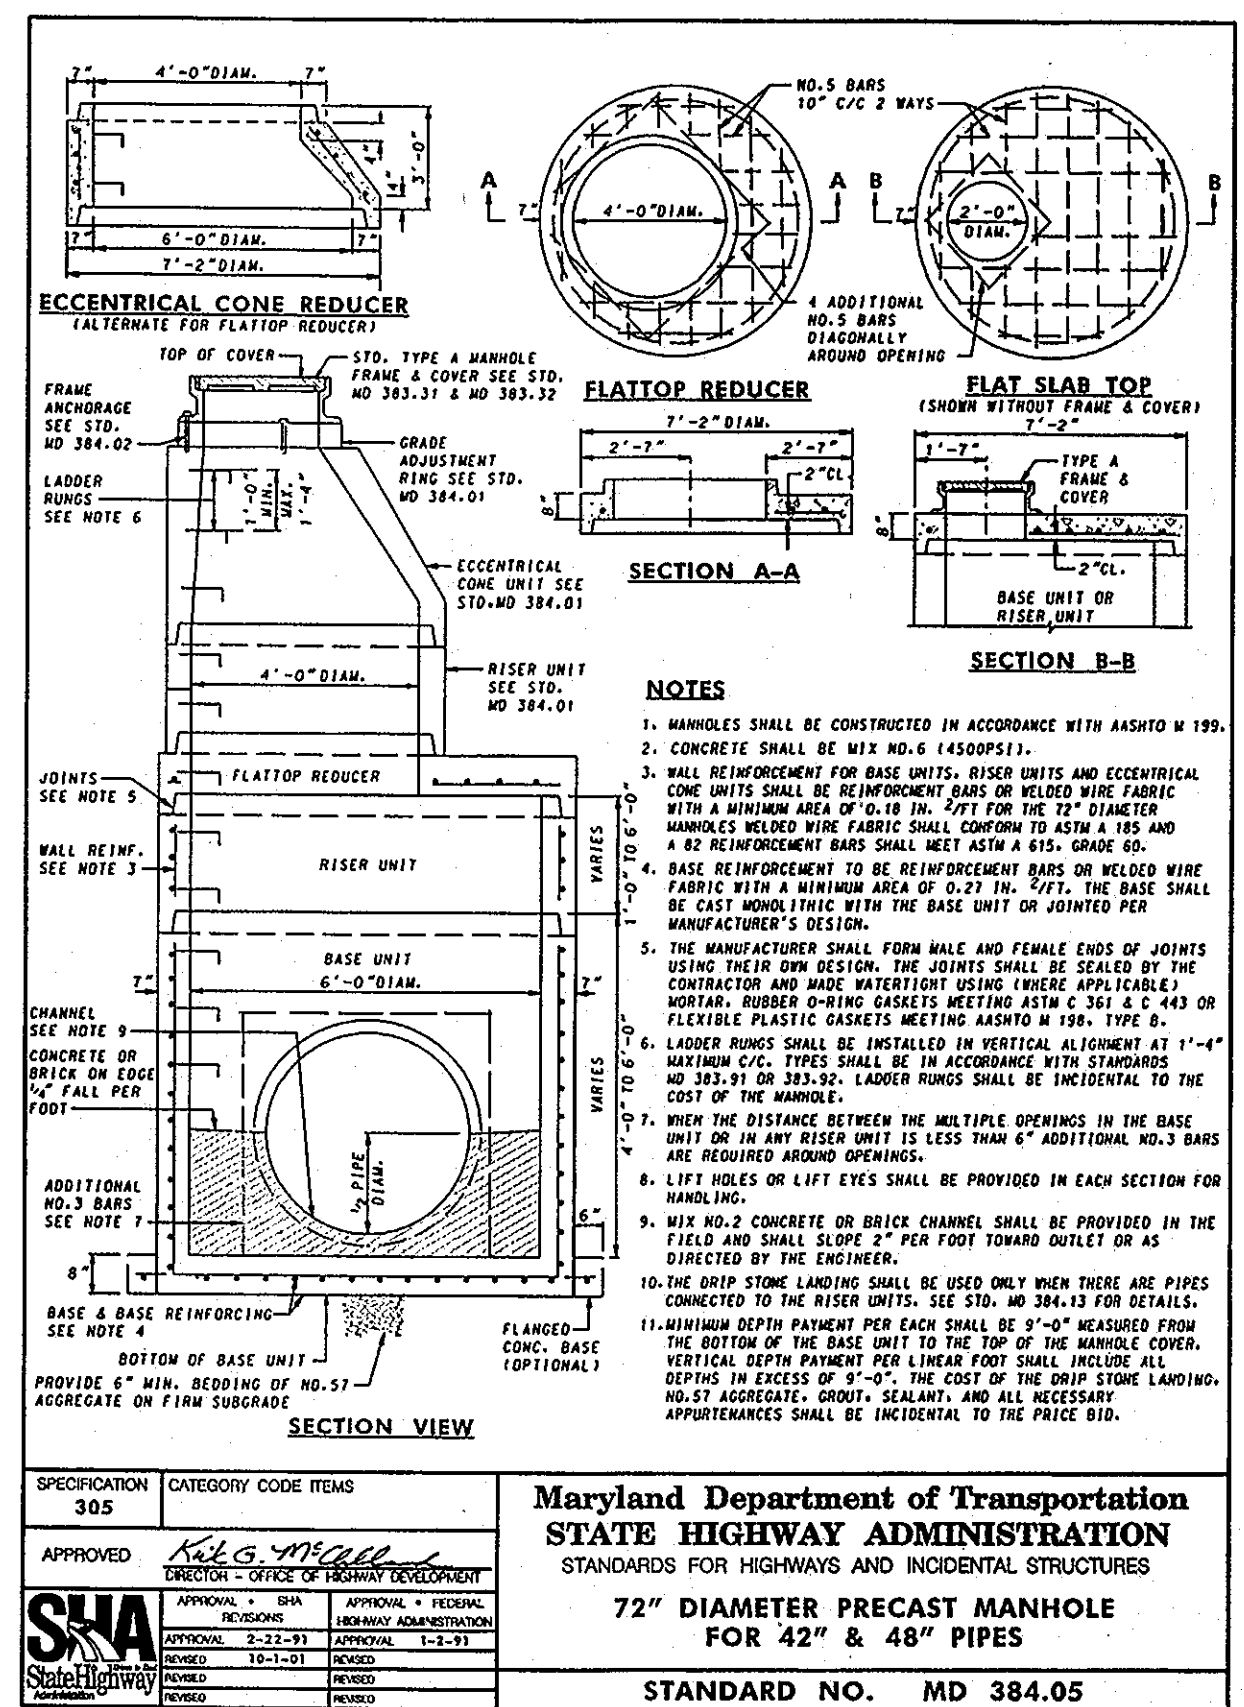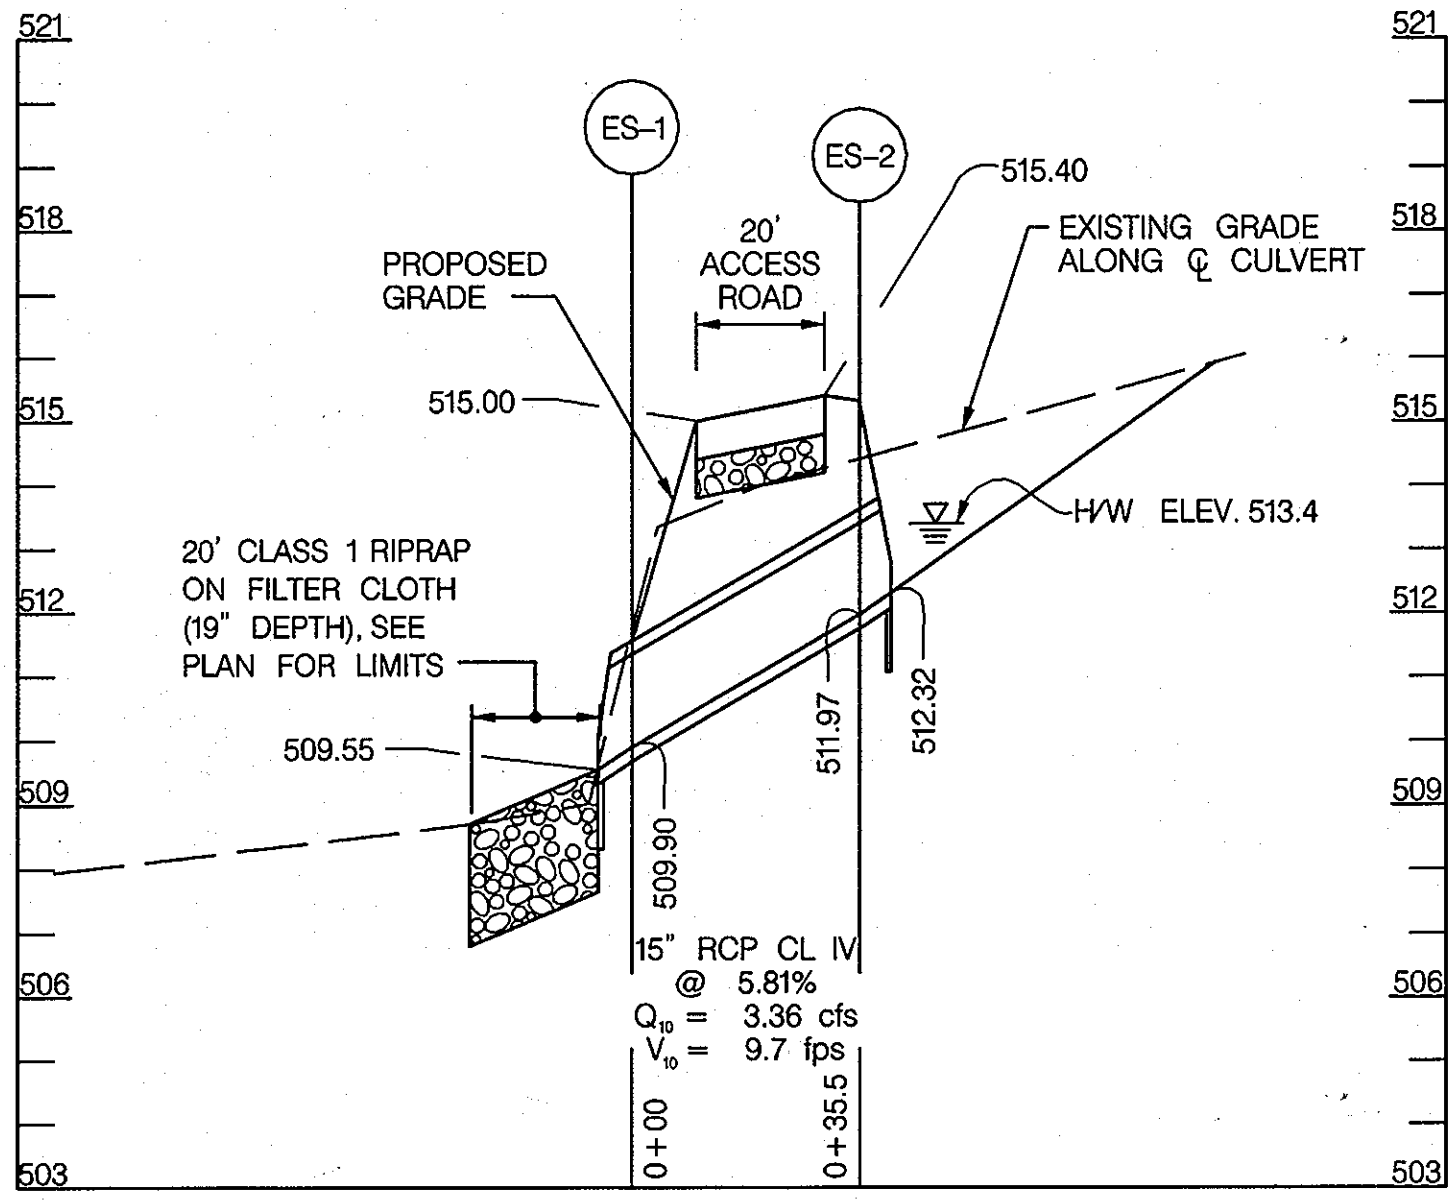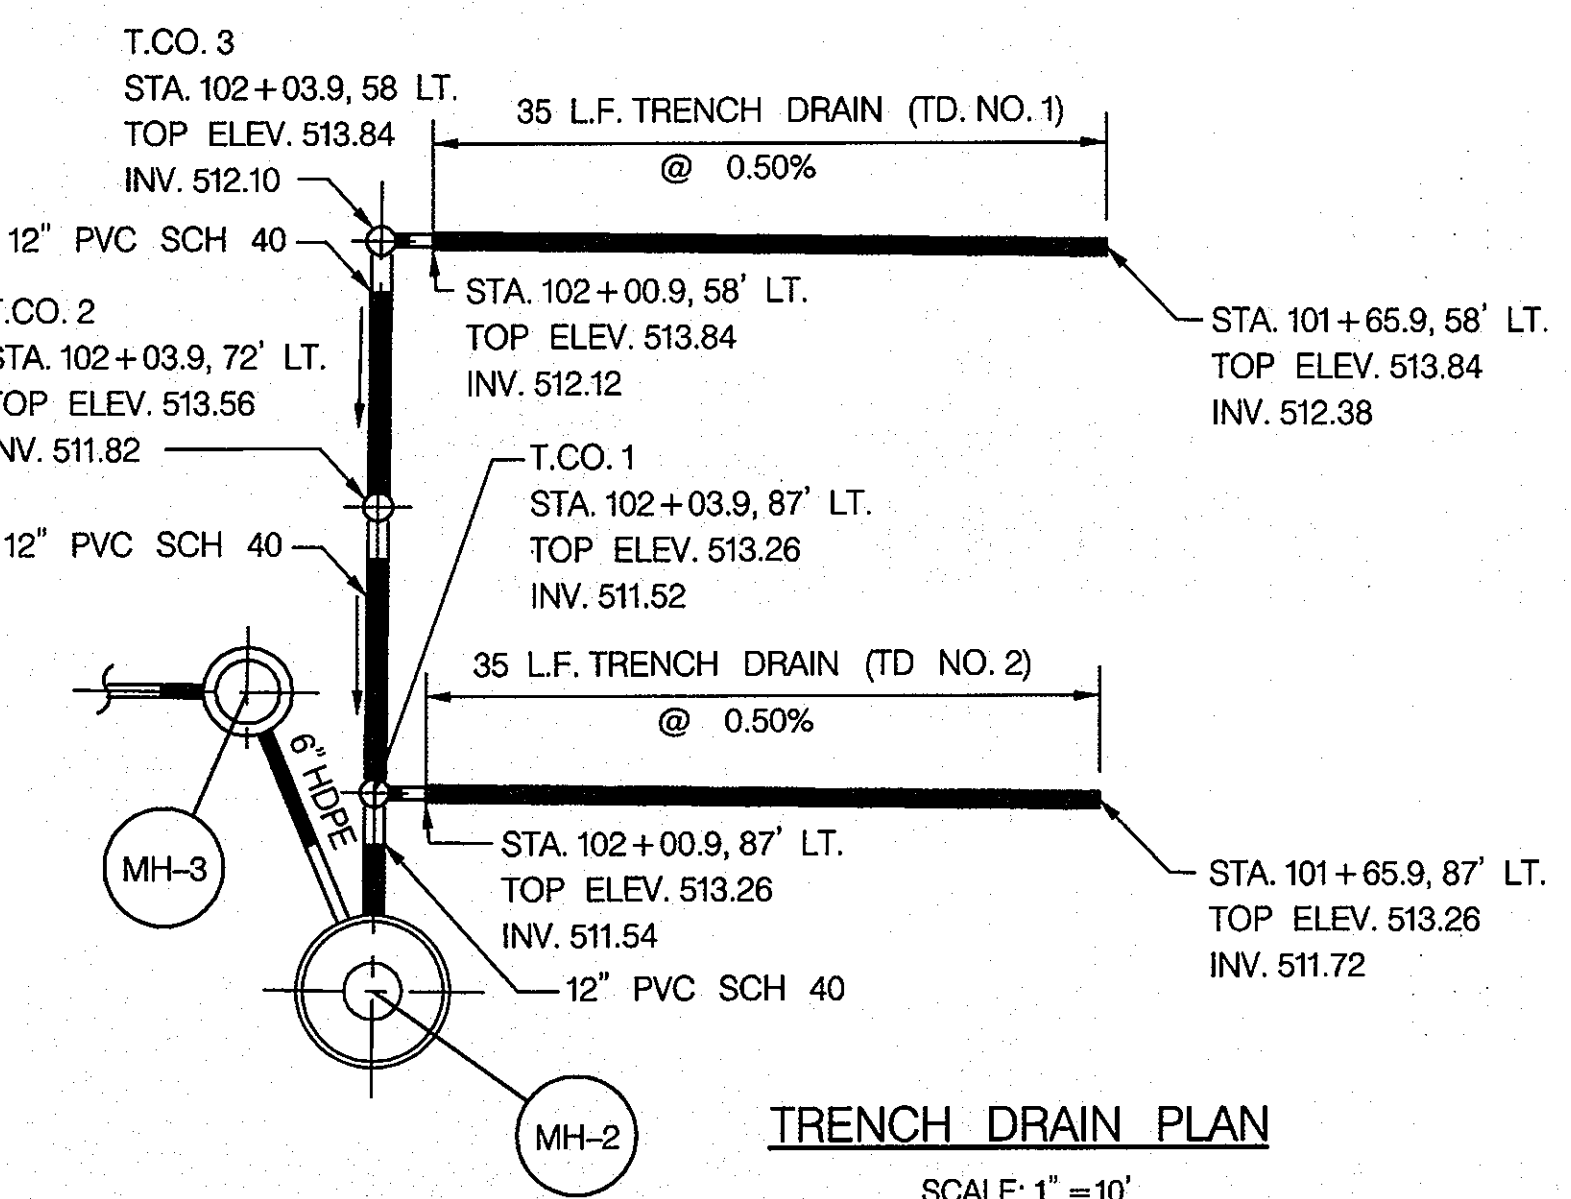

DRAINAGE PIPE SCHEDULE				
FROM STRUCT.	TO STRUCT.	SIZE (IN.)	TYPE	LENGTH (FT.)
MH-1	OUTFALL	6"	PVC SCH 40 *	97'
MH-1	BIO-SWALE	6"	PVC SCH 40 *	40'
BIO-SWALE	CO-1	6"	PERF. PVC SCH 40	35'
CO-1	CO-2	6"	PERF. PVC SCH 40	100'
CO-2	CO-3	6"	PERF. PVC SCH 40	100'
ES-1	ES-2	15"	RCCP CL IV	36'
MH-3	MH-2	6"	HDPE	30'

DRAINAGE STRUCTURE SCHEDULE						
NO.	TYPE	LOCATION	INV. IN	INV. OUT	TOP EL.	STD. NO.
MH-1	PRECAST MANHOLE	STA. 101+69.01, 117' LT.	505.04	504.94	511.50	G - 5.12
ES-1	15" CONCRETE END SECTION	STA. 100+39.3, 10' LT.	509.90	509.55	---	D - 5.51
ES-2	15" CONCRETE END SECTION	STA. 100+30.8, 24' LT.	512.32	511.97	---	D - 5.51
CO-1	CLEAN OUT	STA. 102+43.3, 117.5' LT.	---	506.42	509.5	SEE DETAIL
CO-2	CLEAN OUT	STA. 103+43.3, 117.5' LT.	---	505.92	509.5	SEE DETAIL
CO-3	CLEAN OUT	STA. 104+43.3, 117.5' LT.	---	505.42	509.5	SEE DETAIL
CISTERN	SEE DETAIL	STA. 101+62.9, 100' LT.	---	---	512.0	SEE DETAIL
MH-2	72" DIA. PRECAST MANHOLE	STA. 102+03.9, 97.5' LT.	510.45 (6") 509.95 (12")	504.45 (1)	512.45	MD SHA STD. NO. MD 384.05
MH-3	POURED IN PLACE MANHOLE	STA. 102+10.75, 80.75' LT.	509.63	510.88	513.38	SEE DETAIL (2)




- (1) BOTTOM OF MANHOLE ELEVATION & 4" PVC INV. OUT ELEVATION. MANHOLE MH-2 TO ALSO BE USED AS HOLDING / STORAGE FACILITY FOR TRENCH DRAIN / PROCESS WATER DRAINAGE SYSTEMS.
- (2) INLET TO BE CAST IN PLACE AROUND PROCESS WATER HDPE SUMP LINER (TO BE SUPPLIED BY OTHERS).

APPROVED: DEPARTMENT OF PLANNING AND ZONING

Chad E. ... 3-29-12
 CHIEF, DEVELOPMENT ENGINEERING DIVISION DATE

Kat ... 4-02-12
 CHIEF, DIVISION OF LAND DEVELOPMENT DATE

David ... 4/24/12
 DIRECTOR DATE

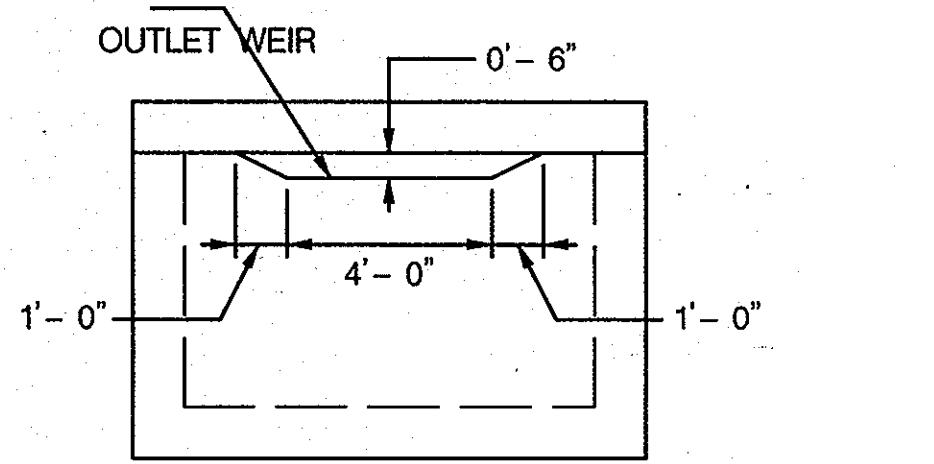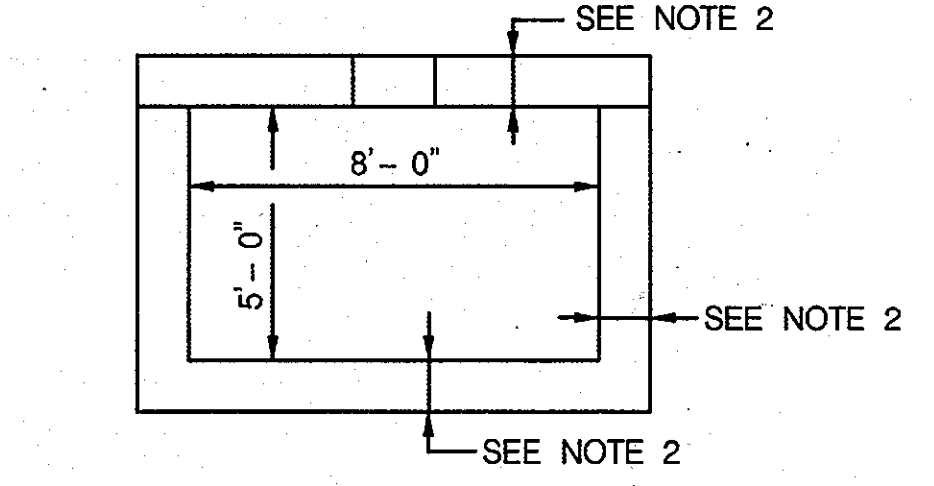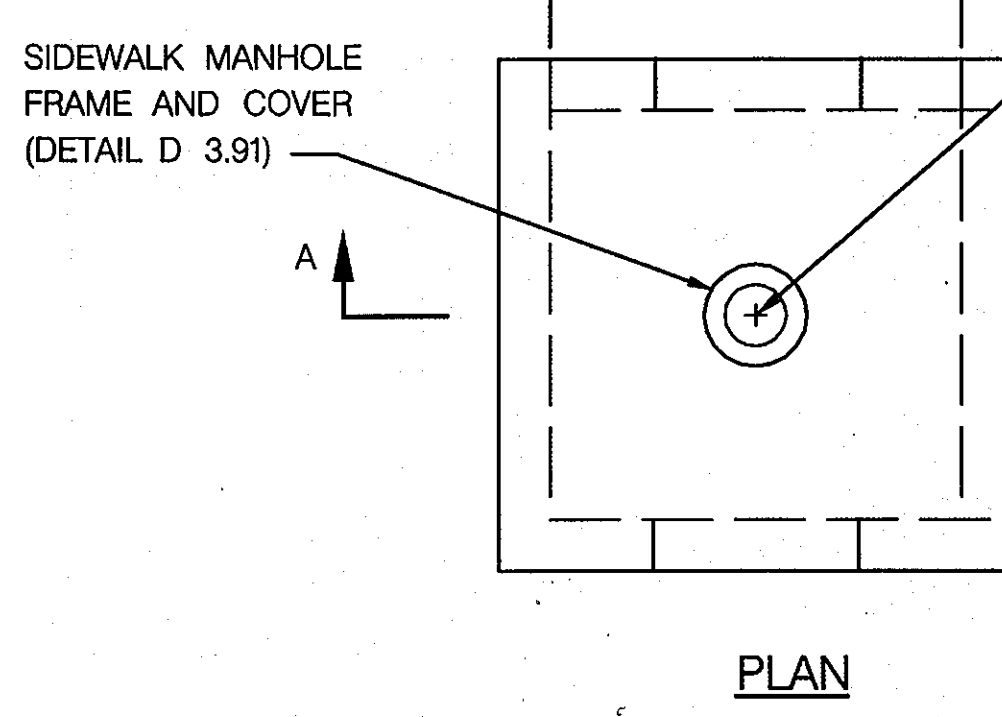

- NOTES:
- CISTERN TO BE USED AS HOLDING TANK FOR STORMWATER RUNOFF TO BE USED FOR COMPOST FACILITY IRRIGATION PURPOSES.
 - WALL THICKNESS SHOWN AS 1'-0" FOR INFORMATIONAL PURPOSES. CISTERN TO BE PRE-CAST WITH THICKNESS AND REINFORCEMENT DETERMINED BY PRE-CAST MANUFACTURER.


CISTERN DETAILS
 SCALE 1/4" = 1'-0"

SUBDIVISION NAME ALPHA RIDGE SOLID WASTE MANAGEMENT CENTER	LOT / PARCEL 54, 253, 220, 11
LIBER / FOLIO 10-847/606 16-878/215 10-897/314	ZONE PEC
TAX / ZONE MAP 10 & 16	CENSUS TR. 60-30

DEPARTMENT OF PUBLIC WORKS
 HOWARD COUNTY, MARYLAND

Evelyn E. ... 3/15/12
 CHIEF, BUREAU OF ENVIRONMENTAL SERVICES DATE

NOLAN
 Associates, Inc.
 Engineers - Civil/Structural/Inspections
 4785 Dorsey Hall Drive
 Suite 124
 Ellicott City, Maryland 21042

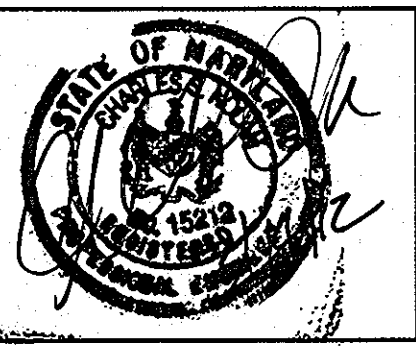

DES: GWF	DRN: JRW	CHK:	DATE: MARCH 2012
BY: NO.	REVISION:	DATE:	60' SCALE MAP NO. 16 BLOCK NO. 8

ALPHA RIDGE LANDFILL
 AERATED STATIC PILE COMPOST FACILITY
 CAPITAL PROJECT NO. C-0299
 TAX MAP 10 & 16. PARCEL NUMBERS 54, 253, 220 & 11
 ELECTION DISTRICT NO. 3 HOWARD COUNTY, MARYLAND


SCALE: AS SHOWN
 SHEET CO-3 OF 9
 TOTAL OF 98

BIO-SWALE SPECIFICATIONS

MATERIAL	SPECIFICATION	SIZE	NOTES
PLANTING SOIL ORGANIC CONTENT	LOAMY SAND (60 - 65%) & COMPOST (35 - 40%) OR SANDY LOAM (30%), COARSE SAND (30%) & COMPOST (40%) MIN. 10% BY DRY WEIGHT (ASTM D 2974)		USDA SOIL TYPES LOAMY SAND OR SANDY LOAM; CLAY CONTENT < 5%
MULCH	SHREDDED HARDWOOD	3" DEPTH	AGED 6 MONTHS, MINIMUM; NO PINE OR WOOD CHIPS
GEOTEXTILE			PE TYPE 1 NONWOVEN
AGGREGATE	AASHTO M-43	NO. 57 OR NO. 7 AGGREGATE	
PEA GRAVEL	ASTM-D-448	NO. 6 OR 2" TO 5" STONE	
UNDERDRAIN PIPING	F 758, TYPE PS 28 OR AASHTO M-728	6" RIGID SCHEDULE 40 PVC OR SDR35	SLOTTED OR PERFORATED PIPE; 3/8" PERF. @ 6" ON CENTER, 4 HOLES PER ROW; MINIMUM OF 4" OF GRAVEL OVER PIPES AND UNDERNEATH PIPE. PERFORATED PIPE SHALL BE WRAPPED WITH 1/4"-INCH GALVANIZED HARDWARE CLOTH
TURFGRASS SOD ESTABLISHMENT	REFER TO SECTION 708 OF THE SPECIFICATIONS		

OPERATION AND MAINTENANCE SCHEDULE FOR BIORETENTION SWALE

- THE OWNER SHALL MAINTAIN THE PLANT MATERIAL, MULCH LAYER AND SOIL LAYER ANNUALLY. MAINTENANCE OF MULCH AND SOIL IS LIMITED TO CORRECTION AREAS OF EROSION OR WASH OUT. ANY MULCH REPLACEMENT SHALL BE DONE IN THE SPRING. PLANT MATERIAL SHALL BE CHECKED FOR DISEASE AND INSECT INFESTATION AND MAINTENANCE WILL ADDRESS DEAD MATERIAL AND PRUNING. ACCEPTABLE REPLACEMENT PLANT MATERIAL IS LIMITED TO THE FOLLOWING: 2000 MARYLAND STORMWATER DESIGN MANUAL VOLUME II, TABLE A.4.1 AND 2.
- THE OWNER SHALL PERFORM A PLANT IN THE SPRING AND IN THE FALL OF EACH YEAR. DURING THE INSPECTION, THE OWNER SHALL REMOVE DEAD AND DISEASED VEGETATION CONSIDERED BEYOND TREATMENT, REPLACE DEAD PLANT MATERIAL WITH ACCEPTABLE REPLACEMENT PLANT MATERIAL, TREAT DISEASED TREES AND SHRUBS, AND REPLACE ALL DEFICIENT STAKES AND WIRES.
- THE OWNER SHALL INSPECT THE MULCH EACH SPRING. THE MULCH SHALL BE REPLACED EVERY TWO TO THREE YEARS. THE PREVIOUS MULCH LAYER SHALL BE REMOVED BEFORE THE NEW LAYER IS APPLIED.
- THE OWNER SHALL CORRECT SOIL EROSION ON AN AS NEEDED BASIS, WITH A MINIMUM OF ONCE PER MONTH AND AFTER EACH HEAVY STORM.


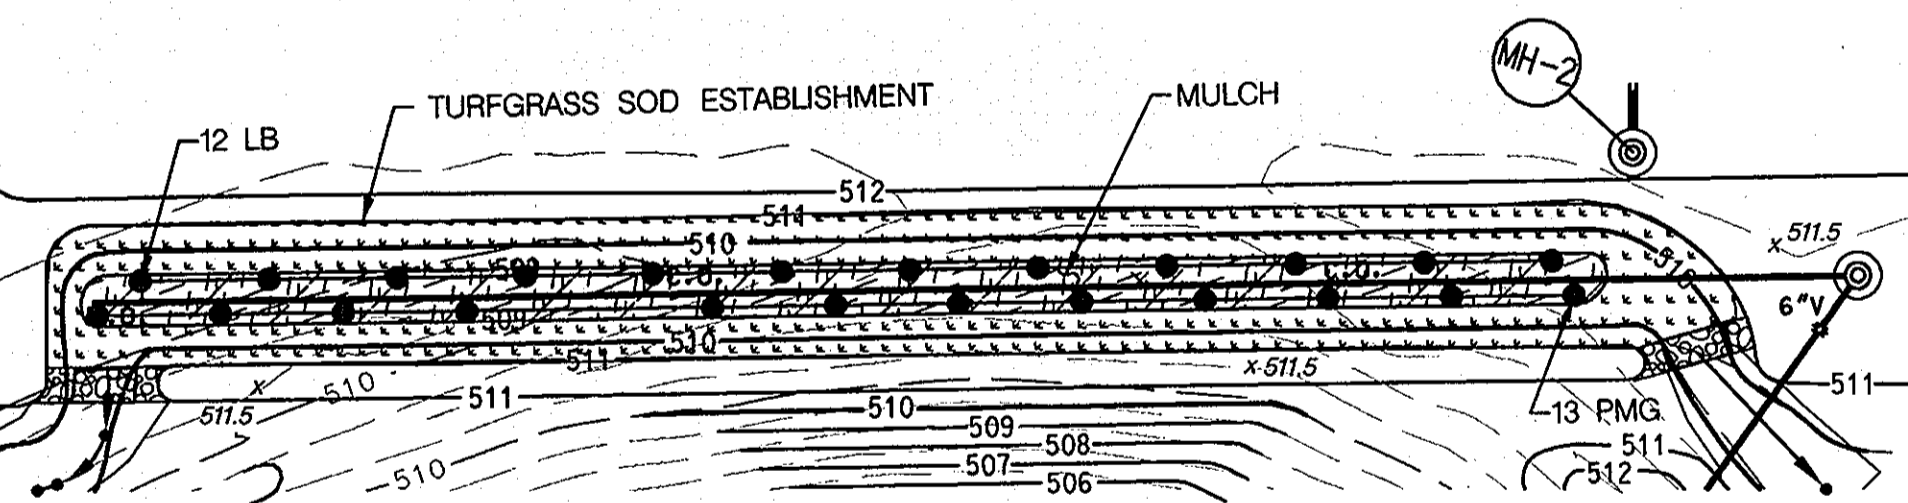


BIO-SWALE PLANTING PLAN

SCALE: 1" = 30'

BIO-SWALE PLANTING LIST


SYMBOL	SCIENTIFIC NAME	COMMON NAME	SIZE	NUMBER
LB	ANDROPOGON GLOMERATUS	LITTLE BLUESTEM	GALLON	12
PMG	MUHLENBERGIA GLOMERATA	PINK MUHLYGRASS	GALLON	13

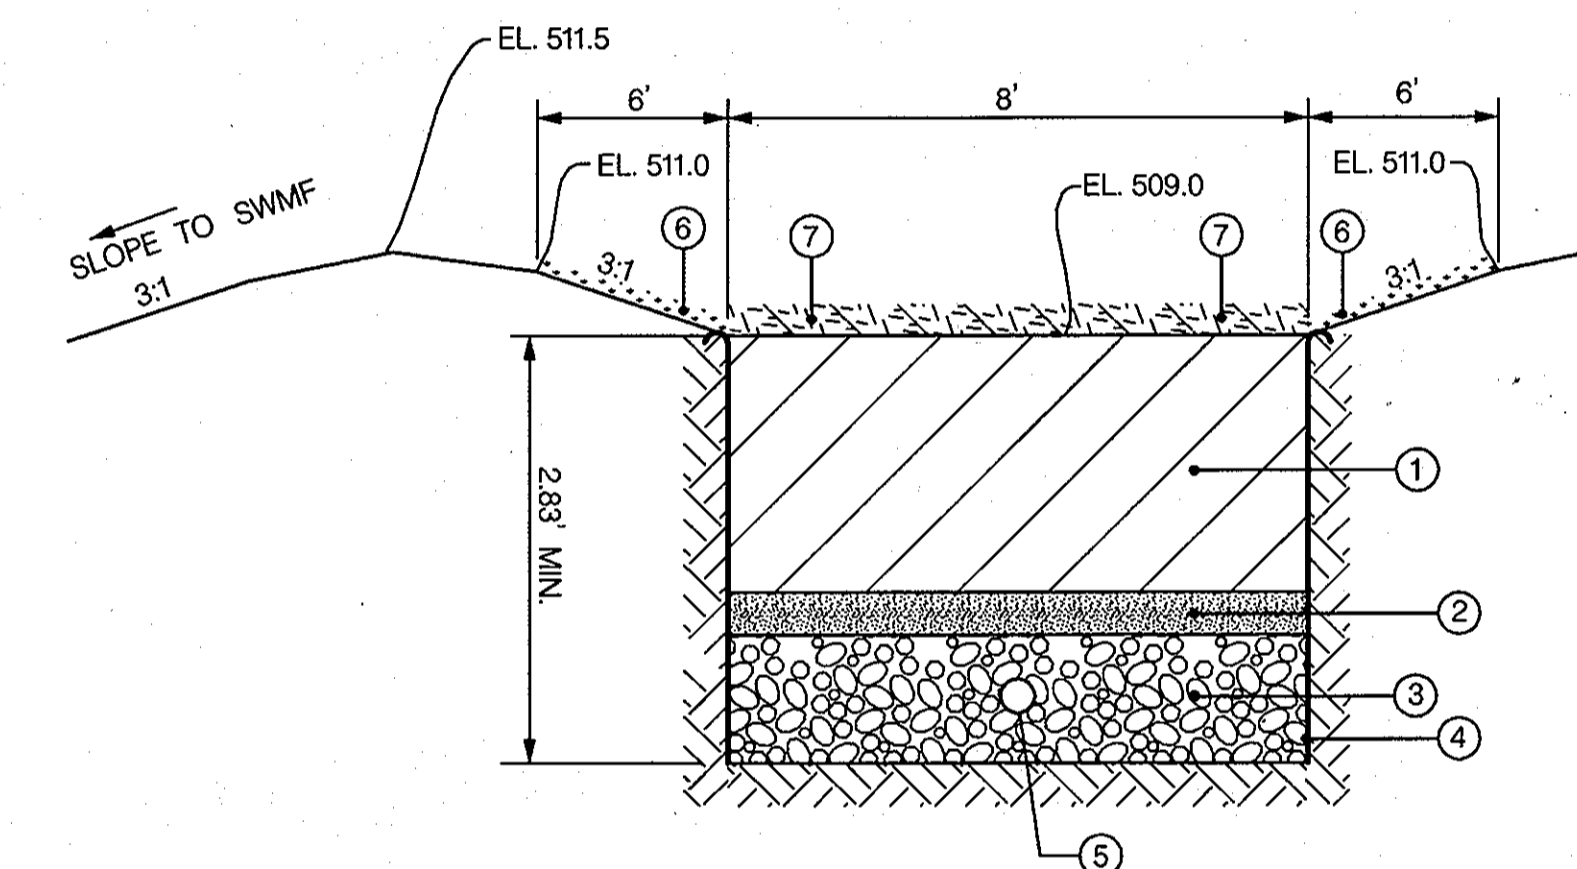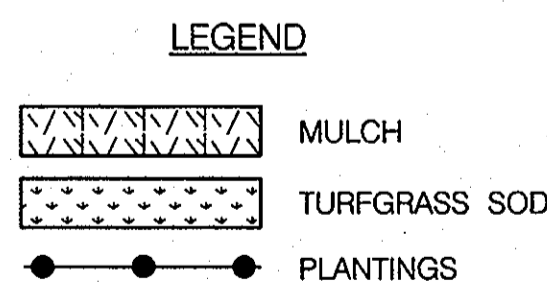

BIO-SWALE SECTION
NOT TO SCALE


LEGEND

- 1'-6" BIORETENTION SOIL MIXTURE
- 4-INCH PEA GRAVEL
- 1-FOOT NO. 57 AGGREGATE (MIN.)
- GEOTEXTILE, PE TYPE 1 NONWOVEN (ON SIDES AND BOTTOM)
- 6" INCH PERF. UNDERDRAIN, WRAP WITH HARDWARE MESH
- TURFGRASS SOD ESTABLISHMENT
- MULCH, 3" DEPTH WITH BIO-SWALE PLANTINGS

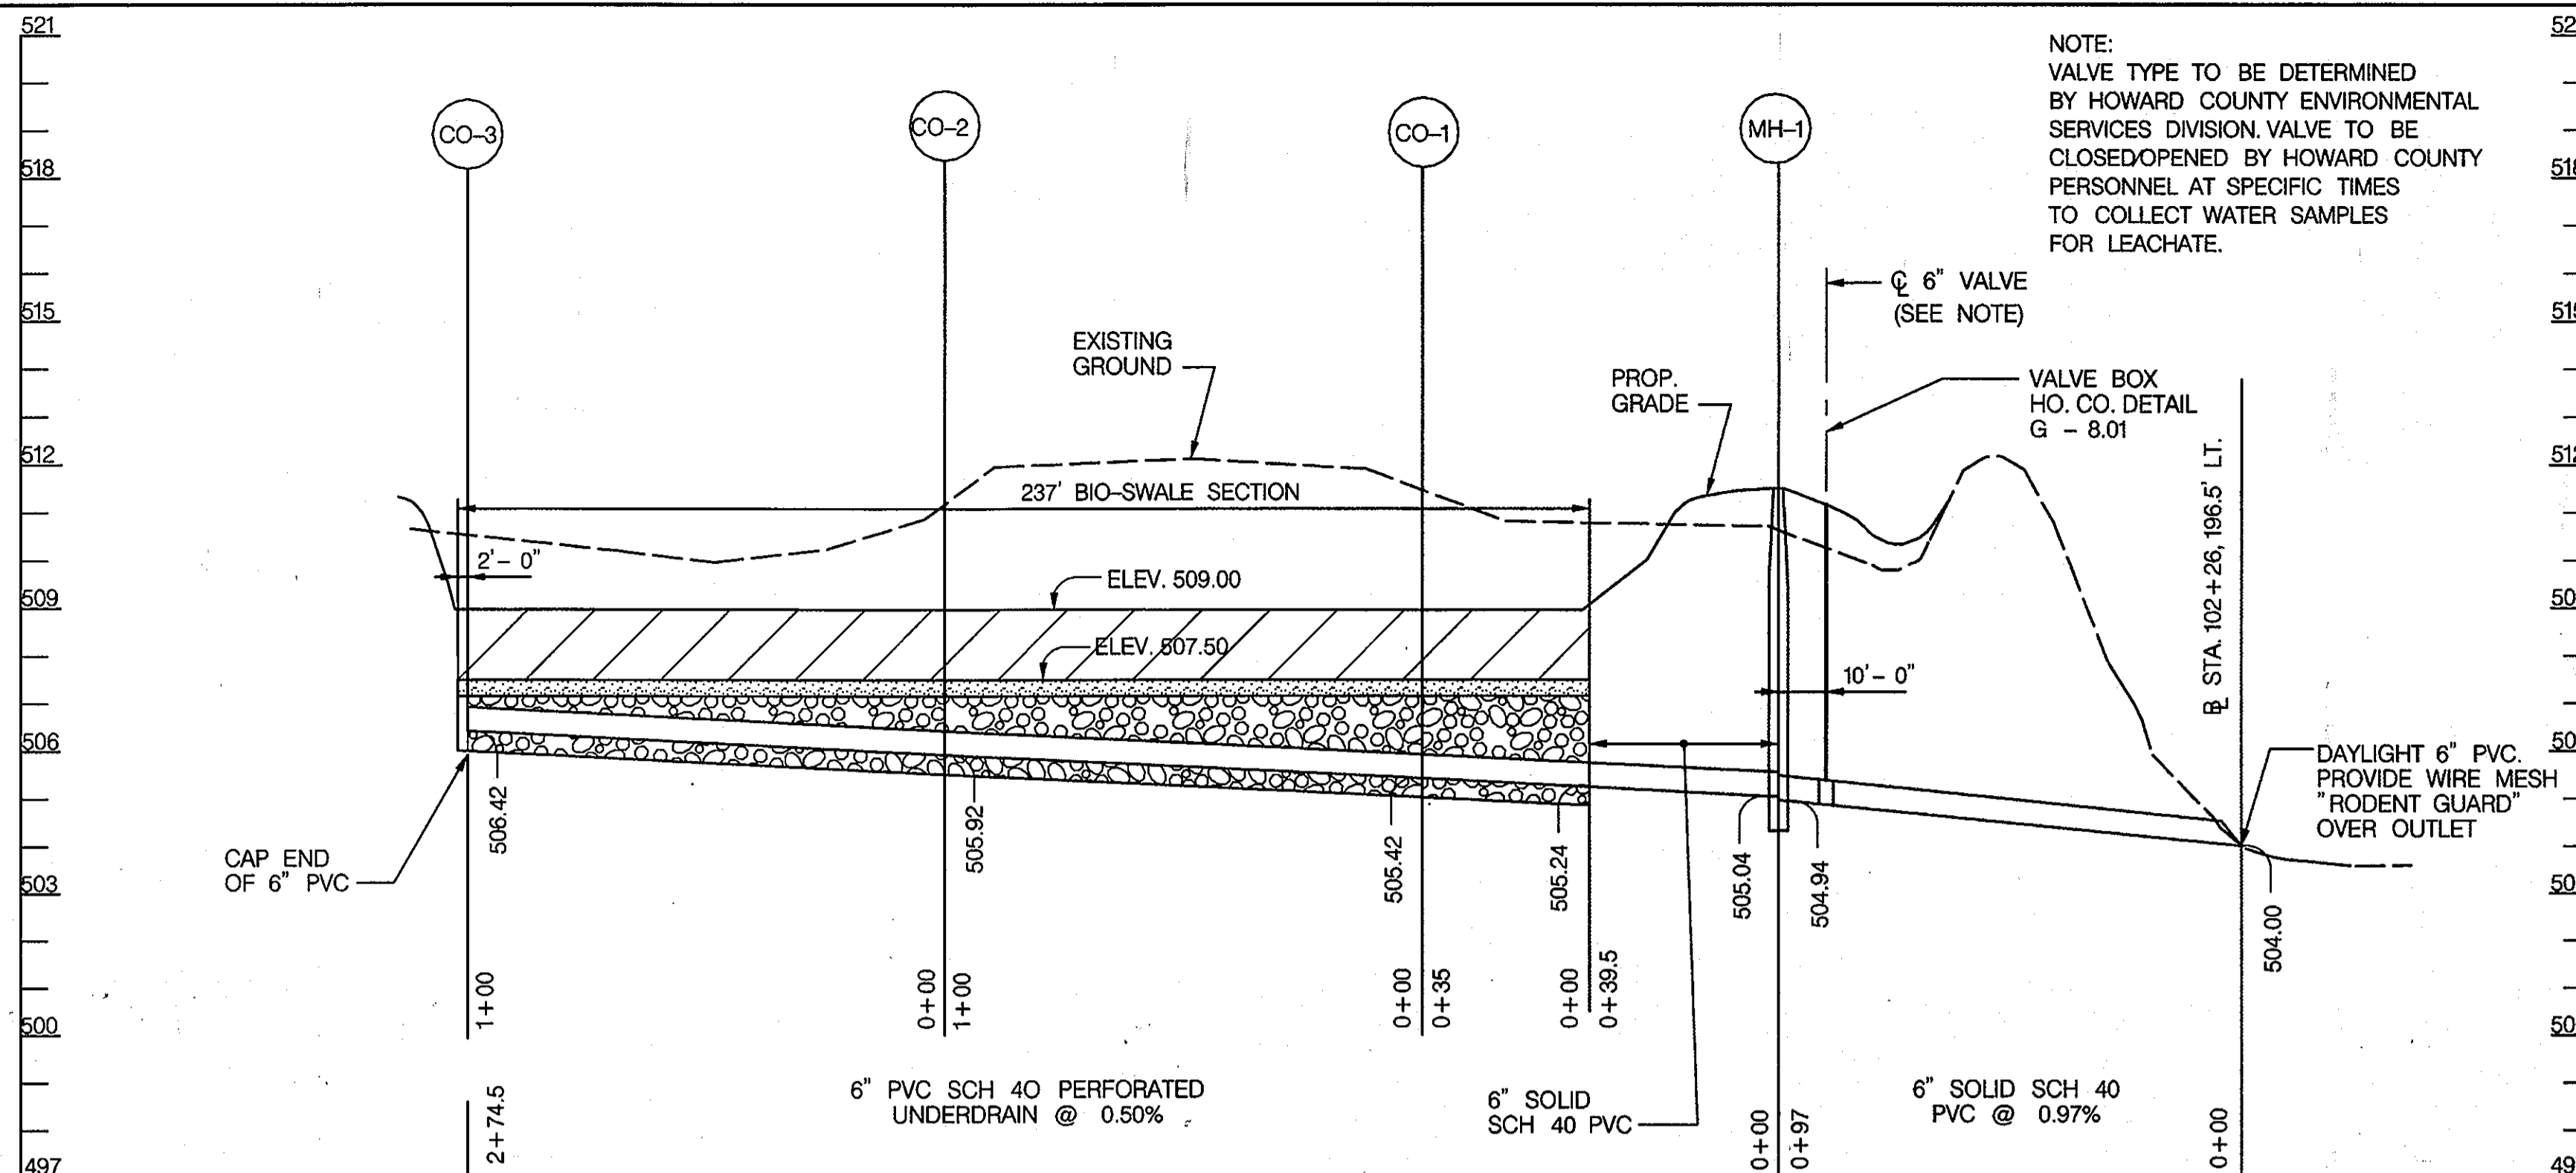

PROFILE ALONG BIO-SWALE AND OUTLET PIPE


SCALE: HORIZ. 1" = 30'
VERT. 1" = 3'

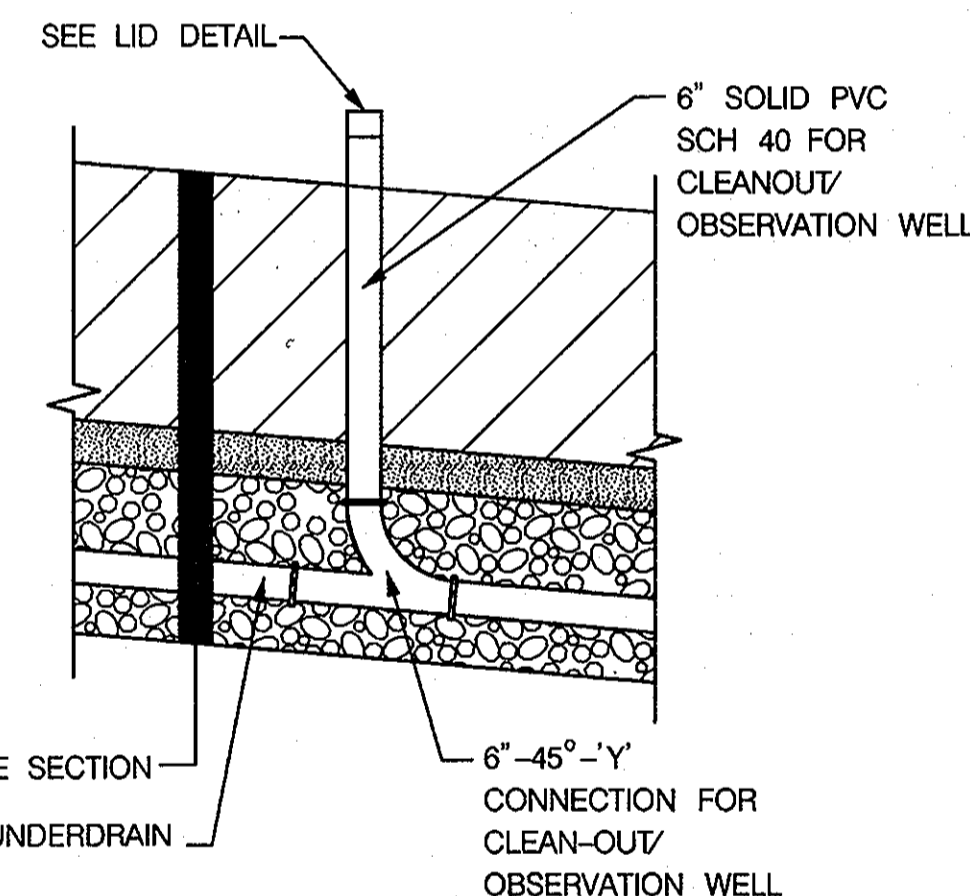

NOTE:
BIO-SWALE CLEAN-OUT/OBSERVATION WELL SHALL BE INCIDENTAL TO THE UNIT COST OF BIO-SWALE PAY ITEM.

BIO-SWALE CLEANOUT/OBSERVATION WELL DETAIL

NOT TO SCALE

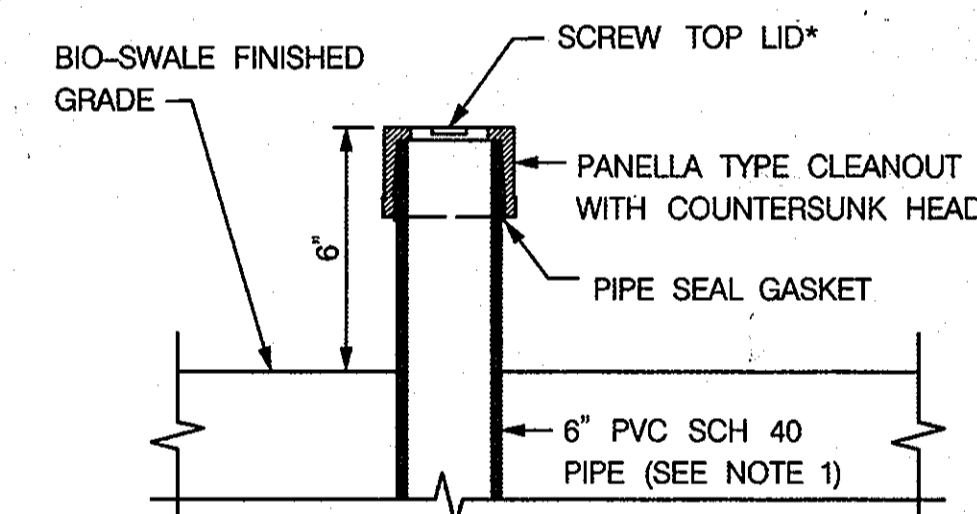


*ABOVE DETAIL PROVIDED AS SCHEMATIC SCREW TOP PVC WELL CAP ONLY. SEE NOTE 2

BIO-SWALE CLEANOUT/OBSERVATION WELL LID DETAIL

NOT TO SCALE

NOTES:

- THE TUBE SHALL HAVE A FACTORY ATTACHED CAST IRON OR HIGH IMPACT PLASTIC COLLAR WITH RIBS TO PREVENT ROTATION WHEN REMOVING SCREW TOP LID. THE SCREW TOP LID SHALL BE CAST IRON OR HIGH IMPACT PLASTIC THAT WILL WITHSTAND ULTRA-VIOLET RAYS.
- FOR LOCATION, SEE DRAINAGE STRUCTURE SCHEDULE.

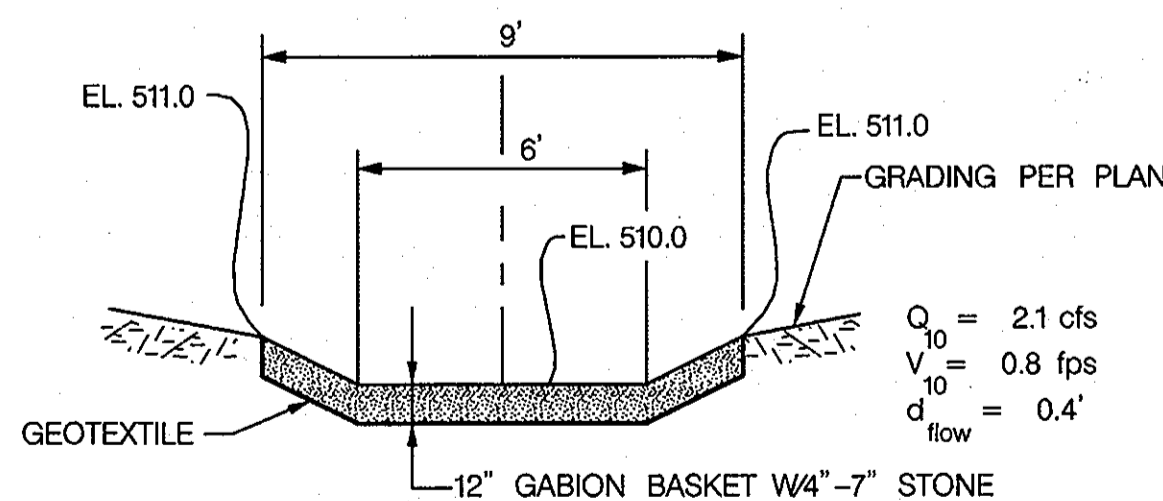


NOTE:
SEE SCS DETAIL 6 FOR ADDITIONAL INFORMATION

SECTION A-A

BIO-SWALE FACILITY OUTLET WEIR DETAIL

NOT TO SCALE

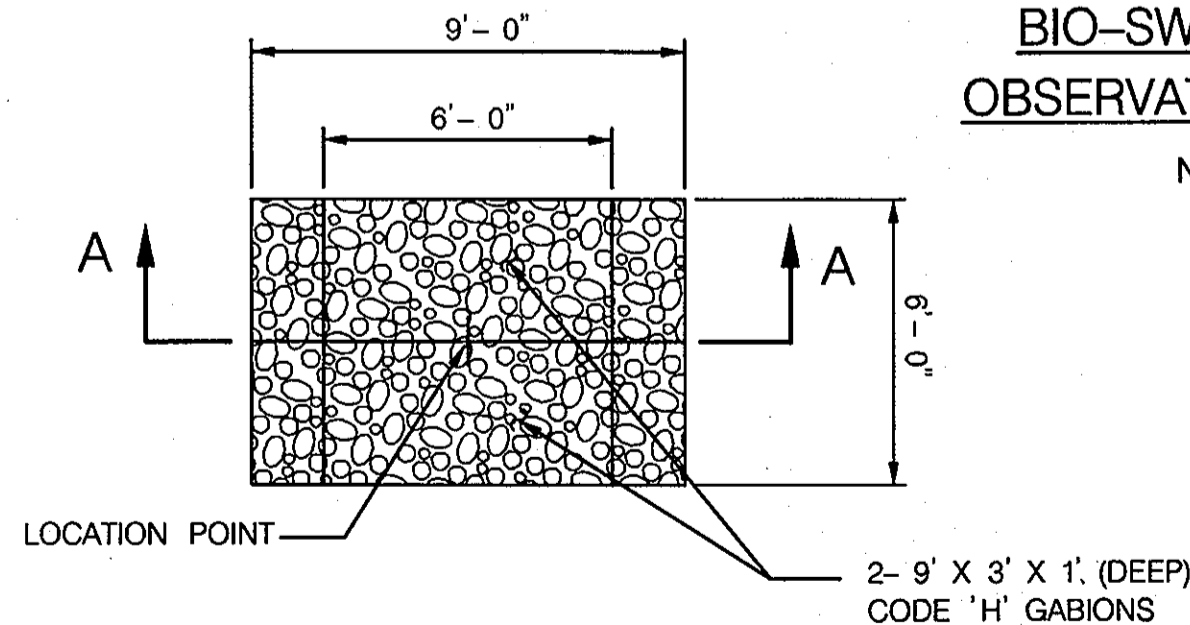

PLAN

BIO-SWALE DETAILS

DES:	GWF			
DRN:	JRW			
CHK:				
DATE:	MARCH 2012	BY:	NO.	REVISION

APPROVED: DEPARTMENT OF PLANNING AND ZONING

Chad Edwards 3-29-12
CHIEF, DEVELOPMENT ENGINEERING DIVISION DATE

Kurt Schuler 4-02-12
CHIEF, DIVISION OF LAND DEVELOPMENT DATE

David A. Gyllen 7/6/12
DIRECTOR DATE

DEPARTMENT OF PUBLIC WORKS
HOWARD COUNTY, MARYLAND

Eugene J. Gault 2/15/12
CHIEF, BUREAU OF ENVIRONMENTAL SERVICES DATE

NOTIAN
Associates, Inc.
Engineers - Civil/Structural/Inspections
4785 Dorsey Hall Drive
Suite 124
Ellicott City, Maryland 21042
Phone: (410) 995-3851 Fax: (410) 995-1983



SUBDIVISION NAME ALPHA RIDGE SOLID WASTE MANAGEMENT CENTER	LOT / PARCEL 54, 253, 220, 11	ZONE PEC	TAX / ZONE MAP 10 & 16
LIBER / FOLIO 10-847606 16-878215 10-897314	SEWER CODE PRIVATE, EXISTING	CENSUS TR. 60-30	

**ALPHA RIDGE LANDFILL
AERATED STATIC PILE COMPOST FACILITY**
CAPITAL PROJECT NO. C-0299
TAX MAP 10 & 16. PARCEL NUMBERS 54, 253, 220 & 11
ELECTION DISTRICT NO. 3 HOWARD COUNTY, MARYLAND

SCALE:
AS SHOWN

SHEET
CO-4 OF 9
TOTAL OF 98

DETAIL 33 - SUPER SILT FENCE

NOTE: FENCE POST SPACING SHALL NOT EXCEED 10' CENTER TO CENTER

Construction Specifications

- Fencing shall be 42" in height and constructed in accordance with the latest Maryland State Highway Details for Chain Link Fencing. The specification for a 6' fence shall be used, substituting 42" fabric and 6' length posts.
- Chain link fence shall be fastened securely to the fence posts with wire ties. The lower tension wire, brace and truss rods, drive anchors and post caps are not required except on the ends of the fence.
- Filter cloth shall be fastened securely to the chain link fence with ties spaced every 24" at the top and mid section.
- Filter cloth shall be embedded a minimum of 8" into the ground.
- When two sections of filter cloth adjoin each other, they shall be overlapped by 6" and folded.
- Maintenance shall be performed as needed and silt buildup removed when "bulges" develop in the silt fence, or when silt reaches 50% of fence height.
- Filter cloth shall be fastened securely to each fence post with wire ties or staples at top and mid section and shall meet the following requirements for Geotextile Class F:

Tensile Strength	50 lbs/in (min.)	Test: ASTM D-4595
Tensile Modulus	20 lbs/in (min.)	Test: ASTM D-4595
Flow Rate	0.3 gal/ft ² /minute (max.)	Test: ASTM D-5141
Filtering Efficiency	75% (min.)	Test: ASTM D-5141

U.S. DEPARTMENT OF AGRICULTURE SOIL CONSERVATION SERVICE PAGE H - 26 - 3 MARYLAND DEPARTMENT OF ENVIRONMENT WATER MANAGEMENT ADMINISTRATION

DETAIL 22 - SILT FENCE

Construction Specifications

- Fence posts shall be a minimum of 36" long driven 16" minimum into the ground. Wood posts shall be 1 1/2" x 1 1/2" square (minimum) cut, or 1 1/2" diameter (minimum) round and shall be of sound quality hardwood. Steel posts will be standard T or U section weighting not less than 1.00 pond per linear foot.
- Geotextile shall be fastened securely to each fence post with wire ties or staples at top and mid-section and shall meet the following requirements for Geotextile Class F:

Tensile Strength	50 lbs/in (min.)	Test: ASTM D-4595
Tensile Modulus	20 lbs/in (min.)	Test: ASTM D-4595
Flow Rate	0.3 gal/ft ² /minute (max.)	Test: ASTM D-5141
Filtering Efficiency	75% (min.)	Test: ASTM D-5141

U.S. DEPARTMENT OF AGRICULTURE SOIL CONSERVATION SERVICE PAGE E - 15 - 3 MARYLAND DEPARTMENT OF ENVIRONMENT WATER MANAGEMENT ADMINISTRATION

DETAIL 24 - STABILIZED CONSTRUCTION ENTRANCE

Construction Specifications

- Length - minimum of 50' (#30' for single residence lot).
- Width - 10' minimum, should be flared at the existing road to provide a turning radius.
- Geotextile fabric (filter cloth) shall be placed over the existing ground prior to placing stone. The plan approval authority may not require single family residences to use geotextile.
- Stone - crushed aggregate (2" to 3") or reclaimed or recycled concrete equivalent shall be placed at least 6" deep over the length and width of the entrance.
- Surface Water - all surface water flowing to or diverted toward construction entrances shall be piped through the entrance, maintaining positive drainage. Pipe installed through the stabilized construction entrance shall be protected with a mountable berm with 5:1 slopes and a minimum of 6" of stone over the pipe. Pipe has to be sized according to the drainage. When the SCE is located at a high spot and has no drainage to convey a pipe will not be necessary. Pipe should be sized according to the amount of runoff to be conveyed. A 6" minimum will be required.
- Location - A stabilized construction entrance shall be located at every point where construction traffic enters or leaves a construction site. Vehicles leaving the site must travel over the entire length of the stabilized construction entrance.

U.S. DEPARTMENT OF AGRICULTURE SOIL CONSERVATION SERVICE PAGE F - 17 - 3 MARYLAND DEPARTMENT OF ENVIRONMENT WATER MANAGEMENT ADMINISTRATION

DETAIL 30 - EROSION CONTROL MATTING

Construction Specifications

- Key-in the matting by placing the top ends of the matting in a narrow trench, 6" in depth. Backfill the trench and top firmly to conform to the channel cross-section. Secure with a row of staples about 4" down slope from the trench. Spacing between staples is 6".
- Staple the 4" overlap in the channel center using an 18" spacing between staples.
- Before stapling the outer edges of the matting, make sure the matting is smooth and in firm contact with the soil.
- Staples shall be placed 2' apart with 4 rows for each strip, 2 outer rows, and 2 alternating rows down the center.
- Where one roll of matting ends and another begins, the end of the top strip shall overlap the upper end of the lower strip by 4", shingle fashion. Reinforce the overlap with a double row of staples spaced 6" apart in a staggered pattern on either side.
- The discharge end of the matting liner should be similarly secured with 2 double rows of staples.

Note: If flow will enter from the edge of the matting then the area affected by the flow must be keyed-in.

U.S. DEPARTMENT OF AGRICULTURE SOIL CONSERVATION SERVICE PAGE G - 22 - 2 MARYLAND DEPARTMENT OF ENVIRONMENT WATER MANAGEMENT ADMINISTRATION

DETAIL 5 - RIP-RAP INFLOW PROTECTION

Construction Specifications

- Rip-rap lined inflow channels shall be 1' in depth, have a trapezoidal cross section with 2:1 or flatter side slopes and 3' (min.) bottom width. The channel shall be lined with 4" to 12" rip-rap to a depth of 18".
- Filter cloth shall be installed under all rip-rap. Filter cloth shall be Geotextile Class C.
- Entrance and exit sections shall be installed as shown on the detail section.
- Rip-rap used for the lining may be recycled for permanent outlet protection if the basin is to be converted to a stormwater management facility.
- Gabion Inflow Protection may be used in lieu of Rip-rap Inflow Protection.
- Rip-rap should blend into existing ground.
- Rip-rap Inflow Protection shall be used where the slope is between 4:1 and 10:1, for slopes flatter than 10:1 use Earth Dike or Temporary Dike Lining criteria.

U.S. DEPARTMENT OF AGRICULTURE SOIL CONSERVATION SERVICE PAGE B - 9 - 2 MARYLAND DEPARTMENT OF ENVIRONMENT WATER MANAGEMENT ADMINISTRATION

SUPER SILT FENCE

Design Criteria

Slope	Slope Steepness	Slope Length (maximum)	Silt Fence Length (maximum)
0 - 10%	0 - 10:1	Unlimited	Unlimited
10 - 20%	10:1 - 5:1	200 feet	1,500 feet
20 - 33%	5:1 - 3:1	100 feet	1,000 feet
33 - 50%	3:1 - 2:1	100 feet	500 feet
50% +	2:1 +	50 feet	250 feet

U.S. DEPARTMENT OF AGRICULTURE SOIL CONSERVATION SERVICE PAGE H - 26 - 3A MARYLAND DEPARTMENT OF ENVIRONMENT WATER MANAGEMENT ADMINISTRATION

SILT FENCE

Silt Fence Design Criteria

Slope Steepness	(Maximum) Slope Length	(Maximum) Silt Fence Length
Flatter than 50:1	unlimited	unlimited
50:1 to 10:1	125 feet	1,000 feet
10:1 to 5:1	100 feet	750 feet
5:1 to 3:1	60 feet	500 feet
3:1 to 2:1	40 feet	250 feet
2:1 and steeper	20 feet	125 feet

Note: In areas of less than 2% slope and sandy soils (USDA general classification system, soil Class A) maximum slope length and silt fence length will be unlimited. In these areas a silt fence may be the only perimeter control required.

U.S. DEPARTMENT OF AGRICULTURE SOIL CONSERVATION SERVICE PAGE E - 15 - 3A MARYLAND DEPARTMENT OF ENVIRONMENT WATER MANAGEMENT ADMINISTRATION

SUPER FENCE DIVERSION

Construction Specifications

- FENCING SHALL BE 42" IN HEIGHT AND CONSTRUCTED IN ACCORDANCE WITH THE LATEST MARYLAND STATE HIGHWAY ADMINISTRATION (SHA) DETAILS FOR CHAIN LINK FENCING. THE SPECIFICATIONS FOR A 6'-0" FENCE SHALL BE USED, SUBSTITUTING 42" FABRIC AND 6' LENGTH POSTS.
- THE POSTS DO NOT NEED TO BE SET IN CONCRETE.
- CHAIN LINK FENCE TO BE FASTENED SECURELY TO FENCE POSTS WITH WIRE TIES OR STAPLES. THE LOWER TENSION WIRE, BRACE AND TRUSS RODS, ANCHORS AND POST CAPS ARE NOT REQUIRED EXCEPT ON THE ENDS OF THE FENCE. THE CHAIN LINK FENCING SHALL BE SIX (6) GAUGE OR HEAVIER.
- MIRAFI MCF 1212 OR APPROVED EQUIVALENT SHALL BE FASTENED SECURELY TO THE CHAIN LINK FENCE WITH TIES SPACED EVERY 24" AT TOP AND MID SECTION.
- MIRAFI MCF 1212 OR APPROVED EQUIVALENT SHALL BE EMBEDDED MINIMUM OF 8" INTO THE GROUND.
- WHEN THE TWO SECTIONS OF MIRAFI MCF 1212 OR APPROVED EQUIVALENT ADJOIN EACH OTHER THEY SHALL BE OVERLAPPED BY SIX INCHES AND FOLDED.
- MAINTENANCE SHALL BE PERFORMED AS NEEDED.
- MAXIMUM FLOW SLOPE 10.0%
- MAXIMUM DRAINAGE AREA 5 ac

U.S. DEPARTMENT OF AGRICULTURE SOIL CONSERVATION SERVICE PAGE G - 22 - 2A MARYLAND DEPARTMENT OF ENVIRONMENT WATER MANAGEMENT ADMINISTRATION

EROSION CONTROL MATTING

Construction Specifications

- Key-in the matting by placing the top ends of the matting in a narrow trench, 6" in depth. Backfill the trench and top firmly to conform to the channel cross-section. Secure with a row of staples about 4" down slope from the trench. Spacing between staples is 6".
- Staple the 4" overlap in the channel center using an 18" spacing between staples.
- Before stapling the outer edges of the matting, make sure the matting is smooth and in firm contact with the soil.
- Staples shall be placed 2' apart with 4 rows for each strip, 2 outer rows, and 2 alternating rows down the center.
- Where one roll of matting ends and another begins, the end of the top strip shall overlap the upper end of the lower strip by 4", shingle fashion. Reinforce the overlap with a double row of staples spaced 6" apart in a staggered pattern on either side.
- The discharge end of the matting liner should be similarly secured with 2 double rows of staples.

Note: If flow will enter from the edge of the matting then the area affected by the flow must be keyed-in.

U.S. DEPARTMENT OF AGRICULTURE SOIL CONSERVATION SERVICE PAGE G - 22 - 2A MARYLAND DEPARTMENT OF ENVIRONMENT WATER MANAGEMENT ADMINISTRATION

By the Owner/Developer

"I/We certify that all development and/or construction will be done according to these plans, and that any responsible personnel involved in the construction project will have a Certificate of Attendance at a Department of the Environment Approved Training Program for the Control of Sediment and Erosion before beginning project. I also authorize periodic on-site inspections by the Howard Soil Conservation District."

Evelyn G. Tomlin
Signature of Owner/Developer
Date: 3/14/2012

By the Owner/Engineer

"I certify that this plan for erosion and sediment control represents a practical and workable plan based on my personal knowledge of the site conditions. This Plan was prepared in accordance with the requirements of the Howard Soil Conservation District."

Charles S. Nolan
Signature of Engineer
Print name below signature
Date: 3/14/2012

These plans are approved for soil erosion and sediment control by the Howard Soil Conservation District.

John R. Plater
Signature of Engineer
Print name below signature
Date: 3/27/12
Howard S.C.D.

APPROVED: DEPARTMENT OF PLANNING AND ZONING

Chad Edwards
DATE: 3-29-12

Kate Schindler
DATE: 4-2-12

Marsha A. Cavalli
DATE: 4/4/12

U.S. DEPARTMENT OF AGRICULTURE SOIL CONSERVATION SERVICE PAGE E - 15 - 3A MARYLAND DEPARTMENT OF ENVIRONMENT WATER MANAGEMENT ADMINISTRATION

U.S. DEPARTMENT OF AGRICULTURE SOIL CONSERVATION SERVICE PAGE G - 22 - 2A MARYLAND DEPARTMENT OF ENVIRONMENT WATER MANAGEMENT ADMINISTRATION

U.S. DEPARTMENT OF AGRICULTURE SOIL CONSERVATION SERVICE PAGE G - 22 - 2A MARYLAND DEPARTMENT OF ENVIRONMENT WATER MANAGEMENT ADMINISTRATION

SUBDIVISION NAME ALPHA RIDGE SOLID WASTE MANAGEMENT CENTER	LOT /PARCEL 54, 253, 220, 11	ZONE PEC	TAX / ZONE MAP 10 & 16
LIBER / FOLIO 10-947896 16-378215 10-691314	SEWER CODE PRIVATE, EXISTING	CENSUS TR. 60-30	SCALE: AS SHOWN
WATER CODE PRIVATE, EXISTING	SEWER CODE PRIVATE, EXISTING	CENSUS TR. 60-30	SHEET CO-7 OF 9

DEPARTMENT OF PUBLIC WORKS
HOWARD COUNTY, MARYLAND

Evelyn E. Bond
DATE: 3/15/12

NOLAN Associates, Inc.
Engineers - Civil/Structural/Inspections
4785 Dorsey Hall Drive
Suite 124
Ellicott City, Maryland 21042
Phone: (410) 995-3651 Fax: (410) 995-1963

DES: GWF			
DRN: JRW			
CHK:			
DATE: MARCH 2012	BY NO.	REVISION	DATE

EROSION AND SEDIMENT CONTROL NOTES AND DETAILS

600' SCALE MAP NO. 16 BLOCK NO. 8

ALPHA RIDGE LANDFILL
AERATED STATIC PILE COMPOST FACILITY
CAPITAL PROJECT NO. C-0299
TAX MAP 10 & 16. PARCEL NUMBERS 54, 253, 220 & 11
ELECTION DISTRICT NO. 3 HOWARD COUNTY, MARYLAND

SDP-97-128

