


EXTENSION OF INDIAN HILL  
SECTION 1  
P.B. 10 F. 52  
LOT 1  
RR-DEO

EXTENSION OF INDIAN HILL  
SECTION 2  
P.B. 13 F. 30  
LOT 5  
RR-DEO

N/F LANDS OF  
JONATHAN M. JONES  
& MERIDITH JONES  
1058/478  
RR-DEO

N/F LANDS OF  
MARK D. SKROUPA  
1441/542  
RR-DEO  
  
PARCEL 170

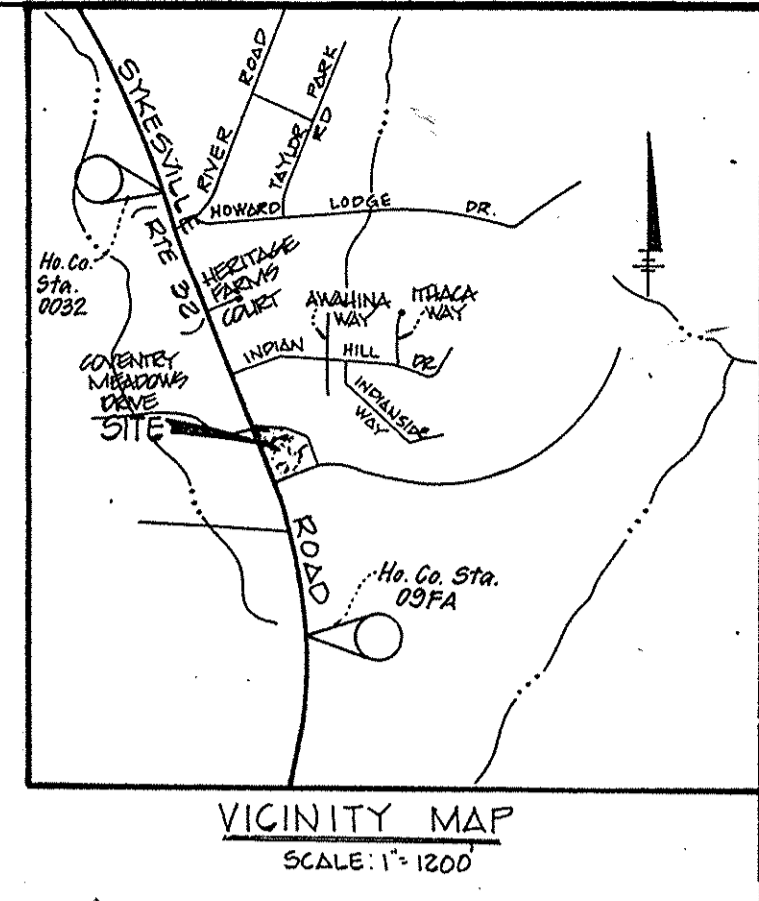

**LEGEND**

Contour Interval = 2'  
 Existing Contour [Symbol]  
 Proposed Contour [Symbol]  
 Prop. Conc. Sidewalk [Symbol]  
 Prop. Asphalt Paving [Symbol]  
 Proposed Grass Pavers (see typical detail) [Symbol]  
 Silt Fence [Symbol]  
 Super Silt Fence [Symbol]  
 Stabilized Construction Entrance [Symbol]  
 Perimeter Dike/Swale [Symbol]  
 Perforated P.V.C. [Symbol]  
 Non Perforated P.V.C. [Symbol]  
 Existing Pavement Edge [Symbol]

**Parking**

Proposed Parking 161 spaces  
 Hard Pavement 89  
 Grass Pavers 72

**SITE ANALYSIS:**

- PRESSENT ZONING RR-DEO
- TOTAL PROJECT AREA 5.06 AC
- AREA OF PLAN SUBMISSION 1.69 AC
- LIMIT OF DISTURBED AREA 1.85 AC
- PROPOSED USE: EXPANSION OF EXISTING RELIGIOUS FACILITY
- EXISTING STRUCTURE FLOOR AREA 4,750 X 2 = 9,500 SF
- PROPOSED STRUCT. FLOOR AREA 7,840 X 2 = 15,680 SF
- TOTAL PROPOSED FLOOR AREA 12,990 X 2 = 25,980 SF
- SEATS IN ASSEMBLY AREA 181 SEATS EXISTING  
387 SEATS PROPOSED

**10. PARKING TABULATION**

EXISTING SPACES	PROPOSED SPACES	TOTAL
100	129	229
1 SPACE PER 3 SEATS IN ASSEMBLY AREA = 129 INCL. 6 HC SPACES		
PROPOSED PARKING	161	
PROPOSED COVERAGE: 4,750 SF 2.2% OF SITE		
EXPANSION 7,840 SF 57.7% OF SITE		
TOTAL 12,990 SF 79.9% OF SITE		

**12. GREEN AREA**

EXISTING	PROPOSED	TOTAL
4.0 AC	3.67 AC	7.67 AC
79.5% OF SITE		

**13. APPLICABLE DPZ FILES**

FILE	APPROVED	DATE
BA-97-30E	APPROVED	10.2.97
BA-93-57V	"	5.24.94
BA-93-34E	"	11.23.93
BA-88-03E	"	"
SDP 95-22	"	"
SDP 89-161	"	"

- GENERAL NOTES:**
- ALL CONSTRUCTION SHALL BE IN ACCORDANCE WITH THE LATEST STANDARDS AND SPECIFICATIONS OF HOWARD COUNTY.
  - THE CONTRACTOR SHALL NOTIFY THE PUBLIC CONSTRUCTION INSPECTION DIVISION AT (410) 313-1880 AT LEAST FIVE (5) WORKING DAYS PRIOR TO THE START OF WORK.
  - THE CONTRACTOR SHALL NOTIFY "MISS UTILITY" AT 1-800-257-7777 AT LEAST 48 HOURS PRIOR TO ANY EXCAVATION WORK.
  - PROJECT BACKGROUND - SEE SITE ANALYSIS.
  - TRAFFIC CONTROL DEVICES, MARKINGS, AND SIGNING SHALL BE IN ACCORDANCE WITH THE LATEST EDITION OF THE MANUAL ON UNIFORM TRAFFIC CONTROL DEVICES (MUTCD). ALL STREET AND REGULATORY SIGNS SHALL BE IN PLACE PRIOR TO THE PLACEMENT OF ANY RESULT.
  - ALL PLAN DIMENSIONS ARE TO THE FACE OF CURB UNLESS OTHERWISE NOTED.
  - OVERALL TOPOGRAPHY TAKEN FROM ORIGINAL SURVEY FOR SDP 89-161 BY FISHER COLLINS AND CARTER. TOPOGRAPHY WITHIN LIMIT OF DISTURBANCE WAS UPDATED BY CLARK FINEFROCK AND SACKETT INC. APRIL 1997.
  - HORIZONTAL AND VERTICAL DATUM ESTABLISHED BY BENCHMARKS TIED INTO ORIGINAL TOPO FOR SDP 89-161.
  - NO 100 YEAR FLOODPLAIN APPLIES TO THIS SITE PER FEMA MAP, HOWARD COUNTY PANEL #9.
  - PRIVATE WATER AND SEWER TO BE UTILIZED.
  - STORMWATER MANAGEMENT FOR THIS SITE TO UTILIZE THE EXISTING EXTENDED DETENTION BASIN AND A NEW BIOTRETENTION AREA.
  - STORMWATER MANAGEMENT FACILITIES FOR THIS PROJECT WILL BE PRIVATELY OWNED AND MAINTAINED.
  - EXISTING WETLANDS SHOWN WERE TAKEN FROM PREVIOUSLY APPROVED SDP 89-161.
  - TRAFFIC REPORT FOR THIS PROJECT WAS PREPARED BY TRAFFIC CONCEPTS, INC. TITLED "TRAFFIC IMPACT BRIEF", DATED APRIL 27, 1998.
  - EXISTING UTILITIES WERE LOCATED BY FIELD SURVEY.
  - HANDICAP ACCESSIBLE ROUTES ARE PROVIDED TO THE MAIN ENTRANCE OF THE EXPANSION TO THE LOWER REAR OF THE EXISTING BUILDING.

- SEPTIC SYSTEM EXPANSION:**
- EXISTING SYSTEM (PER SDP 89-161)  
FOR 144 SEATS @ 5 GAL/DAY = 720 GAL/DAY  
240 LF. EXISTING TRENCH @ 3 GAL/FT = 720 GAL/DAY
  - EXPANSION:  
FOR 387 SEATS X 3 GAL/DAY = 1161 GAL/DAY  
TOTAL TRENCH LENGTH NEEDED = 1161 / 3 GAL PER FT. = 387 FT.  
TRENCH EXPANSION REQUIRED = 147
  - SEPTIC SYSTEM PLAN LEGEND  
 (1) DISCHARGE FROM NEW BUILDING BY GRINDER PUMP TO SEPTIC TANK  
 (2) EXISTING SEPTIC TANK (1,500 GALLON PER SDP 89-161)  
 (3) EXISTING CLEANOUT  
 (4) EXISTING DISTRIBUTION BOX TO BE MODIFIED FOR THREE ADDITIONAL TRENCHES F, G & H  
 EXISTING TRENCHES A, B, C, D, & E TO REMAIN.

**SUMMARY TABLE FOR BIOTRETENTION AREA**

INFLOW (QCF/S)	DEVELOPED (QCF/S)	EXISTING (QCF/S)	DEVELOPED (QCF/S)	STORAGE VOLUME (CU FT)
1 YEAR	87.89	0.0	0.0	12,302.47
10 YEAR	87.89	0.0	0.0	12,302.47

**SUMMARY TABLE FOR EXISTING DETENTION FACILITY**

EXISTING WSEL & STOR. VOL. (AC.FT.)	DEVELOP. WSEL & STOR. VOL. (AC.FT.)	EXISTING (QCF/S)	DEVELOPED (QCF/S)	INCREASE (QCF/S)
89.54	89.50	27.50	27.7	2.2
10 YEAR	90.06	27.50	27.7	2.2
100 YEAR	90.39	27.50	27.7	2.2

**SUMMARY TABLE FOR EXISTING DETENTION FACILITY**




EXISTING WSEL & STOR. VOL. (AC.FT.)	DEVELOP. WSEL & STOR. VOL. (AC.FT.)	EXISTING (QCF/S)	DEVELOPED (QCF/S)	INCREASE (QCF/S)
89.54	89.50	27.50	27.7	2.2
10 YEAR	90.06	27.50	27.7	2.2
100 YEAR	90.39	27.50	27.7	2.2

NOTE: EXISTING CATTAILS TO BE REMOVED FROM EX. S.W. FACILITY & MAINTAINED AS SUCH.

**Sheet Index**

NO.	Description
1	Site development Plan
2	Stormwater Management & Paving Details
3	Sediment & Erosion Control Plan
4	Sediment & Erosion Control Details
5	Landscape Plan

**PARKING LOT LIGHTING:**  
 LOCATION: PROPOSED LIGHTING SHOWN THUS ON PLAN (3' SW/2W)  
 MOUNTING HEIGHT: 15' HEIGHT  
 FIXTURE TYPE: AREA CUT-OFF "J" SERIES BY RUID or approved equal  
 400 WATT METAL HALIDE CUT-OFF WITH BACK LIGHT SHIELDS FOR CUT-OFF TO PREVENT ANY GLARE ONTO NEIGHBORING PROPERTIES  
 NOTE: SITE LIGHTING SHALL COMPLY WITH THE REQUIREMENTS OF SECTION 134 OF THE HOWARD COUNTY ZONING REGULATIONS.

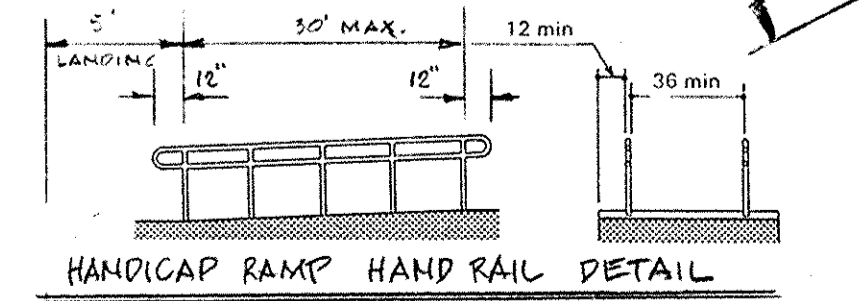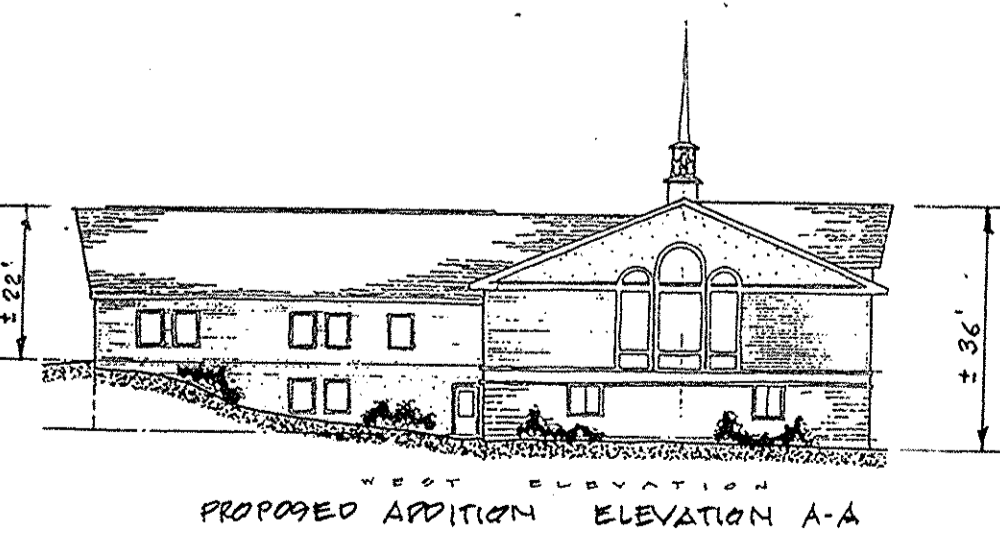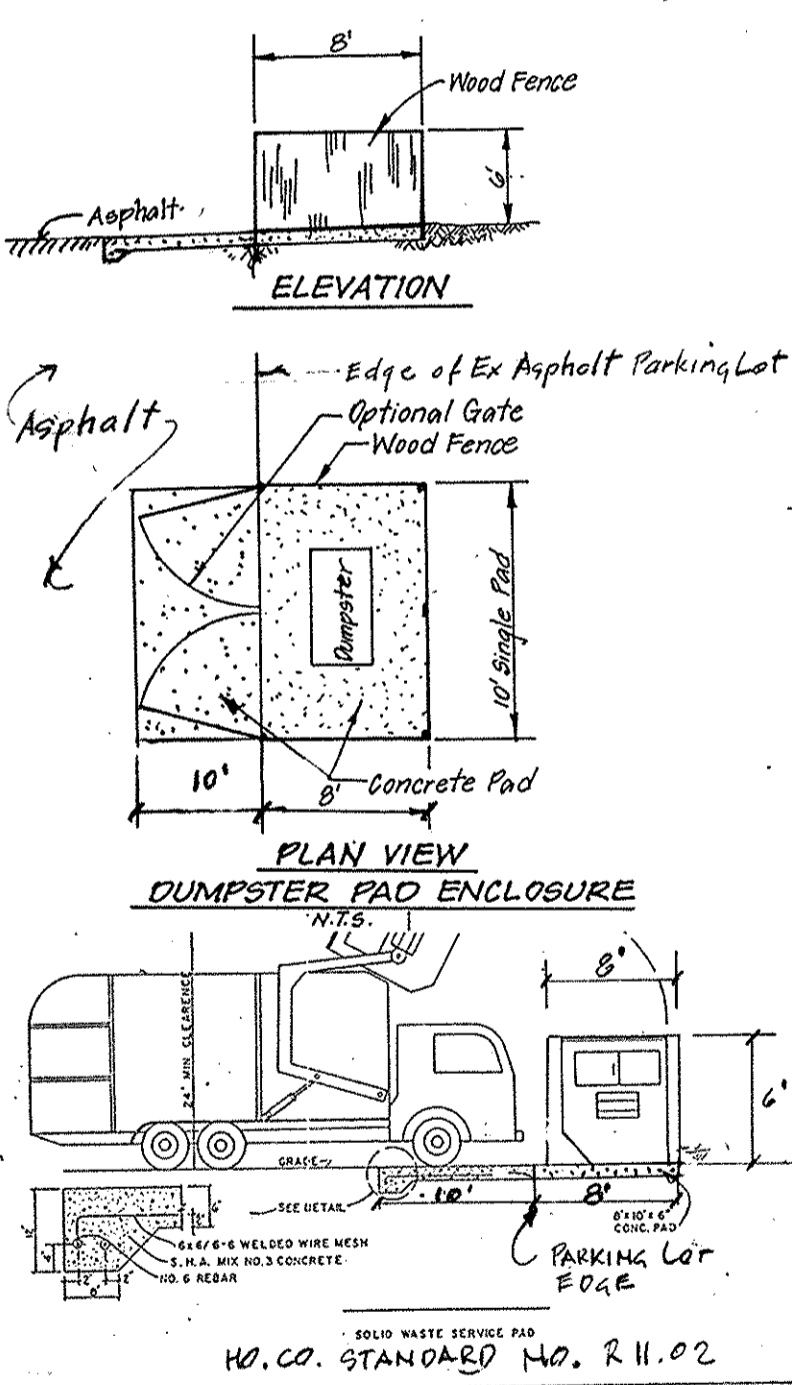

APPROVED: DEPARTMENT OF PLANNING AND ZONING  
 Chief, Development Engineering Division: [Signature] 1/28/99  
 Chief, Division of Land Development and Research: [Signature] 2/12/99  
 Director: [Signature] 2/12/99

APPROVED: FOR PRIVATE WATER AND SEWAGE SYSTEMS  
 HOWARD COUNTY DEPARTMENT OF HEALTH  
 [Signature] 2-8-99  
 COUNTY HEALTH OFFICER

**REVISIONS**

NO.	DESCRIPTION	DATE
1	(REV) Walks for handicap Access.	12-14-98



**ADDRESS CHART**

PARCEL	STREET ADDRESSES
178	1331 SYKESVILLE ROAD SYKESVILLE, MD 21784






SUBDIVISION NAME	SECTION/AREA	LOTS/PARCELS			
FRIENDSHIP BAPTIST CHURCH	-	178			
PLAT NO.	BLOCK NO.	ZONE	TAX MAP NO.	ELECTION DIST.	CENSUS TRACT
1547/395	11 17	RR-DEO	9	380	6030
WATER CODE	SEWER CODE				

**CLARK • FINEFROCK & SACKETT, INC.**  
 ENGINEERS • PLANNERS • SURVEYORS  
 7135 MINSTREL WAY • COLUMBIA, MD 21045 • (410) 381-7500 - BALTO. • (301) 621-8100 - WASH.


DESIGNED	DATE	SCALE	
WHT	1-21-99	1"=30'	
DRAWN	DATE	DRAWING	
ZAH		1 OF 5	
CHECKED	DATE	JOB NO.	
CM		95-200	
DATE	FILE NO.		
10-16-98	95-200 X		

**SITE DEVELOPMENT PLAN**  
**FRIENDSHIP BAPTIST CHURCH**  
 TAX MAP 9 PARCEL 178  
 THIRD (3rd) ELECTION DISTRICT  
 HOWARD COUNTY, MARYLAND  
 FOR: FRIENDSHIP BAPTIST CHURCH  
 1331 SYKESVILLE ROAD  
 SYKESVILLE, MARYLAND 21784  
 410-442-5506 (OWNER)

SECTION NUMBER	ROAD AND STREET CLASSIFICATION	PAVEMENT MATERIALS	
		FULL DEPTH BIT. CONC. ALTERNATE	GRANULAR BASE ALTERNATES
P-1	PARKING BAYS APARTMENTS AND COMMERCIAL- INDUSTRIAL ZONES WITH NO HEAVY TRUCKS TRAVELWAYS FOR APARTMENTS AND COMMERCIAL INDUSTRIAL ZONES WITH NO HEAVY TRUCK	1" BIT. CONC. SURFACE	1" BIT. CONC. SURFACE
		4" BIT. CONC. BASE	2" BIT. CONC. BASE
			4" GRADED AGGREGATE BASE (GAB)

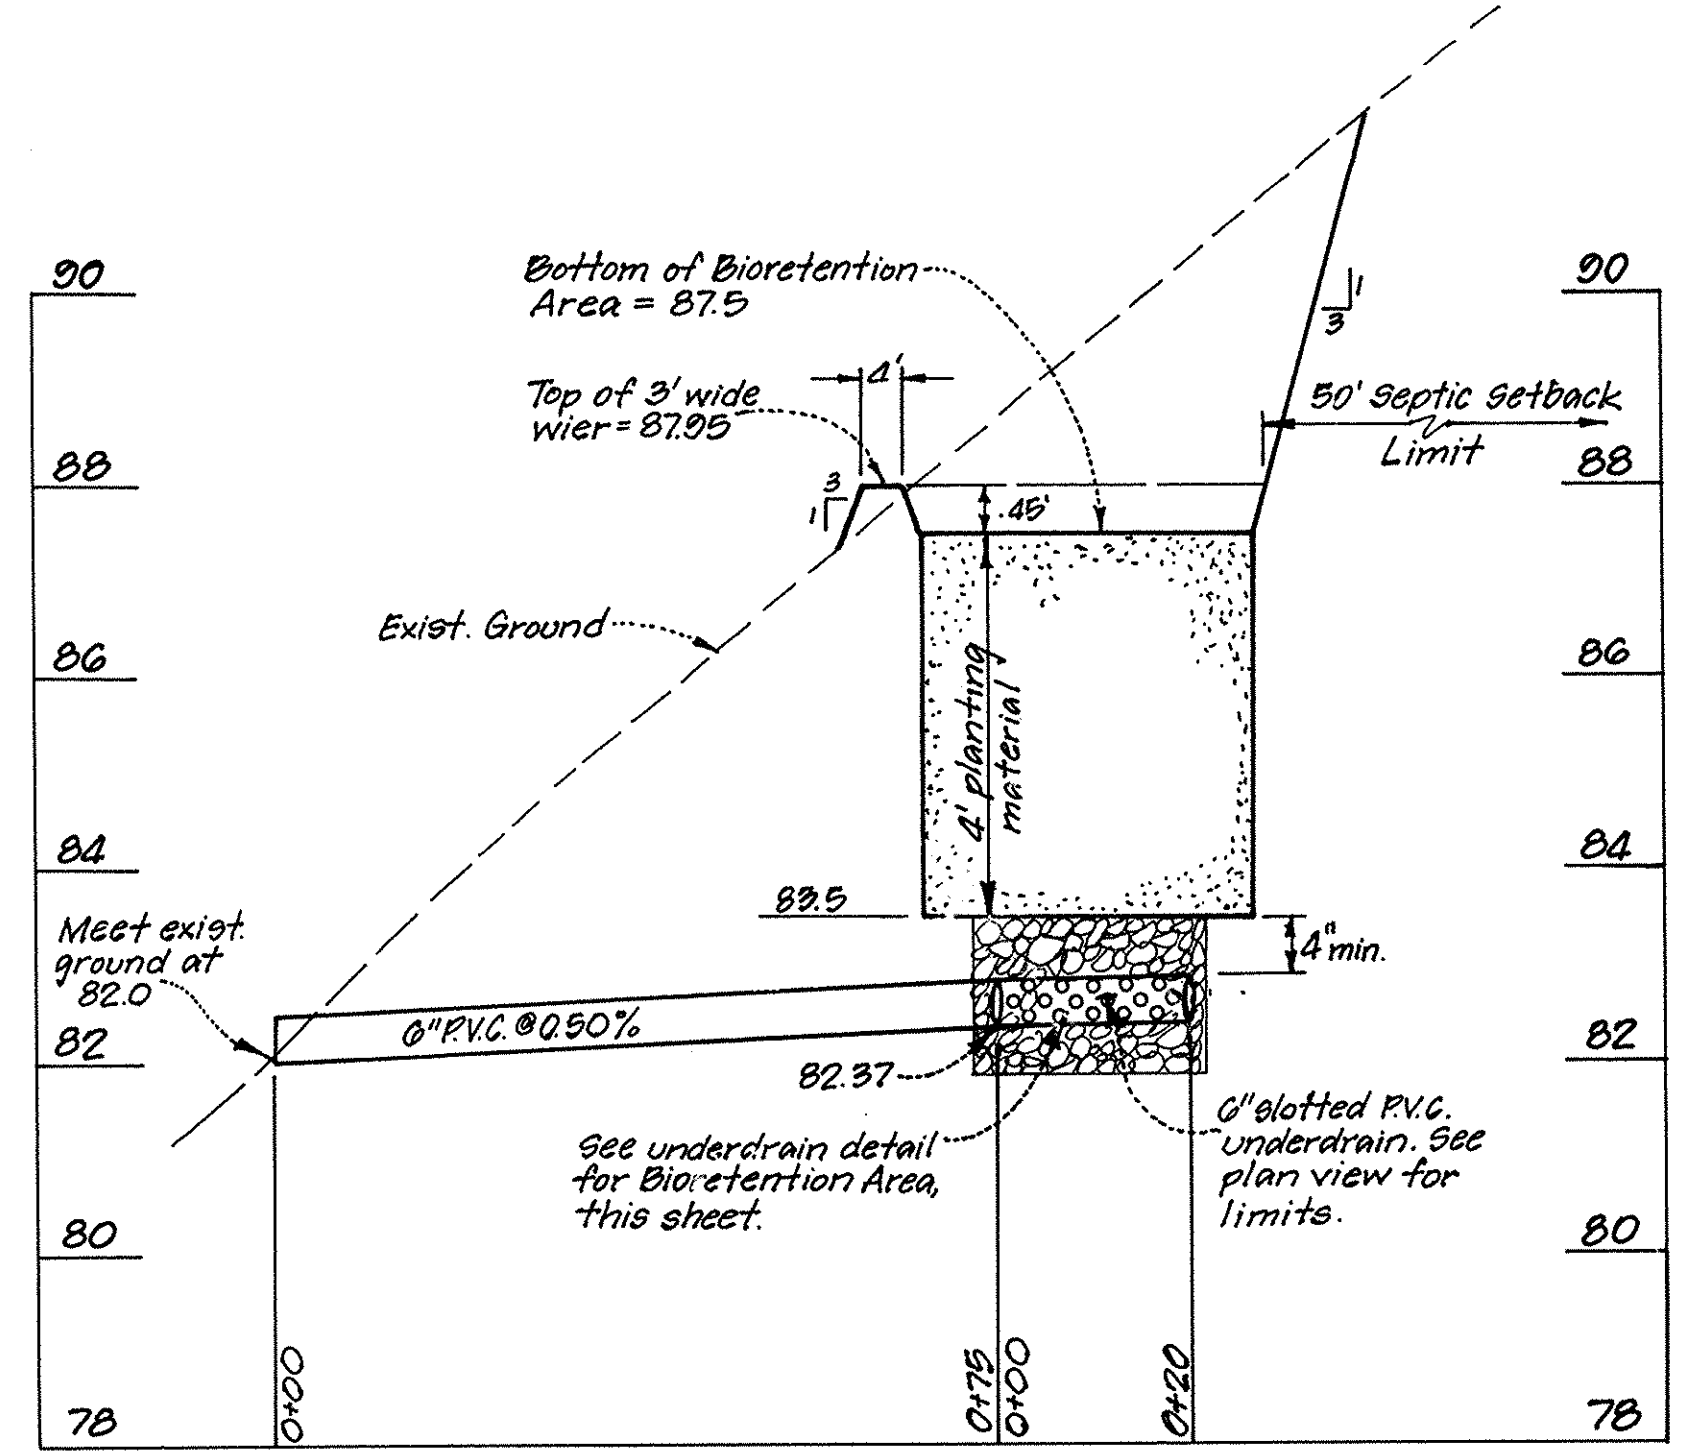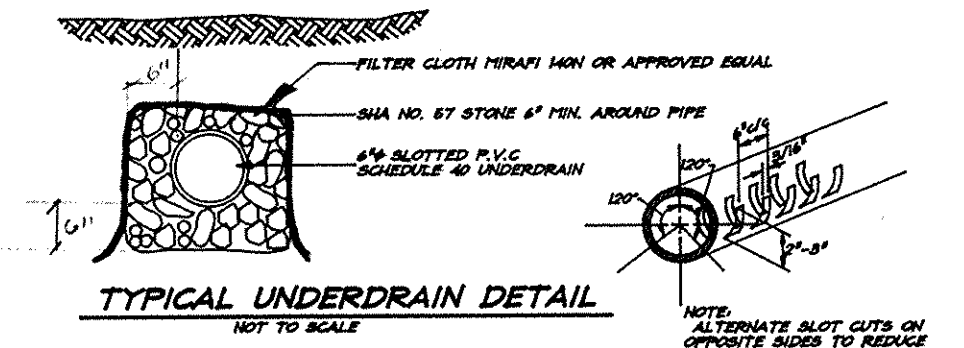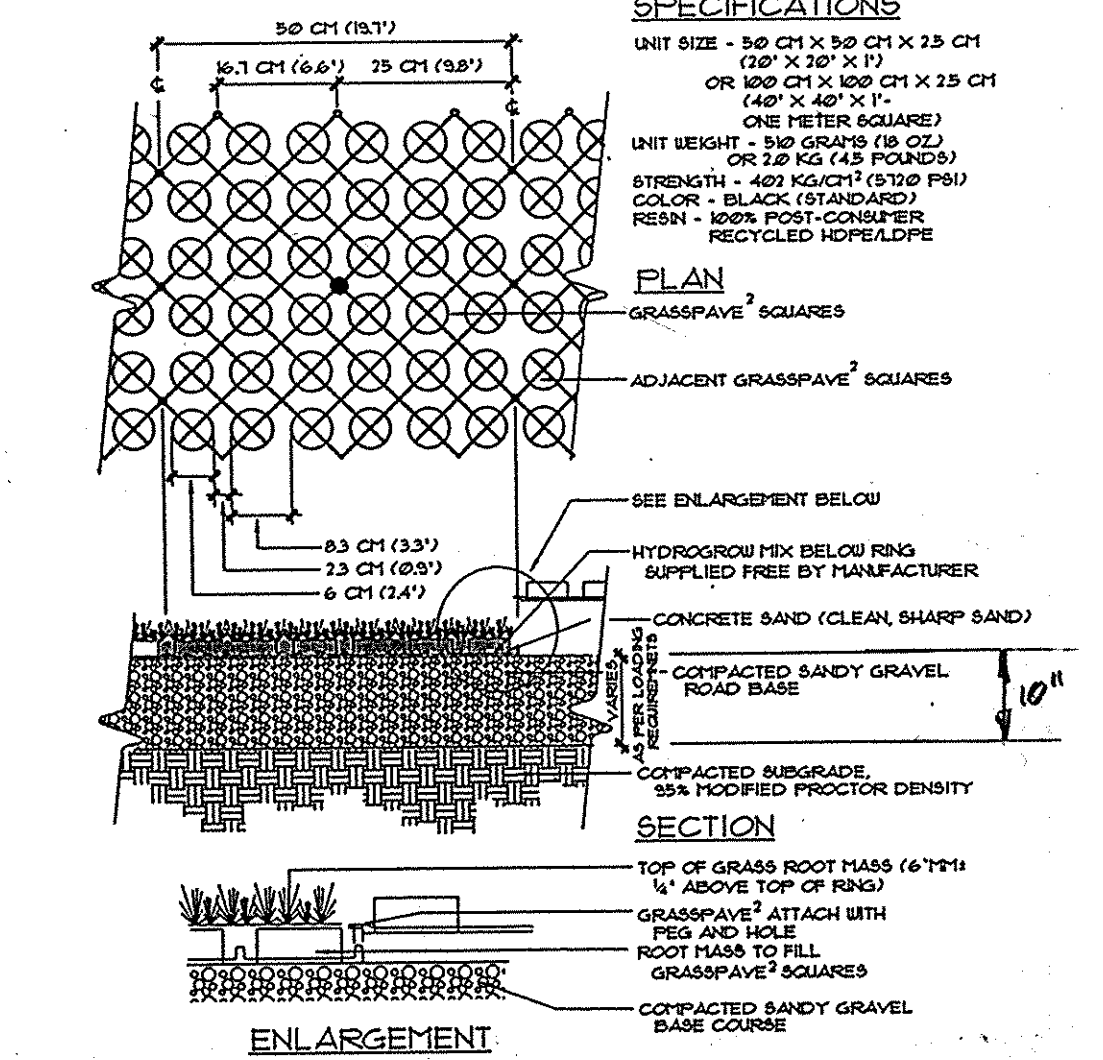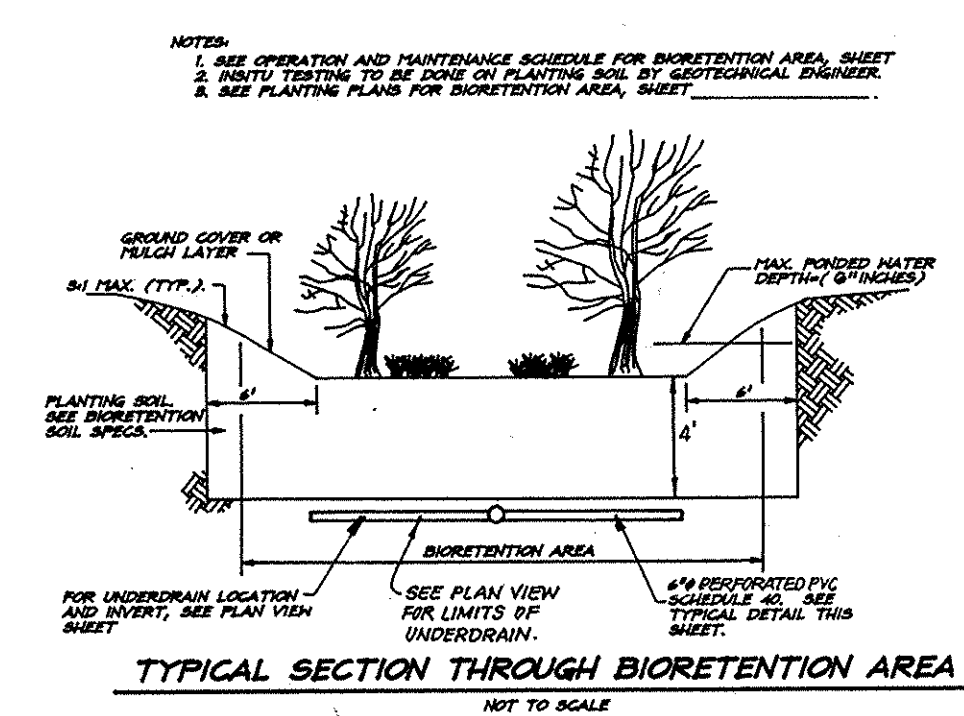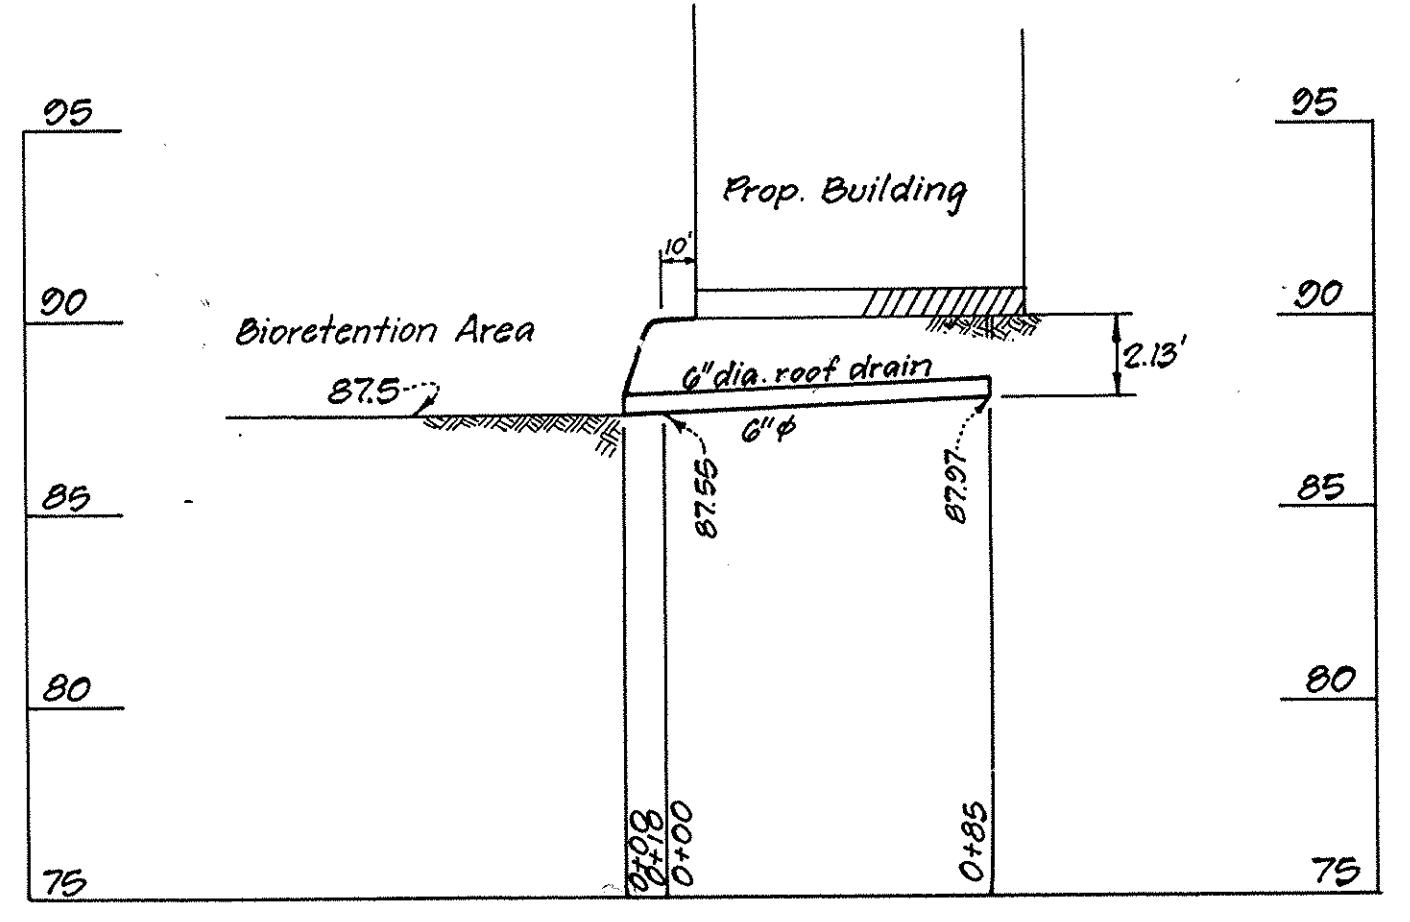


SIZE	TYPE	LENGTH
4"	PVC SCH 40	100LF
6"	PVC SCH 40	175LF

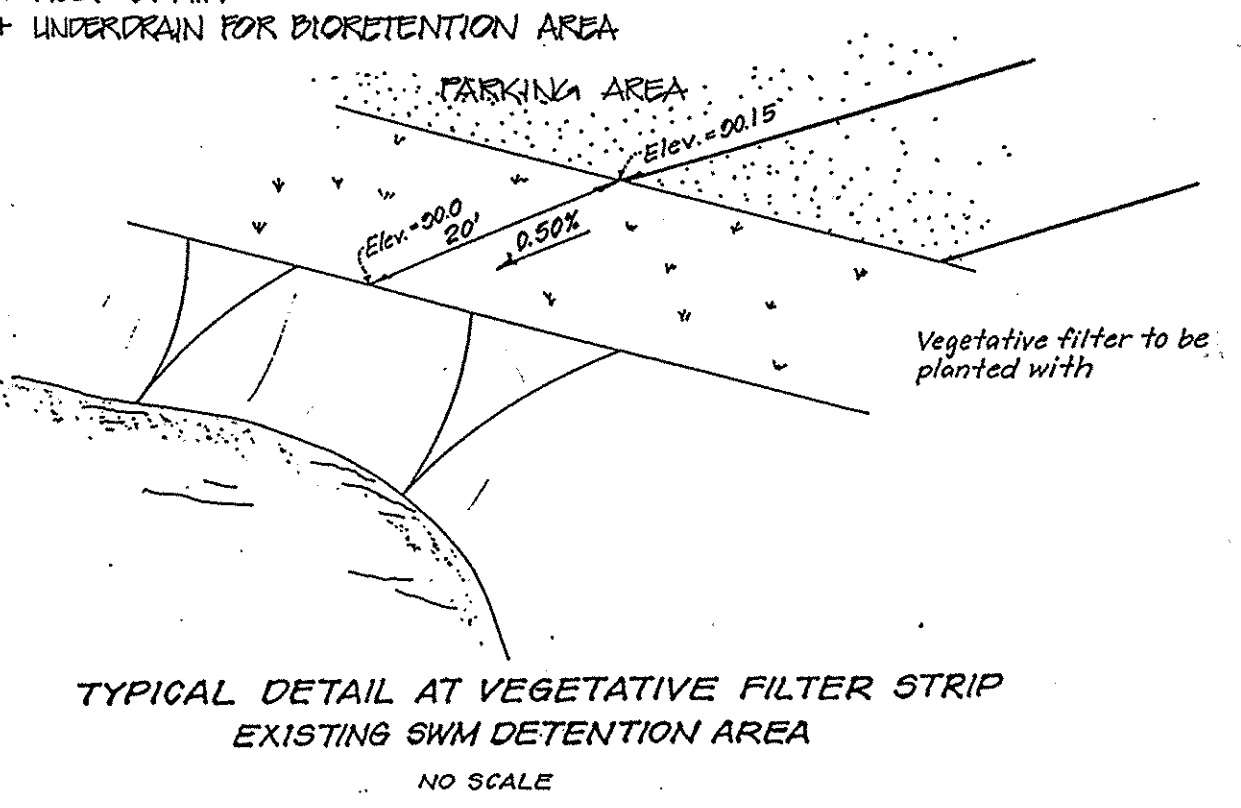

NOTE: GRASS/PLANT TYPES SHALL BE SPECIFIED BY A LANDSCAPE ARCHITECT OR LANDSCAPE DESIGNER.  
**INVISIBLE Structures, Inc.**  
 800-333-8488 OR 303-773-1234 FAX: 303-773-1232  
 1764-D EAST 30RD PLACE, ANCHORAGE, ALASKA 99501


**OPERATION AND MAINTENANCE OF "GRASS PAVE" AREAS:**

- For installation follow manufacturer's specifications. Invisible Structures Inc. (1-800-233-1510)
- After installation, protect the grass from traffic until its root system is well established.
- Maintain grass paving as any other turf area. Irrigate when necessary.
- Micro-nutrient fertilizers should be applied at least once per growing season in addition to regular fertilization.

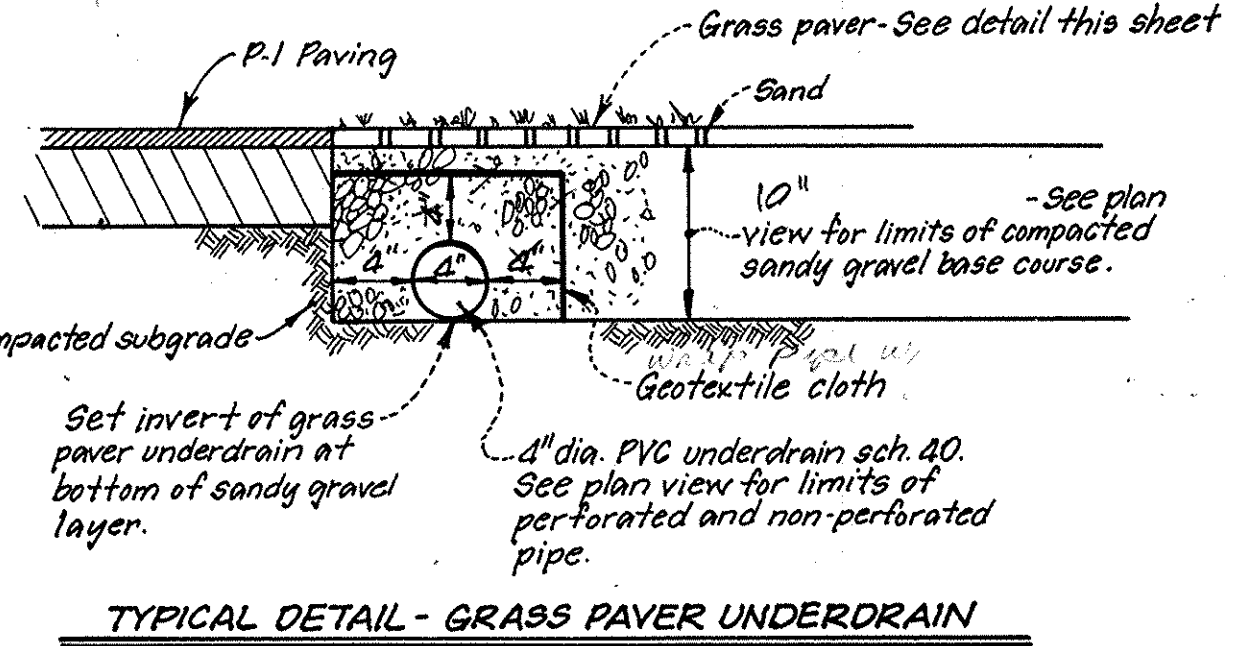

- GRASSPAVE 2 SYSTEM SPECIFICATIONS:**
- Base course shall be sandy gravel material from local sources commonly used for road base construction passing the following sieve analysis:  
 Sieve Size      % Passing  
 100                1/2"  
 85                 3/8"  
 60                 #4  
 30                 #40  
 <3                 #200
  - Place Hydrogrow Conditioner mix supplied by manufacturer below ring system
  - Fill ring voids with clean sharp sand (washed concrete sand).
  - Fertilize w/ "starter" fertilizer Guaranteed Analysis of 17-23-6 for rapid germination and root development.
  - Seed with a Blue/Rye/Fescue mix used for athletic fields. Seed shall be from certified sources, provided in clearly labeled containers, showing seed name, lot number, net weight, % weed seed content, and guaranteed % of purity for germination. Seed types shall be per "Permanent Seeding Notes" schedule on S&E plans sheet 4 of 5.
  - Mulch (for seeding only) with wood or paper cellulose type of commercial mulch material such as used with hydroseeding operations. Straw mulch will not be acceptable due to its low moisture holding capacity. Seed types shall be per "Permanent Seeding Notes" schedule on S&E plans sheet 4 of 5.
  - Sod optionally with 0.5" thick (soil thickness) rolled sod from a reputable local grower. Species should be wear resistant, free from disease, and in excellent condition. Sod shall be grown in sand or sandy loam only or supplied from a recognized "Washed Sod" process. Sod grown in soils of clay, silt, or high organic material such as peat will not be accepted.
  - Irrigate regularly during drought periods.
  - Maintain a weekly mowing schedule and by-yearly (spring and fall) application of Super Turf Assurance 28-2-8 fertilizer.
  - Traffic frequency shall not be for daily use but rather weekly or by weekly parking.

- NOTES:**
- LONGITUDINAL JOINT BETWEEN SILE WALK AND CURB SHALL BE CONTINUOUS AND TO A DEPTH OF 1/4 THE SIDEWALK THICKNESS OR 1" MAX. LATITUDINAL JOINTS SHALL RUN FROM BACK EDGE OF SIDEWALK, CONTINUOUS TO THE BOTTOM FACE OF CURB TO A DEPTH OF 1/4 AND SPACED 5' APART.
  - PROVIDE 1/2" EXPANSION JOINTS AT 15' INTERVALS. IN LATITUDINAL JOINTS TO FULL CROSS SECTION.

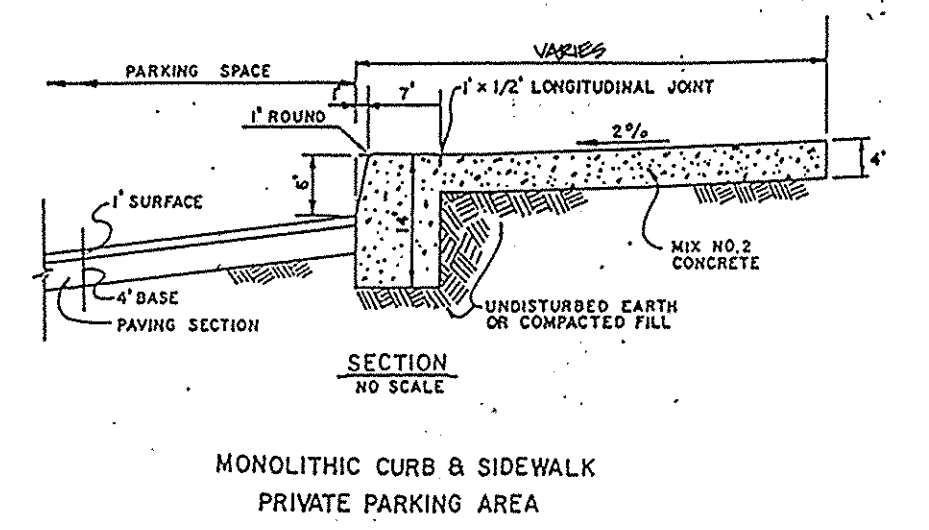

APPROVED: DEPARTMENT OF PLANNING AND ZONING  
 Chief, Development Engineering Division  
 Chief, Division of Land Development  
 Director


DRAINAGE AREA MAP DEVELOPED CONDITIONS  
 SCALE: 1" = 100'

APPROVED: FOR PRIVATE WATER AND SEWAGE SYSTEMS  
 HOWARD COUNTY DEPARTMENT OF HEALTH  
 COUNTY HEALTH OFFICER  
 DATE

DRAINAGE AREA MAP EXISTING CONDITIONS  
 SCALE: 1" = 100'



<b>CLARK • FINEFROCK &amp; SACKETT, INC.</b> ENGINEERS • PLANNERS • SURVEYORS 7135 MINSTREL WAY • COLUMBIA, MD. 21045 • (410) 381-7500 - BALTO. • (301) 621-8100 - WASH.	
DESIGNED <b>WHT</b>	SCALE AS SHOWN
DRAWN <b>BAN</b>	DRAWING <b>2 OF 5</b>
CHECKED <b>KJM</b>	JOB NO. <b>95-200</b>
DATE <b>10-16-98</b>	FILE NO. <b>95-200-98</b>
FOR: FRIENDSHIP BAPTIST CHURCH (OWNER) 100 SYKEVILLE ROAD SYKEVILLE, MARYLAND 21704	

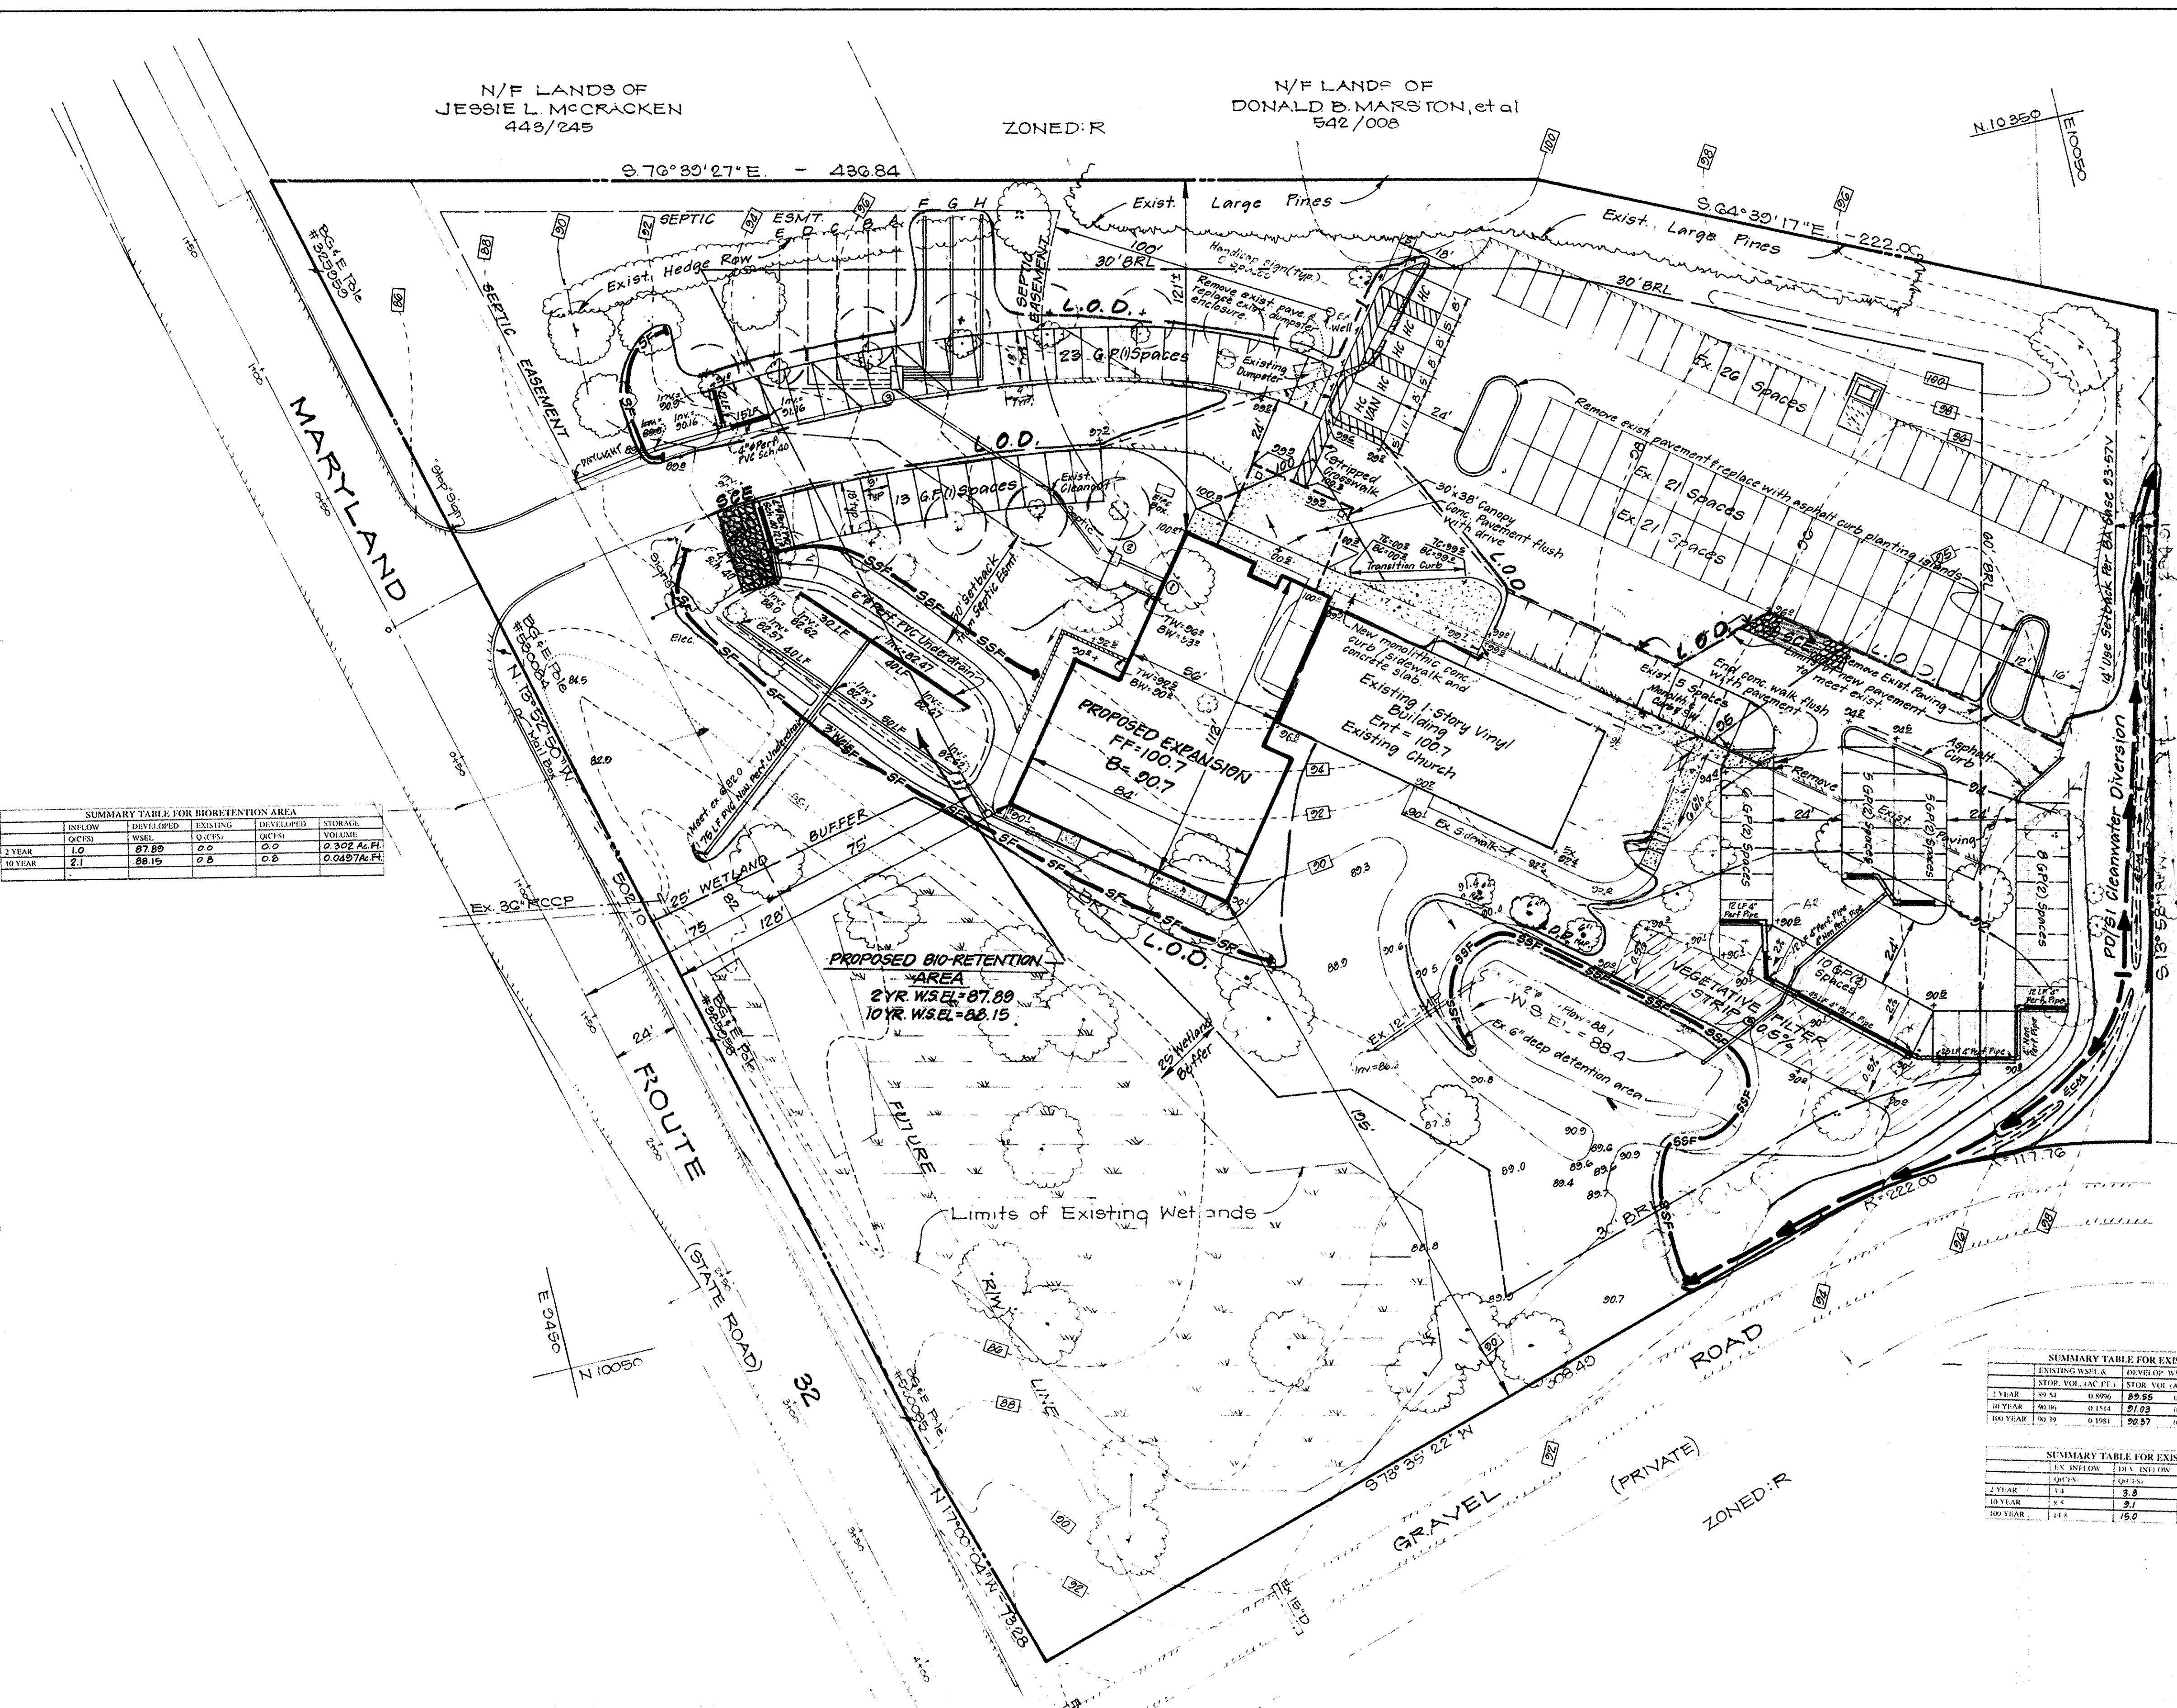

SUMMARY TABLE FOR BIORETENTION AREA


	INFLOW Q.C.T.S.	DEVELOPED WSEL	EXISTING Q.C.T.S.	DEVELOPED Q.C.T.S.	STORAGE VOLUME
2 YEAR	1.0	87.89	0.8	0.8	0.3427 AL FT
10 YEAR	2.1	88.15	0.8	0.8	0.427 AL FT

SUMMARY TABLE FOR EXISTING DETENTION FACILITY

	EXISTING WSEL & STOP VOL. (AC FT)	DEVELOP WSEL & STOP VOL. (AC FT)	EXISTING Q.C.T.S.	DEVELOPED Q.C.T.S.	INCREASE
2 YEAR	89.54	89.96	85.56	87.7	2.14
10 YEAR	90.06	91.14	87.02	89.2	2.18
100 YEAR	90.39	91.98	88.37	91.0	2.63

SUMMARY TABLE FOR EXISTING DETENTION FACILITY

	EXIST. INFLOW	DEV. INFLOW	EXIST. INFL. (CFS)	DEV. INFL. (CFS)
2 YEAR	1.4	3.8	1.4	3.8
10 YEAR	2.8	9.7	2.8	9.7
100 YEAR	14.8	45.0	14.8	45.0

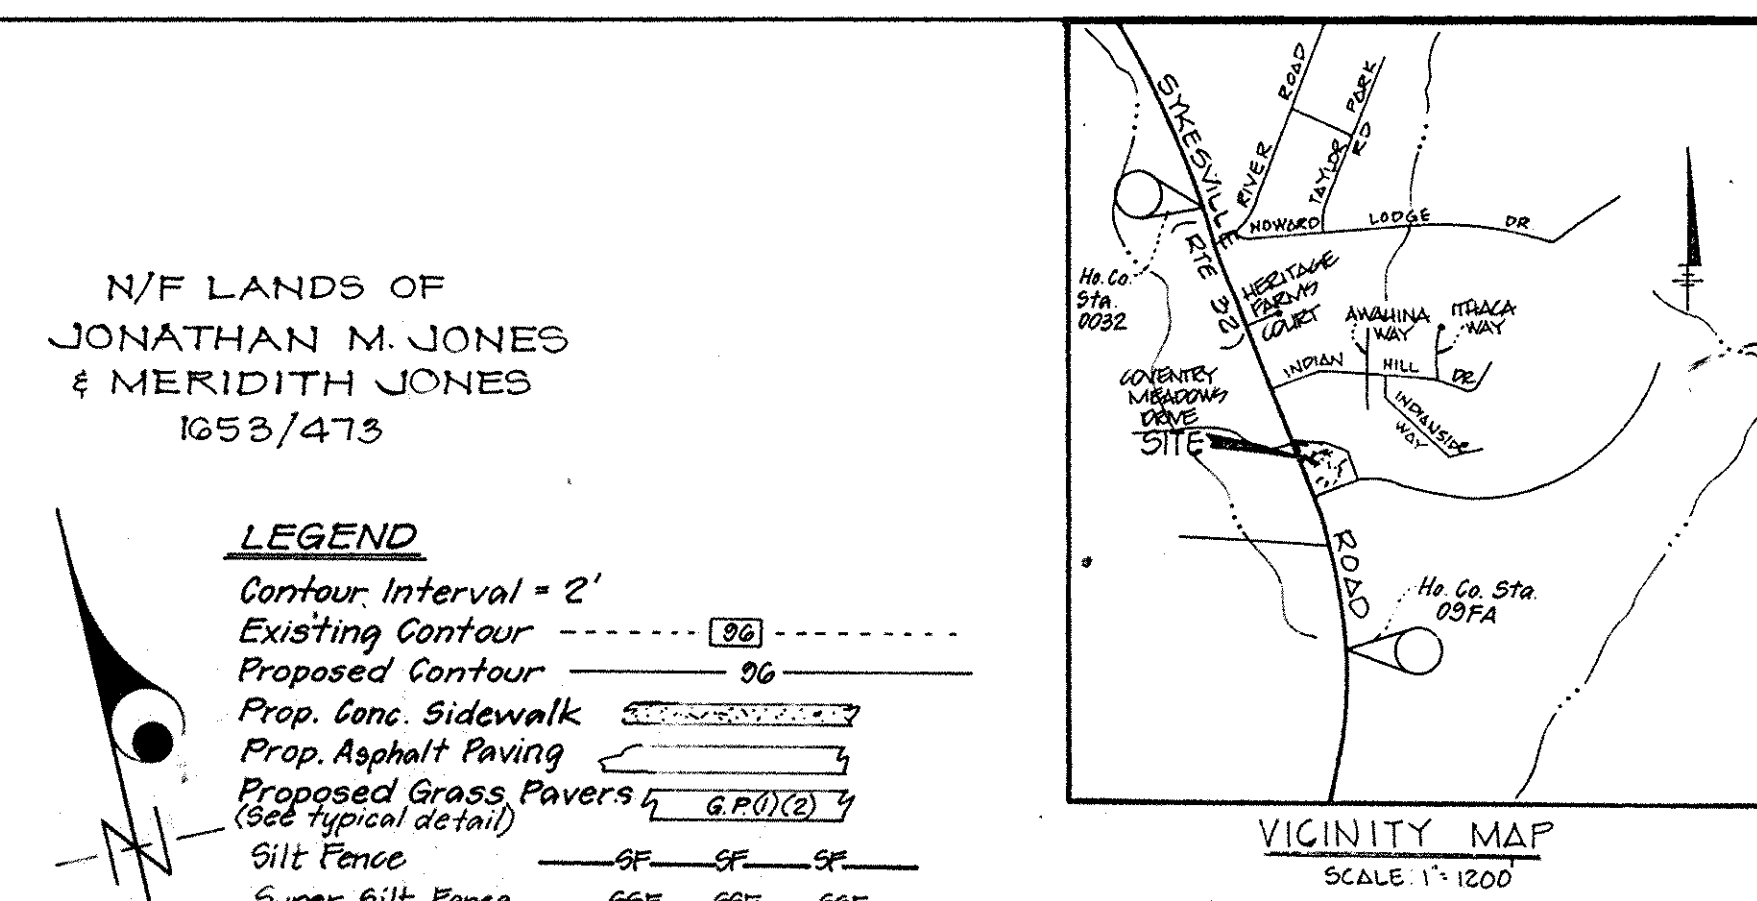

- LEGEND**
- Contour Interval = 2'
  - Existing Contour
  - Proposed Contour
  - Prop. Conc. Sidewalk
  - Prop. Asphalt Paving
  - Proposed Grass Pavers (See typical detail)
  - Silt Fence
  - Super Silt Fence
  - Stabilized Construction Entrance
  - Perimeter Dike/Swale
  - Perforated P.V.C.
  - Non Perforated P.V.C.
  - Erosion Control Matting

N/F LANDS OF  
MARK D. SKROUPA  
1441/542

- Maintenance requirements for existing detention facility**
- 1) Removal of silt when accumulation exceeds six (6) inches.
  - 2) Removal of accumulated paper, trash and debris as necessary.
  - 3) Vegetation growing on the embankment top and faces is not allowed to exceed 18" in height at any time.
  - 4) Annual inspection and repair of the structure.
  - 5) Existing Cattails to be removed & maintained as such.

APPROVED: FOR PRIVATE WATER AND SEWAGE SYSTEMS  
HOWARD COUNTY DEPARTMENT OF HEALTH

*Joseph B. Bell* 2/18/99  
COUNTY HEALTH OFFICER DATE

APPROVED: DEPARTMENT OF PLANNING AND ZONING

*John S. Smith* 2/18/99  
Chief, Division of Land Development and Planning DATE

Reviewed for: HOWARD S.C.D.  
and meets Technical Requirements  
*David Summers* 1/27/99  
Signature Date  
U.S. Natural Resources Conservation Service

THIS DEVELOPMENT PLAN IS APPROVED  
FOR SOIL EROSION AND SEDIMENT  
CONTROL BY THE HOWARD SOIL  
CONSERVATION DISTRICT.

*John M. DeWitt* 1/27/99  
Approved

DEVELOPER'S/BUILDER'S CERTIFICATE

"I/We certify that all development and construction will be done according to this plan of development and plan for sediment and erosion control and that all responsible personnel involved in the construction project will have a Certificate of Attendance at a Department of the Environment Approved Training Program for the Control of Sediment and Erosion before beginning the project. I also authorize periodic on-site inspection by the Howard Soil Conservation District or their authorized agents, as are deemed necessary."

*Donald R. Goss* 1/21/99  
NAME DATE

ENGINEER'S CERTIFICATE

I hereby certify that this plan for Sediment and Erosion Control represents a practical and workable plan based on my personal knowledge of the site conditions and that it was prepared in accordance with the requirements of the Howard Soil Conservation District.

*G. Nelson Clark* 1-21-99  
DATE



**CLARK • FINEFROCK & SACKETT, INC.**  
ENGINEERS • PLANNERS • SURVEYORS

7135 MINNIE WAY • CHILMARK MD 21735 • (410) 481-7000 FAX: (410) 481-8100

DESIGNED: WHF  
DRAWN: ZAH  
CHECKED: LHM  
DATE: 10-16-98



**SEDIMENT AND EROSION CONTROL PLAN**  
**FRIENDSHIP BAPTIST CHURCH**

TAX MAP 9 PARCEL 178  
THIRD (3rd) ELECTION DISTRICT  
HOWARD COUNTY, MARYLAND

FOR: FRIENDSHIP BAPTIST CHURCH  
1301 SYKESVILLE ROAD  
SYKESVILLE, MARYLAND 21784  
410-414-2-5506

SCALE: 1"=30'  
DRAWING: 3 OF 5  
JOB NO.: 95-261  
FILE NO.: 95-200-SE



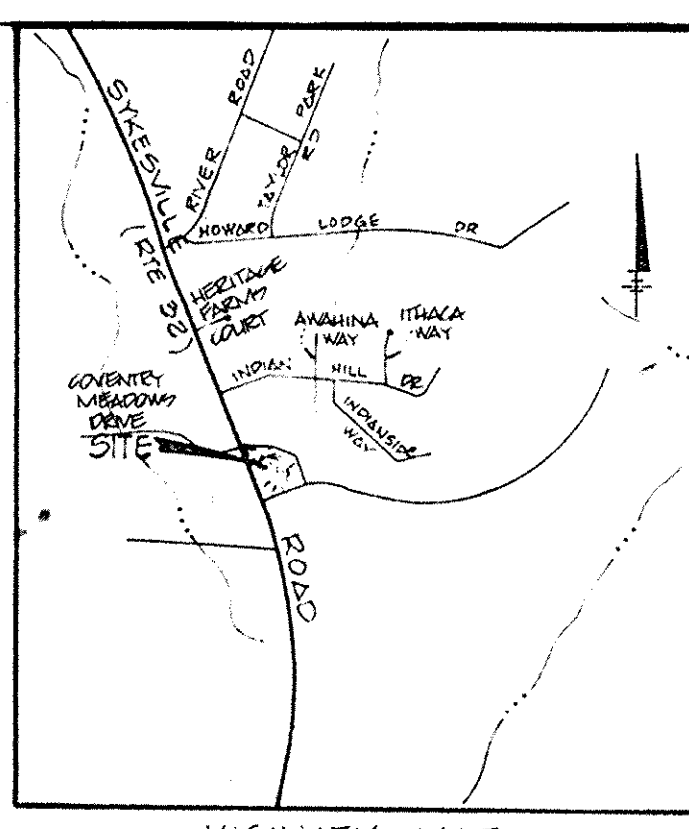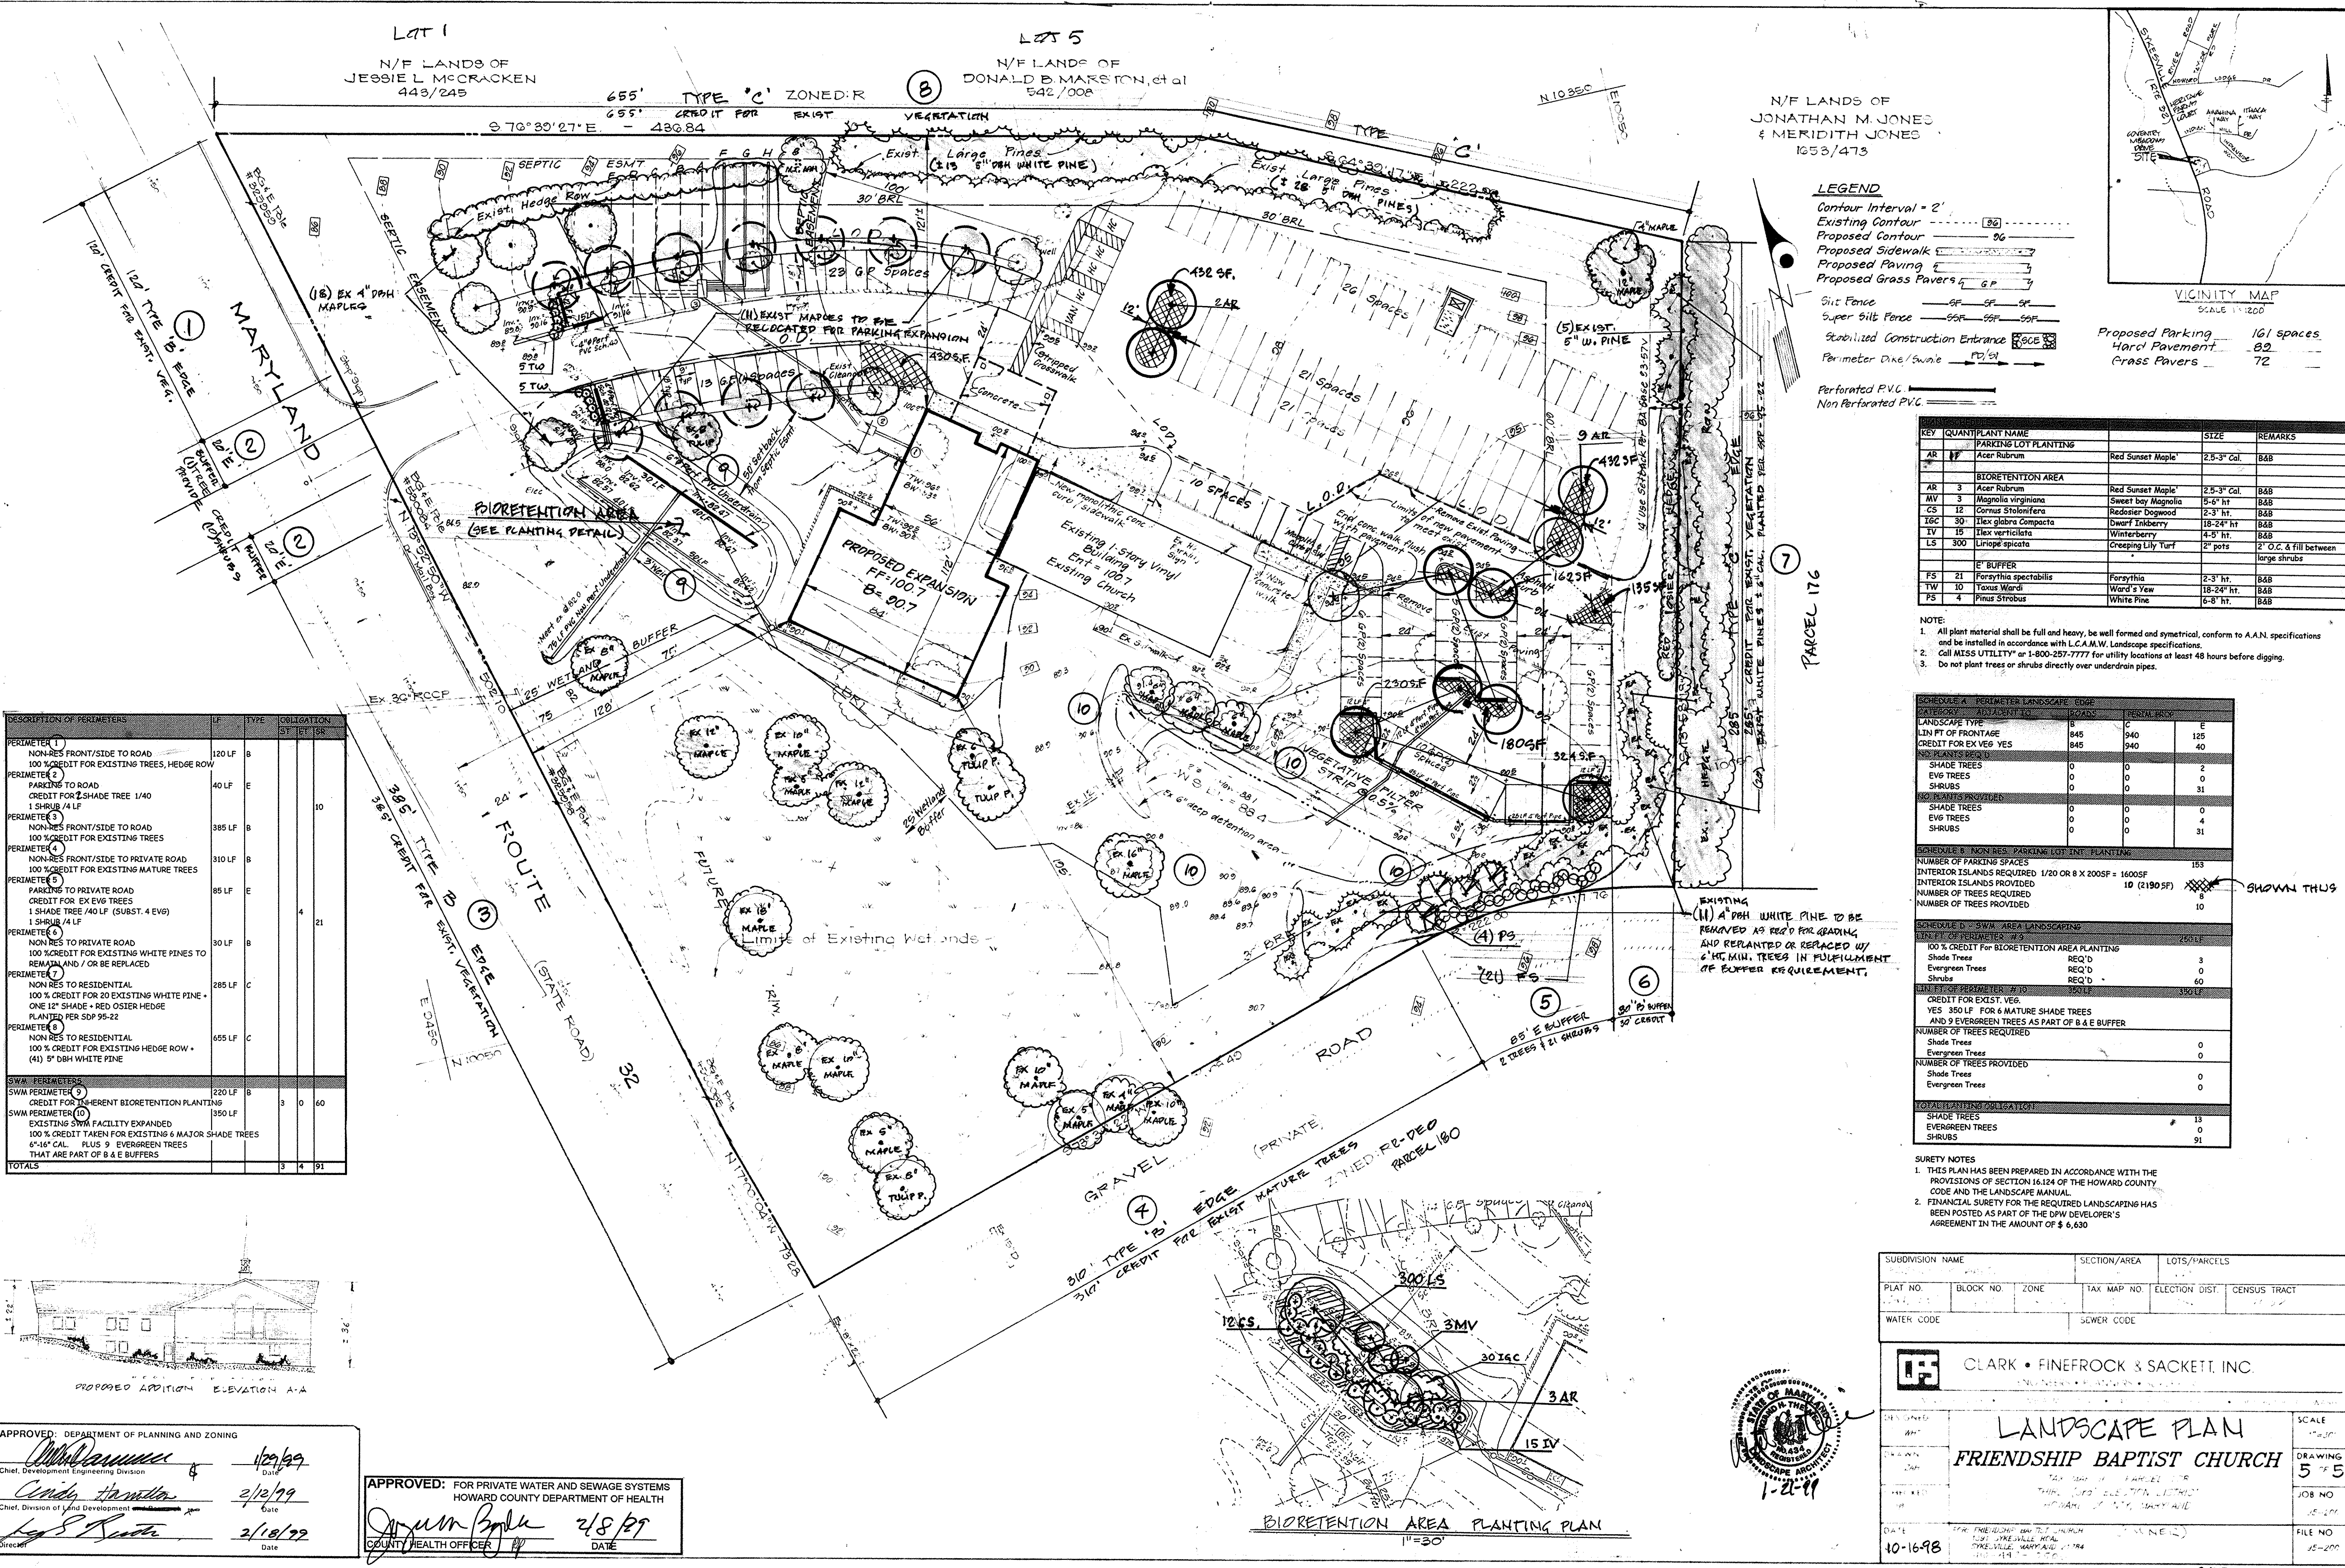

**LEGEND**

Contour Interval = 2'

Existing Contour

Proposed Contour

Proposed Sidewalk

Proposed Paving

Proposed Grass Pavers

Silt Fence

Super Silt Fence

Stabilized Construction Entrance

Perimeter Dike/Swale

Perforated P.V.C.

Non Perforated P.V.C.

Proposed Parking 161 spaces

Hard Pavement 82

Grass Pavers 72

KEY	QUANTITY	PLANT NAME	SIZE	REMARKS
AR	17	Acer Rubrum	Red Sunset Maple	2.5-3" Cal. B&B
<b>BIORETENTION AREA</b>				
AR	3	Acer Rubrum	Red Sunset Maple	2.5-3" Cal. B&B
MV	3	Magnolia virginiana	Sweet bay Magnolia	5-6" ht. B&B
CS	12	Cornus Stolonifera	Redosier Dogwood	2-3" ht. B&B
TGC	30	Ilex glabra Compacta	Dwarf Inkberry	18-24" ht. B&B
IV	15	Ilex verticillata	Winterberry	4-5" ht. B&B
LS	300	Liriodendron tulipifera	Creeping Lily Turf	2" pots 2" O.C. & fill between large shrubs
<b>E' BUFFER</b>				
FS	21	Forsythia spectabilis	Forsythia	2-3" ht. B&B
TW	10	Taxus Wardii	Ward's Yew	18-24" ht. B&B
PS	4	Pinus Strobus	White Pine	6-8" ht. B&B

- NOTE:**
- All plant material shall be full and heavy, be well formed and symmetrical, conform to A.A.N. specifications and be installed in accordance with L.C.A.M.W. Landscape specifications.
  - Call MISS UTILITY\* or 1-800-257-7777 for utility locations at least 48 hours before digging.
  - Do not plant trees or shrubs directly over underdrain pipes.

DESCRIPTION OF PERIMETERS	LF	TYPE	OBIGATION	ST	ET	SR
<b>PERIMETER 1</b> NON-RES FRONT/SIDE TO ROAD 100% CREDIT FOR EXISTING TREES, HEDGE ROW	120 LF	B				
<b>PERIMETER 2</b> PARKING TO ROAD CREDIT FOR 2 SHADE TREE 1/40 1 SHRUB /4 LF	40 LF	E				10
<b>PERIMETER 3</b> NON-RES FRONT/SIDE TO ROAD 100% CREDIT FOR EXISTING TREES	385 LF	B				
<b>PERIMETER 4</b> NON-RES FRONT/SIDE TO PRIVATE ROAD 100% CREDIT FOR EXISTING MATURE TREES	310 LF	B				
<b>PERIMETER 5</b> PARKING TO PRIVATE ROAD CREDIT FOR EX EVG TREES 1 SHADE TREE /40 LF (SUBST. 4 EVG) 1 SHRUB /4 LF	85 LF	E				21
<b>PERIMETER 6</b> NON RES TO PRIVATE ROAD 100% CREDIT FOR EXISTING WHITE PINES TO REMAIN AND / OR BE REPLACED	30 LF	B				
<b>PERIMETER 7</b> NON RES TO RESIDENTIAL 100% CREDIT FOR 20 EXISTING WHITE PINE + ONE 12" SHADE + RED OSIER HEDGE PLANTED PER SDP 95-22	285 LF	C				
<b>PERIMETER 8</b> NON RES TO RESIDENTIAL 100% CREDIT FOR EXISTING HEDGE ROW + (41) 5" DBH WHITE PINE	655 LF	C				
<b>SWM PERIMETERS</b>						
<b>SWM PERIMETER 9</b> CREDIT FOR INHERENT BIORETENTION PLANTING	220 LF	B		3	0	60
<b>SWM PERIMETER 10</b> EXISTING SWM FACILITY EXPANDED 100% CREDIT TAKEN FOR EXISTING 6 MAJOR SHADE TREES 6"-16" CAL. PLUS 9 EVERGREEN TREES THAT ARE PART OF B & E BUFFERS	350 LF					
<b>TOTALS</b>				3	4	91

SCHEDULE A - PERIMETER LANDSCAPE EDGE	ADJACENT TO	ROADS	RESTRICTION	E
LANDSCAPE TYPE		B	C	E
LINE FT OF FRONTAGE		845	940	125
CREDIT FOR EX EVG YES		845	940	40
<b>NO PLANTS PROVIDED</b>				
SHADE TREES		0	0	2
EVG TREES		0	0	0
SHRUBS		0	0	31
<b>PLANTS PROVIDED</b>				
SHADE TREES		0	0	0
EVG TREES		0	0	4
SHRUBS		0	0	31

SCHEDULE B - NON-RES. PARKING LOT INT. PLANTING	REQUIREMENT	PROVIDED
NUMBER OF PARKING SPACES	153	153
INTERIOR ISLANDS REQUIRED: 1/20 OR 8 X 200SF = 1600SF	10 (2190SF)	10
INTERIOR ISLANDS PROVIDED		10
NUMBER OF TREES REQUIRED		9
NUMBER OF TREES PROVIDED		9

SCHEDULE C - SWM AREA LANDSCAPING	REQUIREMENT	PROVIDED
NUMBER OF PERIMETER TREES	250 LF	250 LF
100% CREDIT FOR BIORETENTION AREA PLANTING		
Shade Trees	REQ'D 3	3
Evergreen Trees	REQ'D 0	0
Shrubs	REQ'D 60	60
<b>UNITS OF PERIMETER #10</b>	350 LF	350 LF
CREDIT FOR EXIST. YES		
YES 350 LF FOR 6 MATURE SHADE TREES AND 9 EVERGREEN TREES AS PART OF B & E BUFFER		
NUMBER OF TREES REQUIRED		0
Shade Trees		0
Evergreen Trees		0
NUMBER OF TREES PROVIDED		0
Shade Trees		0
Evergreen Trees		0
<b>TOTAL PLANTING OBLIGATION</b>		
SHADE TREES		13
EVERGREEN TREES		0
SHRUBS		91

- SURETY NOTES**
- THIS PLAN HAS BEEN PREPARED IN ACCORDANCE WITH THE PROVISIONS OF SECTION 16.124 OF THE HOWARD COUNTY CODE AND THE LANDSCAPE MANUAL.
  - FINANCIAL SURETY FOR THE REQUIRED LANDSCAPING HAS BEEN POSTED AS PART OF THE DOW DEVELOPER'S AGREEMENT IN THE AMOUNT OF \$ 6,630

SUBDIVISION NAME	SECTION/AREA	LOTS/PARCELS
PLAT NO.	BLOCK NO.	ZONE
TAX MAP NO.	ELECTION DIST.	CENSUS TRACT
WATER CODE	SEWER CODE	

**CLARK • FINEPROCK & SACKETT, INC.**

**LANDSCAPE PLAN**

**FRIENDSHIP BAPTIST CHURCH**

SCALE: 1"=30'


DRAWING: 5 OF 5

JOB NO: 15-201

FILE NO: 15-200

DATE: 10-16-98

1-21-99

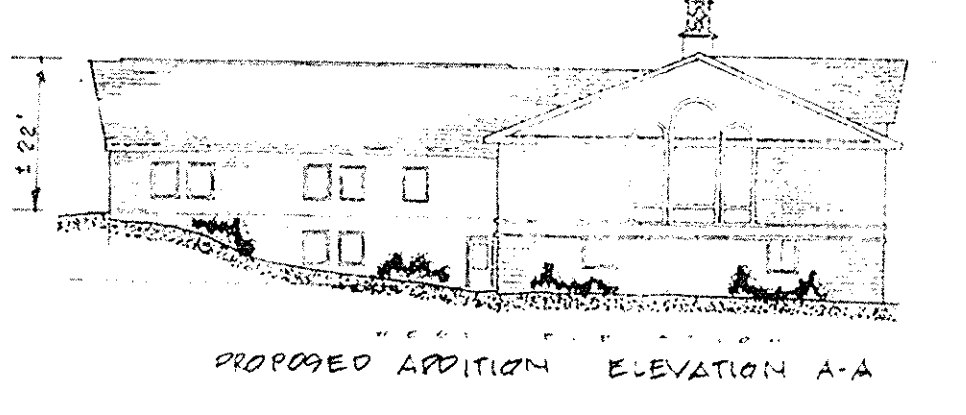

APPROVED: DEPARTMENT OF PLANNING AND ZONING

Chief, Development Engineering Division: *[Signature]* 1/29/99

Chief, Division of Land Development: *[Signature]* 2/12/99

Director: *[Signature]* 2/18/99

APPROVED: FOR PRIVATE WATER AND SEWAGE SYSTEMS

HOWARD COUNTY DEPARTMENT OF HEALTH

County Health Officer: *[Signature]* 2/8/99




EXTENSION OF INDIAN HILL  
SECTION 1  
P.B. 10 F.52  
LOT 1  
RR-DEO

EXTENSION OF INDIAN HILL  
SECTION 2  
P.B. 13 F.30  
LOT 5  
RR-DEO

N/F LANDS OF  
JONATHAN M. JONES  
& MERIDITH JONES  
1053/473  
RR-DEO

N/F LANDS OF  
MARK D. SKROUPA  
1441/542  
RR-DEO

PARCEL 179

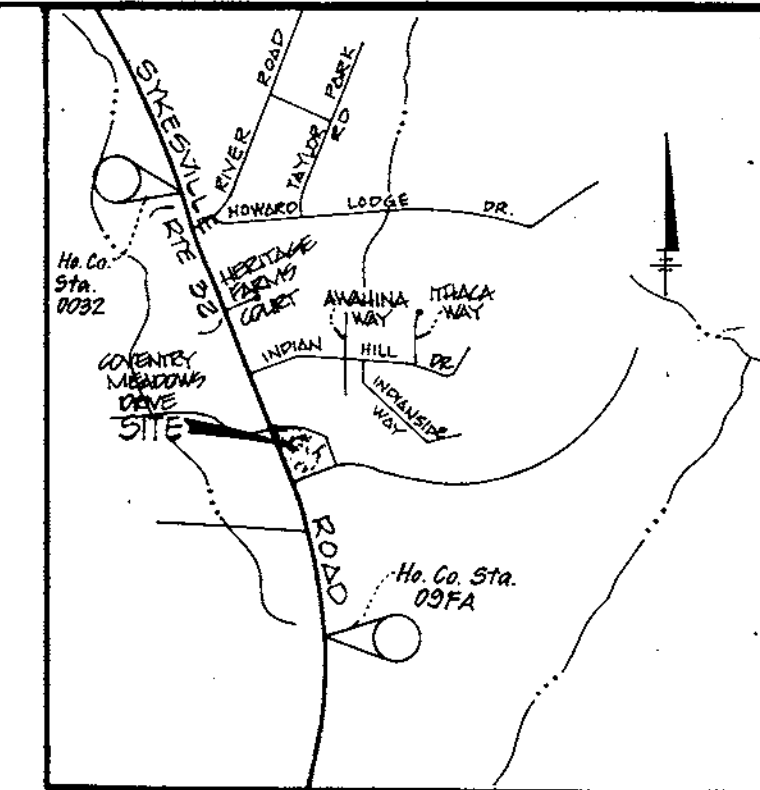

LEGEND

- Contour Interval = 2'
- Existing Contour
- Proposed Contour
- Prop. Conc. Sidewalk
- Prop. Asphalt Paving
- Proposed Grass Pavers
- Silt Fence
- Super Silt Fence
- Stabilized Construction Entrance
- Perimeter Dike/Swale
- Perforated P.V.C.
- Non Perforated P.V.C.
- Existing Pavement Edge

SITE ANALYSIS:

1. PRESENT ZONING RR-DEO
2. TOTAL PROJECT AREA 5.06 AC
3. AREA OF PLAN SUBMISSION 1.85 AC
4. LIMIT OF DISTURBED AREA 1.85 AC
5. PROPOSED USE: EXPANSION OF EXISTING RELIGIOUS FACILITY
6. EXISTING STRUCTURE FLOOR AREA 4,780 X 2 = 9,560 SF
7. PROPOSED STRUCTURE FLOOR AREA 7,840 X 2 = 15,680 SF
8. TOTAL PROPOSED FLOOR AREA 12,580 X 2 = 25,160 SF
9. SEATS IN ASSEMBLY AREA EXISTING 181 SEATS  
PROPOSED 387 SEATS
10. PARKING TABULATION  
EXISTING SPACES 100  
PARKING REQUIRED FOR EXPANSION 129  
1 SPACE PER 3 SEATS IN ASSEMBLY AREA = 129  
PROPOSED PARKING 130 INCL. 8 HC SPACES
11. BUILDING COVERAGE:  
EXISTING 4,780 SF 2.2% OF SITE  
EXPANSION 7,840 SF 2.2% OF SITE  
TOTAL 12,580 SF 5.7% OF SITE
12. GREEN AREA:  
EXISTING 4.0 AC 79%  
PROPOSED 3.57 AC 70.5%  
BA-97-30E APPROVED 10-2-97  
BA-98-57V " " 5-24-94  
BA-98-54E " " 11-23-95  
BA-98-03E " " " "  
SDP 98-22 " " " "  
SDP 98-161 " " " "
13. APPLICABLE DPZ FILES

GENERAL NOTES:

1. ALL CONSTRUCTION SHALL BE IN ACCORDANCE WITH THE LATEST STANDARDS AND SPECIFICATIONS OF HOWARD COUNTY.
2. THE CONTRACTOR SHALL NOTIFY THE PUBLIC UTILITIES INSPECTION DIVISION AT (410) 313-1880 AT LEAST FIVE (5) WORKING DAYS PRIOR TO THE START OF WORK.
3. THE CONTRACTOR SHALL NOTIFY "MISS UTILITY" AT 1-800-251-7777 AT LEAST 48 HOURS PRIOR TO ANY EXCAVATION WORK.
4. PROJECT BACKGROUND: SEE SITE ANALYSIS.
5. TRAFFIC CONTROL DEVICES, MARKINGS, AND SIGNING SHALL BE IN ACCORDANCE WITH THE LATEST EDITION OF THE MANUAL ON UNIFORM TRAFFIC CONTROL DEVICES (MUTCD). ALL STREET AND REGULATORY SIGNS SHALL BE IN PLACE PRIOR TO THE PLACEMENT OF ANY ASPHALT.
6. ALL PLAN DIMENSIONS ARE TO THE FACE OF CURB UNLESS OTHERWISE NOTED.
7. OVERALL TOPOGRAPHY TAKEN FROM ORIGINAL SURVEY FOR SDP 98-161 BY FISHER COLLINS AND CARTER. TOPOGRAPHY WITHIN LIMIT OF DISTURBANCE WAS UPDATED BY CLARK FINEPROCK AND SACKETT INC. APRIL 1997.
8. HORIZONTAL AND VERTICAL DATUM ESTABLISHED BY BENCHMARKS TIED INTO ORIGINAL TOPO FOR SDP 98-161.
9. NO 100 YEAR FLOODPLAIN APPLIES TO THIS SITE PER FEMA MAP, HOWARD COUNTY PANEL 98.
10. PRIVATE WATER AND SEWER TO BE UTILIZED.
11. STORMWATER MANAGEMENT FOR THIS SITE TO UTILIZE THE EXISTING EXTENDED DETENTION BASIN AND A NEW BIOTRETENTION AREA.
12. STORMWATER MANAGEMENT FACILITIES FOR THIS PROJECT WILL BE PRIVATELY OWNED AND MAINTAINED.
13. EXISTING WETLANDS SHOWN WERE TAKEN FROM PREVIOUSLY APPROVED SDP 98-161.
14. TRAFFIC REPORT FOR THIS PROJECT WAS PREPARED BY TRAFFIC CONCEPTS, INC. TITLED "TRAFFIC IMPACT BRIEF", DATED APRIL 27, 1998.
15. EXISTING UTILITIES WERE LOCATED BY FIELD SURVEY.
16. HANDICAP ACCESSIBLE ROUTES ARE PROVIDED TO THE MAIN ENTRANCE OF THE EXPANSION TO THE LOWER REAR OF THE EXISTING BUILDING.

SEPTIC SYSTEM EXPANSION:

1. EXISTING SYSTEM (PER SDP-88-161)  
FOR 144 SEATS @ 5 GAL/DAY = 720 GAL/DAY  
240 L.F. EXISTING TRENCH @ 3 GAL/FT = 720 GAL/DAY
2. EXPANSION:  
FOR 387 SEATS X 3 GAL/DAY = 1161 GAL/DAY  
TOTAL TRENCH LENGTH NEEDED = 1161/3 GAL PER FT. = 387 FT.  
TRENCH EXPANSION REQUIRED = 147
3. SEPTIC SYSTEM PLAN LEGEND  
(1) DISCHARGE FROM NEW BUILDING BY GRINDER PUMP TO SEPTIC TANK  
(2) EXISTING SEPTIC TANK (1,500 GALLON PER SDP-88-161)  
(3) EXISTING CLEANOUT  
(4) EXISTING DISTRIBUTION BOX TO BE MODIFIED FOR THREE ADDITIONAL TRENCHES F, G & H  
EXISTING TRENCHES A, B, C, D, & E TO REMAIN.

INFLOW (CFS)	DEVELOPED WSEL (CFS)	EXISTING WSEL (CFS)	DEVELOPED WSEL (CFS)	STORAGE (CFS)
1 YEAR	87.89	86.15	86.15	12,302 AC FT
10 YEAR	2.1	0.8	0.8	0.0457 AC FT





EXISTING WSEL & STOR. VOL. (AC FT.)	DEVELOP. WSEL & STOR. VOL. (AC FT.)	EXISTING O/CFS	DEVELOPED O/CFS	INCREASE
1 YEAR 87.84 0.8956	87.89 0.8956	0.0892	0.27	NONE
10 YEAR 90.05 0.1514	90.15 0.1514	0.1548	0.4	NONE
100 YEAR 90.39 0.1981	90.37 0.2266	0.22	0.2	NONE

EX. INFLOW (CFS)	DEV. INFLOW (CFS)	O/CFS	INCREASE
1 YEAR 3.4	4.0	0.6	NONE
10 YEAR 8.5	9.2	0.7	NONE
100 YEAR 14.8	16.0	1.2	NONE

NOTE: EXISTING CATTAILS TO BE REMOVED FROM EX. S.W.W. FACILITY & MAINTAINED AS SUCH.

No	Description
1	Site Development Plan
2	Stormwater Management & Paving Details
3	Sediment & Erosion Control Plan
4	Sediment & Erosion Control Details
5	Landscape Plan

PARKING LOT LIGHTING:  
LOCATION: PROPOSED LIGHTING SHOWN THUS ON PLAN (3' SW/WH)  
MOUNTING HEIGHT: 15' HEIGHT  
FIXTURE TYPE: AREA CUT-OFF "J" SERIES BY RUUD or approved equal  
400 WATT METAL HALIDE CUT-OFF WITH BACK LIGHT SHIELDS FOR CUT-OFF TO PREVENT ANY GLARE ONTO NEIGHBORING PROPERTIES  
NOTE: SITE LIGHTING SHALL COMPLY WITH THE REQUIREMENTS OF SECTION 134 OF THE HOWARD COUNTY ZONING REGULATIONS.

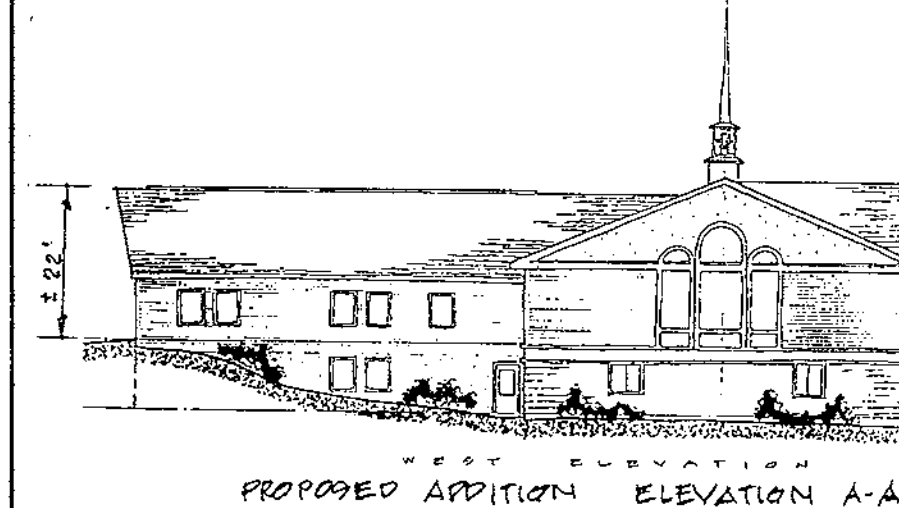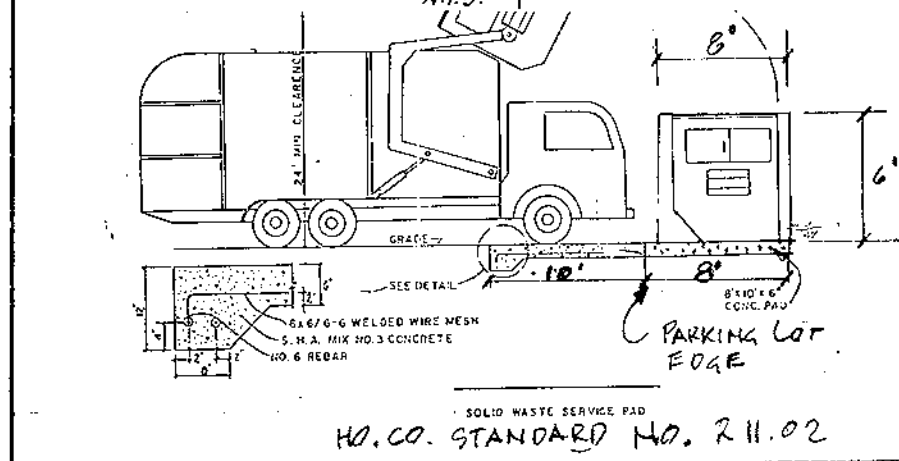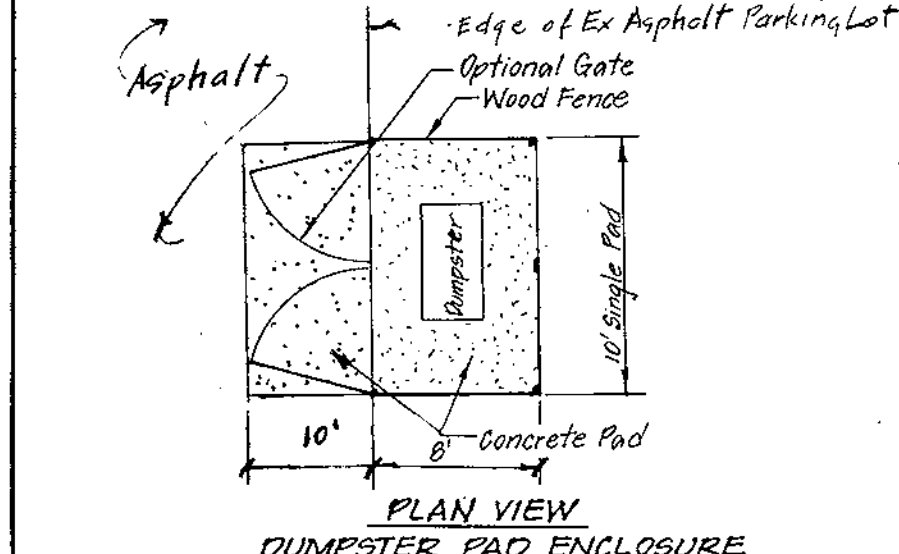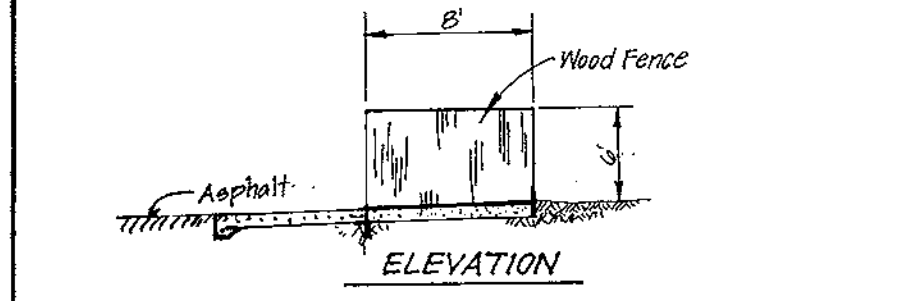

APPROVED: DEPARTMENT OF PLANNING AND ZONING  
Chief, Development Engineering Division  
Date: 1/29/99  
Chief, Division of Land Development and Research  
Date: 2/10/99  
Director  
Date: 2/18/99

APPROVED: FOR PRIVATE WATER AND SEWAGE SYSTEMS  
HOWARD COUNTY DEPARTMENT OF HEALTH  
County Health Officer  
Date: 2-8-99

NO.	REVISIONS	DATE
1	(REV) Walks for handicap Access.	12-14-98




SUBDIVISION NAME	SECTION/AREA	LOTS/PARCELS			
FRIENDSHIP BAPTIST CHURCH		178			
PLAT NO.	BLOCK NO.	ZONE	TAX MAP NO.	ELECTION DIST.	CENSUS TRACT
1547/395	11 & 17	RR-DEO	9	380	6630
WATER CODE	SEWER CODE				

CLARK • FINEPROCK & SACKETT, INC.  
ENGINEERS • PLANNERS • SURVEYORS  
7135 MINSTREL WAY • COLUMBIA, MD. 21045 • (410) 381-7500 - BALTO • (301) 621-8100 - WASH

DESIGNED	SCALE
WHT	1" = 30'
DRAWN	DRAWING
ZAH	1 OF 5
CHECKED	JOB NO.
CM	35-202
DATE	FILE NO.
10-16-98	95-200 X

FOR: FRIENDSHIP BAPTIST CHURCH  
1391 SYKESVILLE ROAD  
SYKESVILLE, MARYLAND 21784  
410-432-5506 (OWNER)

SDP 98-126

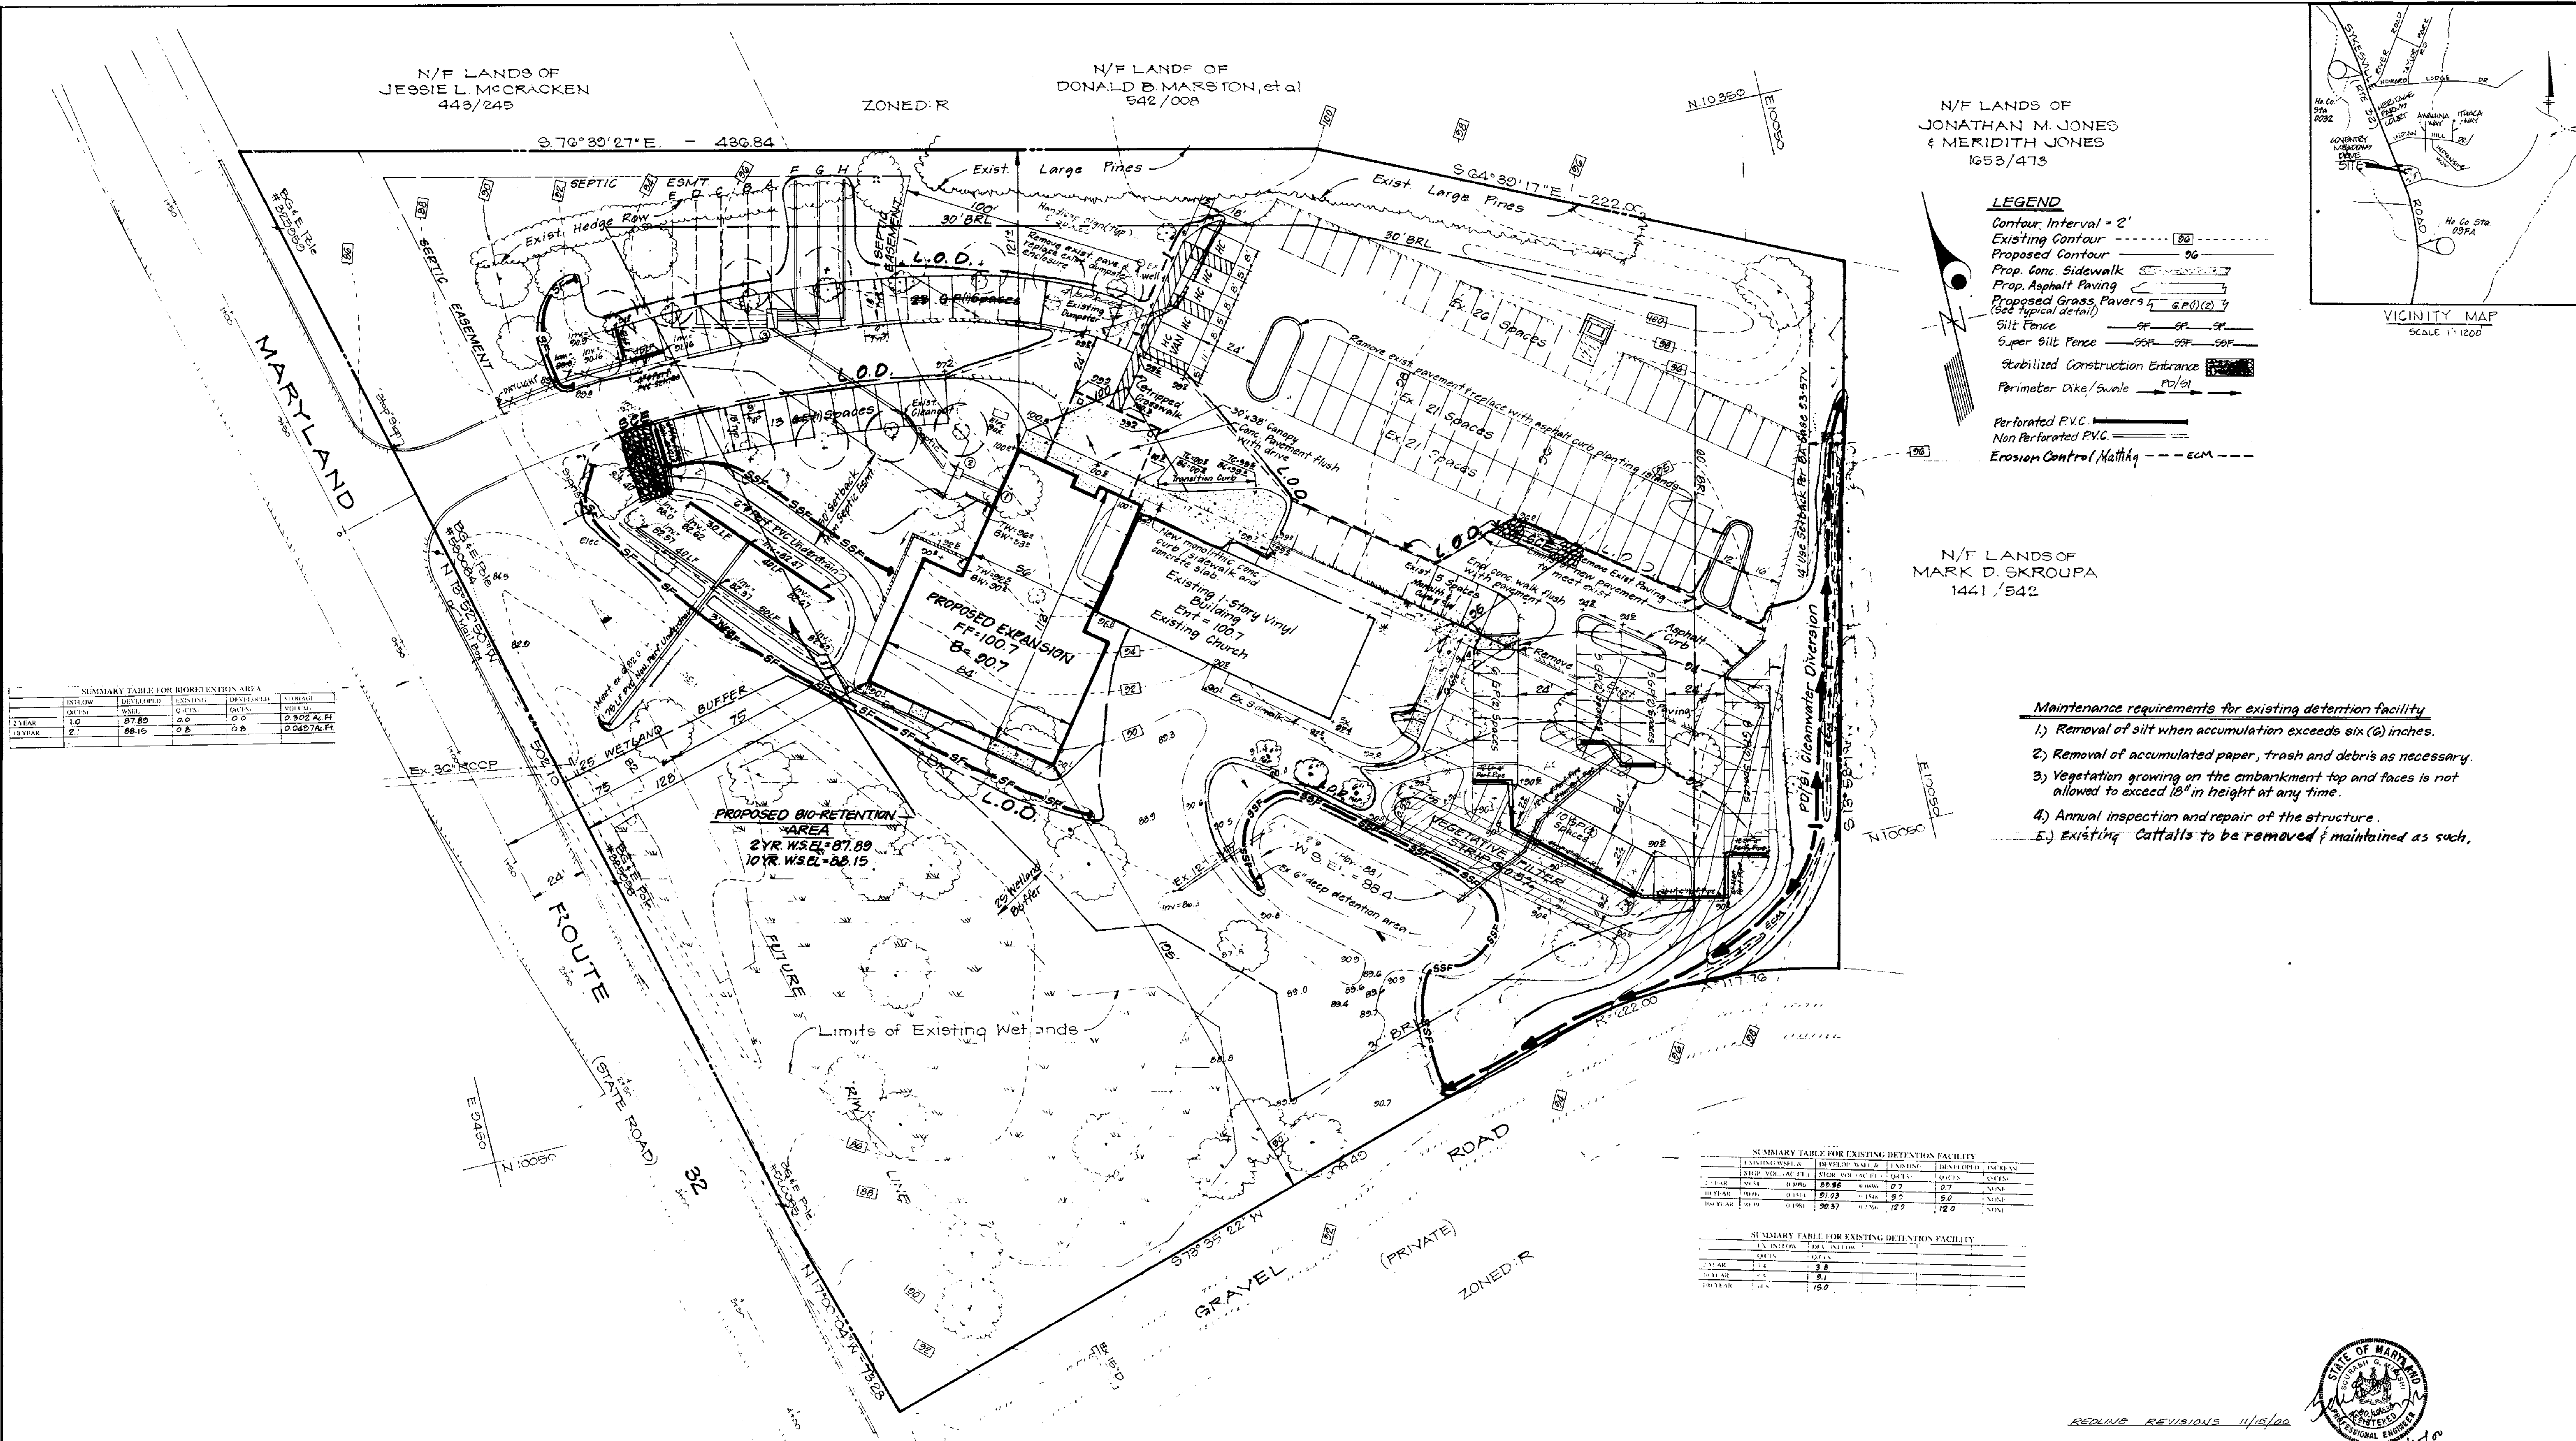

SUMMARY TABLE FOR BIO-RETENTION AREA

INFLOW	DESIGN WSEL	EXISTING WSEL	DEVELOPED WSEL	STORAGE
1 YEAR	87.89	86.00	86.00	0.502 AC FT
10 YEAR	88.16	86.00	86.00	0.6457 AC FT

SUMMARY TABLE FOR EXISTING DETENTION FACILITY


INFLOW	DESIGN WSEL	EXISTING WSEL	DEVELOPED WSEL	STORAGE
1 YEAR	88.51	86.86	86.86	0.7
10 YEAR	89.06	86.86	86.86	5.0
10 YEAR	89.19	86.86	86.86	12.0

SUMMARY TABLE FOR EXISTING DETENTION FACILITY

INFLOW	DESIGN WSEL	EXISTING WSEL	DEVELOPED WSEL	STORAGE
1 YEAR	88.51	86.86	86.86	0.7
10 YEAR	89.06	86.86	86.86	5.0
10 YEAR	89.19	86.86	86.86	12.0

- LEGEND**
- Contour Interval = 2'
  - Existing Contour [dashed line]
  - Proposed Contour [solid line]
  - Prop. Conc. Sidewalk [hatched pattern]
  - Prop. Asphalt Paving [hatched pattern]
  - Proposed Grass Pavers (See typical detail) [hatched pattern]
  - Silt Fence [line with 'SF']
  - Super Silt Fence [line with 'SSF']
  - Stabilized Construction Entrance [hatched pattern]
  - Perimeter Dike/Swale [line with 'P/S']
  - Perforated P.V.C. [line with 'PVC']
  - Non Perforated P.V.C. [line with 'PVC']
  - Erosion Control Matting [line with 'ECM']

- Maintenance requirements for existing detention facility**
- 1) Removal of silt when accumulation exceeds six (6) inches.
  - 2) Removal of accumulated paper, trash and debris as necessary.
  - 3) Vegetation growing on the embankment top and faces is not allowed to exceed 18" in height at any time.
  - 4) Annual inspection and repair of the structure.
  - 5) Existing Cattle to be removed & maintained as such.

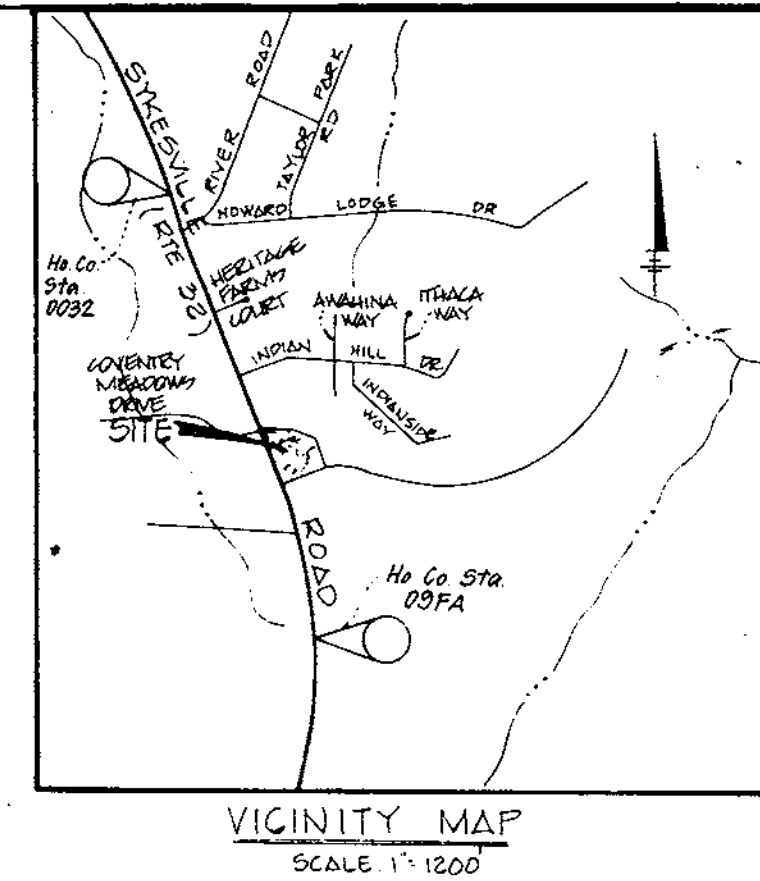

APPROVED: FOR PRIVATE WATER AND SEWAGE SYSTEMS  
 HOWARD COUNTY DEPARTMENT OF HEALTH  
 COUNTY HEALTH OFFICER: [Signature] DATE: 2/8/99


APPROVED: DEPARTMENT OF PLANNING AND ZONING  
 Chief, Development Engineering Division: [Signature] DATE: 1/21/99  
 Chief, Division of Land Development: [Signature] DATE: 2/12/99  
 Director: [Signature] DATE: 2/18/99

Reviewed for: HOWARD S.C.D.  
 and meets Technical Requirements  
 [Signature] DATE: 1/27/99  
 U.S. Natural Resources Conservation Service

THIS DEVELOPMENT PLAN IS APPROVED  
 FOR SOIL EROSION AND SEDIMENT  
 CONTROL BY THE HOWARD SOIL  
 CONSERVATION DISTRICT.  
 [Signature] DATE: 1/27/99  
 Approved

**DEVELOPER'S/BUILDER'S CERTIFICATE**  
 "I/We certify that all development and construction will be done according to this plan of development and plan for sediment and erosion control and that all responsible personnel involved in the construction project will have a Certificate of Attendance at a Department of the Environment approved Training Program for the Control of Sediment and Erosion before beginning the project. I also authorize periodic on-site inspection by the Howard Soil Conservation District or their authorized agents, as are deemed necessary."  
 [Signature] DATE: 1/21/99

**ENGINEER'S CERTIFICATE**  
 I hereby certify that this plan for Sediment and Erosion Control represents a practical and workable plan based on my personal knowledge of the site conditions and that it was prepared in accordance with the requirements of the Howard Soil Conservation District.  
 [Signature] DATE: 1-21-99  
 G. NELSON CLARK

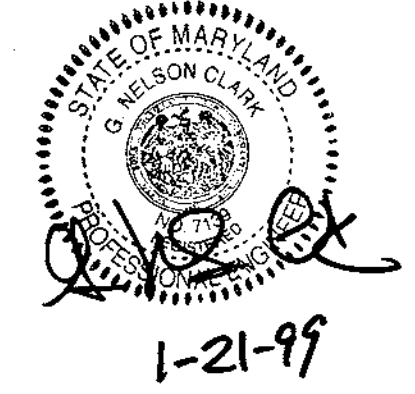

REDLINE REVISIONS 1/18/00

**CLARK • FINEFROCK & SACKETT, INC.**  
 ENGINEERS • PLANNERS • SURVEYORS


**SEDIMENT AND EROSION CONTROL PLAN**  
**FRIENDSHIP BAPTIST CHURCH**

TAX MAP # 3 PARCEL 17E  
 T114, 114A ELECTION DISTRICT  
 HOWARD COUNTY, MARYLAND

FOR: FRIENDSHIP BAPTIST CHURCH  
 1301 SYKESVILLE ROAD  
 SYKESVILLE, MARYLAND 21784  
 410-412-0000

DESIGNED: WHF  
 DRAWN: ZAH  
 CHECKED: JMW  
 DATE: 10-16-98

SCALE: 1"=20'  
 DRAWING: 3 OF 5  
 JOB NO: 98-10  
 FILE NO: 98-100-5E

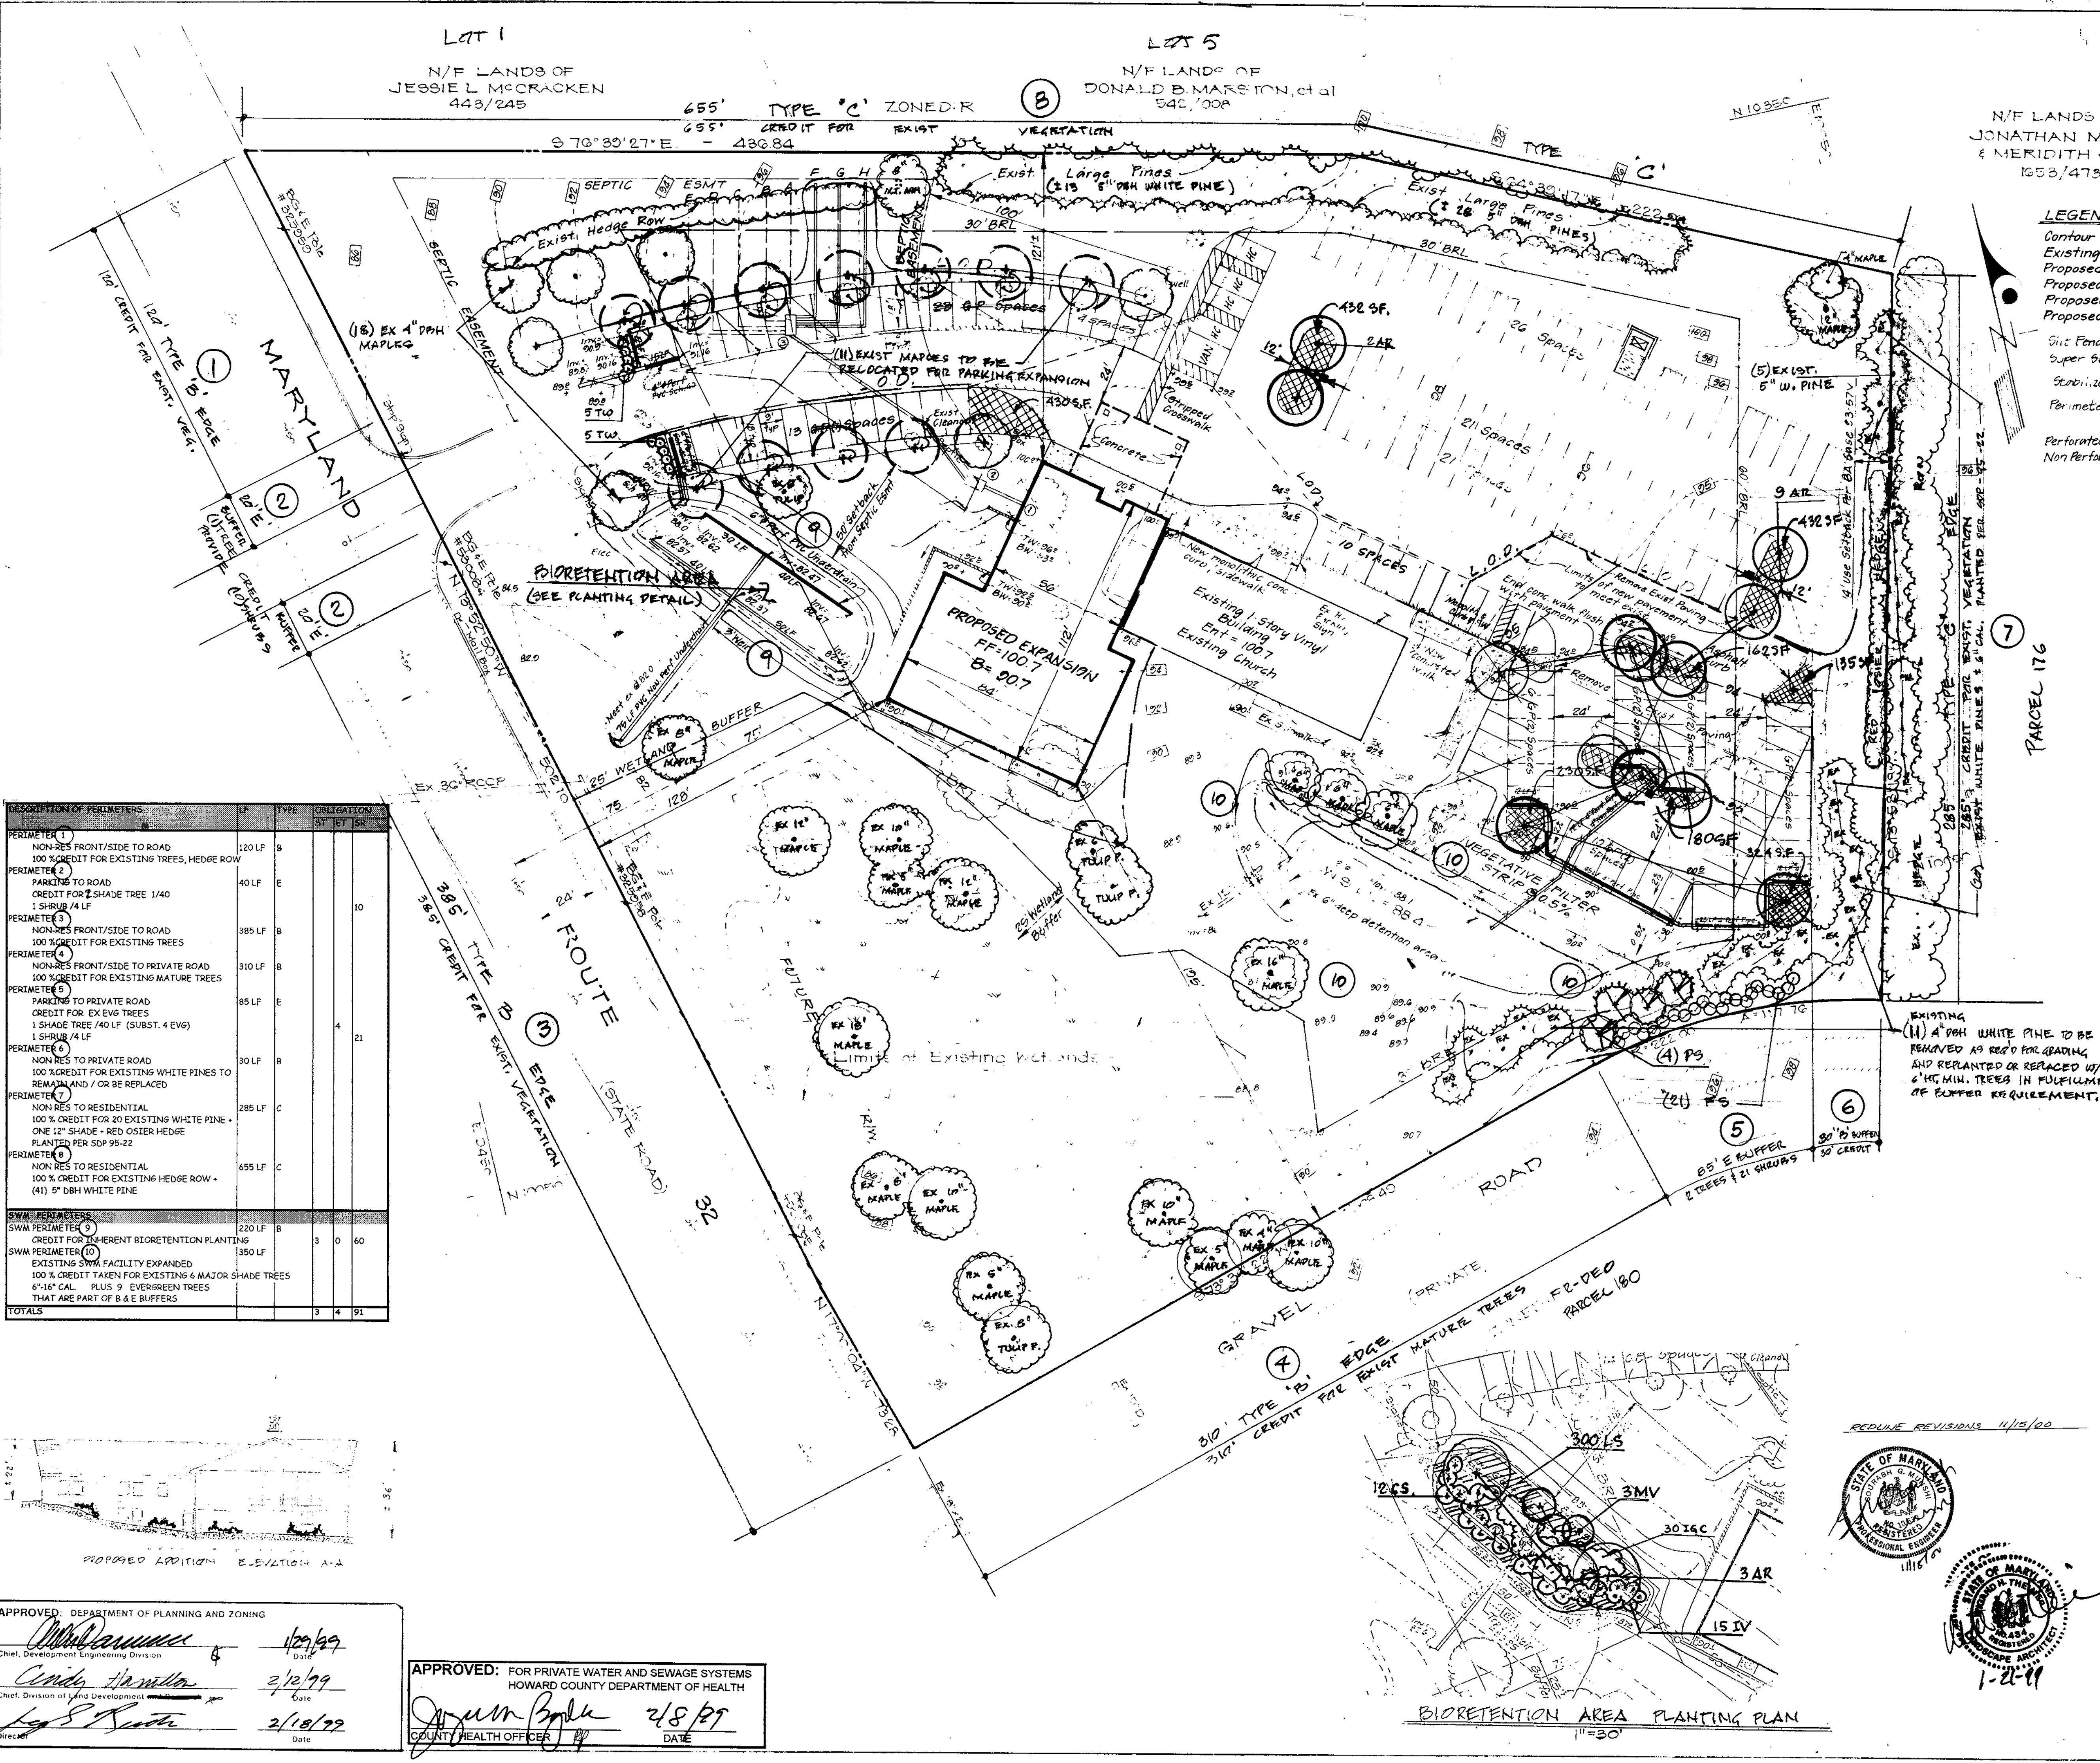

- LEGEND**
- Contour Interval = 2'
  - Existing Contour
  - Proposed Contour
  - Proposed Sidewalk
  - Proposed Paving
  - Proposed Grass Pavers
  - Silt Fence
  - Super Silt Fence
  - Stabilized Construction Entrance
  - Perimeter Dike/Swale
  - Perforated PVC
  - Non Perforated PVC

**PROPOSED PLANTING**

Proposed Parking	-161 spaces
Hard Pavement	-82
Grass Pavers	-72

**KEY**

KEY	QUANTITY	PLANT NAME	SIZE	REMARKS
AR	17	Acer Rubrum	Red Sunset Maple	2.5-3' Cal. B&B
AR	3	Acer Rubrum	Red Sunset Maple	2.5-3' Cal. B&B
MV	3	Magnolia virginiana	Sweet bay Magnolia	5-6' ht. B&B
CS	12	Cornus stolonifera	Redstart Dogwood	2-3' ht. B&B
TG	30	Tilia glabra compacta	Dwarf Inkberry	18-24" ht. B&B
TV	15	Tilia verticillata	Winterberry	4-5' ht. B&B
LS	300	Liriodendron spicata	Creeping Lily Turf	2" O.C. & fill between large shrubs
FS	21	Forsythia spectabilis	Forsythia	2-3' ht. B&B
TW	10	Taxus Wardii	Ward's Yew	18-24" ht. B&B
PS	4	Pinus Strobus	White Pine	6-8' ht. B&B

- NOTE:**
- All plant material shall be full and heavy, be well formed and symmetrical, conform to A.A.N. specifications and be installed in accordance with L.C.A.M.W. Landscape specifications.
  - Call MISS UTILITY or 1-800-257-7777 for utility locations at least 48 hours before digging.
  - Do not plant trees or shrubs directly over under-drain pipes.


**RESOLUTION OF PERIMETERS**

PERIMETER	TYPE	CRIGLIGATION	ST	BT	SR
PERIMETER 1	NON-RES FRONT/SIDE TO ROAD	120 LF	B		
PERIMETER 2	PARKING TO ROAD	40 LF	E		
PERIMETER 3	NON-RES FRONT/SIDE TO ROAD	385 LF	B		
PERIMETER 4	NON-RES FRONT/SIDE TO PRIVATE ROAD	310 LF	B		
PERIMETER 5	PARKING TO PRIVATE ROAD	85 LF	E		
PERIMETER 6	NON-RES TO PRIVATE ROAD	30 LF	B		
PERIMETER 7	NON-RES TO RESIDENTIAL	285 LF	C		
PERIMETER 8	NON-RES TO RESIDENTIAL	655 LF	C		
SWM PERIMETER 9	CREDIT FOR BIoretention PLANTING	220 LF	B		
SWM PERIMETER 10	EXISTING SWM FACILITY EXPANDED	350 LF	B		
<b>TOTALS</b>			<b>3</b>	<b>4</b>	<b>91</b>

**LANDSCAPE TYPE**

LANDSCAPE TYPE	B	C	E
LINE FT OF FRONTAGE	845	940	125
CREDIT FOR EX VEG YES	845	940	40
NO PLANTS/SHRUBS	0	0	2
SHADE TREES	0	0	0
EVG TREES	0	0	0
SHRUBS	0	0	31
NO PLANTS PROVIDED	0	0	0
SHADE TREES	0	0	4
EVG TREES	0	0	31
SHRUBS	0	0	0
<b>SCHEDULE B - NON RES. PARKING LOT/DRIVE PLANTING</b>			
NUMBER OF PARKING SPACES			160
INTERIOR ISLANDS REQUIRED	1/20 OR 8 X 2005F = 1600SF		160
INTERIOR ISLANDS PROVIDED			160
NUMBER OF TREES REQUIRED	618 (2190 SF)		160
NUMBER OF TREES PROVIDED			160
<b>SCHEDULE D - SWM AREA LANDSCAPING</b>			
LINE FT OF PERIMETER #9		250 LF	
100% CREDIT FOR BIoretention AREA PLANTING			
Shade Trees	REQ'D	3	
Evergreen Trees	REQ'D	0	
Shrubs	REQ'D	60	
LINE FT OF PERIMETER #10		150 LF	
CREDIT FOR EXIST. VEG			
YES 350 LF FOR 6 MATURE SHADE TREES AND 9 EVERGREEN TREES AS PART OF B & E BUFFER			
NUMBER OF TREES REQUIRED			
Shade Trees		0	
Evergreen Trees		0	
NUMBER OF TREES PROVIDED			
Shade Trees		0	
Evergreen Trees		0	
<b>TOTAL PLANTING REQUIREMENT</b>			
SHADE TREES			13
EVERGREEN TREES			0
SHRUBS			91

- SURETY NOTES**
- THIS PLAN HAS BEEN PREPARED IN ACCORDANCE WITH THE PROVISIONS OF SECTION 16.124 OF THE HOWARD COUNTY CODE AND THE LANDSCAPE MANUAL.
  - FINANCIAL SURETY FOR THE REQUIRED LANDSCAPING HAS BEEN POSTED AS PART OF THE DPW DEVELOPER'S AGREEMENT IN THE AMOUNT OF \$ 6,630.

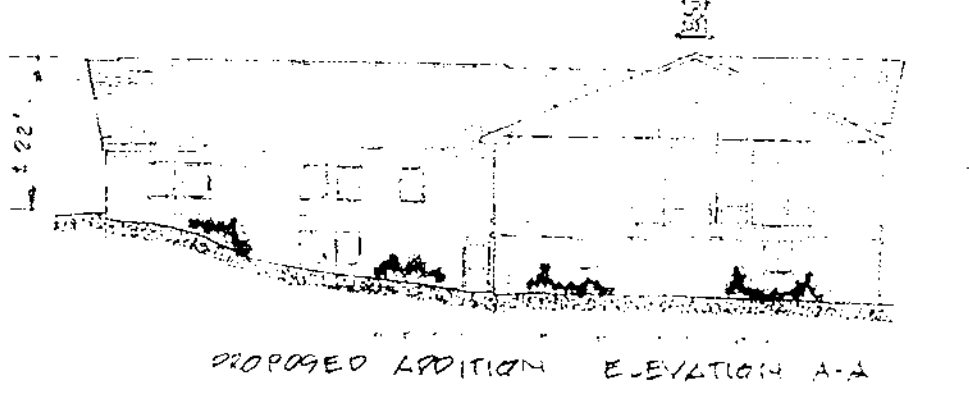

APPROVED: DEPARTMENT OF PLANNING AND ZONING

*[Signature]* 1/29/99  
Chief, Development Engineering Division

*[Signature]* 2/12/99  
Chief, Division of Land Development

*[Signature]* 2/18/99  
Recorder

APPROVED: FOR PRIVATE WATER AND SEWAGE SYSTEMS  
HOWARD COUNTY DEPARTMENT OF HEALTH

*[Signature]* 2/8/99  
COUNTY HEALTH OFFICER

REDLINE REVISIONS 4/12/00

STATE OF MARYLAND  
PROFESSIONAL ENGINEER  
1116

STATE OF MARYLAND  
PROFESSIONAL LANDSCAPE ARCHITECT  
1-2-99

SUBDIVISION NAME: SECTION/AREA: LOTS/MARSHALS:

PLAT NO.: BLOCK NO.: ZONE: TAX MAP NO.: ELECTION DIST: CENSUS TRACT:

WATER CODE: SEWER CODE:

**CLARK • FINEFROCK & SACKETT, INC.**

**LANDSCAPE PLAN**

**FRIENDSHIP BAPTIST CHURCH**

SCALE: 5" = 5'

DRAWING NO.:

JOB NO.:

FILE NO.:

10-16-98

APP 98-126