


# STAVLAS - ROUTE 40 BUSINESS CENTER

## 2nd ELECTION DISTRICT

### HOWARD COUNTY, MARYLAND

#### GENERAL NOTES

- ALL CONSTRUCTION SHALL BE IN ACCORDANCE WITH THE LATEST STANDARDS AND SPECIFICATIONS OF HOWARD COUNTY PLUS MSHA STANDARDS AND SPECIFICATIONS IF APPLICABLE.
- THE CONTRACTOR SHALL NOTIFY THE DEPARTMENT OF PUBLIC WORKS, BUREAU OF ENGINEERING, AND CONSTRUCTION INSPECTION DIVISION AT (410) 313-1880 AT LEAST FIVE (5) WORKING DAYS PRIOR TO THE START OF WORK.
- THE CONTRACTOR SHALL NOTIFY "MISS UTILITY" AT 1-800-257-7777 AT LEAST 48 HOURS PRIOR TO ANY EXCAVATION WORK BEING DONE.
- TRAFFIC CONTROL DEVICES, MARKINGS, AND SIGNING SHALL BE IN ACCORDANCE WITH THE LATEST EDITION OF THE MANUAL OF UNIFORM TRAFFIC CONTROL DEVICES (MUTCD). ALL STREET AND REGULATORY SIGNS SHALL BE IN PLACE PRIOR TO THE PLACEMENT OF ANY ASPHALT.
- ALL PLAN DIMENSIONS ARE TO FACE OF CURB UNLESS OTHERWISE NOTED. THE EXISTING TOPOGRAPHY IS TAKEN FROM FIELD RUN SURVEY WITH TWO FOOT CONTOUR INTERVALS PREPARED BY DESIGN TECH. INC., DATED JULY 1997.
- THE COORDINATES SHOWN HEREON ARE BASED UPON THE HOWARD COUNTY GEODETIC CONTROL WHICH IS BASED UPON THE MARYLAND STATE PLANE COORDINATE SYSTEM, HOWARD COUNTY MONUMENT NOS. 24AA AND 24B5 WERE USED FOR THIS PROJECT.
- WATER IS PUBLIC. STATE CONTRACT NO. 131-W.
- SEWER IS PUBLIC. STATE CONTRACT NO. 41-S.
- STORMWATER MANAGEMENT CONTROL IS TO BE PROVIDED BY PRIVATE UNDERGROUND STORAGE PIPES (CONSTRUCTED UNDER PHASE I WITH STORAGE FOR BOTH PHASE 1 AND PHASE 2) WITH STORMCEPTORS (PROPOSED ON THIS PLAN) AND WILL BE MAINTAINED BY OWNER OF PROPERTY.
- THERE IS NO FLOODPLAIN ON SITE.
- THERE ARE NO WETLANDS ON THIS SITE.
- NO TRAFFIC STUDY IS REQUIRED FOR THIS PROJECT.
- ALL INLETS SHALL BE CONSTRUCTED IN ACCORDANCE WITH HOWARD COUNTY STANDARDS.
- ALL PIPE ELEVATIONS SHOWN ARE INVERT ELEVATIONS.
- THE CONTRACTOR SHALL PROVIDE A JOINT IN ALL SEWER MAINS WITHIN 2'-0" OF EXTERIOR MANHOLE WALLS.
- PROFILE STATIONS SHALL BE ADJUSTED AS NECESSARY TO CONFORM TO PLAN DIMENSIONS.
- NO PIPE SHALL BE LAID UNTIL LINES OF EXCAVATION HAVE BEEN BROUGHT TO SUBGRADE.
- ALL STORM DRAIN PIPE BEDDING SHALL BE AS SHOWN IN DETAIL 62.01 (TRENCH IN ROCK OR TRENCH IN EARTH AS DETERMINED BY FIELD CONDITIONS) IN VOL. IV OF HOWARD COUNTY DESIGN MANUAL UNLESS OTHERWISE DIRECTED BY THE ENGINEER OR AS SHOWN ON THE DRAWINGS.
- THE DEVELOPER IS RESPONSIBLE FOR THE ACQUISITION OF ALL EASEMENTS, RIGHTS-OF-WAY THAT MAY BE REQUIRED FOR THE SEDIMENT AND EROSION CONTROL PRACTICES, STORM WATER MANAGEMENT PRACTICES AND THE DISCHARGE OF STORM WATER ONTO OR ACROSS ADJACENT OR DOWNSTREAM PROPERTIES INCLUDED IN THIS PLAN. HE IS ALSO RESPONSIBLE FOR THE ACQUISITION OF ALL EASEMENTS, RIGHTS-OF-WAY AND/OR WORK ON ADJACENT PROPERTIES INCLUDED IN THIS PLAN.
- THE OWNER SHALL PROVIDE A SEPARATE AND INDEPENDENT SEWER CONNECTION FOR EACH TENANT OR OCCUPANT OF ANY BUILDING, SHOWN ON THIS SITE DEVELOPMENT PLAN, WHO WILL DISCHARGE NON-DOMESTIC WASTE TO THE PUBLIC SEWERAGE SYSTEM. IF THIS WASTE IS REGULATED UNDER SECTION 18.122A OF THE HOWARD COUNTY CODE, EACH SEPARATE AND INDEPENDENT SEWER CONNECTION SHALL INCLUDE A STANDARD MANHOLE AND OTHER WATER PRE-TREATMENT DEVICES AS REQUIRED AND APPROVED BY HOWARD COUNTY. WASTE LINES ON THE INTERIOR OF THE BUILDING SHALL BE DESIGNED, CONSTRUCTED OR MODIFIED SUCH THAT NON-DOMESTIC WASTE WILL BE DISCHARGED TO THE SEPARATE AND INDEPENDENT SEWER CONNECTION. NO PLAN SHALL DISCHARGE REGULATED NON-DOMESTIC WATER TO PUBLIC SEWERAGE SYSTEM PRIOR TO INSTALLATION OF THE SEPARATE AND INDEPENDENT SEWER CONNECTION AND RELATED INTERIOR WASTE LINES. THE ABOVE REQUIREMENTS SHALL APPLY TO ALL INITIAL AND FUTURE OCCUPANTS OR TENANTS.
- ALL IMPROVEMENTS AS SHOWN ON THESE PLANS WITHIN THE R/W OF U.S. ROUTE 40 WILL BE THE RESPONSIBILITY OF THE DEVELOPER.
- ALL EXTERIOR LIGHTING SHALL CONFORM TO SECTION 134 - OUTDOOR LIGHTING, ZONING REGULATIONS.
- NO UNDERGROUND/GROUNDWATER TESTING CONDUCTED FOR THE PRESENCE OF CONTAMINANTS BY GAMMA ENGINEERING AT THIS TIME.

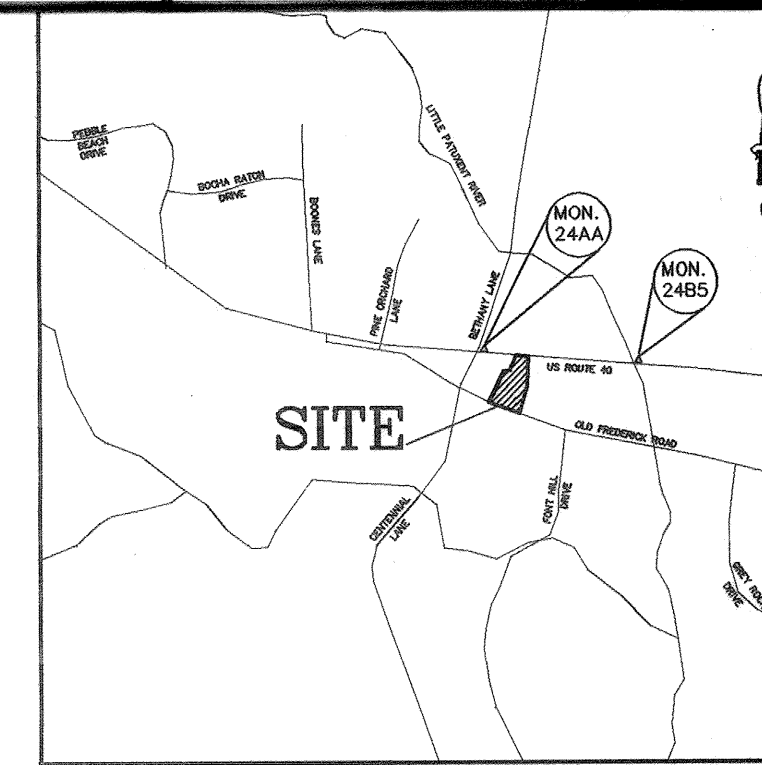

VICINITY MAP  
SCALE: 1" = 2000'

#### LANDSCAPING NOTES

- THIS PLAN HAS BEEN PREPARED IN ACCORDANCE WITH THE PROVISIONS OF SECTION 16.124 OF THE HOWARD COUNTY CODE AND THE LANDSCAPE MANUAL.
- FINANCIAL SURETY FOR THE REQUIRED LANDSCAPING HAS BEEN POSTED AS PART OF THE DPW DEVELOPER'S AGREEMENT IN THE AMOUNT OF \$.
- THE OWNER, TENANT, AND/OR THEIR AGENTS SHALL BE RESPONSIBLE FOR MAINTENANCE OF THE REQUIRED LANDSCAPING, INCLUDING BOTH PLANT MATERIALS AND BERMS, FENCES, AND WALLS. ALL PLANT MATERIALS IN GOOD GROWING CONDITION, AND WHEN NECESSARY, REPLACED WITH NEW MATERIALS TO ENSURE CONTINUED COMPLIANCE WITH APPLICABLE REGULATIONS. ALL OTHER REQUIRED LANDSCAPING SHALL BE PERMANENTLY MAINTAINED IN GOOD CONDITION, AND WHEN NECESSARY, REPAIRED OR REPLACED.
- PHASE I WAS APPROVED AS SITE DEVELOPMENT PLAN - (SDP 98-32)

#### PHASE II PERIMETER LANDSCAPE EDGE SCHEDULE

CATEGORY	ADJACENT TO FREDERICK RD.		ADJACENT TO PERIMETER PROPERTIES			ADJACENT TO PHASE I
	SOUTH	WEST	WEST	EAST	NORTH	NONE REQUIRED
LANDSCAPE TYPE	D	C	A	C	A	NONE REQUIRED
LINEAR FEET OF ROADWAY FRONTAGE/PERIMETER	382'	220'	180'	110'	310'	
CREDIT FOR EXISTING VEGETATION	YES - 3 EX. TREES TO SUBSTITUTE FOR 3 EVERGREEN TREES	NO	NO	NO	NO	
CREDIT FOR WALL, FENCE, OR BERM	NO	NO	NO	NO	NO	
NUMBER OF PLANTS REQUIRED						
SHADE TREES	382/60 = 7	220/40 = 6	180/60 = 5	110/40 = 3	310/60 = 5	
EVERGREEN TREES	382/10 = 39	180/20 = 9	0	110/20 = 6	0	
SHRUBS	0	0	0	0	0	
NUMBER OF PLANTS PROVIDED						
SHADE TREES	7	6	5	3	5	
EVERGREEN TREES	33 (11 CLUSTERS OF 3)	9	0	6	0	
OTHER TREES (2:1 SUB.)	3 (EXISTING)	0	0	0	0	
SHRUBS (10:1 SUB.)	50 (= 5 EVERGREEN TREES)	0	0	20	0	

#### SITE TABULATION

AREA OF PARCEL	5,006 AC.		
AREA OF EX-PHASE 1 SUBMISSION	2,39 AC.		
AREA OF PHASE 2 SUBMISSION	2,616 AC.		
EXISTING PHASE 1 USE:	6,544 SQ. FT. RESTAURANT		
NUMBER OF PARKING SPACES REQUIRED PHASE 1	92 SPACES (INCLUDES 4 HANDICAP) (14 SPACES PER 1,000 S.F.)		
PROPOSED PHASE II: SHOPPING CENTER	38,550 SQ. FT. TOTAL (MIXED USES)		
PROPOSED USE	PARKING REQUIREMENT RATE	PROPOSED SQ. FT.	REQUIRED PARKING SPACES
MEDICAL OFFICE	1/200	4800	24
GENERAL OFFICE	1/303	4000	13
RETAIL	1/200	29,750	149
TOTAL	5/1000	38,550	193
NUMBER OF PARKING SPACES PROVIDED PHASE 1			86 SPACES (INCLUDES 4 HANDICAP) (14 SPACES PER 1,000 S.F.)
NUMBER OF PARKING SPACES PROVIDED PHASE 2			193 SPACES
NUMBER OF PARKING SPACES PROVIDED PHASE 2			206 SPACES (INCLUDES 8 HANDICAP SPACES)
TOTAL NUMBER OF PARKING SPACES REQUIRED (PHASE 1 & PHASE 2)			285 SPACES
TOTAL NUMBER OF PARKING SPACES PROVIDED (PHASE 1 & PHASE 2)			292 SPACES

#### PLANTING SCHEDULE

ABBREVIATION	BOTANICAL NAME	COMMON NAME	QUANTITY	SIZE	SPACING	COST	INSTALLED	REMARKS
QR	QUERCUS RUBRA	RED OAK	36	2 1/2" - 3"	CAL., 8'-10' TALL	\$	\$	
JC	JUNIPERUS CHINENSIS SARGENTI JUNIPER	GREEN SERGEANT JUNIPER	35	18" - 24"	SP. MIN. 36" TALL	\$	\$	
PS	PINUS STROBUS	WHITE PINE	48	6" - 8"	HIGH	\$	\$	PROVIDE MINIMUM 10' SPACING
IC	ILEX CORNATA COMPACTA	JAPANESE HOLLY	35	MIN. 2 1/2" - 3"	HIGH	\$	\$	
TOTAL PLANTS			154					

#### PHASE II INTERNAL LANDSCAPE SCHEDULE


FEATURE	214 SPACES REQUIRED	PROVIDE
ISLANDS	10	10 ISLANDS @ 200 SQ. FT.
SHADE TREES	10	= 10 TREES PROVIDED

REVIEWED FOR HOWARD SCD AND MEETS TECHNICAL REQUIREMENTS


*Cheryl Summers* 4/26/99  
USDA-NATURAL RESOURCES CONSERVATION SERVICE

#### ADDRESS CHART

BUILDING	STREET ADDRESS
	10055 BALTIMORE NATIONAL PIKE

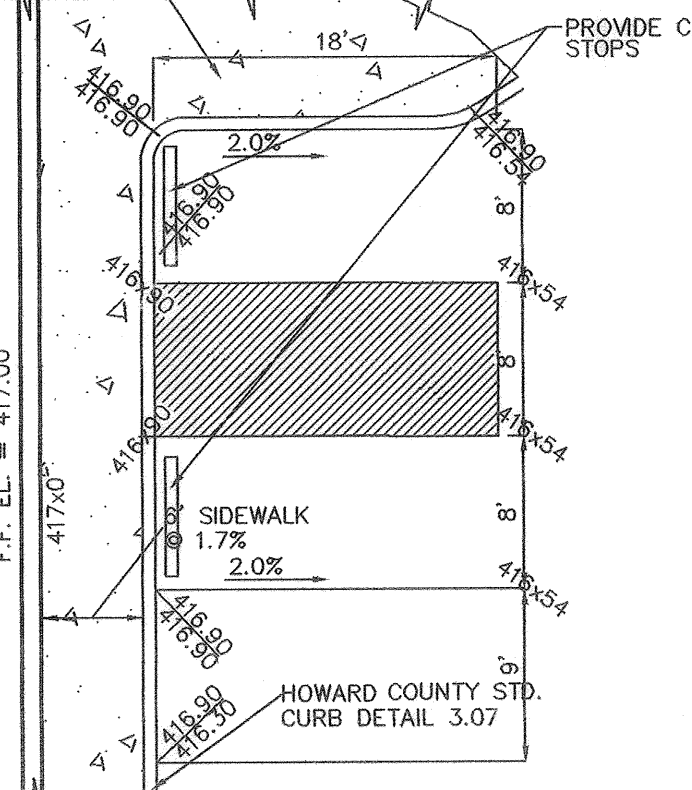

PLAN (ALL H.C. SPACES)

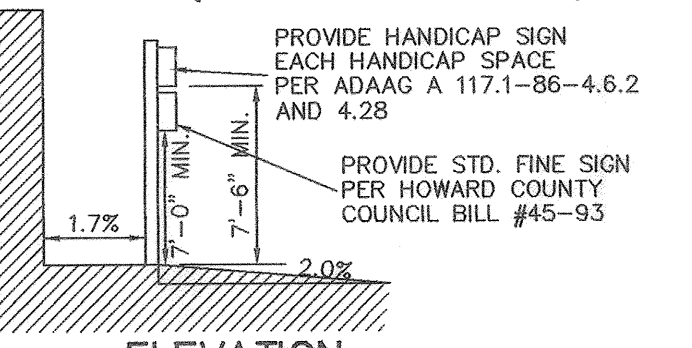

ELEVATION HANDICAP PARKING SPACE & SIGN DETAIL

#### SHEET INDEX

NO.	DESCRIPTION
1	SITE DEVELOPMENT PLAN, NOTES AND DETAILS
2	SITE DEVELOPMENT & LANDSCAPE PLAN
3	STORM DRAIN PROFILES AND DETAILS
4	GRADING, SEDIMENT AND EROSION CONTROL
5	SOILS AND DRAINAGE AREA MAP

#### REVISIONS

NO.	DESCRIPTION
1	4075/612
2	B-2
3	24
4	2nd
5	688

N 587250  
E 1352000

P. 69  
SOUTHERN STATES  
10065 BALTIMORE NATIONAL PIKE  
ELLICOTT CITY, MD.  
191/228  
ZONED: B-2

P. 70  
WILLIAM C. CORNELL, JR.  
10066 FREDERICK RD.  
ELLICOTT CITY, MD.  
1404/473  
ZONED: B-2

P. 72  
FOREST MOTEL INC.  
10021 BALTIMORE NATIONAL PIKE  
ELLICOTT CITY, MD.  
479/581  
ZONED: B-2

P. 487  
HARRY F. FRANCE  
9954 FREDERICK RD.  
ELLICOTT CITY, MD.  
3432/71  
ZONED: B-2

P. 497  
HARRY F. FRANCE  
9954 FREDERICK RD.  
ELLICOTT CITY, MD.  
3432/71  
ZONED: B-2

EXIST. GRADE  
PROP. GRADE

FIRST FLOOR ELEV. = 417.0

EAST BUILDING ELEVATION  
SCALE: 1" = 30'

OWNER / DEVELOPER  
**MICHAEL STAVLAS**  
1726 DORSEY ROAD  
HANOVER, MD. 21076

PROJECT  
**S.D.P. 99-56**  
STAVLAS - ROUTE 40 BUSINESS CENTER  
PHASE II


AREA  
TAX MAP 24 PARCEL 68  
2nd ELECTION DISTRICT  
HOWARD COUNTY, MARYLAND

TITLE  
SITE DEVELOPMENT PLAN - COVER SHEET SHOWING ENTIRE SITE  
(EXISTING PHASE I AND PROPOSED PHASE II)

**GAMMA ENGINEERING**  
844 WEST STREET  
ANNAPOLIS, MD 21401  
(410) 626-1070

DESIGNED BY: MHH  
DRAWN BY: APF  
PROJECT NO. SDP 99-56  
DATE: MAR 1999  
SCALE: 1" = 50'  
DRAWING NO. 1 OF 5

\* STORM CEPTOR AS BUILTS - see Sheets 2 & 3 of 5  
SDP-99-56

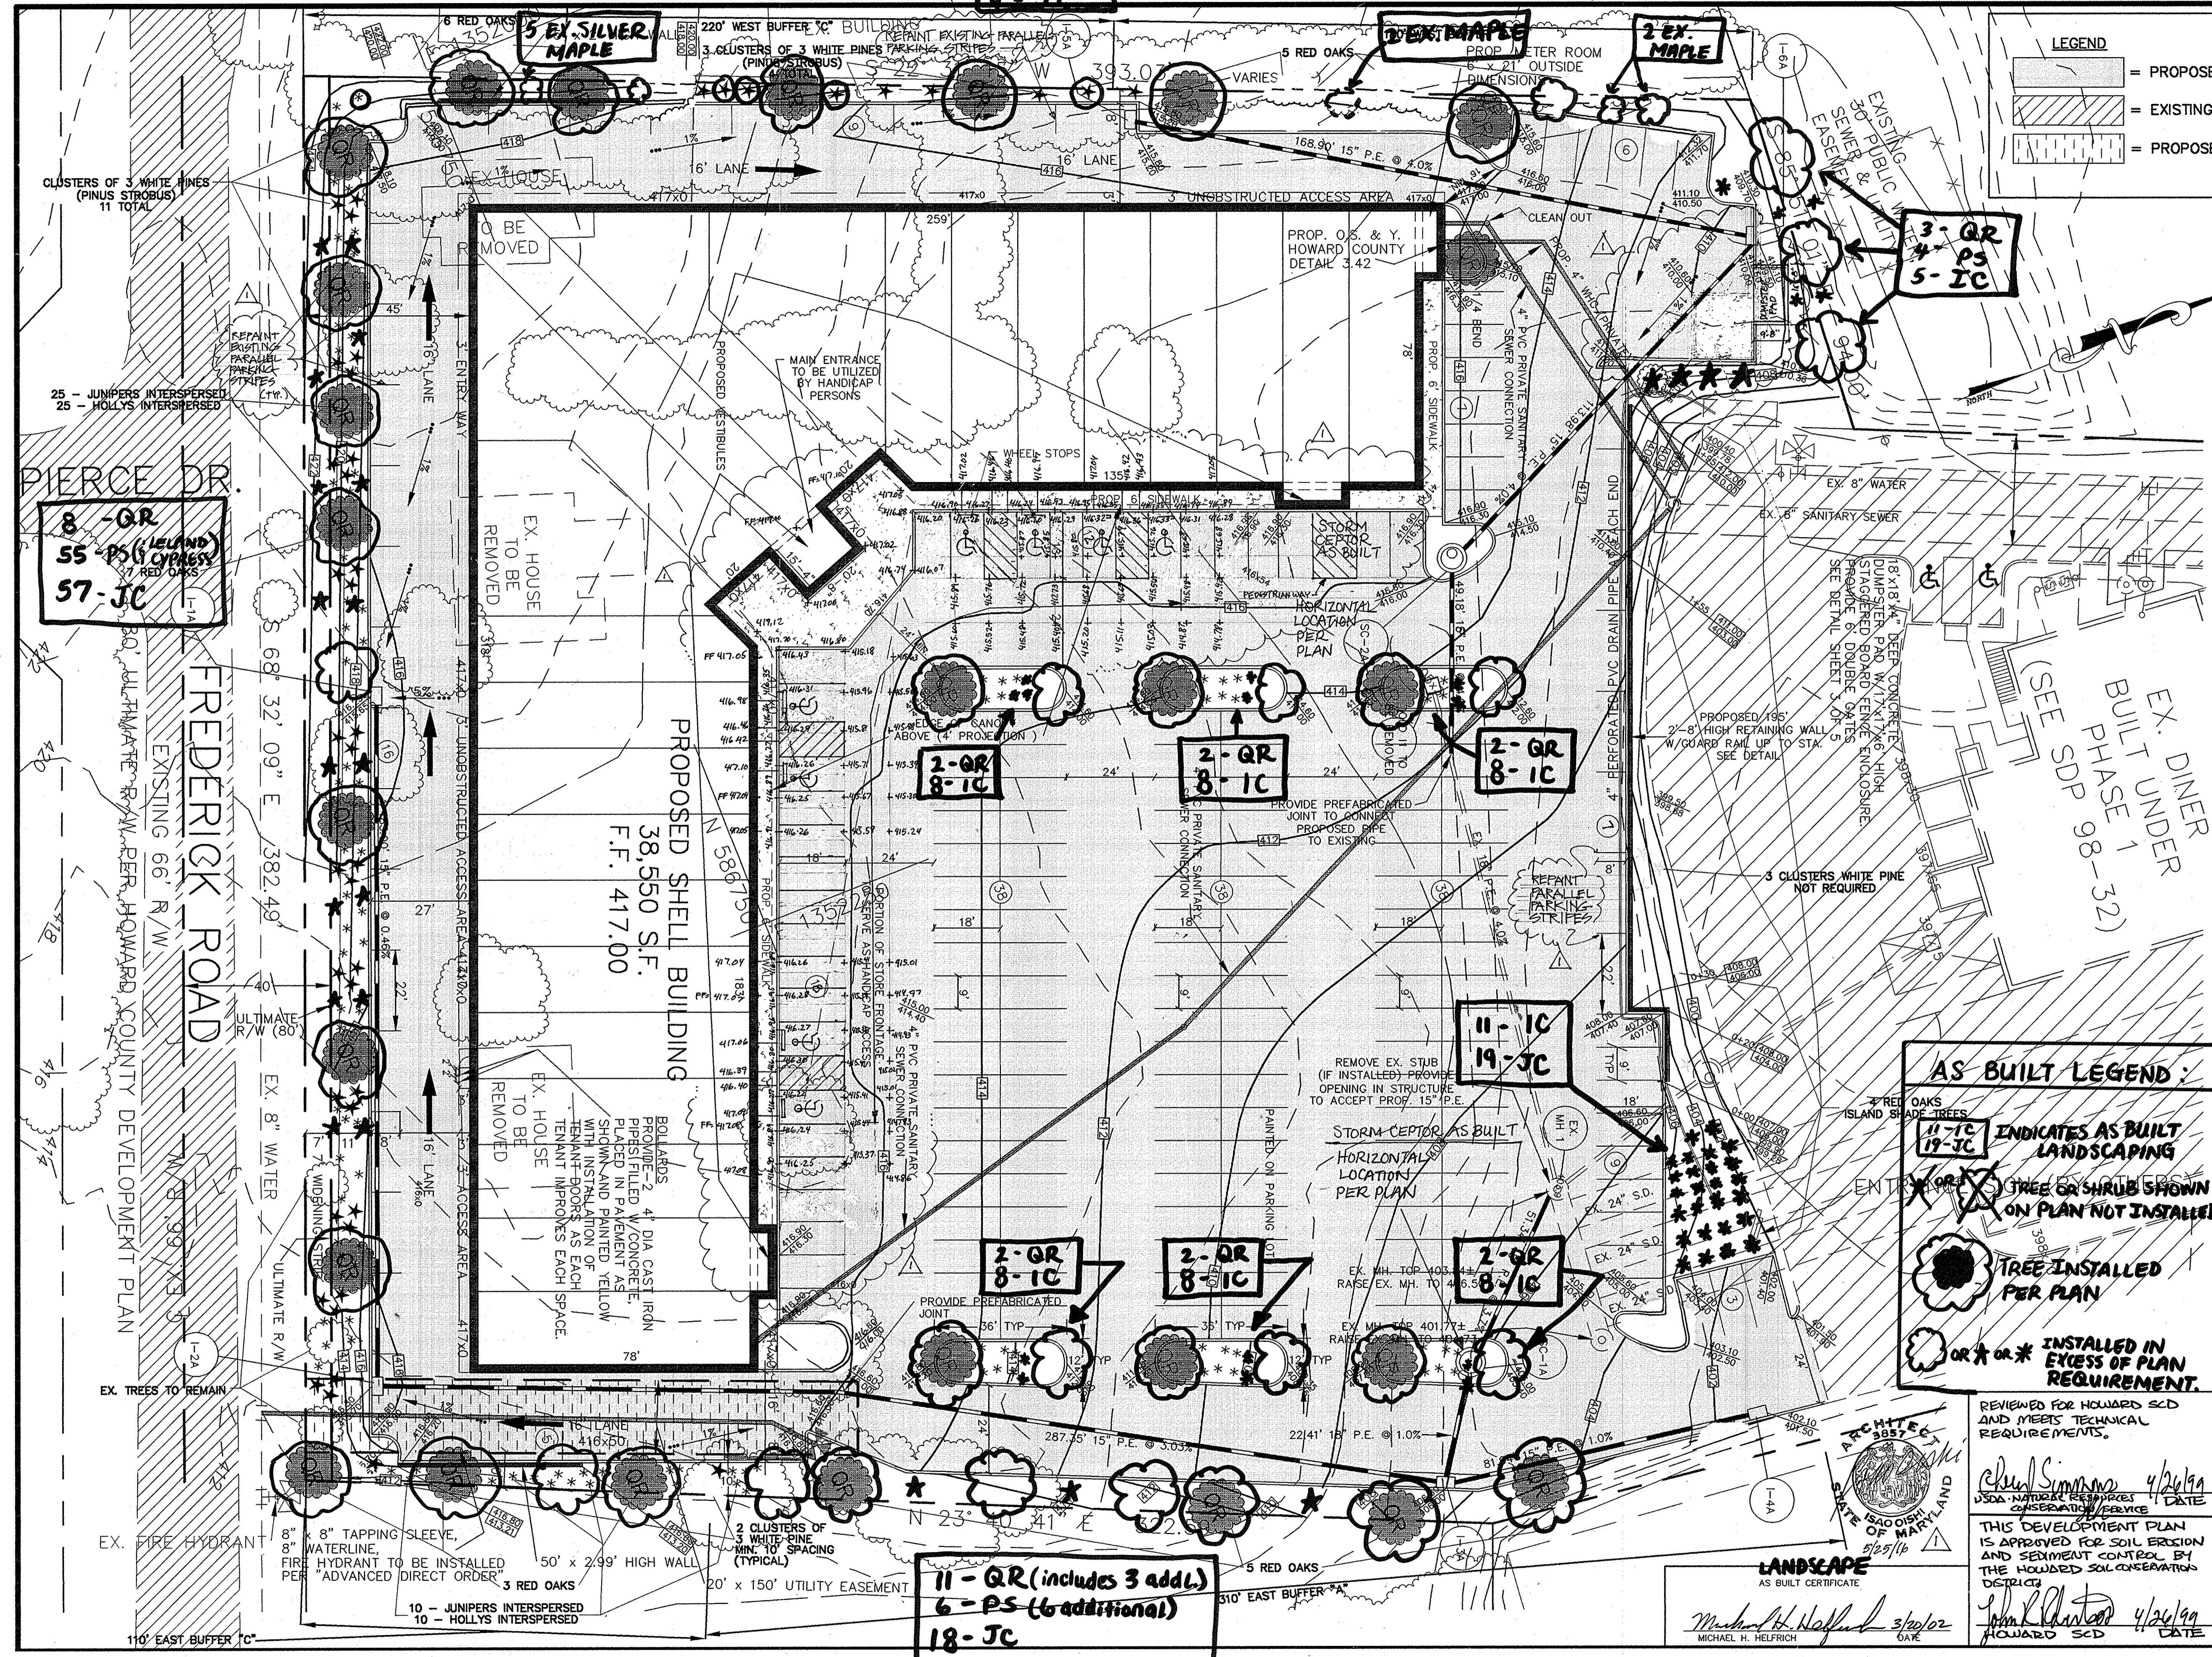

**LEGEND**

- [Pattern] = PROPOSED PAVED AREA
- [Pattern] = EXISTING PAVED AREA
- [Pattern] = PROPOSED UTILITY EASEMENT

BY THE DEVELOPER: I/WE CERTIFY THAT ALL DEVELOPMENT AND/OR CONSTRUCTION WILL BE DONE ACCORDING TO THESE PLANS, AND THAT ANY RESPONSIBLE PERSONNEL INVOLVED IN THE CONSTRUCTION PROJECT WILL HAVE A CERTIFICATE OF ATTENDANCE AT A DEPARTMENT OF THE ENVIRONMENT APPROVED TRAINING PROGRAM FOR THE CONTROL OF SEDIMENT AND EROSION BEFORE BEGINNING THE PROJECT. I WILL PROVIDE THE HOWARD SOIL CONSERVATION DISTRICT WITH AN "AS-BUILT" PLAN OF THE PROJECT WITHIN 30 DAYS OF COMPLETION. I ALSO AUTHORIZE PERIODIC ON-SITE INSPECTIONS BY THE HOWARD SOIL CONSERVATION DISTRICT.

*Michael Stavlas* 4/5/99  
DEVELOPER DATE

BY THE ENGINEER: I CERTIFY THAT THIS PLAN FOR CONSTRUCTION, EROSION AND SEDIMENT CONTROL REPRESENTS A PRACTICAL AND WORKABLE PLAN BASED ON MY PERSONAL KNOWLEDGE OF THE SITE CONDITIONS. THIS PLAN WAS PREPARED IN ACCORDANCE WITH THE REQUIREMENTS OF THE HOWARD SOIL CONSERVATION DISTRICT. I HAVE ADVISED THE DEVELOPER THAT HE MUST PROVIDE THE HOWARD SOIL CONSERVATION DISTRICT WITH AN "AS-BUILT" PLAN OF THE PROJECT WITHIN 30 DAYS OF COMPLETION.

*Michael H. Helfrich* 4/2/98  
ENGINEER DATE

APPROVED: FOR PUBLIC WATER AND SEWERAGE SYSTEMS, HOWARD COUNTY HEALTH DEPARTMENT.  
*Mary Sue Baker per John* 5/7/99  
COUNTY HEALTH OFFICER MR DATE

APPROVED: HOWARD COUNTY DEPARTMENT OF PLANNING AND ZONING.  
*John A. Smith* 5/14/99  
DIRECTOR DATE

*Richard B. Wood* 5/1/99  
CHIEF, DIVISION LAND DEVELOPMENT DATE

*John J. ...* 4/28/99  
CHIEF, DEVELOPMENT ENGINEERING DIVISION DATE

DATE	NO.	REVISION
5/25/96	1	REVISE PARKING CONFIGURATION

OWNER / DEVELOPER  
MICHAEL STAVLAS  
1726 DORSEY ROAD  
HANOVER, MD. 21076

PROJECT  
S.D.P. 99-56  
STAVLAS - ROUTE 40 STAVLAS BUSINESS CENTER PHASE II

AREA  
TAX MAP 24 PARCEL 68  
2ND ELECTION DISTRICT  
HOWARD COUNTY, MARYLAND

TITLE  
SITE DEVELOPMENT PLAN AND LANDSCAPE PLAN

**GAMMA ENGINEERING**  
844 WEST STREET  
ANNAPOLIS, MD 21401  
(410) 626-1070

3/23/99 DATE  
DESIGNED BY: MHH  
DRAWN BY: APF  
PROJECT NO. SDP 99-56  
DATE: MAR 1999  
SCALE: 1" = 20'  
DRAWING NO. 2 OF 5

**AS BUILT LEGEND:**

- [Symbol] 11-1C, 19-1C INDICATES AS BUILT LANDSCAPING
- [Symbol] X OR X TREE OR SHRUB SHOWN ON PLAN NOT INSTALLED
- [Symbol] TREE INSTALLED PER PLAN
- [Symbol] OR \* OR \* INSTALLED IN EXCESS OF PLAN REQUIREMENT


**LANDSCAPE AS BUILT CERTIFICATE**

*Michael H. Helfrich* 3/20/02  
MICHAEL H. HELFRICH DATE


REVIEWED FOR HOWARD SCD AND MEETS TECHNICAL REQUIREMENTS.  
*Chris Simmons* 4/24/99  
DATE

USDA NATURAL RESOURCES CONSERVATION SERVICE



THIS DEVELOPMENT PLAN IS APPROVED FOR SOIL EROSION AND SEDIMENT CONTROL BY THE HOWARD SOIL CONSERVATION DISTRICT.  
*John R. ...* 4/24/99  
HOWARD SCD DATE

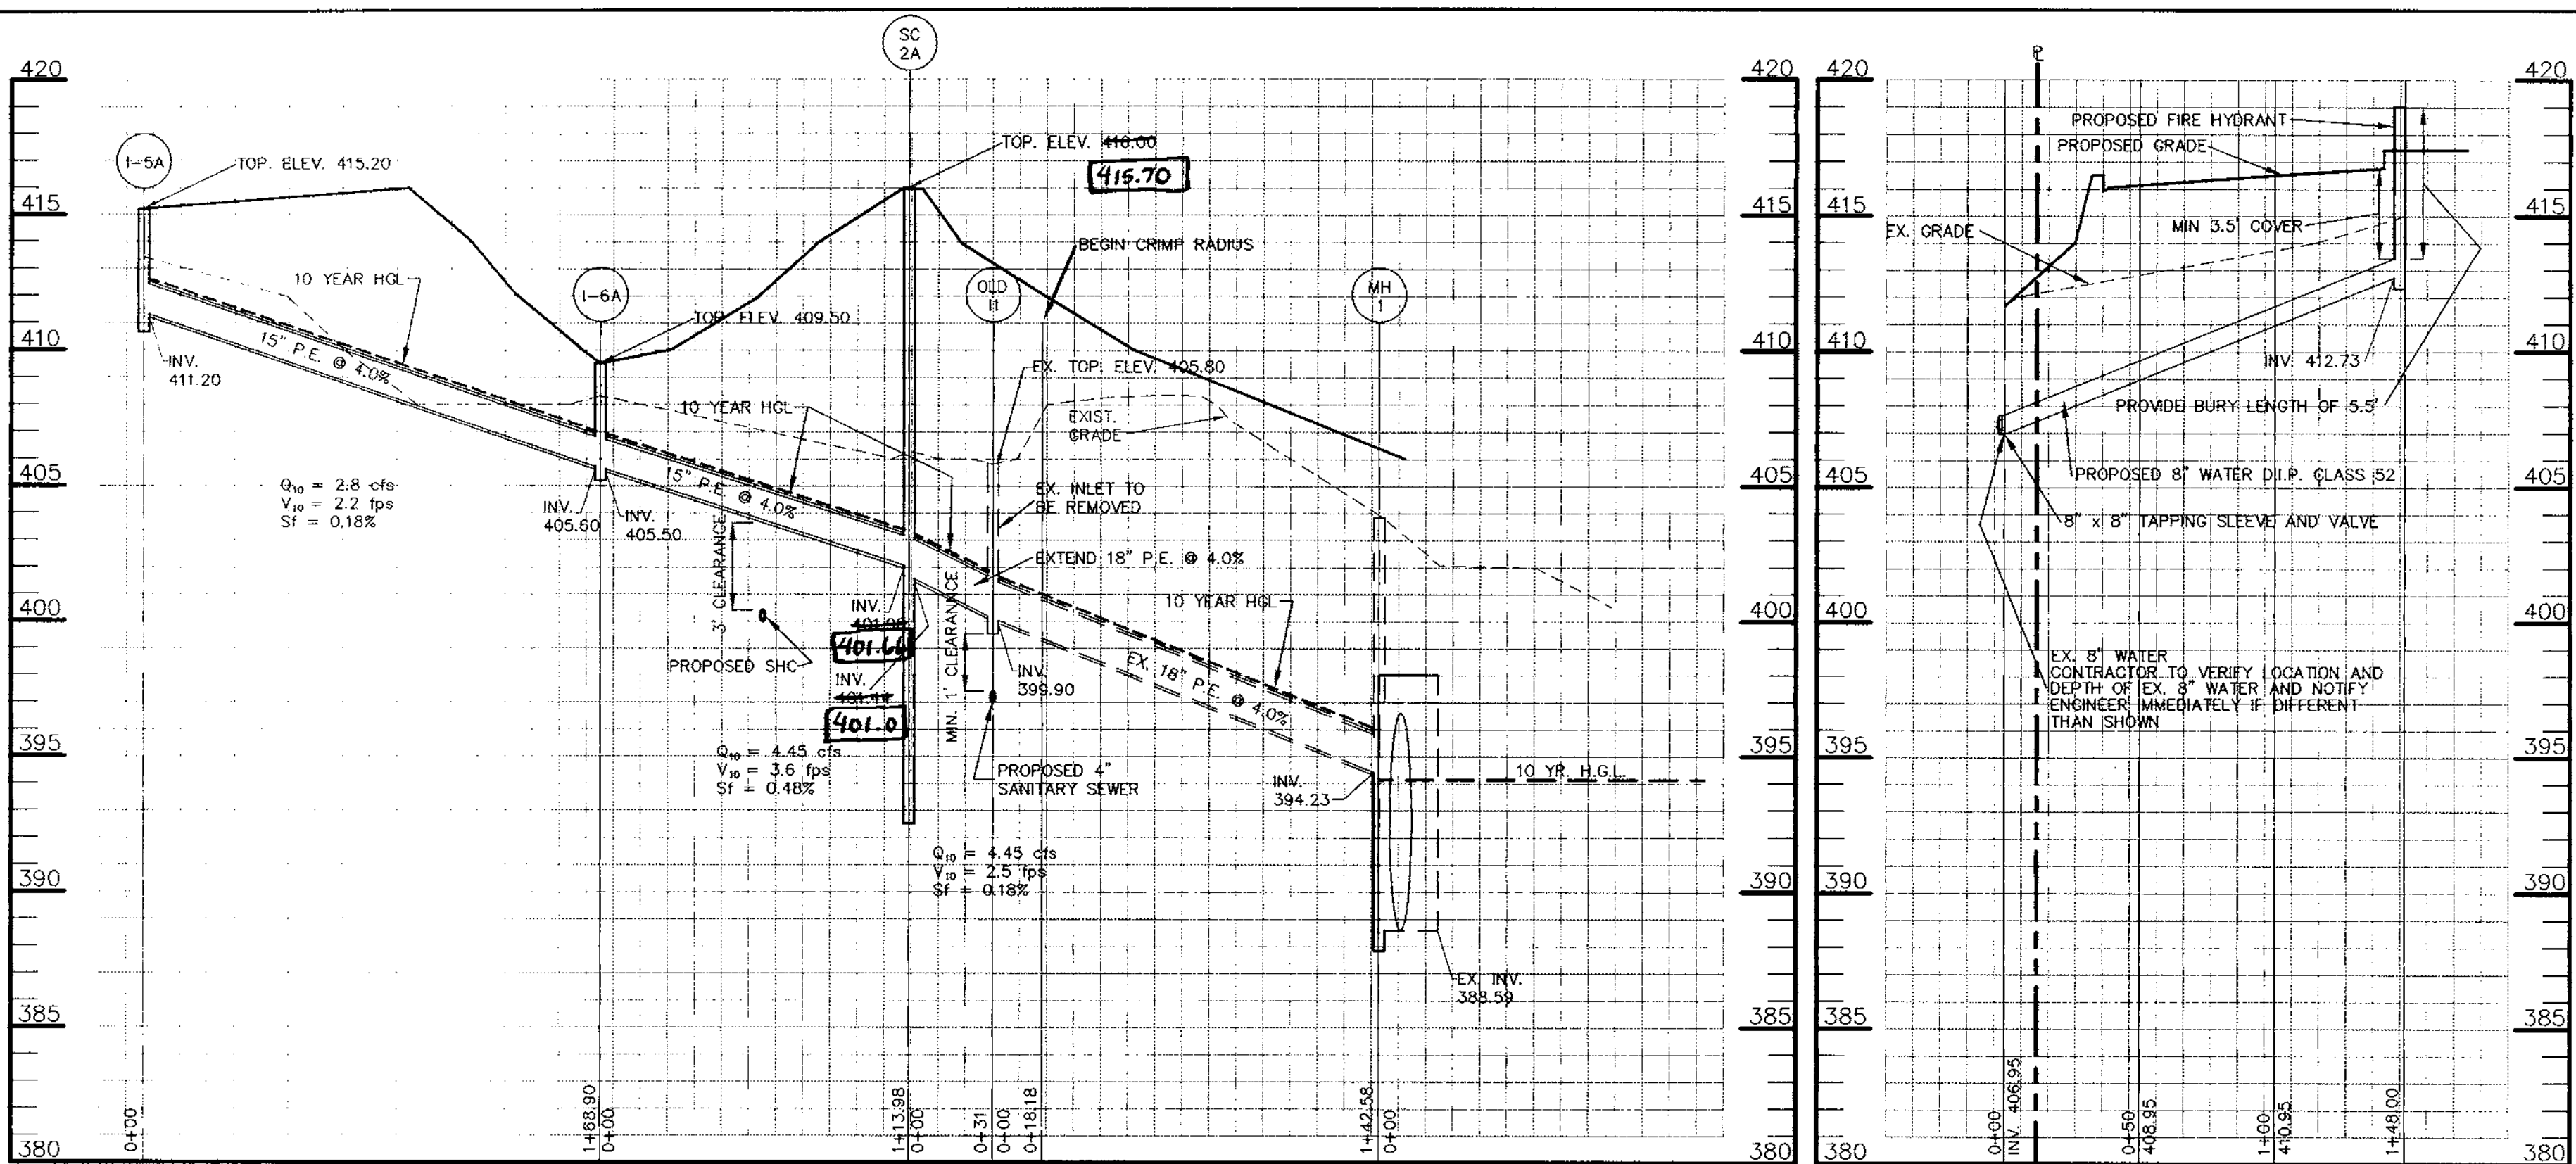

**STORMDRAIN PROFILE**  
SCALE: HOR: 1" = 50'  
VER: 1" = 5'

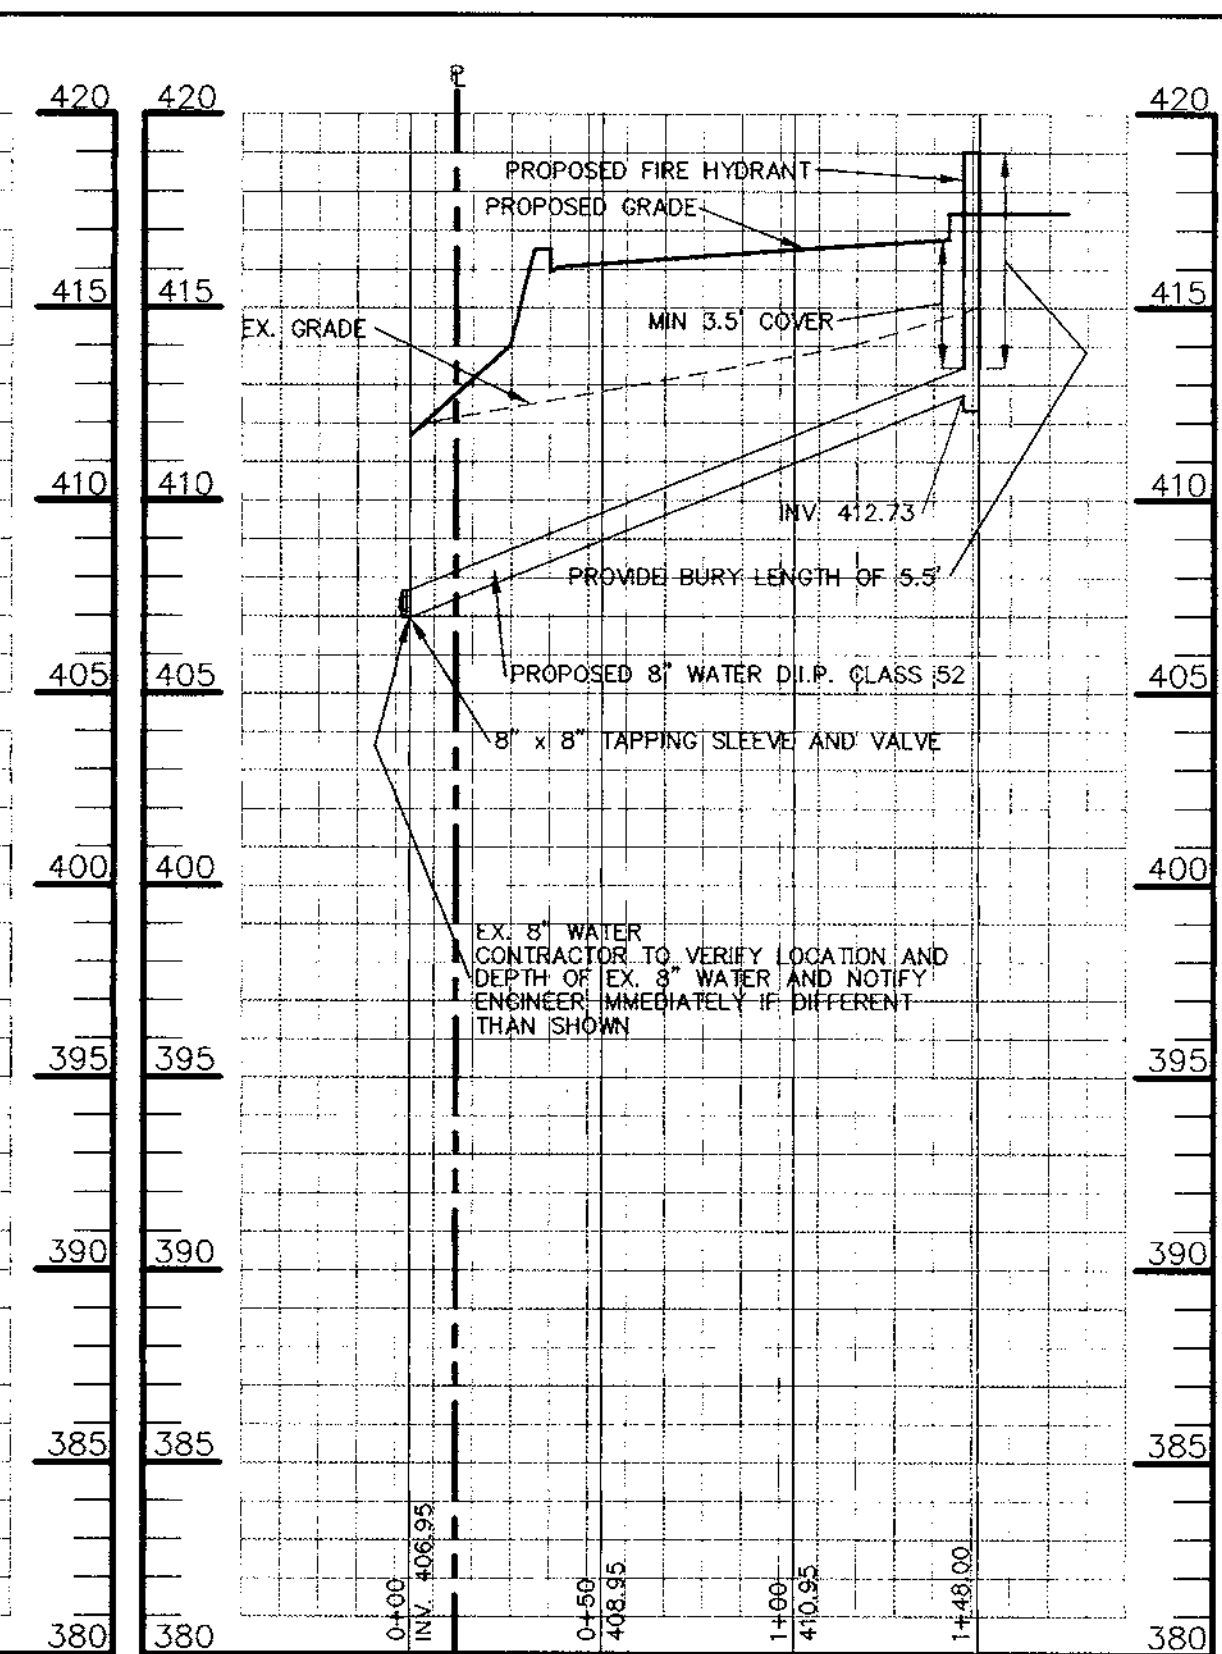

**PUBLIC WATERLINE PROFILE**  
TO BE INSTALLED UNDER "ADO"  
SCALE: HOR: 1" = 50'  
VER: 1" = 5'

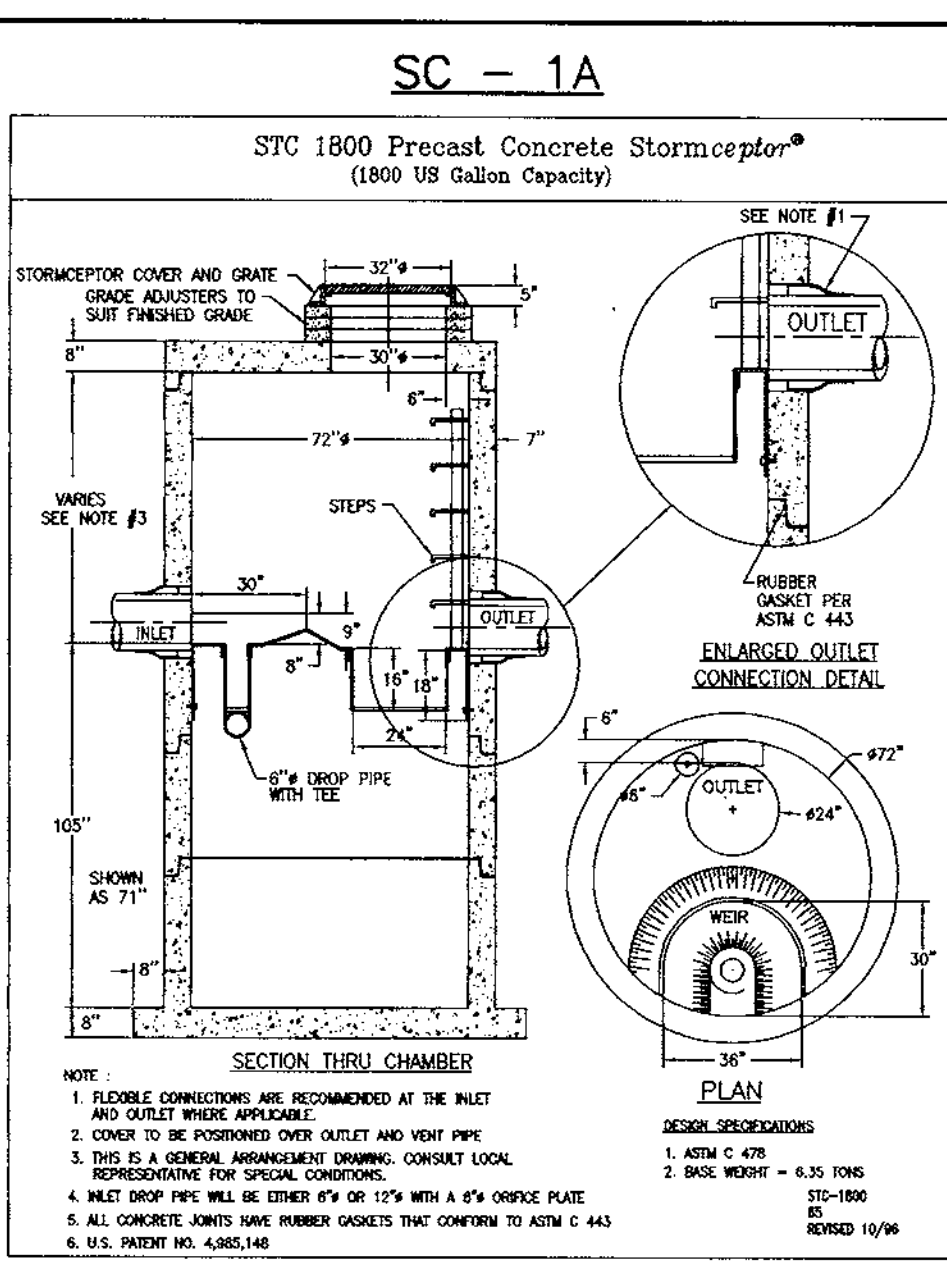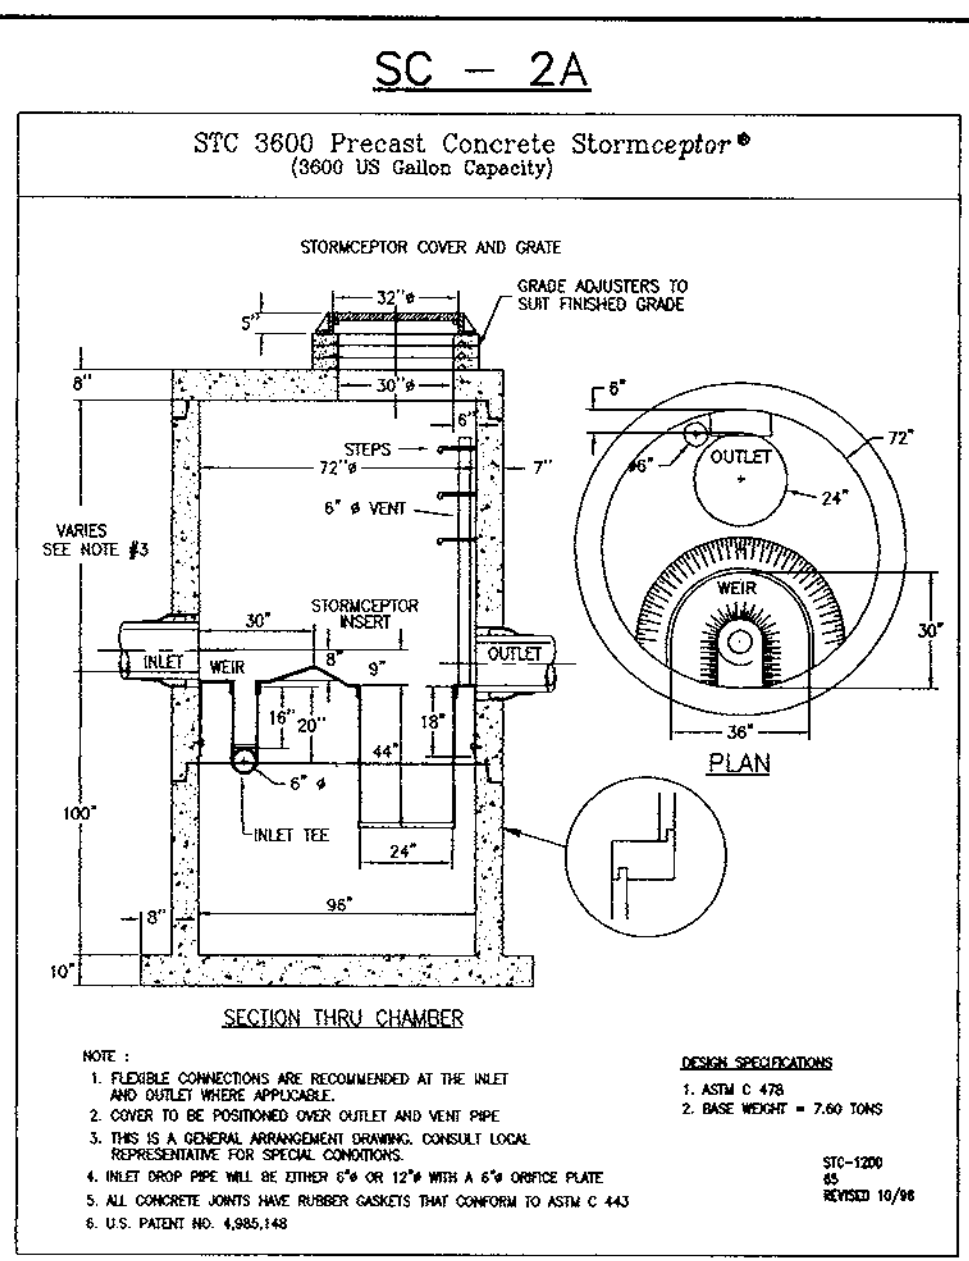

**OPERATION & MAINTENANCE SCHEDULE FOR STORMCEPTOR WATER QUALITY DEVICE**

1. THE STORMCEPTOR WATER QUALITY STRUCTURE SHALL BE PERIODICALLY INSPECTED AND CLEANED TO MAINTAIN OPERATION AND FUNCTION. THE OWNER SHALL INSPECT THE STORMCEPTOR UNIT YEARLY AT A MINIMUM, UTILIZING THE STORMCEPTOR INSPECTION/MONITORING FORM. INSPECTION SHALL BE CONDUCTED BY A CLEAR PLEXIGLASS TUBE (POLYCARBONATE) TO EXTRACT A WATER COLUMN SAMPLE. WHEN THE SEDIMENT DEPTHS EXCEED THE LEVEL SPECIFIED IN TABLE 6 OF THE STORMCEPTOR TECHNICAL MANUAL, THE UNIT MUST BE CLEANED IMMEDIATELY AFTER PETROLEUM SPILLS. THE OWNER SHALL CONTACT THE APPROPRIATE REGULATORY AGENCY.
2. THE MAINTENANCE OF THE STORMCEPTOR UNIT SHALL BE DONE USING A VACUUM TRUCK WHICH WILL REMOVE THE WATER, SEDIMENT, DEBRIS, FLOATING HYDROCARBONS, AND OTHER MATERIALS IN THE UNIT. PROPER CLEANING AND DISPOSAL OF THE REMOVED MATERIALS AND LIQUID MUST BE FOLLOWED BY THE OWNER.
3. THE INLET AND OUTLET PIPES SHALL BE CHECKED FOR ANY OBSTRUCTIONS AT LEAST ONCE EVERY SIX MONTHS. IF OBSTRUCTIONS ARE FOUND THE OWNER SHALL HAVE THEM REMOVED. STRUCTURAL PARTS OF THE STORMCEPTOR UNIT SHALL BE REPAIRED AS NEEDED.
4. THE OWNER SHALL RETAIN AND MAKE THE STORMCEPTOR INSPECTION/MONITORING FORMS AVAILABLE TO THE HOWARD COUNTY OFFICIALS UPON THEIR REQUEST.

BY THE DEVELOPER:  
*Michael Stavlas* 4/5/99  
DEVELOPER DATE

BY THE ENGINEER:  
I CERTIFY THAT THIS PLAN FOR REPAIR/CONSTRUCTION EROSION AND SEDIMENT CONTROL REPRESENTS A PRACTICAL AND WORKABLE PLAN BASED ON MY PERSONAL KNOWLEDGE OF THE SITE CONDITIONS. THIS PLAN WAS PREPARED IN ACCORDANCE WITH THE REQUIREMENTS OF THE HOWARD SOIL CONSERVATION DISTRICT. I HAVE NOTIFIED THE DEVELOPER THAT THE MOST PROBABLY THE HOWARD SOIL CONSERVATION DISTRICT WITHIN 30-DAYS OF COMPLETION.

*Michael Helfrich* 5/2/99  
ENGINEER DATE

APPROVED FOR PUBLIC WATER AND PUBLIC SEWERAGE SYSTEMS, HOWARD COUNTY HEALTH DEPARTMENT.  
*Mary Sue Baker per Jfm* 5/2/99  
COUNTY HEALTH OFFICER MRL DATE

APPROVED HOWARD COUNTY DEPARTMENT OF PLANNING AND ZONING.  
*Richard Blood* 5/2/99  
CHIEF, DIVISION OF LAND DEVELOPMENT DATE

CHIEF, DEVELOPMENT ENGINEERING DIVISION  
*Michael Helfrich* 5/2/99  
DATE

APPROVED FOR PUBLIC WATER, PUBLIC SEWERAGE, STORM DRAINAGE SYSTEMS AND PUBLIC ROADS.

DIRECTOR DATE  
CHIEF, BUREAU OF ENGINEERING DATE

DATE INL REVISION

OWNER / DEVELOPER  
**MICHAEL STAVLAS**  
1726 DORSEY ROAD  
HANOVER, MD. 21076

PROJECT S.D.P. 99-56  
STAVLAS - ROUTE 40 STAVLAS BUSINESS CENTER PHASE II





AREA TAX MAP 24 PARCEL 68  
2nd ELECTION DISTRICT  
HOWARD COUNTY, MARYLAND

TITLE **NOTES, DETAILS, WATERLINE AND STORM DRAIN PROFILES**

**GAMMA ENGINEERING**  
844 WEST STREET  
ANNAPOLIS, MD 21401  
(410) 626-1070

DATE 3/2/99  
DESIGNED BY: MHR  
DRAWN BY: APF  
PROJECT NO. SDP 99-56  
DATE: JAN 1999  
SCALE: AS NOTED  
DRAWING NO. 3 OF 5

3/2/99  
MICHAEL H. HELFRICH

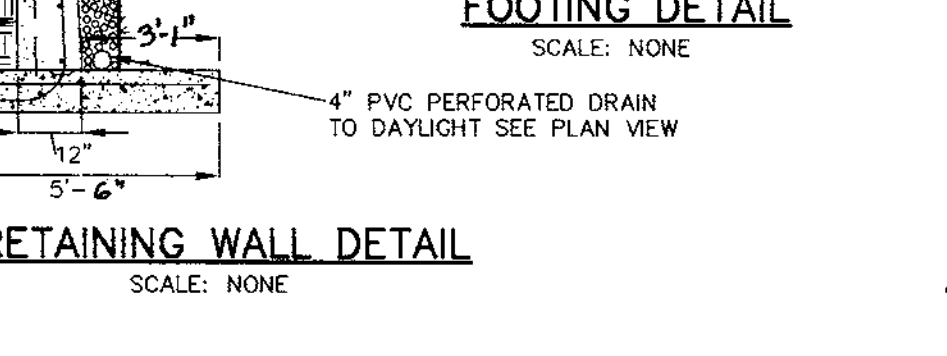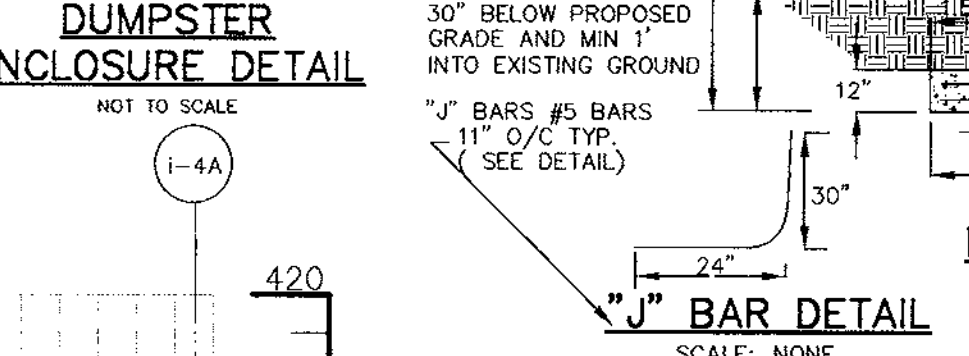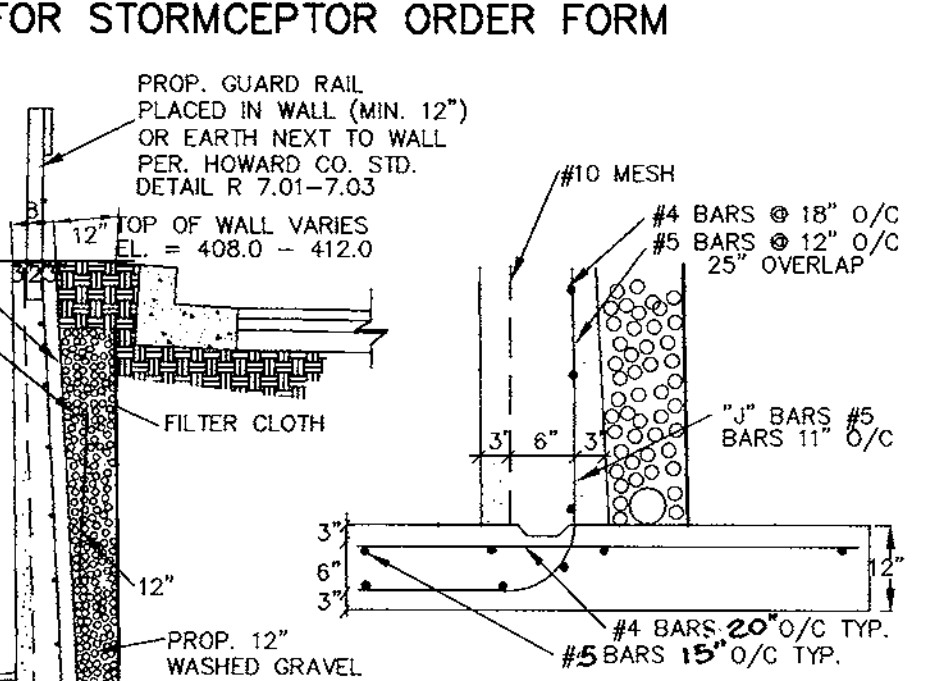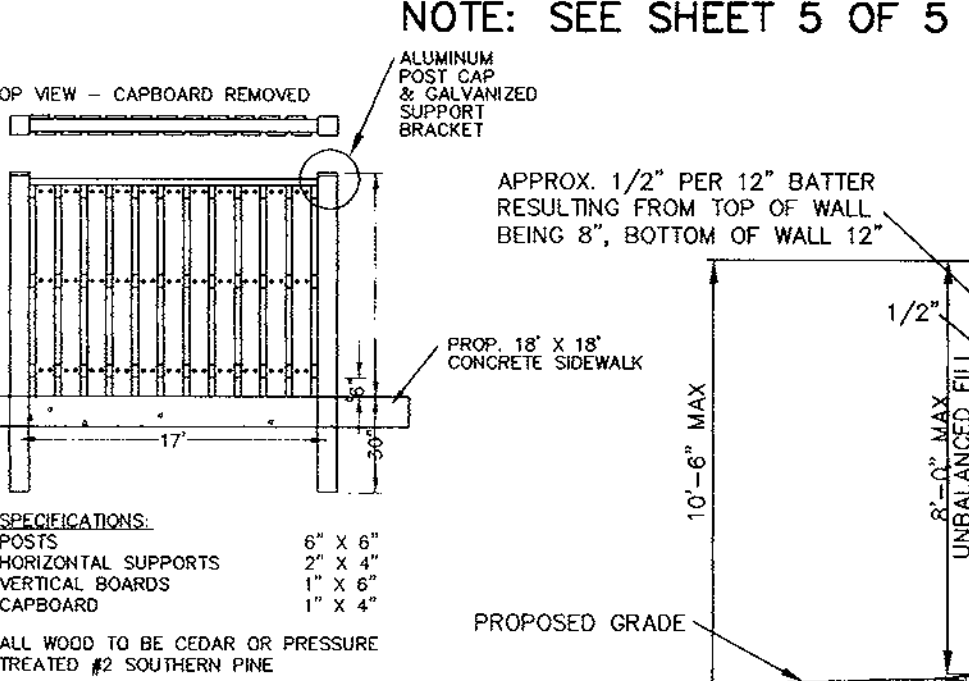


NOTES:  
1. CONSTRUCTION SUPERVISION - CONSTRUCTION OF THIS WALL SHALL BE PERFORMED UNDER THE SUPERVISION OF A MARYLAND REGISTERED PROFESSIONAL ENGINEER.  
2. WALL STRUCTURAL BACKFILL - BACKFILL MATERIAL SHALL BE SANDY SILT NATIVE TO THE SITE. THE FILL SHALL BE PLACED IN HORIZONTAL LAYERS OF 8"-12" AND COMPACTED TO 95% DENSITY AT APPROXIMATELY 10% MOISTURE CONTENT, COMPACTED BY HAND TAMPERS OR OTHER COMPACTION EQUIPMENT. THE MATERIAL NEEDS TO BE FILLED COMPLETELY. ALL SPACES UNDER AND ADJACENT TO THE WALL, AT NO TIME DURING THE BACKFILLING OPERATION SHALL DRIVEN EQUIPMENT BE ALLOWED TO OPERATE CLOSER THAN FOUR FEET, MEASURED HORIZONTALLY, TO ANY PART OF THE STRUCTURE.

**STRUCTURE SCHEDULE**


NO.	TYPE	TOP	INV IN	INV OUT	REMARKS
I-1A	PRECAST "WR"	415.65	---	411.65	SD 4.38
I-2A	PRECAST "WR"	415.70	410.80	410.70	SD 4.38
I-3A	PRECAST "WR"	406.00	396.68	396.58	SD 4.38
I-4A	PRECAST "WR"	401.50	---	397.50	SD 4.38
I-5A	PRECAST "WR"	409.50	405.60	405.50	SD 4.38
I-6A	PRECAST "WR"	401.50	---	397.50	SD 4.38
SC 1	STC 1200	407.19	395.83	395.75	SEE DETAIL THIS SHEET
SC 2	STC 3600	416.0	401.78	401.68	SEE DETAIL THIS SHEET

**PIPE SCHEDULE**


SIZE	MATERIAL	LENGTH
15"	P.E.	886.51'
18"	P.E.	71.58'

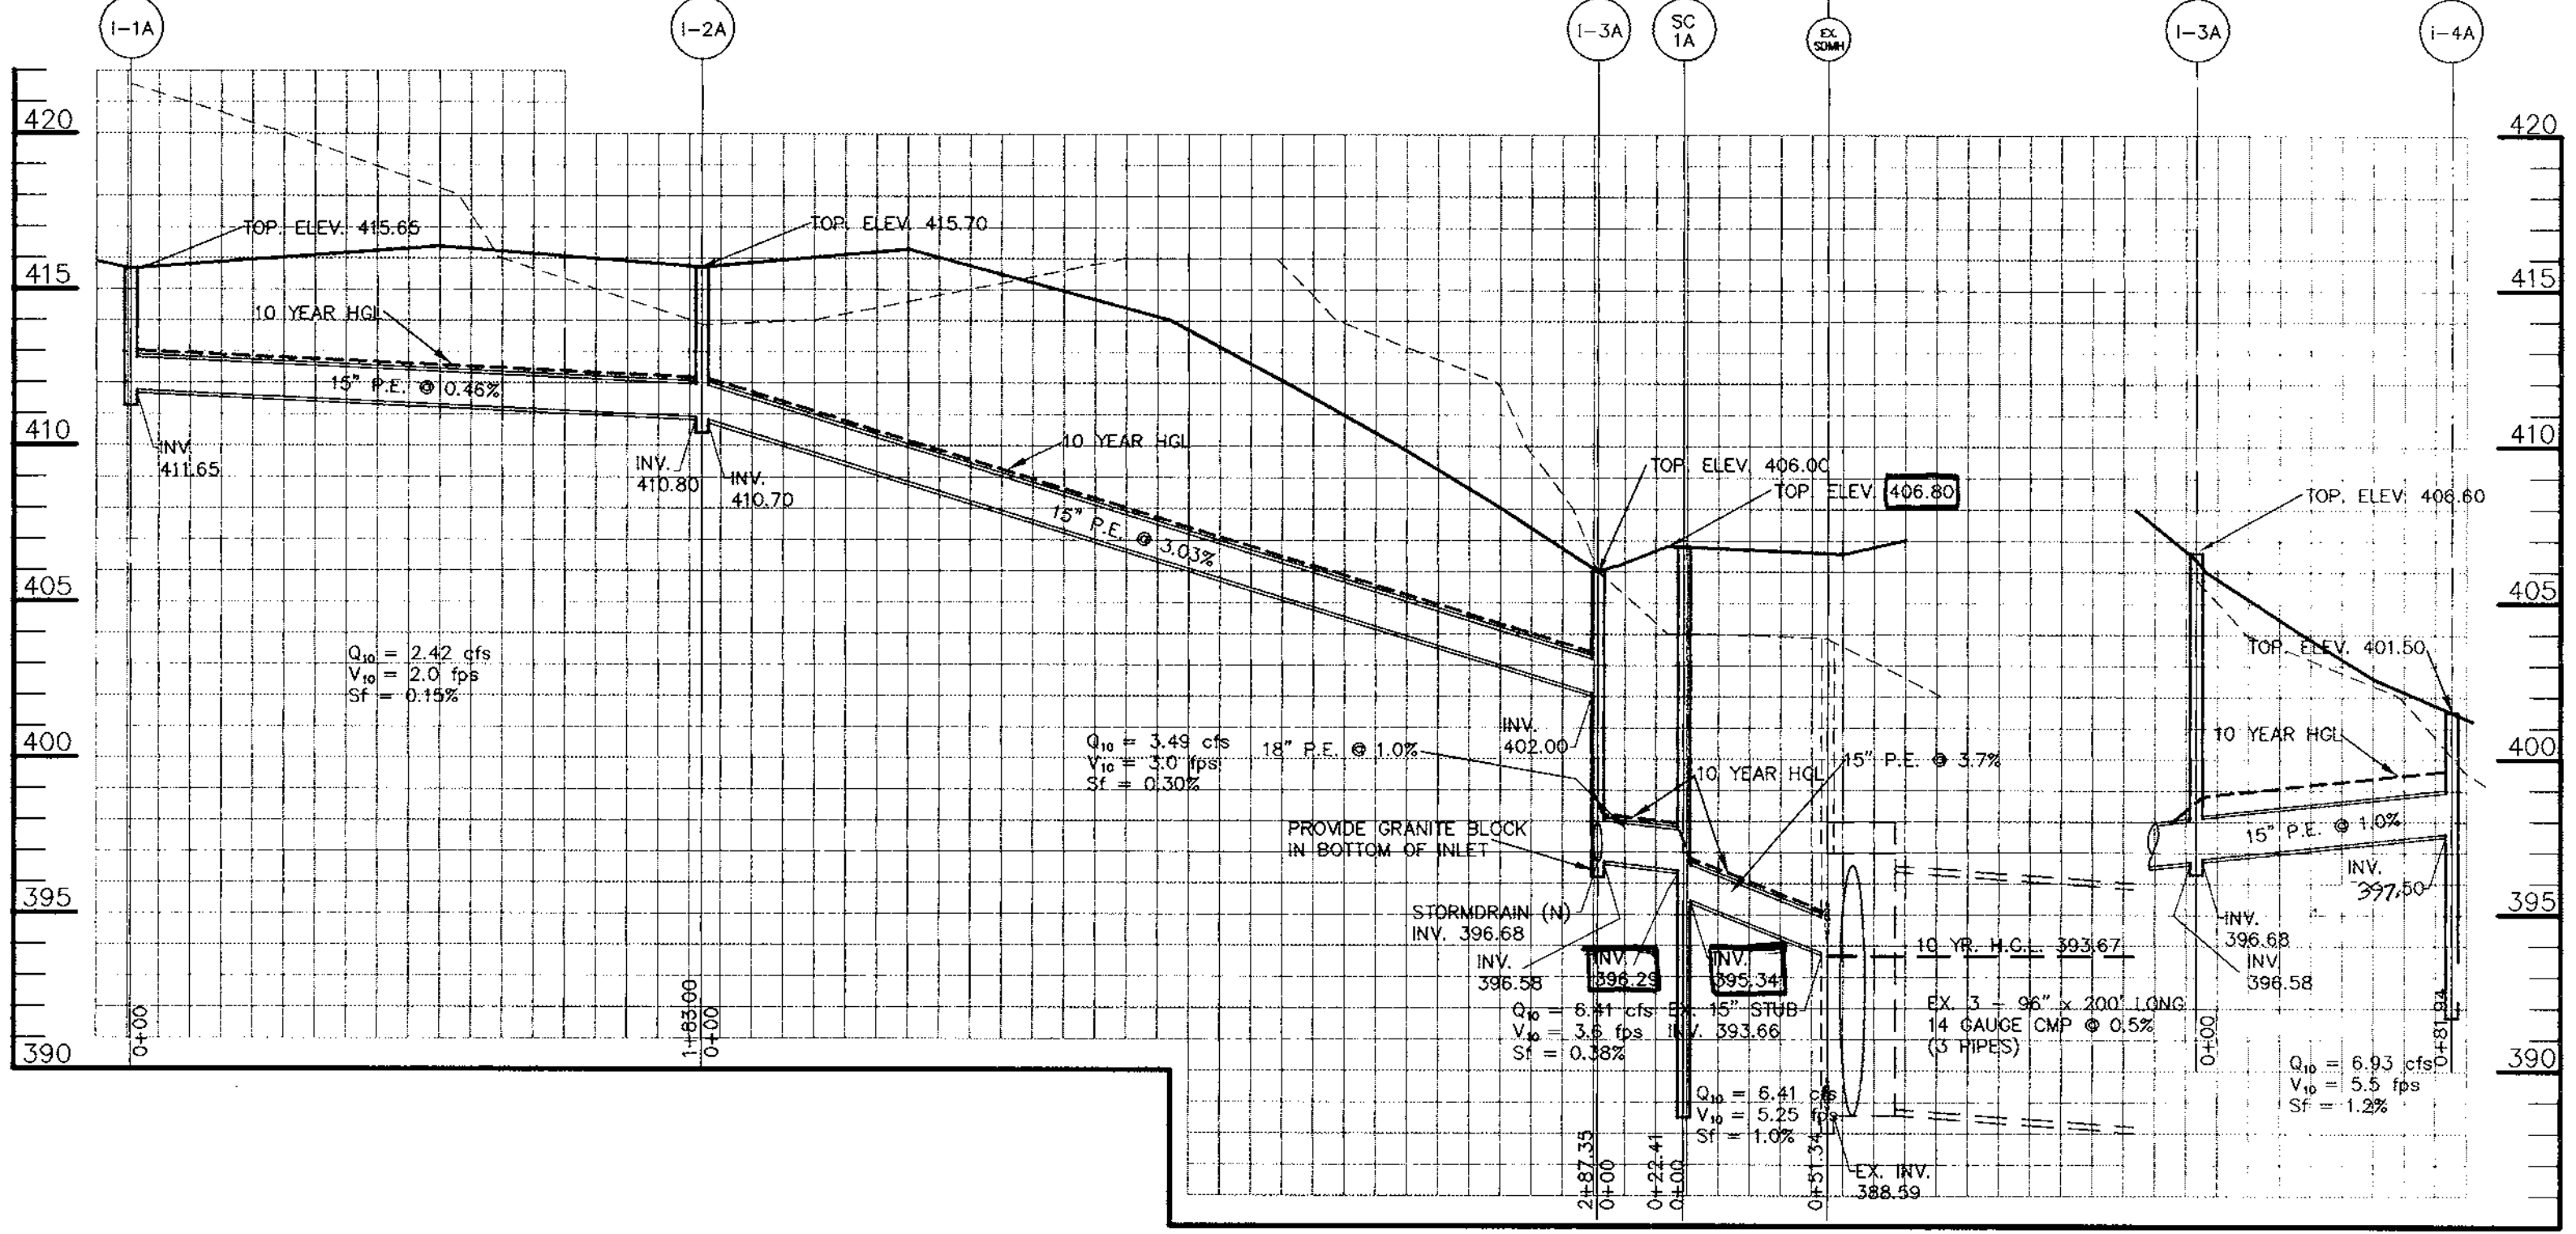


**STORMDRAIN PROFILE**  
SCALE: HOR: 1" = 50'  
VER: 1" = 5'

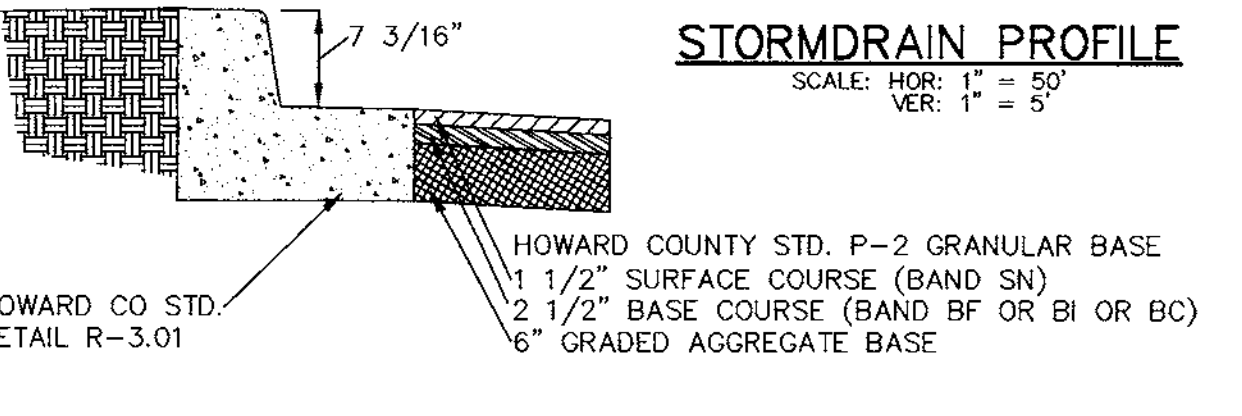

**PAVEMENT SECTION AND CURB DETAIL**  
HOWARD COUNTY STD DETAIL R.2.01 PAVEMENT TYPE "P-2"  
SCALE: NOT TO SCALE

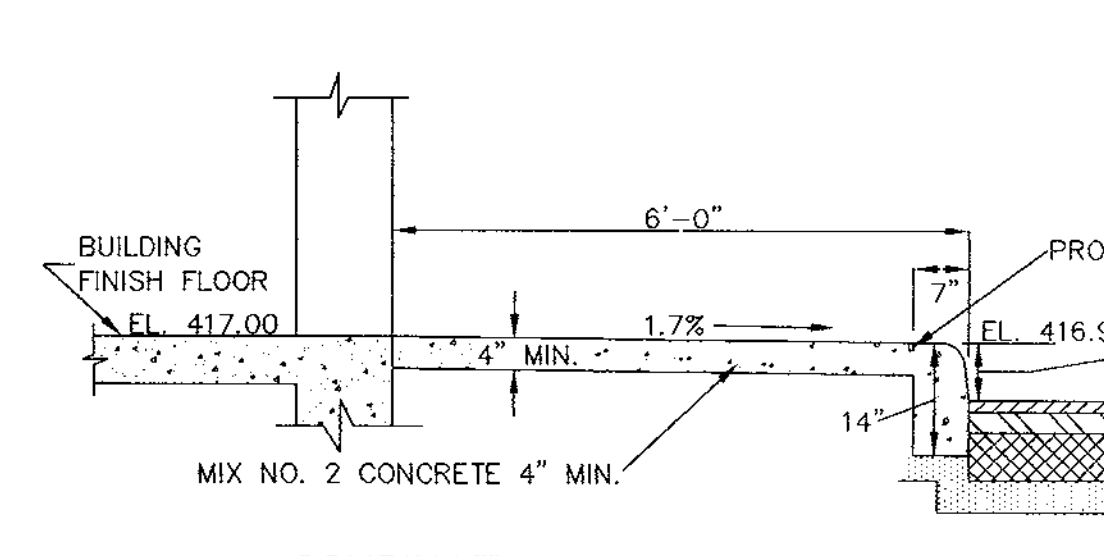

**COMBINATION SIDEWALK AND CURB DETAIL**  
HOWARD COUNTY STD DETAIL R.3.07  
SCALE: 1" = 2'

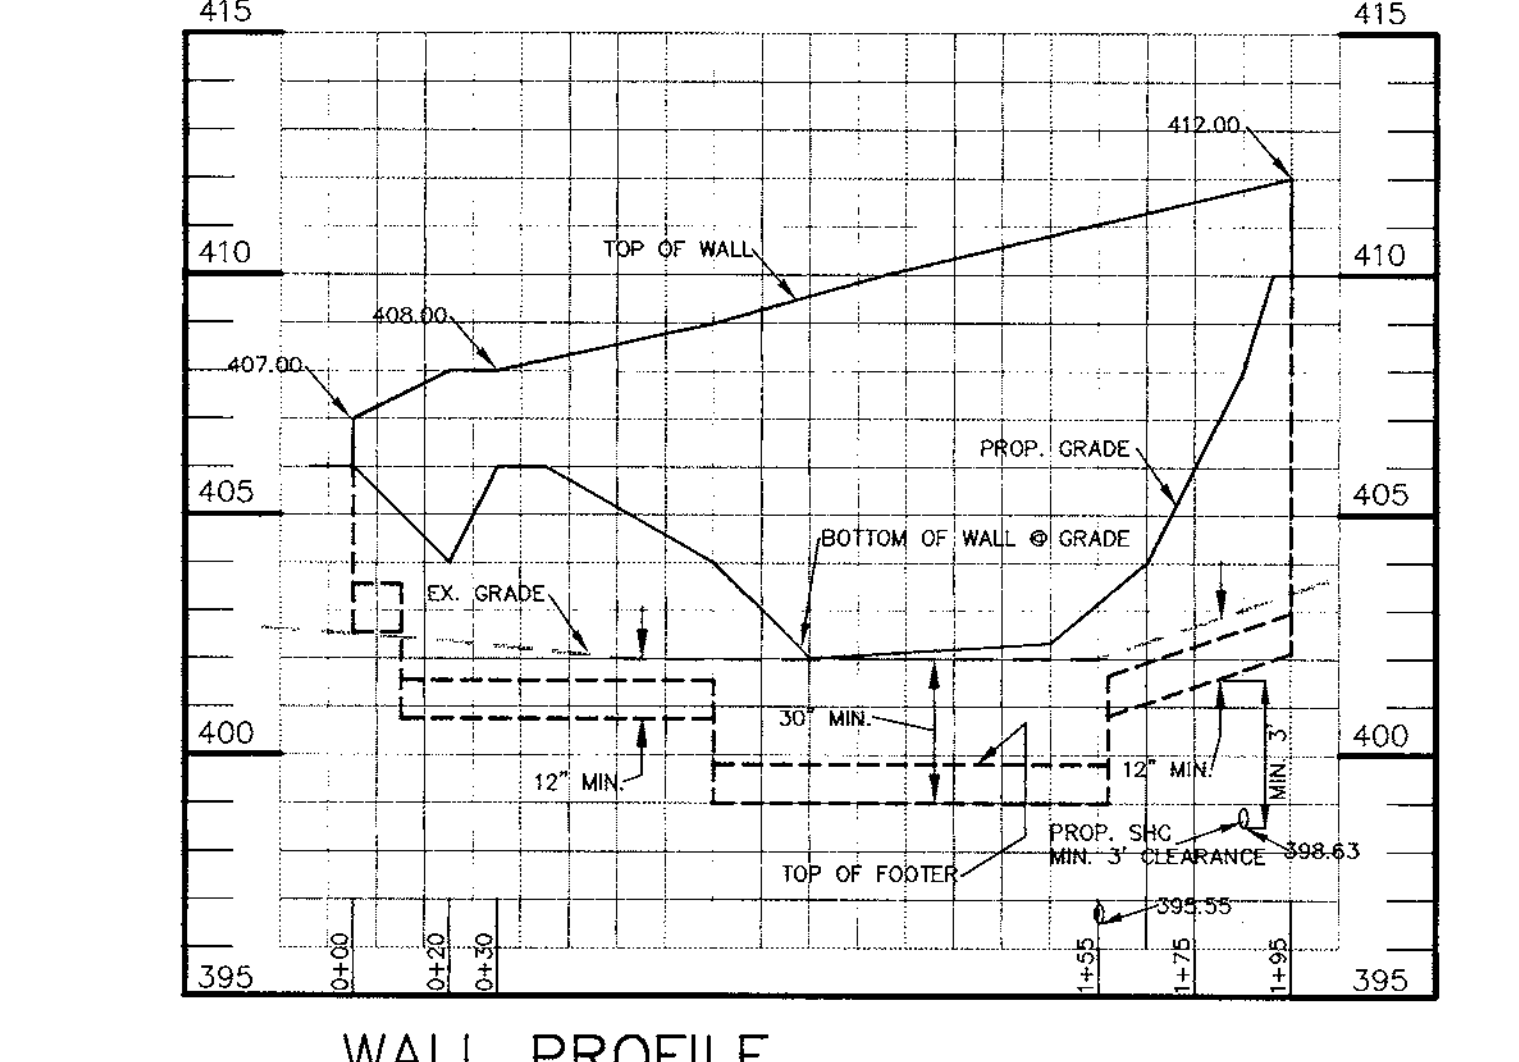

**WALL PROFILE**  
SCALE: VERT: 1" = 4'  
HOR: 1" = 40'

**DESIGN SUMMARY**

	PIPE STORAGE	STORMCEPTOR 1A	STORMCEPTOR 2A
FACILITY IDENTIFICATION	PS1	SC1A	SC2A
FACILITY TYPE:	UNDERGROUND PIPES	"STORMCEPTOR"	"STORMCEPTOR"
INVERT ELEVATION:	397.5		
WATER SURFACE ELEVATION 2yr/10yr/100yr	391.17/393.67/402.3		
STORAGE VOLUME:	30,156 cu ft. 0.70 ac.ft.		
INFLOW 2yr/10yr/100yr	16.8/29.6/42.0		
REQUIRED CONTROL 2yr/10yr/100yr	7.0/16.8/NONE	NONE	NONE
OUTFLOW 2yr/10yr/100yr	6.0/8.1/12.9		
MAINTENANCE RESPONSIBILITY:	PRIVATE	PRIVATE	PRIVATE

AS BUILT CERTIFICATE  
MICHAEL H. HELFRICH DATE


DATE 3/2/99  
DESIGNED BY: MHR  
DRAWN BY: APF  
PROJECT NO. SDP 99-56  
DATE: JAN 1999  
SCALE: AS NOTED  
DRAWING NO. 3 OF 5

3/2/99  
MICHAEL H. HELFRICH

**DETAILS & SPECIFICATIONS VEGETATIVE ESTABLISHMENT**

FOLLOWING INITIAL SOIL DISTURBANCE OR REDISTRIBUTION, PERMANENT OR TEMPORARY STABILIZATION SHALL BE COMPLETED WITHIN SEVEN CALENDAR DAYS FOR THE SURFACE OF ALL PERIMETER CONTROL DIKES, WALLS, DITCHES, PERIMETER SLOPES, AND ALL SLOPES GREATER THAN 3 HORIZONTAL TO 1 VERTICAL (3:1) AND FOURTEEN DAYS FOR ALL OTHER DISTURBED OR GRADED AREAS ON THE PROJECT SITE.

1. PERMANENT SEEDING:  
 a. SOIL TESTS: LIME AND FERTILIZER WILL BE APPLIED PER SOIL TESTS RESULTS FOR SITES GREATER THAN 5 ACRES. SOIL TESTS WILL BE DONE AT COMPLETION OF ROUGH GRADING, RATES AND ANALYSES WILL BE PROVIDED TO THE GRADING INSPECTOR AS WELL AS THE CONTRACTOR.  
 b. OCCURRENCE OF ACID SULFATE SOILS (GRAYISH BLACK COLOR) WILL REQUIRE COVERING WITH A MINIMUM OF 12 INCHES OF CLEAN SOIL WITH 6 INCHES MINIMUM CAPPING OF TOP SOIL. NO TOPSOILING OF MATERIAL IS ALLOWED. IF NEEDED, SOIL TESTS SHOULD BE DONE BEFORE AND AFTER A 6 WEEK INCUBATION PERIOD TO ALLOW OXIDATION OF SULFATE.  
 c. SEEDING PREPARATION: AREA TO BE SEEDING SHALL BE LOOSE AND FRAGILE TO A DEPTH OF AT LEAST 3 INCHES. THE TOP LAYER SHALL BE LOOSENED BY RAKING, DISKING OR OTHER ACCEPTABLE MEANS BEFORE SEEDING OCCURS. FOR SITES LESS THAN 5 ACRES, APPLY 100 POUNDS OF DOLOMITIC LIMESTONE AND 21 POUNDS OF 10-20-20 FERTILIZER PER 1,000 SQUARE FEET. HARROW OR DISK LIME AND FERTILIZER INTO THE SOIL TO A DEPTH OF AT LEAST 3 INCHES ON SLOPES FLATTER THAN 3:1.  
 d. SEEDING: APPLY 5-6 POUNDS PER 1,000 SQUARE FEET OF TALL FESCUE BETWEEN FEBRUARY 1 AND APRIL 30 OR BETWEEN AUGUST 15 AND OCTOBER 31. APPLY SEED UNIFORMLY ON A MOIST FIRM SEEDBED WITH EITHER SEEDING DRILL, CULTRIPACKER SEEDER OR HYDROSEEDER (SLURRY INCLUDES SEEDS AND FERTILIZER, RECOMMENDED ON STEEP SLOPES ONLY). MAXIMUM SEED SHOULD BE 1/4 INCH IN CLAYEY SOILS AND 1/2 INCH IN SANDY SOILS WHEN USING OTHER THAN THE HYDROSEEDER METHOD. IRRIGATE IF SOIL MOISTURE IS DEFICIENT TO SUPPORT ADEQUATE GROWTH UNTIL VEGETATION IS FULLY ESTABLISHED. IF OTHER SEED MIXES ARE TO BE USED, SELECT FROM TABLE 25, ENTITLED "PERMANENT SEEDING FOR LOW MAINTENANCE AREAS" FROM THE 1994 STANDARDS AND SPECIFICATIONS FOR SOIL EROSION AND SEDIMENT CONTROL MIXES APPLICABLE FOR THIS AREA ARE 1.3 AND 5-7. MIXES 5-7 ARE SUITABLE IN NON-EROSIVE SITUATIONS.  
 e. MULCHING: MULCH SHALL BE SUITABLE FOR ALL SEEDING AREAS IMMEDIATELY AFTER SEEDING DURING THE TIME PERIODS WHEN SEEDING IS NOT PERMITTED. MULCH SHALL BE APPLIED IMMEDIATELY AFTER GRADING.  
 f. MULCH SHALL BE UNROTTED, UNCHOPPED, SMALL GRAIN STRAW APPLIED AT A RATE OF 2 TONS PER ACRE OR 90 POUNDS PER 1,000 SQUARE FEET (2 BALE/3). F A MULCH ANCHORING TOOL IS USED, APPLY 2.5 TONS PER ACRE. MULCH MATERIALS SHALL BE RELATIVELY FREE OF ALL KINDS OF WEEDS AND SHALL BE FREE OF PROHIBITED NOXIOUS WEEDS. SPREAD MULCH UNIFORMLY, MECHANICALLY OR BY HAND, TO A DEPTH OF 1-2 INCHES.  
 g. SECURING STRAW MULCH: STRAW MULCH SHALL BE SECURED IMMEDIATELY FOLLOWING MULCH APPLICATION TO MINIMIZE MOVEMENT BY THE WIND OR THE WATER. THE FOLLOWING METHODS ARE PERMITTED:  
 (i) USE A MULCH ANCHORING TOOL WHICH IS DESIGNED TO PUNCH AND ANCHOR MULCH INTO THE SOIL SURFACE TO A MINIMUM DEPTH OF 2 INCHES. THIS IS THE MOST EFFECTIVE METHOD FOR SECURING MULCH. HOWEVER, IT IS LIMITED TO RELATIVELY FLAT AREAS WHERE EQUIPMENT CAN OPERATE SAFELY.  
 (ii) WOOD CELLULOSE FIBER MAY BE USED FOR ANCHORING STRAW. APPLY THE FIBER BINDER AT A NET DRY WEIGHT OF 750 POUNDS PER ACRE. IF MIXED WITH WATER, USE 50 POUNDS OF WOOD CELLULOSE FIBER PER 100 GALLONS OF WATER.  
 (iii) LIQUID BINDERS MAY BE USED AND APPLIED HEAVIER AT THE LOCATIONS WHERE WINDSUCH AS IN VALETS AND ON CRESTS OF SLOPES. THE REMAINDER OF THE AREA SHOULD APPEAR UNIFORM AFTER BINDER APPLICATION. BINDERS LISTED IN THE 1994 STANDARDS AND SPECIFICATIONS FOR SOIL EROSION AND SEDIMENT CONTROL OR APPROVED EQUIV. SHALL BE APPLIED AT RATES RECOMMENDED BY THE MANUFACTURERS.  
 (iv) LIGHTWEIGHT PLASTIC NETTING MAY BE USED TO SECURE MULCH. THE NETTING WILL BE STAPLED TO THE GROUND ACCORDING TO MANUFACTURER'S RECOMMENDATIONS.  
 2. TEMPORARY SEEDING:  
 a. LIME: 100 POUNDS OF DOLOMITIC LIMESTONE PER 1,000 SQUARE FEET.  
 b. FERTILIZER: 15 POUNDS OF 10-10-10 PER 1,000 SQUARE FEET. PERENNIAL PLY - 0.92 POUNDS PER 1,000 SQUARE FEET (FEBRUARY 1 THROUGH APRIL 30 OR AUGUST 15 THROUGH NOVEMBER 1). MILLET - 0.82 POUNDS PER 1,000 SQUARE FEET (MAY 1 THROUGH AUGUST 15).  
 c. MULCH: SAME AS 1 D AND E ABOVE.  
 3. NO FILLS MAY BE PLACED ON FROZEN GROUND. ALL FILL TO BE PLACED IN APPROXIMATELY HORIZONTAL LAYERS, EACH LAYER HAVING A LOOSE THICKNESS OF NOT MORE THAN 8 INCHES. ALL FILL IN PARKWAYS AND PARKING AREAS IS TO BE CLASSIFIED TYPE 2 AND COMPACTED TO 90% DENSITY. COMPACTION TO BE DETERMINED BY ASTM D-1557-87 (MODIFIED PROCTOR). ANY FILL WITHIN THE BUILDING AREA IS TO BE COMPACTED TO A MINIMUM OF 95% AS DETERMINED BY METHODS PREVIOUSLY MENTIONED. FILLS FOR POND EMBANKMENTS SHALL BE COMPACTED AS PER MD-378. ALL OTHER FILLS SHALL BE COMPACTED SUFFICIENTLY SO AS TO BE STABLE AND PREVENT EROSION AND SLIPAGE.  
 4. PERMANENT SOIL:  
 a. INSTALLATION OF SOD SHOULD FOLLOW PERMANENT SEEDING DETAILS. PERMANENT SOD IS TO BE TALL FESCUE, STATE APPROVED SOIL, LIME AND FERTILIZER PER PERMANENT SEEDING SPECIFICATIONS AND LIGHTLY IRRIGATE SOIL PRIOR TO LAYING SOD. SOD IS TO BE LAD ON THE SUBSOIL WITH ALL ENDS TIGHT. ALL BUTTING JOINTS ARE TO BE STAGGERED BETWEEN ROWS. WATER AND ROLL OR TAMP SOD TO INSURE POSITIVE CONTACT WITH THE SOIL. ALL SODS MUST BE 3:1 AS SHOWN. ARE TO BE PERMANENTLY SODDED OR PROTECTED WITH AN APPROVED EROSION CONTROL NETTING. ADDITIONAL WATERING FOR ESTABLISHMENT MAY BE REQUIRED. SOD IS NOT TO BE APPLIED ON FROZEN GROUND. SOD SHALL NOT BE HARVESTED OR TRANSPORTED WHEN MOISTURE CONTENT (OR NET WEIGHT) AND/OR EXTREME TEMPERATURE MAY ADVERSELY AFFECT ITS SURVIVAL. IN THE ABSENCE OF ADEQUATE RAINFALL, IRRIGATION SHOULD BE PERFORMED TO INSURE ESTABLISHMENT.  
 b. TOPSOIL:  
 i. TOPSOIL SALVAGED FROM THE EXISTING SITE MAY BE USED PROVIDED THAT IT MEETS THE STANDARDS AS SET FORTH IN THESE SPECIFICATIONS. TYPICALLY, THE DEPTH OF TOPSOIL TO BE SALVAGED FOR A GIVEN SOIL TYPE CAN BE FOUND IN THE REPRESENTATIVE SOIL PROFILE SECTION IN THE SOIL SURVEY PUBLISHED BY USDA-SCS IN COOPERATION WITH MARYLAND AGRICULTURAL EXPERIMENTAL STATION.  
 ii. TOPSOIL SPECIFICATIONS - SOIL TO BE USED AS TOPSOIL MUST MEET THE FOLLOWING:  
 1. TOPSOIL SHALL BE A LOAM, SANDY LOAM, CLAY LOAM, SILT LOAM, SANDY CLAY LOAM, AND LOAMY SAND. OTHER SOILS MAY BE USED IF RECOMMENDED BY AN AGRONOMIST OR SOIL SCIENTIST AND APPROVED BY THE APPROPRIATE AUTHORITY.  
 2. REGARDLESS, TOPSOIL SHALL NOT BE A MIXTURE OF CONTRASTING TEXTURED SUBSOILS AND SHALL CONTAIN LESS THAN 5% BY VOLUME OF CONCRETION, STONES, SLUGS, COARSE FRAGMENTS, GRAVEL, STICKS, ROOTS, TRASH, OR OTHER MATERIALS LARGER THAN 1 1/2" IN DIAMETER.  
 3. TOPSOIL MUST BE FREE OF PLANTS OR PLANT PARTS SUCH AS BERBERIS GRASS, QUACKGRASS, JOHNSONGRASS, NUTSEDGE, POISON IVY, THISTLE, OR OTHERS AS SPECIFIED.  
 4. WHERE THE SUBSOIL IS EITHER HIGHLY ACIDIC OR COMPOSED OF HEAVY CLAYS, GROUND LIMESTONE SHALL BE SPREAD AT THE RATE OF 4-8 TONS/ACRE (200-400 POUNDS PER 1,000 SQUARE FEET) PRIOR TO THE PLACEMENT OF TOPSOIL. LIME SHALL BE DISTRIBUTED UNIFORMLY OVER DESIGNATED AREAS AND WORKED INTO THE SOIL IN CONJUNCTION WITH TILLAGE OPERATIONS AS DESCRIBED IN THE FOLLOWING PROCEDURES:  
 5. FOR SITES HAVING DISTURBED AREAS UNDER 5 ACRES:  
 i. PLACE TOPSOIL (IF REQUIRED) AND APPLY SOIL AMENDMENTS AS SPECIFIED IN SOD VEGETATIVE STABILIZATION - SECTION 1.  
 ii. VEGETATIVE STABILIZATION METHODS AND MATERIALS.  
 NOTE: USE OF THIS INFORMATION DOES NOT PRECLUDE MEETING ALL OF THE REQUIREMENTS OF THE 1994 MARYLAND STANDARDS AND SPECIFICATIONS FOR SOIL EROSION AND SEDIMENT CONTROL.

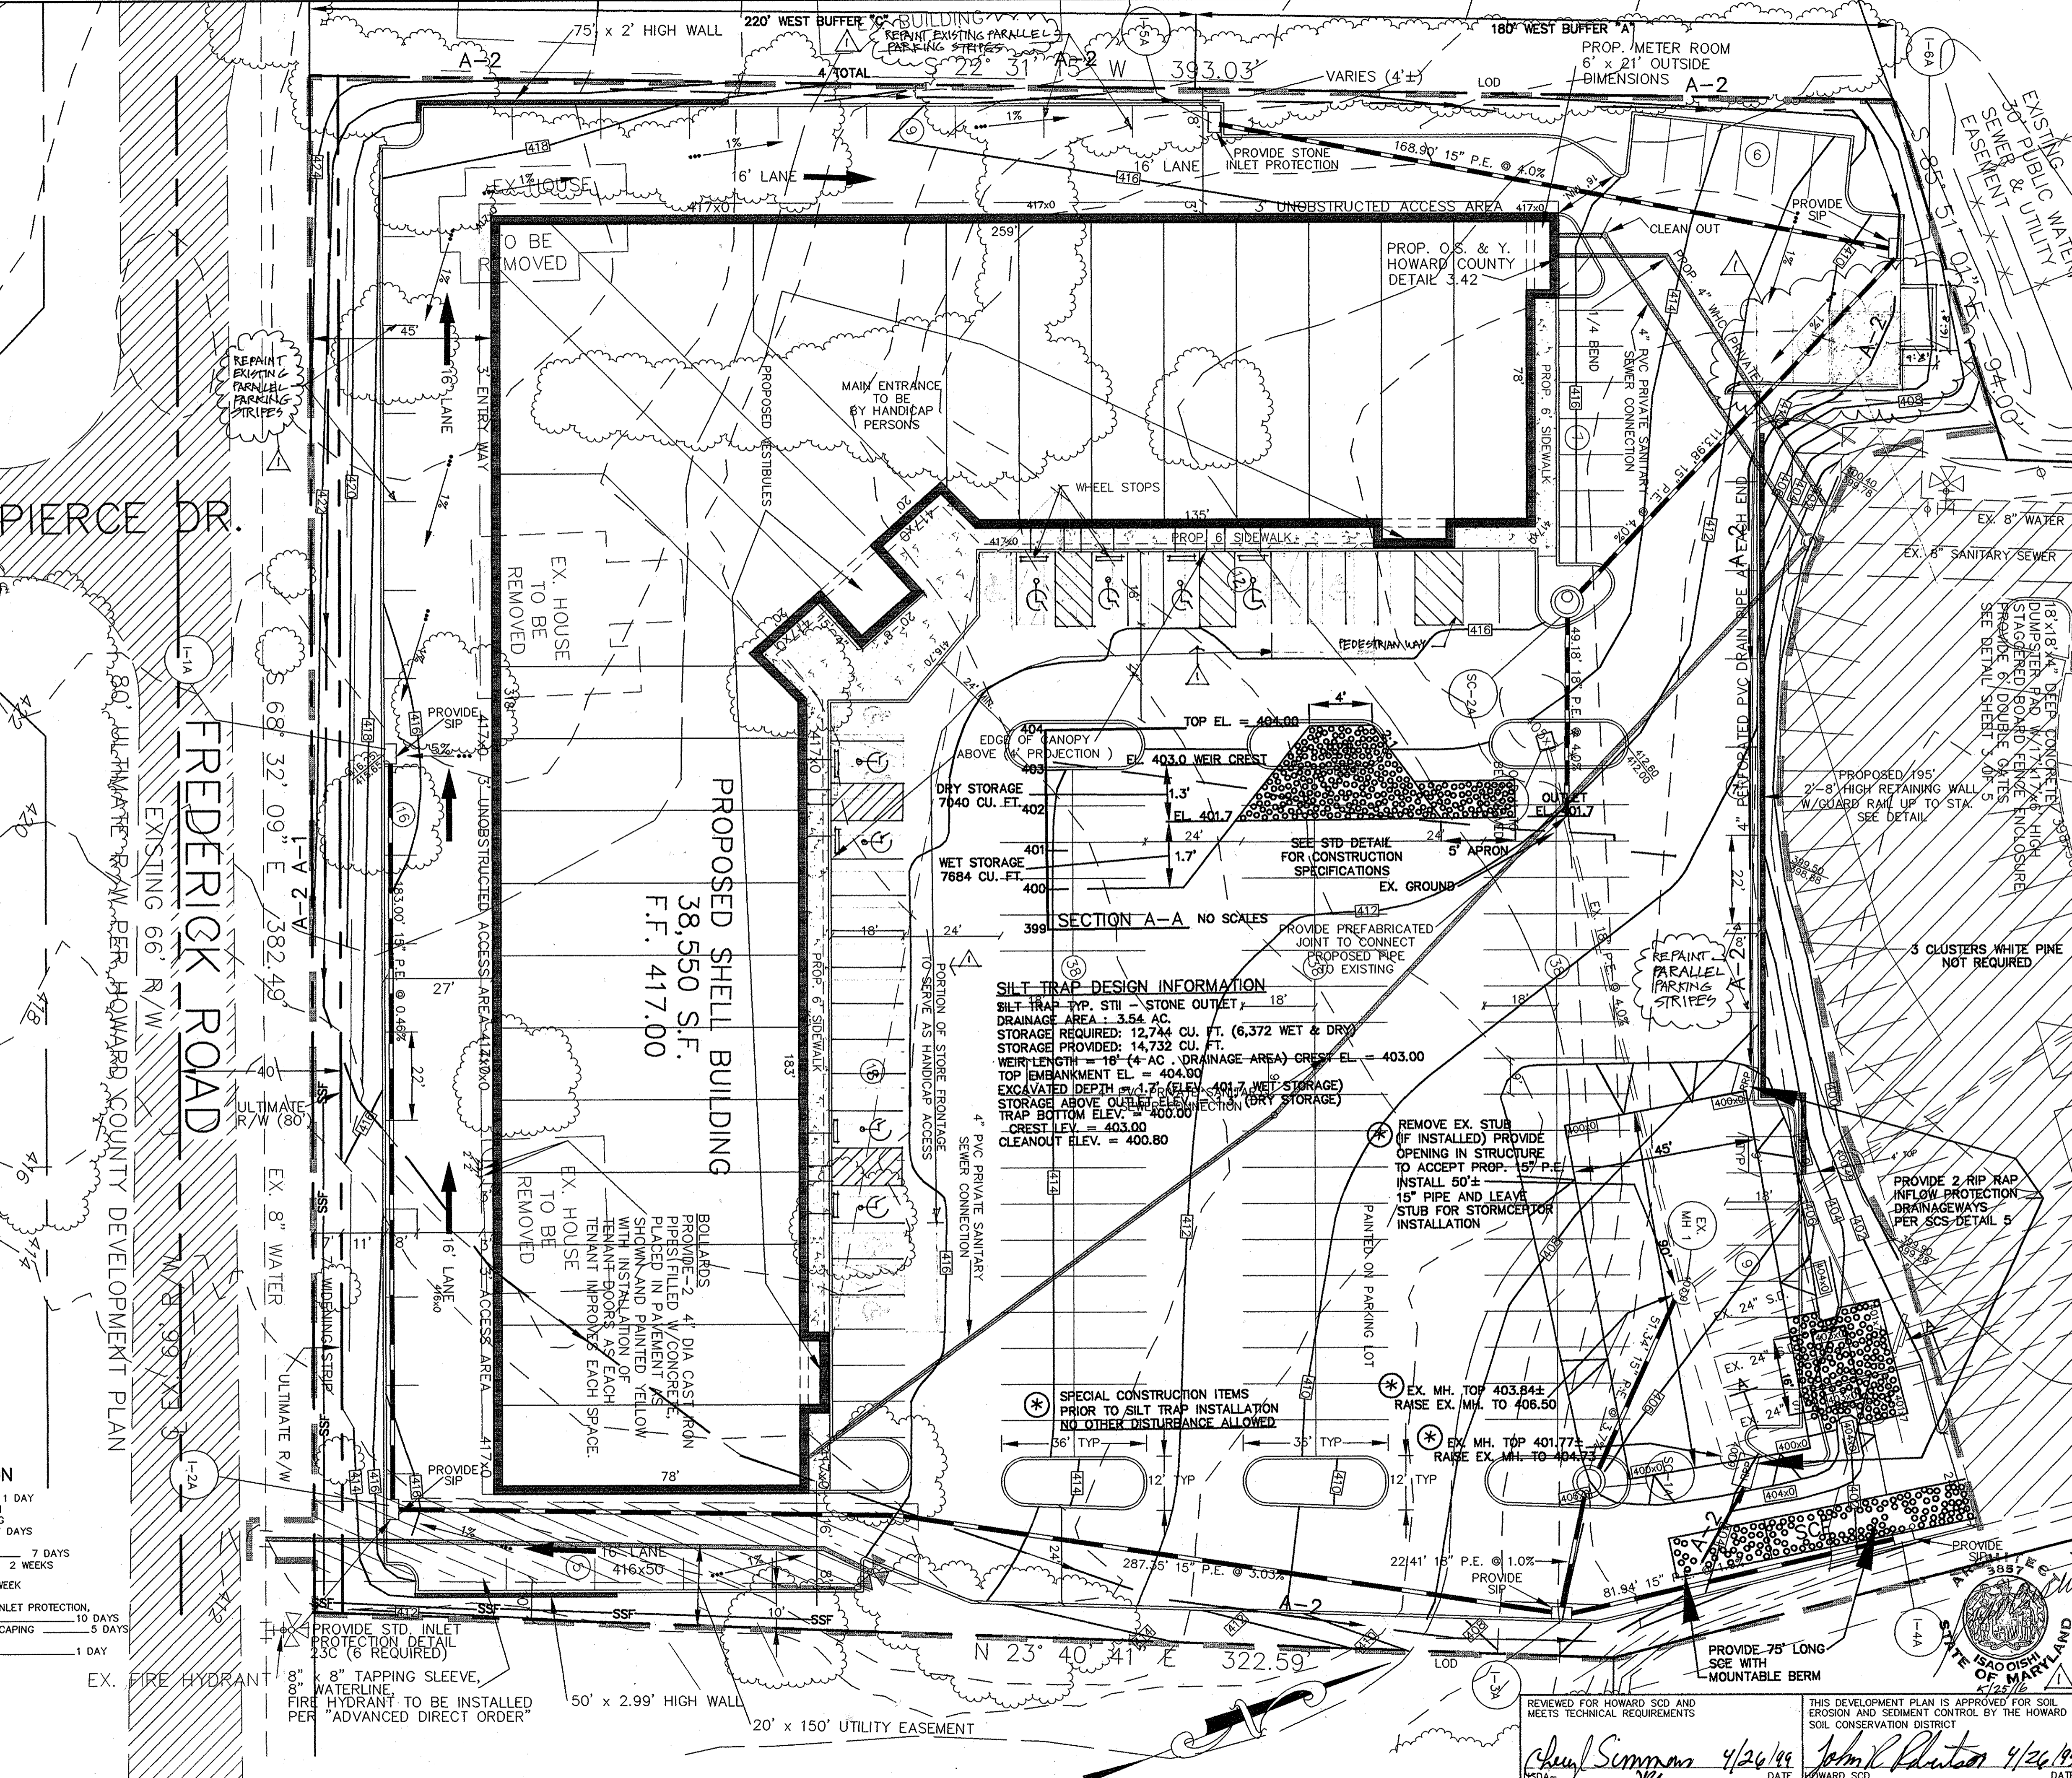

**LEGEND**

EXISTING ELEVATION	102.45
PROPOSED ELEVATION	102x45
EXISTING CONTOUR	102
PROPOSED CONTOUR	102
SILT FENCE	5'-5'
LIMITS OF DISTURBANCE	
EXISTING TREE	
EXISTING TREE (TO BE REMOVED)	
STABILIZED CONSTRUCTION ENTRANCE	

BY THE DEVELOPER:  
 I/WE CERTIFY THAT ALL DEVELOPMENT AND/OR CONSTRUCTION WILL BE DONE ACCORDING TO THESE PLANS, AND THAT ANY RESPONSIBLE PERSONNEL INVOLVED IN THE CONSTRUCTION PROJECT WILL HAVE A CERTIFICATE OF ATTENDANCE AT A DEPARTMENT OF THE ENVIRONMENT APPROVED TRAINING PROGRAM FOR THE CONTROL OF SEDIMENT AND EROSION BEFORE BEGINNING THE PROJECT. I WILL PROVIDE THE HOWARD SOIL CONSERVATION DISTRICT WITH AN "AS-BUILT" PLAN OF THE PROJECT WITHIN 30 DAYS OF COMPLETION. I ALSO AUTHORIZE PERIODIC ON-SITE INSPECTIONS BY THE HOWARD SOIL CONSERVATION DISTRICT.

*Michael Stavlas* 4/15/99  
 DEVELOPER DATE

BY THE ENGINEER:  
 I CERTIFY THAT THIS PLAN FOR POND CONSTRUCTION, EROSION AND SEDIMENT CONTROL REPRESENTS A PRACTICAL AND WORKABLE PLAN BASED ON MY PERSONAL KNOWLEDGE OF THE SITE CONDITIONS. THIS PLAN WAS PREPARED IN ACCORDANCE WITH THE REQUIREMENTS OF THE HOWARD SOIL CONSERVATION DISTRICT. I HAVE NOTIFIED THE DEVELOPER THAT HE MUST PROVIDE THE HOWARD SOIL CONSERVATION DISTRICT WITH AN "AS-BUILT" PLAN WITHIN 30-DAYS OF COMPLETION.

*Michael Hefner* 4/15/99  
 ENGINEER DATE

APPROVED: FOR PUBLIC WATER AND PUBLIC SEWERAGE SYSTEMS, HOWARD COUNTY HEALTH DEPARTMENT.

*Mary Sue Baker per Jgn* 5/18/99  
 COUNTY HEALTH OFFICER DATE

APPROVED: HOWARD COUNTY DEPARTMENT OF PLANNING AND ZONING.

*Richard Blood* 5/18/99  
 CHIEF, DIVISION LAND DEVELOPMENT DATE

*Michael Stavlas* 5/18/99  
 DIRECTOR DATE

*Michael Stavlas* 5/18/99  
 CHIEF, DEVELOPMENT ENGINEERING DIVISION DATE

5/25/99 REVISION 1  
 DATE NO. REVISION

OWNER / DEVELOPER  
 MICHAEL STAVLAS  
 1726 DORSEY ROAD  
 HANOVER, MD. 21076

PROJECT  
 S.D.P. 99-56  
 STAVLAS - ROUTE 40 STAVLAS BUSINESS CENTER  
 PHASE II

AREA  
 TAX MAP 24 PARCEL 68  
 2ND ELECTION DISTRICT  
 HOWARD COUNTY, MARYLAND

TITLE  
 EROSION & SEDIMENT CONTROL  
 PLAN




**GAMMA ENGINEERING**  
 844 WEST STREET  
 ANNAPOLIS, MD 21401  
 (410) 626-1070

DESIGNED BY: MHH  
 DRAWN BY: SDF  
 PROJECT NO. SDP 99-56  
 DATE: MAR 1999  
 SCALE: 1" = 20'  
 DRAWING NO. 4 OF 5

4/21/99  
 STATE OF MARYLAND  
 PROFESSIONAL ENGINEER  
 MICHAEL H. HELFRICH

REVIEWED FOR HOWARD SCD AND MEETS TECHNICAL REQUIREMENTS  
*Greg Simmons* 4/26/99  
 DATE

THIS DEVELOPMENT PLAN IS APPROVED FOR SOIL EROSION AND SEDIMENT CONTROL BY THE HOWARD SOIL CONSERVATION DISTRICT  
*John L. Hunter* 4/26/99  
 DATE

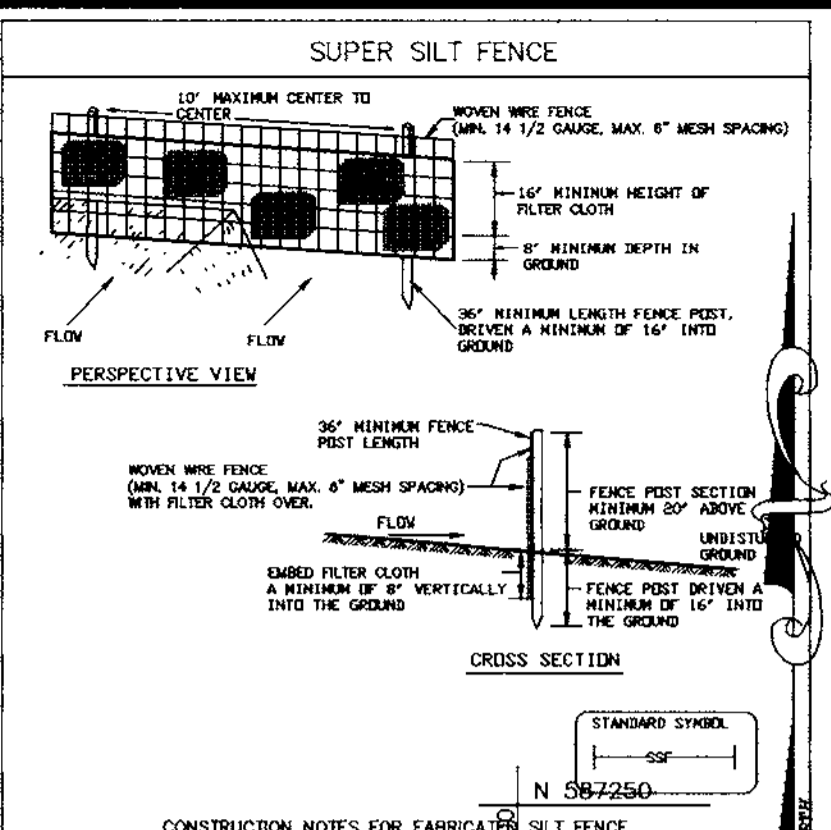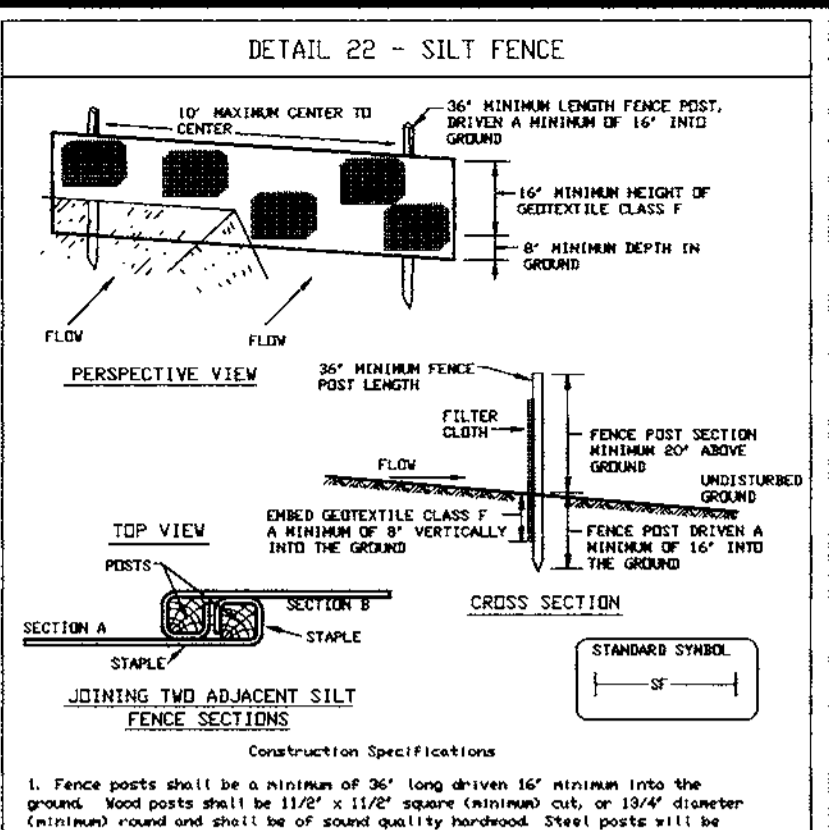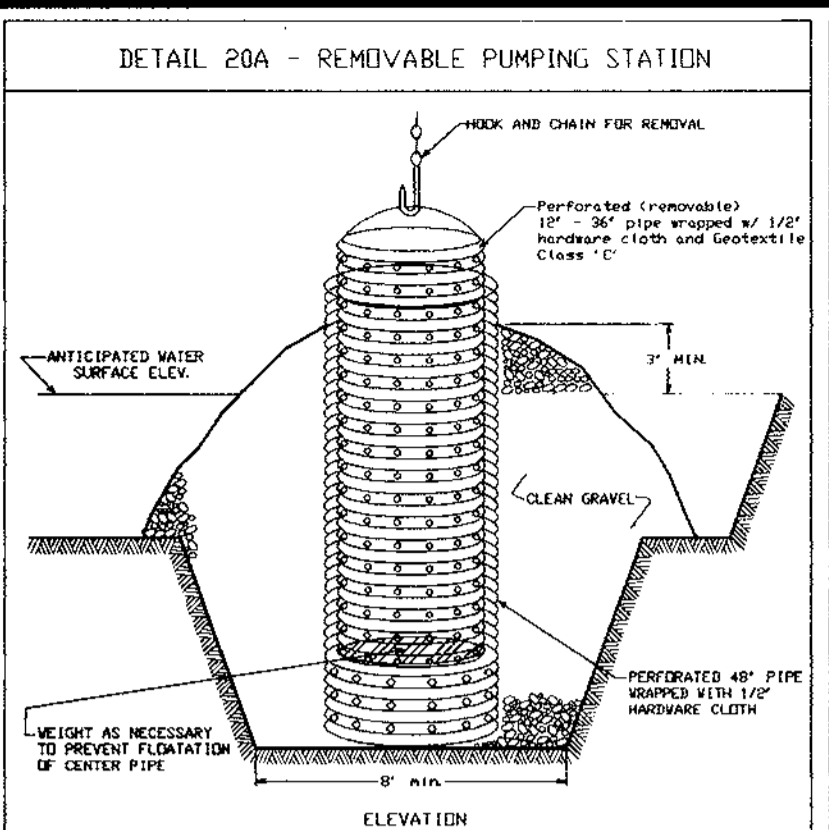

Concrete Stormceptor Order Request Form<sup>®</sup> SC1A

Contractor Information: Name, Address, City, State, Zip, Phone, Fax, E-mail.

Stormceptor Model: 300, 400, 500, 600, 700, 800, 900, 1000, 1200, 1500, 2000, 2500, 3000, 4000, 5000, 6000, 7000, 8000, 9000, 10000, 12000, 15000, 20000, 25000, 30000, 40000, 50000, 60000, 70000, 80000, 90000, 100000.

Project Name: STAVLAS DNER

Approximate Site Name and Address: 1726 S. BALTIMORE NATIONAL PIKE, ELICOTT CITY, MD 21043


Concrete Stormceptor Order Request Form<sup>®</sup> SC2A

Contractor Information: Name, Address, City, State, Zip, Phone, Fax, E-mail.

Stormceptor Model: 300, 400, 500, 600, 700, 800, 900, 1000, 1200, 1500, 2000, 2500, 3000, 4000, 5000, 6000, 7000, 8000, 9000, 10000, 12000, 15000, 20000, 25000, 30000, 40000, 50000, 60000, 70000, 80000, 90000, 100000.

Project Name: STAVLAS DNER

Approximate Site Name and Address: 1726 S. BALTIMORE NATIONAL PIKE, ELICOTT CITY, MD 21043

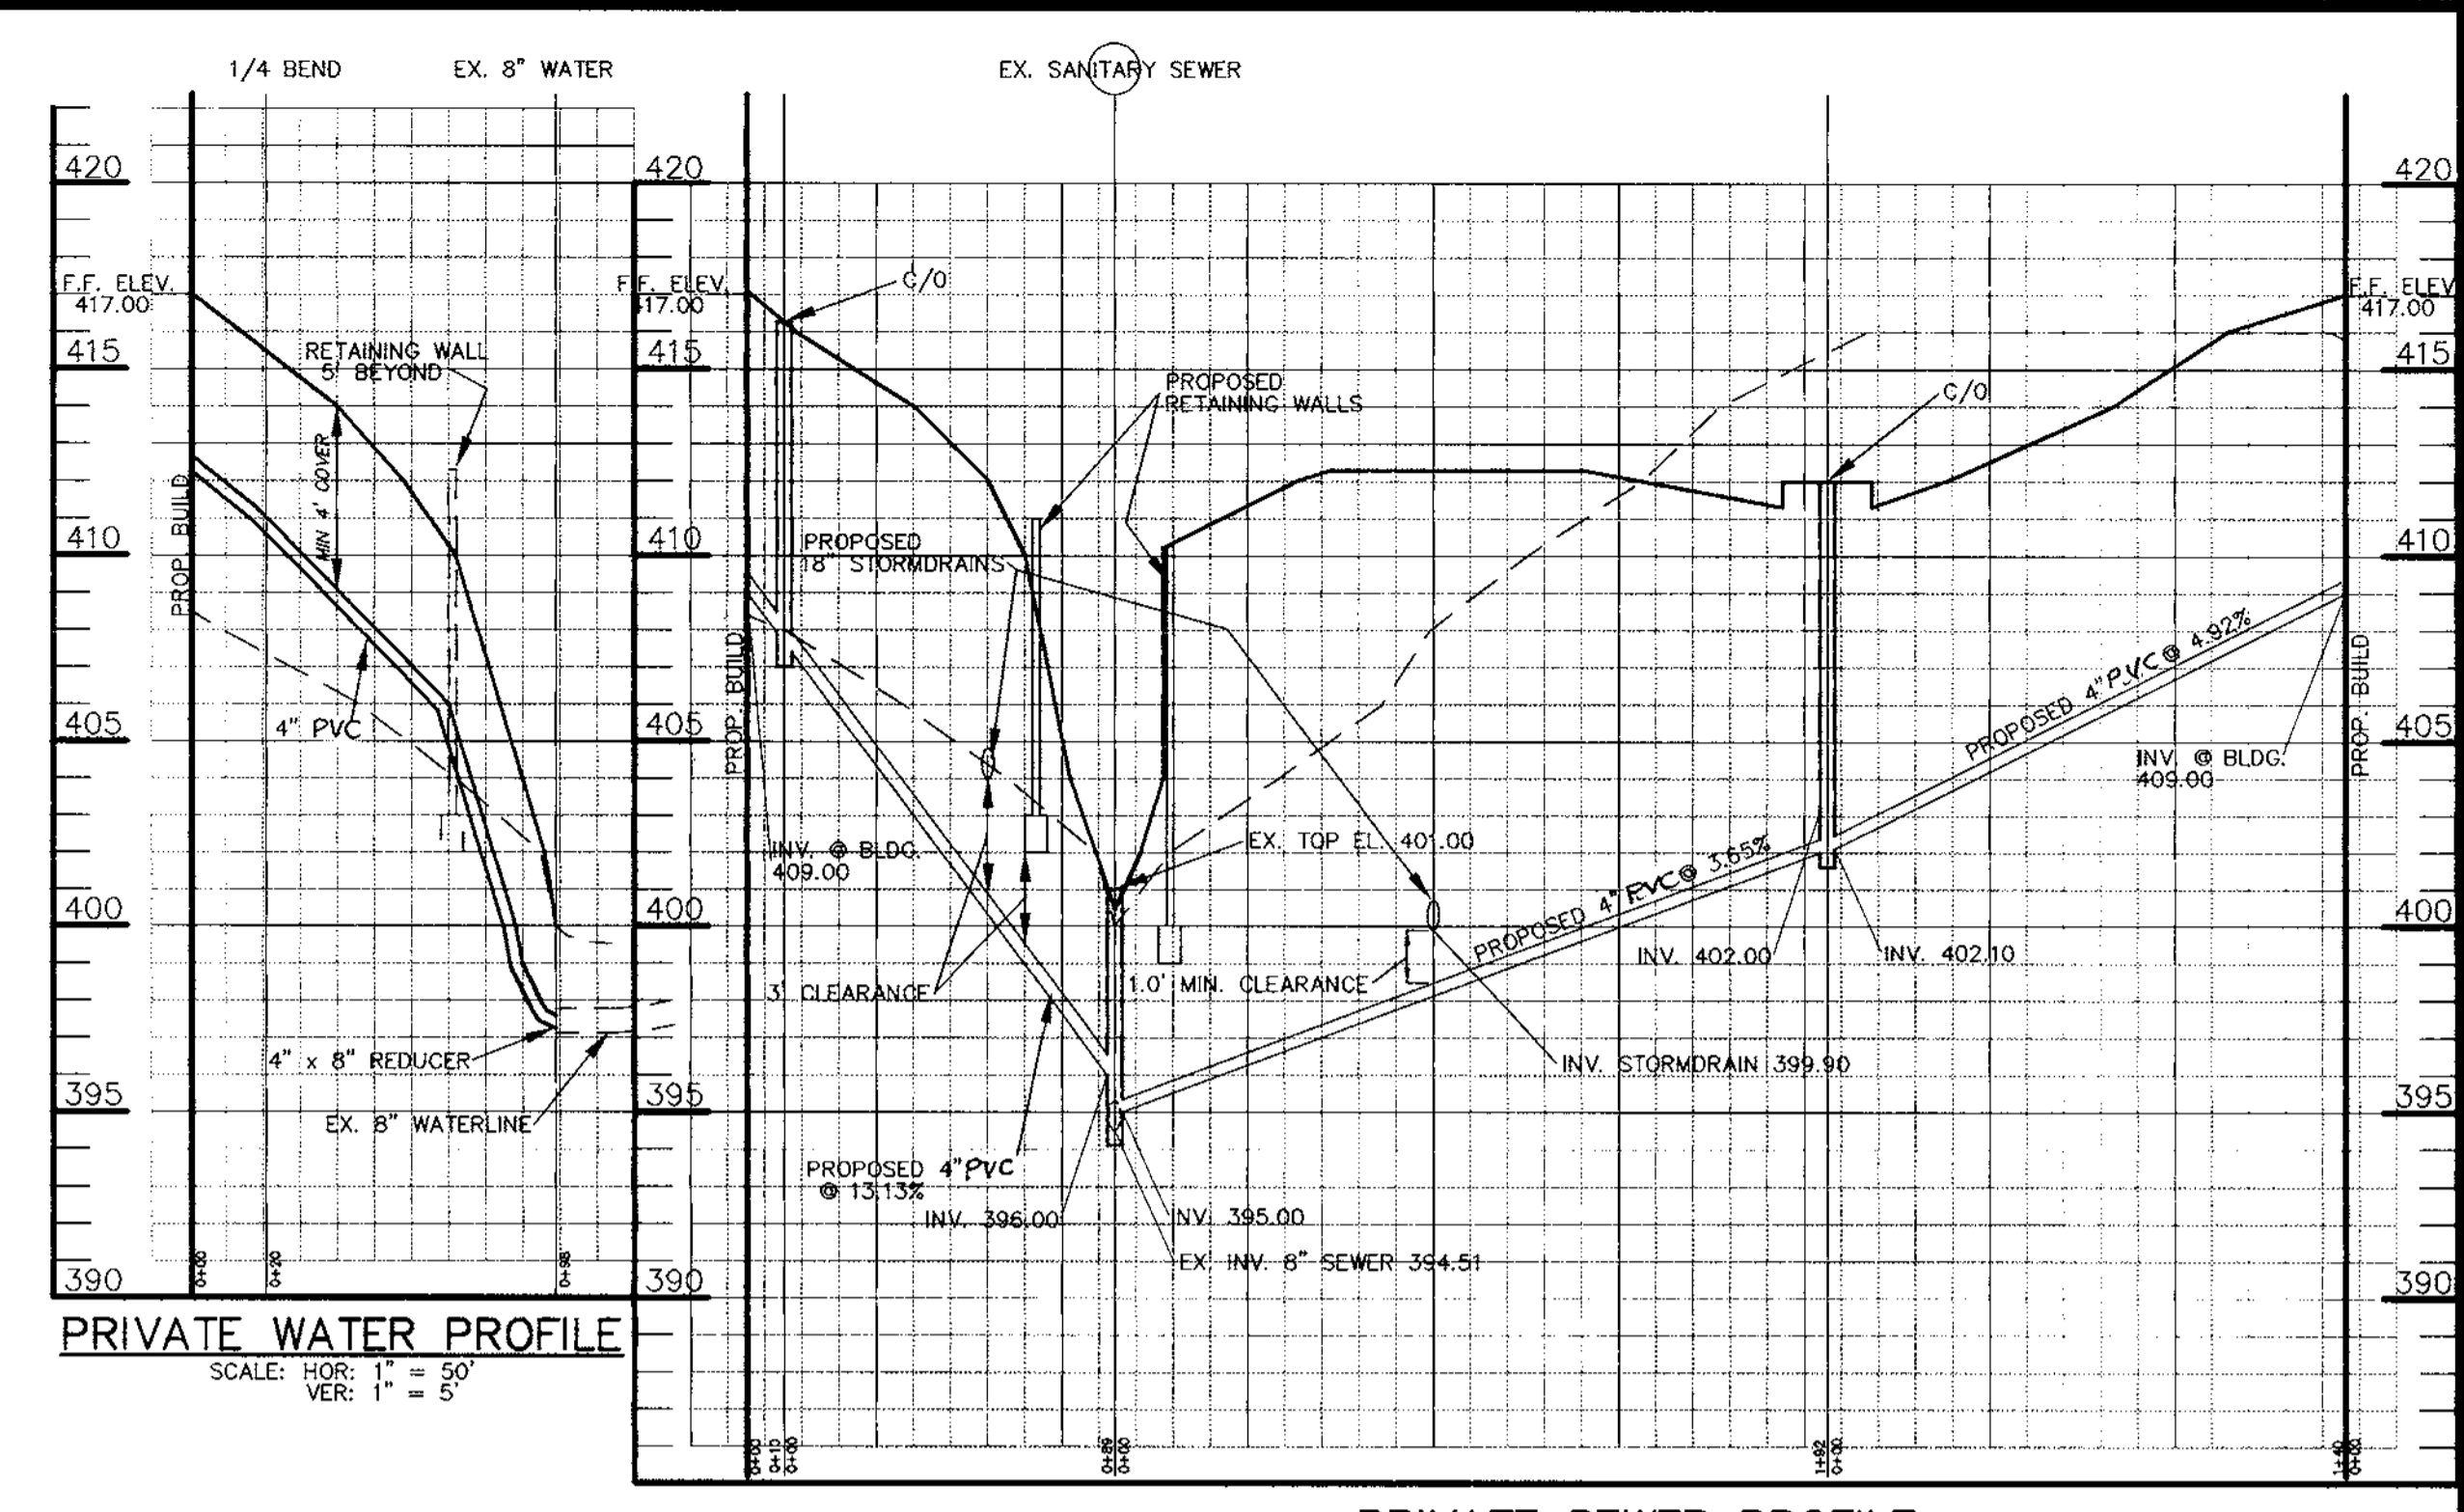

Construction Specifications:





- The outer pipe should be 4\"/>
- After installing the outer pipe, backfill around outer pipe with 2\"/>
- The inside stand pipe (center pipe) should be constructed by perforating a 4\"/>
- The center pipe should extend 12\"/>

Construction Specifications:

- Fence posts shall be a minimum of 2\"/>
- Geotextile shall be fastened securely to each fence post with wire ties or staples of top and mid-section and shall meet the following requirements for Geotextile Class C:
- When two sections of filter cloth meet, they shall be overlapped, folded and stapled to prevent sediment bypass.
- Silt Fence shall be inspected after each rainfall event and maintained when bulges occur or when sediment accumulation reaches 50% of the fabric height.

CONSTRUCTION NOTES FOR FABRICATING SILT FENCE:

- Mow site fence to be fastened securely to fence posts with wire ties or staples every 24\"/>
- Filter cloth to be fastened securely to fence posts with wire ties or staples every 24\"/>
- When two sections of filter cloth meet, they shall be overlapped, folded and stapled to prevent sediment bypass.
- Workmanship shall be performed on graded and leveled removed stone 'budge' dump in the fill fence.

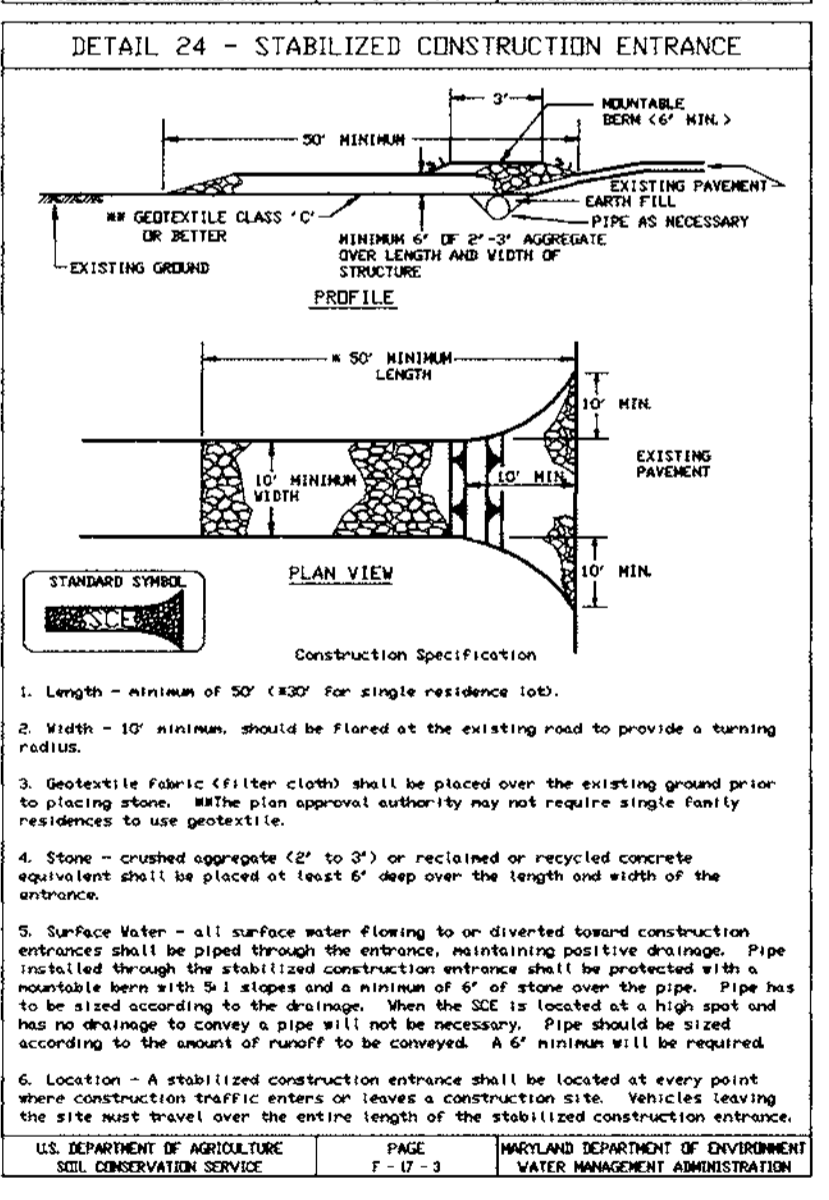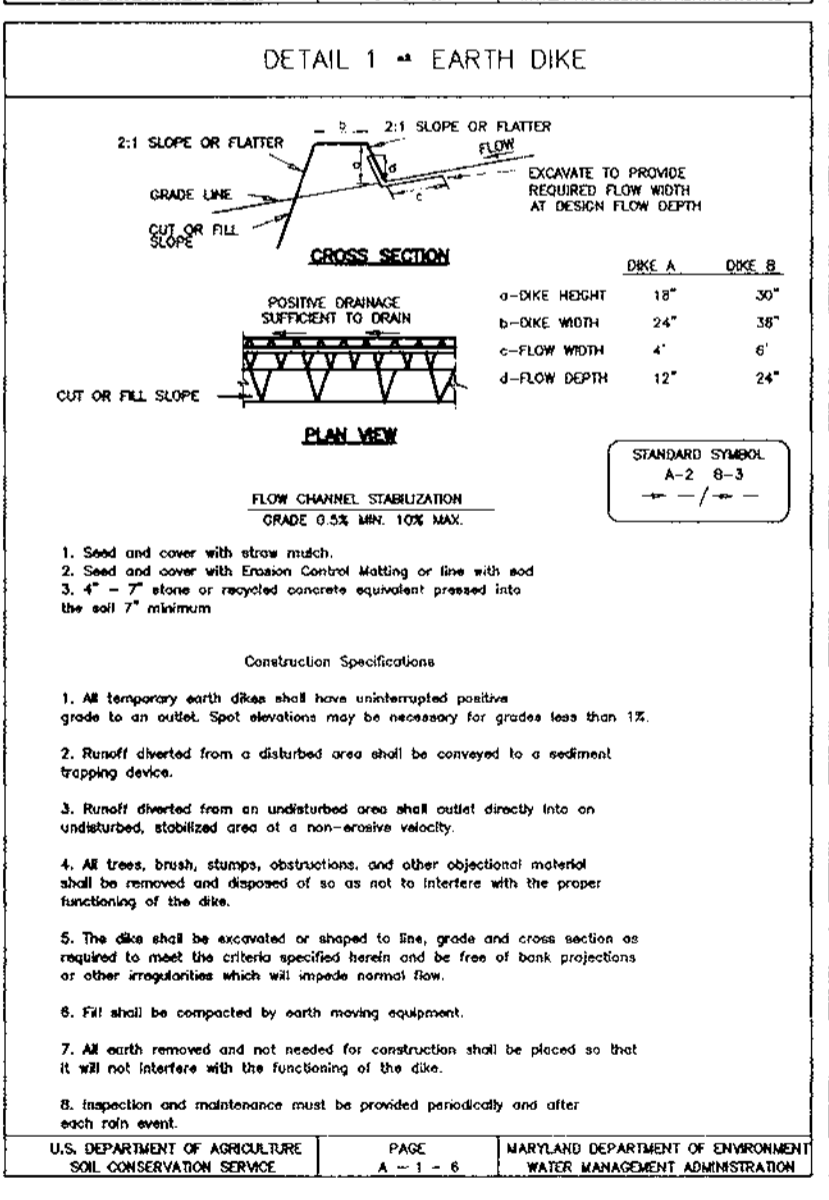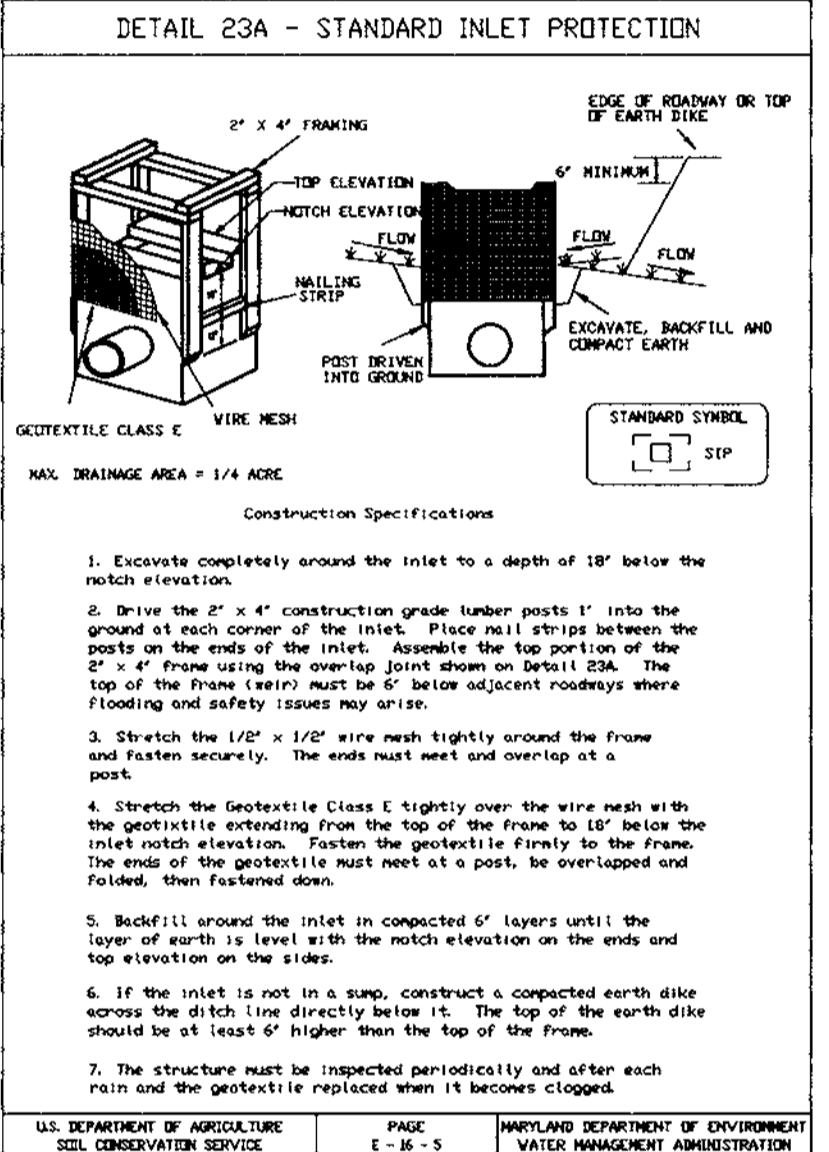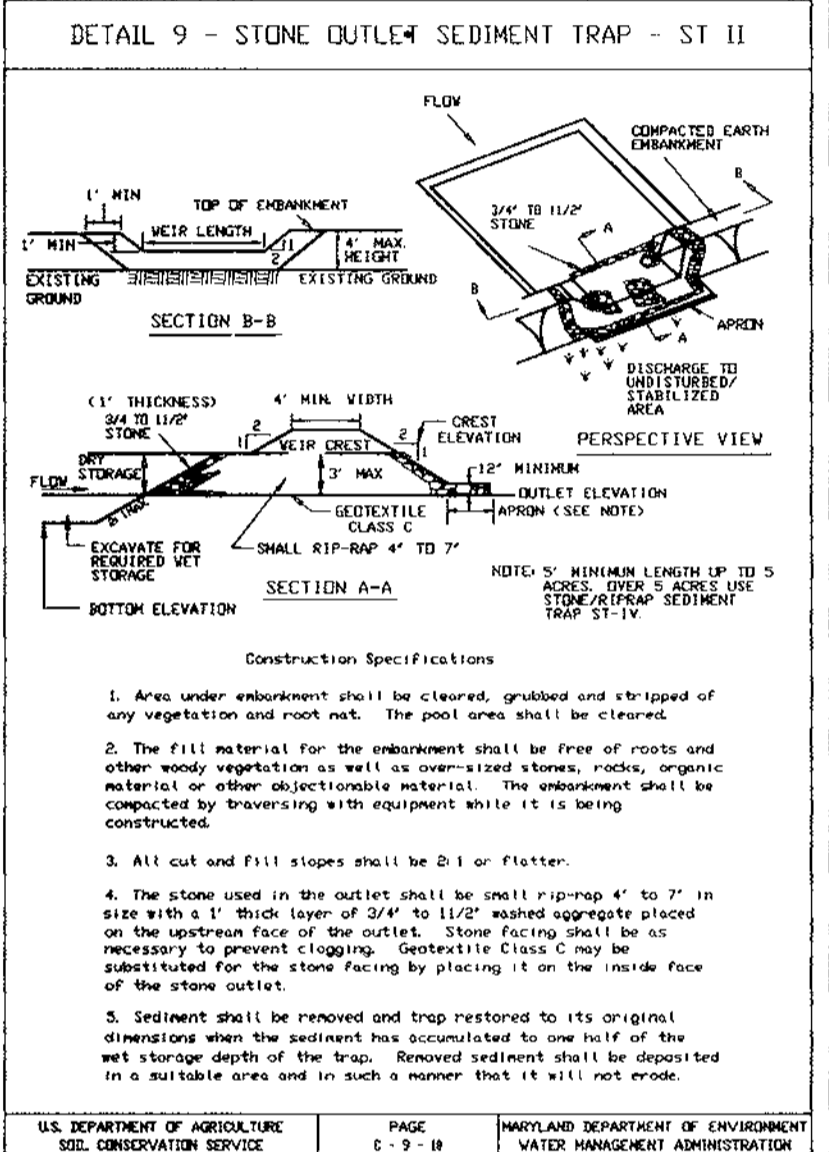

SOILS LIST

ABBREVIATION	MANOR LOAM, 8 - 15% SLOPES, MOD. ERODED	SCD SOILS TYPE
MIC2	MANOR LOAM, 8 - 15% SLOPES, MOD. ERODED	B
CuB	COMUS SILT LOAM, LOCAL ALLUVIUM, 3 - 8% SLOPES	B
GnB2	GLENVILLE SILT LOAM, 3 - 8% SLOPES, MOD. ERODED	B
MIB2	MANOR LOAM, 3 - 8% SLOPES, MOD. ERODED	B


SOILS WHICH MAY CONTAIN HYDRIC INCLUSIONS:

NOTE: CuB, NORMALLY WELL DRAINED, BUT COMUS SOILS MAY CONTAIN HYDRIC INCLUSIONS WHERE IT IS SUBJECT TO FREQUENT FLOODING.

NOTE: THERE IS NO 100 YEAR FLOODPLAIN NOR NON-TIDAL WETLANDS ON THE SITE.

AREA AND "C" FACTOR TABULATION

DRAINAGE AREA/ INLET NO.	AREA (ac)	"C" FACTOR (C)	% IMPERVIOUS (P)
1 / 1A	0.50	0.80	80
2 / 2A	0.30	0.80	79
3 / 3A	0.27	0.85	85
4 / 4A	1.06	0.93	97
5 / 5A	0.56	0.71	66
6 / 6A	0.35	0.79	82
TOTAL	3.04		

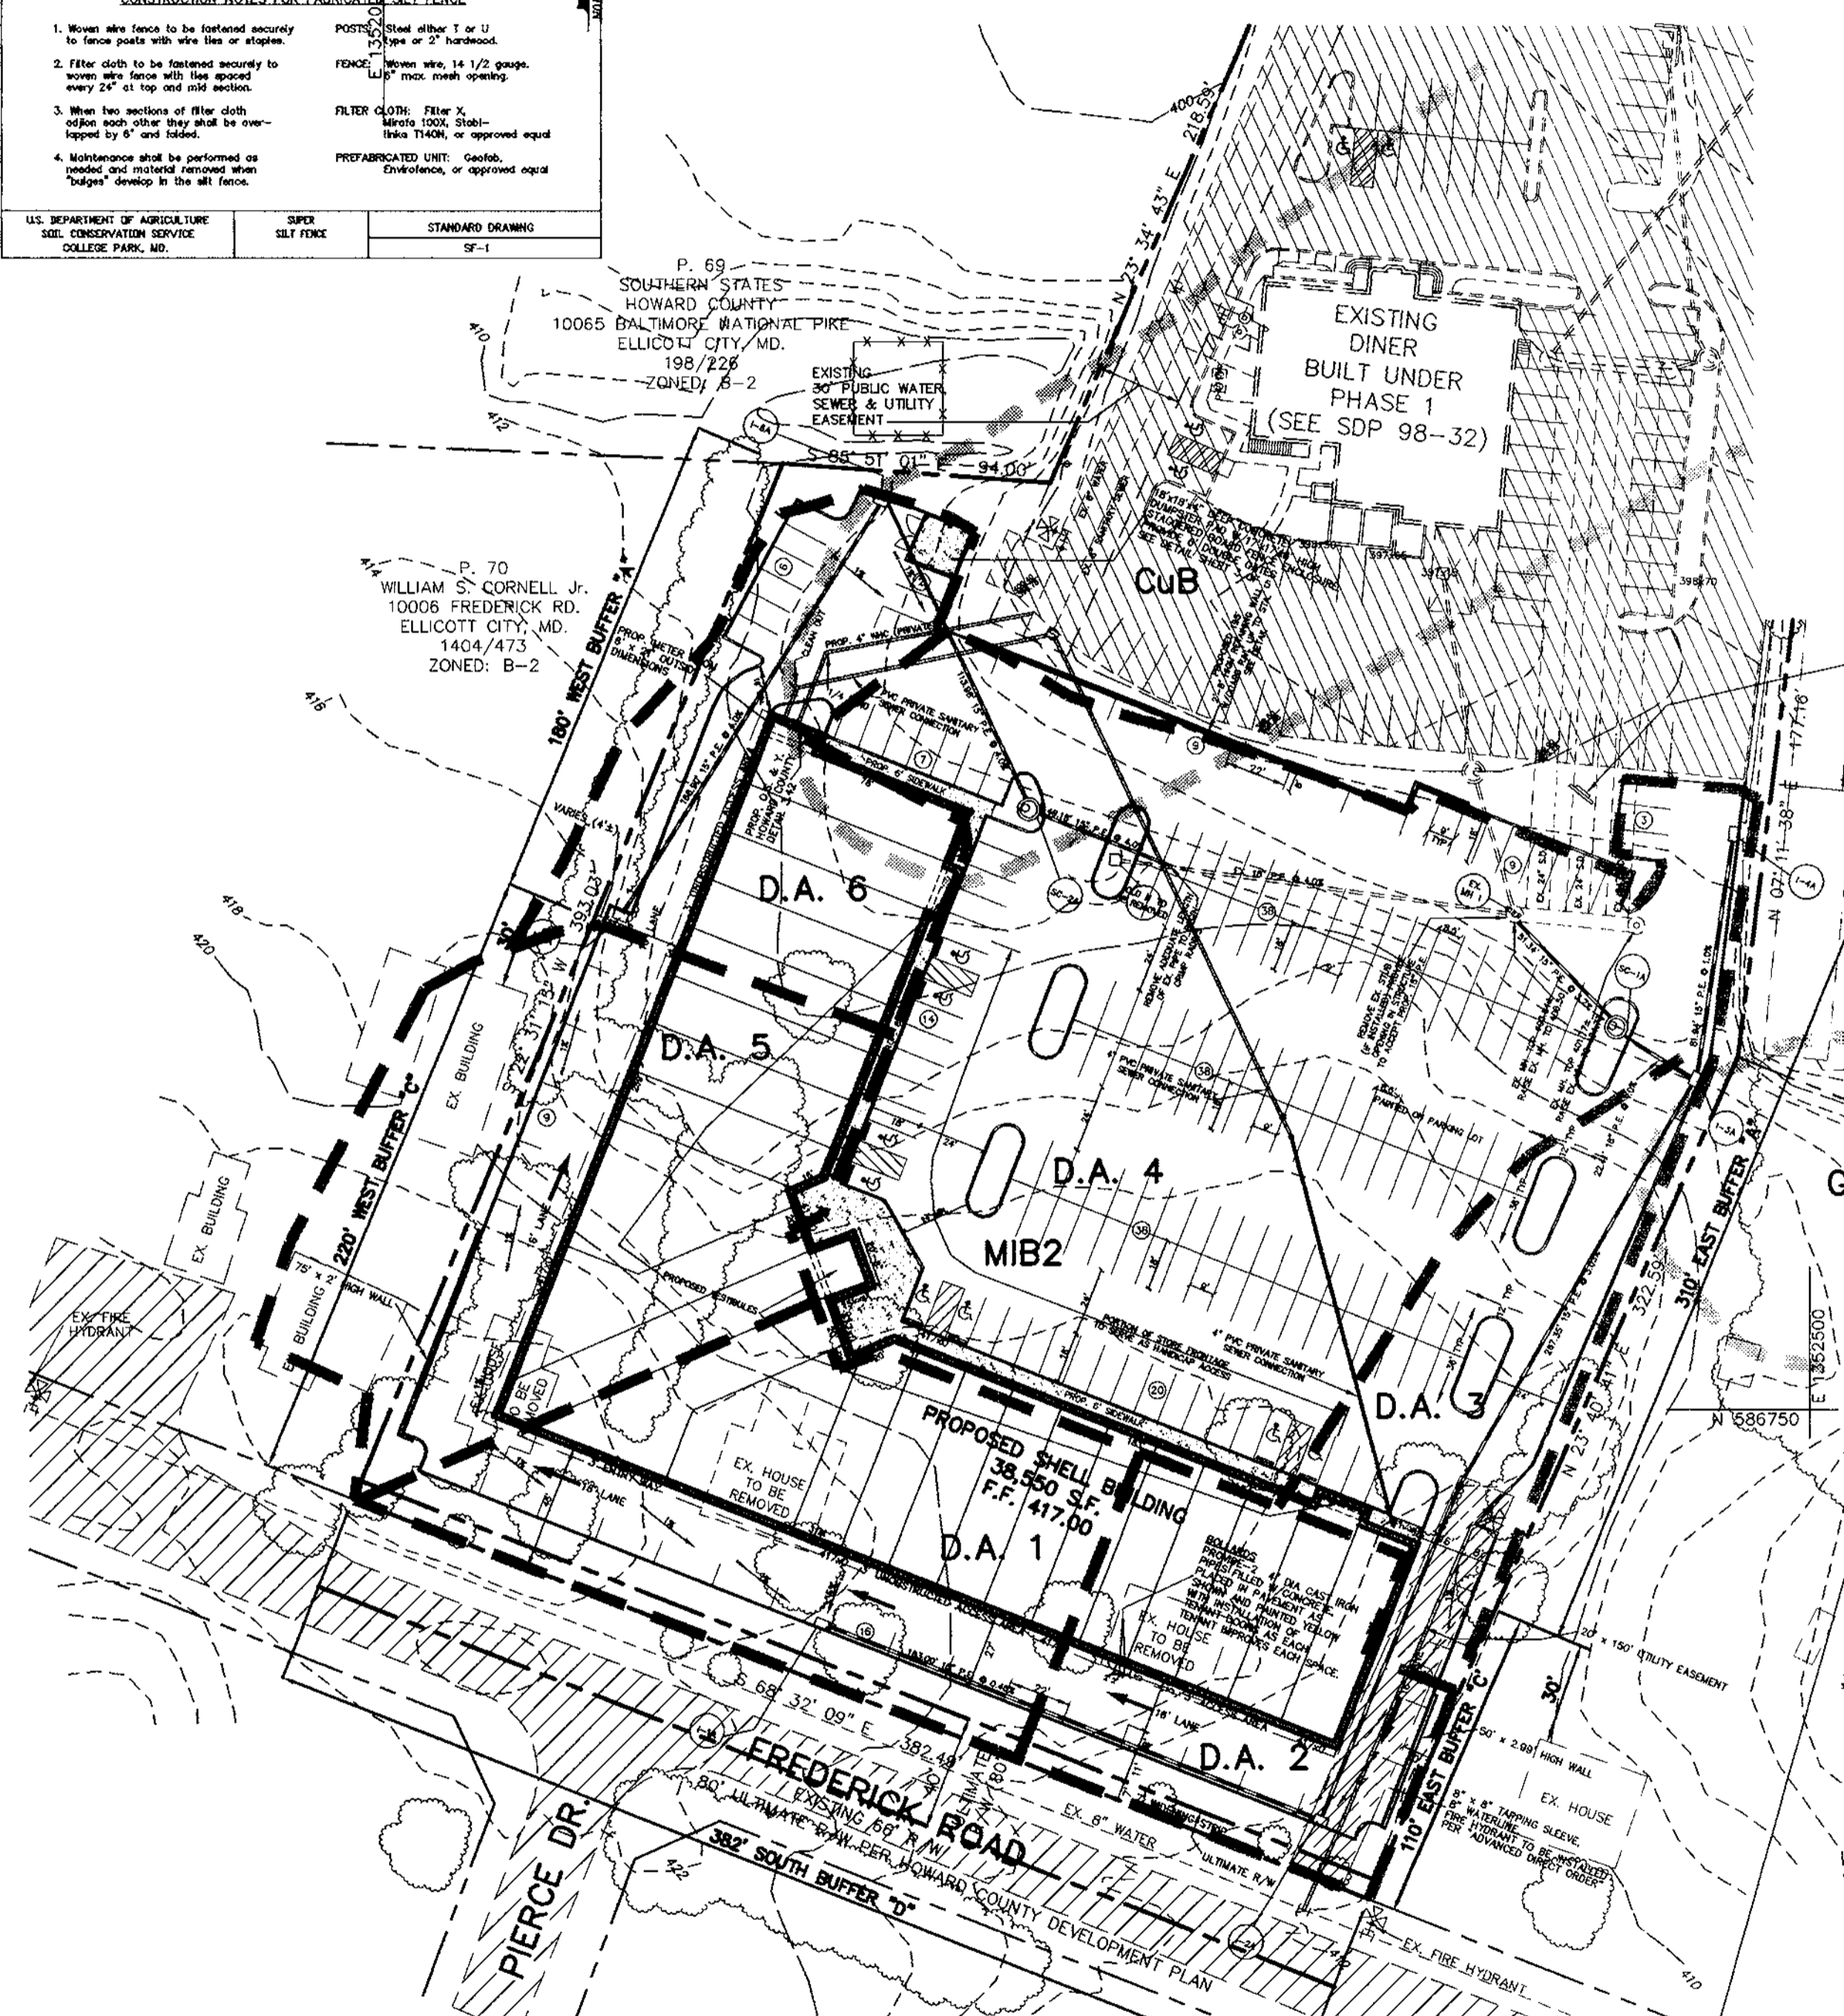

**STANDARD SEDIMENT CONTROL NOTES**

1. WE CERTIFY THAT:

- A MINIMUM OF 48 HOURS NOTICE MUST BE GIVEN TO THE HOWARD COUNTY DEPARTMENT OF INSPECTIONS, LICENSES AND PERMITS, SEDIMENT CONTROL DIVISION PRIOR TO THE START OF ANY CONSTRUCTION (410-313-1855).
- ALL VEGETATIVE AND STRUCTURAL PRACTICES ARE TO BE INSTALLED ACCORDING TO THE PROVISIONS OF THIS PLAN AND ARE TO BE IN CONFORMANCE WITH THE 1994 MARYLAND STANDARDS AND SPECIFICATIONS FOR SOIL EROSION AND SEDIMENT CONTROL AND REVISIONS THERETO.
- FOLLOWING INITIAL SOIL DISTURBANCE OR RE-DISTURBANCE, PERMANENT OR TEMPORARY STABILIZATION SHALL BE COMPLETED WITHIN: a) 7 CALENDAR DAYS FOR ALL PERIMETER SEDIMENT CONTROL STRUCTURES, DIKES, PERMETER SLOPES AND ALL SLOPES STEEPER THAN 3:1; b) 14 DAYS AS TO ALL OTHER DISTURBED OR GRADED AREAS ON THE PROJECT SITE.
- ALL SEDIMENT TRAPS/BASINS SHOWN MUST BE FENCED AND WARNING SIGNS POSTED AROUND THEIR PERIMETER IN ACCORDANCE WITH VOL. 1, CHAPTER 7 OF THE HOWARD COUNTY DESIGN MANUAL, STORM DRAINAGE.
- ALL DISTURBED AREAS MUST BE STABILIZED WITHIN THE TIME PERIOD SPECIFIED ABOVE IN ACCORDANCE WITH THE 1994 MARYLAND STANDARDS AND SPECIFICATIONS FOR SOIL EROSION AND SEDIMENT CONTROL FOR PERMANENT SEEDING, SOD, TEMPORARY SEEDING, AND MULCHING (SEC. G). TEMPORARY STABILIZATION WITH MULCH ALONE SHALL ONLY BE DONE WHEN RECOMMENDED SEEDING DATES DO NOT ALLOW FOR PROPER GERMINATION AND ESTABLISHMENT OF GRASSES.
- ALL SEDIMENT CONTROL STRUCTURES ARE TO REMAIN IN PLACE AND ARE TO BE MAINTAINED IN OPERATIVE CONDITION UNTIL PERMITS FOR THEIR REMOVAL HAS BEEN OBTAINED FROM THE HOWARD COUNTY SEDIMENT CONTROL INSPECTOR.
- SITE ANALYSIS:
 

TOTAL AREA OF SITE	=	5,006 ACRES
PHASE 2 AREA DISTURBED (TOTAL)	=	3,42 ACRES
PHASE 2 AREA TO BE ROOFED OR PAVED	=	3,03 ACRES
PHASE 2 AREA TO BE VEGETATIVELY STABILIZED	=	0.39 ACRES
PHASE 2 TOTAL CUT	=	11,500 CU.YDS.
PHASE 2 TOTAL FILL	=	11,500 CU.YDS.
PHASE 2 OPPOSITE WASTE/BORROW AREA LOCATION	=	0 CU.YDS.
- ANY SEDIMENT CONTROL PRACTICE WHICH DISTURBED BY GRADING ACTIVITY FOR PLACEMENT OF UTILITIES MUST BE REPAIRED ON THE SAME DAY OF DISTURBANCE.
- ADDITIONAL SEDIMENT CONTROL MUST BE PROVIDED, IF DETERMINED NECESSARY BY THE HOWARD COUNTY SEDIMENT CONTROL INSPECTOR.
- ON ALL SITES WITH DISTURBED AREAS IN EXCESS OF 2 ACRES, APPROVAL OF THE INSPECTION AGENCY SHALL BE REQUESTED UPON COMPLETION OF INSTALLATION OF PERIMETER EROSION AND SEDIMENT CONTROLS, BUT BEFORE PROCEEDING WITH ANY OTHER EARTH DISTURBANCE OR GRADING, OTHER BUILDING OR GRADING INSPECTION APPROVALS MAY NOT BE AUTHORIZED UNTIL THIS INITIAL APPROVAL BY THE INSPECTION AGENCY IS MADE.
- TRENCHES FOR THE CONSTRUCTION OF UTILITIES IS LIMITED TO THREE PIPE LENGTHS OR THAT WHICH SHALL BE BACK-FILLED AND STABILIZED WITHIN ONE WORKING DAY, WHICHEVER IS SHORTER.
- ALL DEVELOPMENT AND CONSTRUCTION WILL BE DONE IN ACCORDANCE WITH THIS SEDIMENT AND EROSION CONTROL PLAN, AND FURTHER, AUTHORIZE THE RIGHT OF ENTRY FOR PERIODIC ON-SITE EVALUATION BY THE HOWARD COUNTY INSPECTION STAFF OR THEIR AUTHORIZED AGENTS.
- ANY RESPONSIBLE PERSONNEL INVOLVED IN THE CONSTRUCTION PROJECT WILL HAVE A CERTIFICATE OF ATTENDANCE FROM THE MARYLAND DEPARTMENT OF THE ENVIRONMENT'S APPROVED TRAINING PROGRAM FOR THE CONTROL OF SEDIMENT AND EROSION BEFORE BEGINNING THE PROJECT. RESPONSIBLE PERSON ON SITE:
- THE DEVELOPER IS RESPONSIBLE FOR THE ACQUISITION OF ALL EASEMENTS, RIGHTS, RIGHT-OF-WAYS THAT MAY BE REQUIRED FOR THE SEDIMENT AND EROSION CONTROL PRACTICES, STORMWATER MANAGEMENT PRACTICES, AND THE DISCHARGE OF STORMWATER ONTO OR ACROSS ADJACENT OR DOWNSTREAM PROPERTIES INCLUDED IN THIS PLAN. HE IS ALSO RESPONSIBLE FOR THE ACQUISITION OF ALL EASEMENTS, RIGHTS, AND/OR RIGHT-OF-WAYS THAT MAY BE REQUIRED FOR GRADING AND/OR WORK ON ADJACENT PROPERTIES INCLUDED IN THIS PLAN.
- THE SEDIMENT CONTROL APPROVALS ON THIS PLAN EXTEND ONLY TO AREAS AND PRACTICES IDENTIFIED AS PROPOSED WORK.
- THE APPROVAL OF THIS PLAN FOR SEDIMENT AND EROSION CONTROL DOES NOT RELIEVE THE DEVELOPER/CONSULTANT FROM COMPLYING WITH ANY FEDERAL/STATE COUNTY REQUIREMENTS APPURTENANT TO ENVIRONMENTAL ISSUES.

**VEGETATIVE ANALYSIS**

AREAS INCLUDE A COMBINATION OF:

- WILD BLACK CHERRY
- RED MAPLE & SILVER MAPLE
- BLACK LOCUST, GOLDEN ROD
- BOXELDER, ASPEN
- SMOOTH SUMAC, SASSAFRAS
- MULIFLORA ROSE
- JAPANESE HONEYSUCKLE
- RED MULBERRY, GRASSES
- WHITE CEDAR

-ALL OTHER AREAS ARE EITHER MOWED LAWN OR BARE GROUND/GRAVEL.

AS BUILT CERTIFICATE

MICHAEL H. HELFRICH DATE

APPROVED: FOR PUBLIC WATER AND PUBLIC SEWERAGE SYSTEMS, HOWARD COUNTY HEALTH DEPARTMENT.

Mary Sue Baker per for 5/2/99  
COUNTY HEALTH OFFICER MHE DATE

APPROVED: HOWARD COUNTY DEPARTMENT OF PLANNING AND ZONING.

5/10/99 DATE  
DIRECTOR

5/2/99 DATE  
CHIEF, DIVISION OF LAND DEVELOPMENT

4/20/99 DATE  
CHIEF, DEVELOPMENT ENGINEERING DIVISION

DATE NO. REVISION

OWNER / DEVELOPER

MICHAEL STAVLAS  
1726 DORSEY ROAD  
HANOVER, MD. 21076

PROJECT S.D.P. 99-56  
STAVLAS - ROUTE 40 STAVLAS BUSINESS CENTER PHASE II

AREA 2nd MAP 24 PARCEL 68  
TAX ELECTION DISTRICT  
HOWARD COUNTY, MARYLAND

TITLE SOILS, ENVIRONMENTAL ANALYSIS, SEDIMENT CONTROL NOTES AND DETAILS

GAMMA ENGINEERING  
844 WEST STREET  
ANNAPOLIS, MD 21401  
(410) 626-1070

3/21/99  
SEAL OF BARILEND  
MICHAEL H. HELFRICH  
PROFESSIONAL ENGINEER

DESIGNED BY: MHH  
DRAWN BY: APF  
PROJECT NO. SDP 99-56  
DATE: MAR 1999  
SCALE: 1" = 50'  
DRAWING NO. 5 OF 5

SDP-99-56