



PHASE AND SEQUENCE DIAGRAM	SIGNAL HEADS							
	1	2	3	4	5	6	8/9	10/11
PHASE 2+5	R	R	G	G	R	R	DW	DW
PHASE 5 CHANGE	R	R	-Y	G	R	R	DW	DW
PHASE 2+6	G	G	G	G	R	R	DW	DW
PHASE 2+6 CHANGE	Y	Y	Y	Y	R	R	DW	DW
PHASE 2+6 ALT.	G	G	G	G	R	R	WK	WK
PED CLEAR	G	G	G	G	R	R	FL/DW	FL/DW
PHASE 2+6 ALT CHANGE	Y	Y	Y	Y	R	R	DW	DW
PHASE 8	R	R	R	R	G	G	DW	DW
PHASE 8 CHANGE	R	R	R	R	Y	Y	DW	DW
FLASH OPER.	FL/Y	FL/Y	FL/Y	FL/Y	FL/R	FL/R	DARK	DARK

- ### CONSTRUCTION DETAILS
- AA. INSTALL 21' STEEL SIGNAL POLE WITH SINGLE 60' MAST ARM AND TRAFFIC SIGNAL HEADS. (NOTE: 1-2" GALVANIZED 90° ELBOW).
 - A. INSTALL 21' STEEL SIGNAL POLE WITH SINGLE 54' MAST ARM, TRAFFIC SIGNAL HEADS, PEDESTRIAN PUSHBUTTON, AND PEDESTRIAN SIGNAL HEADS. (NOTE: 1-2" GALVANIZED 90° ELBOW).
 - B. INSTALL 27' STEEL SIGNAL POLE WITH SINGLE 40' MAST ARM, SIGNAL HEADS, SIGN, 20' STREET LIGHTING ARM AND 250 WATT HPS (CUTOFF) LUMINAIRE (NATIONAL PARK SERVICE BROWN (FEDERAL PAINT NO. 30045) GE MODEL NO. M4AC2550M2GMC32013) WITH PHOTOELECTRIC CELL. (NOTE: 1-2" GALVANIZED 90° ELBOW).
 - C. INSTALL BASE MOUNTED CABINET/CONTROLLER AND ALL NECESSARY EQUIPMENT FOR AN ELECTRICAL SERVICE. (NOTE: 2-4" GALVANIZED 90° ELBOWS AND 1-2" PVC 90° ELBOW).
 - D. INSTALL HANDBOX.
 - E. INSTALL 1 IN. GALVANIZED STEEL ELECTRICAL CONDUIT FOR LOOP DETECTOR SLEEVE.
 - F. INSTALL 2 IN. GALVANIZED STEEL ELECTRICAL CONDUIT - TRENCHED.
 - G. INSTALL 3 IN. GALVANIZED STEEL ELECTRICAL CONDUIT - PUSHED.
 - J. INSTALL 4 IN. GALVANIZED STEEL ELECTRICAL CONDUIT - TRENCHED.
 - K. INSTALL 6"x4" QUADRUPOLE TYPE VEHICLE LOOP DETECTOR (2-4-2 TURNS).
 - L. INSTALL 2 IN. PVC ELECTRICAL CONDUIT - TRENCHED.
 - M. INSTALL 8' STEEL BREAKAWAY PEDESTAL POLE WITH PEDESTRIAN SIGNALS, PUSHBUTTON AND SIGN. (NOTE: 1-2" GALVANIZED 90° ELBOW).
 - N. PROPOSED PAVEMENT MARKINGS TO BE INSTALLED BY OTHERS AS DIRECTED BY THE ENGINEER.
 - O. INSTALL 6"x6" LOOP DETECTOR (3 TURNS).
 - P. INSTALL 6"x15" LOOP DETECTOR (3 TURNS).
 - Q. INSTALL 3 IN. GALVANIZED STEEL ELECTRICAL CONDUIT - TRENCHED.

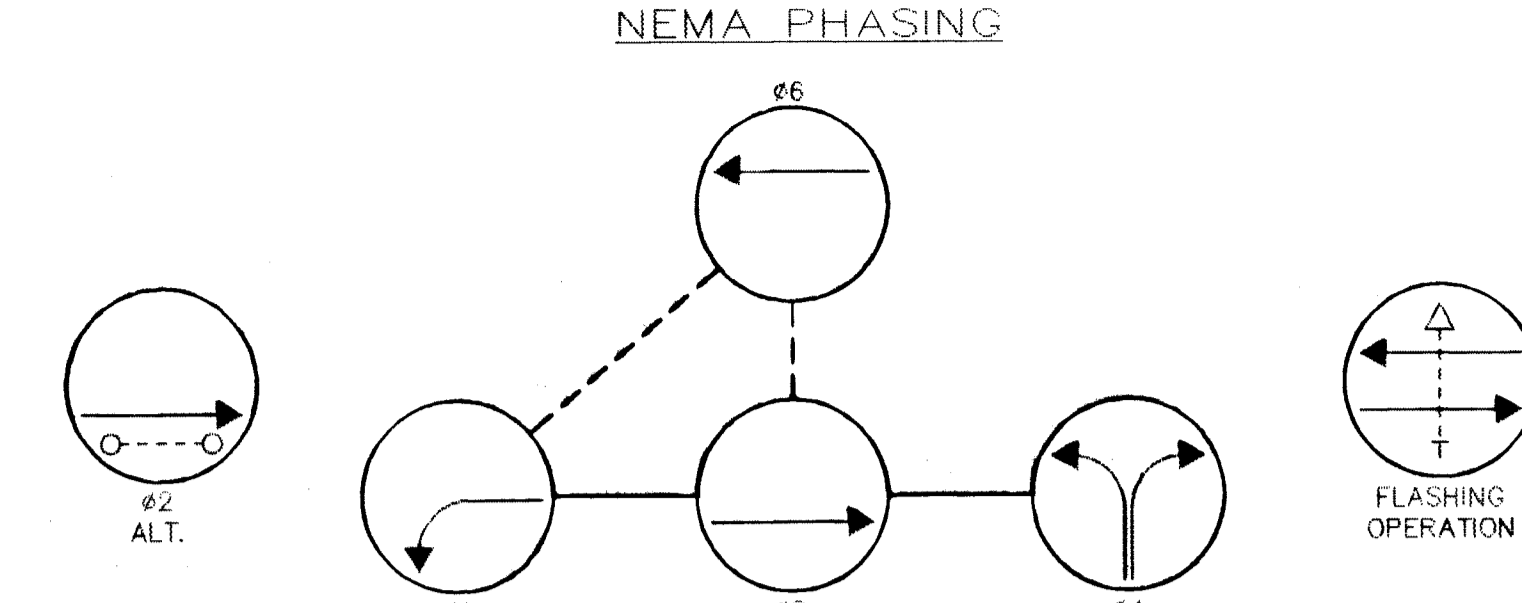


PHASING NOTES:
 1. PHASES ASSOCIATED BY A SOLID LINE WILL NOT OPERATE CONCURRENTLY
 2. PHASES ASSOCIATED BY A DASHED LINE WILL OPERATE CONCURRENTLY

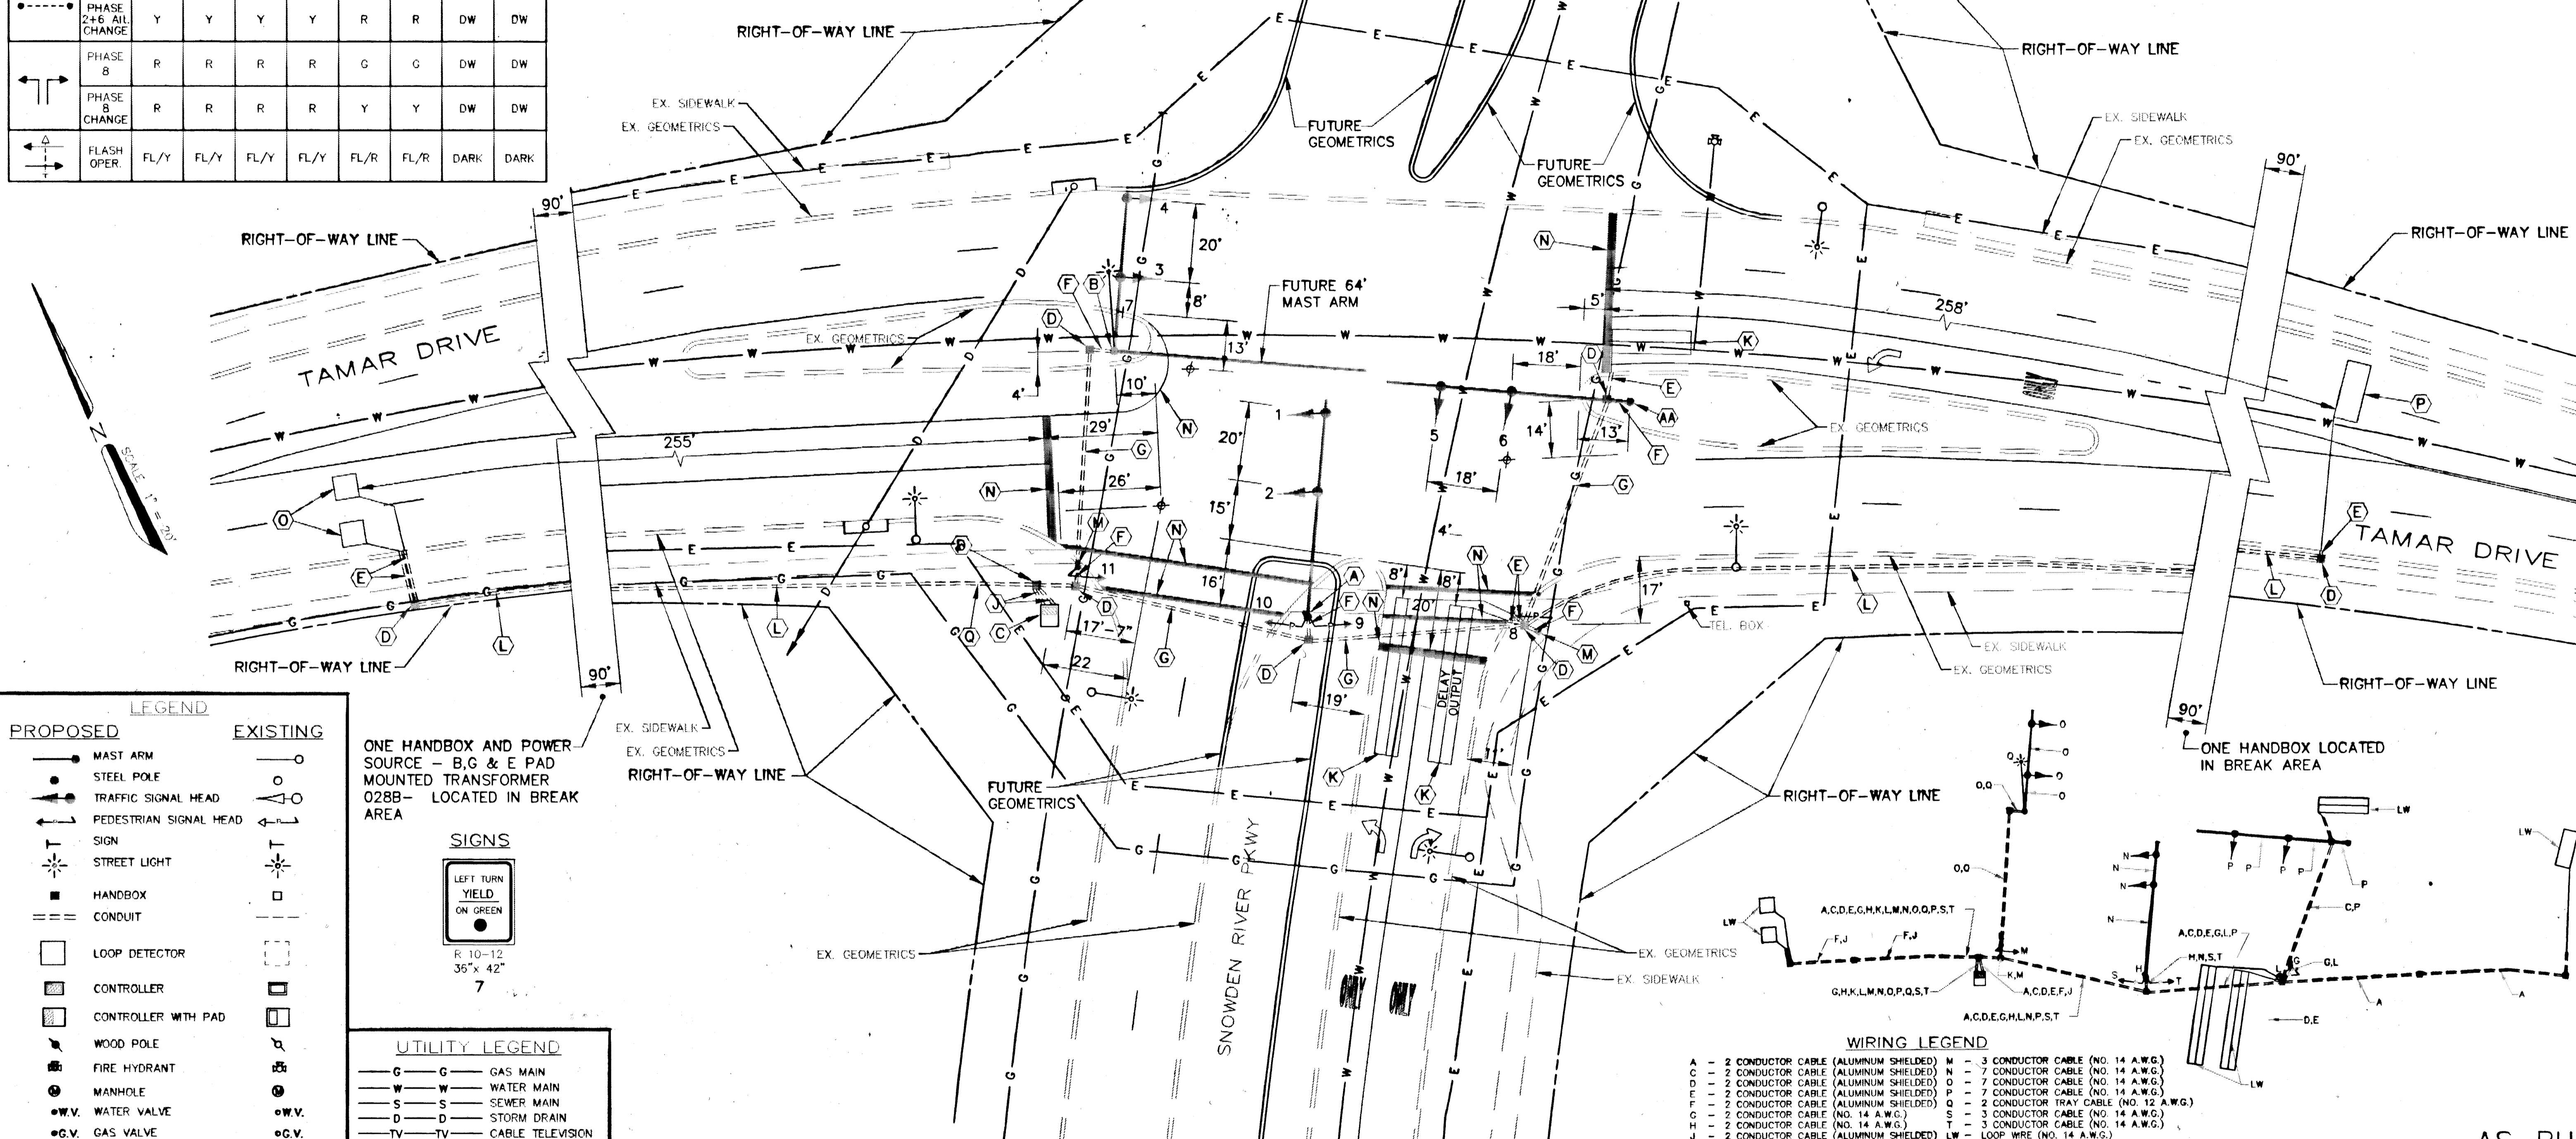

- ### LEGEND
- | PROPOSED | EXISTING |
|--|------------------------|
| MAST ARM | STEEL POLE |
| TRAFFIC SIGNAL HEAD | PEDESTRIAN SIGNAL HEAD |
| SIGN | STREET LIGHT |
| HANDBOX | CONDUIT |
| LOOP DETECTOR | CONTROLLER |
| CONTROLLER WITH PAD | WOOD POLE |
| FIRE HYDRANT | MANHOLE |
| W.V. WATER VALVE | G.V. GAS VALVE |
| GEOMETRICS TO BE CONSTRUCTED BY OTHERS DURING SIGNAL CONSTRUCTION. | |

ONE HANDBOX AND POWER SOURCE - B, G & E PAD MOUNTED TRANSFORMER 028B - LOCATED IN BREAK AREA

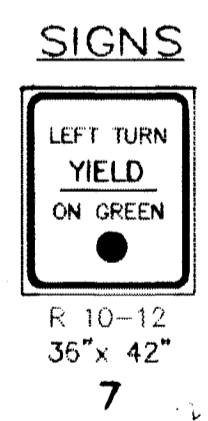

- ### UTILITY LEGEND
- G - GAS MAIN
 - W - WATER MAIN
 - S - SEWER MAIN
 - D - STORM DRAIN
 - TV - CABLE TELEVISION
 - E - ELECTRIC CABLES
 - T - TELEPHONE CABLES
 - A - AERIAL CABLES

- ### WIRING LEGEND
- A - 2 CONDUCTOR CABLE (ALUMINUM SHIELDED)
 - C - 2 CONDUCTOR CABLE (ALUMINUM SHIELDED)
 - D - 2 CONDUCTOR CABLE (ALUMINUM SHIELDED)
 - F - 2 CONDUCTOR CABLE (ALUMINUM SHIELDED)
 - G - 2 CONDUCTOR CABLE (ALUMINUM SHIELDED)
 - H - 2 CONDUCTOR CABLE (NO. 14 A.W.G.)
 - J - 2 CONDUCTOR CABLE (ALUMINUM SHIELDED)
 - K - 2 CONDUCTOR CABLE (NO. 14 A.W.G.)
 - L - 3 CONDUCTOR CABLE (NO. 14 A.W.G.)
 - M - 3 CONDUCTOR CABLE (NO. 14 A.W.G.)
 - N - 7 CONDUCTOR CABLE (NO. 14 A.W.G.)
 - O - 7 CONDUCTOR CABLE (NO. 14 A.W.G.)
 - P - 7 CONDUCTOR CABLE (NO. 14 A.W.G.)
 - Q - 2 CONDUCTOR TRAY CABLE (NO. 12 A.W.G.)
 - S - 3 CONDUCTOR CABLE (NO. 14 A.W.G.)
 - T - 3 CONDUCTOR CABLE (NO. 14 A.W.G.)
 - LW - LOOP WIRE (NO. 14 A.W.G.)

WIRING DIAGRAM

AS-BUILT
7-25-96

DEPARTMENT OF PUBLIC WORKS
HOWARD COUNTY, MARYLAND

James J. Lee 10/23/96
DEPARTMENT OF PUBLIC WORKS
DATE

Robert J. Rupp 10/23/96
CHIEF, BUREAU OF ENGINEERING
DATE

Charles E. Rupp 10/23/96
CHIEF, BUREAU OF HIGHWAYS
DATE

A/E GROUP, INC.
ENGINEERS • PLANNERS
11409 Cronhill Drive
Owings Mills, Maryland 21117
A/E Job No. 94-281-009

DES: J.F.L.				
DRN: J.N.W.				
CHK: E.G.S.				
DATE: 5/96	BY: NO.	REVISION	DATE	600' SCALE MAP NO. DATE:

CAPITAL PROJECT NO.
T-7064FF

PLAN AND DETAILS
Tamar Dr at Snowden River Pkwy
TRAFFIC CONTROL SIGNAL DESIGN
SNOWTAMA

SCALE AS SHOWN
SHEET 1 OF 1

746