


EMERGENCY ACCESS ROAD BETWEEN BLUE STREAM DRIVE AND BUSINESS PARKWAY

CAPITAL PROJECT No. J4244


GENERAL NOTES

1. ALL CONSTRUCTION SHALL BE IN ACCORDANCE WITH THE LATEST STANDARDS AND SPECIFICATIONS OF HOWARD COUNTY AND THE MARYLAND STATE HIGHWAY ADMINISTRATIONS STANDARDS AND SPECIFICATIONS, WHERE APPLICABLE.
2. CONTRACTOR SHALL NOTIFY THE DEPARTMENT OF PUBLIC WORKS CONSTRUCTION INSPECTION DIVISION AT (410) 313-1880 AT LEAST FIVE WORKING DAYS PRIOR TO START OF WORK.
3. THE EXISTING TOPOGRAPHY IS TAKEN FROM A FIELD RUN SURVEY PREPARED BY HOWARD COUNTY'S SURVEY DIVISION ON FEBRUARY 2016.
4. CLEARING SHALL BE LIMITED TO THE LOD (LIMIT OF DISTURBANCE) AS SHOWN ON THE SEDIMENT AND EROSION CONTROL PLAN. GRADING SHALL BE DONE IN SUCH A MANNER AS TO PROVIDE POSITIVE DRAINAGE. CONTRACTOR SHALL SEED AND MULCH ALL DISTURBED AREAS UNLESS OTHERWISE NOTED IN THESE PLANS.
5. ANY DAMAGE CAUSED BY THE CONTRACTOR TO EXISTING PUBLIC RIGHT OF WAY, PAVING CURB AND GUTTER, UTILITIES, ETC. SHALL BE CORRECTED AT THE CONTRACTORS EXPENSE.
6. CONTRACTOR SHALL NOTIFY MISS UTILITY AT 1 (800) 257-7777 AT LEAST 48 HRS PRIOR TO ANY EXCAVATION WORK BEING DONE. THE CONTRACTOR SHALL CONTACT THE FOLLOWING UTILITIES AT LEAST 5 DAYS PRIOR TO BEGINNING ANY WORK:

BUREAU OF UTILITIES, HOWARD COUNTY:	(410) 313-4900
BGE GAS DIVISION:	(410) 291-5834
BGE ELECTRIC:	(410) 855-6958
VERIZON:	(410) 224-9980
COMCAST:	(410) 427-9600
7. PROJECT SITE SHALL BE CONTROLLED IN ACCORDANCE WITH THE HOWARD SOIL CONSERVATION DISTRICT STANDARD EROSION AND SEDIMENT CONTROL PLAN FOR MINOR EARTH DISTURBANCE.

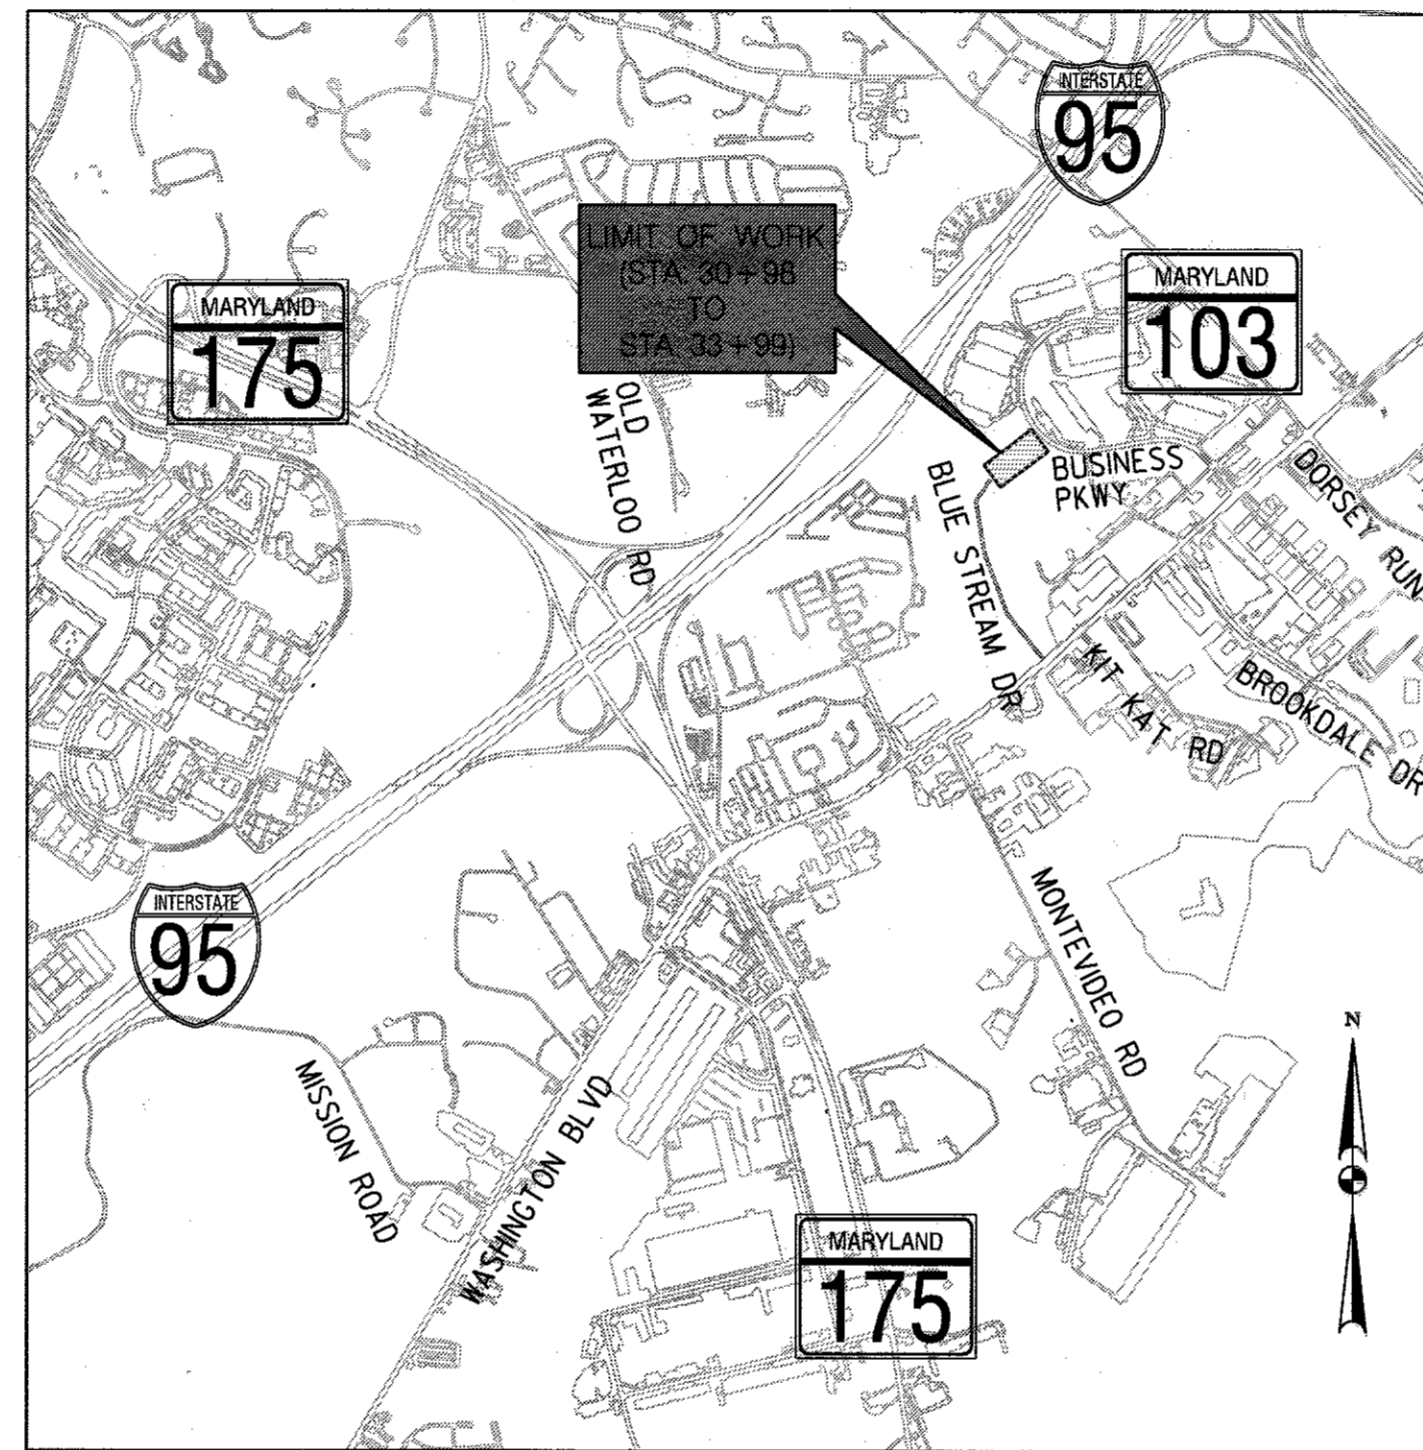

VICINITY MAP

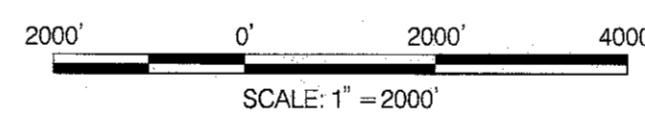

SHEET INDEX

TITLE SHEET	1
GEOMETRY SHEET	2
PLAN AND ROAD PROFILE	3
STORM DRAIN PROFILES AND DETAILS	4
EROSION AND SEDIMENT CONTROL PLAN	5
EROSION AND SEDIMENT CONTROL NOTES	6-7
CROSS SECTIONS	8-9

OWNER'S CERTIFICATION:

I hereby certify that any clearing, grading, construction, or development will be done pursuant to this approved erosion and sediment control plan, including inspecting and maintaining controls, and that the responsible personnel involved in the construction project will have a Certificate of Training at a Maryland Department of the Environment (MDE) approved training program for the control on erosion and sediment prior to beginning the project. I certify right-of-entry for periodic on-site evaluation by Howard County, the Howard Soil Conservation District and/or MDE.

Owner's Signature _____ Date _____

Printed Name & Title _____

DESIGN CERTIFICATION

I hereby certify that this plan has been designed in accordance with current Maryland erosion and sediment control laws, regulations, and standards, that it represents a practical and workable plan based on my personal knowledge of the site, and that it was prepared in accordance with the requirements of the Howard Soil Conservation District.

Brandon H. Love _____ 10-19-16
 Designer's Signature Date


Printed Name Brandon H. Love MD Registration No. 27045
 (P.E., R.L.S., or R.L.A. (circle one))

AS-BUILT FEB 2017

DEPARTMENT OF PUBLIC WORKS HOWARD COUNTY, MARYLAND	
<p><i>Holger Semrau</i> 10-21-16 DIRECTOR OF PUBLIC WORKS DATE</p> <p><i>Miriam</i> 10/24/16 CHIEF, BUREAU OF HIGHWAYS DATE</p>	<p><i>Thomas S. Butler</i> 10-19-16 CHIEF, BUREAU OF ENGINEERING DATE</p> <p><i>Brandon H. Love</i> 10-19-16 CHIEF, TRANSPORTATION AND SPECIAL PROJECTS DIVISION DATE</p>



PROFESSIONAL CERTIFICATION: I HEREBY CERTIFY THAT THESE DOCUMENTS WERE PREPARED OR APPROVED BY ME, AND THAT I AM A DULY LICENSED PROFESSIONAL ENGINEER UNDER THE LAWS OF THE STATE OF MARYLAND. LICENSE NO. 22045, EXPIRATION DATE: 01/24/2018

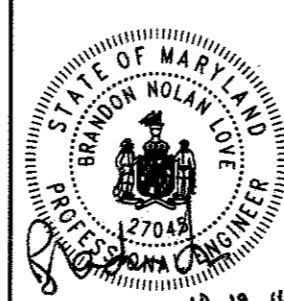

DES:	BNL				
DRN:	BNL				
CHK:	SDS				
DATE:	10/2016	BY	NO.	REVISION	DATE

TITLE SHEET

600' SCALE MAP NO. _____ BLOCK NO. _____

EMERGENCY ACCESS ROAD BETWEEN
BLUE STREAM DRIVE AND BUSINESS PKWY

CAPITAL PROJECT J4244

ELECTION DISTRICT NO. 2
ELKRIDGE, MARYLAND

SCALE:
AS SHOWN


SHEET
1 OF 9

SURVEY CONTROL DATA			
Point	North	East	Elevation
101	552,685.45	1,376,550.23	245.86
102	552,620.31	1,376,525.98	245.31
103	552,599.11	1,376,360.82	243.96
121	552,517.42	1,376,258.30	239.73

BLUE STREAM DRIVE


BUSINESS PARKWAY

ACCESS ROAD

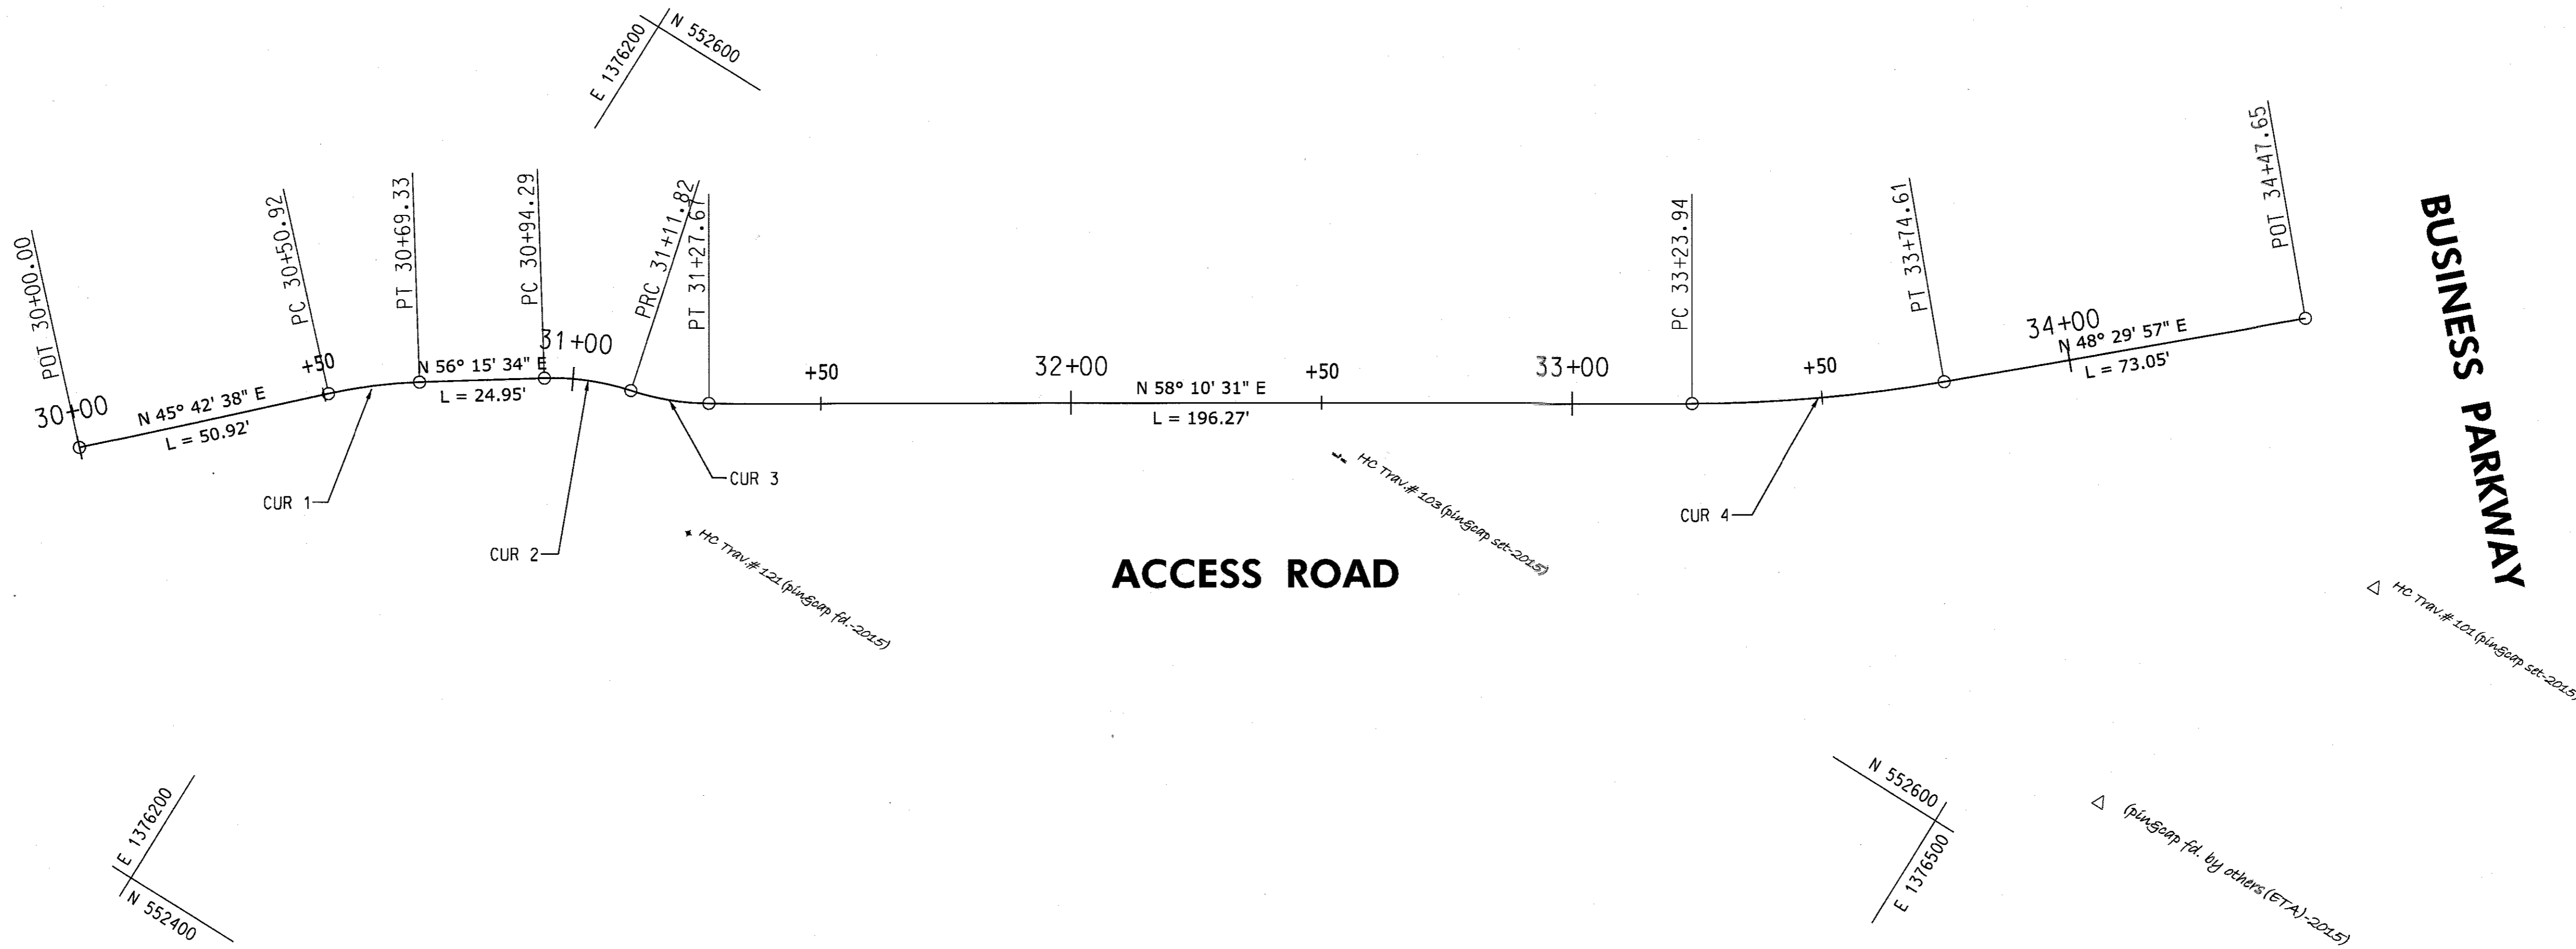

BASELINE COORDINATES		
Station	North	East
POT 30+00.00	552,467.48	1,376,146.11
PC 30+50.92	552,503.04	1,376,182.57
PT 30+69.33	552,514.61	1,376,196.85
PC 30+94.29	552,528.47	1,376,217.60
PRC 31+27.67	552,541.58	1,376,248.13
PT 33+23.94	552,645.08	1,376,414.90
PC 33+74.61	552,675.30	1,376,455.49
PT 34+47.65	552,723.70	1,376,510.20
POT 31+11.82	552,535.48	1,376,233.57

CURVE DATA						
Curve	Delta	Degree	Radius	Tangent	Length	External
CUR 1	10° 32' 55.44" (RT)	57° 17' 44.81"	100.00'	9.23	18.41	0.43
CUR 2	20° 5' 12.01" (RT)	114° 35' 29.61"	50.00'	8.86	17.53	0.78
CUR 3	18° 10' 14.56" (LT)	114° 35' 29.61"	50.00'	8.00	15.86	0.64
CUR 4	9° 40' 34.09" (LT)	19° 5' 54.94"	300.00'	25.39	50.66	1.07

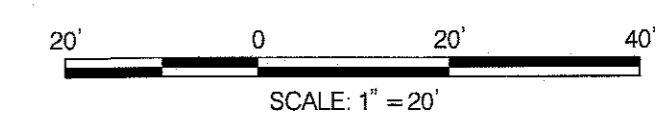

AS-BUILT FEB 2017

DEPARTMENT OF PUBLIC WORKS
HOWARD COUNTY, MARYLAND

William S. Evans 10-21-16
DIRECTOR OF PUBLIC WORKS DATE

Thomas B. Stottle 10/19/16
CHIEF, BUREAU OF ENGINEERING DATE

Robert L. ... 10-19-16
CHIEF, TRANSPORTATION AND SPECIAL PROJECTS DIVISION DATE

PROFESSIONAL CERTIFICATION: I HEREBY CERTIFY THAT THESE DOCUMENTS WERE PREPARED OR APPROVED BY ME, AND THAT I AM A DULY LICENSED PROFESSIONAL ENGINEER UNDER THE LAWS OF THE STATE OF MARYLAND. LICENSE NO. 22045, EXPIRATION DATE: 01/24/2018

DES:	BNL				
DRN:	BNL				
CHK:	SDS				
DATE:	10/2016	BY	NO	REVISION	DATE

GEOMETRY SHEET

800' SCALE MAP NO. _____ BLOCK NO. _____

EMERGENCY ACCESS ROAD BETWEEN BLUE STREAM DRIVE AND BUSINESS PKWY
CAPITAL PROJECT J4244
ELECTION DISTRICT NO. 2
ELKCRIDGE, MARYLAND

SCALE: AS SHOWN
SHEET 2 OF 9



RESIDENTIAL DRIVEWAY ENTRANCE, R-6.05
800 SF ACCESS ROAD - STA. 33+75 TO STA. 33+99
PERMEABLE INTERLOCKING CONC. PAVERS
3,945 SF ACCESS ROAD - STA. 30+98 TO STA. 33+75

LIMIT OF WORK
J4244
BLUE STREAM DR ACCESS RD
STA. 30+97.90

LIMIT OF WORK
J4244
BLUE STREAM DR ACCESS RD
STA. 33+99.30

LEGEND

- EX. PROPERTY LINE
- EX. 1' CONTOURS
- 245 EX. 5' CONTOURS
- Ex. 15" SD EX. STORM DRAIN
- EX. WOODSLINE
- EX. WATER LINE
- ▨ EX. PICP (PERMEABLE INTERLOCKING CONC. PAVEMENT)
- 15" RCP PROPOSED STORM DRAIN
- ⊙ PROPOSED STORM DRAIN MANHOLE
- - - - - LIMITS OF CUT
- - - - - LIMITS OF FILL
- ▨ PICP (PERMEABLE INTERLOCKING CONC. PAVEMENT)
- ▨ PROPOSED CONCRETE

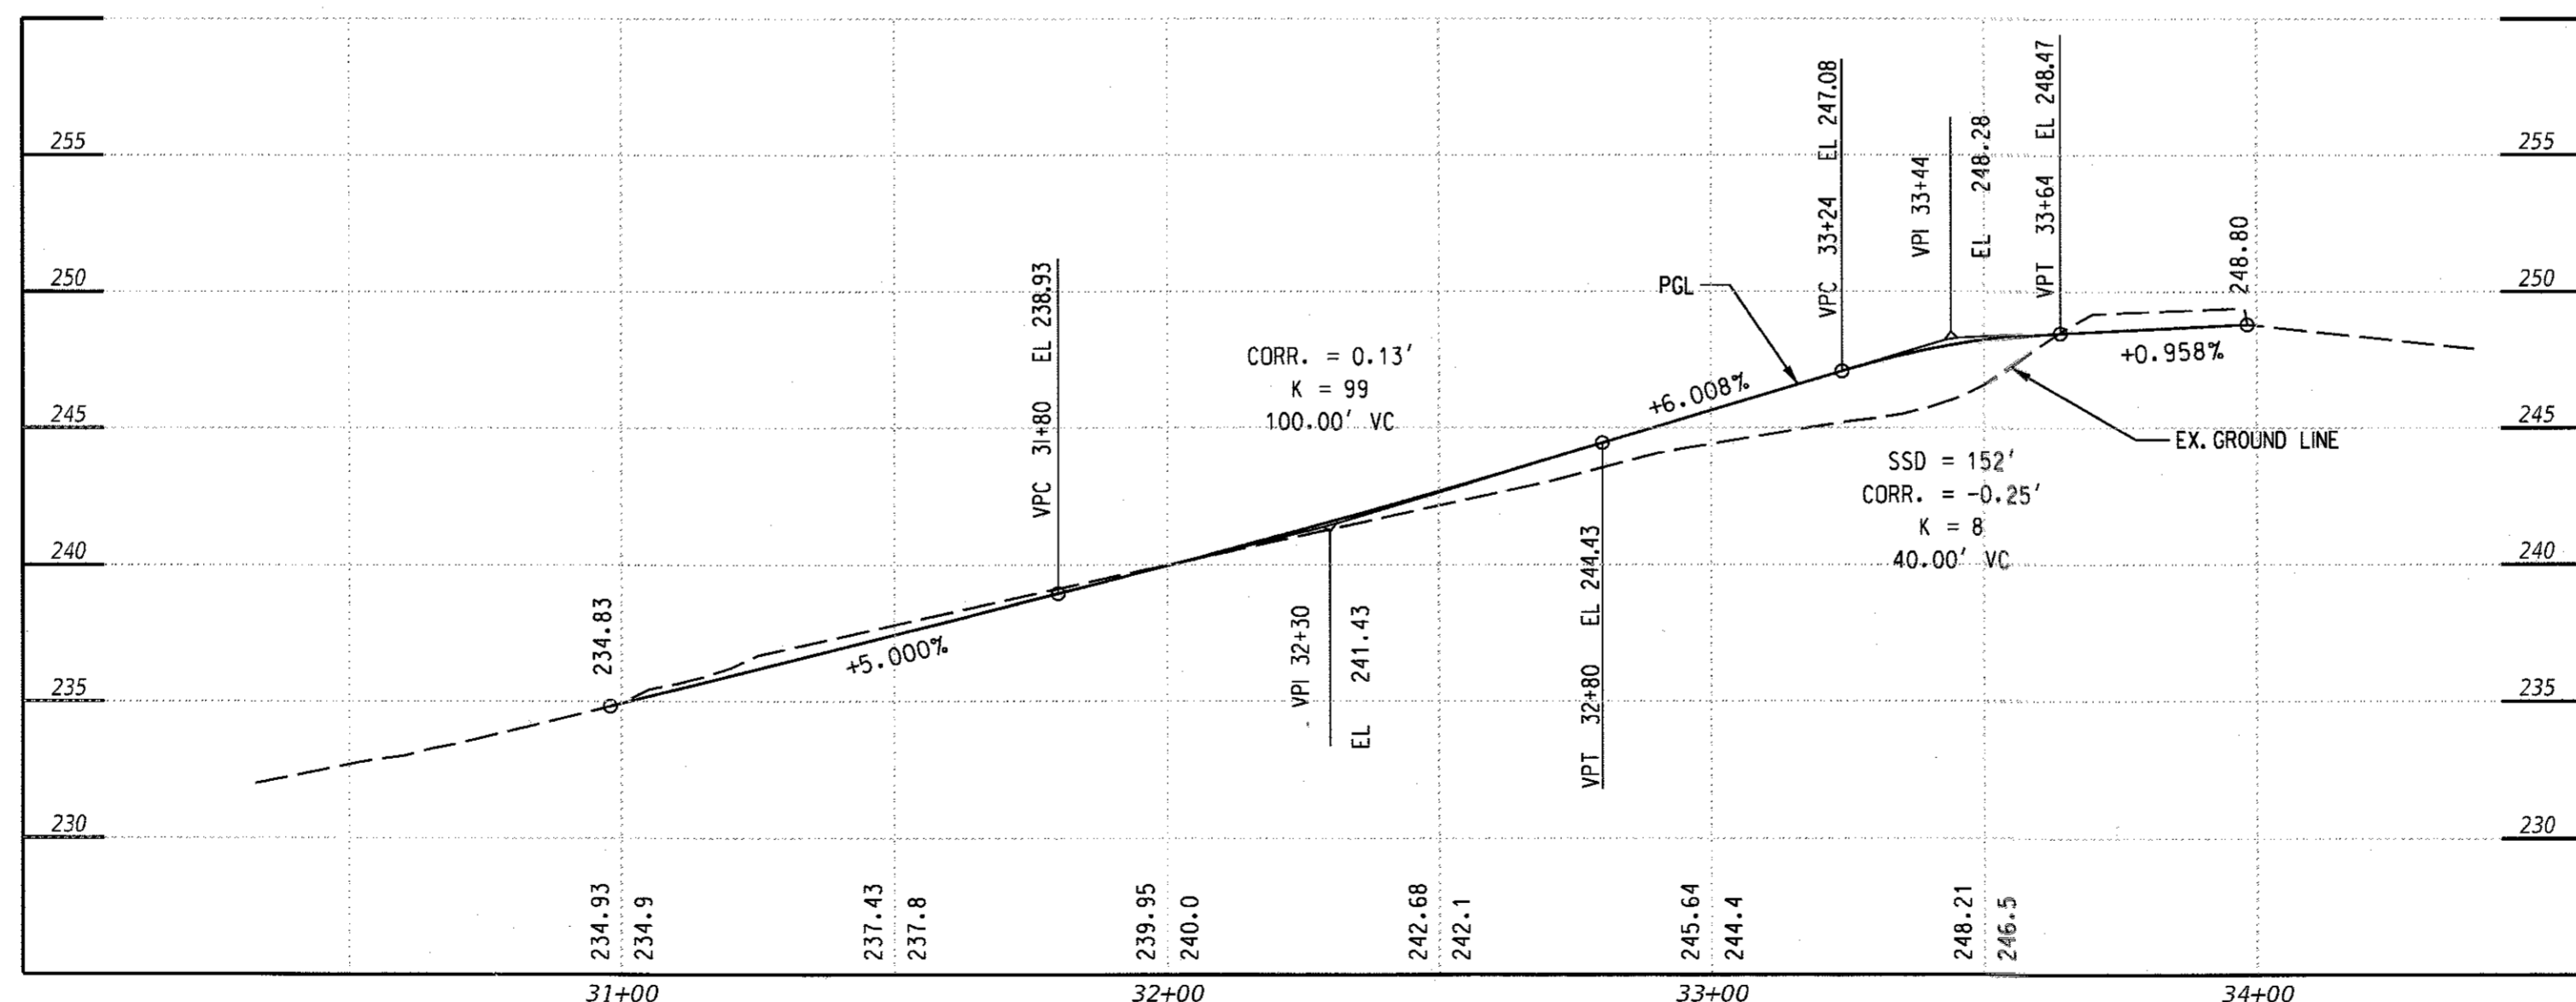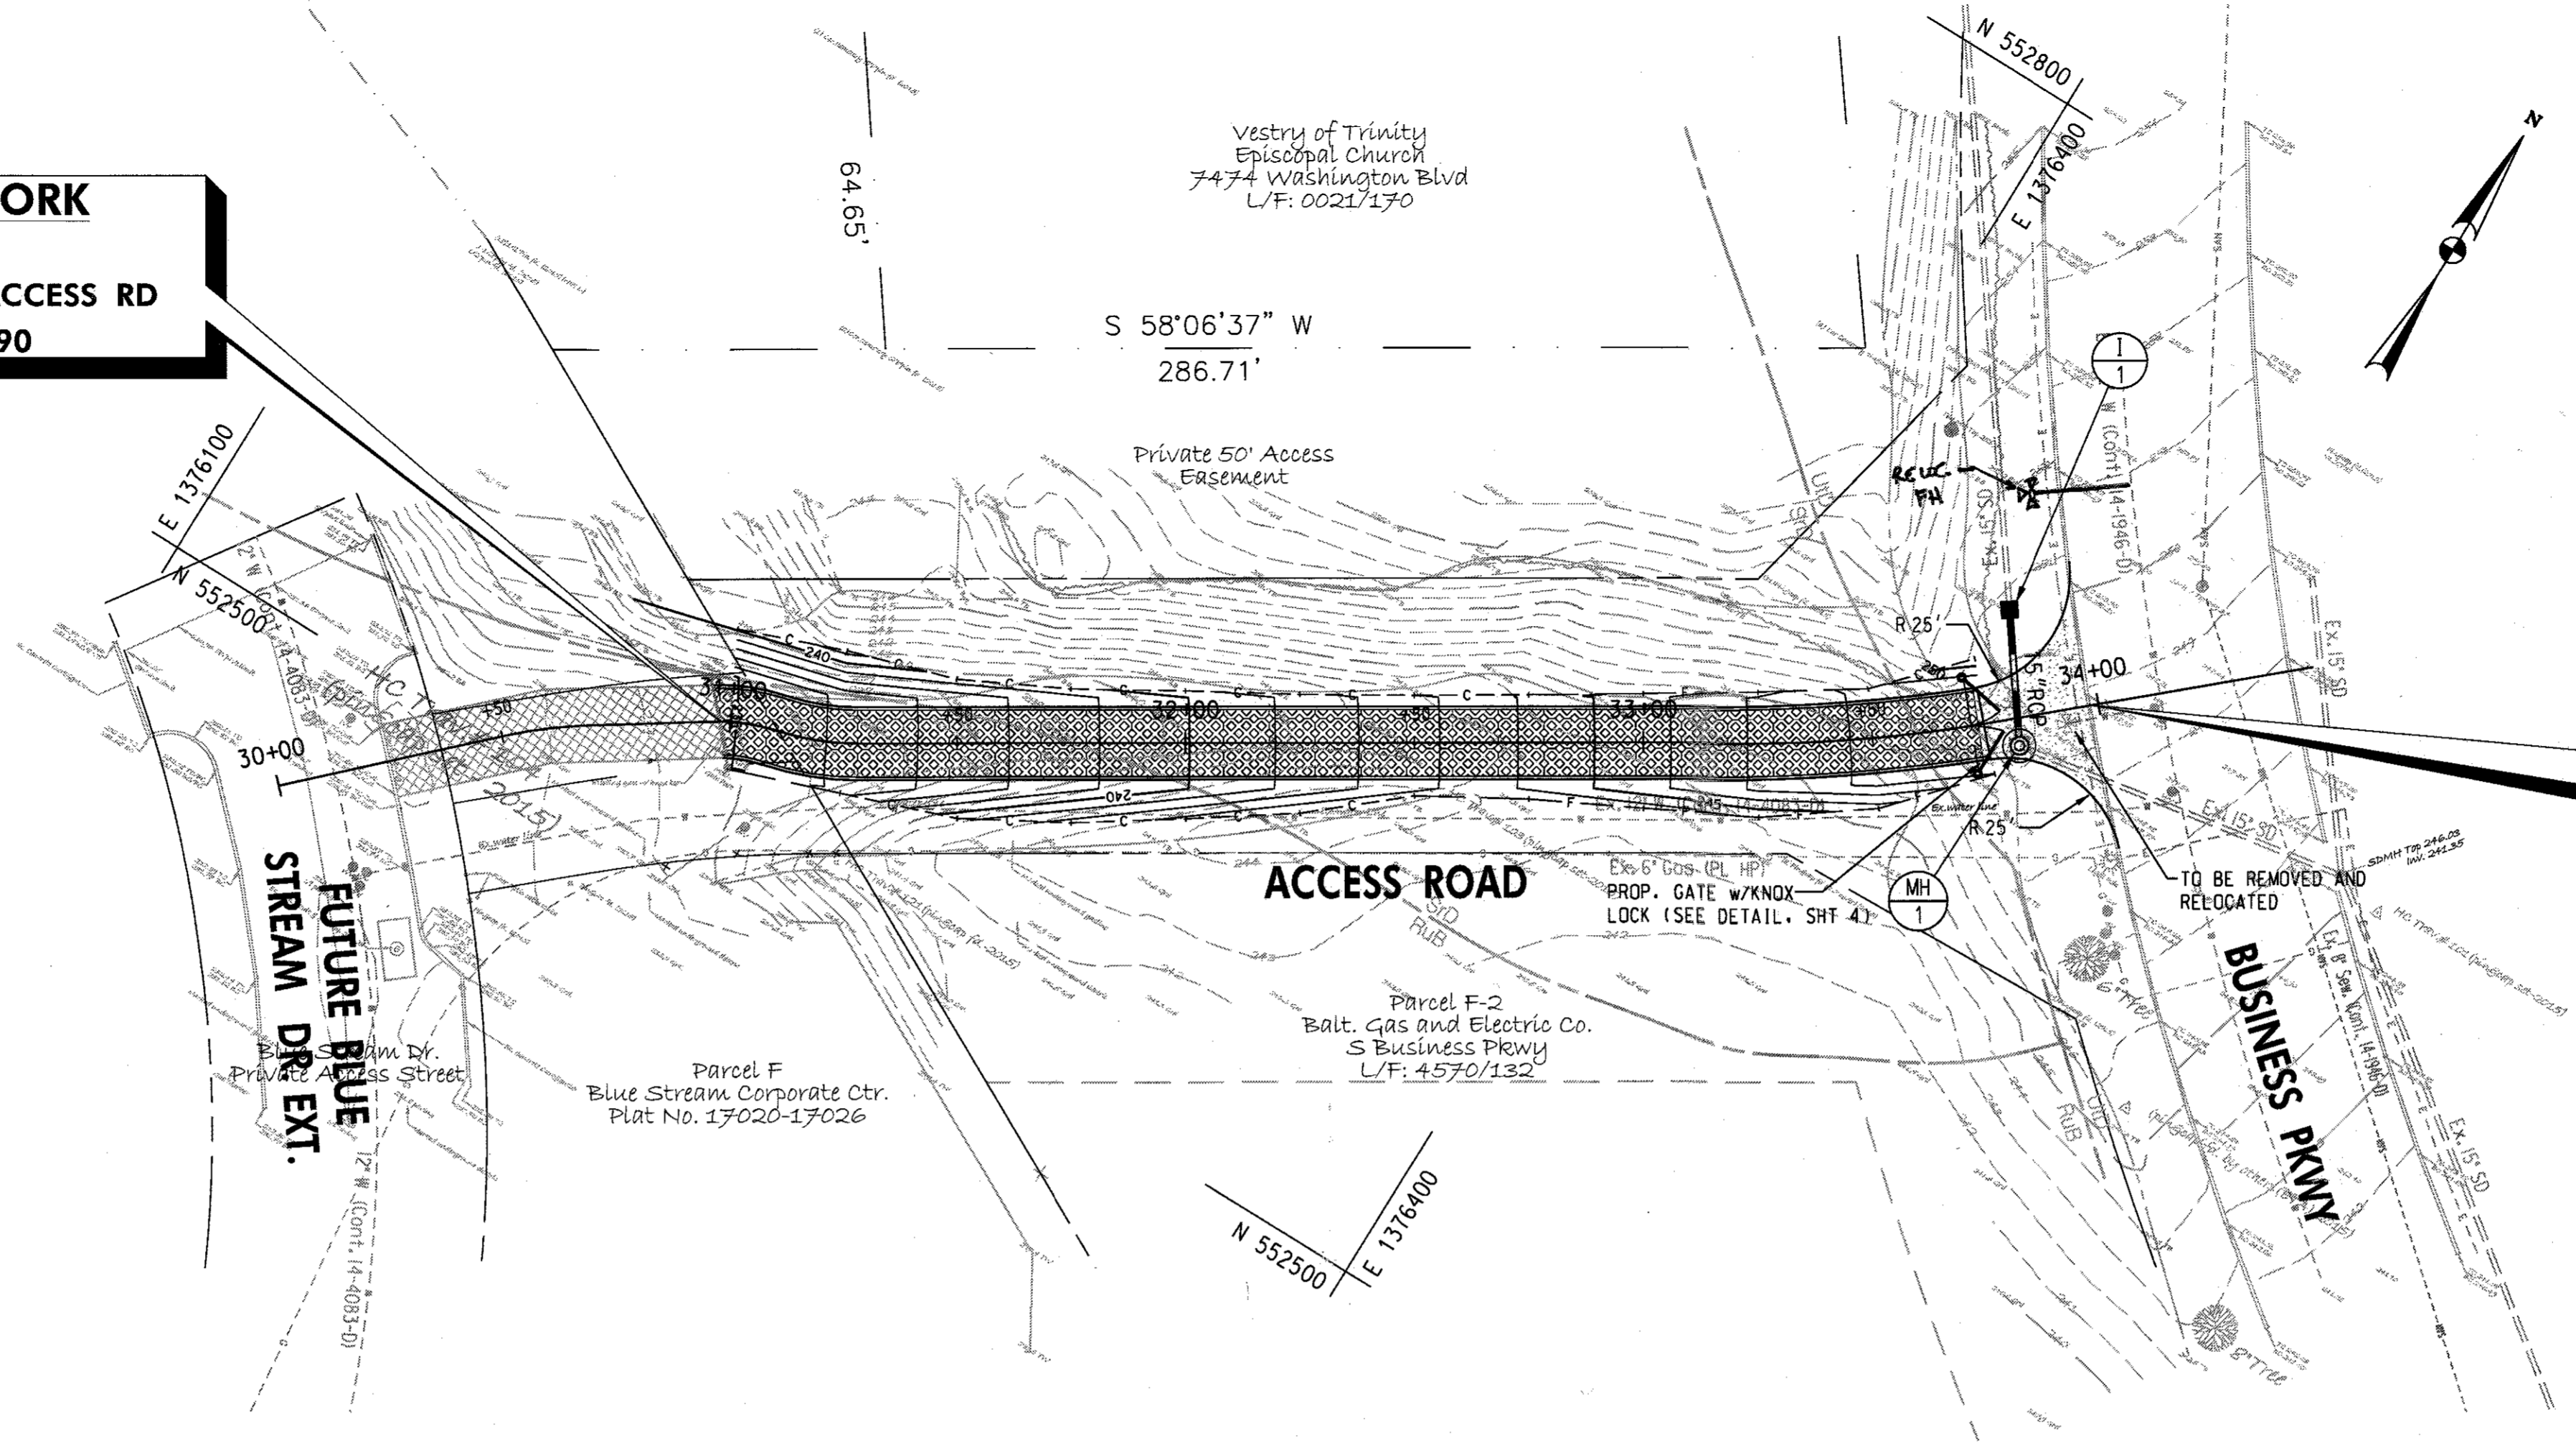

ACCESS ROAD PROFILE


DEPARTMENT OF PUBLIC WORKS
 HOWARD COUNTY, MARYLAND

Allyson S. ... 10-27-16
 DIRECTOR OF PUBLIC WORKS

Thomas E. ... 10-19-16
 CHIEF, BUREAU OF ENGINEERING

... 10-19-16
 CHIEF TRANSPORTATION AND SPECIAL PROJECTS DIVISION

PROFESSIONAL CERTIFICATION: I HEREBY CERTIFY THAT THESE DOCUMENTS WERE PREPARED OR APPROVED BY ME, AND THAT I AM A DULY LICENSED PROFESSIONAL ENGINEER UNDER THE LAWS OF THE STATE OF MARYLAND. LICENSE NO. 22045, EXPIRATION DATE: 01/24/2018

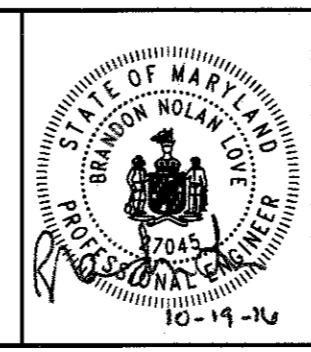

DES:	BNL
DRN:	BNL
CHK:	SDS
DATE:	10/2016
BY:	NO
NO:	
REVISION:	
DATE:	

Roadway Plan and Profile

60' SCALE MAP NO. _____ BLOCK NO. _____

AS-BUILT FEB 2017


EMERGENCY ACCESS ROAD BETWEEN BLUE STREAM DRIVE AND BUSINESS PKWY

CAPITAL PROJECT J4244


ELECTION DISTRICT NO. 2
 ELKCRIDGE, MARYLAND

SCALE: AS SHOWN

SHEET 3 OF 9

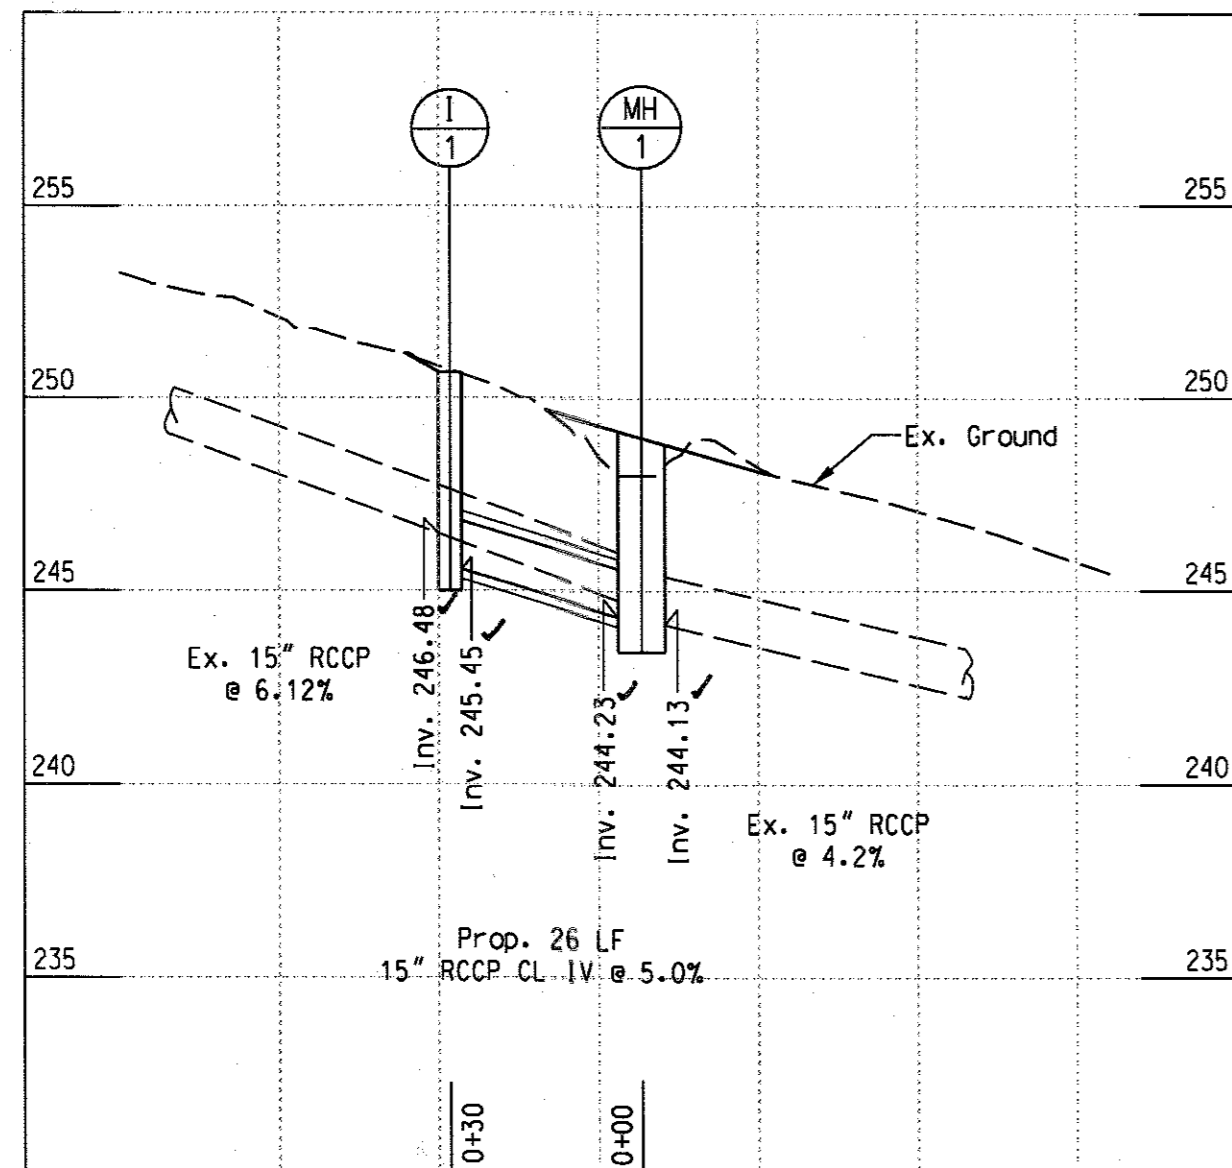

**STORM DRAIN PROFILE
(MH-1 TO I-1)**
SCALE: HORIZ.: 1"=30'
VERT.: 1"=5'

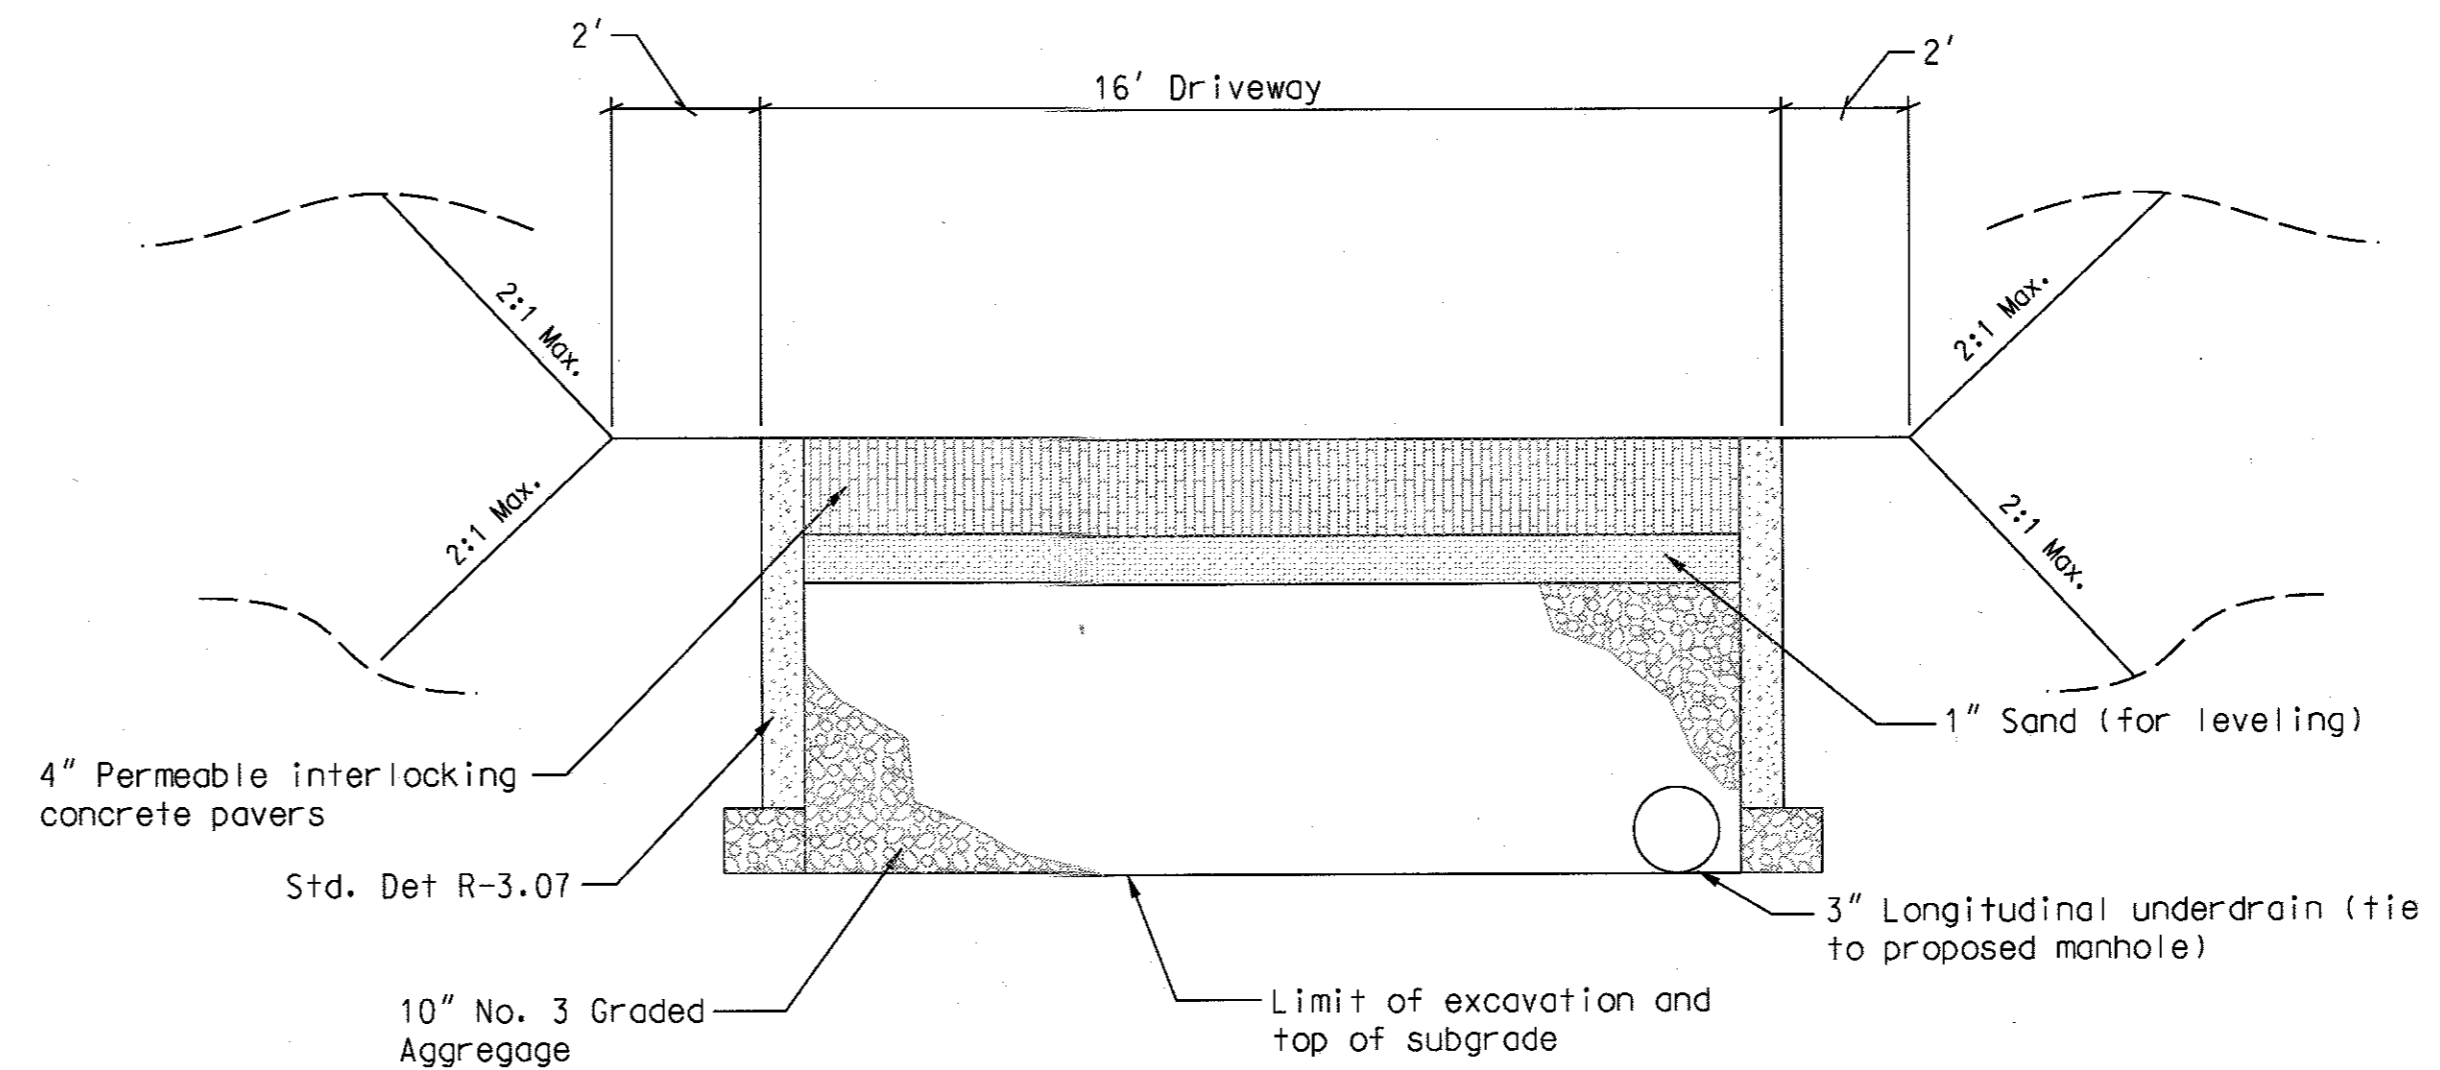



**ACCESS ROAD
TYPICAL SECTION**
SCALE: NTS

STRUCTURE SCHEDULE						
Struct.	Std. Det.	Station	Offset	North	East	Top Elevation
I-1	D-4.14	33+84.11	-21.86	552,697.97	1,376,448.12	250.68
MH-1	G-5.12	33+81.37	6.10	552,675.21	1,376,464.59	248.98

- Note:
1. Work point location for inlet is the midpoint of exterior inlet wall at intersection to new RCCP.
 2. Work point location for manhole is the center of the structure.

GENERAL NOTES:

- 1 PROPERTY OWNER/MANAGEMENT PADLOCK
- 2 FIRE DEPT. PADLOCK SHALL BE ACCESSIBLE FROM BOTH SIDES OF GATE. ORDER FORMS FOR KNOX PADLOCKS ARE AVAILABLE THROUGH EITHER THE ACCESS OR GATE INSPECTORS IN FIRE PREVENTION
- 3 APPROVED FIRE LANE SIGNS (R7-6) WITH REFLECTIVE BACKGROUND, PLACED BACK TO BACK AND FASTENED ON ALL 4 CORNERS. 5/8" X 1 5/8" MOUNTING STRAPS
- 4 THE MINIMUM OVERALL WIDTH OF THE GATE OPENING SHALL BE 20 FT
- 5 WELD MODIFIED L-BRACKET TO GATE FRAME. ROUND ALL EDGES. (TYPICAL 2 PLACES)
- 6 LOCKING BAR LENGTH IS DETERMINED BY THE FRAME WIDTH AND THE GAP WIDTH BETWEEN THE 2 GATES. REMOVE ALL SHARP EDGES / ROUND ALL CORNERS

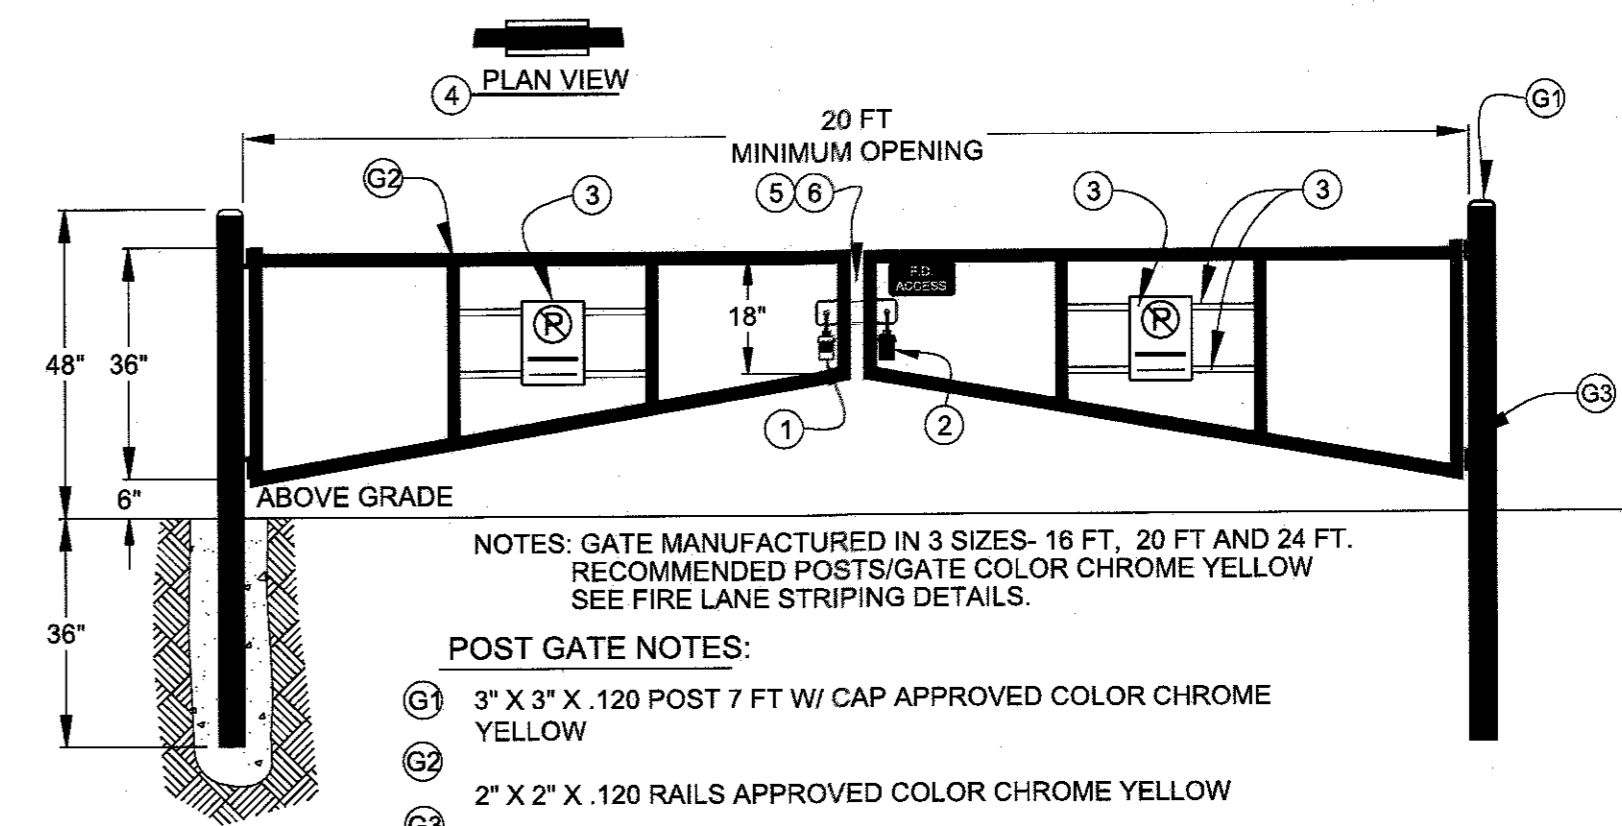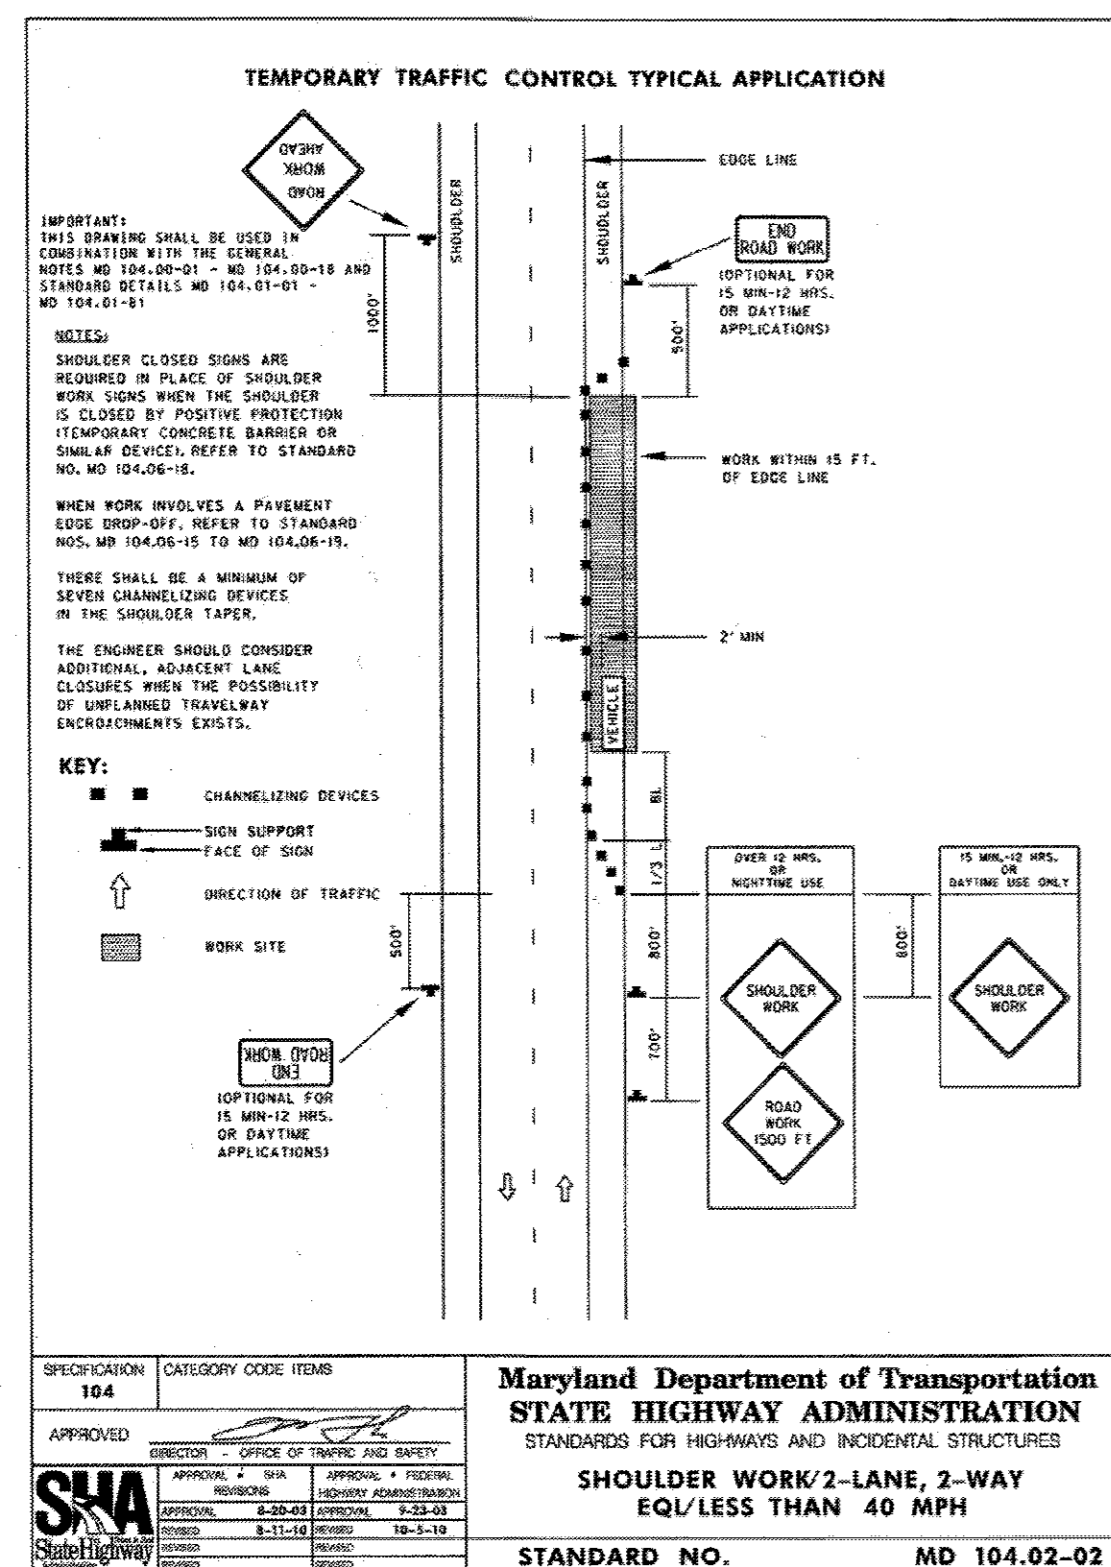

NOTES: GATE MANUFACTURED IN 3 SIZES- 16 FT, 20 FT AND 24 FT.
RECOMMENDED POSTS/GATE COLOR CHROME YELLOW
SEE FIRE LANE STRIPING DETAILS.

POST GATE NOTES:

- 1 3" X 3" X .120 POST 7 FT W/ CAP APPROVED COLOR CHROME YELLOW
- 2 2" X 2" X .120 RAILS APPROVED COLOR CHROME YELLOW
- 3 5" HEAVY DUTY BARREL HINGES (TYPICAL 4 PLACES)

**ACCESS DRIVEWAY GATE WITH
KNOX LOCK**
SCALE: NTS

AS-BUILT FEB 2017


DEPARTMENT OF PUBLIC WORKS
HOWARD COUNTY, MARYLAND

Thomas P. Butler 10-21-16
CHIEF, BUREAU OF ENGINEERING

Thomas P. Butler 10-19-16
CHIEF, TRANSPORTATION AND SPECIAL PROJECTS DIVISION



"PROFESSIONAL CERTIFICATION: I HEREBY CERTIFY THAT THESE DOCUMENTS WERE PREPARED OR APPROVED BY ME, AND THAT I AM A DULY LICENSED PROFESSIONAL ENGINEER UNDER THE LAWS OF THE STATE OF MARYLAND. LICENSE NO. 22205. EXPIRATION DATE: 01/22/2018"

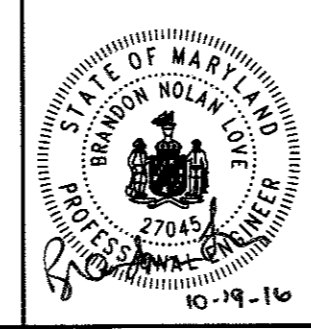

DES:	BNL				
DRN:	BNL				
CHK:	SDS				
DATE:	10/2016	BY:	NO.	REVISION	DATE

**Storm Drain Profile
and Details**

**EMERGENCY ACCESS ROAD BETWEEN
BLUE STREAM DRIVE AND BUSINESS PKWY**

CAPITAL PROJECT J4244

ELECTION DISTRICT NO. 2
ELK RIDGE, MARYLAND

SCALE:
AS SHOWN

SHEET
4 OF 9


SITE ANALYSIS INFORMATION

1. General Site Data
 - a. Proposed use: New access road
 - b. Area of steep slopes 15% and greater: 0.15 ac.
 - c. Total site area: 0.49 ac.
 - d. Total limit of disturbance: 0.28 ac.
 - e. Total impervious area: 0.10 ac.
2. There are no regulated streams, wetlands, 100 year floodplains or associated buffers, as described in the Howard County Code 16.116(c) within the site.
3. There are no specimen trees present on the site.
4. During construction, this plan shall meet the 2011 Maryland Standards & Specifications for Soil Erosion and Sediment Control or applicable Howard SCD requirements.

STANDARD SEDIMENT CONTROL NOTE

1. A pre-construction meeting must occur with the Howard County Department of Public Works, Construction Inspection Division (CID), 410-313-1855 after the future LOD and protected areas are marked clearly in the field. A minimum of 48 hour notice to CID must be given at the following stages:
 - a. Prior to the start of earth disturbance,
 - b. Upon completion of the installation of perimeter erosion and sediment controls, but before proceeding with any other earth disturbance or grading,
 - c. Prior to the start of another phase of construction or opening of another grading unit,
 - d. Prior to the removal or modification of sediment control practices.

Other building or grading inspection approvals may not be authorized until this initial approval by the inspection agency is made. Other related state and federal permits shall be referenced, to ensure coordination and to avoid conflicts with this plan.

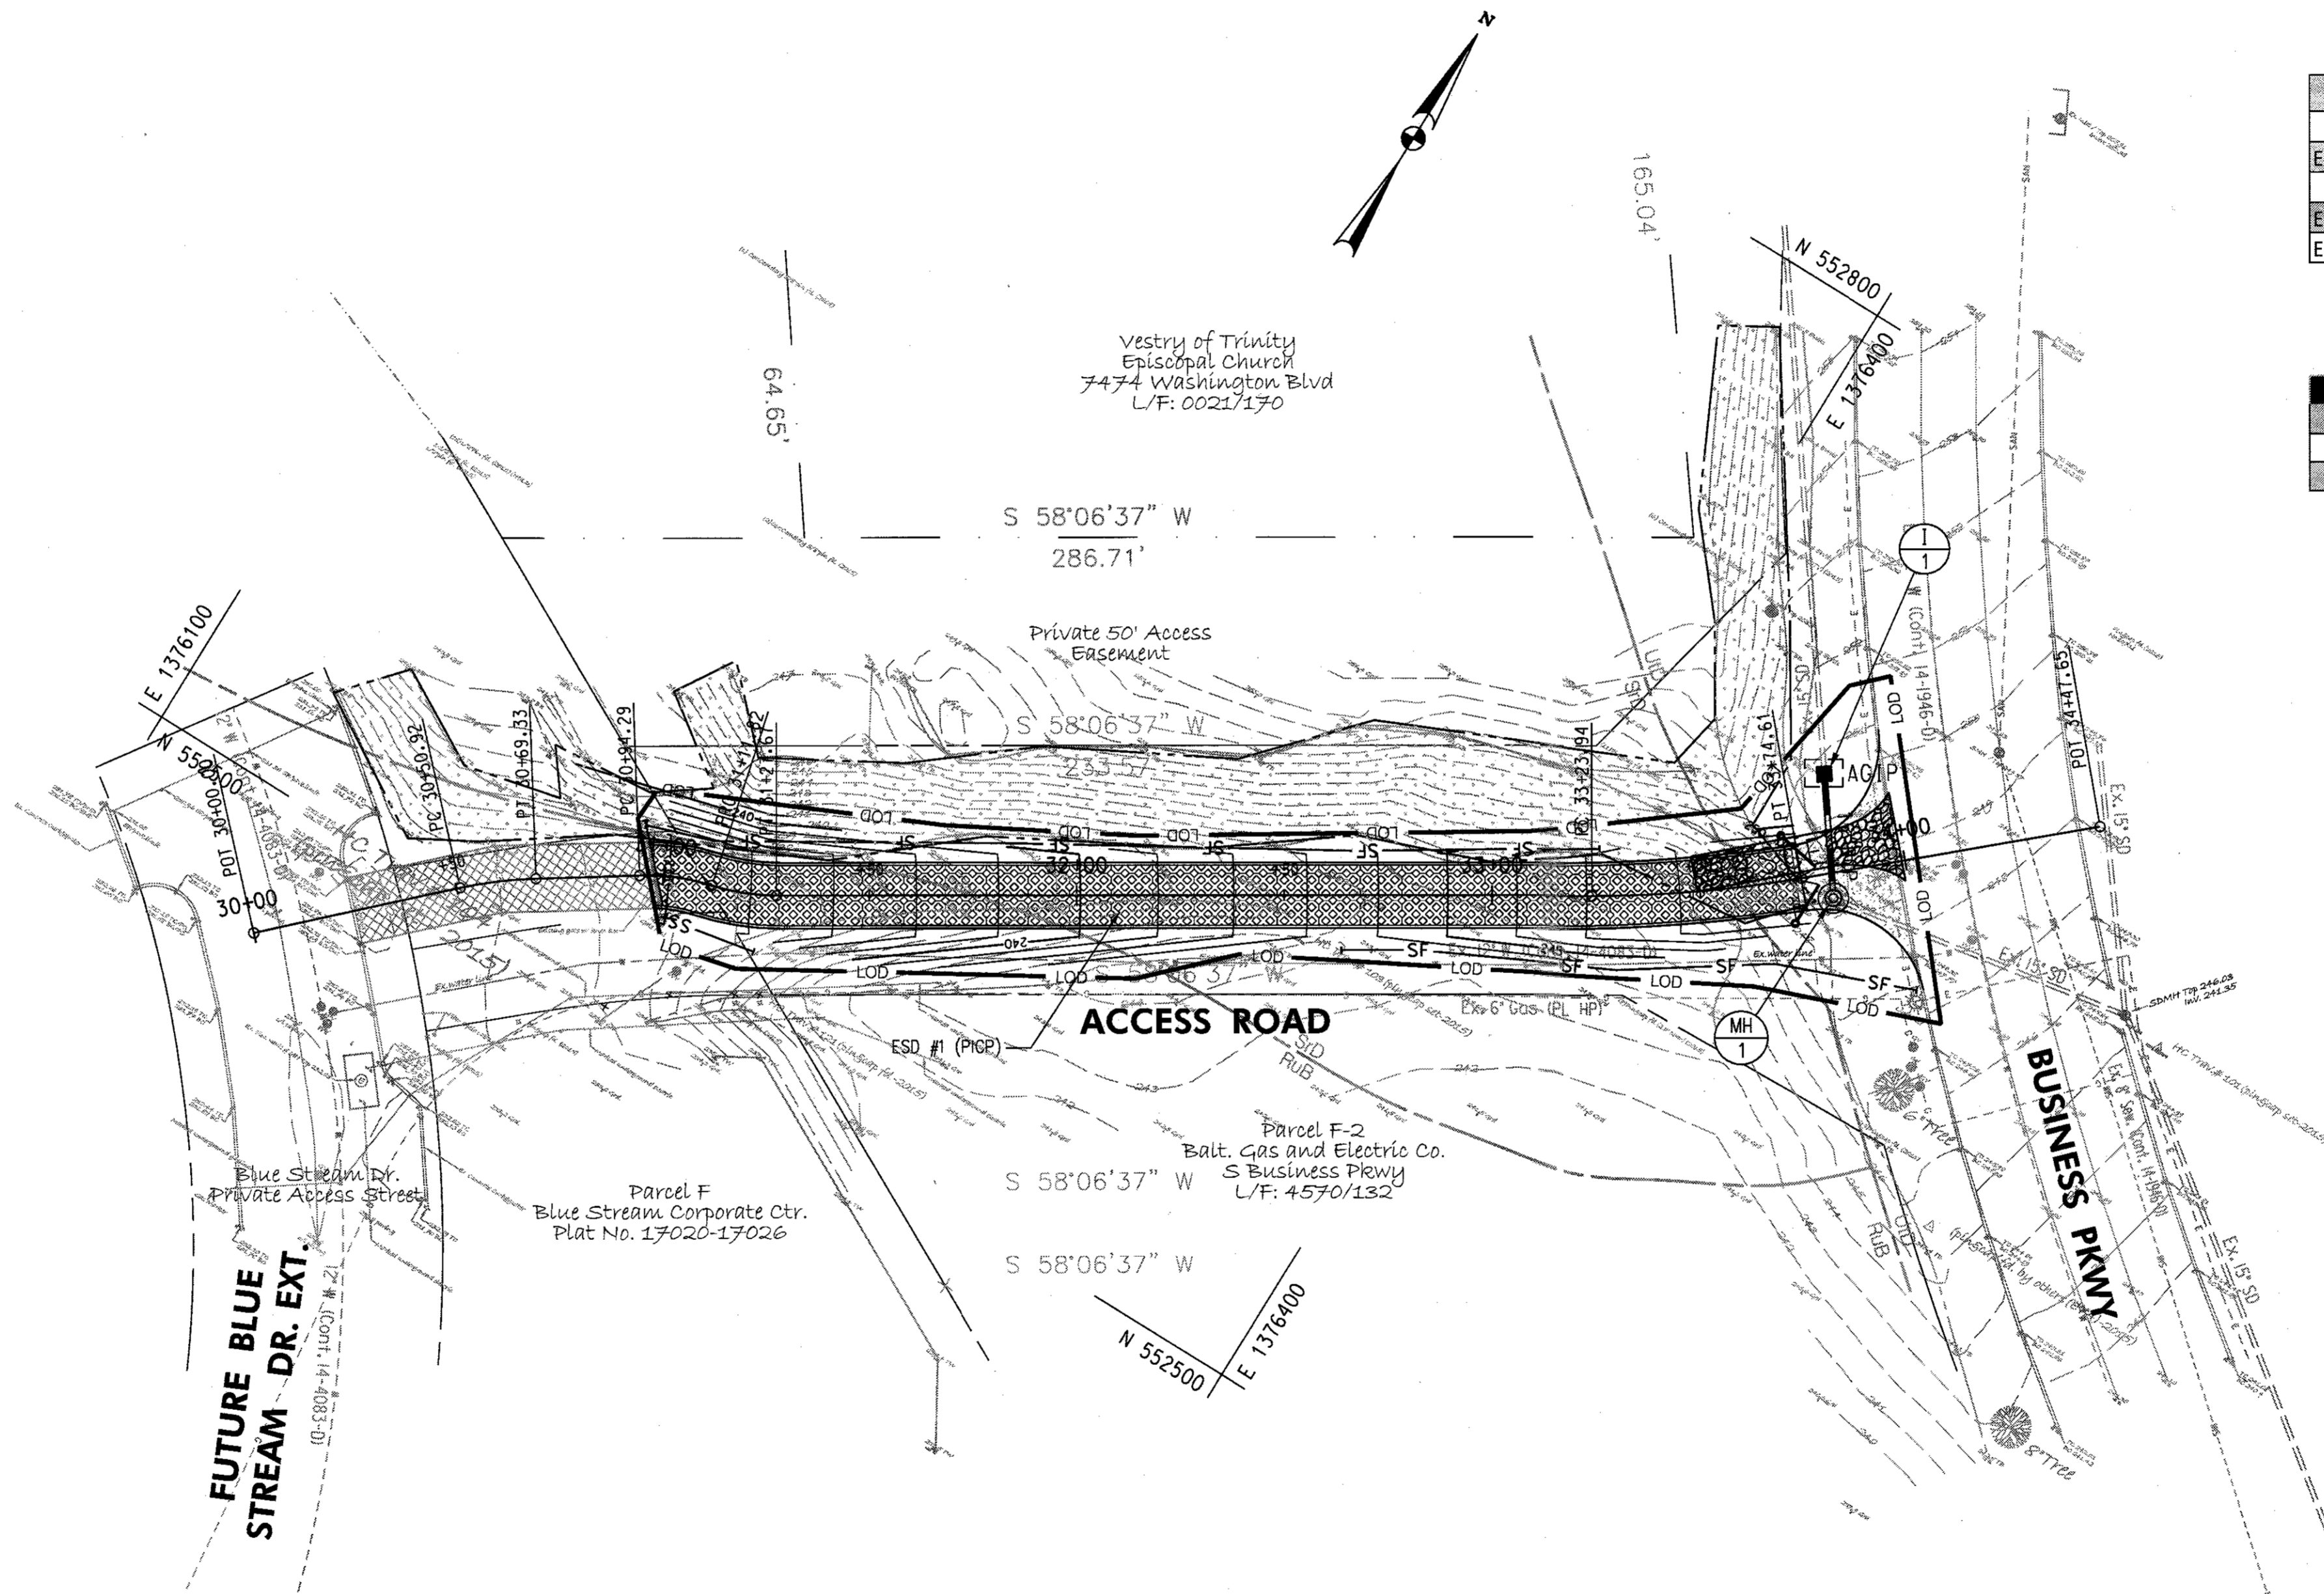

LEGEND

- EX. PROPERTY LINE
- EX. 1' CONTOURS
- 245 EX. 5' CONTOURS
- EX. 15" SD EX. STORM DRAIN
- EX. WOODSLINE
- EX. WATER LINE
- STEEP SLOPES
- 250 PROPOSED CONTOUR
- LOD PROPOSED LIMIT OF DISTURBANCE
- 15" RCP PROPOSED STORM DRAIN
- PROPOSED STORM DRAIN MANHOLE
- DF DIVERSION FENCE
- SF SILT FENCE
- SSF SUPER SILT FENCE
- AGIP AT GRADE INLET PROTECTION
- PICP (PERMEABLE INTERLOCKING CONC. PAVEMENT)
- STABILIZED CONSTRUCTION ENTRANCE

App. B.4 Specifications for ESD practices

B.4.B Specifications for Permeable Pavements

1. Permeable Interlocking Concrete Pavements (PICP)

Paver Blocks - Blocks should be either 3" in. or 4 in. thick, and meet ASTM C 936 or CSA A231.2 requirements. Applications should have 20% or more (40% preferred) of the surface area open. Installation should follow manufacturer's instructions, except that infill and base course materials and dimensions specified in this Appendix shall be followed.


Infill Materials and Leveling Course -- Openings shall be filled with ASTM C-33 graded sand or sandy loam. PICP blocks shall be placed on a one-inch thick leveling course of ASTM C-33 sand.

Base Course - The base course shall be AASHTO No. 3 or 4 course aggregate with an assumed open pore space of 30% (n = 0.30).

ESD Practice Summary		
ESD #1	Area or Volume	Type
ESD #1	3,800 sq. ft.	Permeable Pavement (PICP)
ESDv Req'd	400 cu. ft.	
ESDv Provided	715 cu. ft.	

Map Unit Symbol	Map Unit Name	Hydrologic Soil Group	K Vale (Kw)
Utd	Urban Land-Udorthents, 0 to 15% slopes	D	0.28
SrD	Sassafras and Croom Soils, 10 to 15% slopes	B	0.37
RuB	Russett and Beltsville Soils, 2 to 5% slopes	C	0.24

OWNER / DEVELOPER
 HOWARD COUNTY GOVERNMENT
 9250 BENDIX ROAD
 COLUMBIA, MARYLAND 21045
 PH. (410) 313-6159

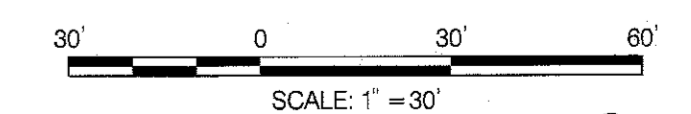

AS-BUILT FEB 2017

DEPARTMENT OF PUBLIC WORKS
 HOWARD COUNTY, MARYLAND

Helen S. Evans 10.28.16
 DIRECTOR OF PUBLIC WORKS DATE

Thomas E. Butler 10.17.16
 CHIEF, BUREAU OF ENGINEERING DATE

Michael 10/24/2016
 CHIEF, BUREAU OF HIGHWAYS DATE

Paul 10-19-16
 CHIEF, TRANSPORTATION AND SPECIAL PROJECTS DIVISION DATE



"PROFESSIONAL CERTIFICATION: I HEREBY CERTIFY THAT THESE DOCUMENTS WERE PREPARED OR APPROVED BY ME, AND THAT I AM A DULY LICENSED PROFESSIONAL ENGINEER UNDER THE LAWS OF THE STATE OF MARYLAND. LICENSE NO. 23245; EXPIRATION DATE: 01/24/2018"



DES:	BNL				
DRN:	BNL				
CHK:	SDS				
DATE:	10/2016	BY	NO.	REVISION	DATE

Erosion and Sediment Control Plan

600' SCALE MAP NO. _____ BLOCK NO. _____

EMERGENCY ACCESS ROAD BETWEEN BLUE STREAM DRIVE AND BUSINESS PKWY

CAPITAL PROJECT J4244

ELECTION DISTRICT NO. 2
 ELKCRIDGE, MARYLAND

SCALE: AS SHOWN

SHEET 5 OF 9

B-4 STANDARDS AND SPECIFICATIONS FOR VEGETATIVE STABILIZATION

Definition
Using vegetation as cover to protect exposed soil from erosion.

Purpose
To promote the establishment of vegetation on exposed soil.

Conditions Where Practice Applies
On all disturbed areas not stabilized by other methods. This specification is divided into sections on incremental stabilization; soil preparation, soil amendments and topsoiling; seeding and mulching; temporary stabilization; and permanent stabilization.

Effects on Water Quality and Quantity
Stabilization practices are used to promote the establishment of vegetation on exposed soil. When soil is stabilized with vegetation, the soil is less likely to erode and more likely to allow infiltration of rainfall, thereby reducing sediment loads and runoff to downstream areas. Planting vegetation in disturbed areas will have an effect on the water budget, especially on volumes and rates of runoff, infiltration, evaporation, transpiration, percolation, and groundwater recharge. Over time, vegetation will increase organic matter content and improve the water holding capacity of the soil and subsequent plant growth. Vegetation will help reduce the movement of sediment, nutrients, and other chemicals carried by runoff to receiving waters. Plants will also help protect groundwater supplies by assimilating those substances present within the root zone. Sediment control practices must remain in place during grading, seedbed preparation, seeding, mulching, and vegetative establishment.

Adequate Vegetative Establishment
Inspect seeded areas for vegetative establishment and make necessary repairs, replacements, and reseedings within the planting season.

1. Adequate vegetative stabilization requires 95 percent groundcover.
2. If an area has less than 40 percent groundcover, restabilize following the original recommendations for lime, fertilizer, seedbed preparation, and seeding.
3. If an area has between 40 and 94 percent groundcover, over-seed and fertilize using half of the rates originally specified.
4. Maintenance fertilizer rates for permanent seeding are shown in Table B.6.

B-4-1 STANDARDS AND SPECIFICATIONS FOR INCREMENTAL STABILIZATION

Definition
Establishment of vegetative cover on cut and fill slopes.

Purpose
To provide timely vegetative cover on cut and fill slopes as work progresses.

Conditions Where Practice Applies
Any cut or fill slope greater than 15 feet in height. This practice also applies to stockpiles.

Criteria

- A. Incremental Stabilization - Cut Slopes**
1. Excavate and stabilize cut slopes in increments not to exceed 15 feet in height. Prepare seedbed and apply seed and mulch on all cut slopes as the work progresses.
 2. Construction sequence example (Refer to Figure B.1):
 - a. Construct and stabilize all temporary swales or dikes that will be used to convey runoff around the excavation.
 - b. Perform Phase 1 excavation, prepare seedbed, and stabilize.
 - c. Perform Phase 2 excavation, prepare seedbed, and stabilize. Overseed Phase 1 areas as necessary.
 - d. Perform final phase excavation, prepare seedbed, and stabilize. Overseed previously seeded areas as necessary.

Note: Once excavation has begun the operation should be continuous from grubbing through the completion of grading and placement of topsoil (if required) and permanent seed and mulch. Any interruptions in the operation or completing the operation out of the seeding season will necessitate the application of temporary stabilization.

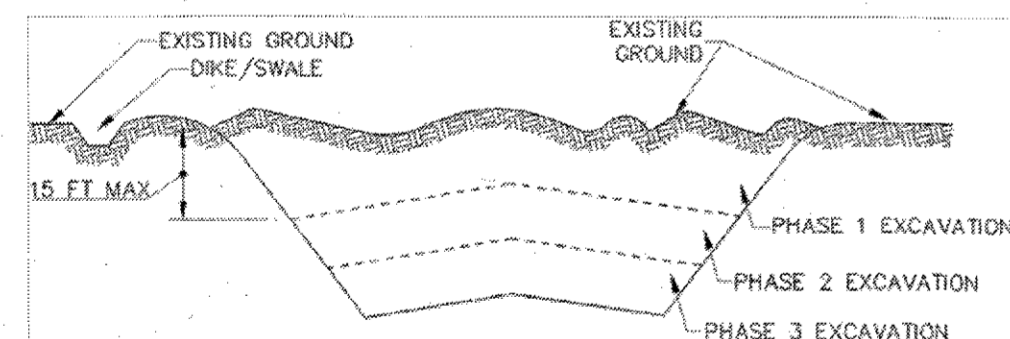


Figure B.1: Incremental Stabilization - Cut

B. Incremental Stabilization - Fill Slopes

1. Construct and stabilize fill slopes in increments not to exceed 15 feet in height. Prepare seedbed and apply seed and mulch on all slopes as the work progresses.
2. Stabilize slopes immediately when the vertical height of a lift reaches 15 feet, or when the grading operation ceases as prescribed in the plans.
3. At the end of each day, install temporary water conveyance practice(s), as necessary, to intercept surface runoff and convey it down the slope in a non-erosive manner.
4. Construction sequence example (Refer to Figure B.2):
 - a. Construct and stabilize all temporary swales or dikes that will be used to divert runoff around the fill. Construct silt fence on low side of fill unless other methods shown on the plans address this area.
 - b. At the end of each day, install temporary water conveyance practice(s), as necessary, to intercept surface runoff and convey it down the slope in a non-erosive manner.
 - c. Place Phase 1 fill, prepare seedbed, and stabilize.
 - d. Place Phase 2 fill, prepare seedbed, and stabilize.
 - e. Place final phase fill, prepare seedbed and stabilize. Overseed previously seeded areas as necessary.

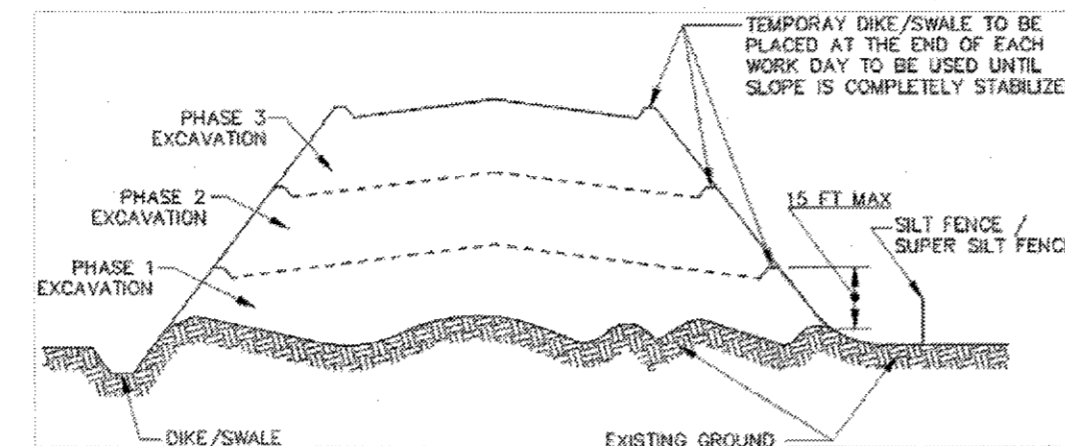


Figure B.2: Incremental Stabilization - Fill

B-4-2 STANDARDS AND SPECIFICATIONS FOR SOIL PREPARATION, TOPSOILING, AND SOIL AMENDMENTS

Definition
The process of preparing the soils to sustain adequate vegetative stabilization.

Purpose
To provide a suitable soil medium for vegetative growth.

Conditions Where Practice Applies
Where vegetative stabilization is to be established.

Criteria

- A. Soil Preparation**
1. Temporary Stabilization
 - a. Seedbed preparation consists of loosening soil to a depth of 3 to 5 inches by means of suitable agricultural or construction equipment, such as disc harrows or chisel plows or rippers mounted on construction equipment. After the soil is loosened, it must not be rolled or dragged smooth but left in the roughened condition. Slopes 3:1 or flatter are to be tracked with ridges running parallel to the contour of the slope.
 - b. Apply fertilizer and lime as prescribed on the plans.
 - c. Incorporate lime and fertilizer into the top 3 to 5 inches of soil by disking or other suitable means.
 2. Permanent Stabilization
 - a. A soil test is required for any earth disturbance of 5 acres or more. The minimum soil conditions required for permanent vegetative establishment are:
 - i. Soil pH between 6.0 and 7.0.
 - ii. Soluble salts less than 500 parts per million (ppm).
 - iii. Soil contains less than 40 percent clay but enough fine grained material (greater than 30 percent silt plus clay) to provide the capacity to hold a moderate amount of moisture. An exception: if lovegrass will be planted, then a sandy soil (less than 30 percent silt plus clay) would be acceptable.
 - iv. Soil contains 1.5 percent minimum organic matter by weight.
 - v. Soil contains sufficient pore space to permit adequate root penetration.
 - b. Application of amendments or topsoil is required if on-site soils do not meet the above conditions.
 - c. Graded areas must be maintained in a true and even grade as specified on the approved plan, then scarified or otherwise loosened to a depth of 3 to 5 inches.
 - d. Apply soil amendments as specified on the approved plan or as indicated by the results of a soil test.
 - e. Mix soil amendments into the top 3 to 5 inches of soil by disking or other suitable means. Rake lawn areas to smooth the surface, remove large objects like stones and branches, and ready the area for seed application. Loosen surface soil by dragging with a heavy chain or other equipment to roughen the surface where site conditions will not permit normal seedbed preparation. Track slopes 3:1 or flatter with tracked equipment leaving the soil in an irregular condition with ridges running parallel to the contour of the slope. Leave the top 1 to 3 inches of soil loose and friable. Seedbed loosening may be unnecessary on newly disturbed areas.

B. Topsoiling

1. Topsoil is placed over prepared subsoil prior to establishment of permanent vegetation. The purpose is to provide a suitable soil medium for vegetative growth. Soils of concern have low moisture content, low nutrient levels, low pH, materials toxic to plants, and/or unacceptable soil gradation.
2. Topsoil salvaged from an existing site may be used provided it meets the standards as set forth in these specifications. Typically, the depth of topsoil to be salvaged for a given soil type can be found in the representative soil profile section in the Soil Survey published by USDA-NRCS.
3. Topsoiling is limited to areas having 2:1 or flatter slopes where:
 - a. The texture of the exposed subsoil/parent material is not adequate to produce vegetative growth.
 - b. The soil material is so shallow that the rooting zone is not deep enough to support plants or furnish continuing supplies of moisture and plant nutrients.
 - c. The original soil to be vegetated contains material toxic to plant growth.
 - d. The soil is so acidic that treatment with limestone is not feasible.
4. Areas having slopes steeper than 2:1 require special consideration and design.
5. Topsoil Specifications: Soil to be used as topsoil must meet the following criteria:
 - a. Topsoil must be a loam, sandy loam, clay loam, silt loam, sandy clay loam, or loamy sand. Other soils may be used if recommended by an agronomist or soil scientist and approved by the appropriate approval authority. Topsoil must not be a mixture of contrasting textured subsoils and must contain less than 5 percent by volume of cinders, stones, slag, coarse fragments, gravel, sticks, roots, trash, or other materials larger than 1 1/2 inches in diameter.
 - b. Topsoil must be free of noxious plants or plant parts such as Bermuda grass, quack grass, Johnson grass, nut sedge, poison ivy, thistle, or others as specified.
 - c. Topsoil substitutes or amendments, as recommended by a qualified agronomist or soil scientist and approved by the appropriate approval authority, may be used in lieu of natural topsoil.
6. Topsoil Application
 - a. Erosion and sediment control practices must be maintained when applying topsoil.
 - b. Uniformly distribute topsoil in a 5 to 8 inch layer and lightly compact to a minimum thickness of 4 inches. Spreading is to be performed in such a manner that sodding or seeding can proceed with a minimum of additional soil preparation and tillage. Any irregularities in the surface resulting from topsoiling or other operations must be corrected in order to prevent the formation of depressions or water pockets.
 - c. Topsoil must not be placed if the topsoil or subsoil is in a frozen or muddy condition, when the subsoil is excessively wet or in a condition that may otherwise be detrimental to proper grading and seedbed preparation.

C. Soil Amendments (Fertilizer and Lime Specifications)

1. Soil tests must be performed to determine the exact ratios and application rates for both lime and fertilizer on sites having disturbed areas of 5 acres or more. Soil analysis may be performed by a recognized private or commercial laboratory. Soil samples taken for engineering purposes may also be used for chemical analyses.
2. Fertilizers must be uniform in composition, free flowing and suitable for accurate application by appropriate equipment. Manure may be substituted for fertilizer with prior approval from the appropriate approval authority. Fertilizers must all be delivered to the site fully labeled according to the applicable laws and must bear the name, trade name or trademark and warranty of the producer.
3. Lime materials must be ground limestone (hydrated or burnt lime may be substituted except when hydroseeding) which contains at least 50 percent total oxides (calcium oxide plus magnesium oxide). Limestone must be ground to such fineness that at least 50 percent will pass through a #100 mesh sieve and 98 to 100 percent will pass through a #20 mesh sieve.
4. Lime and fertilizer are to be evenly distributed and incorporated into the top 3 to 5 inches of soil by disking or other suitable means.
5. Where the subsoil is either highly acidic or composed of heavy clays, spread ground limestone at the rate of 4 to 8 tons/acre (200-400 pounds per 1,000 square feet) prior to the placement of topsoil.

B-4-3 STANDARDS AND SPECIFICATIONS FOR SEEDING AND MULCHING

Definition
The application of seed and mulch to establish vegetative cover.

Purpose
To protect disturbed soils from erosion during and at the end of construction.

Conditions Where Practice Applies
To the surface of all perimeter controls, slopes, and any disturbed area not under active grading.

Criteria

- A. Seeding**
1. Specifications
 - a. All seed must meet the requirements of the Maryland State Seed Law. All seed must be subject to re-testing by a recognized seed laboratory. All seed used must have been tested within the 6 months immediately preceding the date of sowing such material on any project. Refer to Table B.4 regarding the quality of seed. Seed tags must be available upon request to the inspector to verify type of seed and seeding rate.
 - b. Mulch alone may be applied between the fall and spring seeding dates only if the ground is frozen. The appropriate seeding mixture must be applied when the ground thaws.
 - c. Inoculants: The inoculant for treating legume seed in the seed mixtures must be a pure culture of nitrogen fixing bacteria prepared specifically for the species. Inoculants must not be used later than the date indicated on the container. Add fresh inoculants as directed on the package. Use four times the recommended rate when hydroseeding. Note: It is very important to keep inoculant as cool as possible until used. Temperatures above 75 to 80 degrees Fahrenheit can weaken bacteria and make the inoculant less effective.
 - d. Sod or seed must not be placed on soil which has been treated with soil sterilants or chemicals used for weed control until sufficient time has elapsed (14 days min.) to permit dissipation of phytotoxic materials.
 2. Application
 - a. Dry Seeding: This includes use of conventional drop or broadcast spreaders.
 - i. Incorporate seed into the subsoil at the rates prescribed on Temporary Seeding Table B.1, Permanent Seeding Table B.3, or site-specific seeding summaries.
 - ii. Apply seed in two directions, perpendicular to each other. Apply half the seeding rate in each direction. Roll the seeded area with a weighted roller to provide good seed to soil contact.
 - b. Drill or Cultipacker Seeding: Mechanized seeders that apply and cover seed with soil.
 - i. Cultipacker seeders are required to bury the seed in such a fashion as to provide at least 1/4 inch of soil covering. Seedbed must be firm after planting.
 - ii. Apply seed in two directions, perpendicular to each other. Apply half the seeding rate in each direction.
 - c. Hydroseeding: Apply seed uniformly with hydroseeder (slurry includes seed and fertilizer).
 - i. If fertilizer is being applied at the time of seeding, the application rates should not exceed the following: nitrogen, 100 pounds per acre total of soluble nitrogen; P205 (phosphorous), 200 pounds per acre; K20 (potassium), 200 pounds per acre.
 - ii. Lime: Use only ground agricultural limestone (up to 3 tons per acre may be applied by hydroseeding). Normally, not more than 2 tons are applied by hydroseeding at any one time. Do not use burnt or hydrated lime when hydroseeding.
 - iii. Mix seed and fertilizer on site and seed immediately and without interruption.
 - iv. When hydroseeding do not incorporate seed into the soil.
 - B. Mulching**
 - a. Mulch Materials (in order of preference)
 - i. Straw consisting of thoroughly threshed wheat, rye, oat, or barley and reasonably bright in color. Straw is to be free of noxious weed seeds as specified in the Maryland Seed Law and not musty, moldy, caked, decayed, or excessively dusty. Note: Use only sterile straw mulch in areas where one species of grass is desired.
 - ii. Wood Cellulose Fiber Mulch (WCFM) consisting of specially prepared wood cellulose processed into a uniform fibrous physical state.
 - i. WCFM is to be dyed green or contain a green dye in the package that will provide an appropriate color to facilitate visual inspection of the uniformly spread slurry.
 - ii. WCFM, including dye, must contain no germination or growth inhibiting factors.
 - iii. WCFM materials are to be manufactured and processed in such a manner that the wood cellulose fiber mulch will remain in uniform suspension in water under agitation and will blend with seed, fertilizer and other additives to form a homogeneous slurry. The mulch material must form a blotter-like ground cover, on application, having moisture absorption and percolation properties and must cover and hold grass seed in contact with the soil without inhibiting the growth of the grass seedlings.
 - iv. WCFM material must not contain elements or compounds at concentration levels that will be phytotoxic.
 - v. WCFM must conform to the following physical requirements: fiber length of approximately 10 millimeters, diameter approximately 1 millimeter, pH range of 4.0 to 8.5, ash content of 1.6 percent maximum and water holding capacity of 90 percent minimum.

2. Application
 - a. Apply mulch to all seeded areas immediately after seeding.
 - b. When straw mulch is used, spread it over all seeded areas at the rate of 2 tons per acre to a uniform loose depth of 1 to 2 inches. Apply mulch to achieve a uniform distribution and depth so that the soil surface is not exposed. When using a mulch anchoring tool, increase the application rate to 2.5 tons per acre.
 - c. Wood cellulose fiber used as mulch must be applied at a net dry weight of 1500 pounds per acre. Mix the wood cellulose fiber with water to obtain a mixture with a maximum of 50 pounds of wood cellulose fiber per 100 gallons of water.
3. Anchoring
 - a. Perform mulch anchoring immediately following application of mulch to minimize loss by wind or water. This may be done by one of the following methods (listed by preference), depending upon the size of the area and erosion hazard:
 - i. A mulch anchoring tool is a tractor drawn implement designed to punch and anchor mulch into the soil surface a minimum of 2 inches. This practice is most effective on large areas, but is limited to flatter slopes where equipment can operate safely. If used on sloping land, this practice should follow the contour.
 - ii. Wood cellulose fiber may be used for anchoring straw. Apply the fiber binder at a net dry weight of 750 pounds per acre. Mix the wood cellulose fiber with water at a maximum of 50 pounds of wood cellulose fiber per 100 gallons of water.
 - iii. Synthetic binders such as Acrylic DLR (Agra-Tack), DCA-70, Petrosel, Terra Tax II, Terra Tack AR or other approved equal may be used. Follow application rates as specified by the manufacturer. Application of liquid binders needs to be heavier at the edges where wind catches mulch, such as in valleys and on crests of banks. Use of asphalt binders is strictly prohibited.
 - iv. Lightweight plastic netting may be stapled over the mulch according to manufacturer recommendations. Netting is usually available in rolls 4 to 15 feet wide and 300 to 3,000 feet long.

AS-BUILT PER 2017

DEPARTMENT OF PUBLIC WORKS
HOWARD COUNTY, MARYLAND

Hogan Evans 10-31-16
DIRECTOR OF PUBLIC WORKS DATE

Morgan E. Butler 10-19-16
CHIEF, BUREAU OF ENGINEERING DATE

Bradley J. 10-19-16
CHIEF, TRANSPORTATION AND SPECIAL PROJECTS DIVISION DATE



PROFESSIONAL CERTIFICATION: I HEREBY CERTIFY THAT THESE DOCUMENTS WERE PREPARED OR APPROVED BY ME, AND THAT I AM A DULY LICENSED PROFESSIONAL ENGINEER UNDER THE LAWS OF THE STATE OF MARYLAND. LICENSE NO. 27045. EXPIRATION DATE: 12/24/2018

STATE OF MARYLAND
PROFESSIONAL ENGINEER
MORGAN E. BUTLER
10-19-16

DES:	BNL				
DRN:	BNL				
CHK:	SDS				
DATE:	10/2016				
BY	NO.	REVISION	DATE	600' SCALE MAP NO.	BLOCK NO.

Erosion and Sediment Control Notes

EMERGENCY ACCESS ROAD BETWEEN
BLUE STREAM DRIVE AND BUSINESS PKWY

CAPITAL PROJECT J4244

ELECTION DISTRICT NO. 2
ELK RIDGE, MARYLAND

SCALE: AS SHOWN

SHEET 6 OF 9

10/20/16 10:24 AM
 Morgan E. Butler
 License No. 27045
 Expiration Date: 12/24/2018

B-4-4 STANDARDS AND SPECIFICATIONS FOR TEMPORARY STABILIZATION

Definition
To stabilize disturbed soils with vegetation for up to 6 months.

Purpose
To use fast growing vegetation that provides cover on disturbed soils.

Conditions Where Practice Applies
Exposed soils where ground cover is needed for a period of 6 months or less. For longer duration of time, permanent stabilization practices are required.

- Criteria**
- Select one or more of the species or seed mixtures listed in Table B.1 for the appropriate Plant Hardness Zone (from Figure B.3), and enter them in the Temporary Seeding Summary below along with application rates, seeding dates and seeding depths. If this Summary is not put on the plan and completed, then Table B.1 plus fertilizer and lime rates must be put on the plan.
 - For sites having soil tests performed, use and show the recommended rates by the testing agency. Soil tests are not required for Temporary Seeding.
 - When stabilization is required outside of a seeding season, apply seed and mulch or straw mulch alone as prescribed in Section B-4.3.A.1.b and maintain until the next seeding season.

Temporary Seeding Summary

Hardness Zone (from Figure B.3): _____					Fertilizer Rate (10-20-20)	Lime Rate
Seed Mixture (from Table B.1): _____						
No.	Species	Application Rate (lb/ac)	Seeding Dates	Seeding Depths		
					435 lb/ac (10 lb/1000 sf)	2 tons/ac (90 lb/1000sf)

B-4-5 STANDARDS AND SPECIFICATIONS FOR PERMANENT STABILIZATION

Definition
To stabilize disturbed soils with permanent vegetation.

Purpose
To use long-lived perennial grasses and legumes to establish permanent ground cover on disturbed soils.

Conditions Where Practice Applies
Exposed soils where ground cover is needed for 6 months or more.

- Criteria**
- A. Seed Mixtures**
- General Use
 - Select one or more of the species or mixtures listed in Table B.3 for the appropriate Plant Hardness Zone (from Figure B.3) and based on the site condition or purpose found on Table B.2. Enter selected mixture(s), application rates, and seeding dates in the Permanent Seeding Summary. The summary is to be placed on the plan.
 - Additional planting specifications for exceptional sites such as shorelines, stream banks, or dunes or for special purposes such as wildlife or aesthetic treatment may be found in USDA-NRCS Technical Field Office Guide, Section 342 - Critical Area Planting.
 - For sites having disturbed area over 5 acres, use and show the rates recommended by the soil testing agency.
 - For areas receiving low maintenance, apply urea form fertilizer (46-0-0) at 3 1/2 pounds per 1000 square feet (150 pounds per acre) at the time of seeding in addition to the soil amendments shown in the Permanent Seeding Summary.
 - Turfgrass Mixtures
 - Areas where turfgrass may be desired include lawns, parks, playgrounds, and commercial sites which will receive a medium to high level of maintenance.
 - Select one or more of the species or mixtures listed below based on the site conditions or purpose. Enter selected mixture(s), application rates, and seeding dates in the Permanent Seeding Summary. The summary is to be placed on the plan.
 - Kentucky Bluegrass: Full Sun Mixture: For use in areas that receive intensive management. Irrigation required in the areas of central Maryland and Eastern Shore. Recommended Certified Kentucky Bluegrass Cultivars Seeding Rate: 1.5 to 2.0 pounds per 1000 square feet. Choose a minimum of three Kentucky bluegrass cultivars with each ranging from 10 to 35 percent of the total mixture by weight.
 - Kentucky Bluegrass/Perennial Rye: Full Sun Mixture: For use in full sun areas where rapid establishment is necessary and when turf will receive medium to intensive management. Certified Perennial Ryegrass Cultivars/Certified Kentucky Bluegrass Seeding Rate: 2 pounds mixture per 1000 square feet. Choose a minimum of three Kentucky bluegrass cultivars with each ranging from 10 to 35 percent of the total mixture by weight.
 - Tall Fescue/Kentucky Bluegrass: Full Sun Mixture: For use in drought prone areas and/or for areas receiving low to medium management in full sun to medium shade. Recommended mixture includes: Certified Tall Fescue Cultivars 95 to 100 percent, Certified Kentucky Bluegrass Cultivars 0 to 5 percent. Seeding Rate: 5 to 8 pounds per 1000 square feet. One or more cultivars may be blended.
 - Kentucky Bluegrass/Fine Fescue: Shade Mixture: For use in areas with shade in Bluegrass lawns. For establishment in high quality, intensively managed turf area. Mixture includes: Certified Kentucky Bluegrass Cultivars 30 to 40 percent and Certified Fine Fescue and 60 to 70 percent. Seeding Rate: 1 1/2 to 3 pounds per 1000 square feet.

Notes:




- Select turfgrass varieties from those listed in the most current University of Maryland Publication, Agronomy Memo #77, "Turfgrass Cultivar Recommendations for Maryland"
- Choose certified material. Certified material is the best guarantee of cultivar purity. The certification program of the Maryland Department of Agriculture, Turf and Seed Section, provides a reliable means of consumer protection and assures a pure genetic line
- Ideal Times of Seeding for Turf Grass Mixtures Western MD: March 15 to June 1, August 1 to October 1 (Hardiness Zones: 5b, 6a) Central MD: March 1 to May 15, August 15 to October 15 (Hardiness Zone: 6b) Southern MD, Eastern Shore: March 1 to May 15, August 15 to October 15 (Hardiness Zones: 7a, 7b)
 - Till areas to receive seed by disking or other approved methods to a depth of 2 to 4 inches, level and rake the areas to prepare a proper seedbed. Remove stones and debris over 1/2 inches in diameter. The resulting seedbed must be in such condition that future mowing of grasses will pose no difficulty.
 - If soil moisture is deficient, supply new seedlings with adequate water for plant growth (1/2 to 1 inch every 3 to 4 days depending on soil texture) until they are firmly established. This is especially true when seedlings are made late in the planting season, in abnormally dry or hot seasons, or on adverse sites.

Permanent Seeding Summary

Hardness Zone (from Figure B.3): _____					Fertilizer Rate (10-20-20)			Lime Rate
Seed Mixture (from Table B.3): _____					N	P ₂ O ₅	K ₂ O	
No.	Species	Application Rate (lb/ac)	Seeding Dates	Seeding Depths				
				1/4 - 1/2 in	45 pounds per acre (1.0 lb/1000 sf)	90 lb/ac (2 lb/1000 sf)	90 lb/ac (2 lb/1000 sf)	2 tons/ac (90 lb/1000sf)

B. Sod: To provide quick cover on disturbed areas (2:1 grade or flatter).

- General Specifications
 - Class of turfgrass sod must be Maryland State Certified. Sod labels must be made available to the job foreman and inspector.
 - Sod must be machine cut to a uniform soil thickness of 2 inch, plus or minus 1/4 inch, at the time of cutting. Measurement for thickness must exclude top growth and thatch. Broken pads and torn or uneven ends will not be acceptable.
 - Standard size sections of sod must be strong enough to support their own weight and retain their size and shape when suspended vertically with a firm grasp on the upper 10 percent of the section.
 - Sod must not be harvested or transplanted when moisture content (excessively dry or wet) may adversely affect its survival.
 - Sod must be harvested, delivered, and installed within a period of 36 hours. Sod not transplanted within this period must be approved by an agronomist or soil scientist prior to its installation.
- Sod Installation
 - During periods of excessively high temperature or in areas having dry subsoil, lightly irrigate the subsoil immediately prior to laying the sod.
 - Lay the first row of sod in a straight line with subsequent rows placed parallel to it and tightly wedged against each other. Stagger lateral joints to promote more uniform growth and strength. Ensure that sod is not stretched or overlapped and that all joints are butted tight in order to prevent voids which would cause air drying of the roots.
 - Wherever possible, lay sod with the long edges parallel to the contour and with staggering joints. Roll and tamp, peg or otherwise secure the sod to prevent slippage on slopes. Ensure solid contact exists between sod roots and the underlying soil surface.
 - Water the sod immediately following rolling and tamping until the underside of the new sod pad and soil surface below the sod are thoroughly wet. Complete the operations of laying, tamping and irrigating for any piece of sod within eight hours.
- Sod Maintenance
 - In the absence of adequate rainfall, water daily during the first week or as often and sufficiently as necessary to maintain moist soil to a depth of 4 inches. Water sod during the heat of the day to prevent wilting.
 - After the first week, sod watering is required as necessary to maintain adequate moisture content.
 - Do not mow until the sod is firmly rooted. No more than 2 of the grass leaf must be removed by the initial cutting or subsequent cuttings. Maintain a grass height of at least 3 inches unless otherwise specified.

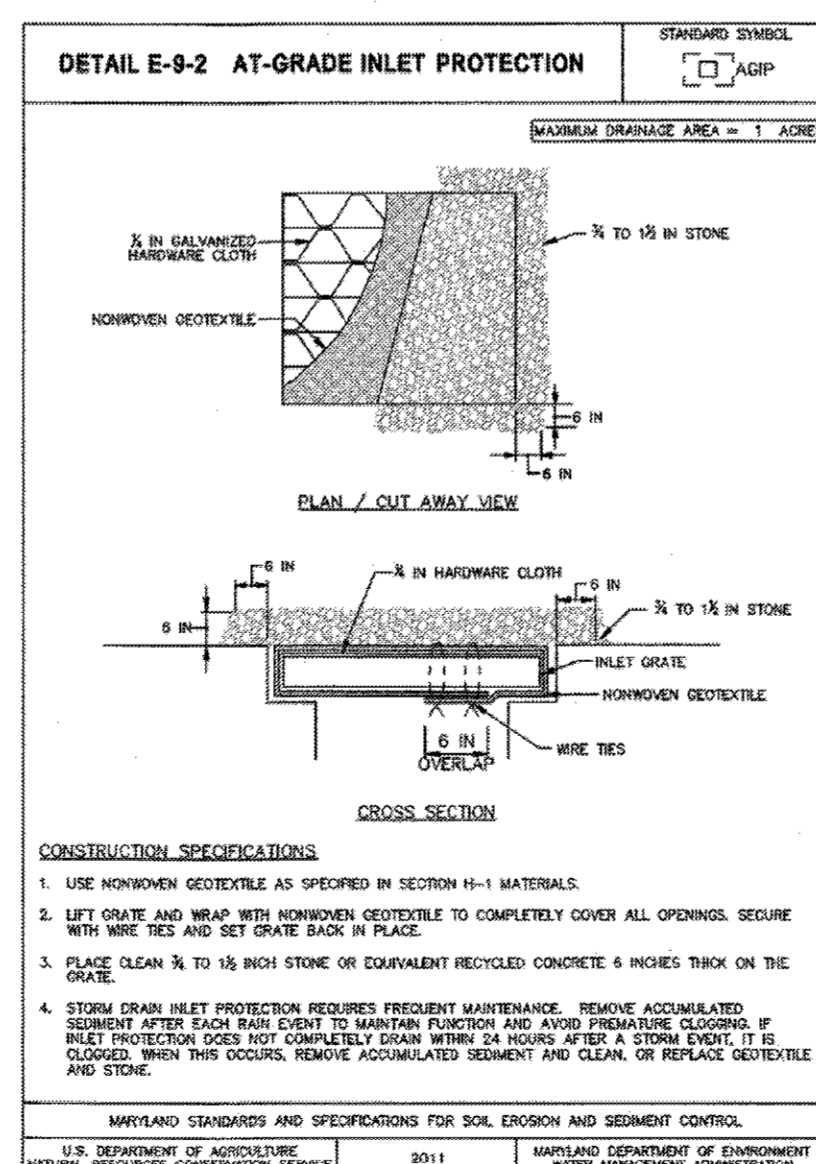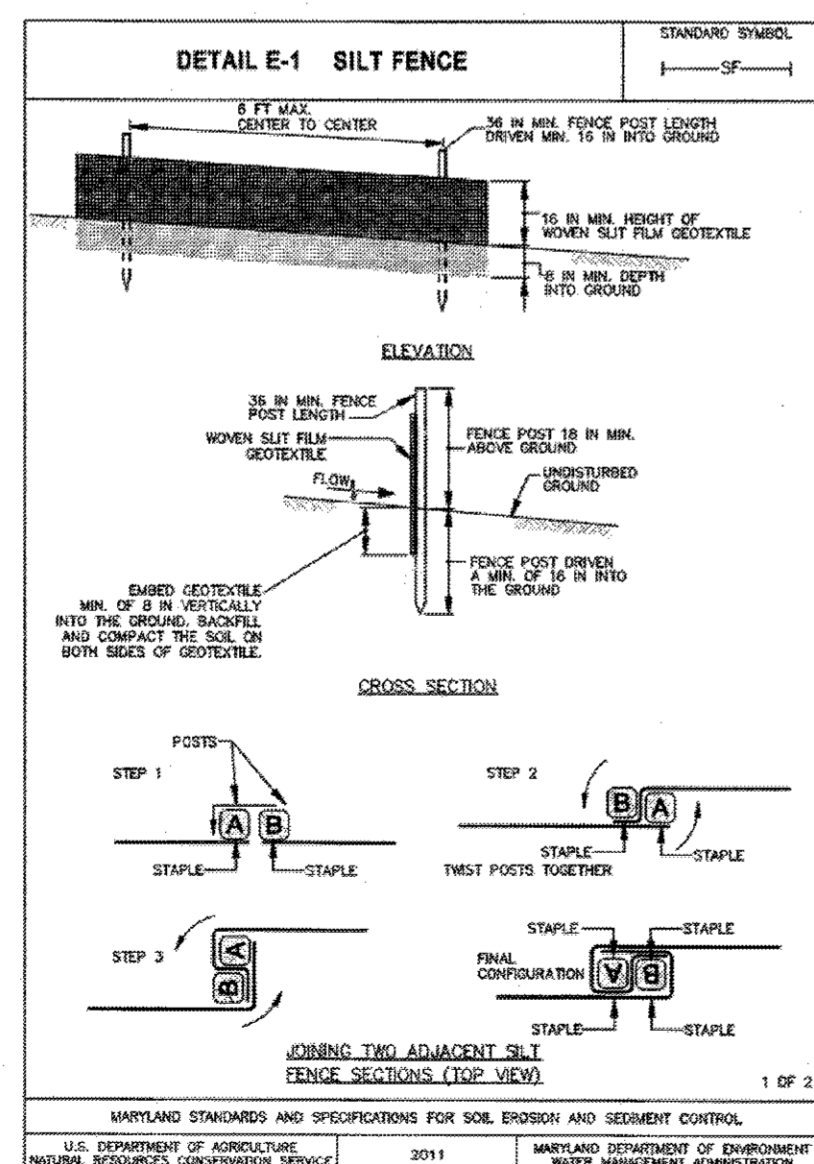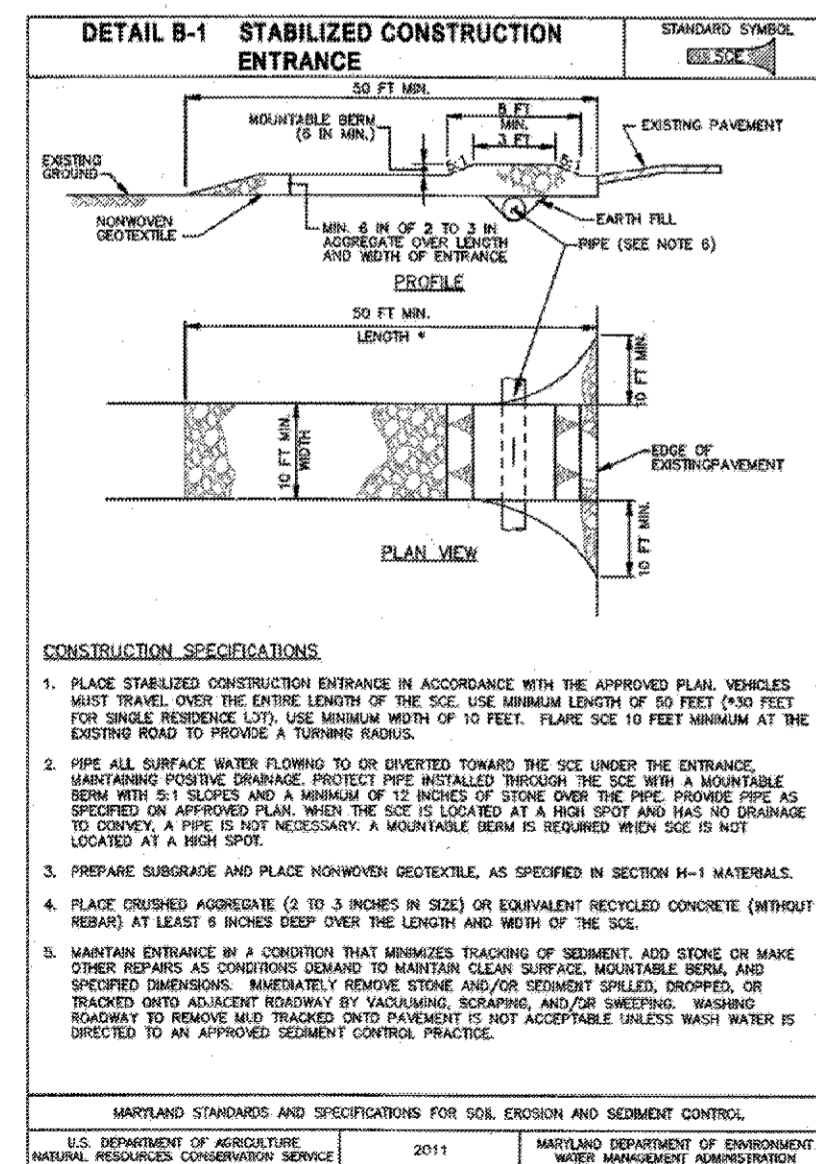

DEPARTMENT OF PUBLIC WORKS
HOWARD COUNTY, MARYLAND

Hector Serrano 10-21-16
DIRECTOR OF PUBLIC WORKS DATE

Diana R. Butler 10-19-16
CHIEF, BUREAU OF ENGINEERING DATE

Bradford 10-19-16
CHIEF, TRANSPORTATION AND SPECIAL PROJECTS DIVISION DATE

PROFESSIONAL CERTIFICATION: I HEREBY CERTIFY THAT THESE DOCUMENTS WERE PREPARED OR APPROVED BY ME, AND THAT I AM A DAILY LICENSED PROFESSIONAL ENGINEER UNDER THE LAWS OF THE STATE OF MARYLAND. LICENSE NO. 22045. EXPIRATION DATE: 02/24/2018

[Signature]

DES: BNL					
DRN: BNL					
CHK: SDS					
DATE: 10/2016	BY:	NO.	REVISION	DATE	

Erosion and Sediment Control Notes and Details

600' SCALE MAP NO. _____ BLOCK NO. _____

AS-BUILT FEB 2017

EMERGENCY ACCESS ROAD BETWEEN BLUE STREAM DRIVE AND BUSINESS PKWY

CAPITAL PROJECT J4244

ELECTION DISTRICT NO. 2 ELKRIDGE, MARYLAND


SCALE: AS SHOWN

SHEET 7 OF 9


DRILL HOLES

DRILL HOLES


DRILL HOLES

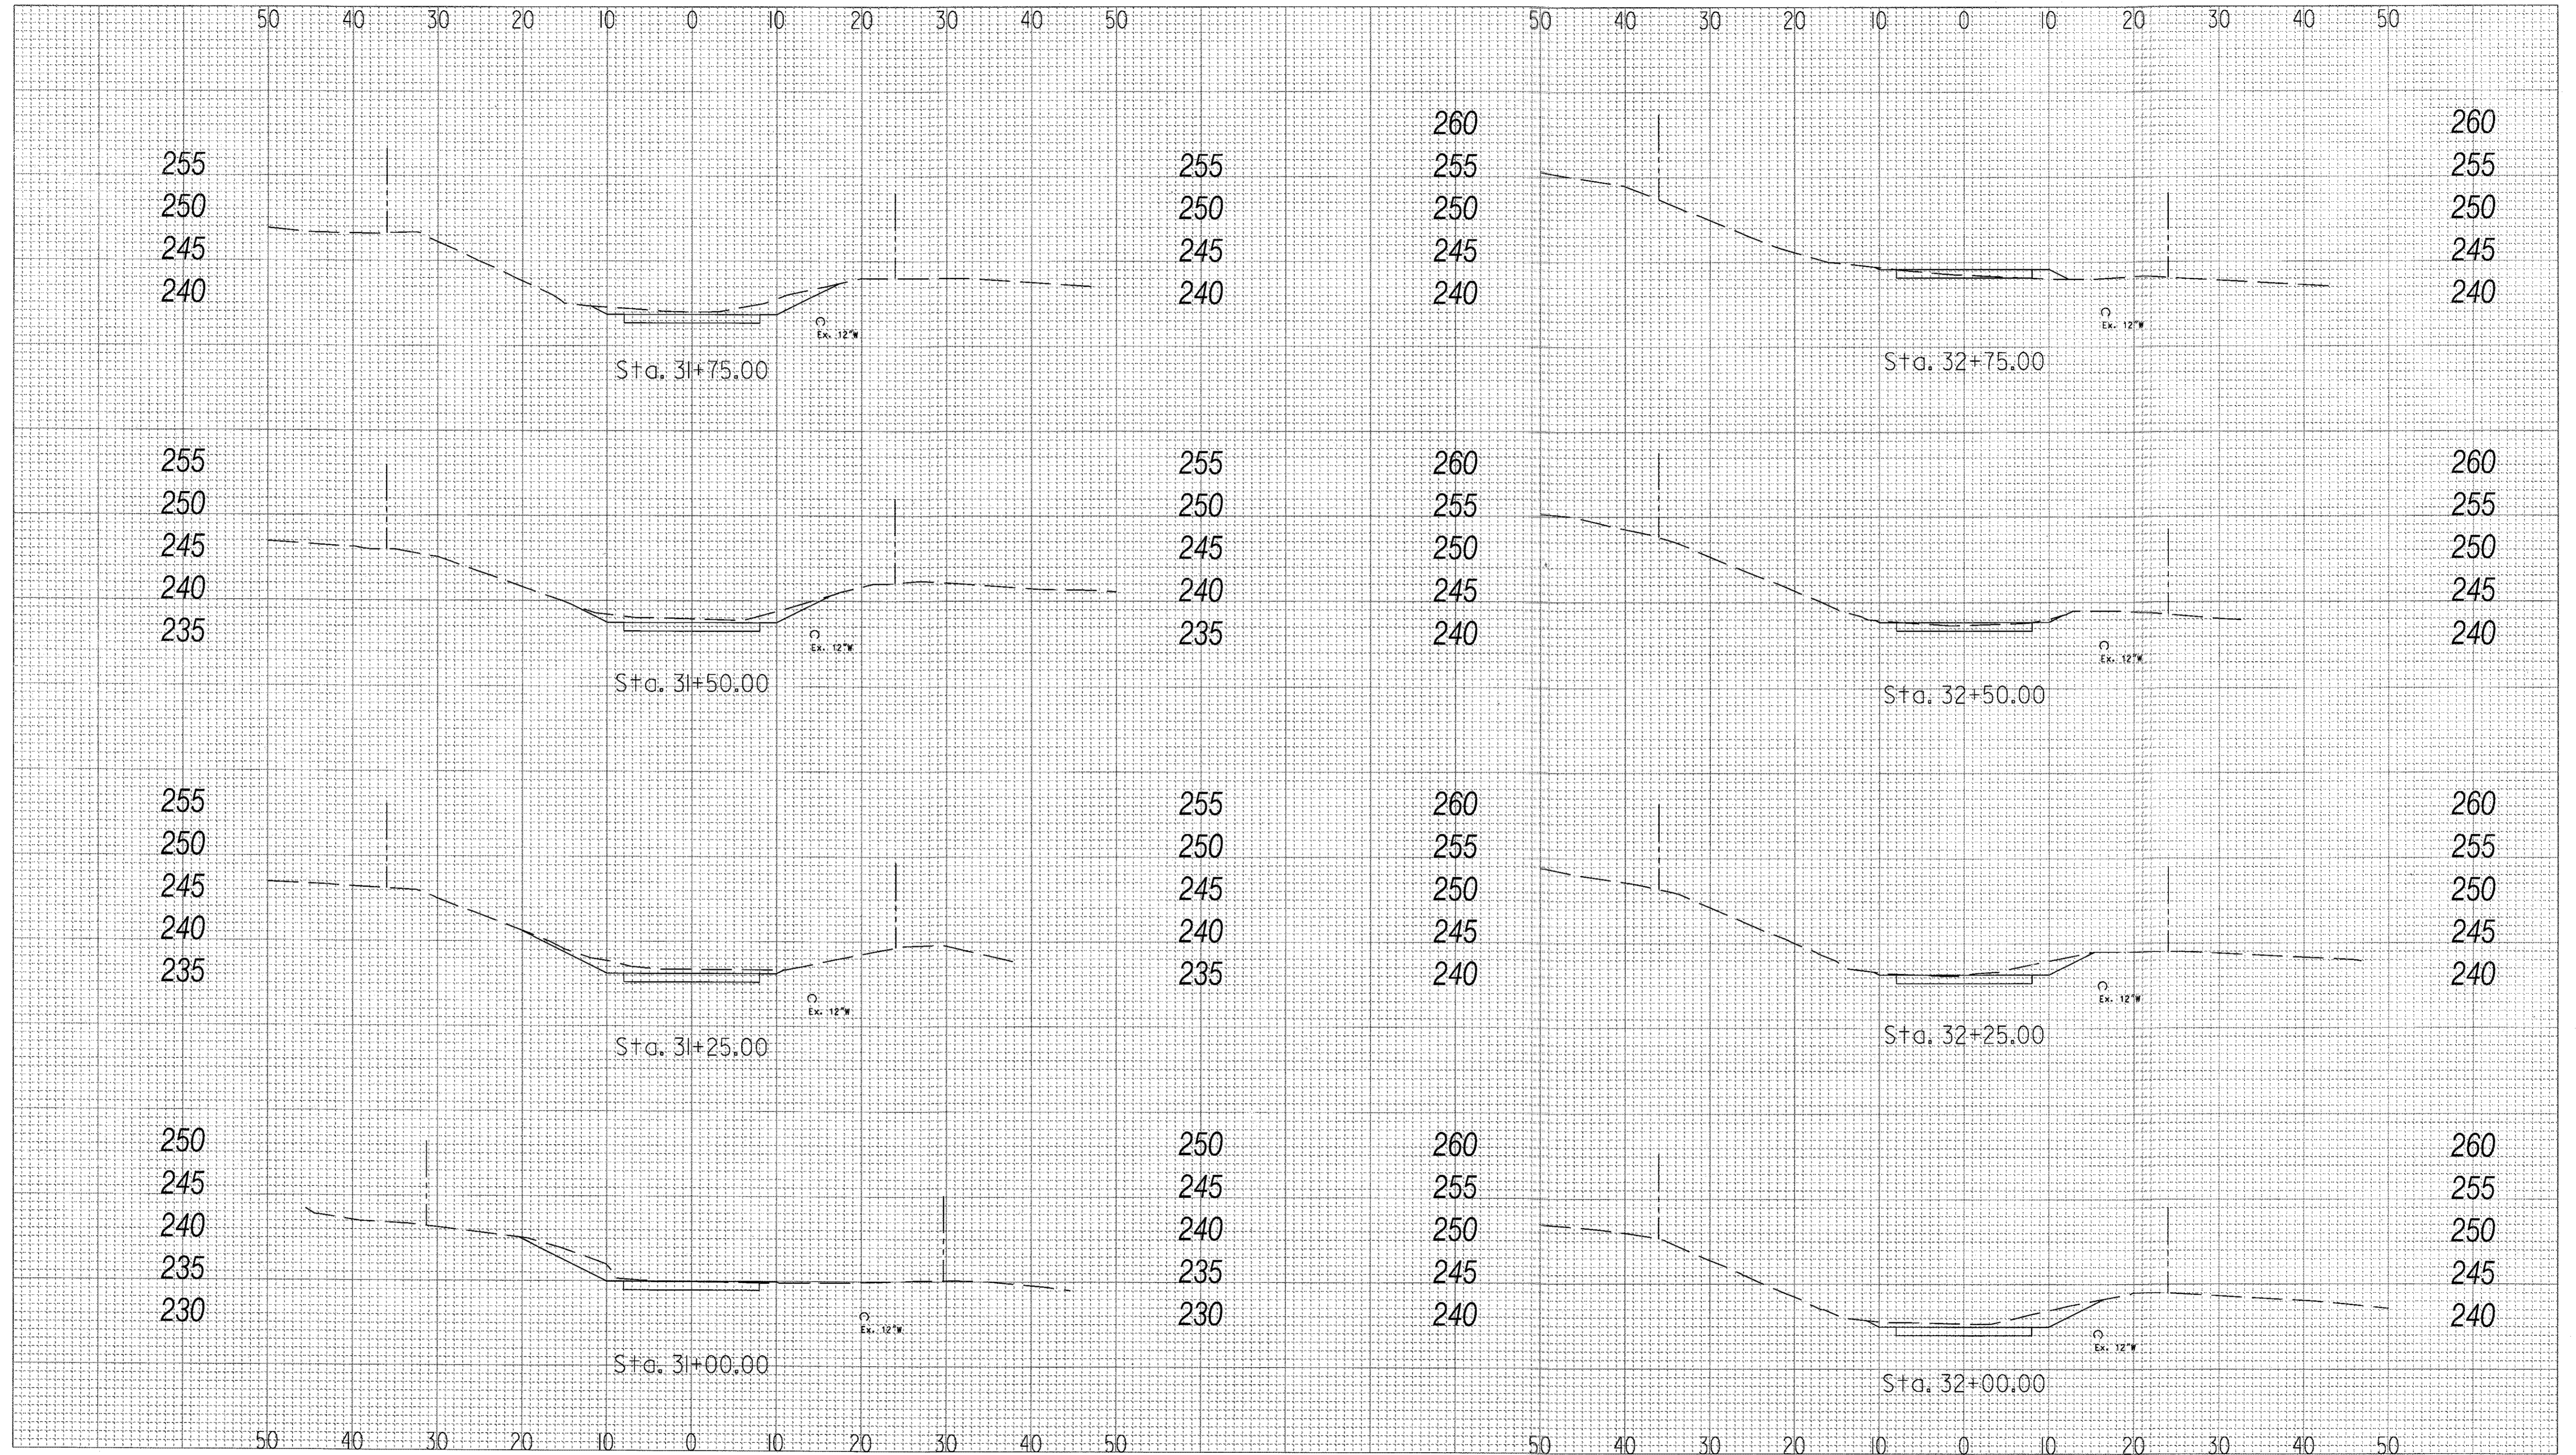

AS-BUILT FEB 2017

ROADWAY CROSS SECTION SHEET		ROAD <u><ROAD></u> STATION <u> </u> TO STATION <u> </u>	
 HOWARD COUNTY DEPARTMENT OF PUBLIC WORKS TRANSPORTATION AND SPECIAL PROJECTS <PROJECT DESCRIPTION LINE 1> <PROJECT DESCRIPTION LINE 2>	DESIGNED BY <u><DESIGNED BY></u>	CAP. PROJ. <u><CONTRACT NO></u>	
	DRAWN BY <u><DRAWN BY></u>	HORIZONTAL SCALE <u><HOR. SCALE></u>	
	CHECKED BY <u><CHECKED BY></u>	VERTICAL SCALE <u><VERT. SCALE></u>	
DRAWING NO. CS-	OF <#>	SHEET NO.	OF <##>

PLOTTED: 8/24/2017 10:58 AM
FILE: SFILES

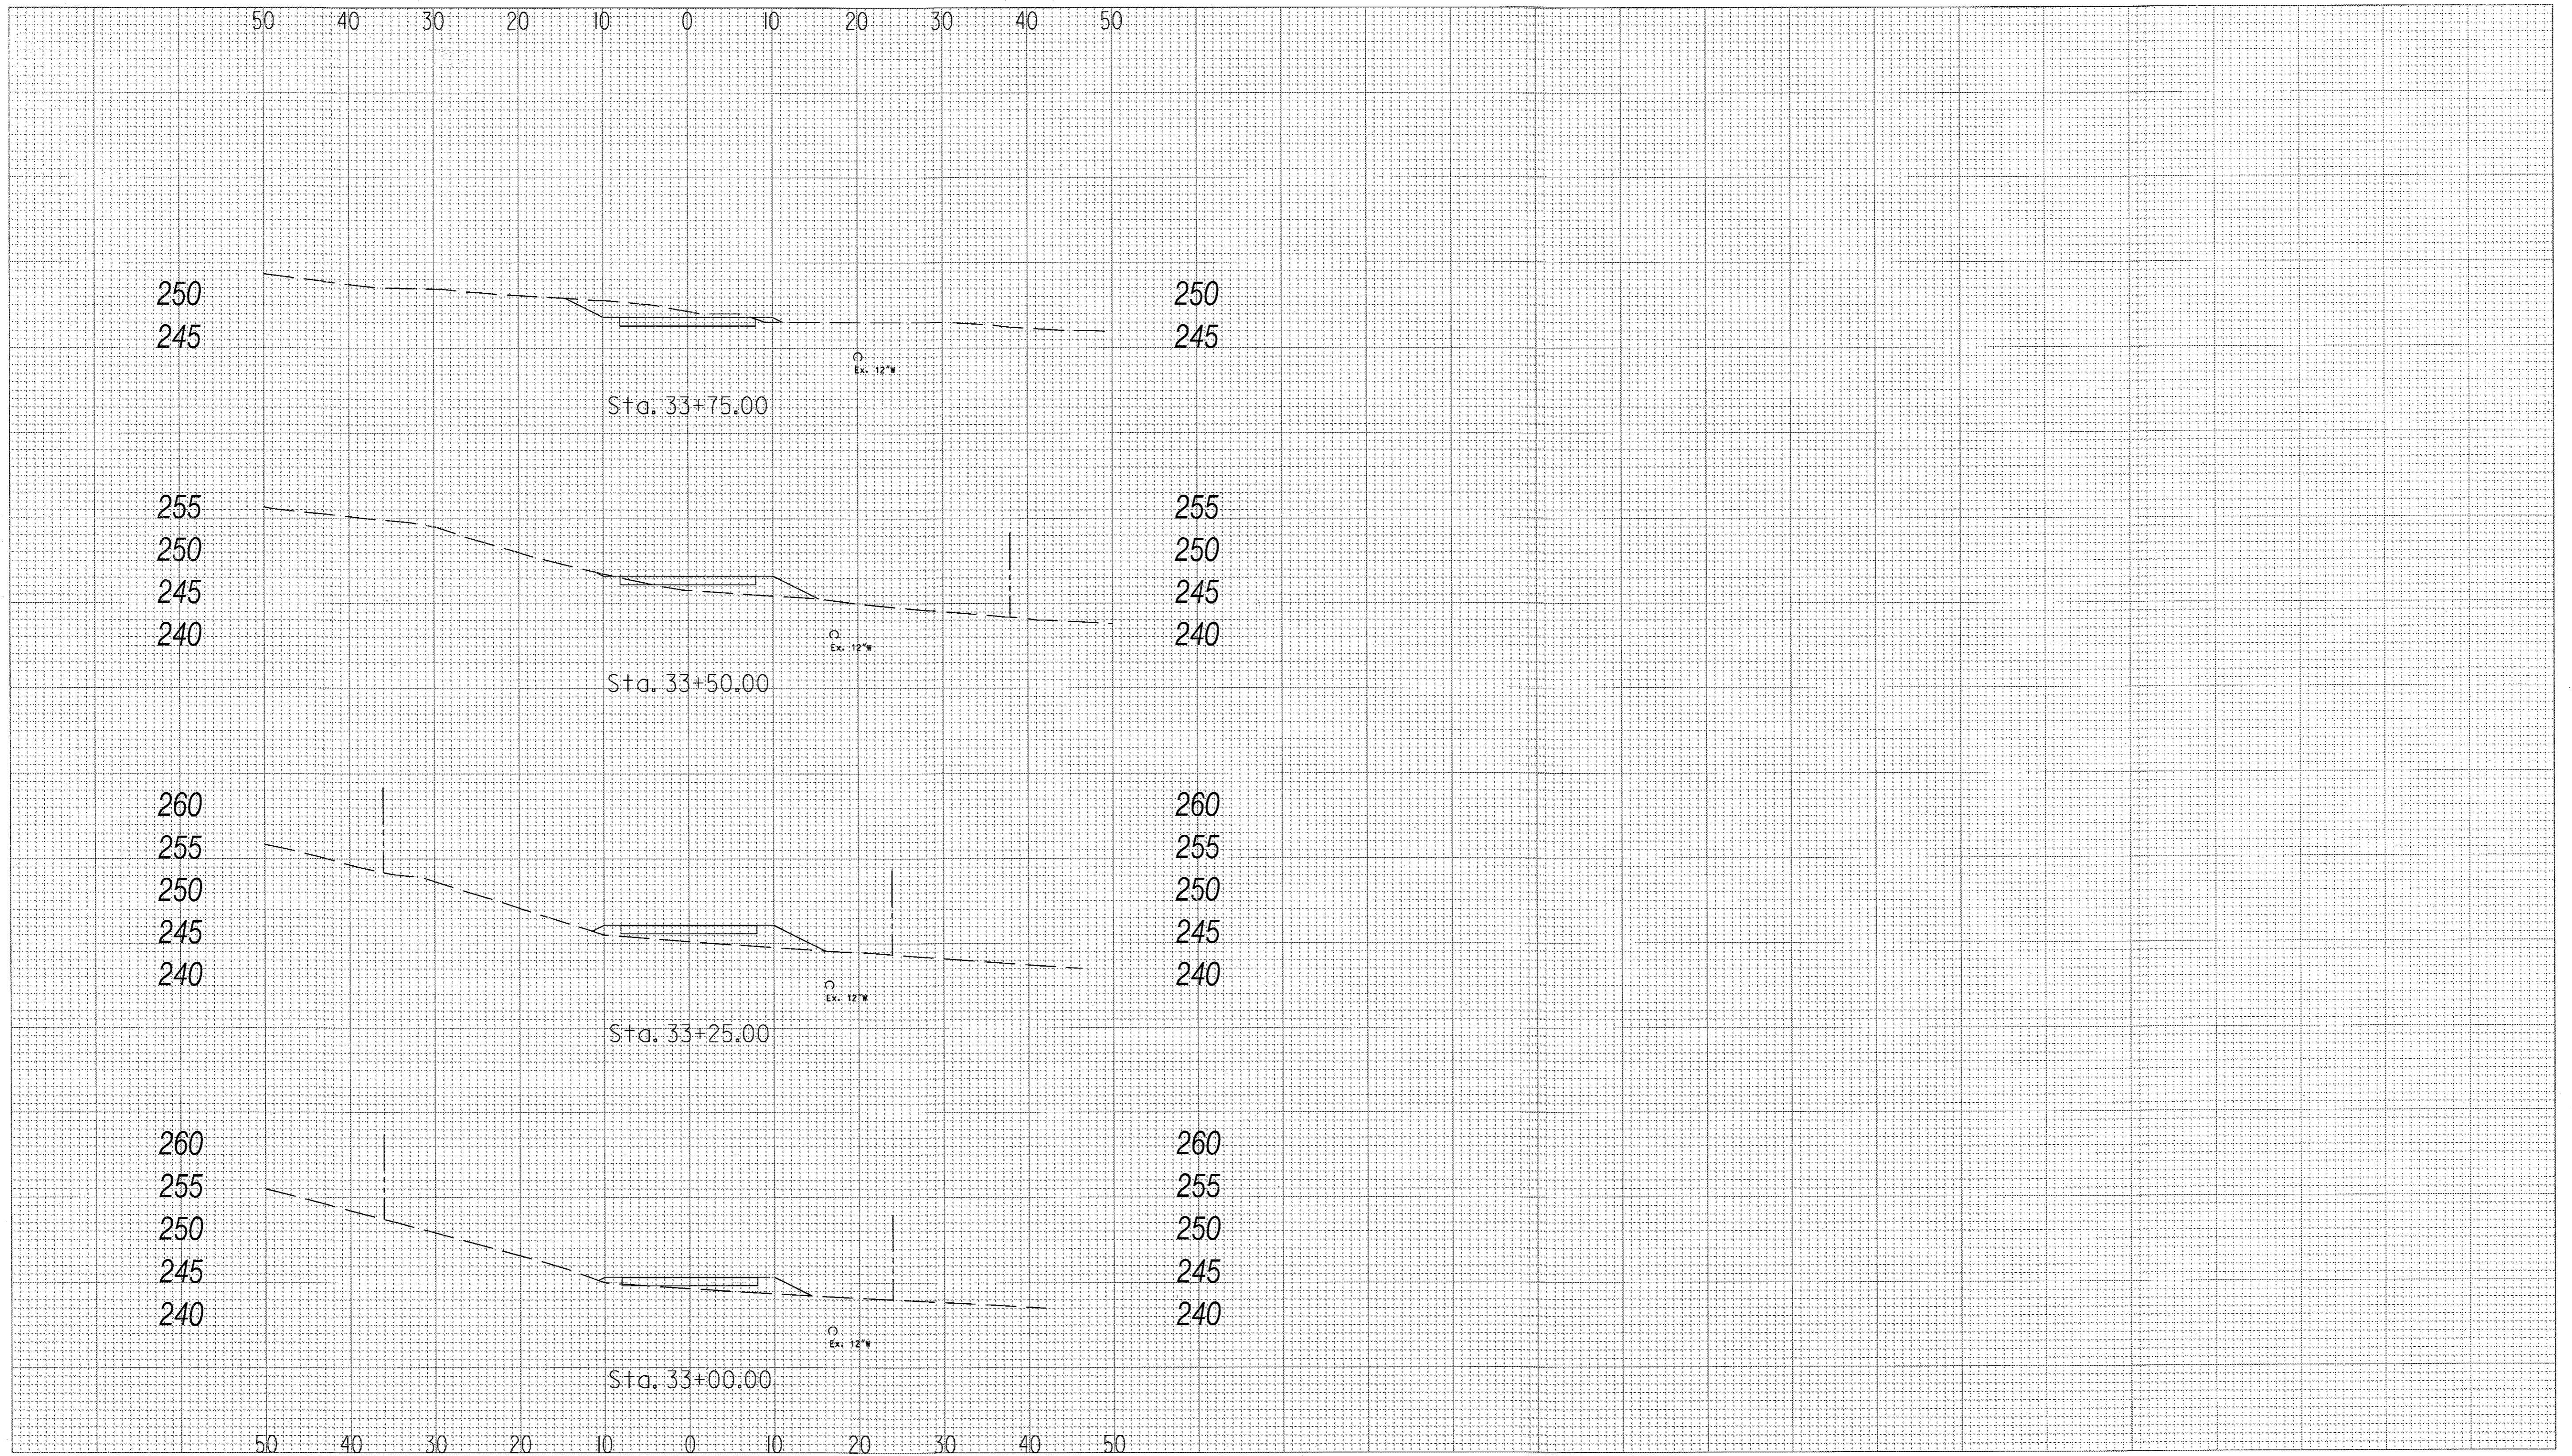

Printed by: blove

ROADWAY CROSS SECTION SHEET		AS-BUILT FEB 2017	
ROAD <ROAD> STATION _____ TO STATION _____		DESIGNED BY <DESIGNED BY> CAP. PROJ. <CONTRACT NO>	
DRAWN BY <DRAWN BY>		HORIZONTAL SCALE <HOR. SCALE>	
CHECKED BY <CHECKED BY>		VERTICAL SCALE <VERT. SCALE>	
DRAWING NO. CS- OF <#>		SHEET NO. OF <#>	



HOWARD COUNTY
DEPARTMENT OF
PUBLIC WORKS
TRANSPORTATION AND
SPECIAL PROJECTS
<PROJECT DESCRIPTION LINE 1>
<PROJECT DESCRIPTION LINE 2>