


**PLAN**  
Scale: 1"=50'

WRIA BM\*G-B Elev. 280.88  
R.R. spike base G&E Pole 222296 in front of  
last house 850' from & Inter. Route 32 &  
Carroll Avenue.

Note:  
Unless otherwise noted, all G.W. to be  
Class 22 CIP and shall have a minimum of  
3.5' cover.

**CARROLL AVENUE**

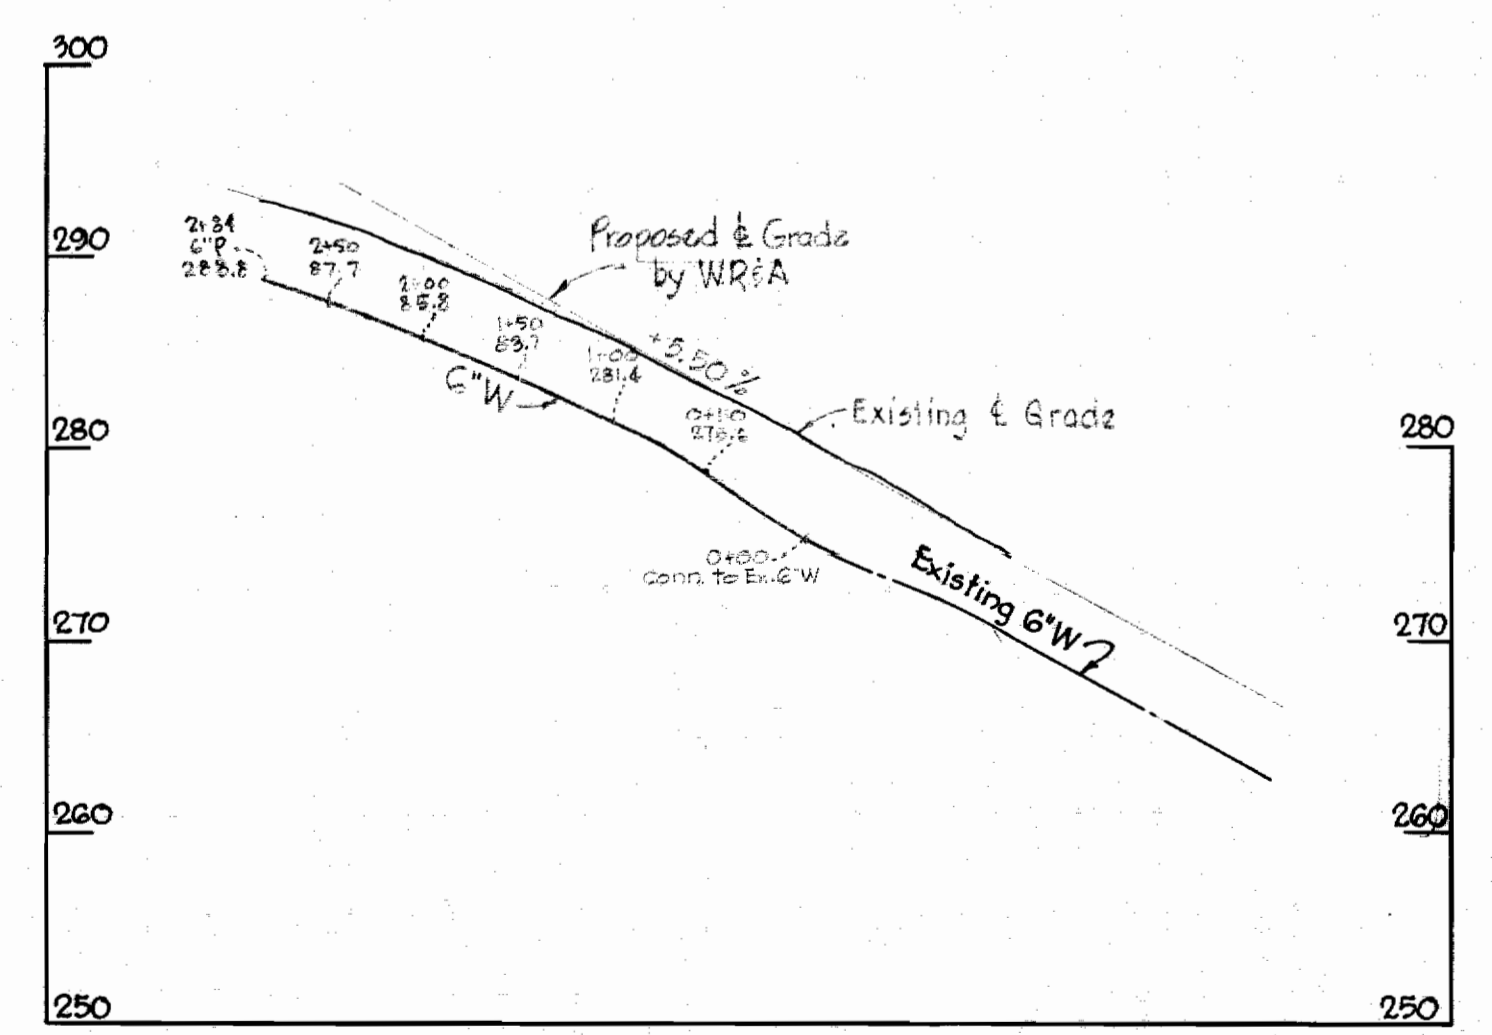

**PROFILE**  
Scale: H: 1"=100'  
V: 1"=10'

Contract 47-W

WHITMAN, REQUARDT & ASSOCIATES ENGINEERS 1304 ST. PAUL ST. BALTIMORE, MARYLAND	HOWARD COUNTY METROPOLITAN COMMISSION <i>Carl W. Meyer</i> DATE: <u>Oct. 18, 1962</u> CHIEF ENGINEER	CONTRACT NO. <u>47-W</u>	PLAN & PROFILE OF WATER MAIN	PATUXENT SUB-DISTRICT NO. 2	DRAWING NO. <u>1</u> OF <u>1</u>	SCALE AS SHOWN
---	--	--------------------------	---------------------------------	-----------------------------	--	----------------------

W. O. 5129-2

AS BUILT 13 OCT. 62

WS 47W/1