


WRAA BM #39-A Elev. 464.68
 x-cut roadside flange bolt of fire hydrant
 between House Nos 187 & 189 Victoria Drive.

PLAN
 Scale 1"=50'

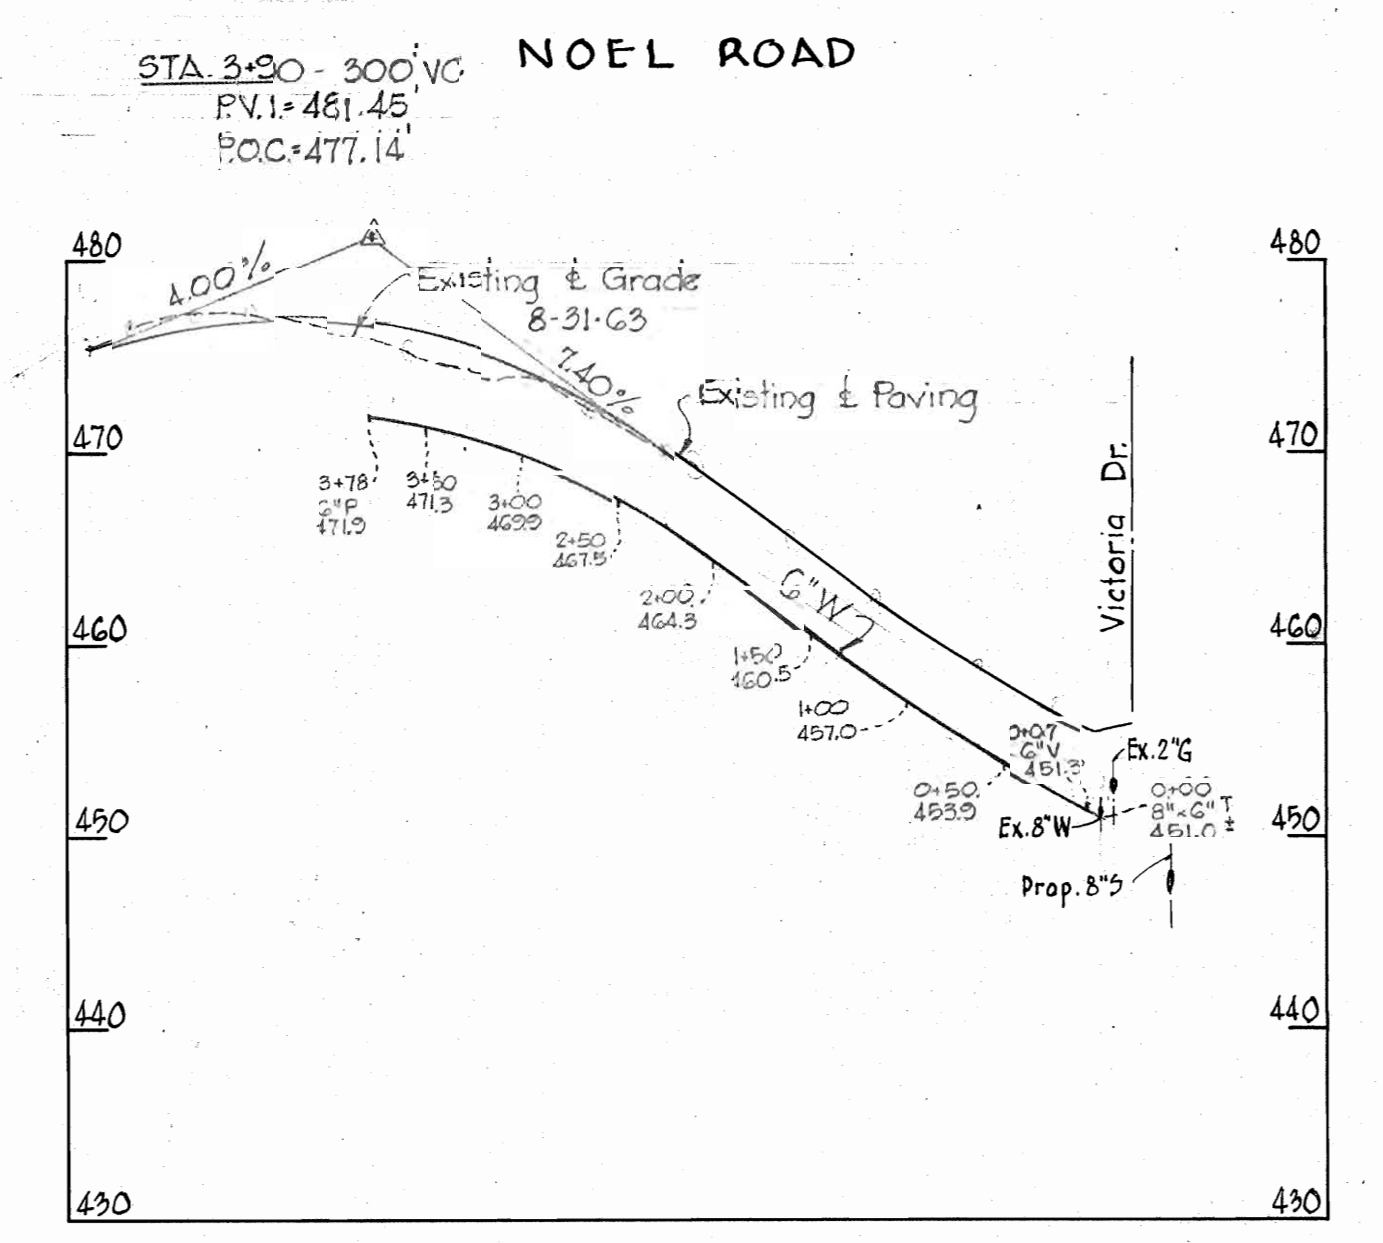

PROFILE
 Scale: Vert. 1"=10'
 Horz. 1"=100'

GENERAL NOTES

1. Approximate location of existing mains are shown. The Contractor shall take all necessary precautions to protect the existing mains and services and maintain uninterrupted supply. Any damage incurred shall be repaired immediately.
2. All pipe elevations shown are invert elevations.
3. The Contractor shall locate existing utilities a minimum of two weeks in advance of construction operations.
4. For all standard details, see Standards bound in Specifications.
5. Block all fittings with concrete, see standard details bound in Specifications.
6. All water mains to be C.I.P. Class 22 and have a minimum of 36" cover.

AS BUILT
 Noel Road
 Contract 62-W

WHITMAN, REQUARDT & ASSOCIATES ENGINEERS 1304 ST. PAUL ST. BALTIMORE, MARYLAND	HOWARD COUNTY METROPOLITAN COMMISSION DATE: 6 Sept. 63 CHIEF ENGINEER	CONTRACT NO. 62-W	PLAN & PROFILE OF WATER MAIN ELLICOTT CITY SUB-DISTRICT
		DRAWING NO. 1 OF 1	SCALE AS SHOWN 3 SW 41

W. O. 5129-2

AS BUILT 20 SEPT., 1963

WS 62W/1